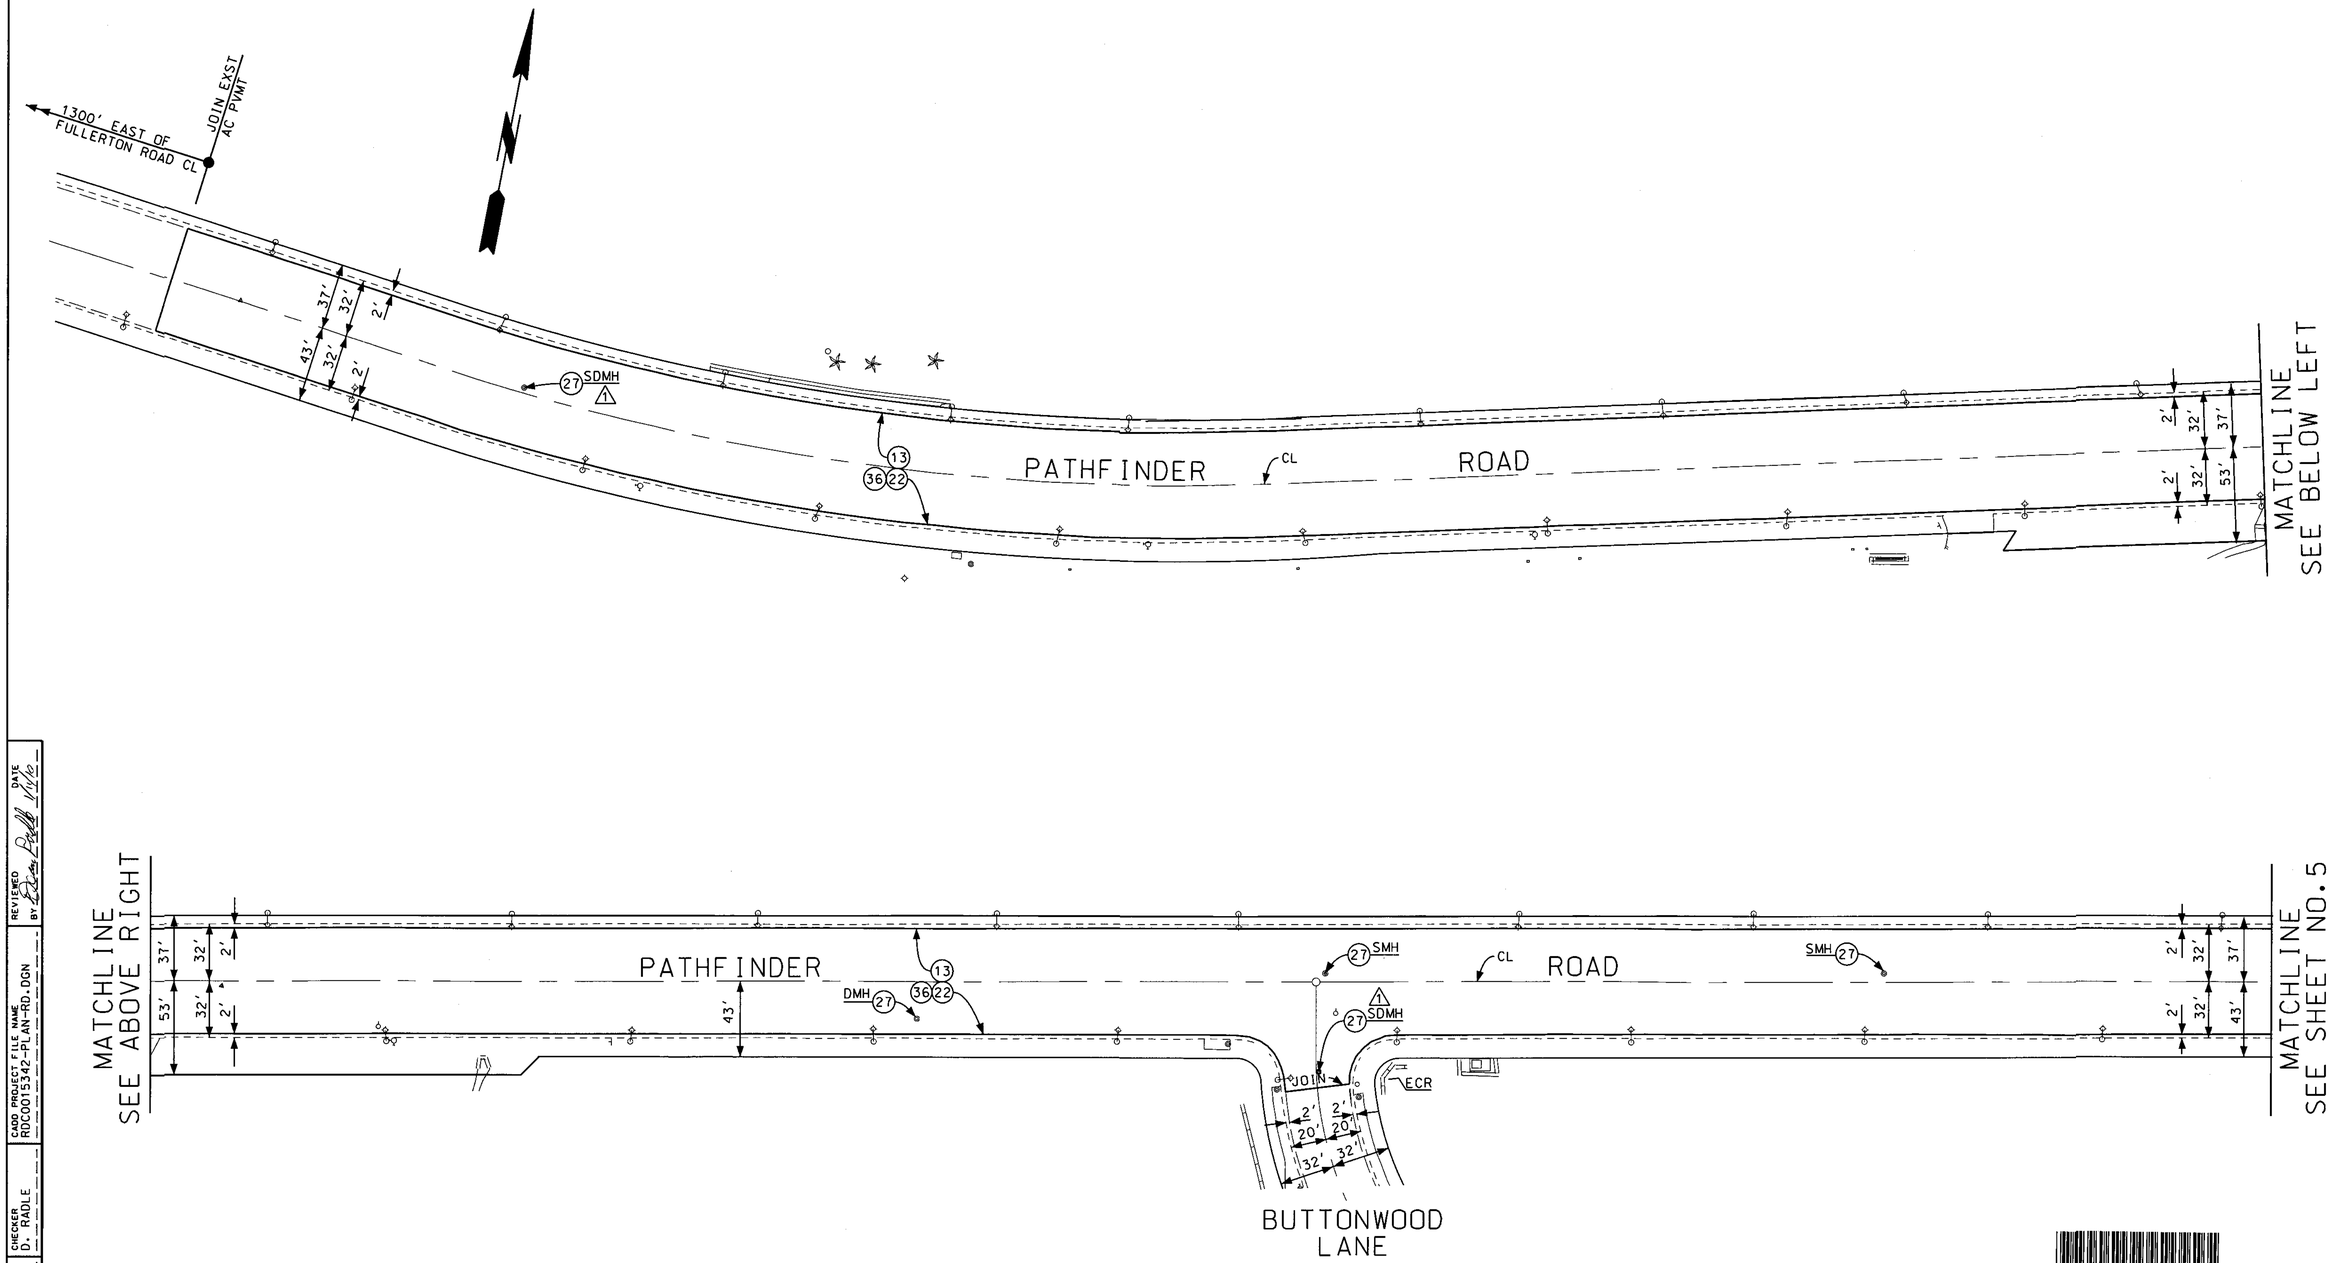

PLAN
SCALE: 1" = 40'
25 0 50 100

AS-BUILT

DATE	MK	DESCRIPTION
2/11/13	1	AS-BUILT

REVISIONS

REGISTERED PROFESSIONAL ENGINEER
SHERRIE JONG
NO. C56647
EXP. 6/30/11
CIVIL
STATE OF CALIFORNIA

PROJECT ENGINEER 01-11-10 DATE

COUNTY OF LOS ANGELES DEPARTMENT OF PUBLIC WORKS

PATHFINDER ROAD

PLAN

PROJECT ID NO. RDC0015342

PCA | DWG | SHEET 4 OF 7

PH081010

DRAFTER S. JONG
DESIGNER S. JONG
CHECKER D. RADLE
CADD PROJECT FILE NAME RDC0015342-PLAN-RD.DGN
REVIEWED BY DATE

PLAN RD

DATE: $DATE$ TIME: $TIME$ FILE: $FILEL$