COUNTY OF LOS ANGELES
DEPARTMENT OF PUBLIC WORKS

SAN GABRIEL RIVER BICYCLE TRAIL IMPROVEMENT - PHASE 3

(355' S/O DEL AMO BLVD TO CARSON STREET)

PROJECT LENGTH - 1.02 MILES

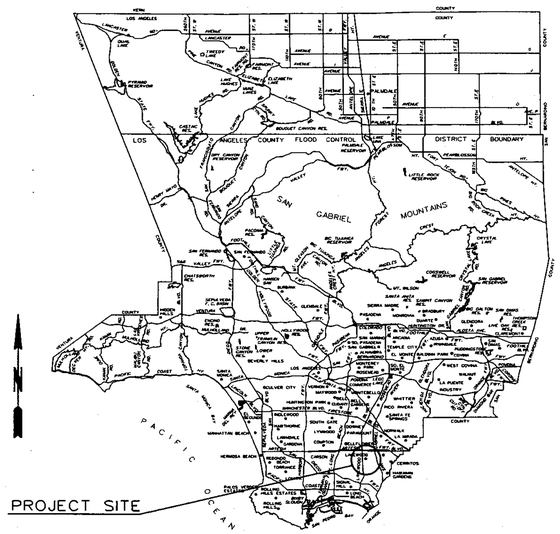

T. G. 766 F4-F6
R. D. 445

LOCATION MAP

INDEX OF SHEETS

SHEET NO. 1	TITLE SHEET
SHEET NO. 2	CONSTRUCTION NOTES AND REFERENCES
SHEET NO. 3-4	PLAN AND CONSTRUCTION DETAILS
PLAN SP	SIGNING AND STRIPING PLAN
PLAN TC	TRAFFIC CONTROL PLANS

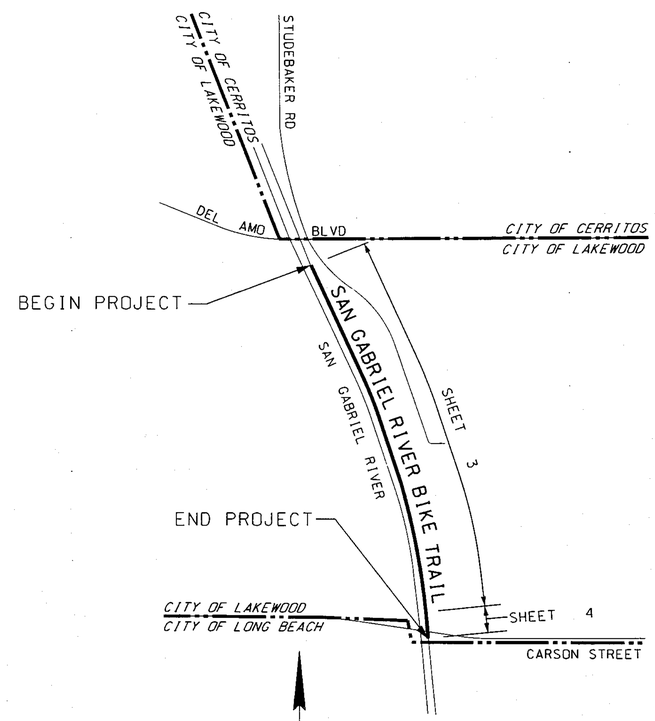

KEY MAP
NOT TO SCALE

AS BUILT

PH081014

PROPOSED FOR CONSTRUCTION: — DATE — ADVERTISED: — DATE — AS BUILT: — DATE —

CADD PROJECT FILE NAME RDC0015064-PLAN-RD.dgn
CHECKER S. JONG
DESIGNER E. DADVAR
DRAFTER E. DADVAR

APPROVED BY [signature] CITY OF LAKEWOOD 02 Jun 2011 DATE

TWO DAYS BEFORE YOU DIG
CALL USA TOLL FREE
1-800-227-2600

APPROVED CAL FARRER DIRECTOR OF PUBLIC WORKS
BY [signature] DEPUTY DIRECTOR 6-15-2011 DATE

RECOMMENDED
BY [signature] ASSISTANT DEPUTY DIRECTOR 6/15/11 DATE

SUBMITTED DFR
BY FOR [signature] HIGHWAY SECTION II 6/8/11 DATE

DATE	MK	DESCRIPTION

REVISIONS

REGISTERED PROFESSIONAL ENGINEER SHERRIE JONG C56647 CIVIL STATE OF CALIFORNIA
PROJECT ENGINEER 3-31-11 DATE

COUNTY OF LOS ANGELES DEPARTMENT OF PUBLIC WORKS

SAN GABRIEL RIVER BICYCLE TRAIL IMPROVEMENT - PHASE 3

TITLE SHEET

PROJECT ID NO. RDC0015064

PCA | DWG | SHEET 1 OF 4

PLAN RD

DATE: $DATE$ TIME: $TIME$ FILE: $FILEL$