COUNTY OF LOS ANGELES
DEPARTMENT OF PUBLIC WORKS
HAWES STREET ET AL.

PROJECT TOTAL LENGTH: ~~5.03~~ MILES
3.41

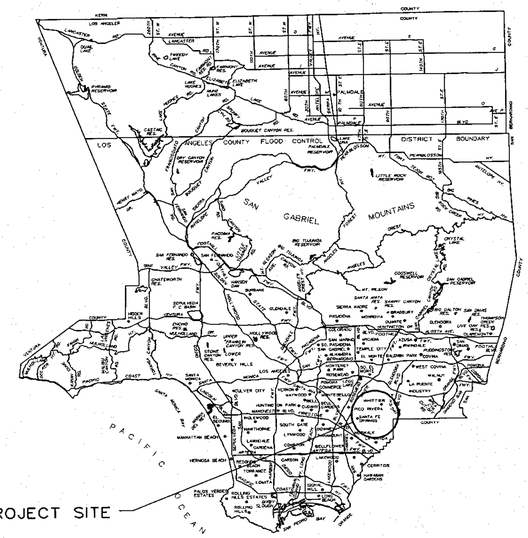

T. G. 707-E4, E5, F4, F5
R. D. 446

LOCATION MAP

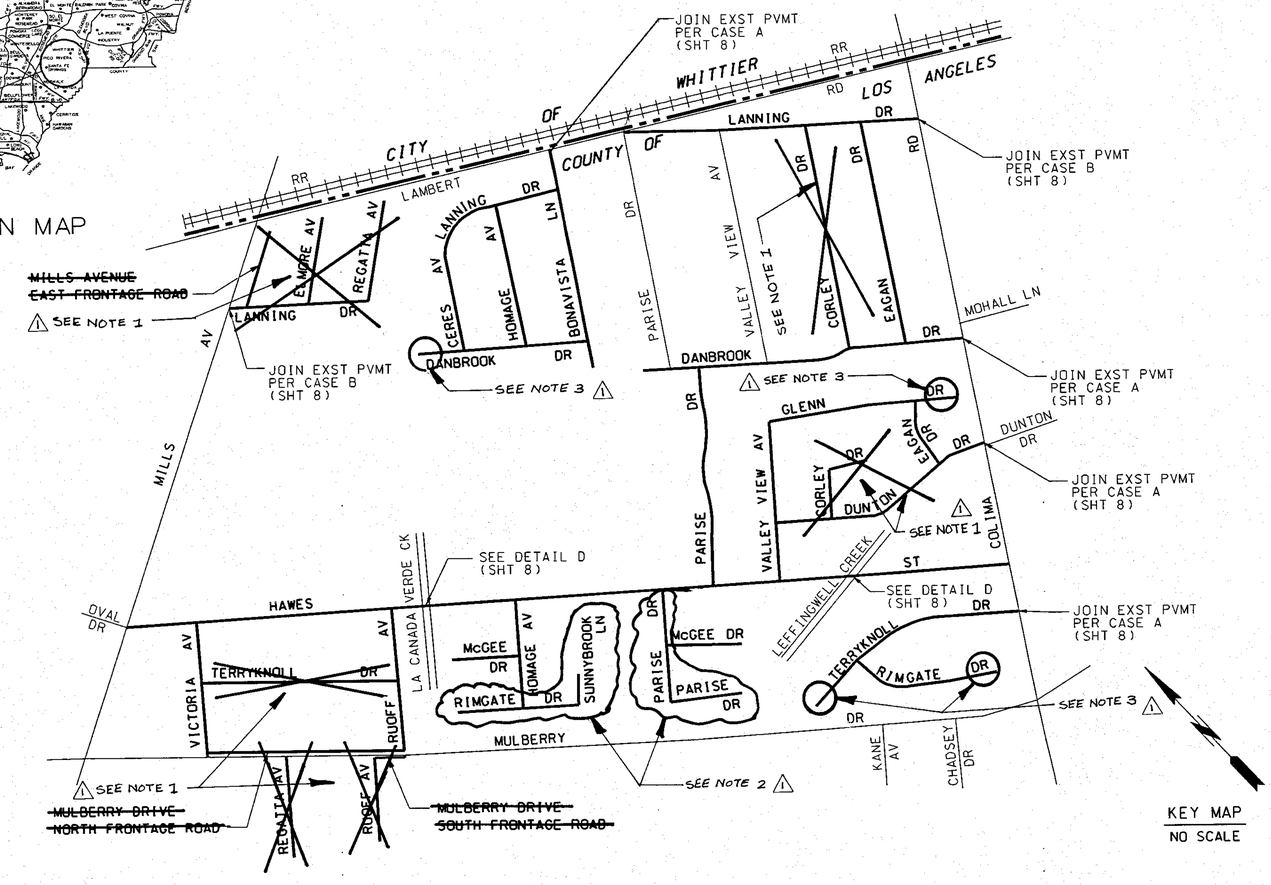

KEY MAP
NO SCALE

INDEX

SHEET NO. 1	TITLE SHEET
SHEET NO. 2	CONSTRUCTION NOTES AND REFERENCES
SHEET NO. 3	TYPICAL SECTIONS
SHEET NO. 4-5	PLAN AND PROFILE
SHEET NO. 6-7	CROSS GUTTER REPLACEMENT
SHEET NO. 8	PAVEMENT MATERIALS TABLE AND DETAILS
SHEET NO. 9-10	CONCRETE IMPROVEMENT TABLES
SHEET NO. 11	TREE IMPROVEMENT TABLE
SHEET NO. 12	CONSTRUCTION DETAILS
PLAN TS	LOOP RESTORATION PLAN

PROJECT LIMITS △1

BONAVISTA LANE - 130' S/O DANBROOK DR TO LAMBERT RD
CERES AVENUE - DANBROOK DR TO LANNING DR
~~CORLEY DRIVE - DUNTON DR TO 450' N/O DUNTON DR~~
~~CORLEY DRIVE - DANBROOK DR TO LANNING DR~~
DANBROOK DRIVE - 250' W/O CERES AV TO BONAVISTA LN
DANBROOK DRIVE - 130' W/O PARISE DR TO COLIMA RD
~~DUNTON DRIVE - VALLEY VIEW AV TO COLIMA RD~~
EAGAN DRIVE - DUNTON DR TO GLENN DR
EAGAN DRIVE - DANBROOK DR TO LANNING DR
~~ELMORE AVENUE - LANNING DR TO 380' N/O LANNING DR~~
GLENN DRIVE - VALLEY VIEW AV TO 230' S/O EAGAN DR
HAWES STREET - MILLS AV TO COLIMA RD
HOMAGE AVENUE - RIMGATE DR TO HAWES ST
HOMAGE AVENUE - DANBROOK DR TO LANNING DR
~~LANNING DRIVE - MILLS AV TO REGATTA AV~~
LANNING DRIVE - CERES AV TO BONAVISTA LN
LANNING DRIVE - LAMBERT RD TO COLIMA RD
McGEE DRIVE - 300' N/O HOMAGE AV TO HOMAGE AV
McGEE DRIVE - PARISE DR TO 340' S/O PARISE DR
~~MILLS AVENUE EAST FRONTAGE - LANNING DR TO 350' N/O LANNING DR~~
~~MULBERRY DRIVE NORTH FRONTAGE - VICTORIA AV TO RUOFF AV~~
~~MULBERRY DRIVE SOUTH FRONTAGE - RUOFF AV TO 155' E/O RUOFF AV~~
PARISE DRIVE - 740' S/O HAWES ST TO HAWES ST
PARISE DRIVE - HAWES ST TO DANBROOK DR
~~REGATTA AVENUE - 510' S/O MULBERRY DR TO MULBERRY DR~~
~~REGATTA AVENUE - LANNING DR TO 400' N/O LANNING DR~~
RIMGATE DRIVE - TERRYKNOLL DR TO 660' E/O TERRYKNOLL DR
RIMGATE DRIVE - 300' N/O HOMAGE AV TO SUNNYBROOK LN
~~RUOFF AVENUE - 415' S/O MULBERRY DR TO MULBERRY DR~~
RUOFF AVENUE - MULBERRY DR TO HAWES ST
SUNNYBROOK LANE - RIMGATE DR TO 145' N/O RIMGATE DR
~~TERRYKNOLL DRIVE - VICTORIA AV TO RUOFF AV~~
TERRYKNOLL DRIVE - 280' W/O RIMGATE DR TO COLIMA RD
VALLEY VIEW AVENUE - HAWES ST TO GLENN DR
VICTORIA AVENUE - MULBERRY DR TO HAWES ST

△1 NOTES:

1. DELETE PAVEMENT WORK.
2. APPLY SLURRY ONLY.
3. REMOVE 4" OF EXST AC PVMT, PLACE 4" OF AC(PI), ~~AND APPLY SLURRY OVER AC~~. SEE TABLE 8 ON SHEET 11 FOR DETAILS AND DIMENSIONS.

PH081018

AS BUILT

TWO DAYS BEFORE YOU DIG	APPROVED: GAIL FARBER DIRECTOR OF PUBLIC WORKS — BY Patrick V. Ochoki (DEPUTY DIRECTOR) — DATE 6-09-2010		
CALL USA TOLL FREE	RECOMMENDED: BY (ASSISTANT DEPUTY DIRECTOR) — DATE 6/7/2010		
1-800-227-2600	SUBMITTED: BY (HIGHWAY SECTION II) — DATE 5/6/10		
		1-14-11	△1 REVISE PROJECT LIMITS AND SCOPE PER GMED'S REQUEST
		DATE	MK — DESCRIPTION
		REVISIONS	

REGISTERED PROFESSIONAL ENGINEER — M. ORELLANA — NO. C62045 — EXP. 09/30/11 — CIVIL — STATE OF CALIFORNIA
PROJECT ENGINEER — DATE 9-28-10

COUNTY OF LOS ANGELES DEPARTMENT OF PUBLIC WORKS

HAWES STREET ET AL.

TITLE SHEET

PROJECT ID NO. RDC0015261

PCA	DWG	SHEET 1 OF 12

DRAFTER A TORRES — DESIGNER M ORELLANA — CHECKER F AGAHI — CADD PROJECT FILE NAME RDC0015261-PLAN-RD.DGN

DATE- $DATE$ TIME- $TIME$ FILE- $FILE$