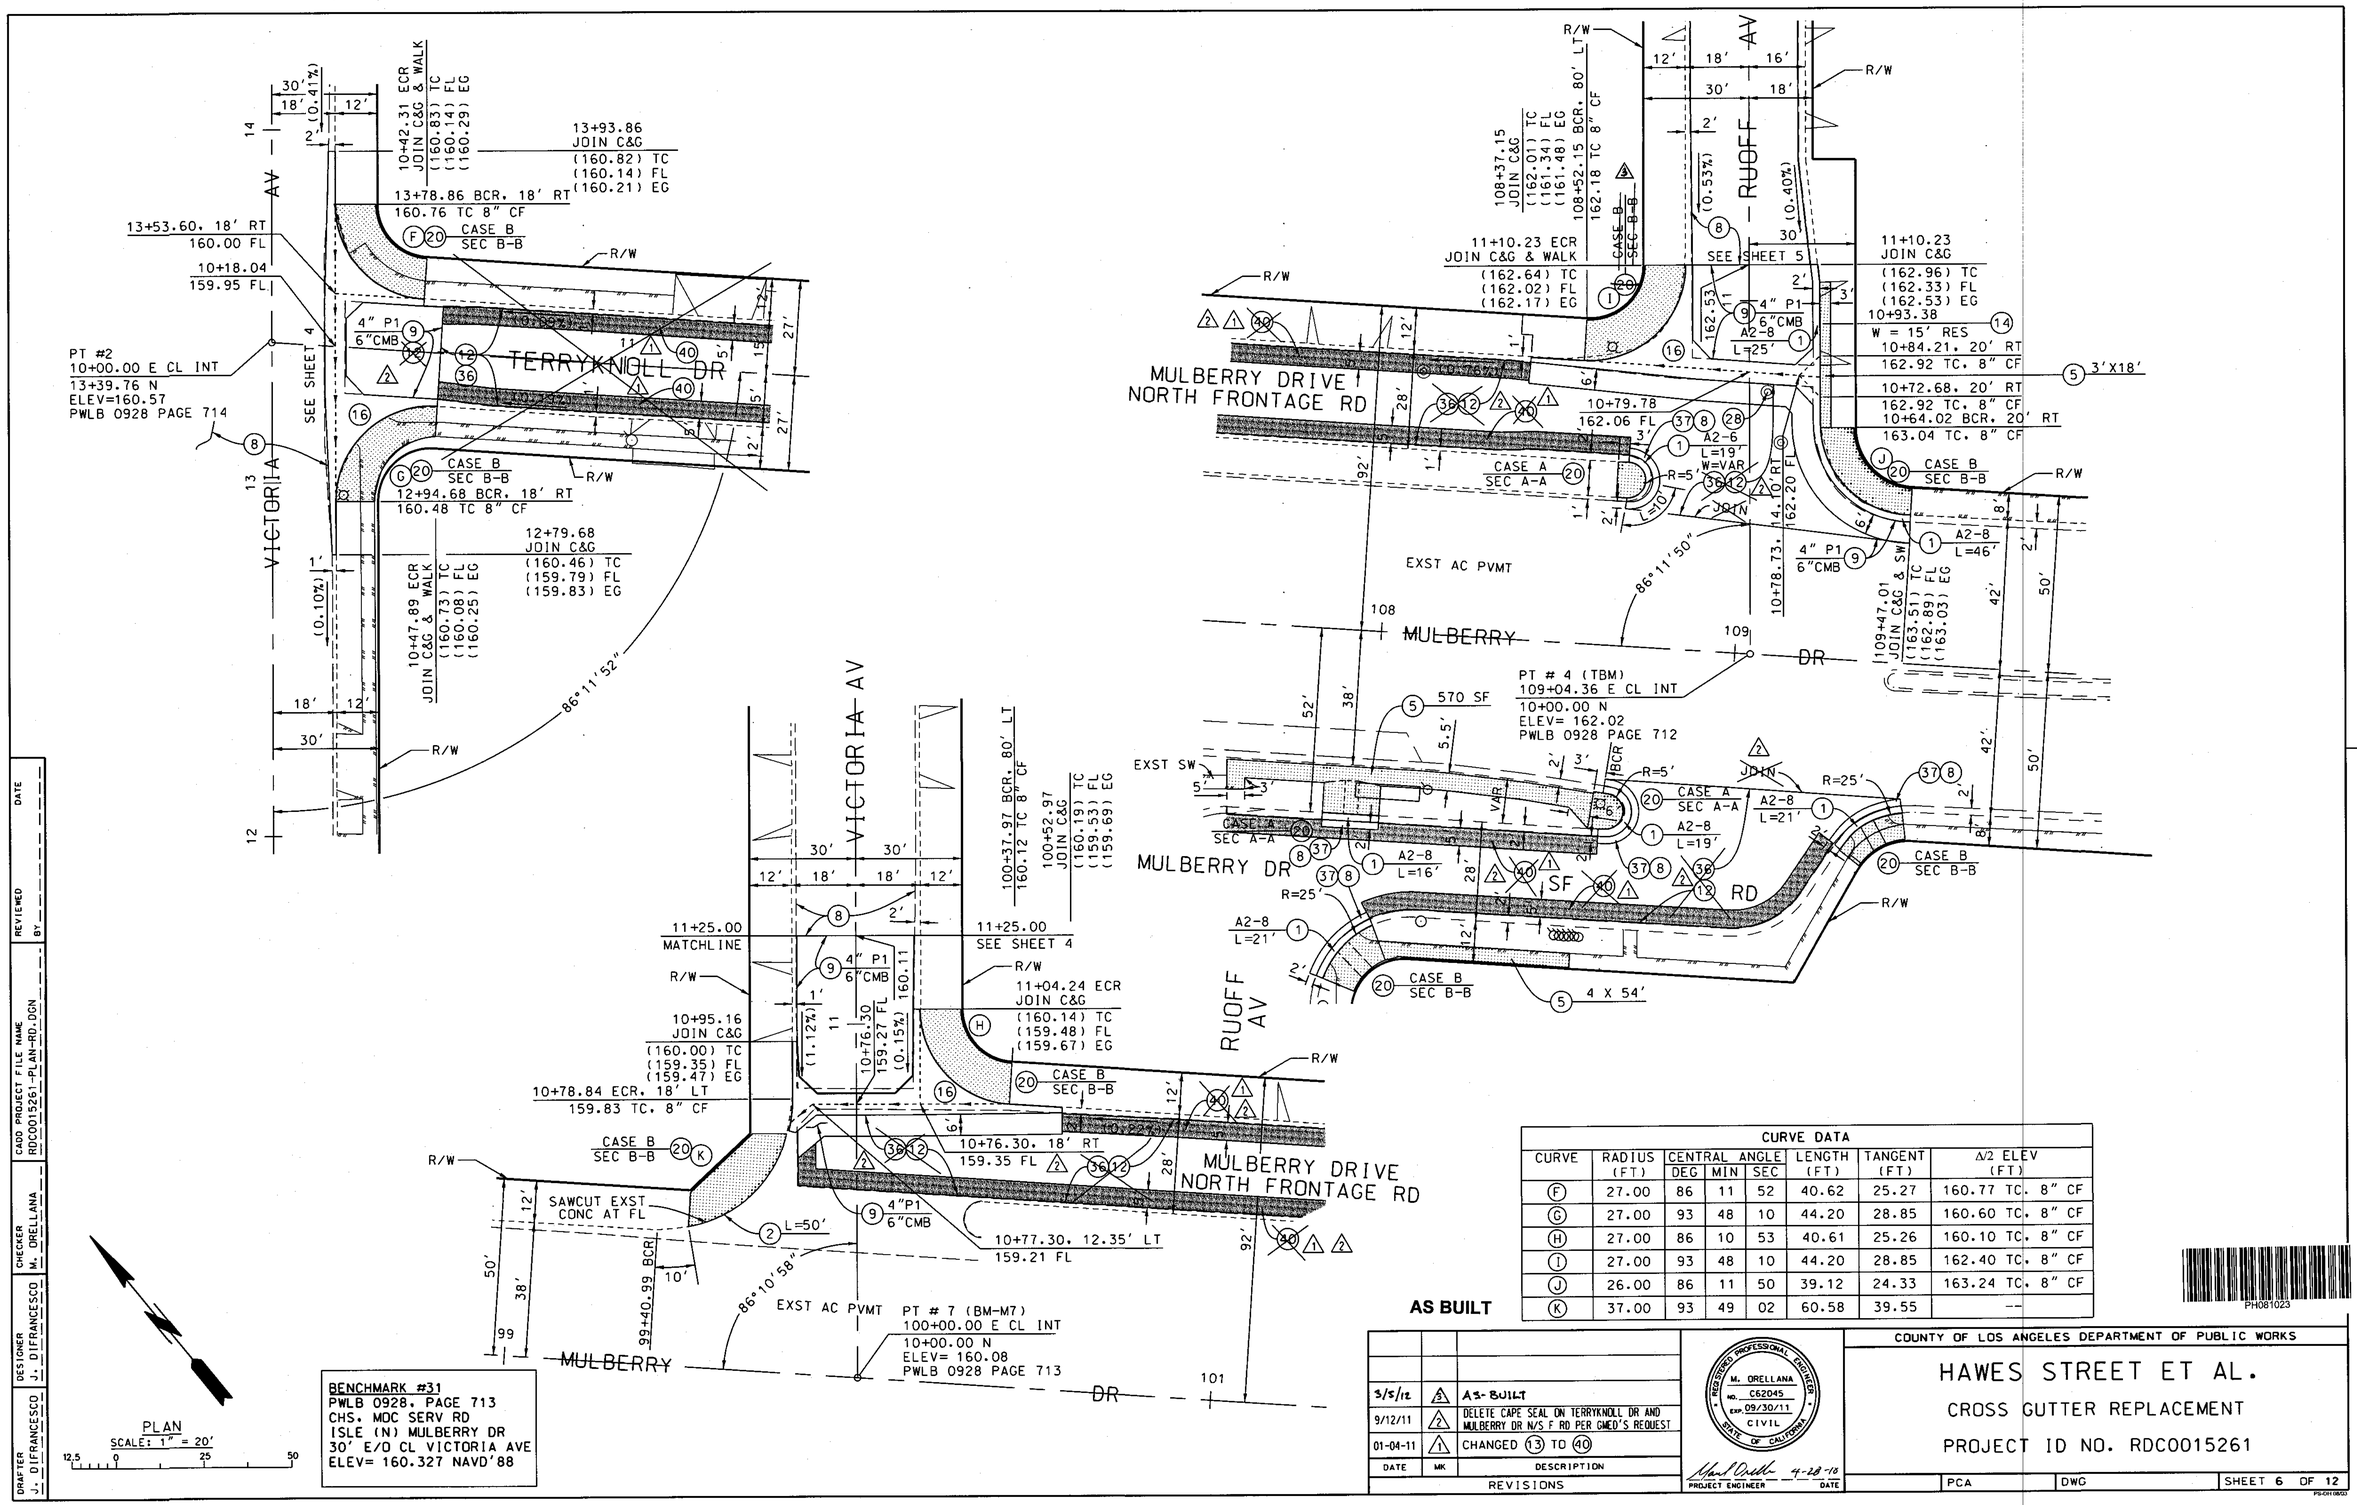

BENCHMARK #31
PWLB 0928, PAGE 713
CHS, MOC SERV RD
ISLE (N) MULBERRY DR
30' E/O CL VICTORIA AVE
ELEV= 160.327 NAVD'88

AS BUILT

CURVE DATA								
CURVE	RADIUS (FT)	CENTRAL ANGLE DEG	MIN	SEC	LENGTH (FT)	TANGENT (FT)	Δ/2 ELEV (FT)
(F)	27.00	86	11	52	40.62	25.27	160.77 TC, 8" CF
(G)	27.00	93	48	10	44.20	28.85	160.60 TC, 8" CF
(H)	27.00	86	10	53	40.61	25.26	160.10 TC, 8" CF
(I)	27.00	93	48	10	44.20	28.85	162.40 TC, 8" CF
(J)	26.00	86	11	50	39.12	24.33	163.24 TC, 8" CF
(K)	37.00	93	49	02	60.58	39.55	--

DATE	MK	DESCRIPTION
3/5/12	3	AS-BUILT
9/12/11	2	DELETE CAPE SEAL ON TERRYKNOLL DR AND MULBERRY DR N/S F RD PER GMED'S REQUEST
01-04-11	1	CHANGED (13) TO (40)

REVISIONS

REGISTERED PROFESSIONAL ENGINEER — M. ORELLANA — NO. C62045 — EXP. 09/30/11 — CIVIL — STATE OF CALIFORNIA

PROJECT ENGINEER — 4-28-10 — DATE

COUNTY OF LOS ANGELES DEPARTMENT OF PUBLIC WORKS

HAWES STREET ET AL.

CROSS GUTTER REPLACEMENT

PROJECT ID NO. RDC0015261

PCA | DWG | SHEET 6 OF 12

PH081023

DRAFTER J. DIFRANCESCO | DESIGNER J. DIFRANCESCO | CHECKER M. ORELLANA | CADD PROJECT FILE NAME RDC0015261-PLAN-RD.DGN | REVIEWED BY | DATE

DATE: $DATE$ TIME: $TIME$ FILE: $FILEL$