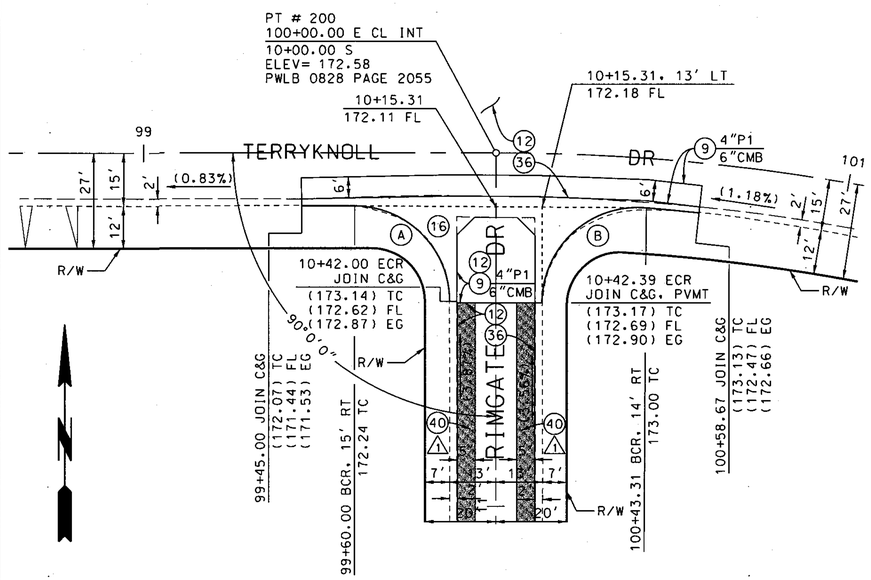

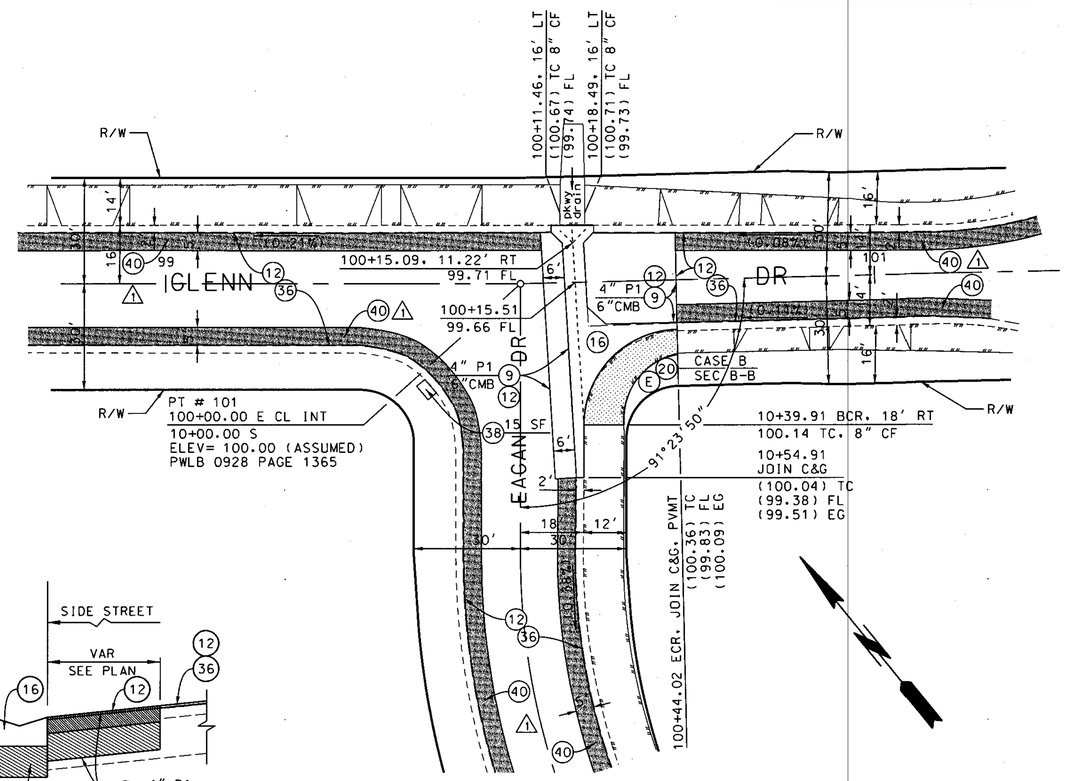

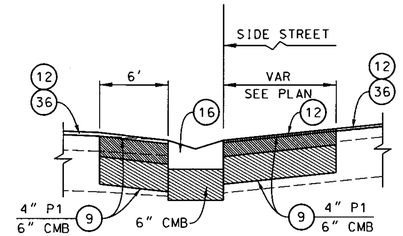

TYPICAL CROSS GUTTER SECTION

NO SCALE

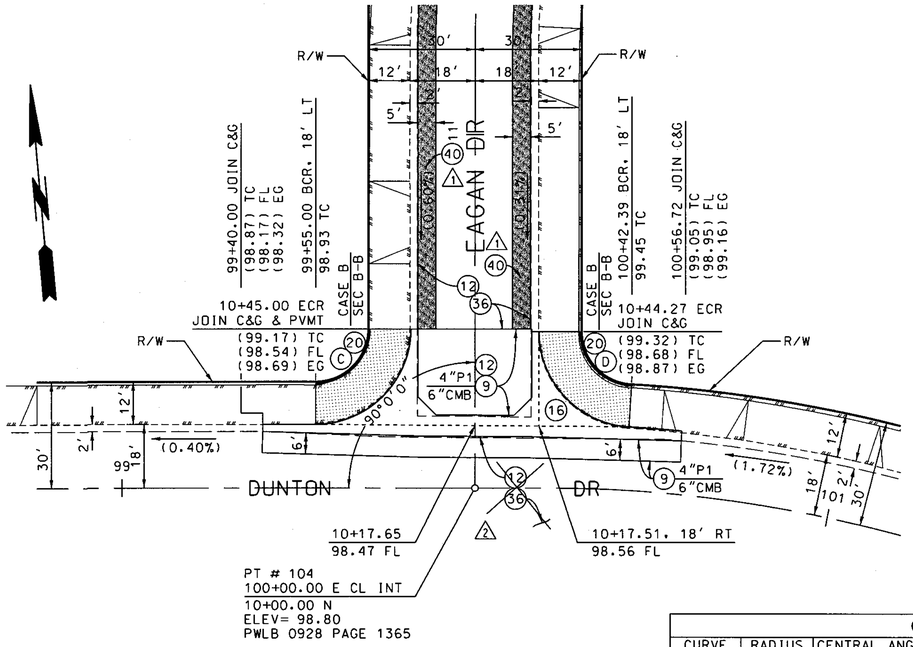

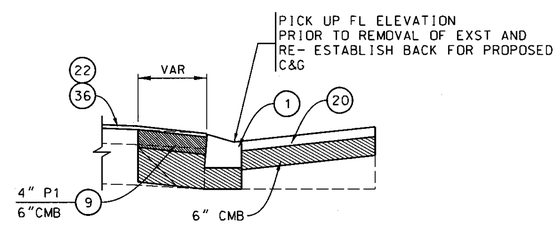

SECTION X-X

NO SCALE

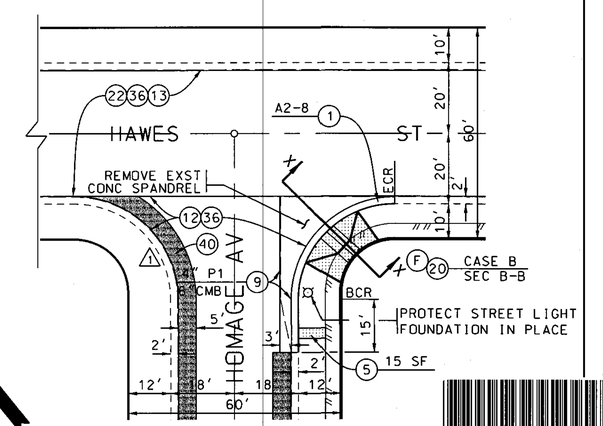

AS BUILT

PH081024

PLAN
SCALE: 1" = 20'

CURVE DATA							
CURVE	RADIUS (FT)	CENTRAL ANGLE DEG	MIN	SEC	LENGTH (FT)	TANGENT (FT)	Δ/2 ELEV (FT)
(A)	27.00	90	00	00	42.41	27.00	172.70 TC. 8" CF
(B)	27.00	93	38	07	44.12	28.77	172.95 TC. 8" CF
(C)	27.00	90	00	00	42.41	27.00	99.05 TC. 8" CF
(D)	27.00	83	59	56	39.58	24.31	99.29 TC. 8" CF
(E)	27.00	88	36	10	41.75	26.35	100.24 TC. 8" CF
(F)	27.00	90	00	00	42.41	27.00	--

BENCHMARK PT NO 101
S&T INT
EAGAN DR & GLENN DR
ELEV= 100.00 (ASSUMED)
PWFB 0928 PAGE 1365

DATE	MK	DESCRIPTION
9/12/11	2	DELETE CAPE SEAL WORK ON DUNTON DR PER CWED'S REQUEST
01-04-11	1	CHANGED (13) TO (40)

REVISIONS

REGISTERED PROFESSIONAL ENGINEER
M. ORELLANA
NO. C62045
EXP. 09/30/11
CIVIL
STATE OF CALIFORNIA

PROJECT ENGINEER 9-28-10 DATE

COUNTY OF LOS ANGELES DEPARTMENT OF PUBLIC WORKS

HAWES STREET ET AL.

CROSS GUTTER REPLACEMENT

PROJECT ID NO. RDC0015261

PCA | DWG | SHEET 7 OF 12

DRAFTER	DESIGNER	CHECKER	CADD PROJECT FILE NAME	REVIEWED BY	DATE
J. DIFRANCESCO	J. DIFRANCESCO	M. ORELLANA	RDC0015261-PLAN-RD.DGN		

DATE: $DATE$ TIME: $TIME$ FILE: $FILE$