SEGMENT	LIMITS	HOUSE NUMBER	W (FT)	X (FT)	(14) (SF)
BONAVISTA LANE	130 FT S/O DANBROOK DR TO LAMBERT RD	9920	10	3	160
	130 FT S/O DANBROOK DR TO LAMBERT RD	9925 & 9931	21	3	270
	130 FT S/O DANBROOK DR TO LAMBERT RD	9949	10	3*	130
	130 FT S/O DANBROOK DR TO LAMBERT RD	9953	10	3	160
CERES AVENUE	DANBROOK DRIVE TO LANNING DRIVE	9913	10	3	160
	DANBROOK DRIVE TO LANNING DRIVE	9926	10	3	160
	DANBROOK DRIVE TO LANNING DRIVE	9936	10	3	160
	DANBROOK DRIVE TO LANNING DRIVE	9942	10	3	160
CORLEY AVENUE	DANBROOK DRIVE TO LANNING DRIVE	10310	10	3	160
	DANBROOK DRIVE TO LANNING DRIVE	10417	10	3	160
DUNTON DRIVE	VALLEY VIEW AVENUE TO COLIMA ROAD	14724	---	---	48
DANBROOK DRIVE	250 FT W/O CERES AVENUE TO BONAVISTA LANE	14622	10	3	160
	250 FT W/O CERES AVENUE TO BONAVISTA LANE	14628	10	3	160
	250 FT W/O CERES AVENUE TO BONAVISTA LANE	14634	10	3	160
EAGAN DRIVE	DANBROOK DRIVE TO LANNING DRIVE	10309	10	3	160
	DANBROOK DRIVE TO LANNING DRIVE	10316	10	3	160
	DANBROOK DRIVE TO LANNING DRIVE	10322	10	3	160
	DANBROOK DRIVE TO LANNING DRIVE	10328	10	3	160
	DANBROOK DRIVE TO LANNING DRIVE	10334	10	3	160
	DANBROOK DRIVE TO LANNING DRIVE	10340	10	3	160
	DANBROOK DRIVE TO LANNING DRIVE	10434	10	3	160
ELMORE AVENUE	LANNING DRIVE TO 380 FT N/O LANNING DRIVE	9605	10	3	160
HAWES STREET	MILLS AVENUE (ON HAWES STREET)	9920	20	3	160
	MILLS AVENUE TO COLIMA ROAD	14402	10	3	160
	MILLS AVENUE TO COLIMA ROAD	14414	10	3	160
	MILLS AVENUE TO COLIMA ROAD	14418	15	3	210
	MILLS AVENUE TO COLIMA ROAD	14460	10	3	96
	MILLS AVENUE TO COLIMA ROAD	14508	10	3	96
LANNING DRIVE	CERES AVENUE TO BONAVISTA LANE	14611	12	3	180
	CERES AVENUE TO BONAVISTA LANE	14633	10	3	160
	CERES AVENUE TO BONAVISTA LANE	14648	16	3	132
LANNING DRIVE	MILLS AVENUE TO REGATTA AVENUE	14520	10	3	96
	MILLS AVENUE TO REGATTA AVENUE	ACROSS FROM 14520	12	3	108
	MILLS AVENUE TO REGATTA AVENUE	14538	10	3	96
	MILLS AVENUE TO REGATTA AVENUE	14560	10	3	160
MCGEE DRIVE	HOMAGE AV TO 300 N/O HOMAGE AVENUE	14504	10	3	96
	HOMAGE AV TO 300 N/O HOMAGE AVENUE	14522	10	3	96
MILLS AVENUE FRONTAGE ROAD	LANNING DRIVE TO 350 FT N/O LANNING DRIVE	9612	10	3	160
	LANNING DRIVE TO 350 FT N/O LANNING DRIVE	9616	12	4	48
MULBERRY DRIVE NORTH FRONTAGE ROAD	VICTORIA AVENUE TO RUOFF AVENUE	14313	10	3	160
	VICTORIA AVENUE TO RUOFF AVENUE	14325	12	3	180
	VICTORIA AVENUE TO RUOFF AVENUE	14357	10	3	160

TABLE 2

DRIVEWAYS

* "X" ON ONE SIDE ONLY

SEGMENT	LIMITS	HOUSE NUMBER	W (FT)	X (FT)	(14) (SF)
REGATTA AVENUE	LANNING DRIVE TO 400 FT N/O LANNING DRIVE	9612	12	3	180
	LANNING DRIVE TO 400 FT N/O LANNING DRIVE	9613	20	3	260
	LANNING DRIVE TO 400 FT N/O LANNING DRIVE	9619	12	3	180
	LANNING DRIVE TO 400 FT N/O LANNING DRIVE	9622	10	3	160
	LANNING DRIVE TO 400 FT N/O LANNING DRIVE	9628	10	3	160
	LANNING DRIVE TO 400 FT N/O LANNING DRIVE	9631	10	3	160
	LANNING DRIVE TO 400 FT N/O LANNING DRIVE	9635	10	3	160
	LANNING DRIVE TO 400 FT N/O LANNING DRIVE	9644	10	3	160
RIMGATE DRIVE	300 FT N/O HOMAGE AVENUE TO SUNNYBROOK LANE	14512	32	---	192
	300 FT N/O HOMAGE AVENUE TO SUNNYBROOK LANE	14528	10	3	48
	300 FT N/O HOMAGE AVENUE TO SUNNYBROOK LANE	14544	10	3	160
	300 FT N/O HOMAGE AVENUE TO SUNNYBROOK LANE	14550	---	---	4
TERRYKNOLL DRIVE	VICTORIA AVENUE TO RUOFF AVENUE	14367	10	3	60
RUOFF AVE	415' S/O MULBERRY DR TO MULBERRY DR	10240	29	4	370
	415' S/O MULBERRY DR TO MULBERRY DR	10241	10	4	180

TABLE 2 -CONT-

DRIVEWAYS

SEGMENT	LIMITS	HOUSE NO.	LENGTH (FT)	(1) TYPE
HAWES STREET	MILLS AV TO COLIMA RD	14625	9	A2-8
MULBERRY DRIVE NORTH FRONTAGE	VICTORIA AV TO RUOFF AV	14363	20	A2-8
CERES AVENUE	DANBROOK DR TO LANNING DR	9948	10	A2-8

TABLE 3

CURB & GUTTER

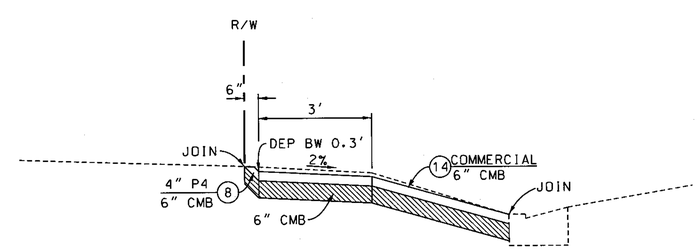

DRIVEWAY PROFILE
9920 MILLS AV (ON HAWES ST)

NO SCALE

AS BUILT

DATE	MK	DESCRIPTION

REVISIONS

REGISTERED PROFESSIONAL ENGINEER M. ORELLANA NO. C62045 EXP. 09/30/11 CIVIL STATE OF CALIFORNIA

PROJECT ENGINEER 4-28-10 DATE

COUNTY OF LOS ANGELES DEPARTMENT OF PUBLIC WORKS

HAWES STREET ET AL.

CONCRETE IMPROVEMENT TABLES

PROJECT ID NO. RDC0015261

PCA | DWG | SHEET 9 OF 12

PS-CH 09/03

PH081026

DRAFTER J. DIFRANCESCO | DESIGNER J. DIFRANCESCO | CHECKER M. ORELLANA | CADD PROJECT FILE NAME RDC0015261-PLAN-RD.DGN | REVIEWED BY | DATE

DATE: $DATE$ TIME: $TIME$ FILE: $FILEL$