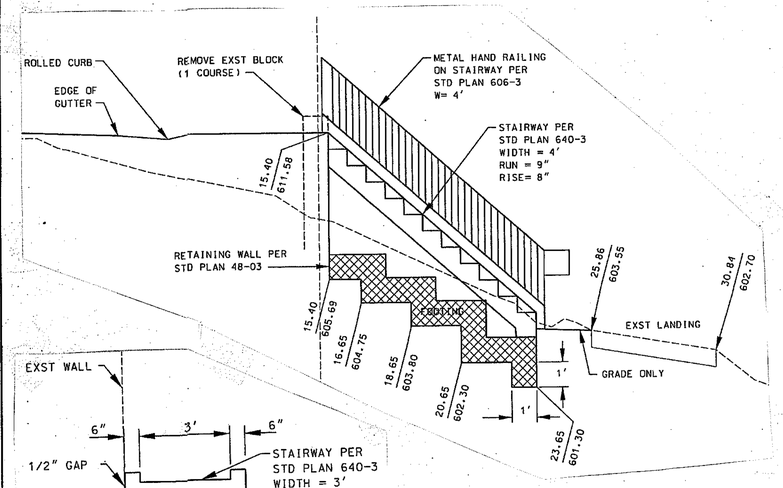

■ AS BUILT DETAILS FROM SH. 8

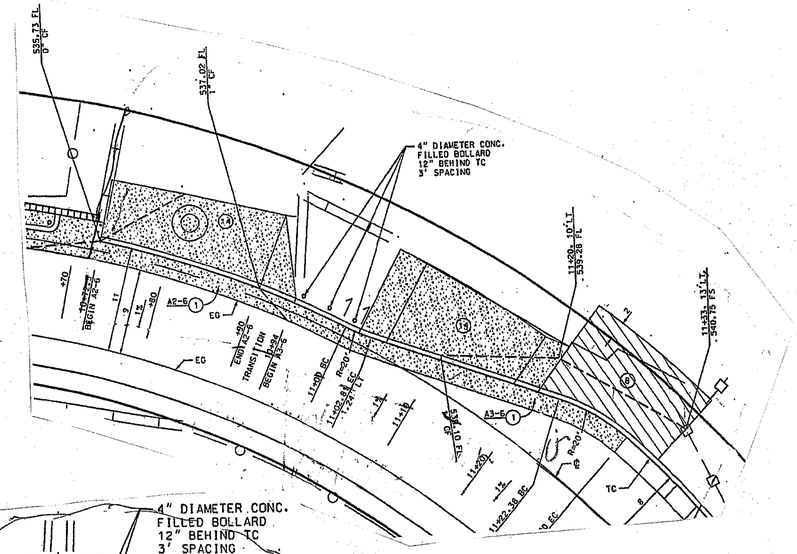

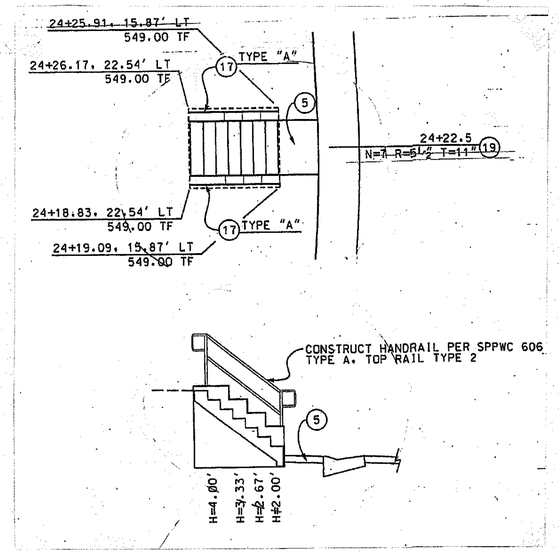

■ AS BUILT DETAILS FROM SH. 12

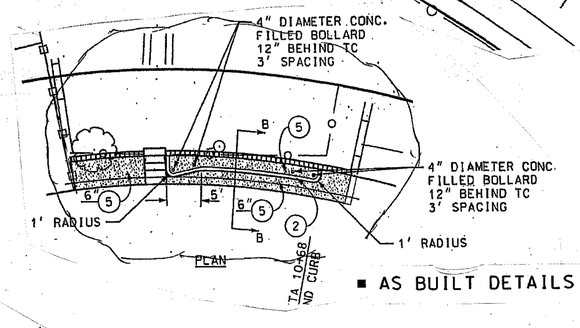

■ AS BUILT DETAILS FROM SH. 11

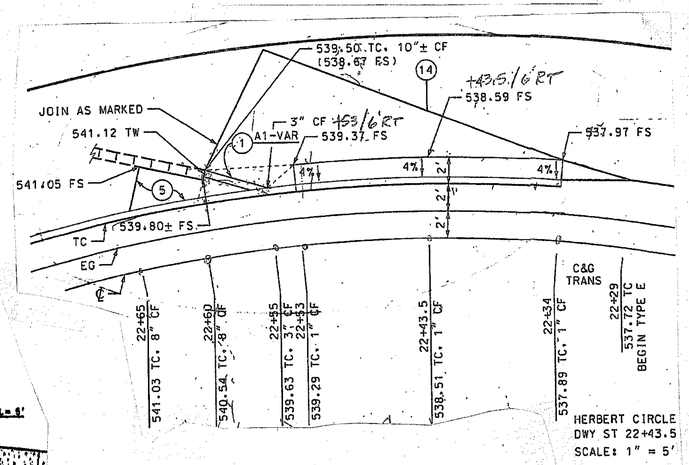

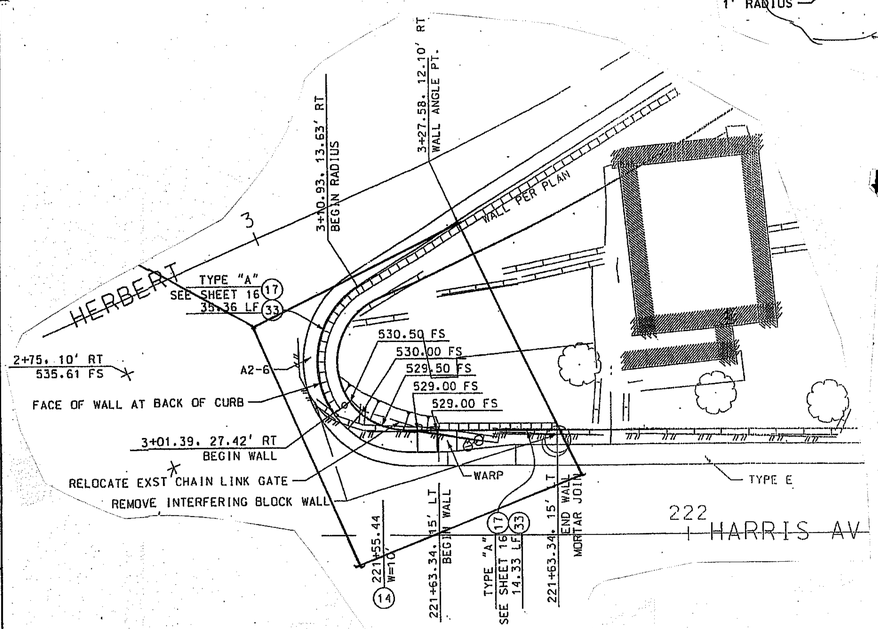

■ AS BUILT DETAILS FROM SH. 10

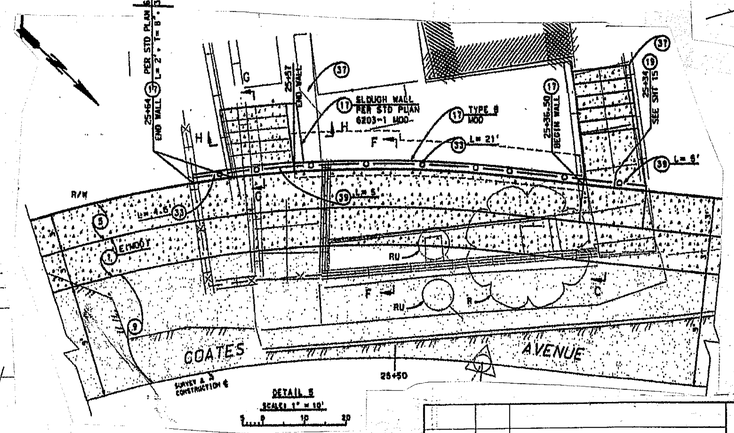

■ AS BUILT DETAILS FROM SH. 9

DATE	MK	DESCRIPTION
8-15-12	■	AS BUILT REVISIONS

REVISIONS

REGISTERED PROFESSIONAL ENGINEER — R. SIAGIAN — NO. C67961 — EXP. 06/30/11 — CIVIL — STATE OF CALIFORNIA

PROJECT ENGINEER — DATE 8/26/10

COUNTY OF LOS ANGELES DEPARTMENT OF PUBLIC WORKS

HARRIS AVENUE, ET AL.

COATES, HARRIS & HERBERT AVENUES

AS BUILT DETAILS

PROJECT ID NO. RDC0011687

T.G. 635 - E3, D4 & E4

RDC0011687 | JOB X2101572 | DWG | SHEET 17 OF 17

AS BUILT DRAWINGS

DRAFTER RS | DESIGNER RS | CHECKER W. LO | CADD PROJECT FILE NAME RDC0011687_HARRIS.DGN | REVIEWED BY