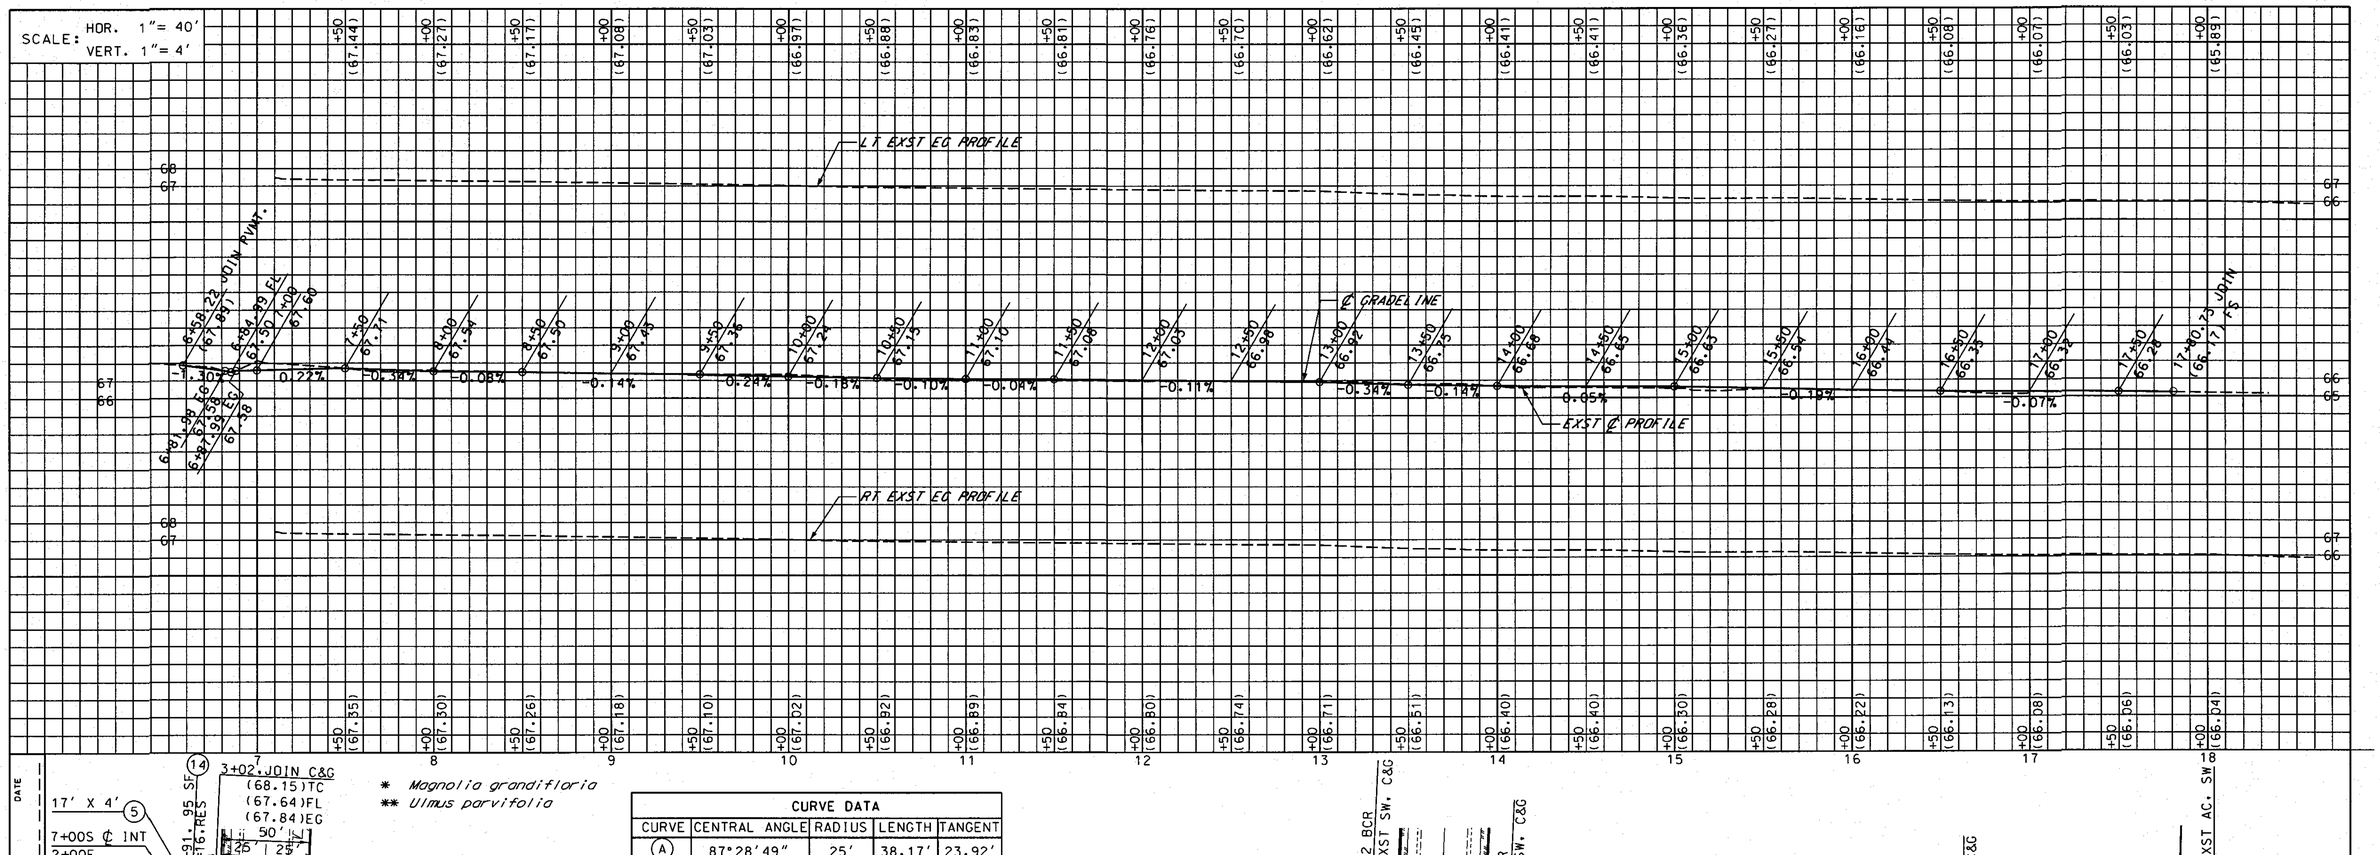

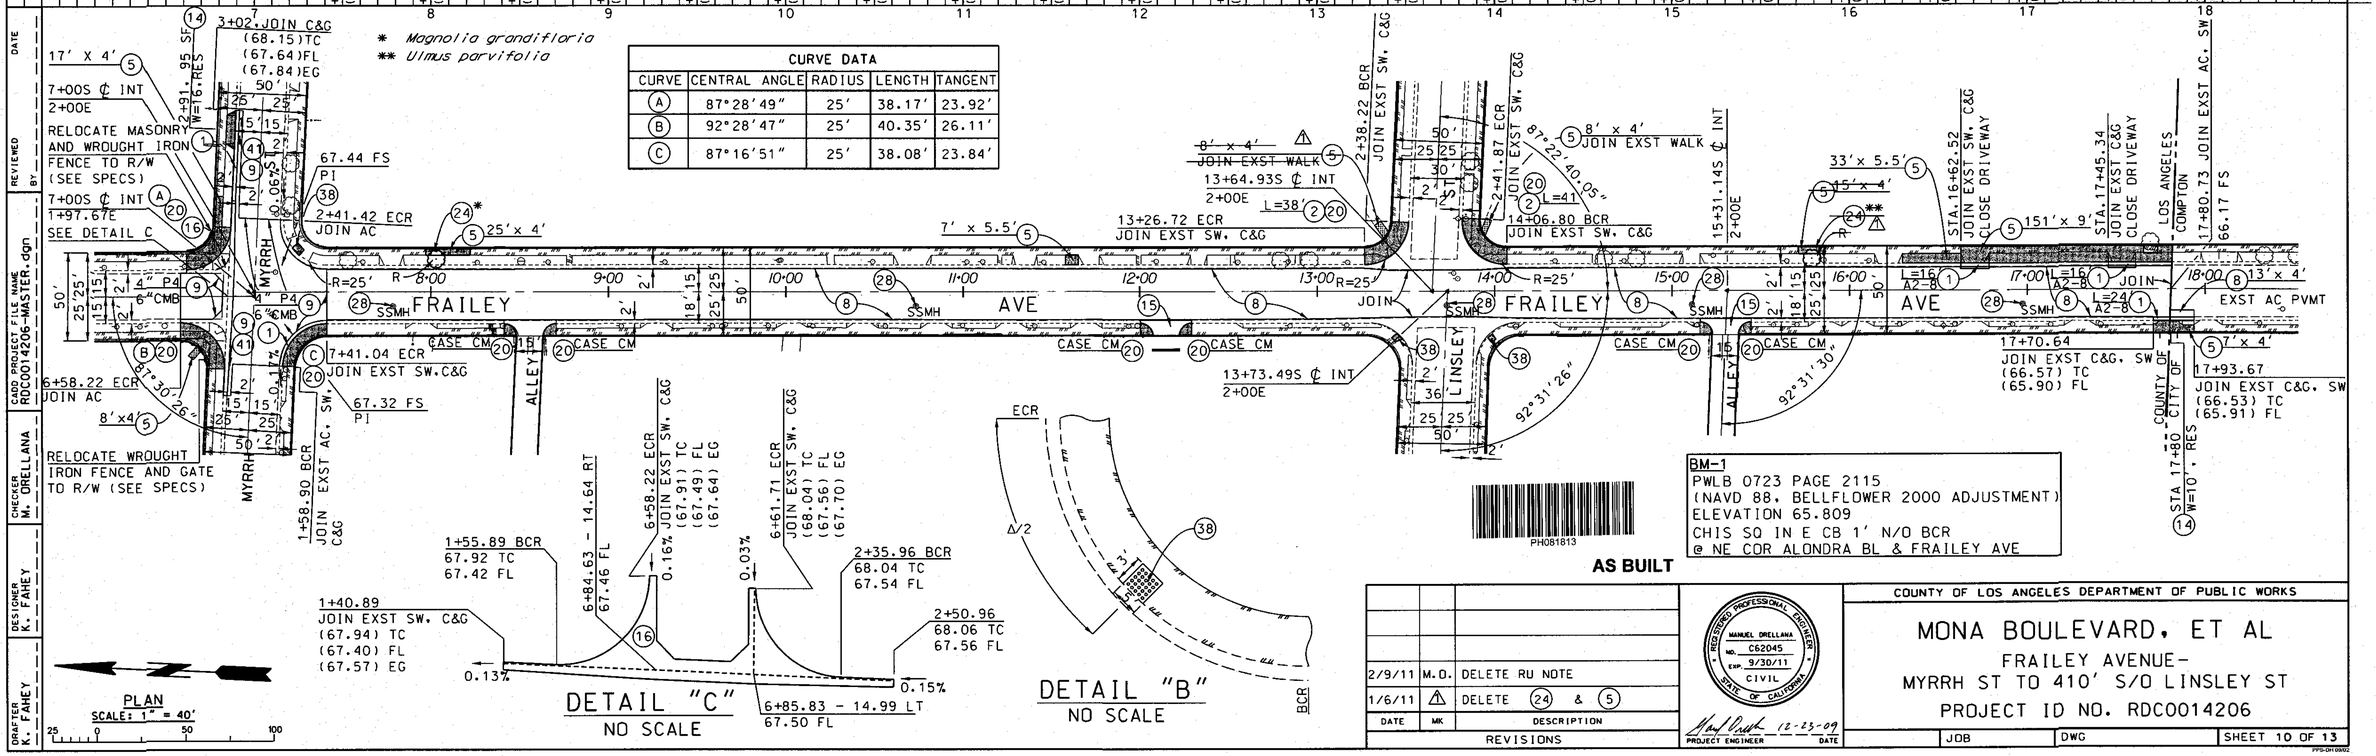

CURVE	CENTRAL ANGLE	RADIUS	LENGTH	TANGENT
A	87°28'49"	25'	38.17'	23.92'
B	92°28'47"	25'	40.35'	26.11'
C	87°16'51"	25'	38.08'	23.84'

BM-1
PWLB 0723 PAGE 2115
(NAVD 88, BELLFLOWER 2000 ADJUSTMENT)
ELEVATION 65.809
CHIS SQ IN E CB 1' N/O BCR
@ NE COR ALONDRA BL & FRAILEY AVE

PH081813

AS BUILT

DATE	MK	DESCRIPTION
2/9/11	M.O.	DELETE RU NOTE
1/6/11	1	DELETE (24) & (5)

REVISIONS

REGISTERED PROFESSIONAL ENGINEER
MANUEL DRELLANA
NO. C62045
EXP. 9/30/11
CIVIL
STATE OF CALIFORNIA

PROJECT ENGINEER 12-23-09 DATE

COUNTY OF LOS ANGELES DEPARTMENT OF PUBLIC WORKS

MONA BOULEVARD, ET AL

FRAILEY AVENUE-
MYRRH ST TO 410' S/O LINSLEY ST
PROJECT ID NO. RDC0014206

JOB	DWG	SHEET 10 OF 13

DATE | REVIEWED BY | CADD PROJECT FILE NAME RDC0014206-MASTER.dgn | CHECKER M. ORELLANA | DESIGNER K. FAHEY | DRAFTER K. FAHEY

DATE. $DATE$ TIME. $TIME$ FILE. $FILEL$