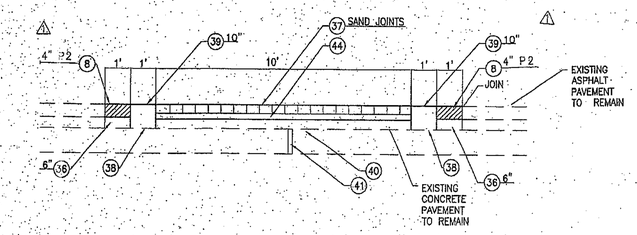

CROSSWALK DETAIL

NTS.

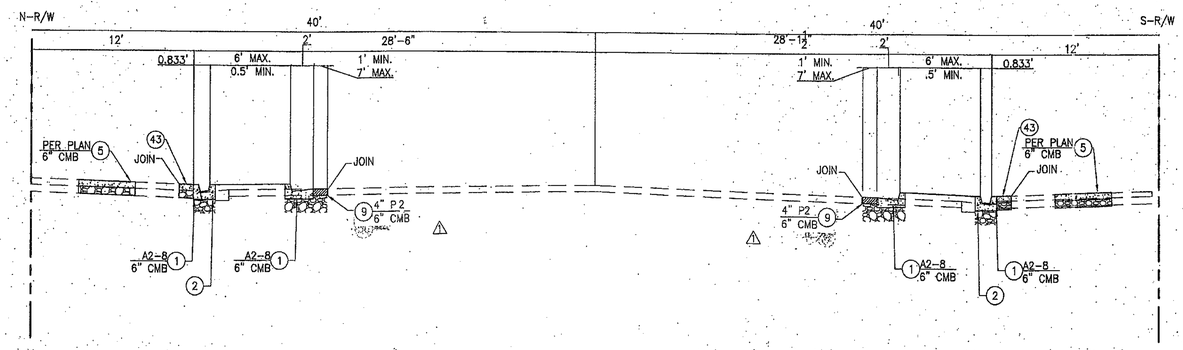

WHITTIER BLVD STA 10+61 TO 10+97

NTS

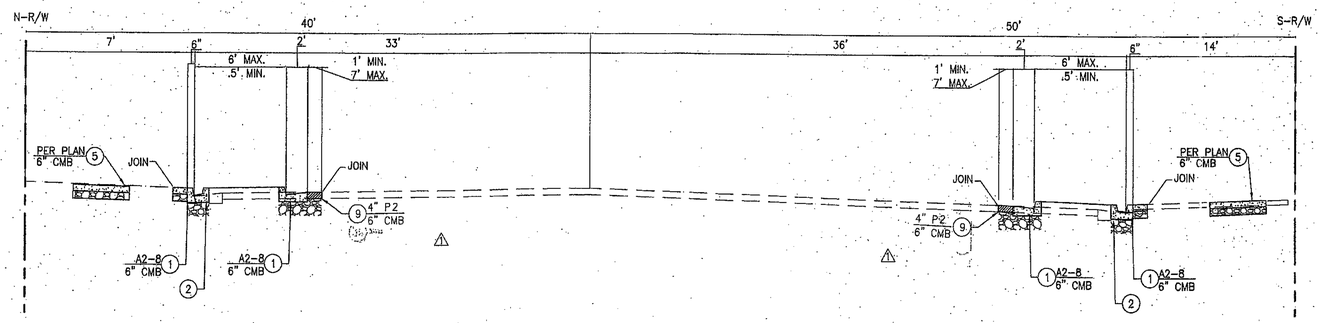

WHITTIER BLVD STA 53+58 TO 53+97

NTS

AS BUILT

PH082657

PROPOSED FOR CONSTRUCTION: DATE | ADVERTISED: DATE | AS BUILT: DATE

DRAFTER NAME: JL | DESIGNER NAME: JB | CHECKER NAME: TJ | CADD PROJECT FILE NAME | REVIEWED BY | DATE

REVIEWED BY:

LACDPW DESIGN DIVISION — DATE 2/16/10

kpff Consulting Engineers
6080 Center Dr. Suite 700
Los Angeles, California 90045
(310) 665-2800 Fax (310) 665-9075

TWO DAYS BEFORE YOU DIG
CALL USA TOLL FREE
1-800-227-2600

DATE	MK	DESCRIPTION
6/10/10	1	REVISED TYPICAL SECTIONS

REVISIONS

REGISTERED PROFESSIONAL ENGINEER PATRICIA K. JOHNS No. C56740 Exp. 9/30/10 CIVIL STATE OF CALIFORNIA

PROJECT ENGINEER — DATE 2-16-10

COUNTY OF LOS ANGELES DEPARTMENT OF PUBLIC WORKS

WHITTIER BOULEVARD REVITALIZATION PROJECT

PROJECT ID NO. RDC0015166

TYPICAL SECTIONS

PCA X2101700 | DWG | SHEET 2 OF 11

PLAN-RD