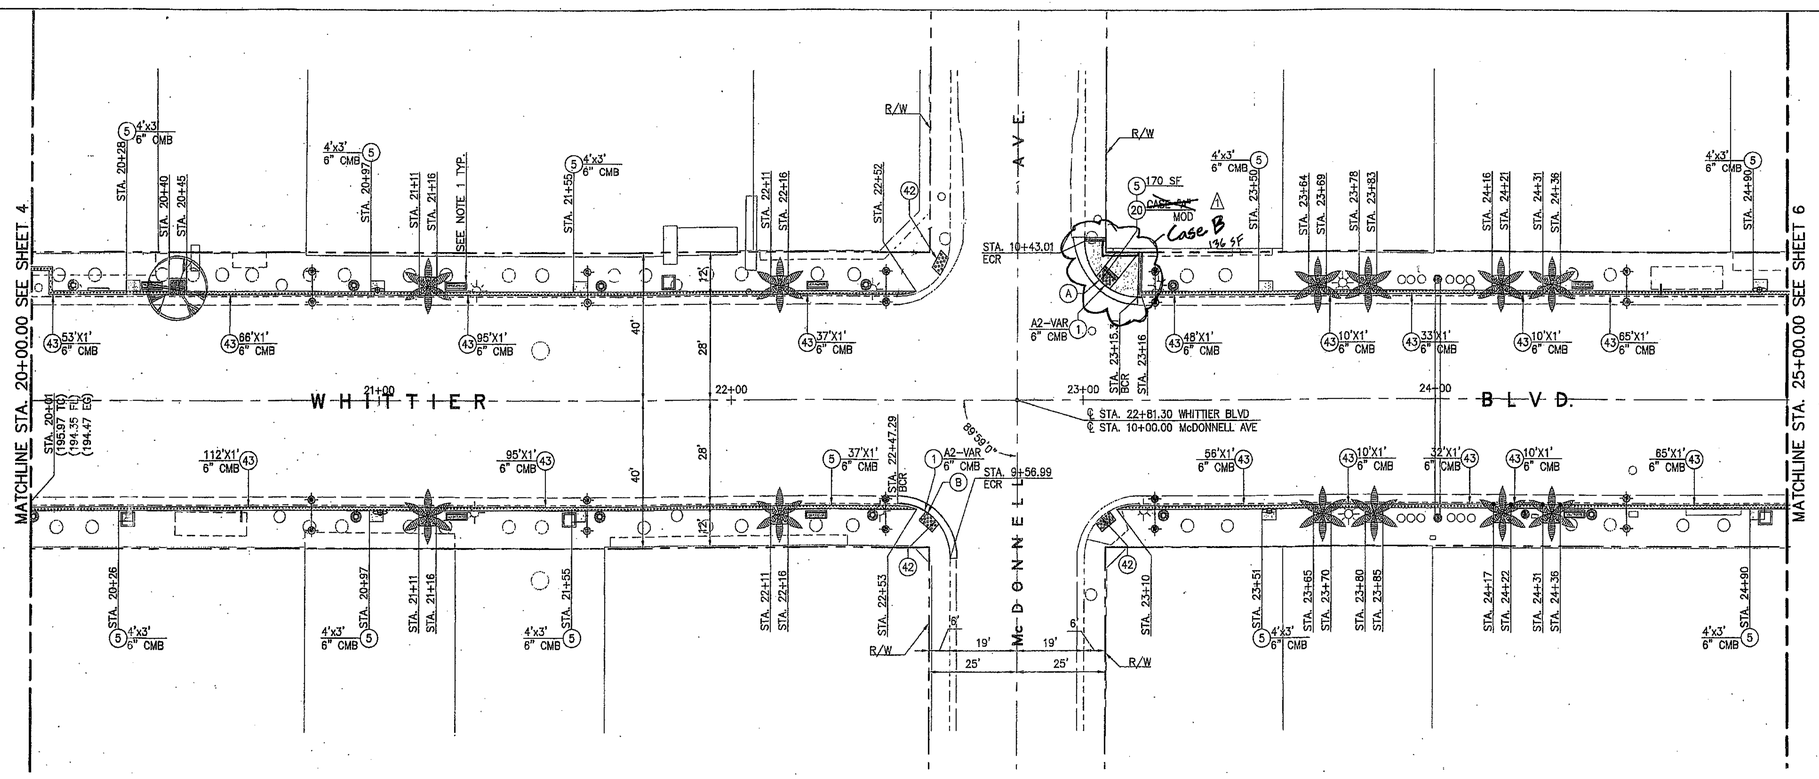

CURB RETURN ELEVATIONS					
	BCR	1/4 Δ	1/2 Δ	3/4 Δ	ECR
A	(196.04 TC) (195.34 FL)	196.08 TC 195.41 FL	196.12 TC 195.45 FL	196.17 TC 195.50 FL	(196.13 TC) (195.57 FL)
B	(195.56 TC) (194.93 FL)	(195.53 TC) 194.95 FL	(194.98 TC) 194.98 FL	(195.44 TC) 194.89 FL	(194.43 TC) (194.80 FL)

CURVE DATA TABLE				
CURVE NO.	LENGTH	RADIUS	DELTA	TANGENT
A.	23.57'	15.00'	90°01'00"	15.00
B	23.57'	15.00'	90°01'00"	15.00

NOTES:

1. SEE PLAN LS FOR LANDSCAPE IMPROVEMENTS

PLAN
SCALE: 1" = 20'-0"
0 10' 20' 40'
GRAPHIC SCALE

PH092660

AS BUILT

REVIEWED BY:

LACDPW DESIGN DIVISION — DATE 3/16/10

BENCHMARKS

BM Y11954 PWFB 1223-6081 L&T NEAR MC @ SW COR. OF WHITTIER BL. & EASTERN AVE. RIVERA 2005 NAVD.88

SURVEYOR'S NOTES:

1. THE BEARING OF N75°37'00"W ALONG THE CENTERLINE OF L&T NEAR MC @ SW COR. OF WHITTIER BLVD. AS PER MAP OF TRACT 4074, M.B. 44-26 WAS TAKEN AS THE BASIS OF BEARINGS FOR THIS SURVEY.
2. ELEVATIONS SHOWN HEREON ARE RELATIVE TO THE COUNTY DATUM. ANY USER OF ELEVATIONS AND/OR COORDINATES SHOWN HEREON FOR THE CONTROL OF CONSTRUCTION, SHALL VERIFY AT LEAST 3 POINTS SHOWN HEREON, FOR MATHEMATICAL CONSISTENCY PRIOR TO SUCH USE.

kpff Consulting Engineers
6080 Center Dr. Suite 700
Los Angeles, California 90045
(310) 665-2800 Fax (310) 665-9075

TWO DAYS BEFORE YOU DIG
CALL USA TOLL FREE
1-800-227-2600

DATE	MK	DESCRIPTION
6/11/13	1	AS-BUILT

REVISIONS

REGISTERED PROFESSIONAL ENGINEER — PATRICK K. WONG — No. C66740 — Exp. 9/30/10 — CIVIL — STATE OF CALIFORNIA

PROJECT ENGINEER — DATE 3-16-10

COUNTY OF LOS ANGELES DEPARTMENT OF PUBLIC WORKS

WHITTIER BOULEVARD REVITALIZATION PROJECT
PROJECT ID NO. RDC0015166

PCA X2101700 | DWG | SHEET 5 OF 11

PLAN-RD

DRAFTER NAME: JL | DESIGNER NAME: JB | CHECKER NAME: TG | CADD PROJECT FILE NAME | REVIEWED BY | DATE

PROPOSED FOR CONSTRUCTION: DATE | ADVERTISED: DATE | AS BUILT: DATE