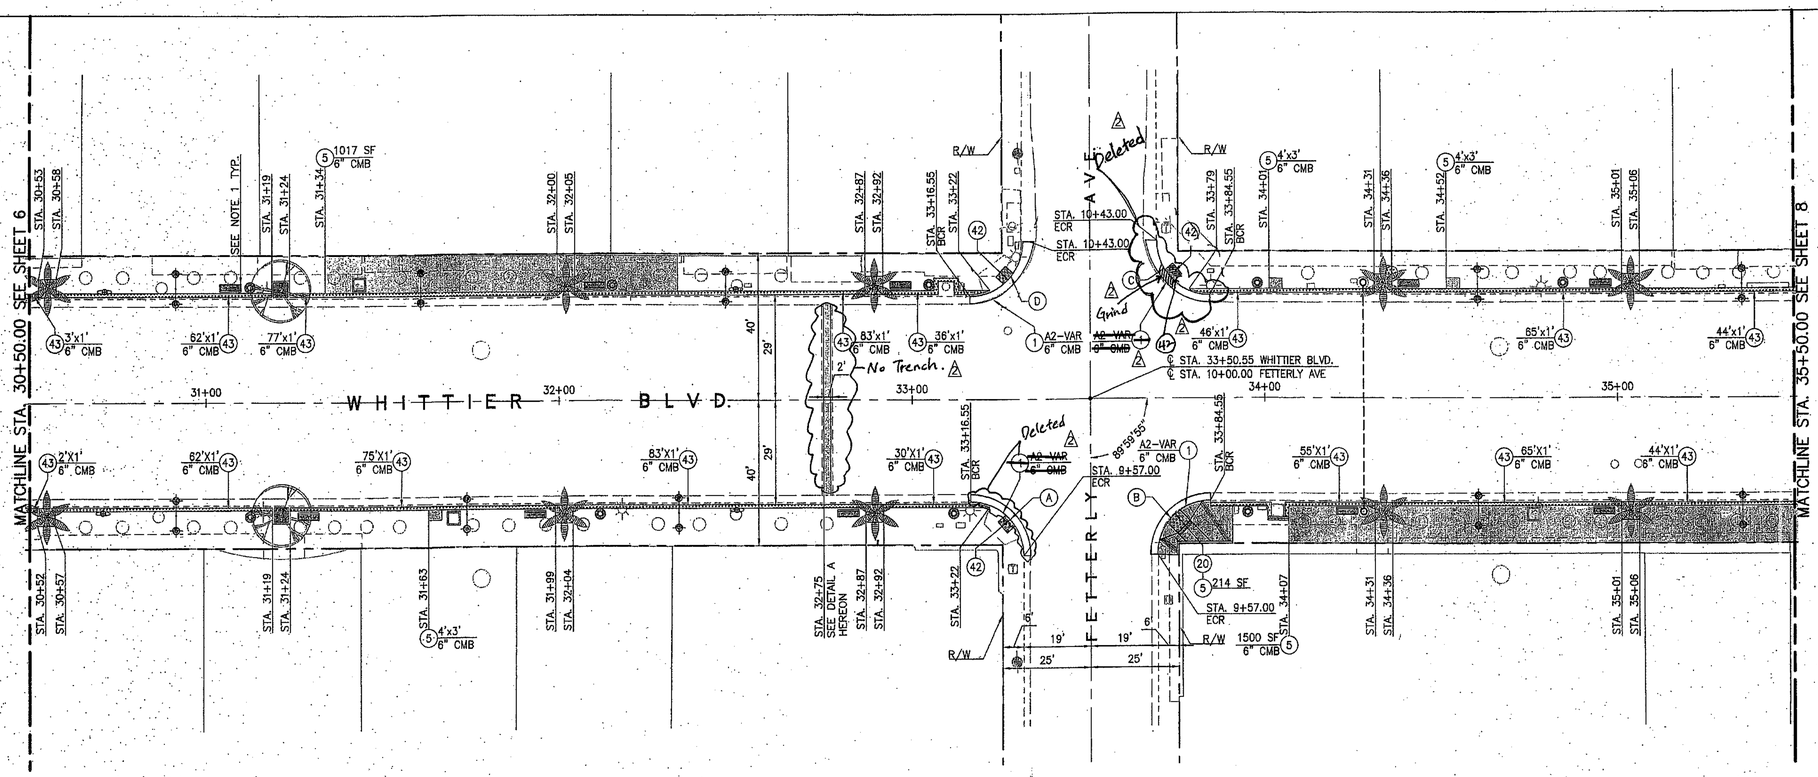

CURB RETURN ELEVATIONS					
	BCR	1/4 Δ	1/2 Δ	3/4 Δ	ECR
A	(194.34 TC) (193.69 FL)	(194.22 TC) 193.63 FL	(193.60 TC) 193.60 FL	(194.09 TC) 193.56 FL	(194.14 TC) (193.50 FL)
B	(194.25 TC) (193.58 FL)	194.27 TC 193.60 FL	194.31 TC 193.64 FL	194.23 TC 193.56 FL	(194.03 TC) (193.50 FL)
C	(194.75 TC) (194.07 FL)	(194.59 TC) 194.14 FL	(194.21 TC) 194.21 FL	(194.73 TC) 194.19 FL	(194.75 TC) (194.17 FL)
D	(194.67 TC) (194.05 FL)	(194.51 TC) 194.06 FL	(194.08 TC) 194.08 FL	(194.60 TC) 194.12 FL	(194.80 TC) (194.17 FL)

CURVE DATA TABLE				
CURVE NO.	LENGTH	RADIUS	DELTA	TANGENT
A	23.56'	15.00'	89°59'55"	15.00
B	23.56'	15.00'	90°00'05"	15.00
C	23.56'	15.00'	89°59'55"	15.00
D	23.56'	15.00'	90°00'05"	15.00

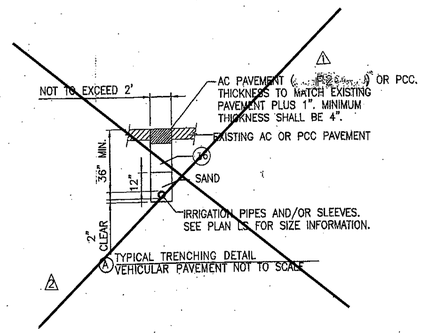

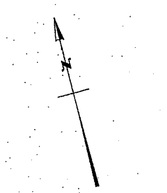

PLAN
SCALE: 1" = 20'-0"
0 10' 20' 40'
GRAPHIC SCALE

PH082662

AS BUILT

NOTES:

1. SEE PLAN LS FOR LANDSCAPE IMPROVEMENTS

REVIEWED BY:

LACDPW DESIGN DIVISION — DATE 3/16/10

BENCHMARKS

BM Y11957 PWFB 1223-6082
L&T NEAR CB @ 5' S/O ECR
SW COR. OF WHITTIER BL. &
ARIZONA AVE.
RIVERA 2005 NAVD.88

SURVEYOR'S NOTES:

1. THE BEARING OF N75°37'00"W ALONG THE CENTERLINE OF L&T NEAR MC @ SW COR. OF WHITTIER BLVD. AS PER MAP OF TRACT 4074, M.B. 44-26 WAS TAKEN AS THE BASIS OF BEARINGS FOR THIS SURVEY.
2. ELEVATIONS SHOWN HEREON ARE RELATIVE TO THE COUNTY DATUM. ANY USER OF ELEVATIONS AND/OR COORDINATES SHOWN HEREON FOR THE CONTROL OF CONSTRUCTION, SHALL VERIFY AT LEAST 3 POINTS SHOWN HEREON, FOR MATHEMATICAL CONSISTENCY PRIOR TO SUCH USE.

kpff Consulting Engineers
6080 Center Dr. Suite 700
Los Angeles, California 90045
(310) 665-2800 Fax (310) 665-9075

TWO DAYS BEFORE YOU DIG
CALL USA TOLL FREE
1-800-227-2600

DATE	MK	DESCRIPTION
6/11/13	2	AS-BUILT
6/10/10	1	REVISED TRENCHING DETAIL

REVISIONS

REGISTERED PROFESSIONAL ENGINEER PATRICIA K. JOANG No. C68740 Exp. 9/30/10 CIVIL STATE OF CALIFORNIA

PROJECT ENGINEER — DATE 3-16-10

COUNTY OF LOS ANGELES DEPARTMENT OF PUBLIC WORKS

WHITTIER BOULEVARD REVITALIZATION PROJECT

PROJECT ID NO. RDC0015166

PCA X2101700 | DWG | SHEET 7 OF 11

PLAN-RD

PROPOSED FOR CONSTRUCTION: DATE | ADVERTISED: DATE | AS BUILT: DATE

DRAFTER NAME: JL | DESIGNER NAME: JB | CHECKER NAME: TJ | CADD PROJECT FILE NAME | REVIEWED BY | DATE