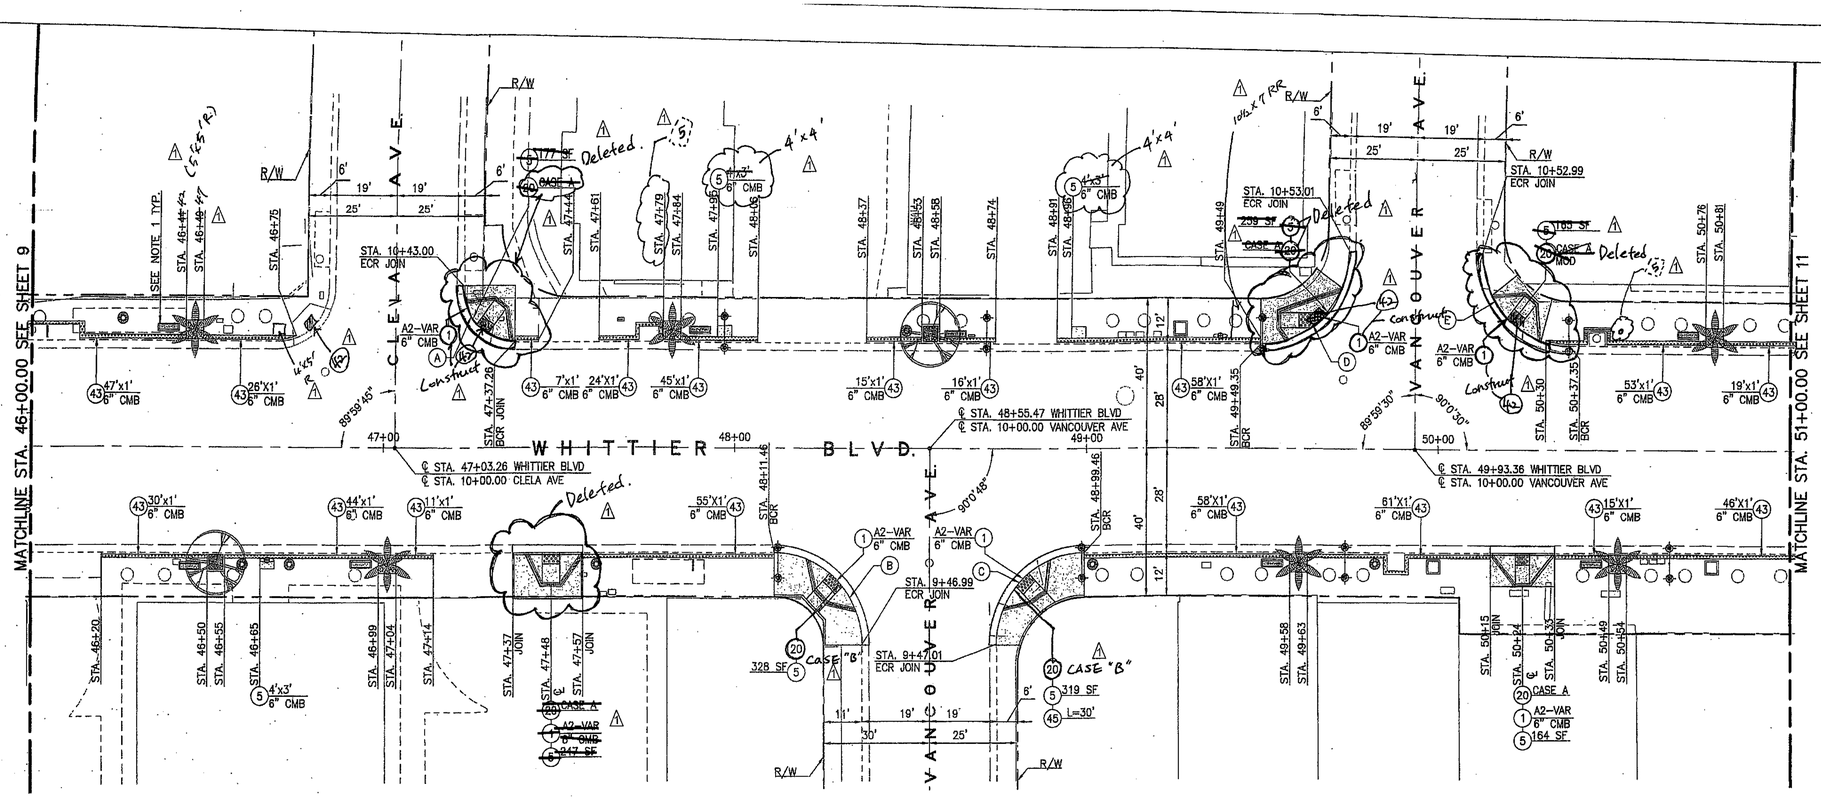

CURB RETURN ELEVATIONS					
	BCR	1/4 Δ	1/2 Δ	3/4 Δ	ECR
A	(193.01 TC) (192.37 FL)	193.10 TC 192.43 FL	193.18 TC 192.51 FL	193.22 TC 192.55 FL	(193.26 TC) (192.61 FL)
B	(193.19 TC) (192.52 FL)	193.23 TC 192.60 FL	193.21 TC 192.62 FL	193.03 TC 192.49 FL	(192.89 TC) (192.38 FL)
C	(192.89 TC) (192.19 FL)	192.91 TC 192.24 FL	192.94 TC 192.27 FL	192.87 TC 192.20 FL	(192.80 TC) (192.14 FL)
D	(193.47 TC) (192.82 FL)	193.54 TC 192.87 FL	193.60 TC 192.93 FL	193.66 TC 192.99 FL	(193.68 TC) (193.06 FL)
E	(193.26 TC) (192.62 FL)	193.44 TC 192.77 FL	193.60 TC 192.93 FL	193.74 TC 193.07 FL	(193.86 TC) (193.21 FL)

CURVE DATA TABLE				
CURVE NO.	LENGTH	RADIUS	DELTA	TANGENT
A	23.56'	15.00'	89°59'45"	15.00
B	39.28'	25.00'	90°00'48"	25.01
C	39.26'	25.00'	89°59'12"	24.99
D	39.27'	25.00'	90°00'30"	25.00
E	39.27'	25.00'	89°59'30"	25.00

PLAN
SCALE: 1" = 20'-0"
0 10' 20' 40'
GRAPHIC SCALE

NOTES:

1. SEE PLAN LS FOR LANDSCAPE IMPROVEMENTS

AS BUILT

REVIEWED BY:

LACDPW DESIGN DIVISION — DATE 3/16/10

BENCHMARKS

BM Y11957 PWFB 1223-6082
L&T NEAR CB @ 5' S/O ECR
SW COR. OF WHITTIER BL. &
ARIZONA AVE.
RIVERA 2005 NAVD.88

SURVEYOR'S NOTES:

1. THE BEARING OF N75°37'00"W ALONG THE CENTERLINE OF L&T NEAR MC @ SW COR. OF WHITTIER BLVD. AS PER MAP OF TRACT 4074, M.B. 44-26 WAS TAKEN AS THE BASIS OF BEARINGS FOR THIS SURVEY.
2. ELEVATIONS SHOWN HEREON ARE RELATIVE TO THE COUNTY DATUM. ANY USER OF ELEVATIONS AND/OR COORDINATES SHOWN HEREON FOR THE CONTROL OF CONSTRUCTION, SHALL VERIFY AT LEAST 3 POINTS SHOWN HEREON, FOR MATHEMATICAL CONSISTENCY PRIOR TO SUCH USE.

kpff Consulting Engineers
6080 Center Dr. Suite 700
Los Angeles, California 90045
(310) 665-2800 Fax (310) 665-9075

TWO DAYS BEFORE YOU DIG
CALL USA TOLL FREE
1-800-227-2600

DATE	MK	DESCRIPTION
6/11/13	1	AS-BUILT

REVISIONS

REGISTERED PROFESSIONAL ENGINEER PATRICIA A. JOHNS No. C66740 Exp. 9/30/10 CIVIL STATE OF CALIFORNIA
PROJECT ENGINEER — DATE 9-16-10

COUNTY OF LOS ANGELES DEPARTMENT OF PUBLIC WORKS

WHITTIER BOULEVARD REVITALIZATION PROJECT

PROJECT ID NO. RDC0015166

PCA X2101700 | DWG | SHEET 10 OF 11

PLAN-RD

PROPOSED FOR CONSTRUCTION: DATE | ADVERTISED: DATE | AS BUILT: DATE

DRAFTER NAME: JL | DESIGNER NAME: JB | CHECKER NAME: TJ | CADD PROJECT FILE NAME | REVIEWED BY | DATE