COUNTY OF LOS ANGELES
DEPARTMENT OF PUBLIC WORKS

PROJECT ID No. RDC0015166

WHITTIER BOULEVARD REVITALIZATION PROJECT

TOTAL LENGTH : 0.86 MILE

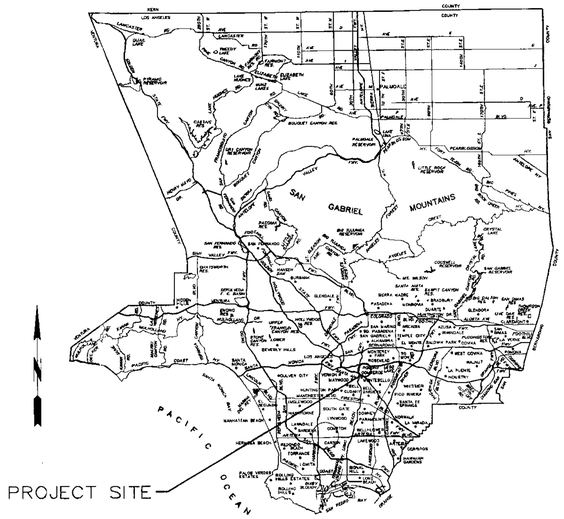

T.G. 635F7 & 675F1-H1
RD142

LOCATION MAP

INDEX OF SHEETS

PLAN EE	LANDSCAPE LIGHTING ELECTRICAL PLANS
PLAN LS	LANDSCAPE PLANS
PLAN RD	ROAD PLANS
PLAN SL	STREET LIGHTING PLANS
PLAN SP	SIGNING AND STRIPING PLANS
PLAN TC	TRAFFIC CONTROL PLANS
PLAN TS	TRAFFIC SIGNAL PLANS

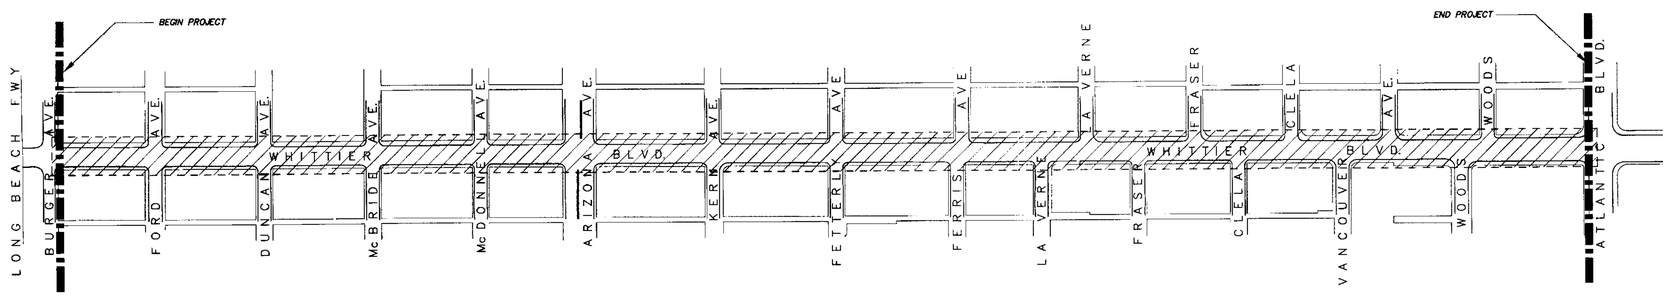

KEY MAP

PRIME CONTRACTOR LICENSE REQUIRED: CLASS A

AS BUILT

PH082667

DATE | REVIEWED BY | CADD PROJECT FILE NAME | CHECKER NAME KS/SL | DESIGNER NAME SL | DRAFTER NAME DJ/KG/SL

PROPOSED FOR CONSTRUCTION: DATE | ADVERTISED: DATE | AS BUILT: DATE

Katherine Spitz Associates Inc.
LANDSCAPE ARCHITECTURE
4212 1/2 GLENCOE AVENUE
MARINA DEL REY, CA. 90292
Ph. 310 574 4460 Fx. 310 574 4462

DIAL BEFORE YOU DIG
1-800-227-2600
DIGALERT
PLAY IT SAFE. DIAL BEFORE YOU DIG!
AT LEAST TWO WORKING DAYS PRIOR TO EXCAVATING
SERVING NINE SOUTHERN CALIFORNIA COUNTIES

DATE	MK	DESCRIPTION

REVISIONS

LICENSED LANDSCAPE ARCHITECT KATHERINE SPITZ No. 2449 STATE OF CALIFORNIA
PROJECT ENGINEER DATE

COUNTY OF LOS ANGELES DEPARTMENT OF PUBLIC WORKS

WHITTIER BOULEVARD REVITALIZATION PROJECT
PROJECT ID NO. RDC0015166

TITLE SHEET

DWG. | PCA X2'01700 | SHEET 1 OF 1

COVER