COUNTY OF LOS ANGELES
DEPARTMENT OF PUBLIC WORKS

ROOSEVELT ELEMENTARY SCHOOL SRTS

TOTAL LENGTH: 0.13 MILE

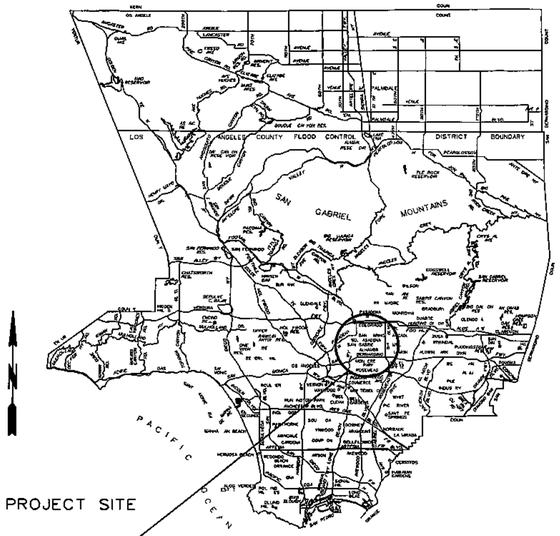

LOCATION MAP

INDEX OF SHEETS

SHEET NO	1	TITLE SHEET
SHEET NO	2	CONSTRUCTION NOTES AND REFERENCES
SHEET NO	3	TYPICAL SECTIONS
SHEET NO	4	PLAN
PLAN SP		SIGNING AND STRIPING PLAN
PLAN TC		TRAFFIC CONTROL PLAN

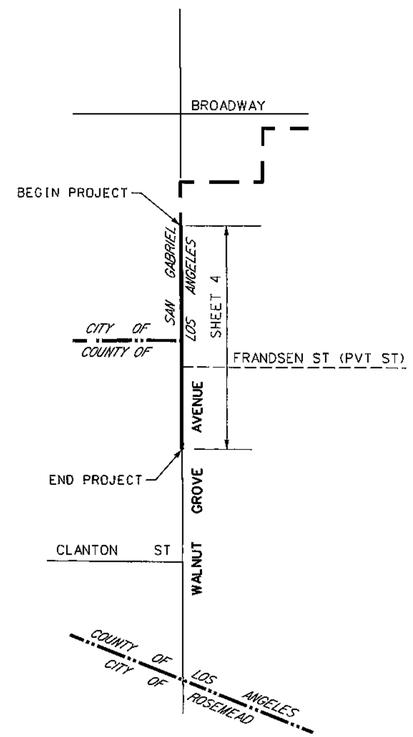

KEY MAP
NO SCALE

AS BUILT

PH083700

CADD PROJECT FILE NAME RDC0015883-PLAN-RD DGN
CHECKER S JUNG
DESIGNER A TORRES
DRAFTER A TORRES

APPROVED BY CITY OF SAN GABRIEL 5/1/14 DATE

TWO DAYS BEFORE YOU DIG
CALL USA TOLL FREE
1-800-227-2600

APPROVED: GAIL FARBER DIRECTOR OF PUBLIC WORKS
BY DEPUTY DIRECTOR 5-15-2014 DATE

RECOMMENDED:
BY ASSISTANT DEPUTY DIRECTOR 5/14/14 DATE

SUBMITTED PER
BY HIGHWAY SECTION II 5/6/14 DATE

DATE	MK	DESCRIPTION

REVISIONS

REGISTERED PROFESSIONAL ENGINEER SHERRIE JONG No 56647 CIVIL STATE OF CALIFORNIA

PROJECT ENGINEER 4-24-14 DATE

COUNTY OF LOS ANGELES DEPARTMENT OF PUBLIC WORKS

ROOSEVELT ELEMENTARY SCHOOL SRTS

TITLE SHEET

PROJECT ID NO. RDC0015883

PCA X250000714 | DWG | SHEET 1 OF 4

PLAN RD

DATE SDATES TIME STIMES FILE $FILEL$