AS BUILT

COUNTY OF LOS ANGELES
DEPARTMENT OF PUBLIC WORKS

PATHFINDER ROAD

FULLERTON ROAD TO 1300' EAST OF FULLERTON ROAD

TOTAL LENGTH: 0.25 MILES

INDEX OF SHEETS

SHEET NO	1	TITLE SHEET
SHEET NO	2	CONSTRUCTION NOTES AND REFERENCES
SHEET NO	3	PLAN VIEW TYPICAL SECTION & DETAILS
SHEET NO	4	FILTRATION BASIN DETAILS
PLAN SP		SIGNING AND STRIPING PLANS
PLAN TS		TRAFFIC SIGNAL PLANS
PLAN TC		TRAFFIC CONTROL PLANS

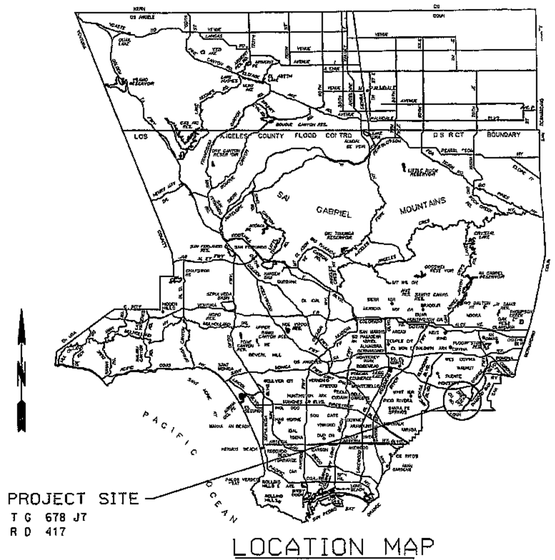

LOCATION MAP
NO SCALE

AS BUILT

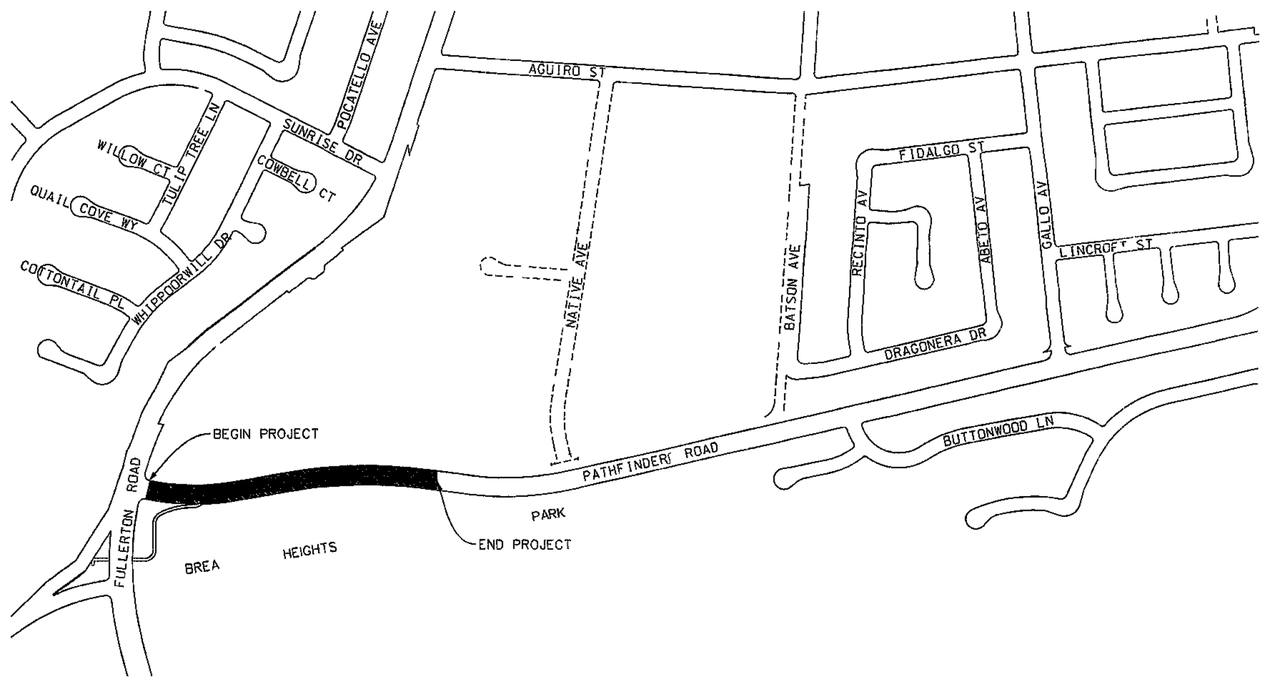

KEY MAP
NO SCALE

PH084472

DRAFTER J DIFRANCESCO	DESIGNER J DIFRANCESCO	CHECKER J MELGAR	CADD PROJECT FILE NAME RDC0015891-PLAN-RD DGN

TWO DAYS BEFORE YOU DIG
CALL USA TOLL FREE
1-800-227-2600

APPROVED GAIL FARBER DIRECTOR OF PUBLIC WORKS
BY Shan Al Shan 4-27-15
DEPUTY DIRECTOR DATE

RECOMMENDED
BY 4/27/15
ASSISTANT DEPUTY DIRECTOR DATE

SUBMITTED
BY 3/17/2015
HIGHWAY DESIGN SECTION DATE

DATE	MK	DESCRIPTION

REVISIONS

REGISTERED PROFESSIONAL ENGINEER EDWARD WHEI LEE No 72035 CIVIL STATE OF CALIFORNIA

Edward Lee 03/19/2015
PROJECT ENGINEER DATE

COUNTY OF LOS ANGELES DEPARTMENT OF PUBLIC WORKS

PATHFINDER ROAD

TITLE SHEET

PROJECT ID NO RDC0015891

BR | JOBX240000728 | DWG | SHEET 1 OF 4

PLAN RD