COUNTY OF LOS ANGELES
DEPARTMENT OF PUBLIC WORKS

OLYMPIC BOULEVARD AT DOWNEY ROAD

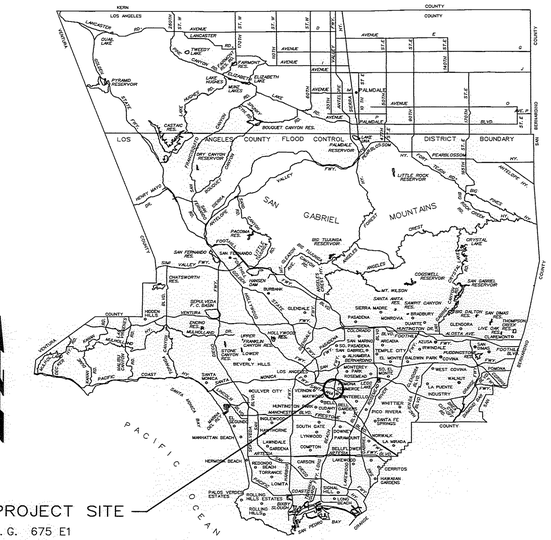

PROJECT SITE
T.G. 675 E1
R.D. 142

LOCATION MAP

KEY MAP
NO SCALE

INDEX OF SHEETS

SHEET NO. 1	TITLE SHEET
SHEET NO. 2	PLAN

CONVENTIONAL SYMBOLS

		EXISTING TOPOGRAPHY	PROPOSED IMPROVEMENTS
CURB			
CURB AND GUTTER			
GUTTER			
PAVEMENT	CONCRETE		
	AC		
CURB RAMP			
BUILDING			
DRIVEWAY			
POLE			
R/W LINE			
PULL BOX		PB	
SIDEWALK			SHADED IF NOT CONTINUOUS
SIGNAL	TRAFFIC		
PALM TREE			
VALVE			

NON-STANDARD ABBREVIATIONS

BCR	BEGINNING OF CURB RETURN
BLVD	BOULEVARD
BM	BENCH MARK
C&G	CURB AND GUTTER
CAB	CRUSHED AGGREGATE BASE
CALTRANS	STATE OF CALIFORNIA DEPARTMENT OF TRANSPORTATION
CF	CURB FACE
CL	CENTERLINE
CONC	CONCRETE
CR	CURB RAMP
DWY	DRIVEWAY
E	EAST
EL	ELEVATION
ECR	END OF CURB RETURN
EX, EXST	EXISTING
FL	FLOW LINE
FS	FINISHED SURFACE
INT	INTERSECTION
LT	LEFT
MOD	MODIFIED
PB	PULL BOX
PG	PAGE
PIP	PROTECT IN PLACE
PT	POINT
PVMT	PAVEMENT
PWFB	PUBLIC WORKS FIELD BOOK
R	RADIUS
RD	ROAD
R/W	RIGHT OF WAY
STD	STANDARD
STR GR	STRAIGHT GRADE
SW	SIDEWALK
TC	TOP OF CURB
TS	TRAFFIC SIGNAL
X	CROSS

CONSTRUCTION LEGEND

(2) PORTLAND CEMENT CONCRETE CURB (ON 4" CAB)

(5) PORTLAND CEMENT CONCRETE SIDEWALK, 4" THICK (ON 4" CAB)

(16) CROSS GUTTER (ON 4" CAB)

(20) CURB RAMP (ON 4" CAB) PER CALTRANS STD PLAN A88A, T=4" AND CASE B UNLESS OTHERWISE NOTED

CONSTRUCTION NOTES

1. PRIME CONTRACTOR LICENSE REQUIRED: CLASS A OR C8
2. STANDARD PLANS REFERENCED ARE PER THE STANDARD PLANS FOR PUBLIC WORKS CONSTRUCTION (SPPWC) UNLESS OTHERWISE NOTED.
3. ELEVATIONS SHOWN ARE IN FEET BASED ON RIVERA QUAD 2005 ADJUSTMENT, NAVD 1988 DATUM.

STANDARD PLANS

SPPWC, 2012 EDITION

101-2	ABOVE-GROUND UTILITIES LOCATION IN PARKWAY
112-2	CURB AND SIDEWALK JOINTS
120-2	CURB AND GUTTER - BARRIER
122-2	CROSS AND LONGITUDINAL GUTTERS

STATE OF CALIFORNIA, 2010 EDITION

A88A	CURB RAMP DETAILS

AC PAVEMENT CLASS AND GRADE LEGEND

P1 C2-PG 64-10 B-PG 64-10	P3 B-PG 64-10
P2 C2-PG 64-10	P4 D2-PG 64-10

REFERENCES

1. PRELIMINARY MATERIALS TEST REPORT, LAB No. 37378 (DATED MAY 8, 2014)
2. PWFB 1123, PAGES 3266, 3280

CONSTRUCTION SYMBOLS

(NO) INDICATES WORK PER CONSTRUCTION LEGEND

AS-BUILT

PH084784

Know what's below. Call 811 before you dig.

APPROVED PER BY HIGHWAY DESIGN SECTION II 1/8/15 DATE

DATE	MK	DESCRIPTION

REVISIONS

REGISTERED PROFESSIONAL ENGINEER SIERRIE JONG No. 56647 CIVIL STATE OF CALIFORNIA

PROJECT ENGINEER 1-8-15 DATE

COUNTY OF LOS ANGELES DEPARTMENT OF PUBLIC WORKS

OLYMPIC BOULEVARD AT DOWNEY ROAD

TITLE SHEET

PROJECT ID NO. RDC0015896

PCA X210001004 | DWG | SHEET 1 OF 2

PROPOSED FOR CONSTRUCTION: ___ DATE | ADVERTISED: ___ DATE | AS BUILT: 10-22-15 DATE

CADD PROJECT FILE NAME RDC0015896-PLAN_RD_OD.DGN

CHECKER D. RADLE | DESIGNER S. JONG | DRAFTER S. JONG

PLAN RD