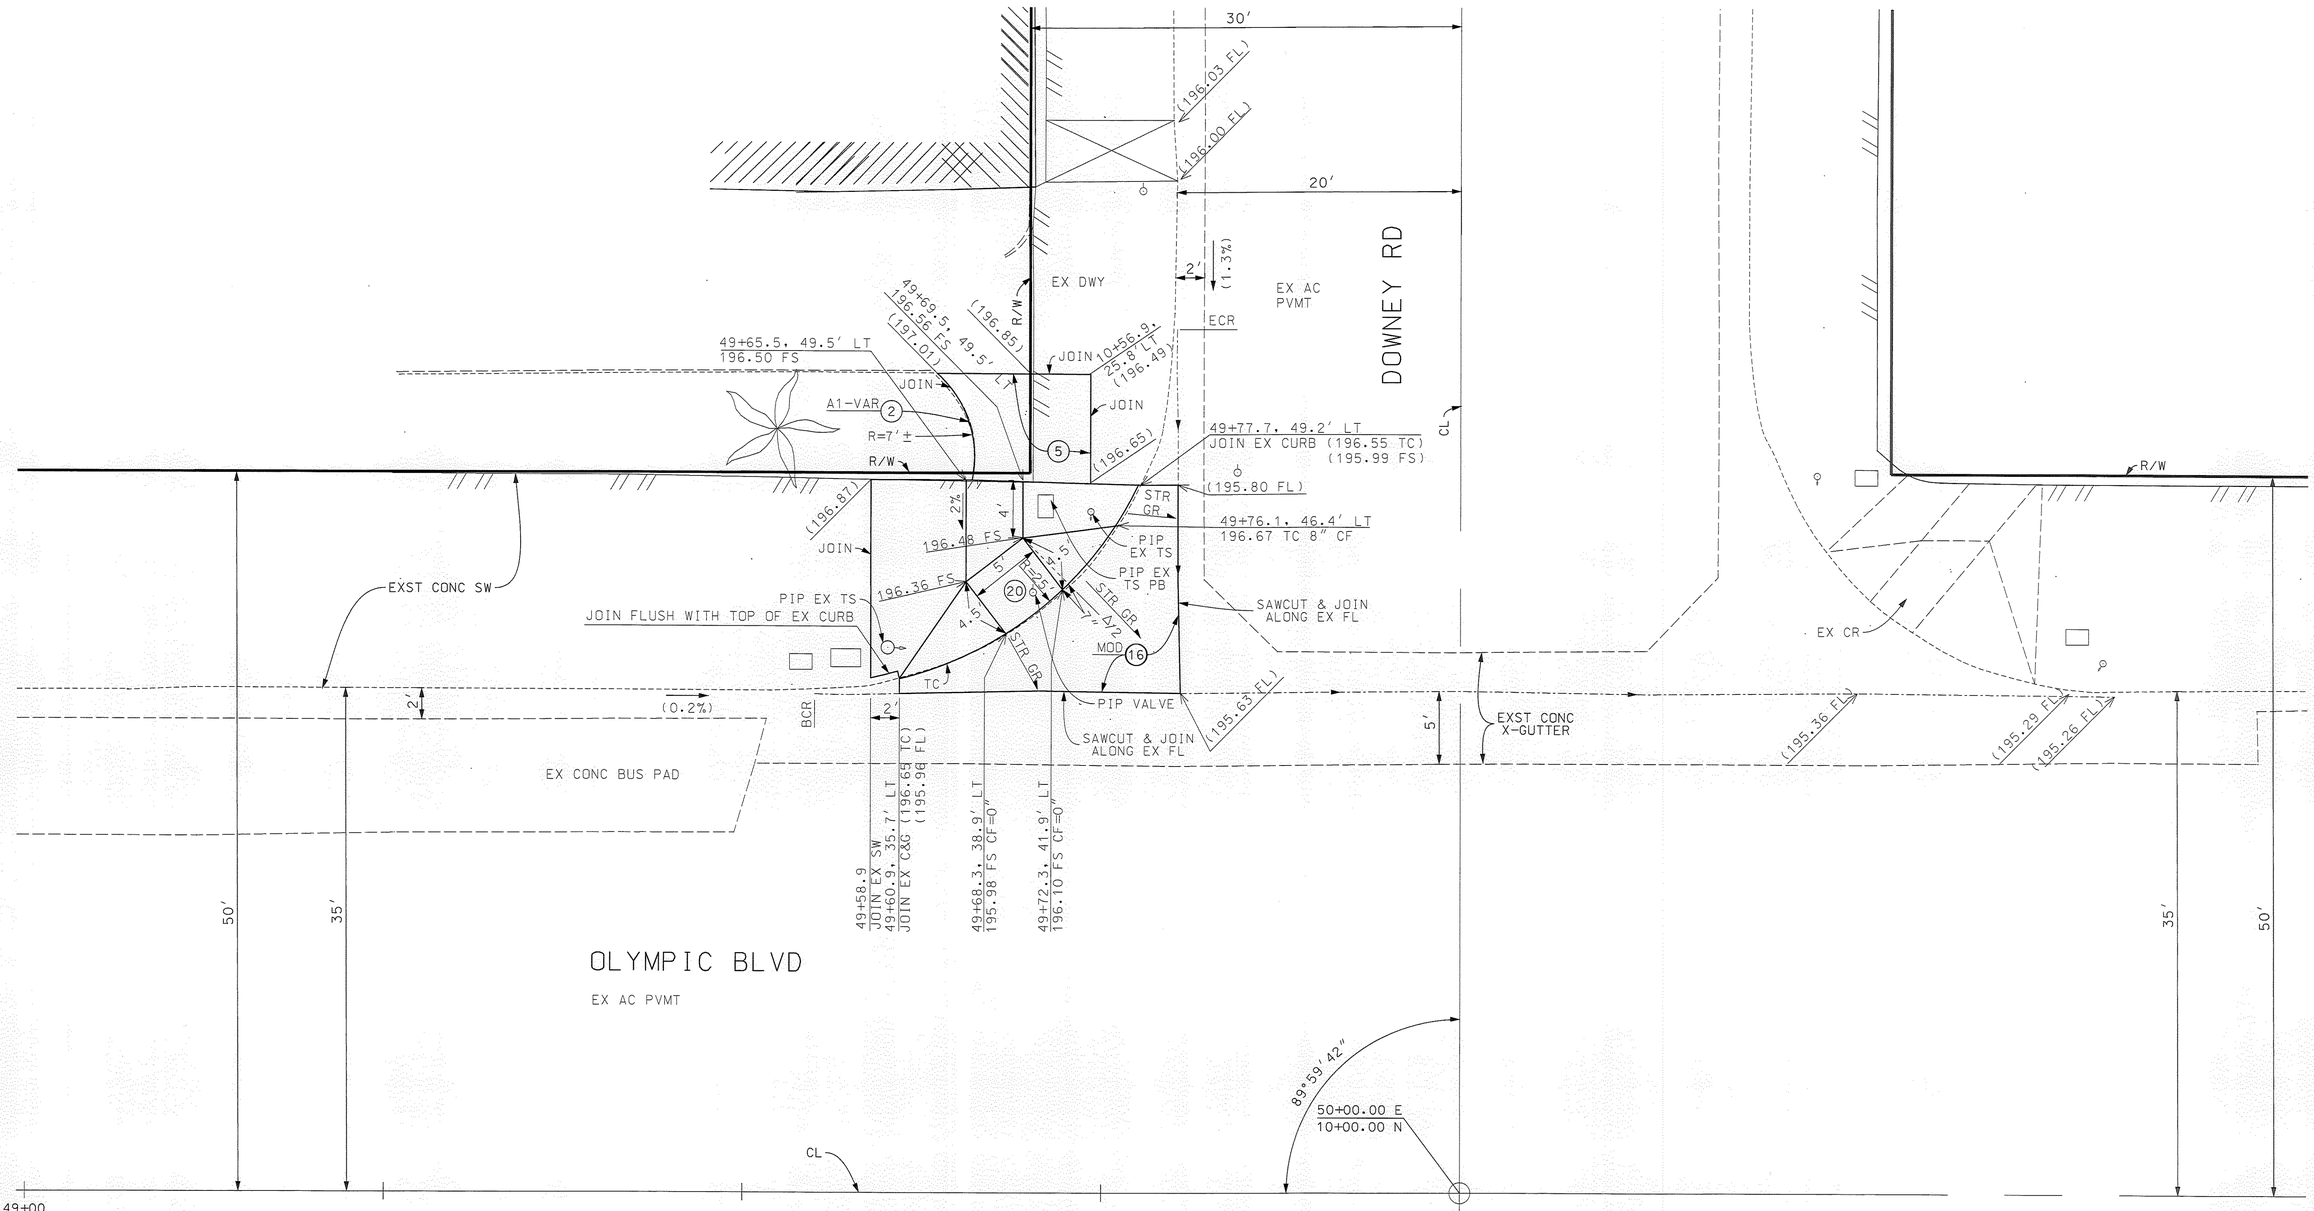

BM PT #212
PWFB 1123, PG 3266
ELEV 196.67 (RIVERA 2005)
BT SPK & DPW W FL
CL INT OLYMPIC BLVD & DOWNEY RD

PLAN
SCALE: 1" = 5'

PH084785

AS-BUILT

DATE	MK	DESCRIPTION

REVISIONS

REGISTERED PROFESSIONAL ENGINEER SHERRIE JONG No. 56647 CIVIL STATE OF CALIFORNIA

PROJECT ENGINEER 1-8-15 DATE

COUNTY OF LOS ANGELES DEPARTMENT OF PUBLIC WORKS

OLYMPIC BOULEVARD AT DOWNEY ROAD

PLAN

PROJECT ID NO. RDC0015896

PCA X210001004 | DWG | SHEET 2 OF 2

DRAFTER S. JONG | DESIGNER S. JONG | CHECKER D. RADLE | CADD PROJECT FILE NAME RDC0015896-PLAN_RD_OD.DGN | REVIEWED BY Dave Radle | DATE 1/08/15

PLAN RD