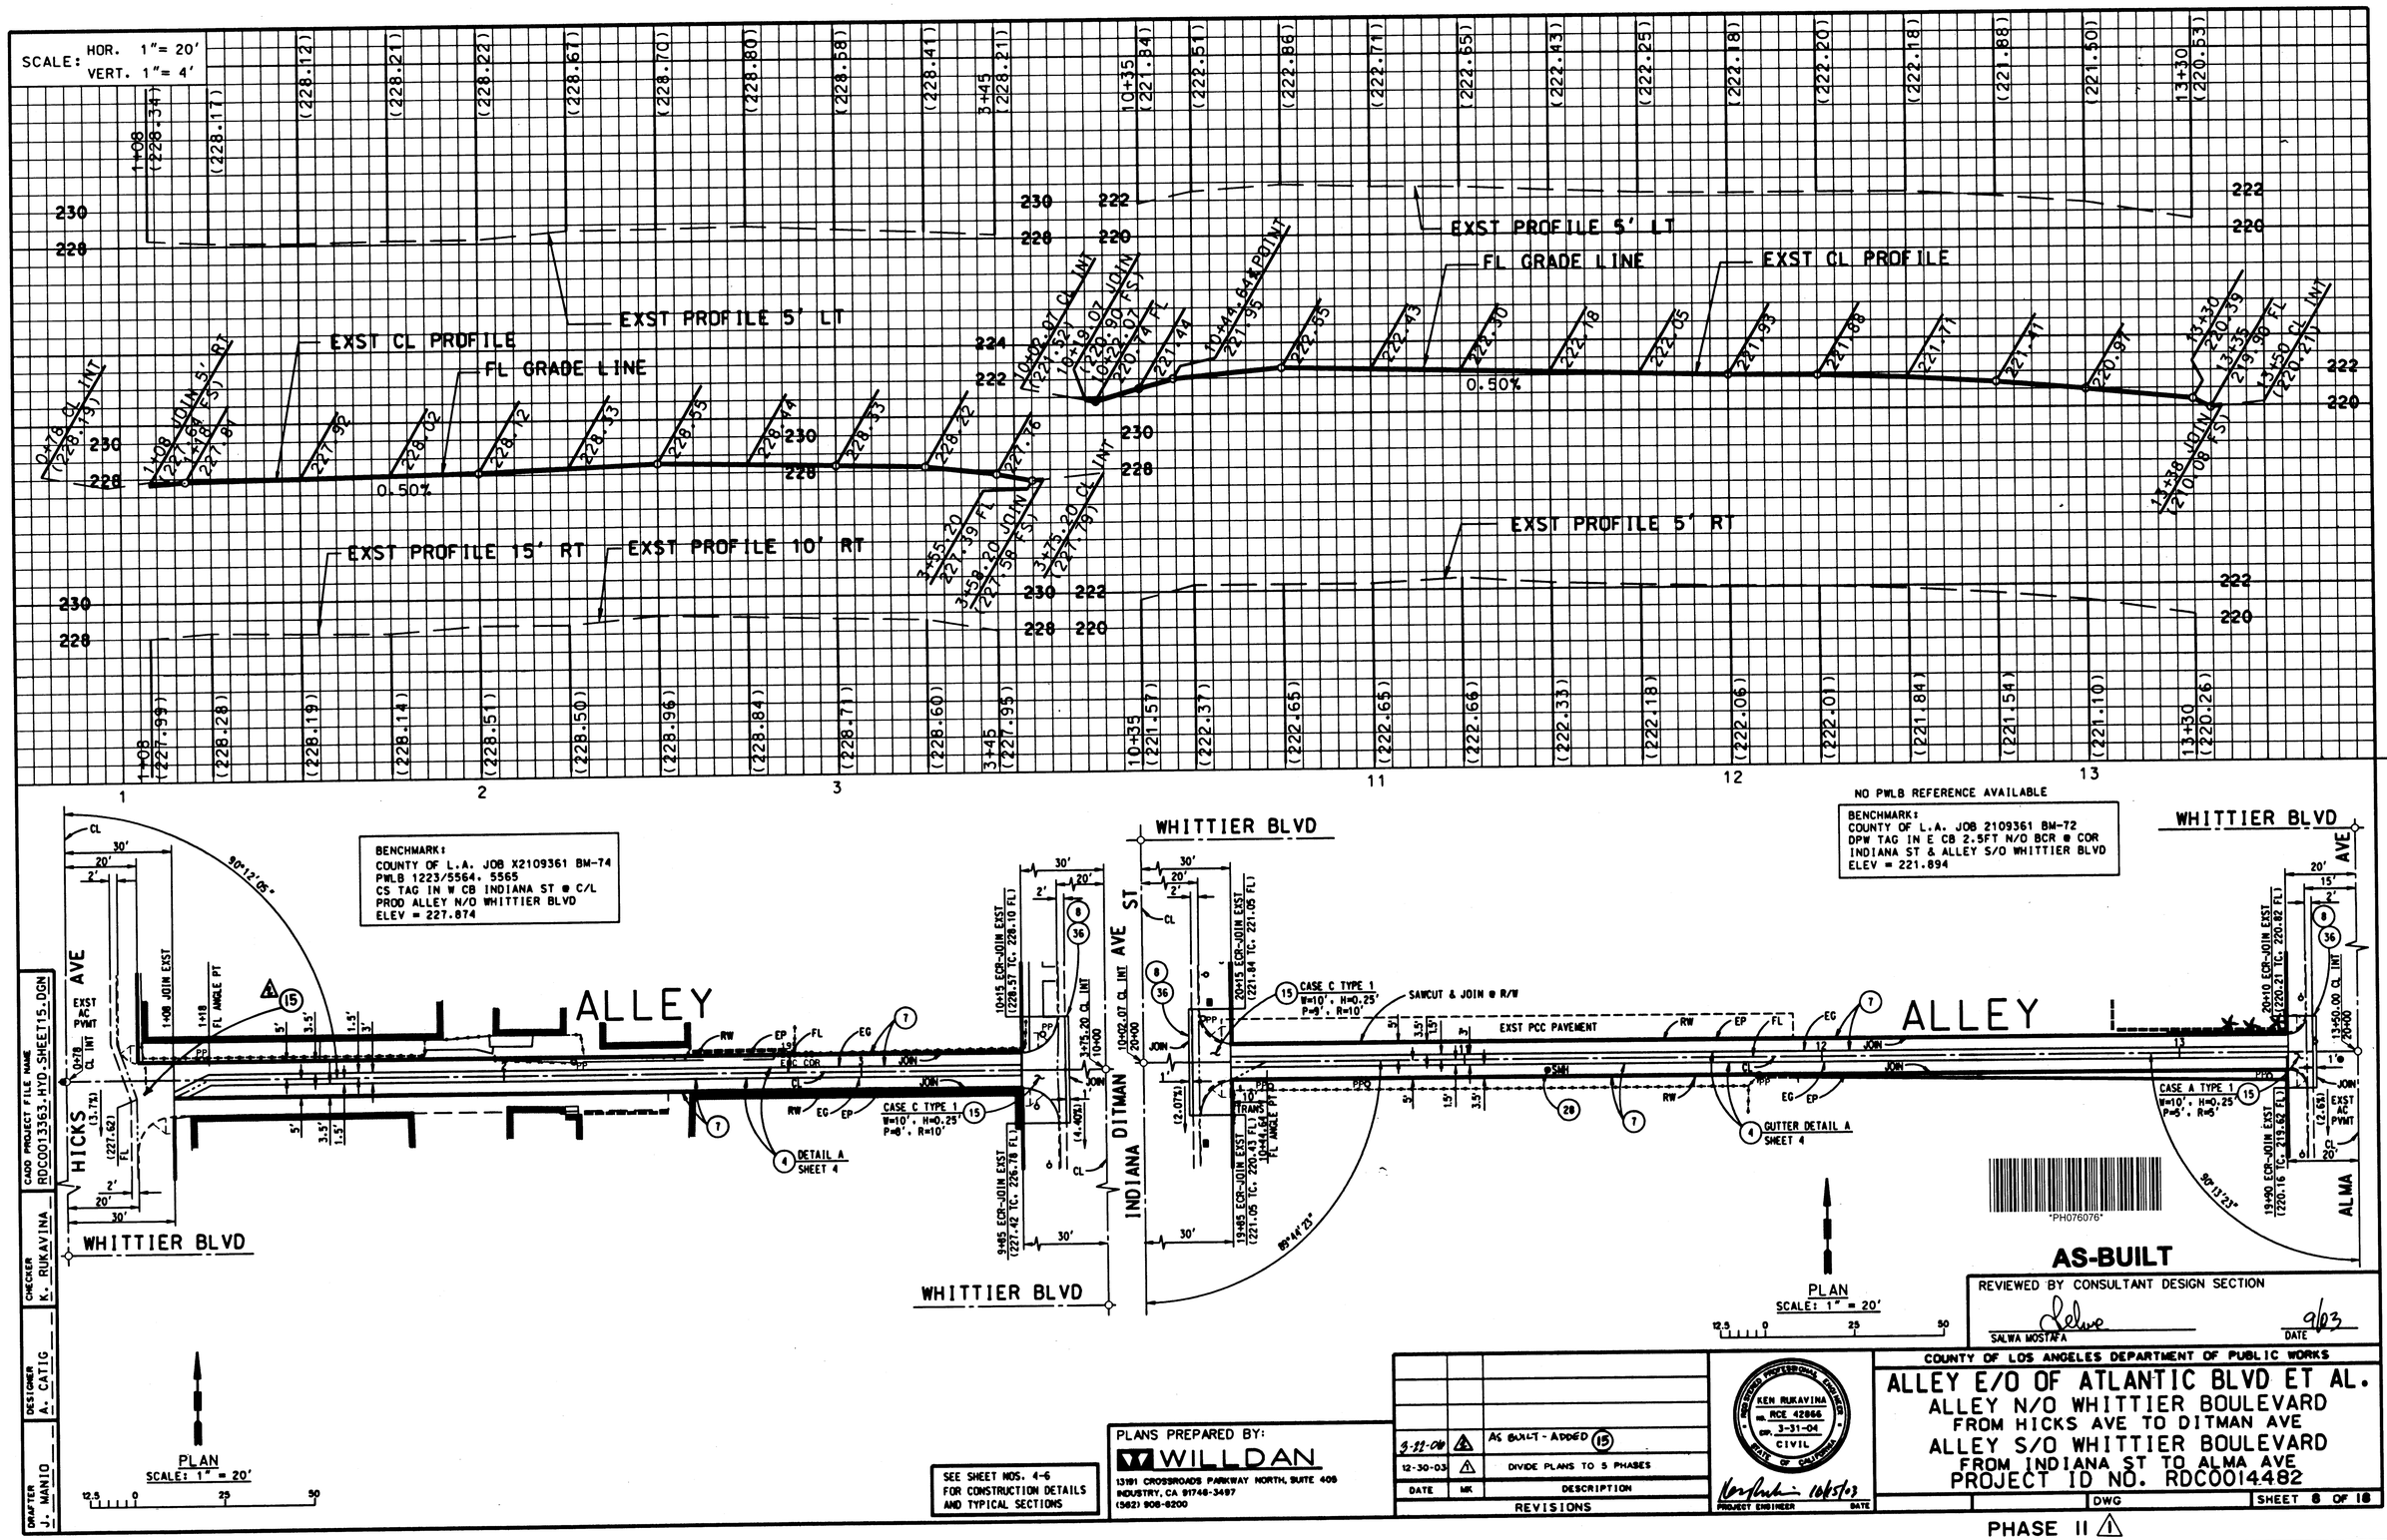
SCALE: HOR. 1"= 20'
VERT. 1"= 4'
EXST PROFILE 5' LT
EXST CL PROFILE
FL GRADE LINE
EXST PROFILE 15' RT
EXST PROFILE 10' RT
EXST PROFILE 5' RT
0.50%
BENCHMARK:
COUNTY OF L.A. JOB X2109361 BM-74
PWLB 1223/5564, 5565
CS TAG IN W CB INDIANA ST @ C/L
PROD ALLEY N/O WHITTIER BLVD
ELEV = 227.874
NO PWLB REFERENCE AVAILABLE
BENCHMARK:
COUNTY OF L.A. JOB 2109361 BM-72
DPW TAG IN E CB 2.5FT N/O BCR @ COR
INDIANA ST & ALLEY S/O WHITTIER BLVD
ELEV = 221.894
WHITTIER BLVD
HICKS AVE
INDIANA ST
DITMAN AVE
ALMA AVE
ALLEY
EXST AC PVMT
EXST PCC PAVEMENT
CASE C TYPE 1
W=10', H=0.25'
P=8', R=10'
CASE A TYPE 1
W=10', H=0.25'
P=5', R=5'
DETAIL A
SHEET 4
GUTTER DETAIL A
SHEET 4
SAWCUT & JOIN @ R/W
PLAN
SCALE: 1" = 20'
AS-BUILT
REVIEWED BY CONSULTANT DESIGN SECTION
SALWA MOSTAFA
DATE
COUNTY OF LOS ANGELES DEPARTMENT OF PUBLIC WORKS
ALLEY E/O OF ATLANTIC BLVD ET AL.
ALLEY N/O WHITTIER BOULEVARD
FROM HICKS AVE TO DITMAN AVE
ALLEY S/O WHITTIER BOULEVARD
FROM INDIANA ST TO ALMA AVE
PROJECT ID NO. RDC0014482
DWG
SHEET 8 OF 18
PHASE II
PLANS PREPARED BY:
WILLDAN
13191 CROSSROADS PARKWAY NORTH, SUITE 408
INDUSTRY, CA 91746-3497
(562) 908-6200
SEE SHEET NOS. 4-6
FOR CONSTRUCTION DETAILS
AND TYPICAL SECTIONS
REVISIONS
DATE
DESCRIPTION
12-30-03
DIVIDE PLANS TO 5 PHASES
AS BUILT - ADDED
KEN RUKAVINA
RCE 42866
3-31-04
CIVIL
STATE OF CALIFORNIA
PROJECT ENGINEER
DATE
CADD PROJECT FILE NAME
RDC0013363-HYD-SHEET15.DGN
CHECKER
K. RUKAVINA
DESIGNER
A. CATIG
DRAFTER
J. MANIO