FOR REALIGNMENT OF THIS PORTION SEE ~~C.S. B-1531-3~~ F.M. 11531-3

IDENTICAL

℄ Curve Data
Δ = 21°10'00"
R = 600'
T = 112.11'
L = 221.66'

℄ Curve Data
Δ = 15°56'50"
R = 600'
T = 84.04'
L = 167.00'

Road built to here

℄ Curve Data
Δ = 48°43'40"
R = 600'
T = 271.72'
L = 510.28'

℄ Curve Data
Δ = 3°42'30"
R = 1700'
T = 109.90'
L = 109.43'

N 89°58'00" E Per C.S. 8870-2
3800.80 TO W.C. - 184.80 E OF SEC. COR

S 70°04'40" W
52.06'

S 19°55'20" E
50.00'

N 89°17'30" W
259.23'

S 86°04'30" W
783.53'

S 86°59'30" W
311.78'

N 89°56'10" E - 993.71'

E 11-167, O.R. 14217-141

N.W. Cor. Lot A
Esl. 3.87' (Rec.) W. of Ref. Pt.

Fd. 2" Pipe Ref. Pt. to N.W. Cor. Lot A
3.87'

N.E. Cor. Lot A
Esl. 0.97 (Rec.) W. of Ref. Pt.

Fd. Conc. Post with S+K, Ref. Pt. to N.E. Cor. Lot A
0.97'

S.W. Cor. Lot A Esl. W. line Lot A parallel (Rec.) with E. line through N.W. Cor.
N.W. Cor. Lot B Esl. 3.87 (Rec.) East of S.W. Cor. Lot A.

Voc. E 8-235, DR 20042-125

N 0°01'50" W
230.57'

N 0°01'50" W
330.75'

770.71'
706.84'

283.00'
283.97'

330.97'
330.00'

S.E. Cor. Lot A. Esl. 0.97 (Rec.) W. of N.E. Cor. Lot B

Fd. C.S. Mon. Sec. Cor. Per C.S. 8870-2.

N.E. Cor. Lot B
Fd. 2" Pipe Rec. Dist. from N.E. Cor. Sec. 27

S.E. Cor. Lot B
Fd. 2" Pipe.

S 0°13'10" E
330.02'

834.31'

N 0°13'10" W
1308.00'
1302.05'

℄ Curve Data
Δ = 95°20'20"
R = 100'
T = 109.60'
L = 101.57'

℄ Curve Data
Δ = 0°58'00"
R = 1000'
L = 16.87'

N 62°59'10" W - 1.00'

Fd. 2"x2" in Mound of rocks per C.S. 8870-2.

N 0°21'50" W
(N 0°20'01" W (Mea.))
113.26'
113.26'

TRACT A
34.24

TRACT B
3.24

℄ Curve Data
Δ = 45°22'20"
R = 900'
T = 555.55'
L = 995.45'

E 11-236, O.R. 16568-81
E 11-206, O.R. 16428-398
Stream Gaging Station
E 11-239, O.R. 16554-137
S.W. Cor. Lot B
Fd. 2" Pipe.
897.08'
Esal 994.55'
Shelter House E 45-118, O.R. 8-Bulletin 21-10
E 13-38, O.R. 14389-86
Along semi-tangent

S0½ of N0½ of N.E.¼ of N.E.¼ Sec. 27
Voc. E 8-235, DR 20042-125

℄ Curve Data
Δ = 23°02'30"
R = 900'
L = 361.56'

R = 1400'
L = 565.79'

E 11-167, O.R. 14128-308
E 9-204, O.R. 14014-129

FOLLOWS CAMP

S0½ of N.E.¼ of N.E.¼ Sec. 27

℄ Curve Data
Δ = 66°05'20"
R = 300'
T = 195.15'
L = 346.04'

℄ Curve Data
Δ = 27°48'10"
R = 700'
T = 173.25'
L = 339.67'

℄ Curve Data
Δ = 7°46'40"
R = 1000'
T = 67.69'
L = 135.17'

℄ Curve Data
Δ = 13°04'30"
R = 1000'
T = 114.60'
L = 228.20'

℄ Curve Data
Δ = 31°39'10"
R = 1000'
T = 283.47'
L = 552.45'

N 0°22'20" E Per C.S. 8870-2
1036.85'

N 67°39'30" W
1616.38'

N 82°18'40" W 65.38'

N 63°44'10" W 54.86'

S 85°54'40" W
1935'

N 89°17'40" W
259.23'

N 89°58'00" E Per C.S. 8870-2
3800.80 TO N.W. Cor. Lot B Tr. 3424

21 22 28 27

Per C.S. 8870-2
184.80

Fd. C.S. Mon. W.C. to Sec. Cor.
5.12 (6) W of N.E. Cor. Sec. 27
Per C.S. 8870-2

563.73
3C2
203

F.M. 11255

A 1 OF A 4

FOR REALIGNMENT BY ROAD DEPT. SEE F.M. 11531 ~~C.S. B-1531-2~~

DEED MAP SHOWING LOCATION OF PROPOSED

SAN GABRIEL CANYON ROAD

THROUGH TRACT Nº 3424 AND N.E.¼ SEC. 27 T 2 N R 9 W.
AND S½ SEC. 22 T 2 N R 9 W.

Los Angeles County Road Dept.
Field Work.. Well and Mc Nitt
Drawn.. Kanow
Checked.. L.G.A

Scale 1"=200'

Notes:-
The bearing of the North Line of Sec. 27 = N 89° 58' 00" E. is the basis of bearings of this map.
Portion colored red shows land to be obtained for road purposes.

SAN GABRIEL CANYON RD.

DEPT. OF PUBLIC WORKS

Fd. Conc. Post with 3pkt. Ref. Pt. to N.E. Cor. Lot A.

Fd. C.S. Mon. Sec. Cor. Per C.S. 8870-2.

N.E. Cor. Lot 4 Fd. 1097 (Rec.) W. of N.E. Cor. Lot B

22 23 T 2 N 26 R 9 W 27

330.97' 330.00'

N.E. Cor. Lot B 27 I.T. Pipe Rec. Dist. from N.E. Cor. Sec. 27

S.E. Cor. Lot B Fd. 2" Pipe.

1308.00' (C.S. 8870-1) (Calc.) 1308.05'

832.81' (C.S. 8870-1) (Meas.) 832.81'

℄ Curve Data
Δ = 35° 10' 20"
R = 700'
T = 709.60'
L = 407.36'

N 0° 21' 50" W (C.S. 8870-2) (Meas.) 473.24' 473.18'

Fd. 2"-2" in Mound of rocks per C.S. 8870-2.

N 0° 21' 50" W 1000'

N 26° 20' 50" E

℄ Curve Data
Δ = 0° 58' 00"
R = 1000'
L = 16.87'

R=1000'

S 0° 59' 10" W. 1.00'

Fd. C.S. Mon. Sect. Cor. per C.S. 8870-2

22 23 T 2 N 26 R 9 W 27

N 0° 21' 50" W (Meas.) 832.81'

N 26° 20' 50" E

Δ = 20° 49' 00"
R = 1000'
T = 183.68'
L = 363.22'

Δ = 46° 11' 30"
R = 450'
L = 362.83'

N 84° 46' 10" W 344.4

Δ = 39° 00' 00"
R = 700'
T = 247.88'
L = 476.47'

N 45° 46' 10" W 362.73'

1308.00' C.S. 8870-2 1308.05' Measured 473.24'

Fd. 2+2 in Mound of rocks per C.S. 8870-2

Δ = 65° 41' 20"
R = 600'
T = 397.33'
L = 687.89'

LOT 40 GRAHAM AND CECIL PLACER CLAIM
E 11-116, O.R. 14216-8
E 11-115, O.R. 14180-59

Fd. 2" Pipe W.C. to N.W. Lot 2 N 85° 48' 40" E., 102.00 From Cor.

Fd. Willow Stump N.W. Cor. Lot 2

S 68° 32' 30" W 394.39'

S 69° 57' 50" W 385.35'

Fd. 2" Pipe

Fd. 6" Pipe W.C. to N.E. Cor. Lot 1 N 89° 57' 50" W, 115.00' From Cor.


N 0° 21' 50" W.

Fd. 2" Pipe

F.M. 11255

A 2 OF A 4

FOR REALIGNMENT BY ROAD DEPARTMENT SEE ~~C.S.B-153-1~~ F.M.1153-1

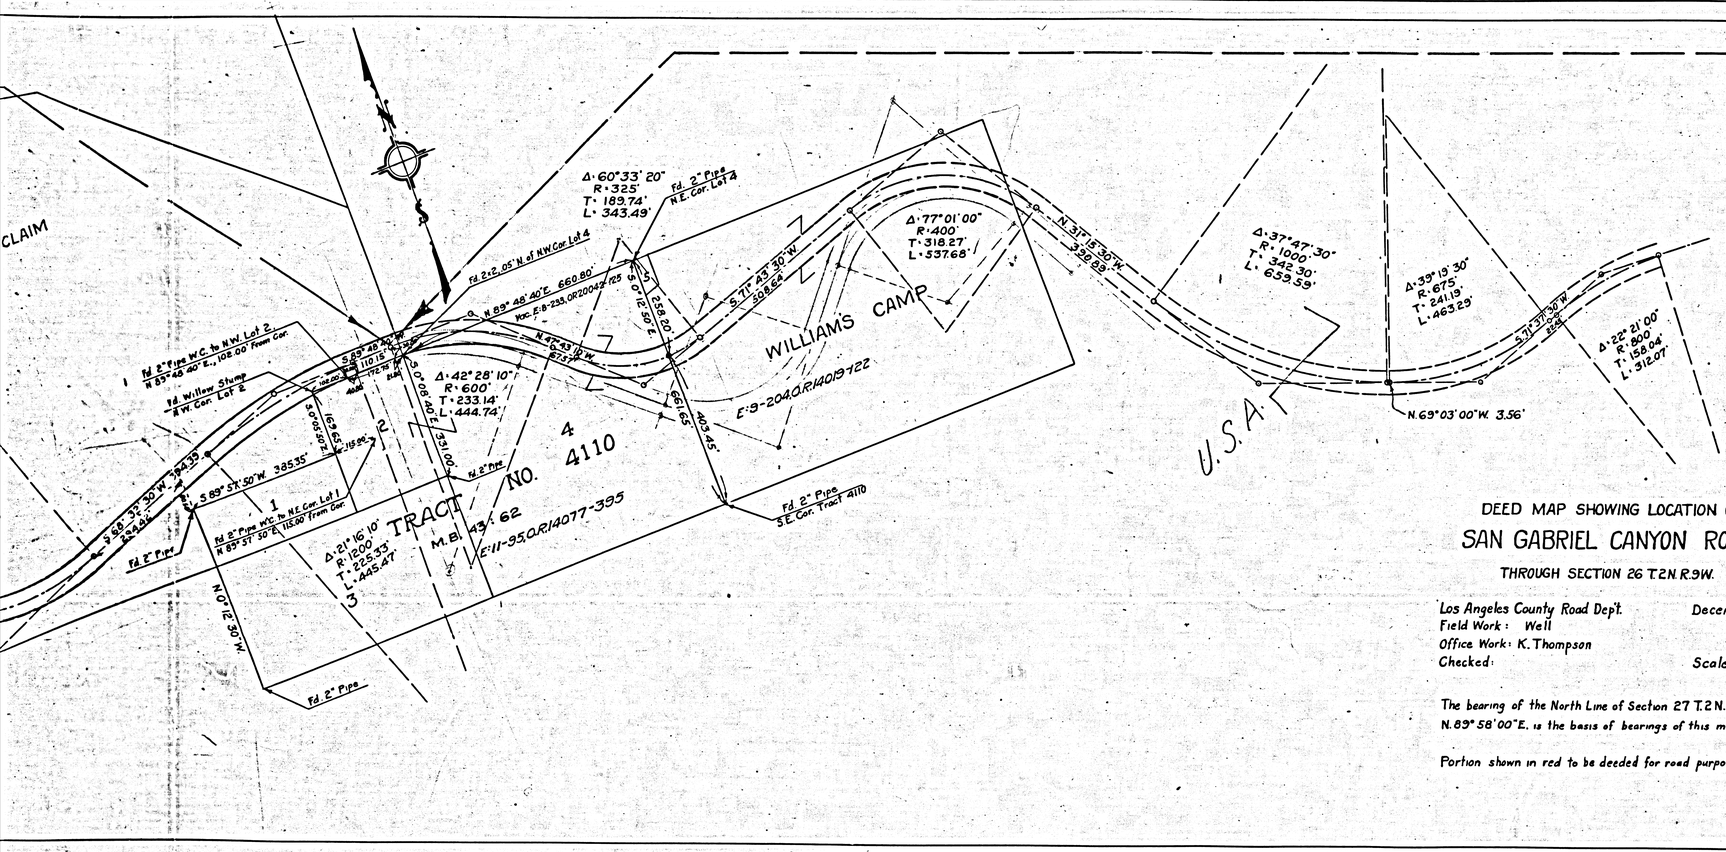

DEED MAP SHOWING LOCATION OF

SAN GABRIEL CANYON ROAD


THROUGH SECTION 26 T.2N. R.9W.

Los Angeles County Road Dep't. December 1936
Field Work: Well
Office Work: K. Thompson
Checked: Scale 1" = 200'

The bearing of the North Line of Section 27 T.2N. R.9W. N.89°58'00"E. is the basis of bearings of this map.

Portion shown in red to be deeded for road purposes.


DEED MAP San Gabriel Canyon Road through Section 26

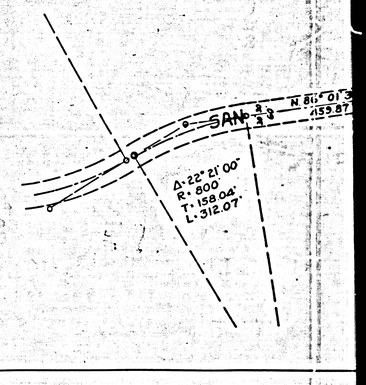

F.M. 11255

A3 OF A4

MENT SEE ~~C.S.B-1531-1~~ F.M. 11531-1

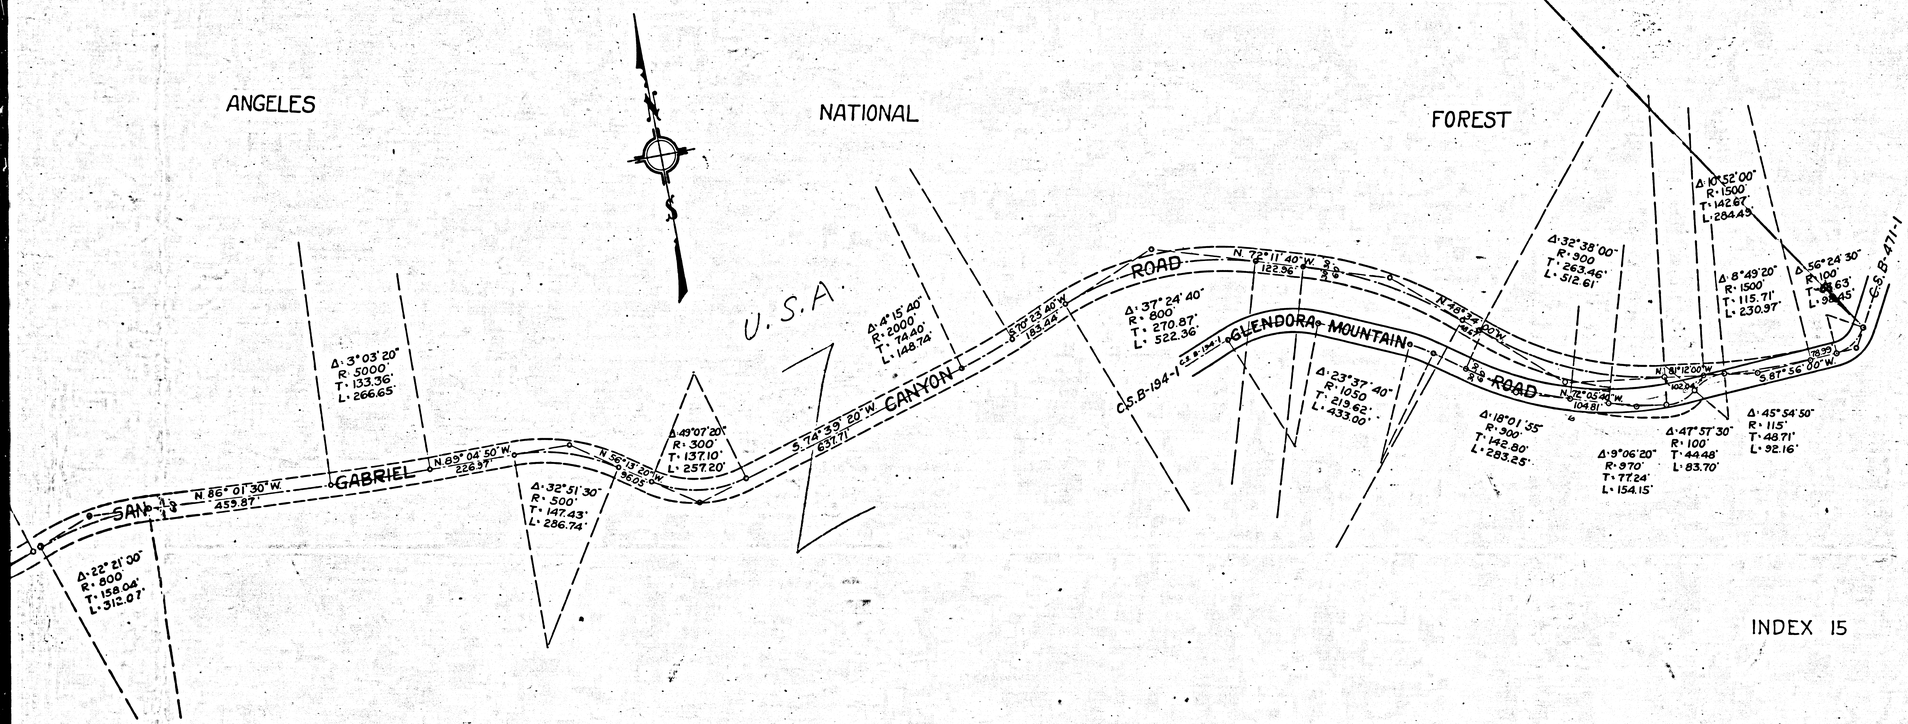

INDEX 15

DEED MAP SHOWING LOCATION OF

SAN GABRIEL CANYON ROAD

THROUGH SECTION 25, T2N. R9W.

Los Angeles County Road Dept. — December 1936
Field Work: Well
Office Work: K. Thompson
Checked: — Scale 1" = 200'

The bearing of the North Line of Section 27 T2N. R9W. = N.89°58'00"E, is the basis of bearings of this map.

Portion shown in red is to be deeded for road purposes.

Negative of this map filed in Blue Print Dept. as Negative No. 283.

F.M. 11255
A4 OF A4