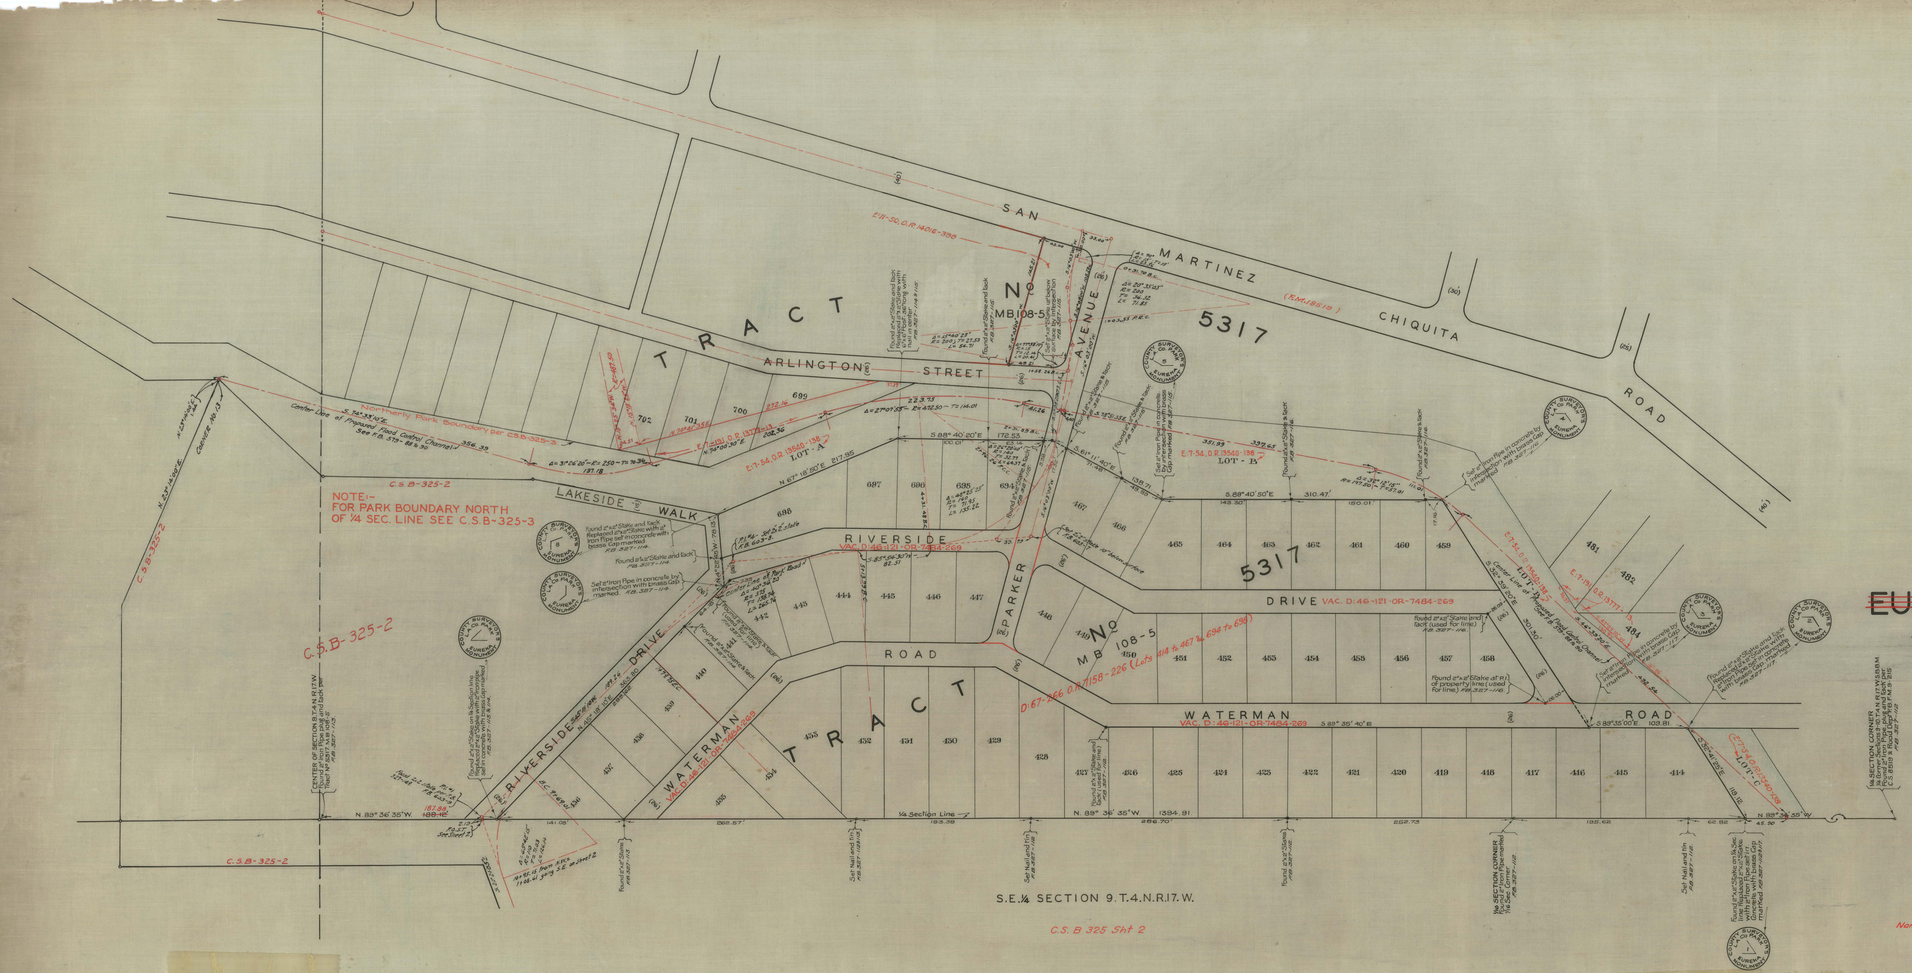

MAP OF
~~EUREKA~~ VAL VERDE PARK
IN
TRACT No 5317-M.B.108-1-5

COUNTY SURVEYORS MAP No B-325
SHEET NO.1 OF 3 SHEETS
SCALE-1.INCH=50.FT.

WORK ORDER No 918

J.E.ROCKHOLD.-COUNTY SURVEYOR
SURVEYED NOVEMBER 1928

BEARINGS ARE BASED ON THE BEARING OF SOUTH LINE OF TRACT No 5317-M.B.108-5

F.B. 327-112-117

FIELD WORK BY. F.C. HOWARD.
OFFICE WORK BY. H.U.M. HIGGINS.
CHECKED BY. K.R. McPHERSON.

~~Sht 63~~
M.264-077
FOR TOPOGRAPHY SEE C.S. ~~B-991-1~~ B-1274-4

Name changed to "Val Verde Park" by L.A. G. Ordinance #1940 (N.S.)
Name established as "Val Verde Park" by Board Order-Min. Bk. 401-98 See E:149-98

NOTE:-
FOR PARK BOUNDARY NORTH OF 1/4 SECTION LINE SEE C.S.B-325-3.