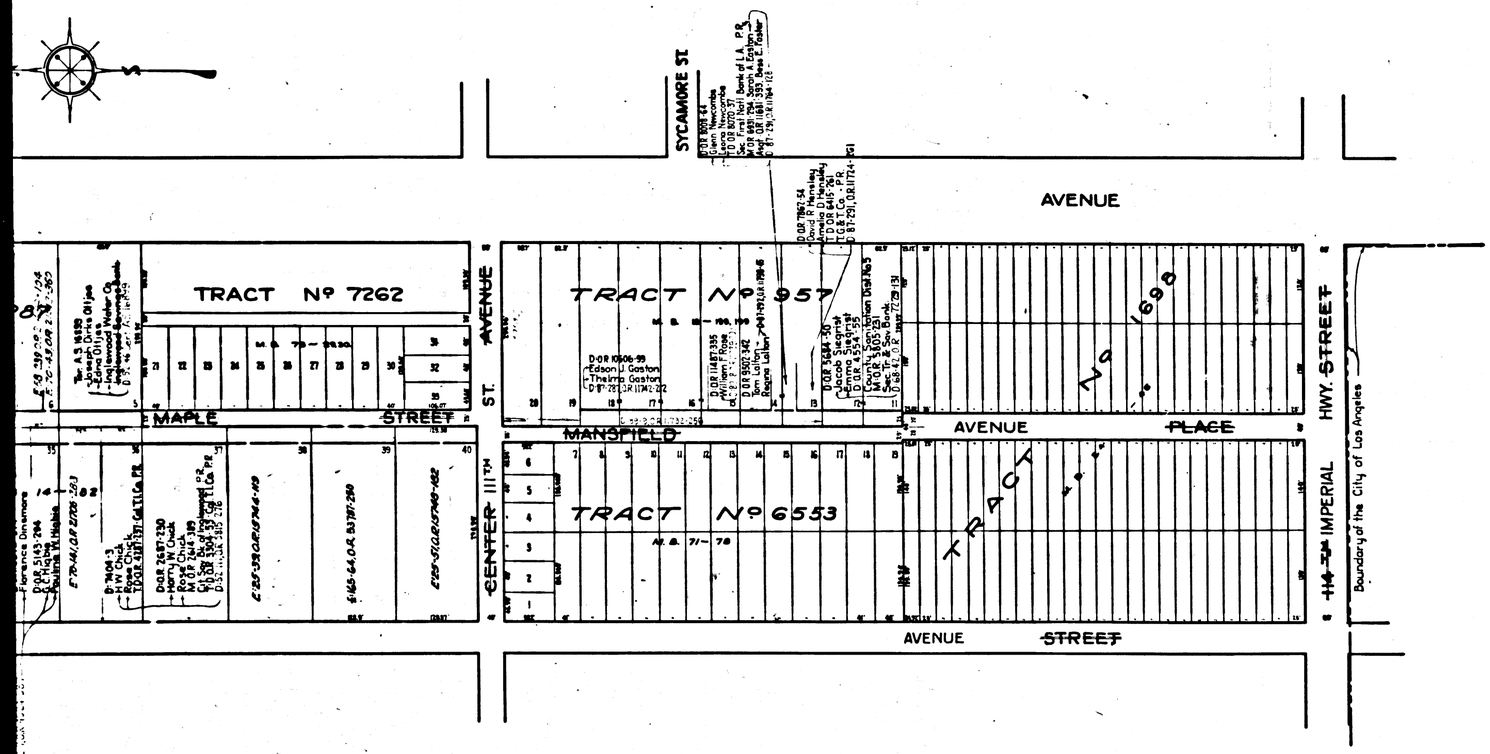

BURIN MAP OF AVE
MAPLE STREET
FROM 104TH ST
~~PALM STREET TO CENTER AVENUE~~
~~AND~~ TO
MANSFIELD PLACE
FROM IMPERIAL HWY
~~CENTER AVENUE TO 114TH STREET~~

COUNTY SURVEYOR'S MAP Nº B-461
Scale:- 1"=100'

This map compiled by the County Surveyor
for the purpose of showing deed references only.
Nov. 1929

Sheet 24

CSB-461
A1 OF A2

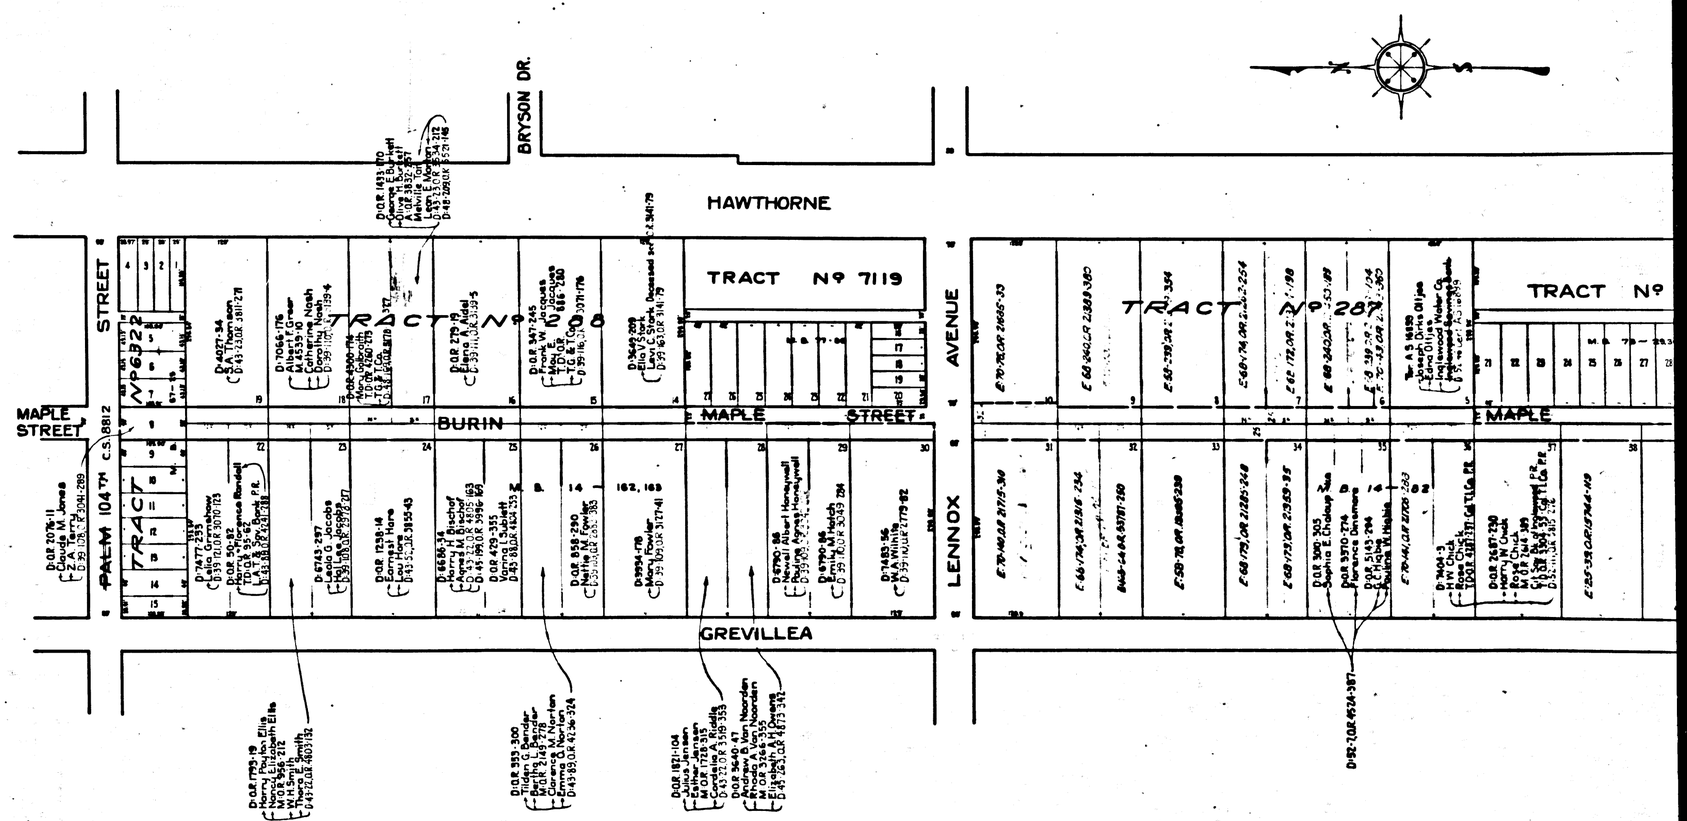

CSB-461
A2 OF A2