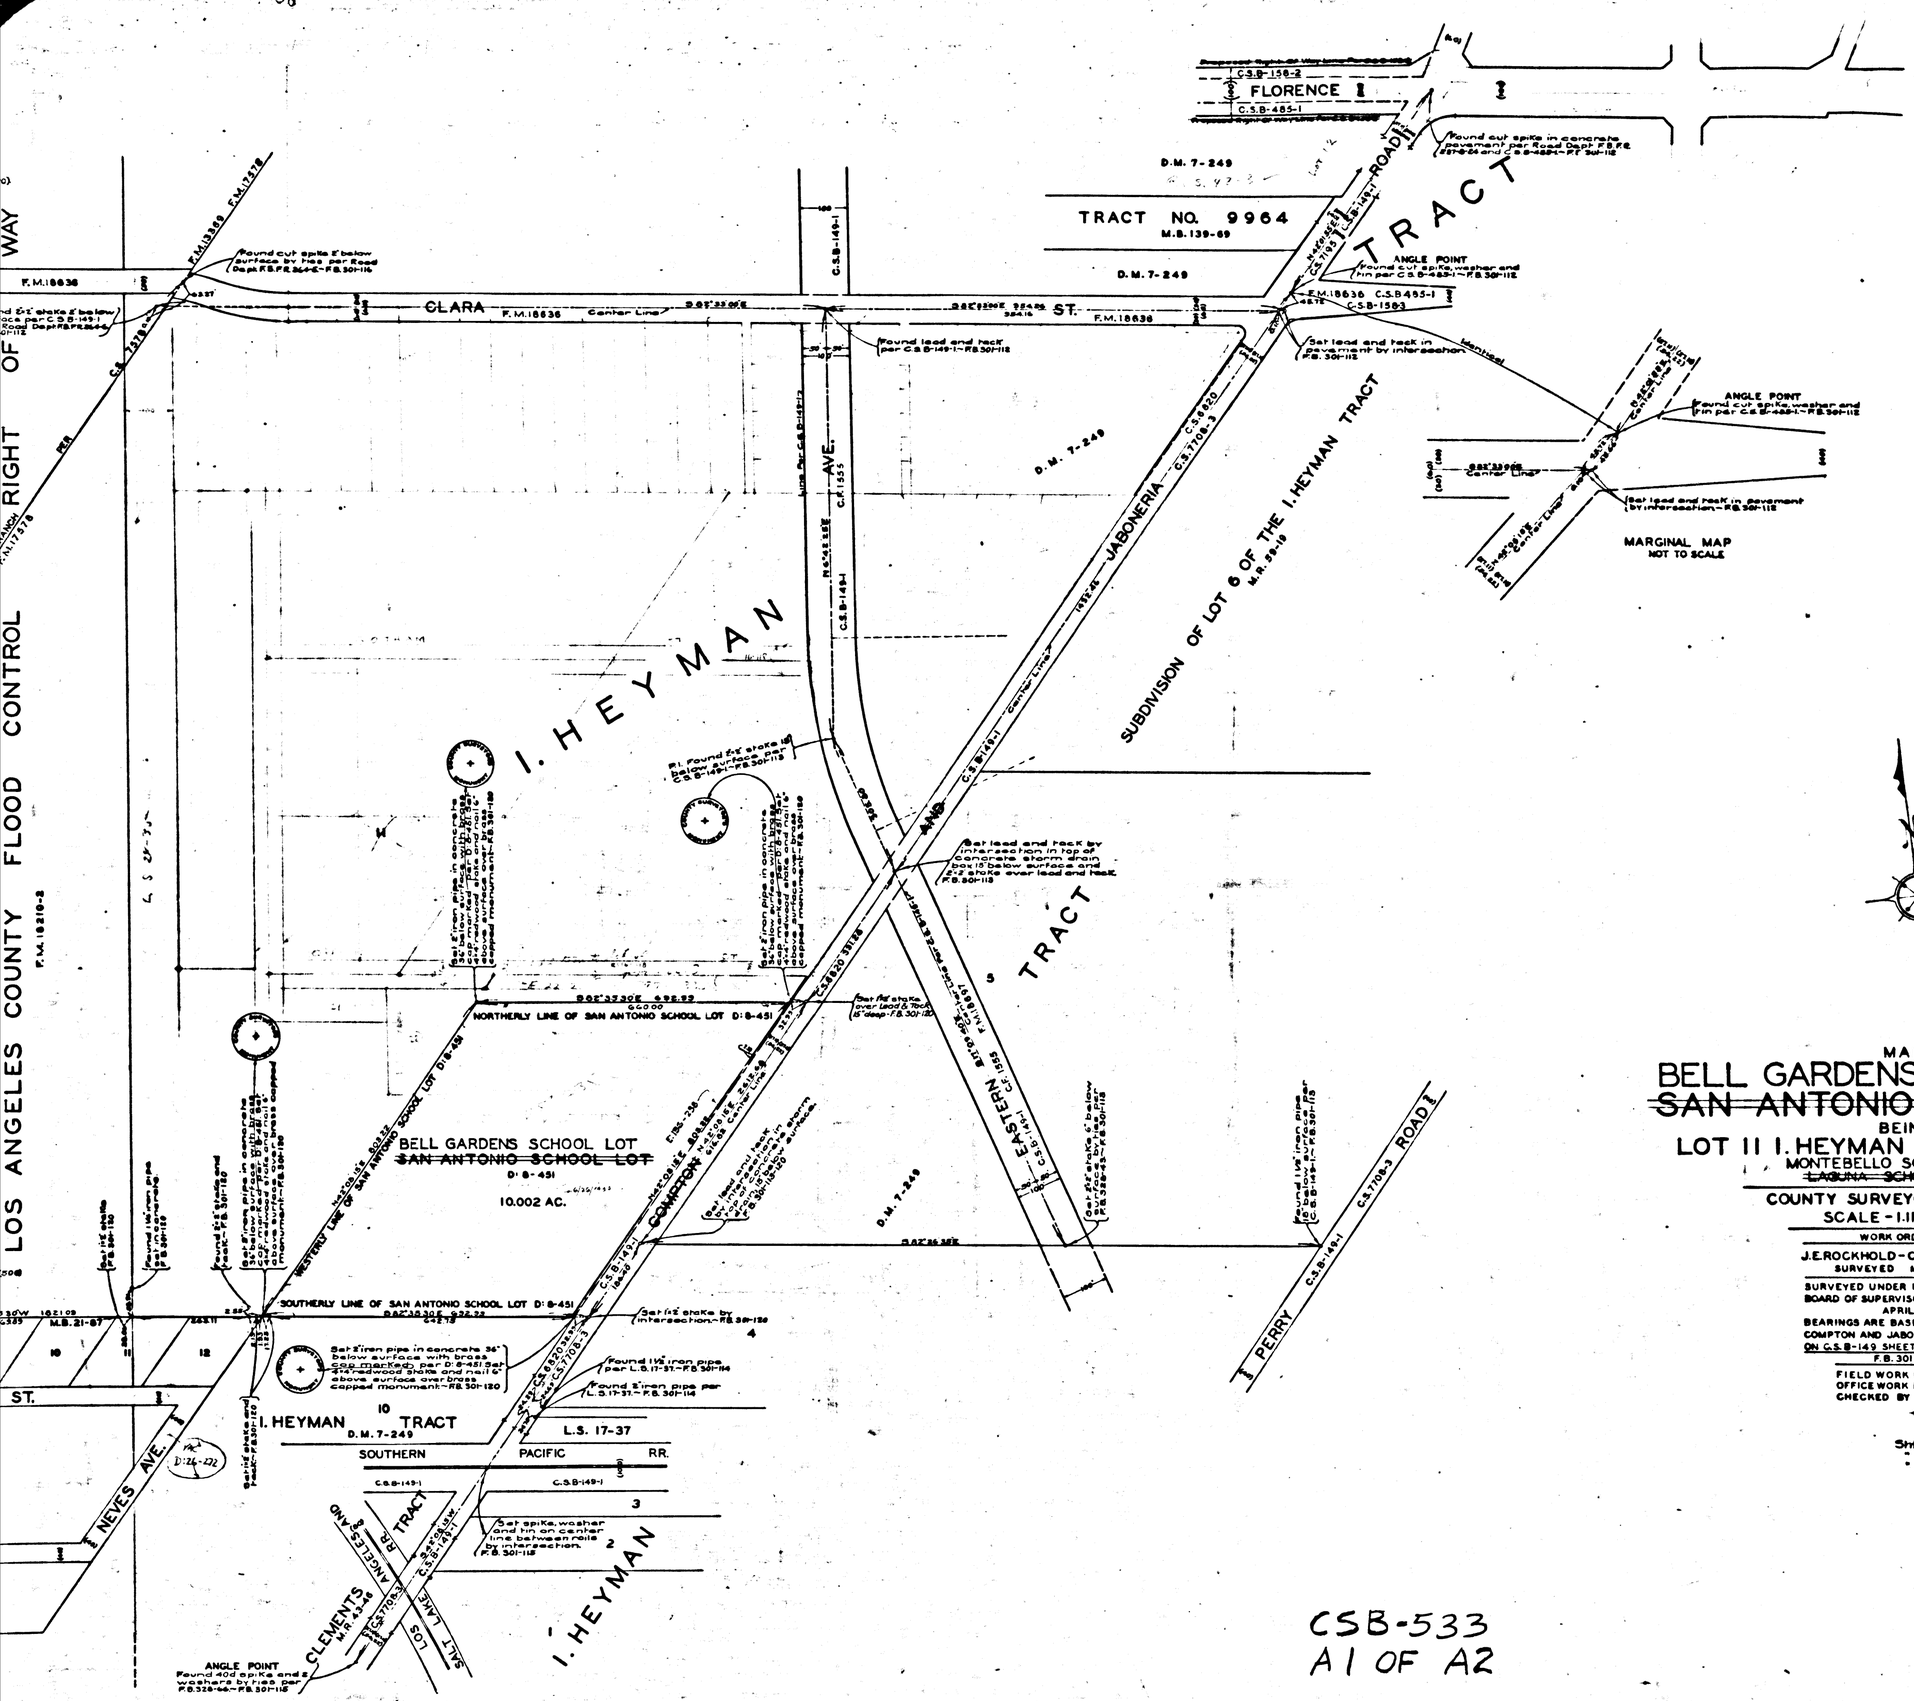

MAP OF

BELL GARDENS SCHOOL LOT

~~SAN ANTONIO SCHOOL LOT~~

BEING IN

LOT 11 I. HEYMAN TRACT D.M. 7-249

MONTEBELLO SCHOOL DISTRICT

~~LAGUNA SCHOOL DISTRICT~~

COUNTY SURVEYORS MAP NO. B-533

SCALE - 1 INCH = 100 FT.

WORK ORDER NO. 977

J.E. ROCKHOLD - COUNTY SURVEYOR

SURVEYED MAY TO JULY 1930

SURVEYED UNDER INSTRUCTIONS OF THE BOARD OF SUPERVISORS PER ORDER DATED APRIL 14, 1930.

BEARINGS ARE BASED ON THE BEARING OF COMPTON AND JABONERIA ROAD AS SHOWN ON C.S. B-149 SHEET NO. 1

F.B. 301-11 TO 120

FIELD WORK BY C.V. CRUMLEY

OFFICE WORK BY BERT McATEE

CHECKED BY D.M. FINLEY

Sht. 36
32
7

CSB-533
A1 OF A2


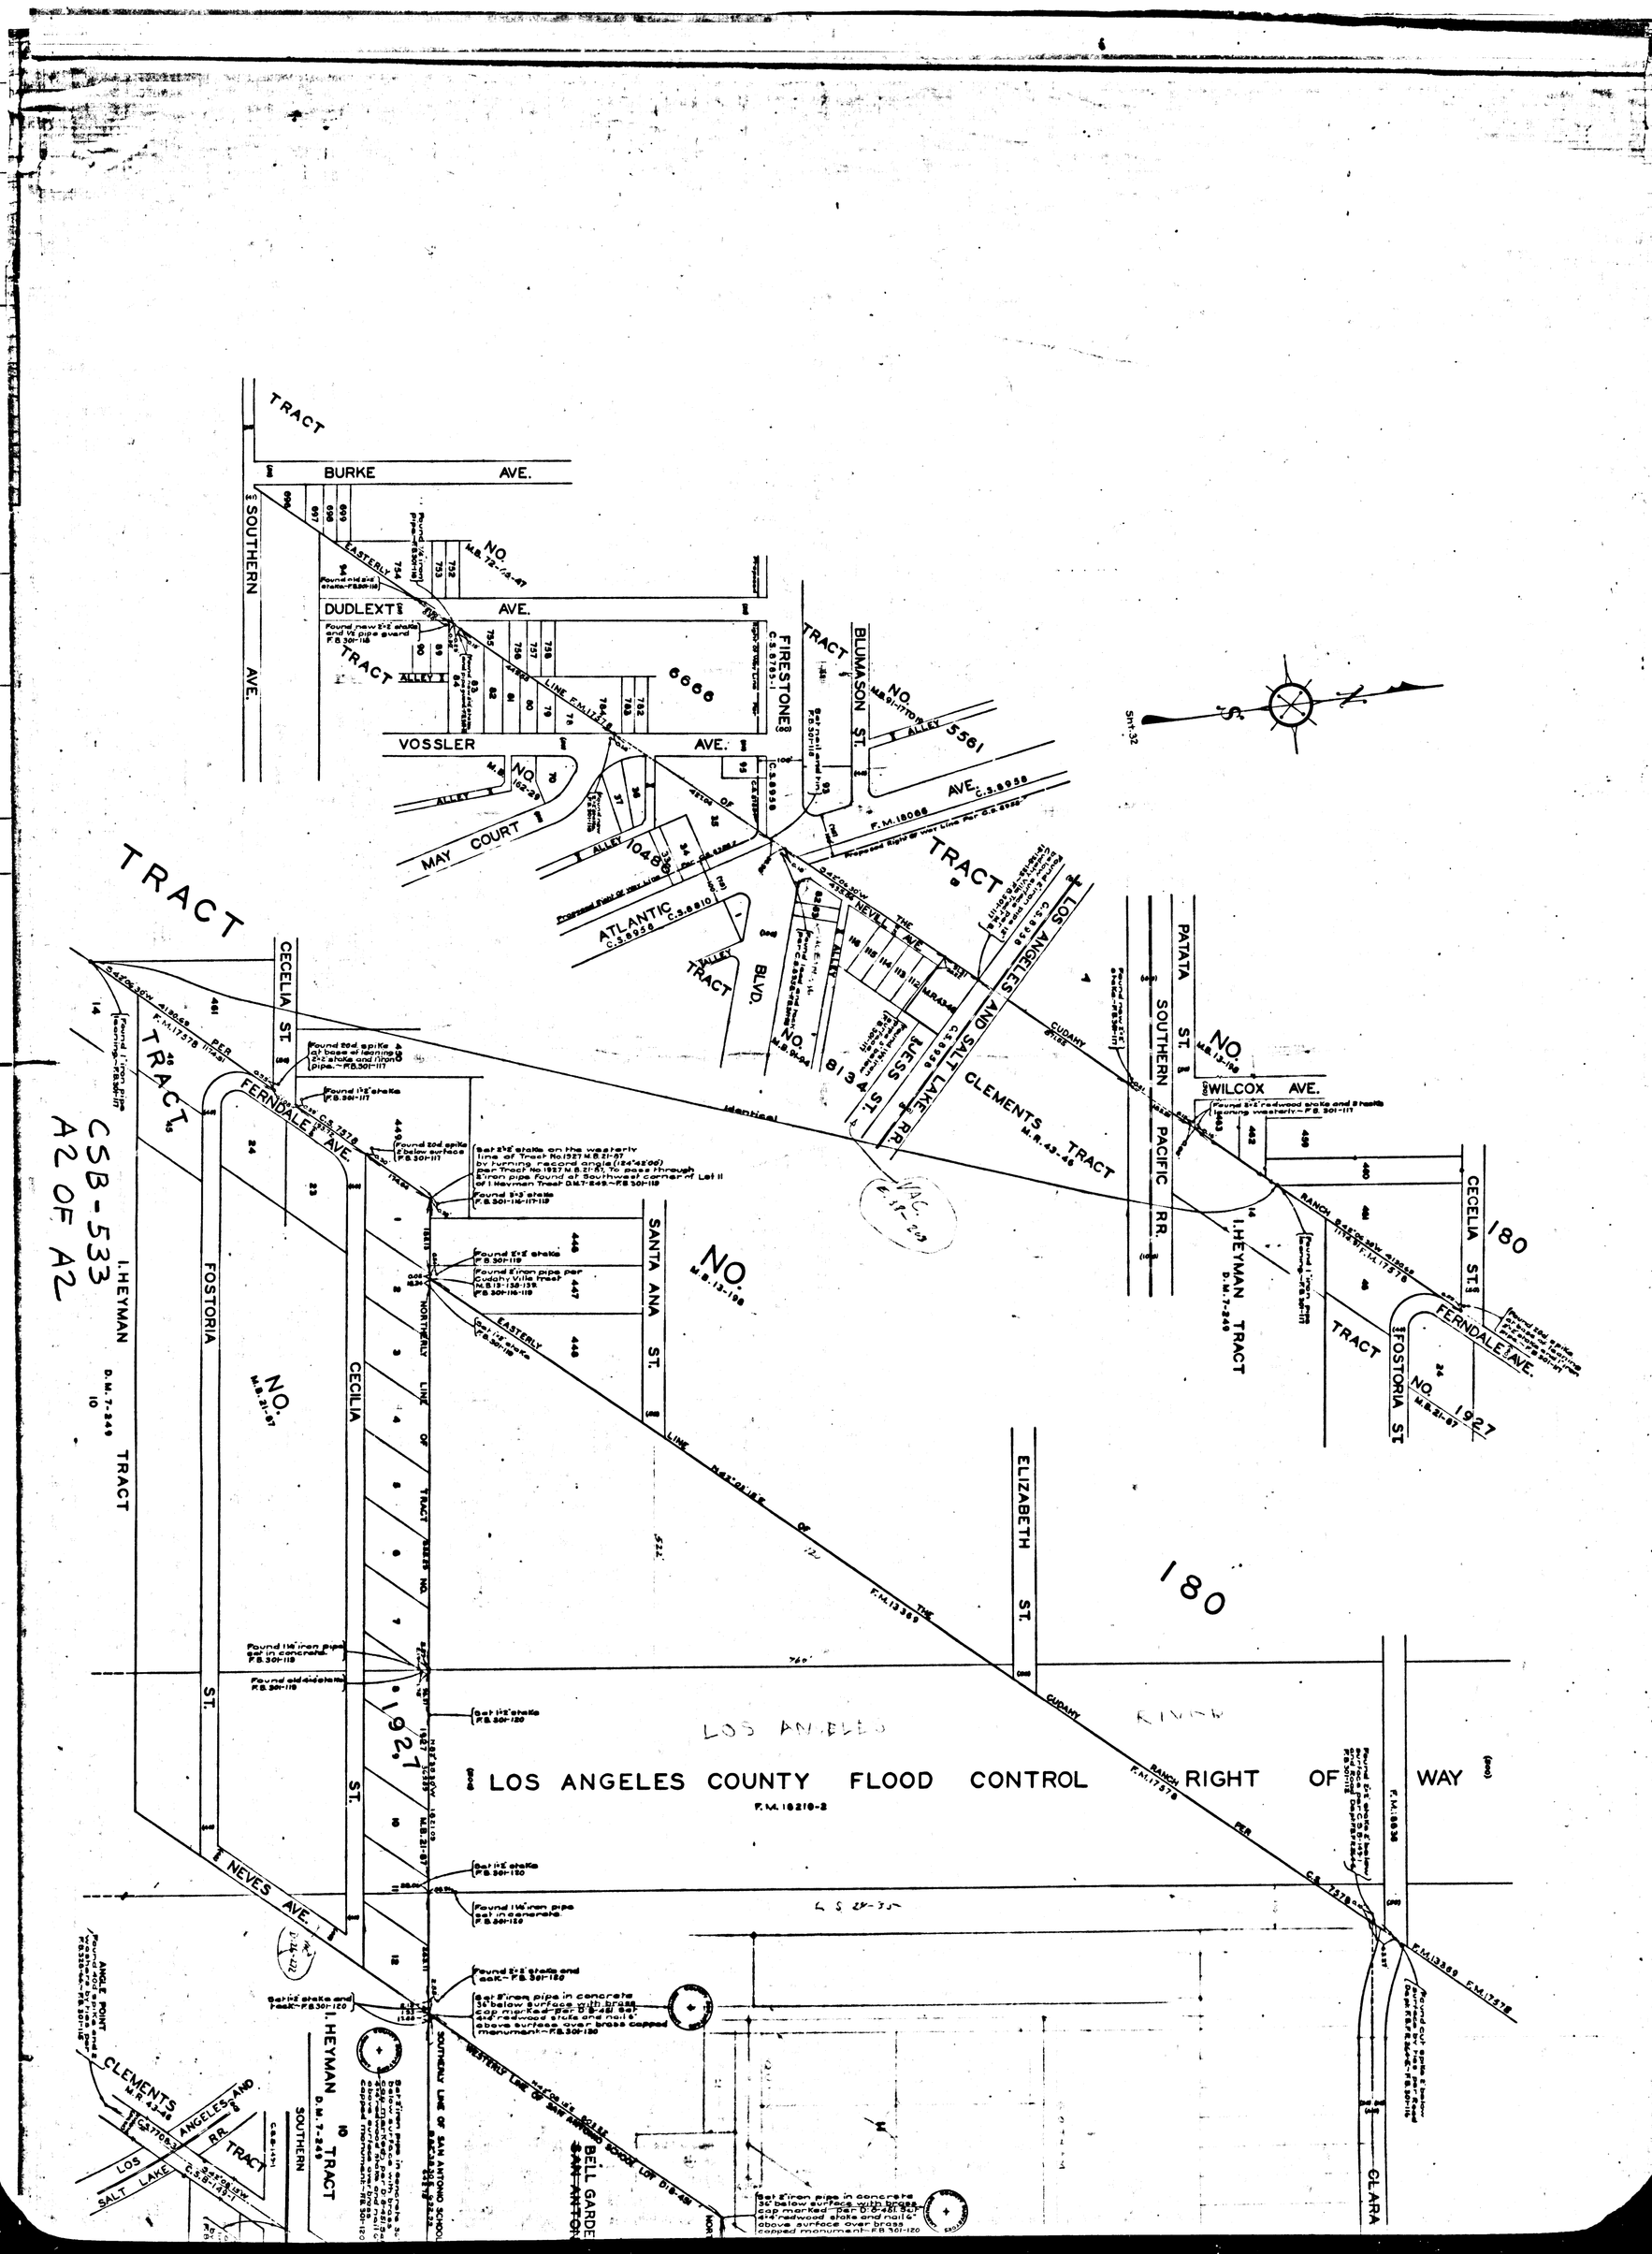

TRACT
BURKE AVE.
SOUTHERN AVE.
DUDLEXT AVE.
VOSSLER AVE.
MAY COURT
ATLANTIC BLVD.
FIRESTONE
BLUMASON ST.
LOS ANGELES AND SALT LAKE RR.
CLEMENTS TRACT
PATATA ST.
WILCOX AVE.
SOUTHERN PACIFIC RR.
I. HEYMAN TRACT
CECELIA ST.
FERNDALE AVE.
FOSTORIA ST.
SANTA ANA ST.
ELIZABETH ST.
NEVES AVE.
CLARA
BELL GARDEN
LOS ANGELES COUNTY FLOOD CONTROL RIGHT OF WAY
F.M. 18218-2
LOS ANGELES RIVER
CSB-533
A2 OF A2