Trim prints to this line

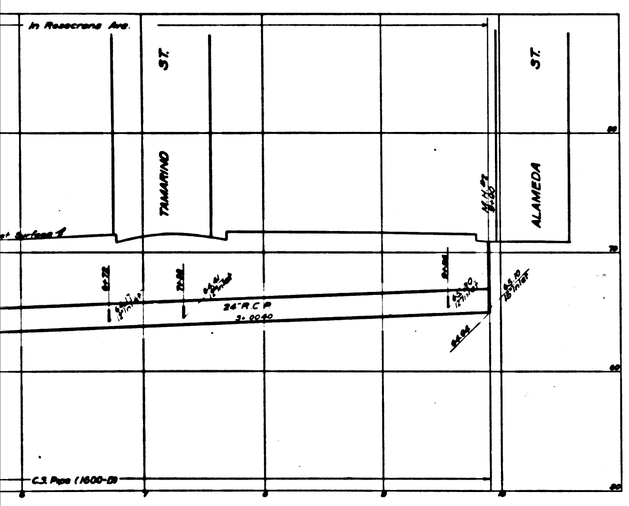

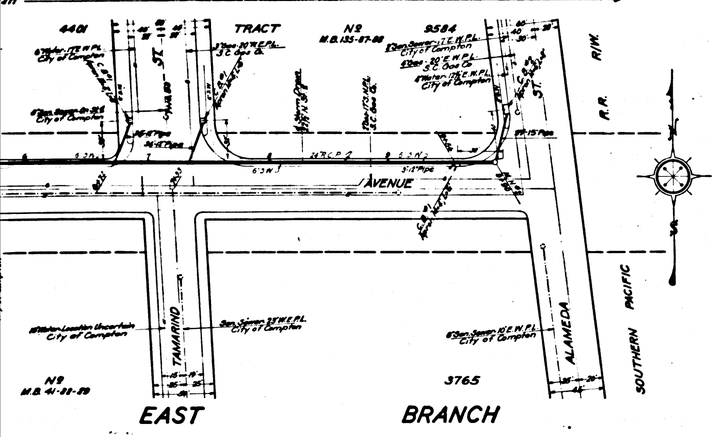

EAST BRANCH

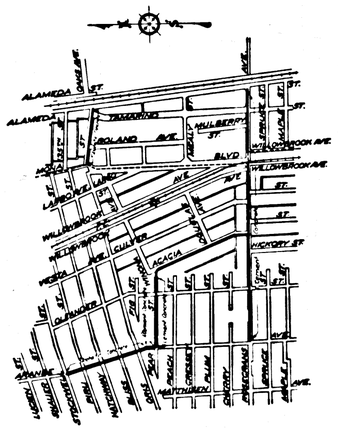

KEY MAP
SHOWING DRAINS AND RESURFACING

NOTES:

Elevations are in feet above U.S.G.S. or mean Sea Level Datum.

Stations of inlets and junctions refer to the intersections of the center lines of the inlets with the center line of the main drain.

Elevations of all inlets except catch basin inlets into box sections refer to the flow lines of the inlets produced on their gradients to the vertical plane thru the center line of the main drain. Elevations of catch basin inlets into box sections refer to the intersections of the flow lines of these inlets with the inside wall of the box section.

For details of all standard structures see Standard Plans.

All pipe not otherwise specified shall be plain cement pipe.

All stubs to be one length of pipe with ends sealed with 2" redwood planking, unless otherwise specified.

Catch basins shall be built with a curb face of 10" or more which shall include a minimum depression at opening of 4" below gutter grade, unless otherwise specified.

Sanitary sewers crossing storm drains, shown in profile with less than 1½ feet clearance, are to be encased as per Sw-6 for a length equal to the width of conduit trench. In addition if less than ½ ft. clearance sewers must be of cast iron pipe and encased as noted above.

Corrected as Constructed

August 1941
A.T. Kincaid

GLEN AVENUE DRAINAGE SYSTEM

OF THE COUNTY OF LOS ANGELES, CALIFORNIA
PLAN AND PROFILE OF

ORIS ST. BRANCH
ARANBE AVE. BRANCH
ROSECRANS AVE. W. BRANCH
ROSECRANS AVE. E. BRANCH

SHEET 12 OF 26 SHEETS

SCALE [illegible] NOVEMBER 1936

ALFRED JONES COUNTY SURVEYOR

RECOMMENDED [signature] APPROVED [signature]

REFERENCE				
F.B.	496	DESIGNED	L. Longacre	MAR. 1932
L.B.	680	TRACED	P.I. Hunstock	SEPT. 1933
	Revised: July, 1937	CHECKED	E.E. Mitchell	MAR. 1934

(12)

CSB-1171-12

A1 OF A6

Trim prints to this line

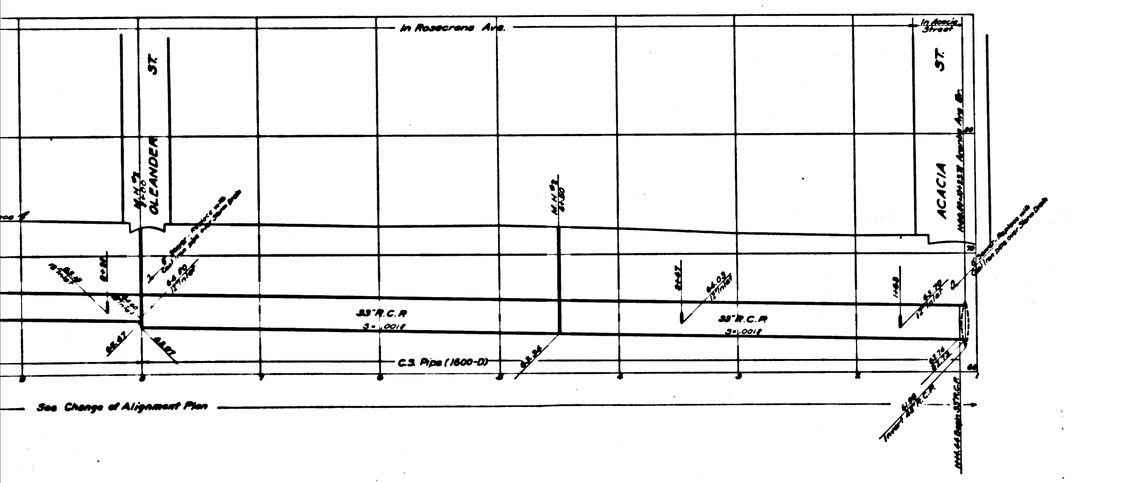

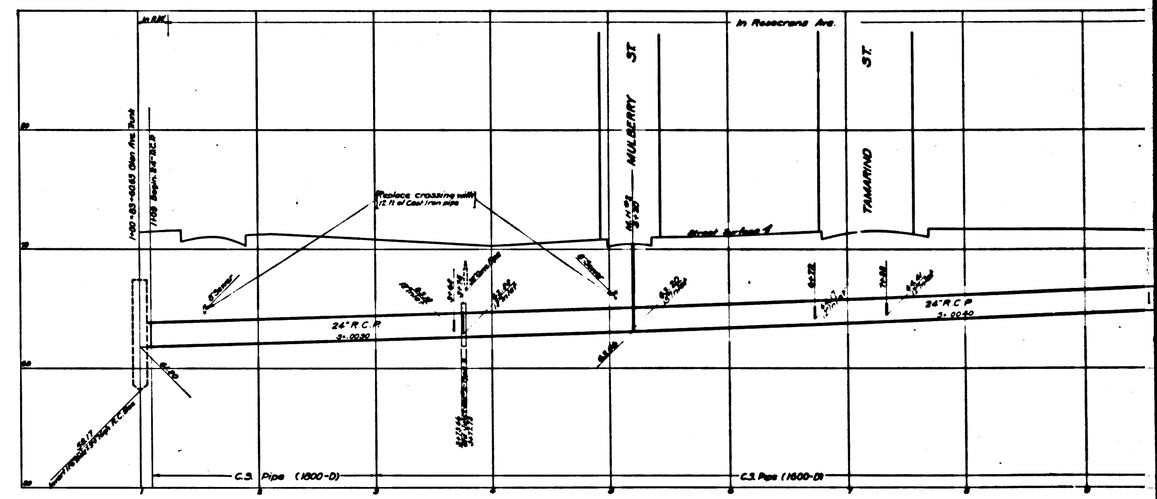

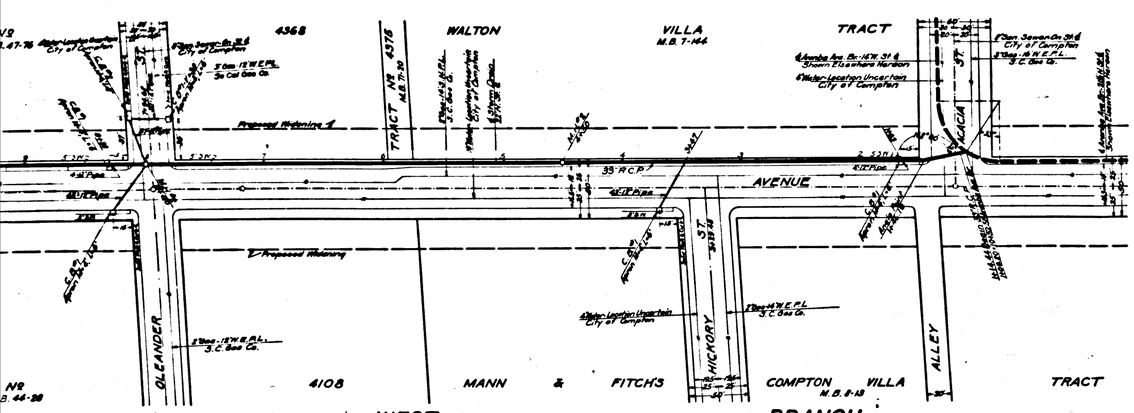

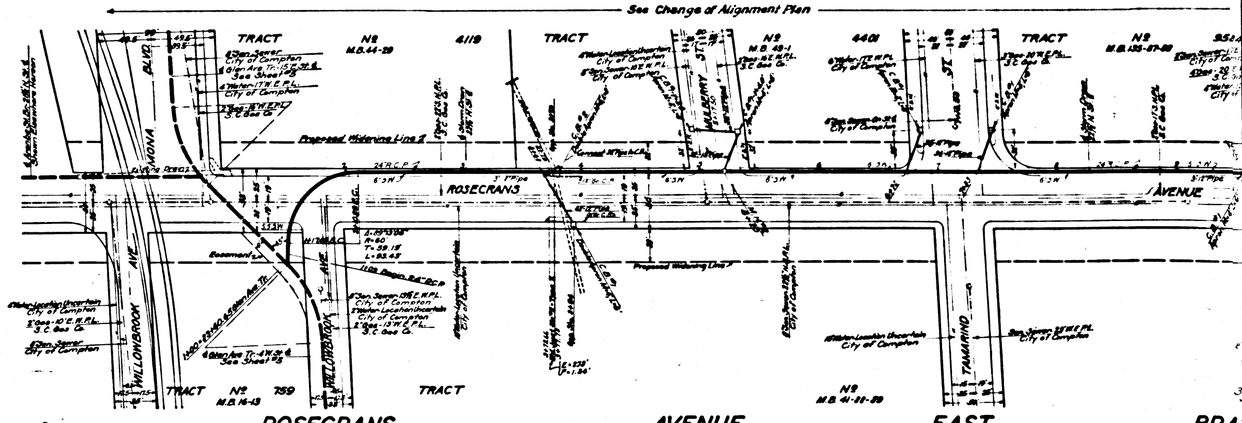

AVENUE WEST BRANCH

ROSECRANS AVENUE EAST BRA

CSB-1171-12
A2 OF A6

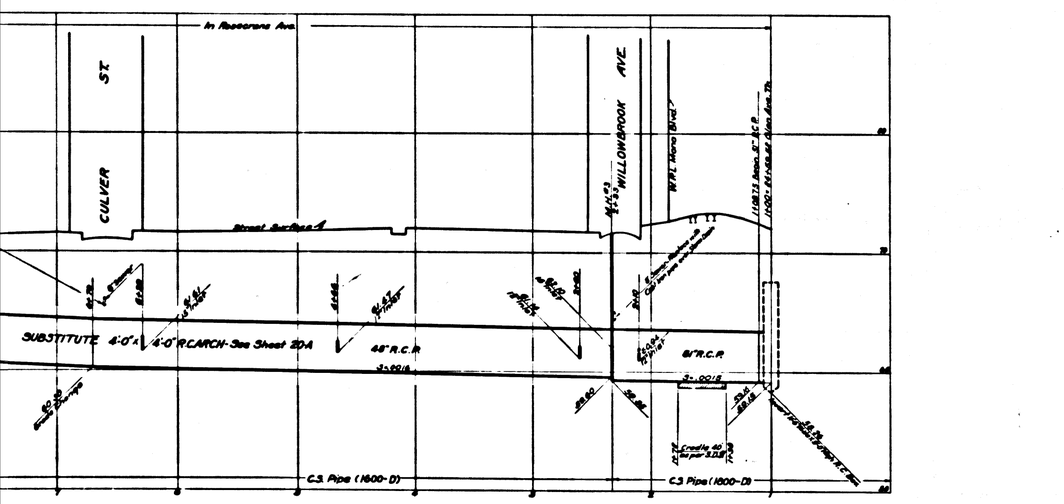

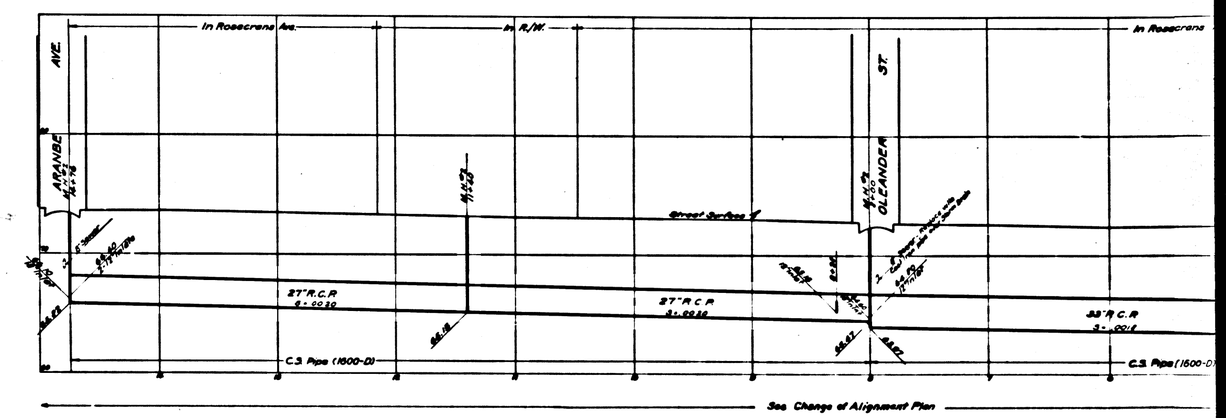

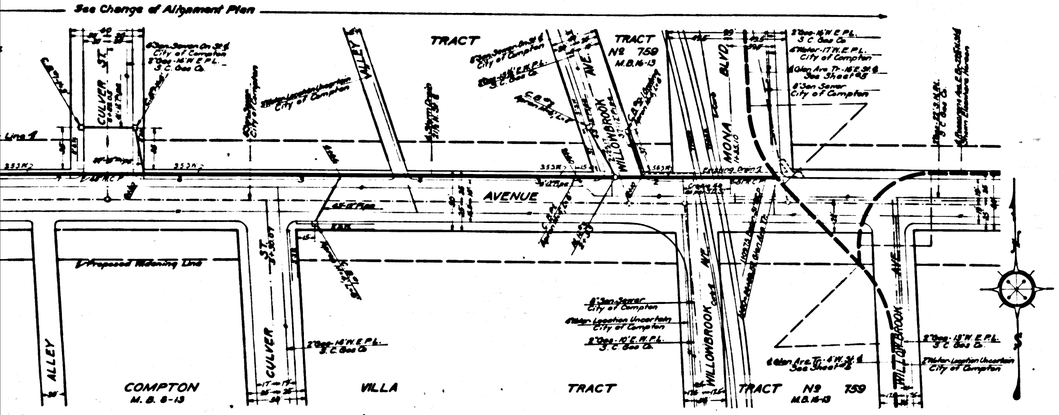

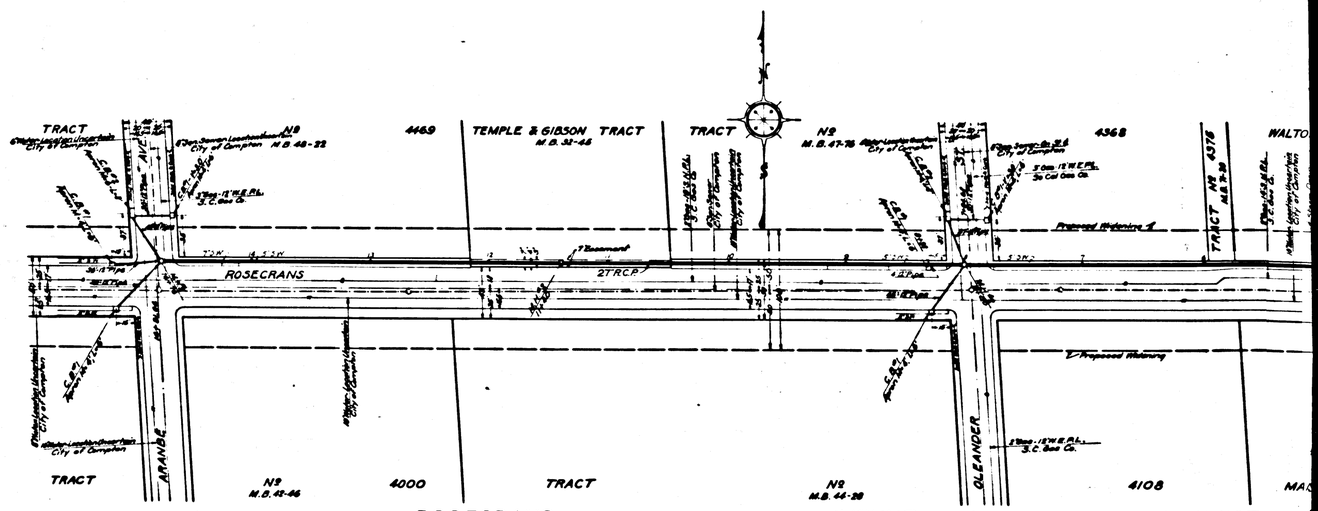

ROSECRANS AVENUE WEST

CSB-1171-12
A3 OF A6

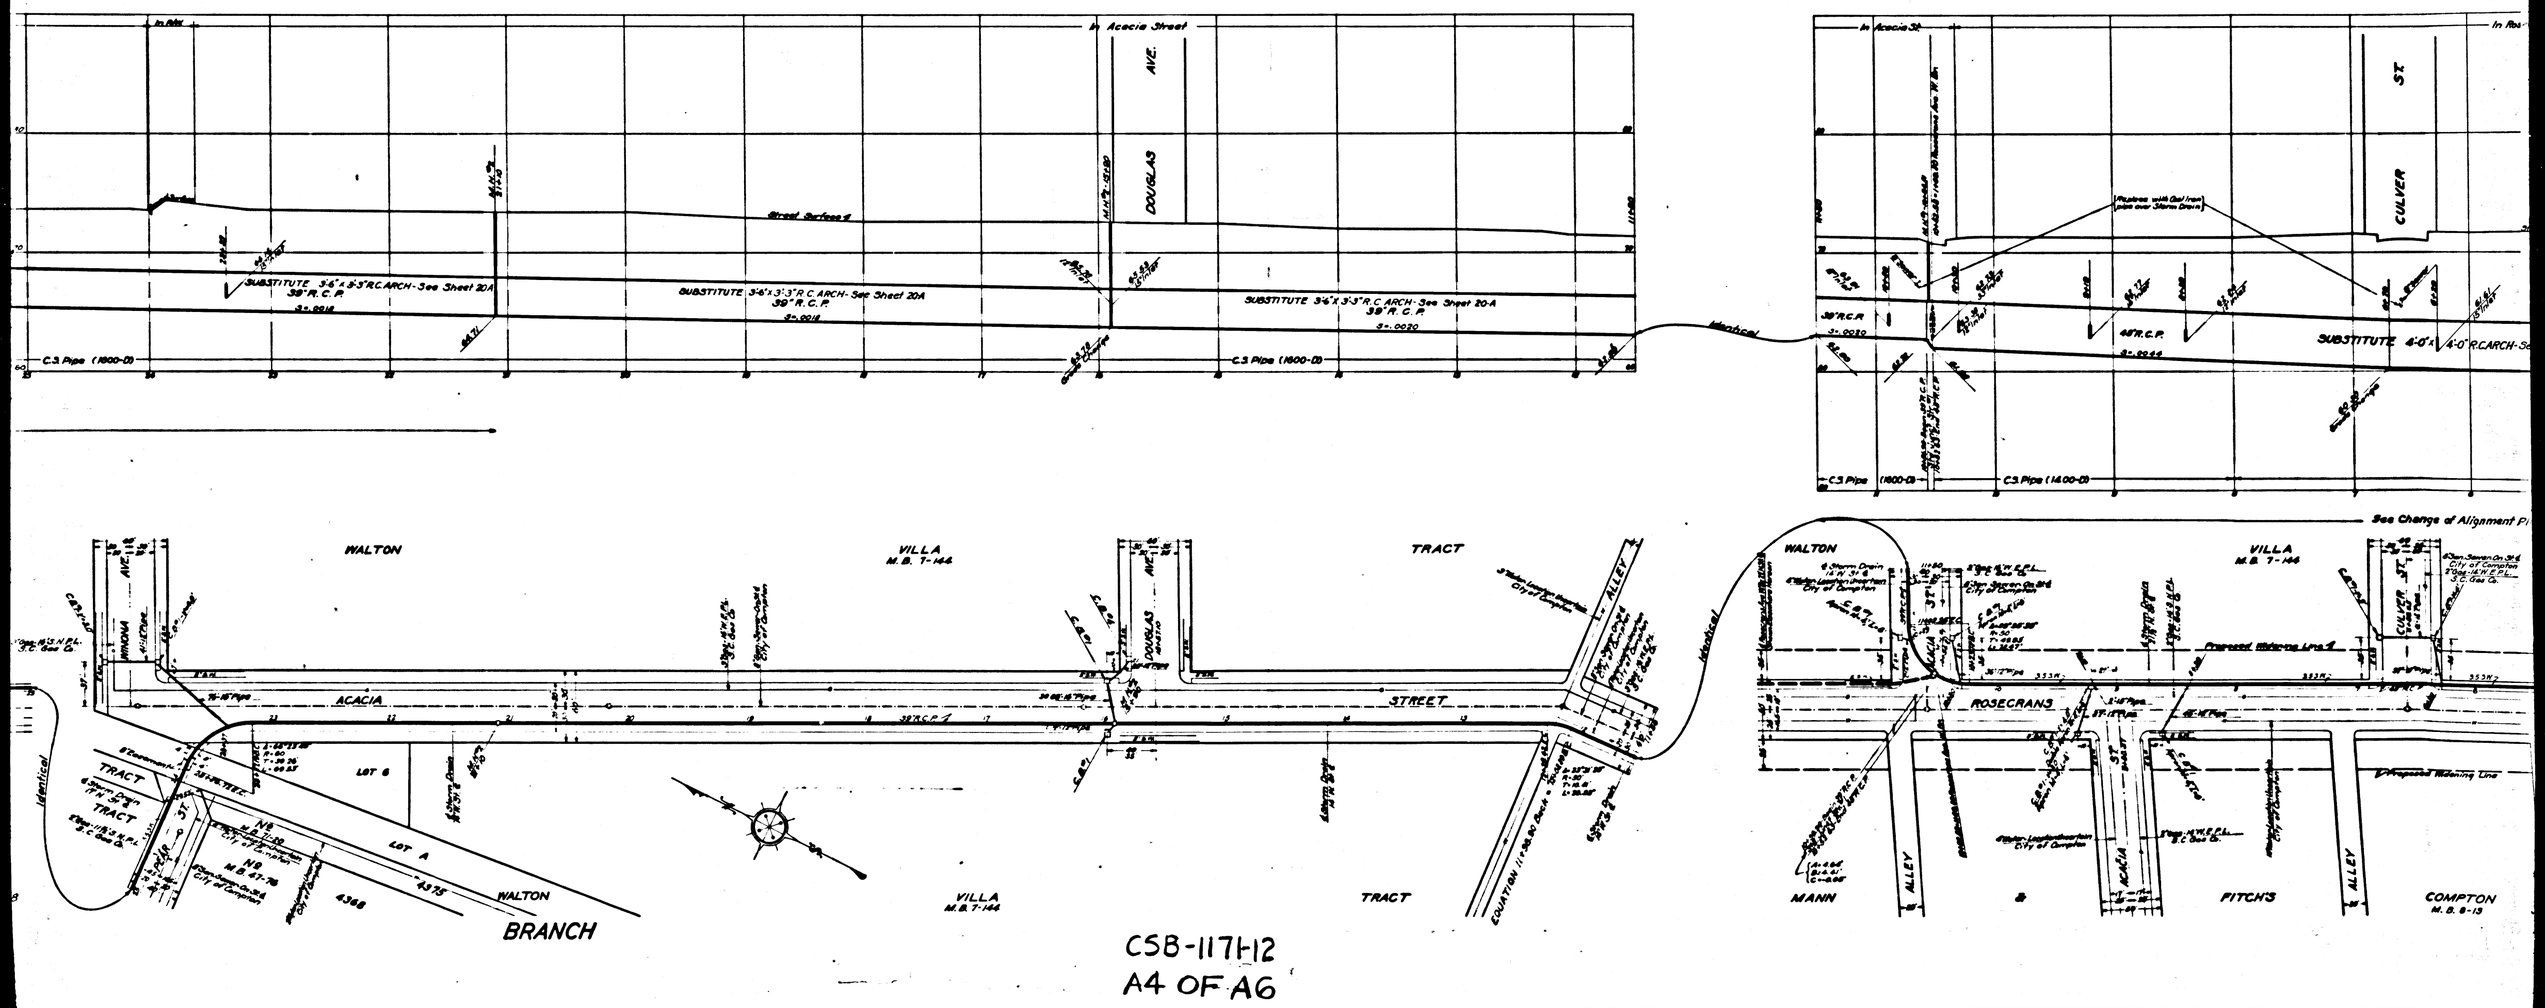

CSB-1171-12
A4 OF A6

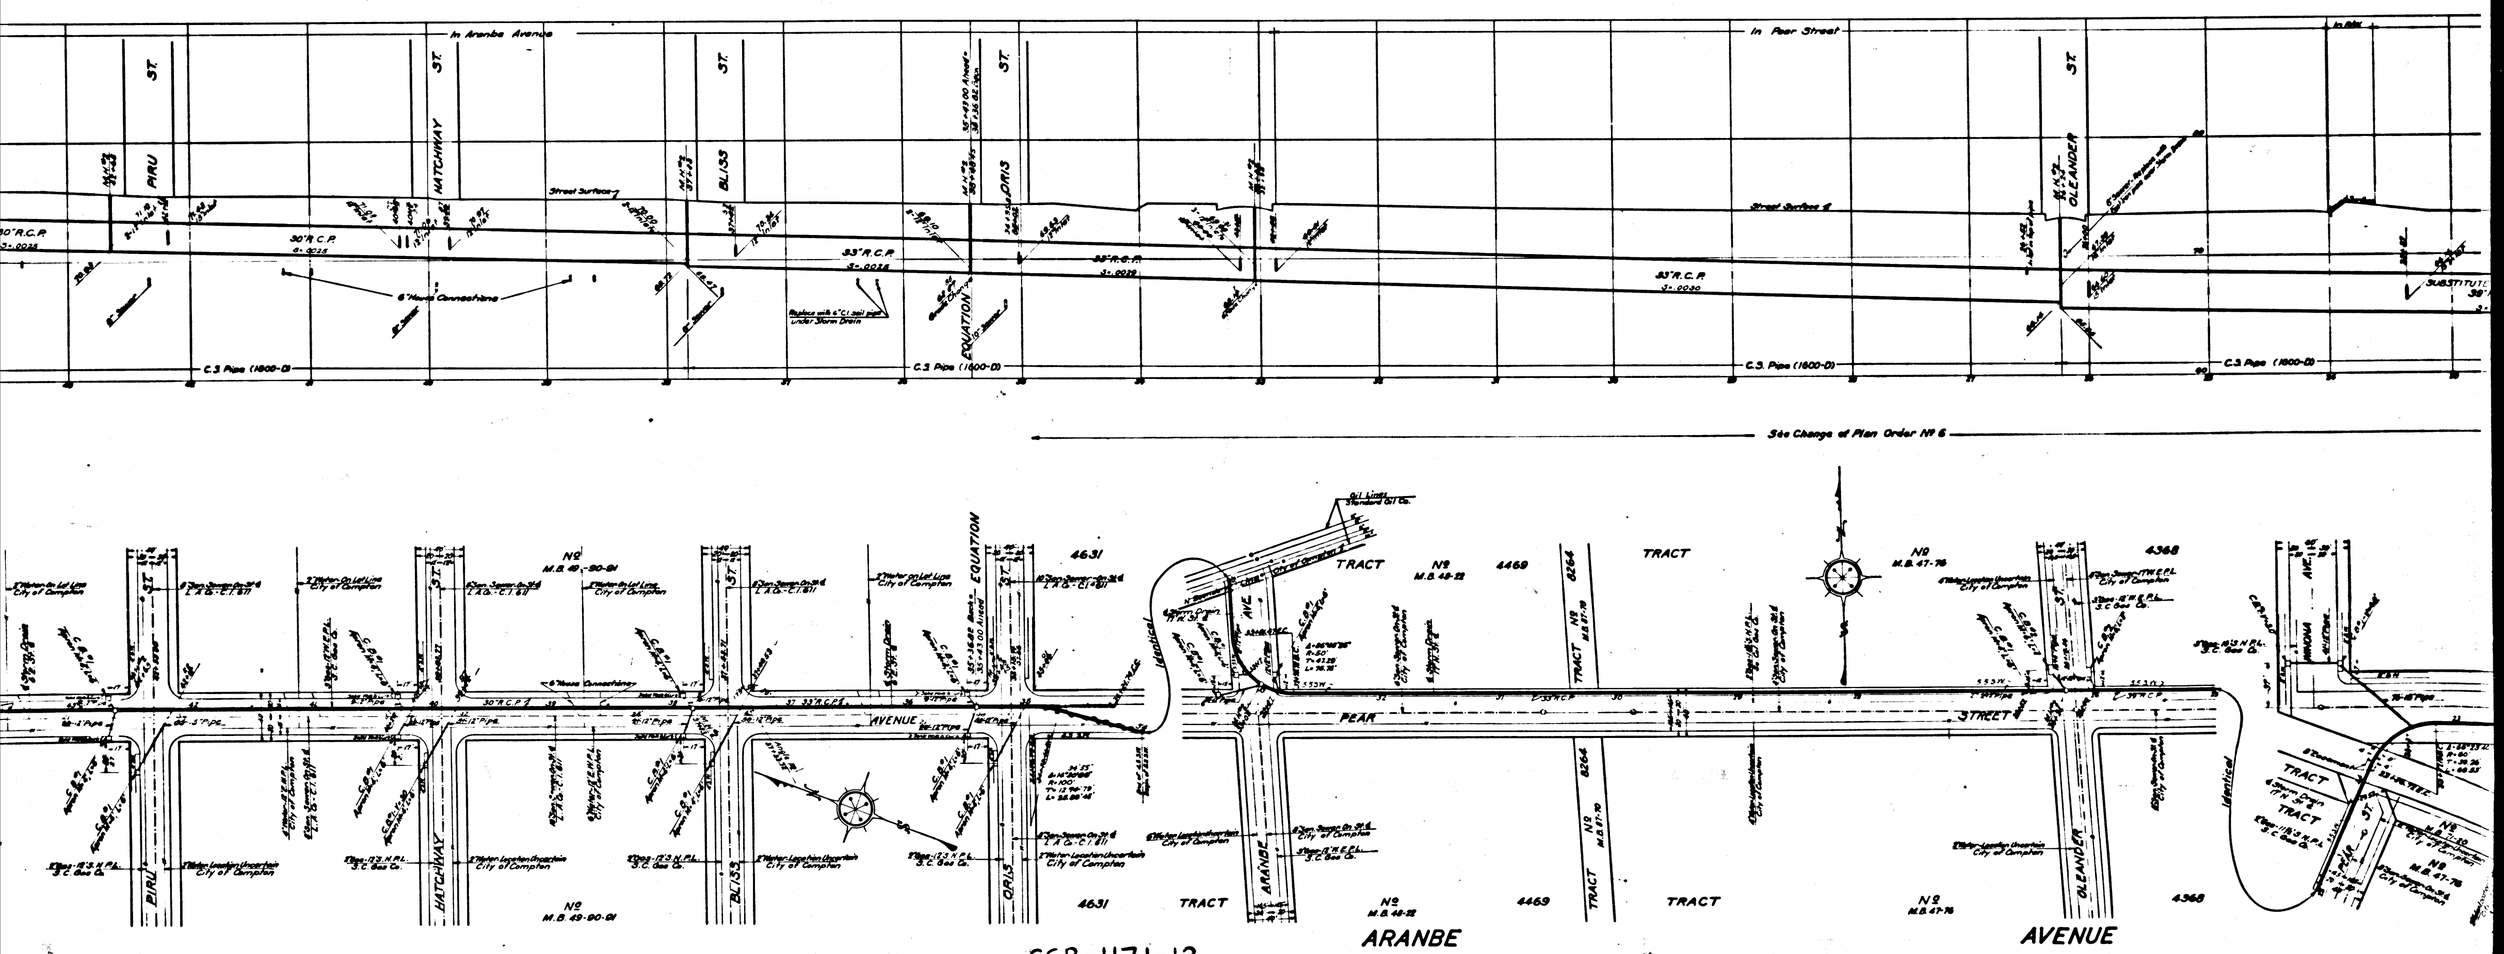

CSB-1171-12
A5 OF A6

Trim prints to this line

INDEX

Lines Shown on this Sheet
Reading from Left to Right

PLAN AND PROFILE
ORIS ST. BR
ARANBE AVE. BR
ROSECRANS AVE. WEST BR
ROSECRANS AVE. EAST BR

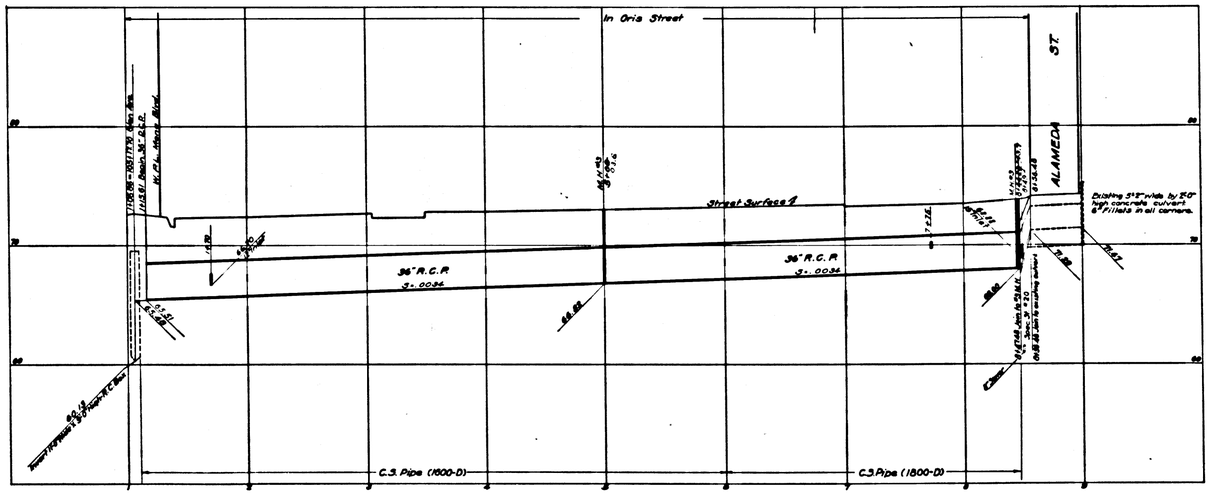

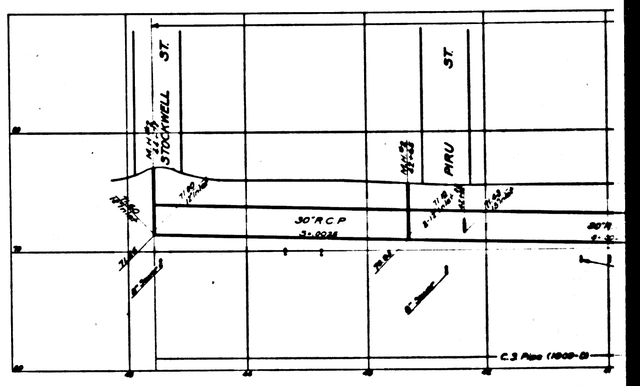

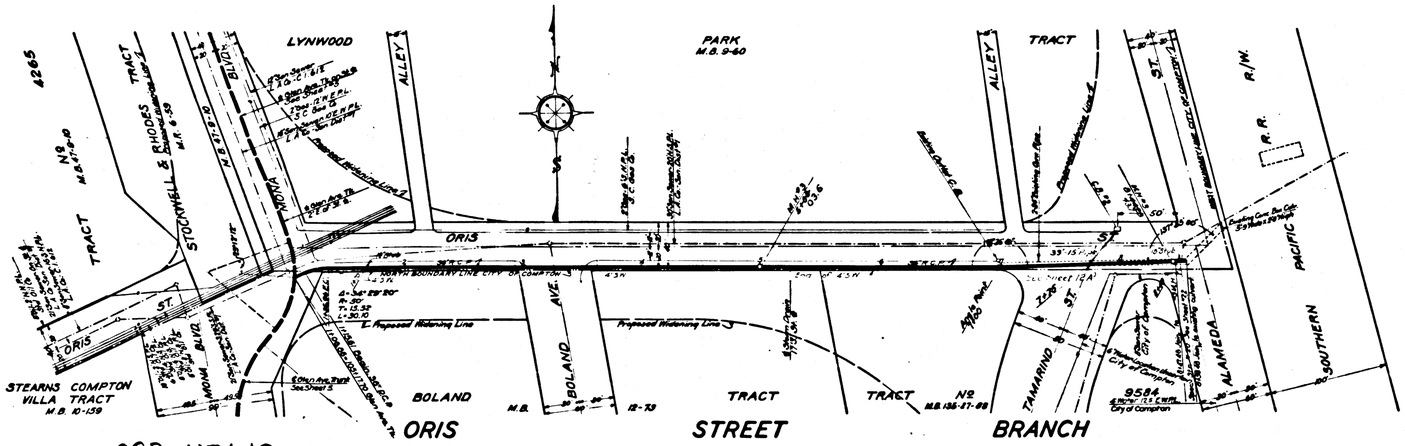

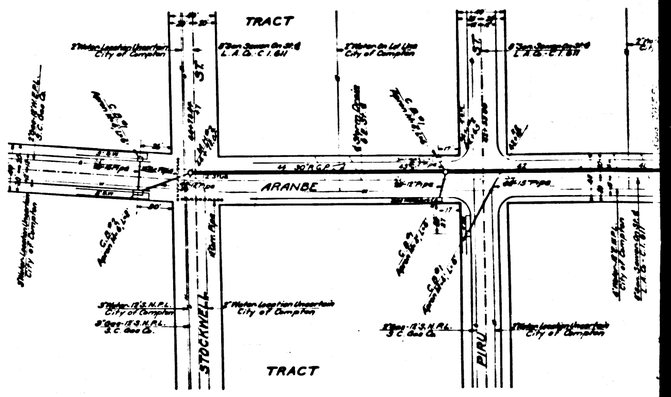

CSB-1171-12
A6 OF A6

Trim prints to this line