Trim prints to this line

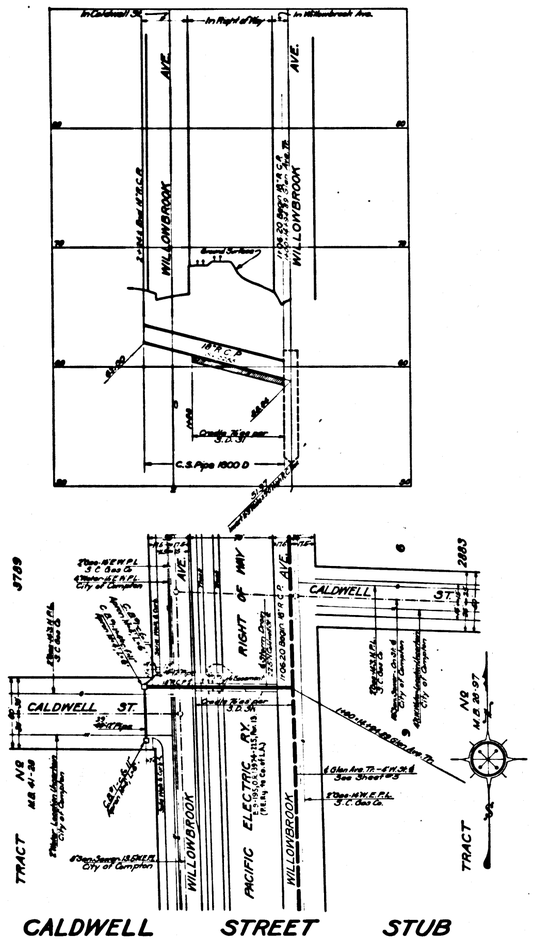

CALDWELL STREET STUB

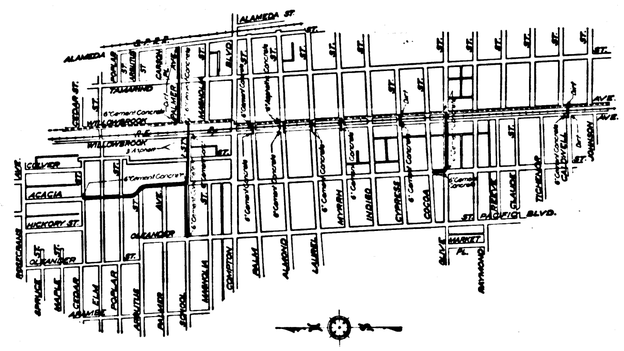

KEY MAP
SHOWING DRAINS AND RESURFACING

NOTES:

Elevations are in feet above U.S.G.S. or mean Sea Level Datum.

Stations of inlets and junctions refer to the intersections of the center lines of the inlets with the center line of the main drain.

Elevations of all inlets except catch basin inlets into box sections refer to the flow lines of the inlets produced on their gradients to the vertical plane thru the center line of the main drain. Elevations of catch basin inlets into box sections refer to the intersections of the flow lines of these inlets with the inside wall of the box sections.

For details of all standard structures see Standard Plans.

All pipe not otherwise specified shall be plain cement pipe.

All stubs to be one length of pipe with ends sealed with 2" redwood planking, unless otherwise specified.

Catch basins shall be built with a curb face of 10" or more which shall include a minimum depression at opening of 4" below gutter grade, unless otherwise specified.

Sanitary sewers crossing storm drains, shown in profile with less than 1½ feet clearance, are to be encased as per Sw-6 for a length equal to the width of conduit trench. In addition if less than ½ ft. clearance sewers must be of cast iron pipe and encased as noted above.

Corrected as Constructed

August 1941
A.T. Kincaid

GLEN AVENUE DRAINAGE SYSTEM

OF THE COUNTY OF LOS ANGELES, CALIFORNIA
PLAN AND PROFILE OF

PALMER AVE. BRANCH - ACACIA ST. BRANCH
SCHOOL ST. BRANCH - PALM ST. STUB
ALMOND ST. STUB - LAUREL ST. STUB
MYRRH ST. STUB - CYPRESS ST. STUB
OLIVE ST. BRANCH - CALDWELL ST. STUB

SHEET 13 OF 26 SHEETS

SCALE VERT. 1" = 5' HORIZ. 1" = 20'

NOVEMBER 1935

ALFRED JONES
COUNTY SURVEYOR

RECOMMENDED [signature] DIST. ENGR.
APPROVED [signature] COUNTY SURVEYOR

REFERENCE				
F.B.	496	DESIGNED	L. Longacre	MAR. 1932
L.B.	680	TRACED	P.I. Hunstock	SEPT. 1933
		CHECKED	E.E. Mitchell	MAR. 1934

13

Trim prints to this line

CSB-1171-13

A1 OF A8

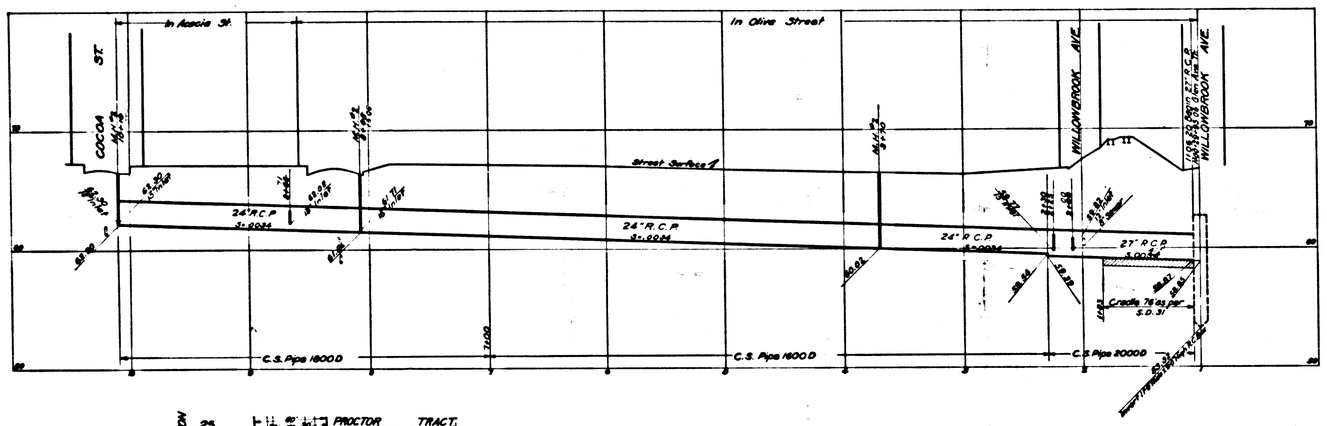

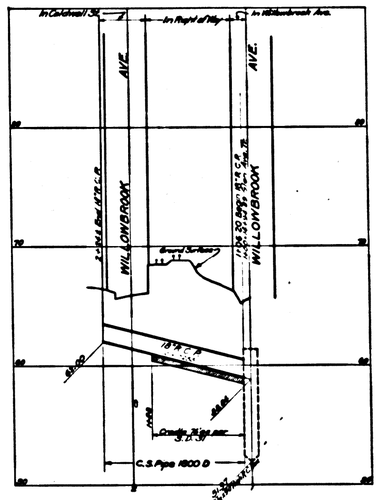

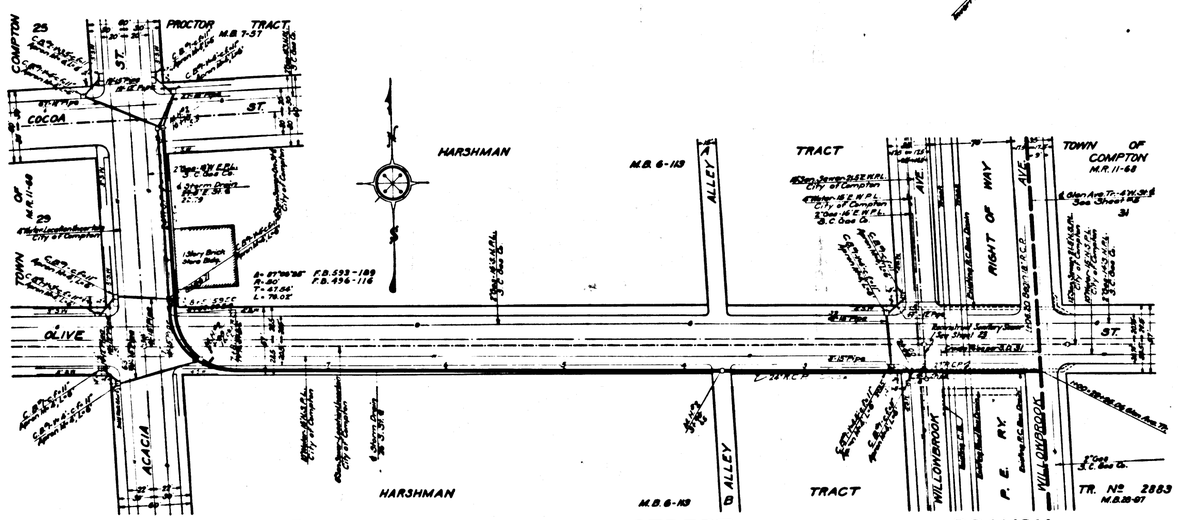

OLIVE STREET BRANCH

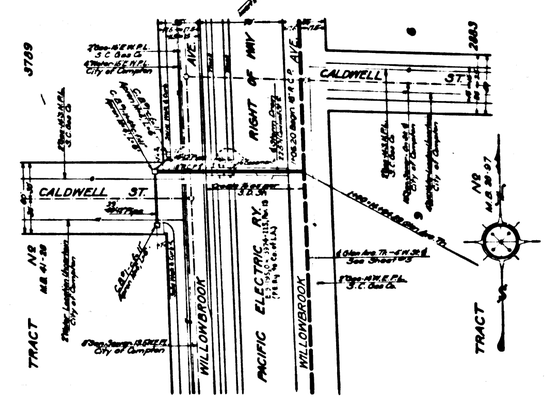

CALDWELL STREET STUB

CSB-1171-13

A2 OF A8

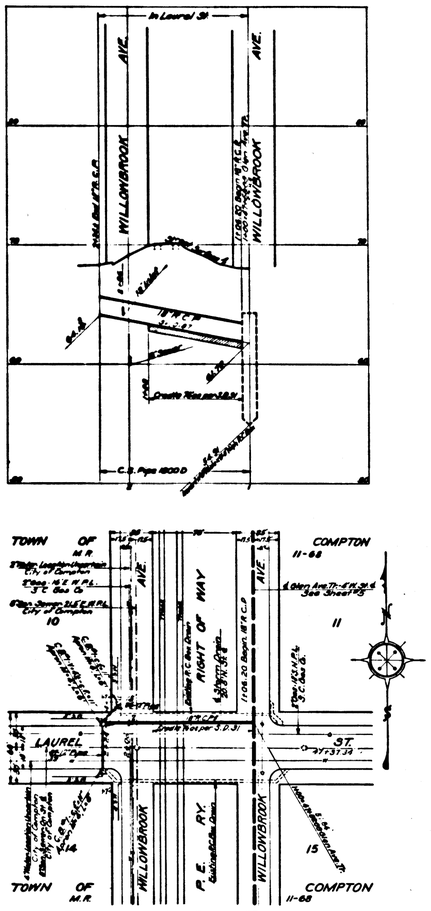

LAUREL STREET STUB

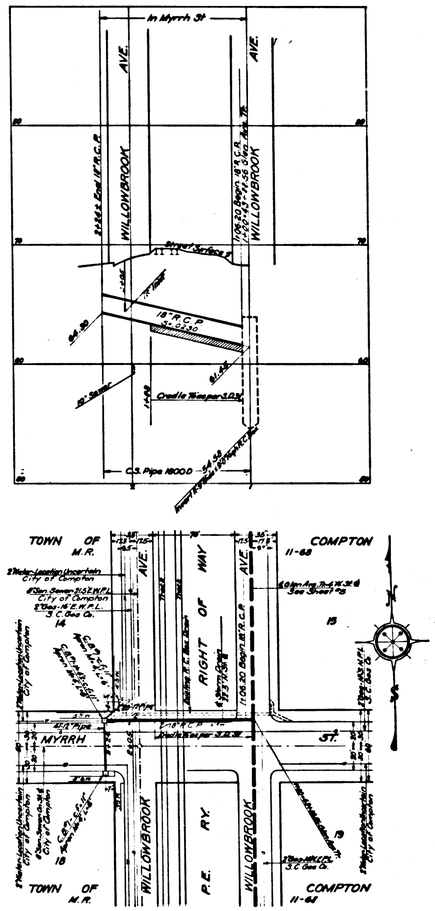

MYRRH STREET STUB

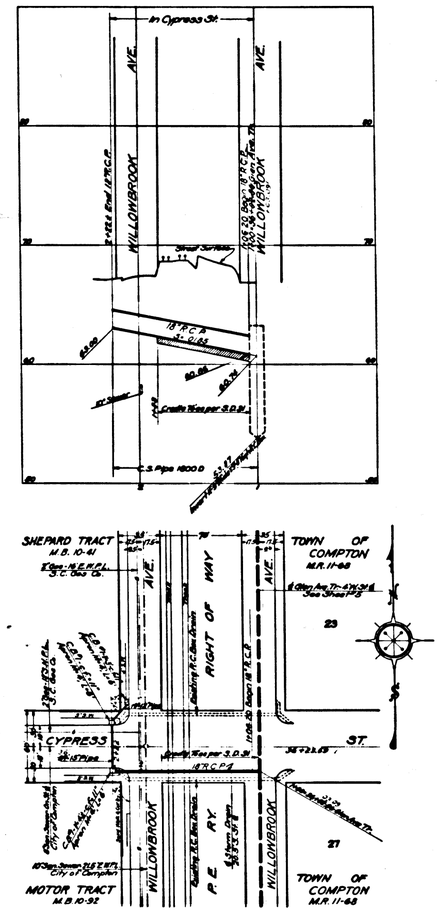

CYPRESS STREET STUB

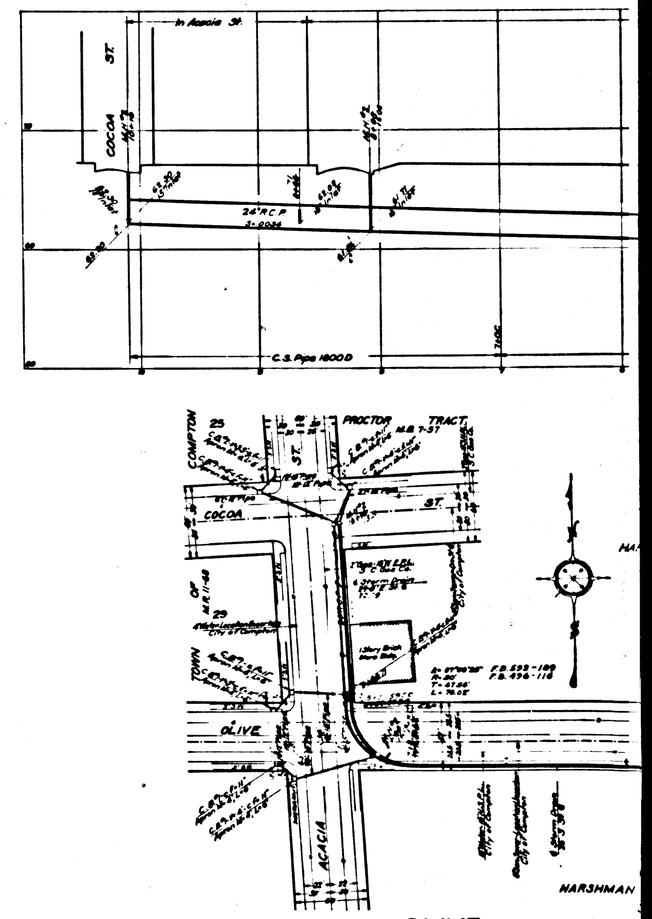

OLIVE

CSB-1171-13

A3 OF A8

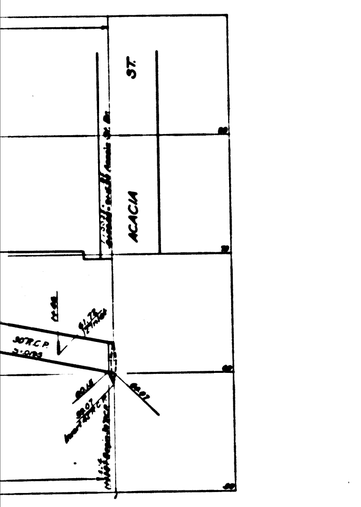

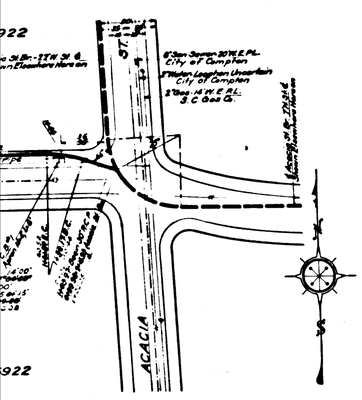

BRANCH

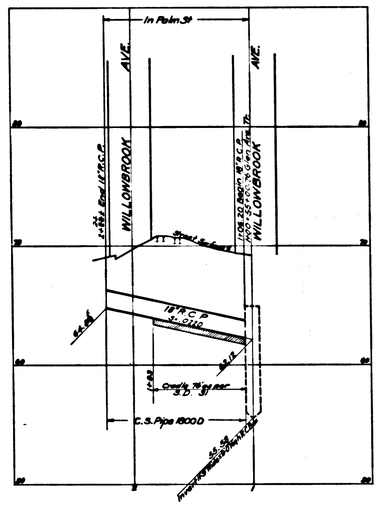

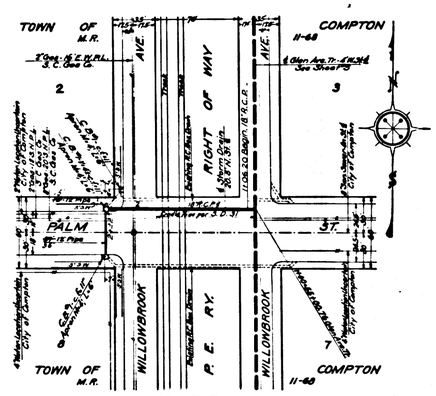

PALM STREET STUB

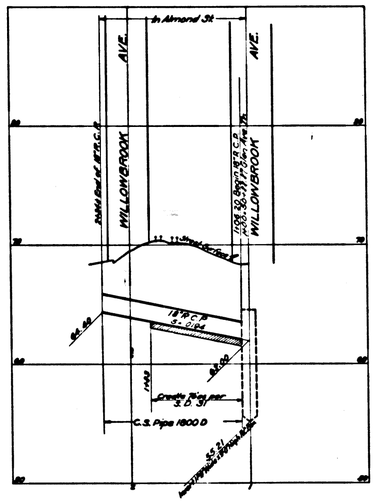

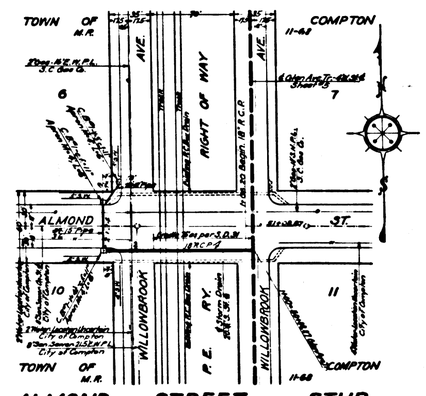

ALMOND STREET STUB

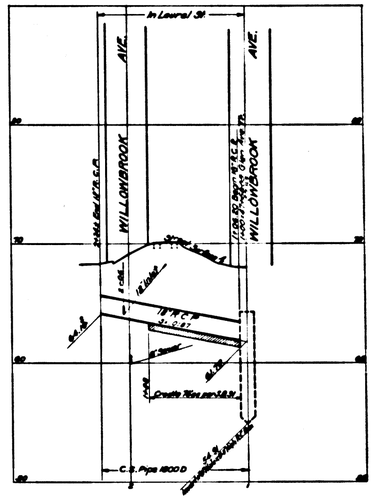

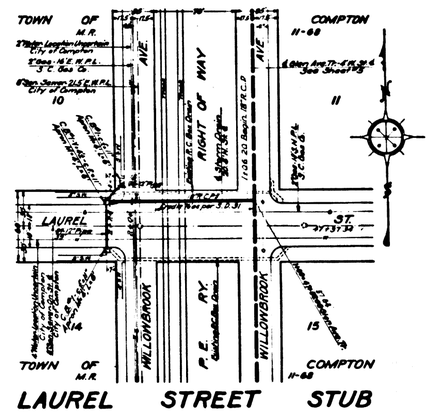

LAUREL STREET STUB

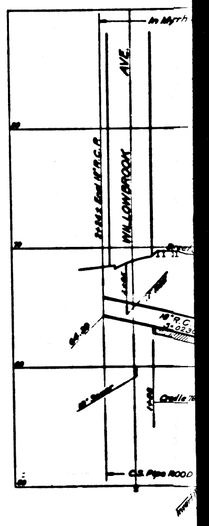

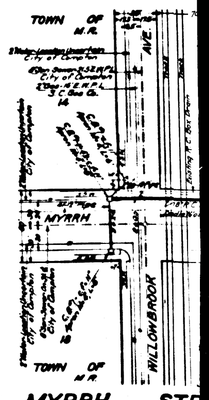

MYRRH STR

CSB-1171-13

A4 OF A8

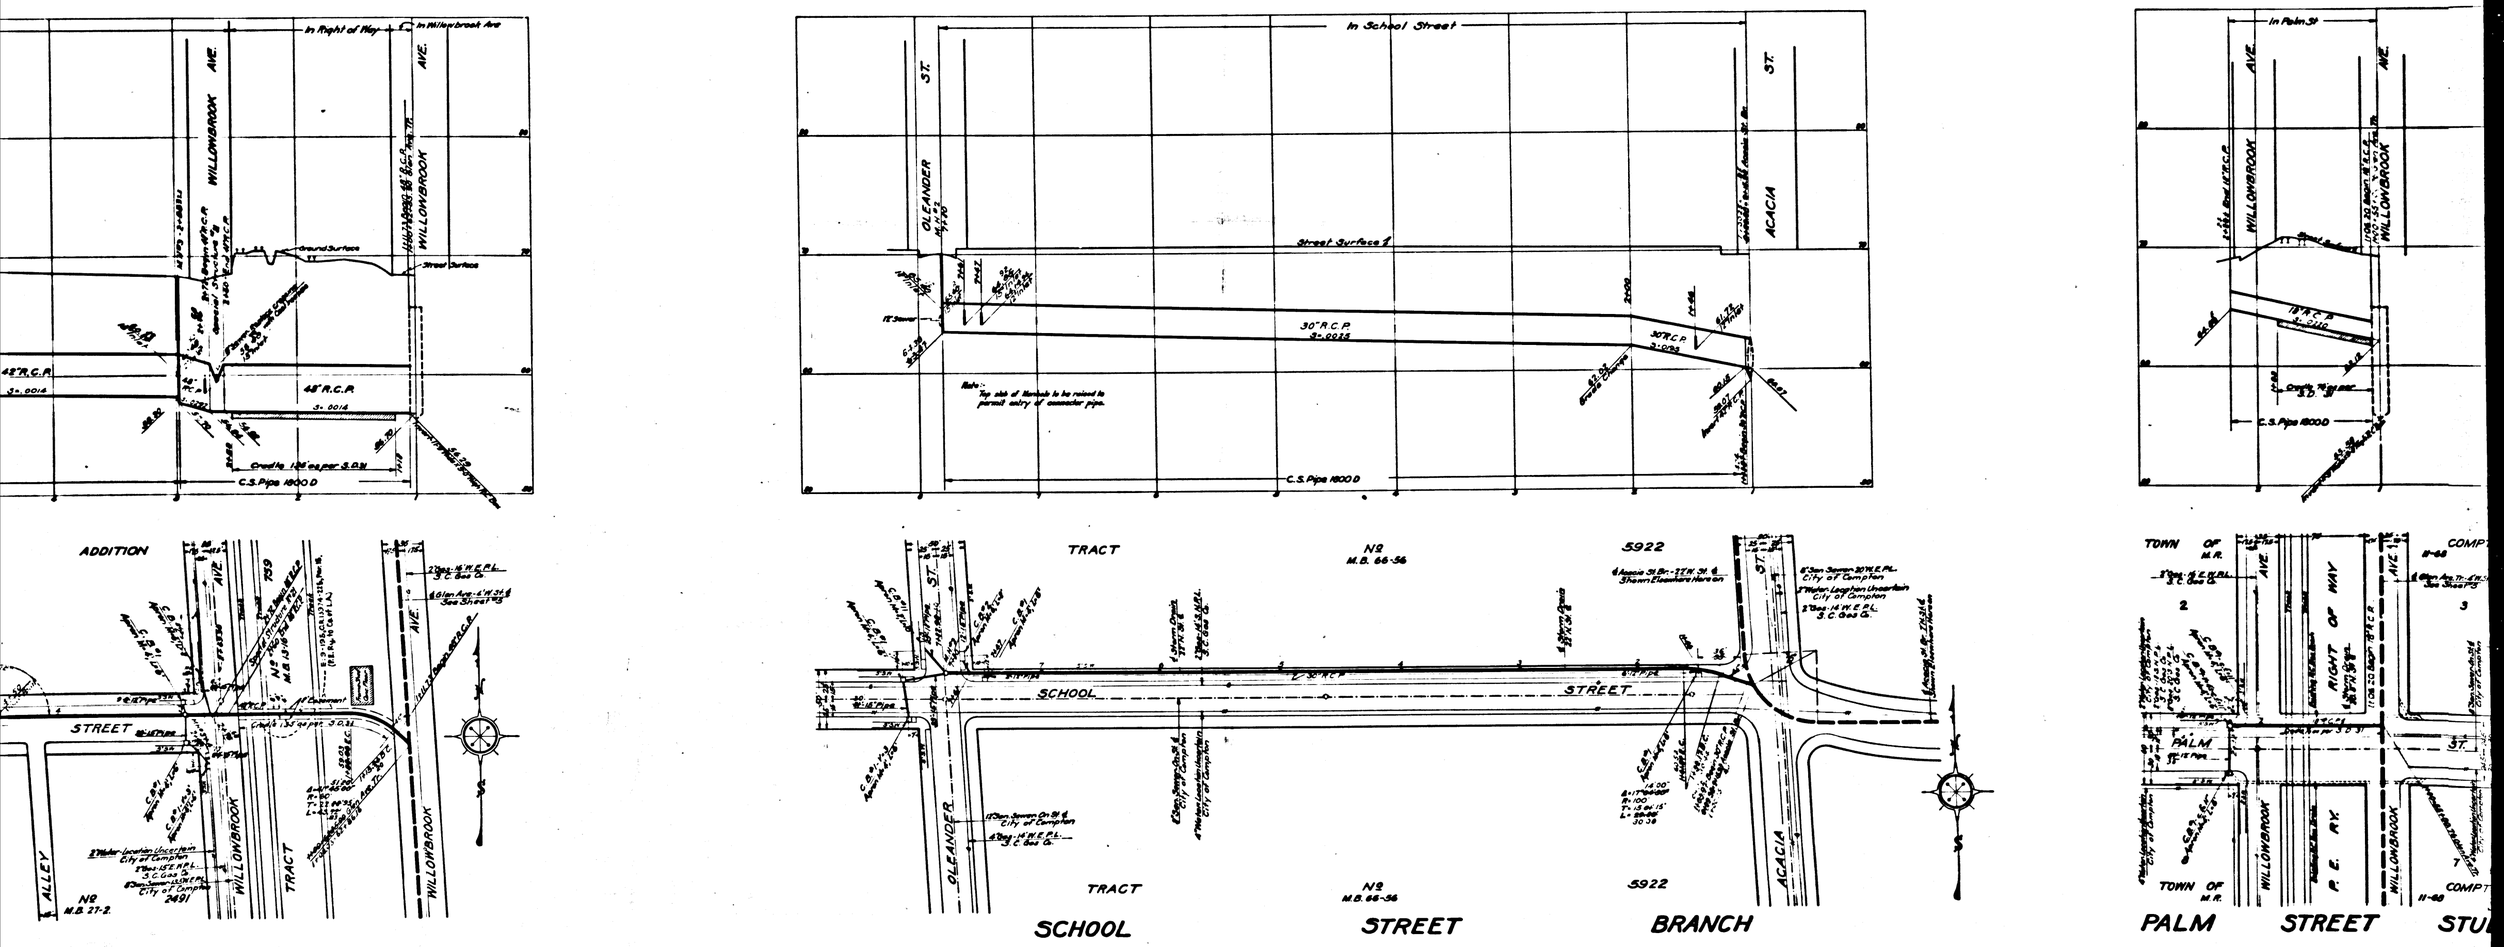

CSB-1171-13

A5 OF A8

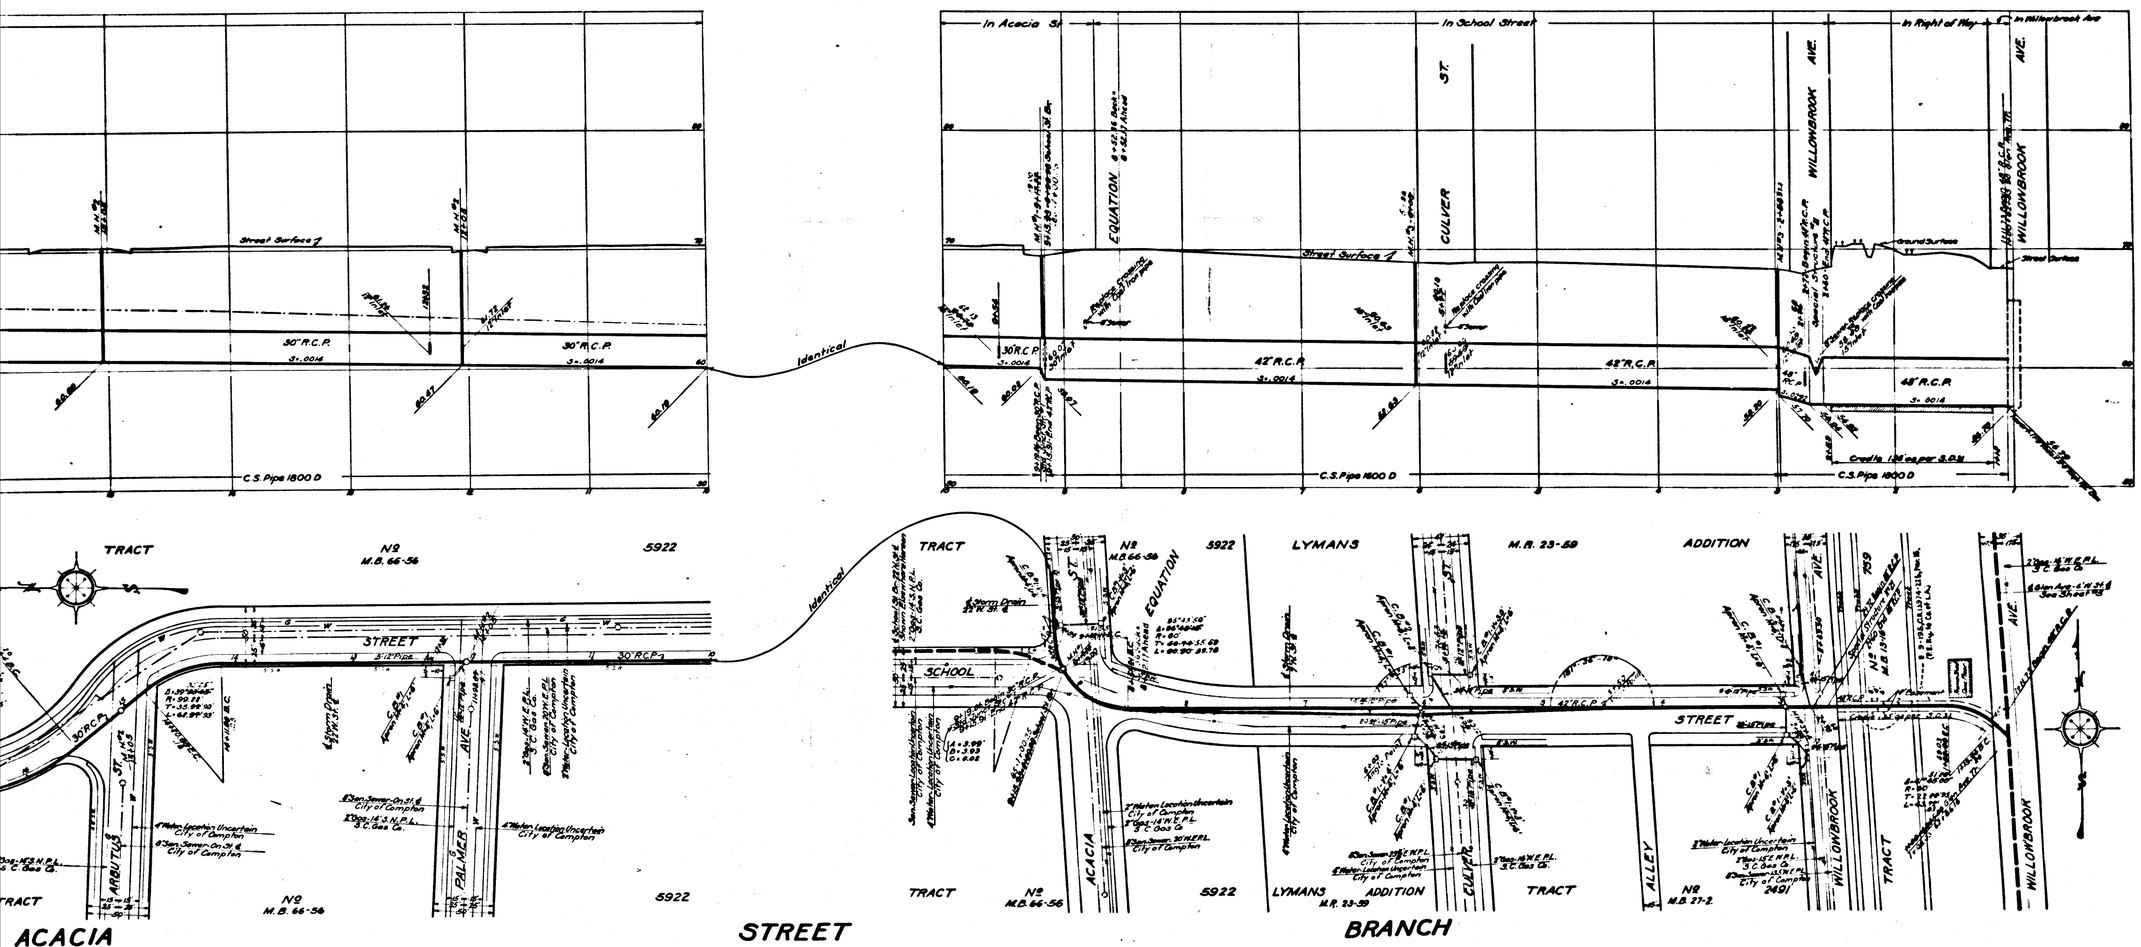

CSB-1171-13

A6 OF A8

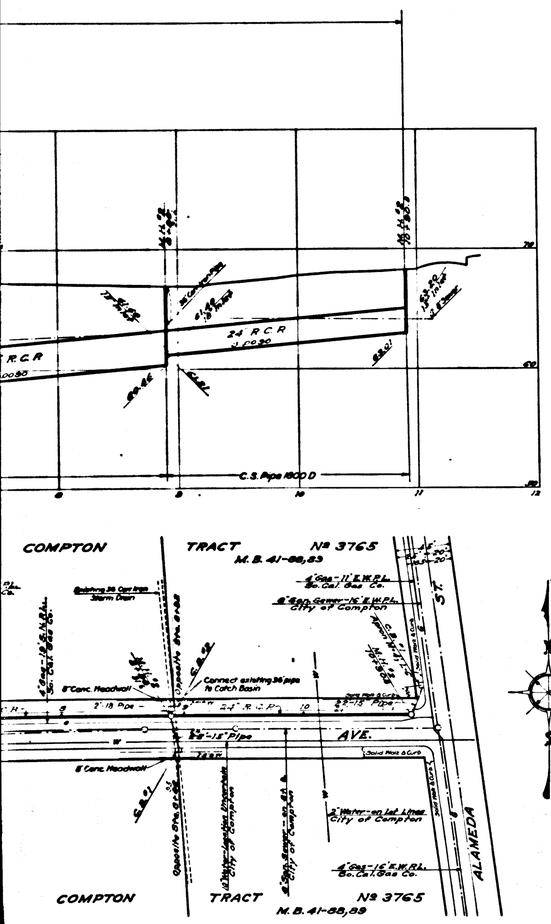

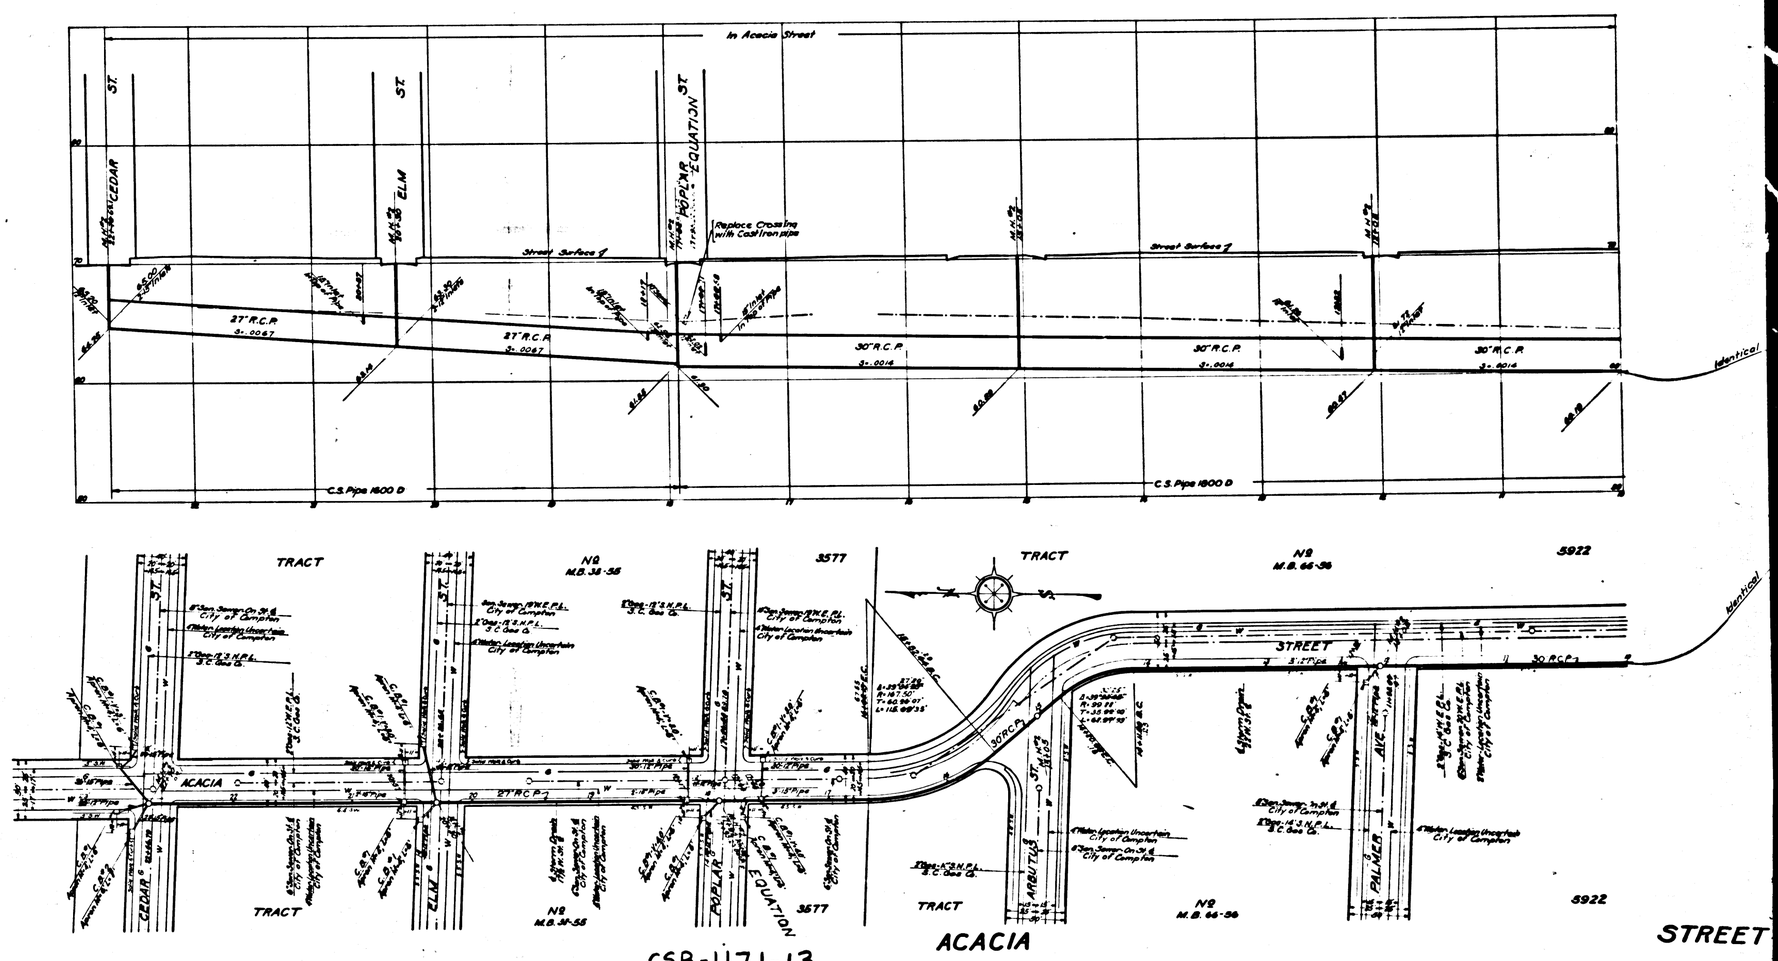

CSB-1171-13
A7 OF A8

Trim prints to this line

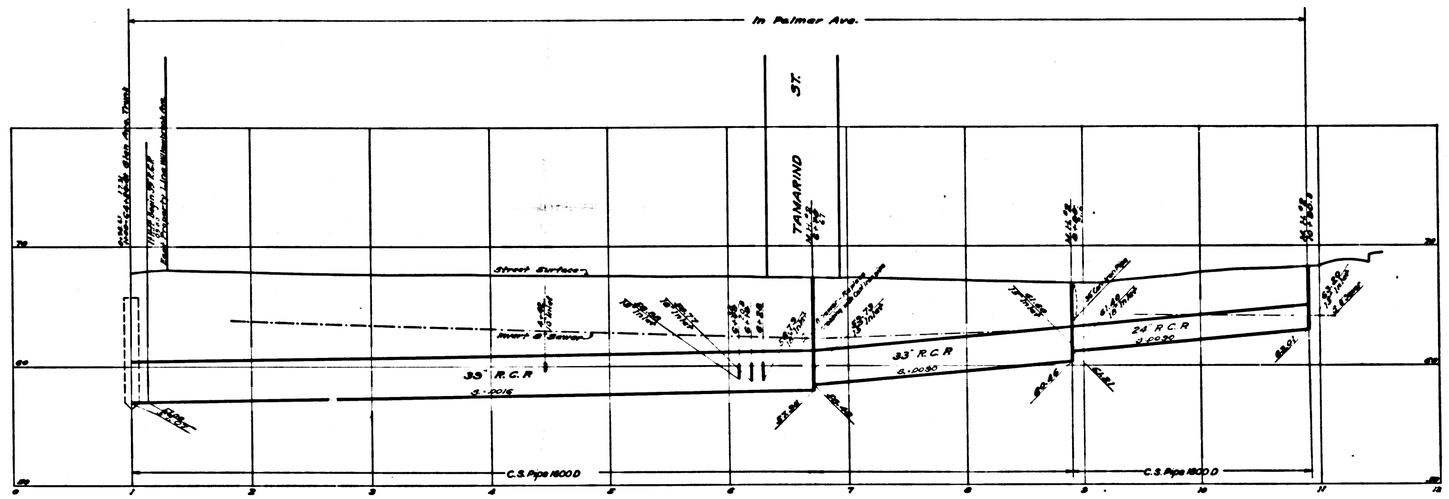

INDEX

Lines Shown on this Sheet Reading from left to right

PLAN AND PROFILE
PALMER AVE. BR.
ACACIA ST. BR.
SCHOOL ST. BR.
PALM ST. STUB
ALMOND ST. STUB
LAUREL ST. STUB
MYRRH ST. STUB
CYPRESS ST. STUB
OLIVE ST. BR.
CALDWELL ST. STUB

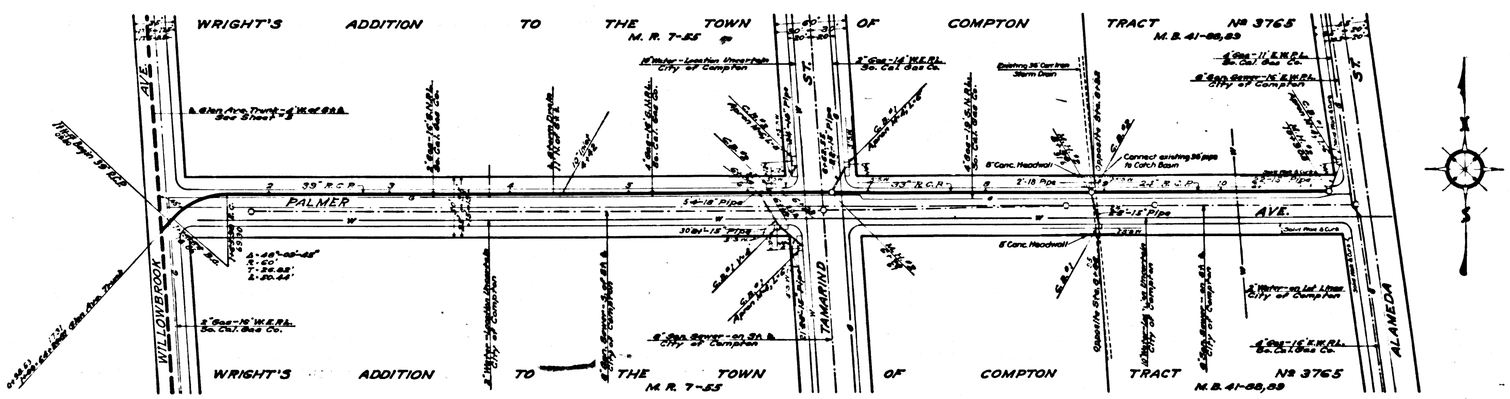

PALMER AVENUE BRANCH

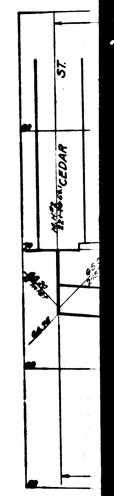

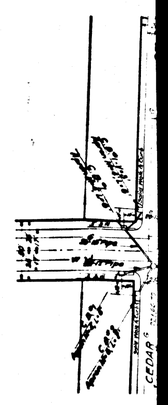

CSB-1171-13

A8 OF A8

Trim prints to this line