Trim Prints 7

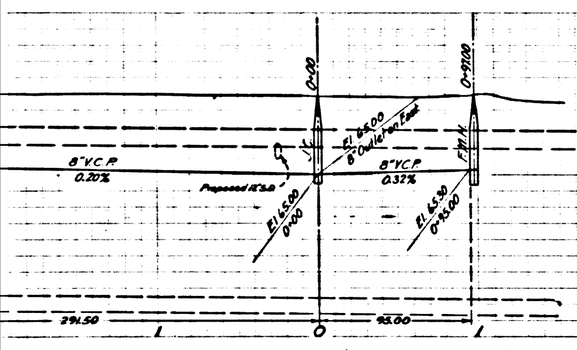

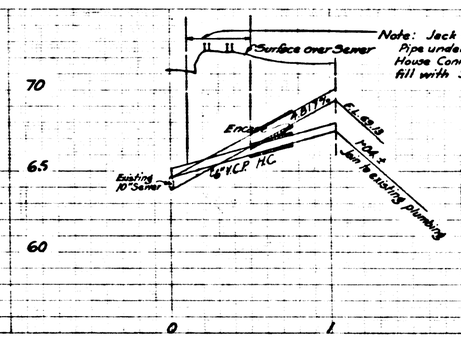

NOTES

1. USE SEWER JOINT COMPOUND FOR ALL PIPE JOINTS EXCEPT AS NOTED.
2. USE "D & D" SAFETY AND NOISELESS MANHOLE FRAMES AND COVERS — NOTE — THE WORD "COUNTY" SHALL BE OMITTED FROM ALL COVERS TO BE INSTALLED WITHIN THE CITY OF COMPTON
3. USE STANDARD STRENGTH PIPE EXCEPT AS NOTED
4. TRENCH NOT TO BE RESURFACED EXCEPT AS NOTED
5. RECONNECT EXISTING HOUSE SERVICES

GLEN AVENUE DRAINAGE SYSTEM

(24)

PROFILE, ALIGNMENT AND GRADE OF

SANITARY SEWERS

TO BE CONSTRUCTED IN

SANITARY SEWER RIGHT OF WAY

IN TRACT No. 759, M. B. 16, 13

WILLOWBROOK AVENUE

BETWEEN SLY. LINE TR. No. 3765, M. B. 41, 88 AND ROSECRANS AVE.

MONA BOULEVARD

BETWEEN ROSECRANS AVE. AND ORIS ST.

ALAMEDA STREET

BETWEEN CALDWELL ST. AND OLIVE ST.

AND IN PORTIONS OF

WILLOWBROOK AVE. ROSECRANS AVE. ORIS ST.

SCALE 1 FOOT = 1 INCH HORIZ. 1 INCH = 40 FEET DEC 1935

SHEET 24 OF 26 SHEETS

COUNTY OF LOS ANGELES, CALIFORNIA

ALFRED JONES COUNTY SURVEYOR

RECOMMENDED [signature] CHIEF DEPUTY APPROVED [signature] COUNTY SURVEYOR

APPROVED [signature] CHIEF ENGINEER OF COUNTY SANITATION DISTRICT No. 2

FOR LEGEND SEE PLAN NO. D-6-84

NOTE:

GRADES TO WHICH THIS IMPROVEMENT IS TO BE CONSTRUCTED ARE SHOWN ON PLANS AND PROFILES. GRADE POINTS FOR TOP OF CURB, CENTER LINE OF STREET OR CENTER LINE OF ALLEY ARE SHOWN BY CIRCLES ON PROFILES. AT ALL POINTS BETWEEN DESIGNATED POINTS THE GRADE SHALL BE ESTABLISHED SO AS TO CONFORM TO A STRAIGHT LINE DRAWN BETWEEN SAID DESIGNATED POINTS.

ELEVATIONS ARE IN FEET ABOVE U. S. G. S. DATUM OR MEAN SEA LEVEL.

UNIT PRICES FOR ADDITIONAL WORK WHICH MAY BE REQUIRED BUT WHICH CANNOT BE ASCERTAINED IN ADVANCE SHALL BE SUBMITTED IN THE PROPOSAL.

THIS DRAWING AND THE DATA HEREON ARE HEREBY MADE A PART OF THE SPECIFICATIONS.

REFERENCES			
W. S. 26	DESIGNED	BEMIS	SEPT. 1935
A. B.	TRACED	BLACKMER	OCT. 1935
L. B. 819-678	CHECKED	KUENZEL	OCT. 1935

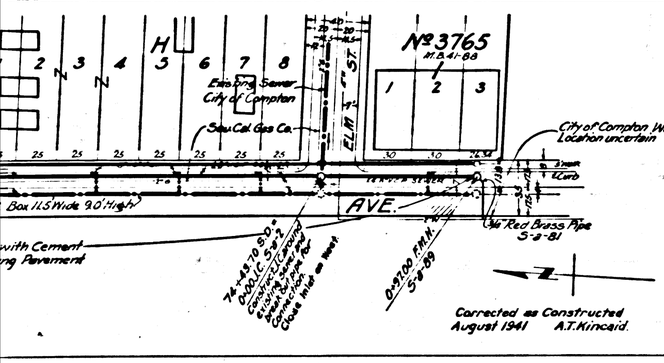

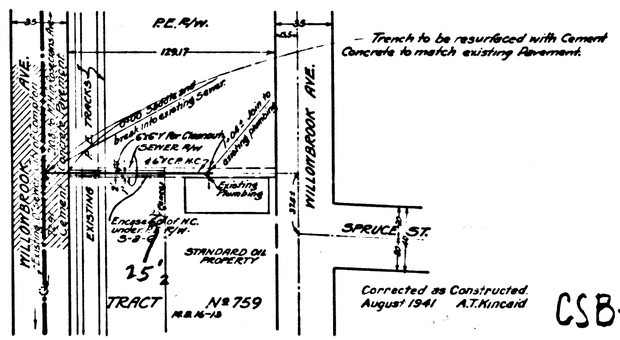

CSB-1171-24

A1 OF A6

Trim Prints
Designed - Bemis - Sept.
Traced - Blackmer - Oct.
Checked - Kuenzel - "

L.B. 819 p 97

W.S. 26 Trace 6.68-10-8-35

L.B. 819 p 123

Top B.M. 63.83

Surface over Sewer

8"V.C.P. 0.32%

S.D. Box 11.5 Wide 9.0 High

El 64.40 0+02.00 Proposed 21" S.D.

M.H. El 64.32 8" Outlet on West

8"V.C.P. 0.20%

El 64.77 5+81.00

El 64.17 5+81.30

294.34 299.70

S.D. Box 11.5 Wide 9.0 High

Proposed 12" S.D.

8"V.C.P. 0.20%

El 65.58 2+91.50

2+91.50

8"V.C.P. 0.20%

Proposed 12" S.D.

8"V.C.P. 0.37%

El 65.00 8" Outlet on East

El 65.50 0+00

El 65.00 0+95.00

95.00

277.50 278.00

S=0.0009

300.10 295.50

291.50

70 65 60

2 1 0 9 8 7 6 5 4 3 2 1 0 1

Sou Cal Gas Co.

Existing 8" Sewer City of Compton

Proposed Sewer Shown at Left

Curb

City of Compton Water Dept.

Existing 8" Sewer to be abandoned

8" V.C.P. Sewer

S.D. Box 11.0 Wide 9.0 High

BLVD.

Curb

ment Concrete Pavement

R.R. Track

R.R. Track

to be resurfaced with Cement to match existing Pavement.

Proposed S.D.

ROSECRANS

0+00 M.H. S=0.1 Construct M.H. around existing Sewer and bench out pipe for connection. Close mist from east.

Corrected as Construction August 1941. A.T. Kincaid

TRACT

A B C D E F G H

1 2 3 4 5 6 7 8

SPRUCE ST.



ELM ST.

AVE.

ROSECRANS AVE.

WILLOWBROOK

City of Compton Water Dept.

Sou Cal Gas Co.

Existing Sewer City of Compton

Cement Concrete Pavement

℄ Proposed S.D. Box 11.5 Wide 9.0 High

Trench to be resurfaced with Cement Concrete to match existing Pavement

Existing Sewer City of Compton

Sou Cal Gas Co.

No 3765 in 3.41.00

1 2 3

¼" Red Brass Pipe S=0.81

Existing H.C.'s

Proposed H.C. Shown at Right

STANDARD OIL PROPERTY

To Be Abandoned

℄ Proposed S.D.

CSB-1171-24

P.E. R/W.

A2 OF A6

Corrected as August 194

L.B. 819 p. 93

L.B. 819 p. 97

M.S. 26 Rev. 6-58

Top B.M. 62.83

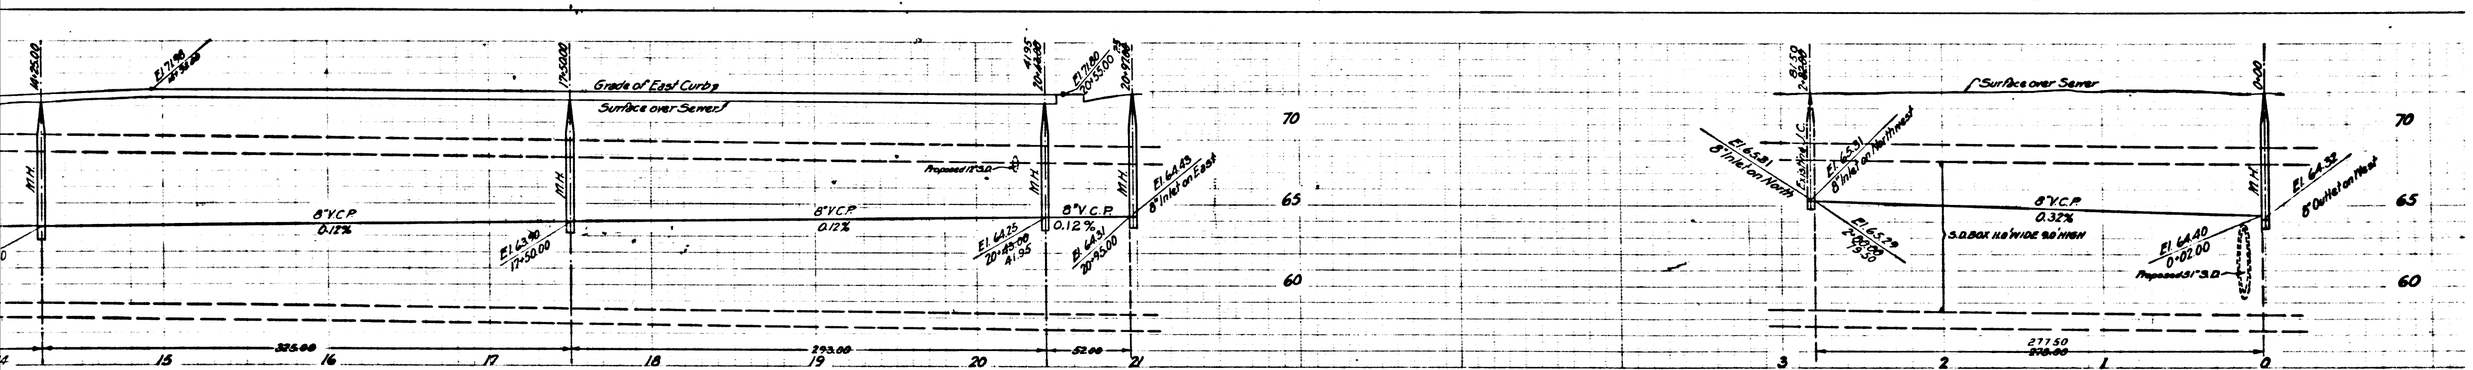
Grade of East Curb
Surface over Sewer
8"V.C.P. 0.12%
8"V.C.P. 0.12%
8"V.C.P. 0.12%
Proposed 17 S.D.
El. 64.43 8" Inlet on East
El. 63.90 17+50.00
El. 64.25 20+43.00 41.35
El. 64.31 20+93.00
335.00
293.00
52.00
15
16
17
18
19
20
21
70
65
60
Surface over Sewer
El. 65.31 8" Inlet on North
El. 65.31 8" Inlet on Northwest
El. 65.29 2+49.50
8"V.C.P. 0.32%
S.D. Box 11.0 Wide 9.0 High
El. 64.40 0+02.00
Proposed 91" S.D.
El. 64.32 8" Outlet on West
277.50
278.00
3
2
1
0

TRACT
TRACT 1
2
3
4
5
6
7
8
9
M.B. 12-73
M.B. 44-29
No. 4119
M 25.00 M.H. S-8-7
City of Compton Water Dept.
Sou. Cal. Gas Co.
Curb & Gutter
Dirt Surface
Trench to be resurfaced with Cement Concrete to match existing Pavement
M 17+50.00 M.H. S-8-7
Existing H.C.'s
8" S.D. Box 11.0 Wide 9' High
8" V.C.P. Sewer
Existing Sewer to be abandoned
Proposed Sewer Shown at Right
Cement Concrete Pavement
Curb
Walk
BLVD.
AVE.
Existing 8" Sewer City of Compton
20+93.00 M.H. S-8-7 Construct M.H. around existing 8" V.C.P. Sewer & lay out existing Connection Close outlet to west
Built 6.0' S. & 71.8' E. of S. intersection
Corrected as Constructed. August 1941 A.T. Kincaid
CSB-1171-24
A 3 OF A 6
ROSECRANS
MILLSBROOK AVE.
E19-38, O.R. 15193-38 (Storm Drain)
L.B. 819 p. 94
L.B. 819 p. 112
L.B. 678 & 685 & p. 81
L.B. 819 p. 93
MONA
Proposed Sewer Shown at Left
Sou. Cal. Gas Co.
Existing 8" Sewer City of Compton
Existing 8" Sewer abandoned
8" V.C.P. Sewer
S.D. Box 11.0 Wide 9.0 High
Cement Concrete Pavement
Curb
Existing 8" Sewer City of Compton
Trench to be resurfaced with Cement Concrete to match existing Pavement.
Corrected as Constructed August 1941 A.T. Kincaid

USE WESTON'S GASKETS AND FORMS FOR ALL PIPE JOINTS.

Surface over Sewer ℄

M.H. 4+50.00

M.H. 7+75.00

M.H. 11+00.00

STORM DRAIN BOX 11.0 WIDE, 9.0 HIGH

M.H. 14+25.00

8" V.C.P. 0.12%

El 62.34 4+50.00

8" V.C.P. 0.12%

El 62.73 7+75.00

8" V.C.P. 0.12%

El 63.12 11+00.00

S=0.0009 per foot ℄

8" V.C.P. 0.12%

El 63.51 14+25.00

8" V.C.P. 0.12%

El 63.9 17+50

El 71.25 13+38.00

El 71.60 14+38.00

2 — 325.00 — 3 — 4 — 5 — 325.00 — 6 — 7 — 8 — 325.00 — 9 — 10 — 11 — 325.00 — 12 — 13 — 14 — 325.00 — 15 — 16 — 17

BOLAND

TRACT M.B. 12-73

TRACT

2 — 3 — 4 — 5 — 6 — 7 — 8 — 9 — 10 — 11 — 12 — 1 — 2 — 3 — 4

ALLEY — ALLEY — MEALY ST.

8"x16" V.S.

4+50.00 M.H. S-8-1

7+75.00 M.H. S-8-1

11+00.00 M.H. S-8-1

14+25.00 M.H. S-8-1

℄ 8" V.C.P. Sewer

Curb Line ℄

Curb & Gutter ℄

City of Compton Water Dept.

Sou. Cal. Gas Co.

Dirt Surface

DITCH

MONA

℄ of St.

Existing Sewer City of Compton

WINONA AVE.

LARGO ST.

ALLEY

Curb & Gutter

WILMINGTON AVE.

E 19-38, O.R. 15,193-38 (Storm Drain)

L.B. 678 & 87

CSB-1171-24

A4 OF A6

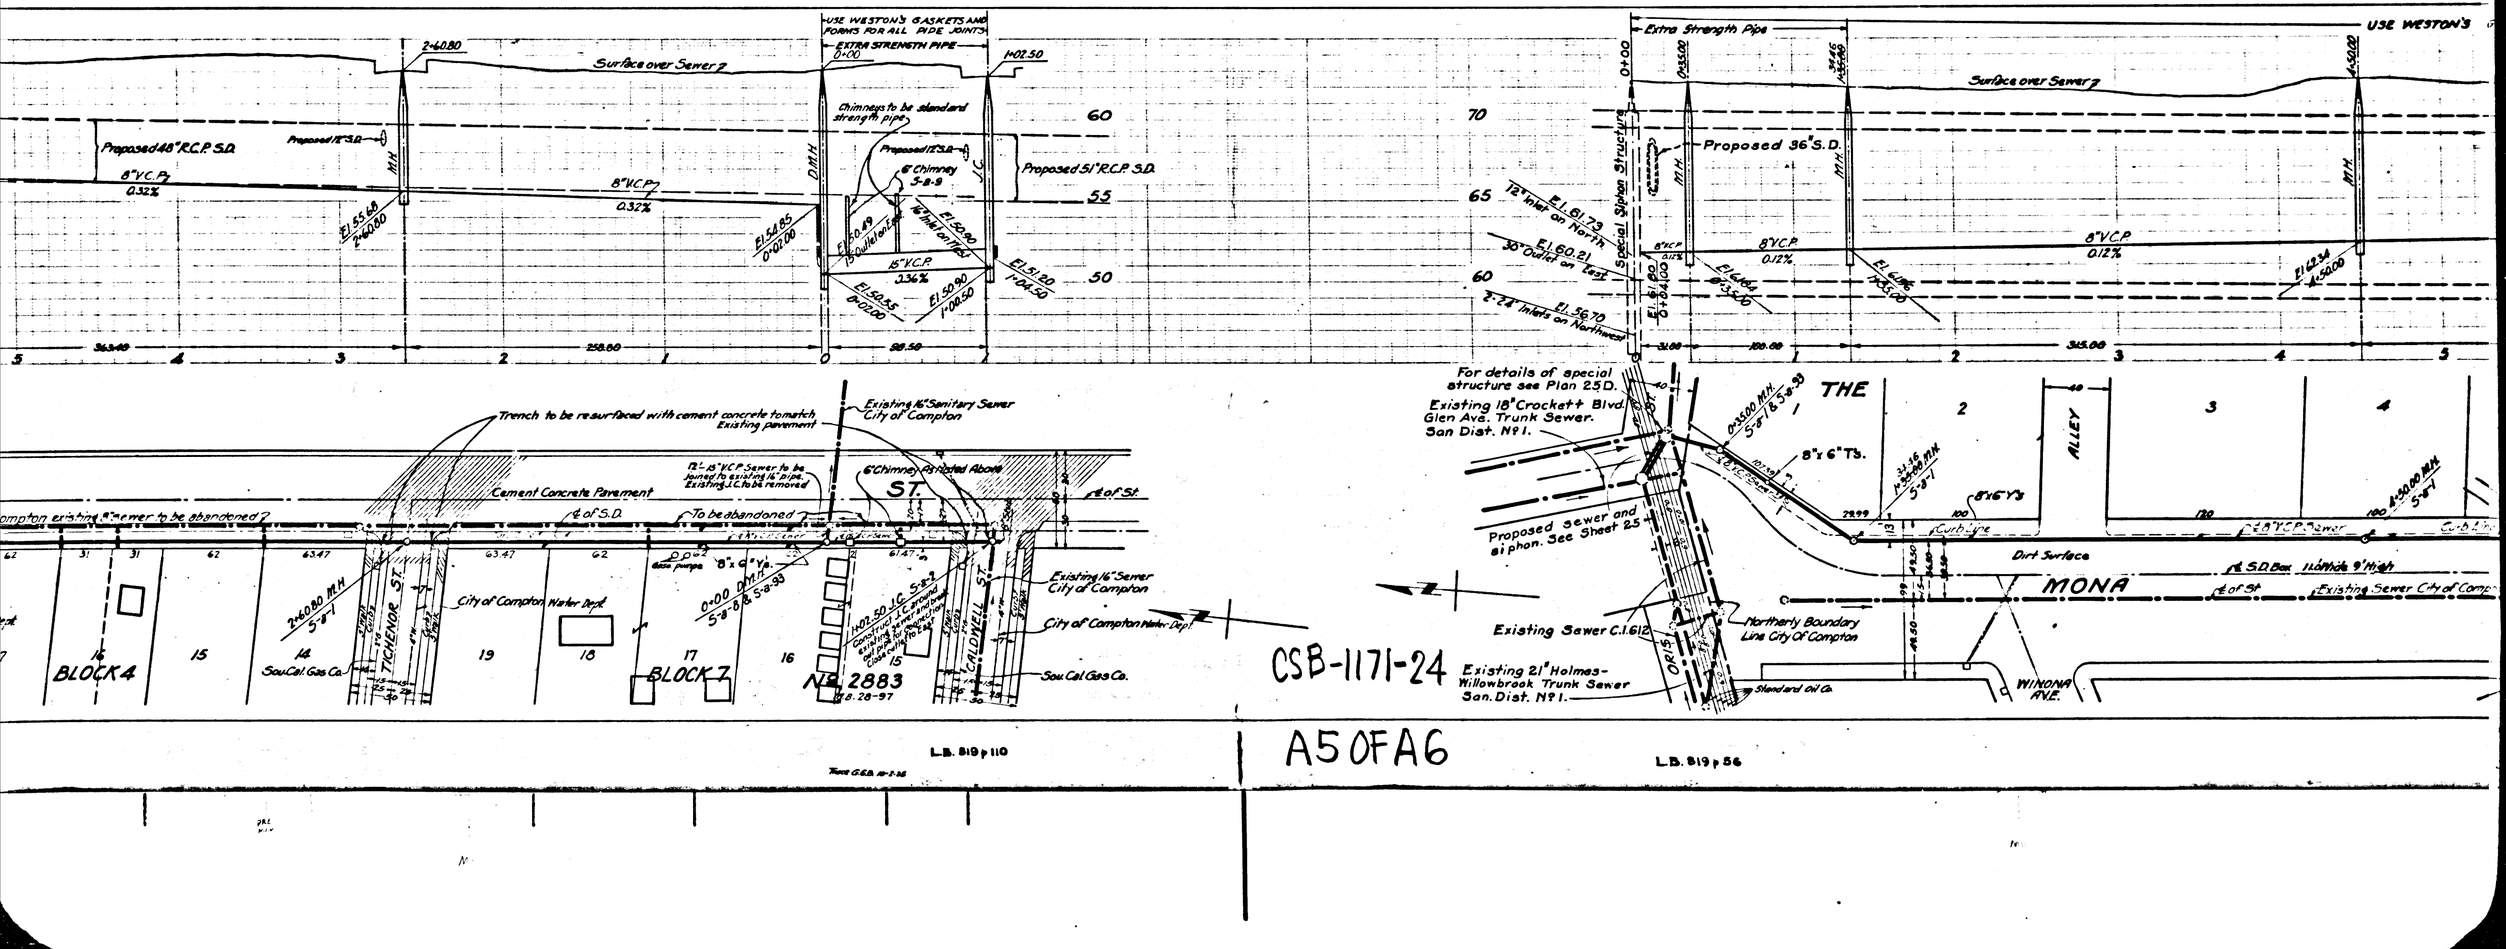
USE WESTON'S GASKETS AND FORMS FOR ALL PIPE JOINTS
EXTRA STRENGTH PIPE
0+00
1+02.50
2+60.80
Surface over Sewer ℄
Proposed 48" R.C.P. S.D.
Proposed 12" S.D.
8" V.C.P. 0.32%
M.H.
El. 55.68 2+60.80
8" V.C.P. 0.32%
El. 54.85 0+02.00
D.M.H.
J.C.
Chimneys to be standard strength pipe.
Proposed 12" S.D.
6' Chimney S-8-9
Proposed 51" R.C.P. S.D.
El. 50.49 12" Outlet on Test
16" Inlet on Test
El. 50.90
15" V.C.P. 0.36%
El. 50.55 0+02.00
El. 50.90 1+02.50
El. 51.20 1+04.50
60
55
50
5
4
3
2
1
0
363.49
258.80
98.50
Extra Strength Pipe
0+00
0+35.00
34+46
35+80
4+50.00
USE WESTON'S
70
65
60
Special Siphon Structure
Proposed 36" S.D.
M.H.
12" Inlet on North
El. 61.73
30" Outlet on Test
El. 60.21
3-24" Inlets on Northwest
El. 56.70
El. 61.90 0+00.00
8" V.C.P. 0.12%
El. 61.46 0+35.00
El. 61.34 4+50.00
31.00
100.00
315.00
For details of special structure see Plan 25D.
Existing 18" Crockett Blvd. Glen Ave. Trunk Sewer. San Dist. No 1.
0+35.00 M.H. S-8 & S-8-93
8" x 6" Ts.
8" x 6" Y's
ALLEY
Proposed sewer and siphon. See Sheet 25
Curb Line
Dirt Surface
℄ S.D. Box 11 Wide 9' High
MONA
℄ of St.
Existing Sewer City of Compton
Northerly Boundary Line City Of Compton
Existing Sewer C.I. 612
Existing 21" Holmes-Willowbrook Trunk Sewer San. Dist. No 1.
Standard Oil Co.
WINONA AVE.
THE
Trench to be resurfaced with cement concrete to match Existing pavement
Existing 16" Sanitary Sewer City of Compton
12"-18" V.C.P. Sewer to be joined to existing 16" Pipe. Existing J.C. to be removed
6' Chimney Pitched Above
ST.
Cement Concrete Pavement
℄ of S.D.
To be abandoned
℄ of St.
Compton existing 8" sewer to be abandoned
2+60.80 M.H. S-8-1
City of Compton Water Dept.
0+00 M.H. S-8-8 & S-8-93
1+02.50 J.C. S-8-2
Existing 16" Sewer City of Compton
City of Compton Water Dept.
TICHENOR ST.
CALDWELL ST.
Sou. Cal. Gas Co.
BLOCK 4
BLOCK 7
No. 2883
11-8-28-97
CSB-1171-24
A5 OF A6
L.B. 819 p 110
L.B. 819 p 56

Trim Prints 7

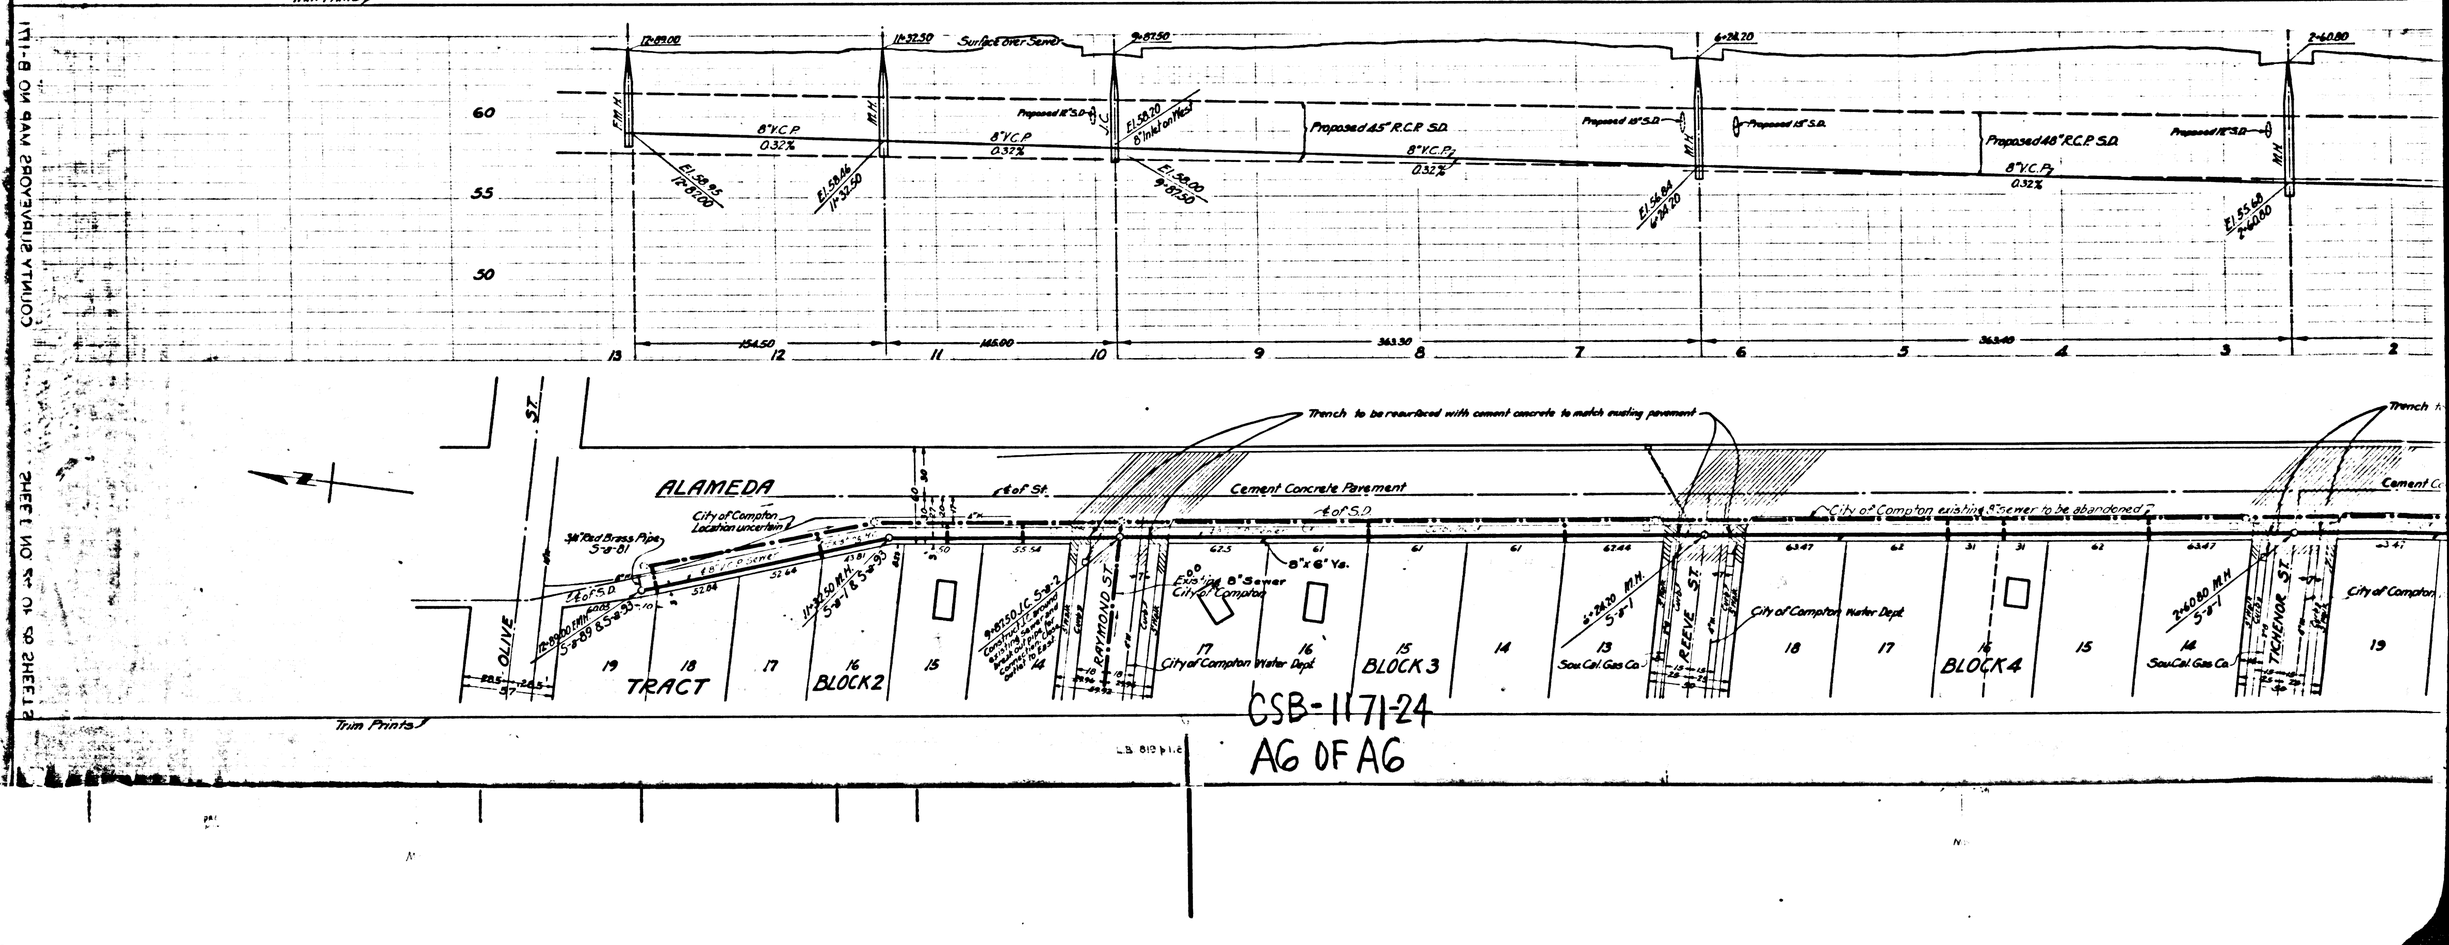

CSB-1171-24
AG OF AG6