Trim prints to this line

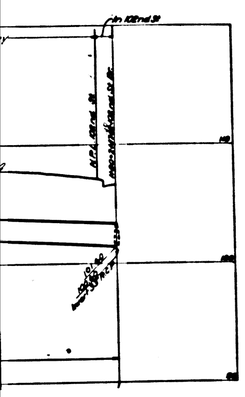

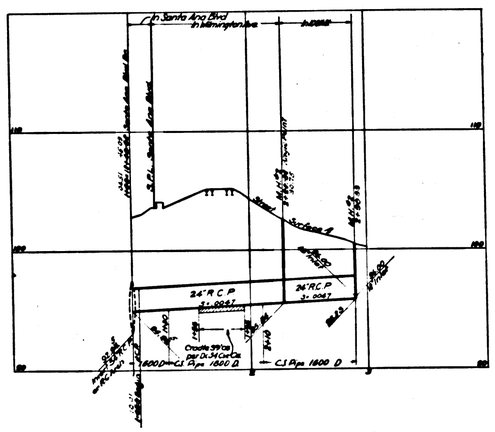

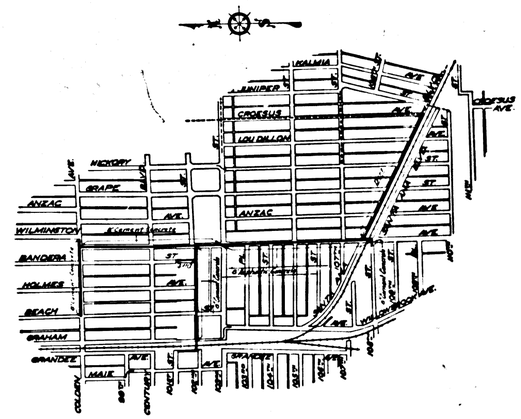

KEY MAP
SHOWING DRAINS AND RESURFACING

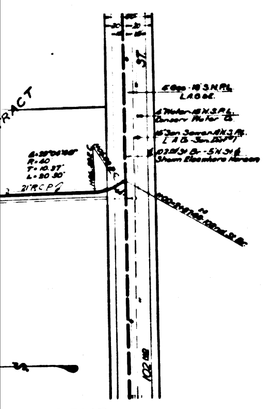

T STUB

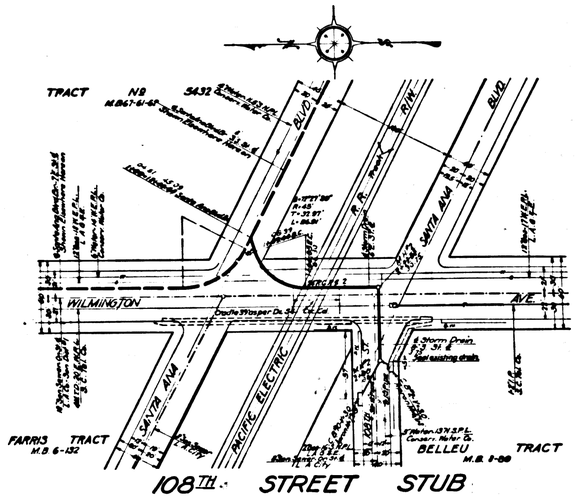

108TH STREET STUB

NOTES:

Elevations are in feet above U.S.G.S. or mean Sea Level Datum.

Stations of inlets and junctions refer to the intersections of the center lines of the inlets with the center line of the main drain.

Elevations of all inlets except catch basin inlets into box sections refer to the flow lines of the inlets produced on their gradients to the vertical plane thru the center line of the main drain. Elevations of catch basin inlets into box sections refer to the intersections of the flow lines of these inlets with the inside wall of the box section.

For details of all standard structures see Standard Plans.

All pipe not otherwise specified shall be plain cement pipe.

All stubs to be one length of pipe with ends sealed with 2" redwood planking, unless otherwise specified.

Catch basins shall be built with a curb face of 10" or more which shall include a minimum depression at opening of 4" below gutter grade, unless otherwise specified.

Sanitary sewers crossing storm drains, shown on profile with less than two feet clearance, are to be encased as per S-6 for a length equal to the width of conduit trench. In addition if less than 1/2 ft. clearance sewers must be of cast iron pipe and encased as noted above.

Corrected as Constructed — *September 1941* — *A.T. Hincaid*

GLEN AVENUE DRAINAGE SYSTEM

OF THE COUNTY OF LOS ANGELES, CALIFORNIA
PLAN AND PROFILE OF

SANTA ANA BLVD. BRANCH
WILMINGTON AVE. STUB
102ND. ST. BRANCH
BANDERA ST. STUB
108TH. ST. STUB

SHEET 9 OF 26 SHEETS

SCALE: HORIZ. 1" = 40' VERT. 1" = 20' — NOVEMBER 1935

ALFRED JONES — COUNTY SURVEYOR

RECOMMENDED [signature] — APPROVED [signature]

REFERENCE				
F.B.	495	DESIGNED	L. Longacre	NOV. 1931
L.B.	679	TRACED	P.I. Hunstock	MAY 1933
	Revised 6-7-38 7-22-38	CHECKED	E.E. Mitchell	MAR. 1934

9

CSB-1171-9
A1 OF A7

Trim prints to this line

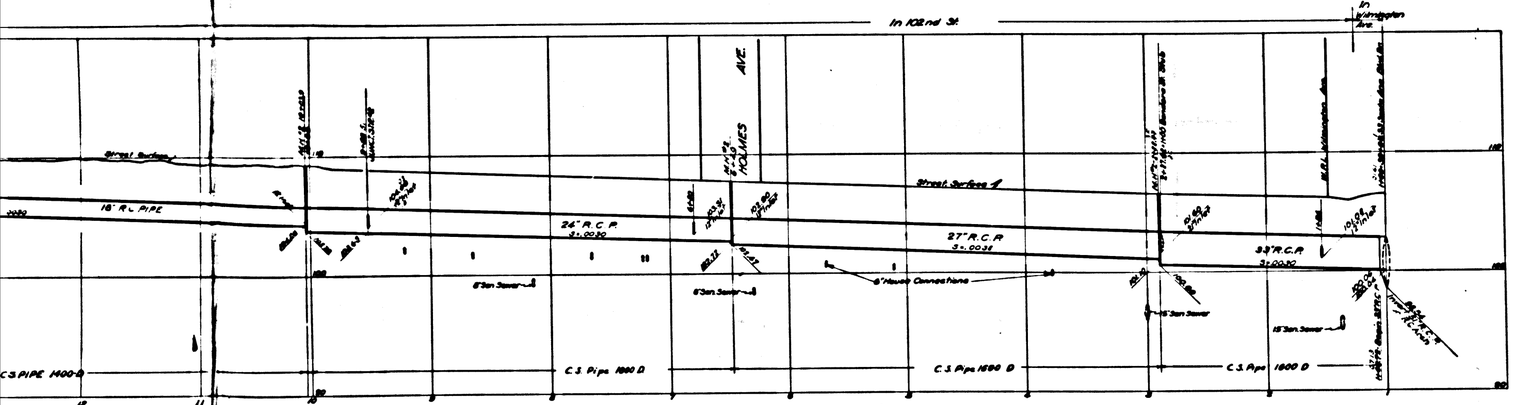

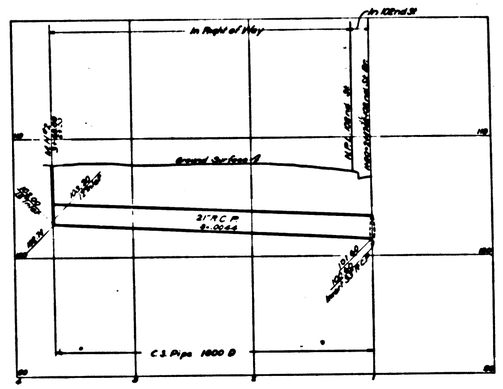

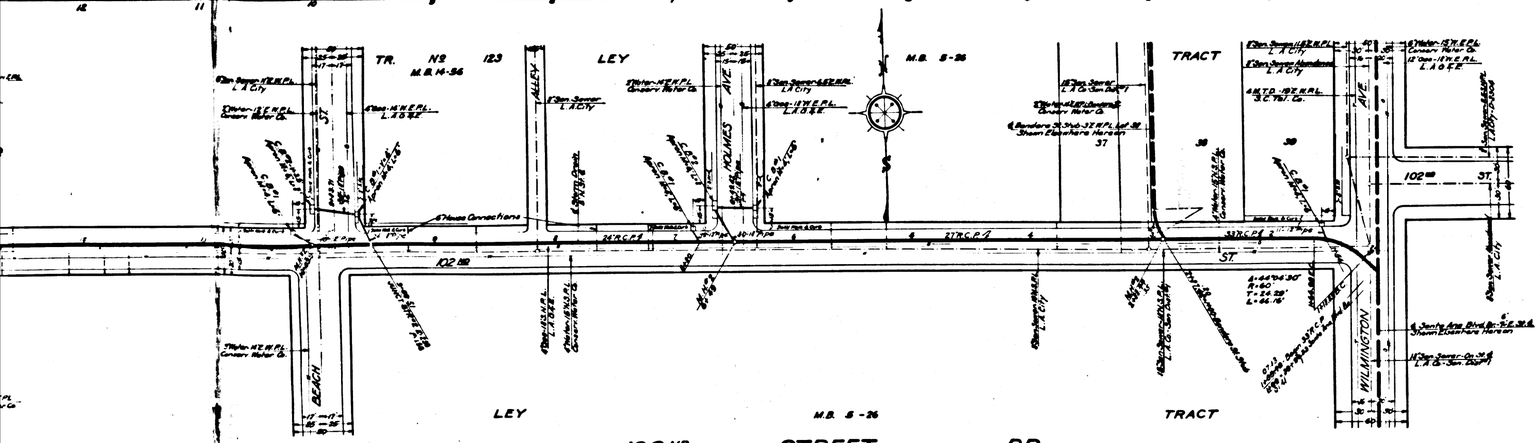

102ND STREET BR.

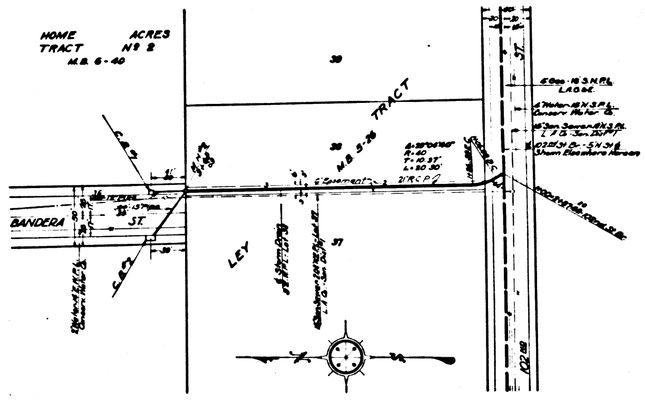

BANDERA STREET STUB

CSB-1171-9
A2 OF A7

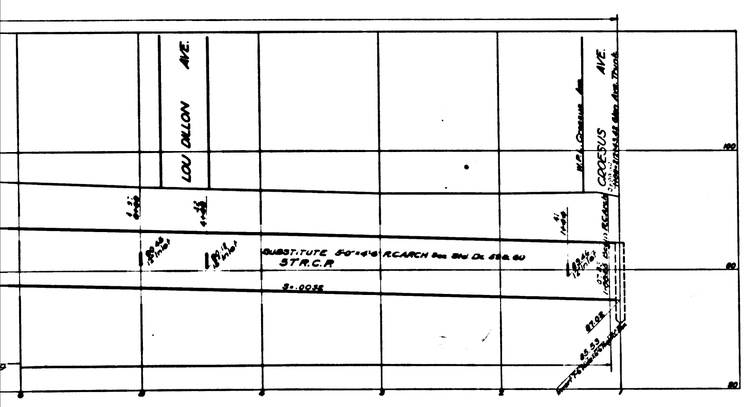

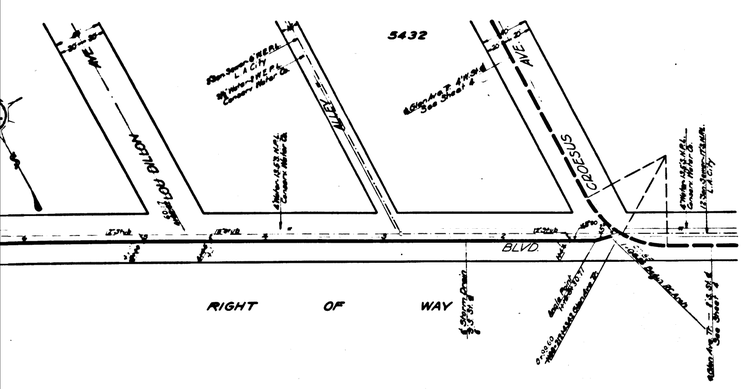

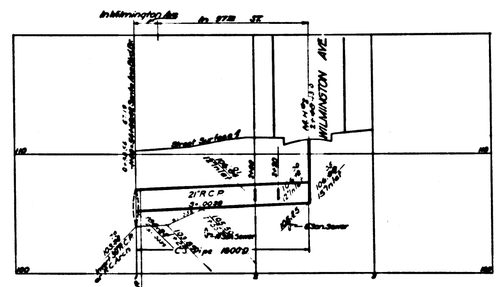

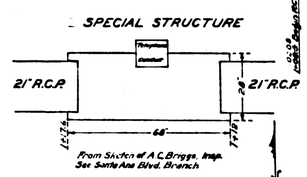

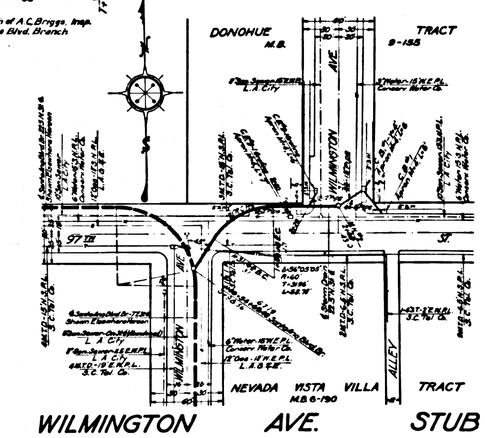

WILMINGTON AVE. STUB

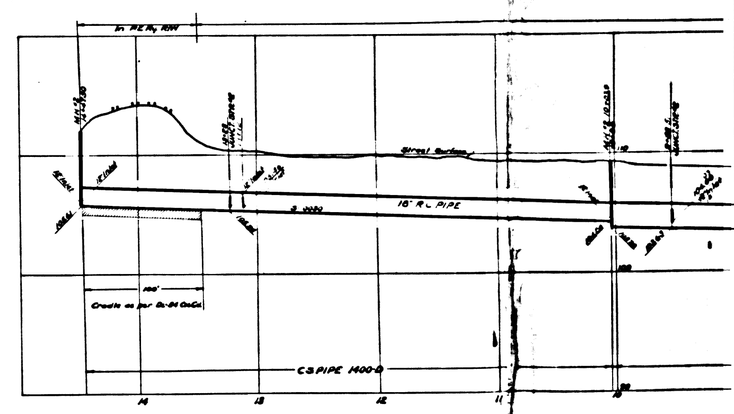

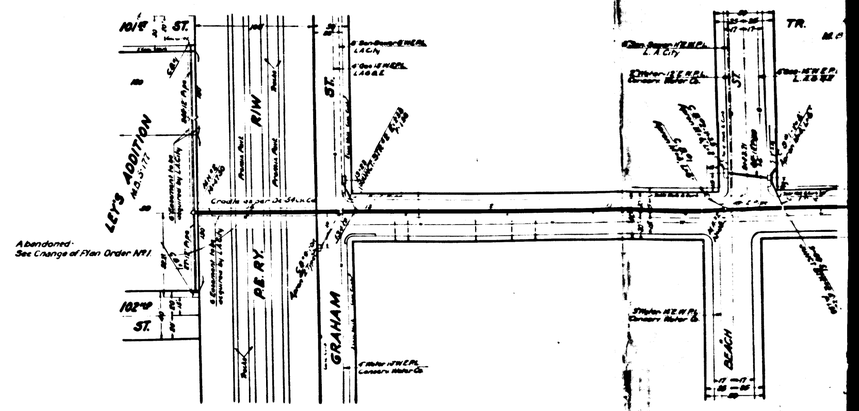

CSB-1171-9

A3 OF A7

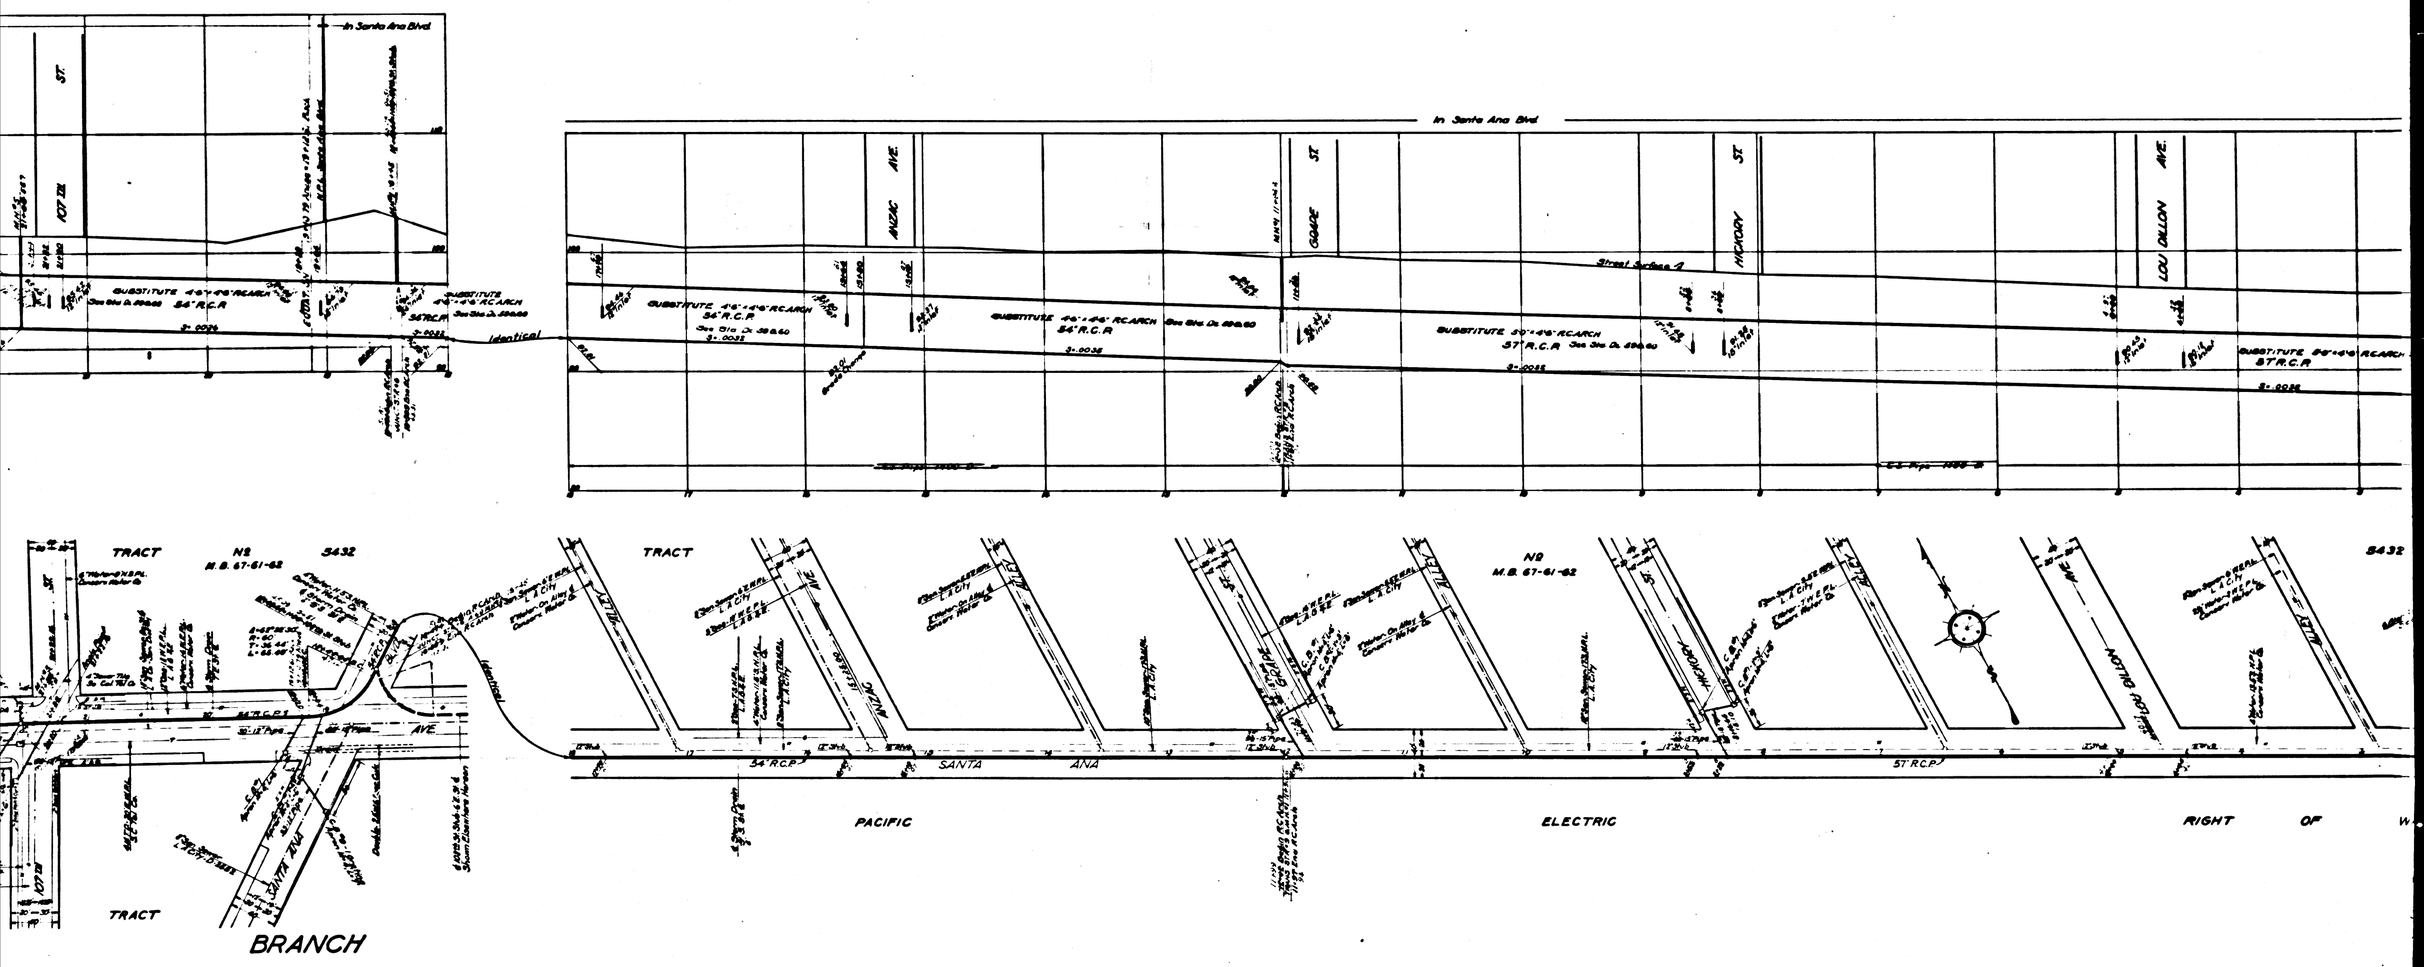

CSB-1171-9
A4 OF A7

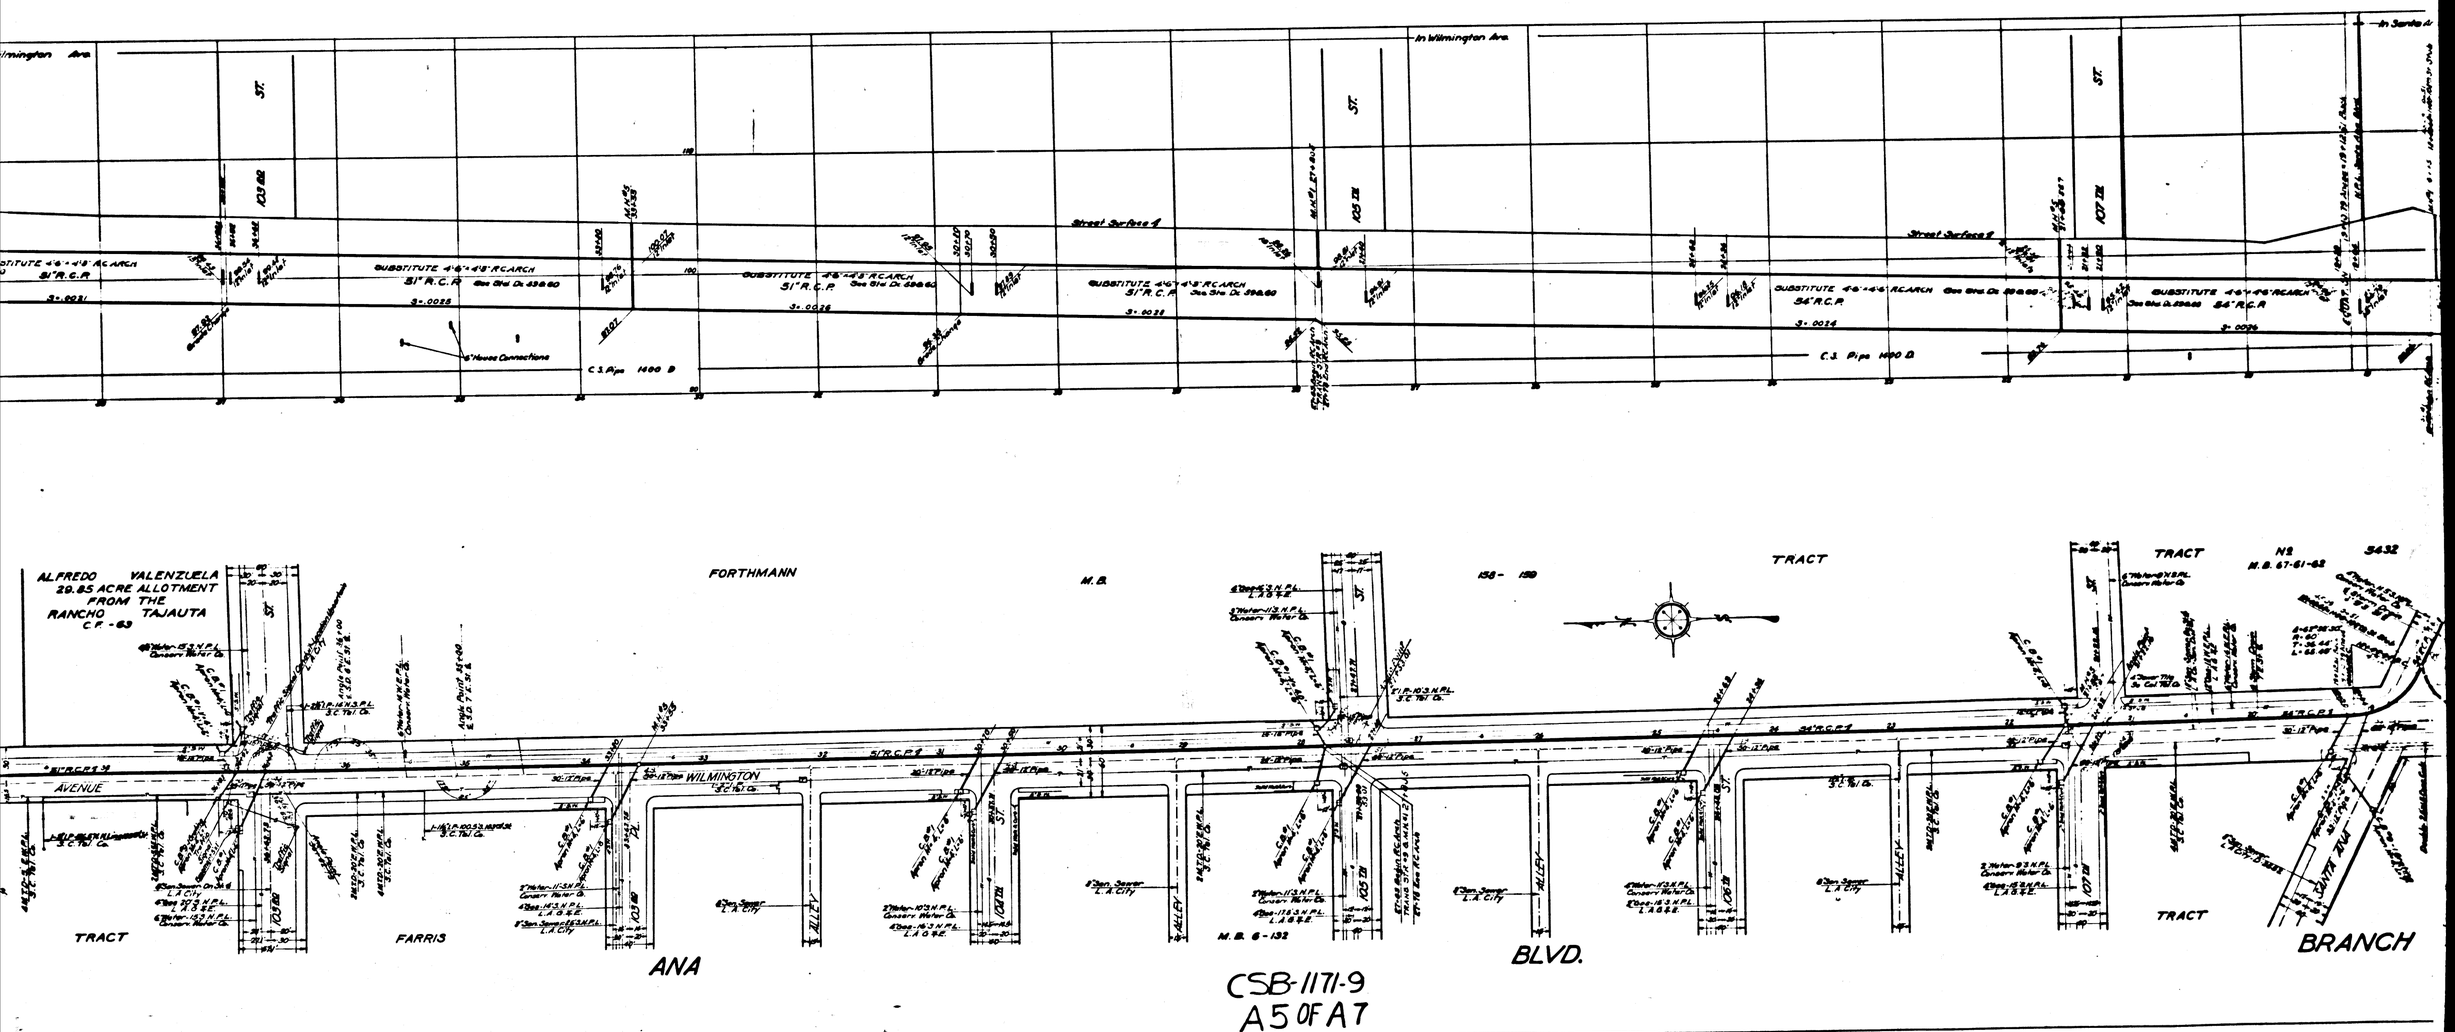

CSB-1171-9
A5 OF A7

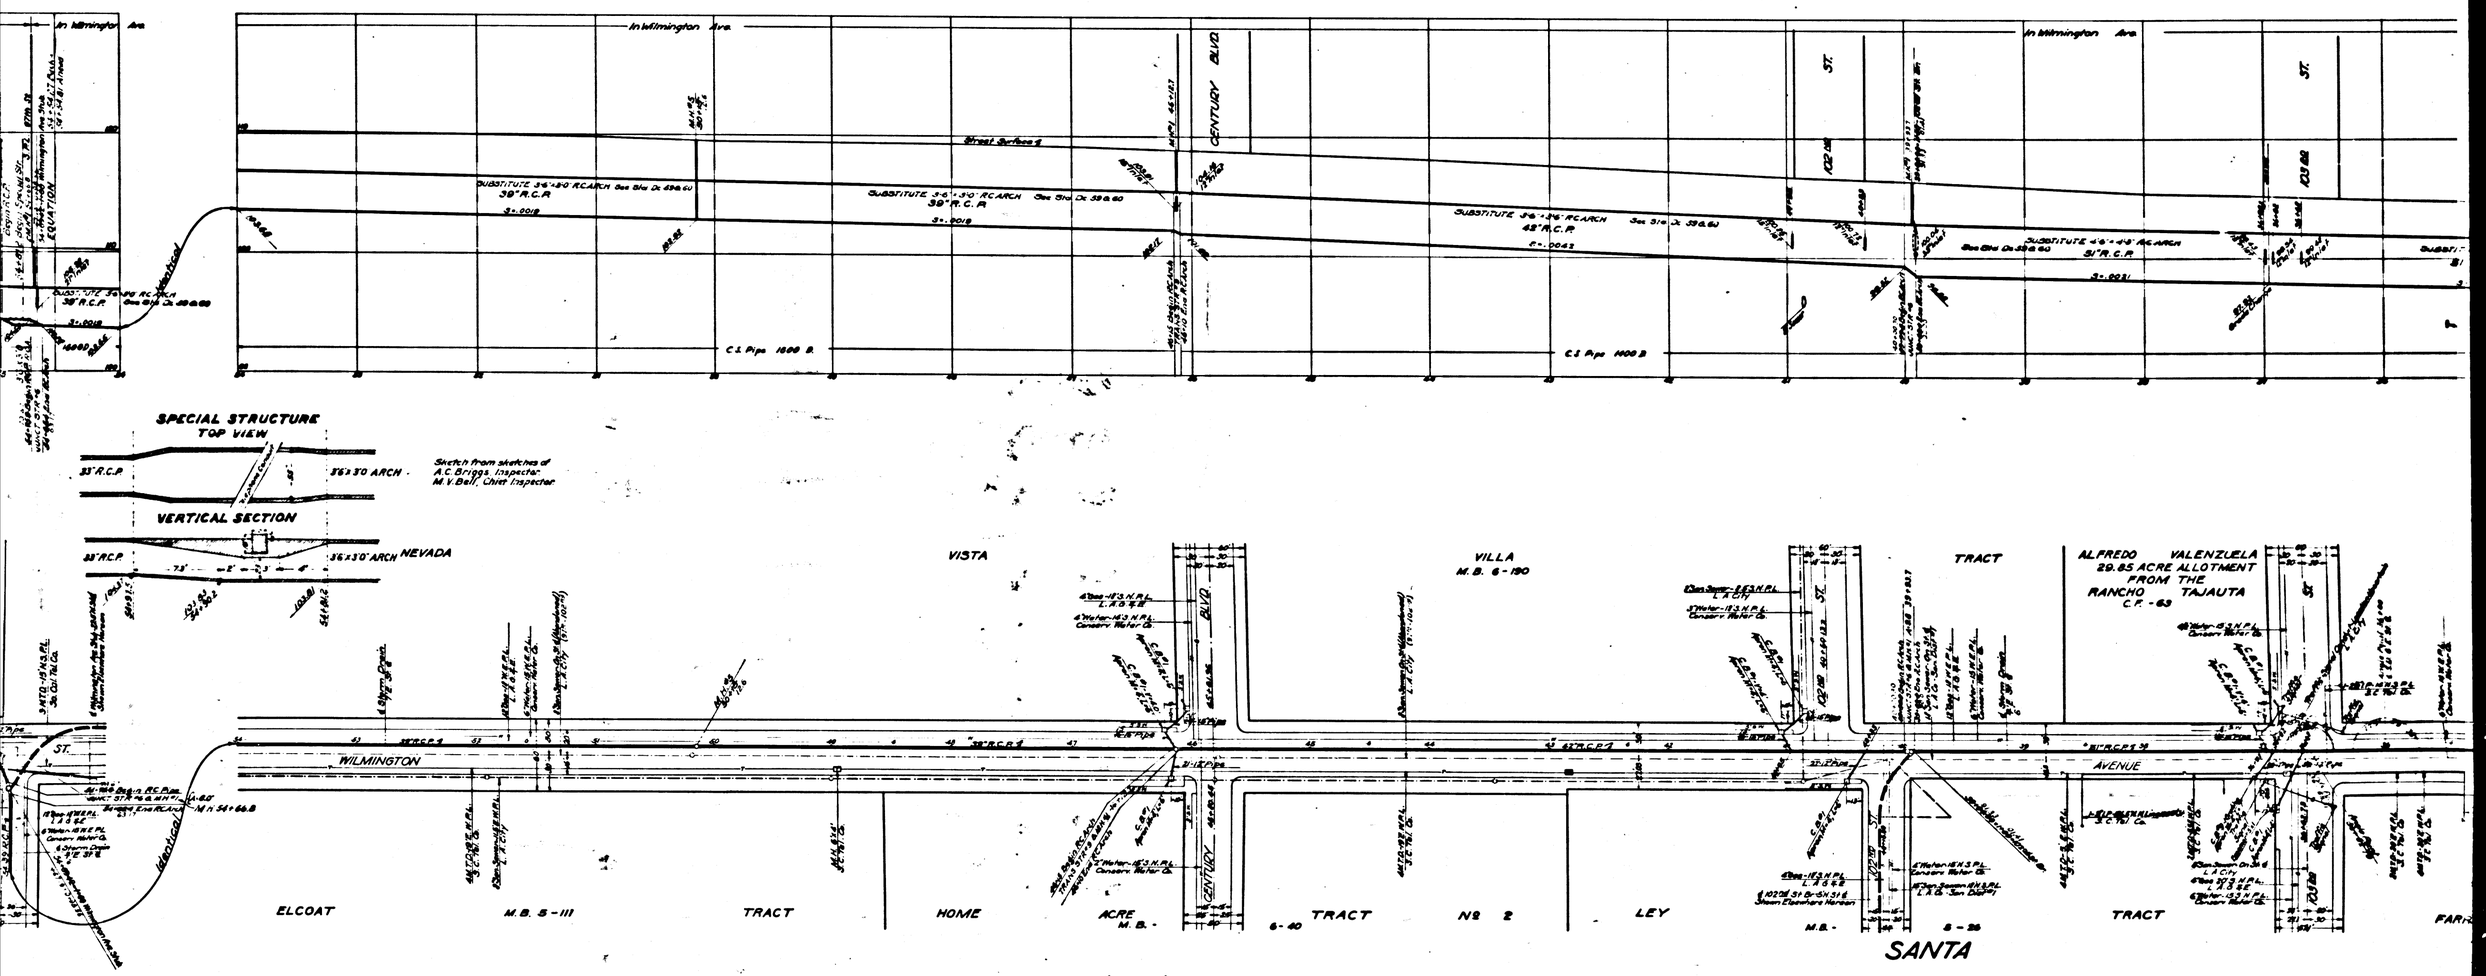

CSB-1171-9
A60FA7

Trim prints to this line

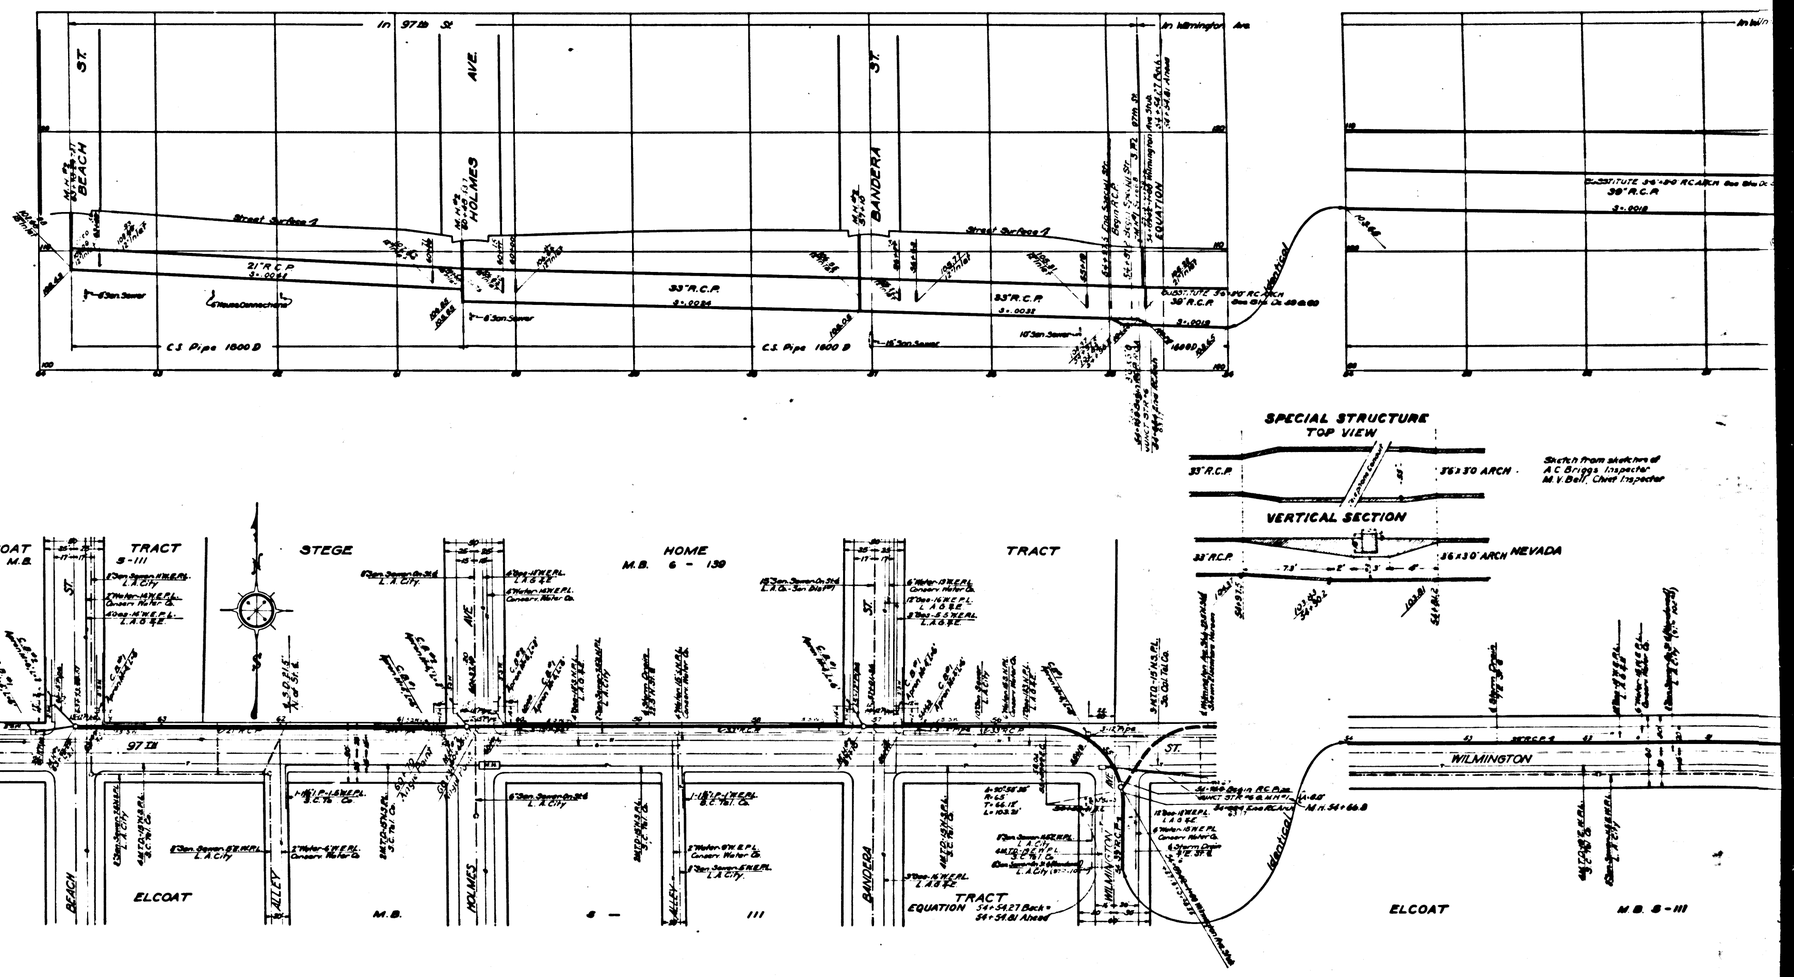

CSB-1171-9

A7 OF A7

Trim prints to this line