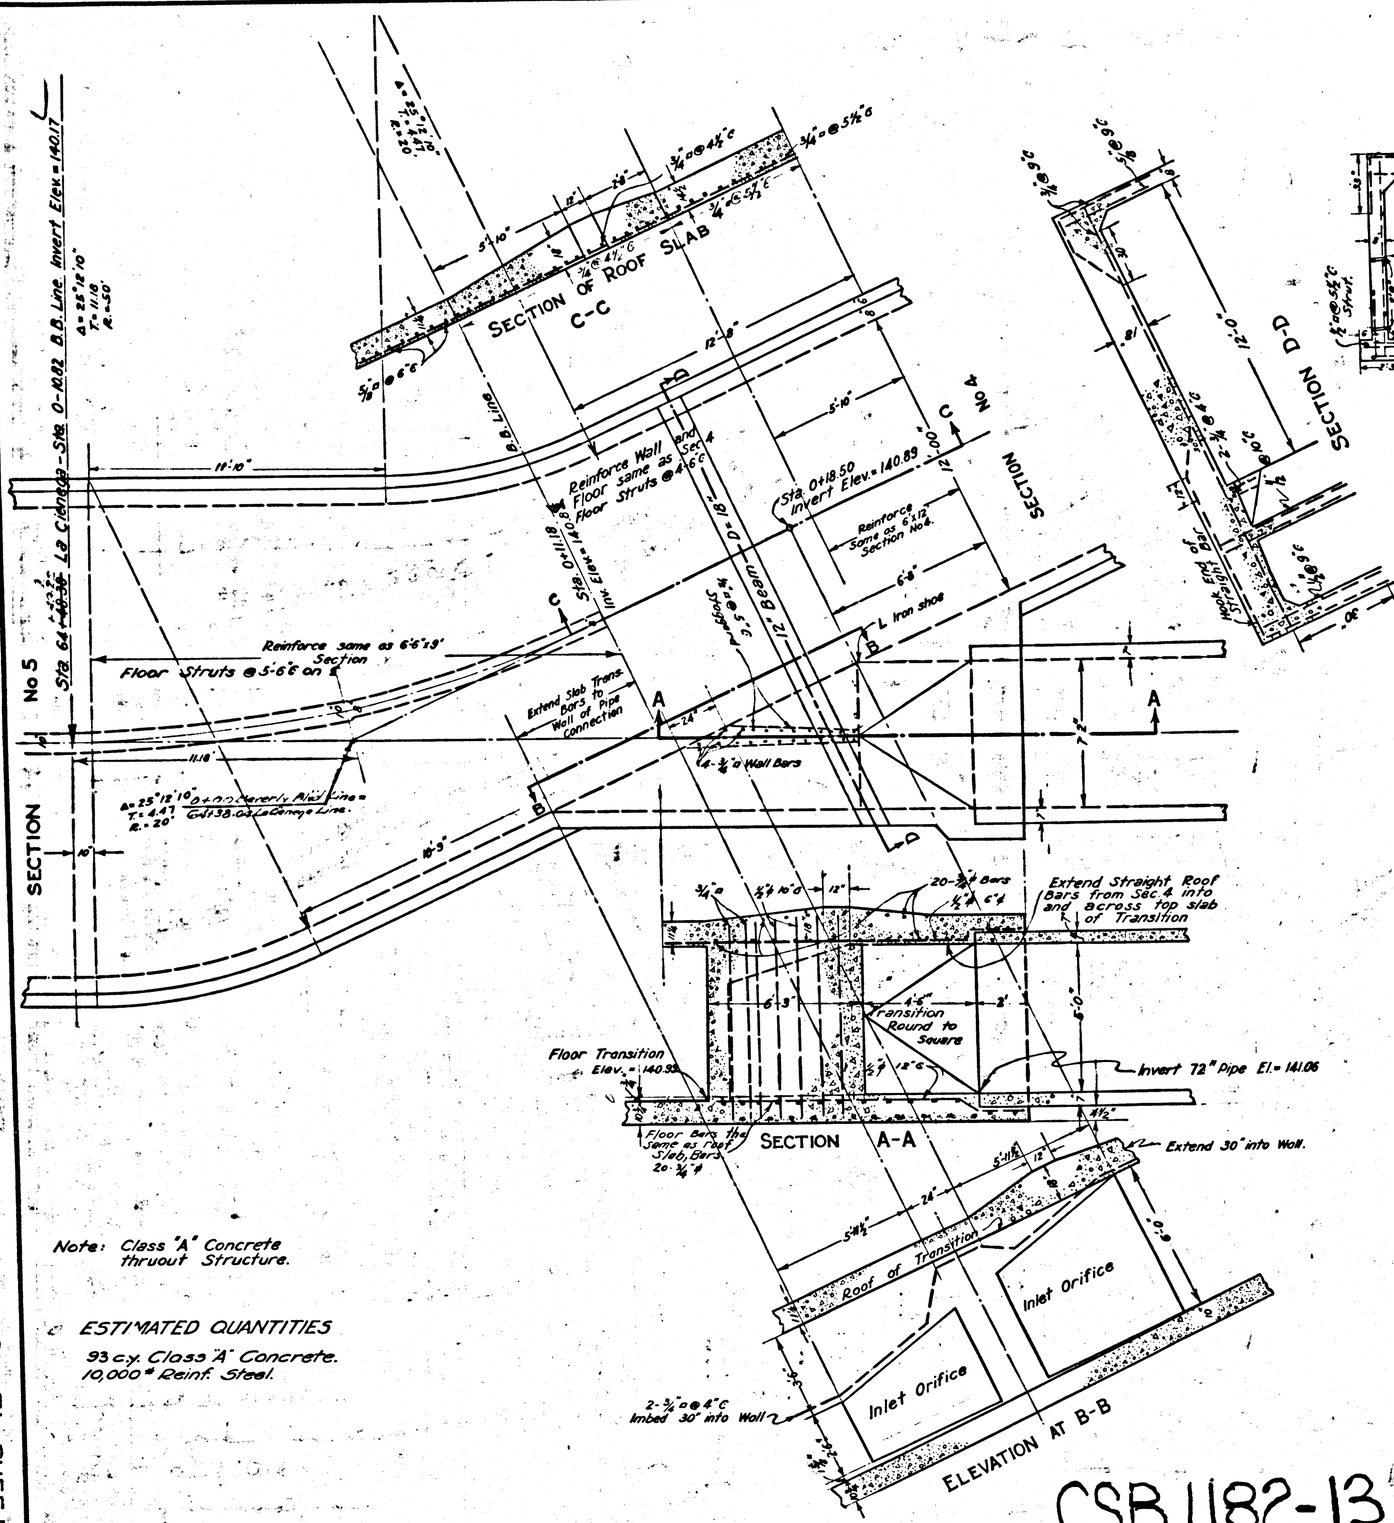

SECTION No. 5
1½" depth to steel thruout
NOTE: This section was constructed as Sec. P-5 with concrete and steel to replace gravel blanket. (See pgs. 9+12+72 of "Computations" book.)

SECTION No 4
1½" depth to steel thruout.
NOTE: This section was constructed as Special Sec. #4 with concrete and steel to replace gravel blanket. (See pgs. 19, 20+61 of "Computations" book.)

DRAINAGE DIST. IMPROVEMENT No 11
LOS ANGELES COUNTY, CALIFORNIA

PLAN AND SECTIONS
TRANSITION STRUCTURE
STA. 64+48.38 (+48.27) LA CIENEGA DRAIN

Scale: ¼" = 1' Oct. 24, 1924

J. E. ROCKHOLD COUNTY SURVEYOR

Submitted A. Warren SENIOR ENGINEER

Approved J. E. Rockhold COUNTY SURVEYOR

Approved as to form
Edward T. Bishop
County Counsel
By J. F. Moroney
DEPUTY

D. D. I. No 11		
DRAWN	A.M. Rawn	10-23-24
TRACED	Jack Renié	10-24-24
CHECKED	[signature]	11-10-24
Revised		2-9-27

CSB 1182-13
A1 of A1

SHEET 13 OF 21 SHEETS

COUNTY SURVEYORS MAP No B-1185
SHEET No 13 OF 21 SHEETS