DM 5556-134

70

134

Banning Company
To
Pacific Electric Railway Co.

Tide Lands Adjacent to
WILMINGTON
Superior Court Case No. 6395

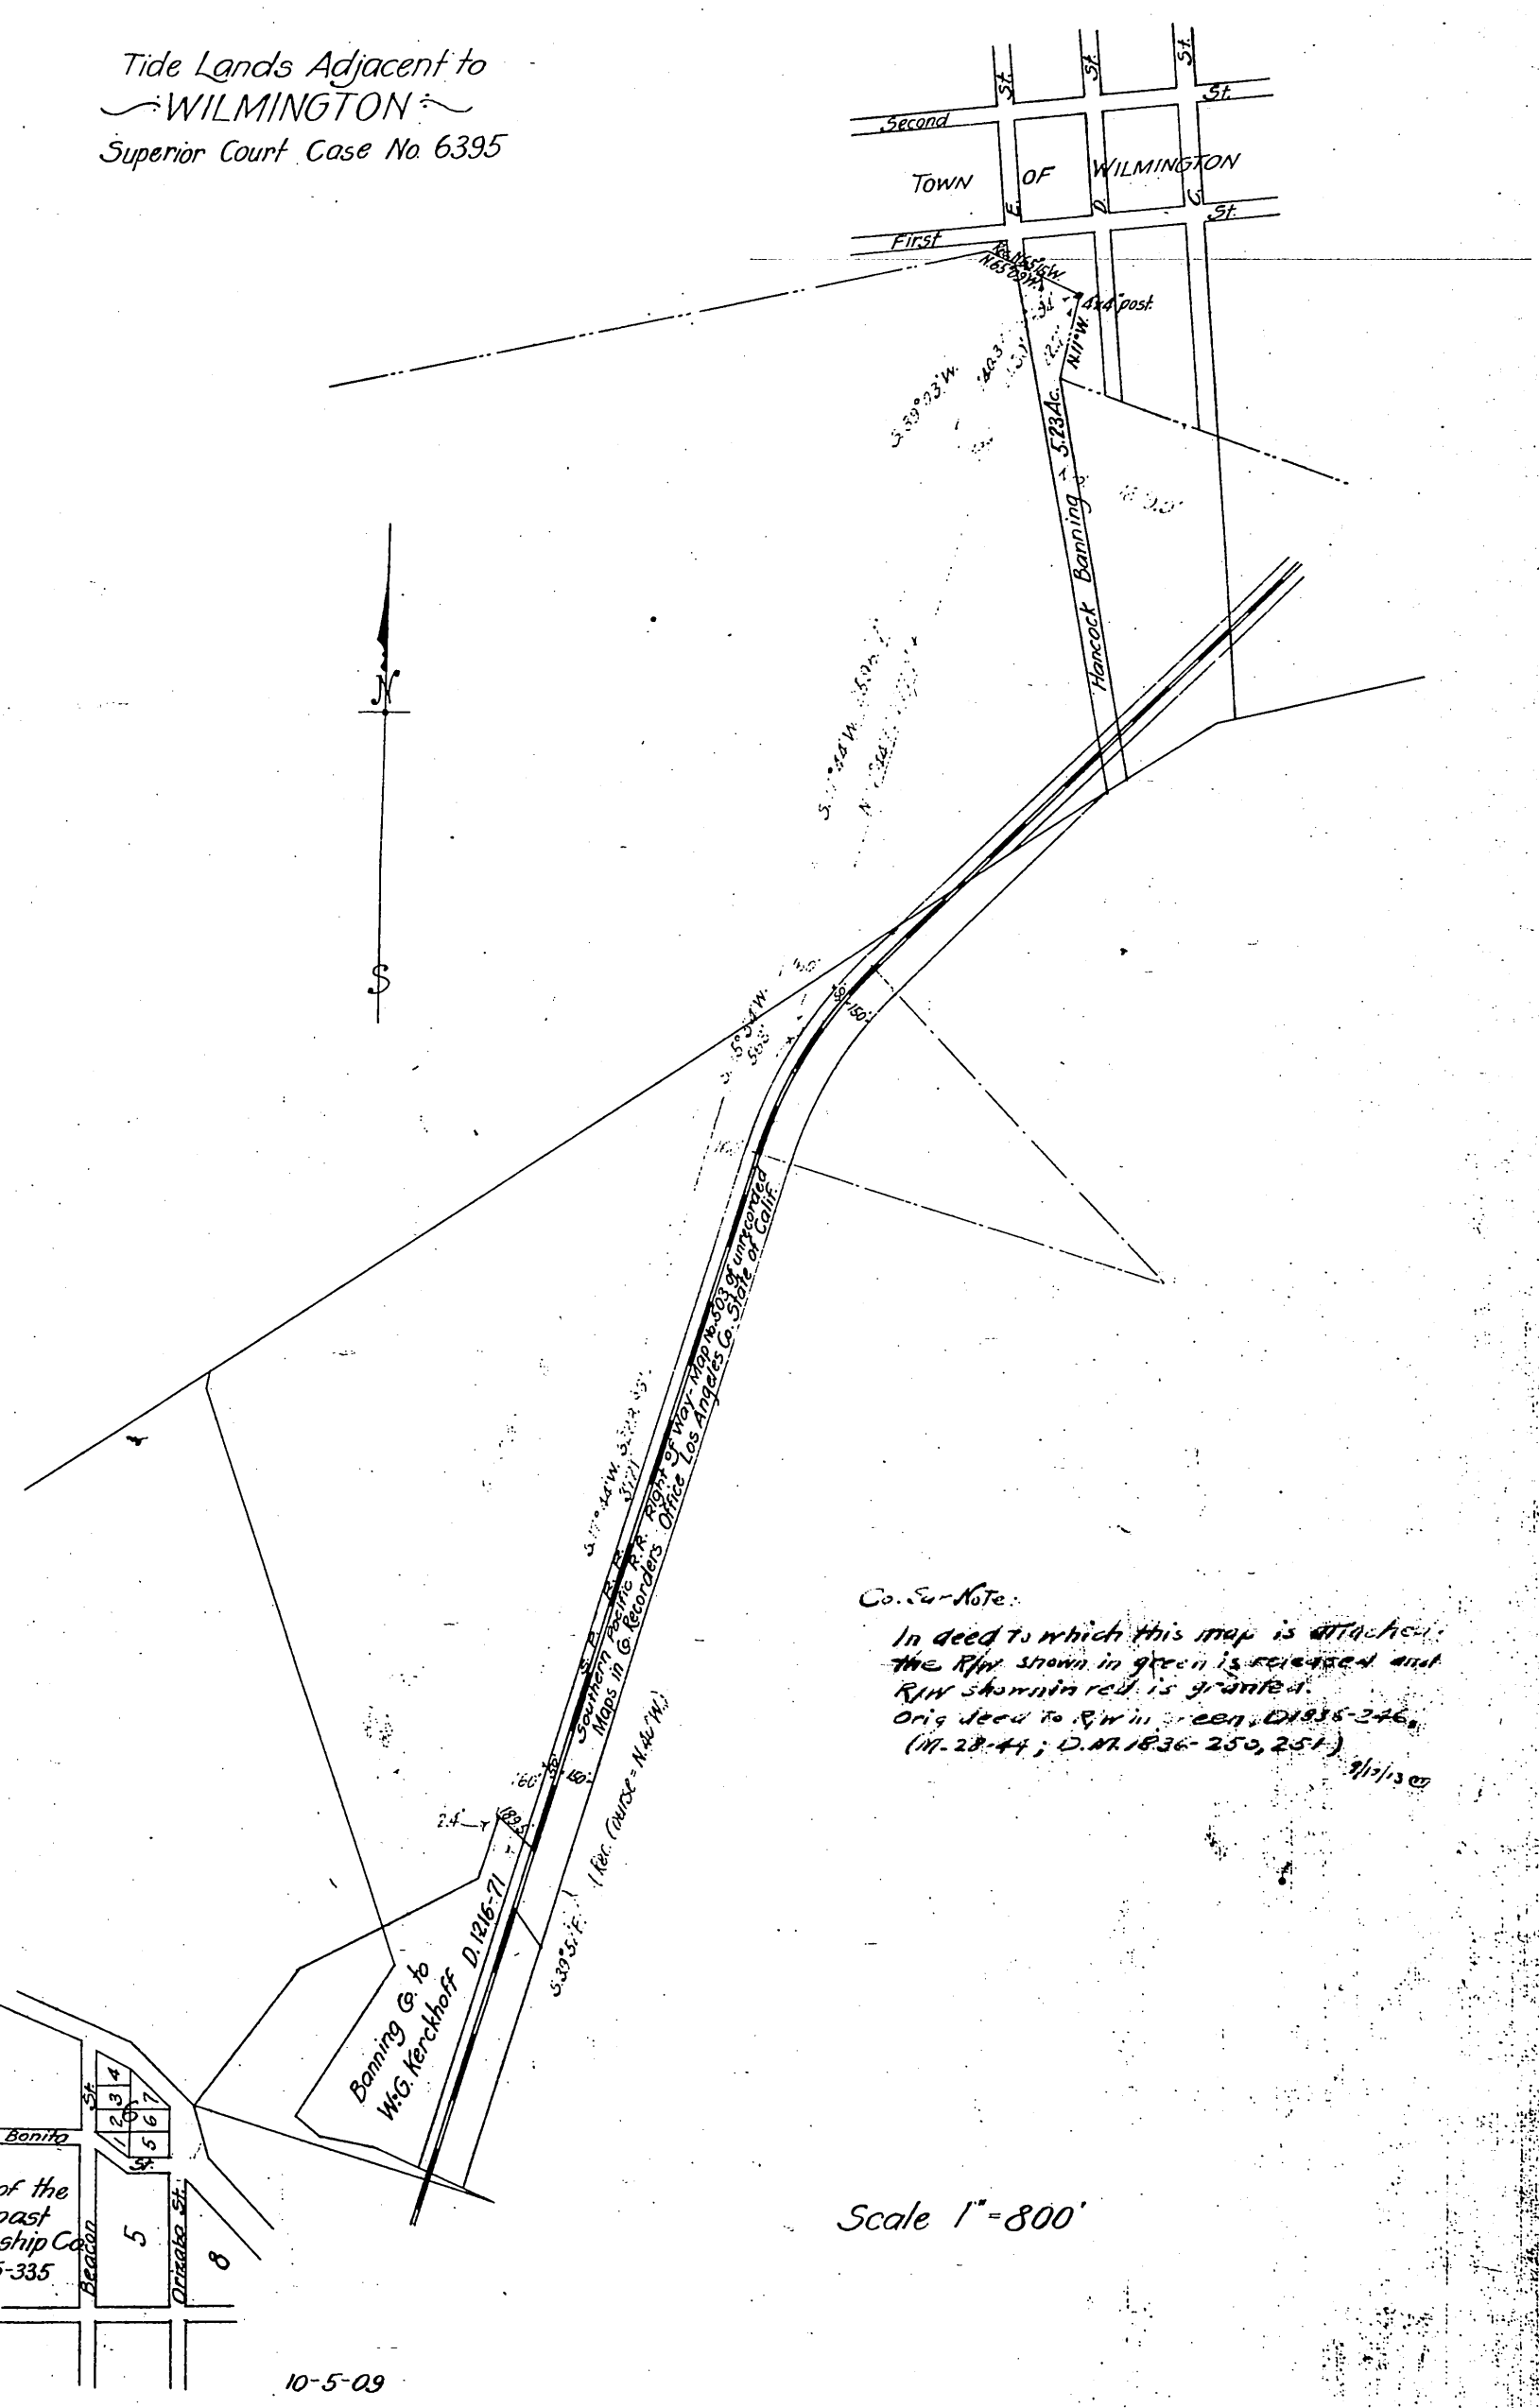


Co. Su-Note:
In deed to which this map is attached the R/W shown in green is released and R/W shown in red is granted.
Orig deed to R/W in green D1838-246.
(M-28-44; D.M. 1836-250, 251.)
8/13/13

Scale 1" = 800'

Recorded Aug. 18 1913

A-207
208

See D 1838-246
M 28-44

Sm 28
Sm 29

D. 5556