DM 5764-205
30

Highland Park Development Co
to
Pacific Light and Power Corp

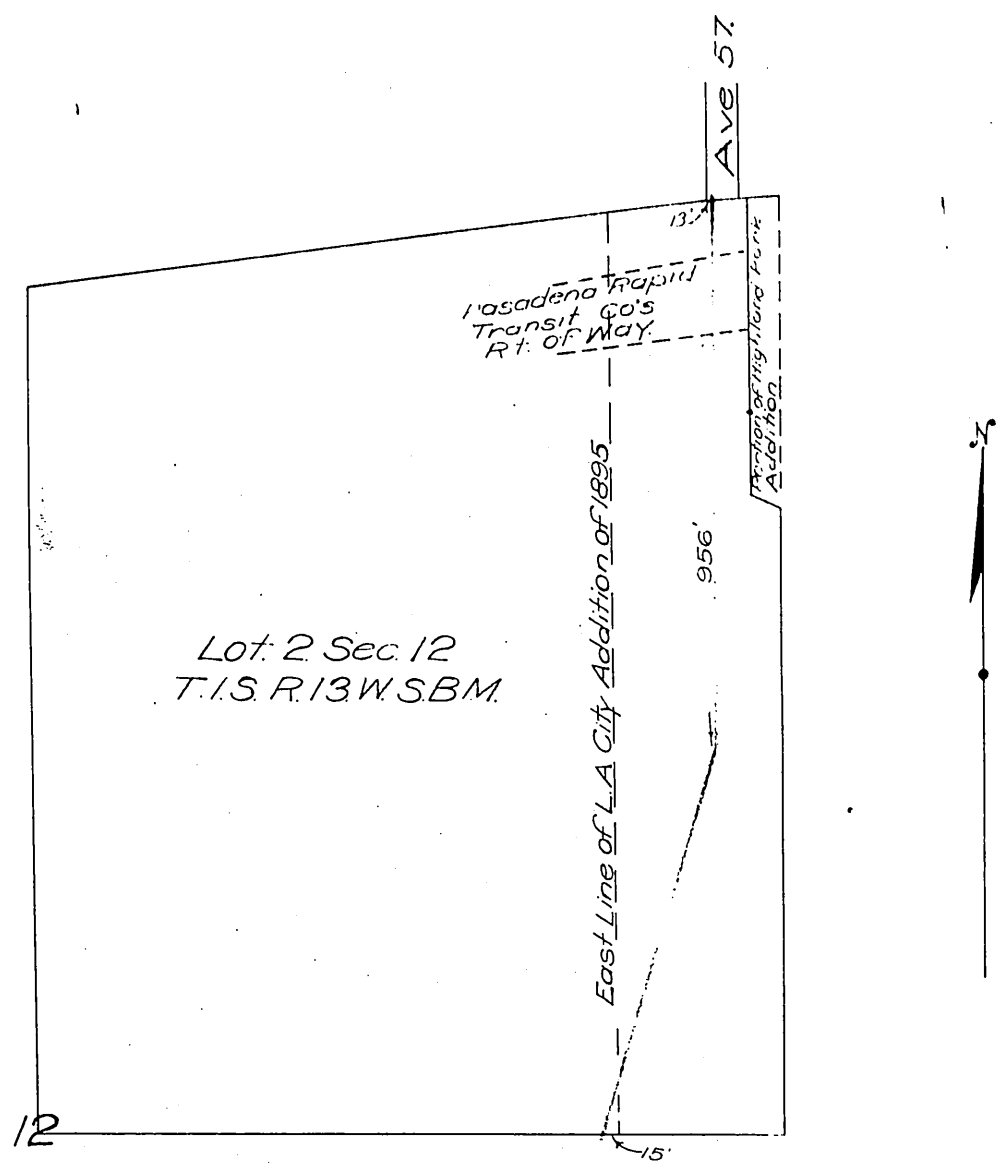

Note:
Red line indicates approximate location of pole line

Location of Pole Line
across
Highland Park Developement Co's
Property
Pacific Light and Power Corp.
Los Angeles California

By G.A.C. Traced by G.A.C.
Checked S.N.B Scale Not to Scale
App. A.O. Adams Date Feb. 16. 1914
1013-B-162

Recorded May 20 1914

D-5764