DM 5833-42
84

12

Felix A. MacNeil
-To-
Pacific Light & Power Corp.

1013-B-165

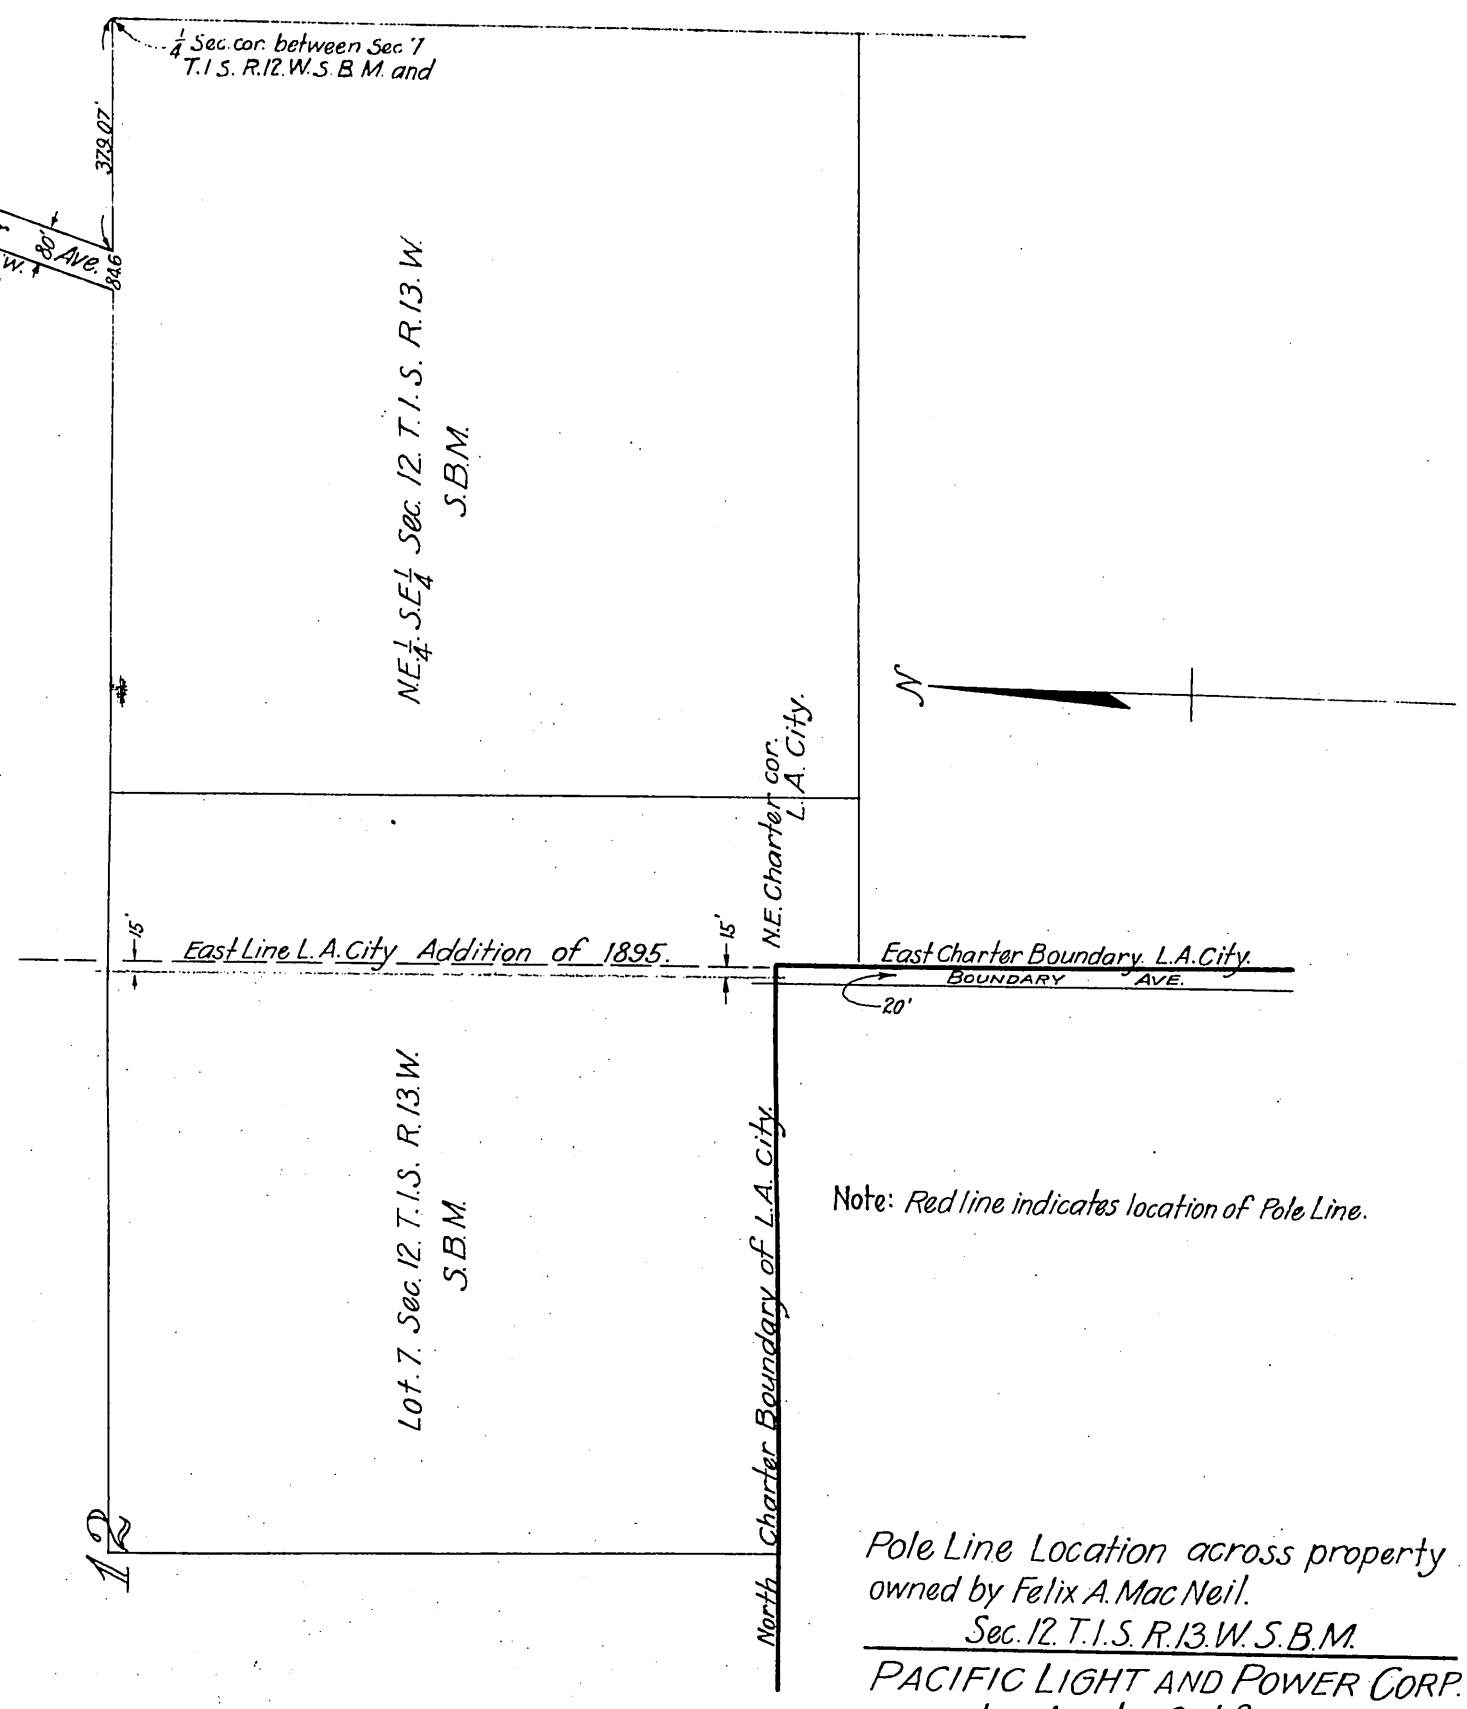

Note: Red line indicates location of Pole Line.

Pole Line Location across property owned by Felix A. MacNeil.
Sec. 12 T. 1 S. R. 13 W. S. B. M.

PACIFIC LIGHT AND POWER CORP.
Los Angeles California
By G.A.C. Traced by G.A.C.
Checked S.N.B. Scale Not to scale
App. A.O. Adams. Date Feb. 24. 1914.

1013-B-165

Recorded May 15 1914

Comp. K.M.D.

SIT + R.O.R.

D: 5833