Notes Ck'd by	Survey of
Map No.	W. O. Tape No. St'd °F.
Office Work	Surveyed by
Checked	Notes Date
Date	Indexed

F.B. PG.

THIS Red MAK.

LOS ANG

FORM 247 (rev)

F.B. 249

2469

F.B. 249 Pg. Index

F.B. 249

PAGES: Index, 1 to 128 incl., 129 to 134 incl.,

RETURN TO
LOS ANGELES COUNTY SURVEYOR
700 HALL OF RECORDS

Note: ANY ADDITIONS OR CHANGES ON THIS SHEET MUST BE MADE OR CIRCLED IN Red Ink WITH DATE AND NAME OF PERSON MAKING CHANGE.

Do not extend notes this side of this line

Date 1-19-27 Notes by Dunn Chief Party Dunn F.B. 249 Pg. L

Platted by	W. O. No. 710 B. O. No.
Date	Location Little Tujunga Canyon Rd.
Map No.	Surveyed by Dunn
Platting C'k'd by	Date 1-19-27
Date	Indexed 3-28-27

NOTE: ANY ADDITION OR CHANGES ON THIS SHEET MUST BE MADE OR CIRCLED IN RED, WITH DATE AND NAME OF PERSON MAKING CHANGE.

DO NOT EXTEND NOTES THIS SIDE OF THIS LINE

RETURN TO LOS ANGELES COUNTY SURVEYOR

SURVEY
OF
LITTLE TUJUNGA ~~CANYON~~ ROAD
SHOWING
Proposed Location of Center Line

For Index Information See Page 2

Solar #1 on Pg. 3
Solar #2 " " 48
Solar #3 " " 122

A.E. Dunn Chf.
C.A. Benson Inst.
Ed Kernberger Ch.
H.W. Gunderson R.
E.P. Hanson Entry
E.T. Gleason Ha. Ch.

For Bench Levels & Profile See L.B. 352.

Note — Berger Transit #15903
Mag. Var. Set 0°? 16°00' W
Control Measured with 300' Tape
Section Lines " " 500' "

Adjoining Side of Survey See F.B. 237, 374, L.B. 370 Cert.

Note: All Curve Data, Stationing & Calculated Distances Calculated And Placed In Notes By E. Brook Checked By A.C. Terry April, 1927.

Angular Adjustments By Brook.

True Section Line Data By D. M. Finley May 1928

F.B. 249 PG. 2 Dunn Chief Party Notes by Dunn Date 3-25-27

LITTLE TUJUNGA CANYON ROAD

INDEX SKETCH

T. 3 N. — R. 14 W.

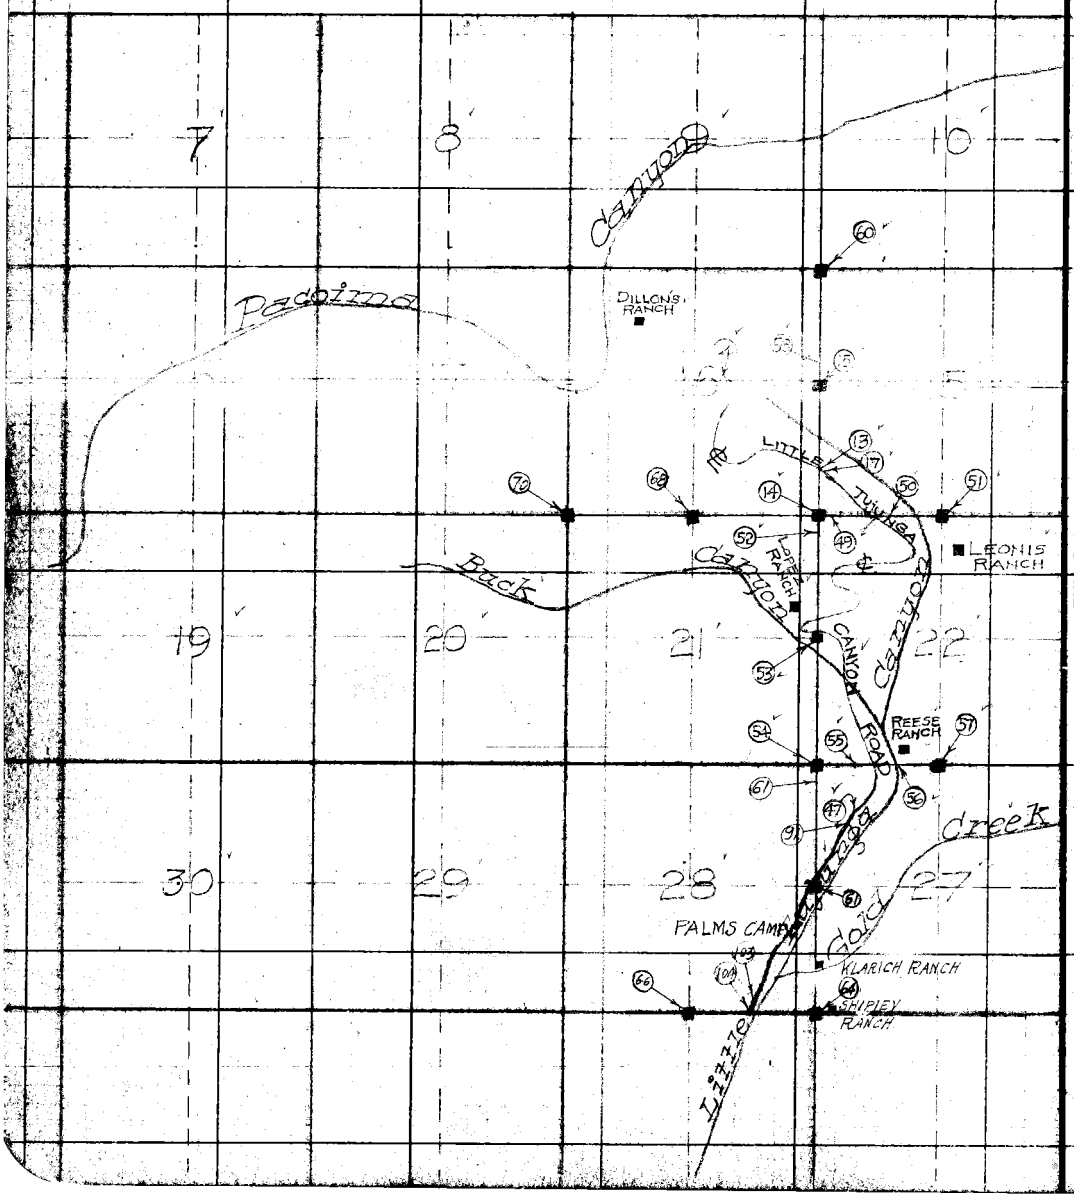

RETURN TO LOS ANGELES COUNTY SURVEYOR

DO NOT EXTEND NOTES THIS SIDE OF THIS LINE

NOTE: ANY ADDITION OR CHANGES ON THIS SHEET MUST BE MADE OR CIRCLED IN RED, WITH DATE AND NAME OF PERSON MAKING CHANGE.

Date 1-28-27 Notes by Dunn Chief Party Dunn F.B. 249 Pg. 3

Plotted by E. J. Brook
Date Apr. 1927
Map No. 8948
Plotting C'k'd by D.M. Finley
Date Apr. 1927

W. O. No. 719 S. P. O. No.
Location Little Tujunga Canyon Rd.
Surveyed by Dunn
Date January 28, 1927
Indexed 3-28-27. GEB

SOLAR No. 1 Jan. 28, 1927 - A.M.

Inst at P*1 Sight at P*2 (See Pg 4) Angle to the Right

Mag Bg. P*1 to P*2 = S. 52°-00'E. with Var. Set at 16°-00'

	Time h-m-s	Hor. Angle ° ' "	Ver. Angle ° ' "
1	9-54-00	16°-11'-00"	28°-56'-30"
2	9-55-00	15-50-15	28-34-15
3	9-56-00	16-41-30	29-12-15
4	9-57-00	16-18-15	28-48-00
5	9-58-00	17-09-15	29-26-15
6	9-59-00	16-46-00	29-02-15
7	10-00-00	17-39-15	29-41-15
8	10-01-30	17-20-45	29-19-15
9	10-02-30	18-13-00	29-57-45
10	10-04-00	17-52-30	29-35-00

Latitude = 34°-20'-35".

Standard Time Used

Dunn Chf & Recorder
Benson Inst.
Kernberger Recorder

Calculated Bearings.

Calculated By. E.J.Brook.
Checked By D.M. Finley

Set #1. - S 52°02'50"E.
" 2. - S 52°03'32"E
" 3. - S 52°03'34"E
" 4. - S 52°03'54"E
" 5. - S 52°03'39"E

Mean Bearing S 52°03'29"E

Adopted Bearing S 52°03'30"E

NOTE: ANY ADDITION OR CHANGES ON THIS SHEET MUST BE MADE OR CIRCLED IN RED, WITH DATE AND NAME OF PERSON MAKING CHANGE.

DO NOT EXTEND NOTES THIS SIDE OF THIS LINE

RETURN TO LOS ANGELES COUNTY SURVEYOR

F.B. 249 Pg. 4 Dunn Chief Party Notes by Dunn Date 1-19-27

To Bot. of Pg. 5'

Road to POST Per Bot. of Pg. 5

Q+97.14 E.C.

Δ 74°12'35"
R. 75'
T = 56.73'
L = 97.14'

105°47'25" Adj
105°47'30"

Canyon

78.42 @ 0°0

10-18-27
Replaced 1X2 with 4 2X2
C.A.B.

P.I. #1
Set 2X2
(R.P. Per Pg. 71)

① 105°47'30"
④ 63-09-45

P #② = (P.I. #1 - Pacoima)
Fd. 1X2
Per L.B. 320-

Little Tujunga Mag. S. 76°45' W.

E.C.

① 111°13'45"
④ 84-54-30

111°13'40"
111°13'50" Adj

142.31 @ 3°50
= 141.99

239.19 @ 4°43 = 237.38

Note - Solar #① on Pg 3

Sec. 16
T. 3 N - R 14 W.

Mag. Bg S. 52° E.

P #①
Fd 1X2
Per L.B. 320-

Saddle - Top of Divide - Little Tujunga Canyon - Pacoima Canyon

RETURN TO
LOS ANGELES COUNTY SURVEYOR

NOTE: ANY ADDITION OR CHANGES ON THIS SHEET MUST BE MADE OR CIRCLED IN RED. WITH DATE AND NAME OF PERSON MAKING CHANGE.

DO NOT EXTEND NOTES THIS SIDE OF THIS LINE

Date 1-20-27 Notes by Dunn Chief Party Dunn F.B. 249 Pg. 5

Plotted by Drew	W. O. No. 710 B. S. O. No.
Date Apr 1927	Location Little Tujunga Canyon Rd.
Map No. 8948	Surveyed by Dunn
Plotting Ch'd by McPherson	Date 1-20-27
Date Apr 1927	Indexed 3-28-27

NOTE: ANY ADDITION OR CHANGES ON THIS SHEET MUST BE MADE OR CIRCLED IN RED. WITH DATE AND NAME OF PERSON MAKING CHANGE.

DO NOT EXTEND NOTES THIS SIDE OF THIS LINE

RETURN TO LOS ANGELES COUNTY SURVEYOR

To Bot. of P.6

POST Set 3/4 I.&T. (R.P.Per.B.7)

POST for Bot. of P.6

151.27 @ 0°-0'

Δ = 73°-51'-00"
Δ/2 = 36°-55'-30"
R = 100'
T = 75.15'
L = 128.89'

82.18 @ 0°-0'

Ⓓ 124°-04'-00"
Ⓐ 136-16-00

104.82 @ 9°-21' = 103.43'

Ⓓ 140°-45'-30"
Ⓐ 203-01-30

145°-23'-45"
145°-23'-45"

P.I. #3 Not Set (Cliff)

POST Set 2x2

56.01'

(62.40') Calc. E.B.

124°-04'-05"
124°-04'-05"

(54.12') Calc. P.C.

21.03'

Ⓓ 145°-23'-45"
Ⓐ 221-34-30

P.I. #2 Not Set (Cliff)

89.04 @ 0°-0'

Δ 99°-35'-10"
Δ/2 49°-47'-35"
R 100'
T = 118.41'
L = 173.90'

Ⓓ 136°-17'-30"
Ⓐ 185-11-00

POST Set 2x2

136°-17'-45"
136°-17'-45"

115.50'

B.C. 2+23.24 Set N.&T.

Mag. S. 13°-15' E.

114.82'

Sec. 16
T. 3N-R14W.

E.C. 1+92.30 Set I.&T.

Δ = 43°-58'-35"
Δ/2 = 21°-54'-17.5"
R = 100'
T = 40.38'
L = 76.75'

Ⓓ 136°-01'-30"
Ⓐ 184-05-

136°-01'-25"
136°-01'-20"

B.C. 1+45.65 1x2

P.I. #2 Set 2x2

38.54 @ 15°-10'
= 37.20'

POST Set 2x2

From Top of P.3 A

F.B. 249 Pg. 6 Dunn Chief Party Notes by Dunn Date 1-21-27

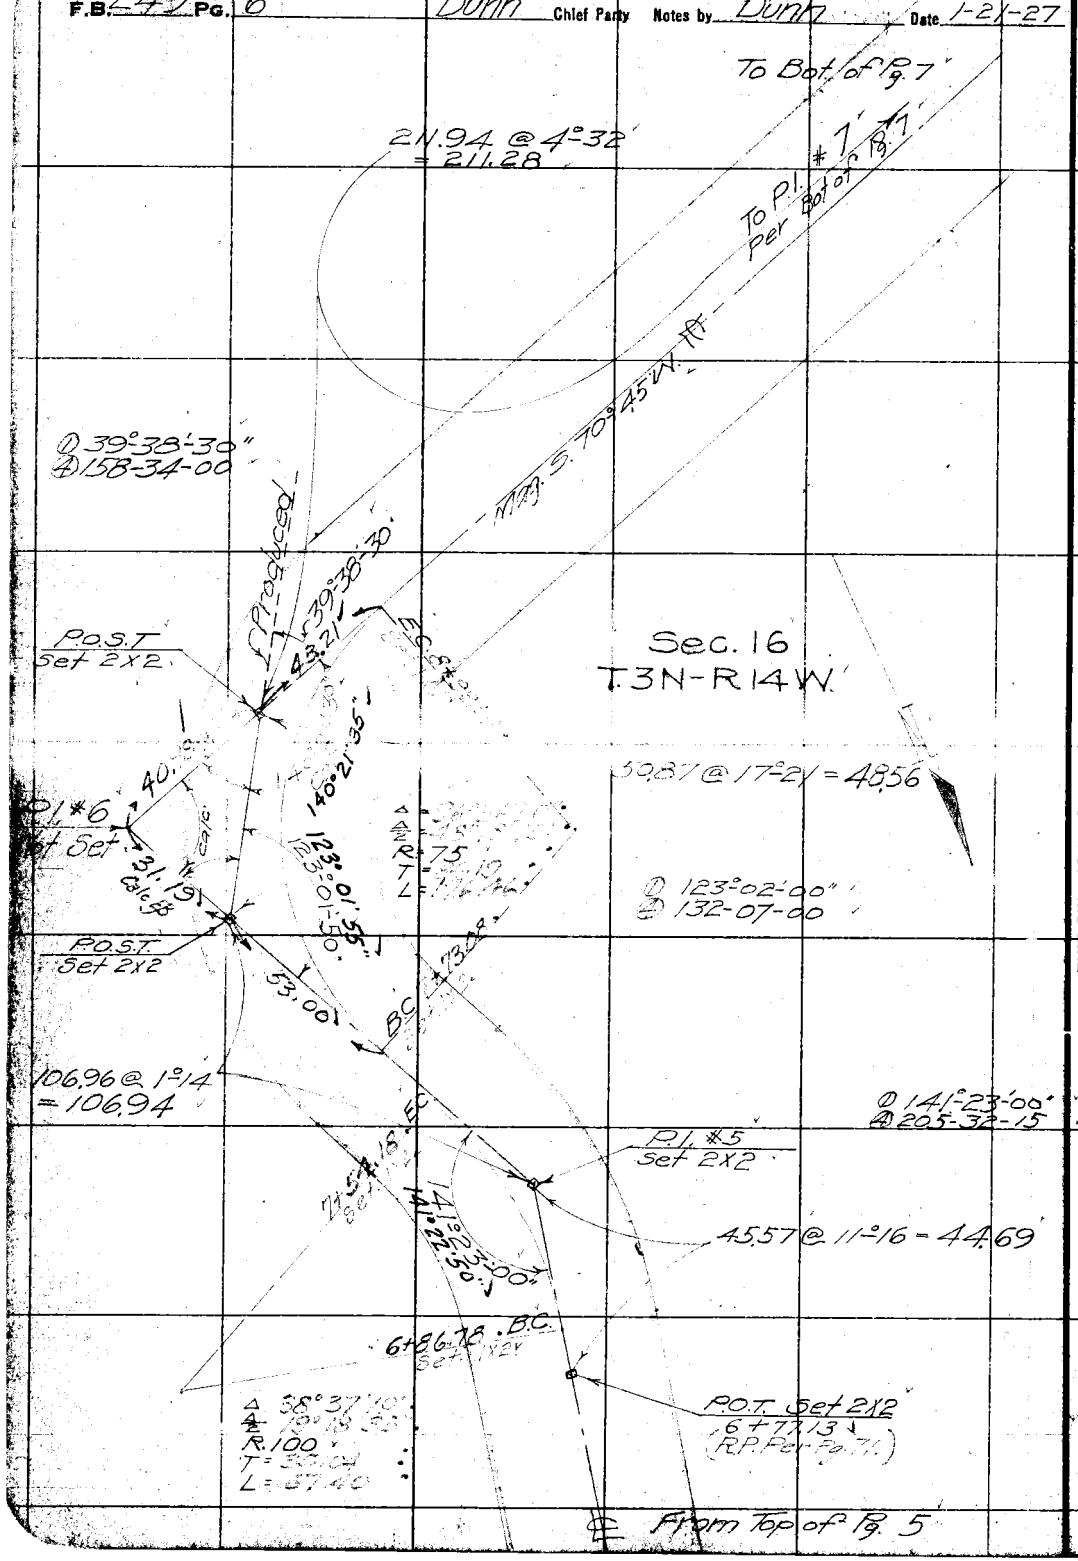

RETURN TO LOS ANGELES COUNTY SURVEYOR

DO NOT EXTEND NOTES THIS SIDE OF THIS LINE

NOTE: ANY ADDITION OR CHANGES ON THIS SHEET MUST BE MADE OR CIRCLED IN RED, WITH DATE AND NAME OF PERSON MAKING CHANGE.

Date 1-21-27 Notes by Dunn Chief Party Dunn F.B. 249 Pg. 7

Platted by Drew	W. O. No. 710 D. S. O. No.
Date Apr. 1927	Location Little Tujunga Canyon Rd.
Map No. 8948	Surveyed by Dunn
Platting C'k'd by McPherson	Date 1-21-27
Date Apr. 1927	Indexed 3-28-27 VEE

NOTE: ANY ADDITION OR CHANGES ON THIS SHEET MUST BE MADE OR CIRCLED IN RED, WITH DATE AND NAME OF PERSON MAKING CHANGE.

DO NOT EXTEND NOTES THIS SIDE OF THIS LINE

RETURN TO LOS ANGELES COUNTY SURVEYOR

To Bdr. of Pg. 8

To P.O.T. Per Bdr. of Pg. 8 Per Min. S. 41° E.

236.56 @ 10°-09' = 232.86

Δ 57°-08'-00"
Δ 228-32-00

Sec. 16 T.3N-R14W.

12+72.31 E.C. Set 1"x2"

Δ = 122°-52'-05"
R = 75
T = 137.75
L = 160.83

57°-07'-55" 57°-08'-00"

P.L. #8 Set 5/8" x 8" (R. per Pg. 12)

Δ 168-31-30
Δ 314-07-00

P.L. #7 Set 2"x2"

11+11.48 B.C. Set 1"x2"

E.C. 10+87.56

182.62 @ 5°-33' = 181.76

168°-31'-40" 168°-31'-45"

B.C. 10+47.52

Δ = 11°-33'-
Δ = 5°-44'-07"
R = 200.00
T = 20.04

From Top of Pg. 6

F.B. 249 PG. 8 — Dunn, Chief Party — Notes by — 1-24-27

To Bot. of Pg. 9

Δ 102°-28'-45"
Δ 49-55-30

18+09.05 E.C. Set 1x2

Δ = 77°-39'-30"
Δ/2 = 38°-45'-45"
R = 75
T = 60.22
L = 101.68

To P.I. #12 Per Bot. of Pg. 9

141.23 @ 11°-00' = 138.64

102°-28'-40"
102-28-50

17+01.57 E.C. Set 1x1

P.I. #11 Set 2x2 (R.P. Per Pg. 73)

P.O.T. Set 2x2
16+59.73

S 12°-45' E

Mag.

76.88 @ 15°-07' = 74.22

108.40 @ 4°-34' = 108.06

P.I. #10 Set 2x2

Δ 110°-14'-45"
Δ 81-00-00

110°-15'-00"
110°-13'-05"

Δ = 69°-44'-55"
Δ/2 = 34°-52'-28"
R 100
T = 69.69
L = 121.73

Sec. 16
T. 3 N - R 14 W.

116.30 @ 17°-49' = 110.72

B.C. 15+33.47 Set 1x2

15+01.62 E.C. Set 1x2

9.18

P.O.S.T. Set 2x2

Δ = 41°-19'-15"
Δ/2 = 20°-39'-42.5"
R = 150
T = 56.57
L = 108.18

47.97 @ 8°-53' = 47.39

138°-40'-35"
138°-40'-40"
C.C. Calc.

Δ 41°-19'-15"
Δ 165-17-30

P.I. #9 Set S.W.&T. (R.P. Per Pg. 72)

13+93.44 B.C. Set 1x2

41°-19'-20"

85.47 @ 14°-55' = 82.59

P.O.T. Set S.W.&T.
13+67.44

From top of R. 7

RETURN TO LOS ANGELES COUNTY SURVEYOR

DO NOT EXTEND NOTES THIS SIDE OF THIS LINE

NOTE: ANY ADDITION OR CHANGES ON THIS SHEET MUST BE MADE OR CIRCLED IN RED. WITH DATE AND NAME OF PERSON MAKING CHANGE.

Date 1-24-27 Notes by Dunn Chief Party Dunn F.B. 249 Pg. 9

Platted by A.H. Drew	W. O. No. 710 D. S. O. No.
Date Apr - 1927	Location Little Tujunga Canyon Rd
Map No. 8948	Surveyed by Dunn
Platting Ck'd by McPherson	Date 1-24-27
Date Apr 1927	Indexed 3-28-27 ACP

NOTE: ANY ADDITION OR CHANGES ON THIS SHEET MUST BE MADE OR CIRCLED IN RED, WITH DATE AND NAME OF PERSON MAKING CHANGE.

DO NOT EXTEND NOTES THIS SIDE OF THIS LINE

RETURN TO LOS ANGELES COUNTY SURVEYOR

#14 P.I. 10 Ft. of Pav. 10 Ft. Per Pg. 8

190.20 @ 7°-09'
= 188.72

Sec. 16
T.3N-R14W.

R.O.T. Set 2X2
21+55.01

N 19° 50' 15" E

Δ = 39°09' 35"
Δ/2 = 19°34' 42" ∠
R 100'
T = 35.57'
L = 68.34'

173.00 @ 5°-56'
= 172.07'

20+18.51 P.C.
Set 1X2

103.92 @ 0°-0'

19+50.17
Set 1X2

140°-50'-40"
140°-50'-40"

B.C.

① 140-50-45 "
② 203-22-30 "

P.I. #13
Set 2X2
(R.P. Per Pg. 73)

P.I. #12
Set 2X2

E.C. 19+27.47
Set 1X2

130°-55'-30"
130°-55'-30"

Δ 43°-04'-55"
Δ/2 21°-32'-27" ∠
R 100'
T 40.65'
L 75.25'

B.C. 18+44.82
Set 1X2

① 130°-55'-15 "
② 163-42-00 "

From Top of Pg 8

F.B. 249 PG. 10 Dunn Chief Party Notes by Dunn Date 1-24-27

To Bot. of Pg. 11

℄

P.O.T. 19 Per Bot of Pg. 11

25+26.28 Set 1"x2"

EC

Δ = 33°32'55"
½Δ = 16°46' 27½"
R 150'
T = 45.24
L = 87.83

146°27'05"
-27-10"

235.18 @ 5°11
= 234.22

℄ 146°-27-15"
℄ 225-48-30

41+32.39 B.C. Set 1"x2"

P.I. #15
Set 2x2
(R.P. Pol. Pg. 74.)

148.90 @ 0°0

Sec. 16
T. 3 N - R 14 W.

NOTE: ANY ADDITION OR CHANGES ON THIS SHEET MUST BE MADE OR CIRCLED IN RED, WITH DATE AND NAME OF PERSON MAKING CHANGE.

DO NOT EXTEND NOTES THIS SIDE OF THIS LINE

RETURN TO LOS ANGELES COUNTY SURVEYOR

P.I. #14
Set 2x2

Mag. S. 30° E

EC 24+04.73 Set 1"x2"

129°56'05"
-1

Δ = 50°03'55"
½Δ = 25°01'57½"
R 150'
T = 70.05
L = 131.07

℄ 129°55'45"
℄ 159-44-00

BC 22+73.68 Set 1"x2"

℄

From Top of Pg. 9

Date 1-24-27 Notes by Dunn Chief Party Dunn F.B. 249 Pg. 11

Platted by Drew	W. O. No. 710 B. S. O. No.
Date Apr 1927	Location Little Tujunga Canyon Rd
Map No. 8948	Surveyed by Dunn
Platting C'k'd by McPherson	Date 1-24-27
Date Apr 1927	Indexed 3-28-27 GCD

NOTE: ANY ADDITION OR CHANGES ON THIS SHEET MUST BE MADE OR CIRCLED IN RED, WITH DATE AND NAME OF PERSON MAKING CHANGE.

DO NOT EXTEND NOTES THIS SIDE OF THIS LINE

RETURN TO LOS ANGELES COUNTY SURVEYOR

To Bot. of Pg. 12

To P.O.S.T. Per Bot. of Pg. 12

20+78.37 E.C. Set 1X2

19534 @ 9°27' = 192.69

Mag. N59°45'E.

① 123-05-00

② 132-21-00

123°05'00"

P.I. #16 Set 2X2 (R.P. Per Pg. 7A)

Δ = 56°54'55"
Δ/2 = 28°27'28"
R = 250
T = 132.50
L = 248.34

150.41 @ 2°09' = 150.30

27+30.03 B.C. Set 1X2

Sec 16
T.3N-R14W.

P.O.T. Set 2X2
27+15.23

℄

From Top of Pg. 10

R.B. 249 PG. 12 — DUNN Chief Party — Notes by DUNN — Date 1-25-27

To Bot of Pg. 13

34+47.40 Set 1X2 EC

Δ = 9°24'50"
Δ/2 = 4°42'25"
R = 500
T = 41.17
L = 82.15

To POST # Per Bot of Pg. 13

170°35'10"
170°35'20"

242.38 @ 4°09 = 241.74

P.I. #18 Set 2X2 (R.P. Per Pg. 75)

① 170°35'15"
④ 322-21-30

33+66.25 BC Set 1X2

POT Set 2X2 32+60.64

147.57 @ 8°56 = 145.78

S 57°15' E

POT Set 2X2 31+46.19

114.45 @ 0°31' = 114.45

Sec. 16
T. 3N - R. 14 W.

72.92 @ 6°14' = 72.49

EC Set 1X2 31+35.49

② 116°34'30"
④ 106-19-00

P.I. #17 Set 2X2

Δ = 63°25'15"
Δ/2 = 31°42'37½"
R = 100
T = 61.79
L = 110.69

116°34'45"
116°34'30"

52.40 @ 13°08' = 51.03

BC 30+74.80 Set 1X2

POST Set 2X2

10.76

℄ From Top of Pg. 11

RETURN TO LOS ANGELES COUNTY SURVEYOR

DO NOT EXTEND NOTES THIS SIDE OF THIS LINE

NOTE: ANY ADDITION OR CHANGES ON THIS SHEET MUST BE MADE OR CIRCLED IN RED, WITH DATE AND NAME OF PERSON MAKING CHANGE.

Date 1-25-27 Notes by Dunn Chief Party Dunn F.B. 249 Pg. 13

Plotted by: Drew	W. O. No. 710 D. S. O. No.
Date Apr. 1927	Location Little Tujunga Canyon Rd.
Map No. 8948	Surveyed by Dunn
Plotting Ch'd by McPherson	Date 1-25-27
Date Apr 1927	Indexed 3-28-27 ADD

NOTE: ANY ADDITION OR CHANGES ON THIS SHEET MUST BE MADE OR CIRCLED IN RED, WITH DATE AND NAME OF PERSON MAKING CHANGE.

DO NOT EXTEND NOTES THIS SIDE OF THIS LINE

RETURN TO LOS ANGELES COUNTY SURVEYOR

P.I. #19 1x2

To Bot. of Pg. 17

P. Line

239.42 @ 0°-0

Mon. N. 68°-45 E. To P.I. #20 Per Bot. of Pg. 17

37+67.64 E.C. Set 1x2

122.68 @ 2°-24 = 121.35

① 88-58-15
④ 355-52-30
Δ = 45°16'05"
Δ/2 = 22°38'02½"
R 200
T 83.39
L 158.02

POST Set 2x2

Transit Line Per Pg. 14

88°-58-10"

53.23 @ 22°-25 = 49.21

134°-43'-55" 134°-44'-00" Calc.

61.40 @ 0°-0

SEE PAGE 14 FOR THIS INTERSECTION

Set 1x2 By Intersection #④ Per Pg. 14

(R.P. Per Pg. 73) P.I. #19 Set 2x2

① 45°16'00"
④ 181-03-25

98.18 @ 15°-11' = 94.75

P. Line

Set 1x2

65°-57'-45"

65°-57'-45"

45°16'-00"

45°16'-05"

saddle

435.15 @ 12°-05 = 425.51

P.I. #18 1x2

℄ 241.74

From P.I. #18

POST Set 2x2 By Intersection #③ Transit Line Per Pg. 14

℄ Transit Line Per Pg. 14

℄ Tangent Pro

④ 65°-57'-45"
④ 263-50-30

Sec. 15 T. 3 N. R. 14 W. ④ Per Pg. 14

From Top of Pg. 12

Sec. 16 T. 3 N. R. 14 W.

F.B. 249 Pg. 14 Dunn Chief Party Notes by Dunn Date 1-25-27

To Bot of Pg. 15

421.28 @ 18°22'
= 399.82

Ⓑ 88-58-15
Ⓐ 355-52-30

P.#18

7465.98 From South
#④ Set 1X2
By Intersection
See Pg. 13

88°58'10" P. Line
239.42

P.#19

64°57'00"

998 @ 5°46'
= 94.75

5323 @ 22°25
= 49.21

Little Tujunga Canyon Road

P.#18
Pg. 12

65°51'40"

13.94

45.04
58.98

P.I. #19
per Pg. 13

Top of Dividing Ridge
East & West

242.38 @ 4°09'
= 241.74

Ⓑ 65-57-45
Ⓐ 263-50-30

From The South
#③ Set 2X2 By Intersection
See Pg. 13

1116.77

242.96

2593.69

NORTH Line

435.15 @ 12°05'
= 425.51

1°00'35"

#② Set 1X2
2719.20

Section Line

242.52 @ 0°0

16

15

#① Set 1X2
Ot 48.74

91°51'40"

Ⓑ 179-09-15
Ⓐ 356-37-30

To ¼ Cor. Page 68

88°05'00"

49.23 @ 8°04'
= 48.74

2576.96
Sec. Line Per R&S

T.3N-R.14W.

2759.80

Section Line

179°09'15" Adj
179°09'20"

527 70.93 fr. South
(C.S. 9198-11) Sec. Cor.
of 00 Going North
Fd. Old Rotted 3"x4" Stake
1' High in Mound of Rock
Marked T.3N.S.15 on NE Side
R.14W.S.22 on SE.
S.21 on S. Side
A Mound of Rock
4' West 2' Base
2' High

89°59'40"

87°39'45"

92°29'35"

103.65 @ 11°10'
= 101.69

21

22

#⑤ Set 1X2
✓ 51+69.24

498.80 @ 16°07'
= 479.20

To ¼ Cor. Page 53
#⑥ - 2653.06

Transit Line

Bot of Pg. 52

To Bot of Pg 52

RETURN TO
LOS ANGELES COUNTY SURVEYOR

DO NOT EXTEND NOTES THIS SIDE OF THIS LINE

NOTE: ANY ADDITION OR CHANGES ON THIS SHEET MUST BE MADE OR CIRCLED IN RED. WITH DATE AND NAME OF PERSON MAKING CHANGE.

Date 1-26-27 Notes by Dunn Cl'd of Party Dunn F.B. 249 Pg. 15

Plotted by Drexel
Date Apr. 1927
Map No. 8948
Plotting Ck'd by McPherson
Date Apr. 1927

W. O. No. 710 R. B. O. No.
Location Little Tujunga Canyon Rd
Surveyed by Dunn
Date 1-26-27
Indexed 3-28-27 CLD

NOTE: ANY ADDITION OR CHANGES ON THIS SHEET MUST BE MADE OR CIRCLED IN RED. WITH DATE AND NAME OF PERSON MAKING CHANGE.

DO NOT EXTEND NOTES THIS SIDE OF THIS LINE

RETURN TO LOS ANGELES COUNTY SURVEYOR

Fd. Rock 8"X14"-7" High Mkd. + on W. Face-Mk. of Rock 3.5 West 3' Base 2.5 High 25+93.28 From South Calc.

291.74 @ 6°57' = 289.60

To *② Per Bof of Pg. 16

To Bof of Pg. 16

Mark Transit Line N. 76°-30' W.

85.57 @ 15°-09' = 82.60

45.70 Calc.

3756 Calc.

33°-35'-40" 6 Miles

3°-35'-50"

71.71 @ 7°-56' = 71.02

S. 9°-38'-E

*⑩ Set 1X2 25+24.48 From South

19.86 @ 0°-20'

25+04.62 From The Same

*⑨ Fd. Rock 5"X10"-18" High Mkd. + on West Face In E. Edge of Mk. of Rock 3' Base 18" High

75.79 @ 11°-16' = 74.33

48.70

Fd. Mk. 25+03.05 Bk.

103°-53'-00" 103°-53'-05" Adj.

① 103°-53'-00"
② 55°-33'-00"

217.35 @ 17°-16'-20"

*⑧ Set 1X2 22+97.07

488.08 @ 4°-09' = 486.80

Section Line

187.13 Transit

*⑦ Set 1X2 On Top of Ridge 18+10.27

26.27

18+13.59

Fd. Nail with Part of Burned Lath in Mk. of

3.32

16

15

2593.69

North 1100-Tow

4107.5 @ 36°-0'

164.87 @ 11°-15'-10"

Total 4

T3N-R14W

*⑥ Set 1X2 13+16.76

60'

Old Trail to Ridge

151.39 @ 4°-10' = 150.96

Center of Road 8' Wide

Center of Wash 8' Wide

Wash Little Tujunga Canyon E.B.W.

33'

*⑤ Set 1X2 11+65.80

From Top of Pg. 14

Survey Continued on Pg. 58 C.L.D.

Fd. Nail with Part of Lath Burned Lath in Mk. of Rock 25+84.75 From South Calc.

33°-35'-45" @ 134°-22'-30"

31°-56'-00" @ 127°-43'-15"

F.B. 249 Pg. 16 Dunn Chief Party Notes by Dunn Date 1-27-27

Saddle-Top of Divide-Little Tujunga Canyon-Pacoima Canyon

@ 33-59-45
Ⓐ 135-59-30

P.* ① Per Pg. 4
Fd. 1X2

1-27-27
A.E. Dunn
C.A. Benson
Ed. Fernberger
H.W. Gunderson
C.R. Lawson

238.81 @ 6°16 = 237.38

33°59'50"
33-59-40 Adj.

S.P. Line-See Pg. 4

N 85° 30' W.

389.32 @ 7°14 = 386.22
207.39 @ 0°0 = 207.39
480.38 @ 17°52 = 457.78
76 = 1051.39

Sec. 16-T. 3 N-R. 14 W.

E. Transit

170°-49'-20"
170-49-10 Adj.

*③ Set 1X2

@ 170°-49'-15"
Ⓐ 323-17-30"

353.33 @ 15°09' = 341.05

E. Transit Line

*② Set 1X2

From Top Left Side of Pg. 15

RETURN TO LOS ANGELES COUNTY SURVEYOR

DO NOT EXTEND NOTES THIS SIDE OF THIS LINE

NOTE: ANY ADDITION OR CHANGES ON THIS SHEET MUST BE MADE OR CIRCLED IN RED. WITH DATE AND NAME OF PERSON MAKING CHANGE.

Date 2-7-27 Notes by Dunn Chief Party Dunn F.B. 249 Pg. 17

Plotted by Drew	W. O. No. 710 D. S. O. No.
Date Apr. 1927	Location Little Tujunga Canyon Road
Map No. 8948	Surveyed by Dunn
Plotting C'k'd by McPherson	Date 2-7-27
Date Apr 1927	Indexed 3-28-27 ADD

NOTE: ANY ADDITION OR CHANGES ON THIS SHEET MUST BE MADE OR CIRCLED IN RED, WITH DATE AND NAME OF PERSON MAKING CHANGE.

DO NOT EXTEND NOTES THIS SIDE OF THIS LINE

RETURN TO LOS ANGELES COUNTY SURVEYOR

2-7-27
A.E. Dunn
C.A. Benson
F.T. Gleason
H.W. Gunderson
C.R. Lamson

143°-45'-45"
215-03-30

11539@ 5°04'
=114.94

P.I. #21
Set 2X2

To P.I. #22 per Bot of Pg 18

E.C. 41+29.38
Set 1X2

143°45'55"
143°45'

Δ = 36°14'05"
Δ/2 = 18°07'02½"
R = 140'
T = 45.81
L = 88.54

B.C. 41+41.39
Set 1X2

29700@5°23'
=295.69

3990@ 8°01' = 38.42

E.C. 37+26.19

Sec. 15
T. 3 N - R. 14 W.

P.O.S.T.
Set 5/8" x 8"

P.I. #20
Set 2X2

Δ = 60°38'15"
Δ/2 = 30°19'07½"
R = 125'
T = 73.10
L = 132.29

D = 60°-38'-30"
C = 42-33-15

Tan
60°-38'-20"
60°-38'-15"

B.C. 37+93.90
Set 1X2

From Top of Pg. 13

F.B. 249 Pg. 18 — Dunn Chief Party — Notes by Dunn — Date 2-7-27

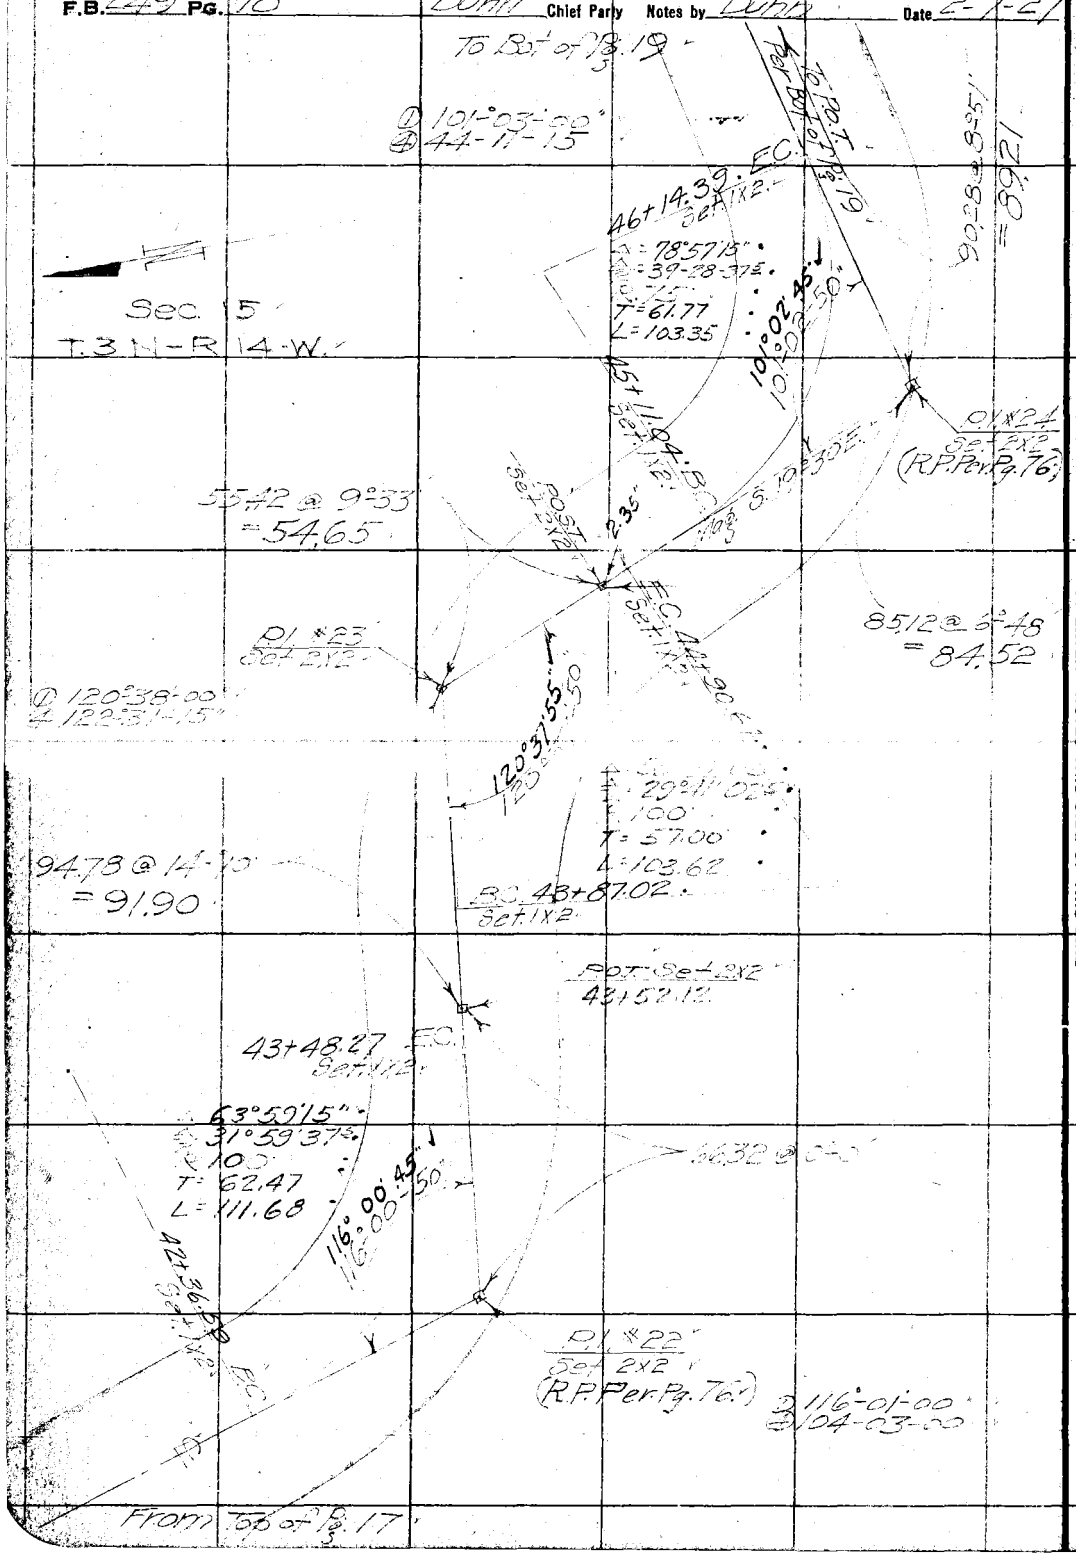

RETURN TO
LOS ANGELES COUNTY SURVEYOR

DO NOT EXTEND NOTES THIS SIDE OF THIS LINE

NOTE: ANY ADDITION OR CHANGES ON THIS SHEET MUST BE MADE OR CIRCLED IN RED, WITH DATE AND NAME OF PERSON MAKING CHANGE.

Date 2-7-27 Notes by Dunn Chief Party Dunn F.B. 249 Pg. 19

Plotted by: Drew	W. O. No. 710 D. B. O. No.
Date Apr. 1927	Location Little Tujunga Canyon Rd.
Map No. 8948	Surveyed by Dunn
Plotting Ck'd by McPherson	Date 2-7-27
Date Apr. 1927	Indexed 3-28-27

NOTE: ANY ADDITION OR CHANGES ON THIS SHEET MUST BE MADE OR CIRCLED IN RED, WITH DATE AND NAME OF PERSON MAKING CHANGE.

DO NOT EXTEND NOTES THIS SIDE OF THIS LINE

RETURN TO LOS ANGELES COUNTY SURVEYOR

POT Set 2x2
49+45.34

Δ = 9°01'45"
Δ/2 = 4°30'52.5"
R 300'
T 23.69
L 47.28

48+97.38 P.C.C.

170°58'15"

48+50.10 Set 1x2

7.65 @ 0°0

Set 2x2
48+03.38

Sec. 15
T. 3 N. - R. 14 W.

37.90 @ 8°45'
= 86.84

48+00.69

67°53'55"
33°56'57.5"
R 125
T 84.15
L 148.13

112°06'00"

99.53 @ 16°29'
= 94.83

112-06-00
88-24-15

BC 46+52.56
Set 1x2

POT Set 4x4
46+41.83

From Top of 18.18

F.B. 249 Pg. 20 Dunn Chief Party Notes by Dunn Date 2-7-27

To Bot. of Pg. 21

To P.I. #29 Per Bot. of Pg. 21

53+50.85 Set 1x2

191.05 @ 12°-37' = 186.44

Δ = 78°-28'-20"
= 39°-14'-10"
R = 125'
T = 102.08'
L = 171.70'

101°-31'-40"

50'

P.I. #28 Set 2x2 (R.P. Per. Pg. 77)

D 101°-32'-00"
A 46°-07'-00"

51+79.

247.39 @ 3°

SEE PAGE 50 FOR THIS INTERSECTION

22

15

P.I. #27 Set 2x2

D 157°-03'-30"
A 268°-15'-00"

E.C. 50+54.63 Set 1x2

157°03'45"

B.C. 50+14.60 Set 1x2

℄

T3N-R14W

22°-56'-15"
11°-28'-07.5"
R = 100'
T = 20.29'
L = 40.03'

From Top of Pg. 19

RETURN TO LOS ANGELES COUNTY SURVEYOR

DO NOT EXTEND NOTES THIS SIDE OF THIS LINE

NOTE: ANY ADDITION OR CHANGES ON THIS SHEET MUST BE MADE OR CIRCLED IN RED. WITH DATE AND NAME OF PERSON MAKING CHANGE.

Date 2-8-27 Notes by Benson Chief Party Dunn F.B. 249 Pg. 21

Platted by Drew	W. O. No. 710 D. B. G. No.
Date Apr 1927	Location Little Tujunga Canyon Road
Map No. 8948	Surveyed by Dunn
Platting Ck'd by McPherson	Date 2-8-27
Date Apr 1927	Indexed 3-28-27

To Bot. of Pg. 22

Δ 142°-25'-15"
Δ 209°-41'-15"

56.87 @ 0°-0'

P.I. #31
Set S.W.&T.

To POT
Per Bot. Pg. 22

EC
Set Tag

57+16.78

142°-25'-20"
142°-25'-30"

Δ = 37°-34'-30"
Δ/2 = 18°-47'-15"
R = 150
T = 51.03
L = 98.31

120.36 @ 7°-40'
= 119.28

BC
Set 3x12

56+18.41

55+84.02 EC
Set 3x12

Δ = 30°-19'-00"
Δ/2 = 15°-09'-30"
R = 125
T = 33.86
L = 66.14

55+17.88 BC
Set 3x12

149°-41'-00"
149°-41'-10"

36.56 @ 7°-12' = 36.27

POST
Set 3x12

P.I. #30
Set 3x12
(R.P. Per Pg. 75)

Δ 149°-41'-15"
Δ 238-44-30

P.I. #29
Set 3x12

96.52 @ 0°-0'

S 20°-30' E
31.24

EC
Set Tag

54+86.46

111°-57'-00"
111°-57'-00"

Δ = 63°-02'-50"
Δ/2 = 34°-01'-25"
R = 100
T = 67.51
L = 115.76

Sec 22
T3N - R14W

BC
Set Tag

53+67.70

Δ 111°-57'-00"
Δ 87-48-00

From Top of Pg 23

NOTE: ANY ADDITION OR CHANGES ON THIS SHEET MUST BE MADE OR CIRCLED IN RED. WITH DATE AND NAME OF PERSON MAKING CHANGE.

DO NOT EXTEND NOTES THIS SIDE OF THIS LINE

RETURN TO LOS ANGELES COUNTY SURVEYOR

F.B. 249 Pg. 22 Dunn Chief Party Notes by Benson Date 2-8-27

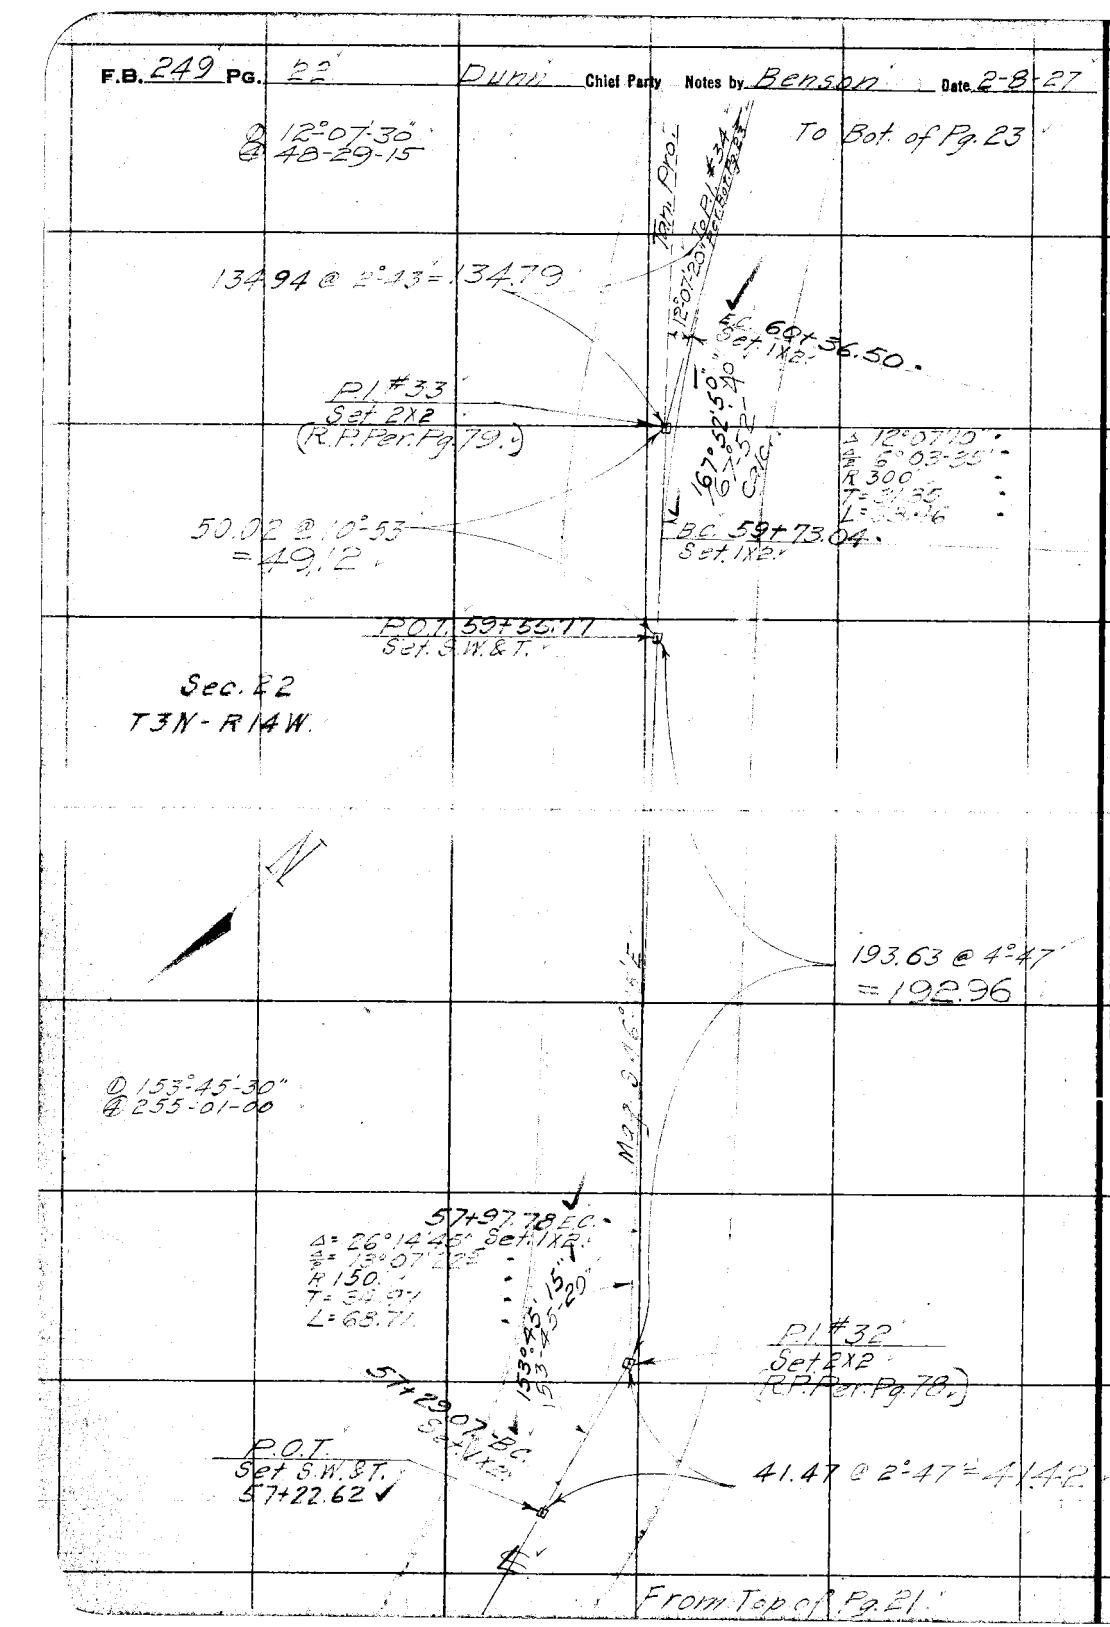

RETURN TO LOS ANGELES COUNTY SURVEYOR

DO NOT EXTEND NOTES THIS SIDE OF THIS LINE

NOTE: ANY ADDITION OR CHANGES ON THIS SHEET MUST BE MADE OR CIRCLED IN RED, WITH DATE AND NAME OF PERSON MAKING CHANGE.

Date 2-8-27 Notes by Benson Chief Party Dunn F.B. 249 PG. 23

Plotted by Drew	W. O. No. 710 D. S. O. No.
Date Apr. 1927	Location Little Tujunga Canyon Rd.
Map No. 8948	Surveyed by Dunn
Plotting Ck'd by McPherson	Date 2-8-27
Date Apr. 1927	Indexed 3-28-27

NOTE: ANY ADDITION OR CHANGES ON THIS SHEET MUST BE MADE OR CIRCLED IN RED. WITH DATE AND NAME OF PERSON MAKING CHANGE.

DO NOT EXTEND NOTES THIS SIDE OF THIS LINE

RETURN TO LOS ANGELES COUNTY SURVEYOR

P.I. #35 Set 2x2 (R.P. Per. Pg. 79)

Δ 36°-04'-15"
Ⓐ 144-18-00

148.85 @ 2°-32' = 148.70

99.46 @ 2°-33' = 92.51

36°04'30"
36°04'45"

Δ = 143°55'20"
½Δ = 71°57'40"
R. 65.
T = 199.59
L = 163.27

P.O.S.T. Set 2x2

P.O.S.T. Set 2x2

163.33 @ 4°-14' = 162.88

To P.I. #36 Per Bot. of Pg. 21

To Bot. of Pg. 21

50.99

S 51°-00' E 107.06

6+00.24 E.C. Set 1x2

205.67 @ 2°-44' = 205.44

B.C. 62+36.97 Set 1x2

Point of Main Ridge

N

E.C.

61+97.28 Set 1x2

P.I. #34 Set 2x2

163°-18'-30"

Sec 22 T3N-R14W

Δ = 16°41'20"
½Δ = 8°20'40"
R. 400.
T = 58.67
L = 116.51

Ⓓ 163°-19'-00"
Ⓐ 293-15-00

60+80.77 Set 1x2

B.C.

From Top of Pg. 22

F.B. 249 Pg. 24 Dunn Chief Party Notes by Dunn Date 2-9-27

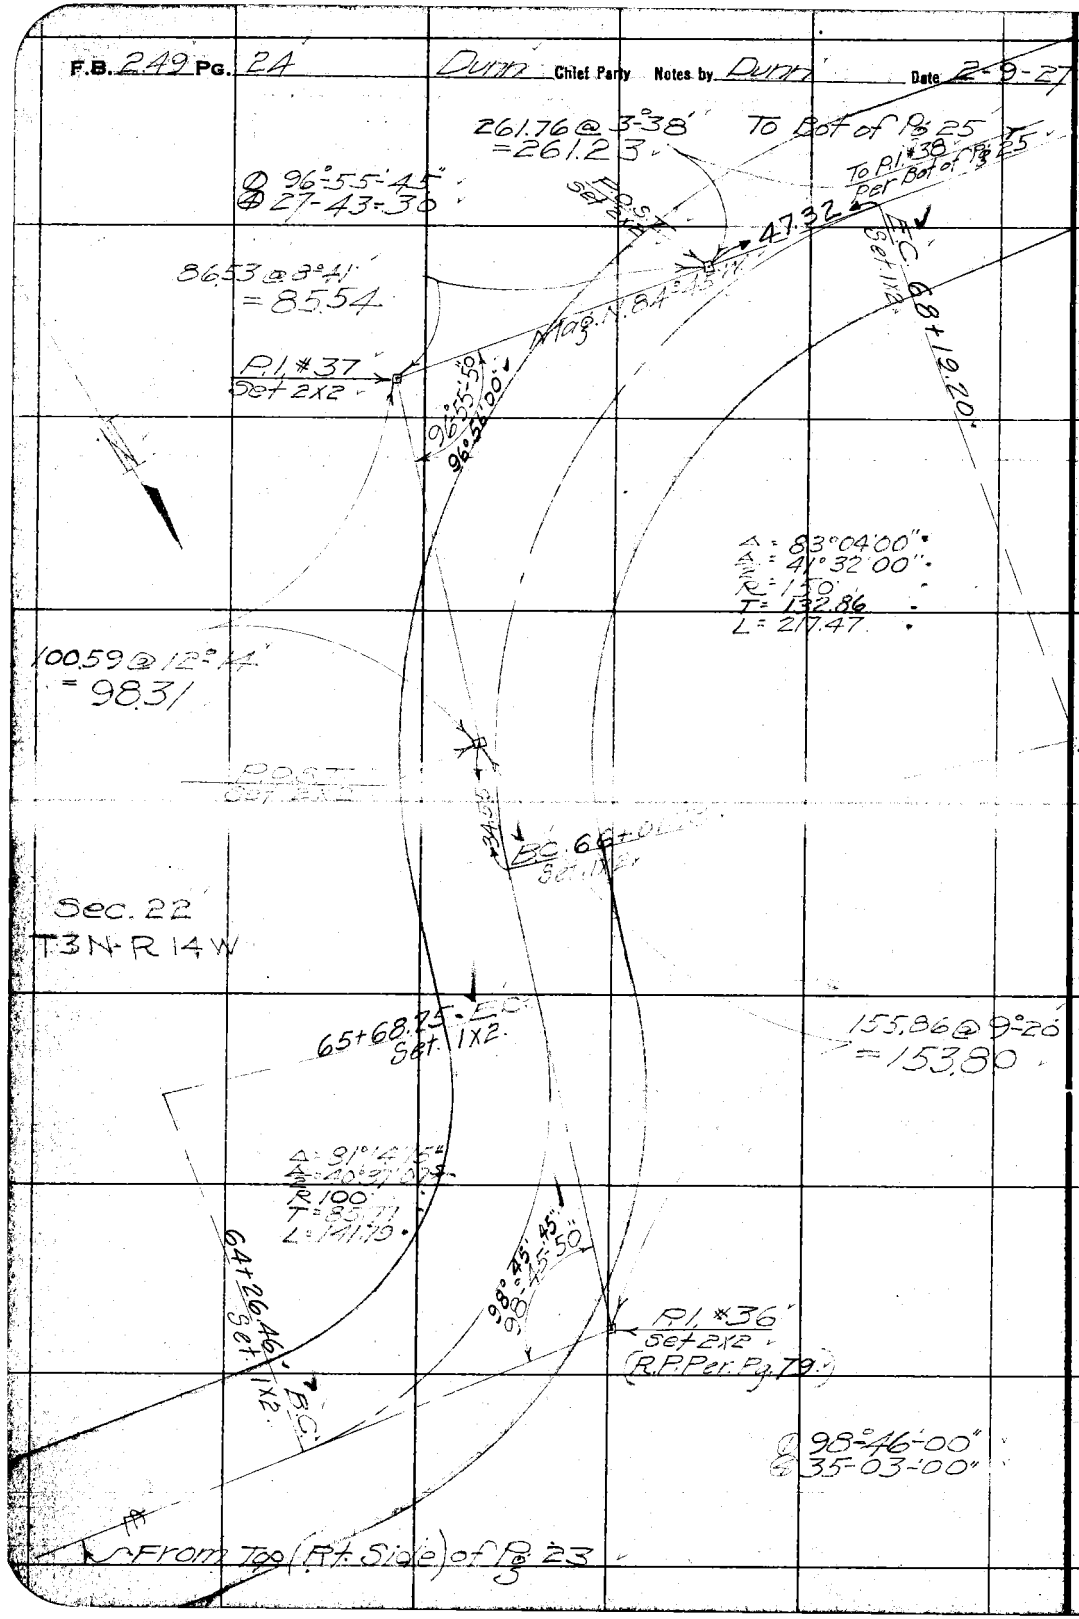

RETURN TO LOS ANGELES COUNTY SURVEYOR

DO NOT EXTEND NOTES THIS SIDE OF THIS LINE

NOTE: ANY ADDITION OR CHANGES ON THIS SHEET MUST BE MADE OR CIRCLED IN RED. WITH DATE AND NAME OF PERSON MAKING CHANGE.

Date 2-9-27 Notes by Dunn & Chief Party Dunn F.B. 249 Pg. 25

Plotted by Drew	W. O. No. 710 D. S. O. No.
Date Apr. 1927	Location Little Tujunga Canyon Rd.
Map No. 8948	Surveyed by Dunn
Plotting C'k'd by McPherson	Date 2-9-27
Date Apr 1927	Indexed 3-28-27 ACD

202.65 @ 1°14' = 202.60

Δ 11°19'30"
D 45°18'00"

P.I. #40
Set 2x2
(R.P. Per Pg 80)
37.14 @ 5°14'
= 36.99

Tan Prod. 11°19'30" Per Pg 80 N. 32°?

#41 76 19 20

To P.I. #40 Set 2x2 F.W.

Δ = 11°19'20"
D = 5°39'40"
R 200'
T = 19.83'
L = 39.52'

Δ 15°14'35"
D = 9°07'15"
R 100'
T = 16.06'
L = 31.84'

Set 1x2

110.68 @ 0°0'

P.I. #39
Set 2x2

34.16 @ 0°0'

Δ 161°45'15"
D 287°02'00"

P.I. #38
Set 2x2
(R.P. Per Pg 80)

119°51'30"
119°51'30"

Δ 60°08'20"
D 30°04'10"
R 190'
T 57.98'
L 104.96'

BC 69+75.21
Set 1x2

Sec. 22
T. 3N - R. 14 W.

Δ 119°51'30"
D 119°26'00"

From Top of Pg 24

NOTE: ANY ADDITION OR CHANGES ON THIS SHEET MUST BE MADE OR CIRCLED IN RED. WITH DATE AND NAME OF PERSON MAKING CHANGE.

DO NOT EXTEND NOTES THIS SIDE OF THIS LINE

RETURN TO LOS ANGELES COUNTY SURVEYOR

F.B. 249 Pg. 26 Dunn Chief Party Notes by Dunn Date 2-9-27

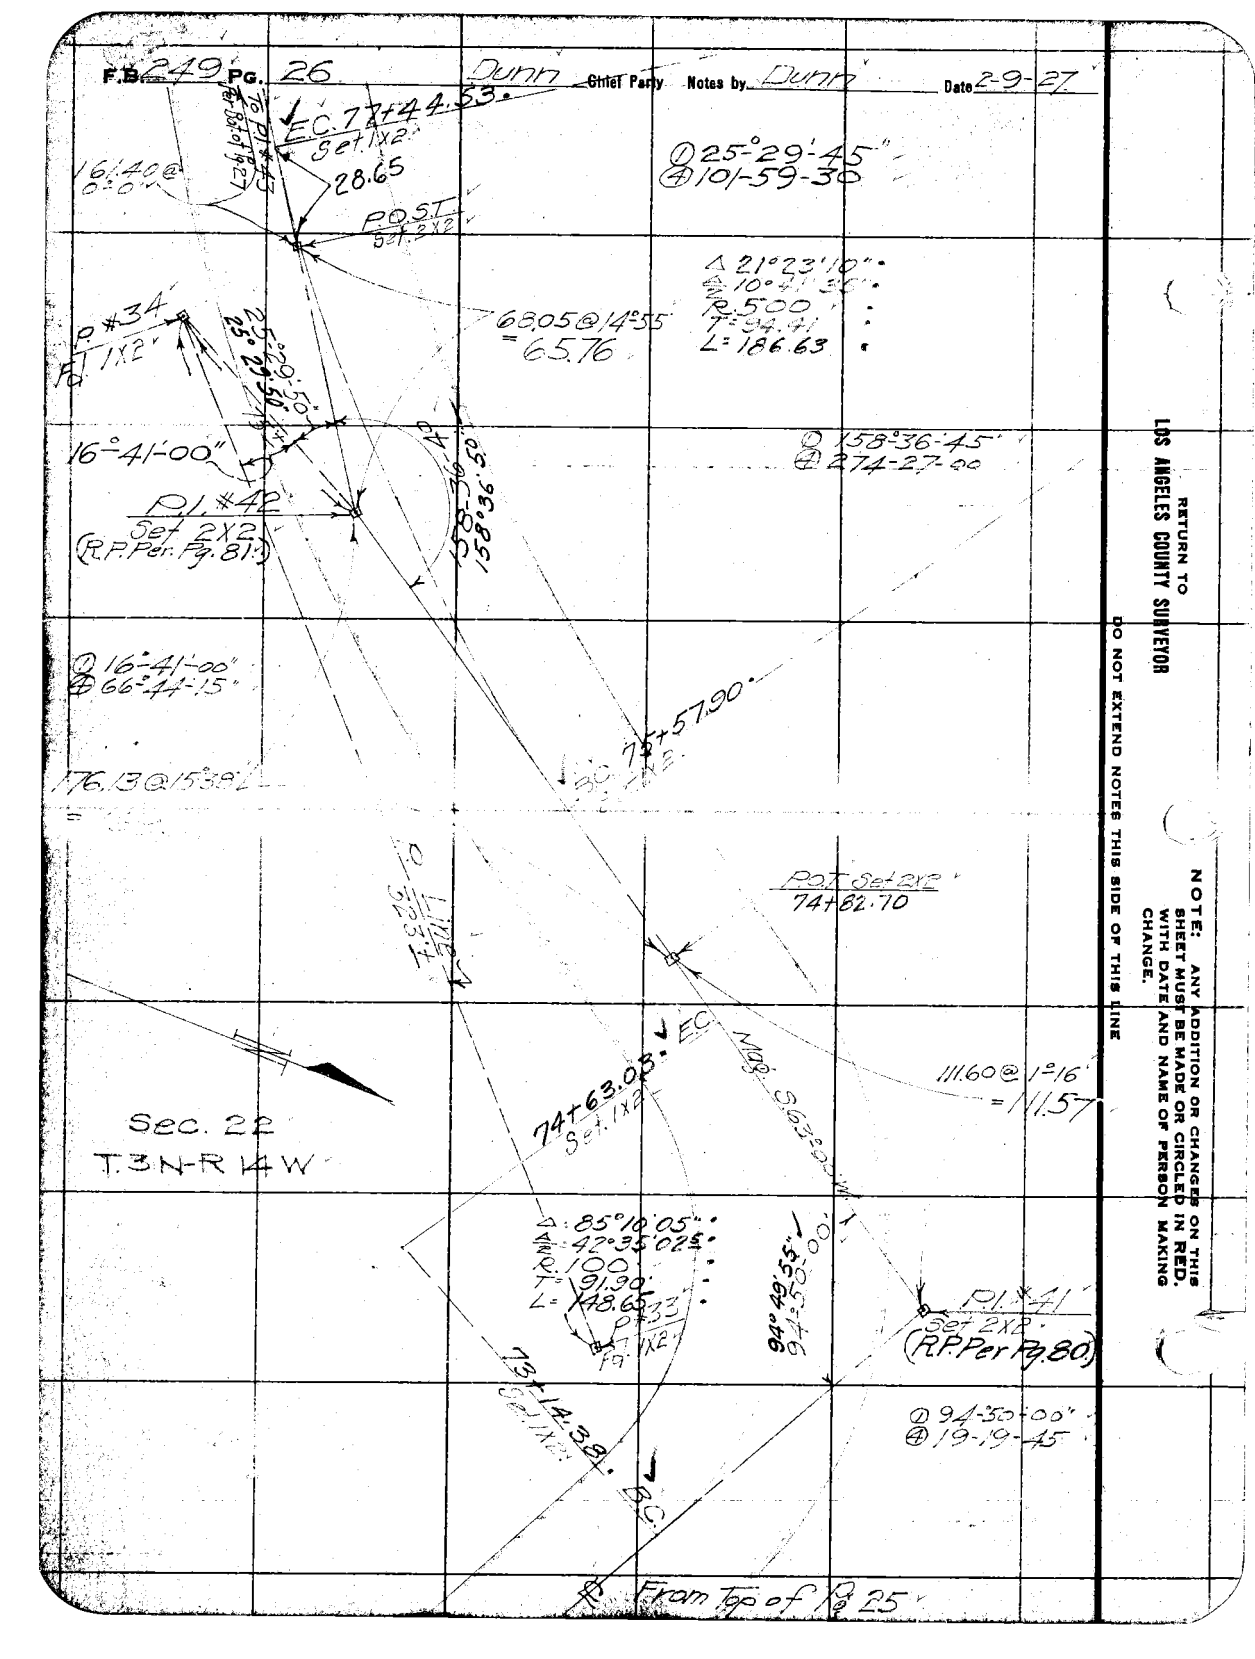

RETURN TO
LOS ANGELES COUNTY SURVEYOR

DO NOT EXTEND NOTES THIS SIDE OF THIS LINE

NOTE: ANY ADDITION OR CHANGES ON THIS SHEET MUST BE MADE OR CIRCLED IN RED, WITH DATE AND NAME OF PERSON MAKING CHANGE.

Date 2-28-27 Notes by Benson Chief Party Dunn F.B. 249 Pg. 27

Plotted by Drew	W. O. No. 710 D. S. O. No.
Date Apr. 1927	Location Little Tujunga Canyon Rd.
Map No. 8948	Surveyed by Dunn
Plotting Ck'd by McPherson	Date 2-26-27
Date Apr. 1927	Indexed 3-28-27 ACR

NOTE: ANY ADDITION OR CHANGES ON THIS SHEET MUST BE MADE OR CIRCLED IN RED, WITH DATE AND NAME OF PERSON MAKING CHANGE.

DO NOT EXTEND NOTES THIS SIDE OF THIS LINE

RETURN TO LOS ANGELES COUNTY SURVEYOR

To Bot. of Pg. 28

103.35 @ 0°-0'

Δ 142°-45'-0" Δ 253°-05'-30"

POST Set 2X2

17.32

To Pl. #45 Per Bot. of Pg. 28

Mag. N 38°-45 W

Pl. #44 Not Set.

50.38 (Calc.)

EC

80+30.31 Set 1X2

120°-45'-15"

140°-45'-15"

45.16 (Calc.)

Sec. 22 T. 3 N - R. 14 W.

POST Set 2X2

35°-06'-15"

Δ = 35°-08'-30"
D = 1°-00'-00"
R = 715'
T = 67.70
L = 110.14

22.54

79+80.17 EC Set 1X2

71.0 @ 0°-0'

D 135°-06'-15" Δ 180°-25'-00"

79+46.66 EC Set 1X2

129.86 @ 9°-25' = 128.11

27°-00'-45" Δ 73°-30'-00"

R 302.96' T 72.06' L 142.24

59.15

152°-59'-15"

Pl. #43 Set 2X2 (R.P. Per Pg. 81)

D 152°-59'-15" Δ 251°-37'-30"

78+05.42 EC Set 1X2

℄

From Top of Pg. 26

F.B. 249 PG. 28 Dunn Chief Party Notes by Benson Date 2-23-27

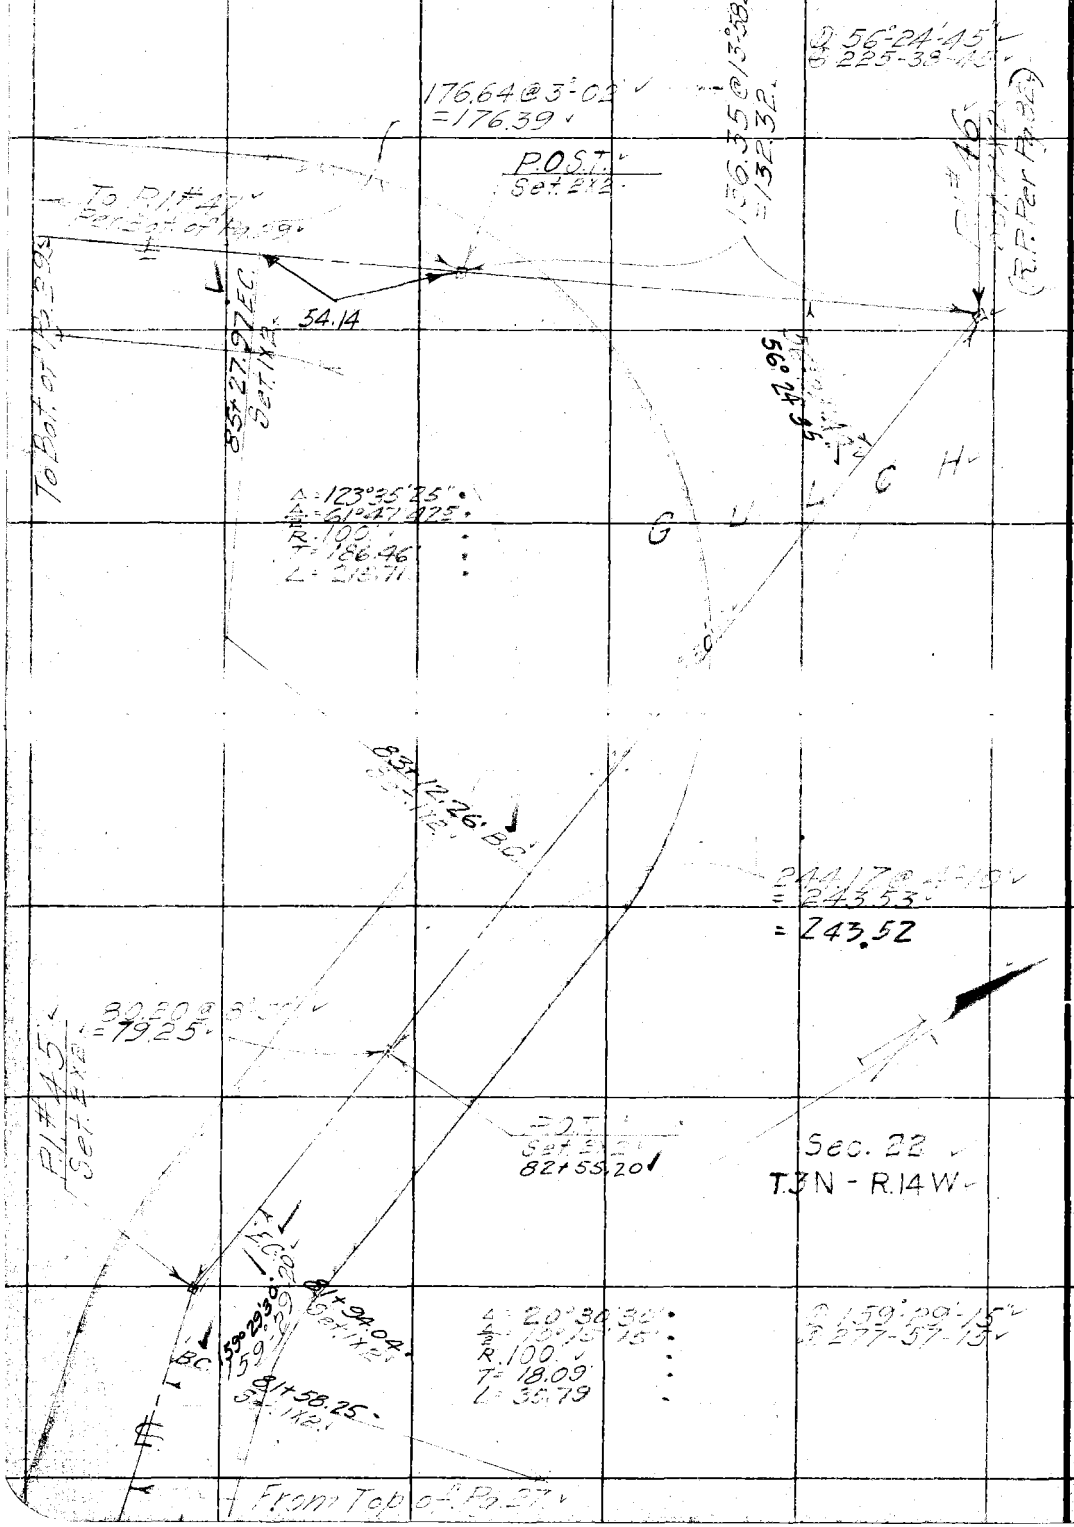

RETURN TO
LOS ANGELES COUNTY SURVEYOR

DO NOT EXTEND NOTES THIS SIDE OF THIS LINE

NOTE: ANY ADDITION OR CHANGES ON THIS SHEET MUST BE MADE OR CIRCLED IN RED, WITH DATE AND NAME OF PERSON MAKING CHANGE.

Date 2-28-27 Notes by Benson Chief Party Dunn F.B. 249 Pg. 29

Platted by Drew	W. O. No. 710 D. S. O. No.
Date Apr. 1927	Location Little Rock Wash & Vic.
Map No. 8948	Surveyed by Dunn
Platting Ck'd by McPherson	Date 2-28-27
Date Apr. 1927	Indexed 3-28-27 RCD

NOTE: ANY ADDITION OR CHANGES ON THIS SHEET MUST BE MADE OR CIRCLED IN RED. WITH DATE AND NAME OF PERSON MAKING CHANGE.

DO NOT EXTEND NOTES THIS SIDE OF THIS LINE

RETURN TO LOS ANGELES COUNTY SURVEYOR

To Bot. of Pg. 30

To P.I. #49 Set 2X2 Pt. on Line 13.32

142.74 @ 11°08'
= 140.53

P.O.T. Set 2X2 88+51.55

104.31 @ 0°02'

E.C. 87+79.04 Set 1X2

P.I. #48 Set 2X2

Sec. 22. T. 3N - R14W.

Δ = 18°04'00"
Δ/2 = 9°02'00"
R. = 200'
T. = 31.50'
L. = 63.06.

16°55'00" 16°56'00"

B.C. 87+15.98 Set 1X2

86+97.09 Set 1X2 E.C.

109.07 @ 7°16'
= 108.19

Δ = 30°47'50"
Δ/2 = 15°23'55"
R. = 200'
T. = 55.50'
L. = 107.47'

B.C. 85+92.72 Set 1X2

120' No Adj.

P.I. #47 Set 2X2 (T.B.M. Set Pin 82')

120°12'15"
120-49-00

From Top (Lt. Side) of Pg. 28

F.B. 249 Pg. 36 Chief Party Notes by Date 3-1-27

93+18.86 E.C.

S 15°-39'-45" E
S 25°-35'-00" E

I = 17°30'10"
D = 13°45'05"
R = 409.
T = 91.69'
L = 192.01

152° 29' 50"

I = 50°
D = 2X2.

1150900-0

91+26.85
Sta. 1+2.

POST
Sta. 2+00.

P.I. #19
Sta. 2+2.

+32.E.T.

B.C. 90+49.23
Sta. 1+2.

157° 42' 10"
57°-42'-00"

I = 22°17'50"
D = 22°18'00"
R = 257.68'
T = 50.68'
L = 100.13

T.S. P.I. #20
22°-18'-00"
22°17'50"

B.C. 89+32.48
Sta. 1+2.

Frame Top at 4.50

229.13 @ 5°-44"
Sta. 2+2.

Sec. 22-
T. 3 N - R. 14 W.

D 22°18'-00"
D 39°-12-00"

NOTE: ANY ADDITION OR CHANGES ON THIS SHEET MUST BE MADE OR CIRCLED IN RED, WITH DATE AND NAME OF PERSON MAKING CHANGE.

DO NOT EXTEND NOTES THIS SIDE OF THIS LINE

RETURN TO
LOS ANGELES COUNTY SURVEYOR

Date 3-1-27 Notes by Benson Chief Party Dunn F.B. 249 Pg. 31

Platted by Drew	W. O. No. 710 D. S. O. No.
Date Apr. 1927	Location Little Rock Creek
Map No. 8948	Surveyed by Dunn
Platting Ck'd by McPherson	Date 3-1-27.
Date Apr. 1927	Indexed 3-28-27

NOTE: ANY ADDITION OR CHANGES ON THIS SHEET MUST BE MADE OR CIRCLED IN RED. WITH DATE AND NAME OF PERSON MAKING CHANGE.

DO NOT EXTEND NOTES THIS SIDE OF THIS LINE

RETURN TO LOS ANGELES COUNTY SURVEYOR

To Bot. of Pg. 32.

To P.O.T. Per Bot. of Pg. 32

℄

℄ 137°-49'-15"
℄ 191°-16'-45"

96+26.00 E.C.
Set 1X2.

253.25 @ 6°-17'
= 251.73

P/# 51
Set 2X2.
(R.P. Per Pg. 83)

Δ = 42°11'00"
℄ = 21°05'30"
R = 240'
T = 92.14
L = 147.25

94+78.75 B.C.
Set 1X2.

221.63 @ 7°-19'
= 219.83

Sec. 22.
T 3 N - R 14 W.

Mag. S 8°-45 E

(R.P. Per Pg. 83)
P.O.T.
Set 2X2.
93+36.06

From Top of F.L. 30'

F.B. 299 Pg. 32 DUMM Chief Party Notes by Benson Date 3-1-27

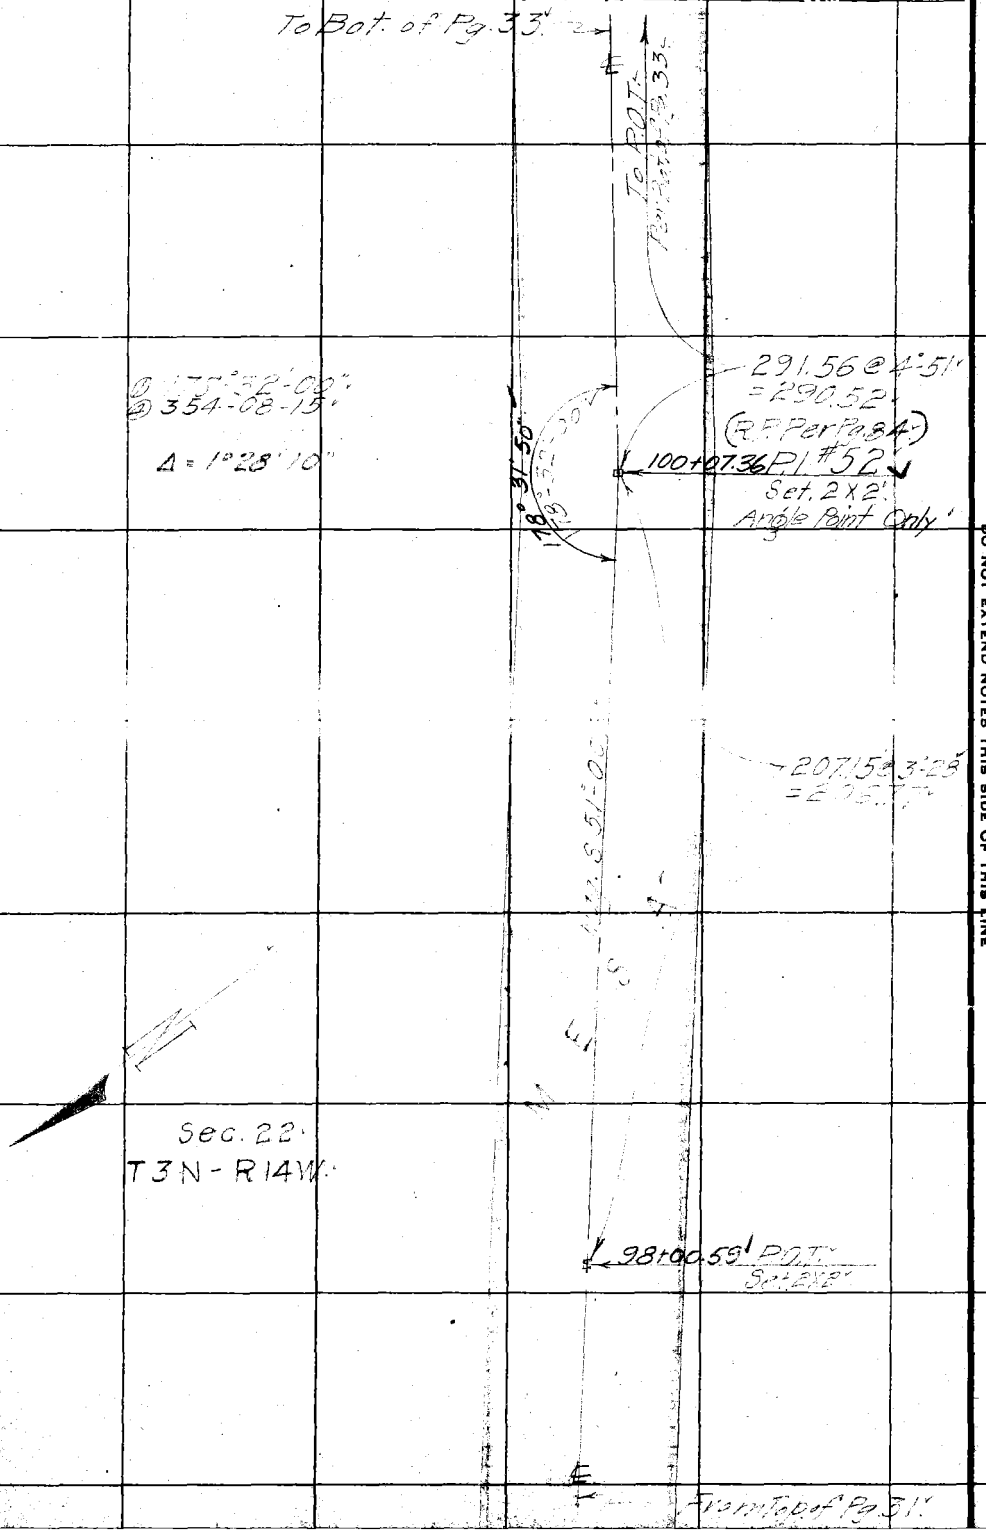

RETURN TO
LOS ANGELES COUNTY SURVEYOR

DO NOT EXTEND NOTES THIS SIDE OF THIS LINE

NOTE: ANY ADDITION OR CHANGES ON THIS SHEET MUST BE MADE OR CIRCLED IN RED, WITH DATE AND NAME OF PERSON MAKING CHANGE.

Date 3-1-27 Notes by Benson Chief Party Dunn F.B. 249 Pg. 33

Platted by Drew	W. O. No. 710 S. O. No.
Date Apr. 1927	Location Littlerock
Map No. 8948	Surveyed by Dunn
Platting Ck'd by McPherson	Date 3-1-27
Date Apr 1927	Indexed 3-28-27 ACP

NOTE: ANY ADDITION OR CHANGES ON THIS SHEET MUST BE MADE OR CIRCLED IN RED, WITH DATE AND NAME OF PERSON MAKING CHANGE.

DO NOT EXTEND NOTES THIS SIDE OF THIS LINE

RETURN TO LOS ANGELES COUNTY SURVEYOR

Pt. #33 Set 2" I.P. (R.P.Pt. Pt.33)

220.80 @ 0°-1'-0" R

63°-45'-15" @ 255-01-15

63°-45'-30"

To P.O.T. Pt. Bot of Pt. 34

106+63.27 S.C.

Δ = 116°14'30"
Δ₂ = 52°-0'-15"
R = 135'
T = 200.98
L = 253.60

BC 104+09.67 Set A.T.

Sec. 22 T. 3 N - R 14 W.

P.O.T. Set 2x2 102+97.88

From Top of Pt. 32

F.B. 2419 PG. 34 Chief Party Notes by Benson Date 3-1-27

To Bot. of Fg. 55'

"D" PO.T. Top of Fg. 55'

253.96 @ 1°53'
= 268.5'

108+74.65
P.O.T.

Sec. 22.
T. 3 N - R 14 W.

191.56 00-0'

106+83.09
P.O.T.
Set 2½"

From Top of Fg. 55' to Top of Fg. 33'

RETURN TO
LOS ANGELES COUNTY SURVEYOR

DO NOT EXTEND NOTES THIS SIDE OF THIS LINE

NOTE: ANY ADDITION OR CHANGES ON THIS SHEET MUST BE MADE OR CIRCLED IN RED, WITH DATE AND NAME OF PERSON MAKING CHANGE.

Date 3-2-27 Notes by Benson Chief Party Drew F.B. 249 Pg. 35

Platted by Drew	W. O. No. 710 D. S. O. No.
Date Apr 1927	Location Little [illegible]
Map No. 8948	Surveyed by
Platting C'k'd by McPherson	Date 2-[illegible]
Date Apr. 1927	Indexed 3-28-27

NOTE: ANY ADDITION OR CHANGES ON THIS SHEET MUST BE MADE OR CIRCLED IN RED, WITH DATE AND NAME OF PERSON MAKING CHANGE.

DO NOT EXTEND NOTES THIS SIDE OF THIS LINE

RETURN TO LOS ANGELES COUNTY SURVEYOR

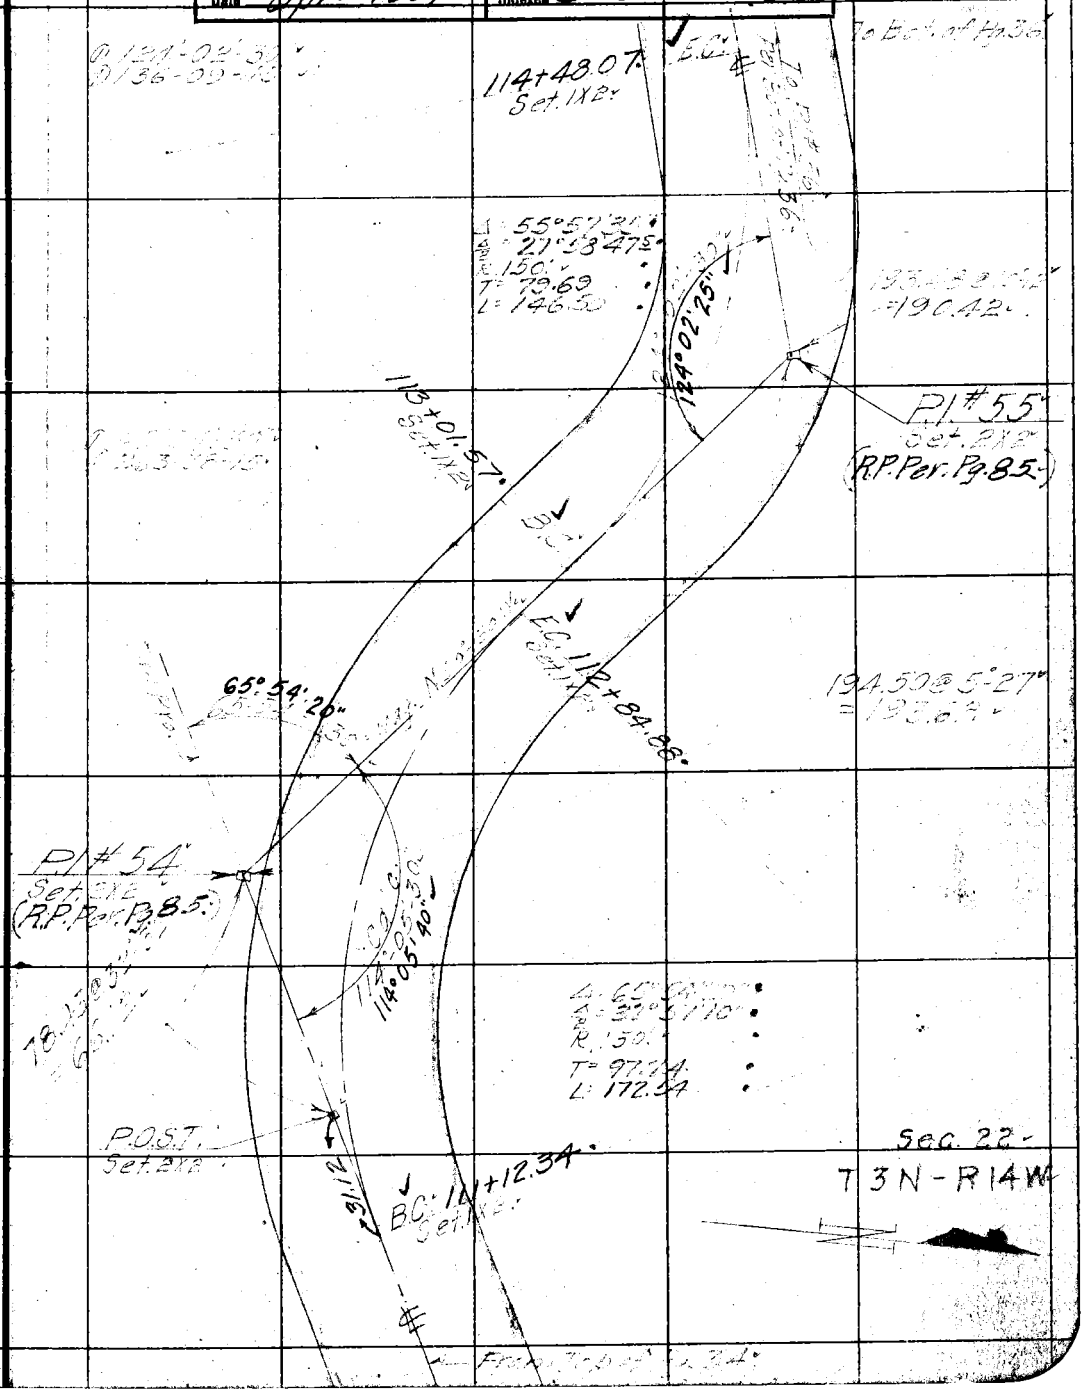

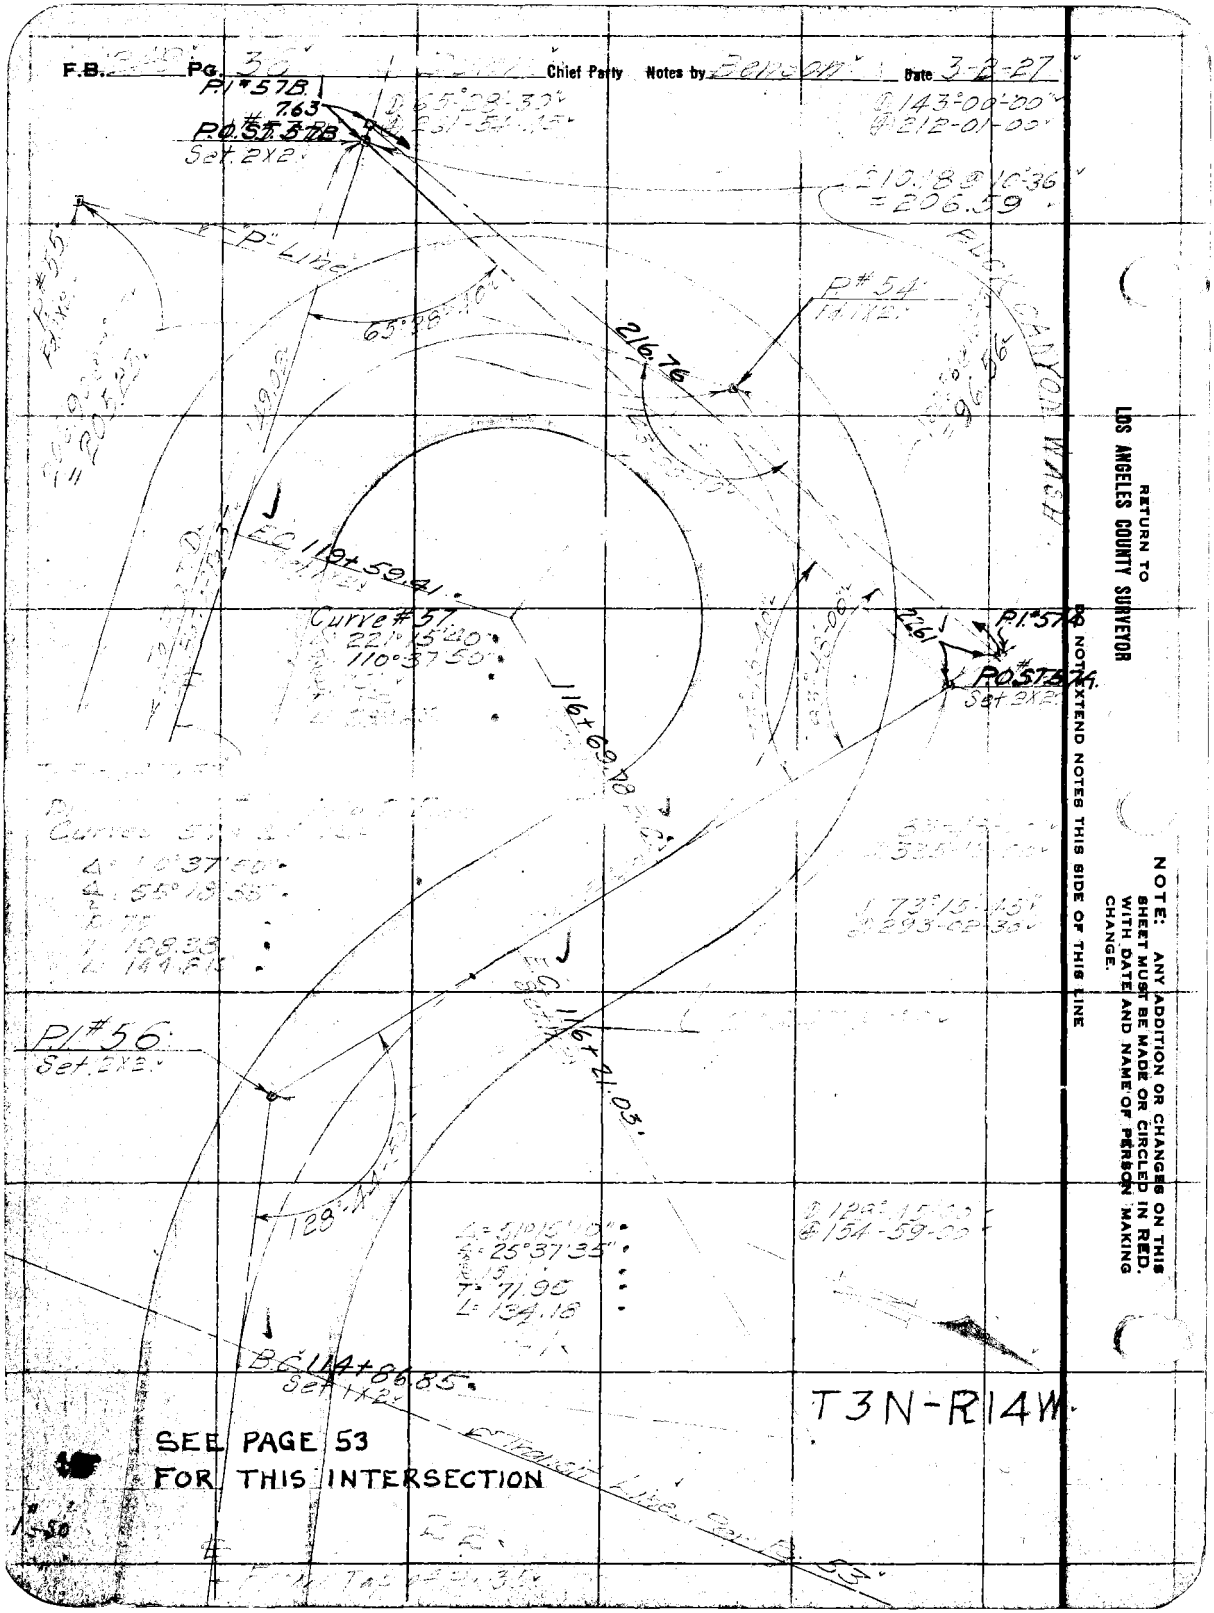
F.B. Pg. 34
Chief Party
Notes by
Date 3-2-87
P.I.#57B
763
P.O.S.#57B
Set 2X2"
"P" Line
65°28'10"
216.76
P.I.#54
Set 1X2"
ELSIE CANYON WASH
EC 110+59.41
Curve #57
22°15'20"
110°37'50"
116+69.10
P.I.#57A
P.O.S.#57A
Set 3X3"
P.I.#56
Set 2X2"
116+41.03
129'
B.C. 114+86.85
Set 1X2"
SEE PAGE 53
FOR THIS INTERSECTION
T3N-R14W
1"=50'
RETURN TO
LOS ANGELES COUNTY SURVEYOR
DO NOT EXTEND NOTES THIS SIDE OF THIS LINE
NOTE: ANY ADDITION OR CHANGES ON THIS SHEET MUST BE MADE OR CIRCLED IN RED, WITH DATE AND NAME OF PERSON MAKING CHANGE.

Date 3-2-27 Notes by Bennett Chief Party Dunn F.B. 249 Pg. 37

Plotted by Drew
Date Apr. 1927
Map No. 8948
Plotting Ck'd by McPherson
Date Apr. 1927

W. O. No. 710 D. S. O. No.
Location
Surveyed by Dunn
Date
Indexed 3-28-27 ACO

NOTE: ANY ADDITION OR CHANGES ON THIS SHEET MUST BE MADE OR CIRCLED IN RED. WITH DATE AND NAME OF PERSON MAKING CHANGE.

DO NOT EXTEND NOTES THIS SIDE OF THIS LINE

RETURN TO LOS ANGELES COUNTY, SURVEYOR

P.O.T. Set 2X2 12B+68.35

19296 @ 7°46' = 191.19

Δ 15°45'15" Δ 15°02'00"

Mag. S 44° 0' E

E.C. Curve

R 2475.24

T3N-R14W

P.I. #58 Set 2X2 (R.P. Per P.B. 25)

Δ 15°45'40" 15°45'

22

Δ = 52°14'20"
Δ = 26°07'10"
R. 200.
T. 98.06
L = 182.35

Line Per B. 53

SEE PAGE 53 FOR THIS INTERSECTION.

21

183.25 @ 0°0'

B.C. 120+92.87

P.O.T. Set 2X2 120+07.68

From Top (L.S. 5113) of Pk. 26'

F.B. 249 Pg. 38 DUNN Chief Party Notes by Benson Date 3-8-27

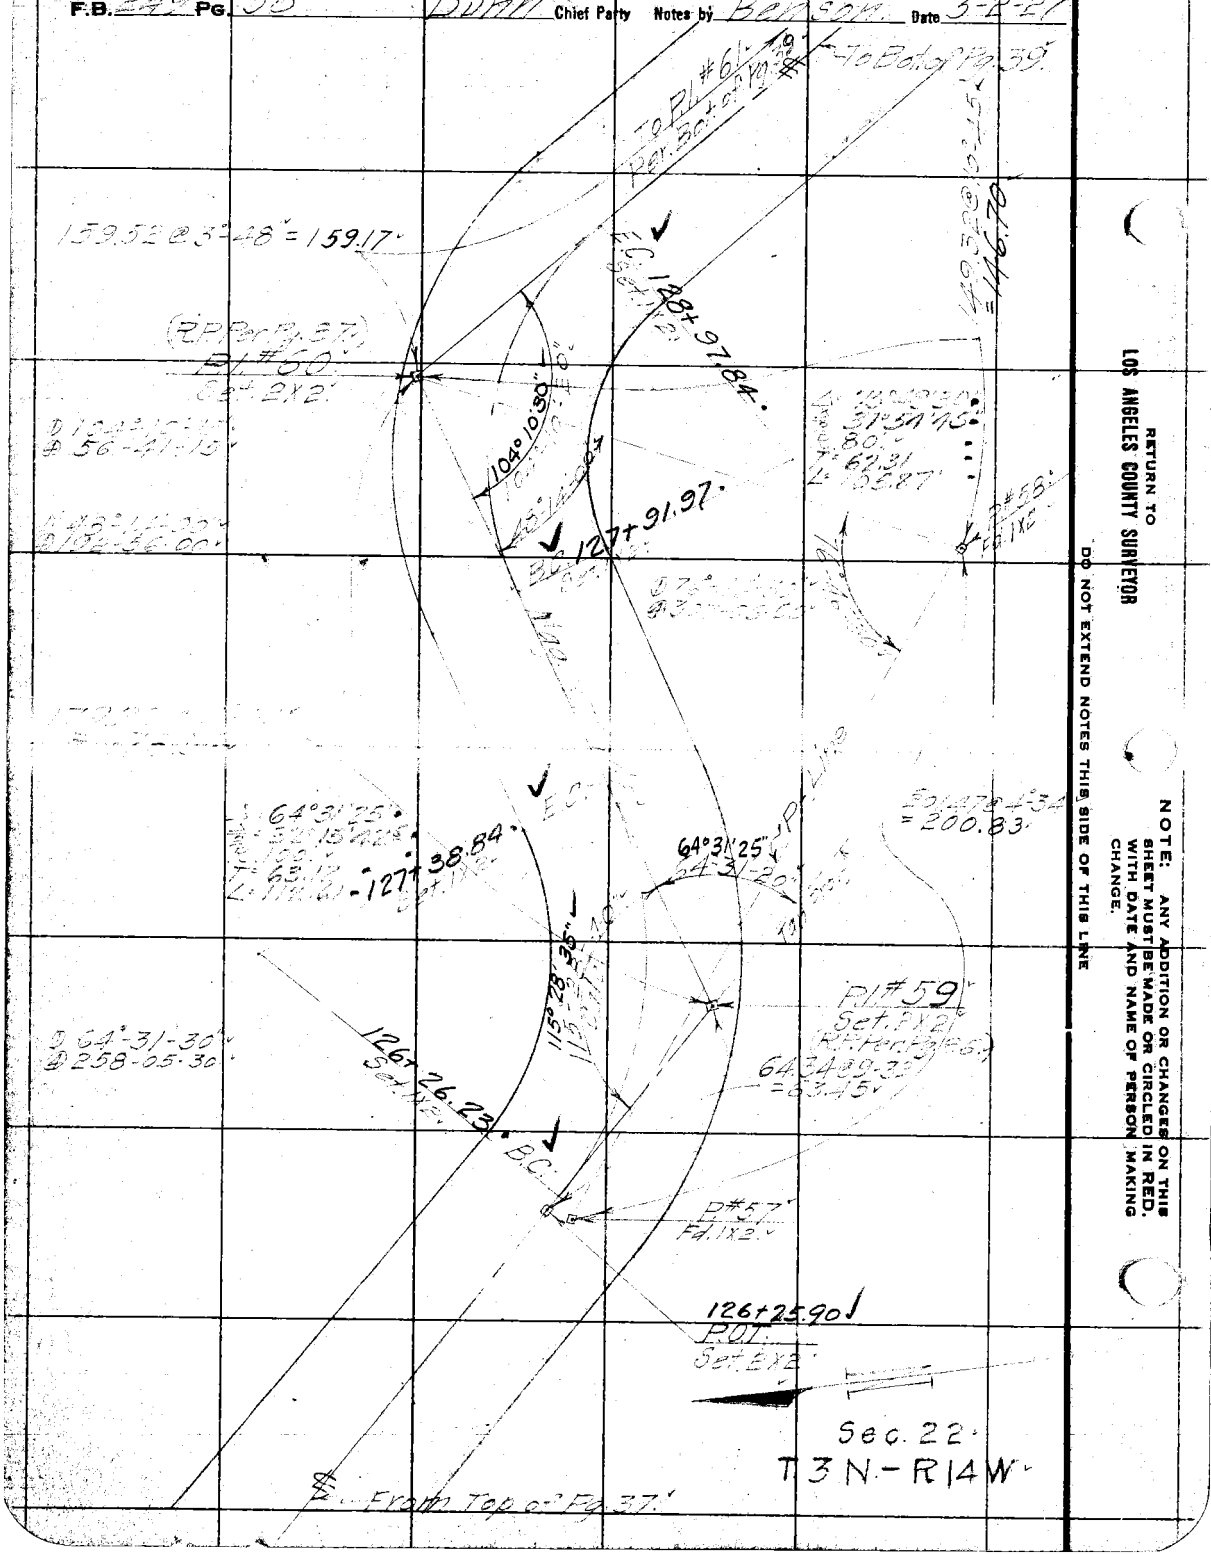

RETURN TO LOS ANGELES COUNTY SURVEYOR

DO NOT EXTEND NOTES THIS SIDE OF THIS LINE

NOTE: ANY ADDITION OR CHANGES ON THIS SHEET MUST BE MADE OR CIRCLED IN RED, WITH DATE AND NAME OF PERSON MAKING CHANGE.

Date 3-7-27 Notes by [illegible] Chief Party [illegible] F.B. 249 PG. 39

Plotted by Drew
Date Apr 1927
Map No. 8948
Plotting C'k'd by McPherson
Date Apr. 1927

W. O. No. 716 D. S. O. No.
Location [illegible]
Surveyed by
Date
Indexed 3-28-27

NOTE: ANY ADDITION OR CHANGE ON THIS SHEET MUST BE MADE OR CIRCLED IN RED. WITH DATE AND NAME OF PERSON MAKING CHANGE.

DO NOT EXTEND NOTES THIS SIDE OF THIS LINE

RETURN TO LOS ANGELES COUNTY SURVEYOR

To Sot. 3" Pg. 40'

To P.C.C. Per. Pg 42

137+66.83 E.C.

Δ 64°11'25"
Tan 32°05'42"
R. 125'
T= 78.40
L= 140.04

Δ 5°49'
= 124.23'

115°48'35"

131+26.79 B.C.

D.I. #62'
Set 2" x 2'
(R.P. Per. Pg 87)

D.I. #61'
Set 2" x 2'

158°38'40"
52.30'

Δ= 21°21'20"
Tan 10°40'40"
R. 200'
T= 37.71
L= 74.54

BUCK CANYON WASH

From Top of Pg 38'

Sec 22

T 3 N - R 14 W

F.B. 249 Pg. 40' Chief Party Notes by [illegible] Date 3-[illegible]

To Saticoy [illegible]

To = 338.13'

133+62.61'

133+18.17'

133+12.66'

RETURN TO
LOS ANGELES COUNTY SURVEYOR

DO NOT EXTEND NOTES THIS SIDE OF THIS LINE

NOTE: ANY ADDITION OR CHANGES ON THIS SHEET MUST BE MADE OR CIRCLED IN RED, WITH DATE AND NAME OF PERSON MAKING CHANGE.

Date 3-7-27 Notes by Benson Chief Party Duell F.B. 249 Pg. 41

Plotted by Drew	W. O. No. 110 D. S. O. No.
Date Apr. 1927	Location Mile Tuning to Sta. 61
Map No. 8948	Surveyed by Duell
Plotting C'k'd by McPherson	Date 3-7-27
Date Apr. 1927	Indexed 3-28-27 OPS

NOTE: ANY ADDITION OR CHANGE ON THIS SHEET MUST BE MADE OR CIRCLED IN RED. WITH DATE AND NAME OF PERSON MAKING CHANGE.

DO NOT EXTEND NOTES THIS SIDE OF THIS LINE

RETURN TO LOS ANGELES COUNTY SURVEYOR

= 39.71'

15" A.C. P.C.P.

= 154.57'

Post Set

35.0'

18.77'

138°37'15"

Sta. 1+38.74

Sta. 1 X 2

P.I. #65 Not Set

A = 56°33'50"
R = 100'
T = 53.84
L = 98.78

164°46'55"

Sta. 1+88+39.96

Sta. 1 X 2

BC

EC

Sta. 2+

T 3 N - R 14 W

= 102.16'

1371+72.85

Sta. 1 X 2

1699.08.00

P.I. #64 Set 2 X 2

= 66.10'

Δ 10°51'00"
D 5°25'30"
R 300'
T = 28.49
L = 56.81

137+16.04

Sta. 1 X 2

136+78.43

P.I. Sta. 2 X 2

F.B. 249 PG. 42 Chief Party Notes by [illegible] Date 3-4-57

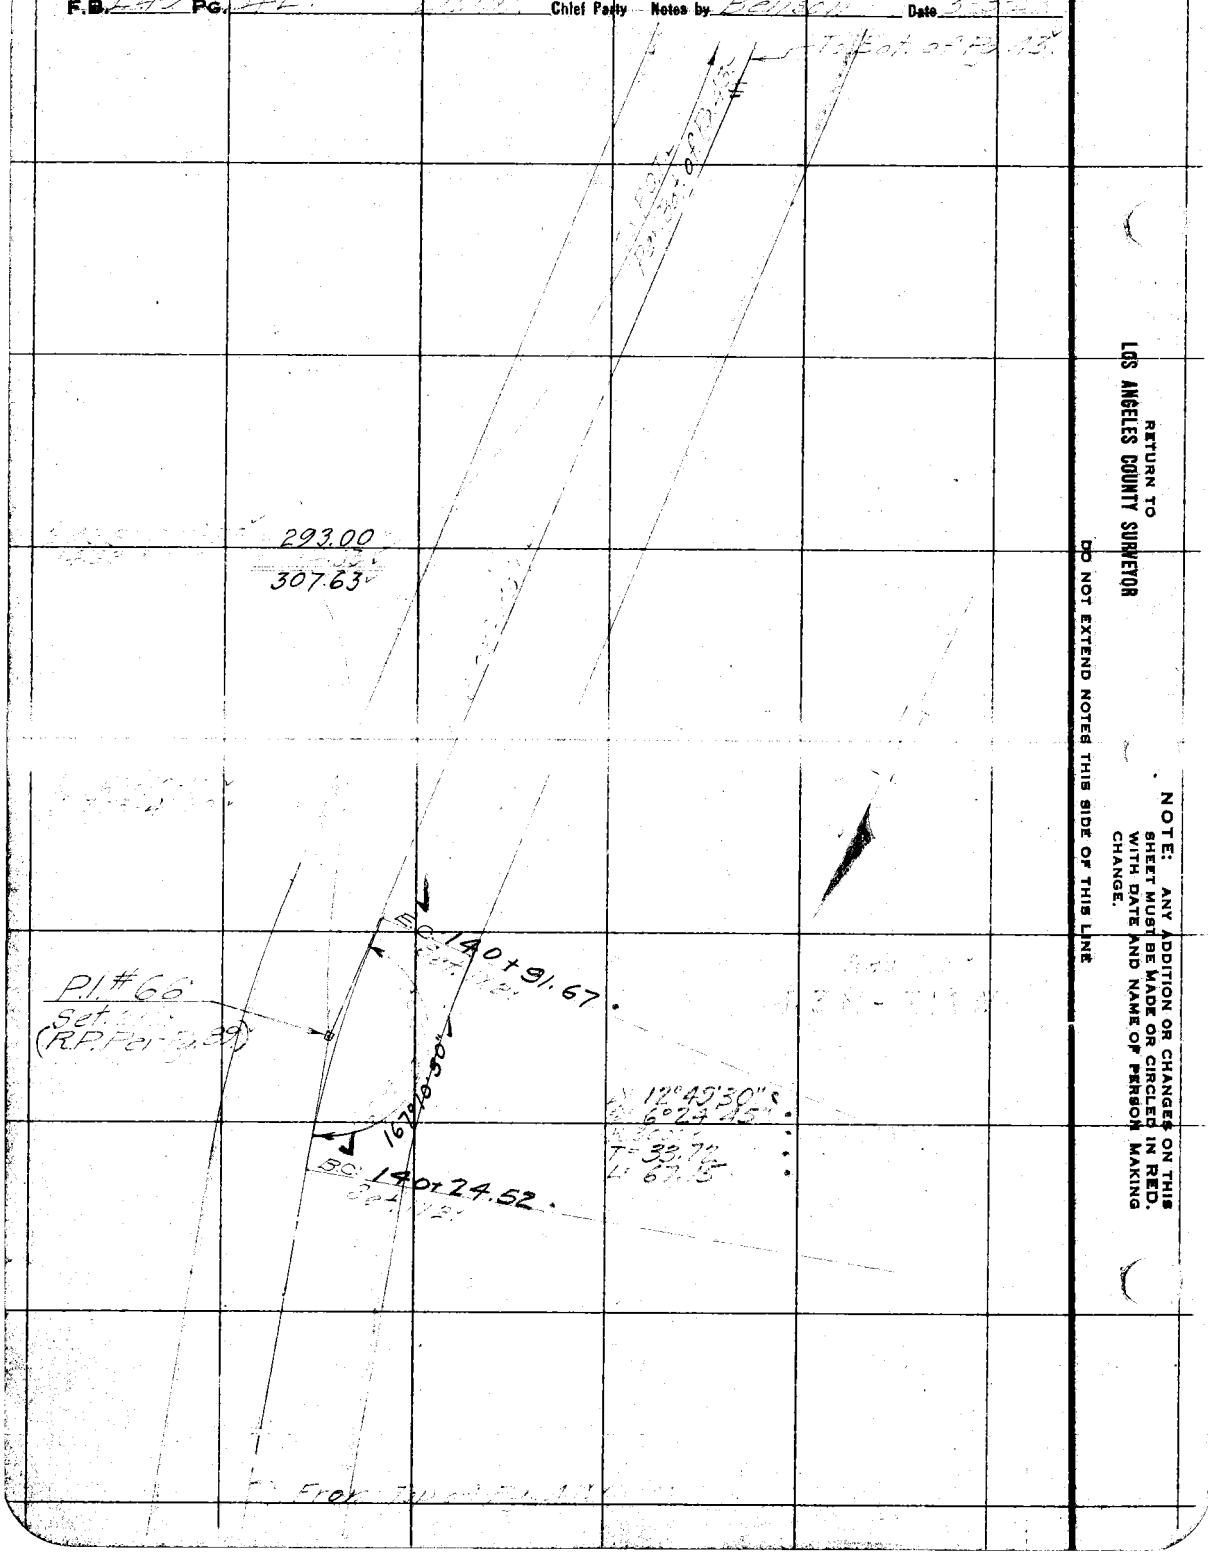

RETURN TO
LOS ANGELES COUNTY SURVEYOR

NOTE: ANY ADDITION OR CHANGES ON THIS SHEET MUST BE MADE OR CIRCLED IN RED. WITH DATE AND NAME OF PERSON MAKING CHANGE.

DO NOT EXTEND NOTES THIS SIDE OF THIS LINE

Date 3-8-27 Notes by [illegible] Chief Party [illegible] F.B. 249 Pg. 43

Plotted by Drew	W. O. No. [illegible] D. S. O. No.
Date Apr. 1927	Location
Map No. 8948	Surveyed by
Plotting Ck'd by McPherson	Date
Date Apr. 1927	Indexed 3-28-27 GBS

NOTE: ANY ADDITION OR CHANGES ON THIS SHEET MUST BE MADE OR CIRCLED IN RED. WITH DATE AND NAME OF PERSON MAKING CHANGE.

DO NOT EXTEND NOTES THIS SIDE OF THIS LINE

RETURN TO LOS ANGELES COUNTY SURVEYOR

Sec. 22.
T. 3 N - R 14 W.

P#66
Fd. 1X2.

146+89.37 EC

Δ = 47°00'10"
Δ = 23°30'05"
T = 43.48
L = 82.04

146+33 BC

132°59'50"

=218.07

=223.55

P.I. #69.
Set 1X2.

P.I. #68.
Not Set.

Calc. 13
40.09

155°36'35"

185+80.54
Set 1X2.

=90.57

=59.89

Δ = 51°47'00"
Δ = 29°51'00"
T = 57.39
L = 104.20

P#65.
Fd. 1X2.

22.68

R = 18.75

144+41.25 BC

144+83.34
Set 1X2.
8-18-50

=93.13

144+52.51 EC
Set 1X2.

17°31'40"
R = 200.00
T = 31.13
L = 61.77

162°18'20"

143+90.74
Set 1X2.

P.I. #67
Set
R.P. Per Pg. 89.

57.15 @ 12°54'

=56.29

143+65.58
EC
Set

F.B. 249 Pg. 44 Dunn Chief Party Notes by Benson Date 3-3-27

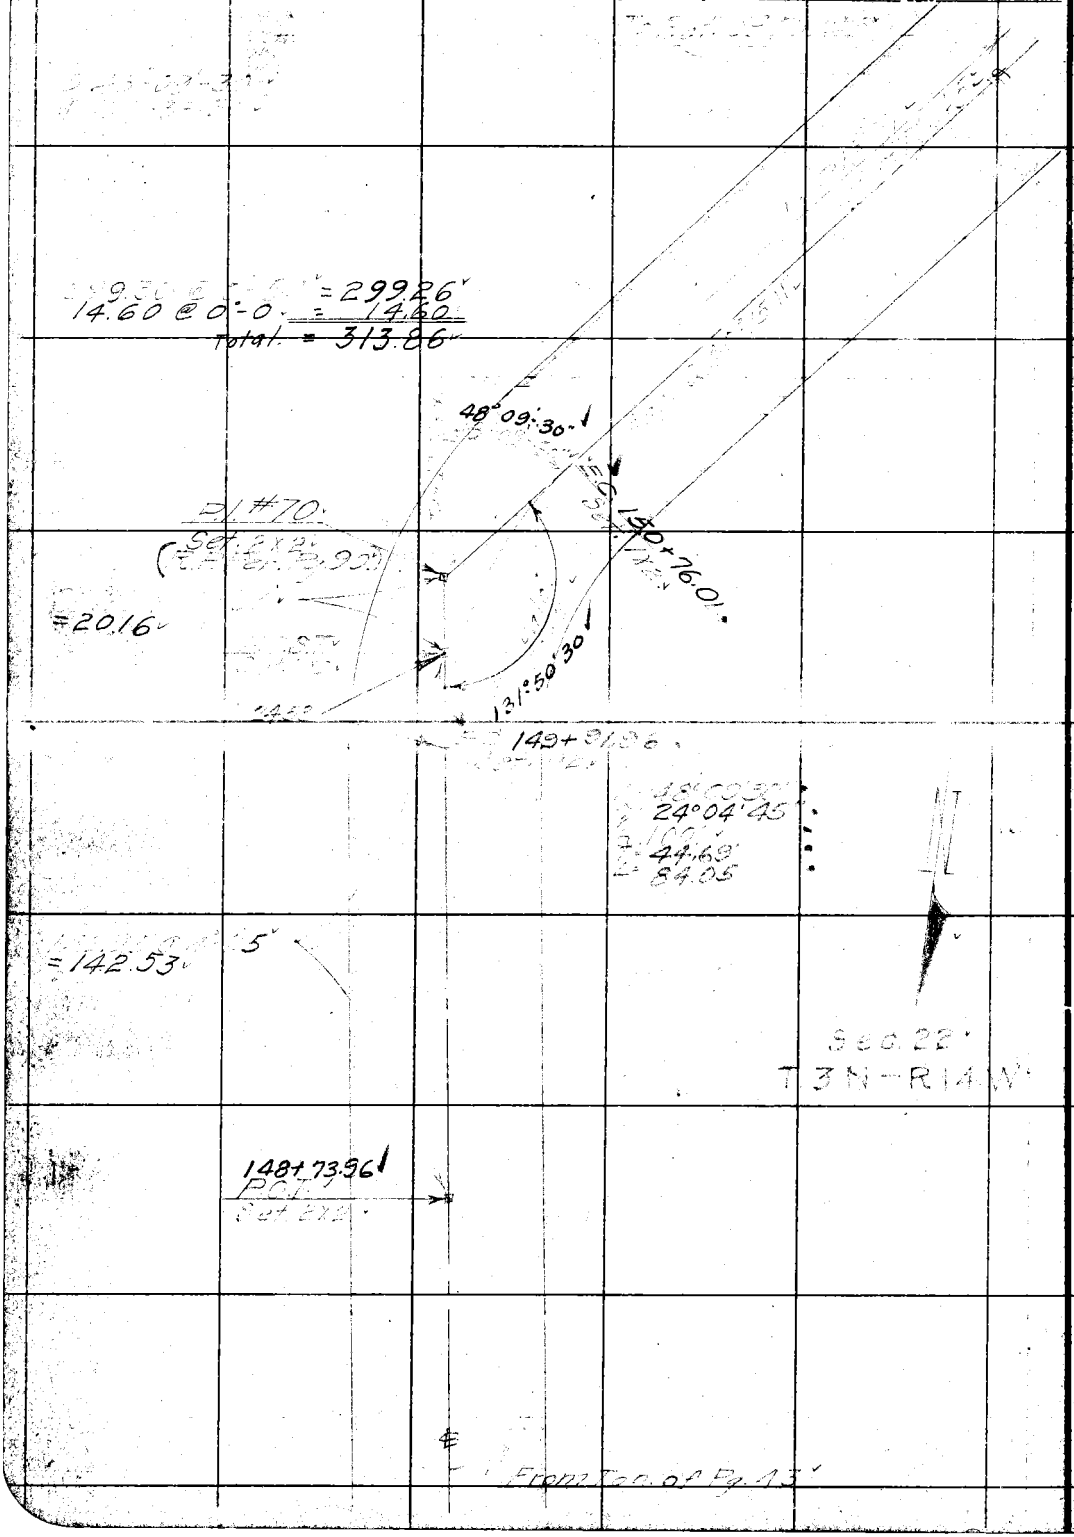

RETURN TO
LOS ANGELES COUNTY SURVEYOR

DO NOT EXTEND NOTES THIS SIDE OF THIS LINE

NOTE: ANY ADDITION OR CHANGES ON THIS SHEET MUST BE MADE OR CIRCLED IN RED. WITH DATE AND NAME OF PERSON MAKING CHANGE.

Date 3-2-27 Notes by Parsons Chief Party Parsons F.B. 249 Pg. 45

Platted by Drew	W. O. No. 710 B. S. O. No.
Date Apr. 1927	Location Little Tujunga Canyon Rd.
Map No. 8948	Surveyed by Dunn
Platting Ch'd by McPherson	Date 3-24-27
Date Apr. 1927	Indexed 3-28-27 GRB

NOTE: ANY ADDITION OR CHANGES ON THIS SHEET MUST BE MADE OR CIRCLED IN RED. WITH DATE AND NAME OF PERSON MAKING CHANGE.

DO NOT EXTEND NOTES THIS SIDE OF THIS LINE

RETURN TO LOS ANGELES COUNTY SURVEYOR

Sec. 22.
T3N-R14W.

154+46.82
Set 1"x2"

EC

R = 2546.7
254.66

67°08'45"
33°34'22"
T = 132.74
L = 234.38

112° 51'

P.I. # 71
Set 2"x2"
(R.P. Par Pg. 90)

152+12.48
Set 1"x2"

BC

R = 2546.7
91-25 °C

F.B. 249 Pg. 46 Chief Party Notes by [illegible] Date 5-9-57

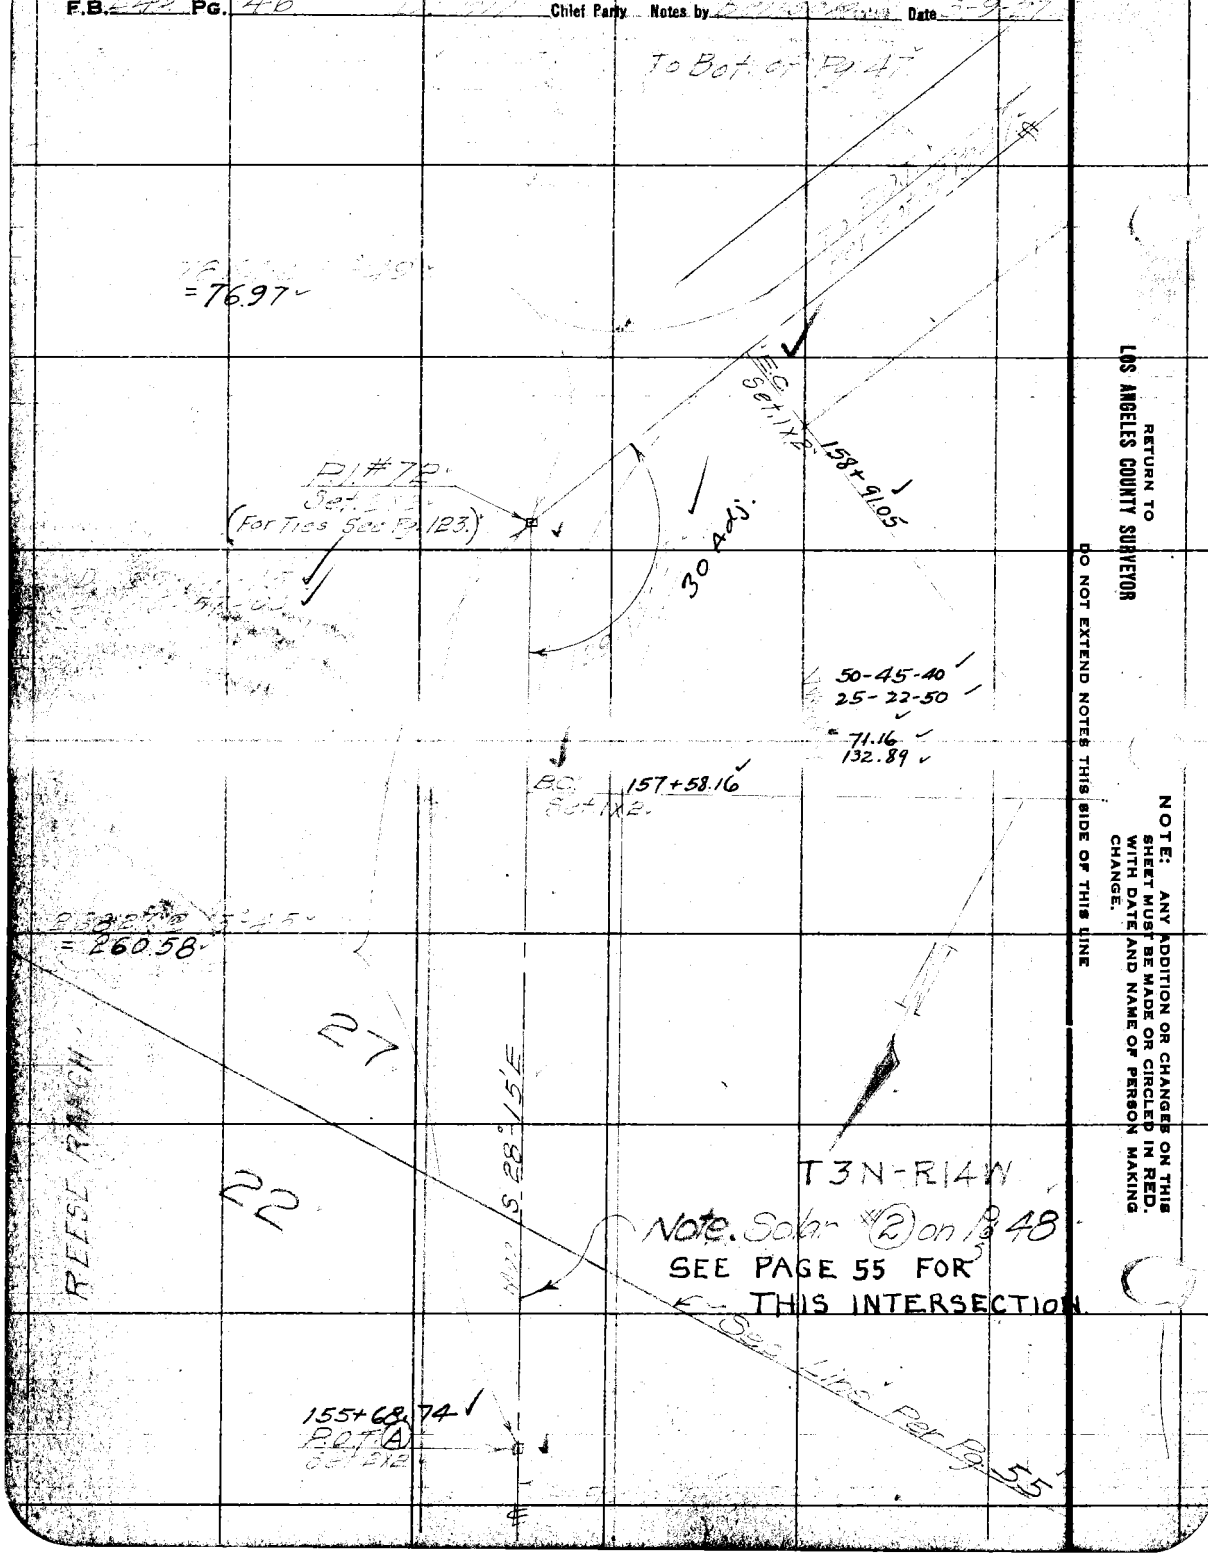

RETURN TO
LOS ANGELES COUNTY SURVEYOR

DO NOT EXTEND NOTES THIS SIDE OF THIS LINE

NOTE: ANY ADDITION OR CHANGES ON THIS SHEET MUST BE MADE OR CIRCLED IN RED. WITH DATE AND NAME OF PERSON MAKING CHANGE.

Date 3-9-27 Noted by [illegible] Filed Refer F.B. 249 Pg. 47

Plotted by A.H. Morrison Comp. pr. Chkd. by D.B. C. No.
Date Apr. 1927 Location
Map No. 8948 Surveyed by
Plotting Chk'd. by McPherson Date
Date Apr. 1927 Indexed 3-28-27 C.E.B.

NOTE: ANY ADDITION OR CHANGES ON THIS SHEET MUST BE MADE OR CIRCLED IN RED, WITH DATE AND NAME OF PERSON MAKING CHANGE.

DO NOT EXTEND NOTES THIS SIDE OF THIS LINE

RETURN TO LOS ANGELES COUNTY SURVEYOR

Note, This Survey to Be Continued Later

@ 74-01-30"
@ 296-07-00"
356.73 @ 2°-28' = 256.69
74-01-30"

P.#72
Fd. 1X2

To P.O.S.T. (A)
Per Pg. 91

P.#74
Set. 2X2.
(For Ties See Pg 123)

E.C.
Set 1X2.

Sec. 27.
T 3N-R 14W

25 Adj.

142+01.95

Cont. 0°17'30" 89.91

61.31 @ 2°-50'-00" = 55.41

98.25

P.O.S.T.
Set. 2X2.

74-01-35
37-00-47½
100'
T = 75.39
L = 129.20

160+72.36

E.C.
Set 1X2.

P.#71
Fd. 1X2.

10' Adj.

136.08 @ 8°-10' = 134.53

112.11

159+81.93

E.C.

27-08-10
13-34-05
100'
T = 24.13
L = 47.36

159+34.57

P.#73
Set. 2X2.

108-32-15

73.46 @ 32°-10' = 61.84

E.C.T.
Set 2X2.

From Tape at Fo. 46

F.B. 249 Pg. 48 Dunn Chief Party Notes by Dunn Date 3-12-27

Solar No. (2) March-12-1927 A.M.
Lat. 34-19-15"
Mag. Bg. Pot. (A) To P.I. #72 S.28°15'E. Var. Set off 16°00'

Inst. at Pot. (A) Sight on P.I. #72 See p. 46
Angles Left (East) to Sun
Standard Time.

	Time	Hor. ∠	Ver. ∠
(1)	9-33-00	22-23-15	38-32-00
(2)	9-34-00	22-43-00	38-15-00
(3)	9-35-00	21-48-30	38-52-00
(4)	9-36-00	22-16-00	38-32-30
(5)	9-37-00	21-17-30	39-14-30
(6)	9-38-00	21-44-30	38-53-30
(7)	9-41-00	21-30-30	39-14-30
(8)	9-42-00	21-45-45	38-58-30
(9)	9-43-00	20-33-30	39-37-00

Calculated Bearings

Set # 1 = S 28°01'12"E
2 = S 28°00'45"E
3 = S 28°00'14"E
4 = S 28°00'58"E
5 = S 28°00'42"E

Adopted Bearing S 28°00'45"E

Calc. By E.J. Brock
Checked By D.M. Finley

RETURN TO LOS ANGELES COUNTY SURVEYOR

DO NOT EXTEND NOTES THIS SIDE OF THIS LINE

NOTE: ANY ADDITION OR CHANGES ON THIS SHEET MUST BE MADE OR CIRCLED IN RED. WITH DATE AND NAME OF PERSON MAKING CHANGE.

Date 3-10-27 Notes by Dunn Chief Party Dunn F.B. 249 Pg. 49

Plotted by A.C. Johnson	W. O. No. 710 D. S. O. No.
Date Apr. 1927	Location Little Tujunga Canyon Rd.
Map No. 8948	Surveyed by Dunn
Plotting C'k'd by O.M. Finley	Date March 10, 1927
Date Apr. 1928	Indexed 3-28-27 249

NOTE: ANY ADDITION OR CHANGES ON THIS SHEET MUST BE MADE OR CIRCLED IN RED. WITH DATE AND NAME OF PERSON MAKING CHANGE.

DO NOT EXTEND NOTES THIS SIDE OF THIS LINE

RETURN TO LOS ANGELES COUNTY SURVEYOR

To Bot. of Pg. 50

March 10, 1927
Cold - Windy

Dunn
Gist
Glass
Henderson
Jansen

#④ Set 1X2 per Bot. of Pg. 50

100.23 @ 27°-13'
= 89.13

#③ Set 1X2
8+82.33

69.40 @ 10°-33' = 68.23

20±

#② Set 1X2
8+14.10

High point of Dividing Ridge Course S.E. & N.W.

4.15

Fd. old Burned Lath 2" High. Also part of 1X2 Marker

5.92

To ¼ Cor. Page 15

S.89°-30' E. 2576.96

Section Line

458.75 @ 19°-03'
= 433.63

#①E Set 1X2
3+80.47

Ascend

T. 3N-R. 14W.

Δ = 90°-51'-00"
Δ = 3°-24'-15"

5

22

380.91 @ 2°-46'
= 380.47

92°-29'-35"

91°-51'-40"

90°-51'-00" N.W.

90°-51'-05"

Fd. 1X2 #① Per Pg. 14

Transit Line Per Pg. 14

Sec. Line ¼ 2593.69

To ¼ Cor. Page 15

Fd. 2X2 #③ Per Pg. 14

Section Line

E. Transit Line Per Pg. 14

2653.06 To ¼ Cor. Page 53

0+80.00 Going E.S.

Fd. Old Rotted 3X4 Stake 1' High in Mid of Rock Sec. Cor. Per Pg. 14 C.S. 9198-11

88°-05'-00"

49.23 @ 8°-04'
= 48.74

6

21

To ¼ Sec. Cor. Page 68

2759.80

Section Line

89°-33'-45"

F.B. 249 PG. 50 — Dunn — Chief Party — Notes by Dunn — Date 3-10-27

To Bot of Pg. 51 ↑

Fence

19°53'

To ⑥

Top Bot of Slope

Wash

142.79 @ 1°20' = 142.93
432.68 @ 7°02' = 484.37
Total = 627.30

867.0 @ 5°27'
= 86.30
= 86.31

Wash

Wash

25'

30'

Canyon Road

15'

Wash

*③ Set 1x2
16+83.41

6'

15' Wash

10'

Toe

12'

Ł of Old Trail Road 6' Wide

277.52 @ 23°45'
= 254.02

T. 3 N + R. 14 W.

Toe of Slope & W. Side Wash

Little Tujunga 20'

14+29.39
*⑦ Set 1x2

15

2576.76

22

385.79 @ 24°16'
= 351.70

@ 73°01'30"
④ 292-05-45

Pl #28 per Pg 20

10+77.69
*⑤ Set 2x2 by Intersection

13°01'35"
13-01-30

Tujunga Canyon Road

Pg 20

60.66 @ 6°26'
= 60.59

Little Tujunga

Fence

Pl #27 per Pg 20

187.12 @ 00°40'
= 187.11

60.52 @ 35°23'
= 49.34

Section Line

*⑤ Set 1x2
10+28.35

68.44 @ 33°46'
= 56.89

*④ Set 1x2
9+71.46

From Top of Pg 49

RETURN TO
LOS ANGELES COUNTY SURVEYOR

DO NOT EXTEND NOTES THIS SIDE OF THIS LINE

NOTE: ANY ADDITION OR CHANGES ON THIS SHEET MUST BE MADE OR CIRCLED IN RED, WITH DATE AND NAME OF PERSON MAKING CHANGE.

Date 3-11-27 Notes by Dunn Chief Party Dunn F.B. 249 Pg. 51

Platted by A.C. Johnson	W. O. No. 710 S. S. D. No.
Date Apr. 1927	Location Little Tujunga Canyon Rd.
Map No. 8948	Surveyed by Dunn
Plotting Ck'd by D. M. F.	Date March 11, 1927
Date Apr. 1928	Indexed 3-28-27 O.E.D.

NOTE: ANY ADDITION OR CHANGES ON THIS SHEET MUST BE MADE OR CIRCLED IN RED. WITH DATE AND NAME OF PERSON MAKING CHANGE.

DO NOT EXTEND NOTES THIS SIDE OF THIS LINE

RETURN TO LOS ANGELES COUNTY SURVEYOR

End of Survey

Fd. Old Burned 2"x3" Stake 2' High in Md. of Rock with 2' Base 18" High 0.56

63.20 @ 21°39' = 58.74

00°33'00"

#13 Set 1X2

117.89 @ 00 = 117.89

#12 Set 1X2

T.3N-R.14W.

119.30 @ 9°21' = 117.71

15 117.72

#11 Set 1X2

22

38.26 @ 28°42' = 33.56

25+76.96

¼ Sec. Cor.

#10 Fd. Rock 5"X10"X15" Buried 10" in Ground Mkd. with 4 on N. Side A Md. of Rock 20 Base 1.0 High 2.5 North of this point. Also Fd. Rock 6"X11"X22" Mkd. ¼ Lying 2' N. and 2' W. of #10

C.S. 91°98'-12"

112.10 @ 29°30' = 97.60

97.57

0°54'

Fence Cor.

266.93 @ 4°05' = 266.25

2676.96 N Sec. Line

Wire fence with Iron Posts

Fence Cor.

23+10.71

#9 Set 1X2

91.60 @ 17°19' = 87.50

87.45

Fence Cor.

Wire

Fence with Iron Posts

15°21'

46°03'

Fence with Iron Posts

Orchard

123.90 @ 14°53' = 119.70

= 119.74

163.10 @ 13°44' = 158.40

= 158.44

From Top of B.50

F.B. 219 Pg. 52 Dunn Chief Party Notes by Dunn Date 3-15-27

To Bot. of Pg. 53

38527@3°51' = 384.40

*⑥ Set 1X2 for P.O.T. on Pg. 53

31+79.88

*⑤ Set 1X2 (Upper Edge of Mesa)

498.37@6°24'
= 495.26

3.24'

Fd. Nail with Burned Marker

6.24'

*④ Set 1X2 (Top of Small Spur)

36+75.14

Δ 25°18'-00"
Δ 101-13-00

P.I. *50 Ran. 1' R

Sec. Line

2653.06

203.22@2°07' = 203.06
417.63@12°40' = 466.01
669.89

Δ 6°28'-15"
Δ 25-53-15

See Tujunga Ca. Road Pg. 30

25°18'-00"

6°28'20"

P.I. *49 Ran. Pg. 30

487.75@8°32'
= 482.35

22

21

Sec. Line

*③ Set 1X2

43+44.03

T. 3 N - R. 14 W.

Mag. S. 00°15' E.

298.65@7°30' = 296.10
4991
346.01

*② Set 1X2

46+90.04

*① 479.20 From Bot. of Pg. 14

From Bot. of Pg. 14

RETURN TO
LOS ANGELES COUNTY SURVEYOR

DO NOT EXTEND NOTES THIS SIDE OF THIS LINE

NOTE: ANY ADDITION OR CHANGES ON THIS SHEET MUST BE MADE OR CIRCLED IN RED. WITH DATE AND NAME OF PERSON MAKING CHANGE.

Date 3-16-27 Notes by Dunn Chief Party Dunn F.B. 249 Pg. 53

Plotted by A.C. Johnson	W. O. No. 710 D.S.O. No.
Date Apr. 1927	Location Little Tujunga Canyon Rd
Map No. 8948	Surveyed by Dunn
Plotting Ck'd by D. M. F.	Date 3-16-27
Date Apr. 1928	Indexed 3-28-27

NOTE: ANY ADDITION OR CHANGES ON THIS SHEET MUST BE MADE OR CIRCLED IN RED, WITH DATE AND NAME OF PERSON MAKING CHANGE.

DO NOT EXTEND NOTES THIS SIDE OF THIS LINE

RETURN TO LOS ANGELES COUNTY SURVEYOR

25+66.03
Ef. Old Burned 2X3" Stake 3' High in Md. of Rock With 3" Base 18" High
Set Rock 5"x6"x4" Mkd. ¼ Lying 2' East of Stake.

To Bot. of Pg. 54

To ⑩ Per Bot. of Pg. 54

51.66 @ 26°01' = 46.43

① 83-52-30
② 335-30-00

Sec. Line

26+22.96

152.05 @ 3-10 = 151.32

9.80
7.10
93°52'30"
P.I. #58 Per Pg. 37
113.68 Little Tujunga
25+73.13
⑨ Set 2X2 By Intersection
38.16
Canyon Road
① Per Pg. 37
② Per Pg. 37
93°35'15"
59.45
P.I. #57 Per Pg. 36

31.43 @ 20°-6'

C.S. 9198-11

68.14 @ 6°21' = 67.72

79.92 @ 36°55' = 63.90

106°-07'-00"
106°-07'-00"
Mkd. ¼ Sec. Line
P.I. #56 Per Pg. 36
¼ Sec. Cor.
60.11

① 106°-07'-00"
② 64-28-15

26+20.39
115.64 Calc.
Road
185°-02'-10"
174°57'50"
32.47
Ef. Rock 5"x7"-12" High Mkd. ¼ on West Face in Md. of Rock With 2' Base 1' High

P.I. #55 Per Pg. 35
22
Little Tujunga Canyon
26+37.03
⑧ Set 2X2 By Intersection
99.12
49°58'30"
57°21'-45"
P.I. #57

124.70 @ 10°-16' = 122.70

170.22 @ 27°29' = 151.01

98.35 @ 35°05' = 30.48

① 49°-58'-30"
② 199-53-45

2653.06'

27+17.5
⑦ Set 1X2 Top of Steep Slope

Sec. Line

T. 3 N - R. 14 W.

81.56 @ 17°04' = 77.97

Transit Line

27+95.48
⑥ Set 1X2 Lower Edge of Mesa

From Top of Pg. 52

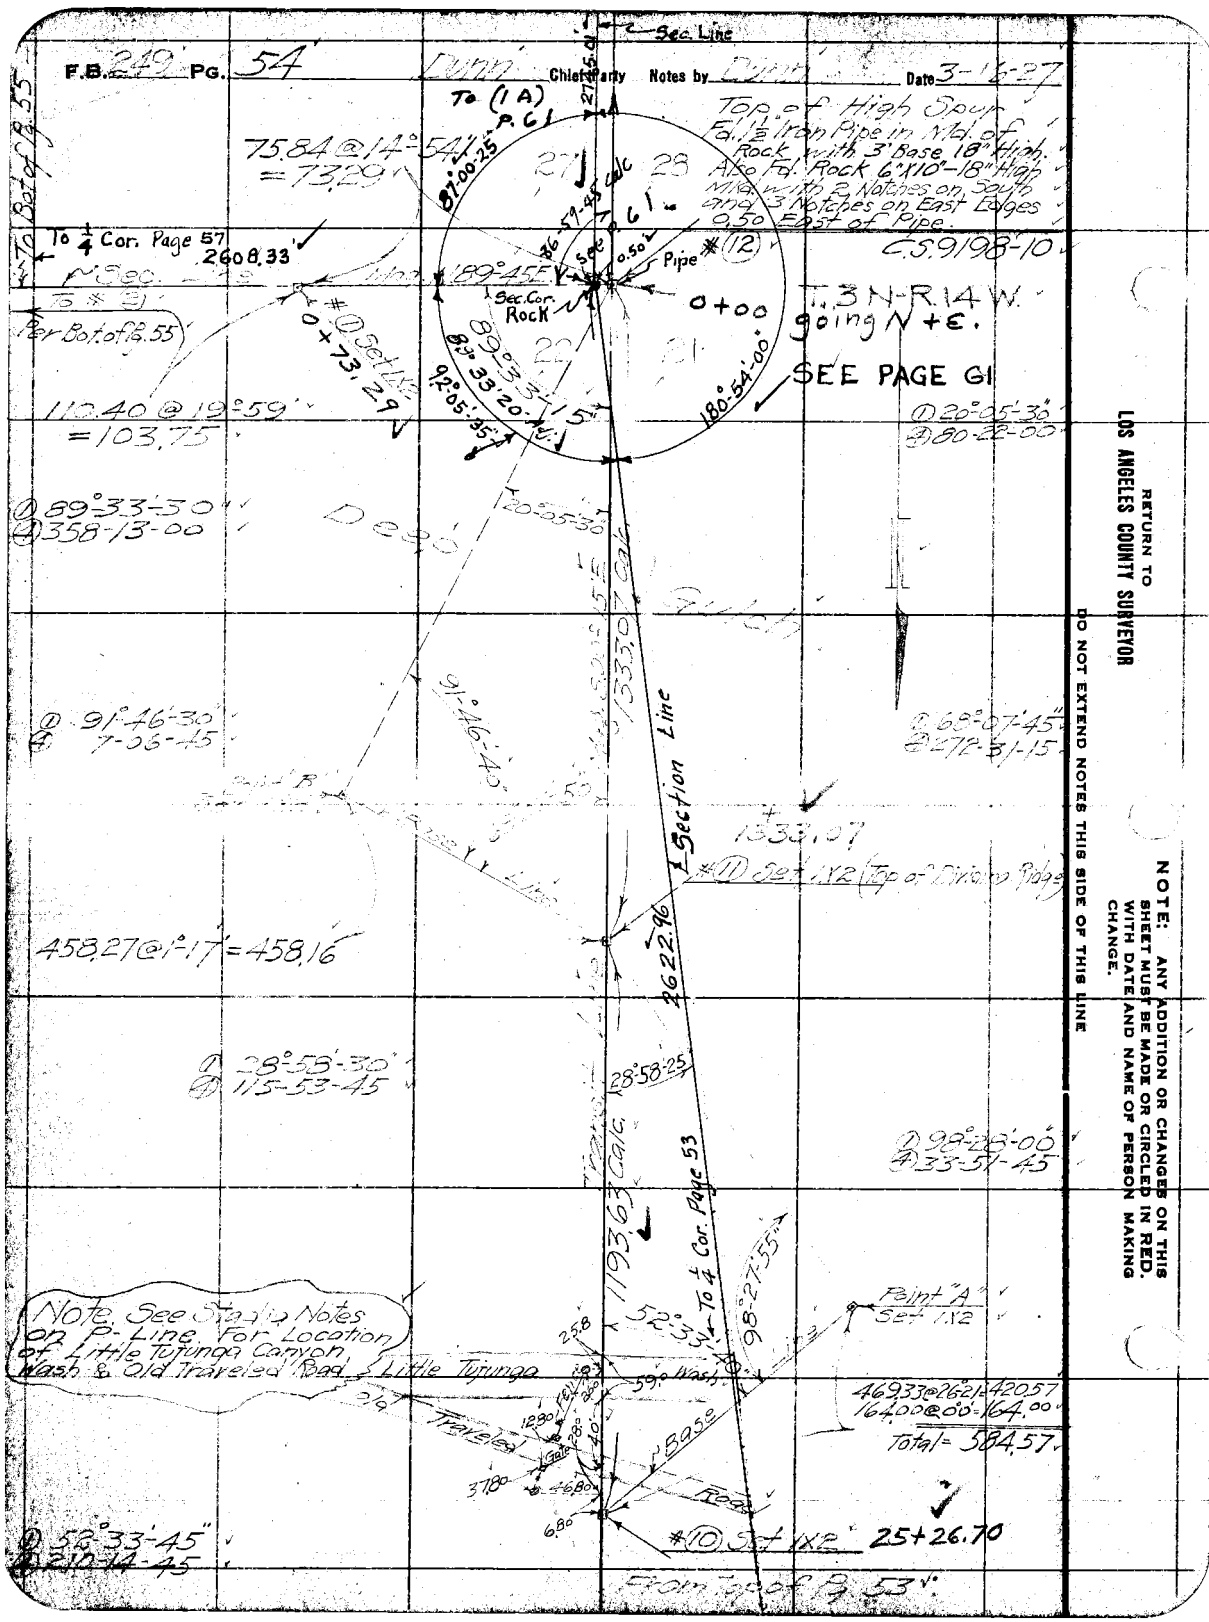

RETURN TO
LOS ANGELES COUNTY SURVEYOR
DO NOT EXTEND NOTES THIS SIDE OF THIS LINE

NOTE: ANY ADDITION OR CHANGES ON THIS SHEET MUST BE MADE OR CIRCLED IN RED. WITH DATE AND NAME OF PERSON MAKING CHANGE.

Date 3-17-27 Notes by Dunn Chief Party Dunn F.B. 249 Pg. 55

Plotted by A.C. Johansen
Date Apr. 1927
Map No. 8948
Plotting C'k'd by D. M. T.
Date Apr 1928

W. O. No. 744 D. S. O. No.
Location Tijuana Canyon Rd
Surveyed by Dunn
Date 3-17-27
Indexed 3-28-27 ACB

NOTE: ANY ADDITION OR CHANGES ON THIS SHEET MUST BE MADE OR CIRCLED IN RED. WITH DATE AND NAME OF PERSON MAKING CHANGE.

DO NOT EXTEND NOTES THIS SIDE OF THIS LINE

RETURN TO LOS ANGELES COUNTY SURVEYOR

To Bot. of Pg. 56

① 62°-20'-45"
④ 249-22-00

89.42 @ 0°-0'

See Line No. ⑤ Page 57 Per Bot. of Pg. 56

122.94 To ④ Cor. Page 57

62°-20'-45" NW

Tijuana Canyon Road

P.I. #12 Per Pg. 46

Ft. Point on Curved Marker on Line

3.56

71.70 @ 20°-23' = 67.21

Little

197.47 @ 11°-42' = 193.37

#④ Set 2x2 By Intersection 13+86.89

Post ④ Per Pg. 46

73.10 @ 0°-0'

1386.38 To ④ Cor. Page 54

#③ Set 1x2 13+13.79 (Replaced 1x2 with ¾" IPP & Tk 6-27-35 C.A.B.)

416.99 @ 7°-25' = 413.50

Base Line

Point "C" Set 1x2

① 74°-02'-45"
④ 296-11-30

74°-02'-50"

84°-43-00"

① 84°-43-00"
④ 338-52-00

22

27

T.3N-R.14W.

2608.33' Calc. N89°-45'E.

Gulch

1136.75'

Mag. 21°-14-15" E

① 21°-14'-15"
④ 84°-56'-45"

Drop

#② Set 1x2 1+77.04

From Top Left Side of Pg. 54

F.B. 249 Pg. 56 Dunn Chief Party Notes by Dunn Date 3-17-27

To Bot. of Pg. 57

To #8 Set 1/2" Pg. Bot. of Pg. 57

175.93 @ 14°26'
= 170.38

#7 Set 1/2" 19+27.32

T. 3 N - R. 14 W.

Mag. N 29° E 15 L.

Small Spur

Top of

110.27 @ 21°55'
= 108.50

22

27

226.70 @ 27°42'

30°21'30"

2608.33

El. Survey 2"x2" Stake 2.5' high

Line

Toe of Slope

#6 Set 1/2" 17+19.74

30.00'

114.43'

Wash

Reese Ranch

Canyon

10' Bridge Road

Old Traveled

19'

Tujunga

Note - See Strata Notes on P-Line, For location of Little Tujunga Canon Wash & Old Traveled Road

243.90 @ 3°34'
= 243.43

70'

Little

30'

#5 Set 1/2" (Top of Bank)
14+76.31

From Top of Pg. 55

RETURN TO
LOS ANGELES COUNTY SURVEYOR

DO NOT EXTEND NOTES THIS SIDE OF THIS LINE

NOTE: ANY ADDITION OR CHANGES ON THIS SHEET MUST BE MADE OR CIRCLED IN RED, WITH DATE AND NAME OF PERSON MAKING CHANGE.

Date 3-18-27 Notes by Dunn Chief Party Dunn F.B. 249 Pg. 57

Plotted by A.C. Johnson
Date Apr. 1927
Map No. 8948
Plotting Ck'd by D. M. F.
Date Apr. 1928

W. O. No. 710 D. S. O. No.
Location Little Tujunga Canyon Rd.
Surveyed by Dunn
Date 3-18-27
Indexed 3-28-27 DRB

A. E. Dunn - Chf.
C. A. Benson - Inst.
F. T. Gleason - Ax Ch.
H. W. Gunderson - R. Ch.
C. R. Lawson - Extra.

Fd. Mkd. Rock 2.5 Base 1' High on Top of Ridge N. 85° E.

30+68.86

453.00 @ 6°34'
= 450'
450.03

5.20

Fd. Bumped 2" x 3" Stake 16" High, In Md. of Rock 3' Base 1' High.

C.S. 9198-11
#11 Fd. Rock 8 x 10 - 10" High Mkd. + on North Face. Fd. P/T 3' East on Line

2608.83

78.40

22

38.80 @ 0°0'

6.00

16.00

Fd. Nail in R Small Md. in Rock

27.20

27

#10 Set 1 x 2
25+70.03

2608.33

Bluff

T3N-R14W.

Bot. of Small Sandstone Bluff

44.00

#9 Set 1 x 2
24+08.11

496.45 @ 17°56'
= 472.33

311.59 @ 4°59'
= 310.41

Sec. Line
Mon. N 89° E.

#8 Set 1 x 2
20+97.70

From Top of Pg. 56

NOTE: ANY ADDITION OR CHANGES ON THIS SHEET MUST BE MADE OR CIRCLED IN RED. WITH DATE AND NAME OF PERSON MAKING CHANGE.

DO NOT EXTEND NOTES THIS SIDE OF THIS LINE

RETURN TO LOS ANGELES COUNTY SURVEYOR

F.B. 249 Pg. 58 Benson Chief Party Notes by Benson Date 3-24-27

C.A. Benson - Chief
F.T. Gleason - Inst.
H.W. Gunderson - Hd. Ch.
C.R. Lawson - R. Ch.
J.L. Fogarty - Extra.

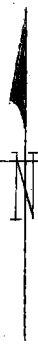

T.3 N. - R.14 W.

To Bot. of Pg. 59.

#(11) Set 1X2" Sta. 38+41.86
On Top of High Spur.
Descends East.

(1) 30°-47'-45"
(2) 123-11-30

30°47'50"

16

15

(1) 13°-25'-15"
(2) 292-21-45

Assd. N. Rough Mt.
Mag. N 00°-30 W.
Transit Calc. 1321-38

73°-05'-25"

#(3) Fd. 1X2"
Per. Pg. 16.

Base Line

704.98'
measured on
& Pg. 16.

76°-06'-45"

(1) 76°-07'-00"
(2) 304-27-00

#(10) Fd. 1X2" Sta. 25+24.48
Per. Pg. 15.

714.21' Per. Pg. 15.

#(9) Fd. 1X2"
Per. Pg. 15.

RETURN TO
LOS ANGELES COUNTY SURVEYOR

DO NOT EXTEND NOTES THIS SIDE OF THIS LINE

NOTE: ANY ADDITION OR CHANGES ON THIS SHEET MUST BE MADE OR CIRCLED IN RED, WITH DATE AND NAME OF PERSON MAKING CHANGE.

Date 3-25-27 Notes by Benson Chief Party Benson F.B. 249 PG. 59

Platted by	W. O. No. 710 D. S. O. No.
Date	Location Little Tujunga Can. Rd.
Map No.	Surveyed by Benson
Platting Ck'd by	Date 3-25-27
Date	Indexed

NOTE: ANY ADDITION OR CHANGES ON THIS SHEET MUST BE MADE OR CIRCLED IN RED, WITH DATE AND NAME OF PERSON MAKING CHANGE.

DO NOT EXTEND NOTES THIS SIDE OF THIS LINE

RETURN TO LOS ANGELES COUNTY SURVEYOR

To Bot. of Pg. 60

To #(14) Per. Bot. of Pg. 60

133.74 @ 31°-18' = 114.28'

T3N - R14W.

#(13) Set 1X2 Sta. 47+53.94

86.15 @ 25°-16' = 77.91'

Sta 46+76.03 #(12) Set 1X2 On Top of Divide between Little Tujunga & Pacoima Canyons. Bears N.E. & S.W.

442 @ 10°-43' = 134.±

39°-40' 334.± Calc.

Top of Sugar Loaf Mt. 277.± Calc.

Δ 20°-28'-00" Δ 81-52-30

20°-28'-05"

16

15

Deep Gulch

Calc. 834.17 Transit Line Mag N 00°-30' W

Δ 55°-30'-30" Δ 222-02-00

Δ 104°-01'-15" Δ 56-05-45

104°-01'-25"

55°-30'-32"

#(11) Per. Pg. 58

Base Line

Point (D) Set 1X2

From Top of Pg. 58

362.46 @ 12°-28' = 353.91'

F.B. 249 Pg. 60 Benson Chief Party Notes by Benson Date 3-30-27

T3N-R14W

#16 Set 1X2
Sta. 51+[illegible]

[illegible] Set 1X2
[illegible]

N 00° 30' W.

Line

20598 @ 33°10'
= 17242

16

#15 Set 1X2
Sta. 49+73.21

15

Transit

12469 @ 32°39'
= 10499

#14 Set 1X2
Sta. 48+68.22

From Top of Pg 59

RETURN TO
LOS ANGELES COUNTY SURVEYOR

DO NOT EXTEND NOTES THIS SIDE OF THIS LINE

NOTE: ANY ADDITION OR CHANGES ON THIS SHEET MUST BE MADE OR CIRCLED IN RED, WITH DATE AND NAME OF PERSON MAKING CHANGE.

Date 3-29-27 Notes by Benson Chief Party Benson F.B. 249 Pg. 61

Plotted by A.C. Johnson	W. O. No. 710 D. S. O. No.
Date Apr. 1927	Location Little Tujunga Canyon Rd.
Map No. 8948	Surveyed by Benson
Plotting Ch'd by D. M. P.	Date 3-29-27
Date Apr. 1926	Indexed

NOTE: ANY ADDITION OR CHANGES ON THIS SHEET MUST BE MADE OR CIRCLED IN RED, WITH DATE AND NAME OF PERSON MAKING CHANGE.

DO NOT EXTEND NOTES THIS SIDE OF THIS LINE

RETURN TO LOS ANGELES COUNTY SURVEYOR

RE 21 W. 5 SEC. 28 T. 3 N. R 14 W. 1/4 COR. SURVEY 1908

Sec. Line

To Bot. of Pg. 62

321.74 @ 2°-0'-0" = 321.74'
299.00 @ 4°-0'-0" = 299.00'
391.67 @ 1°-30'-0" = 391.67'
Total = 1012.41'

439.62 @ 3°-45' = 438.67'
141.89 @ 16-0-0 = 136.07'
Total = 574.74'

C.S. 9198-I'

#1-A Found Rock 8"x8"x12" High marked [illegible] on W. Face, [illegible] Rock 3' [illegible]

Rock 2.5' Bkst. 1' Hgh. 3.35' W. of Cor. Replaced Rock with Co. Sur. Conc. Brass Cap Mon. Stamped as shown. 3-11-35

Little Tujunga Road

Base Line

N 59.10 @ 0-0-45-00

Sec. Line

Set 1x2 Near 2-4" Sycamores

Set N.& T. Tel. P.S. 202/113

Set 1x2 Top Bank Flush

Set 2x8 Flush

Reset C.S. Mon. 12" deep. L.D.M. 7-22-37

Set N.& T. Tel. P.S. 202/112

Set 1x2 above Top Cut W side Little Tuj. Rd.

T 3 N - R 14 W

Set 1x2 Top Bank Little Tujunga Rd

Set 2x2 Top Cut

2745.01

27

28

22

21

87-00-25

See Page 54

To 1/4 Cor. Page 57

2608.33'

Sec. Line

#12 Fd. 1" Iron Pipe in mouth of Rock Adj. per Pg. 54

C + 0 Going South

1333.07 calc. as per Pg. 54

92°-05'-35"

180°-54'-00"

To 1/4 Cor. Page 53

Sec. Line

#10 Per Pg. 54

F.B. 249' Pg. 62' [illegible] Chief Party Notes by [illegible] Date 3-31-27

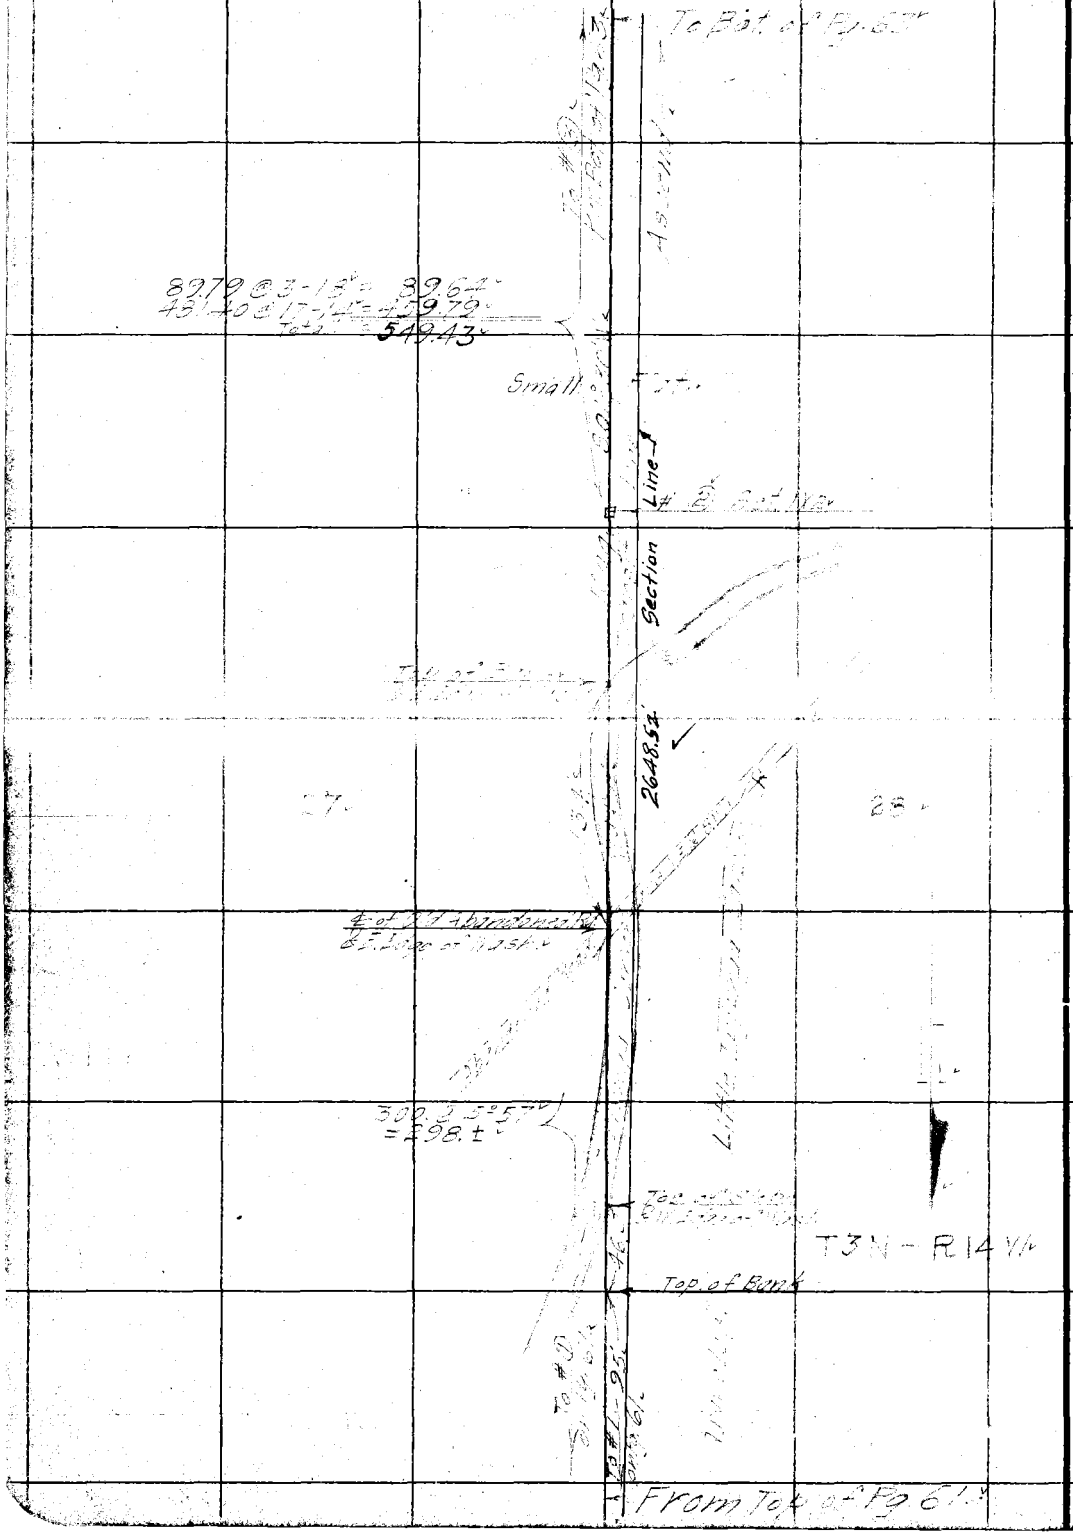

RETURN TO
LOS ANGELES COUNTY SURVEYOR

DO NOT EXTEND NOTES THIS SIDE OF THIS LINE

NOTE: ANY ADDITION OR CHANGES ON THIS SHEET MUST BE MADE OR CIRCLED IN RED. WITH DATE AND NAME OF PERSON MAKING CHANGE.

Date 4-1-27 Notes by Benson Chief Party Benson F.B. 249 Pg. 63

Plotted by A.C. Johnson	W. O. No. 710 D. S. O. No.
Date Apr. 1927	Location Mt. Thomas Quad.
Map No. 8948	Surveyed by Benson
Plotting Ch'd by D. M. F.	Date 4-1-27
Date Apr. 1928	Indexed

NOTE: ANY ADDITION OR CHANGES ON THIS SHEET MUST BE MADE OR CIRCLED IN RED. WITH DATE AND NAME OF PERSON MAKING CHANGE.

DO NOT EXTEND NOTES THIS SIDE OF THIS LINE

RETURN TO LOS ANGELES COUNTY SURVEYOR

Gold Creek

Old Wooden Post, Bark Wire Fence

Found 2"X4" Stake, Light on Bank of Wash

4.17

-464.53 @ 10°-01' = 457.74

#7 Set 1X2

Traverse Gold Creek

128.20 @ 2°-54' = 127.84

44.4

1-Story Frame House

Mouth of Gold Creek Canyon

326

128

2648.52

128 @ 0°-0'

1620.68 @ 35°-27' = 1126.93

493.28 @ 19°-15' = 165.70

Total = 592.63

Sec. Line

T3N - R14W

27

28

Found 2" Pipe 3 Stones Mound of Rock

-53.85 @ 27°-08' = 47.92

#6 Set 1X2

Spur Descends to S.W.

Ed. N&T with marker

56.54

48.71 @ 0°-0'

#5 Set 1X2 on top of Spur

47.43 @ 13°-17' = 46.34

#4 Set 1X2 Spur Descends to N.W.

82.10 @ 25°-31' = 74.09

#3 Set 1X2

From Top

F.B. 249 Pg. 64 Benson Chief Party Notes by Benson Date 4-5-27

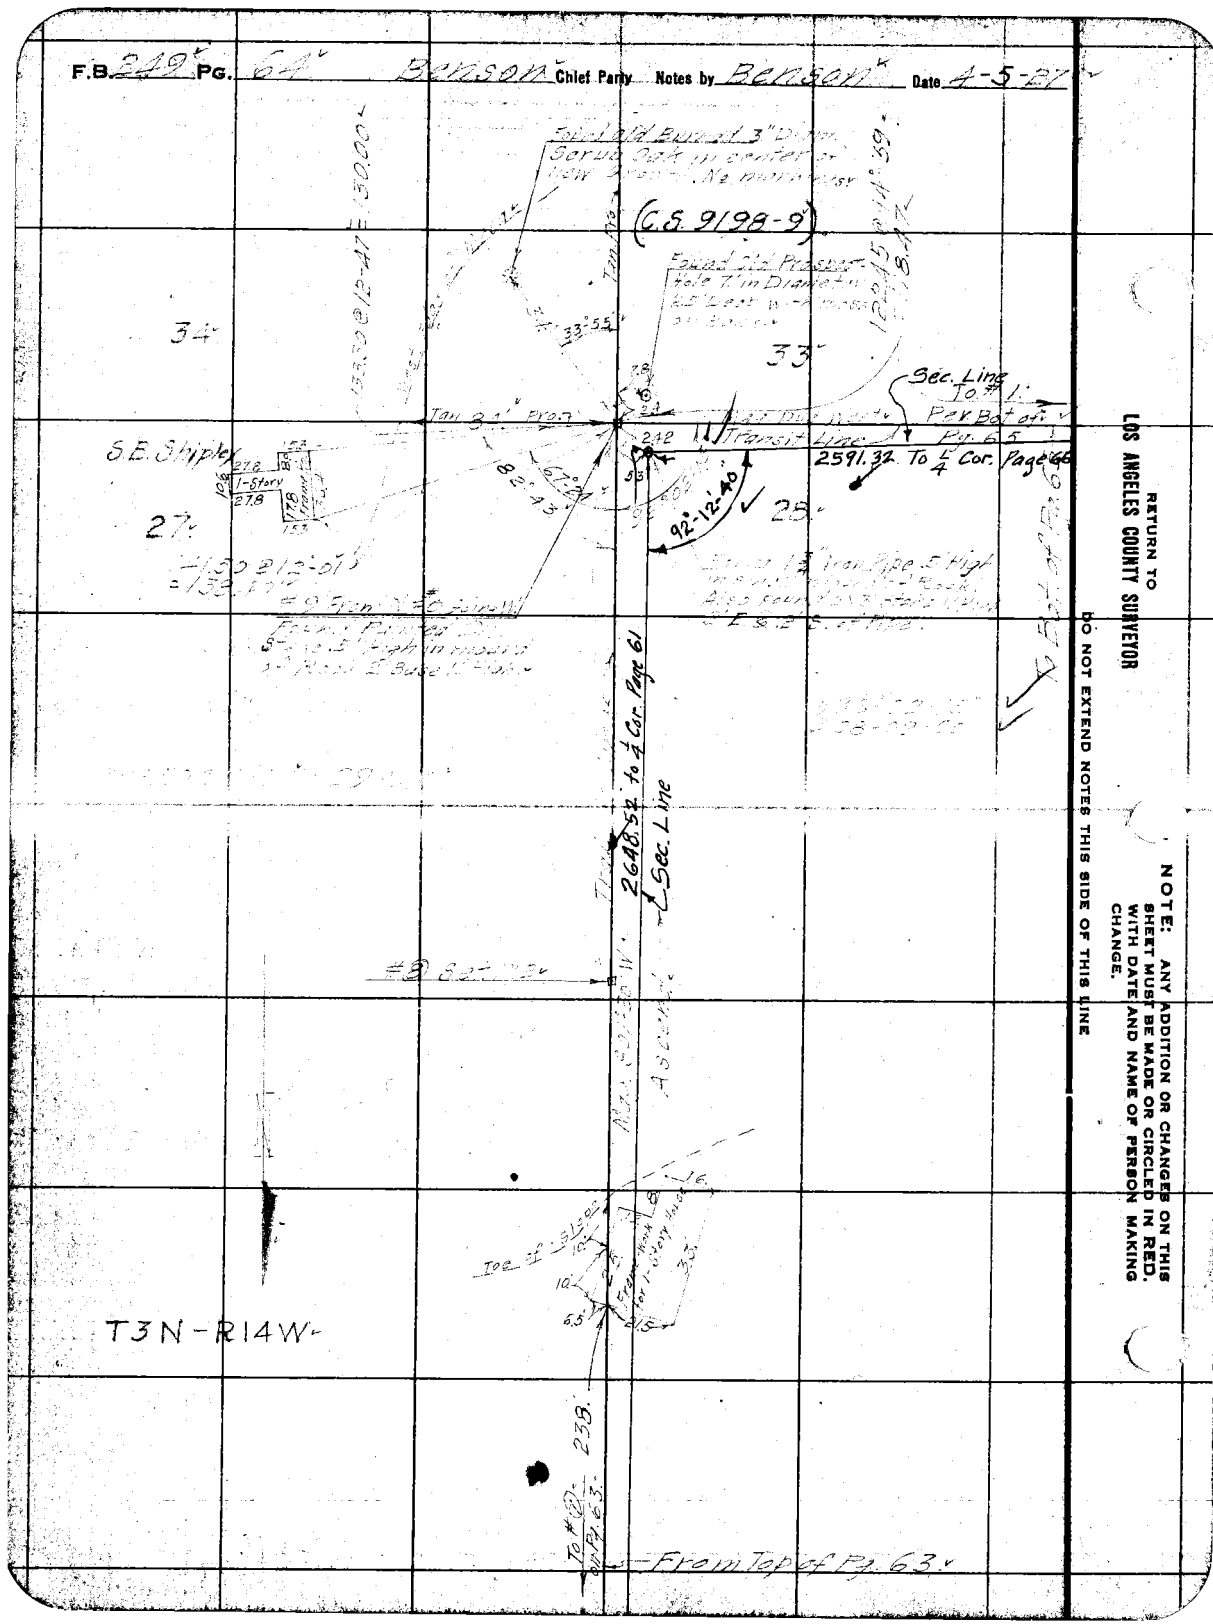

RETURN TO
LOS ANGELES COUNTY SURVEYOR

DO NOT EXTEND NOTES THIS SIDE OF THIS LINE

NOTE: ANY ADDITION OR CHANGES ON THIS SHEET MUST BE MADE OR CIRCLED IN RED, WITH DATE AND NAME OF PERSON MAKING CHANGE.

Date 4-6-27 Notes by Benson Chief Party Benson F.B. 249 Pg. 65

Platted by A.C. Johnsen	W. O. No. 710 S. S. O. No.
Date Apr. 1927.	Location Little Tujunga Canyon Rd.
Map No. 8948	Surveyed by Benson
Platting Ck'd by E. M. F.	Date 4-6-27.
Date Apr. 1928	Indexed

NOTE: ANY ADDITION OR CHANGES ON THIS SHEET MUST BE MADE OR CIRCLED IN RED. WITH DATE AND NAME OF PERSON MAKING CHANGE.

DO NOT EXTEND NOTES THIS SIDE OF THIS LINE

RETURN TO LOS ANGELES COUNTY SURVEYOR

To Bot. of Pg. 66

351.42 @ 55°17' = 337.32'

Found 3"X4" - 3' High

0.14'

34.22'

200.10 @ 7°41' = 198.26

Traveled Way

Sta # 12 Reset Per Pg 103

Found 1" Iron Pipe

Little Tujunga Canyon Rd

Little Tujunga Canyon Rd

Per Pg 103

Per Pg 104

#3-A Set 1X2" 1' Int.

86°51'30"

See Page 104

3 Set 1X2"

8+88.07

0.50'

Found 1" Iron Pipe 1' High

324.35 @ 0°0'

Found 2"X4" Stake 2' High

Found Rock 3.5' x 1.5' High

1.16'

0.90'

2.44'

Found 1" Iron Pipe 1.3' High

0.45'

33'

28'

2 Set 1X2'

5+63.62

1046.89' to ℄ Cur. Pg 66

112.55 @ 6°02' = 111.5'

Toe of Slope

8" V.C. Pipe Water Main

12°00'

25°34'

12" Iron Pipe

Water box 2.5'x2.5'x2' Deep

23'

Stone Ditch

474.99 @ 20°25' = 445.15

T3N - R14W

Thence West 2 Sec. Line

Dist. 3.42

Found Lead & Tack

0 Set 1X2'

1+18.47

From Top (Rt Side) of Pg. 64

F.B. 249 Pg. 66 Benson Chief Party Notes by Benson Date 4-6-27

26+16.75
Found Rock 1'E & 1' High, marked With Chisel X on N.E. face in E. Edge of mound of Rock 2.5' Base 5' High. Also found 3" Brass Cap in Stake. 2.5 High. A N & E of Rock.

(C.S. 2193-14)

#7 Found 2" Iron pipe covered Rock 7'X9'-8" High marked X on N. Face, in form down mound of Rock 2' Base. Elevation of C.S. monument N. of Rock.

25+96.54

39°-30' @ 9°-31' = 39.02

Note: Found [illegible]

Use 55'

E. of Little Tujunga Road

154.43 To

49°-30' @ 6°-09' = 487.65

33

28

#6 Set 1X2
17+16.64

Sec. Line

49°-54' @ 4°-09' = 491.25

T3N - R14W

0.22'

#4 Set 1X2
On Low Spur
Bears S. & E.
12+25.39

From Top of Pg 65

RETURN TO LOS ANGELES COUNTY SURVEYOR

DO NOT EXTEND NOTES THIS SIDE OF THIS LINE

NOTE: ANY ADDITION OR CHANGES ON THIS SHEET MUST BE MADE OR CIRCLED IN RED, WITH DATE AND NAME OF PERSON MAKING CHANGE.

Date 4-7-27 Notes by Benson Chief Party Benson F.B. 249 Pg. 67

Platted by A.C. Johnson
Date Apr. 1927
Map No. 8948
Platting Ck'd by D. M. F.
Date Apr. 1928

W. O. No. 710 D. S. O. No.
Location Little Tujunga Canyon
Surveyed by Benson
Date 4-7-27
Indexed

NOTE: ANY ADDITION OR CHANGES ON THIS SHEET MUST BE MADE OR CIRCLED IN RED. WITH DATE AND NAME OF PERSON MAKING CHANGE.

DO NOT EXTEND NOTES THIS SIDE OF THIS LINE

RETURN TO LOS ANGELES COUNTY SURVEYOR

To Bck. of Pg. 68.

To #① Per Bck of Pg. 68.

E Section Line

381.57 @ 21°32' = 357.73
339.48 @ [illegible] = [illegible]
Total = 683.87

#③ Set 1X2"
6+86.86

2759.80

221.18 @ 5°28 = 2[illegible]

#② Set 1X2"
On Ridge Bears N 8.5° E
4+66.69

T3N - R14W.

435.59 @ 7°47' = 431.52

Transit Line Hwy. West

89°38'30"
93-58-33-45

0+35.11

#(W) Set 1X2"

2' 87°33'45"

Adj. 12-21-27 K.B.H.
89-38-15
89-38-15

16'

88°05'00"

35.11 @ 0°-0

2653.06
Transit Line Per Pg. 14
Section Line

E Section Line 2593.69
Transit Line Per Pg. 14

92°29'35"

Ed. 1X2 #(14) Per Pg. 14.

Ed. 1X2 #③ Per Pg. 14.

0+00 Going West
Fence Old Retired 3X4"
Stake 1' High in mound of Rocks
Sec. Cor. Per Pg. 14.
(C.S. 9198-11) 22'

91°-51'-40"

15'

2576.96

49.23 @ [illegible]

F.B. 249 Pg. 68 Benson Chief Party Notes by Benson Date 4-9-27

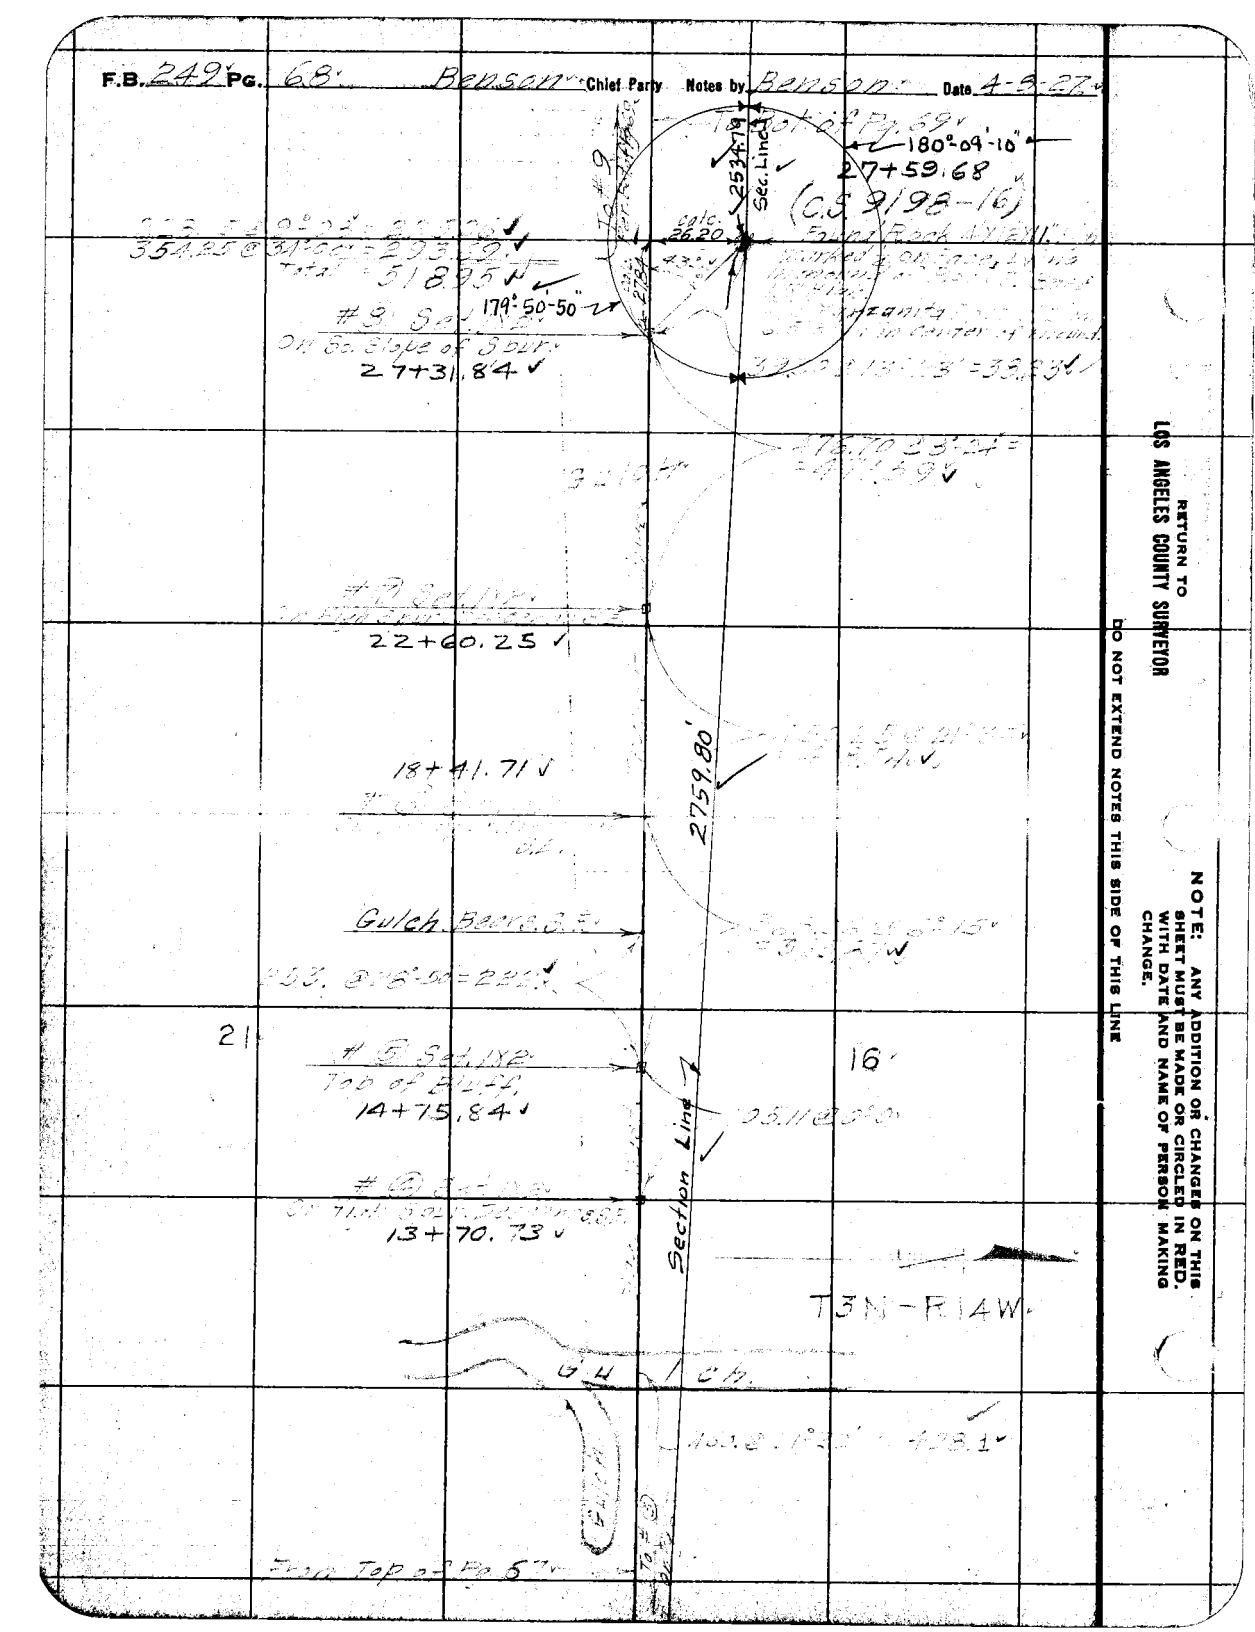

NOTE: ANY ADDITION OR CHANGES ON THIS SHEET MUST BE MADE OR CIRCLED IN RED. WITH DATE AND NAME OF PERSON MAKING CHANGE.

RETURN TO LOS ANGELES COUNTY SURVEYOR

DO NOT EXTEND NOTES THIS SIDE OF THIS LINE

Date 4-9-27 Notes by Benson Comp. Party Benson F.B. 249 Pg. 69

Platted by A.C. Johnson	W. O. No. 710 S. O. No.
Date Apr. 1927	Location Little Tujunga Canyon Rd.
Map No. 8948	Surveyed by Benson
Platting C'k'd by D. M. F.	Date 4-9-27
Date Apr. 1927	Indexed

NOTE: ANY ADDITION OR CHANGES ON THIS SHEET MUST BE MADE OR CIRCLED IN RED, WITH DATE AND NAME OF PERSON MAKING CHANGE.

DO NOT EXTEND NOTES THIS SIDE OF THIS LINE

RETURN TO LOS ANGELES COUNTY SURVEYOR

To Bot. of Pg. 70'

Descends

To #14 Pg. 70

165.82 @ 13°26 = 161.28

#13 Set 1X2'
38+98.67

198.84 @ 7°10' = 197.29

37+01.38
#12 Set 1X2'
On top of Spur. Descends S.E.

2534.79

Section Line

208.90 @ 6°19' = 200.49

#11 Set 1X2'
35+00.89

16'

21'

115.87 @ 25°15' = 104.33

#10 Set 1X2'
33+96.06

167.35 @ 29°46' = 145.27

#9 Set 1X2'
32+50.79

T3N - R14W.

Gulch

From Top of Pg. 68

F.B. 219 Pg. 70 Peterson Chief Party Notes by Benson Date 4-N-27

20

17

4354

52+94.41

2644.83 Ta ¼ Cor. F.B. 282-6

Found Rock 2" Sec. Line

SEE F.B. 282-3

#17 Set 1x2"

51+45.23

88°-43'-05"

399.23

Section Line

47+46.32

21

16

T3N - R14W.

#(15) Set 1x2"

41+31.72

2534.79

Total = 614.60

#(14) Set 1x2"

40+59.95

From Top of Hill 50'

RETURN TO LOS ANGELES COUNTY SURVEYOR

DO NOT EXTEND NOTES THIS SIDE OF THIS LINE

NOTE: ANY ADDITION OR CHANGES ON THIS SHEET MUST BE MADE OR CIRCLED IN RED, WITH DATE AND NAME OF PERSON MAKING CHANGE.

Date 1-12-27 Notes by Benson Chief Party Benson F.B. 249 PG. 71

Platted by A.H. Drew
Date Apr. 1927
Platting C'k'd by K.O. Higgins
Date May 1927

W. O. No. 710 D. S. O. No.
Location Little Tujunga Canyon Rd
Surveyed by Benson
Date 4-12-27
Indexed

NOTE: ANY ADDITION OR CHANGES ON THIS SHEET MUST BE MADE OR CIRCLED IN RED, WITH DATE AND NAME OF PERSON MAKING CHANGE.

DO NOT EXTEND NOTES THIS SIDE OF THIS LINE

RETURN TO LOS ANGELES COUNTY SURVEYOR

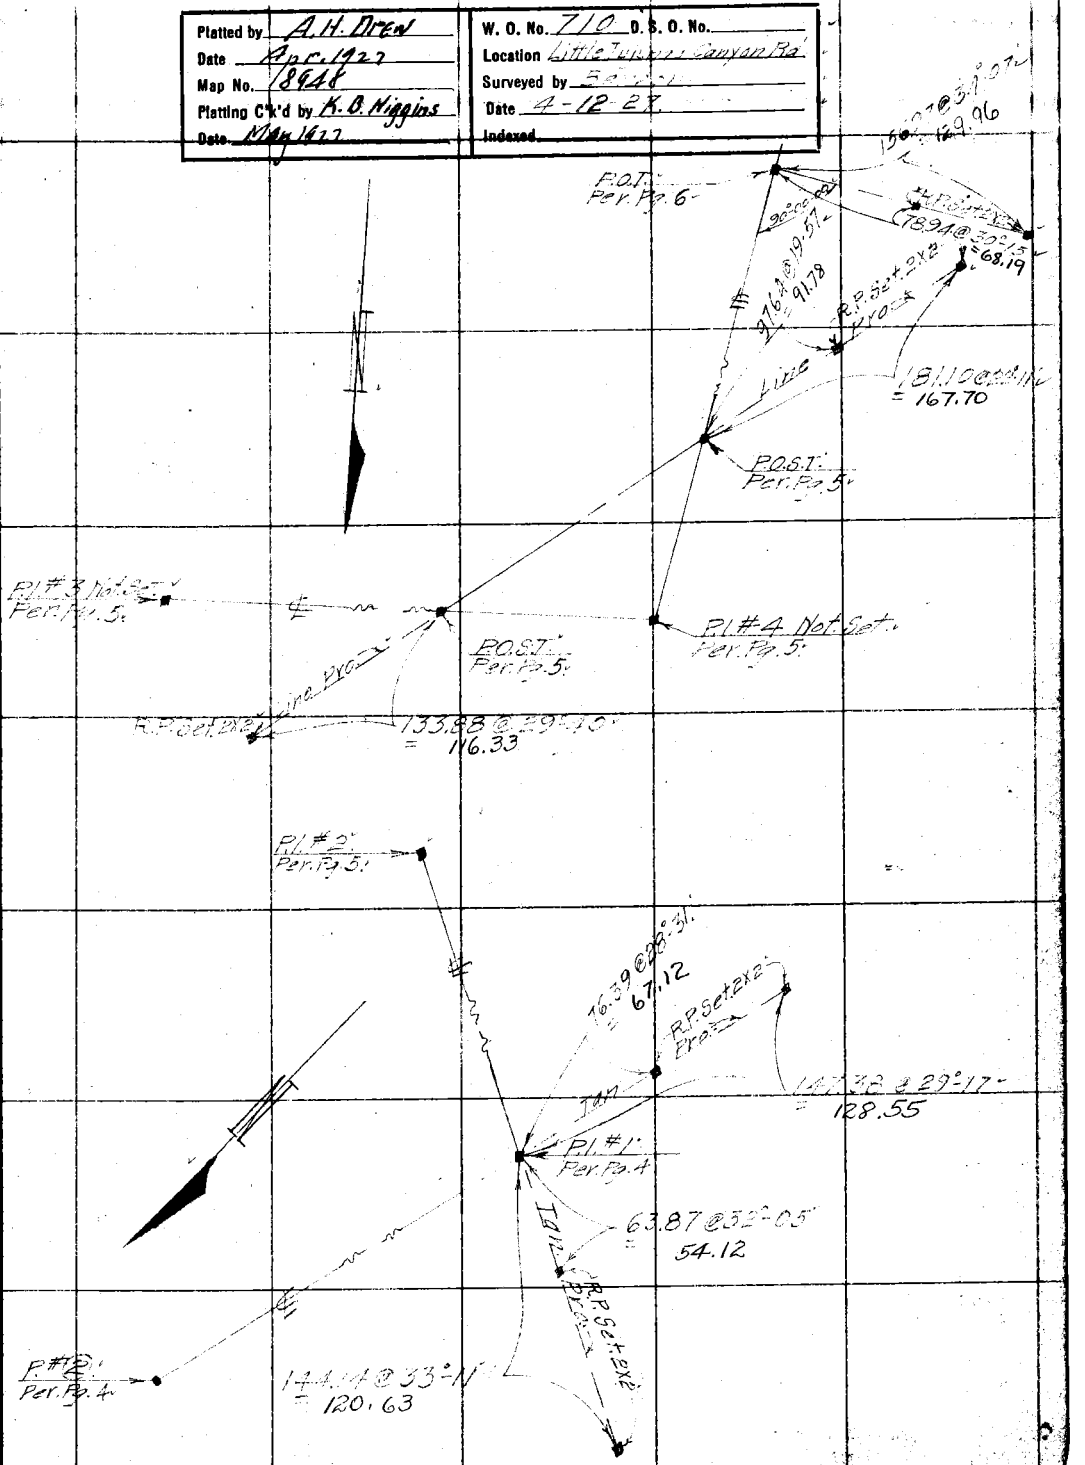

F.B. 249 Pg. 72 Benson Chief Party Notes by Benson Date 4-16-27

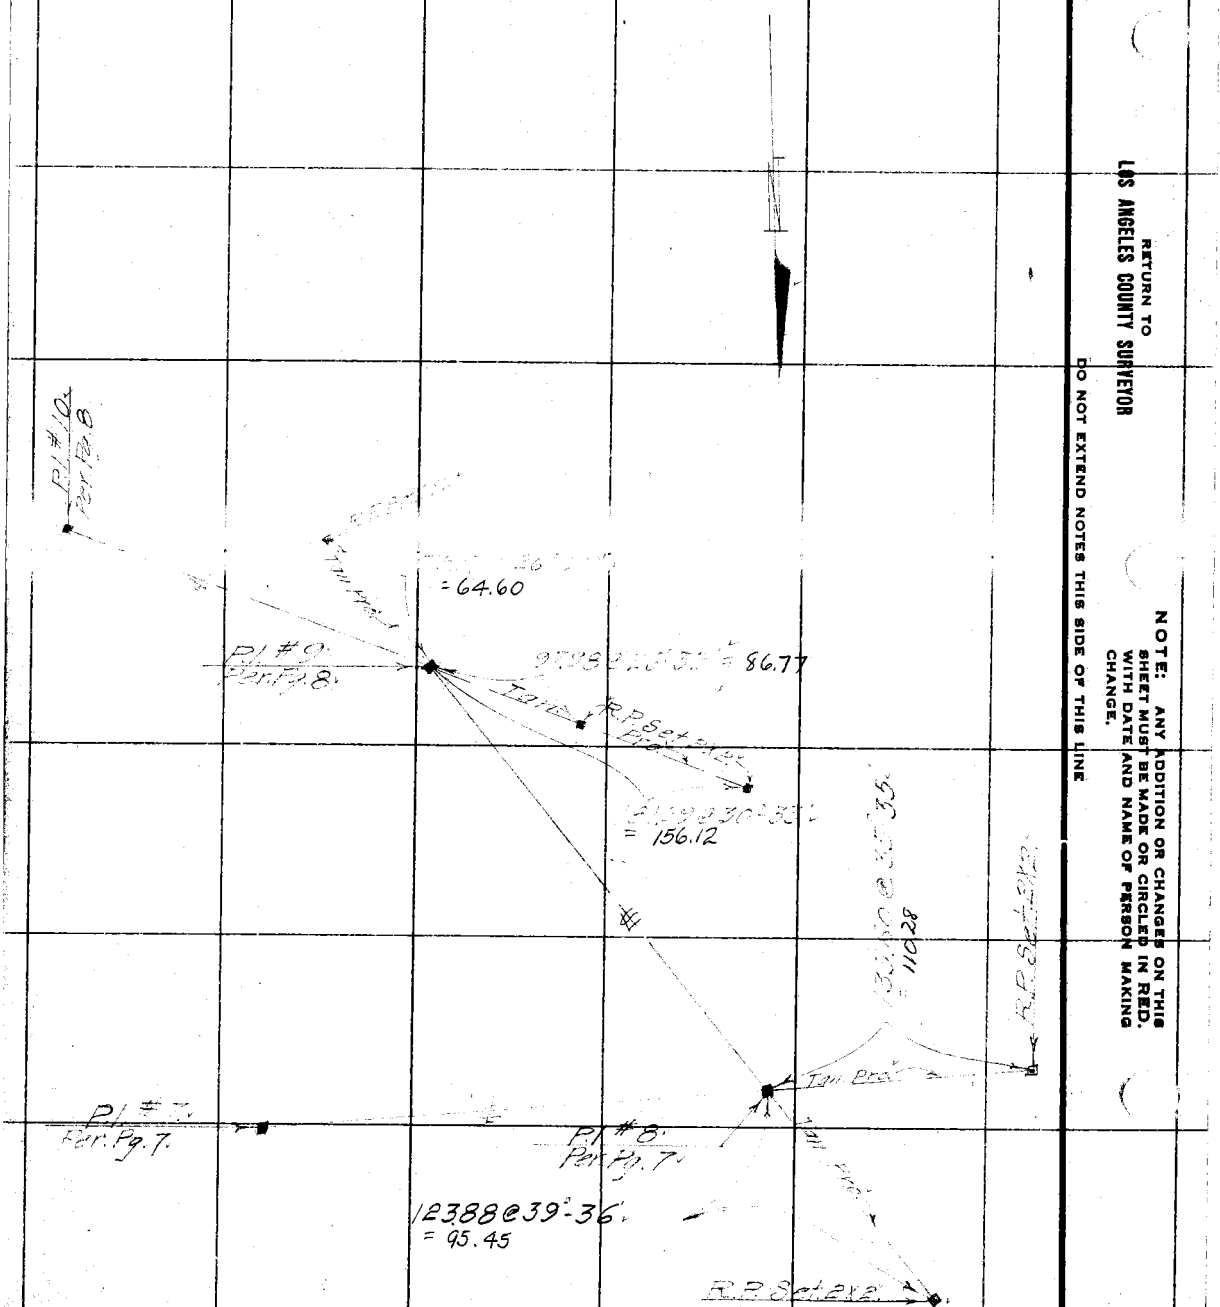

RETURN TO
LOS ANGELES COUNTY SURVEYOR

DO NOT EXTEND NOTES THIS SIDE OF THIS LINE

NOTE: ANY ADDITION OR CHANGES ON THIS SHEET MUST BE MADE OR CIRCLED IN RED, WITH DATE AND NAME OF PERSON MAKING CHANGE.

Date 4-20-27 Notes by Benson Chief Party Benson F.B. 249 Pg. 73

Platted by A.H. Drew	W. O. No. 710 D. S. O. No.
Date Apr. 1927	Location Little Tujunga Canyon
Map No. 8948	Surveyed by [illegible]
Platting C'k'd by K.B. Higgins	Date 4-20-27
Date May 1927	Indexed

NOTE: ANY ADDITION OR CHANGES ON THIS SHEET MUST BE MADE OR CIRCLED IN RED. WITH DATE AND NAME OF PERSON MAKING CHANGE.

DO NOT EXTEND NOTES THIS SIDE OF THIS LINE

RETURN TO LOS ANGELES COUNTY SURVEYOR

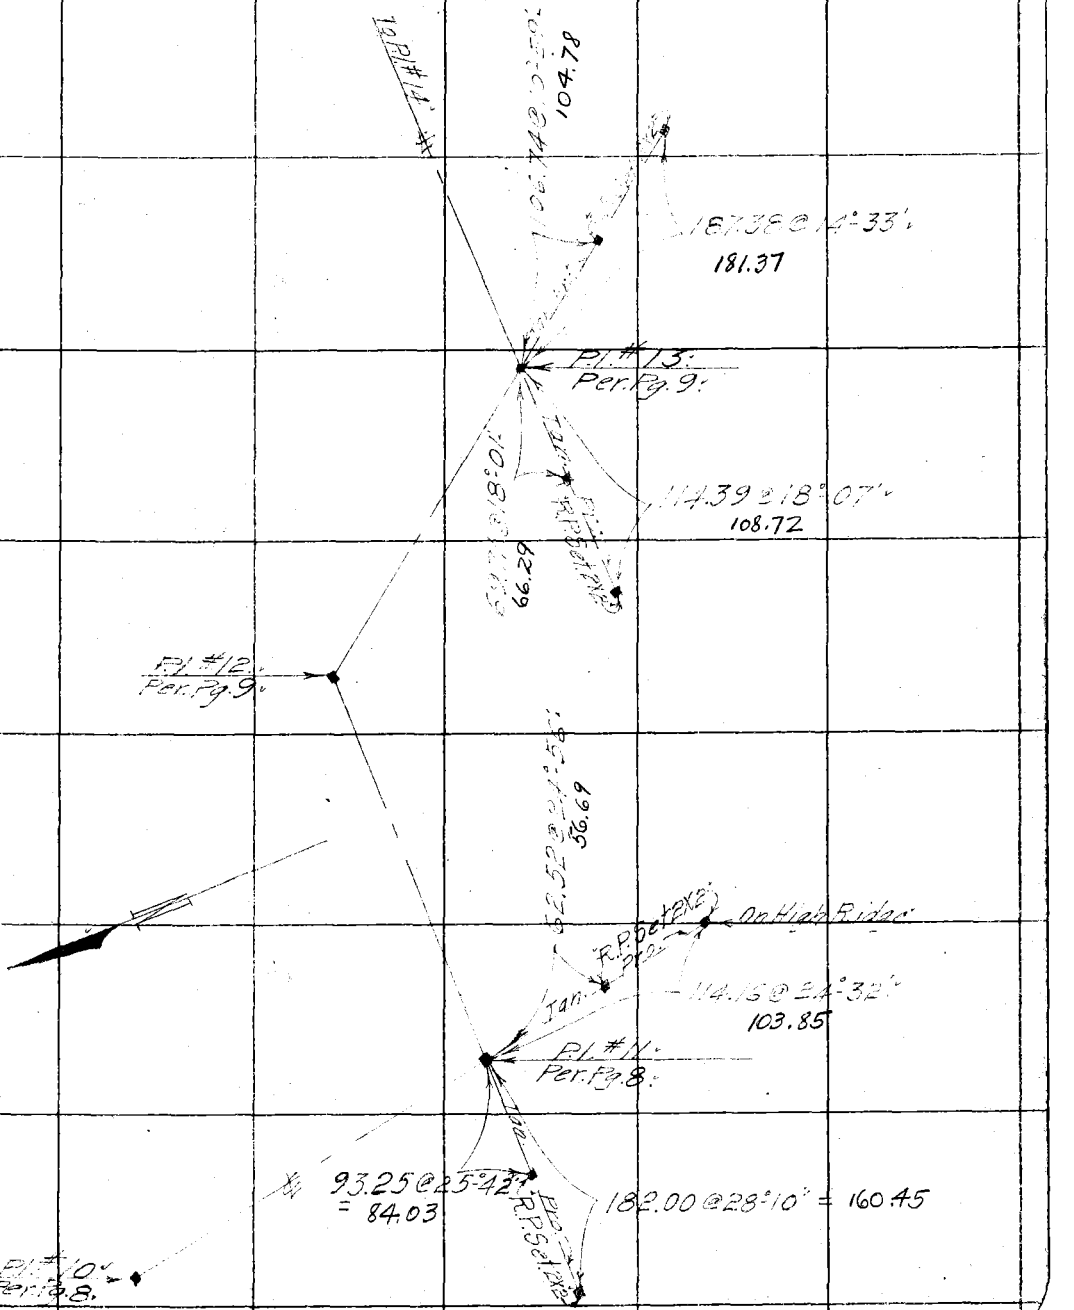

F.B. 249 PG. 71 Benson Chief Party Notes by Benson Date 4-21-27

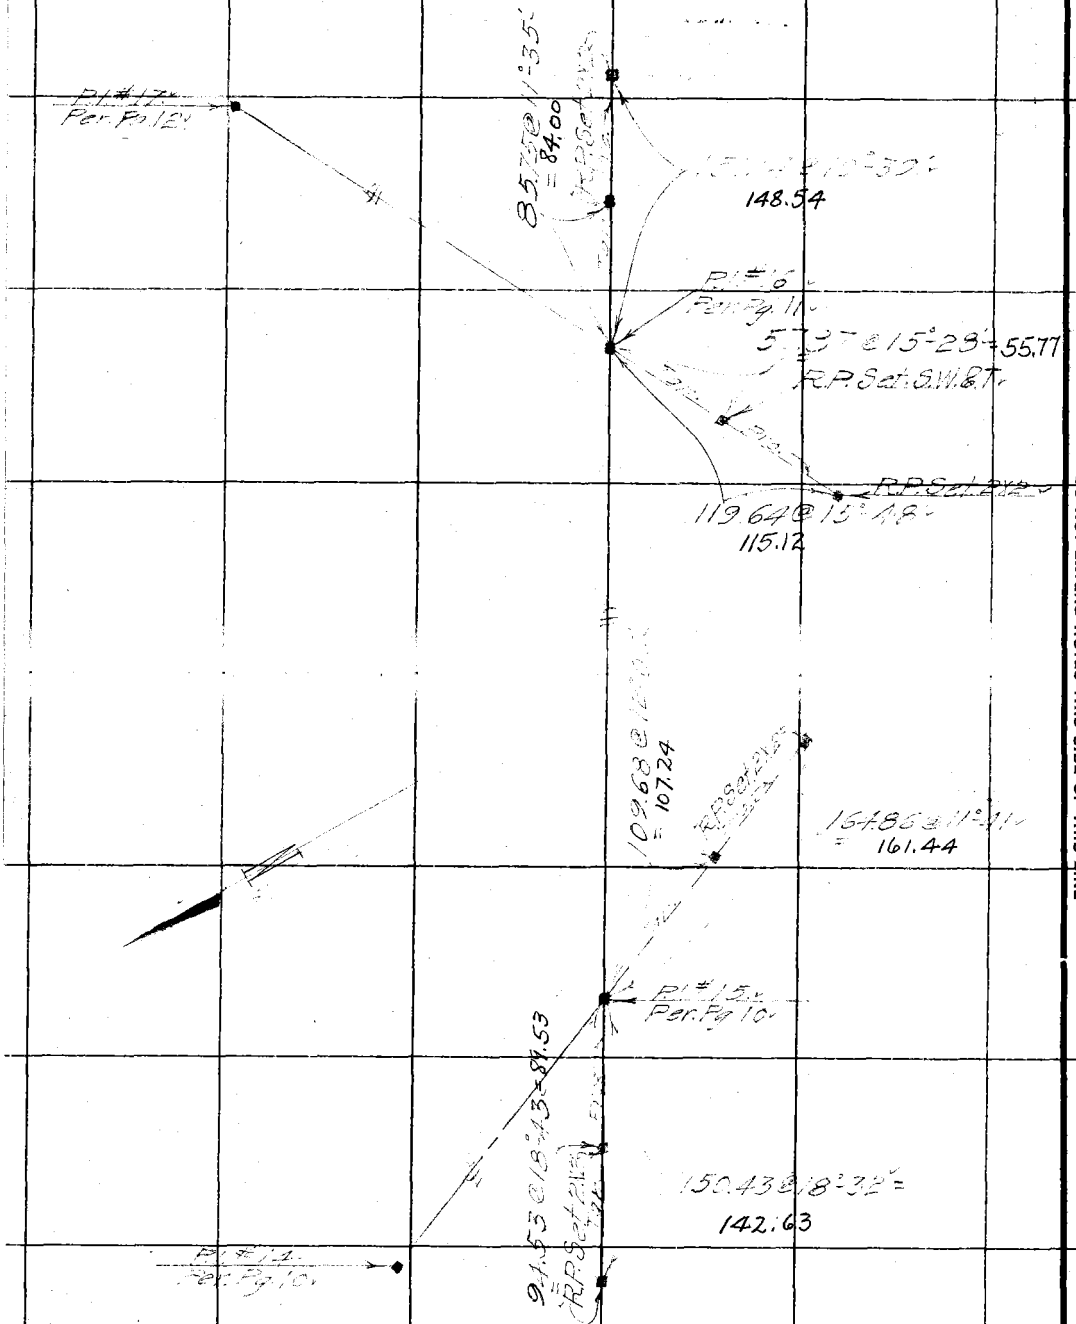

RETURN TO
LOS ANGELES COUNTY SURVEYOR

DO NOT EXTEND NOTES THIS SIDE OF THIS LINE

NOTE: ANY ADDITION OR CHANGES ON THIS SHEET MUST BE MADE OR CIRCLED IN RED. WITH DATE AND NAME OF PERSON MAKING CHANGE.

Date 4-22-27 Notes by Benson Chief Party Benson F.B. 249 Pg. 75

Platted by A.H. Drew	W. O. No. 710 D. S. O. No.
Date Apr. 1927	Location Little Tujunga Canyon Rd
Map No. 8948	Surveyed by Benson
Platting C'k'd by K.O. Higgins	Date 4-22-27.
Date May 1927	Indexed

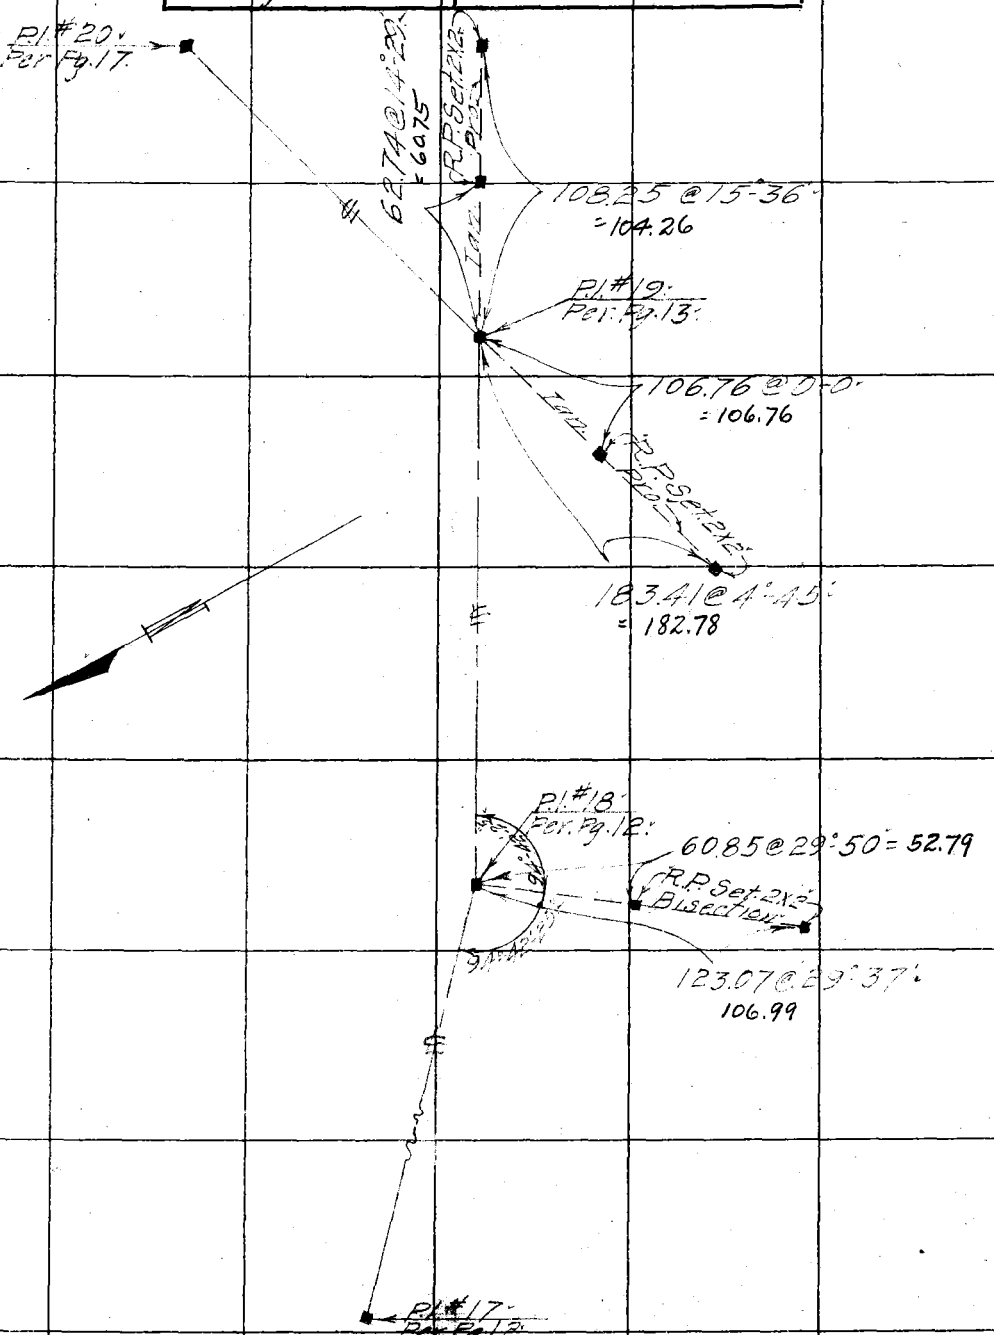

NOTE: ANY ADDITION OR CHANGES ON THIS SHEET MUST BE MADE OR CIRCLED IN RED, WITH DATE AND NAME OF PERSON MAKING CHANGE.

DO NOT EXTEND NOTES THIS SIDE OF THIS LINE

RETURN TO LOS ANGELES COUNTY SURVEYOR

F.B. 249 Pg. 76 Benson Chief Party Notes by Benson Date 4-23-27

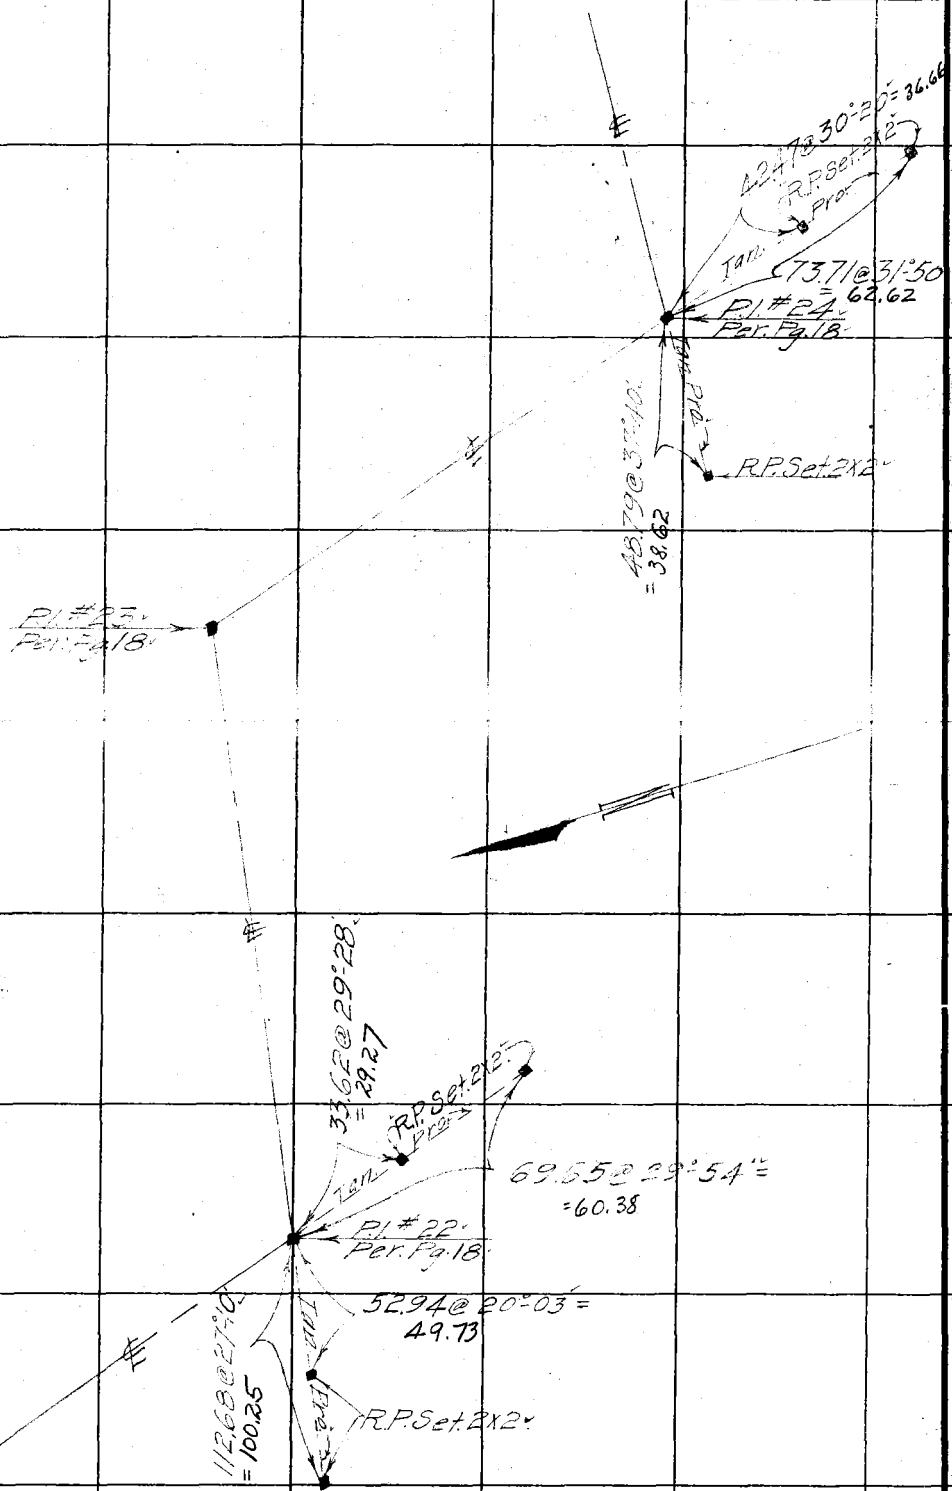

RETURN TO
LOS ANGELES COUNTY SURVEYOR

DO NOT EXTEND NOTES THIS SIDE OF THIS LINE

NOTE: ANY ADDITION OR CHANGES ON THIS SHEET MUST BE MADE OR CIRCLED IN RED, WITH DATE AND NAME OF PERSON MAKING CHANGE.

Date 4-25-27 Notes by Benson Chief Party Benson F.B. 242 Pg. 11

Platted by A.H.Drew	W. O. No. 710 D. B. O. No.
Date Apr. 1927	Location Little Tujunga Canyon Rd.
Map No. 8948	Surveyed by Benson
Platting C'k'd by K.B. Higgins	Date 4-25-27.
Date May 1927	Indexed

NOTE: ANY ADDITION OR CHANGES ON THIS SHEET MUST BE MADE OR CIRCLED IN RED, WITH DATE AND NAME OF PERSON MAKING CHANGE.

DO NOT EXTEND NOTES THIS SIDE OF THIS LINE

RETURN TO LOS ANGELES COUNTY SURVEYOR

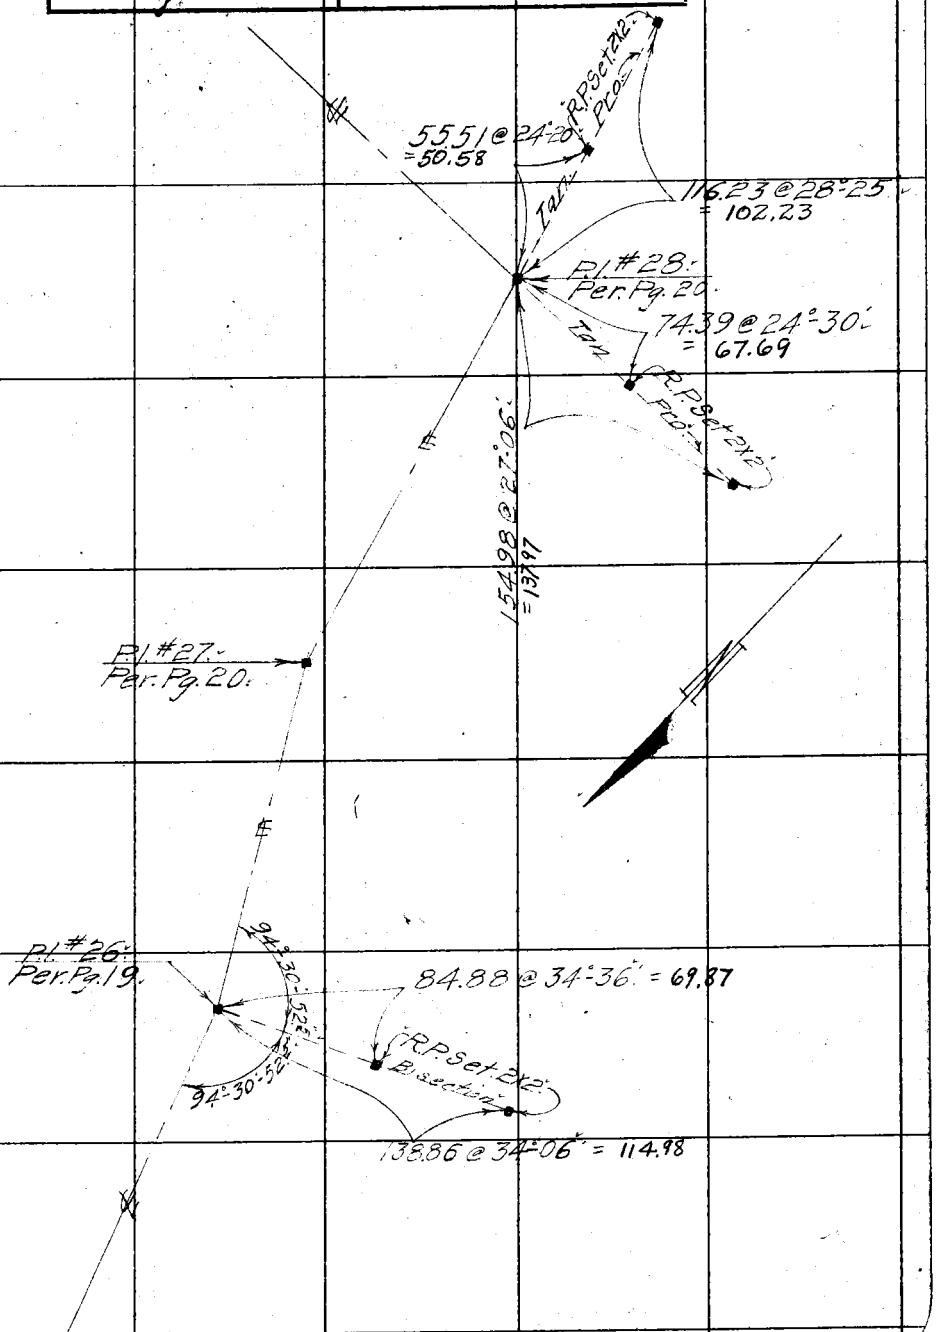

F.B. 249 PG. 78 Benson Chief Party Notes by Benson Date 4-26-27

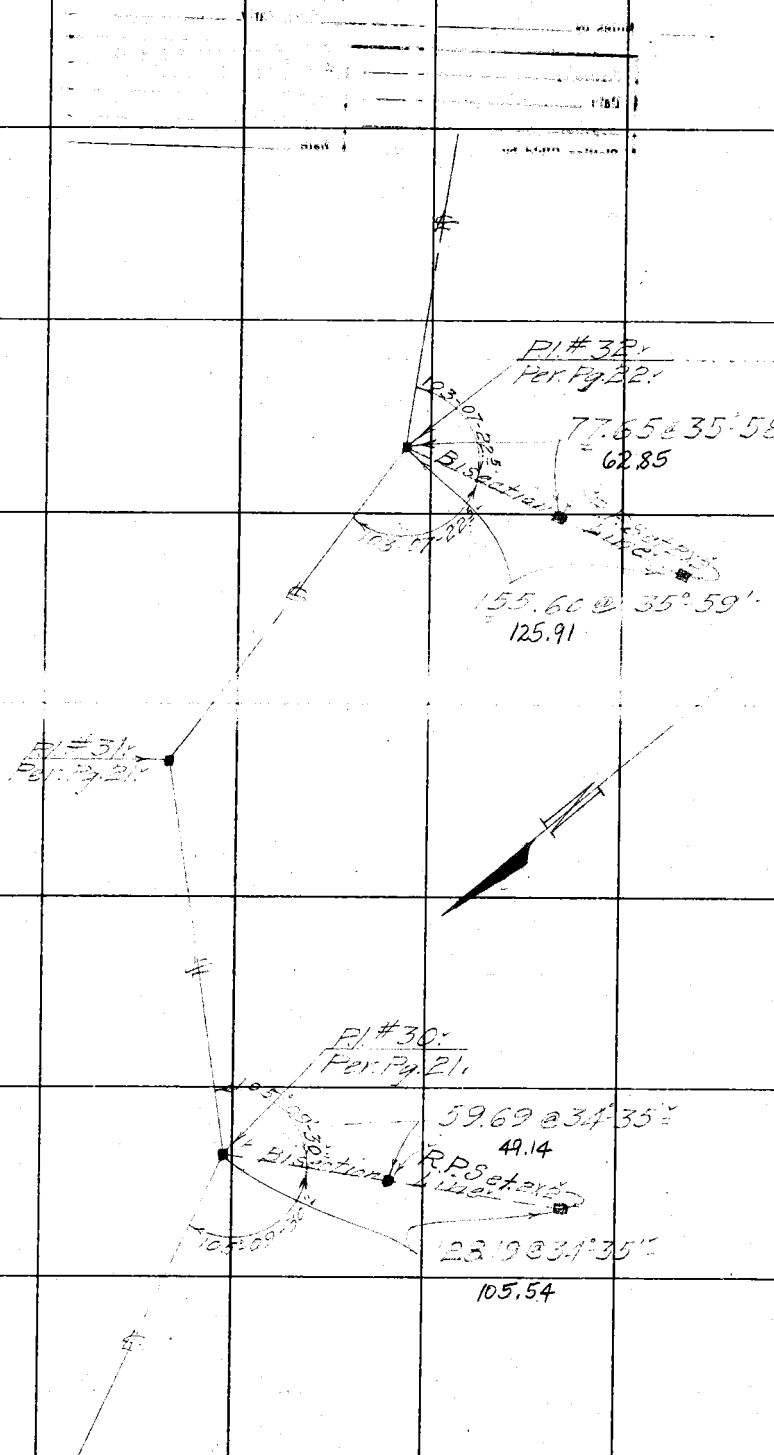

RETURN TO
LOS ANGELES COUNTY SURVEYOR

DO NOT EXTEND NOTES THIS SIDE OF THIS LINE

NOTE: ANY ADDITION OR CHANGES ON THIS SHEET MUST BE MADE OR CIRCLED IN RED. WITH DATE AND NAME OF PERSON MAKING CHANGE.

Date 4-27-27 Notes by Benson Chief Party Benson F.B. 249 Pg. 79

Platted by A.H. Drew	W. O. No. 710 D. S. O. No.
Date May 1927	Location Little Tujunga Canyon Rd.
Map No. 8948	Surveyed by Benson
Platting Ck'd by K.B. Higgins	Date 4-21-27
Date May 1927	Indexed

NOTE: ANY ADDITION OR CHANGES ON THIS SHEET MUST BE MADE OR CIRCLED IN RED. WITH DATE AND NAME OF PERSON MAKING CHANGE.

DO NOT EXTEND NOTES THIS SIDE OF THIS LINE

RETURN TO LOS ANGELES COUNTY SURVEYOR

R.P.S. 1/2" x 24"

Tan. Brg.

Tan. Brg.

87.85 @ 24°-50' = 79.73

P.I. #35' Per Pg. 23'

62.35 @ 12°-24' = 60.90

53.94 @ 15°-34' = 56.78

P.I. #36' Per Pg. 24'

75.96 @ 18°-18' = 72.12

R.P. Set 1/2" x 24" Tan. Brg.

R.P. Set 1/2" x 24" Tan. Brg.

P.I. #34' Per Pg. 23'

18.84 @ 22°-30' = 109.91

165.55 @ 30°-14' = 155.33

69.07 @ 31°-56' = 58.62

R.P. Set 1/2" x 24" Lines

83°-36'

Bisection

83°-36'

P.I. #33' Per Pg. 22'

118.46 @ 31°-24' = 101.11

F.B. 249 Pg. 30' Benson Chief Party Notes by Benson Date 4-29-27

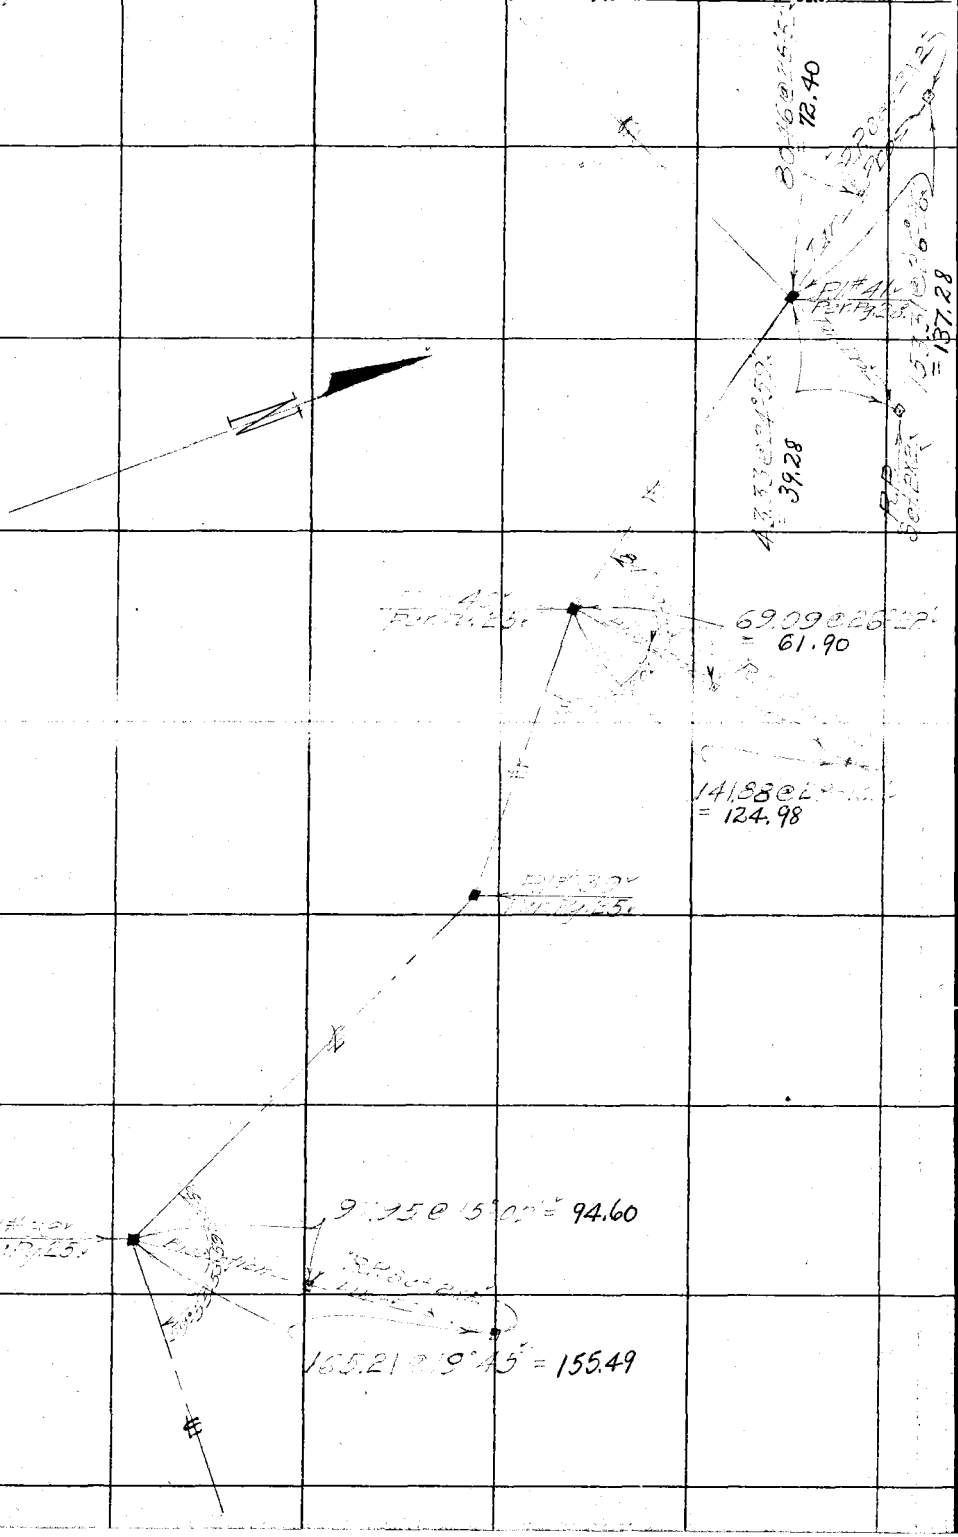

RETURN TO
LOS ANGELES COUNTY SURVEYOR

DO NOT EXTEND NOTES THIS SIDE OF THIS LINE

NOTE: ANY ADDITION OR CHANGES ON THIS SHEET MUST BE MADE OR CIRCLED IN RED, WITH DATE AND NAME OF PERSON MAKING CHANGE.

Date 5-2-27 Notes by Benson Chief Party Benson F.B. 249 Pg. 81

Platted by A.H. Oren	W. O. No. 710 D. S. O. No.
Date May 1927	Location Little Tujunga Canyon Road
Map No. 2948	Surveyed by Benson
Platting C'k'd by K.B. Higgins	Date 5-2-26.
Date May 1927	Indexed

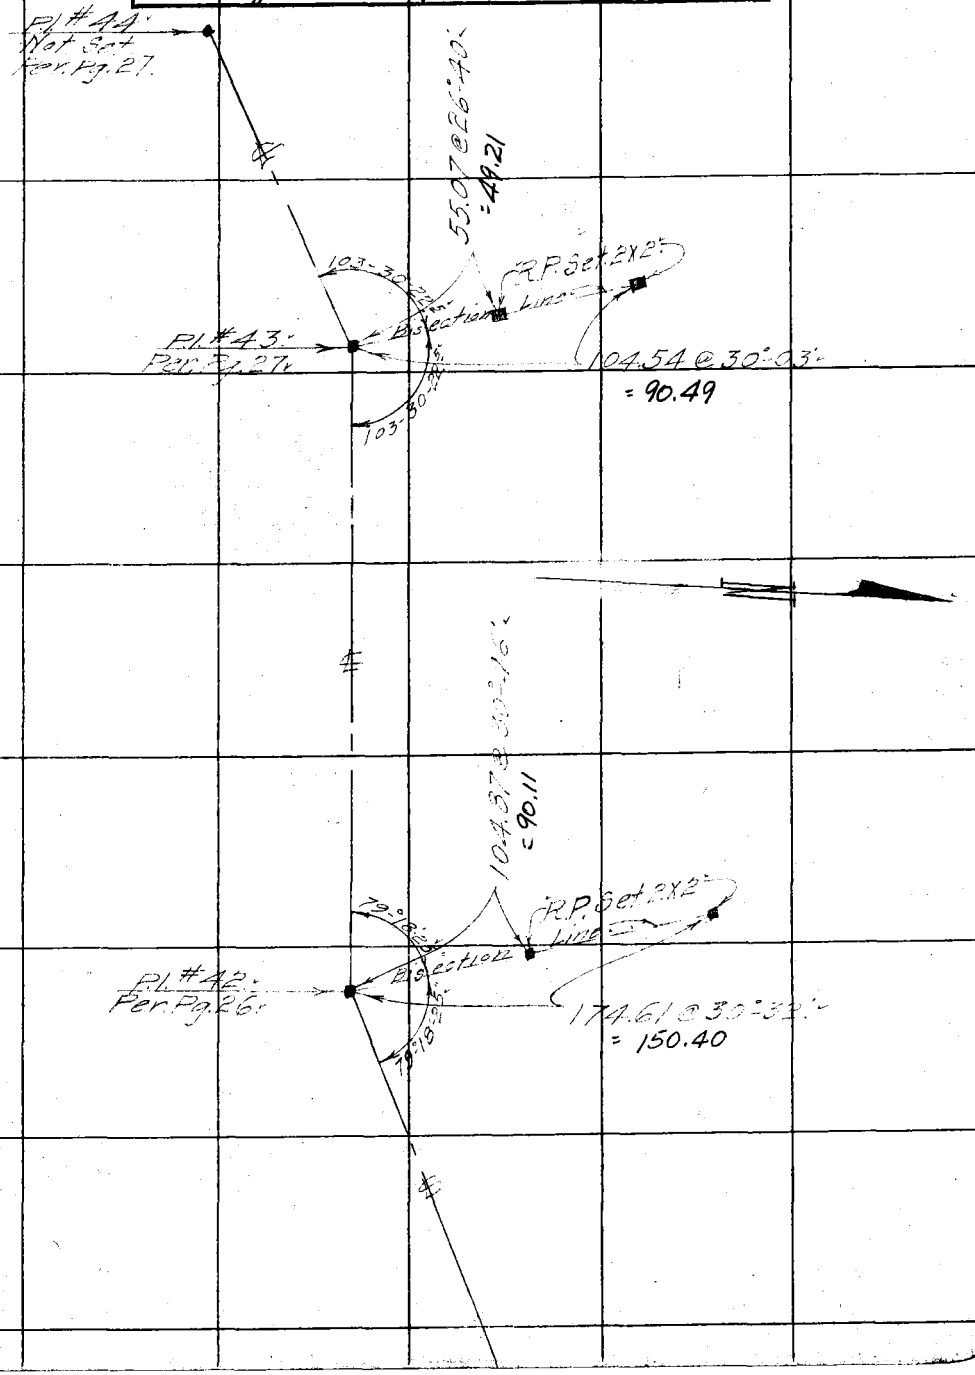

NOTE: ANY ADDITION OR CHANGES ON THIS SHEET MUST BE MADE OR CIRCLED IN RED. WITH DATE AND NAME OF PERSON MAKING CHANGE.

DO NOT EXTEND NOTES THIS SIDE OF THIS LINE

RETURN TO LOS ANGELES COUNTY SURVEYOR

F.B. 249 Pg. 82 Benson Chief Party Notes by Benson Date 5-3-27

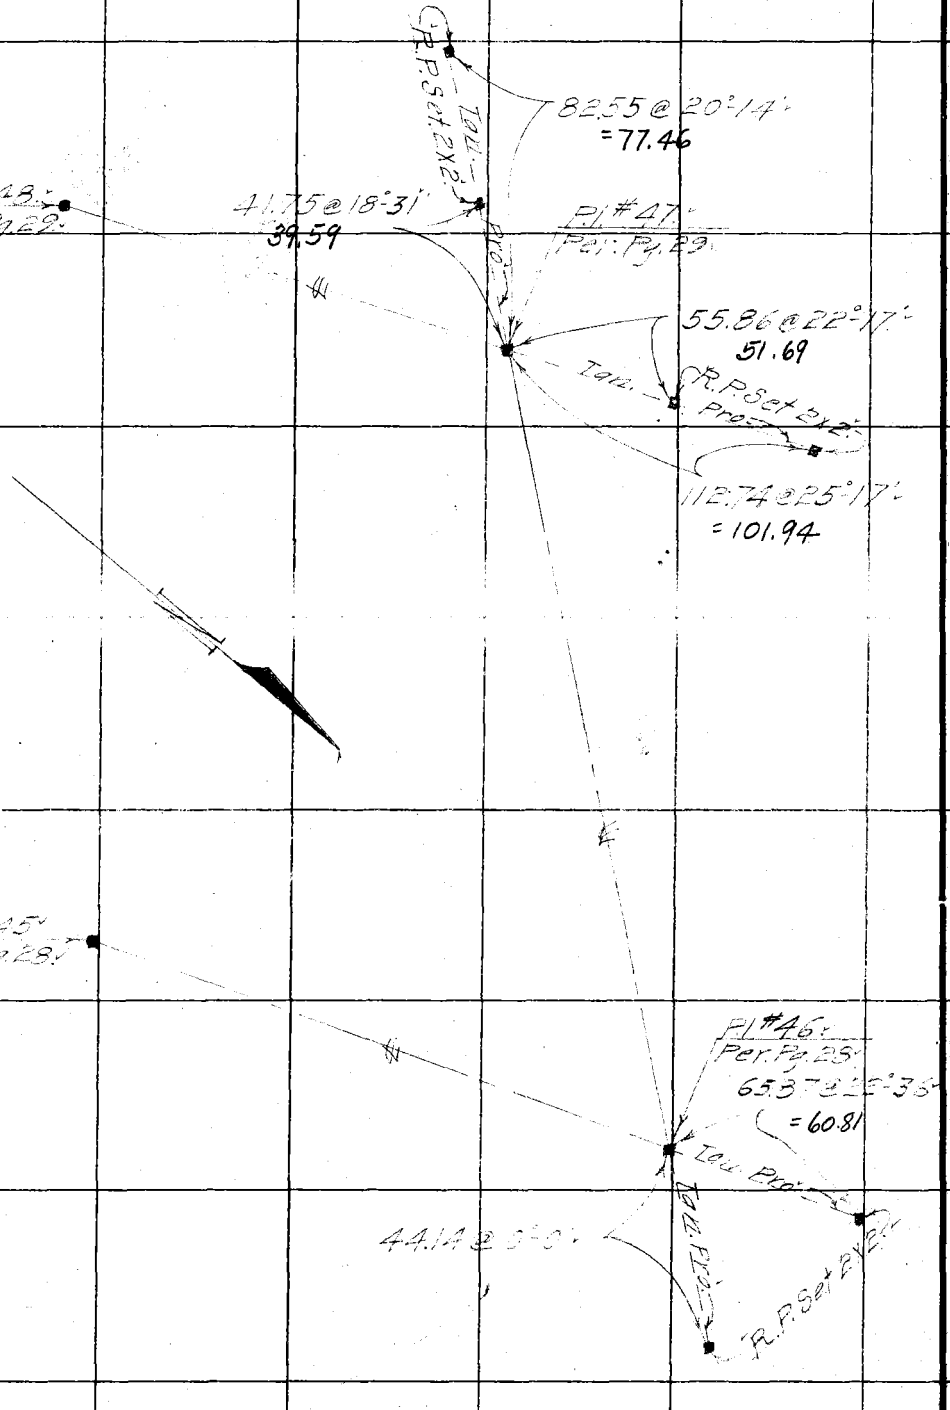

RETURN TO
LOS ANGELES COUNTY SURVEYOR

DO NOT EXTEND NOTES THIS SIDE OF THIS LINE

NOTE: ANY ADDITION OR CHANGES ON THIS SHEET MUST BE MADE OR CIRCLED IN RED, WITH DATE AND NAME OF PERSON MAKING CHANGE.

Date 5-4-27 Notes by Benson Chief Party Benson F.B. 249 PG. 83

Platted by A.H. Drew	W. O. No. 710 D. S. O. No.
Date May 1927	Location Little Tujunga Canyon
Map No. 8948	Surveyed by B[illegible]
Platting C'k'd by K.B. Higgins	Date 5-4-27
Date May 1927	Indexed

NOTE: ANY ADDITION OR CHANGES ON THIS SHEET MUST BE MADE OR CIRCLED IN RED, WITH DATE AND NAME OF PERSON MAKING CHANGE.

DO NOT EXTEND NOTES THIS SIDE OF THIS LINE

RETURN TO LOS ANGELES COUNTY SURVEYOR

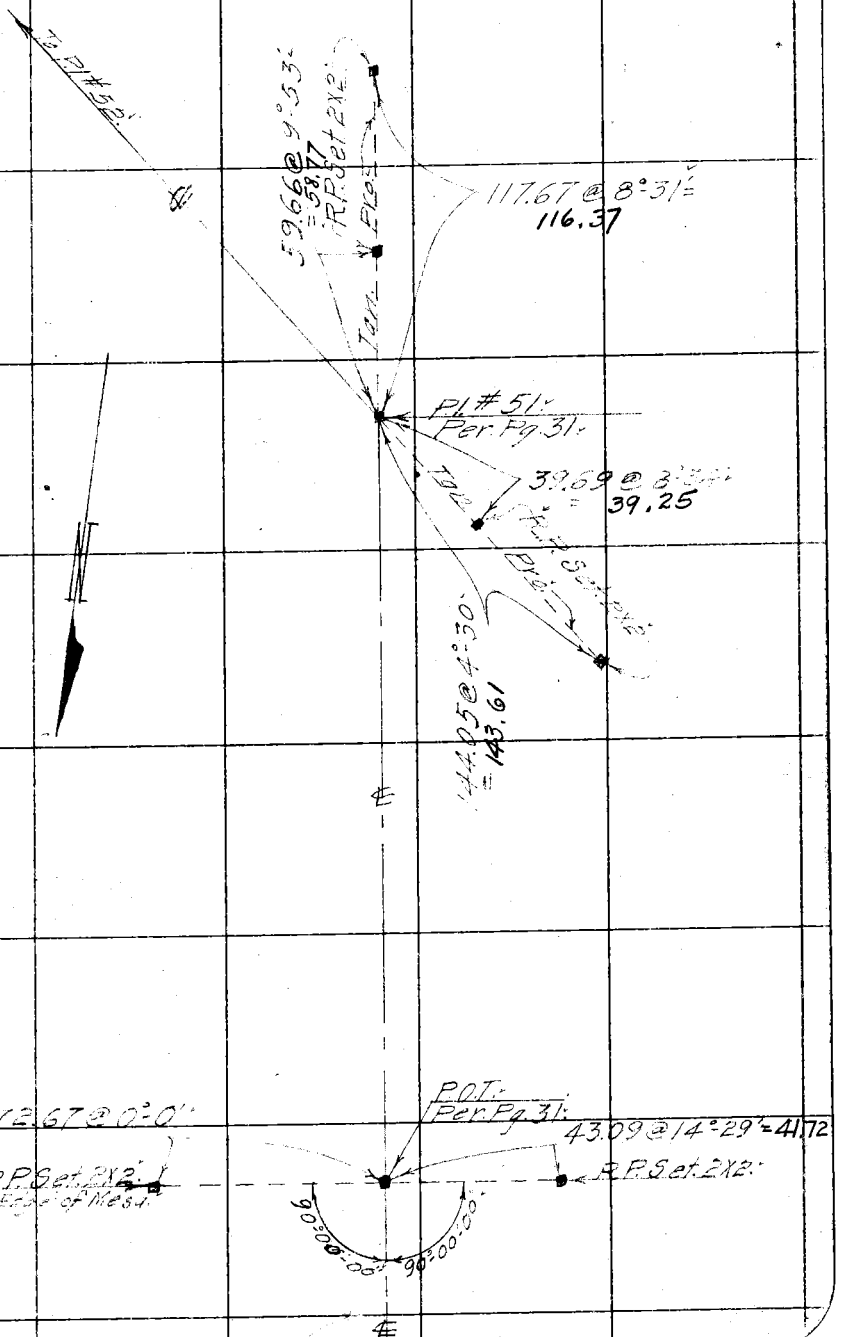


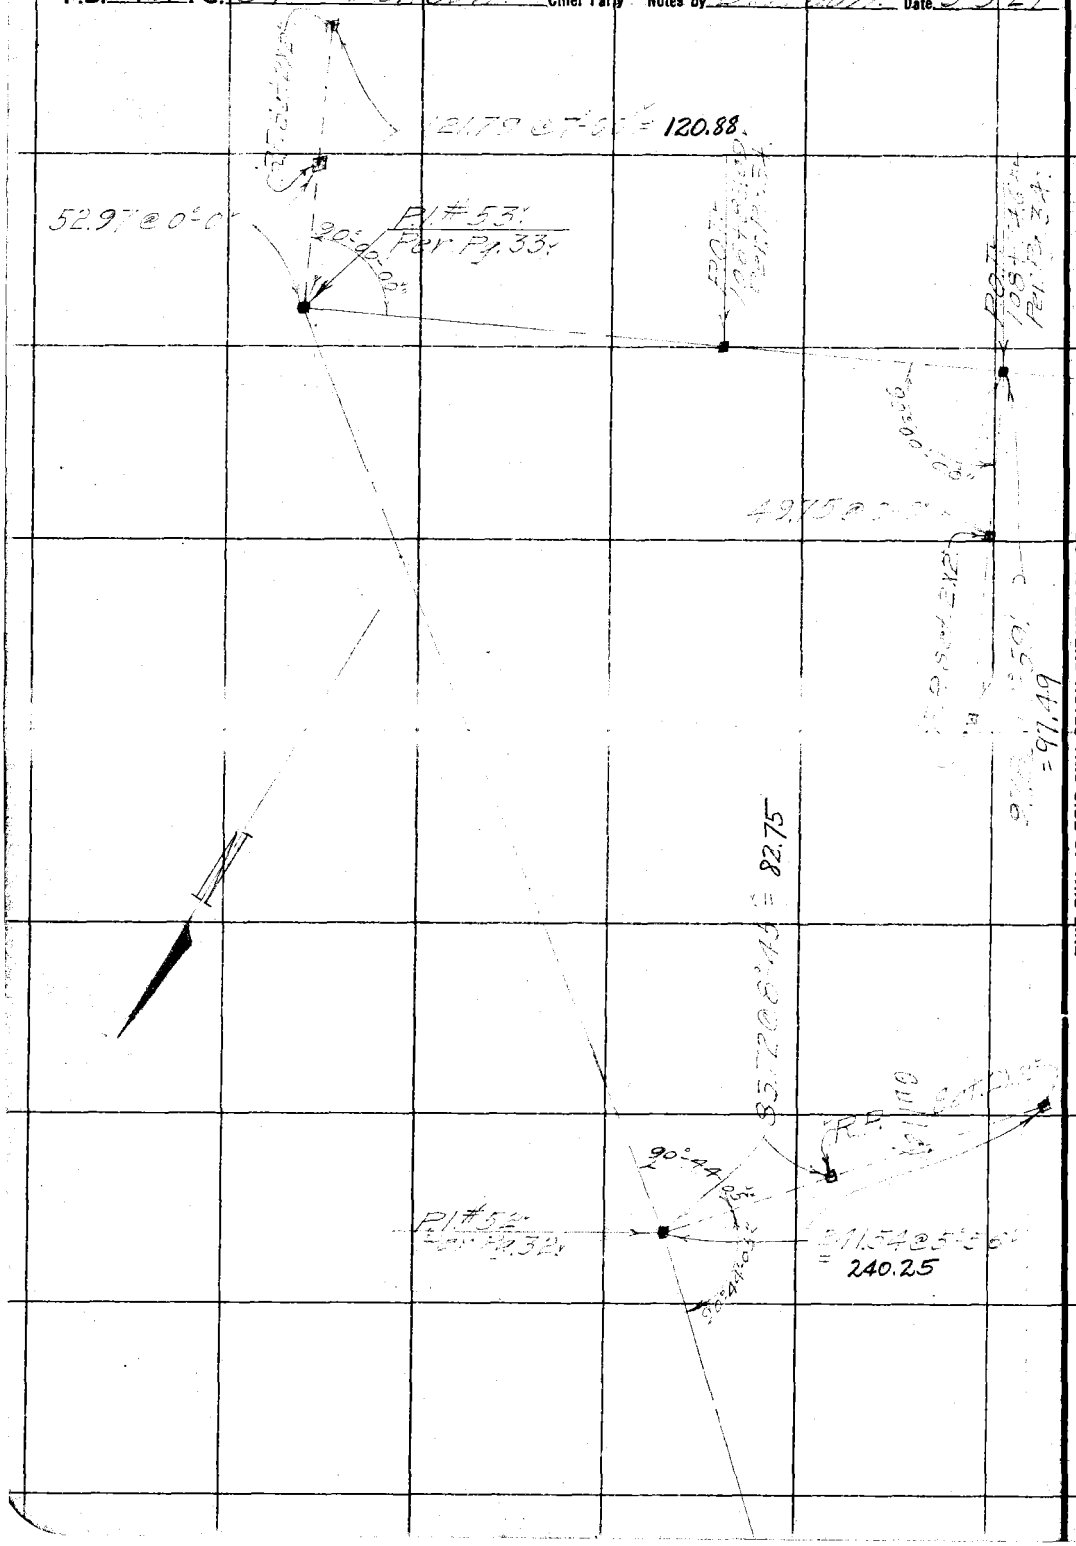

RETURN TO
LOS ANGELES COUNTY SURVEYOR

DO NOT EXTEND NOTES THIS SIDE OF THIS LINE

NOTE: ANY ADDITION OR CHANGES ON THIS SHEET MUST BE MADE OR CIRCLED IN RED. WITH DATE AND NAME OF PERSON MAKING CHANGE.

Date 5-6-27 Notes by Benson Chief Party Benson F.B. 249 Pg. 85

Platted by A. H. Drew	W. O. No. 710 D. S. O. No.
Date May 1927	Location Little Tujunga Canyon Rd.
Map No. 8948	Surveyed by
Platting C'k'd by K. B. Higgins	Date 5-6-27
Date May 1927	Indexed

NOTE: ANY ADDITION OR CHANGES ON THIS SHEET MUST BE MADE OR CIRCLED IN RED. WITH DATE AND NAME OF PERSON MAKING CHANGE.

DO NOT EXTEND NOTES THIS SIDE OF THIS LINE

RETURN TO LOS ANGELES COUNTY SURVEYOR

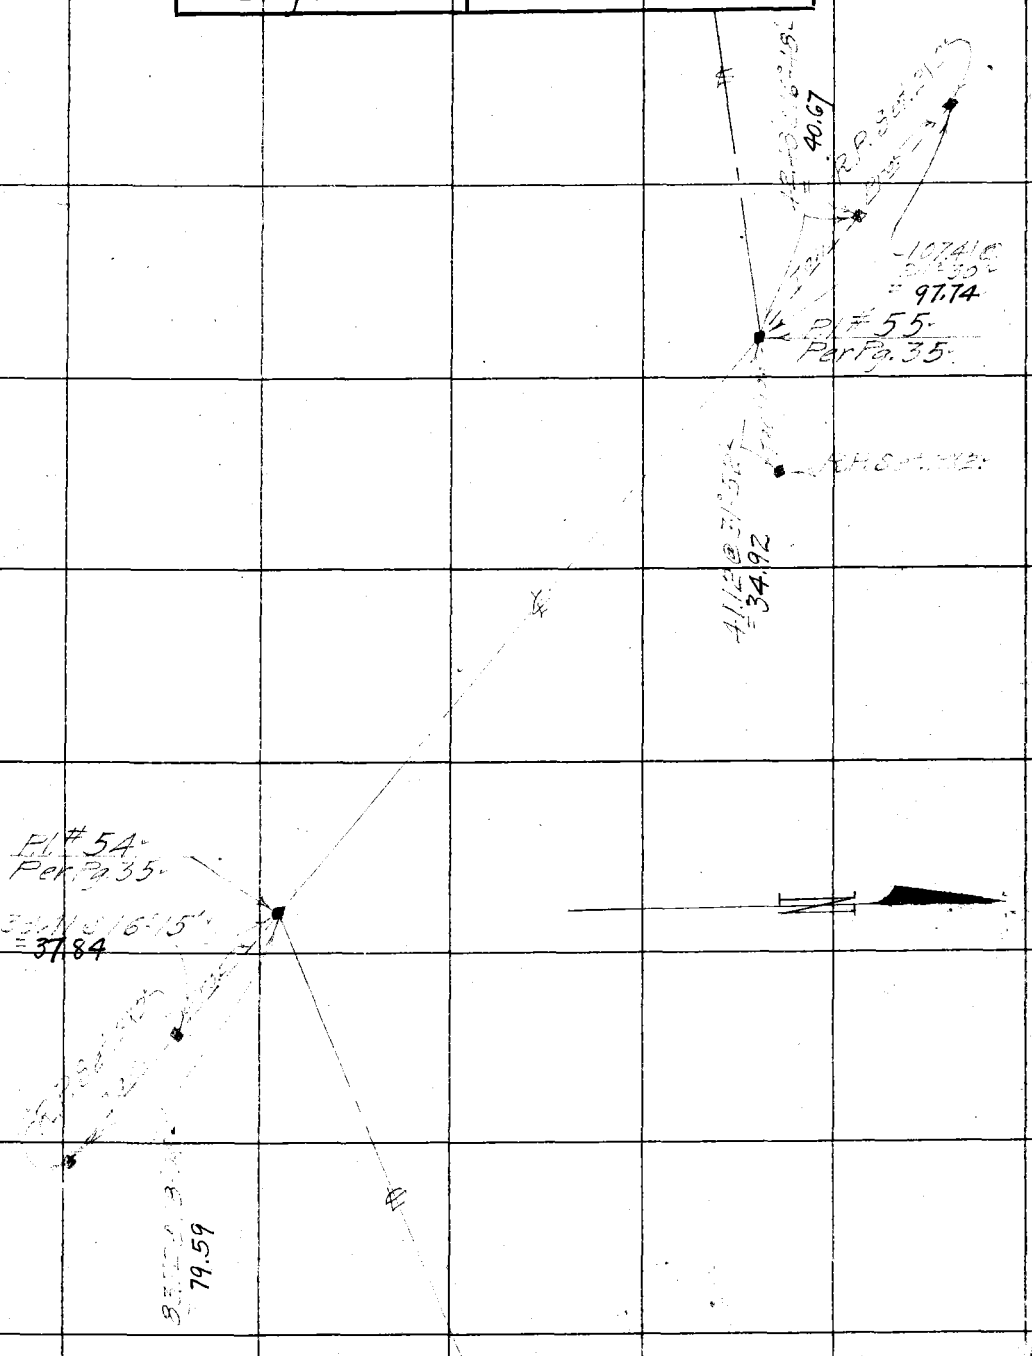

F.B. 249 Pg. 86 Benson Chief Party Notes by Benson Date 5-7-27

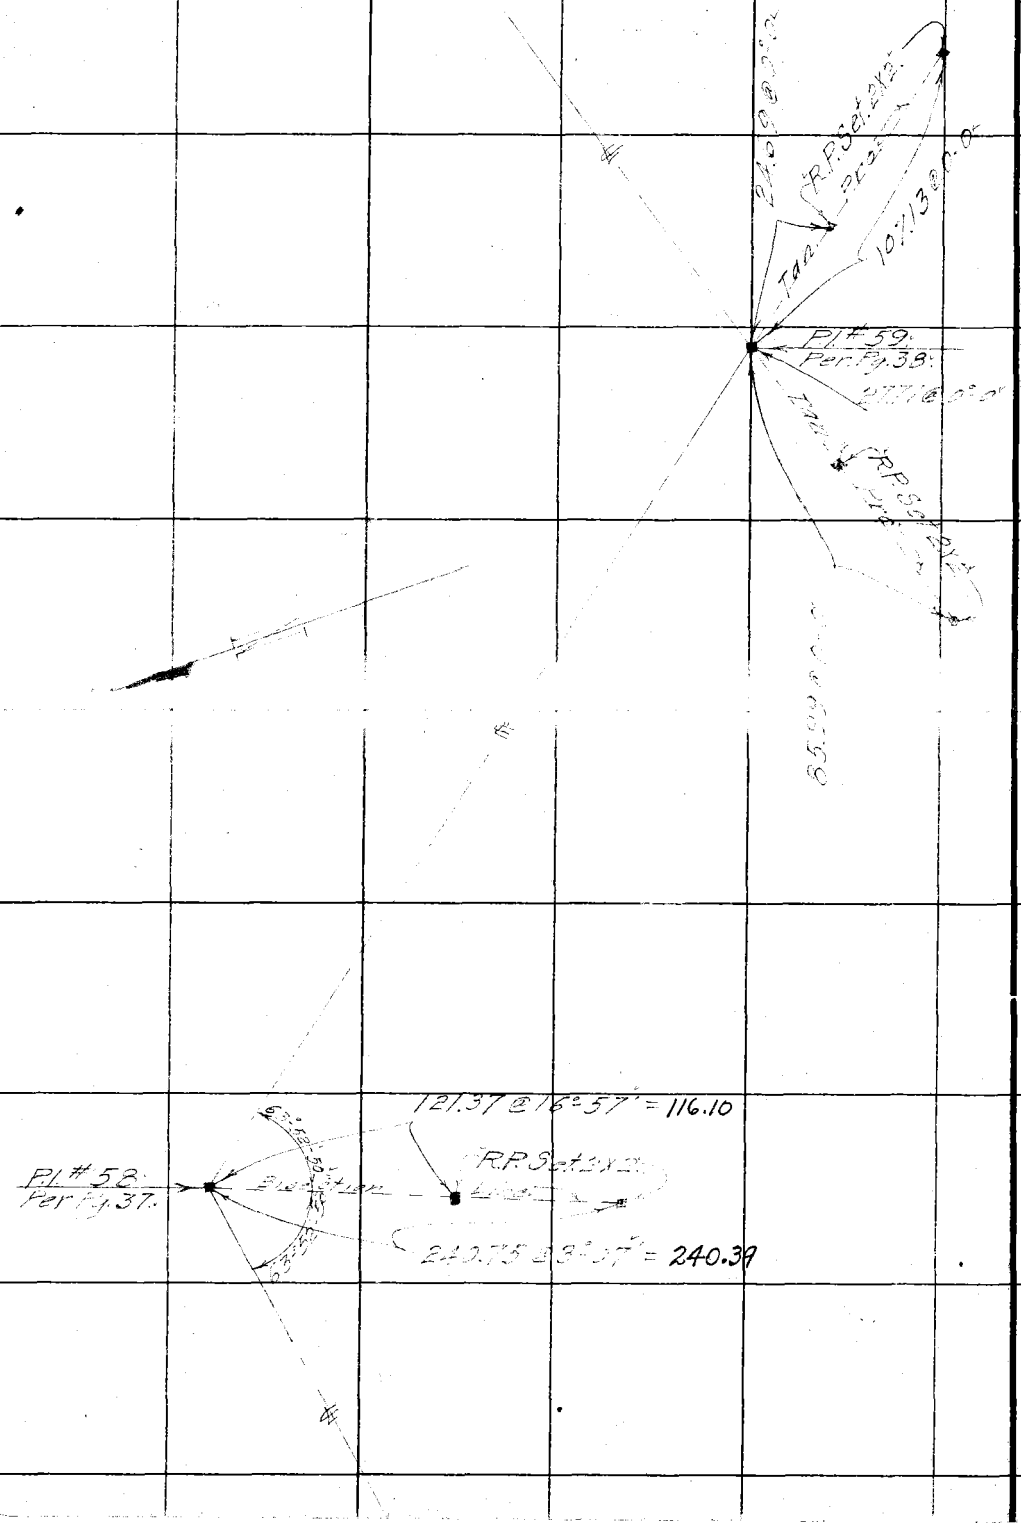

RETURN TO
LOS ANGELES COUNTY SURVEYOR

DO NOT EXTEND NOTES THIS SIDE OF THIS LINE

NOTE: ANY ADDITION OR CHANGES ON THIS SHEET MUST BE MADE OR CIRCLED IN RED, WITH DATE AND NAME OF PERSON MAKING CHANGE.

Date 5-9-27. Notes by Benson. Chief Party Benson. F.B. 249 Pg. 87

Platted by A.H. Drew	W. O. No. 710 D. S. O. No.
Date May 1927	Location Little Tujunga Canyon Rd.
Map No. 8948	Surveyed by
Platting C'k'd by K.B. Higgins	Date 5-9-27.
Date May 1927	Indexed

NOTE: ANY ADDITION OR CHANGES ON THIS SHEET MUST BE MADE OR CIRCLED IN RED. WITH DATE AND NAME OF PERSON MAKING CHANGE.

DO NOT EXTEND NOTES THIS SIDE OF THIS LINE

RETURN TO LOS ANGELES COUNTY SURVEYOR

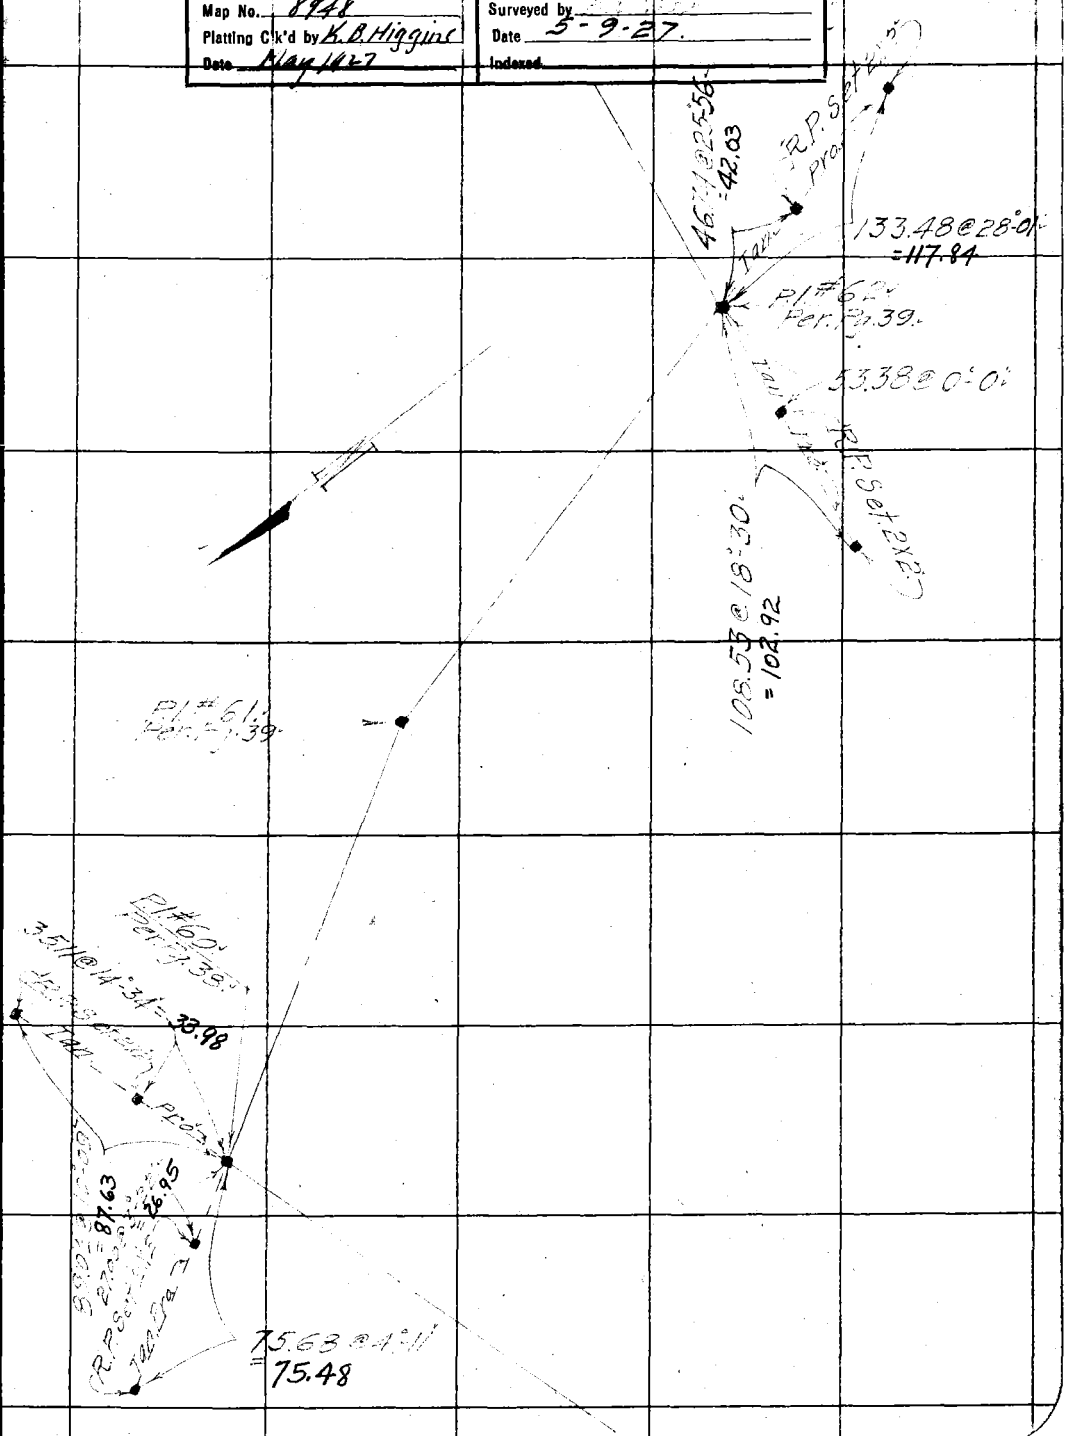

F.B. 219 PG. 88 Benson Chief Party Notes by Benson Date 5-10-27

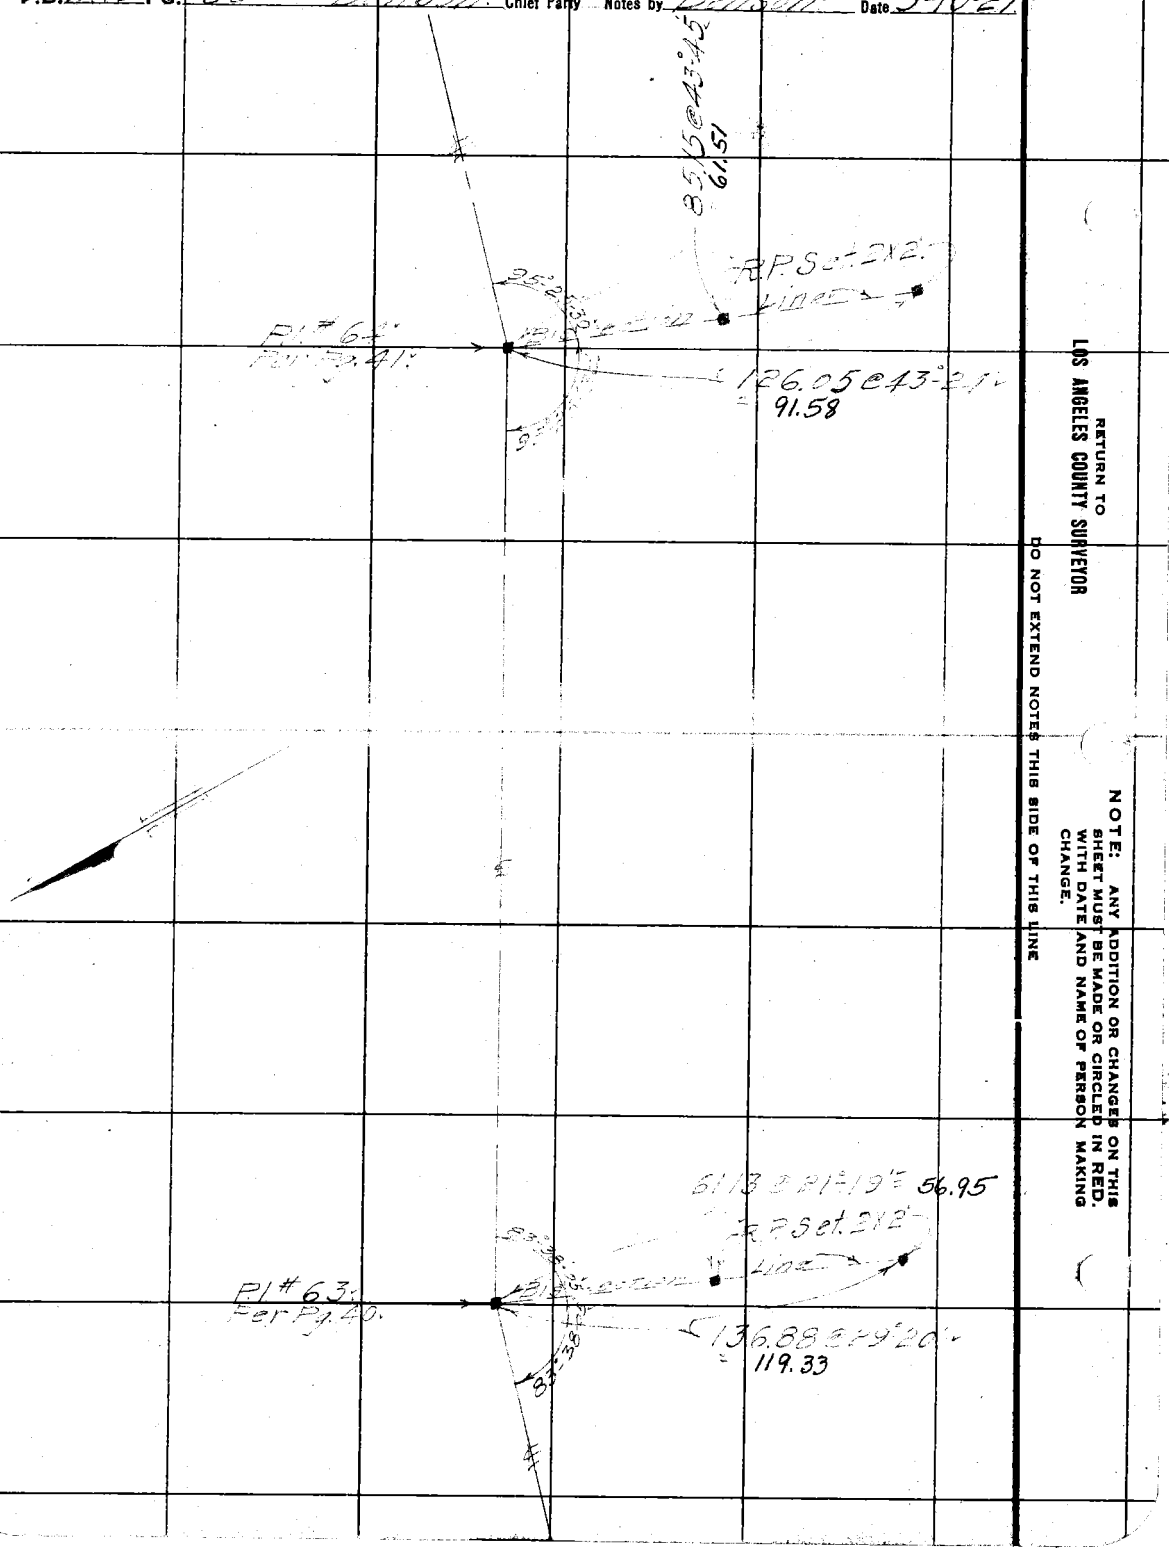

RETURN TO
LOS ANGELES COUNTY SURVEYOR

DO NOT EXTEND NOTES THIS SIDE OF THIS LINE

NOTE: ANY ADDITION OR CHANGES ON THIS SHEET MUST BE MADE OR CIRCLED IN RED. WITH DATE AND NAME OF PERSON MAKING CHANGE.

Date 5-11-27. Notes by Benson Chief Party Benson F.B. 249 Pg. 89

Platted by A.H. Drew	W. O. No. 710 D. S. O. No.
Date May 1927	Location Little Tujunga Canyon Rd.
Map No. 8248	Surveyed by Benson
Platting C'k'd by K.B. Higgins	Date 5-11-27.
Date May 1927	Indexed

NOTE: ANY ADDITION OR CHANGES ON THIS SHEET MUST BE MADE OR CIRCLED IN RED, WITH DATE AND NAME OF PERSON MAKING CHANGE.

DO NOT EXTEND NOTES THIS SIDE OF THIS LINE

RETURN TO LOS ANGELES COUNTY SURVEYOR

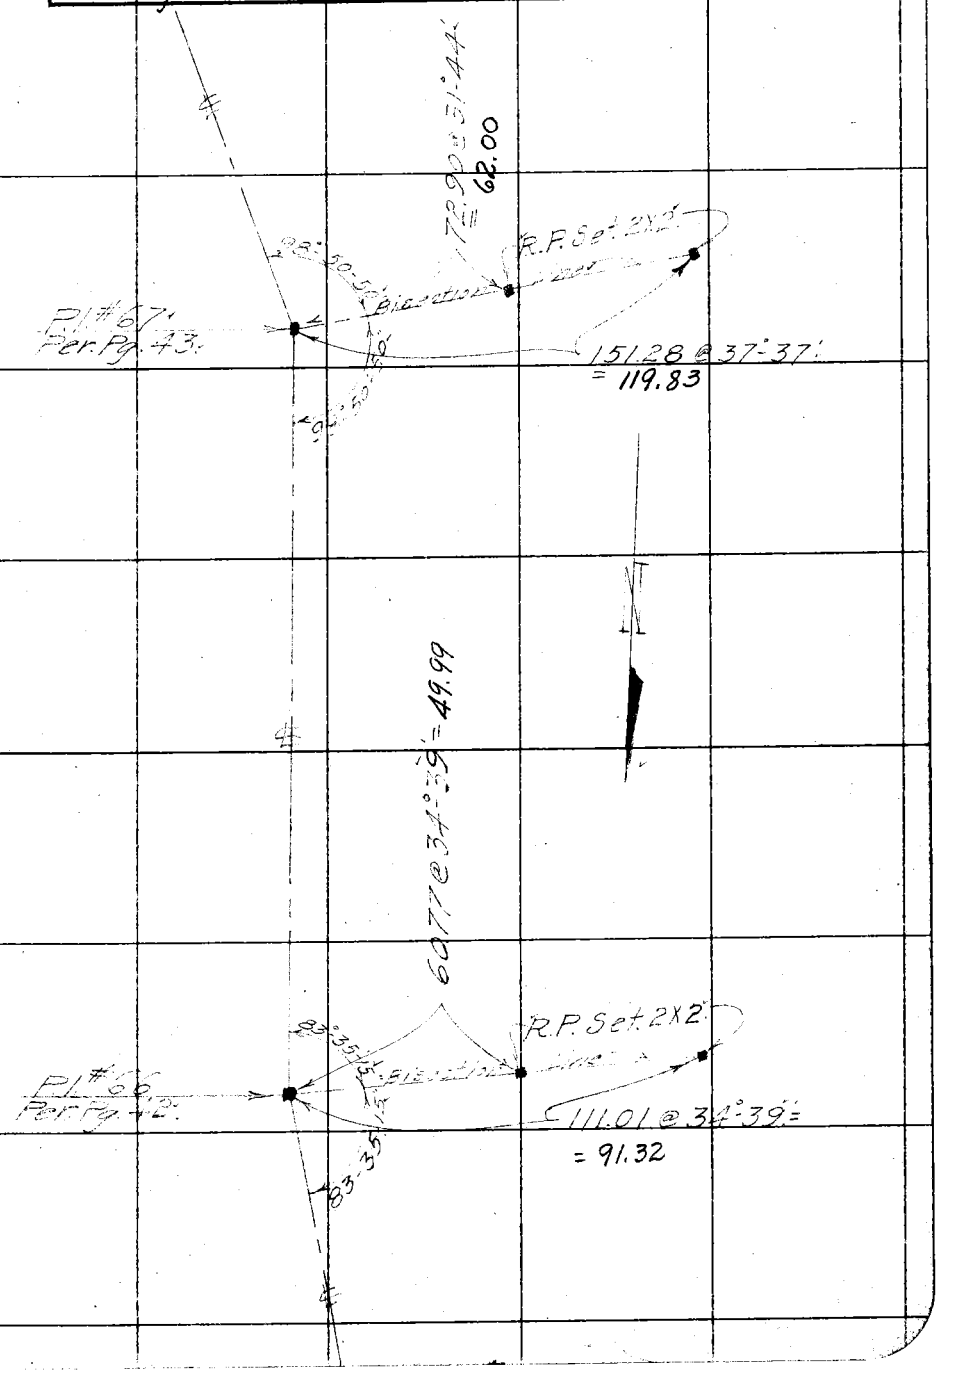

F.B. 449 Pg. 90 Benson Chief Party Notes by Benson Date 5-12-27

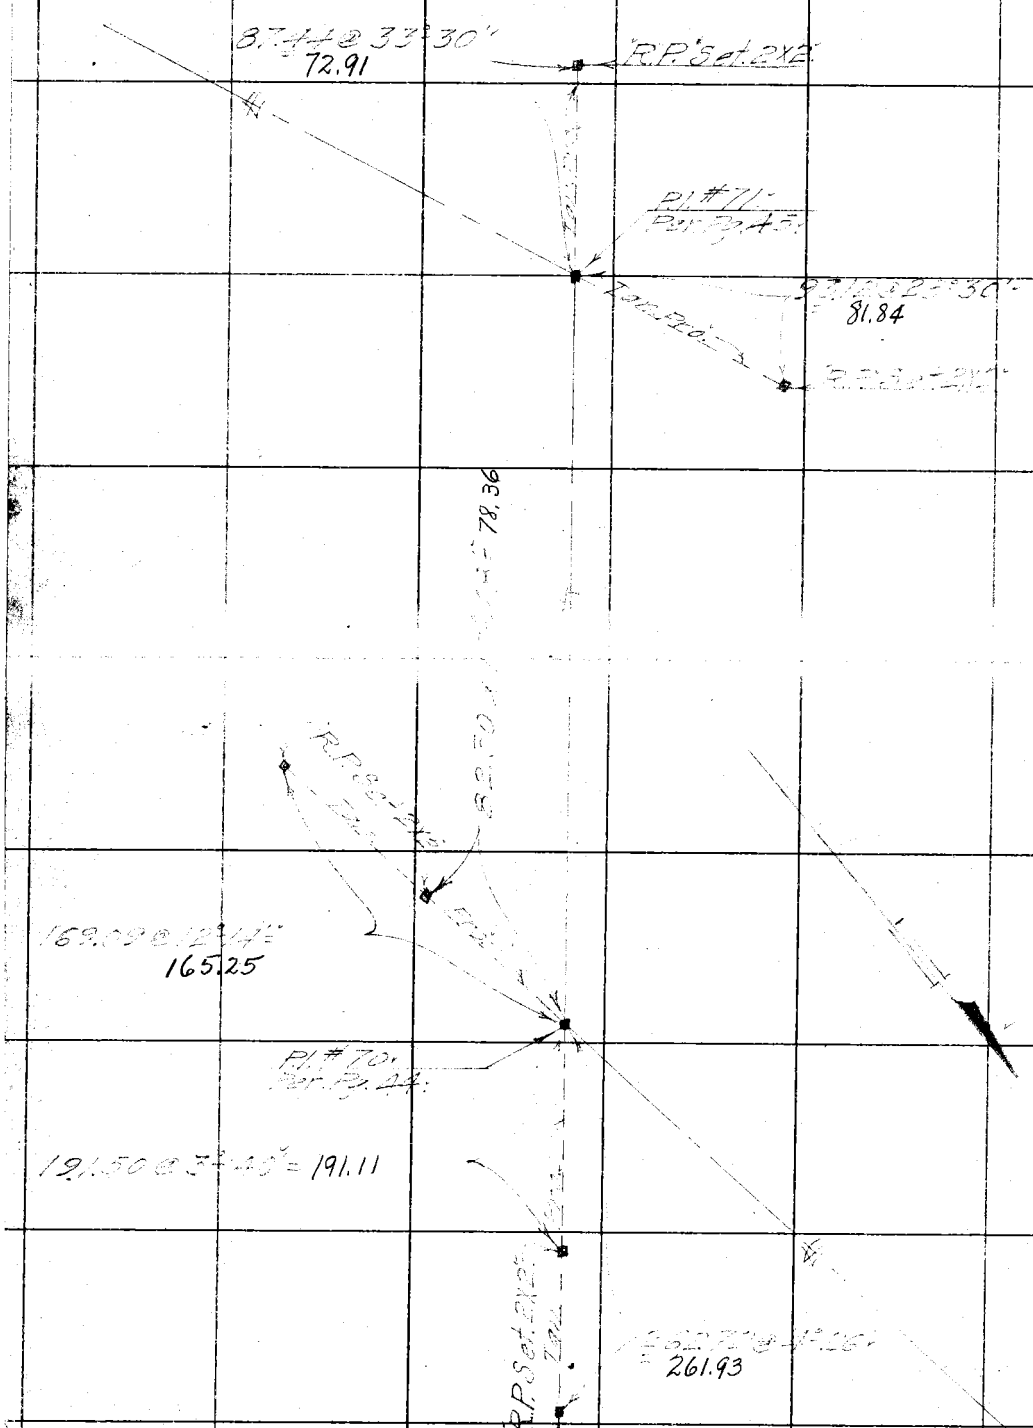

RETURN TO
LOS ANGELES COUNTY SURVEYOR

DO NOT EXTEND NOTES THIS SIDE OF THIS LINE

NOTE: ANY ADDITION OR CHANGES ON THIS SHEET MUST BE MADE OR CIRCLED IN RED, WITH DATE AND NAME OF PERSON MAKING CHANGE.

Date 6-3-27 Notes by Benson Chief [redacted] C.A. Benson F.B. 249 PG. 91

Platted by [illegible]
Date June 1927
Map No. 8948 D.M.P.
Platting C'k'd by
Date Apr. 1928

W. O. No. [redacted] C. O. No.
Location Little Tujunga Canyon Road
Surveyed by Benson.
Date 6-3-27.
Indexed

Con't. on Bot. of Pg. 92.

June 3-1927
C.A. Benson Chief [illegible]

To Pl # 7½ 12½ Bot. of Pg. 92

Note. Little Tujunga County Wash, Road & Bridge Notes are located on Sheet No. 5 to Pg. 121. Ins.

25.50 @ 3°-54' = 250.92

Sec. 27
T3N-R14W.

S 62°-57'-45" E
S 62°-51'-36" E

165+04.40 Set

P.O.S.T. Set 2X2

A 78-26-20
Δ 39-13-10
R 125.
T 102.02
L 171.13

55.9 @ 5°-0'

162 33.27

calc. 37°-02'-10"

20 Adj.

Pl # 7½ Not Set. (Cliff)

24.90 Adj.

P.O.S.T. Set 2X2

@ 136°-35'-15"
@ 194°-21'-30"

S 21° 1X2 B.C.

CI Pipe 6" Dia. 32' Long

Contr. From Top (R+Side) Pg. 47

NOTE: ANY ADDITION OR CHANGES ON THIS SHEET MUST BE MADE OR CIRCLED IN RED. WITH DATE AND NAME OF PERSON MAKING CHANGE.

DO NOT EXTEND NOTES THIS SIDE OF THIS LINE

RETURN TO LOS ANGELES COUNTY SURVEYOR

F.B. 249 PG. 92 Chief Party Notes by Berstrom Date 6-3-27

Cont. on Bk. of Pg. 93

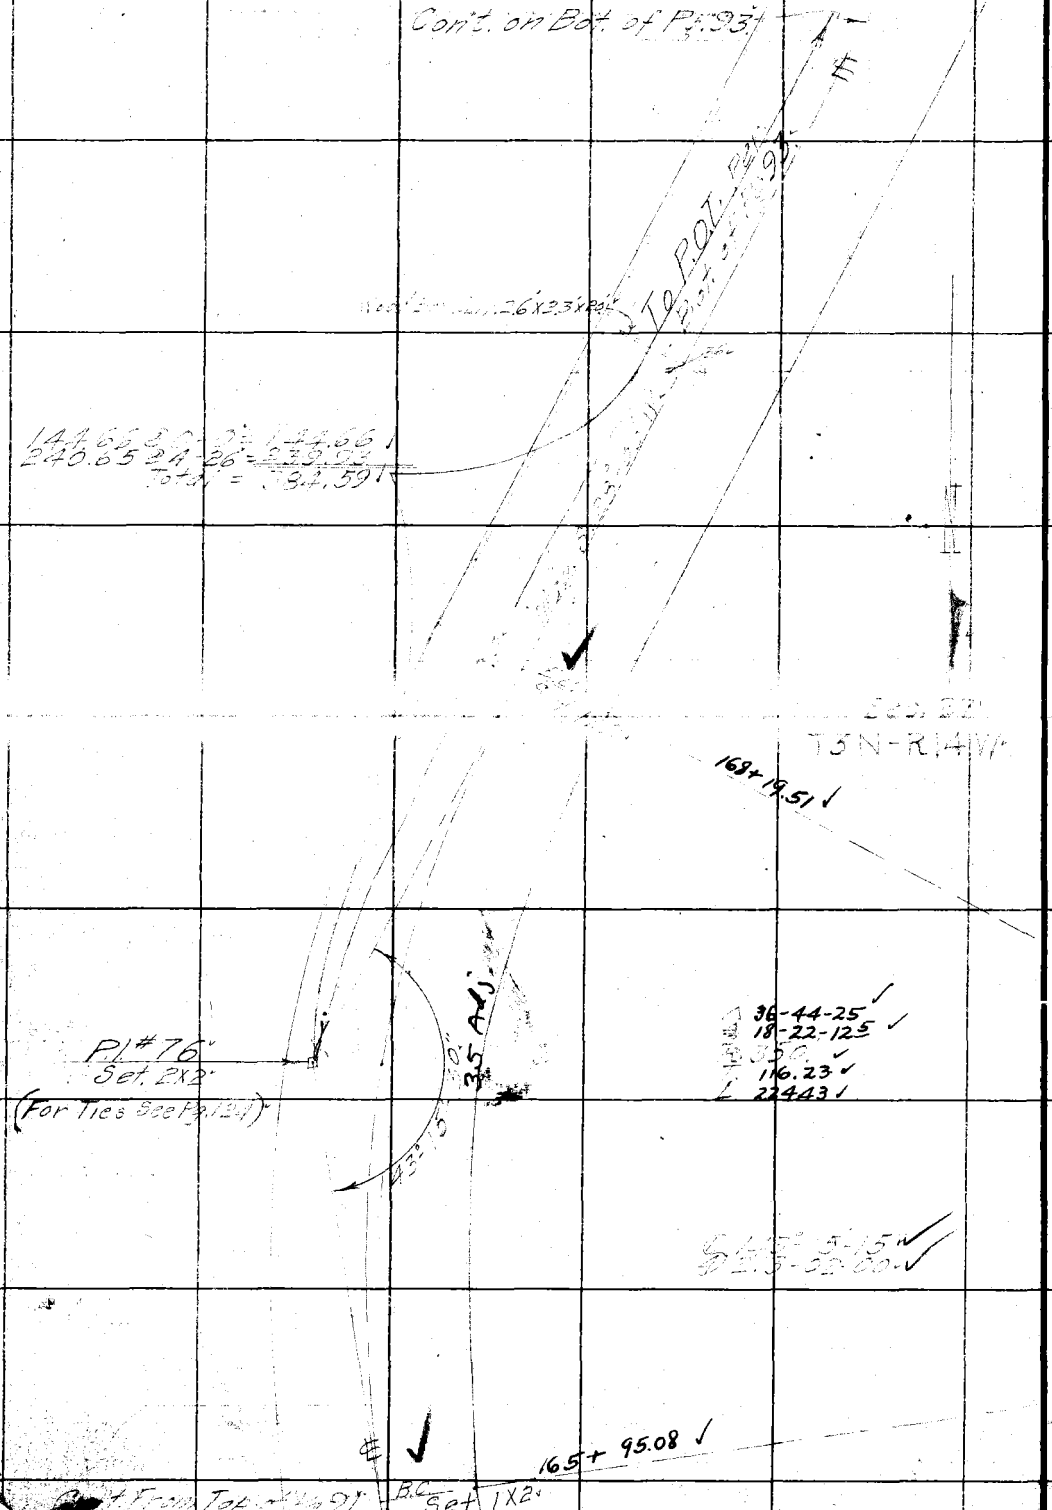

RETURN TO
LOS ANGELES COUNTY SURVEYOR

DO NOT EXTEND NOTES THIS SIDE OF THIS LINE

NOTE: ANY ADDITION OR CHANGES ON THIS SHEET MUST BE MADE OR CIRCLED IN RED, WITH DATE AND NAME OF PERSON MAKING CHANGE.

Date 6-4-27 Notes by Barson Chief Party Barson F.B. 249 Pg. 93

Platted by Browder
Date June 1927
Map No. 8948
Platting C'k'd by D. M. F.
Date Apr 1928

W. O. No. 710 D. S. O. No.
Location Little Tujunga Canyon
Surveyed by
Date 6-4-27

Cont. on pg. 94

NOTE: ANY ADDITION OR CHANGES ON THIS SHEET MUST BE MADE OR CIRCLED IN RED, WITH DATE AND NAME OF PERSON MAKING CHANGE.

DO NOT EXTEND NOTES THIS SIDE OF THIS LINE

RETURN TO LOS ANGELES COUNTY SURVEYOR

Unloading Platform 2 Bins

175+26.64

AETNA PRODUCTS CORPORATION PL. 4.

Rock Crusher

Oak Tank 5.5 Dia. 5.8 High

Oak Tank 5.5 Dia. 5.7 High on 16 High Tower

Ball Mill

Pulley Shaft

173+46.61

Mixer

Elevator

Conc. Foundation

Dust

Loading

Water Main Disconnected

6.3 Dia. 7.0 High

For Ties See Pg. 124

P.I. #77

Set 2x2

P.O.T. Set 2x2

Cont. from Top of Pg. 92

Sec. 27, T3N - R14W

34-23-00
17-11-30
R 300.
T 92.82
L 180.03

145°37'00"
222°28'45"

Wood Post 2"x1"x24"

F.B. 249 Pg. 94 Benson Chief Party Notes by Benson Date 6-6-27

Cont'd on Sh't of F. 95

230.61 @ 3°20' = 230.21
169.70 @ 2°-59' = 169.54
Total = 399.75

Pl #79
Buried 1.3 in Ground

Pl #79
To Bot of Pipe

Cont'd Sh't #2

177+39.41

Δ 58-25-30
D 29-12-45
R 100.
T 55.92
L 101.97

154.51 @ 5°-08' = 193.63

30 Adj.

176+37.44

BC Set 1X2"

Note: Rest. - Building Located by Stadia

Schumacher Wood Tank:
7.6 Dia. 7.5 High

13.86
15°40'
12.16
Shed
33.5
49.0
Wood Water Tank:
6.4 Dia.
4.0 High
59.04
POT Set 2 1/2"
80.13
117.49

Sec 27
T 3 N - R 14 W

Con't From Top of Pg 93

NOTE: ANY ADDITION OR CHANGES ON THIS SHEET MUST BE MADE OR CIRCLED IN RED, WITH DATE AND NAME OF PERSON MAKING CHANGE.

DO NOT EXTEND NOTES THIS SIDE OF THIS LINE

RETURN TO LOS ANGELES COUNTY SURVEYOR

Date 6-6-27 Notes by Benson Chief Party Benson F.B. 249 Pg. 95

Platted by Browder	W. O. No. 710 D. S. O. No.
Date June 1927	Location Little Rock Wash
Map No. 8948	Surveyed by Benson
Platting C'k'd by D. M. P.	Date 6-6-27
Date Apr. 1928	Indexed

NOTE: ANY ADDITION OR CHANGES ON THIS SHEET MUST BE MADE OR CIRCLED IN RED. WITH DATE AND NAME OF PERSON MAKING CHANGE.

DO NOT EXTEND NOTES THIS SIDE OF THIS LINE

RETURN TO LOS ANGELES COUNTY SURVEYOR

Con't on Sht. of Pg. 98

To Pl. #80 Pg. 96

123.54 @ 3°-11' = 123.35
264.80 @ 3°-12' = 264.35
Total = 387.69

Sec. 27.
T3N-R14W.

181+40.07 E.C.
Set 1"x2"

Δ 33-33-05
R 200.
T 60.29
L 117.12

26°55 Adj.

Pl. #79.
Set 2"x2"
(For Ties See Pg. 125)

180+22.95
Set 1" P.C.

Con't From Top of Pg. 94

F.B. 242 Pg. 96 Benson Chief Party Notes by Benson Date 6-6-27

Copy on Bk. 3 Pg 97

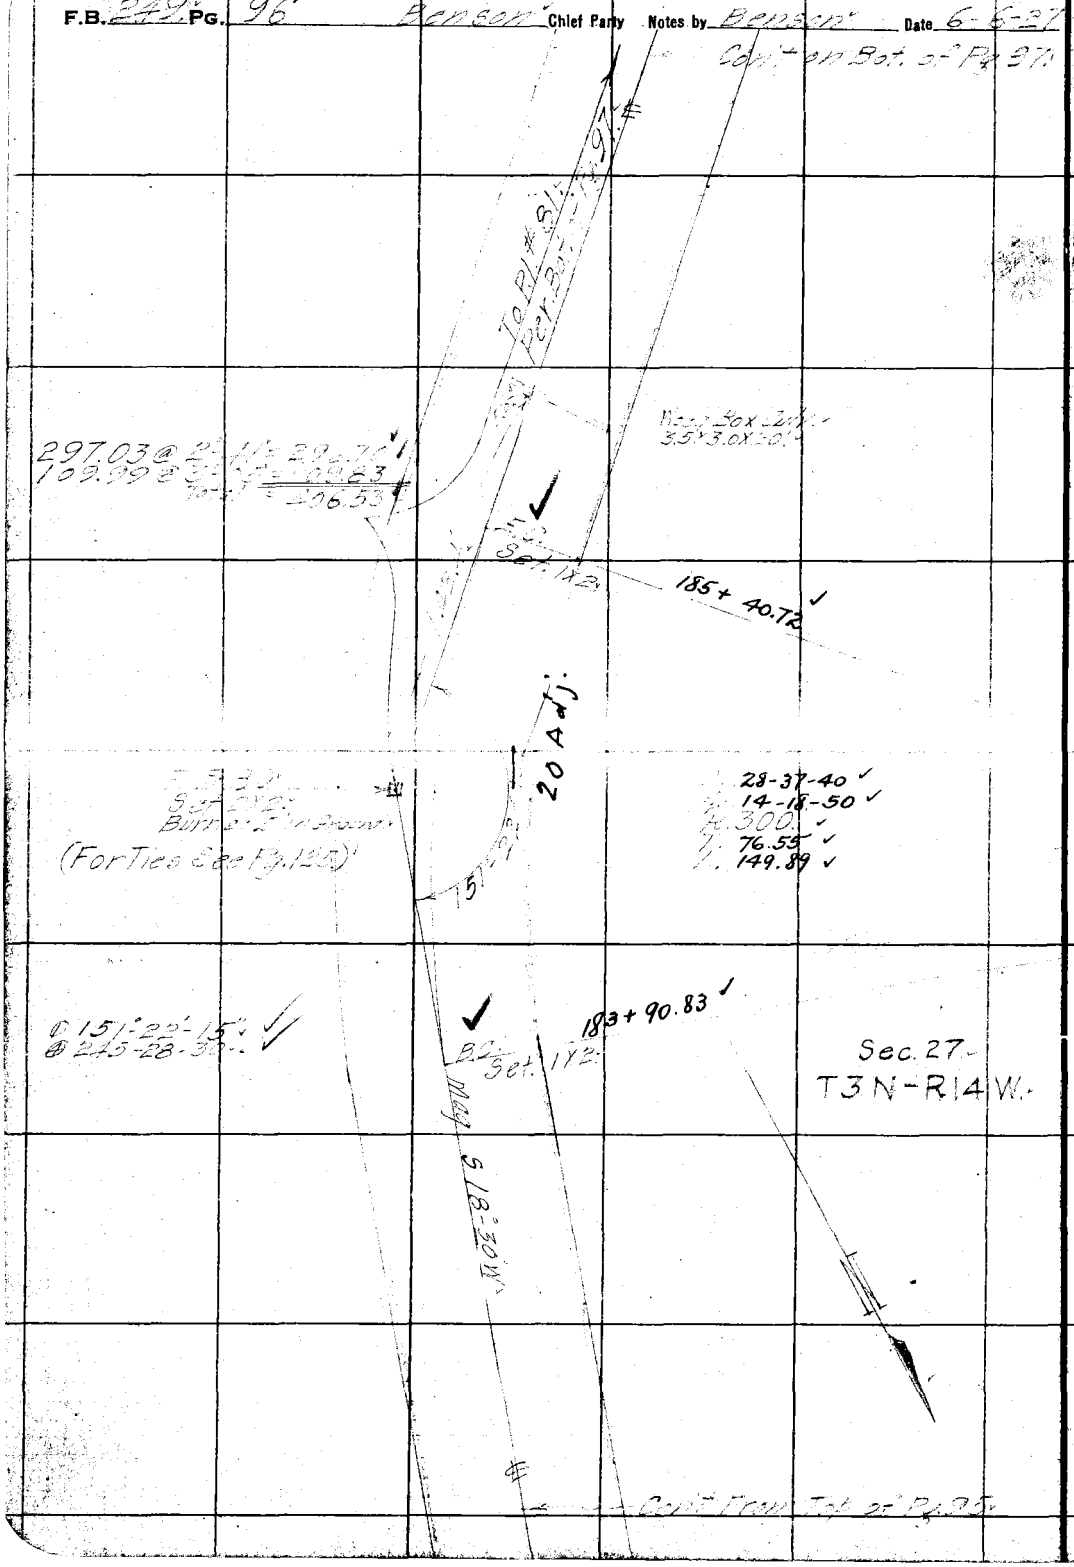

RETURN TO
LOS ANGELES COUNTY SURVEYOR

DO NOT EXTEND NOTES THIS SIDE OF THIS LINE

NOTE: ANY ADDITION OR CHANGES ON THIS SHEET MUST BE MADE OR CIRCLED IN RED, WITH DATE AND NAME OF PERSON MAKING CHANGE.

Date 6-7-27 Notes by Benson Chief Party [illegible] F.B. 249 Pg. 97

Platted by Crowder	W. O. No. 710 D. S. O. No.
Date June 1927	Location Little Tujunga Canada
Map No. 8948	Surveyed by
Platting C'k'd by D. M. P.	Date 6-7-27
Date Apr 1928	Indexed

NOTE: ANY ADDITION OR CHANGES ON THIS SHEET MUST BE MADE OR CIRCLED IN RED. WITH DATE AND NAME OF PERSON MAKING CHANGE.

DO NOT EXTEND NOTES THIS SIDE OF THIS LINE

RETURN TO LOS ANGELES COUNTY SURVEYOR

Cont. on Bot. of Pg. 98

190 + 17.39

Set. K12

T3N-R14W

Δ 145°-16'-45"
R 231.67.00

Δ 34-43-15
R 17-21-37.5
R 500
T 156.31
L. 303.00

239.16 @ 1.20 - 1.86°
= 288.37
57.31 @ 0-0 - 1.86°
= 57.32
To P.T. 345.69

P.T. #81
Set. P.K.
(For Ties See Pg. 126)

SEE PAGE 61 FOR THIS INTERSECTION

187 + 14.39

Set K2 B.C.

Cont. From Top of Pg. 96

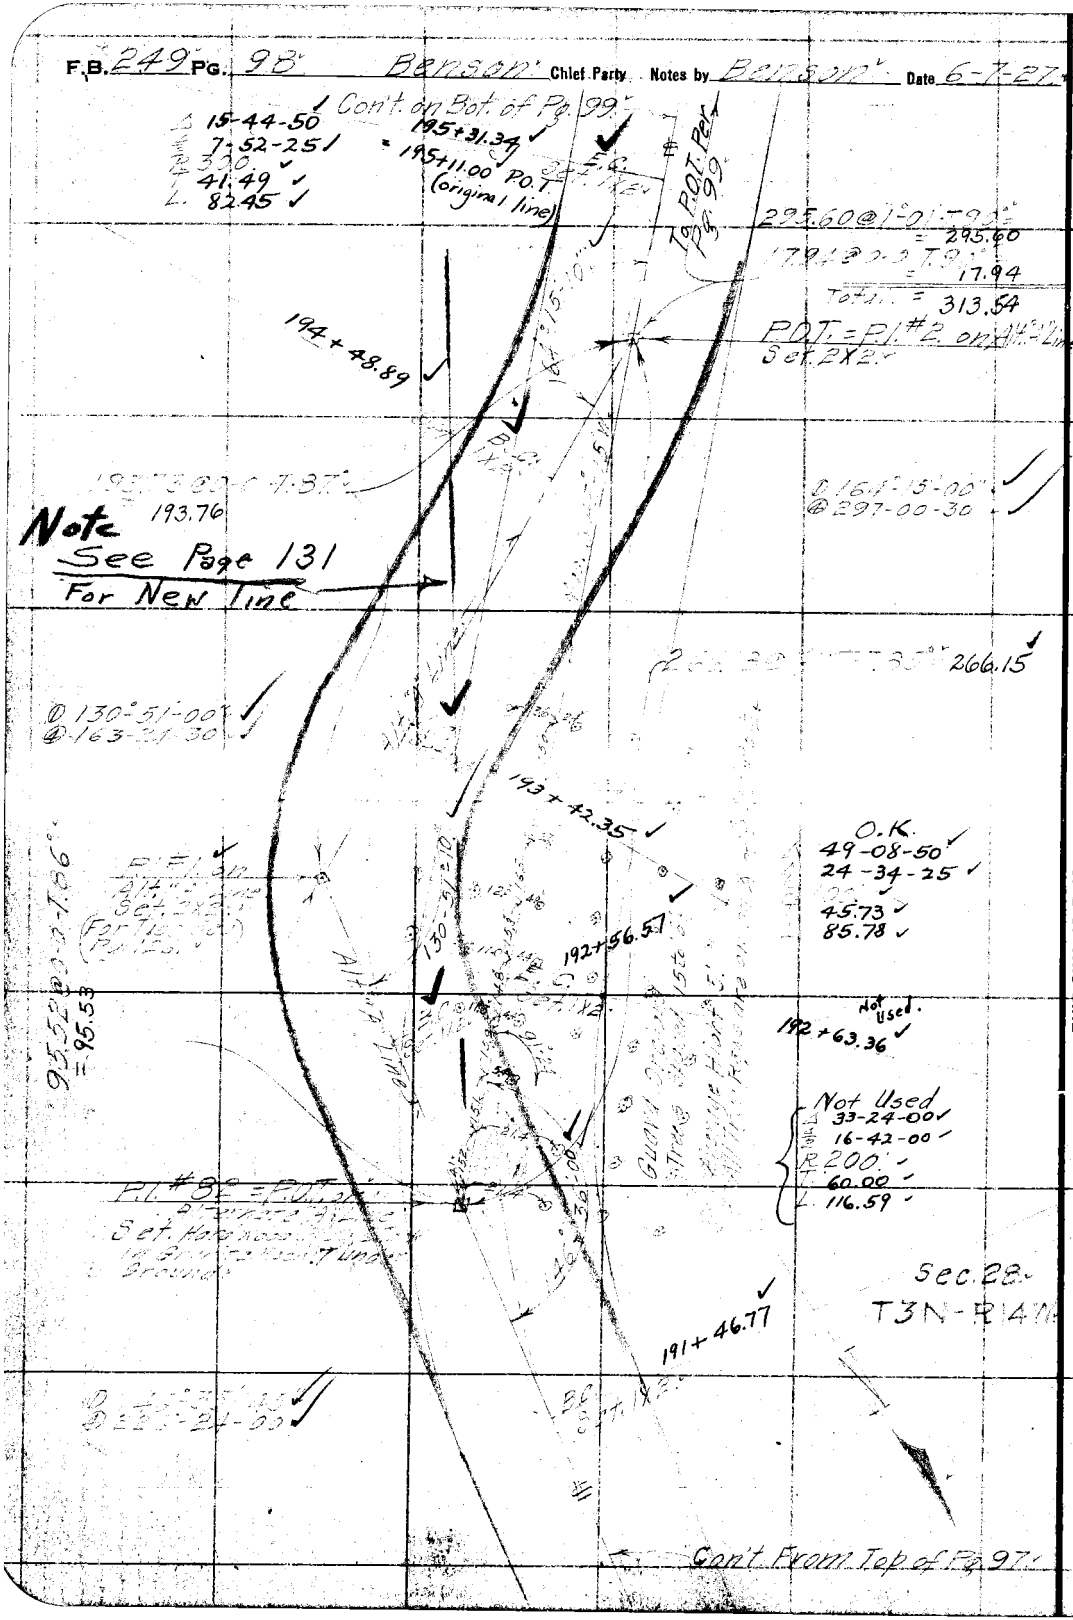
F.B. 249 PG. 98 Benson Chief Party Notes by Benson Date 6-7-27
Con't on Bot. of Pg 99
Δ 15-44-50
D 7-52-25
R 300
T 41.49
L 82.45
195+31.34
= 195+11.00 P.O.T.
(original line)
19 P.O.T. Per Pg 99
295.60 @ 1°-01-
= 295.60
17.94
Total = 313.54
P.O.T. = P.I. #2 on
Set 2X2
194+48.89
193.76
Note
See Page 131
For New Line
Δ 16°-15-00
@ 297-00-30
266.15
Δ 130°-51-00
@ 163-21-30
193+42.35
O.K.
49-08-50
24-34-25
45.73
85.78
192+56.57
95.52
= 95.53
Not Used.
192+63.36
Not Used
33-24-00
16-42-00
R 200.
60.00
116.59
Sec. 28.
T3N-R14W.
191+46.77
Con't From Top of Pg 97
RETURN TO
LOS ANGELES COUNTY SURVEYOR
DO NOT EXTEND NOTES THIS SIDE OF THIS LINE
NOTE: ANY ADDITION OR CHANGES ON THIS SHEET MUST BE MADE OR CIRCLED IN RED. WITH DATE AND NAME OF PERSON MAKING CHANGE.

Date 6-7-27 Notes by Benson Chief Party Benson F.B. 242 Pg. 99

Platted by Browder	W. O. No. 710 D.S.O. No.
Date June 1927	Location Little Tujunga Canyon
Map No. 8948	Surveyed by Benson
Platting C'k'd by D. M. F	Date 6-7-27
Date Apr. 1928	Indexed

NOTE: ANY ADDITION OR CHANGES ON THIS SHEET MUST BE MADE OR CIRCLED IN RED. WITH DATE AND NAME OF PERSON MAKING CHANGE.

DO NOT EXTEND NOTES THIS SIDE OF THIS LINE

RETURN TO LOS ANGELES COUNTY SURVEYOR

Con't on Bot. of Pg 100'

East 1/4 Cor.

194+11.11

206.61 @ 2°44' T 32° = 205.84

Pt #83

Sec. 28 T3N-R14W (Pg 127)

Δ 13-35-05

S 6-47-32 E

R 200.

T 23.82

L 47.42

198+63.69

Δ 166°24'45"

Δ 30°39'30"

See Page 132 For New Line

105.58 @ 8-23 T 85° = 104.46

1-Story Cabin 24.2

1-Story Cabin 14.2

1-Story Cabin 14.3

Aime Kiln 5.0 Dia. 19. Deep.

Lime Kiln 6.0 Dia. 14. Deep.

Sec. 28. T3N-R14W.

Cont From Top of Pg 98'

F.B. 249 Pg. 133 Benson Chief Party Notes by Benson Date 6-8-27

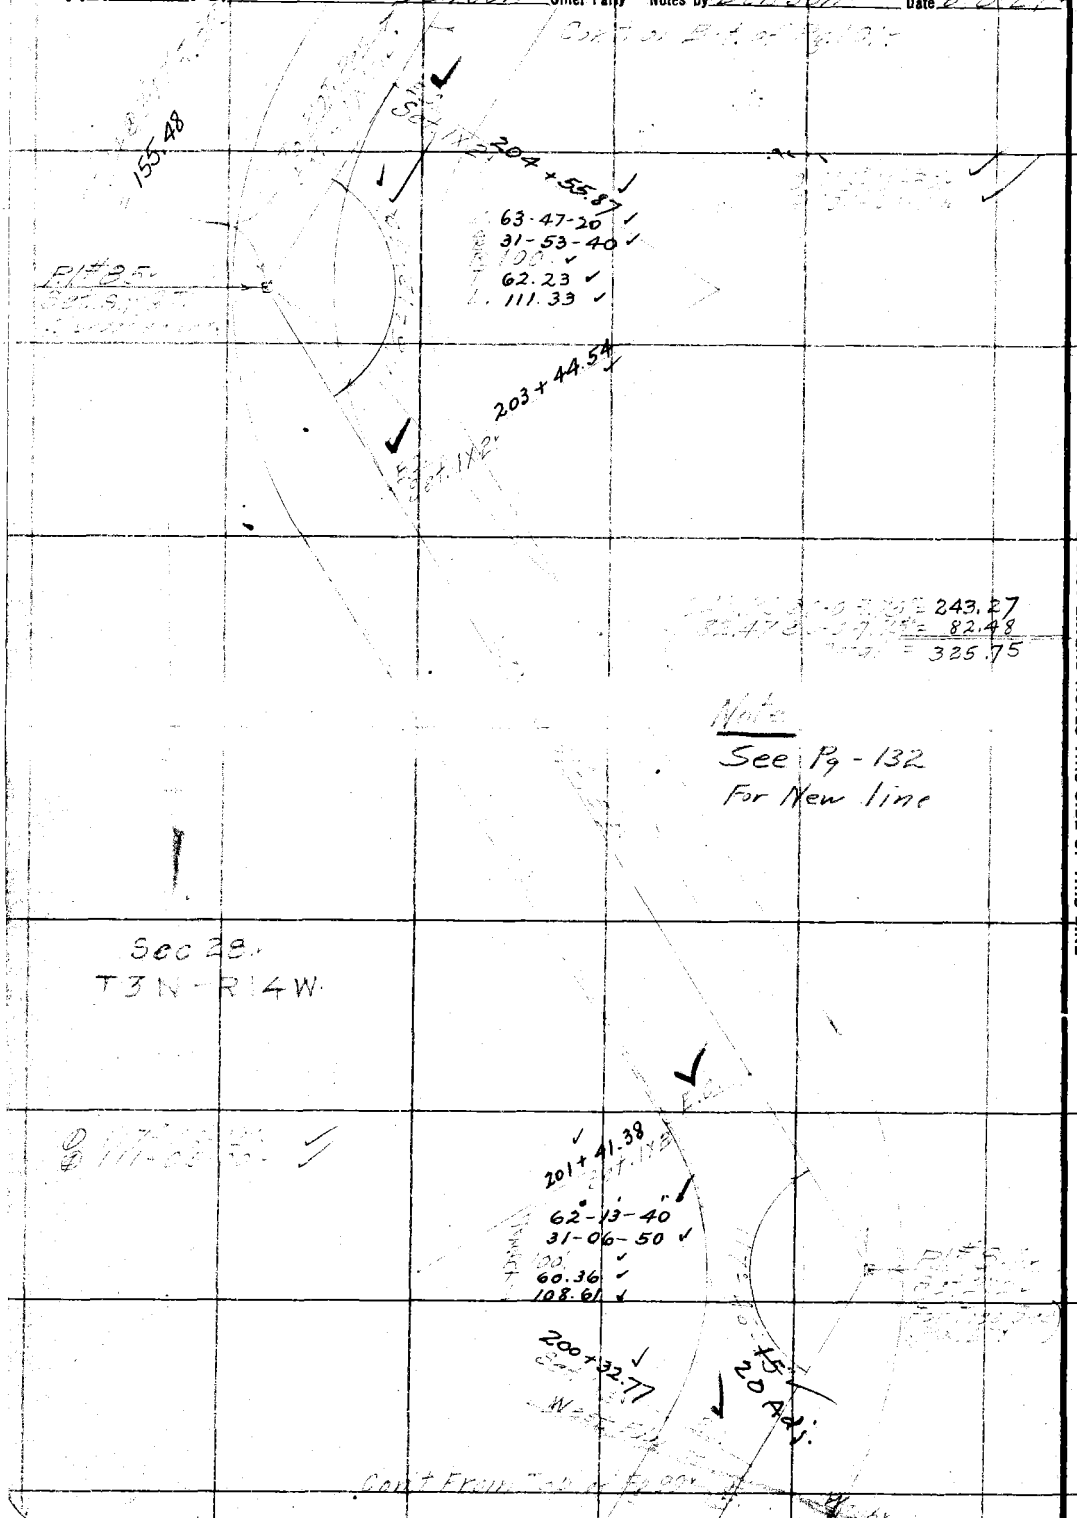

RETURN TO
LOS ANGELES COUNTY SURVEYOR

DO NOT EXTEND NOTES THIS SIDE OF THIS LINE

NOTE: ANY ADDITION OR CHANGES ON THIS SHEET MUST BE MADE OR CIRCLED IN RED. WITH DATE AND NAME OF PERSON MAKING CHANGE.

Date 6-8-27 Notes by Benson Chief Party Benson F.B. 249 Pg. 101

Platted by Crowder	W. O. No. 710 D. B. O. No.
Date June 1927	Location Little Tujunga Canyon Rd
Map No. 8948	Surveyed by Benson
Platting C'k'd by D. M. F.	Date 6-8-27
Date Apr. 1928	Indexed

NOTE: ANY ADDITION OR CHANGES ON THIS SHEET MUST BE MADE OR CIRCLED IN RED, WITH DATE AND NAME OF PERSON MAKING CHANGE.

DO NOT EXTEND NOTES THIS SIDE OF THIS LINE

RETURN TO LOS ANGELES COUNTY SURVEYOR

Cont on Sht. of Fg 102

To P.I. #87 Fg Sht of Fg 102

E.C. Set. 1X2

208 + 45.59

17-25-45
8-42-52.5
R 300'
T 45.98
L 91.26

154.35 @ 5°30' T 82'
= 153.56

P.I. #86 Set. 2X2

P.I. #85 Set. 2X2

207 + 54.33

B.C. Set. 1X2

Note
See Pg- 133
For New Line

D 16°34'45"
@ 290°17'33"

C.I. Pipe 2.5 Dia. 48" Long

252.40 @ 5°39' T 76'
= 251.19

S 32°30'W
125.70

Sec. 28
T3N-R14W

P.O.T. Set. 2X2

Cont From Top of Fg 100

F.B. 649 Pg. 102 Chief Party Notes by Date 2-3-27

Con't on Bot of Pg 103

T.P.O.T. on Pg 101

2553.92 @ 3°-33' T.B.L. = 281.09

P.O.T.

248.67

P1" D Rr Pg. 184

Note See Pg-134

Sec. 28. T3N-R14W.

33-49-10
16-54-35
30.40
59.03

209+81.80 Set 1X2

209+22.77

P1 #87 Set 1X2 (For Ties See Pg 129)

Set 1X2

Con't From Top of Pg 101

RETURN TO LOS ANGELES COUNTY SURVEYOR

DO NOT EXTEND NOTES THIS SIDE OF THIS LINE

NOTE: ANY ADDITION OR CHANGES ON THIS SHEET MUST BE MADE OR CIRCLED IN RED. WITH DATE AND NAME OF PERSON MAKING CHANGE.

Date 6-8-27 Notes by [illegible] Chief Party [illegible] F.B. 249 Pg. 103

Platted by Crowder
Date June 1927
Map No. 8941
Platting C'k'd by D. M. F
Date Apr. 1928

W. O. No. 710 D. S. O. No.
Location Little Tujunga Canyon Rd
Surveyed by
Date 6-8-27
Indexed

NOTE: ANY ADDITION OR CHANGES ON THIS SHEET MUST BE MADE OR CIRCLED IN RED, WITH DATE AND NAME OF PERSON MAKING CHANGE.

DO NOT EXTEND NOTES THIS SIDE OF THIS LINE

RETURN TO LOS ANGELES COUNTY SURVEYOR

Con't on Bot. of Pg. 104

146.33 @ 0°-T. 82°=
146.34
@ 152°-26'-45"
@ 249°-47'-00"

Sta. 51
Fd. PK2. in Good Condition
(Per. 3-299-27.)

98.23 @ 0°-0'-T. 66"
98.23

149.02 @ 7°-49' T. 82'
=147.66

P.O.T.
Set. S.W.B.T. on
[illegible]

NOTE - Solar #3 on Pg. 122.

Wood Box Ch. 1.5 X 1.5 X 26.8'

LOVELL RANCH

268.05 @ 1°-[illegible] T. 82' = 268.03

Sta. #52
Fd. 2X2
(Per. 3-299-28)

Fd. N&T. in
N.E. Cor of Shack

Wood Box Ch. 3.7 X 3.0 X 26.3'

D 161-27-30"
@ 255-42-30"

Sec 28.
T3N - R14W.

258.60 @ 2°-08'-T. 76"
=258.44

(Per. 3-299-28)
Sta. #53.
Fd. Old Rusty wire 30'
& T.W. 3.0 Below Surface
of Ground

P.O.T. (A)
Set. 2X2 on East Edge Road
Buried 4" under Ground.

Con't From Top of Pg. 102

F.B. 242 PG. 104 Benson Chief Party Notes by Benson Date 6-8-27

Con't on Sht. of Pg. 105

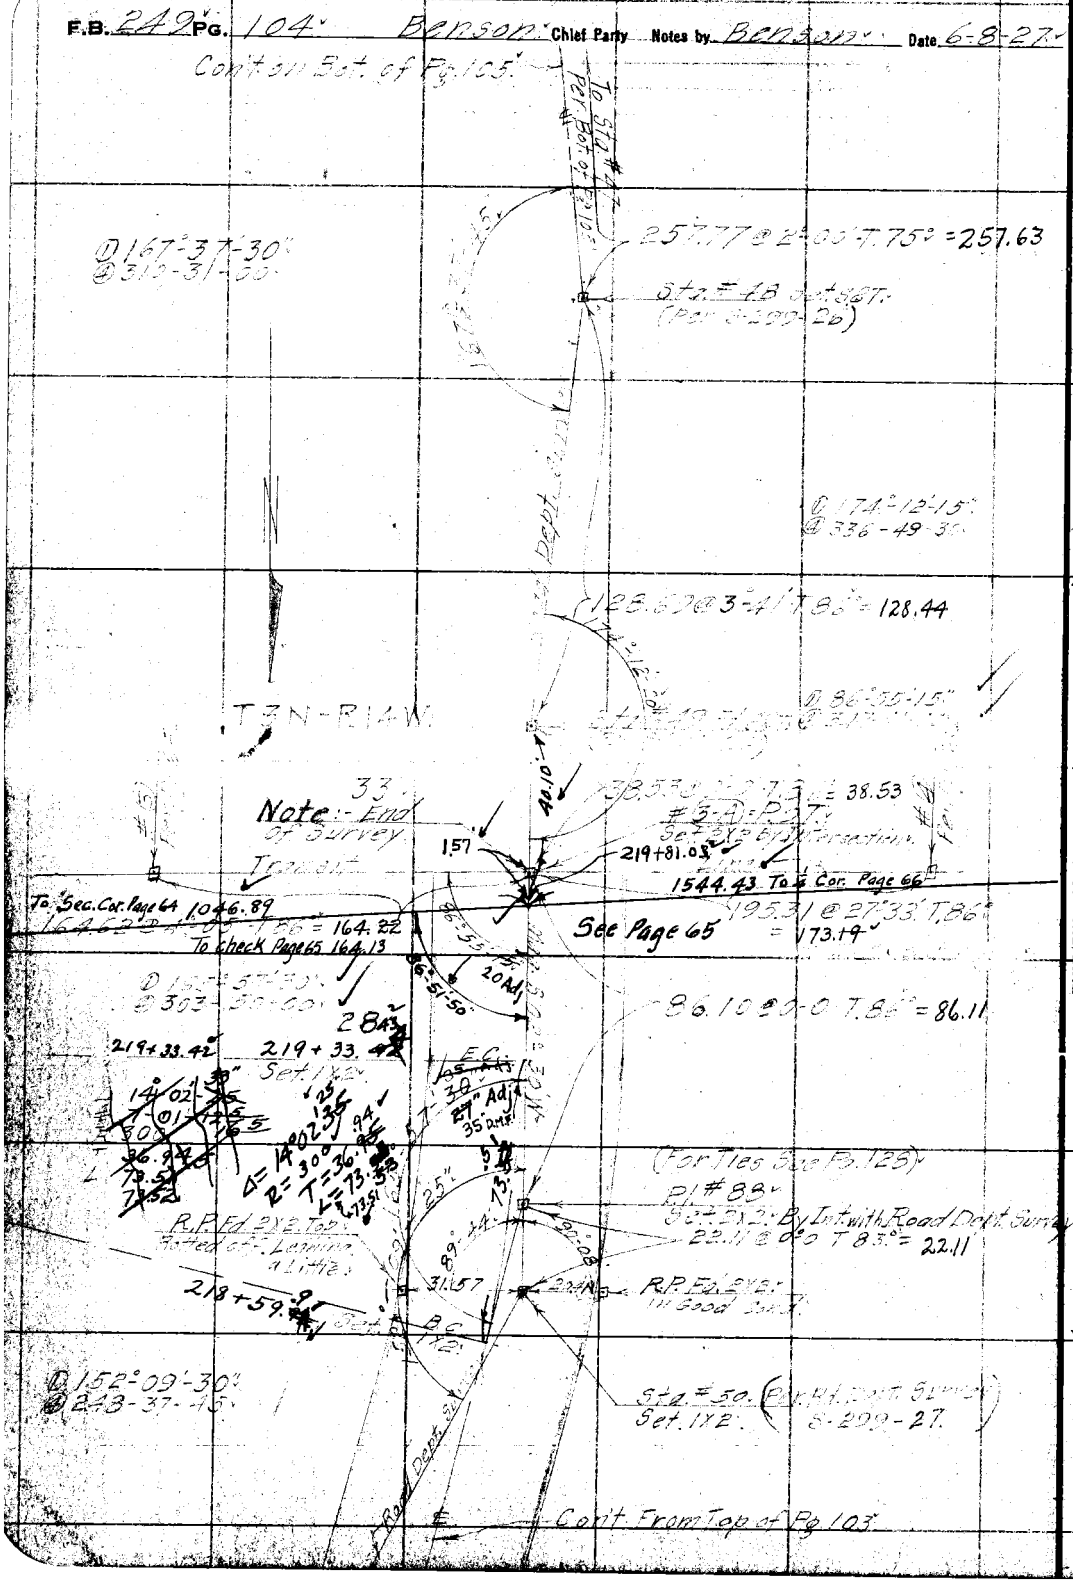

RETURN TO LOS ANGELES COUNTY SURVEYOR

DO NOT EXTEND NOTES THIS SIDE OF THIS LINE

NOTE: ANY ADDITION OR CHANGES ON THIS SHEET MUST BE MADE OR CIRCLED IN RED, WITH DATE AND NAME OF PERSON MAKING CHANGE.

Date 6-9-27. Notes by Benson. Chief Party Benson. F.B. 249 Pg. 105

Platted by E.M. Browder	W. O. No. 710 D. B. O. No.
Date June 1927	Location Little Tujunga Canyon Rd.
Map No. 8948	Surveyed by Party
Platting C'k'd by D. M. F	Date 6-9-27.
Date Apr. 1928	Indexed

NOTE: ANY ADDITION OR CHANGES ON THIS SHEET MUST BE MADE OR CIRCLED IN RED, WITH DATE AND NAME OF PERSON MAKING CHANGE.

DO NOT EXTEND NOTES THIS SIDE OF THIS LINE

RETURN TO LOS ANGELES COUNTY SURVEYOR

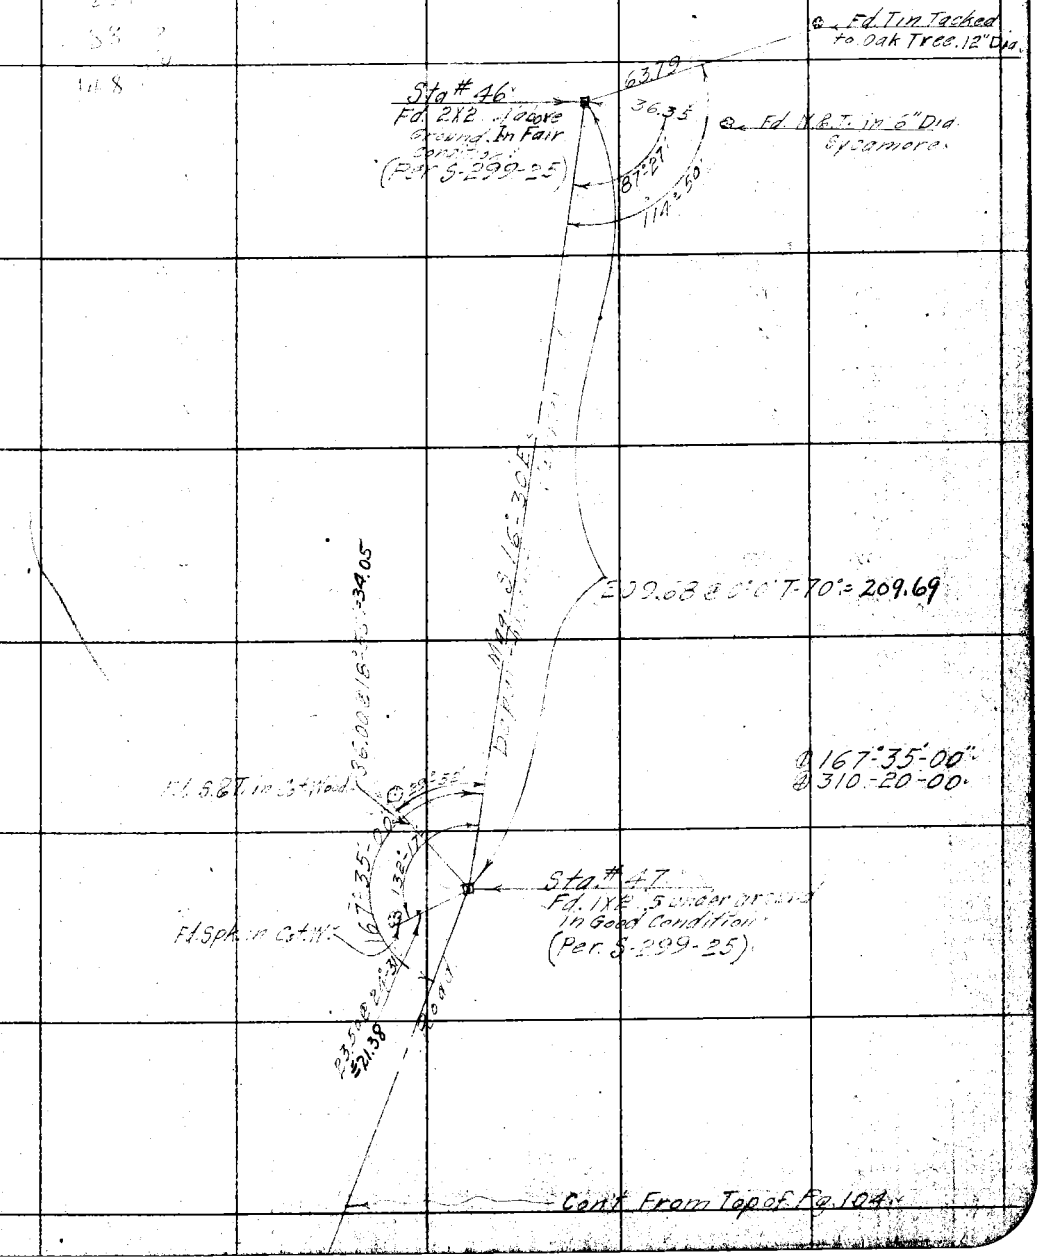

F.B. 249 PG. 106 Chief Party Recorded by Jacobsen Date 6-9-27

Location of Traverse Easterly & Southerly Tujunga Canyon

Inst. At	Sta.	Station	Hor. ∠	Vert. ∠	Horizontal	Remarks
P.I.#74	P.I.#75		0°-0'			
	62	331 950	9°-38'	0°-0'	62	W.Edge Little Tujunga Trav. Rd.
	106	12.05 11.00	5-42	0-0	106	"
	176	12.05 11.00	6-44	0-0	176	"
	264	10.63 8.00	356-50	1-05	264	"
	316	9.45 8.00	351-20	1-10	316	"
	339	12.37 9.00	350-05	1-12	339	"
	351	10.09 8.00	349-30	1-22	351	"
	366	7.85 6.00	348-52	2-28	365	"
	346	10.45 8.00	348-34	1-42	346	E.Edge Little Tujunga Trav. Rd.
	323	11.67 9.00	345-57	1-16	323	"
	299	9.23 9.00	340-32	0-57	299	"
	244	12.43 10.00	338-51	0-25	244	"
	185	10.00 8.00	338-26	0-03	185	"
	141	10.00 8.00	338-23	0-03	141	"
	94	10.43 8.00	338-18	0-03	94	"
	61	9.00 8.00	338-16	0-03	61	"
	142	10.00 8.00	309-15	8-26	139	W.Edge Little Tujunga Trav. Rd.
	167	10.00 8.00	321-02	3-12	163	"
	208	10.00 8.00	314-01	7-05	197	"
	241	10.00 8.00	311-01	5-36	239	"
	299	12.00 8.00	312-35	5-55	297	"
	358	12.57 9.00	308-51	1-52	356	"
	234	12.33 10.00	332-29	6-23	233	E.Edge Little Tujunga Trav. Rd.
	200	5.00 5.00	330-19	8-14	197	"
	172	12.71 11.00	321-04	7-22	169	"
	166	8.65 7.00	306-42	3-05	162	"
P.I.#76	P.I.#77					
	175	6.74 5.00	142-00	4-42	174	W.Edge Little Tujunga Trav. Rd.
	102	10.01 9.00	139-21	6-56	101	"
	65	9.69 9.00	130-45	9-11	63	"
	33	5.32 5.00	62-18	6-35	33	"
	65	8.64 8.00	17-02	3-30	65	"
	136	7.34 6.00	6-34	0-0	136	"

RETURN TO LOS ANGELES COUNTY SURVEYOR

DO NOT EXTEND NOTES THIS SIDE OF THIS LINE

NOTE: ANY ADDITION OR CHANGES ON THIS SHEET MUST BE MADE OR CIRCLED IN RED, WITH DATE AND NAME OF PERSON MAKING CHANGE.

Date 6-9-27 Notes by [illegible] Chief Party Benson F.B. 249 Pg. 107

Platted by Drew
Date July 1927
Map No. 8948
Platting C'k'd by R.B. Higgins
Date July 1927

W. O. No. 710 D. S. O. No.
Location Little Tujunga
Surveyed by
Date 6-9-27
Indexed

NOTE: ANY ADDITION OR CHANGES ON THIS SHEET MUST BE MADE OR CIRCLED IN RED. WITH DATE AND NAME OF PERSON MAKING CHANGE.

DO NOT EXTEND NOTES THIS SIDE OF THIS LINE

RETURN TO LOS ANGELES COUNTY SURVEYOR

Inst. No.	Station	Chain	Horiz. ∠	Vert. ∠	Horiz. Dist.	Remarks
P.I.#76	P.I.#77		0-0			
222		9.21	1°-43'	8-0'	222	W. Edge Little Tujunga Trav. Rd.
297		7.00 9.96	359-57	0-0	297	"
351		7.00 9.50	358-24	0-0	351	"
349		6.00 8.48	356-04	0-0	349	E. Edge Little Tujunga Trav. Rd
287		3.00 8.86	357-36	0-0	287	"
173		6.00 7.72	358-34	0-0	173	"
56		6.00 3.55	01-30	0-0	56	"
6		3.00 1.05	113-05	15-34	6	"
94		1.00 2.93	153-39	4-15	93	W. Edge Little Tujunga Wash
100		2.00 10.89	163-34	1-58	100	"
46		10.00 12.45	163-42	2-01	46	"
22		12.00 12.21	230-10	8-28	21	"
63		12.00 12.62	303-52	4-13	63	"
84		12.00 8.83	324-21	6-29	83	"
151		8.00 10.50	339-05	8-25	148	"
206		9.00 6.05	338-59	4-30	205	E. Edge Little Tujunga Wash
138		4.00 6.37	323-31	5-45	137	"
109		5.00 11.08	315-00	4-16	108	"
79		10.00 5.78	296-51	9-00	77	"
74		5.00 11.73	275-30	4-11	73	"
71		11.00 4.70	250-23	6-56	70	"
75		7.00 6.74	229-55	6-34	74	"
111		6.00 6.10	192-31	3-43	110	"
160		5.00 11.59	178-02	0-0	160	"
212		10.00 10.11	169-14	0-0	212	"
P.O.T. Between #77	P.I.#77	8.00	0-0			
43		9.42 9.00	194-42	17-58	39	W. Edge Little Tujunga Trav. Rd.
21		11.20 11.00	308-40	35-47	14	"
89		9.88 9.00	357-37	8-34	87	"
167		12.66 11.00	358-19	3-32	166	"
239		9.37 7.00	0-11	3-18	237	"
151		9.50 8.00	0-17	2-13	151	"

F.B. 219 PG. 103 Chief Party [illegible] Notes by [illegible] Date 6-9-27

Inst. at	Sta.	Dist.	Dir.	Total Dist.	Remarks
POT			0°-0'		
	Pin 77				
	289	11.88 / 9.00	355-57	1°-55'	289 E Edge Little Tujunga Trav. Rd
	233	11.32 / 9.00	355-36	2-33	232 "
	190	11.89 / 10.00	354-05	3-03	189 "
	143	11.42 / 10.00	350-14	4-12	142 "
	91	11.90 / 11.00	349-02	6-40	90 "
	34	10.33 / 10.00	304-25	20-03	30 "
	165	8.64 / 7.00	197-35	10-13	160 W Edge Little Tujunga Wash
	133	11.32 / 10.00	209-45	12-17	127 "
	114	11.13 / 10.00	226-10	15-14	106. "
	95	8.94 / 8.00	261-23	21-09	83. "
	103	12.02 / 11.00	297-15	17-35	93. "
	142	11.41 / 10.00	314-42	13-20	136. "
	172	11.71 / 10.00	316-11	11-28	165. "
	176	11.75 / 10.00	306-53	11-45	168. "
	217	12.16 / 10.00	305-49	9-51	210. "
	206	11.05 / 8.00	312-04	8-05	200. "
	301	13.00 / 10.00	320-39	8-18	295. "
	316	11.15 / 8.00	320-43	7-50	309. E Edge Little Tujunga Wash
	321	12.20 / 9.00	313-06	7-39	316. "
	302	12.01 / 9.00	308-53	7-34	296. "
	214	11.13 / 9.00	299-32	11-12	205. "
	122	11.21 / 10.00	279-13	15-22	114. "
	132	12.31 / 11.00	226-22	12-24	126. "
	180	11.79 / 10.00	206-14	8-26	176. "
	180	10.79 / 9.00	350-49	4-07	179. "T" Telephone Pole
	50	10.49 / 10.00	307-08	22-56	42. "
	155	11.54 / 10.00	185-51	5-50	153. "
	346	11.45 / 8.00	180-44	2-00	345. "
	641	12.40 / 6.00	179-02	0-17	641. "
POT	Pin 78		0-0		
	159	11.58 / 10.00	191-36	4-29	158. W Edge Little Tujunga Trav. Rd
	111	12.10 / 11.00	186-35	6-18	110. "
	72	11.71 / 11.00	186-21	9-18	70. "
	17	12.16 / 12.00	249-30	46-04	8. "
	53	10.52 / 10.00	358-42	10-42	51. "
	75	11.74 / 11.00	344-41	5-22	74. E Edge Little Tujunga Trav. Rd

RETURN TO LOS ANGELES COUNTY SURVEYOR

DO NOT EXTEND NOTES THIS SIDE OF THIS LINE

NOTE: ANY ADDITION OR CHANGES ON THIS SHEET MUST BE MADE OR CIRCLED IN RED. WITH DATE AND NAME OF PERSON MAKING CHANGE.

Date 6-10-27 Notes by [illegible] Chief Party [illegible] F.B. 249 Pg. 109

Platted by	Drew
Date	July 1927
Map No.	8948
Platting Ck'd by	K.B.H
Date	July 1927

W. O. No.	710 D. S. O. No.
Location	[illegible]
Surveyed by	
Date	6-10-27
Indexed	

NOTE: ANY ADDITION OR CHANGES ON THIS SHEET MUST BE MADE OR CIRCLED IN RED, WITH DATE AND NAME OF PERSON MAKING CHANGE.

DO NOT EXTEND NOTES THIS SIDE OF THIS LINE

RETURN TO LOS ANGELES COUNTY SURVEYOR

Inst At	Sight At	Stadia	Hor ∠	Ver ∠	Hor Dist	Remarks
Pat [illegible]	P.T. 78		0°-0'			
• 45	1144 1100		309-15	14°-54'	42.	E.Edge Little Tujunga Trav. Rd.
• 41	1080 1000		228-36	17-05	37.	"
• 73	1072 1000		199-03	9-32	71.	"
• 111	1110 1000		197-24	6-05	110.	"
• 70	1069 1000		330-33	12-37	67.	Telephone Pole
• 231	1850 1600		249-15	10-53	223.	W.Edge Little Tujunga Wash
• 181	1080 900		255-12	15-38	168.	"
• 123	1322 1200		265-16	24-47	101.	"
• 101	2800 2700		284-25	23-17	85.	"
• 106	2425 2320		301-08	25-22	87.	"
• 121	1920 1800		321-05	22-54	104.	"
• 172	1171 1000		337-54	13-46	162.	"
• 251	1750 1500		340-53	11-46	241.	"
• 296	1295 1000		341-03	11-29	284.	"
• 336	1135 800		343-28	10-57	324.	"
• 362	1161 800		342-57	10-11	350.	E.Edge Little Tujunga Wash
• 297	1196 900		337-10	11-49	285.	"
• 263	1163 900		335-30	13-03	249.	"
• 198	1797 1600		337-11	14-44	185.	"
• 156	1754 1600		329-34	18-25	141.	"
• 131	1630 1500		313-24	22-46	112.	"
• 116	2315 2200		288-56	21-49	100.	"
• 133	1132 1000		281-28	22-50	113.	"
• 151	1150 1000		271-09	19-18	135.	"
• 167	1166 1000		266-35	16-27	154.	"
• 184	1283 1100		260-22	14-08	173.	"
• 221	1520 1300		255-14	11-15	212.	"
• 189	988 800		239-48	10-56	182.	SE Corner Brick Oven 3'x1'4"
• 173	972 800		229-34	12-35	165.	SW. " " "
• 143	1242 1100		284-42	17-55	129.	NW Corner Shed 26'x14'
• 139	1238 1100		296-47	18-26	125.	SW. " "
• 157	1056 900		286-02	14-49	147.	NW Corner Shed 10'x12'

F.B. [illegible] PG. 11C Chief Party [illegible] Notes by [illegible] Date [illegible]

Inst At	Sight At	Station	Hor ∠	Ver ∠	Hor Dist	Remarks
POT	P178		0°-0'			
•	159	1058 / 900	290-19	15°-14'	148.	S.W. Corner Shed 10'X12'
•	165	364 / 200	297-19	17-10	151.	N.W. Corner House 27'X12'
•	171	370 / 200	307-25	17-21	156.	S.W. " "
•	220	919 / 700	314-44	12-13	210.	N.W. Corner Open Shed 43'X24'
•	226	625 / 400	326-21	12-58	215.	S.W. " " "
•	277	776 / 500	316-12	10-20	268.	S.W. Corner Shed 16'X20'
•	275	674 / 400	313-02	10-40	266.	N.W. " "
•	283	1282 / 1000	341-23	10-12	275.	W. End of Bridge 24'L X 14'W
•	284	1283 / 1000	336-10	10-13	275.	E. " " "
•	125	1224 / 1100	286-23	21-00	109.	E End Bridge 28'L X 5'W (Enters Shed at W. End.)
•	190	1189 / 1000	259-10	10-50	184.	SE End Bridge 16'W X 26'L.
•	189	1188 / 1000	251-30	10-42	183.	NW " "
P178	P179		0-0			
	104	303 / 200	122-22	0-0	104	W Edge Little Tujunga Trav. Rd
	66	165 / 100	116-55	0-0	66	"
	33	432 / 400	99-27	0-30	33	"
	27	828 / 800	49-22	0-20	27	"
	59	1258 / 1200	12-25	0-0	59	"
•	112	111 / 1000	6-06	3-30	111.	"
•	164	1163 / 1000	1-24	3-14	163.	"
•	212	1211 / 1000	354-28	3-10	211.	"
•	263	1062 / 800	351-55	3-49	262.	"
•	323	1222 / 900	351-44	3-50	321.	"
•	502	1501 / 1000	348-50	3-26	500.	E Edge Little Tujunga Trav. Rd. Entrance to Acting Corr. Plants
•	246	1245 / 1000	348-39	3-08	245.	E Edge Little Tujunga Trav. Rd.
•	197	1196 / 1000	351-13	3-05	196.	"
•	113	1112 / 1000	353-46	3-16	113.	"
	60	1199 / 1100	348-07	0-0	60	"
	19	618 / 600	323-56	0-0	19.	"
	15	314 / 300	176-29	1-18	15.	"
	43	142 / 100	135-39	0-0	43.	"
	20	819 / 800	244-39	0-24	20.	Telephone Pole
•	211	1110 / 900	346-34	3-54	210.	"
•	292	291 / 1000	344-40	3-38	291.	"
•	351	1400 / 1100	343-43	4-20	349.	"

RETURN TO LOS ANGELES COUNTY SURVEYOR

DO NOT EXTEND NOTES THIS SIDE OF THIS LINE

NOTE: ANY ADDITION OR CHANGES ON THIS SHEET MUST BE MADE OR CIRCLED IN RED. WITH DATE AND NAME OF PERSON MAKING CHANGE.

Date 6-10-27 Notes by S. Hanson Chief Party Berger F.B. 248 Pg. 111

Platted by Drew
Date July 1927
Map No. 8948
Platting C'k'd by K.B.H.
Date July 1927

W. O. No. 710 D. S. O. No.
Location Little Tujunga Canyon Road
Surveyed by
Date 6-10-27
Indexed

NOTE: ANY ADDITION OR CHANGES ON THIS SHEET MUST BE MADE OR CIRCLED IN RED. WITH DATE AND NAME OF PERSON MAKING CHANGE.

DO NOT EXTEND NOTES THIS SIDE OF THIS LINE

RETURN TO LOS ANGELES COUNTY SURVEYOR

Inst At	Sight At	Stadia	Hor ∠	Ver ∠	Hor Dist	Remarks
P#78	P#79		0°-0'			
	114	12.13 11.00	343-10	8°-02'	111.	N.W. Corner Shed 16'x16'
	102	11.01 10.00	338-14	9-53	99.	N.E. " "
	83	12.82 12.00	333-00	10-15	80.	N.W. Corner Barn 26'x16'
	78	16.77 16.00	314-25	9-58	76.	N.E. " " Also Benchmark of Cotton
	82	15.81 15.00	292-11	11-36	79.	N.E. Corner Corral
	93	15.92 15.00	289-06	11-09	90.	E. " "
	140	11.39 10.00	319-57	9-34	136.	S. Corner Corral, Runs To S.W. Corner Shed, Also From S.E. Corner Shed To S.W. Corner Barn
	154	11.33 10.00	318-35	9-25	150.	E. Aetna Corp. Rd 8' Wide
	189	11.88 10.00	335-24	6-27	186.	"
	253	10.52 8.00	340-28	5-00	252.	"
	205	23.04 21.00	275-29	9-04	200.	W. Edge Little Tujunga Wash
	227	15.26 13.00	294-20	11-35	218.	"
	263	18.62 16.00	304-38	9-58	256.	"
	286	15.85 13.00	315-07	9-43	278.	"
	331	17.30 14.00	323-34	8-40	324.	"
	341	16.40 13.00	323-04	8-26	334.	E. Edge Little Tujunga Wash
	306	16.05 13.00	316-24	9-09	298.	"
	285	18.84 16.00	305-48	9-15	278.	"
	247	10.46 8.00	293-27	11-40	236.	"
P#79	P#80		0-0			
	96	11.95 11.00	242-47	0-0	96.	W. Edge Little Tujunga Trav. Rd.
	56	10.55 10.00	278-37	8-59	54.	"
	69	11.68 11.00	329-42	11-17	66.	"
	130	12.29 11.00	346-20	8-40	127.	"
	184	12.83 11.00	352-04	7-08	181.	"
	188	11.87 10.00	346-52	7-12	185.	E. Edge Little Tujunga Trav. Rd.
	143	11.42 10.00	340-51	8-23	140.	"
	86	9.83 9.00	324-27	10-37	83.	"
	68	10.67 10.00	296-55	8-25	66.	"
	76	11.75 11.00	267-53	3-24	76.	"
	213	9.18 7.00	277-23	7-24	210.	W. Edge Little Tujunga Wash
	206	17.05 15.00	287-14	8-14	202.	"

F.B. 219 PG. 112 Swanson Chief Party Reread Gunderson Notes by. Gunderson Date 6-15-27

Inst. at	Sight at	Stadia	Hor. ∠	Ver. ∠	Hor. Dist	Remarks
P179	P180		0°-0'			
•	201	17.00 / 15.00	300-42	8°-46'	196.	W. Edge Little Tujunga Wash.
•	216	17.15 / 15.00	319-21	8-53	212.	"
•	272	12.71 / 10.00	337-29	8-16	266	"
•	243	19.42 / 17.00	345-47	5-49	241.	"
•	398	11.97 / 8.00	350-37	6-25	392.	"
•	435	15.35 / 11.00	354-53	5-38	430.	"
•	447	13.16 / 9.00	353-24	5-44	441	E Edge Little Tujunga Wash.
•	395	14.94 / 11.00	349-05	6-12	390.	"
•	359	18.58 / 15.00	345-12	5-50	354.	"
•	317	14.16 / 11.00	341-29	7-31	312.	"
•	281	10.80 / 8.00	334-38	8-32	274.	"
•	237	13.36 / 11.00	324-12	9-16	231.	"
•	212	17.11 / 15.00	308-54	8-35	207.	"
•	216	17.15 / 15.00	293-47	8-02	213	"
•	227	13.26 / 11.00	282-29	8-10	222.	"
P179	P180		0-0			
	213	11.12 / 9.00	158-08	0-0	213	W. Edge Little Tujunga Trav. Rd.
	146	11.45 / 10.00	156-38	0-0	146	"
	92	7.91 / 7.00	153-55	0-0	92	"
	34	5.33 / 5.00	140-35	0-48	34	"
	17	6.16 / 6.00	42-05	0-0	17	"
	46	8.45 / 8.00	8-46	0-26	46	"
	86	10.85 / 10.00	3-40	0-0	86	"
	138	11.37 / 10.00	4-37	0-0	138	"
	187	12.86 / 11.00	9-23	0-0	187	"
	237	16.36 / 8.00	11-22	1-23	237	"
	317	14.16 / 11.00	11-50	0-0	317	"
	382	19.81 / 7.00	11-33	0-16	382	"
	415	14.14 / 10.00	10-05	0-45	415	"
	442	19.41 / 6.00	6-20	0-0	442	"
	467	14.66 / 10.00	2-17	0-0	467	"
	492	12.91 / 8.00	356-57	0-55	492	"
	511	15.10 / 10.00	355-04	1-20	510	"
	495	14.94 / 10.00	354-06	0-50	495	E Edge Little Tujunga Trav. Rd.
	371	13.70 / 10.00	358-00	0-29	371	"
	442	12.41 / 8.00	3-32	0-0	442	"

RETURN TO LOS ANGELES COUNTY SURVEYOR

DO NOT EXTEND NOTES THIS SIDE OF THIS LINE

NOTE: ANY ADDITION OR CHANGES ON THIS SHEET MUST BE MADE OR CIRCLED IN RED, WITH DATE AND NAME OF PERSON MAKING CHANGE.

Date 6-10-27 Recorded Gunderson Chief Party Bunker F.B. 249 Pg. 113

Platted by Drew
Date July 1927
Map No. 8948
Platting C'k'd by K.B.H.
Date July 1927

W. O. No. D. S. O. No.
Location
Surveyed by
Date
Indexed

NOTE: ANY ADDITION OR CHANGES ON THIS SHEET MUST BE MADE OR CIRCLED IN RED. WITH DATE AND NAME OF PERSON MAKING CHANGE.

DO NOT EXTEND NOTES THIS SIDE OF THIS LINE

RETURN TO LOS ANGELES COUNTY SURVEYOR

Inst AT	Sight AT	Stadia	Hor ∠	Ver ∠	Hor Dist	Remarks
Pl #80	Pl #81		0°-0'			
422		1121 700	6-18	0°-10'	422	E Edge Little Tujunga Trav. Rd.
399		1298 900	8-30	0-36	399	"
358		1258 900	9-25	0-27	358	"
311		1410 1100	8-42	0-24	311	"
246		1045 800	7-09	1-21	246	"
196		1285 1100	4-20	0-0	196	"
150		1249 1100	359-49	0-0	150	"
118		1117 1000	353-42	0-0	118	"
68		867 800	348-02	0-0	68	"
17		516 500	341-25	0-0	17	"
28		527 500	164-49	0-0	28	"
90		789 700	163-07	0-0	90	"
146		1045 900	162-56	0-0	146	"
106		1705 1600	328-00	9-10	103.	W Edge Little Tujunga Wash.
163		1662 1500	335-08	6-44	161.	"
186		1585 1400	338-09	6-00	184.	"
236		1235 1000	336-25	6-00	234.	"
268		1267 1000	333-57	5-40	265.	"
329		1689 1500	340-30	4-20	327.	"
421		1120 1000	340-55	4-00	418.	E Edge Little Tujunga Wash.
344		1143 800	338-16	5-05	342.	"
302		801 500	334-20	6-10	299.	"
262		1261 1000	331-55	5-50	259.	"
185		1284 1100	333-25	7-25	181.	"
111		1918 1700	321-15	9-00	108.	"
184		583 400	167-23	2-40	183.	Telephone Pole
28		527 500	319-35	0-0	28	"
267		1066 800	356-35	2-10	266	"
431		1230 800	354-44	1-05	431	"
Pl #82	Pl #81		0-0			
246		345 100	355-34	2-50	245	W Edge Little Tujunga Trav Rd.
156		655 500	355-47	2-55	155	"

F.B. 249 PG. 114 Ferguson Chief Party Accorsi Notes by Sunderson Date 6-13-27

Inst. At	Sta. At	Stadia	Hor ∠	Ver ∠	Hor Dist	Remarks
Pac.	P181		0°-0'			
	106	705 600	354-25	3°-03'	106	W. Edge Little Tujunga Trav. Rd.
	58	257 200	345-20	0-0	58	"
	12	511 500	313-06	0-40	12	"
	26	825 800	186-07	1-06	26	"
	53	952 900	185-40	0-20	53	"
	86	1079 1000	190-51	0-25	80	"
	131	1230 1100	198-00	0-10	131	"
	133	1132 1000	192-18	0-0	133	E Edge Little Tujunga Trav. Rd.
	87	986 900	181-36	0-0	87	"
	54	855 800	156-30	0-0	54	"
	13	572 500	117-28	1-0	13	"
	65	264 200	2-24	0-0	65	"
	143	442 300	1-50	2-20	143	"
	198	597 400	359-46	3-10	197	"
	291	790 500	19-44	0-50	291	W. Edge Little Tujunga Wash
	222	1681 1450	16-57	1-0	222	"
	158	1657	18-09	0-54	158	"
	102	1201 1100	25-33	1-45	102	"
	135	934 800	30-27	2-15	135	E Edge Little Tujunga Wash
	182	1281 1100	22-14	0-20	182	"
	241	1140 900	22-40	0-0	241	"
Pac. Co. Alt. Alma	P181		0-0			
	49	548 500	235-09	0-0	49	W. Edge Little Tujunga Trav. Rd.
	98	697 600	222-07	0-0	98	"
	162	961 800	217-10	0-0	162	"
	226	925 700	215-23	1-30	226	"
	291	1090 800	215-10	1-30	291	"
	342	1041 700	214-20	1-40	342	"
	336	1235 900	212-40	1-10	336	E Edge Little Tujunga Trav. Rd.
	293	1192 908	212-30	1-10	293	"
	246	1145 901	211-06	1-10	246	"
	191	890 700	211-25	1-05	191	"
	131	750 600	213-10	0-0	131	"
	102	301 200	10-43	4-15	102	Telephone Pole
	87	786 700	210-35	0-30	87	"
	271	1370 1100	209-05	1-40	271	"

RETURN TO LOS ANGELES COUNTY SURVEYOR

DO NOT EXTEND NOTES THIS SIDE OF THIS LINE

NOTE: ANY ADDITION OR CHANGES ON THIS SHEET MUST BE MADE OR CIRCLED IN RED. WITH DATE AND NAME OF PERSON MAKING CHANGE.

Date [illegible] Recorded Gundarson Chief Party Ransom F.B. 242 Pg. 115

Platted by Drew	W. O. No. ____ D. S. O. No. ____
Date July 1927	Location [illegible]
Map No. 8948	Surveyed by ____
Platting C'k'd by K.B.H.	Date 2-12-27
Date July 1927	Indexed ____

NOTE: ANY ADDITION OR CHANGES ON THIS SHEET MUST BE MADE OR CIRCLED IN RED. WITH DATE AND NAME OF PERSON MAKING CHANGE.

DO NOT EXTEND NOTES THIS SIDE OF THIS LINE

RETURN TO LOS ANGELES COUNTY SURVEYOR

Inst At	Sight At	Stadia	Hor. ∠	Ver. ∠	Hor. Dist.	Remarks
P/# on Alt. 4 Line	P/81		0°-0'			
	140	1639 1500	15-15	3°-00'	140	W Edge Little Tujunga Wash
	103	1102 1000	38-25	0-40	103	"
	159	1258 1100	26-40	0-20	159	E Edge Little Tujunga Wash
	116	1215 1100	43-55	0-0	116	"
	92	1091 1000	100-20	2-40	92	℄ Little Tujunga Wash 17' Wide
	87	1186 1100	135-05	3-00	87	" 30' "
	96	1095 1000	179-27	5-50	95	" 14' "
	184	1583 1400	197-25	2-30	184	" 18' "
P/81 P/82-P/83	P/# on Alt. Line		0-0			
	167	1166 1000	15-33	5-20	165.	W Edge Little Tujunga Trav. Rd.
	99	1098 1000	49-16	10-40	96.	℄ Little Tujunga Trav. Rd 13' wide
	102	904 800	90-30	13-30	97.	" 11' "
	147	546 400	119-05	11-25	142	" 12' "
	177	376 200	131-15	9-20	172	" 11' "
	208	607 400	142-30	7-35	205.	℄ Lime Creek 9' Wide 9 "
	236	835 600	25-12	6-30	233.	℄ Little Tujunga Wash 14' Wide
	179	978 800	33-30	8-40	175	" 15' "
	139	638 500	62-45	13-40	131.	" 16' "
	166	1065 900	116-15	10-40	160.	" 19' "
	215	615 400	118-10	10-00	208.	" 17' "
	341	1240 900	125-18	6-20	336.	" 16' "
	381	580 200	124-25	6-40	375.	" 12' "
	124	523 400	96-00	13-20	117.	Telephone Pole
P/84	P/85		0-0			
	166	1165 1000	283-35	7-0	163.	℄ Little Tujunga Trav. Rd 9' Wide
	105	1104 1000	293-28	7-0	103.	" 11' "
	78	777 700	324-25	7-0	77.	" 15' "
	98	697 600	352-55	4-40	97.	" 13' "
	141	640 500	8-05	2-05	141	W Edge Little Tujunga Trav. Rd.
	180	979 800	4-05	0-0	180	"
	233	332 100	0-41	0-0	233	"
	274	373 100	0-03	1-0	274	"

F.B. 249 Pg. 116 Chief Party Notes by Date 6-13-27

Inst. #	Sight #	Stadia	Hor ∠	Ver ∠	Hor Dist	Remarks
P1#84	P1#85		0°-0'			
	310	700 400	0-28	2°-0'	310	W. Edge Little Tujunga Trav. Rd.
	346	445 100	0-0	1-30	346	E. Edge Little Tujunga Trav. Rd.
	326	425 100	358-30	1-40	326	"
	270	469 200	357-25	1-30	270	"
	209	408 200	358-30	0-0	209	"
	178	777 600	359-15	0-0	178	"
	144	1143 1000	359-20	0-0	144	"
	187	996 800	327-40	0-40	187	Telephone Pole
	245	1241 1000	304-02	7-40	241.	Mouth Lime Creek & Little Tujunga Wash 14' Wide
	611	60 (@30) 0000	355-48 (@351-36)	3-20	609.	Stadia Point
Station P1#84			0-0			
	356	1155 800	14-50	12-55	339.	E. Little Tujunga Wash 25' Wide
	313	1012 700	13-00	15-15	292.	" 28' "
	236	935 700	27-20	23-30	199.	" 18' "
	186	485 300	27-10	38-30	114.	" 20' "
	162	1553 1500	8-30	40-40	94.	" 21' "
	209	1208 1000	346-55	29-00	160.	" 13' "
	237	336 100	336-35	29-00	182.	" 11' "
	226	825 600	323-50	29-00	173.	" 13' "
	202	1201 1000	305-00	34-00	139.	" 20' "
	208	1207 1000	282-35	34-30	142.	" 14' "
	241	770 500	268-05	30-00	181.	" 20' "
	302	1101 800	266-15	21-20	262.	" 15' " E. Gold Creek Rd. 8' "
	393	492 100	268-25	17-20	358	E. Little Tujunga Wash 16' "
	478	577 100	267-55	14-00	450.	" 28' "
	381	480 100	274-20	16-00	352.	E. Gold Creek Rd. 8' "
	429	528 100	276-30	13-20	406.	" 8 "
	486	585 100	276-50	11-00	469.	" 8 "
	425	624 (@412) 200	287-11 (@214-22)	6-00	420.	P.I. #86
P1#85	P1#84		0-0			
	21	620 600	353-25	1-20	21	W. Edge Little Tujunga Trav. Rd.
	11	610 600	267-35	1-00	11	"
	30	829 800	244-40	1-40	30	"
	68	667 600	250-40	2-20	68	"
	100	899 800	250-30	2-10	100	"
	136	135 1000	242-15	2-15	136	"

RETURN TO LOS ANGELES COUNTY SURVEYOR

DO NOT EXTEND NOTES THIS SIDE OF THIS LINE

NOTE: ANY ADDITION OR CHANGES ON THIS SHEET MUST BE MADE OR CIRCLED IN RED, WITH DATE AND NAME OF PERSON MAKING CHANGE.

Date 6-13-27 Recorded by Gunderson Chief Party Benson F.B. 242 Pg. 117

Platted by	Drew
Date	July 1927
Map No.	8948
Platting Ck'd by	K.B.H
Date	July 1927

W. O. No.	710 D. S. O. No.
Location	Little Tujunga Trav. Rd.
Surveyed by	[illegible]
Date	6-13-27
Indexed	

Inst At	Sight At	Stadia	Hor ∠	Ver ∠	Hor Dist	Remarks
P1#85	P1#84		0°-0'			
	180	1179 1000	237-40	3°-10'	179	W Edge Little Tujunga Trav. Rd
	196	1035 900	231-55	3-20	195	E Edge Little Tujunga Trav Rd
	166	965 800	231-05	3-20	165	"
	102	601 500	239-30	3-40	102	"
	78	477 400	239-20	4-00	77	"
	46	495 400	224-40	3-30	46	"
	37	236 200	153-00	24-00	31	Telephone Pole
	46	615 600	216-30	0-0	46	"
	206	705 500	227-10	2-00	206	"
P1#86	P1#85		0-0			
	232	531 300	4-50	0-0	232	W Edge Little Tujunga Trav. Rd.
	209	808 600	4-25	0-0	209	"
	180	1179 1000	359-45	0-0	180	"
	156	1555 1400	353-00	0-0	156	"
	121	1420 1300	349-20	0-0	121	"
	91	2590 2500	356-55	1-00	91	"
	72	2271 2200	12-10	3-30	72	"
	46	1785 1700	51-40	17-30	42.	"
	47	1046 1000	107-35	39-00	28.	"
	72	871 800	163-00	28-00	56.	"
	119	1118 1000	175-50	17-30	108.	"
	180	1179 1000	181-40	13-30	170.	"
	246	345 100	177-10	13-30	232.	"
	311	610 300	173-50	11-00	300.	"
	358	557 200	172-45	10-00	348	"
	406	705 300	171-55	9-00	396.	"
	469	569 100	170-20	8-00	459.	"
	402	1001 600	169-40	8-00	394	E Edge Little Tujunga Trav. Rd.
	364	563 200	170-35	10-00	353	"
	300	1299 1000	170-15	10-00	291	"
	248	747 500	172-25	12-30	236	"
	199	1088 1000	175-10	12-30	190	"

NOTE: ANY ADDITION OR CHANGES ON THIS SHEET MUST BE MADE OR CIRCLED IN RED, WITH DATE AND NAME OF PERSON MAKING CHANGE.

DO NOT EXTEND NOTES THIS SIDE OF THIS LINE

RETURN TO LOS ANGELES COUNTY SURVEYOR

F.B. 2-59 Pg. 118 Benson Chief Party Notes by Recorder Gutierrez Date 5-13-57

Inst. At	Sight At	Stadia	Hor ∠	Ver ∠	Hor Dist	Remarks
PI 86	PI 85		0°-0'			
•	157	1156 1000	• 175-15	11°-00'	151.	E Edge Little Tujunga Trav. Rd Junction Gold Creek Rd 8' Wide
•	121	920 800	• 170-20	17-30	110.	E Edge Little Tujunga Trav Rd
•	72	771 700	• 145-20	26-30	58.	"
•	62	661 600	• 86-30	26-00	50.	"
•	70	869 800	• 54-35	17-30	64.	"
•	86	1685 1600	• 18-20	5-00	85.	"
	119	1118 1000	• 359-20	1-30	119	"
	145	1149 1000	• 359-20	1-30	145	"
	163	1062 900	• 2-55	1-00	163	"
	205	1004 800	• 9-25	1-00	205	"
•	85	684 600	• 66-05	21-30	74.	Telephone Pole
•	166	965 800	• 149-20	27-00	132.	W Edge Little Tujunga Wash
•	191	1390 1200	• 166-05	21-00	167.	"
•	216	1615 1400	• 170-25	17-00	198.	"
•	249	948 700	• 168-40	17-00	228.	"
•	2[illegible]	782 [illegible]	• 167-35	15-00	264.	"
•	[illegible]	228 500	• 166-45	13-20	312.	"
•	382	981 600	• 168-00	11-20	367.	"
•	420	579 100	• 167-20	11-10	404.	"
•	440	559 100	• 166-15	11-00	424.	"
•	418	517 100	• 164-05	11-20	402.	E Edge Little Tujunga Wash.
•	370	469 100	• 161-10	12-30	353.	"
•	300	799 500	• 156-20	14-20	281.	"
•	264	963 700	• 145-45	15-40	245.	"
•	212	811 600	• 136-20	19-40	188.	"
•	351	550 200	• 173-20	10-20	340.	Top W End C.I.P. 18" Culvert 28' Long
•	352	951 600	• 169-00	10-20	340.	Top E. End C.I.P. 18" Culvert 28' Long
FOT-A Party 103	PI 88		0-0			
	207	706 500	• 189-05	0-0	207	W Edge Little Tujunga Trav. Rd
	150	949 700	• 189-40	0-0	150	"
	95	784 700	• 185-25	0-0	95	"
	34	733 700	• 162-10	1-40	34	"
	32	731 700	• 314-15	2-20	32	"
	71	770 700	• 21-05	0-0	71	"
	113	1212 1100	• 12-00	0-0	113	"
	143	842 700	• 6-35	2-20	143	"

RETURN TO LOS ANGELES COUNTY SURVEYOR

DO NOT EXTEND NOTES THIS SIDE OF THIS LINE

NOTE: ANY ADDITION OR CHANGES ON THIS SHEET MUST BE MADE OR CIRCLED IN RED, WITH DATE AND NAME OF PERSON MAKING CHANGE.

Date 6-14-27 Notes by Anderson Chief Party Bowen F.B. 249 Pg. 119

Platted by Drew	W. O. No. 710 D. S. O. No.
Date July 1927	Location Little Tujunga Canyon
Map No. 8926	Surveyed by Bowen
Platting Ck'd by K.B.H.	Date 6-14-27
Date July 1927	Indexed

Inst At	Sight At	Stadia	Hor ∠	Ver ∠	Hor Dist	Remarks
POT-AP 188			0-0			
	194	894 700	3-50	2°-20'	194	W Edge Little Tujunga Trav Rd
	238	837 600	1-00	2-00	237	"
	275	674 400	358-40	2-20	274	"
	212	811 600	358-35	2-20	211	E Edge Little Tujunga Trav Rd
	182	681 500	358-40	2-20	182	"
	135	734 600	0-50	2-30	135	"
	95	494 400	0-25	2-40	95	"
	52	831 600	7-00	0-0	52	"
	25	521 500	13-20	0-0	25	"
	3	502 500	280-00	0-0	3	"
	36	535 500	192-10	0-0	36	"
	102	601 500	195-30	0-0	102	"
	152	501 400	194-55	0-0	152	"
	187	686 500	195-20	0-0	187	"
	191	1790 1600	200-20	2-00	191	W Edge Little Tujunga Wash
	151	950 800	213-40	6-00	148.	"
	123	1022 900	238-00	7-40	121.	"
	130	928 800	262-25	9-00	126.	"
	128	1227 1100	287-55	9-00	125.	"
	144	1343 1000	315-55	9-00	140.	"
	186	1285 1100	334-15	7-00	183.	"
	242	1411 1200	343-30	5-00	240.	"
	286	1285 1000	347-05	5-00	284.	"
	333	1032 700	350-40	4-40	331.	"
	408	707 300	346-25	4-40	406.	E Edge Little Tujunga Wash.
	336	1135 800	342-45	4-40	334.	"
	278	1277 1000	337-40	5-00	276.	"
	235	934 700	331-05	6-30	233.	"
	175	774 600	315-55	8-30	171.	"
	147	1146 1000	288-05	8-20	144.	"
	172	577 400	263-10	8-20	168.	"
	186	385 200	249-40	8-20	182.	Mouth Gold Creek 11' Wide

NOTE: ANY ADDITION OR CHANGES ON THIS SHEET MUST BE MADE OR CIRCLED IN RED. WITH DATE AND NAME OF PERSON MAKING CHANGE.

DO NOT EXTEND NOTES THIS SIDE OF THIS LINE

RETURN TO LOS ANGELES COUNTY SURVEYOR

F.B. 249 PG. 120 Chief Party Notes by Date 6-14-27

Inst At	Sight At	Station	Hor. ∠	Ver ∠	Horiz	Remarks
POFA P1#88			0-0			
	186	395 200	235-15	7-00	183.	E Edge Little Tujunga Wash.
	188	1187 1000	224-45	4-00	186.	"
	218	1017 800	209-25	3-40	217.	"
	240	839 600	202-30	3-30	239.	"
	173	1072 900	199-05	1-10	173.	Telephone Pole
	54	753 700	297-45	21-00	47.	"
	145	1194 1000	188-50	0-0	145	Top W End 18" C.I.P. Culvert 22' Long
	142	1241 1100	197-30	0-0	142	" E " "
P1#88	Sta 79		0-0			
	148	247 100	196-25	0-0	148	W Edge Little Tujunga Trav. Rd
	110	409 300	195-40	0-0	110	"
	66	465 400	188-50	0-0	66	"
	28	527 500	171-40	1-00	28	"
	11	610 600	60-55	0-0	11	"
	57	656 600	14-50	0-0	57	"
	76	695 600	12-35	0-0	76	"
	155	754 600	10-10	0-0	155	"
	202	901 700	10-35	0-0	202	"
	256	1055 800	8-35	0-0	256	"
	333	1052 700	5-40	0-0	333	"
	394	693 300	3-20	0-0	394	"
	476	875 400	1-15	0-0	476	"
	549	1148 600	358-40	0-0	549	"
	616	815 200	356-30	0-0	616	"
	591	790 200	355-40	0-0	591	E Edge Little Tujunga Trav Rd
	490	889 400	359-25	0-0	490	"
	441	840 400	00-35	0-0	441	"
	396	695 300	1-35	0-0	396	"
	372	771 400	1-30	0-0	372	"
	344	843 500	3-50	0-0	344	"
	302	1001 700	3-30	0-0	302	"
	257	956 700	4-40	0-0	257	"
	197	796 600	3-55	0-0	197	"
	128	527 400	2-00	0-40	128	"
	82	481 400	1-20	0-30	82	"
	36	535 500	347-10	0-40	36	"

RETURN TO LOS ANGELES COUNTY SURVEYOR

DO NOT EXTEND NOTES THIS SIDE OF THIS LINE

NOTE: ANY ADDITION OR CHANGES ON THIS SHEET MUST BE MADE OR CIRCLED IN RED, WITH DATE AND NAME OF PERSON MAKING CHANGE.

Date 6-14-27 Notes by Sanderson Chief Party [illegible] F.B. 249 Pg. 121

Platted by Drew	W. O. No. 710 O. S. O. No.
Date July 1927	Location [illegible]
Map No. 8948	Surveyed by [illegible]
Platting Ck'd by K.B.H	Date 6-14-27
Date July 1927	Indexed

Inst At	Sight At	Stadia	Hor ∠	Ver ∠	Hor Dist	Remarks
P"88	Sta"49		0°-0'			
	22	421 400	250-20	0°-0'	22	E Edge Little Tujunga Trav. Rd.
	62	361 300	205-40	0-30	62	"
	162	361 400	203-45	1-20	162	"
	150	749 600	205-10	2-00	150	Telephone Pole.
	32	1031 1000	310-20	0-0	32	"
	145	644 500	2-05	0-0	145	"
	377	876 500	0-45	0-0	377	"
•	109	1508 1400	224-20	3-30	109.	W Edge Little Tujunga Wash
•	61	1660 1600	247-05	5-00	61.	"
•	45	1544 1500	291-45	10-30	44.	"
•	65	1664 1600	338-50	7-20	64.	"
•	106	1705 1600	353-00	5-00	105.	"
•	130	1729 1600	352-50	4-00	129.	"
•	176	1775 1600	357-30	3-20	175.	"
•	269	1769 1500	0-25	3-20	268.	"
•	306	1705 1400	359-00	3-00	305.	"
•	331	1630 1300	359-35	2-40	330.	"
•	358	1157 800	357-35	3-20	357.	"
•	382	1081 700	356-40	8-20	375.	"
•	451	1450 1000	350-40	3-00	450.	"
•	377	1476 1100	350-00	3-00	376.	E Edge Little Tujunga Wash
•	316	1415 1100	355-05	3-00	315.	"
•	263	1262 1000	355-20	4-00	262.	"
•	203	1202 1000	349-20	4-20	202.	"
•	140	939 800	335-40	7-40	138.	"
•	112	911 800	315-05	8-30	110.	"

NOTE: ANY ADDITION OR CHANGES ON THIS SHEET MUST BE MADE OR CIRCLED IN RED, WITH DATE AND NAME OF PERSON MAKING CHANGE.

DO NOT EXTEND NOTES THIS SIDE OF THIS LINE

RETURN TO LOS ANGELES COUNTY SURVEYOR

F.B. 249 Pg. 122 Chief Party Notes by Date

Solar No ③ June-16-1927 A.M.
Lat. 34°-19-21
Mag. Az. P.O.T. #83 to [illegible] Var. Sta. 15°-00

Inst. at P.O.T. #83 to P.I. #88 See Pg. 103.
Angle Left [illegible] to Sun
Standard Time

	Time	Horiz.	Vert.
①	8-55-00	[illegible]	44-24-30
②	9-51-00	[illegible]	49-15-00
③	9-55-00	[illegible]	[illegible]
④	9-57-00	[illegible]	[illegible]
⑤	9-58-00	[illegible]	50-11-00
⑥	[illegible]	[illegible]	[illegible]
⑦			
⑧			50-50-30
⑨	[illegible]	[illegible]	51-30-30
⑩	[illegible]	[illegible]	51-45-30

RETURN TO LOS ANGELES COUNTY SURVEYOR

DO NOT EXTEND NOTES THIS SIDE OF THIS LINE

NOTE: ANY ADDITION OR CHANGES ON THIS SHEET MUST BE MADE OR CIRCLED IN RED, WITH DATE AND NAME OF PERSON MAKING CHANGE.

Date 7-7-27 Notes by Benson Chief Party Benson F.B. 249 Pg. 123

Platted by Drew	W. O. No. 710 U. S. O. No.
Date July 1927	Location Little Tujunga Canyon
Map No. 9988	Surveyed by E. Benson
Platting C'k'd by K.B.H	Date 7-7-27
Date July 1927	Indexed

NOTE: ANY ADDITION OR CHANGES ON THIS SHEET MUST BE MADE OR CIRCLED IN RED. WITH DATE AND NAME OF PERSON MAKING CHANGE.

DO NOT EXTEND NOTES THIS SIDE OF THIS LINE

RETURN TO LOS ANGELES COUNTY SURVEYOR

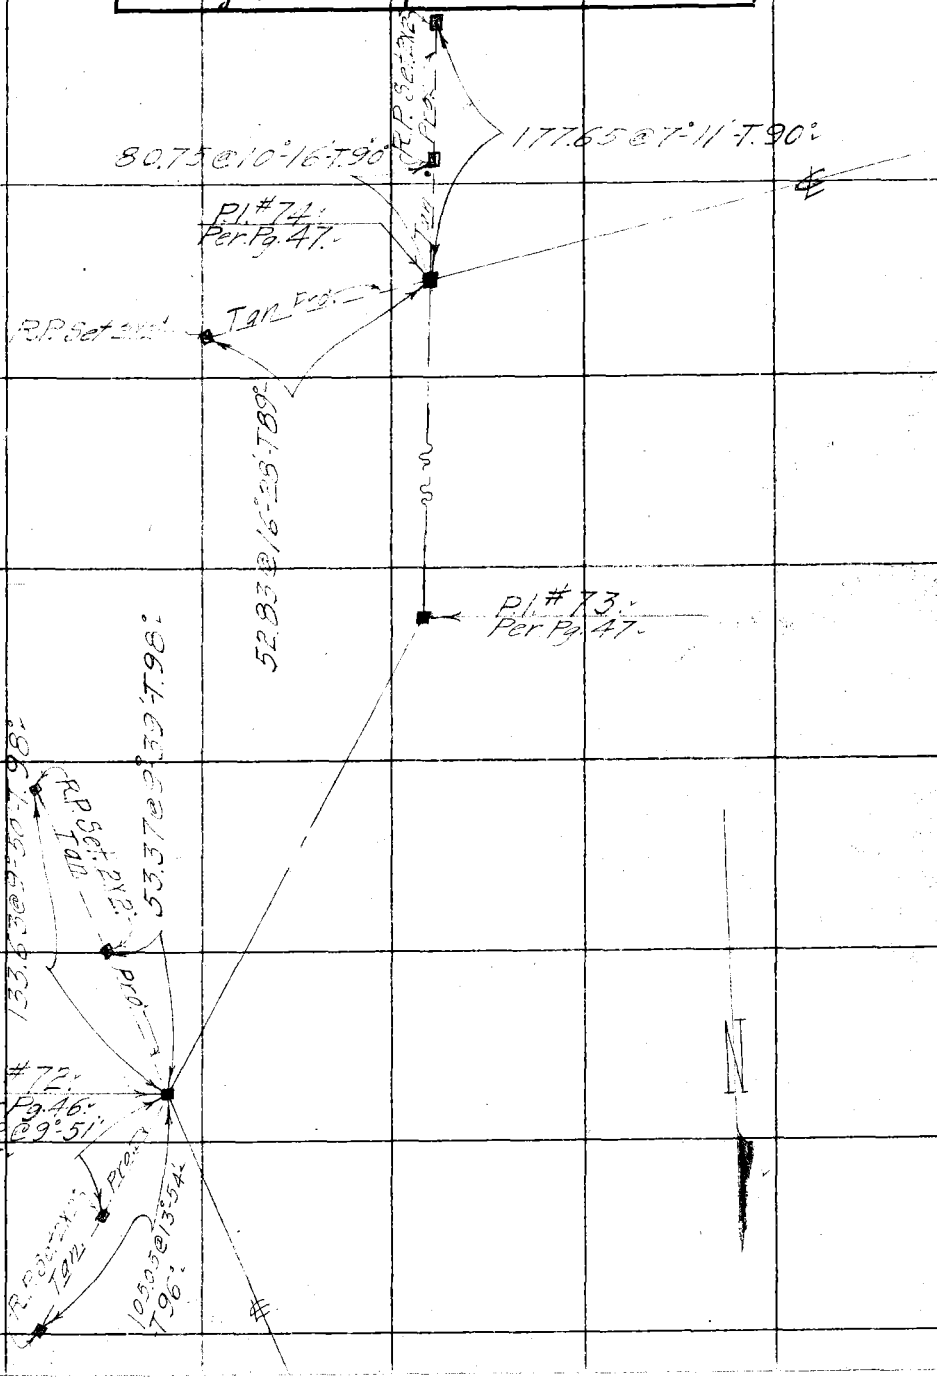

RETURN TO
LOS ANGELES COUNTY SURVEYOR

NOTE: ANY ADDITION OR CHANGES ON THIS SHEET MUST BE MADE OR CIRCLED IN RED. WITH DATE AND NAME OF PERSON MAKING CHANGE.

DO NOT EXTEND NOTES THIS SIDE OF THIS LINE

F.B. 209 PG. 124 Chief Party Bernhardt Notes by Bernhardt Date 7-8-27

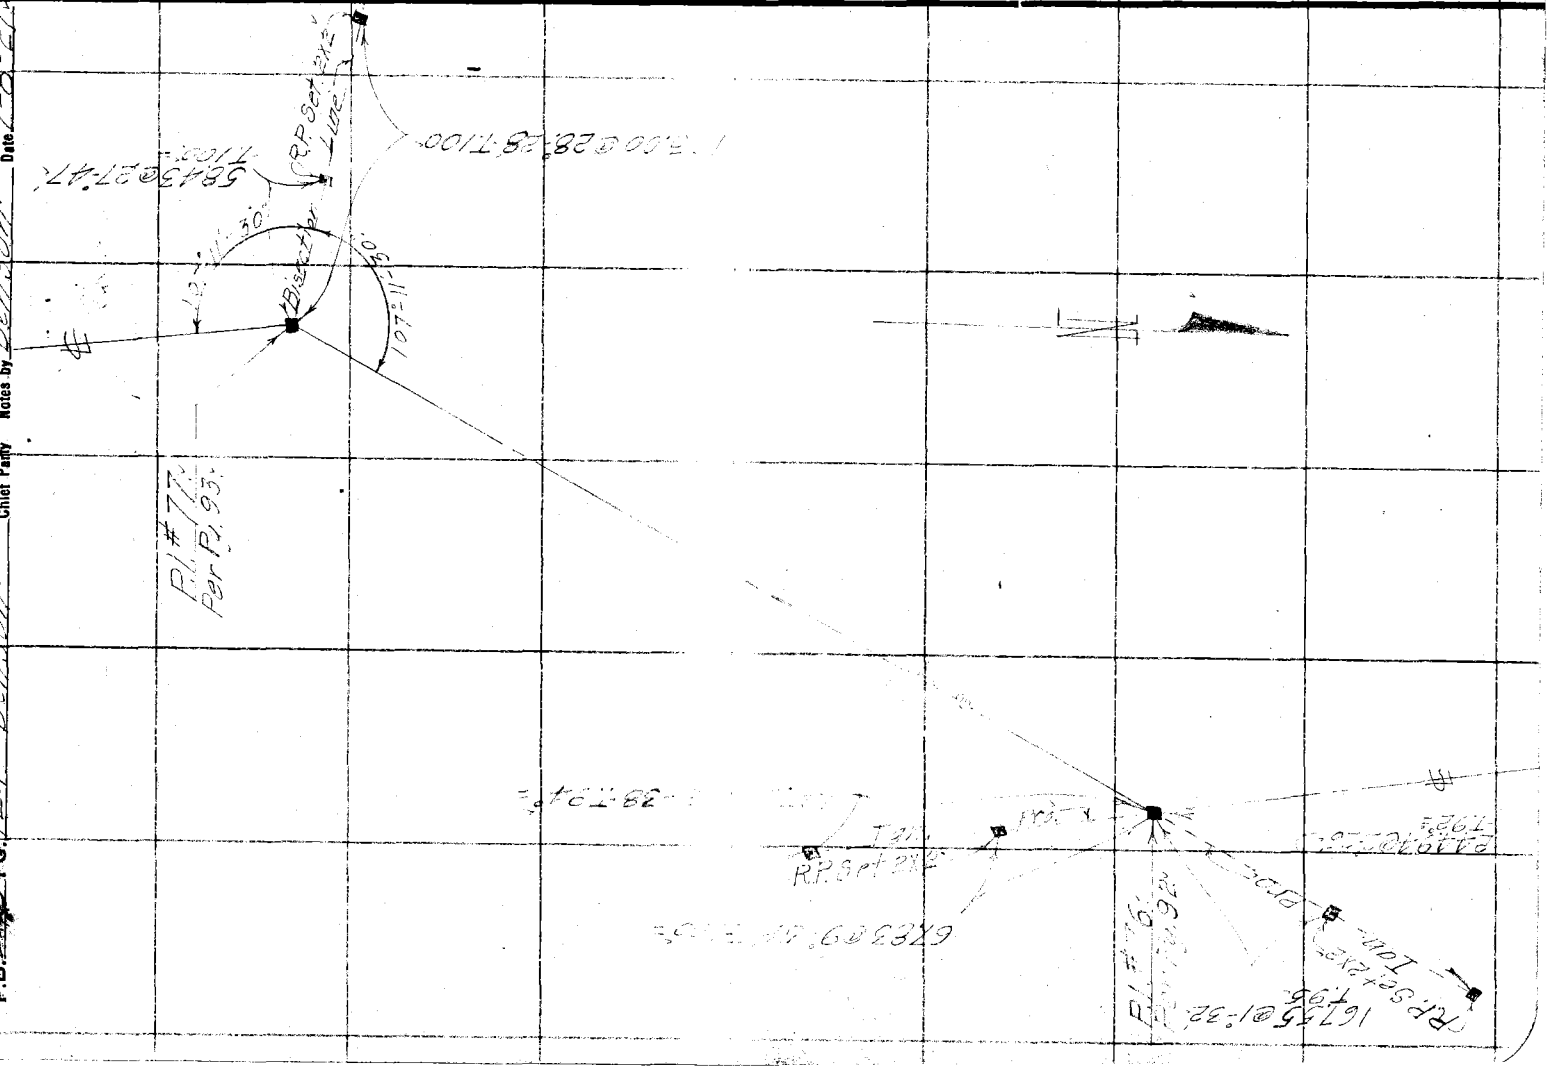

Date 7-11-27 Notes by Benson Chief Party Benson F.B. 249 Pg. 125

Platted by Drew	W. O. No. 710 U. S. O. No.
Date July 1927	Location Little Tujunga Canyon Rd
Map No. 8948	Surveyed by [illegible]
Platting C'k'd by K.B.H	Date 7-11-27
Date July 1927	Indexed

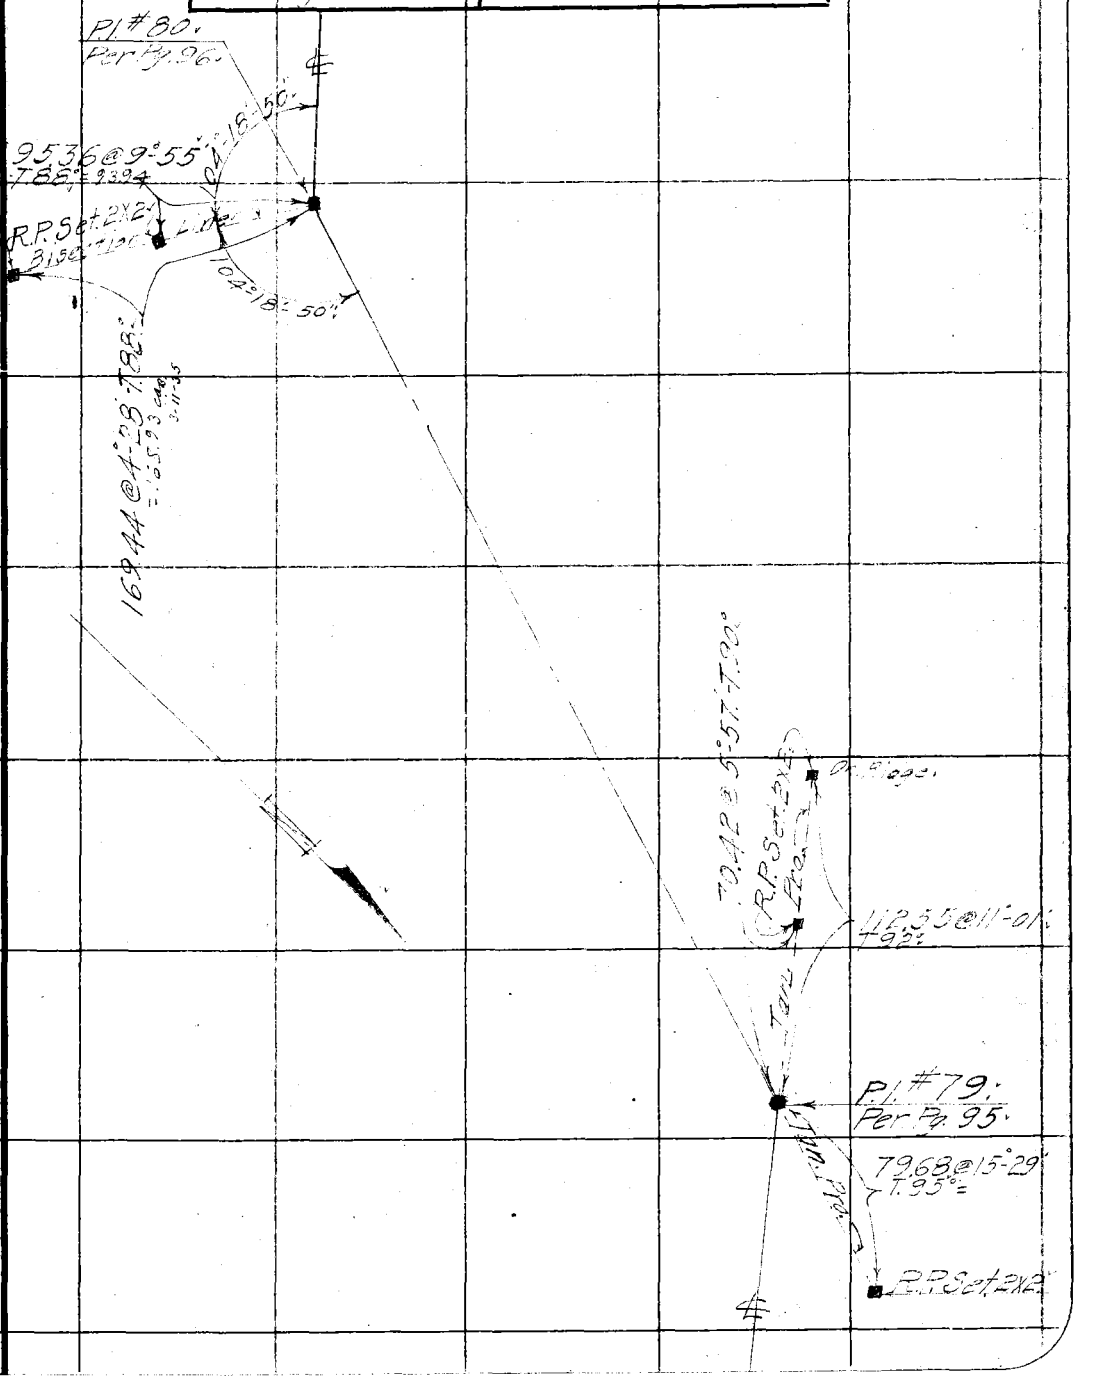

NOTE: ANY ADDITION OR CHANGES ON THIS SHEET MUST BE MADE OR CIRCLED IN RED. WITH DATE AND NAME OF PERSON MAKING CHANGE.

DO NOT EXTEND NOTES THIS SIDE OF THIS LINE

RETURN TO LOS ANGELES COUNTY SURVEYOR

RETURN TO
LOS ANGELES COUNTY SURVEYOR

NOTE: ANY ADDITION OR CHANGES ON THIS SHEET MUST BE MADE OR CIRCLED IN RED. WITH DATE AND NAME OF PERSON MAKING CHANGE.

DO NOT EXTEND NOTES THIS SIDE OF THIS LINE

F.B. 2260 Pg. 126 Chief Party Notes by [illegible] Date 12-27

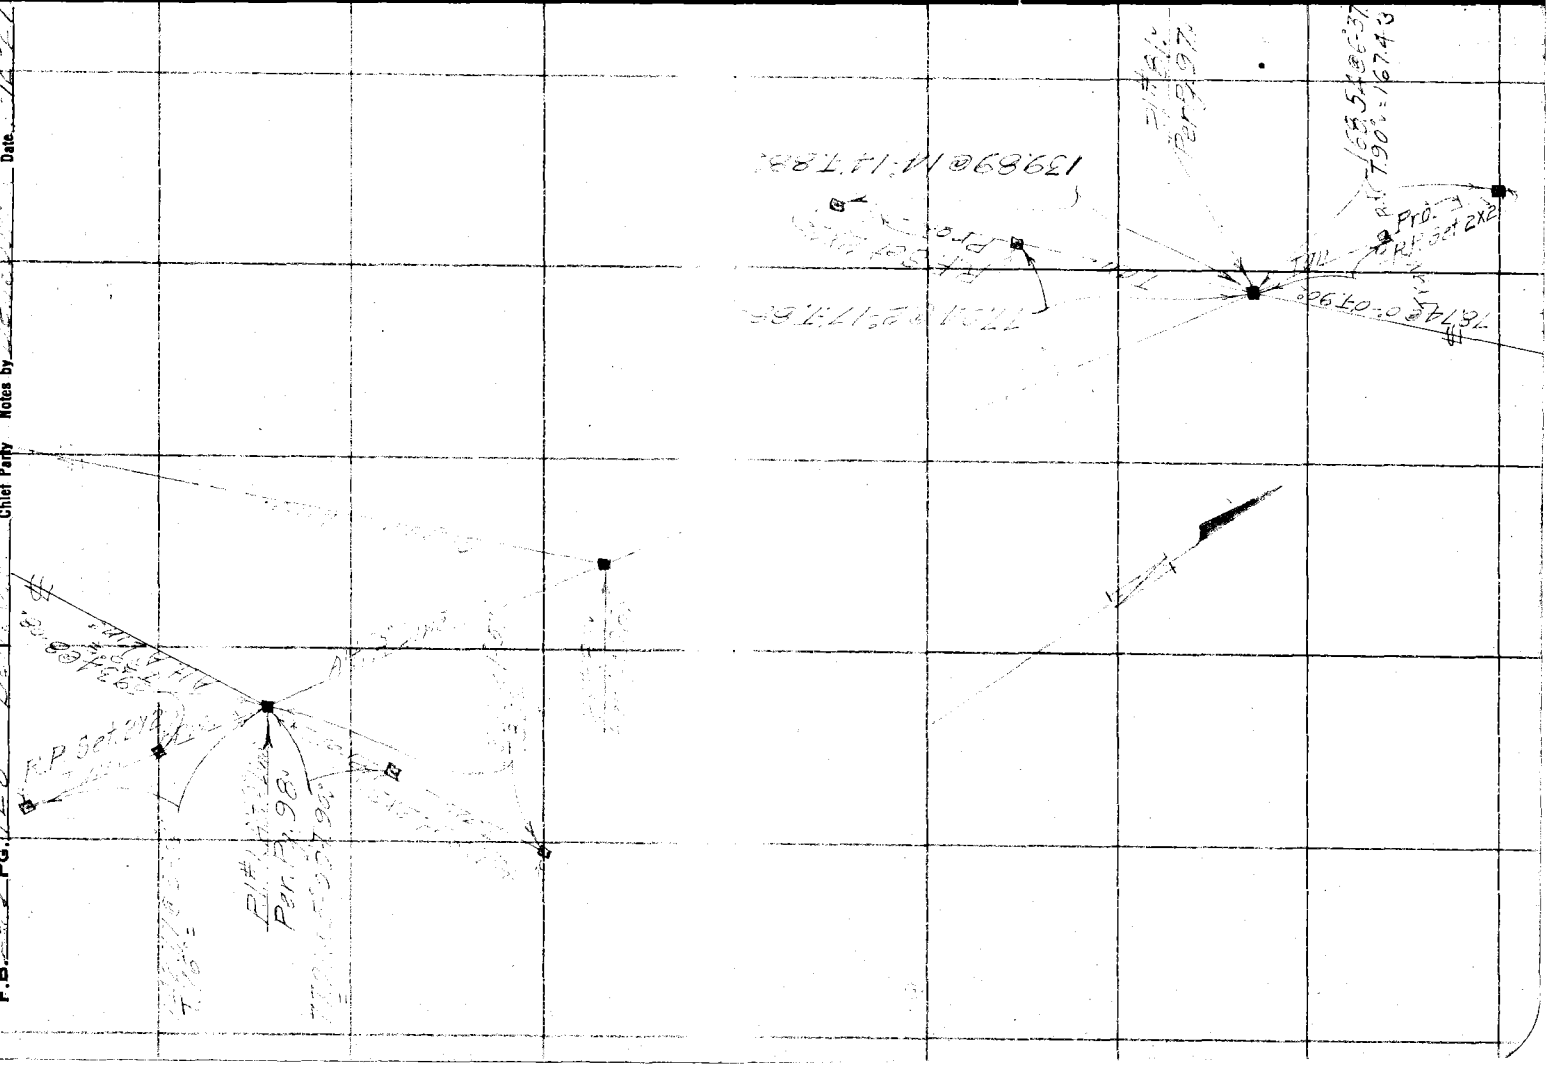

Date 7-13-27 Notes by Benson Chief Party Benson F.B. 249 Pg. 127

Platted by Drew	W. O. No. 710 D. S. O. No.
Date July 1927	Location Little Tujunga Canyon Rd.
Map No. 8928	Surveyed by Benson
Platting C'k'd by K.B.H.	Date 7-13-27
Date July 1927	Indexed

NOTE: ANY ADDITION OR CHANGES ON THIS SHEET MUST BE MADE OR CIRCLED IN RED. WITH DATE AND NAME OF PERSON MAKING CHANGE.

DO NOT EXTEND NOTES THIS SIDE OF THIS LINE

RETURN TO LOS ANGELES COUNTY SURVEYOR

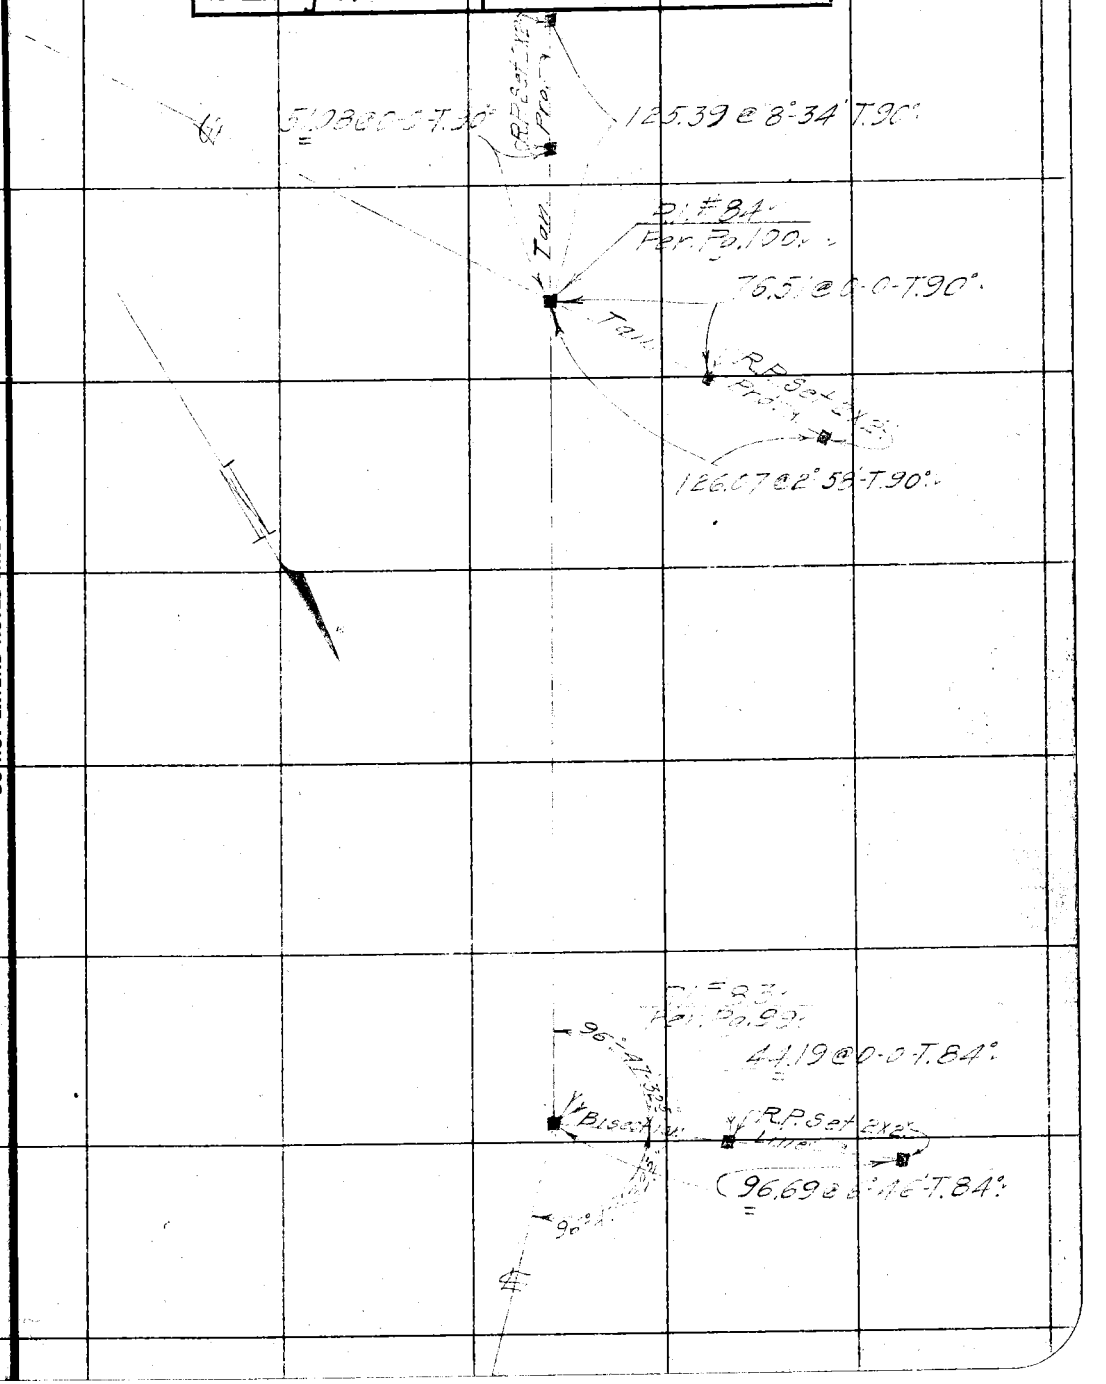

F.B. 229 Pg. 128 Chief Party Notes by Bennett Date 7-14-27

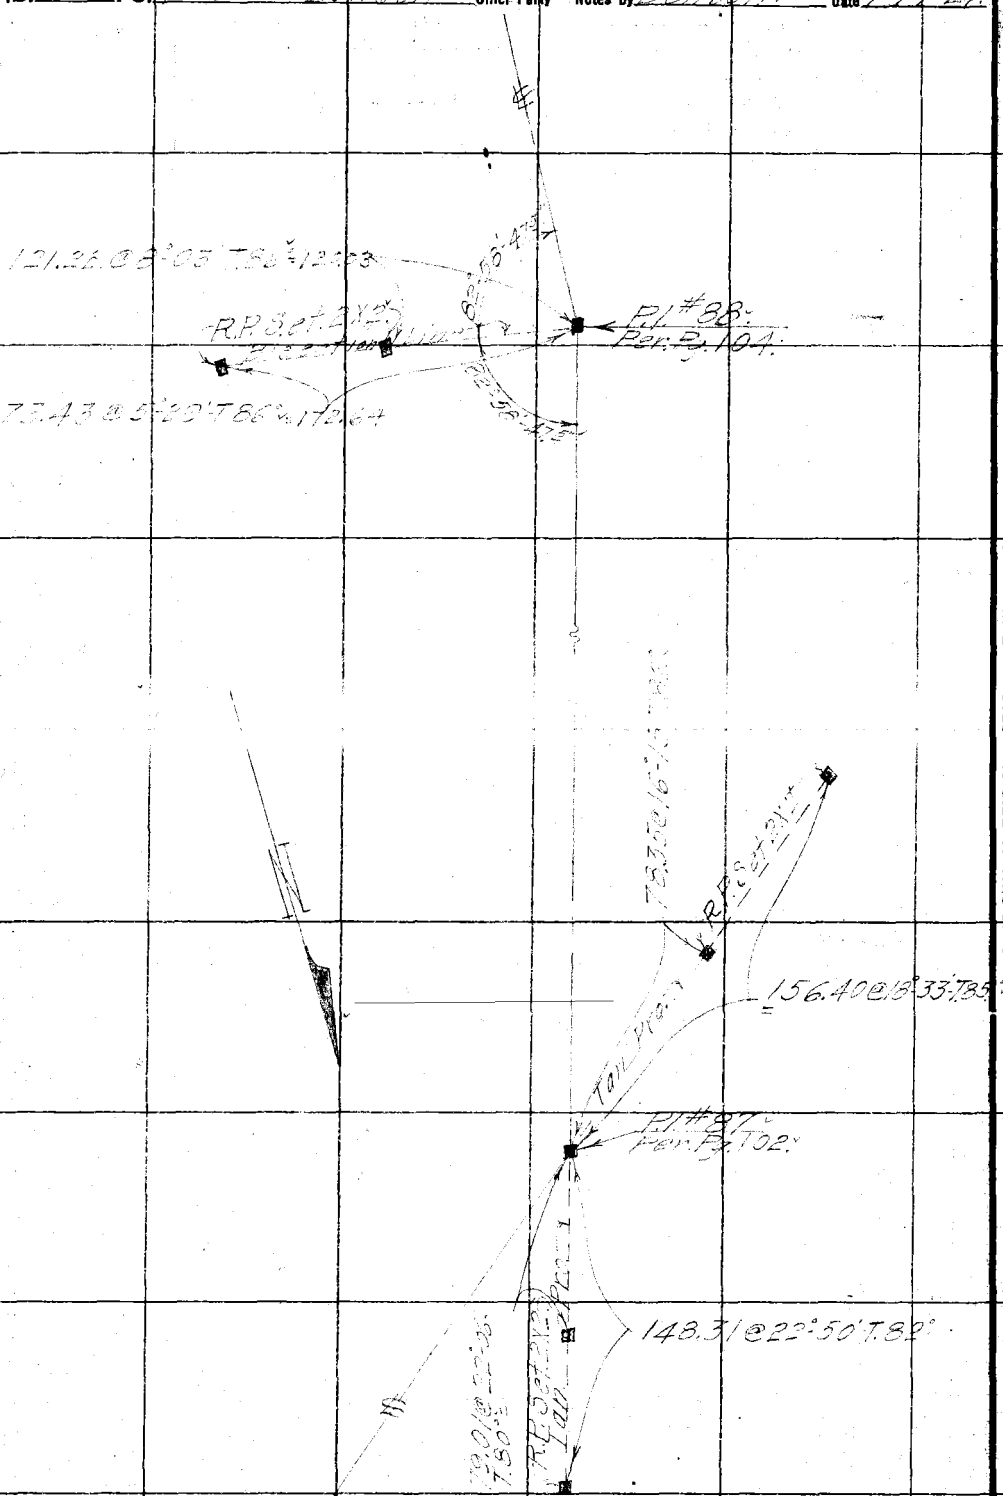

RETURN TO
LOS ANGELES COUNTY SURVEYOR

DO NOT EXTEND NOTES THIS SIDE OF THIS LINE

NOTE: ANY ADDITION OR CHANGES ON THIS SHEET MUST BE MADE OR CIRCLED IN RED. WITH DATE AND NAME OF PERSON MAKING CHANGE.

Notes Ck'd by	Drew	Survey of	Little Tujunga Rd
Map No.	8948-1	W. O.	7710 Tape No. 52 St'd 34 °F.
Office Work	RW.M&A.	Surveyed by	C.A. Benson
Checked	Drew	Notes	Date 3-5-35
Date	Mar 1935	Indexed	A. C. Johnson

F.B. 249 Pg. 129

Note: ANY ADDITIONS OR CHANGES ON THIS SHEET MUST BE MADE, OR CIRCLED IN Red Ink. WITH DATE AND NAME OF PERSON MAKING CHANGE.

Do not extend notes this side of this line

RETURN TO
LOS ANGELES COUNTY SURVEYOR
700 HALL OF RECORDS

FORM 247 10M 5-31

LITTLE TUJUNGA CANYON ROAD.
JOB No. 7710
LINE CHECKS & TIES TO MINING CLAIMS.

March-5-1935.
C.A. Benson
A.E. Swanson
W.E. Brown
H.F. Nauman

F.B. 249 PG 130

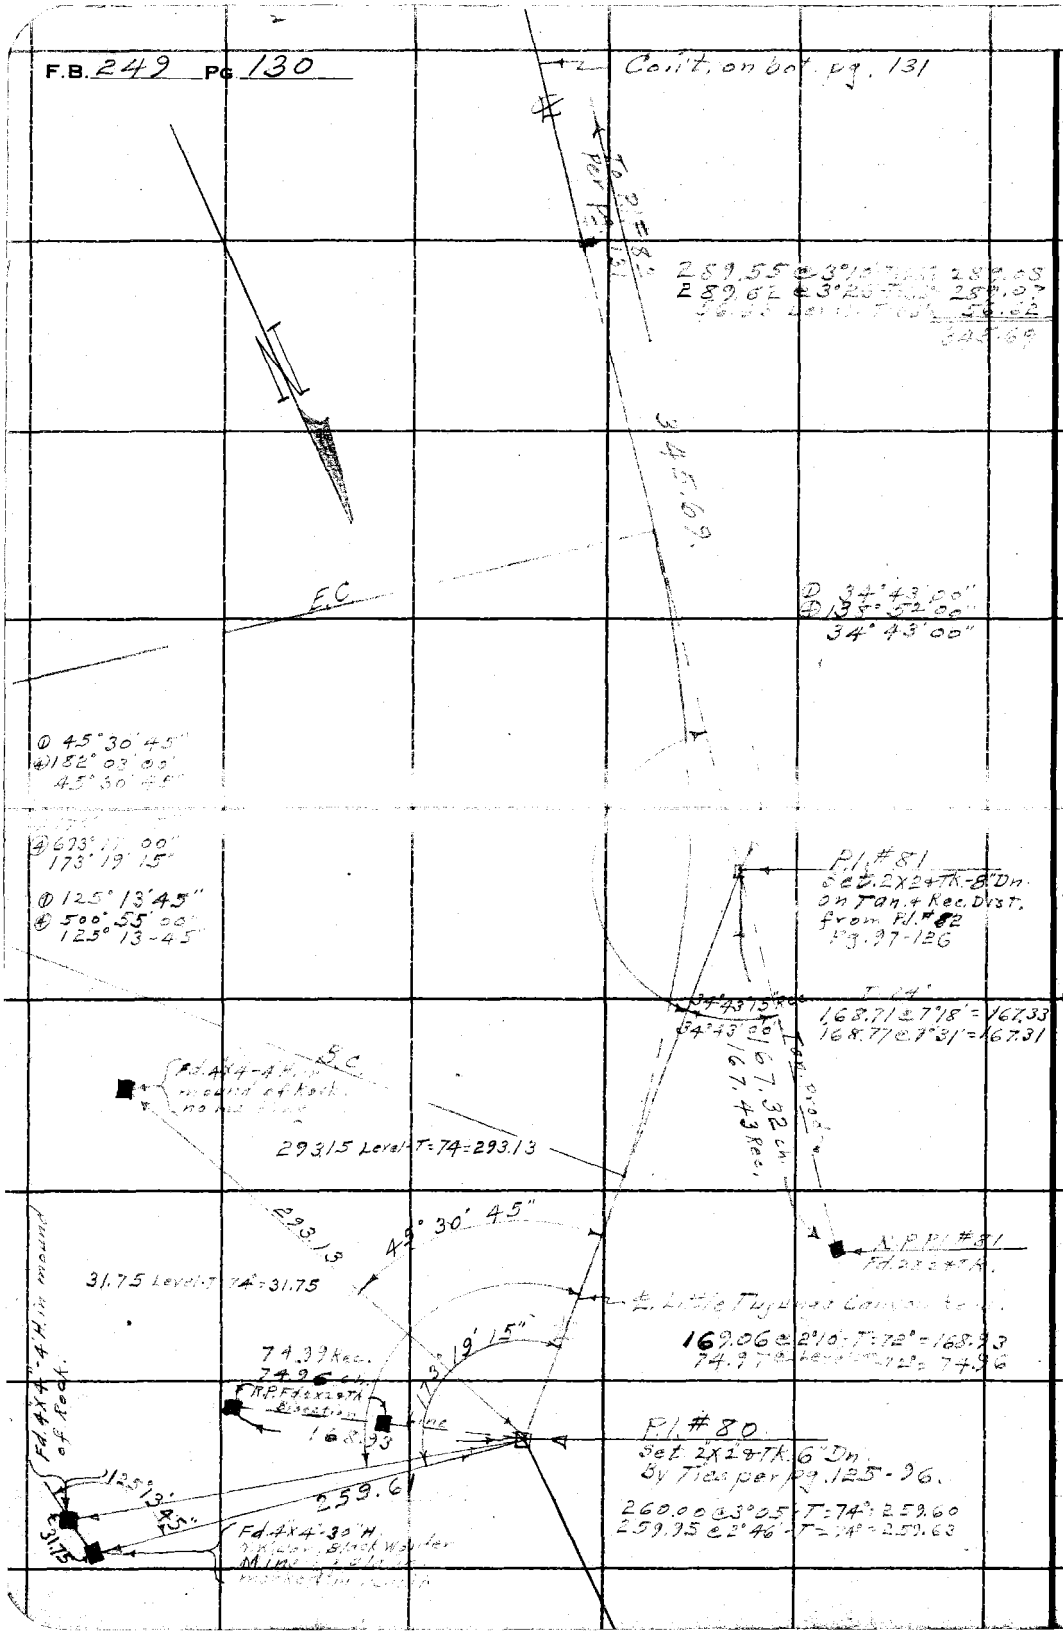

RETURN TO
LOS ANGELES COUNTY SURVEYOR
700 HALL OF RECORDS

Do not extend notes this side of this line

Note: ANY ADDITIONS OR CHANGES ON THIS SHEET MUST BE MADE OR CIRCLED IN **Red** Ink. WITH DATE AND NAME OF PERSON MAKING CHANGE.

Notes Ck'd by Drew	Survey of Little Tujunga Cyn. Rd.	F.B. 249	Pg. 131
Map No. 8948-1	W. O. 2710 Tape No. 52 St'd 71 °F.		
Office Work R.W.M.F.A.	Surveyed by R.A. Benson		
Checked Drew	Notes Date 3-5-35		
Date March 1935	Indexed A. C. Johnson 3-12-35		

Cont. on bot. pg.

D 90° 03' 45"
@ 360° 00' 00"
90° 03' 45"

300.55 @ 1°18' - T=66° =
300.60 @ 1°31' - T=66° =
38.34 Level - T=66° =

To Pl #A
R = 132

301.00 @ 10°49' - T=60° = 295.60
300.88 @ 10°40' - T=60° = 295.63
62.30 @ Level - T=60° = 62.29
Avg. Total = 357.90

137.40

Set 2X2 4 Tk By Int

Fd. 4"x4"-4' marked on S.W. "L.W.M.S.-2" on S.E. side "No. 5902-B"

No. 1 Fd 2"x2"-5' in mound of rock "LADY HELEN MILL S.1-E"

464.00 @ 2°55' - T=70°44' = 32.35
32.35 @ Level - T=70° = 32.35
495.70

207.68 @ Level - T=70° = 207.68

251.83 @ 7°33' - T=72° = 249.63
251.73 @ 7°24' - T=72° = 249.61

No. 4 Fd 2"x4"-4' marked "LADY HELEN MILL S1-E"

207.68

0.67

24.62

84.83

Set N. By Int.

Fd. 4"x4"-3' in mound of Rock Marked on south "L.W.M.S.-1" on East "No 5902-B"

85.72 @ 8°14' - T=60° = 84.83
85.90 @ 9°01' - T=60° = 84.83

38.34 Level - T=66° = 38.34
300.55 @ 1°18' - T=66° = 300.43
300.60 @ 1°31' - T=66° = 300.45
938.78

338.75

E.C.
@ 9° 12' 30"
@ 357° 16' 00"
39° 19' 00"

Pl #1 on Alt "A" Line Fd 2"x2"4 Tk. Per Pg. 98.

D 149° 42' 30"
@ 598° 50' 00"
149° 42' 30"

201.71 @ 2°54' - T=66° = 201.42
201.83 @ 3°28' - T=66° = 201.43
95.54 Level - T=66° = 95.53

Δ =
R = 300.00
T =
L =

201.42

Pl #B.E.
Fd Hole in Rock - 2" Dn.
Set L & T. in Rock on tan. @ Sec. Dist. from Pl #1 on Alt. A. Line Per Pg. 98.

149° 42' 00"
149° 42' 30"

99.46

89° 12' 00"
@ 599° 04' 00"
99° 46' 00"
(check)
99.46 @ 89°03'

Fd 2"x3"-4' mound of rock "No 2 LADY HELEN MILL S.1-E"

Fd. 4"x4"-4' marked on S.W. "L.W.M.S.-2" on S.E. side "No. 5902-B"

Fd. 2"x4"-5' in mound of rock @ Y4 Sec. Cor. Per Pg. 61.

B.C.

201.71 @ 2°54' - T=66° = 201.42
201.83 @ 3°28' - T=66° = 201.43

Cont. from top pg. 130

Note: ANY ADDITIONS OR CHANGES ON THIS SHEET MUST BE MADE OR CIRCLED IN Red Ink. WITH DATE AND NAME OF PERSON MAKING CHANGE.

Do not extend notes this side of this line

RETURN TO
LOS ANGELES COUNTY SURVEYOR
700 HALL OF RECORDS

FORM 247 10M 5-31

F.B. 249 PG. 132

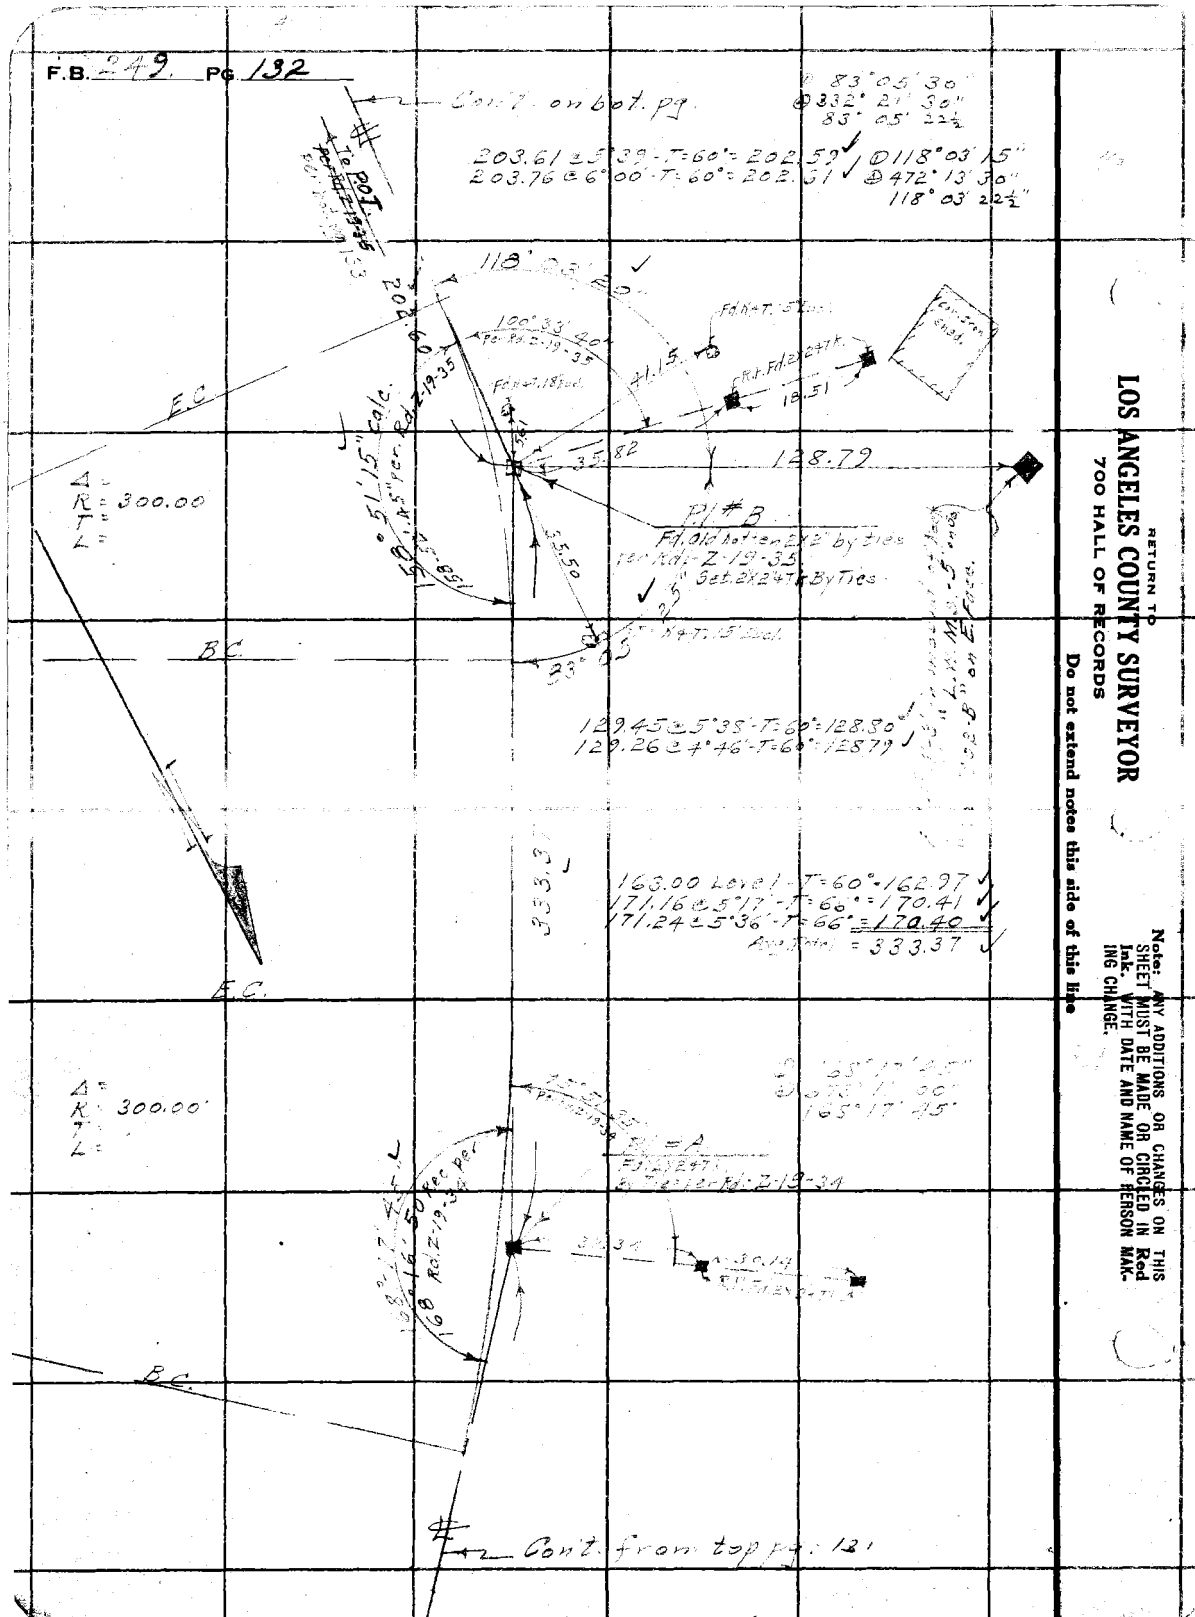
Cont. on 667. pg.
Cont. from top pg. 121
P.O.T.
P.O.B.
P.C.
P.T.
E.C.
B.C.
Fd Nail & Tag
Fd Nail & Shr
Fd Nail & Tag
Fd Nail & Tag
Fd Nail & Tag

Notes Ck'd by Drew
Map No. 8948-1
Office Work RW.MSA
Checked Drew
Date March 1935

Survey of [illegible]
W. O. [illegible] Tape No. [illegible] St'd [illegible] °F.
Surveyed by [illegible]
Notes [illegible] Date 3-8-35
Indexed A. C. Johnson

F.B. 243 PG. 193

Note: ANY ADDITIONS OR CHANGES ON THIS SHEET MUST BE MADE OR CIRCLED IN Red Ink, WITH DATE AND NAME OF PERSON MAKING CHANGE.

RETURN TO
LOS ANGELES COUNTY SURVEYOR
700 HALL OF RECORDS
Do not extend notes this side of this line

FORM 247 10M 8-31

255.75 @ 6°33'.7 = 29.90 ✓
255.65 @ 6°20' T=50° = 274.03 ✓
276.75 @ 5°33' T=66° = 275.42 ✓
276.63 @ 5°44' T=66° = 275.42 ✓
Avg. T. 132° = 529.44

529.44 Rad. 132°

T.P. ∠ 132°

E.T.
Fd. 1X2 9TK. @ Top Wt. 5K.

E.C.

Δ =
R = 300.00
T =
L =

20.18 @ 13°03' T=43° = 117.05 ✓
20.32 @ 13°17' T=43° = 117.05 ✓

157°16'30"
157°05'30"
157°16'22½

Fd. S.W. of T.

Fd.

2.5'

57°
57°

209.10

129.42 @ 1°56' T=40° = 129.32 ✓
129.45 @ 2°17' T=40° = 129.32 ✓
79.80 Level T=40° = 79.78 ✓
= 209.10 ✓

P.O.T.
Fd. 2X2 9TK on Ridge

202.0

5' Cont. [illegible]

F.B. 542 Pg. 134

P.I. #88
Fd. 2X2 Tk. - 2" Dn.
By Ties per pg. 128-104

58.00 Level - T=54° = 57.99 ✓
44.64 @ 21°16' - T=54° = 40.69 ✓
44.26 @ 23°09' - T=54° = 40.69
21.33 Level - T=54° = 21.33
AXIS = 120.01

52.60 Level - T=54° = 52.59

36.75 @ 26° - T=69° =
36.50 @ 27°11 - T=80° = 32.74

25°49' - T=66° 61.69
T=66° 61.70

164° 45' 15"
164° 45' 15"

61.70

123.65 ✓

B.C.

P.I. #87

Cont. from top pg. 133

LOS ANGELES COUNTY SURVEYOR
HALL OF RECORDS