Notes by _____ Chief Party _____ F. B. _____ Pg. _____

Plotted by _____	W. O. No. _____ D. S. O. No. _____
Date _____	Location _____
Map No. _____	Surveyed by _____
Plotting C'k'd by _____	Date _____
Date _____	Indexed _____

F. 252

F.B. 252 PG. INDEX Chief Party Notes by Date

F.B.No. 252

PAGES: Index, Index, A, 1, 2, 1A, 2A, 3, 4, 3A, 4A, 5 to 14 incl., 14A, 14B, 15 to 33 incl., 35 to 120 inclusive.

RETURN TO
LOS ANGELES COUNTY SURVEYOR

Do not extend notes this side of this line

Notes: ANY ADDITIONS OR CHANGES ON THIS SHEET MUST BE MADE OR CIRCLED IN Red. WITH DATE AND NAME OF PERSON MAKING CHANGE.

Date _____ Notes by _____ Chief Party _____ F. B. 252 Pg. INDEX

Platted by	W. O. No. _____ D. S. O. No. _____
Date	Location
Map No.	Surveyed by
Platting C'k'd by	Date
Date	Indexed

F.B. 252—

Survey of Banita Ave.

For Index See other side of this Page

Note: ANY ADDITIONS OR CHANGES ON THIS SHEET MUST BE MADE OR CIRCLED IN Red. WITH DATE AND NAME OF PERSON MAKING CHANGE.

Do not extend notes this side of this line

RETURN TO LOS ANGELES COUNTY SURVEYOR

RETURN TO

LOS ANGELES COUNTY SURVEYOR

Note: ANY ADDITIONS OR CHANGES ON THIS SHEET MUST BE MADE OR CIRCLED IN **Red.** WITH DATE AND NAME OF PERSON MAKING CHANGE.

Do not extend notes this side of this line

Date

Notes by

Chief Party

F.B. 232 PG. A "

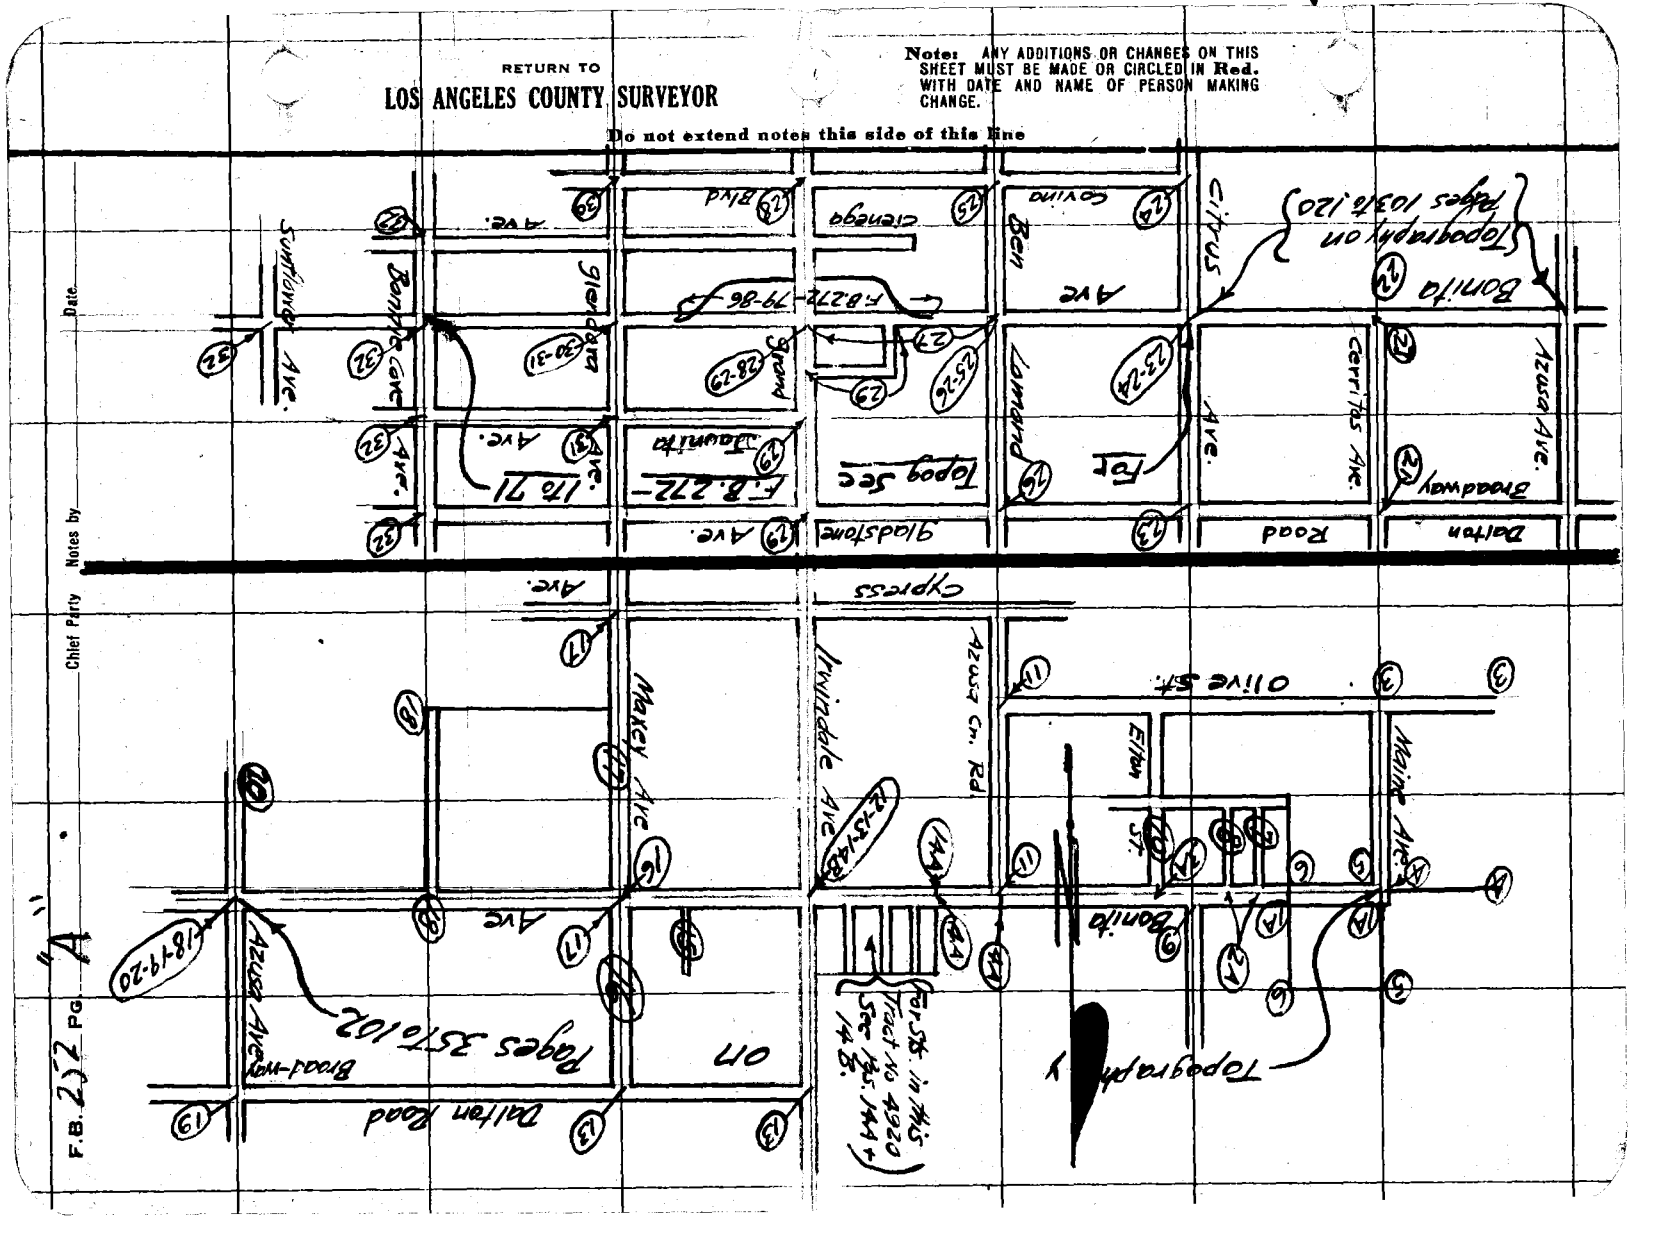

Date _____ Notes by _____ Chief Party _____ F.B. 242 Pg. 1

Plotted by _____
Date Feb. 4 & May 1927
Map No. 8964
Plotting Chkd. by _____
Date April 1927

W. O. No. 4449 D. O. Or. No. _____
Location Benita Ave
Surveyed by C. V. Crumley
Date _____
Indexed Jan. 28-1927-F. Ashton

NOTE: ANY ADDITION OR CHANGES ON THIS SHEET MUST BE MADE OR CIRCLED IN RED, WITH DATE AND NAME OF PERSON MAKING CHANGE.

DO NOT EXTEND NOTES THIS SIDE OF THIS LINE

RETURN TO LOS ANGELES COUNTY SURVEYOR

F.B. 852 Pg. 2 Chief Party Notes by: Date

Bonita Avenue Survey

INDEX

C.V. Crumley
H.S. Johnson
J.L. Willey
P.B. Cooke
B.B. York

Center Line Data Pages 3 To 33
" 173 To 180
" 154.

Ties To Improvements Pages 35 To 170
" 181 To 193

RETURN TO LOS ANGELES COUNTY SURVEYOR

DO NOT EXTEND NOTES THIS SIDE OF THIS LINE

NOTE: ANY ADDITION OR CHANGES ON THIS SHEET MUST BE MADE OR CIRCLED IN RED. WITH DATE AND NAME OF PERSON MAKING CHANGE.

RETURN TO
LOS ANGELES COUNTY SURVEYOR

NOTE: ANY ADDITION OR CHANGES ON THIS SHEET MUST BE MADE OR CIRCLED IN RED, WITH DATE AND NAME OF PERSON MAKING CHANGE.

DO NOT EXTEND NOTES THIS SIDE OF THIS LINE

0+00.02 Set 2"x2" 18" Deep on Split of Angle

Set N. & T. P.P.

Set N. & T. P.P.

To 3/4" I.P. in Mon. of 4" Rock's N.E. Cor. Lot "B" Tr. 1916 See Pg 6

0+00 Set 2"x4" Conc. Mon. Per Pg 5

"A"

"B"

Lot

88.46

99.60

13+30.31 Fd. 3/4" I.P. with Cap 6" Deep S.W. & T. Sta. 13+30.19 Knocked pipe over To 2.5 ft.

Center Line Maine Ave Produced North 1330.29

Proposed ℄

Bonita Ave

Present ℄

1330.19

30°

89°-57'

89°-57'-30"

89°-35'-05"

89°-29'-20"

90°-15'-10"

49.42

39.42

25.00

25.00

333.43

333.28

29.72

90°-30'

40"

0+00 Fd. 6"x18" stone With L. & T. replacing "X" - 15" Deep Per page 4 & 5

13+30.19 Fd. S.W. & T. Per Pg 6

99.55

15.44

23.39

Fd N. & T. P.P. Per F.B. 252-4

Fd small "X" West side 14" standpipe

Fd N. & T. P.P.

Maine Ave

0.16

N

2"x2" at Pt. in Prop. ℄

Track Line

℄

Notes by

Checked by

Plotted by

Date

Map No.

Traced by

Checked by

Location Bonita Ave

Surveyed by C. V. Crumley

Date July 29, 1927

Indexed

RETURN TO
LOS ANGELES COUNTY SURVEYOR

NOTE: ANY ADDITION OR CHANGES ON THIS SHEET MUST BE MADE OR CIRCLED IN RED, WITH DATE AND NAME OF PERSON MAKING CHANGE.

DO NOT EXTEND NOTES THIS SIDE OF THIS LINE

F.B. 2252 Pg. 24

Chief Party — Notes by Crumley — Date 7/20/27

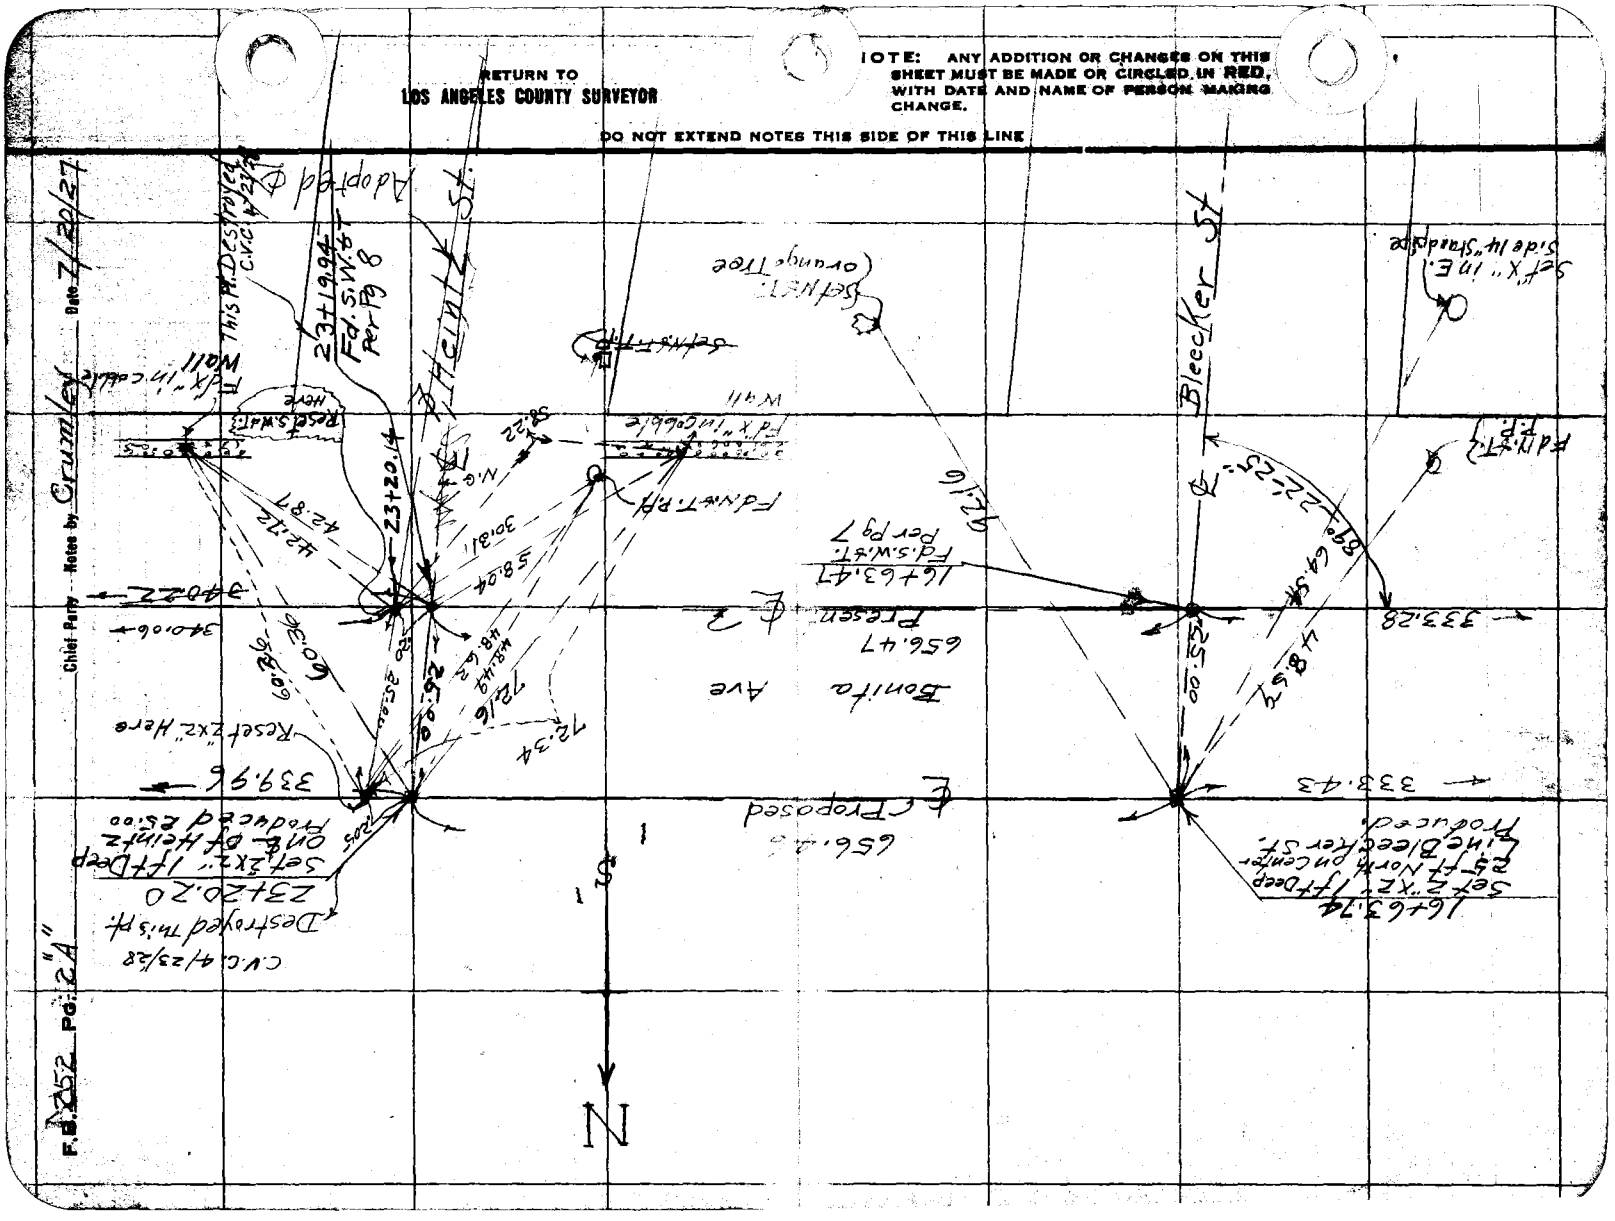
Adopted
Bleecker St
Bonita Ave
Fd. Nail & T. PK
Set Nail
(Orange Tree)
Set "X" in E. Sidewalk
Fd. 1/2" I.P.
Fd. 3/4" I.P.
Fd. "X" in Concrete
Reset 5 Nail Here
Set 2"x2" 1FT Deep 25-Ft North on Center Line Bleecker St. Produced
Set 2"x2" 1FT Deep 25.00 Ft. Northerly of Weinitz Produced
Destroyed This Pt. C.V.C. 4/23/28
Reset 2"x2" Here

Platted by W.O.C.H.
Feb & Mar 1927
Map No. 8904
Platting C'k'd by Paige
Date April 1927

W. O. Set 4249 D. S. C. No.
Location Benita Ave.
Surveyed by C.L. Crumley
Date October 1926
Indexed Jan 28 1927 - Ashton

Found N.&T. in Guy Pole

Fd L.&T. in curb

℄ Main

Found Old 2x2" 3" Deep 0.21 North as shown

Found 2½" O.T. 29.73 Per Rd. Dept Z-43-38

Found 1" I.P. Plug & TK 7+97.57

Found old wire Spk .04 North Line

Found 6"x6" Cement Mon. S.E. Cor. Lot 3 Tr. 1917 M.B. 21-46 & Rd. Dept Z-43-38 Sta. 8+27.62

Found "X" in Top 6"x6" Cement Mon. S.W. Cor. Lot 3 Tr. 1917 & 13+22.46 Per Rd. Dept Z-43-35

Found N.&T. in P.P. Per Z-43-38

Set M.&T. in P.P.

Found 2"x2" Fuidemil Replacing old 2x2" as per R.M. of Z-43-30 & R.M. of Z-146-1 Replaced with C.S. Brass Cap Mon. F.B. 947-25

Found N.&T. in T.P.

Fd L.&T. in Curb 7/20/27

Found N.&T. in P.P. Gone 7/20/27

Fd. Nail on Line

Fd. N.&T. on Line

set Nail

Found Sta. 26+46.6 1" I.P. 4" Deep Z-43-38.

Found 1" I.P. at Cor. of Stone Wall.

Landis Ave

Sierra Madre Ave

Stewart Ave

42.73
48.69
64.38
48.30
48.12
48.58
27.20
34.2
25.02
39-30 = 22-08
0.21
29.97
.04
24.12
23.57
86.75
32.12
27.96

B.B.652 Pg 4

Note:- For change in Center Line of Bonita Ave from Station 0+60 to Station 66+22.70 See Pgs 1A to 4A"

Replaced with C.S. Brass Cap Mon. F.B. 547-25

See Page 35

Found 6"x18" Stone with X in top Sec. Cor. 5, 6, 7, 8, T.15S., R.10W., Per Tr. 1917, M.B. 21-48 & Per Z-43-30 Z-116-142 Rd. Dept. 15" Deep.

Ot oo going East

1320.96

Bonita Ave

Found N.&T. Guy Pole

31.07

Fd 6x6 "Mon." N.E. Cor. Lot 1, Tr. 1917 M.B. 21-48

0.23

29.85

32.85

89°-34'-50"

29.72

358°-17'-30"

90°-30'-40"

362°-02'-30"

To 2"x2" Replacing Red Head of Z-123-105 0.76 So. of old 2½"x2½" STK.

Fd. N.&T. in P.P.

Fd. N.&T. in T.P.

Fd 6"x6" Cement Mon. with Pipe. See Page 4 TK in Top 2½" Pipe N.W. Cor. Lot 1, Tr. 1917 M.B. 21-48.

N

Maine Ave

Δ = 90°-35'-30"

Δ = 362°-22'-00"

Found N.&T. in Guy Pole

Found 2"x2" 1' Deep Evident Y Replacing old 2"x2" O+00 of Rd. Dept. Z-43-30 Red Head of Z-116-142

90°-35'-30"

42.77

Olive St

See Preceding Page - Page 3

Replaced with C.S. Brass Cap Mon. FB 547-25

27.20

65.20

Fd. N.&T. P.P.

Fd. N.&T. T.P.

RETURN TO
LOS ANGELES COUNTY SURVEYOR.

NOTE: ANY ADDITION OR CHANGES ON THIS SHEET MUST BE MADE OR CIRCLED IN RED, WITH DATE AND NAME OF PERSON MAKING CHANGE.

DO NOT EXTEND NOTES THIS SIDE OF THIS LINE

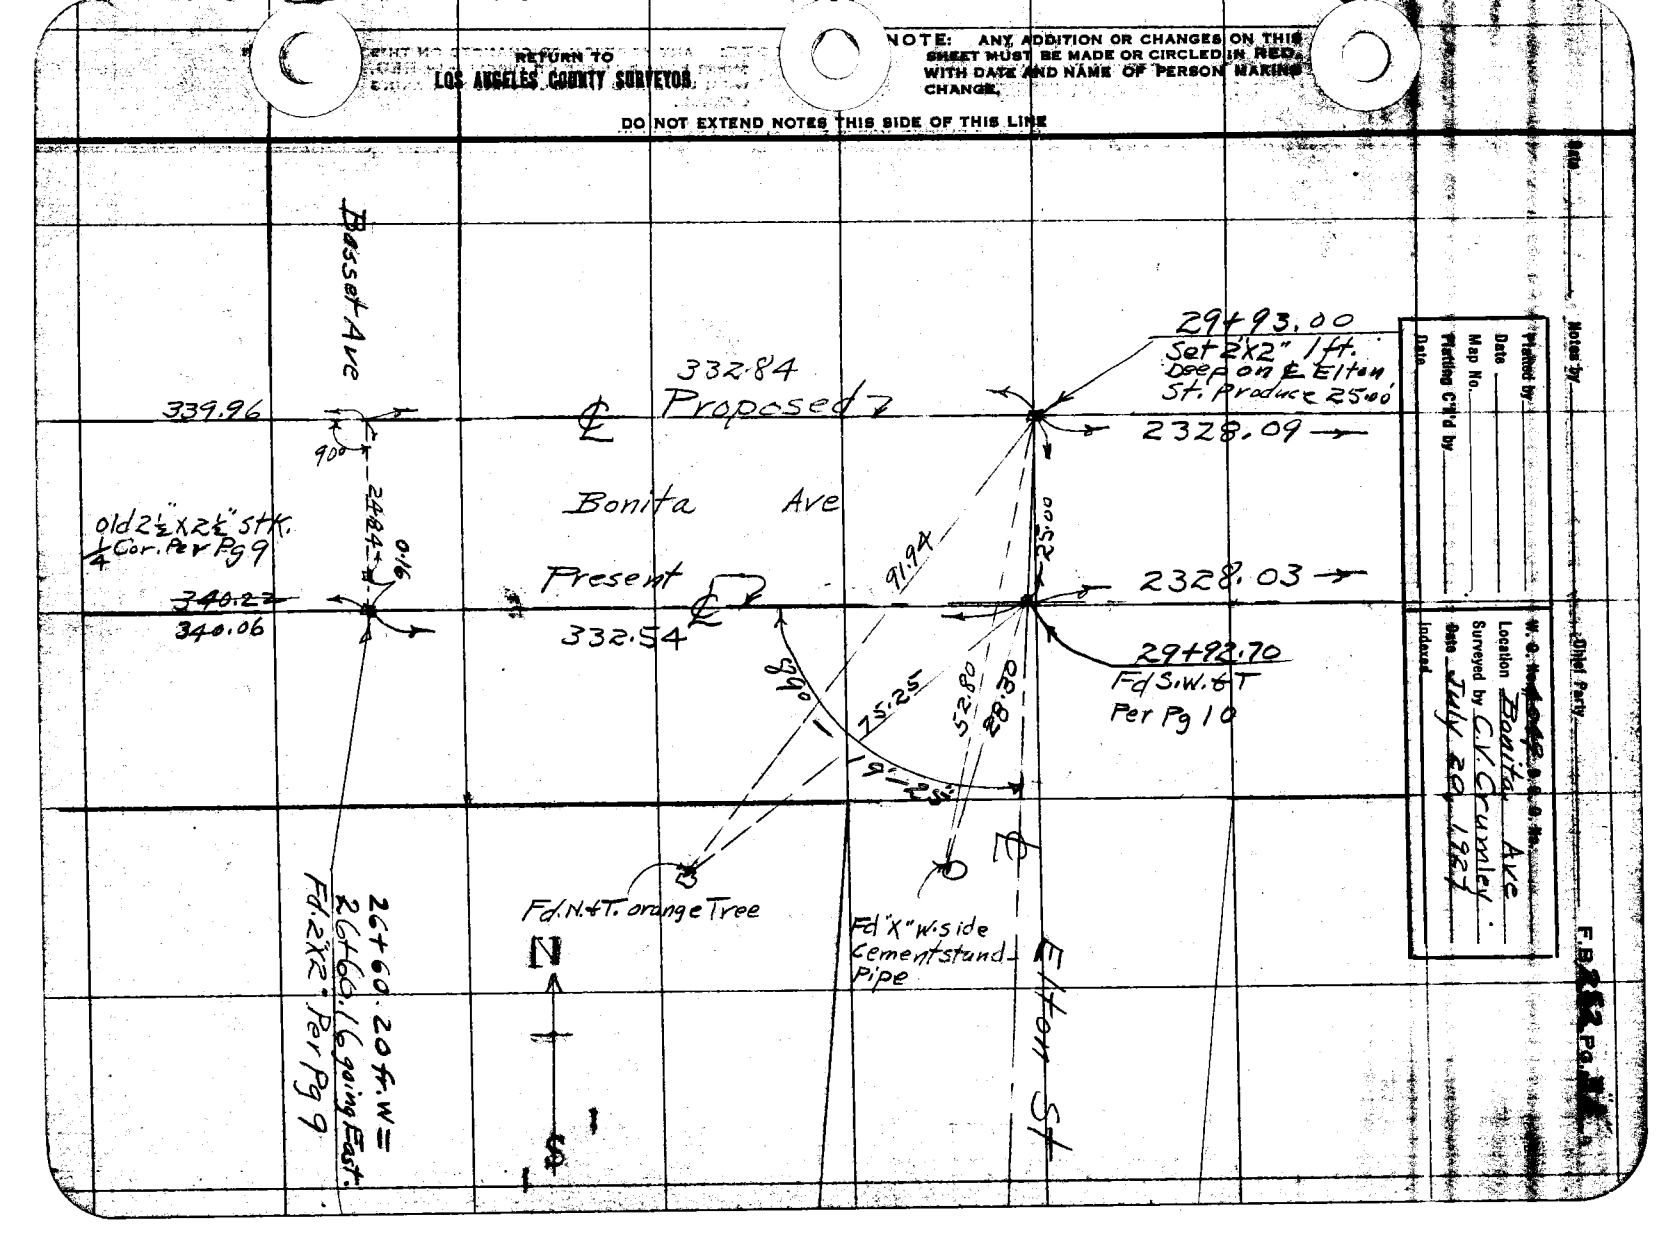

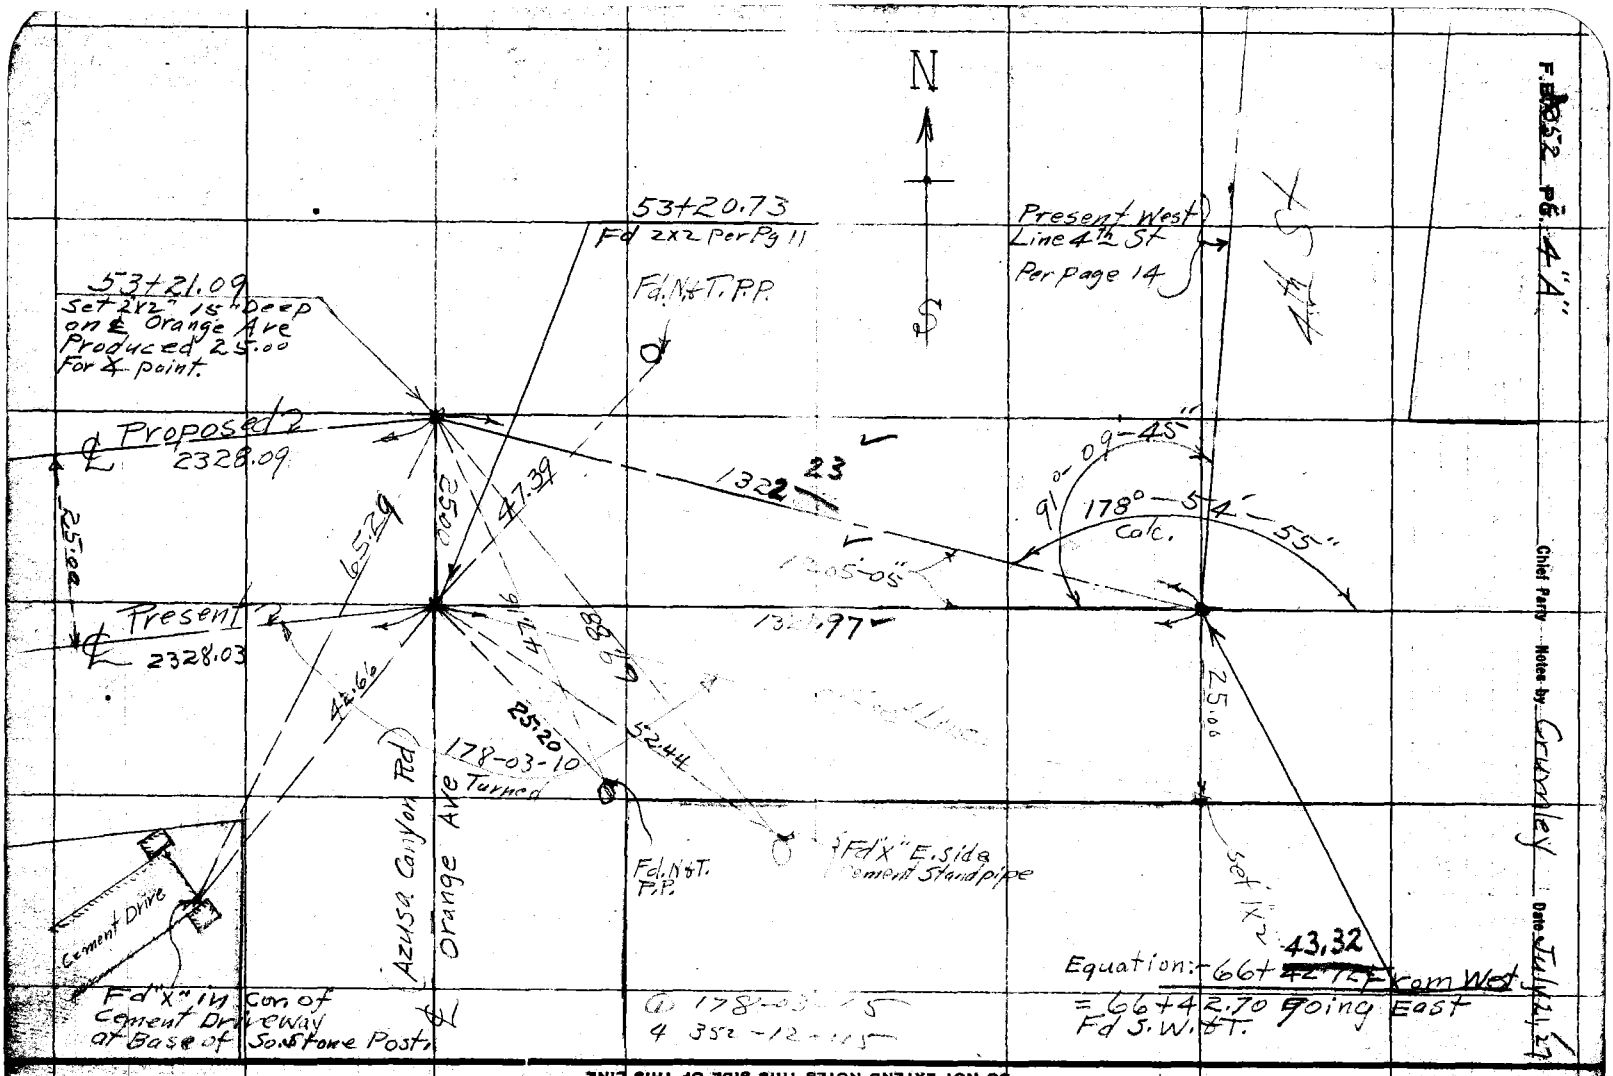
N
53+20.73
Fd 2x2 Per Pg 11
Fd. N&T. P.P.
53+21.09
Set 2x2" 15" deep on ℄ Orange Ave Produced 25.00 For ℄ point.
Present West Line 4th St Per Page 14
℄ Proposed 2328.09
℄ Present 2328.03
25.00
65.29
25.00
47.39
1322.23
9°-09-45"
178°-54'-55" Calc.
1305.05
1322.77
25.00
88.89
91.44
44.66
25.20
178-03-10 Turned
5.24
Fd. N&T. P.P.
Fd "X" E. side Cement Standpipe
Set 1x2
Equation:- 66+43.32 from West
=66+42.70 Going East
Fd S.W.&T.
Cement Drive
Fd "X" in Con of Cement Driveway at Base of Sandstone Post
Azusa Canyon Rd
Orange Ave
℄
178-03-10
4 35.52 -12-11.5
F. Bk. 52 Pg. 4 "A"
Chief Party Notes by Crumley Date July 11, 27
RETURN TO
LOS ANGELES COUNTY SURVEYOR
NOTE: ANY ADDITION OR CHANGES ON THIS SHEET MUST BE MADE OR CIRCLED IN RED, WITH DATE AND NAME OF PERSON MAKING CHANGE.
DO NOT EXTEND NOTES THIS SIDE OF THIS LINE

Plotted by Ward
Checked by EM Mar 1927
Map No. 8904
Platting C'k'd by Paige
Date April 1927

W. O. No. 7249 D. S. O. No.
Location. Benita Ave
Surveyed by C.V. Crumley
Date Oct. 1926
Indexed

Could Find No Pipe here Per Tr. 1916 - M.B. 21-66 Set 1x2 30' W of Conc. Mon. at 90° off Main to Monument

30'

Found 4X4 Conc. Mon. This Note copied from Rd Dept Z-N6-142 Note:— 13+23.07, Rancher (Mr. Stark) claims this Point 30' East of Sec. Line

Lot 5

Lot 6

Lot 7

Lot 8

N

S

Main Ave

Lot 4 (Tr. 1916, M.B. 21-66)

See Page 35

0+00.99 in East.

Found 6"x18" Stone with "X" in Top 15" Deep, Sec. Cor. 5, 6, 7, 8 — T. 1 S., R. 10 W. per Tract 1916 & 1917, Z-43-30, Z-1-6-1-2 Rd. Dept F.S. Replaced with C.S. Grass Cap Mon. F.B. 847-25

Fd 6"x6" Conc. Mon. N.E. Cor. Lot 1 Tr. #1917, M.B. 21-18

.23

89° 58' 35" 20" 130" 31.07 31.4

℄ Fd. N. & T. in Guy Pole

℄ Benita Ave.

29.85

37.85 37.88 40 30 30 90 90

For Center Line Change See B

℄ F & N.T. in T.B.

Fd. N. & T. in R.B.

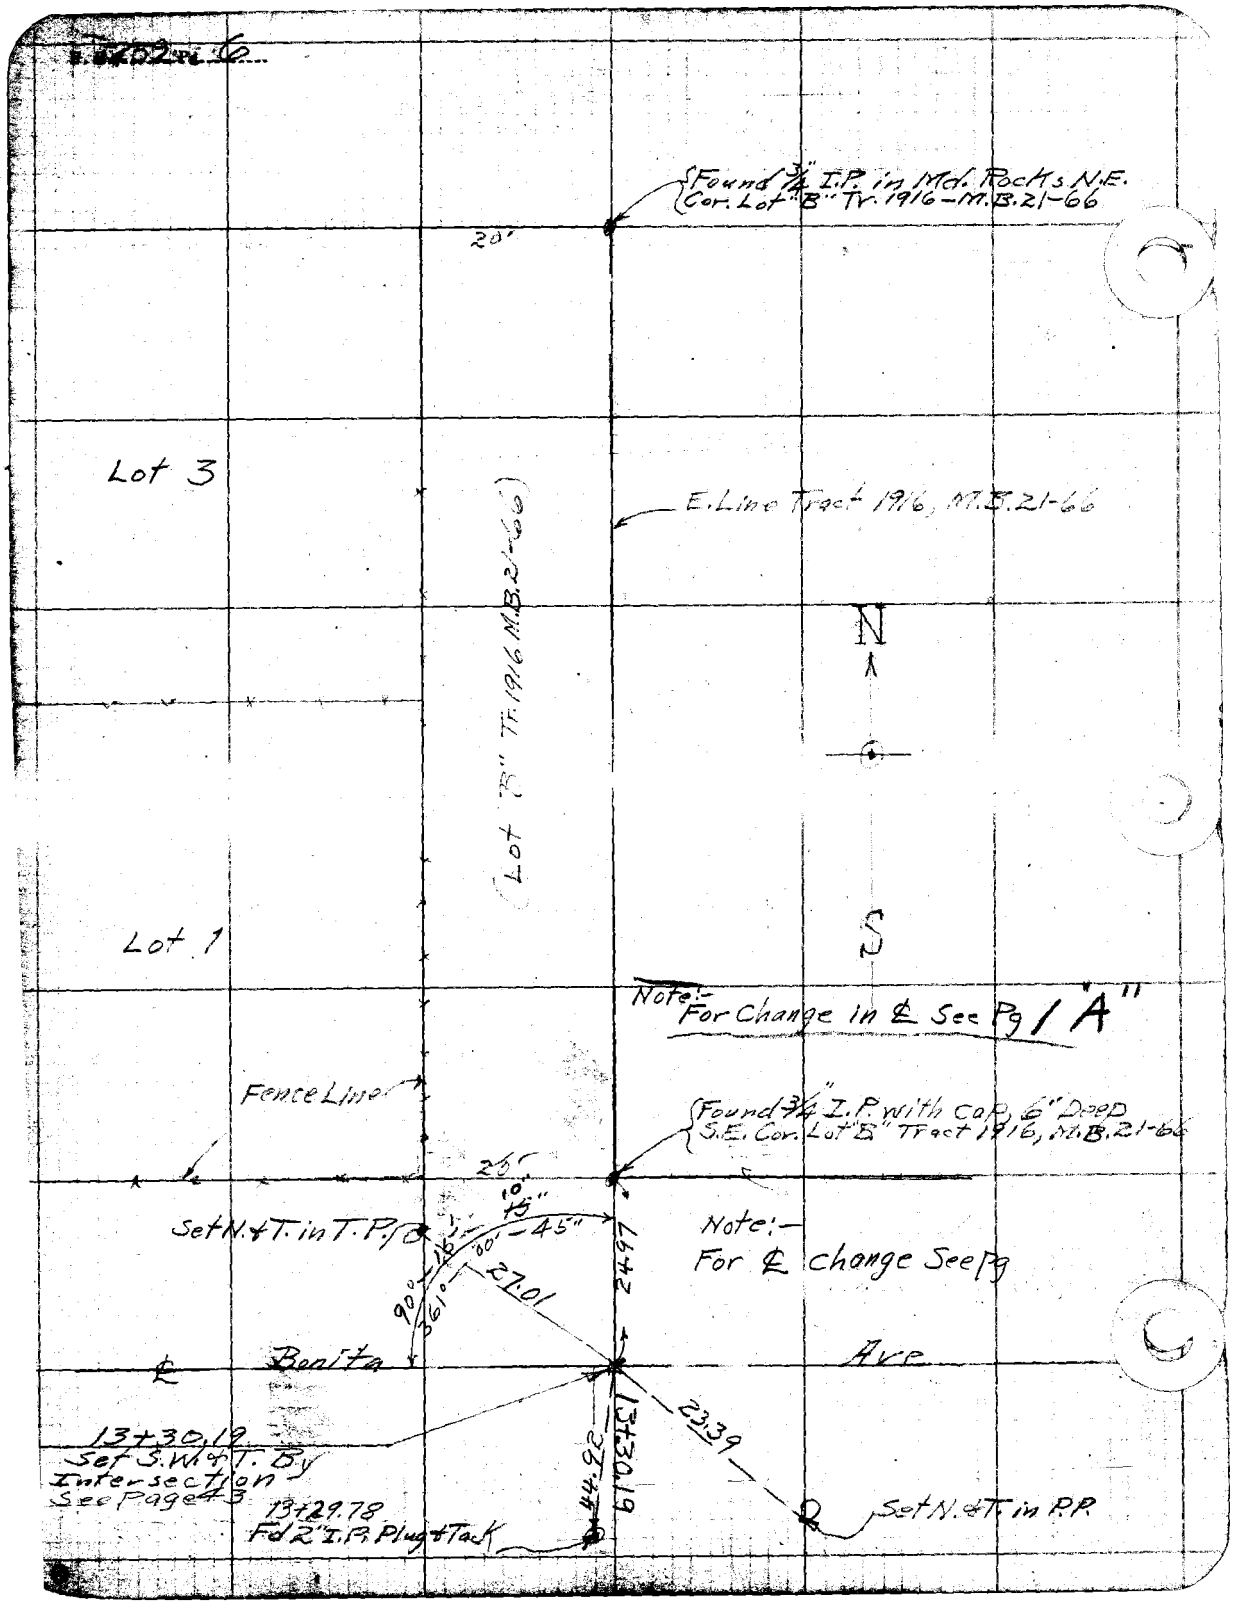
Found ¾" I.P. in Md. Rock's N.E. Cor. Lot "B" Tr. 1916 – M.B. 21-66
20'
Lot 3
E. Line Tract 1916, M.B. 21-66
(Lot "B" Tr. 1916 M.B. 21-66)
N
S
Lot 1
Note:- For Change in ℄ See Pg 1 "A"
Fence Line
Found ¾" I.P. with Cop. 6" Deep S.E. Cor. Lot "B" Tract 1916, M.B. 21-66
25'
Set N. & T. in T. P.
10" 45"
90° 00' – 45"
361.0
27.01
249.7
Note:- For ℄ change See Pg
℄
Benita
Ave.
13+30.19
Set S. W. & T. By Intersection See Page 43
13+29.78
Fd 2" I.P. Plug & Tack
44.22
13+30.19
23.39
Set N. & T. in P.P.

Platted by Wood
Date Feb. & Mar. 1927
Map No. 8904
Platting C'k'd by Paige
Date April 1927

W. O. No. 4049 D. S. O. No.
Location Benita Ave
Surveyed by C. K. Crumley
Date October 1926
Indexed

F. B. 28 Pg. 7

Note:- For ℄ Change See Page 2A

Set N. & T. Guy Pole

16+63.47
Set S. W. & T. By Intersection
See Page 45

34.76

℄ Benita Ave

35°10'

29.82

22-25-90"

29-45"

99.16

(17+17.54 Fd. 2" I.P. Plug & Tack E.C. Lot 6 Tr. 8706 M.B. 113-26 (See P. 45)

Set N. & T. in P.P.

25.13

25.00

16+31.54
Found 2" I.P. Leaning W.
N.E. Cor. Lot 5, Tr. 8706

Set Nail

16+81.67
Found 2" I.P. Plug & Nail
B.C. N.W. Cor. Lot 6, Tr. 8706
M.B. 113-26

Bleecker St ℄

N

S

Set "X" in N.E. Side 12" Irrigation Standpipe

46.28

25.00

Found 2" I.P. S.E. Cor. Lot 28, Tract 8706, M.B. 113-26

Set N. & T.

NUBIA ST.

Tape "09 used — 21# Pull @ T=76° Note:— For ℄ Change see page 2"A"

325.18 @ T=78° = 325.38

340.05 @ T=80° = 340.06

Bassett St.

Set N. & T. Guy Pole

See Page 48

23+19.94

Set S.W. & T. By Proportion Between 2"x2'-1.6 So. of old 2½x2½ 1/4 Cor. & 2" I.P. Plug & Tk. N.E. Cor. Lot 10, Tr. 8706 M.B. 113-26.

Note:— Replaced Red Head of Z-123-105 with 2X2

Fd. N. & T. T.P.

Fd. old 2½x2½ 1/4 Cor. Sh. Pet Tr. 7720 & Z-123-105

0.16

26+60.20 N.W.

26+60.16 going E.

Reset S.W. & T.

Bonita

325.05

325.38

340.06

Fd. 2" I.P. N.E. Cor Lot 10

Set X" Top Cobblestone Wall

Fd 2"x2" End of Wall

Fd X" Top. Cobble Wall

23+20.14

Adopted ℄

N

S.E. Quadrant

D = 90°-37'-00"

R = 362-27-45"

C.V.C. 4/23/28

Fd. 2"x2" Cor. Replaced by 2"x2" Set 0.25 Below Surface

Fd. 2"x2" Cor. Replaced by 2"x2" Set 0.25 Below Surface

Set 2"x2" By Proportion Between Tract 5731 & 96.2 "I.P. N.W. Cor. Lot 19 Tr. 7701

Fd. I.P.H.

Set 1"x1"

Chord 693.75

Rec = 694.36

324.76

Rec = 325.00

324.76

N.G.

Rec = 369.26

368.33

Fd. Leaning 2"x2"

Nubbin This Pt. Reset here

Set "X" N. Side 16" Standard Pipe

Rec = 325.00

324.76

3.63

Rec = 368.91

368°64

328.81

365.01

set 1"x1"

Set Nail By Proportion

Fd 2"x2" No. TK

0.42

Fd 2" I.P. N.W. Cor. Lot 19 Tract 7701, M.B. 88-67

328.80 @ T = 80° = 328.81

365.00 @ T = 80° = 365.01

Date Feb 2 Mar 1927
Map No. 8104
Plotting C.T.S. by Page
Date April 1927

Location Bonita Ave
Surveyed by [illegible]
Date October 1926
Indexed

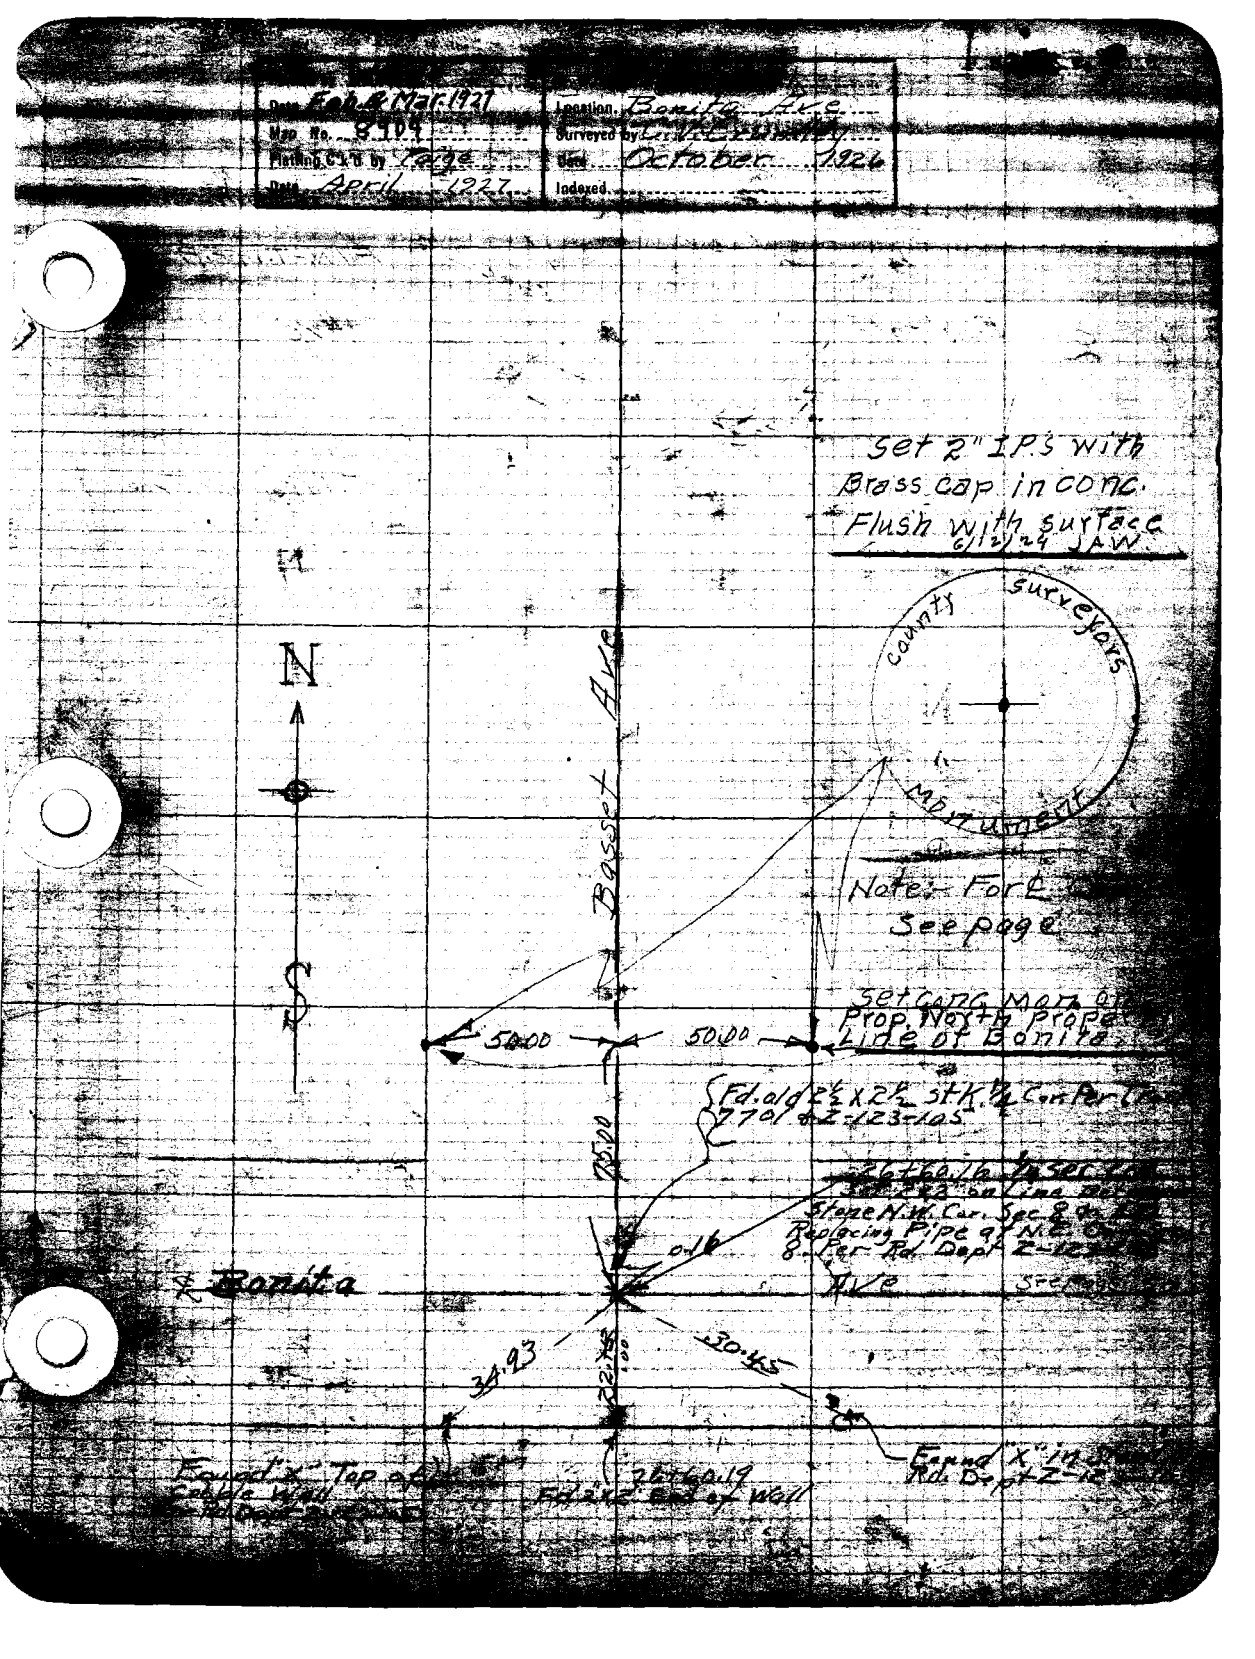

Note:- For ℄ Change See Pg 3A"

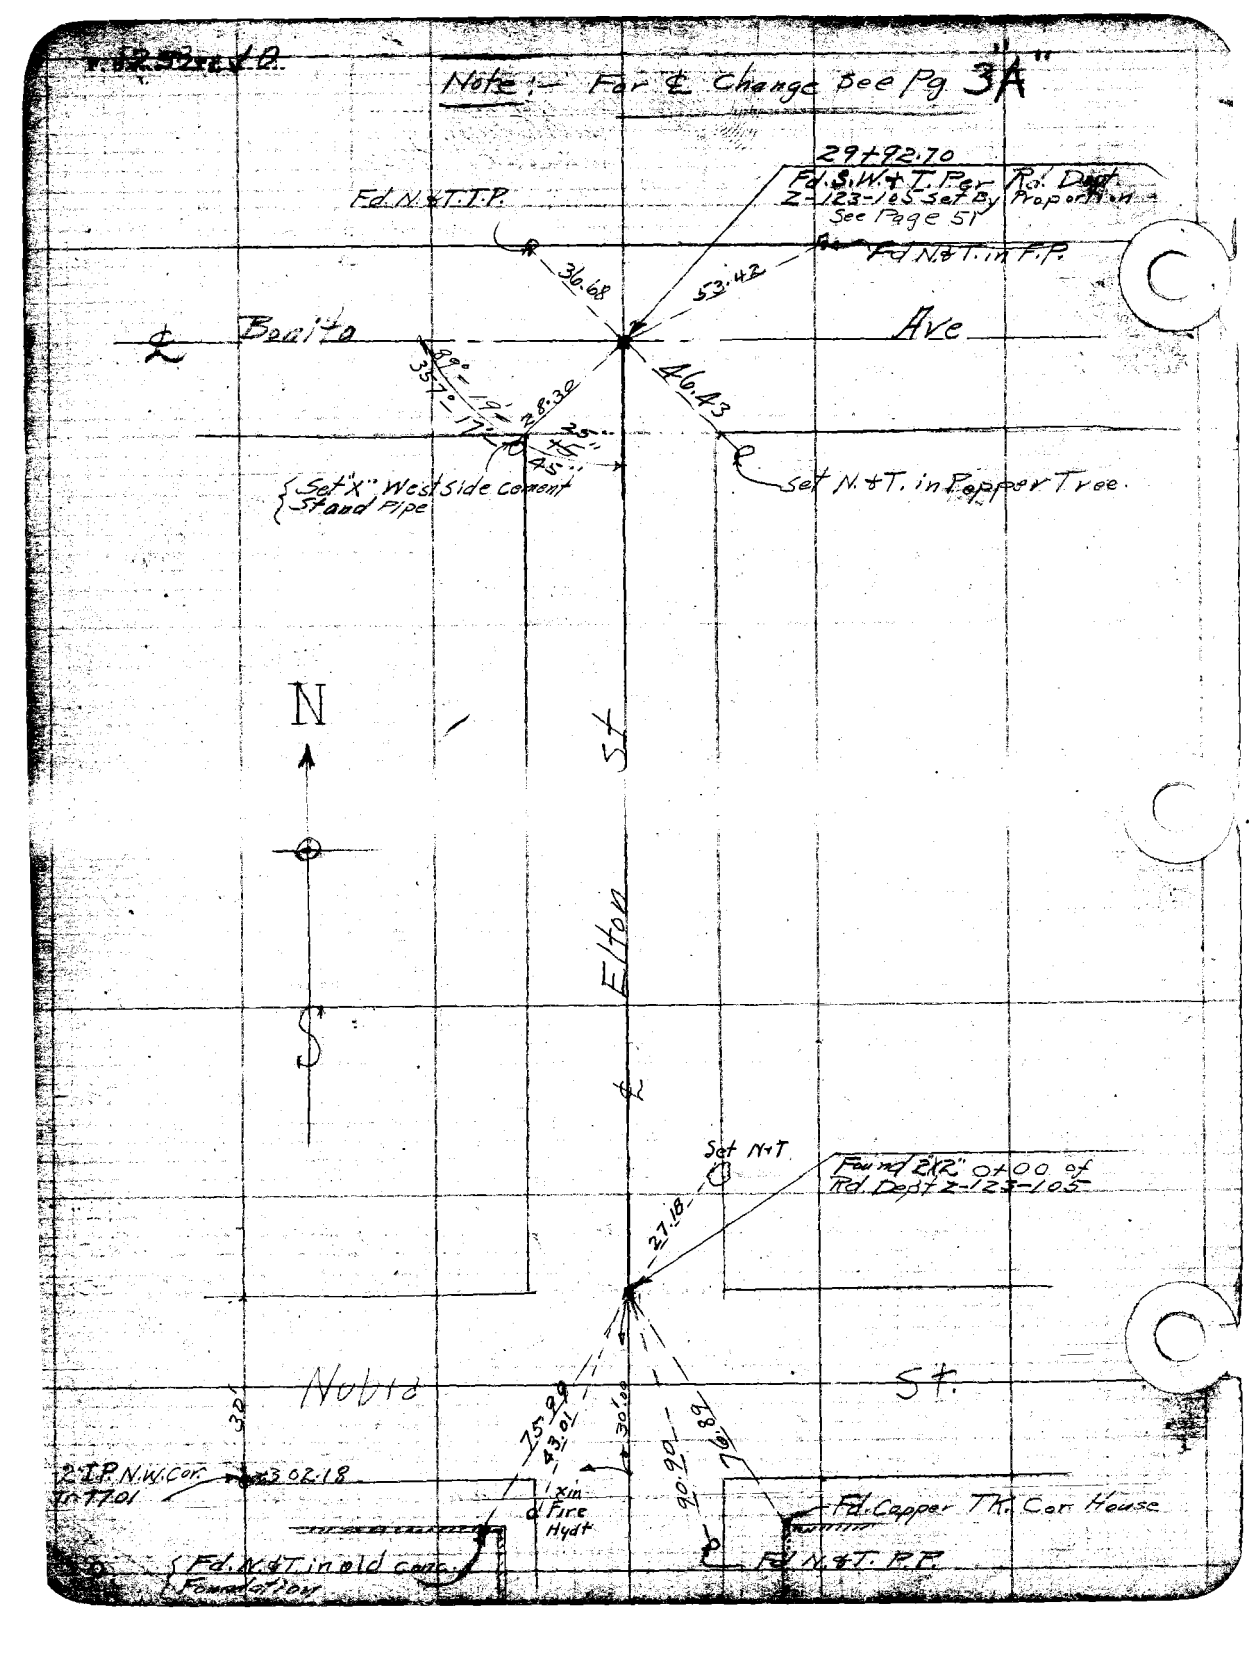

F. B. 288 pg. 46

Plotted by	W. C. Hoff & B. B. H.
Date Feb. & Mar. 1927	Location Bonita Ave.
Map No. 2104	Surveyed by L. V. Crum & Assts.
Platting C'k'd by	Date Oct. & Nov. 1926
Date	Indexed

Note:- For Ł Change see Pg 47A

F. I. N. & T. In P. P. Per Rd. Dept. 2-280-121

See Page 67

53+20.73
Found ZXZ Replacing Ł I. P. of C.S. 75 & 9 of Road Dept F. R. 262-9, By Ties for 2-280-120

Ł Bonita

Replaced with C.S. Brass Cap Mon F.B. 547-19

Ave

89°-12'-00" 42.66

89°-48'-15" 50' 35.20

52.80'

Set X in Ł Conc. Stand P.P.

Fd. N. & T. in P.P. Per Rd. Dept. 2-280-121

Set "X" in cement Drive way at Base of Sar Stone Post

Azusa Canyon Road

179°-07'-45" 716.31'

Ł Orange

Transit Line Per F.R. 262-9.

N

S

Replaced with C.S. Brass Cap Mon. F.B. 547-19

Found Wire Spk & Tin in Macadam Road, Set To Replace old 2½" of Sta. 53+05.82 Per Rd Dept F.R. 262-9

Ł Olive St.

1.77

By Ties Per F.R. 262-9

50.34

Found L & T. in Irrig. Stand Pipe

Found L & T. Ł Irrig. Stand Pipe

 
79+08.06
Fd. 2" I.P. Plug + T.K. S.W.
Cor. Lot 37, Tr. 4920
M.B. 76-114
See page 82
To Page 13
75.55
89.70
10°-50"
Set N.&T. I.P.
79+82.54
Found S.W.&T. Per Rd. Dept
Z-113-100 1/4 Sec. Cor.
See pages 13, 14, 82
Replaced with C.S.
Brass Cap. Mon.
F.B. 547-18
52.98
Ave
39.22
Fd. N.&T. Guy Pole
90°-02'-45"
25.02
25.35
32.00
19.97
79+62.59
N.W. Cor. Lot #1
Found 2" I.P. Plug & TK
Per L.S.B. 14-32
See Page 82
Set X" E. Edge Manhole Rim
N
Note:- This point Fd. S.W.&T. was found to be on line
Tie Per Rd. Dept.
F.M. 14-63
Set S.W.&T. 27.95 from Nail Top of Conc. Wall & on line Between Painted Rock at C.S. 7590 Sta. of 102+12.80
Cypress
Ave
42.18
48.03
33.51
Cut Sp.K. Top Cobble Wall
Found Nail Top Conc. Wall. Per Rd. Dept F.M. 14-63
Set L.&T. in N.W. Cor. of
Manhole, Top
Reservoir
Set N.&T. P.P.
88°-45' Chain = Record
Set N.&T. in Orange Tree
35.51
73.93
Face of Cur
Per Rd. Dept
Found Painted Rock By Ties, Sta. 102+12.8
Per C.S. 7590 & Rd. Dept
F.M. 14-63
20.26
22.63
28.39
39.99
Set L.&T. in C
Set X" in Top Rim of
Set N.&T. in
Cor. F.M.
Page

Number
Date Feb. & Mar. 1927
Map No.
Plotting C'k'd by
Date

U. S. Location
Location. Bonita Ave
Surveyed by: J. W. Beardsley
Date Oct. & Nov., 1926.
Indexed.

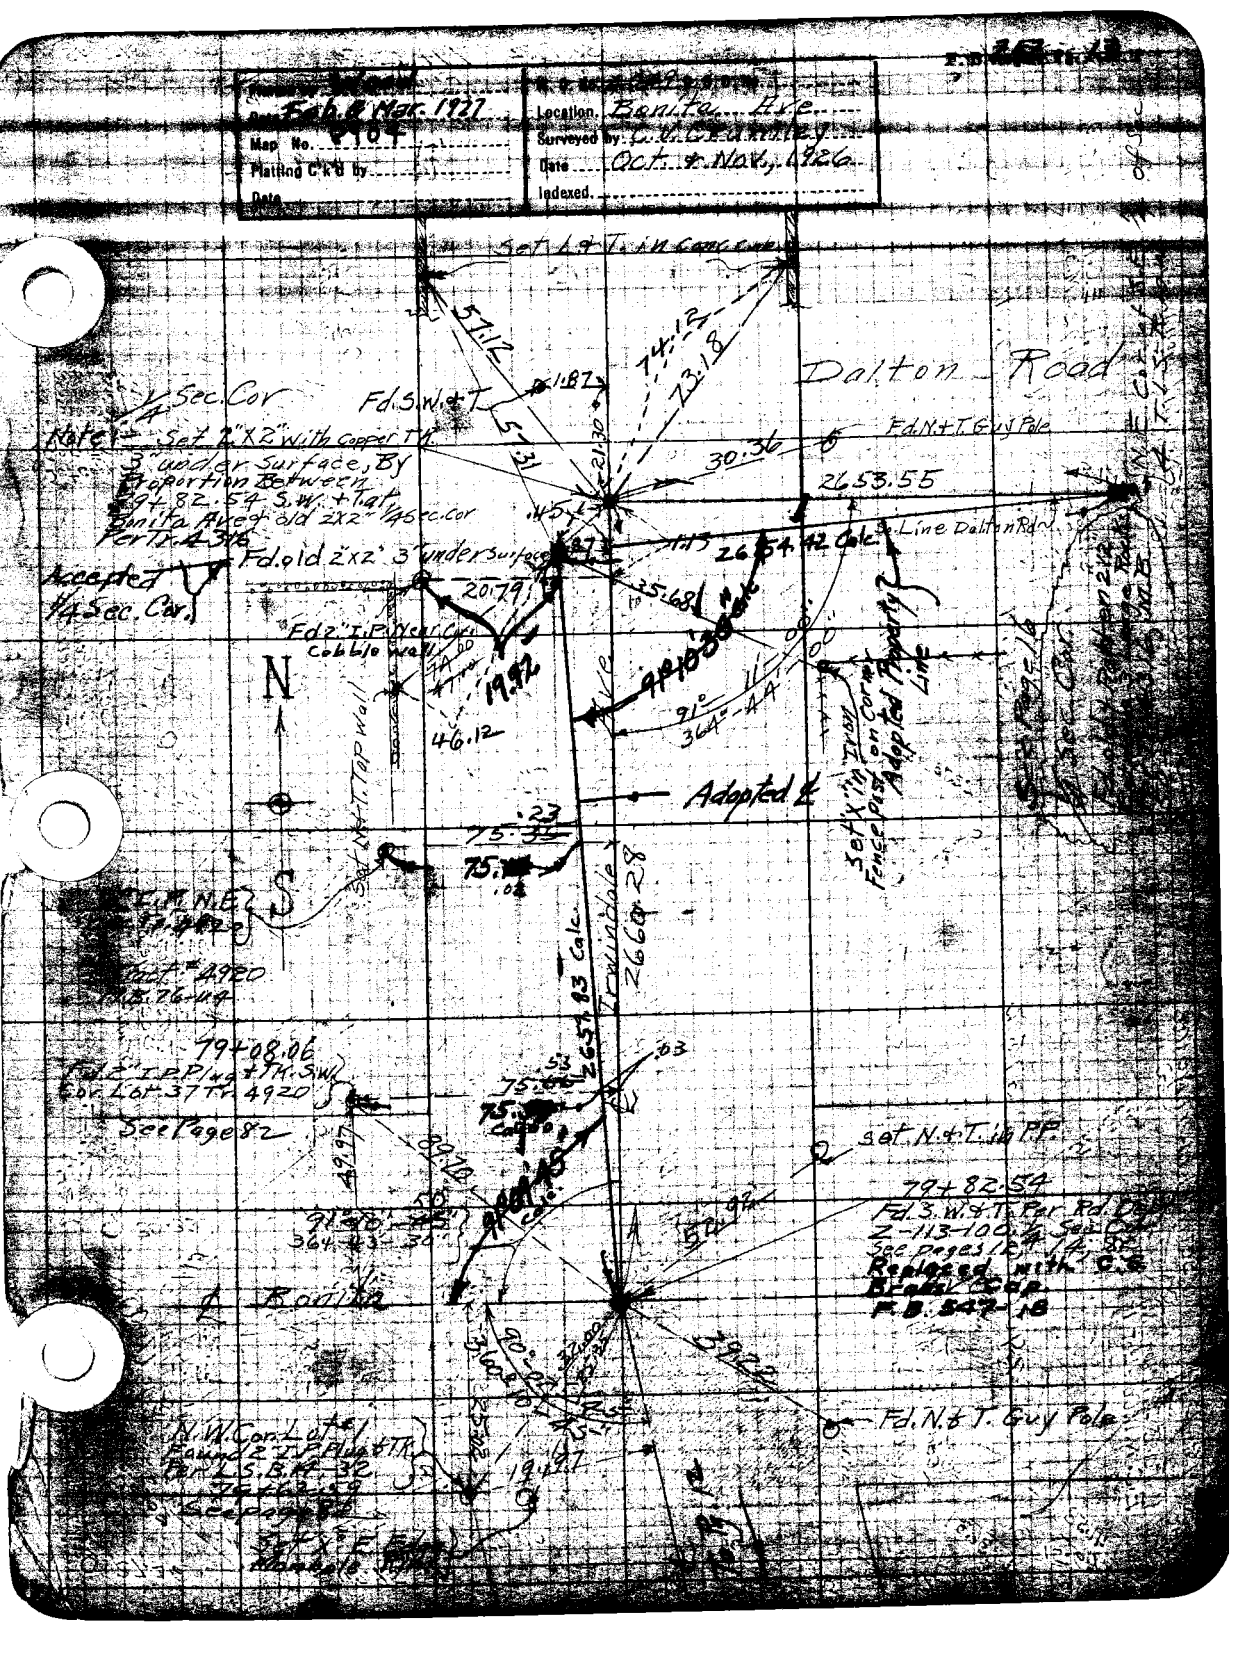

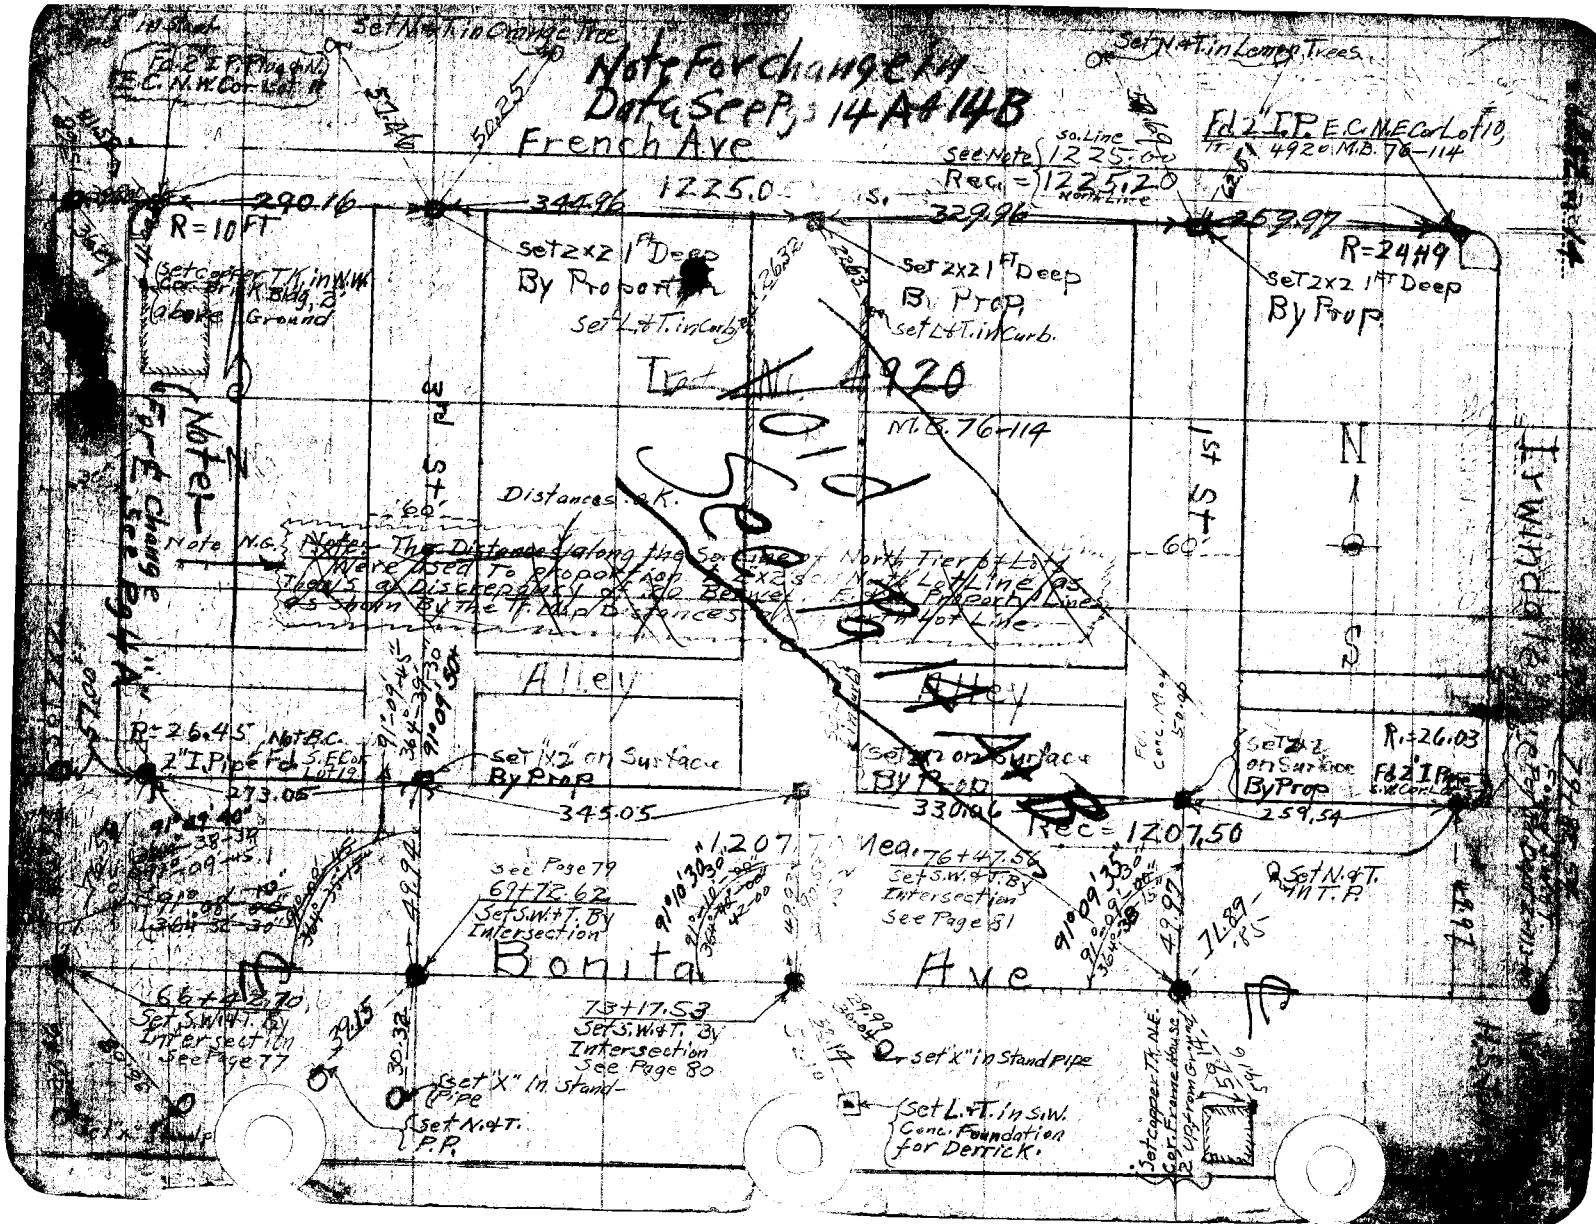
Note For change in Data see Pg 14A & 14B
French Ave
Bonita Ave
Alley
Set N. & T. in Orange Tree
Set N. & T. in Lamp Trees
Fd 2" I.P. E.C. M.E. Cor Lot 10, Tr. 4920 M.B. 76-114
Fd 2" I.P. E.C. N.W. Cor Lot 9
Set 2x2 1ft Deep By Prop
Set L. & T. in Curb
Set Copper Tk. in W.W. Cor. of Brick Bldg. 2 ft Below Ground
Note
Note N.G.
Note: The Distances along the South Line of North Tier of Lots were used to Proportion the Distances as shown by the M. Map Distances
Distances as K.
North Tier of Lots
North Lot Line as Property Lines
Set "X" on Surface By Prop
Set "X" on Surface By Prop
Set "X" on Surface By Prop
Set "X" in Stand Pipe
Set "X" in Stand Pipe
Set N. & T. in P.P.
Set N. & T. in T.P.
Set L.T. in S.W. Conc. Foundation for Derrick.
Set Copper Tk. N.E. Cor. Frame House 12 Upstrong 1 ft. 0
Tract 4920
M. B. 76-114
1st St.
2nd St.
60'
N
S
R=10 FT
R=24 FT
R=26.45
R=26.03
290.16
344.96
1225.00
329.96
259.97
273.05
345.05
330.06
259.54
Rec=1207.50
Rec=1225.20
So. Line
North Line
See Note
See Page 79
69+72.62
Set S.W. & T. By Intersection
See Page 81
76+47.56
Set S.W. & T. By Intersection
See Page 77
66+28.70
Set S.W. & T. By Intersection
See Page 80
78+17.53
Set S.W. & T. By Intersection
Fd. Conc. Mon. 50.96
49.92
49.97
42.00
30.32
29.99
21.89
.85
.15
.14
.97
.97
.97

RETURN TO
LOS ANGELES COUNTY SURVEYOR

Note: ANY ADDITIONS OR CHANGES ON THIS SHEET MUST BE MADE OR CIRCLED IN Red. WITH DATE AND NAME OF PERSON MAKING CHANGE.

Do not extend notes this side of this line

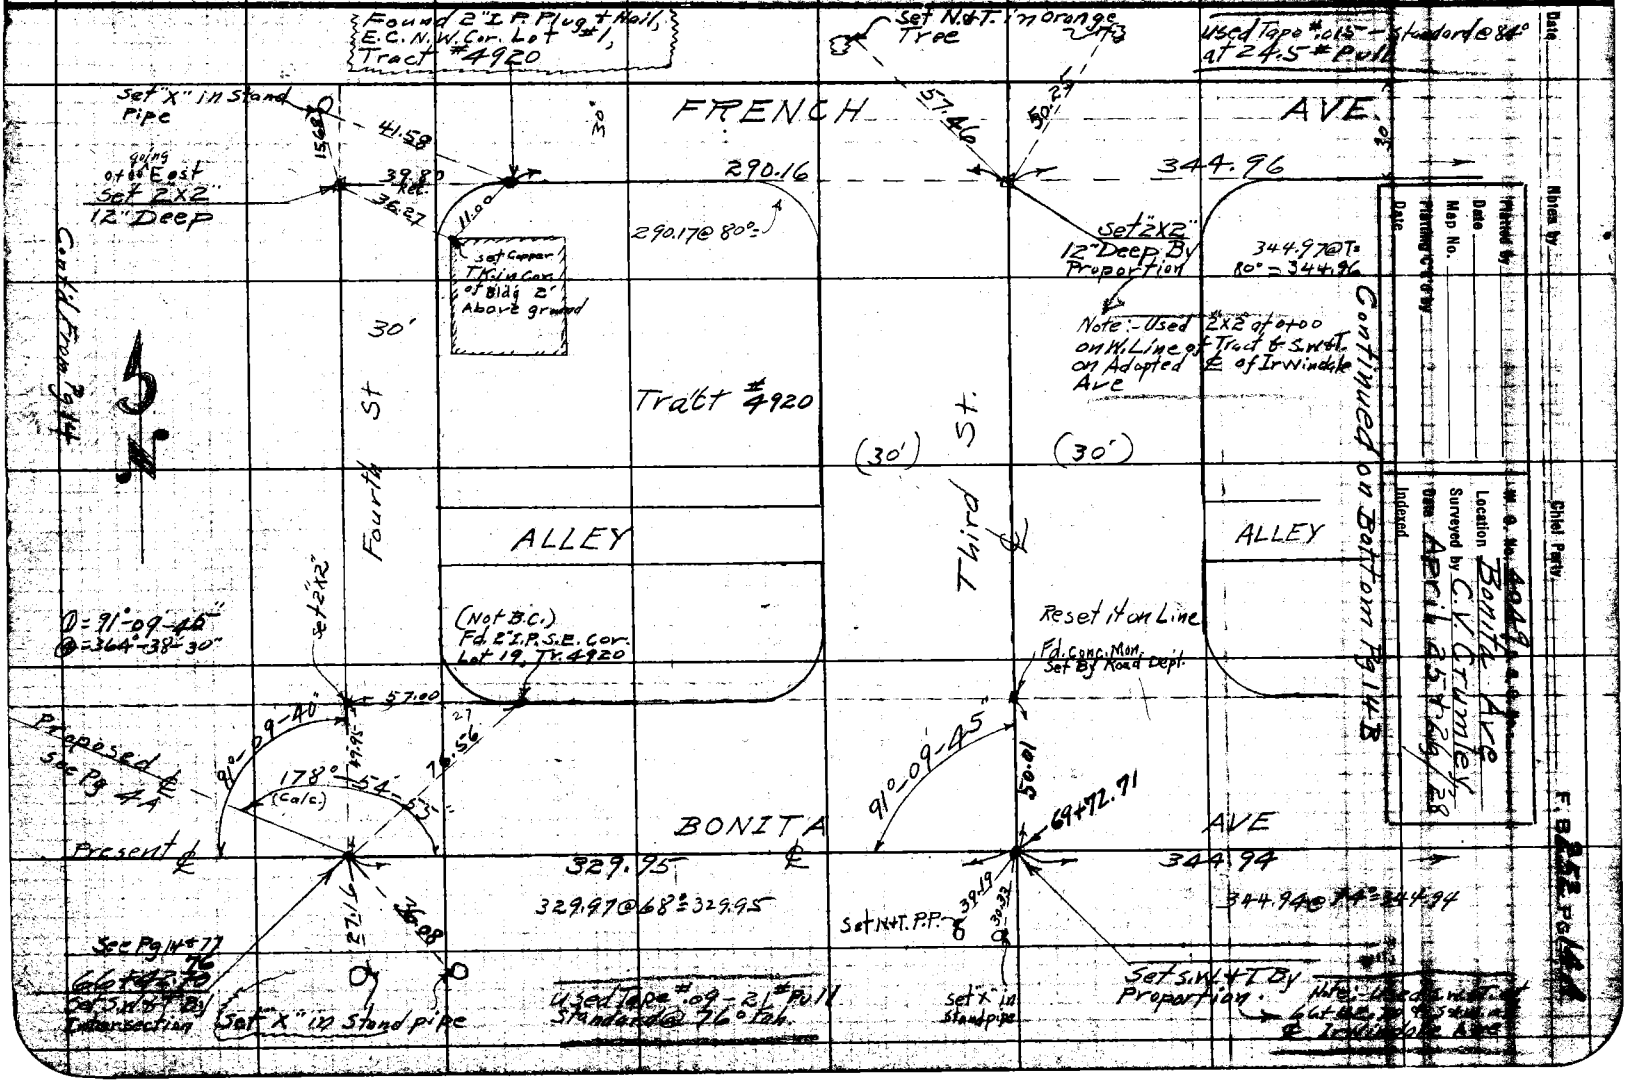

Contd From Pg 14

Date
Noted by
Chief Party
Checked by
Date
Map No.
Plotting Checked by
Date
Indexed
W. O. No. 4044
Location Bonita Ave
Surveyed by C.V. Crumley
Date April 25 & 26, 28
F. B. 252 P. 64

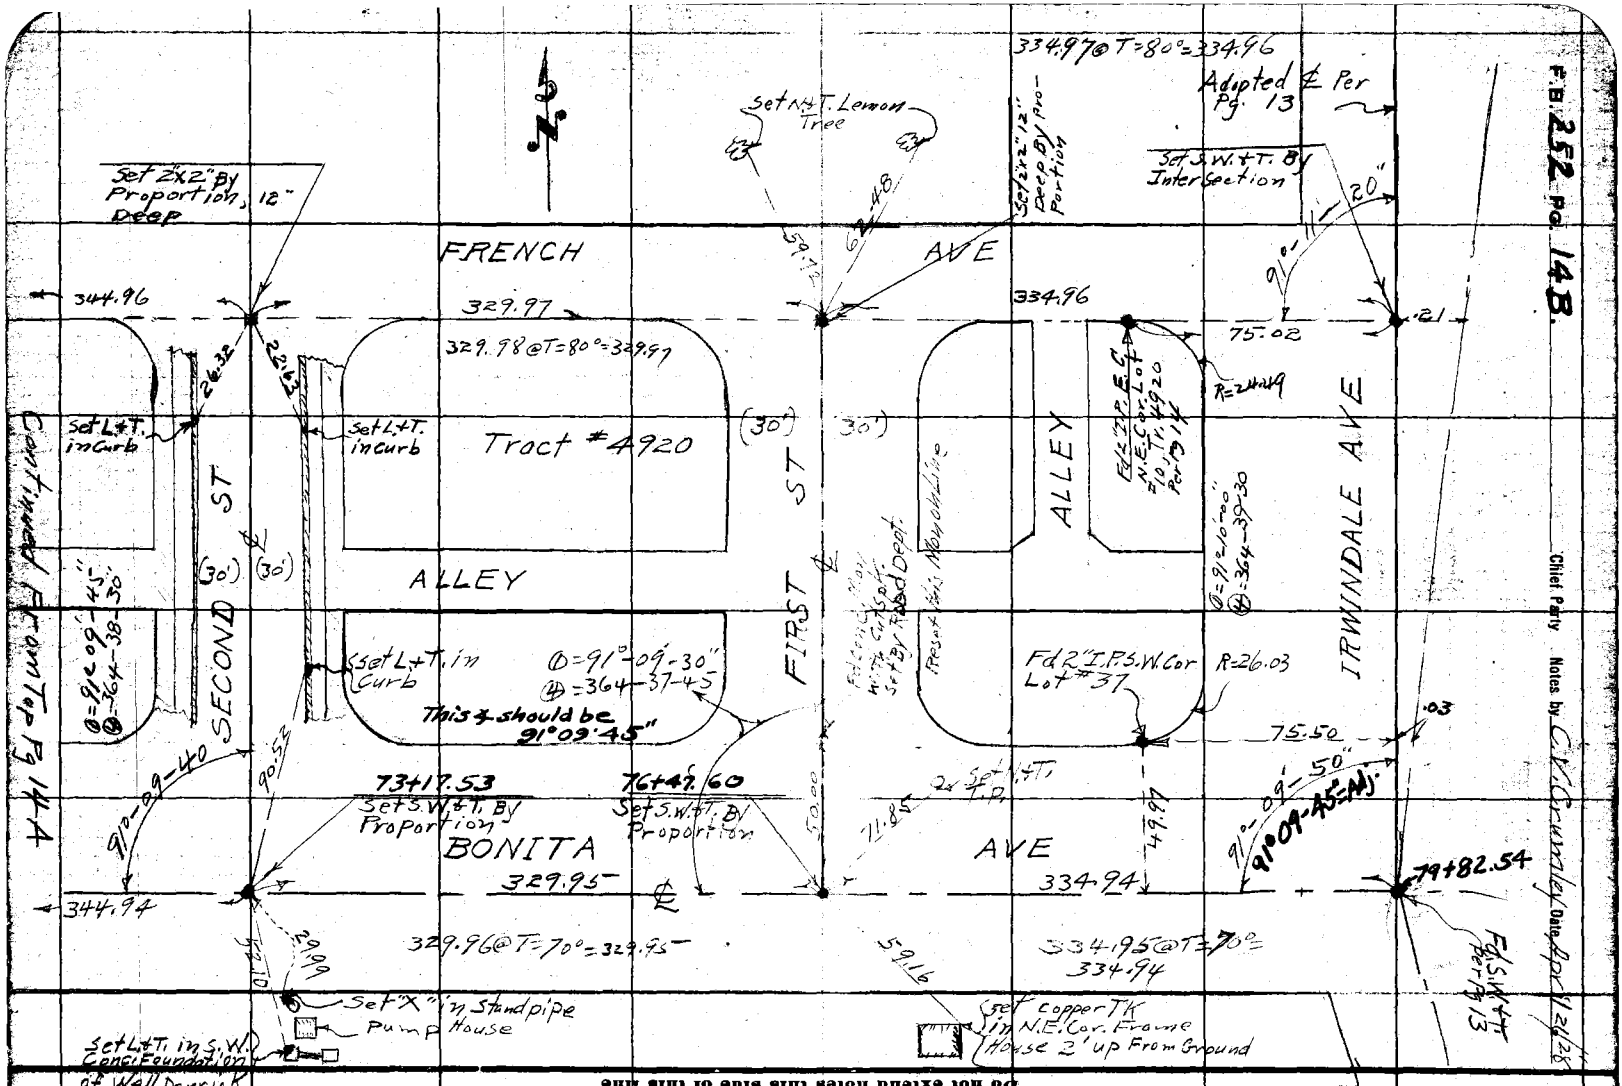
F.B. 252 Pg. 14 B.
Chief Party
Notes by: C.V.C. Crumley Date: Apr 11 28
334.97@T=80°=334.96
Adopted ℄ Per Pg. 13
Set N.+T. Lemon Tree
Set 2"x2" 12" Deep By Proportion
Set S.W.+T. By Intersection
FRENCH AVE
344.96
329.97
329.98@T=80°=329.97
334.96
75.02
R=24.49
Set L+T. in Curb
Set L+T. in Curb
Tract #4920
(30')
(30')
ALLEY
SECOND ST
FIRST ST
ALLEY
Fd 2" I.P.S.W. Cor Lot #37
R=26.03
IRWINDALE AVE
75.50
Δ=91°-09-30"
℄=364-37-45
This ℄ should be 91°09'45"
Δ=91°09'45"
℄=364-38-45
Δ=91°10'00"
℄=364-39-30
Set L+T. in Curb
Set 2"x2" 12" Deep By Proportion
Set L+T.
Set L+T.
91°-09-40
90.53
73+17.53
Set S.W.+T. By Proportion
76+42.60
Set S.W.+T. By Proportion
BONITA AVE
329.95
334.94
344.94
329.96@T=70°=329.95
334.95@T=70°=334.94
79+82.54
Fd S.W.+T. Bent 0.13
Set "X" in Standpipe Pump House
Set L+T. in S.W. Cone. Foundation of Well Derrick
Set Copper Tk in N.E. Cor. Frame House 2' up From Ground
Continued From Top Pg 14A
Continued To Pg 14A
RETURN TO
LOS ANGELES COUNTY SURVEYOR
Do not extend notes this side of this line
Note: ANY ADDITIONS OR CHANGES ON THIS SHEET MUST BE MADE OR CIRCLED IN Red. WITH DATE AND NAME OF PERSON MAKING CHANGE.

Map No. 8904
Surveyed by C. L. C. Linsley
Date Nov. & Dec. 1926

Set "X" in Cap Top 2" I. P. 2½ ft. high

Set 1 X 2" 6" Deep set by Prop bet. Pipes found (O. K.)

14.84

109.00

9.00

89.00

16.5

Found 2" I. P. Plug & Tk. N.W. Cor. Lot #1 Tr. 4316, M. B. 50-5.

Set "X" in N.W. Cor. Cement Bldg

47.95

Set N. & T. P. P.

Found 2" I. P. Plug & Tk. N.E. Cor. Lot #1 Tr. 4316, M. B. 50-5.

N

S

St.

Marcella

Set N. & T. 6 X 6" Flag Pole

Set Nail in Cor. Cobble stone bound P. P. above ground

See Page 84

98 + 12.58

Found 2" I. P. Plug & Tk. 18' West of S.W. Cor. Lot #11, Tr. 4316, M. B. 50-5

88.19

Set N. & T.

9.00

9.00

30

58

54

90

36

19.82

21.63

59.90

13.40

℄ Bonita Ave

98 + 21.25 ± Set S.W. & T. By Inter.

See Page 84

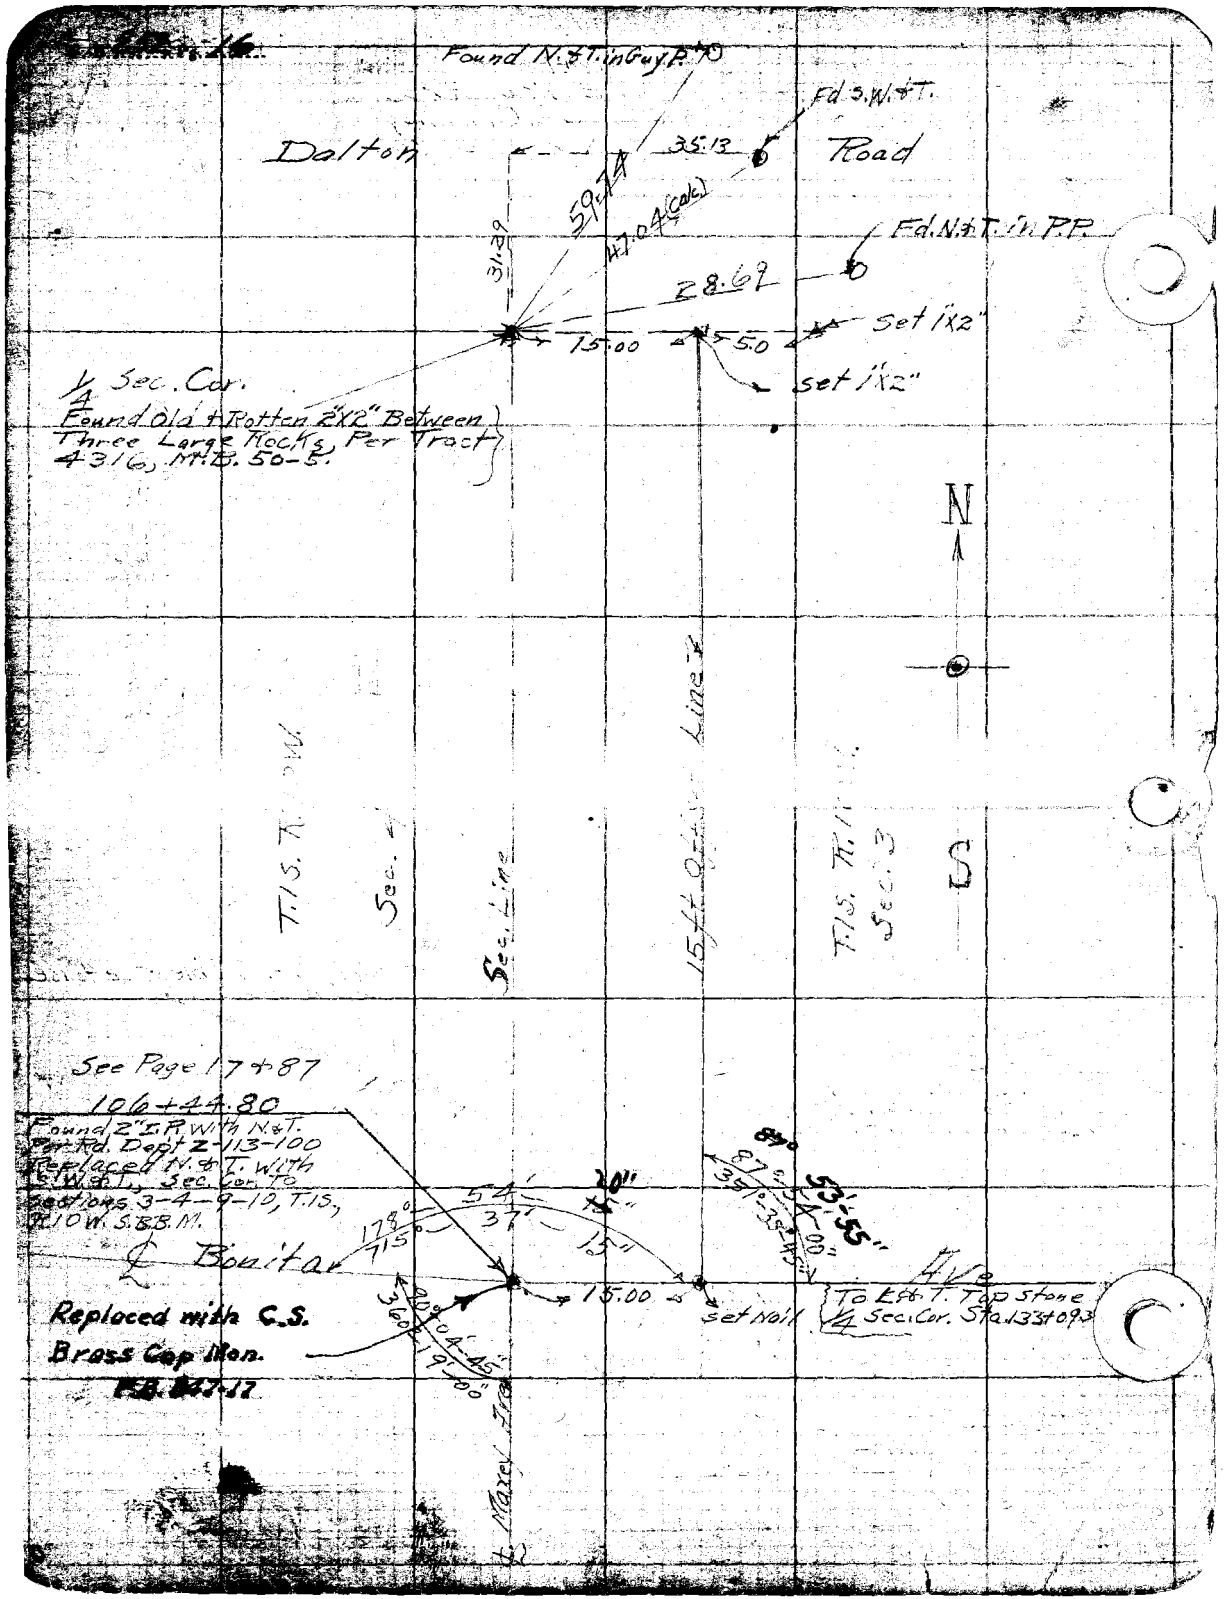
Found N.&T. in Guy P. 70
Fd. S.W.&T.
Dalton
35.13
Road
59.14
47.04 (calc.)
Fd. N.&T. in P.P.
31.39
28.69
Set 1"x2"
15.00
5.0
set 1"x2"
Sec. Cor.
Found Old + Rotten 2"x2" Between
Three Large Rocks, Per Tract
4316, M.B. 50-5.
N
T.1S. R.
Sec. Line
Line
15 Ft. Road
T.1S. R.
Sec. 3
S
See Page 17+87
106+44.80
Found 2" I.P. With N.&T.
For Rd. Dept Z-113-100
Replaced N.&T. With
S.W.&T., Sec. Cor. To
Sections 3-4-9-10, T.13,
R.10W. S.B.B.M.
℄ Bonita
Reploced with C.S.
Brass Cap Mon.
F.B. 447-17
178°
71.5
54.1
37.1
15.1
20"
89°
53°-55'-
67.3
38°-45'-00"
15.00
set Nail
To Ext. T. Top Stone
Sec. Cor. Sta. 133+09.3
360.0
20°-04'-45"
19°-00'
Maxey Tract

Plotted by ...
Feb 6 Mar 1927
Map No. 8904
Plotting C'k'd by ...
Book ...

W. O. No. 7249 C. S. O. No. ...
Location. Bonita Ave
Surveyed by C. E. Chittenden
Date Oct. 4 Nov. 1, 1926
Indexed. ...

Notes By Grunsky

Set N&T. in 6"

106+44.80
Ref. Rd. Dep. 2-113-100
Found 2" I.P. with N&T. in Top
Replaced N&T. with S.W. & T.
S.C. Cor. to Sections 3-4-
9-10, T. 15 S., R. 10 W. S.B.B.M.

See Page 16 & 87
Replaced with C.S.
Brass Cap Mon. F.B. 547-17

℄ Bonita

76.28
20
54
37'
15'
128°
715'
Ave
80.0
360.0
42.37
45"
70.00
58.10
24.98

Set N&T. Cor. of Top of Conc. Weir Box

25.04

Ave

Fd. "X" Top Flow Line of Division Box

Fd. 2" I.P.
See Page 87-18
106+19.79

1/4 1/8 Cor. of Traces of Adj. Lots
Set 2X2" By Proper Lines
2x2" on C. Pass Ave.
Of C.S. 7684 & 2" I.P. in Mon. Well
of Bonita Ave. 75+01.97
12" Deep

N 32.88
Rec. N 32.67
C.S. 7684

Fd. 2" I.P. 4" Deep

90° 00'
45' 11"
.83
.24
(Prop. a.k)

530.32 alng
(529.97 = Rec. C.S. 7684)

Set "X" in Cor. of Conc. Weir Box

15.69

90° 0' 45"
360° 31' 00"

Found Base of Vary of
R.W. Stake 12" Deep
Per C.S. 7684

Found "X" Top 12" Conc. Wall

set N&T. in 6" Walnut Tree

Found N&T. in Guy Pole

Maple
26.96
Rec. = 28.38

25.02
25.03

Cypress

Ave

90°

Found 2X2" Red wood Stake
10 ft. Under Surface.
Replaced with C.S. Brass
Cap. M.B. 547-17

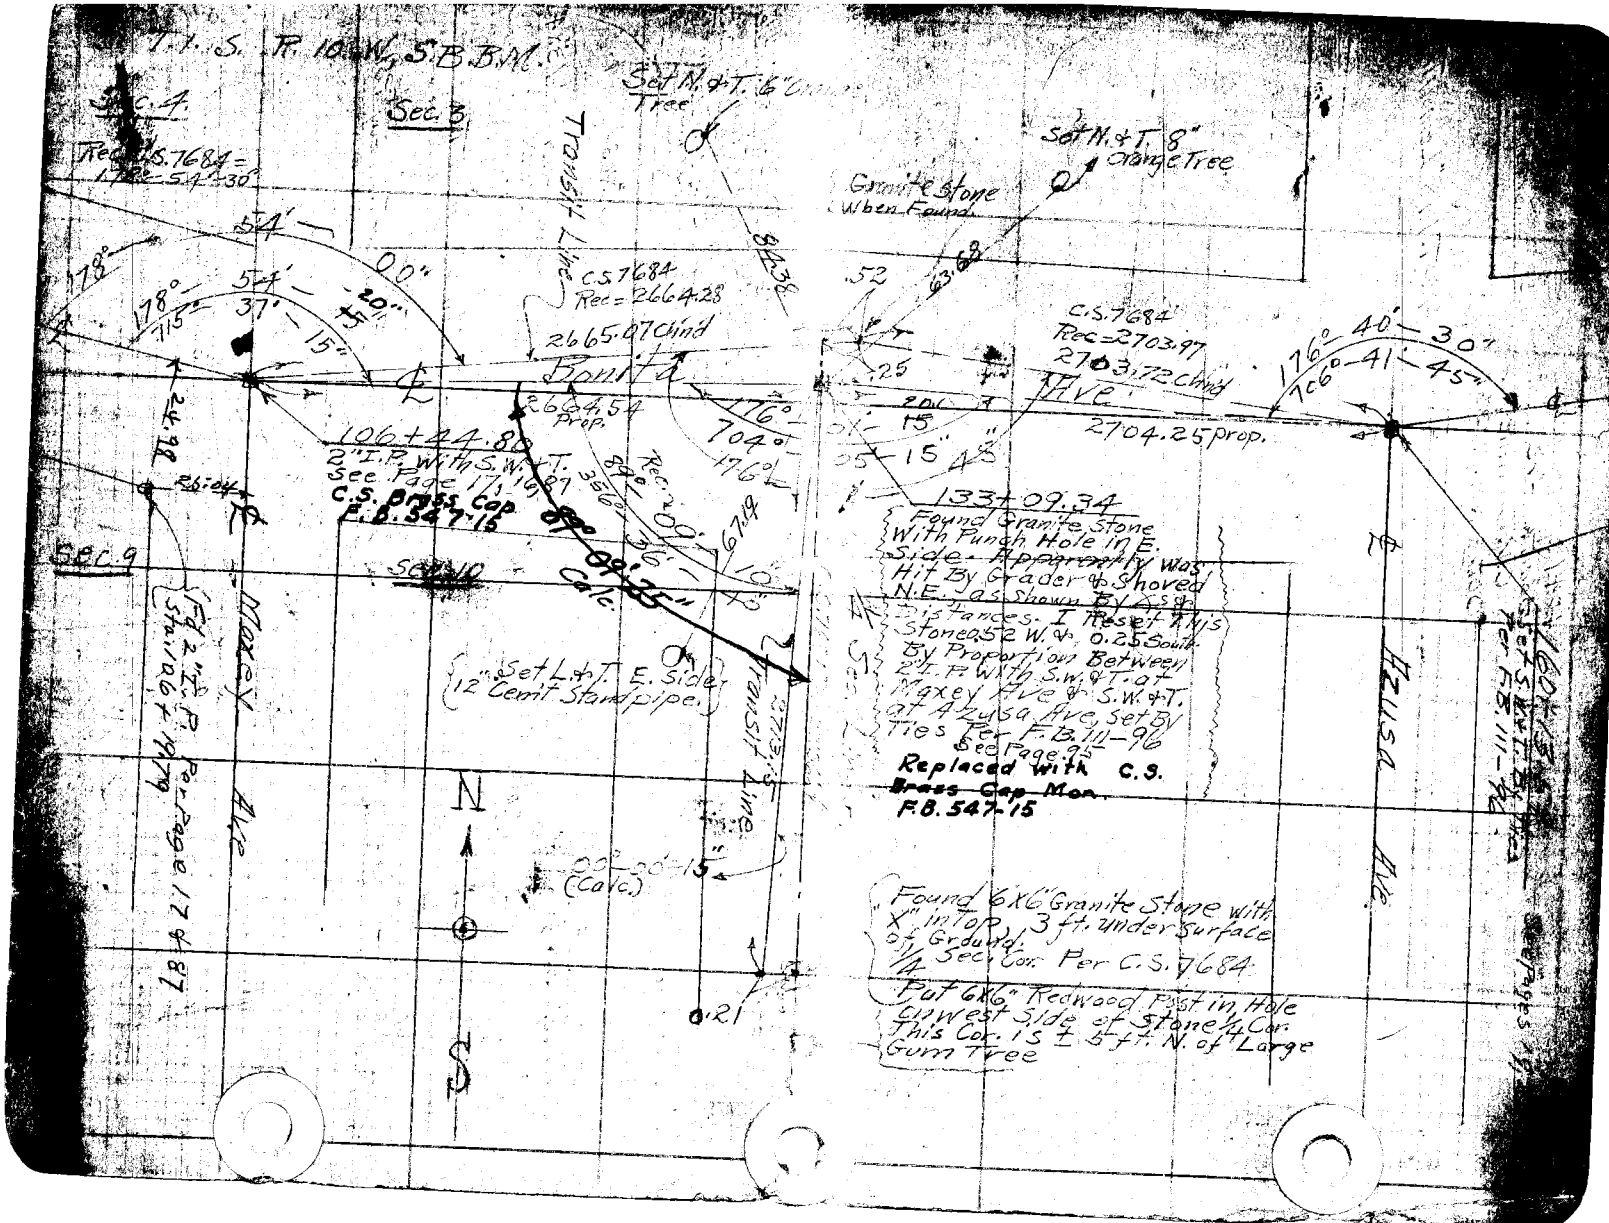
T. 1. S. R. 10 W., S.B.B.M.
Sec. 4
Sec. 9
Rec. 2665.7684 = 178° - 54' 30"
Set N. & T. 6" Tree
Set N. & T. 8" Orange Tree
Granite Stone When Found
C.S. 7684 Rec = 2664.28
2665.97 Chord
Bonita Ave.
2664.54 Prop.
C.S. 7684 Rec = 2703.97
2703.72 Chord
2704.25 prop.
106+44.80
2" I.P. with S.W. & T.
See Page 171-187
C.S. Brass Cap F.B. 547-15
Found Granite Stone With Punch Hole in E. Side. Apparently was Hit By Grader & Shoved N.E. as Shown By Arrows. Distances. I Reset This Stone 0.52 W. & 0.25 South By Proportion Between 2" I.P. With S.W. & T. at Marvey Ave & S.W. & T. at Azusa Ave, set By Ties Per F.B. 111-96 See Page 94
Replaced with C.S. Brass Cap Mon. F.B. 547-15
Set L. & T. E. Side 12" Cemt Standpipe
Set 2" I.P. Per Page 171-187
Found 6"x6" Granite Stone with "X" in Top, 3 ft. under Surface of Ground. Sec. Cor. Per C.S. 7684
Set 6"x6" Redwood Post in Hole in West Side of Stone 4 Cor. This Cor. 15 ± ft. N. of Large Gum Tree
Marvey Ave
Azusa Ave
Transit Line
N
S
0.21

Plotted by	W. O. No. 4049 U. S. C. No.
Checked by	Location Bonita Ave.
Map No. 8904	Surveyed by C. V. Crumley
Plotting C'k'd by Paige	Date Nov. & Dec, 1926
Date April 1927	Indexed

Fd. X on End Wall of Culvert Per 5235-18

27.54

Found Drill Hole in Pavement, One Tie only of Rd. Dept F.B. 5235-18 Fits This Point.

Ties of F.B. 111-92 Cane

℄ Broadway

37.53

Fd "X" on Headwall

N

S

Tangent Bearing Assumed

Fd "X" on Headwall of Culvert Per F.B. 111-96

40'

30'

176° 30' 41"

86° 56' 41" 30"

347° 41' 26.11

℄ Bonita Ave

160+13.59 Set S.&W. in Lead in Pavement By Ties Per F.B. 111-96 See Pages 18, 20, 102

37° 48' 30" 38.65

42.11

Fd M.T. in C.P. Per F.B. 111-96

Note: This tie is on N.W. Cor. Holland Hse 4-21-27

Note: This tie is on S.W. Cor. Fd Cut [illegible] Cor. Per F.B. [illegible]

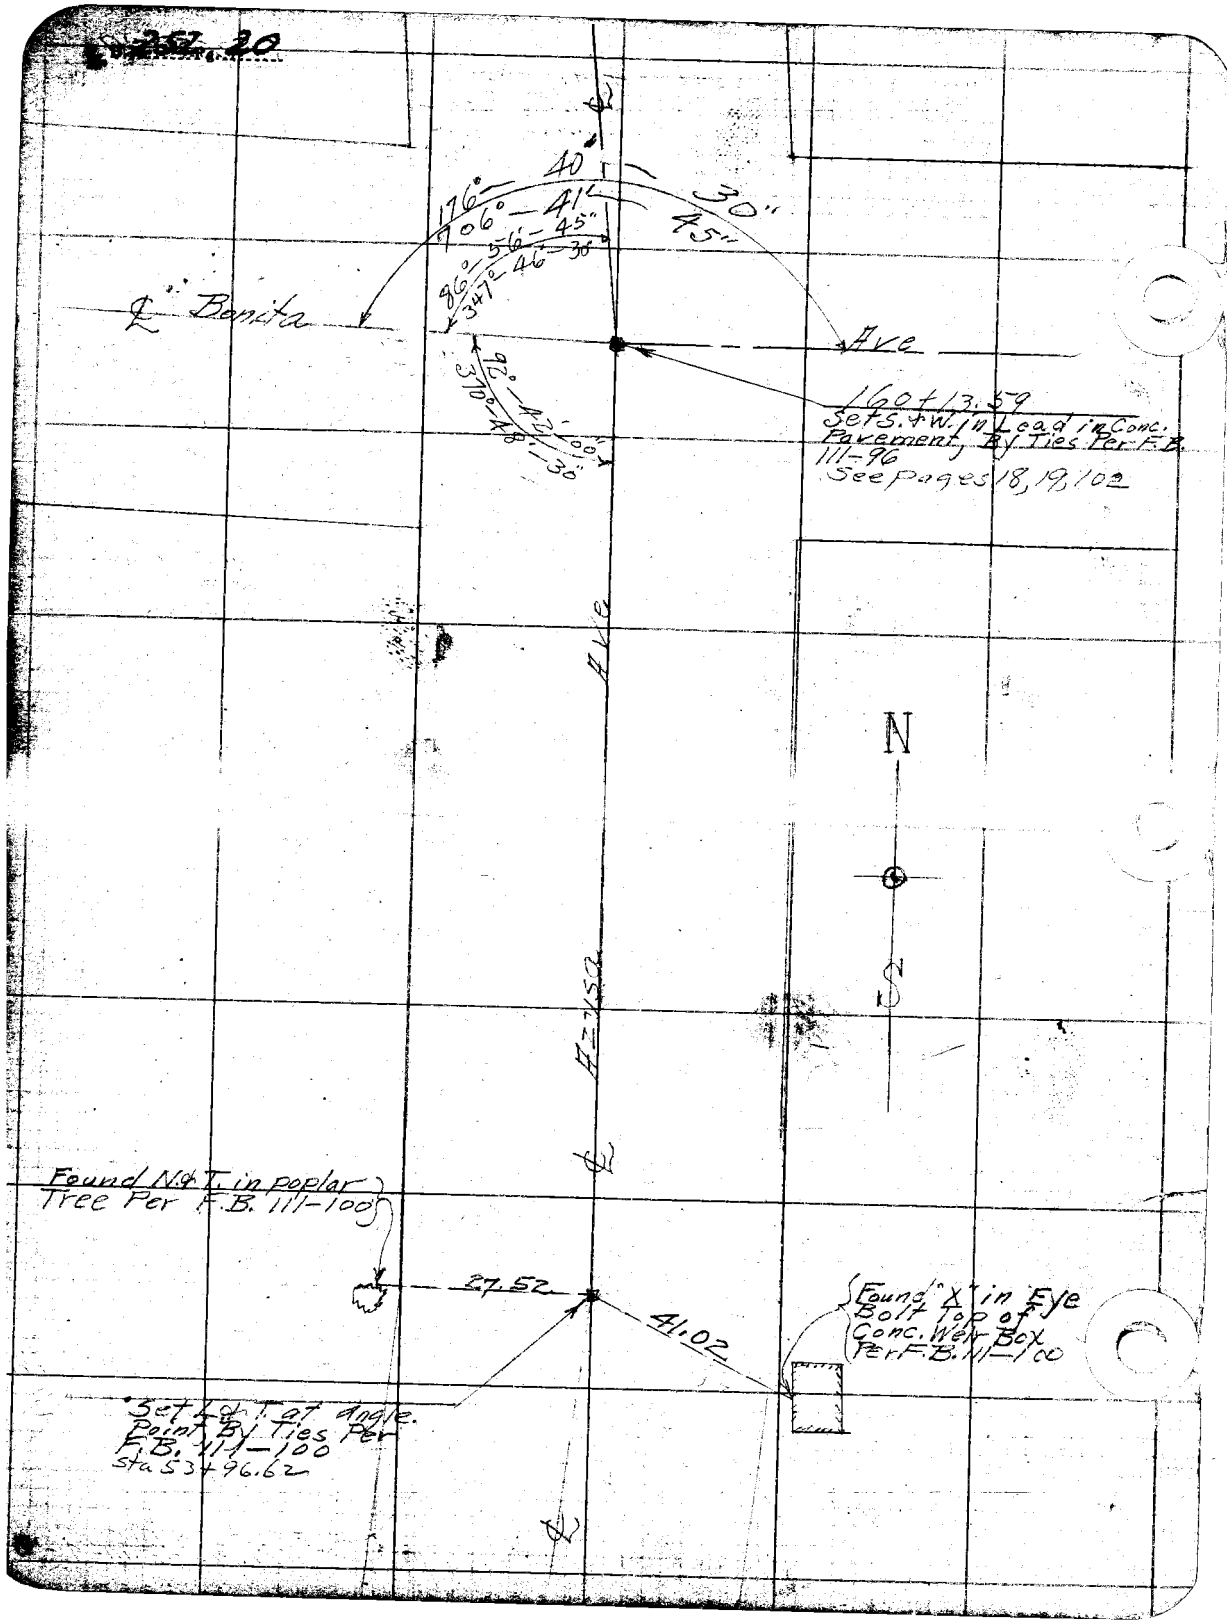
Sheet 20
40'
30"
45"
176°
106°
41'
45"
5-6-45"
96°
34°
46"
30"
℄ Bonita
Ave
92°
37°
48'
100.0'
30"
Set 5/8" W.I. Lead in Conc. Pavement, By Ties Per F.B. 111-96
See Pages 18, 19, 102
Ave
N
S
Found N&T in poplar Tree Per F.B. 111-100
27.52
41.02
Found "X" in Eye Bolt Top of Conc. Well Box Per F.B. 111-100
Set 5/8" I.P. at angle. Point By Ties Per F.B. 111-100
Sta 53+96.62

Plotted by [illegible]
Date Feb. & Mar. 1927
Map No. 2901
Platting C'k'd by Paige
Date April 1927

W. O. No. ..... D. S. O. No. .....
Location .....
Surveyed by .....
Date .....
Indexed .....

F.B. 257 Pg. 31

(Found 1½" ℄ Cerritos Ave Produced Linsley Geodetic Survey)

24.86

Broadway (or Dalton Road)

Found Wire Spk with Galvanized Tin

54.99

52.42

{Made "X" in eye-bolt Top of Conc. Weir Box}

Set L.&T. in Curb.

℄ Cerritos Ave

N

S

35

90

2.16

15"

90°-00'

360°-00'

186+26.69
Found Cut Spk By Ties Per F.B. 111-96
See Pages 224 & 112

℄ Bonita Ave

30.09

180°-00'

72.18

Gasoline Pumps

Set "X" in eye-bolt Top Conc. Weir Box

Set L.&T. in wall End Pump Foundation

Service Station

B. B. 252 pg. 22

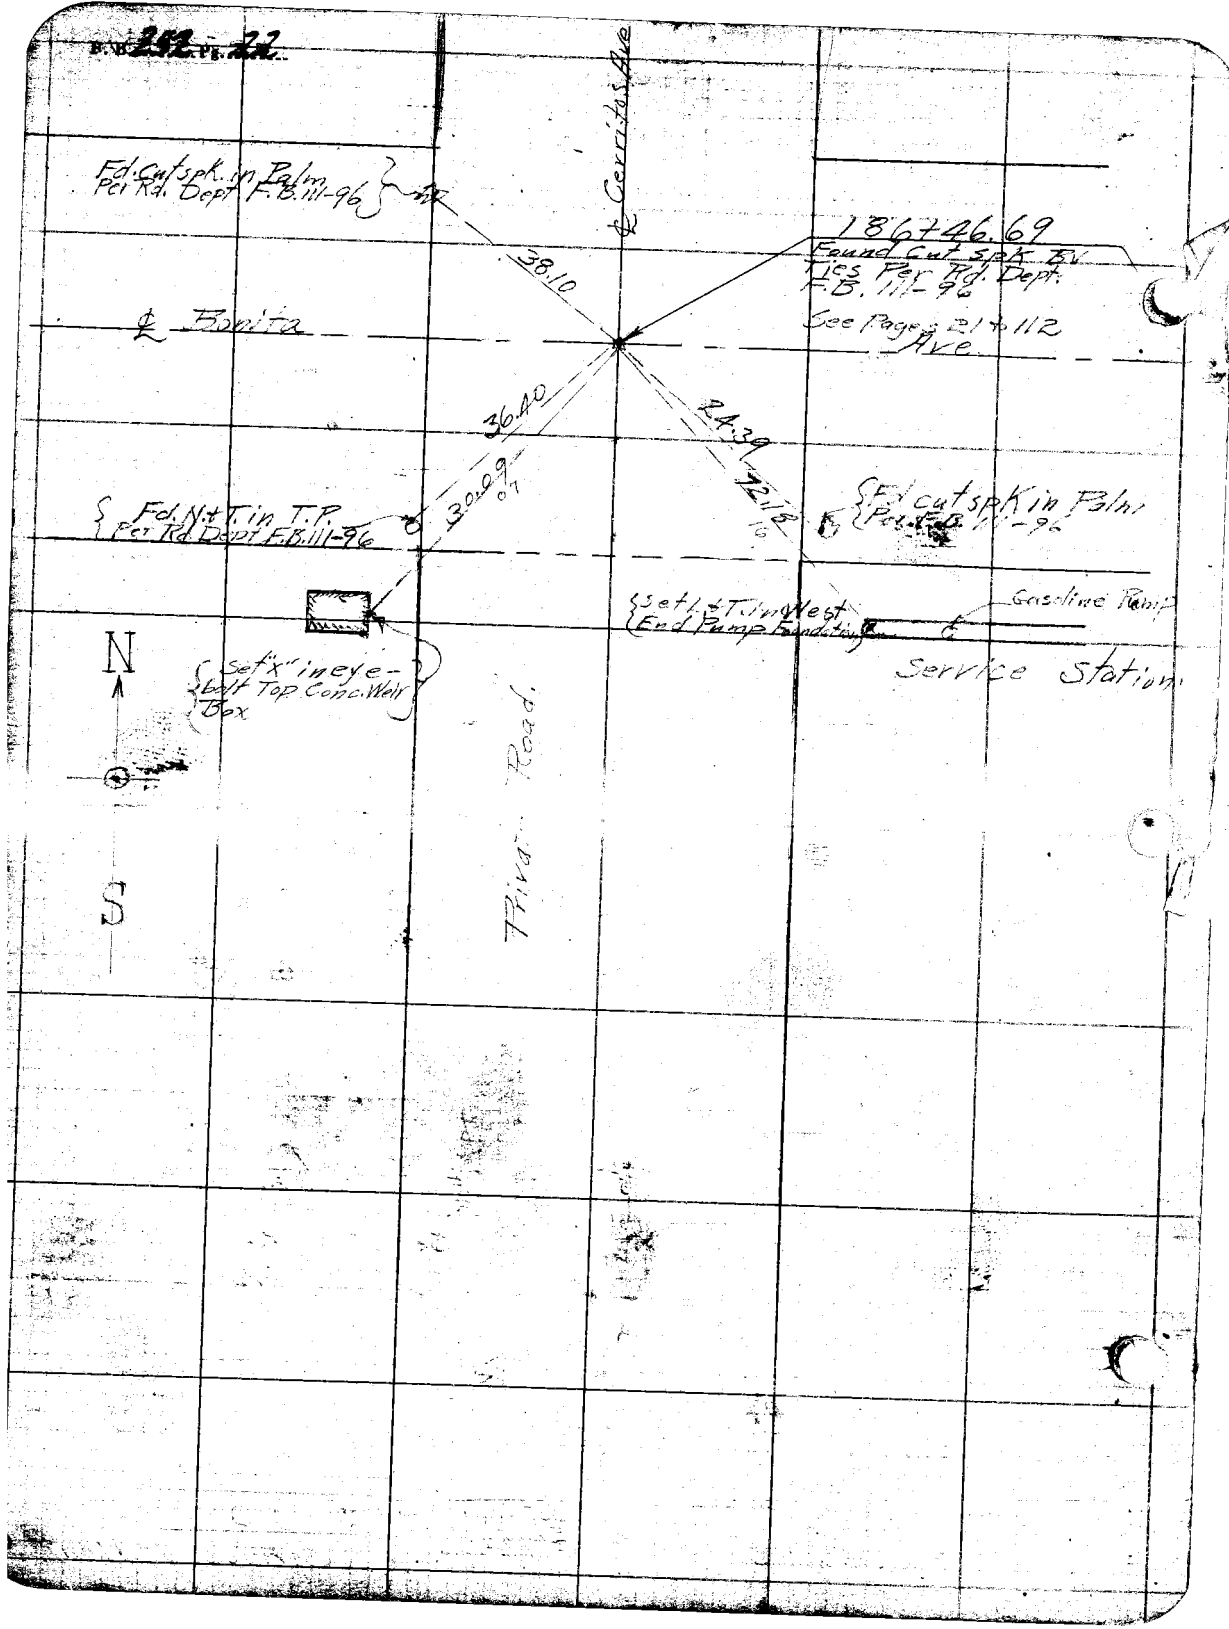
Fd. Cut spk. in Palm Pcr Rd. Dept F.B. 111-96
38.10
186+46.69
Found Cut Spk. Bv. Tics For Rd. Dept. F.B. 111-96
See Page 21 & 112
℄ Bonita
Ave
36.40
24.39
12.18
30.09
Fd. N.+T. in T.P. Pcr Rd. Dept F.B. 111-96
Fd. cut spk in Palm Pcr F.B. 111-96
Set ½" T. in West End Pump Foundation
Gasoline Rack
Service Station
Set "X" in eye-bolt Top Conc. Weir Box
N
S

Plotted by: Wood	W. O. No. 4049 D. S. O. No.
Date Feb. & Mar. 1927	Location. Bonita Ave. C
Map No. 8404	Surveyed by C. V. C. Gammon Kay
Plotting C'k'd by Paige	Date Nov. to Dec. 1926
Date April 1927	Indexed.

Set N.&T. 1 1/2" Gum Tree

U.S. Geodetic Brass Cap in Conc. Mon.

Fd Wire Spk

℄ Dalton

76.41

125.00'

66.49

(Broadway)

U.S. Geodetic Brass Cap in Wing Wall

11.31

Ave ℄

Found "x" in Headless Spk Sta. 737 + 33.99 From South Per Rd. Dept F.B. 111-44

28.60

Fd Cut Spk. S.E. Cor. Weir Box Per Rd. Dept F.B. 111-44

Citrus Ave

N

S

Fd N.&T. in T.P. Per Rd. Dept F.B. 111-42

Fd. N.&T. in Olive Tree Per F.B. 111-42

39.92

10'

37-15

38-30

37.00

90°

36°

27.51

Replaced with C.S. Brass Cap Mon. F.B. 547-13

Ave

℄ Bonita

179° 27.95

212 + 79.56

Found S.W. & T. By Tie & Sta. 4 + 64.30 From South, Per Rd. Dept F.B. 111-42

17'

16'

15'

Fd "X" in Weir Box Per F.B. 111-42

See Pages 24 & 120

To Pg. 247

Fd. N. & T. in T.P. Per Rd. Dept F.B. 111-42

Fd. N. & T. in clivet Per F.B. 111-42

39.92

27.51

37.00

℄ Bonita

Ave

212+79.56

Found S.W. & T. By Ties Sta. 4 Ft. 64.70 From Sou. ℄ Per Rd. Dept F.B. 111-42

See Pages 234.120

Replaced with C.S. Brass Cap Mon F.B. 847-13

See Tr. 8863, M.B. 16-138-139

27.95

90° 05' 30"

360° 22' 00"

179° 55' 00"

717° 60' 00"

19' 15' 16'

Fd "X" in Weir Box Per F.B. 111-42

N

For Check on Dist. Between Citrus & San Lorenzo

Eye

Citrus

Eye-Bolt in Weir Box

Fd. Eyeless Bolt ℄

Note:- Record shows this Distance to be 35.78 Evidently this bolt has been cut off leaving only the Stub End.

35.81

36.30

28° 48'

(Fd. L & T. in Head Wall of Culvert Per F.B. 111-41)

Covina Blvd

(Bonita Ave) F.B. 111-41

Found Cut Sq. Sta. 19+96.35 Per Rd. Dept F.B. 111-41 — 2

0+60 of F.B. 61-25

Date Feb. 1st 1927
Plotted by: Paige
Date April 1927

W. O. No. 4042 O. S. O. No.
Location. Bonita Ave.
Surveyed by: C.V. Carnahan
Date Nov. & Dec. 1926.
Indexed.

Fd N & T. in T.P. Rec Rd. Dept Z-306-53

Sec Cor.
239+34.94
Fd 2"x2", 4" Deep By Ties, Per Z-306-53, In place of Iron Bolt as called for in Rd Dept F.B. 61-62 & S 235-8-32
See Page 29 27 & F.B. Z 72-8

℄ Bonita

New Ties F.B. 252-123

Ben Lomond

Fd N & T. in T.P. Per Z-306-53

Fd N & T. in P.P.

19.97

Set "X" Top Conc. Weir Box

Set N & T. Mar 7, 27.

Fd "X" in old Stand Pipe Per F.B. 61-27

Fd 3"x2" Nail & Tag, 2.0 Deep, Per Z-306-53

239+14.98

Fd Cut Spk in Top of Conc. Hdwl. 0.7 Ft. S. & 3.5 Ft. E. from Sec. Cor. See F.B. 61-27 & F.B. 61-26

Fd 2.4" Iron Cut

Rec = 2659.13
2659.35

℄ Covina

New Ties F.B. 547-189

Fd cut Spk 1" under Surface of MACADAM

Set N & T. in Curb

Set Fx. in Top of Conc. Weir Box

Set N & T. on Line N. By Proportion Between Spk at Citrus Ave & S. on W. at Grand Ave

Blvd. 2677.33

Rec = 2677.10

239+54.94
Set 2"x2" ... Surface

Set Nail on 5' offset

For Adopted ℄ See Pg. 27

Set 2"x2" ... E of ¼ Cor.

Found ... 96 Cor ... Post 2 ...

Note: ... 5' offset ...

Ben Lomond

N

S

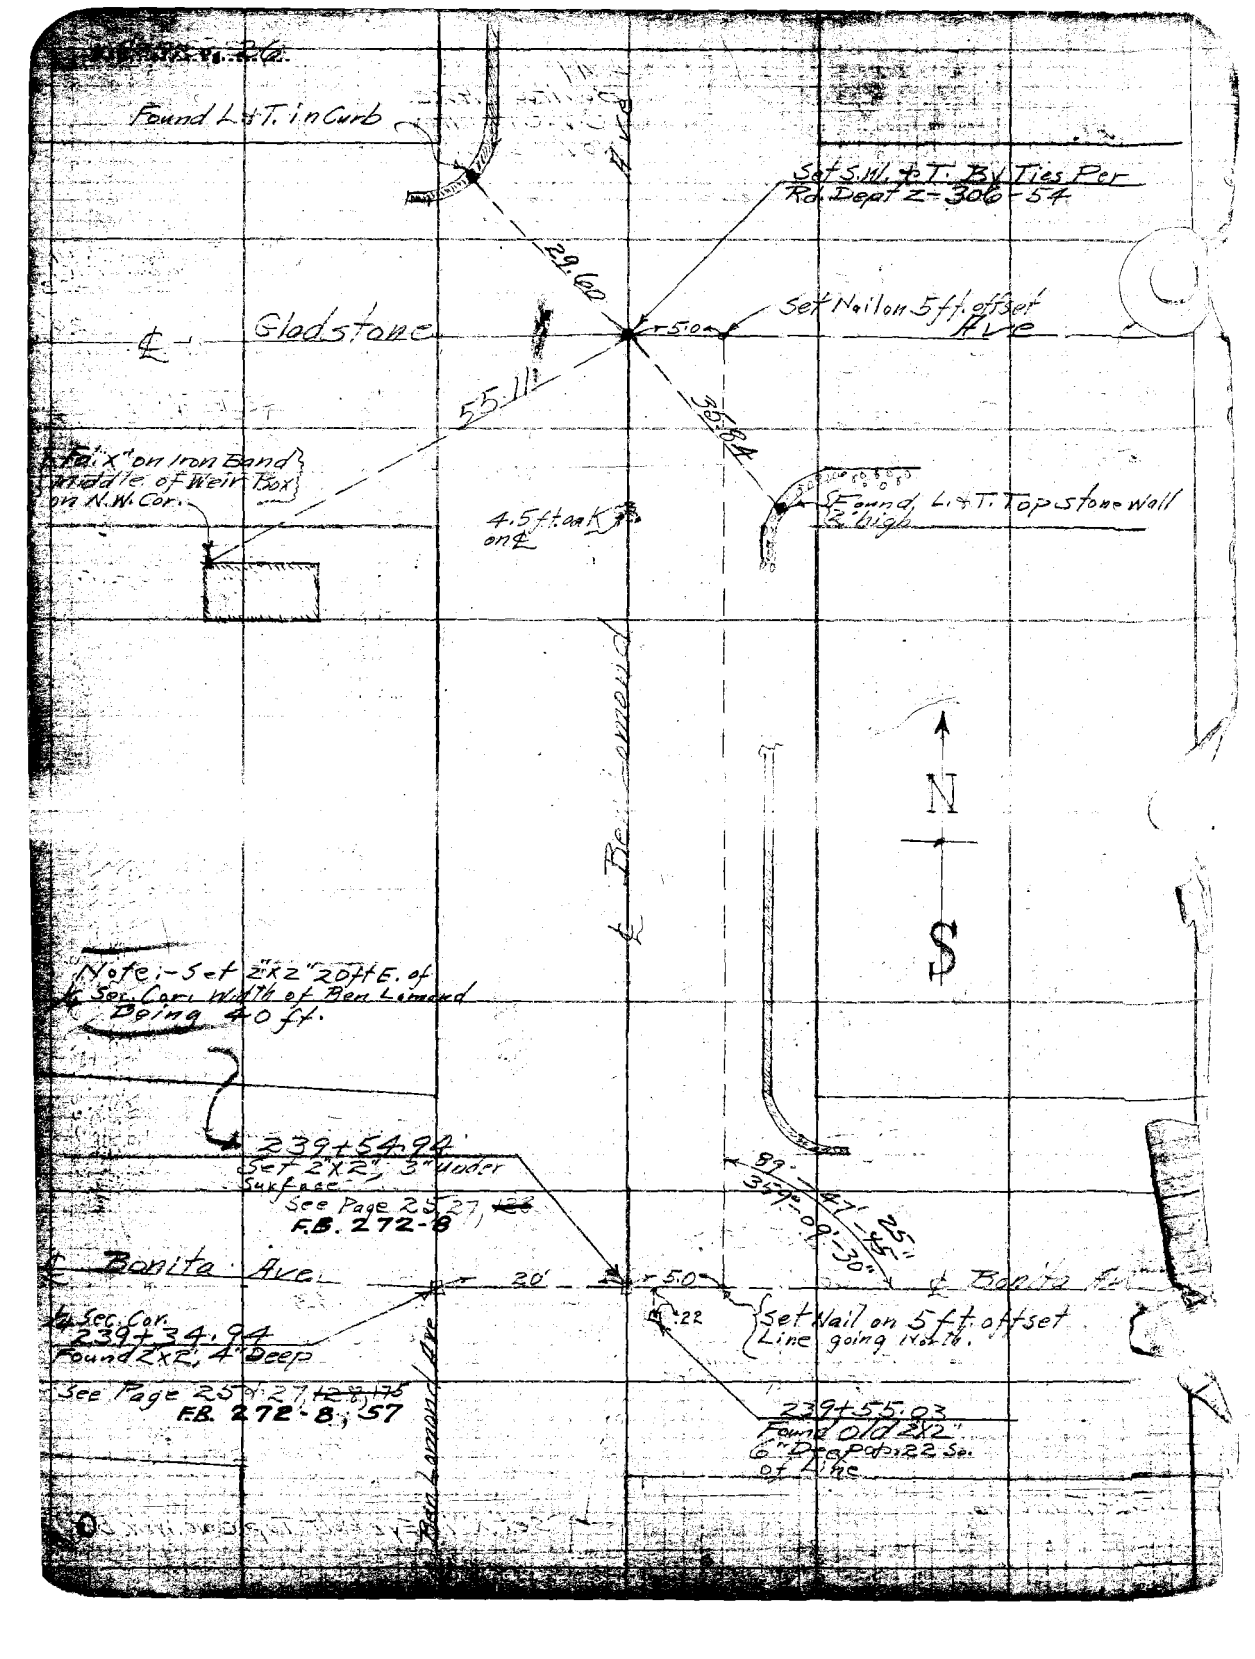
Found L.+T. in Curb
Set S.W. & T. By Ties Per Rd. Dept 2-306-54
29.60
Gladstone
5.0
Set Nail on 5 ft. offset
Ave
55.11
35.64
"X" on Iron Band Middle of Weir Box on N.W. Cor.
4.5 ft. on
Found L.+T. Top Stone Wall
Be. Leonard
N
S
Note:- Set 2"x2" 20" E. of Sec. Corn. Width of Ben Leonard Doing 40 ft.
239+54.94
Set 2"x2", 3" under Surface
See Page 25-27, 28
F.B. 272-8
Bonita Ave.
20'
5.0
.22
Set Nail on 5 ft. offset Line going N. & W.
Sec. Cor. 239+34.94
Found 2x2, 4" Deep
See Page 25-27, 28, 176
F.B. 272-8, 57
239+55.03
Found Old 2x2, 6" Deep .22 Se. of Line
Ben Leonard Ave

F. B. 252 Pg. 27

Platted by Wood	W. O. No. ____ D. S. O. No. ____
Date Feb. & Mar. 1927	Location Hamilton Ave.
Map No. 3304	Surveyed by C.W. Crawford
Platting C'k'd by Paige	Date Dec. 1926
Date April 1927	Indexed

=0+00 going south

Mon. Pg 28

Also F.B. 272-20, 56, 59

0°03 Calc.

F.B. 272-18

Adopted Existing ℄

0°03'45"

0°02

Also F.B. 272-14, 35

0.37

Also F.B. 272-1-14 35, 62, 58

13, 14 F.B. 272

See F.B. 310-111 for New Location

= 0°00'5"

F.B. 272-12

This Point used to fix Proposed ℄

Proposed ℄

12 F.B. 272

Also F.B. 272-8

Also F.B. 272-8, 57

F. Bk. ..... Pg. .....

F.B. 272-28,58

SEC. COR.
Set Co. Sur. Conc. Brass Cap Mon. stamped — 15" dwn. Set 2x2 & Tk. -1' dwn.
7-9-36, C.A.B.

COUNTY SURVEYOR
T 1 S
R 1 W
12 | 7
R 9 W
SEC. COR
R.E. 21.7

Plotted by Ahlgrad	W. O. No. 4049 O. S. O. No.
Date Feb. & Mar. 1927	Location Bonita Ave
Map No. 2904	Surveyed by C.W.C. & Crumley
Plotting C'k'd by Paige	Date Dec. 1926 & Jan. 1927
Date April 1927	Indexed

F.B. 272 P. 37

Set L.P. in Curb

Fd N.+T. in old T.P. F.B. 61-63

Note: This Pole Pulled By Guy Wire

Gladstone

Fd. old N.+T. N.W. Cor. Well Box – Per F.B. 61-63

Fd. 5.+W. By T.C.S. Rd. Dept F.B. 61-63

Fd 2" I.P. – 1 Ft. above ground

set 1"x1"

N

S

Fd X" in St. Pipe Per F.B. 61-62

Fd Nail

6+88.68 Fd 2" I.P. Plug + T.K. Sta. 6+85.08 Per Rd. Dept. 5235-34 See Page 27, N.F. 6 & 4150 F.B. 272-39, 40

Set N.+T.P.P. Set "X" in Curb

Fd "X" W. side Standpipe Per 5235-35 Fd. N.+T.P.

63.14

18.0

Ave

89°-51'-10" = 359-24-45 89°-51'-05" = Adj.+

Set No. 1

2+70 Set N.+T. Per F.B. 272-38

Fd X" in Curb Per Rd. Dept. Z-122-2

25.3+29.38 Exp. in W. = Ot. Going N. – Set N.+T. By Intersection. See Page 1, 126, N.M. Also F.B. 272-38, 58, 63

Bonita Ave

Fd. 5. T.C.S. See

F.B. 272

66 & 18

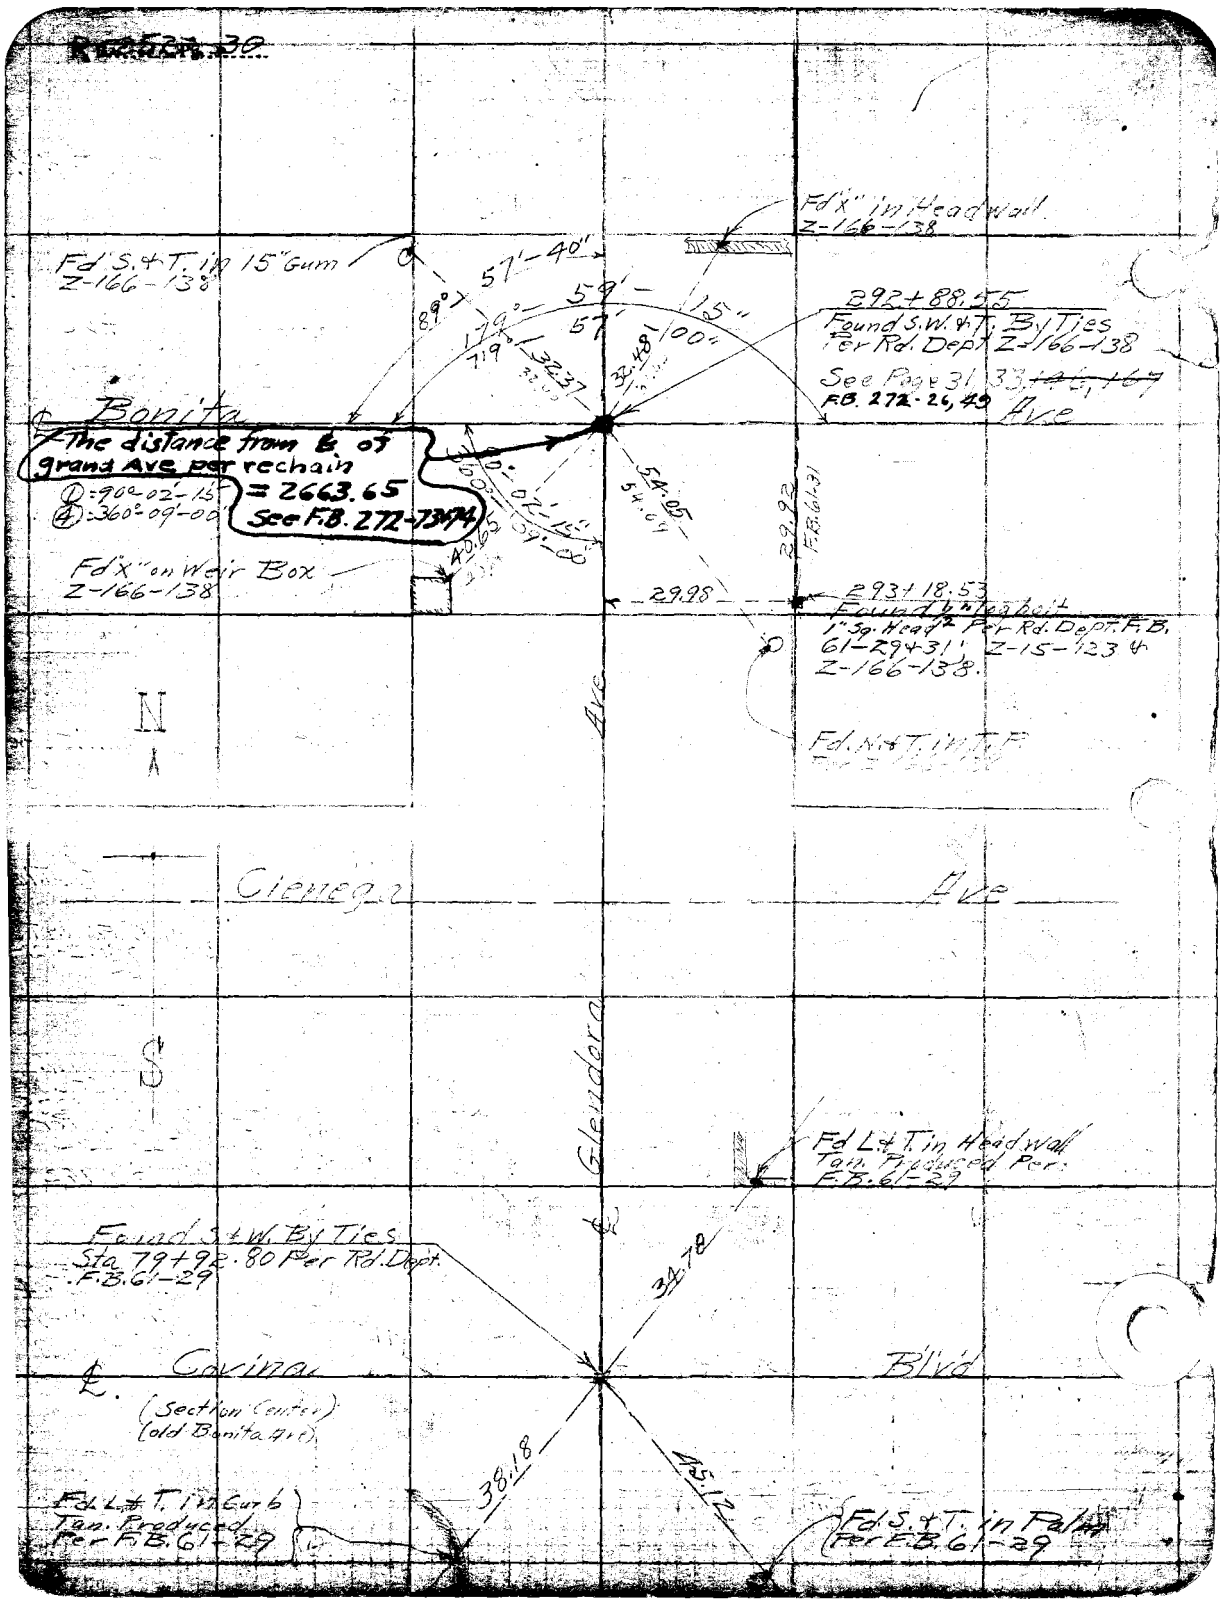
Fd S.&T. in 15" Gum
Z-166-138
Fd "X" in Headwall
Z-166-138
292+88.55
Found S.W. & T. By Ties
Per Rd. Dept Z-166-138
See Page 31.33
F.B. 272-26, 49
Bonita
The distance from ℄ of
grand Ave per rechain
① = 90°-02'-15"
④ = 360°-09'-00"
= 2663.65
See F.B. 272-73/74
Fd "X" on Weir Box
Z-166-138
29.98
29.92
F.B. 61-31
54.05
54.01
29+18.53
Found ½" Pipe with
1" Sq. Head ½ Per Rd. Dept. F.B.
61-29+31 Z-15-123 &
Z-166-138.
Fd. N. & T. in T. F
N
Ave
Cienega
Ave
S
Glendora
Fd L.&T. in Headwall
Tan. Projected Per
F.B. 61-29
Found S.&W. By Ties
Sta 79+92.80 Per Rd. Dept.
F.B. 61-29
34.18
℄ Covina
Blvd
(Section Center)
(old Bonita Mon.)
38.18
45.12
Fd L.&T. in Cut 6
Tan. Projected
Per F.B. 61-29
Fd S.&T. in Rail
Per F.B. 61-29

F.B. 272 Pg. 34

Drawn by Indeed	W. O. No. 4049 D. S. O. No.
Date Feb. & Mar. 1927	Location. Bonita Ave
Map No. 8904	Surveyed by C. V. Cummings
Plotting C'k'd. by Paige	Date January 1927
Date April 1927	Indexed.

Fd. N. & T. in 12" Wd. Inv. Flume Per Rd. Dept Z-166-138

179°-59'-50" Per Z-166-138

℄ Jaunita Ave

Found S. & W. Per Rd. Dept Z-166-138 Sta. 56+86.46 From N.

38.84

90°-03'

51.13

49.45

① = 90°-03'-00"
② = 360°-12'-00"

Fd. "X" N.E. Con Weir Box Per Rd. Dept Z-166-138

Fd. "X" on E. Side 16" Standpipe

89°-57'-00"

Set N. & T. For 5 Ft. off Set Line From West. See Page 33

Fd. small "X" on Top of Plug of 12" Steel Pipe Per Z-166-138

5 Ft. off Set Line

Set S.W. & T. For Property Line Running West. See Page 33

Property Line

20.17

29.09

12.19

Set N. & T. Tin Guard Fence Post

Set N. & T.

13.36

Set N. & T. Tin Guard Fence Post

13.16

457.92

Glenroy Ave

Fd. "X" in Head Wall Per Z-166-138

Fd. Spk. & T. in 15" Gum Tree Z-166-138

adj. 45"

89°-57'-00"

179°-59'-15"

292+88.55 Found Fd. S.W. & T. By Ties Per Rd. Dept Z-166-138 Sta. 70+05.61 From N.

See Page 30 Also F.B. 272-26, 61

32.37

32.48

℄ Bonita Ave

90°-00'-15"

360°-09'-00"

42.65

54.05

Fd. "X" on Weir Box Per Z-166-138

29.98

293+18.53 Fd. P. Lg. Bolt in Sq. Head Pin R.W. Dept. F.B. 61-29 & 31; Z-166-138.

Fd. N. & T. in Top Per Z-166-138

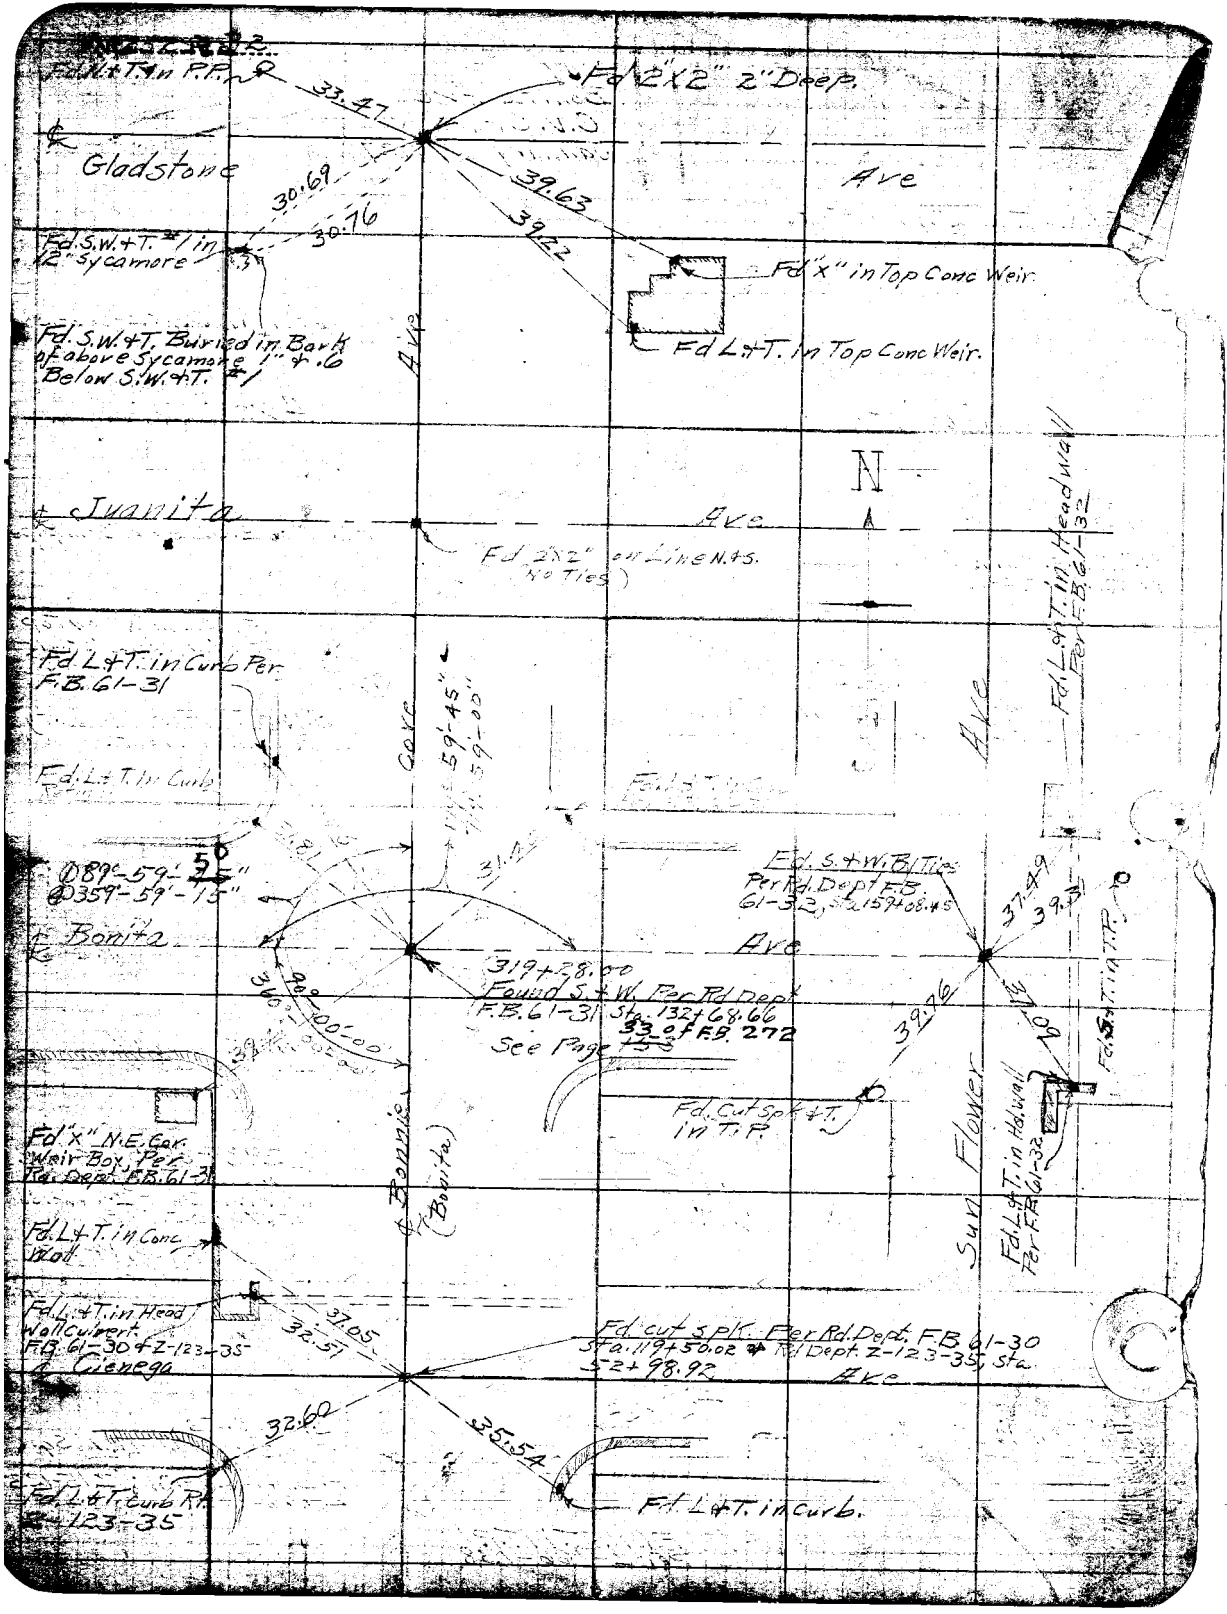
Fd. N. & T. in P.P.
33.47
Fd 2"x2" 2' Deep.
Gladstone
Ave
30.69
30.76
39.63
39.22
Fd. S.W. & T. #/ in 12" Sycamore
Fd "X" in Top Conc Weir.
Fd L. & T. in Top Conc Weir.
Fd. S.W. & T. Buried in Bark of above Sycamore 1.' + .6 Below S.W. & T. #/
Juanita
Ave
N
Fd. 2"x2" on Line N. & S. (No Ties)
Fd. L. & T. in Curb Per F.B. 61-31
Fd. L. & T. in Curb
Fd. L. & T. in Head Wall Per F.B. 61-32
Ave
59'-45"
59'-00"
Fd. L. & T.
Fd. L. & T. in Curb
Fd. L. & T. in Curb
Fd. L. & T. in Curb

Plotted by West
Date Feb. 14 1927
Map No. 6-10-1
Plotting C'k'd by Paige
Date April 1927

W. O. No. 4049 D. S. O. No.
Location. Bonita Ave
Surveyed by C.H. Bonner
Date January 1927
Indexed.

F.B. 282 Pg. 3

Glendora
179°-37'-15"
659.68
457.92
201.76
659.68
Set N&T. See Page 31
Set N&T. of Prop. Line 31 See Page 31
Set N&T.
Set N&T. in orange
Set "X" in sidewalk
Set "X" in Sidewalk
Set N&T. in T.P.
Set N&T. in T.P.
Set N&T.
Set N&T.
Set N&T

Drawn by: Neal
Date: Feb. 8 1927
Map No. 60A04
Platting C'k'd by: Paige
Date: April 1927

B. S. Q. No.
Location: Bonita Ave
Grid Examined by
Date: Oct. 31 Nov. 1926
Indexed

Notes By H.S.

Note:
AVO. = Avocado

T.P. 1+75.5

10 in Dia AVO. 1+56.5 82.1 OUT
10 in Dia 1+56.5 37.1 OUT
10 in Dia AVO. 32.7 OUT

12 in Dia AVO. 1+41 81.4 OUT
12 in Dia 1+41 58.3 OUT
5 in Dia AVO. 32.3 OUT

5 in Dia Orange 1+16.8 82.1 OUT
5 in Dia Orange 1+16.8 57.3
5 in Dia Orange 32.9 OUT

Drive 1+08 OUT

14 in Dia AVO. 0+81 82.1 OUT
12 in Dia AVO. 60.9 OUT
8 in Dia AVO. 0+81 33.4 OUT

Bonita Ave

0+78.7 15.4 OUT PP

T.P. 0+71.2 19.2 OUT

6 in Dia AVO. 0+59.5 83.4 OUT
6 in Dia AVO. 56.1 OUT
Gas Pipe 0+46.5 32.4 OUT
8 in Dia 0+46.5 27.4 OUT

8 in Dia AVO. 0+46.5 68.2 OUT
Century Plant 0+66 22.0 OUT
0+54.3 57.2 OUT
8 in Dia AVO. 0+35.8 38.3
0+21.8 57.2 OUT
0+22.8 24.1 OUT
Beginning of Vineyard

8 in Dia AVOCADO 0+27.9 44.4 OUT
Guy P. 0+22.9 24.1 OUT
0+20.9 1" I.P. 23.6 OUT
0+12.4 O.T.P. 33.3
AVO. 79.2 OUT AVO. 26.3 OUT
Fence
Guy P. 0+12.8 42.4 OUT

Note T.P. Tyms Thru Sta 25+00 East 50ft.

Small Grape Vines

Average Dia. 3"

0+22.3

Orchard

See Page 4

MAIN AVE

Sta 0+17 2.3 OUT Guy P.
Sta 0+23 18.1 OUT P.P.
29.85
.23
6"x6" Conc. Monument Per Deed
Cobble Wall 4' Wide 3' High
Retaining Wall
Lemon Grove
AVO Going East
See Page 4
Note: all off sets are from ℄

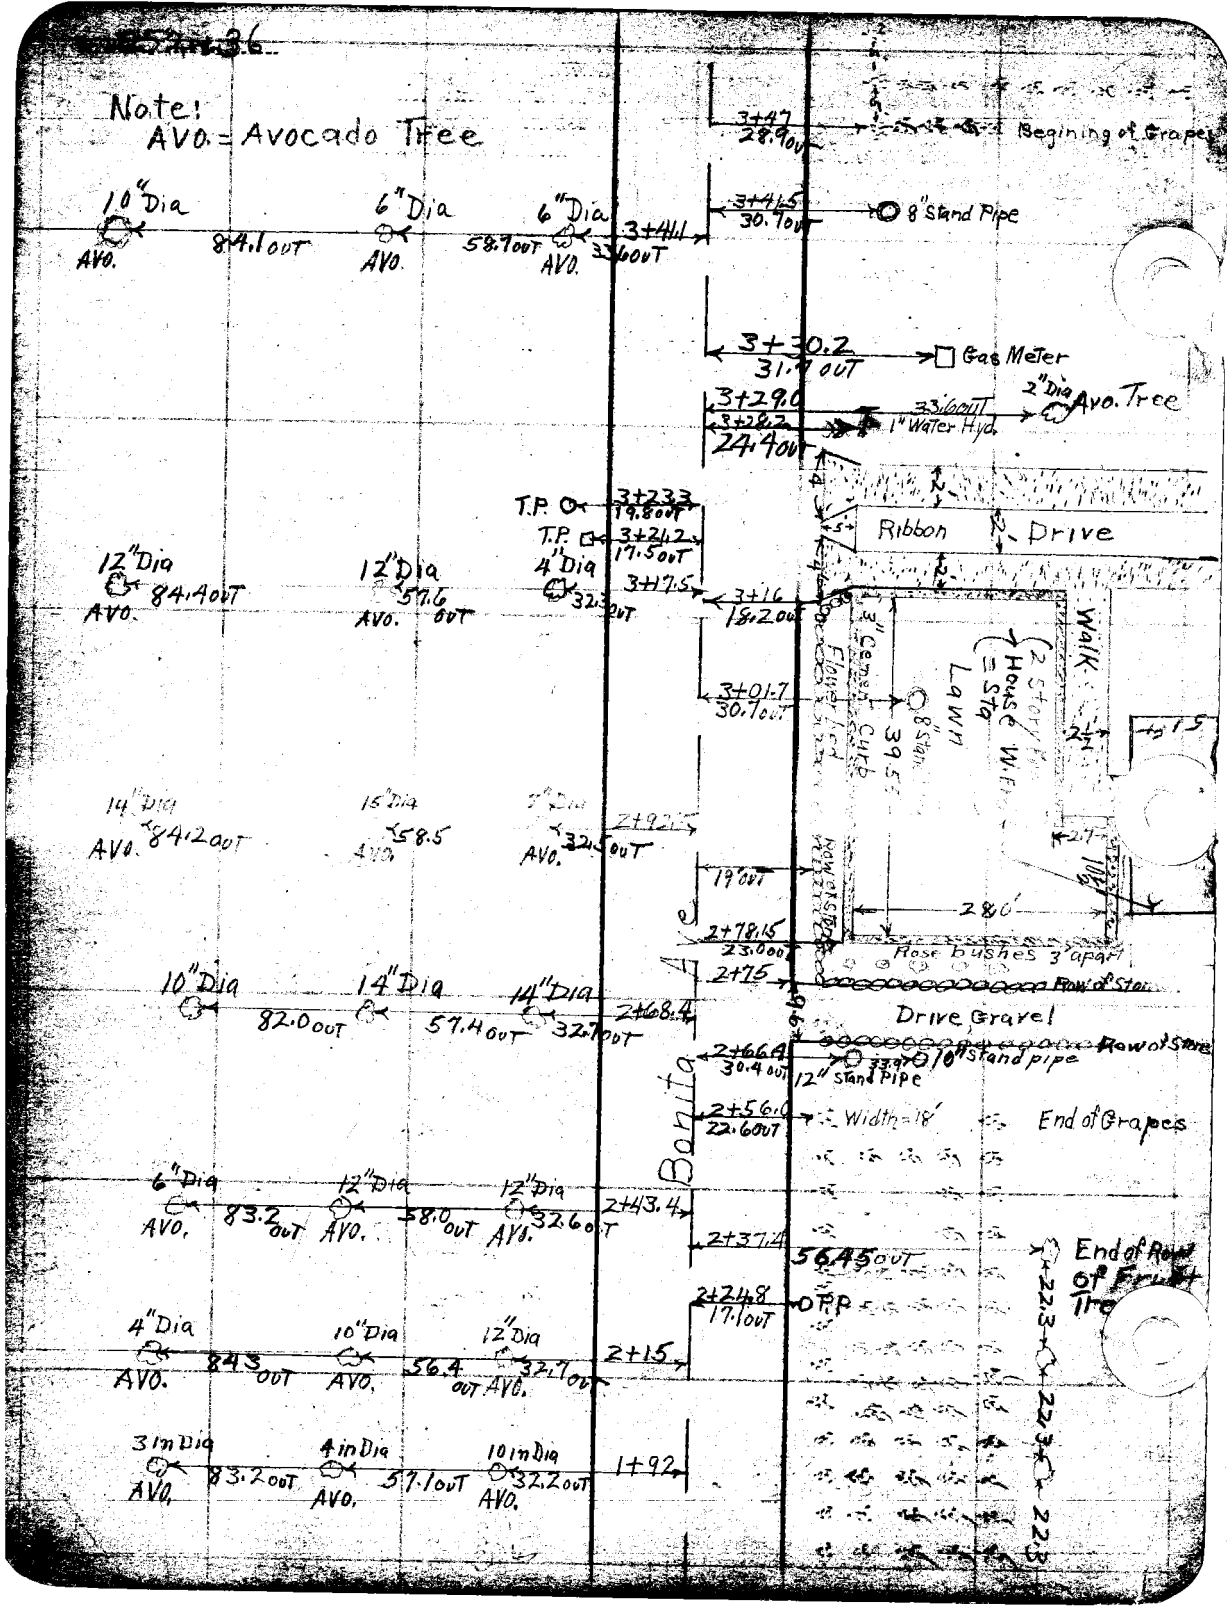
Note!
AVO. = Avocado Tree
10" Dia
AVO.
84.1 OUT
6" Dia
AVO.
58.7 OUT
6" Dia
AVO.
3+41.1
3+47
28.9 OUT
Begining of Grapes
3+41.5
30.7 OUT
8" Stand Pipe
3+30.2
31.7 OUT
Gas Meter
3+29.0
3+28.2
24.4 OUT
33.6 OUT
2" Dia
Avo. Tree
1" Water Hyd.
T.P.
3+23.3
19.8 OUT
T.P.
3+21.2
17.5 OUT
12" Dia
AVO.
84.4 OUT
12" Dia
AVO.
57.6 OUT
4" Dia
32.3 OUT
3+17.5
3+16
18.2 OUT
Ribbon
Drive
Walk
(2 story
House W.F.
= Sta
Lawn
3" Concrete Curb
Flower Bed
8" Stan.
3+01.7
30.7 OUT
39.5'
14" Dia
AVO.
84.2 OUT
15" Dia
AVO.
58.5
5" Dia
AVO.
32.5 OUT
2+92.5
19 OUT
2+78.15
23.0 OUT
28.0'
Rose bushes 3' apart
Row of Stone
2+75
Drive Gravel
10" Dia
82.0 OUT
14" Dia
57.4 OUT
14" Dia
32.7 OUT
2+68.4
2+66.4
30.4 OUT
12" Stand Pipe
10" Stand pipe
Row of Stone
2+56.0
22.6 OUT
Width = 18'
End of Grapes
6" Dia
AVO.
83.2 OUT
12" Dia
AVO.
58.0 OUT
12" Dia
AVO.
32.6 OUT
2+43.4
2+37.4
56.45 OUT
End of Row of Fruit Tree
22.3'
22.3'
22.3'
2+24.8
17.1 OUT
ORP
4" Dia
AVO.
84.3 OUT
10" Dia
AVO.
56.4 OUT
12" Dia
AVO.
32.7 OUT
2+15
3 in Dia
AVO.
83.2 OUT
4 in Dia
AVO.
57.1 OUT
10 in Dia
AVO.
32.2 OUT
1+92

F. B. 252 Pg. 37

Platted by Wood.	W. O. No. ____ D. S. O. No. ____
Date Sep. 9 1947	Location. ____
Map No. 8107	Surveyed by ____
Platting C'k'd by Boyce	Date ____
Date April 1948	Indexed ____

Notes By H. S. Johnson

Note:
Ave A & 26th

F. B. [illegible] Pg. 252 38

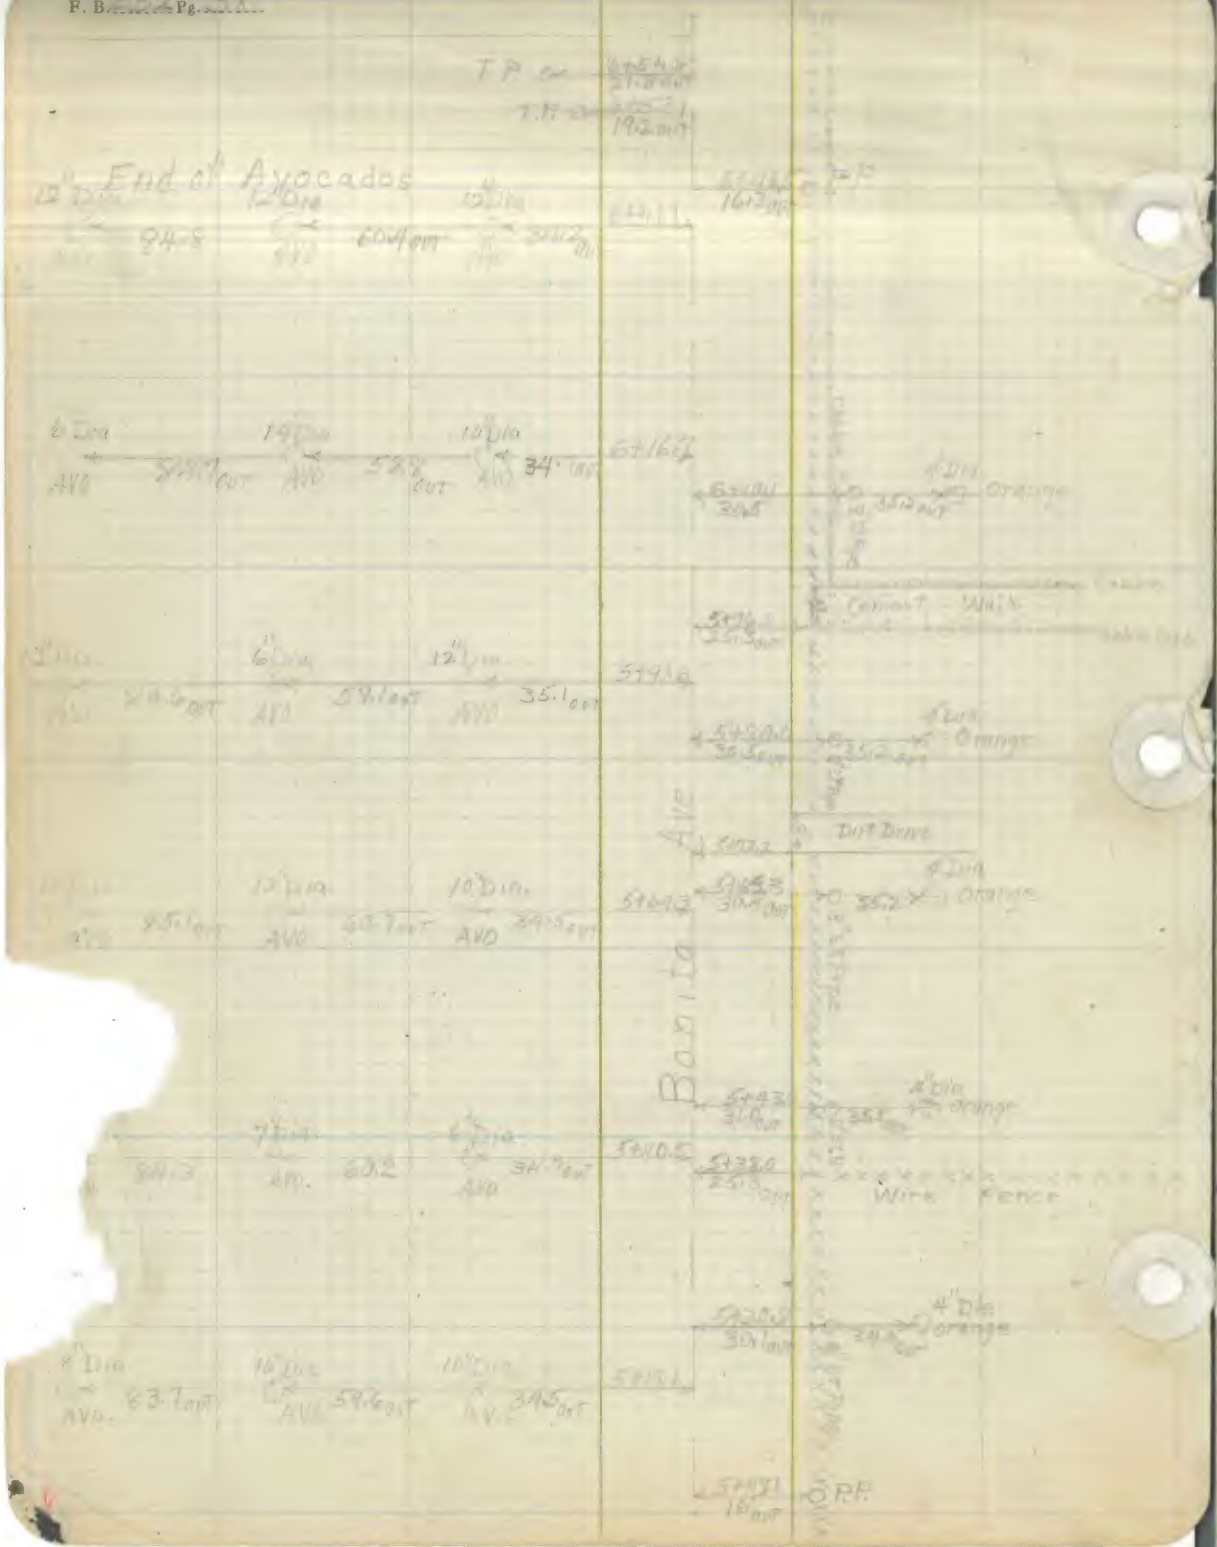
T.P.
End of Avocados
12" Dia
12" Dia
12" Dia
94.8
60.4 OUT
35.2 OUT
6" Dia
12" Dia
10" Dia
AVO
54.1 OUT
AVO
52.8 OUT
AVO
34.1 OUT
6" Dia
12" Dia
AVO
54.6 OUT
AVO
54.1 OUT
AVO
35.1 OUT
12" Dia
10" Dia
AVO
55.1 OUT
AVO
53.7 OUT
AVO
34.5 OUT
7" Dia
6" Dia
AVO
54.3
AVO
60.2
AVO
34.7 OUT
4" Dia
10" Dia
10" Dia
AVO
63.7 OUT
AVO
59.6 OUT
AVO
34.5 OUT
Cement - Walk
4" Dia Orange
4" Dia Orange
Dirt Drive
4" Dia Orange
Barn Lot
4" Dia Orange
Wire Fence
4" Dia Orange
P.P.

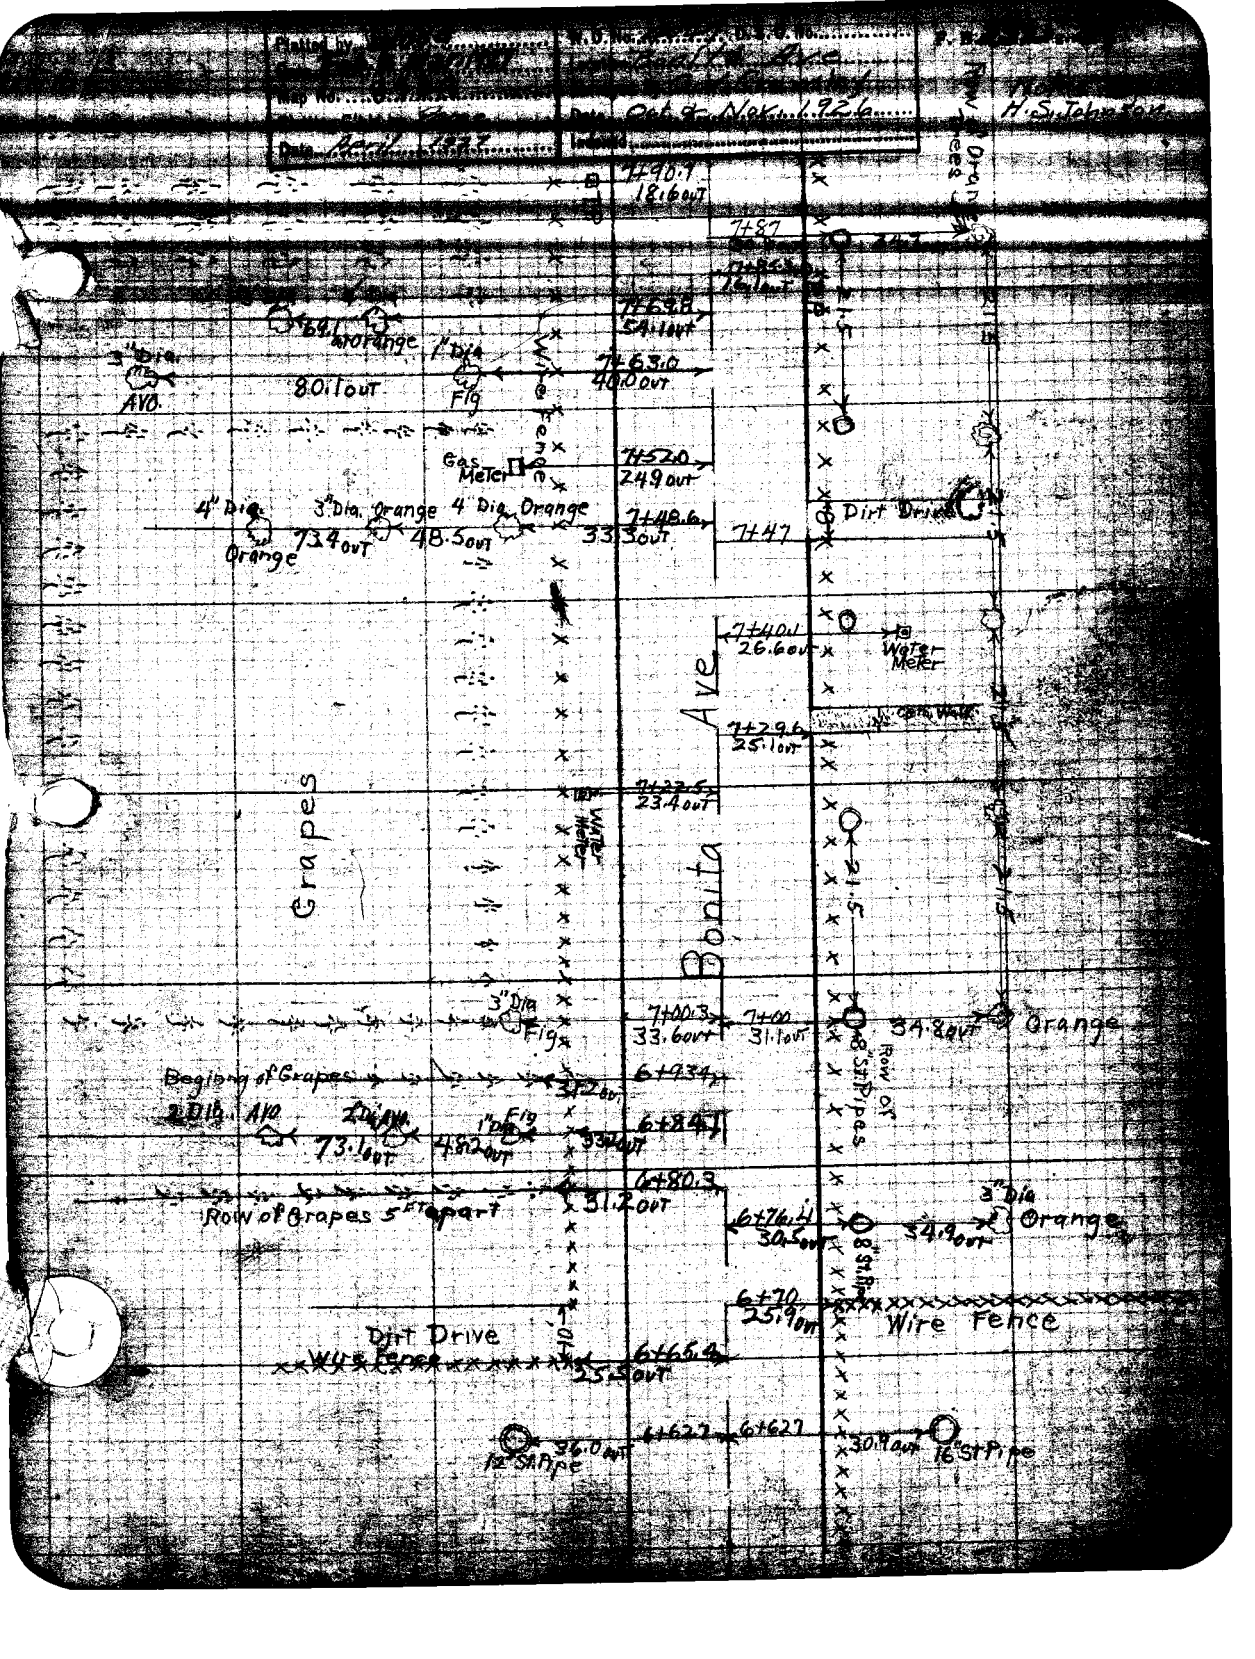
Oct 8 - Nov. 1926
H.S. Johnson
7+90.9
18.6 out
7+87
7+86.3
7+69.8
54.1 out
7+63.0
40.0 out
7+52.0
24.9 out
7+48.6
33.3 out
7+40.1
26.6 out
7+29.6
25.1 out
7+22.5
23.4 out
7+00.3
33.6 out
7+00
31.1 out
6+93.4
6+84.7
6+80.3
31.2 out
6+76.4
30.5 out
6+70
25.9 out
6+65.4
25.5 out
6+62.7
6+62.7
30.9 out
36.0 out
8.0 i out
7.4 out
7.3 out
73.1 out
48.2 out
48.5 out
33.3 out
34.8 out
34.9 out
Dirt Drive
Wire Fence
Row of Grapes 5 Ft apart
Beginning of Grapes
Grapes
Orange
Water Meter
Gas Meter
8" St. Pipe
16" St. Pipe
1/2" Sh. Pipe
3" Dia. AVO.
4" Dia. Orange
3" Dia. Orange
4 Dia. Orange
1" Dia. Fig
2" Dia. AVO.
3" Dia. Orange
3" Dia. Orange
3" Dia. Orange
3" Dia. Fig
2" Dia. AVO.
1" Dia. Fig
4" Dia. Orange
Row of 8" St. Pipes

Platted by Ward
Date Jan. 8 Nov. 1927
Map No. 8994
Platting C'k'd by Price
Date April 1927

W.O. No. 4849 G.B.O. No.
Location Bonita Ave
Surveyed by C.L. Crumley
Date Oct. 4 Nov. 1926
Indexed

Notes By H.S. Johnson

Grades

Wire Fence

Bonita Ave

9+93.9
30.4 OUT
8" ST.P.
3" Dia. Orange
Flowerbed

9+37.6
18.3 OUT
T.P.

9+33.6
24.5 OUT
2x2 With Tack

9+33.5
15.6 OUT
B.P.

9+20.2
30.4 OUT
8" ST. Pipe
2.2+2

4" Curb

8+63.8
45.7 OUT
8" ST.P.
Curb
1/2 Dia. Oak
3" Dia. Orange
56.1 OUT
4" Curb

Ribbon Drive

8+34.2
24.7 OUT
4" Cement Curb

8+17.3
20.8 OUT
T.P.

8+09.4
30.4 OUT

8+01.4
25.1 OUT
Row of 8" ST. Pipe
Wire Fence

Plotted by [illegible]
Map No. [illegible]
Date April 1927
Y.O.M. [illegible] U.S.G.S. No. [illegible]
Survey by [illegible] Bonita Ave. [illegible]
Date Oct & Nov. 1926
Notes by [illegible]

10+97.9
10+75.7
30.3 OUT
8" STP.
10+63.51
24.93 OUT
2x2 with Tack
10+61.0
15.6 OUT
P.P.
10+54.0
30.2 OUT
8" STP.
3" Dia
34.6 OUT
Orange
Farm Land
Wire Fence
Bonita Ave
10+30.8
30.2 OUT
8" STP.
34.0 OUT
3" Dia
Orange
4" Cement Walk
10+21.0
24.8 OUT
4" Cem. Curb
10+08.4
30.5 OUT
8" STP. Set in 12" Cem. base
34.0 OUT
Dia
Orange
LAWN
47.0'
Wire Fence
End of Grapes
9+97.4
25.0 OUT
9+87.2
36.3 OUT
P.P.
9+83.9
20.9 OUT
9+85.9
30.6 OUT
8" STP. Set in 12" Cem. base
34.0 OUT
Dia
Orange
4" Cement Curb
9+71.2
24.8 OUT
9+65.3
30.4 OUT
STP
34.1 OUT
Grapes
Row of Cobble Stones
Dirt Drive
9+48.3
Row of Cobblestones

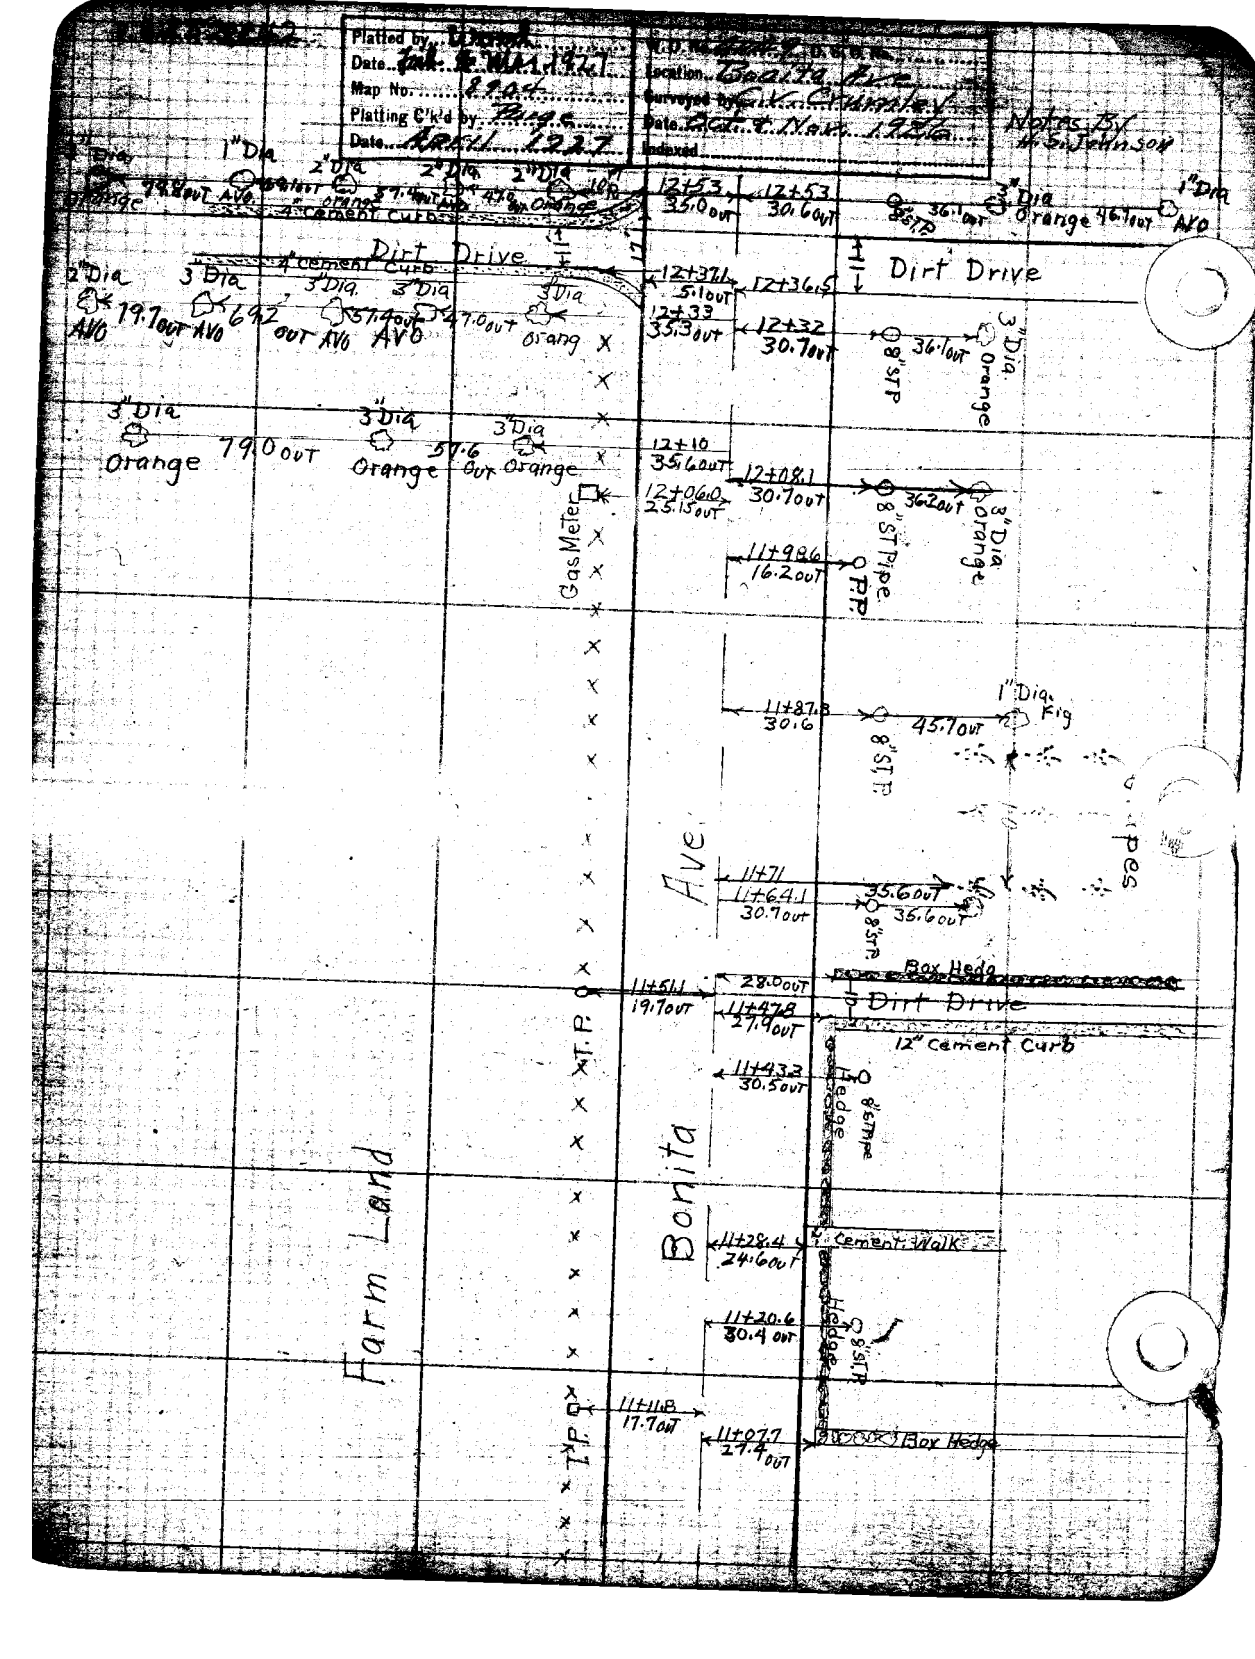
Platted by
Date
Map No.
Platting C'k'd by
Date
Location
Surveyed by
Date
Indexed
Notes By
1" Dia
2" Dia
3" Dia
Orange
AVO
4" Cement Curb
Dirt Drive
12+53
35.0 out
12+53
30.6 out
12+37.6
5.1 out
12+36.5
12+33
33.3 out
12+32
30.7 out
8" ST Pipe
36.1 out
12+10
35.6 out
12+08.1
30.7 out
12+06.0
25.15 out
36.2 out
11+98.6
16.2 out
T.P.
11+87.8
30.6
45.7 out
Fig
11+71
11+64.1
30.7 out
35.6 out
Box Hedge
11+51.1
19.7 out
28.0 out
11+47.8
27.9 out
12" Cement Curb
11+43.2
30.5 out
Hedge
8" ST Pipe
11+28.4
24.6 out
4" Cement Walk
11+20.6
30.4 out
11+11.8
17.7 out
11+07.7
27.4 out
Gas Meter
Farm Land
Bonita
Ave.

Plotted by LeBard	W. O. No. 4049 D. S. O. No.
Date Feb. 6 1927	Location Bonita Ave.
Map No. 2909	Surveyed by C.V.L. Crumley
Platting C'k'd by Paige	Date Oct. & Nov. 1926
Date April 1927	Indexed.

F. B. 252 Pg. 43

Notes By H.S. Johnson

Row of 4" Dia. Orange Trees 21.3 Ft. apart

Row of 8" ST.P. 21.3 Ft. apart

Unimproved Pub—

Bonita Ave

13+47.2 12.2 OUT — RPO

13+43.4 30.6 OUT — 8" ST.P. 36.4 OUT — Orange

13+31.0 30.6 OUT — 16" ST Pipe

13+29.78 — 2" I.P. With Tag "Tack" — See Page 6

3" I.P. with Cap See Back of Page

13+30.31 24.9 OUT — S.W.N.T. Sta 13+30.19 on ℄ — See Page 6

90° 15' 10"
361° 00' 45"

13+20.2 30.6 OUT — 8" ST.P. 36.7 OUT

Lot "B" Tr. 1916 MB 21-66

Gas Meter — 13+13.5 24.5 OUT

T.P. — 13+11.6 20.4 OUT

13+09.8 25.0 OUT

1" Dia 1" Dia 1" Dia

69.1 OUT 57.6 OUT AVO. 47.1 OUT

12+78 31.1 OUT — 8" ST.P. 36.5 OUT — 3" Dia. Orange

3" Dia AVO. 3" Dia AVO.

47.0 OUT 35.8 OUT

12+80 19.0 OUT

12+78

3" Dia AVO. 82.3 OUT 3" Dia AVO. 69.1 OUT

T.P.

12+76 31.0 OUT — 8" ST.P. 36.5 OUT — 3" Dia. Orange 46.7 OUT — 3" Dia AVO.

12+74 26.7 OUT

8" St Pipe — Water Meter in I.P. St. Box

Unimproved Land

Ave

Bonita

Row of 8" standpipes 21.3 Ft apart

3" Dia. Row of Orange Trees 21.3 Ft apart

14+77.7
19.1 OUT

14+95.8
16.0 OUT

CRB

T.P. 14+46.6
19.1 OUT

F.B. 252 Pg. 45

Platted by L.J. Ford	W. O. No. 4249 D. S. O. No.
Date Feb. & Mar. 1927	Location Bonita Ave.
Map No. 8904	Surveyed by C.K. Crumley
Platting C'k'd by Paige	Date Oct. & Nov. 1926
Date April 1927	Indexed.

Notes By H.S. Johnson

17+17.5 44.4 OUT — 5" P.W.P. Plug in Tack — E.C. N.W. Cor. Lot 6, Tr. 8706

17+03.5 30.4 OUT — 8" St. Pipe — 57.9 OUT — 3" Dia Orange

Fd. 2" I.P. N.W. Cor. Lot 5 Tr. 8706 M.B. 113-26 — 74.5 S

16+87.67

16+73.1 30.4 OUT — 8" St. P. — 57.8 OUT — 3" Dia Orange

S.W. Cor. ℄ see Pg 7

16+63.47 — Bleeker St.

16+40.8 30.4 OUT — 8" St Pipe — 57.8 OUT — 3" Dia Orange

16+37.2 21.6 OUT — I.P. — 1.3 OUT — 30" St Pipe — 74.9 S

Guy P.

16+35.6 21.0 OUT — 16+33.1 33.0 OUT — 18" St Pipe

16+19.6 30.4 OUT — 36.6 OUT — Row of 4" Oranges

Unimproved Land

Bonita Ave

16+17.9 21.0 OUT — I.P.

16+15.4 19.6 OUT — I.P.

Row of 8" St Pipe Continued

16+37.5 — E.C. N.E. Cor. Lot 5 Tr. 8706

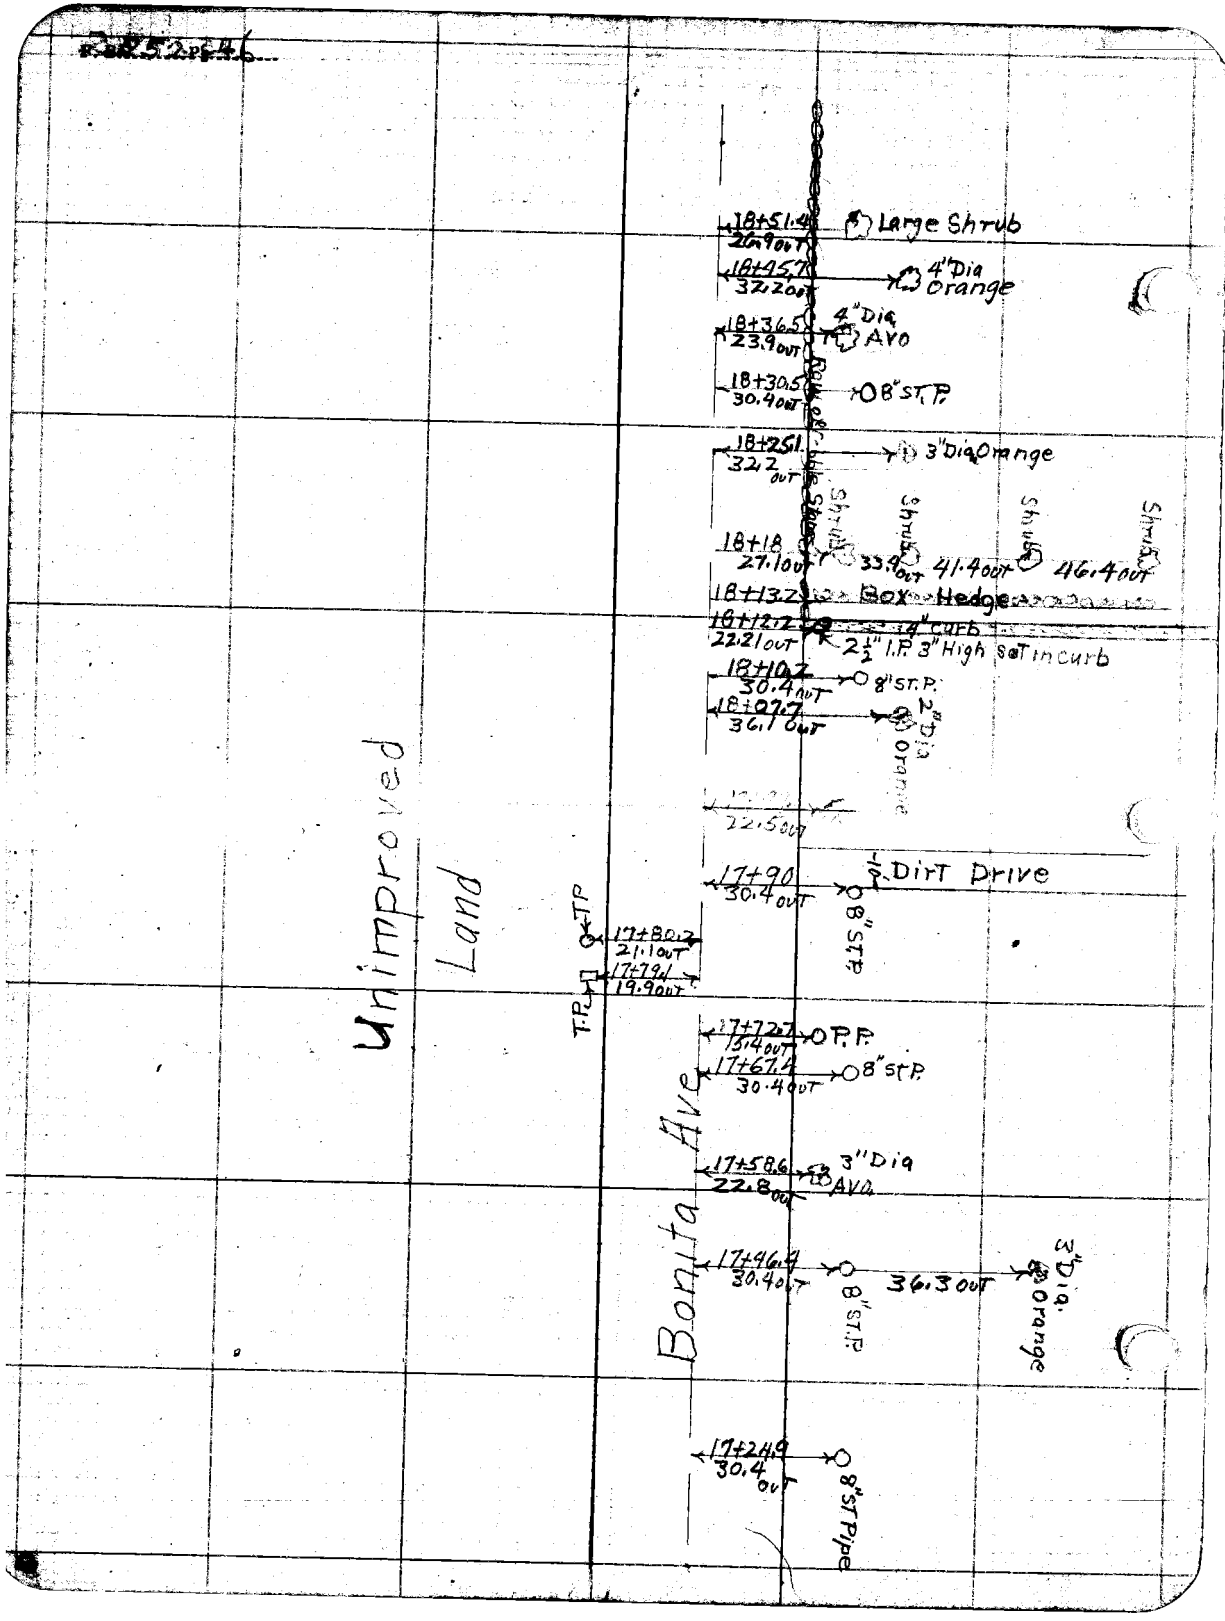
18+51.4
20.9 OUT
Large Shrub
18+45.7
32.2 OUT
4" Dia Orange
18+36.5
23.9 OUT
4" Dia AVO
18+30.5
30.4 OUT
8" ST. P.
18+25.1
32.2 OUT
3" Dia Orange
Shrub
Shrub
Shrub
Shrub
18+18
27.1 OUT
33.9 OUT
41.4 OUT
46.4 OUT
18+13.2
Box Hedge
18+12.2
22.2 OUT
14" Curb
2½" I.P. 3" High set in curb
18+10.7
30.4 OUT
8" ST. P.
18+07.7
36.1 OUT
2" Dia Orange
22.5 OUT
17+90
30.4 OUT
Dirt Drive
8" ST.P.
T.P.
17+80.7
21.1 OUT
17+79.4
19.9 OUT
T.P.
17+72.7
15.4 OUT
P.P.
17+67.4
30.4 OUT
8" ST.P.
17+58.6
22.8 OUT
3" Dia AVO
17+46.9
30.4 OUT
8" ST.P.
36.3 OUT
3" Dia. Orange
17+24.9
30.4 OUT
8" ST Pipe
Unimproved Land
Bonita Ave

F. B. 252 Pg. 47

Platted by Wood	W. O. No. 4049 O. S. O. No.
Date Feb. & Mar. 1927	Location, Bonita Ave
Map No. 8904	Surveyed by C. H. Cummings
Platting C'k'd by Paige	Date Oct. & Nov. 1926
Date April 1927	Indexed.

Notes By H. S. Johnson

Unimproved Land

Bonita Ave

19+86.4 — 30.1 OUT — 16" St. Pipe

19+80.2 — 30.4 OUT — 8" ST.P. — 36.5 OUT — 3" Dia Orange

19+69.6 — 21.5 OUT — T.P.

19+69.2 — 25.0 OUT — 6" Dia Avo.

19+58.9 — 30.4 OUT — 8" ST.P. — 36.6 OUT — 4" Dia Orange

19+57.0 — 15.4 OUT — O.P.P.

19+38.0 — 30.4 OUT — 8" ST.P. — 36.6 OUT — 3" Dia. orange

19+26.7 — 24.0 OUT — 3" Dia Avo.

19+22.8 — 19.6 OUT — T.P.

19+16.2 — 30.5 OUT — 8" ST.P. — 36.6 OUT — 4" Dia. Orange

18+95.1 — 30.4 OUT — 8" ST.P. — 36.6 OUT

18+83.9 — 24.9 OUT — 3" Dia Avocado

18+74.2 — 30.5 OUT — 8" ST.P. — 36.6 OUT — 3" Dia Orange

18+68.4 — 19.9 OUT — 6" Pepper

12'

4" Cement Drive

20.9 OUT

18+56.4 — 25.6 OUT — 4" Curb — Row of Roses

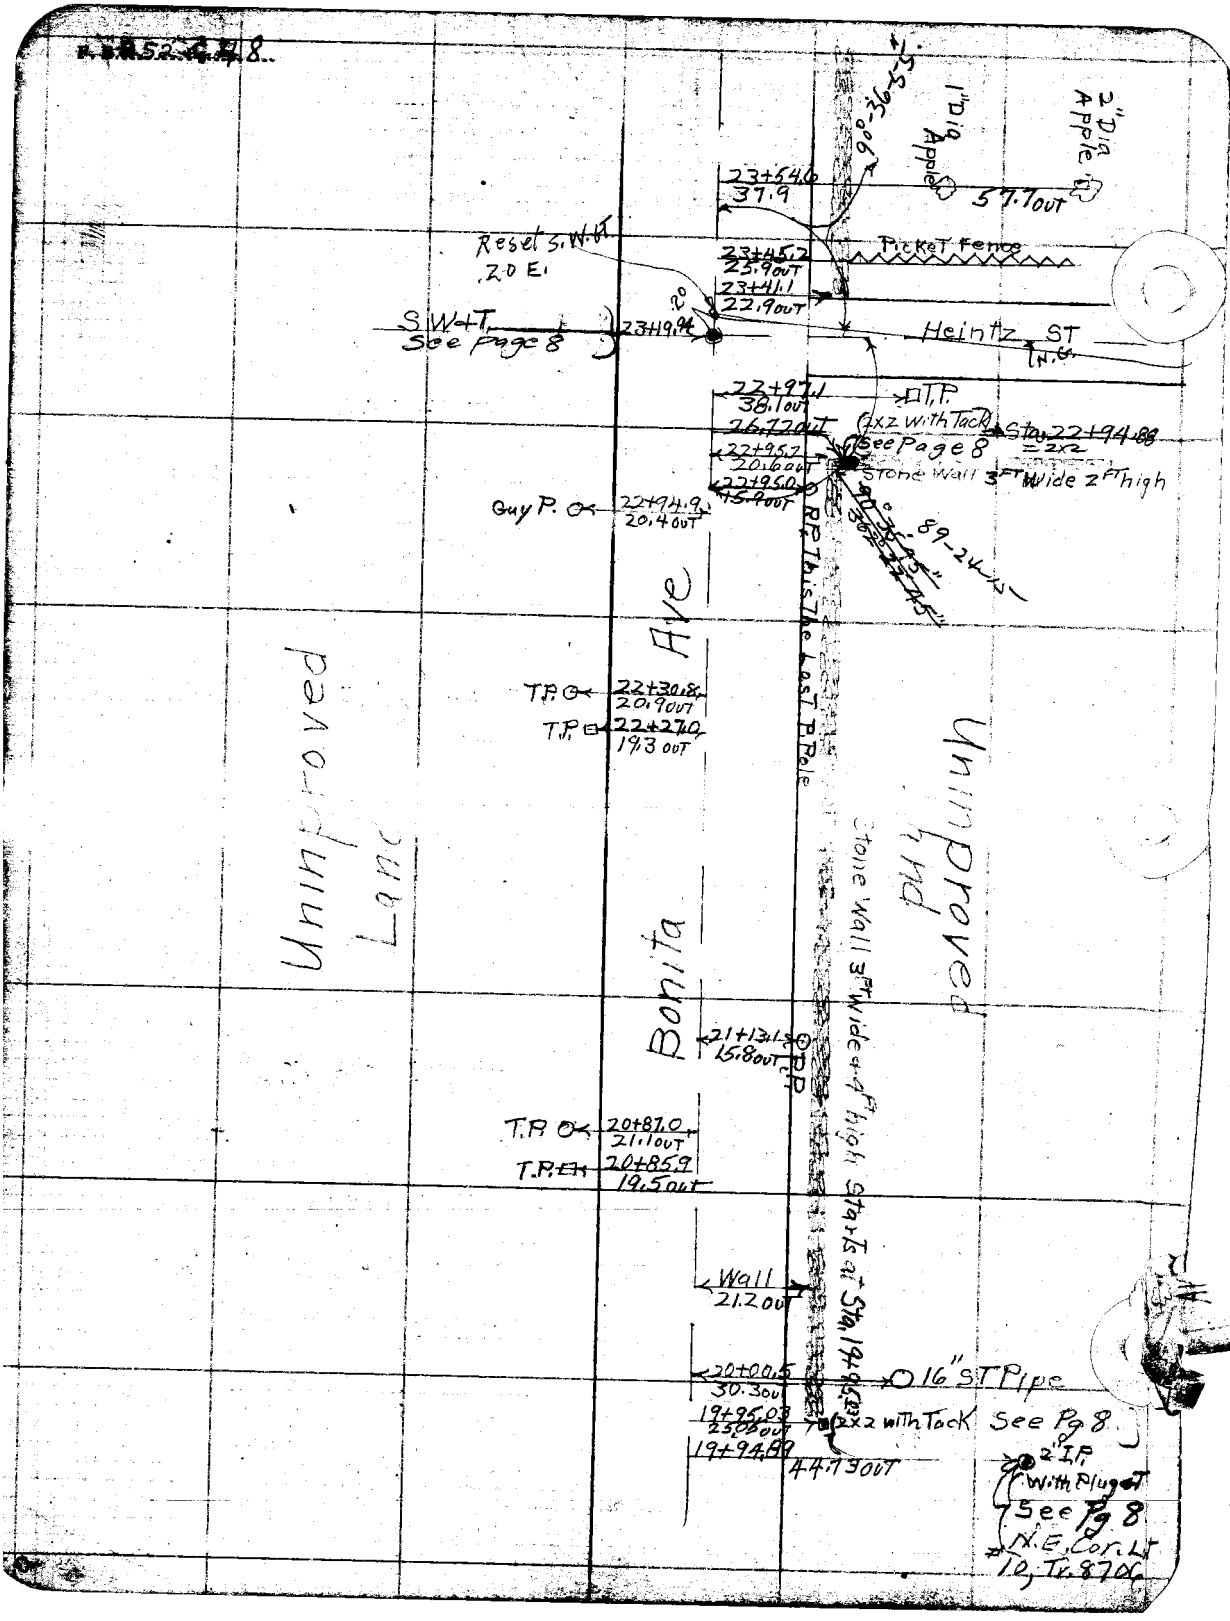
1" D.I.P. Apple
2" D.I.P. Apple
23+54.6
37.9
57.7 out
Picket Fence
Reset S.W.T. 2.0 E.
23+45.2
23.9 out
23+41.1
22.9 out
S.W.T. See Page 8
23+19.9
Heintz ST
22+97.1
38.1 out
T.P.
26.7 out
1x2 with Tack
Sta. 22+94.88 = 2x2
See Page 8
22+95.7
20.6 out
22+95.0
15.9 out
Stone Wall 3FT Wide 2FT High
Guy P.
22+94.9
20.4 out
89-24-1/2 W
R.P. This the Last P. Pole
Unimproved Lane
Bonita Ave
T.P.
22+30.8
20.9 out
T.P.
22+27.0
19.3 out
Unimproved Land
Stone Wall 3FT Wide 4FT High Starts at Sta 19+95.03
21+13.1
15.8 out
R.P.
T.P.
20+87.0
21.1 out
T.P.
20+85.9
19.5 out
Wall
21.2 out
20+00.5
30.3 out
16" ST Pipe
19+95.03
23.8 out
2x2 with Tack See Pg 8
19+94.88
44.1 9 out
2" I.P. with Plug
See Pg 8
N.E. Cor. Lt 10, Tr. 870

Platted by Wescott	W. O. No. 4042 D. S. O. No.
Date Feb. 2 Mar. 1927	Location Bonita Ave
Map No. 2904	Surveyed by C. K. Cavanaugh
Platting C'k'd by Paige	Date 21st Nov. 1926
Date April 1927	Indexed

F. B. 282 Pg. 49

Notes by H. S. Tomson

T.P. O 25+20.7 20.1 OUT
T.P. B 25+18.8 18.6 OUT
25+05.1 22.1
24+86.6 22.1
24+79.0 29.5 OUT
24+73.6 29.5 OUT
29+54.5 15.8 OUT
24+31.1 42.8 OUT
24+27.1 29.5 OUT
24+26.1 22.8 OUT
24+07.7 22.6 OUT
23+96.9 38.1 OUT
23+71.9 20.4 OUT
T.P. O
23+71.0 18.7 OUT
TP B
23+56.6 38.1 OUT

Pilar 4x4
1½ FT Stone Wall 2FT High
20 FT
14½ FT
Dirt Drive
1½ FT Stone Wall 2FT High
8" St. Pipe
16" St. pipe
6" W.P.
Blue Gum
Tree
Stone Wall 1½ FT Wide 2 FT High
14½ FT
Dirt Drive
4'
Stone Wall 2FT High 1½ FT Wide
Stone Pillar
2" Dia Apple
57.6 OUT
2" Dia Apple
Cobble Wall
1" Dia Pressimmon
2" Dia. Peach
37.5 OUT

Bonita Ave

Unimproved Land

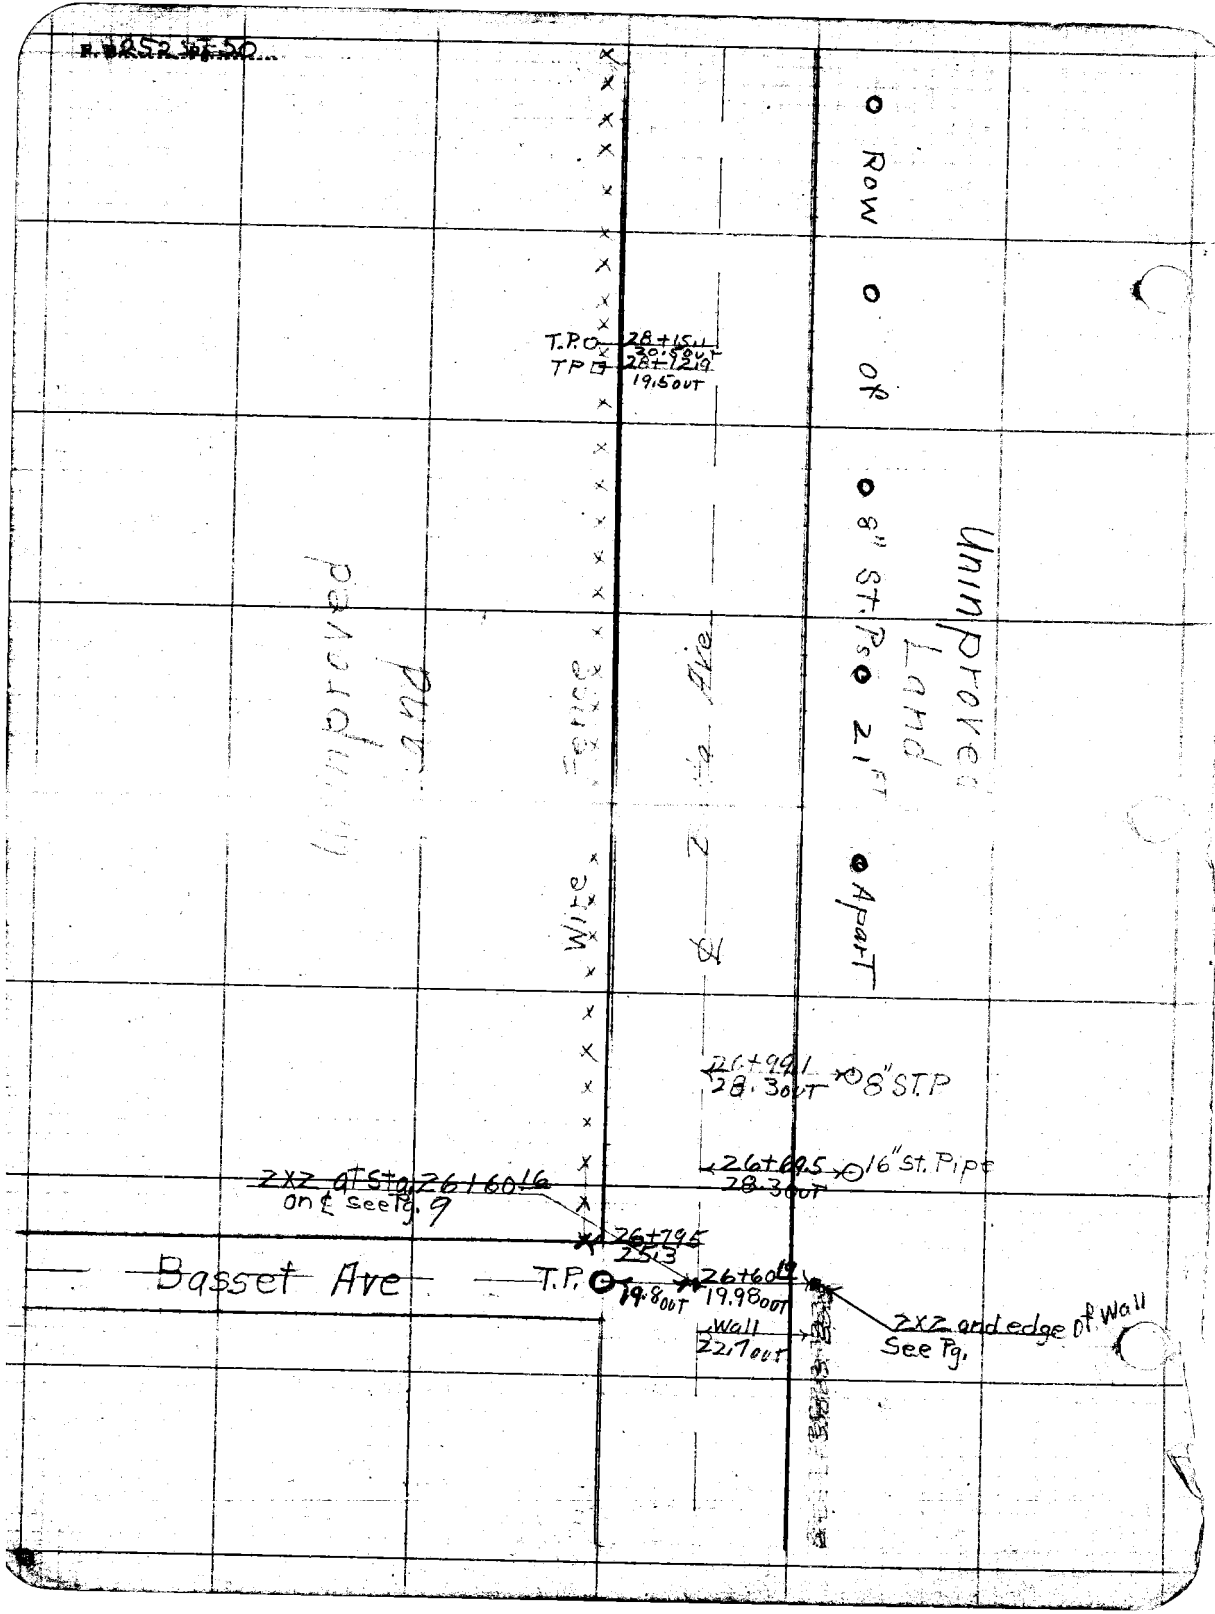
Row
OF
8" ST. P
21 FT
Apart
Unimproved Land
Unimproved Land
Fence
Wire
2 Strs
T.P.O 28+15.41 30.98 OUT
TP 28+12.19 19.50 OUT
26+99.1 28.30 OUT 8" ST.P
26+09.5 28.30 OUT 16" St. Pipe
2X2 at Sta 26+60.16 on ℄ See Pg. 9
26+79.5 25.3
T.P. 19.80 OUT
26+60.9 19.98 OUT
Wall 22.7 OUT
2X2 and edge of Wall See Pg.
Basset Ave

F.B. 258 Pg. 51

Platted by Ward	W. O. No. 7149 D. S. O. No.
Date Feb. & Mar. 1927	Location Berita Ave
Map No. 8904	Surveyed by C.V. Crumley
Platting C'k'd by Paige	Date Oct. T. Nov. 1926
Date April 1927	Indexed

Notes By Mr. Johnson

S.W.+T Sta. 29+92.70
See Page 10

30+06.4
49.3 out

29+86.3
26.5 out

Elton ST

30" ST. P.

Cluster Pepper Trees 5" dia.

29+73.2
28.2 out

8" St. Pipe

T.P. 29+62.0
20.9 out

T.P. 29+52.7
19.4 out

8" St. pipe

8" St pipe

Unimproved Road

29+03.2
28.2 out

8" ST. P.

29+07.6
34.1 out

Spanish Sword

10'

Dirt Drive

28+95.5

28+92.1
34.2 out

Spanish Sword

16.7

28+91.6
28.5 out

8" St. Pipe

28+56
32.3 out

Bed of Flowers

F. B. 252, P. 52

20.3

22.1

19.7

Row of 4" Dia Orange Trees

20.2

20.0

19.7

21.1

Quinn Land

Pavement

Edge of Pavement

31+10.4

43.4 OUT

T.P.

31+08.1
20.5 OUT

T.P.

31+05.7
19.0 OUT

Platted by [redacted]	W. O. No. 4049 D. S. O. No.
Date Feb. & Mar. 1927	Location Eureka Ave
Map No. 8404	Surveyed by C.V. Crumley
Platting C'k'd by Paige	Date Oct. & Nov. 1926
Date April 1927	Indexed.

F. B. 252 Pg. 53

Notes by H.S. Johnson.

19.9

20.1

Row of 8" T.P.'s

20.3

19.6

8" T.P.

3" Dia Lemon

33+42.6
27.80 OUT

44.5 OUT

33+29.8
28.40 OUT

33+19.8
27.80 OUT

16" STUMP

8" T.P.

20" ELM

8" T.P.

45.0 OUT

20.8

19.7

32+73.3

Unimproved Land

T.P.

32+58.6
20.40 OUT

T.P.

32+56.7
19.0 OUT

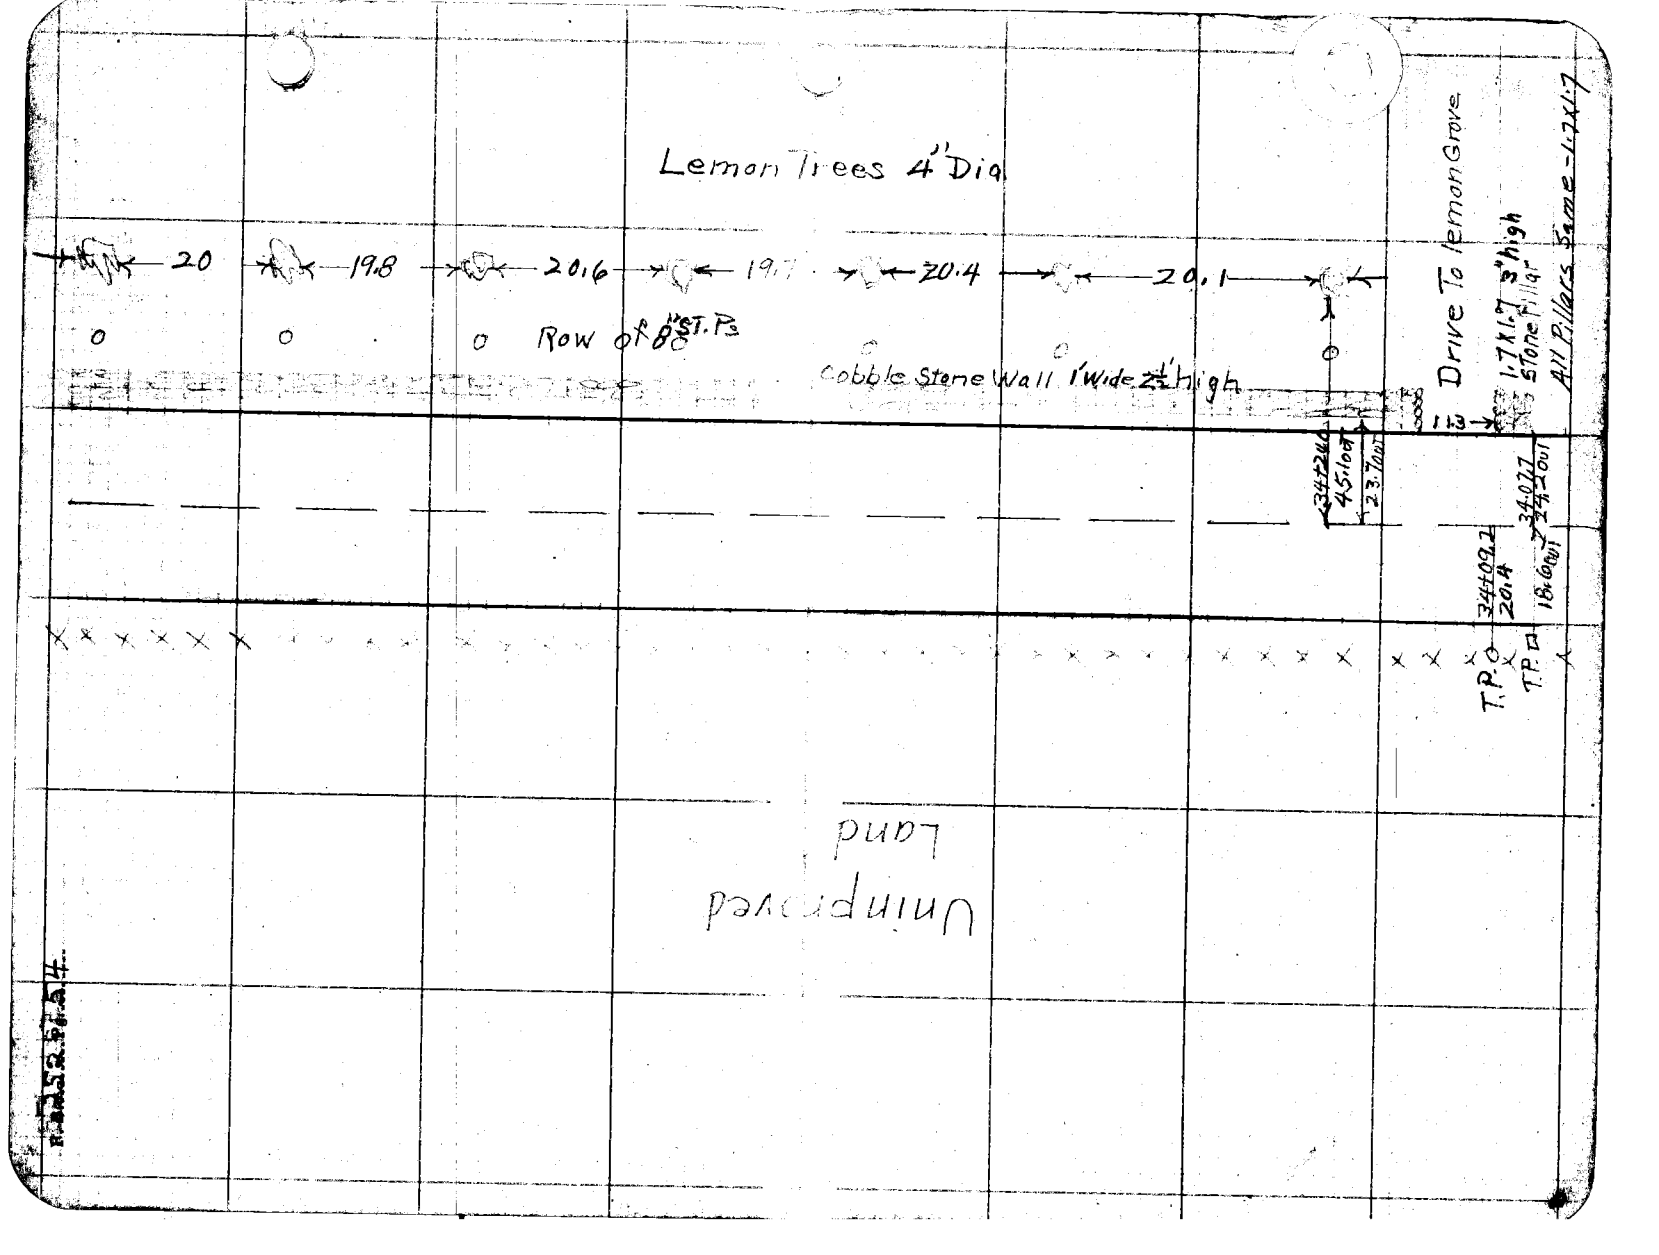
Lemon Trees 4" Dia
20
19.8
20.6
19.7
20.4
20.1
Row of 88 1/2 ST. Ps
Cobble Stone Wall 1' Wide 2½' High
Drive To Lemon Grove
1.7 K 1.7 3" high
Stone Pillars
All Pillars Same - 1.7 x 1.7
1.3
34226
45.10 out
23.7 out
34209.2
20.4
18.6 out
34027
24.2 out
T.P.
T.P.
Unimproved
Land

F. B. 252 Pg. 55

Platted by Wood	W. O. No. 4049 D. S. O. No.
Date Feb. & Mar. 1927	Location Benita Ave.
Map No. 8909	Surveyed by C. V. Crummey
Platting C'k'd by Paige	Date Oct. & Nov. 1926
Date April 1927	Indexed

Notes By H. S. Johnson.

37+38.5
30.0 OUT
37+29.8
26.8 OUT
Wire Fence
45.5 OUT
Lemon
37+10.1
27.6 OUT
46 OUT
Lemon 3" Dia
8" S.P.
T.P. 36+96.5
19.3 OUT
T.P. 36+95.8
20.9 OUT
9
Dirt Drive
36+95.0
Low Rock Wall
36+89.1
27.7 OUT
8" S.P.
47 OUT
3" Dia Lemon
36+79.5
46.5 OUT
3" Dia Lemon
Large Cactus
36+60.9
33.2 OUT
Stone Pillar 1'x1'
Fence
30.8 OUT
36+57.7
24 S OUT
Wire Fence
36+53.1
27.0 OUT
2.7 x 2.7 ± Ft high
Cement Irrig. Box 4" Walls
36+43.2
46.3 OUT
6" Dia. Peach
36+40.6
28.5
8" S.P. Pipe
36+33.2
36.8
5" Dia Peach
Unimproved Land
Dirt Drive
W. side Drive
36+12.8
36+11.1
23.9 OUT
Stone Pillar
35+64
28.2 OUT
43.6 OUT
6" S.P.
20.3

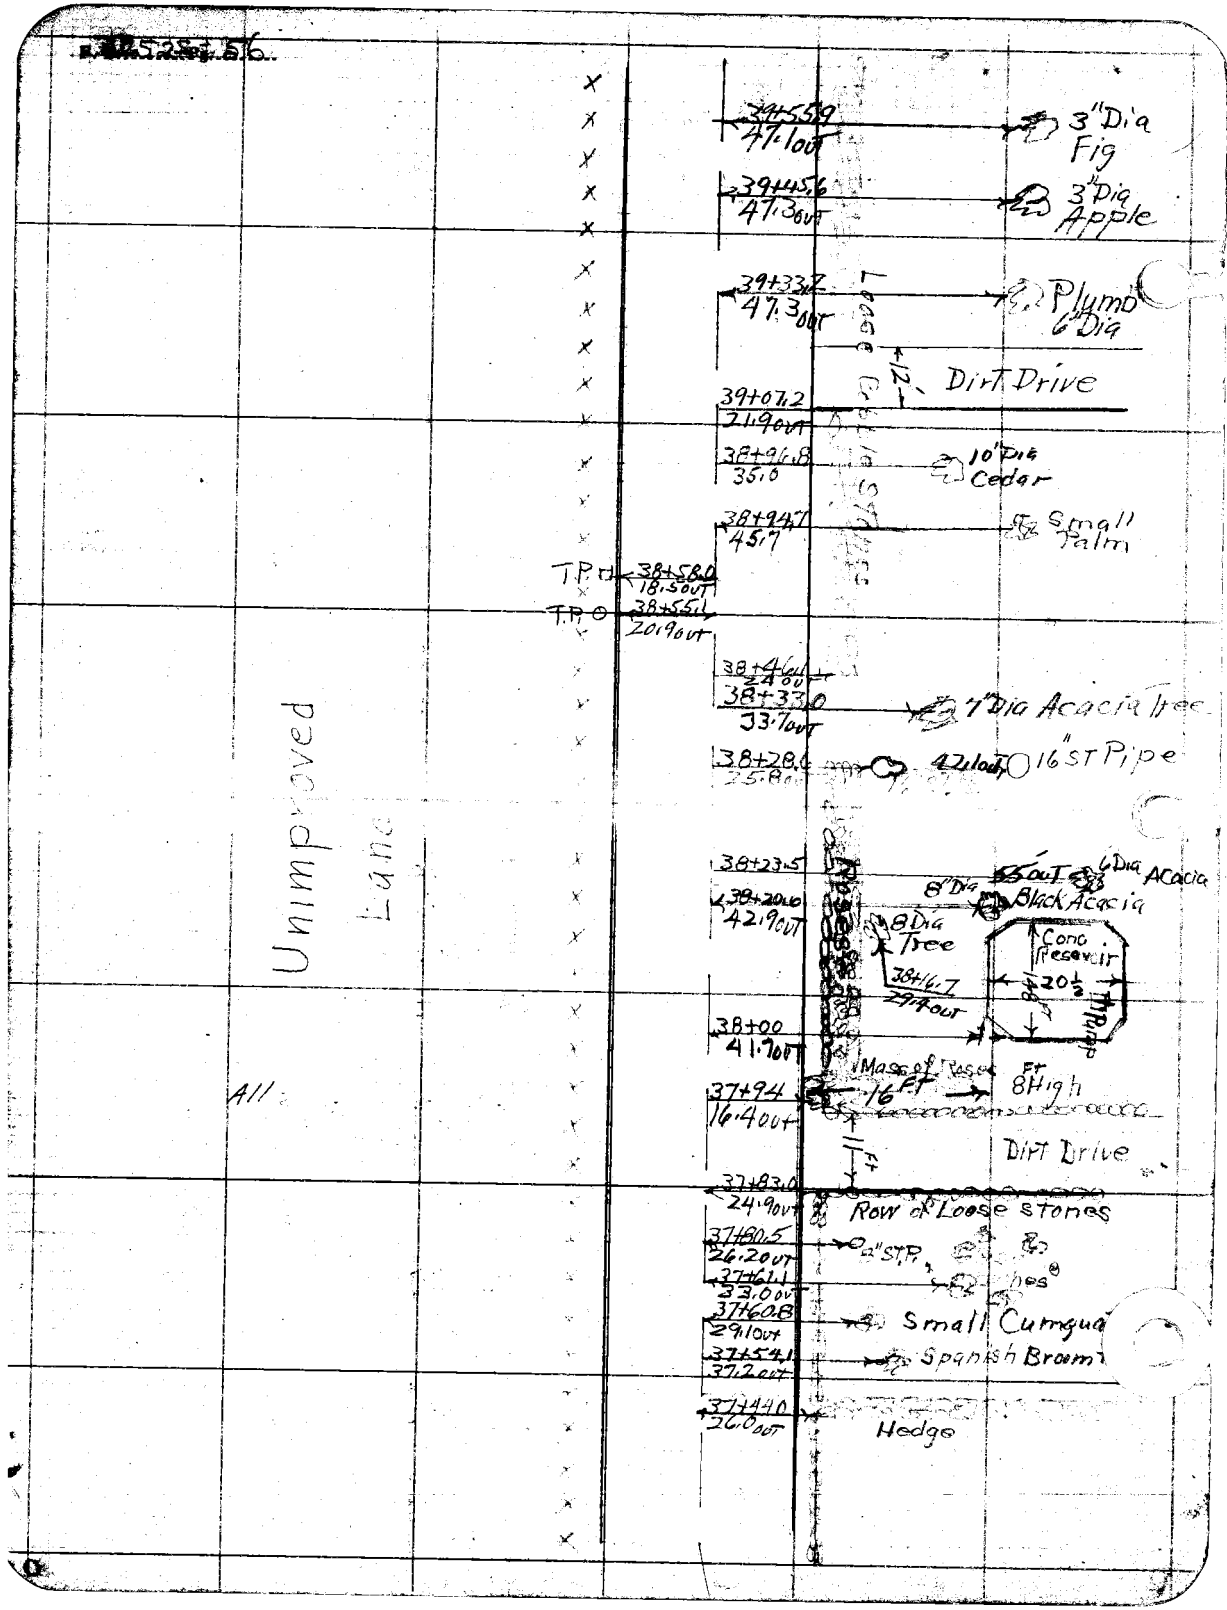
39+55.9
47.1 OUT
3" Dia Fig
39+45.6
47.3 OUT
3" Dia Apple
39+33.7
47.3 OUT
Plymd 6" Dia
Dirt Drive
39+07.2
21.9 OUT
38+96.8
35.0
10" Dia Cedar
38+94.7
45.7
Small Palm
T.P.
38+58.0
18.5 OUT
T.P.
38+55.1
20.9 OUT
38+46.1
24.0 OUT
38+33.0
33.1 OUT
7" Dia Acacia Tree
38+28.0
25.8
42.1 OUT
16" ST Pipe
38+23.5
38+20.0
42.9 OUT
8" Dia Black Acacia
6" Dia Acacia
8" Dia Tree
Conc Reservoir
20½
38+16.7
29.4 OUT
38+00
41.7 OUT
Mass of Rose
16 Ft
8 Ft High
37+94
16.4 OUT
11 Ft
Dirt Drive
37+83.0
24.9 OUT
Row of Loose stones
37+80.5
26.2 OUT
2" ST.P.
37+61.1
33.0 OUT
37+60.8
29.1 OUT
Small Cumgua
37+54.1
37.2 OUT
Spanish Broom
37+44.0
36.0 OUT
Hedge
Unimproved Lane
All

Platted by Lloyd	W. O. No. 4049 D. S. O. No.
Date Feb. 4 Mar. 1927	Location Benita Ave.
Map No. 8904	Surveyed by C.V. Crumley
Platting C'k'd by Paige	Date Oct. & Nov. 1926
Date April 1927	Indexed

F. B. 252 Pg. 57

Notes By H.S. Johnson

Dahlias

T.P. 43+38.9 21.0 out

T.P. 43+36.7 19.6 out

43+24 24.2 out

Cement Walk

31.1 out

16" S.T. Pipe 26.7 out

T.P. 41+94.2 20.9

T.P. 41+92.3 20.0 out

Unimproved Land

Fence 25.2 out

T.P. 40+40.6 20.4 out

T.P. 40+27.3 18.9 out

39+65.9 26.3 out — O 30" ST P

39+81 47.3 out — 1 Fig 1" Dia

39+77.0 30.7 — 08" ST Pipe

39+69.0 47.1 out — 3 Fig 3" Dia

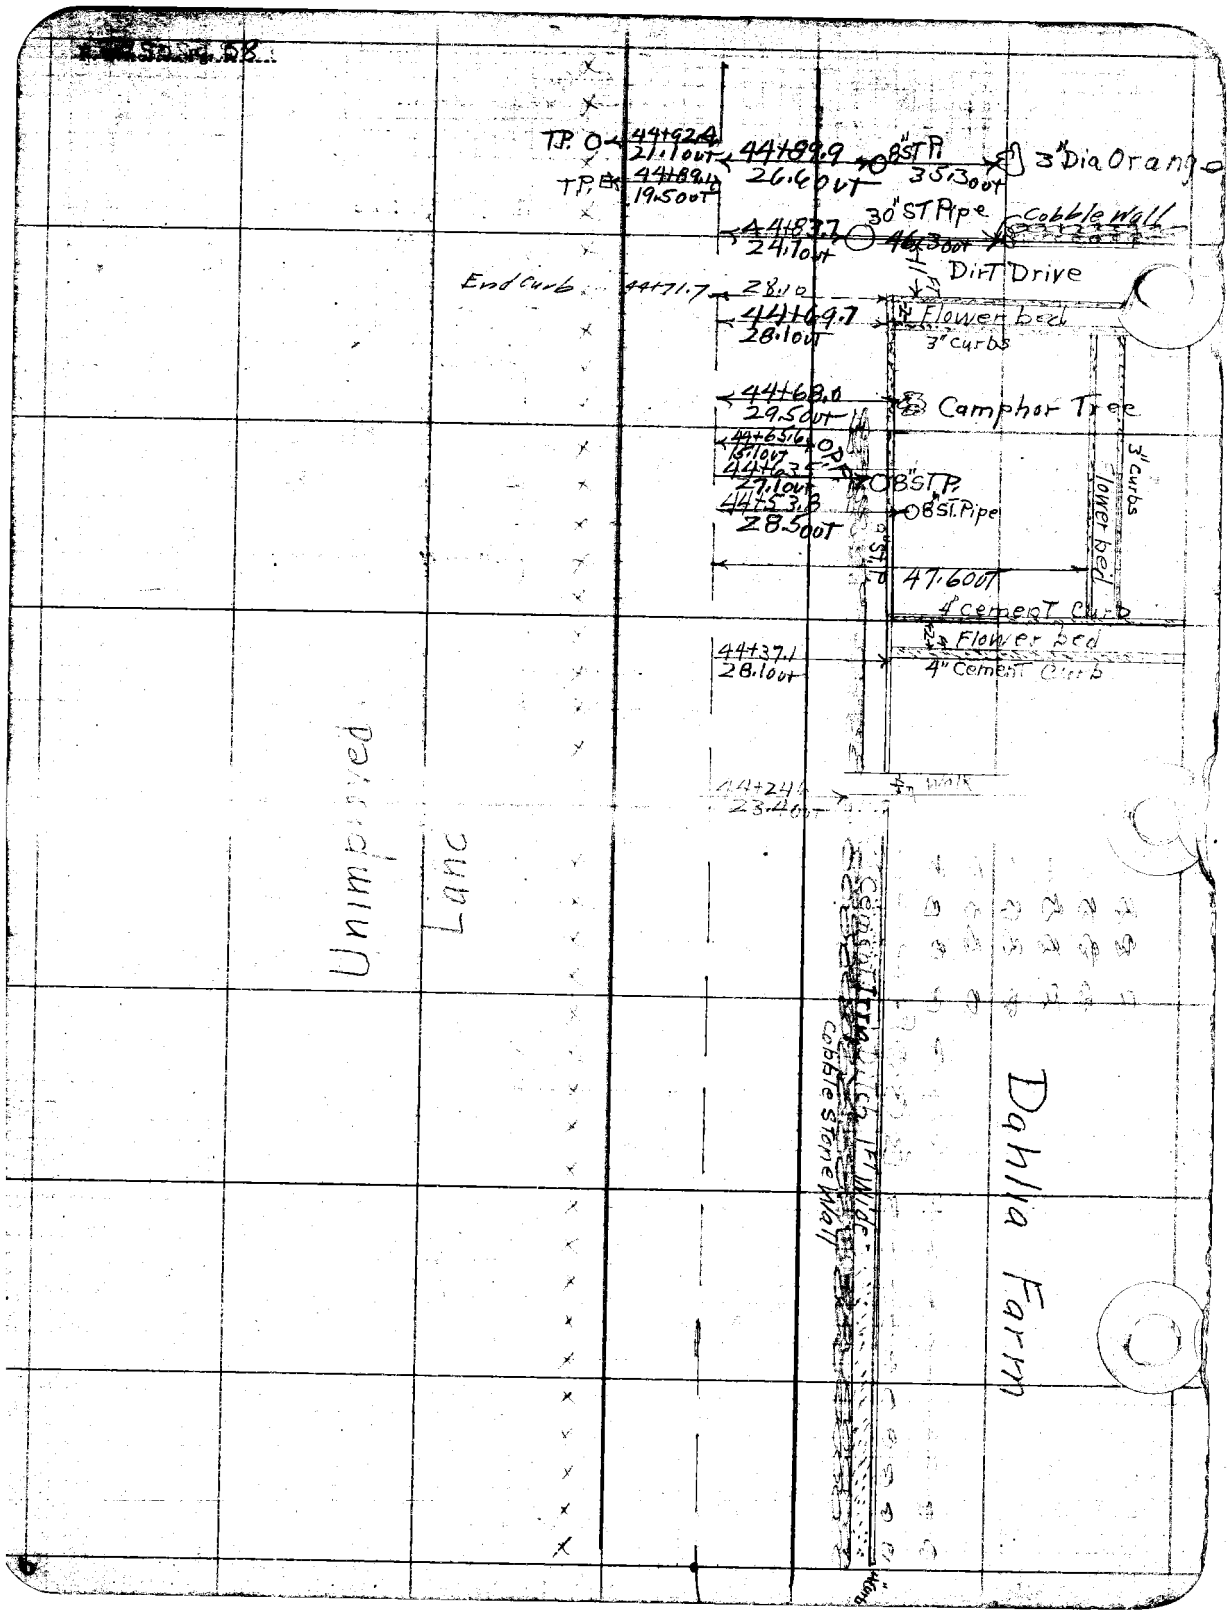
T.P.
44+92.4
21.1 out
44+89.9
26.6 out
8" ST Pi
35.3 out
3" Dia Orang
T.P.
44+89.4
19.5 out
30" ST Pipe
Cobble Wall
44+83.7
24.1 out
Dirt Drive
End Curb
44+71.7
28.1 o
44+69.7
28.1 out
Flower bed
3" curbs
44+68.0
29.5 out
Camphor Tree
44+65.6
15.1 out
OBST.P.
44+63.5
27.1 out
OBST.P.
44+53.8
28.5 out
OBST. Pipe
47.6 out
3" Curbs
Flower bed
4" Cement Curb
44+37.1
28.1 out
Flower bed
4" Cement Curb
44+24.6
23.4 out
Unimproved
Lane
Dahlia Farm
Cobble Stone Wall

Platted by [illegible]	W. O. No. 4049 D. S. O. No.
Date Feb. & Mar. 1927	Location Bonita Ave.
Map No. 8904	Surveyed by C. V. Grumley
Platting C'k'd by Paige	Date Oct. & Nov. 1926
Date April 1927	Indexed

F. B. [illegible] Pg. [illegible]

Notes by H. S. Johnson

Orange

4" Dia Orange

46+83
48.7 out

AVO.

2Ft Stone Wall With Fence on Top

46+79.3
32.4 out

46+76.3
33.0 out

46+69.9
23.3 out

46+42.0
14.3 out

P.P.

46+26.3
22.4 out

T.P. Elev

46+23.8
21.0 out

46+98.7
35.2 out

4" Dia Orange

45+77.7
26.4 out

8" ST Pipe

35.2

4" Dia. Orange

45+56.7
35.2 out

4" Dia Orange

45+34.5
26.6 out

8" ST Pipe

36.2 out

4" Dia. Orange

45+09.7
34.7 out

4" Dia Orange




Note! R. Bush = Rose Bush

47+88.3 17.9 OUT — 16" Stump

47+87.2 26.6 OUT — 8" STP

47+86.6 48.6 — 4" Dia Orange

T.P. 47+85.1 20.5 OUT

T.P. 47+81.9 19.2 OUT

47+75.9 36.1 OUT — Orange 4" Dia

47+64.7 26.6 OUT — 8" STP

47+63.8 48.6 OUT — Orange 4" Dia

47+59.5 23.9 OUT — R. Bush

47+54.3 36.1 OUT — 4" Dia Orange

47+47.6 16.9 OUT — 18" Stump

47+43.1 26.8 OUT — 8" STP

47+42 48.6 OUT — 4" Dia Orange

1.6 x 1.6 Stone Pillar

Unimproved Lane

Drive To Orange Grove

47+31.6 23.7 OUT — 1.6 x 1.6 Stone Pillar 4' High

47+23.8 48.6 OUT — Orange 4" Dia

47+22.9 26.8 OUT — 8" STP

47+11.8 36.6 — Orange 4" Dia

47+06.6 17.9 OUT

47+04.4 48.6 OUT — Orange

47+01.0 26.8 OUT — 12" STP

46+92.1 36.8 OUT

46+85.7 27.9 OUT — 8" STP

F.B. 282 Pg. 61

Platted by L.Wood	W. O. No. 4049 D. S. O. No.
Date Feb. & Mch. 1927	Location Benita Ave.
Map No. 5904	Surveyed by C.V. Crumley
Platting C'k'd by Paige	Date Oct. & Nov. 1926
Date April 1927	Indexed

Notes By H. S. Johnson

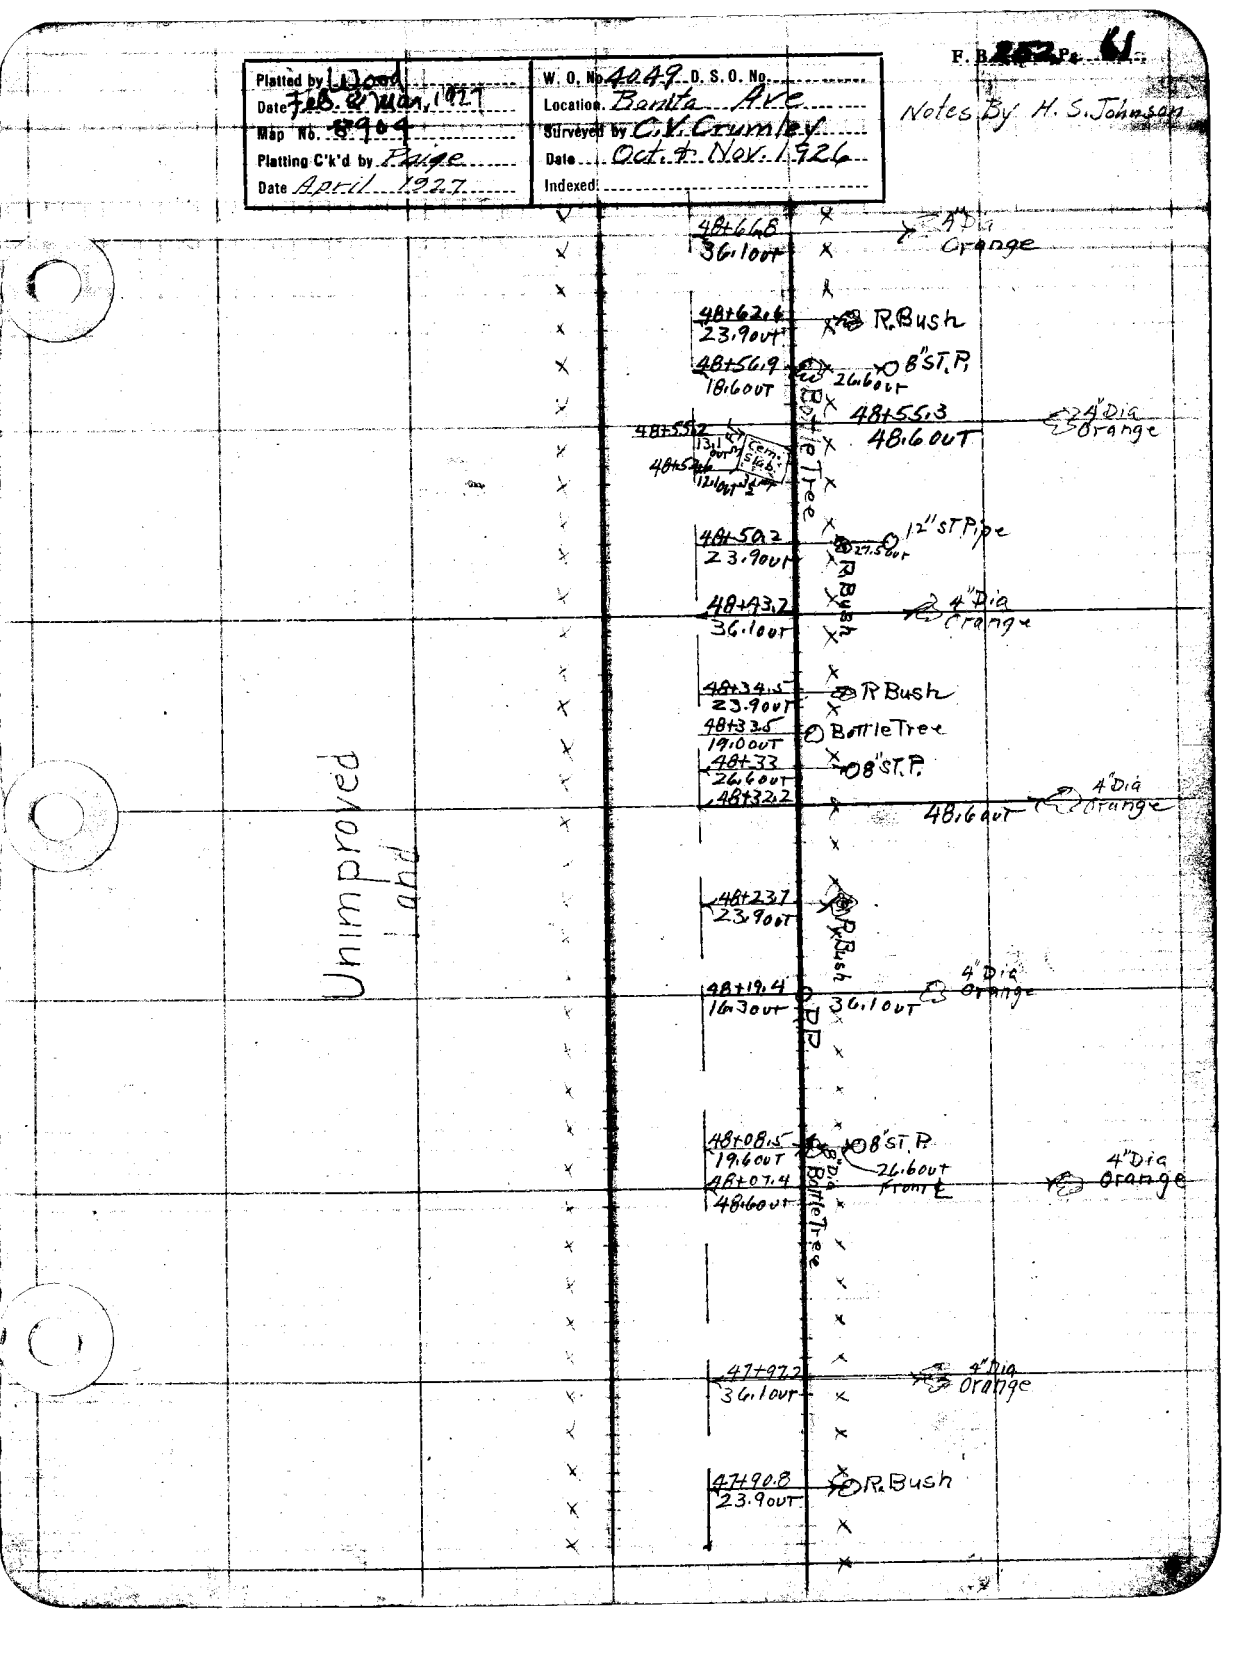

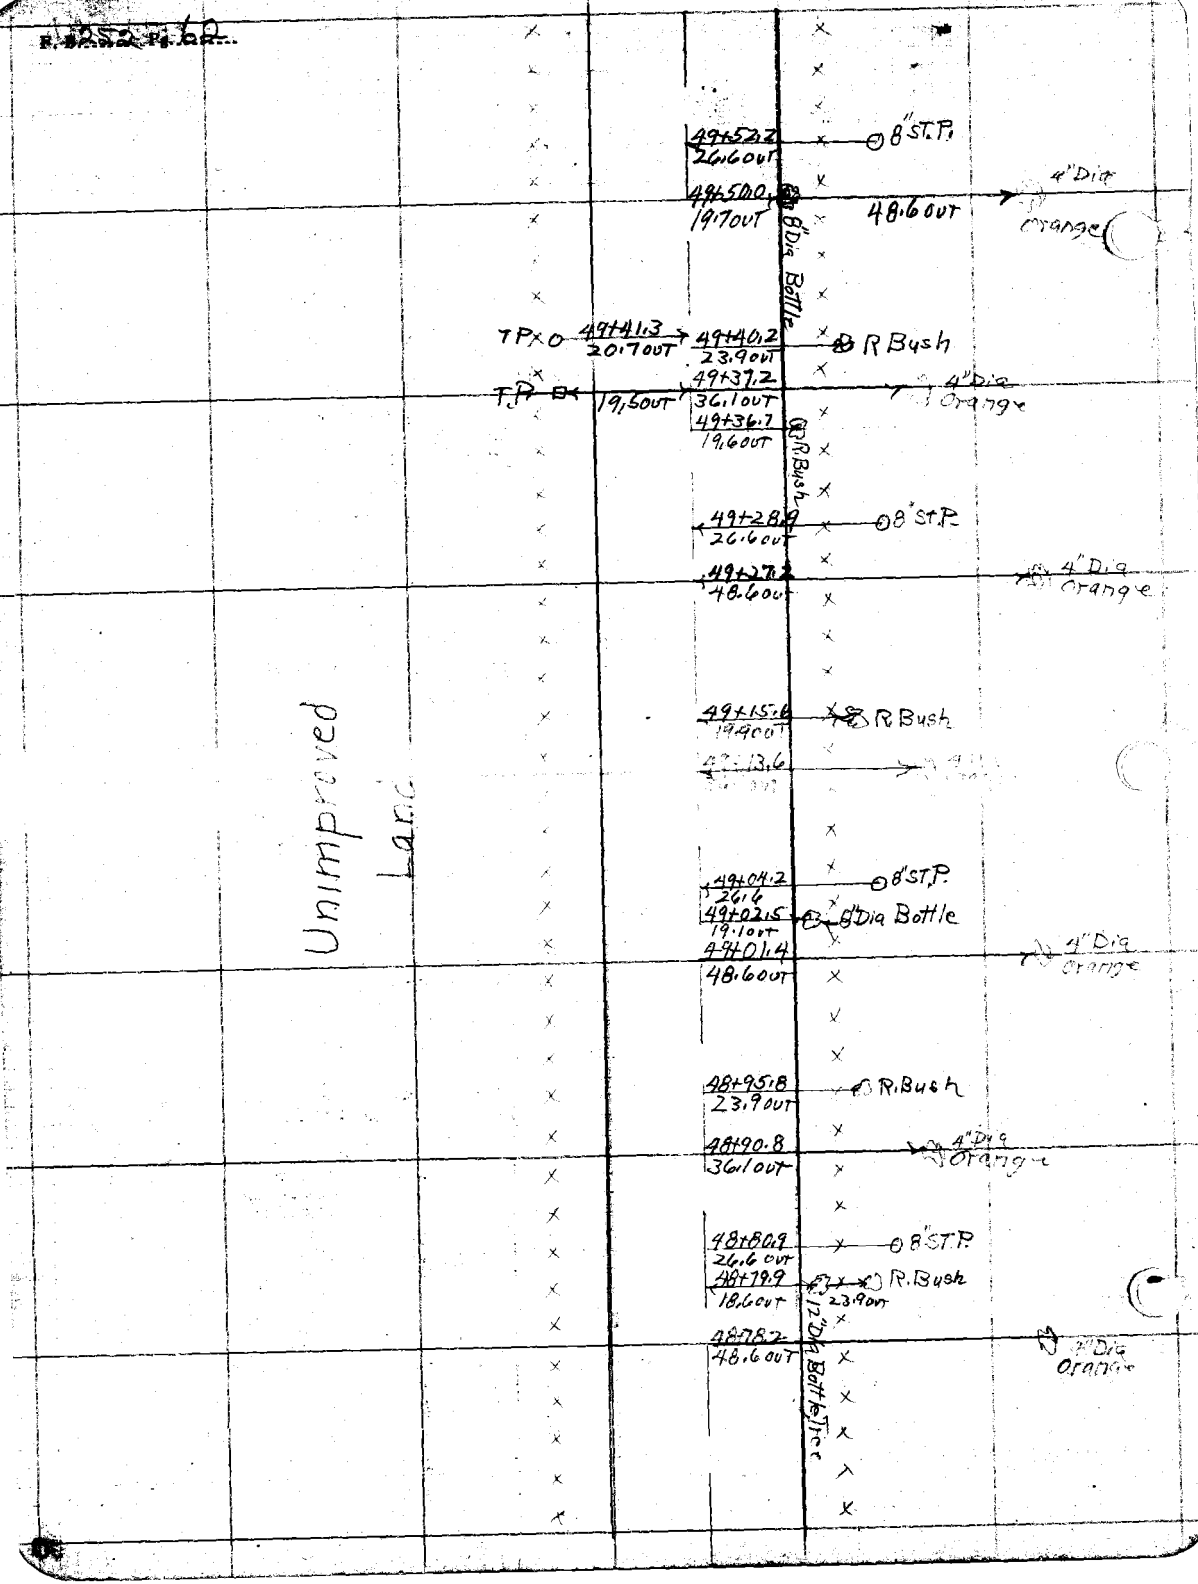
49+52.2
26.6 OUT
8" ST. P.
48+50.0
19.7 OUT
8" Dia Bottle
48.6 OUT
4" Dia Orange
TP
49+41.3
20.7 OUT
49+40.2
23.9 OUT
R Bush
49+37.2
36.1 OUT
4" Dia Orange
TP
19.5 OUT
49+36.7
19.6 OUT
R Bush
49+28.9
26.6 OUT
8" ST. P.
49+27.2
48.6 OUT
4" Dia Orange
49+15.6
19.4 OUT
R Bush
49+13.6
49+04.2
26.6
8" ST. P.
49+02.5
19.1 OUT
8" Dia Bottle
48+01.4
48.6 OUT
4" Dia Orange
48+95.8
23.9 OUT
R. Bush
48+90.8
36.1 OUT
4" Dia Orange
48+80.9
26.6 OUT
8" ST. P.
48+79.9
18.6 OUT
R. Bush
23.9 OUT
48+78.2
48.6 OUT
4" Dia Orange
12" Dia Bottle Tree
Unimproved Land

F. B. 252 Pg. 63

Platted by Wood	W. O. No. 4049 D. S. O. No.
Date Feb. & Mar. 1927	Location. Banita Ave
Map No. 8904	Surveyed by C.V. Crumley
Platting C'k'd by Paige	Date Oct. & Nov. 1926
Date April 1927	Indexed.

Notes By H.S. Johnson

Unimproved Land

50+34.6
36.9 OUT
4" Dia Orange
50+30.0
19.7 OUT
R. Bush
50+23.7
20.3 OUT
Bottle Tree 1" Dia
50+23.0
26.6
8" ST.P.
50+22.7
49.8
4" Dia Orange
50+12.1
19.8 OUT
R. Bush
50+09.9
36.1 OUT
4" Dia Orange
50+01.6
26.6
8" ST.P.
50+01.0
23.9 OUT
R. Bush
49+98.6
48.6 OUT
4" Dia Orange
49+95.8
20.9 OUT
2" Dia Bottle Tree
49+95.0
17.4 OUT
P.P.
49+85.1
36.1 OUT
4" Dia Orange
49+83.8
23.9 OUT
R. Bush
49+80.1
19.6 OUT
Rose Bush
49+76.0
26.6 OUT
8" ST.P.
49+74.1
19.7 OUT
2" Dia Bottle Tree
49+73.2
48.6 OUT
4" Dia Orange
49+72.1
23.9 OUT
R. Bush
49+66.6
19.1 OUT
36.1 OUT
4" Dia Orange
R. Bush

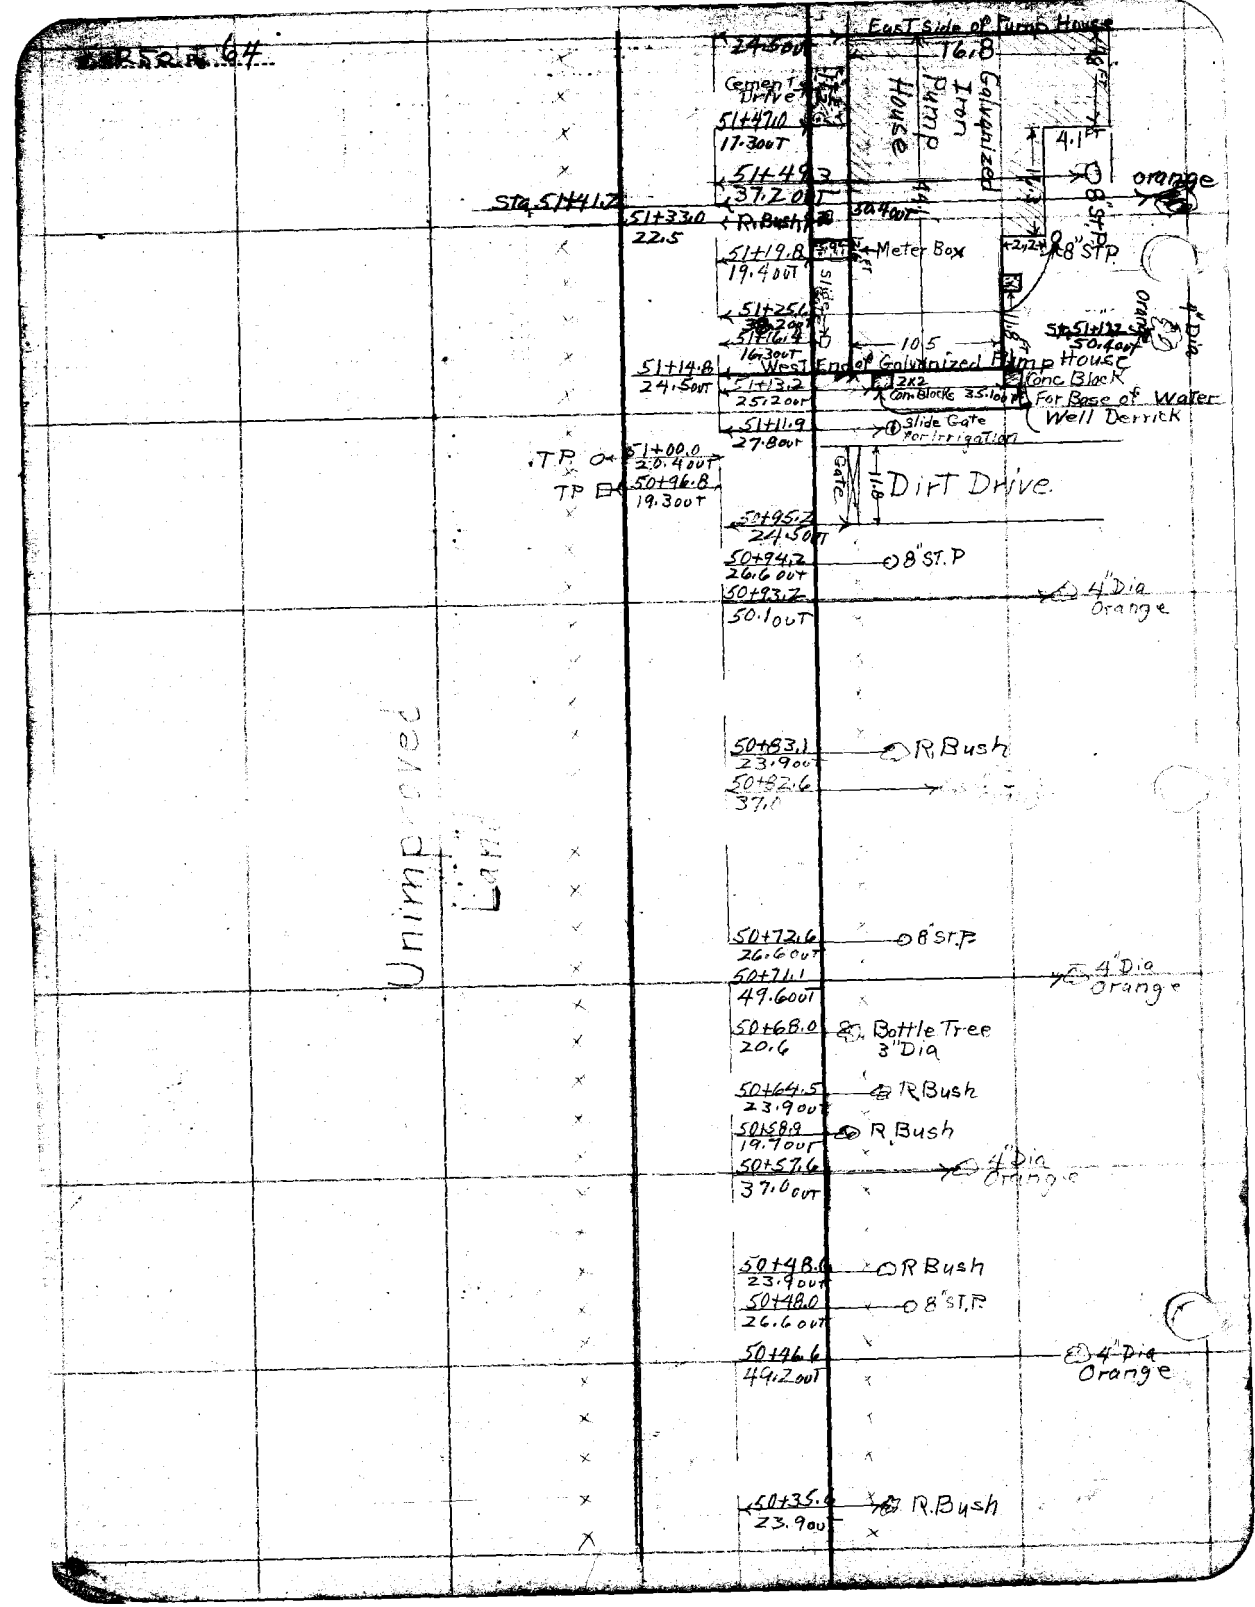
Sta. 64
24.50 OUT
East Side of Pump House
16.8
Cement Drive
Pump House
Galvanized Iron
51+47.0
17.30 OUT
4.1
51+49.3
37.2 OUT
orange
Sta. 51+41.7
51+33.0
R. Bush
30.4 OUT
22.5
8" St. P.
51+19.8
19.4 OUT
Meter Box
51+25.6
30.2 OUT
51+16.4
16.30 OUT
Sta. 51+12.5
50.4 OUT
West End of Galvanized Pump House
Conc Block
51+14.8
24.5 OUT
51+13.2
25.2 OUT
2x2 Con. Blocks
35.1 OUT
For Base of Water Well Derrick
51+11.9
27.8 OUT
Slide Gate For Irrigation
TP
51+00.0
20.4 OUT
50+96.8
19.3 OUT
Dirt Drive
50+95.2
24.5 OUT
50+94.2
26.6 OUT
8" St. P
50+93.2
50.1 OUT
4" Dia Orange
Unimproved Land
50+83.1
23.9 OUT
R Bush
50+82.6
37.1
50+72.6
26.6 OUT
8" St. P
50+71.1
49.6 OUT
4" Dia Orange
50+68.0
20.6
Bottle Tree 3" Dia
50+64.5
23.9 OUT
R Bush
50+58.9
19.7 OUT
R Bush
50+57.6
37.1 OUT
4" Dia Orange
50+48.6
23.9 OUT
R Bush
50+48.0
26.6 OUT
8" St. P
50+46.6
49.2 OUT
4" Dia Orange
50+35.4
23.9 OUT
R. Bush

Plotted by [illegible]
Date [illegible]
Map No. 2409
Plotting C'k'd by Paige
Date April 1927

W. O. No. 4049 D. S. O. No.
Location Bonita Ave
Surveyed by C. V. Cunningham
Date Oct. & Nov. 1926
Indexed.

F. B. 242 Pg. 65

Notes By H. S. Johnson

52+23.0
24.1 Sout
R. Bush

52+20.0
24.1 Sout
32.9 Out
Spanish Broom

52+20.0
38.8 Sout
Bush
44.6 Out
Ornamental Bush

52+14.9
18.7 Out
Camphor Tree
R. Bush

52+09.2
20.1 Out
R. Bush

52+02.8
32.9 Out
Ornamental Bush
48.4 Out
Ornamental Bush

10" Dia
51+94.0
19.1 Out
Acacia Tree

E. Edge
51+92.1
19.4 Out

Ditch
15.9 Out

Bridge is 9FT Wide
VSO

Land Plaindium

Beginning at Lily Pond and Rustic Bridge

51+78.2 W. Edge
19.4 Out

51+76.6
24.5 Out
Wire Fence

51+75.5
25.1 Out
R. Bush

Transformer Pole
51+72.2
19.6 Out

51+69.8
33.1 Out
Ava. Tree

51+68.6
24.5 Out
R. Bush

51+66.2
50.5 Out

8" S.P.

51+64.6
39.8 Out
Dead Bush

51+64.2
19.7

Transformer Poles
51+60.6
19.1 Out

16" S.P.

51+54.0
39.4 Out

51+58.9
24.5 Out

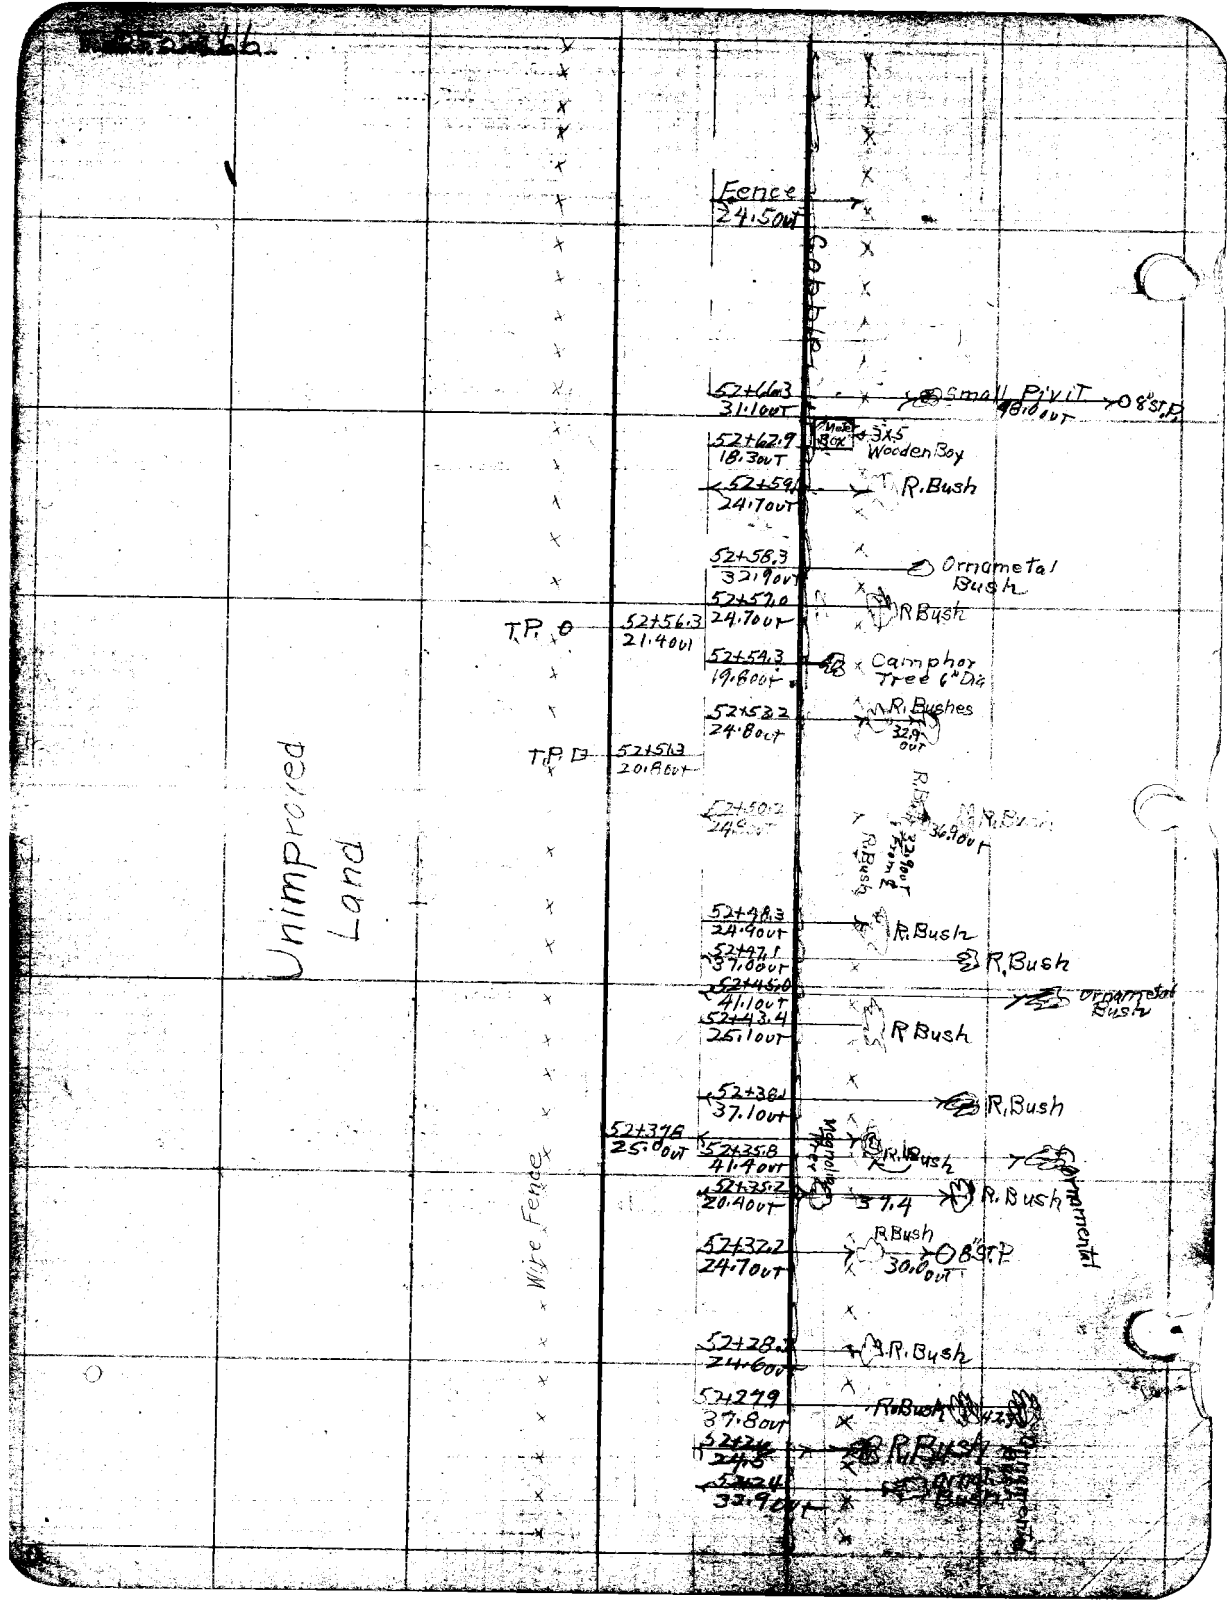
Fence
24.50Rt
Cobble
52+66.3
31.10Rt
Small Privit
48.10Rt
8"St.P
52+62.9
18.30Rt
3X5
Wooden Box
52+59.
24.70Rt
R. Bush
52+58.3
32.90Rt
Ornamental
Bush
52+57.0
24.70Rt
R Bush
T.P. 0
52+56.3
21.40Rt
52+54.3
19.80Rt
Camphor
Tree 6" Dia
52+52.2
24.80Rt
R. Bushes
32.9
Rt
T.P. 1
52+51.3
20.10Rt
36.9Rt
52+48.3
24.90Rt
R. Bush
52+47.1
37.00Rt
R. Bush
52+45.0
41.10Rt
Ornamental
Bush
52+43.4
26.10Rt
R Bush
52+38.4
37.10Rt
R. Bush
52+37.6
25.00Rt
Wire Fence
52+35.8
41.40Rt
R. Bush
52+35.2
20.40Rt
37.4
R. Bush
Ornamental
R. Bush
52+32.2
24.70Rt
30.0Rt
8"St.P
52+28.
24.60Rt
R. Bush
52+27.9
37.80Rt
R. Bush
Unimproved
Land

F. B. 282 Pg. 47

Platted by Wood
Date Feb & Mar. 1927
Map No. 9904
Platting C'k'd by Paige
Date April 1927

W. O. No. 404-9 O. S. O. No.
Location. Santa Ana
Surveyed by C.V.C. & M.J.
Date Oct. & Nov. 1926
Indexed.

4" Dia Lem
2½" Dia Lem
77.6 Out
5' 7.3 Out
37.4 Out
53+85.9
35.4 Out
4" Dia Orange
4" orange
49.1 Out
4" Dia Orange
53+72.2
27.8 Out
2" Dia Lem
2" Dia Lem
2" Dia Lem
77.6 Out
37.2
53+65.8
37.5 Out
53+62.4
Sign Board 6FT High
194.5 Out
15'
55.0 Out
53+50.4
50.0 Out
53+49.4
16" STP
29.7 Out
4" Dia Orange
3" Dia Lem
2" Dia Lem
2" Dia Lem
77.6 Out
51.2 Out
53+44.7
37.5 Out
2x2 Stake Sta. 53+20.73
See Pg. 11
53+36.5
19.8 Out
P.P.
53+34.9
44.9 Out
P.P.
Orange Ave
Bolt in Top
53+06.7
Cobble Curb
36.1 Out
53+05.2
42.2 Out
53+00.5
24.6 Out
End of Fence
52+98.1
36.1 Out
52+96.7
39.8 Out
52+97.0
Palm Tree 46.0 Out
Cement Slab
8" ST.P
36.0 Out
2x2 Stone Pillar
Ornamental Bush
8" ST.P Sta. 52+95.7
42.1 Out
52+91.5
25.6 Out
52+89.1
27.3 Out
2x2 Stone Pillars With Iron Gate Swung between
N. Side of Walk
52+88.1
31.5 Out
52+87.9
Curb
16.1 Out
52+87.6
Pine Tree
20.5 Out
52+85.0
32.1 Out
52+82.8
30.0 Out
St.P
Note: Dist. out from ℄ To N. Edge of Walk is 35.0
Walk + Drive = 11 FT Wide
52+79.6
24.8 Out
52+77.0
N Side of Walk
52+75.0
42.6 Out
52+74.3
38.5 Out
52+72.7
19.1 Out
52+71.8
24.1 Out
52+71.0
30'
Iron Manhole
16.8 Out
44.7 Out
52+63.2
50.2 Out
Curb
15.8 Out
52+95.2
Cobble Curb
Palm Tree
29.8 Out
R. Bush
8" ST.P
3½ Stone Box
R. Bush
R. Bush
R. Bush
Ornamental Bush
Camphor Tree
35.1 Out
R. Bush
Palm Tree
Cobble Curb
Rose
Rose
Rose
11 FT
11 FT
11 FT
Rest
Dirt Drive
Cement Walk

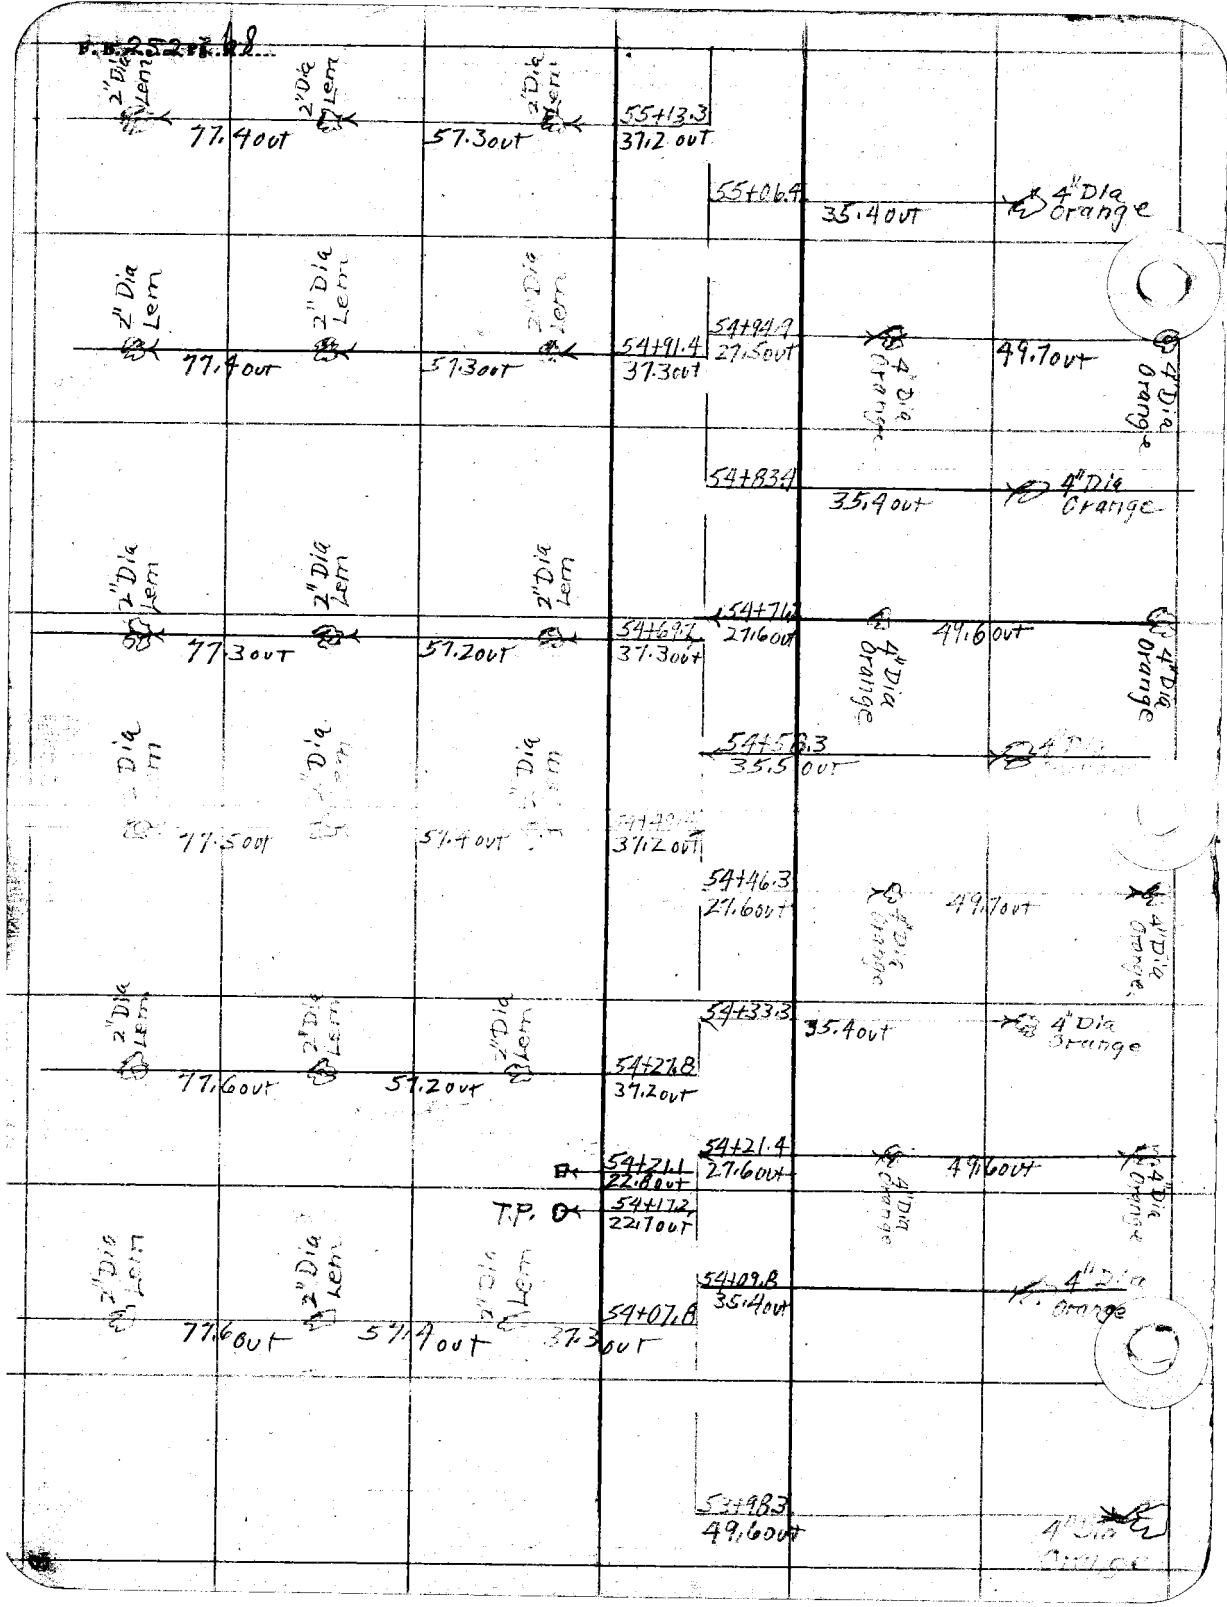
2" Dia Lem
77.4 out
57.3 out
55+13.3
37.2 out
55+06.9
35.4 out
4" Dia Orange
54+91.4
37.3 out
54+99.9
27.5 out
49.7 out
54+83.4
35.4 out
77.3 out
57.2 out
54+69.7
37.3 out
54+71.6
27.6 out
49.6 out
77.5 out
57.4 out
54+56.3
35.5 out
54+46.3
27.6 out
49.7 out
54+33.3
35.4 out
77.6 out
57.2 out
54+27.8
37.2 out
54+21.4
27.6 out
49.6 out
54+21.1
22.8 out
T.P.
54+17.2
22.7 out
54+09.8
35.4 out
77.6 out
57.4 out
54+07.8
37.3 out
54+98.3
49.6 out

F. B. 252 Pg. 69

Platted by: Wood	W. O. No. 4249 D. S. O. No.
Date: Feb. & Mar. 1927	Location: Boxita Ave
Map No. 8904	Surveyed by: C.V. Crumley
Platting C'k'd by: Paige	Date: Oct. & Nov. 1926
Date: April 1927	Indexed:

55+91.2
28.0 out
4" Dia orange
48.7 out
4" Dia orange

55+79.8
35.1 out
Last orange at this dist out
4" Dia orange

2" Dia Lem.
77.6 out
2" Dia Lem.
57.4 out
2" Dia Lem.
55+75.0
37.0 out

55+68.1
27.8 out
4" Dia orange
48.9 out
4" Dia orange

T.P.O
55+68.1
24.1 out

2" Dia Lem.
77.3
2" Dia Lem.
57.3 out
2" Dia Lem.
55+54.8
35.1 out
55+54.4
37.1 out
4" Dia orange

55+40.5
49.4 out
4" Dia
55+40.6
18.7 out
O.P.P

2" Dia Lem.
77.4 out
2" Dia Lem.
57.2 out
2" Dia Lem.
55+33.4
37.2 out

55+29.7
35.2 out
4" Dia orange

55+18.1
27.5 out
4" Dia orange
49.4 out
4" Dia orange

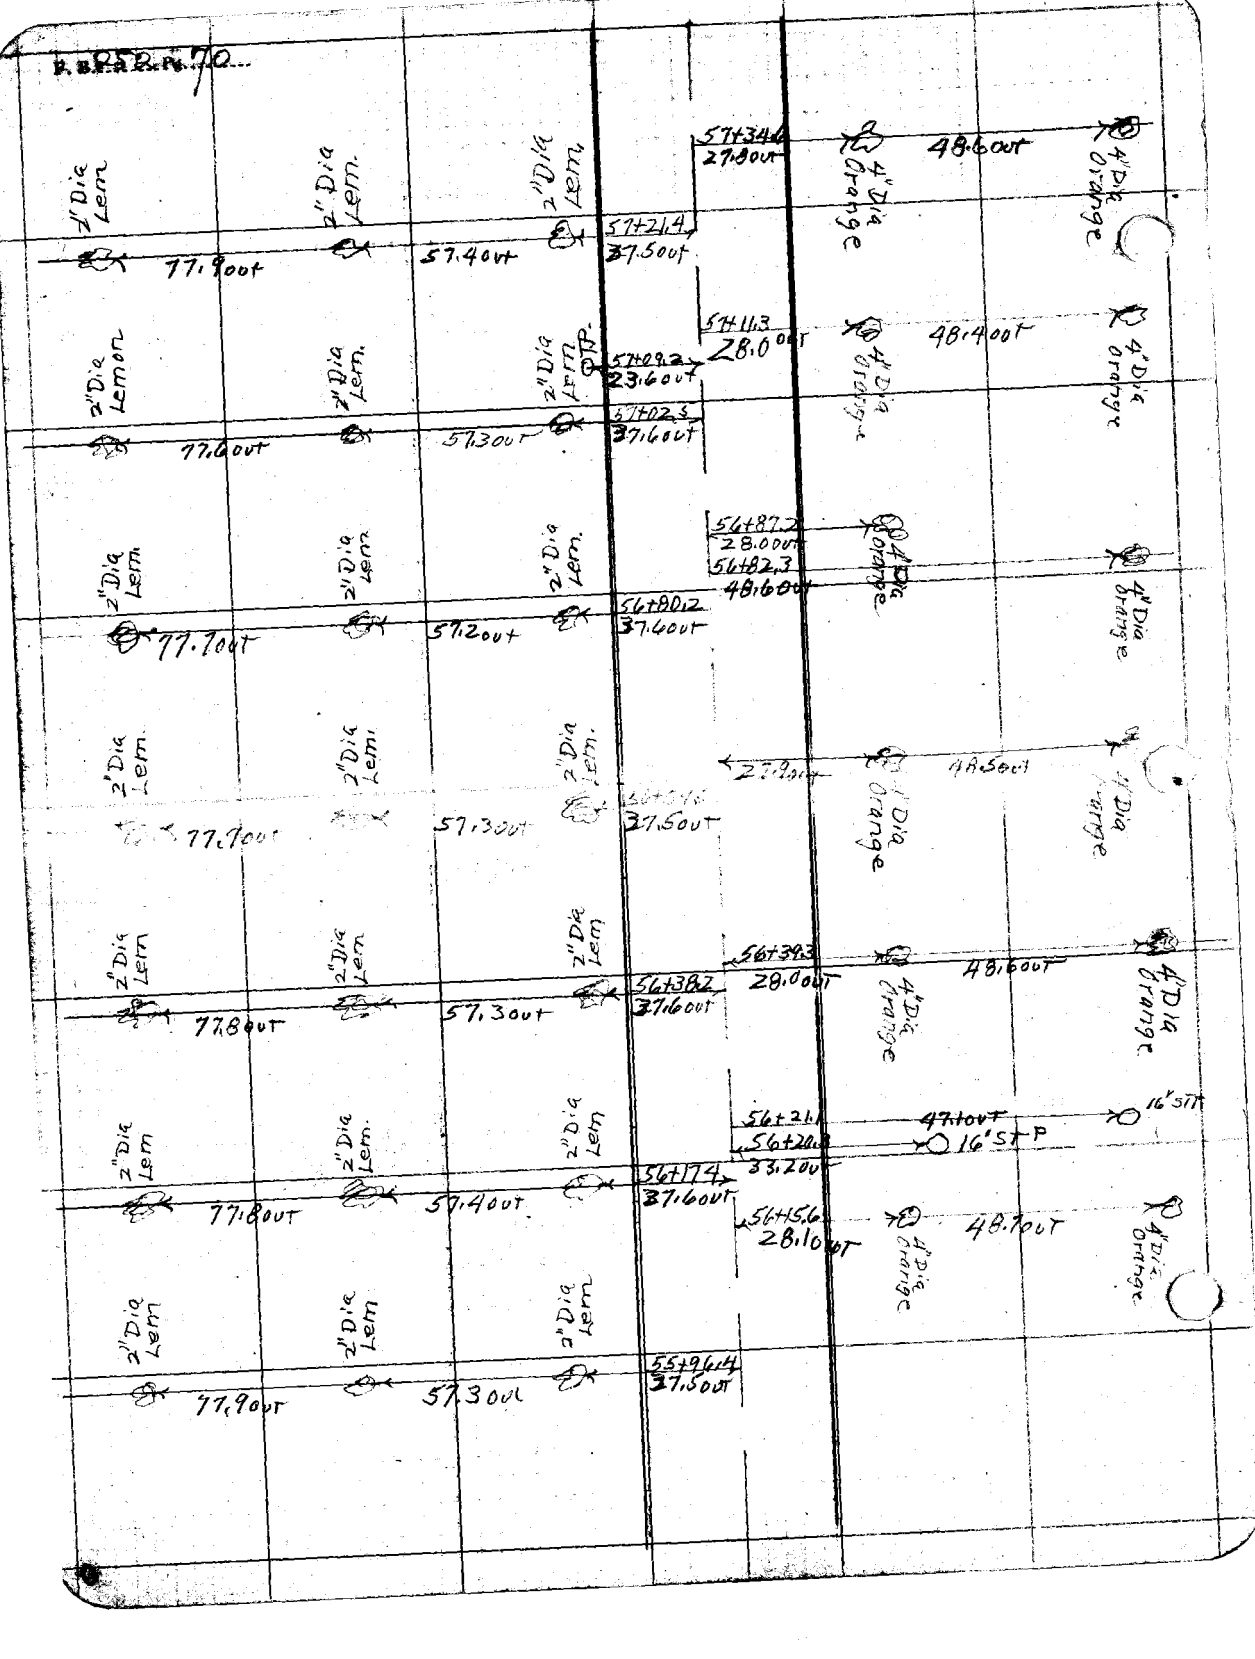
2" Dia Lem.
77.9 out
57.4 out
57+34.6
27.8 out
57+21.4
37.5 out
4" Dia Orange
48.6 out
2" Dia Lemon
77.6 out
57.3 out
57+11.3
28.0 out
57+09.2
23.6 out
57+02.5
37.6 out
48.4 out
56+87.2
28.0 out
56+82.3
48.6 out
56+80.2
37.6 out
77.7 out
57.2 out
48.5 out
56+43.8
37.5 out
57.3 out
56+39.3
28.0 out
56+38.2
37.6 out
48.6 out
77.8 out
56+21.1
47.1 out
16' STP
56+20.8
33.2 out
56+17.4
37.6 out
56+15.6
28.1 out
48.7 out
55+96.4
37.5 out

F. B. 252 Pg. 71

Platted by Wood	W. O. No. 4047 D. S. O. No.
Date Feb. & Mar. 1927	Location Bonita Ave.
Map No. 8904	Surveyed by C.V. Crumley
Platting C'k'd by Paige	Date Oct. & Nov. 1926
Date April 1927	Indexed

58+57.5 20.5 OUT — 3" Water Pipe
58+55.5 3.1 OUT — 16" St. P
58+49.7 36.4 OUT — 6" Dia Orange
58+48.9 37.5 OUT
58+34.6 36.9 OUT — 6" Dia Orange
58+27.9 37.5 OUT
58+07.2 37.5 OUT
58+04.9 37.0 OUT — 6" Dia Orange
57+84.8 28.0 OUT — 8" St. P — 48.4 OUT — 8" Dia Orange
57+84.1 37.5 OUT — 3" Dia Orange
57+63.4 37.8 OUT
57+59.1 28.1 OUT — 4" Dia Orange — 48.4 OUT — 4" Dia Orange
57+44.5 17.4 OUT — PP
57+42.2 37.7 OUT

2" Dia Lem. — 77.6 OUT — 57.4 OUT
2" Dia Lem. — 77.6 OUT — 57.5 OUT
2" Dia Lem. — 77.6 OUT — 57.4 OUT
2" Dia Lem. — 77.6 OUT — 57.3 OUT
2" Dia Lem. — 77.4 OUT — 57.1 OUT
2" Dia Lem. — 77.9 OUT — 57.3

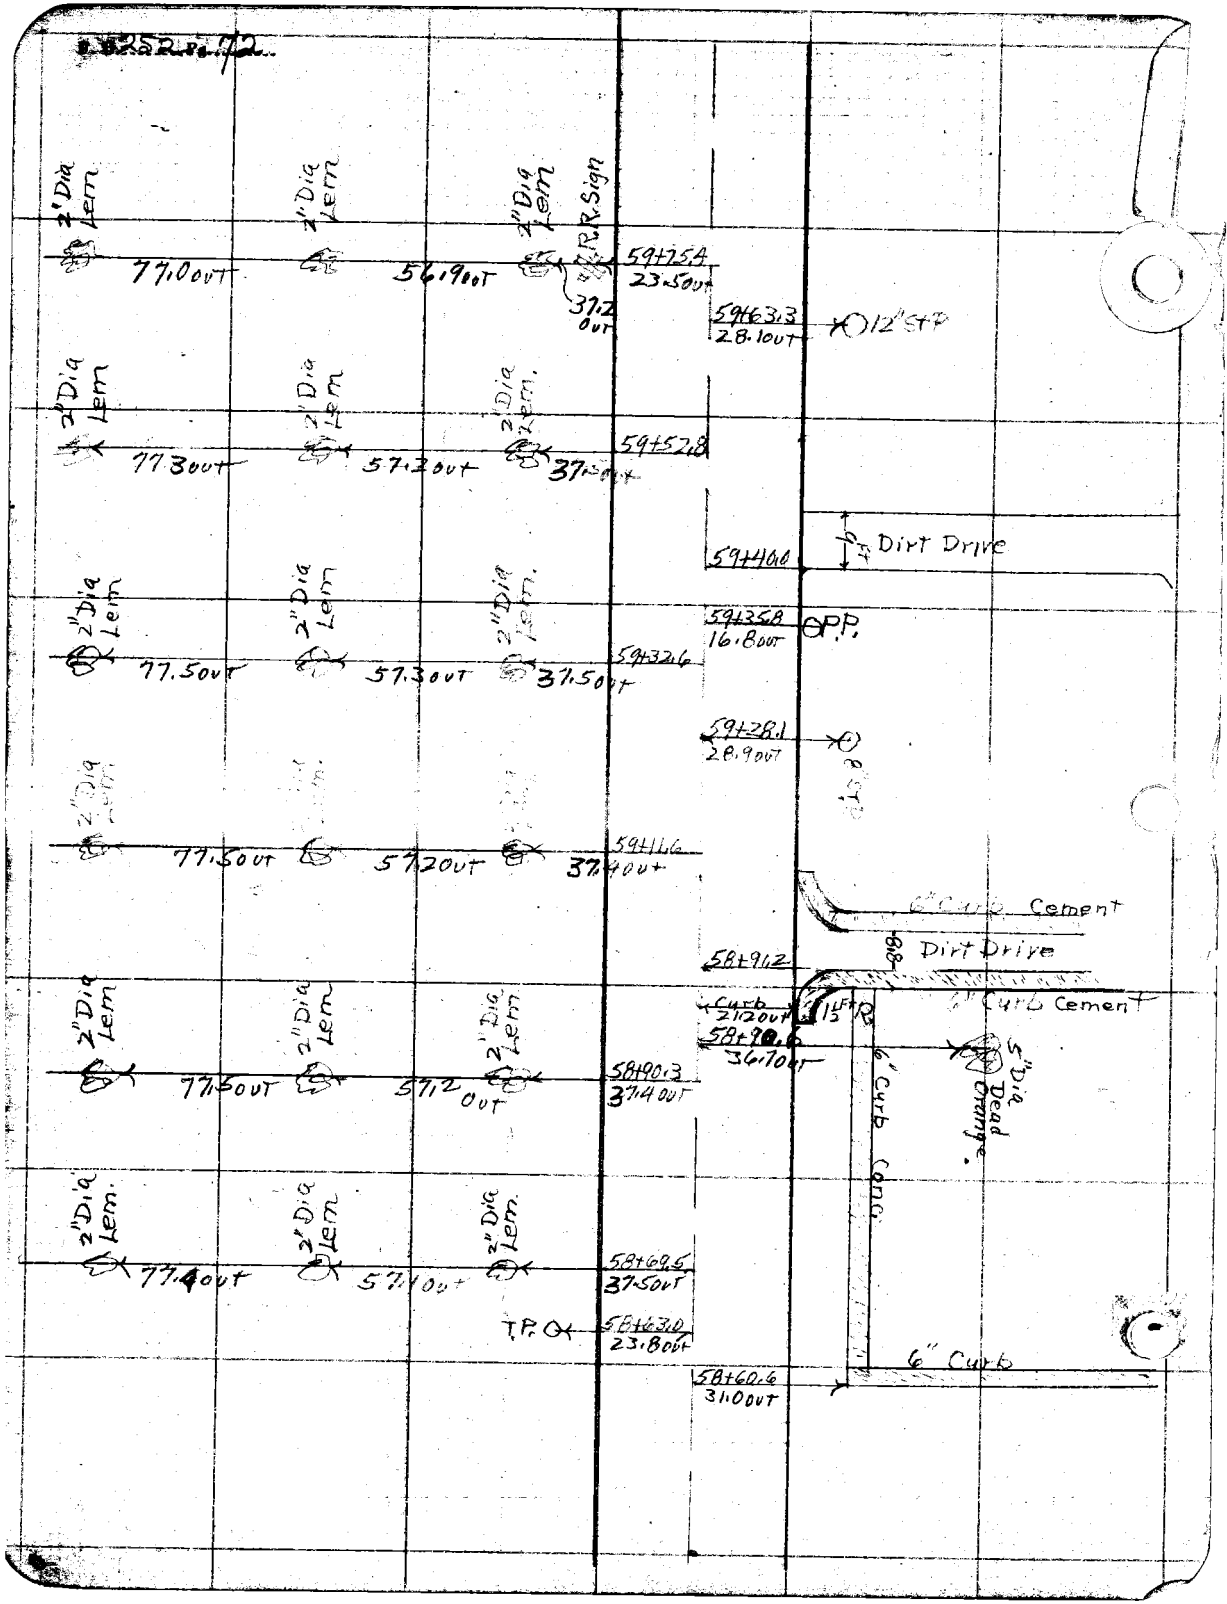
2" Dia Lem
77.0 Out
2" Dia Lem
56.9 Out
2" Dia Lem
R.R. Sign
37.2 Out
59+75.4
23.5 Out
59+63.3
28.1 Out
12" STP
2" Dia Lem
77.3 Out
2" Dia Lem
57.2 Out
2" Dia Lem.
59+52.8
6 Ft. Dirt Drive
59+40.0
2" Dia Lem
77.5 Out
2" Dia Lem
57.3 Out
2" Dia Lem.
37.5 Out
59+32.6
59+35.8
16.8 Out
P.P.
59+28.1
28.9 Out
STP
77.5 Out
57.2 Out
59+11.6
37.4 Out
6" Curb Cement
58+91.2
Dirt Drive
6" Curb Cement
Curb
21.2 Out
58+70.6
36.7 Out
2" Dia Lem
77.5 Out
2" Dia Lem
2" Dia Lem.
57.2 Out
58+90.3
37.4 Out
5" Dia Dead Orange.
6" Curb Conc.
2" Dia Lem.
77.4 Out
2" Dia Lem
2" Dia Lem.
57.1 Out
58+68.5
37.5 Out
T.P.
58+63.0
23.8 Out
6" Curb
58+60.6
31.0 Out

F. B. 252 Pg. 73

Platted by Leland	W. O. No. 4249 D. S. O. No.
Date Jan. & Mar. 1927	Location. Bonita Ave.
Map No. 8904	Surveyed by C. V. Crumley
Platting C'k'd by Paige	Date Oct. & Nov. 1926
Date April 1927	Indexed.

77.1 Out 57.0 Out 60+19.8 36.5 Out

77.1 Out 57.1 Out 60+98.8 36.5 Out

77.3 Out 57.2 Out 60+77.2 36.3 Out 60+68.4 25.3 Out

77.1 Out 57.0 Out 60+57.2 36.4 Out

77.0 Out 57.1 Out 60+36.8 36.5 Out

77.1 Out 57.1 Out 60+14.6 36.5 Out 60+06.2 77.1 Out 60+04.6 24.5 Out

2" Dia Oranges

2" Dia Oranges

2" Dia Oranges

T.P.

Wig Wag Signal Pole

Trolley Pole

Pudt Pomona

Δ To #4 = 87°-37-00" − 175°-14-30"

Δ To #2 = 91°-45-45" / 183°-31-15"

Δ To #3 = 87-15-15 / 174-31-00

Curve Data 4 chords @ 50'

Δ To B.C. = 91°-05-00" / 182°-09-45"

Δ To #1 = 91°-27-00 / 182-53-40

Δ P.E. R.R.

#4 #3 #2 #1

50' 50' 50' 50'

29.02

Set 1/2" B.C. of Curve

91°-05'-00" / 182°-09'-45"

Note:- Δ Turned off E. Bonita Ave From Sta. 59+95.68 To chord Points

59+95.57 Set N.E.t. split of frogs of P.E. Tracks.

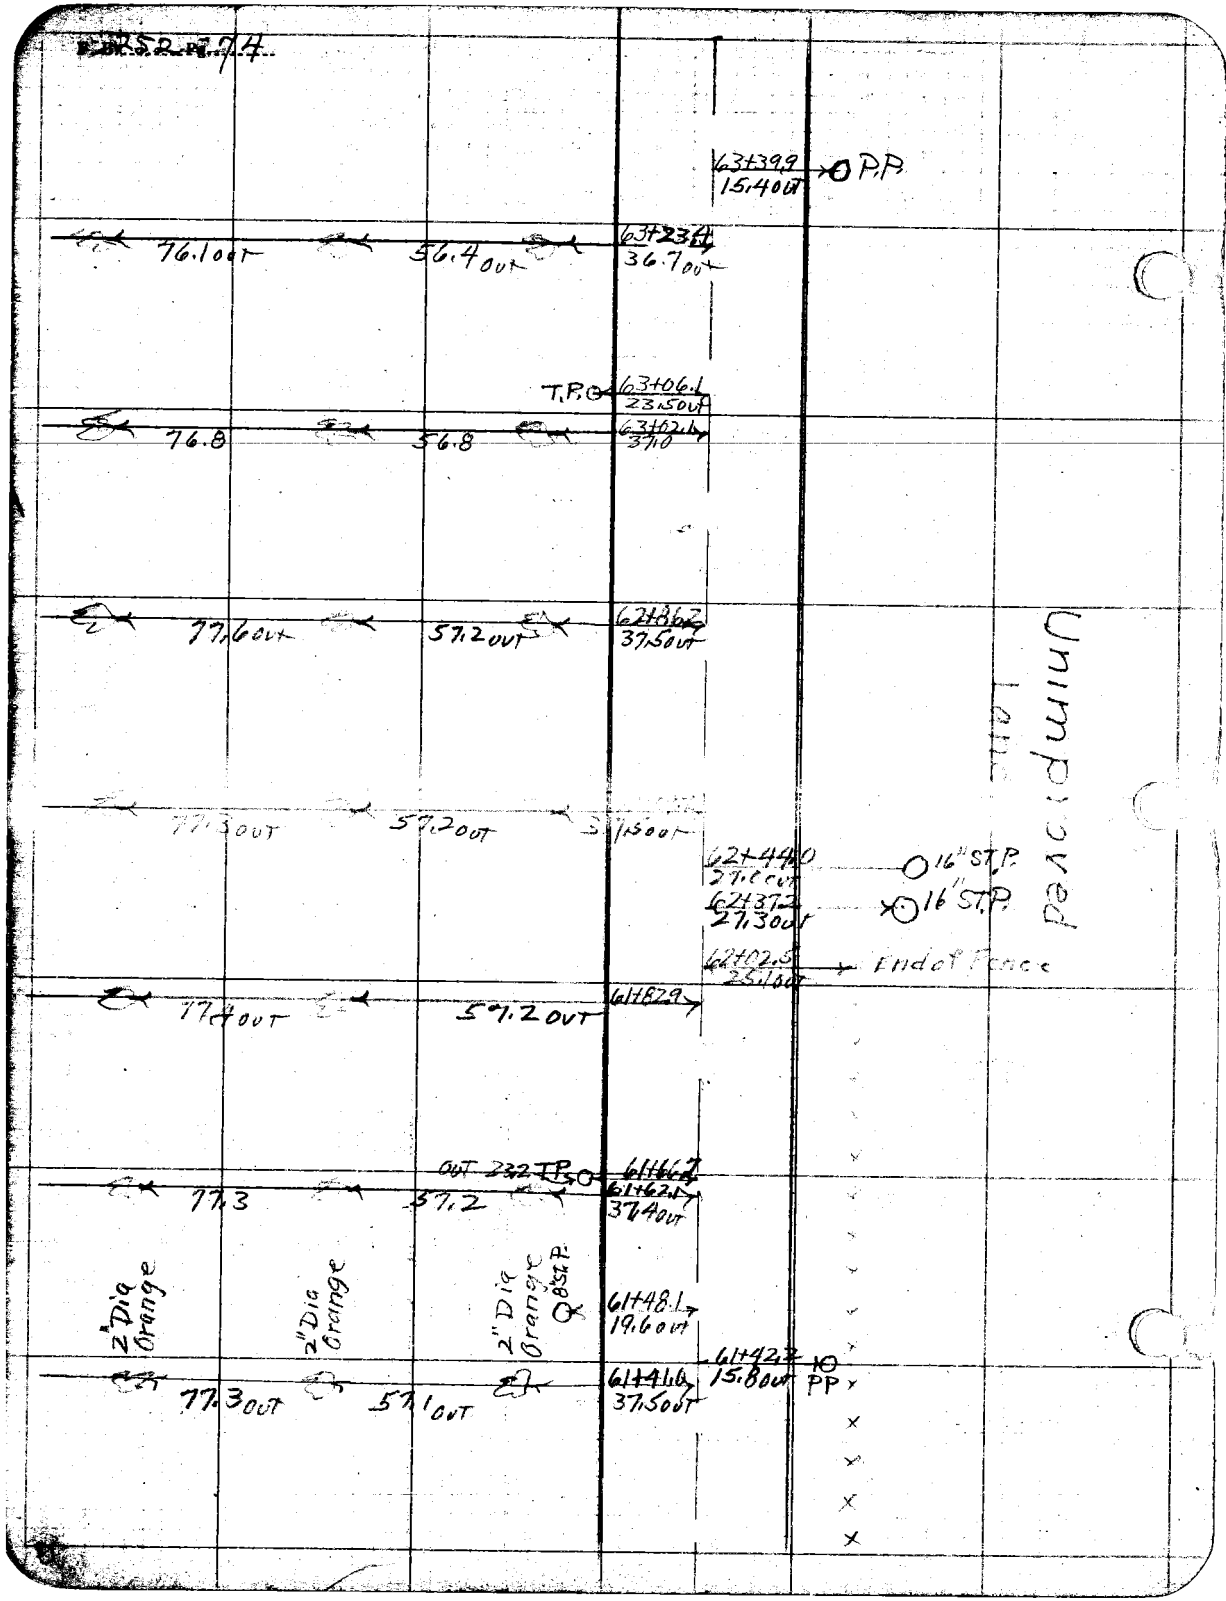
63+39.9
15.40 OUT
PP
63+23.4
36.7 OUT
76.1 OUT
56.4 OUT
T.P.
63+06.1
23.50 OUT
63+02.6
37.0
76.8
56.8
62+86.2
37.50 OUT
77.6 OUT
57.2 OUT
77.3 OUT
57.2 OUT
62+44.0
27.6 OUT
16" ST.P.
62+37.2
27.30 OUT
16" ST.P.
62+02.5
23.1 OUT
Ends Fence
61+82.9
77.4 OUT
57.2 OUT
OUT 23.2 T.P.
61+66.7
61+62.1
37.4 OUT
77.3
57.2
2" Dia Orange
2" Dia Orange
2" Dia Orange
BST.P.
61+48.1
19.6 OUT
61+42.2
15.8 OUT
PP
61+41.6
37.50 OUT
77.3 OUT
57.1 OUT
Unimproved
Land

F.B. 262 Pg. 75

Platted by: Wood	W. O. No. 4044 D. S. O. No.
Date: Feb. & Mar. 1927	Location: Bonita Ave.
Map No. 8904	Surveyed by: C.K. Cummings
Platting C'k'd by: Paige	Date: Oct. & Nov. 1926
Date: April 1927	Indexed:

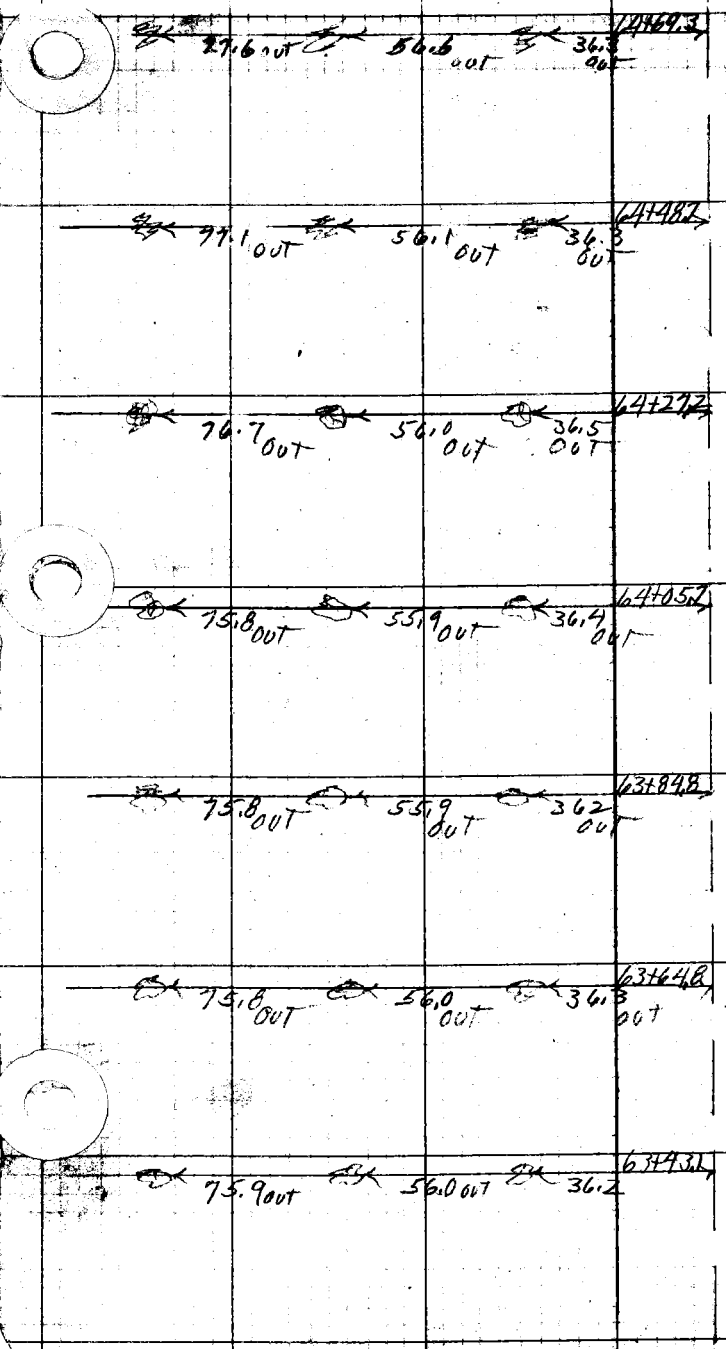

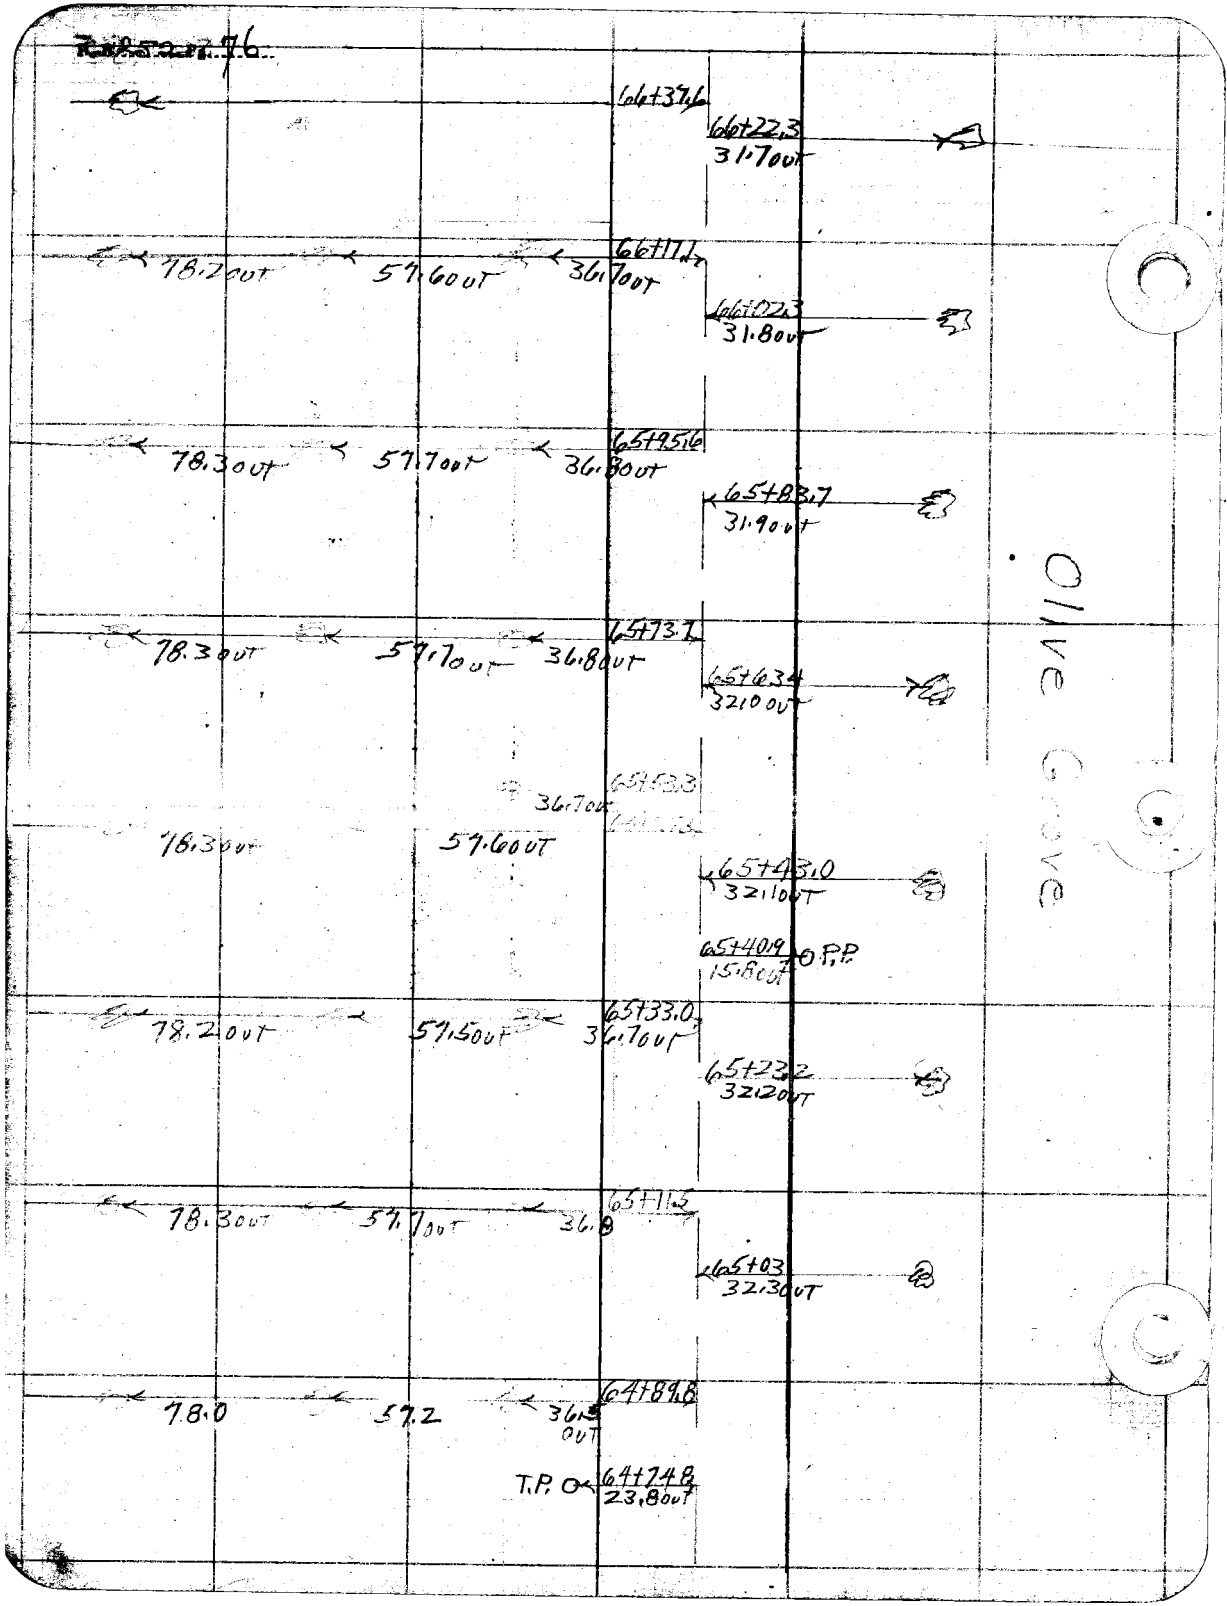
66+37.6
66+22.3
31.7 out
66+11.7
78.2 out
57.60 out
36.7 out
66+02.3
31.8 out
65+95.6
78.3 out
57.7 out
36.8 out
65+83.7
31.9 out
65+73.7
78.3 out
57.7 out
36.8 out
65+63.4
32.0 out
65+53.3
36.7 out
78.3 out
57.60 out
65+43.0
32.1 out
65+40.9
15.8 out
O.P.P
65+33.0
78.2 out
57.50 out
36.7 out
65+23.2
32.2 out
65+11.3
78.3 out
57.7 out
36.8
65+03
32.3 out
64+89.8
78.0
57.2
36.5
out
T.P. 0
64+74.8
23.8 out
Olive Grove

F.B. 252 Pg. 77

Platted by: Wood	W. O. No. 4949 D. S. O. No.
Date: Feb. & Mch. 1927	Location: Bonita Ave.
Map No. 4904	Surveyed by: C.V. Corman & Co.
Platting C'k'd by: Paige	Date: Oct. & Nov. 1926
Date: April 1927	Indexed:

Subdivision Tr. No. 4920

67+37.0 18.0 OUT — P.P. 4.9 OUT — 8" ST.P.

67+36.2 37.8 OUT — 3" Dia Orange

67+16.0 26.3 OUT — 8" ST.P. 38.9 — 3" Dia Orange

67+07.4 29.3 OUT — R. Bush

67+02.7 33.3 OUT — Row of Roses 37.6 OUT 44.0 OUT 42.5 OUT 39.5 OUT 44.4 OUT

Fd 2" I.P. B.C. S.E. Cor. Lot 19 Tr. 4920 Per Page 14

67+00.67 49.95 OUT — 66+99.2 37.8 OUT — 43.9 OUT 40.8

66+97.1 34.1 OUT — 8" Dia AVOCADO Tree

66+89.8 26.2 — 8" ST.P.

66+82.5 20.3 — R. Bush

66+73.4 21.3 OUT — R. Bush

66+66.6 34.8 — 2" Dia Walnut Tree 40.9 OUT — R. Bush 46.8 OUT — R. Bush

66+66.2 20.8 OUT — R. Bush

66+65.2 28.1 OUT — Spanish Broom

T.P. — 66+64.8 24.2 OUT — 16" ST.P.

66+63.7 29.0 OUT — Spanish Broom Tree

66+62.8 27.6 OUT

Fd. N.&T. .075' N of Lime — Fd N.&T. on Line 66+52.44

Dirt Drive

See Page 14

S.W.&T. Sta 66+42.78

4th St

66+49.7 — 2" Dia Fig 26.7 OUT — 16" ST.P.

21.3 OUT

66+41.7 31.6 OUT — 4" olive

F.B. 252 p. 98

694312 — 8" Standpipe
26.6 OUT

694160 — 8" ST.P.
26.6

681974 — 8" ST.P.
26.6 OUT

681777 — 8" ST.P.
26.6 OUT

681570 — 8" ST.P.
26.6 OUT

T.P. 681242
24.8 OUT

681174 — 8" ST.P.
26.6 OUT

678780 — 8" ST.P.
26.6 OUT

T.P. 677770 — 8" ST.P.
25.1 OUT 26.6 OUT

677563 — 8" ST.P.
26.6 OUT

No Improvements

Graded 1920

Paved

Unimproved

F. B. 252 Pg. 79

Platted by L. J. Ward	W. O. No. 4049 D. S. O. No.
Date Feb. 8 & 10, 1927	Location. Bonita Ave.
Map No. 890 F.	Surveyed by C.V.C. & M.E.Y.
Platting C'k'd by Paige	Date Oct. 9 Nov. 1926
Date April 1927	Indexed.

N. Y. Page

T.P.D 71+51.2
24.30 Out

71+36.9 P.P.
16.30 Out

T.P.D 71+26.9
24.7 Out

Subdivison
Tr. No. 4920

Unimproved

8" St. P. 70+35.7
21.2

70+03.72
2x2 L.& Cor.

S.W.& T. Sta. 69+72.63
See Pg. 14

50.12

3rd St.

69+79.7 27.2 Out 8" St. P.

T.P.D 69+76.2 24.3 Out 69+71.1 29.4 12" St. D

69+42.70 3x3 Lot Cor. 50.2 Out

T.P.D 69+64.7
24.2 Out

69+56.3 8" St. P.
26.6 Out

69+38.1 P.P.
15.80 Out

P. Bk. 2, Pg. 80

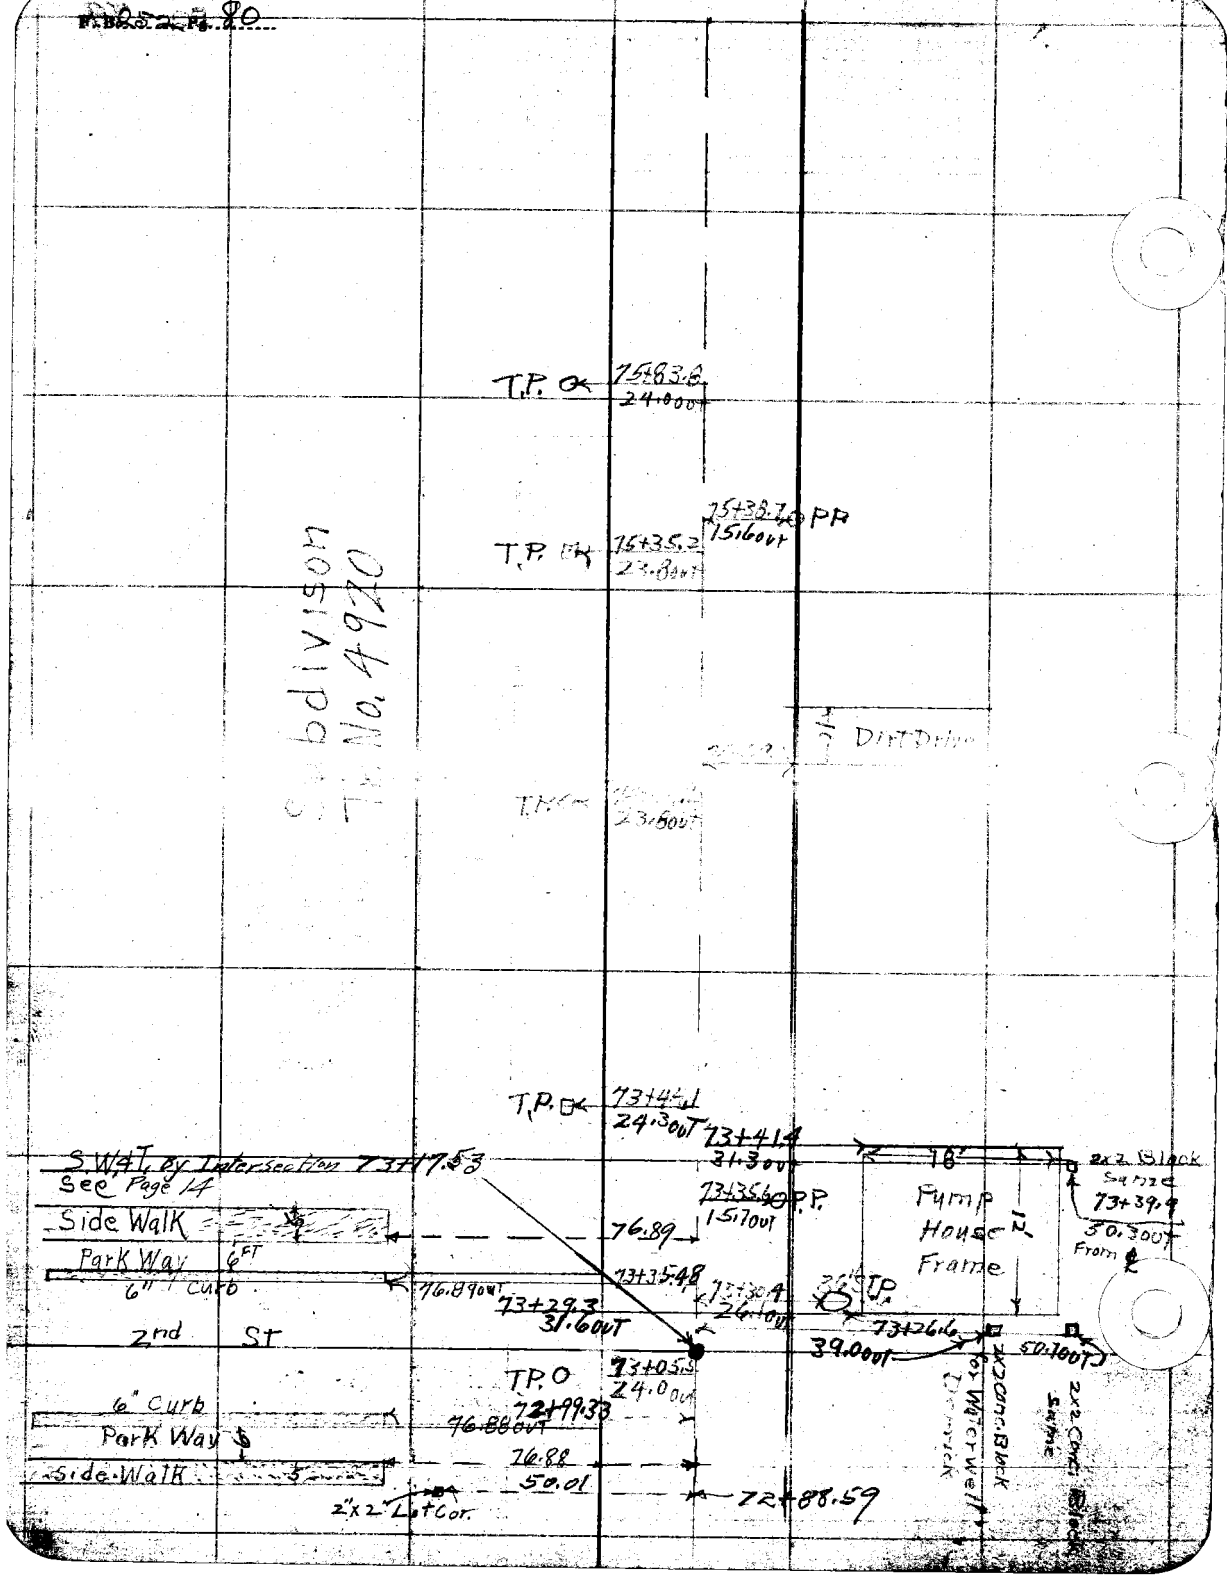
T.P. 75+83.6
24.00 Out
T.P. 75+35.2
23.80 Out
75+38.7 PP
15.16 Out
Subdivision
T. No. 4970
DIRT Drive
T.P. 73+44.1
24.30 Out
S.W.T. by Intersection 73+17.53
See Page 14
Side Walk
Park Way 6FT
6" Curb
76.89
76.89 Out
73+35.48
73+29.3
31.6 Out
2nd St
T.P. 73+05.9
24.0 Out
72+99.38
6" Curb
Park Way
Side Walk
76.88
50.01
72+88.59
2"x2" Lot Cor.
73+41.4
31.3 Out
73+35.6 P.P.
15.70 Out
18'
12'
Pump House Frame
2x2 Block Set
73+39.4
30.30 Out
From ℄
T.P. 73+26.6
39.0 Out
50.10 Out
2x2 Con. Block
Set
Old Well

Platted by Ward	W. O. No. 4949 D. S. O. No.
Date	Indexed

F.B. CFA Pg. 44

Subdivison
Tr No 4920

T.P. ℄ 76+10.9
23.6 out

8" ST.P. ℄ 77+56.7
20.6 out

77+54.0 P.P.
15.6 out

T.P. ℄ 77+44.7
23.1 out

T.P. ℄ 77+43.3
23.4 out

76+79.9
32.5 out — Loquat 1" Dia — 43.5 out — 1" Dia. Quince

76+76.4
32.2 out — Century Plant

76+74.9
34.1 out — 38.6 out — 47.1 out

76+76.4
43.9 out — 1" Dia Fig

76+70.4
47.1 out — E. End of Rose Arbor

76+68.7
32.8 out — R. Bush

76+66.6
48.6 out — 2x2 Cem. Porch Pillar

76+78.57
2x2 Lot Cor — 50.0 ℄

76+47.56
Set S.W. & T. By Intersection
See Page 14

1ST ST

Dirt Walk

76+61.9

76+59.2
32.5 — 1" Dia Loquat — 1" Dia. Loquat — 45.1 out — Porch Pillar 1'x1'

76+56.6
48.7 out — W. End of Rose Arbor

76+55.8
46.1 out

Dirt Drive

76+46.3

76+44.8
32.1 out — 1" Dia Loquat — 1" Dia Apricot

76+43.3
28.8 out — R. Bush — 46.0 out — W. End of Rose Arbor

2x2 Lot Corner
76+18.57 — 50.0 ℄

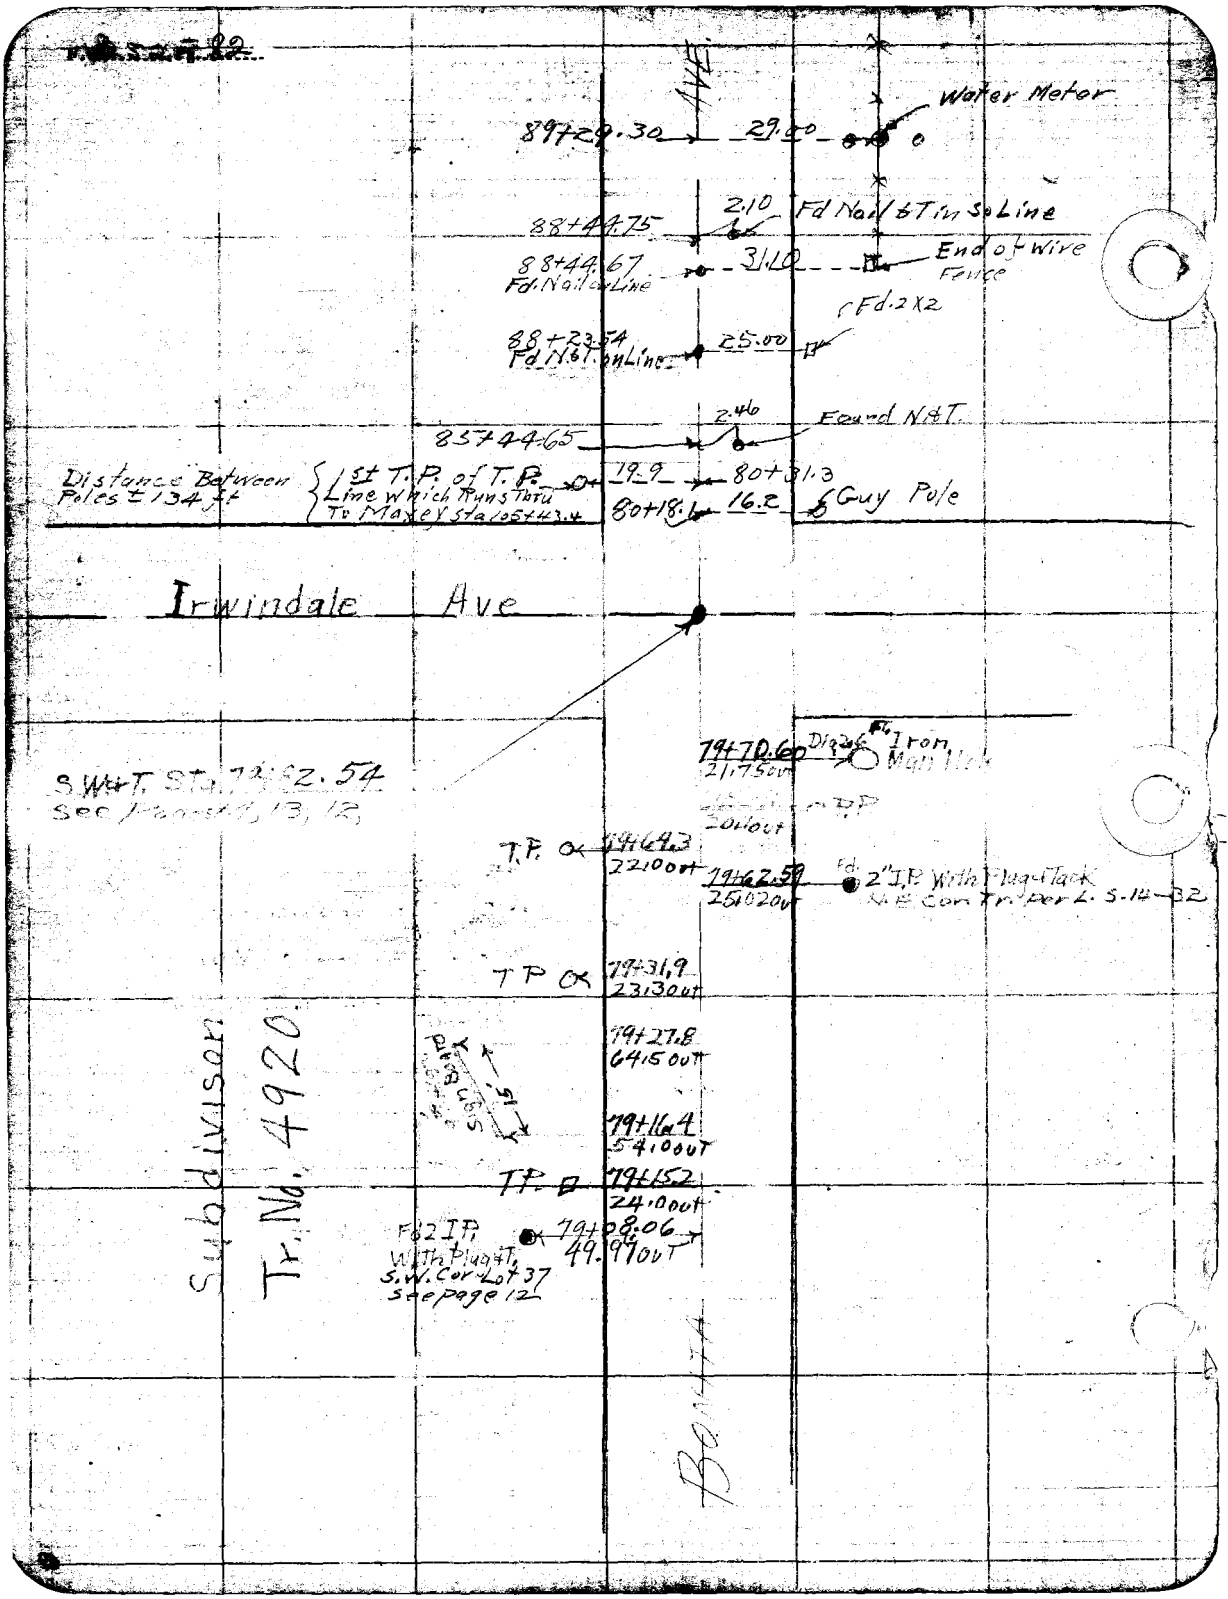
Water Meter
89+29.30
29.00
88+44.75
2.10
Fd Nail & Tin Sc Line
88+44.67
Fd Nail on Line
3.10
End of Wire Fence
Fd. 2 X 2
88+23.54
Fd Nail on Line
25.00
2.46
Found N&T.
85+44.65
Distance Between Poles ± 134 Ft.
1st T.P. of T.P. Line Which Runs Thru To Maxey Sta 105+43.4
19.9
80+31.3
80+18.1
16.2
Guy Pole
Irwindale Ave
S.W.T. Sta. 72+52.54
See page 13, 12
79+70.60
21.75 Out
Fd. Iron
T.P.
79+64.3
22.00 Out
79+62.59
25.02 Out
Fd. 2" I.P. With Plug & Tack N.E. Cor. Tr. Per L.S. 14-32
TP
79+31.9
23.30 Out
79+27.8
64.15 Out
79+16.4
54.00 Out
TP
79+1.52
24.00 Out
Fd 2 I.P. With Plug & Tag S.W. Cor. Lot 37 See page 12
79+08.06
49.99 Out
Subdivision
Tr. No. 4920
Bonita

F. B. [illegible] Pg. [illegible]

Plotted by Wood	W. O. No. 4099 D. S. O. No.
Date Feb. & Mar. 1927	Location. Bonita Ave
Map No. 8904	Surveyed by C. V. Crumley
Plotting C'k'd by Paige	Date Nov. & Dec., 1926
Date April 1927	Indexed.

Notes By C. V. Crumley

Cont'd from Page

4" Gum

22.7 — 57.8 — 94+80.7

3" Pepper

11.2 — 12' — 22.5 — 3" Gum — 35.5 — 94+59.3

½" Gum

Water Meter — 20.1 — 94+17.14

3" Gum Trees — 3" Pepper — 4" Gum

10.7 — 12' — 22' — 36.2 — 94+14.5

81.8 — 94+14.0

T.P. — 16.8 — 94+09.29

22.5 — 8 Iron

Cobble Stone

House — Cement Pavement

35.2 — 9.45

N. Cor.

½ Acacia Tree — 40.15 — 93+90.30

Unimproved Land

81.7 — 93+71.19

Shade Tree — 1½" Tree — 57.9 — 93+68.

½" Acacia Tree — 40.35 — 93+64.15

Fd. 3½" I.P. — 93+63.95

93+47.59 — 30.50

Wire Fence Line

Drive Way

Found S.W.C.T. on Line — 36.80

Row of 2" Gum Trees — 22' — 22'

Fd 2" I.P. Plug & Tk. N.E. Cor. Daniel Ramirez Lot Per L.S. 13-19

93+37.62 — 25.14

22.0 — 22.4 — 35.6 — 93+27

1.23

1.8 — 20.87 — 93+14.6

Water Meter

24" Cem. stand pipe — 3" High — 93+13.50 — 21.40

Fence Line

92+87.62 — 25.13

Fd 2½" I.P. Plug & Tk. 8m Fence Line

N.W. Cor. Daniel Ramirez Lot, Per L.S. 13-19

90°

Bonita Ave

Unimproved Land

Fence Cor.

91+84 — 28.1

15.1

2.1

91+68 — 34.44 — Fence Line

91+67.6 Set Nail — 93.04

27.80 — End of fence

91+54.10

Fence → 89+90.10

30.00

89+89.53 — 89+89.43

Found Nail on Line

25.00

Fd 2"x2"

Fence Line

89°30'

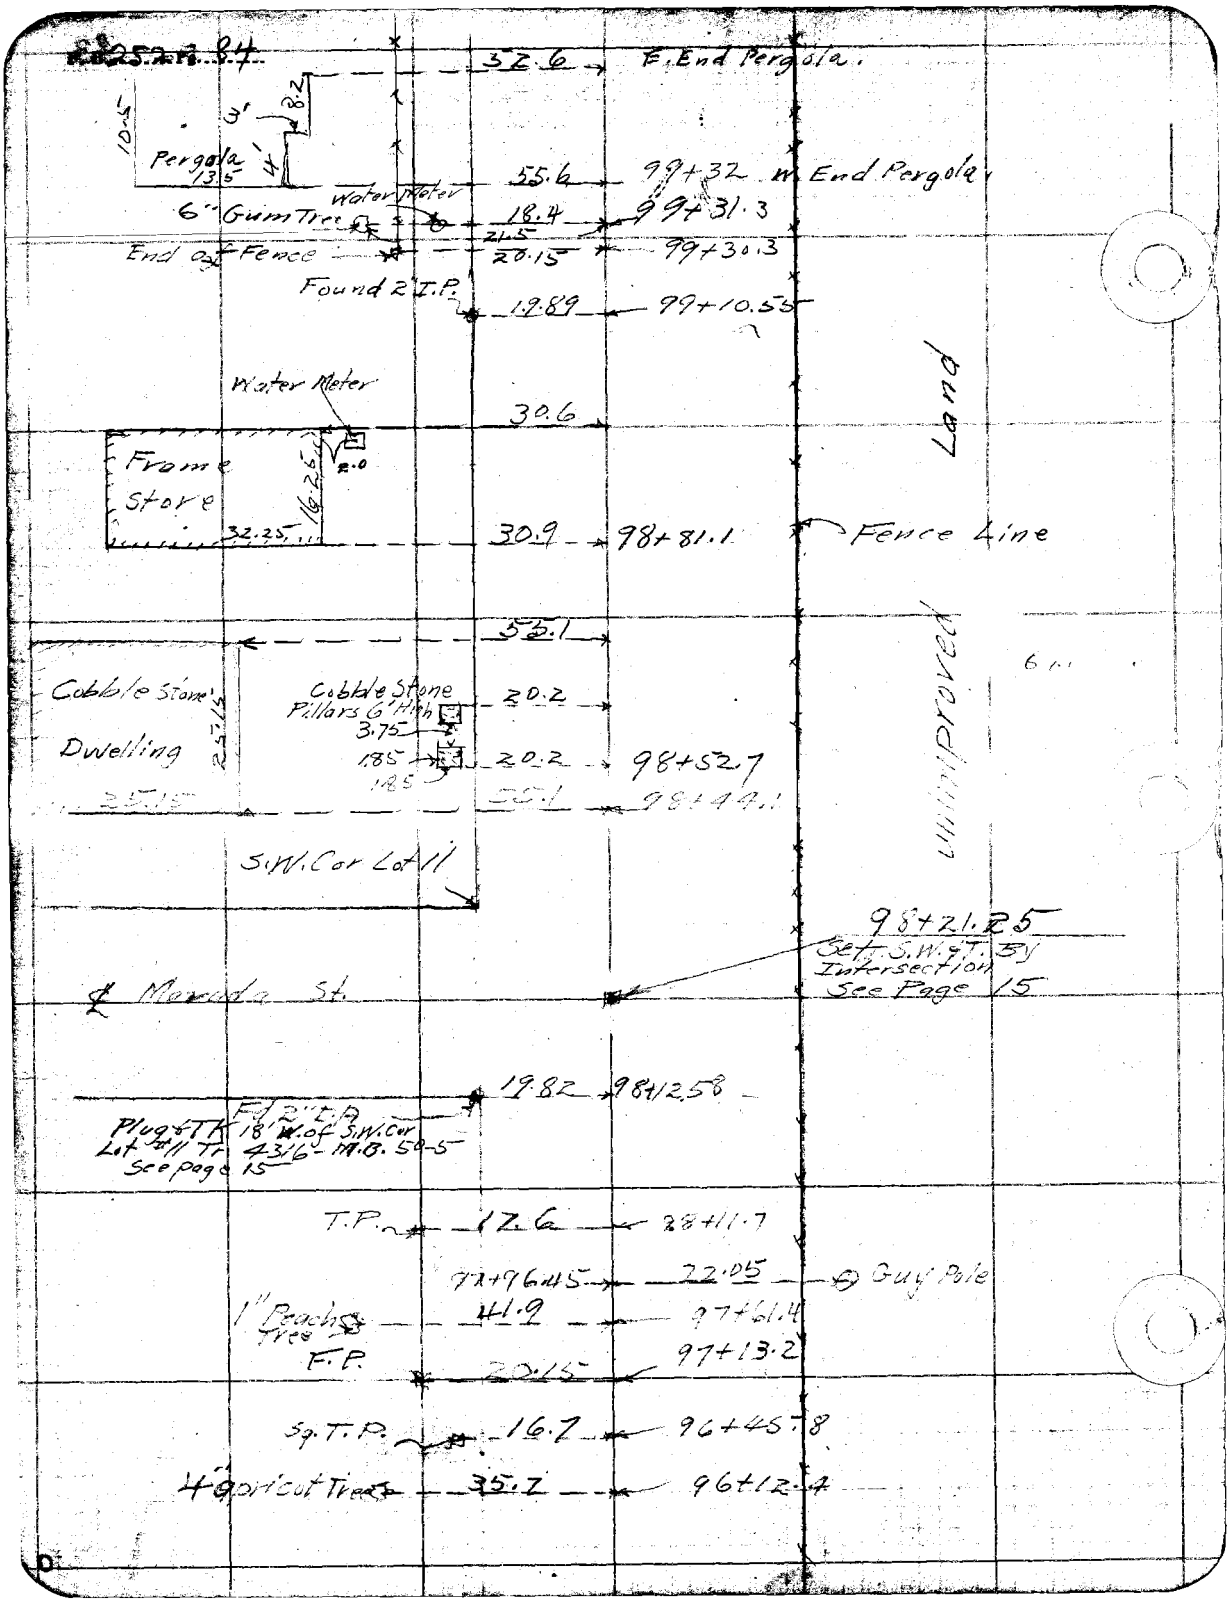
35.6
F. End Pergola
Pergola
13.5
10.4
3'
8.2
4'
55.6
99+32
W. End Pergola
Water Meter
6" Gum Tree
18.4
21.5
99+31.3
End of Fence
20.15
99+30.3
Found 2" I.P.
19.89
99+10.55
Water Meter
30.6
Frame Store
32.25
16.25
2.0
30.9
98+81.1
Fence Line
Land
Improved
55.1
Cobble Stone Dwelling
25.15
Cobble Stone Pillars 6' High
3.75
20.2
18.5
20.2
98+52.7
55.1
98+49.1
S.W. Cor Lot 11
98+21.25
Set T.S.W.F.T. By Intersection See Page 15
Meroda St.
19.82
98+2.58
Found 2" I.P. 18' W. of S.W. Cor
Plug & Tack Lot #11 Tr 43 16 - M.B. 50-5
See page 15
T.P.
12.6
98+11.7
97+96.45
22.05
Guy Pole
1" Peach Tree
41.9
97+61.4
F.P.
20.15
97+13.2
Sq. T.P.
16.7
96+45.8
4" Apricot Tree
35.2
96+12.4

Plotted by: [illegible]
Date: Feb. & Mch. 1927
Platting C'k'd by: Paige
Date: April 1927

Location: Benita Ave
Surveyed by: C.V. Crumley
Date: Nov. & Dec., 1926
Indexed:

F. B. 176 Pg. [illegible]

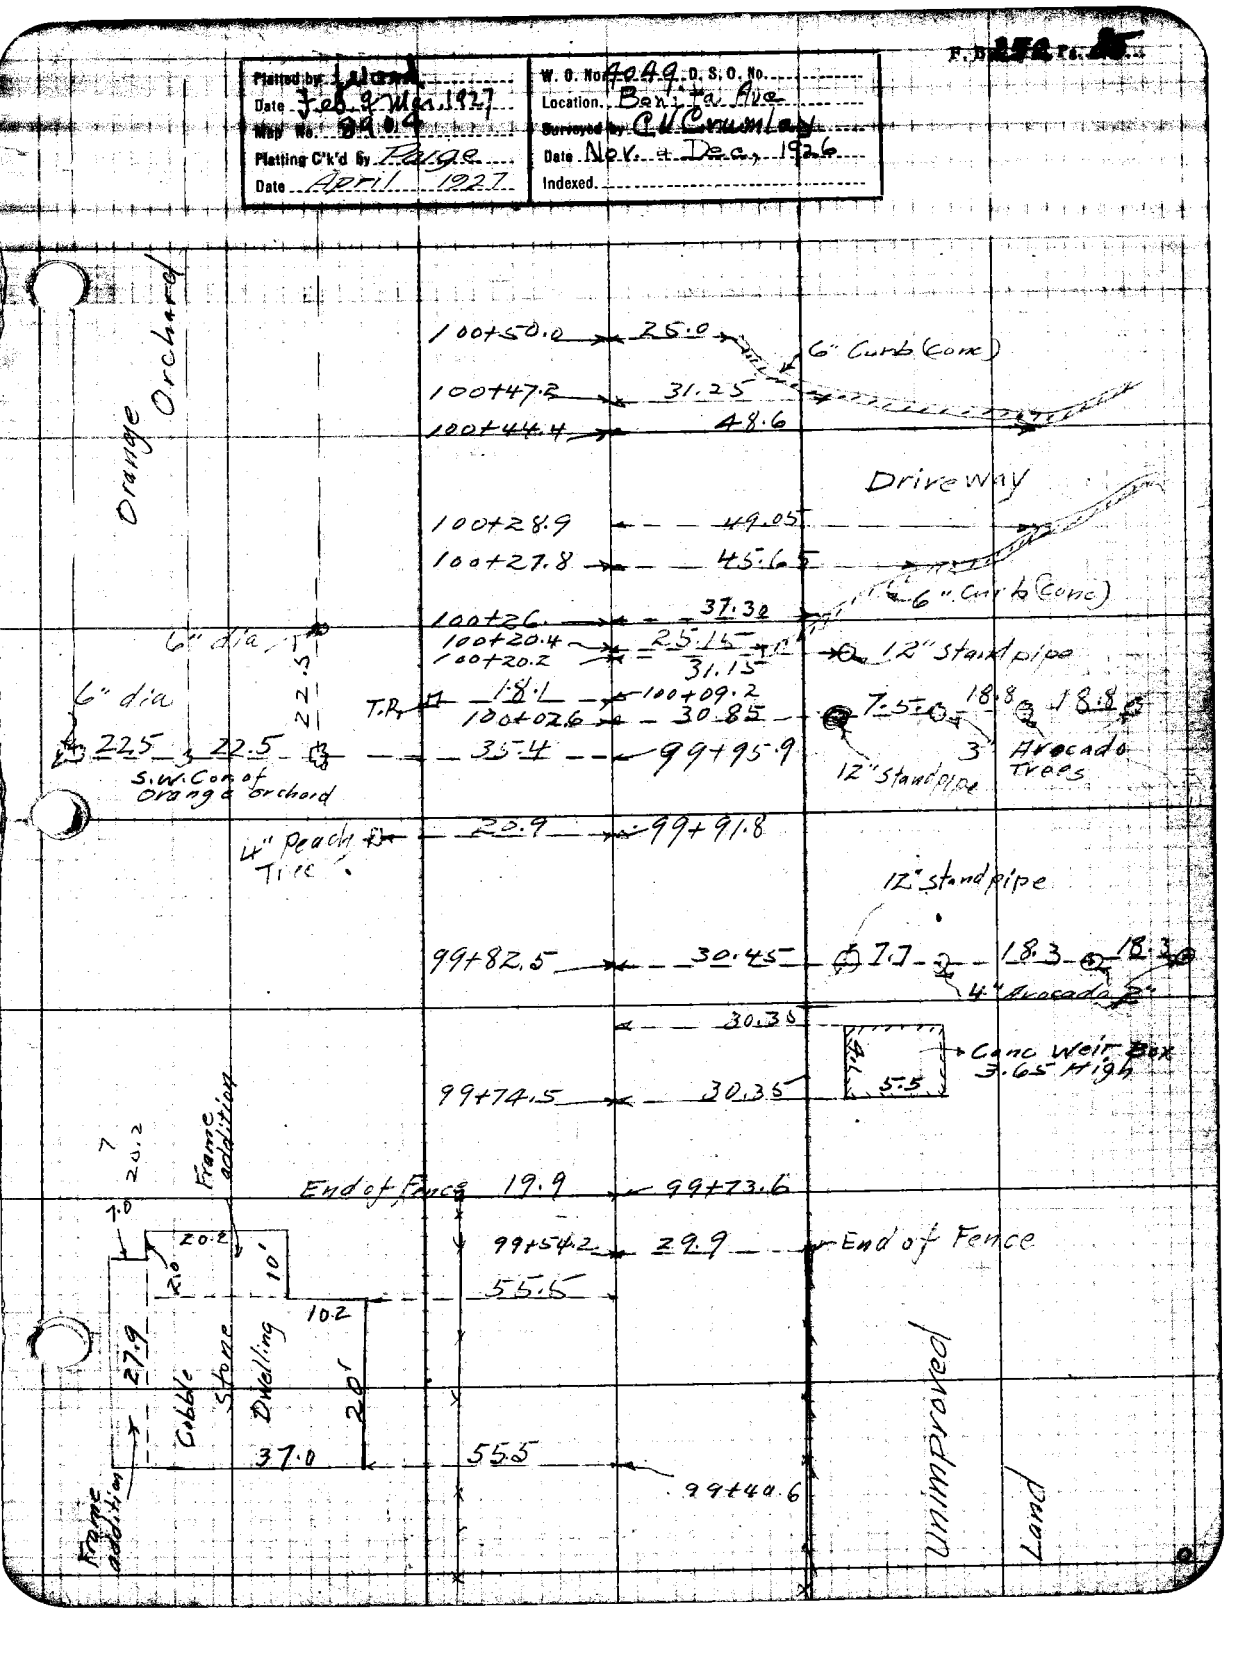

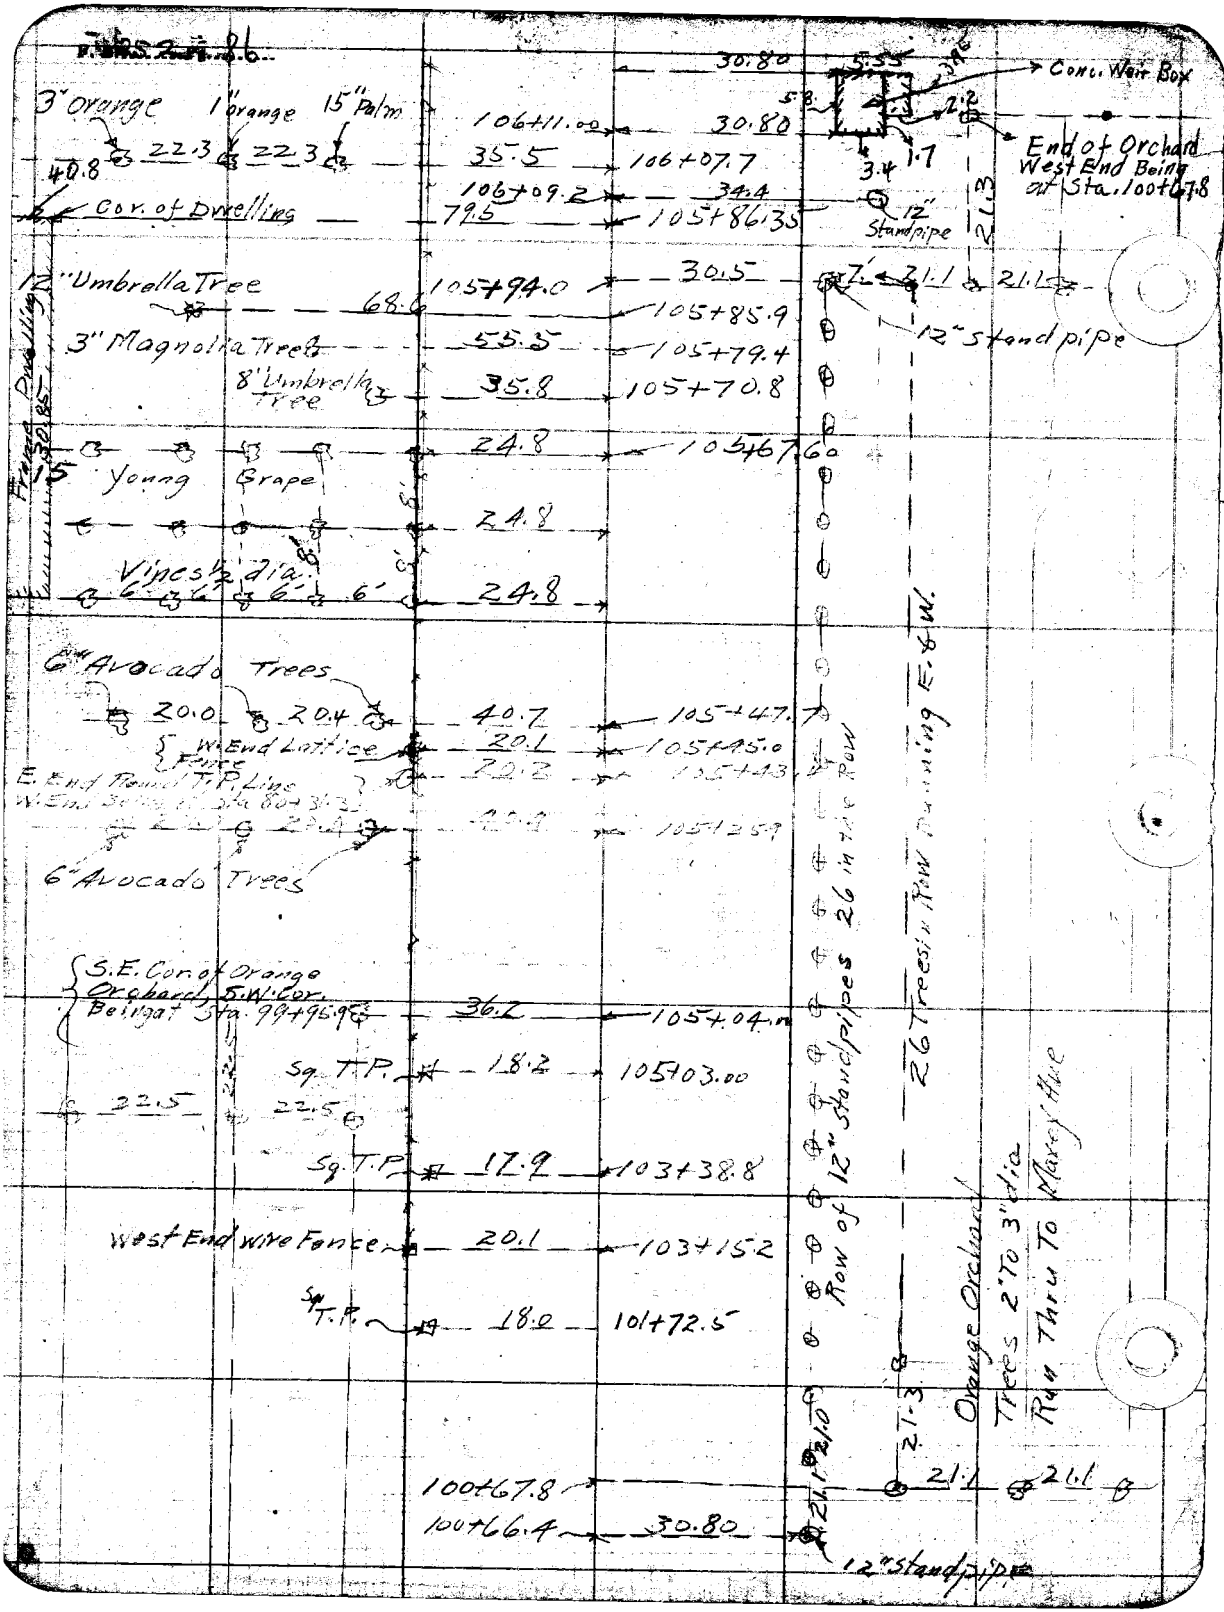
3" Orange
1" Orange
15" Palm
22.3
22.3
40.8
Cor. of Dwelling
106+11.00
35.5
106+09.2
79.5
30.80
106+07.7
34.4
105+86.35
30.80
5.5
5.8
Conc. Weir Box
2.2
End of Orchard
West End Being
at Sta. 100+67.8
3.4
1.7
12" Standpipe
21.3
1" Umbrella Tree
68.6
105+94.0
30.5
105+85.9
7'
21.1
21.1
12" Standpipe
3" Magnolia Trees
55.5
105+79.4
8' Umbrella Tree
35.8
105+70.8
15
Young Grape Vines 2" dia.
6'
6'
6'
24.8
105+67.60
24.8
24.8
6" Avocado Trees
20.0
20.4
40.7
105+47.
W. End Lattice Fence
20.1
105+45.0
E. End Rear T.P. Line
20.2
105+43.
W. End Rear T.P. Line Sta. 99+38.32
22.4
105+12.59
6" Avocado Trees
S.E. Cor of Orange Orchard, S.W. Cor. Being at Sta. 99+95.95
36.2
105+04.
Sq. T.P.
18.2
105+03.00
22.5
22.5
Sq. T.P.
17.9
103+38.8
West End wire Fence
20.1
103+15.2
Sq. T.P.
18.0
101+72.5
26 Trees in Row Running E. & W.
Row of 12" Standpipes 26' in this Row
Orange Orchard
Trees 2' To 3' dia.
Run Thru To Mary's Ave
2T-3
21.1
21.1
100+67.8
100+66.4
30.80
12" Standpipe

F.B. 252 Pg. 87

Platted by: L.A.J.	W. O. No. 4049 D. S. O. No.
Date Feb. & Mar. 1927	Location. Banta Ave
Map No. 8404	Corrected by C.H. Cement lay
Platting C'k'd by Page	Date Nov. + Dec. 1926
Date April 1927	Indexed.

Lemon Ave

4" Lemon Tree

Notice:
4 Rows in here ± 80 From ℄

8" Lemon Tree

Sq T.P.

Average 4" to 6" Dia. Lemon Orchard

W. End orchard

Cobble Stone Wall

Cor. Post & End Lattice Fence W. End at sta. 105+45.0

15" Palm

2" orange Trees

26.4	109+21.5
109+14.4	32.15
109+11	44.0
34.7	109+03.9
26.6	108+87.6
34.55	108+69.2
44.9	107+83.1
22.9	107+67.5
45.2	107+57.6
35.5	107+30.9
27.2	107+12.4
35.5	106+96.5
106+84.5	40.2
106+84.0	44.3
27.3	106+78.5
23.2	106+74.0
21.7	106+73.0
106+62.3	36.3
65.0	
49.1	106+45.3
20.1	
35.3	106+35.2
14.98	

Guy Pole

Row of Lemon Trees 4" to 6" O.a. E End at Sta. 119+08.9

Row of 12" Standpipes 22.5' apart E End at Sta. 119+08.9

Lemon Orchard

30" Standpipe

24" Standpipe

Lemon 12" Standpipe

Lemon

12" Standpipe

4" Lemon Tree

106+44.80 See Page 164-17. Found 2" I.P. with S.W.P.I. in Center ℄ Maxey Ave

Fd 2" I.P.

106+19.79

R = 1504.98

Δ = 90° 00' 00"

360° / Δ = 4

37 - 15½

15 - 5½

P. B. [illegible] Pg. 88

12" Lemon — 1" orange

20 — 27.2 — 26.2 — 113+88.4

20' — 20' — 24.6 — 113+71.2

1" orange

20' — 20' — 34.1 — 113+53.4

43.6 — 113+37.6

12" Lemon — 53.50 — 113+21.10

12" Fig Tree — 22.6 — 113+03.00

113+02.00 Set Nail

Sq. T.P. — 20.15 — 112+94.7

Round T.P. — 21.5 — 112+93.7

W. End of 106+78.5

End of Orchard

24.8 — 111+97.5

34.8 — 111+80.8

25.0 — 111+63.7

34.1 — 111+46.6

111+29.

2 Rows Missing.

Orchard

Round T.P. — 22.3 — 110+96.4

Sq. T.P. — 21.0 — 110+94.6

Lemon

54.6 — 110+79.8

44.6 — 110+59.80

54.6 — 110+39.8

44.8 — 110+24.8

34.8 — 110+08.2

Lemon

6" Lemon — 45.1 — 109+91

75.0 — 109+78.

6" Lemon Tree — Sq. T.P. — 22.1 — 109+68.30

20.9 — 23.5 — 109+65.5

1" Lemon — Round T.P. — 34.25 — 109+39.2

F.B. 152 Pg. 39

Platted by Wood	W. O. No. 4049 D. S. O. No.
Date Feb. & Mar. 1927	Location. Bonita Ave
Map No. 8904	Surveyed by C.K. Crumley
Platting C'k'd by Paige	Date Nov. + Dec. 1926
Date April 1927	Indexed.

43.3 → 116+48.00

6" orange Round T.P. — 20.0 → 116+47.8

4" orange — 18.0 — 33.0 → 116+31.3

1" orange — 116+29.0 → 20.5 — 16" Gum Tree

3" Lemon — 16.6 — 25.6 → 116+14.7

1" orange

1" orange — 18.0 — 33.2 → 115+96.7

4" orange

115+88.2 → 17.5 — 40" Gum Tree

18.0 — 25.0 → 115+78.7

4" orange 1"

33.6 → 115+62.9

6" Orange — 1" orange — 20.0 — 24.6 → 115+45.1

115+37.0 → 17.9 — 48" Gum Tree

6" orange — 18.1 — 33.2 → 115+27.5

20.0 — 23.6 → 115+09.7

6" orange — 12" Lemon

114+96.7 → 17.4 — 42" Gum

19.2 — 33.0 → 114+92.4

1" orange

18.1 — 25.0 → 114+75.3

6" orange — 1" orange

Sq. T.P. — 19.7 → 114+74.5

Round T.P. — 20.8 → 114+71.6

53.3 → 114+56.8

8" Lemon — 18.0 — 24.0 → 114+40.9

1" orange

114+24.4 → 19.1 — 40" Gum Tree

33.4 → 114+22.8

12" Lemon

114+4.3 → 16.5 — 40" Gum Tree

22.0 — 19.2 — 24.5 → 114+05.00

12" Lemon — 1" orange

Lemon Orchard

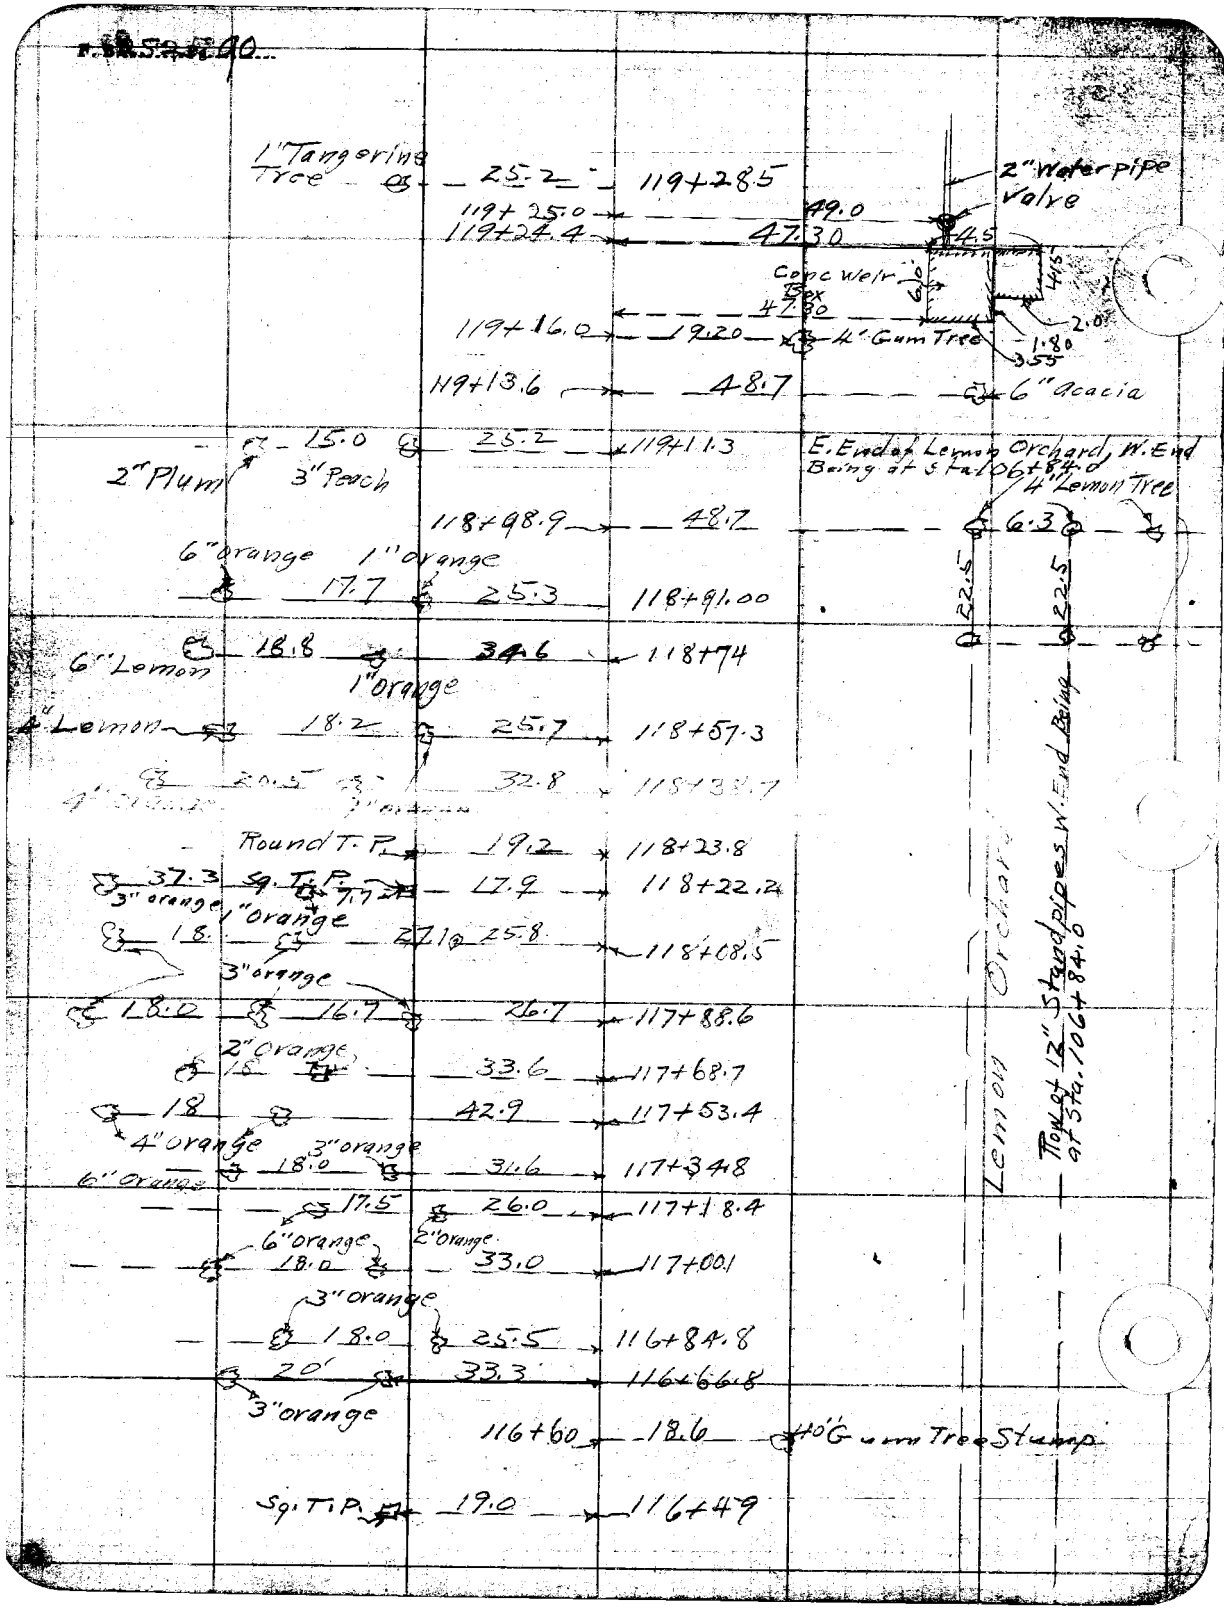
1" Tangerine Tree
25.2
Lemon Orchard
Top of 12" Standpipes W. End Being Sta. 1064+84.0

Plotted by: Wood	W. O. No. 4049 D. S. O. No.
Date Feb. 27th 1927	Location: Benita Ave
Map No. 8904	Surveyed by: C.V. Rawnsley
Platting C'k'd by: Paige	Date: Nov. & Dec. 1926
Date: April 1927	Indexed:

F.B. 352 Pg. 91

E. End of Row

Orange Orchard Trees, Average 4" Dia. 22 ft. Spacing

W. End orchard

Round T.P.

Sq. T.P.

4" Orange

24" Gum Tree

4" Golden Privet Bushes 2' Dia.

21.3	122+61.80	
35.4	122+41.7	
122+26.4	19.5	30" Gum
121+95.5	19.9	Group of 4 2" Gum Trees
121+83.0	18.3	30" Gum Tree
Round T.P. 17.6	121+79.3	
Sq. T.P. 17.0	121+73.2	
121+47.2	39.2	12" Standpipe
121+41.1	39.8	8" standpipe
121+21.6	19.5	30" Gum Tree
120+59.	19.75	30" Gum Tree
22.4	120+27.9	
18.4	120+16.0	
18.4	120+1.4.6	
119+97.6	19.2	5.0 Gum Tree
51.6	119+72.9	
119+66.8	48.8	4" Lemon
22.0		12" Standpipe
22.0	119+33.0	

Row of 4" Standpipes E. End 122+88.3 22.0 20.3 20 20' 20' 20'

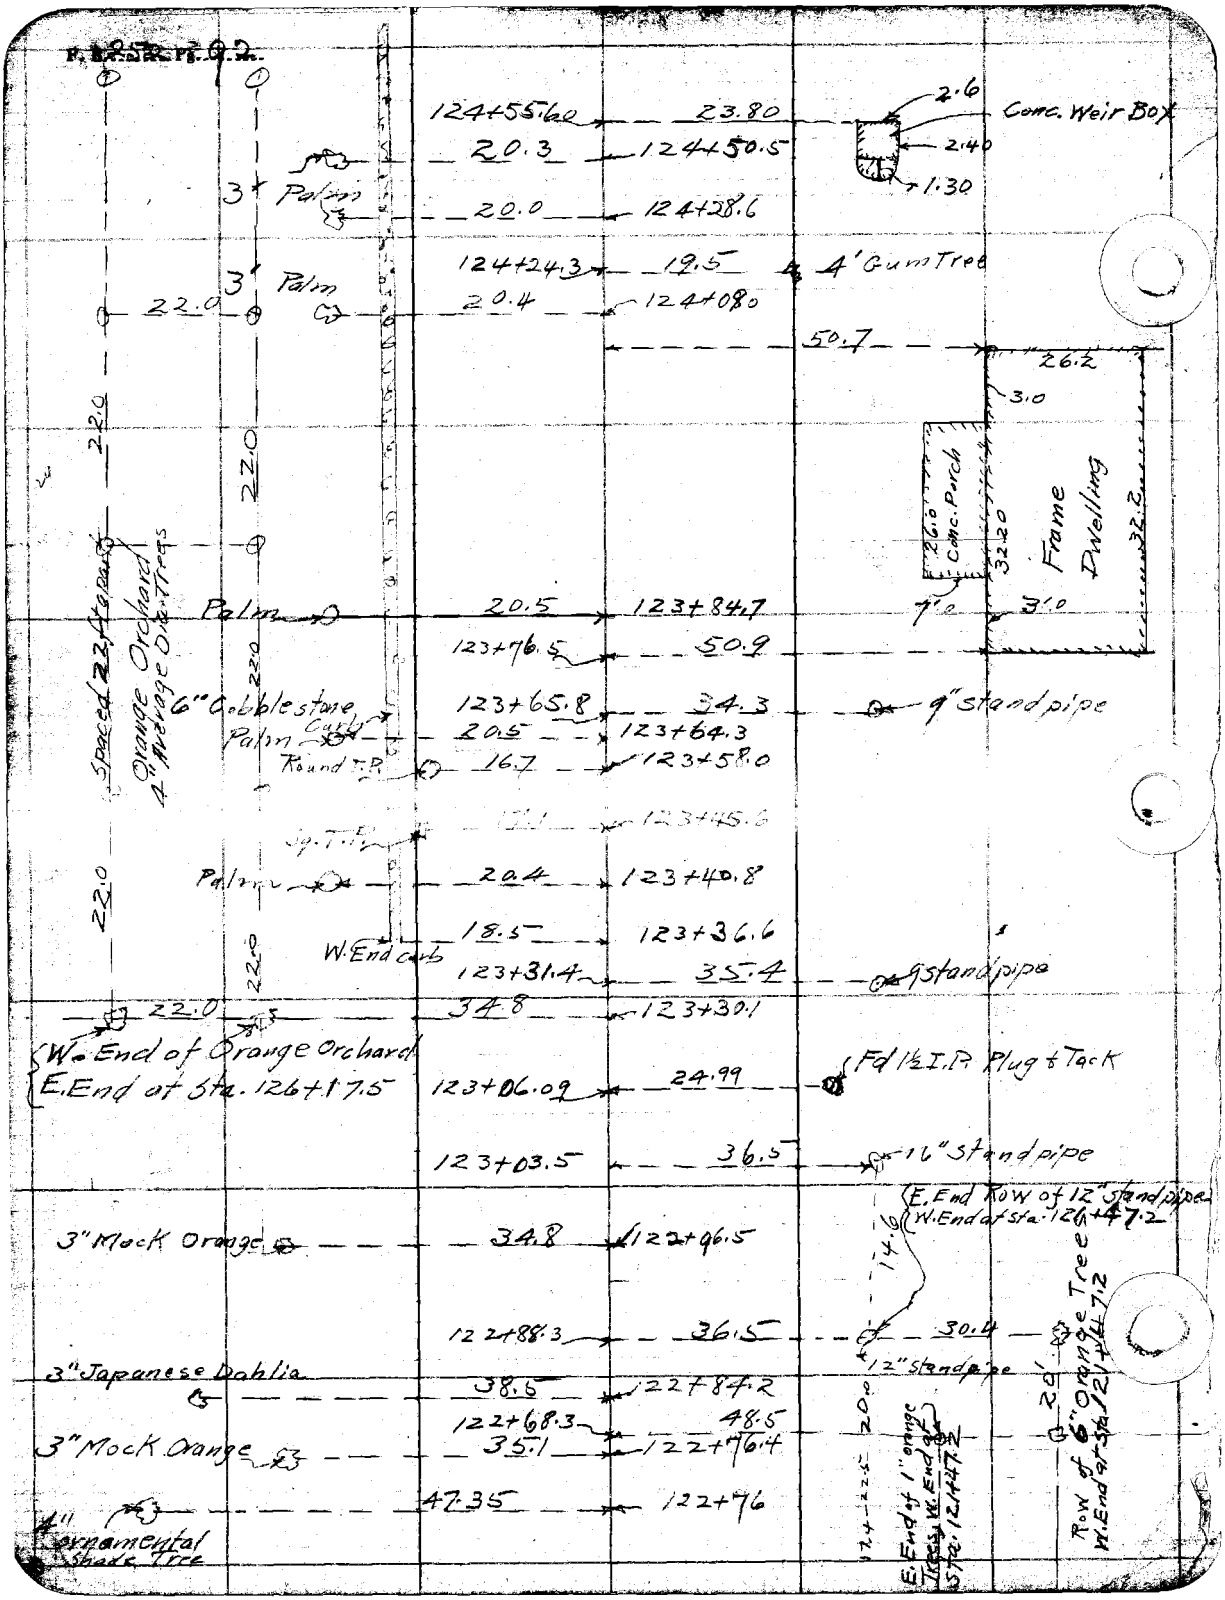
124+55.6
23.80
2.6
Conc. Weir Box
2.40
1.30
20.3
124+50.5
3" Palm
20.0
124+28.6
124+24.3
19.5
4' Gum Tree
3" Palm
22.0
20.4
124+08.0
50.7
26.2
3.0
Conc. Porch
26.0
32.20
Frame Dwelling
32.2
22.0
Spaced 22 Apart
Orange Orchard
4 Average Diameters
Palm
20.5
123+84.7
7'0
3'0
123+76.5
50.9
6" Cobblestone
123+65.8
34.3
9" Standpipe
Palm
Curb
20.5
123+64.3
Round
16.7
123+58.0
123+45.6
Palm
20.4
123+40.8
18.5
123+36.6
W. End curb
123+31.4
35.4
9" Standpipe
22.0
34.8
123+30.1
W. End of Orange Orchard
E. End of Sta. 126+17.5
123+06.09
24.99
Fd 1½ I.P. Plug & Tack
123+03.5
36.5
16" Standpipe
E. End Row of 12" Standpipe
W. End of Sta. 126+47.2
3" Mock Orange
34.8
122+96.5
14.6
122+88.3
36.5
30.4
12" Standpipe
3" Japanese Dahlia
38.6
122+84.2
122+68.3
48.5
3" Mock Orange
35.1
122+76.4
47.35
122+76
4" Ornamental Shade Tree
20.0
E. End of 1" Orange Trees W. End of Sta. 121+44.2
29'
Row of 6" Orange Trees
W. End of Sta. 121+47.2

Plotted by Wood
Date Feb. & Mar. 1927
Map No. 8904
Platting C'k'd by Paige
Date April 1927

W. O. No. 4849 D. S. O. No.
Location. Banta Ave
Surveyed by C.V.C. Crumley
Date Nov. & Dec. 1926
Indexed.

F.B. 52 Pg. 93

Round T.P.
1" Dia
22.5
W. End Orange orchard
E. End at Sta. 128+26
3" Walnut Trees
6" E. End Cobble stone Curb
E. End Orange Orchard
W. End of Station 123+30
Wire Fence
3' Palm
8" Apricot
Cement Rd
24.0
Frame Dwelling
28.0
7.0'
Sq. T.P.
Fd. 2" T.P. with Plug & Tk
Fd Nail 0.06 S. N. of Line
6" Cobble Stone Curb
9" Stand Pipe

	16.1	127+13.	
	33.5	127+04.8	
	54.2	126+85.5	
	126+57.5	20.4	Sq T.P.
	18.20	126+22.1	
	30.20	126+17.5	
	19.8	126+04.9	
		34.7	
	19.6	125+84.0	
		55.5	
125+68.5		48.5	
	19.8	125+62	
125+47.2			
	20.1	125+41.3	
	17.0	125+32.2	
125+21.8		48.5	
		125+18.08	
		24.98	
	20.1	125+16.7	
125+10.4		21.1	Sq.T.P.
	16.2	125+08.0	
	19.9	124+96.	
124+88.5		27.9	
	20.3	124+92.0	

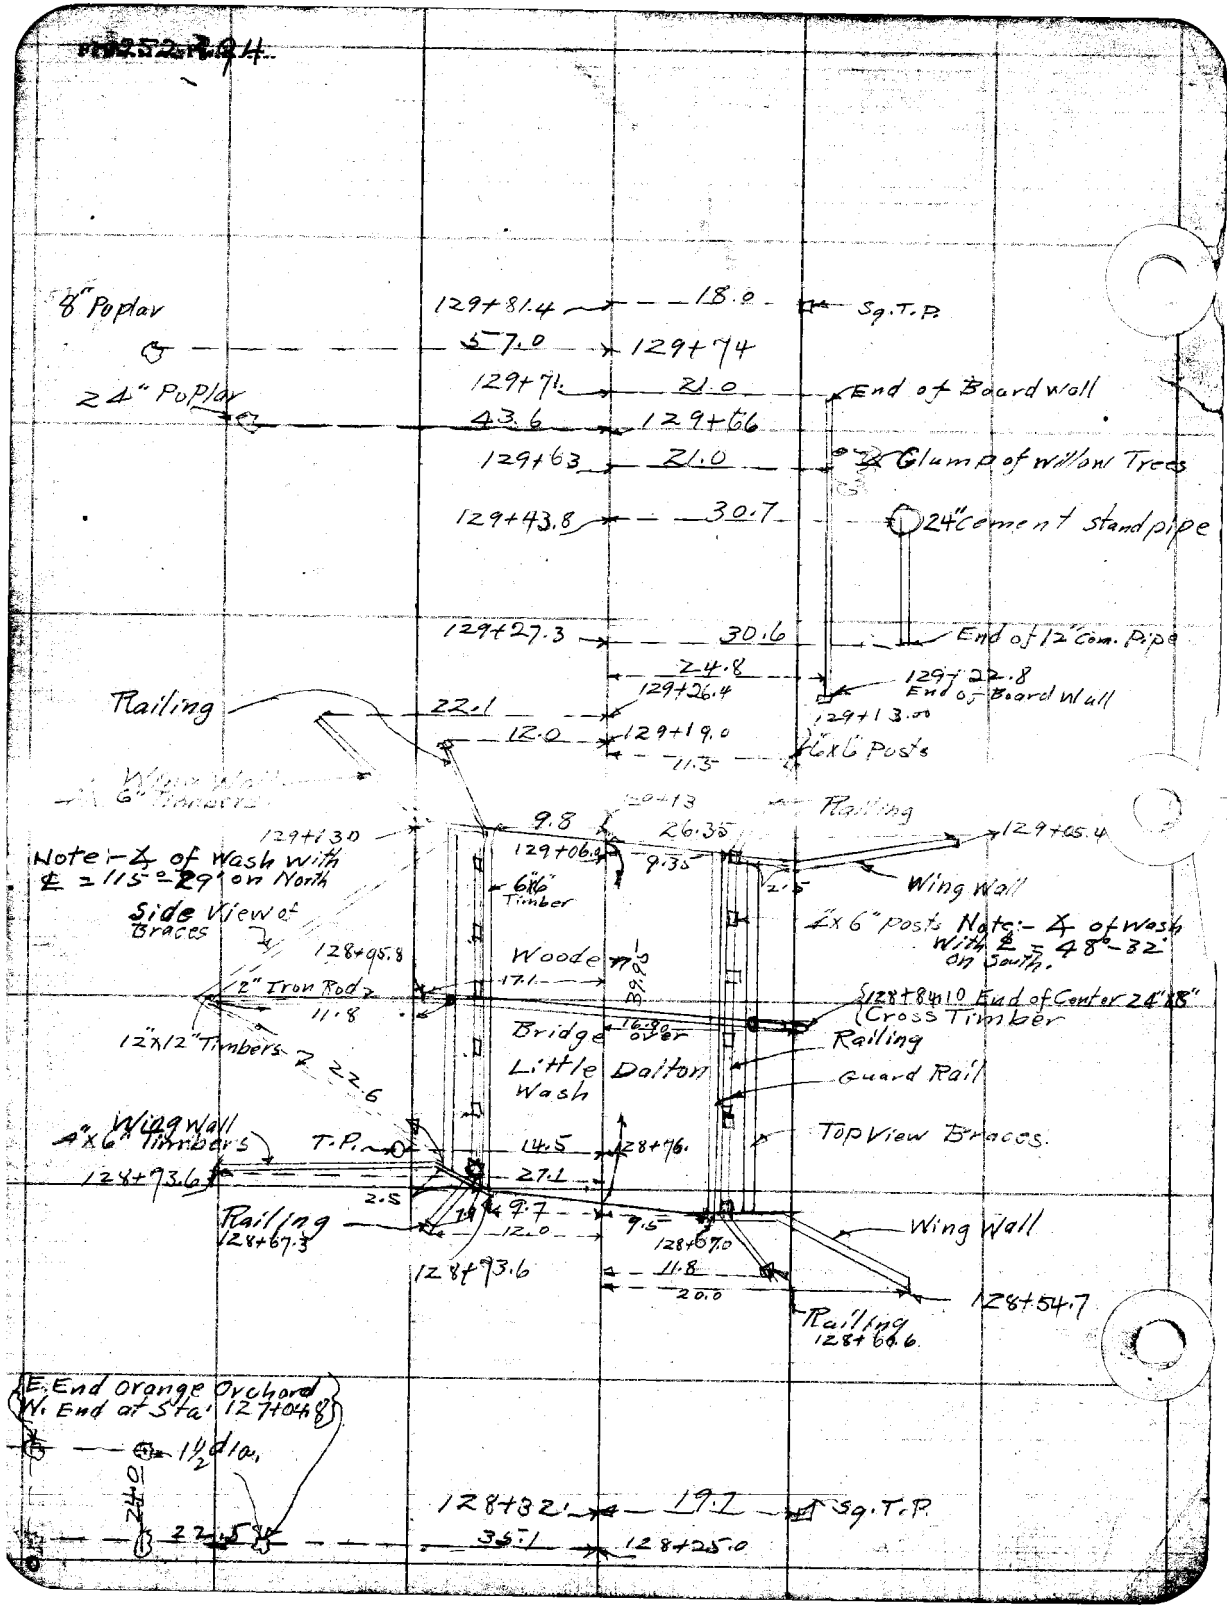
8" Poplar
24" Poplar
129+81.4
18.0
Sq. T.P.
57.0
129+74
129+71.
21.0
End of Board Wall
43.6
129+66
129+63
21.0
Clump of Willow Trees
129+43.8
30.7
24" Cement Stand pipe
129+27.3
30.6
End of 12" Com. Pipe
24.8
129+26.4
129+22.8
End of Board Wall
129+13.0
Railing
22.1
12.0
129+19.0
11.3
6x6 Posts
Wing Wall
6" Timbers
129+13.0
Note:- ∠ of Wash with ℄ = 115°-29' on North Side
Views of Braces
9.8
129+06.8
26.35
9.35
Railing
129+05.4
Wing Wall
2.5
4x6" posts
Note:- ∠ of Wash with ℄ = 48°-32' on South.
128+95.8
2" Iron Rod
11.8
12"x12" Timbers
22.6
Woode
17.1
B9.5
16.9 over
128+84.10 End of Center 24'28"
Cross Timber
Railing
Guard Rail
Bridge
Little Dalton
Wash
4"x6" Wing Wall Timbers
T.P.
14.5
128+76.
Top View Braces.
124+93.6
27.1
2.5
Railing
128+67.3
9.7
12.0
9.5
128+67.0
Wing Wall
128+93.6
11.8
20.0
128+54.7
Railing
128+66.6
E. End Orange Orchard
W. End at Sta. 127+04.8
1½ dia.
22.5
128+32.
19.1
Sq. T.P.
36.1
128+25.0

Planned by: Layout	W. O. No. 4049 D. S. O. No.
Date: Feb. & Mch. 1927	Location: Bonita Ave.
Map No. 8404	Surveyed by: C. V. Crumley
Platting C'k'd by: Paige	Date: Nov. & Dec, 1926
Date: April 1927	Indexed:

Pole Line at Sta. 129+87.9 Poles ± 146ft apart

T.P.

19.30 — 133+32.4

133+22.3 — 31.2

133+19.6 — 22.0

25.9

133+19.8

W. End of Row. E. End at Sta. 135+794

133+09.34 1/4 Sec. Cor. L+T. Top Granite Rock 8" Diam. See Page 8. See Line Table & Center of Sec. 11 T. 1 S., R. 10 W., S.B.M.

12" Standpipe — 30.5

31.0 — 132+96.0

176° 104.01 09'23" 37.45

22.2

2.55 Conc. Walk 2.40

89° 35'56" 22.2

132+82.6

132+79.5 — 18.1 Sq. T.P.

Row 12" Standpipe 23.5 23.5

132+91.2 — 41.1

132+65.6 — 40.4 — 23.5 23.5

132+53.8 — 39.9

Orange Orchard Trees Average 6" Dia.

Poles ± 146' apart

W. End Pole Line at Sta. 106+

T.P. — 16.7 — 132+22.7

131+24.5 — 17.9 Sq. T.P.

T.P. — 16.2 — 130+65

33.5 — 130+63.8

(60.4)

See Sta. 134+50.4 For E. End of Orchard

Orange Orchard Trees Average 4" To 6" Dia.

129+96.9 — 34.6

129+82.80 — 49.1

Sta. Pt. 9.6

E. End Orange Orchard
W. End at Sta. 134+60.4

23.5 23.5 31.7 136+91.5
15.9 44.6
16.7 24" Palm
136+84.
Lnk. 136+82.
43.5 136+78.4
136+64.70 16.7 18" Palm
35.2
23.5 23.5 136+59.6 Chicken
Row 8" standpipes Pens
136+54.6 11.7 Sq. T.P.
Sq. T.P. 136+46.7 17.1 12" Palm
16.8 24.0
136+34.2
136+29 31.2 24" Walnut
136+27.50 17.2
136+00 12" Palm
Sec. Nail Distance only
13.4
30" Palm
135+92.7 23.8 28" Palm
E. End Palm Row. W. End at Sta. 133+19.6
135+86.3 16.6 26.9
E. End Orange W. End. Sta. 133+19.6
135+81 2.25
11.3 Sq. T.P.
3.70
135+79.4 22.95 See Sta. 133+81.9
End of Row of Stand pipe
11.0
Conc. Work Box
27.0
Orange Orchard 8" to 10" Dia.
T. P. Line. Poles ± 146 apart
23.5
23.5 23.5
134+98.9 30.40 E. End of Row W. End at Sta. 133+32.5
42.0 134+72.2
134+40.4 14.7 Sq. T.P.
23.5 23.5 30.5 134+60.4
See 130+83.8 For W. End Orange Orchard T.P. 21.0 134+12.3
133+81.7 25.0
135+79.4 E. End 4 Pts. in Row of Stand pipes
See Sta. 133+81.9 For W. End

Plotted by Wood
Date Feb. 8 Mar. 1927
Page No. 8904
Plotting C'k'd by Paige
Date April 1927

W. O. No. 4244 D. S. O. No.
Location. Bonita Ave.
Surveyed by C. M. C. Crandall
Date Nov. 1 Dec. 1926
Indexed.

F. B. 288 Pg. 97

22.0
5.70
6.0
139+96.8 22.0 Conc. Weir Box
139+94.8 26.6 8" Clay standpipe
E. End Palm Row
139+87.9 17.5 24.5 25.6
E. End orchard
139+77.4 26.9 25.5
Row Palms 30' O/C approx. 12 in Number
64.2 22.0
Orange Orchard 6" Dia Trees
138+83.3 13.7
39 T.P.
Orange Orchard 8"-10" Dia. Trees
137+59.60 29.2 25.5
W. End Orchard
137+49.12 16.4 27.5
12" Palm
6" Orange
137+39 12.4 39 T.P.
24.5
137+35.2 29.8 26.7 25.5
4" Orange 4" Orange
23.6
137+24.6 16.9 9.4 11.0 10.2 11.3
Row 30" Palms
137+16.6
24.5 31.9 43.1 Tangerines
137+02.7 16.7 12" Palm
137+01.4 42.7 12" Grapefruit

F.B. 252 P. 98

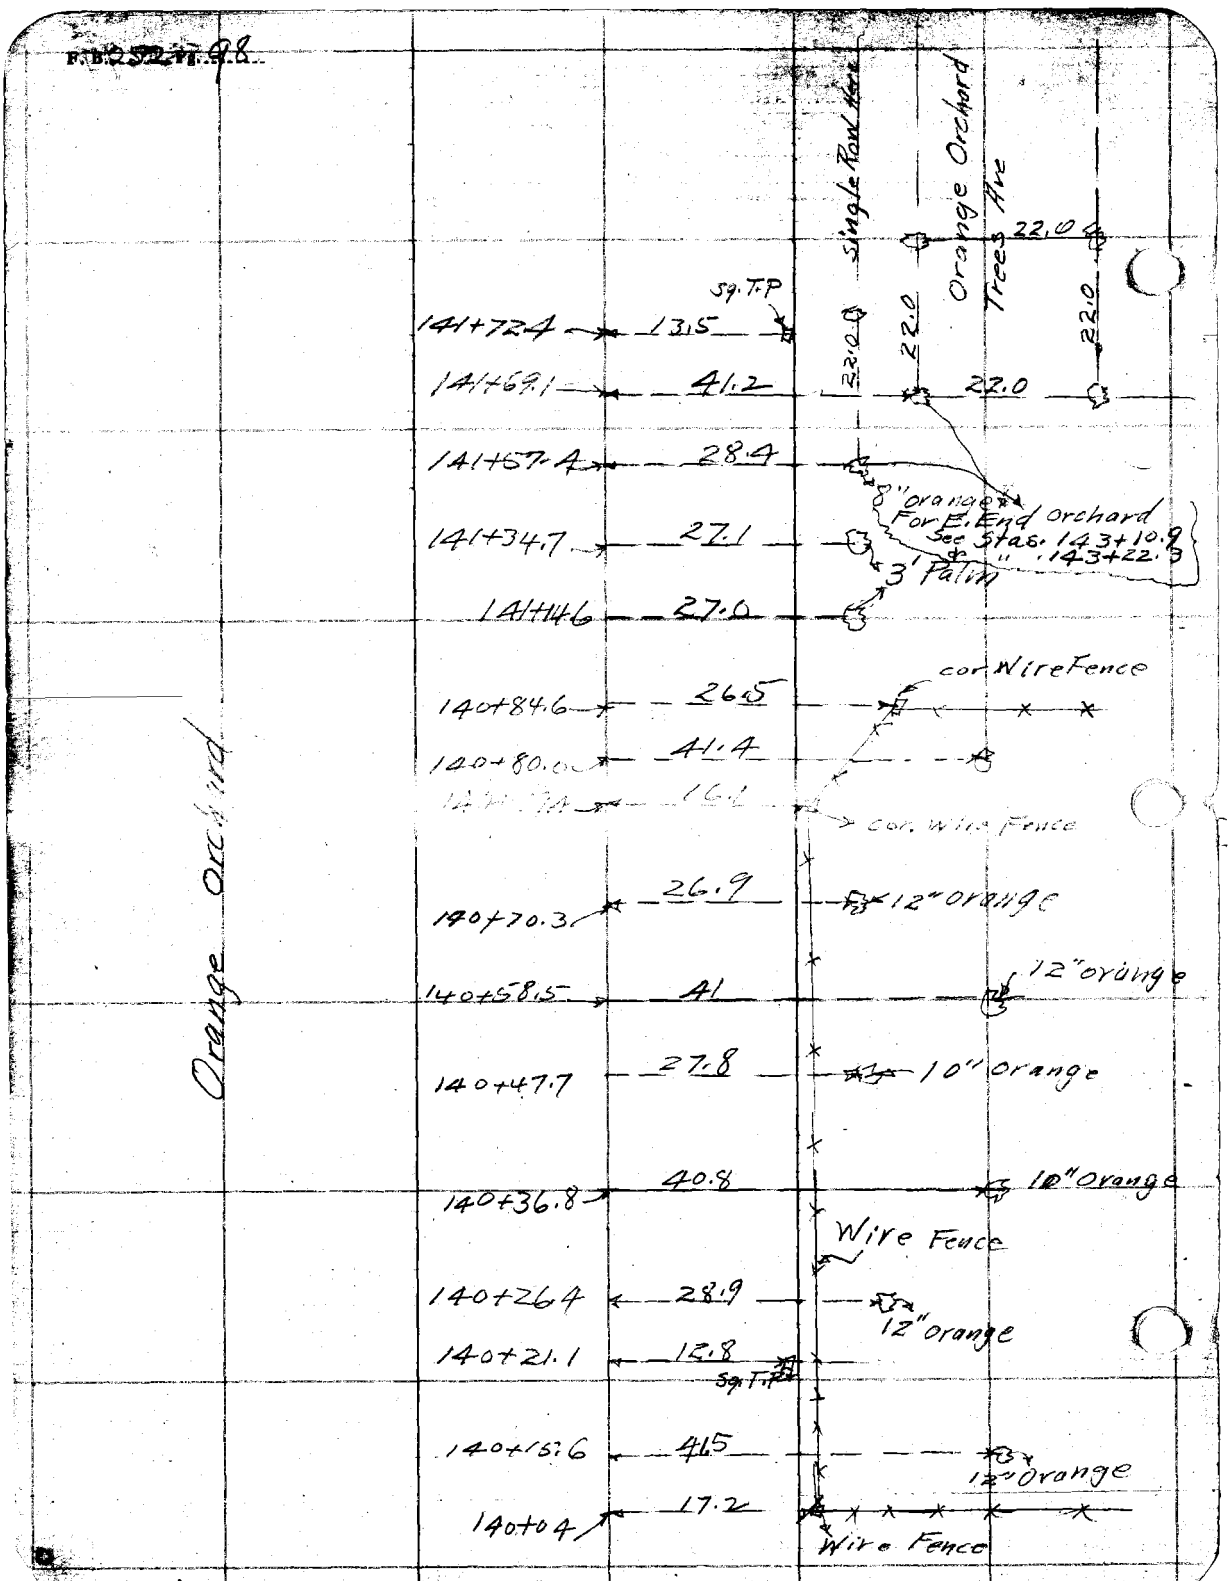
Single Row Trees
Orange Orchard
22.0
22.0
22.0
22.0
Sg. T.P
141+72.4
131.5
141+69.1
41.2
141+57.4
28.4
8" orange
For E. End Orchard
See Stas. 143+10.9
" 143+22.3
141+34.7
27.1
3' Palm
141+14.6
27.0
cor. Wire Fence
140+84.6
26.5
140+80.0
41.4
cor. Wire Fence
140+70.3
26.9
12" orange
140+58.5
41
12" orange
140+47.7
27.8
10" orange
140+36.8
40.8
10" Orange
Wire Fence
140+26.4
28.9
12" orange
140+21.1
12.8
Sg. T.P
140+15.6
46.5
12" Orange
140+04
17.2
Wire Fence
Orange Orchard

Plotted by Wood	W. O. No. 4049 U. S. O. No.
Date Feb. & Mar. 1927	Location. Benita Ave.
Map No. 8904	Surveyed by C.K. Crumley
Plotting C'k'd by Paige	Date Nov. & Dec., 1926
Date April 1927	Indexed.

F. B. 252 Pg. 99

146+47.9

146+41.35 — 36.0 — 31.5

146+26.2 — 33.9

146+20.8 — 16.5 — Sq. T.P.

144+80.7

144+77.3 — 16.0 — Sq. T.P.

144+20.1

143+94.7

143+67.3 — 36.8

143+44.5 — 33.0

143+26.9 — 22.25

143+26.4 — 16.4 — Sq. T.P.

143+22.3 — 40.1

143+10.9 — 27.5

Orange Orchard

7-12" Standpipe in Here 20.0 ft apart.

180

Trees

12" Standpipe

12" Standpipe

12" Standpipe

12" Standpipe

Conc. Weir Box

22.75

5.70 ft.

4.30

2.0

6.0

3.49

1.60

17.5

12" Standpipe

For W. End orchard see Sta. 141+57.4

22.0

22.0

22.0

22.0

F.B. S2+1.00

152+91.0 — 24.1 — 6" Valve

152+83.0 — 41.0 — 40" Palm

36.2

3'6" Cement Walk

152+70.8 — 24.0

152+68.1 — 24.9 — 6" Valve

152+47.4 — 46.4 — 3" Gum Tree

152+38.2 — 34.6 — 12" stand pipe

152+35.4 — 16.5 — Sq.T.P.

E. End Orange Orchard
W. End Sta 3+44.5

152+31.0 — 33.4 — 20.0

20.0 — 20'

Orange Orchard
Tree Average 10" To 12" Dia.

150+83.8 — 16.3 — Sq.T.P.

150+01.4 — 32.0 — 19.8

Row 9" Cement Stand pipes

149+22.5 — 16.4 — Sq.T.P.

147+63.6 — 16.7 — Sq.T.P.

24.3

22.0 — 22.0

24.3 — 34.5 — 146+80.6

W. End Orange Orchard
E. End at Sta. 156+784

146+71.0 — 30.2

20.0 — 20.0 — 20.0

21.6

3.45 — Conc. Weir Box

4' — 2.0 — 2.0

146+56.8 — 21.5

Plotted by L.W.D.
Date Feb. & Mar. 1927
Map No. 3904
Plotting C'k'd by Paige
Date April 1927

W. O. No. 4049 D. S. O. No.
Location. Bonita Ave.
Surveyed by C.V. Crumley
Date Nov. & Dec. 1926
Indexed.

F. B. [illegible] Pg. [illegible]

12" Standpipe
24
42.3
E. End Orange Orchard
W. End of Sta. 157+08.7
24.5
24.5
24.5
24.0
24.0
22.5
24.0
E. End Orange Orchard
W. End of Sta. 146+80.6
12" Standpipe
12"
159+77.8 — 18.—
159+76.20 — 26.6 — 32.7
159+64.8
158+73.2 — 17.3 — Sq. T.P.
29.9 — 157+08.7
156+88.6 — 16.9 — Sq. T.P.
30.9 — 156+86.7
32.8 — 156+78.4
155+39.4 — 16.6 — Sq. T.P.
153+84.0 — 15.4 — Sq. T.P.
153+71.4 — 31.7
Orange Orchard
Orange Orchard
Trees Average 18" Dia.
T.P.
Sq. T.P.
24.0
22.0
E End of Sta. 159+64.8
Conc. Weir Box
6.4
4.3
2.1
0.9
1.6
3.5
22.30
153+42.7 — 22.30
153+38.3 — 18.5
153+30.7 — 32.7
153+09.2 — 52.5
3" Palm
20'
8" Orange
8" Orange
Conc. Weir Box
2.3
3.9
12" Standpipe
18.8
3.5
.40
.70
.30
12" Standpipe
24.0
22.0
3.5
3.9
3.73
1.8
2.2
2.2
2.3
2.3
2.3

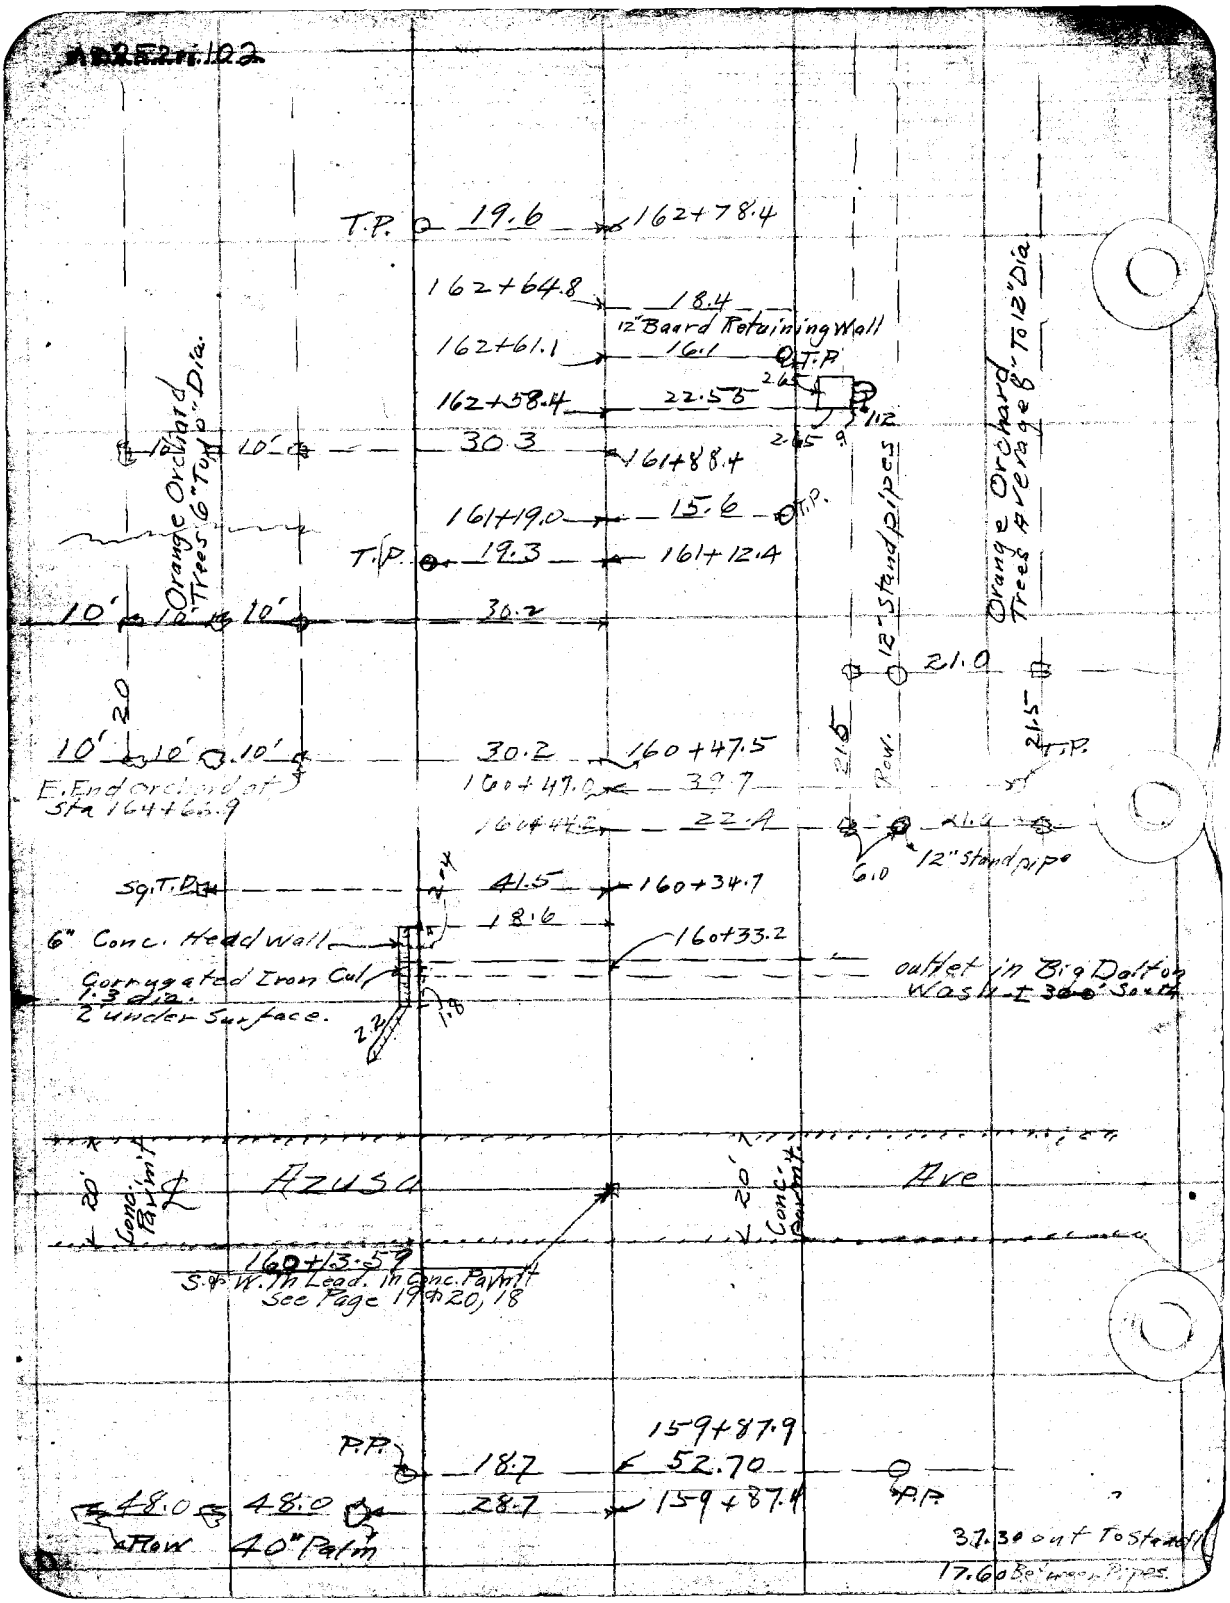
T.P. 19.6 162+78.4
162+64.8 18.4
12" Board Retaining Wall
162+61.1 16.1 T.P.
162+58.4 22.58
Orange Orchard Trees 6" Top Dia.
30.3 161+88.4
161+19.0 15.6 T.P.
T.P. 19.3 161+12.4
30.2
12" Stand pipes
Orange Orchard Trees Average 8" To 12" Dia.
21.0
E. End arch pipe at Sta 164+62.9
30.2 160+47.5
160+49.2 39.7
160+44.5 22.4
12" Stand pipe
Sq. T.P.
41.5 160+34.7
18.6 160+33.2
6" Conc. Head Wall
Corrugated Iron Culvert 1.3 dia. 2 under Surface.
outlet in Big Dalton Wash I 30° South
AZUSA Ave
Cond. Pavement
Conc. Pavement
160+13.59
S.P.W. In Lead. In Conc. Pavmt
See Page 19 & 20, 18
P.P. 18.7 159+87.9
52.70
28.7 159+87.4
48.0 48.0 40" Palm
Flow
37.30 out To Stand
17.60 Between Pipes

Date _____ Notes by _____ Chief Party _____ F.B. 252 Pg. 46

Plotted by Leland
Date Feb. & Mar. 1927
Map No. 8904
Plotting C'k'd by Paige
Date April 1927

W. O. No. 4049 D. S. O. No.
Location Bonita Ave
Surveyed by C.V. Crumley
Date Nov. & Dec, 1926
Indexed

NOTE: ANY ADDITION OR CHANGES ON THIS SHEET MUST BE MADE OR CIRCLED IN RED. WITH DATE AND NAME OF PERSON MAKING CHANGE.

DO NOT EXTEND NOTES THIS SIDE OF THIS LINE

RETURN TO LOS ANGELES COUNTY SURVEYOR

Railing
Wooden Bridge
Big Dalton Wash
Railing
21.7
Board Wing Wall
9.0
164+88.8
W 95 ft.
W. End Bridge 164+74.0
19.1
164+75.8
6" Conc. Wall
11.9
164+72.2
End Orchard
W. End Sta. 164+47.5
164+61.6
10.2
20.8
20'
55.4
164+66.9
2" X 12" Board Wing Wall
Railing
164+55.1
11.9
20'
20'
164+48.3
19.1
6" Conc. Retaining Wall
164+42.2
24.3
Railing
164+42.3
24.3
164+37.4
16.5
T.P.
60
66' 12" Wall
163+85
Railing Sta. 163+46
1st Row Missing From Sta. 163+46
12.0
164+26
Railing
164+08.
11.7
163+93.8
2nd Row Missing
30.9
163+46
6" Conc. Wall
163+19.4
19.1
End Board Retaining Wall
6" Conc. Wall
19.30
163+96.7
179.5' Conc. Wall
30.95
1st Row
30.3

Chief Party Notes by Date

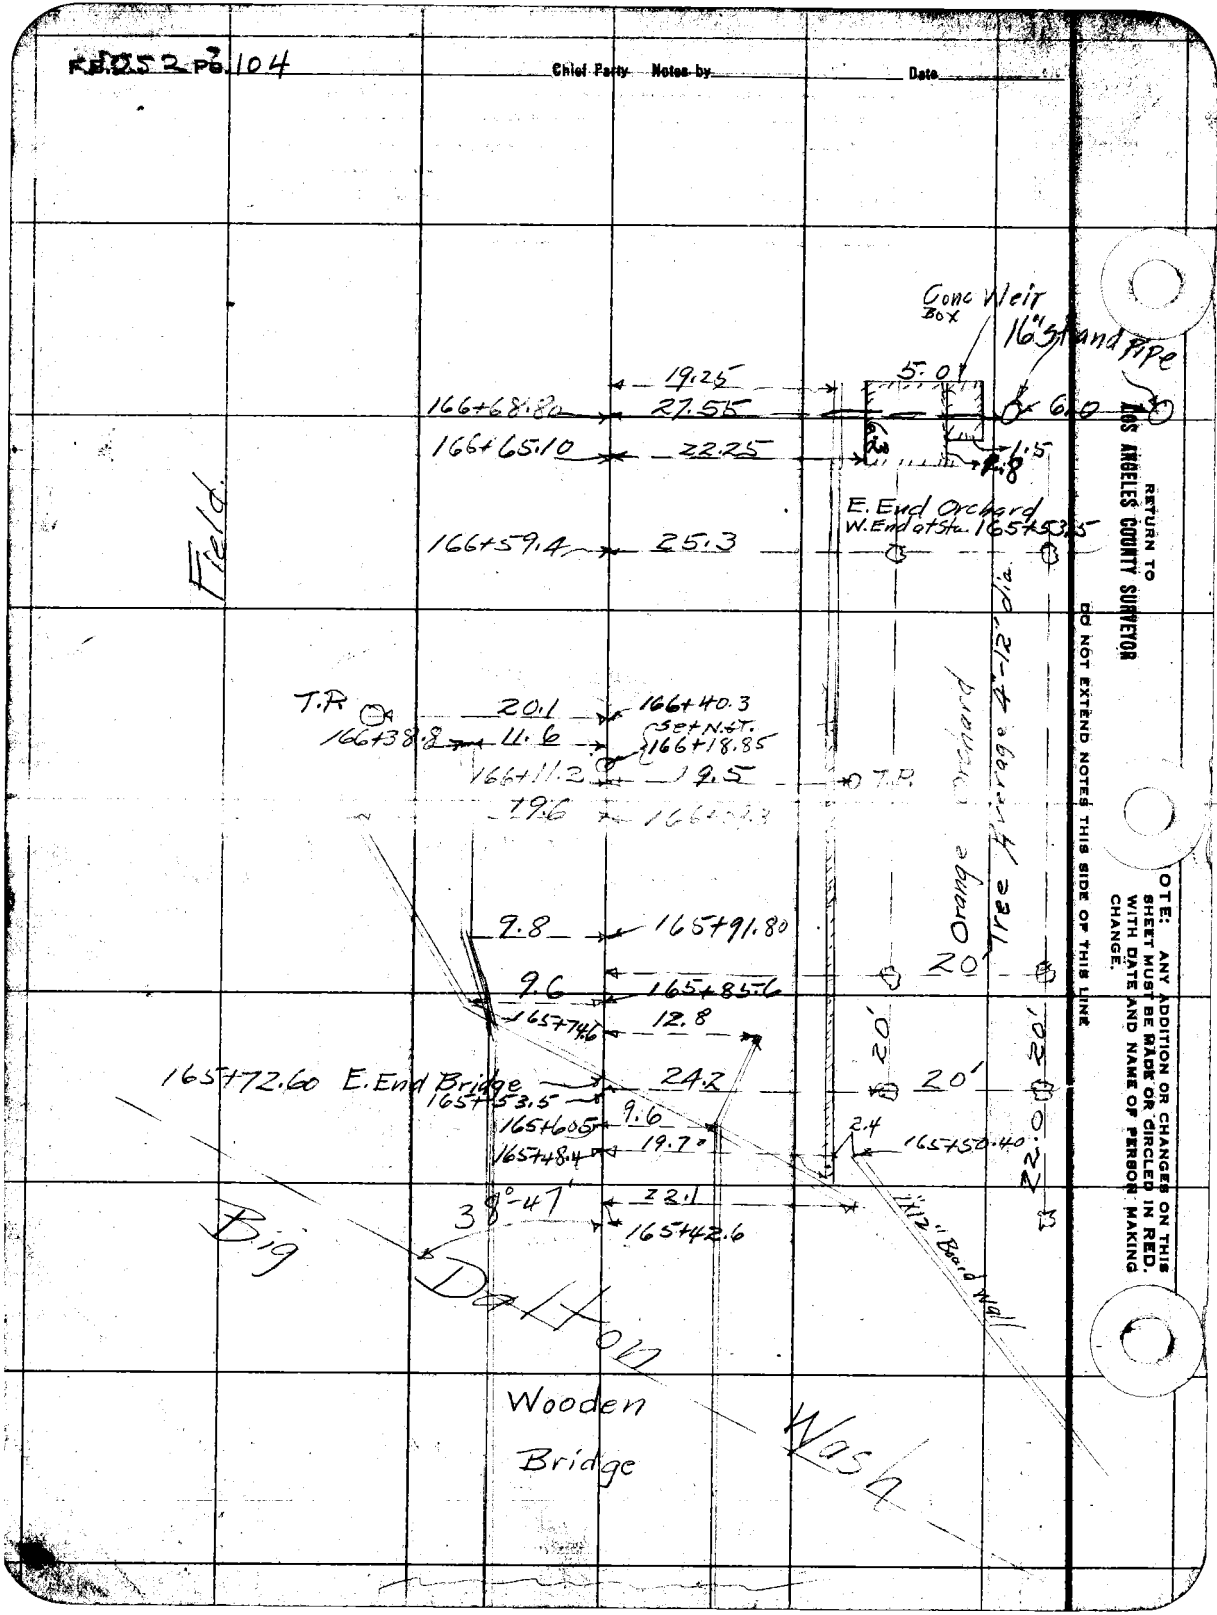

RETURN TO LOS ANGELES COUNTY SURVEYOR

DO NOT EXTEND NOTES THIS SIDE OF THIS LINE

NOTE: ANY ADDITION OR CHANGES ON THIS SHEET MUST BE MADE OR CIRCLED IN RED, WITH DATE AND NAME OF PERSON MAKING CHANGE.

Date _____ Notes by _____ Chief Party _____ F.B 252 Pg. 185

Plotted by [illegible]
Date Feb & Mar. 1927
Map No. 8904
Plotting C'k'd by Paige
Date April 1927

W. O. No 4049 D. S. O. No.
Location Bonita Ave
Surveyed by C. V. Crumley
Date Nov. + Dec., 1926
Indexed

NOTE: ANY ADDITION OR CHANGE ON THIS SHEET MUST BE MADE OR CIRCLED IN RED. WITH DATE AND NAME OF PERSON MAKING CHANGE.

DO NOT EXTEND NOTES THIS SIDE OF THIS LINE

RETURN TO LOS ANGELES COUNTY SURVEYOR

Orange Orchard Trees Average 6"-8" Dia

Big Line Trees Thru To Corr. Itos Ave

169+06.7 — 24.0 — 34" Peach — E. End Orchard W. End Sta. 166+80.4

169+65.7 — 44.3 — 22.0

168+95.8 — 29.4 — 8" Peach Tree

168+73.7 — 15.5 — T.P.

168+73.5 — 29.6 — 10" Apricot

168+50.9 — 29.4 — 6" Peach

T.P. — 19.3 — 168+23.6

168+08.4 — 29.9 — 4" Peach Tree

167+56.2 — 44.4

167+46.30 — 31.6

W. End Orchard E. End Sta. 172+23.0 — 167+39.2 — 16.8 — T.P.

Orchard 8"-12" Dia

4" Orange Tree — 30.4 — 167+25.0

12" Peach Tree

167+18.3 — 31.0

Orange Trees Average

Field

166+80.4 — 43.9

E. End orchard at Sta. 169+05.7

22.0 22.50 22.0 22.52 22.0 22.0 22.0

FB 252 Pg 106

Chief Party — Notes by — Date

170+57.7	15.4	16" Cypress
		9.0 Cemt Driveway
170+47.8	20.90	
170+46	51.2	
170+45	15.4	16" Cypress
		½" Hyd
170+40.9	14.4 T.B?	7.8 40" Palm
170+21.0	45.8	2" Hydrant 4½"
170+17	52.10	
170+15.9	48.4	14" Magnolia
		24" Ornamental Tree
169+98.2	31.4	
169+88.0	21.2	6½" Hydrant
		8" Plum
169+83?	16.5	
		½" Myaron
169+68.8	28.3	
		2" Acacia
169+61.0	37.0	
169+59.	48.6	
169+56.0	28.6	3.8' Pine 12.20 Shrub 4"
169+49.7	38.3	12" Standpipe
169+46.50	19.3	12" Sycamore
		6" Oak
169+42.4	29.4	
		4" Apricot
169+36.70	34.7	
169+27.3	23.0	14" Oak Tree
		Clump of Century Plants
169+16.4	14.9	

Orange Orchard

RETURN TO LOS ANGELES COUNTY SURVEYOR

DO NOT EXTEND NOTES THIS SIDE OF THIS LINE

NOTE: ANY ADDITION OR CHANGES ON THIS SHEET MUST BE MADE OR CIRCLED IN RED, WITH DATE AND NAME OF PERSON MAKING CHANGE.

Date _____ Notes by _____ Chief Party _____ F.B. 252 Pg. 107

Plotted by Wood
Date Feb. 7th, 1927
Map No. 8904
Platting C'k'd by Paige
Date April 1927

W. O. No. 4049 D. S. O. No.
Location Bonita Ave
Surveyed by C.V. Crumley
Date Nov. & Dec., 1926
Indexed

NOTE: ANY ADDITION OR CHANGE ON THIS SHEET MUST BE MADE OR CIRCLED IN RED, WITH DATE AND NAME OF PERSON MAKING CHANGE

DO NOT EXTEND NOTES THIS SIDE OF THIS LINE

RETURN TO LOS ANGELES COUNTY SURVEYOR

W. End Orchard at Sta. 172+35.0

173+27.0 — 20.45 — End of Fence

31.0 — 173+24.0

W. End Orchard at Sta 171+21.0

173+21.0 — 40.6 — 25.0

22.5 — 22.5

22.0 — 4 Rows oranges Trees Average 10"-12" Dia. — 22.0

22.0 — 22.0 — 31.0 — 172+35.0

E. End orchard at 173+24.0

Orange Orchard Trees Average 6"-10" Dia.

W. End orchard at Sta. 167+46.3

42.2 — 172+23.0

172+21.4 — 1.61 — 40" Pine

31.4 — 172+12.6

171+87.2 — 14.7 — T.P. — 25.0

171+32.1 — 18.9 — 24" Pine

22.50

171+23 — 18.0 — 40" Pine

~~171+21.0~~ — 41.6 — 25.0

E. End at Sta. 173+21.0

171+13.9 — 18.0 — 30

171+02.3 — 18.6 — Picket Fence

171+01 — 16.7 — 30" Pine

170+79.1 — 18.0 — 30" Pine

Orange Orchard

Fence Trellis For Vines

170+75.9 — 18.8

F.B. 252 PG. 108

Chief Party Notes by Date

24" Standpipe
6" Conc. Wall
7.0 20.3 On 12" Standpipe
176+60.0 21.40
176+48.2 18.50
176+47.2 57.1
W. End Orchard at Sta. 173+46.0
176+35.0 29.2
176+07.4 19.1 T.P.
Orange Orchard 8"-12" Dia.
174+61. 18.8 T.P.
Orange Orchard Average 8"-12" Dia. Trees
9" Conc. Wall
41.0
41.0
24.0
24.0
24.0
24.0
24.0
41.0
41.0
30" Palm
35.7 173+63.0
173+52.1
19.0
173+58.7 50.4
173+46.0 29.9
173+38.5 50.4
173+35.3 19.0 T.P.
E. End at Sta. 176+47.0
17.75
9" Conc Wall
11" I.P.
9" Conc Wall
173+29.8 20.45
18.90
173+28.2 39.8
173+27.2 20.45
5.40
6.0
Conc Weir Box
23.2
New 8" Stand Pipe
30" Palm, All Leaves White Stand 2 Trees in Fits 1 Tree

RETURN TO LOS ANGELES COUNTY SURVEYOR

DO NOT EXTEND NOTES THIS SIDE OF THIS LINE

NOTE: ANY ADDITION OR CHANGES ON THIS SHEET MUST BE MADE OR CIRCLED IN RED, WITH DATE AND NAME OF PERSON MAKING CHANGE.

Notes by _____ Chief Party _____ F.B. 282 PG. 109

Platted by Wood
Date Feb. & Mar. 1927
Map No. 8904
Platting C'k'd by Paige
Date April 1927

W. O. No. 4049 D. S. O. No.
Location Bonita Ave
Surveyed by C. V. Crumley
Date Nov. & Dec., 1926
Indexed

NOTE: ANY ADDITION OR CHANGES ON THIS SHEET MUST BE MADE OR CIRCLED IN RED. WITH DATE AND NAME OF PERSON MAKING CHANGE.

DO NOT EXTEND NOTES THIS SIDE OF THIS LINE

RETURN TO LOS ANGELES COUNTY SURVEYOR

41.2 — 179+16.5

18.5 — 179+05 — T.P.

178+86 — 17.5

41.6

This Palm Tree Missing

178+82.0

177+72.6 — 50.8 — 24.0 — 24.0 — 41.0

177+61 — 30.4 — 41.0

177+58.0 — 27.20 — E. End orchard at sta 183+09.3

177+43.2 — 18.1 — T.P. 3" valve

177+28.3 — 48.9

177+26.5 — 32.3 — 3' Palm

177+25.2 — 21.3 — 6" Palm

177+10.0 — 16.70 — 3" Iron Post

177+08 — 32.7 — 3 Palms — 25.4

176+97 — 25.1 — 12" Shade Tree

Orange Orchard Trees 8" to 12" Dia

176+96.0 — 51.25 — 18" Palm

176+92.4 — 16.6 — 3" Iron Post — 3.8 — 1/2" Hydt

176+88.6 — 32.6 — 3' Palm

176+82.7 — 58.4 — 40" Palm

176+79.6 — 19.8 — 14" ornamental Shade Tree

RS 252 PG 110

Chief Party Notes by Date

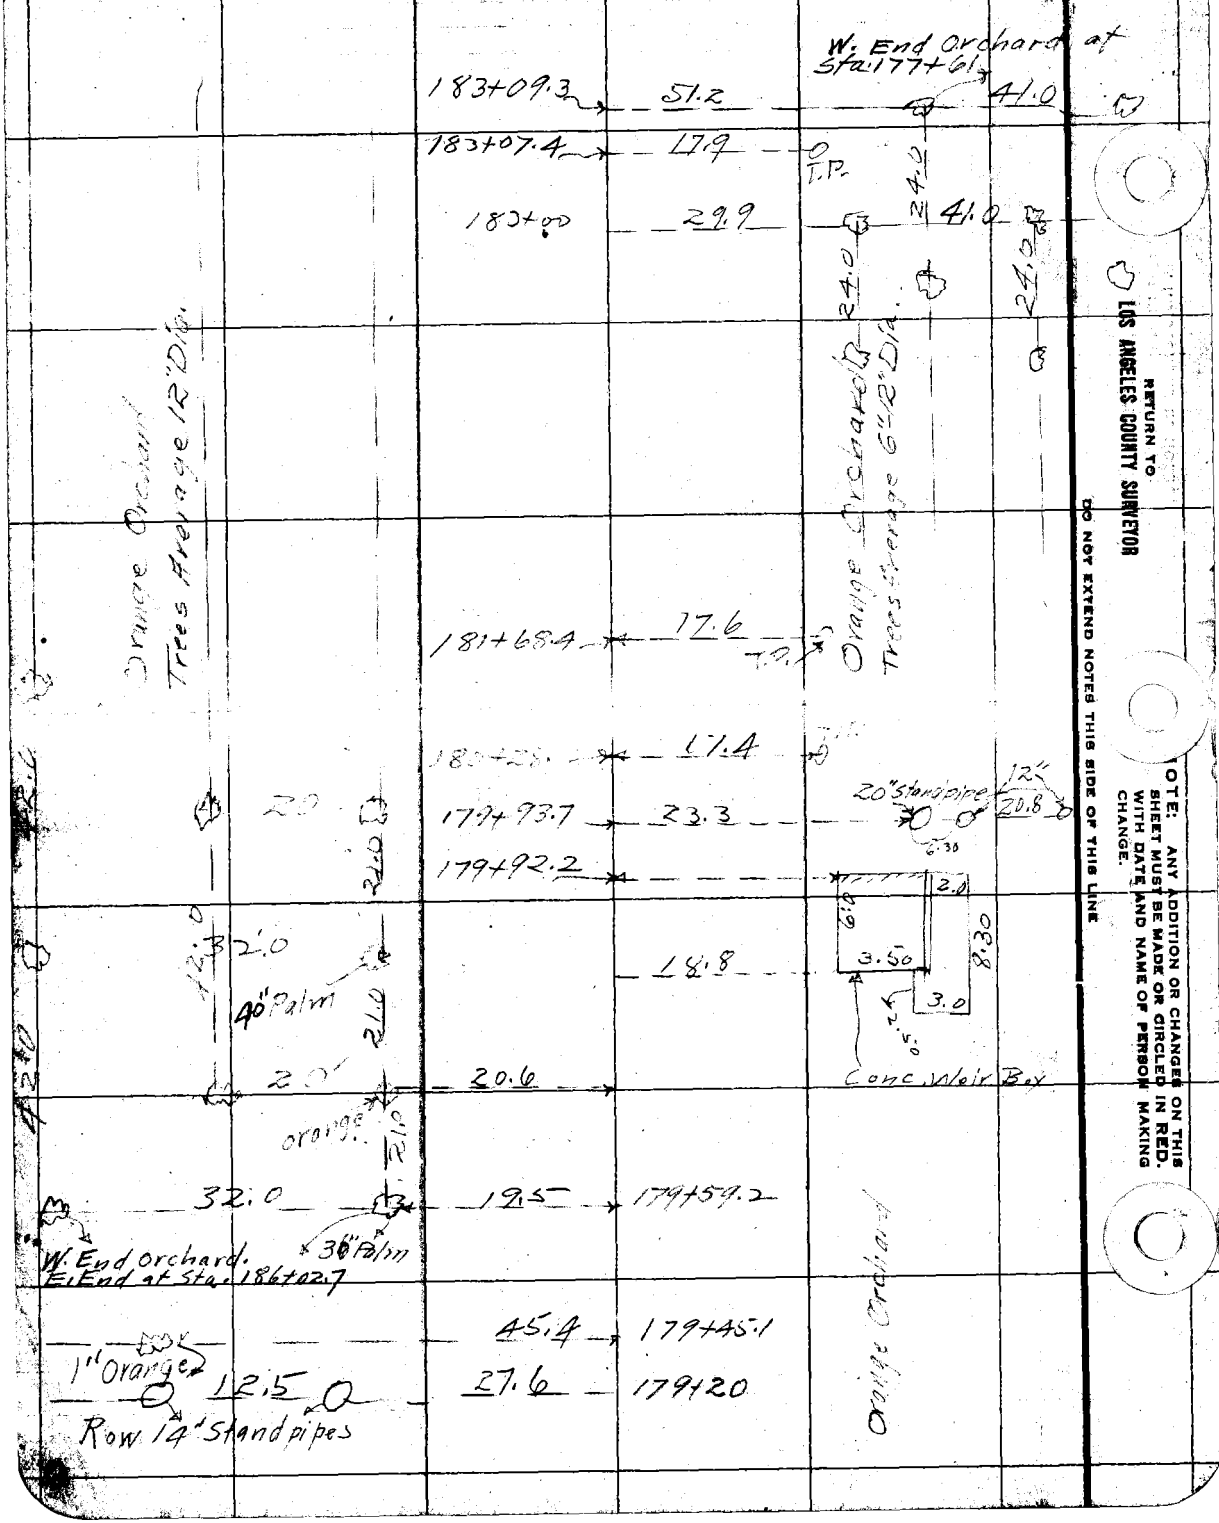

RETURN TO LOS ANGELES COUNTY SURVEYOR

DO NOT EXTEND NOTES THIS SIDE OF THIS LINE

NOTE: ANY ADDITION OR CHANGES ON THIS SHEET MUST BE MADE OR CIRCLED IN RED, WITH DATE AND NAME OF PERSON MAKING CHANGE.

Date _____ Notes by _____ Chief Party _____ F.B. 252 PG. 111

Platted by Wood
Date Feb. & Mar. 1927
Map No. 8904
Platting C'k'd by Paige
Date April

W. O. No. 4049 D. S. O. No.
Location Bonita Ave
Surveyed by C. V. Crumley
Date Nov. & Dec., 1926
Indexed

NOTE: ANY ADDITION OR CHANGES ON THIS SHEET MUST BE MADE OR CIRCLED IN RED. WITH DATE AND NAME OF PERSON MAKING CHANGE.

DO NOT EXTEND NOTES THIS SIDE OF THIS LINE

RETURN TO LOS ANGELES COUNTY SURVEYOR

Orange Orchard
Trees (Average 12" Dia.
Palms in 1st Row alternate with
an orange Tree (Every other space).

184+43.40 — 21.85
Cypress Hedge
3'6

184+36 — 32.1
184+35
184+32.5 — 44.0
53.7
184+26 — 27.6
184+06 — 28.7
5" cypress
5" oak
3"
3" cypress
Lawn
3" Cypress

183+94.1 — 26.3
183+90.5 — 43.0
3" curb
Hedge
6" ornamental Shade Tree
3.0
3" Cypress
N. Rad.

183+80.6 — 29.65
1' Privet Hedge
E. Edge Cement Walk
183+78.35 — 21.65
Cem't Walk
183+73.3 — 21.65
Privet Hedge
1' Privet Hedge
3" curb
183+64.0 — 27.8
3" Cypress
Lawn
183+53.4 — 31.6
2" Cypress
183+40.7 — 27.1
3" cypress
21.65
Cypress
5' R.
Cem't Walk
Cem't Brick

Cypress Hedge
3" Curb
4.10
1.5 Cement Driveway
32.25

W. Edge Drive
183+19.7
183+16.5
183+16.1 — 30 — 3
183+15.6 — 24.8
183+14.6 — 21.65
3" Curb
Privet Hedge 3.0
20.60 20.60
"Valve
8" Water
B.C. of Curb
5' Rad. 45
TOW 12" Standard

F.B. 252 Pg. 12

Civil Party Notes by Date

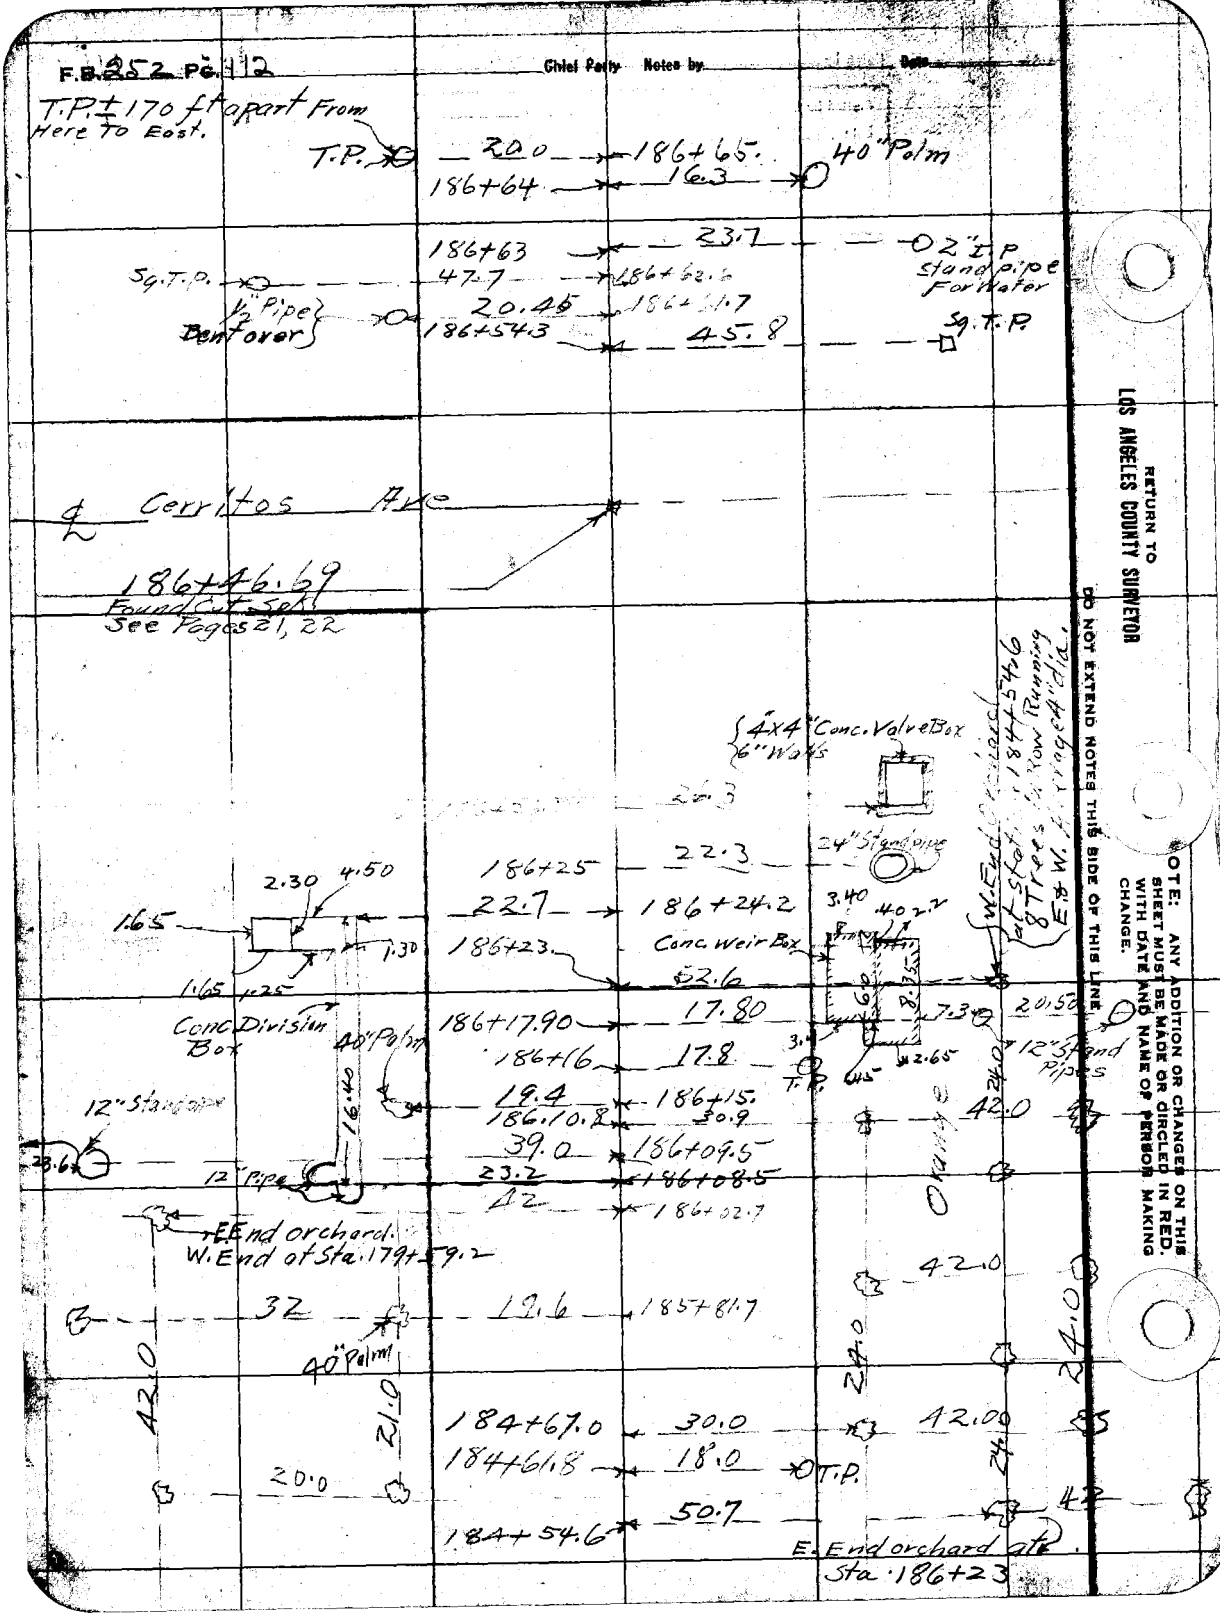

RETURN TO LOS ANGELES COUNTY SURVEYOR

DO NOT EXTEND NOTES THIS SIDE OF THIS LINE.

NOTE: ANY ADDITION OR CHANGES ON THIS SHEET MUST BE MADE OR CIRCLED IN RED. WITH DATE AND NAME OF PERSON MAKING CHANGE.

Date _____ Notes by _____ Chief Party _____ F.B. 252 Pg. 113

Platted by Wood
Date Feb. 4 Mon. 1927
Map No. 8909
Platting C'k'd by Paige
Date April 1927

W. O. No. 4049 D. S. O. No. _____
Location Zenita Ave
Surveyed by C.V. Crumley
Date Nov. & Dec., 1926
Indexed

NOTE: ANY ADDITION OR CHANGE ON THIS SHEET MUST BE MADE OR CIRCLED IN RED. WITH DATE AND NAME OF PERSON MAKING CHANGE.

DO NOT EXTEND NOTES THIS SIDE OF THIS LINE

RETURN TO LOS ANGELES COUNTY SURVEYOR

54.15
35.45
3" Water Meter
Frame Dwelling 34.10
44.0
Porch 15.8
8.9
189+22.7 17.2 T.P.
54.15
189+11.6
Alfalfa Field
E. End of Palms at Sta. 199+49.
Orange Orchard Trees Average 6"-10"
39.0
22.0
22.0
22.0
187+79 33.7
187+70.e 16.6
24" Palm
187+64.4 17.4 O.T.B.
E. End orchard at Sta. 199+49.
24" Locust 23.8 187+49
187+34. 16.5 20" Palm
20" Locust 24.1 187+26.
24" Locust 24.6 187+14.8
15" Locust Tree
186+97 16.2 40" Palm
30" Locust Tree 21.2 186+83

F.B. 252 P. 314 Chief Party Notes by Date

196+45 — 17.4 — T.P.

19?+24.2 — 32.5 — 3.0 — 12" Standpipe — 22.0

195+01 — 17.6 — T.P. — 4" Valve

193+60 — 17.2 — T.P.

Orchard

193+?? — 23.15 — 12" Standpipe

3.45 — 18.90 — 2.0 — 3.0 — 2.0 — 1.80 — 1.5

192+93.5 — 18.9

192+72.8 — 34.9 — 34.7

Conc. Wall Box

192+86.8 — 34.7 — 22.0

22.0 — 22.0

Vacant Field

Orange

192+22.8 — 12.6 — T.P.

190+73.90 — 17.7 — T.P.

4" Valve — 12" Standpipe — 4"

189+60 — 31.65 — 1.16 — 1.0 — 23.2

RETURN TO LOS ANGELES COUNTY SURVEYOR

DO NOT EXTEND NOTES THIS SIDE OF THIS LINE

NOTE: ANY ADDITION OR CHANGES ON THIS SHEET MUST BE MADE OR CIRCLED IN RED. WITH DATE AND NAME OF PERSON MAKING CHANGE.

Date _____ Notes by _____ Chief Party _____ F.B. 282 Pg. 115

Platted by Wood	W. O. No. 4049 D. S. O. No.
Date Feb. 8 Mer. 1927	Location Bonita Ave
Map No. 8904	Surveyed by C.V. Crumley
Platting C'k'd by Paige	Date Nov. & Dec. 1926
Date April 1927	Indexed

NOTE: ANY ADDITION OR CHANGES ON THIS SHEET MUST BE MADE OR CIRCLED IN RED, WITH DATE AND NAME OF PERSON MAKING CHANGE.

DO NOT EXTEND NOTES THIS SIDE OF THIS LINE

RETURN TO LOS ANGELES COUNTY SURVEYOR

200+72.5 — 19.1 — T.P.

199+79.3 — 21.8

199+68.0 — 36.7

199+60. — 26.2

Found Wire Sp. — 199+59.79

.045

Orange Orchard Trees Average 2" Dia.

21.0 Trees in This Row Average 2" Dia.

Orange Orchard Tree Average 8" Dia.

22.0 21.0 21.0 22.0 21.0

E. End orchard at Sta. 201+34

4" Valve

Conc. Weir Box 6" Walls

14.0

6.0 5.0

1.90

3.40

199+53.0 — 20.1

199+52.5 — 26.4

199+52.0 — 24.6

199+49.9 — 24.6

24.6

4" valve 22.0

12" Standpipe

4" Valve

199+48.5

W. End Orchard at Sta. 187+79

199+49.0 — 18.1

18.3

22.0

40' Palm

199+30.6 — 17.5 — T.P.

24" Palm

22.0

22.0

199+90 — 16.6 — T.P.

40' Palm

Palms Average 38' to 39' Height W. End of Row at Sta. 187+79.

Orange Orchard Trees 6'-10" Dia.

24.0 24.0

22.0 22.0

30.3 — 197+36.0

E. End Orchard at Sta. 203+59.1

F.B. 352 PG. 116

Chief Party _____ Notes by _____ Date _____

W. End orchard at Sta. 197+35.0

22.0

24.0

24.0

22.0

Row of 12" Stand Pipes

21.80

Orchard Trees 11' apart 2' Dia.

203+64 — 20.85 — T.P.

W. End orchard at Sta. 201+63.2

203+63 — 37.0

22.0

29.4

203+59.0 — 36.75

203+58.5

T Pole 8' Stand pipes

22.0

22.0

22.0

29.45

203+15.0

202+86.0 — 21.1 — 1" orange

202+42.0 — 21.6 — 1½" orange

202+19.0 — 21.95 — 2" Orange

202+17.6 — I & W T.P.

1" orange

201+74.0 — 21.8

22.0

22.0

20+63.2 — 36.5

22.0

E. End Orchard at Sta. 203+63.0

10" Orange

201+34.8 — 37.1

8" Stand Pipe

201+29.7 — 36.6

W. End Orchard at Sta. 199+68.

201+13.4 — 36.7

22.0

201+05 — 27

2" orange W. End of Row at Sta.

17.5

N 21°

210

RETURN TO LOS ANGELES COUNTY SURVEYOR

DO NOT EXTEND NOTES THIS SIDE OF THIS LINE

NOTE: ANY ADDITION OR CHANGES ON THIS SHEET MUST BE MADE OR CIRCLED IN RED. WITH DATE AND NAME OF PERSON MAKING CHANGE.

Date _____ Notes by _____ Chief Party _____ F.B. 252 Pg. 117

Platted by Wood
Date Feb. & Mar. 1927
Map No. 8904
Platting C'k'd by Paige
Date April 1927

W. O. No. 4049 D. S. O. No.
Location Bonita Ave
Surveyed by C.V. Crumley
Date Nov. & Dec, 1926
Indexed

NOTE: ANY ADDITION OR CHANGES ON THIS SHEET MUST BE MADE OR CIRCLED IN RED, WITH DATE AND NAME OF PERSON MAKING CHANGE.

DO NOT EXTEND NOTES THIS SIDE OF THIS LINE

RETURN TO LOS ANGELES COUNTY SURVEYOR

Conc. Flume

20.80

3.45 .75 5.0 2.0 3" Walls 1.9 1.2

207+79.4 20.80

Conc. Weir Box with 5" Walls.

40" Palm

W. End Orchard at Sta. 203+90.

207+70.00 18.35 30.6

20'

Orange Orchard Trees Average 6'-10" Dia.

206+45 19.7 T.P.

12" Standpipe 21.3

30.7 206+33.

Row of 40" Palms

205+07 20.1 T.P.

45° Front Trees

18.8 204+62

22.0 22.0 22.0 22.0

40" Palm

203+90.2 17.9 299

29.40 203+82.4

E. End Orchard at Sta. 212+37

E. End Orchard at Sta. 207+70

20.30

3.45 6.0 36" 1.0 2' 1/2 of 36" Pipe

203+67.9 20.30

Conc. Weir Box

F.B. 252 P.S. 118

Chief Party _____ Notes by _____ Date _____

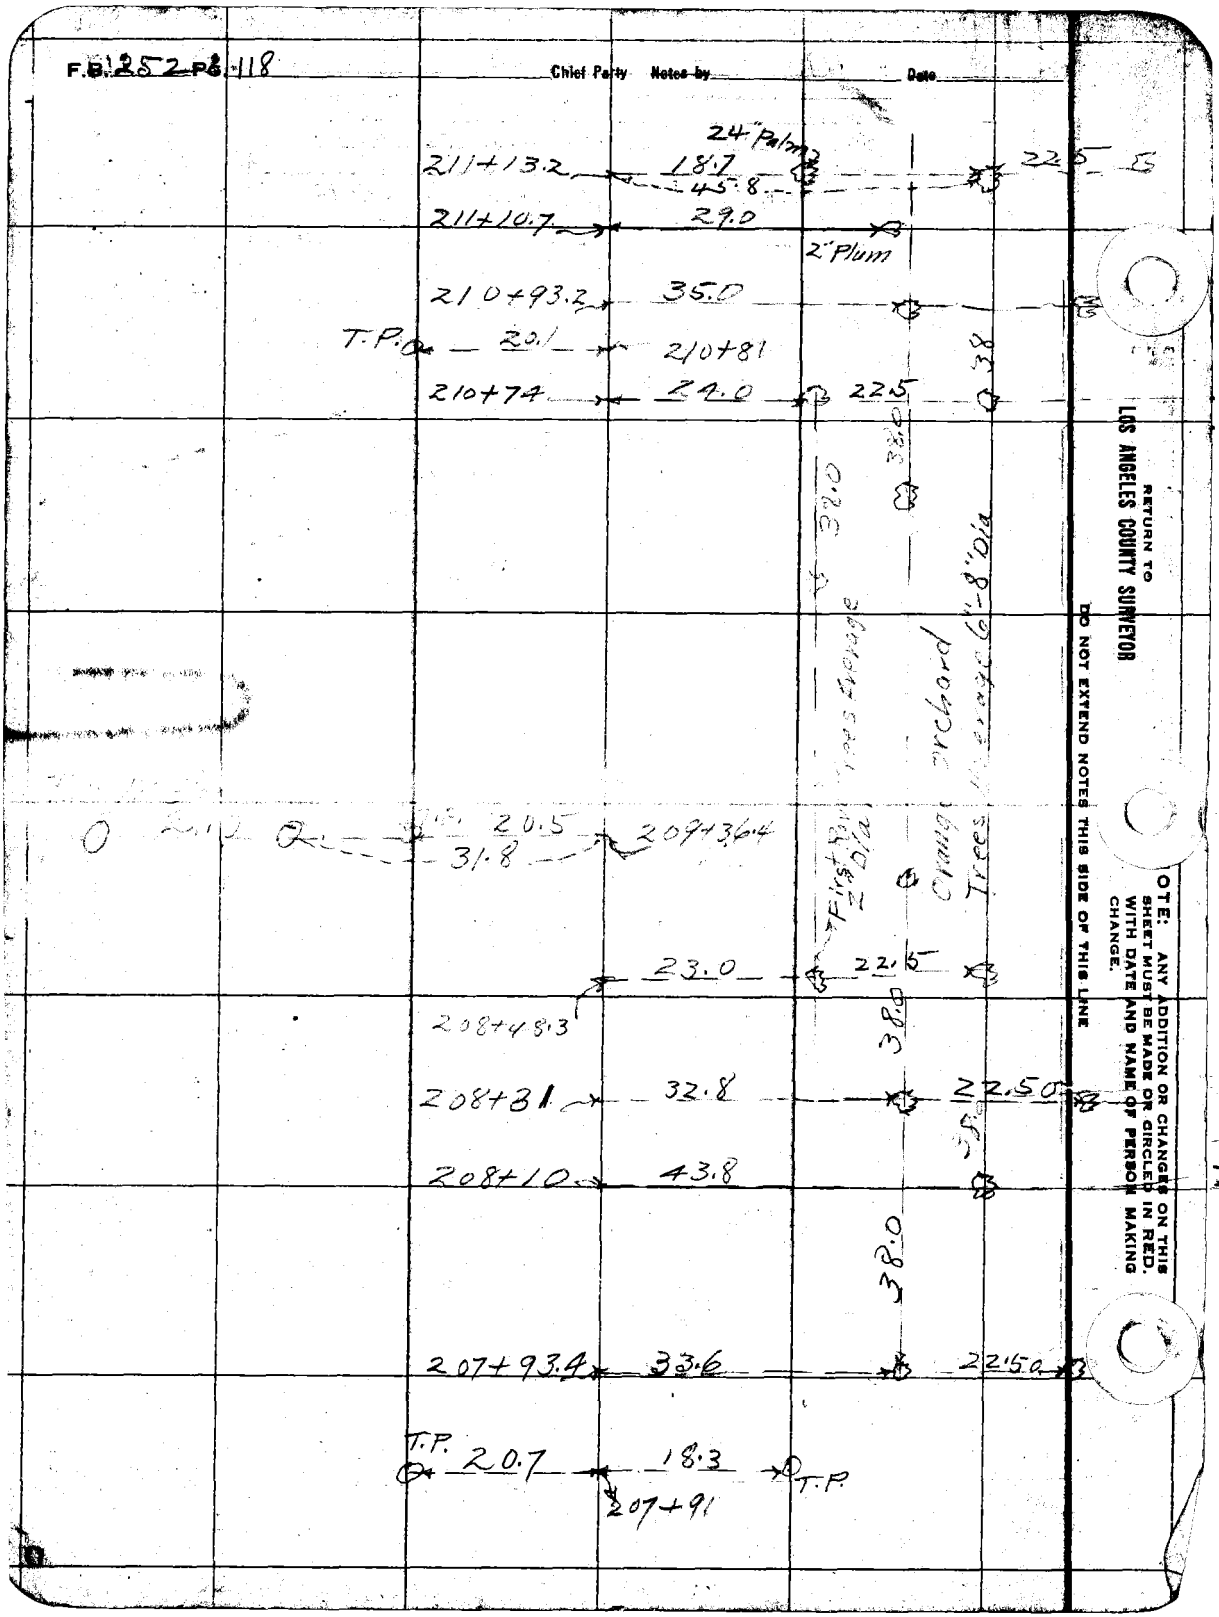

RETURN TO
LOS ANGELES COUNTY SURVEYOR

DO NOT EXTEND NOTES THIS SIDE OF THIS LINE

NOTE: ANY ADDITION OR CHANGES ON THIS SHEET MUST BE MADE OR CIRCLED IN RED. WITH DATE AND NAME OF PERSON MAKING CHANGE.

Date _____ Notes by _____ Chief Party _____ F.B. 252 Pg. 119

Platted by Wood
Date Feb. & Mar. 1927
Map No 2404
Platting C'k'd by Paige
Date April 1927

W. O. No. 4049 D. S. O. No. _____
Location Benita Ave
Surveyed by C. V. Crumley
Date Nov. & Dec., 1926
Indexed

NOTE: ANY ADDITION OR CHANGES ON THIS SHEET MUST BE MADE OR CIRCLED IN RED, WITH DATE AND NAME OF PERSON MAKING CHANGE.

DO NOT EXTEND NOTES THIS SIDE OF THIS LINE

RETURN TO LOS ANGELES COUNTY SURVEYOR

74.6

T.P. 19.6 212+60.6
19.5 212+60.0
3/4" Gas Pipe Drain 23.7.0
212+59.4 17.90
T.P. 19.7 212+53
212+49.6 E. End Curb. 17.30
212+49.5
Row of 12" Standpipes 21.2 32.9 212+42
212+39 28.1
212+38 51.8
22.0 32.2 212+37
212+27.6 22.6
T.P. 20.5 212+21
212+20.4 59.6
212+12.2 51.90
212+05 21.8
211+98.6 48.80
48.80
211+94 24.1
211+90 45.9
211+75 16.65
12" Conc. Meter Box 211+74 18.2
29.6 211+73.9
211+57 17.0
211+37.6 18.5

212+59.5
212+59.0
2.5 Gutter
5" Conc. Curb
9.8 9.25 49.70
2.0
Conc. Weir Box
7.9 2.0 1.90
4" Curb
1.75 Gutter
24" Palm
3" Walnut
6" Peach
E. Line of Porch
Cor. of Porch
E. Line of House
House is 46 Ft E & W. 48 Ft N & S
34" Peach
Steps
Porch
Concrete
5.20
4" Orange
1.75 conc. Gutter
30" Olive
4" Conc. Curb
28.9
End of Curb
6.35
12.2
4" Peach Tree
Cor. of Porch
6" Palm
33.8
24" Pepper Tree
15" Palm

F.B. 252 Pg. 120 Chief Party Notes by Date

Continued on Bottom of Page 1, F.B. 272

214+86.0 — 18.5 → T.P.

2" Palm ⊙ — 26.0 → 214+75

12" Meter Box

214+53 — 32.8 → 12" Meter Box

2nd Row

9 Trees 24" Canopy 10 Feet From Row

16" Walnut ⊙ — 22.7 → 214+56

T.P. Line — 25.7 → 214+26

19.2 → 214+16.2

6" Orange

69.2 → 213+53

117.5 → 213+44

6" Orange Tree

E. End ... 225+96.5 — 42.5 → 213+17.0

213+06 — 36.5

24.0

25.0

2" Olive ⊙ — 25.4 → 213+05

Stone Post 1.7 Square

213+00 — 23.60

R=10'

8" Stone Wall

3" Palm ⊙ — 46.5 → 212+96 (722.3)

60'

212+95.26

212+96.16

Ave

℄ Citrus

212+79.56

Fd. S.W. & T. Ey. Ties

See Pages 23 & 24

RETURN TO LOS ANGELES COUNTY SURVEYOR

DO NOT EXTEND NOTES THIS SIDE OF THIS LINE

NOTE: ANY ADDITION OR CHANGES ON THIS SHEET MUST BE MADE OR CIRCLED IN RED, WITH DATE AND NAME OF PERSON MAKING CHANGE.

Date _____ Notes by _____ Chief Party _____ F. B. 252 PG. 121

Platted by	W. O. No. _____ D. S. O. No. _____
Date	Location
Map No.	Surveyed by
Platting C'k'd by	Date
Date	Indexed

Note: ANY ADDITIONS OR CHANGES ON THIS SHEET MUST BE MADE OR CIRCLED IN Red. WITH DATE AND NAME OF PERSON MAKING CHANGE.

Do not extend notes this side of this line

RETURN TO

LOS ANGELES COUNTY SURVEYOR

RETURN TO

LOS ANGELES COUNTY SURVEYOR

Note: ANY ADDITIONS OR CHANGES ON THIS SHEET MUST BE MADE OR CIRCLED IN **Red.** WITH DATE AND NAME OF PERSON MAKING CHANGE.

Do not extend notes this side of this line

F.B. _____ PG. _____ Chief Party _____ Notes by _____ Date _____

Notes Ck'd by	Survey of Arrow Hwy
Map No.	W. O. Tape No. St'd °F.
Office Work	Surveyed by Emmett
Checked	Notes Date
Date	Indexed A. C. Johnson 5-28-37

F.B. 252 PG. 121

Note: Any Additions or Changes on This Sheet Must be Made or Circled in Red Ink With Date and Name of Person Making Change.

Do not extend notes this side of this line

RETURN TO
LOS ANGELES COUNTY SURVEYOR
700 HALL OF RECORDS

ARROW HIGHWAY

THROUGH

HENEY THOMAS' SUBDIVISION

J.N. 8192

May 6, 1937

Emmett
Brock
Naumann
Wilson
Harris

For improvements along this line change see Plane Table Sheet D-130

FORM 247 10M 11-36

F.B. 252 Pg. 122

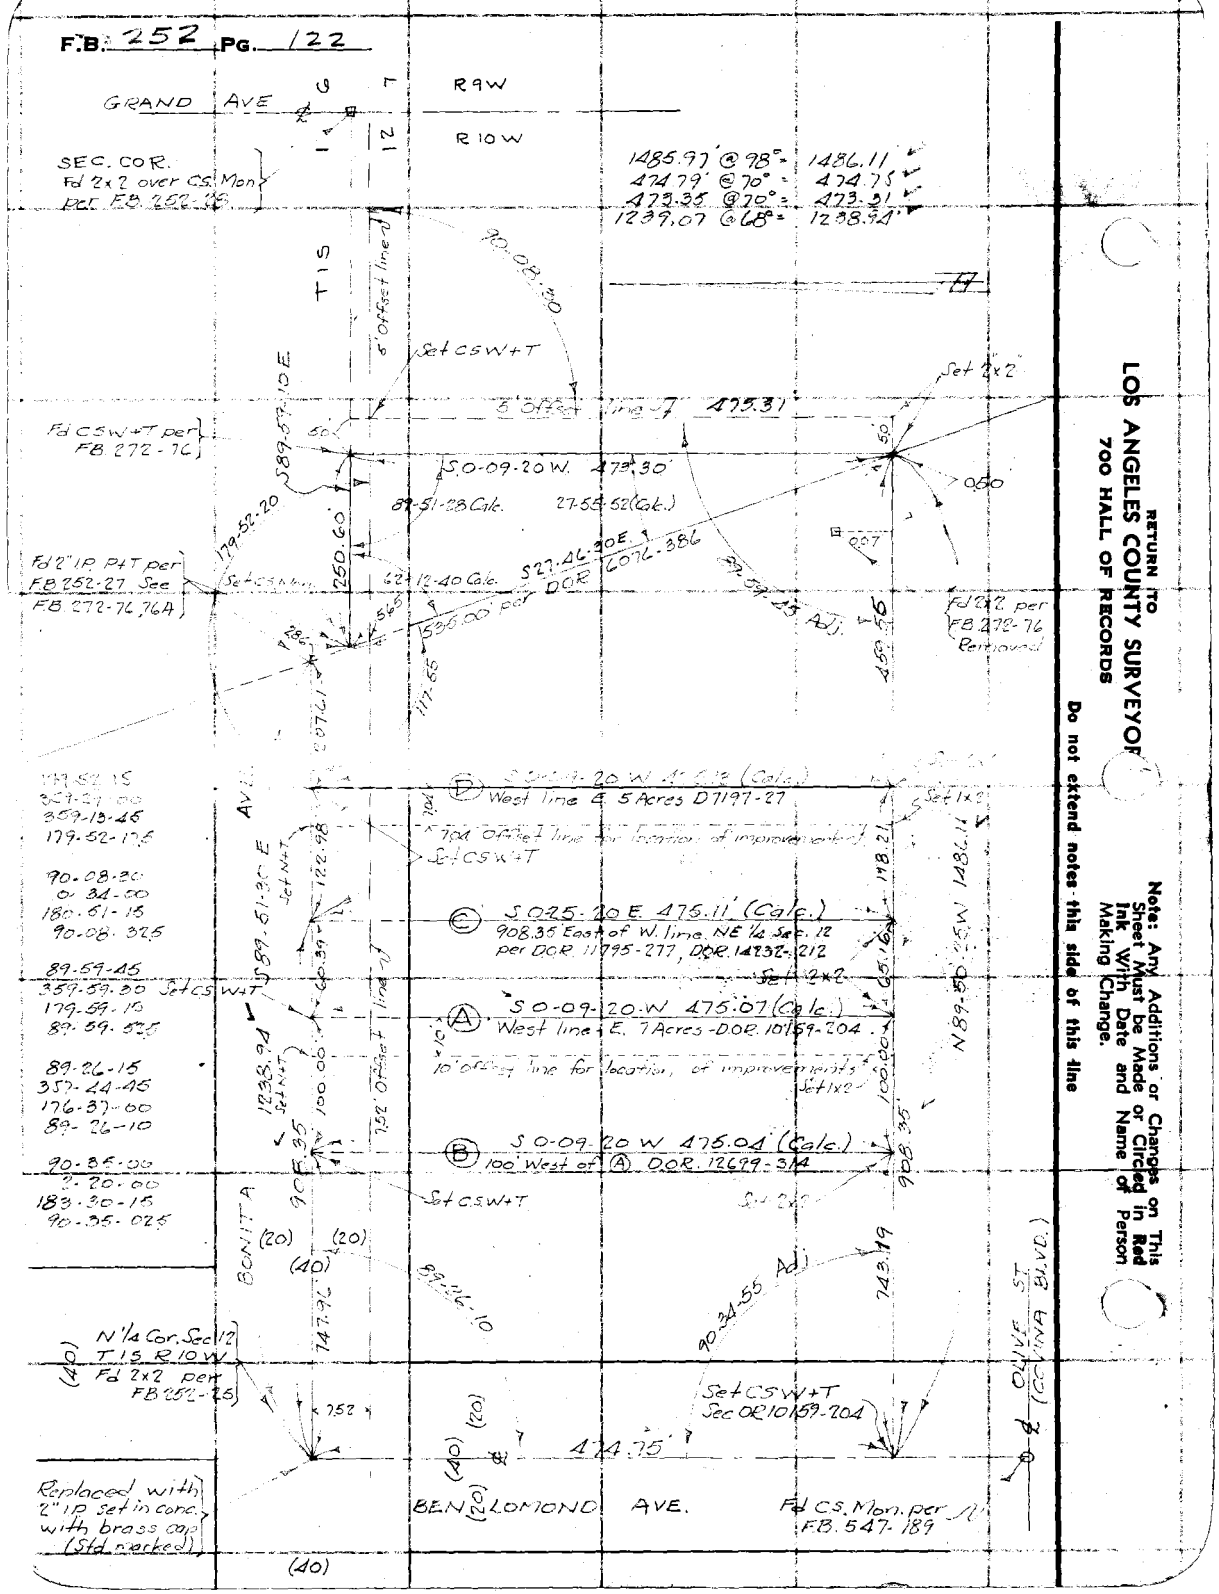

RETURN TO
LOS ANGELES COUNTY SURVEYOR
700 HALL OF RECORDS

Note: Any Additions or Changes on This Sheet Must be Made or Circled in Red Ink With Date and Name of Person Making Change.

Do not extend notes this side of this line

Notes Ck'd by	Survey of
Map No.	W. O. Tape No. St'd °F
Office Work	Surveyed by
Checked	Notes Date
Date	Indexed A. C. Johnson

F.B. 252 Pg. 123

Note: Any Additions or Changes on This Sheet Must be Made in Red Ink With Date and Name of Person Making Change.

Do not extend notes this side of this line

RETURN TO
LOS ANGELES COUNTY SURVEYOR
700 HALL OF RECORDS

FORM 247 10M 11-35

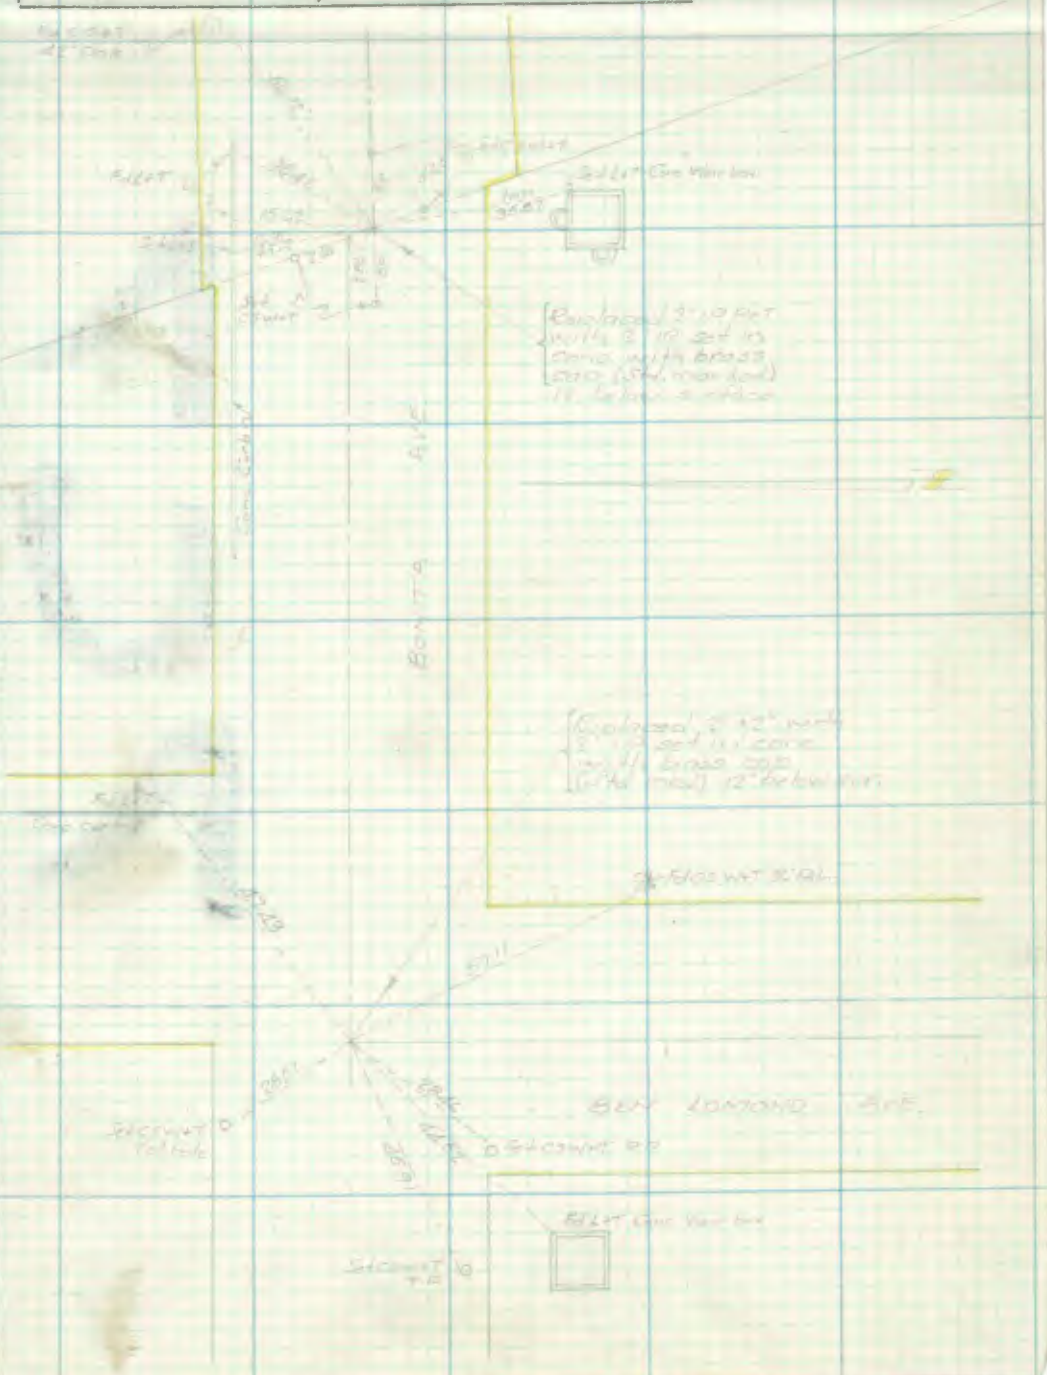

RETURN TO
LOS ANGELES COUNTY SURVEYOR
RECORDS

Notes: Any Additions or Changes on This Sheet Must Be Made or Dated in Red
Do not extend notes [illegible] this line

252

F.B. 252 PG. 124