Date _____ Notes by _____ Chief Party _____ F.B. _____ Pg. _____

Plotted by	W. O. No.
Date	Location
Map No.	Surveyed by
Plotting C'k'd by	Date
Date	Indexed

4 6 5 00
2 [illegible] 75
[illegible] 1,6 5

F.B. 289

F.B. 289 Pg. Index Chief Party Notes by Date

F.B. 289

PAGES: Index, 1 to 24 incl., 24A, 24A,
24B, , 25 to 94 incl., , 96 to
124 incl., , 135 to 137 incl.
, 139 to 147 incl., ,
171 to 193 incl., , 195 to 206 incl.,
, 211 to 212 incl., ,
214 to 222 incl., 241-259

RETURN TO
LOS ANGELES COUNTY SURVEYOR

Do not extend notch this side of this line

Note: ANY ADDITIONS OR CHANGES ON THIS SHEET MUST BE MADE OR CIRCLED IN Red. WITH DATE AND NAME OF PERSON MAKING CHANGE.

Date _____ Notes by _____ Chief Party _____ F. B. 289 PG. 1

Plotted by C.C.Gaul
Date Apr. 28
Map No. B-117
Plotting Ch'k'd by R. W. S.
Date JUL 11 1928

W. O. No. 4159 C. S. O. No.
Location SOMERSET AVE
Surveyed by
Date Feb 1928
Indexed A. C. Johnson

F.B. 289 Pages 1 to 20

SURVEY
OF
SOMERSET AVE
From SPRING ST. to ANAHEIM ST.

W.O. No. 4159

Feb 1928

Berger Transit No. 16382

Band tape No. 91 Standard at 20 lbs. tension 84° F.

M Hayes
F.E. Carlson Inst.
B.O. Rockhold H.C.
H.W. Anderson R.C.

Also Topography Notes from North Line Montana Land Co. South to Spring St.

Notes. ANY ADDITIONS OR CHANGES OF THIS SHEET MUST BE MADE OR CIRCLED IN Red., WITH DATE AND NAME OF PERSON MAKING CHANGE.

Do not extend notes this side of this line

RETURN TO LOS ANGELES COUNTY SURVEYOR

F.B. 389 Pg. 2 Chief Party Notes by Date

INDEX

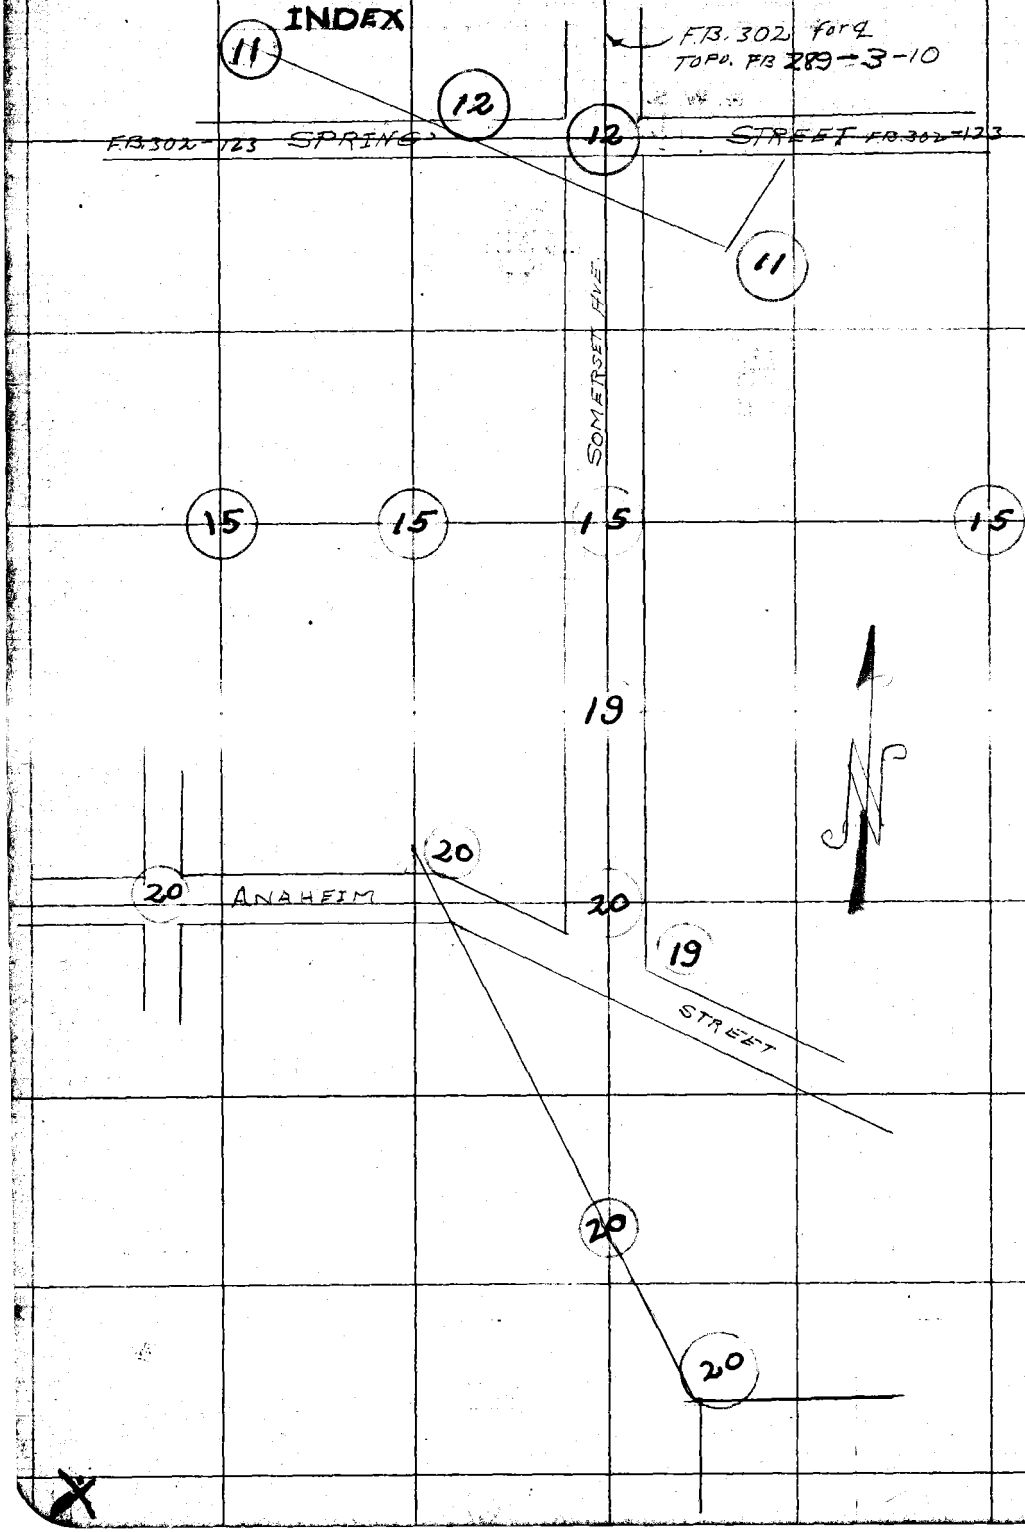

RETURN TO
LOS ANGELES COUNTY SURVEYOR
Do not extend notes this side of this line

Note: ANY ADDITIONS OR CHANGES ON THIS SHEET MUST BE MADE OR CIRCLED IN Red. WITH DATE AND NAME OF PERSON MAKING CHANGE.

Date _____ Notes by _____ Chief Party _____ F. B. 289 PG. 3

Plotted by Crowl
Date Apr 28
Map No. 13 11th
Plotting Ch'd by R. W. S.
Date JUL 1 1928

W. O. No. 1459 D. S. O. No.
Location Somerset Ave
Surveyed by M. Hayes
Date Feb 10 1928
Indexed A. C. Johnson

No. Hdg.
F.E. Carlson
B.O. Proctor
H.W. Anderson, Rc.

Topography Notes From No 2142 Anaheim Landing Sheet
to Anaheim St.
From F.B. 302-80

2 X 2 in So Line Somerset Acres & 0+00 going South = 73+87.15 from North
See Page 80 for Topography + Pages 49, 50 & 117 for & Data

AVE

30.9 — 0+15.3 Conc. stilling basin 5'X5' X 4.4 deep
6.43 — 8X8 Stone block cylindrical housing pump over 8" Pipe
33.4 — 6 0+30.6 6
33.3 — Frame + Corrug. Sheet Metal pump House
36'

0+62.8 — 41.6 — 41.6
L.A.G. & E. Corp. Steel, high Tension transmission Tower No. 91

15.6 — 0+72.8 Wood valve box
36.0 — 0+74.2 T. Pole
15.8 — 33 — Shallow Gate valve box 3.3 X 4.0

SOMERSET

19.7 + 0 — 2+18.8 1st Pole of 14 on South St Average 220' apart

Conc. stilling basin 5'X5' X 4.4 deep
1 6+92.4 — 30.3 30.6 — 1 6+99.7
Conc. stilling basin 5'X5' X 4.4 deep

C.O. Fence 1+4 0.7 — 32.9
Continuous

22+20 — 32.3

To top Page 4

Notes ANY ADDITIONS OR CHANGES ON THIS SHEET MUST BE MADE OR CIRCLED IN Red. WITH DATE AND NAME OF PERSON MAKING CHANGE.

RETURN TO LOS ANGELES COUNTY SURVEYOR

Do not extend notes this side of this line

F.B. 289 Pg. 4 M. Hayes Chief Party Notes by M. H Date 1-10-27

From bot. Page 3

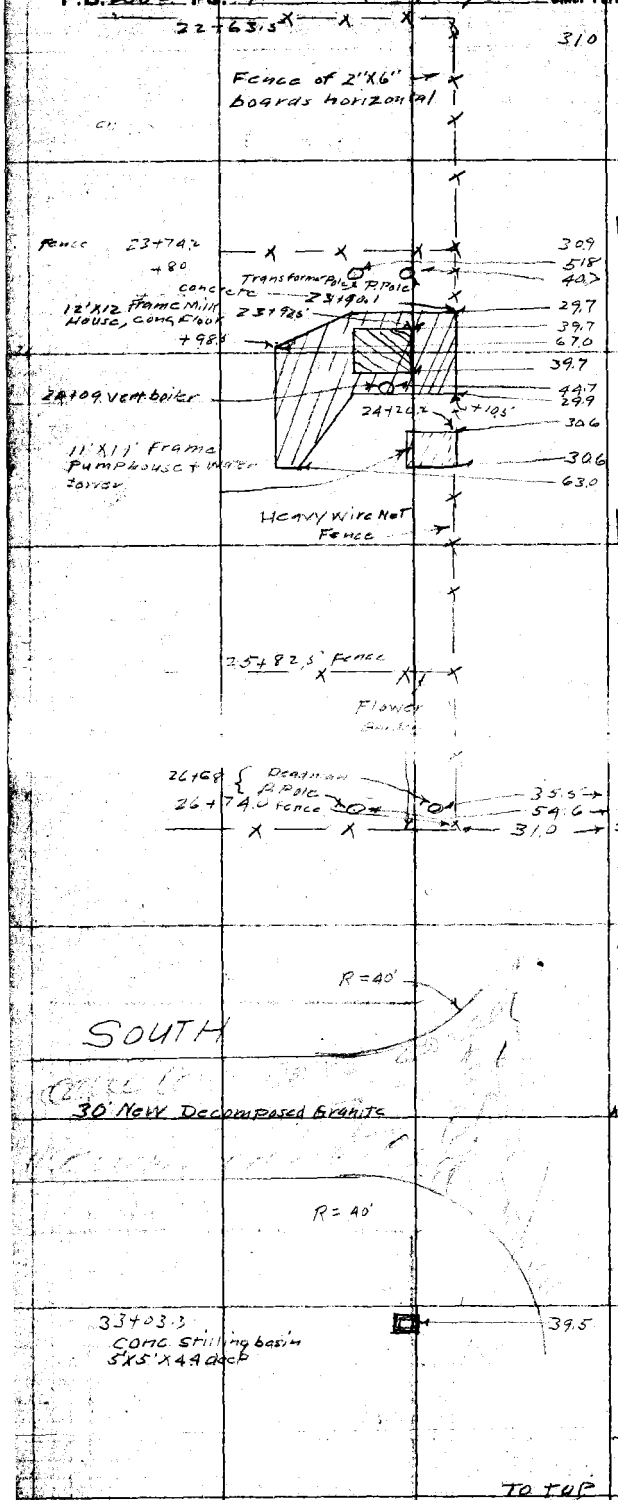

To top Page 5

RETURN TO
LOS ANGELES COUNTY SURVEYOR

Do not extend notes this side of this line

Note: ANY ADDITIONS OR CHANGES ON THIS SHEET MUST BE MADE OR CIRCLED IN Red. WITH DATE AND NAME OF PERSON MAKING CHANGE.

Date _____ Notes by _____ Chief Party _____ F. B. 289 PG. 5

Plotted by Crowl
Date Apr '28
Map No. R-167
Plotting Chkd by
Date JUL 11 1928

W. O. No. 4159 D. S. O. No.
Location Somerset Ave
Surveyed by M. Hayes
Date Feb 10 1927
Indexed

Notes: ANY ADDITIONS OR CHANGES ON THIS SHEET MUST BE MADE OR CIRCLED IN Red. WITH DATE AND NAME OF PERSON MAKING CHANGE.

RETURN TO LOS ANGELES COUNTY SURVEYOR
Do not extend notes this side of this line

From Bk. Page 4

214.6' Apart

10th Pole from South St. R Pole

52+50

19.2

Cultivated field

Grain field

Fd 2" I 52+84.16 See Page 116

21.1 49.5'

Deadman

O+P Pole 52+97

Field

53+08

90° 30'

Road

Alfalfa field

67+85' ±

Cultivated field

14 Power Poles Average 221' Apart

80

80+12 Fence 36.5

+22.2" Fig 44.1

Lattice fence

+35 2" orange

+50.7 2" orange

+65.6 6" Peach 45.3

+75.2 Fence 35.7

89°

80+92

Field

Road

Deadman

25.1

54.7

O P. Pole 81+03

81+17 24" conc irrig Stand Pipe 36.4

18.3

14th Pole from Anglo Rd. +22 R Pole Fd 2"

Grain field

80+35 Beg Alfalfa Field

TO TOP Page 6

F.B. 289 Pg. 6 M. Hayes Chief Party Notes by M. H Date 1-1-28

From bot. Page 5

Grain Field

Field Road

Alfalfa Field

1X2.947 +5.2' See Page

Private Road To Ranch House

P. Pole #136
94+43.6
Lt 4 Pole from Sta.
81+22 Av. 220' @ Part

Cultivated Field

187

90°

90°

107+37.6

Field

Road

Grain Field

P. Pole #136
107+60.7
Lt 4 Pole from Sta.
94+43.6 Av. 220' @ Part
Cultivated Field

120+45.6
Beg. Curve 19

19.0

P. Pole #119
131+47
117+4 Pole from Sta 107+60.7
Av. 217' @ Part

Grain field

Alfalfa Field

Guy Pole

133+50.3
Deadman

7.0 3.6 19.4 40.8

Fd 2x4 133+66.46
See Page

19.1 P. Pole 133+46

BIXBY STATION ROAD

T. Pole 39.5'
Deadman 32.7

133+93.0

Grain field

2.0' 133+89.2 Guy Pole
34.7 Deadman +93.
42.2 P. Pole

19.6 134+13.1
+ 15.9 Deadmen
+ 21.9

Grain field

To Top Page 7

RETURN TO
LOS ANGELES COUNTY SURVEYOR
Do not extend notes this side of this line

Notes: ANY ADDITIONS OR CHANGES ON THIS SHEET MUST BE MADE OR CIRCLED IN Red. WITH DATE AND NAME OF PERSON MAKING CHANGE.

Date _____ Notes by _____ Chief Party _____ F. B. 289 PG. 7

Plotted by Crouch
Date Apr '28
Map No. B-17
Checked by P. W. S.
Date JUL 11 1928

W. O. No. 4152 C. S. O. No. _____
Location Somerset Ave
Surveyed by M. Hayes
Date Feb 11 1928
Indexed A. C. Johnson

From Bot Page 6

19.4 → 135+25 R Pole
1st Pole of 15 Pole to 5th.
160+28.6

Grain Field
Waste land
135+68

142+23.7
X—X—X—X—X 22.5
Beg Grain field
Barb Wire fence →

Field

Field

142+49.5 70
Seepage

24" conc irrig valve
147+13.7 Iron cover 34.0

24" conc irrig valve
Iron cover 150+46.4 34.0

Grain

Grain

24" conc. irrig valve Iron cover
153+77 34.0

153+73.6 Fence Cor.
20.8 X—X X—X
19.6 → 154+97 R Pole

To Top Page 8

Notes ANY ADDITIONS OR CHANGES ON THIS SHEET MUST BE MADE OR CIRCLED IN Red. WITH DATE AND NAME OF PERSON MAKING CHANGE.

Do not extend notes this side of this line

RETURN TO
LOS ANGELES COUNTY SURVEYOR

F.B. 289 Pg. 8. M. Hayes Chief Party Notes by M.H Date 1-11-28

From bot Page 7

15 P. Pole Average 1788' a Part

24" Irrig Valve Iron Cover 157+07.8

34.0

Pasture Land

23.0

160+81.1 F. Cor

Field

Fence 160+08.14 See Page

20.3

Private Road

15 Th Pole 160+28.6

160+27.1 Guy Pole Eastline +39.6

42" Conc. Standpipe

160+29 Fence

163+35.7 24" Conc Irrig Valve Iron Cover

33.5

Grain

Fence 163+95.3

20.6

Pasture Land

166+09.6 Fence

23.2

166+67.2 24" Conc. Irrig Valve Iron Cover

34.2

Field

Grain

Cultivated Field

To top Page 9

RETURN TO LOS ANGELES COUNTY SURVEYOR

Do not extend notes this side of this line

Notes: ANY ADDITIONS OR CHANGES ON THIS SHEET MUST BE MADE OR CIRCLED IN Red. WITH DATE AND NAME OF PERSON MAKING CHANGE.

Date _____ Notes by M.H.H. Chief Party _____ F. B. 289 PG. 9

Checked by _____
Date May 28 '28
Map No. B-17
Plotted by P. W. S.
Date JUL 1 1928

W. O. No. 4159 C. S. O. No. _____
Location Somerset Ave
Surveyed by M. Hayes
Date Feb 11 1928
Indexed A. C. Johnson

Notes: ANY ADDITIONS OR CHANGES ON THIS SHEET MUST BE MADE OR CIRCLED IN Red. WITH DATE AND NAME OF PERSON MAKING CHANGE.

Do not extend notes this side of this line

RETURN TO LOS ANGELES COUNTY SURVEYOR

From bot Page 8

24" conc irrig Valve iron cover
169+94.5 ⑫ 33.4

Field

173+29 ⑬ 33.6
24" conc. irrig valve iron cover

Cultivated field

450'

179+00

Grain

330' +0.

Marsh Land

180+05

Marsh Land

Fence

186+50

+238
+42.0

185+60

Grain

186+80.1

Field

Fence 181+18.03
SEE Page

Grain

Field

To top Page 10

F.B. 289 Pg. 10 M. Hayes Chief Party Notes by M.H. Date 1-11-28

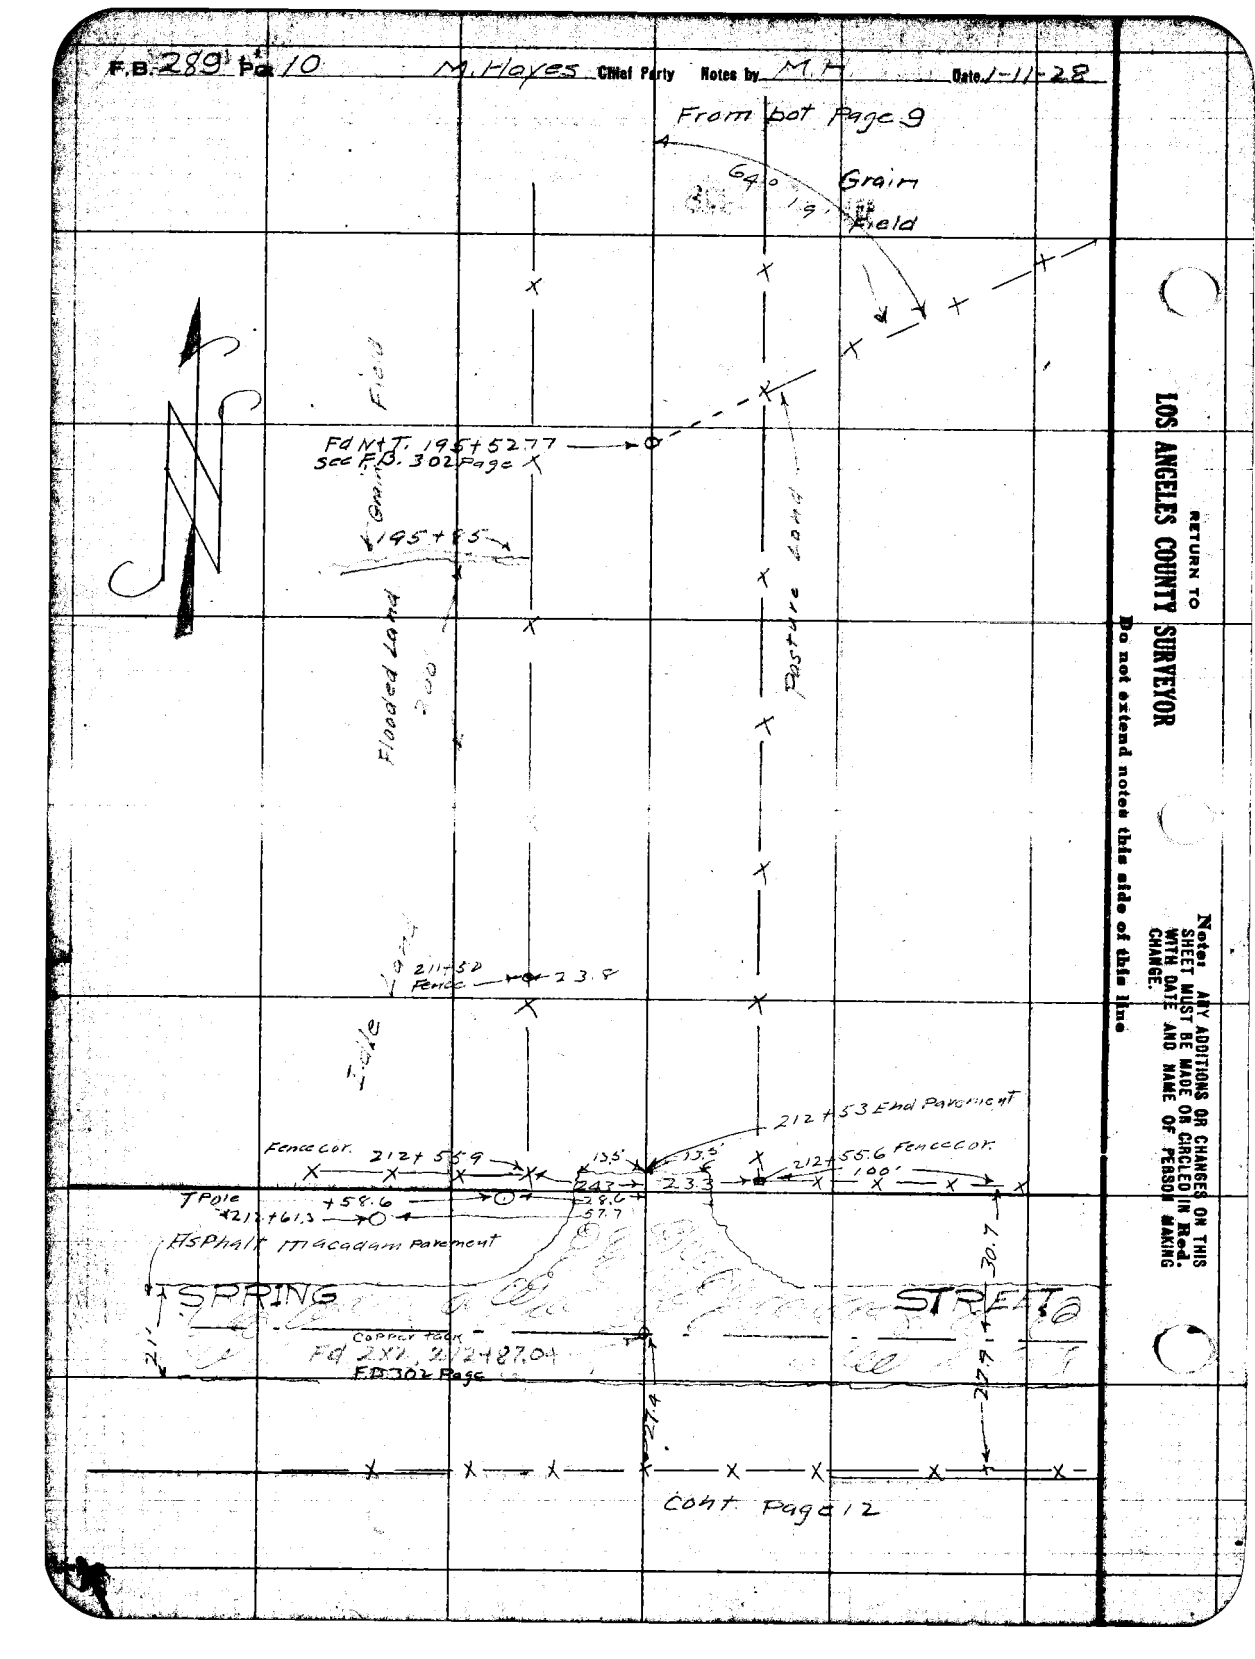

RETURN TO
LOS ANGELES COUNTY SURVEYOR
Do not extend notes this side of this line

Notes: ANY ADDITIONS OR CHANGES ON THIS SHEET MUST BE MADE OR CIRCLED IN Red. WITH DATE AND NAME OF PERSON MAKING CHANGE.

RETURN TO

LOS ANGELES COUNTY SURVEYOR

Notes: ANY ADDITIONS OR CHANGES ON THIS SHEET MUST BE MADE OR CIRCLED IN Red. WITH DATE AND NAME OF PERSON MAKING CHANGE.

Do not extend notes this side of this line

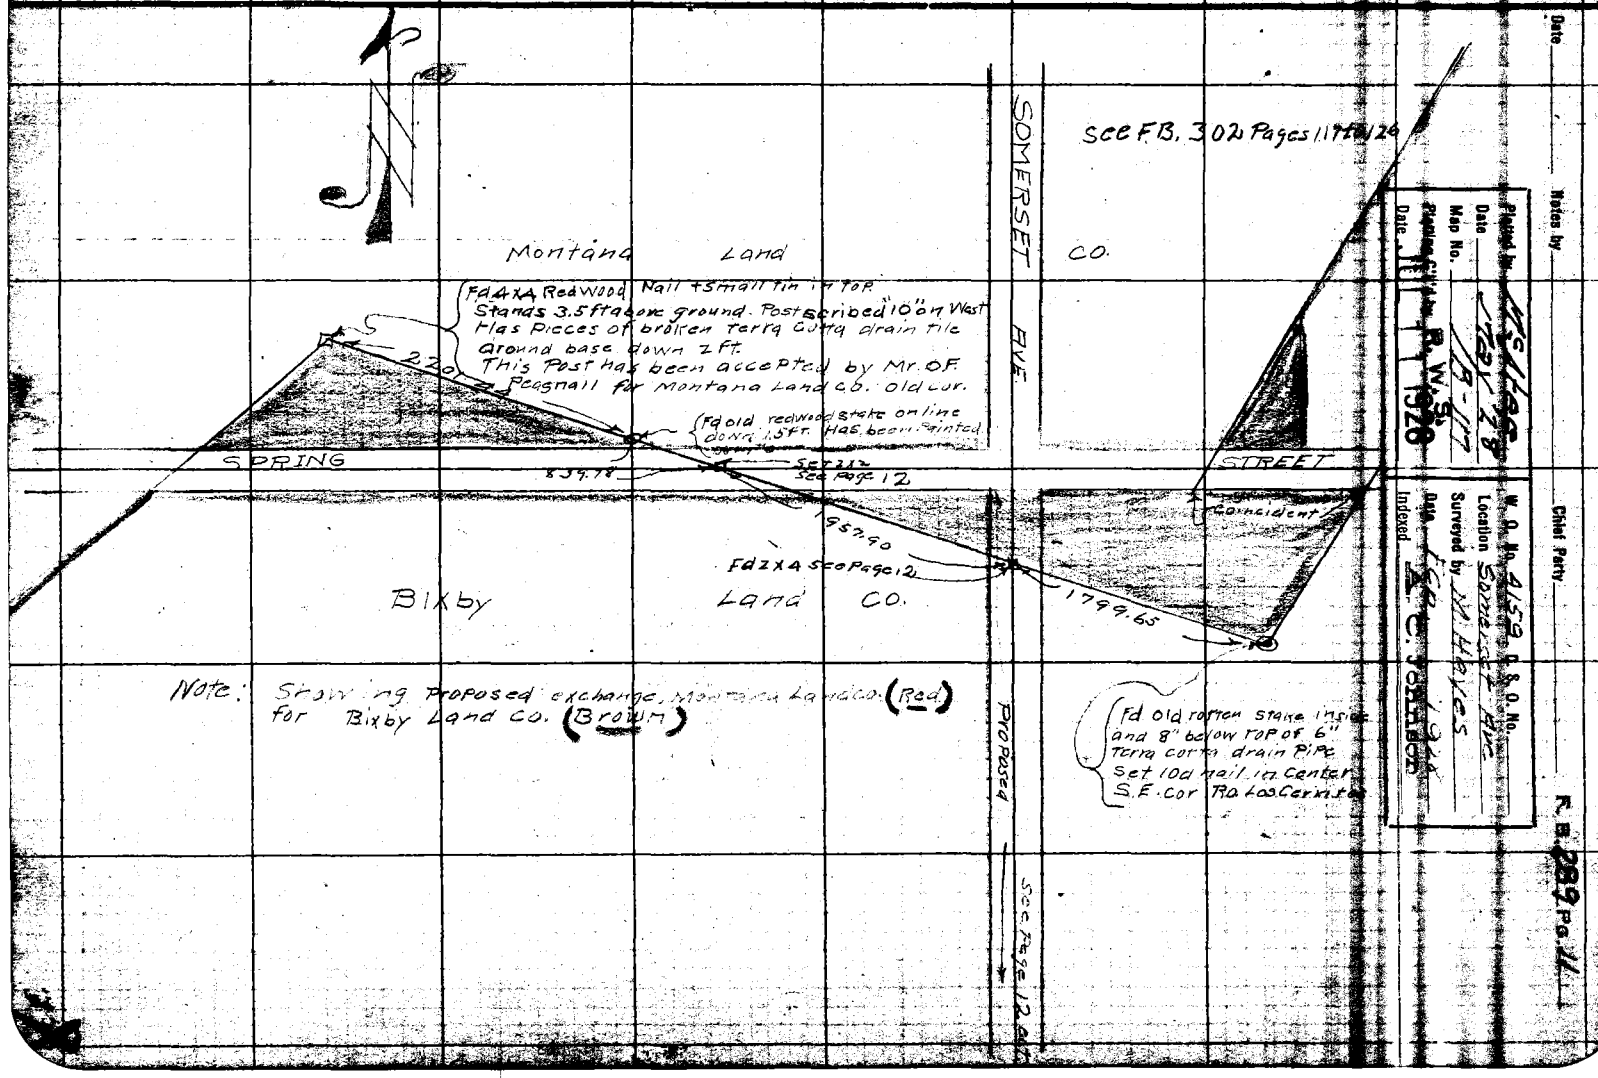

Date _____ Notes by _____ Chief Party _____




F.B. 289 Pg. 11

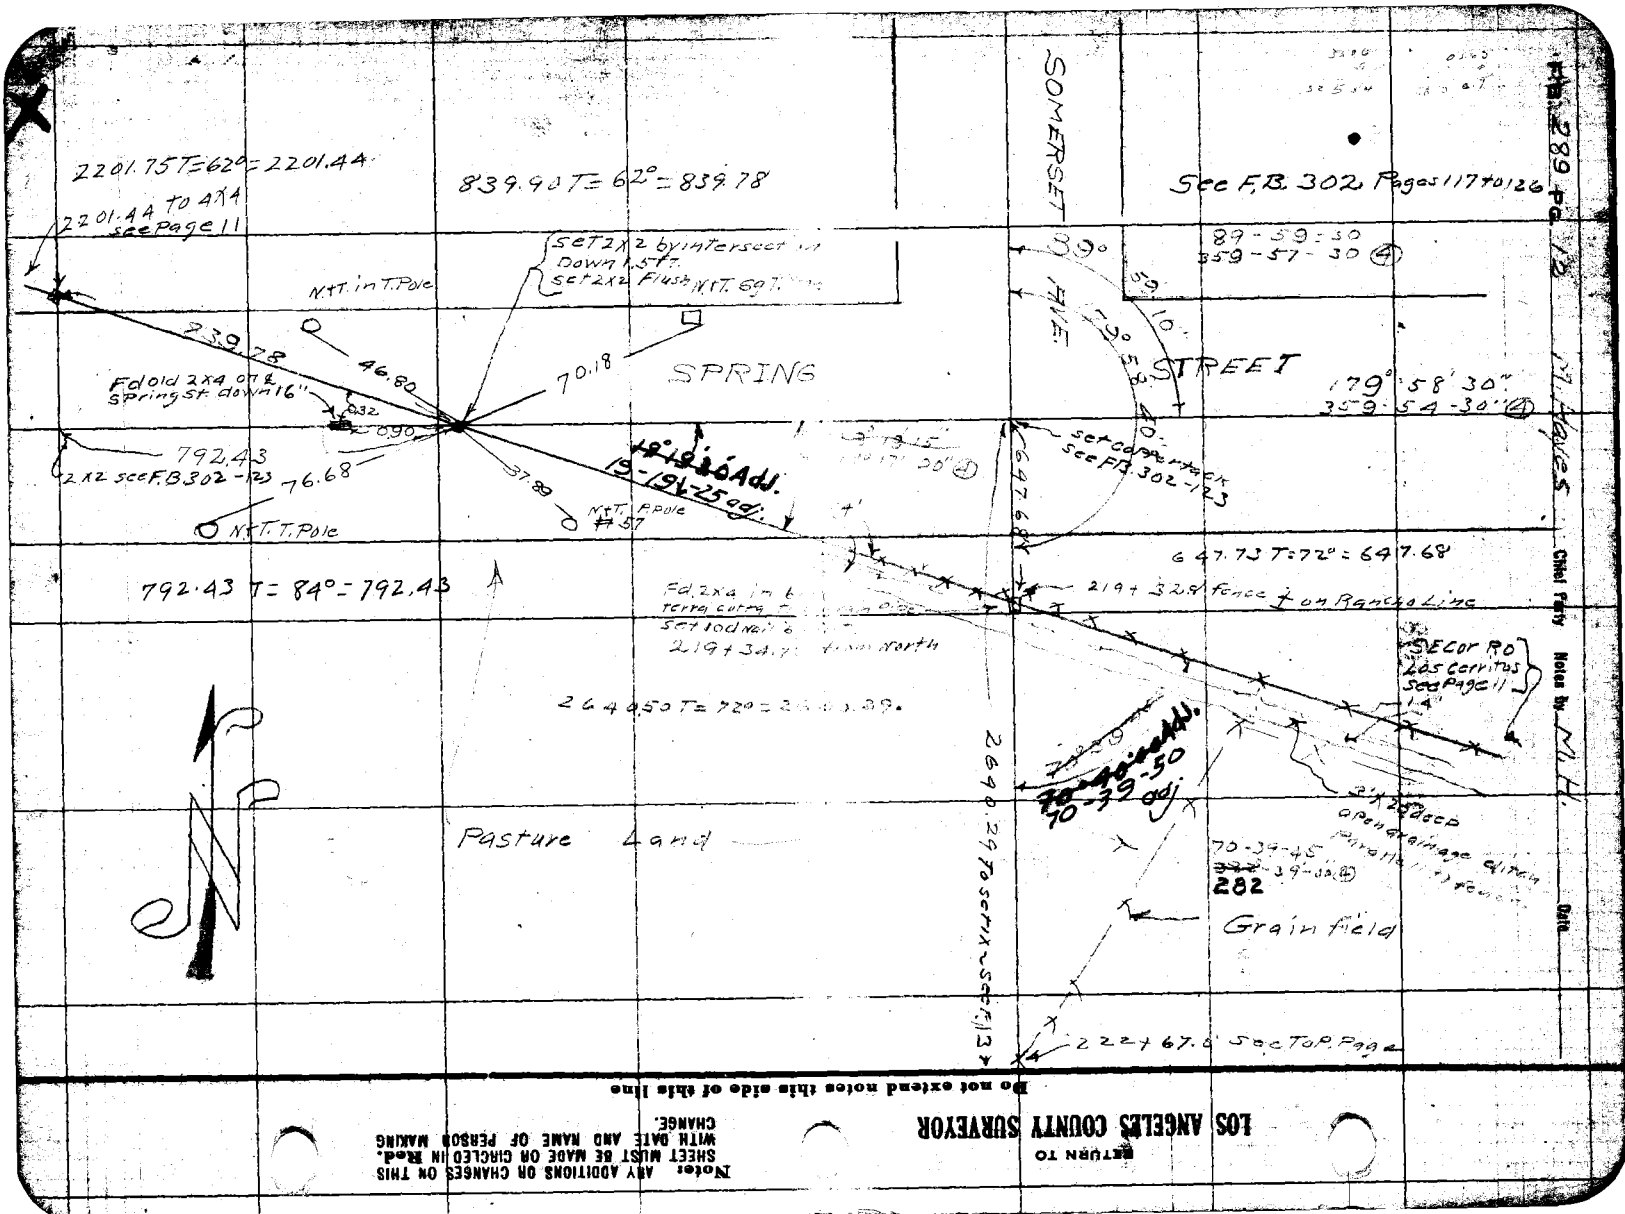
2201.75 T=62°=2201.44
2201.44 to 4A4
see Page 11
839.90 T=62°=839.78
See F.B. 302 Pages 117 to 126
SOMERSET AVE.
SPRING STREET
N.T.T. in T. Pole
239.78
Fd old 2X4 on E Spring St. down 16"
46.80
0.32
0.90
70.18
Set 2X2 by intersect
Down 1.5 FT.
Set 2X2 Flush N.T.T. 69
89-59-30
359-57-30 (A)
179°-58'30"
359-54-30" (A)
792.43
2X2 see F.B. 302-123
76.68
N.T.T. Pole
37.89
N.T.T. Pole #57
Set Cross in Rock
See F.B. 302-123
647.68
647.73 T=72°=647.68
792.43 T=84°=792.43
Fd 2X4 in b
Terra cutta
Set 10d Nail
219+34.
North
219+32.9 Fence ⊥ on Rancho Line
SEC Cor RO
Las Cerritos
See Page 11
1.4'
2X2 Post
Open Drainage ditch
Parallel to Fence
70-39-50
70-40-00 Adj.
70-39-50 adj
70-39-45
359-39-30 (A)
282
Pasture Land
Grain field
2644.50 T=72°=2644.38
2644.29 To Sec. N. Sec. 13
222+67.6 Sec. T. of P. Page
Adj. 289 Pg. 73
M. Hayes, Chief Party
Notes by M.H.
Date
RETURN TO
LOS ANGELES COUNTY SURVEYOR
Do not extend notes this side of this line
Note: ANY ADDITIONS OR CHANGES ON THIS SHEET MUST BE MADE ON CIRCLED IN Red. WITH DATE AND NAME OF PERSON MAKING CHANGE.

Date _____ Notes by _____ Chief Party _____ F. B. 289 Pg. 14

Plotted by J.S. Mac
Date Nov 28
Map No. B-17
Planning C.M. by D. W. S.
Date JUL 11 1928

W. O. No. 4159 S. O. No.
Location Somerset Ave
Surveyed by M. Hayes
Date Feb 20 1928
Indexed A. C. Johnson

Note: ANY ADDITIONS OR CHANGES ON THIS SHEET MUST BE MADE IN CIRCLED M Bod. WITH DATE AND NAME OF PERSON MAKING CHANGE.

RETURN TO

LOS ANGELES COUNTY SURVEYOR

Do not extend notes this side of this line

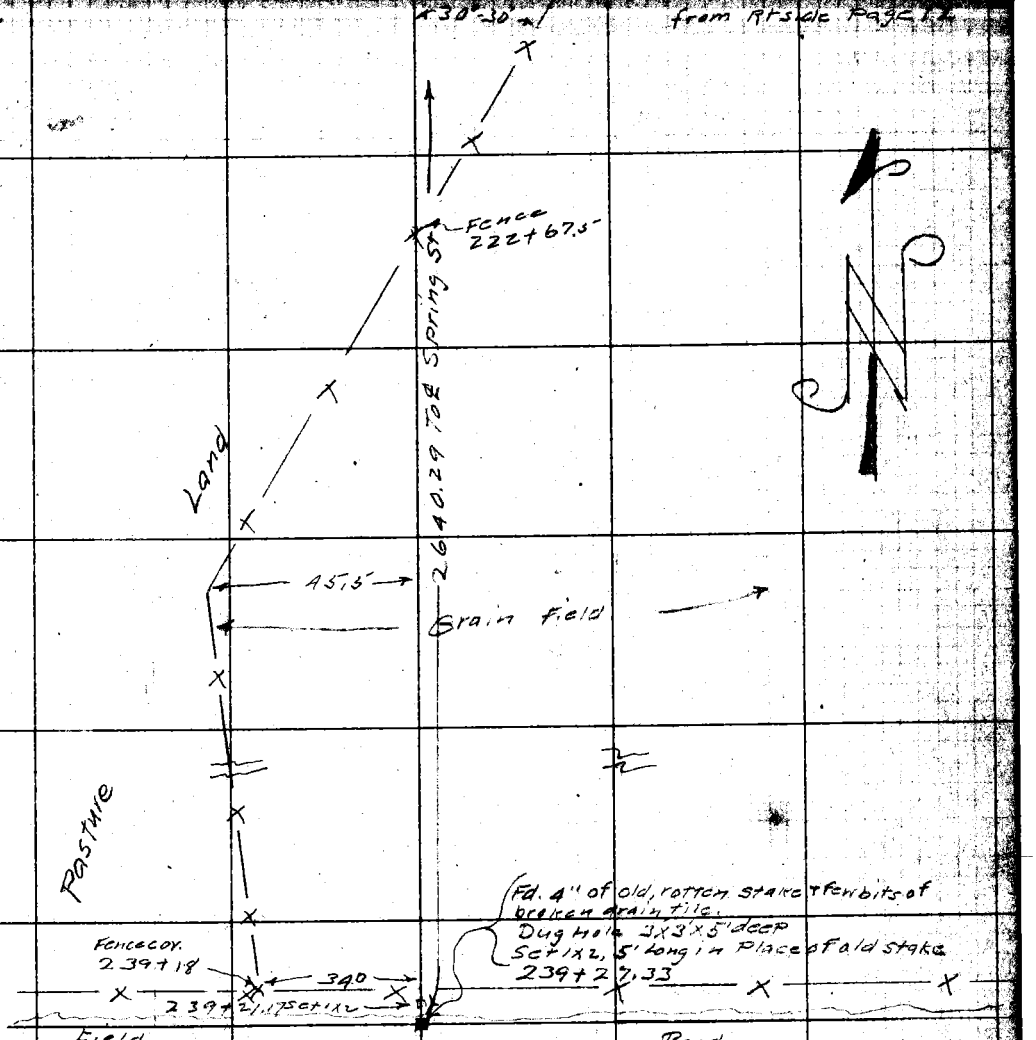

F.B. 289 Pg. 14 M. Hayes Chief Party Notes by M.H. Date 2-21-28

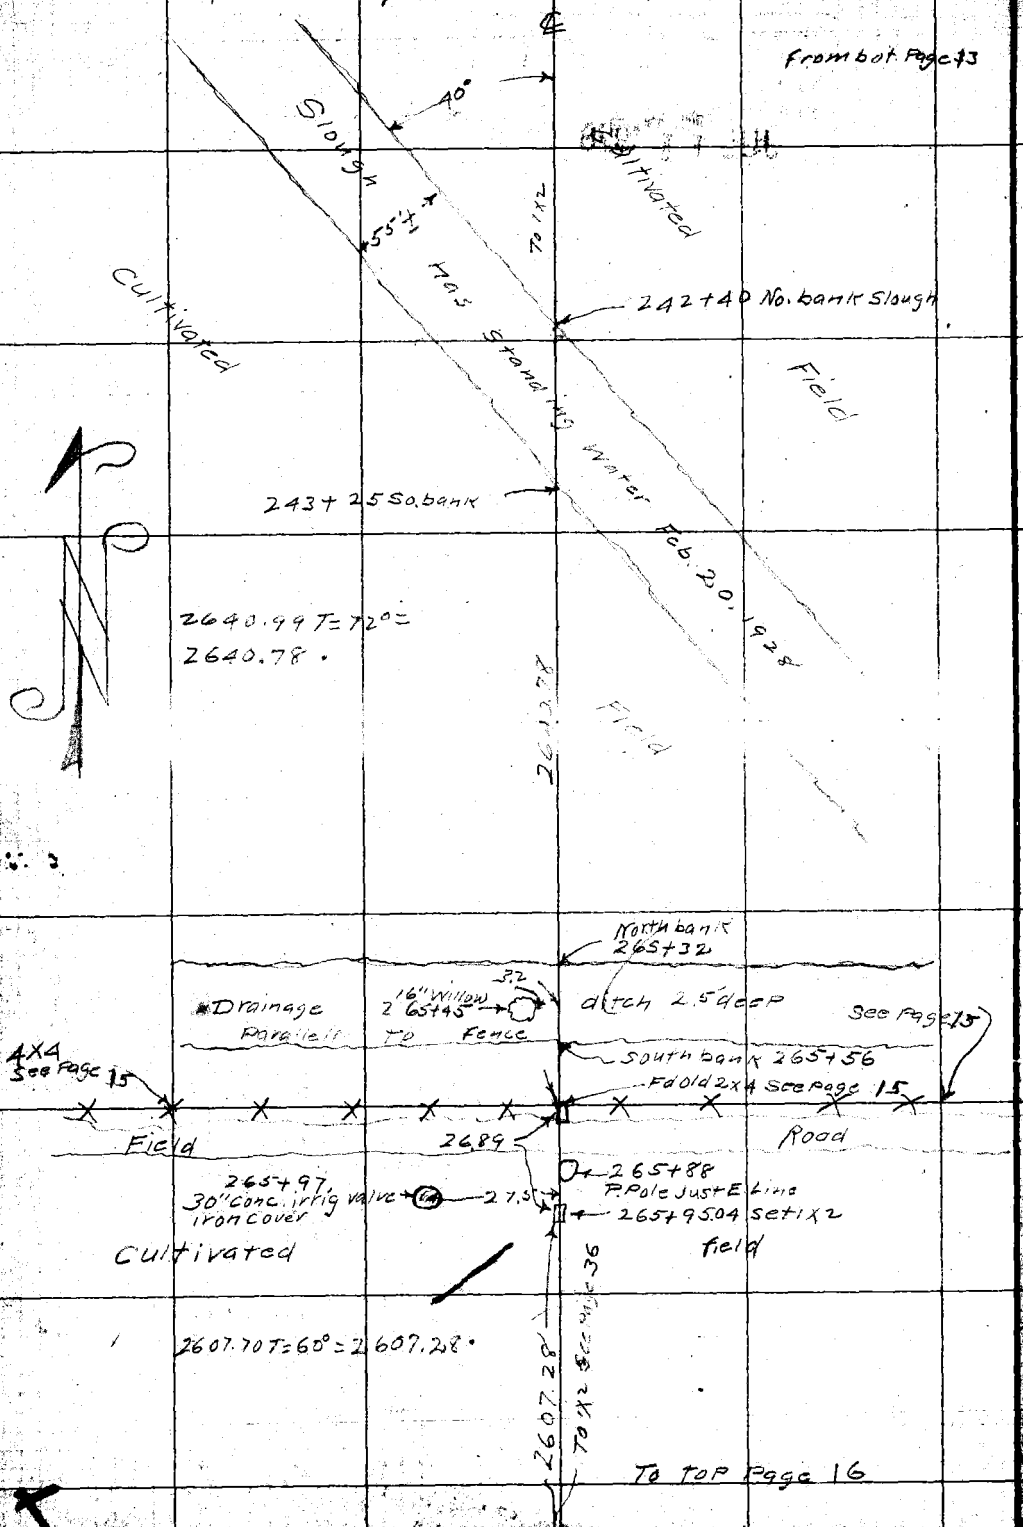

RETURN TO
LOS ANGELES COUNTY SURVEYOR
Do not extend notes this side of this line

Note: ANY ADDITIONS OR CHANGES ON THIS SHEET MUST BE MADE OR CIRCLED IN Red. WITH DATE AND NAME OF PERSON MAKING CHANGE.

RETURN TO
LOS ANGELES COUNTY SURVEYOR

Note: ANY ADDITIONS OR CHANGES ON THIS SHEET MUST BE MADE OR CIRCLED IN Red. WITH DATE AND NAME OF PERSON MAKING CHANGE.

Do not extend notes this side of this line

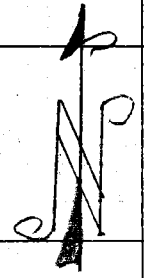

T.4S. R.12W.

T & Spring St

Bixby Land Co.

90°-00' 00"

360° 00' 00"

00' 00"

5281.32 T=66° =
5280.69

Fd old Redwood stk. 4 appears to be 3x3, with 10d nail. Broken terra cotta tile ground base 1½ ft below Pavement Set 2x2 down 2" Center Sec. 26

5280.88 T=64° =
5280.19

N.T.T. 1459 T.P.H.=
School

40 Ft.

Set N.T.T. Guy Pole

25.10

STEARNS AVE.

1/4 Sec cor Set 2x2 by Prop. bet. Centers Secs. 27 & 28

2640.345

2640.345

5280.69

5280.19

Susan P. Bryant

N.T.T. P. Pole

23.7

98°

27.5

N.T.T.P.Pole

2654 68.15
Fd old 2X4 Set nail in N.W. cor by intersection Center Sec. 27
D.M. 4046-240
C.F. 228½

Replaced 2X4 With 2" I.P. Plug & Tack Down 1.8'

D.M. 4046-240 } References

D 17-196

Road

Set N.T.T. P. Pole # 233223E

Set N.T.T. Fence Post

Fd old 4X4 With 20d nail Broken 5" Terra cotta Pipe around 4X4 Center Sec. 28

Fd 2X4 Cent. Sec. 34
See Pages 19 & 20

Notes by

Date

Chief Party

F. B. 289 Pg. 15

Date JUL 11 1928

Map No.

Location Surveyed by M. Hayes

Indexed

Date

Checked by A. C. Pearson

F.B. 289 Pg. 16 M. Hayes Chief Party Notes by M.H Date 2-21-28

from bot Page 14

2607.28

Field

Set 1X2
2.7

Sec

Fd. old "XA"
IN 5" Terra Cotta Pipe
1/4 Sec Cor. bet Secs 27 & 34
set 10d nail in W Side

7.66

Sec 34

cultivated

84.0±

Open drainage ditch

296+49 North bank
Small

Running West

Sec

Feb. 21, 1928

Semi-Wall 5 ft on bank

Flows

296+67 So. bank

994.96 T = 60° = 994.80

Field

Grain

69.33

Nails + Tins in Pepper trees

4098

POT Set 1X2
302+04.78

Page 19

1645.72 T = 58° = 1645.49

To Center Sec 34

1645.44

73.11

TO TOP Page 17

RETURN TO
LOS ANGELES COUNTY SURVEYOR
Do not extend notes this side of this line

Note: ANY ADDITIONS OR CHANGES ON THIS SHEET MUST BE MADE OR CIRCLED IN Red. WITH DATE AND NAME OF PERSON MAKING CHANGE.

Date _____ Notes by _____ Chief Party _____ F. B. 289 PG. 17

Plotted by M. Hoyes
Date May 28
Map No. B-117
Plotting Chk'd by B. W. S.
Date JUL 11 1928

W. O. No. 4159 C. S. O. No.
Location Somerset Ave
Surveyed by M. Hayes
Date Feb 21 1928
Indexed A. C. Jackson

Notes: ANY ADDITIONS OR CHANGES ON THIS SHEET MUST BE MADE OR CIRCLED IN Red. WITH DATE AND NAME OF PERSON MAKING CHANGE.

RETURN TO LOS ANGELES COUNTY SURVEYOR

Do not extend notes this side of this line

℄ from bot Page 16

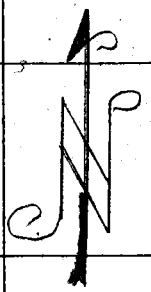

36.2

1st trac in row 14" PePPers 299+09

299+485

Field

+88

300+11 Corbarn

57.7

24'

36'

1 Story Frame & Corrug. Sheet metal barn

57.7

300+67

300+77 ± Entrance

57.3

X—X Heavy board fence 8' high

301+08±

301+32

301+49

Grain

72.8

Frame Implement House

24.4

58.3

301+88

To top Page 18

F.B. 289 Pg. 18 M. Hayes Chief Party Notes by M.H Date 2-7-28

from bot. Page 17

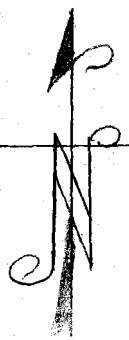

field

Grain

307+70.5

Pepper
303+28.7
Begin Noses.

303+57

Pepper
304+26
20S+ in row

40.0'

12" Pepper
304+64

45'

10" Pepper
304+94

63.0

To top Page 19

RETURN TO
LOS ANGELES COUNTY SURVEYOR
Do not extend notes this side of this line

Notes: ANY ADDITIONS OR CHANGES ON THIS SHEET MUST BE MADE OR CIRCLED IN Red. WITH DATE AND NAME OF PERSON MAKING CHANGE.

Date _____ Notes by _____ Chief Party _____ F. B. 289 PG. 19

Plotted by _____
Date _____
Map No. _____
Plotting Ckd by _____
Date _____

W. O. No. 4159 L. S. O. No. _____
Location Somerset Ave
Surveyed by M. Hayes
Date _____
Indexed A. C. Johnson

Notes: ANY ADDITIONS OR CHANGES ON THIS SHEET MUST BE MADE OR CIRCLED IN Red. WITH DATE AND NAME OF PERSON MAKING CHANGE.

Do not extend notes this side of this line

RETURN TO LOS ANGELES COUNTY SURVEYOR

From bot. Page 18

2X4 centers cc. 34
318+50.22

Grain

Field

438.15

16" Pepper 322+56

Set 2X2 down 1ft. on line

Set S.W.I.T. by intersection 322+88.37 from South line Somerset Aves

ANAHEIM

Set S.T. Pepper

16" Pepper 322+76.4

Set S.T. in Pepper

Asphalt Conc. Macadam Pavement

Set S.T. Pepper

16" Pepper 323+09.8

Set 2X2 down 1ft. on line

Set S.T. in Pepper tree

16" Pepper 323+31.0

CONT TO Page 20 Left.

Grain

Field

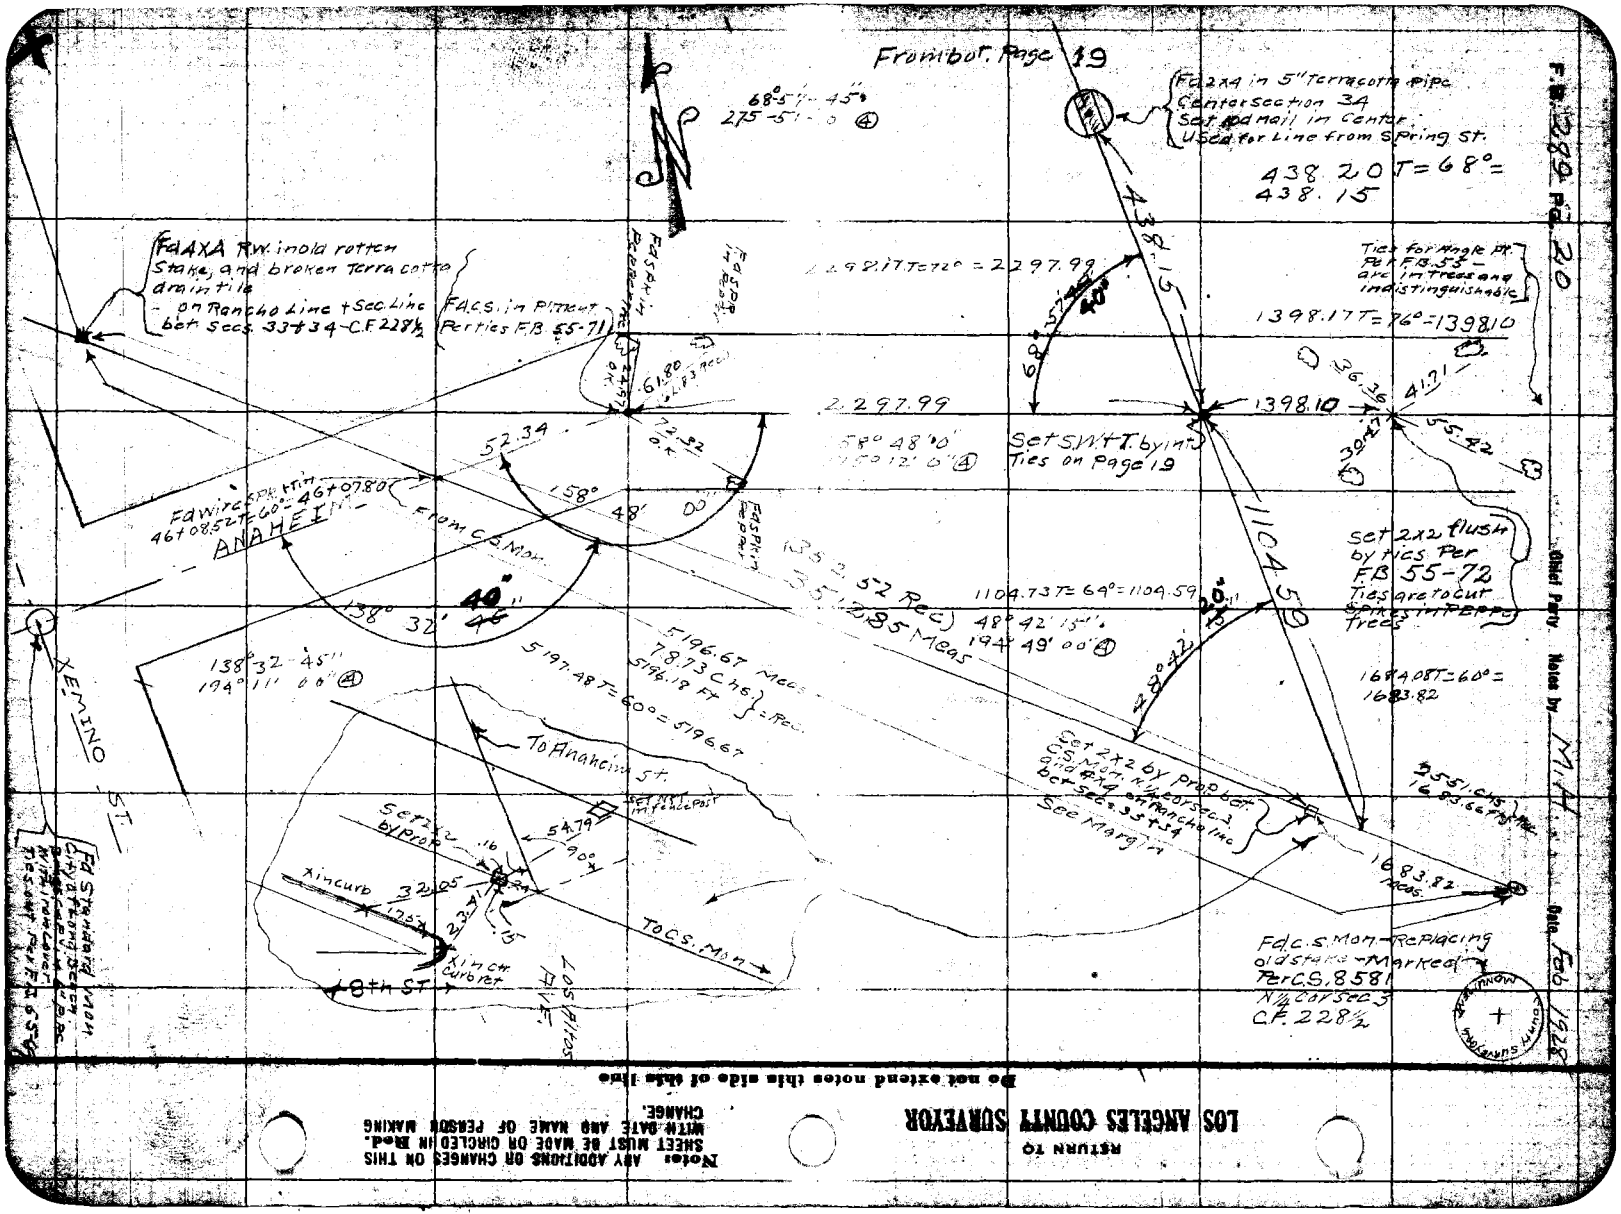
From bot. Page 19
68° 57' 45"
275-51-0 (A)
Fd 2x4 in 5" terracotta pipe
Center section 34
Set nail in center.
Used for Line from S. Spring St.
438.20 T = 68° =
438.15
Fd AXA RW. in old rotten
Stake, and broken Terra cotta
drain tile
- on Rancho Line + Sec. Line
bet Secs. 33 & 34 - C.F. 228½
F.A.C.S. in Pittset
Parties F.B. 55-71
Fd Spike in Post
Fd Spike in Post
2297.99
1398.17 T = 76° = 1398.10
Ties for Angle Pt.
Per F.B. 55-
are in trees and
indistinguishable
61.80
72.52
O.K.
52.34
158° 48' 00"
58° 48' 10"
1398.10
Set S.W.T. by intf.
Ties on Page 19
Fd wire spike in
46 + 08.52 T = 60° = 46 + 07.80
FROM C.S. Mon.
ANAHEIM
1104.59
Set 2x2 flush
by T.C.S. Per
F.B. 55-72
Ties are to cut
spikes in Pepper
trees
1104.73 T = 69° = 1104.59
138° 32' 46"
138° 32' 45"
194° 11' 00" (A)
5196.67 Meas
7.8.73 C.H.S.
5196.18 Ft
5197.48 T = 60° = 5196.67
194° 49' 00" (A)
1684.08 T = 60° =
1683.82
To Anaheim St.
Set 2x2 by prob. 0.5' S. of C.S. Mon. in C.L. of Spring St. on Rancho line bet Secs. 33 & 34
See Margin
Set 2x2 by Prob
5479
90°
Xincurb
32.05
1.25
2.34
.15
Xincurb
To C.S. Mon
8th St
Fd C.S. Mon - Replacing
old stake - Marked
Per C.S. 8581
N¼ cor Sec 3
C.F. 228½
1683.82
Meas
5551.C.H.S.
16 83.66 Ft
City & Flood Section
Bridge Level Mon.
Fd Standard Mon.
N.W. Rancho Cor.
Ties set per F.B. 55-72
F.B. 289 Pg. 20
Chief Party
Notes by M.M.H.
LOS ANGELES COUNTY SURVEYOR
RETURN TO
Note: ANY ADDITIONS OR CHANGES ON THIS SHEET MUST BE MADE ON CIRCLED IN RED. WITH DATE AND NAME OF PERSON MAKING CHANGE.
Do not extend notes this side of this line

Date _____ Notes by _____ Chief Party _____ F. B. 289 Pg. 21

Plotted by [illegible] Date June 28 Map No. B-117 Plotting Ch'd by [illegible] Date JUL 11 1928

W. O. No. 4159 S. A. O. No. _____ Location Somerset Ave. Surveyed by L.S.Hammond Date July 1928 Indexed A. C. Johnson

Notes: ANY ADDITIONS OR CHANGES ON THIS SHEET MUST BE MADE OR CIRCLED IN Red. WITH DATE AND NAME OF PERSON MAKING CHANGE.

Do not extend notes this side of this line

RETURN TO LOS ANGELES COUNTY SURVEYOR

— W. O. 4159 —

→ SOMERSET AVE ←

LINE CHANGE FROM FIRST ST. TO THIRD ST.

— JULY 1928 —

BY :—

L.S.HAMMOND (chief)

D.W.REYNOLDS (Inst.)

R.C.POWERS (Hd. ch)

C.M.DUNLAP (Rr. ch.)

Band Tape *030 used which is 100.000 @ 76°F. pull 21½ lbs:

F.B. 289 Pg. 22 LSH Chief Party Notes by LSH Date

RETURN TO
LOS ANGELES COUNTY SURVEYOR
Do not extend notes this side of this line

Note: ANY ADDITIONS OR CHANGES ON THIS SHEET MUST BE MADE OR CIRCLED IN Red. WITH DATE AND NAME OF PERSON MAKING CHANGE.

Date 7-2-28 Notes by L.S.H. Chief Party L.S.H. F. B. 209 Pg. 23

Plotted by Holmgren
Date June 28
Map No. B-117
Checked by R. M. S.
Date JUL 11 1928

W. O. No. 4159 R. S. O. No.
Location Somerset Ave
Surveyed by L.S. Hammond
Date July 1928
Indexed A. C. Johnson

Notes: ANY ADDITIONS OR CHANGES ON THIS SHEET MUST BE MADE OR CIRCLED IN Red. WITH DATE AND NAME OF PERSON MAKING CHANGE.

Do not extend notes this side of this line

RETURN TO LOS ANGELES COUNTY SURVEYOR

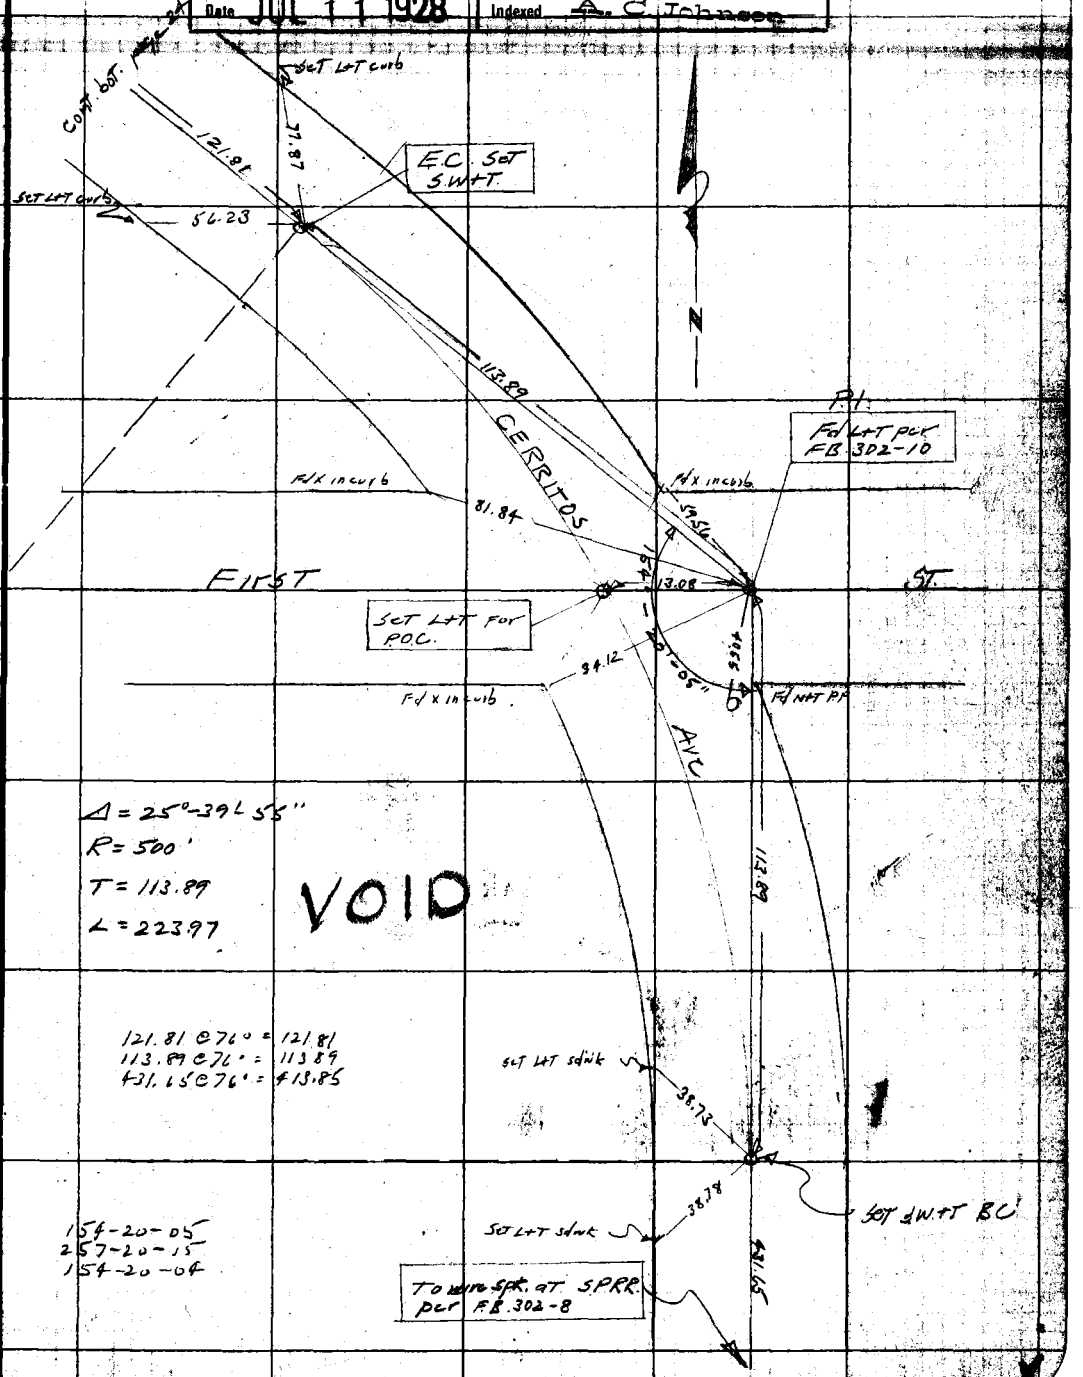

F.B. 289 Pg. 24 LSH Chief Party Notes by LSH Date 7-2-28

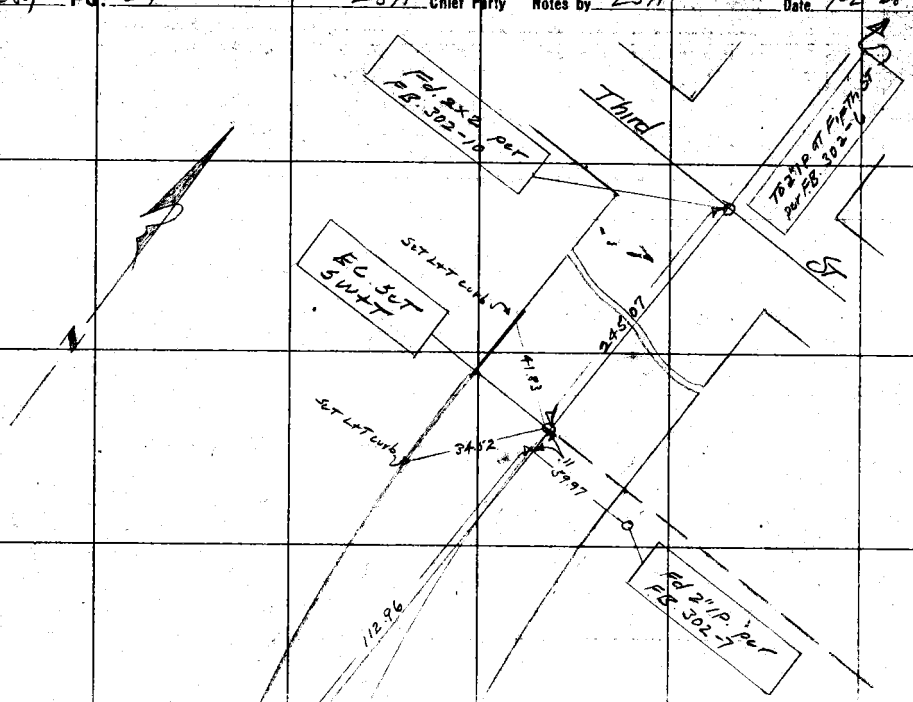

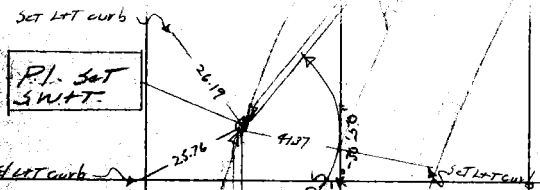

VOID

Δ = 25°-29'-10"
R = 500'
T = 113.07
L = 222.41

113.07 @ 76' = 113.07
245.07 @ 76' = 245.07
112.96 @ 76' = 112.96

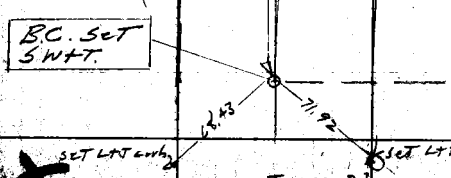

154-30-45
258-03-15
154-30-49

cont. from Top page 23

RETURN TO
LOS ANGELES COUNTY SURVEYOR
Do not extend notes this side of this line

Note: ANY ADDITIONS OR CHANGES ON THIS SHEET MUST BE MADE OR CIRCLED IN Red. WITH DATE AND NAME OF PERSON MAKING CHANGE.

Date _____ Notes by _____ Chief Party _____ F.B. 289 24A

Plotted R.W.M.S.A.
Date Nov. 1928
Map No. 5-310
Plotting C'k'd by R.W.S.
Dec '28

W.O. No. 914 D. S. O. No.
Location La Tijera Blvd.
Surveyed by Evans - H.F.
Date 11-2-28
Indexed A. C. Johnson

LA TIJERA BLVD.

W.O. 914

DEFIANCE ST. to HIGHLAND AVE & SLAUSON

Surveyed by
H.F. Evans + Party.

Notes: ANY ADDITIONS OR CHANGES OF THIS SHEET MUST BE MADE OR CIRCLED IN RED WITH DATE AND NAME OF PERSON MAKING CHANGE.

Do not extend notes this side of this line

RETURN TO
LOS ANGELES COUNTY SURVEYOR

F.B. 289 Pg. 24 "A" Chief Party Notes by Date

INDEX MAP OF LA TIJERA BLVD.

Note.
Inked lines denote lines ran on this survey.

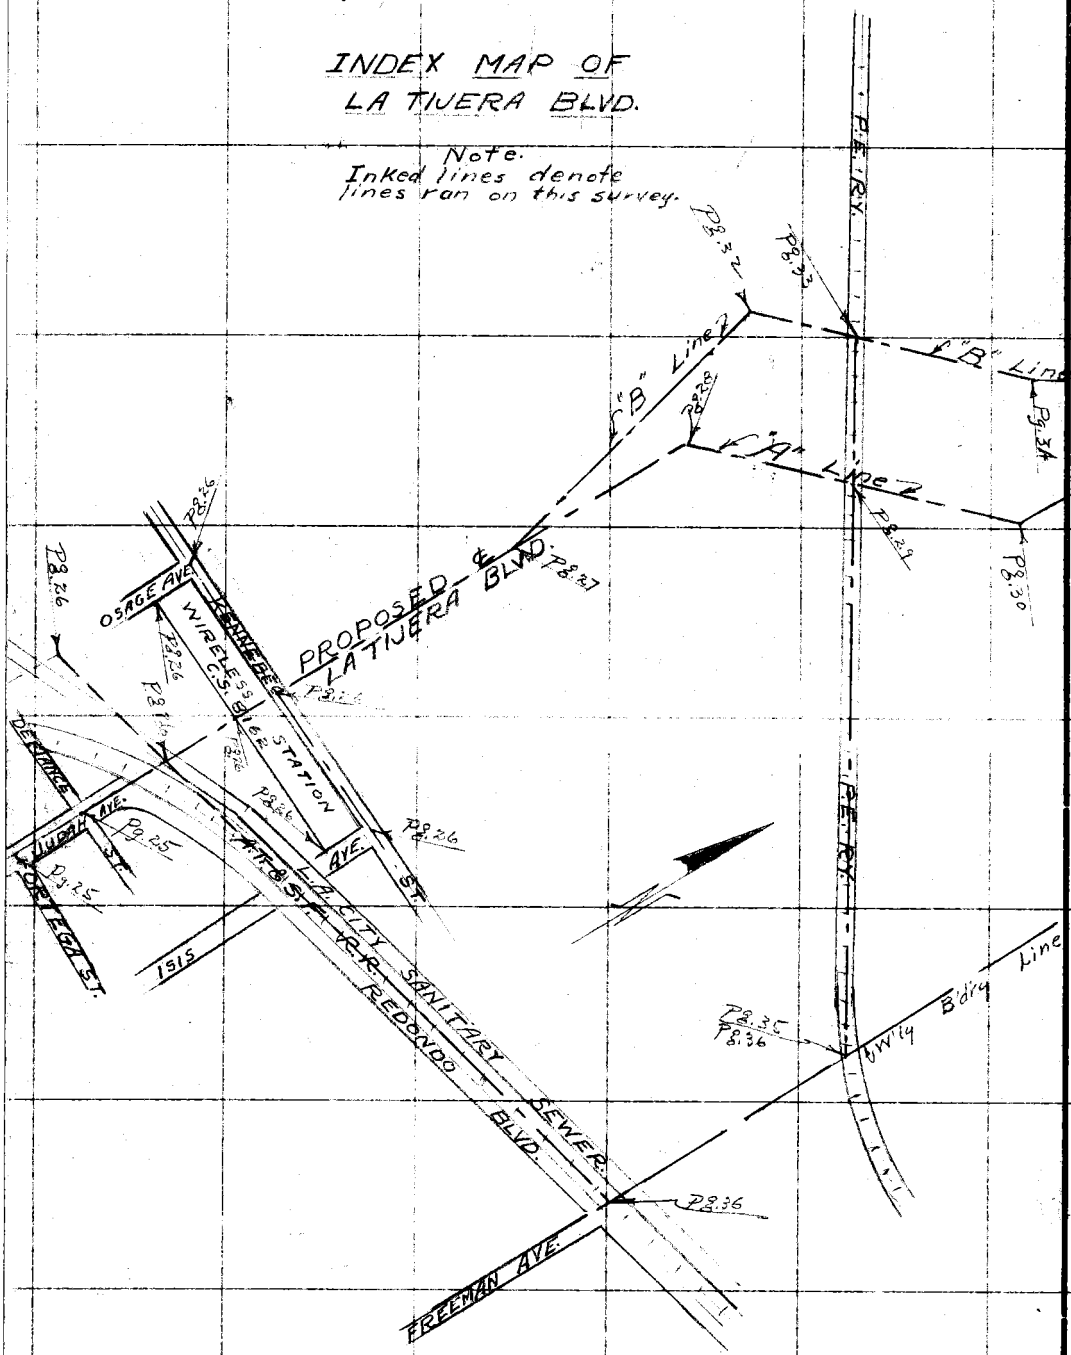

RETURN TO
LOS ANGELES COUNTY SURVEYOR
Do not extend notes this side of this line

Note: ANY ADDITIONS OR CHANGES ON THIS SHEET MUST BE MADE OR CIRCLED IN RED WITH DATE AND NAME OF PERSON MAKING CHANGE.

Date _____ Notes by _____ Chief Party _____ F.B. 289 Pg. 24 "B"

Platted by McAllister	W. O. No. 914 D. S. O. No.
Date Oct '28	Location LA TIJERA Blvd
Map No. B-310	Surveyed by Evans
Platting Ck'd by R.M.S.	Date 11-2-28
Date Dec 28	Indexed A. C. Johnson

INDEX MAP OF LA TIJERA BLVD.

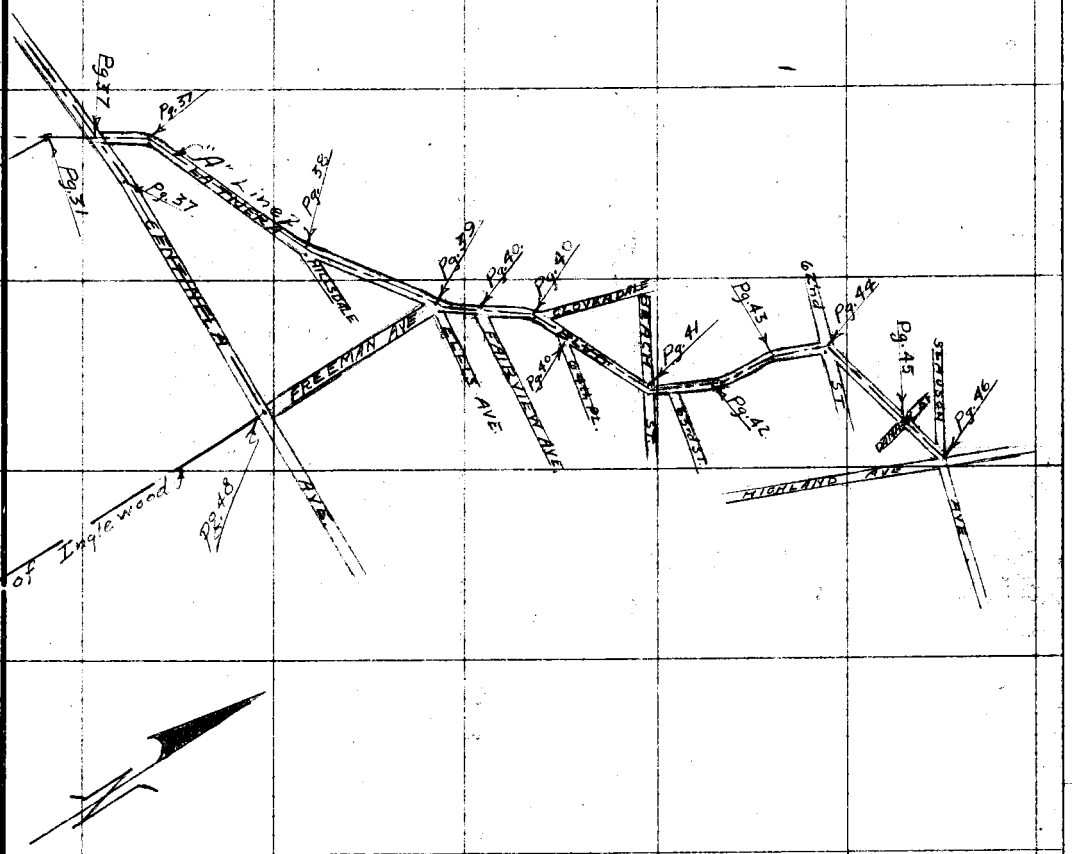

Notes: ANY ADDITIONS OR CHANGES ON THIS SHEET MUST BE MADE OR CIRCLED IN Red. WITH DATE AND NAME OF PERSON MAKING CHANGE.

Do not extend notes this side of this line

RETURN TO
LOS ANGELES COUNTY SURVEYOR

RETURN TO

LOS ANGELES COUNTY SURVEYOR

Note: ANY ADDITIONS OR CHANGES ON THIS SHEET MUST BE MADE OR CIRCLED IN **Red.** WITH DATE AND NAME OF PERSON MAKING CHANGE.

Do not extend notes this side of this line

F. B. _____ Pg _____

Chief Party _____ Notes by _____ Date _____

(To Bot. pg. 27/26)

Date _____ Maps by _____ Chief Party _____ F. B. 289 Pg. 27

R.W.M. 10/25/28

(Take #06) 100.00 @ P.C.

Dist. Oct. '28

Map No. B-310

Date Dec '28

Location La Tijera Blvd.

Surveyed by Evans

Indexed A. S. Johnson

(See L.B. 460 pg. 2 for bench levels & profile)

26

Tie semi tangent per F.B. 295-69

S.F. R.R.

Fd. Spk. & Tack

Fd. Spk. & Tack

Fd. Spk. & Tack

To Bot. pg. 327

F.B. 289 Pg. 2220 Chief Party Notes by Date

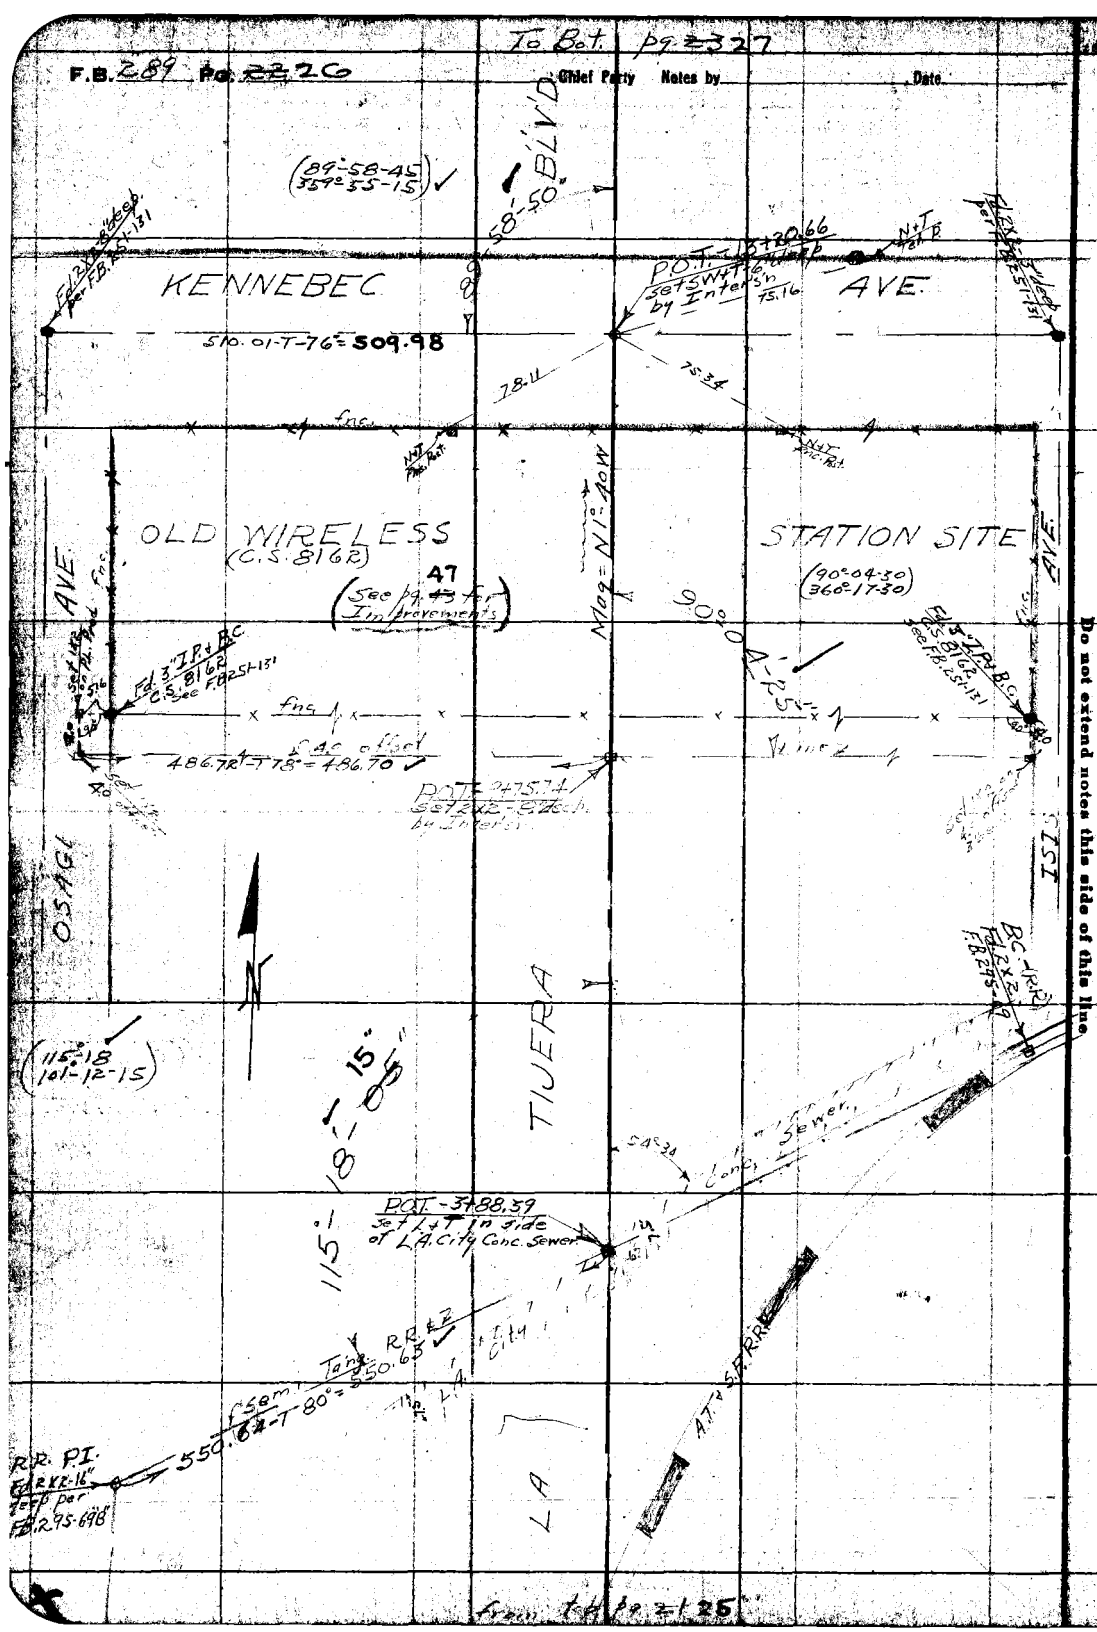

RETURN TO
LOS ANGELES COUNTY SURVEYOR

Do not extend notes this side of this line

Note: ANY ADDITIONS OR CHANGES ON THIS SHEET MUST BE MADE OR CIRCLED IN Red. WITH DATE AND NAME OF PERSON MAKING CHANGE.

Date _____ Notes by _____ Chief Party _____ F. B. 287 Pg. 97

Date Oct '28
Map No. B-310
Date Dec '28

Location La Tijera Blvd.
Surveyed by Evans
Indexed A. C.

To Sta. 11+32

(100' tape #.06)

{See L.B. 460-2 for bench levels & profile}

Sta. 11+28

"B" Line

"A" Line

1105.38 - 7.74 = 1102.31

1695.08 - T 80° = 1695.04

E.C. Sta 1+12.10

25+85.17

Δ = 14°-17'-35"
R = 1000
T = 125.38
L = 249.46

(6 chords @ 41.575
Def. Δ = 1°-11'-28")

P.I. #1 "B" Line
Sta 1+10.52
= P.O.T. 24+CRSG
90°-00'

45°-00'

1000

Locate

23+35.11

P.C. "B" Sta 1+12
= P.O.T. "A" 10" deep.

(165°-42'-30"
302°-49'-30")

P.P.L. - 55'
R/R's 14 Deep.

Notes: ANY ADDITIONS OR CHANGES ON THIS SHEET MUST BE MADE BY CIRCLED IN Red. WITH DATE AND NAME OF PERSON MAKING CHANGE.

Do not extend notes this side of this line

RETURN TO LOS ANGELES COUNTY SURVEYOR

To Bk. pg. 529

F.B. 289 Pg. 27 28 Chief Party Notes by Date

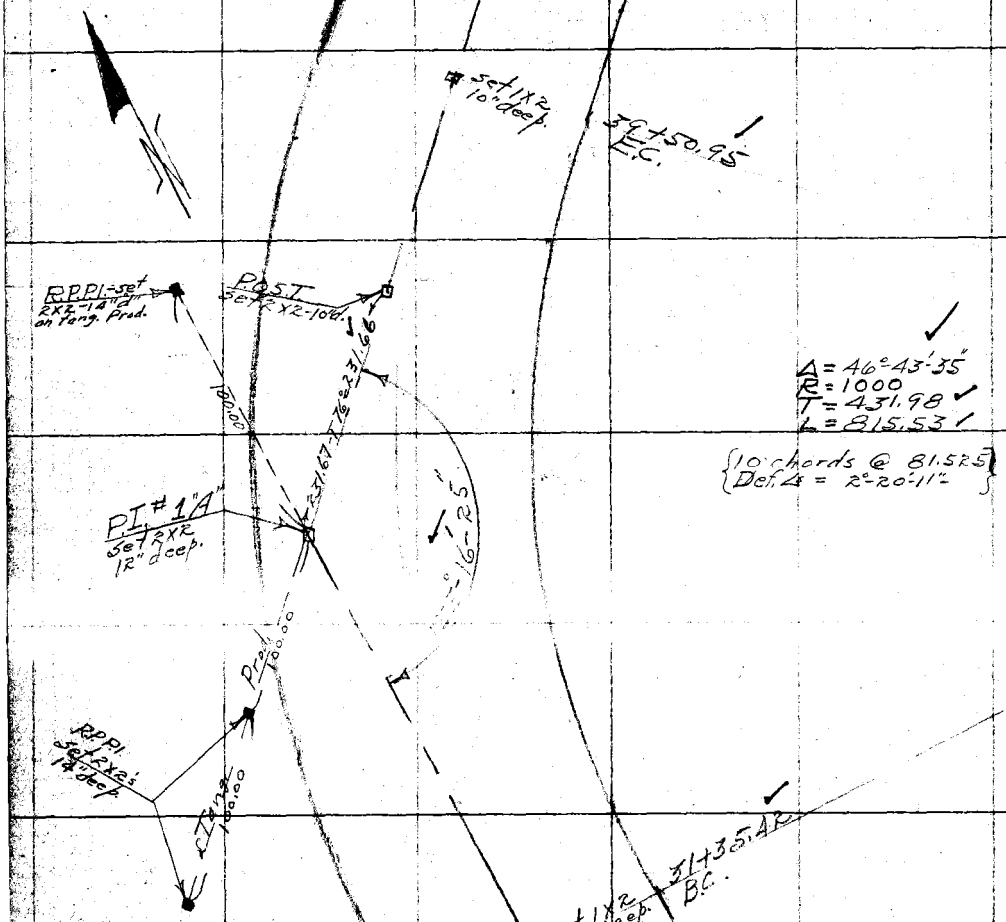

Note: ANY ADDITIONS OR CHANGES ON THIS SHEET MUST BE MADE OR CIRCLED IN Red. WITH DATE AND NAME OF PERSON MAKING CHANGE.

RETURN TO LOS ANGELES COUNTY SURVEYOR

Do not extend notes this side of this line

from Bk. pg. 27

Date _____ Notes by _____ Chief Party _____ F. B. 221 PG. 25

21

Drawn by [illegible]
Date Oct '28
Map No. B-310
Traced by [illegible]
Date Dec '28

M. C. No. 775 S. & S. D. No.
Location La Tijera Blvd.
Surveyed by Evans
Date 9-3-28
Indexed A. C. Johnson

To Curve Pg 30

(100' topo #06)

To PI "24" Pg 30

S22.30-T-74° = 822.25

"A" Line

POT - 43+01.98 (Marginal for ties)
Set 2x2 by Intersn
See Pg 30
107'
241'

fnc.

P.E. R.R.
See pg 31
Trolley
Line 107'
℄ of rails 79

fnc.

fnc.

"A" Line
N89.12'E

"A" Line
N46°20E

N.T. ℄ of the Pk

N.T. ℄ Pk

POT - Astride "A" Line

℄ IRR.

N.T. in Tree bottom

"A" Line

Notes top pg 28

Notes: ANY ADDITIONS OR CHANGES ON THIS SHEET MUST BE MADE OR CIRCLED IN Red. WITH DATE AND NAME OF PERSON MAKING CHANGE.

Do not extend notes this side of this line

RETURN TO LOS ANGELES COUNTY SURVEYOR

F.B. 289 Pg. 26 30 Chief Party Notes by 31 Date

To Bot. (Rt.) 1927

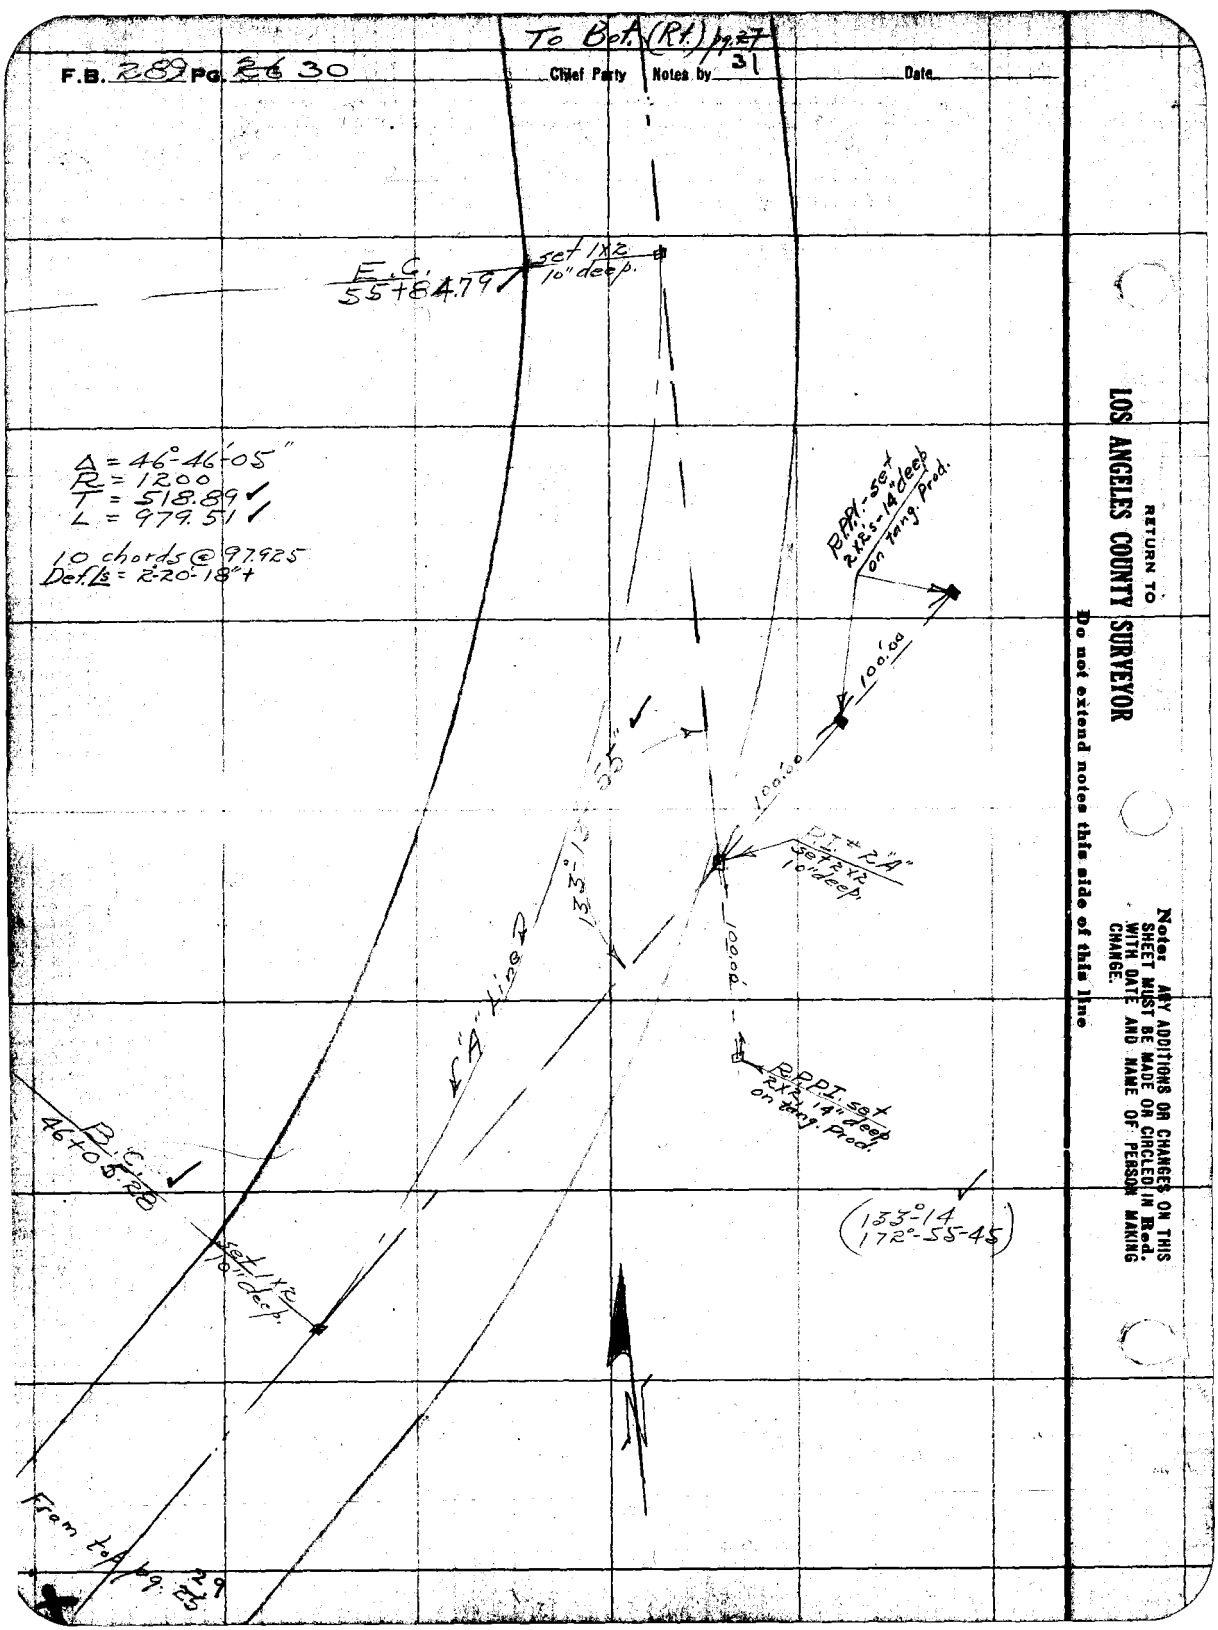

RETURN TO
LOS ANGELES COUNTY SURVEYOR
Do not extend notes this side of this line

Notes: ANY ADDITIONS OR CHANGES ON THIS SHEET MUST BE MADE OR CIRCLED IN Red. WITH DATE AND NAME OF PERSON MAKING CHANGE.

Date _____ Notes by _____ Chief Party _____ F. B. 201 Pg. 31

Date Oct '28
Map No. B-310
Date Dec '28

Location La Tijera Blvd.
Surveyed by Evans
Indexed A.J.C. Tennyson

{100' tape #06 = 100.00 @ 84°}

37

"A" line

(153°-26'-30"
253°-46'-00")

set 1/2" rd. 10" deep

E.C. 64+80.58
Find o.t.p. 1/2" rod

Δ = 26°-33'-30"
R = 1000
T = 236.01
L = 463.58

T. 235.99
L. 463.51

(10 chords @ 46.35
Def. ∠ = 1°-19'-47")

P.T. #3 A = P.O.T.
65+36.67 "B" Line
Set 2x2-10" d.

RP: P.T. 1/2" rd. 10" deep

Adj. 4 R.W.M.C. 35'

90°-00'

153°-26'-30"

100.00

Mag. N 82°-15' E.

RP: P.T. Set 2x2x10" deep

"B" Line 2

"A" Line 2

P.O.T. = 58+27.74
Set 2x2-10" deep

P.C. 60+16.75

From Top pg. 34

30

(From Top pg. 24)

RETURN TO
LOS ANGELES COUNTY SURVEYOR

Notes: ANY ADDITIONS OR CHANGES ON THIS SHEET MUST BE MADE AS CIRCLED IN Red, WITH DATE AND NAME OF PERSON MAKING CHANGE.

Do not extend notes this side of this line

F.B. 289 Pg. 28 32 — Chief Party — Notes by — Date

T. Bet. / pg. 29 33

RETURN TO
LOS ANGELES COUNTY SURVEYOR
Do not extend notes this side of this line

Note: ANY ADDITIONS OR CHANGES ON THIS SHEET MUST BE MADE OR CIRCLED IN Red. WITH DATE AND NAME OF PERSON MAKING CHANGE.

N

Set 1"x2" 10" deep

T 45+16.06 E.C.

P.O.S.T. Set 2"x2"-10"d

R.P.P.I. set 2"x2"-15" w/ Mag. Nail

Δ = 69°-45'-40"
R = 500
T = 348.55
L = 608.78
{Ch. = 572.54
Def. Δ = 3°-29'-17"}

R=324.41 I=80°-22'-40" "C" to "B" Line

P.I. #2 "B" set 2"x2" Copper

Rad. 150.00

100.00 84.0

110°-14'

100.00 Tang.

R.P.I. set 2"x2"-15" deep

P.O.S.T. Set 2"x2"-10"d.

39+07.28 B.C.

(110°-14'-15")
(80°-57'-15")

Set 1"x2" 10" deep

"B" Line

Mag. N 14-30 W

27

from 1st Wall Mon.

Date _____ Notes by _____ Chief Party _____ F. B. 287 Pg. 33

Date Oct '28
Map No. B-310
Date Dec '28

Location La Tijera Blvd.
Surveyed by Evans
Indexed A. C. Johnson

34 (100 Tape #06)

Notes: ANY ADDITIONS OR CHANGES ON THIS SHEET MUST BE MADE OR CIRCLED IN Red. WITH DATE AND NAME OF PERSON MAKING CHANGE.

RETURN TO LOS ANGELES COUNTY SURVEYOR

Do not extend notes this side of this line

P.O.T. - 52+78.45
Set 2X2-10"d.

SEE L.B. 460 FOR BENCH LEVELS, PROFILE, & CROSS SECTIONS.

P.O.T. - 49+90.78
Set 2X2-10"d.

"B" Line - P.O.T. - 46+97.98
2X2 - Intersn. per p9 35

P.E. (see P.P. p9 35 & details)

N 47 (tie)
464+97.15
A.

"B" Line P.O.T. = N 55° 24' E 109.00 (Meas.)

From p. 32
32
28

F.B. 289 Pg. 50 34

To Bot. Lt. side Pg. 31

Chief Party | Notes by | Date

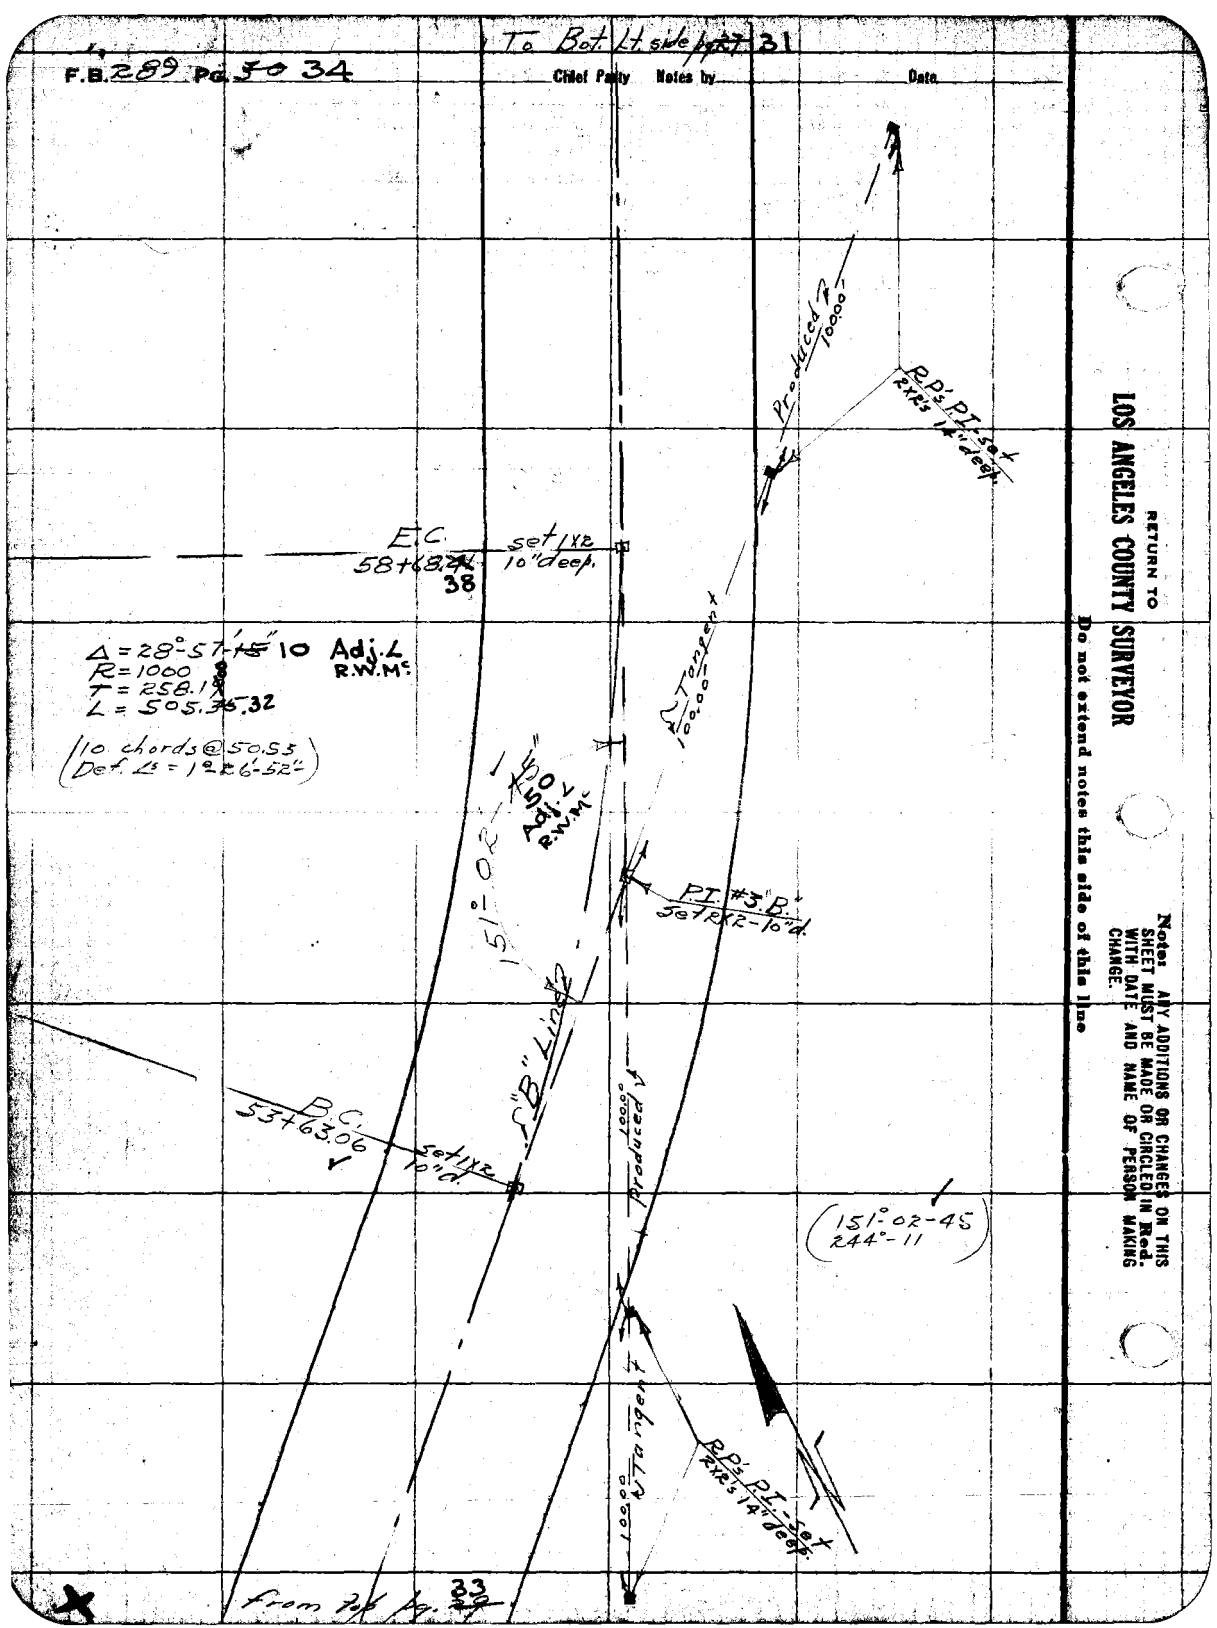

RETURN TO
LOS ANGELES COUNTY SURVEYOR
Do not extend notes this side of this line

Notes: ANY ADDITIONS OR CHANGES ON THIS SHEET MUST BE MADE OR CIRCLED IN Red. WITH DATE AND NAME OF PERSON MAKING CHANGE.

Date _____ Notes by _____ Chief Party _____ F. B. 282 Pg 71

Date Oct '28
Map No. O-310
Date Dec '28

Location La Tijera Blvd.
Surveyed by Evans
Indexed A. C. Johnson

(100' tape *06 =100.00 @ 84°)

(102°-06 48°-23-30)

(110°-50-15 83°-21-15)

To P.I. Sta 28

"A" Line POT - Approx. Sta 28+ (Surface)

"B" Line POT - Approx. Sta 28+ (Surface)

"B" Line

"A" Line






F.B. 289 Pg. 72 36

Chief Party Notes by Date

To Bk. pg. 44 48

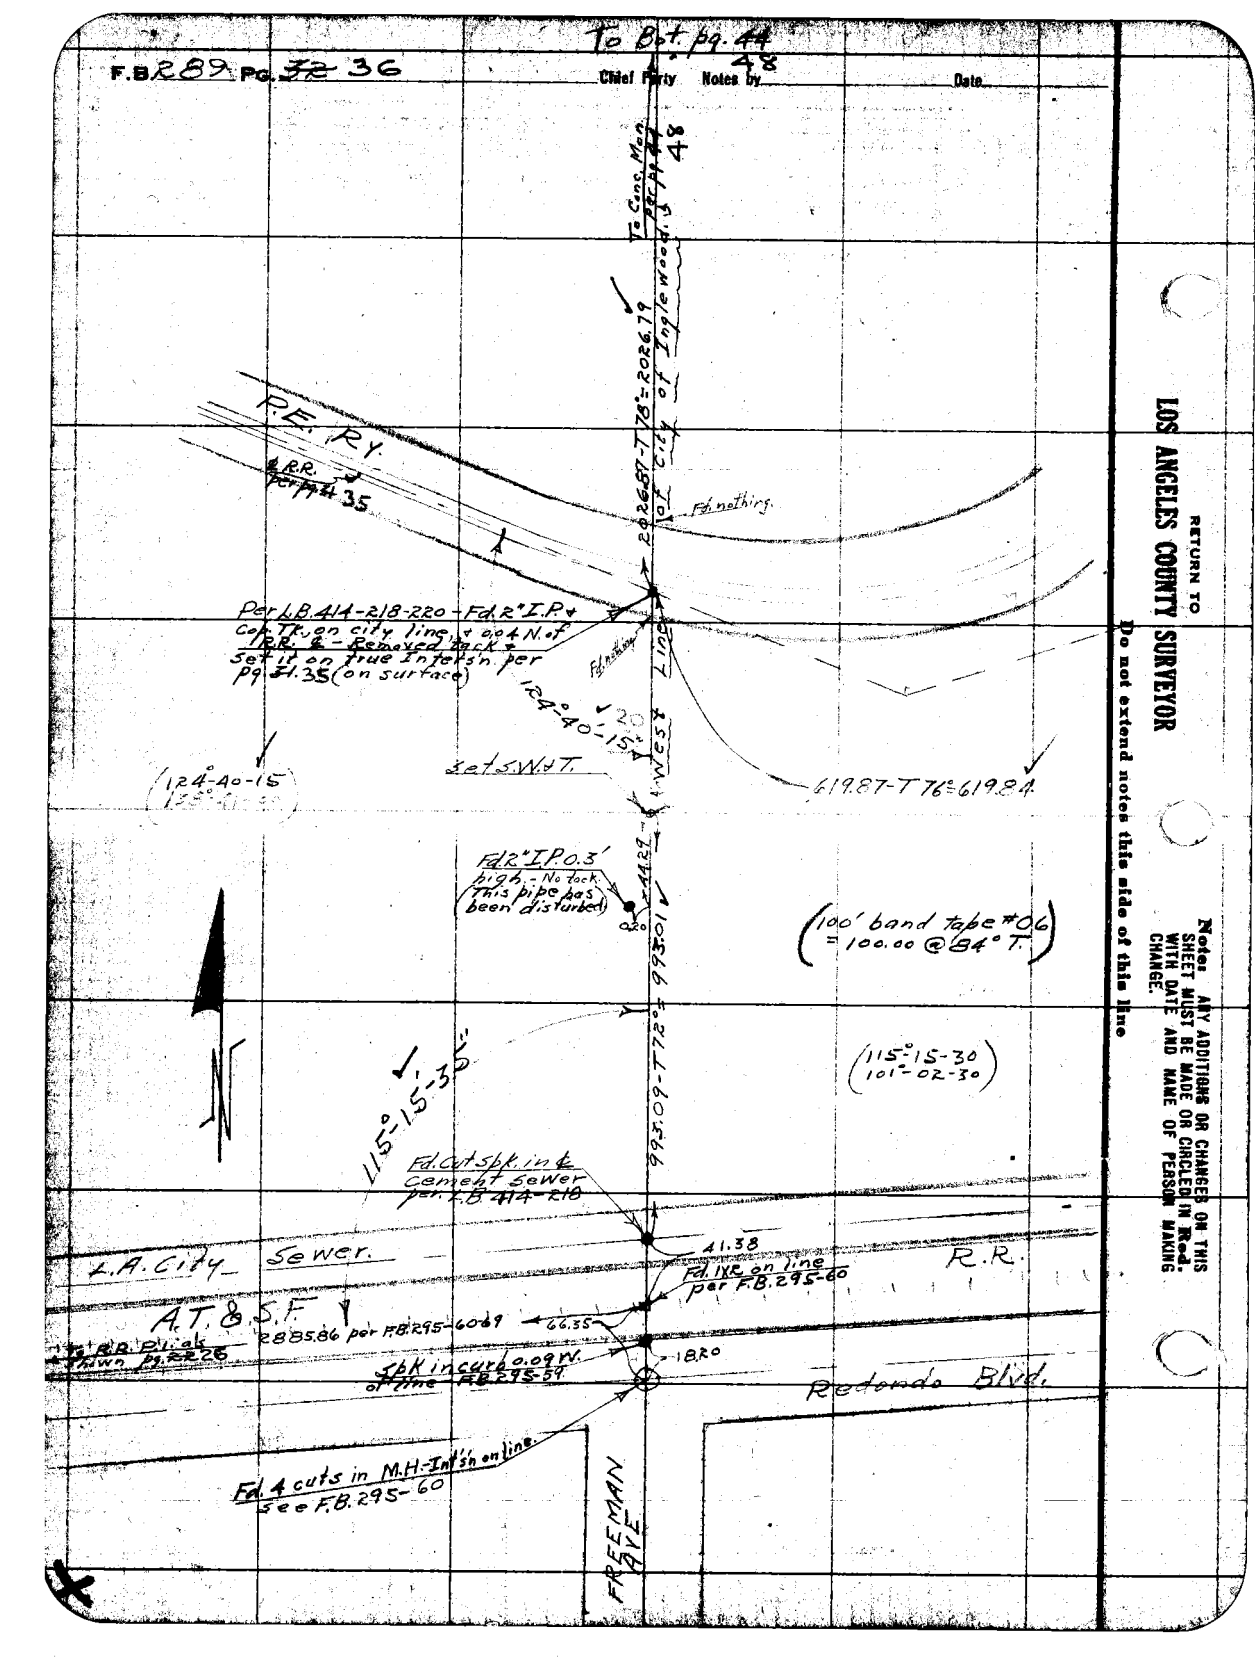

RETURN TO LOS ANGELES COUNTY SURVEYOR

Do not extend notes this side of this line

Notes: ANY ADDITIONS OR CHANGES ON THIS SHEET MUST BE MADE OR CIRCLED IN Red. WITH DATE AND NAME OF PERSON MAKING CHANGE.

Date _____ Notes by _____ Chief Party _____ F. B. 282 Pg. 37

Date Oct. 28
Map No. B-310
Date Dec '28

Location La Tijera Blvd
Surveyed by Evans 9-27-28
Indexed A. C. Johnson

(= 1,000.00 @ 84 T.)

Notes: ANY ADDITIONS OR CHANGES ON THIS SHEET MUST BE MADE OR CIRCLED IN Red. WITH DATE AND INITIALS OF PERSON MAKING CHANGE.

RETURN TO LOS ANGELES COUNTY SURVEYOR

Do not extend notes this side of this line

PT "4"A"
Fd. 2X2 - per L.A.I.Co.

303.45 T 84°

71+90.42 E.C.

Δ = 40°-46'-30"
R = 400
T = 148.66
L = 284.66

"A" Line

139-13-30

(139°-13'-30")
(196°-54')

(59°-59'-15")
(239°-56'-30")

(REDONDO BLVD)

288.86 T 84°

69+05.76 - B.C.

59°-59'-15"

BLVD.

(A" Line)
P.O.T. - 67+65.56
Set Spk. & W by Interstate

309.61 T 76°

AVE.

Fd. SW & T - POT
per F.B. 325-31

90.97 T 72°

90.96'

Fd. L & T

CENTINELA

Mon. = N 2° E

"A" Line

LA TIJERA

from 68+99.27

F.B. 289 Pg. 3438 Chief Party Notes by Date

To Bk. 14 pg. 37 & 39

To Intersection per M.B. 14-39

74+12.83 - E.C.

Δ = 15°35'35"
R = 500
T = 68.46
L = 136.08

383.74 - T 78 = 383.73

164°-24'-25"

P.T. 75"A" Fd. Rivet 6.0' Ber. L.A. Co.

HILLSDALE AVE.

B.C. 72+76.75

164°-24'-30"
197°-37'-30"

LA TIJERA BLVD.

303.45 T 84°

(REDONDO BLVD.)

From Pg. 37

To PT. 44A pg. 3437 Pg. 37

RETURN TO LOS ANGELES COUNTY SURVEYOR

Do not extend notes this side of this line

Notes: ANY ADDITIONS OR CHANGES ON THIS SHEET MUST BE MADE OR CIRCLED IN Red. WITH DATE AND NAME OF PERSON MAKING CHANGE.

Date _____ Notes by _____ Chief Party _____ F. B. 237 PG. 35 39

Plotted by MS Allister
Date Oct 28
Map No. B-310
Plotting Chkd by RM S
Date Dec '28

W. O. No. 214 S. S. O. No.
Location La Tijera Blvd.
Surveyed by Evans
Date 9-26-28
Indexed A. C. Johnson

To B.2 A Pg. 40

Note: ANY ADDITIONS OR CHANGES ON THIS SHEET MUST BE MADE OR CIRCLED IN Red. WITH DATE AND NAME OF PERSON MAKING CHANGE.

RETURN TO LOS ANGELES COUNTY SURVEYOR

Do not extend notes this side of this line

78+91.20 E.C.
Δ = 27°07'30"
R = 500
T = 120.62
L = 236.71

Mag = NE 4.30 E
La DPT #14
Pg 20

"A" Line
537.31 + 7.92 = 537.28

152°-52'-30"

ELLIS AVE.

16+54.55 P.C.

P.I. #6 "A" - Fd. 1/2" I.P. for Inv. St. Co.

Fd. 1/2" B.C. Bent P.O.S.T.

(152°-52'-30" 251°-30")

(REDONDO BLVD.)

LA TIJERA BLVD.

FREEMAN AVE.

From P.I. #5 La #38

F.B. 289 Pg. 36
40

Chief Party Notes by Date

To Bk 1 Pg 37
41

LA TIJERA BLVD.

CLOVERDALE AVE.

To P.T. "A" Line Pg 41

Fd. 2x2-8" deep per L.A.I. Co.

84+64.85 P.O.T.

64th PL.

3

771.62 - T66° = 771.53 "A" Line

771.62 - T66° = 160.70

160.70 R.

(152°-28'-15" / 249°-53'-00")

84+02.12 E.C.

152°-28'-15"

Void

(Fd. 1" deep) P.P. Pl. per L.A.I. Co. Tack in Top of Line. Point appears to have been disturbed since set.

Fd. #7 "A" Ed. 2x2-8" deep per L.A.I. Invest. Co.

Void

Δ = 27°31'45"
R = 400
T = 97.99
L = 192.19

82+09.93 P.C.

LA TIJERA BLVD.

"A" Line 2098 - T74 = 2097

FAIRVIEW AVE.

80+97.94 P.O.T.

Fd. 2x2-6" deep per L.A.I. Co.

From Tab Pg 39

RETURN TO
LOS ANGELES COUNTY SURVEYOR
Do not extend notes this side of this line

Notes: ANY ADDITIONS OR CHANGES ON THIS SHEET MUST BE MADE OR CIRCLED IN Red. WITH DATE AND NAME OF PERSON MAKING CHANGE.

Date _____ Notes by _____ Chief Party _____ F. B. 289 PG. 41

Plotted by A.C. Nielsen
Date Oct '28
Map No. B-310
Plotting Check BM S
Date Dec '28

M. G. No. 914 L. S. G. No.
Location La Tijera Blvd.
Surveyed by Evans
Date 9-28-28
Indexed E. C. Johnson

(Used 4 Poles 200 = 100.00 @ 84 ft.)

T- 2S R- 14W

Ls. 42

BLVD.

To PI #94 Pg. 42

427.22 - T80°-42'W

6 3rd 6

(160°-39'-45")
(282-39'-30")

160°-39'-50"

To ± of 50' W. 3rd Water Main
INTL. 90° 0'

BEACH ST.

PI #84" - 90+75.66
Fd. 2x2-84.
(Angle Point)

R.P.P.I. Fd. 1/2" Rd. No. 41, Co. Eng. Dept.

VOID

LA TIJERA

(REDONDO BLVD.)

From Top Pg. 40

Notes: ANY ADDITIONS OR CHANGES ON THIS SHEET MUST BE MADE OR CIRCLED IN Red. WITH DATE AND NAME OF PERSON MAKING CHANGE.

Do not extend notes this side of this line

RETURN TO LOS ANGELES COUNTY SURVEYOR

F.B. 289 Pg. 38 42

To Bot. Pg. 37 43

Chief Party | Notes by | Date

Map = N3°30E
Tab 2 #104
Pg 43

264.88-180°=26487

96+26.02 E.C.

Δ = 28°-51'-00"
R = 500
T = 128.61
L = 251.76

09-00

1" I.P. Fd. 2½"-10" deep Per L.A.C.O.

Not in Road
W of W in Water Tank

93+74.26 B.C.

(151°09'-00)
244°36'-00

From Tab 4 Pg 43

RAPI Parking Lot Void.

RETURN TO
LOS ANGELES COUNTY SURVEYOR

Do not extend notes this side of this line

Notes: ANY ADDITIONS OR CHANGES ON THIS SHEET MUST BE MADE OR CIRCLED IN Red. WITH DATE AND NAME OF PERSON MAKING CHANGE.

Date _____ Notes by _____ Chief Party _____ F. B. 209 Pg. 39/40

Plotted by _____ W. O. No. 916 J. O. No. _____
Date Oct '28 Location La Tijera Blvd.
Map No. B-310 Surveyed by Evans
Plotting Crew _____ Date 9-29-28
Date Dec '28 Indexed A. C. Johnson

(Leave ft. to P.O.B.) To Top pg. 44

T.P.I. #11A
pg. 44

98+53.39 P.C.

299.95-I 74°=299.93

Δ = 21°07'25"
R = 500
T = 93.23.
L = 184.34

P.I. #10A
Fd. 2X2-8" deep
per L.A.I. Co.

299.95

158°-52'-35"

(158°-52-30)
(275°-30-30)

96+69.05 - B.C.

From Top. pg. 42 38

RETURN TO
LOS ANGELES COUNTY SURVEYOR

Do not extend notes this side of this line

Notice ANY ADDITIONS OR CHANGES ON THIS SHEET MUST BE MADE OR CIRCLED IN Red. WITH DATE AND NAME OF PERSON MAKING CHANGE.

F.B. 289 Pg. ~~40~~ 44

Chief Party _____ Notes by _____ Date _____

To Bot. of pg. 41


1061.45-76.6°=1061.33

ST.

100+60.09

PI #18A"
Fd. 1/2" I.P. in conc. L.H.
& "I.P. for R.E. L.A.I. Co
used for 18rd. per LA.I. Co
(Angle Point)

62.00

164°-24'-15"

(164°-24'-15")
297°-37'-00"

LA TIJERA BLVD.

(REDONDO BLVD.)

From To pg. ~~39~~ 43

RETURN TO
LOS ANGELES COUNTY SURVEYOR

Do not extend notch this side of this line

Notes: ANY ADDITIONS OR CHANGES ON THIS SHEET MUST BE MADE OR CANCELED IN Red. WITH DATE AND NAME OF PERSON MAKING CHANGE.

Date _____ Notes by _____ Chief Party _____ F. B. 289 Pg. 45

Plotted by M.E. Wilcox
Date Oct 28
Map No. B-310
Plotting Checked by [illegible]
Date Dec '28

M. C. No. 914 S. P. C. No.
Location La Tijera Blvd.
Surveyed by Evans
Date 9-29-28
Indexed A. C. Johnson

Tr. 46

(Hoff Tract)
(=100.00 @ 82°-7')

Notes: ANY ADDITIONS OR CHANGES ON THIS SHEET MUST BE MADE OR CIRCLED IN Red. WITH DATE AND NAME OF PERSON MAKING CHANGE.

Do not extend notes this side of this line

RETURN to LOS ANGELES COUNTY SURVEYOR

BLVD.

546.02-T 1/2 = 545.98 "To Intersection of Highland Ave." per Tr. 46

~~DAMASK~~
MANSFIELD

AVE

P.O.T. - 111+21.42
Fd. 3/4" I.P. in conc.
14"d., per L.A.I.Co.

LA TIJERA

Mag. = N 40° E

(REDONDO BLVD)

From T.p. pg. 40
44

F.B. 289 Pg. 42 46 Chief Party Notes by Date

RETURN TO
LOS ANGELES COUNTY SURVEYOR
Do not extend notes this side of this line

Note: ANY ADDITIONS OR CHANGES ON THIS SHEET MUST BE MADE OR CIRCLED IN Red. WITH DATE AND NAME OF PERSON MAKING CHANGE.

SLAUSON AVE.

HIGHLAND

Fd. 2" I.P. in Conc. Set at per L.A. Investment Co.

116+67.40

60°-36'-40"

SLAUSON AVE.

ST.

AVE.

(60°-36'-45")
(2AP 26-45")

LA TIJERA BLVD.

(REDONDO BLVD.)

ACACIA

Fd. 1" I.P. in conc. Set per L.A. Inter. Co.

From Top pg. 41 45

Date _____ Notes by _____ Chief Party _____ F. B. 289 PG. 45 47

Checked by [illegible]
Date Oct '28
Map No. B-310
Traced by [illegible]
Date Dec '28

Bk. & No. 814 & S. B. No.
Location La Tijera Blvd.
Surveyed by Evans
Date 10-1-28
Indexed A. C. Johnson

LOCATION OF IMPROVEMENTS AT BEGINNING OF LA TIJERA BLVD

Notes: ANY ADDITIONS OR CHANGES ON THIS SHEET MUST BE MADE ON CHECKED IN Red. WITH DATE AND NAME OF PERSON MAKING CHANGE.

Do not extend notes this side of this line

RETURN TO LOS ANGELES COUNTY SURVEYOR

54.4
12.8 12+66 Conc Headwall
42.0 Conc foundation
29.6
54.7
44.1
64.2
conc headwall 12+28.8
18.7
30.10
16.0
15.7 old Conc block foundation
19.4
31.2
62.7
19.2
42.6
11.1
37.0
74.3
45.1
Teleg P 1+44.5
42.8
Bruce P 1+72.7
20.9
22.5
59.6
48.5
94.4
0+69.9
0+60.5
1+15.5
63.5
62.8
3 Pepper 1+18.8
6" Alum 0+73.9
44.6
1 Story Frame Ho.
32.6
conc walk
3.4
3.7
0+62.1
9.8
6.2
7.6
6.6
78.9
Tel. P 0+22.9
Defiance
S.W.C.T. - 0+00 LA TIJERA BLVD per pg. 21
S (per pp 25-26 & 21-22)
LA TIJERA BLVD
Redondo Blvd.
ST.

F.B. 289 Pg. 4448

Chief Party Notes by

37

(see pg. 38)

Fd. L+T- Pl. - Centinela
per F.B. 325-31
see F.B. 297-5

Fd. C+T on W. edge
per F.B. 325-31
see F.B. 297-5

400.02-T 70°- 399.98

CENTINELA Ave.

Rec.: 110°-38-10" / 70°-38-50" Turned.

(95°-54-15 / 25°-36-45)

(170°-38-10 / 352°-34-00)

Cp. SAND-15

568.92-T 70°-568.87

SHORT ST.

662.84-T TR°-662.79

(Tape #06 cv 60.00 @ 84° T)

Station "BHXP 01-L" on East side of Fd. 18" conc. Mon. - round head screw center, 0.01 E. of line - This point lays at foot of steep hill & is on surface. Sec 48.414-220

HILL ST.

Fd. nothing

Fd. nothing

GLENWAY DR.

NEW ST.

CORY DR.

CITY OF INGLEWOOD

West

Cont. from Pg. 36

Notice: Any alteration or change on this sheet must be made on affidavit in red with date and name of person making change.

Returned to Los Angeles County Surveyor

Do not attach note this side of this line

Date _____ Notes by _____ Chief Party _____ F.B. 289 PG. 49

Plotted by	W. O. No. 958 S. S. O. No.
Date	Location Vernon Ave
Map No.	Surveyed by Evans
Plotting Ch'd by	Date
Date	Indexed A. C. Johnson

Notes: ANY ADDITIONS OR CHANGES ON THIS SHEET MUST BE MADE OR CIRCLED IN Red. WITH DATE AND NAME OF PERSON MAKING CHANGE.

Do not extend notes this side of this line

RETURN TO LOS ANGELES COUNTY SURVEYOR

VERNON AVE

W.O. 958

ANGELES MESA DRIVE W'LY
TO
JEFFERSON BLVD

H.F. Evans
H. Martin
G.F. Brock
D.S. Sedig
R. Markham

F.B. 289 PG. 50 Chief Party Notes by Date

(Pgs. 50 951)

INDEX SKETCH of VERNON AVE (West of Highland Ave)

W.O. 958

Red — · — · — denotes Proposed ℄
Blue ——— " Property Lines run.

(For location of "P" lines West of Highland Ave. see pgs. 110-118)

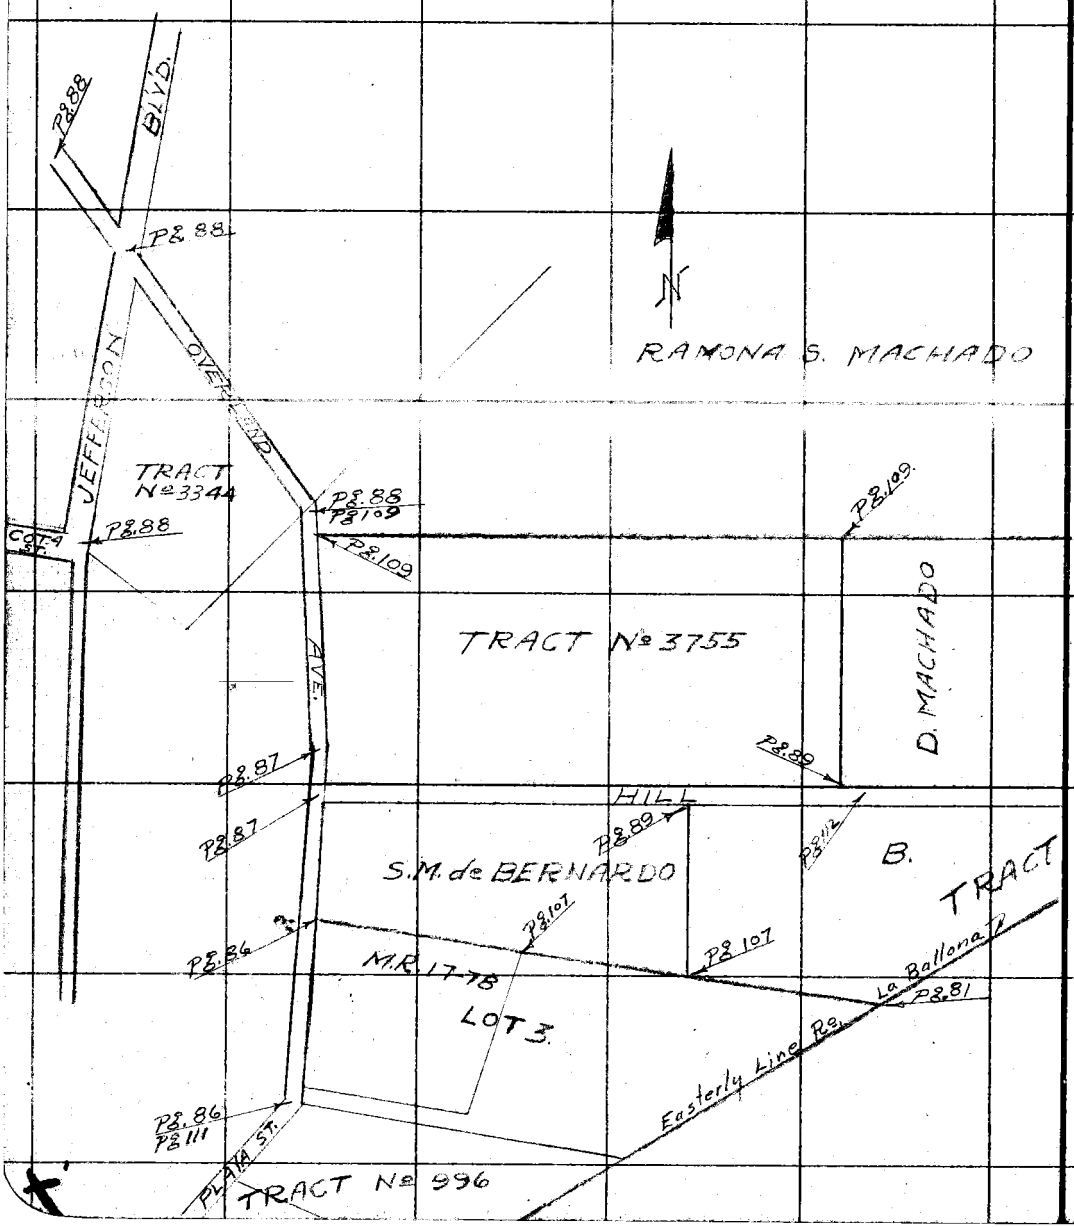

RETURN TO LOS ANGELES COUNTY SURVEYOR

Do not extend notes this side of this line

Note: ANY ADDITIONS OR CHANGES ON THIS SHEET MUST BE MADE OR CIRCLED IN Red. WITH DATE AND NAME OF PERSON MAKING CHANGE.

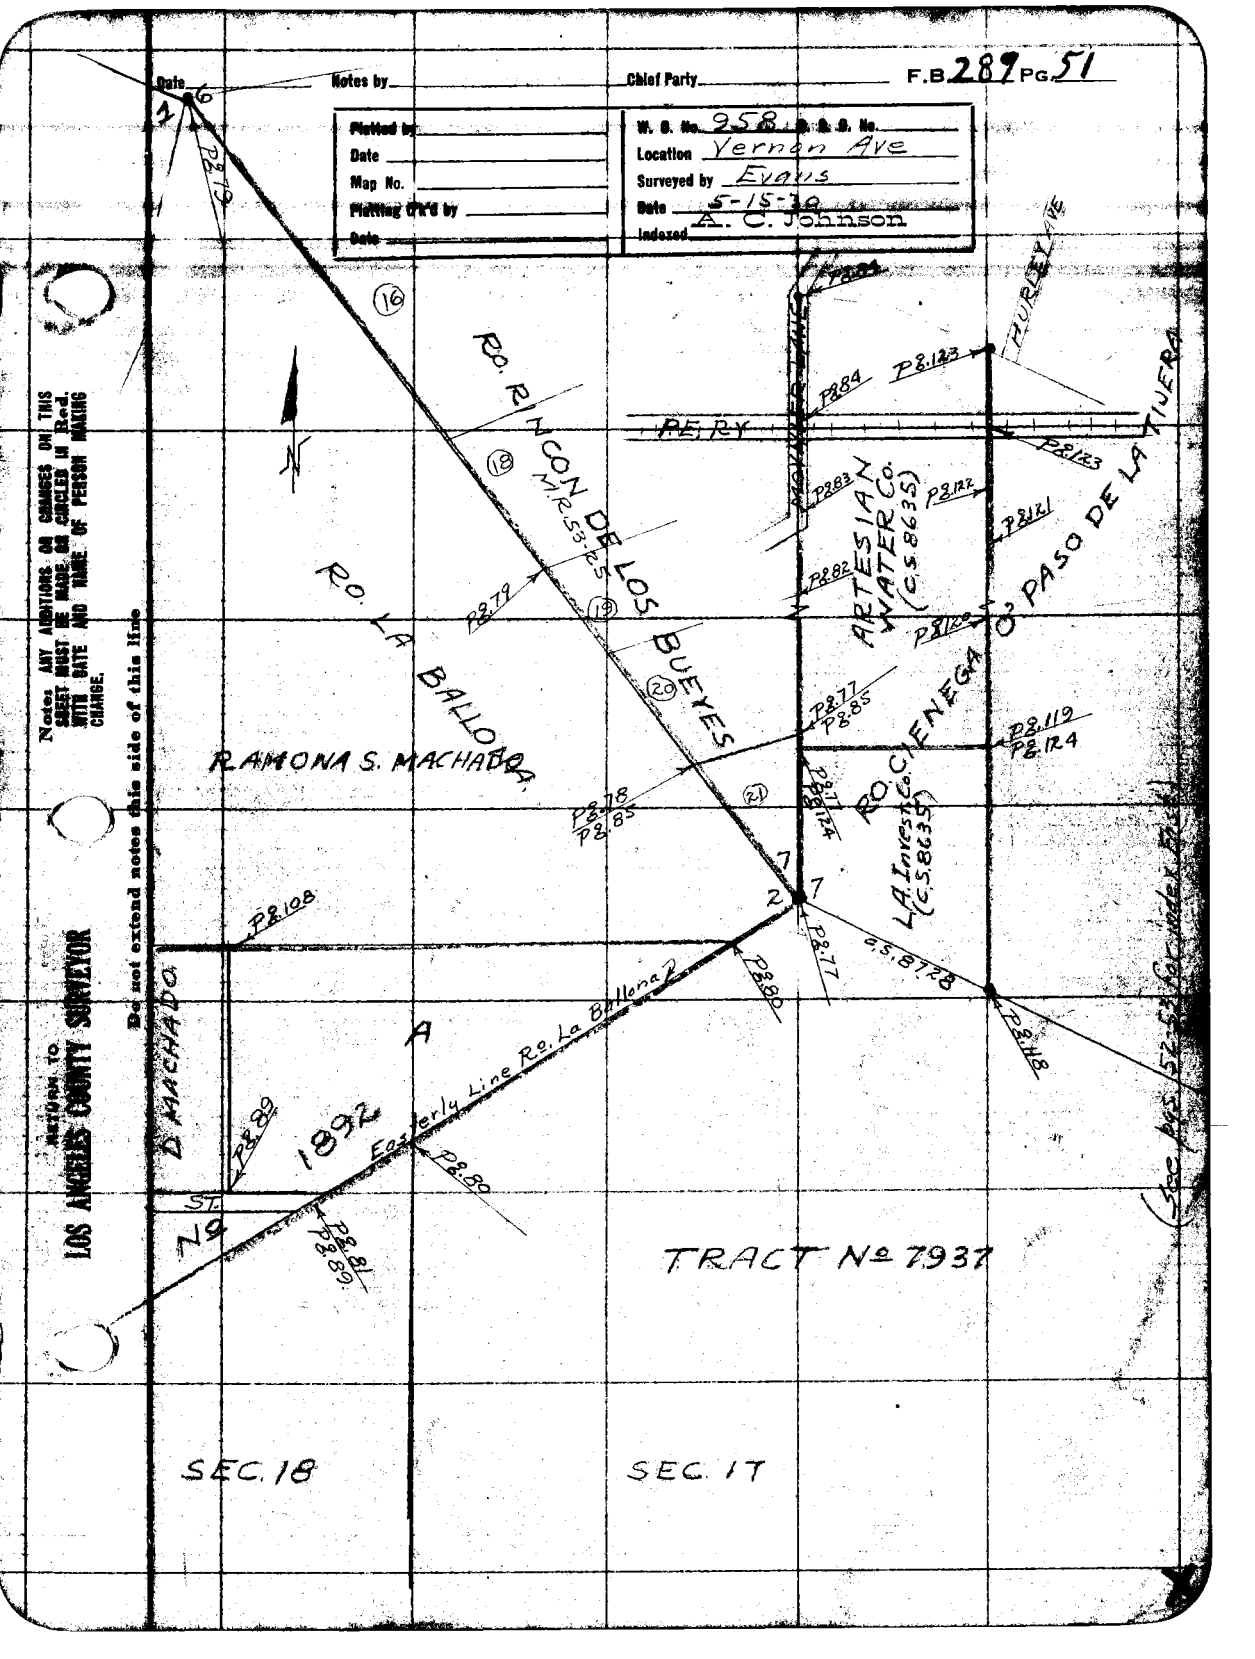
Date
Notes by
Chief Party
F.B. 289 Pg. 51
Plotted by
Date
Map No.
Plotting Chk'd by
Date
W. O. No. 958 R. & S. No.
Location Vernon Ave
Surveyed by Evans
Date 5-15-30
Indexed A. C. Johnson
Notes: ANY ADDITIONS OR CHANGES ON THIS SHEET MUST BE MADE OR CANCELED IN Red. WITH DATE AND NAME OF PERSON MAKING CHANGE.
Do not extend notes this side of this line
Return to
LOS ANGELES COUNTY SURVEYOR
Rancho La Ballona
Rancho Rincon de los Bueyes

F.B. 289 Pg. 52 Chief Party Notes by Date

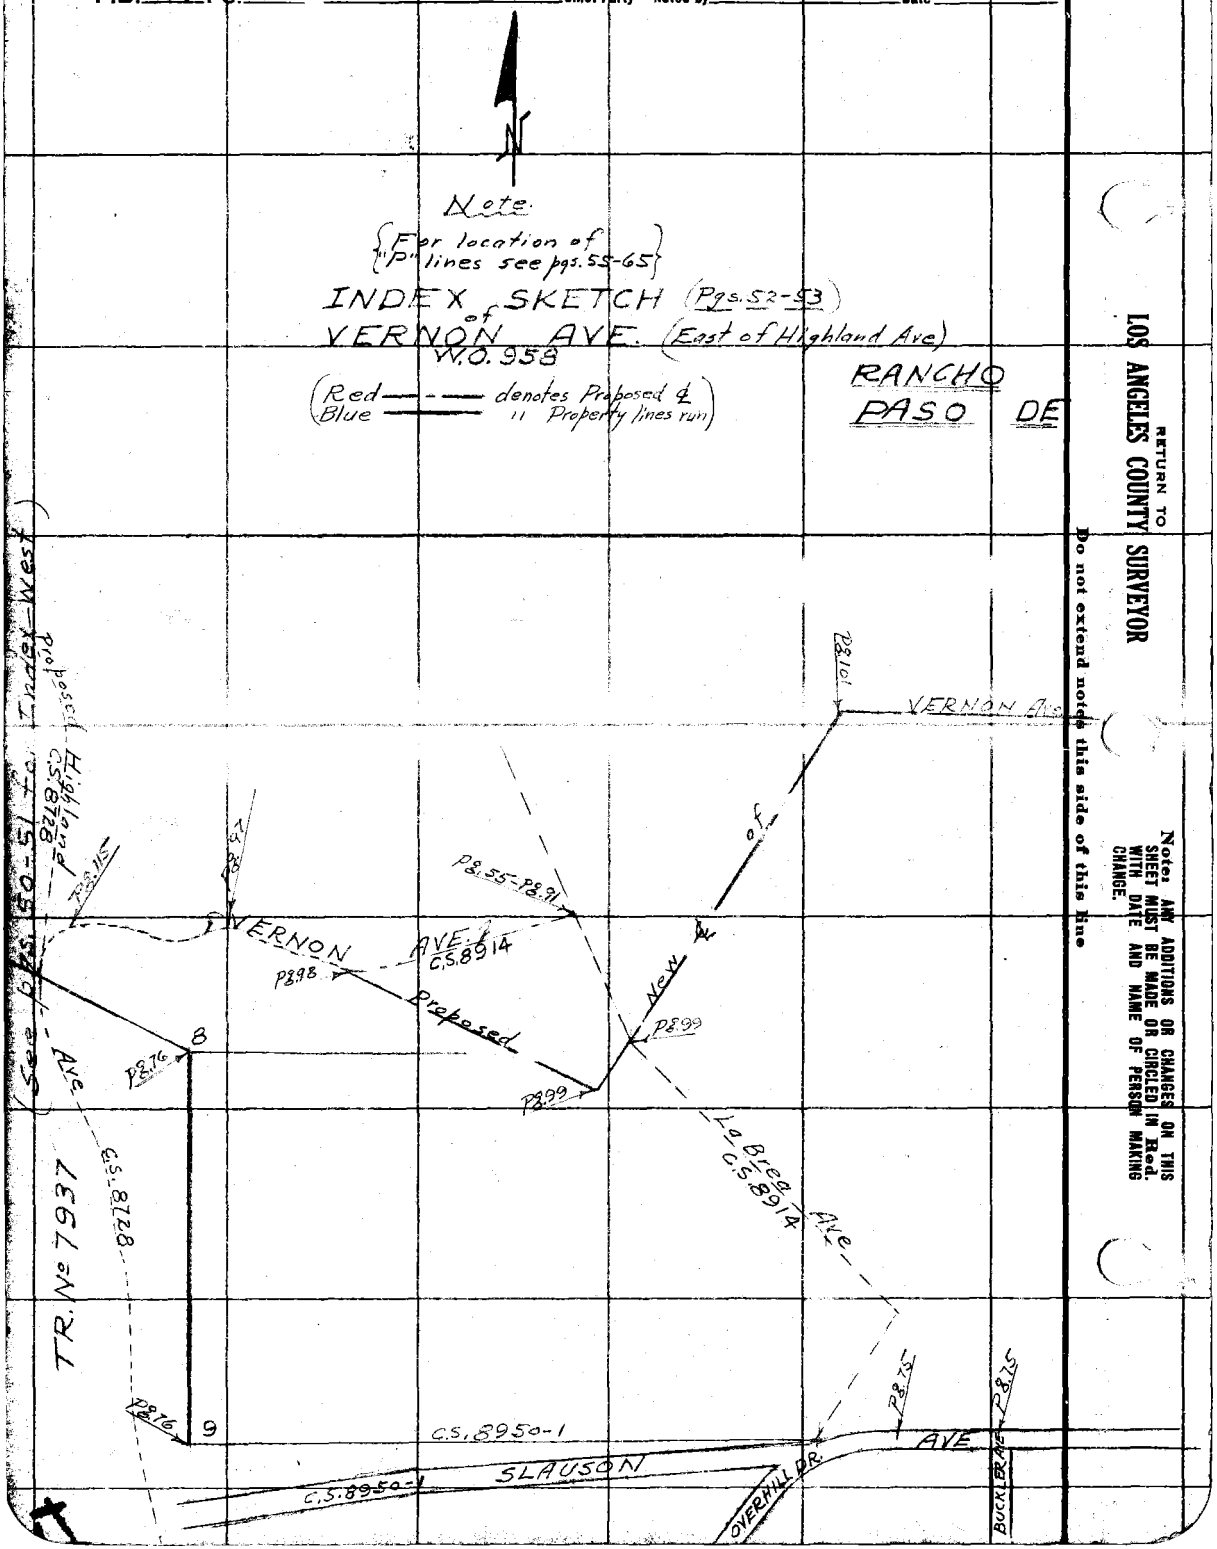

Date _____ Notes by _____ Chief Party _____ F.B. 289 PG. 53

Plotted by J.D. Price	W. O. No. 958 B. S. S. No.
Date April, 1930	Location Vernon Ave
Map No. C.S. B-501	Surveyed by Evans
Plotting Ch'd by RWMc	Date 4-1-30
Date 4/18/30	Indexed A. C. Johnson

Notes: ANY ADDITIONS OR CHANGES ON THIS SHEET MUST BE MADE OR CIRCLED IN Red. WITH DATE AND NAME OF PERSON MAKING CHANGE.

Do not extend notes this side of this line

RETURN TO LOS ANGELES COUNTY SURVEYOR

INDEX SKETCH VERNON AVE. W.O. 958

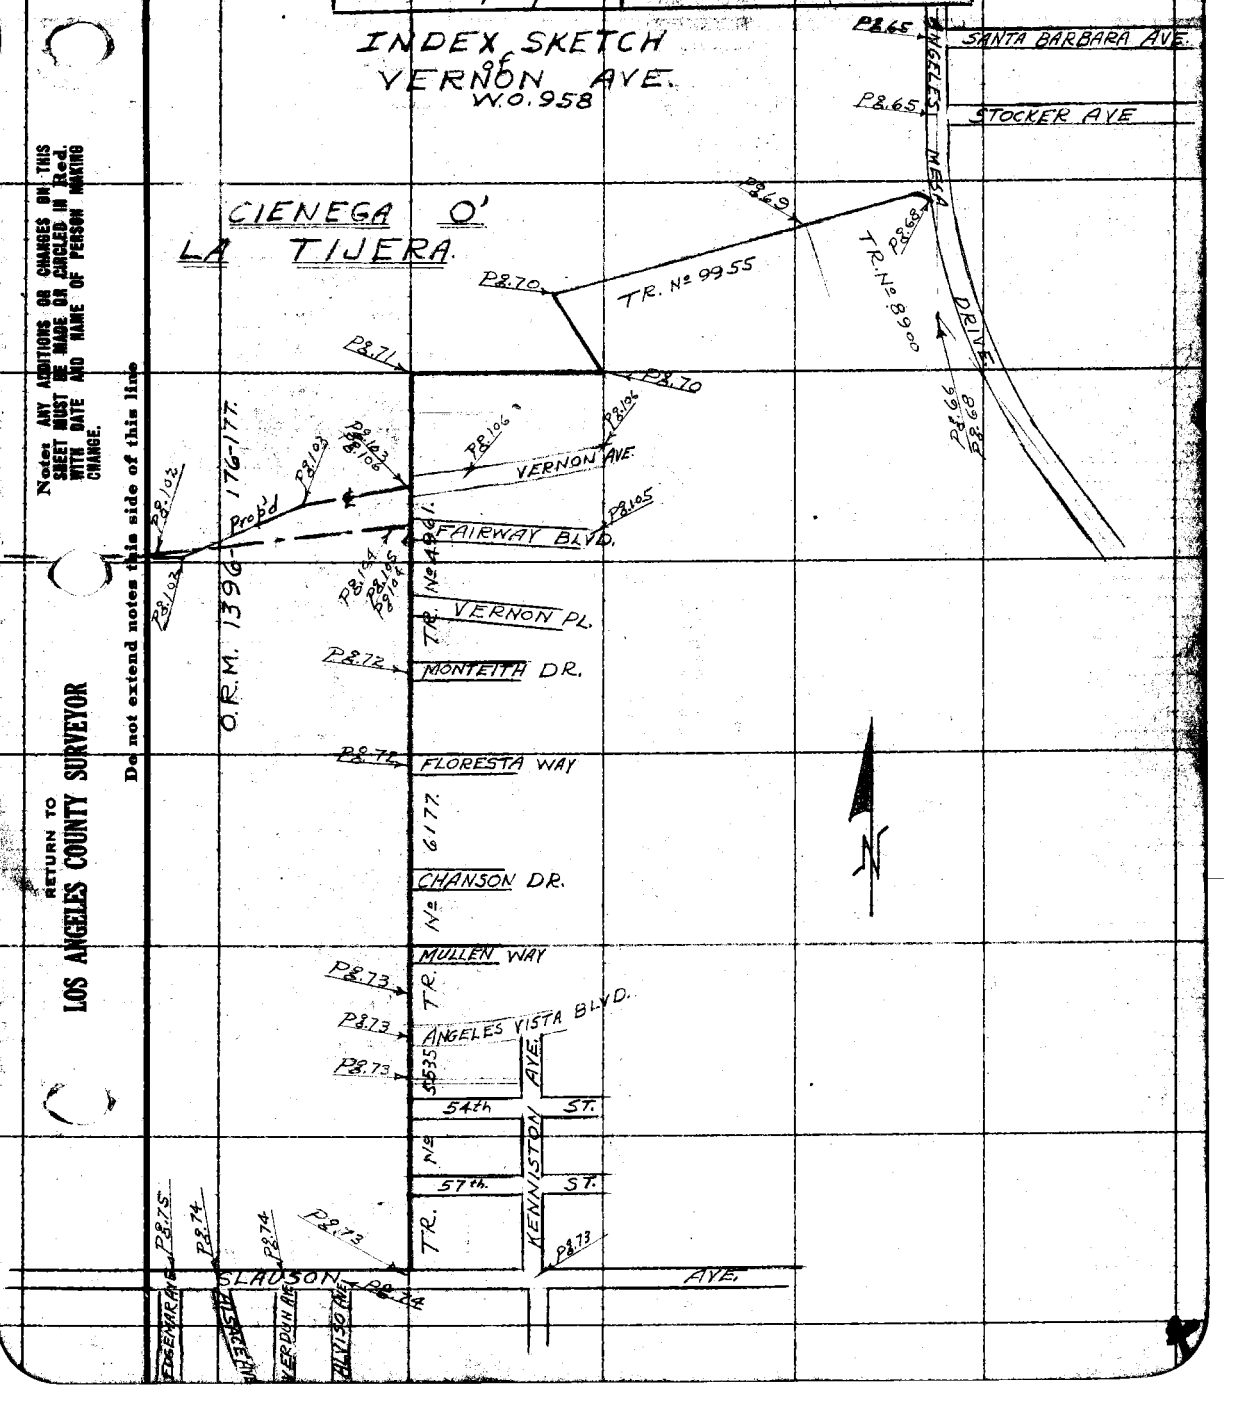

F.B. 289 Pg. 54 Chief Party Notes by Date

PELIMINARY LINES FOR PROPOSED VERNON AVE. from LA BREA AVE. to VERNON AVE. (& STOCKER AVE.)

Jan. 29, 1930

H.F. Evans - Dep.
Henry Martin - "
L.C. Wilson - H.C.
Ralph Taylor - R.C.
Roy Markham - Ex.

(for Bench Levels see L.B. 302-11-87)

RETURN TO
LOS ANGELES COUNTY SURVEYOR

Do not extend notes this side of this line

Note: ANY ADDITIONS OR CHANGES ON THIS SHEET MUST BE MADE OR CIRCLED IN Red. WITH DATE AND NAME OF PERSON MAKING CHANGE.

To Bot. (pg 52.)

Date _____ Notes by _____ Chief Party _____ F.B 289 PG 55

Tape #40 84°

Plotted by _____
Date _____
Map No. _____
Plotting C'k'd by _____
Date _____

W. O. No. 958 D. S. C. No. _____
Location Vernon Ave
Surveyed by Evans
Date 1-28-30
Indexed A. C. Johnson

12°06'10"

"P" Line
N49°-N.60°E.
Temp. Prod. ℄

181.75-T62° = 181.72

(12°06'-15
48°-24'-45)

P.I. #6 - VERNON AVE.
= P.O.T. - 104+12.65 LA BREA
AVE. - Fd. 2X2, 2½ ft. below
top of hill. See F.B 89-82

111°-25'-25"

(111°-25'-30
85°-41'-30)

℄ LA BREA

AVE. ℄

VERNON ℄ AVE.

C.S. 8914

P.I. #7 - La Brea Ave
Fd. 2X2 on surface
per F.B 89-62.

Notes: ANY ADDITIONS OR CHANGES ON THIS SHEET MUST BE MADE OR CIRCLED IN Red. WITH DATE AND NAME OF PERSON MAKING CHANGE.

Do not extend notes this side of this line

RETURN TO
LOS ANGELES COUNTY SURVEYOR

(To Bot. pg. 57)

F.B. 289 Pg. 56 Chief Party Notes by Date

Note
The Lindberg Beacon atop L.A. City Hall, used as fore sight on this line

To P#3 pg. 57

243.70 @ 2-45-T62° = 243.39 ✓

P#2 set 2x2-12" deep.

279.24 @ 5°39 = 277.88 ✓
33.75 @ 14°37 = 32.85 ✓
T72° = 310.73 ✓
.02
310.71 ✓

To P"10" pg. 59

Alternate P"10"

P line

298.81 ✓
104.87 ✓
403.68 ✓
.20
403.48 ✓

298.81 @ 22°50 =
104.87 @ 15°10 =
T72°

"P"#101 set 1x2

Line P

137°-35-30"

P#1 set 2x2-12" deep.

288.37 @ 6°18 = 286.63 ✓
267.17 @ 1°43 = 266.41 ✓
T72° = 553.04 ✓
.04
553.00 ✓

(137°-35-30
190°-22-00)

From to pg. 55.

RETURN TO
LOS ANGELES COUNTY SURVEYOR

Do not extend notes this side of this line

Note: ANY ADDITIONS OR CHANGES ON THIS SHEET MUST BE MADE OR CIRCLED IN Red. WITH DATE AND NAME OF PERSON MAKING CHANGE.

(To Bot pg. 58)

Date _____ Notes by _____ Chief Party _____ F.B. 289 PG. 57

(84° Tape #40)

Plotted by _____
Date _____
Map No. _____
Plotting C'k'd by _____
Date _____

W. O. No. 458 D. S. O. No. _____
Location Vernon Ave
Surveyed by Evans
Date 1-30-30
Indexed A. C. Johnson

(To Bot. pg. 58)

To P#6 pg. 58

299.27 @ 1°-02 = 299.08 ✓
195.06 @ 1°-54 = 194.95 ✓
494.03 ✓
T68° = .05 ✓
493.98 ✓

P#5 set 2x2-12" deep.

191.22 @ 2-45 = 191.00 ✓
230.10 @ 4-27 = 229.41 ✓
299.35 @ 3-08 = 298.90 ✓
171.48 @ 0-52 = 171.46 ✓
890.77 ✓
T82° = .01 ✓
890.76

"P" LINE

P#4 set 2x2-12" deep.

472.67 - T62° = 472.60

Mag. = N. 40° E.

P#3 set 2x2-12" deep.

Note: ANY ADDITIONS OR CHANGES ON THIS SHEET MUST BE MADE OR CIRCLED IN Red. WITH DATE AND NAME OF PERSON MAKING CHANGE.

Do not extend notes this side of this line

RETURN TO LOS ANGELES COUNTY SURVEYOR

From top pg. 56

(To Bot. P9.63)

F.B. 289 Pg. 58 Chief Party Notes by Date

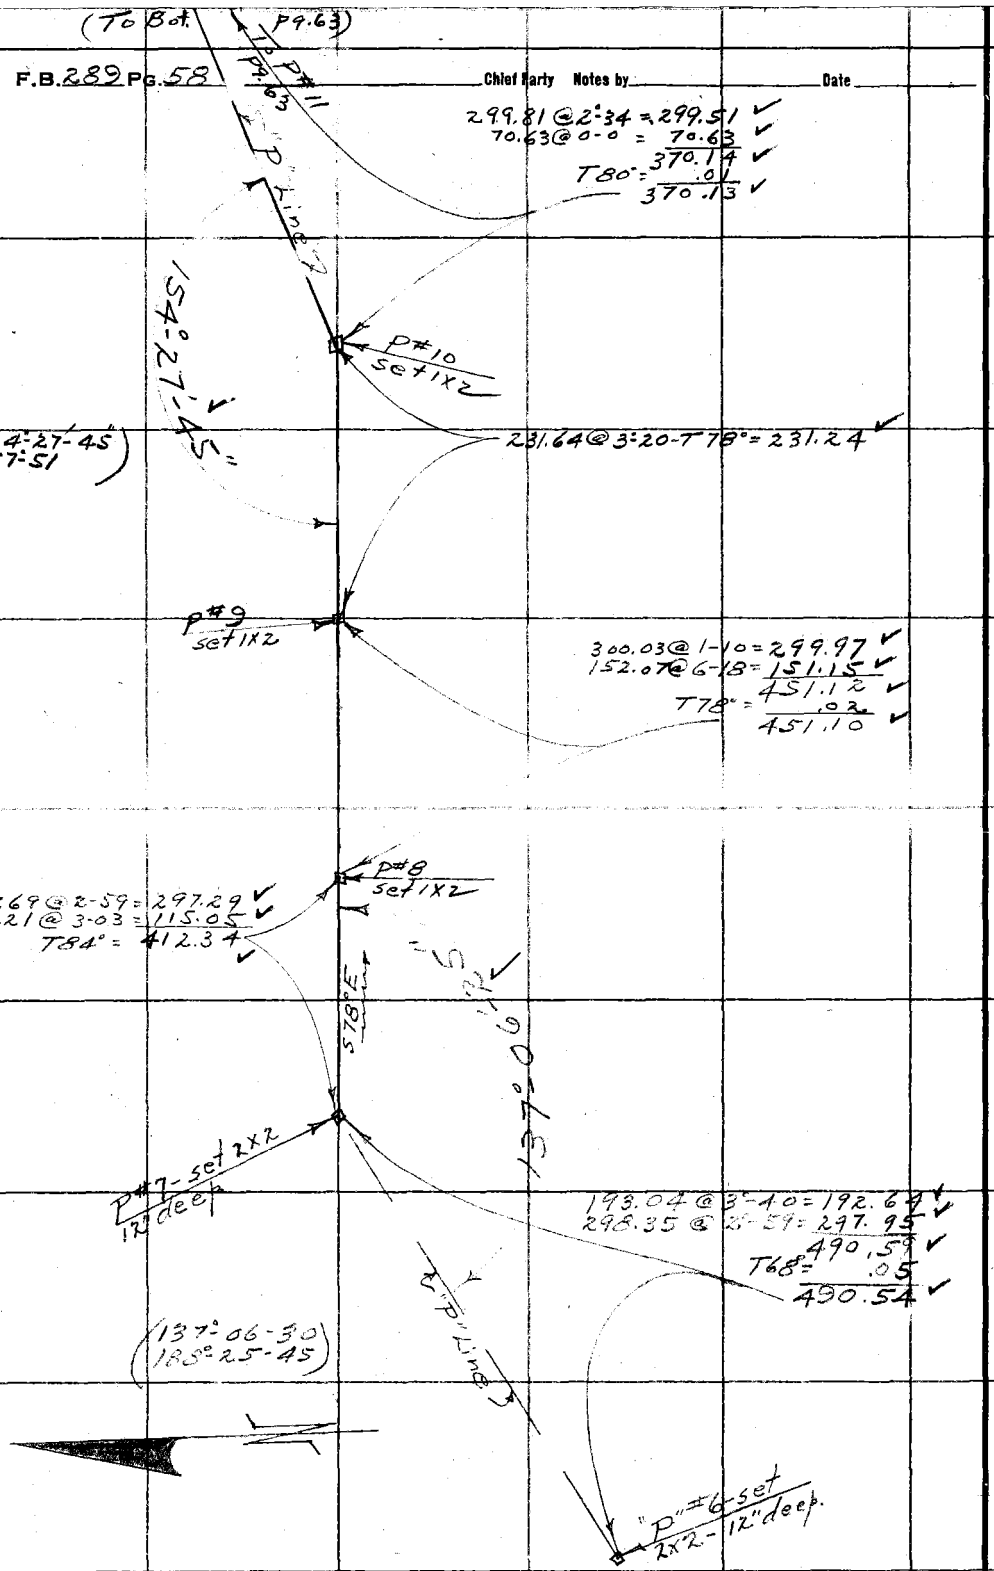

299.81 @ 2°-34 = 299.51 ✓
70.63 @ 0-0 = 70.63 ✓
T80° = 370.14 ✓
.01
370.13 ✓

231.64 @ 3°-20 - T78° = 231.24 ✓

300.03 @ 1-10 = 299.97 ✓
152.07 @ 6-18 = 151.15 ✓
T78° = 451.12 ✓
.02
451.10 ✓

297.69 @ 2-59 = 297.29 ✓
115.21 @ 3-03 = 115.05 ✓
T84° = 412.34 ✓

193.04 @ 3°-10 = 192.69 ✓
298.35 @ 2°-59 = 297.95 ✓
T68° = 490.64 ✓
.05
490.54 ✓

(from top pg. 57)

RETURN TO
LOS ANGELES COUNTY SURVEYOR
Do not extend notes this side of this line

Notes: ANY ADDITIONS OR CHANGES ON THIS SHEET MUST BE MADE OR CIRCLED IN Red. WITH DATE AND NAME OF PERSON MAKING CHANGE.

(To B#1 Pg. 60)

Date

Notes by

Chief Party

F.B. 289 Pg. 59

(84° Tape #40)

Plotted by
Date
Map No.
Plotting C'k'd by
Date

W. O. No. 958 D. S. D. No.
Location Vernon Ave
Surveyed by Evans
Date 1-31-30
Indexed A. C. Johnson

Top 106 Pg. 60

(171°-26-45
325°-47-00)

P#105 Set 1x2

S 4°-22-11 E

298.21 @ 2-18 = 297.97
300.91 @ 2-15 = 300.68
598.65
T 68° = .06
598.59

297.62 T 68° = 297.59

P#104 Set 1x2

"P" Line

299.50 @ 4°-12 = 298.69
275.56 @ 0°-0 = 275.56
574.25
T 68° = .06
574.19

N 44°-20 E

Alternate

147°-28-10"

P#103 Set 1x2

219.47 @ 4°-05 = 218.91
134.24 @ 5°-26 = 133.64
352.55
T 70° = .03
352.52

(147°-28-15
229°-52-30)

P#102 Set 1x2

(from Lt. side pg. 56)

Notes: ANY ADDITIONS OR CHANGES ON THIS SHEET MUST BE MADE OR CIRCLED IN Red. WITH DATE AND NAME OF PERSON MAKING CHANGE.

Do not extend notes this side of this line

RETURN TO LOS ANGELES COUNTY SURVEYOR

F.B. 289 PG. 60 Chief Party Notes by Date

(To Bot. Pg. 61)

To P#111 Per Pg. 59

255.53 @ 3°-30 = 255.05
295.55 @ 2°-17 = 295.32
146.14 @ 2°-39 = 146.02
T84° = 696.39

℄ Line

113.30 @ 4°-20 = 112.98
240.93 @ 0-0 = 240.93
T84° = 353.91

P#110 set 1x2

Alley 16'

199.11 @ 6°-23 = 197.88
183.11 @ 2°-53 = 182.88
T84° = 380.76

P#109 set 1x2

14°-07
232°-16

Fd. 2" I.P. flush with 3/4" iron rod 2 ft. high driven in center, see O.R.M. 1396-176

15°-11-15
60°-45-00

6°-51-00
21°-24-15

124°-26'

(124°-27-00
137°-47-45)

P#108 set 1x2

211.53 @ 6°-49 - T70° = 210.01

15°-11-15

Tie Line 220.29 Meas.

6°-51-05

252.18 @ 3-06 = 251.81
186.13 @ 0-0 = 186.13
T74° = 437.94
.03
437.91

148°-04'

296.53 @ 1°-10 = 296.47
35.05 @ 0-0 = 35.05
T68° = 331.52
.03
331.49

Fd. 2" I.P. flush with 3/4 iron rod 2 ft. high driven in center - see O.R.M. 1396-176

P#107 set 1x2

236.29 (Meas.)

MAG = N 40°-30 E

Fd. 2" I.P. flush with 3/4 iron rod 2 ft. high driven in center see O.R.M. 1396-176

P#106 set 1x2

(from top Pg. 59)

RETURN TO LOS ANGELES COUNTY SURVEYOR

Do not extend notes this side of this line

Notes: ANY ADDITIONS OR CHANGES ON THIS SHEET MUST BE MADE OR CIRCLED IN Red. WITH DATE AND NAME OF PERSON MAKING CHANGE.

Date _____ Notes by H.M. Chief Party _____ F.B. 289 Pg. 61

(84° Tape #40)

Platted by _____
Date _____
Map No. _____
Platting Ck'd by _____
Date _____

W. O. No. 958 D. S. O. No. _____
Location Vernon Ave.
Surveyed by Ferris
Date 1-31-30
Indexed A. C. Johnson

Notes: ANY ADDITIONS OR CHANGES ON THIS SHEET MUST BE MADE OR CIRCLED IN Red. WITH DATE AND NAME OF PERSON MAKING CHANGE.

Do not extend notes this side of this line

RETURN TO LOS ANGELES COUNTY SURVEYOR

(To Bot. Page 62)

40 P# 114

Alternate "P" Line

399.47 @ 0°0' T=80° = 399.46 ✓

P# 113 Set 1x2

Mag = N-85°15'E

299.64 @ 5°22' = 298.33 ✓
50.00 @ 0°0' = 50.00 ✓
289.07 @ 0°0' = 289.07 ✓
117.21 @ 0°0' = 117.21 ✓
T=78 754.61
.03
754.58 ✓

Fd. 2" I.P. flush with 3/4" iron rod 2 ft. high in center. see O.R.M. 1396-176

P# 112 Set 1x2

(169-05-15)
(316-21-00)

(8°-42'-45"
34°-50'-30")

Tie 296.42

8°-42'-40" ✓

360.25 Meas

Line "P"

252.23 @ 5°00' = 251.27
108.58 @ 8°31' = 107.38
T=78 358.65
.01
358.64 ✓

Fd. 2" I.P. flush with 3/4" iron rod 2 ft. high in center. see O.R.M. 1396

157°-53'-25" 154°-42'-30" 155.20 Meas

P# 111 Set 1x2

(152°-43
250°-51-30)

(157°-53-30
271°-33-30)

(From Top Pg. 60)

F.B. 289 Pg. 62 — EVANS Chief Party — Notes by H.M. — Date 1-31-30

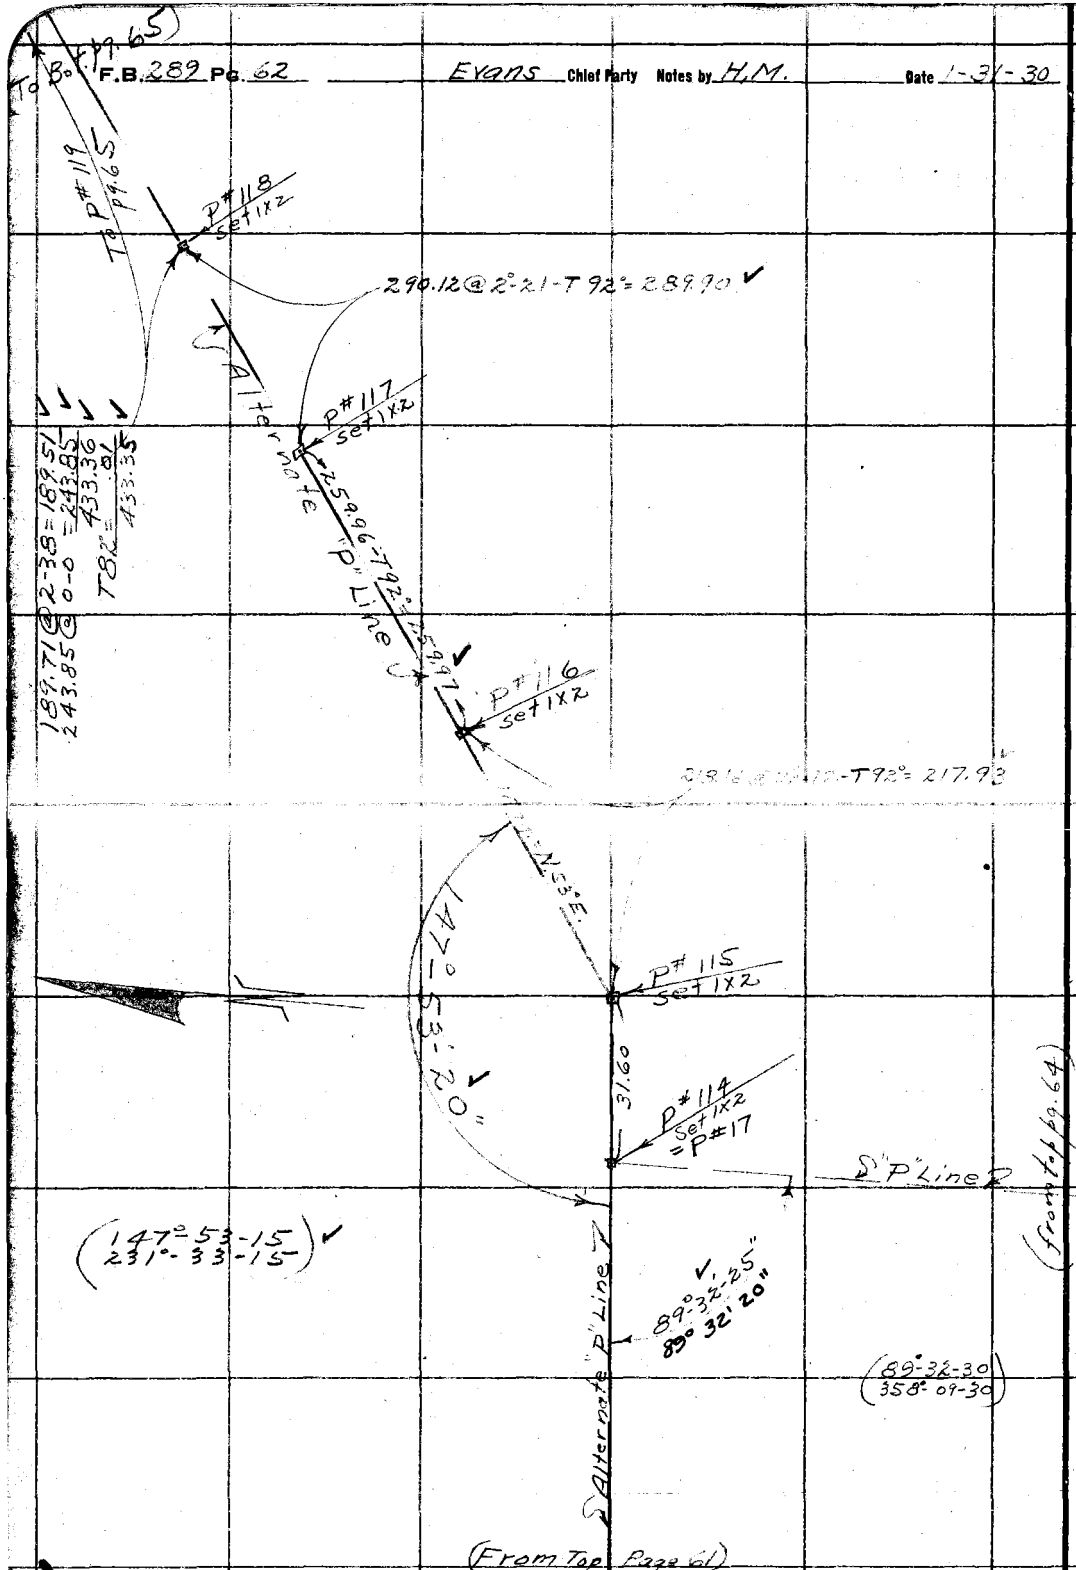

RETURN TO
LOS ANGELES COUNTY SURVEYOR

Do not extend notes this side of this line

Note: ANY ADDITIONS OR CHANGES ON THIS SHEET MUST BE MADE OR CIRCLED IN Red. WITH DATE AND NAME OF PERSON MAKING CHANGE.

Date (84° Tape #40)

Notes by _____ Chief Party _____ F.B. 289 Pg. 63

Platted by _____
Date _____
Map No. _____
Platting C'k'd by _____
Date _____

W. O. No. 958 D. S. O. No. _____
Location Vernon Ave
Surveyed by Evans
Date 4-3-30
Indexed A. C. Johnson

(changes in red by Evans)

Note: ANY ADDITIONS OR CHANGES ON THIS SHEET MUST BE MADE OR CIRCLED IN Red. WITH DATE AND NAME OF PERSON MAKING CHANGE.

Do not extend notes this side of this line

RETURN TO LOS ANGELES COUNTY SURVEYOR

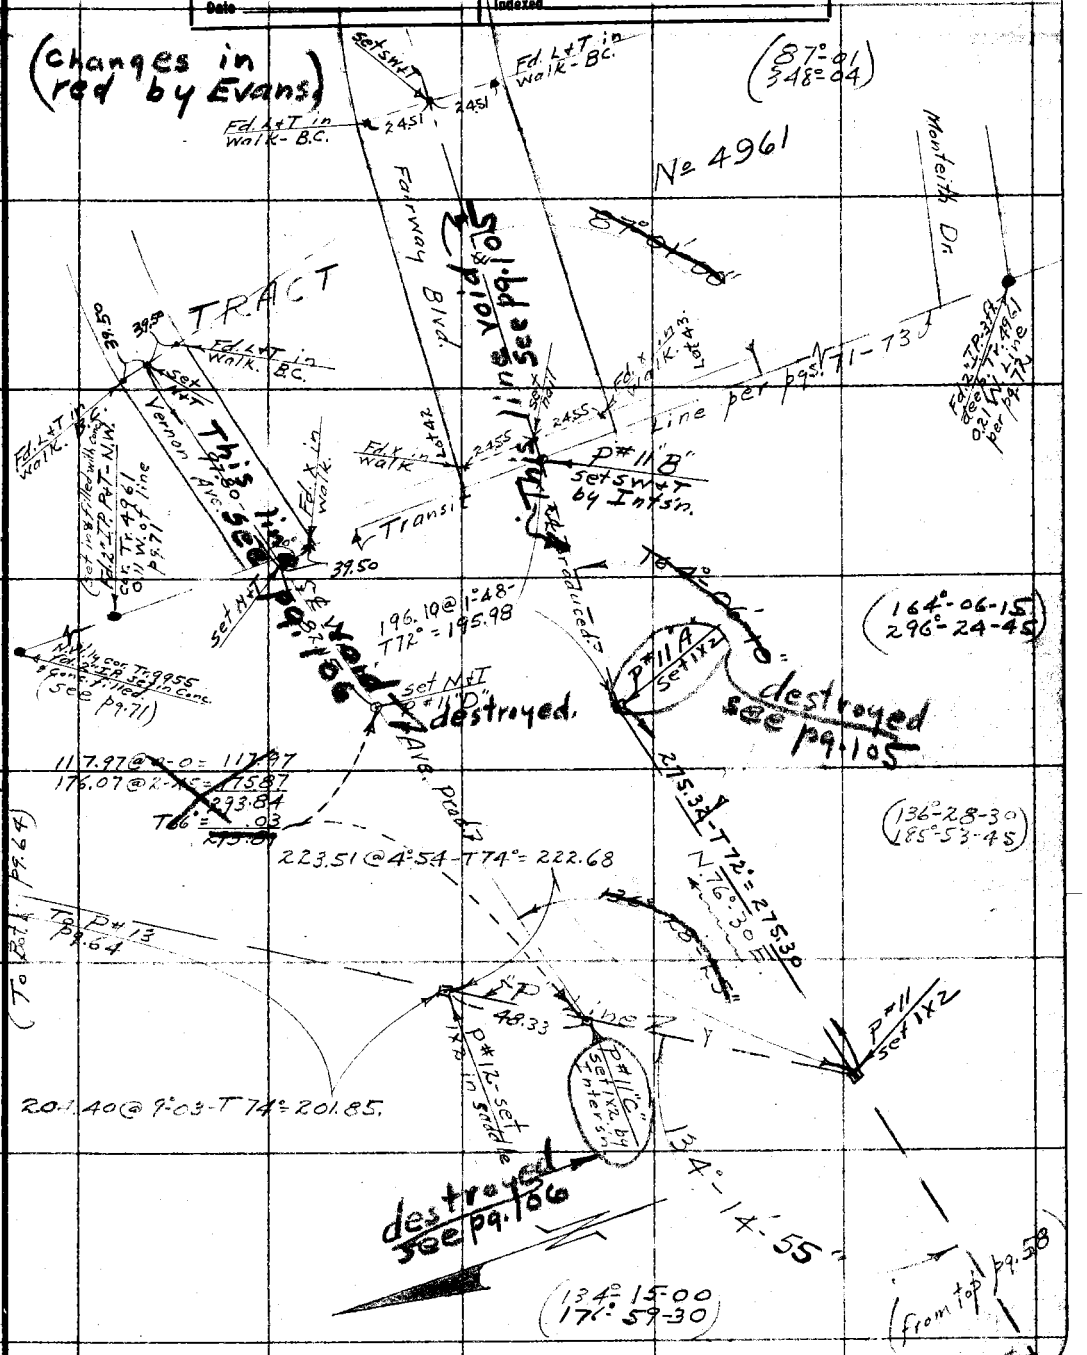

F.B. 282 Pg. 64 Chief Party Notes by Date

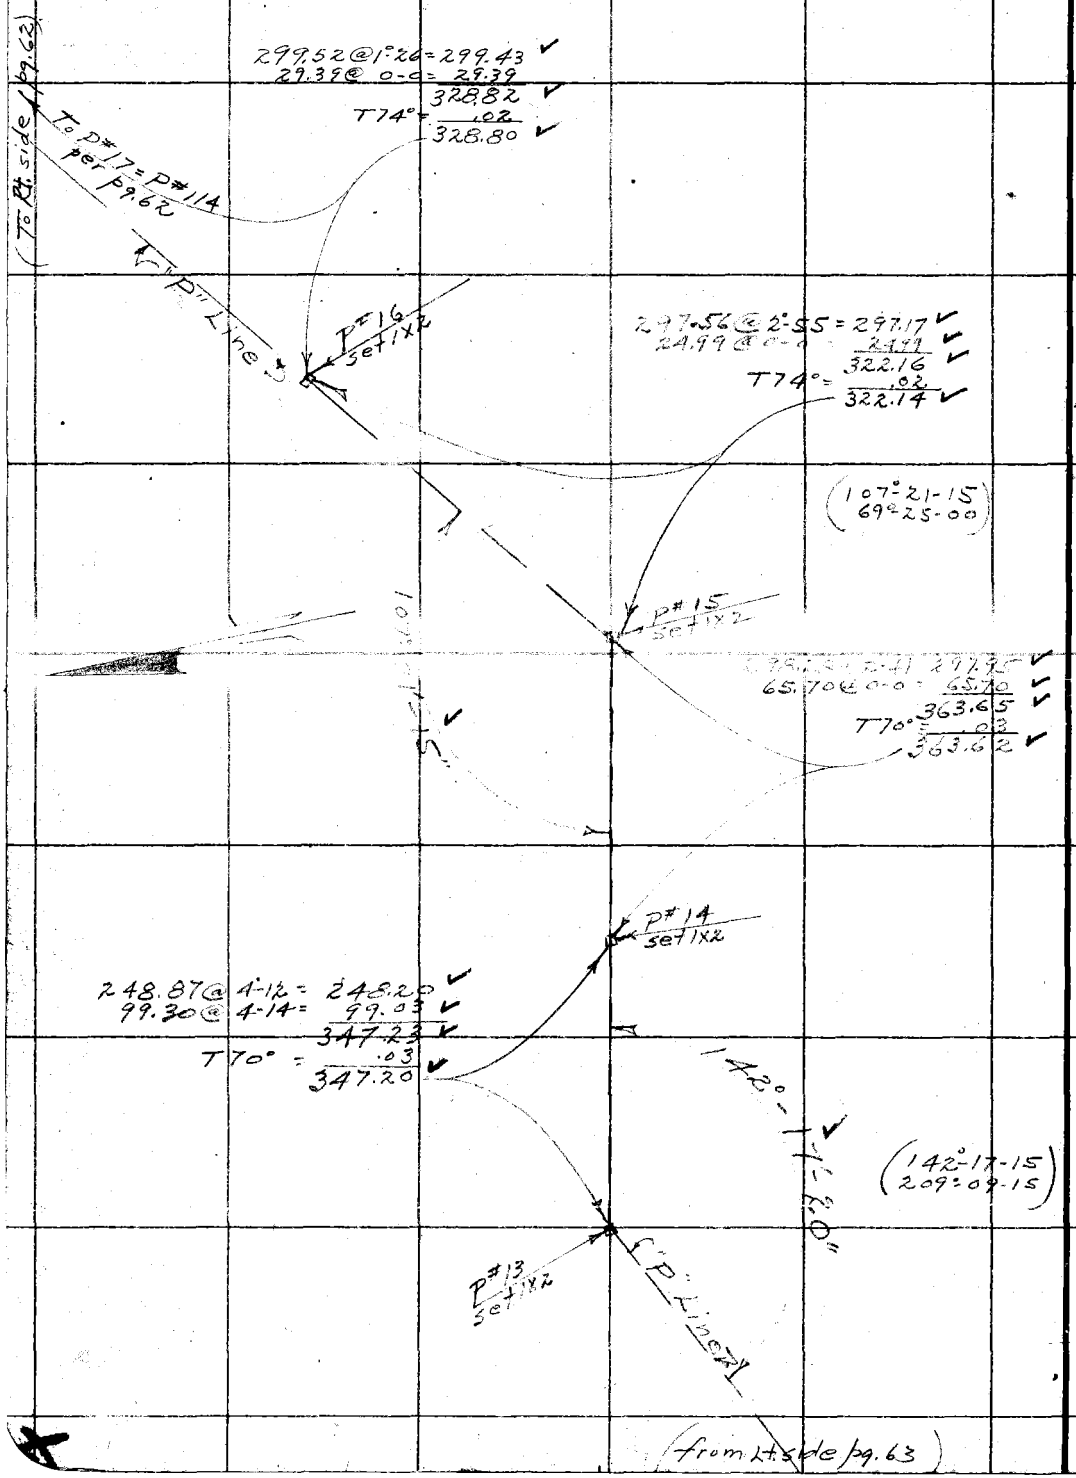

RETURN TO
LOS ANGELES COUNTY SURVEYOR

Do not extend notes this side of this line

Notes: ANY ADDITIONS OR CHANGES ON THIS SHEET MUST BE MADE OR CIRCLED IN Red. WITH DATE AND NAME OF PERSON MAKING CHANGE.

Date _____ Notes by _____ Chief Party _____ F.B. 289 PG. 65

(84° Tape #40)

Platted by	W. O. No. 958 D. S. O. No.
Date	Location Vernon Ave.
Map No.	Surveyed by Evans
Platting C'k'd by	Date 2-4-30
Date	Indexed A. C. John

Notes: ANY ADDITIONS OR CHANGES ON THIS SHEET MUST BE MADE OR CIRCLED IN Red. WITH DATE AND NAME OF PERSON MAKING CHANGE.

Do not extend notes this side of this line

RETURN TO LOS ANGELES COUNTY SURVEYOR

SANTA BARBARA AVE.

STOCKER AVE.

Fd. L+T. in Pymt. per LB 614-27 F.B. 444-45 & 53

P#121 - Interim Mesa Dr. & Stocker Ave - Fd. L+T. in Pymt. per LB 614-27 F.B. 444-44 & 52

B.C.

37.73

t-Semi Tang.

ANGELES MESA DR.

(No. B.T. Pg. 66)

(126°-26'-45" 145°-47'-00)

126°-26'-45" 126°-26'-40"

Fd. L+T. - B.C. per F.B. 444-44 & 52.

Calculated Meas. - N.53°E.

P#120 Set 1/2"

P.

Line

P#119 Set 1/2"

(From P#62)

146.74 @ 2-52 = 146.56
300.98 @ 1-18 = 300.90
295.40 @ 1-37 = 295.28
89.29 @ 0-0 = 89.29
832.03
T 76° = .04
831.99

147.00 @ 3-07 = 146.78
129.63 @ 0-0 = 129.63
276.41
T 74° = .02
276.39

F.B. 289 PG. 66 Chief Party Notes by Date

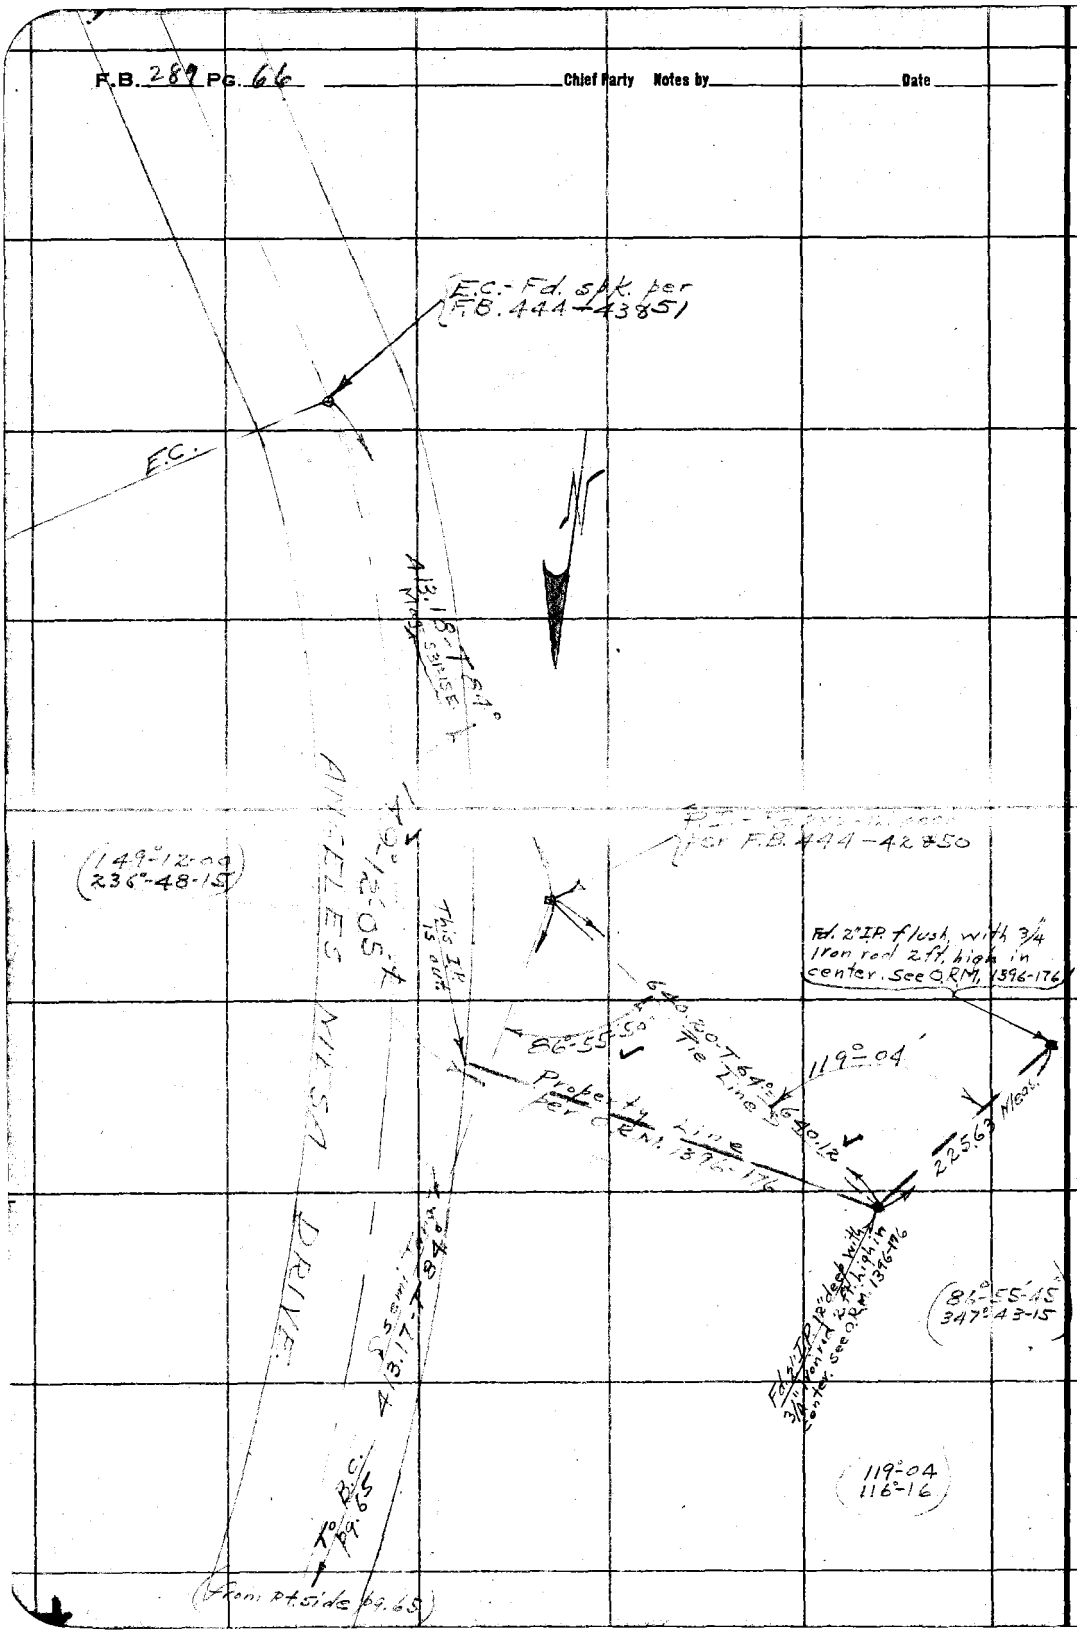

RETURN TO
LOS ANGELES COUNTY SURVEYOR
Do not extend notes this side of this line

Notes: ANY ADDITIONS OR CHANGES ON THIS SHEET MUST BE MADE OR CIRCLED IN Red. WITH DATE AND NAME OF PERSON MAKING CHANGE.

Date _____ Notes by _____ Chief Party _____ F.B. 289 PG. 67

Platted by	W. O. No. 958 D. S. O. No.
Date	Location Vernon Ave
Map No.	Surveyed by Evans
Platting C'k'd by	Date 2-7-30
Date	Indexed A. C. Johnson

Tract & Property Lines Survey for VERNON AVE.

Evans - Dep.
Martin - "
Wilson - H.C. - Brock
Taylor - R.C. - Sodig
Markham. Ey

Note: ANY ADDITIONS OR CHANGES ON THIS SHEET MUST BE MADE OR CIRCLED IN Red. WITH DATE AND NAME OF PERSON MAKING CHANGE.

Do not extend notes this side of this line

RETURN TO LOS ANGELES COUNTY SURVEYOR

F.B. 289 Pg. 68 Chief Party Notes by Date

(84° Tape) #40

TRACT No. 8900

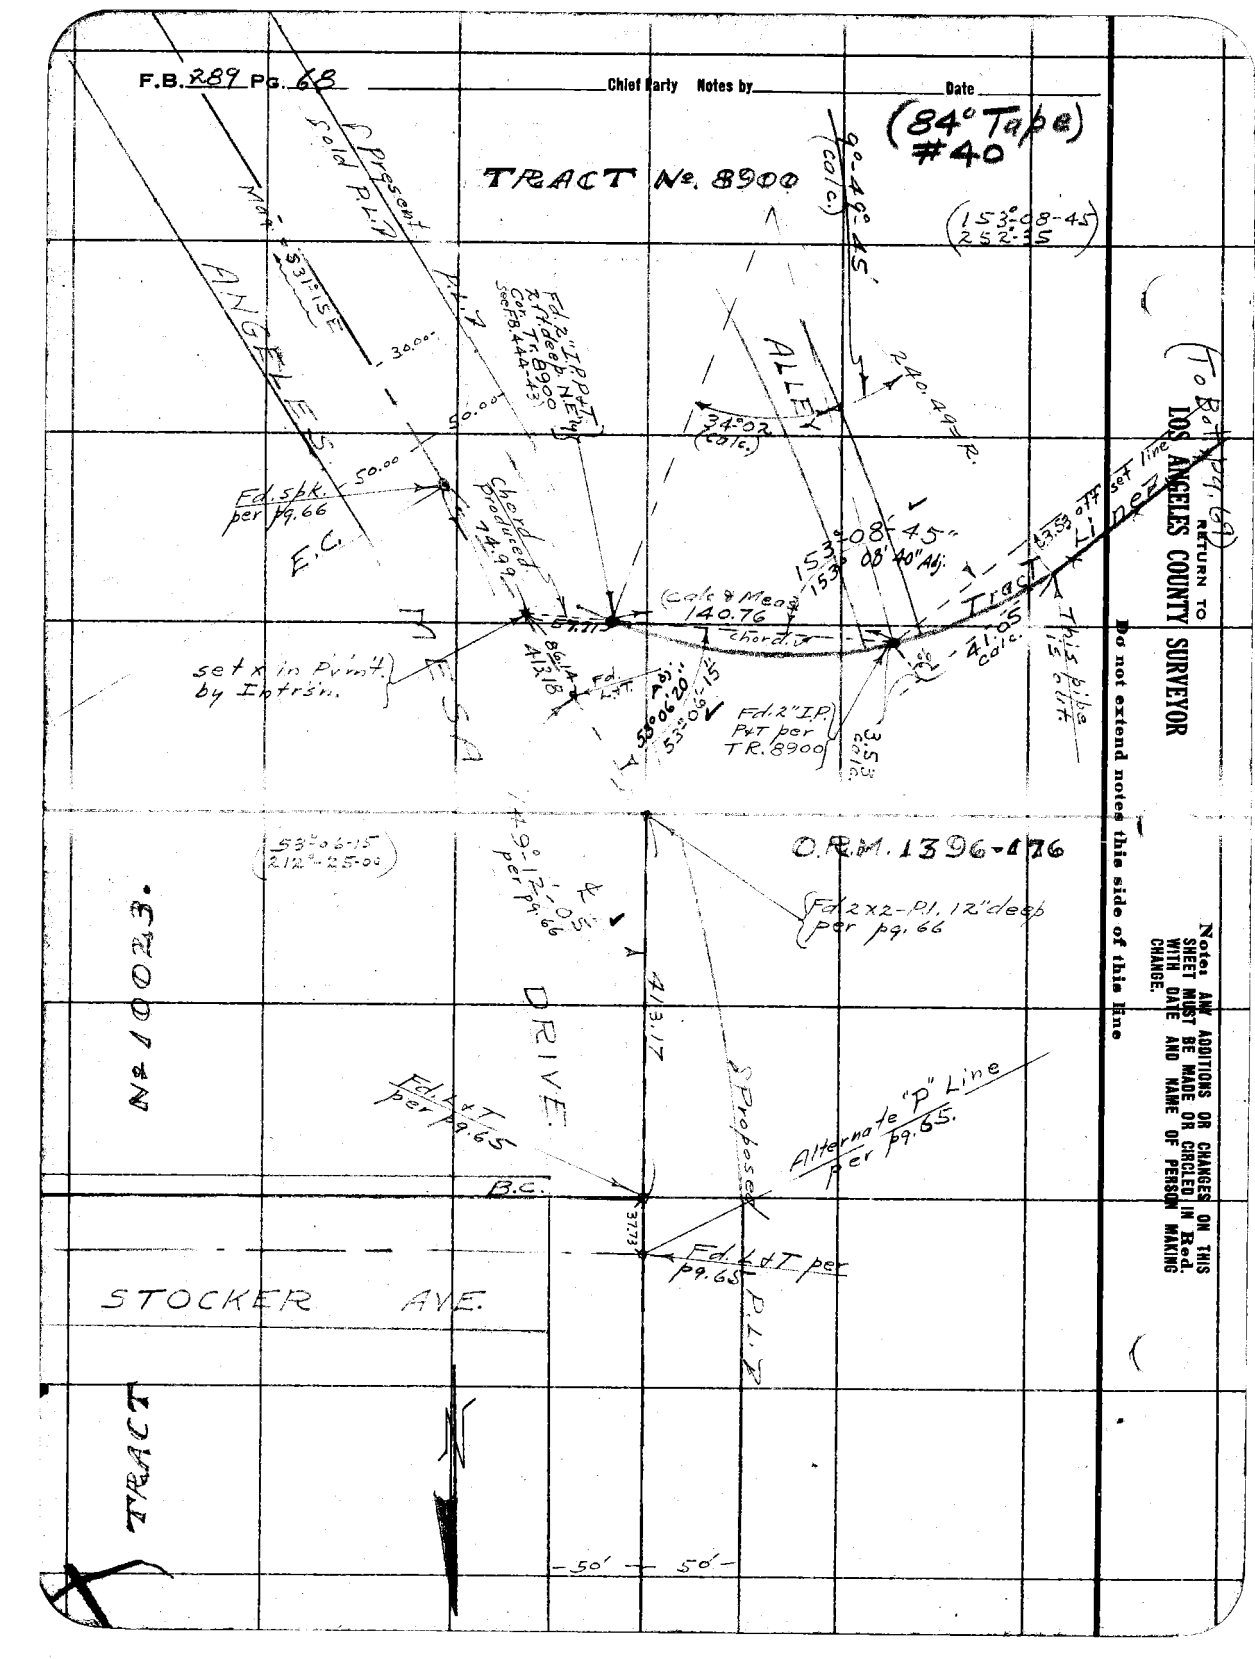

Date _____ Notes by _____ Chief Party _____ F.B. 289 PG. 69

Platted by	W. O. No. 958 D. S. O. No.
Date	Location Vernon Ave
Map No.	Surveyed by Evans
Platting c'k'd by	Date 2-7-30
Date	Indexed A. C. Johnson

(To A Bot. pg. 70)

143.84 @ 11°24 = 141.00 ✓
300.13 @ 5°30 = 298.75 ✓
300.32 @ 8°12 = 297.25 ✓
59.10 @ 12°43 = 57.65 ✓
33.24 @ 0°0 = 33.24 ✓
827.89 ✓
T62° = .12 ✓
827.77 ✓

TRACT Nº 9955

PALMERO BLVD.

Set 1x2 #1

5.53
3.40

299.94 @ 1°58 = 299.76 ✓
161.33 @ 4°18 = 160.83 ✓
201.80 @ 1°33 = 201.73 ✓
662.37 ✓
T62° = .09 ✓
662.28 ✓

ANGELES VISTA BLVD.

TRACT Nº 8900

VICTORIA AVE.

To 1x2 Set pg. 70

Mag. = 339.15 W.

TRACT LINE

O.R.M. 1396-176-177

Fd. I.T.P. and Spike Flush, 4.56 E. in Conc. Flush, N.W. Cor. Tr. 8900

13.53 offset Line Sags on Line

From 2" I.P. in Alley per 29.68

(From Rt. Side pg 68)

RETURN TO
LOS ANGELES COUNTY SURVEYOR

Note: ANY ADDITIONS OR CHANGES ON THIS SHEET MUST BE MADE OR CIRCLED IN Red. WITH DATE AND NAME OF PERSON MAKING CHANGE.

Do not extend notes this side of this line

F.B. 289 Pg. 70 Chief Party Notes by Date

(84° Tape)

TRACT No 9955.
LOT 68.

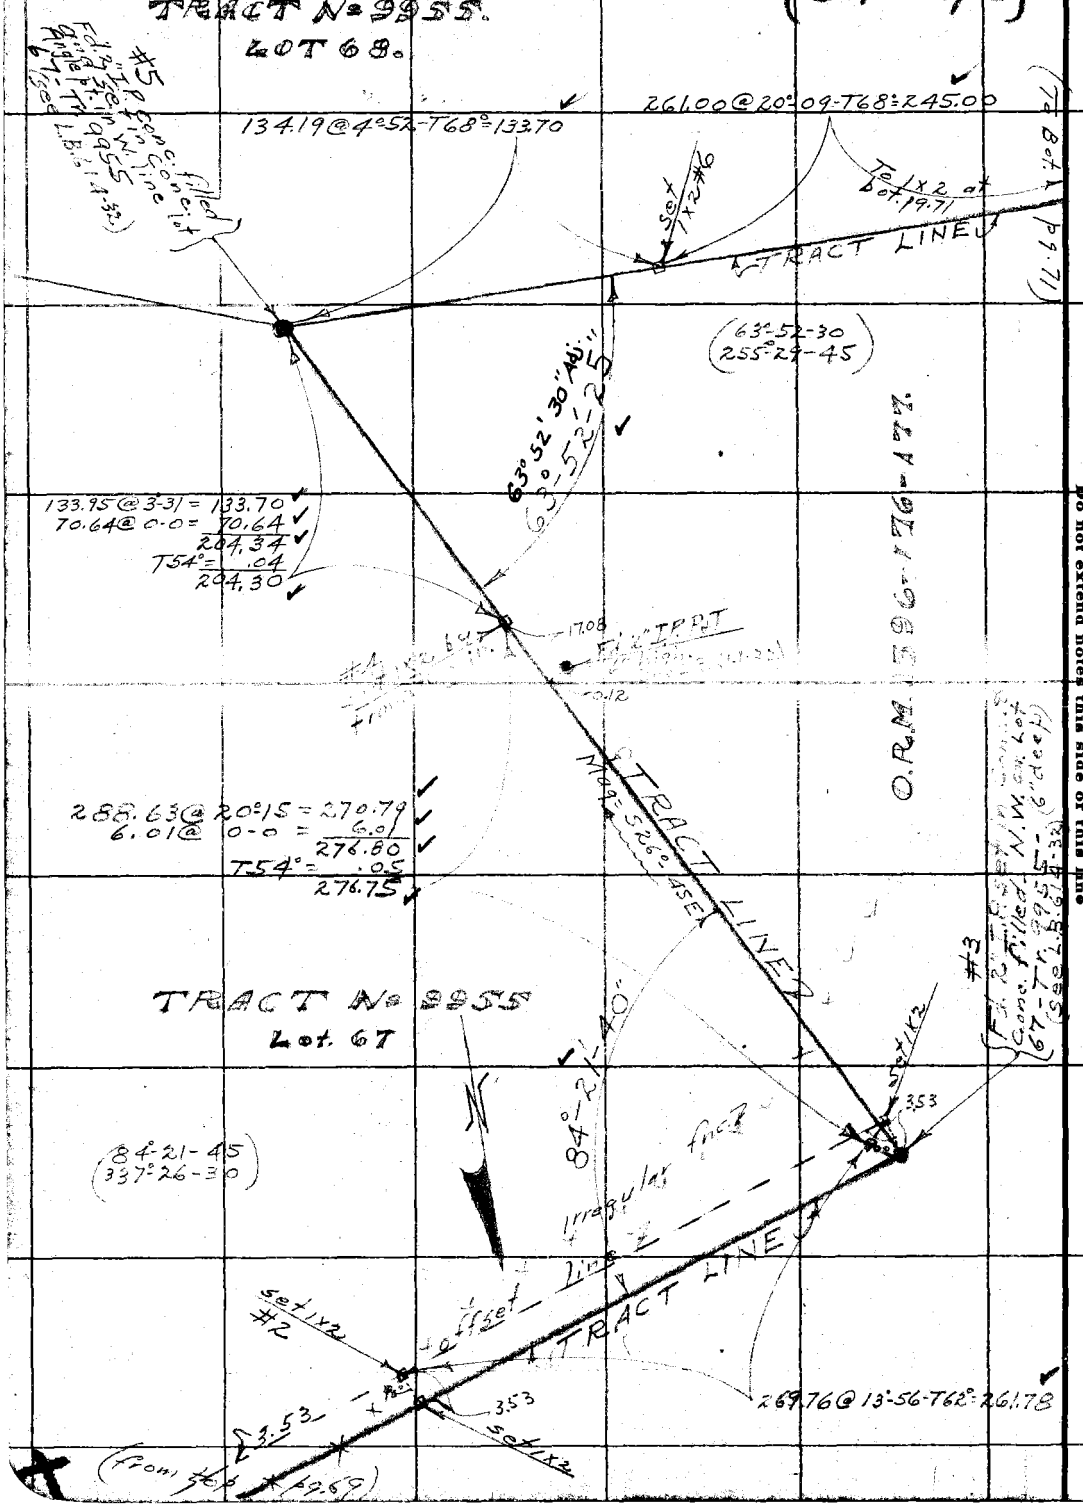
#5
Fd. 3/4" IP Bent
Angle Pt. TT
L.B. 1-1-32

(To Bk. 2 pg. 72)

Date _____ Notes by _____ Chief Party _____ F.B. 289 Pg 71

(84° Tapg)

Plotted by J. D. Price	W. O. No. 958 R. S. O. No.
Date April, 1930	Location Vernon Ave.
Map No. C.S.B-501	Surveyed by Evans
Plotting Ch'd by R.W.M.	Date 2-19-30
Date 4/18/30	Indexed A. C. Johnson

Notes: ANY ADDITIONS OR CHANGES ON THIS SHEET MUST BE MADE OR CIRCLED IN Red. WITH DATE AND NAME OF PERSON MAKING CHANGE.

Do not extend notes this side of this line

RETURN TO LOS ANGELES COUNTY SURVEYOR

ORM 1396-176-177

TRACT

Fair Way per pg. 63 Blvd. 105

destroyed sept. 10S

Set 1X2 #11

Set 1X2 #10

Fd 1X2 "I.P. 8" high 0.23 W. of line. see L.B. 614-31

LOT 68
TRACT No 9955

Fd 2" I.P. conc. fillet in conc. N.W. cor. Tr. 9955-4 deep see pg. 63 #9

Set 1X2 #8

Fd 2" I.P. see L.B. 614-31

Set 1X2 #7 at bot. of canyon.

(from top Rt side pg. 76)

-201.50 @ 14°-01-30 - T60 = 195.46 ✓

160.77 @ 14°-01 - T60° = 155.96 ✓

291.58 @ 7°-13 = 287.33 ✓
196.17 @ 5°-00 = 184.57 ✓
83.83 @ 0-0 = 83.83 ✓
555.73 ✓
T60° = .09 ✓
555.64 ✓

291.58 @ 9°-45 = 287.33 ✓
119.43 @ 7°-20 = 116.45 ✓
405.78 ✓
T60° = .06 ✓
405.72 ✓

108.73 @ 18°-20'-30" ✓
T 70° = 103.20 ✓

298.54 @ 13°-52 = 289.84 ✓
30.00 @ 0-0 = 30.00 ✓
319.84 ✓
T 68° = .03 ✓
319.81 ✓

90°-00-15
360°-01

121.01 @ N°-00 - T 68° = 118.78 ✓

(To Bat. Pg. 73)

F.B. 289 Pg. 72

Chief Party _____ Notes by _____ Date _____

114.00 @ 2°38 = 113.88 ✓
299.85 @ 7°23 = 297.34 ✓
99.17 @ 15°05 = 95.75 ✓
506.97 ✓
T64° = .07 ✓
506.90 ✓

MULLEN WAY.

10.0 Pg. 73 Line B.T.P.

299.85 @ 7-28 = 297.34 ✓
64.84 @ 12-36 = 63.28 ✓
360.62 ✓
T64° = .05 ✓
360.57 ✓

set 1x2 #17

CHANSON DRIVE.

25.0 offset

298.43 @ 2°29 = 298.15 ✓
101.45 @ 0-0 = 101.45 ✓
399.60 ✓
T62° = .06 ✓
399.54 ✓

set 1x2 #16

3.00

set 1x2

245.72 - T62° = 245.68 ✓

Nothing Found.

FLORESTA WAY.

Fd 2" I.P. & nail set in g.f. filled with conc. per L.B. 614-30 6" deep.

0.03

164.11 @ 4°08 - T62° = 163.66 ✓

TRACT No. 6177

set 1x2 #15

21883 - T62° = 20944 ✓
62-0-0 = 60.49 ✓
T62° = 361.22 ✓
.05 ✓
361.17 ✓

STRANSIT Mag. S.

Fd 2" I.P. no tack 30' Northerly of Sec. 177 - Sec. 63

set 1x2 #14

129.53 @ 8°18 - T64° = 128.15 ✓

0.21

MONTEITH DR.

TRACT No. 4961

300.40 @ 105 = 300.35 ✓
78.30 @ 0-0 = 78.30 ✓
378.65 ✓
T64° = .05 ✓
378.60 ✓

O.R.M. 1896 - 177

Fd 2" I.P. & nail set in conc. & filled with conc. per L.B. 614-30

0.07

30.91

set 1x2 #13

110.63 @ 2°24 - T60° = 110.51 ✓

VERNON PL.

set 1x2 #12

(from top pg. 71)

RETURN TO LOS ANGELES COUNTY SURVEYOR

Do not extend notes this side of this line

Notes: ANY ADDITIONS OR CHANGES ON THIS SHEET MUST BE MADE OR CIRCLED IN Red. WITH DATE AND NAME OF PERSON MAKING CHANGE.

Date _____ Notes by _____ Chief Party _____ F.B. 289 Pg. 73

Plotted by J. D. Price	W. O. No. 956 O. S. O. No.
Date April, 1930	Location Vernon Ave.
Map No. C.S. B-501	Surveyed by Ennis
Plotting C'k'd by R.W.M.F.A. 4/18/30	Date 2-13-30
Date	Indexed A. C. Johnson

84° Tape #40

Notes: ANY ADDITIONS OR CHANGES ON THIS SHEET MUST BE MADE OR CIRCLED IN Red. WITH DATE AND NAME OF PERSON MAKING CHANGE.

Do not extend notes this side of this line

RETURN TO LOS ANGELES COUNTY SURVEYOR

AVE.

set L+T by Intrsn

SLAUSON AVE.

To L+T-Angle Ft.-Bot. pg. 74

To Bot. pg. 74

Piper

168.65-T66°-168.63
L.B. 614-53

439.12-T66°-439.07

90°-12'-15"

(90°-12-15
360°-49-00)

245.14 @ 1.44 = 245.03
94.36 @ 2.14 = 94.29
145.16 @ 0.0 = 145.16
484.48
T60° = .08
484.40

Fd. L+T-for ties see L.B. 614-53

KENISTON

N 21° 15' E

set 1X2 #20

57th ST.

299.75 @ 1.43 = 299.62
299.92 @ 1.01 = 299.87
299.82 @ 1.17 = 299.75
281.07 @ 0.0 = 281.07
1180.31
T60° = .18
1180.13

TRACT No 5535

54th ST.

ALLEY.

LINE

5.00 to

set 1X2 #19

Fd. 2" I.P. P+T 4" deep. Per Tr. 5535 - This point used for transit line control

494.79

494.87-T60°-494.79

TRANSIT

LINE

ANGELES VISTA BLVD.

Fd. 2" I.P. conc. filled & set in conc. 0.04 West of line. See L.B. 614-29

28.50

set 1X2 #18

N.W. Cor. Tr. 5535 Fd. 2" I.P. P+T - 4" high. See L.B. 614-29

50.90

50.0' offset

TRACT No 6177

0.14

(from Tab 99.72)

(To Bk 19.75)

F/B 289 Pg. 74 Chief Party Notes by Date

270.74 @ 3-30 = 270.24
270.23 @ 4-43 = 269.31
37.09 @ 0-0 = 37.09
576.64
T60° = .09
576.55

To L & T at Ferndale Ave - pg. 75

ALSACE AVE.

Fd. L & T on line per L.B. 614-55

AVE.

612.92 - T66° - 612.85

VERDUN AVE.

Fd. L & T on line per L.B. 614-54

SLAUSON

0.9A

287.60 @ 2°-08 = 287.40
106.20 @ 0-0 = 106.20
393.60
T66° = .05
393.55

ALLEY

Fd. L & T per L.B. 614-54 (on line)

262.84 @ 2°24 - T66° = 262.58

ALVISO AVE.

Fd. L & T in P.M.'s per L.B. 614-53 & 54 N.E. Cor. Sec. 21 T. 2 S. - R 14 W.

Fd. L & T - per F.B. 269-3 - This P.M. is on Sec. line 16 West but is not N.E. Cor. Sec. 21 as shown in F.B. 269-3

(179°-56-45)
359°-46-45

439.07

From Folder 69-73

(From to Bk 69-73)

RETURN TO
LOS ANGELES COUNTY SURVEYOR

Do not extend notes this side of this line

Note: ANY ADDITIONS OR CHANGES ON THIS SHEET MUST BE MADE OR CIRCLED IN Red. WITH DATE AND NAME OF PERSON MAKING CHANGE.

Date _____ Notes by _____ Chief Party _____ F.B. 289 PG. 75

(84° Tape #48)

Platted by J.D. Price	W. O. No. 958 B. S. C. No.
Date April, 1930	Location Vernon Ave
Map No. C.S. B-501	Surveyed by EVANS
Platting C'k'd by R.W.M's	Date 2-14-30
Date 7/18/30	Indexed C. Johnson

Note: ANY ADDITIONS OR CHANGES ON THIS SHEET MUST BE MADE OR CIRCLED IN Red. WITH DATE AND NAME OF PERSON MAKING CHANGE.

Do not extend notes this side of this line

RETURN TO
LOS ANGELES COUNTY SURVEYOR

see p. 76 (Lt.)

(See p. 76) N. 1/4 Cor. Sec. 21-T2S-R14W. Fd. L&T per F.B. 269-38 & 105 (See L.B. 614-56)

Per F.B. 269-38 & 105

178.27 - 269.35

BUCKLER AVE.

AVE.

SLAUSON

EDGMAR AVE.

+ 2644.95 - T84°

Fd. L&T.

270.29 @ 3-34 = 269.77
261.16 @ 3-41 = 260.62
T60° = 530.39
.08
530.31

Fd. L&T on line per L.B. 614-55

℄ per F.B. 269-38 per L.B. 614-53-56

F.B. 289 Pg. 76 Evans Chief Party Notes by H.E. Date 2/15/30

{84° Tape #14}

{Fd. conc. Mon. with nail - N.W. cor Sec. 21 per F.B. 269-4-8. See Tr. 7937 Sta. 9 - Re. C.O.R.D. La Tijera.}

SLAUSON AVE.

Sec. Line per F.B. 269-38 105

21 20 16 17

{North 1/4 Cor. Sec. 21 - Fd. L+T in prmt per pg. 75 - See F.B. 269-38 105}

91°18'.05

(91°-18 365-12-30)

RETURN TO LOS ANGELES COUNTY SURVEYOR

Do not extend notes this side of this line

Note: ANY ADDITIONS OR CHANGES ON THIS SHEET MUST BE MADE IN Red. CIRCLED WITH DATE AND NAME OF PERSON MAKING CHANGE.

TRACT No. 7937

(East line Tract 7937)

O.R.M. 1396.

300.25 @ 1-54 = 297.40
299.37 @ 3-53 = 298.68
298.95 @ 1-00 = 218.90
299.95 @ 1-07 = 299.59
66.56 @ 0-0 = 66.56
237.79 @ 0-0 = 237.73
249.49 @ 1-c = 249.46
95.96 @ 0-0 = 95.92
12-1-1.60
T 70° 17
15 1.45

{Fd. 2" I.P. - 8" high on line - no tack.}

299.55 @ 8°35 = 295.24
284.08 @ 1°03 = 284.03
579.27
.02
579.25

{Fd. 6" pipe with wire spk. center, set in 8 filled with conc. (on line)}

157.45 @ 10°31' T 70° = 154.80

28-15"

90°28'-15"

(90°-28-15 361-53)

Fd. 1" I.P. - 12" deep See F.B. 89-21

Fd. 1" I.P. F.B. 89-21

198.82

154.37

Transit Line per F.B. 89-21-22

{Fd. 2 3/4" I.P. set in conc. - Sta. 8 Re. Cien. egg O.R.D. La Tijera per F.B. 89-21 (9" high)}

To Bot. pg. 78)

Date _____ Notes by _____ Chief Party _____ F.B. 289 Pg. 77

84° Tape #40

Plotted by _____
Date _____
Map No. _____
Plotting C'k'd by _____
Date _____

W. O. No. 958 U. S. G. No. _____
Location Vernon Ave.
Surveyed by Evans
Date 2-27-30
Indexed A. C. Johnson

(To Bot. pg. 82)

20

(see p. 85)
Fd. 2" I.P. set in 8" filled with Conc. Nail center 2B+83.72

RANCHO RINCONADA LOS BUEYES

LA INVESTMENT CO. PROPERTY

RANCHO CIENEGA O' PASO DE LA TIJERA.

To N2-34+72.52 per p. 9.82

598.12 @ 0-0 = 598.12
153.04 @ 1-09 = 153.01
245.61 @ 3-29 = 245.16
297.68 @ 3-16 = 297.20
1293.49
T62° 1293.29

6B+9.85 N 72.53-25 E

set 1/2" 5B+1.72

set 1/2" 9+98.21

18.00

90°

22+85.68
Fd. 3" I.P. in 14" Conc. Mon. No tack. See C.S. 8635 & F.B. 29-76

180

21

98.3

20+49

set 1/2" 21+79.23

(23°-21'-15"
98°-24'-30"
18.)

23°-21'-10"

M.R. 3-209

RANCHO LA BALLONA

226.26 @ 3°-37 = 2.25.71
97.03 @ 10-47 = 97.32
677.32 @ 0-0 = 677.32
998.35
.14
998.21
T62°

To first Line

Ranch Line

set 1/2" 5+18.00 Set in Sand

N 18°-00' E

110°-57'-10"

111°-00'-10"

418.63 @ 0-0 = 418.63
165.54 @ 4-35 = 165.00
296.18 @ 2-07 = 297.90
296.65 @ 2-03 = 296.46
299.71 @ 0-59 = 295.17
113.41 @ 6-25 = 112.70
295.42 @ S48 = 293.91
300.00 @ 2-46 = 299.65
2179.51
T64° 2179.23

51.38

L.B. 2

C.P.T. 7

set 1/2" 8+00

18.00

98°

F.B. 269-16 Line per From S.W.

Tract 7937 (Produced)

0+00 going North. Fd. 3/4" I.P. in conc. Mon. marked "H.H." per F.B. 269-19 & 116 - L.B. #2 per C.S. 8635

(111°-00-15
84°-00-45
11.)

(110°-57'
83°-48'
11.)

Tract 7937

136.70 @ 2°-38-T 84° = 136.56

N. Line of Tract 7937 & W. Line of Tract 7937

(Continued on bot. pg. 80)

Bot. pg. 80

(See C.S. 8728)

(See p. 118)

TRACT N: 7937

RETURN TO
LOS ANGELES COUNTY SURVEYOR

Notes: ANY ADDITIONS OR CHANGES ON THIS SHEET MUST BE MADE OR CIRCLED IN Red. WITH DATE AND NAME OF PERSON MAKING CHANGE.

Do not extend notes this side of this line

(To Bk. pg. 79)

F.B. 289 Pg. 78 Chief Party Notes by Date

RETURN TO LOS ANGELES COUNTY SURVEYOR

Do not extend notes this side of this line

Notes: ANY ADDITIONS OR CHANGES ON THIS SHEET MUST BE MADE OR CIRCLED IN Red. WITH DATE AND NAME OF PERSON MAKING CHANGE.

52.22 @ 8-25 = 51.66 ✓
108.20 @ 21-2530 = 100.72 ✓
152.38 ✓
T64° = .02
152.36 ✓

To 1X1 Bet. pg. 79

Set 1X2
45+43.10

299.28 @ 5-19 = 297.99 ✓
272.39 @ 3-28 = 271.89 ✓
53.83 @ 19-14 = 50.83 ✓
192.21 @ 8-55 = 189.89 ✓
299.04 @ 3-14 = 298.56 ✓
177.48 @ 5-05 = 176.78 ✓
44.80 @ 0-0 = 44.80 ✓
1330.74 ✓
T64° = .17 ✓
1330.57 ✓

18 ft. offset Line

Fd. nothing.

LOT 19.

RANCHO RINCON DE LOS BUEYES

M.R. 3-209

RANCHO LA BALLONA

LOT 20.

M.R. 53-25

Set 1X2
3+12.53 ✓

300.61 @ 1-20 = 300.53 ✓
261.88 @ 1-55 = 261.73 ✓
192.04 @ 0-0 = 192.04 ✓
754.30 ✓
T56° = .14 ✓
754.16 ✓

N21°W

25+04.65 ✓
Fd. 1" IP tball
Set nail and tag
See pg. 85

See pg. 85

18.42

462.8

18.56

Fd. 1" IP Tack
Plug Surface

2A+74.63

Set 1X2 Tack
2A+88.97

137.00 @ 5-28 = 136.38 ✓
137.67 @ 4-26 = 137.26 ✓
300.17 @ 0-30 = 300.16 ✓
299.48 @ 0-52 = 299.45 ✓
587.14 @ 0-0 = 587.14 ✓
1460.39 ✓
T60° = .23 ✓
1460.16 ✓

LOT 21

Set 1X2 Tack
Fd. 1" IP Tack
Plug Surface

X

(from Bk. pg. 77)

Date _____ Notes by _____ Chief Party _____ F.B 289 Pg 79

84° Tape #40

Plotted by _____
Date _____
Map No. _____
Plotting C'k'd By _____
Date _____

W. O. No. 958 U. S. O. No. _____
Location Vernon Ave
Surveyed by Evans
Date 2-28-30
Indexed _____

Notes: ANY ADDITIONS OR CHANGES ON THIS SHEET MUST BE MADE OR CIRCLED IN Red. WITH DATE AND NAME OF PERSON MAKING CHANGE.

Do not extend notes this side of this line

RETURN TO LOS ANGELES COUNTY SURVEYOR

70+96.59
Fd. 7"x7" Conc. Mon.-8" deep. With Iron cap 2" diam. Mkd. as shown. This point is on side hill

L.A.C.F.C.D. C.A. C.U.L.

Marked

9.21

8207

R.B.1

set 1"x2" 70+14.52

R.B.6

LOT 15

On hill top. Fd. 10" Conc. Mon. with 2" copper cap Mkd. "H.R. Brown" (on surface)

RANCHO RINCON DE LOS BUEYES

278.02 @ 1°-30 = 277.92 ✓
137.49 @ 0-0 = 137.49 ✓
T64° = 415.41 ✓
.05 ✓
415.36 ✓

LOT 16

set 1"x2" 65+99.16 J

set 1"x2" 62+89.64 J

62+76.07 Fd. 2" I.P. Plug & Tack. (Flush.)

Fd. Nothing

See F.B. 89-124

277.35 @ 4°-44 = 276.40 ✓
299.23 @ 4°-57 = 298.16 ✓
299.17 @ 5°-13 = 297.93 ✓
256.06 @ 9°-54 = 252.25 ✓
86.07 @ 3°-54 = 85.87 ✓
90.03 @ 11°-31 = 88.22 ✓
299.36 @ 6°-10 = 297.63 ✓
298.38 @ 1°-32 = 298.27 ✓
9.22 @ 0-0 = 9.22 ✓
1903.95 ✓
T64° = .25 ✓
1903.70 ✓

LOT 18

Fd. Nothing.

set 1"x1" 46+95.46

46+89.72 Fd. 2" I.P. Small - 1/2" high.

LOT 19

RANCHO LA BALLONA.

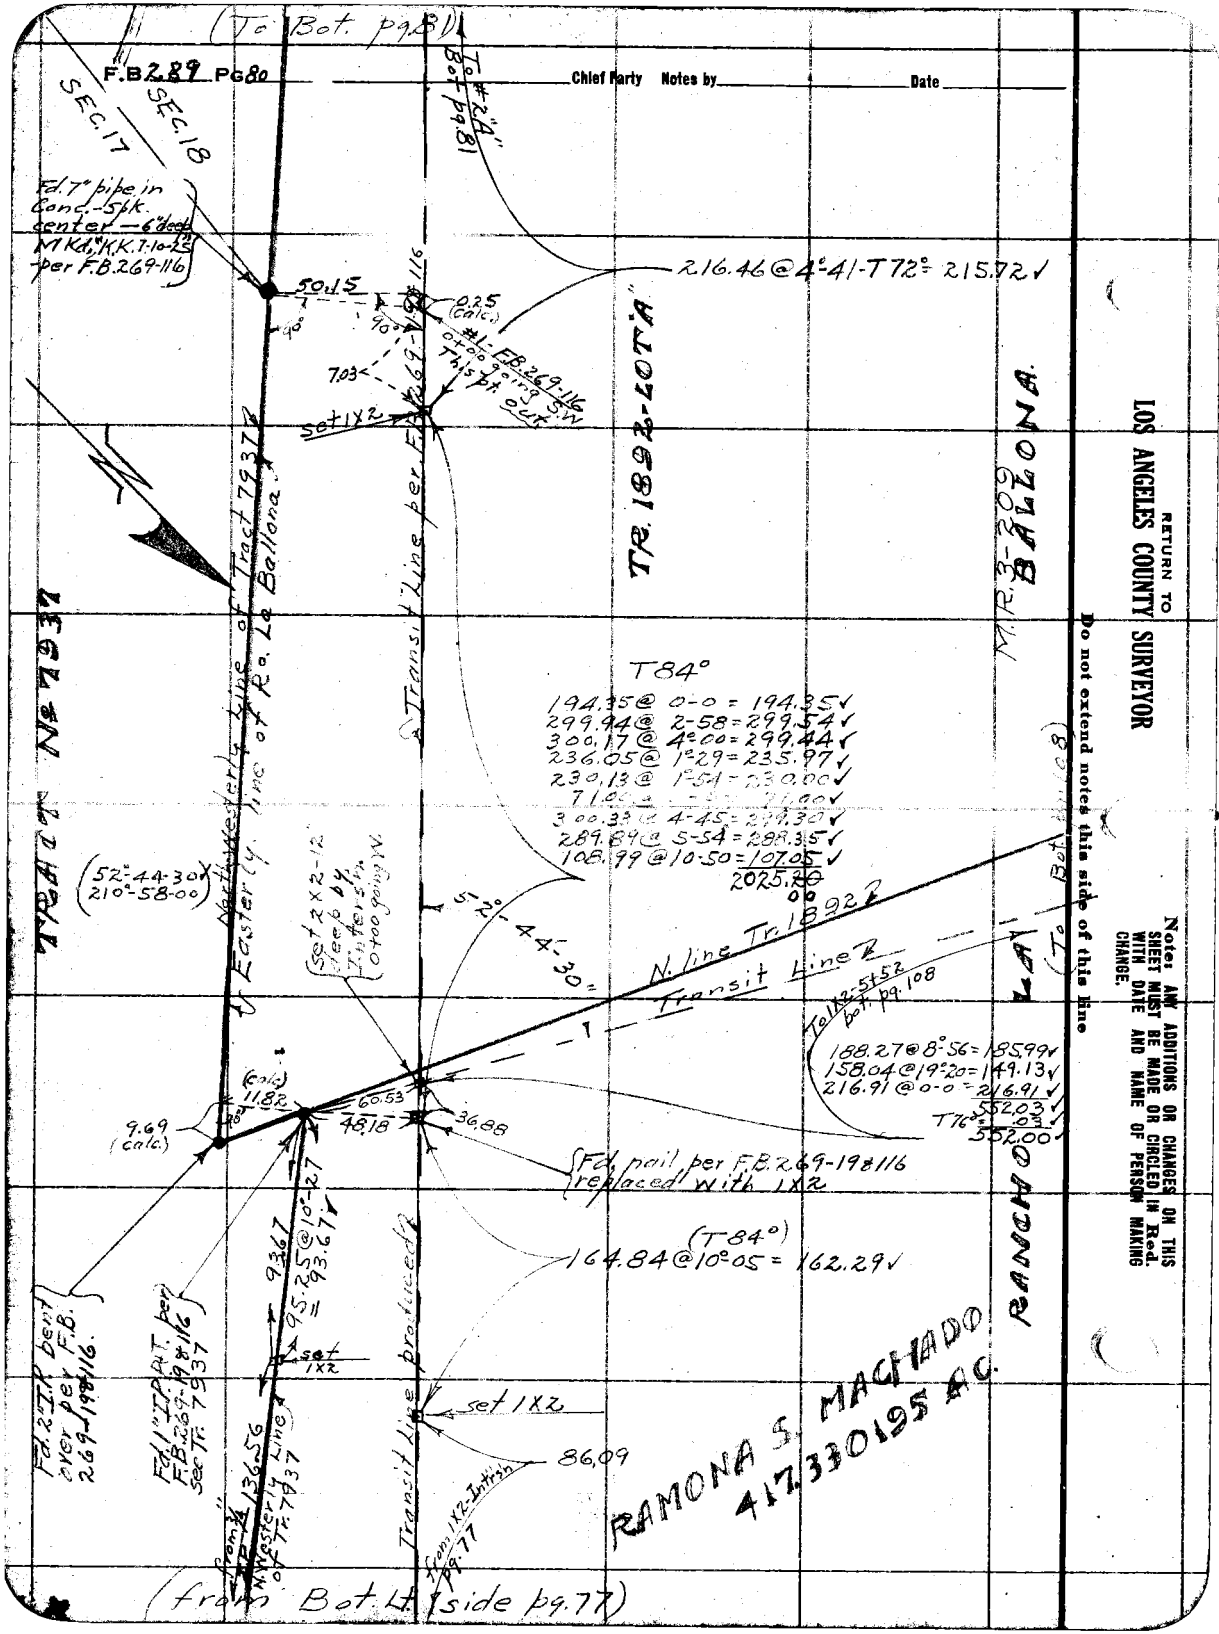
(To Bot. pg.81)
F.B. 289 PG 80
Chief Party
Notes by
Date
SEC. 17
SEC. 18
Fd. 7" pipe in Conc. - 5pk. center - 6" deep M Kd. "K.K. T-10-23" per F.B. 269-116
50.15
0.25 (Calc.)
#1 - F.B. 269-116
Tr. 1892
7.03
Set 1X2
216.46 @ 4°-41 - T 72° = 215.72
Tr. 1892-40 T.A.
M.R. 3-209
BALLONA
Transit Line per F.B. 269-116
Northwesterly Line of Tract 7937 & Easterly Line of R.O. La Ballona
T84°
194.35 @ 0-0 = 194.35
299.94 @ 2-58 = 299.54
300.17 @ 4°00 = 299.44
236.05 @ 1°29 = 235.97
230.13 @ 1°-54 = 230.00
71.00 = 70.90
300.33 @ 4-45 = 299.32
289.84 @ 5-54 = 288.35
108.99 @ 10-50 = 107.05
2025.80
(52°-44-30)
(210°-58-00)
Set 2 x 2 - 12 deep 4 1/2 in. Tie to W. 0.40 going N.W.
5°-12°-44'-30"
N. line Tr. 1892
Transit Line
Tell: 5+52 bot. pg. 108
188.27 @ 8°-56 = 185.99
158.04 @ 19°-20 = 149.13
216.91 @ 0-0 = 216.91
T76° 552.03
552.00
(Calc.) 11.82
9.69 (calc.)
60.53
48.18
36.88
Fd. nail per F.B. 269-198 116 replaced with 1X2
(T84°)
164.84 @ 10°05 = 162.29
Fd. 2" I.P. bent over per F.B. 269-198 116.
Fd. 1" I.P. ART. bent F.B. 269-116 & set Tr. 7937
9367
95.25 @ 10°-27 = 93.67
set 1X2
set 1X2
86.09
RAMONA S. MACHADO
417.330195 A.C.
RANCHO
Tract 4 136/56
N. Easterly Line of Tr. 7937
Transit Line produced
from 1X2 - Within 9.77
(from Bot Lt. Iside pg. 77)
N 25° 37' W 1782.47'
RETURN TO
LOS ANGELES COUNTY SURVEYOR
Do not extend notes this side of this line
Notes: ANY ADDITIONS OR CHANGES ON THIS SHEET MUST BE MADE OR CIRCLED IN Red. WITH DATE AND NAME OF PERSON MAKING CHANGE.

Date _____ Notes by _____ Chief Party _____ F.B. 289 PG 81

(Evans
Martin
Brock
Seelig
Markham)

Platted by _____
Date _____
Map No. _____
Platting Ch'k'd by _____
Date _____

W. O. No. 958 D. S. O. No. _____
Location Vernon Ave.
Surveyed by Evans
Date 3-3-30
Indexed _____

(84° Tape #40)

Fd. 1/2" I.P. in Conc. Sta. #3 L.B. per F.B. 269-119

19.68

Fd. 1X2 #15 - F.B. 269-119

#5 - F.B. 269-117
Fd. 1X2 - 18+51.77

Fd. 1½" I.P. 14" high leaning E. Meas. to base.

Fd. 1½" I.P. per Tr. 1892 L 16" high - See F.B. 269-117

14.46

Eucalyptus trees

20.22

Line 2 on line of Tr. 1892

23.42

42.53

20 ft. offset

Line 2 (1036.47 per pg. 107)

To 1X2 Bot pg. 107

(To Bot pg. 107)

set 1X2

38.58

To foresight off ridge

set 1X2 on line 0.12 E. of 0+87.70

74°-30'-25"

(74°-30-30
298°-01-30
23.

S. 89°50' E. Easterly Line of Rancho La Ballona

Set 2X2 - 30" high, 6 grooves, 6 saws, deep, #44

91.44 @ 16°-29'-30" - T72° = 87.70'

Line 2

269-116-195

3+70.79
#3"A" set 1X2 by transiting in

TR. 1892 - LOT "B"

163.89 @ 90°2 - T72° = 161.85'

Transit Line per pg. 89 ST.

HILL

Fd. 2" I.P. R.E. Mkd. T.A.P. Co. per F.B. 269-116 (4" high)

Transit per F.B.

12.42

49.21

#2"A" - 2X2 - Intersn

2+08.94 going S. per pg. 89

This pipe fd. plowed out

from top pg. 80)

Notes: ANY ADDITIONS OR CHANGES ON THIS SHEET MUST BE MADE OR CIRCLED IN Red. WITH DATE AND NAME OF PERSON MAKING CHANGE.

Do not extend notes this side of this line

RETURN TO
LOS ANGELES COUNTY SURVEYOR

(To Bot. of Pg. 83)

F.B. 282 PG. 82 — Chief Party Notes by _____ Date _____

17

Bot. of Pg. 83.

256.70 @ 6-11 = 255.21
240.14 @ 4-26 = 239.42
494.63
T66° = .06
494.57

51+86.24
Fd. 2" I.P. - 6" high set in conc. see C.S. 8635 - Plug + Tack

0.86

1330

Set 1X2

10.00

90°

Set 1X2
51+72.94

MONNIER
F.B. 89-126

260.78 @ 6-05 = 259.31
92.49 @ 10-00 = 91.08
298.57 @ 5-21 = 297.24
647.63
T66° = .08
647.55

SAN GABRIEL RIVER M.R. 3-25

LANE

18

Set 1X2
45+25.39

5940

8.49

44+65.90
Fd. 2" I.P. set in conc. 8" high - see C.S. 8635
This point has been disturbed. Plug + tack 0.42 West

FB. 89-125

344.88 @ 9-0 = 344.80
297.50 @ 7-57 = 294.64
639.52
T66° .07
639.45

Ranch Line

N 17° E = North

19

Set 1X2
38+85.94

35+69.17
Fd. 2" I.P. + T
3" high - C.S. 8635

1.60

Fd. 2" I.P. + T
SE corner of gum trees

2665'

300.03 @ 7-08 = 297.71
115.76 @ 0-0 = 115.76
413.47
T66° .05
413.42

Set Nail

10.00

90°

Set 1X2
34+72.52

20

(From top Rt. pg. 77)

RANCHO CIENEGA DE LA TIJERA

RETURN TO LOS ANGELES COUNTY SURVEYOR

Do not extend notes this side of this line

Note: ANY ADDITIONS OR CHANGES ON THIS SHEET MUST BE MADE OR CIRCLED IN Red. WITH DATE AND NAME OF PERSON MAKING CHANGE.

Date _____ Notes by _____ Chief Party _____ F.B. 289 Pg. 83

84' Tape #46

Plotted by _____
Date _____
Map No. _____
Plotting Ck'd by _____
Date _____

W. O. No. 958 B. S. G. No. _____
Location Vernon Ave.
Surveyed by Evans
Date 3-5-30
Indexed A. C. Johnson

13

(To Bot. pg. 84)

MOYNIER LANE

30'

Fd. 2" I.P. P&T 6" brig. 71+67.22

29.81

20.41

Set S.V.M.T. 70+86.81

10.02

29.86

(2" deep) Fd. 2" I.P. P&T and remains of conc. Mon. see C.S. 8635 and F.B. 29-75-76-79 76+76.79

156.62 @ 14-59 = 151.30 ✓
296.32 @ 23-55-30 = 270.86 ✓
297.89 @ 4-56 = 296.79 ✓
148.84 @ 0-0 = 148.84 ✓
867.79 ✓
T60° = 14 ✓
867.65 ✓

See F.B. 89-129

Set 1x2 62+19.16

123.23 @ 4-34 - T58° = 122.82 ✓

Set 1x2 by transiting in between end pts. 60+96.34

236.24 @ 8-18 = 233.77 ✓
200.96 @ 13-50 = 195.13 ✓
428.90 ✓
T58° = .07
428.83 ✓

Set 1x2 56+67.51

56+58.33 Fd. 2" I.P. P&T set in conc. See C.S. 8635

9.18

0.57

(from top pg. 82)

RANCHO RINCON de los BUEYES M.R. 53-25

RANCHO CIENEGA O' PASO de la TIJERA

17

Notes: ANY ADDITIONS OR CHANGES ON THIS SHEET MUST BE MADE OR CIRCLED IN Red. WITH DATE AND NAME OF PERSON MAKING CHANGE.

Do not extend notes this side of this line

RETURN TO LOS ANGELES COUNTY SURVEYOR

F.B. 289 Pg. 84 Chief Party Notes by Date

Fd 1" I.P. P.T. - 4" deep by ties per L.B. 614-67, see also p93. 63-66 - Angle Pt. per F.B. 29-79. P.T. 110+24.84

0.12

0.06

Fd. 2 x 2 on surface

200.27

LANE

Fd. 2" I.P. + nail with remains of conc. Mon. See F.B. 29-79 - This Pt. has been disturbed. 108+24.57

200.29.76

0.12

MOYNIER Road Line

696.41 @ 0-0 = 696.41
299.08 @ 1-46 = 298.94
299.19 @ 0-32 = 299.18
1294.53
T66 = .15
1294.38

29

97+34.91

(falls 0.24 L. of line

P.E. R.Y.

SANTA MONICA AIR LINE

0.24

203.72

12

sets N & T. 95+30.19

M.R. 53-25

30' 30'

HIGUERA ST.

298.26 @ 1-43 = 298.89
299.05 @ 1-54 = 298.89
184.65 @ 0-0 = 184.65
T66 = .15
2443.69
2443.29
2443.84

13

from SW & T. 96+89.83

(from Tot Pg. 83)

RETURN TO LOS ANGELES COUNTY SURVEYOR

Do not extend notes this side of this line

Note: ANY ADDITIONS OR CHANGES ON THIS SHEET MUST BE MADE OR CIRCLED IN Red. WITH DATE AND NAME OF PERSON MAKING CHANGE.

Date _____ Notes by _____ Chief Party _____ F.B. 289 Pg. 85

84° Tape #40.

Platted by	W. O. No. 958 D. S. O. No.
Date	Location Vernon Ave
Map No.	Surveyed by Evans
Platting Ch'k'd by	Date 3-6-30
Date	Indexed A. C. Johnson

117.95 @ 7-18 = 116.86 ✓
88.42 @ 7-11 = 87.73 ✓
204.59 ✓
T 68° = .02 ✓
204.57 ✓

1 x 2 - 2 1/2 + 79.23 Rt. Side pg. 77

℄ Ranch Line per pg. 77 (Rt.)

2" I.P. & nail set in conc. 23 + 83.68 from South. - pg. 77

1.00

Set 1 x 2 by Intrsn.

85°09'15"

(85°09'15)
(340°37'30)
23.

M. R. 53 - 25

20

21

26.15 @ 0-0 = 26.15 ✓
47.36 @ 2-50 = 47.36 ✓
221.40 @ 10°18 = 221.40 ✓
109.24 @ 4°07 = 109.24 ✓
298.87 @ 8°56 = 298.87 ✓
T. 68° = 994.68 ✓
994.68 ✓

71°29'35"

2" I.P. & nail set in conc. 25 + 04.65 from South per pg. 78

per pg. 78 ✓

1 x 2 - 24 + 58.37 pg. 78

19.58

52.52

918 ft. of ℄ set line

Set 1 x 2 by Intrsn.

(71°29'30)
(285°55'15)
34.

Notes: ANY ADDITIONS OR CHANGES ON THIS SHEET MUST BE MADE OR CIRCLED IN Red. WITH DATE AND NAME OF PERSON MAKING CHANGE.

Do not extend notes this side of this line

RETURN TO LOS ANGELES COUNTY SURVEYOR

F.B. 289 Pg. 86 Chief Party Notes by Date

(To Bot pg 87.)

300.36 @ 0-54 = 300.32 ✓
299.73 @ 2-05 = 299.53 ✓
599.85 ✓
T 12° = .05 ✓
599.80 ✓

To W.H.T. Bot pg 87

S. M. de Bernardo
30.89 Ac.

Set S.W.O.T. by Intersection 24+05.40 from E.

AVE.

{Fd. old 5"x6" post 16" deep. May be fnc. post. Very rotten

3.09 ft

1.67 ft

286.36 @ 1-34 - T 80° = 286.24 ✓

20' offset line See pg 109

57-56'25"

16.28

14.30

OVERLAND

Set T.

{Fd. 2" I.P. 6" high No. tack.

661.47 - T 22° = 661.72 ✓

(Florence St)

(Found 0.6 ft. 107)

M.P.

Set 2"x4"-12" deep by Intersn.-P.I.

127°-50'-40"

(S 56-30 E 231.45-45)

(127°-50-45 51°-22-30)

38'

8.91

set nail

Fd. 16.50

16.50

Fd. 1" I.P. (surface) per F.B. 269-124

set nail

PLAYA ST. per F.B. 269-124

JEFFERSON ST.

S 89°50-W

Fd. S.W.O.T. - 12+47.57 per F.B. 269-125

RETURN TO
LOS ANGELES COUNTY SURVEYOR

Do not extend notes this side of this line

Note: ANY ADDITIONS OR CHANGES ON THIS SHEET MUST BE MADE OR CIRCLED IN Red. WITH DATE AND NAME OF PERSON MAKING CHANGE.

Date _____ Notes by _____ Chief Party _____ F.B. 289 PG 87

(84° Tape.)

Platted by	W. O. No. 458 D. S. B. No.
Date	Location Vernon Ave
Map No.	Surveyed by Evans
Platting C'k'd by	Date 4-3-20
Date	Indexed C. Tolman

(To Bot. pg 88)

To P.I. Per pg 88.

1146.13 - T72° = 1146.04 ✓

(165°-57'-30"
315°-50'-30"
38.

168.57'-35"

Fd. 2" I.P. P&T - 24" deep per Tr. 3755

16.50
158
16.50

P.I. - set 2x2 12" deep by Intsn

TRACT No. 3755

300.10 @ 1-26 = 300.01 ✓
56.17 @ 0-0 = 56.17 ✓
356.19
T72° = .03
356.15

Fd. 2" I.P. P&T - 18" deep per Tract 3755

AVE.

1646.2

HILL ST.

Set 2x2 - 12" deep by Intersection 10+00 going East.

10.5
16.

Mag = S 73°-00 E.
Transit Line

58.92
46.15

To Bot. pg 89

Set N&T

75°-36'-40"

OVERLAND

Mag = N 2°-00 E.

299.80 @ 1-11 = 299.74 ✓
298.956 @ 2°-55 = 298.56 ✓
295.22 @ 9°-12 = 291.42 ✓
243.97 @ 20°-06 = 229.11 ✓
18.04 @ 0-0 = 18.04 ✓
1136.87 ✓
T64° = .15 ✓
1136.72 ✓

(75°-36-45
302°-26-45
41.

from top pg 86

Notes: ANY ADDITIONS OR CHANGES ON THIS SHEET MUST BE MADE OR CIRCLED IN Red. WITH DATE AND NAME OF PERSON MAKING CHANGE.

Do not extend notes this side of this line

RETURN TO LOS ANGELES COUNTY SURVEYOR

F.B. 289 Pg. 88 — Chief Party — Notes by — Date

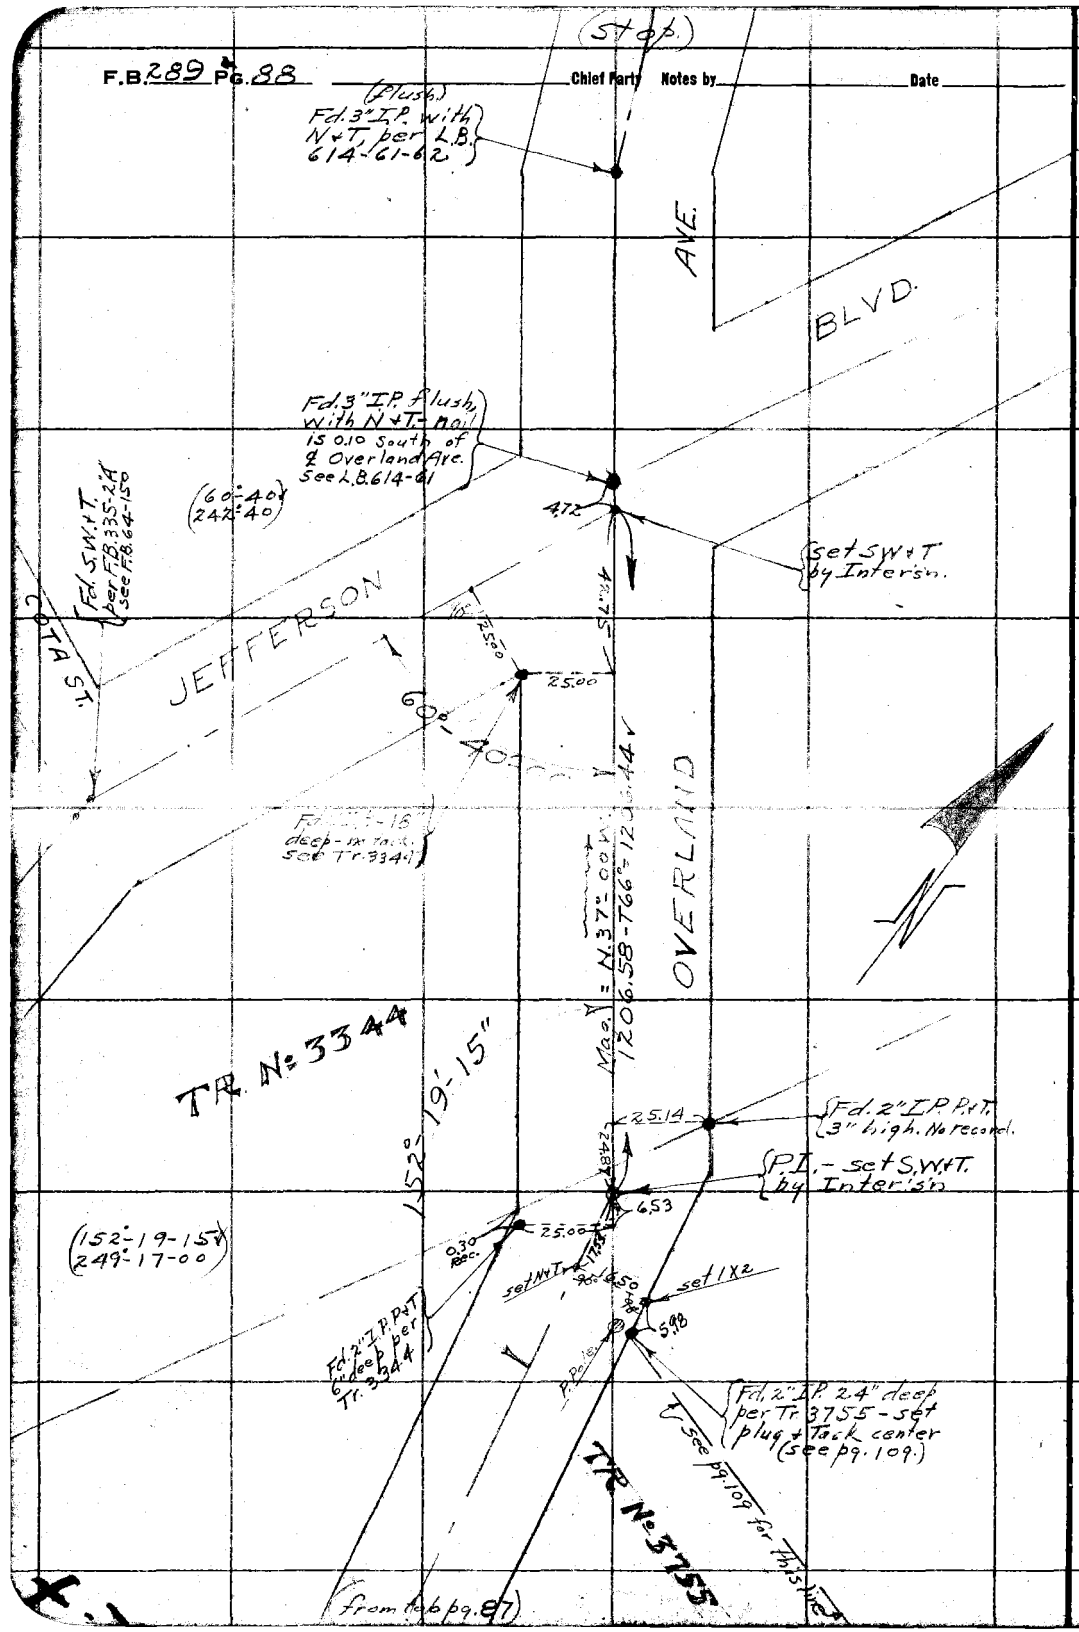

Date _____ Notes by _____ Chief Party _____ F.B. 289 Pg 87 (84° Tape)

Platted by _____ Date _____ Map No. _____ Platting Verified by _____ Date _____

W. O. No. 958 D. S. O. No. _____ Location Vernon Ave. Surveyed by Evans. Date 4-7+30 Indexed _____

Note: ANY ADDITIONS OR CHANGES ON THIS SHEET MUST BE MADE OR CIRCLED IN Red. WITH DATE AND NAME OF PERSON MAKING CHANGE.

Do not extend notes this side of this line

RETURN TO LOS ANGELES COUNTY SURVEYOR

Transit Line per P.S. 80-81

9929@19°01-T64=9.97✓

1X2 per P.S. 80-81

56°50'05"

215.72

4.99

16.52

(56°50-00
227°20-15
04.

Fd. 2" I.P. & B.C. Mkd. "P.A.P. Co." 4" high - Per F.B. 269-116

Easterly Line C.S. 8950-1 Rº. La Ballona

161.85

#2"A" p9.81 33+38.26 from East set 2X2 by Inferen 12" deep

#3"A" 1X2 Per P.S. 81

32+46.29 set 1X2 flush.

TRACT Nº 1862 LOT "A"

85.50@2-35=85.41✓
298.67@2-23=298.41✓
23.50@0-0=23.50✓
407.32✓
T72°=.03✓
407.29✓

D. Machado 38.66 Ac.

28+39.00 Set 2X2 12" deep

299.61@2-37=299.30✓
282.10@3-42=281.51✓
580.81✓
T72°=.05✓
580.76✓

22+58.24 Set 2X2 12" deep.

ST.

19+74.97 Fd. 2" I.P. (no tack) 2" deep. S.E. Cor. Tr. 3755

300.68@10°-15-T72°=295.86✓

24.38
12.59

18908@11°43'30=185.13✓
16.75@0-0=16.75✓
201.88✓
T72°=.02✓
201.86✓

19762.38 Set 2X2 12" deep

17+69.52 Set 2X2 12" deep.

Line 7

299.34@1°56'30=299.17✓
324.70@0-0=324.70✓
623.87✓
T64°=.07
623.80✓

Tr. Nº 1892 - Lot "B"

Tr. Nº 3755

HILL

Transit Mag. = S 73°E.

S. M. de Bernardo 30.89 Ac.

14+36.72 Set 1X2 Stake. (Flush)

(From R.H. side p9.87)

F.B. 289 PG. 90 Chief Party Notes by Date

SURVEY OF PROPOSED VERNON AVE. from LABREA AVE to FAIRWAY DR.

H.F. Evans - Dep.
Henry Martin - K
Geo. F. Brock - H.C.
D.S. Sedig - R.C.
Ray Markham - Ex

RETURN TO
LOS ANGELES COUNTY SURVEYOR

Do not extend notes this side of this line

Note: ANY ADDITIONS OR CHANGES ON THIS SHEET MUST BE MADE OR CIRCLED IN Red. WITH DATE AND NAME OF PERSON MAKING CHANGE.

Date _____ Notes by _____ Chief Party _____ F.B. 289 Pg. 91

Plotted by J. D. Price	W. O. No. 958 D. S. O. No.
Date April, 1930.	Location Vernon Ave
Map No. c.s. B-581	Surveyed by Evans
Plotting C'k'd by R.W.M.s	Date 3-18-30
Date 4/18/30	Indexed A. C. Johnson

Note: ANY ADDITIONS OR CHANGES ON THIS SHEET MUST BE MADE OR CIRCLED IN Red. WITH DATE AND NAME OF PERSON MAKING CHANGE.

Do not extend notes this side of this line

RETURN TO LOS ANGELES COUNTY SURVEYOR

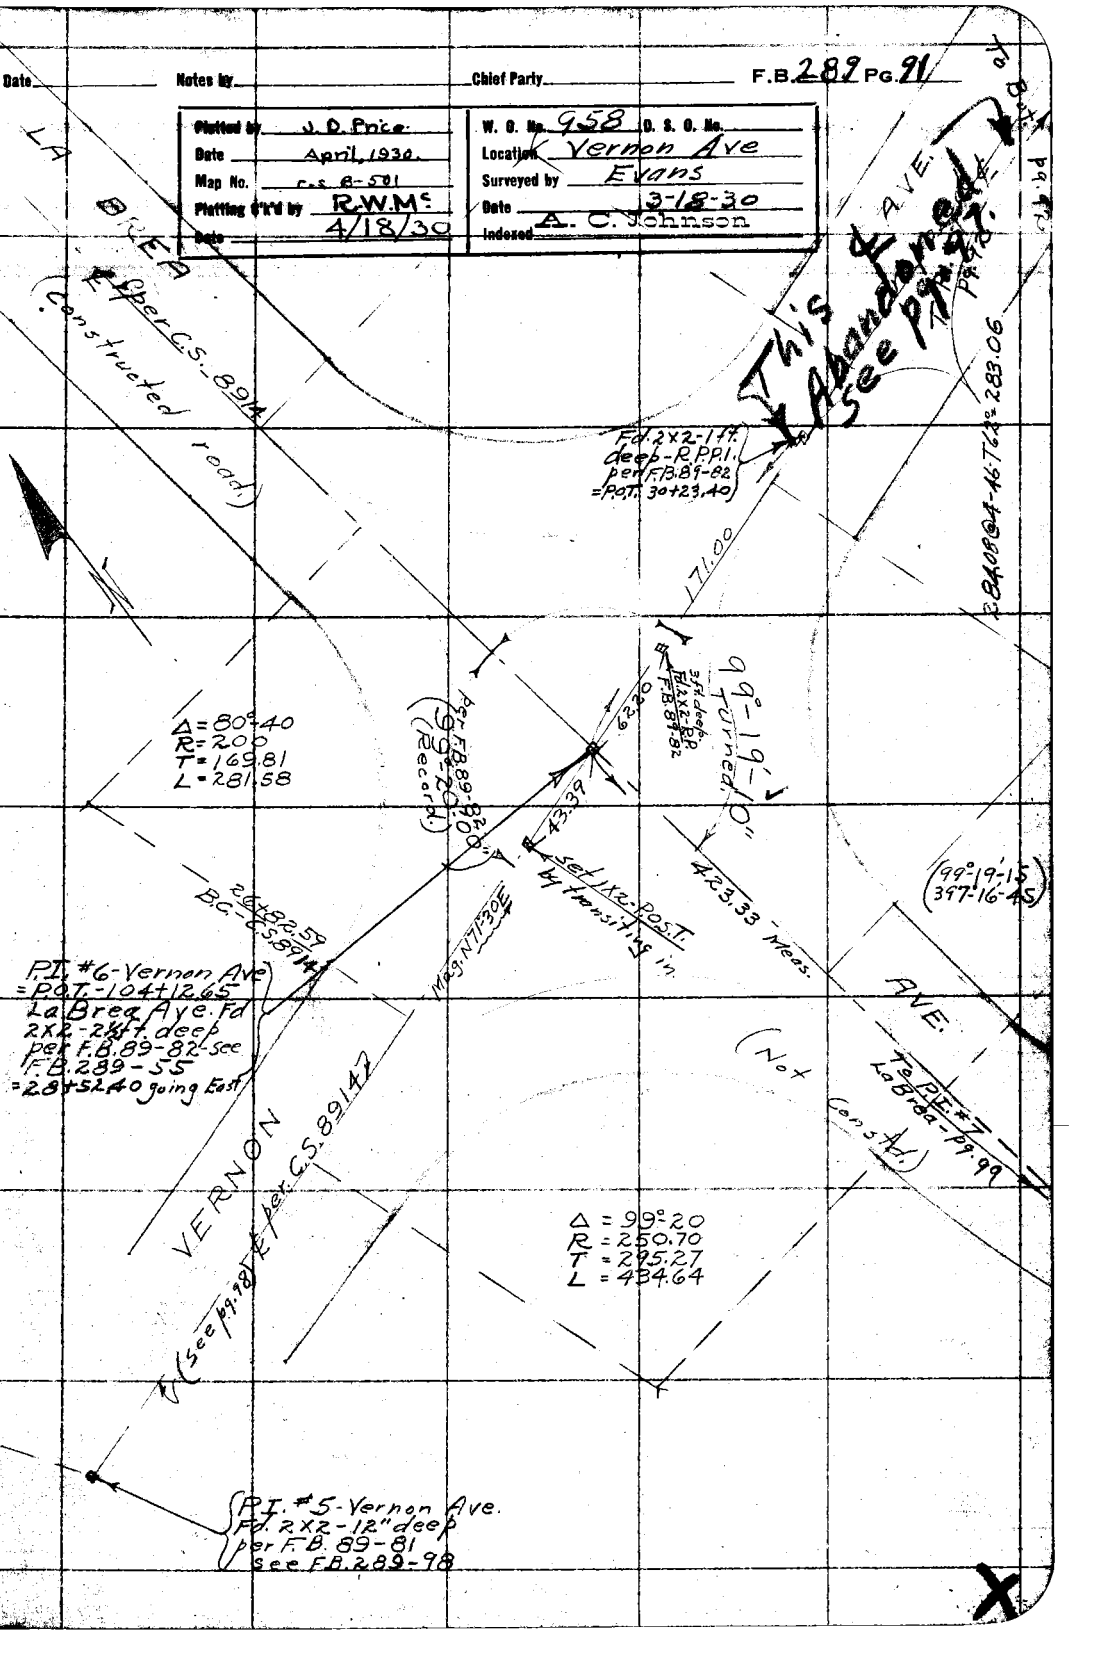

F.B. 289 PG. 92 Chief Party Notes by Date

To Bot. p9.93

To PRT-36+50 Rt. p9.93

This is Abandoned - See p9.97 for new location

Mag = N52°E.

212.41 @ 3-14 = 211.86
135.29 @ 0-0 = 135.29
347.15
T62° = .05
347.10

34+75.36 E.C.
Set 2x2-14" deep

Δ = 19°32'-45"
R = 1000
T = 172.24
L = 341.14

150.27-15 Curve

PI #7 - Vernon Ave.
Set 2x2-14" deep

31+34.22 B.C.
Set 2x2-12" deep

VERNON AVE.

(Proposed ℄ location)

(19°32'-45"
78°11'-00")

19°32'-45"

To foresight on Tang. Prod.

(From top p9.91)

RETURN TO
LOS ANGELES COUNTY SURVEYOR

Do not extend notes this side of this line

Note: ANY ADDITIONS OR CHANGES ON THIS SHEET MUST BE MADE OR CIRCLED IN Red. WITH DATE AND NAME OF PERSON MAKING CHANGE.

Date _____ Notes by _____ Chief Party _____ F.B. 289 PG. 93

Platted by	W. O. No. 958 D. S. O. No.
Date	Location Vernon Ave
Map No.	Surveyed by Evans
Platting C'k'd by	Date 3-19-30
Date	Indexed A. C. Johnson

(84° Tape)

(To Bot pg. 94)

To P.O.T. pg. 94

298.69 @ 3-59 = 297.97
299.40 @ 1-12 = 299.33
288.83 @ 1-18 = 288.76
886.06
T68° = .09
885.97

Note: ANY ADDITIONS OR CHANGES ON THIS SHEET MUST BE MADE OR CIRCLED IN Red. WITH DATE AND NAME OF PERSON MAKING CHANGE.

Do not extend notes this side of this line

RETURN TO LOS ANGELES COUNTY SURVEYOR

P.O.T. - 45+19.38
Set 2x2 - 16" deep

Old location of Vernon Ave. This & Abandoned - see pg. 97

Monument

N25°W

297.95 @ 2-17 = 297.71
95.31 @ 1-29 = 95.28
392.99
T68° = .04
392.95

P.O.T. - 41+26.43
Set 2x2 - 16" deep

VERNON

T 476.26 - T68° = 476.21

P.O.T. - 36+50.22
Set 2x2 - 16" deep

(From top pg. 92)

F.B. 289 Pg. 94 Chief Party Notes by Date

RETURN TO
LOS ANGELES COUNTY SURVEYOR
Do not extend notes this side of this line

Notes: ANY ADDITIONS OR CHANGES ON THIS SHEET MUST BE MADE OR CIRCLED IN Red. WITH DATE AND NAME OF PERSON MAKING CHANGE.

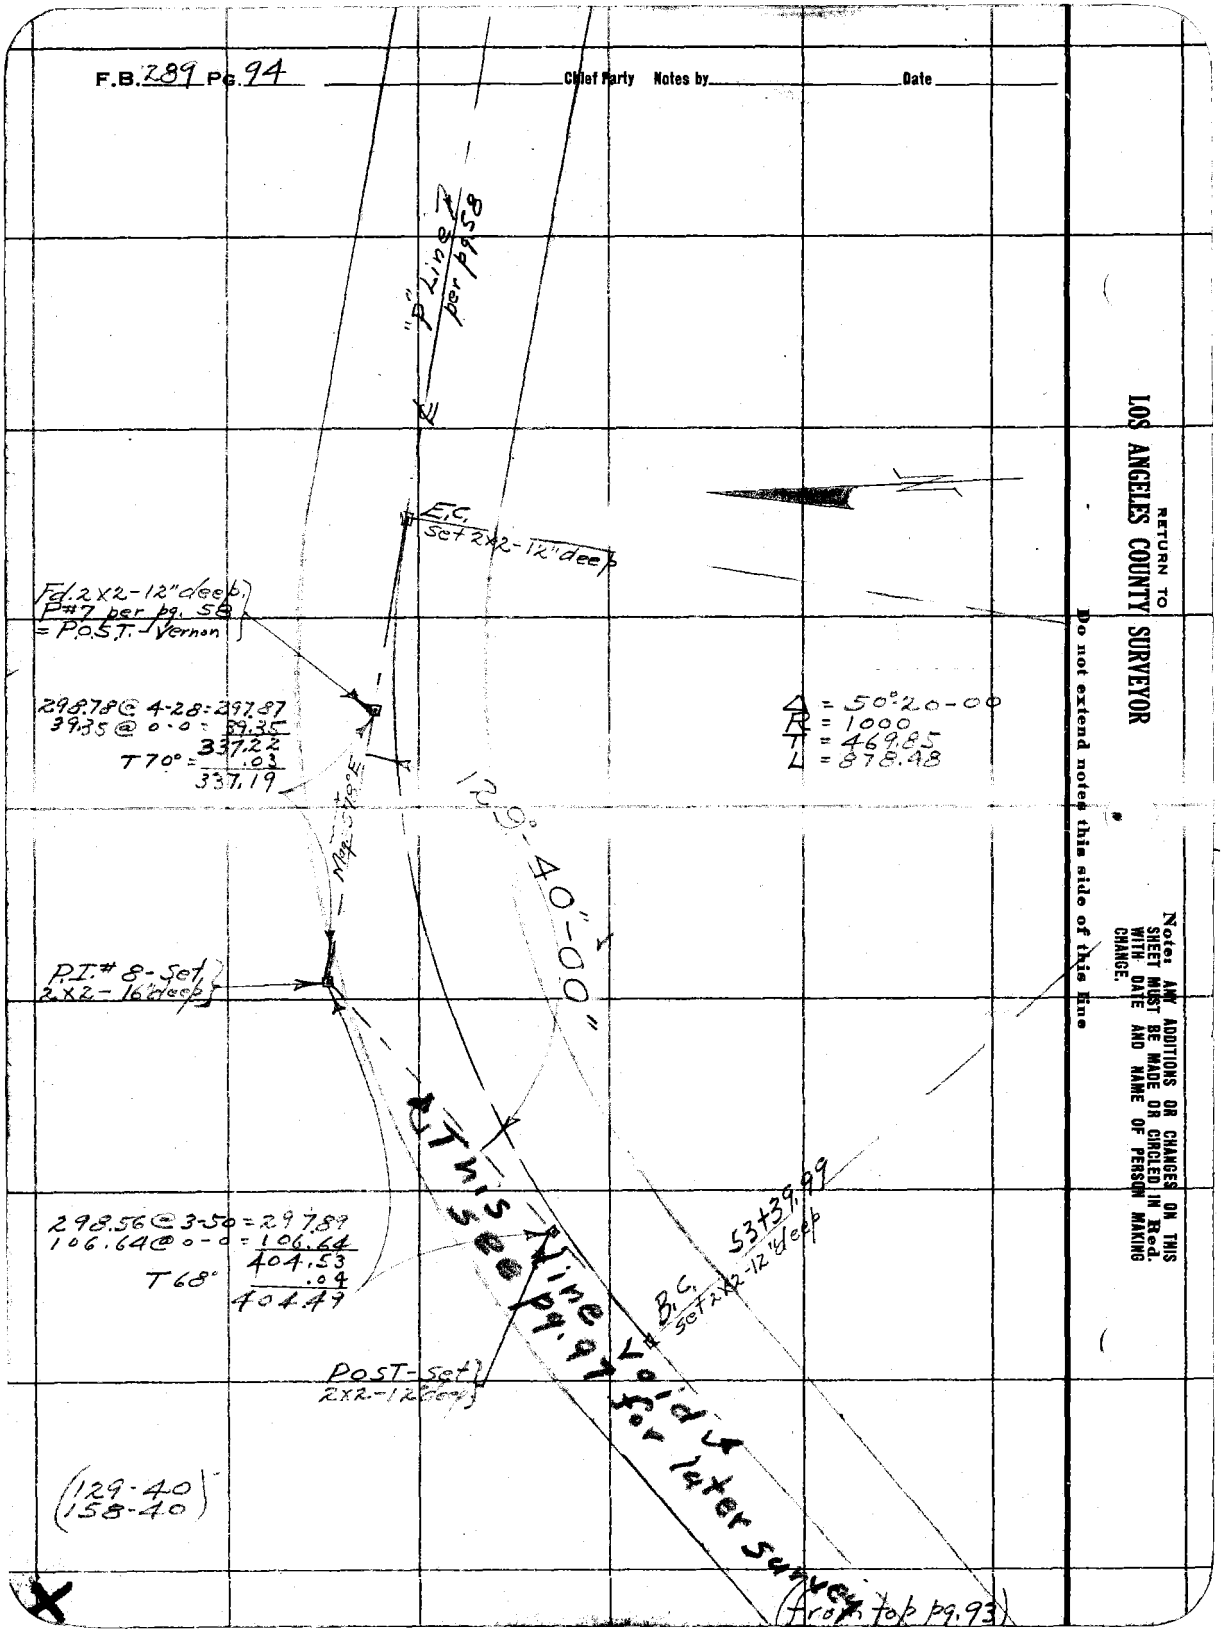

Date _____ Notes by _____ Chief Party _____ F.B. 289 PG. 95

Platted by	W. O. No. _____ D. S. O. No. _____
Date	Location
Map No.	Surveyed by
Platting C'k'd by	Date
Date	Indexed A. C. Johnson

Note: ANY ADDITIONS OR CHANGES ON THIS SHEET MUST BE MADE OR CIRCLED IN Red. WITH DATE AND NAME OF PERSON MAKING CHANGE.

Do not extend notes this side of this line

RETURN TO
LOS ANGELES COUNTY SURVEYOR

F.B. 289 PG. 96 Chief Party Notes by Date

SURVEY OF PROPOSED VERNON AVE. ("A" LINE.)

from

P.I. #4 - VERNON AVE. (C.S. 8914)

east to, & connecting with

FAIRWAY BLVD. - and - VERNON AVE

H.F. Evans - Dep.
Henry Martin - R
G.F. Brock - H.C.
D.S. Sedig - R.C.
R. Markham - Ex.

RETURN TO
LOS ANGELES COUNTY SURVEYOR

Do not extend notes this side of this line

Notes. ANY ADDITIONS OR CHANGES ON THIS SHEET MUST BE MADE OR CIRCLED IN Red. WITH DATE AND NAME OF PERSON MAKING CHANGE.

Date _____ Notes by _____ Chief Party _____ F.B. 289 PG. 97

(84° Tape)

Plotted by J. D. Price.	W. O. No. 958 B. S. O. No.
Date 4-15-'30.	Location Vernon Ave
Map No. C. S. B-501	Surveyed by Engrs.
Plotting Ch'k'd by R.W.M.s	Date 3-21-'29
Date 4/18/30	Indexed A. C. Johnson

(To Bgn. pg. 98)

299.25 @ 3°-05 = 298.82 ✓
28.51 @ 19°-10 = 26.93 ✓
258.42 @ 0°-0 = 258.42 ✓
26.43 @ 0°-0 = 26.43 ✓
T 88° = 610.60 ✓
.02 ✓
610.62 ✓

To P.I. #5 pg. 98

Mag. = 5.31°45 E.

(610.33 Rec.)

E.C.

P.I. #4 - Fd. Conc. Mon. with 3 pkt T. center set by Rd. Dep't. 12" deep - Set punch mark in top on line of Tr'ynd R.P.s & rec. dist. from R.P. N.W. of P.I.

Fd. 2 x 2 L.B. 89-80 on surface

16.42 S.80

S.80

Rad. 93.66

Rad. Dep't spk.

16.42 S.80 R.P. 12" deep L.B. 89-80

VERNON AVE. (Constructed road)

per C.S. 8914 & per C.S. 8914

174.70 ✓ per C.S. 8914

(Record)
Δ = 86°-49-45 ✓
R = 200
T = 189.23
L = 303.09 ✓✓✓

Notes: ANY ADDITIONS OR CHANGES ON THIS SHEET MUST BE MADE OR CIRCLED IN Red. WITH DATE AND NAME OF PERSON MAKING CHANGE.

Do not extend notes this side of this line

RETURN TO LOS ANGELES COUNTY SURVEYOR

(To Bot. pg. 91)

F.B. 289 PG. 98

Chief Party _____ Notes by _____ Date _____

(To Bot. pg. 99)

RETURN TO
LOS ANGELES COUNTY SURVEYOR

Do not extend notes this side of this line

Notes: ANY ADDITIONS OR CHANGES ON THIS SHEET MUST BE MADE OR CIRCLED IN Red. WITH DATE AND NAME OF PERSON MAKING CHANGE.

VERNON AVE. (C.S. 8914)

Const. Traced road

PROPOSED VERNON AVE. "A" Line

Transit Line

P.O.T. - 25+13.95 Set 2x2-12" deep.

set 1x2 by transiting in Pt. "Z"

Mag. S 51°E

T 84°
296.37 @ 4°33' = 295.41
35.00 @ 0-0 = 35.00
330.41

300.76 @ 1°52' = 300.60
300.65 @ 1°55' = 300.47
77.32 @ 3°50' = 77.25
T 88° 678.22
678.32

Δ = 16°-40'-15" (Δ = 16°-40'-00" Rec.)

R = 250 - 45°

T = 197.64

L = 202.11

250 - 22°-52'-30" - 197.64 - 202.11

45°-42'-10"

Fd. 2x2 - R.P. 12" deep per F.B. 89-91

Per F.B. 89-81 P.I. #5 - Fd. 2x2 in "deep. - Set c/p in rock by Int's and R.P.'s (See pg. 91)

464.11 - T 84°

103°-20'-35"

21+07.27

E.C. Set 2x2 3" deep.

Calc. + Turned. 154°-07'-30"

(Calc. + Meas.) 140.21

(122.40 Meas. 122.33 Rec.)

Fd. 2x2 - R.P. 12" deep per F.B. 89-91

19+24.37

Set 2x2 3" deep

57.43

P.I. #5 "A" Set 2x2-12" below road surface

(154°-07'-30" 256°-30'-00")

(45°-42'-15" 182°-48'-30")

(103°-20'-30" 53°-22'-30")

To C.S. 8914 P.I. #4 - 610.62 Pg. 99

From C.S. 8914 P.I. #4 - 1197.97

Date _____ Notes by _____ Chief Party _____ F.B. 289 PG. 99

(84° Tape)

Plotted by J.D. Price	W. O. No. 958 B. S. O. No.
Date April, 1930	Location Vernon Ave
Map No. C.S. 8-501	Surveyed by Evans
Plotting Chkd by R.W.M.E.	Date 3-24-30
Date 4/18/30	Indexed C. Johnson

(To B.of A. Pg 100)

To P.O.T. - Pg. 100

PROPOSED VERNON AVE.

N47°30E

677.20 - T 84°

56°-22-30
225°-29-30

T 84°
299.42 @ 1-14 = 299.35
299.44 @ 1-48 = 299.29
95.54 @ 0-0 = 95.54
694.18

POT - 36+43.72
Set 2x2 - 14" deep

"A" Line

See F.B. 289-143

3+08.39

AVE.

(56°-22-30
225°-29-30)

2" I.P. 2.5' Meas.

F.C. Set 1x2 14" deep

C.S. 8914 (Not constructed)

S6° E Calc.

Abandon

LA BREA

(From C.S. 8914 E. side Hwy)

P.I. #7 - La Brea Ave. - Fd 2x2 per F.B. 89-62 = Post. - "A" Line

C.S. 8914 VERNON AVE.

Δ = 75°-05'-20"
R = 450
T = 345.85
L = 589.75

109°-59-25"

104°-54-40" Turned Calc.

T 180.00

P.I. #6A Set 2x2 14" deep

(109°-59-30
79°-57-30)

(104°-54-45
39°-38-30)

257+18.64

T 84°
298.54 @ 1°-55 = 298.37
62.40 @ 0-0 = 62.40
360.77

B.C. Set 1x2 12" deep

POT - 25+35.95 - 350.54 - TOE

To P.I. 2 Pg. 98

To P.I. 1 Pg. 98

(Pg. 98)

Note: ANY ADDITIONS OR CHANGES ON THIS SHEET MUST BE MADE ON CIRCLED IN Red. WITH DATE AND NAME OF PERSON MAKING CHANGE.

Do not extend notes this side of this line

RETURN TO LOS ANGELES COUNTY SURVEYOR

(To Bot. pg. 101)

F.B. 289 PG. 100 Chief Party Notes by Date

To Post pg. 101

299.39 @ 3-35 = 29880
300.01 @ 0-55 = 299.97
296.93 @ 1-29 = 296.83
895.60
T 80° = .02
895.58

N 47°30' E.

AVE.

POT - 47+63.52
Set 2x2 - 14" deep.

300.76 @ 1-57 = 300.59
142.11 @ 2-04 = 142.02
442.61
T 80° = .01
442.60

"A" Line

PROPOSED VERNON

P.O.T. - 43+20.92
Set 2x2 - 14" deep

(From top pg. 99)

RETURN TO
LOS ANGELES COUNTY SURVEYOR

Do not extend notes this side of this line

Notes: ANY ADDITIONS OR CHANGES ON THIS SHEET MUST BE MADE OR CIRCLED IN Red. WITH DATE AND NAME OF PERSON MAKING CHANGE.

Date _____ Notes by _____ Chief Party _____ F.B. 289 Pg. 101

(84° Tape)

Plotted by J. D. Price	W. O. No. 958 B. S. O. No.
Date April, 1930	Location Vernon Ave.
Map No. C.S. B-501	Surveyed by E. Voris
Plotting C'k'd by R.W.M.c	Date 3-26-39
Date 4/18/30	Indexed A. C. Johnson

To / Bk. pg. 102

412.34 (pg. 58)

To P.O.T. bot pg. 102

P#7-pg. 58+94 2x2-12" deep = P.O.S.T. "A" Line

E.I. 2x2-12" deep per pg. 94

55+06.16

old P.I. #8 per pg. 94 = P.O.S.T. "A" Line

337.19

P.I. #7"A" set 2x2 14" deep.

Calc. + Meas. 51.77

Calc. + turned 124-54-20"

Total Curve: = 55°-05'-40" = 1000.62 ΔR = 521.62 T = 964.58

Δ=50°-20'-00" R=1000 pg. 94

P.O.C. - 56+27.68 - "A" Line = B.C. - 53+39.99 - per pg. 94 - 2x2

(calc.) Δ=45°40" R=1000

P.O.S.T. Set 2x2 14" deep

T 80° 407.10

298.68 @ 2-44 = 298.68
208.43 @ 0.0 = 109.43
407.11

55+44.58

(124°-54-15 139°-37-30)

B.C. set 2x2

11°-45'

Calc. Line per pg. 94

Calc. Line

(from top pg. 100)

Notes: ANY ADDITIONS OR CHANGES ON THIS SHEET MUST BE MADE OR CIRCLED IN Red. WITH DATE AND NAME OF PERSON MAKING CHANGE.

Do not extend notes this side of this line

RETURN TO LOS ANGELES COUNTY SURVEYOR

F.B. 289 Pg. 102 — Chief Party — Notes by — Date

(To Bof. pg. 103) (To Bof. pg. 104)

300.61 @ 1-45 = 300.47 ✓
219.62 @ 4-53 = 218.82 ✓
277.76 @ 0-0 = 277.76 ✓
797.05
T82° = .01 ✓
797.04

To P.T. "A" pg. 103

To P.C. "A" pg. 104

PRO P'O FAIRWAYS BLVD.

77+66.70

E.C. Set 2x2 12" deep.

296.28 @ 3-19 = 295.78 ✓
275.14 @ 2-55 = 274.78 ✓
183.11 @ 0-0 = 183.11 ✓
753.67 ✓
T66° = .09 ✓
753.58 ✓
(calc'd & meas.)

Total Curve
Δ = 35-22-35 ✓
R = 1000 ✓
T = 318.91 ✓
L = 614.43 ✓

VERNON AVE.

Prop'd 5"A" Line

X-25"

P.O.C. - Vernon - E.C. Fair Way
74+82.63 - Set 1x2 - 12" deep.

Fd. 1x2 - P#10 per pg. 58 - Replaced with 2x2 - 14" deep.

Δ = 19°06'
R = 1000
T = 168.44
L = 333.36

144°37'30" Δ

160°-54'-00" (calc'd & turned)

231.25

150.67 (calc'd & meas.)

P.I. - FAIRWAY BLVD. Connection - Set 2x2 12" deep, by calculation.

77+49.27

60.57

P.O.S.T. - Fd 1x2 - P#9 per pg. 58 - Replaced with 2x2 - 12" deep.

P.C. Set 2x2 12" deep

151.10

(144°-37-30)
(218°-29-45)

(160°-54)
(283°-36)

Mag. = N 7°-30 E.

P.O.T. - 67+85.84
Fd. 1x2 - P# 8 - per pg. 58
Replaced with 2x2 12" deep.

(from tab pg. 101)

RETURN TO LOS ANGELES COUNTY SURVEYOR

Do not extend notes this side of this line

Note: ANY ADDITIONS OR CHANGES ON THIS SHEET MUST BE MADE OR CIRCLED IN Red. WITH DATE AND NAME OF PERSON MAKING CHANGE.

Date _____ Notes by _____ Chief Party _____ F.B. 289 Pg. 103

(84° Tape)

Plotted by J. D. Price.	W. O. No. 958 D. S. O. No.
Date April, 1930.	Location Vernon Ave.
Map No. C.S. B-501	Surveyed by Evans
Plotting C'k'd by R.W.M^C	Date 3-3-30
Date 4/18/30	Indexed by C. Johnson

Notes: ANY ADDITIONS OR CHANGES ON THIS SHEET MUST BE MADE OR CIRCLED IN Red. WITH DATE AND NAME OF PERSON MAKING CHANGE.

Do not extend notes this side of this line

RETURN TO LOS ANGELES COUNTY SURVEYOR

TRACT

Transit

P.I. Sta. 80+

End of curb & walk

VERNON AVE per pg. 106

curb

walk

P.O.T. — 83+37.69 S.W.+T. = Intrsn. per pg. 106

E.C.

93.05

PI # 9 "A" - Fd. 2x2, 8" deep P# 11 "D" per pg. 106

No 4961

83+10.90

Line per pgs. 7 & 106

Δ = 7°-34-55
R = 1000
T = 66.26
L = 132.33
Ex = 2.19

82+44.73

VERNON AVE

B.C.

81+78.57

7°-34'-55"

40.00

40.00

"A" Line

PROPOSED

from top pg. 102

(7°-35'-00" 30°-19'-30")

F.B. 289 PG. 104 Chief Party Notes by Date

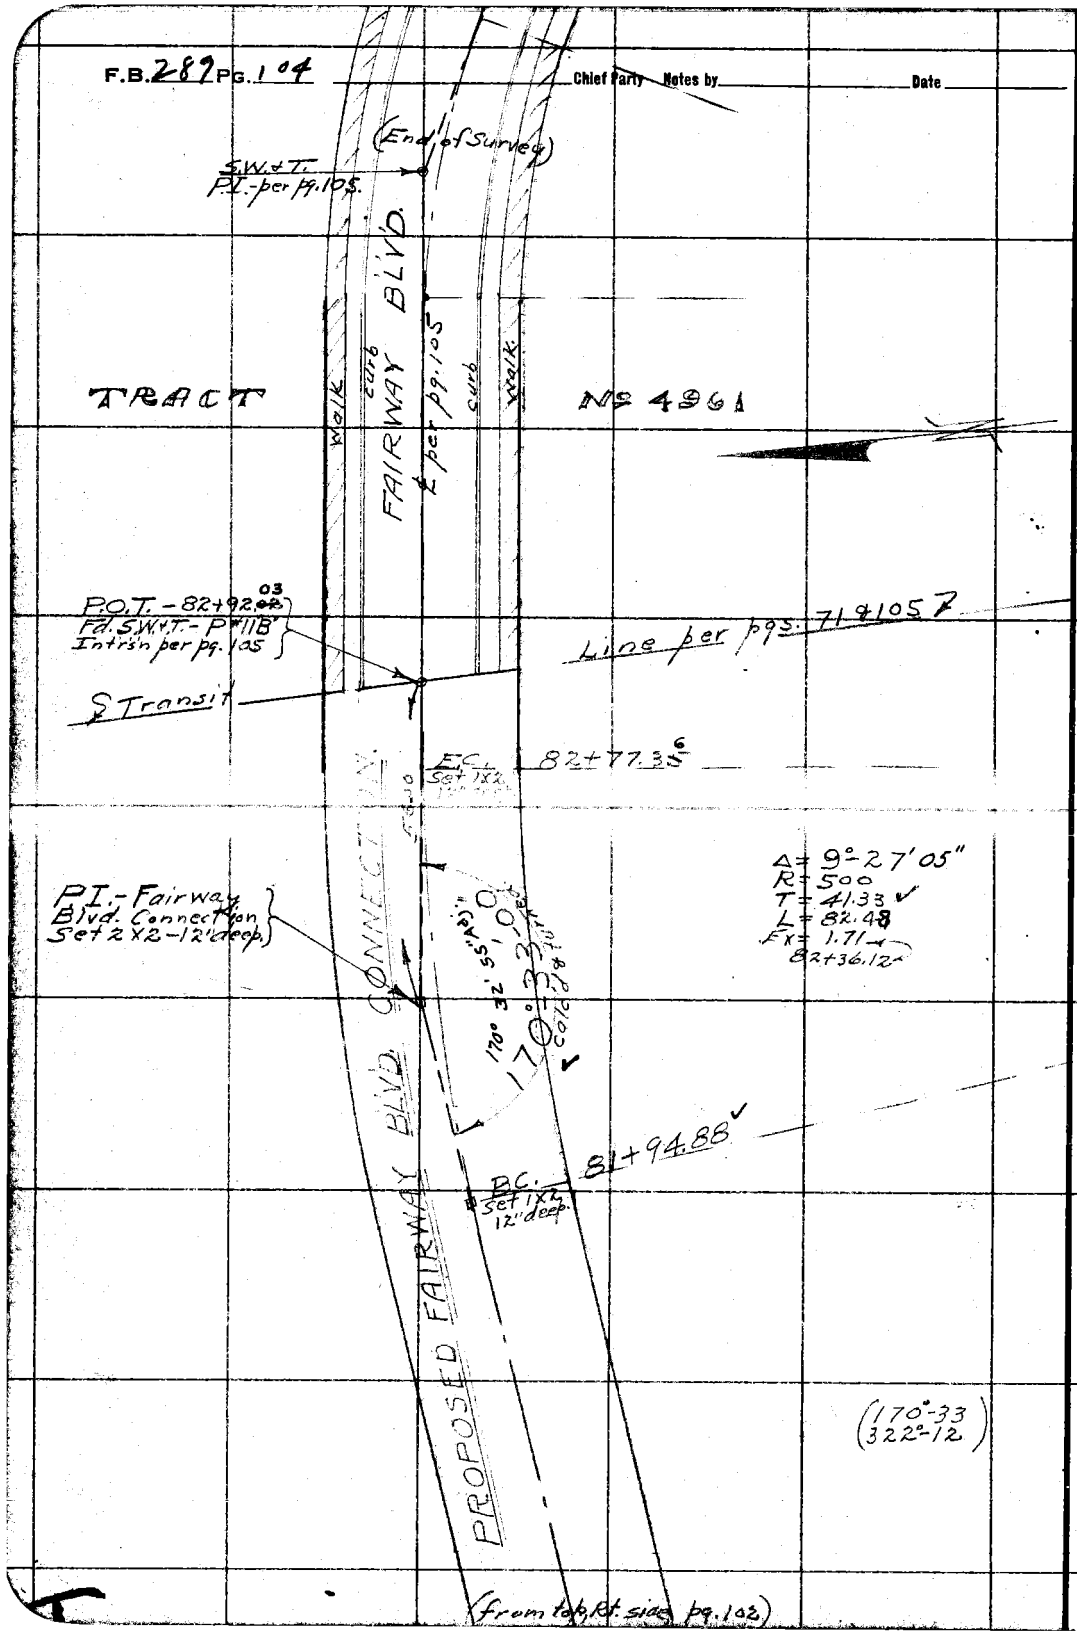

RETURN TO
LOS ANGELES COUNTY SURVEYOR

Do not extend notes this side of this line

Notes: ANY ADDITIONS OR CHANGES ON THIS SHEET MUST BE MADE OR CIRCLED IN Red. WITH DATE AND NAME OF PERSON MAKING CHANGE.

Date _____ Notes by _____ Chief Party _____ F.B. 289 Pg 105

(84° Tape)

Plotted by J.D. Price.	W. O. No. 958 B. S. O. No.
Date April, 1930.	Location Vernon Ave
Map No. C.S. B-501.	Surveyed by Evans
Plotting C'k'd by R.W.Mc	Date 3-28-30
Date 4/18/30	Indexed C. Johnson

Note: ANY ADDITIONS OR CHANGES ON THIS SHEET MUST BE MADE OR CIRCLED IN Red. WITH DATE AND NAME OF PERSON MAKING CHANGE.

Do not extend notes this side of this line

RETURN TO LOS ANGELES COUNTY SURVEYOR

#10 P.T. 63 #1

274.92 "P" - "P"

See Pg. 104

(164°-06-45 / 296°-26-30)

164°-06'-40" Line 1

P#11A set 1X2. by Int'rs'n.

0.38 old P#11"A" - Pg. 63. destroyed.

196.59 @ 2°-45-T66° = 196.34

160.92 @ 14°-08-T66° = 156.03

#11 per Pg. 71

Set nail by Proportion bet. ties on curbs

Fd. L+T in curb per L.B. 614-49

15.32 .05 15.26 .05

Transit Line 2 per Pg. 71

#12 per Pg. 71

92°-58'-15"

Set S.W.+T. by Int'rs'n. P#1.B.

19.28 @ 0-0 = 19.28
299.56 @ 2-15 = 299.33
299.58 @ 2-13 = 299.36
617.97
T66° = .07
617.90

(92°-58-15 / 11°-33-00) - ?

FAIRWAY BLVD. 4 per L.B. 614-49

walk curb curb walk

TRACT No 4961

Fd. L+T in curb per L.B. 614-49

15.37 15.08

B.C. - set by Proportion bet. ties.

Fd. L+T in curb per L.B. 614-49

16.66 13.83

P.I. - Set S.W.+T. by proportion between ties

Fd. L+T in curb per L.B. 614-49

F.B. 289 PG. 106 — Chief Party — Notes by — Date

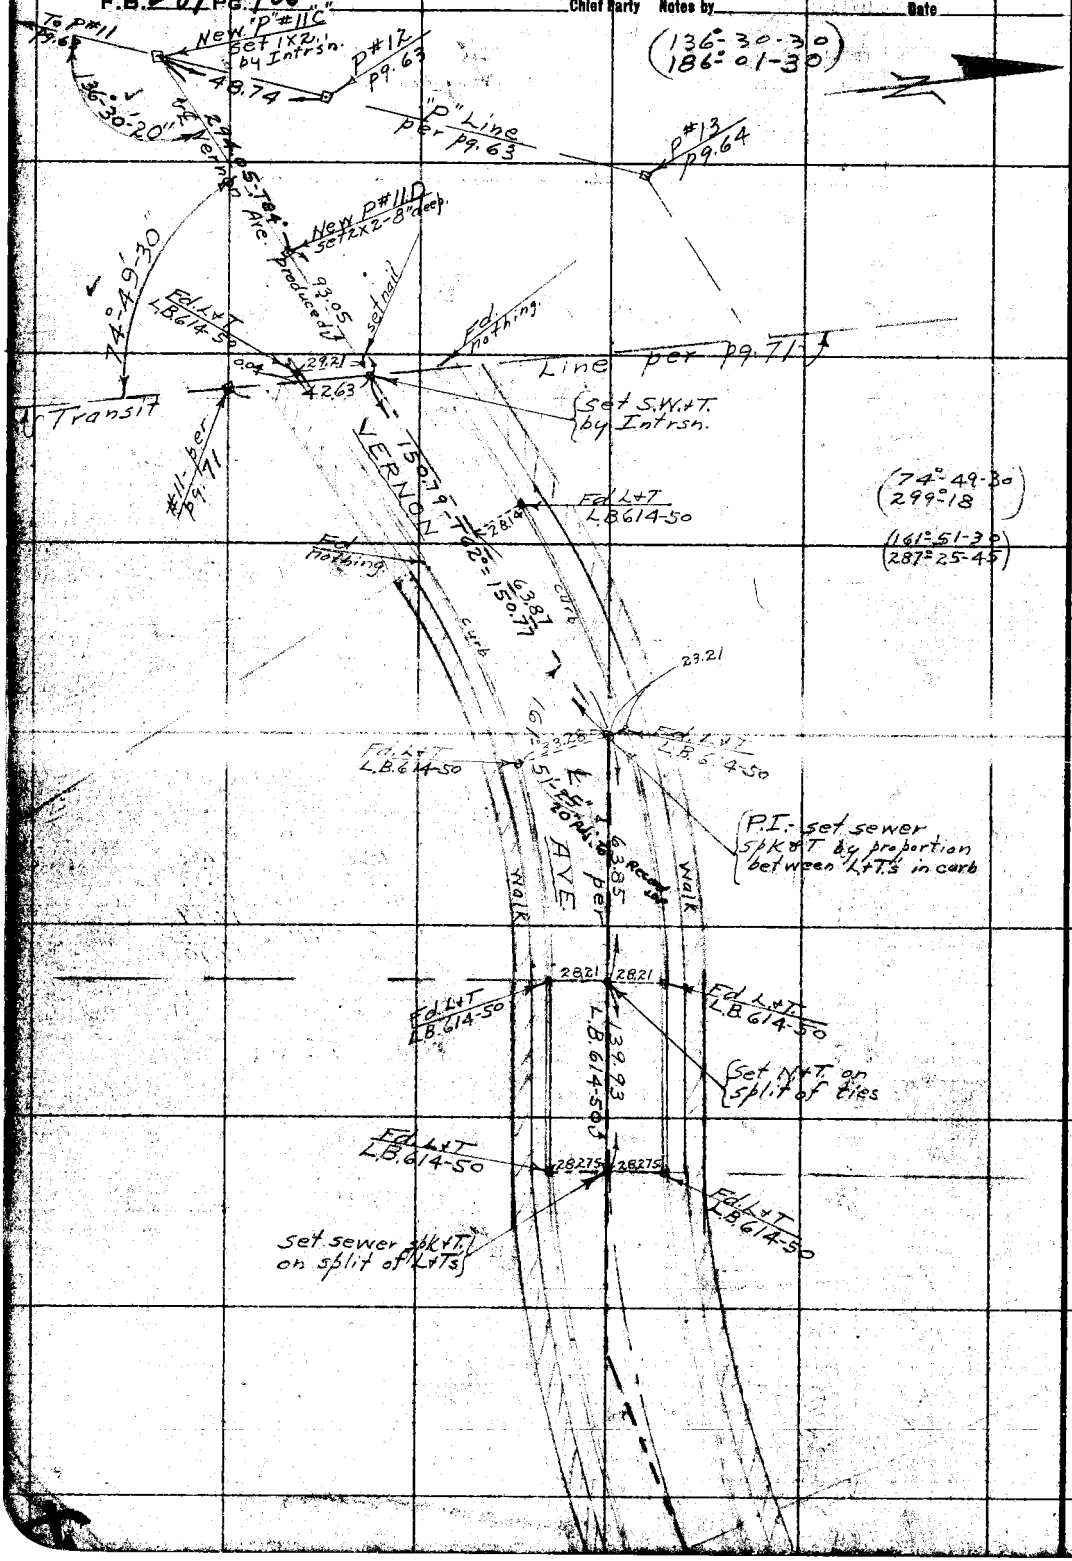

RETURN TO LOS ANGELES COUNTY SURVEYOR

Do not extend notes this side of this line

Notes: ANY ADDITIONS OR CHANGES ON THIS SHEET MUST BE MADE OR CIRCLED IN Red. WITH DATE AND NAME OF PERSON MAKING CHANGE.

Date _____ Notes by _____ Chief Party _____ F.B. 289 Pg. 107

(84° Tape)

Plotted by	W. O. No. 958 D. S. O. No.
Date	Location Vernon Ave
Map No.	Surveyed by Evans
Plotting C'k'd by	Date 4-9-30
Date	Indexed A. C. Johnson

Notes: ANY ADDITIONS OR CHANGES ON THIS SHEET MUST BE MADE OR CIRCLED IN Red. WITH DATE AND NAME OF PERSON MAKING CHANGE.

Do not extend notes this side of this line

RETURN TO LOS ANGELES COUNTY SURVEYOR

(To Rt. side pg. 86)

M 21.78

To SW'ly T.B.M. pg. 86

220 ft. offset line N. 57° W

298.72 @ 18-51 = 282.70 ✓
219.39 @ 4-34 = 218.69 ✓
182.02 @ 1-16 = 181.98 ✓
683.37 ✓
T 72° = .05 ✓
683.32 ✓

17+22.08
set 1X2
10" deep.

Fd. 2½" casing pipe 12" high - nail center

wire fnc.

19.51

10.82

297.86 @ 8-58 = 294.22 ✓
268.75 @ 10-33 = 264.21 ✓
558.43 ✓
T 72° = .04 ✓
558.39 ✓

S. M. de BERNARDO
30.8508 Ac.

M. M. de CORTA
37.8037 Ac.

11+63.69
set 1X2
10" deep.

Fd. 1" Axel bar 6" high - punch mark center

39.52

11+24.17
set 1X2
(surface)

20.00

90°

300.02 @ 0-54 = 299.98 ✓
298.02 @ 6-42 = 295.98 ✓
204.69 @ 8-52 = 202.24 ✓
238.35 @ 0-0 = 238.35 ✓
1036.55 ✓
T 72° = .08 ✓
1036.47 ✓

W'ly line Tr. 1892 M.R.

Nothing found

18 x 1 set in concrete

TR. No 1892

(from upper Rt. side pg. 81)

RETURN TO
LOS ANGELES COUNTY SURVEYOR

Note: ANY ADDITIONS OR CHANGES ON THIS SHEET MUST BE MADE OR CIRCLED IN Red. WITH DATE AND NAME OF PERSON MAKING CHANGE.

Do not extend notes this side of this line

Date

Notes by

Chkd Party

(To Bot. pg. 109.)

F.B. 289 PG. 108

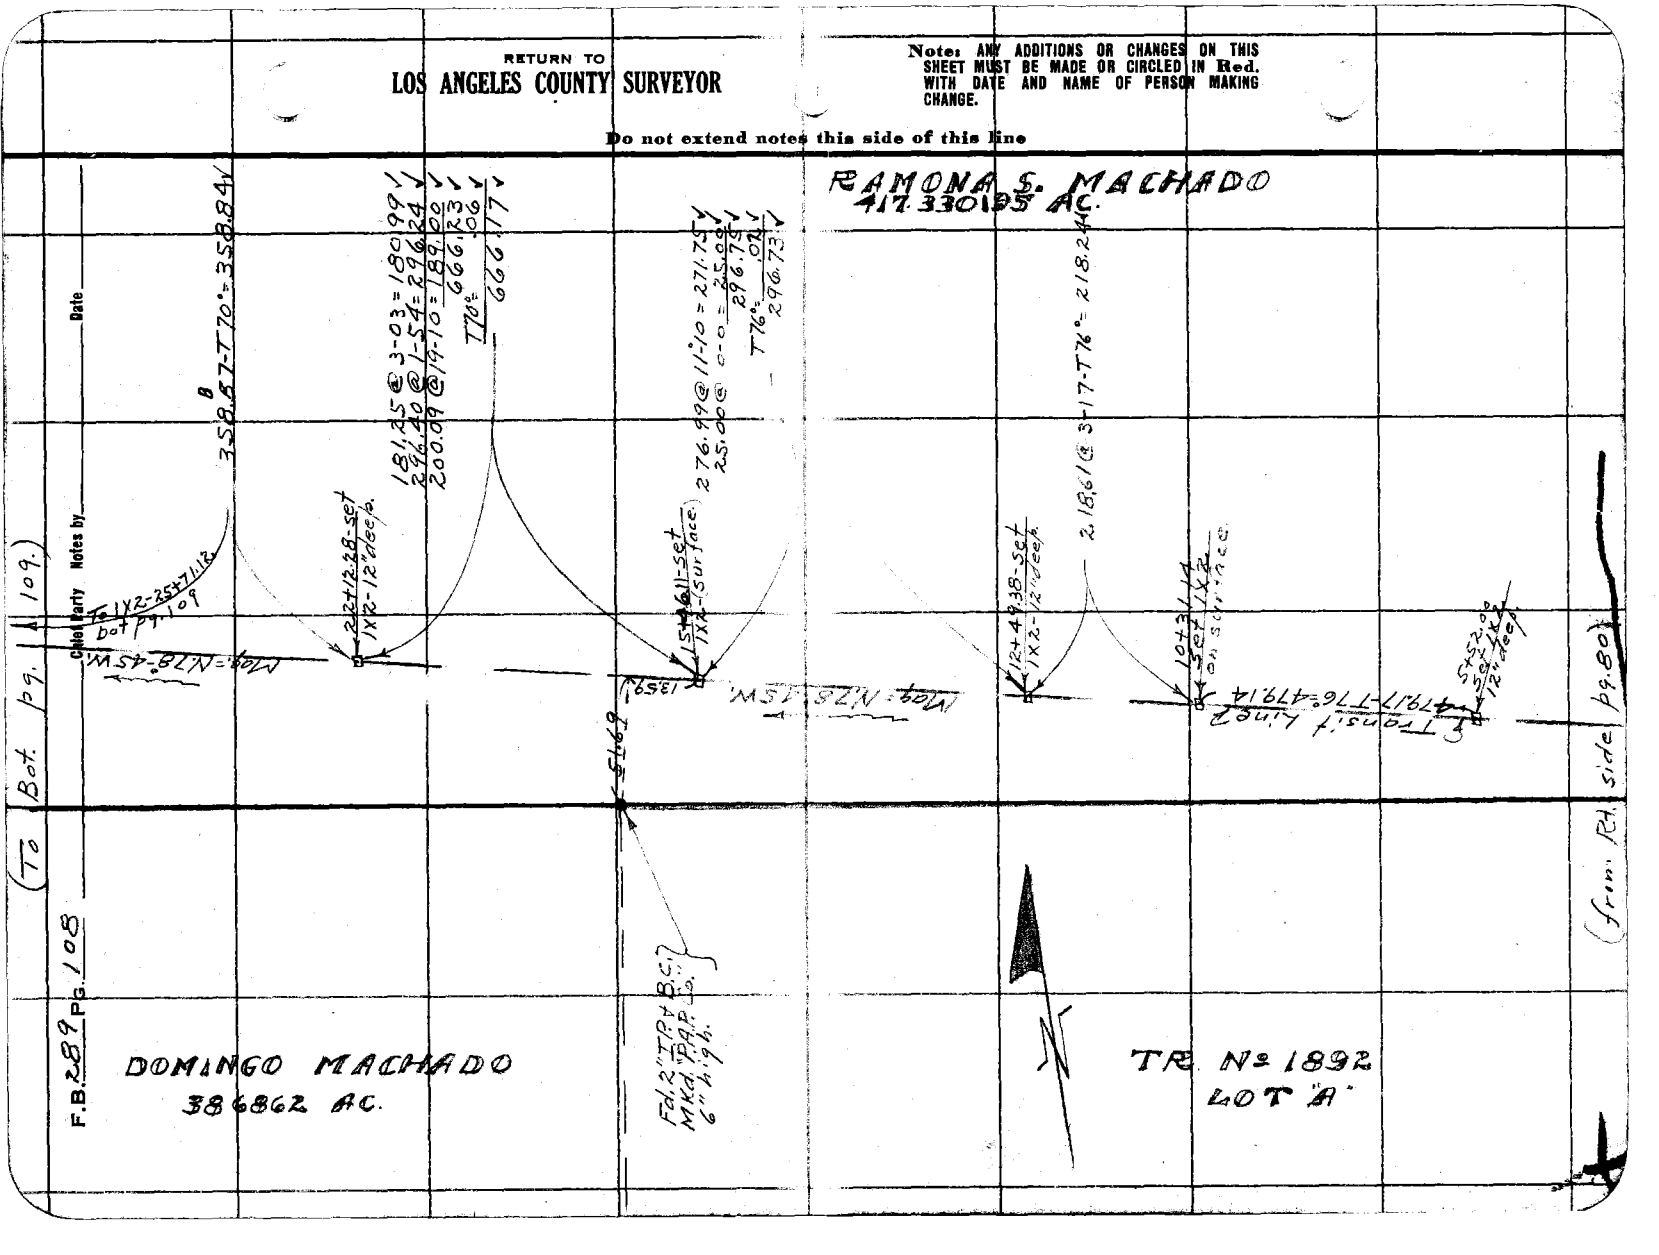

Date _____ Notes by _____ Chief Party _____ F.B. 289 Pg. 109

(84° Tape)

Platted by	W. O. No. 958 B. S. O. No.
Date	Location Vernon Ave.
Map No.	Surveyed by Evans
Platting C'k'd by	Date 4-11-30
Date	Indexed A. C. Johnson

TR. No. 3344

Fd. S.W.T. - P.T. per pg. 88

OVERLAND AVE.

℄ Overland Ave. produced.

51+92.99 - set 2X2 12" deep by Intersn.

154.23

800.3

see ℄ pgs. 87-88

159.56

Fd. 2" I.P. - 24" deep - per pg. 88 - N.W. Cor. Tr. 3755

68°39'40"

(68°39-45
274°38-45
41.

TR. No 3755

Notes ANY ADDITIONS OR CHANGES ON THIS SHEET MUST BE MADE OR CIRCLED IN Red. WITH DATE AND NAME OF PERSON MAKING CHANGE.

Do not extend notes this side of this line

RETURN TO LOS ANGELES COUNTY SURVEYOR

106.17	@ 0-0	= 106.17 ✓
298.36	@ 23°-41-30	= 273.21 ✓
299.41	@ 7°-24-30	= 296.91 ✓
297.39	@ 6°-16	= 295.61 ✓
140.52	@ 6°-36	= 139.59 ✓
66.60	@ 17°-04	= 63.67 ✓
297.48	@ 13°-58	= 288.69 ✓
298.28	@ 2°-08	= 298.07 ✓
298.10	@ 1°-29	= 298.00 ✓
125.16	@ 1°-17	= 125.13 ✓
298.52	@ 1°-32	= 298.41 ✓
138.77	@ 2°-02	= 138.69 ✓
		2622.14 ✓
T 68°		= 27 ✓
		2621.87 ✓

RANCHO SAN PEDRO

℄ Transit Line

Fd. old 3"X4" stake - 3" high - Tack center

83.63

0.19

83.58

Fd. 2" I.P. - no tack - (3" high) N.E. cor. Tract No 3755

POB

25+71.12 - set 1X2 - 12" deep

D. MACHADO
38.6862 AC.

(from tab pg. 108)

F.B. 289 Pg. 110 Chief Party Notes by Date

"P" LINE SURVEY FOR
VERNON AVE.
from
OVERLAND AVE.
to
HIGHLAND AVE.

H.F. Evans
Henry Martin
Geo. F. Brock
Ray Markham.

RETURN TO
LOS ANGELES COUNTY SURVEYOR

Do not extend notes this side of this line

Notes: ANY ADDITIONS OR CHANGES ON THIS SHEET MUST BE MADE OR CIRCLED IN Red. WITH DATE AND NAME OF PERSON MAKING CHANGE.

Date _____ Notes by _____ Chief Party _____ F.B. 289 Pg. 111

(84° Tape)

Platted by	W. O. No. 958 B. O. E. No.
Date	Location Vernon Ave
Map No.	Surveyed by Evans
Platting C'k'd by	Date 4-14-30
Date	Indexed A. C. Johnson

(To Bot. pg. 112)

To P#200 pg. 112

Map = "P" Line N. 75° 15 E.

218.08 @ 3°17 = 217.72 ✓
297.84 @ 9°22 = 293.87 ✓
45.76 @ 0°0 = 45.76 ✓
557.35 ✓
T 68° = .06 ✓
557.29 ✓

157°-53'-10"

(157°-53'-15" 271°-32'-45" 11.)

OVERLAND AVE.

2X2-12' deep P.I. per pg. 86

℄ per C.S. 2950-2

PLAYA ST.

SWK T-12+4757 per pg. 86

JEFFERSON AVE.

Note: ANY ADDITIONS OR CHANGES ON THIS SHEET MUST BE MADE OR CIRCLED IN Red. WITH DATE AND NAME OF PERSON MAKING CHANGE.

Do not extend notes this side of this line

RETURN TO LOS ANGELES COUNTY SURVEYOR

(To Bot. pg. 113)

F.B. 289 Pg. 112 — Chief Party — Notes by — Date

(To Bot. pg. 116)

298.82 @ 2°-43 = 298.48 ✓
297.52 @ 5°-08 = 296.33 ✓
T66° = 594.81 ✓ .07 ✓
594.74 ✓

To P#205 per pg. 113

I. P#300 pg. 116

1°P Line

P#205 Set 1X2

Line - T pg. 892

2 X 2 - 22 - 58.24 per pg. 89

243.46 @ 1-53 = 243.33 ✓
108.26 @ 4°-21 = 107.95 ✓
295.96 @ 0-0 = 295.96 ✓
T66° = 647.24 ✓ .08 ✓
647.16 ✓

129°-29'-

Nat. Conc. Mon.

2 X 2 - 19 + 62.38 per pg. 89

59.12

Hill S.T.

Transit

127°-34'-25"

(129°-29'
157°-56')

P#204 Set 1X2

P#204'A' Set 2X2 by Interp'n

(127°-34'-30"
150°-17'-30"
22°

299.06 @ 2°-58 = 298.66 ✓
87.94 @ 6°-15 = 87.42 ✓
T72° = 386.08 ✓ .03 ✓
386.05 ✓

P"#203 Set 1X2

193.39 @ 1°-50 - T72° = 193.27 ✓

(170°-17'-15
321°-08'-30)

170°-17'-

Line

T

300.11 @ 3°-01 = 299.69 ✓
156.58 @ 14°-09 = 151.83 ✓
T72° = 451.52 ✓ .04 ✓
451.58 ✓

73°-41'-30"

P#203'A' Set 1X2

(73°-41'-30"
294°-46'-00"

P#202 Set 1X2

207.86 @ 5°-50 - T72° = 206.76 ✓

P#201 Set 1X2

143.92 @ 0°-0 - T68° = 143.91 ✓

(167°-24'-45"
309°-38'-30"
38.

167°-24'-40"

P"#200 Set 1X2

P"

Line

(from top pg. 111)

RETURN TO LOS ANGELES COUNTY SURVEYOR

Do not extend notes this side of this line

Note: ANY ADDITIONS OR CHANGES ON THIS SHEET MUST BE MADE OR CIRCLED IN Red. WITH DATE AND NAME OF PERSON MAKING CHANGE.

(To Bot. pg. 114)

Date _____ Notes by _____ Chief Party _____ F.B. 289 PG 113

(84° Tape)

Platted by	W. O. No. 958 D. S. O. No.
Date	Location Vernon Ave
Map No.	Surveyed by Evans
Platting C'k'd by	Date 4-15-30
Date	Indexed A. C. Johnson

P#212 set 1X2

79.21 @ 17°27 = 75.56 ✓
119.19 @ 0-0 = 119.19 ✓
194.75 ✓
T72° = .02
194.73

P#211 set 1X2

Tang Produced

(49°-22
197°-28-30)

259.01 @ 3°33 - T72° = 258.49 ✓

49°-22-05"

P#210 set 1X2

296.65 @ 4°44 = 295.64 ✓
128.68 @ 8°43 = 127.19 ✓
422.83 ✓
T72° = .03 ✓
422.80 ✓

P#209 set 1X2

142.30 @ 1°-21 = 142.26 ✓
122.08 @ 0-0 = 122.08 ✓
264.34 ✓
T74° = .02 ✓
264.32 ✓

M169 = N.40°E

P#208 set 1X2

298.77 @ 7°45 = 296.04 ✓
116.22 @ 7°34 = 115.21 ✓
411.25 ✓
T74° = .03 ✓
411.22 ✓

P#207 set 1X2

(167°-50-45
311°-22-45
41°

167°-50-40"

M68 = N.5°E

295.32 @ 4°11 = 294.53 ✓
297.39 @ 7°07 = 295.10 ✓
589.63 ✓
T66° = .07 ✓
589.56 ✓

P#206 set 1X2

(from top pg. 112)

Note: ANY ADDITIONS OR CHANGES ON THIS SHEET MUST BE MADE OR CIRCLED IN Red. WITH DATE AND NAME OF PERSON MAKING CHANGE.

Do not extend notes this side of this line

RETURN TO LOS ANGELES COUNTY SURVEYOR

(To Bot. pg. 115)

F.B. 289 Pg 114 Chief Party Notes by Date

To P#219 pg. 113

300.73 @ 6°-26 = 298.84 ✓
84.97 @ 5°-45 = 84.54 ✓
383.38 ✓
T78° .01 ✓
383.37 ✓

P#218 set 1X2

142°-29-10"

293.17 @ 1°-35 = 293.06 ✓
82.69 @ 0-0 = 82.69 ✓
375.75 ✓
T78° .01 ✓
375.74 ✓

(144-29-15
217-56-30
08.

"P" line 2

P#217 set 1X2

263.27 @ 1°-01-T78° = 260.93 ✓

(170°-14
320°-55-45
12-66.

170°-13-55"

P#216 set 1X2

97.53

P#215 set 1X2

89.87 @ 10°13 = 88.45 ✓
298.55 @ 0-0 = 298.55 ✓
387.00 ✓
T78° .02 ✓
386.98 ✓

"P" #214 set 1X2

Mag. N 68-30 E.

274.82 @ 4°-42-T78° = 273.89 ✓

P#213 set 1X2

203.47-T72° = 203.45 ✓

P#212 Set S.W.T. 2" deep

(from top pg. 113)

RETURN TO
LOS ANGELES COUNTY SURVEYOR

Do not extend notes this side of this line

Notes: ANY ADDITIONS OR CHANGES ON THIS SHEET MUST BE MADE OR CIRCLED IN Red. WITH DATE AND NAME OF PERSON MAKING CHANGE.

Date _____ Notes by _____ Chief Party _____ F.B. 289 Pg. 115

(84° Tape)

Platted by _____
Date _____
Map No. _____
Platting C'k'd by _____
Date _____

W. O. No. 958 U. S. O. No. _____
Location Vernon Ave. #1
Surveyed by Evans
Date 4-16-30
Indexed A. C. Johnson

Notes: ANY ADDITIONS OR CHANGES ON THIS SHEET MUST BE MADE OR CIRCLED IN Red. WITH DATE AND NAME OF PERSON MAKING CHANGE.

Do not extend notes this side of this line

RETURN TO LOS ANGELES COUNTY SURVEYOR

P.I. #2-Vernon Ave Fd. 2x2 (flush) per F.B. 89-57

298.90 @ 0°-38 = 298.88 ✓
141.43 @ 0-0 = 141.43 ✓
440.31 ✓
T74° = .03 ✓
440.28 ✓

Vernon Ave #1

(36°-46-00)
(147°-03-30)

36°-45'-55"

R = 1600.00

P.I. #1-Vernon Ave Fd. 2x2, 6" deep per F.B. 89-56

(167°-23)
(309°-32)

P#224 set 1x2

296.26 @ 3°-45 = 295.63 ✓
57.74 @ 0-0 = 57.74 ✓
353.37 ✓
T76° = .02 ✓
353.35 ✓

267.60 @ 3°-36 - T76° = 267.06 ✓

P#223 set 1x2

P.T. Line 2 Mag. S 73°-40 E

P#222 set 1x2

218.88 @ 2°-47 = 218.62 ✓
80.62 @ 0-0 = 80.62 ✓
299.24 ✓
T76° = .02 ✓
299.22 ✓

P#221 set 1x2

(148°-57-30)
(235°-50-30)

154.71 @ 8°-19 = 153.08 ✓
297.67 @ 0-0 = 297.67 ✓
450.75 ✓
T78° = .02 ✓
450.73 ✓

148° 57'-35"

P#220 set 1x2

284.59 @ 3°-45 = 283.98 ✓
33.00 @ 0-0 = 33.00 ✓
316.98 ✓
T78° = .01 ✓
316.97 ✓

P#219 set 1x2

(from top pg. 114)

(To Bot. / pg. 117)

F.B. 289 Pg. 116 Chief Party Notes by Date

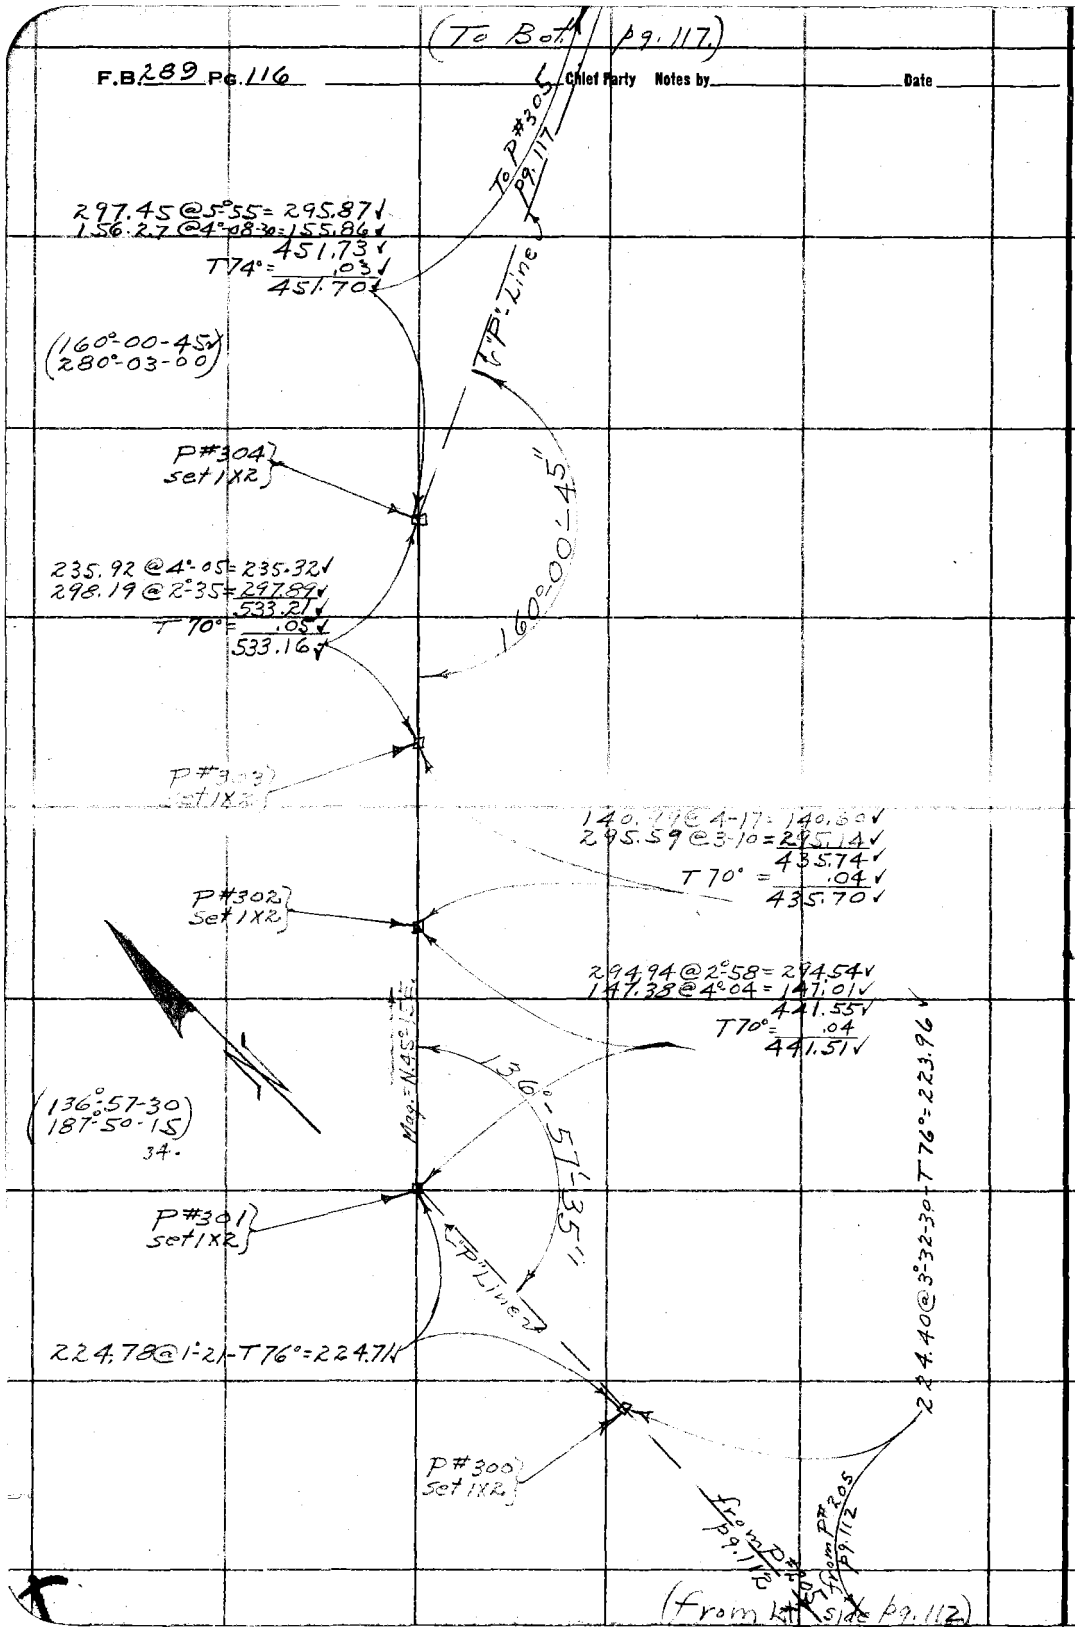

RETURN TO
LOS ANGELES COUNTY SURVEYOR

Do not extend notes this side of this line

Note: ANY ADDITIONS OR CHANGES ON THIS SHEET MUST BE MADE OR CIRCLED IN Red. WITH DATE AND NAME OF PERSON MAKING CHANGE.

Date _____ Notes by _____ Chief Party _____ F.B. 289 Pg. 117

Platted by	W. O. No. 958 U. S. G. No.
Date	Location Vernon Ave
Map No.	Surveyed by
Platting C'k'd by	Date 4-18-30
Date	Indexed A. C. Johnson

(see pg. 114)

"P" Line per pg. 113-114

P#212 Fd. S.W.T. per pg. 114

P#211 Fd. 1x2 per pg. 113

"P" Line per

142.10 @ 7°47 - T 74° = 140.78 ✓

pg. 113-114

P#210 pg. 113

P#306 Set 1X2

281.03 @ 2°16 - T 74° = 280.79 ✓

(24°-52-00)
(98°-47-30)
51-53

To fore sight ±

24°41'55"

P#305 Set 1X2

(from top pg. 116)

Notes: ANY ADDITIONS OR CHANGES ON THIS SHEET MUST BE MADE OR CIRCLED IN Red. WITH DATE AND NAME OF PERSON MAKING CHANGE.

Do not extend notes this side of this line

RETURN TO LOS ANGELES COUNTY SURVEYOR

RETURN TO
LOS ANGELES COUNTY SURVEYOR

Note: ANY ADDITIONS OR CHANGES ON THIS SHEET MUST BE MADE OR CIRCLED IN Red. WITH DATE AND NAME OF PERSON MAKING CHANGE.

Do not extend notes this side of this line

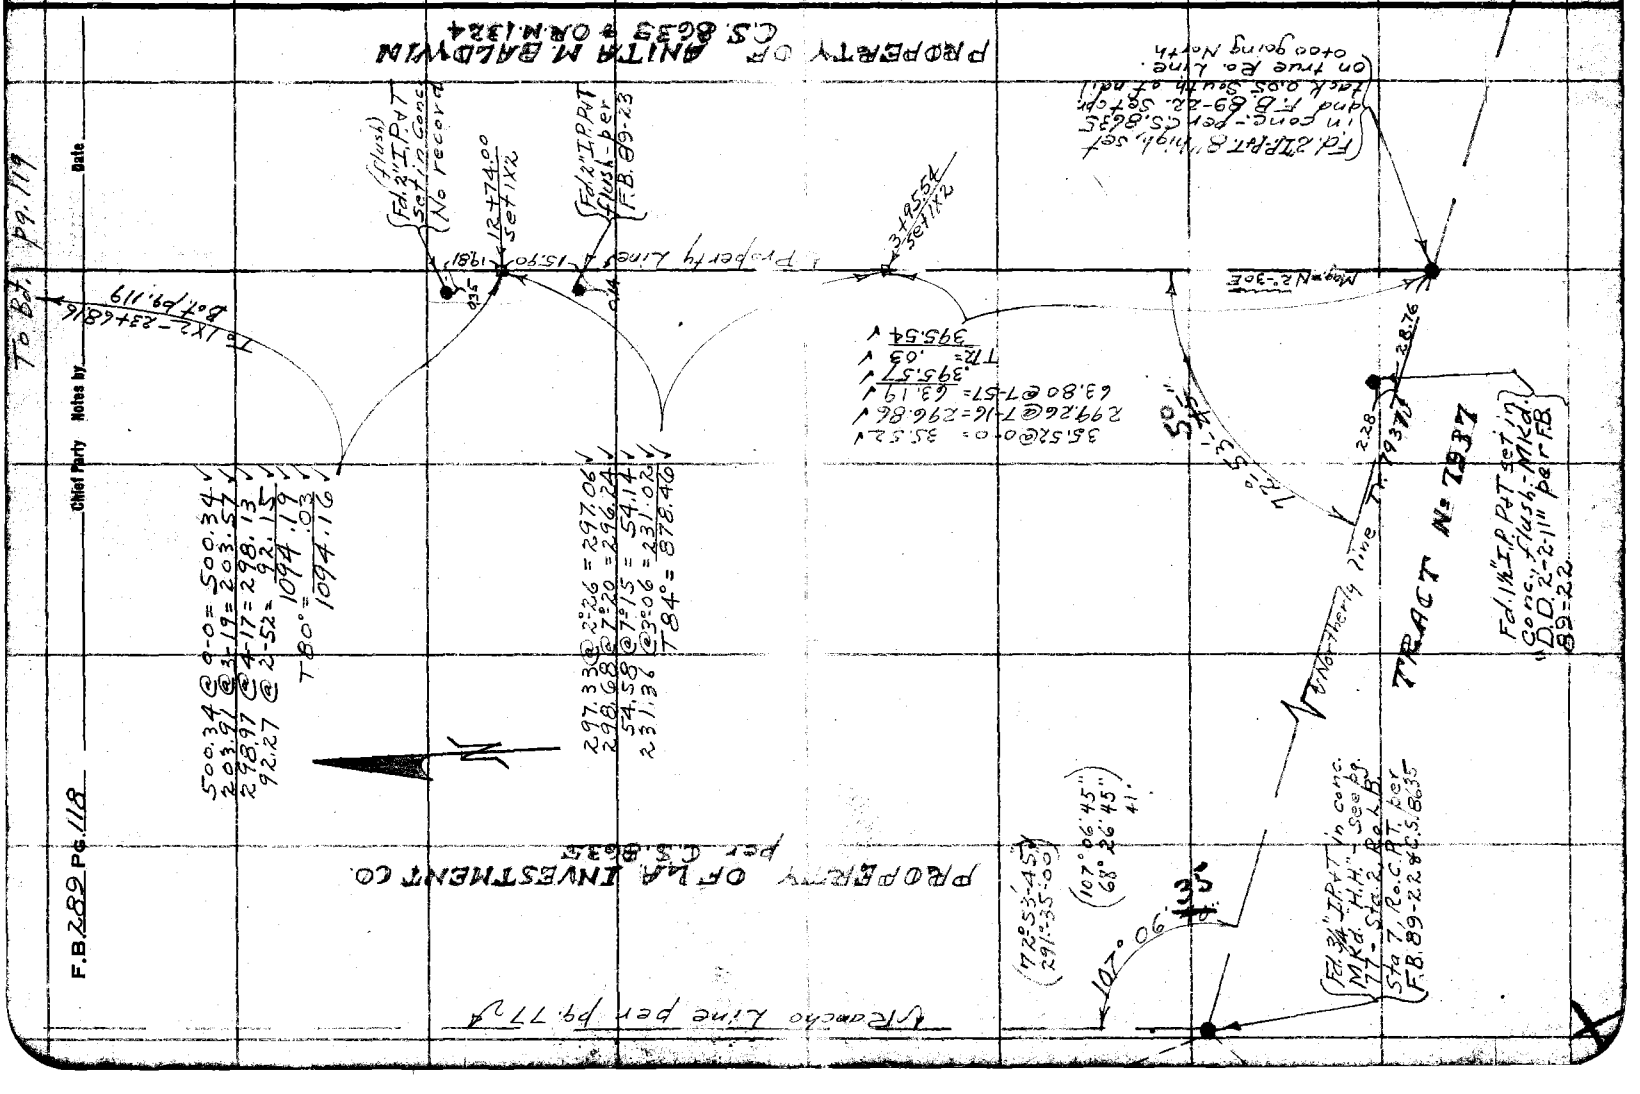

Date _____ Notes by _____ Chief Party _____ F.B 289 PG. 119

Platted by _____
Date _____
Map No. _____
Platting C'k'd by _____
Date _____

W. O. No. 958 U. S. G. No. _____
Location Vernon Ave.
Surveyed by Evans
Date 4-22-30
Indexed A. C. Johnson

(To Bottom Page 120)

37+11.02 Set 1X2

5.03

4.09 Fd. 2" I.P. 18" high Plug & Nail

296.07 @ 4°50'30" = 295.01 ✓
123.16 @ 7°09'30" = 121.59 ✓
52.00 @ 0°0'0" = 52.00 ✓
295.83 @ 10°32'00" = 290.84 ✓
70.94 @ 12°05'30" = 69.37 ✓
828.81 ✓
-.03 ✓
828.78 ✓
T = 78°

ARTESIAN WATER CO
C.S. 8635

28+82.24 Set 1X2

13.0'

45.54

28+36.70
Fd. 2" I.P. in concrete 6" high
S.E. Cor. Artesian Water Co.
Per C.S. 8728 Plug & Tack
C.S. 8635

4.06

170.48 @ 6°59 - T 76° = 169.21 ✓
South line Artesian Water Co.

See C.S. 8728 for P.C. line South of here.

Transit Line. See Pg. 124

2X2 T.P. Pg. 124

1.48

L.A. INVESTMENT CO. PROPERTY.

27+13.03 Set 1X2

4.11 Fd. 1" I.P.R.T. (Flush)

4.11 Fd. 2" I.P.R.T. set in Conc. (Flush)

3.30 2.24

4.02 Fd. 2" I.P.R.T. 6" high.

298.24 @ 3°05 = 297.81 ✓
47.08 @ 0°0 = 47.08 ✓
344.89 ✓
T 76° = .02 ✓
344.87 ✓

Marginal

1X2 2+37 68.16

Fd. 1" I.P.R.T. Flush

0.77

2.57

Fd. 2" I.P.R.T. Set in Conc.

0.80

2.13 3.34 3.084

Property Line

0.78

Set 1X2

5.00

2+37 68.16 Set 1X2

Fd. 2" I.P.R.T. 4" high see marginal

3.084

0.78

Property Line

IDENTICAL

(from Top pg. 118)

M. BALDWIN OF ANITA PROPERTY

RETURN TO LOS ANGELES COUNTY SURVEYOR

Notes: ANY ADDITIONS OR CHANGES ON THIS SHEET MUST BE MADE OR CIRCLED IN Red. WITH DATE AND NAME OF PERSON MAKING CHANGE.

Do not extend notes this side of this line

F.B. 289 PG. 120 Martin Chief Party Notes by H.M. Date 4-23-30

(To Bottom Page 121)

53+21.74 Set 1x2 — 29.7

299.64 @ 1°52'30" = 299.48 ✓
71.84 @ 0° 0' = 71.84 ✓
371.32 ✓
-.02 ✓
371.30 ✓
T = 74°

1.40
0.68
Fd. 2" I.P. in con. 12" high Plug & T. C.S. 8635

47+50.44 Set 1x2 — 28.0

298.86 @ 0° 55' = 298.82 ✓
244.85 @ 1° 13' = 244.79 ✓
543.61 ✓
-.04 ✓
543.57 ✓
T = 74°

5.35
0.80
Fd. 2" I.P. in con. 6" high, Plug & T. C.S. 8635

Fd. 2" I.P. Plug & Tack in con. 6" high C.S. 8635

4.14
6.35
44+06.87 Set 1x2 — 5.00 — Set 1x2

22.00 @ 0° 0' = 22.00 ✓
300.57 @ 11°32' = 294.50 ✓
60.77 @ 10°01'30" = 59.82 ✓
376.32 ✓
-.02 ✓
376.30 ✓
T = 76°

5 ft. offset line

Barb Wire Fence

Property Line

4.01
15.44
Fd. 2" I.P. No Tack 12" high

40+90.57 Set 1x2

298.11 @ 0° 0' = 298.11 ✓
21.45 @ 0° 0' = 21.45 ✓
319.56 ✓
-.01 ✓
319.55 ✓
T = 78°

From 1x2 37+11.02

(From Top Page 119)

ARTESIAN / WATER
C.S. 8635

NORTH BROADWAY
H. M.

RETURN TO LOS ANGELES COUNTY SURVEYOR

Do not extend notes this side of this line

Note: ANY ADDITIONS OR CHANGES ON THIS SHEET MUST BE MADE OR CIRCLED IN Red. WITH DATE AND NAME OF PERSON MAKING CHANGE.

Date _____ Notes by _____ Chief Party _____ F.B. 289 PG. 121

Platted by	W. O. No. 958 D. S. O. No.
Date	Location Vernon Ave
Map No.	Surveyed by Martin
Platting C'k'd by	Date 4-24-30
Date	Indexed L. C. Johnson

(To Bottom Page 122)

To 1X2 63+10.34

234.39 @ 21° 52' 30" = 217.51 ✓
155.43 @ 21° 50' 00" = 144.28 ✓
T = 74° 361.79 ✓
-.02 ✓
361.77 ✓

Fd. 6" Steel Casing Pipe 42" high Marked S.O. Co. on The east side

4.60

143.26

61+48.57 Set 1X2

26.0

300.55 @ 13° 38' = 292.08 ✓
34.97 @ 6° 57' 34.71 ✓
T = 74° 326.79 ✓
-.02 ✓
326.77 ✓

Fd. 2" I.P. no tag 12" high

0.69

8.73

Fence

58+21.80 Set 1X2

36.78 @ 0° 0' = 36.78 ✓
299.36 @ 8° 18' = 296.22 ✓
43.86 @ 0° 0' = 43.86 ✓
T = 74° 376.86 ✓
-.02 ✓
376.84 ✓

Wire

Back

Property Line

54+44.96 Set 1X2

31.4

8.24

Fd. 2" I.P. in con. 6" high plug & tag C.S. 863 35

0.67

123.43 @ 3° 15' T = 72° = 123.22 ✓

(From Top Page 120)

ARTESIAN WATER CO. C.S. 8635

ANITA M. BALDWIN

Note: ANY ADDITIONS OR CHANGES ON THIS SHEET MUST BE MADE OR CIRCLED IN Red. WITH DATE AND NAME OF PERSON MAKING CHANGE.

Do not extend notes this side of this line

RETURN TO LOS ANGELES COUNTY SURVEYOR

F.B. 289 Pg. 122 Martin Chief Party Notes by H.M. Date 4-25-30

(To Bottom Page 123)

Fd. 3" I.P. in con. Filled with con. 30" high

Fd. 2" I.P. P&T. 5" high

Wire fence

Property line

Wire fence

Fd. 2" I.P. P&T. 12" high

(From Top Pg. 122)

ARTESIAN WATER CO.
C.S. 9635

N. MOUNTAIN AVE.

296.73 @ 1° 04' = 296.68 ✓
596.33 @ 0° 0' = 596.33 ✓
893.01 ✓
-.06 ✓
892.95 ✓
T = 74°

147.34 @ 0° 0' = 147.34 ✓
285.91 @ 0° 0' = 285.91 ✓
299.63 @ 0° 0' = 299.63 ✓
126.23 @ 1° 25' = 126.19 ✓
157.33 @ 0° 0' = 157.33 ✓
297.55 @ 0° 0' = 297.55 ✓
198.01 @ 0° 42' = 198.00 ✓
109.74 @ 0° 0' = 109.70 ✓
162.57 ✓
T = 78°

287.21 @ 6° 0' = 285.64 ✓
84.32 @ 6° 30' = 83.78 ✓
297.95 @ 9° 09' = 294.16 ✓
297.24 @ 3° 37' 30" = 296.65 ✓
173.11 @ 2° 28' 30" = 172.95 ✓
1133.18 ✓
-.04 ✓
1133.14 ✓
T = 78°

RETURN TO
LOS ANGELES COUNTY SURVEYOR
Do not extend notes this side of this line

Note: ANY ADDITIONS OR CHANGES ON THIS SHEET MUST BE MADE OR CIRCLED IN Red. WITH DATE AND NAME OF PERSON MAKING CHANGE.

Date _____ Notes by _____ Chief Party _____ F.B. 289 Pg. 123

Platted by _____
Date _____
Map No. _____
Platting C'k'd by _____
Date _____

W. O. No. 958 D. S. O. No. _____
Location Vernon Ave
Surveyed by Martin
Date 4-25-30
Indexed A. C. Johnson

Notes: ANY ADDITIONS OR CHANGES ON THIS SHEET MUST BE MADE OR CIRCLED IN Red. WITH DATE AND NAME OF PERSON MAKING CHANGE.

Do not extend notes this side of this line

RETURN TO LOS ANGELES COUNTY SURVEYOR

ARTESIAN WATER CO.
C.S. 8635
1"

North R/W

Hunkey Ave

Fd. 3" I.P. 24" high
Set in con. Filled with con.
Per. C.S. 8635. 108+01.02

Drainage Improvement District No. 3
Per. C.S. 8635

289.62 @ 1° 17' = 289.59 ✓
181.12 @ 0° 0' = 181.12 ✓
470.71 ✓
T=74° -.03 ✓
470.68 ✓

0.20

Fd. 3" I.P. 18" high
Filled with concrete
C.S. 8635

181.11

103+30.34
Set 1X2

Fd. 2" I.P. P+T.
(Flush)

0.21

452.74

Property line

172.33 T=74° = 172.32 ✓

0.50

Fd. 1" I.P. P+T. 12" deep
102+17.51

P.E. R.R.

473

101+64.88
Pt. on Curve

101+58.02
Set 1X2

93° 49'

(From Top Page 122)

F.B. 289 PG. 124 — Evans — Chief Party — Notes by H.M. — Date 4-26-30

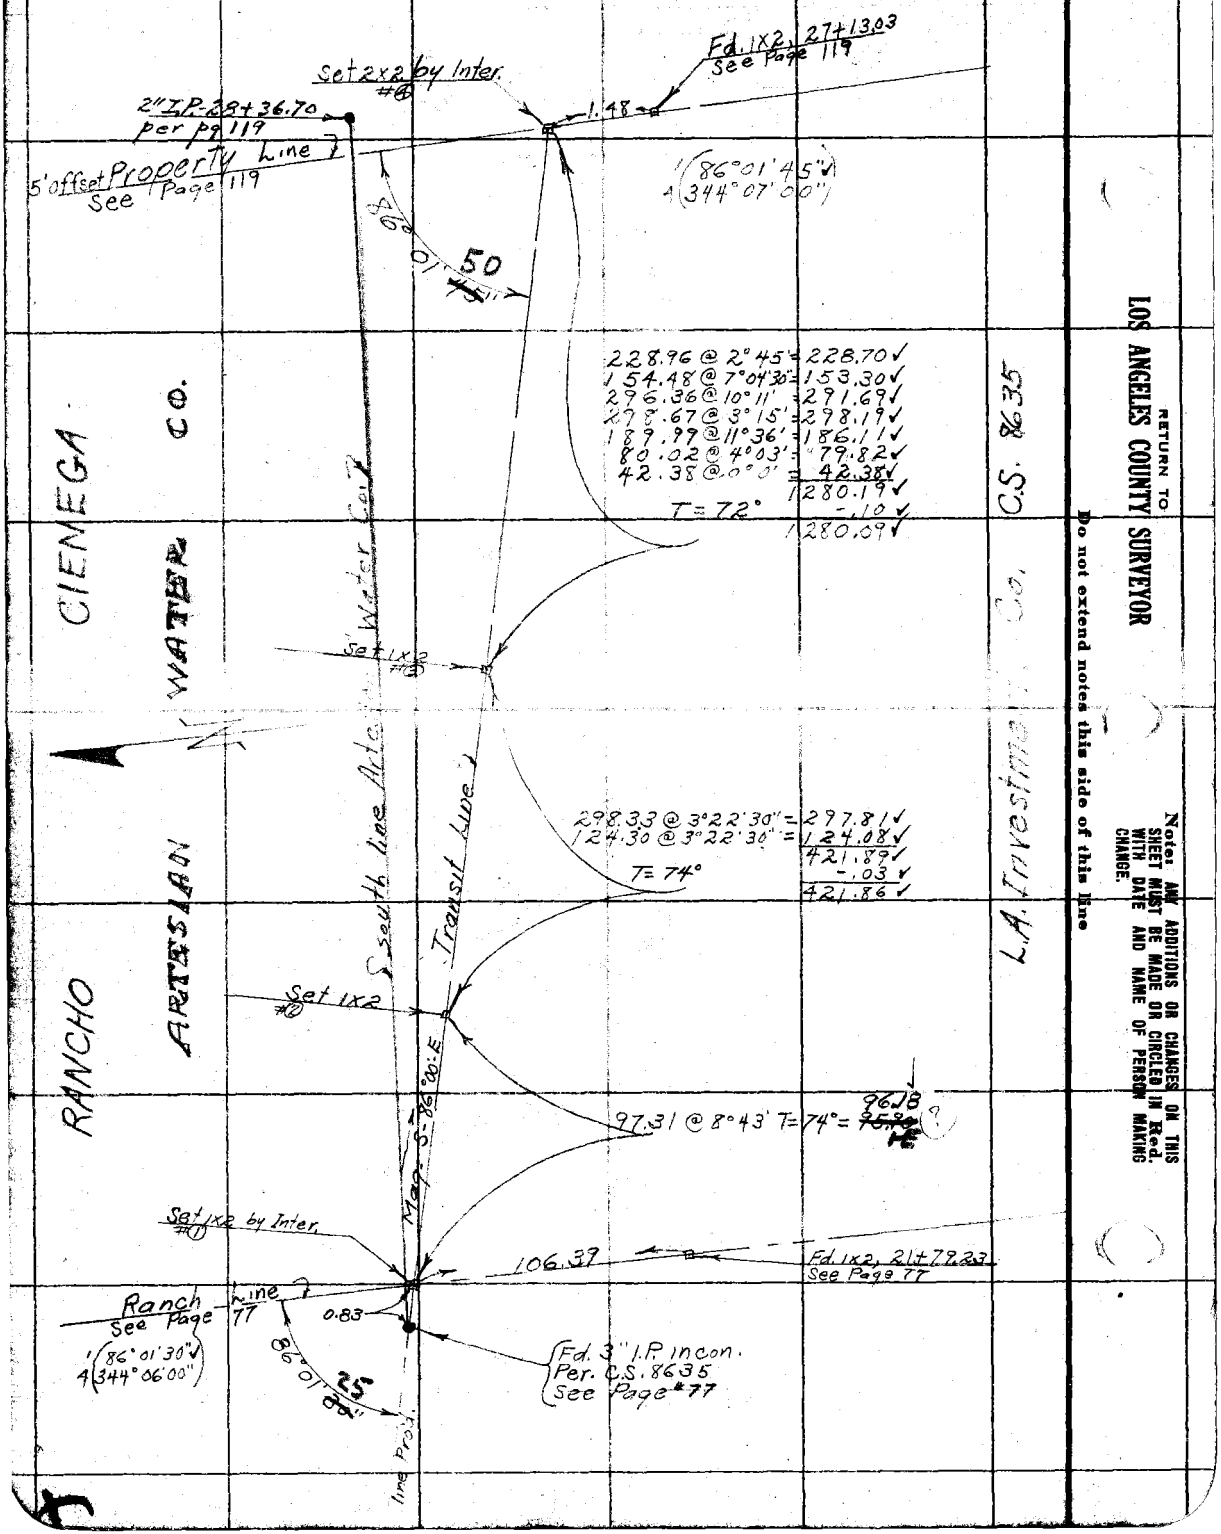

RETURN TO LOS ANGELES COUNTY SURVEYOR

Do not extend notes this side of this line

Notes: ANY ADDITIONS OR CHANGES ON THIS SHEET MUST BE MADE OR CIRCLED IN Red. WITH DATE AND NAME OF PERSON MAKING CHANGE.

Date _____ Notes by _____ Chief Party _____ F.B. 287 Pg 125

Platted by	W. O. No. D. S. O. No.
Date	Location
Map No.	Surveyed by
Platting C'k'd by	Date
Date	Indexed

Note: ANY ADDITIONS OR CHANGES ON THIS SHEET MUST BE MADE OR CIRCLED IN Red. WITH DATE AND NAME OF PERSON MAKING CHANGE.

Do not extend notes this side of this line

RETURN TO
LOS ANGELES COUNTY SURVEYOR

RETURN TO

LOS ANGELES COUNTY SURVEYOR

Note: ANY ADDITIONS OR CHANGES ON THIS SHEET MUST BE MADE OR CIRCLED IN Red. WITH DATE AND NAME OF PERSON MAKING CHANGE.

Do not extend notes this side of this line

F.B.____ Pg.____

Chief Party _____ Notes by _____

Date _____

Date 4/21/31. Notes by BUTLER Chief Party BUTLER F.B. 289 PG 135

Platted by	W. O. No. 7032 U. S. C. & G. No. 031
Date	Location MARKET ST
Map No.	Surveyed by S.E. BUTLER
Platting C'k'd by	Date 4/21/31.
Date	Indexed C. Johnson 4-29-31

Notes: ANY ADDITIONS OR CHANGES ON THIS SHEET MUST BE MADE OR CIRCLED IN Red. WITH DATE AND NAME OF PERSON MAKING CHANGE.

Do not extend notes this side of this line

RETURN TO LOS ANGELES COUNTY SURVEYOR

W.O. 7032

(Proposed)

MARKET ST.

62ND ST. to LA BREA AVE.

C.L. Berger # 14766
100' Tape # 031-Std-76°

BUTLER
BAKER
NAUMANN
J. WILLEY
BEARDSLEY

NOTE:
℄ LINE from 62ND & ORANGE ST. to SLAUSON AVE is retracement of ℄ Highland AVE as planned by L.A. Investment Co per their map of proposed TRACT # 9831.

NOTE: FOR "P" Line notes & TOPOS from SLAUSON AVE to LA BREA AVE See L.B 30E-207

RETURN TO
LOS ANGELES COUNTY SURVEYOR

Note: ANY ADDITIONS OR CHANGES ON THIS SHEET MUST BE MADE OR CIRCLED IN Red. WITH DATE AND NAME OF PERSON MAKING CHANGE.

Do not extend notes this side of this line

F.B. 289 Pg. 136 — Notes by BUTLER Date 4/13/37

Chief Party

See F.B. 463 Pg. 42 for pipe found

BUTLER ST.

Ed WSK+T No REE

14747.07' V

Ed 1/2" I.P. with copper Witness Cone. 1.0N Spoor T.E.#9831 M.B. 160-Ex-29

Ed 1/2" I.P. with copper Witness Cone. to E.D.N. Spoor T.E.#9831 M.B. 160-Ex-29

CITRUS AVE (60)

M.B. 160-Ex-29

TRACT NO. 9831

Tope Std-26'

Ed L+T

Ed L+T-Cone MON 3"D.N. O.S. Per T.E. #9676 M.B. 167-E W. Ely 1.8' Inf 4 L+TS

Ed L+T

Ed L+T

Ed L+T

Date 4/21/31 Notes by BUTLER Chief Party BUTLER F.B. 289 PG. 137

Platted by L. G. McMILLAN
Date MAY 20 1931
Map No. 86-17
Platting C'k'd by
Date MAY 1931

W. O. No. 7032 R. & G. No. 931
Location MARKET ST
Surveyed by BUTLER
Date 4/21/31
Indexed A. S. Johnson

Fd 3" Conc Monument with Iron Pin in Mon Well Sec. 2

Tape Std. 76°

SECTION LINE SEE F.B. 289-4-3-1931

530.91'
300' Tape Std @ 84° F
236.31 @ 63°68' = 234.72
298.82 @ 77°35'68" = 296.19'
530.91'

Fd L+T in Conc pave = R.I. per F.A. 149/32

Fd L+T in Conc pave = R.I. per F.A. 149/31

Set 12"x4" 0.5 DN BY I.N.T.

Fd's F.A. 149 (Conc.) SLAUSON

Fd CSet N+T @ LA BREA per F.A. 149/63

980.79'
980.78'

1537.86'
1537.98 @ 64°

165°52'30"

206.95'

206.98'

Set N+T PP

165°53'00"

5.07

Fd 2x2 NAIL Flush = P.L. per L.A. INV. Map

Fd 1½" I.P. with copper Tack Set in Conc 1'DN, 0.015' W of LINE.

Fd 1½" I.P. with copper Tack Set in Conc 1'ON. P.T.

This Center Line of Highland Ave is Void. For proposed Center Line See F.B. 463-206, 207.

HIGHLAND AVE.

TRACT

INVESTMENT

PROPOSED

See File #619 Map #37

prop. TYRELL

Co. Surv.

Co.

983

1208.75'

45° copied from Map

100.01'

145°41'37½"

Data from Map
Δ = 34°18'30"
R = 500'
T = 154.36
L = 299.45

Notes ANY ADDITIONS OR CHANGES ON THIS SHEET MUST BE MADE OR CIRCLED IN Red. WITH DATE AND NAME OF PERSON MAKING CHANGE.

Do not extend notes this side of this line

RETURN TO LOS ANGELES COUNTY SURVEYOR

CONT'D ON L SHT PREC PG

F.B. 289 Pg. 138 Chief Party Notes by Date

RETURN TO
LOS ANGELES COUNTY SURVEYOR

Do not extend notes this side of this line

Note: ANY ADDITIONS OR CHANGES ON THIS SHEET MUST BE MADE OR CIRCLED IN Red. WITH DATE AND NAME OF PERSON MAKING CHANGE.

Drawn (C.S.) by Drew
Dwg. No. D-768
Checked C.S. M.E.A.
Traced Drew
Date 11-9-32

Survey of Market St.
W. O. 7032 Tape No. 044 St'd 84 °F.
Surveyed by D.B. Emmett
Notes R.B.E. Date 5/23/32
Indexed A. C. Johnson

F.B. 28.9 Pg. 139

Fd 2" IP plug + nail per F.B. 89. 73

23-36
94. 28. 30
141. 36. 3
23-36-00

Cont. top edge 144

317.00	160.00
115.30	240.00
79.15	40.00
149-49-45	
239-19-15	
179-59-00	
149-49-50	

89-37-30
358-30-00
177-45-00
89-37-30

23.96-66
33.35

Fd 2" IP plug + nail See F.B. 89. 73. 82

74.52

236.36 @ 66° = 236.33
96.66 @ 72° = 96.65

Set 2x2 dh. in by intersection

100° 45' Calc. 60.69

96.65

Cont. top edge 140

Fd 2" IP plug + nail per F.B. 89. 73

89-37-30

65.10
28.33

40° 00'

79° 15'

28.32

Proposed ℄ STOCKER ST.
520.00

Fd 2x2 + tk flush per F.B. 89-61, 69, 82

Proposed
451.29
190.87

Set 1x2 flush

Cont. top edge 145

55.00

28.97

Set 2x2 dh. in by inter.

VERNON AVE.

11.10

23.02

POST SET IN LINE OF FENCE

Set 2x2 dh. in

Proposed ℄ MARKET ST.
190.55

Proposed ℄ OVERHILL DRIVE

70° 34' Calc.

Old ℄ LA BREA AVE. per F.B. 89

126.32.20

99.95 @ 9°09' @ 68
99.83 @ 8°45

98.67
98.66

98.66
12.44
111.10

99.68 @ 5°30' @ 74°
99.79 @ 6°05
level

99.21
99.22
91.05
90.77

COUNTY SURVEYOR'S MONUMENT

3172.68 Market St.
Set 2" IP in conc. monument in conc. base and marker

126-32-15
140-09-15
39 41-00
126-32-20

top edge 144

Cont.

Note: ANY ADDITIONS OR CHANGES ON THIS SHEET MUST BE MADE OR CIRCLED IN Red Ink, WITH DATE AND NAME OF PERSON MAKING CHANGE.

RETURN TO
LOS ANGELES COUNTY SURVEYOR
700 HALL OF RECORDS
Do not cancel notes, this side of this line

FORM 647 10M 8-31

RETURN TO
LOS ANGELES COUNTY SURVEYOR
700 HALL OF RECORDS

Note: ANY ADDITIONS OR CHANGES ON THIS SHEET MUST BE MADE OR CIRCLED IN **Red** Ink, WITH DATE AND NAME OF PERSON MAKING CHANGE.

Do not extend notes this side of this line

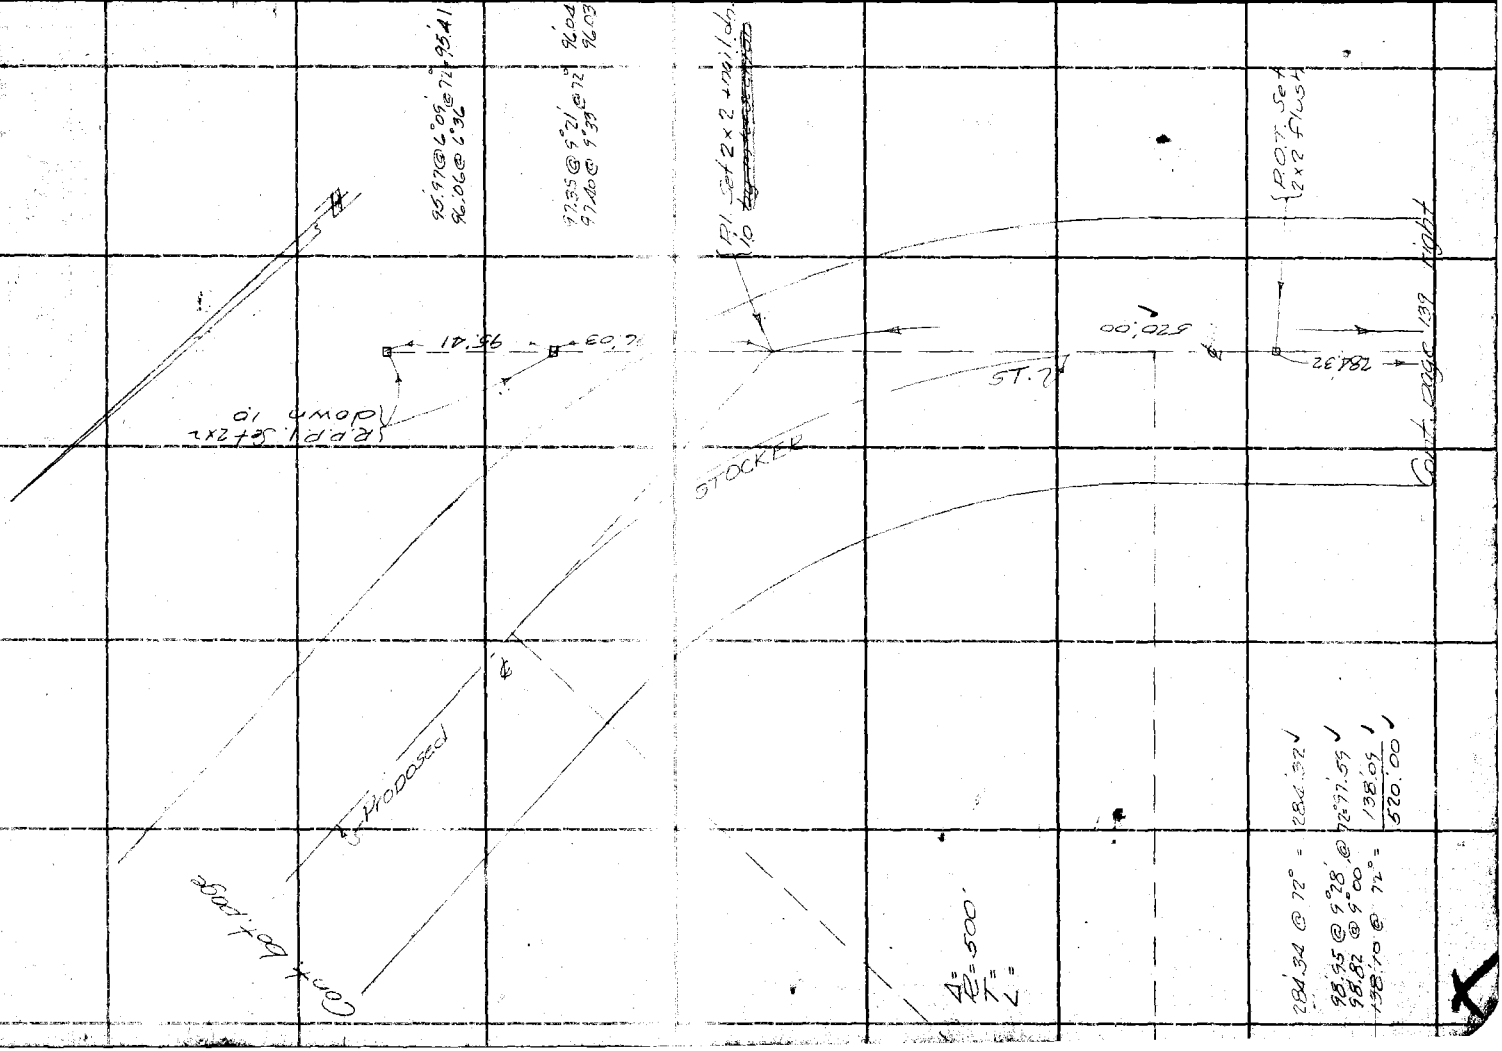

F.B. 285 Pg. 140

Notes Ck'd by Drew	Survey of Market St.
Map No. B-768	W. O. 2032 Tape No. 244 St'd 64 °F.
Office Work R.W.Mc	Surveyed by R.B. Emmott
Checked Drew	Notes R.B.E. Date 6/1/32
Date 11-9-32	Indexed A. C. Johnson

F.B. 287 PG. 144

Note: ANY ADDITIONS OR CHANGES OF THIS SHEET MUST BE MADE OR CIRCLED IN Red Ink. WITH DATE AND NAME OF PERSON MAKING CHANGE.

Do not extend notes this side of this line

RETURN TO
LOS ANGELES COUNTY SURVEYOR
700 HALL OF RECORDS

FORM 847 10M 8-31

{R.P. Fd 2x2 dn .10 per pg. 97 also FB. 89 page 80

{P.I. Fd common with spk + dn. wood mark in tin. See page 97

85.63'

610.68 @ 70° = 610.62 ✓

610.62

B.C. Set C.S.W. + T.

(50) (50)

{R.P. Fd 2x2 dn .10 per FB 89-81 and FB 295-88

(Δ = 76-40-15
R = 250'
T = 197.61'
L = 331.91)

Δ = 66°58'15" ✓
R = 500'
T = 330.76 ✓
L = 584.43 ✓

122.33±

721.72 @ 70° = 721.65 ✓

{P.I. Fd remains of 2x2 Stake. Reset 2x2 + nail by intersection

R.P.P.I. Set V 2x2 dn. 10

P.I. Set 4x4 + spk. dn .10 by intersection

125.11

460.82

Projected

LH BREA AVE.

721.65 ✓

(50)

Cont. Adj. 748 Left

130.21 @ 16°05 @ 14° = 125.10
130.05 @ 15°49 = 125.12

66-58-15
267-58-00
41-49-30

220.35 @ 70° = 220.33 ✓

VERNON AVE.

451.29 ✓

50

50

298.84 @ 9°33' @ 70° = 294.67 ✓
298.69 @ 9°22' = 294.68 ✓
156.62 @ 72° = 156.61 ✓
451.29 ✓

Cont. Adj. 139 Left

R.P. Fd. 2x2 dn .10 per page 98 also FB. 89-81

F.B. 289 Pg. 142

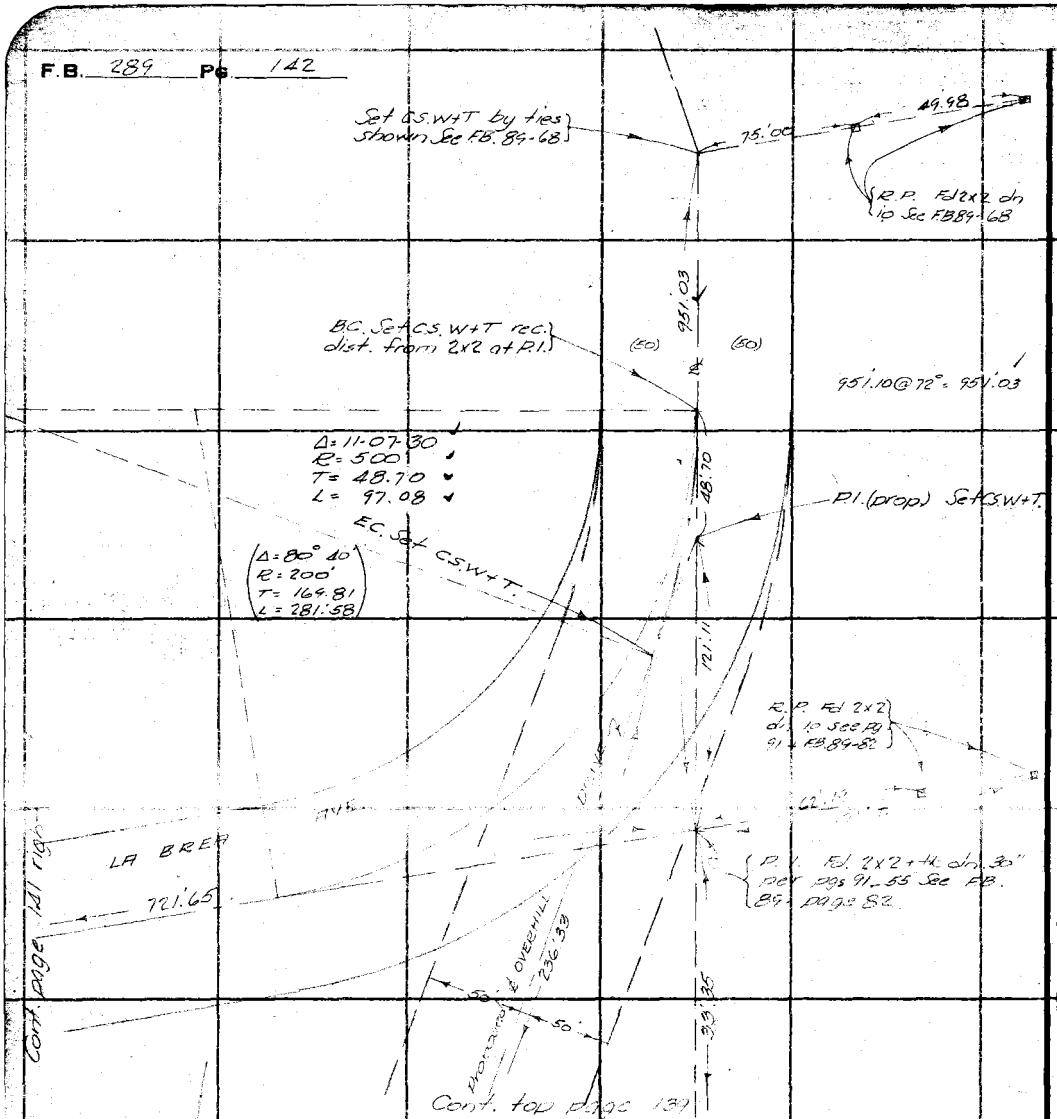

RETURN TO
LOS ANGELES COUNTY SURVEYOR
700 HALL OF RECORDS

Do not extend notes this side of this line

Note: ANY ADDITIONS OR CHANGES ON THIS SHEET MUST BE MADE OR CIRCLED IN Red Ink. WITH DATE AND NAME OF PERSON MAKING CHANGE.

Notes Ck'd by Drew	Survey of Market St.	F.B. 387	PG. 1143
Map No. B-768	W. O. 7032 Tape No. 044 St'd 84 °F.		
Office Work R.W. McA.	Surveyed by R.B. Emmett		
Checked Drew	Notes R.B.E. Date 6/1/32		
Date 11-9-32	Indexed A. C. Johnson		

Cont Lot. page 100

To P.O.T 43+20.92 - 2x2 See pg. 100

372.87

40 40

EC Set 2x2 + nail dn. 1.0

37+28.05 E.C.

AVE. 84.33

Δ = 33°59' 30"
R = 1000'
T = 305.65
L = 593.27

VERNON

P.O.S.T. Fd 2x2 dn 1.0 = P.O.T. 36+43.72 per page 99

P.O.S.T. 2x2 dn. Set 1.0

EC Set 2x2 + nail dn. 1.0

P.I. Set 2x2 + nail down 1.0

Proposed

23.06

314.00 535.36

Former proposed & VERNON AVE. now abandoned

40 40

111.10

Fd 1x2 down 1.0 = E.C. 31+08.39 per page 99

158.85 @ 72° = 158.84
535.36 @ 72° = 535.32
314.02 @ 72° = 314.00

158.84

Cont. page 139 right

Cont. page 144 right

RETURN TO
LOS ANGELES COUNTY SURVEYOR
700 HALL OF RECORDS
Do not extend notes this side of this line

Note: ANY ADDITIONS OR CHANGES ON THIS SHEET MUST BE MADE OR CIRCLED IN Red Ink, WITH DATE AND NAME OF PERSON MAKING CHANGE.

FORM 247 10M 8-31

RETURN TO

LOS ANGELES COUNTY SURVEYOR

700 HALL OF RECORDS

Note: ANY ADDITIONS OR CHANGES ON THIS SHEET MUST BE MADE OR CIRCLED IN **Red Ink.** WITH DATE AND NAME OF PERSON MAKING CHANGE.

Do not extend notes this side of this line

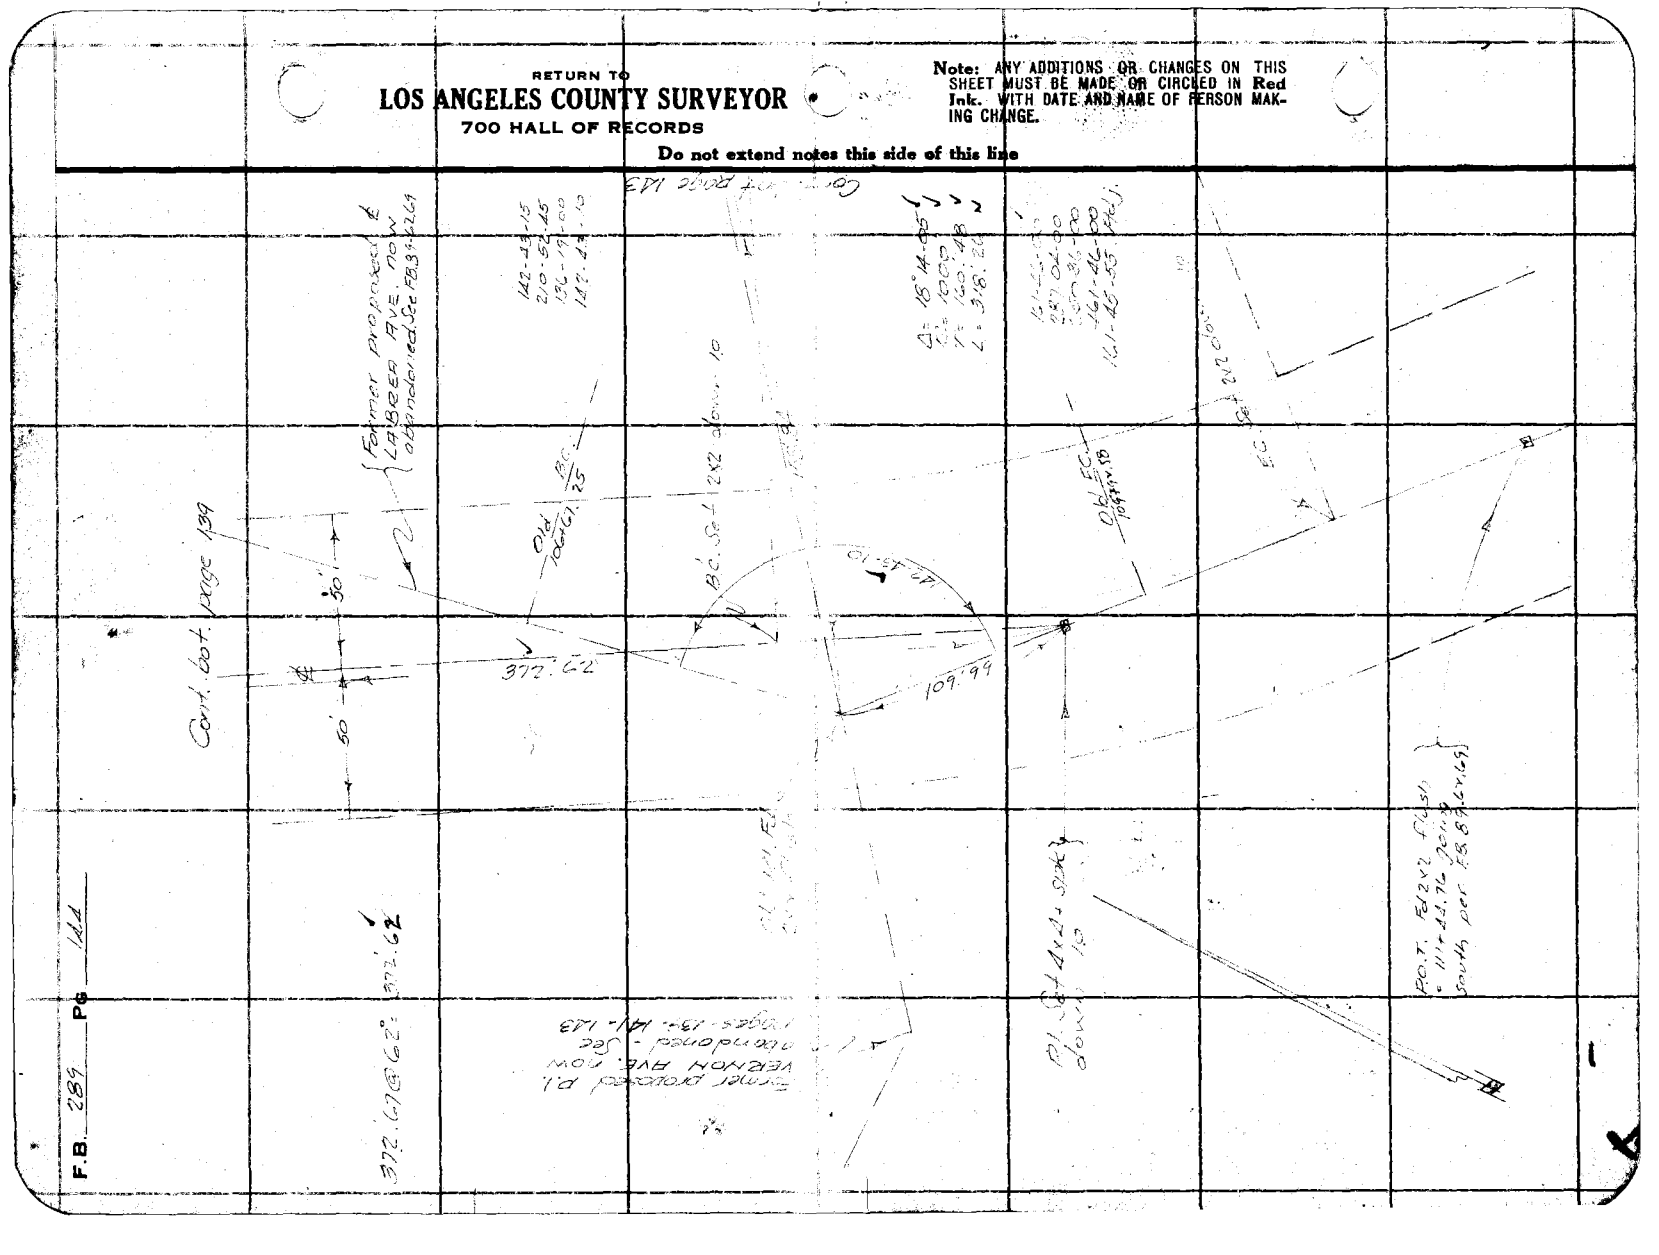

Notes Ck'd by Drew	Survey of Market St.
Map No. B-768	W. O. 2032 Tape No. 044 St'd 84 °F.
Office Work R.W.M.S.A.	Surveyed by R.B. Emmott
Checked Drew	Notes R.B.E. Date 6/3/32
Date 11-9-32	Indexed A. C. Johnson

F.B. 289 PG. 146

Note: ANY ADDITIONS OR CHANGES ON THIS SHEET MUST BE MADE OR CIRCLED IN Red Ink. WITH NAME OF PERSON MAKING CHANGE.

RETURN TO
LOS ANGELES COUNTY SURVEYOR
700 HALL OF RECORDS
Do not extend notes this side of this line

FORM 247 10M 8-31

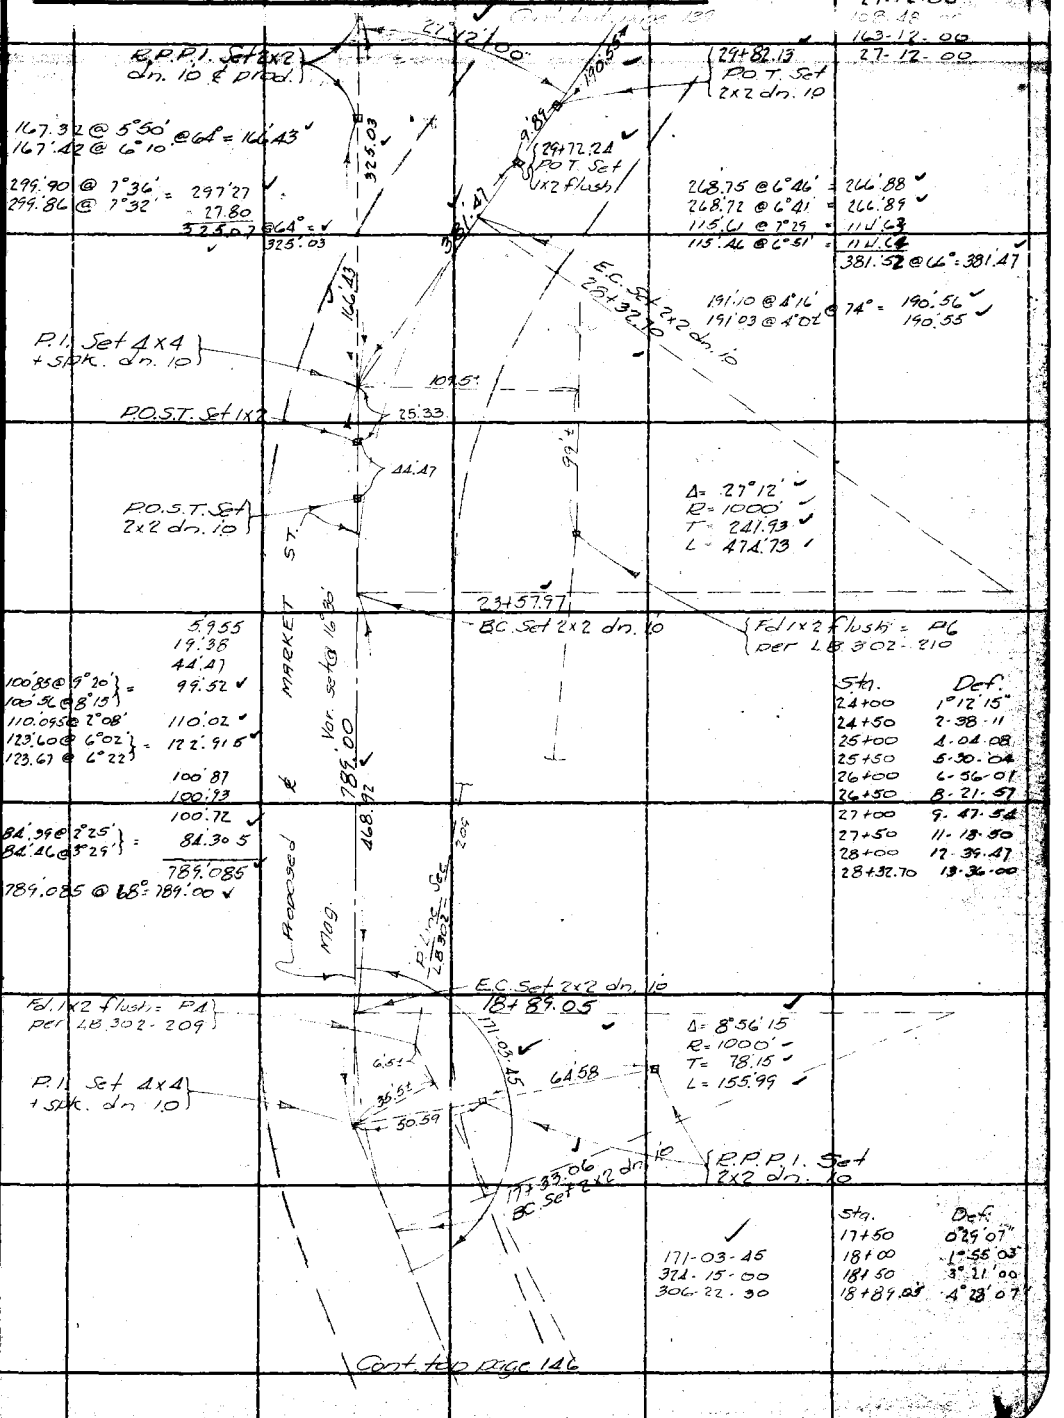

F.B. 289 PG 146

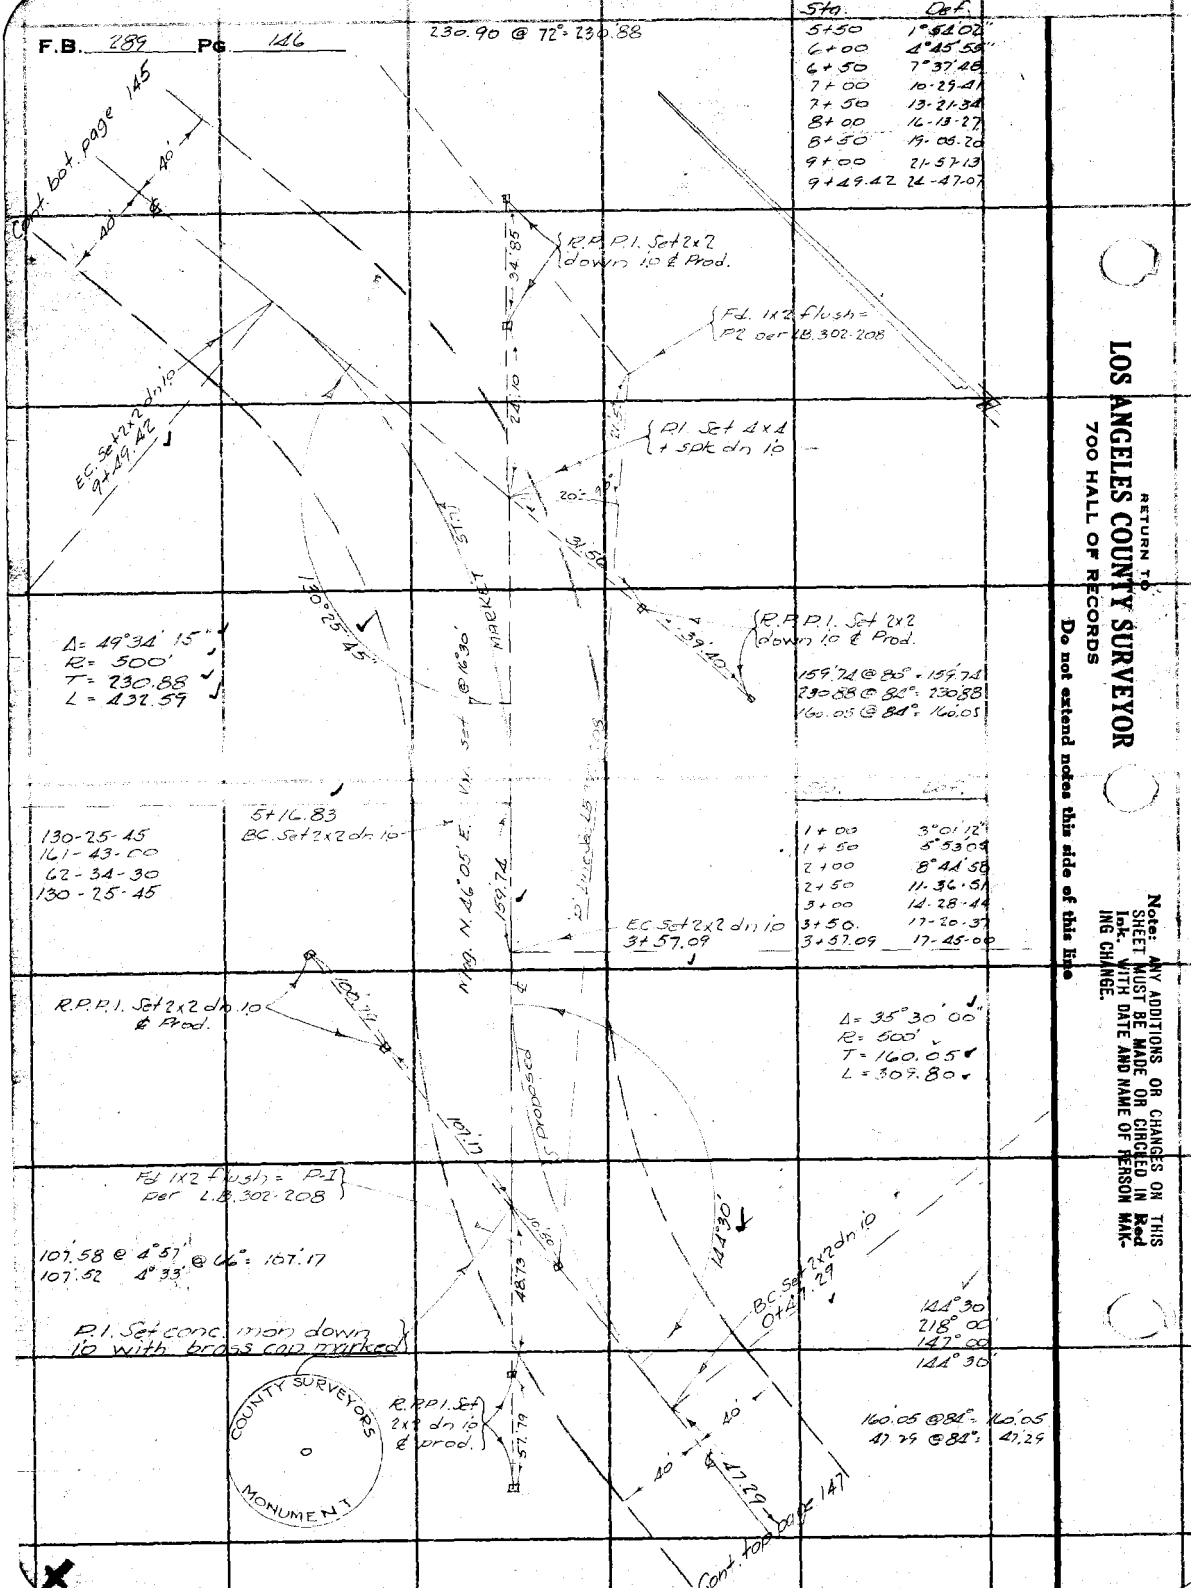

RETURN TO
LOS ANGELES COUNTY SURVEYOR
700 HALL OF RECORDS

Note: ANY ADDITIONS OR CHANGES ON THIS SHEET MUST BE MADE OR CIRCLED IN Red Ink. WITH DATE AND NAME OF PERSON MAKING CHANGE.

Do not extend notes this side of this line

Date _____ Notes by _____ Chief Party _____ F. B. 289 Pg. 137

Platted by R.W. MSA.
Date Oct. 1932.
Map No. B-768
Platting C'k'd by Drew
Date 11-9-32

W. O. No. 7032 U. S. G. No. _____
Location Market St.
Surveyed by R.B. Emmett
Date 6-3-32
Indexed A. C. Johnson

Notes: ANY ADDITIONS OR CHANGES ON THIS SHEET MUST BE MADE OR CIRCLED IN Red. WITH DATE AND NAME OF PERSON MAKING CHANGE.

Do not extend notes this side of this line

RETURN TO LOS ANGELES COUNTY SURVEYOR

Contd. on Bottom / page 146

Δ = 35°30'00"
R = 500
T = 160.05

0+47.89 B.C. Pg 146

115°51'30" per L.B. 302-208

47.89

0+00 Going N.
Fd. L.T. in conc.
pav. P.I. per this
F.A. 149-32. Pg 137

1537.86 per pg. 137

Fd. L.T. in Conc. Pg 137

Fd. C.S.W.T. Pg 137

980.70 per pg. 137

SLAUSON

AVE.

165°52'35" Pg 137 per F.B. 289-137

Page 137

Proposed MARKET

RETURN TO

LOS ANGELES COUNTY SURVEYOR

Note: ANY ADDITIONS OR CHANGES ON THIS SHEET MUST BE MADE OR CIRCLED IN **Red.** WITH DATE AND NAME OF PERSON MAKING CHANGE.

Do not extend notes this side of this line

F.B. ____ Pg. ____ Chief Party ____ Notes by ____ Date ____

FORM 247 10M 5-31

RETURN TO

LOS ANGELES COUNTY SURVEYOR

700 HALL OF RECORDS

Note: ANY ADDITIONS OR CHANGES ON THIS SHEET MUST BE MADE OR CIRCLED IN **Red Ink.** WITH DATE AND NAME OF PERSON MAKING CHANGE.

Do not extend notes this side of this line

Notes Ck'd by

Map No.

Office Work

Checked

Date

Survey of

W. O.

Surveyed by

Notes

Indexed

Tape No.

St'd

Date

oF.

F.B.

PG.

RETURN TO

LOS ANGELES COUNTY SURVEYOR

700 HALL OF RECORDS

Note: ANY ADDITIONS OR CHANGES ON THIS SHEET MUST BE MADE OR CIRCLED IN **Red Ink.** WITH DATE AND NAME OF PERSON MAKING CHANGE.

Do not extend notes this side of this line

F.B. _____ Pg. _____

Notes Ck'd by K.R.M.	Survey of		F.B. 289 Pg. 171
Map No.	W. O.	Tape No. St'd °F.	
Office Work	Surveyed by		
Checked	Notes HE	Date 10-9-31	
Date	Indexed A. C. Johnson		

SURVEY OF JEFFERSON BL'VD.

FROM.

MOYNIER LANE

to

MACHADO RD.

9-2-'31 to 10-9-'31

H.F. Evans - Dep.
H.L. Martin - K
G.E. Willits - H.C.
L.C. Wilson - R.C.
J.L. Willey - R.C.

Tapes #04, 17, #32 all standard at 84° F.

See pg. 172 for index Sketch

Reference Books

C.S.	Rd. Dept.
F.B. 89	F.A. 173
F.B. 289	
F.B. 476	
L.B. 614	

Notes: ANY ADDITIONS OR CHANGES TO THIS SURVEY MUST BE RECORDED ON THIS BOOK, WITH DATE AND NAME OF PERSON MAKING SAME.

RETURN TO LOS ANGELES COUNTY SURVEYOR 700 HALL OF RECORDS

Do not extend notes this side of this line

FORM 247 10M 8-31

RETURN TO
LOS ANGELES COUNTY SURVEYOR
700 HALL OF RECORDS

Note: ANY ADDITIONS OR CHANGES ON THIS SHEET MUST BE MADE OR CIRCLED IN Red Ink. WITH DATE AND NAME OF PERSON MAKING CHANGE.

Do not extend notes this side of this line

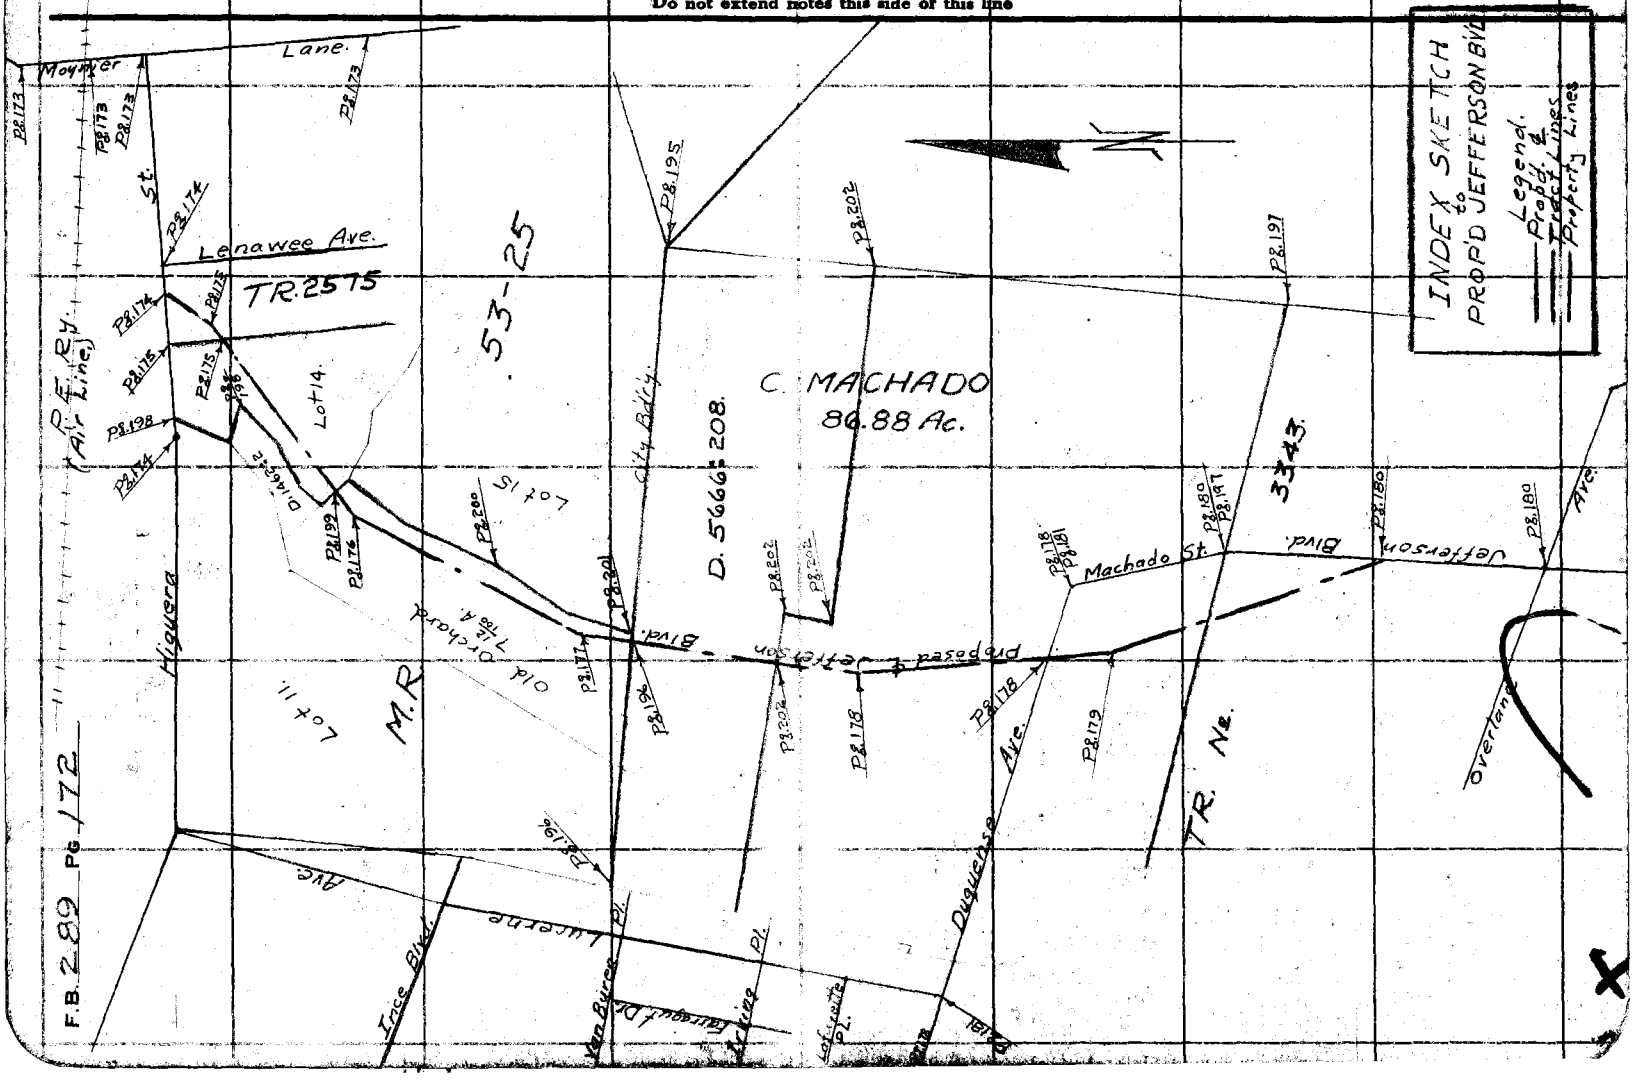

Notes Ck'd by K.R.M.	Survey of Jefferson Blvd.
Map No.	W. O. 4173 Tape No. 04 St'd 84° °F.
Office Work	Surveyed by Evans
Checked	Notes HE Date 9-18-31
Date	Indexed A. C. Johnson

F.B. 289 Pg. 173

Note: ANY ADDITIONS OR CHANGES ON THIS SHEET MUST BE MADE OR CIRCLED IN Red Ink. WITH DATE AND NAME OF PERSON MAKING CHANGE.

Do not extend notes this side of this line

RETURN TO
LOS ANGELES COUNTY SURVEYOR
700 HALL OF RECORDS

FORM 247 10M 8-31

N&T P.P.
38.52
23.68
Chr. T.C. find post.
Chr. T.C. Plug & Tack
37.97
Chr. T.C. find post.
Fd. S.W.T.-4" deep 70+86.81 from S. per pg. 83
Lane
(90°-50-15)
(363°-50-15 21-15)
(Turned) 90-59-20 Tan.
N&T weld Valve box
N&T Tel. P.
65.87
59.07
Fd. Wire Spk. & T P.P.
Prop'd Jefferson Blvd.
To Int'sn Lenawee
T 76° = 1008.50
1008.55
Higuera St.
Set 2"x2"-2' dn. by intersn. from West. Old hub gone 80+27.43 going N. per F.B. 89-100
1523.38
T 96° = 1523.50
1523.50
1.29
Set P.K. Nail
Δ =
R = 150
T =
L =
L&T in conc. base of Trfc. Post. 8th P. N. of gate.
7.49
Set 2" I.P. P. & T. 6" deep 93 95+50.88 from S.
37.59
30.93
N&T 90° R
40.62
N&T
P.E. Ry.
1473.65
T 96° = 1473.76
Maynier
Fd. 1" I.P. P. & T. 4" deep per pg. 84
29.43
L&T's conc. headwall
L&T on conc. Hdwl.
To Bell. Pg. 174

RETURN TO
LOS ANGELES COUNTY SURVEYOR
720 HALL OF RECORDS

Note: ANY ADDITIONS OR CHANGES ON THIS SHEET MUST BE MADE OR CIRCLED IN Red Ink. WITH DATE AND NAME OF PERSON MAKING CHANGE.

Do not extend notes this side of this line

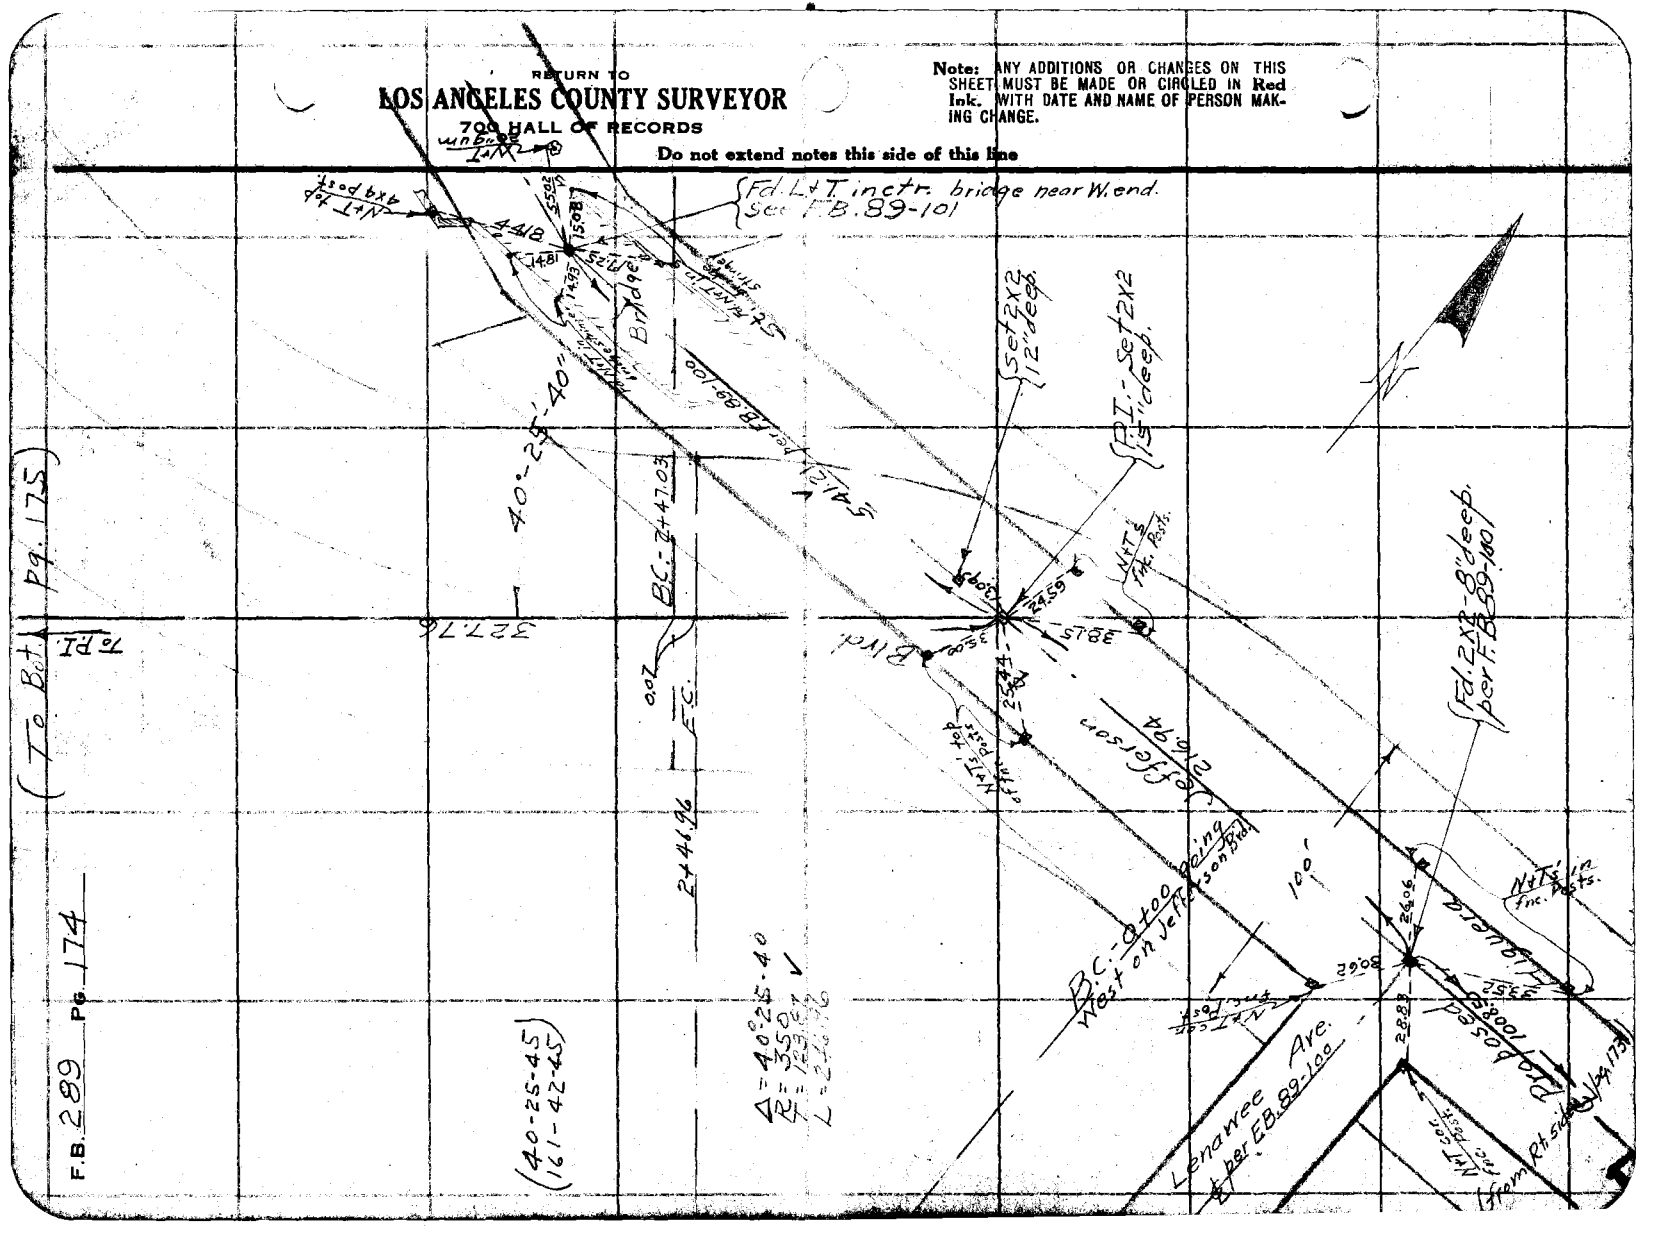

Notes Ck'd by KRM	Survey of Jefferson Blvd.
Map No.	W. O. 4173 Tape No. 051 St'd 84 °F.
Office Work	Surveyed by Evans
Checked	Notes HE Date 9-10-31
Date	Indexed A. C. Johnson

F.B. 289 PG 175

To B.C. pg. 176

LOT 14

Fd. rotten 1X2 +T (old E.C. - 7+28.89 per F.A. 173-13) Set 2X2 - flush = P.O.T. - 10+69.63

10+69.63

T 84° 464.41

50.00

Fd. rotten 1X2 +T set 2X2 flush.

M.R. 53-25

100'

E.C. 6+37.65

575.83

Fd. 2X2 - 6" deep per F.B. 89-103

(76°-41 306°-44)

16° 41'-00" 76° 41' 95 Adj

S 75°32'-T 86°

Radial 50'

Δ = 26°19'-50"
R = 850
T = 198.62
L = 390.62

E. 50 / B 101-68.90 + 12 = 2417 + 50.00 N 10° W

10' dirt rd.

20093 - T 76°-20092

Fnc. cor.

P.O.T. Set 2X2 8" deep

Wire fnc.

2" I.P. per F.B. 89-103

58.36

54.97

Blvd.

62.91

Jefferson

2" Brasscap in conc. per F.B. 89-101

T. SW + T per F.B. 89-101

Glaucera St

51.9

P.I. - Set 2X2 14" deep

TR. No. 2565

Proposed

Tan. Prod.

set 2X2 12" deep.

26°-19'-50" Adj.

(26°-20 105°-19-45)

From Tab pg. 174

RETURN TO
LOS ANGELES COUNTY SURVEYOR
700 HALL OF RECORDS
Do not extend notes this side of this line

Notes: ANY ADDITIONS OR CHANGES ON THIS SHEET MUST BE MADE OR CIRCLED IN Red Ink, WITH DATE AND NAME OF PERSON MAKING CHANGE.

FORM 847 10M 8-31

F.B. 289 PG 176

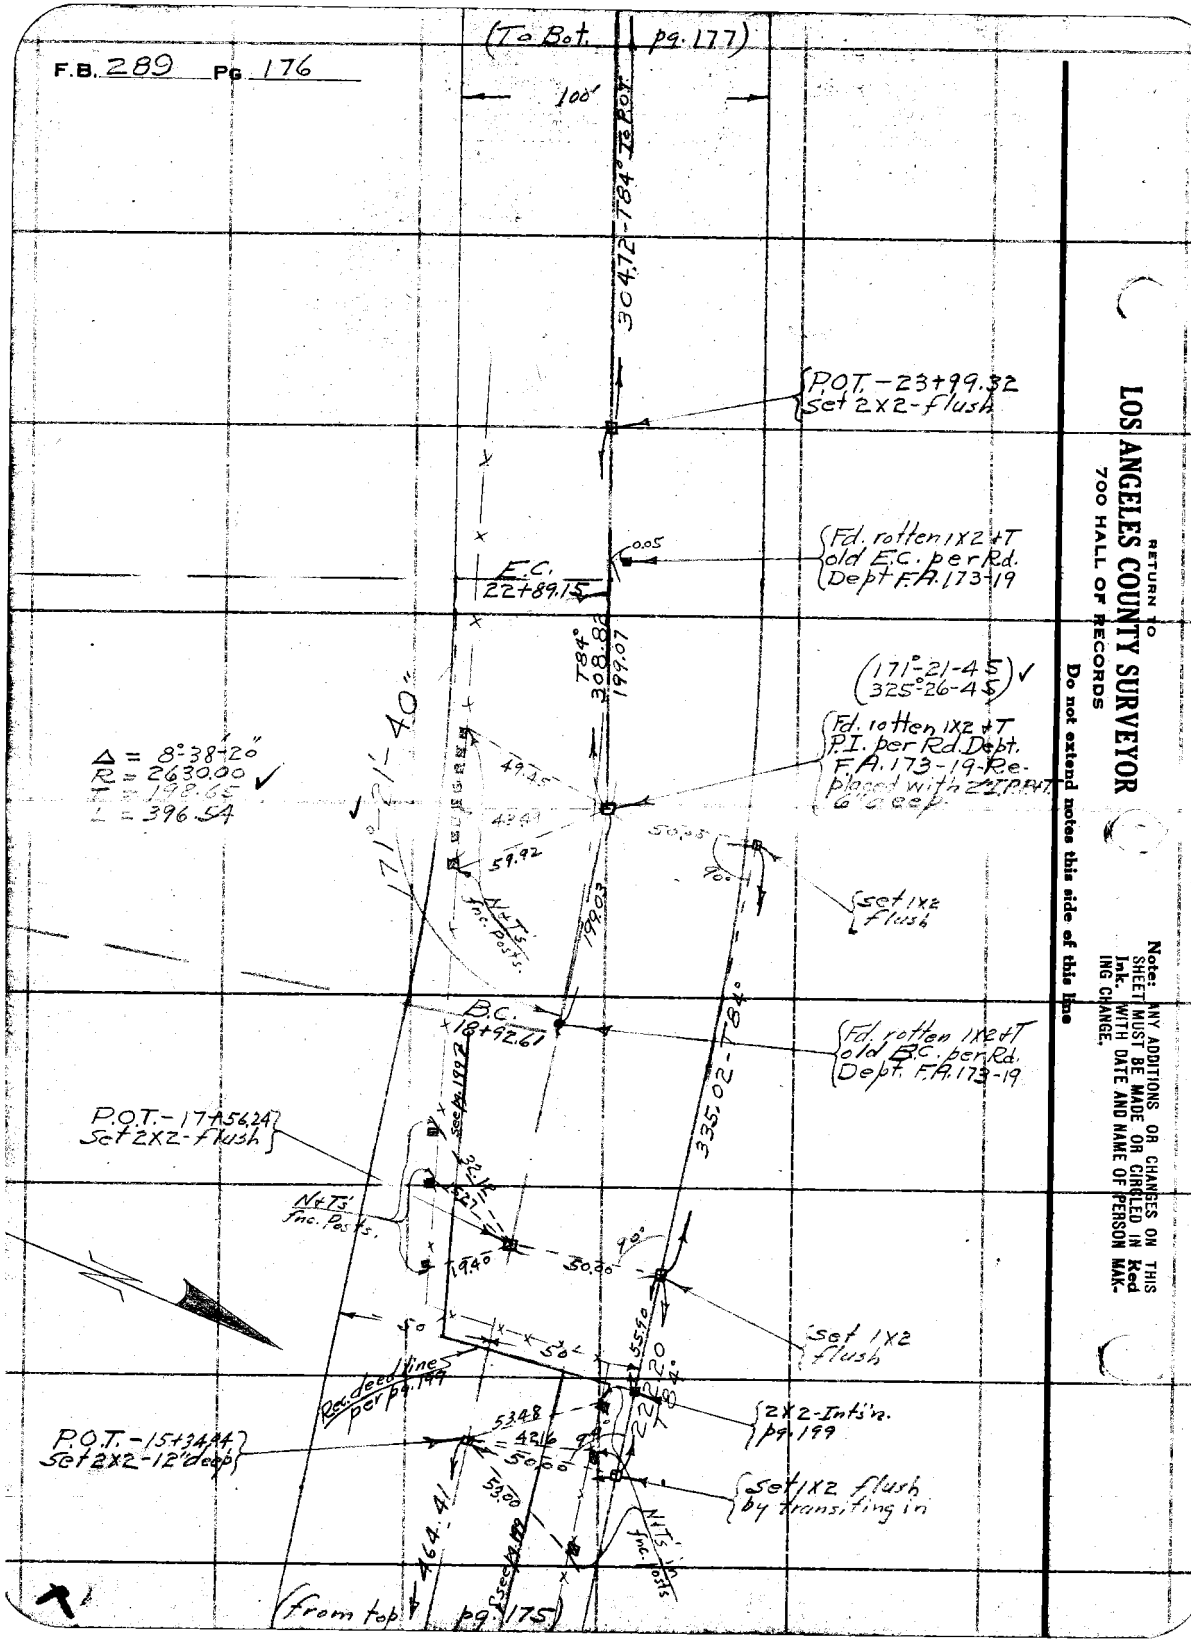

RETURN TO
LOS ANGELES COUNTY SURVEYOR
700 HALL OF RECORDS

Do not extend notes this side of this line

Note: ANY ADDITIONS OR CHANGES ON THIS SHEET MUST BE MADE OR CIRCLED IN Red Ink. WITH DATE AND NAME OF PERSON MAKING CHANGE.

Notes Ck'd by KRM	Survey of Jefferson Blvd.
Map No.	W. O. 4173 Tape No. 04 St'd 84° °F.
Office Work	Surveyed by Evans
Checked	Notes LE Date 9-11-31
Date	Indexed A. C. Johnson

F.B. 289 PG. 177

RETURN TO
LOS ANGELES COUNTY SURVEYOR
700 HALL OF RECORDS

Note: ANY ADDITIONS OR CHANGES ON THIS SHEET MUST BE MADE OR CIRCLED IN Red Ink. WITH DATE AND NAME OF PERSON MAKING CHANGE.

Do not extend notes this side of this line

FORM 847 10M 8-31

To Bc. Pg. 178.
100'
Mag = 54°45' W.
To P.O.T. Pg. 178

100.12 @ 2-51 = 100.00 ✓
78.38 @ 9-28-30 = 77.31 ✓
26.29 @ 0-0 = 26.29 ✓
203.60 ✓
T 70° = .02
203.58 ✓

F.C. 31+14.65

City Boundary ?
10ft. offset line
Pg. 196 ✓

2 X 2 - 14" deep
P.O.S.T. - Int's'n
per pg. 196

203.58 ✓

Δ = 26°-46'-55" ✓
R = 750.
T = 178.55
L = 350.58

19.90

Jefferson Blvd.

42.79

Fd. rotten 1 X 2 + T
P.I. - per Rd. Dept.
F.A. 173-25-Re
placed with 2" I.P. P.I.K
12" deep.

Proposed 17858
238.68 - 78 4°

(153°13
252°52-15) ✓

B.C. 27+64.07

0.62

Fd old rotten
1 X 2 + T - old
B.C. per Rd. Dep.
F.A. 173-25

P.O.T. - 27+04.04
Set 2 X 2 - Flush

304.72

50'

From t/p
50'
pg. 176)

F.B. 289 Pg 178

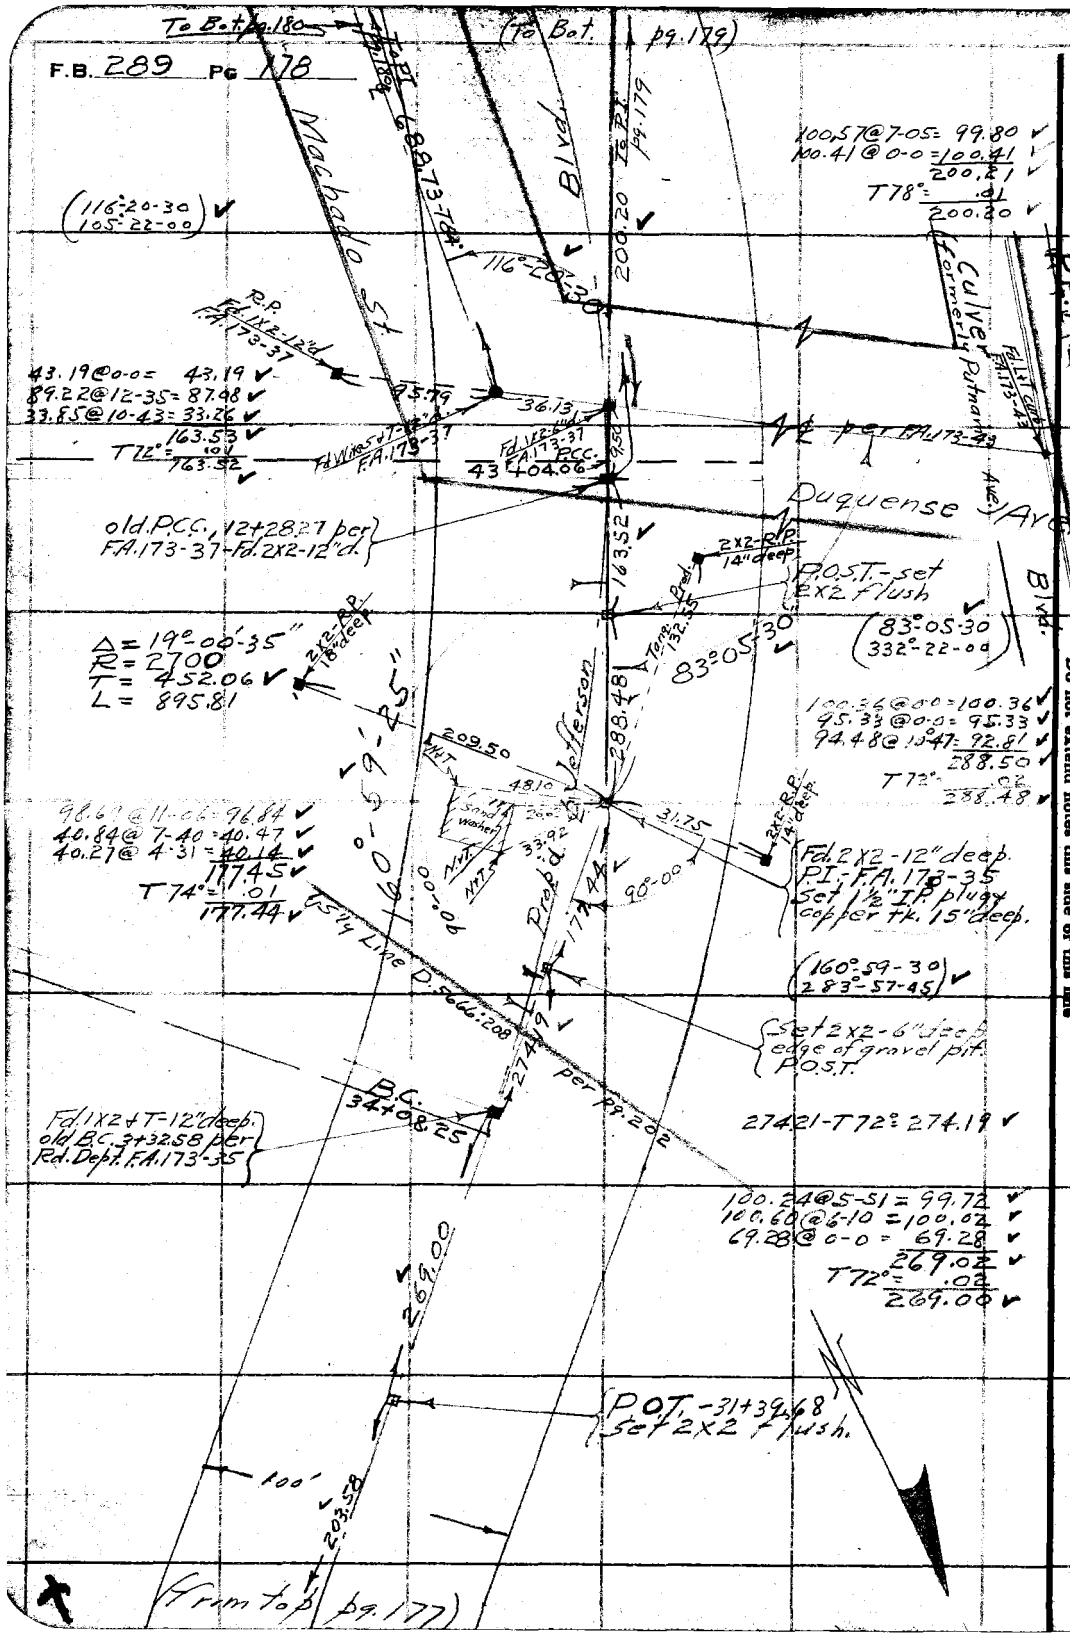

RETURN TO
LOS ANGELES COUNTY SURVEYOR
720 HALL OF RECORDS

Do not extend notes this side of this line

Note: ANY ADDITIONS OR CHANGES ON THIS SHEET MUST BE MADE OR CIRCLED IN Red Ink. WITH DATE AND NAME OF PERSON MAKING CHANGE.

Notes Ck'd by K.R.M.	Survey of Jefferson Blvd.
Map No.	W. O. 4173 Tape No. 04 St'd 84 °F.
Office Work	Surveyed by Evans
Checked	Notes HE Date 9-15-31
Date	Indexed A. C. Johnson

F.B. 289 Pg. 179

To Book A Pg. 184

To Post #1 Pg. 180

0.30 Rd. 1X2 * T 24" deep.

E.C. 47+00.44

35 Ft. offset Line 2

461.43

461.45 - T 76 = 461.43

Δ = 19°-35'-20"
R = 1159.36
L = 396.38

Jefferson Blvd.

201.57

40' adj.

24°-35'

160°

20°

35°

6.50

Set 1"X1" bars turned at Jefferson Blvd

P.I. - set 1¼" IP 24" deep w. tk. 18" deep by intersecting line from North with line established by turning rec. angle off Jefferson Blvd. on 35 ft. offset line.

(160°-24'-30")
(281°-38'-30")

Jefferson

200.20

50'

50'

Property

(From tab pg. 178)

Note: ANY ADDITIONS OR CHANGES ON THIS SHEET MUST BE MADE OR CIRCLED IN Red Ink. WITH DATE AND NAME OF PERSON MAKING CHANGE.

Do not extend notes this side of this line

RETURN TO
LOS ANGELES COUNTY SURVEYOR
700 HALL OF RECORDS

FORM 247 10M 8-31

RETURN TO
LOS ANGELES COUNTY SURVEYOR
700 HALL OF RECORDS

Note: ANY ADDITIONS OR CHANGES ON THIS SHEET MUST BE MADE OR CIRCLED IN **Red** Ink. WITH DATE AND NAME OF PERSON MAKING CHANGE.

Do not extend notes this side of this line

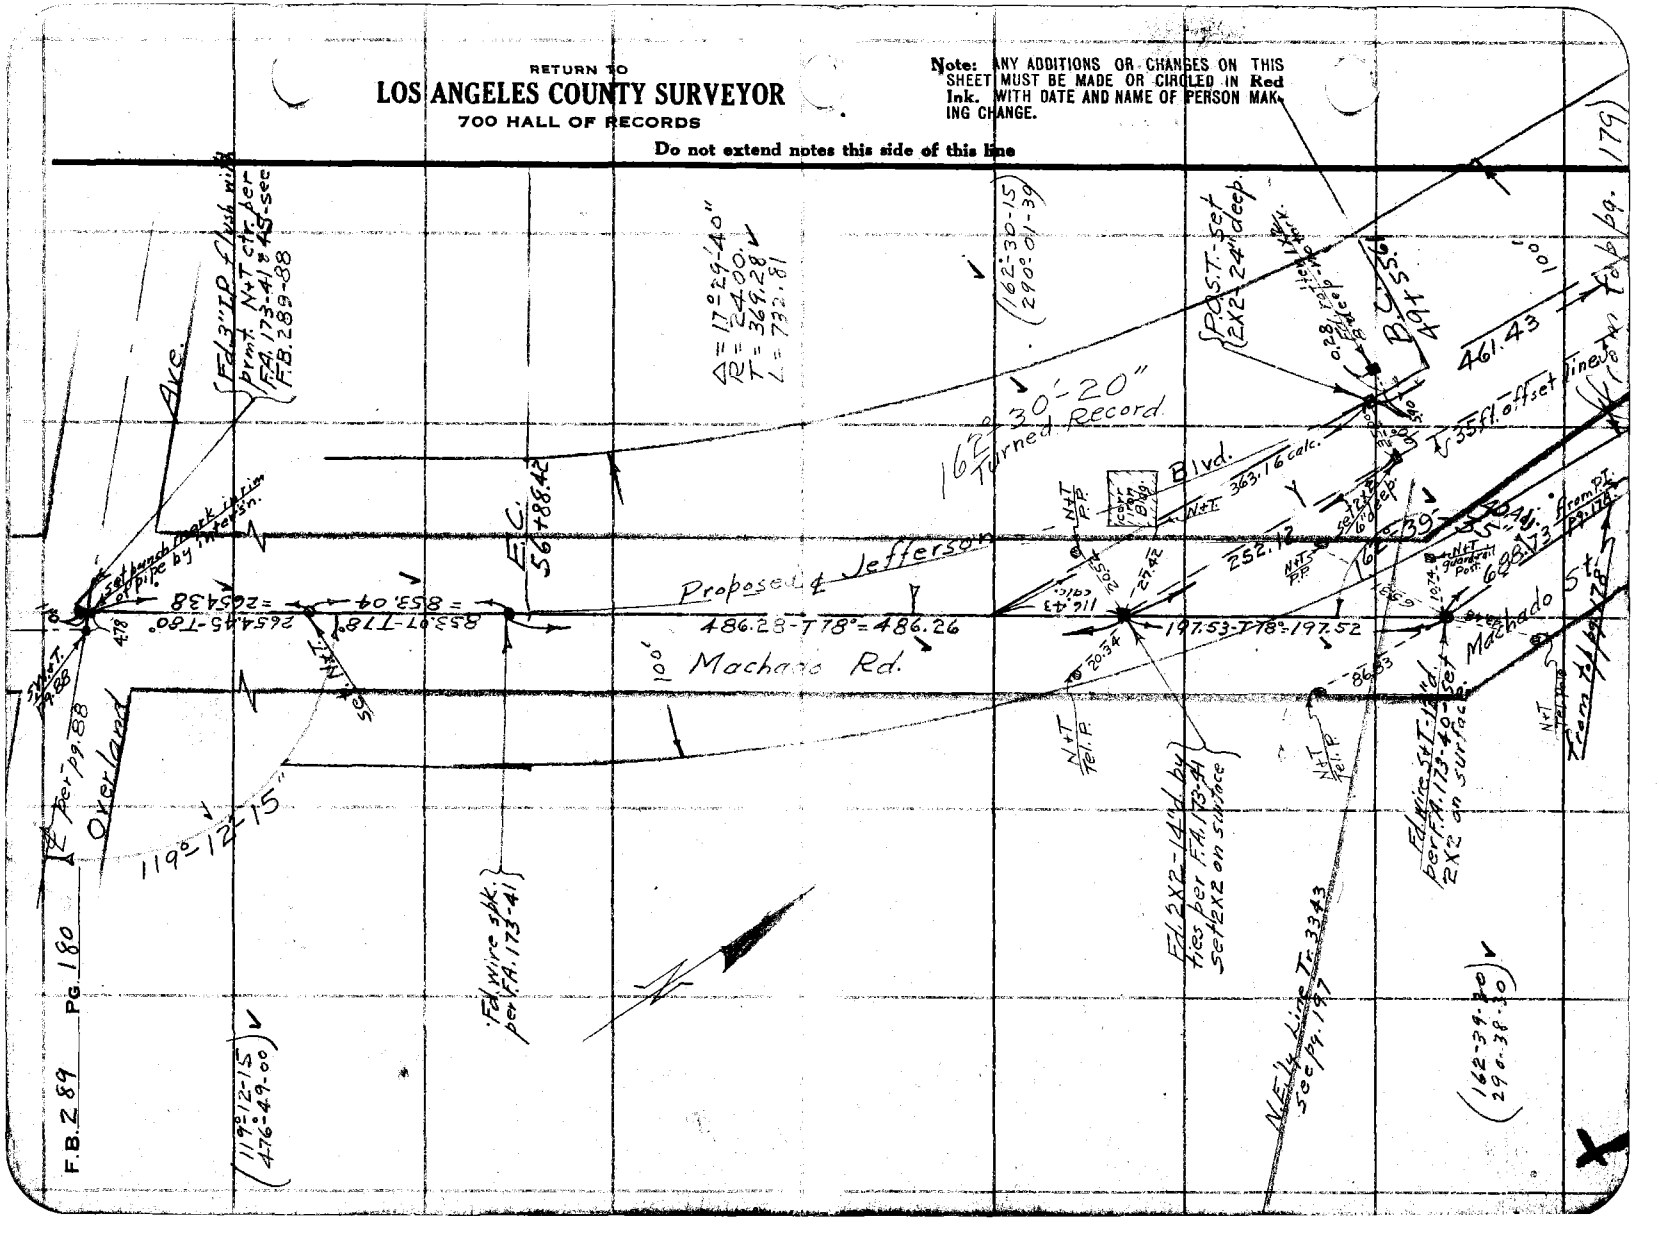
Fd 3" I.P. flush with prmt. N+T ctr. per F.A. 173-41 & 45-sec F.B. 289-88
Ave.
Δ = 17°29'40"
R = 2400.
T = 369.28
L = 732.81
(162°30'15" 290°01'39")
P.O.S.T. - set 2x2 24" deep.
B.C. 55+66
461.43
Tan. to Bg.
Tan. to Bg.
30'-20" Turned Record
16'
Blvd.
E.C. 56+88.42
Proposed Jefferson
486.28-T78°=486.26
197.53-T78°=197.52
Machado St.
Machado Rd.
100'
Overland
119°-12'15"
(119°12'15" 476°49.00)
F.B. 289 Pg. 180
Fd. wire spk. per F.A. 173-41
Fd. 2x2-14" deep ties per F.A. 173-41 set 2x2 on surface
N.E.'ly Line Tr. 3343 See Pg. 197
(162°39'50" 290°38'10")
Fd. wire tack per F.A. 173-41 2x2 on surface
N+T Tel. P.
N+T P.P.
Set N+T
Set Punch Mark in Top of pipe by Monument
Fd. 3/4" I.P. per 289-88
Set N+T 478
478
665445-T60°=665438
853.07-T78°=853.04
Fd. N+T
Fd. N+T
Fd. N+T

Notes Ck'd by KRM	Survey of Jefferson Blvd.
Map No.	W. O. 4173 Tape No. 04 St'd 84 OF.
Office Work	Surveyed by Evans
Checked	Notes HE Date 9-14-31
Date	Indexed A. C. Johnson

F.B. 289 PG. 181

RETURN TO
LOS ANGELES COUNTY SURVEYOR
700 HALL OF RECORDS
Do not extend notes this side of this line

Note: ANY ADDITIONS OR CHANGES ON THIS SHEET MUST BE MADE OR CIRCLED IN Red Ink. WITH DATE AND NAME OF PERSON MAKING CHANGE.

FORM 247 10M 5-31

P.E. RY.

Blvd.

Culver.

Fd. L+T on a prod. see F.A. 173-43

Ave.

L+T curb

32.46

Fd. Wire 5.2' de South & Deacon in line - see F.A. 173-43

L+T curb

01'-58.6

Duquesne

Lucerne Ave.

L+T curb

Fd. Wire & P.K. 2 deep. - F.A. 173-43.

0.03

766.74-784°

513.21-784

Jefferson Blvd. pg. 178.

1 X 2 - int'sn. pg. 178

Proposed

36.13

28.14.

L+T P.P.

Machado St. per pg. 178

89.88

25.79

L+T Tel. P.

2 X 2-12" d. - P.P. on E prod. - pg. 178

RETURN TO
LOS ANGELES COUNTY SURVEYOR
700 HALL OF RECORDS

Note: ANY ADDITIONS OR CHANGES ON THIS SHEET MUST BE MADE OR CIRCLED IN **Red Ink.** WITH DATE AND NAME OF PERSON MAKING CHANGE.

Do not extend notes this side of this line

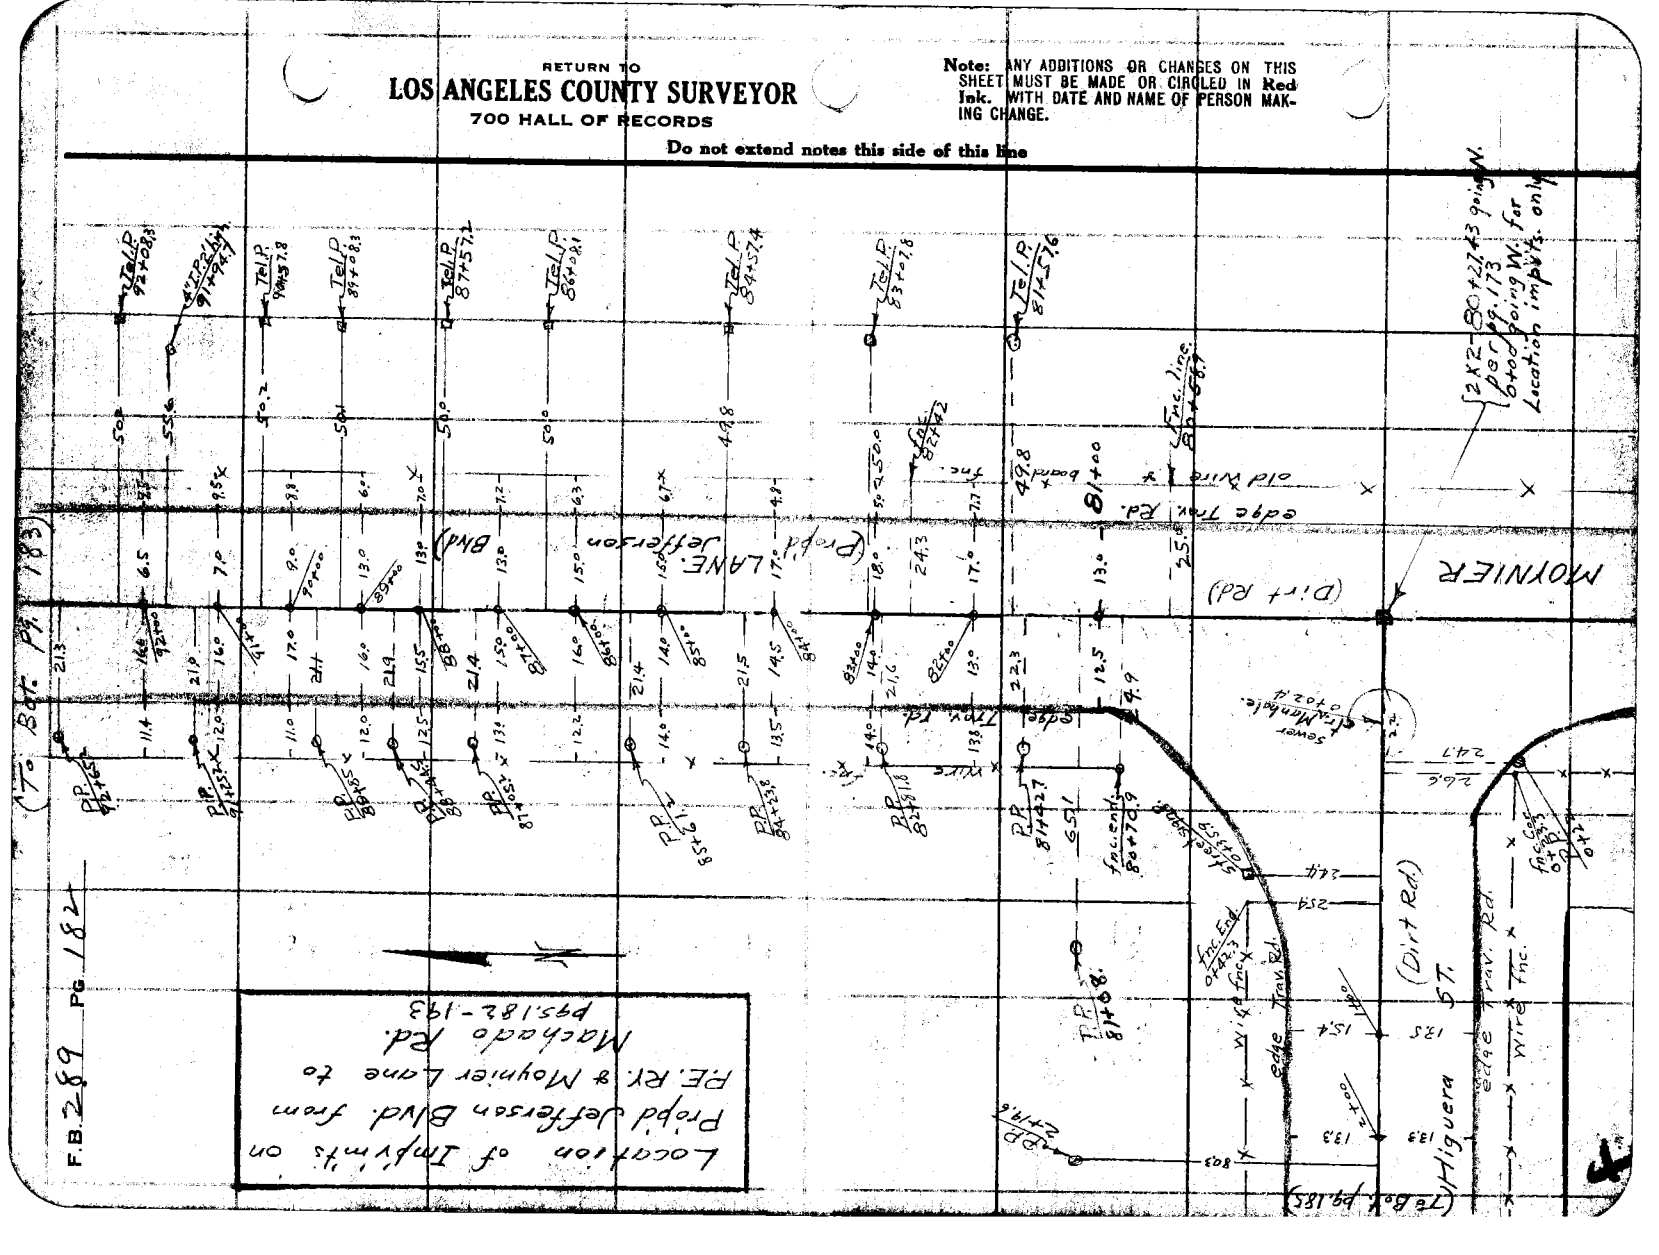

Notes Ck'd by K.P.M.	Survey of Jefferson Blvd.		F.B. 289 PG. 183
Map No.	W.O. 4173	Type No. 04	St'd 64 OF.
Office Work	Surveyed by Evans		
Checked	Notes HE	Date 9-21-31	
Date	Inspected A. C. Johnson		

(To Est. pg. 184)

Note: ANY ADDITIONS OR CHANGES ON THIS SHEET MUST BE MADE OR CIRCLED IN Red Ink. WITH DATE AND NAME OF PERSON MAKING CHANGE.

RETURN TO
LOS ANGELES COUNTY SURVEYOR
700 HALL OF RECORDS
Do not extend notes this side of this line

FORM 247 10M 8-31

(From pg. 182)

RETURN TO
LOS ANGELES COUNTY SURVEYOR
700 HALL OF RECORDS

Note: ANY ADDITIONS OR CHANGES ON THIS SHEET MUST BE MADE OR CIRCLED IN Red Ink. WITH DATE AND NAME OF PERSON MAKING CHANGE.

Do not extend notes this side of this line

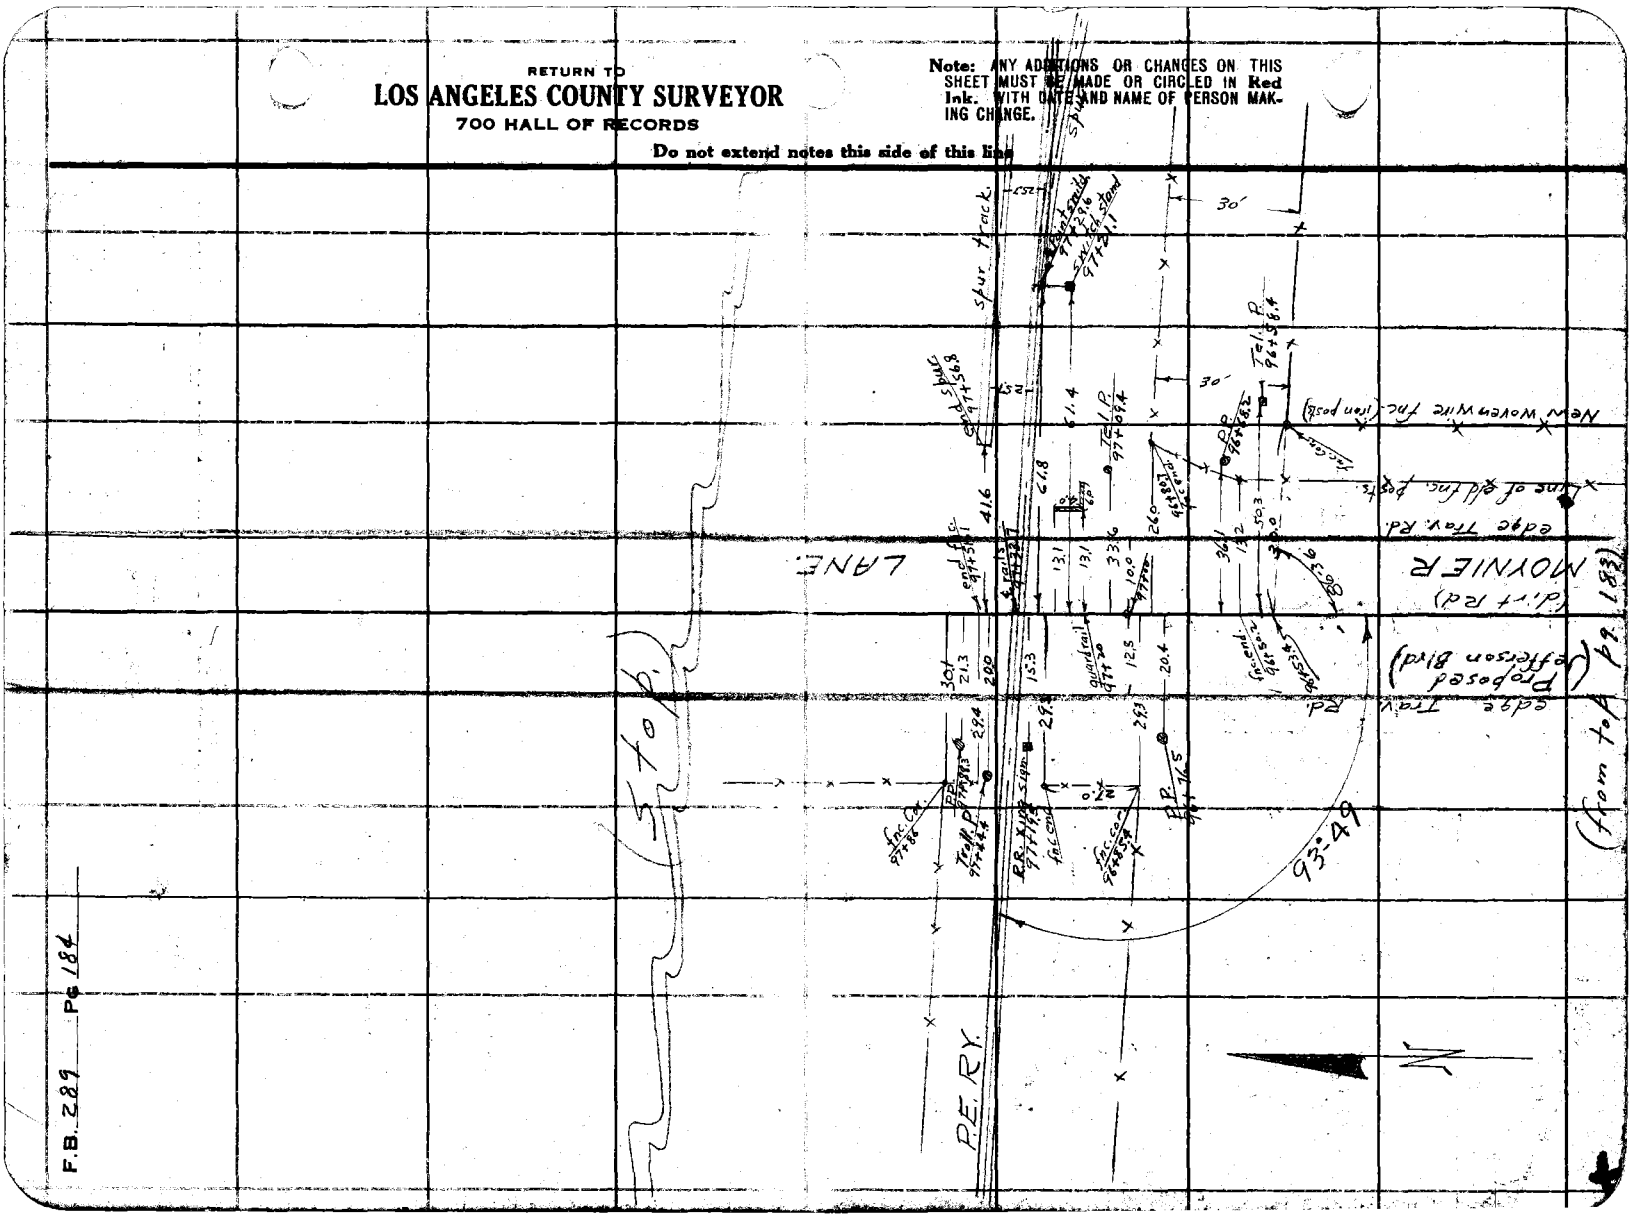

F.B. 289 P.G. 184

Notes Ck'd by K.R.M.	Survey of Jefferson Blvd.	F.B. 289	PG. 185
Map No.	W. O. 4173 Tape No. 04 St'd 84 OF.		
Office Work	Surveyed by Evans		
Checked	Notes HE Date 9-22-31		
Date	Indexed A. C. Johnson		

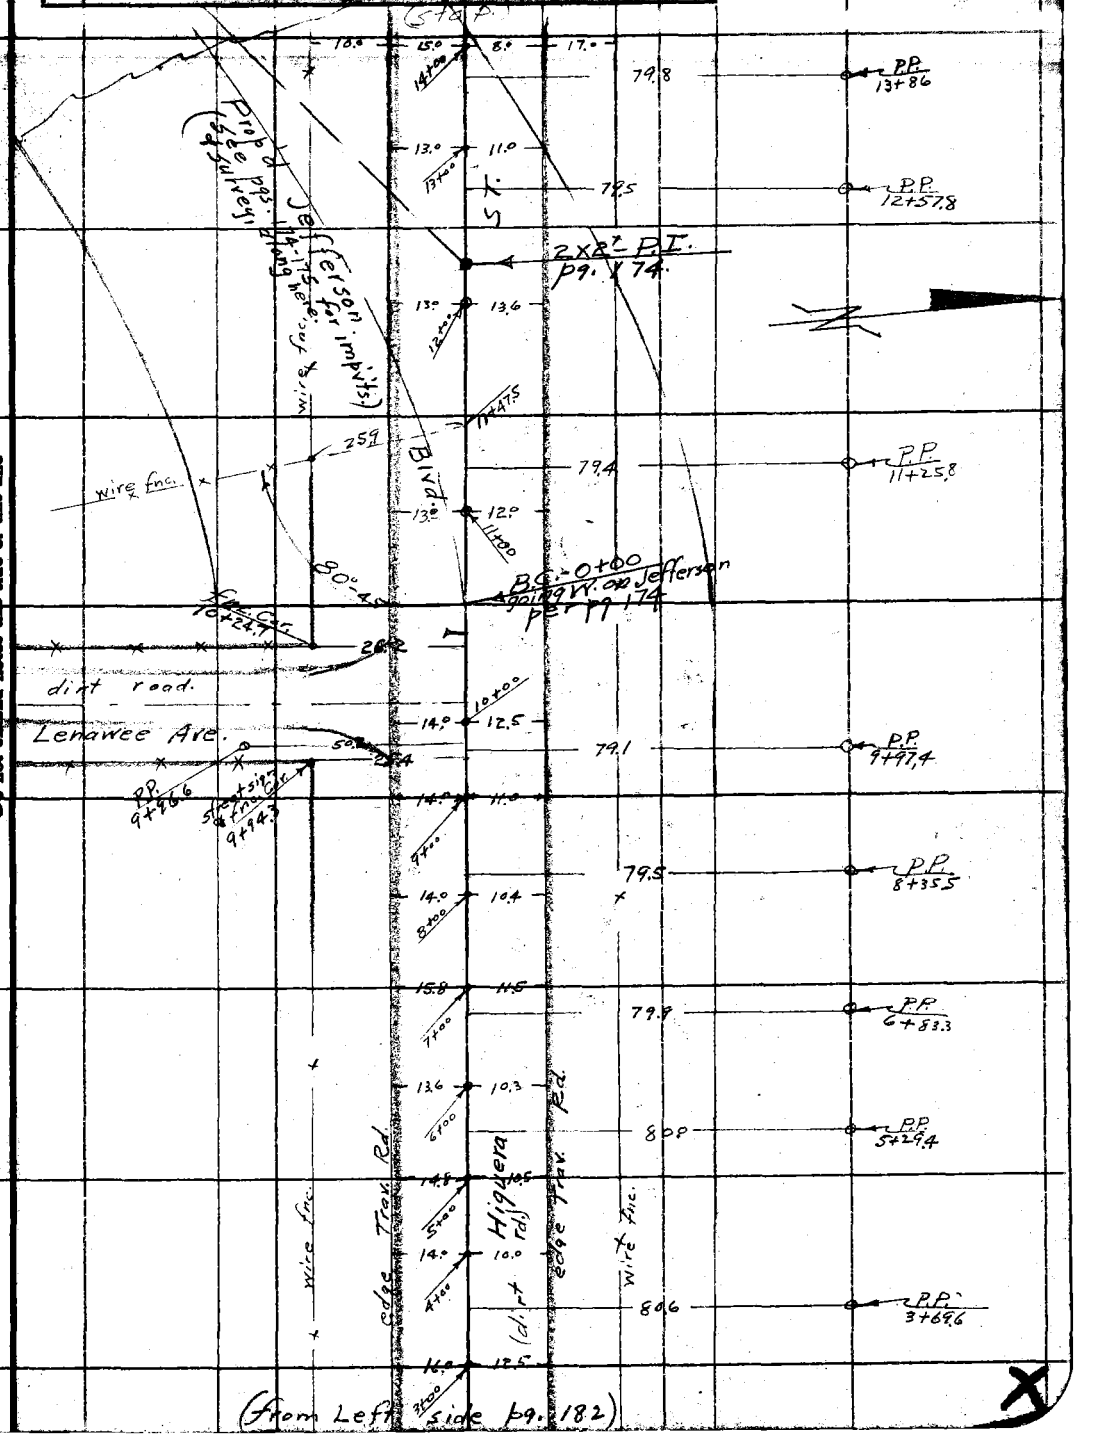

Note: ANY ADDITIONS OR CHANGES ON THIS SHEET MUST BE MADE OR CIRCLED IN Red Ink. WITH DATE AND NAME OF PERSON MAKING CHANGE.

Do not extend notes this side of this line

RETURN TO
LOS ANGELES COUNTY SURVEYOR
700 HALL OF RECORDS

FORM 247 10M 8-31

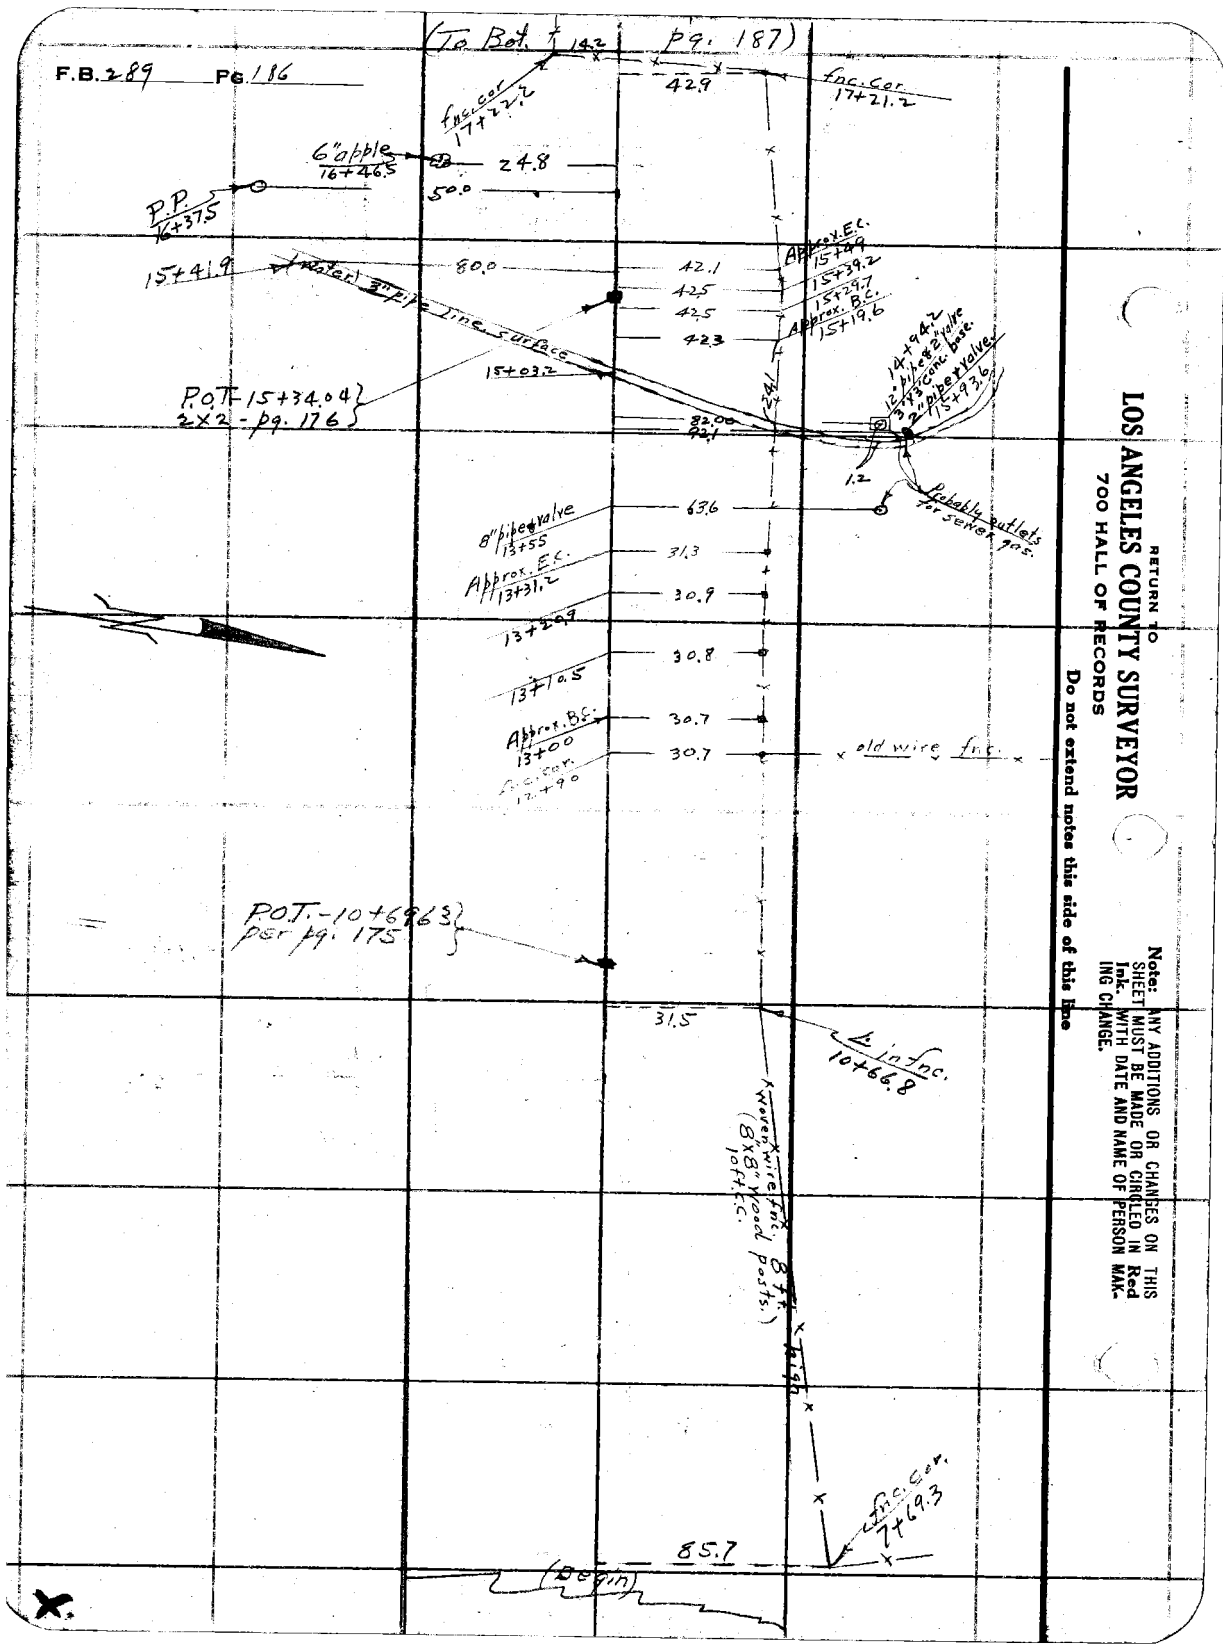

RETURN TO
LOS ANGELES COUNTY SURVEYOR
700 HALL OF RECORDS

Do not extend notes this side of this line

Notes: ANY ADDITIONS OR CHANGES ON THIS SHEET MUST BE MADE OR CIRCLED IN Red Ink. WITH DATE AND NAME OF PERSON MAKING CHANGE.

Notes Ck'd by K.R.M.	Survey of Jefferson Blvd.
Map No.	W. O. 4173 Tape No. 04 St'd 84 OF.
Office Work	Surveyed by Evans
Checked	Notes LE Date 9-23-31
Date	Indexed A. C. Johnson

F.B. 289 PG. 187

(To Bot Pg. 188)

8" Walnut 23+57.7 — 21.7

℄ fnc. Line 23+57.3 — 47.0

47.4

℄ fnc. Line 23+26

E.C. 22+89.15

Wire fns. 8 ft. high 8"x8" posts 10' c.c.

P.I. - 2" I.P. per pg. 176
= 20+91.26 from East.
= 20+90.50 going West.

℄ Incline 14"x55'

9.4

B.C. 18+92.61

18+92.61

1.6

1.4

frame Toilet

P.O.T. - 17+56.24
2 x 2 - pg. 176

17+93.4

8.0

17+38

5.2

frame Store 13.2

70.4

P.P. 17+48.9

(from to b pg. 186)

Note: ANY ADDITIONS OR CHANGES ON THIS SHEET MUST BE MADE OR CIRCLED IN Red Ink. WITH DATE AND NAME OF PERSON MAKING CHANGE.

Do not extend notes this side of this line

RETURN TO
LOS ANGELES COUNTY SURVEYOR
700 HALL OF RECORDS

FORM 847 10M 5-31

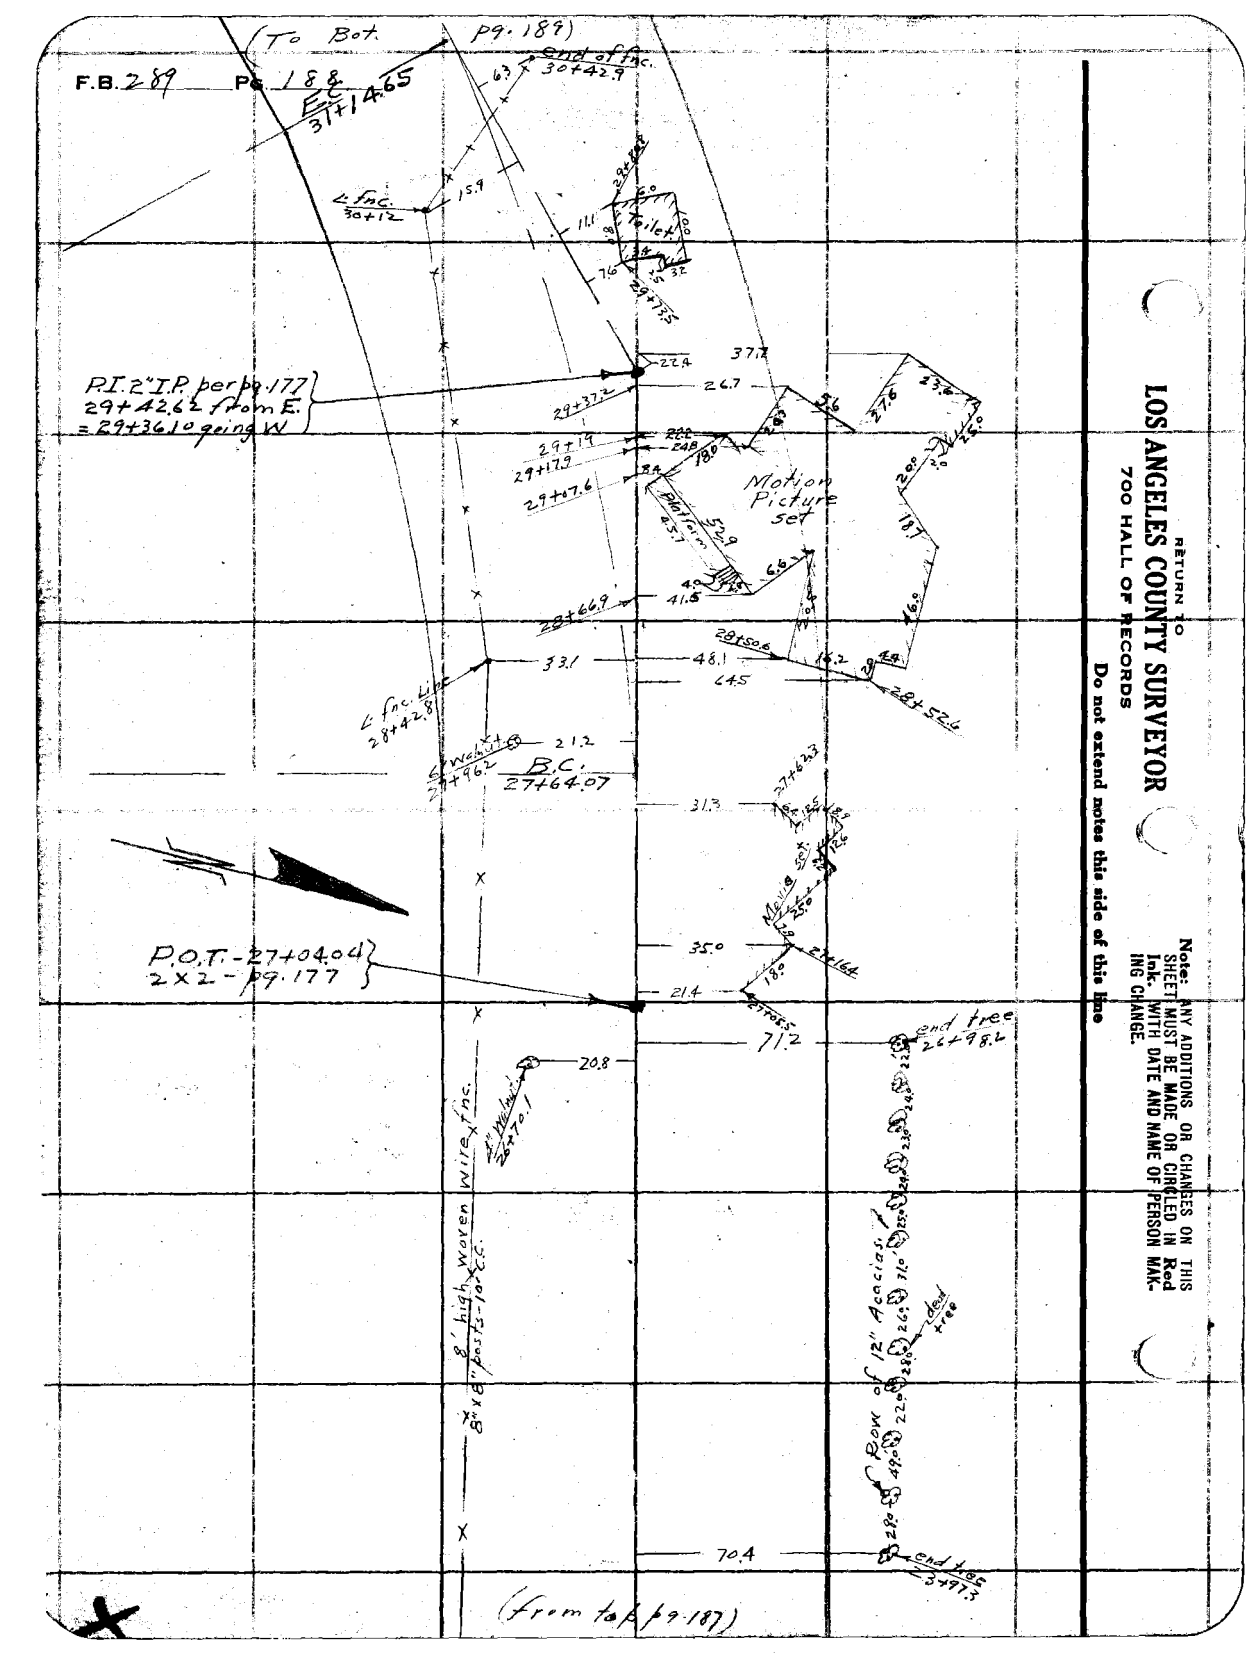

RETURN TO
LOS ANGELES COUNTY SURVEYOR
700 HALL OF RECORDS
Do not extend notes this side of this line

Note: ANY ADDITIONS OR CHANGES ON THIS SHEET MUST BE MADE OR CIRCLED IN Red Ink. WITH DATE AND NAME OF PERSON MAKING CHANGE.

Notes Ck'd by K.R.M.
Map No.
Office Work
Checked
Date

Survey of Jefferson Blvd.
W. O. 4173 Tape No. 04 St'd 84 oF.
Surveyed by Evans
Notes TE Date 9-24-31
Indexed A. C. Johnson

F.B. 289 PG. 177

Pg. 110

(To B.C.)
P.C.C.
43+04.06

42+073
139
Frame
Steel
Noise
239
550
41+872
6" Willow
40+77
287
47.9
Guy Pole
41+78
6" Willow
39+15.2

PI-2"I.P. per pg. 178
38+60.31 From East.
= 38+52.00 going West.

47.9
PP
37+58.5
37+54.9
2" Pipe line.
71°21'

PP
37+23.9
0°40'
97.0
54.5
1.1
Old abandoned wood flume
36+50
1.1
34+69.5
81.2
34+08.7
65.0
1.1
end
36+27
89.9
Old abandoned wood flume
5.7
B.C.
34+08.25
79.0
57.2
33+58.7
78.6
end flume
33+09.7
186
3.8
31+50.3
12.0
Abandoned old loading Tunnel
100
31+39.9
P.O.T. - 31+39.68
per pg. 178
31+36.3
24.4
6.5
186
3.3
31+30.6

Note: ANY ADDITIONS OR CHANGES ON THIS SHEET MUST BE MADE OR CIRCLED IN Red Ink. WITH DATE AND NAME OF PERSON MAKING CHANGE.

RETURN TO
LOS ANGELES COUNTY SURVEYOR
700 HALL OF RECORDS
Do not extend notes this side of this line

FORM 247 10M 8-31

X

F.B. 289 PG 190

(To Bot. Page 191)

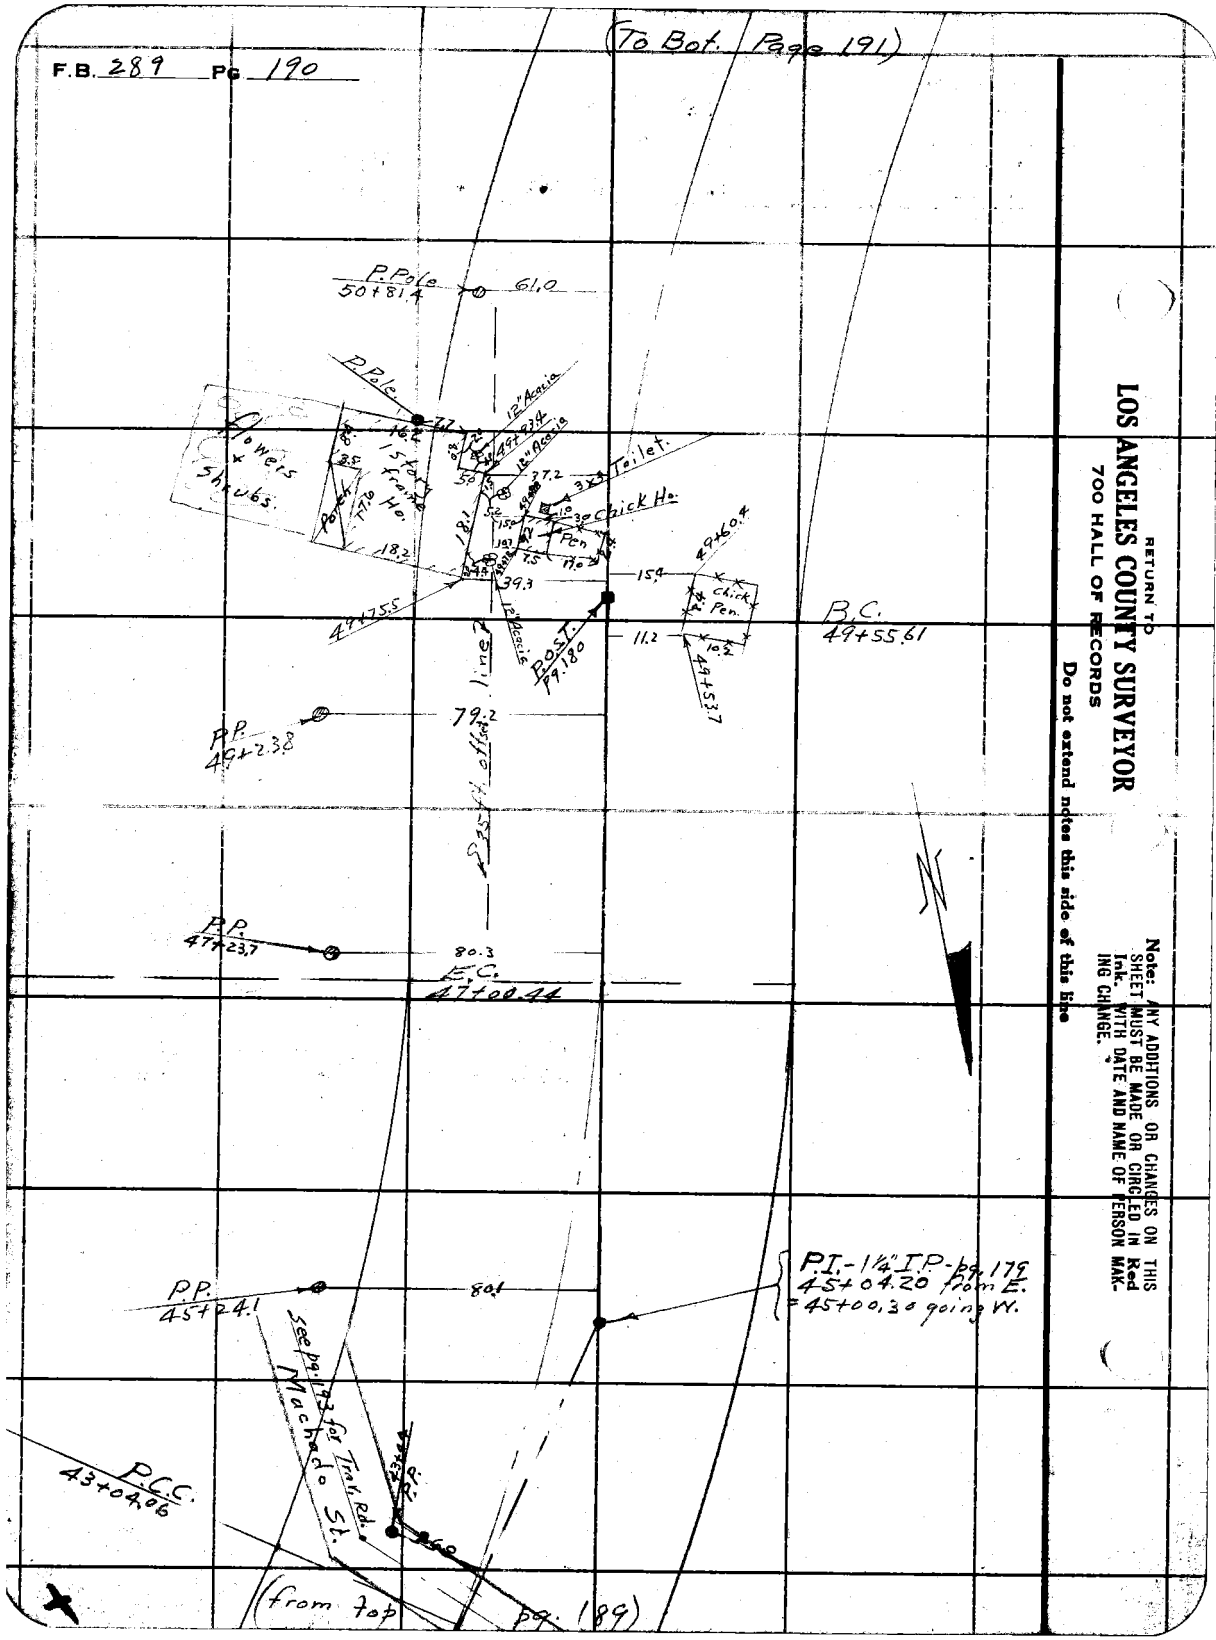

RETURN TO
LOS ANGELES COUNTY SURVEYOR
700 HALL OF RECORDS

Do not extend notes this side of this line

Note: ANY ADDITIONS OR CHANGES ON THIS SHEET MUST BE MADE OR CIRCLED IN Red Ink. WITH DATE AND NAME OF PERSON MAKING CHANGE.

Notes Ck'd by KRM	Survey of Jefferson Blvd.
Map No.	W. O. 9173 Tape No. 04 St'd 84 °F.
Office Work	Surveyed by Evans
Checked	Notes H. Martin Date 9-25-31
Date	Indexed C. Johnson

F.B. 289 PG. 191

(From Top Pg. 190)

E.C. 56+88.42

P. Pole 56+86.5

16.3

24.6 18.0 Shack 10.2

28.0 3.8 Shed 12.0 Shack 14.2

21.2 13.3 12.3

56+06.0

73.0

64.3

72.1

3" Pepper 55+46.8

14.0 Shed 8.6

35.0 10.5 1 story Shack 27.0

24.5

55+34.5

8" Gum 55+52.9 23.7

8" Gum 55+08.0 25.8

8" Gum 54+70.0 23.8

5-6" Gums 53+57.1 23.2

5-6" Gums 53+57.1 23.2

4" Pine Tree 53+43.0 30.9

5-6" Gums 53+34.8 23.2

14.0 P. Pole 55+31.0

15.2 P. Pole 55+19.1

15.1 P. Pole 53+72.7

P/L. Nothing Set 53+24.89 From Nor. = 53+19.14 Going So.

Water Pipe

Gas Meter 53+03.4

T. Pole 52+32.2

P.P. 52+22.2

35' Offset P/L @ 180° 52+38.5 From North

116.43 Calc.

45.9

24.5

52+94.2

79.3

65.8

52+58.4

75.8

67.0

6" olive 52+52.0

8" Sy. C. 52+40.5

52+28.3

81.9

43.4

90°

50.2 (wooden addition)

16.3

9.0

5.8

12" Acacia

Hyd.

6.0

10.1

10

12.1

5.3

12.6

5.2

12.6

Toilet

Iron Foundry

37.0

(corr. iron) Bldg.

218.5

5P

Shed.

19.0

1.9

13.0

22.7

Line 2

51+98.5

51+86.6

51+61.9

51+6.51

44.8

27.0

15.5

564

Shed (Frame)

16.2

20.2

Shed

Con. Walls 3' high Old Foundation

10.4

10'

52+54.8

Note: ANY ADDITIONS OR CHANGES ON THIS SHEET MUST BE MADE OR CIRCLED IN Red Ink. WITH DATE AND NAME OF PERSON MAKING CHANGE.

Do not extend notes this side of this line

RETURN TO
LOS ANGELES COUNTY SURVEYOR
700 HALL OF RECORDS

FORM 847 10M 8-31

(All angles turned to Right from sight.)

F.B. 289 Pg. 192

Location of dirt roads

Int. At.	Sight At	Stadia	Hor. Angle	Vert. ∠	Dist.	Remarks
P.O.T. 17+56.24	B.C. 18+92.61	6.45 / 6.0	203° 45'	+3-18	91	℄ 8" dirt rd.
		4.39 / 4.0	317-30	+11-52	39	" " " "
		4.74 / 4.0	340-10	+7-11	74	" " " "
✓		5.46 / 4.0	348-30	+4-35	147	" " " "
		6.21 / 5.0	349-05	+3-53	203	" " " "
P.I. Per. Page 176	P.O.T. 17+56.24					
		3.77 / 3.0	53-30	+10-08	77	" " " "
✓		4.50 / 3.0	141-50	+3-34	151	" " " "
		4.10 / 2.0	150-40	+1-57	211	" " " "
Sta. 26+00	Sta. 24+00					
		6.50 / 4.0	17° 05'	+2-14	251	" " " "
		5.92 / 4.0	21-20	+2-47	193	" " " "
		5.29 / 4.0	27-55	+4-17	130	" " " "
✓		3.69 / 3.0	52-40	+6-05	70	" " " "
		4.88 / 4.0	142-10	+4-37	89	" " " "
		4.60 / 2.3	163-50	+2-25	170	" " " "
		6.60 / 4.0	169-35	+1-54	261	" " " "
		5.18 / 6.0	170-15	+1-49	319	" " " "
P.O.T. 31+39.68	B.C. 34+08.25					
		6.42 / 5.0	197-40	-4-45	143	" " " "
		6.77 / 6.0	203-00	-7-0	77	" " " "
		11.14 / 11.0	267-20	-27-13	13	end of rd.
P.I. Per. Page 178	P.C.C. 43+04.06					
		5.40 / 5.0	256-40	-2-45	41	℄ 10' dirt rd. bearing
		5.44 / 5.0	303-35	-2-52	45	" " " "
		7.82 / 7.0	322-40	-0-30	83	" " " "
✓		8.19 / 7.0	326-35	0-0	120	" " " "
		4.86 / 3.0	337-05	-1-0	187	" " " "
		10.83 / 7.0	349-50	+0-17	384	" Junction "
		8.56 / 5.0	343-40	+0-35	357	℄ 15' Gravel rd.
		6.15 / 3.0	342-20	+0-54	316	" " " "
		8.55 / 6.0	343-45	+3-05	256	" " " "
		11.18 / 9.0	321-05	+5-42	218	" " " "
		7.0 / 5.0	306-30	+6-22	200	" " " "
		7.93 / 6.0	293-55	+7-38	192	" " " "
		8.95 / 7.0	273-10	+8-38	194	" " " "

RETURN TO
LOS ANGELES COUNTY SURVEYOR
700 HALL OF RECORDS

Do not extend notes this side of this line

Note: ANY ADDITIONS OR CHANGES ON THIS SHEET MUST BE MADE OR CIRCLED IN Red Ink. WITH DATE AND NAME OF PERSON MAKING CHANGE.

Notes Ck'd by K.A.M.
Map No.
Office Work
Checked
Date

Survey of Jefferson Blvd.
W. O. 4173 Tape No. 04 St'd 84 °F.
Surveyed by Evans
Notes H. Martin Date 9-25-31
Indexed A. C. Johnson

F.B. 289 Pg. 143

Inst. At	Shot on	Stadia	Hor. Angle	Vert. ∠	Hor. Dist.	REMARKS
P.C.C. Sta. 93+04.00	P.I. Pg. 178					
		2.62 / 2.0 63	74 - 50	+2-30	63	℄ 10' dirt rd.
		2.64 / 2.0 65	131 - 05	0-0	65	Junction ℄ 26' oiled rd.
		5.18 / 5.0 19	227 - 05	0-0	19	" " " "
	✓	8.09 / 7.0 110	273 - 35	0-0	110	" " " "
		8.32 / 6.0 233	275 - 10	0-0	233	" " " "
		1.19 / 0.0 120	139 - 20	0-0	120	" " " "
		1.15 / 8.0 216	157 - 30	+3-33	216	" " " "
Sta. 97+00	P.I. Pg. 178					
		5.25 / 4.0 126	50 - 55	+1-36	126	" " " "
		5.05 / 4.0 106	76 - 00	+2-48	106	" " " "
		5.15 / 2.0 116	112 - 50	+2-40	116	" " " "
		5.98 / 4.0 149	138 - 45	+3-26	149	" " " "
	✓	6.07 / 4.0 208	152 - 40	+3-12	208	" " " "
		6.50 / 4.0 251	157 - 50	+3-06	251	" " " "
		7.03 / 4.0 304	161 - 50	+3-0	304	" " " "
		7.42 / 6.0 343	163 - 45	+3-17	342	" " " "
Offset P.I. Pg. 180	P.C.C. Sta. 56+89.42					
		3.37 / 3.0 138	180 - 35	-0-35	138	" " " "
		3.94 / 4.0 95	180 - 25	0-0	95	" " " "
		5.10 / 5.0 11	175 - 15	0-0	11	" " " "
	✓	5.34 / 5.8 35	2 - 50	0-0	35	" " " "
		6.98 / 6.0 99	1 - 10	0-0	99	" 25' " "
		11.25 / 10.0 251	0 - 0	0-0	251	" " " "
	1/2	6.20 / 3.0 371	0 - 15	-1-37	371	" " " "

Notice: ANY ADDITIONS OR CHANGES ON THIS SHEET MUST BE MADE OR CIRCLED IN Red Ink, WITH DATE AND NAME OF PERSON MAKING CHANGE.

Do not extend notes this side of this line

RETURN TO
LOS ANGELES COUNTY SURVEYOR
700 HALL OF RECORDS

FORM 847 10M 8-31

RETURN TO

LOS ANGELES COUNTY SURVEYOR

700 HALL OF RECORDS

Note: ANY ADDITIONS OR CHANGES ON THIS SHEET MUST BE MADE OR CIRCLED-IN Red Ink. WITH DATE AND NAME OF PERSON MAKING CHANGE.

Do not extend notes this side of this line

F.B. 289 Pg 194

Notes Ck'd by KRM.	Survey of Jefferson Blvd.
Map No.	W. O. 4173 Tape No. 17 St'd 84 OF.
Office Work	Surveyed by Evans
Checked	Notes HE Date 9-26-31
Date	Indexed by C. Johnson

F.B. 289 PG. 195

(To Bot. pg. 196)

Note: ANY ADDITIONS OR CHANGES ON THIS SHEET MUST BE MADE OR CIRCLED IN Red Ink. WITH DATE AND NAME OF PERSON MAKING CHANGE.

RETURN TO
LOS ANGELES COUNTY SURVEYOR
700 HALL OF RECORDS
Do not extend notes this side of this line

FORM 247 10M 5-31

LA BALLONA

R2.

N'ly Line Rc La Ballona

L.A. City Bdry.

S'ly Line of Rc La Ballona

MR 53-25

113.62 @ 16°-39' = 101.67
265.90 @ 15°-25' = 286.24
364.91
T74° .02
364.89

63.55 @ 18°-15' = 60.35
297.65 @ 18°-07'30" = 282.88
274.94 @ 8°-11'30" = 272.13
615.36
T74° .04
615.32

615.32

01-35"

142°

set 1x2

Fd. 1x2 -70+14.52 per pg. 79.

LB1

RB6

set 1x2 0+56.95

0+56.95

set 1x2 0+60 going W.

Fd. 10" conc. mon. & 2" copper cap marked "H.D. Brown" flush per pg. 79

(142°-01-30
208°-06-15)

18 ft. of 6 ft. Line pg. 79

Fd. 1x2 6+99.16 per pg. 79

90°
180.00

set 1x2

15

16

N'ly Survey Line of Rc La Ballona pgs. 195-196

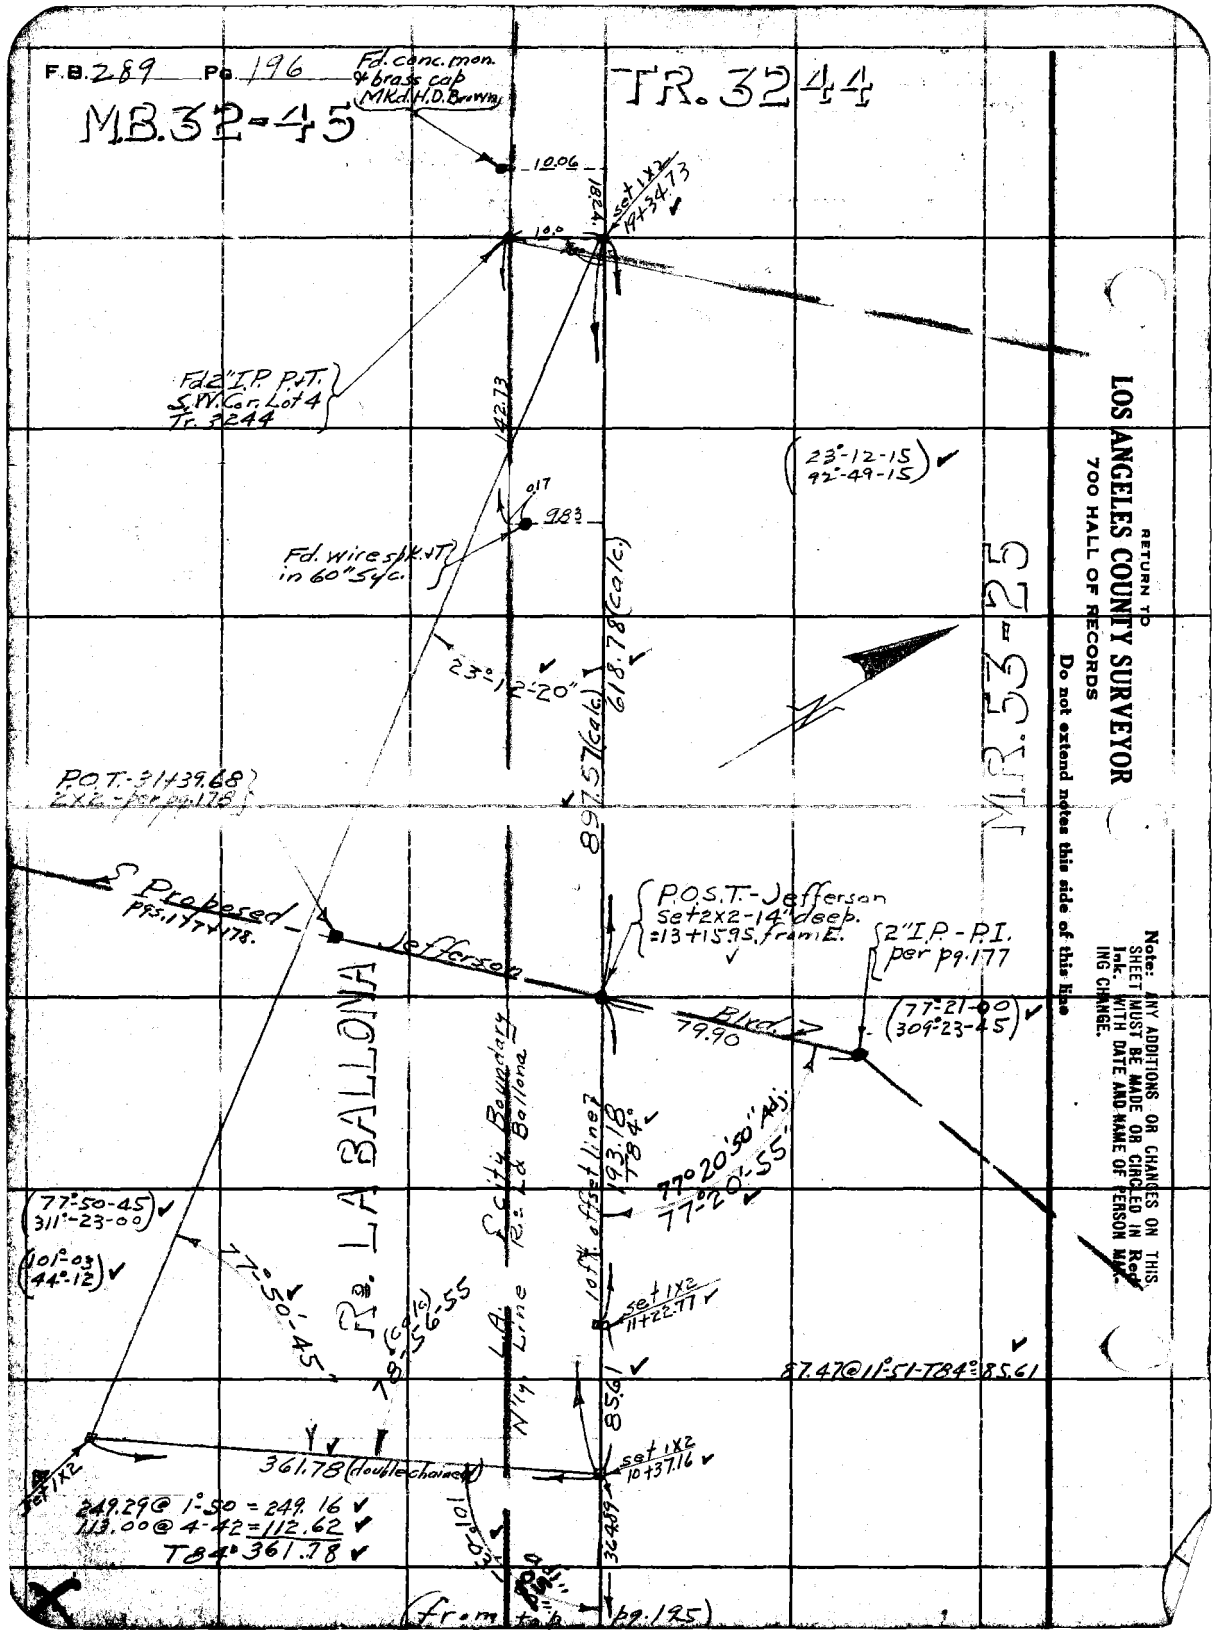
F.B. 289 Pg. 196
M.B. 32-45
TR. 3244
Fd. conc. mon. w/ brass cap MKd. H.D. Brown
10.06
set 1X2 14+34.73
Fd 2" I.P. P.O.T. S.W. Cor. Lot 4 Tr. 3244
142.73
(23°-12-15) (92°-49-15)
Fd. wire sh. N.T. in 60" S/c.
618.78 (calc.)
23°-12'-20"
897.57 (calc.)
P.O.T. = 1439.68 2X2 - for pg. 178
Proposed
Jefferson
P.O.S.T. - Jefferson set 2x2 - 14" deep. = 13+15.95 S. from E.
2" I.P. - P.I. per pg. 177
(77°-21-00) (309°-23-45)
Blvd.
79.90
77°-20'-50" Adj. 77°-20'-55"
193.18
78.84
set 1X2 11+22.77
87.47 @ 11°-51-T84° = 85.61
85.91
(77°-50-45) (311°-23-00)
(101°-03) (44°-12)
77°-50'-45"
78°-15'-10" 6.55
R3 LA BALLONA
City Boundary
Rs. La Ballona
N'ly Line Lot 4
10ft. offset line
361.78 (double chained)
set 1X2 10+37.16
324.59
249.29 @ 1°-50 = 249.16
113.00 @ 4-42 = 112.62
T84° 361.78
(from pg. 195)
R32-25
RETURN TO
LOS ANGELES COUNTY SURVEYOR
700 HALL OF RECORDS
Do not extend notes this side of this line
Note: ANY ADDITIONS OR CHANGES ON THIS SHEET MUST BE MADE OR CIRCLED IN Red Ink. WITH DATE AND NAME OF PERSON MAK-ING CHANGE.

Notes Ck'd by KRM	Survey of Jefferson Blvd.
Map No.	W. O. 4173 Tape No. 32 St'd 84 °F.
Office Work	Surveyed by Evans
Checked	Notes FE Date 9-30-31
Date	Indexed A. C. Johnson

F.B. 289 PG. 197

Note: ANY ADDITIONS OR CHANGES ON THIS SHEET MUST BE MADE OR CIRCLED IN Red Ink. WITH DATE AND NAME OF PERSON MAKING CHANGE.

Do not extend notes this side of this line

RETURN TO
LOS ANGELES COUNTY SURVEYOR
700 HALL OF RECORDS

FORM 247 10M 8-31

Sec. Line 117+88.62

Fd. 1" I.P. (iron pipe) probably oil Co. mon.
117+88.62

30.0

28.51

11'

Fd. 1 1/4" I.P. P.K.T. flush. S.E. ly cor Tr. 3343
11+87.96

C. MACHADO
38.38 Ac.

S.N.E. ly Line Tr. 33432

98.710
Mag = S 49°30' E.

TR. 33432

49.00 @ 10°05' = 48.24
225.80 @ 13°42' = 219.38
275.54 @ 7°26' = 273.22
148.71 @ 3°10' = 148.48
298.74 @ 4°42' = 297.79
987.11
T 82° = .01
987.10

Fd. 2" I.P. (iron pipe) flush. 2+03.82 probably oil Co. mon.

31.34

2.30

(72°33'-15)
(290°-18'-15)

set 1 X
2+01.52

111.83 @ 2°39' = 111.71
89.86 @ 1°51' = 89.81
T 84 201.52

72°-33'

Set S.W. I.T. rec. from 2X2 per F.A. 173-40

20'

201.52

Machado Rd.

set 1 X

86° 30'

set S.W. I.T. by int's. of no going S.E.

22.13

1993

30.38

2 X 2 - flush. ∠ per pg. 180

Fd. 1" I.P. flush Tr. 3343 - Appears to have been moved.

Survey of N.E. ly Line of Tract No. 3343 (pg. 197)

F.B. 289 Pg 198

Survey of
The S'ly Line of Property Described in D.1462:2 and O.R. 206-41. Said Line being established by Rec. angles & distances from the east. Pgs 198 & 201

Note
The starting point for this line is 21.51 too far West at Higuera St. thus throwing all record pts. off the same dist. on bearing of Higuera.

(To Bot. Pg. 199)

set 1x2 #4

calc + meas. 41.21

Off set line

Deed Line 2

45.05 (calc.)

46.14 calc.

19.80

397

cor. Post.

set 1x2 #3

167°-29'-00" Turned Rec.

277.87

294.36 Rec.

8 ft. wvrn. fnc.

(167°-29)
(309°-56)

65°-26' Turned Rec.

D.1462:2

set 1x2 #2

Nothing Set

1 Transit Line 15 ft. offset Fnc.

17.71 calc + meas.

1 D.1462-2

8 ft. wvrn. fnc.

90.00 Rec.

Deed Line 2

8.15

89.99

cor. Post.

(65°-26)
(261°-44)

1 1/2

(155-20-15)
(261-21)

(155°-20-15)
(261-23)

(65°-34-15)
(262°-17-00)

65°-34-15 Turned

o.k.

falls in creek

84 Rec.

180.84

271.58

Transit Line 2

237.76

1647 calc + meas.

2 1/2 x 1 1/2

#2

15°-11

155°-20-45 Turned

137-07 Rec.

11

calc 36.74

70.62 Rec.

48.51

Fd. L+T Pg. 174

℄ Pg. 174

Higuera St.

set N+T floor of bridge (Starting Pt.)

12

10

M.R. 53-25

The Green Line shown is not good for the Record Line. For Adopted Property Line see R of S 202

RETURN TO
LOS ANGELES COUNTY SURVEYOR
700 HALL OF RECORDS
Do not extend notes this side of this line

Note: ANY ADDITIONS OR CHANGES ON THIS SHEET MUST BE MADE OR CIRCLED IN Red Ink. WITH DATE AND NAME OF PERSON MAKING CHANGE.

Notes Ck'd by KRM
Misc. No.
Office Work
Checked
Date

Survey of Jefferson Blvd.
W. O. 4173 Tape No. 32 St'd 84 oF.
Surveyed by Evans
Notes HE Date
Indexed A. C. Johnson

F.B. 289 Pg. 199

(To Bk. pg. 200)

OLD ORCHARD
7.12 Ac.

MR 193 - 2 CR

D. 14622.2

(89°-30 358°-00)

89°-30' O.K. Turned Rec. 182.82 Rec.

S 1 E

15.0

15.00

1.85

1.42

Proj. Lot Line

Lot Line 184.56

8ft. fence

48.18 Rec. 38.04

#6-set 1X2

#7-set 1X2

Calc. + Turned 99°25' O.K.

(99°25 37°40)

(87°-00-45 348°-03-00)

87°-00'-45" 87°00'40" Adj.

Conc. Fnc. Post

17756.24 P.O.T.-R/W. per pg. 176

Set 3X2 14" deep by Inish

75.55

1.33

1.88

28.63

4' W'ly Line Lot 14

For Adopted Property Line See Pg. 202-BC

16ft calc.

10.0

10.0

8°

Deed Line

1956 calc + meas.

10ft offset

Proposed Jefferson Blvd.

Ref. Point

North R/W See pg. 176

1947.70 Rec.

Angle Pt. Fnc.

11.8

10.0

10.0

0.0

#5-set 1X2 calcd. split of angle

Unit 2

462.00 Rec.

Jefferson Blvd. Z

416.21 18771

3.71

Angle Pt. Fnc.

(171°-29 325°-56)

(from f.b. pg. 198)

14

Note: ANY ADDITIONS OR CHANGES ON THIS SHEET MUST BE MADE OR CIRCLED IN Red Ink. WITH DATE AND NAME OF PERSON MAKING CHANGE.

RETURN TO
LOS ANGELES COUNTY SURVEYOR
700 HALL OF RECORDS
Do not extend notes this side of this line

FORM 247 10M 5-51

RETURN TO
LOS ANGELES COUNTY SURVEYOR
700 HALL OF RECORDS

Note: ANY ADDITIONS OR CHANGES ON THIS SHEET MUST BE MADE OR CIRCLED IN Red Ink. WITH DATE AND NAME OF PERSON MAKING CHANGE.

Do not extend notes this side of this line

OLD ORCHARD

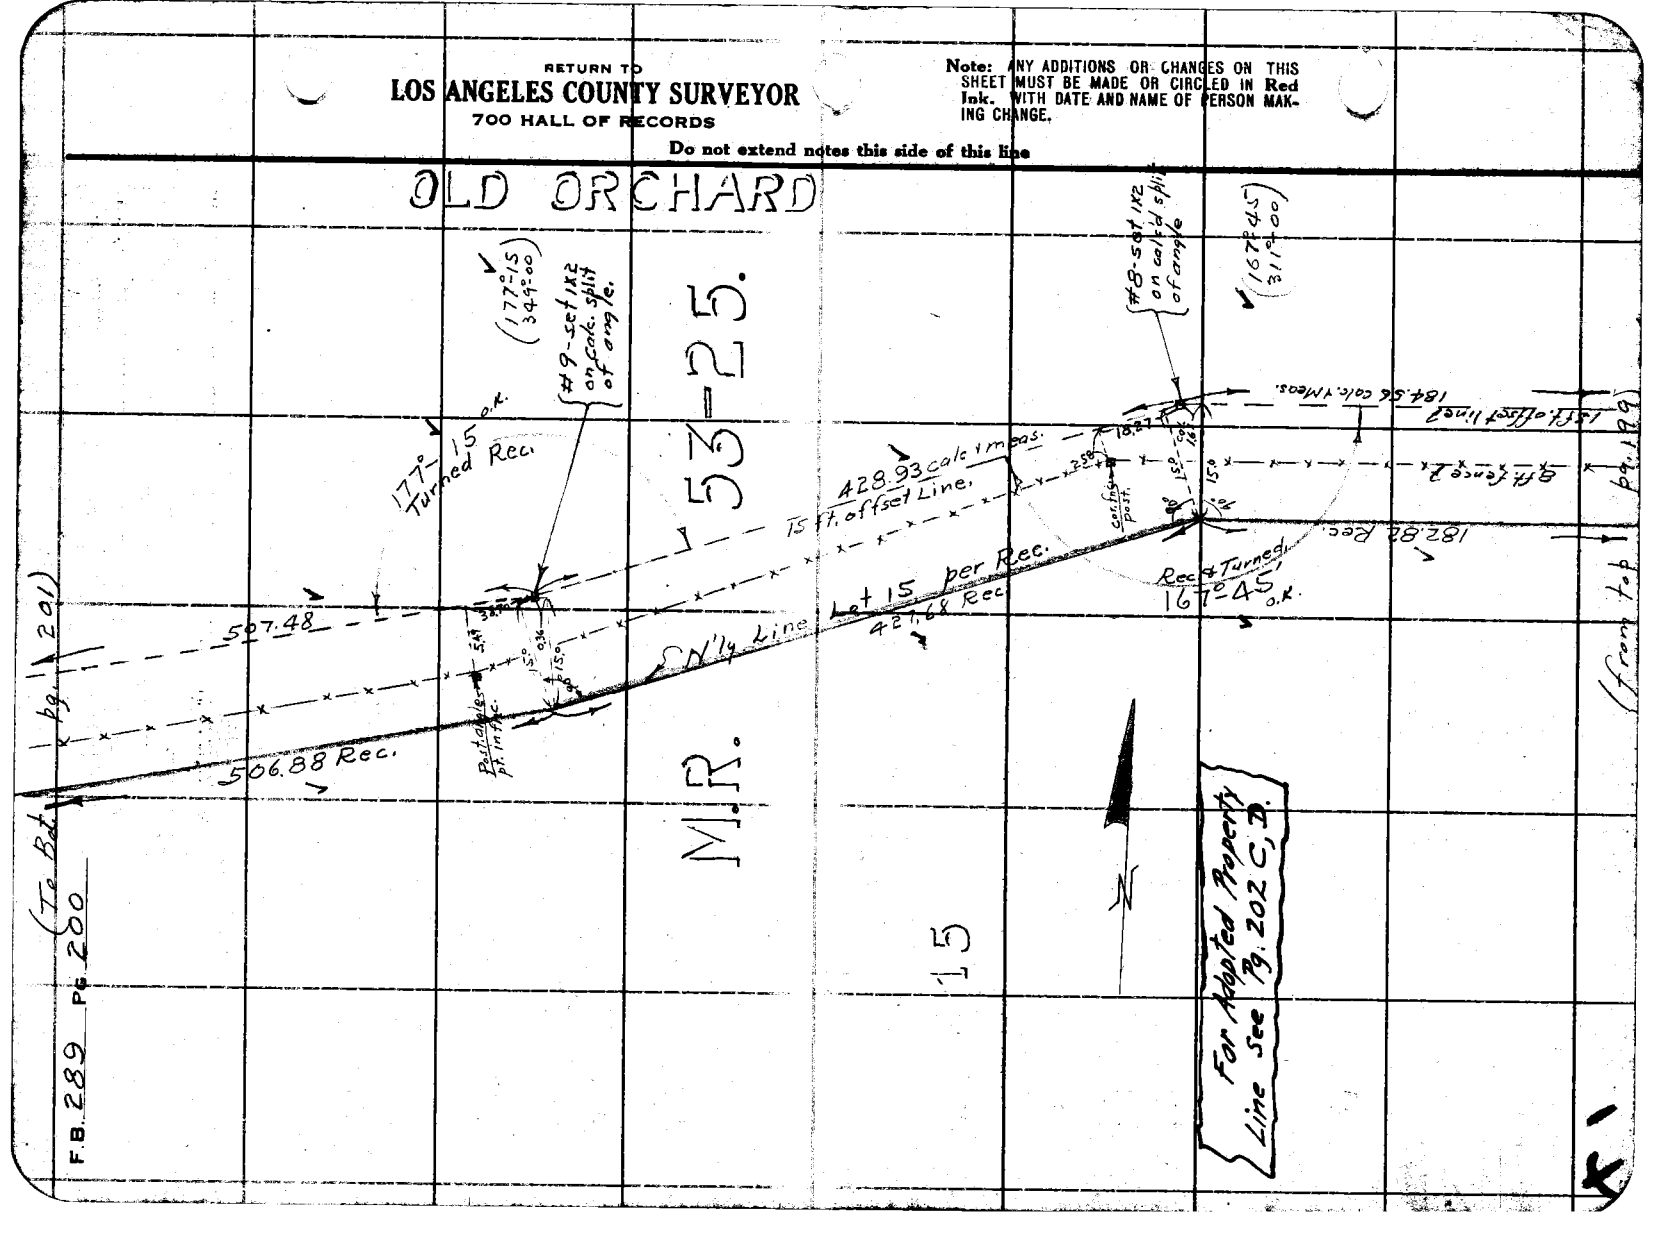

Notes Ck'd by K.R.M.	Survey of Jefferson Blvd.
Map No.	W. O. 4173 Tape No. 32 St'd 84 °F.
Office Work	Surveyed by Evans
Checked	Notes H Date 10-7-31
Date	Indexed A. C. Johnson

F.B. 289 PG. 201

Notes: ANY ADDITIONS OR CHANGES ON THIS SHEET MUST BE MADE OR CIRCLED IN Red Ink, WITH DATE AND NAME OF PERSON MAKING CHANGE.

Do not extend notes this side of this line

RETURN TO
LOS ANGELES COUNTY SURVEYOR
700 HALL OF RECORDS

Jefferson Blvd.
See pgs. 177 & 196

S'Ly Line R. La Ballona

10 ft. offset Line per Pg. 196

LA BALLONA

OLD ORCHARD

P.O.S.T. - int'sn 2x2 per pgs. 177 & 196

#11-set 2X2 12" deep by int'sn

2" I.P. - P.I. (per pg. 177)

55-21 E

123° 43' 50" Adj.
123° 43' 55"

(123°-44'-00)
(134°-55'-30)

Fd. Conc. Mon. & Brass cap Hdd. M.D. Brown-'59 set Rec.-'59 1ft. Lo. on Surface

S'Ly Line Lot 15 per Rec. 181.28 Calc. (173.58 Rec.)

180°24'-00" Adj.

Angle Pt. in Fnc.

Turned Rec. 172°40' 172°40'-05" Adj.

#10-set 1X2 on calc. split of angle.

S 27°48' Calc. across

506.88 Rec.

For Adopted N. Line Lot 15
See Pg. 202 D.

(172°-40)
(330°-40)

(from to 4 pg.

1200)

FORM 847 10M 5-31

F.B. 289 Pg 202

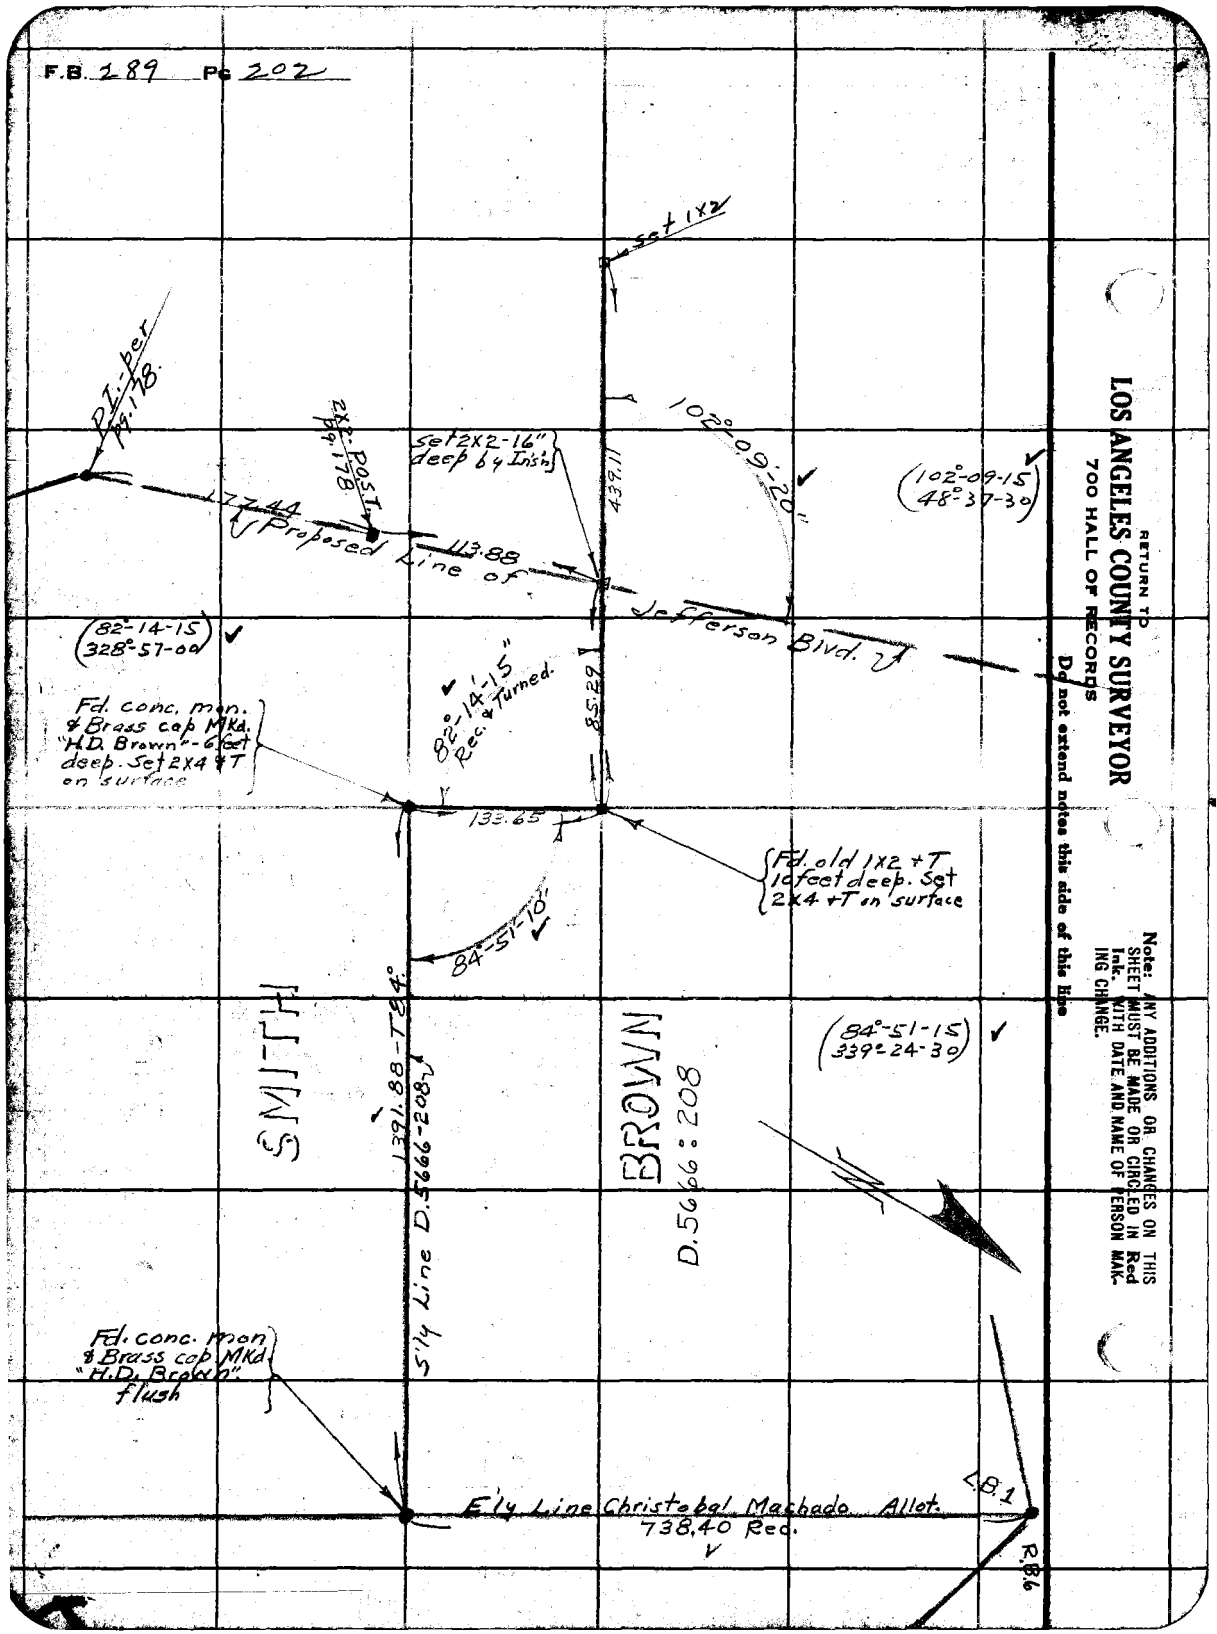

RETURN TO
LOS ANGELES COUNTY SURVEYOR
700 HALL OF RECORDS
Do not extend notes this side of this line

Note: ANY ADDITIONS OR CHANGES ON THIS SHEET MUST BE MADE OR CIRCLED IN Red Ink. WITH DATE AND NAME OF PERSON MAKING CHANGE.

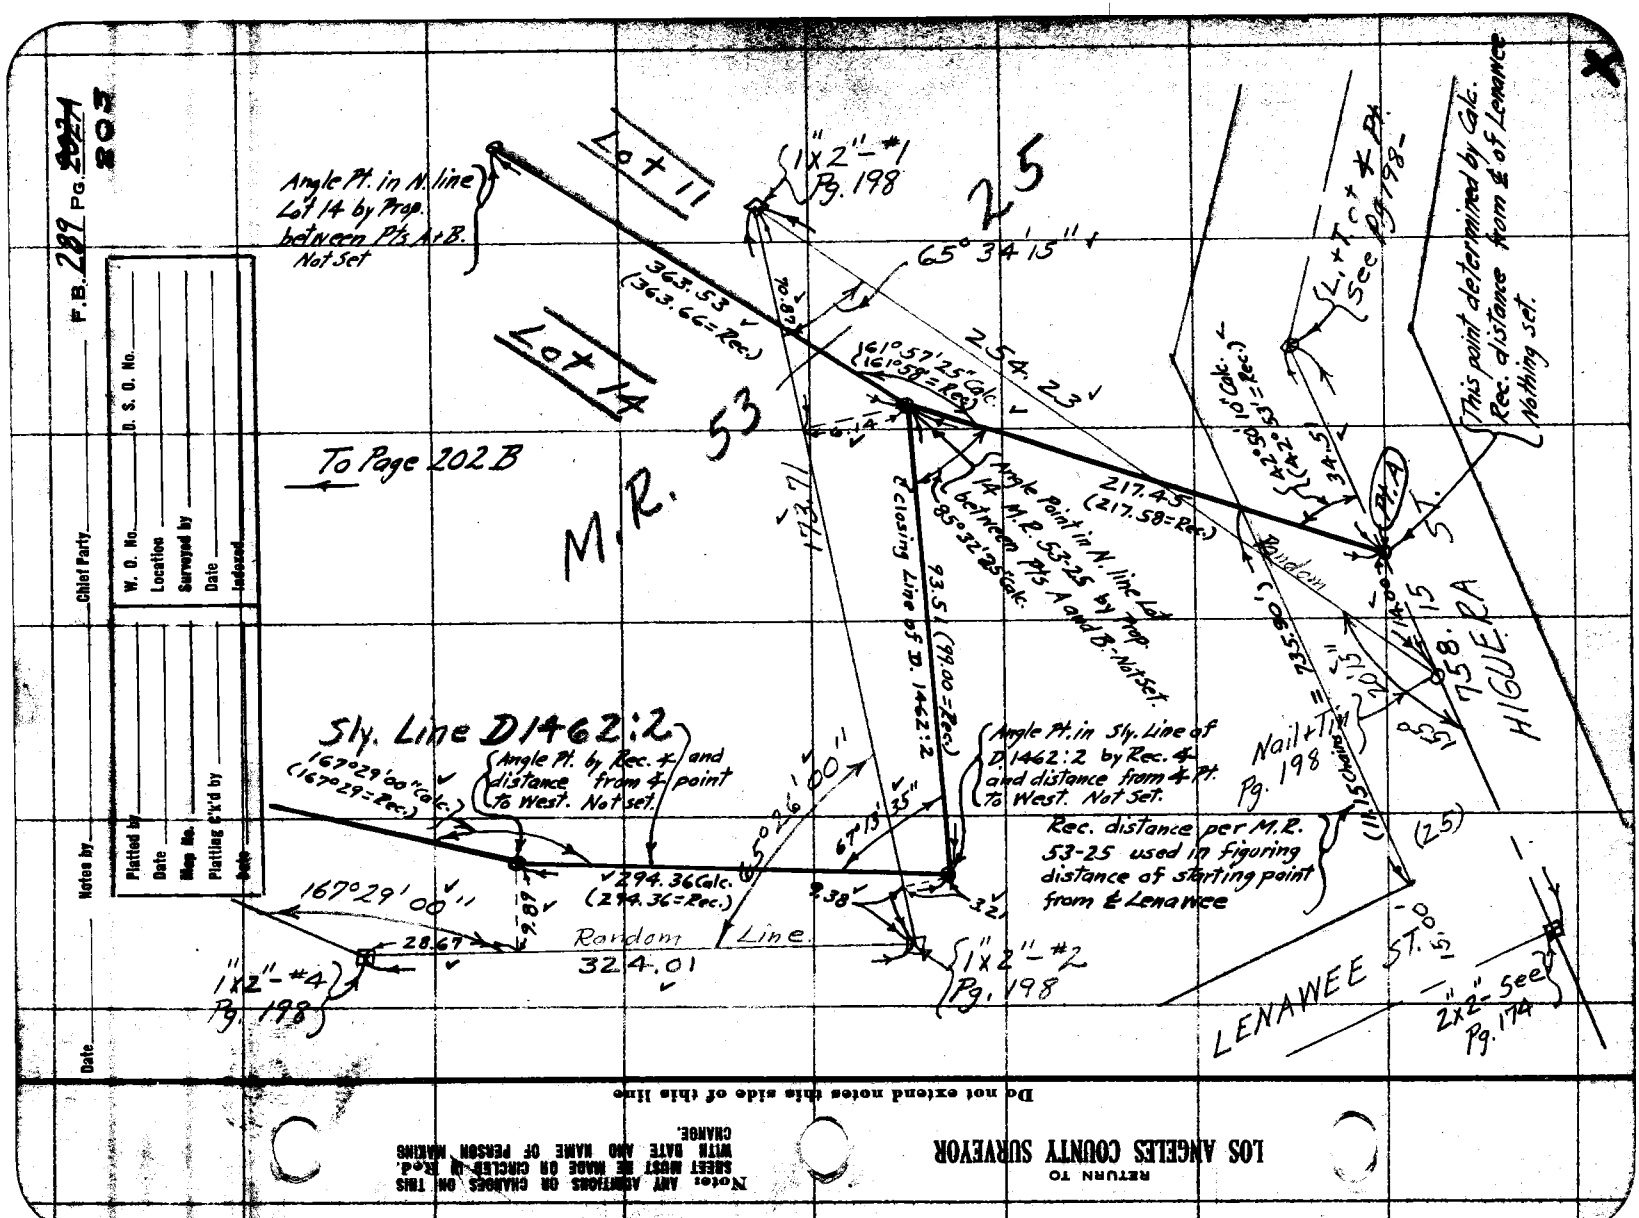
F.B. 289 Pg. 2021
203
Chief Party
D. S. O. No.
W. O. No.
Location
Surveyed by
Date
Indexed
Platted by
Date
Map No.
Platting Ch'k'd by
Date
Notes by
Date
Lot 11
Lot 14
M.R. 53
25
Angle Pt. in N. line Lot 14 by Prop. between Pts A & B. Not Set
(1"x2"-#1 Pg. 198
65° 34' 15"
363.53 (363.66=Rec.)
2.54
2.3
161° 57' 25" Calc. (161° 58' = Rec.)
0.14
To Page 202B
173.71
Angle Point in N. line Lot 14 M.R. 53-25 by Prop. between Pts A and B. Not set.
85° 32' 25" Calc.
2 Closing Line of D. 1462:2
99.51 (99.00=Rec.)
217.45 (217.58=Rec.)
Sly. Line D1462:2
167° 29' 60" Calc. (167° 29' = Rec.)
Angle Pt. by Rec. ∠ and distance from ∠ point To West. Not set.
Angle Pt. in Sly. Line of D. 1462:2 by Rec. ∠ and distance from ∠ Pt. To West. Not set.
Rec. distance per M.R. 53-25 used in figuring distance of starting point from ℄ Lenawee
294.36 Calc. (294.36=Rec.)
167° 29' 00"
28.67
9.87
Random Line
324.01
1"x2"-#4 Pg. 198
1"x2"-#2 Pg. 198
1"x2"-#3 Pg. 198
See Pg. 198
This point determined by Calc. Rec. distance from ℄ of Lenawee Nothing set.
10' Calc. (63'=Rec.)
42° 50'
(42° 52')
34.5
P.A.
Random
735.90'
Nail + Tin
(11.5 Chains)
20.15
65.15
758.15
HIGUERA
(25)
LENAWEE ST.
2"x2"-See Pg. 174
Do not extend notes this side of this line
RETURN TO
LOS ANGELES COUNTY SURVEYOR
Note: ANY ADDITIONS OR CHANGES ON THIS SHEET MUST BE MADE ON CIRCLED OR R'c'd. WITH DATE AND NAME OF PERSON MAKING CHANGE.

F.B. 289 PG. ~~202 B~~ 204 Chief Party Notes by Date

Point of beginning of D. 1462:2 is N.W. Corner of Lot 14. and it ties back into the Lot line between Lots 11 and 14 at the first angle point W. of Higuera St. The deed description does not close by several feet so the deed line has been established by record angle and distances from the N.W. Cor. of Lot 14 and closing in on the ℄ point in Lot Line.

From Pg. 202-A.

Angle Pt. See Pg. 202A

1"x2"-#4

℄ Pt. - See Pg. 202A

S 1° 25' E

S½ Line D. 1462:2

462.00 Calc. (462.00=Rec.)

416.21

Lot 11

Lot 14

363.53 (363.66=Rec.)

1"x2"-#5-Pg. 199

19.38

18.667

Angle Point by Rec. ℄ and distance from ℄ point to West. Not Set.

Angle Pt. in N. Line Lot 14 - See Pg. 202A

161° 19' 55" Calc. (161° 20" = Rec.)

17° 29' 00" Calc. (17° 29' 00" Rec.)

194.70 = Rec.

194.70 Calc.

Random Line

195.62

333.94 Calc. (333.94 = Rec.)

1"x2"-#6-Pg. 199

99° 25' 00"

1"x2"-#7-Pg. 199

151.72

23.04

N. W. Corner of Lot 14 and beginning point of D. 1462:2. By Prop. between points A + B. Not set

85° 01' 11" Calc. (85° 02' Rec.)

80° 35' 00" Calc. (80° 35' = Rec.)

191.20

19.29

19.46

18.69

143.22 (143.22 = Rec.)

To Pg. 202-C

Angle Pt. in property described in D. 1462:2 By Rec. distance from N.W. Cor. Lot 14

RETURN TO LOS ANGELES COUNTY SURVEYOR

Do not extend notes this side of this line

Note: ANY ADDITIONS OR CHANGES ON THIS SHEET MUST BE MADE OR CIRCLED IN Red. WITH DATE AND NAME OF PERSON MAKING CHANGE.

Date _____ Notes by _____ Chief Party _____ F.B. 289 PG. ~~202~~ 205

Platted by	W. O. No. _____ D. S. O. No. _____
Date	Location
Map No.	Surveyed by
Platting C'k'd by	Date
Date	Indexed

Notes ANY ADDITIONS OR CHANGES ON THIS SHEET MUST BE MADE OR CIRCLED IN Red. WITH DATE AND NAME OF PERSON MAKING CHANGE.

Do not extend notes this side of this line

RETURN TO LOS ANGELES COUNTY SURVEYOR

Angle Point in N. Line Lot 15 - M.R. 53-25. By prop. between points A + B - Not Set.

1"x2"-#9-Pg. 200

To Pg. 202 D

427.53 (427.68 = Rec.)

428.93

Old M.R. 53-25

167°44'35" Calc. (167°45' = Rec.)

Angle Point in N. Line Lot 15 - M.R. 53-25 By prop. between points A + B - Not Set

8.90

167°45'00"

19.09

1"x2"-#8-Pg. 200

Old Orchard Lot

Lot 15

182.80 Calc. (182.82 = Rec.)

Random Line.

184.56 Calc.

90°26'00" (90°30' Rec.)

N.W. Cor. Lot 14 See B. 202-B

N.E. Cor. Lot 15 - M.R. 53-25 By prop. between points A + B Not Set

9.06

191.20 Calc. (191.40 = Rec.)

1"x2"-#6 Pg. 199

89°30'00"

19.29

19.37

1"x2"-#7 Pg. 199

9.22

23.04

Lot 14

From Page 202 B.

RETURN TO
LOS ANGELES COUNTY SURVEYOR

Notes: ANY ADDITIONS OR CHANGES ON THIS SHEET MUST BE MADE OR CIRCLED IN Red. WITH DATE AND NAME OF PERSON MAKING CHANGE.

Do not extend notes this side of this line

Chief Party _____ Notes by _____ Date _____

F.B. 202 PG. D
289-206

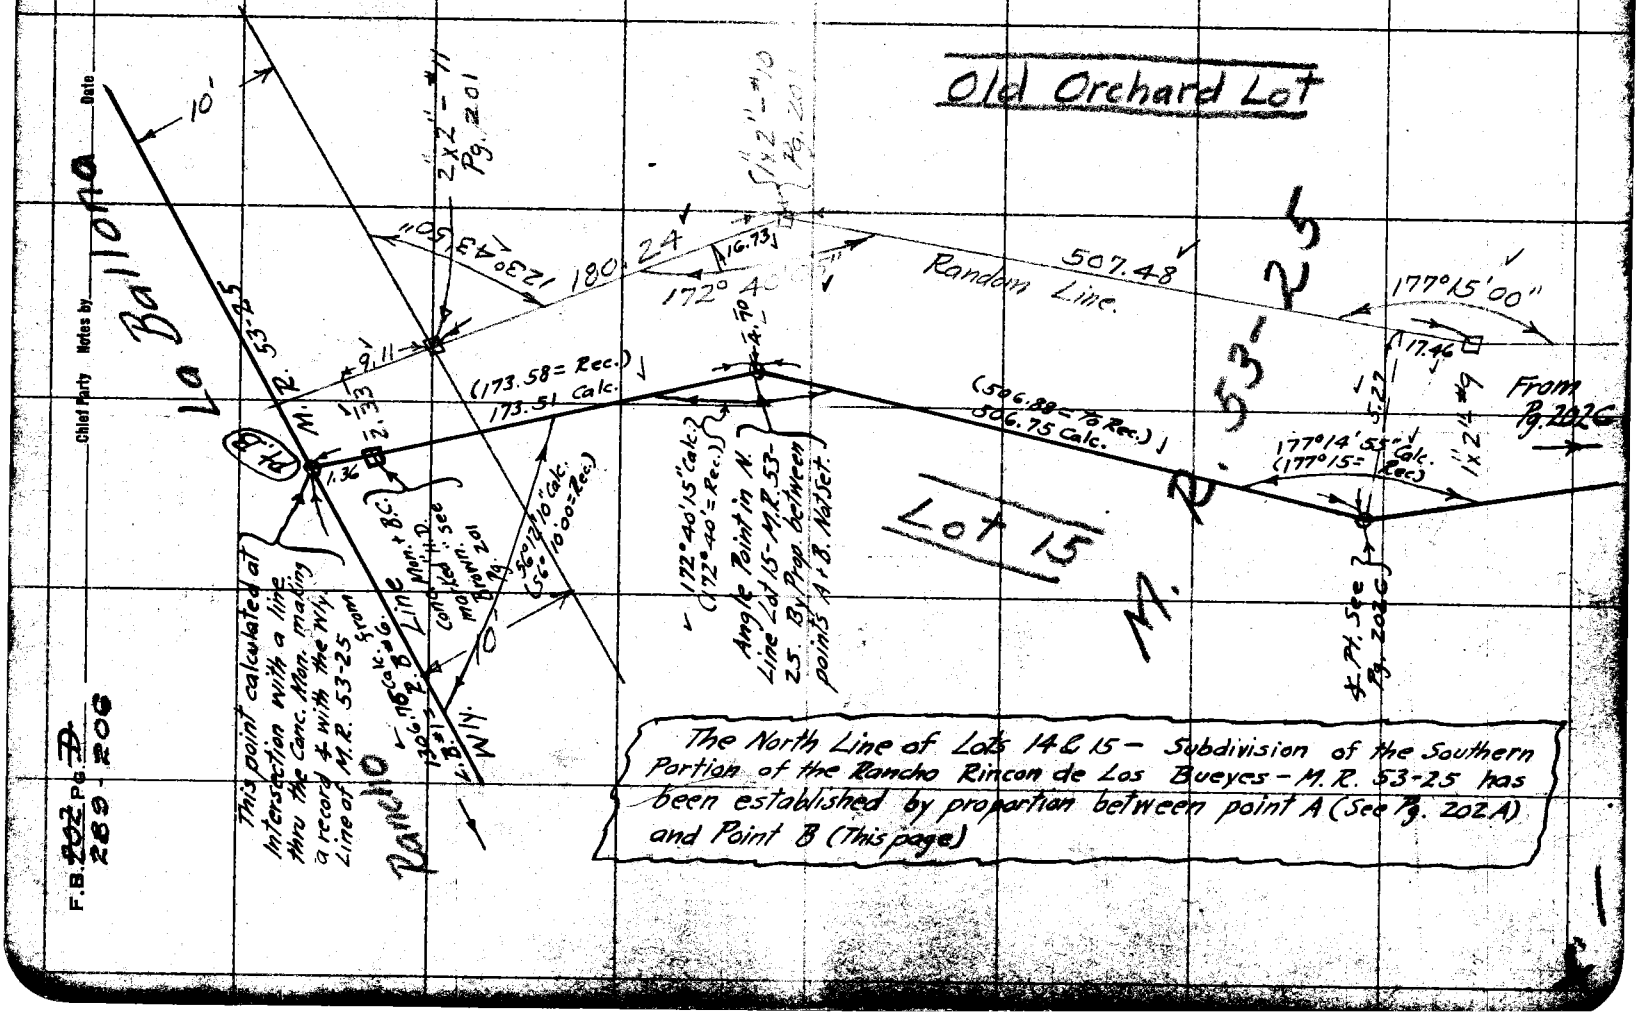

The North Line of Lots 14 & 15 - Subdivision of the Southern Portion of the Rancho Rincon de Los Bueyes - M.R. 53-25 has been established by proportion between point A (See Pg. 202A) and Point B (This page)

Notes Ck'd by Drew	Survey of Angeles Vista Blvd.
Map No. B-811	W. O. 7167 Tape No. 051 St'd 84 °F.
Office Work C.W. Cox	Surveyed by Evans
Checked D. M. Finley	Notes LE Date 10-21-32
Date Dec. 1932.	Indexed A. C. Johnson 11-2-32

F.B. 289 Pg. 211

SURVEY OF ANGELES VISTA BLVD. FROM KENISTON AVE. TO SLAUSON AVE.

H.F. Evans - Dep.
A.L. Martin - T.
G.F. Brack - H.C.
D.M. Reynolds - R.C.
} Party

100' Tape # 051 std. @ 84°F.

(For Bench Levels, Profile & X-Sections see L.B. 697-3-119)

References

C.S.
F.B. 89-71-72
F.B. 262-4-6
L.B. 614-29
F.B. 289-71-76

Rd. Dept.
F.A. 149-30-32
F.W. 5875-3-5

Tract Maps.
5535-6177

Deeds.
O.R. 11274:80

Note: ANY ADDITIONS OR CHANGES ON THIS SHEET MUST BE MADE OR CIRCLED IN Red Ink. WITH DATE AND NAME OF PERSON MAKING CHANGE.

Do not extend notes this side of this line

RETURN TO
LOS ANGELES COUNTY SURVEYOR
700 HALL OF RECORDS

FORM 247 10M 8-31

RETURN TO

LOS ANGELES COUNTY SURVEYOR

700 HALL OF RECORDS

Note: ANY ADDITIONS OR CHANGES ON THIS SHEET MUST BE MADE OR CIRCLED IN **Red Ink.** WITH DATE AND NAME OF PERSON MAKING CHANGE.

Do not extend notes this side of this line

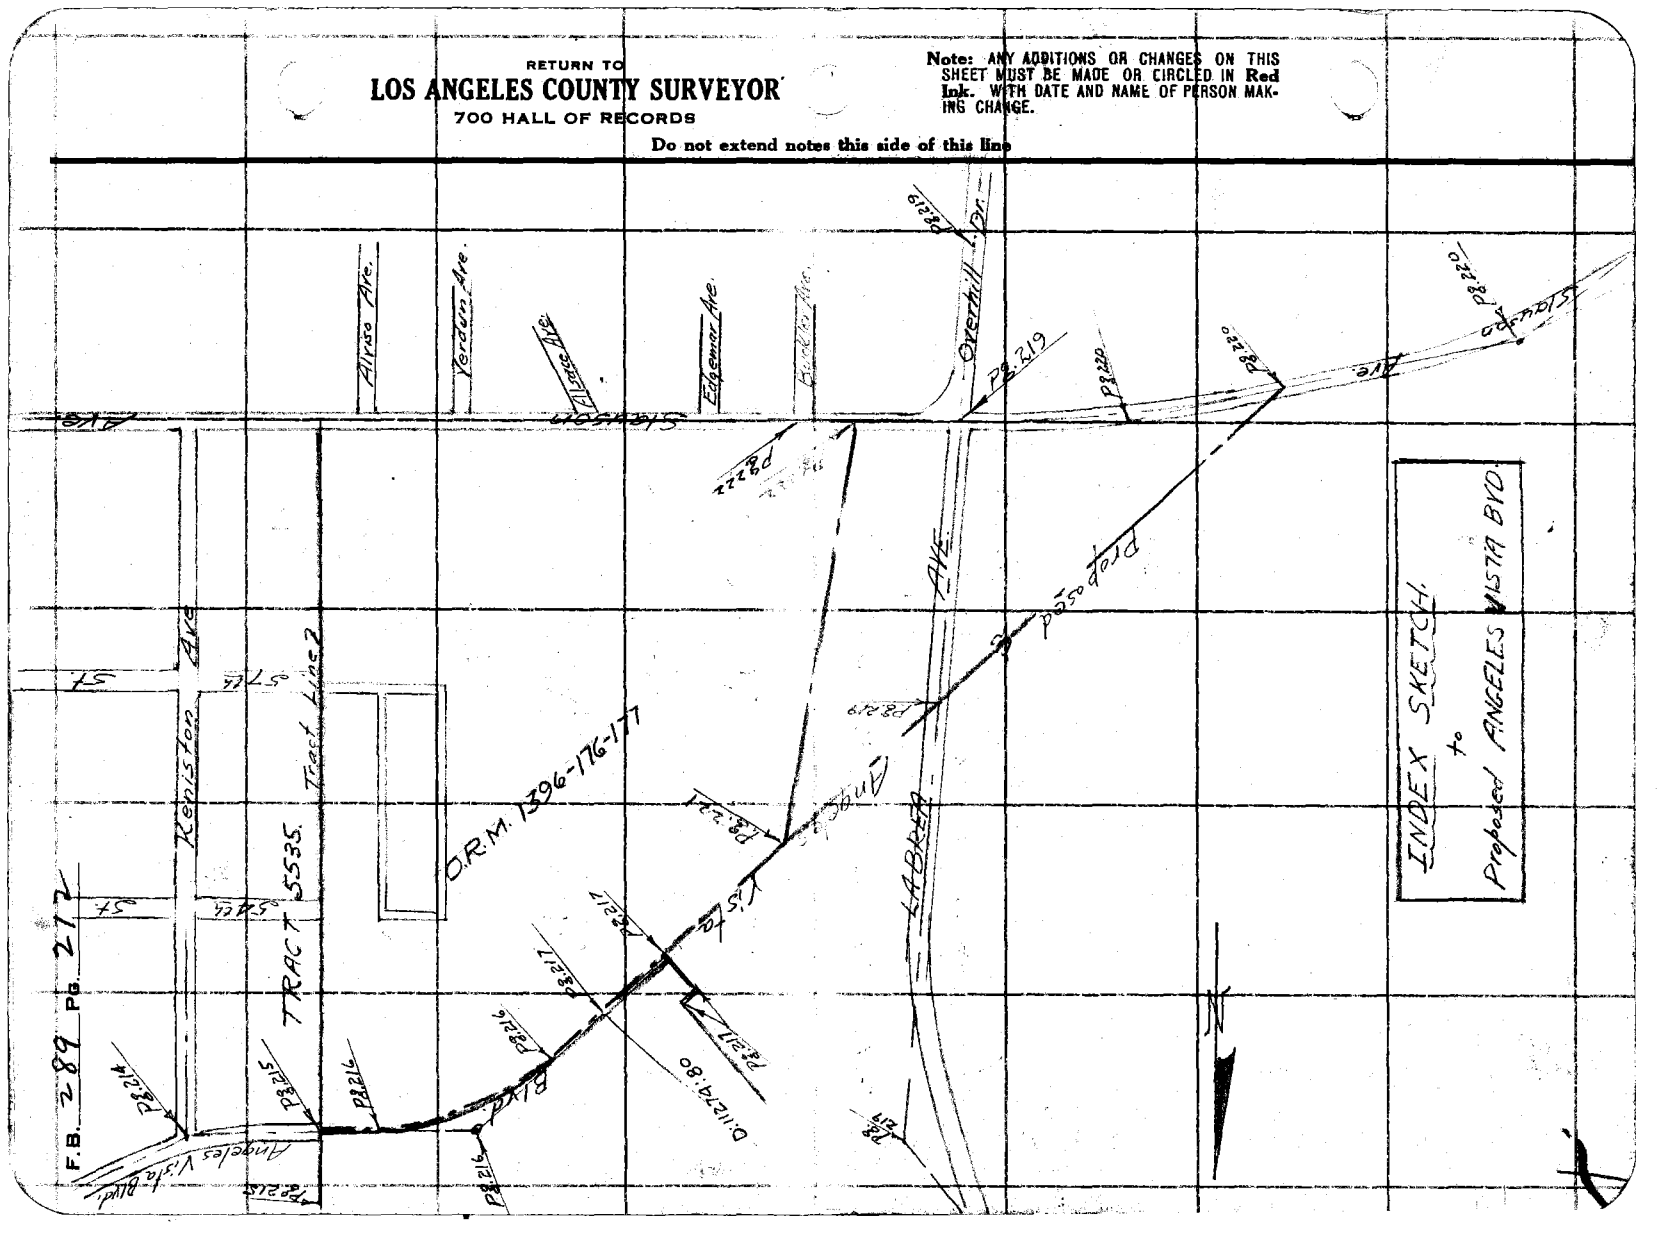

Notes Ck'd by Drew	Survey of
Map No. B-811	W. O. Tape No. St'd °F.
Office Work C.W.Cox	Surveyed by
Checked D. M. Finley	Notes Date
Date Dec. 1932	Indexed C. Johnson

F.B. 284 Pg. 213

Note: ANY ADDITIONS OR CHANGES ON THIS SHEET MUST BE MADE OR CIRCLED IN Red Ink. WITH DATE AND NAME OF PERSON MAKING CHANGE.

Do not extend notes this side of this line

RETURN TO
LOS ANGELES COUNTY SURVEYOR
700 HALL OF RECORDS

FORM 247 10M 8-31

X

RETURN TO
LOS ANGELES COUNTY SURVEYOR
700 HALL OF RECORDS

Note: ANY ADDITIONS OR CHANGES ON THIS SHEET MUST BE MADE OR CIRCLED IN **Red Ink.** WITH DATE AND NAME OF PERSON MAKING CHANGE.

Do not extend notes this side of this line

MS 24 B-2

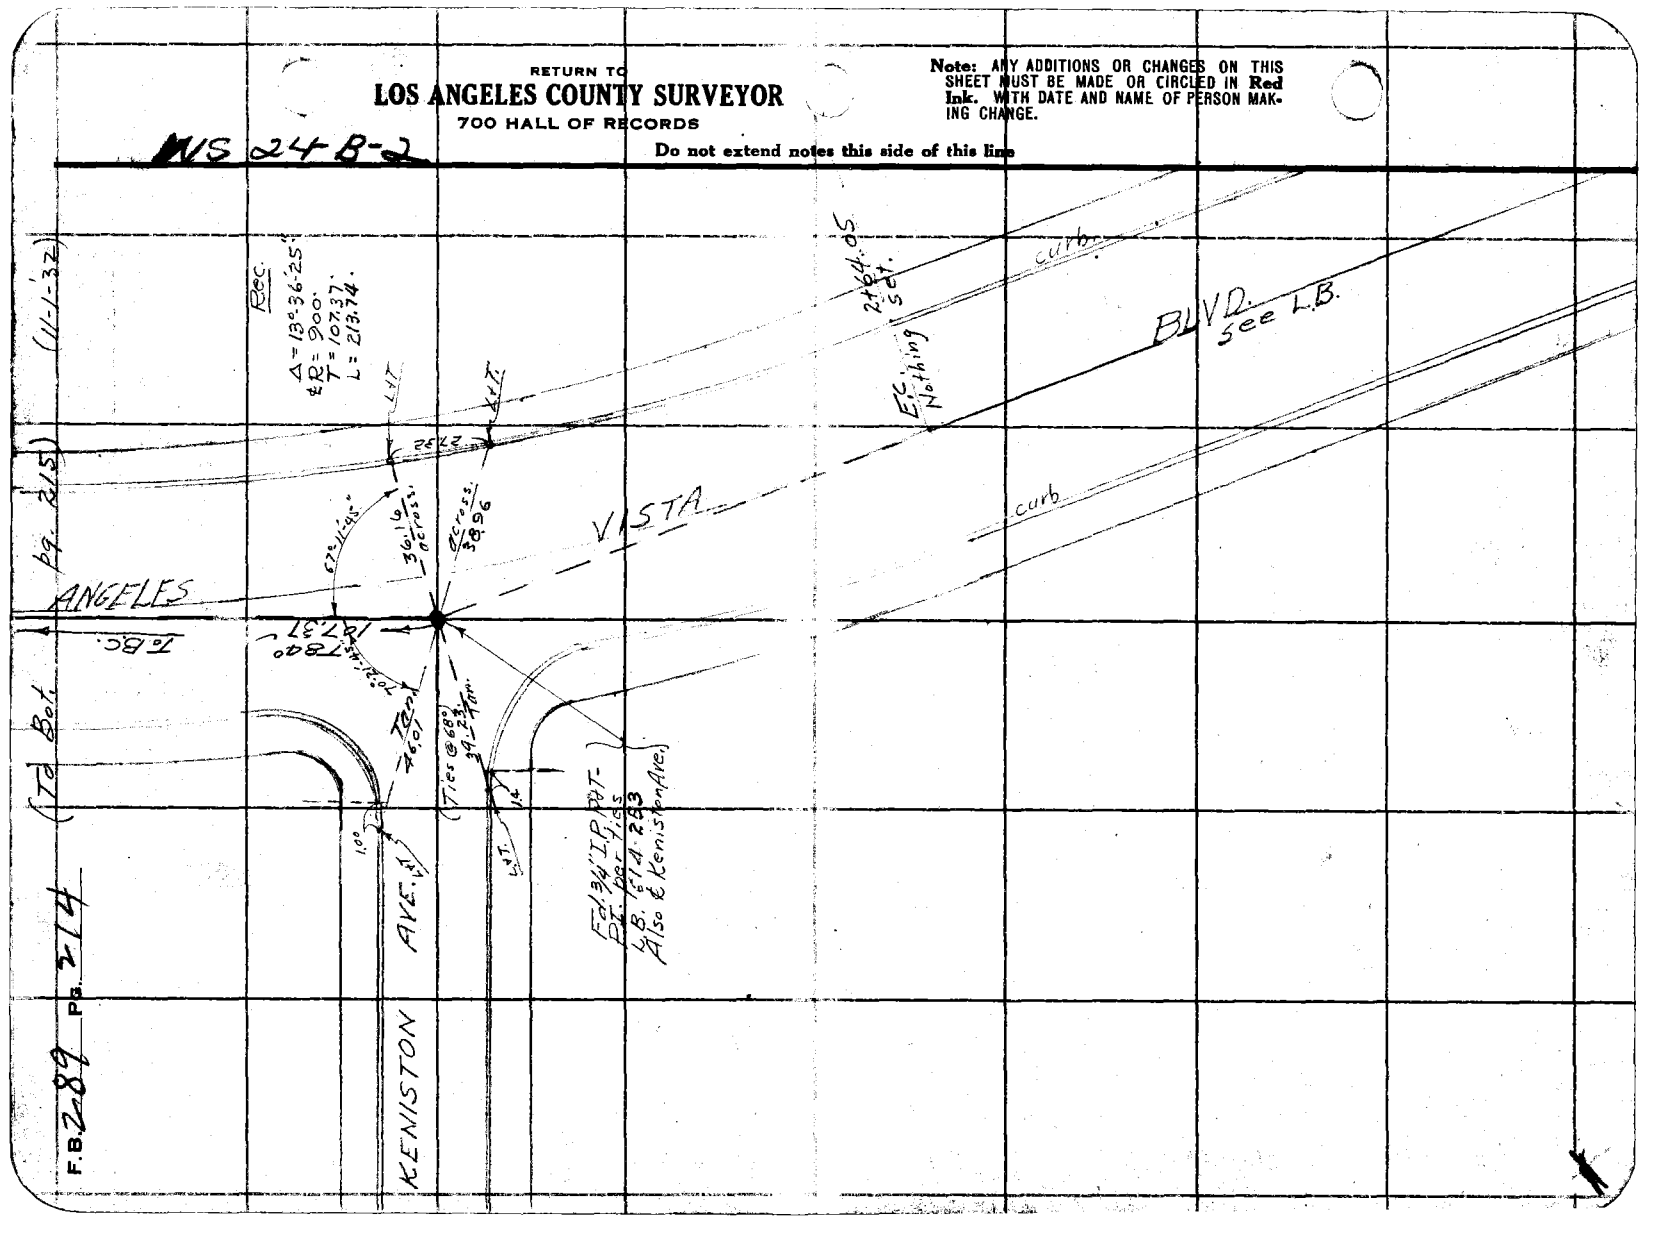

Notes Ck'd by Drew	Survey of Angeles Vista Blvd.
Map No. B-811	W. O. 7167 Tape No. 051 St'd 84 of.
Office Work C.W. Cox	Surveyed by Evans.
Checked D. M. Finley	Notes HE Date 10-21-32
Date Dec. 1932.	Indexed A. C. Johnson

F.B. 284 Pg. 215

(To Bk. pg. 216)

WS 24-B-2

Note: ANY ADDITIONS OR CHANGES OF THIS SHEET MUST BE MADE OR CIRCLED IN Red Ink. WITH DATE AND NAME OF PERSON MAKING CHANGE.

Do not extend notes this side of this line

RETURN TO LOS ANGELES COUNTY SURVEYOR 700 HALL OF RECORDS

BLVD.

To 2nd PP. Bk. 316

74.80')

Proposed Angeles Vista Blvd.

O.R.M. 1396 - 176-177

Proposed ANGELES VISTA

231.43' S78°-23'-42"E The line described in Or. 11

(90°-11-15)
(360°-45-09)

90°

11'

60.00'

Fd. Lke. #18 F.B. 289-73

Fd. Lke. #17 per F.B. 289-72

Fd. Lke. F.B. 289-72

Transit Line per

28.50

F.B. 289-71-732

30"

(L.B. 614-29)
Fd. 2" I.P. & nail, set in, & filled with cem. per F.B. 289-73. Ctr. of nail 0.01 W. of line. set P.K. at int'sn. (6" deep.) 0+00 going W. & 0+08 going E.

28.10 39.99 LVT

27.91 39.97 LVT

9.173

9.172

Angeles Vista Blvd.

Set Spike & tack in top of curb

(50.35 Rec.) 50.32-T66°-50-3/4"

Set Spike & tack in top of curb

28.11 107.37

28.00

B.C. Set S.W.T.

0+50.31 from W.

Set Spike & tack in top of curb per F.B. 289-72

(179°-57-30)
(359°-58-00)

TR. No. 5535.

(From F.B. top pg. 214)

FORM 247 10M 8-31

F.B. 289 Pg. 216

(To Bot pg. 217) (10-21-32)

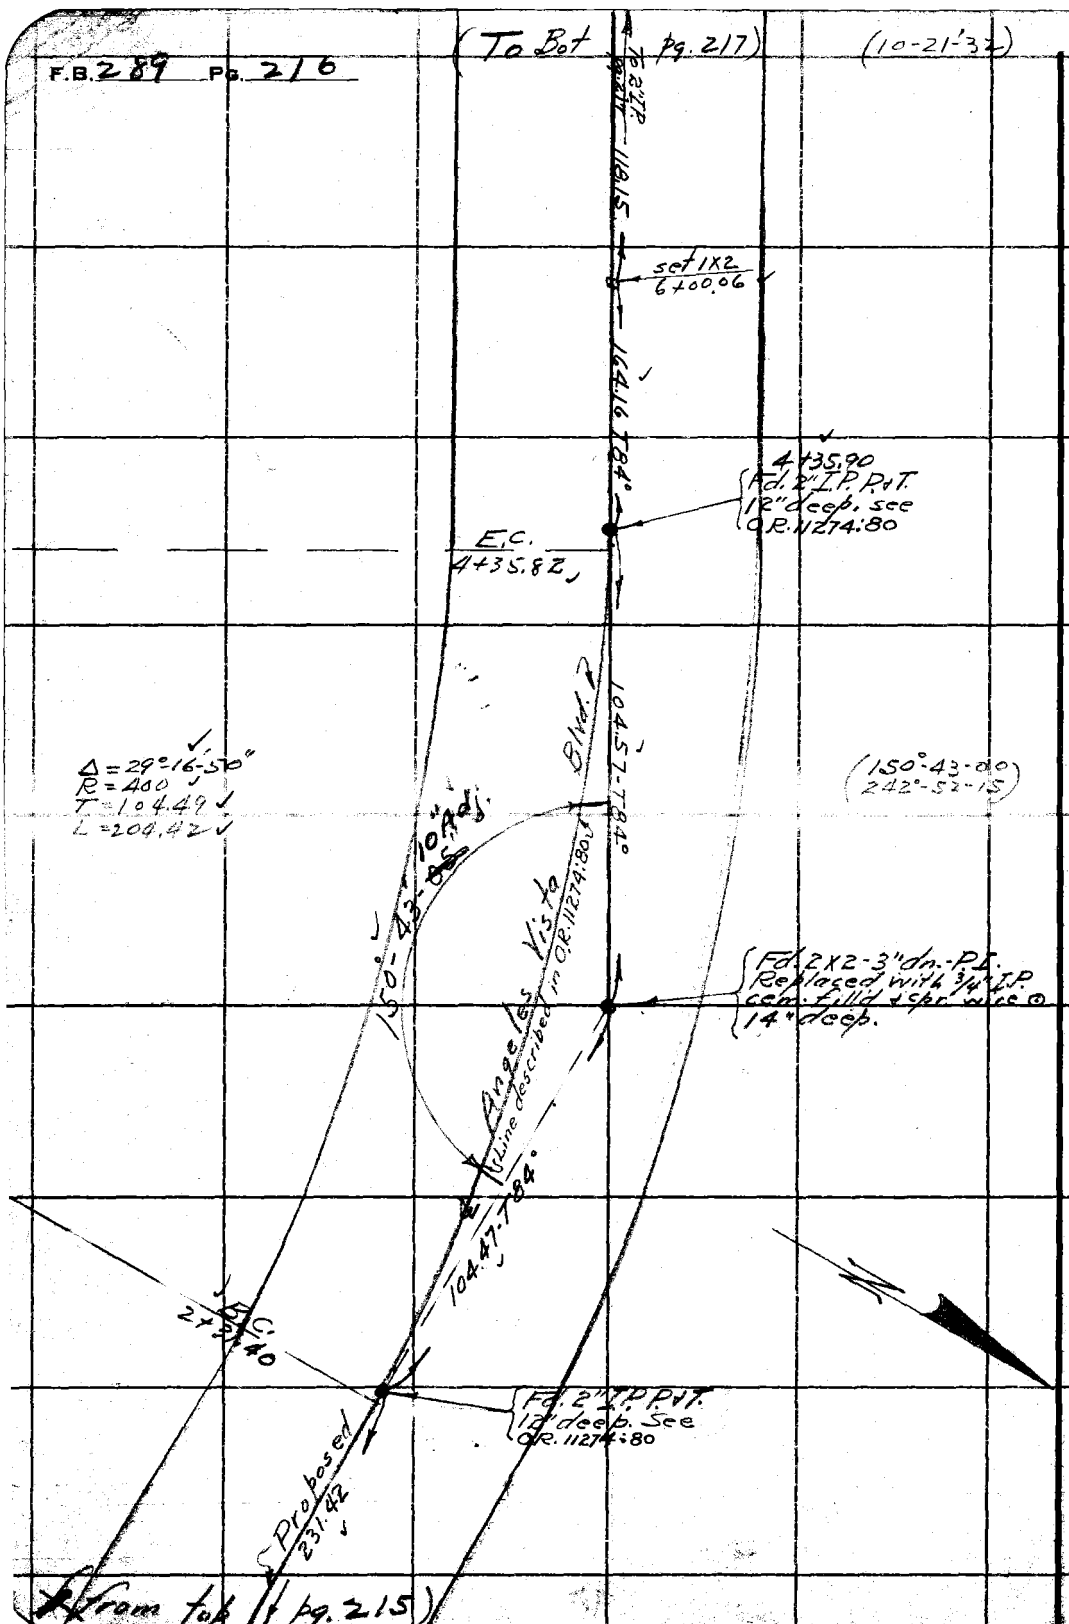

RETURN TO
LOS ANGELES COUNTY SURVEYOR
700 HALL OF RECORDS

Do not extend notes this side of this line

Note: ANY ADDITIONS OR CHANGES ON THIS SHEET MUST BE MADE OR CIRCLED IN Red Ink. WITH DATE AND NAME OF PERSON MAKING CHANGE.

Notes Ck'd by	Drew	Survey of	Angeles Vista Blvd
Map No.	B-811	W. O.	7167
Office Work	C.W.Cox	Tape No.	051
Checked	D. M. Finley	St'd	84 °F.
Date	Dec. 1932	Surveyed by	Evans
		Notes	LE
		Date	10-24-32
		Indexed	C. Johnson

F.B. 289 PG. 217

(To Bo... pg. 219 221)

P.L. Produced. Proposed ℄

Fd. 2" I.P. P/T 10" deep. Sec O.R. 11274:80 15+26.42

180°-00

64.95 - T 84° O.R. 11274:80

Fd. 2" I.P. P/T 8" d in. O.R. 11274 pg 80.

30.01

90°-00'-00" Rt

89°-59'-30"

(90°-00-00 359°59-30)

Proposed ℄ Angeles Vista Blvd

808.21 - T 84°

℄ Line described in O.R. 11274:80

T 84°

1181.5 from

Fd. 2" I.P. P/T 8" deep. 7+18.21

(From top pg. 216)

Note: ANY ADDITIONS OR CHANGES OR THIS SHEET MUST BE MADE OR CIRCLED IN Red Ink, WITH DATE AND NAME OF PERSON MAKING CHANGE.

RETURN TO
LOS ANGELES COUNTY SURVEYOR
700 HALL OF RECORDS.

Do not extend notes this side of this line

FORM 247 10M 8-31

RETURN TO
LOS ANGELES COUNTY SURVEYOR
700 HALL OF RECORDS

Note: ANY ADDITIONS OR CHANGES ON THIS SHEET MUST BE MADE OR CIRCLED IN **Red Ink.** WITH DATE AND NAME OF PERSON MAKING CHANGE.

Do not extend notes this side of this line

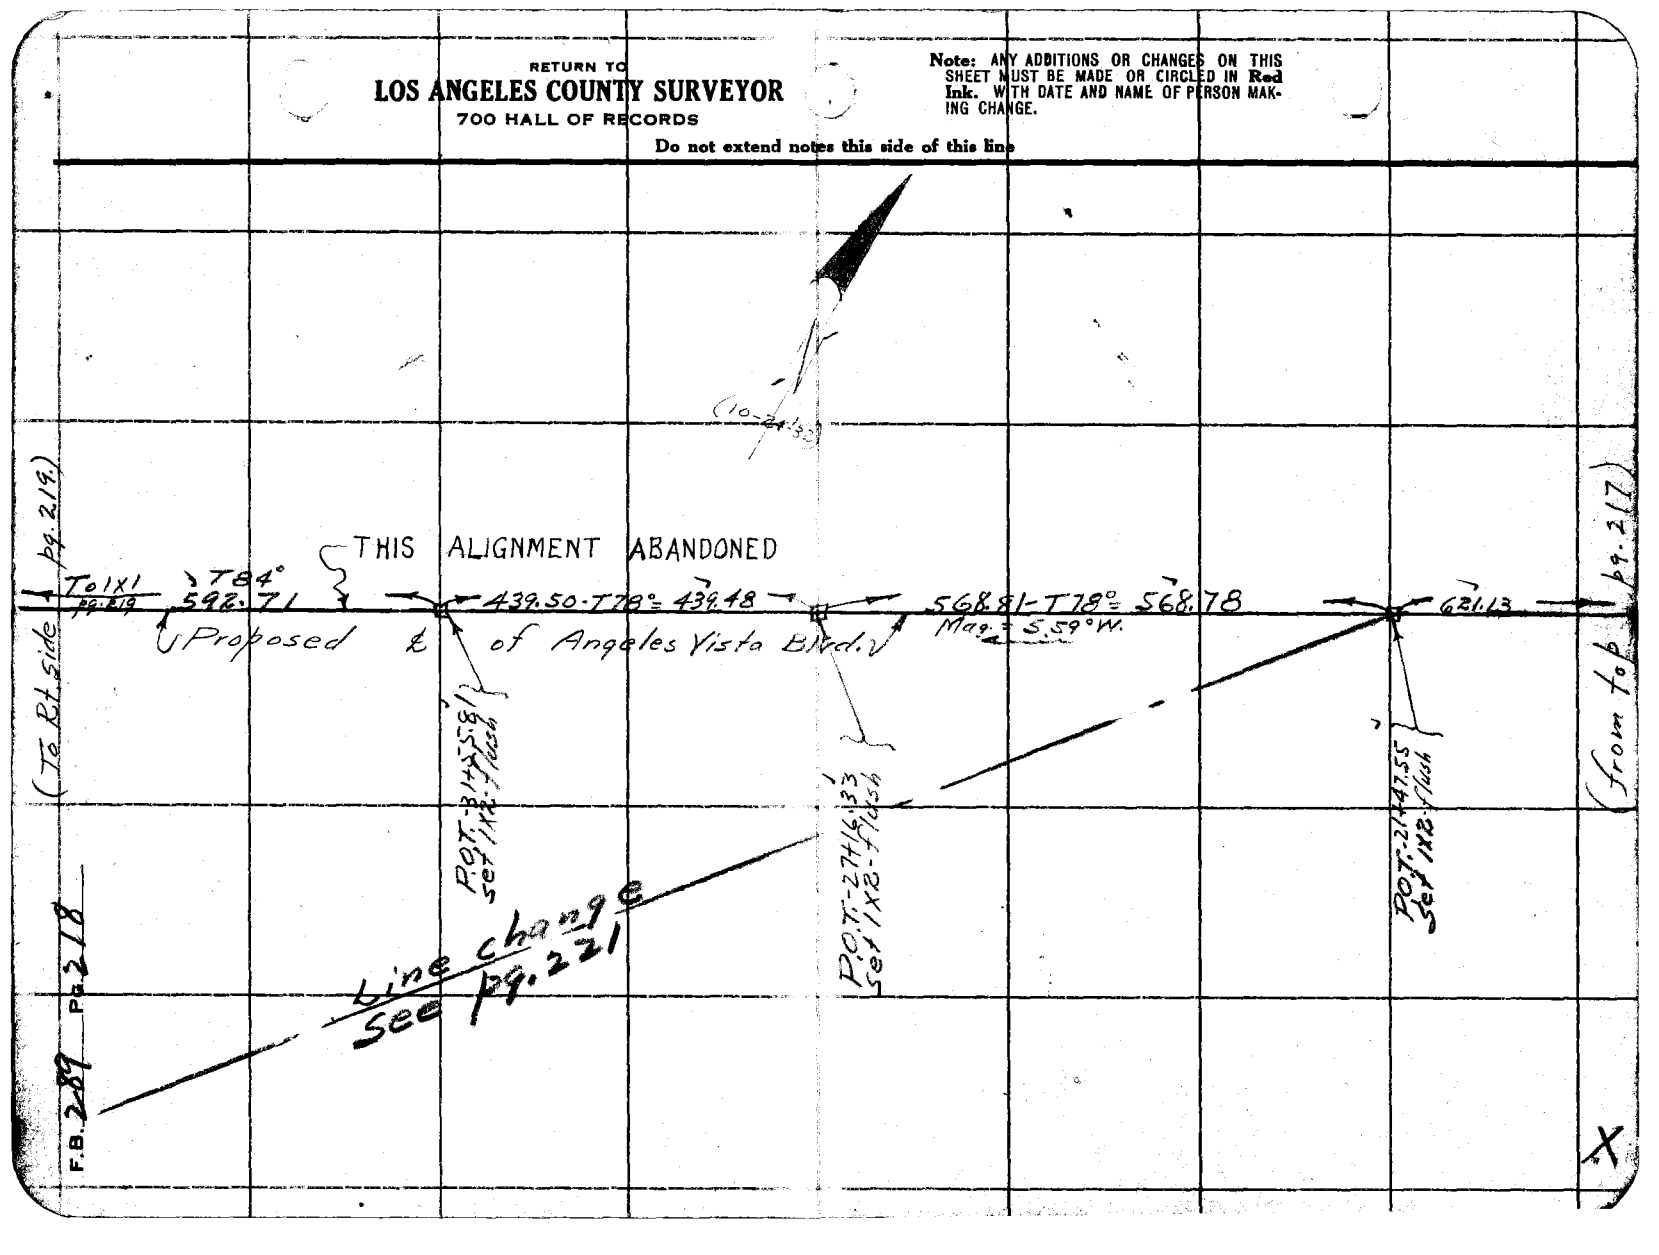

Notes Ck'd by Drew	Survey of Angeles Vista Blvd.
Map No. B-811	W. O. 7167 Tape No. 951 St'd 84 °F.
Office Work C.W. Cox	Surveyed by Evans
Checked D. M. Finley	Notes HE Date 10-25-32
Date Dec. 1932.	Indexed

F.B. 289 PG. 219

Note: ANY ADDITIONS OR CHANGES OR THIS SHEET MUST BE MADE OR CIRCLED IN Red Ink. WITH DATE AND NAME OF PERSON MAKING CHANGE.

Do not extend notes this side of this line

RETURN TO
LOS ANGELES COUNTY SURVEYOR
700 HALL OF RECORDS

FORM 247 10M 5-31

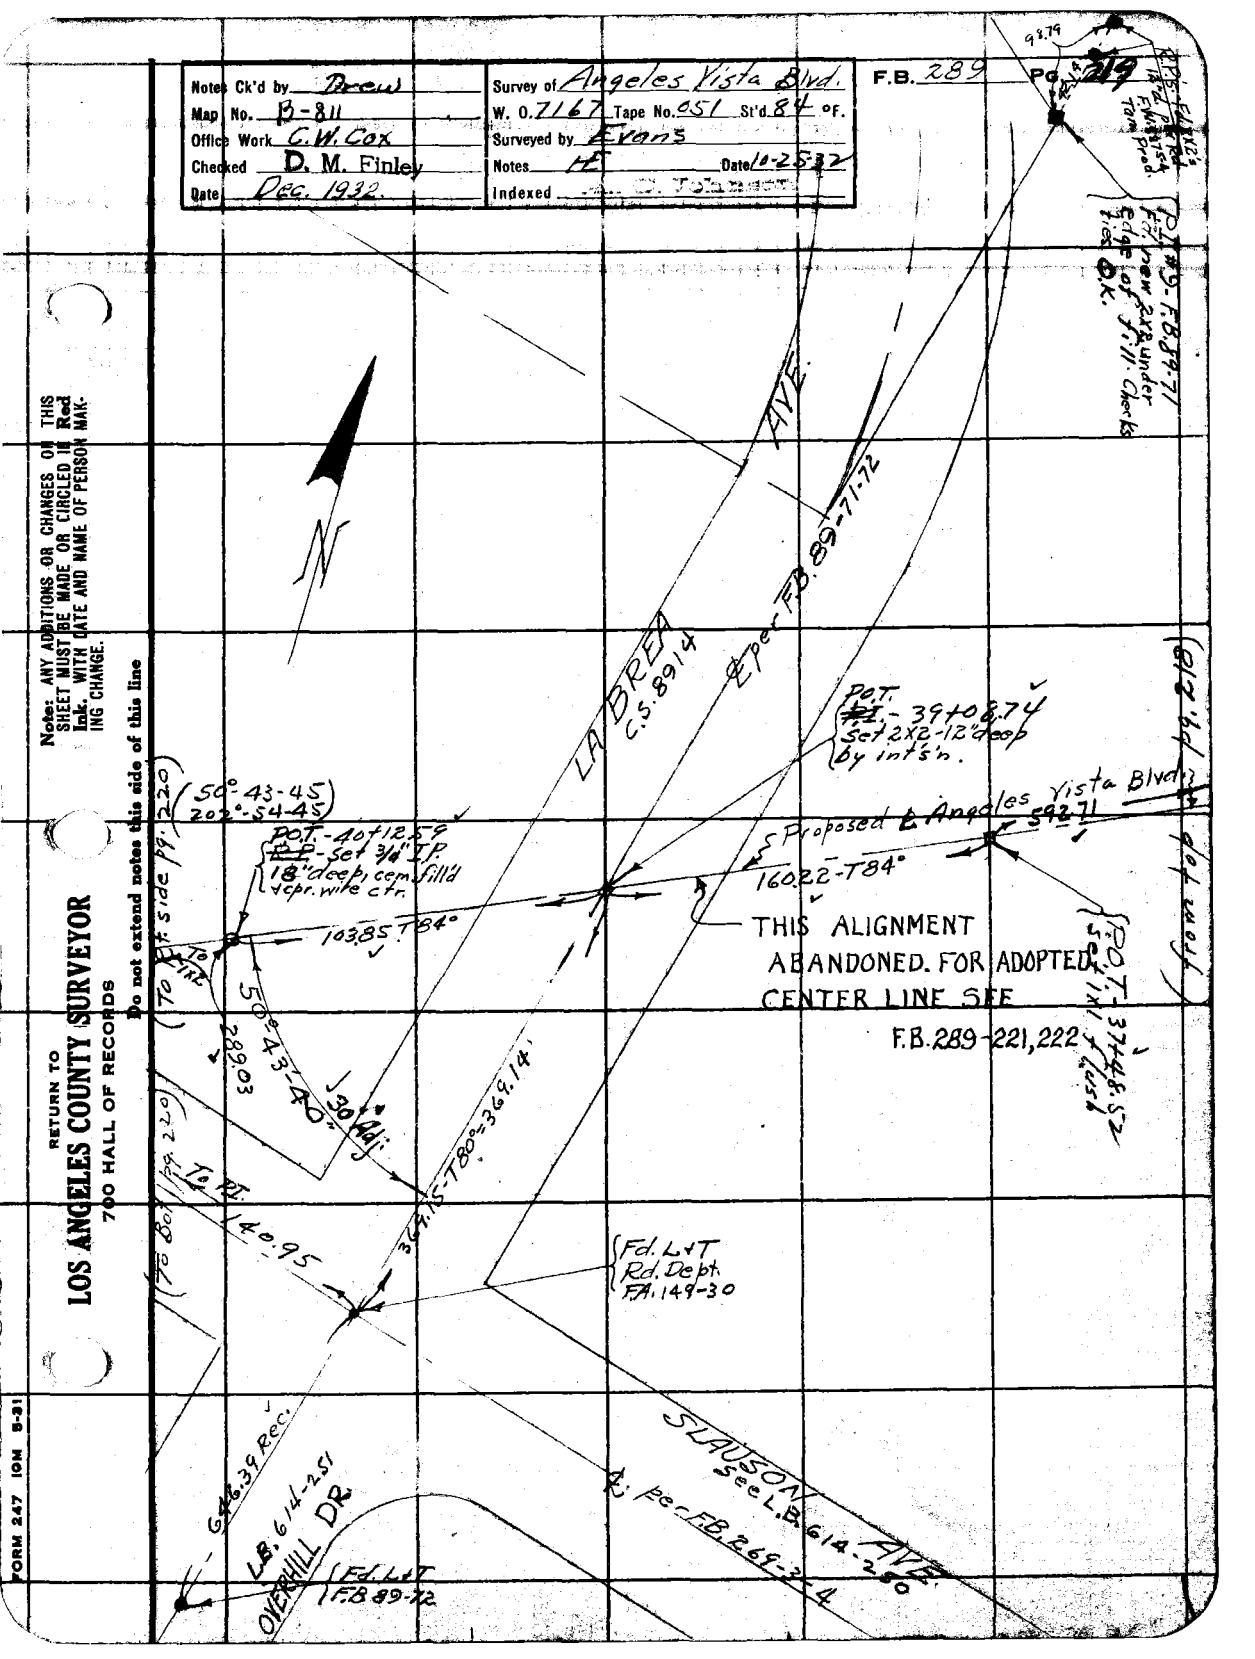

RETURN TO
LOS ANGELES COUNTY SURVEYOR
700 HALL OF RECORDS

Note: ANY ADDITIONS OR CHANGES ON THIS SHEET MUST BE MADE OR CIRCLED IN **Red Ink.** WITH DATE AND NAME OF PERSON MAKING CHANGE.

Do not extend notes this side of this line

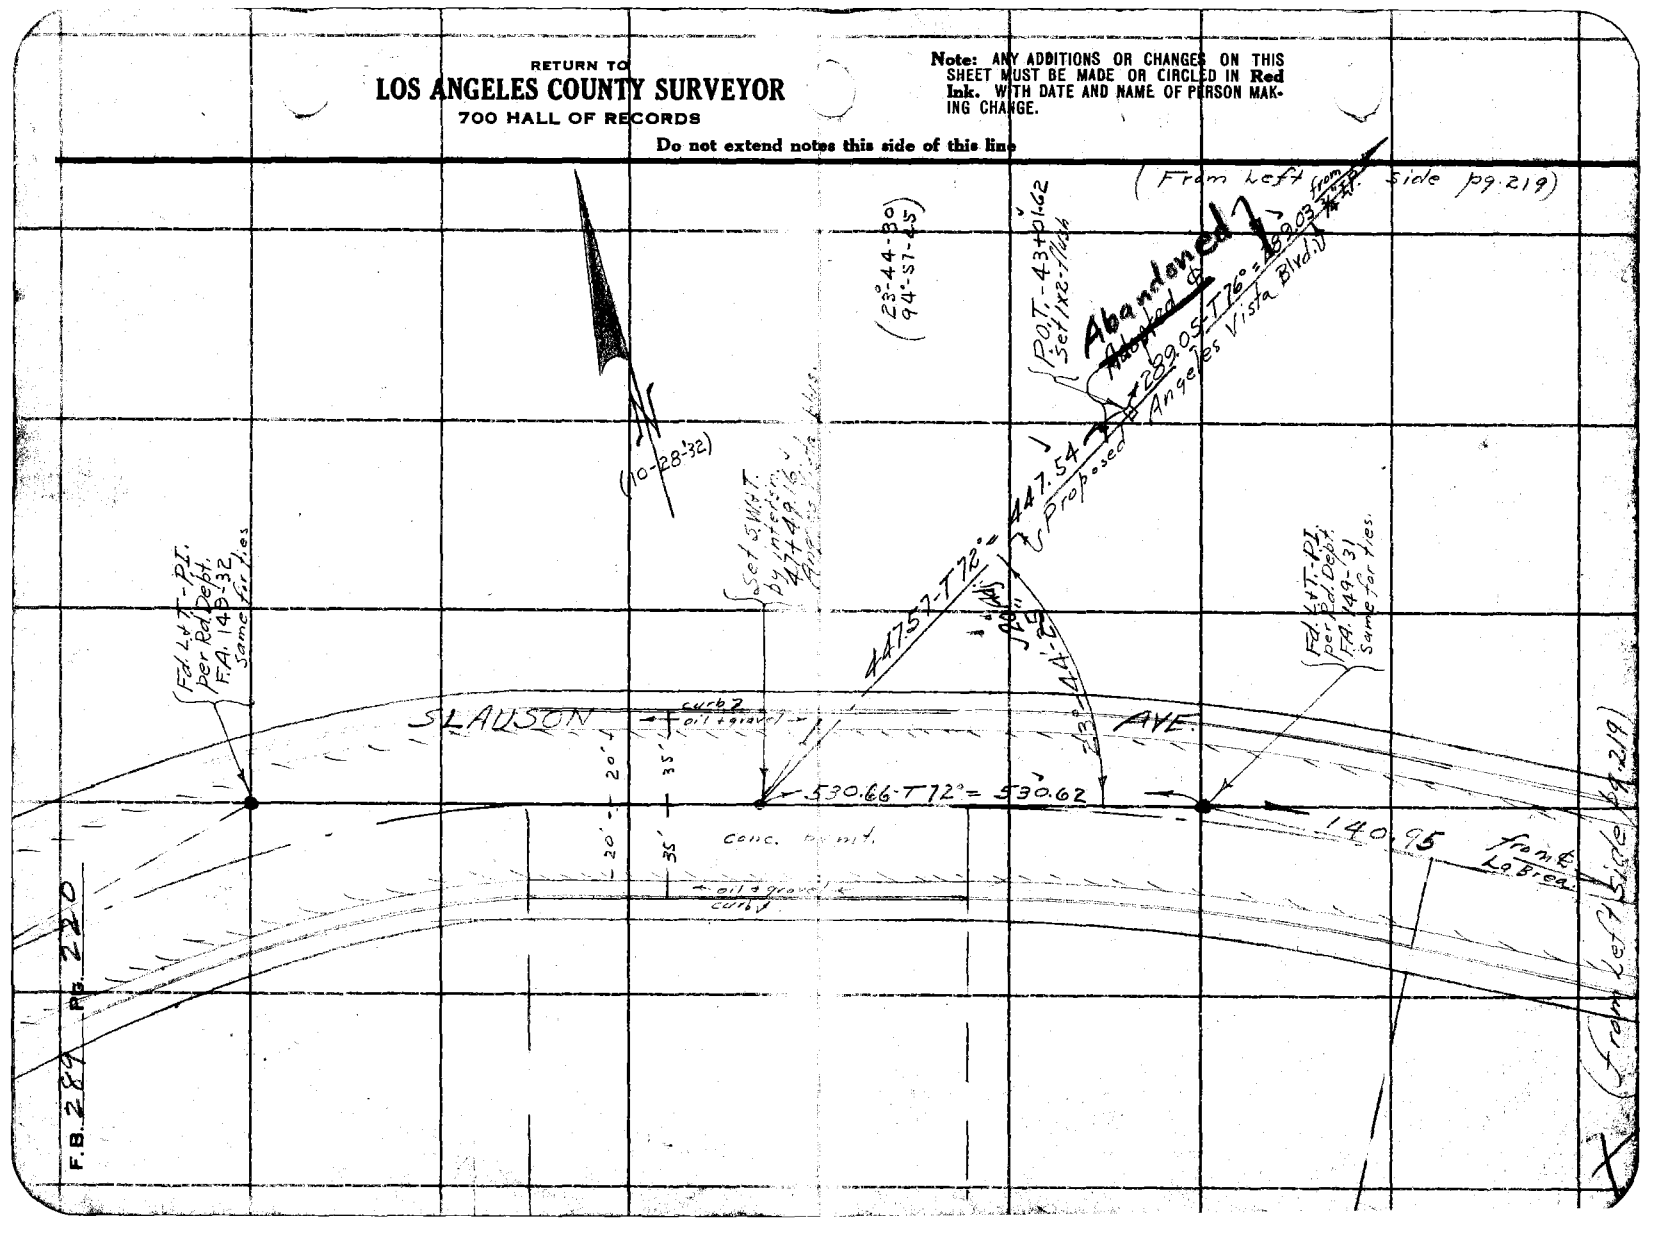

Notes Ck'd by Drew	Survey of Angeles Vista Blvd.
Map No. B-811	W. O. 7167 Tape No. 051 St'd 84 °F.
Office Work C.W.Cox	Surveyed by Evans
Checked D. M. Finley	Notes HE Date 12-2-32
Date Dec. 1932.	Indexed A. O. Johnson

F.B. 281 PG. 221

(To Bot. pg. 222)

To P.O.T. pg. 222 (New 11"ner)

(Adopted ℄)

PROPOSED

38245-768°=38241

ANGELES VISTA BLVD.

25+19.34 E.C.
Set 2x2-18" deep

LINE CHANGE.
from Sta. 21+47.55, pg. 218
to Slauson Ave.
(N 22°32'18" E)

Fd. 1½ 2-21+47.55 per bot. pg. 218 Replaced with ¾ I.P. conc. filled & chr. wire center, 15" deep. PT.

Δ = 21°33'35"
R = 2000
T = 380.79
L = 752.58

158°-26-25"

(158°-26-30
273°-45-45
158°-26-26)

17+66.76 P.C.
Set 2x2-14" deep.

R = 2000

(from top pg. 217)

RETURN TO
LOS ANGELES COUNTY SURVEYOR
700 HALL OF RECORDS

Do not extend notes this side of this line

Notice ANY ADDITIONS OR CHANGES OR THIS SHEET MUST BE MADE ON CIRCLED IN Red Ink WITH DATE AND NAME OF PERSON MAKING CHANGE.

FORM 247 10M 8-31

RETURN TO
LOS ANGELES COUNTY SURVEYOR
700 HALL OF RECORDS

Note: ANY ADDITIONS OR CHANGES ON THIS SHEET MUST BE MADE OR CIRCLED IN **Red Ink.** WITH DATE AND NAME OF PERSON MAKING CHANGE.

Do not extend notes this side of this line

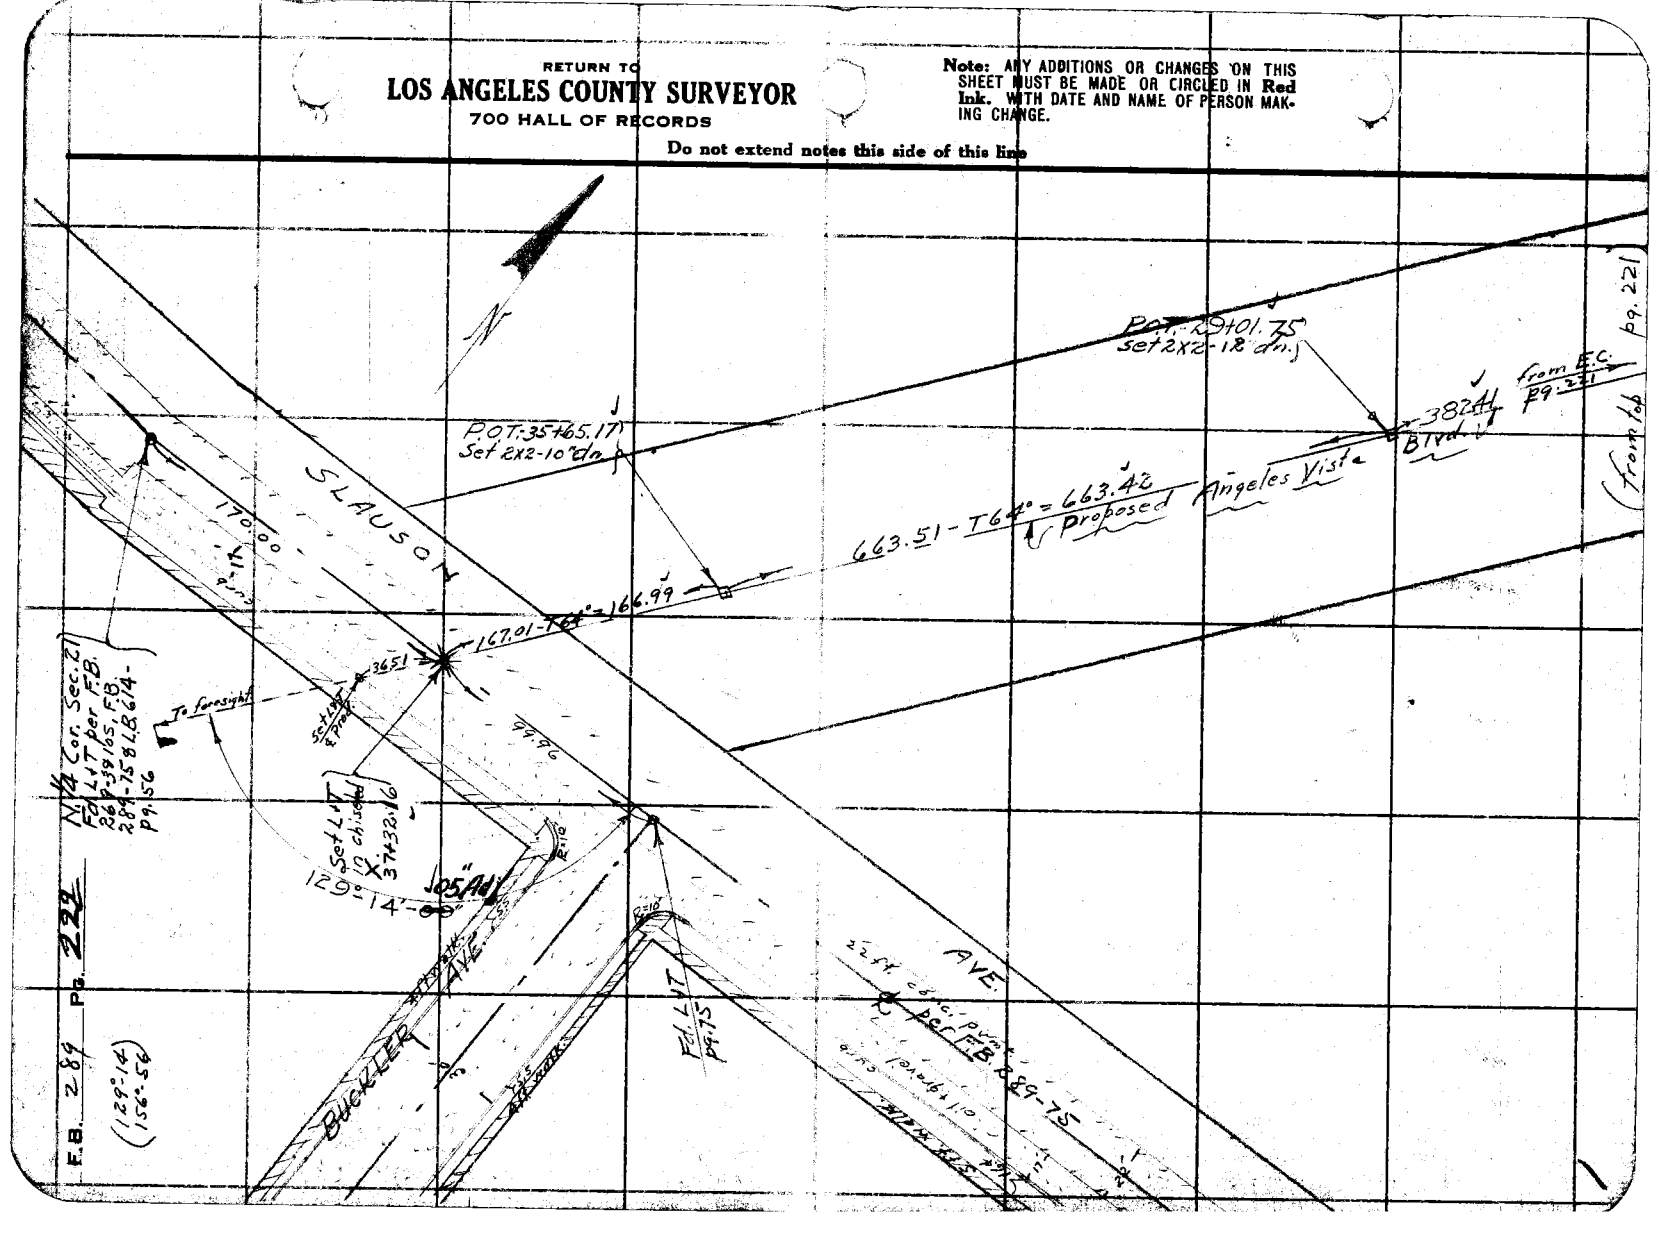

Form 307 5M 11-35

PLEASE RETURN TO
LOS ANGELES COUNTY SURVEYOR
700 HALL OF RECORDS

NOTE: ANY ADDITIONS OR CHANGES ON THIS SHEET MUST BE MADE OR CIRCLED IN RED INK, WITH DATE AND NAME OF PERSON MAKING CHANGE

Do not extend notes this side of this line

STATION	B. S.	H. I.	F. S.	ELEV.		
B.M. A.V. #1	12.06	321 47.		309 41	B.M. AV #1	S+W. in S. Curb - S/Lauson Ave - 13 overhill Dr Elev = 309.41 L.B 697-5
T.P.	5 90	326 02.	1 35	320 12.		
T.P.	0 43	316 57.	9 88	316 14.		
T.P.	0 08	305 07.	11 58	304 99.		
32+50			74	29 77	℄ Angeles Vista Blvd.	
			77	974	25' R - B.C.	
			42	300 9	30⁵ R - T.C.	
			06	04 5	80' R -	
			79	297 2	22' L - B.B.	
			65	98 6	25' L - T.B.	
			66	98 5	27' L - T.F.	
			164	88 7	44' L - B.F.	
			225	82 6	80' L	
33+00			139	91 2	80' L	
			108	943	54 L - B.T.	
			40	3011	41 L - T.F.	
			28	023	27 L - T.B.	
			40	011	23' L B.E.	
			35	3016	℄	
			41	010	25' R - B.C.	
T.P.	10 82	315 48	0 41	304 66		

Monument Pot Solidly Between Both Lines of Sts.

Sections on Angeles Vista Blvd. at S/Lauson Ave

Profile
No.
Notes Red L. K. F. Plotted L. K. F. Job No. 7167 Division No. V
Date NOV 6 1936 Date NOV 9 1936 Survey of Angeles Vista Blvd
X-Sec.
No.
Notes CHARLES E. TILLING Checked Survey by Meserve Notes Meserve Date 10-27-36
Date NOV 6 1936 Map No. Index C. Johnson Date 10-9-36

F. B. 289 Pg. 223

Form 307 5M 11-35

PLEASE RETURN TO
LOS ANGELES COUNTY SURVEYOR
700 HALL OF RECORDS

NOTE: ANY ADDITIONS OR CHANGES ON THIS SHEET MUST BE MADE OR CIRCLED IN RED INK, WITH DATE AND NAME OF PERSON MAKING CHANGE

Do not extend notes this side of this line

F. B. 289 PG. 224 | Job No. 2162 Division No. V | Notes Rod L. K. F. Plotted [illegible] | Profile
Survey of Angeles Mesa Blvd. Date NOV 6 1936 Date NOV 6 1936 | X-Sec.
Survey by A. C. Johnson Notes Clear Notes CALBERT E. TIMMONS Checked | No.
Indexed Date Date NOV 6 1936 Date

STATION	B. S.	H. I.	F. S.	ELEV.		
33+00		315 48	56	309 9	31' R - T.C.	
			50	10 5	80' R	
33+50			03	15 2	80' R	
			45	11 0	32 R - T.C	
			104	05 1	25' R - BC	
			100	305 5	℄	
			105	05 0	24 L - End Fill	- Begin Cut
			160	299 5	80' L	
34+00			80	3075	80' L	
			46	3104	28 L - TC	
			70	305 5	24 L - BC	
			60	306 5	℄	
			68	3087	25' R - BC	
T P	11 20	326 52	016	315 32		
34+00			114	15 1	32' R - T.C.	
			74	19 1	80' R	
34+50			34	23 1	80' R	
			69	19 6	33' R - TC.	
			140	12 5	25 5 R - BC.	
			134	3131	℄	
			141	12 4	24' L - BC	

Form 307 5M 11-35

PLEASE RETURN TO
LOS ANGELES COUNTY SURVEYOR
700 HALL OF RECORDS

NOTE: ANY ADDITIONS OR CHANGES ON THIS SHEET MUST BE MADE OR CIRCLED IN RED INK, WITH DATE AND NAME OF PERSON MAKING CHANGE

Do not extend notes this side of this line

STATION	B. S.	H. I.	F. S.	ELEV.		
34+50		326 52'	103	316 2	29' L - T.C.	
			133	13 2	80' L	
35+00			92	173	80' L	
			66	199	28' L - T.C.	
			104	161	24' L - B.C.	
			98	3167	℄	
			103	162	26.5' R - B.C.	
			29	236	33' R - T.C.	
			110	264	80' R	
35+50			78	187	26' R - B.C.	
			73	3192	℄	
			78	187	24.5' L - B.C.	
			39	226	29 L - T.C.	
			68	197	80' L	
36+00			53	212	77.5' L - T.C. (Clauson)	
			28	237	28' L - T.C.	
			66	199	24' L - B.C.	
			59	3206	℄	
			65	200	25' R - B.C.	
T.P.	11 10	331 71'	591	32061		
35+50			56	25'+	28' R - T.C.	

Profile
No.
X-Sec.
No.

Notes Plotted L. K. FREEMAN Job No. 712 Division No. V
Notes CLIFFORD E. TINNEY Checked Survey by Reeve Notes Moore Date 10-7-36
Date NOV 6 1936 Map No. Indexed A. C. Johnson

F. B. 289 PG. 225

Form 307 5M 11-35

PLEASE RETURN TO
LOS ANGELES COUNTY SURVEYOR
700 HALL OF RECORDS

NOTE: ANY ADDITIONS OR CHANGES ON THIS SHEET MUST BE MADE OR CIRCLED IN RED INK, WITH DATE AND NAME OF PERSON MAKING CHANGE

Do not extend notes this side of this line

F. B. 2289 Pg. 226 | Job No. 2162 Division No. K | Notes Red. L. K. E. Plotted K. Profile No. | Survey of Angeles Vista Blvd Date NOV 6 1936 Date NOV 9 1936 | Survey by A. C. Johnson Notes Notes Checked ROBERT E. TIMM Checked X-Sec. No. | Indexed Date Date NOV 6 1936 Date

STATION	B. S.	H. I.	F. S.	ELEV.		
35+50		331 71.	35	328 2	80'R	
36+00			23	2?4	80'R	
			50	267	32'R - T.C.	
36+24			107	3210	℄	
			115	202	30'L - B.C.	
			85	232	40'L - T.C.	
			88	229	45'L - T.C.	
			127	190	54'L B.C.	
			140	177	80'L	
			110	207	25°R - B.C.	
			47	270	31 R T.C.	
			26	291	80'R	
36+33			138	179	80'L	
			110	207	40 L - B.C.	
			106	321 1	℄	
			110	207	25 R - B.C.	
			46	271	31 R - T.C.	
			25	212	80'R	
36+84			103	3214	℄	
			106	211	24'R - B.C.	
			51	266	31 R - T.C.	

Form 307 5M 11-35

PLEASE RETURN TO
LOS ANGELES COUNTY SURVEYOR
700 HALL OF RECORDS

NOTE: ANY ADDITIONS OR CHANGES ON THIS SHEET MUST BE MADE OR CIRCLED IN RED INK, WITH DATE AND NAME OF PERSON MAKING CHANGE

Do not extend notes this side of this line

STATION	B. S.	H. I.	F. S.	ELEV.		
36+84		331 71	31	3286	- 80' R	
			111	206	- 45' L - N. edge	conc. Pvt.
			122	195	- 80' L - S. "	" "
37+00			102	3215	- ℄	
			106	211	- 28 R - E. Pvt	Macadam
			100	217	- 37.5 R - B.C	
			55	262	- 47 R - T.C.	
			39	278	- 80' R	
			105	212	- 22.5 L - N. edge	conc Pvt
			111	206	- 57' L S "	" "
			127	190	- 80' L - gutter	
37+18			102	3215	- ℄ - N edge	Conc. Pvt.
37+32.16			1014	321 57	- ℄ - inter ℄ Slauson	
T P.	482	324 76	1177	31994		
	East		on	Slauson Ave		
37+32.16 0+00 going E			319	321 57	- ℄ Slauson - inter ℄ Tujunga	
0+50			366	32110	- ℄	
			379	2097	- 11 R - S. edge conc Pvt	
			447	2029	- 28 R - B. Curb	
			374	2102	- 25.5 R - T. "	
			383	2093	- 44.5 N edge walk	

Profile No. _____ X-Sec. No. _____

Notes Red. L. K. F. Plotted L. K. FREEMAN Job No. 716.7 Division No. 1
Notes CHKD. HERBERT E. TILLOTSON Checked _____ Survey by _____ Date 10-7-36
Date NOV 6 1936 Date _____ Map No. _____ Indexed A. C. Johnson

F. B. 289 Pg. 227

Form 307 5M 11-35

PLEASE RETURN TO
LOS ANGELES COUNTY SURVEYOR
700 HALL OF RECORDS

NOTE: ANY ADDITIONS OR CHANGES ON THIS SHEET MUST BE MADE OR CIRCLED IN RED INK, WITH DATE AND NAME OF PERSON MAKING CHANGE

Do not extend notes this side of this line

F. B. 289 Pg. 228 | Job No. 2162 Division No. V | Notes Red L. K. F. Plotted 9 NOV 1936 | Profile No. | X-Sec. No.
Survey of Angeles Vista Blvd Date 9 NOV 1936 | Notes Moore | Notes CHARLES E. TINNEY Checked Date 9 NOV 1936 | Date
Survey by A. C. Johnson | Indexed Date NOV 6 1936

STATION	B. S.	H. I.	F. S.	ELEV.		
6+50		324 76	370	321 06	49.5 R	S. Edge walk
			30	321 8	57 R	
			33	321 5	80' R	
			376	321 00	11' L	N edge Conc Pvt
			37	21 1	80' L	Macadam
0+74.5			38	21 0	80' L	"
			446	20 30	11' L	N. edge Conc Pvt
			439	320 37	℄	
			447	20 29	11' R	S. " " "
			530	19 46	28 R	B. curb
			459	20 17	28.5 R	T " & W edgewalk
			458	2[illegible] 18	44.5 R	N " edge walk
			450	20 26	49.5 R	S edge walk
			581	18 95	80 R	W edge walk
0+55			635	19 41	66' R	T. 0.7 curb
			530	19 46	49.5 R	T 0.7 " & S edgewalk
			514	1962	38' R	T. curb E.C.R.
			594	1882	38' R	B. " "
			573	1903	28' R	Gutter Macadam
			483	1993	11' R	S. edge Conc Pvt
			476	320 00	℄	

Form 307 5M 11-35

PLEASE RETURN TO
LOS ANGELES COUNTY SURVEYOR
700 HALL OF RECORDS

NOTE: ANY ADDITIONS OR CHANGES ON THIS SHEET MUST BE MADE OR CIRCLED IN RED INK, WITH DATE AND NAME OF PERSON MAKING CHANGE

Do not extend notes this side of this line

Profile No. ____ X-Sec. No. ____

Notes Red. L. K. F. Plotted L. K. FREEMAN Job No. 2162 Division No. L
Date NOV 6 1936 Date NOV 9 1936 Survey of Angeles Mesa Subd
Notes CHAS. E. TIMMONS Checked ____ Survey by ____ Notes ____ Date 10-7-36
Date NOV 6 1936 Date ____ Map No. ____ Indexed C. C. Johnson

F. B. 289 Pg. 229

STATION	B. S.	H. I.	F. S.	ELEV.		
0+85		324 76	4 86	319 90	11' L — N. edge conc Pvt	
			4 0	20 8	80' L — Macadam	
1+00			0 9	23 9	86' L — T.C.	
			1 8	23 0	55' L T.C	
			5 2	19 6	50' L — B.C	
			5 34	19 42	21 L — N. edge	Macadam
			5 50	19 26	11' L N. "	Conc Pvt
			5 44	319 32	℄	
			5 45	19 31	11' R S. "	" "
			6 36	18 40	28' R — gutter	Macadam
			6 15	18 61	50' R — ℄ Buckler	" Pvt
			6 65	18 11	80' R " "	" "
1+15			7 19	17 57	80' R T 0.4	Curb
			7 01	17 75	49' R — T. 0.5	" + S. edge walk
			7 19	17 57	38' R — T 0.2	" E.C.R.
			7 40	17 36	38' R B.	" "
			7 20	17 56	25' R — gutter	Macadam
			6 26	18 50	11' R — S. edge conc Pvt	
			6 23	318 53	℄	
			6 30	18 46	11' L — N. "	" "
			6 26	18 50	20' L — N. "	Macadam

Form 307 5M 11-35

PLEASE RETURN TO
LOS ANGELES COUNTY SURVEYOR
700 HALL OF RECORDS

NOTE: ANY ADDITIONS OR CHANGES ON THIS SHEET MUST BE MADE OR CIRCLED IN RED INK, WITH DATE AND NAME OF PERSON MAKING CHANGE

Do not extend notes this side of this line

Survey of L. K. F. Plotted L. K. F. Date NOV 9 1936 No. Profile
Survey by A. C. Johnson Notes Checked E. TIMMONS Date NOV 6 1936 No. X-Sec.
Indexed A. C. Johnson Date NOV 6 1936 Date
Notes Rod L. K. F. Date NOV 6 1936
Division No 1 Job No 2162
T. B289 Pg. 230

STATION	B. S.	H. I.	F. S.	ELEV.		
1+15		324 76	57	3191	49' L — B.C	Note- Macadam Pvt. between S. edge Conc. Pvt + B. curb
			22	2216	55' L T.C	
			16	2332	80' L	
1+245			19	2297	80' L	
			26	2272	55' L — T.C.	
			64	1384	49' L — B.C.	
			697	1779	17 L — N. edge	Macadam,
			686	1790	11' L " "	Conc. Pvt
			678	31798	[illegible]	
			684	1792	11' R — S "	" "
			757	1719	28' R — B. curb	
			695	1781	28½ R — T. "	+ N edge walk
			674	1802	44½ R — N + E. edge walk	
			666	1810	49½ R — S. + " "	
			762	1774	80' R E	" "
1+50			70	1776	80' R	
			76	1772	53' R T.C.	
			830	1646	49½ R — S. edge walk + B.C.	
			842	1634	44½ R N. " "	
			860	1616	28½ R — T curb.	
			907	1569	28 R B "	

Form 307 5M 11-35

PLEASE RETURN TO
LOS ANGELES COUNTY SURVEYOR
700 HALL OF RECORDS

NOTE: ANY ADDITIONS OR CHANGES ON THIS SHEET MUST BE MADE OR CIRCLED IN RED INK, WITH DATE AND NAME OF PERSON MAKING CHANGE

Do not extend notes this side of this line

STATION	B. S.	H. I.	F. S.	ELEV.		
1+50		324 76	8 53	316 23	11'R - S. edge	Conc Pvt.
			8 48	316 28	℄	
			8 59	16 17	11'L - N "	" "
			8 52	16 24	17'L - " "	Macadam
			77	17 1	48'L - B.C.	
			39	20 9	55'L - T.C.	
			35	21 3	80'L	
2+00			6 8	180	80'L	
			65	183	55'L - T.C.	
			11 9	129	28 L - B.C.	
			1201	1275	17'L - N. edge	Macadam
			1208	1268	11'L - N "	Conc Pvt.
			1200	312 76	℄	
			1208	1268	11'R - S "	" "
			1252	1224	28'R - B. Curb	
			1202	1274	28'R T. "	
			1183	1293	44'R N. edge	Walk
			1174	1302	49'R S "	" + B.C.
			91	157	54 R - T C	
			99	149	80' R	
T.P.		314 49.	1182	312 94.		

Profile No. _____ X-Sec. No. _____

Notes Red. L. K. F. Plotted L. K. FREEMAN Job No. 2167 Division No. V F.B. 289 Pg. 229

Date NOV 1936 Date NOV 1936 Survey of Angeles Mesa

Notes CHAS. HERBERT E. TINKHAM Checked _____ Survey by _____ Notes Date 10-7-36

Date NOV 6 1936 Date _____ Map No. _____ Indexed by C. Johnson

Form 307 5M 11-35

PLEASE RETURN TO
LOS ANGELES COUNTY SURVEYOR
700 HALL OF RECORDS

NOTE: ANY ADDITIONS OR CHANGES ON THIS SHEET MUST BE MADE OR CIRCLED IN RED INK, WITH DATE AND NAME OF PERSON MAKING CHANGE

Do not extend notes this side of this line

F. B. 289 PG. 230 | Job No. 2162 Division No. V | Notes Red L. K. F. Plotted K. FREEMAN Profile
Survey of Alpine Angeles Crest Highway | Date NOV 6 1936 Date NOV 9 1936 No.
Survey by A. C. Johnson | Notes | Notes Chkd ALBERT E. TIMMONS Checked X-Sec.
Indexed | Date | Date NOV 6 1936 Date | No.

STATION	B. S.	H. I.	F. S.	ELEV.		
2+50		314 49.	16	312 9	-80' R	
			16	12 9	-54 R - T.C.	
			477	0972	-49.5 R - S. edge	Walk + B.C.
			487	0962	-44.5 R - N. "	"
			534	0915	-25.5 R - T. curb	
			584	0865	-28' R - B. "	
			533	0916	-11' R - S. edge	Conc. P.J.
			520	309 29	-Z	
			529	0920	-11' L - N. "	" "
			526	0923	-17' L - " "	Macadam
			51	094	-50' L - B.C.	
			00	145	-56 L - TC	
			03	142	-50' L	
3+00			35	110	-50' L	
			30	115	-55' L - T.C.	
			85	060	-50 L - B.C.	
			859	0590	-11' L - N. edge	Macadam
			880	0569	-11' L - "	Conc. H.J.
			872	305 77	-Z	
			871	0578	-11' R - S. "	" "
			918	0531	-28' R - B. Curb	

Form 307 5M 11-35

PLEASE RETURN TO
LOS ANGELES COUNTY SURVEYOR
700 HALL OF RECORDS

NOTE: ANY ADDITIONS OR CHANGES ON THIS SHEET MUST BE MADE OR CIRCLED IN RED INK, WITH DATE AND NAME OF PERSON MAKING CHANGE

Do not extend notes this side of this line

STATION	B. S.	H. I.	F. S.	ELEV.		
3+00		314 49	861	30588	28 R — T. Curb	
			825	06 24	44 R — N edge	Walk
			810	06 35	49 R — S "	" & B.C
			41	10 4	54 R — T.C	
			45	10 0	80' R	
3+50			85	06 0	80' R	
			78	06 7	54 R T.C.	
			1186	0263	49 R S. edge walk & B.C.	
			1188	0261	44 R — N "	"
			1289	0230	28 R — T. Curb	
			1269	0180	28 R — B. "	
			1226	0223	11' R — S. edge conc. Pvt.	
			1221	30228		
			1228	0221	11' L N "	" "
			1229	0220	17' L N "	Macadam
			118	027	49 L — B.C	
			62	083	57 L — T.C	
			72	073	80 L	
T.P. 4+00	205	304 23	1161	30288		
			06	043	80' L	
			04	045	56' L — T.C.	

Profile No. _____ X-Sec. No. _____

Notes Red. L. K. F. Plotted L. K. FREEMAN Job No. 716? Division No. V
Date NOV 6 1936 Date NOV 9 1936 Survey of Pasa. Vista Blvd.
Notes Chkd. ALBERT E. TIMME Checked _____ Survey by A. Moore Notes A. Moore Date 10-7-36
Date NOV 6 1936 _____ Map No. _____ Indexed A. C. Johnson

F. B. 289 Pg. 231

Form 307 5M 11-35

PLEASE RETURN TO
LOS ANGELES COUNTY SURVEYOR
700 HALL OF RECORDS

NOTE: ANY ADDITIONS OR CHANGES ON THIS SHEET MUST BE MADE OR CIRCLED IN RED INK, WITH DATE AND NAME OF PERSON MAKING CHANGE

Do not extend notes this side of this line

F.B. 289 PG. 232 | Job No. 7167 | Division No. V | Notes Bid | L. K. F. | Platted L. K. FREEMAN | Profile
Survey of Alameda Los Angeles Blvd | Date NOV 9 1936 | No.
Survey by A. C. Johnson | Notes | Notes Calculated E. TIMMONS | Checked | X-Sec.
Indexed | Date | Date NOV 6 1936 Date | No.

STATION	B. S.	H. I.	F. S.	ELEV.		
4+00		304 93	60	293 9	50' L - B.C.	
			621	98 72	16' L - N. edge	Macadam
			627	98 66	11' L - " "	Conc. P.T.
			618	298 75	℄	
			625	98 68	11' R - S "	" "
			676	98 17	28' R - B. curb	
			625	98 68	28 5 R - T "	
			523	99 20	44 5 R - N. edge	Walk
			559	99 34	49 5 R - S. "	" & B.C.
			28	302 1	53 R - T.C.	
			21	02 8	80' R	
4+50			58	299 1	50' R	
			55	99 14	54 R - T.C.	
			924	96 69	49 5 R - S. edge	Walk & B.C.
			932	95 61	44 5 R - N. "	"
			970	95 23	28 5 R - T Curb	
			1028	94 65	28 R - B. "	
			975	95 18	11' R - S. edge	Conc. P.T.
			969	295 24	℄	
			979	95 14	11' L - N. "	" "
			971	95 22	16' L - " "	Macadam

Form 307 5M 11-35

PLEASE RETURN TO
LOS ANGELES COUNTY SURVEYOR
700 HALL OF RECORDS

NOTE: ANY ADDITIONS OR CHANGES ON THIS SHEET MUST BE MADE OR CIRCLED IN RED INK, WITH DATE AND NAME OF PERSON MAKING CHANGE

Do not extend notes this side of this line

STATION	B. S.	H. I.	F. S.	ELEV.		
4+50		304 93	95	2954	49 L	B.C.
			42	3007	55 L	T.C
			40	009	80' L	
5+00			81	2968	80' L	
			85	2964	55' L	T.C.
			141	908	49 L	B.C
			1330	9163	16' L	N. edge M/acadam.
			1335	9158	11' L	" " Conc. Pvt
			1321	29172	℄	
			1326	9167	11' R	S. " " "
			1404	9089	28 R	B. Curb
			1340	9153	28' R	T. "
			1309	9184	44' R	N. edge Walk
			1303	9190	49' R	S. " " & B.C
			102	947	53' R	T.C.
			106	943	50' R	
T.P.	1146	315 92.	047	304 46.		
T.P.	875	324 48.	019	315 73.		
T.P.	976	331 00	324	321 24.		

Profile

No. _____ Noted L. K. F. Plotted L. K. FREEMAN Job No. 2167 Division No. 1

X-Sec. Date NOV 6 1936 Checked NOV 6 1936 Survey of Alleys

Notes CHARLES E. THURSTON Survey by Alleys Notes Alleys Date 12-7-36

No. _____ Date NOV 6 1936 Map No. _____ Indexed C. Johnson

F.B. 289 Pg. 233

Form 307 5M 11-35

PLEASE RETURN TO
LOS ANGELES COUNTY SURVEYOR
700 HALL OF RECORDS

NOTE: ANY ADDITIONS OR CHANGES ON THIS SHEET MUST BE MADE OR CIRCLED IN RED INK, WITH DATE AND NAME OF PERSON MAKING CHANGE

Do not extend notes this side of this line

F.B. 289 PG. 234 | Job No. 7162 Division No. V Notes Rod I. K. F. Plotted L. K. FREEMAN Profile
Survey of Alameda Blvd. Date NOV 9 1936 No. X-Sec.
Survey by A. C. Johnson Notes Alders Date NOV 6 1936 Checked ROBERT E. TIMMONS Notes CAR Date NOV 6 1936 No.

STATION	B. S.	H. I.	F. S.	ELEV.	
		West on	S/a		Ave.
37+32.16		331 00	943	321 57	℄ inter.
0400			943	21 57	11' L – S. edge Conc. Pvt
			1017	20 83	28' L – E. Curb
			952	21 48	28.5 L – T "
			935	21 65	44.5 L – N. edge walk
			924	21 76	49.5 L – S. " "
			88	22 2	55' L
			92	21 8	80' L
			945	21 55	11' R – N. edge Conc. Pvt
			983	21 7	43' R – " " Macadam
			96	21 4	50' R – B.C.
			38	27 2	57 R – T.C.
			32	27 8	50' R
0150			31	27 9	50' R
			39	27 1	56' R – T.C.
			95	21 5	50' R – B.C.
			995	21 05	30' R – N. edge Macadam
			973	21 27	11' R – " " Conc Pave
			965	321 35	℄
			969	21 31	11' L – S. " " "

Form 307 5M 11-35

PLEASE RETURN TO
LOS ANGELES COUNTY SURVEYOR
700 HALL OF RECORDS

NOTE: ANY ADDITIONS OR CHANGES ON THIS SHEET MUST BE MADE OR CIRCLED IN RED INK, WITH DATE AND NAME OF PERSON MAKING CHANGE

Do not extend notes this side of this line

STATION	B. S.	H. I.	F. S.	ELEV.		
0+50		331 00	1028	320 72	28'L — B. Curb.	
			980	21 20	28°L — T. "	
			946	21 54	44°L — N edge walk	
			939	21 61	49°L — S " "	
			83	22 7	57 L	
			95	21 5	80'L	
1+00			109	20 1	80'L	
			92	21 8	55'L	
			960	21 40	49°L — S. edge Walk	
			968	21 32	44°L — N. " "	
			1000	2100	28°L — T. curb	
			1052	20 48	28'L B. "	
			1000	2100	11'L — S. edge Conc Pvt.	
			999	32101	℄	
			1003	2097	11'R — N " " "	
			1004	2096	27'R — " " Macadam	
			94	216	49'R — B.C.	
			45	265	55°R — T.C	
			34	276	80'R —	
1+70	4 pt	Defl. 1°-32'-R	40	270	80'R	Section at 90 to back tang
			54	256	57 R — T.C.	

Note — Macadam between S. edge conc. Pvt and S. curb

Profile No.
X-Sec. No.
Notes red. L. K. F. Plotted L. K. FREEMAN Map No. 7162 Division No. V
Date NOV 6 1938 Date NOV 9 1938 Survey of
Notes checked HERBERT E. TIMMERMAN Survey by
Date NOV 6 1938 Date Map No.
Notes Date
Indexed A. C. Johnson

F. B. 289 Pg. 235

Form 307 5M 11-35

PLEASE RETURN TO
LOS ANGELES COUNTY SURVEYOR
700 HALL OF RECORDS

NOTE: ANY ADDITIONS OR CHANGES ON THIS SHEET MUST BE MADE OR CIRCLED IN RED INK, WITH DATE AND NAME OF PERSON MAKING CHANGE

Do not extend notes this side of this line

F. B. 289 PG. 236 | Job No. 7162 Division No. V | Notes Red. L. K. F. Plotted L. K. FREEMAN No. | Profile
Survey of [illegible] | Date NOV 6 1936 Date NOV 6 1936 | X-Sec.
Survey by C. JOHNSON Notes [illegible] Notes CHAS. E. TIBBOTS Checked No.
Indexed Date Date NOV 6 1936 Date

STATION	B. S.	H. I.	F. S.	ELEV.		
1+10		331 00.	105	320 5	50 R - B.C.	
			1094	20 06	26.5 R. - N edge	Macadam
			1061	20 39	20' R - N "	Conc Pvt to West
			1048	20 52	11' R - " "	" " " East.
			1044	320 56	℄	
			1045	20 55	11' L S "	" " " "
			1068	20 32	20' L S. "	" " " West
			1134	1966	28. L - B. curb	
			1058	20 42	28.5 L - T "	
			1028	20 72	39.5 N edge	walk to West
			1018	20 82	44.5 L - N. "	" " East
			1004	20 96	49.5 L - S "	"
			117	193	80' L	
2+00			109	201	80' L	
			1026	20 74	49.5 L - S. "	"
			1048	20 52	39.5 L N. "	"
			1064	20 36	25.5 L - T. curb	
			1131	1969	28 L - B. "	
			1058	20 12	20' L - S. edge	Conc. Pvt
			1062	320 38	℄	
			1083	20 17	20' R - N "	" "

Form 307 5M 11-35

PLEASE RETURN TO
LOS ANGELES COUNTY SURVEYOR
700 HALL OF RECORDS

NOTE: ANY ADDITIONS OR CHANGES ON THIS SHEET MUST BE MADE OR CIRCLED IN RED INK, WITH DATE AND NAME OF PERSON MAKING CHANGE

Do not extend notes this side of this line

STATION	B. S.	H. I.	F. S.	ELEV.		
2+00		331 00	1117	319 83	26.5 R - N edge	Macadam
			107	203	49' R - B.C.	
			54	256	56 R - T.C.	
			42	268	80' R	
2+50			42	268	80' R	
			54	256	57 R - T.C.	
			107	203	50 R - B.C.	
			1152	1948	26.5 R - N. edge	Macadam
			1105	1995	20' R - " "	Conc. Pat
			1087	2013	℄	
			1112	1988	20' L - S. "	" "
			1171	1929	28' L - B. Curb	
			1100	2000	28.5 L - T "	
			1075	2025	39.5 L - N. edge	walk
			1060	2040	49.5 L - S. "	"
			1100	2000	80' L	
T.P.	979	329 40	1139	319 61		
3+00			96	198	80' L	
			927	2013	49.5 L - S	" "
			951	1989	39.5 L - N	" "
			970	1970	28.5 L - T	Curb
			10.34	1906	28' L - B	"

Profile No. _____ X-Sec. No. _____ Notes Red'd NOV 6 1936 Date _____ Checked _____ Date _____

Notes Plotted L. K. FREEMAN Date NOV 6 1936 Checked ROBERT E. TINNEY Date NOV 6 1936

Bob No. 2162 Division No. L Survey of _____ Survey by _____ Map No. _____ Indexed A. C. Johnson Notes _____ Date 10-7-36

F.B. 289 Pg. 237

Form 307 5M 11-35

PLEASE RETURN TO
LOS ANGELES COUNTY SURVEYOR
700 HALL OF RECORDS

NOTE: ANY ADDITIONS OR CHANGES ON THIS SHEET MUST BE MADE OR CIRCLED IN RED INK, WITH DATE AND NAME OF PERSON MAKING CHANGE

Do not extend notes this side of this line

F. B. 289 PG. 238 | Job No. 2162 | Division No. | Notes Red. L. K. F. | Date NOV 9 1936 | Notes Ck. ROBERT E. TIMMONS | Date NOV 6 1936 | Profile No. | X-Sec. No.

Survey of: Alhambra Vista Blvd

Survey by: Pierce Moore | Notes | Date

Indexed A. C. Johnson | Date

STATION	B. S.	H. I.	F. S.	ELEV.		
3+00		329 40	979	31961	20' L - S. edge	Conc Pt.
			954	31986	℄	
			973	1967	20' R - N. "	" "
			1018	1922	29' R - " "	Macadam
			93	201	50' R - B.C.	
			35	259	56 R - T.C.	
			25	269	50' R	
3+37.5			30	264	50' R	
			39	255	56 R - T.C.	
			98	196	50' R - B.C.	
			1041	1899	28' R - N. edge	Macadam
			1003	1937	20' R " "	Conc Pt.
			983	31957	℄	
			1010	1930	20' L - S " " "	Begin curve to left
			1050	1890	28 L - B. Curb.	"
			985	1955	28.5 L - T "	"
			973	1967	39.5 L - N. edge walk	"
			953	1987	49.5 L - S. "	" "
			102	192	80' L	
4+00			112	182	80' L	
			1082	1858	62' L - S. "	"
			1097	1843.52	L - N. "	"

Form 307 5M 11-35

PLEASE RETURN TO
LOS ANGELES COUNTY SURVEYOR
700 HALL OF RECORDS

NOTE: ANY ADDITIONS OR CHANGES ON THIS SHEET MUST BE MADE OR CIRCLED IN RED INK, WITH DATE AND NAME OF PERSON MAKING CHANGE

Do not extend notes this side of this line

STATION	B. S.	H. I.	F. S.	ELEV.		
4+00		32940	1109	31831	42.5 L - T Curb	
			1174	1766	42 L - 13 "	
			1096	1844	32 L - S. edge	Conc. Pvt
			1077	31863	℄	
			1090	1850	20' R - N. "	" "
			1129	1811	28 R N. "	Macadam
			107	187	47 R - B.C.	
			53	241	55 R - T.C.	
			39	255	80' R	
4+50			55	239	80' R	
			68	226	55' R - T.C.	
			118	176	46 R - B.C.	
			1243	1697	28 R - N. edge	Macadam
			1209	1731	20' R N "	Conc Pvt
			1184	31756	℄	
			1248	1692	49.8 L - S. "	" "
			1309	1631	61.5 L - B. Curb	
			1244	1696	62' L - T "	
5+00			1420	1520	93.5 L - T "	
			1485	1455	93.5 L B "	
			1410	1530	79.2 L - S. edge	Conc Pvt.

Profile
No.
X-Sec.
No.
Notes Red L. K. F. Plotted L. K. FREEMAN Job No. 7163 Division No. 4
Date NOV 6 1938 NOV 8 1938 Survey of
Noted Clerk E. TIMMONS Checked Survey by
Date NOV 6 1938 Map No. Indexed A. C. JOHNSON
Notes Date 10-7-38
F.B. 289 Pg. 239

Form 307 5M 11-35

PLEASE RETURN TO
LOS ANGELES COUNTY SURVEYOR
700 HALL OF RECORDS

NOTE: ANY ADDITIONS OR CHANGES ON THIS SHEET MUST BE MADE OR CIRCLED IN RED INK, WITH DATE AND NAME OF PERSON MAKING CHANGE

Do not extend notes this side of this line

F. B. 389 Pg. 240 | Job No. 2162 Division No. V | Notes Red L. K. F. Date NOV 6 1936 | Checked L. K. FREEMAN Date NOV 9 1936 | Profile No. | X-Sec. No.
Survey of Angeles Vista Blvd. | Notes Cal. ALBERT E. TIMIOS Date NOV 6 1936 | Checked Date
Survey by Meade | Notes | Date
Indexed A. C. Johnson | Date

STATION	B. S.	H. I.	F. S.	ELEV.		
5+00		329 40	12 84	316 56	℄	
			13 09	16 31	20' R. N. edge Conc. Pvt.	
			12 96	16 44	34' R - [illegible]	Macadam
			12 5	16 9	46' R - B C	
			7 3	22 1	58 R - T C	
			5 9	23 5	80' R	
T.P.	2 29	319 98.	11 71	317 69.		
BM. AV #1			10 56	309 42	BM AV #1 Spk in S. Curb Slauson 135' W ℄ Overhill. Elev 309.4 U.S.G.S. 697-5	

SURVEY
OF
LATIMER BLVD
From
CENTURY AVE
To
ARIZONA AVE
W. of 9th AVE

RETURN TO
LOS ANGELES COUNTY SURVEYOR
700 HALL OF RECORDS

Note: ANY ADDITIONS OR CHANGES ON THIS SHEET MUST BE MADE OR CIRCLED IN Red Ink, WITH DATE AND NAME OF PERSON MAKING CHANGE.

Do not extend notes this side of this line

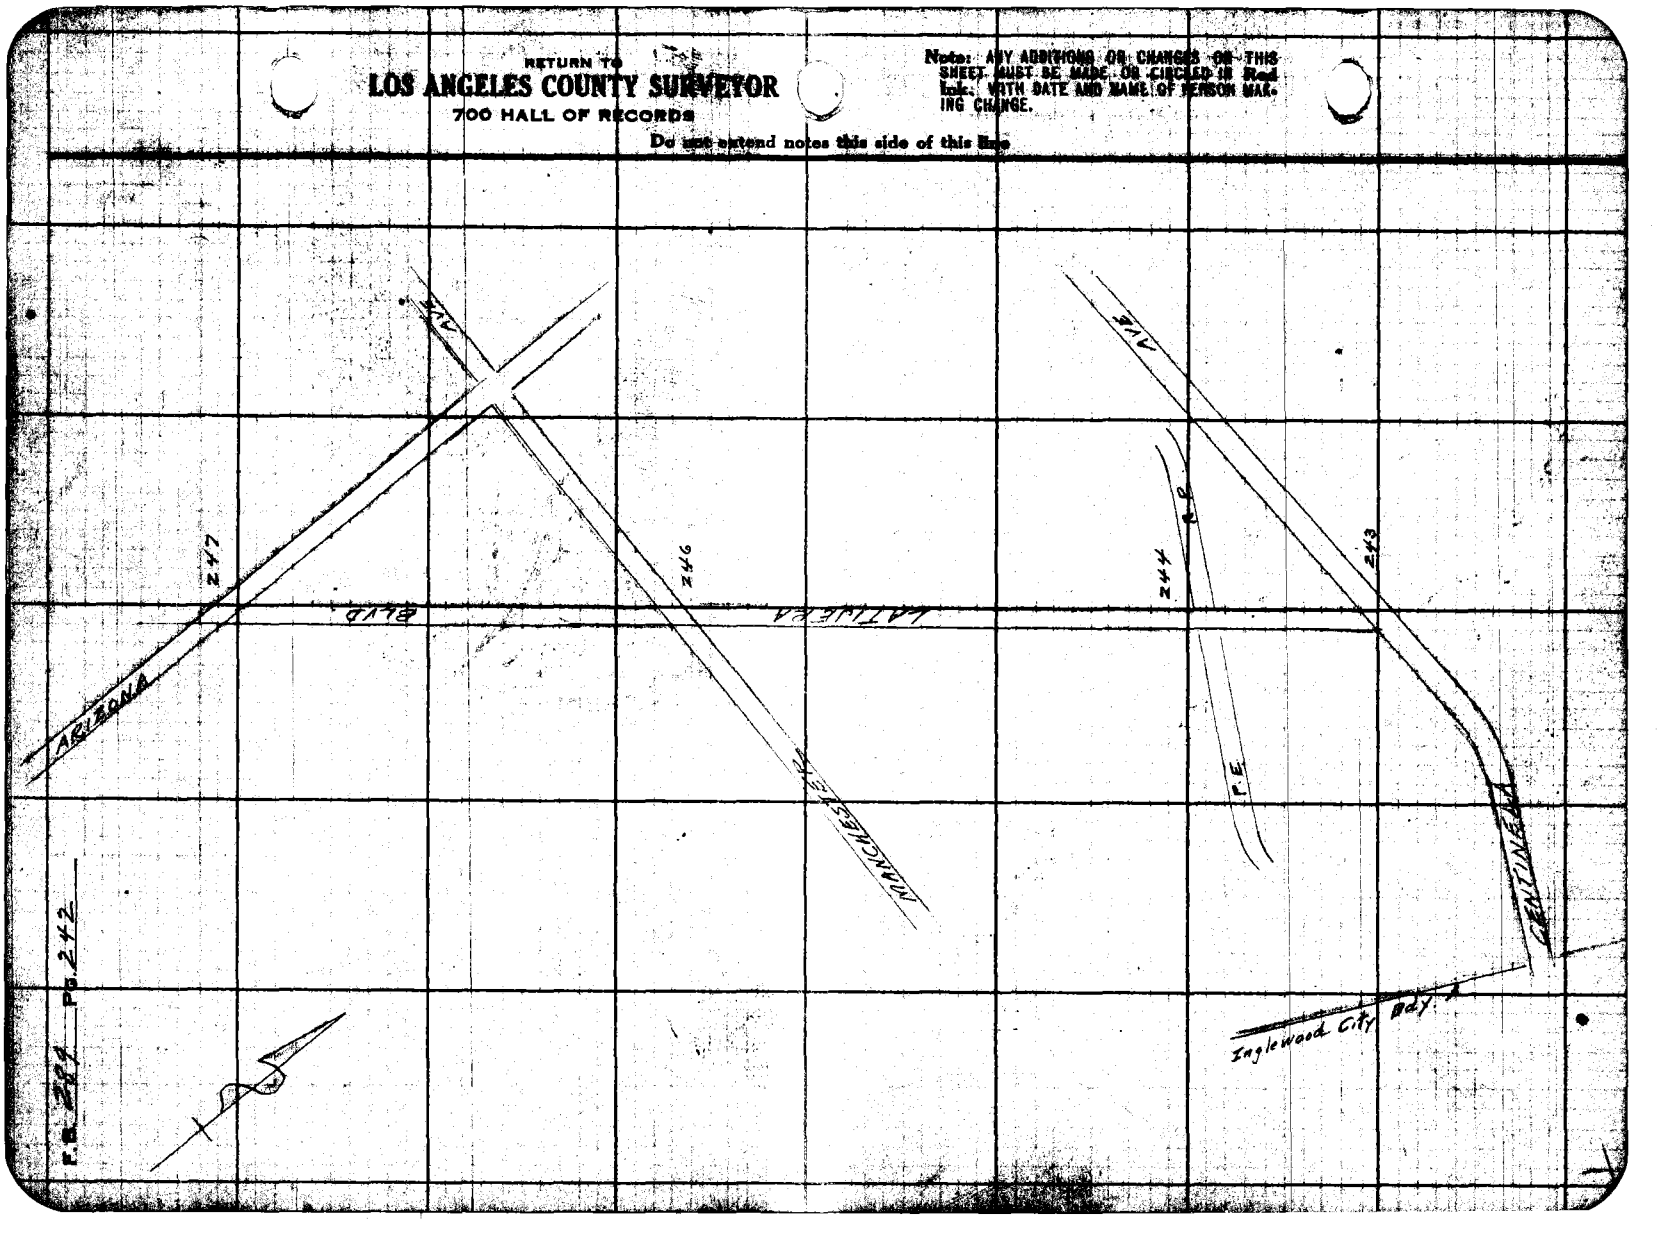

F.B. 284 Pg. 242

Name Ch'd by Blankenship — Survey of Via Tijera Blvd. — F.B. 287
Map No. B-310-6 — W. O. 914 — Tape No. 22 — Sht 84 of
Checked Blankenship — Surveyed by Mercer — 2-17-33
Date March 1933 — Indexed A. C. Johnson

To bottom pg 244

LOS ANGELES COUNTY SURVEYOR
700 HALL OF RECORDS
Do not extend outside this side of this line

MS 4-3

174.18 @ 67° @ 2°-45' = 17556
295.88 @ 66° @ 1°-30' = 19875
277.79 @ 66° @ 1°-15' = 17483
749.85

300.35 @ 66° @ 1°-30' = 30021
208.31 @ 66° @ level = 20824
508.50

295.53 @ 66° @ 2°-37' = 29815
299.23 @ 66° @ level = 29911
134.52 @ 66° @ 4°-12' = 13477
733.65

50+50

84+52.20 P.O.T. Set C&T 15' deep

74+33

(43°-12'-15" 172-48-45 43-12-15)

47+07.87 Set C&T

52+44.44 P.O.T.

(40°-38'-30" P.O. 38+35.58)

115+30.86 P.O.T.

112+30.21 P.O.T. Centinela Rd C&T P.O. 325-311

82.62

82.04

Set N&T P.P.

95.2

130.01

Set N&T Sign Board.

216.11

(136°-12'-15" 184-48-30 136-12-15)

CENTINELA

96.5

P.I. Rd C&T 12" deep P.O. 325-311

Sewer to P.O. 255

RETURN TO
LOS ANGELES COUNTY SURVEYOR
700 HALL OF RECORDS

Notes: ANY ADDITIONS OR CHANGES ON THIS SHEET MUST BE MADE OR CHECKED IN Red Ink. WITH DATE AND NAME OF PERSON MAKING CHANGE.

Do not extend notes this side of this line

W.S. 24-A-3

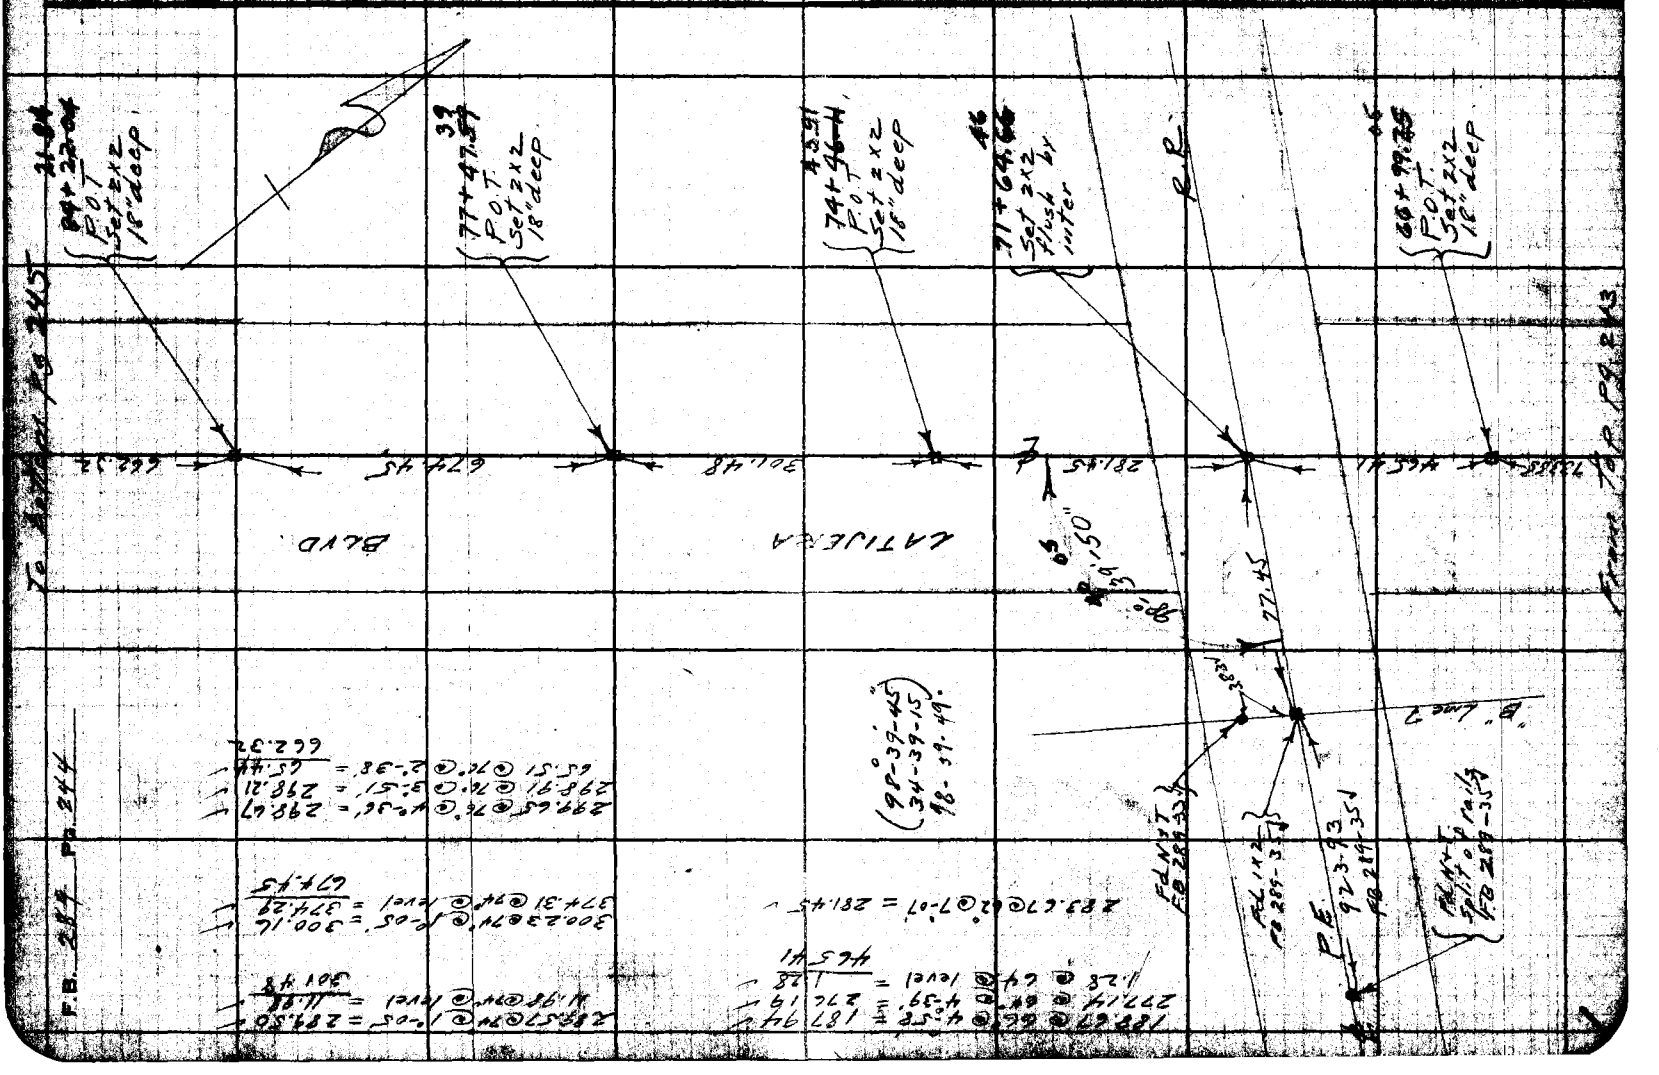

Date: March 1933 | Ck'd by Blackmer | Map No. B-310-6

Survey of La Tijera Blvd | W. O. 914 | Tape No. 22 | Std. 24 °F.

Indexed A. C. Johnson

F.B. 287 Pg. 45

To Bottom Pg 246

37

LA TIJERA

BLVD.






103+89.20 P.O.T. Set 2x2 18" deep

99+91.69 P.O.T. Set 2x2 18" deep

90+84.36 P.O.T. Set 2x2 18" deep

108+08.88 P.O.T. Set 2x2 18" deep

642.32

To page 246

LOS ANGELES COUNTY SURVEYOR
700 HALL OF RECORDS

RETURN TO
LOS ANGELES COUNTY SURVEYOR
700 HALL OF RECORDS

Notice: ANY ADDITIONS OR CHANGES ON THIS SHEET MUST BE MADE OR CIRCLED IN Black Ink. WITH DATE AND NAME OF PERSON MAKING CHANGE.

Do not extend notes this side of this line

W.S. 23-D-4

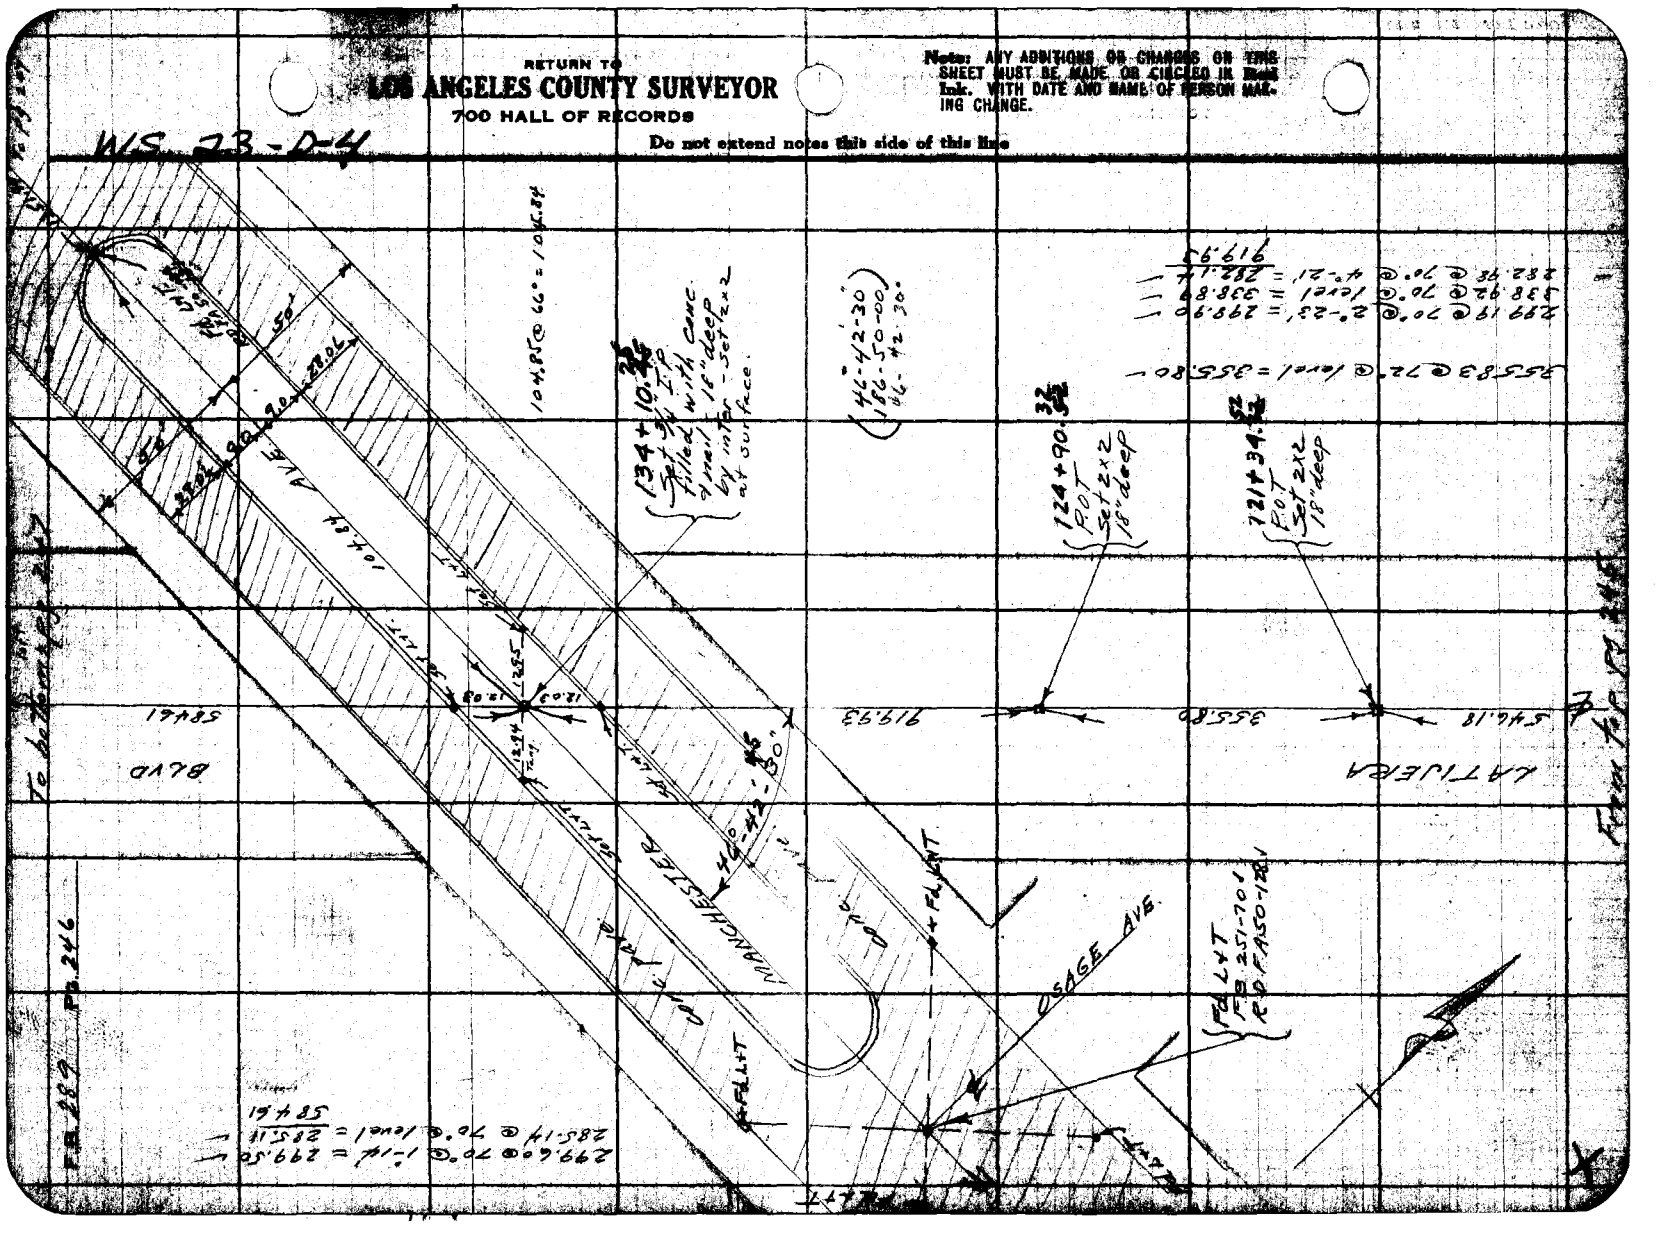

Map Ck'd by Blackmer
Map No. B-310-6
Drawn Blackmer
Date March 1933

Survey of Latijera Blvd
W. O. 714 Type No. 22 Sht'd 8 L of F.
Plotted Blackmer
Indexed C. Johnson

F.B. 289 Pg. 2[illegible]

Fd Set Concrete FP

FB SAN ANTONIO (CENTURY)

Fd LAT. in 8" conc. Mon. 6" deep FB 251-72 FB 614-111

Set Nail & P.P.

Set Nail P.P.

Set Nail P.P.

Set Nail

RETURN TO
LOS ANGELES COUNTY SURVEYOR
700 HALL OF RECORDS

Notes: ANY ADDITIONS OR CHANGES ON THIS SHEET MUST BE MADE OR CIRCLED IN Red Ink. WITH DATE AND NAME OF PERSON MAKING CHANGE.

Do not extend notes this side of this line

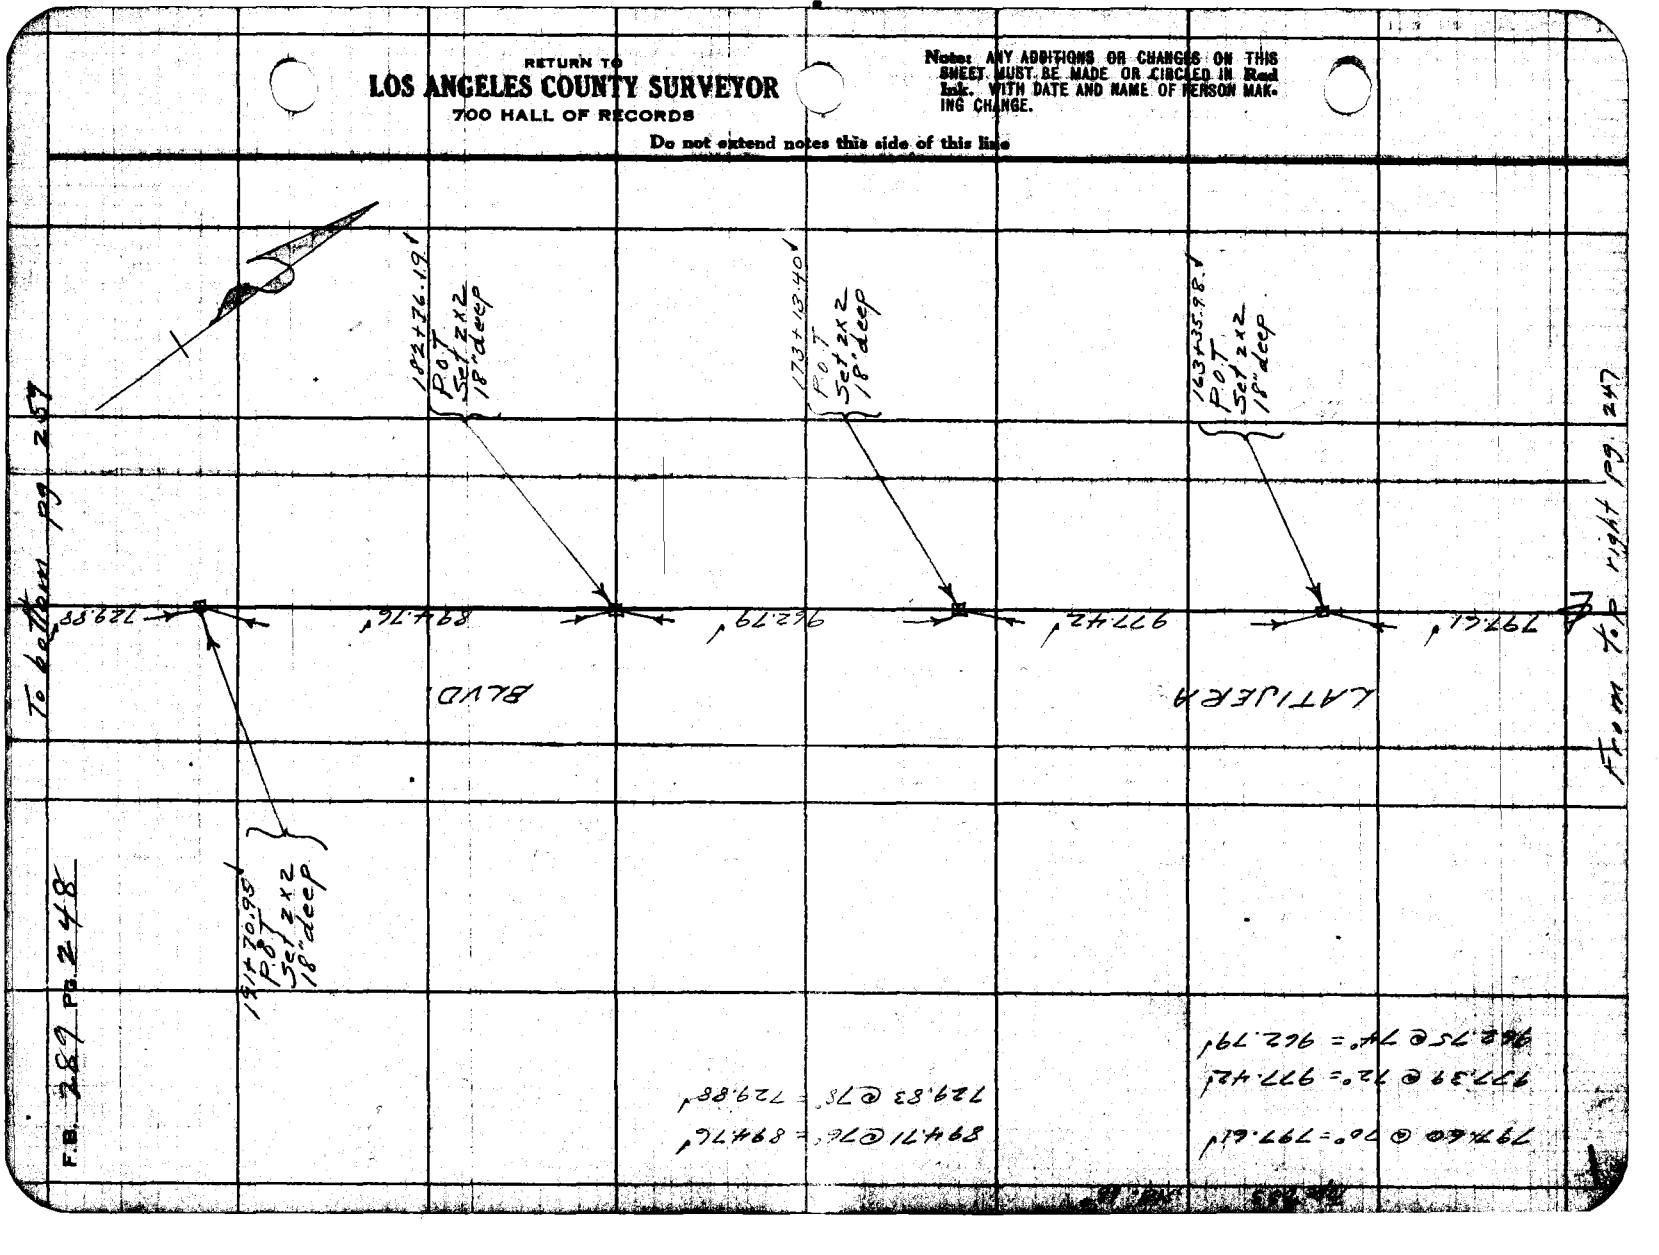

F.B. 289 Pg. 248

729.83 @ 75° = 729.88'
894.71 @ 76° = 894.76'

977.39 @ 72° = 977.42'
962.75 @ 74° = 962.79'
797.60 @ 76° = 797.61'

Notes Ck'd by Blackmer		Survey of La Tijera Blvd.	F.B. 289 Pg. 349
Map No. B-310-6		W. O. 914 Tape No. 033 St'd 68 °F.	
Office Work Proof		Notes by Party	
Checked Blackmer		Notes Moore Pub 2-27-33	
Date March 1933		Indexed A. C. Johnson	

SURVEY
of
LA TIJERA BLVD.
from
SLAUSON AVE.
to
CENTINELA A.V.E.
W.O.# 914

Party

Feb. 27, 28, 1933

Moore
Van Fleet
Fanner
Harris

(B.C.'s & E.C.'s set by Evans & Party 3/8/33)

(For Profile & X-sections, see L.B. 460-165)

Notice: Any additions or changes on this sheet must be made in ink and initialed. Do not erase entries on this side of this line.

RETURN TO
LOS ANGELES COUNTY SURVEYOR
700 HALL OF RECORDS

RETURN TO
LOS ANGELES COUNTY SURVEYOR
700 HALL OF RECORDS

Note: ANY ADDITIONS OR CHANGES ON THIS SHEET MUST BE MADE OR CIRCLED IN **Red Ink.** WITH DATE AND NAME OF PERSON MAKING CHANGE.

Do not extend notes this side of this line

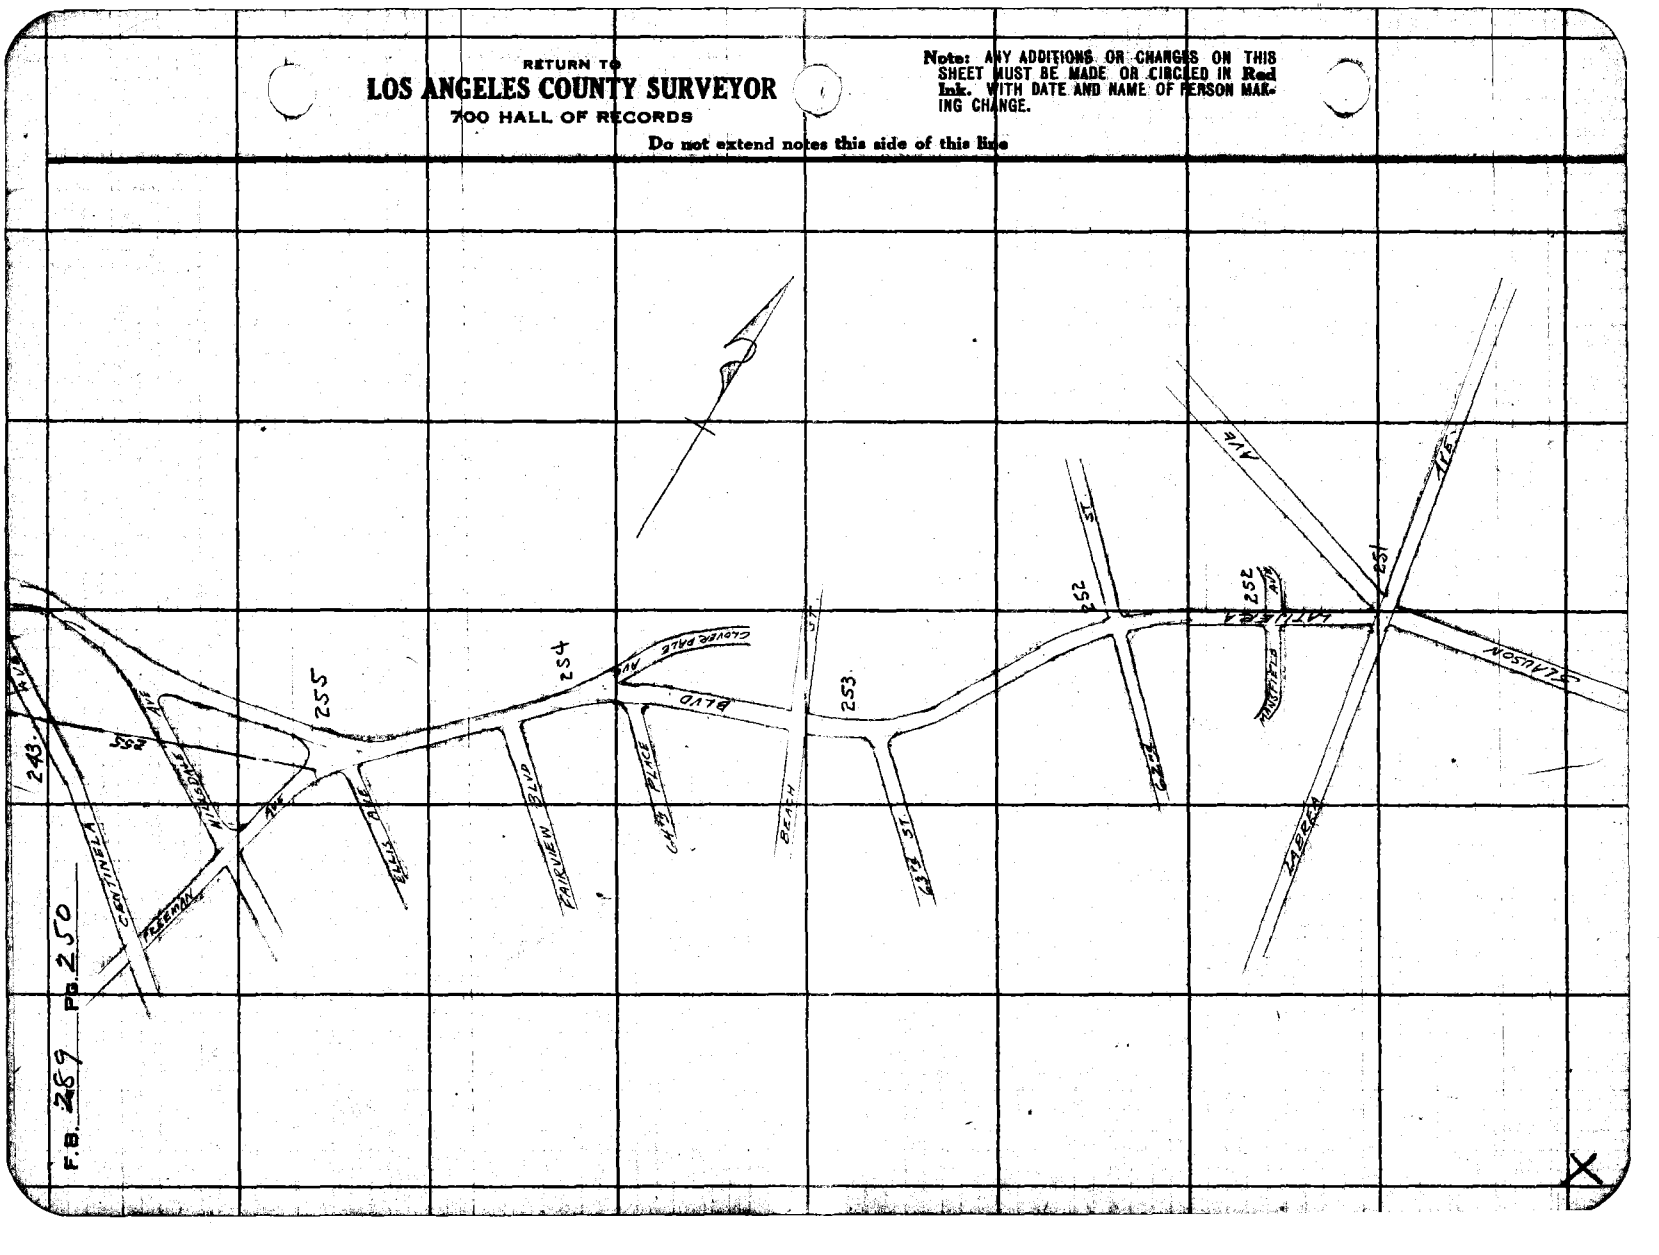

F.B. 289 Pg. 250

Notes Ck'd by Blackmer
Map No. B-310-6
Other Work None
Checked Blackmer
Date March 1933

Survey of La Tijera Blvd
W. O. 714 Tape No. 033 St'd 62° F.
Surveyed by [illegible]
Notes Moore Date 2-27-33
Indexed A. C. Johnson

F.B. 289 Pg. 281


LOS ANGELES COUNTY SURVEYOR

Do not extend notes this side of this line

(60°-36'-45"
242-26-30
60-36-39½"

Fd. L+T P.I.

LA BREA

60°-36'-40"

LA TIJERA BLVD

S45°-22'E

S45°-22'E @ 62°

AVE.

Fd. S.T+W. See F.B. 289-484

SLAUSON

AVE.

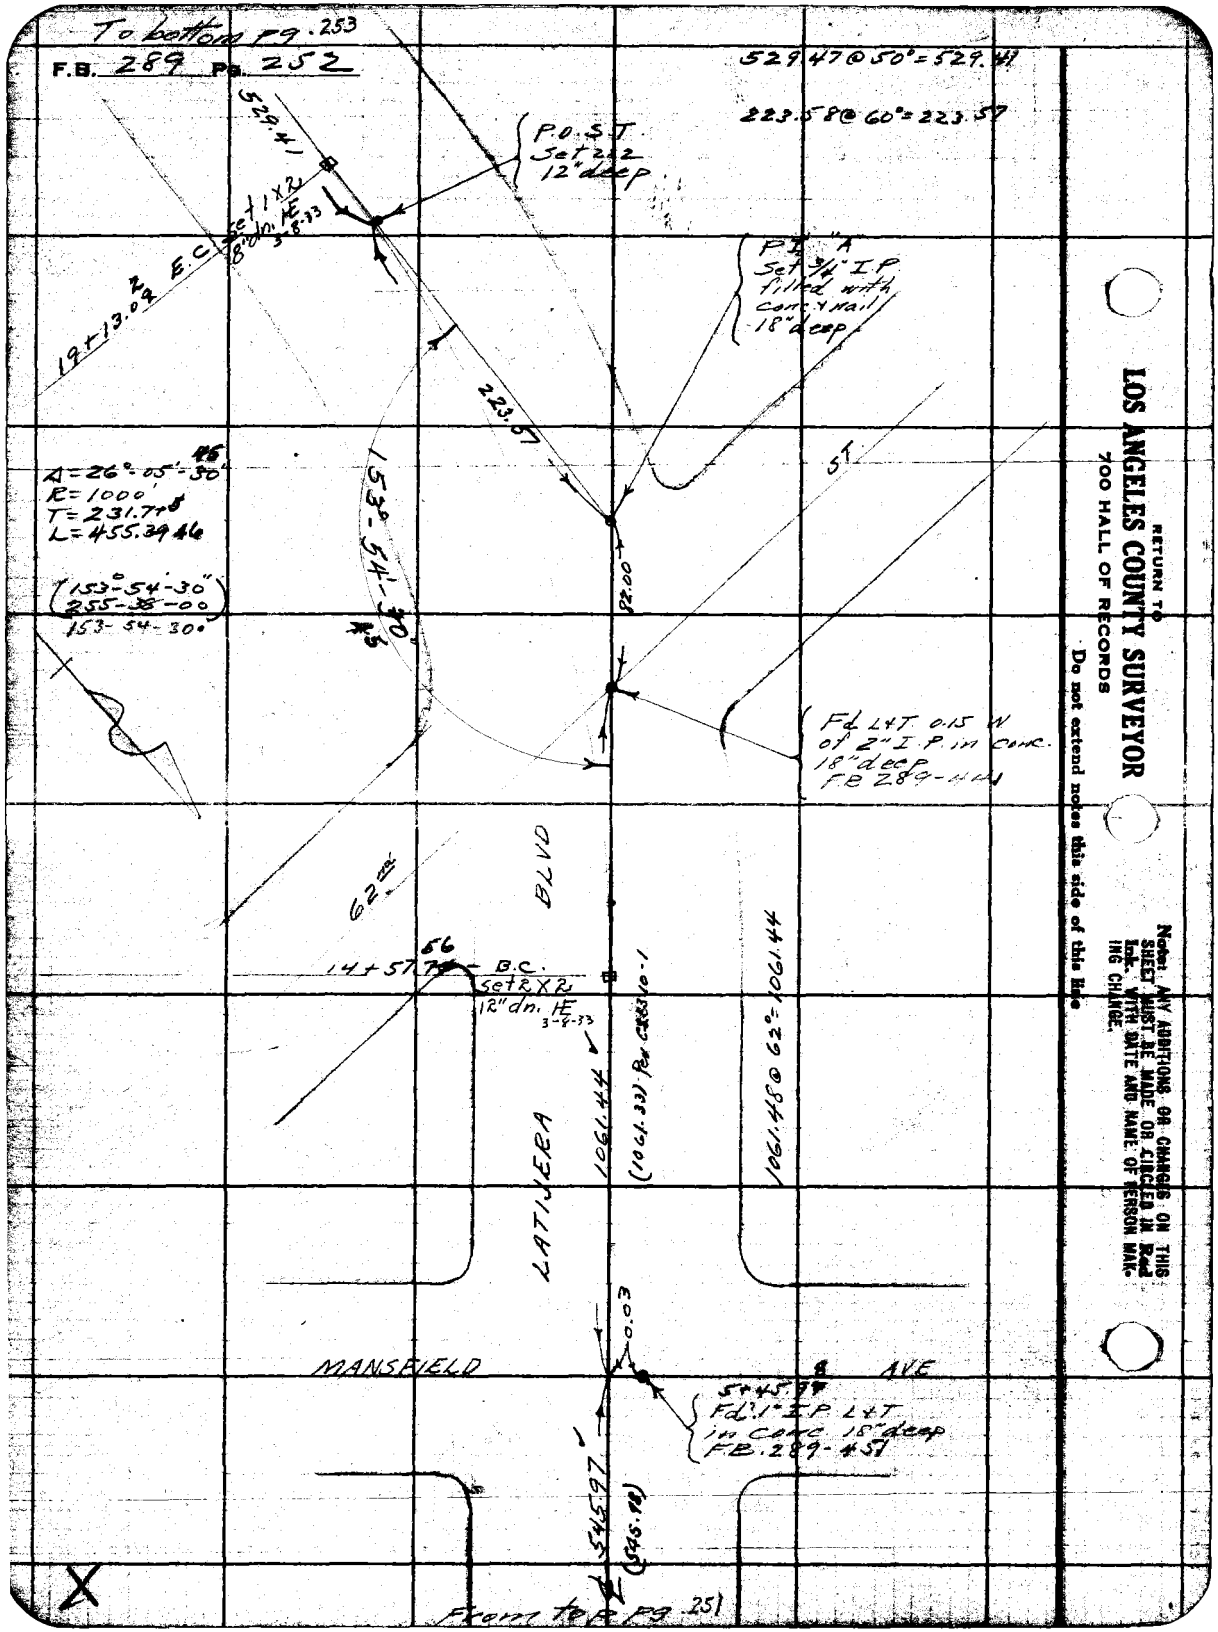
To bottom pg. 253
F.B. 289 Pg. 252
529.47 @ 50° = 529.41
223.58 @ 60° = 223.57
529.41
P.O.S.T. Set 2x2 12" deep
Set 1x2 8" dn. HE 3-8-73
P.T. "A" Set ¾" I.P. filled with Cont. Nail 18" deep
19+13.0 P.C.
223.67
Δ = 26° 05' 30"
R = 1000'
T = 231.78
L = 455.39
(153° 54' 30")
255° 35' 00"
153° 54' 30"
153° 54' 30"
22.00
Fd. L&T 0.15 N of 2" I.P. in Conc. 18" deep F.B. 289-44
62.88
14+57.78 B.C.
Set R x R1 12" dn. HE 3-8-73
BLVD
1061.44
(1061.33) Per Case 10-1
1061.48 @ 62° = 1061.44
LATIMER
MANSFIELD
0.03
AVE
5+45.97
Fd. 1" I.P. L&T in Conc. 18" deep F.B. 289-457
5+45.97
(545.98)
From top pg. 251
RETURN TO
LOS ANGELES COUNTY SURVEYOR
700 HALL OF RECORDS
Do not extend notes this side of this line
Note: ANY ADDITIONS OR CHANGES ON THIS SHEET MUST BE MADE OR CIRCLED IN Red Ink. WITH DATE AND NAME OF PERSON MAKING CHANGE.

Spec. Cl'd by Blankenship
Map No. B-310-C
Checked Blankenship
Date March 1933

Survey of La Tijera Blvd.
W. O. 914 Tape No. 033 St'd 68 °F.
Indexed A. C. Johnson

F.B. 289 Pg. 1633

610.96 @ 50° = 610.89

Set 2x2 22149.44 P.C.
12" deep. 12-38-33

FD. 2x24"
18" deep.
FB 289-41

LA TIJERA

ST.

BEACH

169.62

(142°-26-00"
209-44-15
142-26-00

P.I. "B"
Set ¾" I.P.
filled with
copper nail
12" deep.

Δ = 37°-
R = 1000
T = 34
L = 6

BLVD.

529.44

5T.

63rd


LOS ANGELES COUNTY SURVEYOR

F.B. 289 PG. 254

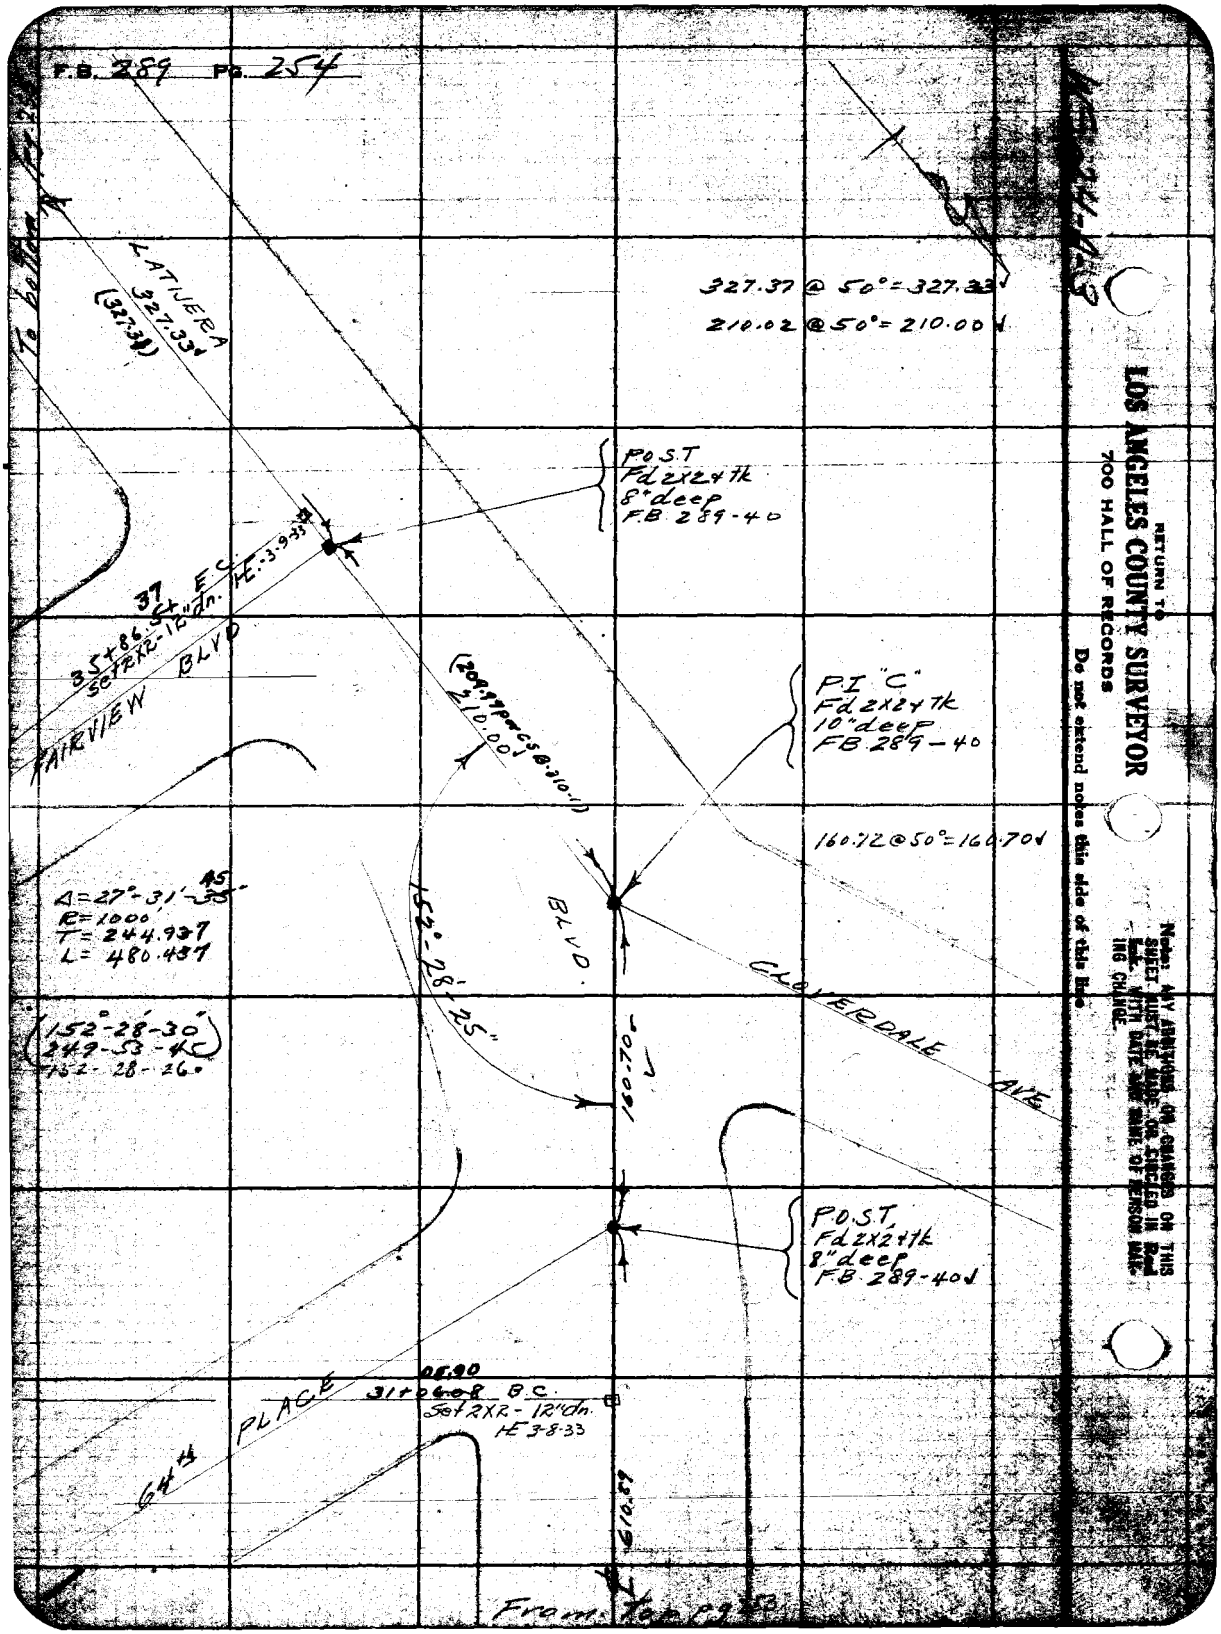

RETURN TO
LOS ANGELES COUNTY SURVEYOR
700 HALL OF RECORDS
Do not extend notes this side of this line

Notes: ANY ANNOTATIONS OR CHANGES ON THIS SHEET MUST BE MADE OR CIRCLED IN Red Ink WITH DATE AND NAME OF PERSON MAKING CHANGE

Map No. B-310-C
Date March 1933
Surveyed by La Tijera Blvd
W. O. 914 Topo No. 033 Sht's 6 of.
Mapped Blank
Indexed A. C. Johnson
F.B. 289 Pg. 25
To bottom pg 2

Notice: Any alteration of, change in, or addition to this map or the data thereon, without the written consent of the Los Angeles County Surveyor, will relieve him of responsibility for the correctness of the map or any part thereof.
LOS ANGELES COUNTY SURVEYOR
700 HALL OF RECORDS
Do not write on this map

HILLSDALE AVE
FREEMAN AVE
ELLIS AVE
LA TIJERA BLVD
REDONDO BLVD
LA TIJERA

PI "E+D" Set 3/4" I.P. filled with conc. stamped 18" deep by inter.

A = 24°-19'-10"
R = 300
T = 64.64
L = 122.34

Fd 2x2 x 7" P-deep FB 289-39

Set 3/4" I.P. by calc. dist.

Fd 2x2 x 4" P-deep FB 289-39

(161-42-00)
(287-28-15)
161-52-15

(152°-52'-30")
251.30 - 18
152-52-12

(51°-26'-15")
205-
51-26-30"

Ref. Pt. Set 2x2 Stamped 3-9-33 - LE.

39+44.66 P.C.

39+78.84

Ref. Pt. Set 2x2 Stamped 3-9-33 - LE.

F.B. 289 Pg. 256

To bottom pg 257

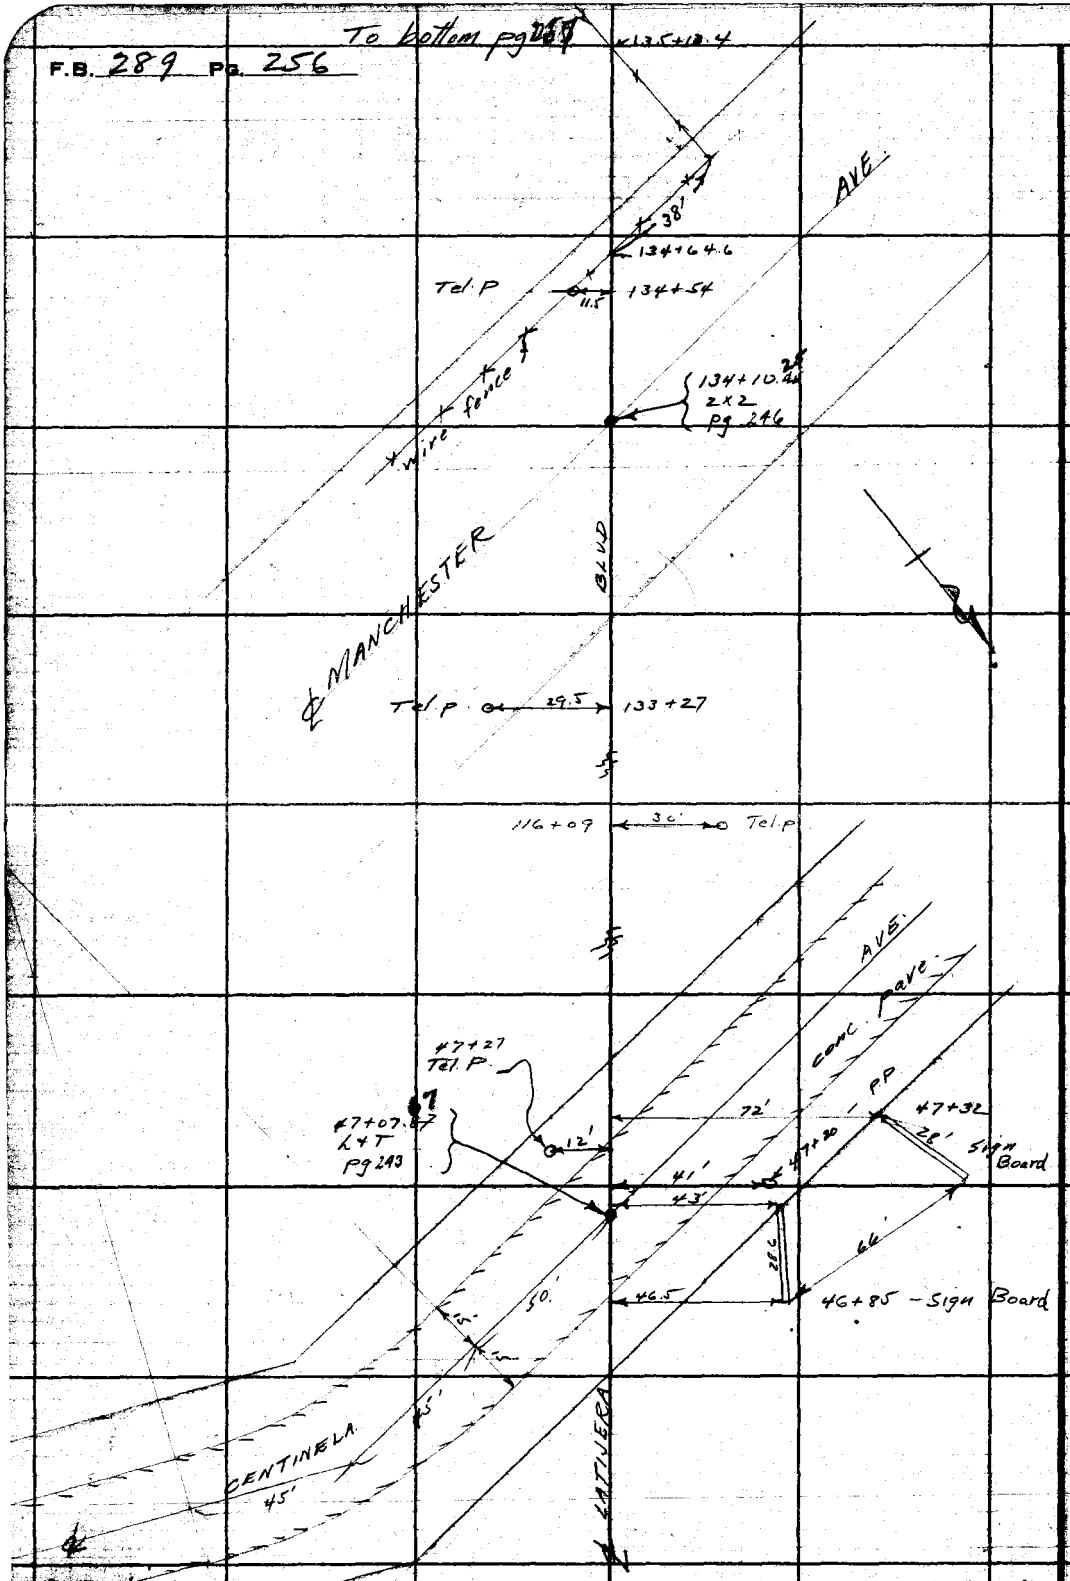

RETURN TO
LOS ANGELES COUNTY SURVEYOR
700 HALL OF RECORDS
Do not extend notes this side of this line

Note: ANY ADDITIONS OR CHANGES ON THIS SHEET MUST BE MADE OR CIRCLED IN Red Ink. WITH DATE AND NAME OF PERSON MAKING CHANGE.

Maps Ck'd by Blackmer
Map No. B-310-6
Checked Blackmer
Date March 1933

Survey of La Tijera Blvd.
W. O. 914
Tape No. St'd of.
Notes by Moore Date 3-2-33
Indexed A. C. Johnson


To Bottom pg

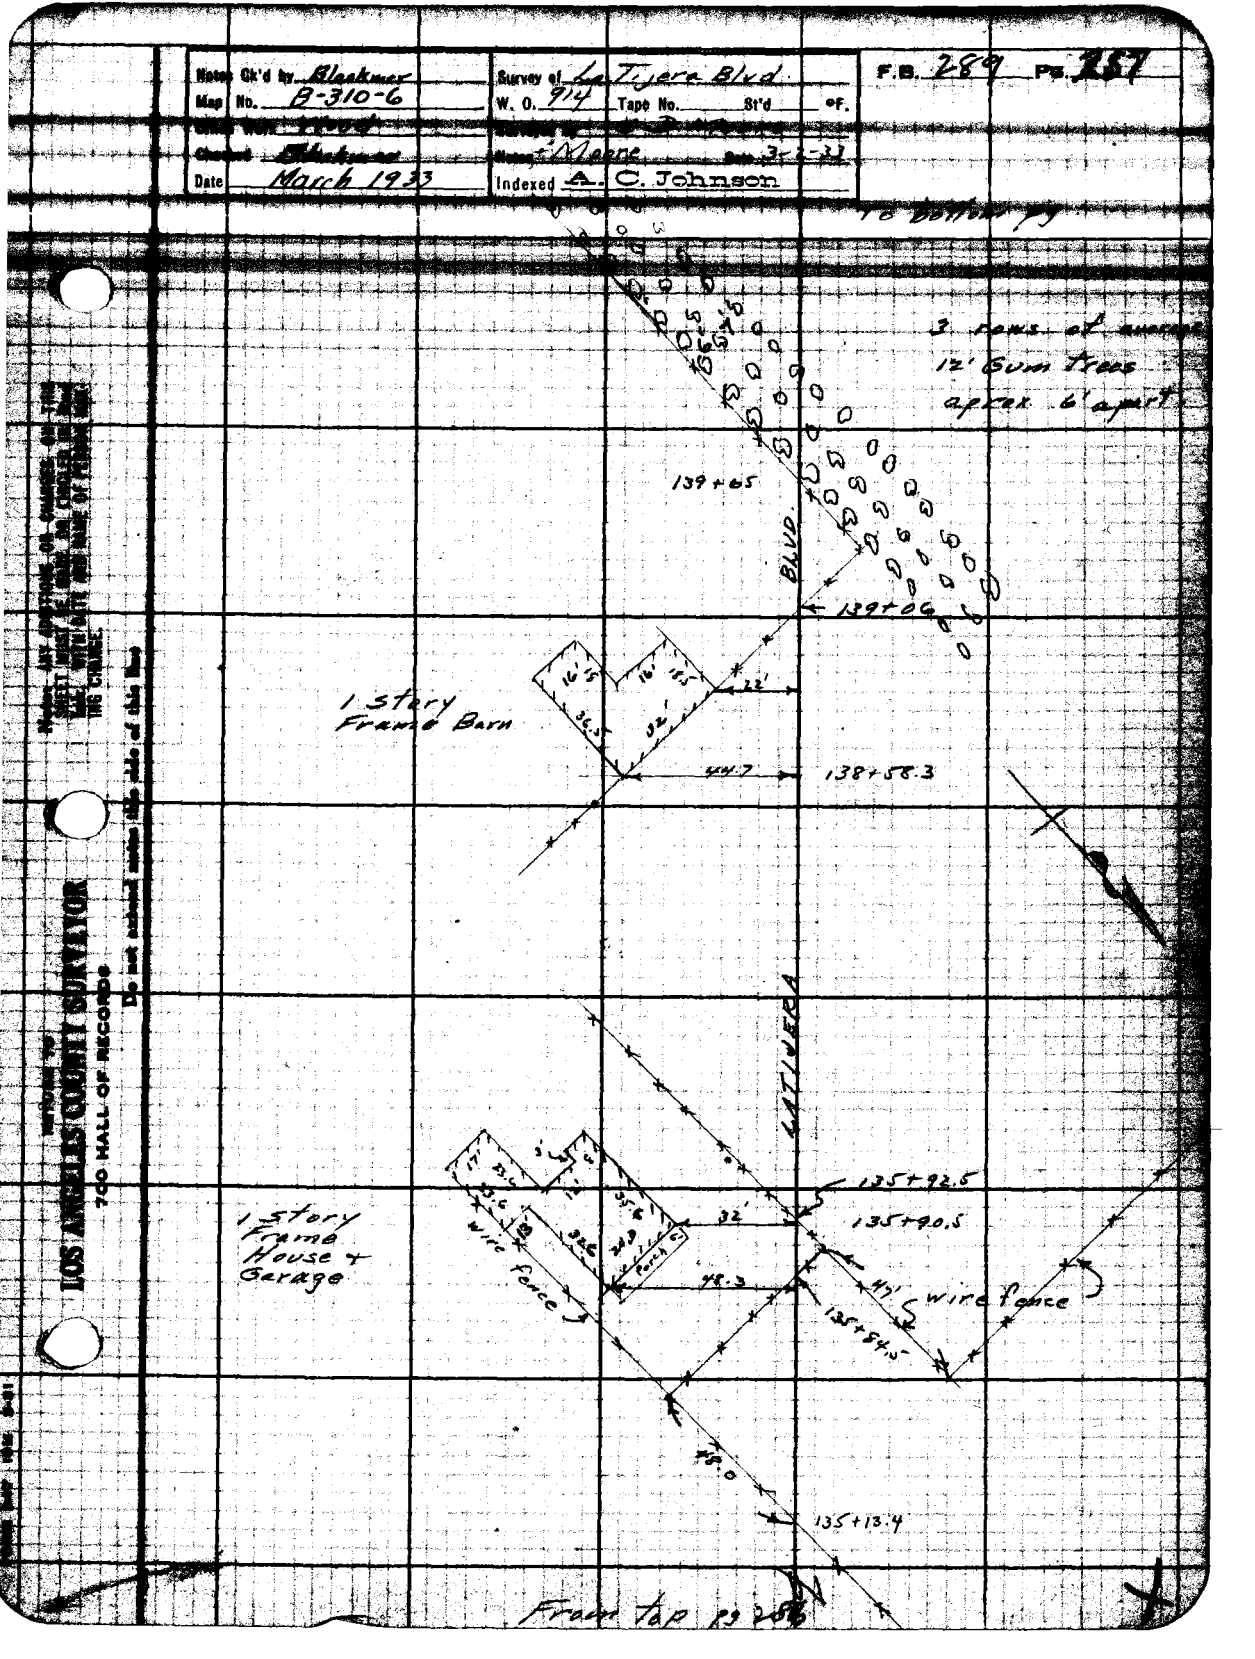

Notice to Surveyors
Maps are the property of the County of Los Angeles and must be returned upon demand. Any alteration, addition or erasure of any kind whatsoever made upon any map or plat without the written consent of the County Surveyor is prohibited by law.
LOS ANGELES COUNTY SURVEYOR
720 HALL OF RECORDS
Do not publish within this side of this line

F.B. 289 Pg. 258

RETURN TO
LOS ANGELES COUNTY SURVEYOR
700 HALL OF RECORDS
Do not extend notes this side of this line

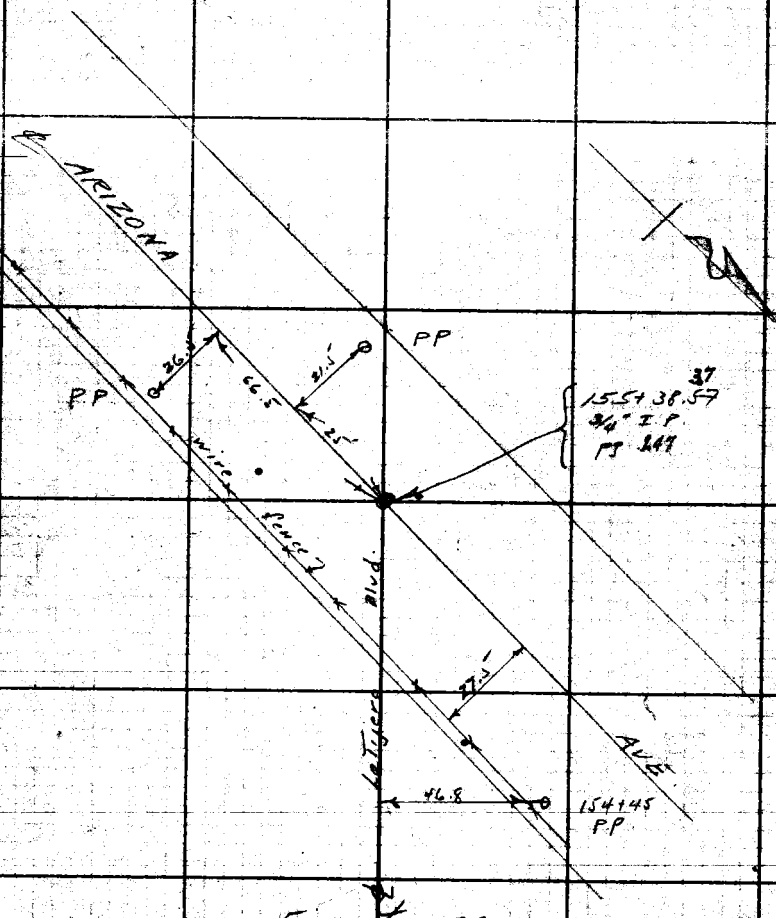

From Top P9

Notes Ck'd by Blackmer
Map No. B-310-6
Checked Blackmer
Date March 1933

Survey of La Tijera Blvd
W. O. 914 Tape No. St'd 66 oF.
Notes M. Rivera Date 3-29-33
Indexed C. Johnson

F.B. 289 Pg 28[illegible]

St Hwy C.P.

732.52 @ 90° = 732.53'
396.86 @ 90° = 396.86'

Road & R. Survey

(46°-44'-45"
186-59-15
46-44-49

POT 200+00 Fd LHT in obl. sidewalk Cross-State Highway 1.60-C-P7 FB 614-120

Set LHT by intersection tangents from LHT 1.0° from inter

BLVD

953.62'

46°-44'

50'

732.53'

(50)

(82°-44'-30")
FB 614-119

49°-44'-30"

T=68°
570.62'

T=68°
128.4'

LINCOLN

BLVD

(50)

20'

20'

conc. pave

CENTURY

2534.09'

83°-30'-45"

40'

POT 190+00 Fd LHT in obl. sidewalk Cross-State Highway 1.60-C-P7 FB 614-120

190+00.83' Set LHT by intersection tangents from LHT 1.0° from inter

50'

50'

(49°-44'-30"
198-58-00
49°-44'-30"

2534.06 @ 70° = 2534.09'

LATIJERA

729.82'

(83°-30'-45"
334-02-45

Fd. MC P7 2+17

LOS ANGELES COUNTY SURVEYOR
720 HALL OF RECORDS

RETURN TO
LOS ANGELES COUNTY SURVEYOR
700 HALL OF RECORDS

Note: ANY ADDITIONS OR CHANGES ON THIS SHEET MUST BE MADE OR CHECKED IN Red Ink. WITH DATE AND NAME OF PERSON MAKING CHANGE.

Do not extend notes this side of this line

F.B. 2289 Pg. 260

Form 307 5M 11-35

PLEASE RETURN TO
LOS ANGELES COUNTY SURVEYOR
700 HALL OF RECORDS

NOTE: ANY ADDITIONS OR CHANGES ON THIS SHEET MUST BE MADE OR CIRCLED IN RED INK, WITH DATE AND NAME OF PERSON MAKING CHANGE

Do not extend notes this side of this line

STATION	B. S.	H. I.	F. S.	ELEV.		
B.M. #10	2 48	151 23		148 75	B.M. #10	C. Spk. & W. in N. curb - Manchester Ave. 435 Mt. sta. 134+90 adj. elev. = 148.750 L.B. 460 p. 15
T.P.	1 12	141 60	10 75	140 48		
T.P.	085	137 37	5 08	136 52		
129+00			4 36	133 01	℄ La Tijera Blvd.	
			4 62		20⁵ L - Gutter	
			4 31		23' L - Edge Pvt. (Macadam)	
			3 6		49' L - T.F.	
			1 4 6		69' L B.F.	
			1 4 9		80' L	
			4 60		19⁵ R - Gutter	
			4 22		23' R - E. Pvt.	
			3 1		47' R - T.F.	
			1 2 7		65' R - B.F.	
			1 3 5		80' R	
129+50			1 2 3		80' R	
			1 1 4		65 R - B.F.	
			2 7		50' R - T.F.	
			2 8 9		22⁵ R - E. Pvt.	
			3 1 8		19⁵ R - Gutter	
			2 8 7	134 50	℄	
			3 2 2		20' L - "	

Profile
No. ____ Plotted ____ Job No. 794 Division No. K
Notes Red ____ Date ____ Survey of La Tijera Blvd
X-Sec. ____ Date ____ Survey by Wilshire Notes Wilshire Date 10-7-36
Notes Chkd. ____ Checked ____ Map No. ____ Indexed ____ Date 10-9-36
No. ____ Date ____

F. B. 289 Pg. 261

La Tijera Blvd. X-Sections

Form 307 5M 11-35

PLEASE RETURN TO
LOS ANGELES COUNTY SURVEYOR
700 HALL OF RECORDS

NOTE: ANY ADDITIONS OR CHANGES ON THIS SHEET MUST BE MADE OR CIRCLED IN RED INK, WITH DATE AND NAME OF PERSON MAKING CHANGE

Do not extend notes this side of this line

F.B. 289 Pg. 162 | Job No. 2214 | Division No. V | Notes Red | Plotted | Profile
Survey of La Tijera Blvd | Date | Date | No.
Survey by Valerie | Notes | Notes Chkd. | Checked | X-Sec.
Indexed | Date | Date | Date | No.

STATION	B. S.	H. I.	F. S.	ELEV.		
129+50		137.37	2.92		23' L - E.Pvt.	
			2.5		48 L - T.F.	
			11.5		68' L - B.F.	
			12.9		80 L	
130+00			10.8		80' L	
			10.3		69' L - B.F.	
			1.2		50' L - T.F.	
			1.63		23' L - E.Pvt	
			1.99		20' L - Gutter	
			1.66	135.71	℄	
			1.93		20' R - "	
			1.73		23' R E.Pvt	
			0.8		50' R - T.F.	
			9.6		69' R - B.F.	
			10.5		80' R	
TP	6.81	143.50	0.68	136.69		
130+50			1.41		80' R	
			1.30		62' R - B.F.	
			5.5		49' R - T.F.	
			6.58		23' R - E.Pvt.	
			6.80		20' R - Gutter	

Form 307 5M 11-35

PLEASE RETURN TO
LOS ANGELES COUNTY SURVEYOR
700 HALL OF RECORDS

NOTE: ANY ADDITIONS OR CHANGES ON THIS SHEET MUST BE MADE OR CIRCLED IN RED INK, WITH DATE AND NAME OF PERSON MAKING CHANGE

Do not extend notes this side of this line

Profile No. ____ Notes Red ____ Plotted ____ Job No. 73-[illegible] Division No. 1
X-Sec. No. ____ Date ____ Date ____ Survey of [illegible]
Notes Chkd. ____ Checked ____ Survey by [illegible] Notes [illegible]
Date ____ Date ____ Map No. ____ Indexed ____ Date [illegible] Date [illegible]

F. B. 289 Pg. 263

STATION	B. S.	H. I.	F. S.	ELEV.		
1304.50		1433.50	6.54	1369.6	℄	
			6.82		20' L - Gutter	
			6.62		23' L - E. Pvt	
			6.4		50' L - T.F.	
			12.5		64' L - B.F.	
			12.7		80' L	
1314.00			8.9		80' L	
			8.6		59' L - B.F.	
			4.5		50' L - T.F.	
			5.36		23' L - E. Pvt	
			5.74		19.5 L - Gutter	
			5.90	1380.6	℄	
			5.58		19.5 R - "	
			5.28		23' R - E. Pvt	
			4.2		50' R - T.F.	
			9.8		59' R - B.F.	
			10.4		80' R	
1317.50			6.6		80' R	
			5.8		54' R - B.F.	
			2.9		50' R - T.F.	
			4.14		23' R - E. Pvt	

Form 307 5M 11-35

PLEASE RETURN TO
LOS ANGELES COUNTY SURVEYOR
700 HALL OF RECORDS

NOTE: ANY ADDITIONS OR CHANGES ON THIS SHEET MUST BE MADE OR CIRCLED IN RED INK, WITH DATE AND NAME OF PERSON MAKING CHANGE

Do not extend notes this side of this line

F.B. 289 PG. 264 | Job No. 2214 | Division No. V | Notes Red. | Plotted | Profile No.
Survey of La Tuna Blvd. | Date | Date | X-Sec. No.
Survey by Moore & Moore | Notes Chkd. | Checked
Indexed | Date | Date

STATION	B. S.	H. I.	F. S.	ELEV.		
131+50		140 50	490		19' R - Gutter	
			4 00	139 09	℄	
			456		19' L - "	
			421		23' L - E.P.T.	
			30		50' L - T.F.	
			55		57 L - B.F.	
			55		60 L	
132+00			23		80' L	
			14		51' L - End Fill - Begin Cut	
			1 82		23 L - E.P.T.	
			329		9 L - Gutter	
			294	140 56	℄	
			314		19' R - "	
			277		23' R - E.P.T.	
			17		50' R - End Fill - Begin Cut.	
			30		80' R	
TP	901	151 61.	090	140 60		
132+50			83		80' R	
			74		51 R - T.C.	
			63		50' R - B.C.	
			946		23 R - E.P.T.	

Form 307 5M 11-35

PLEASE RETURN TO
LOS ANGELES COUNTY SURVEYOR
700 HALL OF RECORDS

NOTE: ANY ADDITIONS OR CHANGES ON THIS SHEET MUST BE MADE OR CIRCLED IN RED INK, WITH DATE AND NAME OF PERSON MAKING CHANGE

Do not extend notes this side of this line

STATION	B. S.	H. I.	F. S.	ELEV.		
132+50		151 61	7 84		18' R - Gutter	
			9 65	141 96	℄	
			9 80		20' L - "	
			9 61		23' L - E.P.T.	
			8 6		46 L - B.C.	
			7 1		53 L - T.C.	
			7 6		101' L - "	
133+00			6 0		61 L - "	
			6 2		53' L - "	
			7 1		47' L - BC	
			7 51		24' L - E.P.T.	
			8 10		22' L - Gutter	
			7 95	143 66	℄	
			8 11		20' R "	
			7 82		23' R - E.P.T.	
			6 80		49 R - BC	
			4 6		53 R - T.C.	
			5 2		80' R	
133+50			2 9		80' R	
			2 9		53 R - T.C.	
			5 3		49' R BC	

Profile No. ____ Notes Red. ____ Plotted ____ Job No. 73[illegible] Division No. L
X-Sec. No. ____ Date ____ Date ____ Survey of La Cienega Blvd
Notes Chkd. ____ Checked ____ Survey by [illegible] Notes [illegible] Date 12-7-36
Date ____ Date ____ Map No. ____ Indexed ____ Date ____

F. B. 280 Pg. 265

Form 307 5M 11-35

PLEASE RETURN TO
LOS ANGELES COUNTY SURVEYOR
700 HALL OF RECORDS

NOTE: ANY ADDITIONS OR CHANGES ON THIS SHEET MUST BE MADE OR CIRCLED IN RED INK, WITH DATE AND NAME OF PERSON MAKING CHANGE

Do not extend notes this side of this line

F. B. 789 Pg. 266 | Job No. 2[illegible] | Division No. [illegible] | Notes Red. | Plotted | Profile
Survey of | Date | No.
Survey by | Notes | Date | X-Sec.
Indexed | Notes Chkd. | Date | Checked | Date | No.

STATION	B. S.	H. I.	F. S.	ELEV.	
133+50		151.01	6.32		27'R - E. R/W
			6.52		[illegible] Gutter
			5.85	145.73	℄
+57.7			5.50	146.11	℄ - Edge conc. Pvt
+77			4.17	147.44	℄ - " " " + Ed Macadam Pvt.
134+00			4.12	147.49	℄
+10.25			3.90	147.71	℄ Inter ℄ Manchester Ave
+24			3.94	147.67	℄ Ed Macadam Pvt + Ed Conc Pvt.
+50			4.12	147.49	℄
			4.58		11.8'L - Edge Conc. Pvt. + Macadam
			5.50		35'L - Gutter
			5.40		31'L - E. Macadam Pvt.
			4.8		50'L - B.C.
			1.4		55'L - T.C.
			1.9		80'L
+60.5			4.35	147.26	℄ - Edge conc. Pvt. - Begin Macadam Pvt
135+00			2.8		80'L
			2.3		53'L - T.C.
			4.6		50'L B.C.
			5.98		24'L E.R/W
			6.10		23'L - Gutter

Form 307 5M 11-35

PLEASE RETURN TO
LOS ANGELES COUNTY SURVEYOR
700 HALL OF RECORDS

NOTE: ANY ADDITIONS OR CHANGES ON THIS SHEET MUST BE MADE OR CIRCLED IN RED INK, WITH DATE AND NAME OF PERSON MAKING CHANGE

Do not extend notes this side of this line

STATION	B. S.	H. I.	F. S.	ELEV.		
135+00		151.61	5.42	146.19	℄	
+50			6.54	145.07	℄	
			6.64		26' R - Gutter	
			6.33		23' R - E. Pvt	
			4.6		51' R - B.C.	
			3.0		53 R - T.C	
			2.0		94 R - TC - Manhole	
			6.92		20' L - Gutter	
			6.54		23½ L - E. Pvt	
			5.4		45' L - BC	
			3.8		61' L TC	
			4.2		80' L	
T.P.	2.03	146.58	7.06	144.55		
135+00			2.42	144.16	℄	
			2.34		17½ R - Gutter	
			2.35		23 R - E. Pvt	
			1.1		50 R - BC	
		+	0.7		53' R TC	
		+	1.3		80' R	
			2.10		20' L - Gutter	
			2.41		23½ L - E. Pvt.	

Profile
No. Notes Red Plotted Job No. Division No.
X-Sec. Date Date Survey of
Notes Ckkd. Checked Survey by Notes Date
Date Date Map No. Indexed Date

F. B. 289 Pg. 267

Form 307 5M 11-35

PLEASE RETURN TO
LOS ANGELES COUNTY SURVEYOR
700 HALL OF RECORDS

NOTE: ANY ADDITIONS OR CHANGES ON THIS SHEET MUST BE MADE OR CIRCLED IN RED INK, WITH DATE AND NAME OF PERSON MAKING CHANGE

Do not extend notes this side of this line

F. B. 2M Pg. 270 | Job No. 7944 | Division No. V | Notes Red | Plotted | Profile No.
Survey of La Tijera Blvd | Date | Date | X-Sec. No.
Survey by Meerc | Notes | Notes Chkd. | Checked
Indexed | Date | Date | Date

STATION	B. S.	H. I.	F. S.	ELEV.		
138+00		146 58	39		49'L - T.F.	
			82		57'L - B.F.	
			96		80 L -	
+50			100		80'L	
			92		57'L B.F.	
			45		49 L - T.F.	
			5'98		24'L - E.P.T.	
			657		19' L G.Tiller	
			627	146 31	℄	
			649		19' R - "	
			578		23 R - E.P.T.	
			42		49' R - T.F.	
			65		54 R - B.F.	
			74		80' R	
139+00			76		80' R	
			75		54 R - B.F.	
			51		48 R - T.F.	
			656		23' R - E.P.T.	
			720		19 R G.Tiller	
			703	139 55	℄	
			734		19' L - "	

Form 307 5M 11-35

PLEASE RETURN TO
LOS ANGELES COUNTY SURVEYOR
700 HALL OF RECORDS

NOTE: ANY ADDITIONS OR CHANGES ON THIS SHEET MUST BE MADE OR CIRCLED IN RED INK, WITH DATE AND NAME OF PERSON MAKING CHANGE

Do not extend notes this side of this line

STATION	B. S.	H. I.	F. S.	ELEV.		
139+00		146 58	6 30		23' L - E. P. T.	
			54		49' L - T T	
			92		56' L - B. F.	
			98		80' L	
T P	541	151 62	0 35	146 23		

X-Sections along Manchester Ave
134+10.25 E. Inter. = 0+00 going E. on ℄ Manchester.

0+00			394	147 70	℄ Inter. - Foresight P.O.	
			4 0		9' R - Edge Conc. P.T.	
			4 82		37 R " "	
			5 53		54 R " Macadam	
			47		73' R - B.C.	
			17		78' R - T.C.	
			17		80' R	
			407		9' L - Edge Conc. P.T.	
			496		37' L " "	
			562		48' L Gutter	
			546		51' L - E. Macadam P.T.	
			50		72' L - B.C.	

Profile
No. ____ Notes Red. ____ Plotted. ____ Job No. 2644 Division No. 5
X-Sec. ____ Date ____ Date ____ Survey of Lots 7 thru 13 Blk 2
No. ____ Notes Chkd. ____ Checked ____ Survey by Wood & Notes Date 10-7-36
Date ____ Date ____ Map No. ____ Indexed ____ Date ____

F. B. 289 Pg. 27

Form 307 5M 11-35

PLEASE RETURN TO
LOS ANGELES COUNTY SURVEYOR
700 HALL OF RECORDS

NOTE: ANY ADDITIONS OR CHANGES ON THIS SHEET MUST BE MADE OR CIRCLED IN RED INK, WITH DATE AND NAME OF PERSON MAKING CHANGE

Do not extend notes this side of this line

F. B. 289 Pg. 272 | Job No. 7214 Division No. V | Notes Red. | Plotted | Profile No. | X-Sec. No.
Survey of La Tuna Canyon Rd. | Date | Date | Date | Date
Survey by Alvarez Notes Alvarez | Notes Chkd. | Checked | Date | Date
Indexed | Date | Date | Date | Date

STATION	B. S.	H. I.	F. S.	ELEV.		
[illegible]		151 64	2 5		81' L - T.C.	
0+22			6 4		56' L	
			6 41		64 L - C.L.	
			6 50		57' L - G. Flow	
			5 32		37' L - E. Conc. Pvt.	
			4 [illegible]		9 L - " " "	
			4 37	147 27	℄ Macadam	
			4 47		9' R - E. Conc. Pvt.	
			5 24		37' R - " " "	
			47		48' R - B.C.	
			1 7		54 R - T.C.	
			1 9		80' R	
0+35			2 0		80' R	
			1 6		53 R T.C	
			4 4		49 R B.C	
			4 74		37.5 R - T. curb - beginning	
			5 57		37 R - B. " "	
			4 80		9 R E. Conc. Pvt.	
			4 66	140 98	℄ Macadam	
			4 68		9' L - E. Conc. Pvt.	
			5 56		37' L " " "	

Form 307 5M 11-35

PLEASE RETURN TO
LOS ANGELES COUNTY SURVEYOR
700 HALL OF RECORDS

NOTE: ANY ADDITIONS OR CHANGES ON THIS SHEET MUST BE MADE OR CIRCLED IN RED INK, WITH DATE AND NAME OF PERSON MAKING CHANGE

Do not extend notes this side of this line

STATION	B. S.	H. I.	F. S.	ELEV.		
0+35		151 64.	7 18		72 L - Gutter	
			7 00		77½ L - E. Pat Macadam	
			6 9		80' L -	
0+72			8 00		80' L - Macadam	
			6 37		37 L - E. Conc. Pat	
			5 58		9' L " "	" & Begin B.C.
			5 07		8½ L	" T.
			5 34	146 30	℄ - End Macadam	
			5 10		85 R	" T.
			5 57		9' R	" B
			6 29		37 R - B. Curb	
			5 48		37½ R T. "	
			49		49 R - B.C.	
			16		49 R - T.C.	
			24		80' R	
1+04			32		80' R	
			24		54 R - T.C.	
			60		50' R B.C.	
			6 37		37½ R - T curb	
			7 18		37 R 13 "	
			6 35		9' R - B "	

Profile No. _____ Notes Red _____ Plotted _____ Job No. 7644 Division No. V F.B. 289 Pg. 273
X-Sec. No. _____ Date _____ Date _____ Survey of La Tijera (2WD)
Notes Chkd. _____ Checked _____ Survey by Pierce Notes Pierce Date 10-7-36
Date _____ Date _____ Map No. _____ Indexed _____ Date _____

Form 307 5M 11-35

PLEASE RETURN TO
LOS ANGELES COUNTY SURVEYOR
700 HALL OF RECORDS

NOTE: ANY ADDITIONS OR CHANGES ON THIS SHEET MUST BE MADE OR CIRCLED IN RED INK, WITH DATE AND NAME OF PERSON MAKING CHANGE

Do not extend notes this side of this line

F.B. 2289 PG. 274 | Job No. 7914 Division No. K | La Tijera Blvd | Profile No. | X-Sec. No.
Survey of Alleys | Notes Red | Plotted
Survey by | Notes | Date | Date
Indexed | Notes Chkd | Checked
Date | Date | Date

STATION	B. S.	H. I.	F. S.	ELEV.		
1+04		151.61	588		8' R - T Curb	
			57	1459	℄	
			525		8' L - T "	
			643		9' L - B "	
			719		37' L - B "	- Begin.
			640		37' L - T "	"
			562		75' L - E Rd	Drainage
1+50			71		83' L - T C.	
			70		45' L - T C.	
			75		42 L - B C.	
			777		37' L - T Curb	
			857		37' L - B. "	
			782		9' L - B	
			731		8' L T "	
			70	1446	℄	
			729		8' R T "	
			778		9' R B "	
			560		37' R - B "	
			778		37' R T "	
			74		49' R - B C.	
			42		54 R - T C.	
			46		80' R	

Form 307 5M 11-35

PLEASE RETURN TO
LOS ANGELES COUNTY SURVEYOR
700 HALL OF RECORDS

NOTE: ANY ADDITIONS OR CHANGES ON THIS SHEET MUST BE MADE OR CIRCLED IN RED INK, WITH DATE AND NAME OF PERSON MAKING CHANGE

Do not extend notes this side of this line

Profile No. ____ Notes Red. ____ Plotted ____ Job No. 2911 Division No. V
X-Sec. ____ Date ____ Date ____ Survey of La Tijera Blvd
Notes Chkd. ____ Checked ____ Survey by Moore Notes Moore Date 10-2-36
No. ____ Date ____ Date ____ Map No. ____ Indexed ____ Date ____

F. B. 289 Pg. 27

STATION	B. S.	H. I.	F. S.	ELEV.		
2+00		151 64	69		80' R	
			63		53 R - T.C.	
			92		49' R - BC	
			930		37.5 R - T. Curb	
			1051		37 R - B. "	
			973		9 R 13. "	
			923		8.5 R T. "	
			90	1426	℄	
			920		8.5 L T. "	
			968		9 L 13. "	
			1043		37 L B. "	
			964		37.5 L T. "	
			92		45 L - BC	
			83		48' L TC	
			95		80' L	
T.P	5 20	153 51	3 33	145 31		
	X Sections along Manchester Ave					
	134 + 10.5 = 0+00 going West on ℄ Manchester Ave					
	For ℄ Section at 0+00 - reverse L & R of X-Section 0+00					
0+22			555	147 96	℄ Macadam	
			564		9' R - E conc Pvt.	

Form 307 5M 11-35

PLEASE RETURN TO
LOS ANGELES COUNTY SURVEYOR
700 HALL OF RECORDS

NOTE: ANY ADDITIONS OR CHANGES ON THIS SHEET MUST BE MADE OR CIRCLED IN RED INK, WITH DATE AND NAME OF PERSON MAKING CHANGE

Do not extend notes this side of this line

F.B. 789 PG. 276 | Job No. 2914 Division No. V | La Tijera Blvd. | Survey of Moore | Survey by Moore | Indexed

Profile No. | X-Sec. No. | Plotted Date | Checked Date | Notes Red. Date | Notes Chkd. Date | Notes Date

STATION	B. S.	H. I.	F. S.	ELEV.		
0+22		1535	645		37 R - Begin. B. Curb	
			564		37 R " T "	
			58		61 R - B.C.	
			45		68 R - T.C.	
			42		80' R	
			568		9' L - E. Conc. Pvt.	
			600		37' L " " "	
			761		62 L Gutter	
			749		69 L - E. Pvt. Macadam	
			70		80' L	
0+64			784		80' L Macadam	
			595		37' L - E. Conc. Pvt	
			520		9' L - Begin B. Curb	
			471		5 L " T "	
			50	1485	℄ - End Macadam	
			473		5 R - Begin T. Curb	
			518		9 R " B "	
			60		37 R B "	
			517		37 R T "	
			50		50' R - B.C.	
			40		55 R - T.C.	
			40		50' R	

Form 307 5M 11-35

PLEASE RETURN TO
LOS ANGELES COUNTY SURVEYOR
700 HALL OF RECORDS

NOTE: ANY ADDITIONS OR CHANGES ON THIS SHEET MUST BE MADE OR CIRCLED IN RED INK, WITH DATE AND NAME OF PERSON MAKING CHANGE

Do not extend notes this side of this line

Profile No. ____ Notes Red ____ Plotted ____ Job No 2914 Division No. V
X-Sec. ____ Date ____ Date ____ Survey of La Tuna Blvd
No. ____ Notes Chkd ____ Checked ____ Survey by Meade Notes Meade Date 10-7-36
Date ____ Date ____ Map No. ____ Indexed ____ Date ____

F.B. 289 Pg. 27

STATION	B. S.	H. I.	F. S.	ELEV.		
0+96		1535	38		80' R	
			31		52' R - T.C.	
			48		48 R - B.C.	
			496		37.5 R - T. Curb	
			576		37 R B. "	
			496		9 R B "	- Return
			450		8.5 R T "	"
			44	1491	℄	
			448		5.5 L " "	"
			497		9 L B "	"
			571		37' L E. Conc Pvt.	
			643		50 L - E. Macadam Pvt.	
			785		69 L - " "	-
			809		72.5 L - Gutter	
			821		80 L - Macadam	
1+04.5			409	1490.2	℄ - T. Curb -	M.C.R.
1+03			453	1486.8	℄ B "	" " " - B.C.
1+30			745		80' L	
			66		66' L - B.C.	
			48		61' L T.C.	
			489		37.5 L - Begin	T. Curb
			560		37' L - "	B "

Form 307 5M 11-35

PLEASE RETURN TO
LOS ANGELES COUNTY SURVEYOR
700 HALL OF RECORDS

NOTE: ANY ADDITIONS OR CHANGES ON THIS SHEET MUST BE MADE OR CIRCLED IN RED INK, WITH DATE AND NAME OF PERSON MAKING CHANGE

Do not extend notes this side of this line

F. B. 289 PG. 278 | Job No. 7914 Division No. V | Notes Red. | Date | Plotted | Date | Profile No. | X-Sec. No.
Survey of La Tijera Blvd. | Notes Chkd. | Date | Checked | Date
Survey by Moore Notes Moore | Date | Date
Indexed | Date

STATION	B. S.	H. I.	F. S.	ELEV.		
1+30		153.51	4.91		10' L - E. Conc.	Pvt
			4.77	148.74	℄ - Macadam	
			4.79		10' R - E. Conc.	Pvt
			4.64		37' R - B. Curb	
			4.56		37½ R - T "	
			4.8		48 R - B.C.	
			33		52 R - T.C.	
			35		80' R	
1+50			36		80' R	
			31		51 R - T.C.	
			4.8		48 R - B.C.	
			4.86		37½ R - T. Curb	
			5.68		37' R - B. "	
			4.79		10' R - E. Conc.	Pvt
			4.78	148.73	℄ - Macadam	
			4.59		10' L - E. Conc.	Pvt
			5.69		37' L - B. Curb	
			4.54		37½ L - T "	
			4.7		80 L - T.C.	
1+97.3			5.00	148.51	℄ - B. Curb - M.C.R. -	End Macadam
1+97.5			4.58	148.93	℄ - T "	"

Form 307 5M 11-35

PLEASE RETURN TO
LOS ANGELES COUNTY SURVEYOR
700 HALL OF RECORDS

NOTE: ANY ADDITIONS OR CHANGES ON THIS SHEET MUST BE MADE OR CIRCLED IN RED INK, WITH DATE AND NAME OF PERSON MAKING CHANGE

Do not extend notes this side of this line

STATION	B. S.	H. I.	F. S.	ELEV.		
2+05		1535	5.8		80' L	
			5.22		37.5 L — T. Curb.	
			6.03		37 L — B. "	
			5.22		9' L — " "	— Return
			4.74		8.5 L — T. "	"
			4.6	1489	℄	
			4.75		8.5 R — T. "	"
			5.23		9 R — B. "	"
			6.00		37 R — B. "	
			5.20		37.5 R — T. "	
			4.9		48' R — B.C.	
			3.5		51 R — T.C.	
			3.8		80' R	
B.M. #10			4.78	1487.3	B.M. #10 — E. spk. in W — N. Curb 1 mi. Sta. 135 L W. of 134+90. El. = 1488.75 ✓ L.B. 4[illegible]-15	

Profile

No. _____ Notes Red _____ Plotted _____ Job No. 79-W Division No. V

X-Sec. _____ Date _____ Date _____ Survey of La Puente F.B. 289 Pg. 279

No. _____ Notes Chkd _____ Checked _____ Survey by Meeks Notes Meeks Date 10-7-36

Date _____ Date _____ Map No. _____ Indexed _____ Date _____

F. B. 289 Pg. 78

Job No. Division No. Notes Red. Plotted

Survey of Date Date

Survey by Notes Notes Chkd. Checked
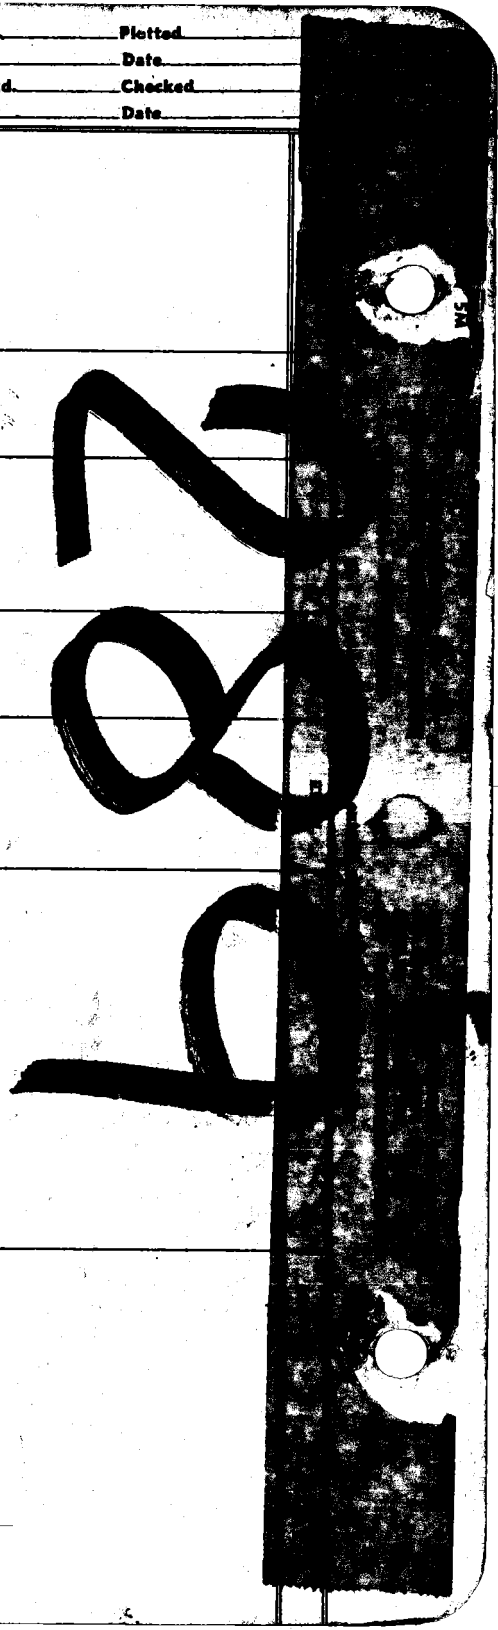
Indexed Date Date Date