Notes by _____ Chief Party _____ F.B. _____ Pg. _____

Platted by _____	W. O. No. _____ D. S. O. No. _____
Date _____	Location _____
Map No. _____	Surveyed by _____
Platting Ck'd by _____	Date _____
Date _____	Indexed _____

Property of the [illegible] County Surveyor
Do not remove from office

2E3

F.B. 293 Pg. INDEX Chief Party Notes by Date

F.B.293

PAGES: Index, 1 to 75 incl., , 77 to 93 incl., , , , 97 to 105 incl., , 107 to 115 incl., , 117, 118, , , 121, , 123, 124, 125, , 127 to 135 incl.

201 to 209 incl., 211 to 216 incl.,

RETURN TO LOS ANGELES COUNTY SURVEYOR

Do not extend notes this side of this line

Note: ANY ADDITIONS OR CHANGES ON THIS SHEET MUST BE MADE OR CIRCLED IN Red. WITH DATE AND NAME OF PERSON MAKING CHANGE.

Date _____ Notes by _____ Chief Party _____ F.B. 293 Pg. 0

Platted by	W. O. No. 4140 D. S. O. No.
Date	Location Hermosa Ave
Map No.	Surveyed by Rosecrans
Platting C'k'd by	Date Oct 7, 1927
Date	Indexed A. C. Johnson

HERMOSA AVE

A & I DIST.° 140

ENCENITAS AVE to DEL MAR AVE

RIVERSIDE DRIVE - WO 262 At
Los Angeles - San Bernardino Bdy.

STATE ST - A & I 245

Pages 85-93
95-136

Note: ANY ADDITIONS OR CHANGES ON THIS SHEET MUST BE MADE OR CIRCLED IN Red. WITH DATE AND NAME OF PERSON MAKING CHANGE.

Do not extend notes this side of this line

RETURN TO LOS ANGELES COUNTY SURVEYOR

RETURN TO

LOS ANGELES COUNTY SURVEYOR

Note: ANY ADDITIONS OR CHANGES ON THIS SHEET MUST BE MADE OR CIRCLED IN Red. WITH DATE AND NAME OF PERSON MAKING CHANGE.

Do not extend notes this side of this line

F.B.____ Pg.____ Chief Party____ Notes by____ Date____

Date _____ Notes by _____ Chief Party _____ F. B. 223 Pg. 1

Plotted by _____
Date _____
Map No. _____
Plotting C'k'd by _____
Date _____

W. O. No. 7190 D. S. O. No. _____
Location Hermosa Ave
Surveyed by Rosecrans
Date Oct 6, 1947
Indexed by C. Johnson

Index to Street Center Lines

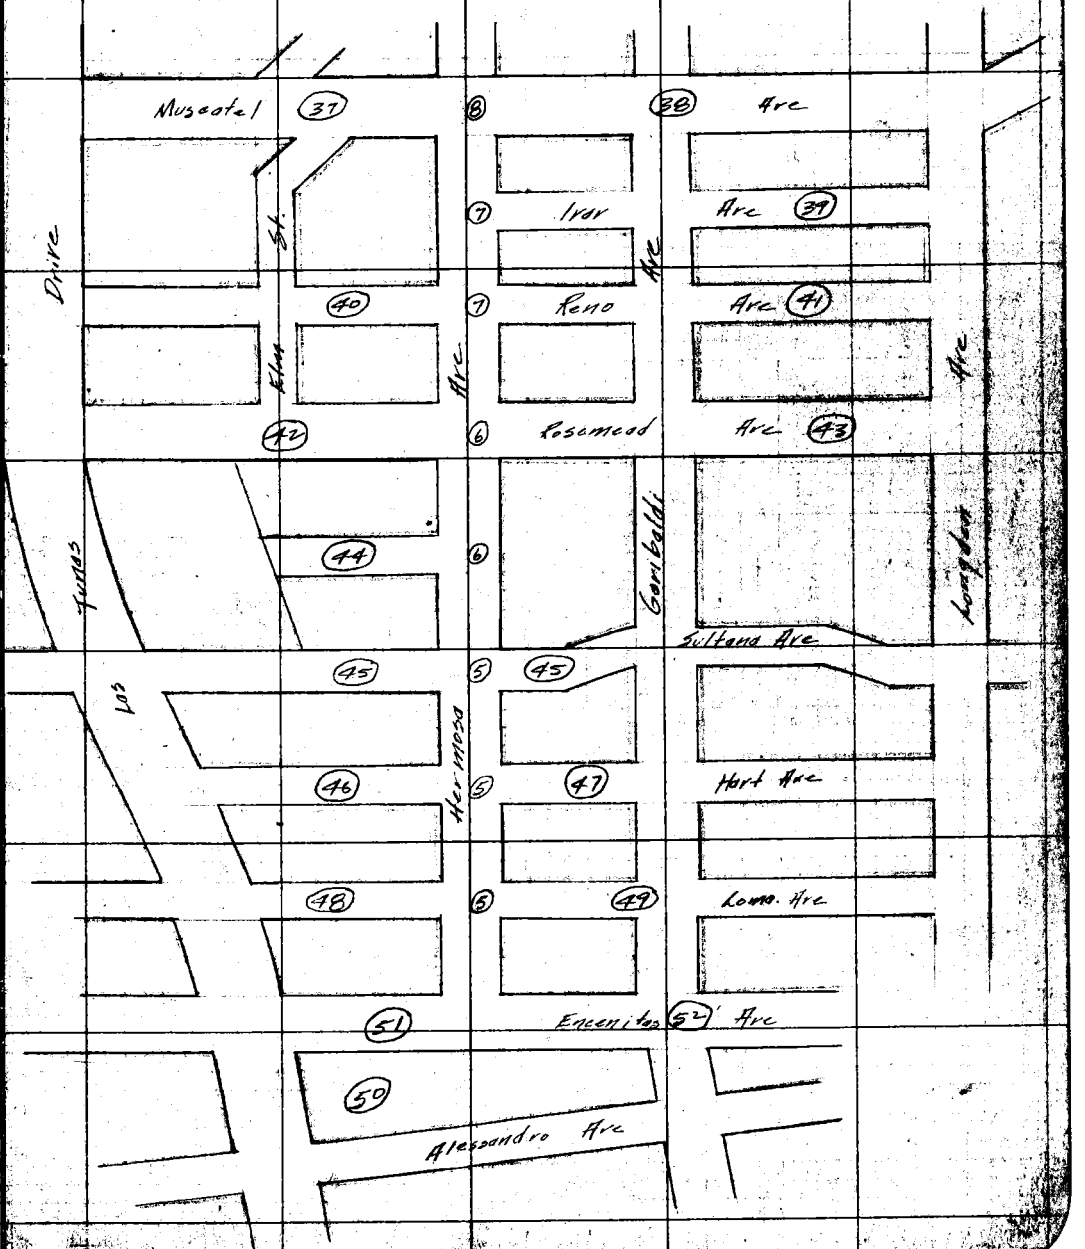

Notes: ANY ADDITIONS OR CHANGES ON THIS SHEET MUST BE MADE OR CIRCLED IN Red. WITH DATE AND NAME OF PERSON MAKING CHANGE.

Do not extend notes this side of this line

RETURN TO LOS ANGELES COUNTY SURVEYOR

F.B. 293 Pg. 2 Chief Party Notes by Rosecrans Date Oct. 4-27

Pine (22) St. (13) Santa Inez Lane

St. (23) San Gabriel (12) (24) Blvd.

Elm Charlotte (25) St. (11)

Ave Earle St. (26) (11)

Pine Elm St. (27) Ave Pine Ave

(28) Willard (11) St. (29)

Ruthey (30) (10) Ave (31) St. Hermosa Garibaldi Beverly Hampton Inez

Vista St. (32) (10) Santa

Los Tunos (9) Vista (33) St.

(34)

St. (35) Burton (9) Ave (35)

Elm (8) Bartlette St. (36)

RETURN TO
LOS ANGELES COUNTY SURVEYOR

Do not extend notes this side of this line

Note: ANY ADDITIONS OR CHANGES ON THIS SHEET MUST BE MADE OR CIRCLED IN Red. WITH DATE AND NAME OF PERSON MAKING CHANGE.

Date _____ Notes by _____ Chief Party _____ F. B. 293 PG. 3

Plotted by _____
Date _____
Map No. _____
Plotting C'k'd by _____
Date _____

W. O. No. 4140 D. S. O. No. _____
Location Hermosa Ave
Surveyed by Rosecrans
Date Oct 4 1921
Indexed C. Johnson

Notes: ANY ADDITIONS OR CHANGES ON THIS SHEET MUST BE MADE OR CIRCLED IN Red. WITH DATE AND NAME OF PERSON MAKING CHANGE.

Do not extend notes this side of this line

RETURN TO LOS ANGELES COUNTY SURVEYOR

Del Mar
Ave
Rd.
Alabama St.
Rosas
Country Club Drive
Hermosa
Ave
Longden
Las Tunas Drive
West St.
St.
California
St.
Ave
Rosas Rd.
Tract Line

F.B. 293 PG. 4 Roscerans Chief Party Notes by Date Oct. 4-27

RETURN TO
LOS ANGELES COUNTY SURVEYOR
Do not extend notes this side of this line

Notes ANY ADDITIONS OR CHANGES ON THIS SHEET MUST BE MADE OR CIRCLED IN Red. WITH DATE AND NAME OF PERSON MAKING CHANGE.

Hermosa ~~Ave.~~ Drive Survey

From intersection of ℄ of Hermosa Ave and ℄ of Del Mar Ave. in San Gabriel east to intersection of ℄ of Hermosa Ave and ℄ of Encenitas Ave.

W.O. 4140
Oct. - Nov. 1927

Party - Roscerans
Miller
Miley
Carson

Topography by MacGillivray and Party

Date _____ Notes by _____ Chief Party _____ F. B. 293 Pg. 5

Plotted by O.L. Peck
Date Dec. 1927
Map No. B-122
Plotting C'k'd by R.W. Stewart
Date Dec. 1927

W. O. No. 4140 D. S. O. No.
Location Hermosa Ave Dr.
Surveyed by Rosecrans
Date Oct. 4, 1927
Indexed by C. Johnson

Cont. bottom next page

Notes: ANY ADDITIONS OR CHANGES ON THIS SHEET MUST BE MADE OR CIRCLED IN Red. WITH DATE AND NAME OF PERSON MAKING CHANGE.

Do not extend notes this side of this line

RETURN TO LOS ANGELES COUNTY SURVEYOR

Sultana Ave

Sta 11+18.81 Set 2"x2"-12" down and S.M.&T. flush intersection of ℄ of Hermosa Ave and ℄ of Sultana Ave F.B. 293-45

0.02

Fd 2½" flush Z 168-23.9

Fd 1½" stake N.W. Cor lot 98 Tr 5905

30.59

279.47 T. 66° = 279.48

279.48

Leon or Hart

Sta 8+39.33 Intersection of ℄ of Hermosa Ave. and ℄ of Hart Ave. Set 2½"-12" down and S.M.&T. flush See P.96

0.06

Fd 2½" flush Z 168-24

417.14

Hermosa Ave

417.11 T. 72° = 417.14

Loma Ave

Sta 4+22.19 Intersection of ℄ of Hermosa Ave and ℄ of Loma Ave. Set 2½"-12" down and S.M.&T. Flush See P.98

0.09

Fd 1½" flush Z 168-24

30' 30'

422.19

422.16 T. 72° = 422.19

Sta. 0+00 to W. Ed. S.M.&T. 2" down intersection of ℄ of Hermosa Ave and ℄ of Encanita Ave See P.

F.B. 293 Pg. 6 Roscrans Chief Party Notes by Date Oct. 5-27

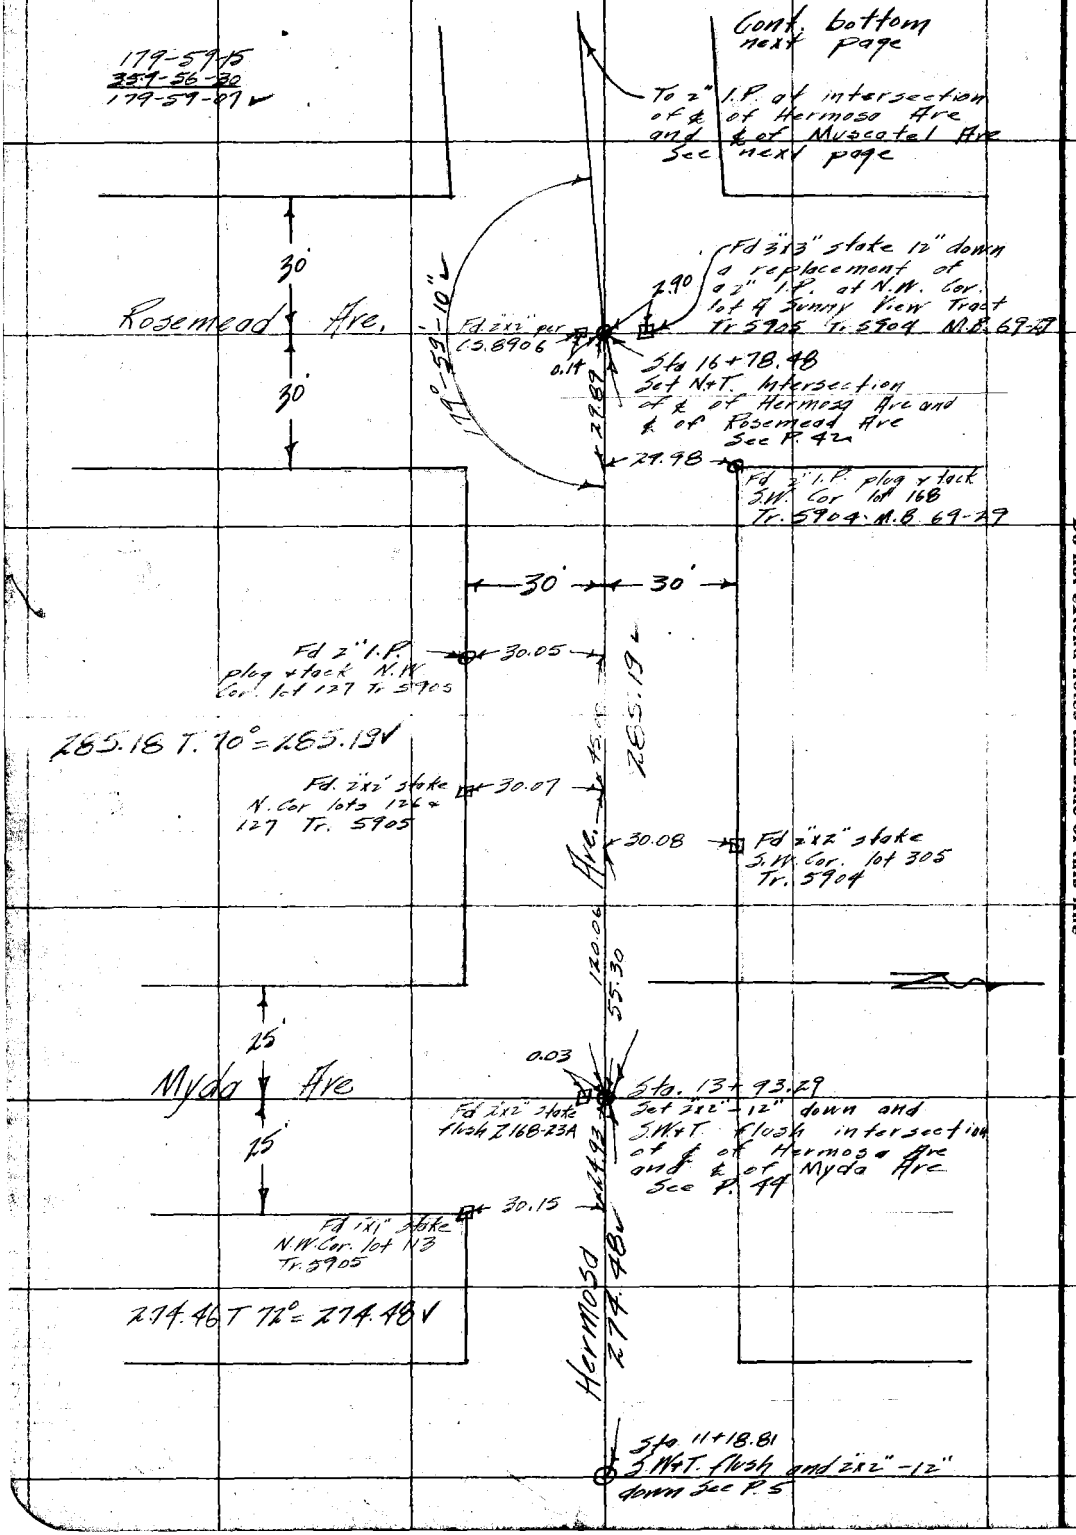

RETURN TO
LOS ANGELES COUNTY SURVEYOR
Do not extend notes this side of this line

Note: ANY ADDITIONS OR CHANGES ON THIS SHEET MUST BE MADE OR CIRCLED IN Red. WITH DATE AND NAME OF PERSON MAKING CHANGE.

Date _____ Notes by _____ Chief Party _____ F. B. 293 PG. 7

Plotted by A.L. Cook
Date Dec 1927
Map No. B-122
Plotting C'k'd by R. W. S.
Date FEB 20 1928

W. O. No. 7140 D. S. O. No. _____
Location Hermosa Ave Dr.
Surveyed by Rosecrans
Date Oct 5, 1927
Indexed A. C. Johnson

Cont. bottom next page

Muscatel Ave

Sta. 27+86.47
Intersection of ℄ of Muscatel Ave and ℄ of Hermosa Ave Fd. 2" I.P. 18" down Set 2x2" over it.
Tr. 5904

30'

Fd. 2x2" stake 29.99
N.E. Cor. lot N1
Tr 3623

370.97

370.95 T. 70° = 370.97 V

30' 30'

Fd 1x1" Stake S.E. Cor lot 113
Tr 5904 M.B. 69-29

30.09

12.27
Set N+T.
Sta. 24+28.38
12.87
Fd 2x2" flush
0.01
12.51
0.03
Fd cut Spk. W. flush
Z 168-23
12.88

Ivar Ave

25'
25'

Sta. 24+15.50
Intersection of ℄ of Ivar Ave and ℄ of Hermosa Ave Set 2x2" -12" down and S.N.T. flush See P. 39

Hermosa Ave

365.73

365.91 T. 70° = 365.93 V

25'

Sta. 20+58.44
Set N+T.
8.87
0.05
8.90
Sta. 20+49.57
Intersection of ℄ of Reno Ave and ℄ of Hermosa Ave. Set 2x2" -12" down and S.N.T. flush See P. 40

Reno Ave

25'

Fd cut Spk + W. flush
Fd cut Spk + W. flush
Z 168-23 C.S. 8906
0.06
35.96

50.01

30.05

Fd 1" I.P. Stake S.W. Cor lot 149
Tr. 5904 M.B. 69-29

Fd. 2x2" stake 29.91
3" down N.W. Cor.
lot 106 Tr. 3623

371.09

371.07 T. 72° = 371.09 V

Sta. 16+78.48
N+T. intersection of ℄ of Hermosa Ave and ℄ of Rosemead Ave

Notes ANY ADDITIONS OR CHANGES ON THIS SHEET MUST BE MADE OR CIRCLED IN Red. WITH DATE AND NAME OF PERSON MAKING CHANGE.

Do not extend notes this side of this line

RETURN TO LOS ANGELES COUNTY SURVEYOR

F.B. 293 Pg. 6 Roserans Chief Party Notes by Date Oct 8. '27

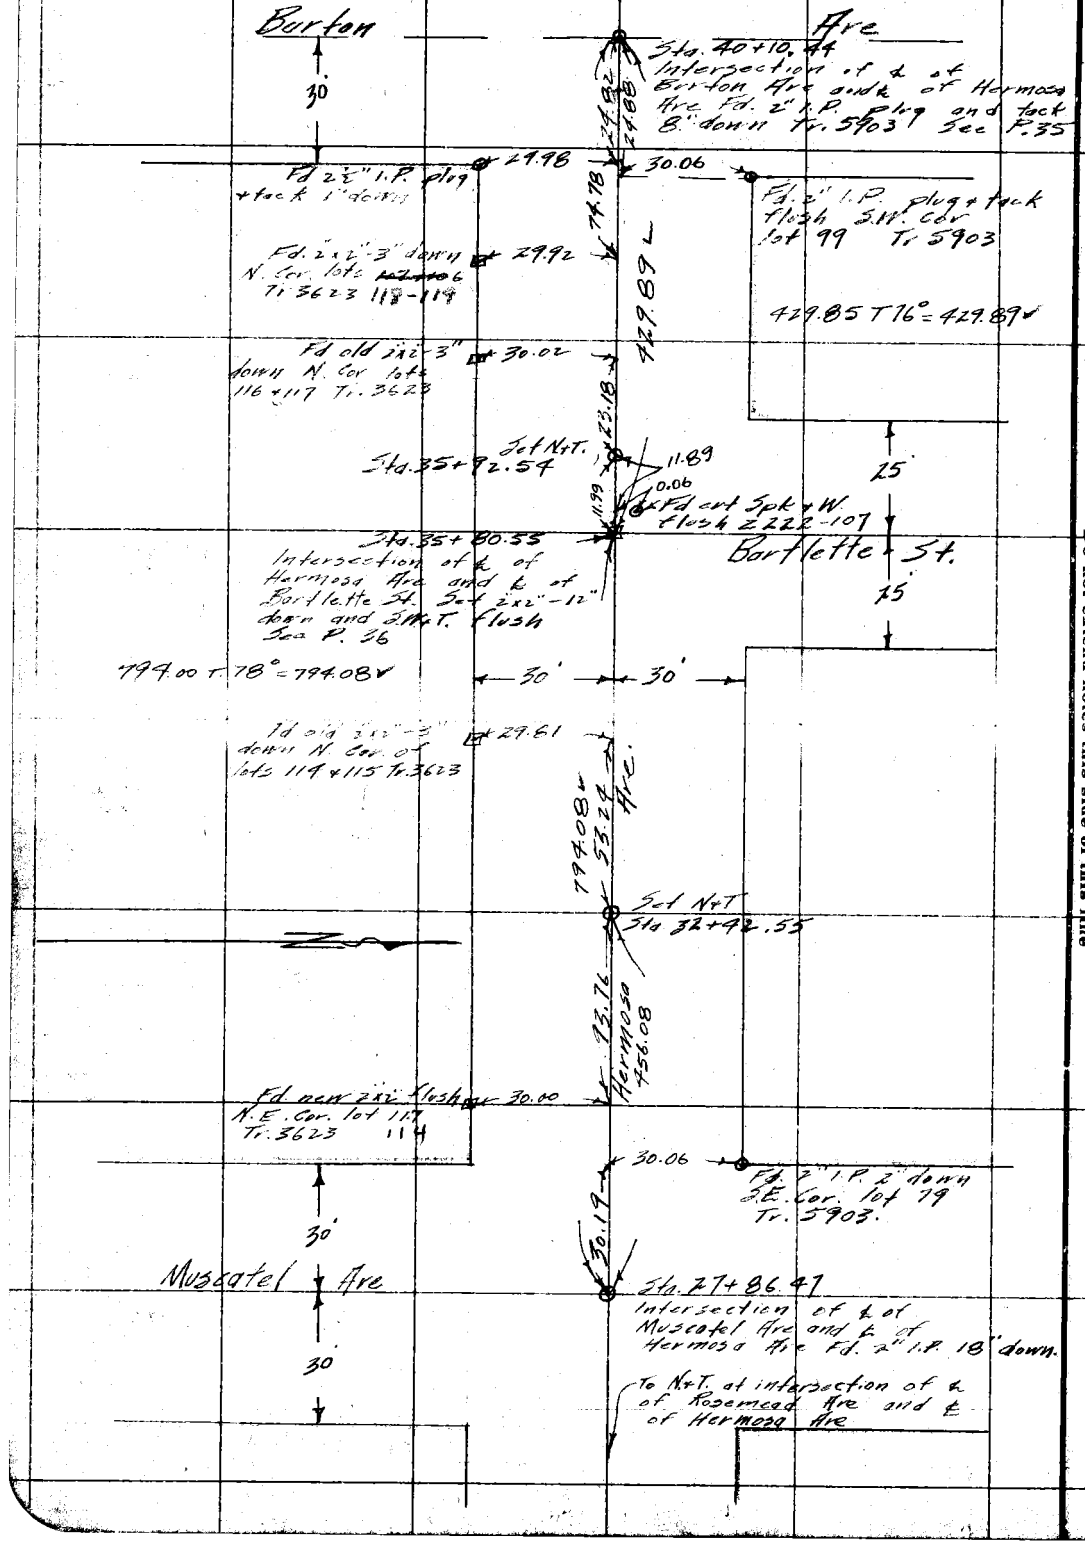

RETURN TO
LOS ANGELES COUNTY SURVEYOR

Do not extend notes this side of this line

Notes: ANY ADDITIONS OR CHANGES ON THIS SHEET MUST BE MADE OR CIRCLED IN Red. WITH DATE AND NAME OF PERSON MAKING CHANGE.

Date _____ Notes by _____ Chief Party _____ F. B. 293 PG. 9

Plotted by Cal Pratt
Date Dec 1927
Map No. B-172
Platting Ck'd by R. W. S.
Date FEB 20 1928

W. O. No. 4140 S. S. O. No.
Location Hermosa Ave Dr.
Surveyed by Rosecrans
Date Oct 6 1927
Indexed C. Johnson

Cont. bottom next page

47 | 20'

90.87 (Calc.)

V chiseled in curb

N.&T. in P. pole

Set N.&T.

42.72 39.97 2.68

44+66.69 Set S.W.&T. Flush.

Sta. 44+72.76

Sta. 44+66.7

Intersection of ℄ of Hermosa Ave and ℄ of Vista St. Set 3x2". 12" down and S.W.&T. Flush See P. 33

Vista St.

25 | 25'

32.60

V chiseled in curb

171.40 (Calc.)

Ave. 171.41

171.40 T. 68° = 171.41 ✓

Fd 2 I.P. with brass cap marked as shown 6" down

1.51 29.94

0.17 30.00 4.90

283.00

Fd 2x2" knocked over; Straightened & E Cor Lots 9+10 T. 735

Fd 2" I.P. with brass cap marked as shown 6" down

2.30

0.03

Sta 42+95.44 Intersection of ℄ of Hermosa Ave Ft. E and Sec line Set 2x2" 12" down and Flush See P. 34

Sta 42+95.36

0.08 Sec. Cor. Fd 3x3" R.W. Stake 6" down See Edison Co. Field Notes said R.B. 293-34

30' | 30'

284.97 T. 76° = 285.00 ✓

285.00 Hermosa

Fd 2" I.P. with brass cap knocked as shown 3" down

29.70

30.07

Fd 2" I.P. with brass cap Marked as shown 6" down

25.31 (Calc.)

30'

Burton Ave.

30'

Sta. 40+10.74 Intersection of ℄ of Burton Ave and ℄ of Hermosa Ave Fd 2" I.P. plug & tack 8" down See Top Page 8

To N.&T. at intersection of ℄ of Rosecrans Ave and ℄ of Hermosa Ave

Notes: ANY ADDITIONS OR CHANGES ON THIS SHEET MUST BE MADE OR CIRCLED IN Red. WITH DATE AND NAME OF PERSON MAKING CHANGE.

Do not extend notes this side of this line

RETURN TO LOS ANGELES COUNTY SURVEYOR

F.B. 293 PG. 10 Rosecrans Chief Party Notes by Date Oct. 11 27

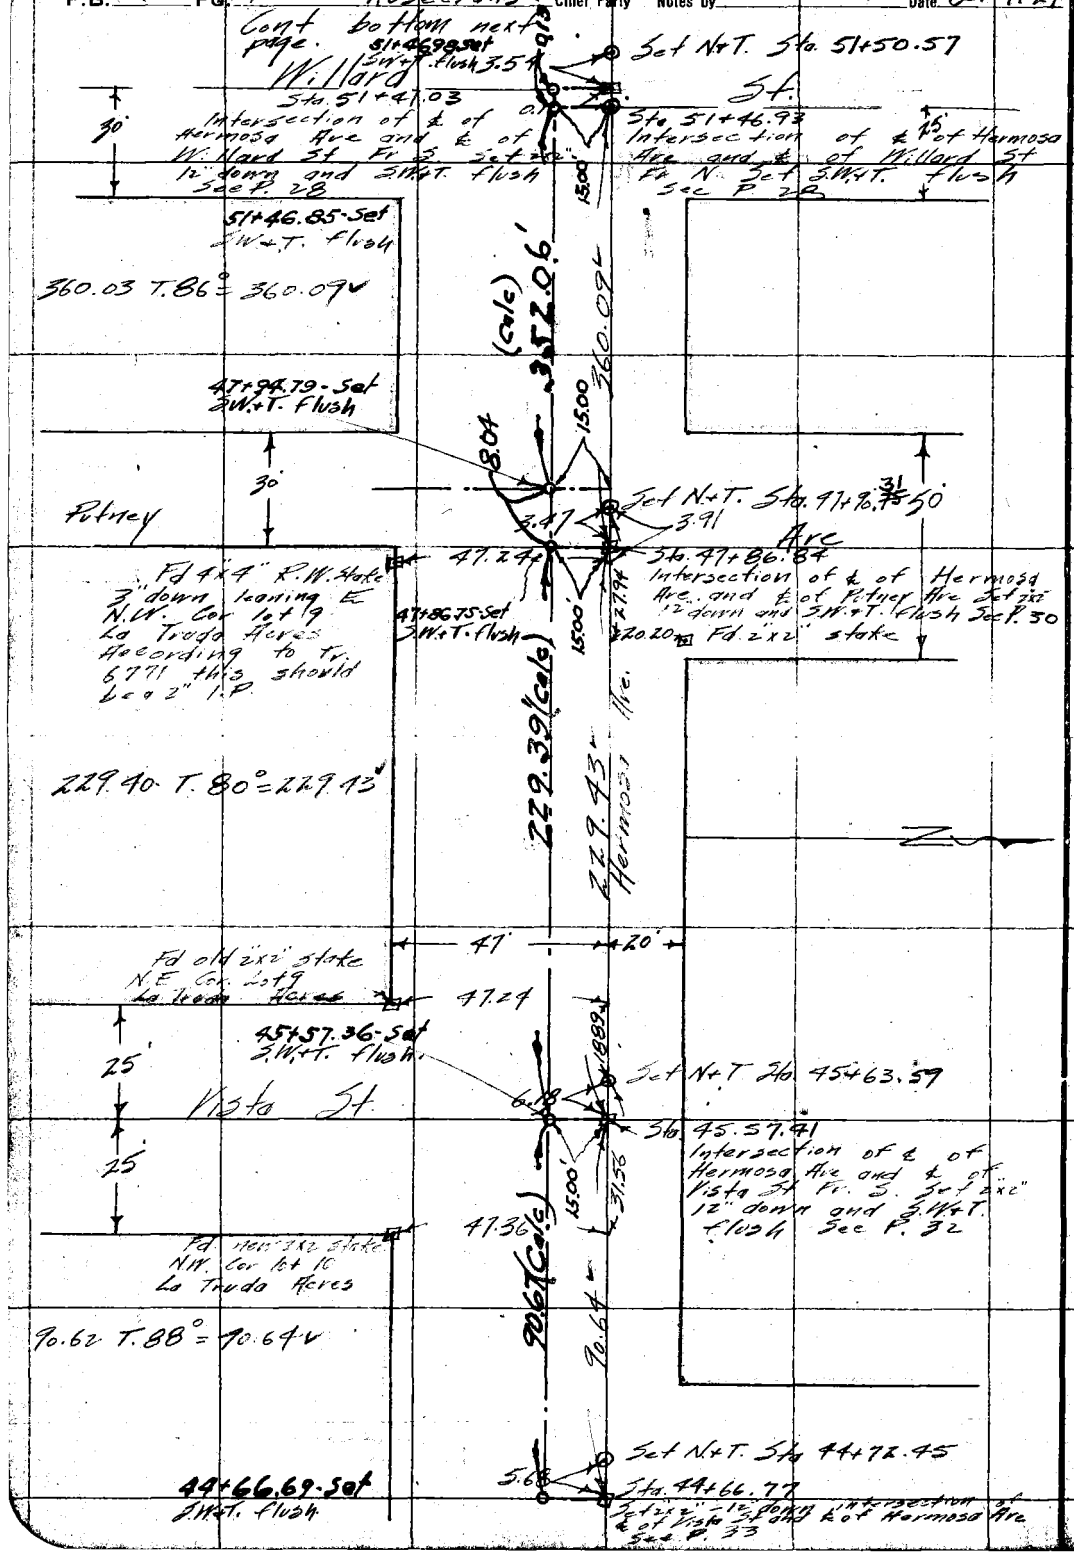

RETURN TO
LOS ANGELES COUNTY SURVEYOR

Do not extend notes this side of this line

Notes: ANY ADDITIONS OR CHANGES ON THIS SHEET MUST BE MADE OR CIRCLED IN Red. WITH DATE AND NAME OF PERSON MAKING CHANGE.

Date _____ Notes by _____ Chief Party _____ F. B. 298 PG. 11

Plotted by OL. Peaks
Date Dec. 1927
Map No. B-177
Plotting Checked by R. W.
Date FEB 20 1928

W. O. No. 4149 S. O. No. _____
Location Hermosa Ave. Bet
Surveyed by _____
Date Oct. 11 1927
Indexed C. John

Cont. bottom next page

62+27.65 Set SM.+T. flush

Set N.+T. Sta. 62+29.63

Charlotte Ave.

Ed SM.+T. flush Z 208-159 C 3.8906

Sta. 62+27.30 Intersection of ℄ of Charlotte Ave. and ℄ of Hermosa Ave. Set 2"x2" 12" down and SM.+T. flush See P. 25

Set 1/2" Sta 62+24.11

720.11 T. 74° = 720.17 ✓

55+07.08 - Set SM.+T. flush

Fd 2" I.P. 47.08

Sta. 55+07.13 Intersection of W. line of Earle St and ℄ of Hermosa Ave. Set 2"x2" - 12" down and SM.+T. flush See P. 26

Plotted on Earle St Tr. 6771

Earle St.

Set N.+T. Sta. 54+30.51

360.03 T. 90° = 360.10 ✓

Fd 2"x2" N. Cor. lot 2 & 3 Tr. 6771 — 47.31

Fd 2"x2" N. Cor. lot 3 & 4 Tr. 6771 — 47.20

Fd 2"x2" Stake Tract 6771 — 47.14

Fd 2" I.P. SW. Cor. lot 77 Tr. 7352

Fd 2"x2" N.E. Cor. Lot 6 Tr. 6771 — 47.21

51+46.98 - Set SM.+T. flush

Set N.+T. Sta. 51+50.57

Willard St.

Sta. 51+49.03 Intersection of ℄ of Hermosa Ave. and ℄ of Willard St. to S. Set 2"x2" - 12" down and SM.+T. flush See P. 26

Sta. 51+46.93 Intersection of ℄ of Hermosa Ave. and ℄ of Willard St. to N. Set SM.+T. flush See P. 26

51+46.85 - Set SM.+T. flush

Note: ANY ADDITIONS OR CHANGES ON THIS SHEET MUST BE MADE OR CIRCLED IN Red. WITH DATE AND NAME OF PERSON MAKING CHANGE.

RETURN TO LOS ANGELES COUNTY SURVEYOR

Do not extend notes this side of this line

F.B. 293 PG. 12 Roscrans Chief Party Notes by Date Oct 11-27

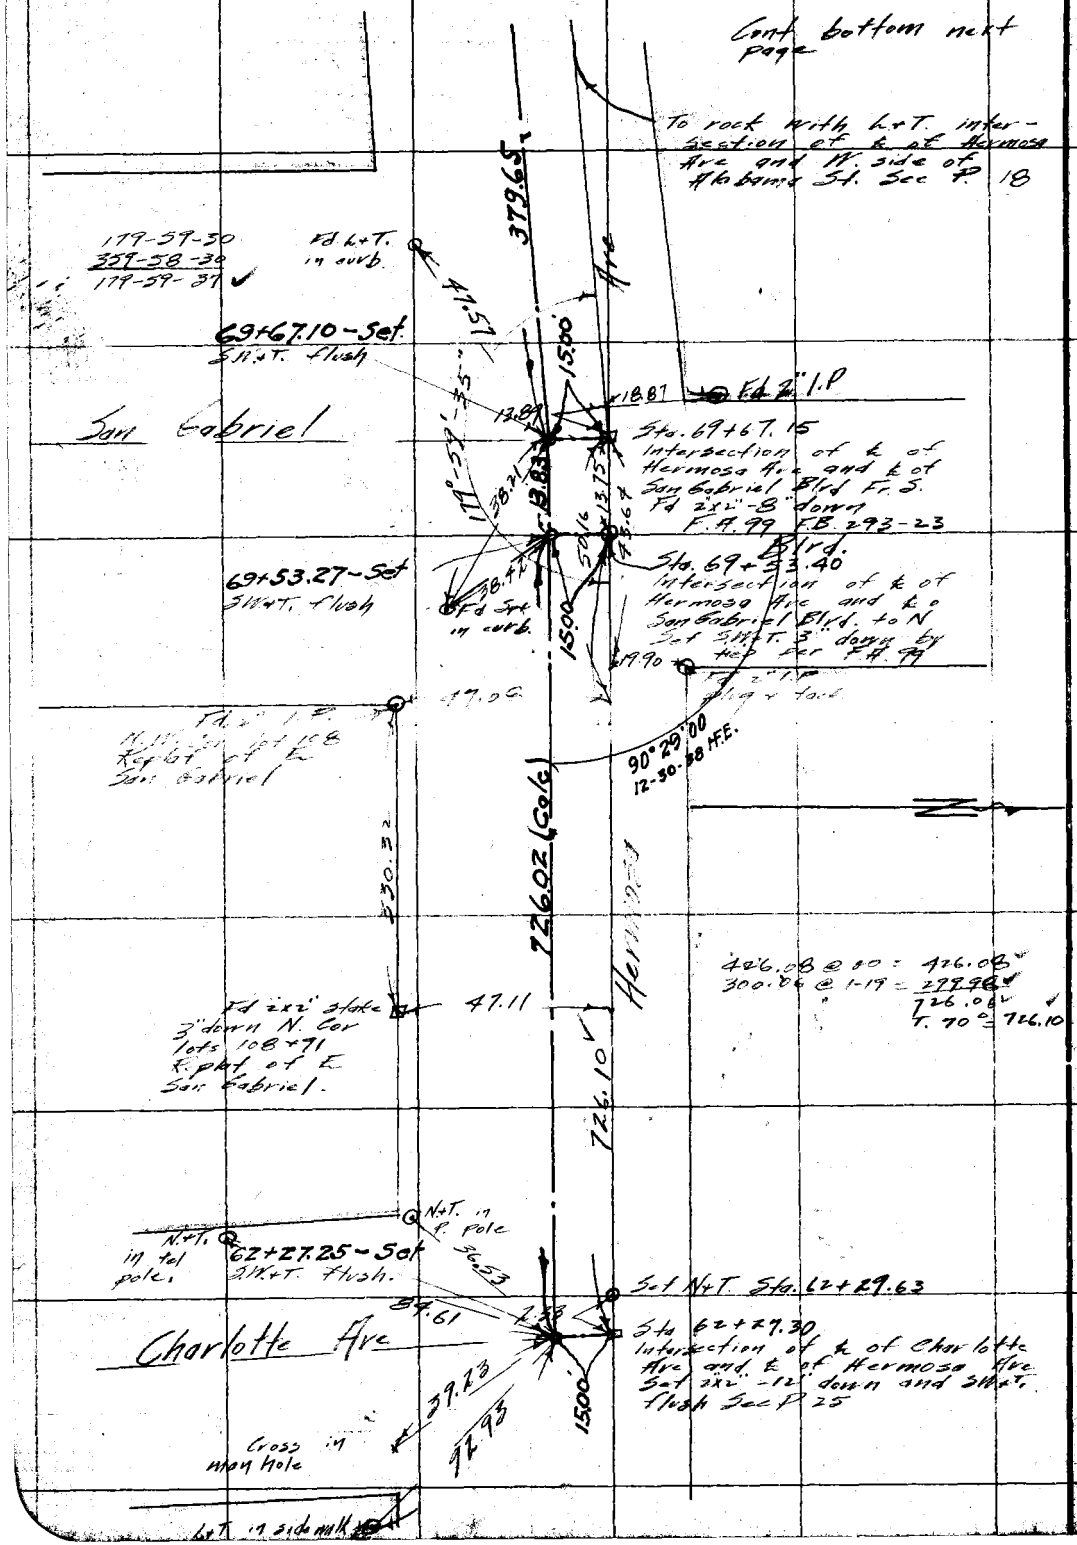

RETURN TO
LOS ANGELES COUNTY SURVEYOR
Do not extend notes this side of this line

Notes: ANY ADDITIONS OR CHANGES ON THIS SHEET MUST BE MADE OR CIRCLED IN Red. WITH DATE AND NAME OF PERSON MAKING CHANGE.

Date _____ Notes by _____ Chief Party _____ F. B. 293 PG. 13

Plotted by Chk. Check | W. O. No. 4170 | S. S. O. No. _____
Date Dec 1927 | Location Hermosa Ave Dr.
Map No. B-122 | Surveyed by Rosecrans
Planning C'mtd by R. W. S. | Date Oct. 15 1927
Date FEB 20 1928 | Indexed C. Johnson

Sta. 80 +67.73 Set M.T. Cent bottom mark
Fd 2" I.P. 19.86 3.58
Fd 2" I.P. 29.89 30' 10'
7366
361.08 T. 78° = 361.12 ✓
361.12
30'
California
Sta 77+06.61 (Calc)
Sta 77+06.30 Intersection of ℄ of Hermosa Ave and ℄ of California St. Fr N. Set 2"x2" -12" down and S.M.T. flush See P. 21
30'
Sta 77+07.34 Intersection of ℄ of Hermosa Ave and ℄ of California St Fr S Set S.M.T. flush See P. 21
Fd Spk + W. flush St.
R.R. Bridge notes
0.58
25'
25'
30.05 Fd 2"x2" stake
47' 10'
359.86 (Calc)
359.52 ✓
Hermosa Ave.
359.50 T 70° = 359.52 ✓
30'
73+46.35 - Set S.M.T. 0.10 down
1500
Set N.T. Sta. 73+57.21 10.43
Pine St.
30'
Sta 73+46.78 Intersection of ℄ of Hermosa Ave and ℄ of Pine St. Set 2"x2" -12" down and S.M.T. flush See P. 22
24.46
Fd new 2"x2" stake 29.95
379.61 T. 70° = 379.63 ✓
379.65 (Calc)
379.63
15.00
Set S.M.T. flush
Sta. 69+67.15 Intersection of ℄ of Hermosa Ave and ℄ of San Gabriel Blvd to S Fd 2"x2" See P. 12

RETURN TO LOS ANGELES COUNTY SURVEYOR

Notes: ANY ADDITIONS OR CHANGES ON THIS SHEET MUST BE MADE OR CIRCLED IN Red. WITH DATE AND NAME OF PERSON MAKING CHANGE.

Do not extend notes this side of this line

F.B. 293 Pg. 19 Rosecrans Chief Party Notes by Date Oct 13-27

Cont. bottom next page.

179-59-30
359-58-30
179-59-37 ✓

To lock with L.n.T. in Intersection of ℄ of Hermosa Ave and ℄ of Del Mar. See P. 15

Alabama St.

Sta. 91+18.78 41
Intersection of ℄ of Hermosa Ave and W. side of Alabama St. Fd rock with L.n.T. 18' down M.B. 7-146 R.D. Bridge notes.

30'

8.78
Set N.n.T.

Sta. 91+09.

119°59'35"

300.00 T. 82° = 300.07 ✓
142.62 T. 88° = 142.64 ✓
442.68 ✓

Ave 442.68

Fd. 2"x2" stake 29.79

20.92 Fd x in sidewalk S.E. Cor lot 15 M.B. 7-146

Set N.n.T. Sta. 86+75.~~77~~ 73 25'

1.18

Sta. 86+71.~~77~~ 53
Intersection of ℄ of Hermosa Ave and ℄ of Country Club Drive Set 2"x2" 12" down and SM n.T. flush See P. 19

Country Club Drive 25'

Hermosa 401.66

20' 20'

401.62 T. 78° = 401.66 ✓

Fd ½" I.P. bent over tied in base of it 28.51

8.30
1.5

4.06

Sta. 82+73.76
Intersection of ℄ of Hermosa Ave and W side West St. Set 2x2"-12" down and SM n.T. flush See P. 20

92
Set N.n.T. Sta. 82+66.61

30'

West St.

Fd 2" I.P. plug + tack Set for N.W. Cor lot 125 by Wright Eng. Co. of San Gabriel

29.84

206.32 T. 78° = 206.34 ✓

206.39

30' 10'

N.n.T. Sta. 80+67.42

RETURN TO
LOS ANGELES COUNTY SURVEYOR
Do not extend notes this side of this line

Notes: ANY ADDITIONS OR CHANGES ON THIS SHEET MUST BE MADE OR CIRCLED IN Red. WITH DATE AND NAME OF PERSON MAKING CHANGE.

Date _____ Notes by _____ Chief Party _____ F. B. 293 PG. 15

Plotted by O.L.Peek
Date Dec 1927
Map No. B-127
Plotting C'k'd by R. W. S.
Date FEB 20 1928

W. O. No. 4180 D. S. O. No.
Location Hermosa Ave. Dr.
Surveyed by Rosecrans
Date Oct 13 1927
Indexed with C. Johnson

LOS ANGELES

Notes: ANY ADDITIONS OR CHANGES ON THIS SHEET MUST BE MADE OR CIRCLED IN Red. WITH DATE AND NAME OF PERSON MAKING CHANGE.

Do not extend notes this side of this line

RETURN TO LOS ANGELES COUNTY SURVEYOR

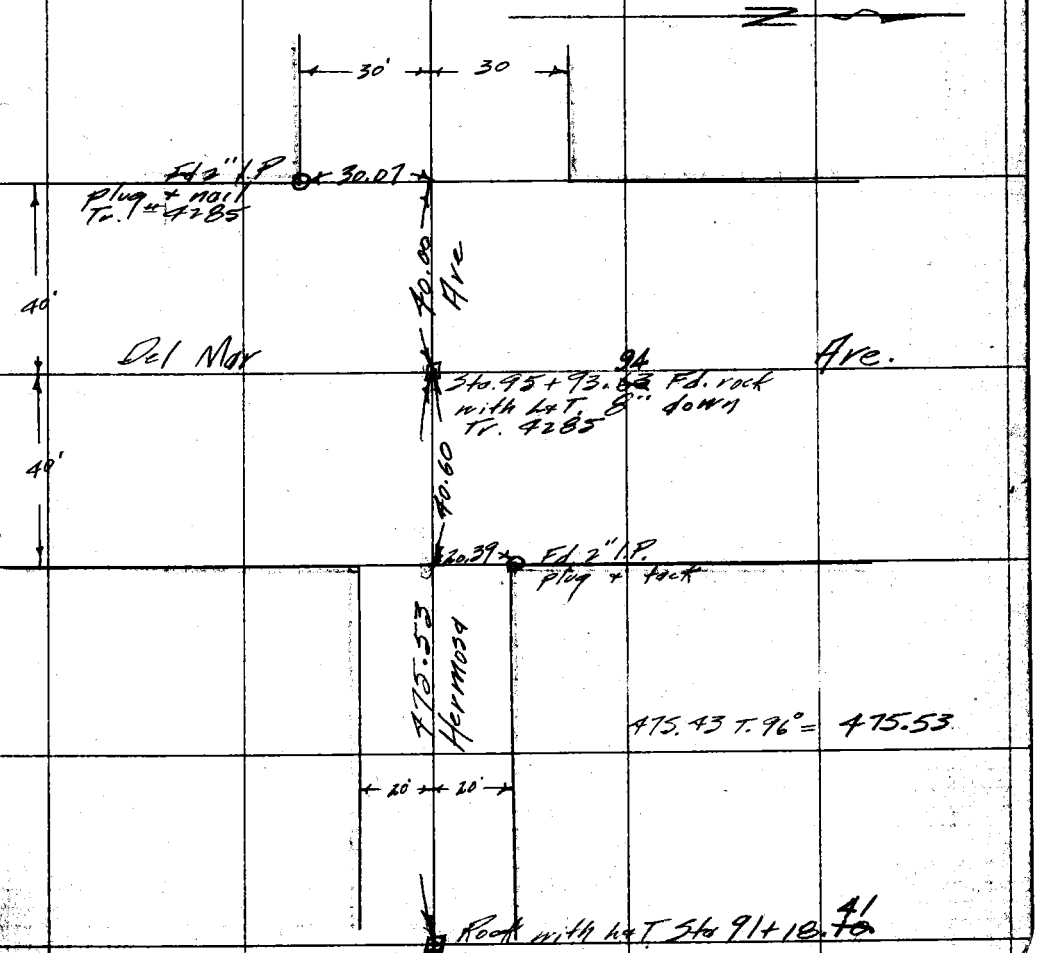

F.B. 293 Pg. 16 Chief Party Notes by Rozecrans Date Oct. 18-27

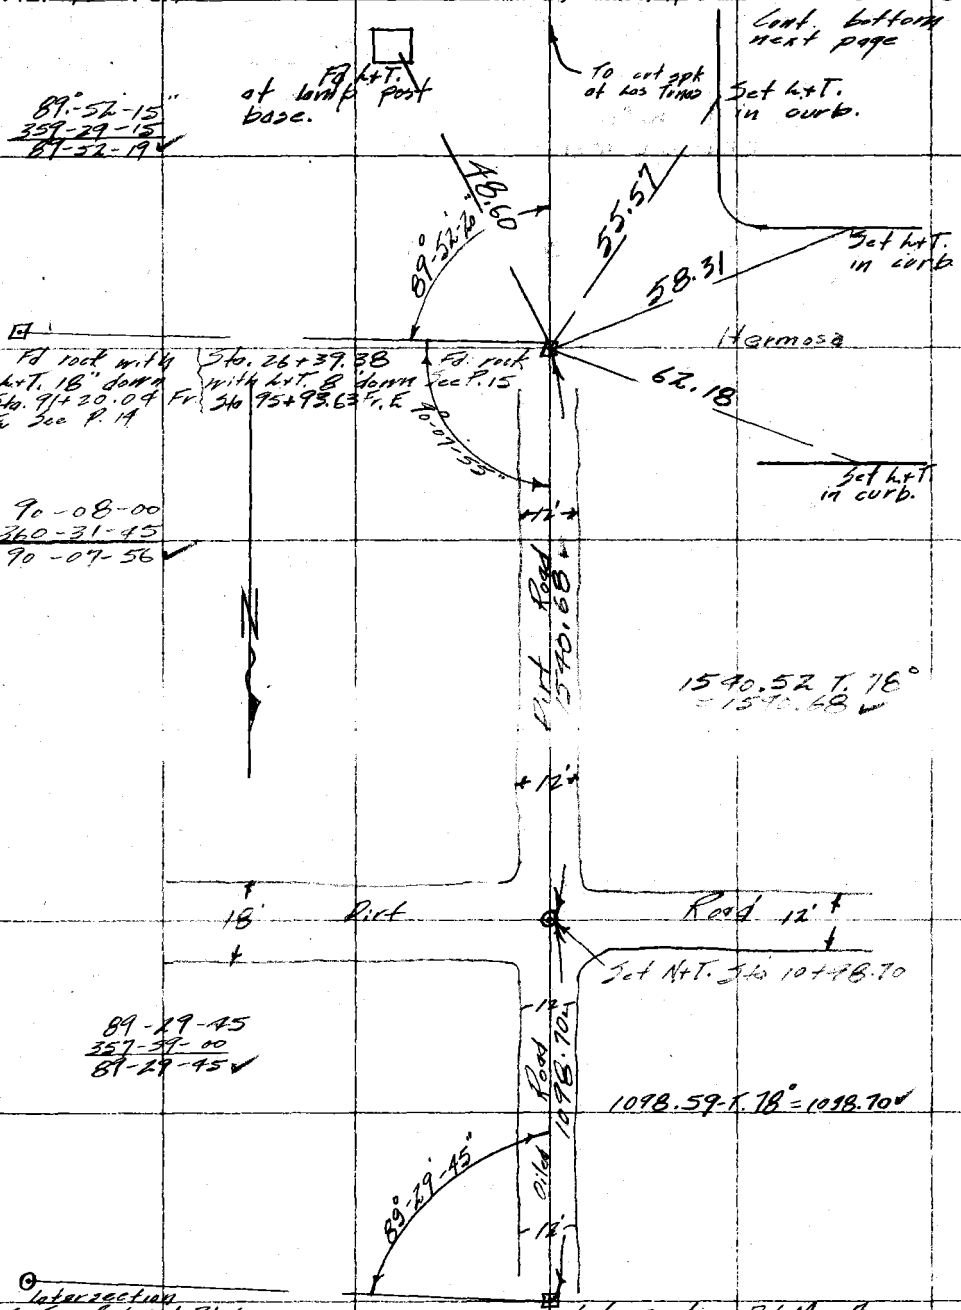

RETURN TO
LOS ANGELES COUNTY SURVEYOR
Do not extend notes this side of this line

Notes: ANY ADDITIONS OR CHANGES ON THIS SHEET MUST BE MADE OR CIRCLED IN Red. WITH DATE AND NAME OF PERSON MAKING CHANGE.

Date _____ Notes by _____ Chief Party _____ F. B. 293 PG. 17

Plotted by O.L. Peak
Date Dec 1927
Map No. B-122
Plotting C'kd by R. W. S.
Date FEB 20 1928

W. O. No. 4140 O. S. O. No.
Location Hermosa Ave Dr.
Surveyed by Rozecrans
Date Oct 19, 27
Indexed C. Johnson

Notes: ANY ADDITIONS OR CHANGES ON THIS SHEET MUST BE MADE OR CIRCLED IN Red. WITH DATE AND NAME OF PERSON MAKING CHANGE.

Do not extend notes this side of this line

RETURN TO LOS ANGELES COUNTY SURVEYOR

Sta 39+05.79
Fd. Cut Spk & S side Las Tunas Tr. 7720

Las Tunas Blvd

14'

72'

66'

4'

Set N&T. Sta 34+24.98

40.02 → Fd. 2" I.P. plug + tack S.E. Cor. Lot #94 Tr. 4285

Ave

387.91 T 80° = 387.96'

387.96'

1266.41'

1266.26 T-80° = 1266.41 ✓

Fd 2" I.P. ← 43.00

16.61

Fd 2" I.P. ← 40.00

Plug + tack N.W. Cor. Lot 1 Tr. 7720

Set N&T. Sta. 30+37.02

40' 40'

397.59 T 80° = 397.64'

Del Mar

40.10 → Fd. 2" I.P. plug + tack

30'

20'

Hermosa

20'

Rock with N&T. 8" down Sta 26+39.38

Ave

30'

F.B. 293 Pg. 16 Chief Party Notes by Rozecrans Date Oct 18-21

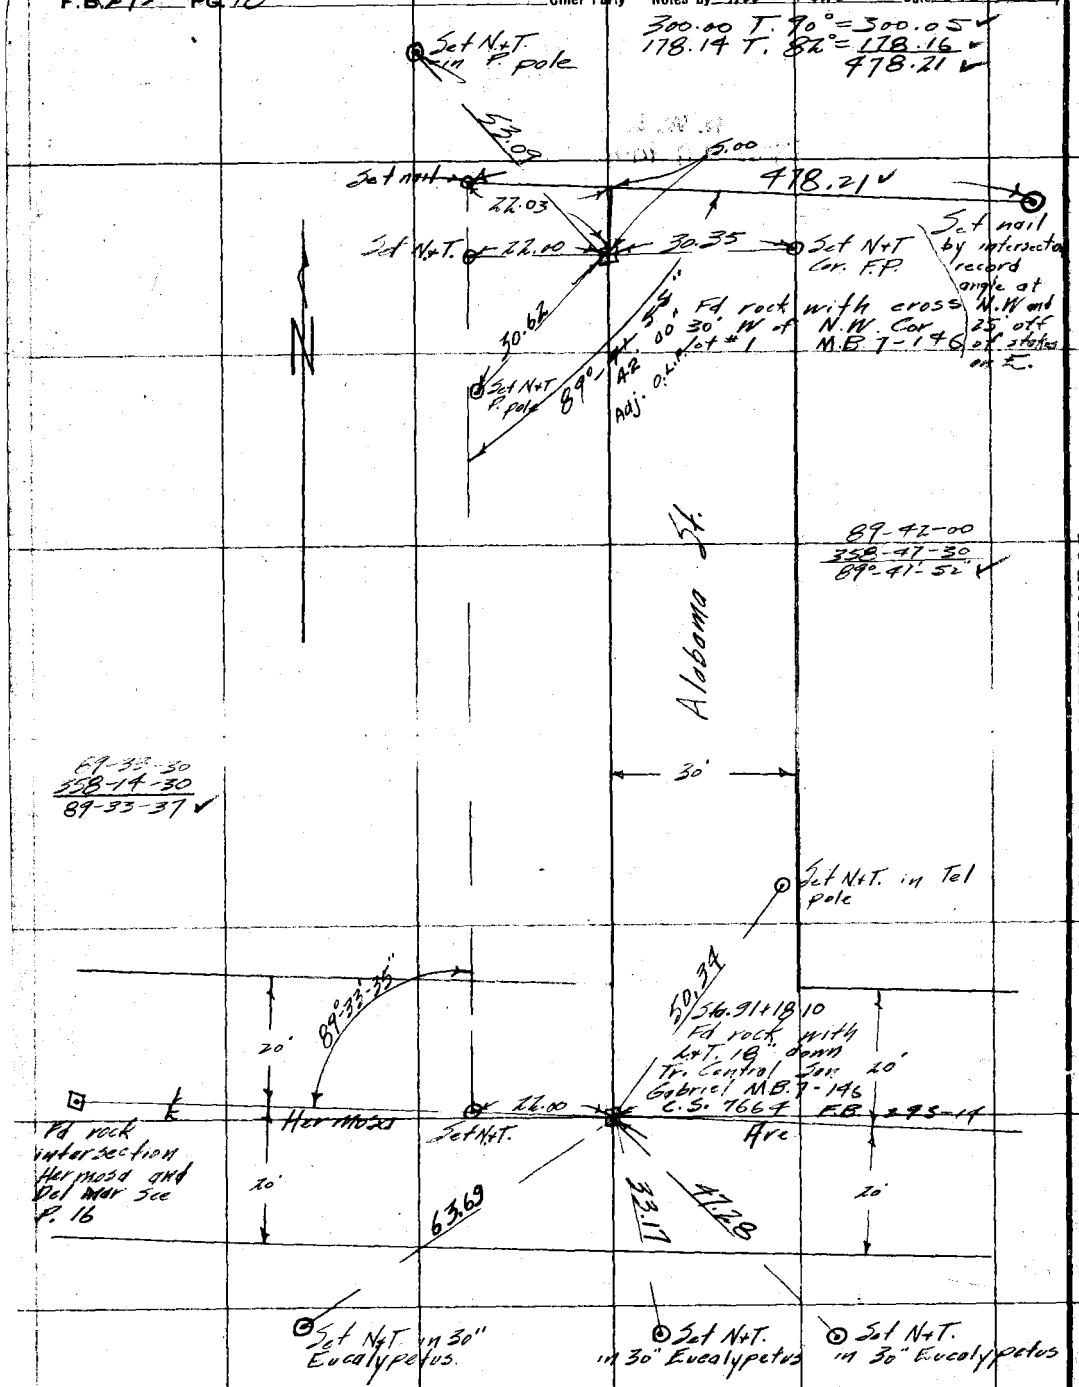

RETURN TO
LOS ANGELES COUNTY SURVEYOR
Do not extend notes this side of this line

Note: ANY ADDITIONS OR CHANGES ON THIS SHEET MUST BE MADE OR CIRCLED IN Red. WITH DATE AND NAME OF PERSON MAKING CHANGE.

Date _____ Notes by _____ Chief Party _____ F. B. 293 Pg. 19

Plotted by	W. O. No. 5140 D. S. O. No.
Date Dec 1927	Location Hermosa Ave Dr
Map No. B-122	Surveyed by Roscrans
Plotting C'k'd by	Date Oct 31, 1927
Date FEB 20 1928	Indexed by C. Johnson

Notes. ANY ADDITIONS OR CHANGES ON THIS SHEET MUST BE MADE OR CIRCLED IN Red. WITH DATE AND NAME OF PERSON MAKING CHANGE.

RETURN TO LOS ANGELES COUNTY SURVEYOR

Do not extend notes this side of this line

Set nail
22.03
5.00
178.21
Set nail Sta 15+18.97 See P. 18
58.66
5.80
Set N+T. in 8" bottle tree
14.78
Set S.W+T.
Fd rock with X cross 30 W of NW. Cor lot 1 M.B. 7-196 See P. 18
Sta. 15+13.97 — 25' E of N.E. Cor lot #1 M.B. 7-196
89-57-00
259-48-00
89-57-00
Country Club Dr.
25'
25'
300.00 T. 86° =
300.00 T. 86° =
300.00 T. 86° =
300.00 T. 86° =
18.74 T. 82° =
1200.19 W
300.04 W
1500.23 W
18.74 W
1518.97 W
Fd 2x2 stake E Cor. Lots 8+7 M.B. 7-196
24.98
7+20.97
Fd 2x2 stake E Cor Lots 9+10 M.B. 7-196
24.96
6+20.98
89-54-30
259-36-00
89-54-30
Fd 2x2 stake E Cor Lots 13+14 M.B. 7-196
25.02
2+21.00
Fd 2x2 stake E Cor Lots 14+15 M.B. 7-196
24.94
1+20.93
Fd cross in sidewalk S.E. Cor Lot 15 MB 7-196
35" Adj. ol. 9
25.00
Set N+T. in F.P.
89°54'30"
32.62
45.54
20
20'
20'
Hermosa
Ave
Fd N+T. Sta 86+75.42 See P. 14
4.18
Sta 0+00 to N Sta 86+71.24
Set 2x2 -12" down and S.W+T. at surface
To rock with X+T. at Hermosa + Alabama See P.
Set N+T. in 30" Eucalyptus
Set N+T. in 30" Eucalyptus

F.B. 293 PG. 20 Chief Party Notes by Rosecrans Date Oct. 21-27

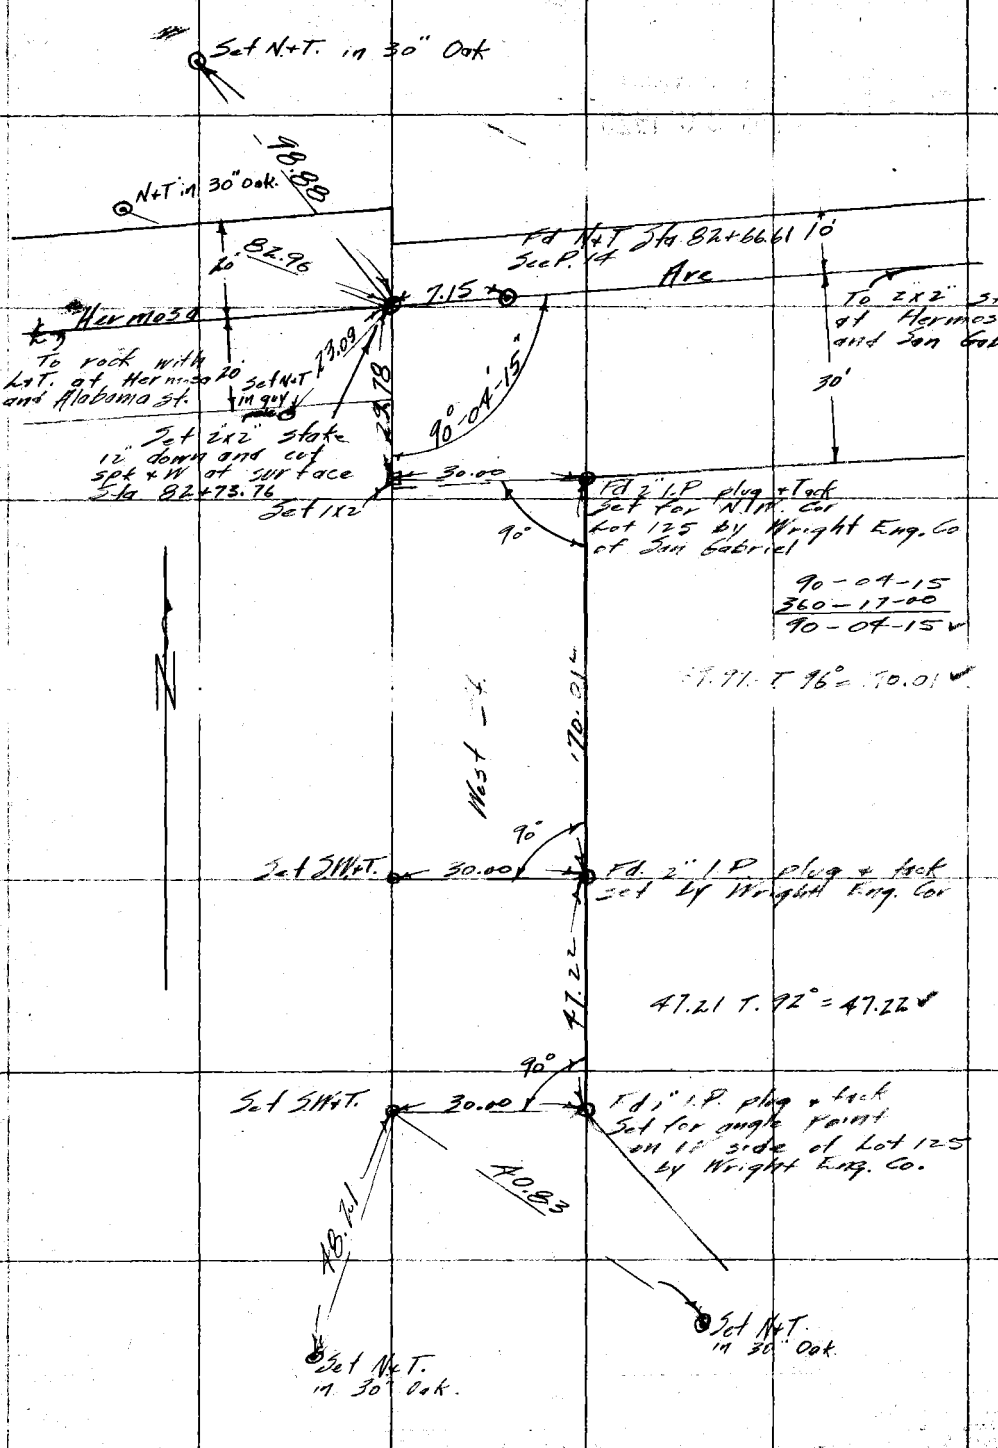

RETURN TO
LOS ANGELES COUNTY SURVEYOR
Do not extend notes this side of this line

Note: ANY ADDITIONS OR CHANGES ON THIS SHEET MUST BE MADE OR CIRCLED IN Red. WITH DATE AND NAME OF PERSON MAKING CHANGE.

Date _____ Notes by _____ Chief Party _____ F. B. 293 PG. 21

Plotted by AL Peck
Date Dec-1927
Map No. B-122
Plotting C'k'd by R. W. S.
Date FEB 20 1928

W. O. No. 4140 D. S. O. No. _____
Location Hermosa Ave Dr.
Surveyed by Rosecrans
Date Oct. 24, 1927
Indexed A. C. Johnson

Notes ANY ADDITIONS OR CHANGES ON THIS SHEET MUST BE MADE OR CIRCLED IN Red. WITH DATE AND NAME OF PERSON MAKING CHARGE.

Do not extend notes this side of this line

RETURN TO LOS ANGELES COUNTY SURVEYOR

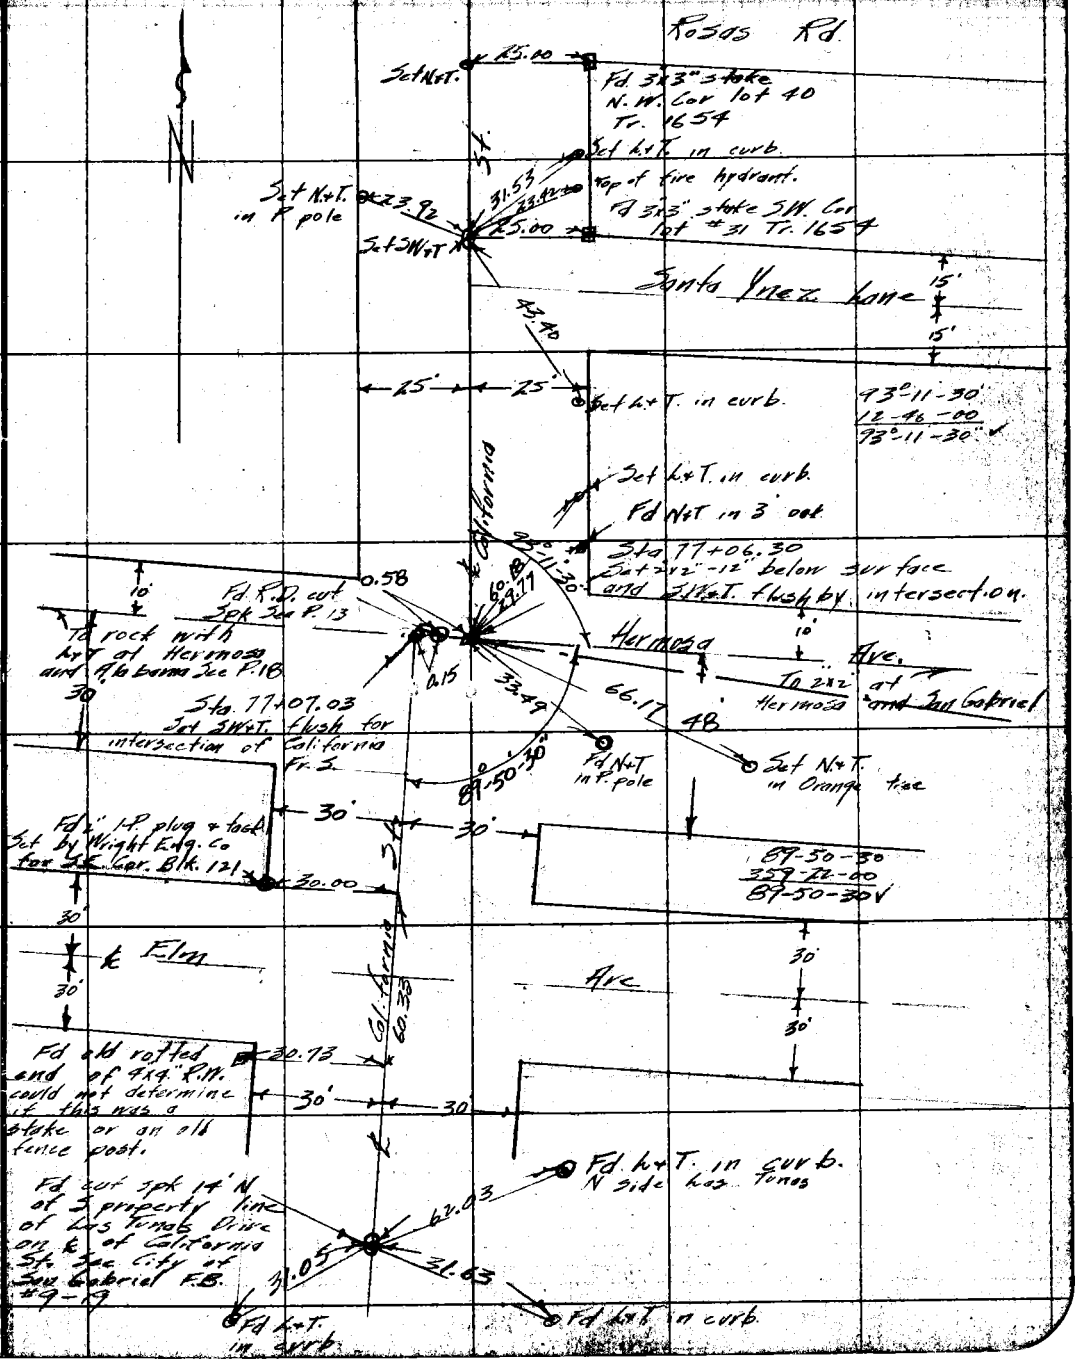

F.B. 293 PG. 22 Chief Party Notes by Rosecrans Date Oct 25-27

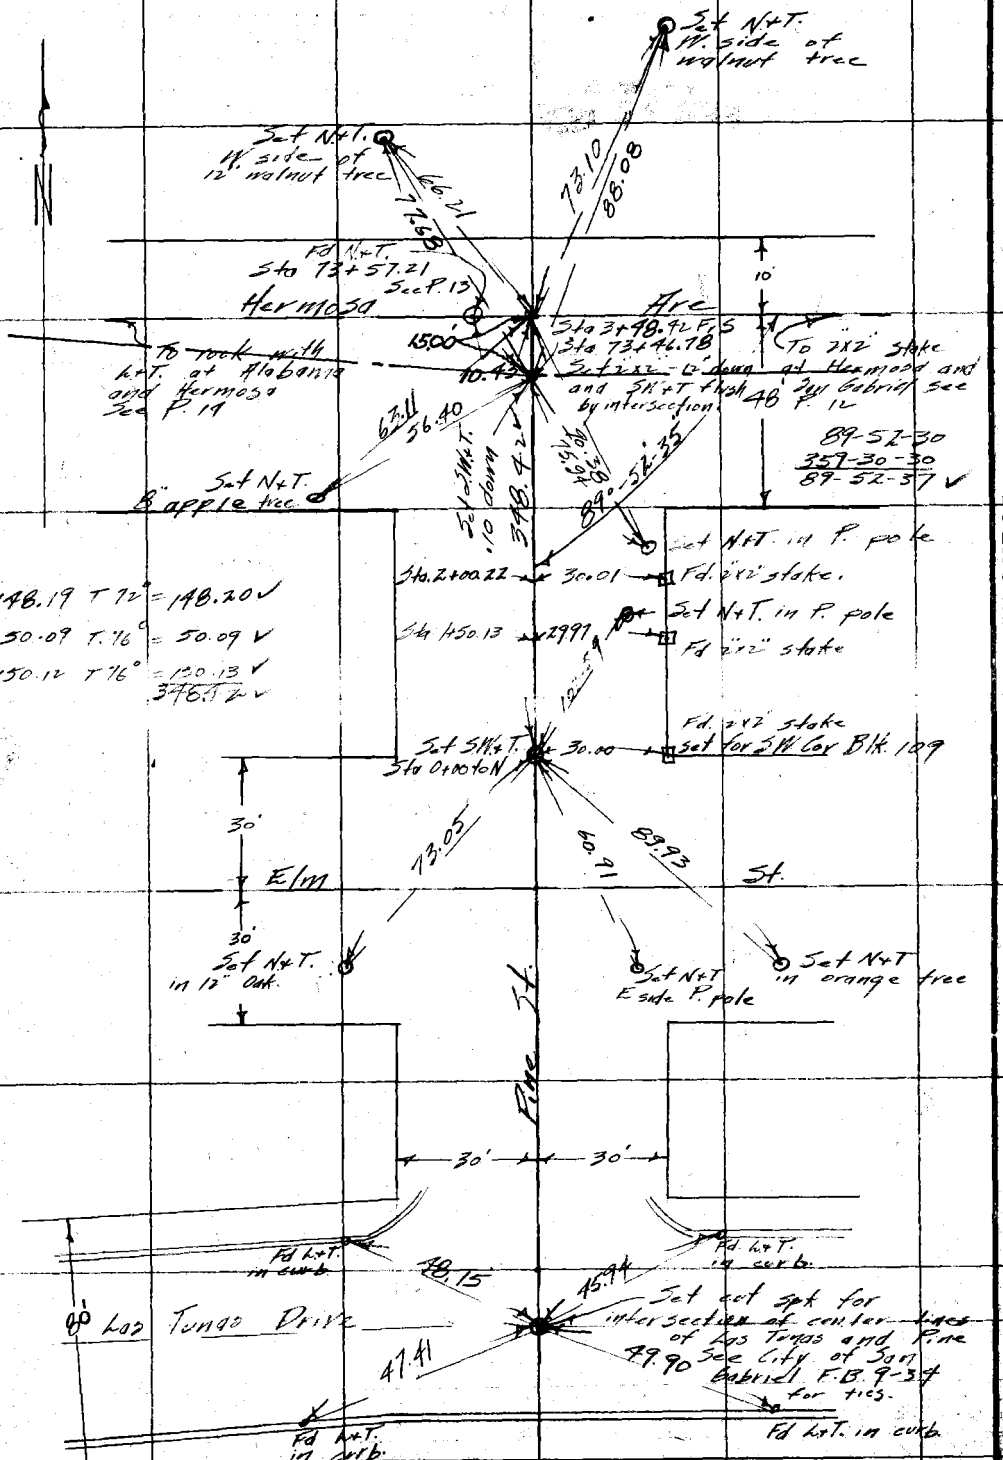

RETURN TO
LOS ANGELES COUNTY SURVEYOR
Do not extend notes this side of this line

Notes: ANY ADDITIONS OR CHANGES ON THIS SHEET MUST BE MADE OR CIRCLED IN Red. WITH DATE AND NAME OF PERSON MAKING CHANGE.

Date _____ Notes by _____ Chief Party _____ F. B. 293 Pg. 23

Plotted by W. Peck
Date Dec 1927
Map No. B-172
Plotting Checked by W. W. S.
Date FEB 20 1928

W. O. No. 8190 D. S. O. No.
Location Hermosa Ave Dr
Surveyed by Rosecrans
Date Oct 26 (27)
Indexed A. C. Johnson

Cont. bottom next page

90-29-00
360-59-15
90-59-45

90°29'
361°58'

Notes: ANY ADDITIONS OR CHANGES ON THIS SHEET MUST BE MADE OR CIRCLED IN Red. WITH DATE AND NAME OF PERSON MAKING CHANGE.

RETURN TO LOS ANGELES COUNTY SURVEYOR

Do not extend notes this side of this line

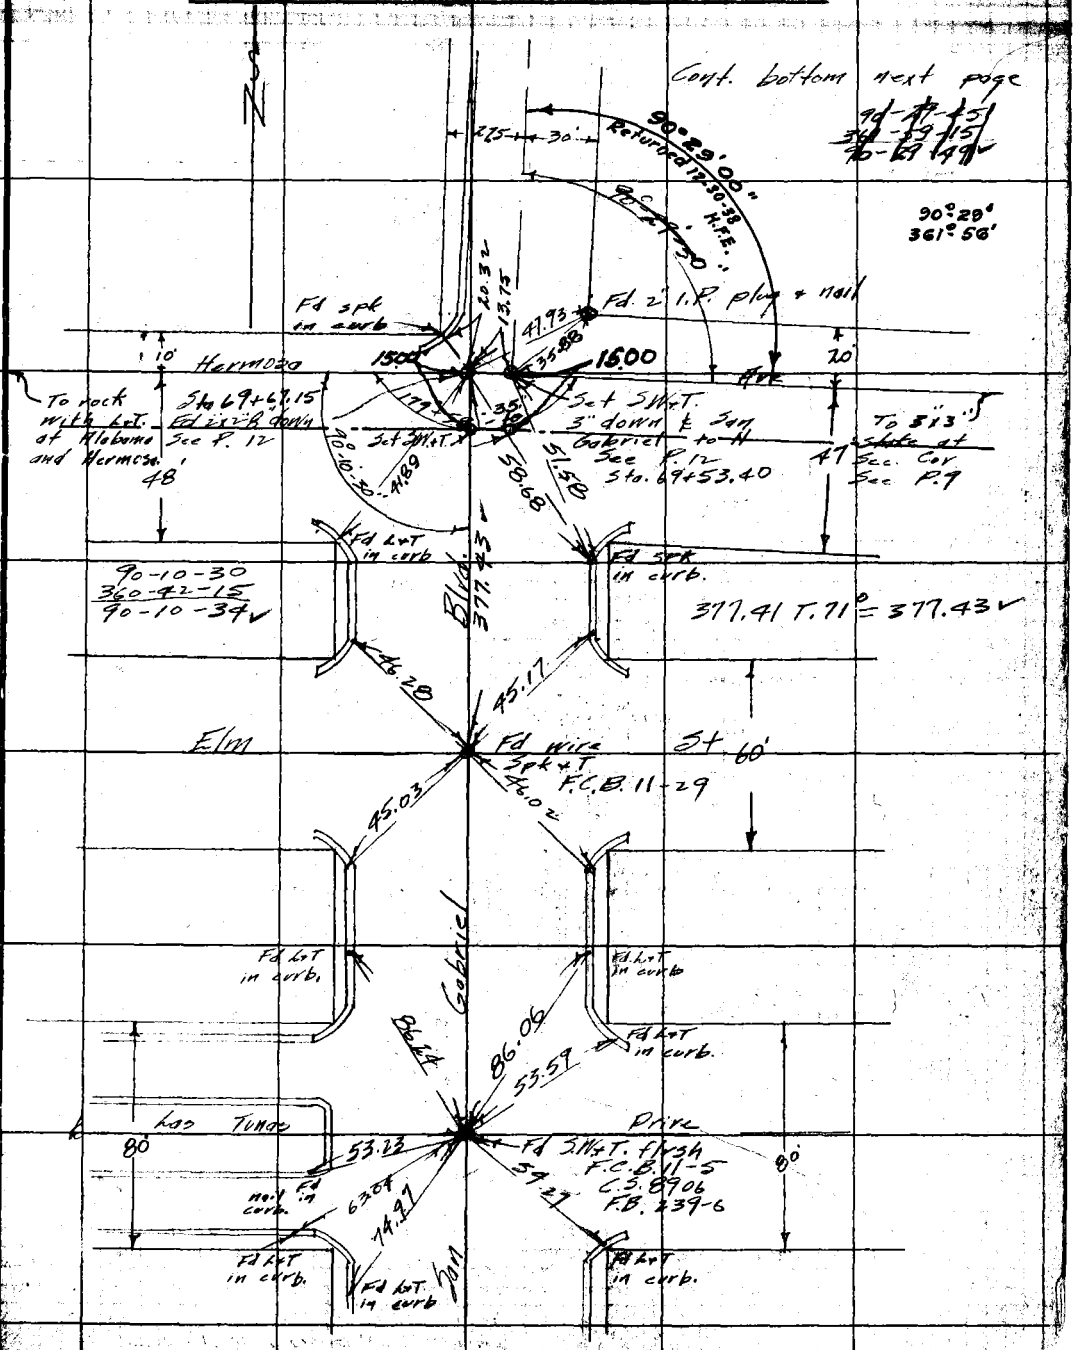

F.B. 293 Pg. 24 Chief Party Notes by Foscrams Date Oct. 28-27

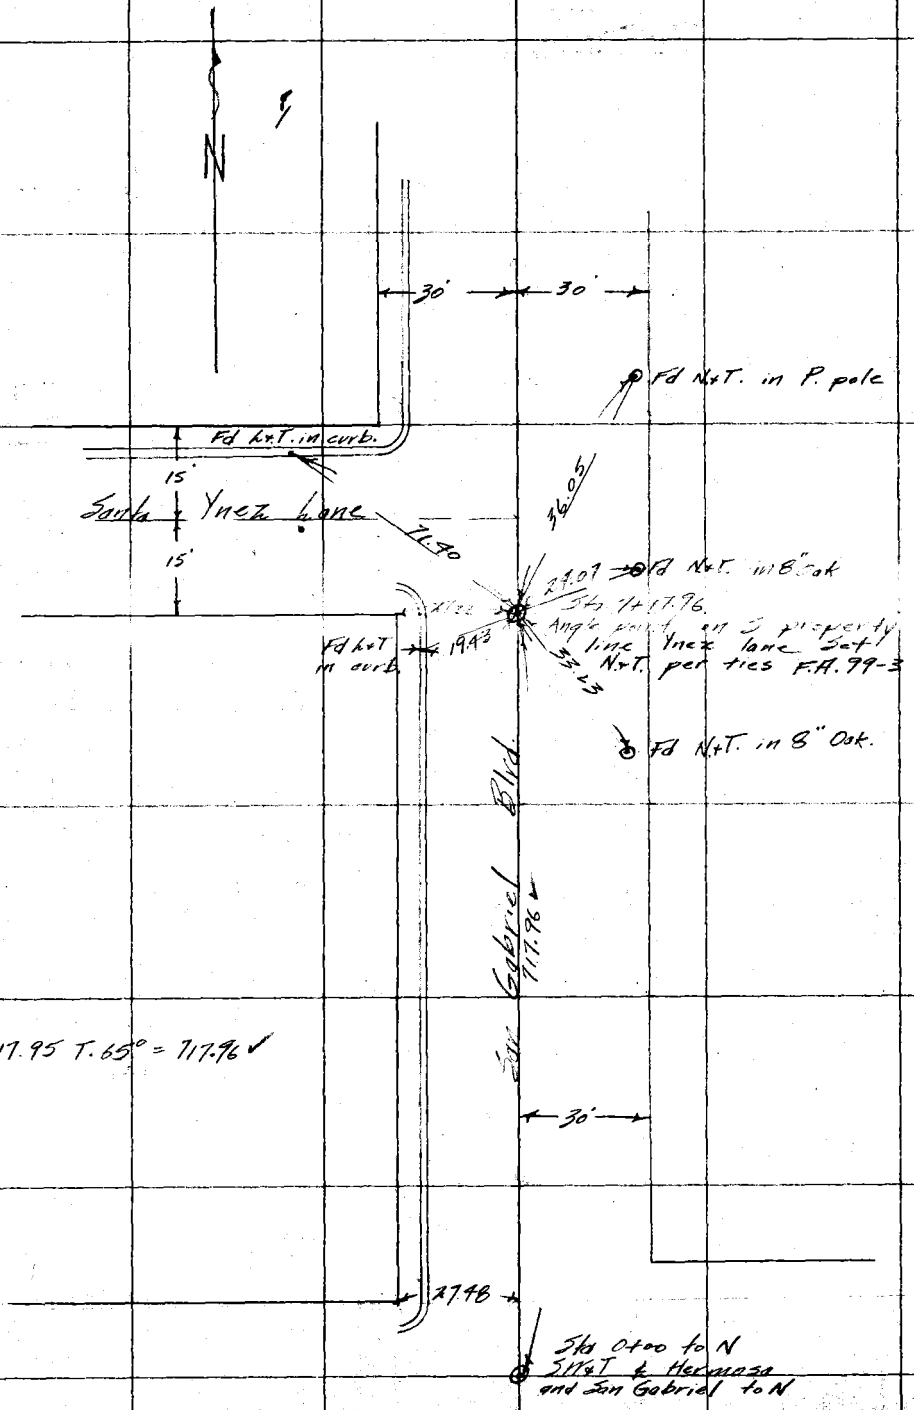

RETURN TO
LOS ANGELES COUNTY SURVEYOR
Do not extend notes this side of this line

Notes: ANY ADDITIONS OR CHANGES ON THIS SHEET MUST BE MADE OR CIRCLED IN Red. WITH DATE AND NAME OF PERSON MAKING CHANGE.

Date _____ Notes by _____ Chief Party _____ F. B. 293 Pg. 25

Plotted by AC Pmch
Date Dec 1927
Map No. 8-122
Plotting C'k'd by R. W. S.
Date FEB 20 1928

W. O. No. 7140 D. S. O. No.
Location Hermosa Ave Dr.
Surveyed by Rosecrans
Date Oct. 28, 1927
Indexed A. C. Johnson

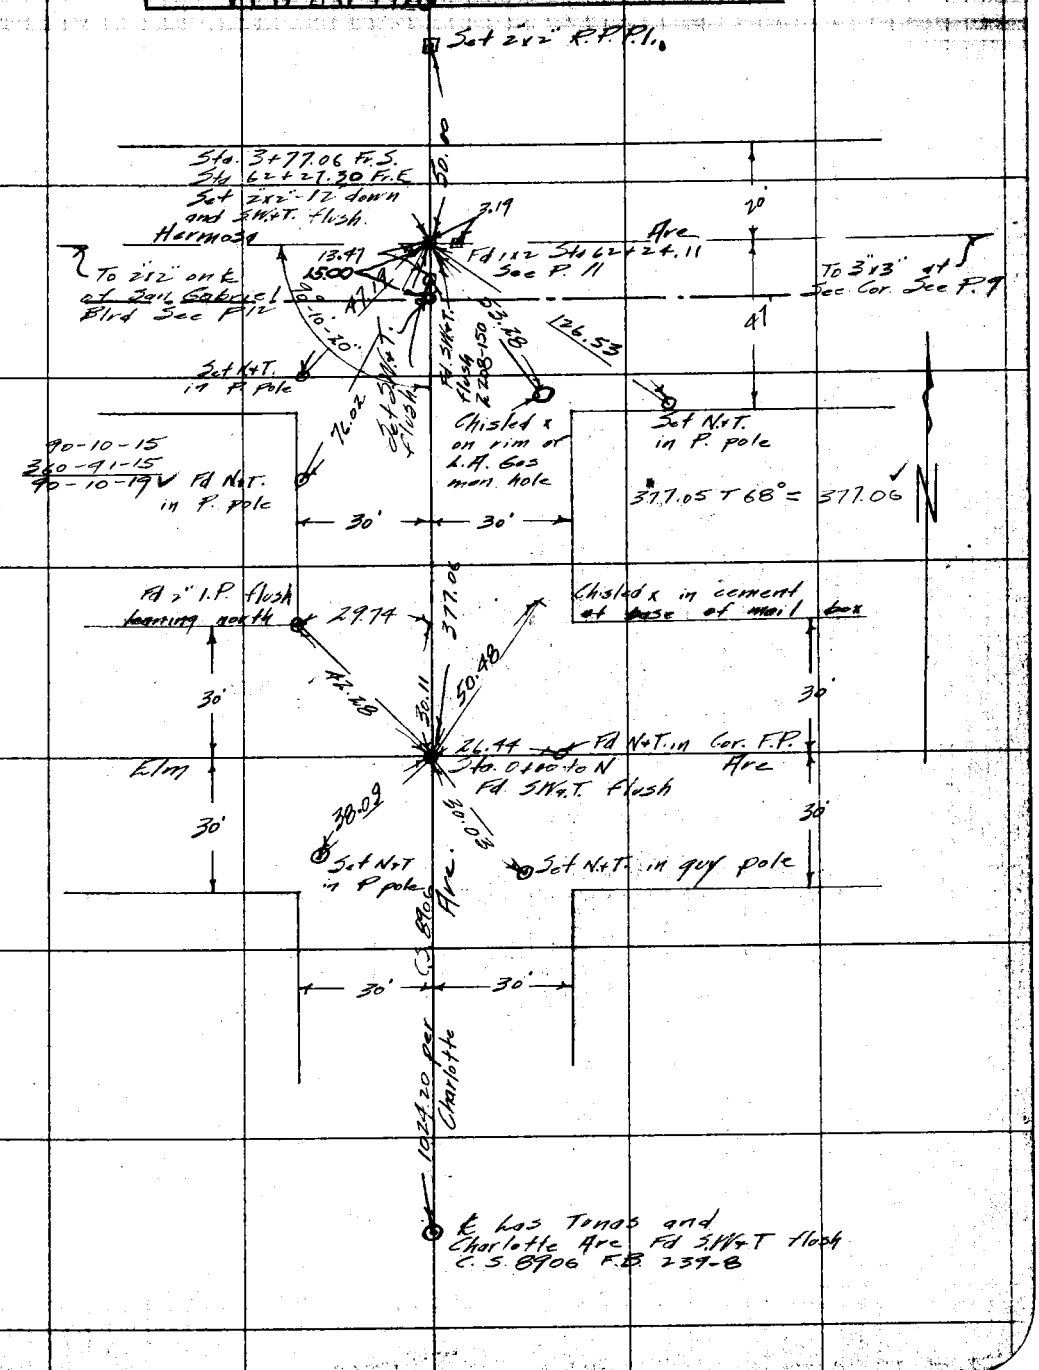

RETURN TO
LOS ANGELES COUNTY SURVEYOR

Notes. ANY ADDITIONS OR CHANGES ON THIS SHEET MUST BE MADE OR CIRCLED IN Red. WITH DATE AND NAME OF PERSON MAKING CHANGE.

Do not extend notes this side of this line

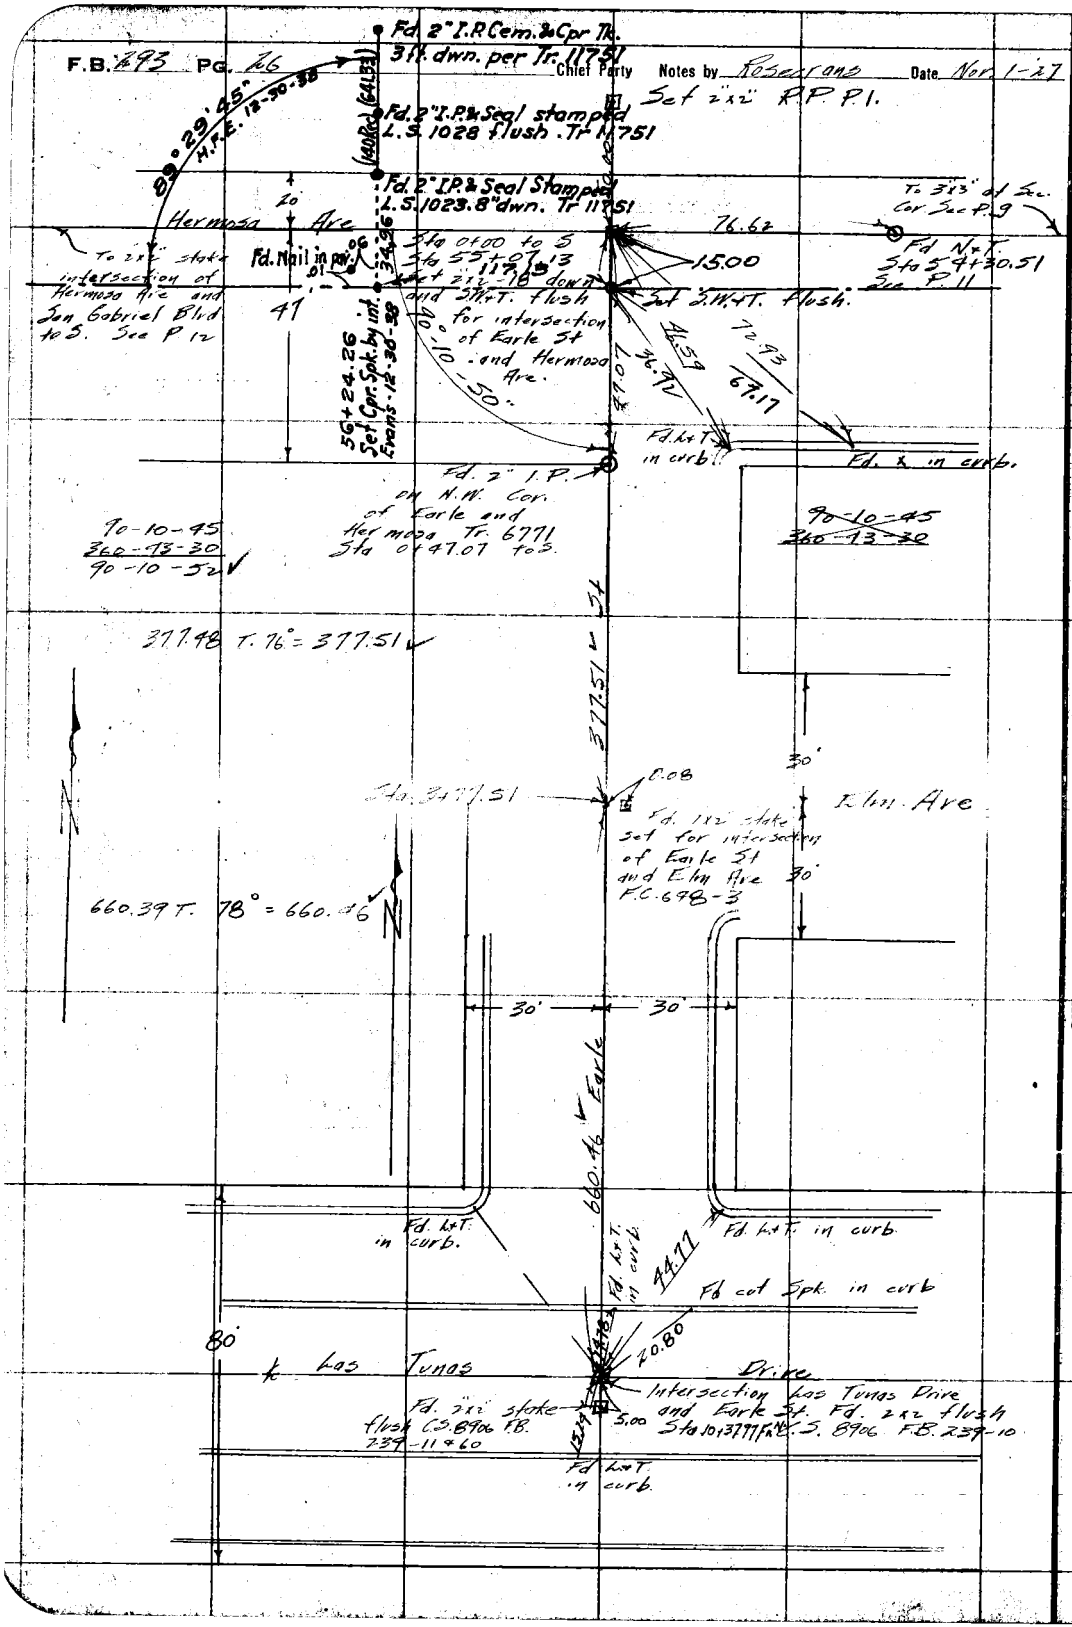

RETURN TO
LOS ANGELES COUNTY SURVEYOR
Do not extend notes this side of this line

Notes: ANY ADDITIONS OR CHANGES ON THIS SHEET MUST BE MADE OR CIRCLED IN Red. WITH DATE AND NAME OF PERSON MAKING CHANGE.

Date _____ Notes by _____ Chief Party _____ F. B. 293 PG. 27

Plotted by: M. Book	W. O. No. 4149 D. S. O. No.
Date: Dec 1927	Location: Hermosa Ave Dr
Map No.: 13-122	Surveyed by: Rosecrans
Plotting C'k'd by: R. W. S.	Date: Nov. 1, 1927
Date: FEB 20 1928	Indexed: A. C. Johnson

Notes: ANY ADDITIONS OR CHANGES ON THIS SHEET MUST BE MADE OR CIRCLED IN Red. WITH DATE AND NAME OF PERSON MAKING CHANGE.

Do not extend notes this side of this line

RETURN TO LOS ANGELES COUNTY SURVEYOR

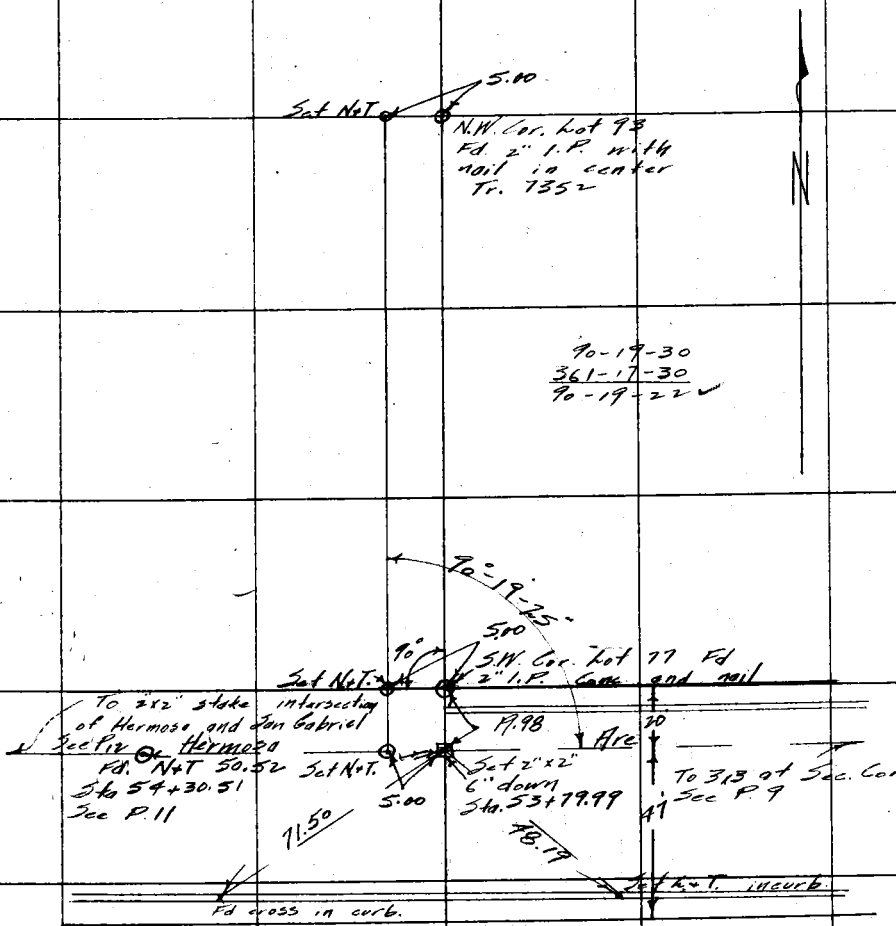

F.B. 293 Pg. 28 Chief Party Notes by Rosecrans Date Nov. 7-27

Cont. page bottom next.

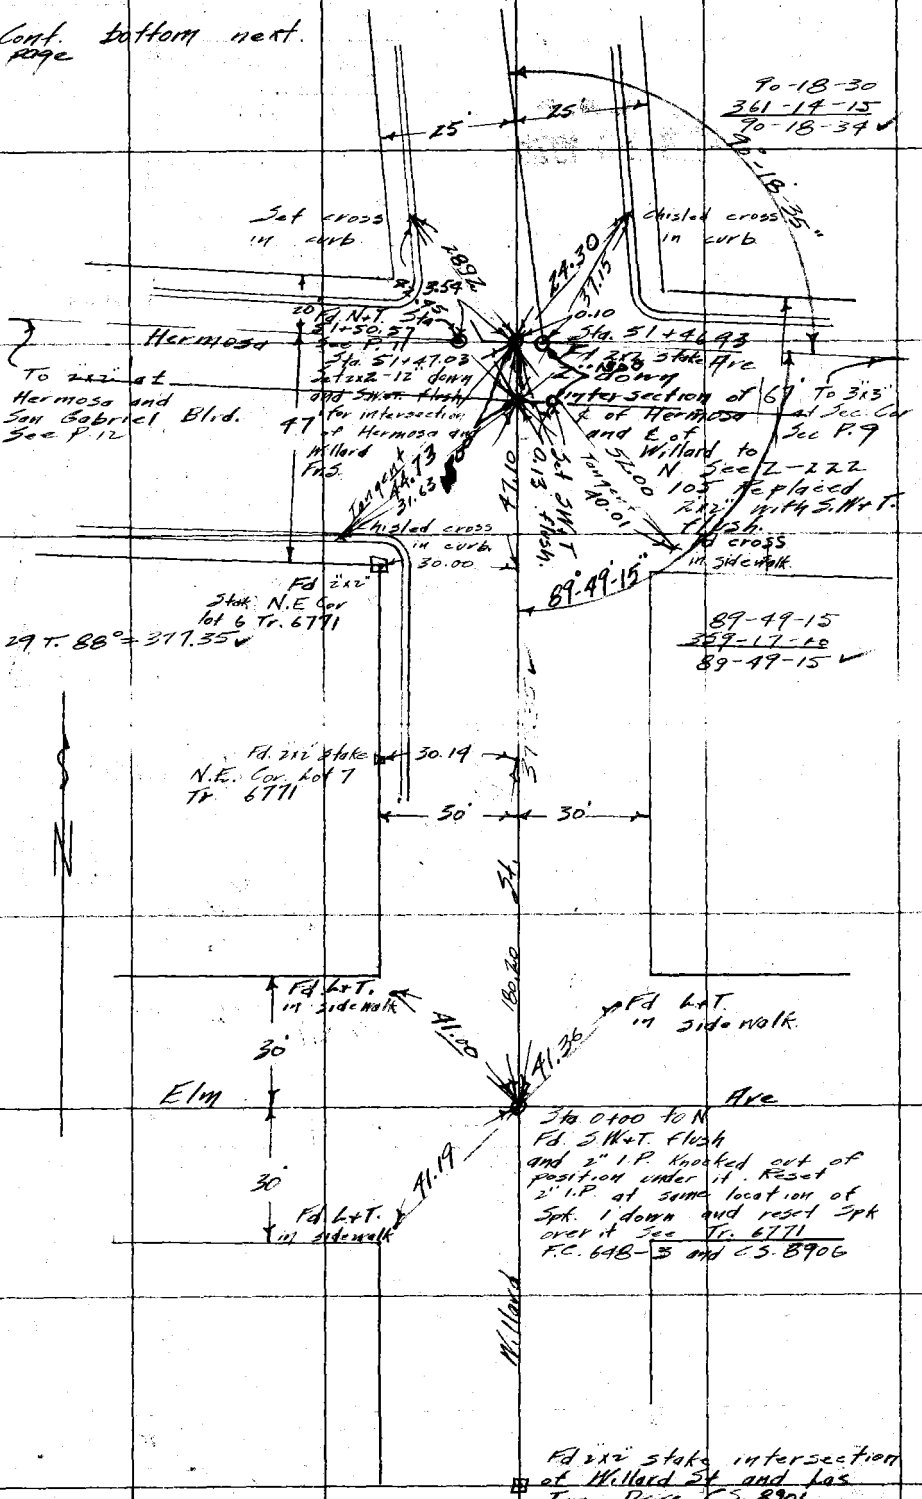

RETURN TO
LOS ANGELES COUNTY SURVEYOR
Do not extend notes this side of this line

Notes: ANY ADDITIONS OR CHANGES ON THIS SHEET MUST BE MADE OR CIRCLED IN Red. WITH DATE AND NAME OF PERSON MAKING CHANGE.

Date _____ Notes by _____ Chief Party _____ F. B. 273 Pg. 29

Plotted by AL. Peak
Date Dec 1927
Map No. B-177
Plotting Ck'd by R. W. S.
Date FEB 20 1928

W. O. No. 4140 D. S. O. No. _____
Location Hermosa Ave. Dr.
Surveyed by Rasmussen
Date Nov. 8, 1927.
Indexed by C. Johnson

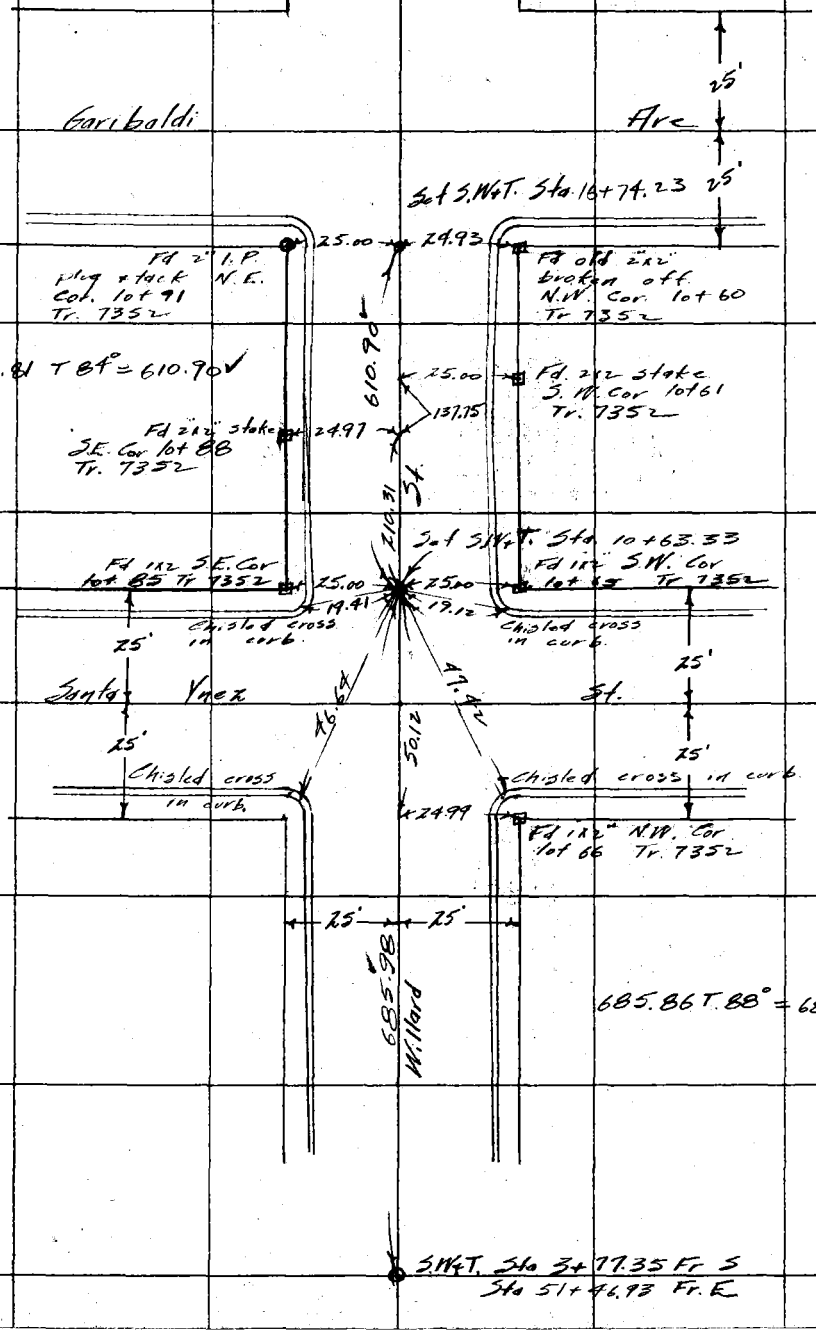

RETURN TO
LOS ANGELES COUNTY SURVEYOR
Do not extend notes this side of this line

Notes: ANY ADDITIONS OR CHANGES ON THIS SHEET MUST BE MADE OR CIRCLED IN Red. WITH DATE AND NAME OF PERSON MAKING CHANGE.

F.B. 293 Pg. 30 Chief Party Notes by Rosecrans Date Nov 3-27

Cont. bottom next page

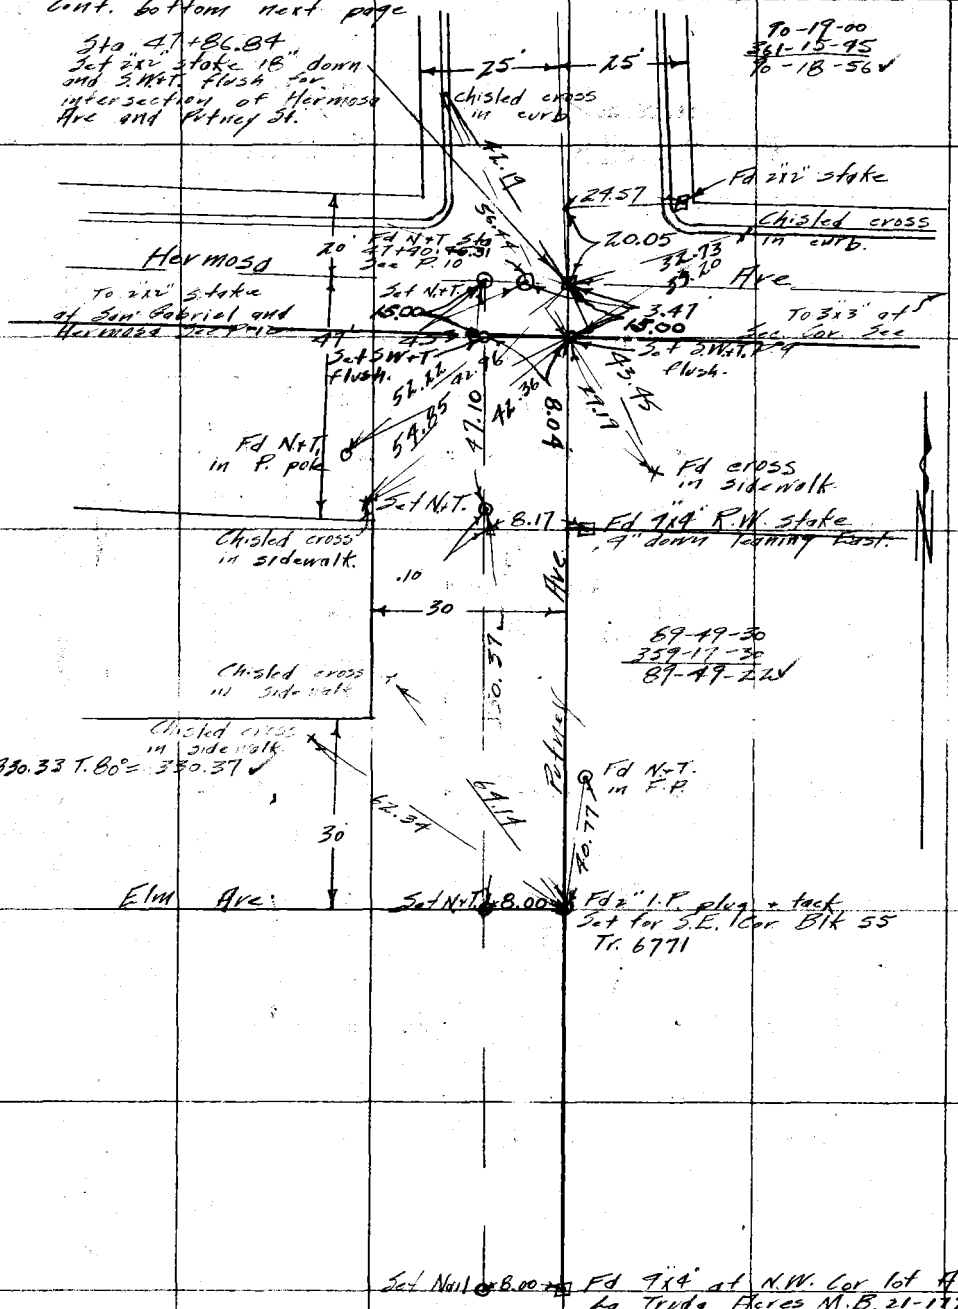

RETURN TO
LOS ANGELES COUNTY SURVEYOR
Do not extend notes this side of this line

Notes: ANY ADDITIONS OR CHANGES ON THIS SHEET MUST BE MADE OR CIRCLED IN Red. WITH DATE AND NAME OF PERSON MAKING CHANGE.

Date _____ Notes by _____ Chief Party _____ F. B. 293 PG. 31

Platted by D. Peck
Date Dec 1927
Map No. R.M.?
Plotting C'kd by R. W. S.
Date FEB 9 9 1928

W. O. No. 4140 D. S. O. No.
Location Hermosa Ave. Dr
Surveyed by Rosecrans
Date Nov 3, 1927
Indexed A. C. Johnson

Notes: ANY ADDITIONS OR CHANGES ON THIS SHEET MUST BE MADE OR CIRCLED IN Red. WITH DATE AND NAME OF PERSON MAKING CHANGE.

Do not extend notes this side of this line

RETURN TO LOS ANGELES COUNTY SURVEYOR

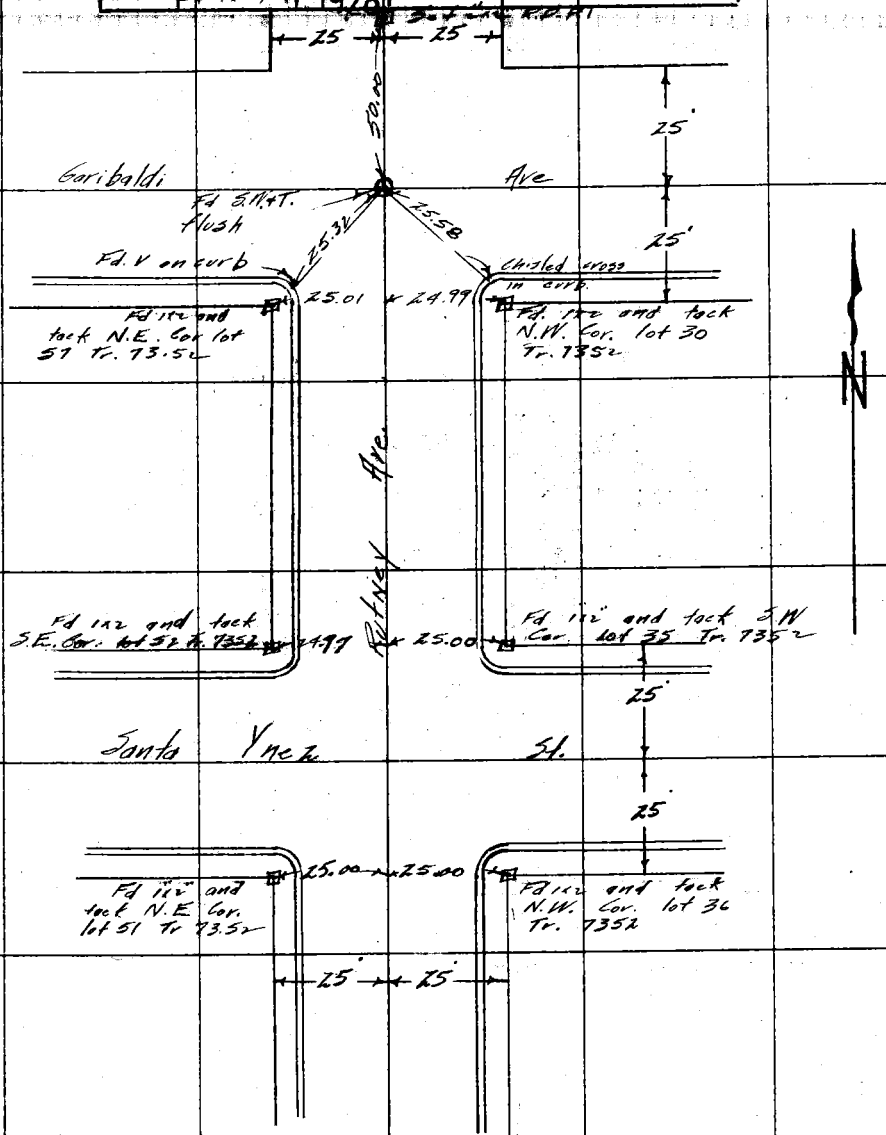

Sta. 47+86.84 Fr. E
2½" Stake 18" down
Intersection of ℄ of Putney Ave and ℄ of Hermosa Ave

F.B. 293 PG. 32 Chief Party Notes by Rosecrans Date Nov. 4-47

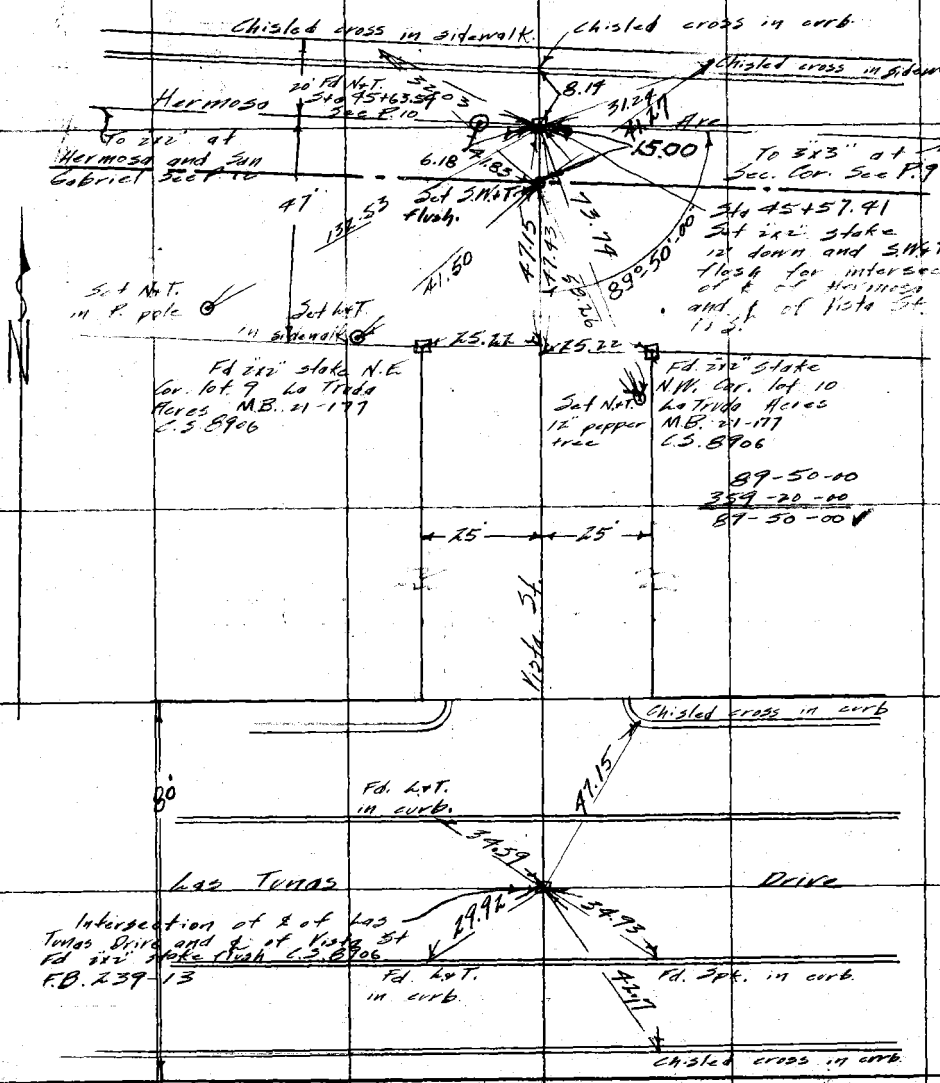

RETURN TO
LOS ANGELES COUNTY SURVEYOR
Do not extend notes this side of this line

Note ANY ADDITIONS OR CHANGES ON THIS SHEET MUST BE MADE OR CIRCLED IN Red. WITH DATE AND NAME OF PERSON MAKING CHANGE.

Date _____ Notes by _____ Chief Party _____ F. B. 293 PG. 33

Plotted by DL Peck
Date Dec 1927
Map No. 3-122
Plotting C'k'd by R. W. Sx
Date FEB 20 1928

W. O. No. 4140 D. S. O. No.
Location Hermosa Ave. Dr.
Surveyed by Rosecrans
Date Nov. 4, 1927
Indexed A. C. Johnson

Note: ANY ADDITIONS OR CHANGES ON THIS SHEET MUST BE MADE OR CIRCLED IN Red. WITH DATE AND NAME OF PERSON MAKING CHARGE.

RETURN TO LOS ANGELES COUNTY SURVEYOR

Do not extend notes this side of this line

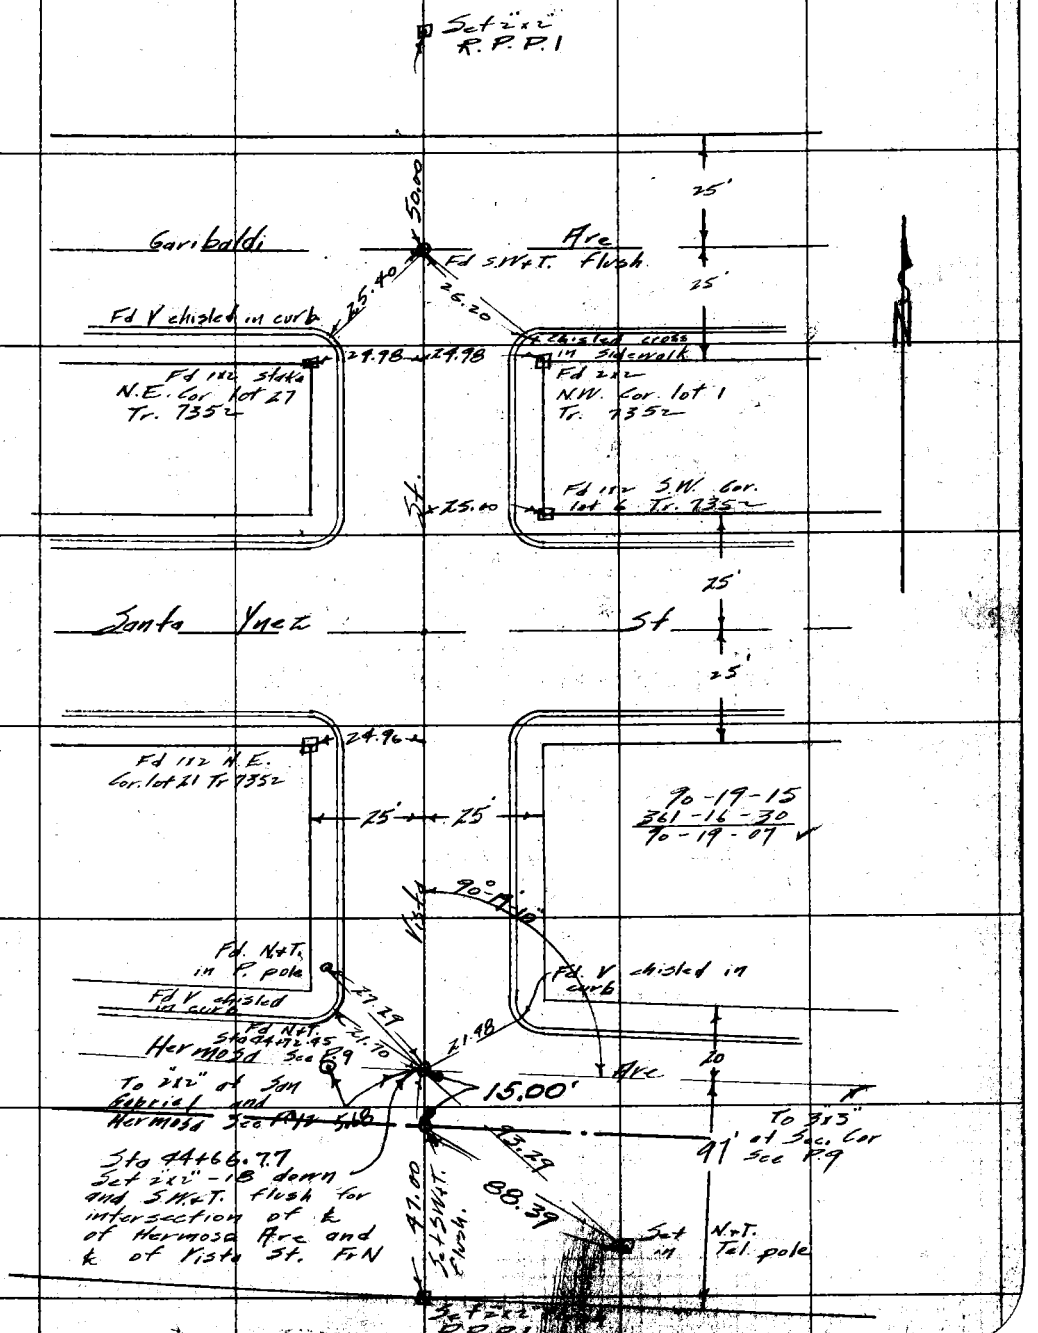

F.B. 293 PG. 37 Chief Party Notes by Rosecrans Date Nov 4, 27

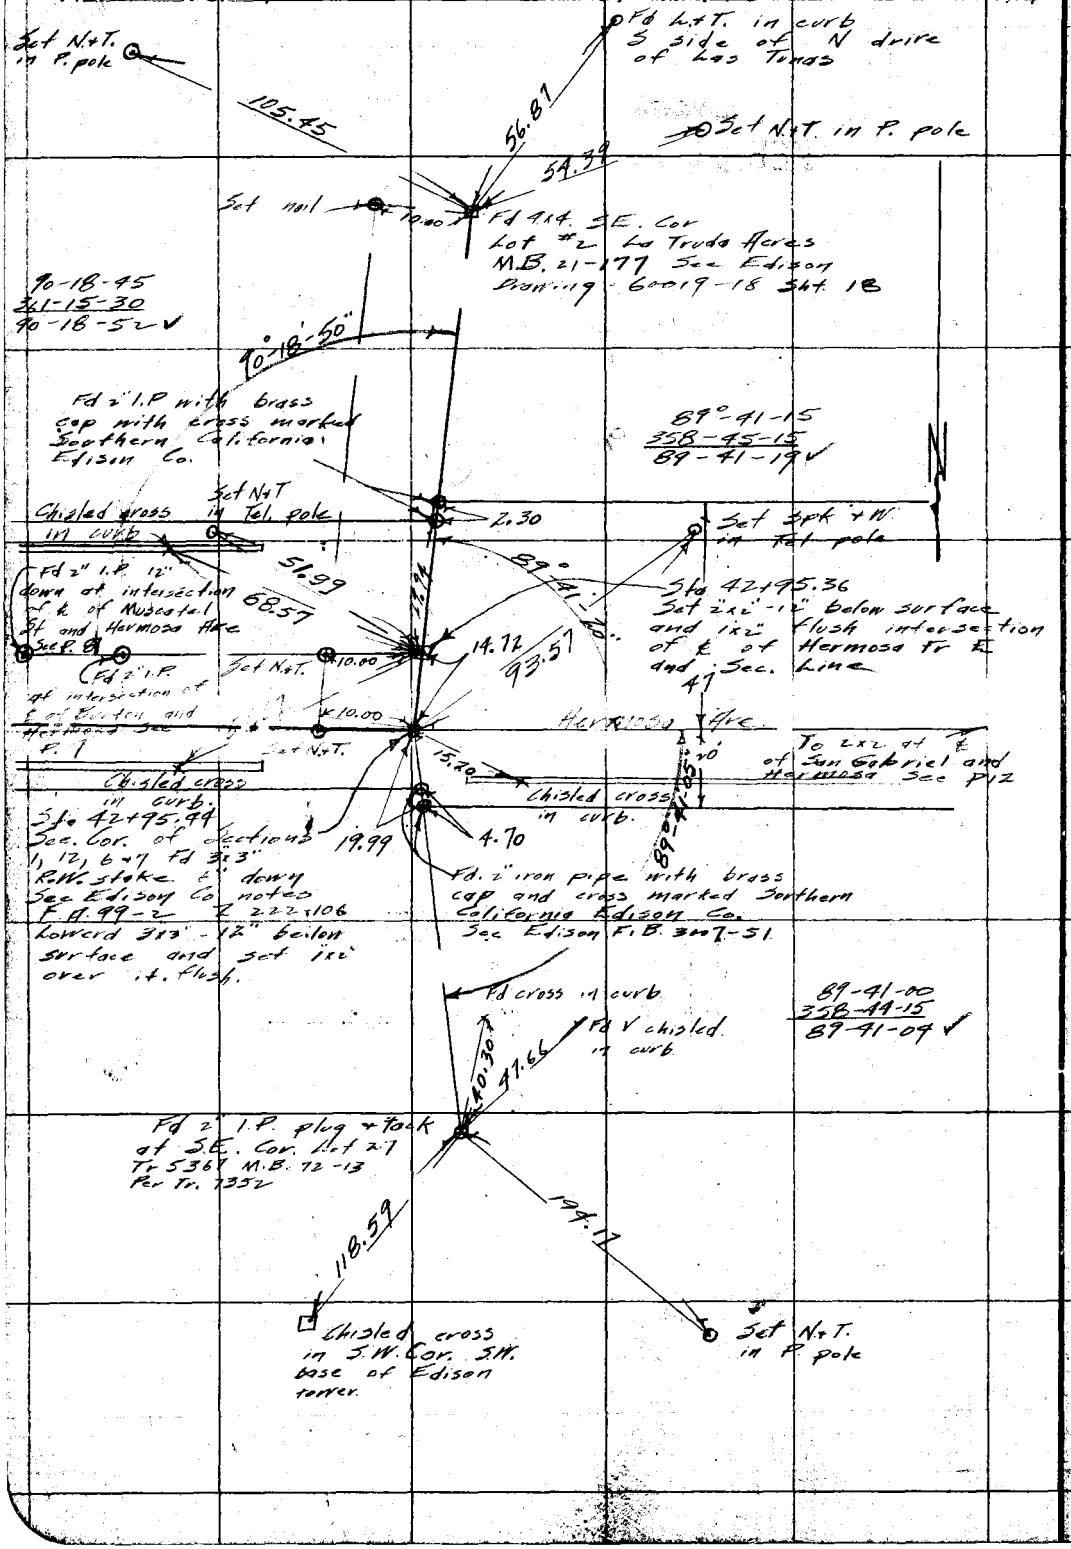

RETURN TO
LOS ANGELES COUNTY SURVEYOR
Do not extend notes this side of this line

Notes: ANY ADDITIONS OR CHANGES ON THIS SHEET MUST BE MADE OR CIRCLED IN Red. WITH DATE AND NAME OF PERSON MAKING CHANGE.

Date _____ Notes by _____ Chief Party _____ F. B. 293 Pg. 35

Plotted by DL. Peck
Date Dec 1927
Map No. 3-122
Plotting C'k'd by R. W. B.
Date FEB 20 1928

W. O. No. 4140 D. S. O. No.
Location Hermosa Ave Dr.
Surveyed by Rosecrans
Date Nov. 5, 1927
Indexed E. G. Johnson

Fd 3/4" I.P. Intersection of ℄ of Longden Ave and ℄ of Burton Ave. C.S. 8906 F.B. 262-28 For this see right of page.

Fd 2" I.P. with brass cap and cross marked Southern California Edison Co.

Fd chisled on curb

Hermosa

To 2" stake on Sec. line See P. 34

Fd chisled on curb

Fd 2" I.P. with brass cap and cross marked Southern California Edison Co. See Edison F.B. 3007-51

Fd 2" I.P. with brass cap marked Southern California Edison Co. See Edison Co F.B. 3007-51

Fd. L.&T. in curb

Fd. L.&T. in curb

Fd. L.&T. in curb

Fd. L.&T. in curb

Fd. L.&T. in curb

Fd 2" I.P. S.W. Cor lot 99 Tr. 5903

Fd L.&T. in curb

Sta. 40+10.4 Intersection of ℄ of Burton Ave and ℄ of Hermosa Ave Fd 2" I.P. plug & Tack 8" down Tr. 5903 See P. 8

To 2" I.P. 12" down at ℄ of Muscatel and Hermosa See P. 8

Fd L.&T. in curb

Fd 2" I.P. 1" down

90-19-15
361-16-30
90-19-07

Intersection of ℄ of Las Tunas Drive and ℄ of Burton Ave Fd. Mkt. Chisled C.S. 8906 F.B. 239-19

Chisled across in curb.

Chisled across in curb

E line

St.

Ave.

Ave.

Las Tunas Drive

Burton

25.03
24.89
29.90
29.19
29.11
29.39
29.84
29.97
25.15
25.23
25.07
32.89
30.18
90-18-10
90-18-15
361-12-45
90-18-11
90-19-10
A3.49
A3.67
43.37
44.57
25'
25'
25'
75
75'
N

Notes: ANY ADDITIONS OR CHANGES ON THIS SHEET MUST BE MADE OR CIRCLED IN Red. WITH DATE AND NAME OF PERSON MAKING CHANGE.

Do not extend notes this side of this line

RETURN TO LOS ANGELES COUNTY SURVEYOR

F.B. 293 Pg. 36 Chief Party Notes by Roscrans Date Nov. 1-27

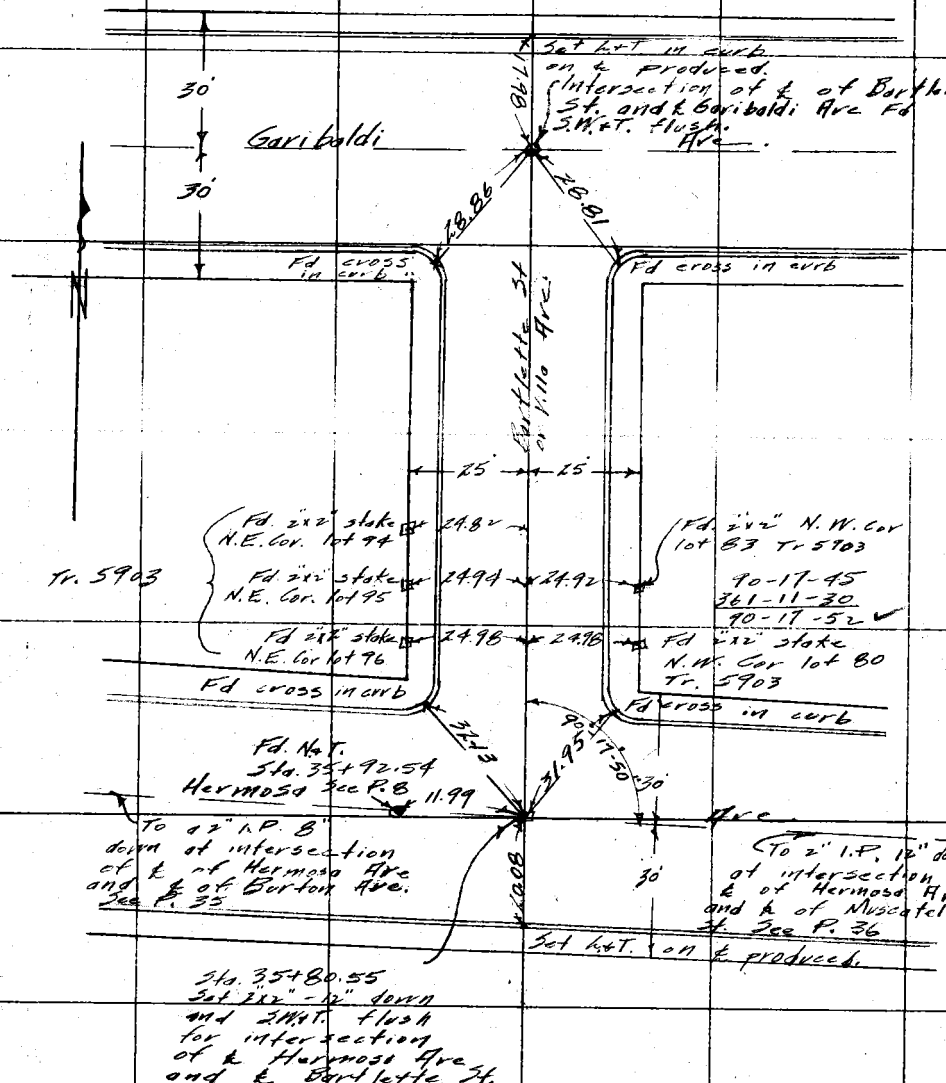

RETURN TO
LOS ANGELES COUNTY SURVEYOR

Note: ANY ADDITIONS OR CHANGES ON THIS SHEET MUST BE MADE OR CIRCLED IN Red. WITH DATE AND NAME OF PERSON MAKING CHANGE.

Do not extend notes this side of this line

Date _____ Notes by _____ Chief Party _____ F. B. 293 Pg. 37

Plotted by A.L. Beck
Date DEC-1927
Map No. B-129
Plotting Ck'kd by R. W. B.
Date FEB 20 1928

W. O. No. 9140 D. S. O. No. _____
Location Hermosa Ave. Dr.
Surveyed by Rosecrans
Date Nov. 1, 1927.
Indexed C. Johnson

Notes: ANY ADDITIONS OR CHANGES ON THIS SHEET MUST BE MADE OR CIRCLED IN Red. WITH DATE AND NAME OF PERSON MAKING CHANGE.

Do not extend notes this side of this line

RETURN TO LOS ANGELES COUNTY SURVEYOR

To S.M.T. on ℄ of Longden and ℄ of Muscatel See P. 38

89-42-00
358-48-30
89-42-07

30' 30'

Cont. bottom next page.

Fd. nail in curb

89°42'07" 32.65

32.80

Fd. nail in curb

To 2"x2" stake at intersection of ℄ of Rosemead Ave and ℄ of Hermosa Ave. 30'

See P. 6

Hermosa

To 2" I.P. at intersection of ℄ of Hermosa Ave and ℄ of Burton Ave. P. 35

89°42'07" 32.46

33.63

Sta. 27+86.47 See P. 7 Intersection of ℄ of 30' Hermosa Ave and ℄ of Muscatel Ave. Fd 2" I.P. 12" down. See 2x2" over it + 3" down See Tr 5904 M.B. 69-29

Fd nail in curb

Fd nail in curb

89-49-30
359-18-15
89-49-34

Muscatel Ave.

30' 30'

Fd. L.&T. in curb

45.45

46°0'

Fd. L.&T. in curb

40'

E Las Tunas Drive

Intersection of ℄ of Las Tunas Drive and ℄ of Muscatel

St. Fd. S.M.T. Flush
C.S. 8906 F.B. 239-15

46°0'

45.72

Drive

40'

Fd. L.&T. in curb

Fd. L.&T. in curb

F.B. 293 PG. 38 Chief Party Notes by Rosecrans Date Nov. 7-27

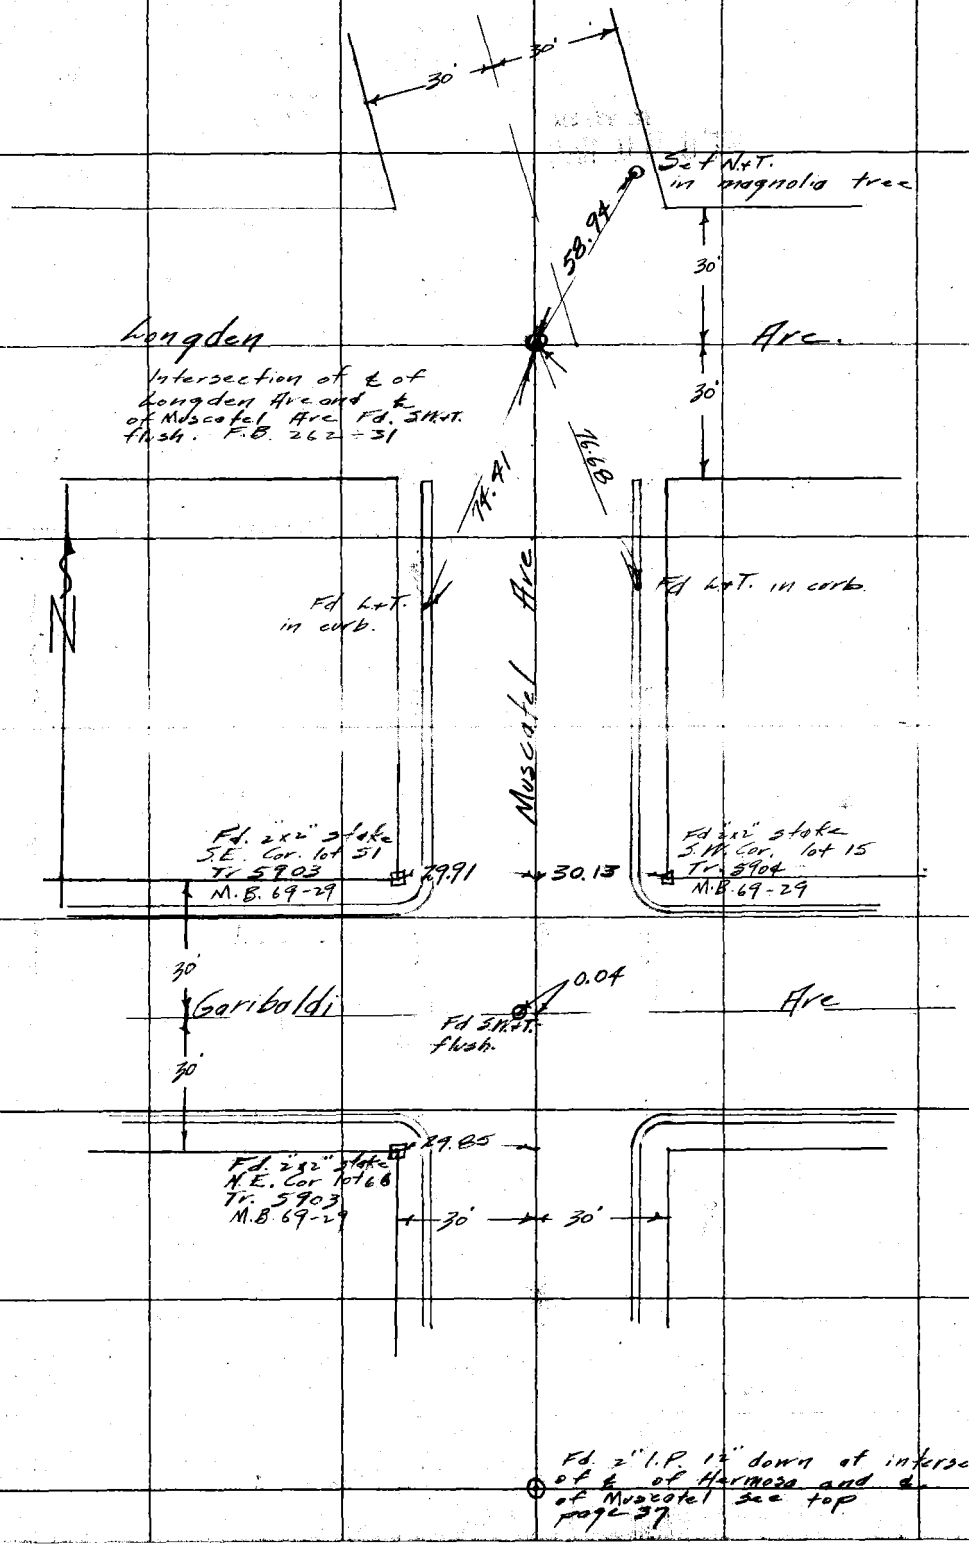

RETURN TO
LOS ANGELES COUNTY SURVEYOR
Do not extend notes this side of this line

Note: ANY ADDITIONS OR CHANGES ON THIS SHEET MUST BE MADE OR CIRCLED IN Red. WITH DATE AND NAME OF PERSON MAKING CHANGE.

Date _____ Notes by _____ Chief Party _____ F. B. 293 PG. 39

Plotted by A.C. Peck
Date Dec 1927
Map No. P.17
Plotting Chkd by R.W.S.
Date FEB 20 1928

W. O. No. 71.40 D. S. O. No. _____
Location Hermosa Ave Dr.
Surveyed by Roscrans
Date Nov 6, 1927.
Indexed A. C. Johnson

Notes: ANY ADDITIONS OR CHANGES ON THIS SHEET MUST BE MADE OR CIRCLED IN Red. WITH DATE AND NAME OF PERSON MAKING CHARGE.

Do not extend notes this side of this line

RETURN TO LOS ANGELES COUNTY SURVEYOR

Set Nail in Orange tree

54.18

106.22

Set Nail in P. pole

30'

Longden Ave

Intersection of ℄ of Longden Ave and ℄ of Ivar Ave Fd. 30' S. M. T. Flush F.B. 202-32

14.13

13.44

Fd. L. & T. in curb.

Ivar Ave.

25' 25'

Fd. L. & T. in curb.

Fd. L. & T. in curb.

27.60

30'

Garibaldi Ave

Fd. 2" Flush

27.67

27.82

30'

Fd. L. & T. in curb.

x25.01

Fd. L. & T. in curb.

Fd. 1" x 1" stake N.W. Cor. lot 112 Tr. 5904 M.B. 69-29

361-44-00
90-17-45

Fd. 1" x 1" Stake S.E. Cor. lot 113 Tr. 5904 M.B. 69-29

Fd. L. & T. in curb.

25.01

90° 17' 45"

Fd. L. & T. in curb

22.44

30.21

27.15

30'

Fd. N. & T. Sta 24+28.38 Sec. P. 7

Hermosa Ave

12.88

Sta 24+15.50 Set 2½" I.P. 12" down and S. M. T. flush for intersection of ℄ of Hermosa and ℄ of Ivar.

To 2" I.P. of intersection of ℄ of Hermosa Ave and ℄ of Muscatel Ave Sec R. 37

To N. & T. of intersection of ℄ of Hermosa Ave and ℄ of Rosemead Ave Sec P. 6

Set L. & T. in curb on ℄ produced.

F.B. 293 Pg. 40 Chief Party Notes by Rosecrans Date Nov 8-27

Cont. bottom next page

89-42-00
359-48-15
89-42-04 ✓

To S.M.T. at intersection of ℄ of Longden Ave and ℄ of Reno Ave.

Fd. 1x1 Stake S.W. Cor. lot 149 Tr. 3904 M.B. 69-29

Fd. L.+T. in curb.

15.03

89°41'05"

27.98

27.93

29.34

Fd S.M.T. See P. 7
0.05 F.B. 239-16

Fd N.+T.
Sta 20+58.44
See P. 7

B.M.

30'

Hermosa

Ave

To N.+T. intersection of ℄ of Hermosa Ave and ℄ Rosemead Ave See P. 6

Sta 20+49.57
Set 2x2"-12" down & 30' S.W.T. flush intersection of ℄ of Hermosa Ave and ℄ of Reno Ave

28.57

28.59

To 2" I.P. 12" down at intersection of ℄ of Hermosa Ave and ℄ of Muscatel Ave See P. 37

Fd L.+T. in curb

Fd L.+T. in curb

89-50-10"

89-50-15
359-20-45
89-50-11 ✓

Elm

Ave

25'

25'

24.90

Fd 2½" stake

25'

25'

Reno

Fd L.+T. in curb

Fd L.+T. in curb

40'

44.14

44.43

Fd L.+T. in curb

31.32

Las Tunas

Drive

37.22

Fd. L.+T. in curb.

40'

37.21

Intersection of ℄ of Las Tunas Drive and ℄ of Reno Ave
Fd. 2½" Flush C.S. B906
F.B. 239-17

Fd L.+T. in curb.

RETURN TO
LOS ANGELES COUNTY SURVEYOR
Do not extend notes this side of this line

Note: ANY ADDITIONS OR CHANGES ON THIS SHEET MUST BE MADE OR CIRCLED IN Red. WITH DATE AND NAME OF PERSON MAKING CHANGE.

Date _____ Notes by _____ Chief Party _____ F. B. 293 Pg. 41

Plotted by C.L. Prock
Date Dec 1927
Map No. R. 7
Plotting C'k'd by R. W. S.
Date FEB 20 1928

W. O. No. 4140 D. S. O. No. _____
Location Hermosa Ave Dr
Surveyed by Rosedrans
Date Nov. 8 - 1927
Indexed A. C. Johnson

Notes: ANY ADDITIONS OR CHANGES ON THIS SHEET MUST BE MADE OR CIRCLED IN Red. WITH DATE AND NAME OF PERSON MAKING CHANGE.

Do not extend notes this side of this line

RETURN TO LOS ANGELES COUNTY SURVEYOR

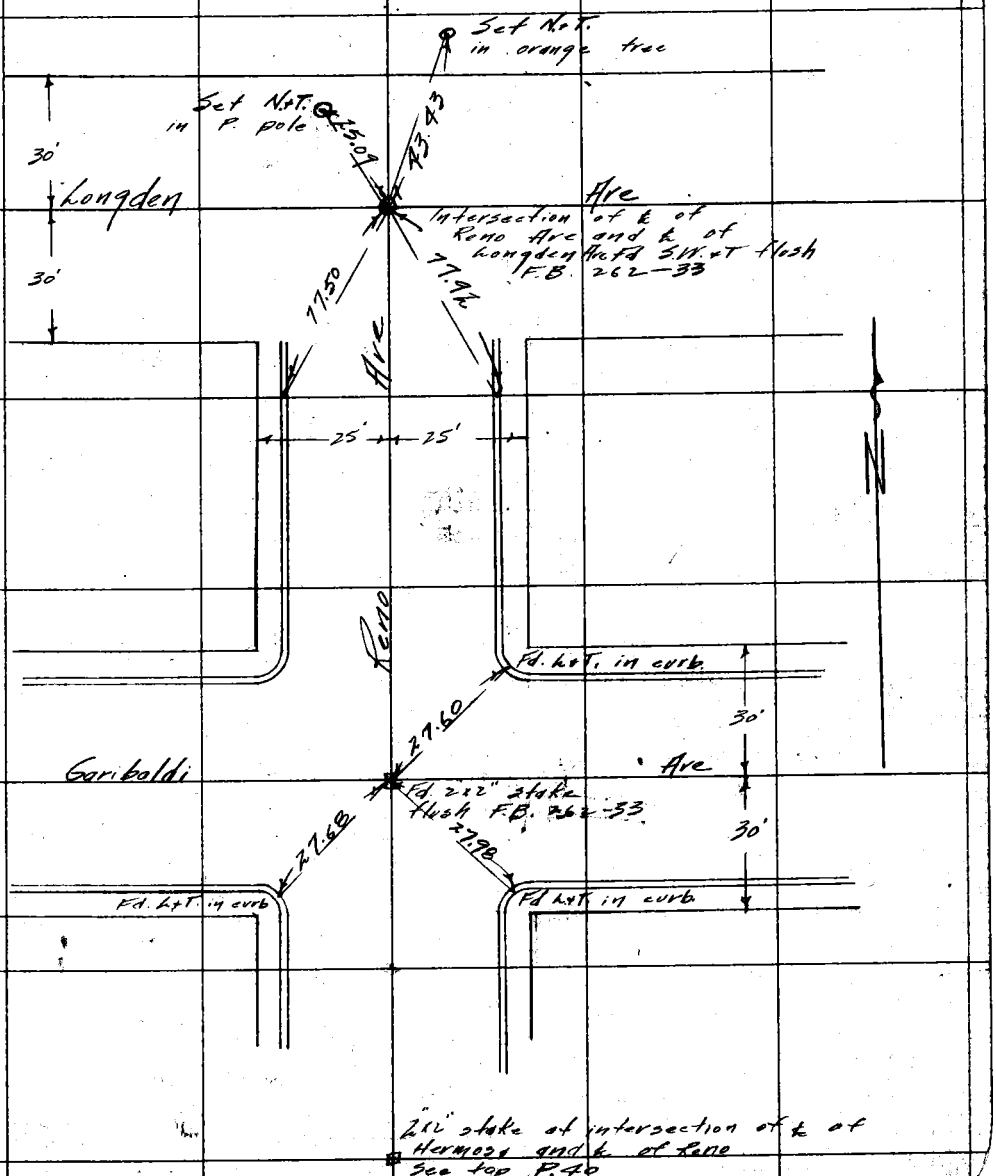

F.B. 293 Pg. 42 Rosecrans Chief Party Notes by Date Nov. 9-27

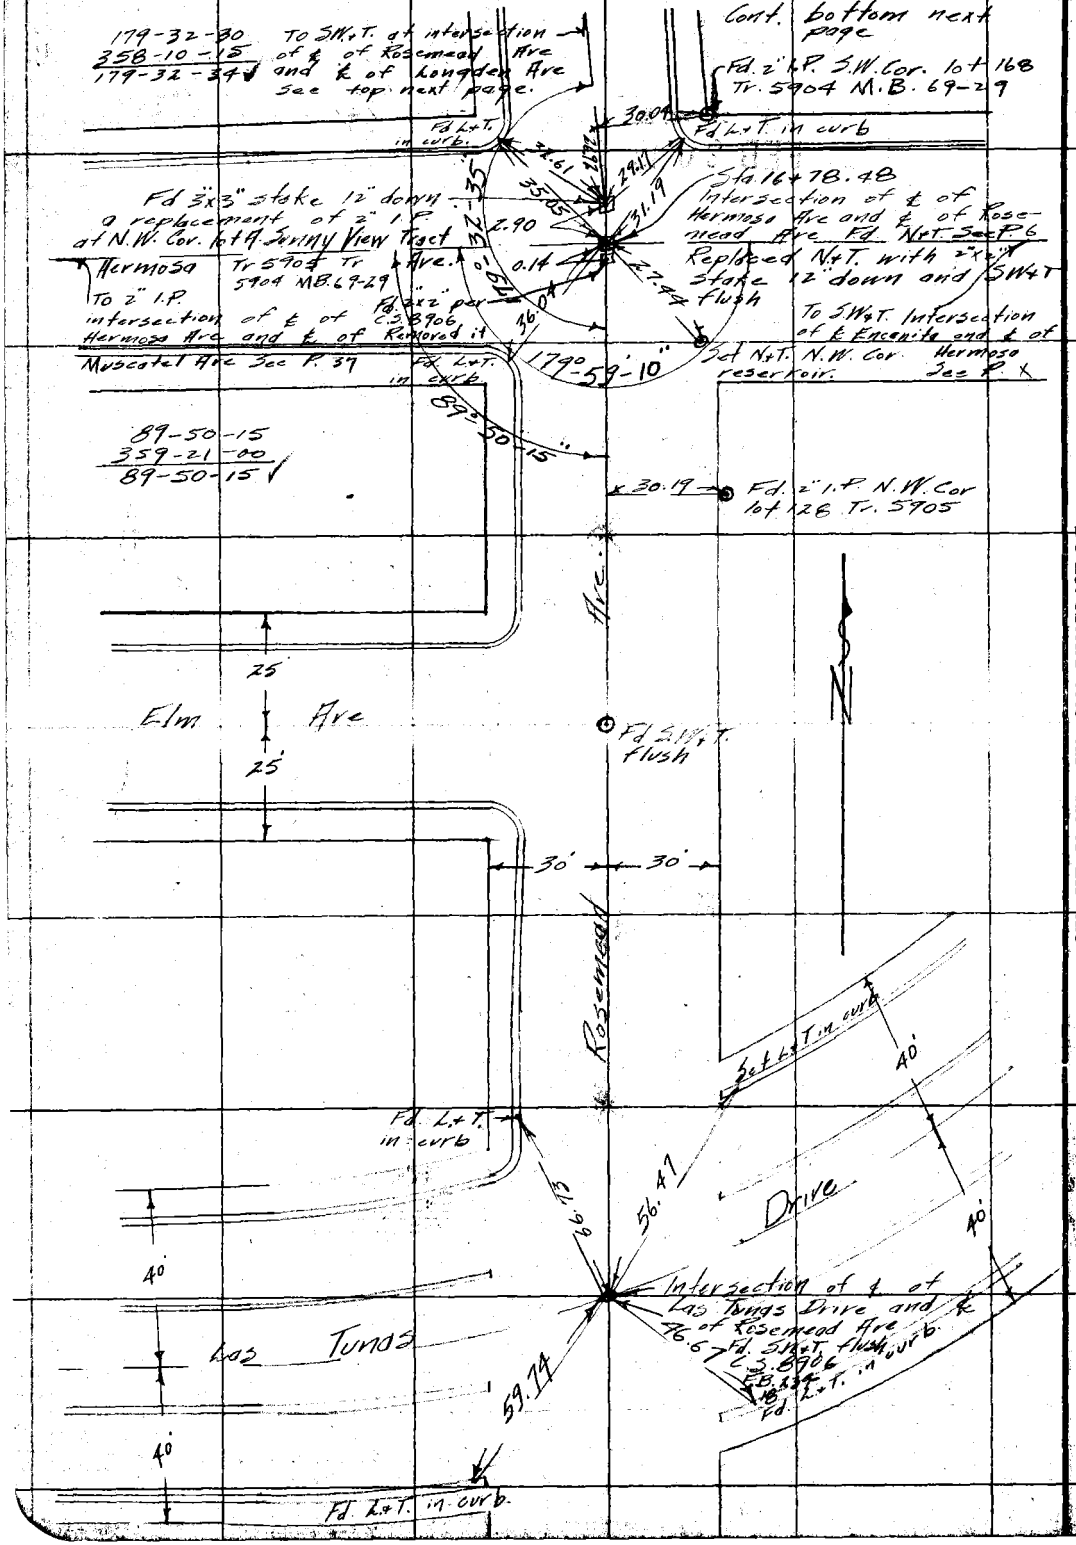

RETURN TO
LOS ANGELES COUNTY SURVEYOR
Do not extend notes this side of this line

Note ANY ADDITIONS OR CHANGES ON THIS SHEET MUST BE MADE OR CIRCLED IN Red. WITH DATE AND NAME OF PERSON MAKING CHANGE.

Date _____ Notes by _____ Chief Party _____ F. B 293 PG. 43

Platted by O.C. Peck
Date Dec. 1927
Map No. 3 1mm
Platting C'k'd by R. W. S.
Date FEB 20 1928

W. O. No. 4140 S. O. No.
Location Hermosa Ave Dr.
Surveyed by Rosecrans
Date Nov 9, 1927
Indexed A. C. Johnson

Notes: ANY ADDITIONS OR CHANGES ON THIS SHEET MUST BE MADE OR CIRCLED IN Red. WITH DATE AND NAME OF PERSON MAKING CHANGE.

RETURN TO LOS ANGELES COUNTY SURVEYOR

Do not extend notes this side of this line

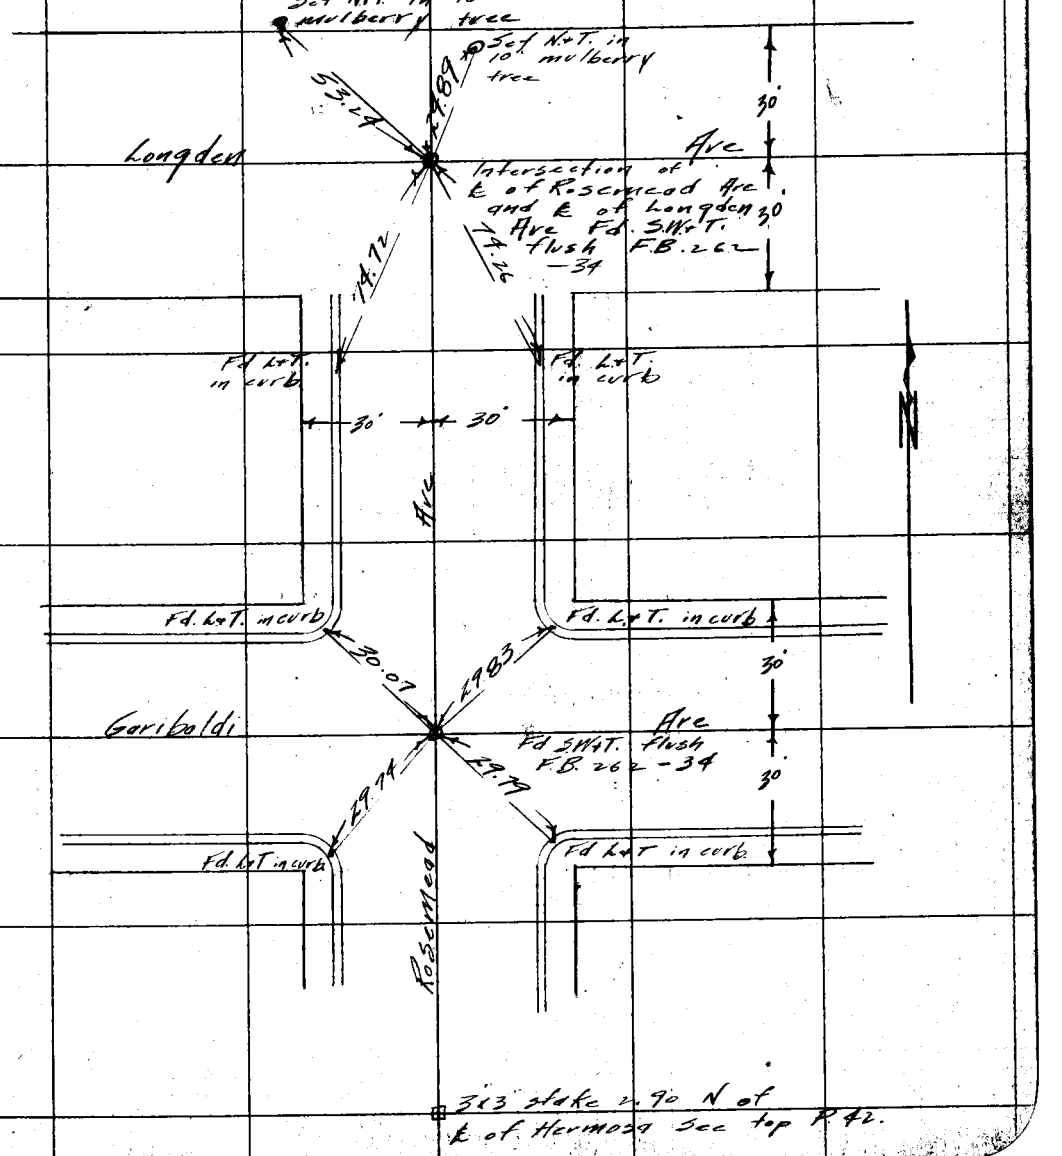

F.B. 293 Pg. 44 Rosecrans Chief Party Notes by Date Nov 9-27

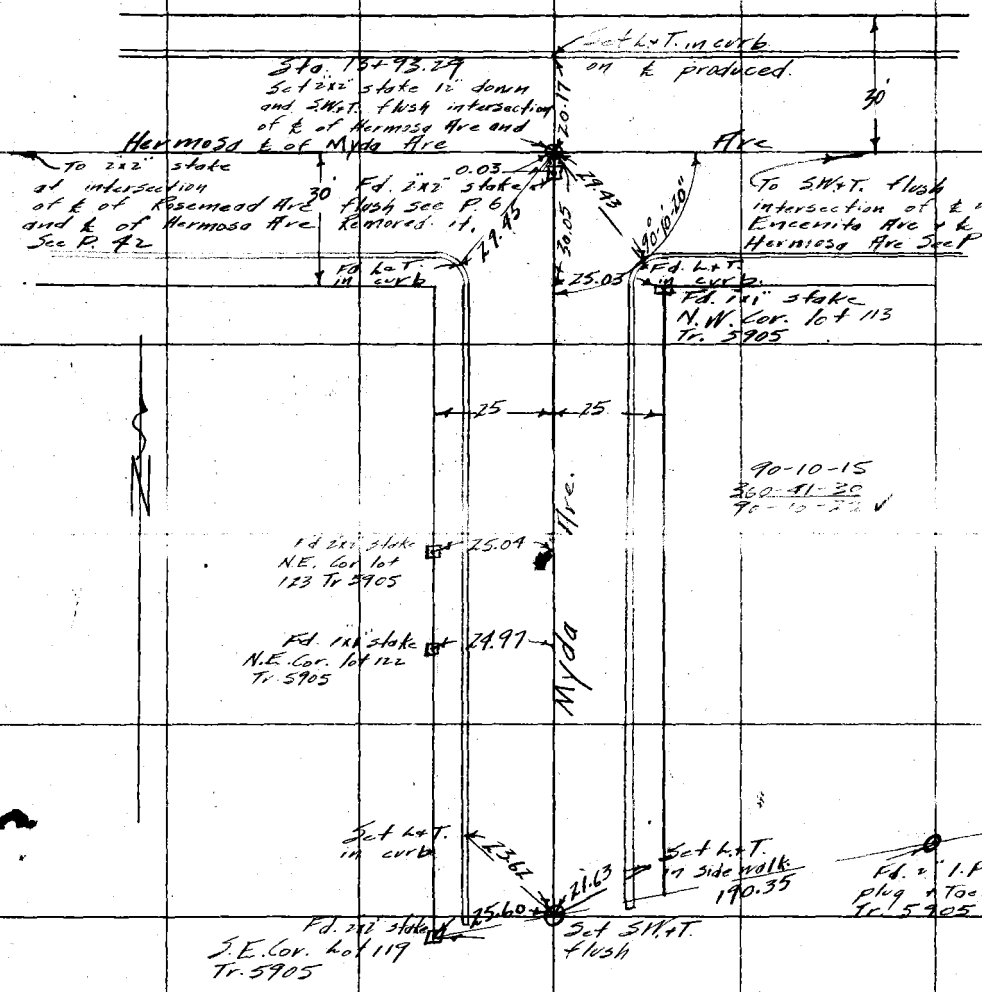

RETURN TO
LOS ANGELES COUNTY SURVEYOR
Do not extend notes this side of this line

Notice: ANY ADDITIONS OR CHANGES ON THIS SHEET MUST BE MADE OR CIRCLED IN Red. WITH DATE AND NAME OF PERSON MAKING CHANGE.

Date _____ Notes by _____ Chief Party _____ F. B. 293 Pg. 45

Plotted by O.C. Peak
Date Dec 1927
Map No. B-177
Plotting C'kd by R. W. S.
Date FEB 20 1928

W. O. No. 4140 D. S. O. No.
Location Hermosa Ave Dr
Surveyed by Rosecrans
Date Nov. 10, 1927.
Indexed C. Johnson

Notes: ANY ADDITIONS OR CHANGES ON THIS SHEET MUST BE MADE OR CIRCLED IN Red. WITH DATE AND NAME OF PERSON MAKING CHANGE.

Do not extend notes this side of this line

RETURN TO LOS ANGELES COUNTY SURVEYOR

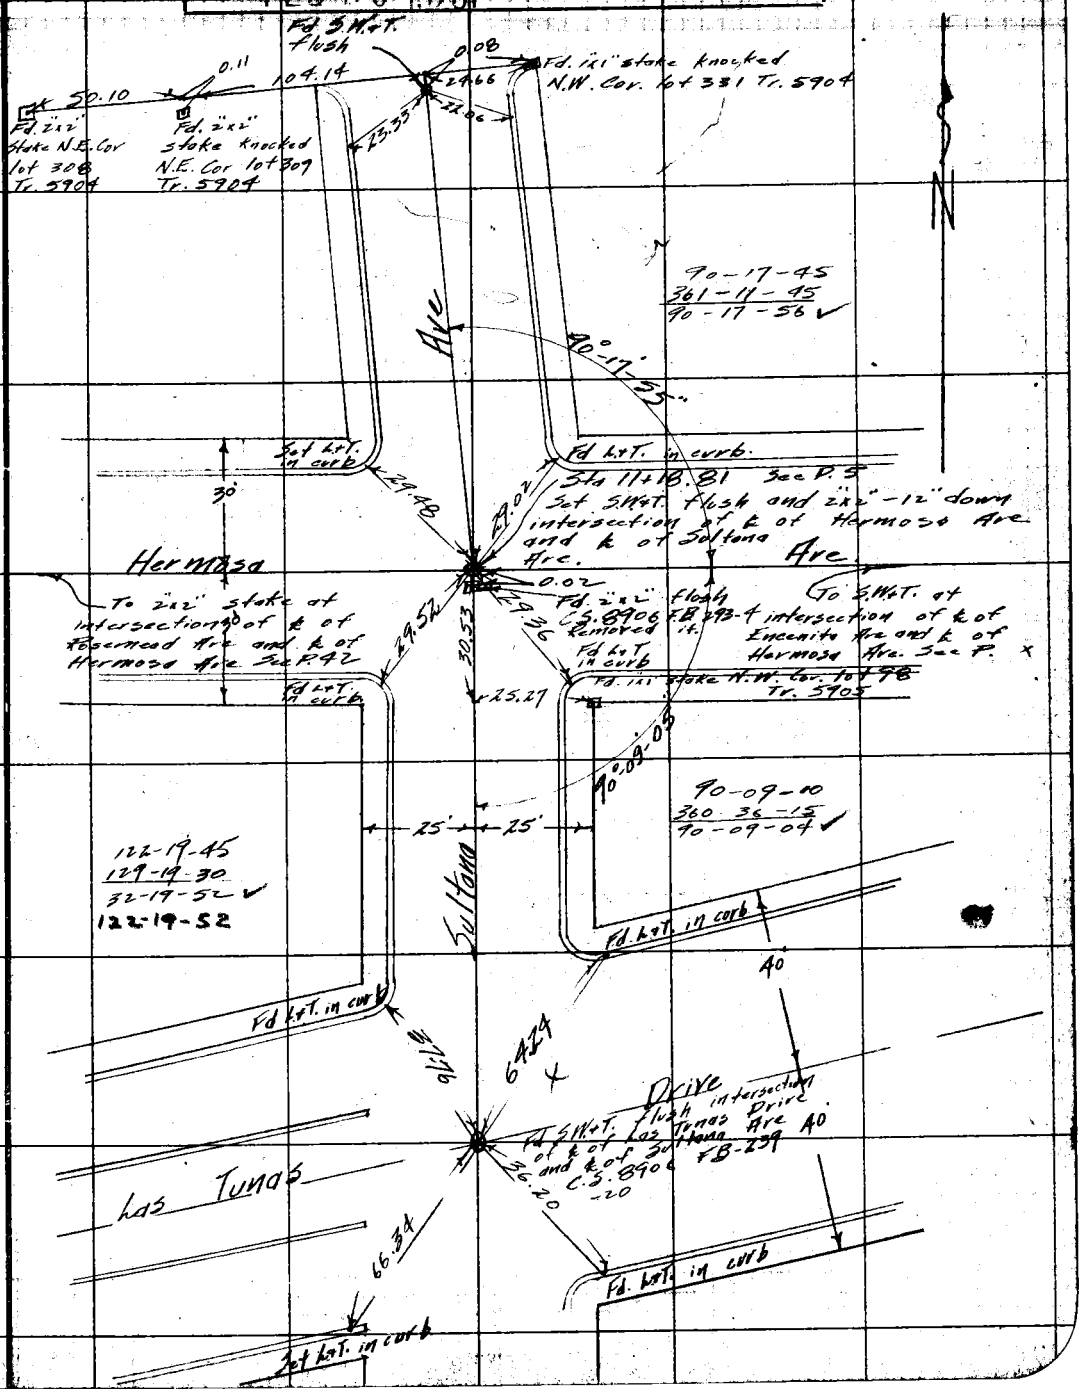

F.B. 493 Pg. 46 Rosecrans Chief Party Notes by Date Nov 14-27

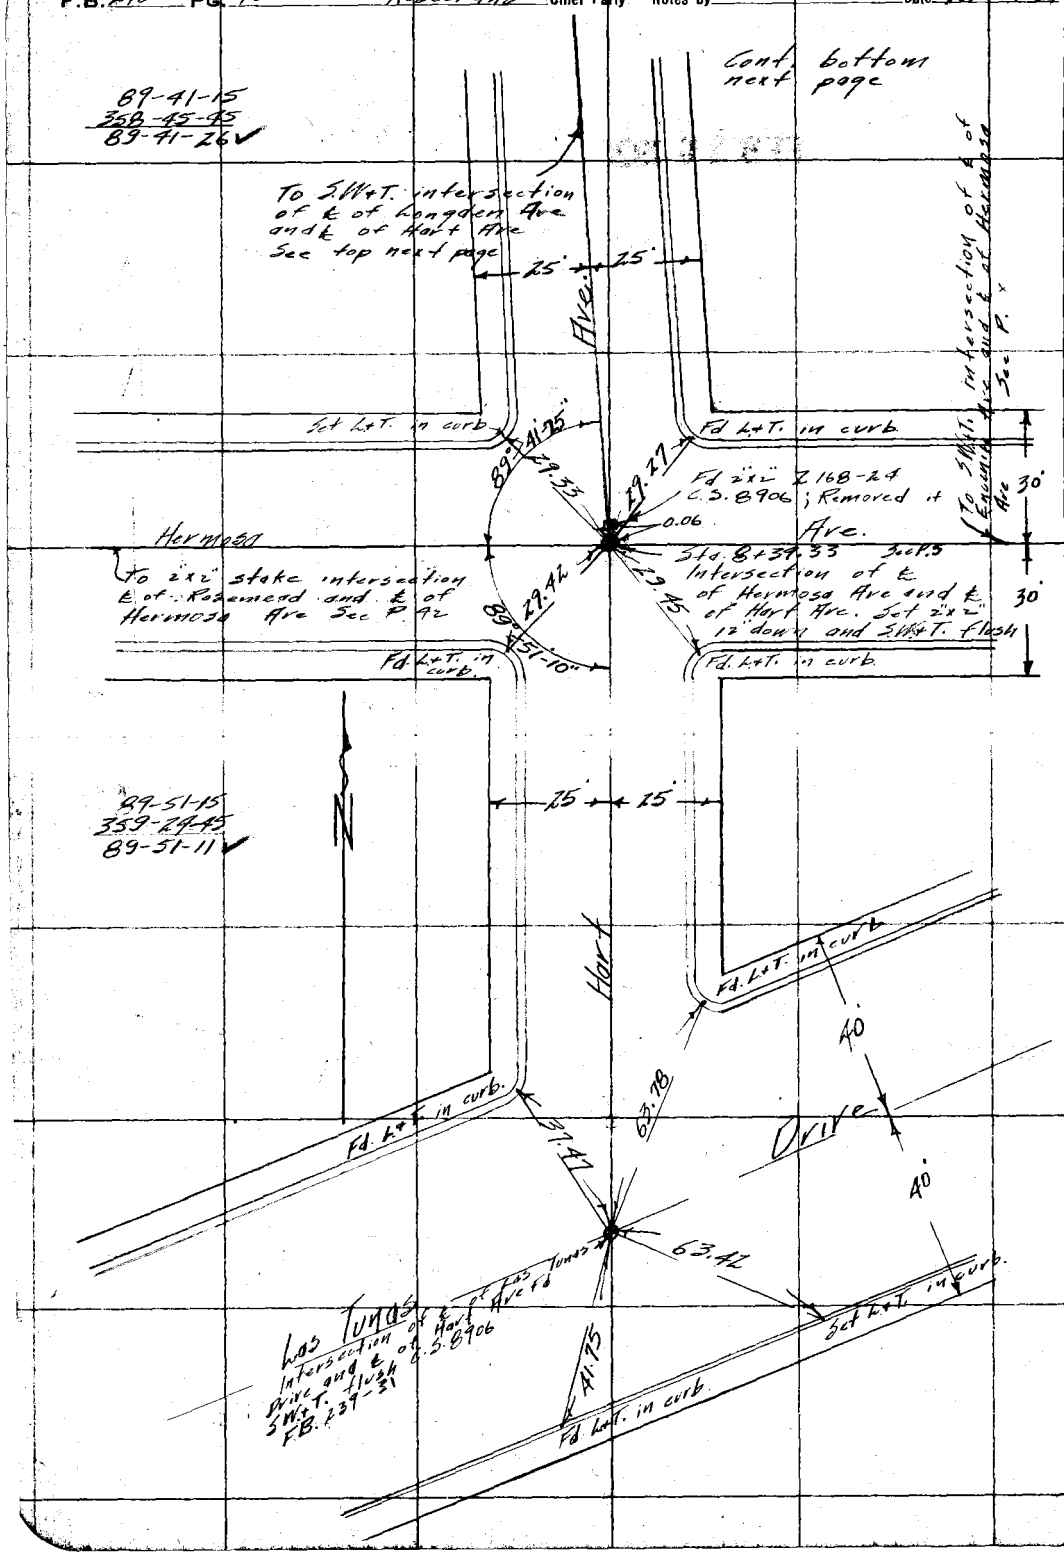

RETURN TO
LOS ANGELES COUNTY SURVEYOR

Do not extend notes this side of this line

Note: ANY ADDITIONS OR CHANGES ON THIS SHEET MUST BE MADE OR CIRCLED IN Red. WITH DATE AND NAME OF PERSON MAKING CHANGE.

Date _____ Notes by _____ Chief Party _____ F. B. 293 PG. 47

Platted by O.L. Park
Date Nov 1927
Map No. _____
Platting C'k'd by [illegible]
Date Dec 20 1928

W. O. No. 7190 D. S. O. No. _____
Location Hermosa Ave Dr.
Surveyed by Rezecrans
Date Nov. 14, 1927
Indexed by J. Johnson

Notes: ANY ADDITIONS OR CHANGES ON THIS SHEET MUST BE MADE OR CIRCLED IN Red. WITH DATE AND NAME OF PERSON MAKING CHANGE.

Do not extend notes this side of this line

RETURN TO LOS ANGELES COUNTY SURVEYOR

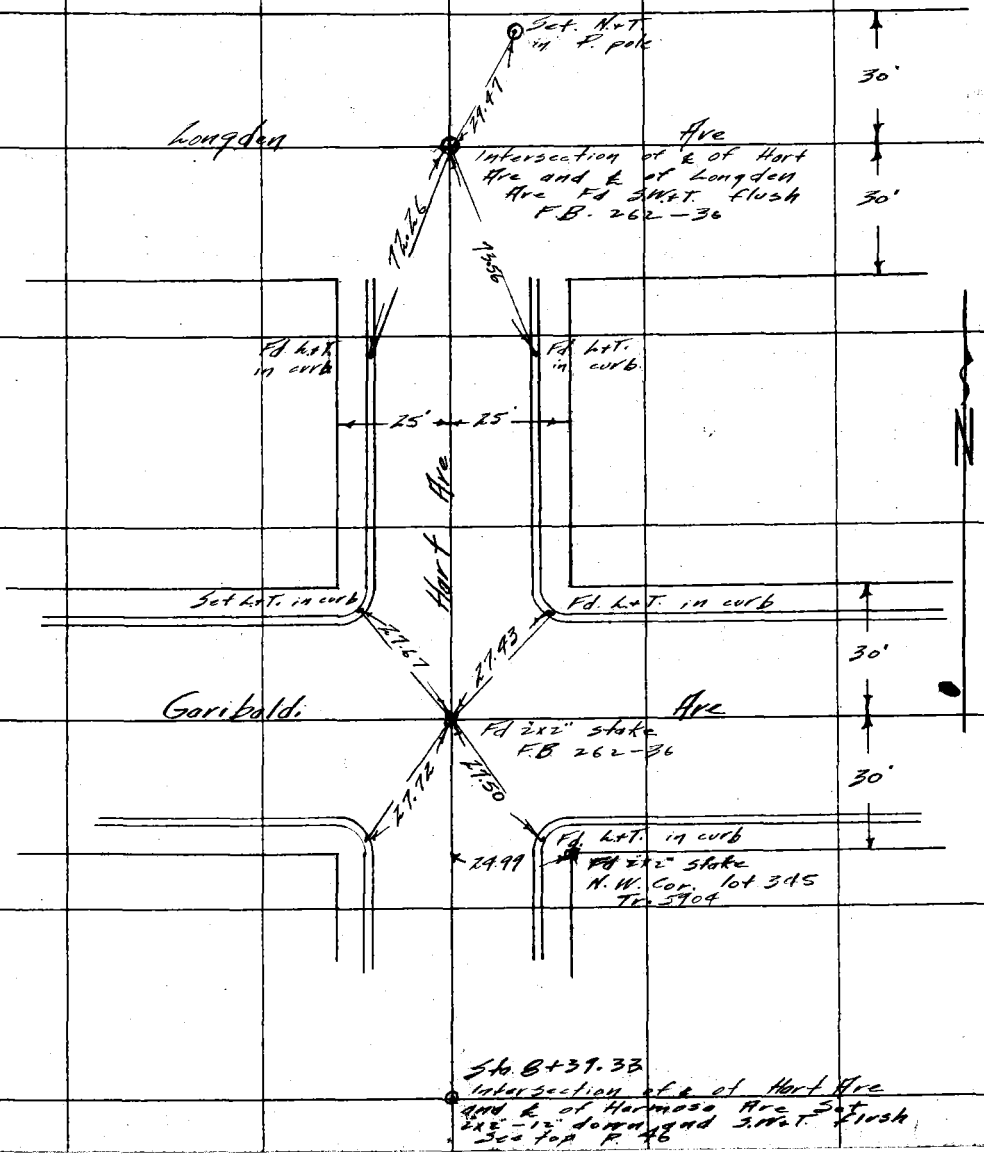

F.B. 293 Pg. 48 Rosecrans Chief Party Notes by Date Nov. 14-27

Cont. bottom next page

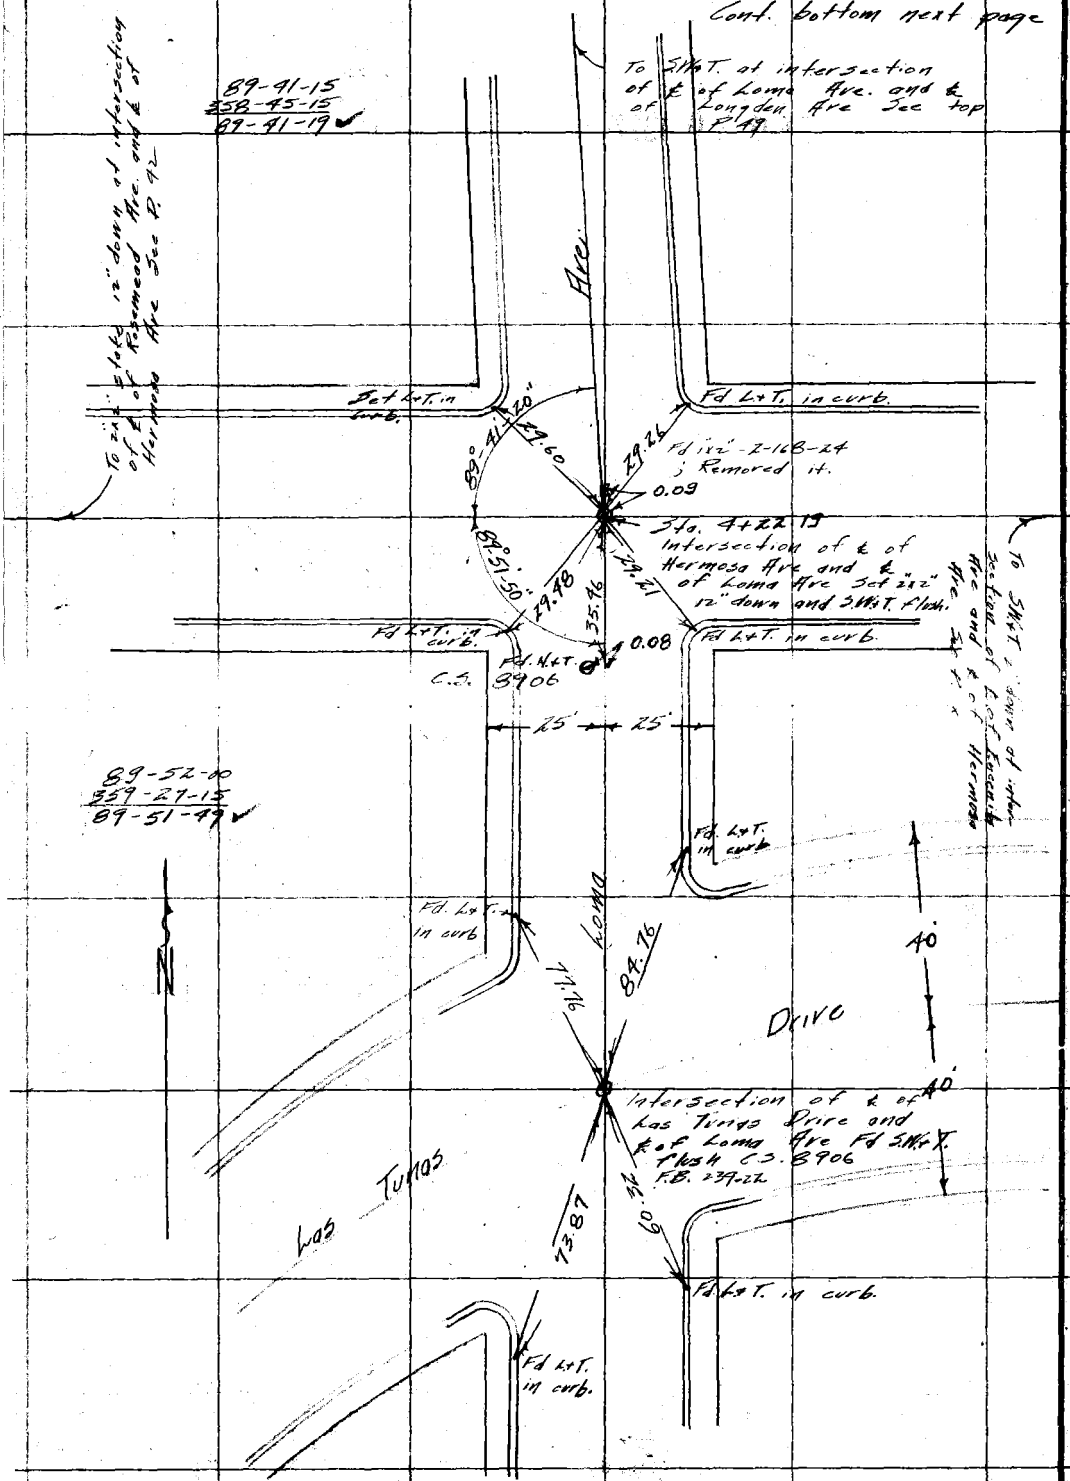

RETURN TO
LOS ANGELES COUNTY SURVEYOR

Do not extend notes this side of this line

Note: ANY ADDITIONS OR CHANGES ON THIS SHEET MUST BE MADE OR CIRCLED IN Red. WITH DATE AND NAME OF PERSON MAKING CHANGE.

Date _____ Notes by _____ Chief Party _____ F. B. 293 PG. 49

Platted by O.L. Peak
Date Dec. 1927
Map No. 3 Sht
Platting C'k'd by R. W. S.
Date FEB 20 1928

W. O. No. 7190 D. S. O. No.
Location Hermosa Ave Dr.
Surveyed by Rosecrans
Date Nov. 14, 1927.
Indexed Johnson

Notes: ANY ADDITIONS OR CHANGES ON THIS SHEET MUST BE MADE OR CIRCLED IN Red. WITH DATE AND NAME OF PERSON MAKING CHANGE.

Do not extend notes this side of this line

RETURN TO
LOS ANGELES COUNTY SURVEYOR

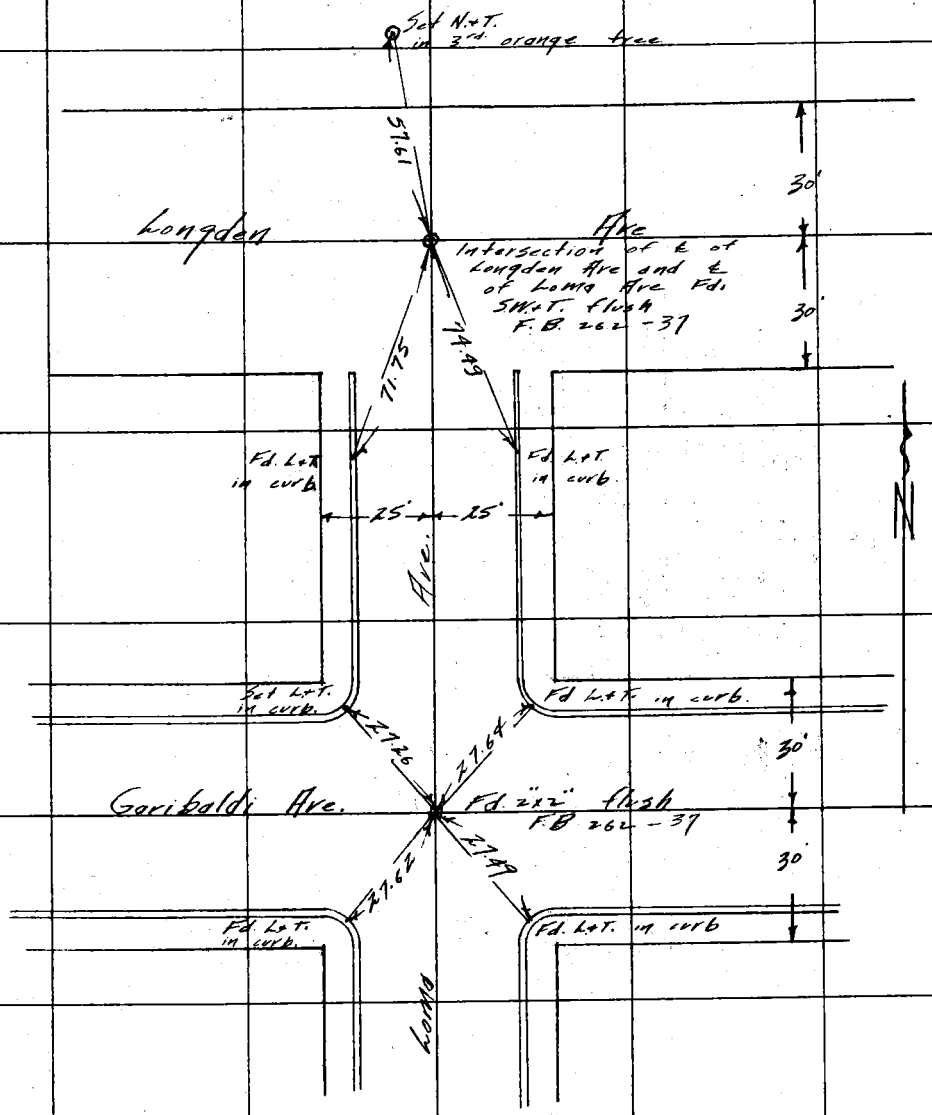

F.B. 293 Pg. 50 Rosecrans Chief Party Notes by Date Nov 15-27

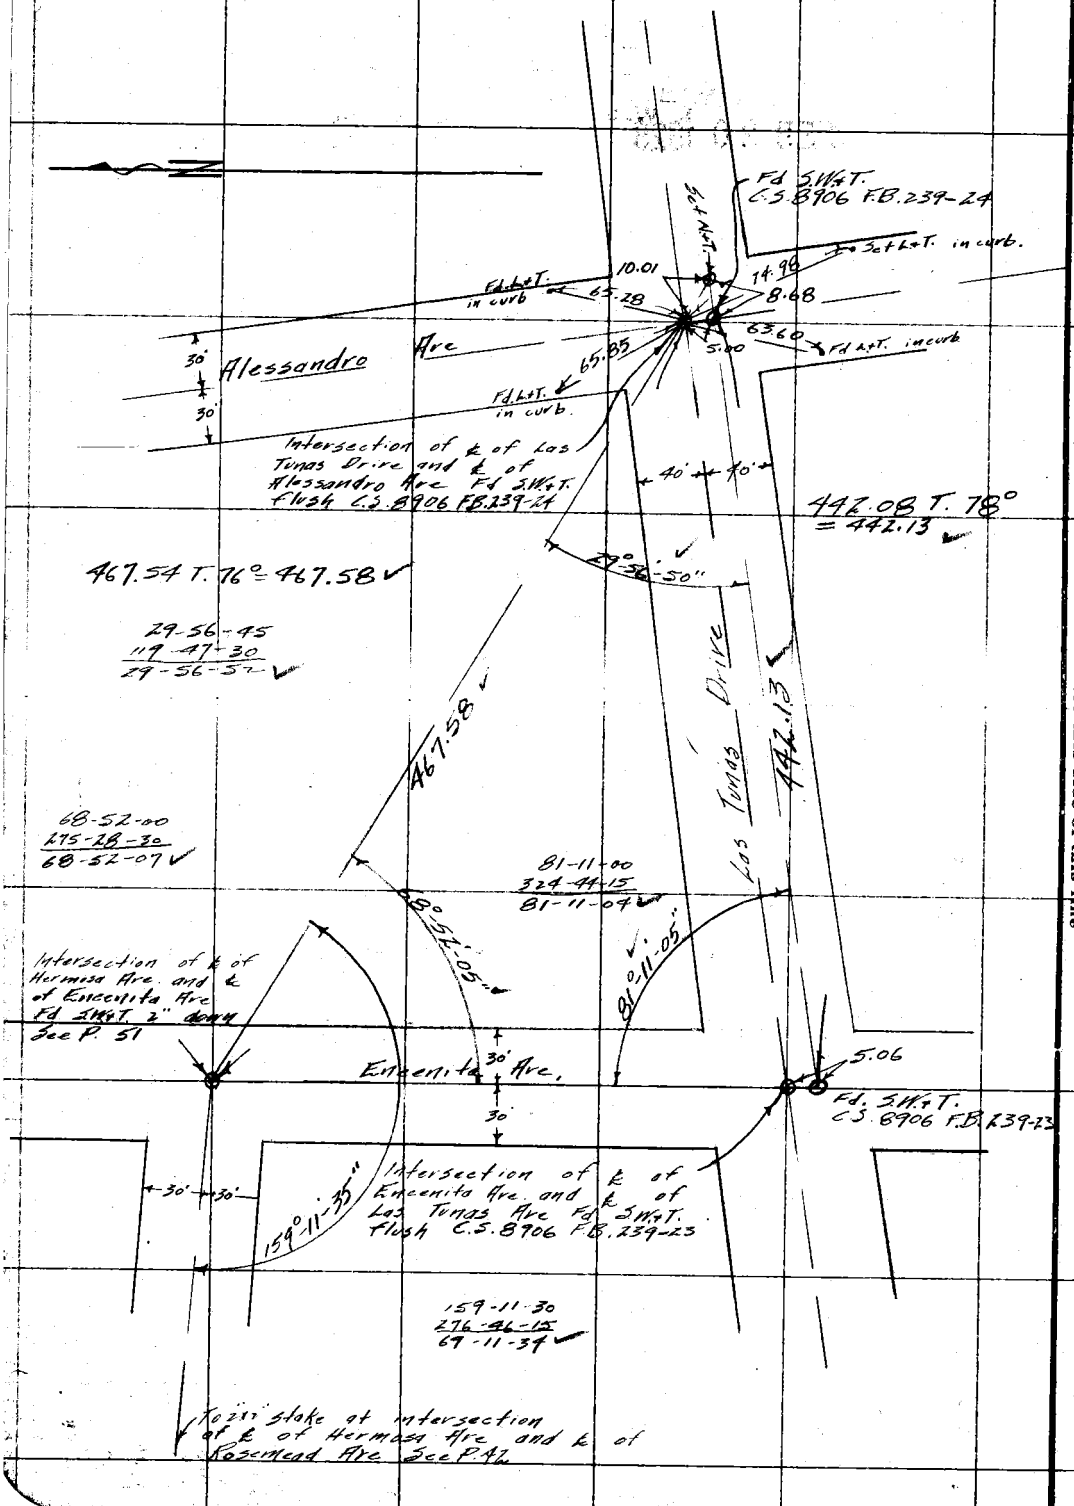

RETURN TO
LOS ANGELES COUNTY SURVEYOR
Do not extend notes this side of this line

Note: ANY ADDITIONS OR CHANGES ON THIS SHEET MUST BE MADE OR CIRCLED IN Red. WITH DATE AND NAME OF PERSON MAKING CHANGE.

Date _____ Notes by _____ Chief Party _____ F. B. 293 Pg. 51

Plotted by DC Hook
Date Dec 27 1927
Map No. B-197
Plotting C'k'd by S. M. B.
Date FEB 20 1928 B. W. S.

W. O. No. 4190 D. S. O. No.
Surveyed by R. S. - I. H. C.
Date Oct 4, 1927
Indexed A. C. Johnson

Notes: ANY ADDITIONS OR CHANGES ON THIS SHEET MUST BE MADE OR CIRCLED IN Red. WITH DATE AND NAME OF PERSON MAKING CHANGE.

Do not extend notes this side of this line

RETURN TO LOS ANGELES COUNTY SURVEYOR



































F.B. 293 PG. 52 Rosecrans Chief Party Notes by Date Oct 4-27

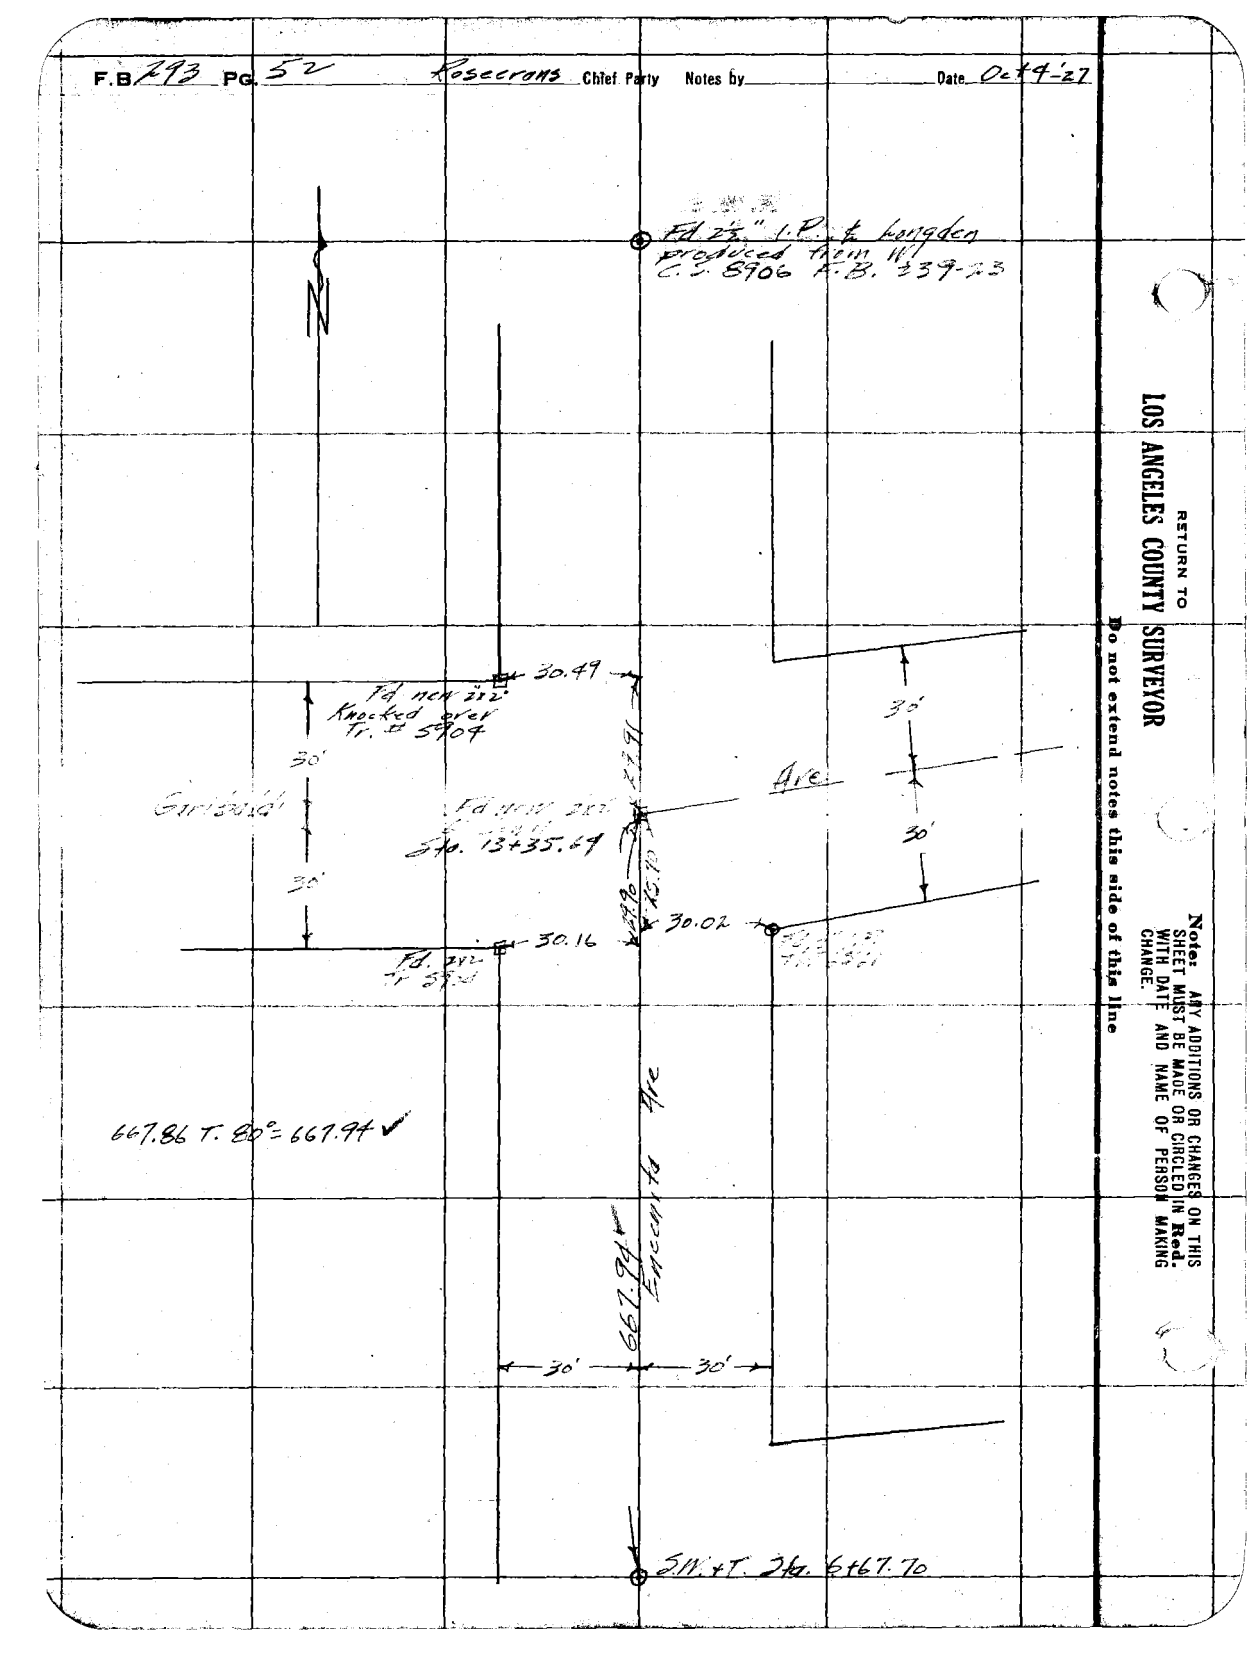

RETURN TO
LOS ANGELES COUNTY SURVEYOR

Do not extend notes this side of this line

Note: ANY ADDITIONS OR CHANGES ON THIS SHEET MUST BE MADE OR CIRCLED IN Red. WITH DATE AND NAME OF PERSON MAKING CHANGE.

Date Oct 1927 Notes by Cunningham Chief Party McGillivray F. B. 293 PG. 53

Planned by O.K. Rock
Date Dec 1927
Map No. B-122
Planting C't'd by Dy. Mt. Co.
Date FEB 20 1928

M. C. No. 4140 C. S. D. No.
Location Hermosa Drive
Surveyed by
Indexed A. C. Johnson

Continued Bottom Right Page

Notes ANY ADDITIONS OR CHANGES ON THIS SHEET MUST BE MADE OR CIRCLED IN Red. WITH DATE AND NAME OF PERSON MAKING CHANGE.

RETURN TO LOS ANGELES COUNTY SURVEYOR

Do not extend notes this side of this line

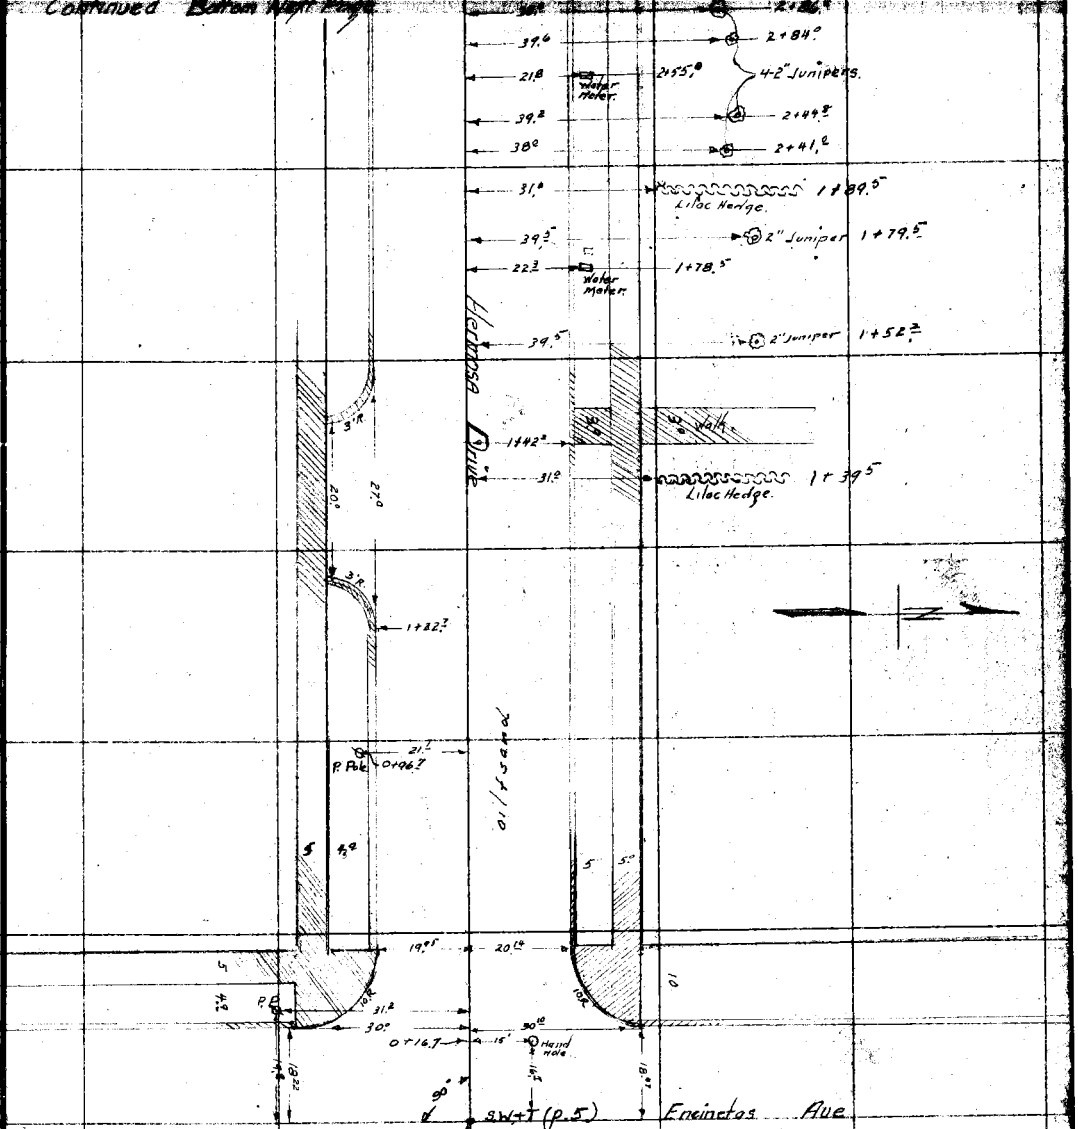

F.B. 293 PG. 54 Chief Party Notes by Date

Continued bottom next page.

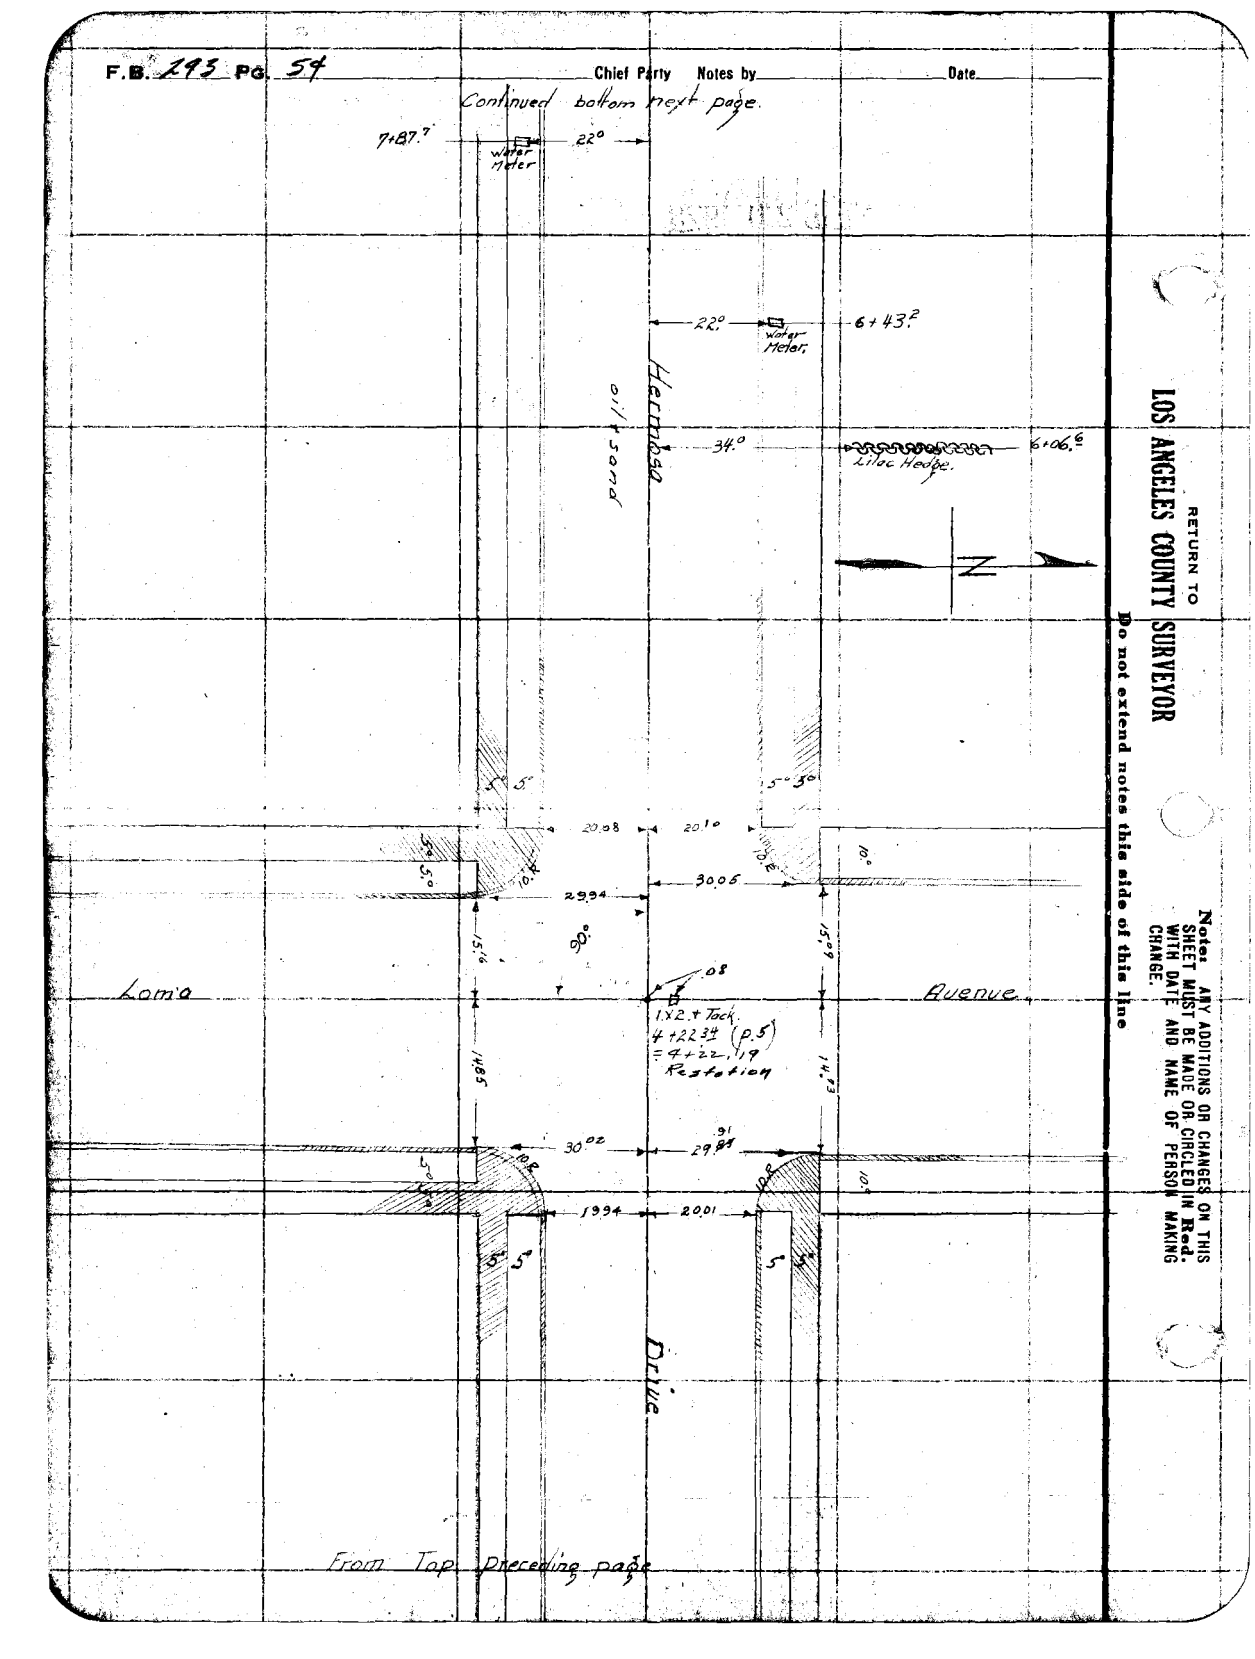

From Top Preceding page

RETURN TO
LOS ANGELES COUNTY SURVEYOR
Do not extend notes this side of this line

Notes: ANY ADDITIONS OR CHANGES ON THIS SHEET MUST BE MADE OR CIRCLED IN Red. WITH DATE AND NAME OF PERSON MAKING CHANGE.

Date Oct 1927 Notes by Cunningham Chief Party McGilvray F. B. 292 PG. 55

Plotted by: C.K. Cook
Date Dec 1927
Map No. A-172
Plotted by: R. W. S.
Date FEB 20 1928

W. O. No. 4160 A. S. O. No.
Location Hermosa Dr.
Surveyed by
Date
Indexed C. Joh

Continued Bottom Next Page

Notes: ANY ADDITIONS OR CHANGES ON THIS SHEET MUST BE MADE OR CIRCLED IN Red. WITH DATE AND NAME OF PERSON MAKING CHANGE.

Do not extend notes this side of this line

RETURN TO LOS ANGELES COUNTY SURVEYOR

Hermosa Drive

Hart Avenue

20.04 19.98 30.05 29.98

.5 .5 10.2 10.2 .01

90°

.06 2"x2" P.K.S. + Tack, 8+39.52 (p.5) = 8+39.33 Registion

114.97 151.03 151.03 114.97

from top pmr. p.

5.° 5.°

F.B. 273 Pg 56 Chief Party Notes by Date

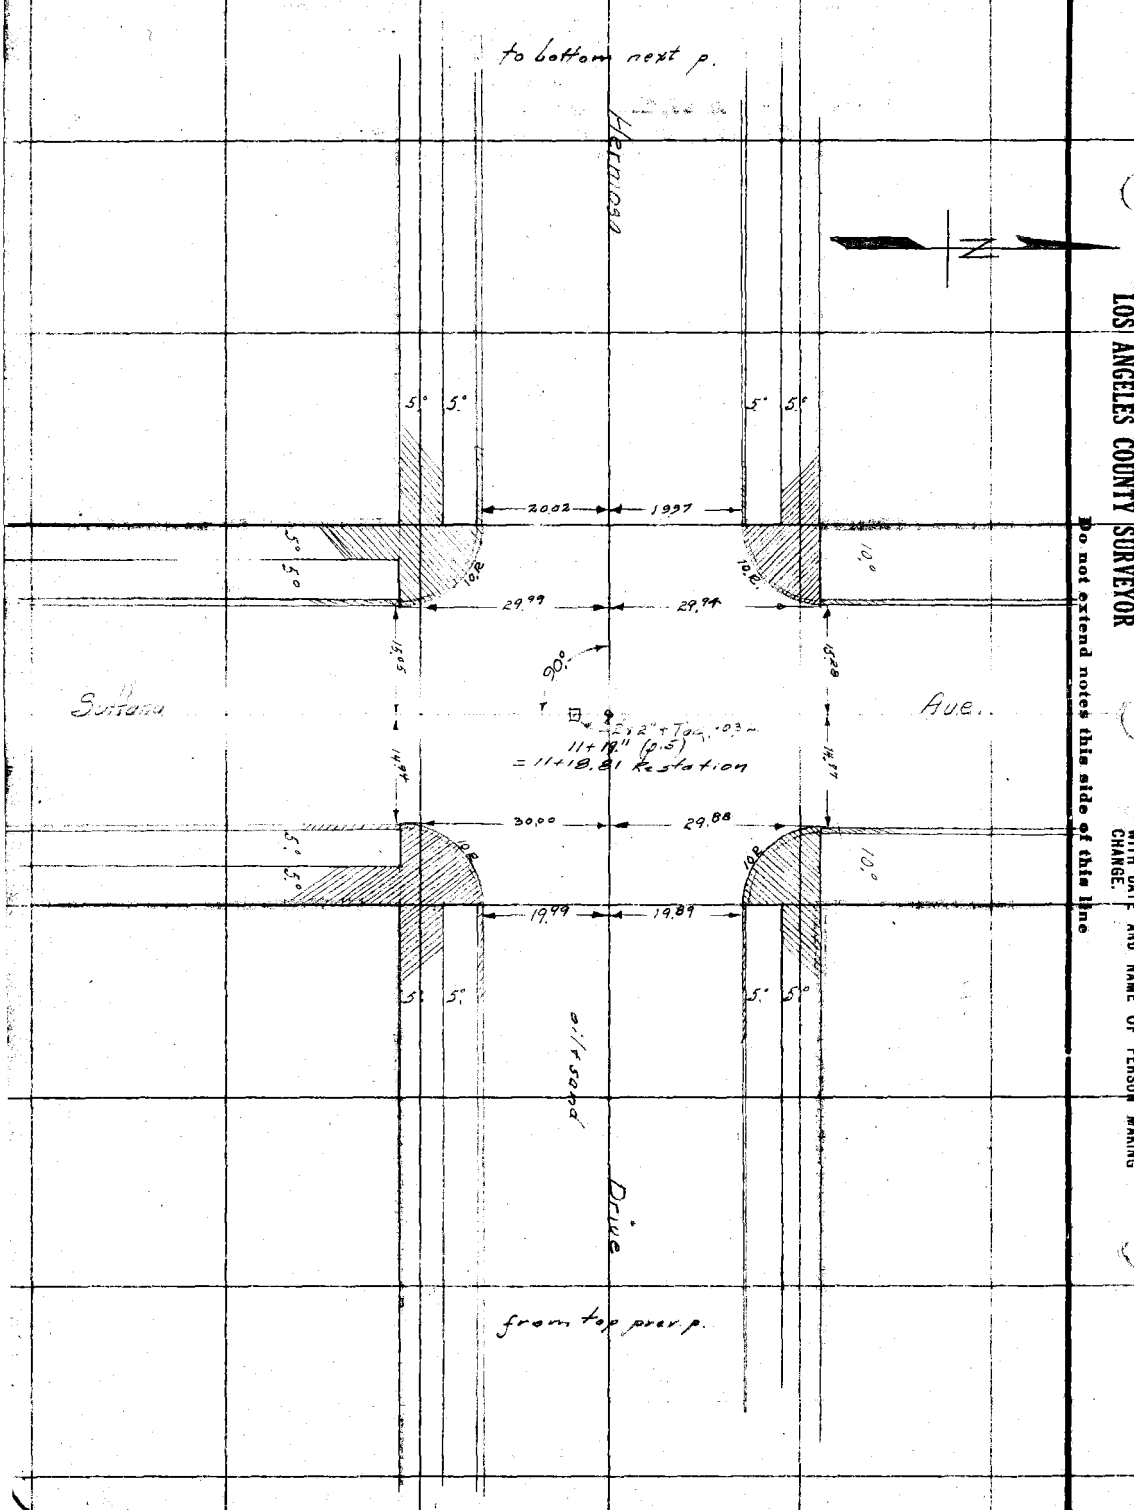

RETURN TO
LOS ANGELES COUNTY SURVEYOR
Do not extend notes this side of this line

Notes: ANY ADDITIONS OR CHANGES ON THIS SHEET MUST BE MADE OR CIRCLED IN Red. WITH DATE AND NAME OF PERSON MAKING CHANGE.

Date Oct. 1927. Notes by Cunningham Chief Party McClurray F. B. 293 PG. 57

Plotted by A.L. Rock
Date Dec 1927
Map No. B-122
Plotting Chkd by R. W. S.
Date FEB 29 1928

W. O. No. 4140 D. S. O. No.
Location Hermosa Dr.
Surveyed by
Date
Indexed A. C. Johnson

Rosemead Ave.

Continued on bottom Next Page.

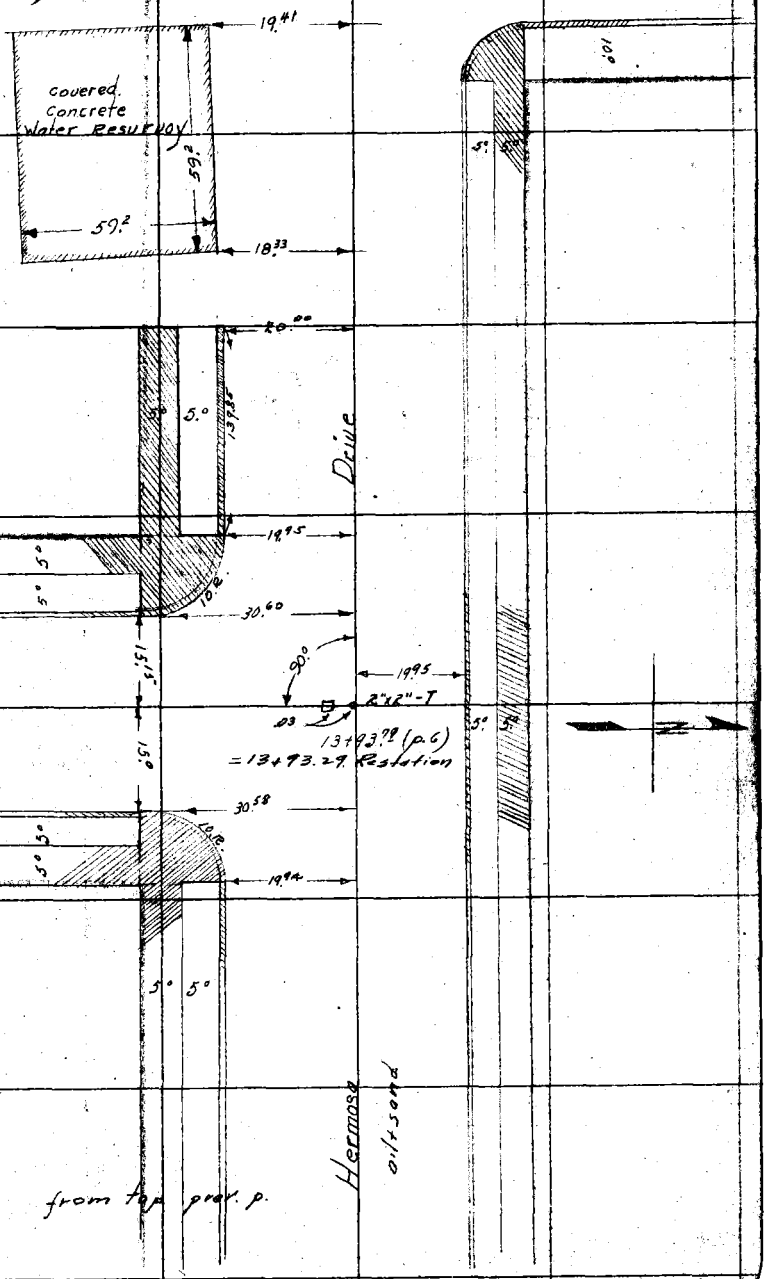

from top prev. p.

Notes: ANY ADDITIONS OR CHANGES ON THIS SHEET MUST BE MADE OR CIRCLED IN Red. WITH DATE AND NAME OF PERSON MAKING CHANGE.

Do not extend notes this side of this line

RETURN TO LOS ANGELES COUNTY SURVEYOR

F.B. 1293 Pg. 58 — Chief Party — Notes by — Date

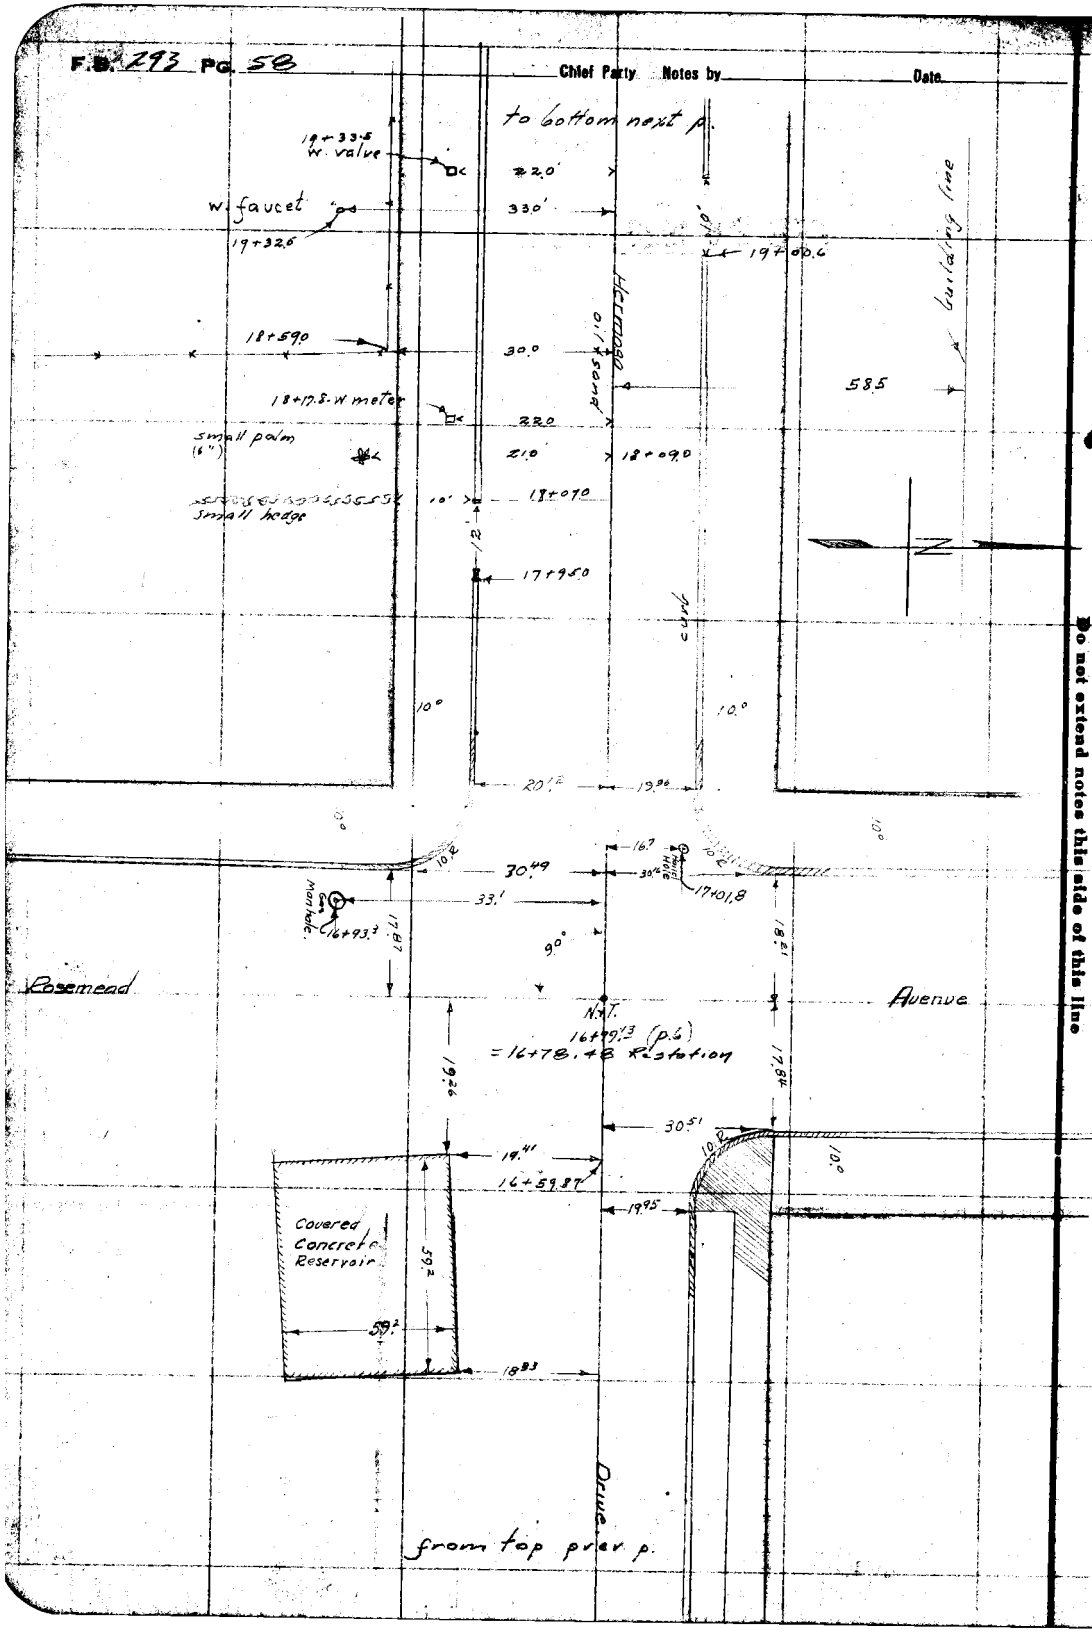

RETURN TO
LOS ANGELES COUNTY SURVEYOR
Do not extend notes this side of this line

Note: ANY ADDITIONS OR CHANGES ON THIS SHEET MUST BE MADE OR CIRCLED IN Red. WITH DATE AND NAME OF PERSON MAKING CHANGE.

Date Oct 1927 Notes by JVG Chief Party McGillivray F. B. 293 Pg. 59

Plotted by O.K. Peck
Date Dec 1927
Map No. A-1755
Plotting Chkd by R. W. S.
Date FEB 20 1928

W. O. No. 4140 R. & O. No.
Location Hermosa Dr
Surveyed by
Date
Indexed A. C. Johnson

Notes: ANY ADDITIONS OR CHANGES ON THIS SHEET MUST BE MADE OR CIRCLED IN Red. WITH DATE AND NAME OF PERSON MAKING CHANGE.

Do not extend notes this side of this line

RETURN TO LOS ANGELES COUNTY SURVEYOR

Fr bottom next sh.

20.00
10' R
30.07
N.T. 24+29.29 = 24+28.38 Restation
12.87 (p.f.)
1523
19.98
.02
Fd 2x2
90°
14.89
Ivar Ave.
28.97
10' R
19.97
curb
Hermosa Dr.
5' conc drive
10.5
22+82.4
23.0 22+78.0 12" low palm
23.0 12" low palm 22+55.2
22.0 22+46.3 w. meter
22+41.6 hedge
21+.050 W. meter
22.0
20.02
19.97
10' R
29.64
29.61
10' R
Reno Ave
14.84
8.90 N.T. 20+59.21 (p.f.) = 20+49.51 Restation
.08 s.w.t.
.06 s.w.t.
90°
15.26
14.82
28.54
30.52
10' R
10' R
19.98
30.1
20+25.0
from top prev. p.

F.B. 293 Pg. 60 Chief Party Notes by Date

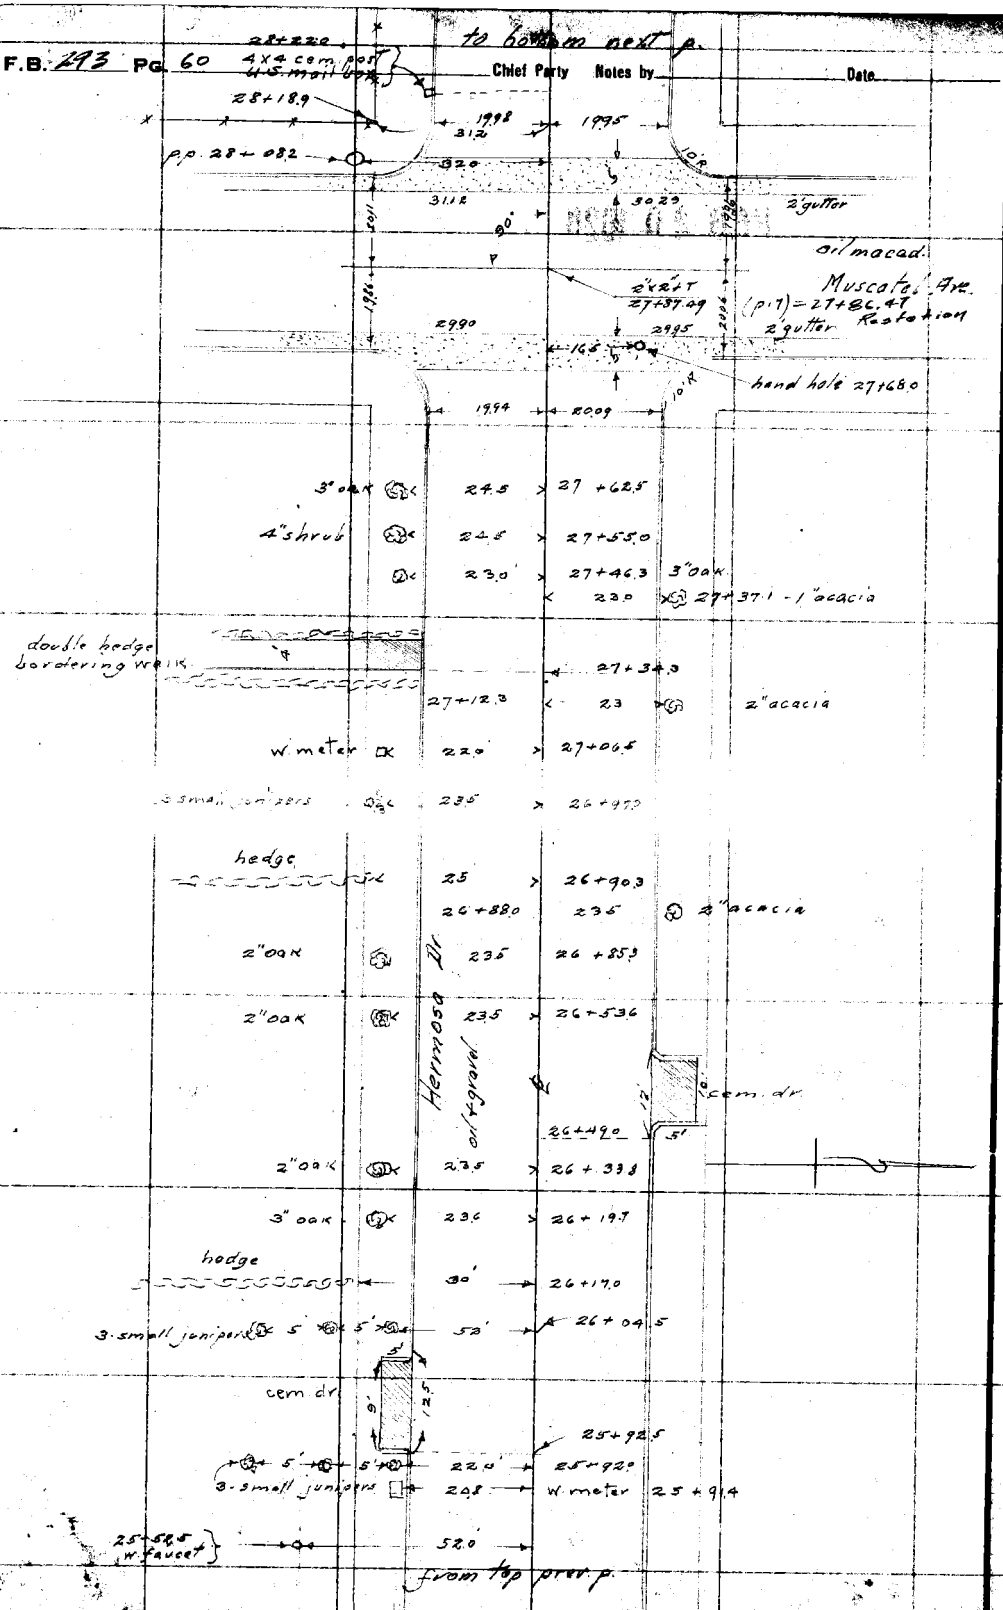

RETURN TO
LOS ANGELES COUNTY SURVEYOR
Do not extend notes this side of this line

Notes: ANY ADDITIONS OR CHANGES ON THIS SHEET MUST BE MADE OR CIRCLED IN Red. WITH DATE AND NAME OF PERSON MAKING CHANGE.

Date Oct. 1929 Notes by [illegible] Chief Party McGillivray F. B. 293 PG. 61

Plotted by C.L. Poole
Date Dec. 1927
Map No.
Plotting Chkd by R.W.S.
Date FEB 20 1928

W. O. No. 4140 D. & O. No.
Location Hermosa Dr.
Surveyed by
Date
Indexed A. C. Johnson

Notes: ANY ADDITIONS OR CHANGES ON THIS SHEET MUST BE MADE OR CIRCLED IN Red. WITH DATE AND NAME OF PERSON MAKING CHANGE.

Do not extend notes this side of this line

RETURN TO LOS ANGELES COUNTY SURVEYOR

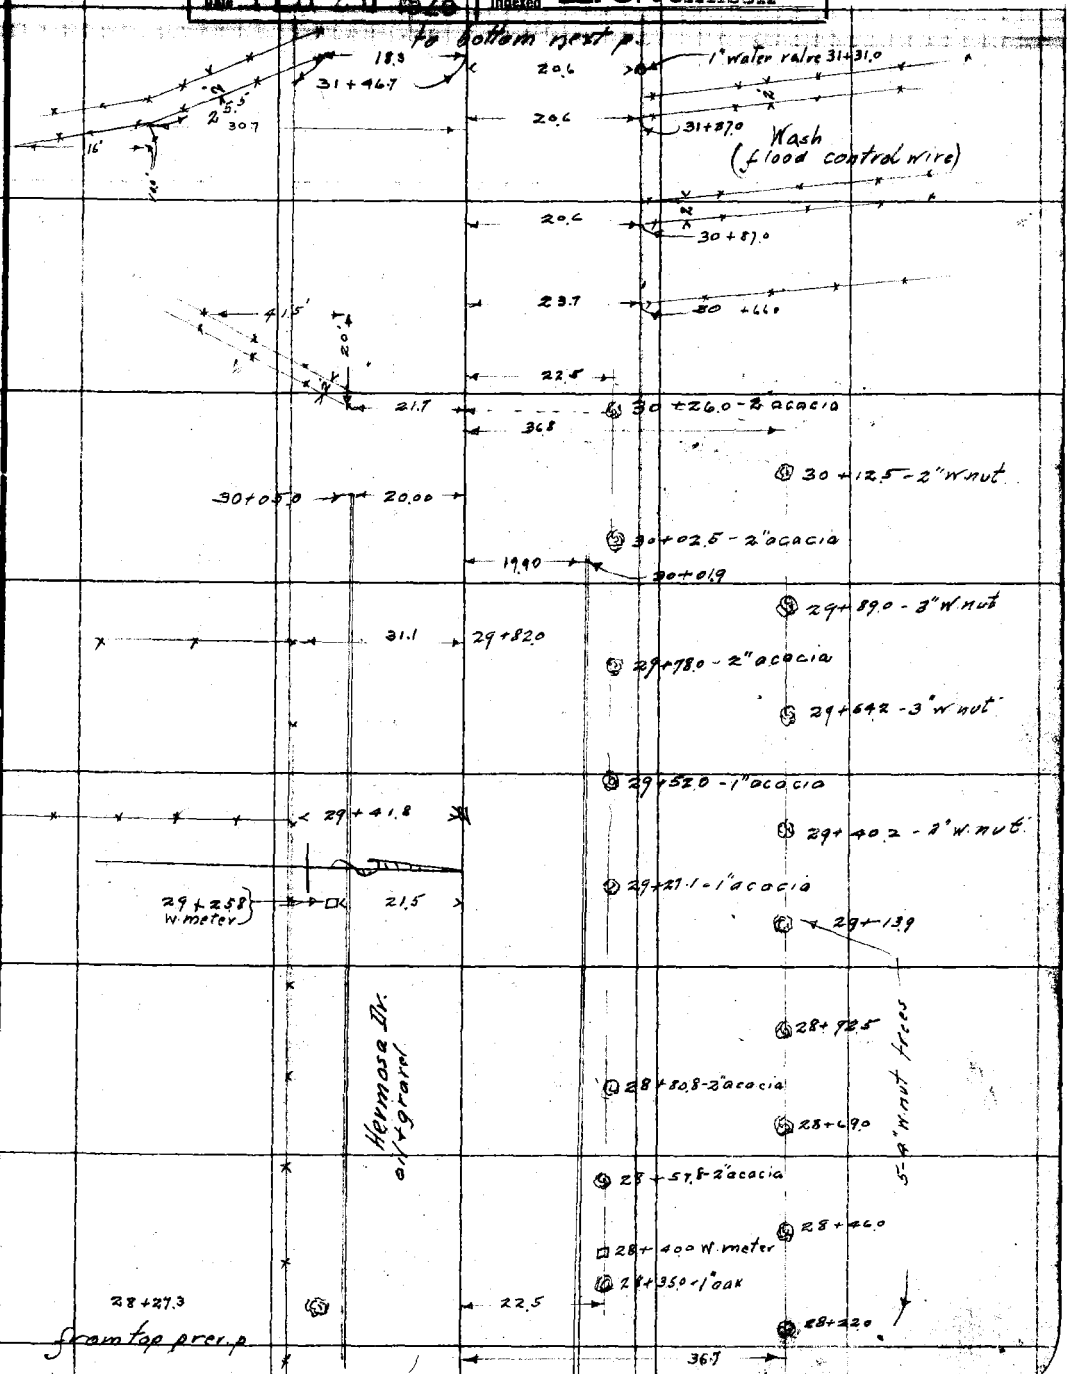

F.B. 293 PG. 62 Chief Party Notes by Date

to bottom next p.

A'cmt W.

37+56.6

W meter 37+51.7

37+45.4 2"orange

38'

200.1

35+90.5 hand hole

N.T. 35+93.64 (p.8) = 35+92.54 Restation

Bartlett st.

(page 8)

30.62

20.10

hedge

35+37.5 hedge

c. drive

35+27.2

5"locust 35+16.3

W meter

35+20.8 W meter

35+13.4

cem. w.

hedge

34+93.0

34+82.0 35' 2"orange

5"locust

31.6 34+70.8

34+67.0 35' 3"loquat

hedge

34+58.7

24.0 34+50 shrub

W. meter

22.0' 34+39.5

24' 34+37.3 shrub

cem. w.

34+30.2

24' 34+27.0 shrub

22.5 34+08.8 3"juniper

cem. dr.

33+96.0

22.5' 33+95.0 3"juniper

21.0' 33+80.8 hedge

19.80 20.06 32+46.7

cont'd from top prev. p.

RETURN TO LOS ANGELES COUNTY SURVEYOR

Do not extend notes this side of this line

Note: ANY ADDITIONS OR CHANGES ON THIS SHEET MUST BE MADE OR CIRCLED IN Red. WITH DATE AND NAME OF PERSON MAKING CHANGE.

Date Oct 1927 Notes by MG Chief Party MG Gilliscay F. B. 293 Pg. 63

Plotted by O.K. Peck
Date Dec 1927
Map No.
Plotting Chkd by R.W.S.
Date FEB 20

W. O. No. 41649 S. S. O. No.
Location Hermosa Dr.
Surveyed by
Date
Indexed A. C. Johnson

to bottom next page

Note: ANY ADDITIONS OR CHANGES ON THIS SHEET MUST BE MADE OR CIRCLED IN Red. WITH DATE AND NAME OF PERSON MAKING CHANGE.

RETURN TO LOS ANGELES COUNTY SURVEYOR
Do not extend notes this side of this line

5' walk
t. pp 45+31.4
37.5
9.5
22.8
46'
42'
one sty fr bldg
stor
9.5'
44 + 95.6
22.8
8.02
4' walk
9.5
PP
19.92
21.2' R of 44+84.8
9.40
N.T. 44+79.44 (p.8) = 44+72.45 Restation
9°
20.55
Vista St.
20.11
9.5
8.07
4' walk
42+85.5 tp
37.4
12'
8'
5' walk
guy p 43+55.0
N.T. 42+96.49 = 42+95.49 Restation
20' mac. dirt from here west.
40' oil & sand from here east
0.13
8.36
42+96.44
23.06
14.70
3 x 3 - 42+96.36 = 42+95.36 Restation (p.9)
42+75.51
42+49.0 tp
41+23.0 tp
Hermosa Dr
19.90
22'
22'
19.49
20.22
20.12
42+76.62
40+37.04
Burton Ave.
30.58
25.55
Fd. 2" IP plug-T
40+11.49 (p.8) = 40+10.44 Restation
15.31
14.81
9°0
15.10
16.8
40+01.0 hand hole
39+99.0 hand hole
14.91
30.44
32.0
29.79
4"x4" comp post U.S. mbil (ot)
39+96.0
19.76
20.11
tp
22.0'
39+82.6
cont'd from top prev. p

F.B. 293 Pg. 64 Chief Party Notes by Date

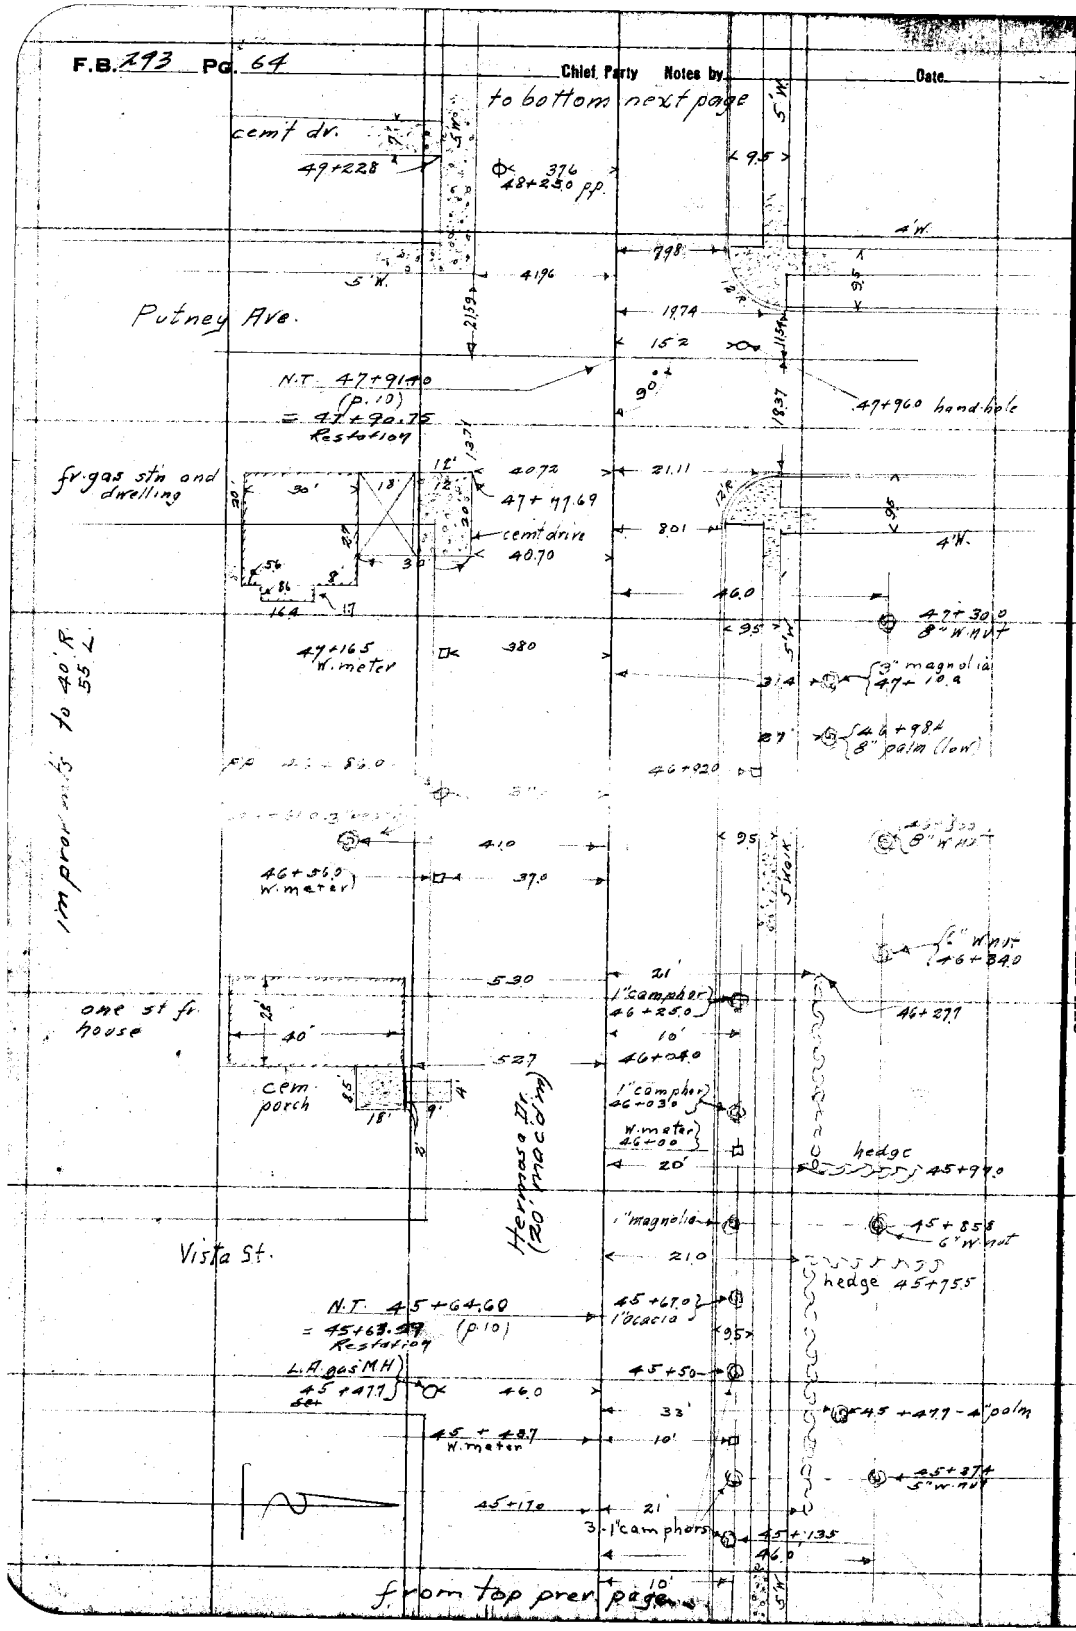

RETURN TO
LOS ANGELES COUNTY SURVEYOR
Do not extend notes this side of this line

Note: ANY ADDITIONS OR CHANGES ON THIS SHEET MUST BE MADE OR CIRCLED IN Red. WITH DATE AND NAME OF PERSON MAKING CHANGE.

Date Oct 1927 Notes by MG Chief Party MG Gilliray F. B. 293 PG. 65

Plotted by OK Peck
Date Dec 1927
Map No.
Plotting C'k'd by R. W. S.
Date FEB 20 1928

W. O. No. 4140 S. O. No.
Location Hermosa Dr.
Surveyed by
Date
Indexed A. C. Johnson

Notes ANY ADDITIONS OR CHANGES ON THIS SHEET MUST BE MADE OR CIRCLED IN Red. WITH DATE AND NAME OF PERSON MAKING CHANGE.

RETURN TO LOS ANGELES COUNTY SURVEYOR

Do not extend notes this side of this line

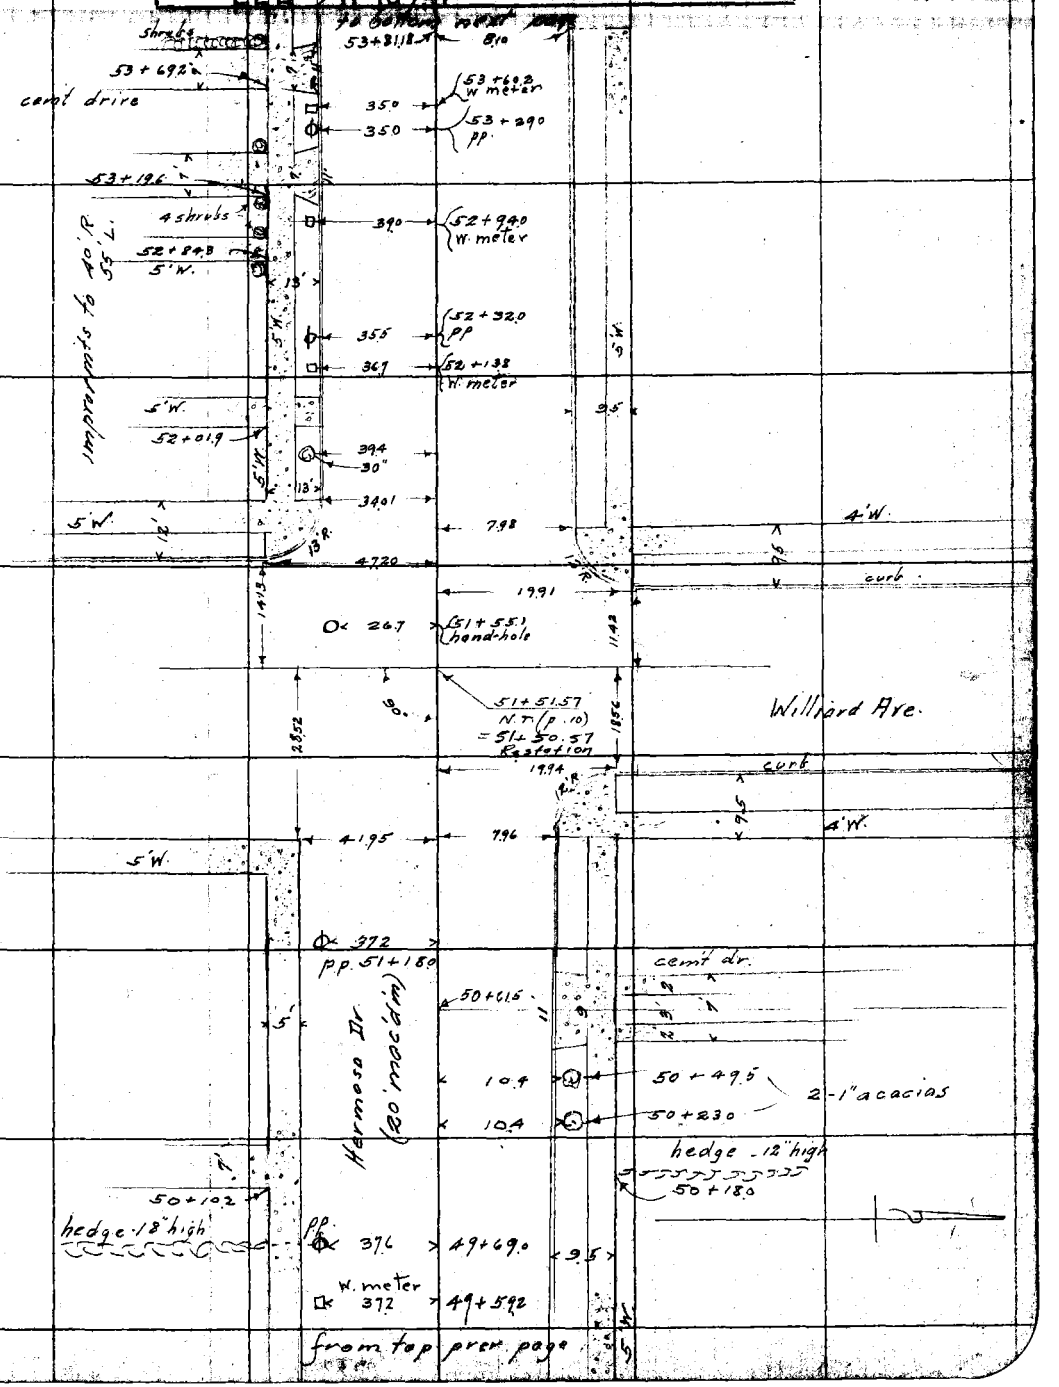

F.B. 293 Pg. 66 W meter Chief Party Notes by Date

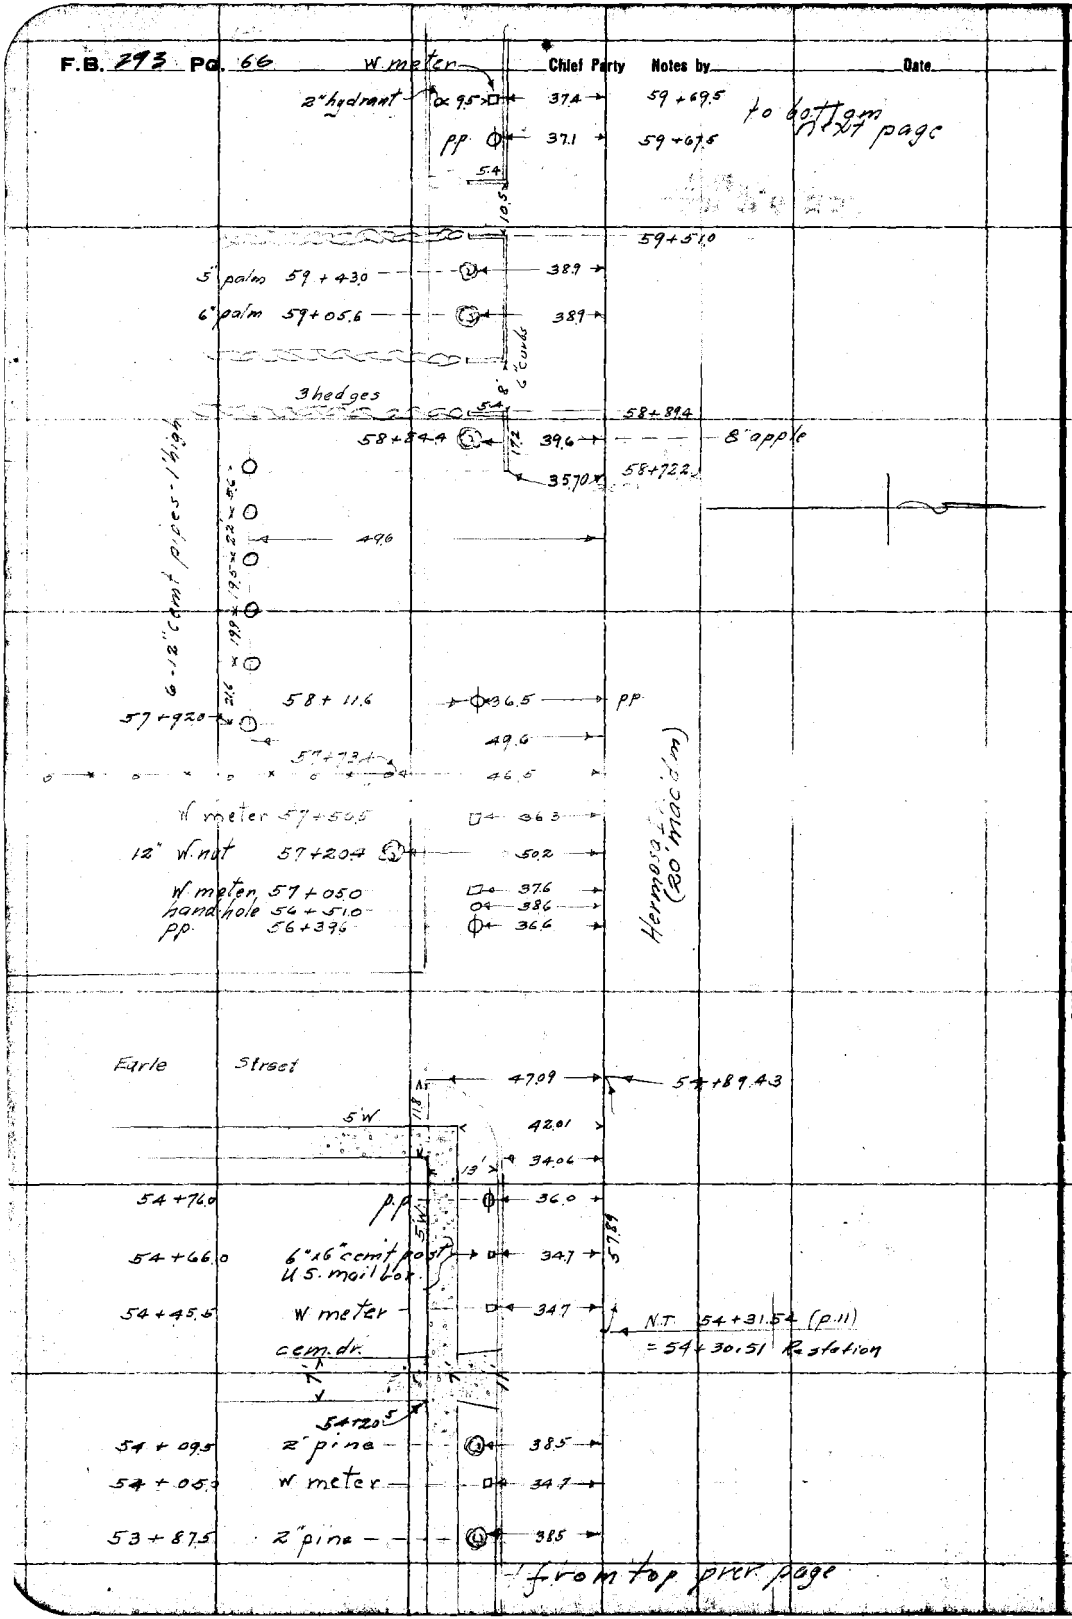

RETURN TO
LOS ANGELES COUNTY SURVEYOR
Do not extend notes this side of this line

Notes: ANY ADDITIONS OR CHANGES ON THIS SHEET MUST BE MADE OR CIRCLED IN Red. WITH DATE AND NAME OF PERSON MAKING CHANGE.

Date Oct 1927 Notes by MG Chief Party McGilvray F. B. 293 Pg. 67

Plotted by [illegible] Date Dec 1927 Map No. [illegible] Plotting C'k'd by [illegible] Date [illegible]

W. O. No. 4140 S. & O. No. Location Hermosa Dr Surveyed by Date Indexed A. C. Johnson

Notes: ANY ADDITIONS OR CHANGES ON THIS SHEET MUST BE MADE OR CIRCLED IN Red. WITH DATE AND NAME OF PERSON MAKING CHANGE.

Do not extend notes this side of this line

RETURN TO LOS ANGELES COUNTY SURVEYOR

87.7 → 67+38.0 pp.
87.7 → 65+82.0 pp.
37.1 → 64+24.1 pp.
to bottom next page

62+72.0 ← 11.8 → W. meter

8.1
4.7 x 5.1
62+62.4 ← 8.7 → shed - meter house?

62+57.0 pp. ← 37.3 → 10.6 gugpole 62+57.8

street....

3' ← 25.5 → hand holes 62+49.0

1"x2" - 62+25.22 (p. 11) = 62+24.11 Restation

CHARLOTTE AVE

HERMOSA DR.

improvements shown to 40' R + 55' L.

4' W

48.6 → 61+38.5

36.4 → 61+35.0 W. meter

12" conc. pipe 12" high ← 48.7 → 61+12.0

37.6 → 61+07.2 pp.

36.65 → 60+98.5

3" willow ← 52.3 → 60+94.5

SHRUBS

37.0 → 60+73.4 W. meter

3" willow ← 52.3 → 60+70.5

10.5

60+51.7

4" pepper ← 50.8 → 60+40.0

6' SHRUBS

(20' max'd)

3-2" cypress ← 51.5 → 37.5 → 60+05.5 W. meter

60+03.0

6' 10'

59+88.0

W. meter ← 37.4 → 59+75.0

from top prev. page.

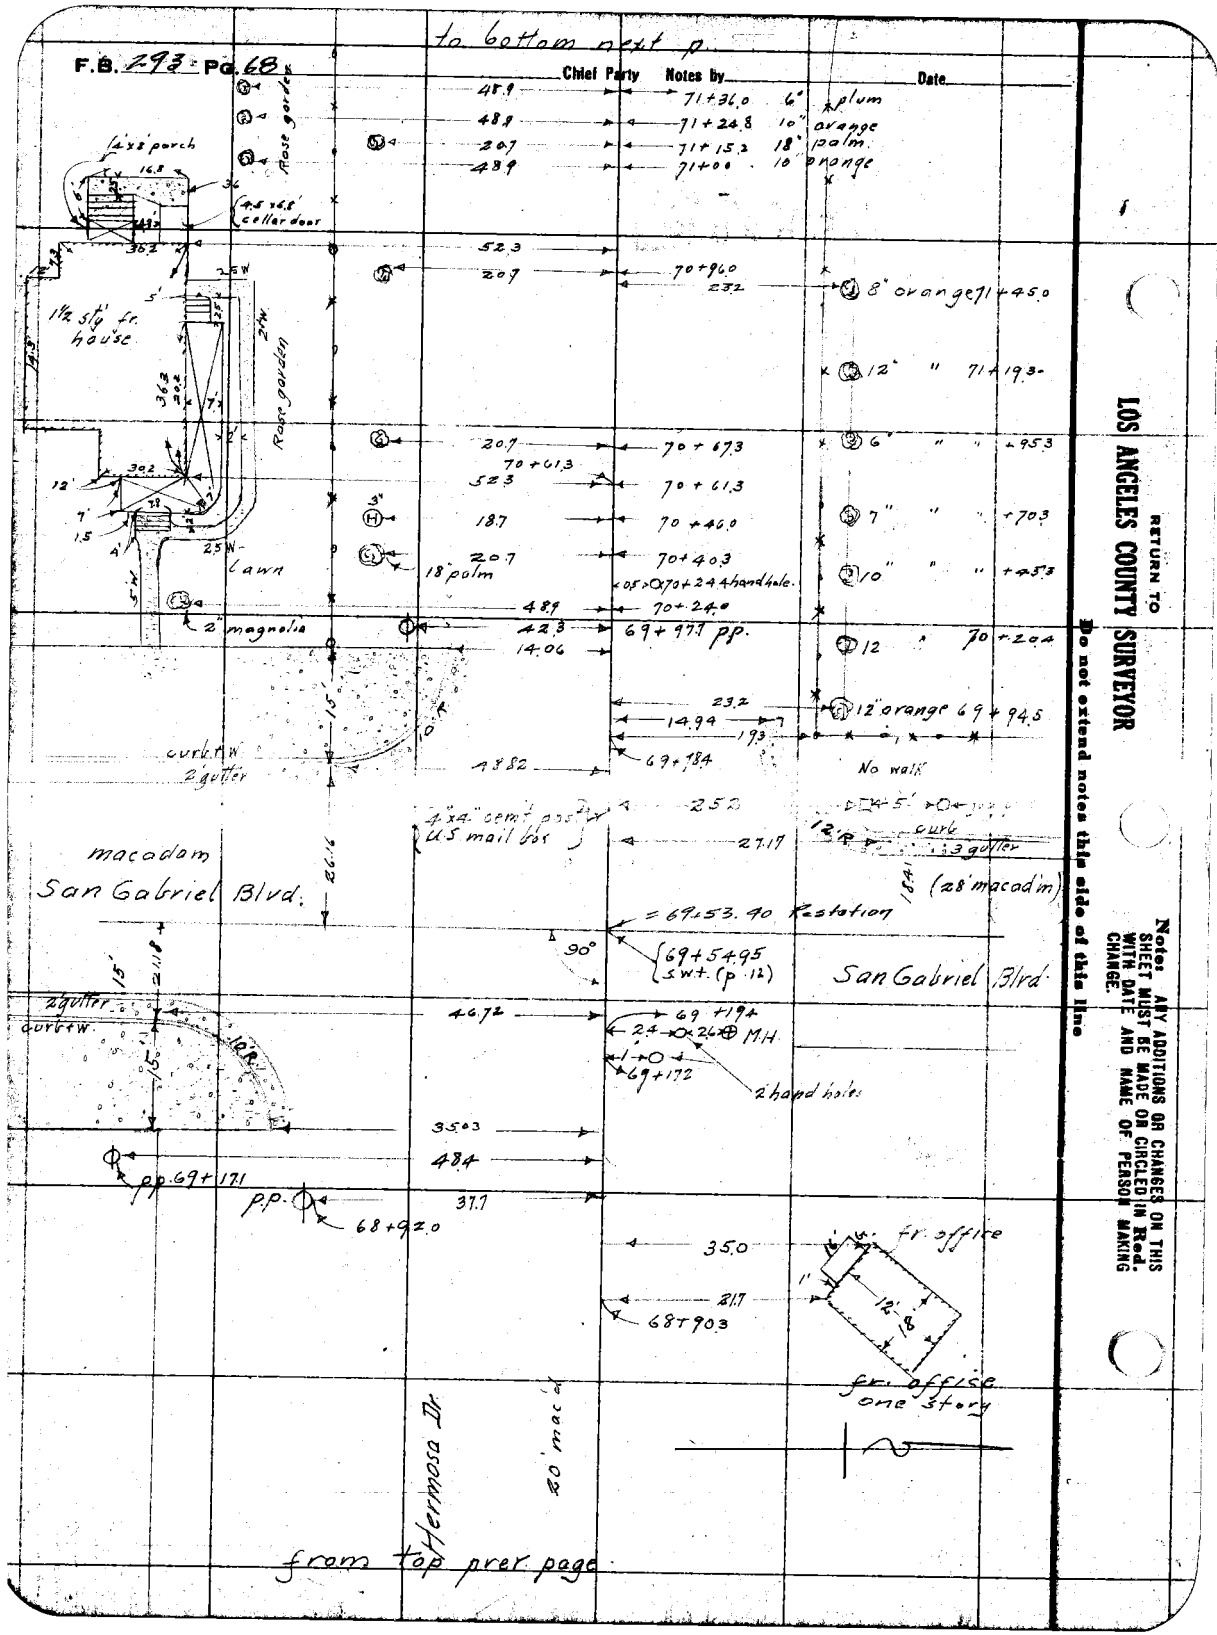

RETURN TO
LOS ANGELES COUNTY SURVEYOR

Do not extend notes this side of this line

Notes: ANY ADDITIONS OR CHANGES ON THIS SHEET MUST BE MADE OR CIRCLED IN Red. WITH DATE AND NAME OF PERSON MAKING CHANGE.

Date Oct 1927 Notes by MG Chief Party McGillivray F. B. 293 PG. 69

Plotted by Oil Peck
Date Dec 1927
Map No.
Plotting C'k'd by R. W. S.
Date FEB 20 1928

W. O. No. 4140 C. S. O. No.
Location Hermosa Dr.
Surveyed by
Date
Indexed A. C. Johnson

to bottom next page

Pine St.

N.T. 73+58.78 (p.13)
= 73+57.21
R. sta + ion

237 Black W. nut 20" 73+46.6

W. Valve W. meter 29.5 73+35.0

29.1 73+34.0

19.5

73+33.5 - 14" cemt pipe 35.2 shrubs against brick pillar 2x2' - 4.5 high

73+33.0 pp 19.5 18.5

73+29.6 hand hole (valve) 25.3

73+24.0 - 8" orange 47.7 16.7 pp 73+24.7

40.7

73+00 - 8" orange

72+74.0 - 12" orange

12" pipes (cement)

23.2 3" orange 72+93.8

19.3 ¾" faucet 72+69.3

72+49.4 8" orange

72+48.2 - 12" cemt pipe 40.7

72+23.7 10" orange 47.7

3" orange 72+68.0

3" orange 72+17.6

27.5
48.5

fr. barn 34' 20'

4" orange 71+95.3

48.5 71+87.8

27.0 23.2 4" orange 71+68.8

20.7 24" palm 71+67.5

19.2 pp 71+64.0

48.9 10" orange 71+50.0

Rose garden

20.7 18" palm 71+42.5

from top prev. page

RETURN TO LOS ANGELES COUNTY SURVEYOR

Notes: ANY ADDITIONS OR CHANGES ON THIS SHEET MUST BE MADE OR CIRCLED IN Red. WITH DATE AND NAME OF PERSON MAKING CHANGE.

Do not extend notes this side of this line

F.B. 293 PG. 70,

Chief Party Notes by Date

to bottom next page.

Stn	Off ℄	Object
73+69.5	23.9 R.	16" bl. walnut
" +77.0	49.3 L.	8" orange
" "	34.4 L.	" "
" +80.5	22.5 L.	4" W. nut
74+00.5	49.3 L.	8" orange
" "	34.4 L.	12" "
" +06.3	21.6 L.	2" W. nut
" +16.5	35.0 R.	30" L. oak ✓
" +27.6	49.4 L.	10" orange - 34.4 L. 10" plum
" "	22.5 L.	8" W. nut
" +48.5	36.3 R.	12" pine
" +50.6	49.3 L.	8" orange - 34.4 L. 8" apple
" +70.0	22.0 R.	W. meter
" +74.3	49.3 L.	8" orange - 34.4 L. 8" peach
" "	22.5 L.	10" W. nut
" +77.6	36.5 R.	6" Pine
75+00	49.3 L.	8" orange - 34.4 L. 10" apricot
+04.7	19.0 L.	P.P.
+26.0	49.3 L.	6" orange
"	5" L.	plum "
"	20.6 L.	12" acacia
+49.6	49.3 L.	6" orange
"	34.4 L.	10" apricot
+58.0	38.1 R.	4" pine
+76.0	49.3 L.	8" orange
"	34.4 L.	8" peach
"	20.6 L.	10" W. nut
76+00.7	49.3 L.	6" orange
" "	34.4 L.	6" apple
" +07.7	36.5 R.	12" low palm
" +27.0	49.3 L.	8" orange
" "	34.4 L.	10" apple
" "	20.6 L.	12" W. nut
"	25.1 L.	W. meter
" +28.0	27.4 L.	" "
" +30.0	26.3 L.	" "
" +52.0	49.3 L.	6" orange
" "	34.4 L.	8" apple
" +54.0	30.0 L.	6" pine
" +81.4	19.1 L.	P.P.
76+87.5	23.0 R. (on walk)	20" oak
" +93.5	26.0 R. (on curb)	4" oak.

78+04.0

(Wash) bridge under construction cut banks

77+36.0

S.+W. 77+05.54 (p.13)
California St.
= 77+06.88 K station

12.3 handhole 77+01.0

90°

145'

1760
172 gas hand-hole
4' walk
1760
174
76+84.3

76+93.0

76+520 177

222
76+460

24.6

2'+4'x4' plaster pillars ± 55 high

151'

2.3

23.0
76+19.4 243

76+32.7 cement water box - 2' high

hedge 2' from edge of walk

76+082

2'x2' brick pillar 4.5' high

17.9
75+08.4
18.9

2'x2' pillars of brick

4' Walk

18.1

18.1

19.1

19.1

4" curb

22.0

drive

15'

11'

board flume 10" wide - 8" high

73+77.0

22.0

4" curb

23.0

73+74.0

73+75.0 19.1

Improvements shown to 55' so. and 40' North.

Hermosa Dr.

Alhambra Ave.

from top prev. page.

RETURN TO
LOS ANGELES COUNTY SURVEYOR
Do not extend notes this side of this line

Note: ANY ADDITIONS OR CHANGES ON THIS SHEET MUST BE MADE OR CIRCLED IN Red. WITH DATE AND NAME OF PERSON MAKING CHANGE.

Date Oct 1916 Notes by M°G. Chief Party M°G. Murray F. B. 283 PG. 71

Plotted by O'Toole
Date Dec 1927
Map No.
Plotting Chkd by R.W.S.
Date F.F.R.

W. O. No. 4140 C. S. G. No.
Location Hermosa Dr.
Surveyed by
Date
Indexed by A. C. Johnson

cont'd bottom next page.

Sta.	Off.	Object
77+90.0	30.0 L.	1½" gum
78+00.0	" "	8"-6" Twin gum
78+21.0	" "	13" gum
" + 23.0	40' L.	12" "
" + 33.0	19.6 L.	pp.
" + 39.0	12.2 L.	hand-hole
" + 43.0	30.0 L.	10" gum
" + 48.0	28.9 L.	20" "
" + 50.2	21.6 L.	W. meter
" + 54.0	30.0 L.	15" gum
79 + 6.97	19.5 L.	pp.
" + 7.55	22.0 L.	8" cascara bush
80 + 0.20	28.5 L.	1" ~~not~~ OAK
" + 3.0	32.4 R.	clump 4-8 oaks
" + 13.3	24.6 L.	1" OAK
" + 26.8	35.7 L.	3" fig
" + 33.0	28.5 L.	2" oak
" + 51.9	36.6 L.	3" quince
" + 52.7	31.5 L.	W. meter
" + 73.0	32.4 L.	6" rose tree
" + 81.2	27.5 L.	W. meter
" "	26.6 L.	W. valve
" + 82.0	31.0 L.	3" hydrant
" + 83.0	38.8 R.	2" poplar
" + 84.2	31.5 R.	4" acacia
" + 85.2	25.7 R.	3" poplar
" + 86.0	20.0 L.	pp.
" "	37.0 L.	4" fig
" + 89.0	38.8 R.	3" poplar
" + 94.6	24.7 R.	4" tobacco bush
" + 97.0	38.8 R.	3" poplar
" + 98.0	29.8 R.	4" pine

81+26.7	39.0 L.	6" shrub
82+42.0	24.8 L.	W. valve (hand-hole)
"	28.8 L.	" meter
"	31.8 L.	" valve (hand-hole)

shrubs 24' 30' 24.6 82+14.0

shrubs 22' 81+36.0

macadam drive 12' wide

81+11.2

hedge 81+05.5 (against rail)

shrubs 27' 81+03.0

Row of bricks 30.8 80+54.7

beginning hedge rail one ft high 80+42.4

17.8

end of lattice f.

17.0 80+02.4

break in f.

17.6 79+62.0

Hermosa Dr.

17.6 Lattice f. 78+11.0

from top over page.

RETURN TO LOS ANGELES COUNTY SURVEYOR

Notes: ANY ADDITIONS OR CHANGES ON THIS SHEET MUST BE MADE OR CIRCLED IN Red. WITH DATE AND NAME OF PERSON MAKING CHANGE.

Do not extend notes this side of this line

F.B. 293 Pg. 72 Chief Party Notes by Date

to bottom next page

82 +84.0	21.0 L.	P.P.
" +85.0	31.5 L.	4" holly
" +94.0	29.1 L.	4" pine
" +96.0	41.0 L.	Holly clump
83 +12.5	183 L.	4" camphor
83 +53.0	29.7 R.	18" oak
" "	34.8 R.	24" "
84 + 29.0	20.7 L.	W. valve
84 + 63.2	19.6 L.	1" water faucet
" " "	39.9 R.	1" " "
" + 81.0	38.0 R.	2" oak
85 + 20.5	22.0 L.	4" gum
" + 38.5	22.0 L.	10" gum
" + 47.3	22.0 L.	18" "
" +58.0	" L.	15" "
" +64.6	" L.	24" "
" +73.6	L.	24" stump
86 + 52.5	29.1 L.	30" gum
" + 82.3	33.6 R.	hand hole
" + 86.0	21.8 L.	36 gum
" +89.1	38.5 R	3" hydrant
" +95.0	28.4 L	20" gum
" +99.9	18.5 L.	guy p
" "	18.3 R.	pp
87 + 13.2	28.4 L.	36" gum
" +21.6	29.5 R.	3" monkey tree
+29.3	34.0 R	3" cedar
+31.8	35.0 R	2" shrub
+36.0	28.4 L.	14" gum
+43.0	29.0 R.	2" Shrub
+44.5	28.4 L.	16" gum
+52.5	35.1 R	bamboo stash
+61.0	29.1 R.	"
+64.4	33.1 R.	8" Nilon
+72.0	22.5 R.	3" Sauer
+78.0	28.4 L	16" gum
+89.0	27.0 R.	3" acacia
+95.3	20.3 L.	15" gum
88 + 04.0	20.3 L.	24" "
+05.0	31.0 R.	4" holly
+11.3	26.0 R	5" tree (?)
+25.2	23.8 R.	4" gum
+31.0	28.4 L.	3" "
+41.0	13.3 L.	2" gum
+41.0	17.8 L.	tp.
+44.6	12.6 R.	pp
+46.5	27.7 R.	2" orange
+60.2	27.7 R.	3" loquat
+64.0	31.0 L.	30" gum
+73.2	27.7 R.	3" quince
89 + 06.0	27.1 R.	4" umbrella
+22.0	" "	2" camphor
+40.0	13.3 R	pp
+40.1	17.8 R.	Shrub
"	27.1 R.	4" umbrella
+69.0	17.7 R.	Shrub
"	16.5 L.	tp.
90 + 03.0	25.8 R.	6" pine
+20.6	13.1 R.	W. meter
+25.5	12.4 R.	Shrub 2"
+51.7	19.9 R.	" 2"
+67.0	19.0 R.	" 3"
+72.7	25.2 R.	" 6' high
+77.7	20.0 L.	18" gum
+84.0	12.9 R.	PP
"	17.0 R.	2" Shrub
+96.4	16.0 L.	tp. Shrubs
91 + 04.0	27.9 L.	24 gum

Hermosa Dr.

NT 86+77.36 (p.10)
= 86+75.42
R 24 47.07

4.18

swt. (p.14)

90°

Country Club Dr.

San Gabriel Golf Club

14.5		85+10.0
13.0'		84+05.0
13.0		83+93.3
83+12.0		
hedge		
13.0		82+96.0
33.4		82+79.0

hedge

hedge

86+47.3	38.4	
86+38.0	20.5	
85+87.5	20.5	
85+79.0	39.2	

chicken wire 7' high

stone fish pond 18' x 5'

35.1
87+59.0

17'
87+47.0

loose brick walk - 1' wide

15'

12'

48 N

39

18'

4' N

17.33

3 curb

20.9

15.24

35' oil surface

Driveway to Clubhouse
15' oil

contd from top
prev page

RETURN TO
LOS ANGELES COUNTY SURVEYOR
Do not extend notes this side of this line

Notes: ANY ADDITIONS OR CHANGES ON THIS SHEET MUST BE MADE OR CIRCLED IN Red. WITH DATE AND NAME OF PERSON MAKING CHANGE.

Oct 1927 Notes by MG Chief Party MG, Oliver 24 F. B. 293 Pg. 73

Plotted by D. L. Peck
Date Dec 1927
Map No. [illegible]
Plotting Checked by R. W. S.
Date [illegible]

W. O. No. 4140 L. S. O. No.
Location Hermosa Dr
Surveyed by
Date
Indexed A. C. Johnson

to bottom next page.

91+	30.5	33.8 R.	∅ meter
" +	38.5	15.2 L.	guy p.
"	"	17.0 R.	pp.
" +	77.3	25.0 L.	24" gum
" +	86.5	" "	15" "
92 +	20.5	" "	30" "
" +	37.5	" "	" "
" +	55.0	" "	" "
" +	63.5	" "	30" "
" +	72.0	" "	24" "
" +	84.5	12.7 R.	pp.
93 +	14.0	17.5 L.	24" gum
" +	31.5	16.6 L.	30" "
" +	58.0	" "	" "
" +	66.8	17.3 "	24" "
" +	"	24.0 "	20" "
94 +	36.0	16.6 "	20" "
" +	39.5	" "	" "
" +	42.2	" "	36" "
"	"	12.6 R.	pp.
" +	84.7	16.6 L.	30" gum
95 +	10.8	16.2 "	20" "
" +	29.0	22.2 "	16" "
" +	37.6	22.2 "	14" "
" +	46.5	22.7 "	36" "
" +	61.5	9.5 "	hand hole
" +	63.0	16.5 L.	30" gum
" +	66.0	40.0 L.	Electrolier
" +	71.5	12.6 R.	pp.

Alabama St. (unimproved)

91+20.04 L.T. in rock
= 91+18.10 Restation (P 15)

hedge

13'
90+91.0
16' R
11'

90+32.0
16' R
11'

89+49.4
16' R
10'

hedge 3' high
11.9
21.0
88+94.3
woven w.f. shrubery on f.

209
88+43.0
8 arbor
78'
88+87.3
22.8
cem. dr.

Hermosa Dr.

golf club

from top prev. page.

Notes: ANY ADDITIONS OR CHANGES ON THIS SHEET MUST BE MADE OR CIRCLED IN Red. WITH DATE AND NAME OF PERSON MAKING CHANGE.

Do not extend notes this side of this line

RETURN TO LOS ANGELES COUNTY SURVEYOR

F.B. 293 PG. 74 Chief Party Notes by Date

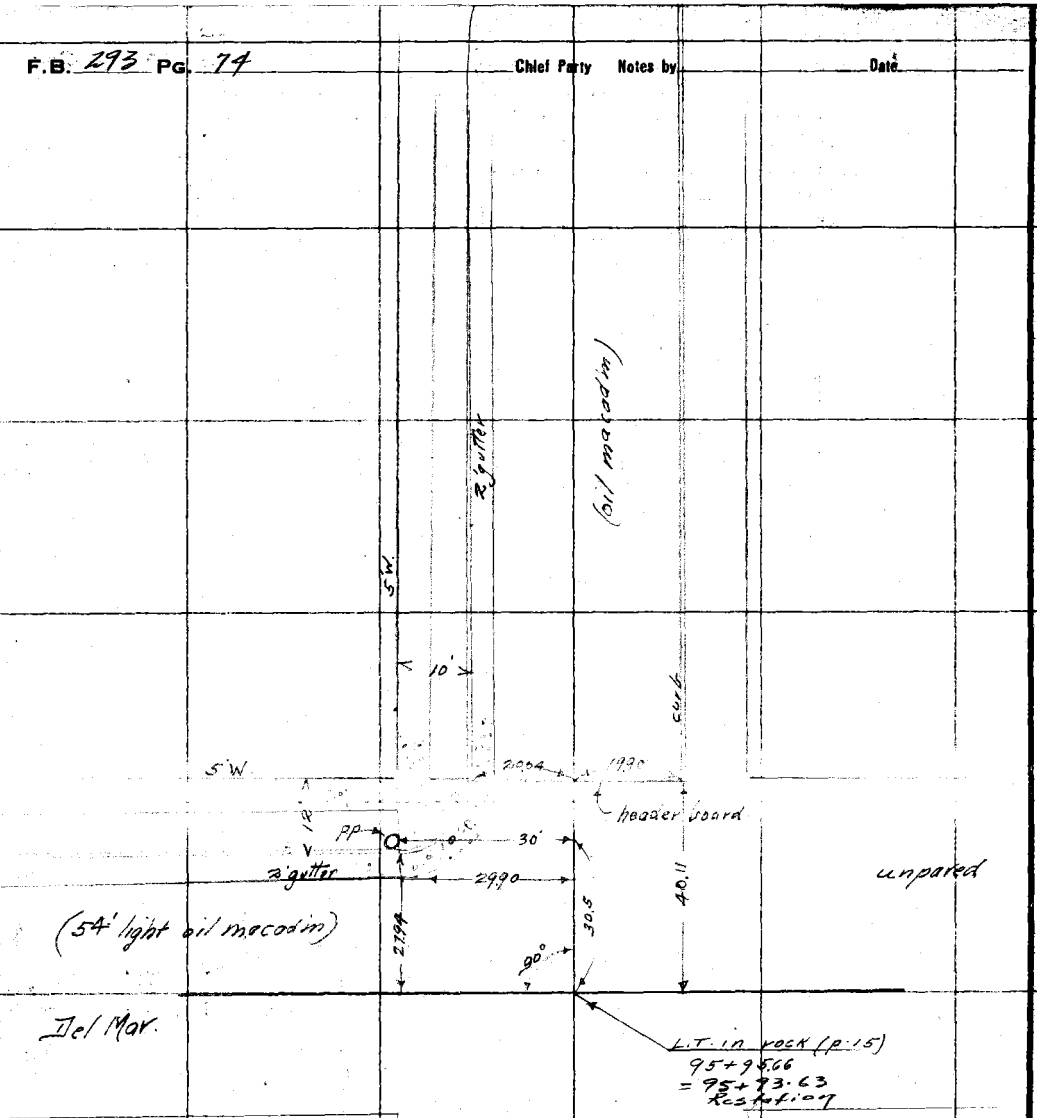

RETURN TO
LOS ANGELES COUNTY SURVEYOR
Do not extend notes this side of this line

Note: ANY ADDITIONS OR CHANGES ON THIS SHEET MUST BE MADE OR CIRCLED IN Red. WITH DATE AND NAME OF PERSON MAKING CHANGE.

Date _____ Notes by Boyd Chief Party _____ F. B. 293 Pg. 75

Plotted by K. Peck
Date Dec 1927
Map No. 17-122
Plotting C'k'd by _____
Date _____

W. O. No. _____ D. & O. No. _____
Location _____
Surveyed by _____
Date _____
Indexed A. C. Johnson

Copied from San Gabriel City
F.B. 4 Page 8

9"x3" ST.

ST.

BLVD.

To Nail Pt. of Store on S. side Hermosa Pl.

89°56'

3"x3" 17.48' Set Nail & T.

HERMOSA DRIVE

L&T. 23.41'

1" IP 0.00 Scale N.W.

41.00' L&T.

41.16' L&T.

Set 2"x12"

8°41.0'

17°13.92'

90°10'15"

CALIFORNIA

SAN GABRIEL

Notes: ANY ADDITIONS OR CHANGES ON THIS SHEET MUST BE MADE OR CIRCLED IN Red. WITH DATE AND NAME OF PERSON MAKING CHANGE.

Do not extend notes this side of this line

RETURN TO LOS ANGELES COUNTY SURVEYOR

F.B. 293 PG. 76 Chief Party Notes by Date

RETURN TO

LOS ANGELES COUNTY SURVEYOR

Do not extend notes this side of this line

Note: ANY ADDITIONS OR CHANGES ON THIS SHEET MUST BE MADE OR CIRCLED IN Red. WITH DATE AND NAME OF PERSON MAKING CHANGE.

Date _____ Notes by Boyd Chief Party _____ F. B. 293 Pg. 77

Plotted By	W. O. No. _____ D. S. O. No. _____
Date	Location
Map No.	Surveyed by
Plotting C'k'd by	Date
Date	Indexed A. C. Johnson

Copied from San Gabriel City F.B. 9 Page 18

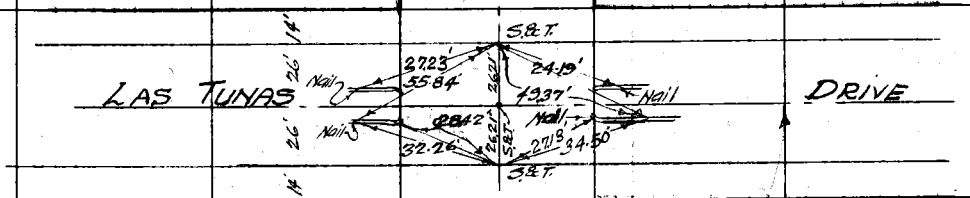

Notes: ANY ADDITIONS OR CHANGES ON THIS SHEET MUST BE MADE OR CIRCLED IN Red. WITH DATE AND NAME OF PERSON MAKING CHANGE.

Do not extend notes this side of this line

RETURN TO LOS ANGELES COUNTY SURVEYOR

RETURN TO

LOS ANGELES COUNTY SURVEYOR

Note: ANY ADDITIONS OR CHANGES ON THIS SHEET MUST BE MADE OR CIRCLED IN **Red.** WITH DATE AND NAME OF PERSON MAKING CHANGE.

Do not extend notes this side of this line

F.B. 193 Pg. 18 Chief Party Notes by Boyd Date

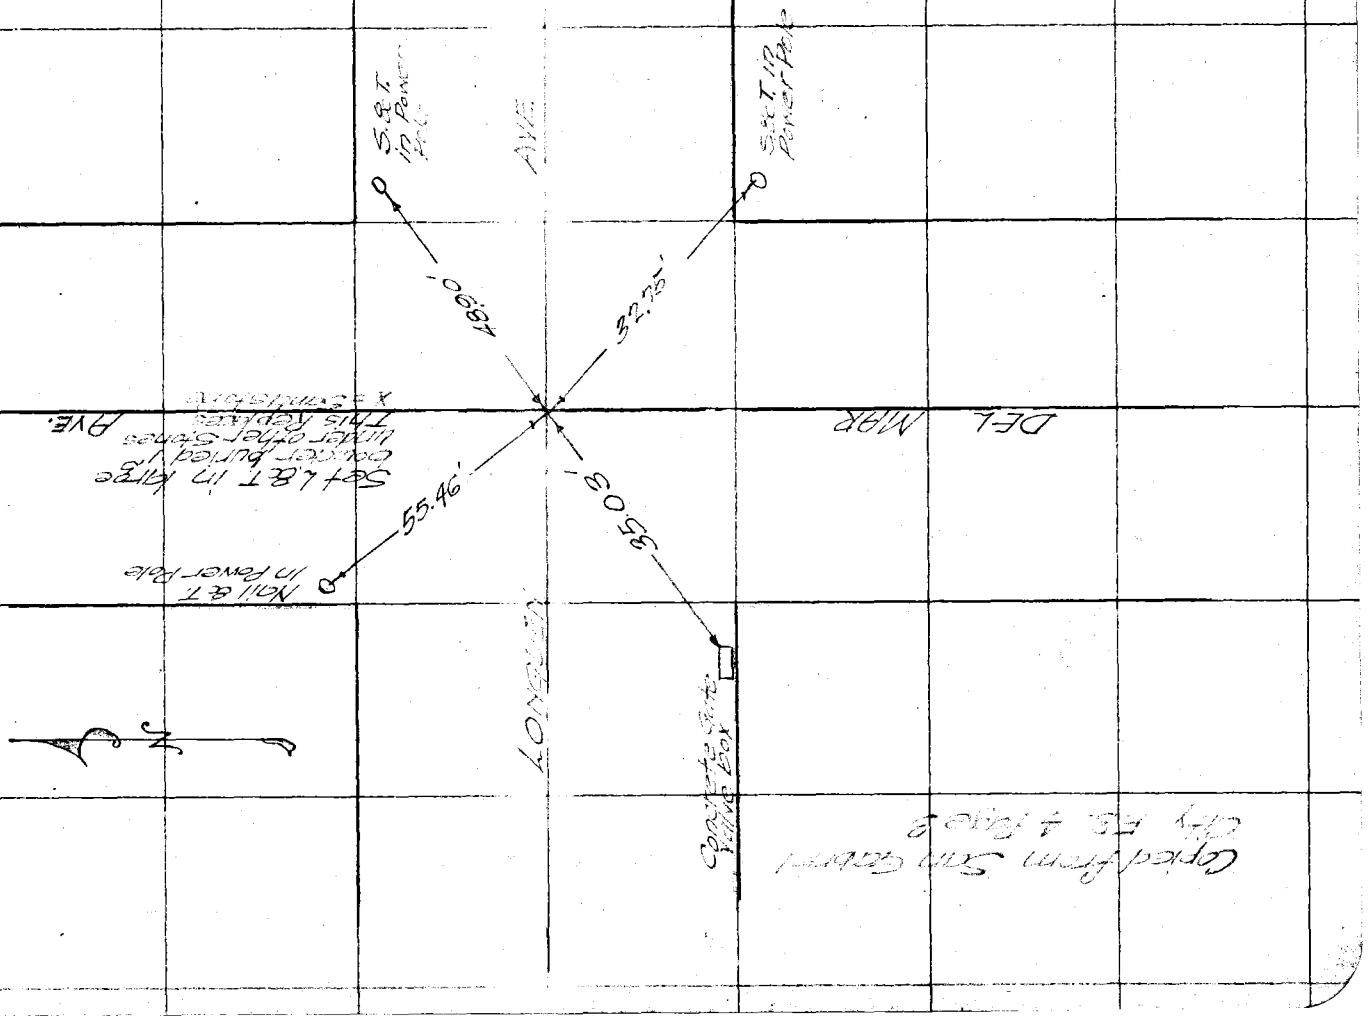

Date _____ Notes by Boyd Chief Party _____ F. B. 293 Pg. 79

Platted by D.L.P.
Date Feb. 1928
Map No. _____
Platting C'k'd by _____
Date _____

W. O. No. _____ U. S. C. No. _____
Location _____
Surveyed by _____
Date _____
Indexed by A. C. Johnson

Copied from City of San Gabriel F.B. #9 Page 34

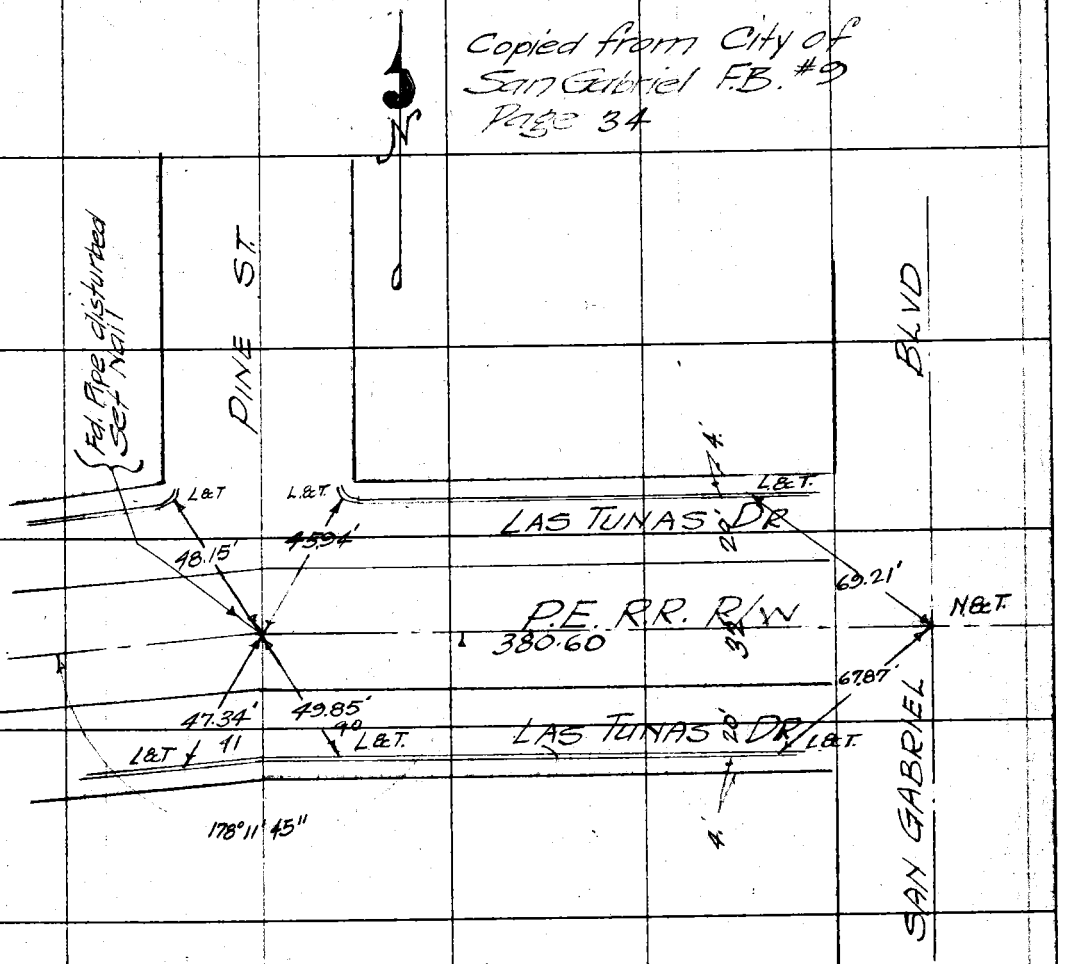

Notes ANY ADDITIONS OR CHANGES ON THIS SHEET MUST BE MADE OR CIRCLED IN Red. WITH DATE AND NAME OF PERSON MAKING CHANGE.

Do not extend notes this side of this line

RETURN TO LOS ANGELES COUNTY SURVEYOR

F.B. 293 Pg. 80 Chief Party Notes by U.W. Boyd Date

Copied from City of San Gabriel F.B. #9 Page 19

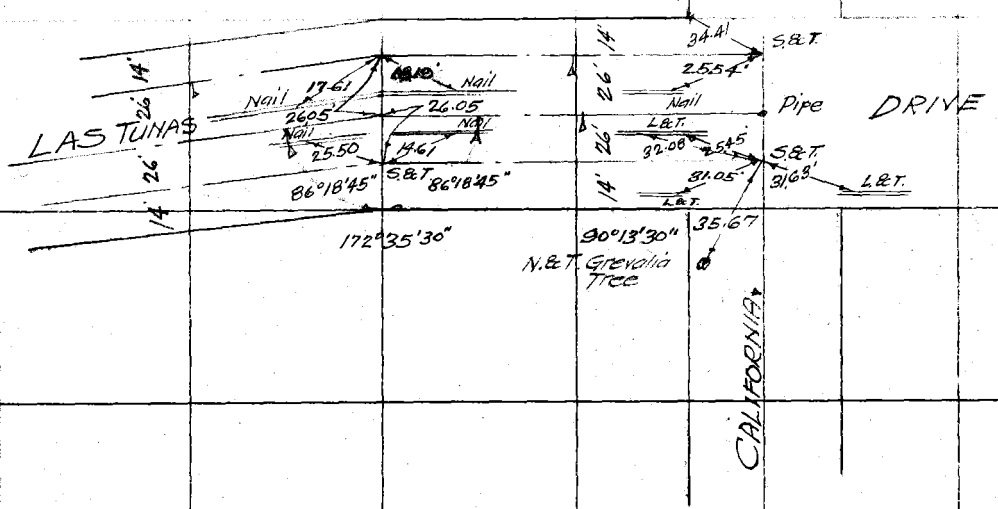

RETURN TO LOS ANGELES COUNTY SURVEYOR

Do not extend notes this side of this line

Note: ANY ADDITIONS OR CHANGES ON THIS SHEET MUST BE MADE OR CIRCLED IN Red. WITH DATE AND NAME OF PERSON MAKING CHANGE.

RETURN TO

LOS ANGELES COUNTY SURVEYOR

Note: ANY ADDITIONS OR CHANGES ON THIS SHEET MUST BE MADE OR CIRCLED IN **Red.** WITH DATE AND NAME OF PERSON MAKING CHANGE.

Do not extend notes this side of this line

Date _____ Notes by Boyd Chief Party _____ F. B. 273 Pg. 81

Platted by _____ W. O. No. _____

Date _____ Location _____ U. S. C. No. _____

Map No. _____ Surveyed by _____

Platting C'k'd by _____ Date _____

Date _____ Judgment Ent. C. Johnson

4

Copied from San Gabriel City
F.B. 15 Page 14

Fd. Sandstone Mon. ORT X Painted X
Reing 0.40'W. & 0.04'
S. of Lines Extended
To Sept L.&T.

E. Hermosa Ave.

Spk 383.71 N&T. 304.98 N&T. 309.98 N&T 320.21

34.93 34.75 36.20 36.33 36.50 36.16 49.68 48.58 89°52'30"

L&T L&T L&T L&T L&T L&T L&T L&T L&T

179°55'00"

Over to Next Page

E. Santa Anita St.

E. San Marino Ave.

71°03' Calc.

Parcel

E. Segovia

E. Gerona

40' 40'

Del Mar Ave.

LAS TUNAS DRIVE

F.B. 293 Pg. 82 Chief Party Notes by Boyd Date

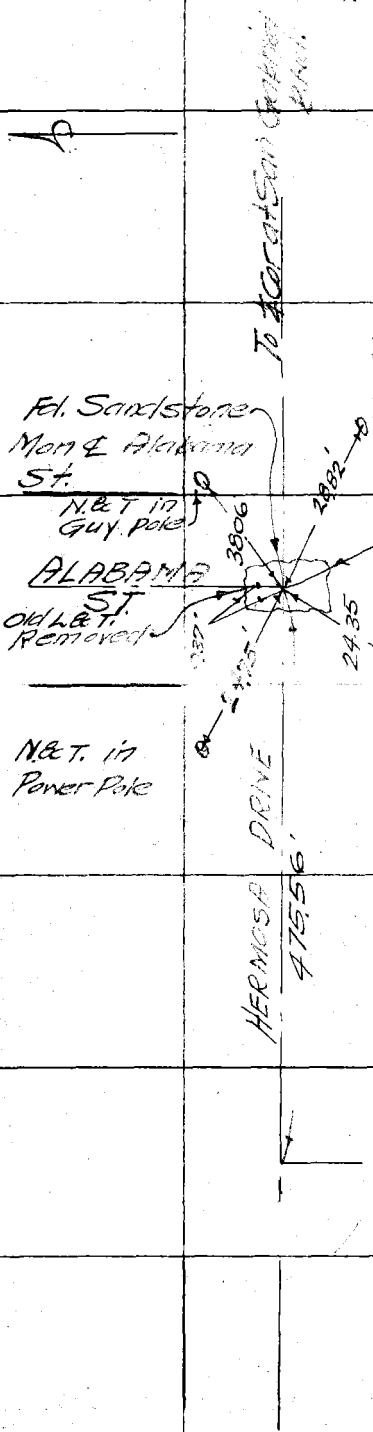

RETURN TO
LOS ANGELES COUNTY SURVEYOR

Do not extend notes this side of this line

Note: ANY ADDITIONS OR CHANGES ON THIS SHEET MUST BE MADE OR CIRCLED IN Red. WITH DATE AND NAME OF PERSON MAKING CHANGE.

RETURN TO

LOS ANGELES COUNTY SURVEYOR

Notes: ANY ADDITIONS OR CHANGES ON THIS SHEET MUST BE MADE OR CIRCLED IN **Red.** WITH DATE AND NAME OF PERSON MAKING CHANGE.

Do not extend notes this side of this line

Date _____ Notes by _____ Chief Party _____ F. B. 4993 PG. 83

Plotted by D.L.Beck

Date Feb '23

Map No. 3-422

Plotting C'k'd by W.W.S.

Date Feb 28

W. O. No. 7176 E. E. C. No. _____

Location Hermosa Ave

Surveyed by Assistants

Date Feb. 1, 1923

Inked by C. Johnson

Fd rock w.m. L+T. 18" down Sta 91+18.10 ℄ of Hermosa Drive and W. side of Alabama St.
68-03-30
272-14-30
68-03-31

68° 03' 35"

162-21-15 Concrete bridge on
289-29-30 Hermosa Drive between
162-21-07 California and West Streets.

Rock and gravel.

28.98

77+75.3

Conc pillar 2.5 sq.

Conc. railing

Conc. railing

Conc. railing

Conc. Shoulder

Conc Wall 5' high

open drain

110.47

Reenforced Conc.

162° 21'-10"

Conc. Shoulder

Sidewalk

Sidewalk

77+58.61

77+42.9

28.83

Sta. 77+06.30
Set nail ℄ ties replacing 2" ℄ of California St. F.N. and ℄ of Hermosa Drive FB. 273-21

F.B. 293 Pg. 84 Rosecrans Chief Party Notes by Date Feb. 25, 28

℄ Hermosa Drive and ℄ of Burton Ave
Fd. 2" I.P. plug & tack
8" Down FB 293-35
Sta. 40+10.44

℄ Hermosa Drive

℄ of Hermosa Drive and ℄ of Bonnie Brae Ave
Fd. 2x2" stake 12" down
Sta. 35+80.55 FB. 293-26

281.21

31.10

1.35

Wood bridge on Hermosa Drive Between Muscatel and Parkette Avenues

17.17

31+30.80

31+18.96

17.09

16.0

1.35

34.38

70°-39'30"

51.21

℄ of channel

2.00

17.0

55.4

13.6

Tot. N.T.
Sta. 30+79.34

57.30

Iron pipe woven wire iron post retaining fences

Retaining fence

30+79.52

17.29

1.35

22.0

38.87

17.19

30+67.99

RETURN TO
LOS ANGELES COUNTY SURVEYOR

Do not extend notes this side of this line

Notes: ANY ADDITIONS OR CHANGES ON THIS SHEET MUST BE MADE OR CIRCLED IN Red. WITH DATE AND NAME OF PERSON MAKING CHANGE.

COPIES TO

SAN DIMAS

(REGIONAL OFFICE)

pages 85 thru 88

Date _____ Notes by _____ Chief Party _____ F.B. 293 G. 85

85

Plotted by _____
Date _____
Map No. _____
Plotting Ck'd by _____
Date _____

W. O. No. 1.62 Topo No. 15
Location County Bd'y - Pomona
Surveyed by P. T. Dunlap
Date 2-6-29
Indexed A. C. Johnson

Notice: ANY ADDITIONS OR CHANGES ON THIS SHEET MUST BE MADE OR CHECKED IN Red. WITH DATE AND NAME OF PERSON MAKING CHANGE.

Do not extend notes this side of this line

RETURN TO LOS ANGELES COUNTY SURVEYOR

RIVERSIDE DRIVE
AT
LOS ANGELES AND SAN BERNARDINO COUNTY BOUNDARY

Feb. 8, 1929.

F. B. 293 Pg. 86 P. T. D. Chief Party Notes by P. T. D. Date 2-8-29

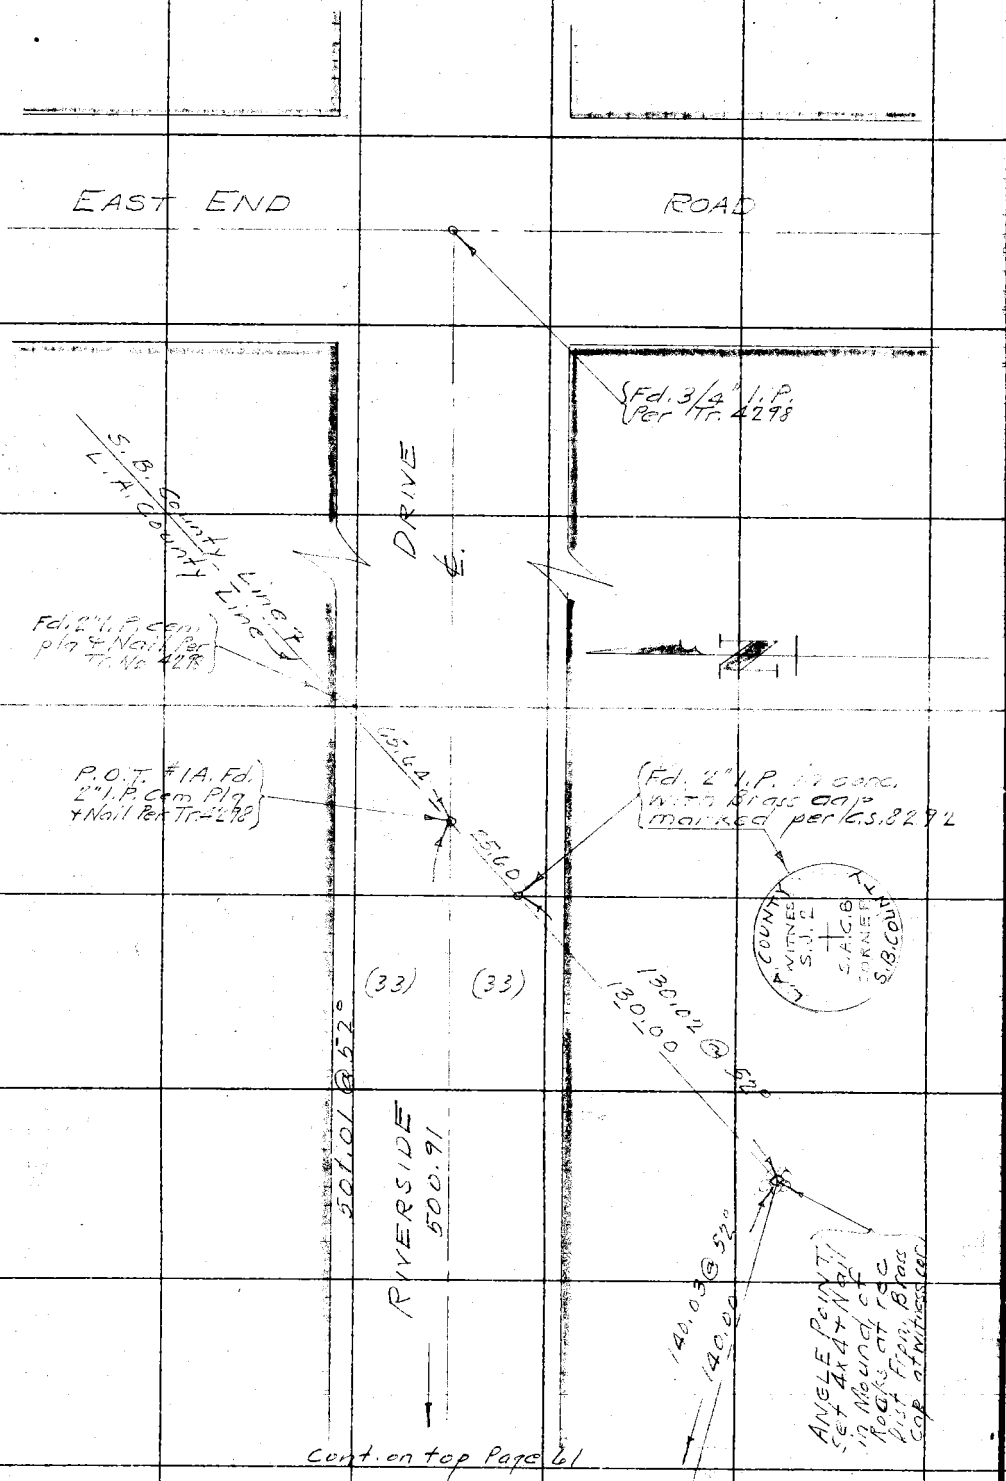

RETURN TO
LOS ANGELES COUNTY SURVEYOR

Do not extend notes this side of this line

Note! ANY ADDITIONS OR CHANGES ON THIS SHEET MUST BE MADE OR CIRCLED IN Red. WITH DATE AND NAME OF PERSON MAKING CHANGE.

Date 2-8-29 Notes by P.T.D. Chief Party P.T. Dunlap F.B. 293 Pg. 87

Platted by	W. O. No. 262 1986 C.O. No. 15
Date	Location County Bdy Pomona
Map No.	Surveyed by P.T. Dunlap
Platting C'k'd by	Date 2-8-29
Date	Indexed C. Johnson

Cont. From Bot Page 60

140.00'

Fd. 2" I.P. in conc. with Brass cap marked Per C.S. 8292

Y SURVEYORS WITNESS S.T.N. S.A.C.B CORNER MONUMENT

Ⓒ 149-56-30
Ⓐ 239-46-00
Ⓑ 147-56-30
Ⓒ 119-32-00
149-56-30

500.9 RADIAL

DRIVE

149-56-30

P.I. #1 Set 1x24 Nail at Rec. From P.O.T. #1A Per Tr. 4298

Ⓐ 42°

168.34

164.38

P.I. #2 Set 1x24 Nail at rec. from P.O.T. #1A Per Tr. 4298

Transit Line

Ⓒ 158-58-30
Ⓐ 275-54-00
158-58-30
Ⓑ 191-48-00
158-58-30

158-58-30

1025.01

225.00 Transit Line

225.05 @ 42°

RIVERSIDE

L.A. Co. Line & S.B. Co. Line

Cont. on Top Page 62.

RETURN TO LOS ANGELES COUNTY SURVEYOR

Notice: ANY ADDITIONS OR CHANGES OF THIS SHEET MUST BE MADE BY CIRCLED & Red. WITH DATE AND NAME OF PERSON MAKING CHANGE.

Do not extend notes this side of this line

F.B. 293 PG. 88 P.T. Dunlap Chief Party Notes by P.T.D. Date 2-8-29

Cont From Bet Page 61

(P.I. #3 Set N.E.T. of Rec. from P.O.T. #1A Per T.T. 4298

DRIVE

1225.00

Transit Line

1025.01

170-42-15

① 170-42-15
④ 322-49-00
170-42-15
⑧ 258-38-50
170-42-15

(P.I. #4 Fd. 2" I.P. Cem. plg & Nail Per T.T. No 4298

① 168-40-30
④ 314-41-45
168-40-24
⑧ 269-38-45
168-40-30

40-30

11.10 @ 11.4°

0.53

RIVERSIDE

Fd. 2" I.P. cem. Plg & Nail Per T.T. No. 4298

AVE

TOWNE

L.A. Co. Dist. S.B. Co. Line

S. AVE.

GAREY

Fd. 2" I.P. in Conc with Brass Cap marked Per E.S. 8292

L.A. COUNTY S.B. COUNTY

RETURN TO LOS ANGELES COUNTY SURVEYOR

Do not extend notes this side of this line

Note: ANY ADDITIONS OR CHANGES ON THIS SHEET MUST BE MADE OR CIRCLED IN Red. WITH DATE AND NAME OF PERSON MAKING CHANGE.

Date _____ Notes by _____ Chief Party _____ F.B. 293 Pg. 89

Platted by	W. O. No.
Date	Location
Map No.	Surveyed by
Platting C'k'd by	Date
Date	Indexed

LOCATION OF TRAVELLED ROAD ON RIVERSIDE DRIVE AT COUNTY BDY.

Notice: ANY ADDITIONS OR CHANGES ON THIS SHEET MUST BE MADE ON CIRCLED M Rod. WITH DATE AND NAME OF PERSON MAKING CHANGE.

Do not extend notes this side of this line

RETURN TO LOS ANGELES COUNTY SURVEYOR

F.B. 293 Pg. 90 P.T.D. Chief Party Notes by P.T.D. Date 2-8-29

Inst. at.	Sight on.	Cross Hairs Upper	Cross Hairs Lower	Horizontal & Right	Horizontal & Left	Vert'l &	Dist.	Discription	
P.I. # 4	P.I. #3	5.94	3.00		182-27	+1-49	295	N. Shoulder Tr.	Rd.
		5.83	3.00		187-48	-1-51	284	"	
		4.72	2.00		187-01	+1-43	273	"	
		4.61	2.00		186-19	+1-45	262	"	
		4.50	2.00		185-28	+1-45	251	"	
		4.41	2.00		184-54	+1-46	242	"	
		4.32	2.00		184-17	+1-44	233	"	
		4.21	2.00		183-33	+1-45	222	"	
		3.88	2.00		181-24	+1-44	189	"	
		3.63	2.00		179-27	+1-37	164	"	
		2.37	1.00		177-45	+1-00	138	"	
		3.11	2.00		176-11	+1-03	112	"	
		1.85	1.00		174-55	-0-13	86	"	
		2.05	2.00		173-41	-0-15	59	"	
		4.17	3.85		166-07	-0-00	33	"	
		5.44	5.36		109-34	-0-00	9	"	
		5.26	5.00		20-51	-3-22	27	"	
		5.52	5.00		11-16	-2-40	53	"	
		5.80	5.00		8-37	-2-34	81	"	
		6.07	5.00		8-50	-2-22	108	"	
		5.34	4.00		7-56	-2-40	135	"	
		5.62	4.00		6-55	-2-29	163	"	
		5.90	4.00		5-36	-2-25	191	"	
		6.15	4.00		4-50	-2-28	216	"	
		6.44	4.00		3-49	-2-28	245	"	
		5.69	3.00		2-52	-2-40	270	"	
		5.94	3.00		1-40	-2-40	295	"	
		6.21	3.00		0-48	-2-42	322	"	
		5.48	2.00		0-02	-2-49	349	"	
		5.74	2.00	0-41		-2-46	375	"	
		6.00	2.00	1-04		-2-43	401	"	
		6.25	2.00	1-23		-2-42	426	"	
		6.50	2.00	1-45		-2-39	450	"	
		5.75	1.00	2-09		-2-45	475	"	

RETURN TO
LOS ANGELES COUNTY SURVEYOR
Do not extend notes this side of this line

Note: ANY ADDITIONS OR CHANGES ON THIS SHEET MUST BE MADE OR CIRCLED IN Red. WITH DATE AND NAME OF PERSON MAKING CHANGE.

Date 2-8-29 Notes by H.B. Rockhold Chief Party P.T.D. F.B. 293 Pg. 91

Platted by
Date
Map No.
Platting C'k'd by
Date

W. O. No. 262 C. S. C. No. 15
Location Pomona.
Surveyed by P.T. Dunlap
Date 2-8-29
Indexed C. Johnson

Inst at.	Sight on.	Cross Hairs Upper	Cross Hairs Lower	Horizontal & Right	Horizontal & Left.	Vert &	Dist	Description
P.I.#4	P.I.#3	5.70	1.00	5-27	-	-2-50	4.70	S. Toe of Cut. To. Road.
		5.46	1.00	5-31		-2-54	4.46	
		5.20	1.00	5-21		-2-57	4.19	
		5.90	2.00	5-10		-2-45	3.89	
		5.64	2.00	5-02		-2-50	3.63	
		5.37	2.00	4-55		-2-50	3.36	
		5.13	2.00	4-50		-2-45	3.10	
		4.85	2.00	4-44		-2-40	2.84	
		4.89	2.00	4-32		-3-02	2.60	
		5.30	3.00	4-[illegible]		-3-[illegible]	2.31	
		6.08	4.00	4-09		-3-[illegible]	2.09	
		5.91	4.00	4-[illegible]		-3-[illegible]	1.92	[illegible] (South)
		6.22	5.00	4-[illegible]		-3-31	1.56	
		6.30	5.00	6-20		-2-07	1.31	
		6.05	5.00	7-43		-2-12	1.06	
		5.98	5.00	[illegible]		-2-08	0.79	
		5.90	5.00	[illegible]		-2-38	0.41	
		5.87	5.00	[illegible]		-2-32	0.38	
		[illegible]	4.91		263-58	0-00	2.10	
		3.43	3.34		202-16	0-00	0.30	
		3.30	3.25		192-42	0-00	0.16	
		2.06	1.25		139-47	0-00	0.82	
		[illegible]	1.00		188-05	+0-38	1.08	
		2.33	1.00		187-2[illegible]	[illegible]-00	1.34	
		2.56	1.00		165-08	[illegible]-00	1.59	
		2.84	1.00		187-[illegible]	[illegible]-38	1.85	
		5.03	3.00		139-52	-2-16	2.10	
		6.40	4.00		120-05	-[illegible]	1.[illegible]	
		7.60	5.[illegible]		[illegible]	+2-38	2.61	
		8.90	[illegible]		172-42	-[illegible]	2.91	

Note: ANY ADDITIONS OR CHANGES ON THIS SHEET MUST BE MADE OR CANCELED BY Road. WITH DATE AND NAME OF PERSON MAKING CHANGE.

Do not extend notes this side of this line

RETURN TO LOS ANGELES COUNTY SURVEYOR

F. B. 293 Pg. 92 — P. T. D. Chief Party — Notes by H. B. R. — Date 2-8-29

Inst. at	Sight on	Cross Upper	Cross Lower	Horizontal & Right	Horizontal & Left	Vertical	Dist.	Description
P.T. #1	P.O.T. #2	2.72	1.00		1-20-00	+0-20	1.73	No. Elevation to TBM
		2.54	1.00		43-52	0-10	1.55	"
		3.33	2.00		141-30	+0-04	1.34	"
		4.13	3.00		141-48	+0-11	1.14	"
		3.92	3.00		140-38	-0-06	0.93	"
		4.44	3.70		139-38	0-00	0.75	"
		5.14	4.60		138-21	0-00	0.55	"
		5.64	5.30		139-12	0-00	0.35	"
		5.93	5.74		95-07	0-00	0.19	"
		6.20	5.79		41-21	0-00	0.42	"
		5.96	5.55		17-46	0-00	0.42	"
		5.60	5.00		9-46	-0-22	0.61	"
		5.82	5.00		6-32	-0-15	0.83	"
		6.07	5.00		4-11	0-00	0.8	"
		5.98	5.90		3-05	-0-03	0.5	"
		6.66	5.00		2-27	+0-10	1.59	"
		5.85	4.00		2-41	+0-10	1.36	"
		5.96	4.00		2-37	0-00	1.97	No. W. Cor. of Sec.
		5.37	3.00		2-16	0-00	2.38	No. E. " "
		5.09	3.00	2-35		-0-30	2.10	No. W. " "
		5.47	3.00	2-06		-0-20	2.48	No. E. " "
		5.60	3.00		1-10	-0-20	2.61	No. Stone 0.6' To TBM
		5.92	2.00		1-26	-1-05	3.93	"
		5.92	1.00		1-08	-1-02	4.93	"
		6.00	2.00		0-34	-1-00	6.01	"
		7.00	0.00		0-28	-0-50	7.01	"
		7.00	0.00	0-43		-1-00	7.01	No. Chiseled X [illegible]
		6.00	0.00	0-43		-1-00	6.01	"
		6.00	1.00	0-56		-1-02	5.01	"
		4.94	1.00	1-28		-1-15	3.95	"
		5.82	4.00	3-32		0-10	.33	"
		5.61	4.00	4-19		-0-20	1.62	"
		6.37	5.00	5-13		0-00	1.38	"
		6.10	5.00	5-44		0-00	1.14	"

RETURN TO LOS ANGELES COUNTY SURVEYOR

Do not extend notes this side of this line

Note: ANY ADDITIONS OR CHANGES ON THIS SHEET MUST BE MADE OR CIRCLED IN Red. WITH DATE AND NAME OF PERSON MAKING CHANGE.

Date 28-29 Notes by H. B. R. Chief Party P. T. D. F.B. 293 Pg. 93

Platted by
Date
Map No.
Platting C'k'd by
Date

W. O. No. 262 ~~1865~~ C. O. O. No. 15
Location Pomona
Surveyed by P. T. D
Date 2-8-29
Indexed C. JOHNSON

Note: ANY ADDITIONS OR CHANGES ON THIS SHEET MUST BE MADE ON CIRCLES IN Red. WITH DATE AND NAME OF PERSON MAKING CHANGE.

Do not extend notes this side of this line

RETURN TO LOS ANGELES COUNTY SURVEYOR

Inst. of Sta.	Sight on	Cross Upper	Hairs Lower	Horizontal ∠ Right	Horizontal ∠ Left	Vert. ∠	Dist.	Description
		5.85	5.00	6-41		0-00	0.85	So. Shoulder Th. Rd.
		5.60	5.00	11-58		-0-15	0.60	"
		5.33	5.00	20-50		-0-30	0.34	"
		4.80	4.66	60-22		0-00	0.15	"
		4.37	4.20		235-26	0-00	0.18	No. E. Cor. Wooden Corner
		5.33	5.00		234-45	0-00	0.34	So. E. " " "
		5.00	4.66		236-11	+0-10	0.35	So. W " " "
		4.21	4.00		210-17	+ 0-00	0.22	No. W. " " "
		4.22	4.00		192-34	0-00	0.23	So. Shoulder Th. Rd.
		4.00	3.61		195-14	-0-05	0.40	E. Shoulder T-4 Rd 4
		0.90	0.40		200-53	+1-00	0.51	E. Shoulder T-4 Rd. 7 So.
		5.93	5.00		238-28	+10-48	0.94	" " " " "
		6.00	5.00		233-16	+10-12	1.01	W. Shoulder T-4 Rd. 7 So
		3.58	3.00		180-25	+00-10	0.59	" " " " "
		4.61	4.00		166-49	+ 0-50	0.62	Junct. T-4 Rd 6 Runway 24
		3.79	3.00		159-14	0-00	0.80	So. Shoulder Th. Rd.
		4.02	3.00		155-27	0-00	1.03	" " " "
		4.25	3.00		155-00	+0-10	1.26	" " " "
		3.46	2.00		155-02	+0-08	1.49	" "
		2.68	1.00		155-57	0-00	1.69	"

RETURN TO
LOS ANGELES COUNTY SURVEYOR

Note: ANY ADDITIONS OR CHANGES ON THIS SHEET MUST BE MADE OR CIRCLED IN Red. WITH DATE AND NAME OF PERSON MAKING CHANGE.

Do not extend notes this side of this line

Date

Notes by

Chief Party

F. B. 293 Pg. 94

Date _____ Rough by McNeal Other Party _____ F.B. 293 Pg. 95

Plotted by McCASH
Date 6-27-29
Map No. _____
Plotting Ck'd by _____
Date _____

W. O. No. 4245 C. O. No. _____
Location State St.
Surveyed by _____
Date May 1929
Inspected C. Johnson

STATE STREET

W.O. 4245

FROM

F.B-366-30-[illegible]

For Index See F.B 366-31

F. B. 293 Pg. 96 Chief Party Notes by Date

Blank

RETURN TO
LOS ANGELES COUNTY SURVEYOR

Do not extend notes this side of this line

Note: ANY ADDITIONS OR CHANGES ON THIS SHEET MUST BE MADE OR CIRCLED IN Red. WITH DATE AND NAME OF PERSON MAKING CHANGE.

Date _____ Notes by McNeal Chief Party _____ F.B. 293 Pg. 97

Plotted by McCassy
Date 6-27-29
Map No. B-350-1
Platting Ck'd by A.A.B.
Date AUG 1929

W.O. No. 4245 D.S.O. No. _____
Location State St.
Surveyed by _____
Date May -1929
Indexed A. C. Johnson

Notes: ANY ADDITIONS OR CHANGES OR THIS SHEET MUST BE MADE OR CIRCLED IN Red. WITH DATE AND NAME OF PERSON MAKING CHANGE.

Do not extend notes this side of this line

RETURN TO LOS ANGELES COUNTY SURVEYOR

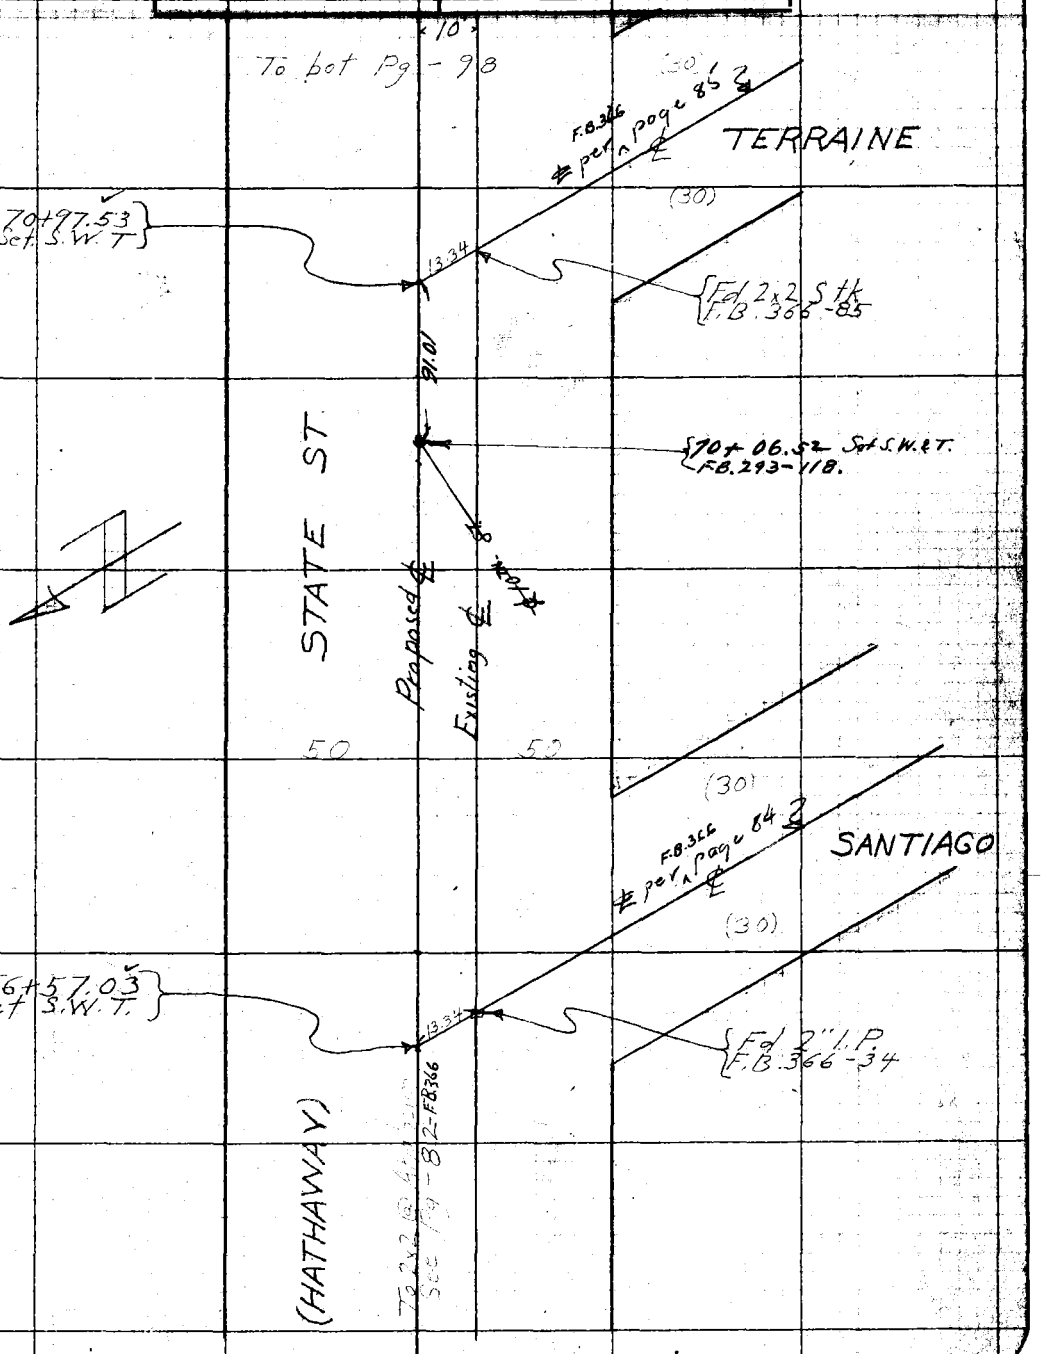

F.B. 293 Pg. 98 Chief Party Notes by McNeal Date

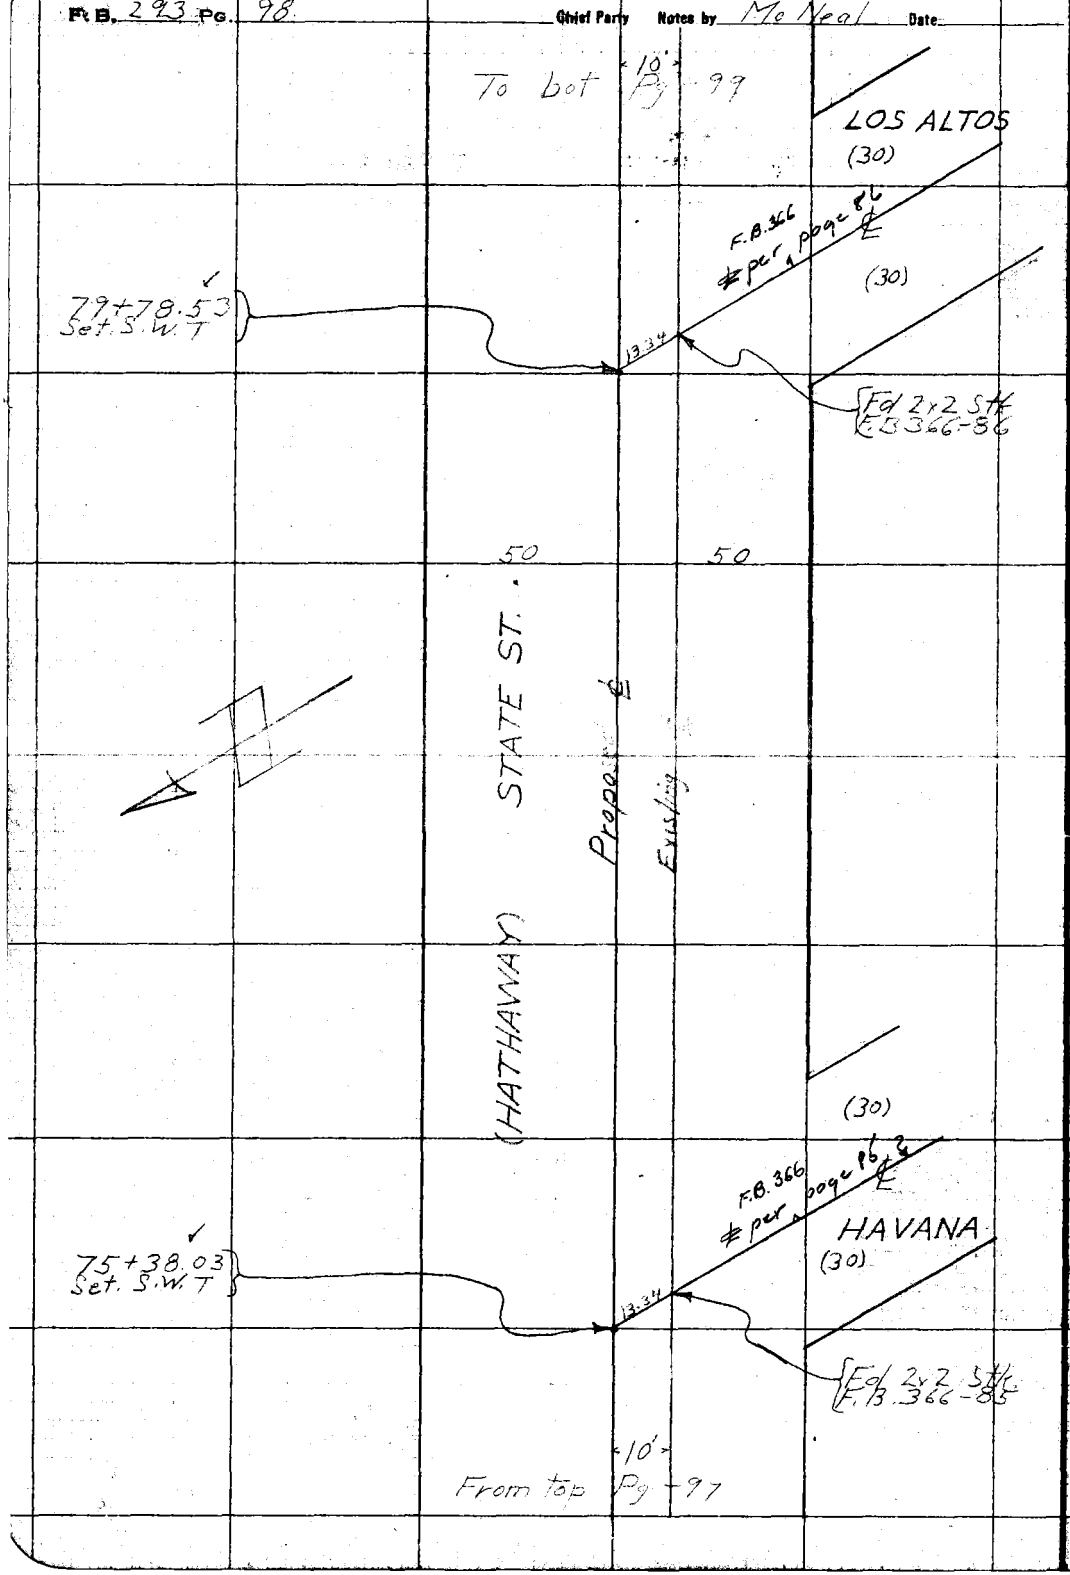

RETURN TO LOS ANGELES COUNTY SURVEYOR

Do not extend notes this side of this line

Note: ANY ADDITIONS OR CHANGES ON THIS SHEET MUST BE MADE OR CIRCLED IN Red WITH DATE AND NAME OF PERSON MAKING CHANGE.

Date _____ Notes by P.A.Neal Chief Party _____ F. B. 293 PG. 99

Plotted by M.E.Cassity
Date 6-27-29
Map No. B-350-1
Plotting Ck'd by A.A.R.
Date AUG 1929

W. O. No. 1245 S. O. No. _____
Location Sta. 84
Surveyed by F. M. Neal
Date May-June
Indexed A. C. Johnson

To bot Pg 100

STATE

(HATHAWAY)

Proposed ℄

Existing ℄

50

50

(30)

F.B. 366 pg 882 ℄ per ∧

FLINT

(30)

88+59.53
Set S.W.T

13.34

Fd 2x2 S/K
F.B. 366-88

(30)

F.B. 366 pg 872 ℄ per ∧

ULTIMO

(30)

84+19.03
Set S.W.T

13.34

Fd 2x2 S/K
F.B. 366-87

From top Pg 98

Notes: ANY ADDITIONS OR CHANGES ON THIS SHEET MUST BE MADE OR CIRCLED IN Red. WITH DATE AND NAME OF PERSON MAKING CHANGE.

Do not extend notes this side of this line

RETURN TO LOS ANGELES COUNTY SURVEYOR

F.B. 293 Pg. 100 Chief Party Notes by McNeal Date

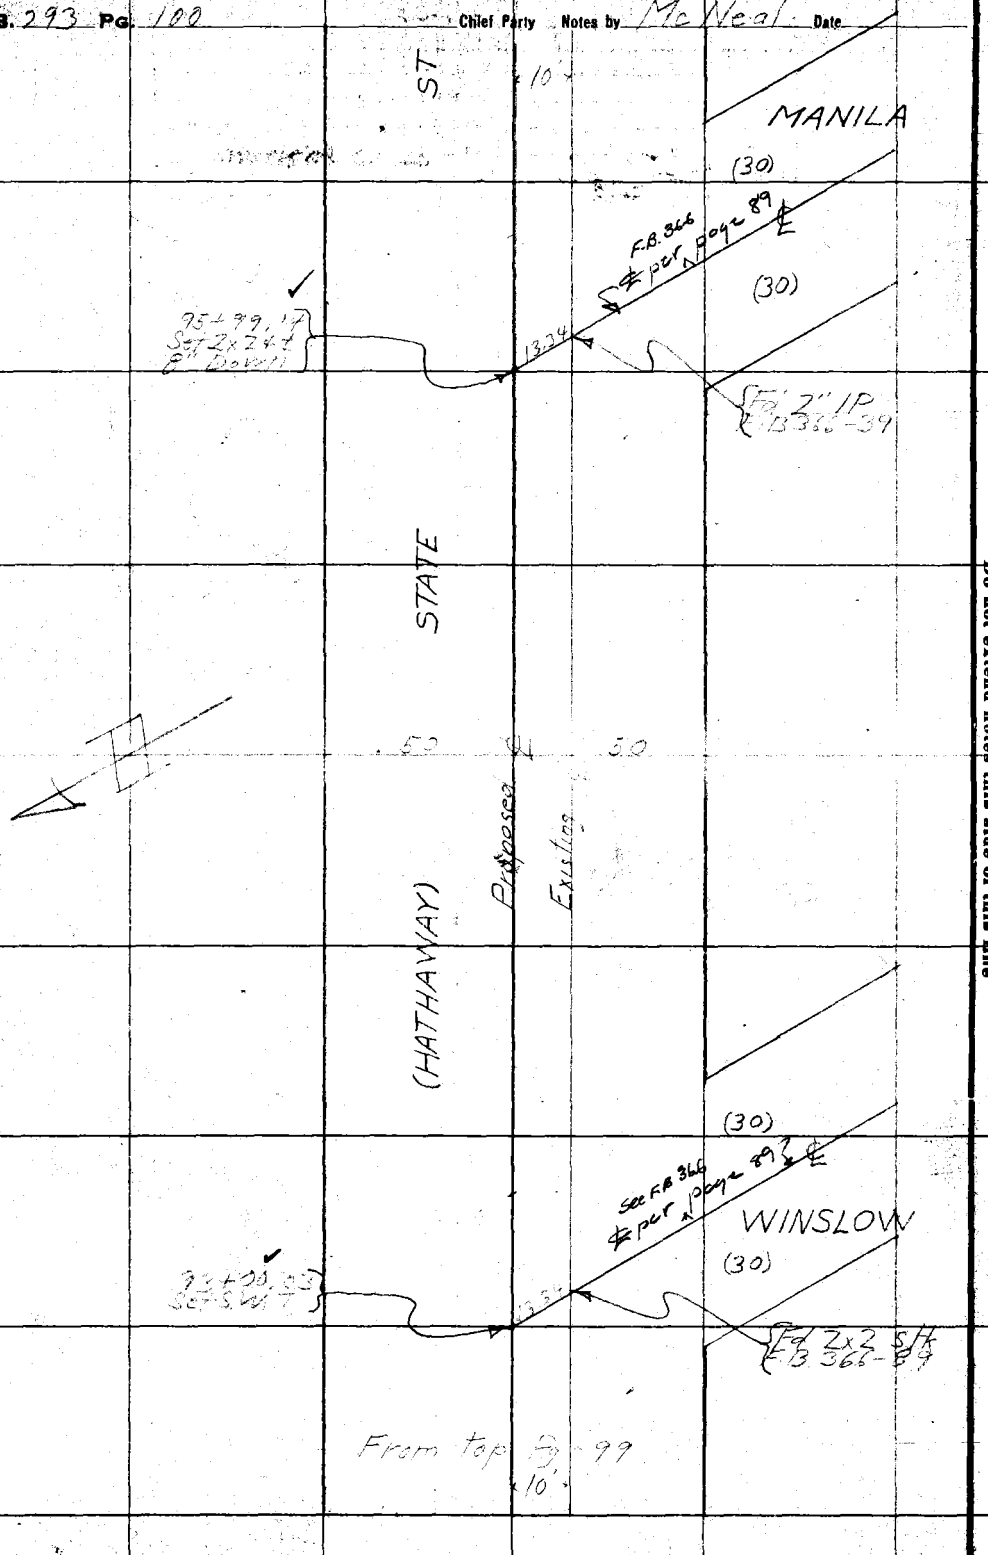

RETURN TO
LOS ANGELES COUNTY SURVEYOR
Do not extend notes this side of this line

Notes: ANY ADDITIONS OR CHANGES ON THIS SHEET MUST BE MADE OR CIRCLED IN Red WITH DATE AND NAME OF PERSON MAKING CHANGE.

Date _____ Notes by McNeal Chief Party _____ F. B. 293 Pg. 101

Plotted by MSC 8-6-29
Date 7-2-29
Map No. B-350-1r2
Plotting C'k'd by A. A. M.
Date AUG 1929

W. O. No. 4245 & S/S No. 0214 29
Location State St
Surveyed by F. J. McNeal
Date 1/19-1929
Indexed A. C. Johnson

Notes: ANY ADDITIONS OR CHANGES ON THIS SHEET MUST BE MADE OR CIRCLED IN Red. WITH DATE AND NAME OF PERSON MAKING CHANGE.

RETURN TO LOS ANGELES COUNTY SURVEYOR

Do not extend notes this side of this line

Fd 4" I.P. See F.B. 366-57

300@ 4-46 = 298.76
295.52@ 1-30 = 295.42
288.53@ 0-0 = 288.53
= 882.86

882.91 @ 76°

395.47 @ 76°
= 395.45

To bot Pg -107

449.02

87.89

87.98

50.00

882.86

90°

Set 2x2 ± 12" Down

Pt. 1A See Pg. 123.

(Proposed)

15+49.44
Set 1x2 ± by inter.

Surveyor, Aug. 1929.

Set 2x2 ± Tang 12" Dn

449.05 @ 74°
= 449.02

922.83 @ 74°
= 922.77

113-37-00
74-27-45
23-36-55

501.77

Set 2x2 ± 18" Down

Set 2x2 ± 12" Down

47.92

81.35

151-49-55

F.C. 106+66.58
Set 1x2 ± 12" Down

Note: This Location Abandoned by County Surveyor, Aug. 1929. See Pg. 123 for Reference Location.

Δ = 28-10-05
R = 2000
T = 501.77
L = 983.25

151-50-00
247-19-40
151-49-55

(30)

STATE

3°-35'

300' @ 3-27 = 299.41
206' @ 3-12 = 205.69
3-27 = 3.27
501.82 @ 68°
= 501.77

Set 2x2 ± 12" Down

Set 96 ± 83.33
Set 1x2 ± 3" Dn

50.00

90°

50.00

50

50

84.19

MANILA

AVE

Fd 4x4 See F.B. 366-57

2x2 Stk See Pg -100
95 x 99.14

S.W.T. @ Flint See Pg - 99

F.B. 293 Pg. 102 — Chief Party — Notes by Mc Neal — Date

Triangulation

C = 1-44-24-45
4-177-38-45
8-355-17-45
Av = 44-24-40 ✓

B = 1-45-35-40
4-182-22-15
8-364-45-00
Av. = 45-35-35 ✓

A = 1-89-59-45
4-359-58-45
8-359-57-45
Av = 89-59-45 ✓

A-B = 326.09 @ 72
326.09 @ 72
= 326.06 ✓

A-C = 332.84 Calc ✓

Sta # 50-81 I.P.
F.B. 366-45

P.I. #3 Fd 2x6 & nail
Set by State Hwy

1x2 Stk F.B. 366-45

See Pg. 103

E.C. 149+38.41
Set 1x2 ± flush

3838.13

107.45

09

ST.

W.T.P.P.

Δ = 17-24-40 ✓
R = 3000 ✓
T = 459.30 ✓
L = 911.64 ✓

162-35-15
290-21-30
72-35-20 ✓

14" IP FB 366-57

1925.83 @ 74°
= 1925.71 ✓

221.22 @ 74°
= 221.21 ✓

Set by County Surveyor, Aug. 1929.

(Proposed)

N & T I.P. 2½ Boiler Platform

X in 4" I.P. 5.0' East

266.75 @ 70°
= 266.73 ✓

P.I. 29
See Pg. 124, 125.

(See data at Top Pg.)

119-44.91
Set 1x2 ± by Hiller

This Location Abandoned by State Hwy. Dept. 1925.
See Pg. 395.45 from Top Pg. 101

50

℄ STATE

125-21-15
141-25-15
35-21-20 ✓

4" I.P. F.B. 366-57

RETURN TO
LOS ANGELES COUNTY SURVEYOR
Do not extend notes this side of this line

Notes: ANY ADDITIONS OR CHANGES ON THIS SHEET MUST BE MADE OR CIRCLED IN Red WITH DATE AND NAME OF PERSON MAKING CHANGE.

Date _____ Notes by McNeal Chief Party Mc F. B. 293 Pg. 103

Plotted by McCarthy
Date 7-3-39
Map No. B-350-2
Plotting Chkd by A. A. M.
Date AUG 1939

W. O. No. 4275 Sec. No. 021
Location State St.
Surveyed by F. A. McNeal
Date 1/29/39
Indexed

Notes: ANY ADDITIONS OR CHANGES ON THIS SHEET MUST BE MADE ON CIRCLED # Rod. WITH DATE AND NAME OF PERSON MAKING CHANGE.

Do not extend notes this side of this line

RETURN TO LOS ANGELES COUNTY SURVEYOR

Set 2x2 Tack 0.82 from PI

To Bof Pg 101

846.19 @ 72°
= 846.12

52.36

846.12

33

E.C. 194+27.77
Set 2x2 & tack

658.08 @ 66°
= 658.00

90°

1.43

Fd 2x3 & t Removed

(Proposed) ℄

658.43

Fd 2x6 & nail
Removed nail

0.05

P.I. Set nail in 2x6 stk

Δ = 36-26-40
R = 2090
T = 658.43
L = 1272.15

Old P.I. 2x2 stk
F.B. 366-77

42.08

142.33

101.07

P.O.S.T.
1x2 stk F.B. 366-45

92.54

Set 2x2 x 2'
12" Down

1832.13

551.36

B.C. 182+25.18 Nothing Set

25' Offset Line

℄ STATE

50 50

From Top Pg 102

F.B. 393 Pg. 104 McNeal Chief Party Notes by [illegible] Date

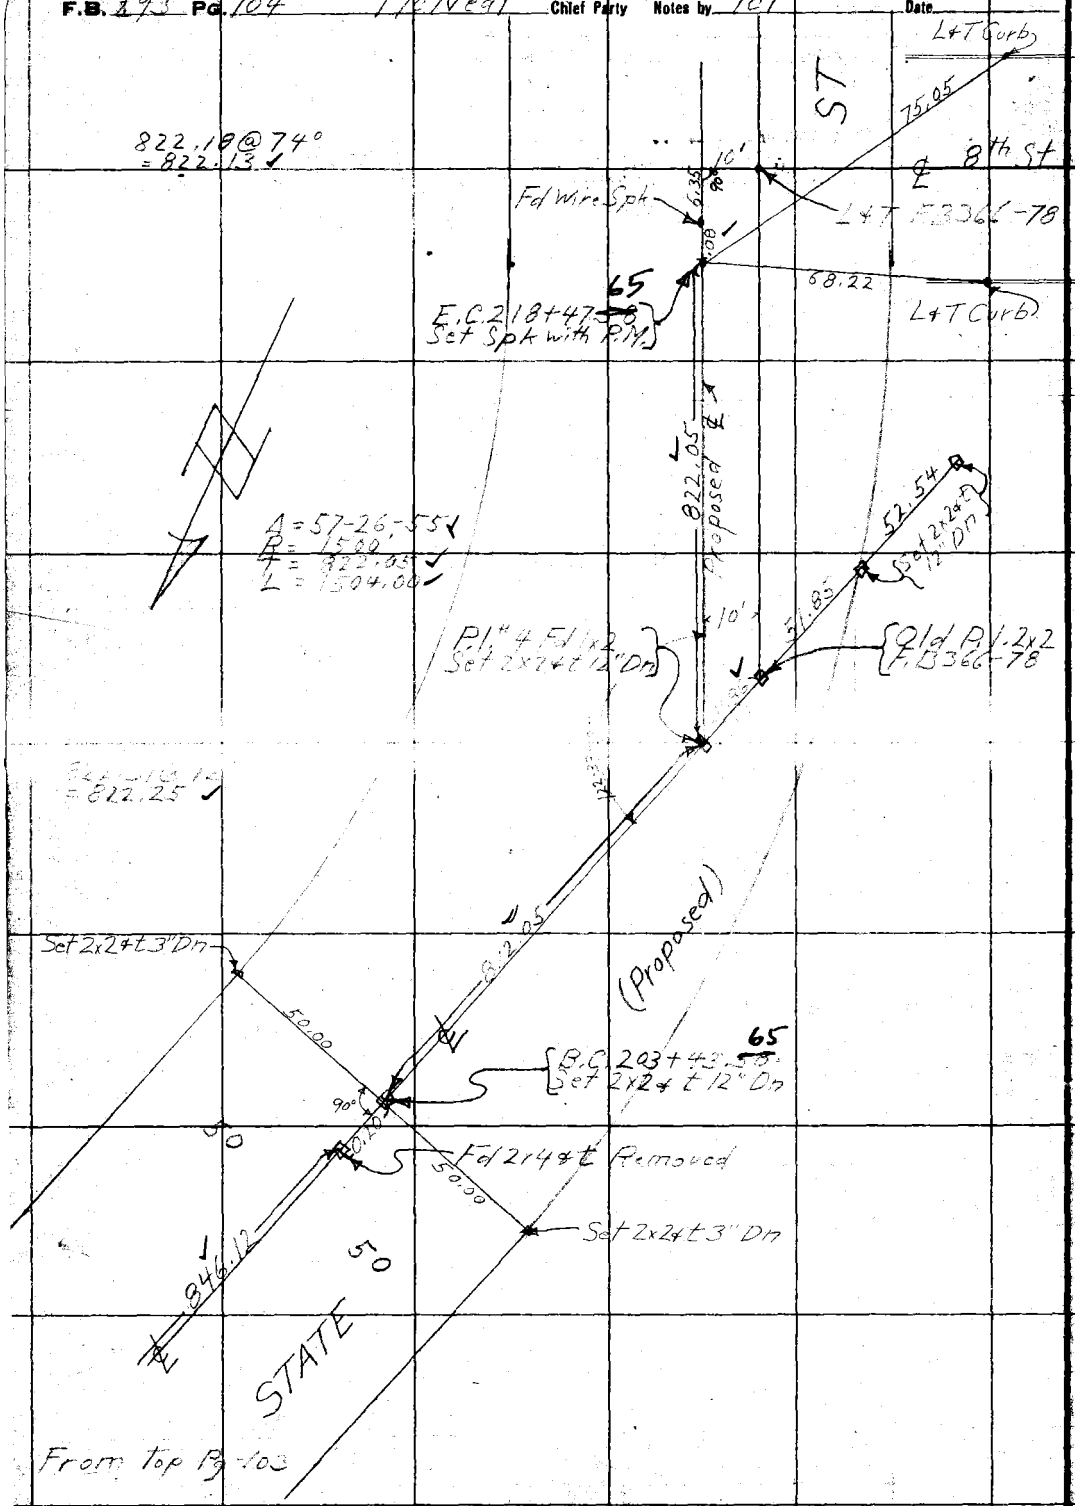

RETURN TO
LOS ANGELES COUNTY SURVEYOR
Do not extend notes this side of this line

Note: ANY ADDITIONS OR CHANGES ON THIS SHEET MUST BE MADE OR CIRCLED IN Red. WITH DATE AND NAME OF PERSON MAKING CHANGE.

Date 6/25/29 Notes by [illegible] Chief Party [illegible] F.B. 293 Pg. 105

Platted by McCassy	W. O. No. 4245 D. S. O. No.
Date 7-3-29	Location
Map No. B-350-2	Surveyed by
Platting C'k'd by A. A. R.	Date
Date AUG 1929	Indexed

Notes: ANY ADDITIONS OR CHANGES ON THIS SHEET MUST BE MADE OR CIRCLED IN Red. WITH DATE AND NAME OF PERSON MAKING CHANGE.

Do not extend notes this side of this line

RETURN TO LOS ANGELES COUNTY SURVEYOR

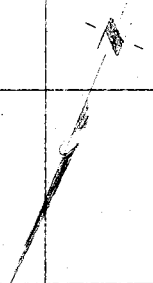

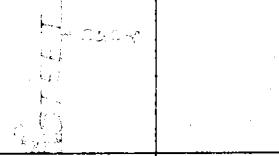

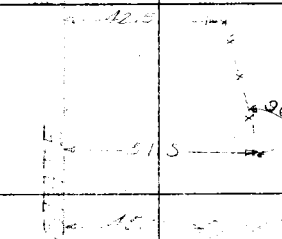

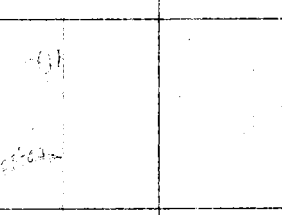

115+49 44 1x2 stk
See Pg 101

115+49.46 Fence

F. B. 223 Pg. 96 Chief Party Notes by Date

RETURN TO
LOS ANGELES COUNTY SURVEYOR

Do not extend notes this side of this line

Note: ANY ADDITIONS OR CHANGES ON THIS SHEET MUST BE MADE OR CIRCLED IN Red. WITH DATE AND NAME OF PERSON MAKING CHANGE.

Date _____ Notes by _____ Chief Party _____ F.B. 293 Pg. 107

Platted by McCassy
Date 6-27-29
Map No. B-350-1
Platting C'k'd by A. A. R.
Date AUG 1929

W. O. No. 4243 D. S. O. No. _____
Location _____
Surveyed by _____
Date _____
Indexed E. C. Johnson

Notes: ANY ADDITIONS OR CHANGES ON THIS SHEET MUST BE MADE OR CIRCLED IN Red. WITH DATE AND NAME OF PERSON MAKING CHANGE.

Do not extend notes this side of this line

RETURN TO LOS ANGELES COUNTY SURVEYOR

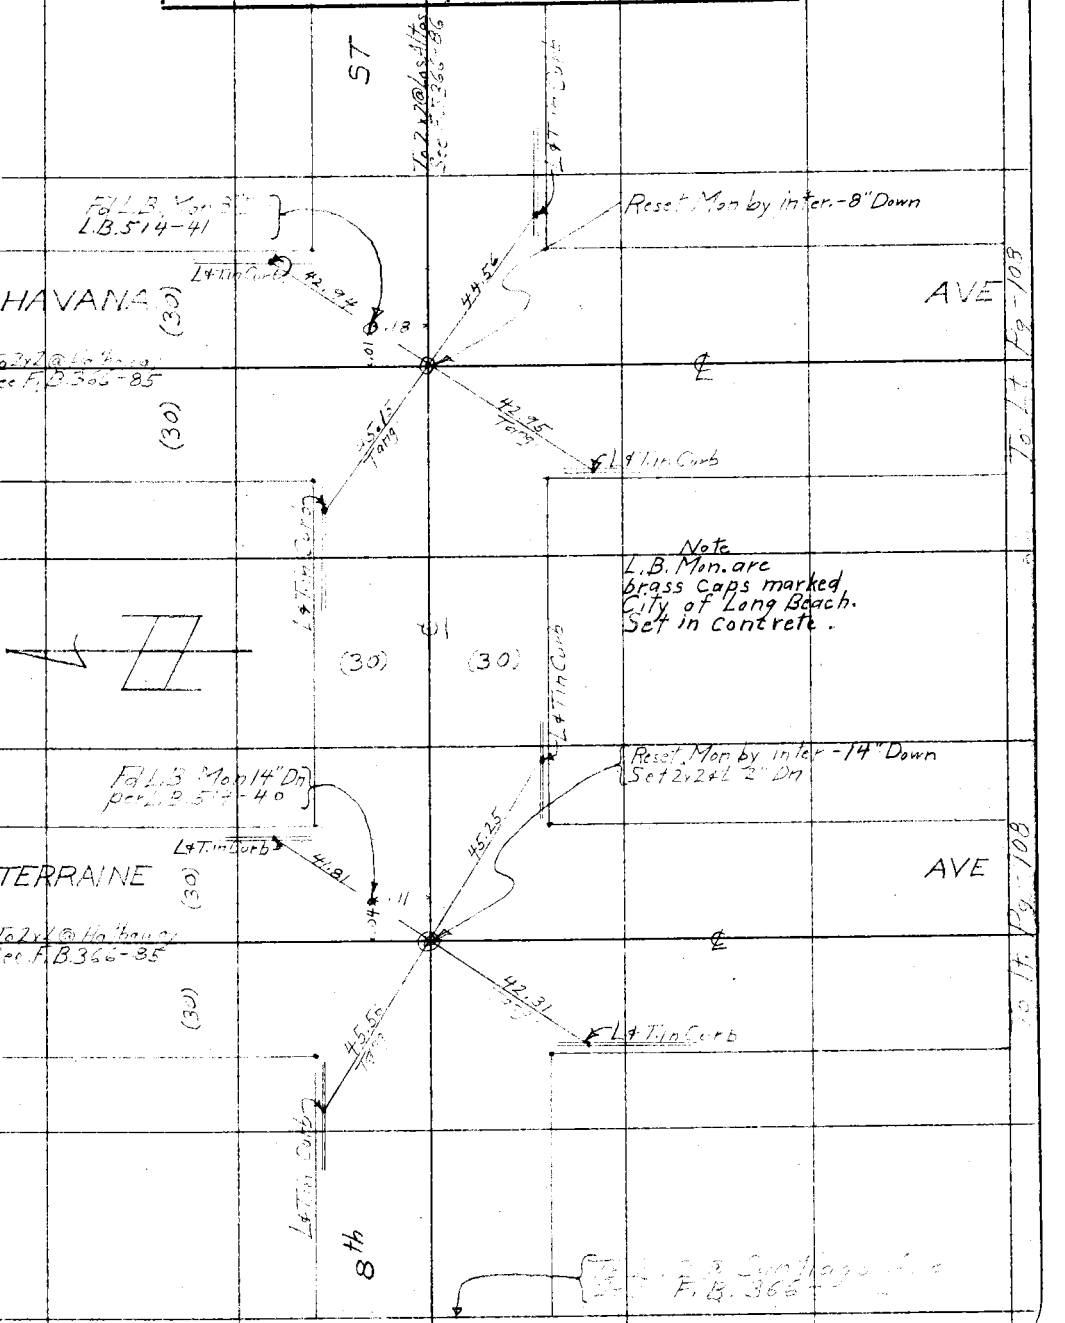

F.B. 293 PG. 103 Chief Party Notes by Mc Neal Date

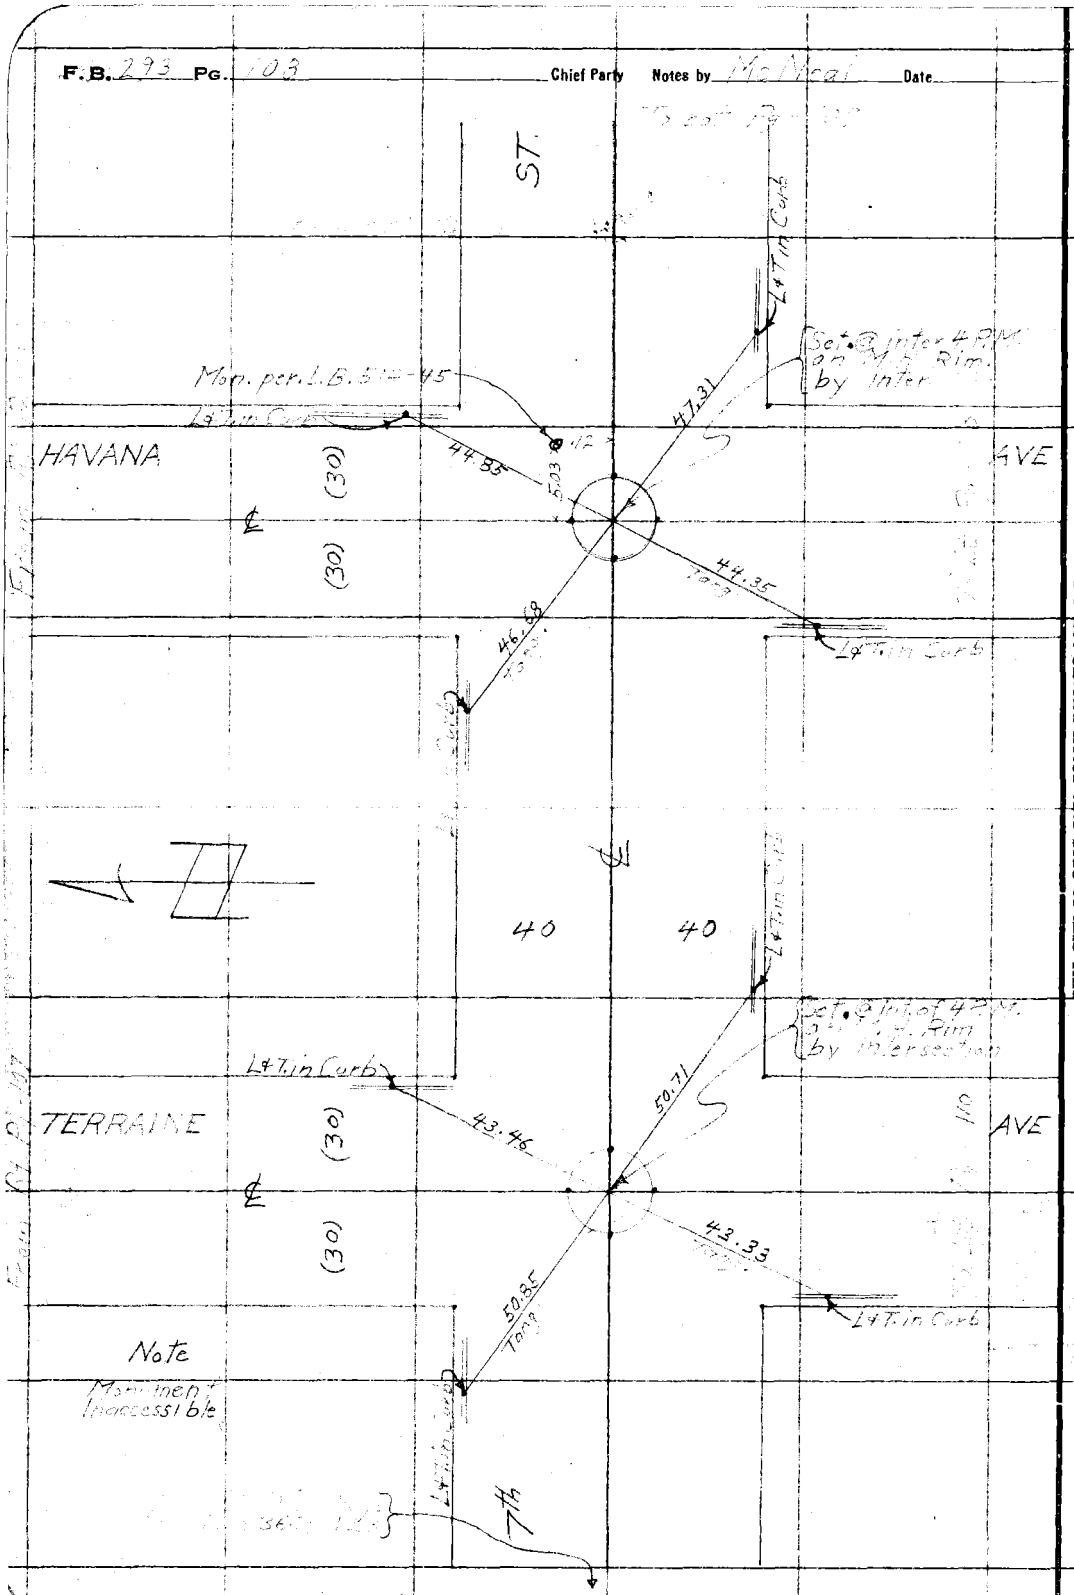

RETURN TO
LOS ANGELES COUNTY SURVEYOR

Do not extend notes this side of this line

Note: ANY ADDITIONS OR CHANGES ON THIS SHEET MUST BE MADE OR CIRCLED IN Red. WITH DATE AND NAME OF PERSON MAKING CHANGE.

Date _____ Notes by CJ Chief Party _____ F.B. 293 Pg. 109

Plotted by McCasey
Date 6-28-29
Map No. B-350-1
Plotting C'k'd by A. A. R.
Date AUG 1929

W. O. No. 4245 U. S. C. No.
Location State St.
Surveyed by
Date June 1929
Indexed A. C. JOHNSON

Notice: ANY ADDITIONS OR CHANGES OF THIS SHEET MUST BE MADE IN CIRCLED "I" Red. WITH DATE AND INITIALS MADE OF PERSON MAKING CHANGE.

Do not extend notes this side of this line

RETURN TO LOS ANGELES COUNTY SURVEYOR

ST

To P.M. @ Flint F.B. 366-89

L+T. in Curb

Set • @ inter of 4 P.M. on Mon. Cor. Rim by inter.

L+T in Curb

ULTIMO

43.88

53.04

AVE

(30)

To 2x2 @ Hathaway F.B. 366-87

Δ .03

Δ .18°

Not Tang.

52.44

52.08

Not Tang.

L+T. in Curb

Mon. per L.B. 514-47

40

40

L+T. in Curb

L+T. in Curb

Set • @ inter. 4 R.M. on Mon. Cor. Rim by inter.

Mon. per L.B. 514-46

L+T. in Curb

LOS ALTOS

44.29

Δ .04

Δ .14°

49.21

(JAPAN)

(30)

AVE

To 2x2 @ Hathaway F.B. 366-86

43.76 Tang.

49.15 Tang.

L+T. in Curb

L+T. in Curb

7th

To L+ Pg. 111

To L+ Pg. 111

From Top Pg - 108

F.B. 293 Pg. 110 Chief Party Notes by [illegible] Date

To bot. Pg. 111

ST

Fd L.B. Mon. 12" Dn. per L.B. 5-14-5

L & T. in Curb

Reset Mon. by inter +12" Dn. Set 2x2 ℄ 2" Dn.

HAVANA

(30)

From Pg. 109

42.153

.05

.03

38.66

AVE.

To L.T. Pg. 112

38.83 Tang.

42.26 Tang.

L & T. in Curb

L & T. in Curb

(30) (30)

Note: L.B. Mon. are brass caps marked City of Long Beach. Set in Concrete

Fd L.B. Mon. 14" Dn. per L.B. 5-14-5

L & T. in Curb

Reset Mon. by inter. -14" Dn. Set 2x2 ℄ 2" Dn.

TERRAINE

(30)

From Pg. 108

37.59

.05

.07

42.185

AVE.

To L.T. Pg. 113

(30)

42.375 Tang.

39.33 Tang.

L & T. in Curb

L & T. in Curb

To 2x2 @ Santiago See F.B. 366-12-4

6th

RETURN TO LOS ANGELES COUNTY SURVEYOR

Do not extend notes this side of this line

Note: ANY ADDITIONS OR CHANGES ON THIS SHEET MUST BE MADE OR CIRCLED IN Red. WITH DATE AND NAME OF PERSON MAKING CHANGE.

Date _____ Notes by M Chief Party _____ F.B. 293 Pg. 111

Plotted by McCassy
Date 6-28-29
Map No. B-350-1
Plotting C'k'd by A. A. R.
Date AUG 1929

W.O. No. #245 B. S. O. No.
Location State St.
Surveyed by M. No. 1
Date June 1929
Indexed A. C. Johnson

Notes: ANY ADDITIONS OR CHANGES ON THIS SHEET MUST BE MADE ON CIRCLED "I" Red. WITH NAME AND NAME OF PERSON MAKING CHANGE.

Do not extend notes this side of this line

RETURN TO LOS ANGELES COUNTY SURVEYOR

ST.

To bot Pg-112

L & T. in Curb

{Reset Mon by Inter-12" Down
Set 2x2 t 2" Dn

L & T. in Curb

ULTIMO (30)

45.80 Tang.

44.48

AVE

From Rt Pg 113

To Lt Pg-114

44.53 Tang.

.13'

.04

46.11

L & T. in Curb

{Fd L.B. Mon 12" Down per L.B. 514-57

L & T. in Curb

(30) (30)

L & T. in Curb

{Reset Mon by Inter-12" Down
Set 2x2 t 2" Down.

L & T. in Curb

LOS ALTOS (30)

45.95

48.86 Tang.

(JAPAN) AVE

.09'

.04

46.28 Tang.

To Lt. Pg-114

From Rt. Pg-109

{Fd L.B. Mon 12" Dn per L.B. 514-56

48.98

L & T. in Curb

6th

From Top Pg-110

F.B. 293 Pg. 112 Chief Party Notes by [illegible] Date

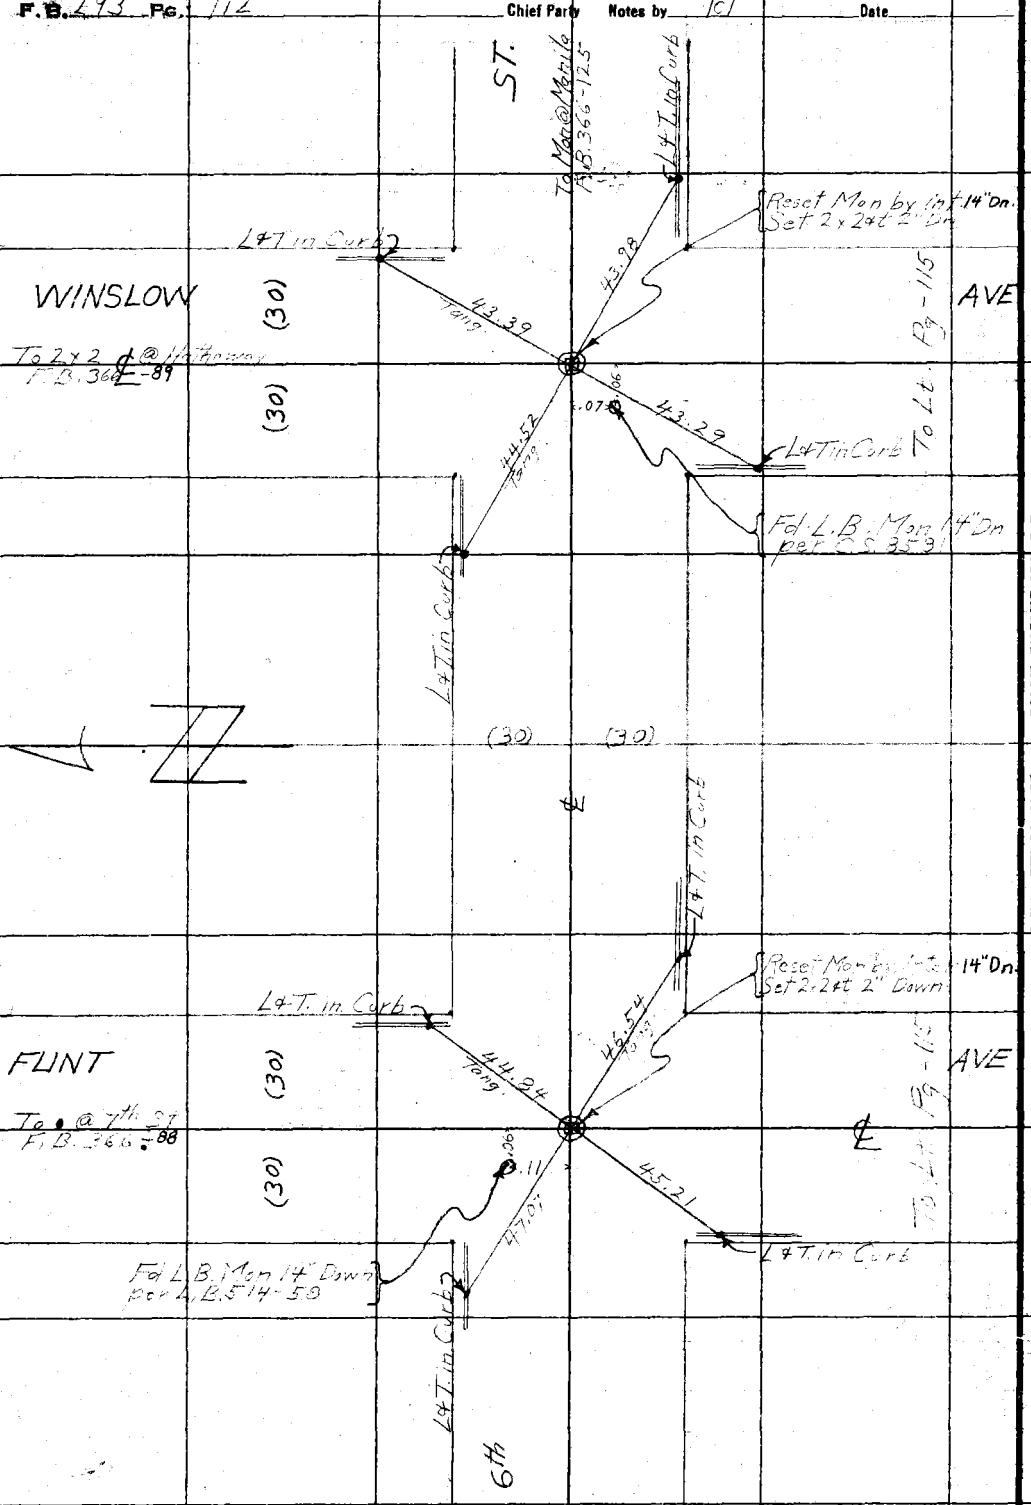

From Top Pg - 111

RETURN TO
LOS ANGELES COUNTY SURVEYOR

Do not extend notes this side of this line

Note: ANY ADDITIONS OR CHANGES ON THIS SHEET MUST BE MADE OR CIRCLED IN Red. WITH DATE AND NAME OF PERSON MAKING CHANGE.

Date _____ Noted by M Chief Party _____ F.B. 293 Pg. 113

Plotted by Mc Cassy
Date June 1929
Map No. B-350-1
Plotting C'k'd by A. A. R.
Date AUG 1929

W. O. No. 4245 S. B. O. No. _____
Location State St
Surveyed by F. J. M. Neal
Date June 1929
Indexed A. C. Johnson


Do not extend notes this side of this line

RETURN TO LOS ANGELES COUNTY SURVEYOR

To bot. Pg - 114

ST

L & T in Curb

Reset Mon by inter - 12" Down
Set 2x24t 2" Down

From Pt. Pg - 110

HAVANA (30) AVE

46.47

45.05 Tang.

To 2x2 @ Colorado
F. B. 366 - 71

(30)

45.71

.04 ↑

45.21 Tang.

L & T in Curb

Fd L. B. Mon 12" Dn
per L. B. 514 - 56

L & T in Curb

Note
L.B. Mon. are brass caps marked City of Long Beach. Set in Concrete.

(30) (30)

L & T in Curb

Reset Mon by inter - 12" Dn
Set 2x24t 2" Down

L & T in Curb

TERRAINE (30) AVE

40.46

38.54 Tang.

To 2x2 @ Colorado
F. B. 366 - 90

From Pt Pg - 110

(30)

.14 ↑

38.80

38.74 Tang.

L & T in Curb

Fd L. B. Mon 12" Dn
per L. B. 514 - 65

L & T in Curb

4th

To 2x2 @ Santiago
Sec F. B. 366 - 124

F.B. 293 Pg. 114 McNeal Chief Party Notes by CM Date June-1927

To bot Pg 115

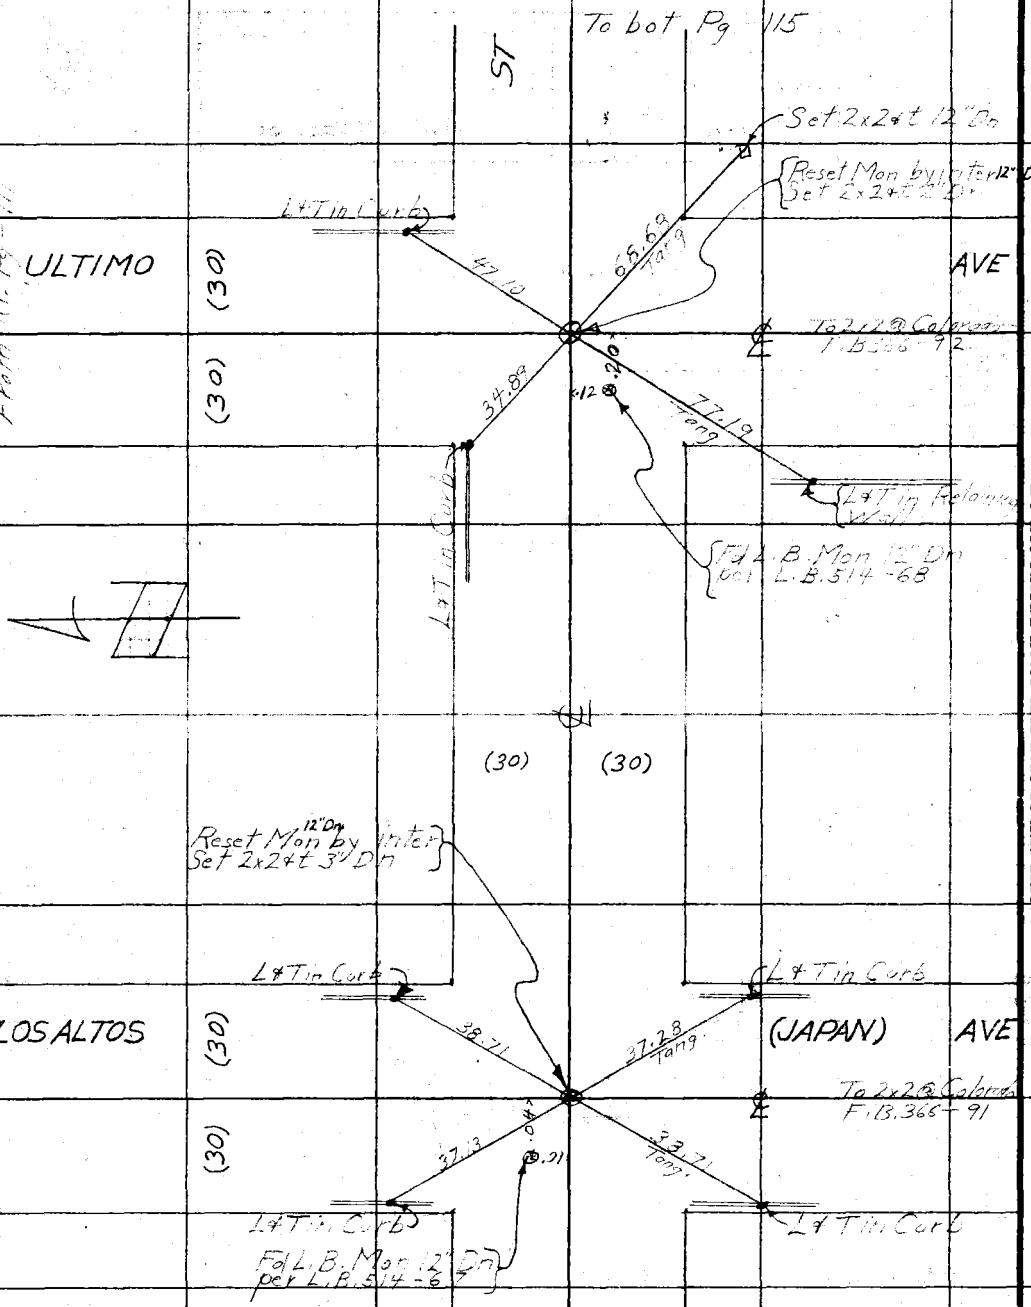

From Pt. Pg - 111

From Top Pg - 113

RETURN TO LOS ANGELES COUNTY SURVEYOR

Do not extend notes this side of this line

Notice: ANY ADDITIONS OR CHANGES ON THIS SHEET MUST BE MADE OR ENCLOSED IN Red. WITH NAME AND NAME OF PERSON MAKING CHANGE.

Date _____ Notes by M Chief Party _____ F.B. 293 Pg. 115

Plotted By McCassy
Date 6-28-29
Map No. B-350-11
Plotting C'K'd by A. A. R.
Date AUG 1929

W. O. No. 4245 S. S. O. No.
Location State St.
Surveyed by F. J. M. Neal
Date June 1929
Indexed by C. Johnson

Notice: ANY ADDITIONS OR CHANGES ON THIS SHEET MUST BE MADE IN CIRCLED AREA WITH DATE AND NAME OF PERSON MAKING CHANGE.

Do not extend notes this side of this line

RETURN TO LOS ANGELES COUNTY SURVEYOR

ST.

To Mon @ Main & 1st
F.B. 342-125

L & T in Curb

Reset Mon By Inter - 6" Dn.

L & T Curb

WINSLOW (30)

AVE

39.87 Tang.

41.35

To 2x2 @ Colorado
F.B. 366-93

From Ft. Pg - 112

(30)

41.09 Tang.

.06

39.71

L & T Curb

Fd L.B. Mon 6" Down per L.B. 514-70

L & T Curb

(30) (30)

L & T in Curb

Reset Mon by Inter - 6" Dn.

41.30

L & T in Curb

FLINT (30)

AVE

39.22 Tang.

To 2x2 @ Colorado
F.B. 366-92

From Ft. P. - 112

(30)

.07

39.93

40.77 Tang.

L & T in Curb

Fd L.B. Mon 6" Dn per L.B. 514-69

L & T in Curb

4th

From Top Pg - 114

F.B. 293 PG. 116 Chief Party Notes by Date

BLANK

RETURN TO
LOS ANGELES COUNTY SURVEYOR

Do not extend notes this side of this line

Note: ANY ADDITIONS OR CHANGES ON THIS SHEET MUST BE MADE OR CIRCLED IN Red. WITH DATE AND NAME OF PERSON MAKING CHANGE.

Date _____ Notes by M Chief Party _____ F.B. 293 Pg. 117

Plotted by Price
Date Aug. 29
Map No. B-350-1
Plotting Checked by A. A. R.
Date AUG 1929

W. O. No. 4245 78sc Dist. No. 021
Location State St.
Surveyed by F.J. McNeal
Date July-11-1929
Indexed J. Johnson

Notes: ANY ADDITIONS OR CHANGES ON THIS SHEET MUST BE MADE OR CIRCLED IN Red. WITH DATE AND NAME OF PERSON MAKING CHANGE.

Do not extend notes this side of this line

RETURN TO LOS ANGELES COUNTY SURVEYOR

RETURN TO
LOS ANGELES COUNTY SURVEYOR

Note: ANY ADDITIONS OR CHANGES ON THIS SHEET MUST BE MADE OR CIRCLED IN Red. WITH DATE AND NAME OF PERSON MAKING CHANGE.

Do not extend notes this side of this line

F.B. 293 Pg. 118 Chief Party Notes by MT Date

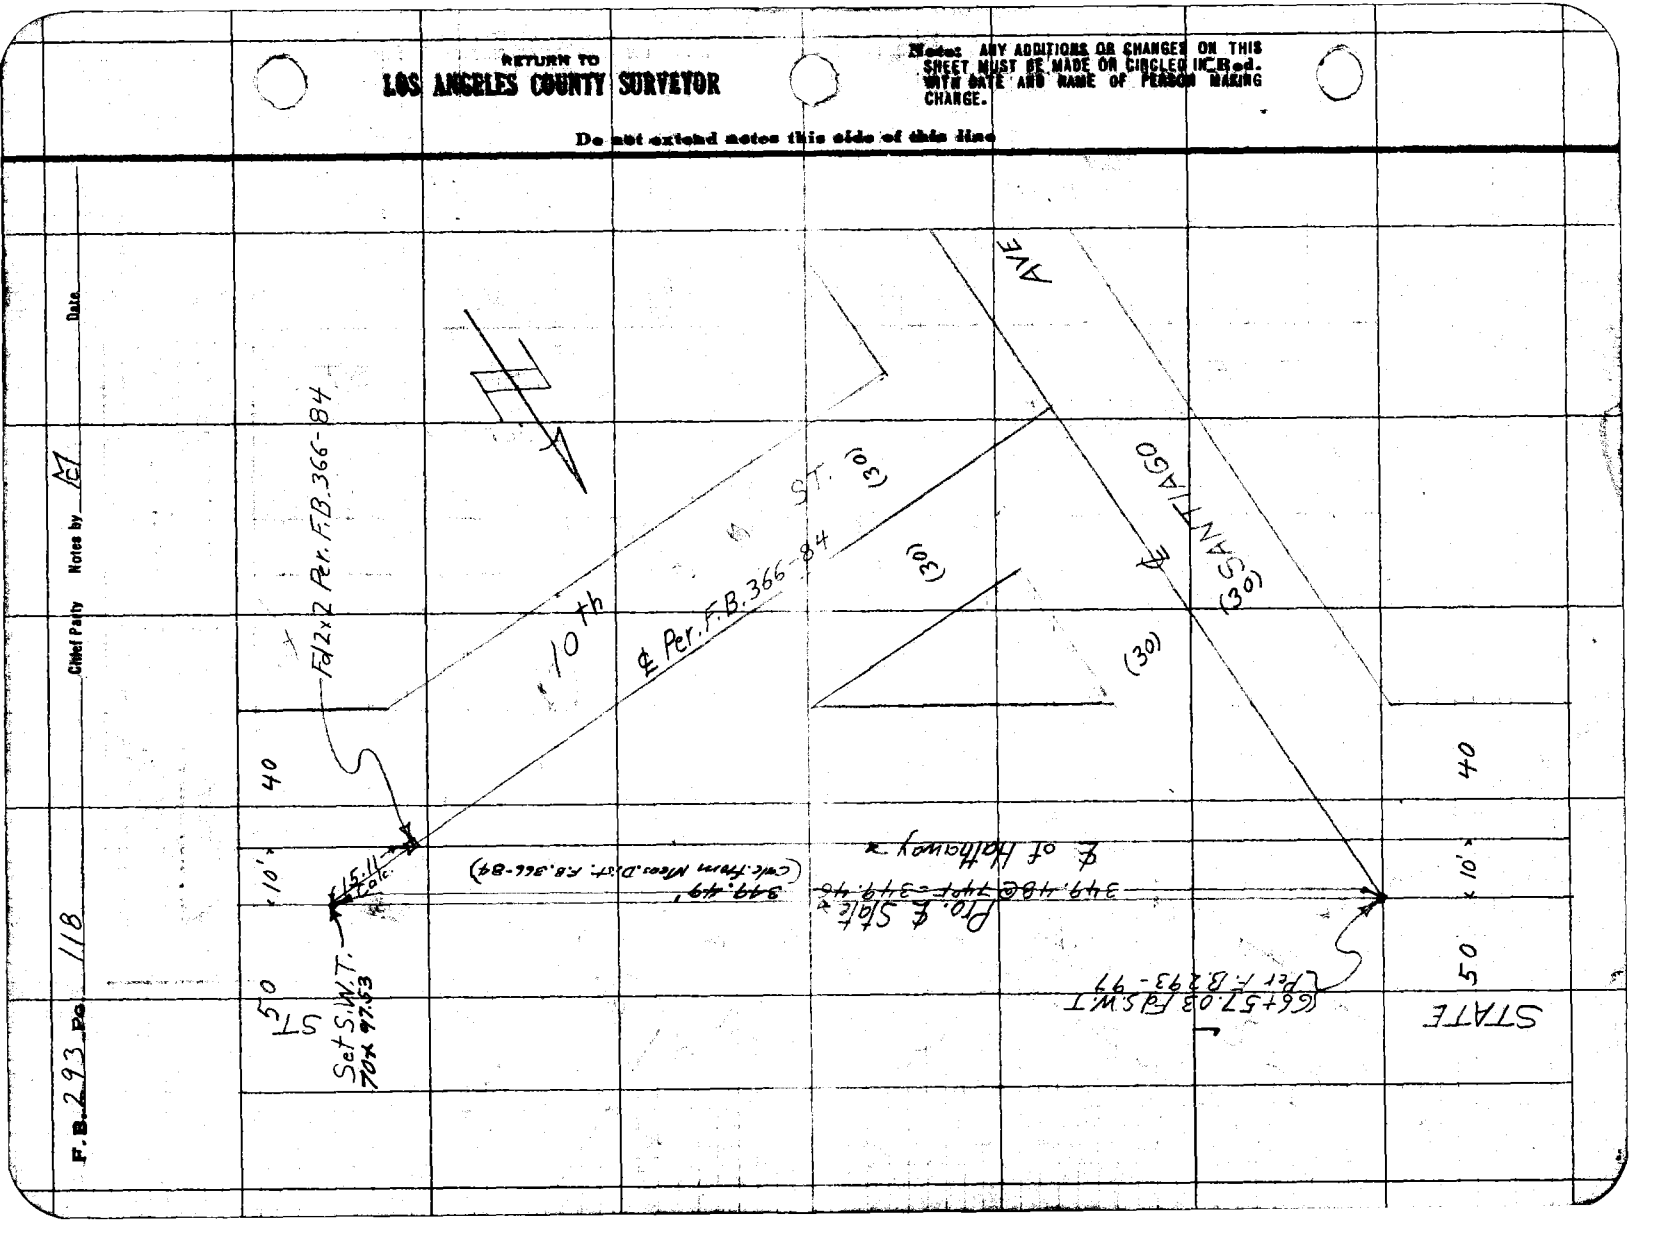

Date _____ Notes by MT Chief Party _____ F.B. 293 Pg. 119

Plotted by S. McCassy
Date 7-30-29
Map No. B-350-Sht 2
Plotting Ck'd by J.W. Price
Date 7-30-29

W. O. No. 4345 O. E. O. No.
Location Slate St
Surveyed by F.J. M. Neal
Date July - 1929
Indexed C. Johnson

Distances are Stadia
Location of Draw thru Bryant Property

Transit @ P.I. # 1 - See F.B. 293-101 - Sight @ B.C.
All Angles to the Right

	Angle	Distance		Angle	Distance
1	0-0	71'	2	48-57	91'
3	131-44	45'	4	190-57	71'
5	185-00	164'	6	183-06	300'
7	187-10	385'	8	187-21	470'

Transit @ E.C. - See F.B. 293-101 - Sight @ Int. 115+49.44.

	Angle	Distance		Angle	Distance
1	259-20	180'	2	283-31	197'
3	317-17	250'	4	329-21	335'
5	338-22	440'	6	344-46	556'

Transit @ Int. 115+49.44 - F.B. 293-101 - Sight @ E.C.

	Angle	Distance		Angle	Distance
1	21-37	385'	2	17-35	270'
3	9-03	190'	4	330-52	112'
5	294-09	108'	6	257-38	155'
7	241-20	185'	8	223-03	215'
9	212-39	263'			

Notes: ANY ADDITIONS OR CHANGES OF THIS SHEET MUST BE MADE OR CIRCLED IN Red, WITH DATE AND NAME OF PERSON MAKING CHANGE.

Do not extend notes this side of this line

RETURN TO LOS ANGELES COUNTY SURVEYOR

RETURN TO

LOS ANGELES COUNTY SURVEYOR

Note: ANY ADDITIONS OR CHANGES ON THIS SHEET MUST BE MADE OR CIRCLED IN Red. WITH DATE AND NAME OF PERSON MAKING CHANGE.

Do not extend notes this side of this line

Date

Notes by

Chief Party

F.B. 222 PG 120

Date _____ Notes by Mc Chief Party _____ F.B. 293 Pg. 121

Plotted by Price
Date Aug. 29
Map No. B-350-1
Plotting Chkd by A. A. Rice
Date AUG 1929

W. O. No. 4245-[illegible] Dist. No. 021
Location State St.
Surveyed by F.J. McNeal
Date July-1929
Indexed A. C. Johnson

179-58-15
359-52-45
89-58-10

1/4-1/4 Sec.

St

Fd S.W.T. which checked 40.00 from R.W. Mon. Per F.B. 397-42

Fd 2x2x24t-12" Dn by ties F.B. 397-49

Line

S. Mon F.B. 397-42,49

Manila Ave

Ave

518.98@76°F = 518.95

518.95

41-27-15
165-48-45
41-27-10

41-27-15

S.W.T. Per F.B. 293-117

Fd 2x2x24t-2" Dn Per F.B. 366-88

Hathaway

7th

Note: ANY ADDITIONS OR CHANGES OF THIS SHEET MUST BE MADE OR CHECKED IN Red. WITH DATE AND NAME OF PERSON MAKING CHANGE.

Do not extend notes this side of this line

RETURN TO LOS ANGELES COUNTY SURVEYOR

RETURN TO
LOS ANGELES COUNTY SURVEYOR

Note: ANY ADDITIONS OR CHANGES ON THIS SHEET MUST BE MADE OR CIRCLED IN Red. WITH DATE AND NAME OF PERSON MAKING CHANGE.

Do not extend notes this side of this line

Date

Notes by

Chief Party

Blank

F.B. 293 Pg. 122

Date 8/15/29 Notes by E.H.B. Chief Party Blanchard F.B. 293 Pg. 123

Plotted by [illegible]	W. O. No. 4245 D. S. O. No.
Date 8-23-29	Location STATE ST
Map No. B-350 Sht 2	Surveyed by E.H. Blanchard
Plotting Checked by [illegible]	Date 8/15/29
Date Sept 2 29	Indexed A. C. Jones

ADOPTED

~~ALTERNATE~~ LINE

SOUTH OF

MANILLA AVE

cont 3 of pg 124

STREET

110+15.62 E.C.
EC Set 2x2 18" deep

424.08

PI #1A set 2x2 18" deep. 424.08 from BC

45°

77.61

PI #1 set 2x2 18" deep

61.59

148-25-30
233-42-00
148-25-30

Δ = 31-34-25
R = 1500
T = 424.08
L = 826.60

50 50

424.08

101+89.02 B.C.
BC Set 2x2 18" deep
Calc dist

322 (calc)

101+86.10
Fd 2x2 18"
deep Ref. to B.293-107

96+83.33 P.C. 1"x2' Hole 3' to Conc. surface Abandoned Per F.B. 293-10

Fd 2x2 Per FB 293-100. 95+99.19

STATE

S 85° 54' W 84.47

S 80° 17' W 80.96

Notice: Any additions or changes on this sheet must be made as directed by the date, name and title of person making change.

Do not write notes this side of this line.

RETURN TO LOS ANGELES COUNTY SURVEYOR

F.B. 293 Pg 124 (Blanchard Chief Party Notes by EHB Date 8/15/29

cont dot pg 125

121°-57-00
127-48-30
121°-57-05

121°-57-05

Fd 4" I.P Per FB 293-102 & FB 366-57

81.76
N 6°-15' E

120+77.98
Set 1X2 by Int.

139.45
139.44

221.21

FB 293-102

Fd 1X2 119+44.91
FB 293-102

32.98 @ 0° T 84° = 32.98
297.33 @ 2°30 = 297.05
297.41 @ 2°45 = 297.07
297.06 @ T 84° = 297.06
86.24 @ 0° T 84° = 86.24

STREET

Fd 4" I.P Per FB 366-57

Fd 4" I.P 18" deep Per F.B. 366-57

110-12-45 25"

110-12-45
80-51-00
110-12-45

set 1X1 by Int.

116+61.70
Set 1X2 by Calc. dist.

71.01

151.14

100

Fd 1X2 Per 293-101 115+99.44

1.00

50 50

646.06 @ 0° T 88° = 646.08

STATE

Fd 4X4 Per FB 366-57

646.08

cont from Top pg 123

RETURN TO LOS ANGELES COUNTY SURVEYOR
Do not extend notes this side of this line
Note: ANY ADDITIONS OR CHANGES ON THIS SHEET MUST BE MADE OR CHECKED IN Red. WITH DATE AND NAME OF PERSON MAKING CHANGE.

Date 8/21/29 Notes by Blanchard Chief Party E.T. McNeal F.B. 293 Pg. 125

Plotted by	S.M.C.	W. O. No.	4245 D. S. O. No.
Date	8-23-29	Location	STATE ST.
Map No.	B-350 Sht 2	Surveyed by	McNeal
Plotting Chkd by	A. R. M.	Date	8/21/29
Date	AUG 1929	Indexed	A. C. Johnson

Notice ANY ADDITIONS OR CHANGES ON THIS SHEET MUST BE MADE IN CIRCLED AREA WITH DATE AND NAME OF PERSON MAKING CHANGE

Do not extend notes this side of this line

LOS ANGELES COUNTY SURVEYOR

149+38.41
Fd 1x1 ab EC Per
Used for New EC.

367.167

PI #2 Sta 151 Conc Mon
Per FB 293-102

9169
Rad. LSH

A 20-49-00
R 3000
T = 551.05 ✓
L = 1089.96 ✓

159-11-00

64.76

Set 2x24"
1/2" Dr

53.18

90°

PI #2A set
2x2 12" deep

159-11-00
276-44-00
159-11-00 ✓

2376.90 calc.

139+03.83 B.C
Not set
point lands in middle
of Slough.

cont from Top pg 124

RETURN TO

LOS ANGELES COUNTY SURVEYOR

Note: ANY ADDITIONS OR CHANGES ON THIS SHEET MUST BE MADE OR CIRCLED IN Red. WITH DATE AND NAME OF PERSON MAKING CHANGE.

Do not extend notes this side of this line

Date

Notes by

Chief Party

F 293 Pg 126

Date _____ Notes by McNeal Chief Party M F.B. 293 Pg 127

Date Sept. 5-29. Location State St
Map No. C.S.B-358-Sh-#1. Surveyed by F.H. Blanchard
Plotting checked by A.A.M. Date Aug-1929
Date SEP 1929 Inspected

68-38-00
274-32-15
68-38-03 3/4

To Dot. Pg 128

Set 2x2+t 12" Dn

Mon Pac F.B. 366-94
67.53
Set 2x2+t 12" Dn
11.30

Set 2x2+t 12" Dn

242.58
=242.58

50
50

STREET
Long Beach

E.C. 15+32.68
Set 2x2+t 12" Dn

(Proposed ℄)
See P9-281.06

XIMENO AVE
Per F.B. 366-94

(80)
13.34

Set 2x2+t 12" Dn

Pl. Set 2x2+t 12" Down

STATE Line

60.94 64.10

RPPL set 2x2 8" deep

2x2 stk Per F.B. 366-94

520.71 @ 9+00
=520.71

Δ = 41-29-10
R = 1500
T = 567.24
L = 1085.57

BENNETT AVE

(30)
868.92 ℄
(30)

Set S.W. by Inf

Set 2x2+t 12" Dn

21-22-45
85-31-00
21-22-45

PROPOSED ℄
282.62

Ed Pac R/R Sta 561+93

See F.B. 366-94 Note To Terminal Ave

TERMINO AVE

Notice ANY DEVIATION OR CHANGES IN THIS SHEET MUST BE MADE IN CIRCLES OR RED WITH DATE AND NAME OF PERSON MAKING CHANGE.

RETURN TO LOS ANGELES COUNTY SURVEYOR

Do not subtract anything this side of this line

F.B. 293 Pg 128 McNeal Chief Party Notes by Mc Date

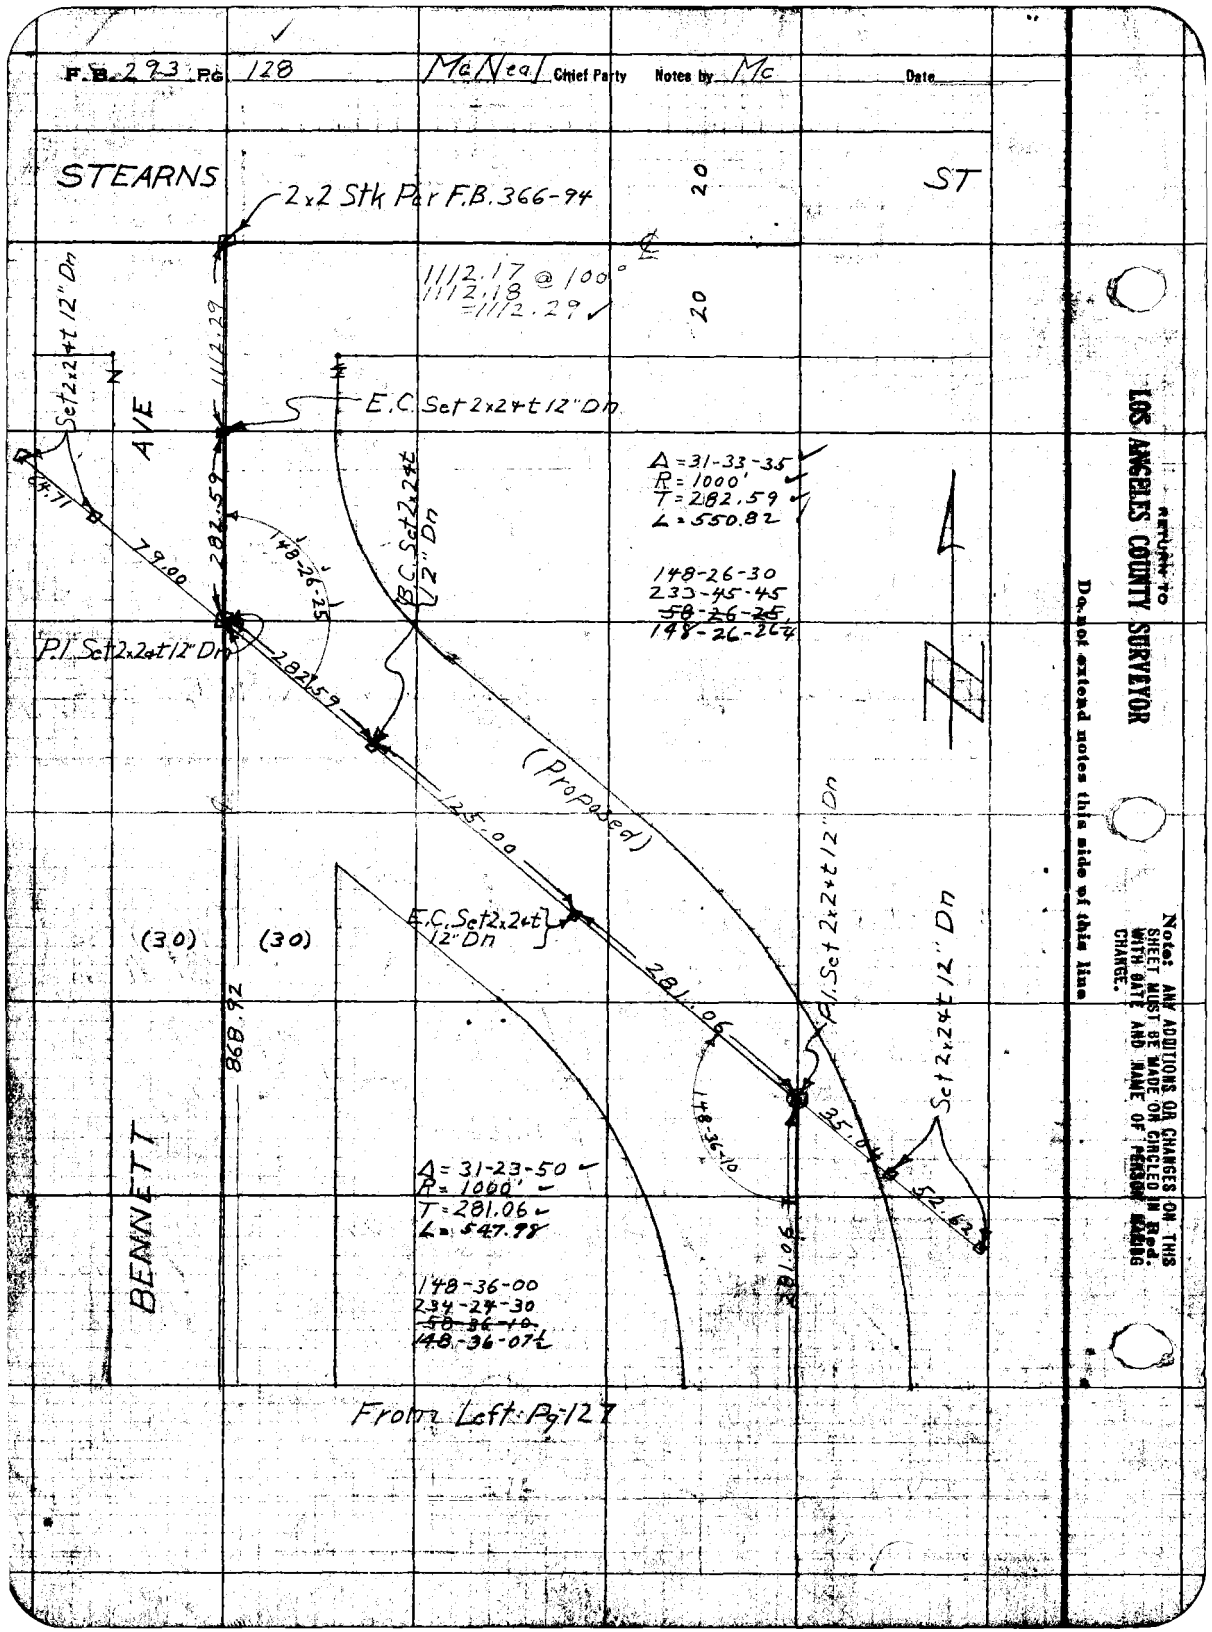

RETURN TO LOS ANGELES COUNTY SURVEYOR

Do not extend notes this side of this line

Note: ANY ADDITIONS OR CHANGES ON THIS SHEET MUST BE MADE OR CIRCLED IN Red. WITH DATE AND NAME OF PERSON MAKING CHANGE.

Date _____ Notes by M Chief Party McNeal F.B. 293 Pg. 129

Started by J.D. Place
Date Sept. 6-'29.
Map No. C.S.B-350-St. #1
Plotting Chkd by A. B. R.
Date SEP 1929

W. O. No. 4245 Sec. No. 821
Location State St
Surveyed by E. J. McNeal
Date Aug. 1927
Indexed

179-59-15
359-57-30
179-59-29

Note: ANY ADDITIONS OR CHANGES ON THIS SHEET MUST BE MADE BY CIRCLE M Mod. WITH DATE AND NAME OF PERSON MAKING CHANGE.

RETURN TO LOS ANGELES COUNTY SURVEYOR

Do not extend notes this side of this line

1/4 Sec Cor Fd N4T in Conc 24" Dn FB 289-16

Sec Cor Fd N4T in Conc 36" Dn No Ref

Set N4T in Bridge

To Lt. Pg-130

1509.70 @ 92°
= 1509.78

142.75

31.33

0°-0'-42"

180

1509.78

E.C. Set 2x2x12" Dn

Set N4T in Tree

158-47-45
475-11-15
158-47-30

Δ = 21-12-10
R = 1500'
T = 280.76

64.28

Set 2x2x12" Dn

50

ST

50'

(Calc)

1454.46 Calc.

41-17-00
165-08-30
41-17-00

(Proposed)

280.76

58.29

Set 2x2x12" Dn by int

158-47-50

(N&W)

41-17-50

280.76

Ranch Line

167.38.36'

Set 2x2x12" Dn by int

B.C. Set 2x2x12" Dn

5.68

75.72

Fd N4T in Cone 30" Dn No Ref
Probably set by City of Long Beach.

242.58

0.08

Set 2x2x12" Dn by Inter

STATE

50'

22.37

43.75

Set 2x2x12 Dn

From top Pg-127

R.B. 293 Pg. 130 McNeal Chief Party Notes by RT Date

RETURN TO
LOS ANGELES COUNTY SURVEYOR
Do not extend notes this side of this line

Note: ANY ADDITIONS OR CHANGES ON THIS SHEET MUST BE MADE OR CIRCLED IN Red WITH DATE AND NAME OF PERSON MAKING CHANGE.

STATE

S 75° E 1454.45 (Calc)

165.26

75.69

Set 2x24 t 12" Dn

30+92.81
Set 2x24 t 12" Dn
By Tan.

66.53

131-26-35

℄ 22' W of Ang

℄ SANTA FE AVE

Per F.B. 366-95

2x2 Stk Per F.B. 366-95

131-26-00
165-44-30
~~41-26-05~~
131-26-07

(30) (30)

Ranch Line

131-26-00
165-44-30
~~41-26-05~~
131-26-07

℄ ANAHEIM RD.

℄ Per F.B. 366-95

66.53

131-26-07

161.24

Set 2x24 t 12" Dn

33+16.85
Set 2x24 t 12" Dn
By Tan.

53.29

131-26-07

202.53

2x2 stk Per F.B. 366-95

ST

To 1+29.13

RETURN TO
LOS ANGELES COUNTY SURVEYOR

Note: ANY ADDITIONS OR CHANGES ON THIS SHEET MUST BE MADE OR CIRCLED IN Red. WITH DATE AND NAME OF PERSON MAKING CHANGE.

Do not extend notes this side of this line

Date _____ Noted by _____ Chief Party MC Vea F.B. 273 Pg. 121

Plotted by U.D. Parker
Date Sept. 5-69
Map No. C.S. 62-350-04 #1
Plotting checked by A.N. RE
Date SEP 1969

W.O. No. 4245
Location State St
Surveyed by C.V.
Date Aug - 1969
Indexed by [illegible]

From Rt Pg-130

STATE

50

202.63

50

RUSSELL Dr.

℄ Per F.B. 366-96

66.68

134.16

62.34

Set 2x24" 12" Dwn

2x2 Stk Per F.B. 366-96

Set 2x24" 12" Dwn @ Calc Dist From 2x2 South

55+19.48

Route Line

℄ 195.67 Calc'd

ARGONNE AVE

℄ Per F.B. 366-96

66.68

150.08

79.97

71.11

Set 2x24" 12" Dwn

2x2 Stk Per F.B. 366-96

Set 2x24" 12" Dwn @ Calc Dist From 2x2 South

37+16.14

To Lt Pg F 132

F.B. 293 Pg. 132 McNeal Chief Party Notes by CM Date

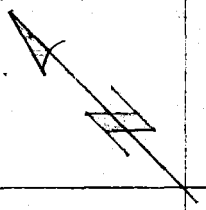

340.39 @ 92 = 340.43
ch. 3-25-30 L.S.M.

Set 2x24t 12" Dn

118.26

80.00

STATE

Pg-131

340.32 Calc. FB.366-96
~~340.43 ch~~
~~3+42.39~~

72.51 ch

40+56.46
Set 2x24t 12" Dn
@ Calc Dist from 2x2 West

50

ST.

33

50

To Lt. Pg-

From Pt.

2x2 Stk Per F.B 366-97

Ranch line

ST.

72.51 @ 78° = 72.51
ch. 3-21-30 L.S.M.

(30)

(30)

Per F.B. 366-97

14th

RETURN TO
LOS ANGELES COUNTY SURVEYOR

Do not extend notes this side of this line

Note: ANY ADDITIONS OR CHANGES ON THIS SHEET MUST BE MADE OR CIRCLED IN Red. WITH DATE AND NAME OF PERSON MAKING CHANGE.

Date _____ Notes by MC Chief Party McNeal F.B. 293 Pg 123

Plotted by J.D. Rodgers
Date Sept. 6 '29.
Map No. C.S. B-350-sh. #1
Plotting Checked by _____
Date SEP 1929

W.O. No. 42445 Proj. No. A21
Location State St
Surveyed by F.J. McNeal
Date Aug. 1929
Computed by A.C. JOHNSON
Indexed

To Bk Pg 134

S.W.T. Per R.B. 397-51

Set SWT by INT. = 50+32.98

2x2 Stk Per F.B. 366-82

E.C. Set 2X2 12" deep Tang dist 50+08.04 E.C.

Per R.B. 397-51

57.08

45° 24' 25" Calc

129.80

48-52-25 Calc

35

2494
129.80
5-4.74

ANAHEIM ST

(40)

(40)

P.I. set 2X2 12' deep calc dist from Granada

50.91

S 5° 7' W

172-34-25

172-34-30
330-17-45
172-34-25 ✓

Δ = 7°-25-35 ✓
R = 2000 ✓
T = 129.80 ✓
L = 259.23 ✓

STREET

129.80

47+48.81 P.C.

P.C. set 2x2 12" deep Tang dist

P.P.I. set 2x2 12' deep

50' 50'

Fd cone Mon Per F.B. 366-97

(52)

AVE.

(52)

GRANADA

STATE

618.28

66.61

2x2 Stk Per F.B. 366-97

417+30.53

Set 2x2 12' deep calc dist from 2x2 South

71.36

52.96

Set 2x2 ± 12" Down

72.51 Chord

From Rt. Pg 132

Note: ANY ADDITIONS OR CHANGES IN THIS SHEET MUST BE MADE ON A SHEET IN THE SAME FORMAT WITH DATE AND NAME OF PERSON MAKING CHANGE

Do not write below this line

F.B. 293 Pg. 134 McNeal Chief Party Notes by M Date

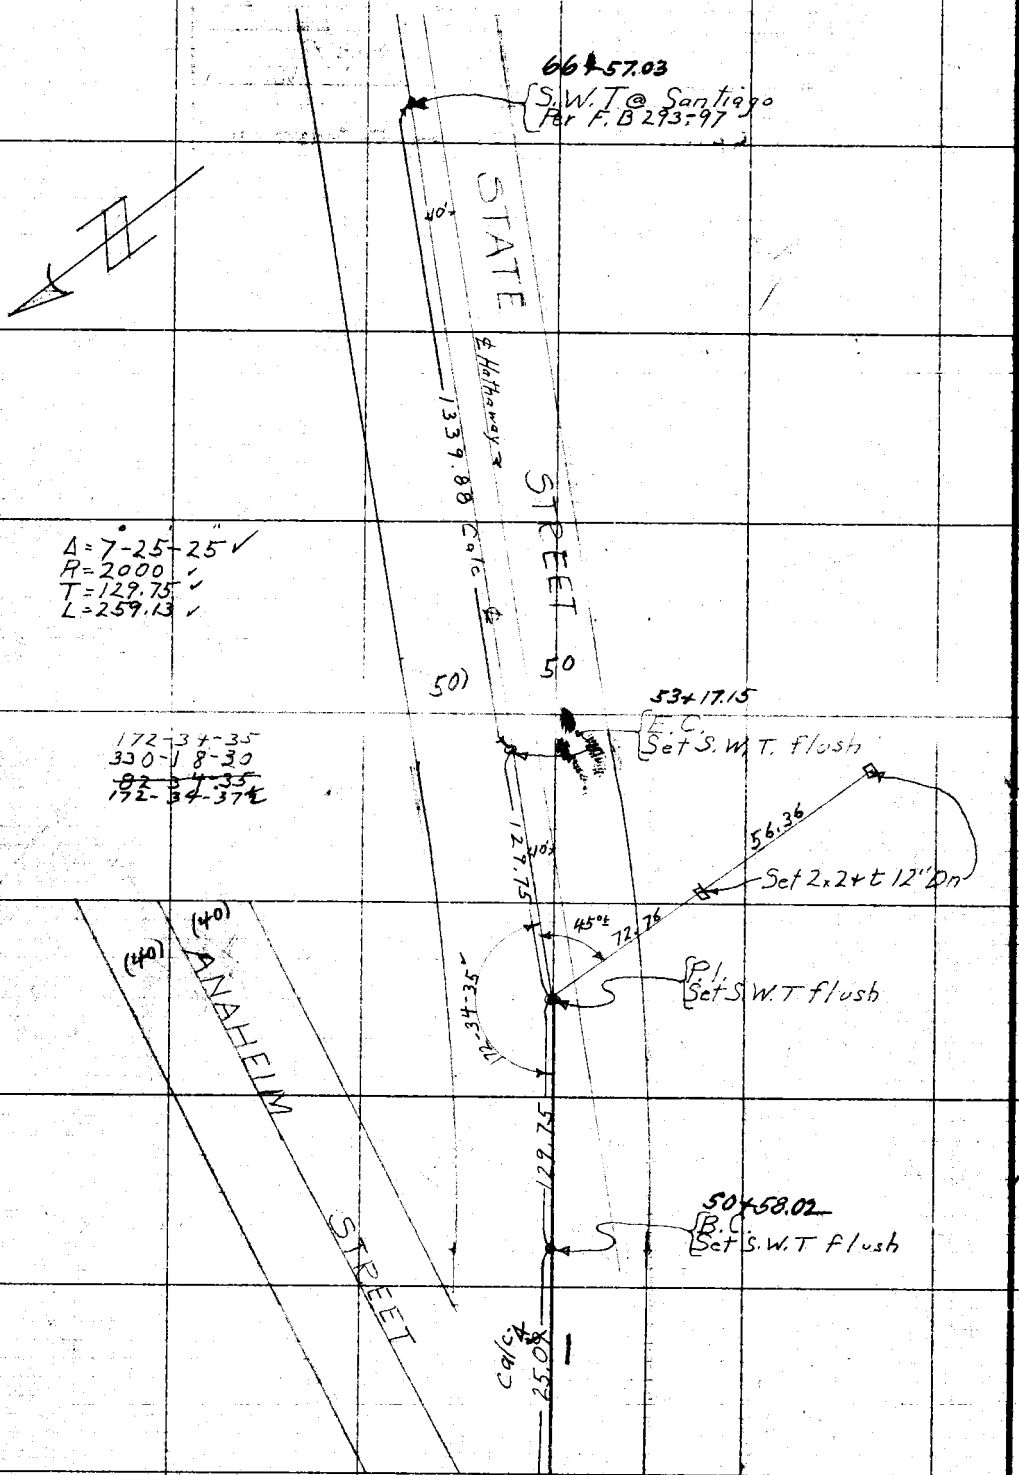

RETURN TO LOS ANGELES COUNTY SURVEYOR

Do not extend notes this side of this line

Note: ANY ADDITIONS OR CHANGES ON THIS SHEET MUST BE MADE OR CHECKED BY PERSON IN CHARGE.

Date _____ Notes by _____ Chief Party McNeal F.B. 293 Pg. 135

Plotted by J.B. Peters
Date Sept. 5, 1929
Map No. C.S.B-350-54.#7
Plotting Chk'd by A. B. M.
Date SEP 1929

W. O. No. 4245 Sht. No. 921
Location State St
Surveyed by E. L. Maxfield
Book 1149 - 1127
Indexed A. C. Johnson

Notice: ANY ADDITIONS OR CHANGES OR THIS SHEET MUST BE MADE OR CIRCLED IN Red. WITH DATE AND NAME OF PERSON MAKING CHANGE.

Do not extend notes this side of this line

LOS ANGELES COUNTY SURVEYOR

Returned

ST

66+57.03
S.W.T Per Pg-97

(10)

(30) SANTIAGO AVE

ST

E.C. Set S.W.T

P.I. Per Pg-134

S.W.T. Per F.B. 397-51

S.W.T Per Pg-134

51.08' Per F.B. 397-51

5.74'

30.24'

13.04'

176.16'

Hathaway Ave

A = 41-27-10
R = 500'
T = 189.20'
L = 361.74'

10'

Set S.W.T by inter

2x2 stk Per Pg 134 F.B. 366-82

15.11'

174.09'

(40)

S.B.C. Set S.W.T

(40)

To Mon @ Intersection

50

50

STATE

Per Pg 134

ANAHEIM

F. B 22 2 Pg 136 Chief Party Noted by Date

LOS ANGELES COUNTY SURVEYOR

Property of Los Angeles County Surveyor
Do not remove from this drawer

SURVEY OF PROPOSED HATHAWAY

W.O. 101

RETURN TO
LOS ANGELES COUNTY SURVEYOR

Notes: ANY ADDITIONS OR CHANGES ON THIS SHEET MUST BE MADE OR CANCELED IN Red WITH DATE AND NAME OF PERSON MAKING CHANGE.

Do not extend notes this side of this line

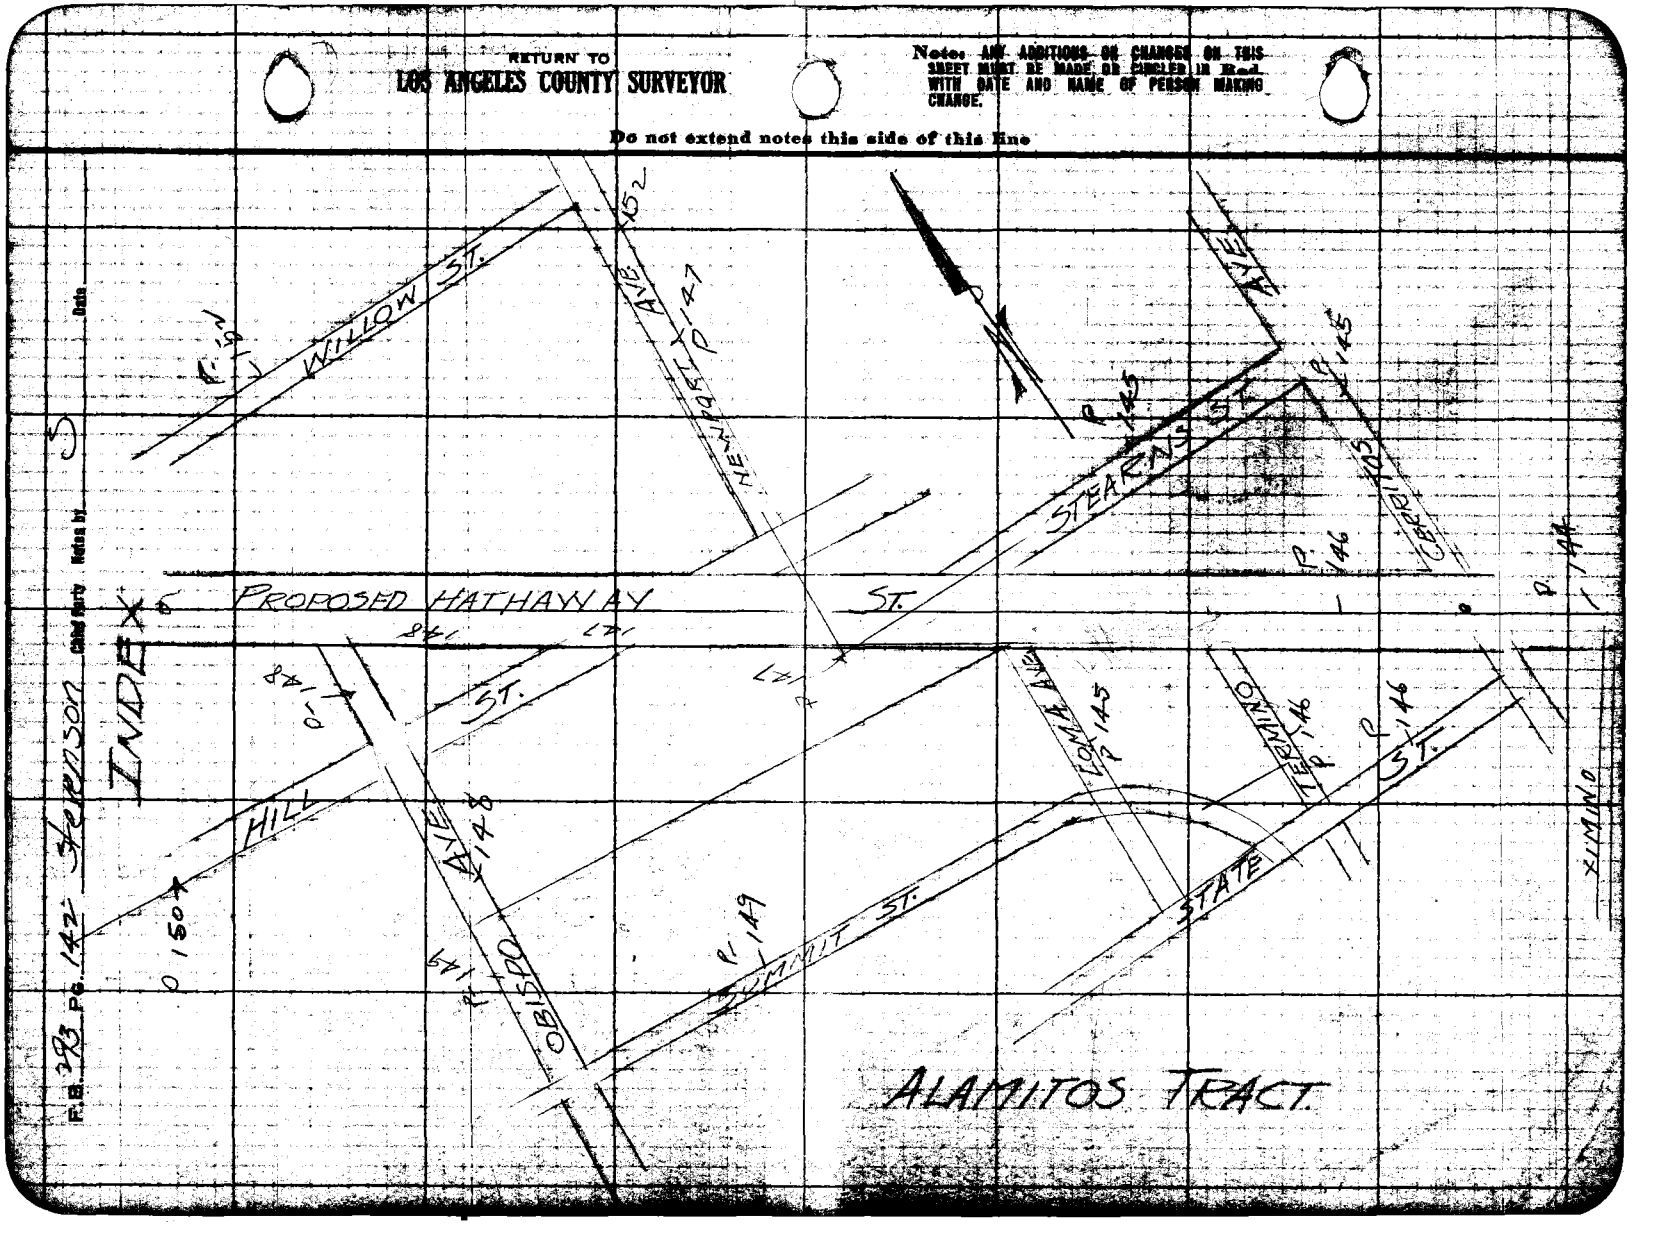

R.B. 393 Pg. 42 Johnson Chief Clerk Notes by Date

Date: Jan. 1933
Map No. C.S.B-644
Plotted: Feb 1933
Location: Hathaway St
Surveyed by: Stevenson
Checked: C. Johnson
Field Book: Stevenson F.B. 393 Pg. 4

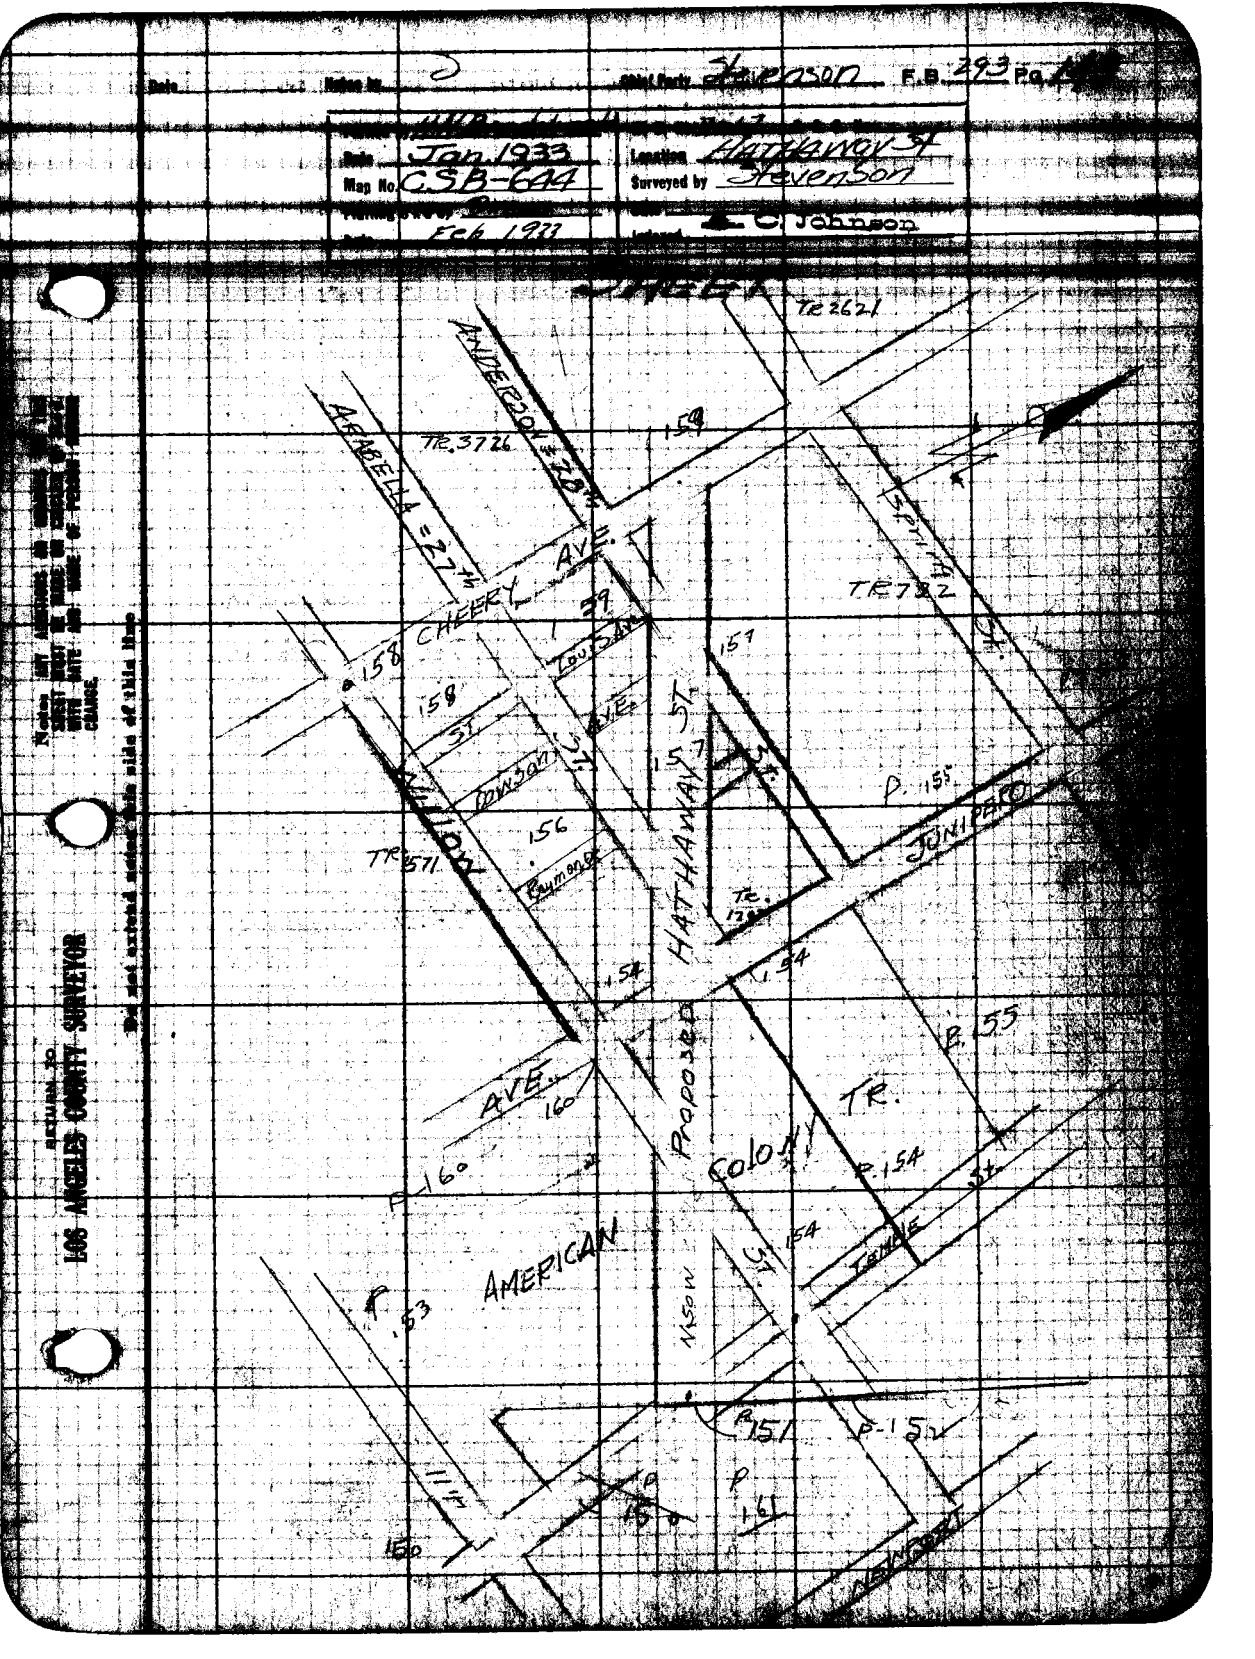

RETURN TO
LOS ANGELES COUNTY SURVEYOR

Do not extend across this side of this line

Notice: All figures on this map are subject to correction

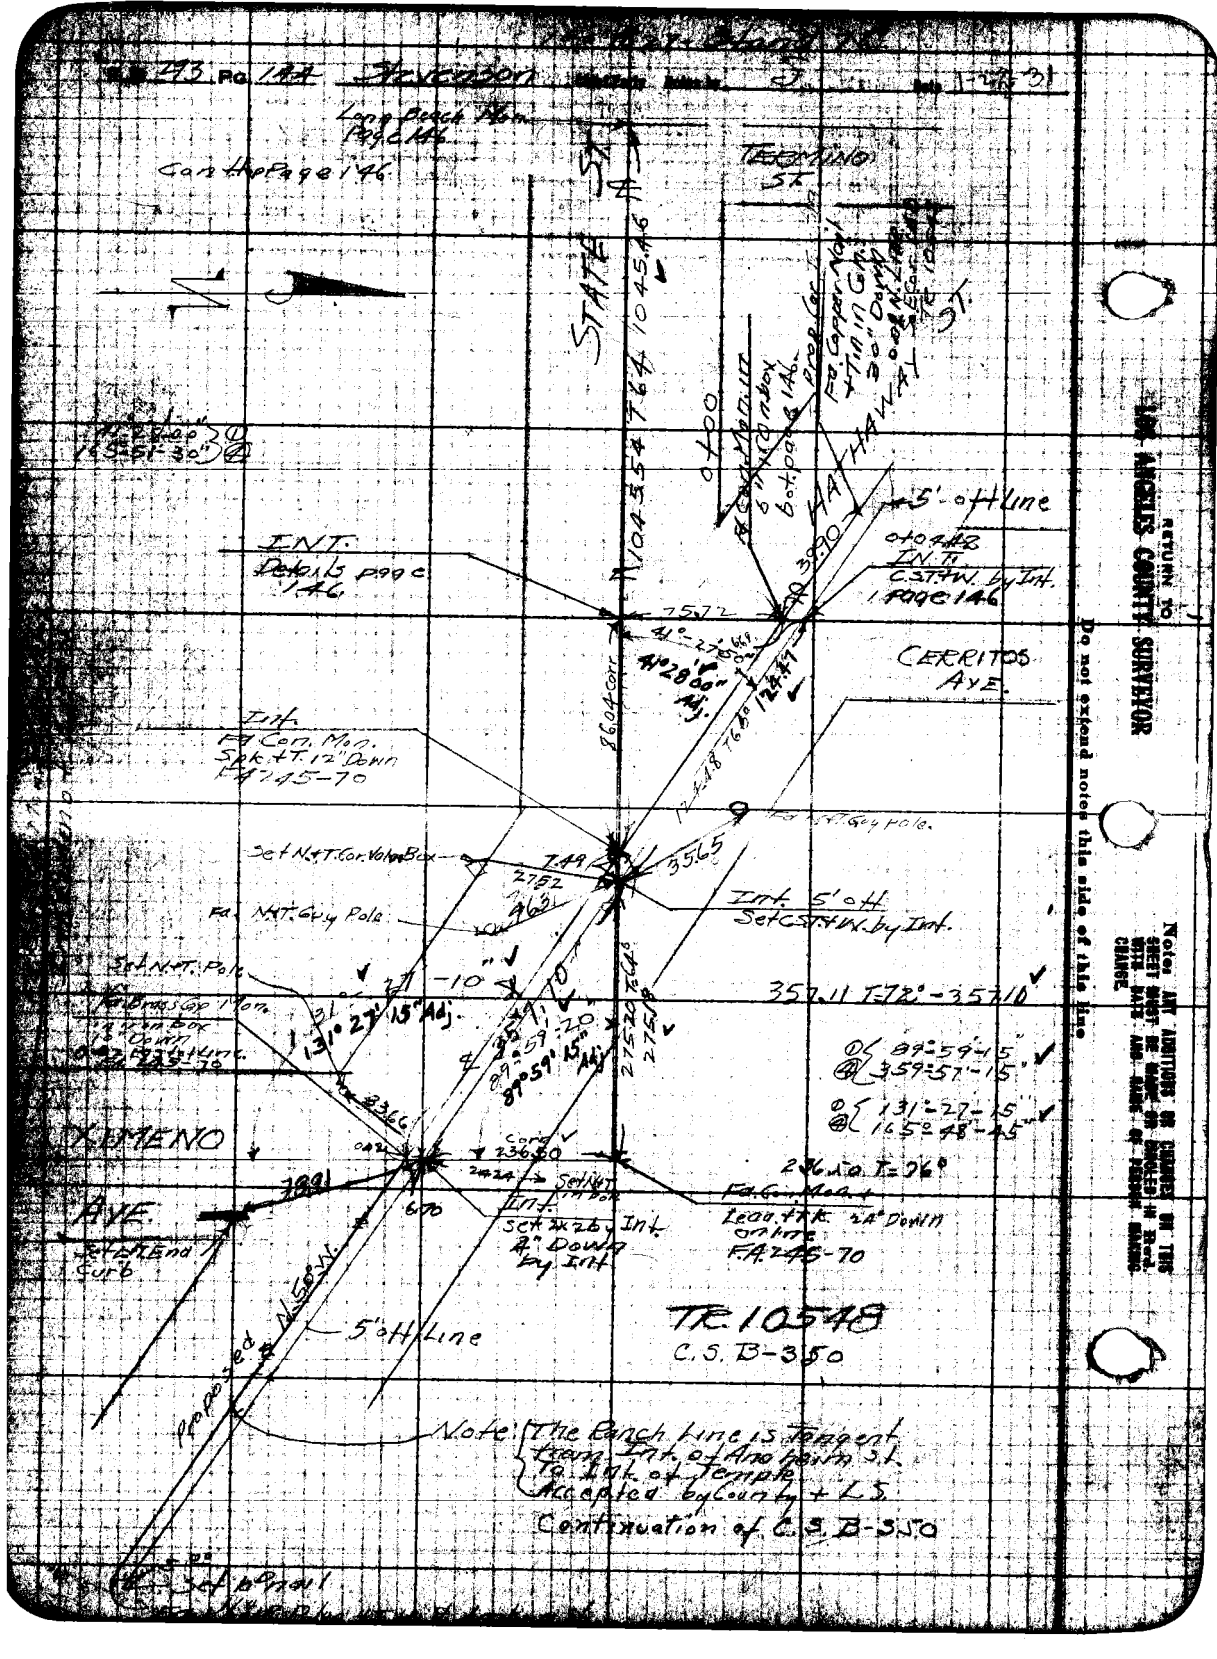
Long Beach Mem. Pg 2 146
Cont'd on Page 146
TERMINO ST.
STATE ST.
Int. 5' o/H Line
Int. C.S.T.P.W. by Int.
Page 146
CERRITOS AVE.
Int. F.A. Com. M.o.m. Set & T. 12" Down F.A. 145-70
Set N.& T. Cor. Valve Box
F.A. N.& T. Guy Pole
Int. 5' o/H Set C.S.T.P.W. by Int.
3rd N.& T. Pole
Brass Cap 1" Mon. 12" Down
TERMINO AVE.
Int. Set & T. 25' Int. 2" Down by Int.
F.A. Com. M.o.m. Lead & T. 24" Down on line F.A. 245-70
TR. 10548
C.S. B-350
5' o/H Line
Note: The Curb Line is Tangent from Pt. of Ang. Point 3.1 to Pt. of Tangent Accepted by County & L.S.
Continuation of C.S. B-350
Set 6" Prod
RETURN TO LOS ANGELES COUNTY SURVEYOR
Do not extend notes this side of this line

100 #027 Stang 16

Date _____ Notes by S Chief Party Stevenson F.B. 793 Pg

Date Feb 1933 Location Hathaway St

Map No. C.S.B-644 Surveyed by Stevenson

Date Feb 1933 Indexed by C. Johnson



Do not extend notes this side of this line

RETURN TO LOS ANGELES COUNTY SURVEYOR

156.71 T64° 156.69

Fd. Copper Spk. in Con. 15" Down L.B. 514-143

S. Int. 33+16.76 Set L.P. in Con. by Int.

N.W. Cor. Lot 8 Los Alamitos Tr. Fd. Copper Spk. in Con. 15" Down TR 10548

Set by Int. Set L.P. in Con. 19.13 Line 21.3 Cent.

LOMA

762.97 T60° = 769.89

AVE.

Hathaway

Proposed C.L. Sta. 11+68.13

Centerline

TR10548

STEARNS AVE.

2611.65 T60° = 2611.65

Fd. Copper Spk. in Con. 15" Down N.E. Cor. Lot 8

CERRITOS

2181.74 T66° = 2181.60

AVE

From C.S.T. Hwy. Off Line

Cont. from Top of Page 146

Fd. Copper Spk. in Con. 15" Down

Int. 33+16.76 Set L.P. 12" Down by Int.

Fd. Copper Spk. in Con. Cor. Lot 8 TR 10548

Set Nail & T.

Set Nail & T.

Set Nail & T.

Cont. from Page 146

Cont. on Page 148

F.B. 793 Pg. 146 Stevenson Date Dec 31

Cont'd to bot. page 145

89°-59-30 ✓
359-57-30

Fd. 4x4 T.K.
L.B. 514-38

Int.
Fd. Brass Cap Mon. in Iron box L.S. 4.B.514-38 3.5

5' off Line

TERMINO
924.26 T=0°-924.26

612

2636

ST.

R=1859.86'

89°-59-15" ✓

2334

N88°-W

Fd. 1½" IP
3c+10 nail
F.B. 245-70
TR. 10548

N.784.89
Int.
3c+2x2
12" Conn
by Int.

AVIATION ST.

1280.53 ✓

STATE

PROP HAT

1280.63 T=64°

TR 10548

20°
90°-10'-45"

10'-50

5' off Line

131°-27'-30" ✓
165°-50'-15"

Tot. 0+04A2
3c+CST+W.
by Int.

CARRITOS
Dist. page 145

AVE. cont'd to bot. page 145

751.2
T=76°

669

Int.
Fd. 2x2
6" Conn
by Int.
Ref. FA 245
70

90°-10'-45" ✓
360°-43'-15"

49°-42'-45" ✓
194°-51'-00"

a+0
Fd. Copper
Spike in Con.
Station
Ref. FA 245-70

Cont'd to [illegible] page 147

RETURN TO
LOS ANGELES COUNTY SURVEYOR
Do not extend notes this side of this line

Notes: ANY ADDITIONS OR CHANGES ON THIS SHEET MUST BE MADE OR CHECKED IN RED WITH DATE AND NAME OF PERSON MAKING CHANGE.

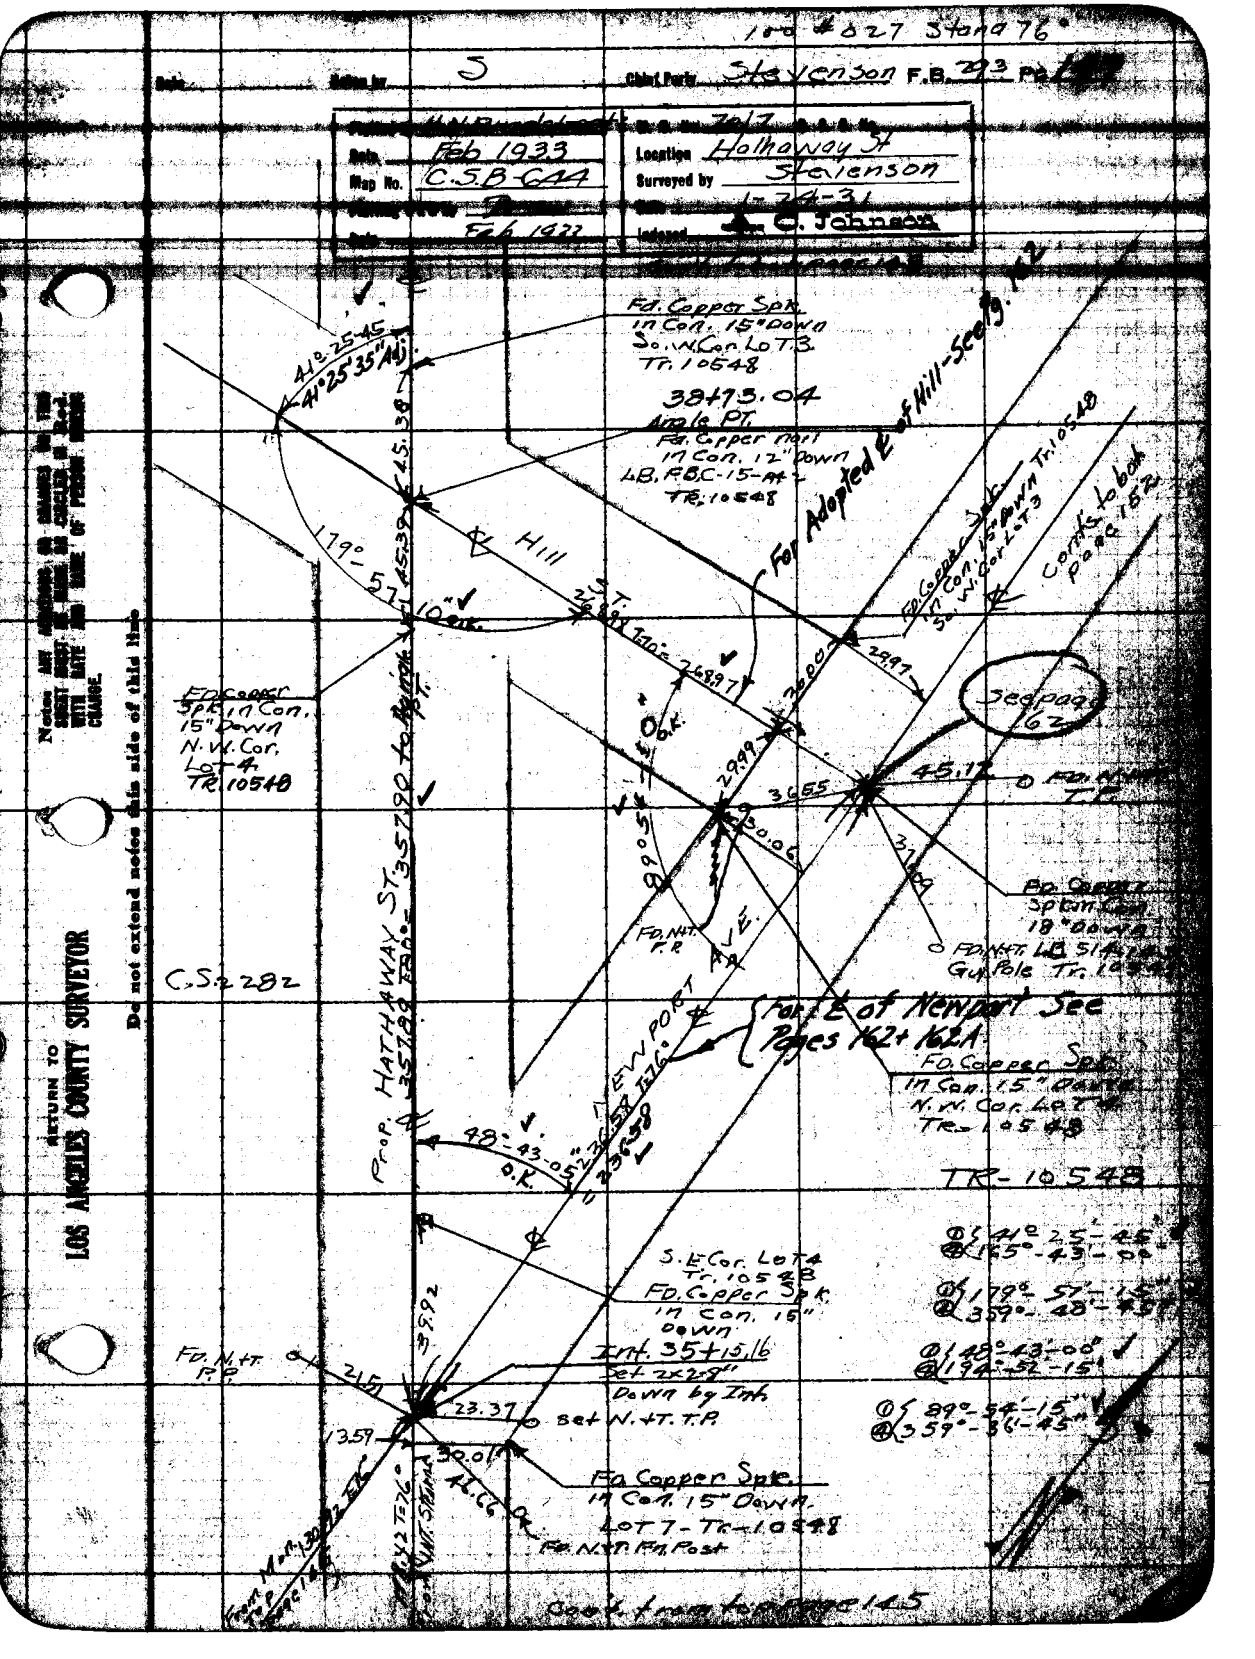
Date Feb 1933
Map No. C.S.B-644
Date Feb 1922
Location Holloway St
Surveyed by Stevenson 1-24-31
Indexed C. Johnson
Fd. Copper Spk. in Con. 15" Down So. W. Cor. Lot 3 Tr. 10548
38+73.04
Angle Pt.
Fd. Copper Nail in Con. 12" Down L.B. F.B.C-15-AA Tr. 10548
For Adopted E of Hill-See Sh'g.
41° 25' 45"
41° 25' 35" Adj.
179° 57'
Hill
Tangent 748.97
Fd. Copper Spk. 15" Down N. W. Cor. Lot 4 Tr. 10548
Fd. Copper Spk. in Con. 15" Down Tr. 10548 So. W. Cor. Lot 3
Jeepway
Works to be Done Page 162
45.17
Fd. N.H.T. T.P.
Fd. Copper Spk. in Con. 18" Down
Fd. N.H.T. L.B. 51 AA Gas Pole Tr. 10548
Fd. N.H.T. T.P.
AVE.
PROP. HATHAWAY ST. 35+87.80 Tangent
C.S. 2282
NEWPORT
For E of Newport See Pages 162+162A
Fd. Copper Spk. in Con. 15" Down N. W. Cor. Lot 4 Tr. 10548
TR-10548
48° 43' 05"
O.K.
S.E. Cor. Lot 4 Tr. 10548
Fd. Copper Spk. in Con. 15" Down
Fd. N.H.T. T.P.
Intf. 35+15.16
Set 2x2x8" Down by Int.
Set N.H.T. T.P.
Fd. Copper Spk. in Con. 15" Down
LOT 7 - Tr. 10548
Fd. N.H.T. Fn. Post
Cont. from Page 145
Return to Los Angeles County Surveyor
Notice Any changes or erasures on this sheet must be noted with date and name of person making change
Do not extend notes this side of this line

10-0 #027-5467976°

F.B. 793 Pg. 140 Stevenson Chief Party Notes by Date 1-24-31

Tobot. page 150

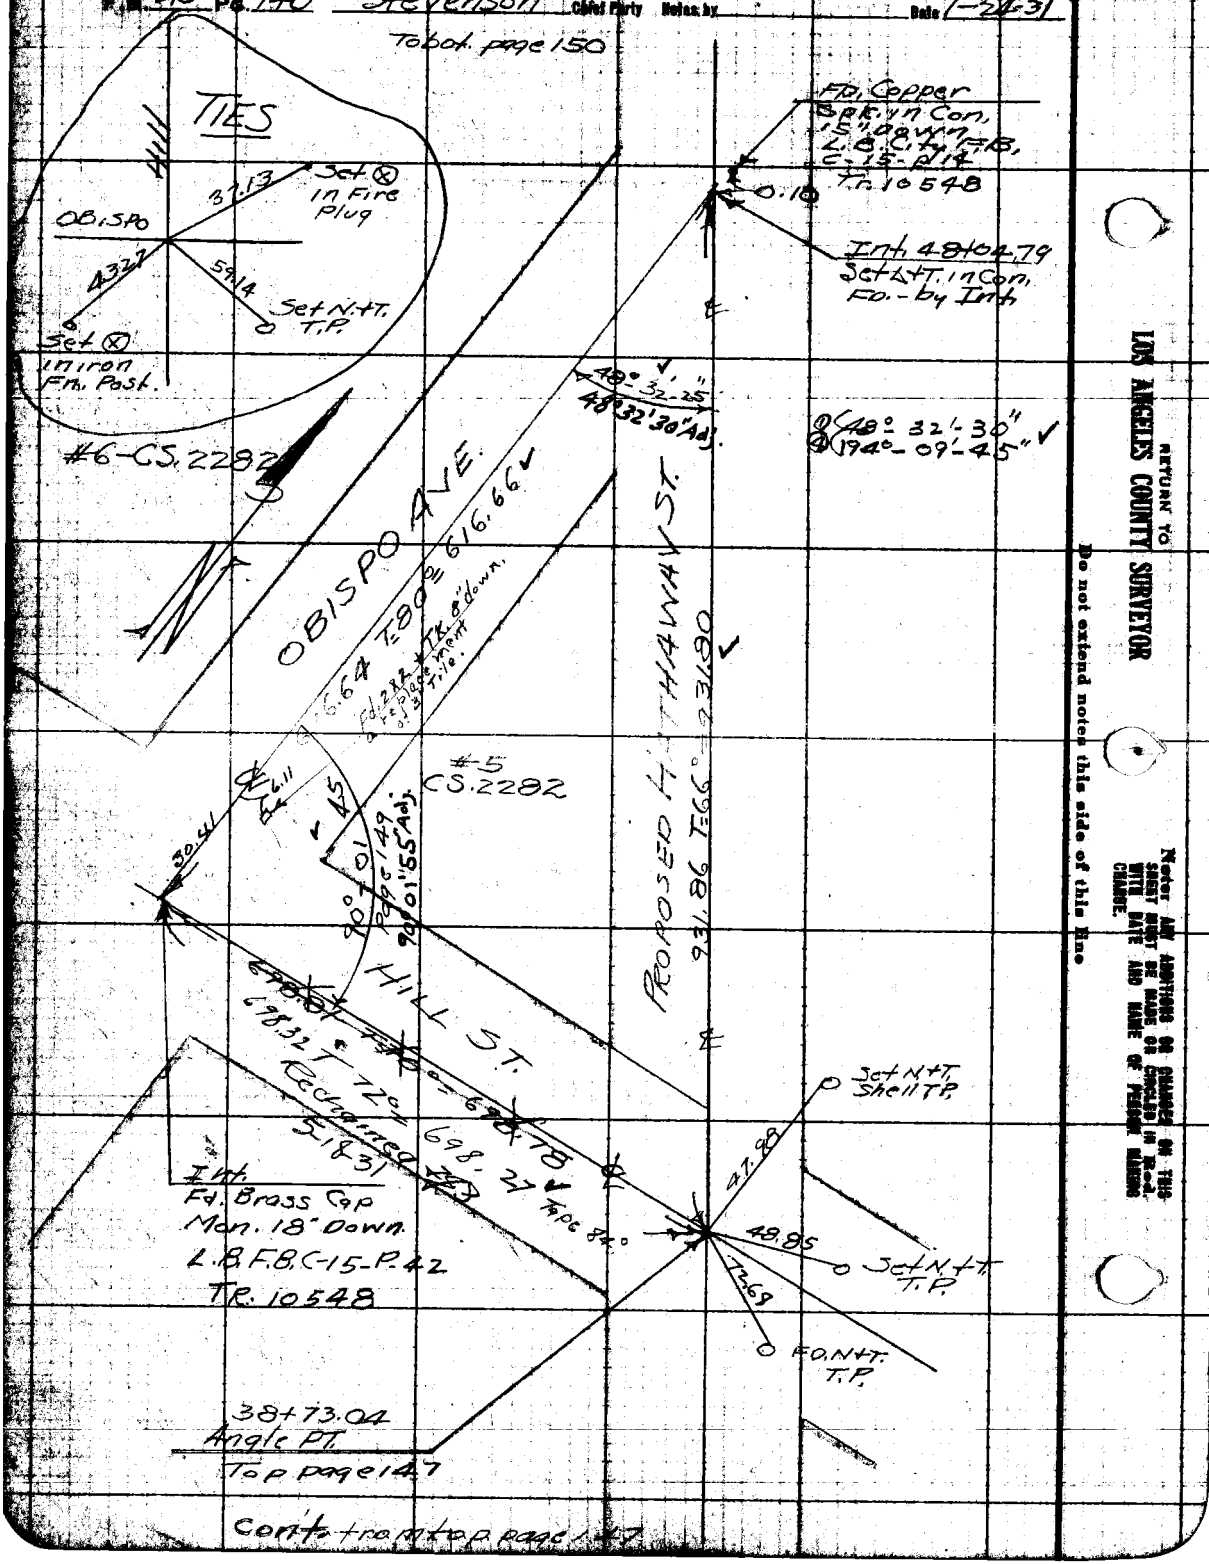

RETURN TO LOS ANGELES COUNTY SURVEYOR

Do not extend notes this side of this line

Notes ADDITIONS OR CHANGES ON THIS SHEET MUST BE MADE OR CANCELED IN RED. WITH DATE AND NAME OF PERSON MAKING CHANGE.

1 00 ± 27.76'


Book 1 Bk 4 page 145

13 20.86 T 76° = 1320.79

SUMMIT

1320.34 T 76° 1320.34
1320.31 T 76 = 1320.31

ST. Recharged 5-78.31

T 76°
Par. 88°

ENTER
Fd 1" Bolt in Con. 01'
10" Down
No Ref.
#14 C.S. 2282

LOMA ALTA AVE.

HALFWAY ST.

Roadway Toll Line

#13 - C.S. 2282

OSUNA AVE.

INTER. 39+49.31
=42.15 Down
by Int.

HILL ST.

Cont's Tan. to Terminus

Cont. to Page 145

Sta 38-00.00
359°-37'-43"

Mon. @ Int. Halfway & Hill Sts.
Page 147 14

90°-01-45"
360-07-00

Mon. @ Int. Page 145

Stevenson
Tract #105
Lot 2
Int. Easterly Pole Per Shell Oil Co.
Set Fire Hydrant
Set Nail
Set Nail
Set Nail

Stevenson F.B. 293 Pg. 161

Date Feb 1933
Map No. C.S.D-644
Location Hathaway St.
Surveyed by Stevenson
Feb 1933

Patent Survey
5°10'
A.V.E. 5° off Line
46.20 x 7.74° = 46.19
Eq 3+76
Temp Nail set 0.9 W of Valve box
5°
Lot 1
Lot 2
Lot A
From Lt Con Mon. 176.43 N 71°-W
Cobispo Proposed Hathaway St.
℄ = Lot A Ramitos Tr. line
Prop. Cor. Lot 1 & 4 on Rock line
Bug Down 3
N 4 Th Inv Fd
Note:
Change of Tape
on next page.

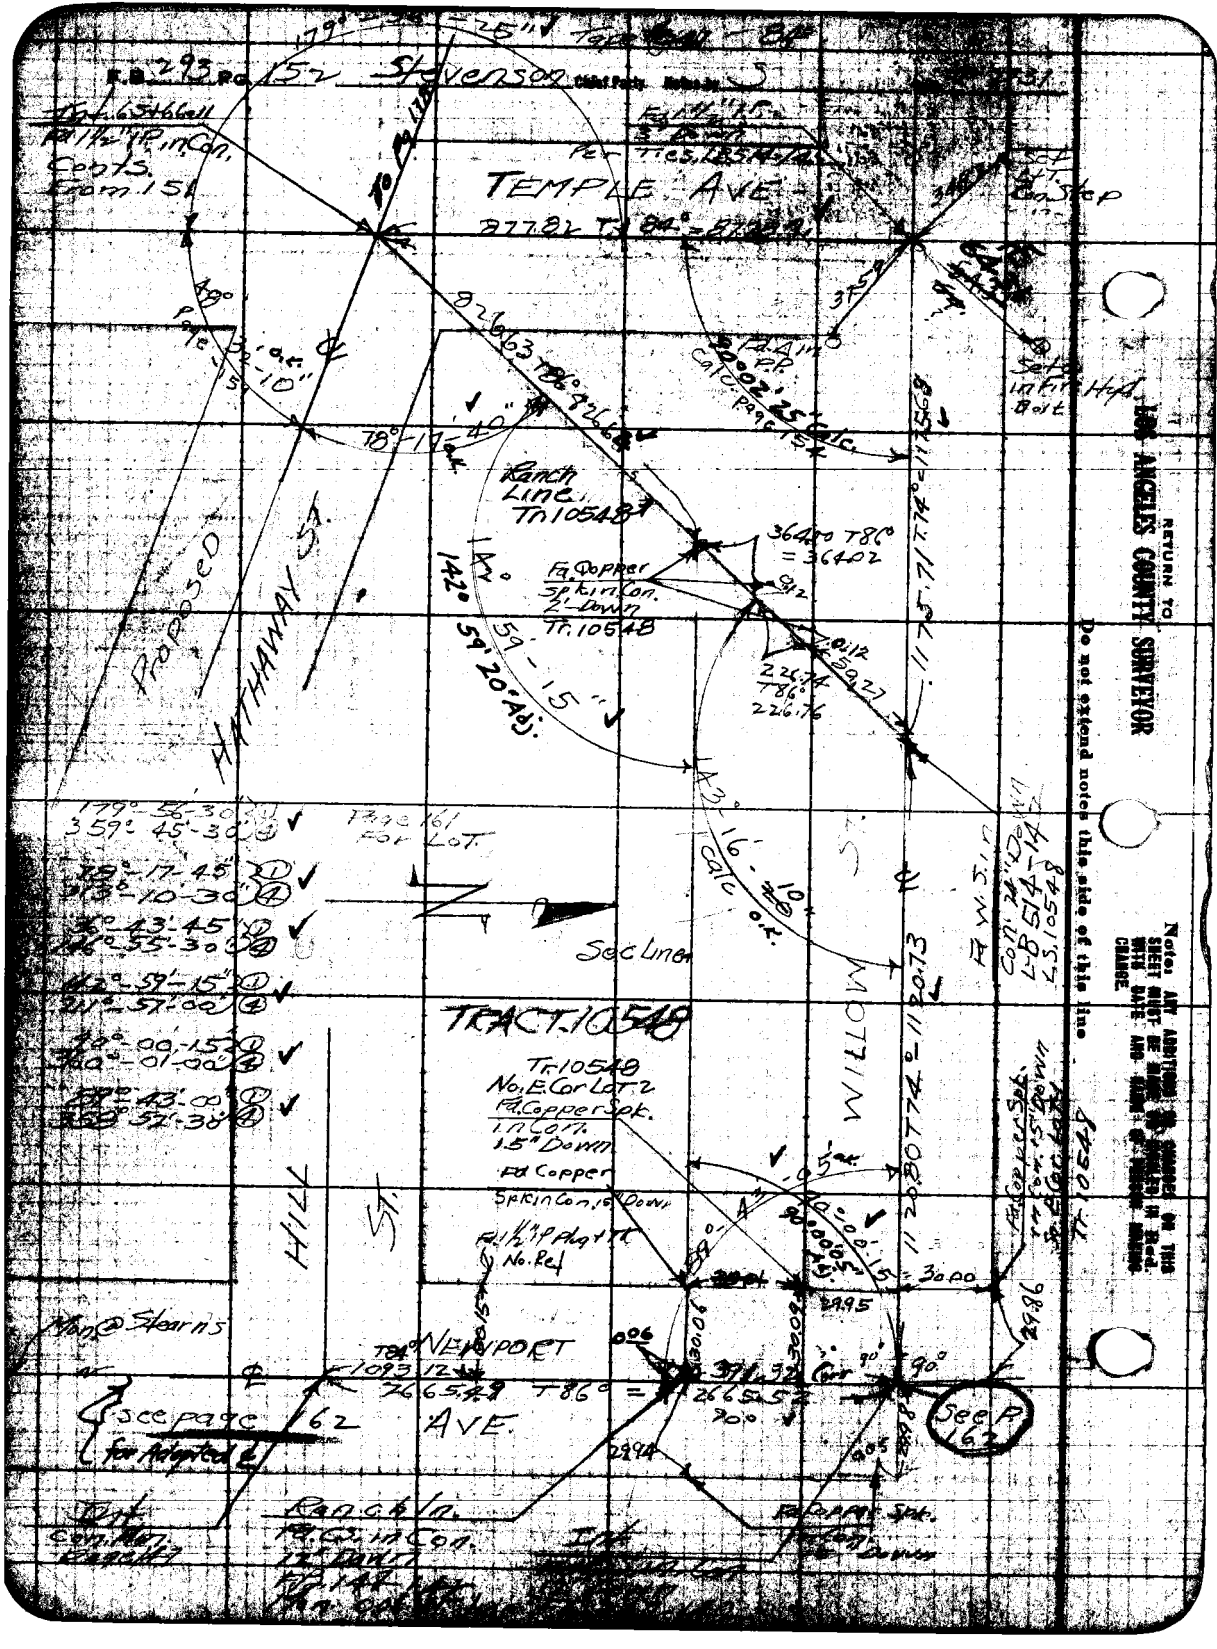
TEMPLE AVE.
HATHAWAY ST.
PROPOSED
Ranch Line, Tr 10548
Fd. Copper Spk. in Con. 2" Down Tr. 10548
Fd. Copper Spk. in Con.
Tr. 10548 No. E. Cor Lot 2
Fd. Copper Spk. in Con. 1.5" Down
Fd Copper Spk in Con, 1.0 Down
Fd 1/2" IP Plug & Tag No. R.E.
Fd 1/2" IP, in Con, Coor's. from 154
Fd. 3/4" IP
Fd. 3/4" IP, Tag R.E. 154

LOS ANGELES COUNTY SURVEYOR
Do not extend notes this side of this line

Sheet No. 5 Book Steven 300 F.B. 223 Pg. 68

Feb. 1932 — Map No. C.S.B. 64 — Surveyed by Steven 300 — Jan 84

Feb. 1932 — A. C. Johnson

Ha Haraway et.

MOXLINO AVE.

To Ind. 325.05 T = 325.00

D.f. Checks ok 5-28-31 RS

324.79 T 76° = 324.76 Recks M&S 5-28-31 248

23rd ST.

Set L+T Curb

Ang. Adj.

Ang. 90°

Set L+T Curb

Ang. 90°

Set M+T.C.E.

OHIO ST.

Tank 20'0 mail No Bat. Set L+T. Curb

TRACT 105

Set M+T.C.E.

Transit Line

Set L+T. C.E. Temporary

Curb Front for Angles

R.B. 290 Pg. 154 Stevenson Field Party Notes by: Date:

Cont. to bot. page 156

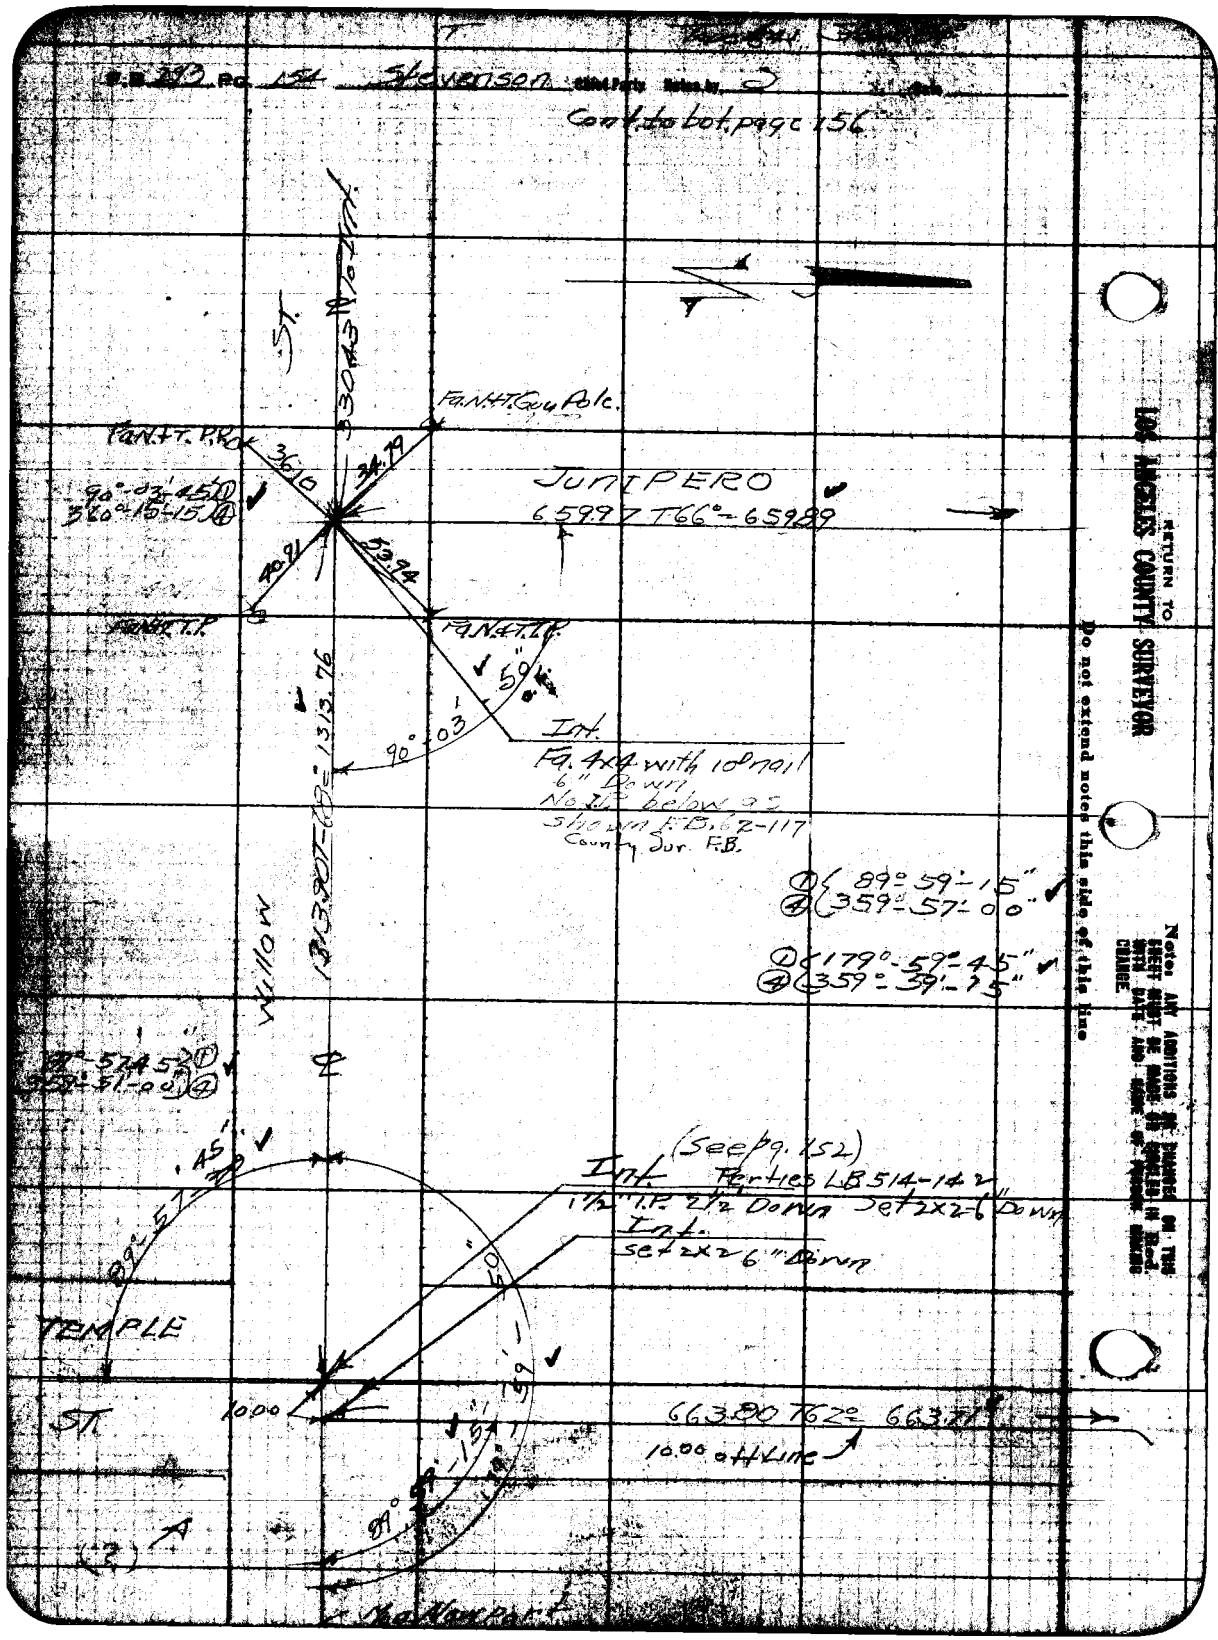

RETURN TO LOS ANGELES COUNTY SURVEYOR

Do not extend notes this side of this line

Note: ANY ADDITIONS OR CHANGES ON THIS SHEET MUST BE MADE AND INITIALED IN RED WITH DATE AND NAME OF PERSON MAKING CHANGE

Date: Feb. 1933 | Location: Hathaway St.
Map No. C.S.B-644 | Surveyed by Stevenson
Feb. 1933 | C. Johnson

Stevenson F.B. 192 P.G. 1

Set ⊗ Fire Hdg.

Set ⊗ in Con. wire box

INT. by Intersection. Set 2x2 6" Down

INT. Set 2x2 8" Down by Intersection.

INT. Fd. 1½" I.P. 12" Down Set 2x2 6" Down F.B. 62-119

Fd. ¾" I.P. Mar. Kea Western Oil Refining Co. No. W. Cor.

Fd. ¾" I.P. Western Oil Refining Co. So. W. Cor.

5' off line

Junipero

Ave.

So. E. Cor. Western Oil Refining Co. Prop. Cor. Fd. 2" I.P. + Cap 1½" U.P.

Note: The I.P. of Western Oil Refining Co. not set accurately according to their Engr.

Int. Set 2x2

Found Fd. Temple Page 154

RETURN TO LOS ANGELES COUNTY SURVEYOR

Do not extend notes this side of this line

Tape #41 Hand. 34°

F.B. 293 Pg 156 Stevenson Chief Party Notes by S Date

Cont'd to bot. page 158

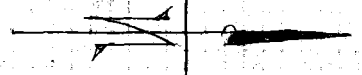

① 90°-00'-45"
② 360°-02'-30"

St. Louis

330.46 M

330.29 T64° = 330.25 To ST. LOUIS

Schmitt 4x4x4'-0"

Int. Fd. 2x2 6" Down No Ref.

40 = ST.

90° 00' 30" Adj.

90°

DAWSON

659.68 T62° = 659.59

660.20 T6

Fnt. 36"x2x2 6" Down by Intersection

37.10

Set ½" I.P.

90°-01'-00" ①
360°-07'-45" ②

0.K

90°-01'-

330.43 Corr

WILLOW

330.25 T64° = 330.21

27.74

89°-57'-10" Adj.

90°-01'-39"

90°-01'-25" Adj.

Set ½" I.P.

38.89

30.41

659.83 T68° = 659.76

Not Const.

RAYMOND

660.04 T68°

Set ½" I.P.

Set ½" I.P.

5.23

39.31

39.73

Set ⊗ in Gr. Box.

89°-57'-15" ①
359°-49'-30" ②

Int. Set 2x2 by Intersection. 6" Down

Int. 4"x2x2 36"x2x2 6" Down No Ref.

① 90°-01'-30"
② 360°-02'-30"

Cont'd to ...

RETURN TO LOS ANGELES COUNTY SURVEYOR

Do not extend notes this side of this line

Notes: ANY ADDITIONS OR CHANGES ON THIS SHEET MUST BE MADE OR CHECKED IN Red. WITH DATE AND NAME OF PERSON MAKING CHANGE.

Date _____ Notes by S Field Party Stevenson F.B. 293 Pg 157

Date Feb. 1933
Map No. C.S.B-644
Plotted by Dyer Feb 1933

Location Hathaway St
Surveyed by Stevenson
Date C. Johnson
Inspected

Stand. 84°

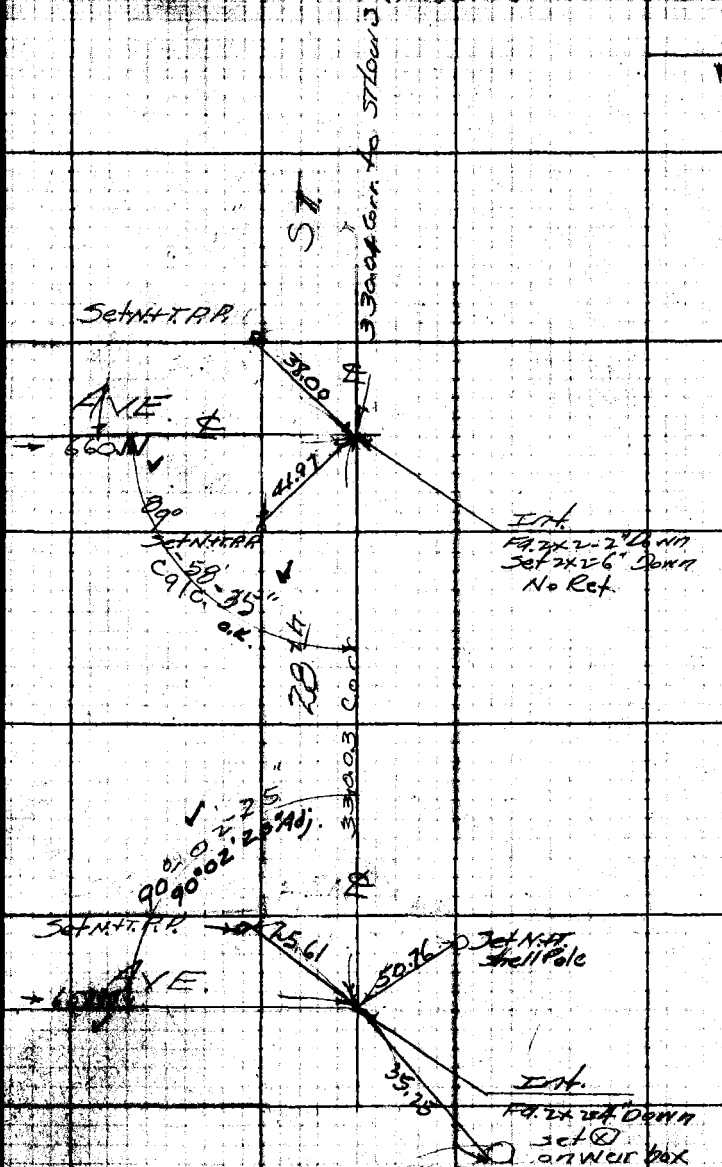

Return to LOS ANGELES COUNTY SURVEYOR

Do not extend notes this side of this line

Tract 41 Hom. 84

F.B. 293 Pg. 52 Stevenson Called Party Notes by Date

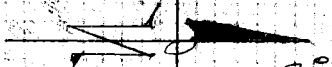

90°-01-45" 30 ✓
360°-01-15" 30 ✓

INTER.
Fd. 1" I.P. plug + tk.
4" Down
No Ref.

Set ⊗ in Fire Hydrant

Jct N+T T.P.

Fd Nail in Curb

CHERRY

3.28 0

40.02

58.46

6.59 42 T64°-6.59 33 ✓

41.23

30.85

660.82 T 64°

Set ⊗ in I.P. in L.R. Cuy Pg 80

Set N+T P.P.

Set N+T P.P.

N.O.K.

89°-59'

Int.
Fd. 3/4" I.P.
No Ref.

50'

90°-01'45" Adj.

330.40 Calc.

99°-59-30" 30 ✓
359°-59'30" ✓

St.

99°-59-30" 30 ✓
359°-57'45" ✓

330.77 Calc.

Int.
Fd 2x2 4" Down
Set 1x3 6" Down
No Ref

Set N+T. 4x4 4" UP

90°-01-0" 00
360°-04-15" 00

Set ⊗ in I.P. 3" UP.

35.01

38.55

Set ⊗ in I.P.
Gate Post

29.89

34.35

St. LOUIS ✓

659.54 T64°-659.45 ✓

660.26 T 64°

24.98

Jct N+T P.P.

32.21

Set N+T P.P.

Fd. 3/4" I.P.

90°-00'-45" 00

90°-01'-15" 00

89°-58'-30"

89°-58'-30"

Int.
Fd 2x2
Set 1x3
2" Down

Return to Los Angeles County Surveyor

Do not extend notes this side of this line.



Stevenson F.B. 293 Pg 157

1976 Const. Stand. 84

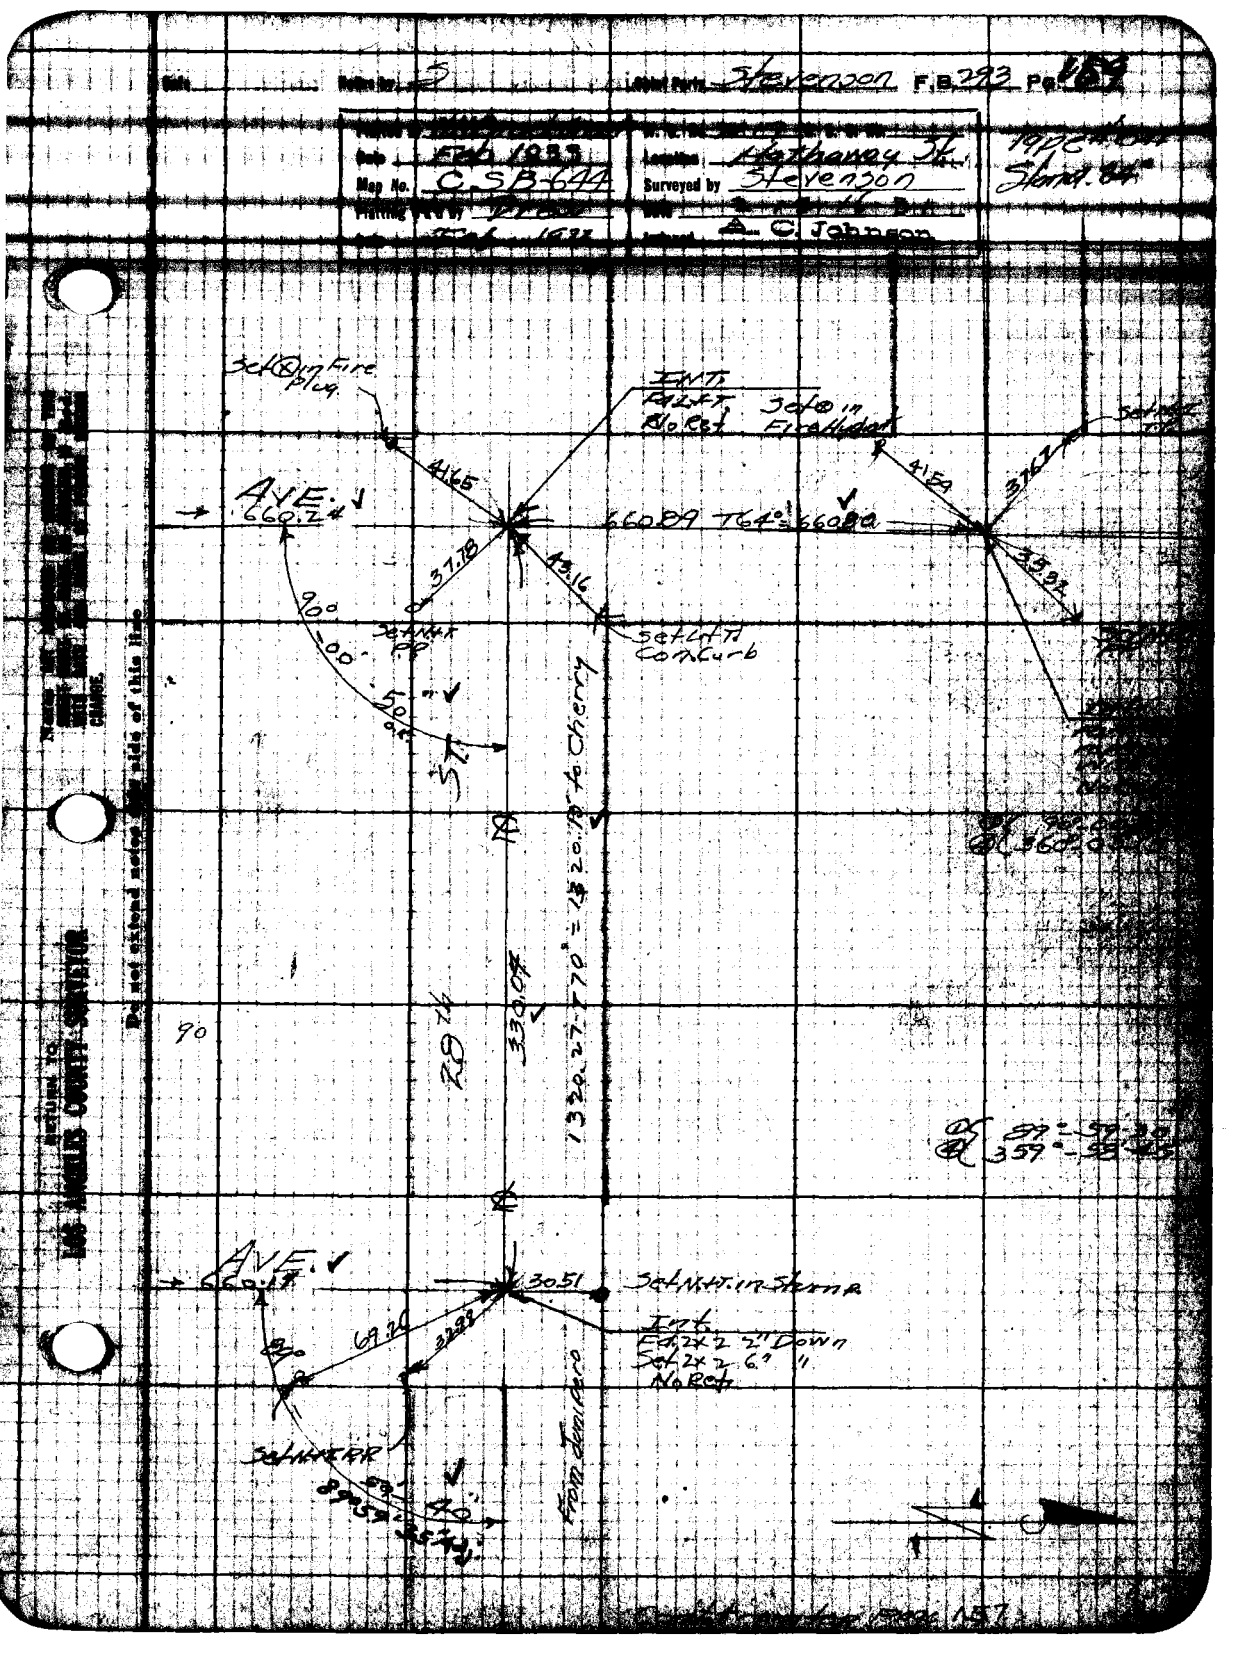

Return to
Do not extend notes to the sides of this line.

Tract 41 Sheet 24

Bk. 293 Pg. 160 Stevenson Chief Party Notes by S Date



WILLOW ST.

Transit Line page 154

VACATED Roadway

S 43.46 T 72° = S 43.46

Int. 4+4+TK page 154

Set 1x2

Note: addition of 1.00 = 5-18-31

100.00 @ 90° = 100.00
99.76 @ 115° 2 = 97.63
99.97 @ 120° 23
99.52 @ 110° 10 = 98.49
99.23 @ 7° 07
78.87 @ 0° 0 = 76.86
374.96

Do not correct for temp.

4 x 2.82 T 76° = 4 x 2.82

T = 76°

574 @ 0° 0
83.54 @ 7° 29 = 82.83
83.36 @ 6° 27
77.22 @ 12° 29 = 75.39
76.77 @ 10° 5
71.42 @ 14° 35 = 69.12
71.16 @ 13° 44
54.06 @ 0° 0 = 54.06
79.57 @ 18° 27
79.10 @ 17° 23 = 82.00
82.00 @ 0° 0 = 75.48
68.39 @ 17° 27
67.90 @ 16° 06 = 65.24
63.91 @ 17° 40
63.26 @ 15° 44 = 60.90
92.07 @ 20° 50
91.31 @ 19° 33 = 86.05
656.81

STANLEY AVE.

Int. Fd. 2" Cobber Set. No. Rock

Con't from Top Page 153

JUNIPER AVE.

Int. Fd. 2" Cobber No Ret

Set Nail & Shiner

90° 90° 12' 10" Adj.

S 17.3 Rd

ST.

Reclaimed 5 24.99 T 74° = 5 24.99

5/18-31 Pg 98 Tape 84°

Note: the 563 5.22 Set Spike & Washer

Set Spike & Washer

90° 12' 10" = 90° 0' 0"

RETURN TO LOS ANGELES COUNTY SURVEYOR

Do not extend notes this side of this line

Notice: ANY ADDITIONS OR CHANGES ON THIS SHEET MUST BE MADE OR INITIALED IN RED WITH DATE AND NAME OF PERSON MAKING CHANGE.

RETURN TO
LOS ANGELES COUNTY SURVEYOR

Notes: ANY ADDITIONS OR CHANGES MUST BE MADE BY SURVEYOR OR ENGINEER WITH DATE AND NAME OF PERSON MAKING CHANGE.

Do not extend notes this side of this line

Date _____ Order No. _____ Book _____ Page _____

Date Feb. 1933 Location Hathaway St.
Map No. C.S.B. 644 Surveyed by Stevenson
Traverse by [illegible] Plotted by [illegible] Checked by C. Johnson

Stevenson #02 Sheet 76

90°-02'-30" 30 ①
360°-09'-45" 30 ④

90°-06'-15" 30 ①
360°-24'-45" 30 ④

Note: change back to 100.827 Standard

10°39'-00" ①
46°35'45" ④

Proposed Hathaway St.

For Adopted Tract Boundary See M.B. 1628

Int. 30' Lot. in Con. about 5a W. Cor. Lot 2 Tr. 10548

Int. Fd. Copper Spk. in Con. 2' Down Int. Scc. Lng 30' line Lot 2 Tr. 10548

Int. Fd. 2x2 w/ Tk. in Con. 2' Down Int. Scc. Lng 30' line Lot 2 Tr. 10548

Fd. 1" I.P. in Con. 2' Down Int. Scc. Lng 30' line Lot 2 Tr. 10548

Fd. 1" I.P. in Con. Floor 1.4'

Fd. Copper Spk. in Con. 2' Down Int. Scc. Lng 30' line Lot 2 Tr. 10548

Fd. 2x2 w/ Tk. No Marks shown on Mkg. Sa.B. Cor. Lot 2 Tr. 10548

Tr. 10548

Constructed

Ave.

RETURN TO
LOS ANGELES COUNTY SURVEYOR

Notes: ANY ADDITIONS OR CHANGES ON THIS SHEET MUST BE MADE OR CANCLED IN Red. WITH DATE AND NAME OF PERSON MAKING CHANGE.

Do not extend notes this side of this line

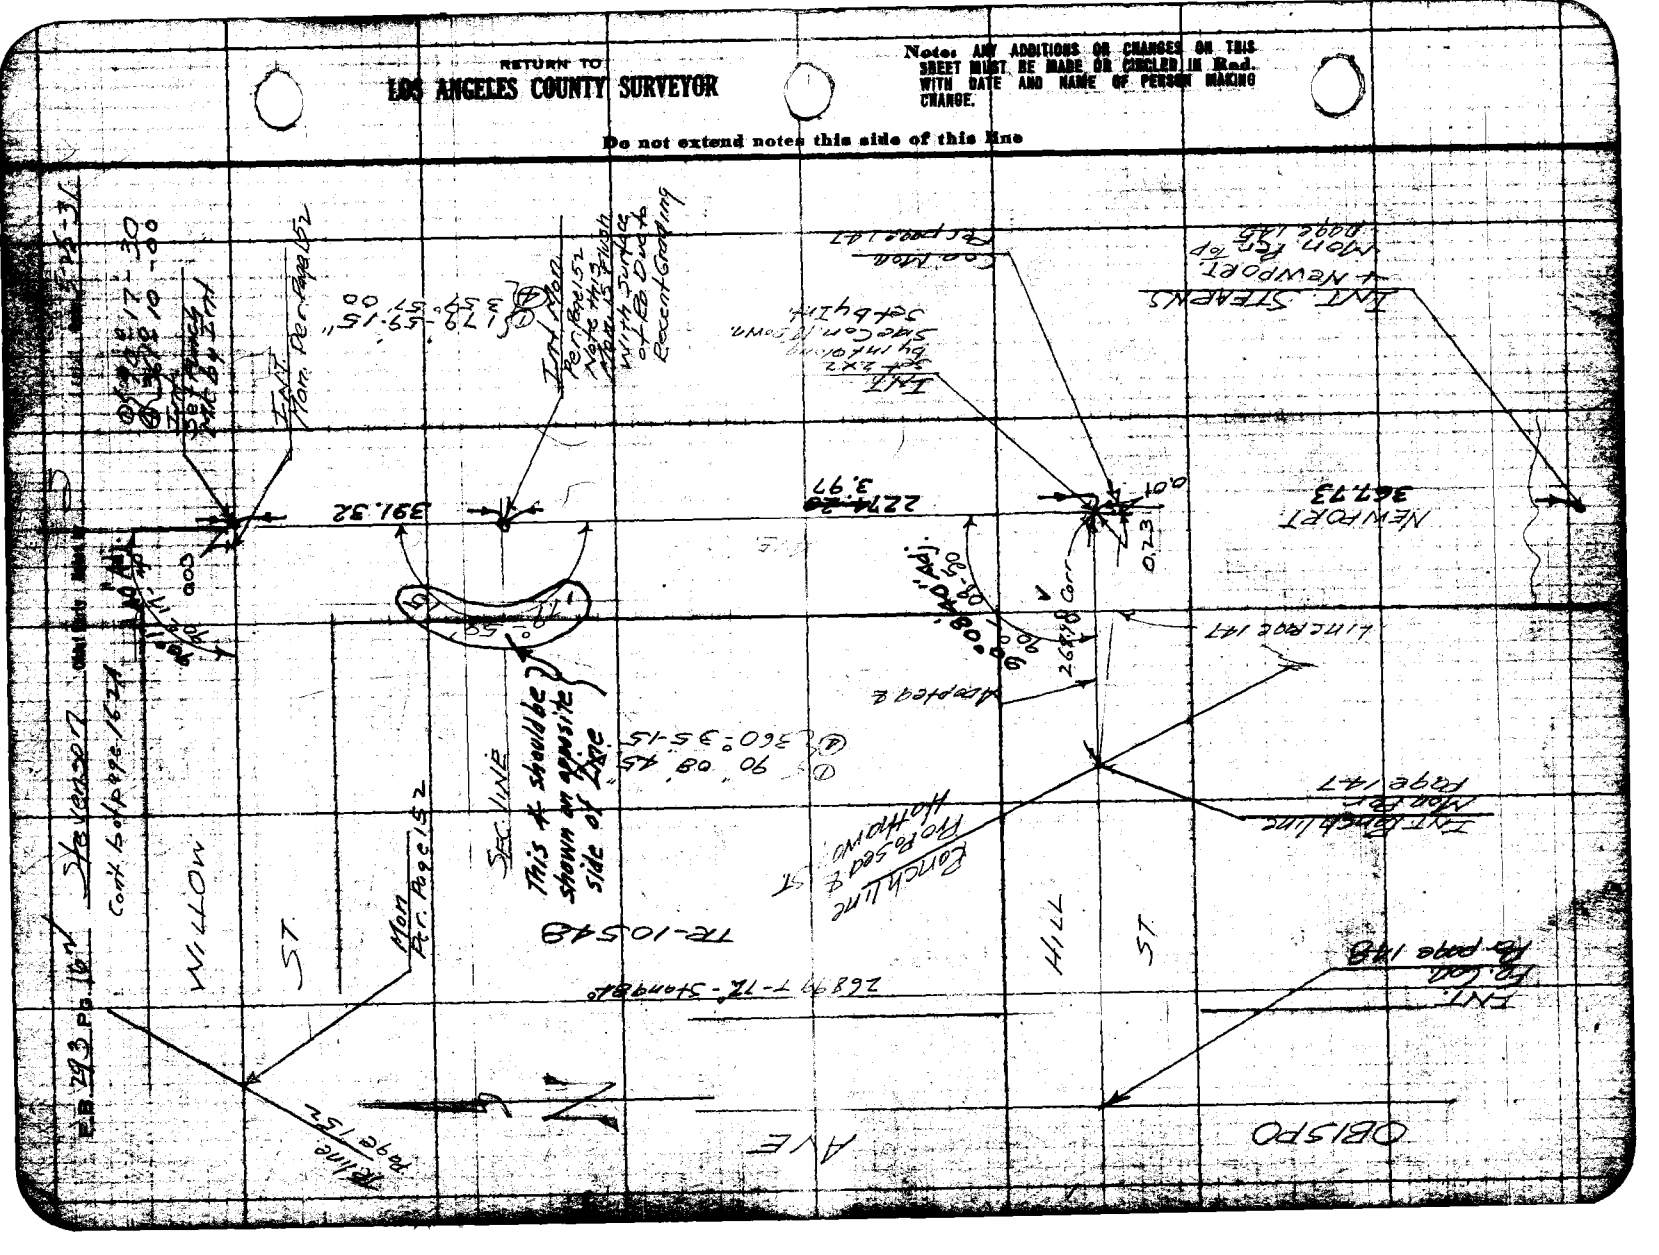
391.32
3.97
0.23
Adjusted

Date ____ Notes by ____ Checked by Stevenson F.B. Pg. 162A

Date Feb. 1933 Location HATHAWAY ST.
Map No. C.S.B-644 Surveyed by Stevenson
Date Feb. 1933

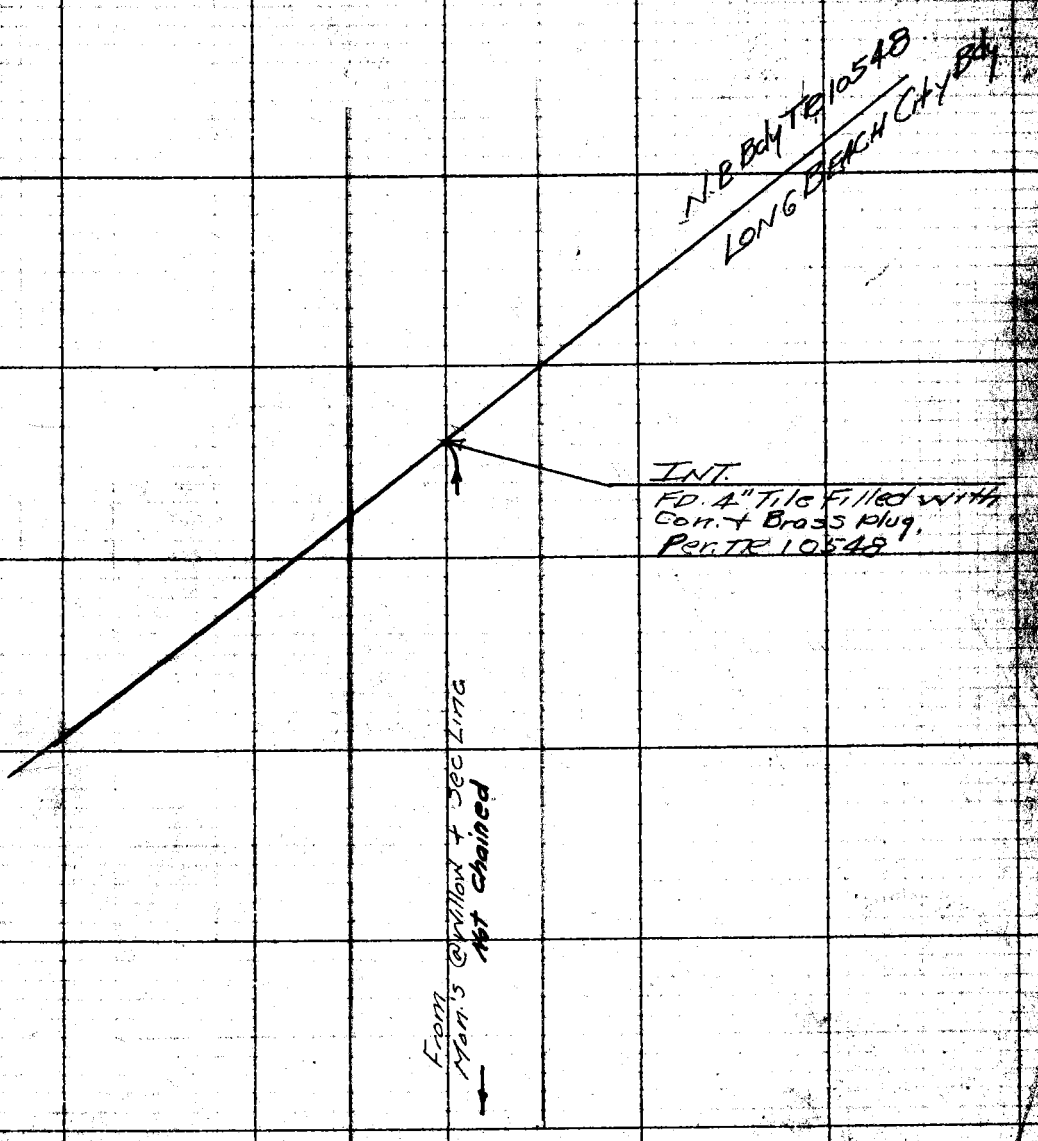

cont from top page 162

RETURN TO
LOS ANGELES COUNTY SURVEYOR

Do not extend notes this side of this line

Notes ANY ADDITIONS OR CHANGES MUST BE DATED AND SIGNED BY THE PERSON MAKING SAME

F.B. 193 Pg. 162B Stevenson Chief Party Notes by [illegible] Date 5-26-31

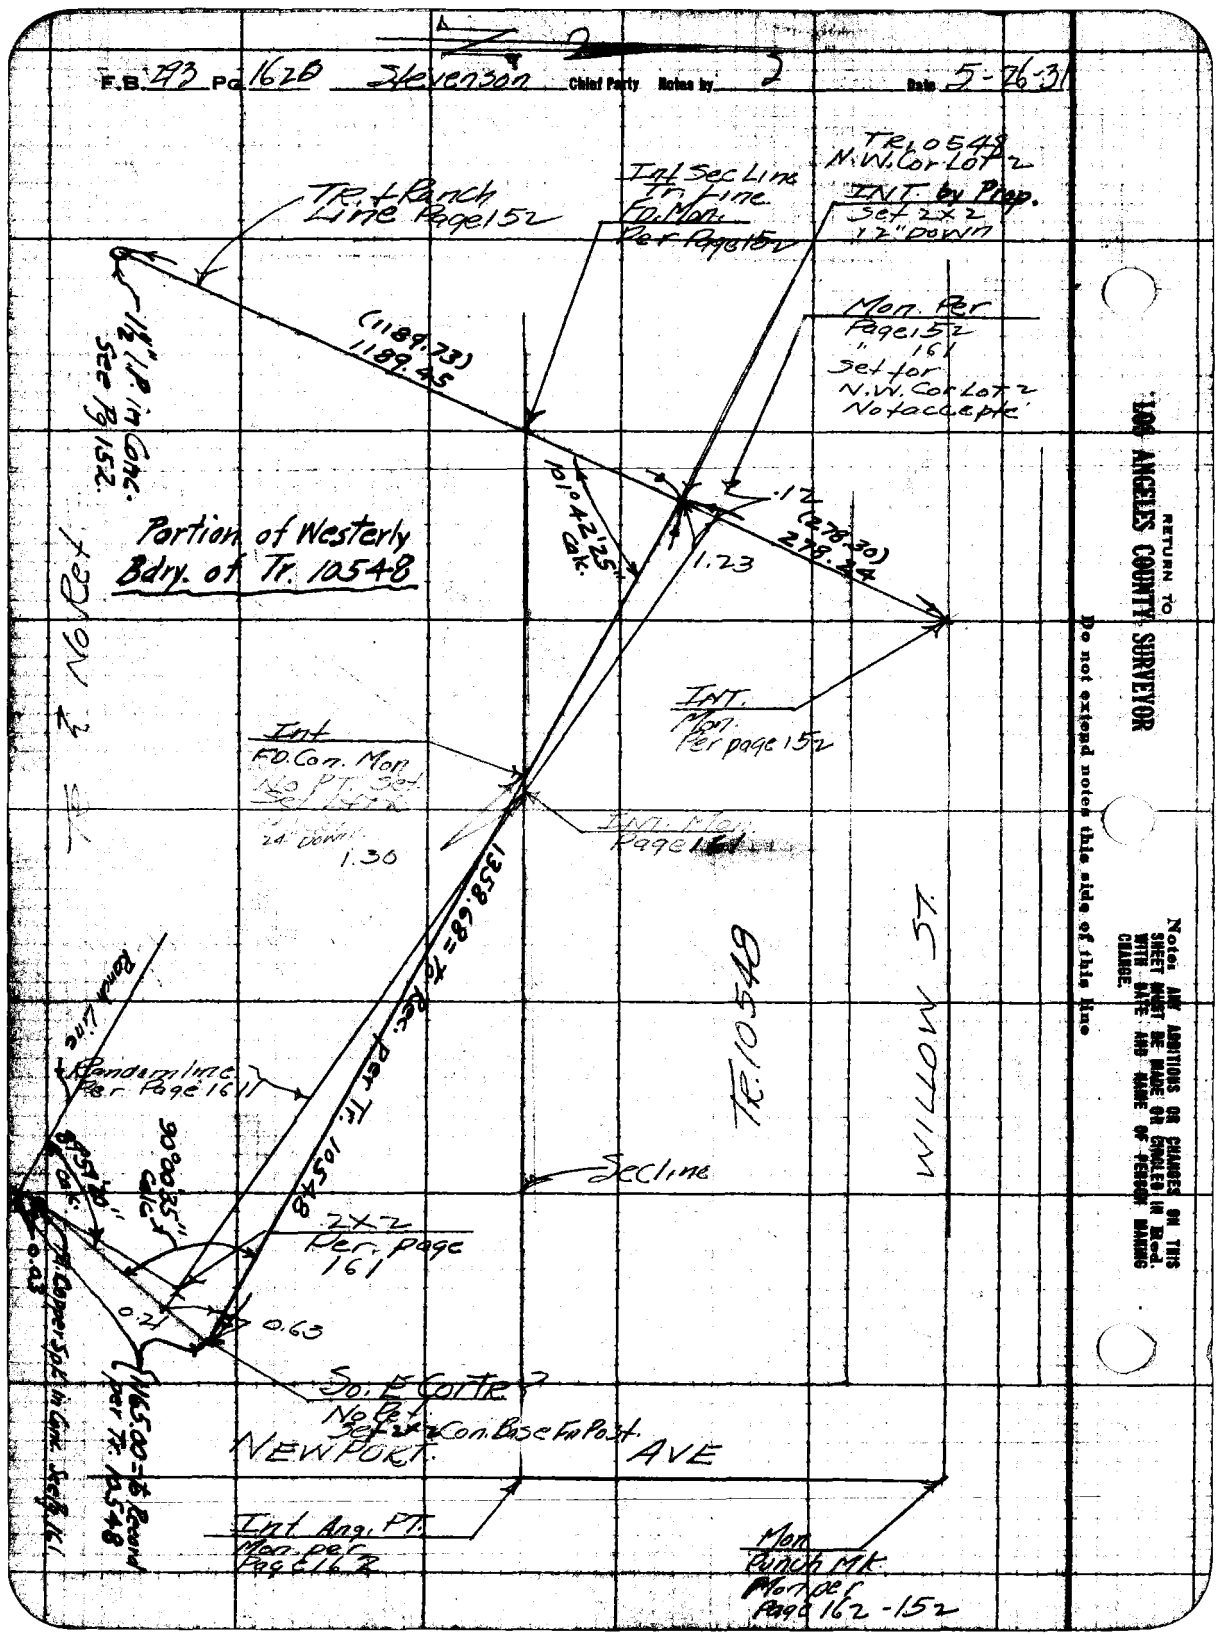

RETURN TO LOS ANGELES COUNTY SURVEYOR

Do not extend notes this side of this line

Notes: ANY ADDITIONS OR CHANGES ON THIS SHEET MUST BE MADE IN ENGLISH IN Red. WITH DATE AND NAME OF PERSON MAKING CHANGE.

Date _____ Notes by _____ Chief Party _____ F.B. 293 Pg 163

Date Jan 1933
Map No. C.S.B-644
Surveyed by _____
Drawn A. C. Johnson

TOPOGRAPHY ON PROPOSED HATHAWAY ST.

W.O. 7017

NOTE { Topog taken to Temple. Continuation on Alone Table Sheet.

T. J. Stevenson
L. H. Reimer
R. F. Neumann
C. N. Johnson
A. Wood

RETURN TO LOS ANGELES COUNTY SURVEYOR

Do not extend notes this side of this line

F.B. 293 Pg. 164 Hagerman Chief Party Notes by S Date 2-20-31

con't to bot page 165

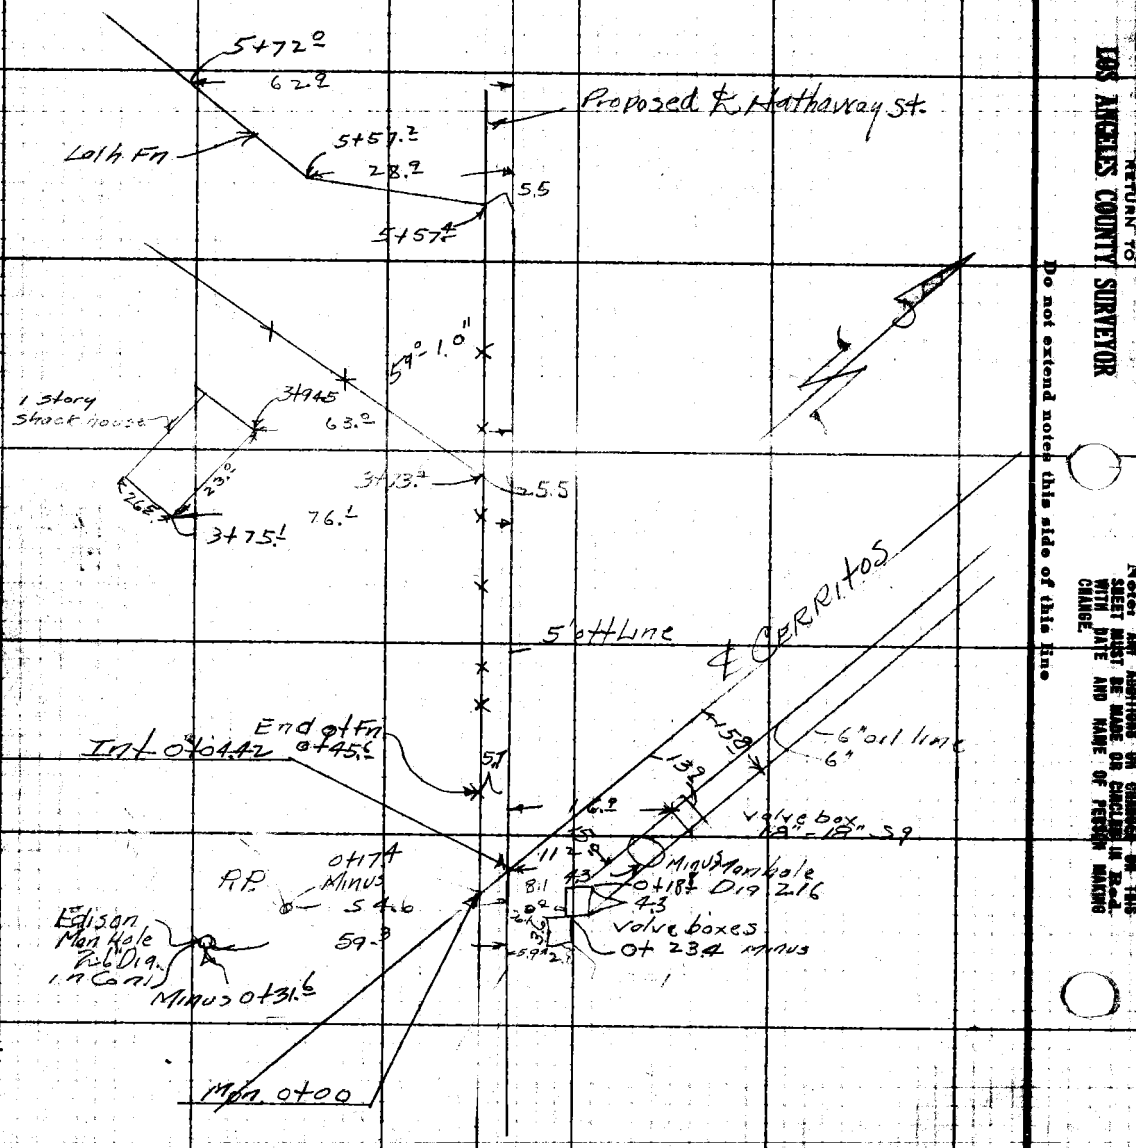

RETURN TO LOS ANGELES COUNTY SURVEYOR

Do not extend notes this side of this line

Note: ANY ADDITIONS OR CHANGES ON THIS SHEET MUST BE MADE OR CANCELLED IN RED WITH DATE AND NAME OF PERSON MAKING CHANGE.

Date _____ Notes by Fenner Field Party Stevenson F.B. 293 Pg 164

Plotted _____ Date Jan. 1933 Map No. C.S.B-644 Plotting Chkd by Dean Date Feb. 1933

Location HATHAWAY ST
Surveyed by STEVENSON
Date 2-24-31
Inspected C. Johnson

Notes: ANY ALTERATIONS OR CHANGES OF SURVEY MUST BE MADE ON SURVEY OF RECORD WITH NOTE AND NAME OF PERSON MAKING CHANGE.

Do not extend notes this side of this line

RETURN TO LOS ANGELES COUNTY SURVEYOR

15+62.5 T.P. 0

14+04 T.P. 0-9.5

12+90.9 Begin fence 55

P.O.T. 59.89

12+48.9 end of fence 4.9

12+37.7 T.P. 0 14.3

5' ht. line

7+58± 10.7 36.0 26.5

75.0

69.4 Del. patch barn and Chicken coop-

6+95± 71.4

N. 5'

7+35± 12 5 10.0

old Shed Gdv. roof

Cont. from top page 164

F.B. 793 Pg. 166 — Stevenson — Chief Party — Notes by: Fennell — Date: 2-21-31

Cont'd to bot. page 167

Shell Co. Valve Box

See left bottom next pg.

30+04.8 — 64.8

29+69.8 T.P. — 27.7

28+91 T.P. — 8.9

26+83 T.P. — 0

27.7 — 10.8

Old Shed — Rabbit Notch — 12.4 — 10.1

25+87.8 — 75.1

25+69.2 — 98.4

Shed — 15.4 — 9.2 — 2.2 — 8.2 — 21.4 — 10.2 — 8.1 — 2.0 — 10.4 — 3.6 — 5.0 — 10.0 — 4.6 — Barn — 50.0

25+67.0 — 86.9

25+61.4 — 62.2

25+23 — T.P. — 8.9

Proposed L. Halfaway

23+63 — T.P. — 0

22+03 — T.P. — 0

Fence — 5' off Line

20+43 — T.P. — 0

18+83 — T.P. — 0

17+22 — T.P. — 0

Cont. from top page 165

RETURN TO LOS ANGELES COUNTY SURVEYOR

Do not extend notes this side of this line

Notes: ANY ADDITIONS OR CHANGES ON THIS SHEET MUST BE MADE OR CHECKED IN RED WITH DATE AND NAME OF PERSON MAKING CHANGE.

Date _____ Notes by 2 Abbot Party Stevenson F.B. 293 Pg. 167

Drawn by [illegible] W.O. No. [illegible]

Date Jan. 1933 Location Hathaway St.

Map No. C.S.B-644 Surveyed by Stevenson

Plotting Data by [illegible] Date [illegible]

Date Feb. 1933 Indexed C. Johnson

Continued from Page 165

Manhole 19° 39+08.7 11.0 67.5 39+18.8 0.8 9.6 39+20 180 15.9 0 1.8 6.6 26.4 outside 38+70.± 38+59.4 47.9 30.8 T.P. 38+06.2 28.2 P.P. 35+69 P.R. 19.2 90.° 35+56.8 21.9 21.5 35+07.° 35+05.± Proposed & Hathaway St. 21.2 Barb Wire Fn. P.P. 33+23.° 33+21.± 20.8 24.° 43.2 59.1 77.° 12" S/S 11 Col. 33+97.2 T.P. 32+65.± 33+08.6 T.P. 0 19.5 32+55.2 T.P. 0 63.2 32+00 32.2 End Fn. 31+85.5 End Fn. T.A. + P.P. 46.7 + 31+04.° 5' S of H Line 3' Line 9° 27 20 5.8 30+87.4 Shell Gas Line 30 5.7 30+81.4 3.1° 30

Pipe Rack Shell Oil

Valve Box 4° 92.9 72.2 69.6 64.° 66.3 3° 3° 3° 19.± 11.00 Fn. 39+07.1 2.6 Dia.

Barb Wire Fn.


Do not extend notes this side of this line

RETURN TO LOS ANGELES COUNTY SURVEYOR

Top preceding Page 166

Cont'd from top 166

F.B. 293 Pg. 168 — Heyenson, Chief Party — Notes by — 3 — Date

Cont. to bot. page 169

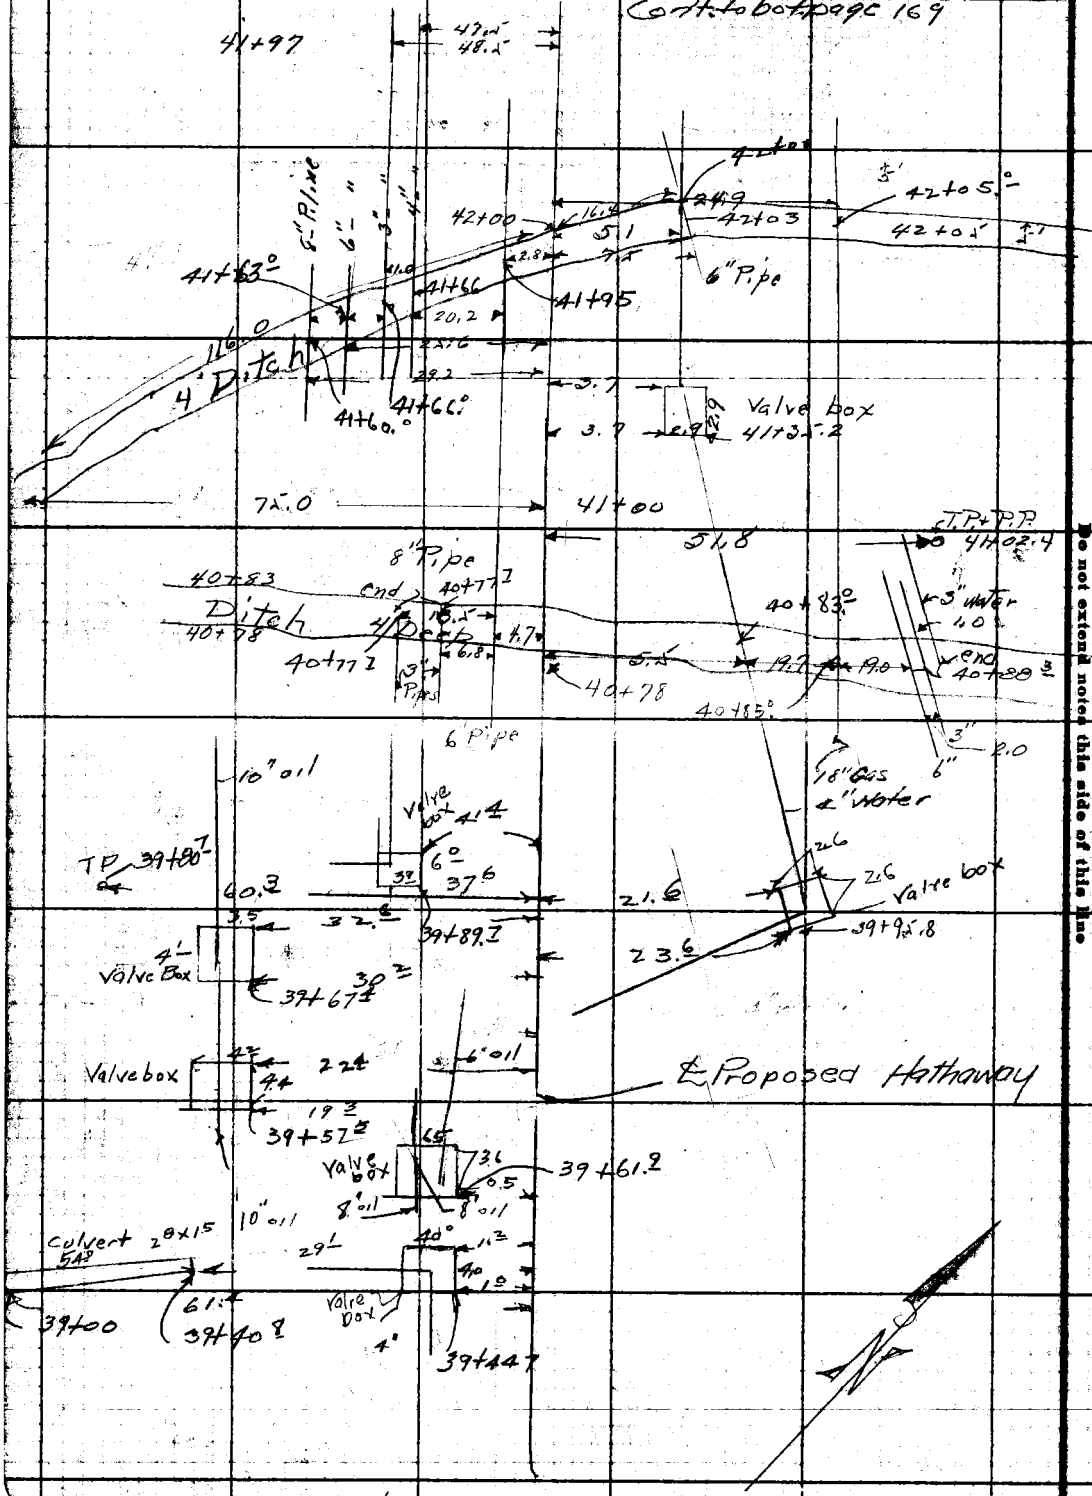

Cont. from top page 167

RETURN TO LOS ANGELES COUNTY SURVEYOR

Do not extend notes this side of this line

Note: ANY ADDITIONS OR CHANGES ON THIS SHEET MUST BE MADE IN RED INK WITH DATE AND NAME OF PERSON MAKING CHANGE.

Date _____ Notes by _____ Chief Party Stevenson F.B. 293 Pg. 169

Plotted by H.H. Underhill | W. O. No. 7-47 | Sht. No. _____
Date Jan. 1933 | Location Hathaway St.
Map No. C.S.B-644 | Surveyed by Stevenson
Plotting Chkd by Dell | Date 2 of 3 ft
Date Feb 1933 | Inked C. Johnson

M.F. to Bk. 1 page 118

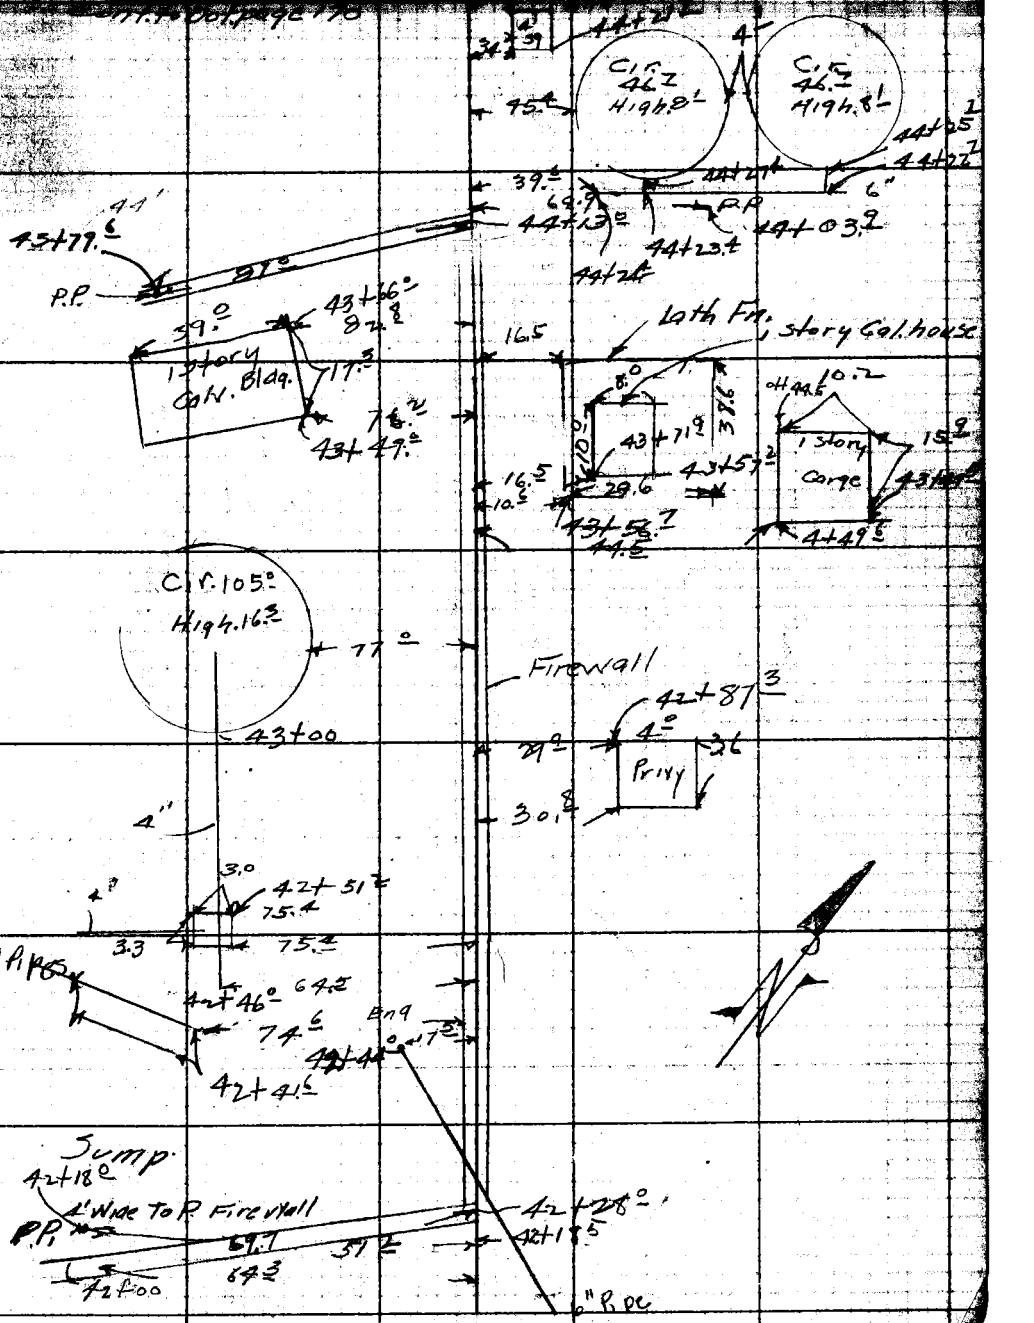

Return to LOS ANGELES COUNTY SURVEYOR

Do not extend notes this side of this line

F.B 293 Pg. 170 — Chief Party — Notes by — Date 2-21-31

Cont. to bot. page 171

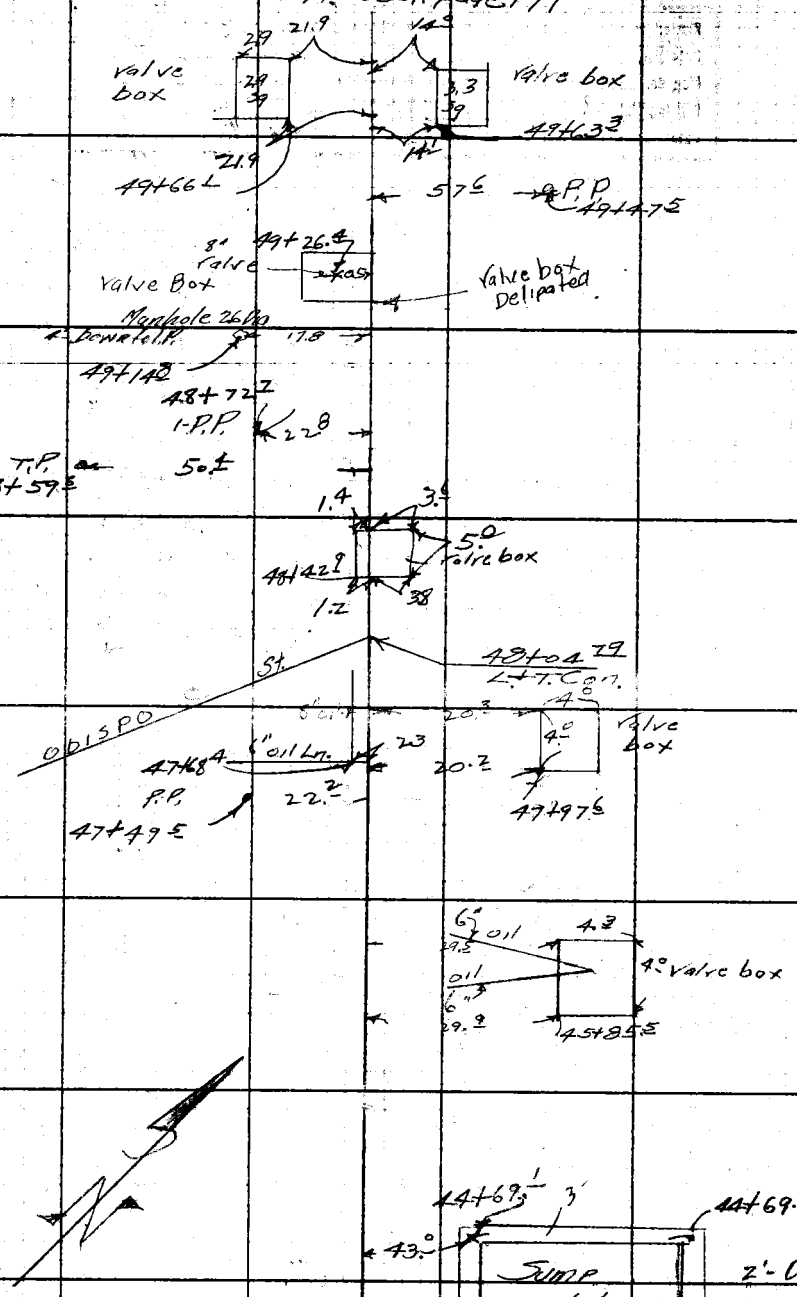

Cont. from top page 169

RETURN TO LOS ANGELES COUNTY SURVEYOR

Do not extend notes this side of this line

Note: ANY ADDITIONS OR CHANGES ON THIS SHEET MUST BE MADE OR CHECKED IN RED WITH DATE AND NAME OF PERSON MAKING CHANGE.

Date _____ Notes by _____ Field Party _____ F.B. 293 Pg. 17

Date Jan. 1933 Location Hathaway St.
Map No. C.S.B-644 Surveyed by Stevenson
Date Feb 1933 Inked A. C. Johnson

Rotary

P.I.T

P.P. 20.2 24.2 P.P. 54+94.6 56

54+78.1

14

6°

Post N 56

6°

30.6 30.6

25.3 M.S. Parland #3
Dolly Lease

30.3 54°15' 54°05' 54+04.1

13.5 54+04.1

59.5 25

28.7 28.1 24 26 Valvebox

57.5

54+11.2

53+74

53+43.6

3.5 11" H 19-ant.
Water Meter
53+45.2

P.P. 53+34.8 24.3 37° P.P. 53+35.6

25.1 T.P. 53+26°

Valvebox 26.1 26.8 53+20°

Const. Oil Rd.

11.6 Euc. Tree 53+04.4

P.P. 52+77.3 20.2

44 15° 52+40°

27.2 T.P. 51+84.1

Valve Box 26.1 26.8 P.P. 21.1

50+80°

50+77.4

50+09.8 R.P. 79°

12.3 5.1 50+00 Beginning

50+03.5

27.2 28° T.P. 50+00.4

1.8 Limit

1-8"

Cont. from top page 170

Return to LOS ANGELES COUNTY SURVEYOR

Notes may be written in this space

Do not extend notes this side of this line

F.B. 293 Pg. 172 Fenner Chief Party Fenner Date 2-24-91

cont from bot pg 173

59+38.8 Palm 40" 20.4 22.3 Palm tree - 40"

22.1 21.8 Palm tree - 40"

59+36.8 Pepper - 10"

60.3 59+32.9

59+18.7 Palm 24.8 51.6 Pepper - 10" 59+16.2

22.5 Guy Pole 59+09.8

57+92.8 Palm 24.2

58+91.2 P.P. 14.5

Valve box 72.8 72.8 58+29.4

22.7 62.1 63.0 Privy 58+63.9

22.9 21.1 20.7 40" Palms

22.7 20.7

22.6 58+11.3

21.5 47 45.0 PP 58+00

40" Palms

22.8 21.2

9.6 22.6 19.2

Wood Culvert 20'

22.4 57+28.5

57+10.7 10.1 56+48.2

P.P. 20 23.3 Const Rd

56+78 5°13' 56+00

Wood cul. 14.8

55+62.4 57.1 2'59 36.5 15.8

55+62.4

Valve box 27.0

4' 39 26.2

55+54.2

Rotary 30°

At 21.1

6.4 21.6

55+40.2

Note: Distances shown from trees + poles are from the center.

Note: ANY ADDITIONS OR CHANGES ON THIS SHEET MUST BE MADE OR CHECKED IN RED WITH DATE AND NAME OF PERSON MAKING CHANGE.

RETURN TO LOS ANGELES COUNTY SURVEYOR

Do not extend notes this side of this line

cont from top page 171

Date _____ Notes by J Fenner Chief Party Stevenson F.B. 293 Pg. 175

Plotted by H.H.B. Checked _____ W.O. No. _____ D.R. No. _____

Date Jan. 1933 Location Halfaway St.

Map No. C.S.B-644 Surveyed by Stevenson

Plotting Checked by DR CSB Date _____

Date Feb. 1933 Indexed _____ Johnson

Water
Cir. = 46.9
Livalve Nut = 2.5±
Tank

T.P.
2" valves — 62+73.2
steam pump: conc. base
Boiler
galvanized iron shed
62+62.4
62+27.4
62+63.9
62+27.4
62+31.0
62+53.8
62+11.7
40" Palms
40" Palm
61+90.4
61+89.6
61+66.8
61+55±
61+22.8
3" valve
T.P.
61+16.9
61+18.7
61+08.9
Water valve
61+04.6
60+90.4
60+87.4
3-3" Water valves
40" Palm
60+84.2
60+64.6
Steel Culvert 8" Pipe
60+44.0
40" Palms
60+02.0
60+07.9
60+01
59+87.9
59+81.1
T.P.
59+29.2

Notice To
LOS ANGELES COUNTY SURVEYOR
Do not extend notes this side of this line
Notes: ANY

F.B. 293 Pg. 178 Stevenson Chief Party Notes by: J Date

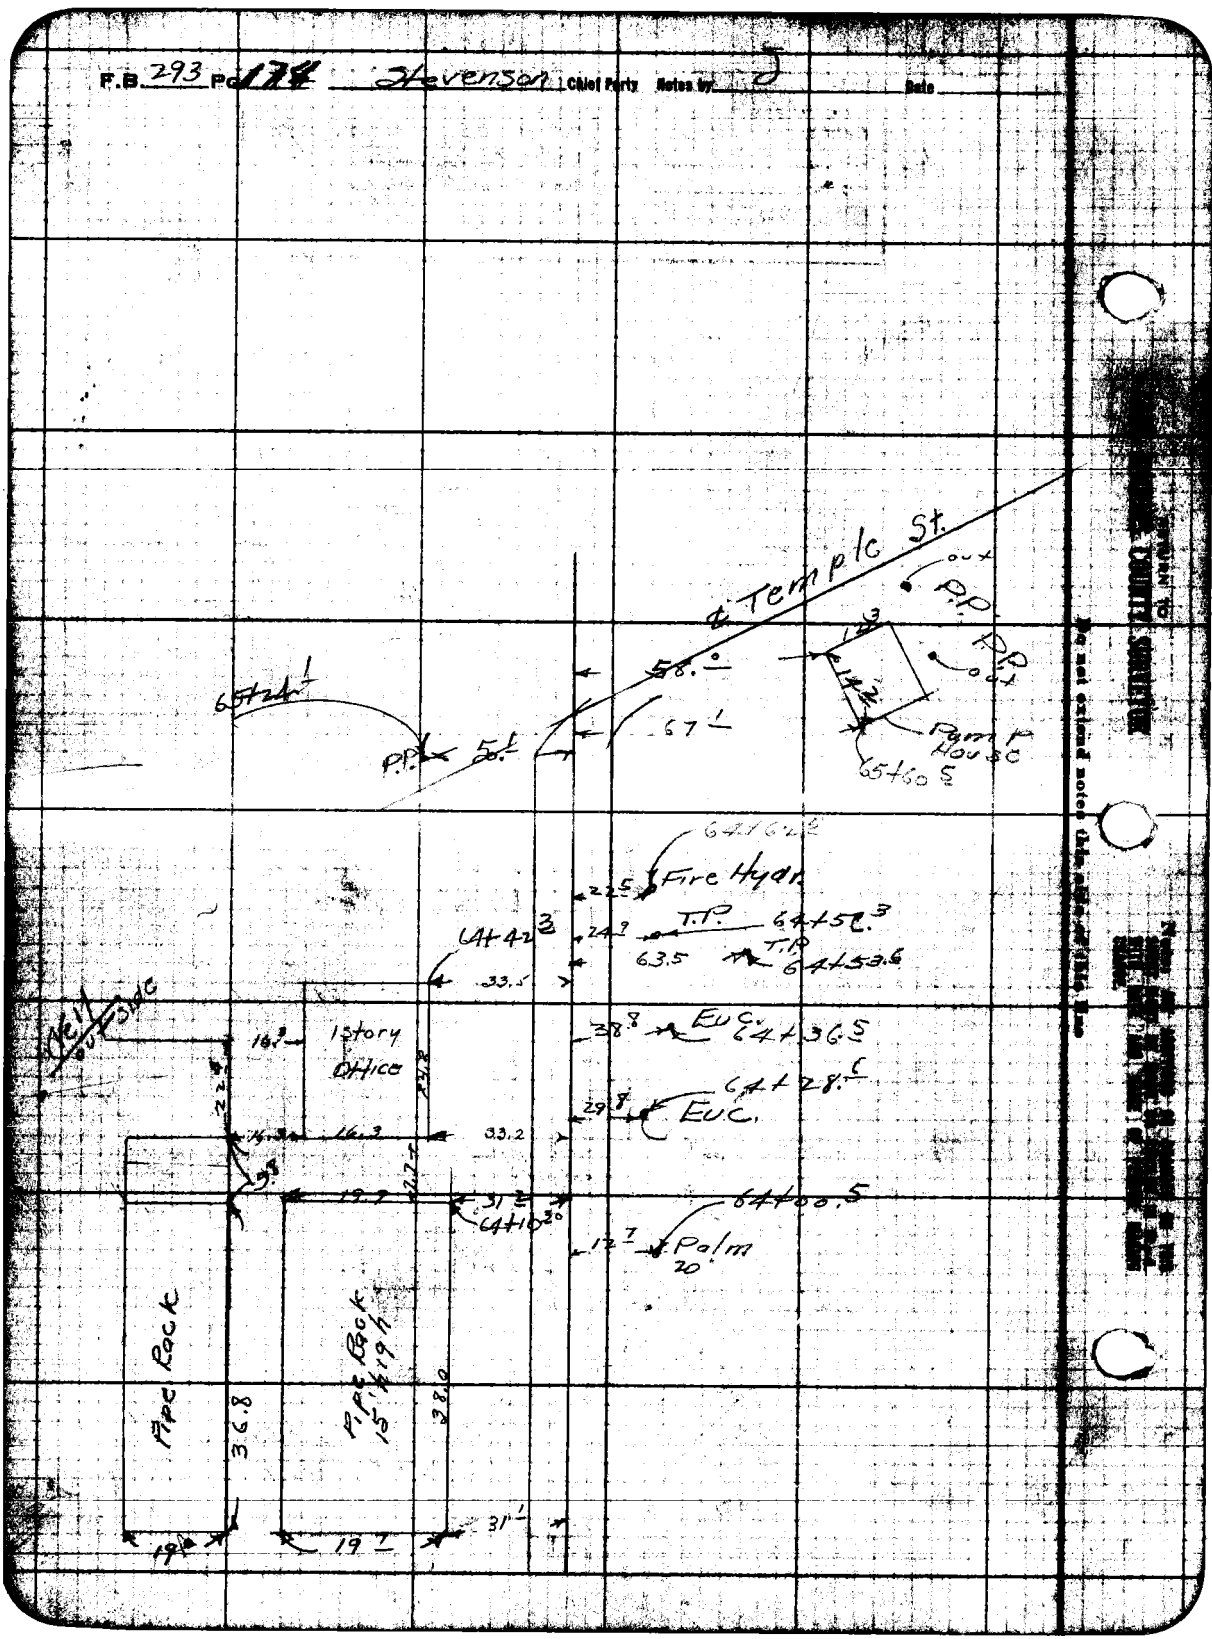

Map No. C-3 E. 6 dd | Survey of Hathaway St | F.B. 293 Pg. 175

W. O. 7017 | Tape No. 045 St'd. 84 of F.

Checked [illegible] | Plotted 12-24

Date 5/2/24 | Indexed A. C. Johnson







Notice: ANY ADDITIONS OR CHANGES OF THIS SHEET MUST BE MADE ON CIRCLED IN RED INK WITH NAME AND NAME OF PERSON MAKING THE CHANGE

LOS ANGELES COUNTY SURVEYOR
720 HALL OF RECORDS

Do not extend maps to side of this Book

RETURN TO
LOS ANGELES COUNTY SURVEYOR
700 HALL OF RECORDS

Notes: ANY ADDITIONS OR CHANGES ON THIS SHEET MUST BE MADE OR CIRCLED IN Red Ink. WITH DATE AND NAME OF PERSON MAKING THE CHANGE.

Do not extend notes this side of this line

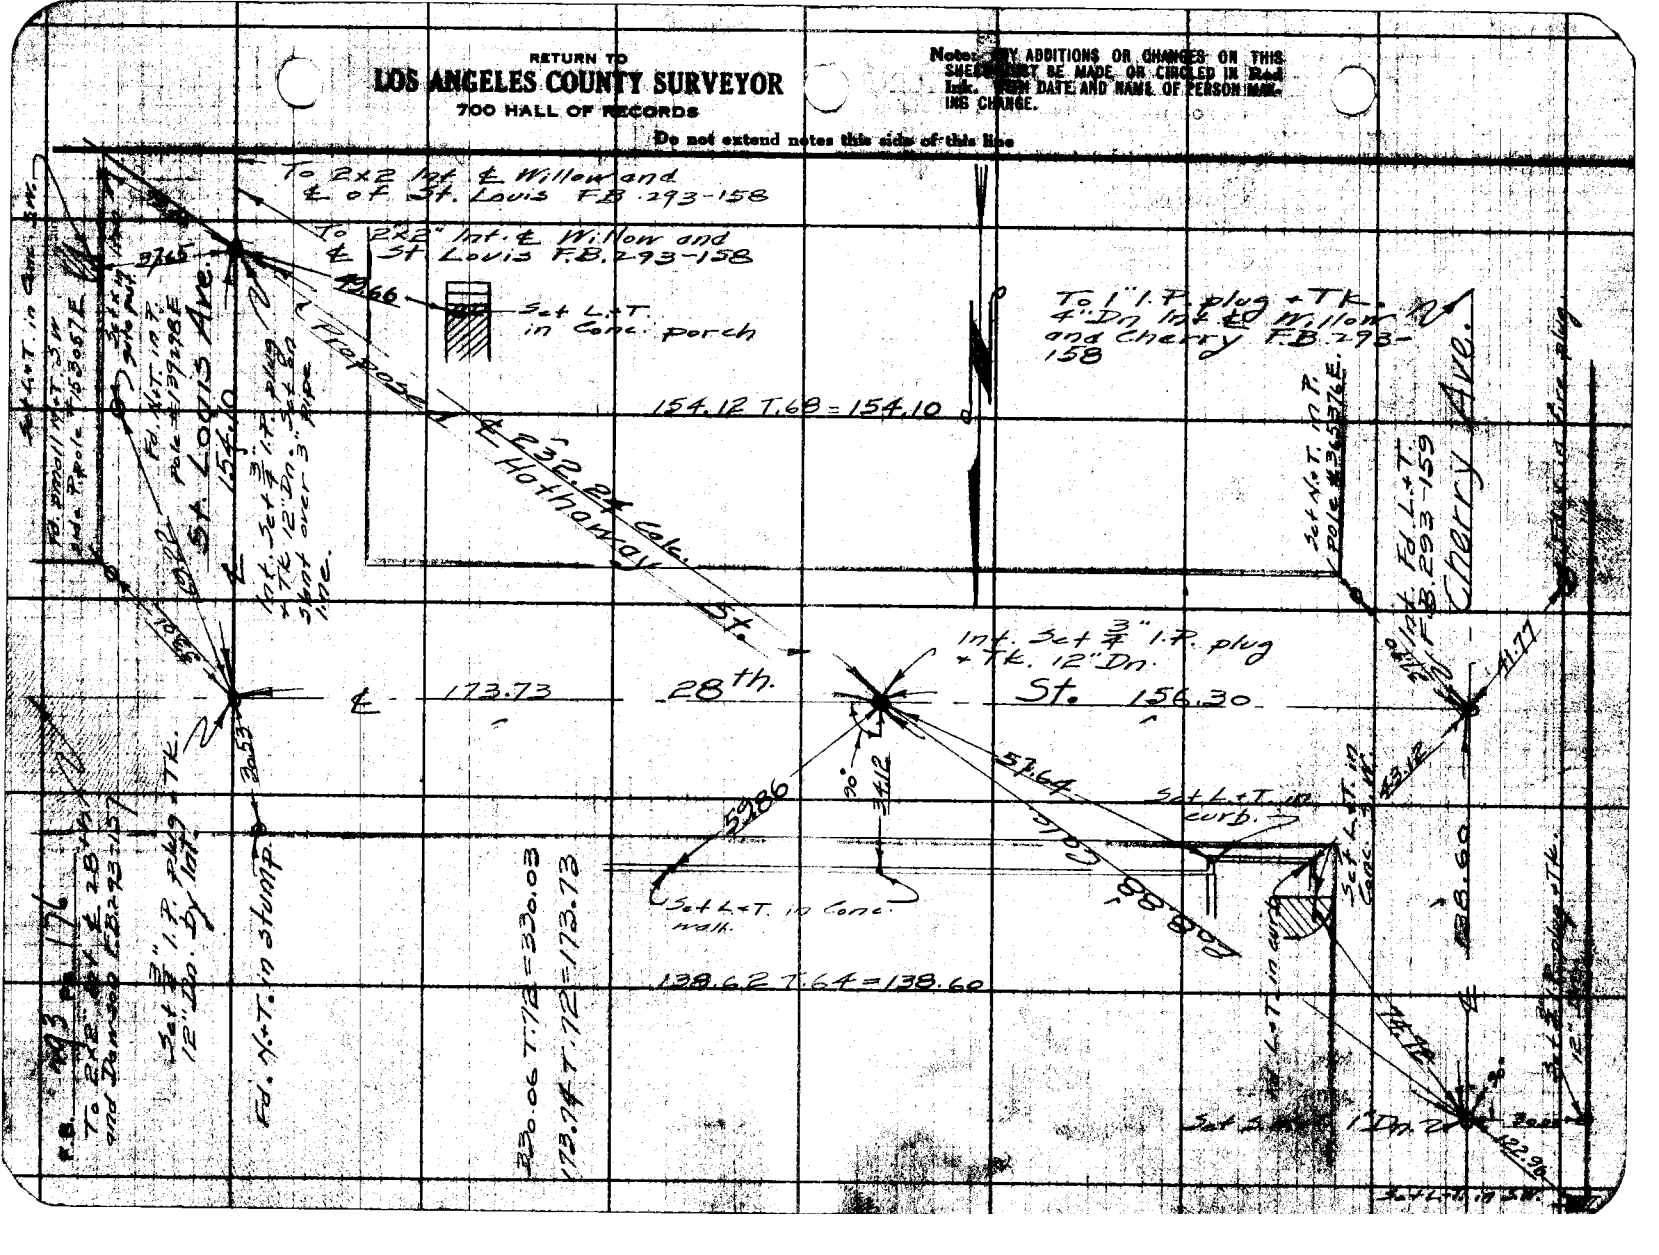

Name of Subd'n Dream
Map No. C.S.P.G.A.
Checked Dream
Date 5/4/34

Survey of Hathaway St.
W. O. 1017 Tape No. 245 St'd 82° F.
Notes
Indexed A. C. Johnson

F.B. 293 Pg. 177

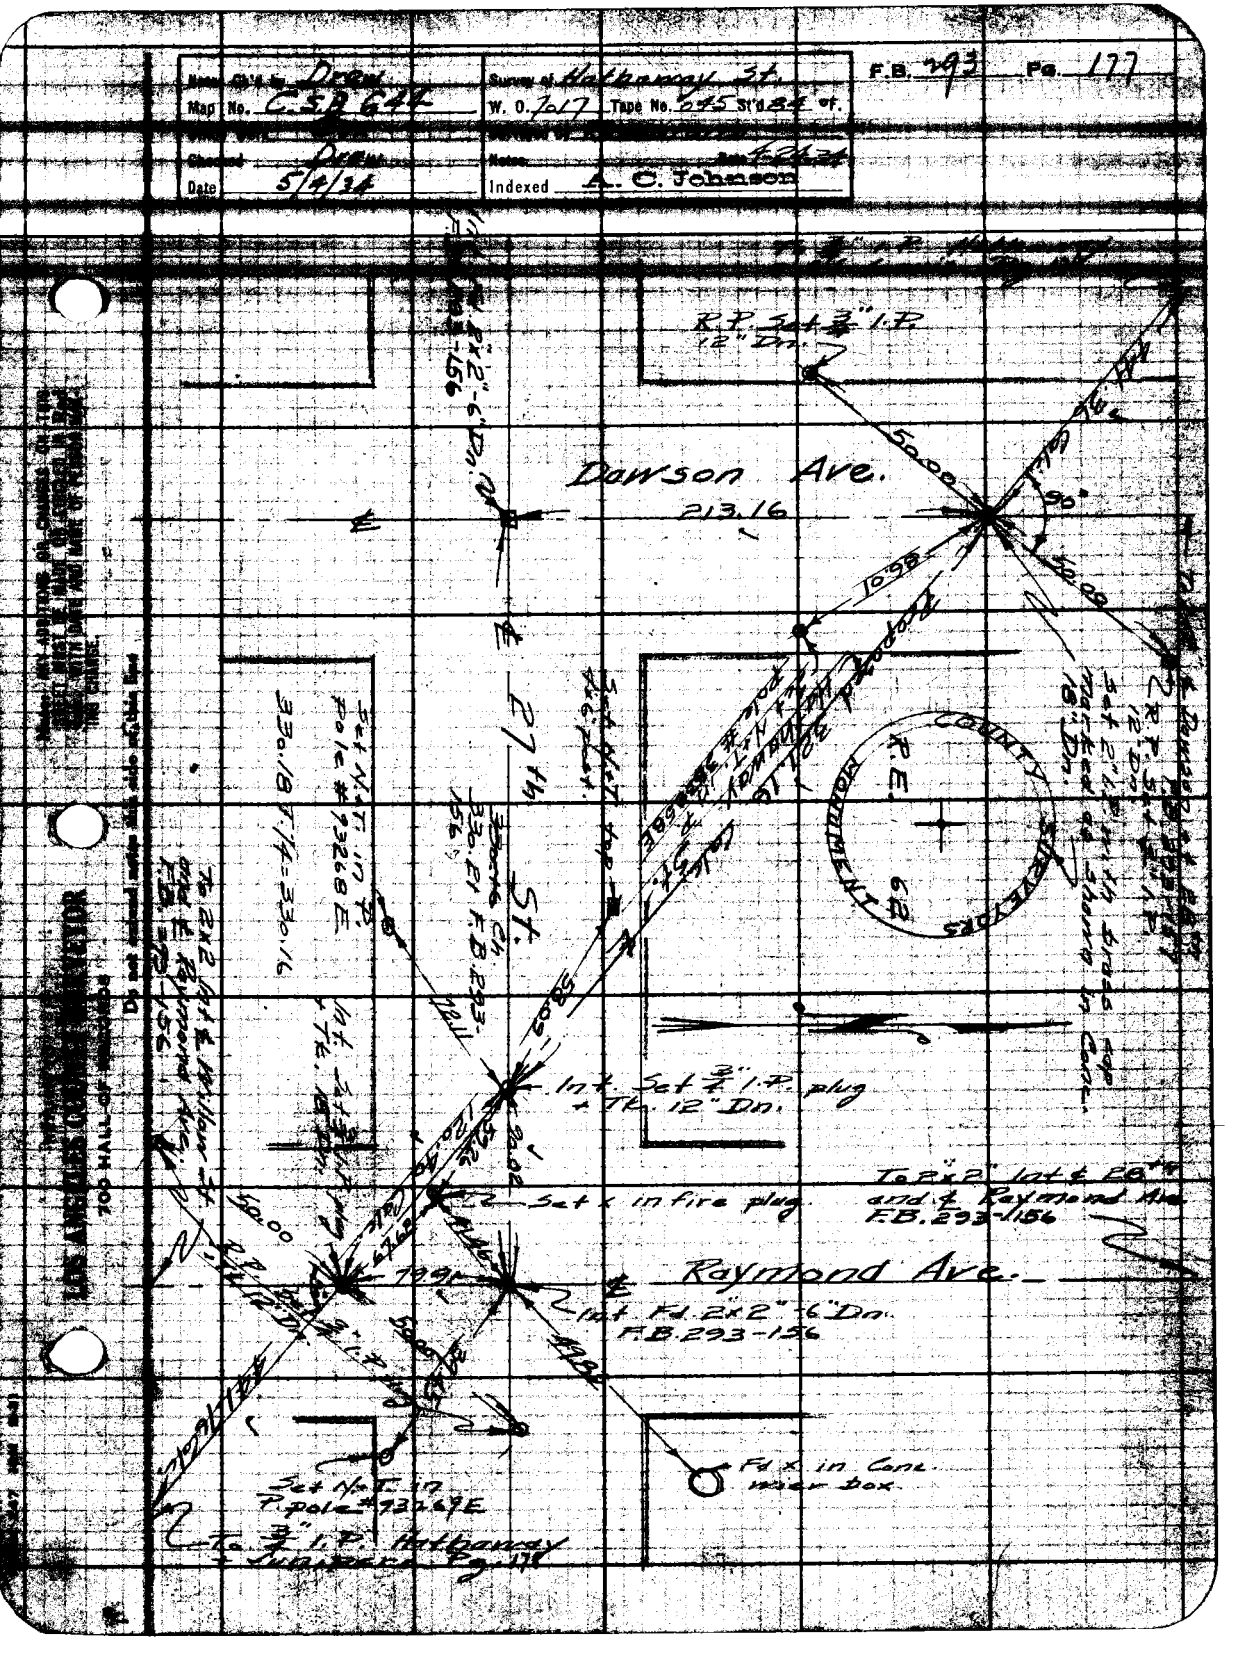

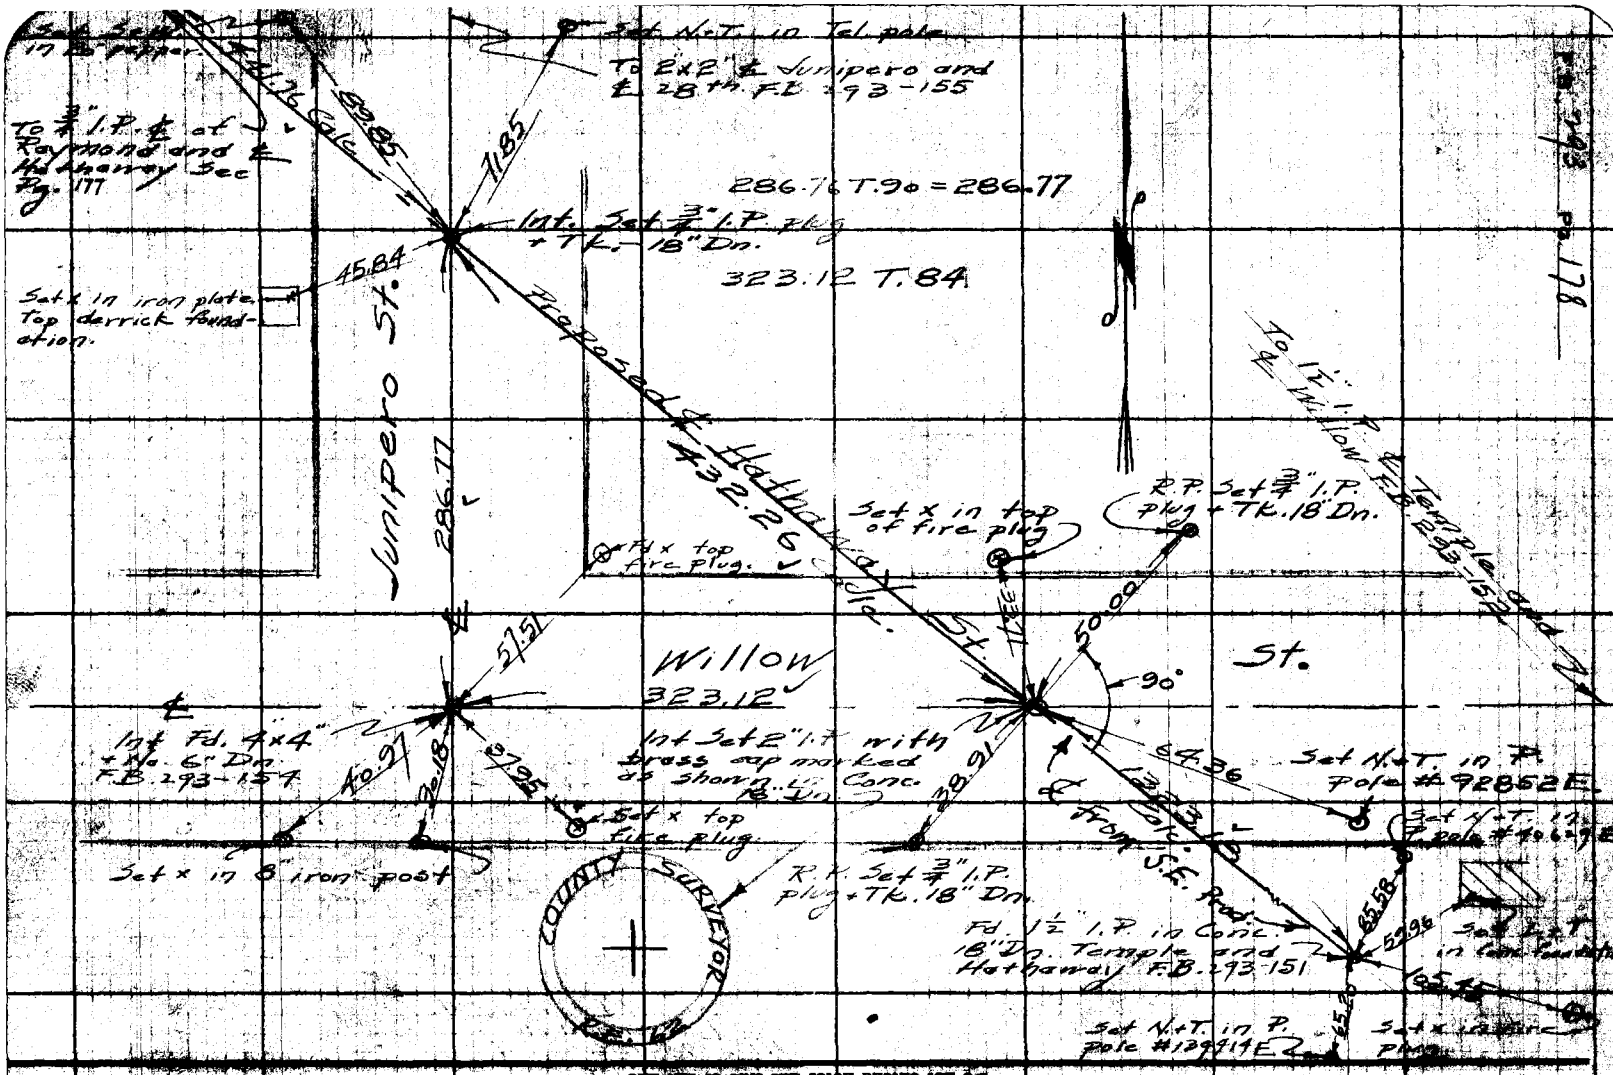
Set N.T. in Tel. pole
To 2"x2" ± Junipero and ± 28th. F.B. 293-155
To ¾" I.P. ± at Raymond and ± Hathaway Sec Pg. 177
286.76 T.90 = 286.77
Int. Set ¾" I.P. plug + Tk. 18" Dn.
323.12 T.84
Set x in iron plate. Top derrick foundation.
Junipero St.
Proposed Hathaway Dr.
To 1½" I.P. ± Willow F.B. 293-152
R.P. Set ¾" I.P. Plug + Tk. 18" Dn.
Set x in top of fire plug
Fd x top fire plug.
Willow St.
323.12
Int Fd. 4"x4" + No. 6" Dia. F.B. 293-154
Int Set 2" I.P. with brass cap marked as shown. Li. Conc. P.B. 41
Set N.T. in P. pole #92852E
Set x in 8" iron post
R.P. Set ¾" I.P. plug + Tk. 18" Dn.
Fd. 1½" I.P. in Conc. 18" Dia. Temple and Hathaway F.B. 293-151
Set N.T. in P. pole #139414E
Set x in plug
LOS ANGELES COUNTY SURVEYOR
RETURN TO
700 HALL OF RECORDS
Do not extend notes this side of this line
Note: ANY ADDITIONS OR CHANGES ON THIS SHEET MUST BE MADE ON CHECKED IN Red Ink, WITH DATE AND INITIAL OF PERSON MAKING CHANGE.

Date _____ Notes by _____ Chief Party _____ F.B. 293 Pg. 201

Plotted by Wood
Date Oct. 1932
Map No. B-787
Plotting Data by
Date

W. O. No.
Location
Surveyed by
Date
Indexed A. C. Johnson

RETURN TO LOS ANGELES COUNTY SURVEYOR

Do not extend notes this side of this line

PRELIMINARY SURVEY
OF
COLORADO STREET
W.O.No. 7099

From:- O.Co. Line
To:- Manila Ave.
Survey Began July 20, 1932
Survey Ended Aug. 3, 1932.

Topog. Pgs. 212 to 216 Incl.

C.A. Benson Deputy
H.L. Smelser Rman.
W.T. Lind Rdmen.
M. Taylor Rmen.
Joa Tape #036
B. Transit #16429.
Var. set. off 16°

F.B. 293 Pg. 202 Chief Party Notes by CB Date

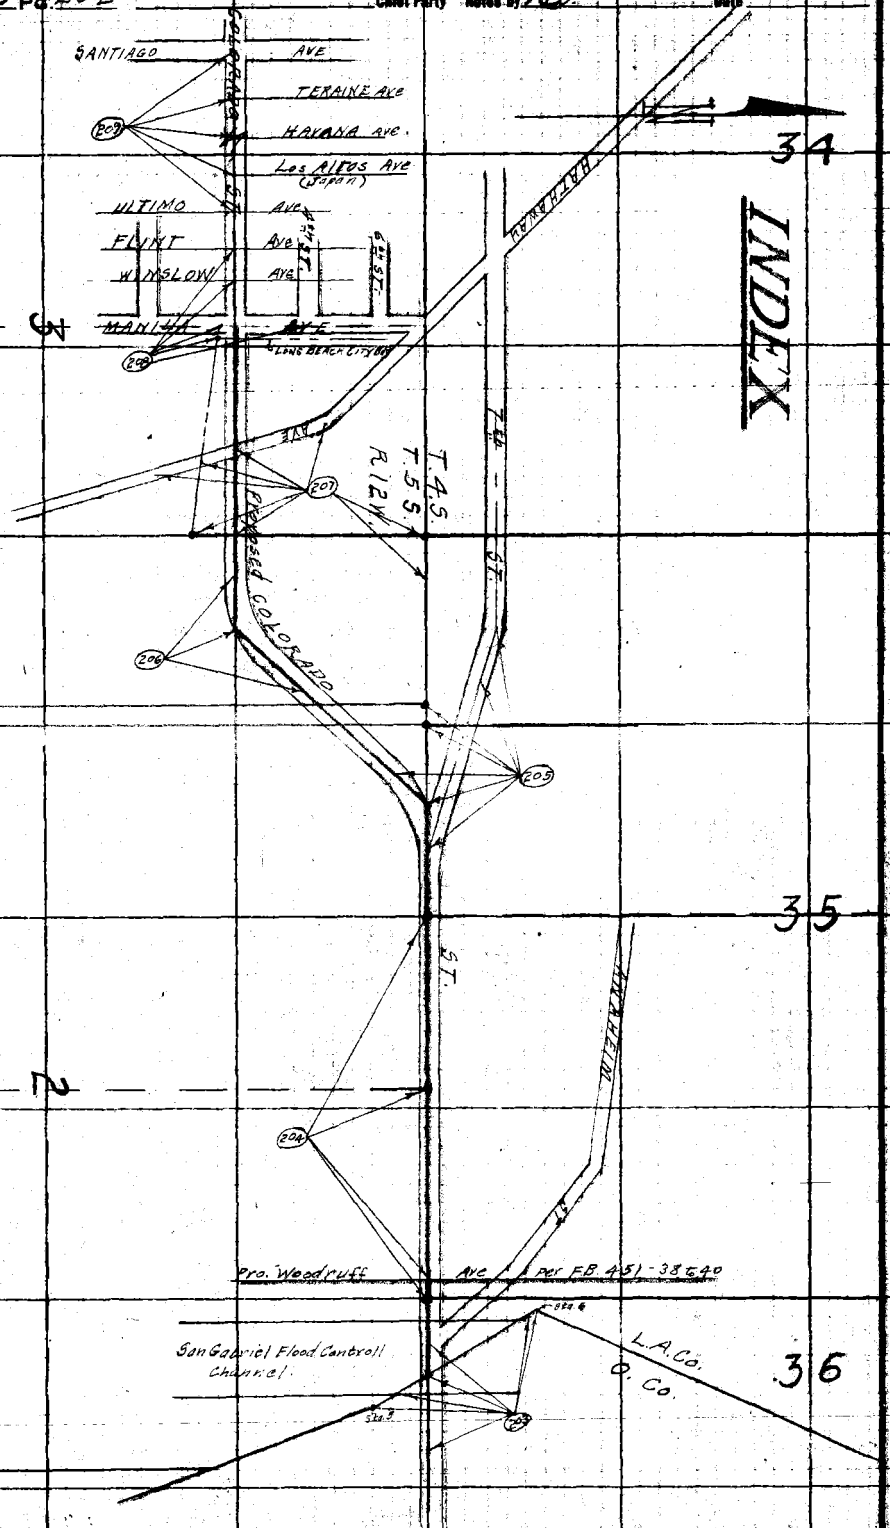

INDEX

RETURN TO
LOS ANGELES COUNTY SURVEYOR

Do not extend notes this side of this line

Note: ANY ADDITIONS OR CHANGES ON THIS SHEET MUST BE MADE OR CHECKED IN RED, WITH DATE AND NAME OF PERSON MAKING CHANGE.

Notes Ck'd by W.H.R.
Map No. B-787
Check Mon. 1/1/64
Checked
Date

Survey of Colorado St. 100 ft
W. O. 7092 Tape No. 236 St'd 84 °F.
Surveyed by [illegible]
Notes Benson Date 7-22-32
Indexed A. C. Johnson

F.B. 293 Pg 203

Cont. on Dist. of Pl. 2293

294.92 Level-T=72°-294.90'
294.91 Level-T=72°-294.89'

294.89 of M.S.

ST.

Calc. 90° 00' 00" Per F.B. 451-39

2+92.55
Fd. 2" I.P. Conc. Plug
+ C.S.P.M. 12' Dn. Par.
F.B. 451-38, F.B. 397-9, 397-10
F.C. 24-78
Fd. 1/2" I.P. F.C. 24-77

49° 45' 00" Par. F.B. 451-38

ANAHEIM ST.

Witness Cor. set
1/2" I.P. 30" deep
with tag

SEC. 2 T.5S. R.12W.

W'ly R/W F.C. 24-77

13.30'

2+86.25
Fd. 2x2+T.K. 1' On.
P.I. Par. F.B. 451-38
+ 39.1

Set Nail & Tag

SEC. 36 T.4S.-R.12W.

L.A. CO. WITNESS 6' S. 30° W.

13.31 T=66°=13.31
13.30 T=72°=13.30

SAN GABRIEL

291.20 Level-T=72°=291.18
291.20 Level-T=72°=291.18

291.18

Tr. 451-2 Line

Pm. COLORADO (NW 7th ST.)

RIVER

L.A. CO. F.C. 24-77 Fd. 1" I.P. W. 1.1 Brass Plug Flush & Stamped as Shown F.B. 52-72, F.B. 451-38

L.A. CO.

S 58° 21' 00" W

Rad. 358.21.00

0 58° 21' 00"
Δ 233° 24' 00"
58° 21' 00"

0+00 going West
Nothing set as it falls between bridge Trusses.

0-04.93
Set C. Spk. L.P.T.
By Tr.

0-04.06
Fd. Spk. in Conc. Mon.
12' Dn. Rd. F.C. 357-2
1.1' of sign post at End of Bridge

L.S. 23-21
Fd. 4" I.P. F. Weld 24" Conc. P.M. marked "L.A.C.S.A." Flush
F.B. 237-24

E'ly R/W F.C.

94.23

Fd. 1" I.P. + N. 2' Dn. Par. F.C. 24-18, F.B. 397-10
Rd. F.C. 357-2

94.24-T=74°=94.23

300.03 T=76°=300.01

L.A.C.O. STA #5
Fd. 2" I.P. with Brass Cap 4" up. Stamped as Shown
F.B. 52-72, F.B. 397-10
Rd. F.C. 357-2

96.53-T=72°=96.52
182.05-T=72°=182.04

L.A.CO. STA + NO5 0.CO

B' Eff. 9.2'

300.01 (300.00 Rec.)

Fd. L+T. in Conc. Par. Par. F.B. 397-10
F.C. 24-18
Rd. F.C. 357-2

Sta + in Conc. P.M.

L.A.CO. STA + NO6 0.CO

RETURN TO LOS ANGELES COUNTY SURVEYOR 700 HALL OF RECORDS

Do not cancel notice this side of this line

Notice: Any alteration or removal of this monument or its accessories will be punishable as a misdemeanor under the provisions of Section 8304 of the Business and Professions Code.

F.B. 293 PG. 204

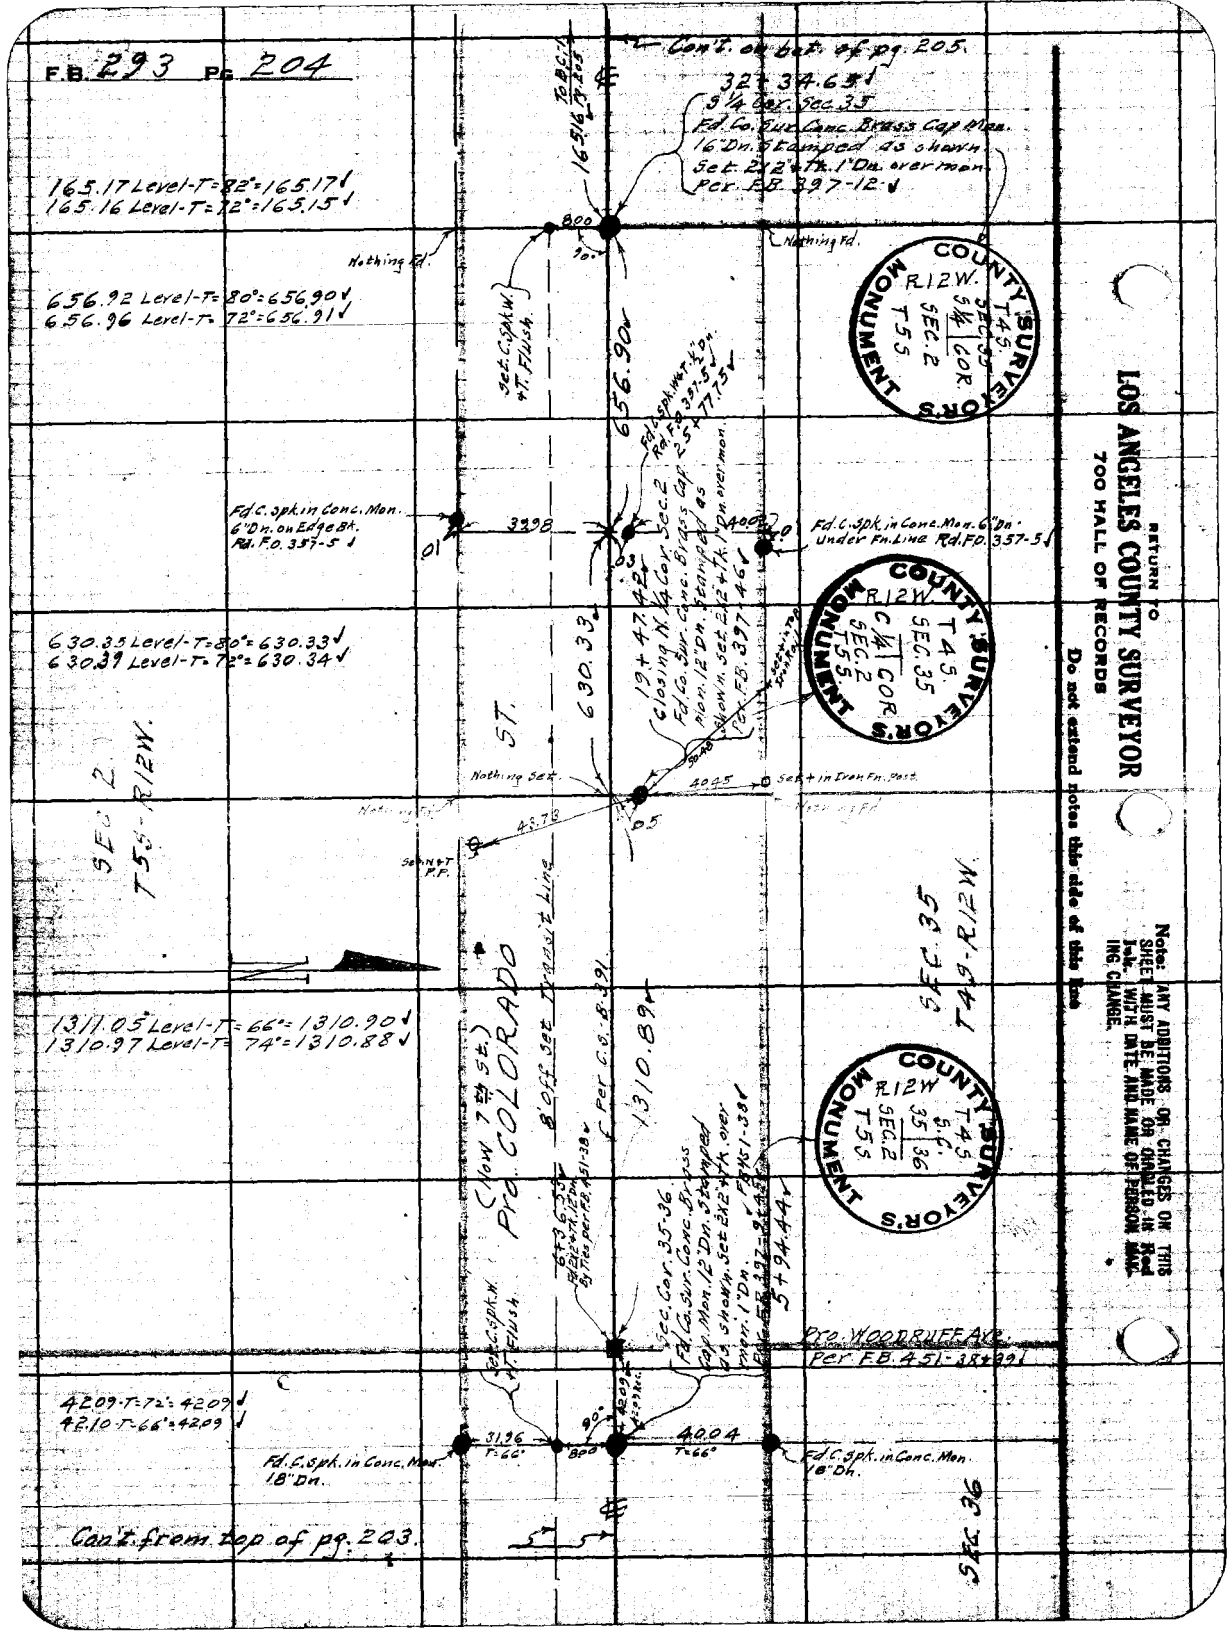

RETURN TO
LOS ANGELES COUNTY SURVEYOR
700 HALL OF RECORDS
Do not extend notes this side of this line

Notice: ANY ADDITIONS OR CHANGES ON THIS SHEET MUST BE MADE ON ORIGINAL IN Red Ink. WITH DATE AND NAME OF PERSON MAKING CHANGE.

Notes Ck'd by W.H.B.
Map No. B-787
Office Work
Checked
Date

Survey of Colorado St.
W. O. 7099 Tape No. 236 St'd 84 °F.
Computed by
Notes
Indexed A. C. Johnson

F.B. 293 Pg. 205

SEC. 35 T4S-R12W

710.33 Rec. Bear. T=70°= S 3°E. 2-1
For 30 Curve Data see Pg 204

Cont. from bot of Pg 206.

T5S.-R12W.

SEC. 2.

COUNTY SURVEYOR'S MONUMENT

T5S-R12W / T4S-R12W / SEC. 35 / SEC. 2 / COR.

Fd. Co. Std. Cone. Bridge Cap. Mon. 18" Dn. Stamped as shown. Per. F.B. 397-50




710.26

Pro. COLORADO ST.

Tan. to C.L.

R=1146.83


F.B. 293 Pg. 206

Con't. on bot. of pg. 207

51.34 Level-T=72°=51.34
51.33 Level-T=72°=51.33

407.66 Level-T=72°=407.63
407.68 Level-T=72°=407.65

51.33 To P.O.T. #1 Pg. 207

E.C.
Set 2X2+Tk.-18"Dn.

54.44 To P.O.T. #2 R.P.I. Set 2X2+Tk.-18"Dn.

E.C. 63+88.52

(Ties T=76°)

407.64

51.68 To P.O.T. #1

R.P.I. #2
Set 2X2+Tk.-18"Dn.
By Int.

61.73 Ex. C.P.I. Set 2X2+Tk.-18"Dn.

135°38'45" (R)

PRO. COLORADO ST.

Δ 44°21'20"
R 1000.
T 407.64
L 774.15

D 135°38'45"
(R) 542°35'00"
135°38'45"

407.64

407.68 Level-T=72°=407.65
407.66 Level-T=72°=407.63

Set N&T Top Fn. P.

78.57

B.C.
Set 2X2+Tk.-18"Dn.

B.C. 56+14.37

38.73

Set N&T in Fn. Cor. P.

72.86

Ties are not very Permanent

Set N&T Fn. P.

727.63

727.67 Level-T=72°=727.61
727.70 Level-T=74°=727.65

P.O.T. #2
Set 2X2+Tk.-18"Dn.
48+86.74

℄ Con't from top (Lt. side) of pg. 205

RETURN TO
LOS ANGELES COUNTY SURVEYOR
700 HALL OF RECORDS

Do not extend notes this side of this line

Note: ANY ADDITIONS OR CHANGES ON THIS SHEET MUST BE MADE ON CIRCLED-IN Red Ink. WITH DATE AND NAME OF PERSON MAKING CHANGE.

Notes Ck'd by W.H.B.
Map No. B-787
Other Work Survey
Checked
Date

Survey of Colorado St. 100 FT
W. O. 7099 Tape No. 036 St'd 84 °F.
Notes in Field Book
Notes By A. C. Johnson Date 7-27-32
Indexed

F.B. 293 Pg. 207

Cont. on bot of pg 208

To P.O.T. Per Pg 208

532.47 Level-T=78°= 532.47
113.20 Level-T=78°= 113.20
330.83 Level-T=74°= 330.81
330.82 Level-T=74°= 330.80

Fd. C.S.P.K. in Conc. Mon. 18" Dp. Per. Rd. F.A. 245-E3

Fd. C.S.P.K. in Conc. Mon. 18" Dp. Per. Rd. F.A. 245-E2

P.I. #14 Fd. C.S.P.K. in Conc. Mon. 18" Dp. Per. Rd. F.A. 245-E3

Δ 73°00'15"
Δ 292°01'00"
73°00'15"

E. Bdy of Long Beach

ST.

(Tie T-74)

10°39.14'

532.45

113.20

67+70.65
P.O.T.-#2
50± L.T. of 4'+ in Pav. Proj. by Tan. No Ref.

AVE. (STATE ST.)

Fd. C.S.P.K. in Conc. Mon. 18" Dp. Per. Rd. F.A. 245-E2

Fd. C.S.P.K. in Conc. Mon. 18" Dp. Per. Rd. F.A. 245-E1

Set L.T. in Conc. Per. 4 inch way From Edge Pav.

Set L.T. in Conc. Per. 4 inch way From Edge Pav.

Set L.T. in Conc. Per. Curbline way from Edge Pav.

Fd. C.S.P.K. in Conc. Mon. 18" Dp. Per. Rd. F.A. 245-E3

Fd. C.S.P.K. in Conc. Mon. 18" Dp. Per. Rd. F.A. 245-E4

Fd. C.S.P.K. in Conc. Mon. 18" Dp. Per. Rd. F.A. 245-E5

Fd. C.S.P.K. in Conc. Mon. 18" Dp. Per. Rd. F.A.

F.B. 293 Pg. 208

Con't on bot. of pg. 209

NOTE:-
All Mon. on Cala. St. from Manila Ave. to Santiago Ave. Incl. were destroyed when they regraded + Paved Street.

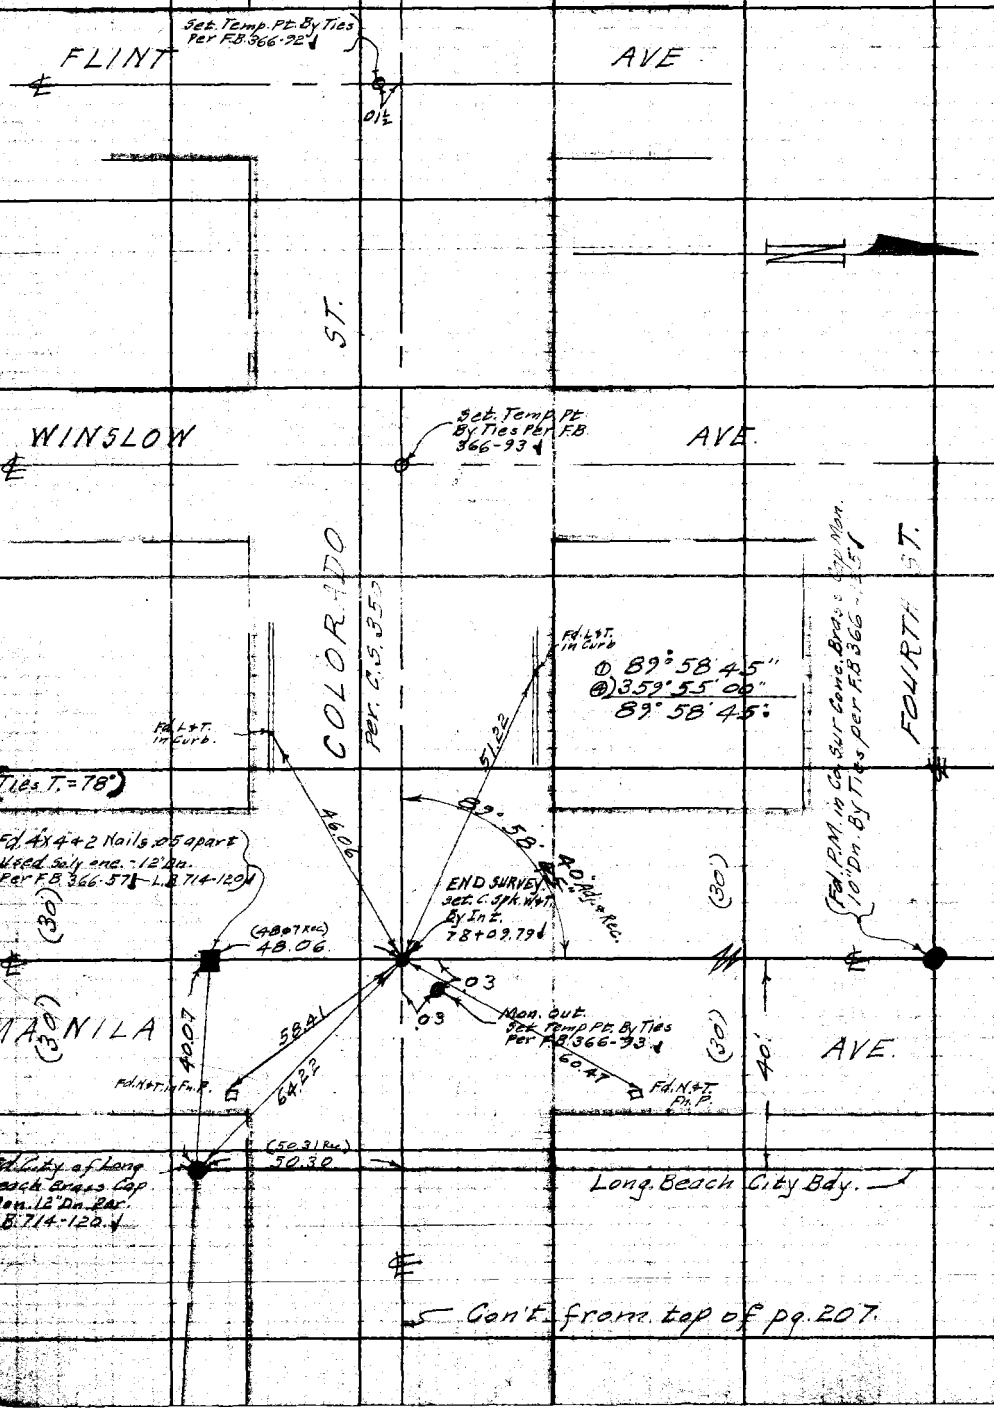

Con't from top of pg. 207

RETURN TO
LOS ANGELES COUNTY SURVEYOR
700 HALL OF RECORDS
Do not extend notes this side of this line

Note: ANY ADDITIONS OR CHANGES ON THIS SHEET MUST BE MADE OR CIRCLED IN Red Ink. WITH DATE AND NAME OF PERSON MAKING CHANGE.

Plotted by: W.H.B.
Map No. B-787
Office Work
Checked
Date

Survey of Colorado St
W. O. 7099 Tape No. 836 St'd 84 °F.
Computed by C.H.Berry
Plotted
Indexed A. C. Johnson

F.B. 293 Pg. 209

NOTE:-
All Monuments on Colorado St. between Manila Ave & Santiago Ave Incl. Were destroyed when Long Beach regraded & Paved Street.

(Ties T=74')

SANTIAGO AVE

End

Fd. L & T. in Curb.

.03

54.35

Set C. Sph. W.T. Flush in new Pav.

Set Temp Pt. By Ties Per F.B. 366-90 - L.B. 714-119.4

55.67

34.12

33.45

Fd. L & T. in Curb.

Set + in side of Fire Hydrant.

Fd. L & T. in Curb.

Set L & T in Curb.

TERRAINE AVE.

Only one Tie Fd. So did not Establish, F.B. 366-90.

ST.

HAVANA AVE.

Set Temp Pt. by Ties Per F.B. 366-91.4

.02

COLORADO

Per C.S. 350.

Set Temp. Pt. by Ties Per F.B. 366-91.4

.01

(Japan) LOS ALTOS AVE

ULTIMO AVE.

Set Temp Pt By Ties Per F.B. 366-92.4

Con't. from top of pg. 208

Notice: ANY ALTERATION OR CHANGE ON THIS SHEET MUST BE DULY NOTED AND INITIALED, WITH DATE AND NAME OF PERSON MAKING THE CHANGE.

RETURN TO LOS ANGELES COUNTY SURVEYOR 700 HALL OF RECORDS

Do not extend notes this side of this line

FORM 247 10M-1-51

RETURN TO
LOS ANGELES COUNTY SURVEYOR
700 HALL OF RECORDS

Note: ANY ADDITIONS OR CHANGES ON THIS SHEET MUST BE MADE OR CIRCLED IN Red Ink. WITH DATE AND NAME OF PERSON MAKING CHANGE.

Do not extend notes this side of this line

F.B. 293 Pg. 210

Notes Ck'd by W.H.B.	Survey of Colorado St.	F.B. 293	Pg. 211
Map No. B-787	W. O. 7099 Tape No.	St'd	°F.
Office Work Wood	Surveyed by C.A. Benson		
Checked	Notes	Date	
Date	Indexed	A. C. Johnson	

Notes: ANY ADDITIONS OR CHANGES OF THIS SHEET MUST BE MADE OR CIRCLED IN Red Ink. WITH DATE AND NAME OF PERSON MAK-ING CHANGE.

Do not extend notes this side of this line

RETURN TO
LOS ANGELES COUNTY SURVEYOR
700 HALL OF RECORDS

FORM 247 BM 5-31

TOPOGRAPHY
— OF —
PRO. COLORADO STREET
W.O № 7099

From:- Orange-L.A. Co. Line on Seventh St. Pg. 212.
To:- Manila Ave on Colorado St. Pg. 216.

Aug.-1932.
C.A. Benson
H.L. Smelser
W.T. Lind
M. Taylor.

F.B. 293 Pg. 212

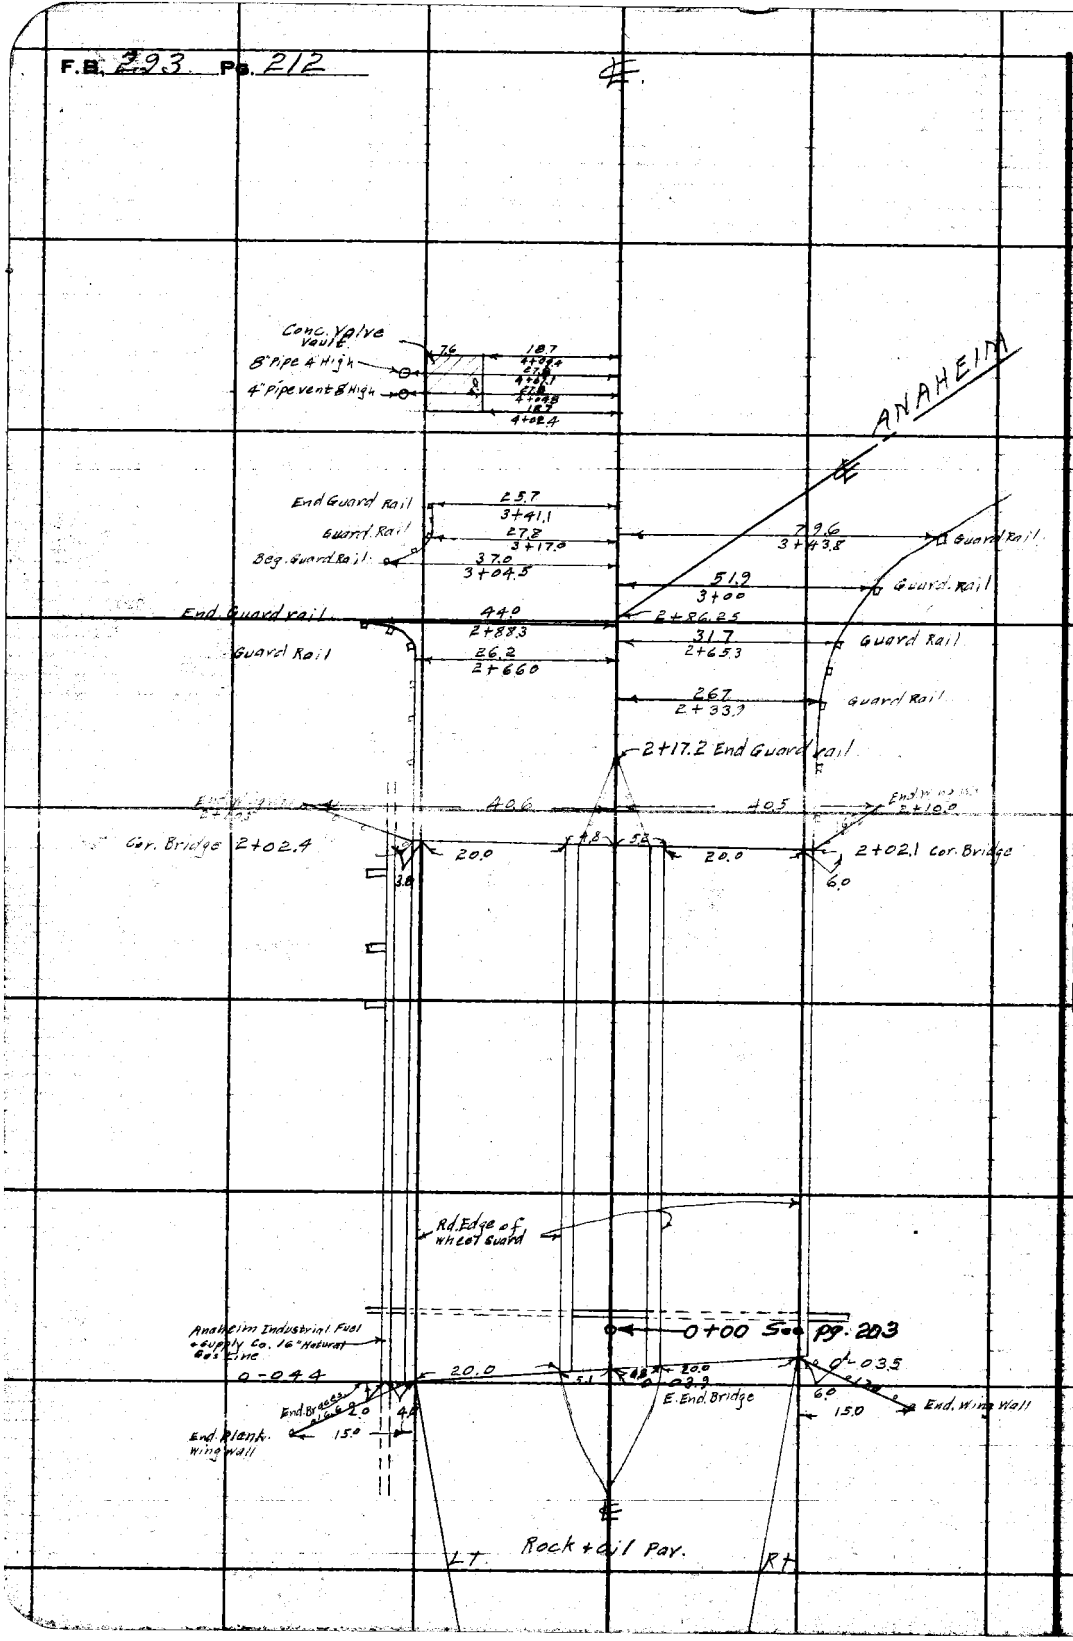

RETURN TO
LOS ANGELES COUNTY SURVEYOR
700 HALL OF RECORDS
Do not extend notes this side of this line

Note: ANY ADDITIONS OR CHANGES ON THIS SHEET MUST BE MADE OR CIRCLED IN Red Ink. WITH DATE AND NAME OF PERSON MAKING CHANGE.

Notes Gr'd by W.H.B. Survey of Colorado St. F.B. 293 Pg. 21
Map No. B-787 W. O. 7099 Tape No. St'd °F.
Checked Notes B Date 8-12-32
Date Indexed A. C. Johnson

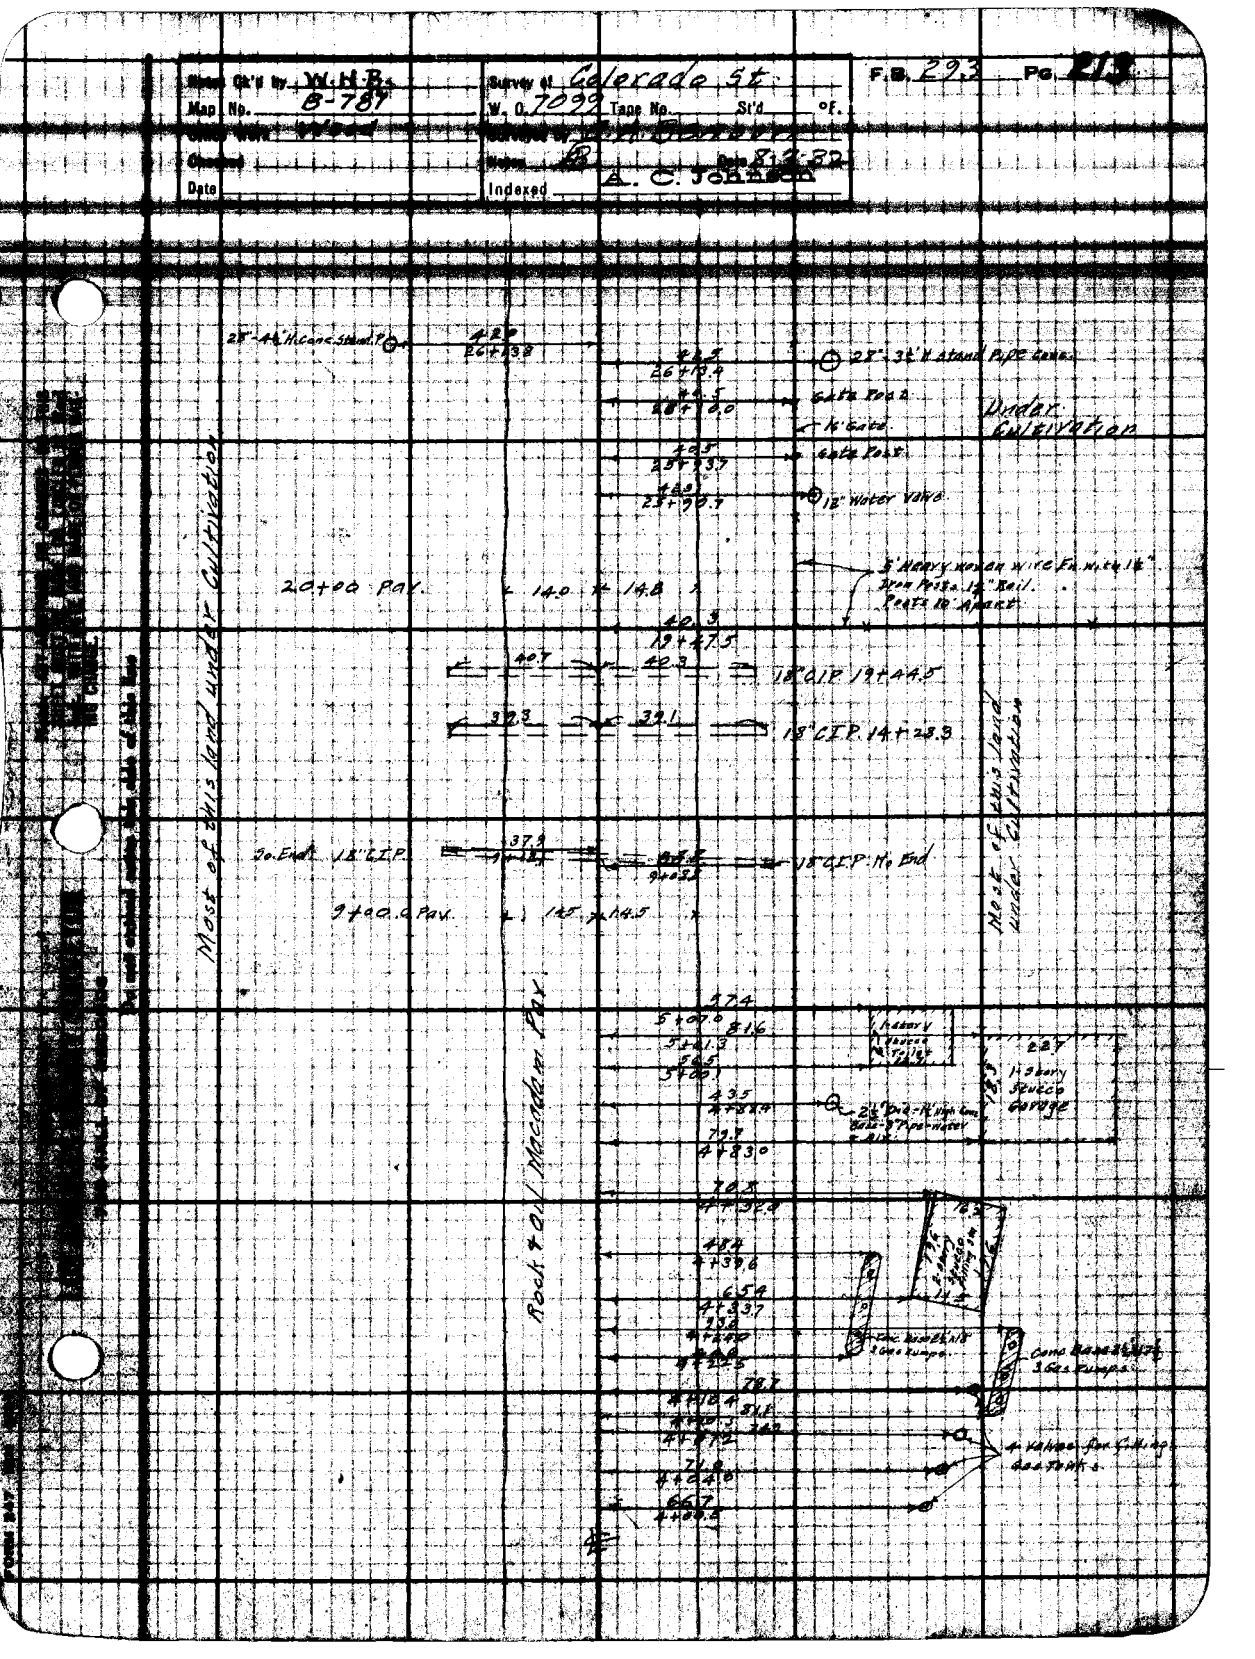
25'-14" H conc. Stand. P.
42.7
26+13.8
26+13.8
42.5
26+13.4
25'-3½" H Stand. Pipe Conn.
#4.5
28+20.0
Gate Pole
N. Gate
Under Cultivation
42.5
25+13.7
Gate Pole
42.9
25+00.7
12" Water Valve
3' Heavy Woven Wire Fence with 4" Iron Posts, 12" Rail. Posts 10' Apart.
20+00 Pav.
14.0
14.8
40.3
19+27.5
40.7
40.3
18" C.I.P. 19+44.5
32.3
32.1
18" C.I.P. 14+28.3
Most of this land under Cultivation
Most of this land under Cultivation
Jo. End 18" C.I.P.
37.9
9+12.1
38.7
9+50.1
18" C.I.P. No End
9+00.0 Pav.
14.5
14.5
27.4
5+07.0
8.16
5+41.3
5.85
5+47.1
23.5
5+84.7
23.5 Deg. R.H. Conc. Base-Type Meter Box
79.7
Concrete Base & Unit 3 Gate Pumps
Concrete Base & Unit 3 Gate Pumps
4 Valves for Sidewalk Boxes

F.B. 293 Pg. 214

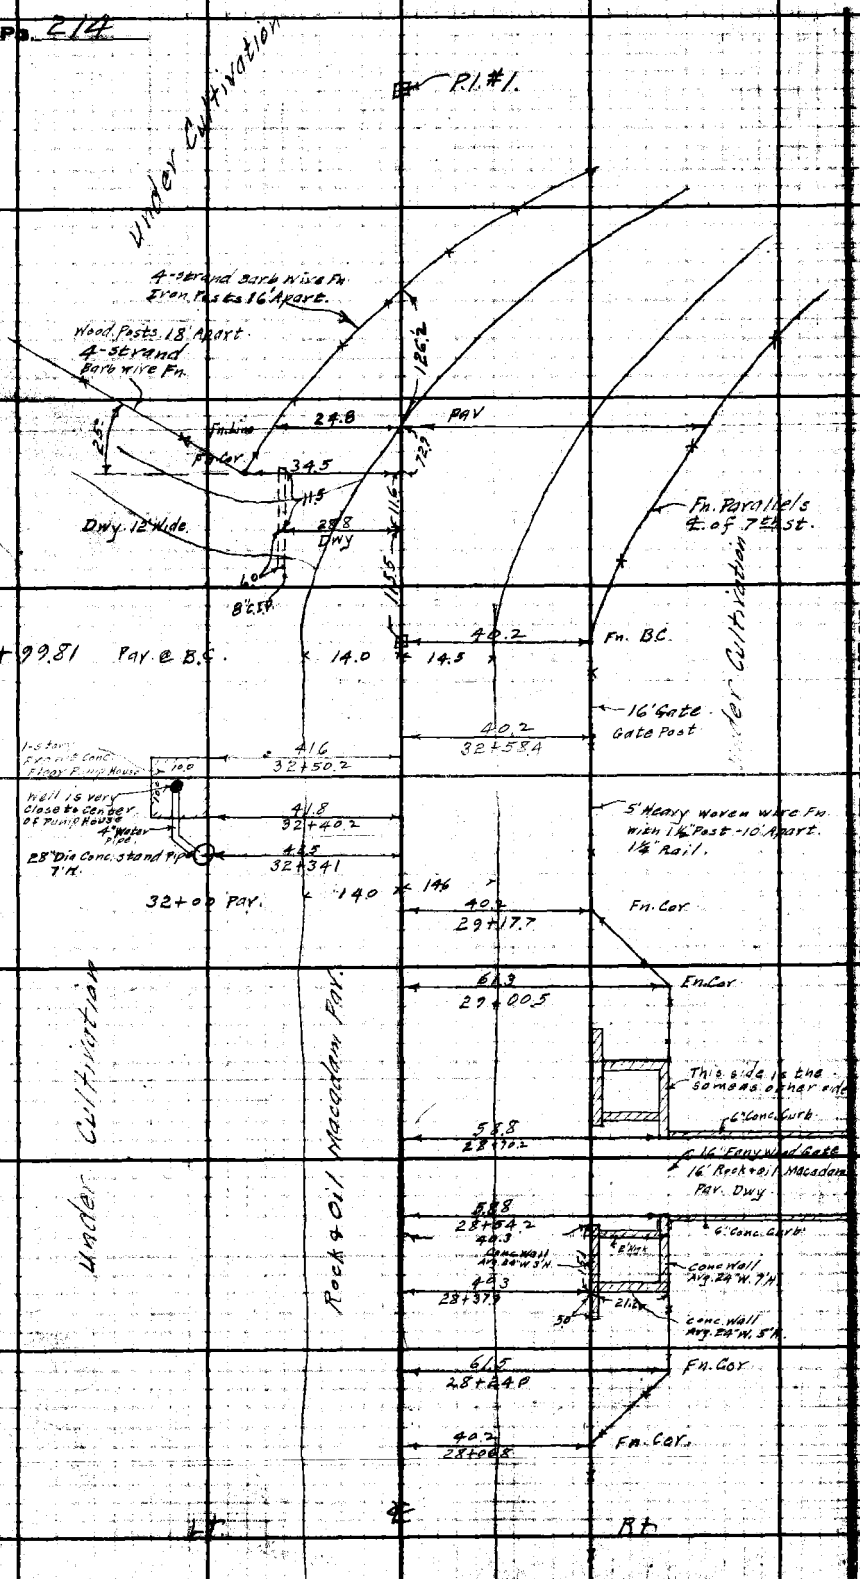

RETURN TO
LOS ANGELES COUNTY SURVEYOR
206 HALL OF RECORDS

Do not extend notes this side of this line

Under ANY ADDITIONS OR CHANGES ON THIS SHEET, MUST BE MADE BY CANCELLING SAME, WITH DATE AND NAME OF PERSON MAKING CHANGE.

Notes Ck'd by W.H.B.
Map No. B-787
Street Name Wood
Checked
Date

Survey of Colorado St.
W. O. 7092 Tape No. St'd °F.
Surveyed by C.A.Berglund
Notes B Date 8-32
Indexed A. C. Johnson

F.B. 293 Pg. 215

B.C 56+14.37

Fn. Cor.

Under Cultivation

70°

55+00.8 Int. Fn Line

Under Cultivation

20°

4-Strand Barb wire Fn Wood Post 20' Apart.

48+84.8 Int. Fn Line

45°30'

3-Strand Barb wire Fn. Wood Posts 20' Apart.

300

Abandoned Reservoir 4 ft.

60.

42+50

300

42+00

Under Cultivation

E.C 41+76.48

Int. Fn. Line

53°40'

122.2

Cultivation

3-Strand Barb wire Fn. Wood post. 20' Apart.

P.O.T. #1

Under

P.I. #1

Lt.

Rt.

RETURN TO
LOS ANGELES COUNTY SURVEYOR
700 HALL OF RECORDS

Notice: ANY ADDITIONS OR CHANGES OF THIS SHEET MUST BE MADE ON CIRCLED RED BAR WITH INK AND INITIALED. Do not extend notes this side of this line

ORM 247 10M 8-31

F.B. 293 Pg. 216

 
END SURVEY
MANILA
AVE.
78+09.79
152
150
4-Strand Barb
Post 15' Apart
Fn. Cor
17.1
End Fn.
32.7
77+79.6
35.9
77+79.6
End Fn
Asphalt Pav.
4 strand Barb wire Fn.
Wood Post 15' Apart.
No Headwall at present.
30.7
30.0
69+79.0
36" C.I.P.
Conc. Hd. Wall on En
4' High 8" Thick
15' apart at bot.
68+44.4 End Conc. & Beg. Asphalt
15.2
14.8
22.7
22.3
25.7
R=20
69.0
Fn. Cor
End. Fn.
68+23.9
Fn. Line
67+91.6
East Int.
33.0
55.9
HATHAWAY
AVE
Int. 67+70.65
CONC. PAV.
Edge Pav.
67+39.0
67+18.6 Int. Fn Line
Int. Fn. Line. 64+37.9
4 Strand Barb Wire Fn
Wood Post 15' Apart
EC. 63+88.52
P/#2.
Lt.
Rt.