302

Plotted by	W. O. No. D. S. O. No.
Date	Location
Map No.	Computed by
Plotting C'k'd by	Date
Date	Indexed

F. B. Pg.

51,890

51,817

F. B. 302 Pg. INDEX

Platted by	W.O.No. D.S.O.No.
Date	Location
Map No.	Surveyed by
Platting C'k'd by	Date
Date	Indexed

F.B.No. 302

PAGES: Index, 1 to 48 incl., 53 to 124 incl.
124A, 125, 126 inclusive. 129 to 135
incl., , 137 to 165 incl.,
167 to 181 incl.,

Date _____ Notes by _____ Chief Party _____ F. B. 302 PG. 1

Plotted by Crouch	M.C.Q. No. _____ U. S. Q. No. _____
Date Mar '28	Location _____
Map No. B-117	Surveyed by _____
Plotting C'k'd by R. W. S.	Date _____
Date JUL 1 1928	Indexed C. Johnson

Notes: ANY ADDITIONS OR CHANGES ON THIS SHEET MUST BE MADE OR CIRCLED IN Red. WITH DATE AND NAME OF PERSON MAKING CHANGE.

Do not extend notes this side of this line

RETURN TO LOS ANGELES COUNTY SURVEYOR

SURVEY

of

SOMERSET M.

Berger Transit No. 16582
Band TOPC #911 Standard at [illegible] Transit 8.27
Used on this [illegible] 2.7 to 117

M. Hayes
[illegible]

TOPO Notes on same. 52 to 116 inc.

F.B. 302 Pg. 2 Chief Party Notes by Date

INDEX

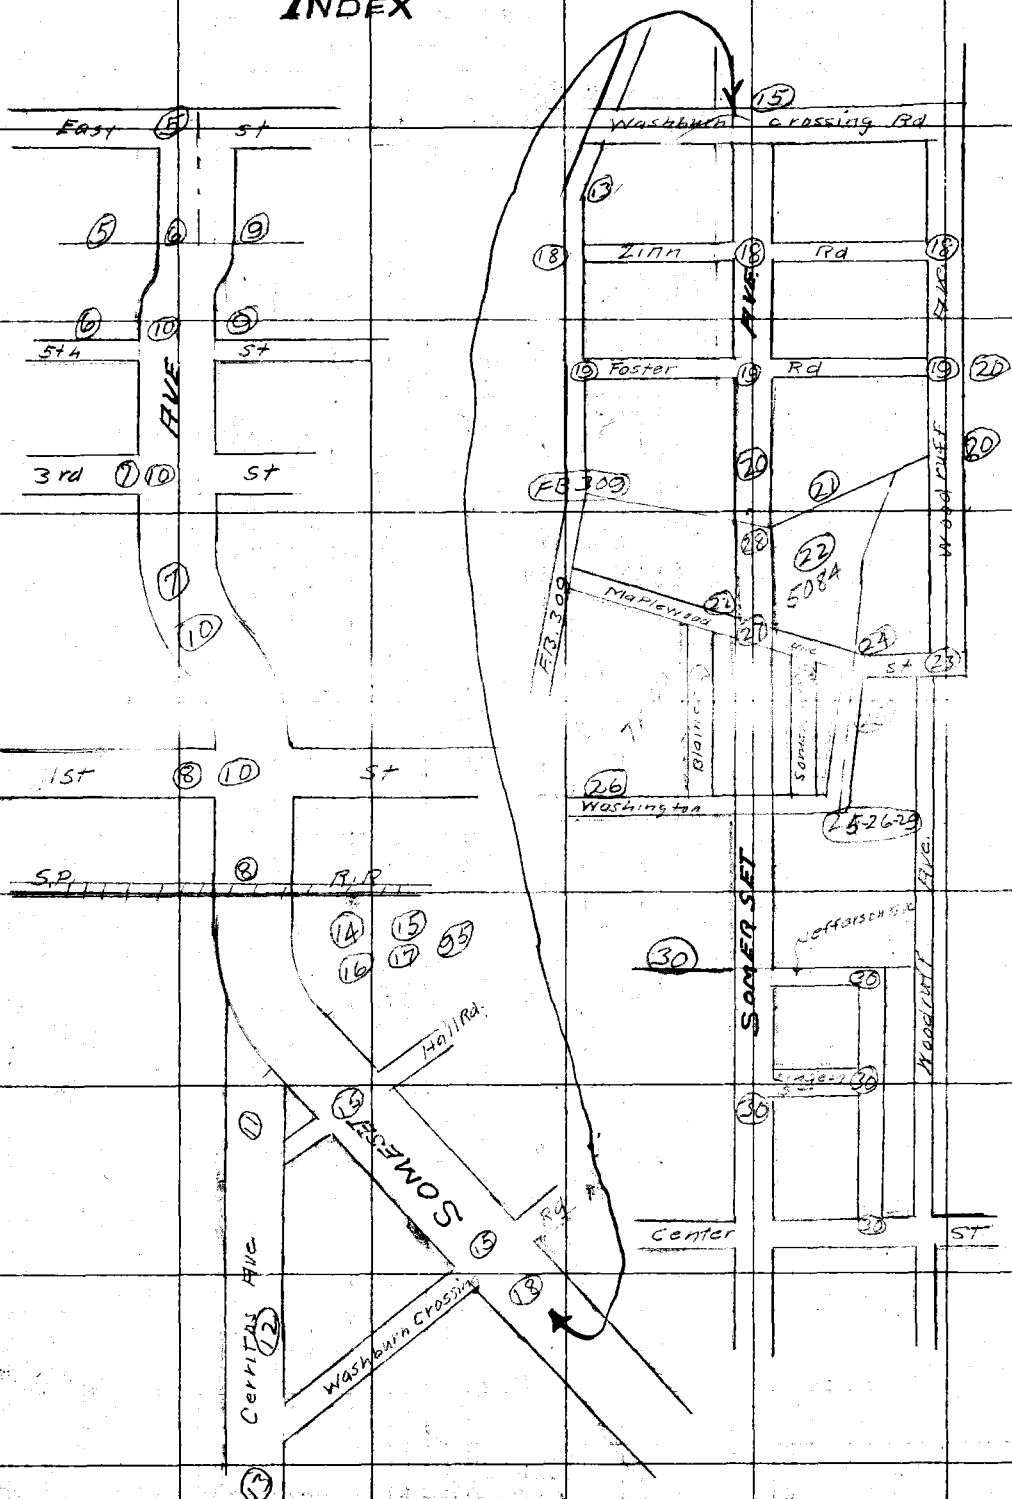

RETURN TO
LOS ANGELES COUNTY SURVEYOR
Do not extend notes this side of this line

Notes: ANY ADDITIONS OR CHANGES ON THIS SHEET MUST BE MADE OR CIRCLED IN Red. WITH DATE AND NAME OF PERSON MAKING CHANGE.

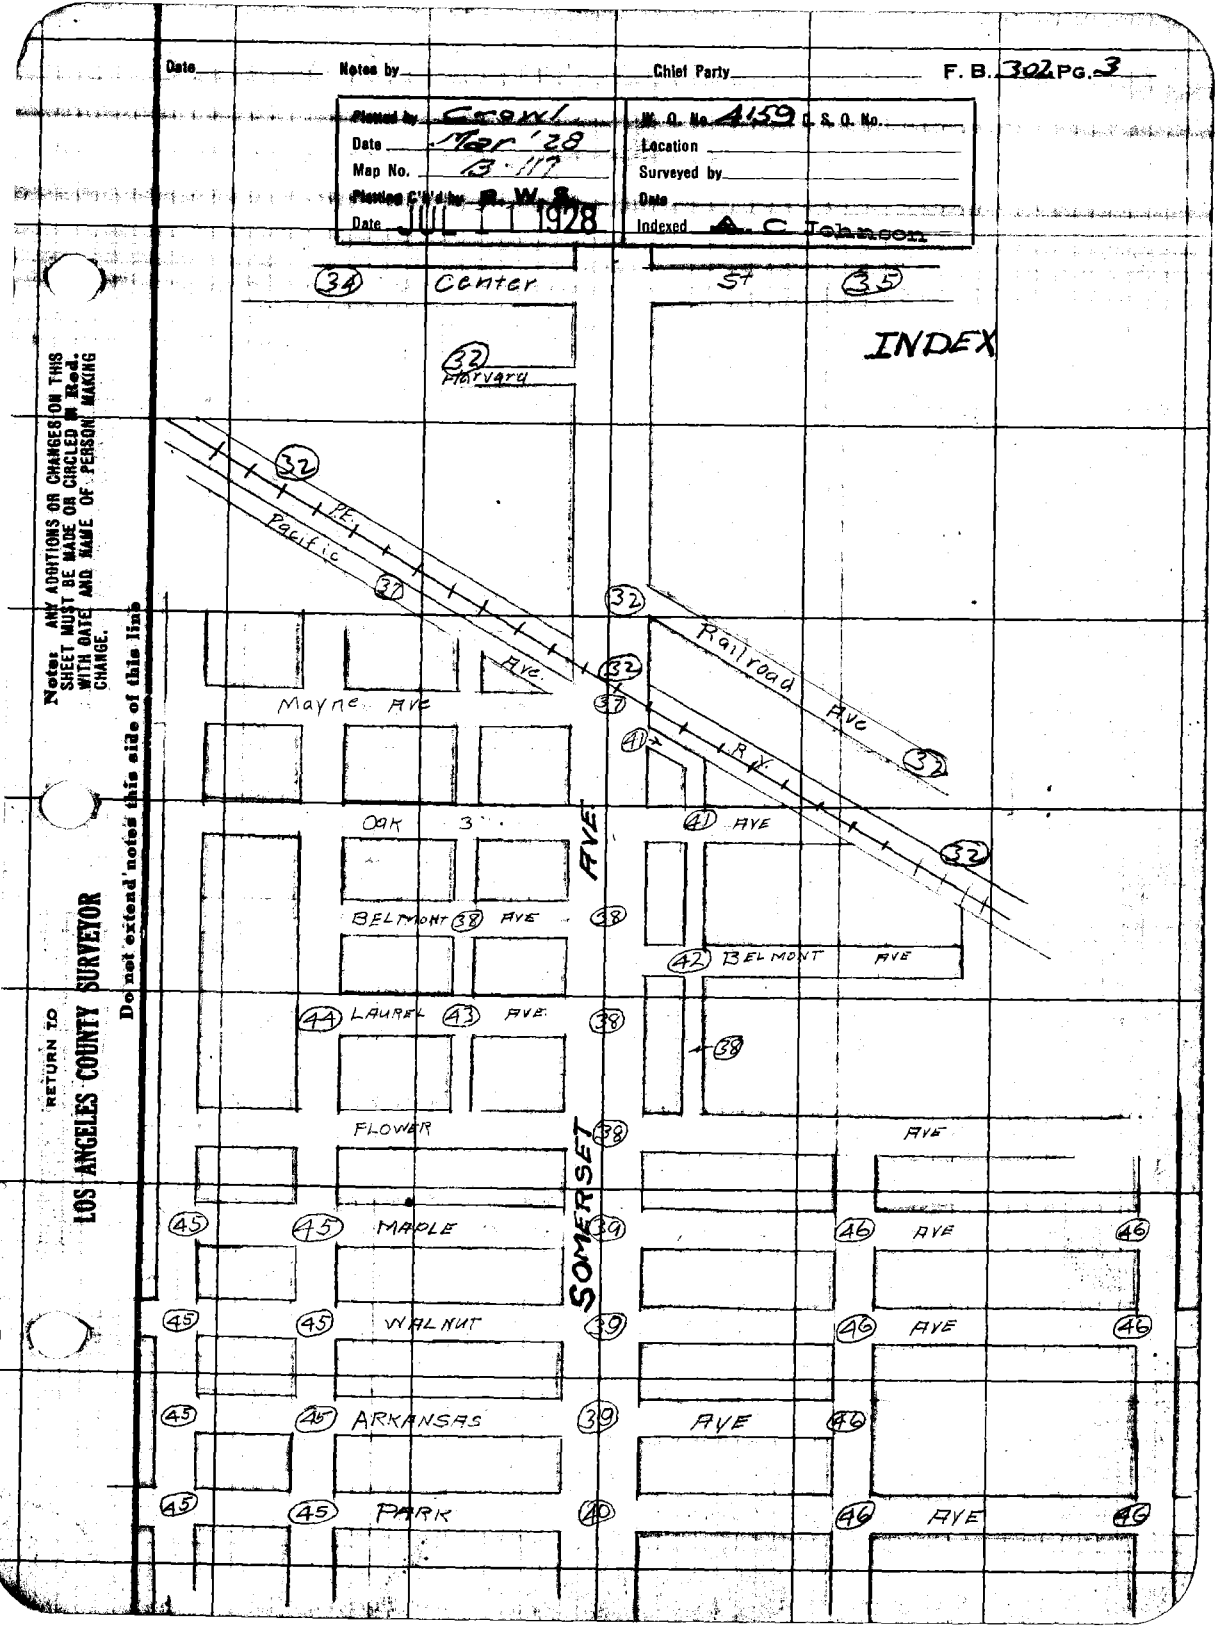
Date
Notes by
Chief Party
F. B. 302 PG. 3
Plotted by Crowl
Date Mar '28
Map No. 3-117
Plotting Ck'd by R. W. S.
Date JUL 1 1928
W. O. No. 4459 C. S. O. No.
Location
Surveyed by
Date
Indexed A. C. Johnson
INDEX
Center
ST
Harvard
P.E.
Pacific
Ave.
Railroad
Ave
R.W.
Mayne Ave
Oak
Belmont Ave
Laurel Ave
Flower
Maple
Walnut
Arkansas
Park
Somerset
Ave
Notes: ANY ADDITIONS OR CHANGES ON THIS SHEET MUST BE MADE OR CIRCLED IN Red. WITH DATE AND NAME OF PERSON MAKING CHANGE.
Do not extend notes this side of this line
RETURN TO
LOS ANGELES COUNTY SURVEYOR

F.B. 302 Pg. 4 Chief Party Notes by Date

INDEX

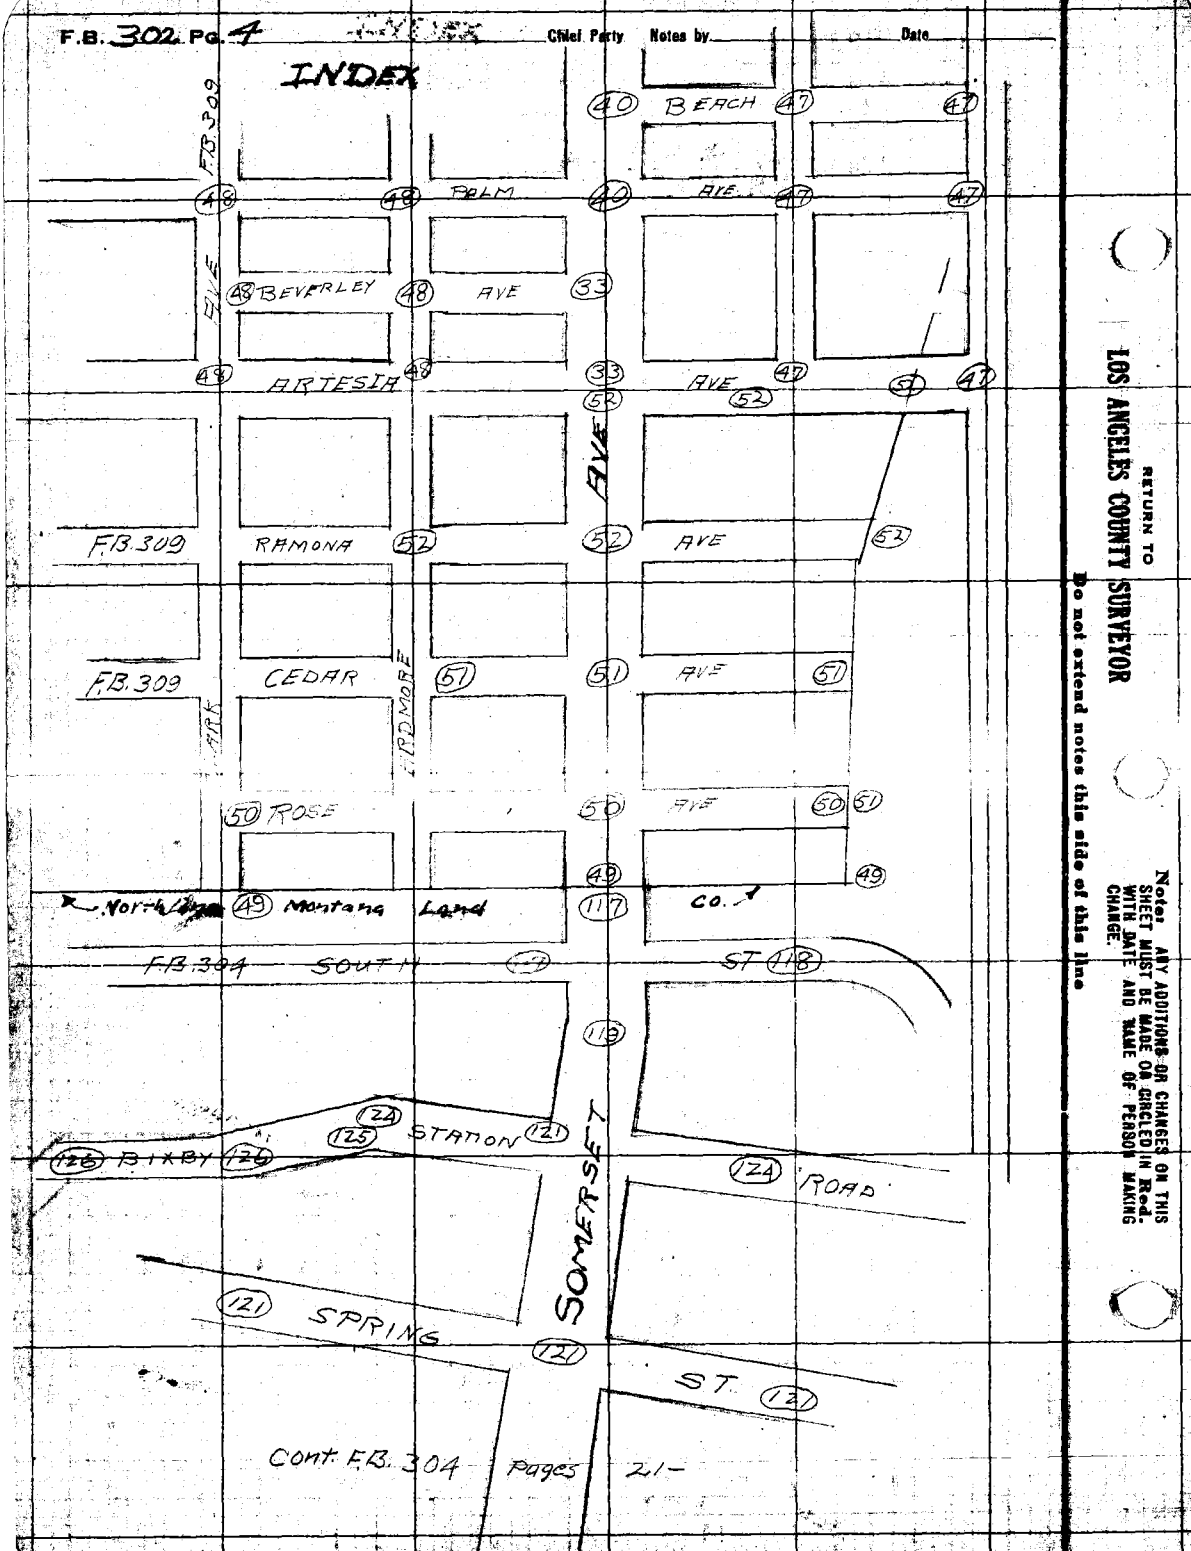

RETURN TO
LOS ANGELES COUNTY SURVEYOR

Do not extend notes this side of this line

Note: ANY ADDITIONS OR CHANGES ON THIS SHEET MUST BE MADE OR CIRCLED IN Red. WITH DATE AND NAME OF PERSON MAKING CHANGE.

F. B. 202 Pg. 2

Date Feb '28
Map No. B-117
Date JUL 1 1928

Location Downey
Surveyed by Boyer & Party
Date Oct 1927
Indexed A. C. Johnson

Note: ANY ADDITIONS OR CHANGES OF ANY KIND SHALL BE MADE ON THIS SHEET ONLY AND NOT ON ANY OTHER SHEET. WHEN DATE AND NAME OF PERSON MAKING CHANGE.

Retain 1st sheet; mail this side of this sheet

RETURN TO LOS ANGELES COUNTY SURVEYOR

Set + in pav. 8'00 A.D.
Cross ties in P.C. 251-7
+ 18.17 at P. angles Et

Cross L&T.

EASY

736.02 @ 74°

736.08

Set + in Pav.

214.97

214.95 @ 74°

Fd L&T 256.70
18+41.39
Per F.C. 251-7

256.08 @ 74°

230.02
230.00 @ 74°

Fd + in Pav. 1.00 Mig

Set +

Set + in Pav.

ST

89° 25' 55"
89° 26' 00"
357 43' 45"
1 short sight

Fd. 2" I.P.

Fd 2" I.P.

Fd 2" I.P.

191.86 @ 82°

Fd L&T in Conc Water Box

1 2 3

Set Nail

Hayes & Parks

N 0° 16' 48" E 1852.50

N 0° 16' 48" E 1641.06

1640.85 @ 82°

TRACT NO. 6486

M.M. 40

Fd L&T in Conc Water Box

489.08
489.02
@ 82°

Fd ¾" I.P.

144.35
144.32 @ 82°

Fd 2" I.P.

N 74° 54' 25" Adj.

179° 59' 30"

432.72
432.66 @ 82°

Fd 2" I.P.

Fd 2" I.P. marked to W. Straightened up to line & sec dist N & E of lot

N 89° 59' 55" E

223.87

Fd L&T in Conc Alley Wall E. Side

Fd hole in conc where pipe had been

35.38

15.00

15.00

15.00

F.B. 302 PG. 6

Chief Party Notes by Date

From bottom Page 5

3.33

Fd 2" I.P. W'ly Cor Lot 1

816.43

289.25

Fd. 2" I.P.

Fd 2" I.P. N'ly Cor Lot 6

Fd 2" I.P. E'ly Cor Lot 6

Set Spk

Ro Santa Gertrudes

1505.13@84°

1505.35

TRACT NO. 4844

360° 11' 45"

89° 44' 50"

89° 44' 45"

358° 59' 15"

89° 57' 00"

359° 48' 00"

Fd 2" I.P.

Fd 2" I.P. Most W'ly Cor Lot 6 Tract 4844

Fd 2" I.P. Most W'ly Cor, Lot 5 Tr 4844

166.30@80°

166.32'

10.00

10.00

289.14@82°

289.18'

171.29

719.65

729.60

@80°

30.00'

FIFTH ST

Fd. old 2x2 No pipe

Fd. 2" I.P.

TR. NO. 8326

TR. NO. 9177

50'

50'

740.30@84°

740.45'

RETURN TO
LOS ANGELES COUNTY SURVEYOR

Do not extend notes this side of this line

Notes: ANY ADDITIONS OR CHANGES ON THIS SHEET MUST BE MADE OR CIRCLED IN Red. WITH DATE AND NAME OF PERSON MAKING CHANGE.

F. B. 302 Pg. 7

Date Feb 28
Map No. B-117-Sh1
R.W.S.
Date 1928

Location Downey
Surveyed by Boyer & Party
Date Oct 1927
Indexed C. C. Johnson

From bottom Page: 6

AVE

9177

THIRD

Fd 2x2

ST.

Fd 3" I.P.

NO. 8826

CERRITOS

50.

50.

255.41@84

255.46.

TRACT

Fd 2x2 BC

Fd. 3" I.P.

50.00

Fd ¾" Iron Pin by S. of Rigtangles from 2x2 B.C.

125.17
125.15@84°

Fd 2x2 P.I.

144°26'45"
217.43.00

125.41
125.13@84°

Fd 2x2 P.R.C.

F.B. 397 Pg. 8 — Chief Party — Notes by — Date

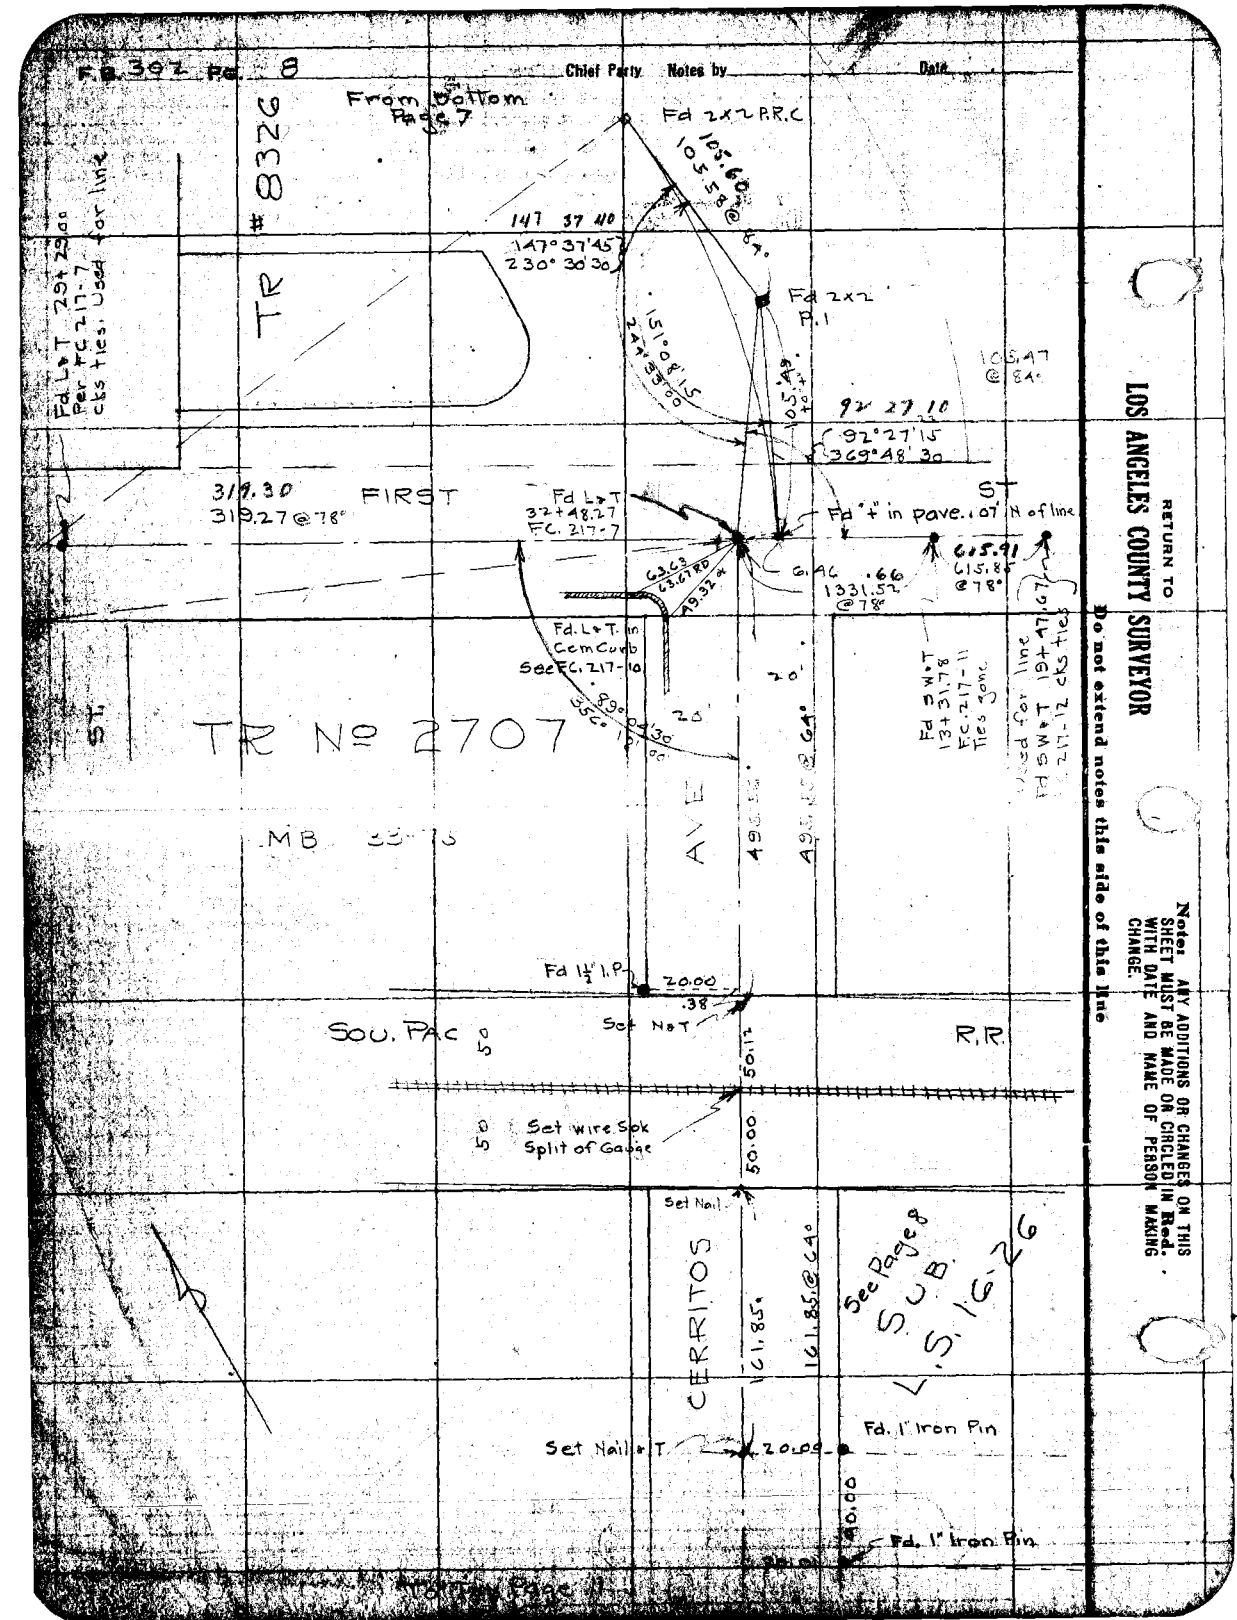

RETURN TO
LOS ANGELES COUNTY SURVEYOR
Do not extend notes this side of this line

Notes: ANY ADDITIONS OR CHANGES ON THIS SHEET MUST BE MADE OR CIRCLED IN Red. WITH DATE AND NAME OF PERSON MAKING CHANGE.

Continued Page 11

Notes by _____ Chief Party _____ F. B. 302 Pg. 7

Date Feb '28
Map No. B-117
Date JUL 1 1928

W. O. No. 1458 R. & O. No. _____
Location SOMERSET AVE
Surveyed by M. Hayes
Date _____ 1928
Indexed

M. Hayes
T.B. Tract 6486
Rec. Surveys
Pat. Jarvis

From Page 5-8

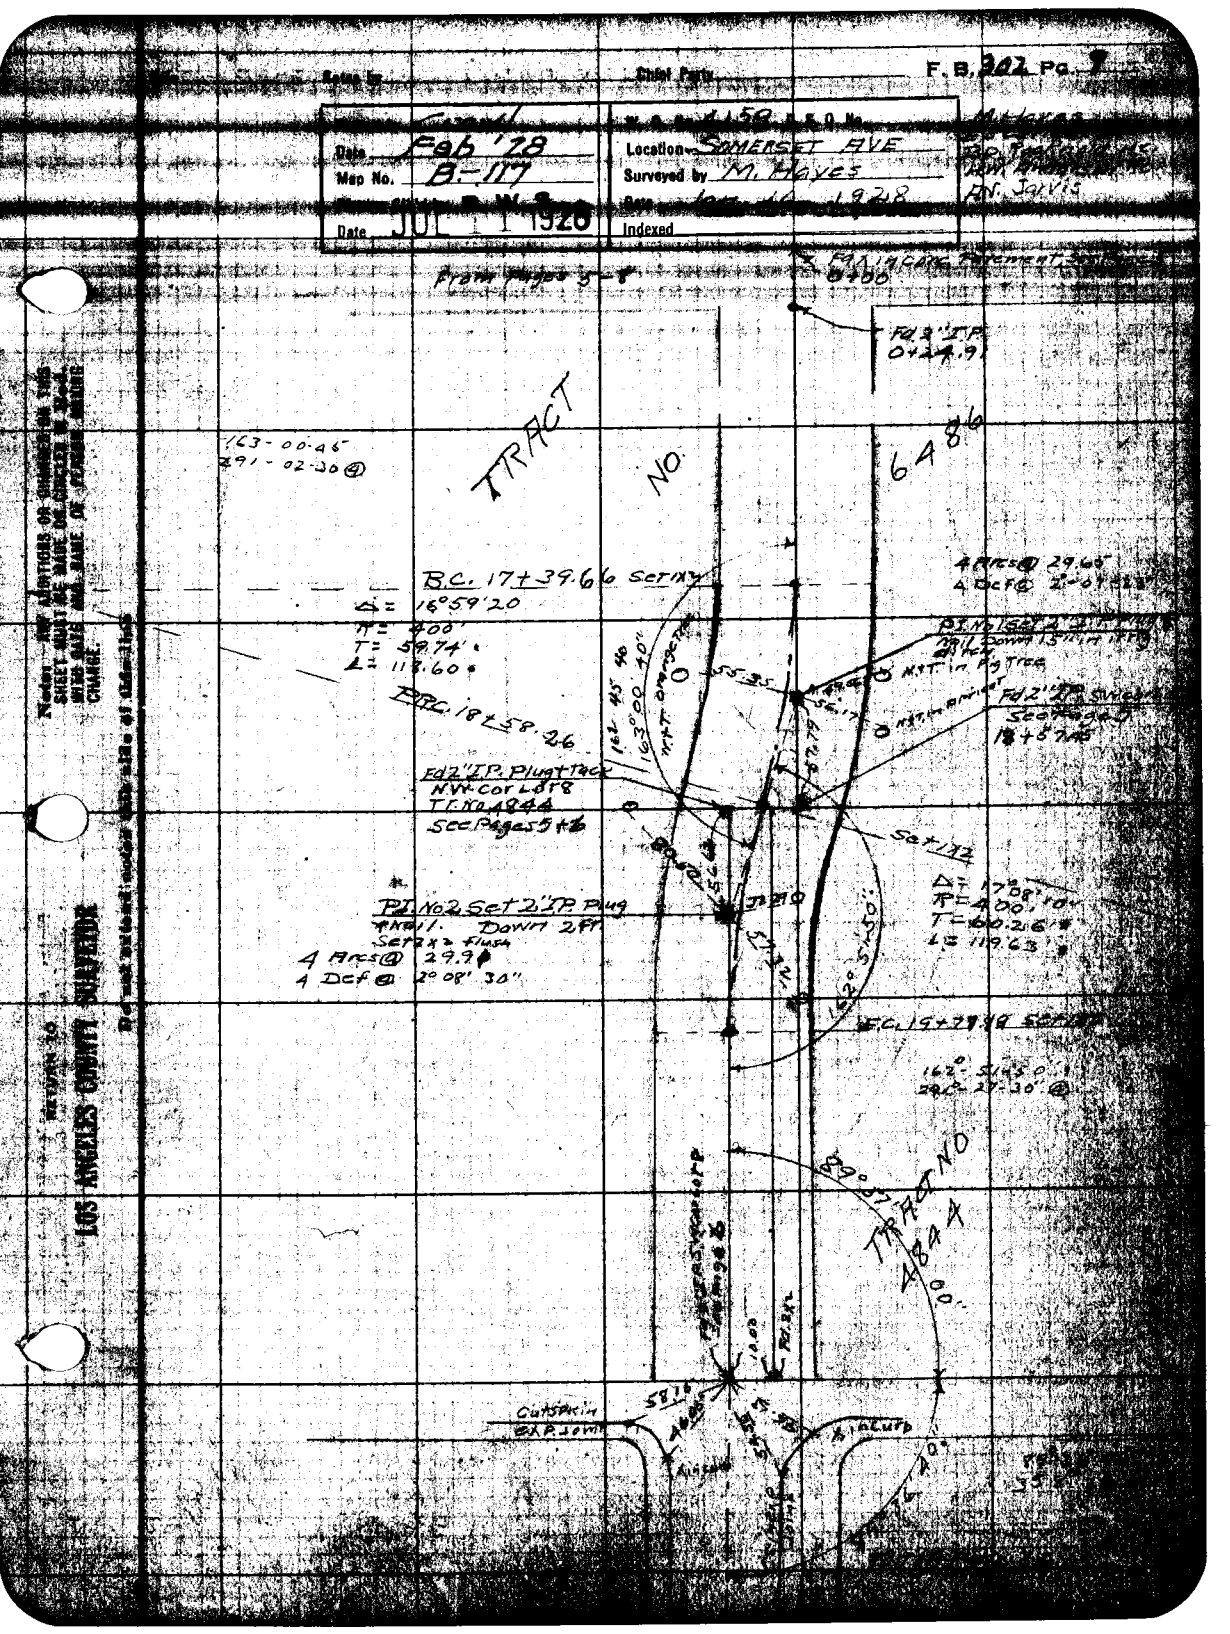


LOS ANGELES COUNTY SURVEYOR


Bk. 302 Pg. 10 M. Hayes Chief Party Notes by E. Carlson 1-10-28

Contd. from bottom Page #9

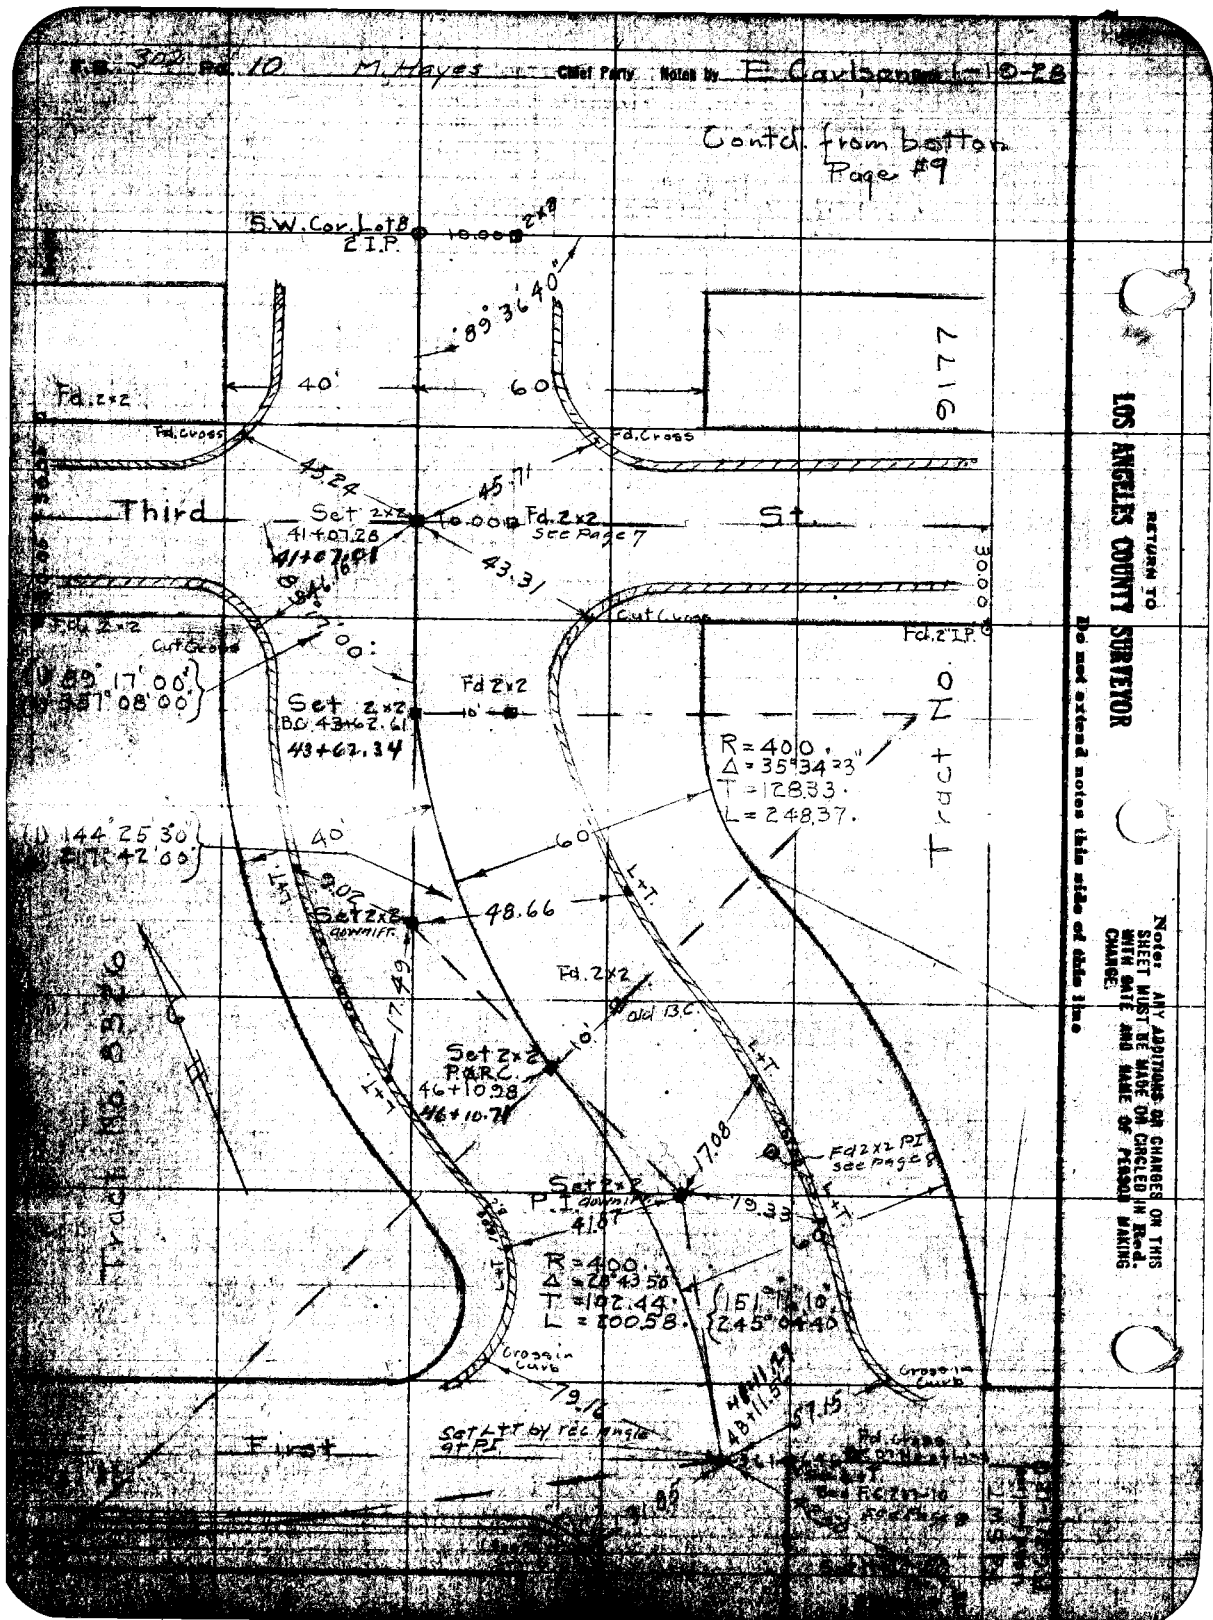
S.W. Cor. Lot 8
2 I.P.
10.00
2x9
89° 36' 40"
Fd. 2x2
40'
60'
Fd. Cross
Fd. Cross
9177
45.24
45.71
Third
Set 2x2
41+07.28
40.00
Fd. 2x2
See Page 7
St.
43.31
30.00
Fd. 2x2
Cut Cross
Cut Cross
Fd. 2 I.P.
89° 17' 00"
87° 08' 00"
Set 2x2
B.C. 43+62.61
43+67.34
Fd 2x2
10'
R = 400'
Δ = 35° 34' 23"
T = 128.33'
L = 248.37'
144° 25' 30"
217° 42' 00"
40'
60'
9.02
Set 2x2
Gonniff.
48.66
L+T
Fd. 2x2
old B.C.
17.49
Set 2x2
P.R.C.
46+10.28
46+10.78
10'
17.08
Fd 2x2 P.I.
See Page 8
Set 2x2
P.T.
41.67
19.33
R = 400'
Δ = 28° 43' 50"
T = 102.44'
L = 200.58'
151° 16' 10"
245° 04' 40"
Crossing Curve
Crossing Curve
19.12
Set L+T by rec. angle at P.T.
47.15
Fd. Cross
End F.C. in 10
Fd. Cross
Fd. Cross
Fd. Cross

Chief Party F. B 302 PG. 11

Date Feb '28
Map No. B-117
Date JUL 1 1928

Location Downey
Surveyed by Boyer + Party
Date Oct 1927
Indexed A. C. Johnson

From Bottom Page 8

Set Nail + T

Fd 1" Iron Pin

Set punch Mk

Fd 1½" Iron Pipe

Set nail

Fd 1" Iron Pin

Fd 1½" I.P.

Set punch mk

Fd spk + T
Used for line

S 29.38 E

SUBDIVISION

HALL

Notice: ANY ADDITIONS OR CHANGES ON THIS SHEET MUST BE MADE OR CHALED IN RED. WITH DATE AND NAME OF PERSON MAKING CHANGE.

RETURN TO LOS ANGELES COUNTY SURVEYOR

Do not write on this side of this line

To TSP Page 12

F.B. 302 PG. 12 Chief Party Notes by Date

From bottom Page 11

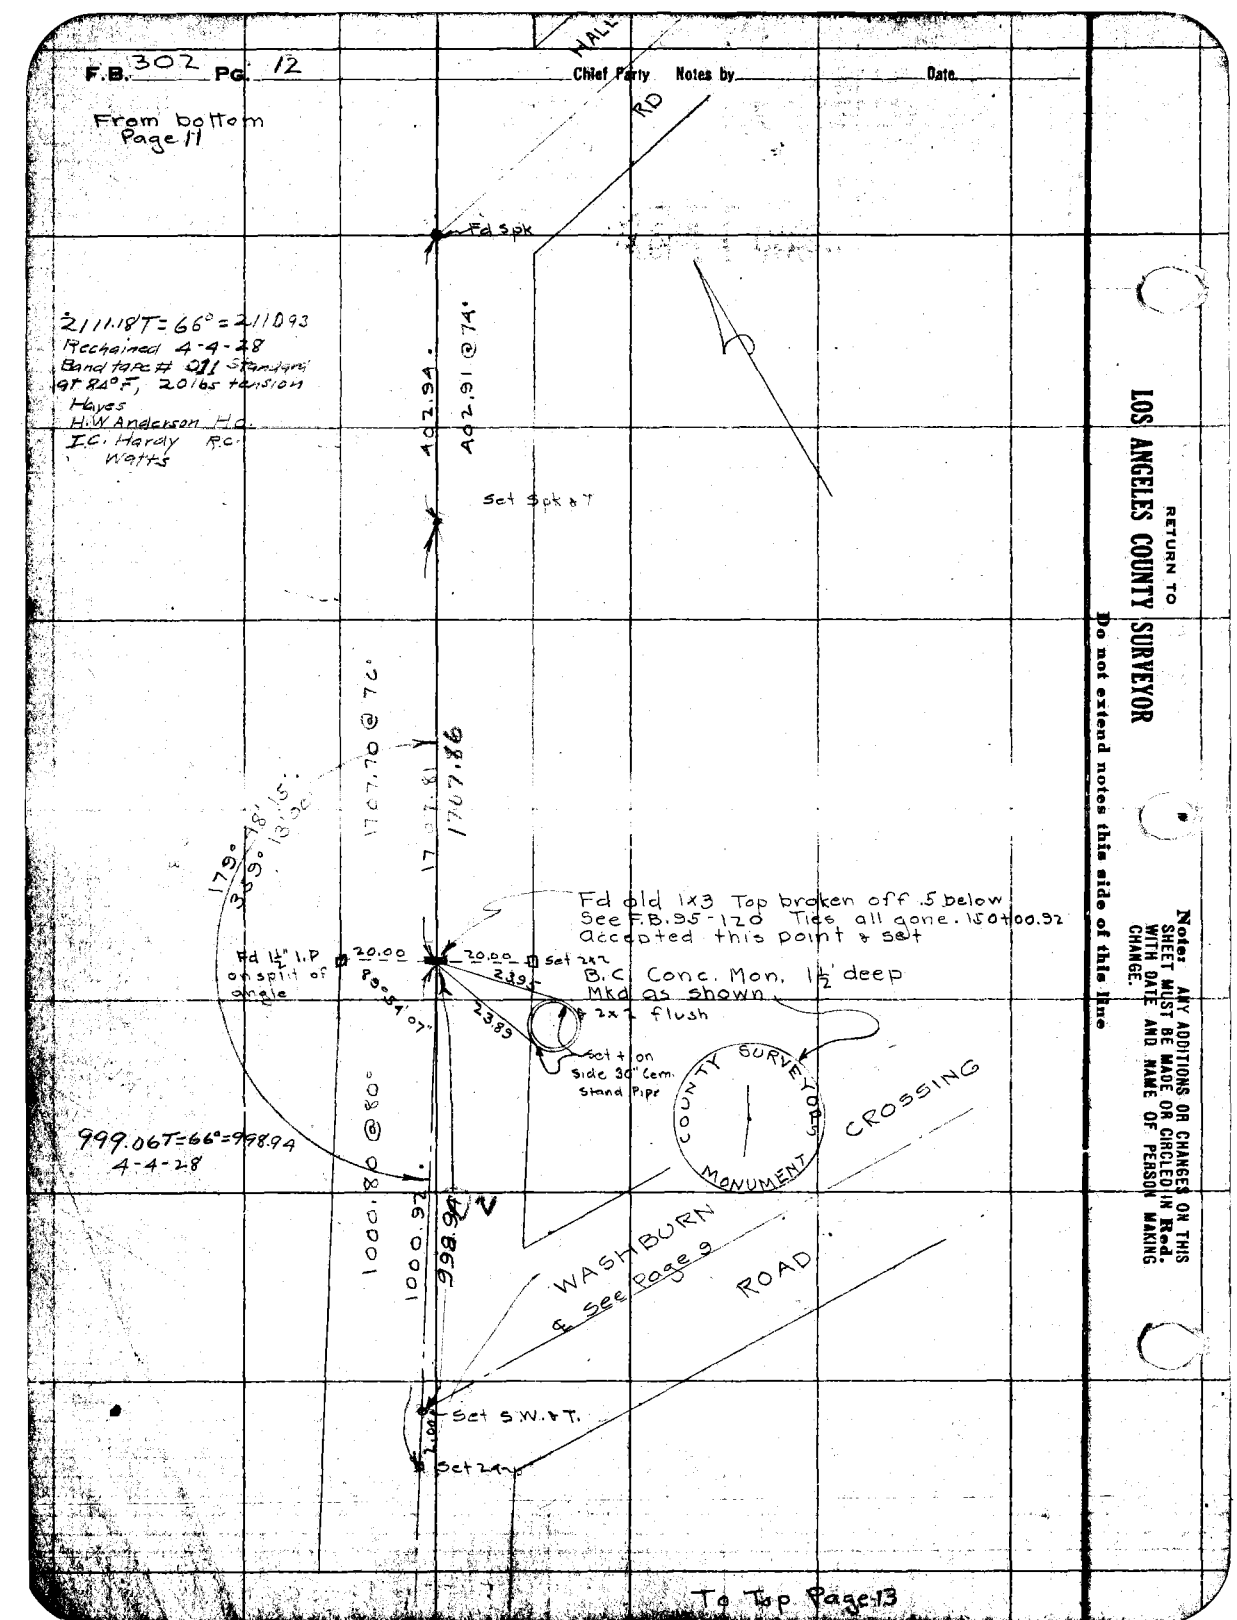

211.18T = 66° = 211.93
Rechained 4-4-28
Band tape # 911 Standard
at 84°F, 20 lbs tension
Hayes
H.W. Anderson H.C.
I.C. Hardy R.C.
Watts

999.06T = 66° = 998.94
4-4-28

RETURN TO
LOS ANGELES COUNTY SURVEYOR
Do not extend notes this side of this line

Note: ANY ADDITIONS OR CHANGES ON THIS SHEET MUST BE MADE OR CIRCLED IN Red. WITH DATE AND NAME OF PERSON MAKING CHANGE.

To Top Page 13

Date _____ Notes by _____ Chief Party _____ F. B 302 PG. 13

Plotted by Cassel
Date Feb'28
Map No. B-117
Plotting C'k'd by R. W. S.
Date JUL 11 1928

W. O. No. A-53 D. & O. No.
Location Downey
Surveyed by Boyer & Party
Date Oct 1927
Indexed A. C. Johnson

Washburn
From bottom Page 12
2.00' Set SPKT
See page 12
Set 2x2
Crossing Rd.
AVE
Travelled Road
323.50 @ 40°
323.54'
Fd Wire Spkt
Fd Wire Spkt
.36
.70
.50
Set Cut Spk N&T
778.07 @ 78°
778.15'
Fd. Old N&T P.P. See FB. 95
Fd. Old N&T Tel Pole
.15 of .99
66.81 ok
Fd 2x2 flush cks tie in F.B. 95-118 accepted this point & set B.C. Mon 1½' deep Mkd as shown & 2x2 flush
63.24 ok
Fd. Old N&T P.P.
DOWNEY RD.
CERRITOS

COUNTY SURVEYOR MON. MONUMENT

Notes ANY ADDITIONS OR CHANGES ON THIS SHEET MUST BE MADE OR CIRCLED IN Red. WITH DATE AND NAME OF PERSON MAKING CHANGE.

RETURN TO LOS ANGELES COUNTY SURVEYOR

Do not extend notes this side of this line

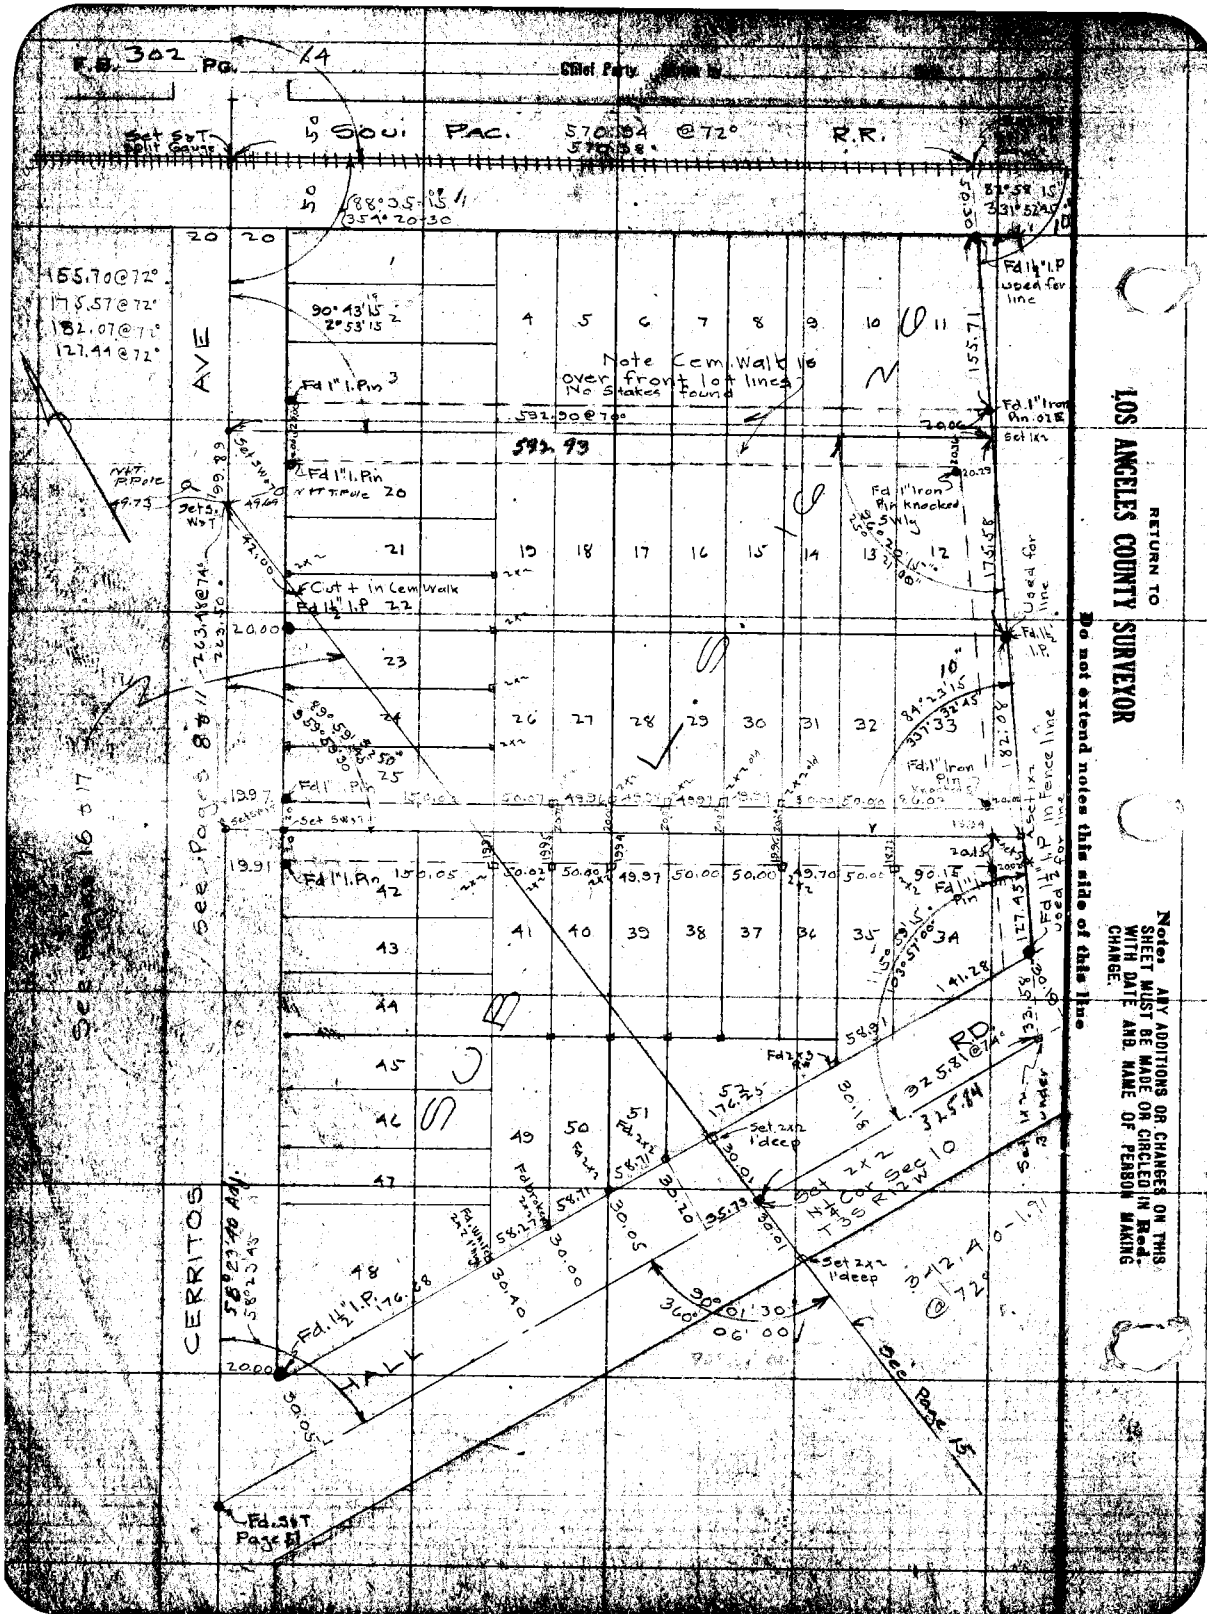
R.B. 302 Pg. 14
Chief Party
S. Pac. 570.94 @ 72° R.R.
Fd 1½" I.P used for line
Note Cem. Walk lie over front lot lines No Stakes found
Fd 1" I. Pin
Fd 1" Iron Pin Knocked
Fd 1½" I.P
Set 1x2
Fd 1" Iron Pin
Used for line
Fd 1" I.P in Fence line
Fd 1" I. Pin
Fd 1" Iron Pin
Set 2x2 1 deep
Fd 1½" I.P.
Fd 1½" I.P. 176.28
See Page 15
AVE
CERRITOS
HALY
RD
Ser. Pac. R.R.
Notes ANY ADDITIONS OR CHANGES ON THIS SHEET MUST BE MADE OR CIRCLED IN Red. WITH DATE AND NAME OF PERSON MAKING CHANGE.
Do not extend notes this side of this line
RETURN TO LOS ANGELES COUNTY SURVEYOR

RETURN TO

LOS ANGELES COUNTY SURVEYOR

Notes: ANY ADDITIONS OR CHANGES OR ERRORS SHEET MUST BE MADE OR CIRCLED IN RED WITH DATE AND NAME OF PERSON MAKING CHANGE.

Do not extend notes this side of this line

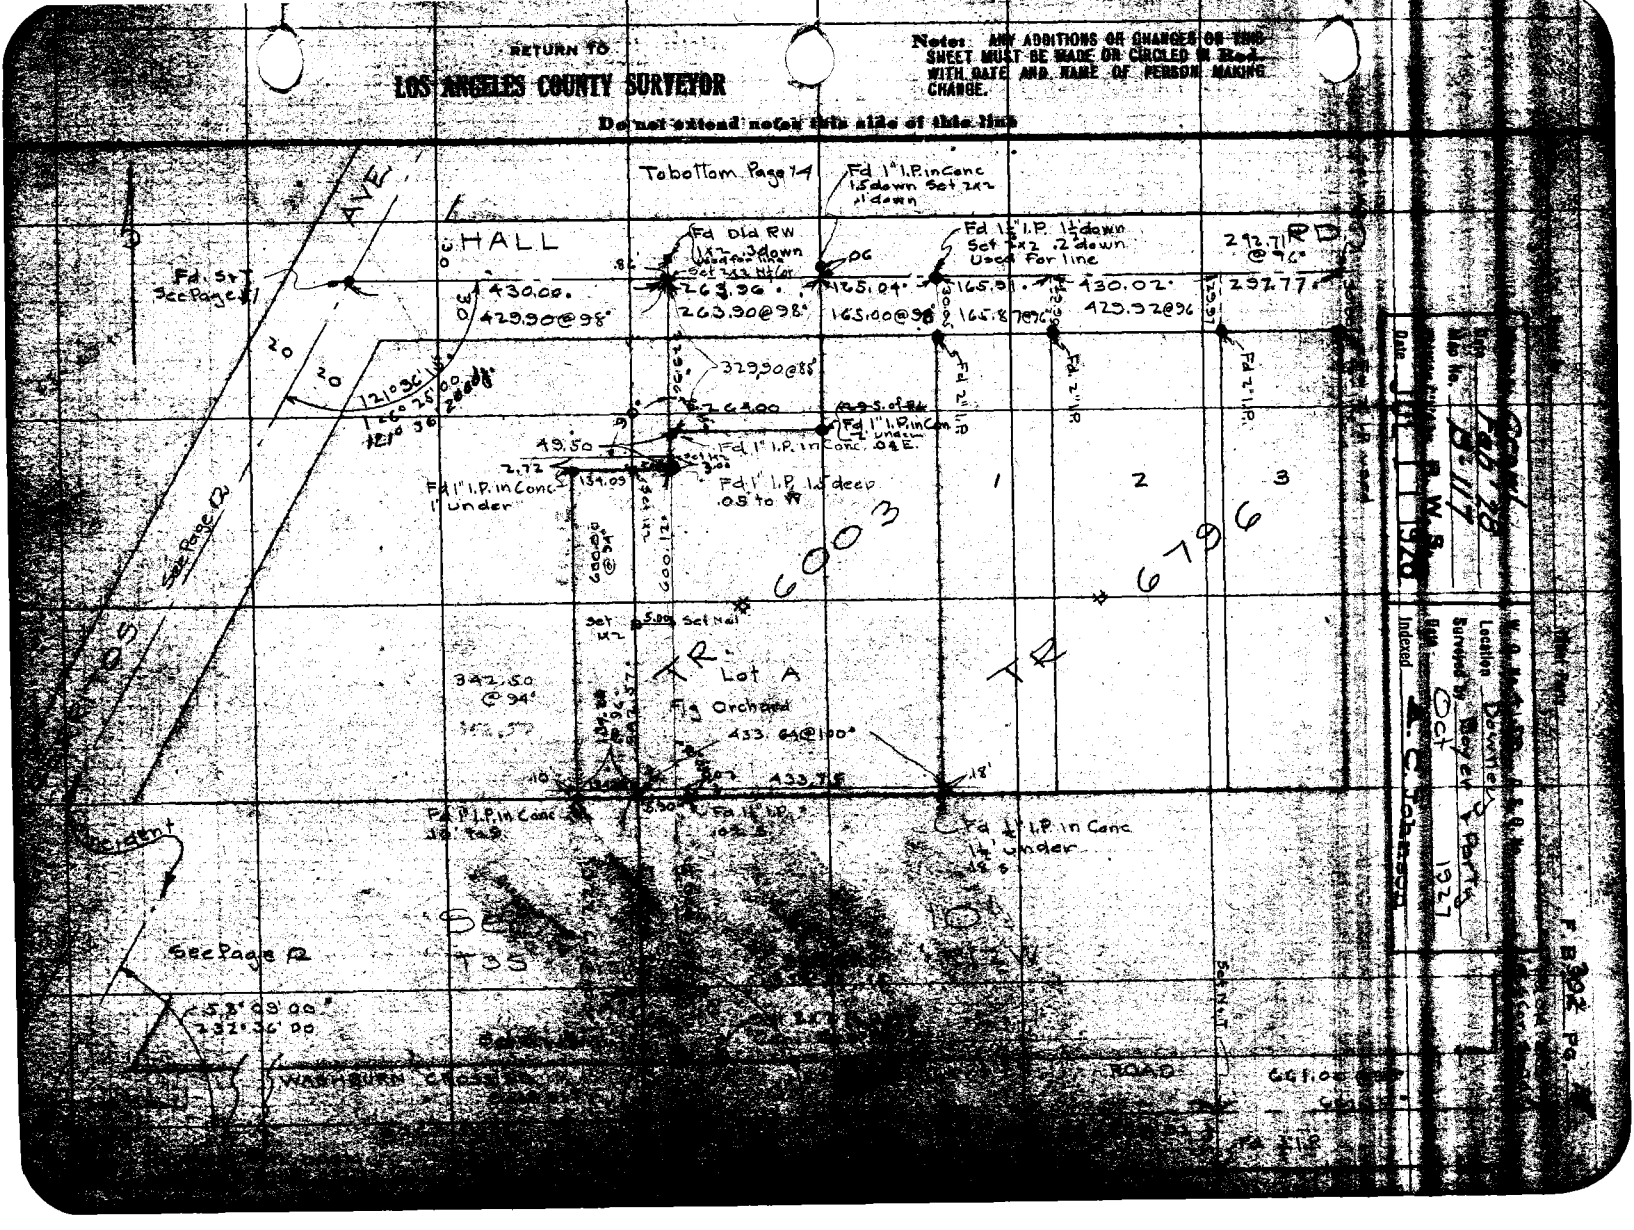

F.B. 302 Pg. 16 Chief Party Notes by Date

To bottom Page 17

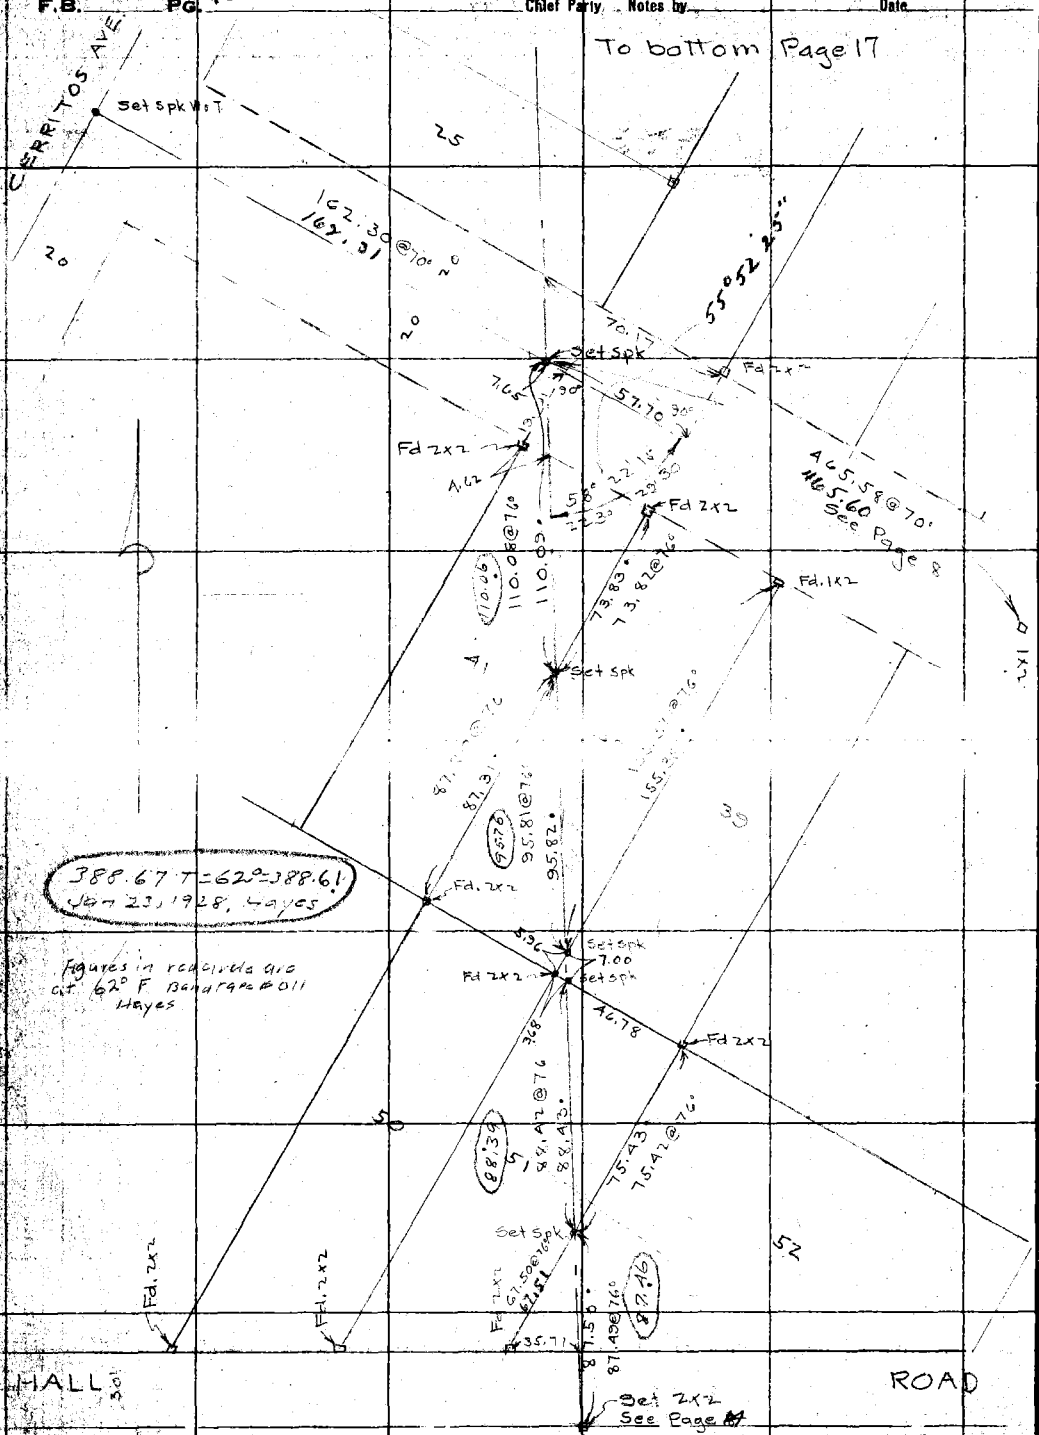

RETURN TO
LOS ANGELES COUNTY SURVEYOR
Do not extend notes this side of this line

Notes: ANY ADDITIONS OR CHANGES ON THIS SHEET MUST BE MADE OR CIRCLED IN Red. WITH DATE AND NAME OF PERSON MAKING CHANGE.

Date _____ Noted by _____ Checked by _____ F. B 302 PG. 17

Plotted by Gerow
Date Feb. 29
Map No. B-117
Plotting Ck'd by _____
Date JUL 11 1928

W. O. No. 4159 C. S. O. No. _____
Location Downey
Surveyed by Boyer + Party
Date Oct 1927
Indexed A. C. Johnson

Notice: ANY ADDITIONS OR CHANGES ON THIS SHEET MUST BE MADE OR CIRCLED IN RED WITH DATE AND NAME OF PERSON MAKING CHANGE.

RETURN TO LOS ANGELES COUNTY SURVEYOR
Do not extend notes into this side of this limb

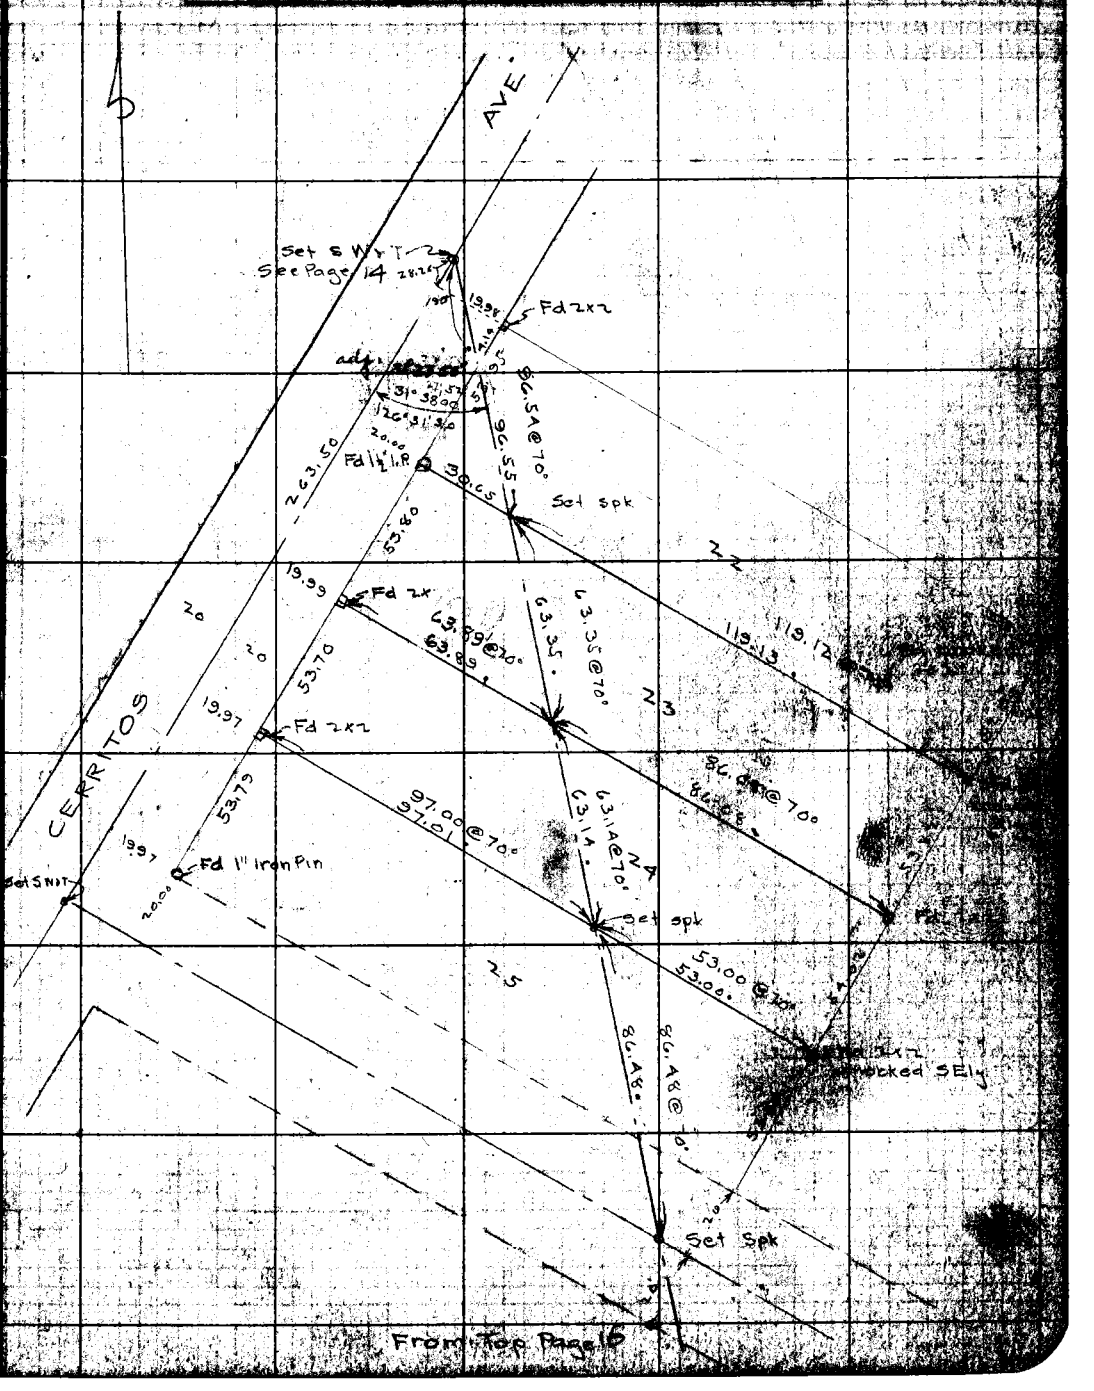

F.B. 302 S. 7 PG. 10

Chief Party, Notes by, Date

From Right side, Page 10

WASHBURN CROSSING ROAD

Set 1x2 Set 2x2 1' under Cor Sec 10

Fd old 4x4 Page 10

AVE.

Set 2x2 1' under

90°05'00" 360° 20' 15"

89° 55' 00" 359° 10' 15"

@ 31.27

assumed pull Tem. std of 62°+ These Tapes had not been standardized at this date L.D.B.

Fd. BC. Con Mon See Page 7

Reckon 10 ... Tape #03 = 2647.56 @ 76° = 2642.42

1323.87 @ 68°

Reckon 10 ... Tape #03 = 2642.33 @ 68° = 2642.05

Reckon 10 ... 2643.11

See L.S. 8-1

1/4 Sec Line

Set 1x2 in Occupation

535.18 @ 68° = 535.20 783.03 @ 88° 183.82' 1319.02'

1319.07'

300' tape

Fd. Old 3x3 RW

Found Old 4x4 RW SW Cor Sec 10 See Tr 6200 Ties shown in FB 35-117 are all gone

Set Nail & P.D.

Fd Old 3x3 RW 1' under Set Nail & Shiner

S45°15'E 1.45

90°01'00" 360° 15' 45"

179°58'20" 359°53'30"

Fd old 4x4 1' under RW

Fd Nail & P.D. in Conc. 1' under

Fd Nail & Tag

1324.59 1324.92 @ 76

1323.12 1323.00 @ 76

2644.36 @ 72°

ZINN

ROAD

Fd Nail & P.D.

Fd Nail & Tag











RETURN TO LOS ANGELES COUNTY SURVEYOR

Do not extend notes this side of this line

Notice: ANY ADDITIONS OR CHANGES ON THIS SHEET MUST BE MADE OR CIRCLED IN Red. WITH DATE AND NAME OF PERSON MAKING CHANGE.

F. B. 302 Pg. 19

Date Mar 28
Map No. B-111
Date JUL 1926

Location Somerset Ave
Surveyed by
Date Dec 16 1926
Indexed A. C. Johnson

WOODRUFF AVE.

ZINN ROAD

CERRITOS AVE

26.38

179-58-30
339-54-00

90-00
339-59-10

5' offset
265.13

265.41 T=68° = 265.13

89° 52' 40" (CALC)

Fd 2x2 down 0.3

Fd 2" pipe 0.3 down

Fd 2" pipe 0.3 down

Fd 2" pipe 0.3 down

F. B. 302 Pg. 20 Chief Party Notes by Date Dec 19, 1927

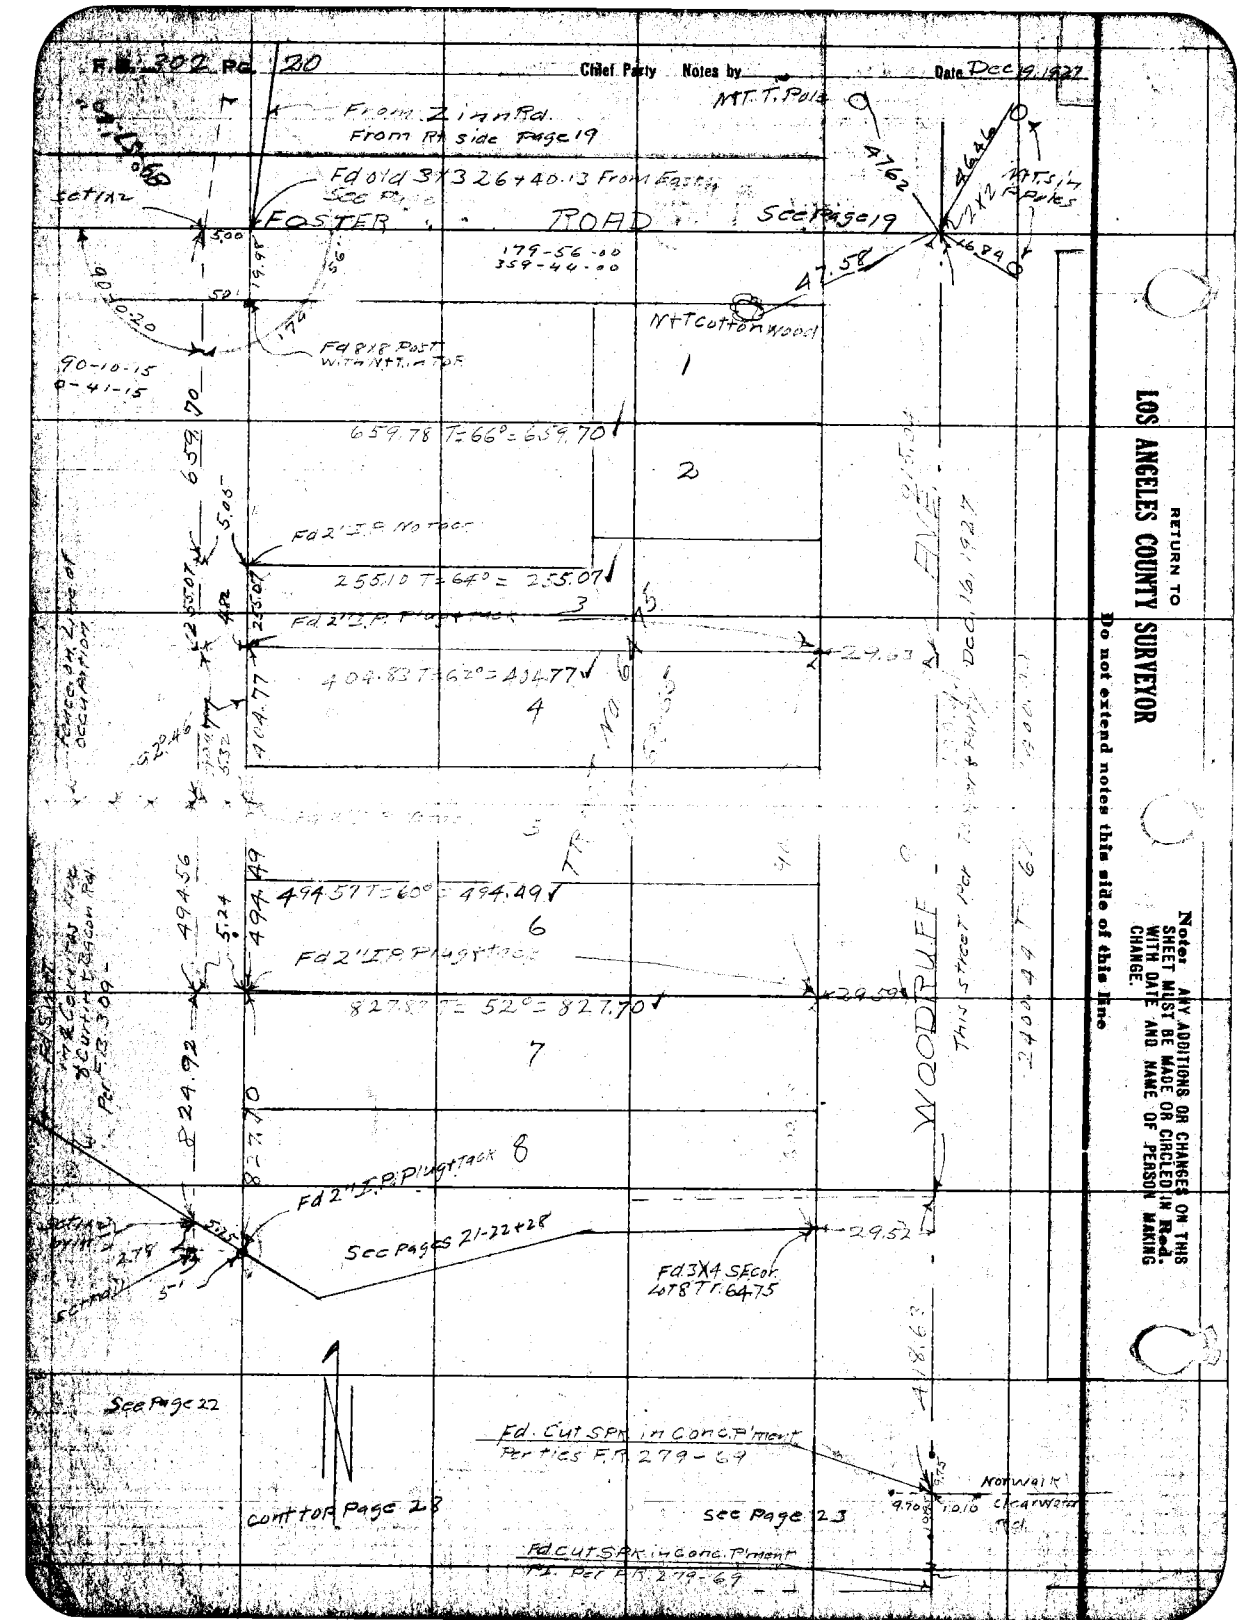

RETURN TO
LOS ANGELES COUNTY SURVEYOR
Do not extend notes this side of this line

Note: ANY ADDITIONS OR CHANGES ON THIS SHEET MUST BE MADE OR CIRCLED IN Red. WITH DATE AND NAME OF PERSON MAKING CHANGE.

RETURN TO
LOS ANGELES COUNTY SURVEYOR

Notes: ANY ADDITIONS OR CHANGES ON THIS SHEET MUST BE MADE OR CIRCLED IN Red. WITH DATE AND NAME OF PERSON MAKING CHANGE.

Do not extend notes this side of this line

Indexed

F. B. 302 Pg. 21

Tract No 6475
M.B 69-65

WOODRUFF AVE.

90-09-30
360-33-30
708.10 T = 60° = 707.99

Note: This P.R. is NOT the same as shown in F.B. 309 — See Page 21 for ref.

Set 1½ by 1 I.T.

Fd 2" I.P. Plug & Tack

Fd 2" I.P. Plug & Tack Leaning E.

See Page 22

61.13

709.99

15' offset

Set nail & tin.

90° 06' 25"

62.91

100

90°

120.506

1' offset

120.52 T = 6°
120.06

3.72

1.27

N & T in fence posts

65° 18' 20"

517.61

Fd 2" I.P. Plug & Tack NE cor. Lot 1 Tract 5084

126° 40' 07.5"

517.69 T = 6° = 517.61

Set 1½ by 1 I.T.

Fd 3/4" P. Tract 5473

LOT 1
TRACT NO. 5084
M.B 54-71-72

2' offset
321.91 T = 60°
321.72

1286

90°

Set nail

Fd 2" I.P. with Patton Plug in E. line Lot 1 Tr 5084

Set 1½ by 1 I.T.

1' offset

See Pages 22-24-26

RETURN TO

LOS ANGELES COUNTY SURVEYOR

Note: ANY ADDITIONS OR CHANGES ON THIS SHEET MUST BE MADE OR CIRCLED IN **Red.** WITH DATE AND NAME OF PERSON MAKING CHANGE.

Do not extend notes this side of this line

Date 12-22-27

Chief Party Notes by

F.B. 1502 Pg. 8 D.

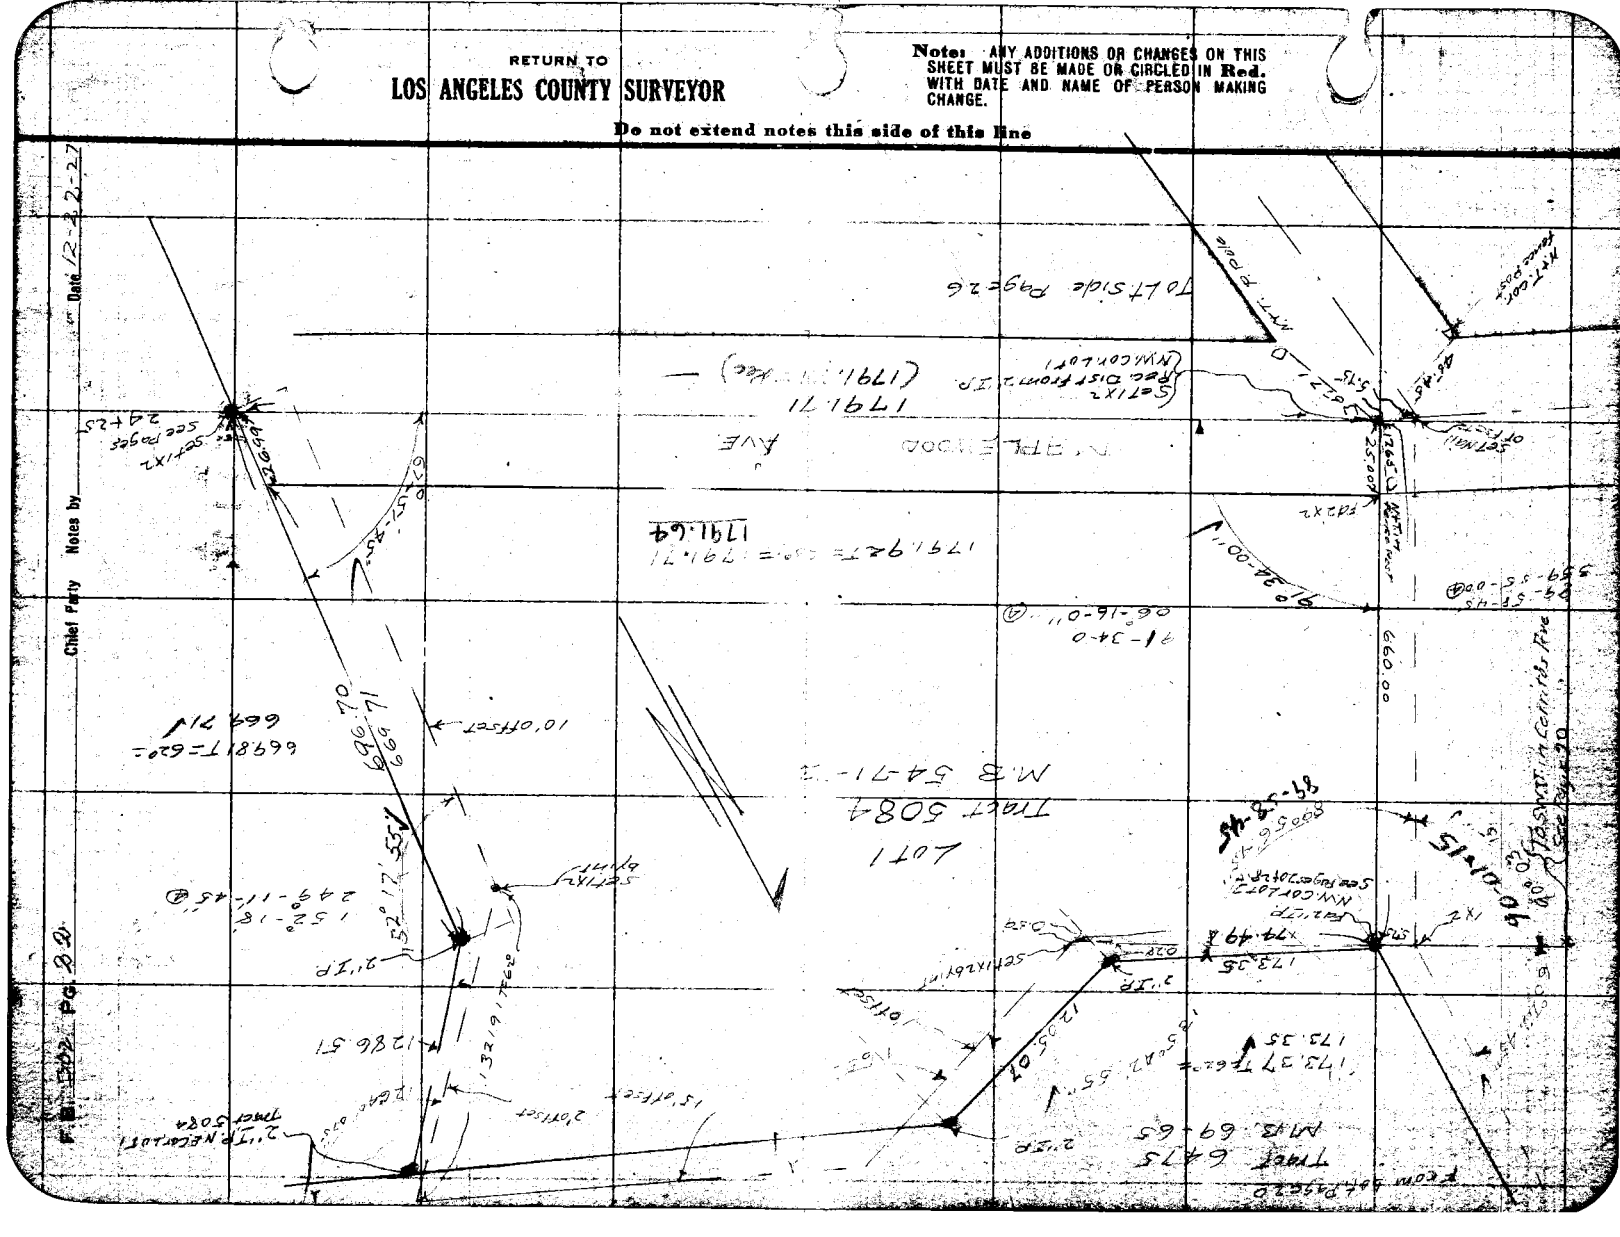
Lot 1
Tract 5084
M.B. 54-71-73
660.00
1791.71
1791.64
1791.92
1791.71
1732.35
1205.07
1286.51
1321.91
669.71
669.17
669.70
S 89°-58'-45" E
S 0°-01'-15" E
S 89°-55'-00" E
S 89°-55'-45" E
S 0°-01'-15" E
S 0°-16'-0" W
S 1°-34'-0" W
S 52°-17'-55" W
S 0°-15'-45" E

Date _____ Notes by _____ Chief Party _____ F. B. 302 Pg. 23

Plotted by: Keeby
Date: Mar '28
Map No. B-117
Plotting Checked by R. W. S.
Date JUL 11 1928

W. O. No. 4159 H. S. O. No. _____
Location Somerset Ave, Bellflower
Surveyed by M. Hayes
Date Dec 1927
Indexed A. C. Johnson

From Rt Side Page 20

FdCS. in Conc. Pavement
F.R. 279-21-25-69

9.75
9.90 10.10
10.75

Norwalk-Clearwater Rd.

Ties are L+T's in Pavement

Woodruff Ave

1320.46

1320.58' T=60°1320.46
1320.37

90°-14'-45"

To Top Page 24

9.77 9.55

Ties are L+T's in Pavement

FdCS. in Conc. Pavement
F.R. 279-69

1406.72

Note: ANY ADDITIONS OR CHANGES ON THIS SHEET MUST BE MADE OR CIRCLED IN RED WITH DATE AND NAME OF PERSON MAKING CHANGE.

Do not extend notes this side of this line

RETURN TO
LOS ANGELES COUNTY SURVEYOR

F.B. 302 PG. 24 Chief Party Notes by Date Dec. 1927

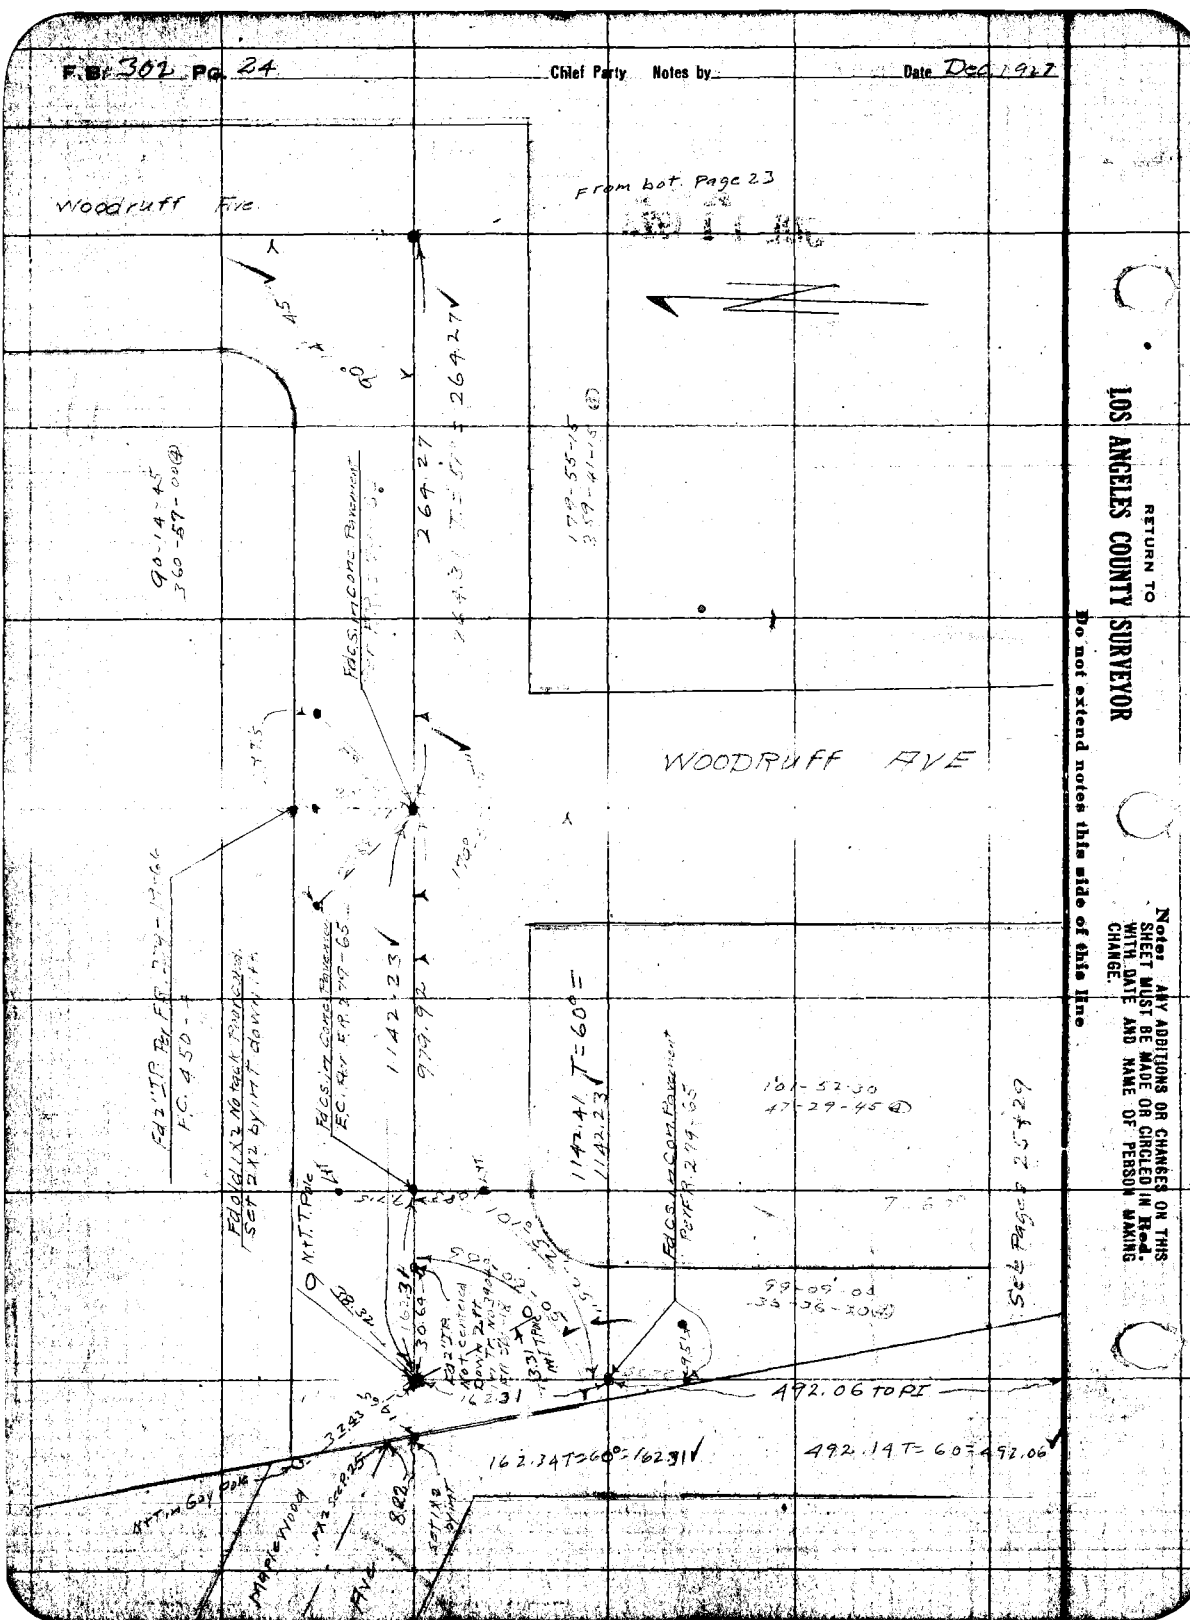

RETURN TO
LOS ANGELES COUNTY SURVEYOR

Note: ANY ADDITIONS OR CHANGES ON THIS SHEET MUST BE MADE OR CIRCLED IN Red. WITH DATE AND NAME OF PERSON MAKING CHANGE.

Do not extend notes this side of this line

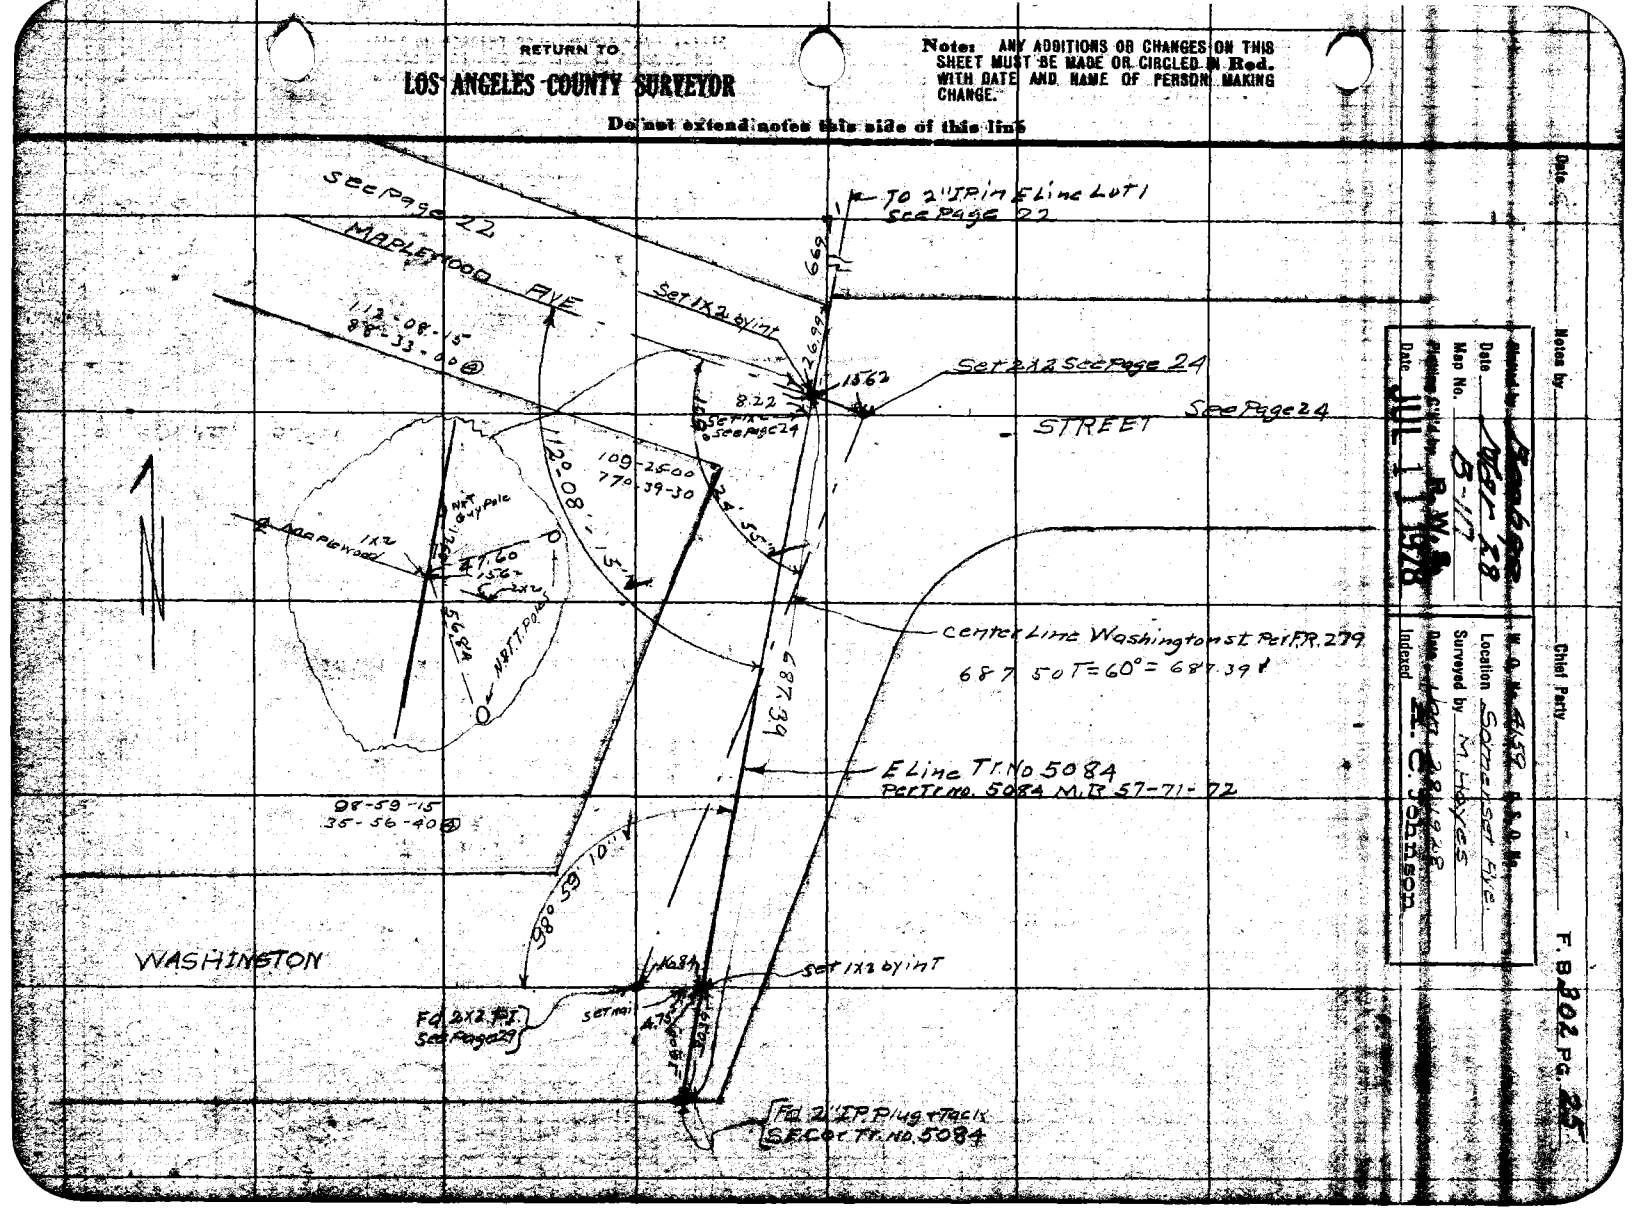

Date: Notes by:
Drawn by: Checked by:
Date: Map No.
Plotting Checked by:
Date: JULY 11 1978

Location: Surveyed by: M. Hayes
Date: Indexed: E. C. Shinson

W. O. No. Dist. No.
Chief Party

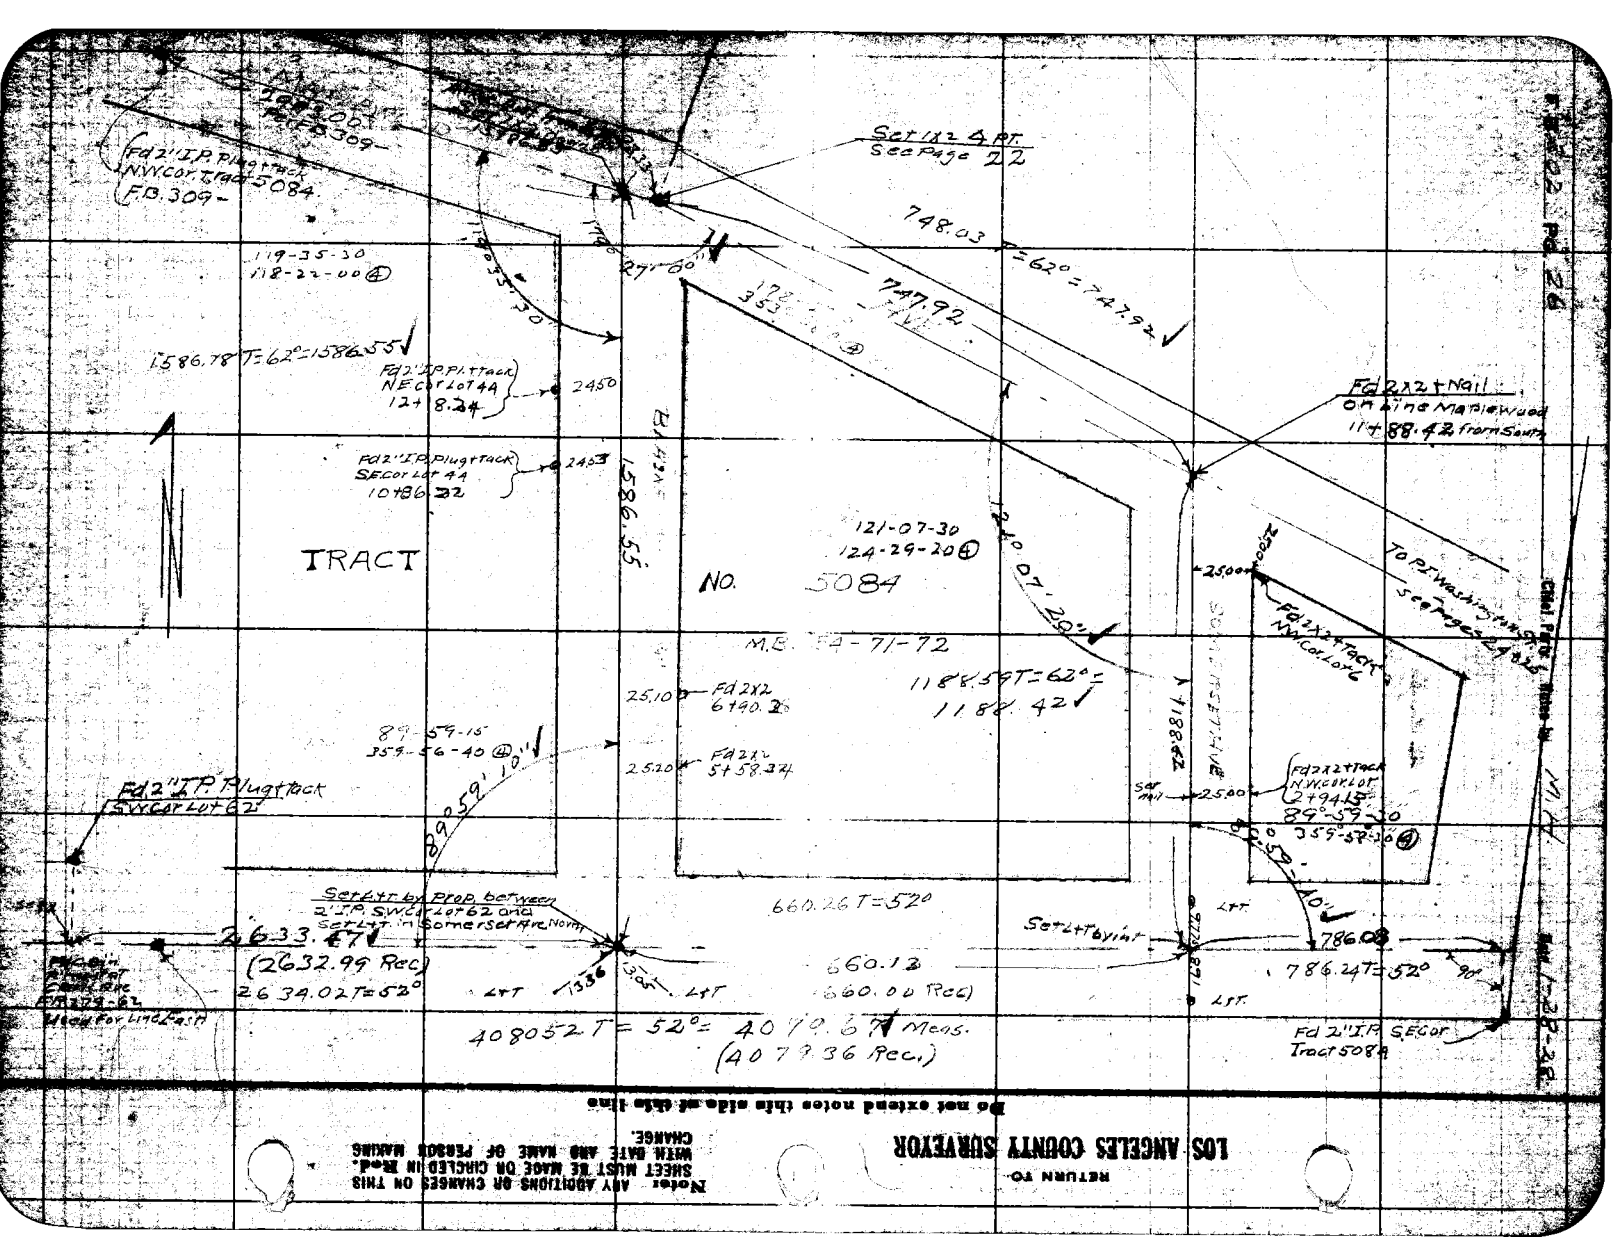
TRACT
NO. 5084
M.B. 74-71-72
Set 12 4 pt. See Page 22
748.03
747.92
Fd 2 1/2 + Nail
Fd 2" I.P. Plug + Tack
Fd 2" I.P. Plug + Tack
Fd 2" I.P. Plug + Tack
Fd 2 1/2 + Tack
Fd 2" I.P. Plug + Tack
Set 1/2 by Prop. between 2" I.P. S.W. Cor. Lot 62 and Set 1/2 in Somerset Ave. North
2633.47
(2632.99 Rec.)
2634.02 T=52°
660.26 T=52°
660.13
(660.00 Rec.)
786.08
786.24 T=52°
1586.78 T=62°=1586.55
1188.59 T=62°=1188.42
1586.55'
1188.42'
Fd 2" I.P. S.E. Cor. Tract 5084
Fd 2" I.P. Plug + Tack N.W. Cor. Tract 5084 F.B. 309-
Fd 2" I.P. Plug + Tack S.W. Cor. Lot 62
Fd 2" I.P. Plug + Tack NE Cor. Lot 44
Fd 2" I.P. Plug + Tack SE Cor. Lot 44
Fd 2 1/2 + Tack N.W. Cor. Lot 6
Fd 2 1/2 + Tack N.W. Cor. Lot 5
Fd 2 1/2 + Nail On Line Maple Wood
To P.T. Wash. Inst. See Page 22
Set Mon. in Conc. Flush
Mon. for Line
LOS ANGELES COUNTY SURVEYOR
RETURN TO
Do not extend notes this side of data line
Note: ANY ADDITIONS OR CHANGES ON THIS SHEET MUST BE MADE ON CIRCLED IN Red. WITH DATE AND NAME OF PERSON MAKING CHANGE.

Notes by M.H. Chief Party F. B. 302 Pg. 27

Date Mar '28
Map No. B-117
Date JUL 1928

W. O. No. 4159 S. O. No.
Location Somerset Ave
Surveyed by M. Hayes
Date Jan. 30, 1928
Indexed A. C. Johnson

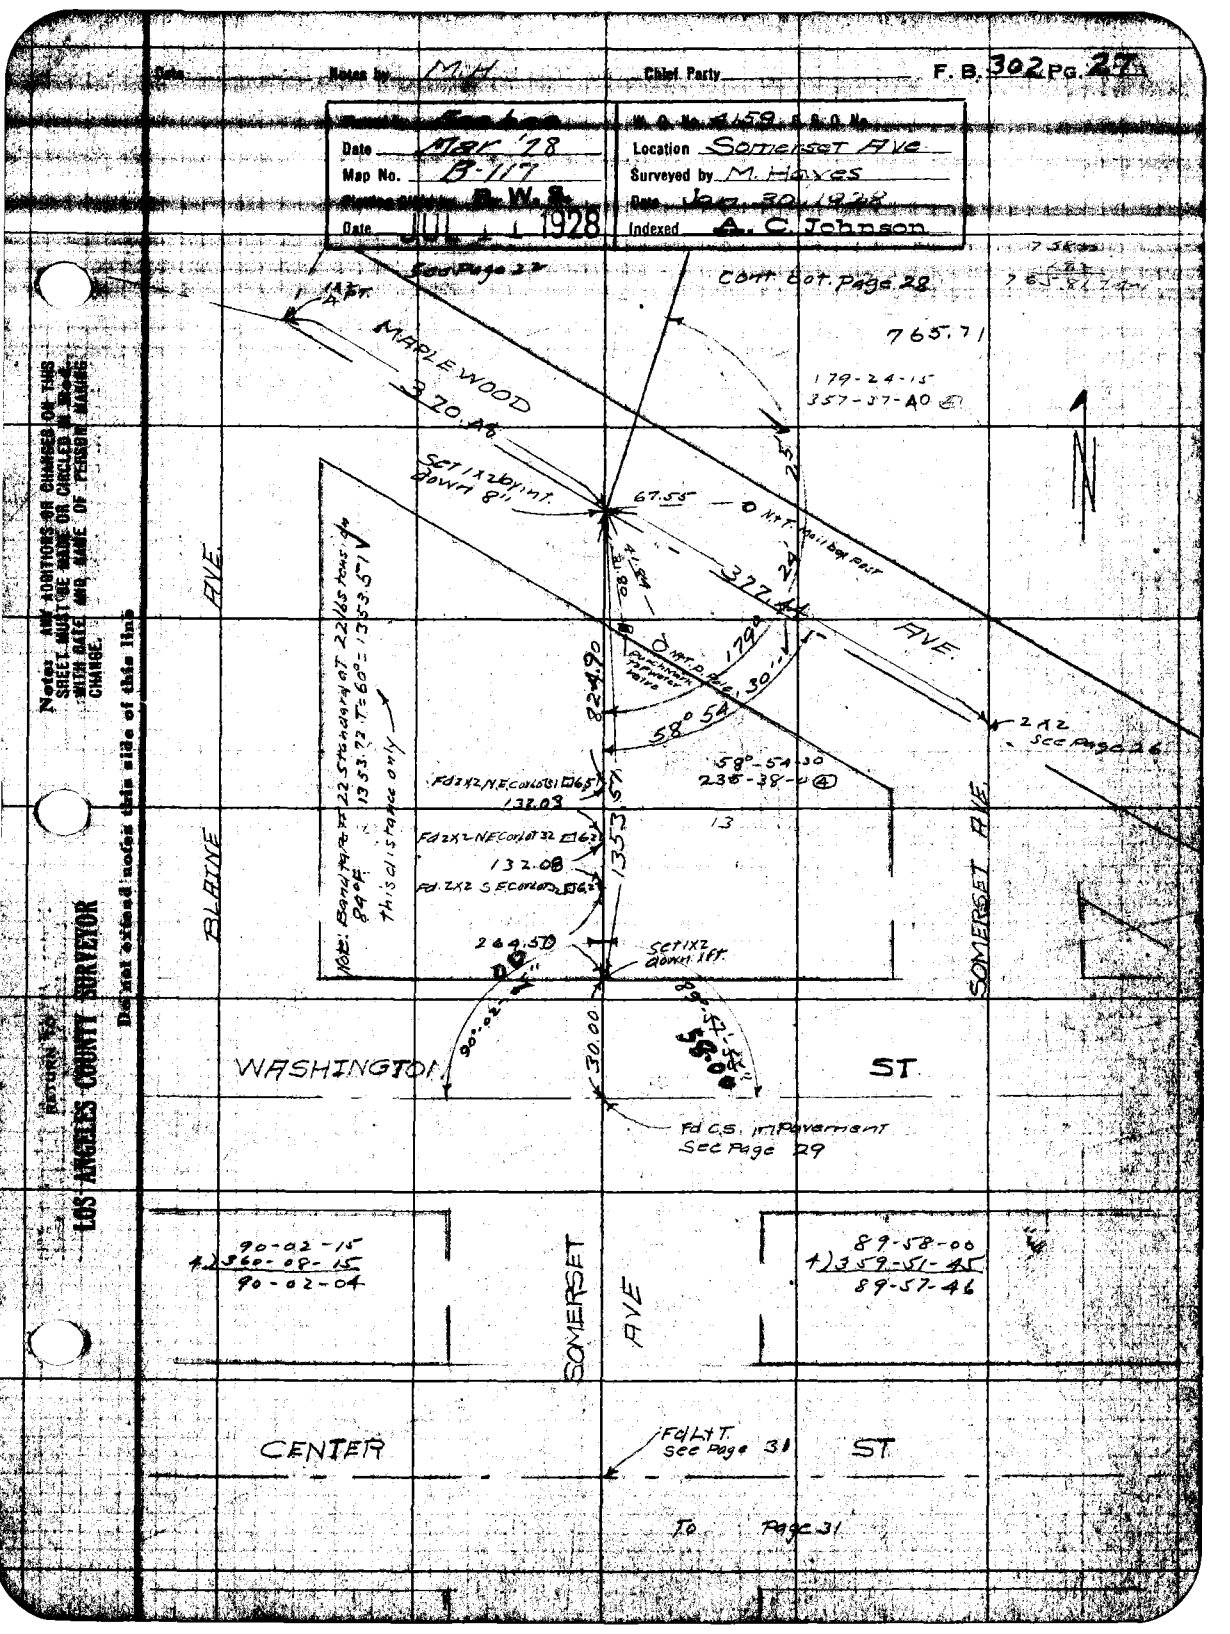

Notes: ANY ADDITIONS OR CHANGES OF THIS SHEET MUST BE MADE OR CIRCLED IN RED WITH DATE AND NAME OF PERSON MAKING CHANGE.

Do not extend notes this side of this line

LOS ANGELES COUNTY SURVEYOR

F.B. 302 Pg. 28 M. Hayes Chief Party Notes by M.H. Date 1-30-28

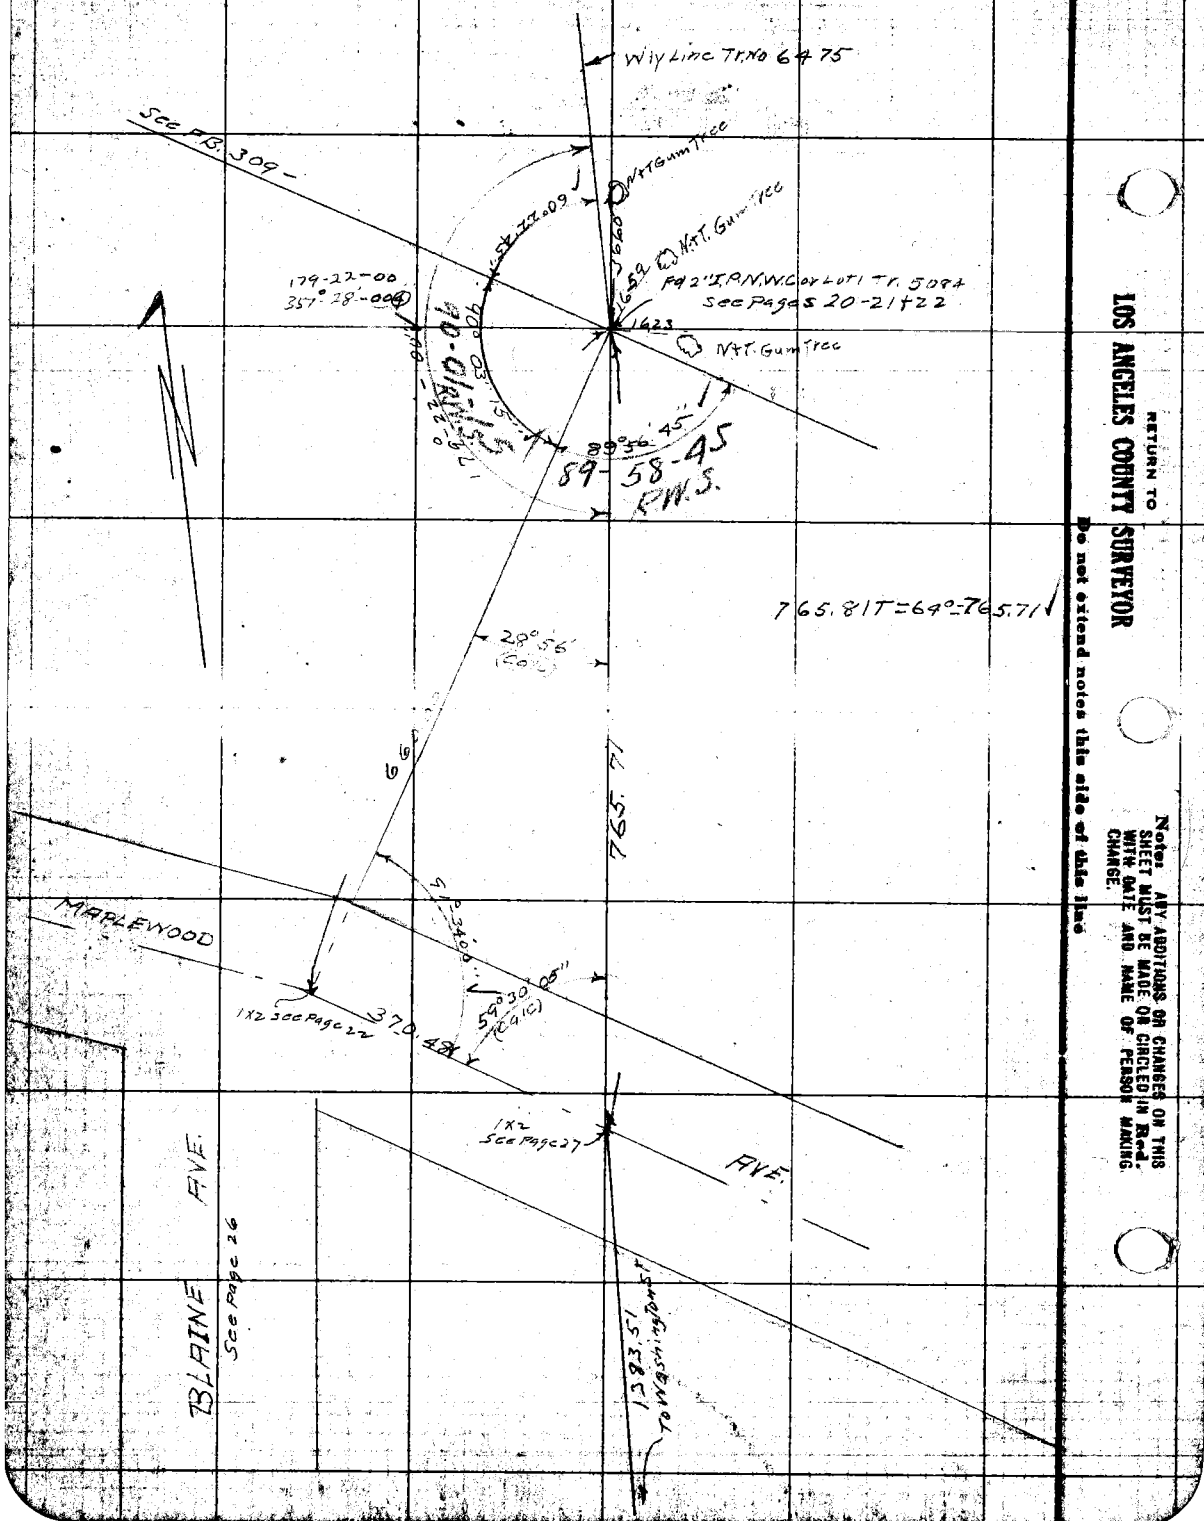

RETURN TO
LOS ANGELES COUNTY SURVEYOR
Do not extend notes this side of this line

Note: ANY ADDITIONS OR CHANGES ON THIS SHEET MUST BE MADE OR CIRCLED IN Red. WITH DATE AND NAME OF PERSON MAKING CHANGE.

RETURN TO

LOS ANGELES COUNTY SURVEYOR

Notice - ANY ADDITIONS OR CHANGES OF THIS SHEET MUST BE MADE OR CIRCLED IN Red, WITH DATE AND NAME OF PERSON MAKING CHANGE.

Do not extend angles this side of this line

Notes by _____ Date _____

Checked by _____ Date _____

Map No. _____

Plotting C'k'd by R. W. S. Date JUL 11 1978

Tabel Party _____

W. O. No. _____ D. S. O. No. _____

Location _____

Surveyed by M. HAYES Date 1978

Inderal A. E. Johnson

F. B. 302 PG. 29

SOMERSET AVE

SOMERSET AVE

STREET

WASHINGTON

RCS. in Conc. Pavement at Clark Ave. F.R. 279-62

Fd. C.S. in Conc. Pinnent per F.R. 279-62

1109.98

1110.16 T = 54° = 1109.98

1109.94

90°

90°

360-09-00

30.06

30.09

30.01

RR 172

Fd 2 1/2 PI F.R. 279-1746

Fd 2 1/2 PI Line Washington Ref F.R. 279-17

Fd 2" IR No Cap Flush

TO TAP FROM 30

F.B. 302 Pg. 30 Chief Party Notes by Date 1-28

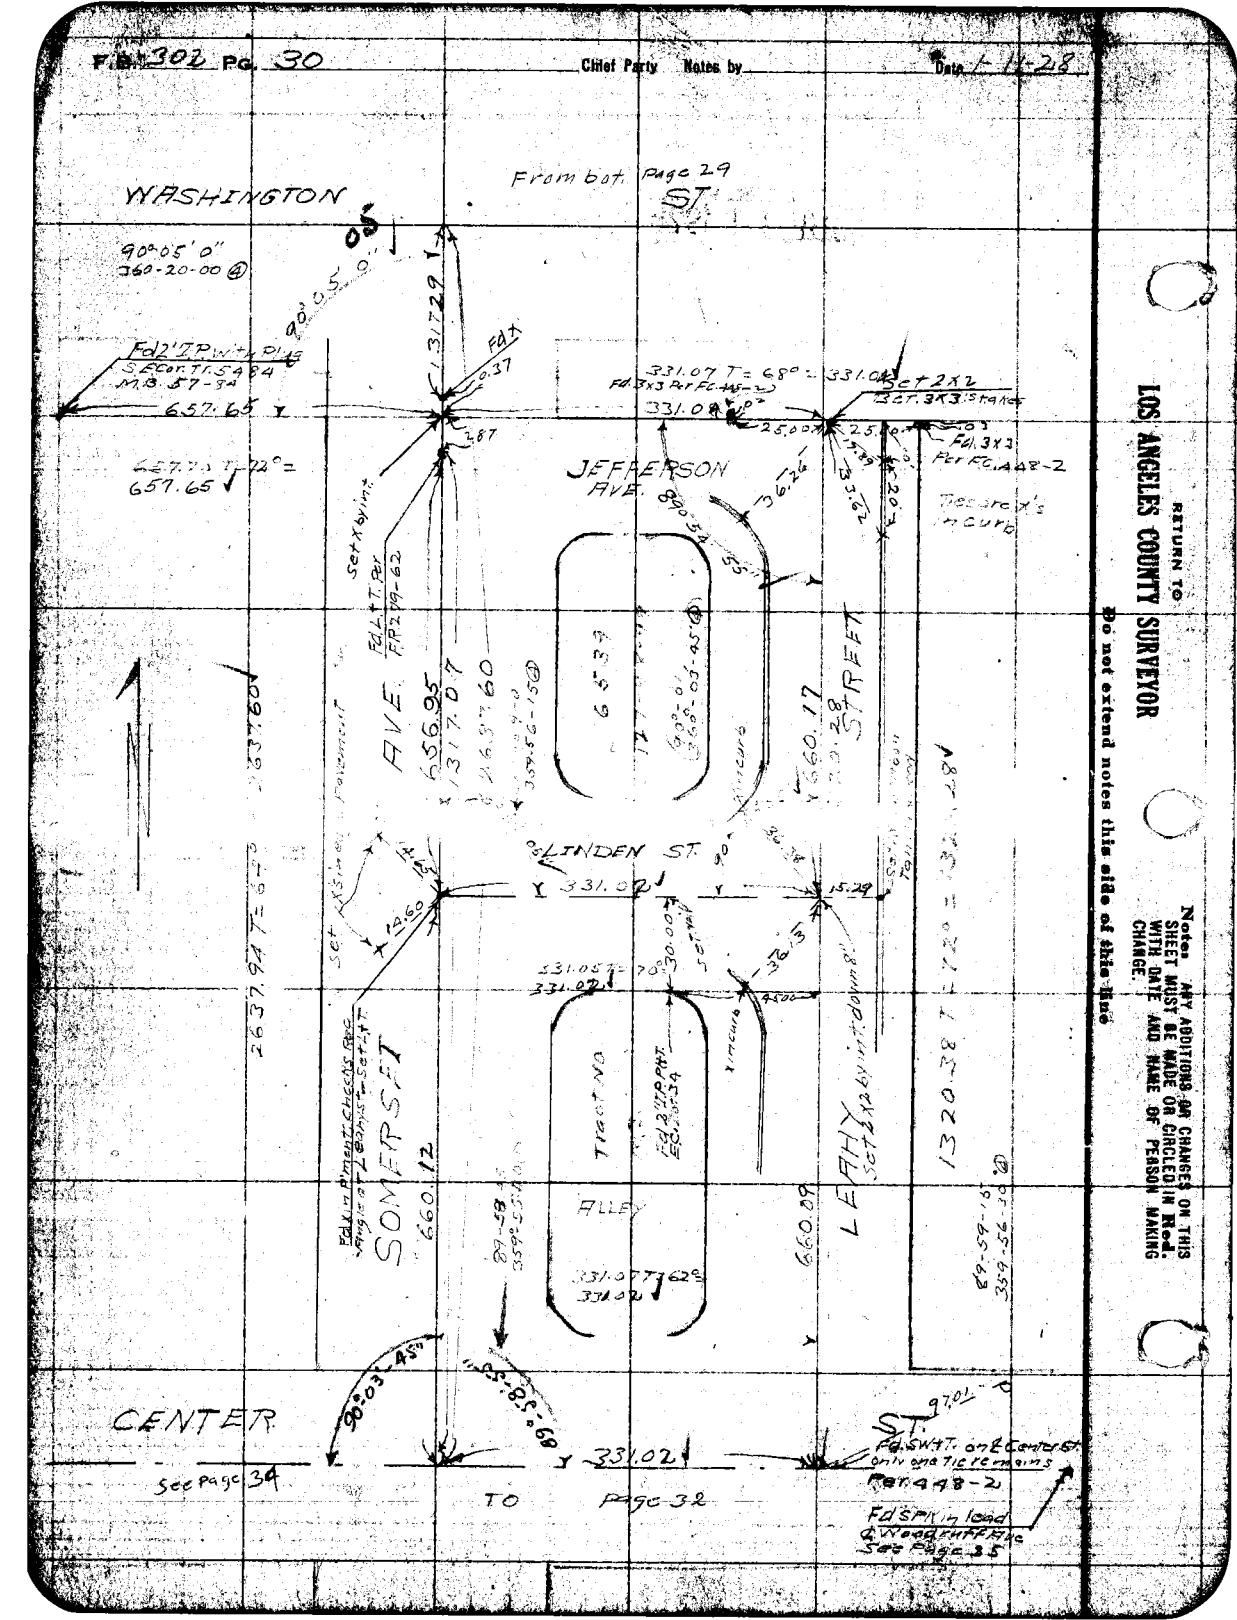

RETURN TO
LOS ANGELES COUNTY SURVEYOR

Notes. ANY ADDITIONS OR CHANGES ON THIS SHEET MUST BE MADE OR CIRCLED IN Red. WITH DATE AND NAME OF PERSON MAKING CHANGE.

Do not extend notes this side of this line

Date _____ Notes by _____ Chief Party _____ F. B. 302 Pg. 31/33

Plotted by Beebee
Date Mar '28
Map No. B-117
Plotting C'k'd by R. W. S.
Date JUL 11 1978

W. O. No. 1159 D. S. O. No. _____
Location Downey & Bly
Surveyed by Boyer & Party
Date Oct 1927
Indexed _____

90-03-45
89-58-55
160.02-40

Notes: ANY ADDITIONS OR CHANGES ON THIS SHEET MUST BE MADE OR CHECKED IN RED WITH DATE AND NAME OF PERSON MAKING CHANGE.

Do not extend notes this side of this line

RETURN TO LOS ANGELES COUNTY SURVEYOR

F.B. 392 Pg. 32 24

Chief Party Notes by Date

CENTER ST.

See Page 30 31

Fd Lead T See Page 30

See Page 30 33

RETURN TO LOS ANGELES COUNTY SURVEYOR

Do not extend notes this side of this line

Notes: ANY ADDITIONS OR CHANGES ON THIS SHEET MUST BE MADE OR CIRCLED IN Red. WITH DATE AND NAME OF PERSON MAKING CHANGE.

This seems to be the ℄ of Somerset Ave established by F.B. 101-138 et seq & F.O. 220 as near as can be determined from what few ties are left. See also F.R. 279-47

Fd at ℄ Ryan Ave

ORCHARD AVE 50'

688.36 @ 86°

330.00 @ 78°

AVE

330.03

30 30

HARVARD AVE 25

688.47

℄ per F.C. 442-6 & 7

Set 1x2 by ties

25

83° 56' 40" Adj.

Ties shown in F.O. 220-15 are gone

Fd + in pav ck's ties F.C. 442 See F.C. 442-6 ℄ Harvard per F.O. 220-15

652.08 @ 78°

652.15

Fd 4" I.P. filled with Cem. W about 2 1/2d of Somerset Ave See F.C. 442-6

Fd + in Pav See F.C. 443-2

Ties shown in F.O. 220-16 are gone

SOMERSET

317.76 @ 78°

317.79

Fd Cross

RAILROAD AVE

1166.55 @ 92°

& per F.C. 443-2 & 6

Fd Nail in Aspha

Fd Nail in Asphalt

Fd Nail in Asphalt

Fd Nail in Asphalt

Date _____ Notes by _____ Chief Party _____ F. B. 302 PG. 33 29

Plotted by Beeppe
Date Apr 28
Map No. B-118
Plotting Chkd by R. W. S.
Date JUL 11 1978

W. O. No. 4159 O. S. O. No.
Location Bellflower
Surveyed by Bayer & Party
Date Nov. 1927
Indexed A. C. Johnson

From bottom, page 26 40

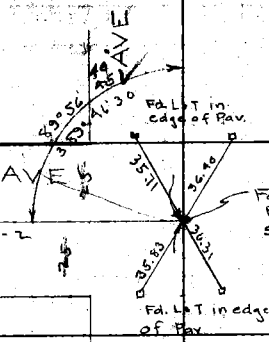

BEVERLY AVE

To 2x2 at Clark Ave Page 38 48 & per FC 234-2 CF 1210

30 30

331.52 @ 82'

331.56

SOMERSET

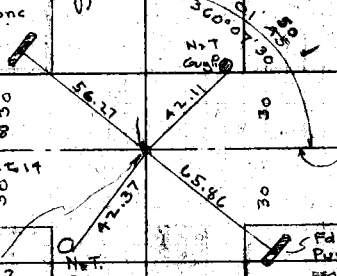

ARTESIA AVE

To spk at See Page 38 48 & Clark

See Page 37 To L&T at & Woodruff

& per FO 234-1&14 & per FO 234-1&14

30 30

Fd L&T FO 234-2

N&T P.P.

Fd L&T Conc Gas Pump foundation
FO 220-25
FC 441-10
F.B 101-193
FC 336-3

Z 178-118
FR 62-2
F.C. 441-93
F.O. 234-

Cont. Left side Page 52

RETURN TO LOS ANGELES COUNTY SURVEYOR

Notes: ANY ADDITIONS OR CHANGES ON THIS SHEET MUST BE MADE OR CIRCLED IN RED WITH DATE AND NAME OF PERSON MAKING CHANGE.

Do not extend notes this side of this line

F.B. 302 PG. 34

Chief Party Notes by 30 Date

To bottom Page 35

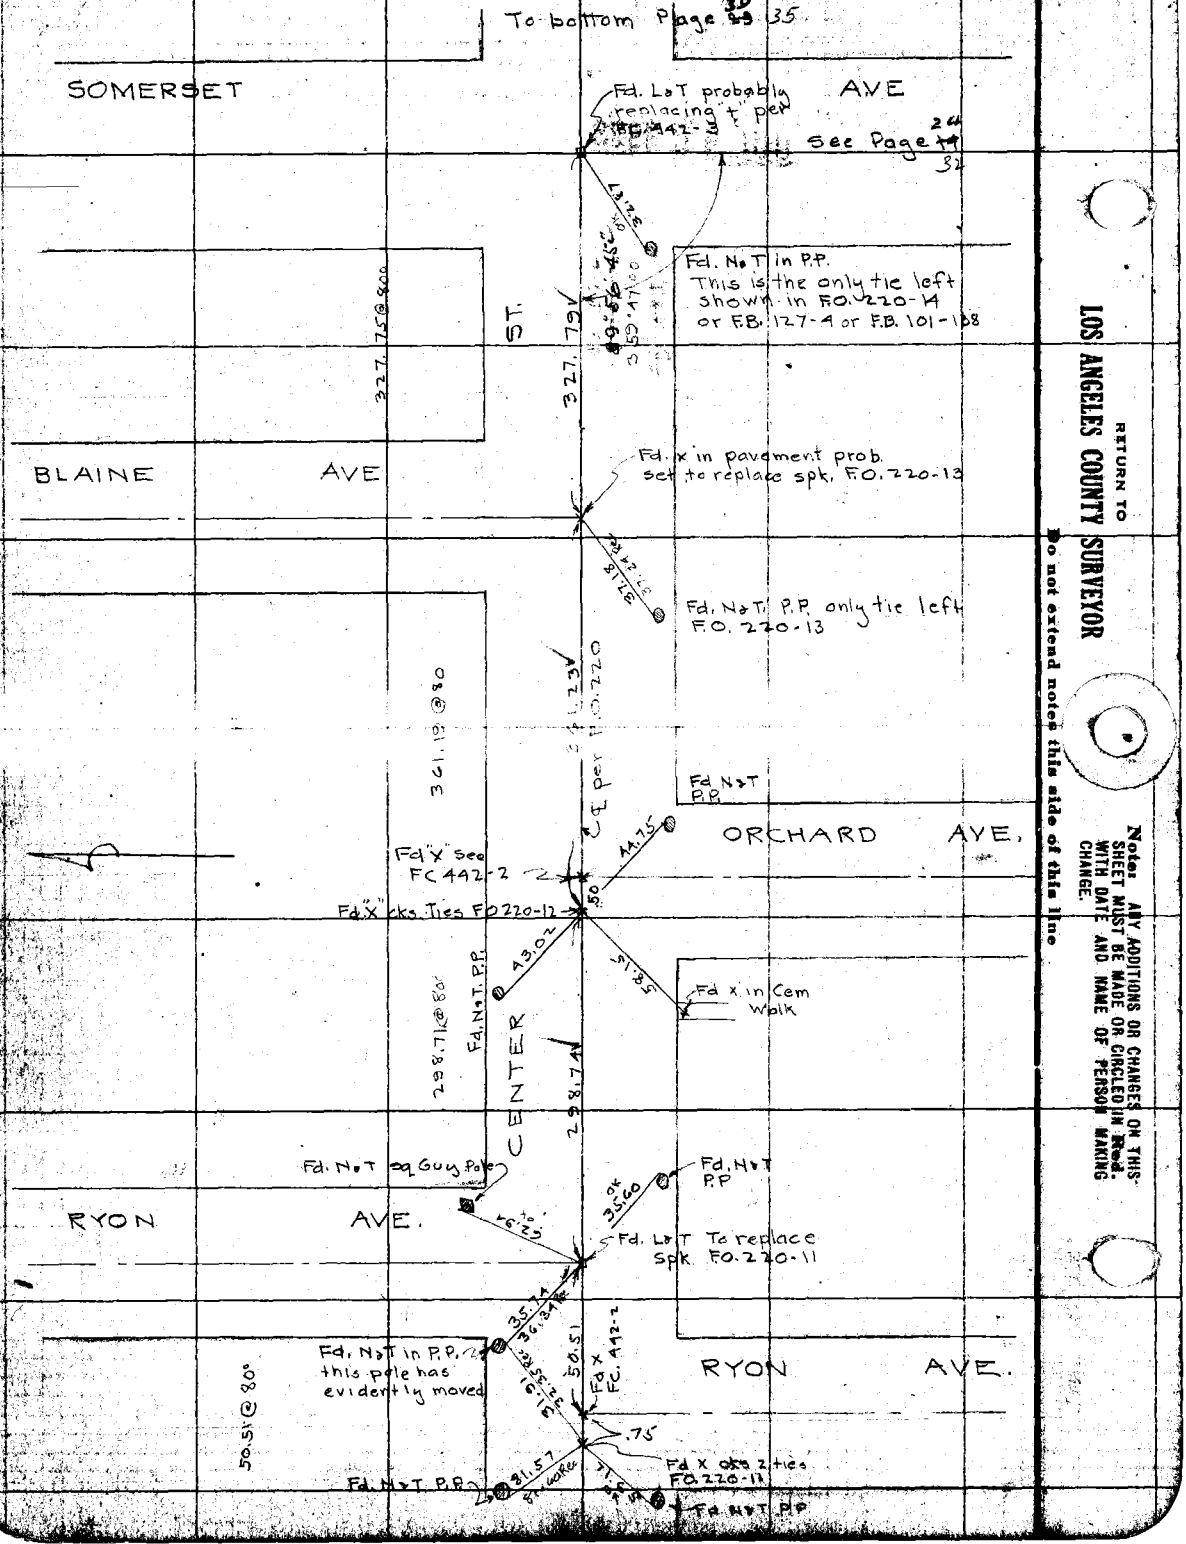

RETURN TO LOS ANGELES COUNTY SURVEYOR

Do not extend notes this side of this line

Note: ANY ADDITIONS OR CHANGES ON THIS SHEET MUST BE MADE OR CIRCLED IN Red. WITH DATE AND NAME OF PERSON MAKING CHANGE.

RETURN TO
LOS ANGELES COUNTY SURVEYOR

Note: ANY ADDITIONS OR CHANGES ON THIS SHEET MUST BE MADE OR CIRCLED IN Red. WITH DATE AND NAME OF PERSON MAKING CHANGE.

Do not extend notes this side of this line

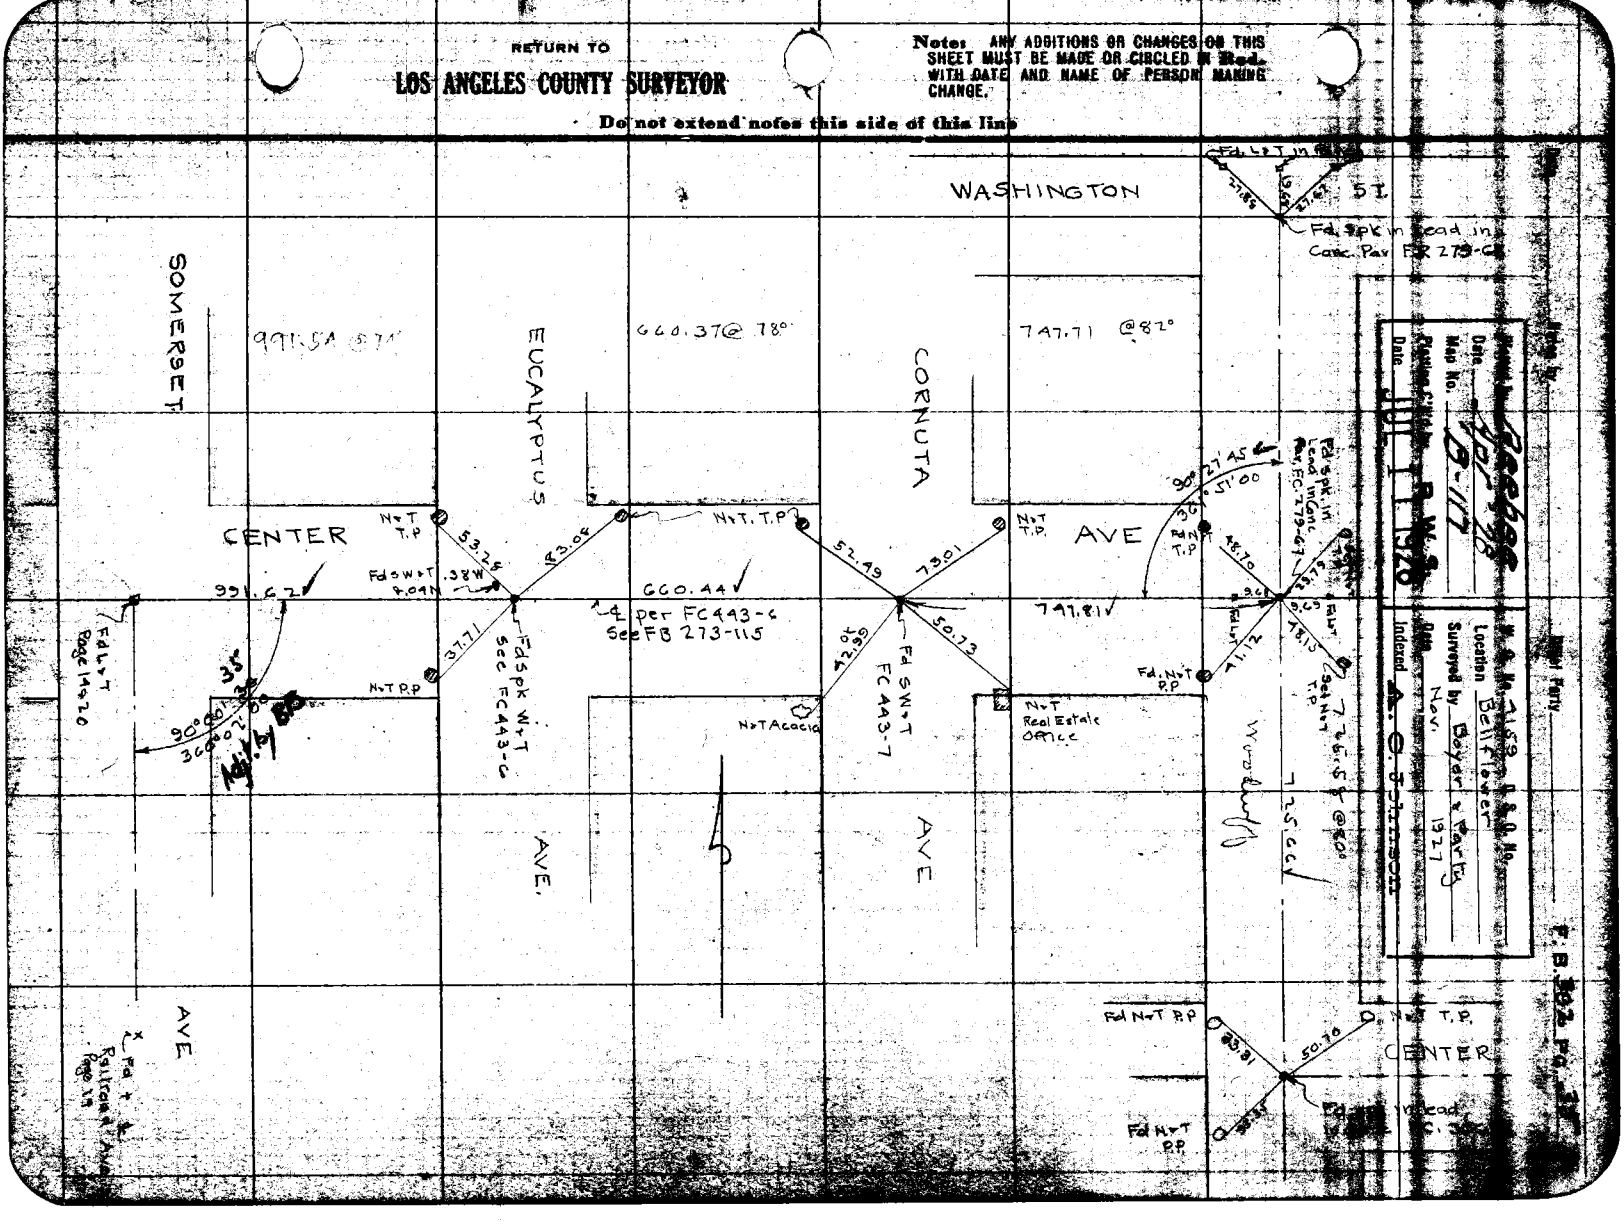

F.B. 302 PG. 36 Chief Party Notes by Date

RETURN TO
LOS ANGELES COUNTY SURVEYOR

Do not extend notes this side of this line

Note: ANY ADDITIONS OR CHANGES ON THIS SHEET MUST BE MADE OR CIRCLED IN Red. WITH DATE AND NAME OF PERSON MAKING CHANGE.

Date _____ Noted by _____ Chief Party _____ F. B. 302 PG. 37

Plotted by Pachet Apr 28
Date
Map No. 13-117
Plotting C'd'd by R. W. S.
Date JUL 11 1928

W. O. No. 1158 C. S. O. No.
Location Bellflower
Surveyed by Boyer & Party
Date Nov 1927
Indexed

Notes: ANY ADDITIONS OR CHANGES ON THIS SHEET MUST BE MADE OR CHECKED IN Red, WITH DATE AND NAME OF PERSON MAKING CHANGE.

Do not extend notes this side of this line

RETURN TO LOS ANGELES COUNTY SURVEYOR

From bottom Page 1

Fd. Nail & B. mks on line

PAC. ELEC. R.R.

Fd. Nail & B. mks on line

PACIFIC AVE

Parallel to Pac. Elec. Ry

Fd. L & T. Cks ties F.O. 220-17

Fd. M & T in R.R. Pole evidently moved

Fd. M & T. R.R. Pole evidently moved

Fd. M & T in R.R. Pole evidently moved

Fd. L & T FC 329-2

Fd. 1½" I.P. with & Plug

Fd. Cut "S" in Curb Pg. 220-17

Fd. M & T in R.R.

MAYNE AVE.

670.05 @ 70°

670.08 ℄ Per F.C. 441-72 + Z 119-164

Fd. X in Conc. See F.O. 220-17

Reset 2x2 to ties F.C. 441-73, cks. line to 2x2 at Clark Ave. Fd. 2" I.P. & Plug 1.63 N. 1.14 W.

ORCHARD AVE

Set Nail to ties F.C. 441-64 cks. line to 2x2 at Clark Ave.

670.00 @ 70°

OAK AVE

670.12 ℄ Per F.C. 441-64

Fd. L & T F.C. 329-2

311.85 @ 87°

311.83

556.28 @ 72°

556.32 ℄ Per F.C. 441-68

Tie

2.50 ft. offset to ℄ P.E.

See Page 15

See Page 37-41

SOMERSET

To Top Page 38

RETURN TO
LOS ANGELES COUNTY SURVEYOR
Do not extend notes this side of this line

Notes: ANY ADDITIONS OR CHANGES ON THIS SHEET MUST BE MADE OR CIRCLED IN Red. WITH DATE AND NAME OF PERSON MAKING CHANGE.

Chief Party Notes by Date

From bottom Page 37

Fd 1 1/2" Aluminum Cap tie 0.6' W

Set N'ly Ties FC 191 Page 45

Fd Old 3/4" Cor tie 0.1' ly 31.92

Fd Old 3/4" Cor tie 26.37

Fd Rotten 3/4" Cor tie 0.7' ly 35

Fd Rotten 3/4" Cor tie 39.40

30° 00' 15"
300° 01' 00"

Fd 1" edge pav

BELMONT AVE

Fd. 1" edge Pav

Fd L & T. & per FC 329-3

Set X ties FD 220-19 prob. moved

25' Adj
90° 00' 30" L
300° 01' 30

1065.68 @ 7.40

Fd 1" edge Pavement

Fd 1" edge Pav.

Fd L & T. FC 329-1

1065.76 & Per FC 441-60

Set 1x2 1½' under 1x2 flush

168.50 BELMONT

168.49 @ 7.20

Fd White 6x6 Post 0.52 x 0.2

Ties are to L & T in Lwn

90.02 @ 82°

90.03

Fd 1" edge Pav

Fd 1" edge Pavement

Fd 1" edge Pav.

Cks ties

7.5

7.5

359° 59' 30"

359° 59' 30"

AVE

See Page 44

LAUREL AVE

See Page 44

670.12 & per FC 441-52 & Z 179-140

Fd. L & T. FC 329-1 cks Ties

Ties to Crosses in edge of Pav.

533.20 @ 70°

533.23

ORCHARD

50'

SOMERSET

311.96 @ 82°

312.00

30

30

89° 59' 45"
359° 59' 15"

89° 59' 45"
359° 59' 00"

Adj 50'

Adj 50'

Fd 2" I.P.

Fd L & T FC 329-5 & 441-46

168.49 @ 7.20

Set 1x2 flush & Set 1x2 1½' under

Fd 2x2 10" deep

C.S. 8875

FLOWER AVE

Fd 1" I.P. with Tag 0.02' W of line Bent 2x2 5' ties FC 191-19 & Ardmore Ave

See FC 441-49 2.5 Ties are crossed in Pav.

179° 30'

359° 30'

AVE

Town _____ Maps In _____ Chief Party _____ F. B. 302 PG. 39

Plotted by Gerber Apr 28
Date _____
Map No. B-117
Plotting Ck'd by R. W. S.
Date JUL 1 1928

W. O. No. 0159 D. S. O. No.
Location Bellflower
Surveyed by Beyer & Party
Date Nov 1927
Indexed

From bottom page 38

Notes: ANY ADDITIONS OR CHANGES ON THIS SHEET MUST BE MADE OR CIRCLED IN Red. WITH DATE AND NAME OF PERSON MAKING CHANGE.

Do not extend notes this side of this line

RETURN TO LOS ANGELES COUNTY SURVEYOR

330.15 @ 82
330.19

MAPLE
CF 1249

See Page
t per F.C. 335-2

Fd. L & T
F.C. 335-2

t & per F.C. 172-2

AVE

To Lo T of Woodruff
Set Page 39

CF 1209

328.54 @ 82
328.58

WALNUT

Ties are crossed in Pav.

Fd L & T F.C. 441-45

See Page
F.C. 441-40 et seq

F.C. 441-1 et seq 441-8

SOMERSET

328.57
328.55 @ 82

90° 02' 45"
360 - 11' - 00 @
Maps 1-9-28

ARKANSAS

See Page

Fd L & T

CE 1181
See Page

Accepted F.C. 323-2, F.C. 341-1
C.F. 1329

Fd L & T
F.C. 130-2

t & per F.C. 130-2

To Top Page 40

R.S. 302 PG. 10 28

Chief Party Notes by Date

From bottom Page 39

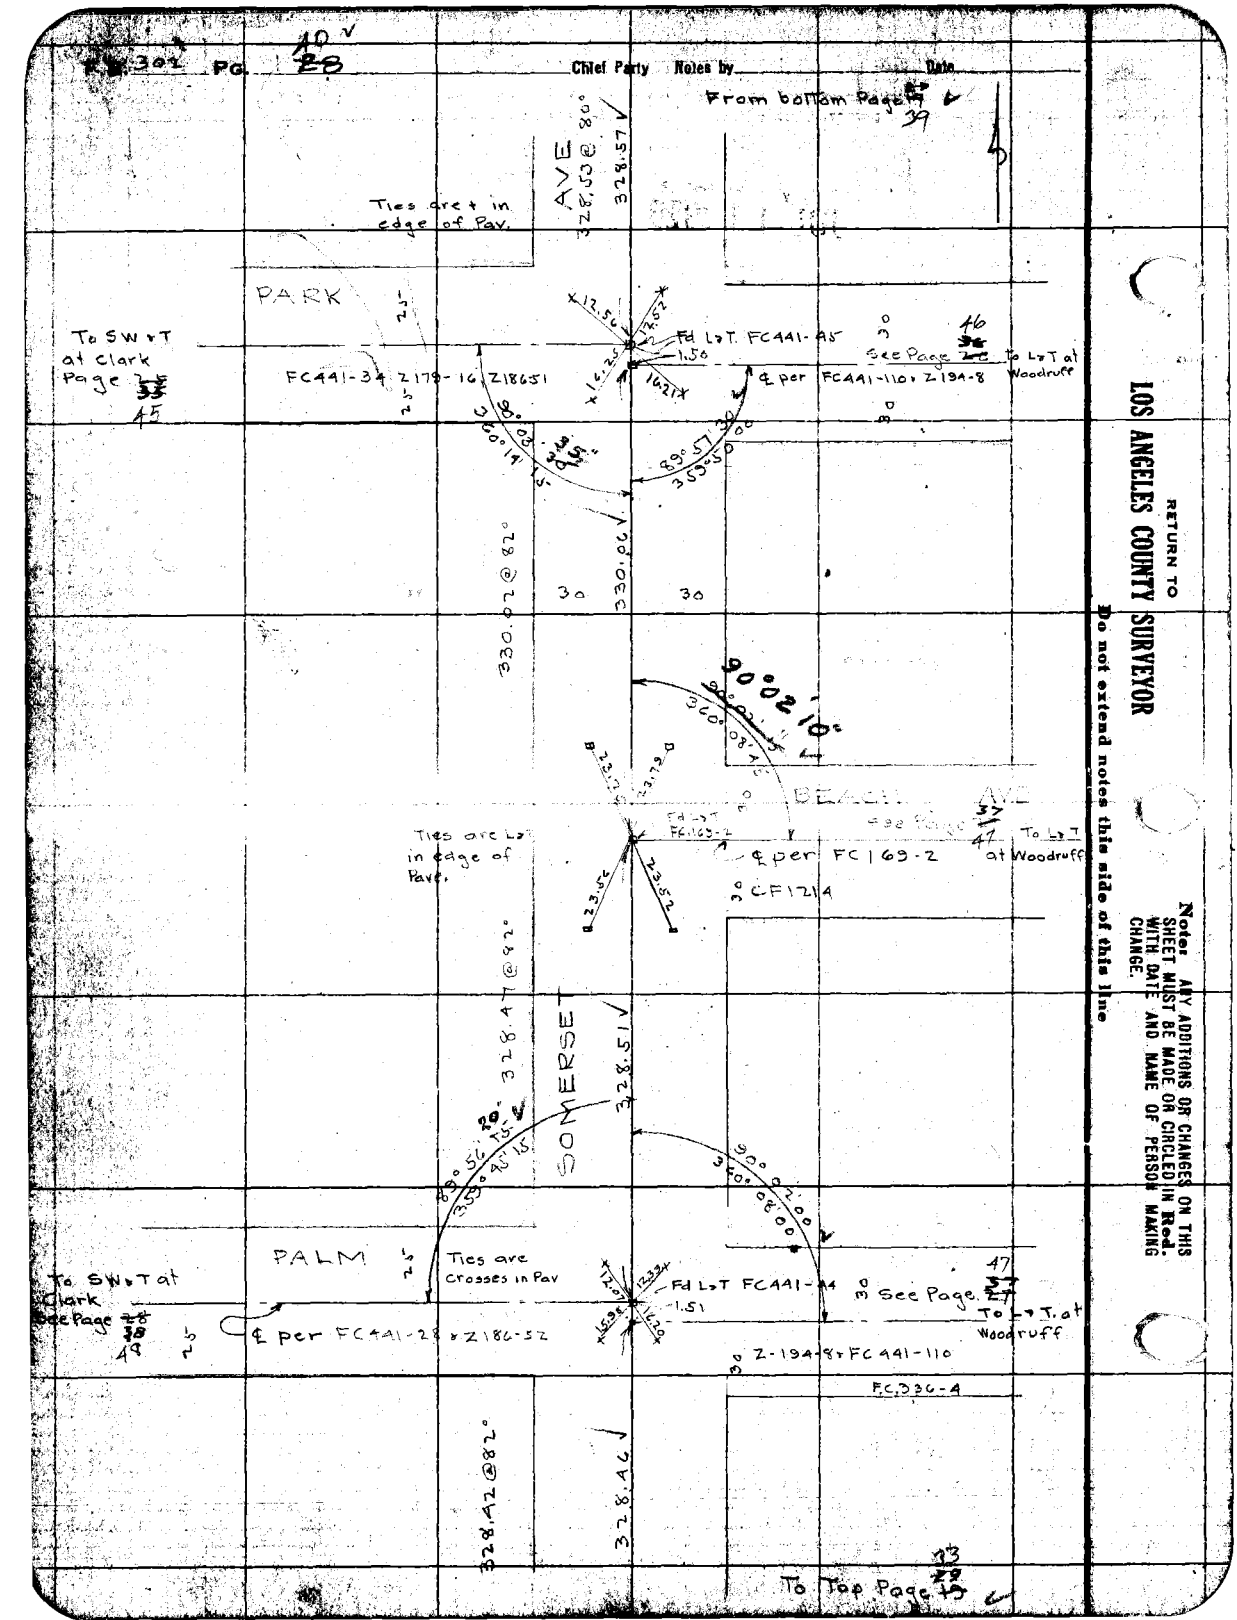

To Top Page 33 29

RETURN TO
LOS ANGELES COUNTY SURVEYOR
Do not extend notes this side of this line

Note: ANY ADDITIONS OR CHANGES ON THIS SHEET MUST BE MADE OR CIRCLED IN Red. WITH DATE AND NAME OF PERSON MAKING CHANGE.

RETURN TO
LOS ANGELES COUNTY SURVEYOR

Note: ANY ADDITIONS OR CHANGES ON THIS SHEET MUST BE MADE OR CIRCLED IN Red. WITH DATE AND NAME OF PERSON MAKING CHANGE.

Do not extend notes this side of this line

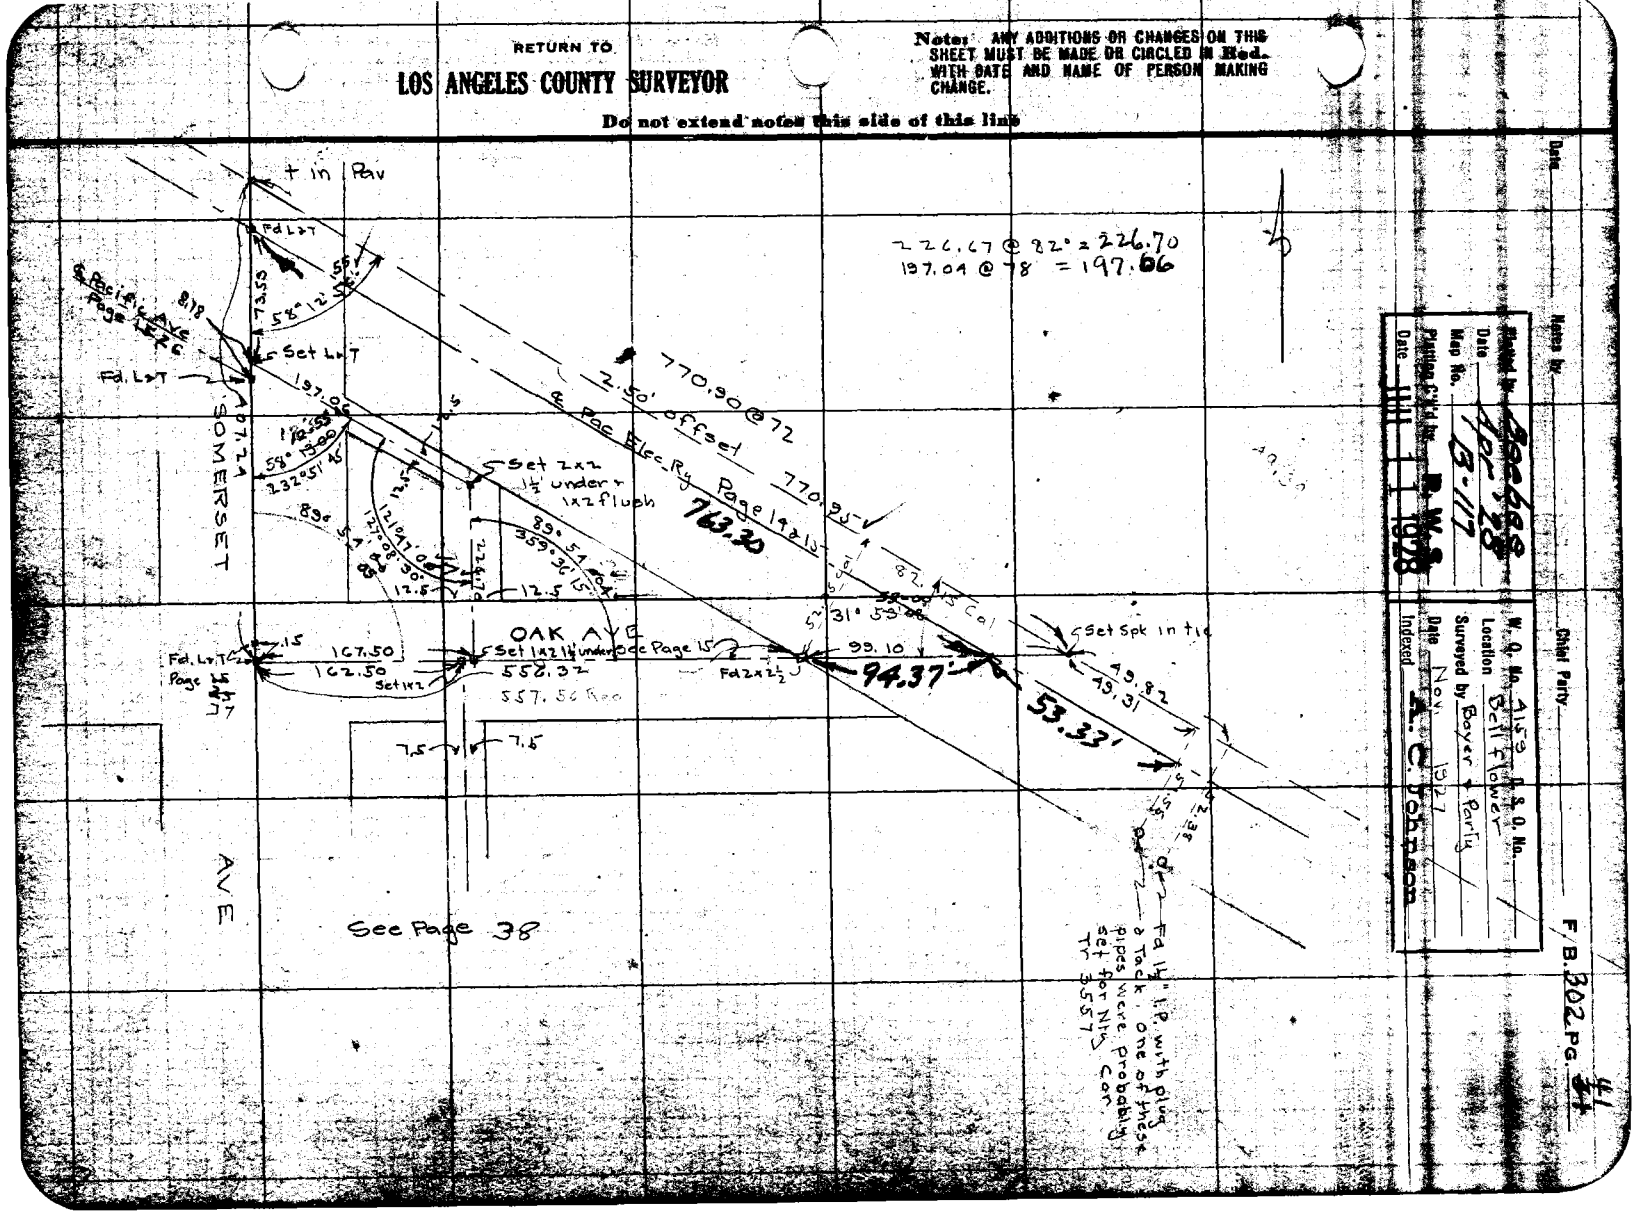

Notes by _____ Chief Party _____ F.B. 302 Pg. 41

Plotted by Jacobs Date 12-6-28
Map No. B-117
Plotting Ck'd by R. W. S. Date 12-7-28

W. O. No. 1153 R. S. O. No. _____
Location Bell Flower
Surveyed by Boyer + Party
Date Nov. 1927
Indexed A. C. Johnson

RETURN TO

LOS ANGELES COUNTY SURVEYOR

Note: ANY ADDITIONS OR CHANGES ON THIS SHEET MUST BE MADE OR CIRCLED IN **Red.** WITH DATE AND NAME OF PERSON MAKING CHANGE.

Do not extend notes this side of this line

Page 32

F.B. 302 PG. 32

Date

Chief Party Notes by

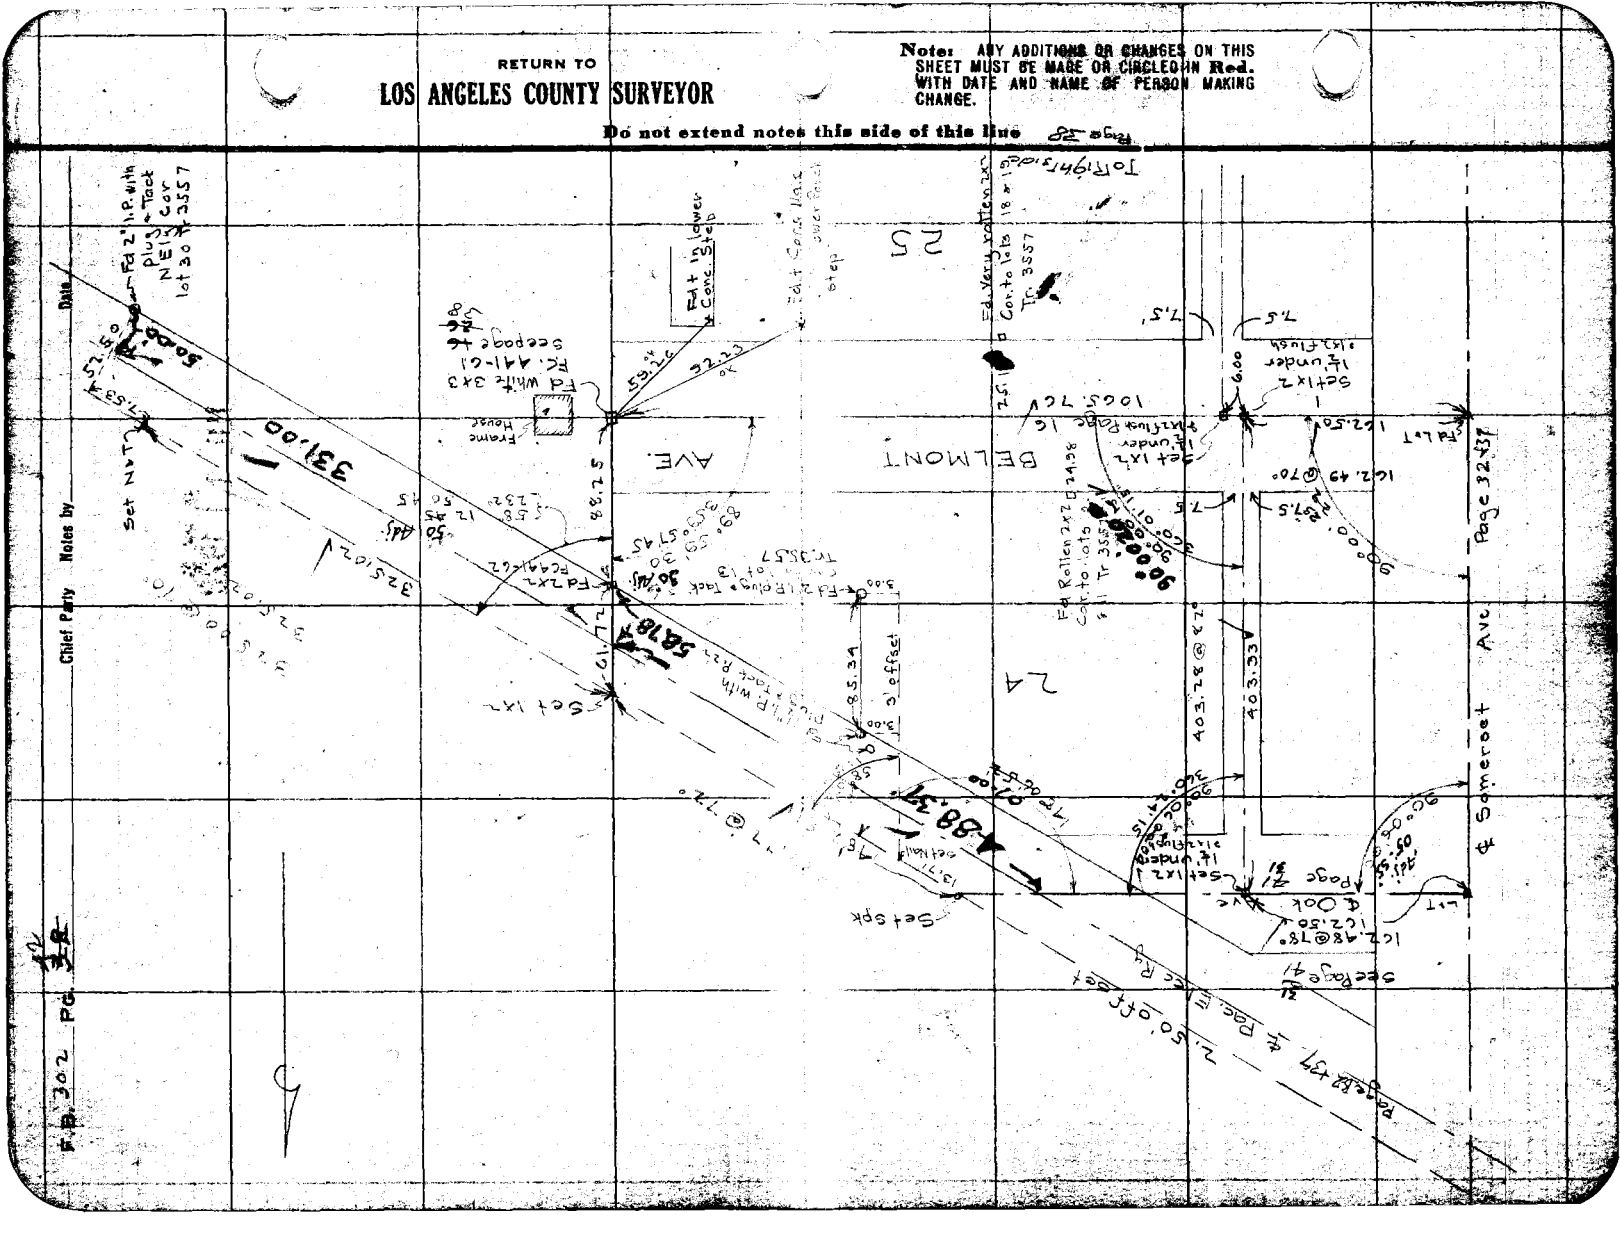
Fd 2" I.P. with Plug & Tack NE'ly Cor Lot 30 # 3557
Set N'LY
331.00'
325°02'
Fd 1" I.P. with Plug & Tack
Set Spk
Set 1x2
Set 1x2 14" under
Fd 1x2 P.C. 44.62
Fd 2" I.P. Plug & Tack

Date _____ Notes by _____ Chief Party 302 F. B. 302 PG. 38

Plotted by Geebee
Date Apr '28
Map No. B-117
Plotting Chkd by R. W. S.
Date JUL 11 1928

W. O. No. 4152 O. S. O. No.
Location Bellflower
Surveyed by Boyer & Party
Date Nov. 1927
Indexed

Notes: ANY ADDITIONS OR CHANGES ON THIS SHEET MUST BE MADE OR CIRCLED IN Red. WITH DATE AND NAME OF PERSON MAKING CHANGE.

RETURN TO LOS ANGELES COUNTY SURVEYOR

Do not extend notes this side of this line

See Page 26 Fd 38

SOMERSET AVE

Fd. L & T Page 26 38

AVE

304

TRACT

LAUREL

ORCHARD

Set Nail & Tin

AVE.

To Top Page 27

F.B. 302 PG. 44 34

Chief Party Notes by Date

From bottom Page 33 43

ORCHARD AVE

Fd. L & T Curb Ret

Set Nail & Tag PC 441-42

Fd L & T Curb Ret

29.92

35.67

25.66

49.58

old 2x2

25.00

25.12

2x2

AVE

149.95

100.25

25.17

2x2

304

N (5)

24" I.R

25.08

25.11

50.00

TRACT 9

TRACT 7

LAUREL

25.02

old 2x2

29.91

32.9

2x2

ARDMORE

Fd. L & T. Curb Ret.

Fd L & T Curb Ret

AVE.

25.65

0K

S 89° 59' 00" E

Fd. 2" I.P. with plug & Nail See PC 441-53 Set nail .01 N & .01 E Per PC 441-53 for ties per P.C. 441-42

Fd. L & T. in Curb

RETURN TO LOS ANGELES COUNTY SURVEYOR

Do not extend notes this side of this line

Note: ANY ADDITIONS OR CHANGES ON THIS SHEET MUST BE MADE OR CIRCLED IN Red. WITH DATE AND NAME OF PERSON MAKING CHANGE.

F. B. 302 Pg. 45

Date _____ Notes by _____ Chief Party _____

Blocks for '28
Date _____
Map No. B-117
Checked C.W.S. B. W. S.
Date JUL 11 1928

W. O. No. _____ S. O. & S. No. _____
Location Bellflower
Surveyed by Boyer & Parry
Date Nov. 1927
Indexed A. C. Johnson

To bottom of Page 76

Notes: ANY ADDITIONS OR CHANGES ON THIS SHEET MUST BE MADE OR CIRCLED IN Red. WITH DATE AND NAME OF PERSON MAKING CHANGE.

RETURN TO LOS ANGELES COUNTY SURVEYOR

Do not extend notes this side of this line

SOMERSET AVE
NORWALK AVE
STATE
ARDMORE
FLOWER
MAPLE
WALNUT
CLARK
ARKANSAS
PARK
AVE
CIRCLE

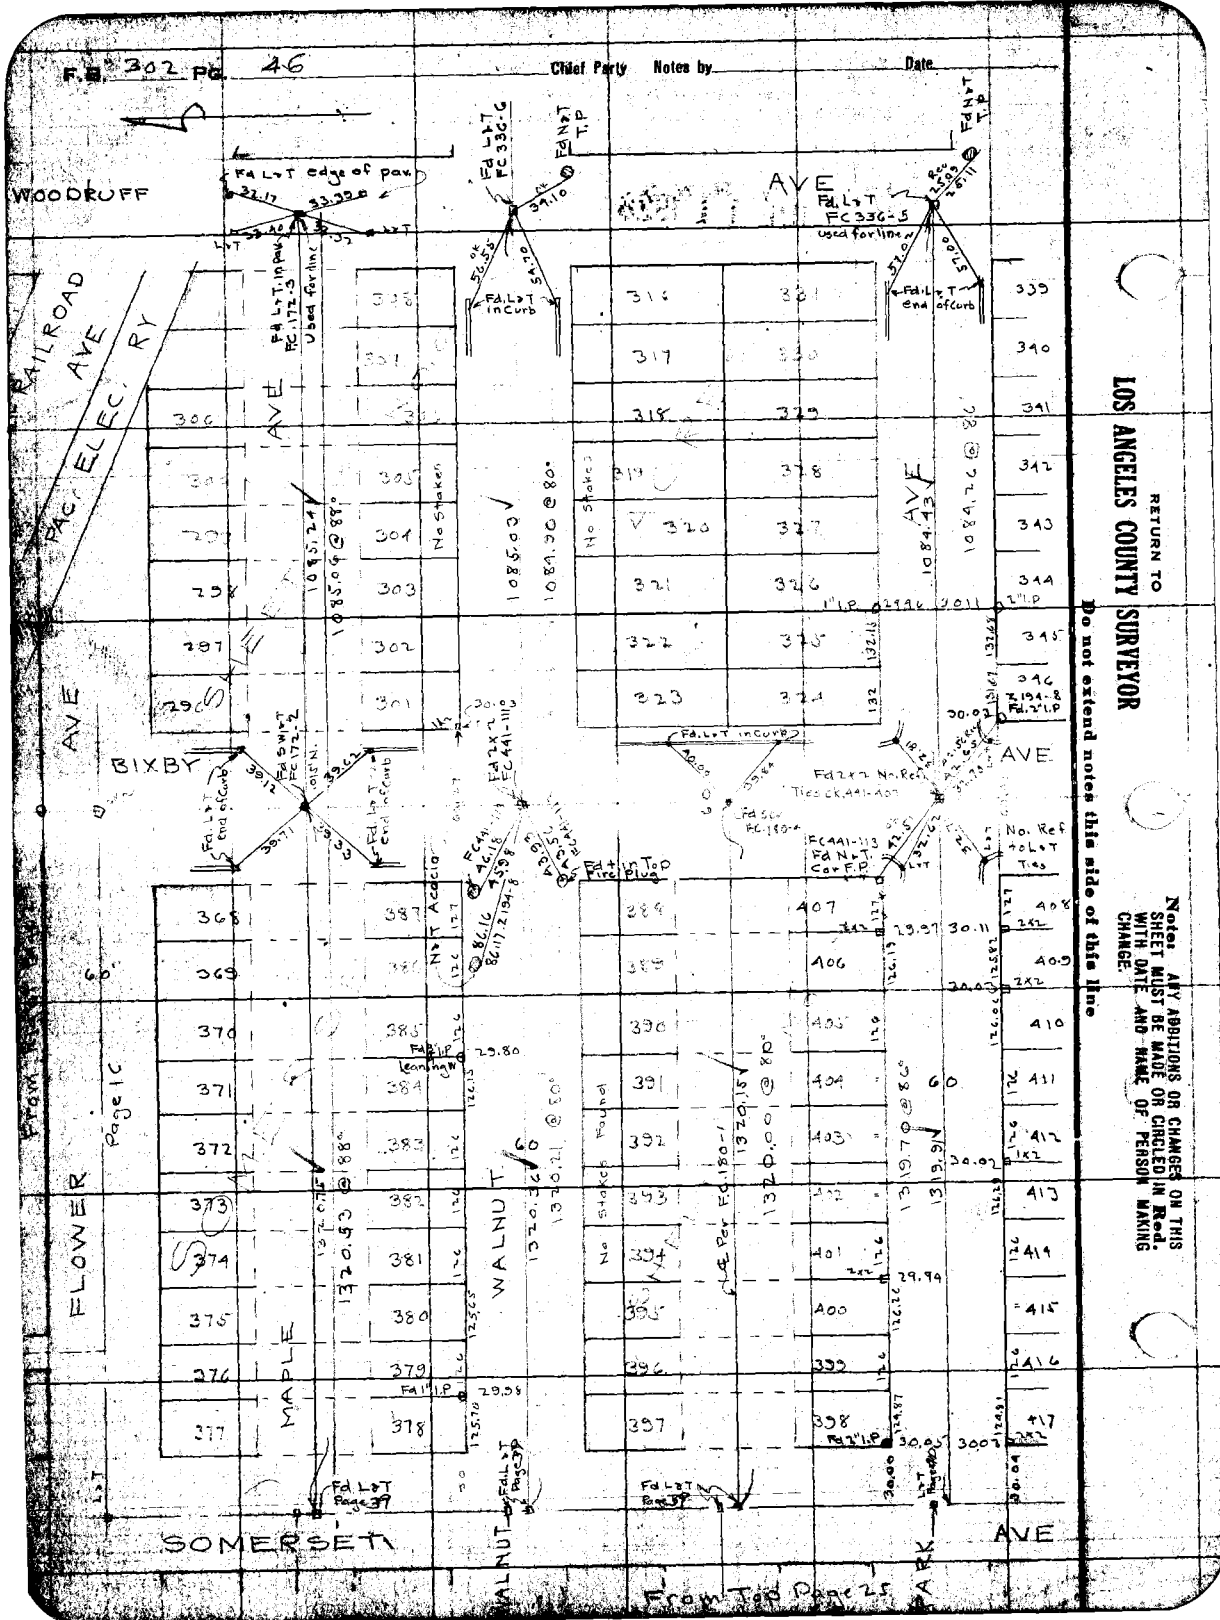
F.B. 302 Pg. 46
Chief Party
Notes by
Date
WOODRUFF AVE
RAILROAD
PAC. ELEC. RY
BIXBY AVE
FLOWER
MAPLE
WALNUT
SOMERSET
PARK AVE
Fd L&T edge of pav
Fd L&T FC 330-6
Fd L&T FC 330-5 used for line
Fd L&T in Curb
Fd L&T end of Curb
Fd 2x2 No Ref Ties CK 441-A00
Fd Spike FC 150-A
Fd 1" IP
Fd Nail & Tag
Fd Nail & Shr
Fd L&T Page 39
Fd L&T Page 39
From Top Page 25
RETURN TO
LOS ANGELES COUNTY SURVEYOR
Do not extend notes this side of this line
Note: ANY ADDITIONS OR CHANGES ON THIS SHEET MUST BE MADE OR CIRCLED IN Red. WITH DATE AND NAME OF PERSON MAKING CHANGE.

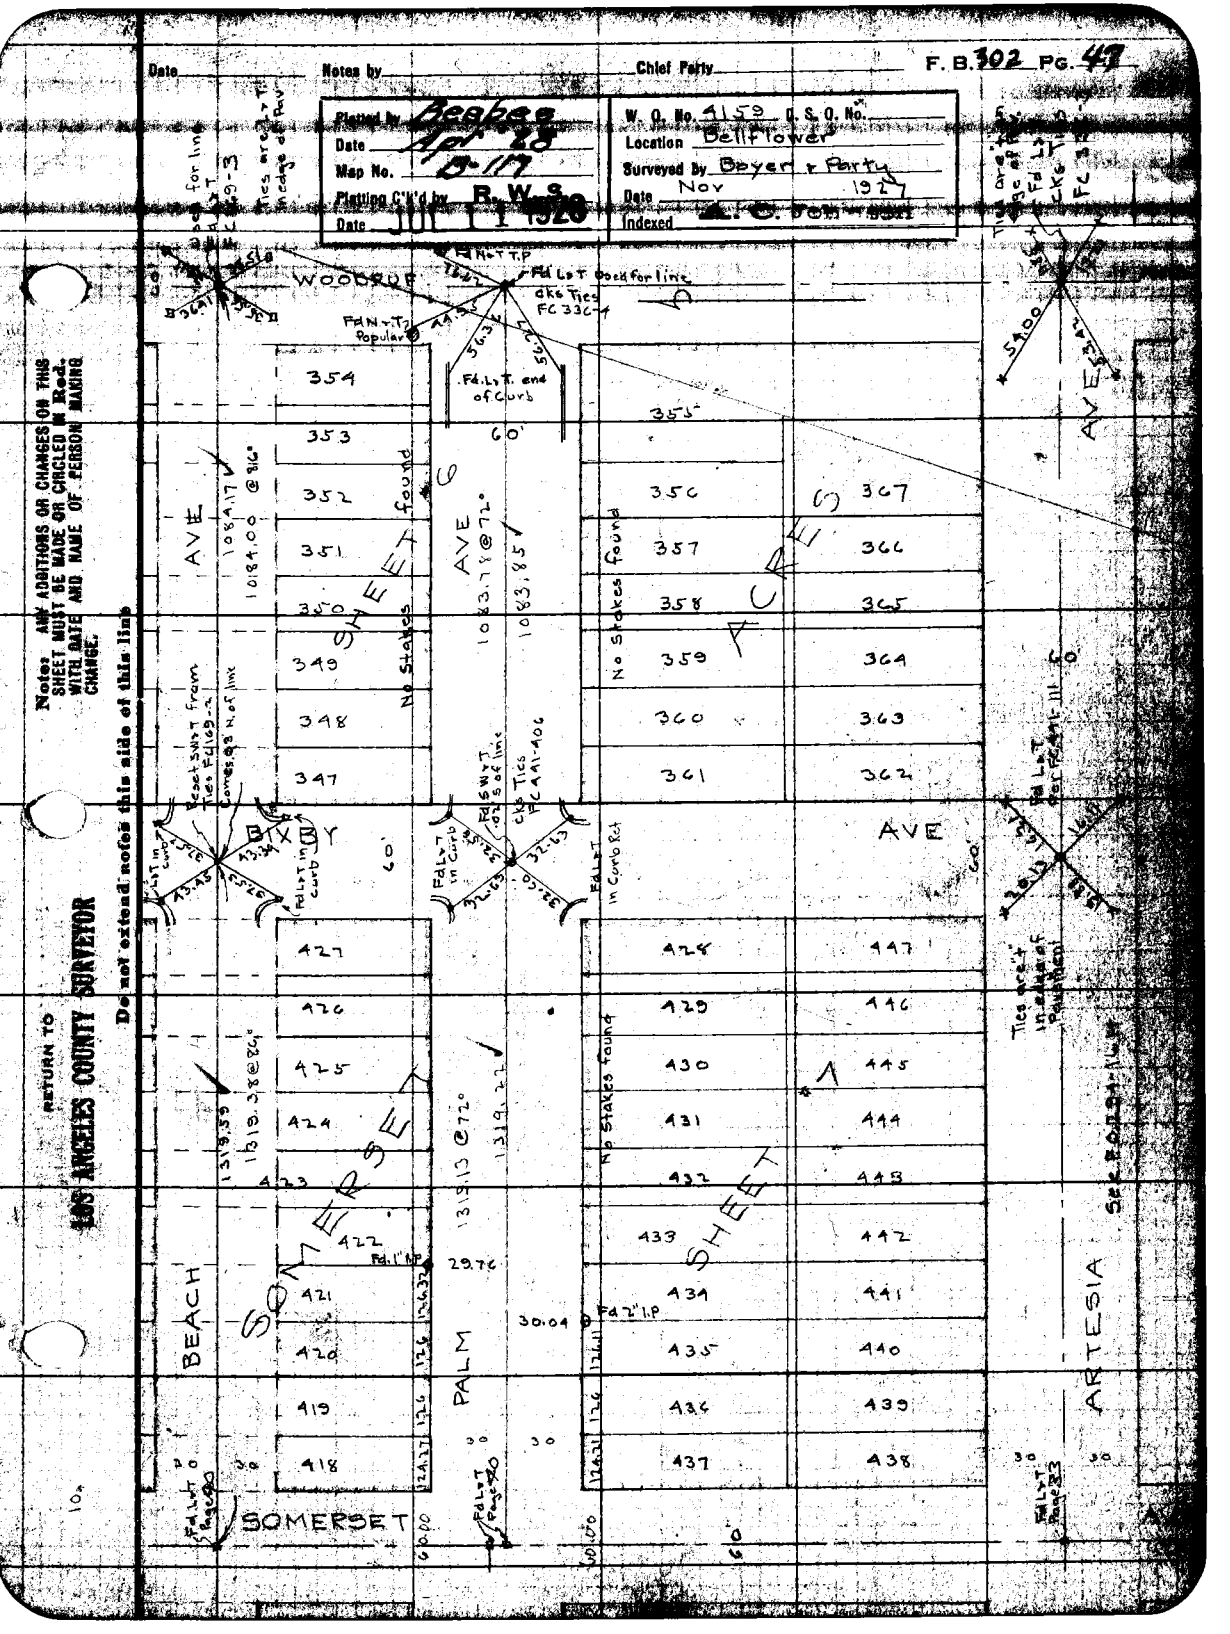
Date
Notes by
Chief Party
F. B. 302 PG. 47
Plotted by Beakes Apr 28
Date
Map No. 5-17
Plotting Ck'd by R.W.S.
Date JUL 11 1928
W. O. No. 4159 C. S. O. No.
Location Bellflower
Surveyed by Boyer & Party
Date Nov 192
Indexed
Notes: ANY ADDITIONS OR CHANGES ON THIS SHEET MUST BE MADE OR CIRCLED IN Red. WITH DATE AND NAME OF PERSON MAKING CHANGE.
Do not extend notes this side of this line
RETURN TO LOS ANGELES COUNTY SURVEYOR
WOODRUFF AVE
BIXBY
SOMERSET
BEACH
PALM
ARTESIA
ACRES
SHEET 5
SHEET 1
No Stakes found
Fd L&T
Fd L&T in Curb
Fd L&T in Curb Rd
Fd L&T end of Curb
Fd Nail & Tag
Fd 2" I.P
Tie Area
Tie Area of Pavement
354
353
352
351
350
349
348
347
355
356
357
358
359
360
361
367
366
365
364
363
362
427
426
425
424
423
422
421
420
419
418
428
429
430
431
432
433
434
435
436
437
447
446
445
444
443
442
441
440
439
438
60'
30'
1319.38 @ 86°
1319.13 @ 72°
1319.22
1084.17
1018.00 @ 86°
1083.17 @ 72°
1083.85
29.76
30.04

F.B. 302 PG. 48

Chief Party Notes By Date

RETURN TO

LOS ANGELES COUNTY SURVEYOR

Do not extend notes this side of this line

Note: ANY ADDITIONS OR CHANGES ON THIS SHEET MUST BE MADE OR CIRCLED IN Red. WITH DATE AND NAME OF PERSON MAKING CHANGE.

SOMERSET

ARDMORE

CLARK

PALM

BEVERLEY

ACRE

SHELDON

ARTESIA

AVE

Fd. Nail

Fd. Ford

Fd. Old

Fd. 1" I.P

Fd. L.T. in Curb Retn

Fd. L.T. end of walk

Fd. L.T. end of curb

Fd. S.W.T. by Ties Per F.C. 441-300 Ideal Comes 0.2 South

Fd. S.W.T. by Ties F.C. 441-300 Comes 0.2 S. of line

Fd. S.W.T. Cks Ties R.O. 294-3

Fd. S.W.T. FC. 441-29 2100 Used for line

Used for line Fd 2x2 .5 under F.C. 234-3

N.T.P.

1174.80

1174.97 @ 84°

1174.68

1465.00 @ 78°

1465.15

1465.24

1465.03 @ 89°

24.88

24.91

24.93

24.94

24.70

25.00

25.07

25.11

25.59

37.73

71.25

52.73

50

80 79 78 77 76 75 74 73 72 71 70 69 68 67 66 65 64 63 62 61

81 82 83 84 85 86 87 88 89 90 91 92 93 94 95 96 97 98 99 100

120 119 118 117 116 115 114 113 112 111 110 109 108 107 106 105 104 103 102 101

RETURN TO
LOS ANGELES COUNTY SURVEYOR

Note: ANY ADDITIONS OR CHANGES ON THIS SHEET MUST BE MADE OR CIRCLED IN Red. WITH DATE AND NAME OF PERSON MAKING CHANGE.

Do not extend notes to this side of blueline

Cont. Rt. side Page 52

March 19, 1928.
Replaced 2x2 with
C.S. Brass Cap Monument
Marked
COUNTY SURVEYOR'S MONUMENT

See Also R.D. F0326-27

ARDMORE AVE.

SOMERSET AVE.

Fd 2x2 in E Clark Ave
Ref F.B. 309-

28+77.30
Fd Old 2x2
SE Cor of
Bell Flower Acres

(2642.00 Rec)
2642.03 Meas.

4317.06 Meas.
4317.02 Rec)

CITY OF LONG BEACH

Fd 1" I.P. 2.43 + 17.06
F.B. 309-

4317.73 T=60° = 4317.06

90-02-30
360-00-00
28+27.29
Fd. Old 2x2 Tr. across
S.W. Cor. Lot
Bell Flower Acres

Adopted line

Set 1x2 by Int.
16+75.045

Set 2x2 down 1ft.
16+75.03 From East
Set 2x2 Flush
For ties see Page 50
Fd 4x4 UP 4' used
as fence Post. Marked
W.A. — ?
B.L.M. Sta. -

90° (1675.02 Rec)
1675.03 Meas)
0+00
Fd 2x2 on
13.0' Offset

16+75.03
Set N.T. by Prop. between
4x4 S.E. Cor. Lot 521 Somerset Ave
and 2x2 in E Clark Ave.
Per Sheet No 75 Somerset Ave
M.B. 14 / 06

Fd 6" Round Conc Mon
With Cut Spk + Tin
16+75.25

Fd Spk + T. Removed
16+75.06
Fd 2x2 Tr. Ref 2208-6
16+94.74

5'0 Post Line

1x2 Sq

Cont. Page 117

Plotted by
Date
Map No.
Elevation Check by
Date

W.O. No. 4453
Location Somerset Ave
Surveyed by M. Hayes
Date
Indexed

Chief Party
F.B. 302 Pg. 49

F.B. 302 Pg. 50 M. Hayes Chief Party Notes by M.H. Date 1-9-28

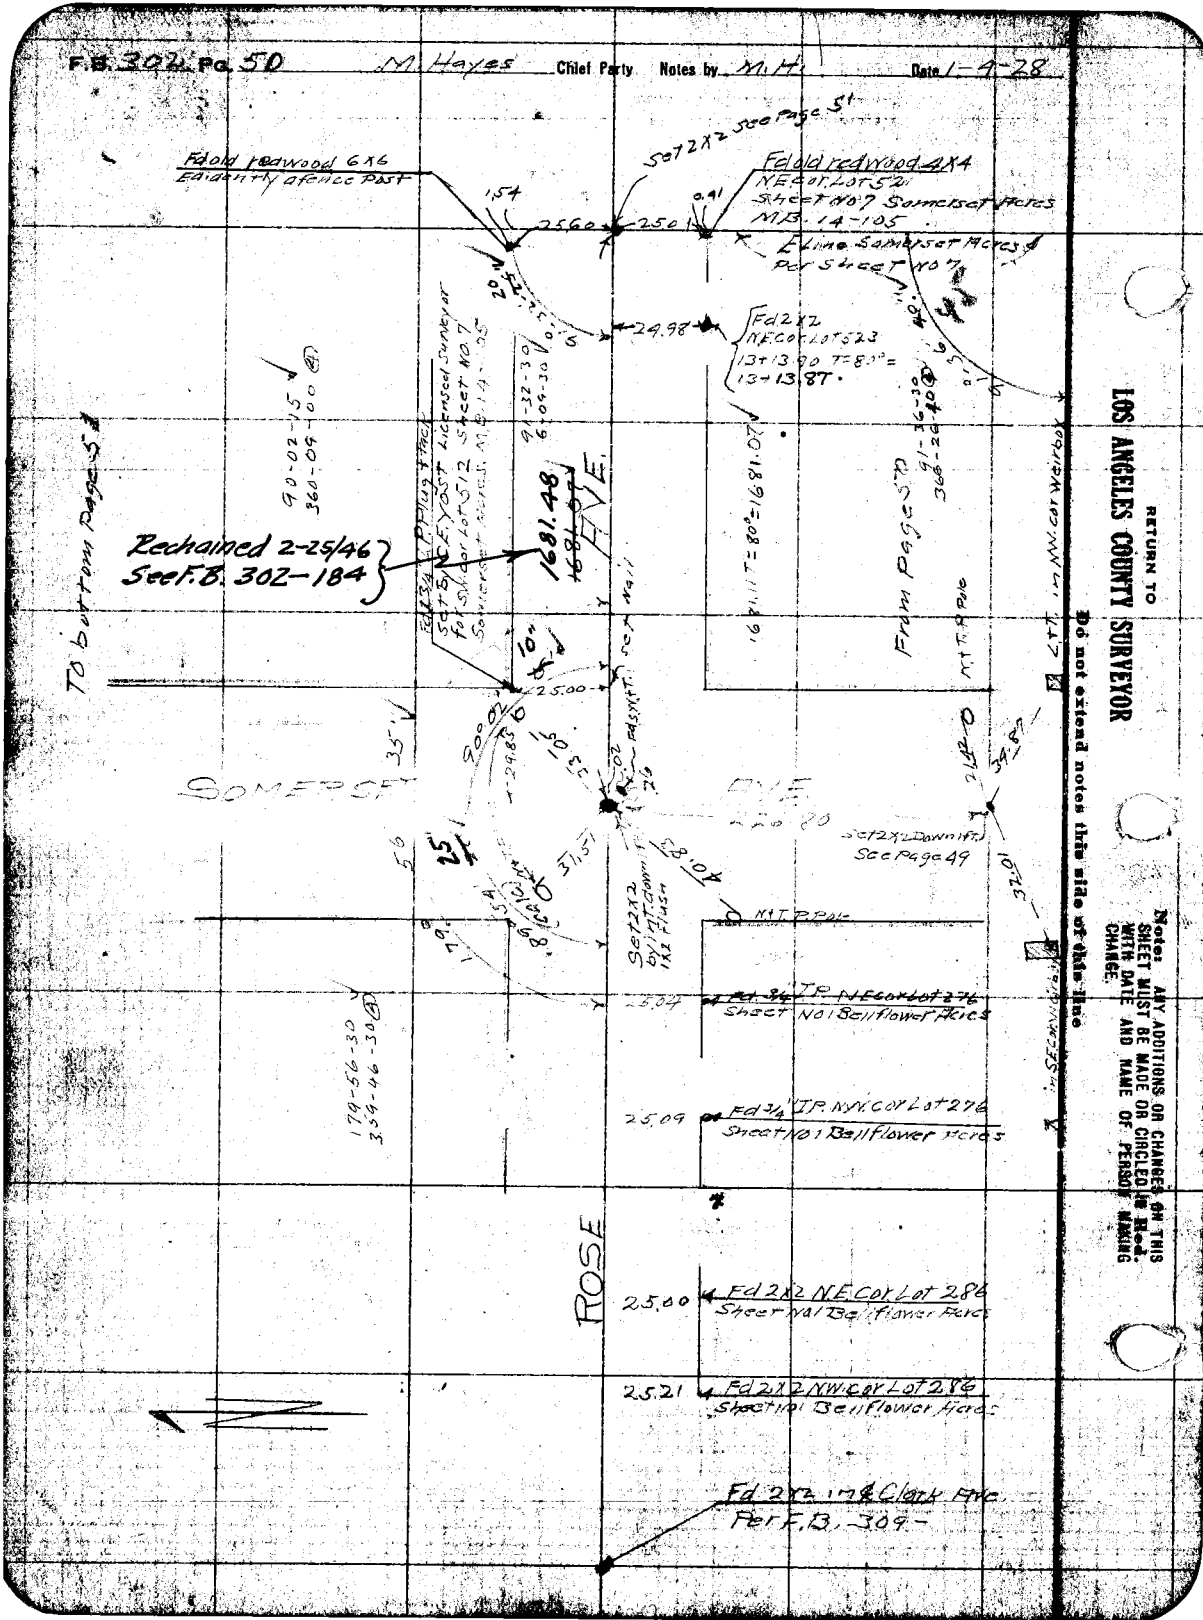

RETURN TO
LOS ANGELES COUNTY SURVEYOR
Do not extend notes this side of this line

Note: ANY ADDITIONS OR CHANGES ON THIS SHEET MUST BE MADE OR CIRCLED IN Red WITH DATE AND NAME OF PERSON MAKING CHANGE.

Date _____ Notes by _____ Chief Party _____ F. B. 302 Pg. 51

Checked by _____
Date _____
Map No. _____
Checked by _____
Date _____

W. O. No. 2459 L. S. D. No. _____
Location Somerset Ave.
Surveyed by M.J.HAYES
Date May 5 1928
Indexed A. C. Johnson

Notes: ANY ADDITIONS OR CHANGES ON THIS SHEET MUST BE MADE IN RED AND CIRCLED IN Red. WITH DATE AND NAME OF PERSON MAKING CHANGE.

Do not write in this space on this side of this line

RETURN TO LOS ANGELES COUNTY SURVEYOR

Cont. on Rt. Side Page 54

Set 2x2 26 Lvt.
See Page 52

RAMONA
2640.70
To & Clark Per FB 309-

I AVE

90-06
0-23-45 (A)

89-58-30
359-53-30 (A)

88-27-05
353-48-20 (A)

To & Clark Ave

(660.00 Rec)
659.98 Meas

AVE
2104.34

618.08 Meas
(619.46 Rec)

1150.60 Meas

Fd 2x2 in & Clark Ave per FB 309-41

N.T.I. in P. Pole

N.T.I. in P. Pole

N.T.I. in R.R. Pk'd

26.41.39
To & Clark Ave
Per FB 309-

CEDAR

AVE
1696.46

7182.42 from Sta.
Set 2x2 by P.P. at
bent 3x3 in Fence
for 17.75' R.R.
Cut C. Rose Ave.

Fd old 3x2
Set Conc. Monument
Near

N.T.I. in Composition

90-06-45
0-22-45 (A)

Fd 3/4" I.P.
(Fd. Axle in Rec Cor 5")

8.9-58-0
359-52-0 (A)

88-27-30
353-50-0 (A)

1696.59 T = 720 = 1696.462

(1217.25 Rec)

Set 2x2 Dynamited
in Rock & Stone Mound

SOMERSET

(1150.37 Rec)

91-32-30
6-09-30 (A)

2+29.85

2+29.90 From S.
Set 2x2

ROSE

2641.86
To & Clark Ave
Per FB 309-45

AVE.
1681.07

N.T.I. in Pipe
Old Mon.

Set 2x2

F.B. 302 Pg. 52 M. Hayes Chief Party Notes by Date 1-5-28

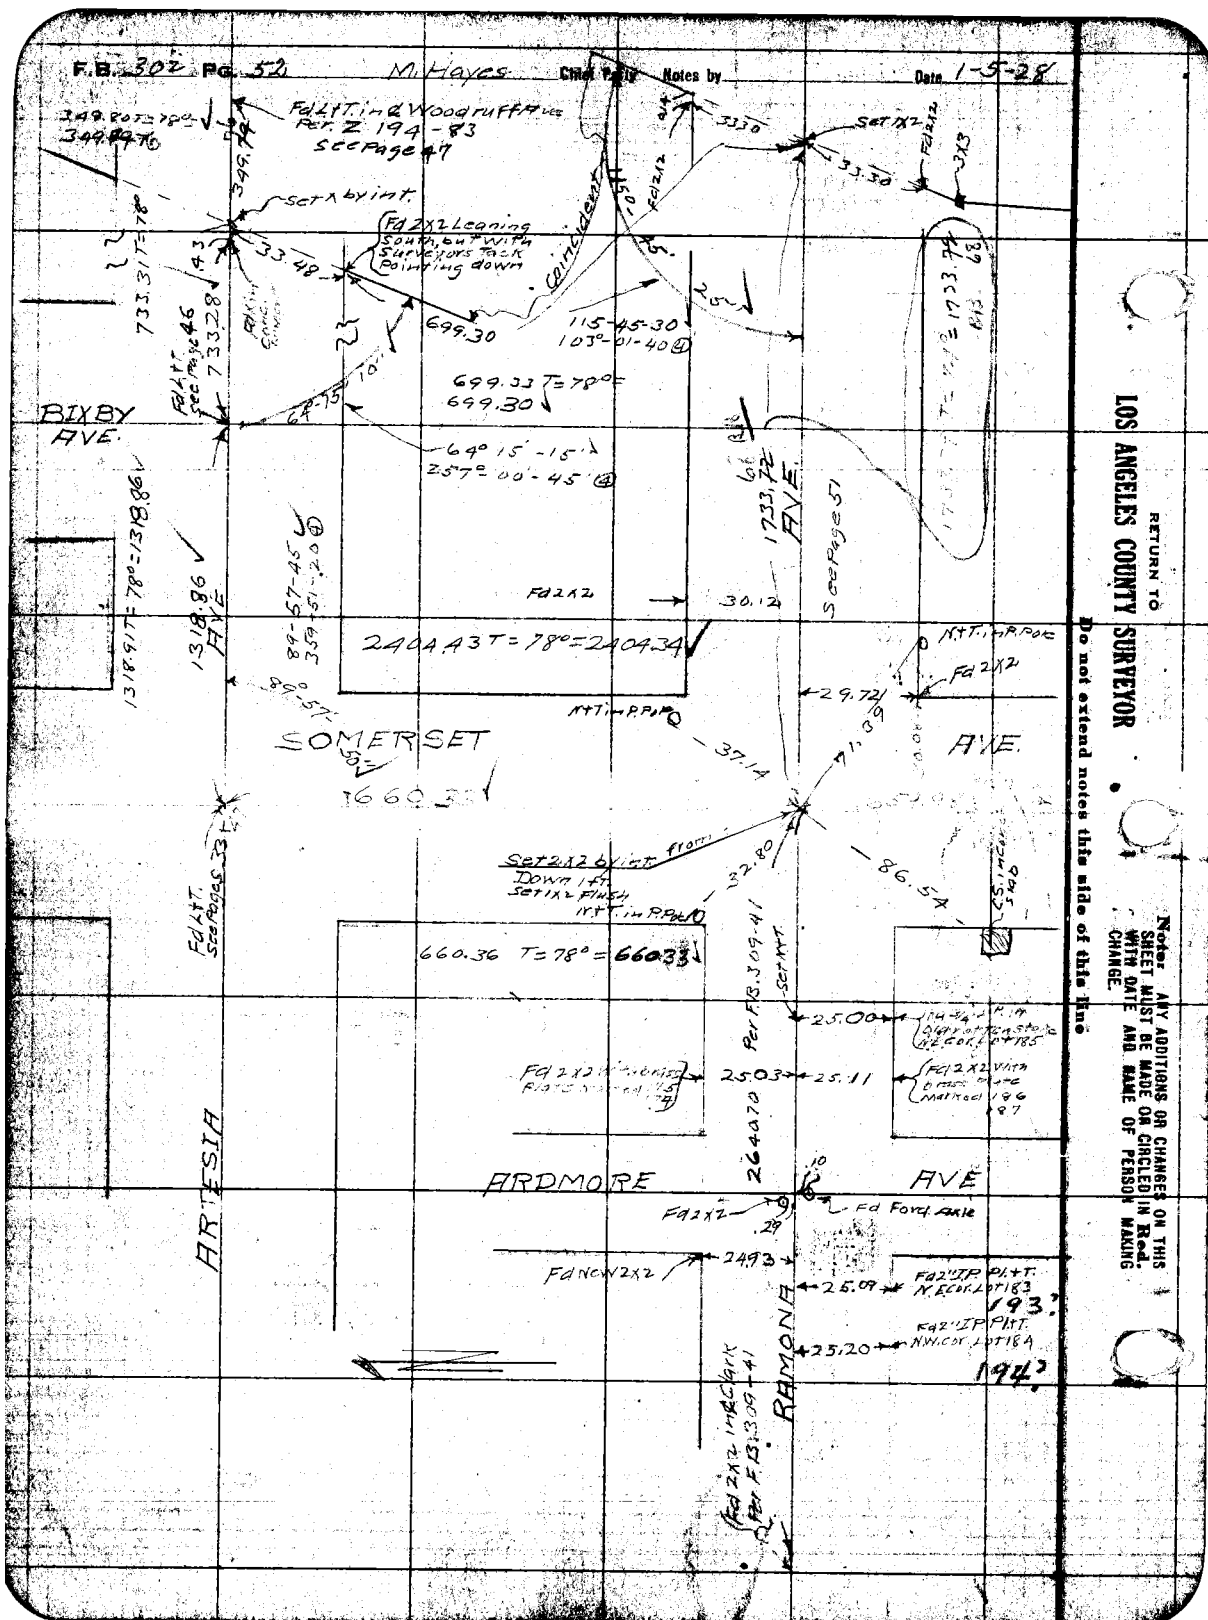
BIXBY AVE.
SOMERSET AVE.
ARDMORE AVE
ARTESIA
RAMONA
Fd 1/2" I.P. in Woodruff Acc Per Z 194-83 See Page 47
Set X by int.
Fd 2x2 Leaning South, but with Surveyors Tack pointing down
Fd 1/2" I.P. See Page 46
See Page 51
See Page 53
Set 2x2 by int. from Down 1.5' Set 1x2 Flush
Fd 2x2

Notes by _____ Chief Party _____ F. B. 302 Pg. 53

Planned by H.E. Clymer
Date Dec. 1927
Map No. B-117
Checked by C.M. Finley
Date Dec. 1927

W. O. No. _____ D. S. O. No. _____
Location _____
Surveyed by _____
Date _____
Indexed A. C. Johnson

Topography on
Somerset Ave., Bellflower
from
Center Street
To
Artesia Ave.
W.O. No. 4159

Nov. 24 - Dec. [illegible]
M. Hayes
E.E. Carlson [illegible]
B.O. Telephone [illegible]
Hk. [illegible]
L.E. Pa. [illegible]

Center Line Data Pages 1 to 52

LOS ANGELES COUNTY SURVEYOR

F.B. 302 PG. 5A M. Hayes Chief Party Notes by: M. H. Date: Oct 24 1927

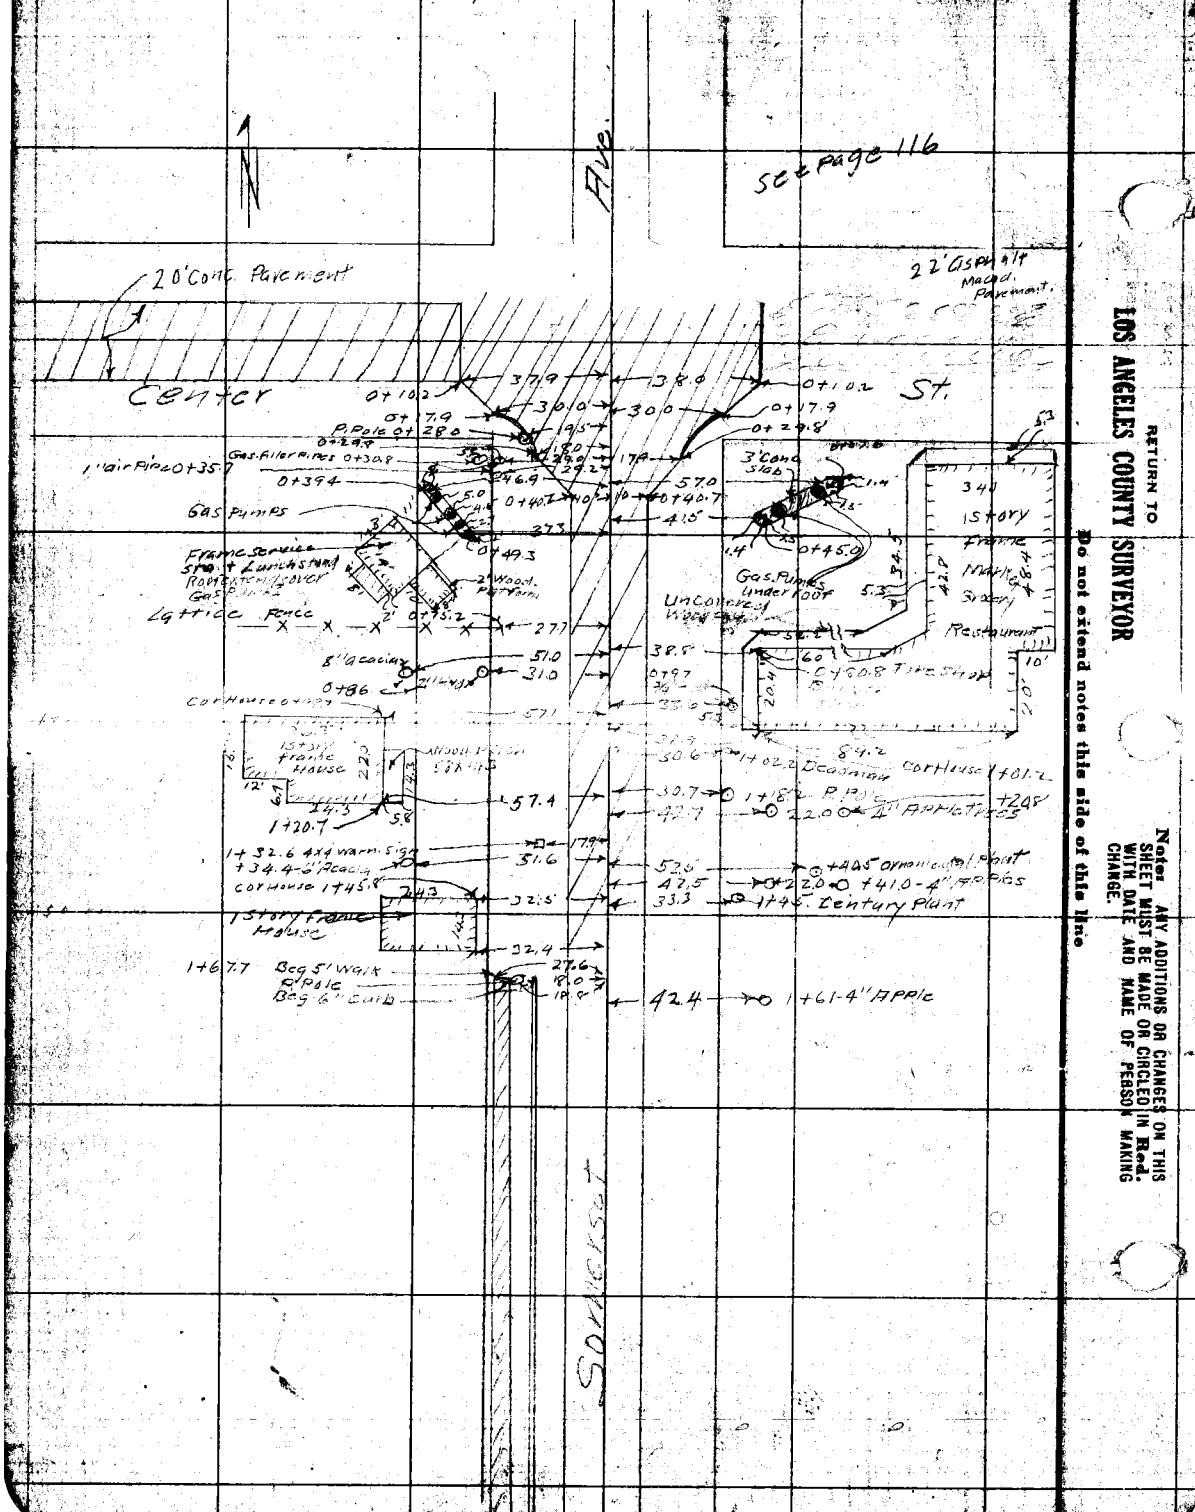

RETURN TO
LOS ANGELES COUNTY SURVEYOR

Do not extend notes this side of this line

Note: ANY ADDITIONS OR CHANGES ON THIS SHEET MUST BE MADE OR CIRCLED IN Red. WITH DATE AND NAME OF PERSON MAKING CHANGE.

Date _____ Name by _____ Chief Party M. Hayes F. B. 302 PG. 55

Plotted by Clayne
Date Dec. 1927
Map No. 1117
Checked by Finley
Date Dec. 1927

W. O. No. 1159 D. S. O. No.
Location Somerset Ave. Bellflower
Surveyed by M. Hayes
Date Nov. 25, 1927
Indexed A. C. Johnson

Notes: ANY ADDITIONS OR CHANGES SHEET MUST BE MADE OR CIRCLED WITH DATE AND NAME OF PERSON MAKING CHANGE.

RETURN TO LOS ANGELES COUNTY SURVEYOR

Do not extend notes this side of this line

20' Conc. Pavement
Cor. Conc. Porch 1+89.5
1"x18" Gutter
1 Story Stucco Dwelling
49.5
2+02.2
2+13
7' Con. drive
1 Story Frame Real Estate office
37.3
2+23.3
2+33.4
19.0
27.6
End walk, curb 2.1
5" l/o quat 1+45.2
38.2
Curb
End walk 2+58.7
T. Pole 1+54.7
Cor. Ivonic 1+60.6
24.2
39.5
31.0
30.1
42.0
54.6
57.5
2" Hyd. 2+29.5
1+67.2
38.6
1 Story Frame Dwelling
Wood steps 3 risers
5'
16'
29.2
57.3
1+80.4
1+84.6
2+86.9
39.9
1+60.6 4" Applic
1+70.2
1 Story Frame Dwelling
26.4
24.4
51.6
51.6
1+98.9
3' Walk 1+84.9
2' Walk
1+99.8
2.7
1 Story Frame Garage
39.9
1+96.4
P. Pole 3+07.1 +0.19
2' Conc. strips
3+04.2
3' 11 Conc stub for driveway
3+22
40.0
Sig. Warning Sign
Light
Hat
Yard
Ave
5' Sidewalk
7" Curb
2' Gutter
Macadam Pavement
6' Curbes & Gutters
15.5
20.1
To Conc
40.0
51.2
52.5
55.0
47.0
1+58.1 - 2" Copied water line
1+61.3 1" Com. Pipe to fence
30.2
3.7
6.2 Conc. steps
1+60.1 Cor. Fence
1+64.2 Cor. Walk
1+72 Cor. Fence
1+84.6 2" Conduit
3+54.8
End walk curb
3+60.8
6" Fire Plug
5' Walk
8' Curb
32.6
47.0
31.4
48.0
1+94.4 A Pole No. W
1+96.4 " " 019
1+98.8 Deadman
1 Story Frame Dwelling
4+00.7 Cor. Fence
24.2
1 Story Frame Dwelling
46.7
6.5 x 12.5 Conc. Stoop
46.7
24.2
4+27.7
Somerset Ave
Conc. Walk 1+54.08
4+33.3
20.7
4+43.5

F.B. 302 PG. 56 — Chief Party — Notes by — Date NOV 25 27

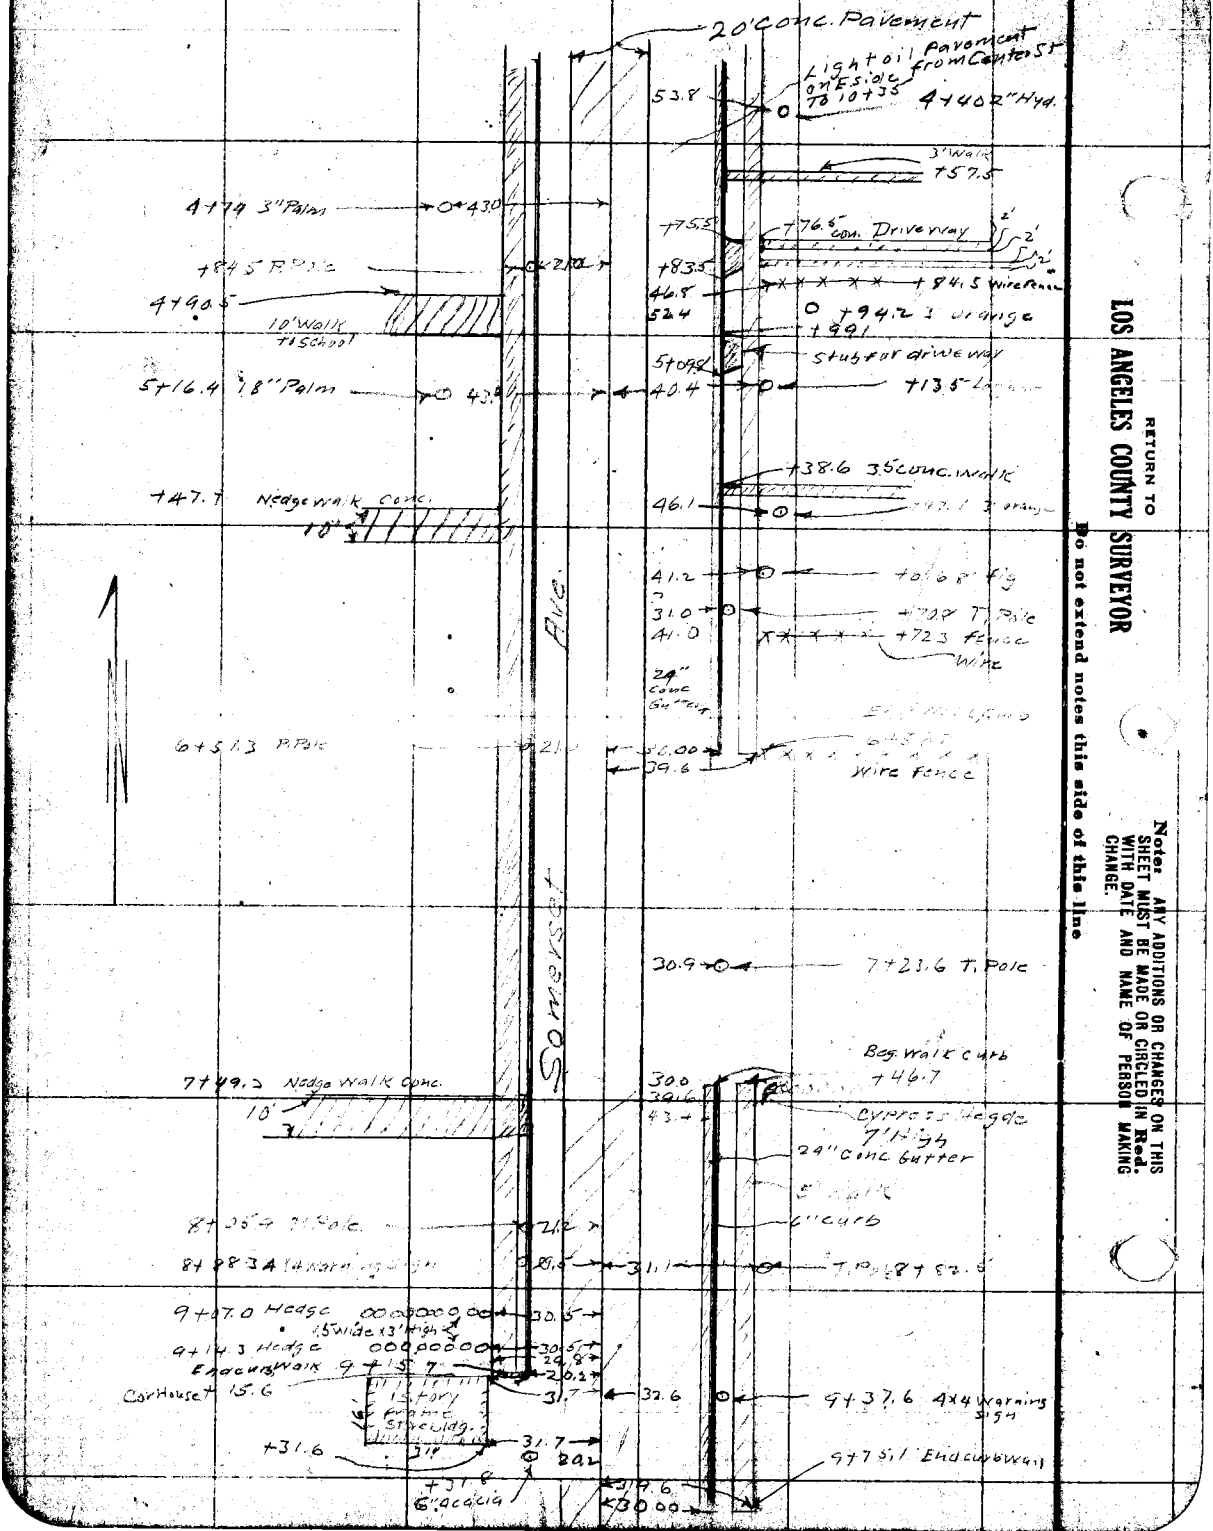

RETURN TO
LOS ANGELES COUNTY SURVEYOR

Do not extend notes this side of this line

Note: ANY ADDITIONS OR CHANGES ON THIS SHEET MUST BE MADE OR CIRCLED IN Red. WITH DATE AND NAME OF PERSON MAKING CHANGE.

Date _____ Notes by _____ Chief Party _____ F. B. 302 PG. 57

Plotted by Cilyna
Date Dec 1927
Map No. 53-117
Plotted Chkd by F. Finley
Date Dec. 1927

W. O. No. 4159 D. S. O. No.
Location Somerset Ave Bellflower
Surveyed by M. Hayes
Date 11/25/1927
Indexed A. C. Johnson

Note: ANY ADDITIONS OR CHANGES ON THIS SHEET MUST BE MADE OR CIRCLED IN Red. WITH DATE AND NAME OF PERSON MAKING CHANGE.

Do not extend notes this side of this line

RETURN TO LOS ANGELES COUNTY SURVEYOR

R Pole 9+62.5 — 24.5' — 20' Conc. Pavement
F.A. F.B. 302 - Pg 24
9+82.40
Pavement
9790 Begin. Dirt Grade Walk 29.0
5'
Rail road Ave
20' access posed Surface
T. Pole 10+36
44.0 Deadman
11+09.3 9x4 Warning sign 19.5'
11+16 P. Pole 20.7'
Ave
47.5 — 11+43.9
38.6 — 50.5 — Foster & Kleiser double bill board 40'
50.5
11+56.5
31.4
11+77 T. Pole
32.00 11+96.9 Deadman
P. Pole 107.9 — 20.5
8'x3' Gate 122.8 — 35.0
Guard Trolley Pole 126.2 — 30.7
126.7 — 29.9
Somerset
12+38
W. Edge oil + Gravel Walk — 28.2
12+51.64 Guage rail
12+57.14 Guage rail
6'x6" Warning sign 58.8 — 21.3
Spur Track
590.10

F.B. 302 Pg. 58 — Chief Party — Notes by — Date Nov 28 '30

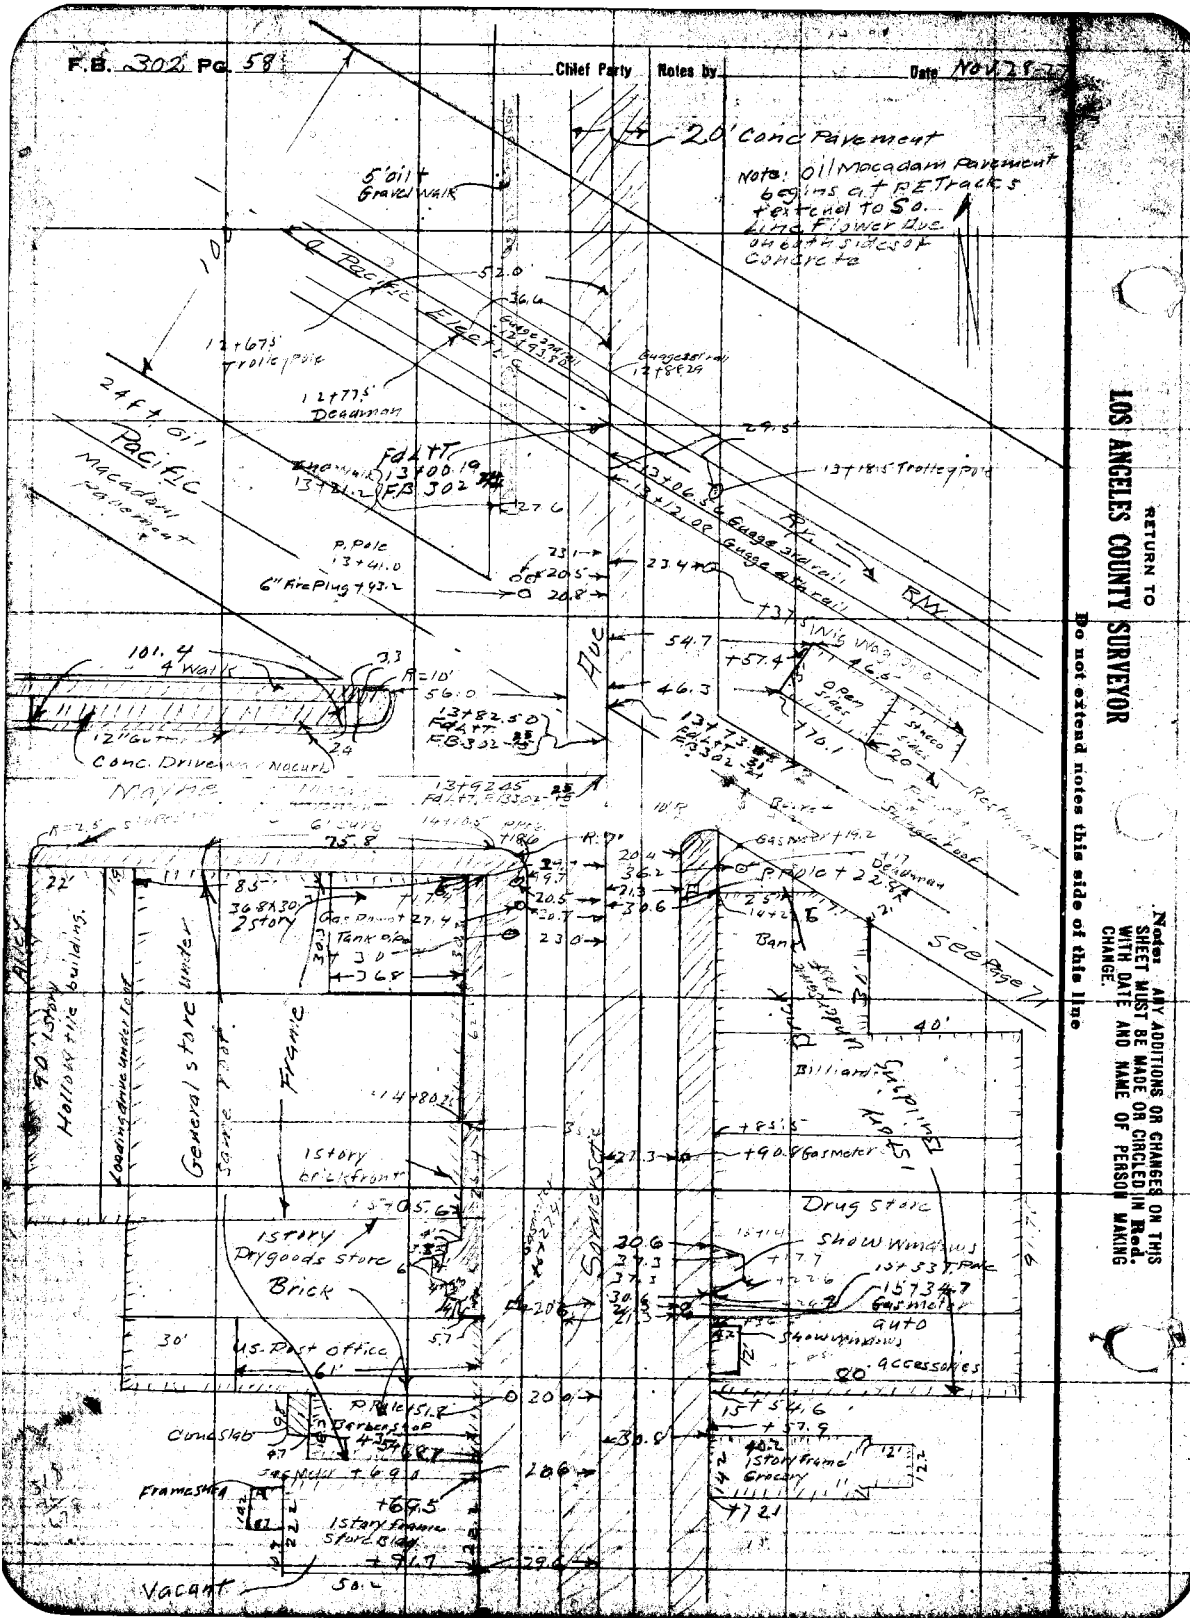

RETURN TO
LOS ANGELES COUNTY SURVEYOR
Do not extend notes this side of this line

Notes: ANY ADDITIONS OR CHANGES ON THIS SHEET MUST BE MADE OR CIRCLED IN Red. WITH DATE AND NAME OF PERSON MAKING CHANGE.

Notes by _____ Chief Party _____ F. B. 302 PG. 59

Plotted by Glynn
Date Dec. 1927
Map No. 8-117
Plotting Ck'd by Finley
Date Dec. 1927

W. O. No. 4159 U. S. O. No.
Location Somerset Ave. 3rd Floor
Surveyed by M. Hayes
Date Nov. 28-1927
Indexed A. C. Johnson

Notice ANY ADDITIONS OR CHANGES SHEET MUST BE MADE OR CIRCLED WITH DATE AND NAME OF PERSON MAKING CHANGE.

Do not extend notes this side of this line

RETURN TO LOS ANGELES COUNTY SURVEYOR

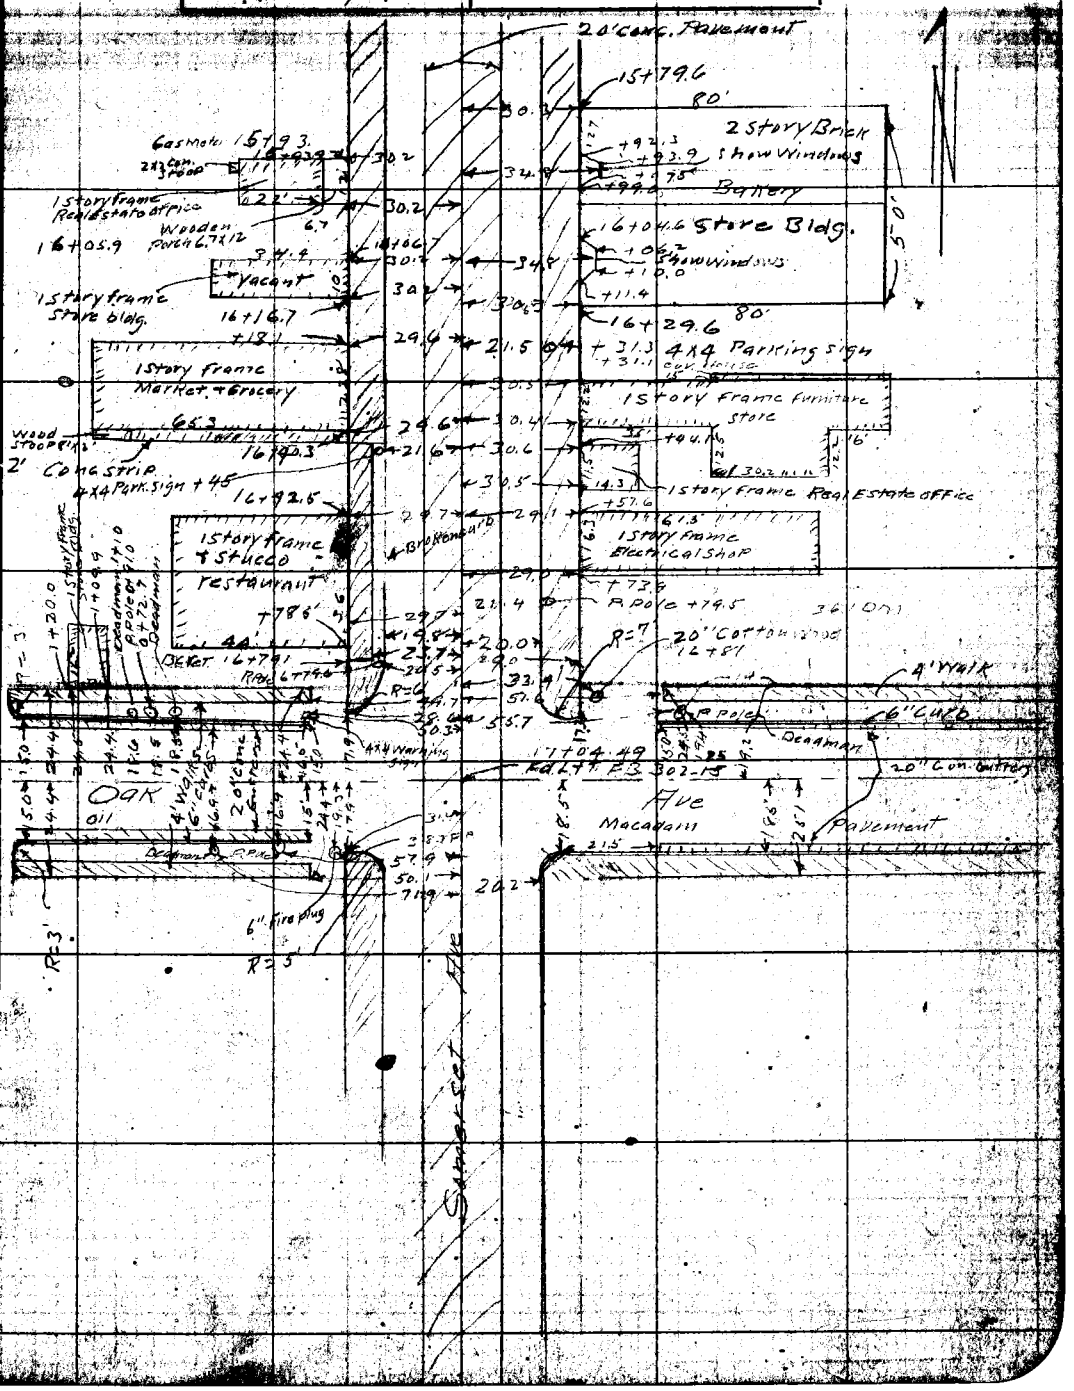

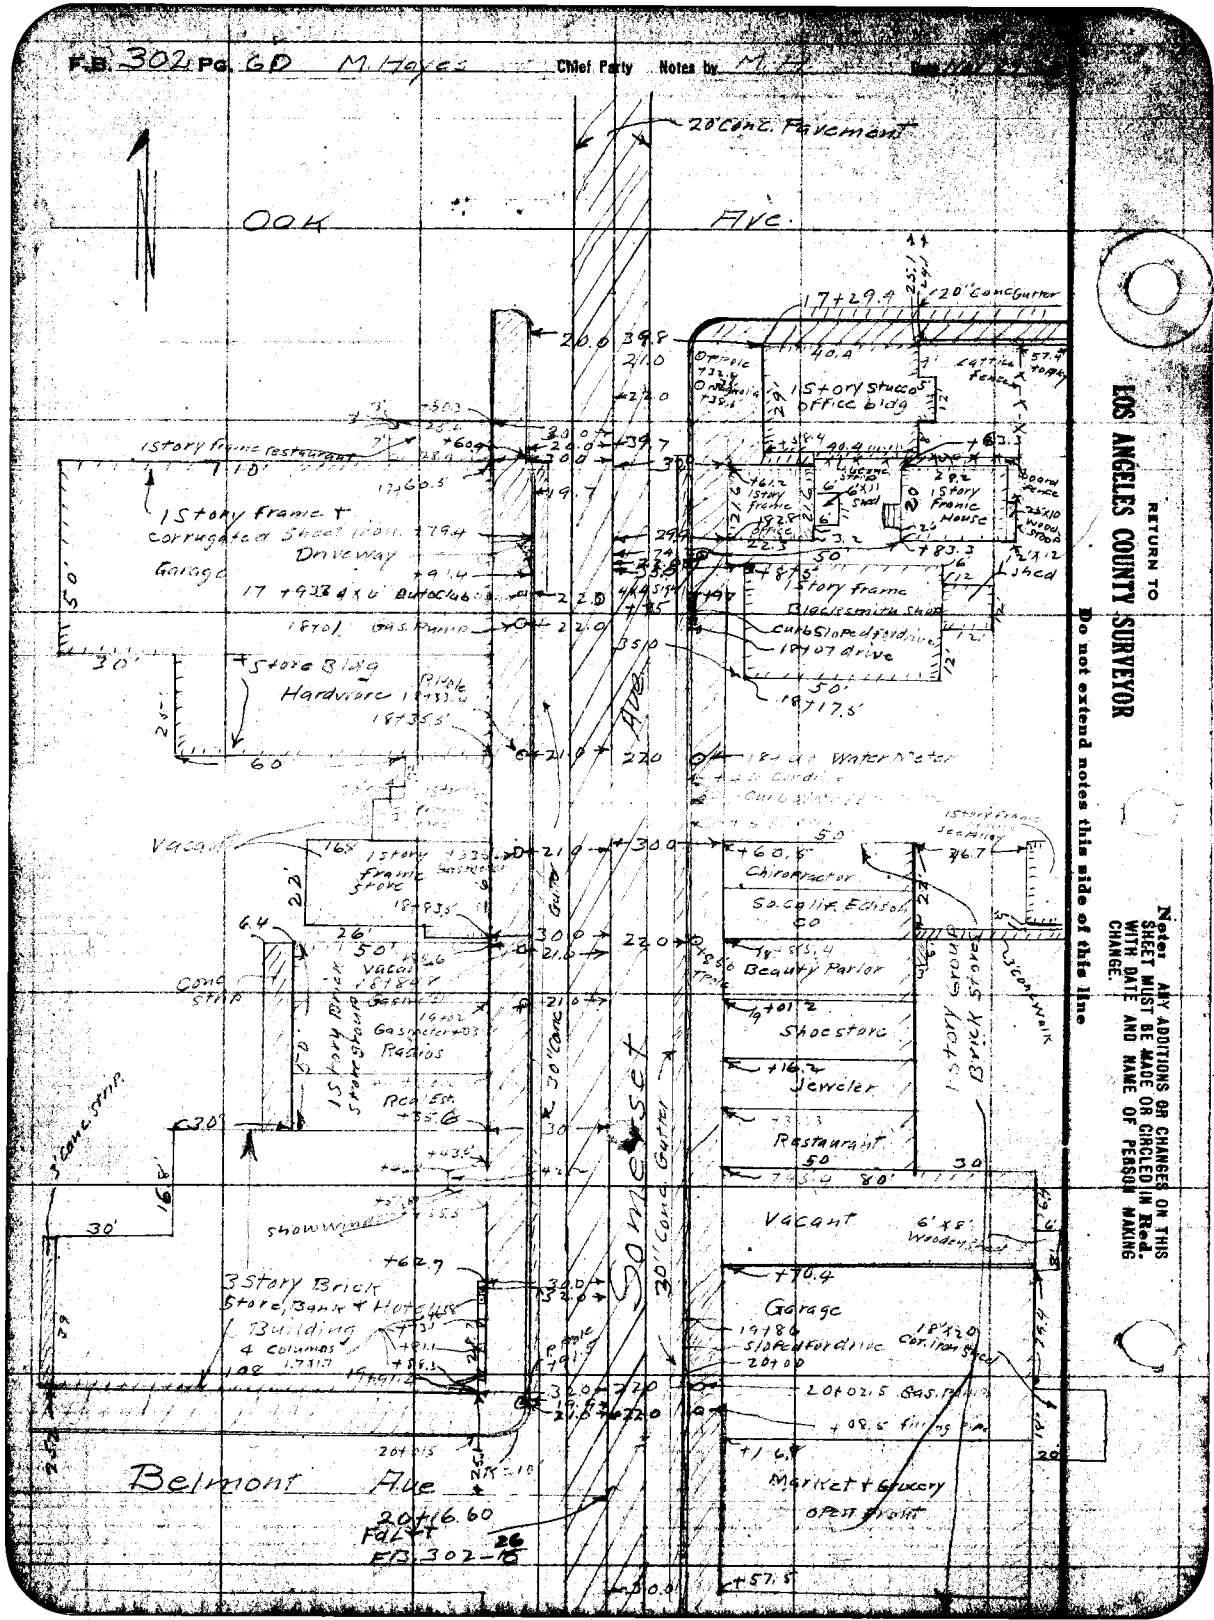
F.B. 302 Pg. 60 M. Hayes Chief Party Notes by M.H.
20' Conc. Pavement
Oak Ave.
17+29.9
20' Conc Gutter
1 Story Stucco office bldg
1 Story frame restaurant
1 Story Frame & corrugated Sheet Iron Garage
Driveway
17+93.4 x 6' Bulk
Gas Pump
Store Bldg Hardware
Vacant
1 Story Frame Store
Vacant
Cone Strip
Gas Meter
Radios
Rca Sta.
Show Window
3 Story Brick Store, Bank & Hotel Building
4 Columns
Belmont Ave
20+16.60
Sewer
20' Conc. Gutter
1 Story Frame Blacksmith Shop
Curb & Sloped for drive
19+07 drive
19+17.5
Water Meter
Chiropractor
So. Calif. Edison Co
Beauty Parlor
Shoe store
Jeweler
Restaurant
Vacant
6' x 6' Wooden Post
Garage
Slope for drive
Market & Grocery
Open Front
Concrete Walk
1 Story Frame Store
1 Story Frame House
Lattice Fence
Lattice Screen
Wood Shed
Shed
Curb
Gutter
5' Conc. Strip
Return to
Los Angeles County Surveyor
Do not extend notes this side of this line
Note: Any additions or changes on this sheet must be made or circled in Red. with date and name of person making change.

Date _____ Notes by M.H. Chief Party M. Hayes F. B. 302 Pg. 61

W. O. No. 4159 C. S. O. No. _____
Location Somerset
Surveyed by M. Hayes
Date Nov. 30. 1927
Indexed E. C. Johnson

Notice ANY ADDITIONS OR CHANGES SHEET MUST BE MADE ONLY WITH DATE AND NAME OF CHANGE.

Do not extend notes this side of this line

RETURN TO LOS ANGELES COUNTY SURVEYOR

20' conc Pavement
20+16.60
Pd Ltr. F.B. 302-76 26
Belmont
30" Conc Gutters
5' conc Valley
Conc Walk
Market
+57.5 T. Pole
Upholstr's Shop
P. Pole
Conc Walk
Belmont Ave
Pavement
Conc Walk
Somerset
Restaurant
Elec. Appliances
Baker P. Pole
Hardware
Fruit
Hall
Confection
Automobile Agency
Gas Meter
Water Meter
Dry Goods
Theater Entrance
Gas Meter
Fruit
1 story Brick + Stucco Bldg.
2 story Brick Store + Office Bldg.

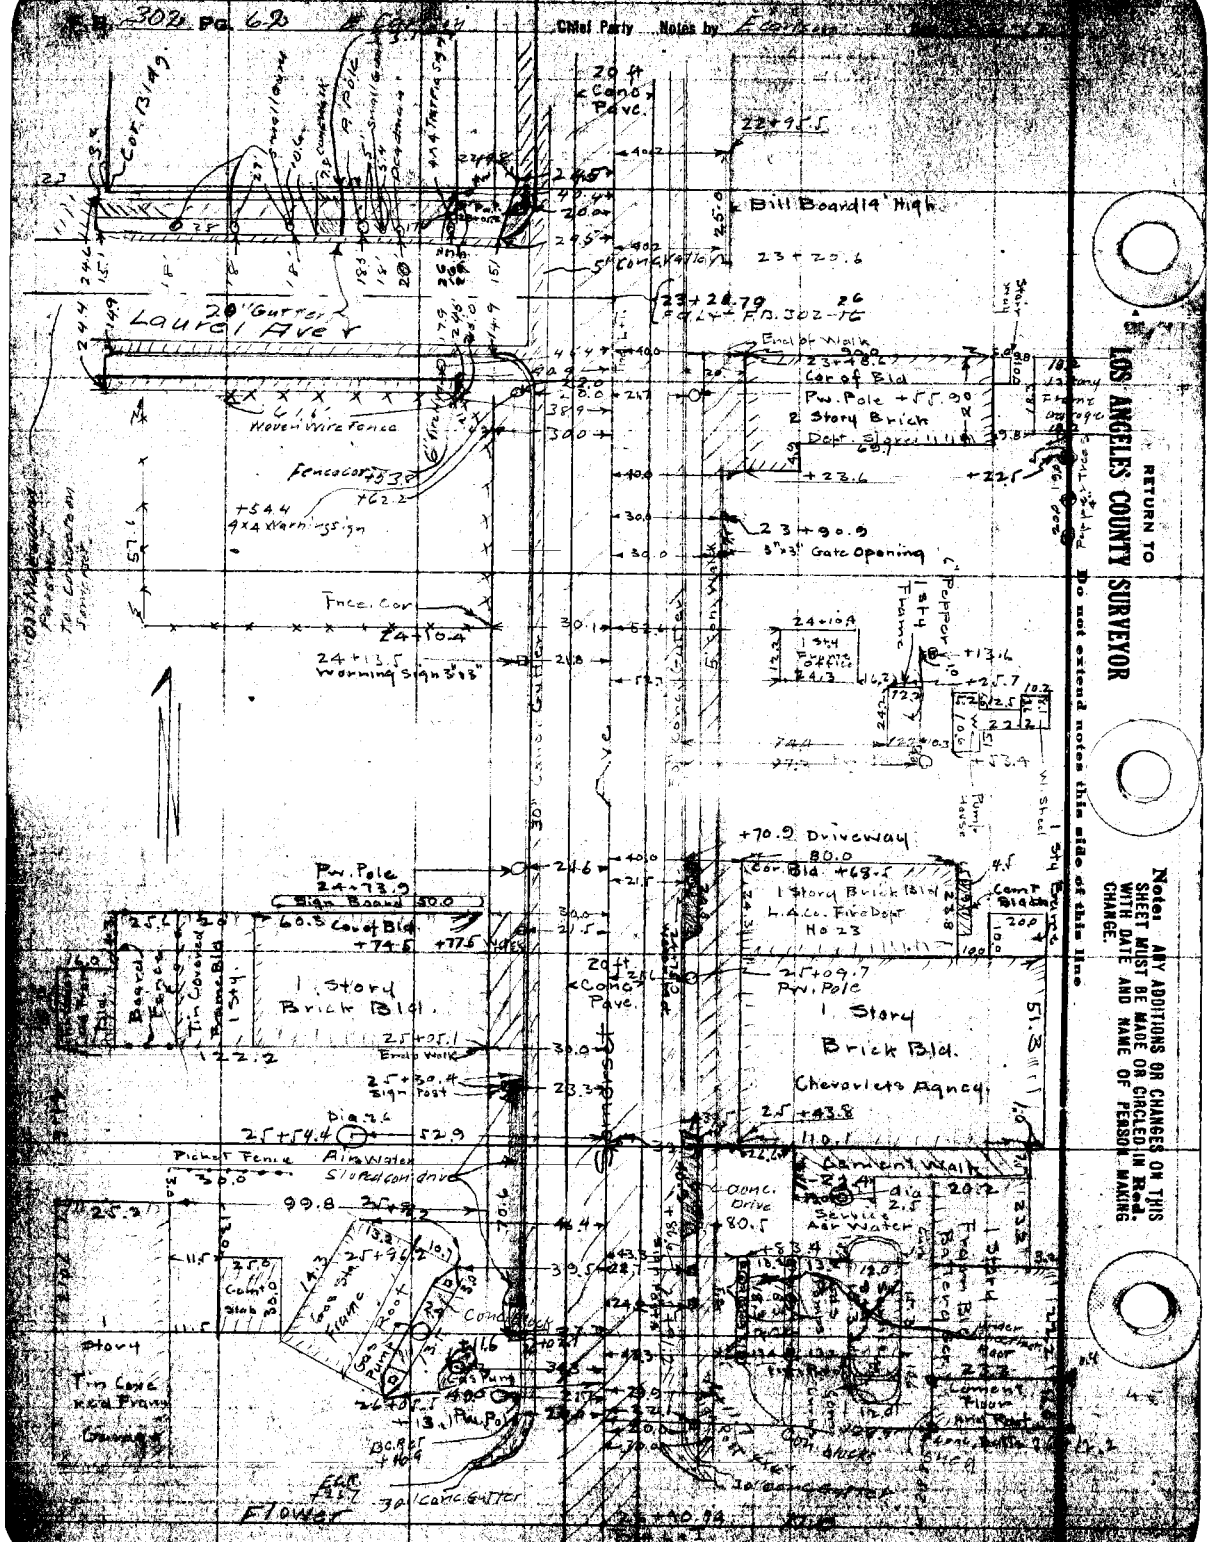
Chief Party Notes by E.C.
20 ft Conc. Pave.
Bill Board 14' High
20" Gutter
Laurel Ave
C.L. Woven Wire Fence
Fence Cor
Warning Sign 3'x5"
Gate Opening
Pepper 1 st 4 Trunc
Driveway
Pwr. Pole
Sign Board
Cor. Bld.
1 Story Brick Bld.
L.A. Co. Fire Dept Ho 23
Chevrolets Agency
Cement Walk
Conc. Drive
Service Air Water
Picket Fence
Alta Water
Stand Conn Drive
Tin Cover Frame Bldg
Tin Cover Frame Roof
Cement Floor
Conc. Gutter
E. Tower
RETURN TO LOS ANGELES COUNTY SURVEYOR
Do not extend notes this side of this line
Notes: ANY ADDITIONS OR CHANGES ON THIS SHEET MUST BE MADE OR CIRCLED IN Red. WITH DATE AND NAME OF PERSON MAKING CHANGE.

Notes by M.H. Chief Party M. Hayes F. B. 302 Pg. 63

Plotted by Chase
Date Dec. 1927
Map No. D-1167
Plotting Checked by Farley
Date Dec. 1927

W. O. No. 4159 U. S. O. No.
Location Somerset
Surveyed by M. Hayes
Date Dec. 9 1927
Indexed C. E. Johnson

Notice: ANY ADDITIONS OR CORRECTIONS SHEET MUST BE MADE OR CANCELED WITH DATE AND NAME OF PERSON MAKING CHANGE.

RETURN TO LOS ANGELES COUNTY SURVEYOR

Do not extend notes this side of this line

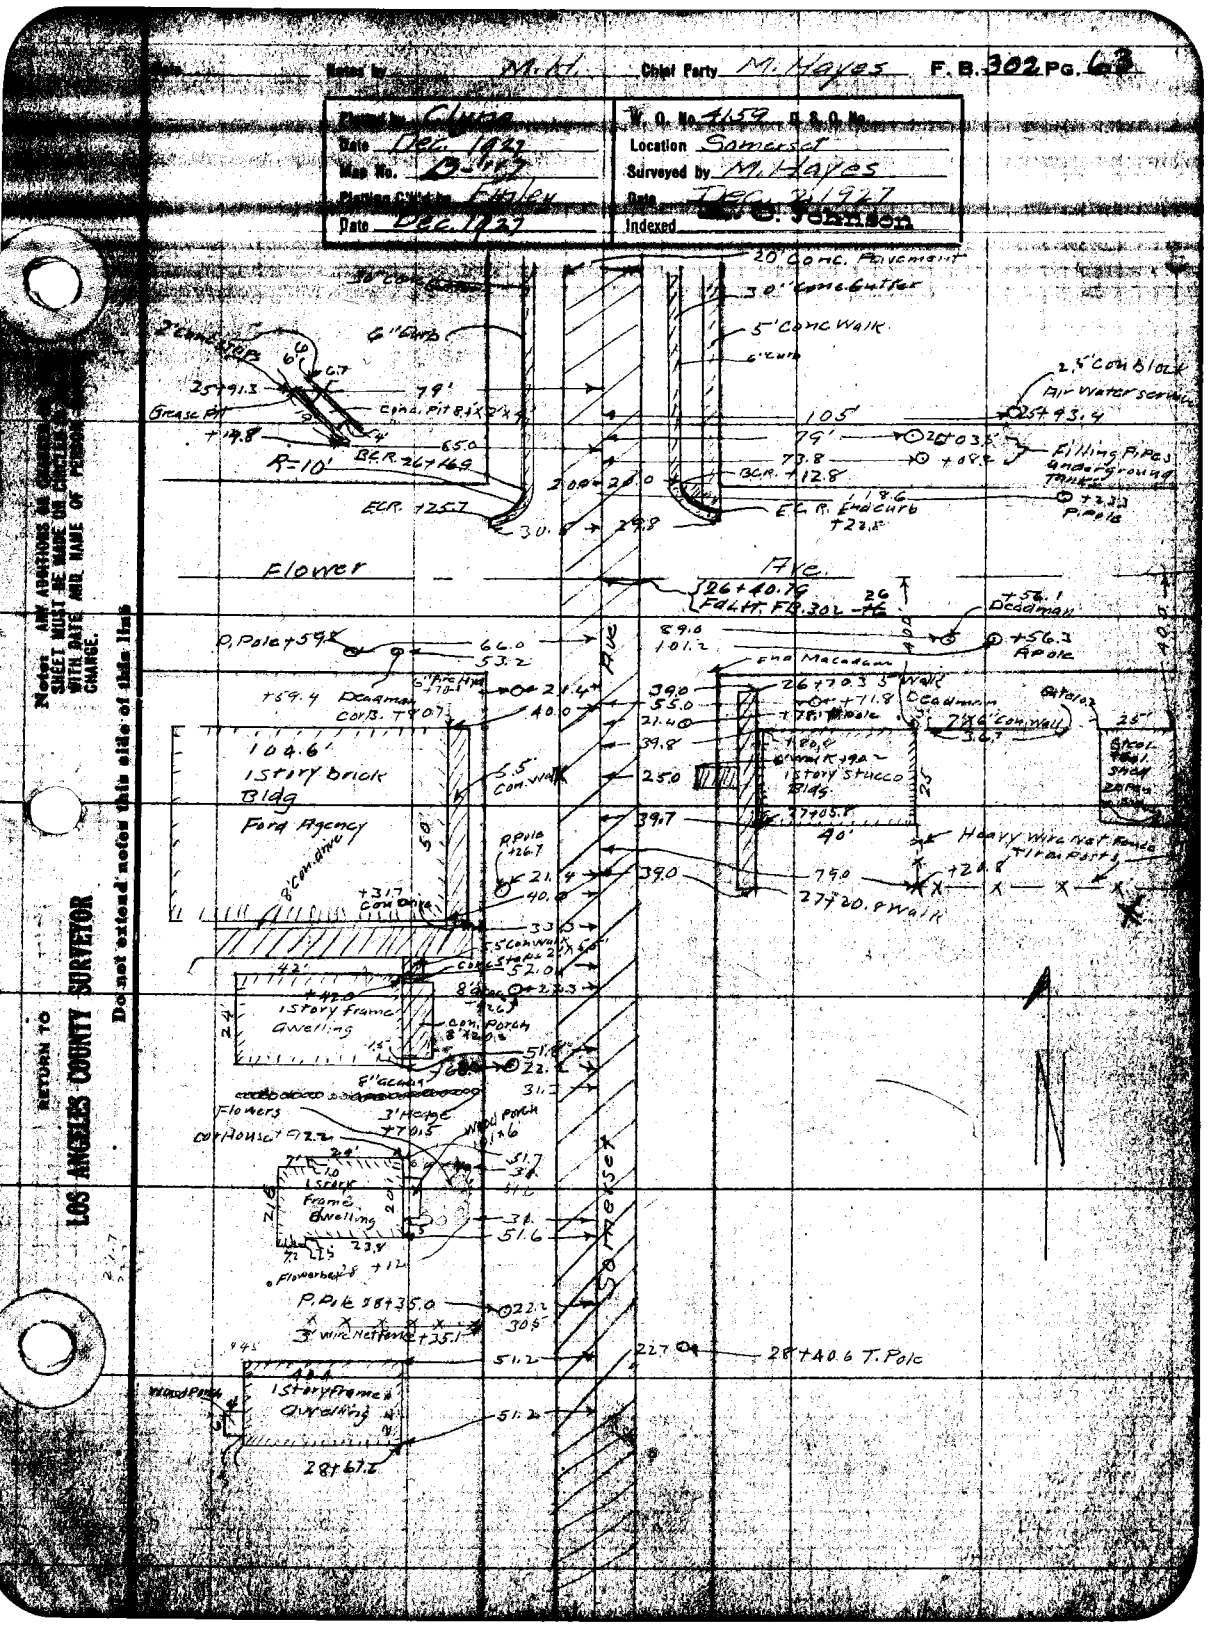

F.B. 302 Pg. 64 M. Hayes Chief Party Notes by M. H. Date Dec 2, 1922

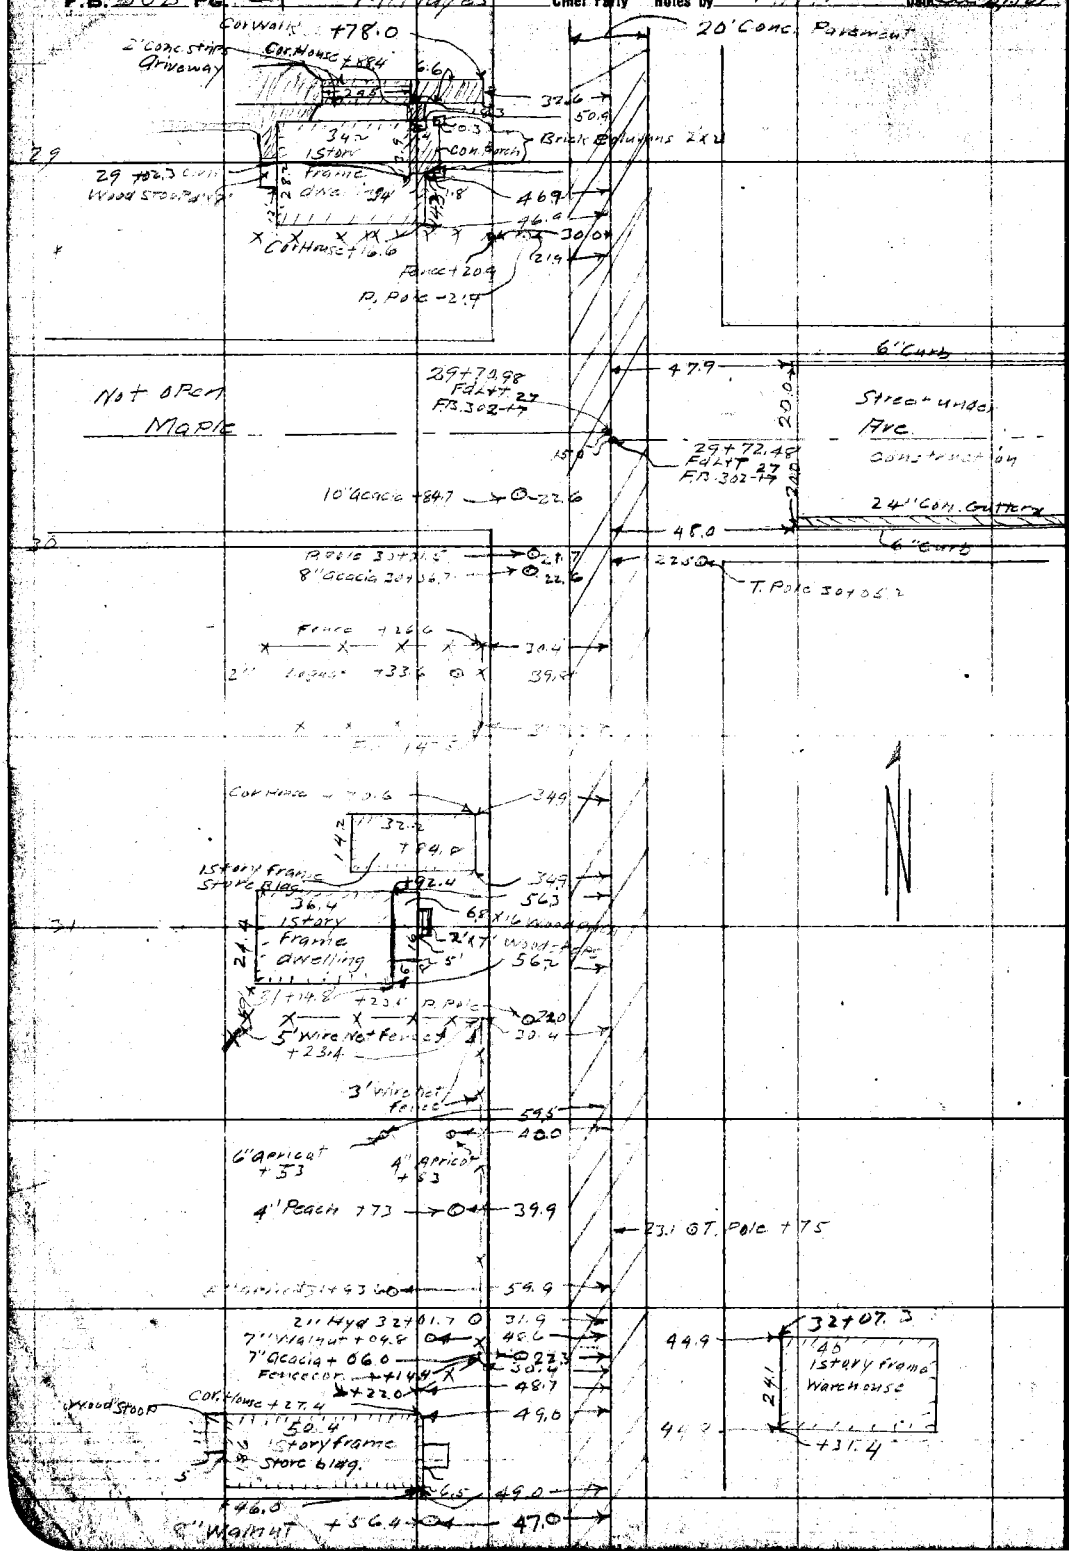

RETURN TO
LOS ANGELES COUNTY SURVEYOR

Do not extend notes this side of this line

Notes: ANY ADDITIONS OR CHANGES ON THIS SHEET MUST BE MADE OR CIRCLED IN Red. WITH DATE AND NAME OF PERSON MAKING CHANGE.

Chief Party M. Hayes F. B. 302 PG. 65

Name of Subdivision Clyma
Date Dec 1927
Map No. B-117
Plotted by Finley
Date Dec 1927

No. Q. Mo. 4459 U. S. Q. No.
Location Somerset
Surveyed by M. Hayes
Date Dec 3 1927
Indexed E. C. Johnson

Notes: ANY ADDITIONS OR CORRECTIONS SHEET MUST BE MADE AND SIGNED WITH DATE AND NAME OF PERSON MAKING CHANGE.

RETURN TO LOS ANGELES COUNTY SURVEYOR

Do not extend notes this side of this line

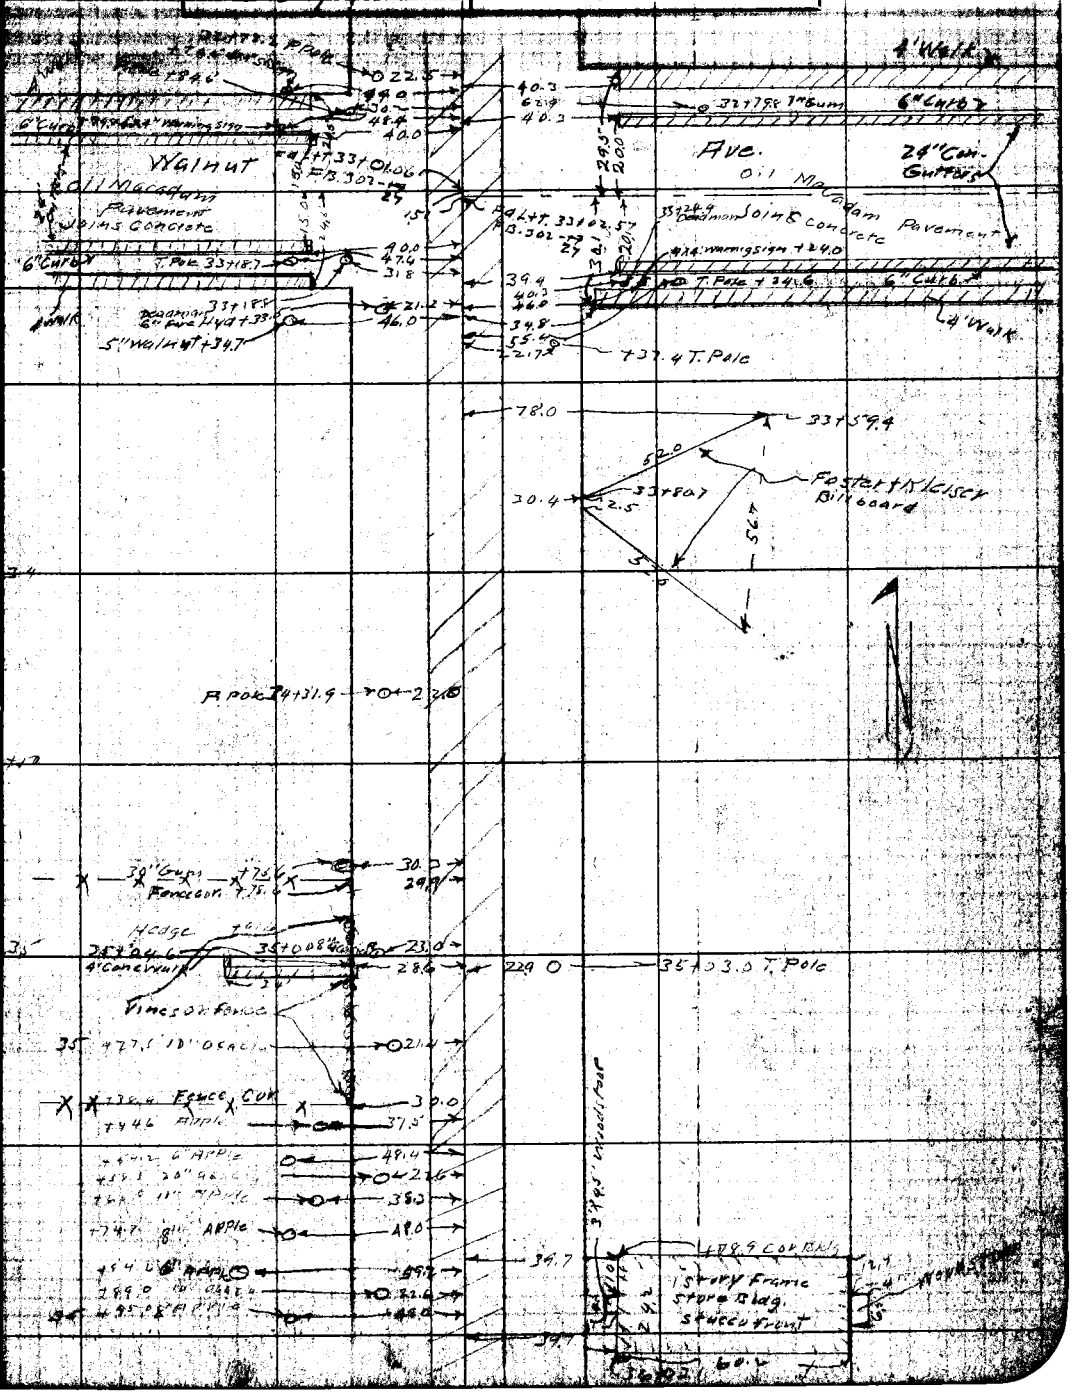
4' Walk
6" Curb
24" Con. Gutter
Ave.
0.1 Macadam
Pavement
Joints Concrete
Foster & Kleiser Billboard
1 Story Frame Store Bldg. 5 Stores Front
Hedge
Fence
Cor.
Fences
Fence & Cor.
Apple
Walnut

F.B. 302 Pg. 66 M. Hayes Chief Party Notes by M. H. Date Dec 3, 1927

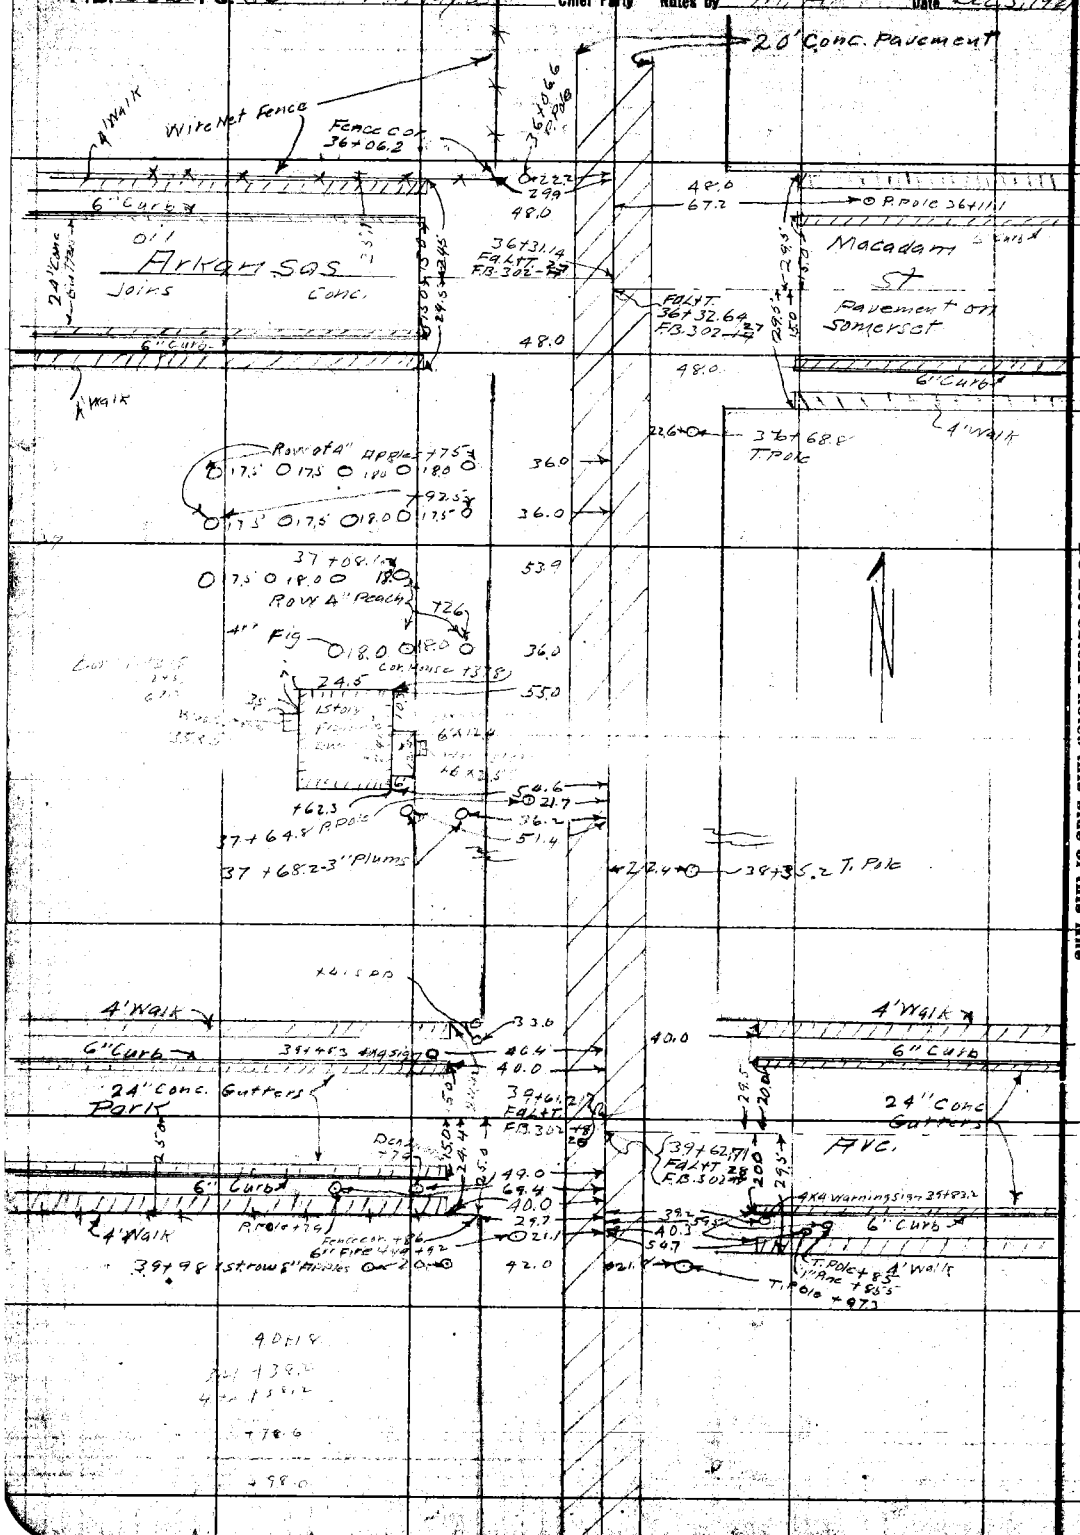

RETURN TO
LOS ANGELES COUNTY SURVEYOR

Do not extend notes this side of this line

Note: ANY ADDITIONS OR CHANGES ON THIS SHEET MUST BE MADE OR CIRCLED IN Red. WITH DATE AND NAME OF PERSON MAKING CHANGE.

Date _____ Notes by _____ Chief Party _____ F. B. 302 PG. 67

Plotted by Clyne
Date Dec. 1927
Map No. B 117
Plotting C'k'd by Finley
Date Dec. 1927

W. O. No. 4159 C. S. O. No.
Location Somerset Ave, Bellflower
Surveyed by M. Hopes
Date Dec - 3-7-1927
Indexed A. C Johnson

Notes ANY ADDITIONS OR CHANGES OR TIES SHEET MUST BE MADE OR CHECKED IN RED WITH DATE AND NAME OF PERSON MAKING CHANGE.

Do not extend notes this side of this line

RETURN TO LOS ANGELES COUNTY SURVEYOR

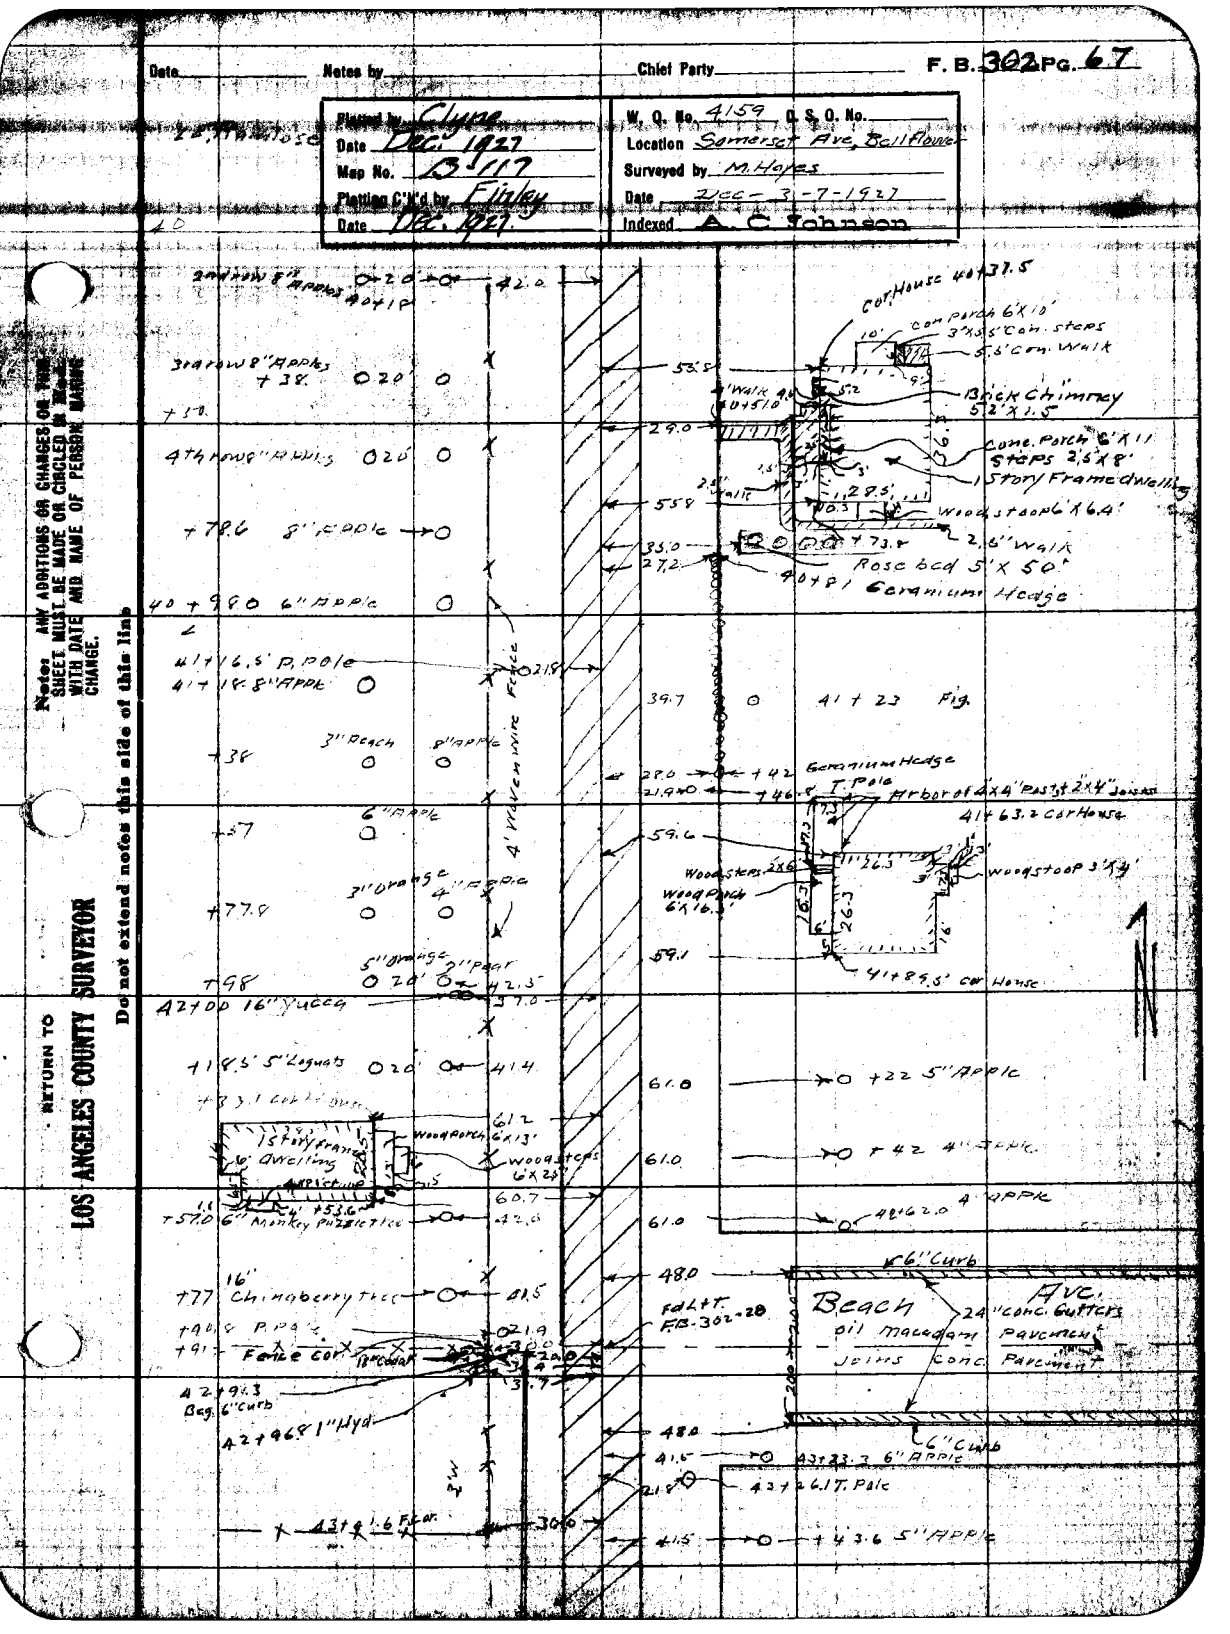
Beach
Ave.
24' Conc. Gutters
Pavement
Brick Chimney
Conc. Porch
Steps
1 Story Frame Dwelling
Woodshed
Rose bcd
Geranium Hedge
Arbor of 4x4" Pos
Wood Steps
Wood Porch
Wood Steps
1 Story Frame Dwelling
Fence Cor
Fd L.T.
Fig.
Car House
Fence
Wire Fence
Pipe
Pole
Apple
Yucca
Monkey Puzzle Tree
Chinaberry Tree
Oil Macadam
Joints
Conc. Pavement
6" Curb
Beg. 6" Curb

F.B. 302 Pg. 68 M. Hayes Chief Party Notes by M.H. Date Dec 7, 1937

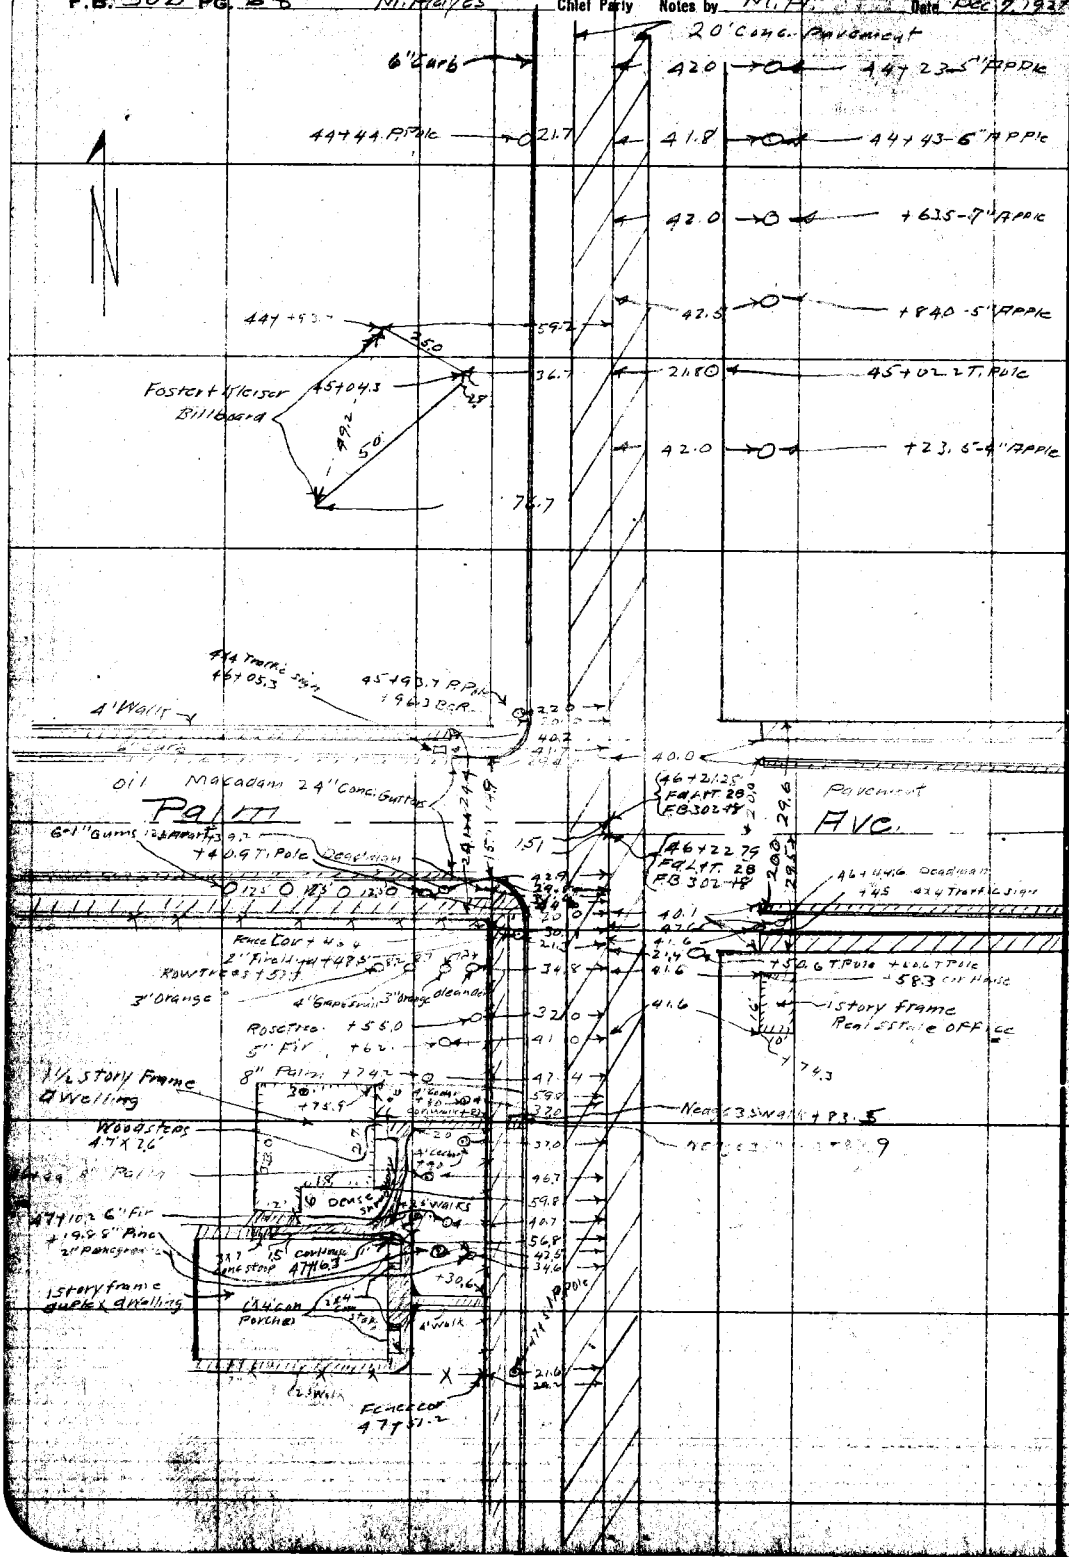

RETURN TO
LOS ANGELES COUNTY SURVEYOR
Do not extend notes this side of this line

Note: ANY ADDITIONS OR CHANGES ON THIS SHEET MUST BE MADE OR CIRCLED IN Red. WITH DATE AND NAME OF PERSON MAKING CHANGE.

Notes by

Chief Party

F. B. 302 PG. 69

Checked by Clyne
Date Dec. 1927
Map No. 13-17
Plotting Ck'd by Finley
Date Dec. 1927.

W. O. No. 4159 O. S. O. No.
Location Somerset Ave. Bellflower
Surveyed by M. Hayes
Date Dec. 8, 1927
Indexed A. C. Johnson

Notice: ANY ADDITIONS OR CHANGES ON THIS SHEET MUST BE MADE OR CIRCLED IN RED, WITH DATE AND NAME OF PERSON MAKING CHANGE.

RETURN TO LOS ANGELES COUNTY SURVEYOR

Do not extend notes this side of this line

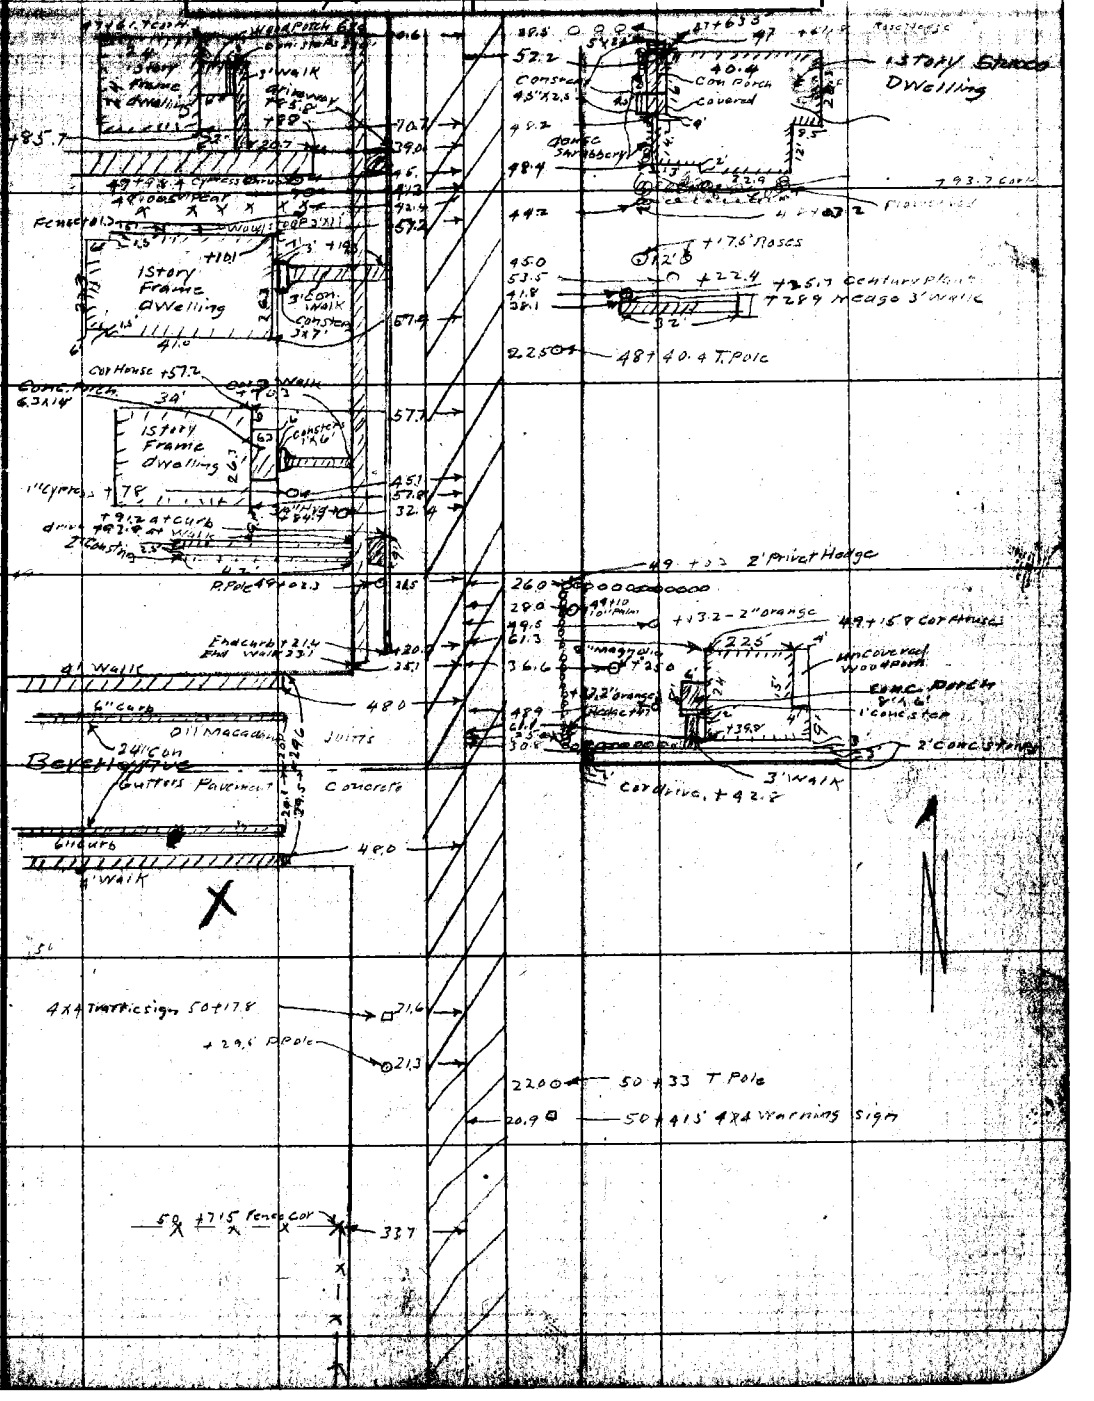

F.B. 302 Pg. 70 M. Hayes Chief Party Notes by M.H Date Dec. 1927

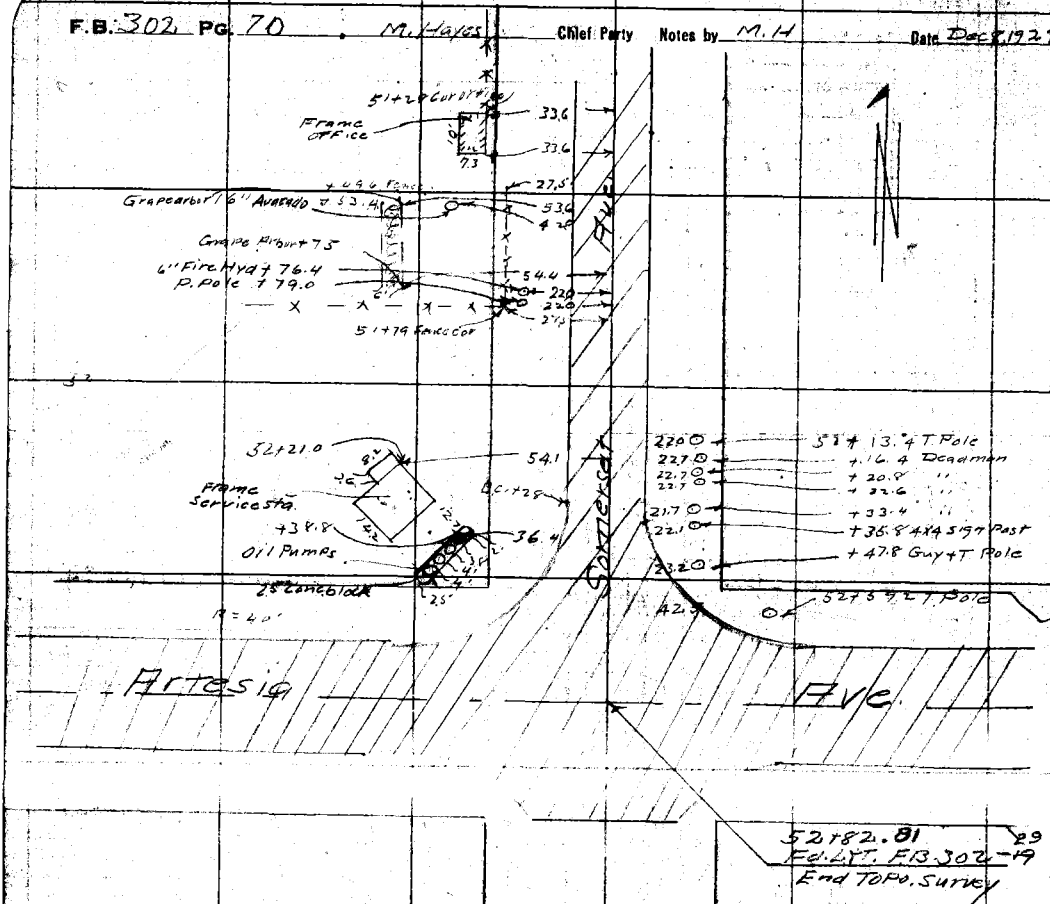

RETURN TO
LOS ANGELES COUNTY SURVEYOR

Do not extend notes this side of this line

Notes: ANY ADDITIONS OR CHANGES ON THIS SHEET MUST BE MADE OR CIRCLED IN Red. WITH DATE AND NAME OF PERSON MAKING CHANGE.

Date _____ Notes by _____ Chief Party _____ F.B. 302 Pg. 71

Plotted by Glynn
Date Dec. 1927
Map No. 13+17
Plotting C'k'd by Finley
Date Dec. 1927

W. O. No. 4159 D. S. O. No. _____
Location Alley, Bellflower
Surveyed by M. Hayes
Date Dec. 9, 1927
Indexed A. C. Johnson

NOTE: ANY ADDITION OR CHANGES ON THIS SHEET MUST BE MADE OR CIRCLED IN RED WITH DATE AND NAME OF PERSON MAKING CHANGE.

DO NOT EXTEND NOTES THIS SIDE OF THIS LINE

RETURN TO LOS ANGELES COUNTY SURVEYOR.

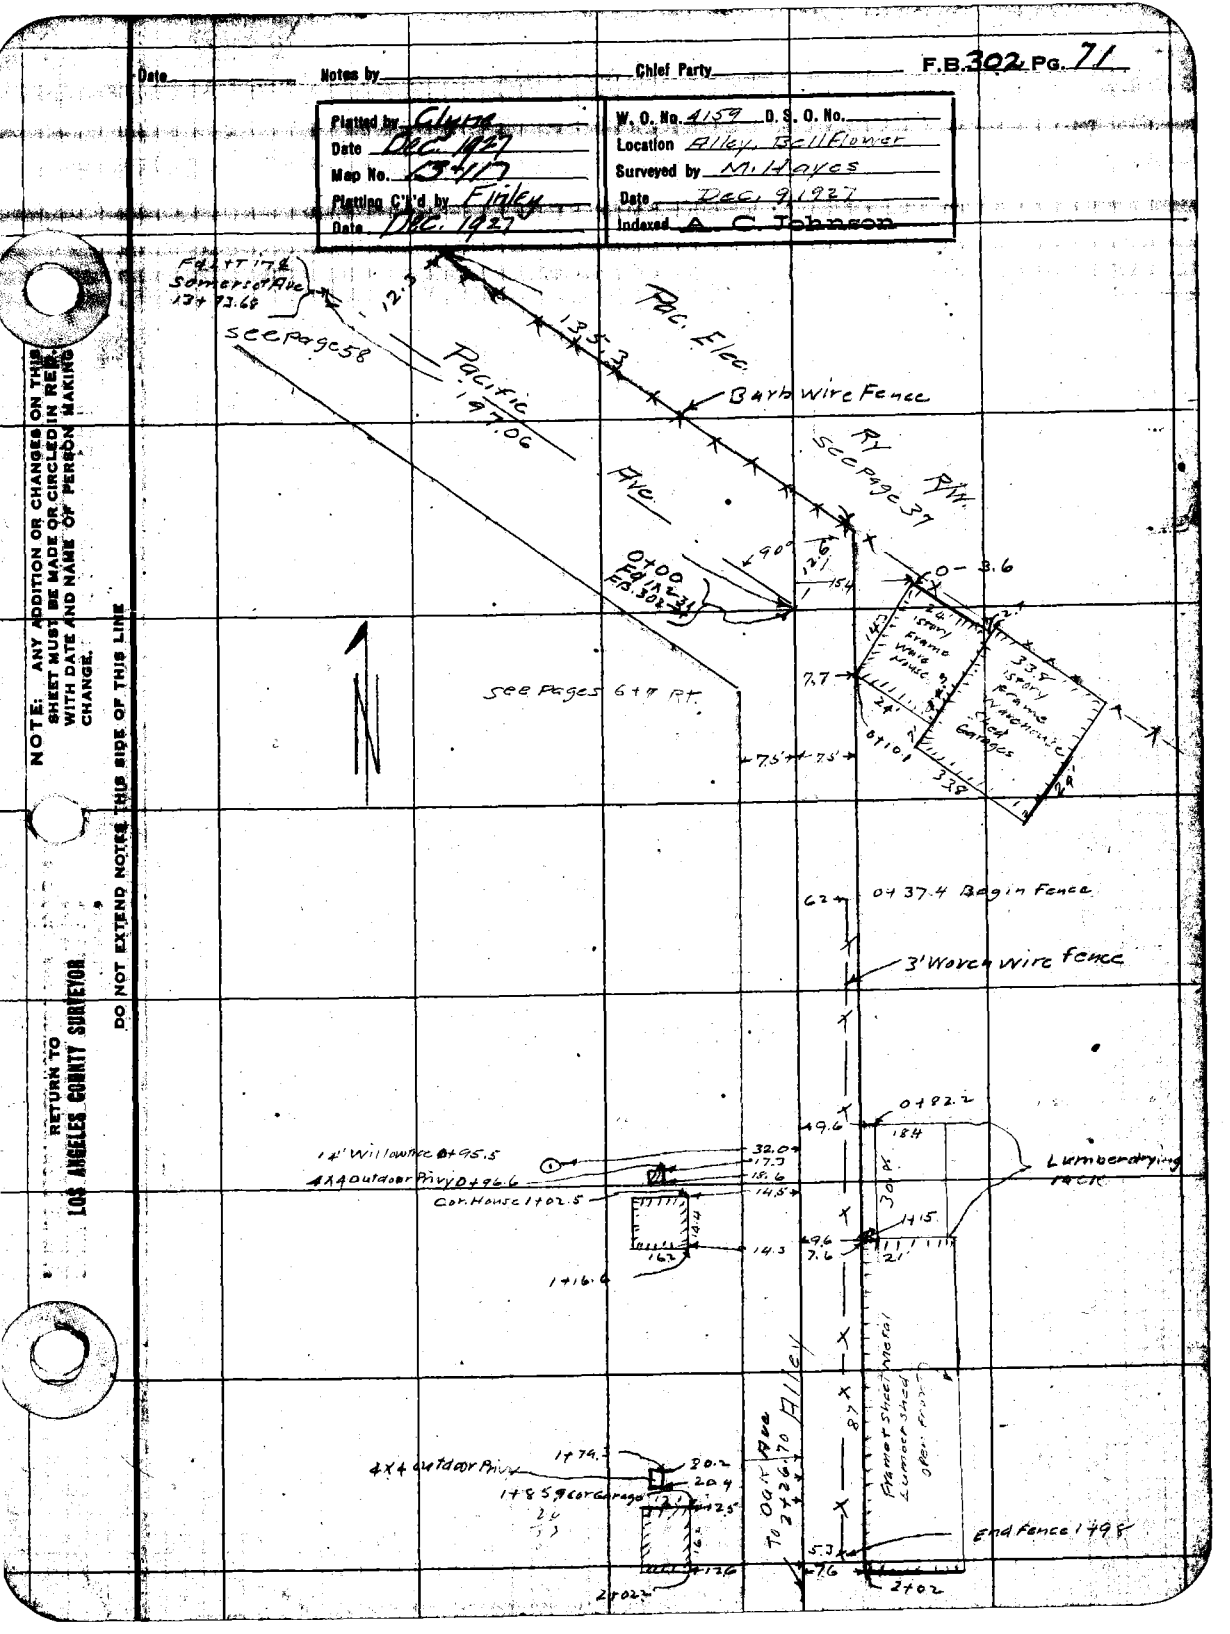

F.B. 3071 Pg. 72 M. Hayes Chief Party Notes by: M.H. Date Dec. 9, 1927

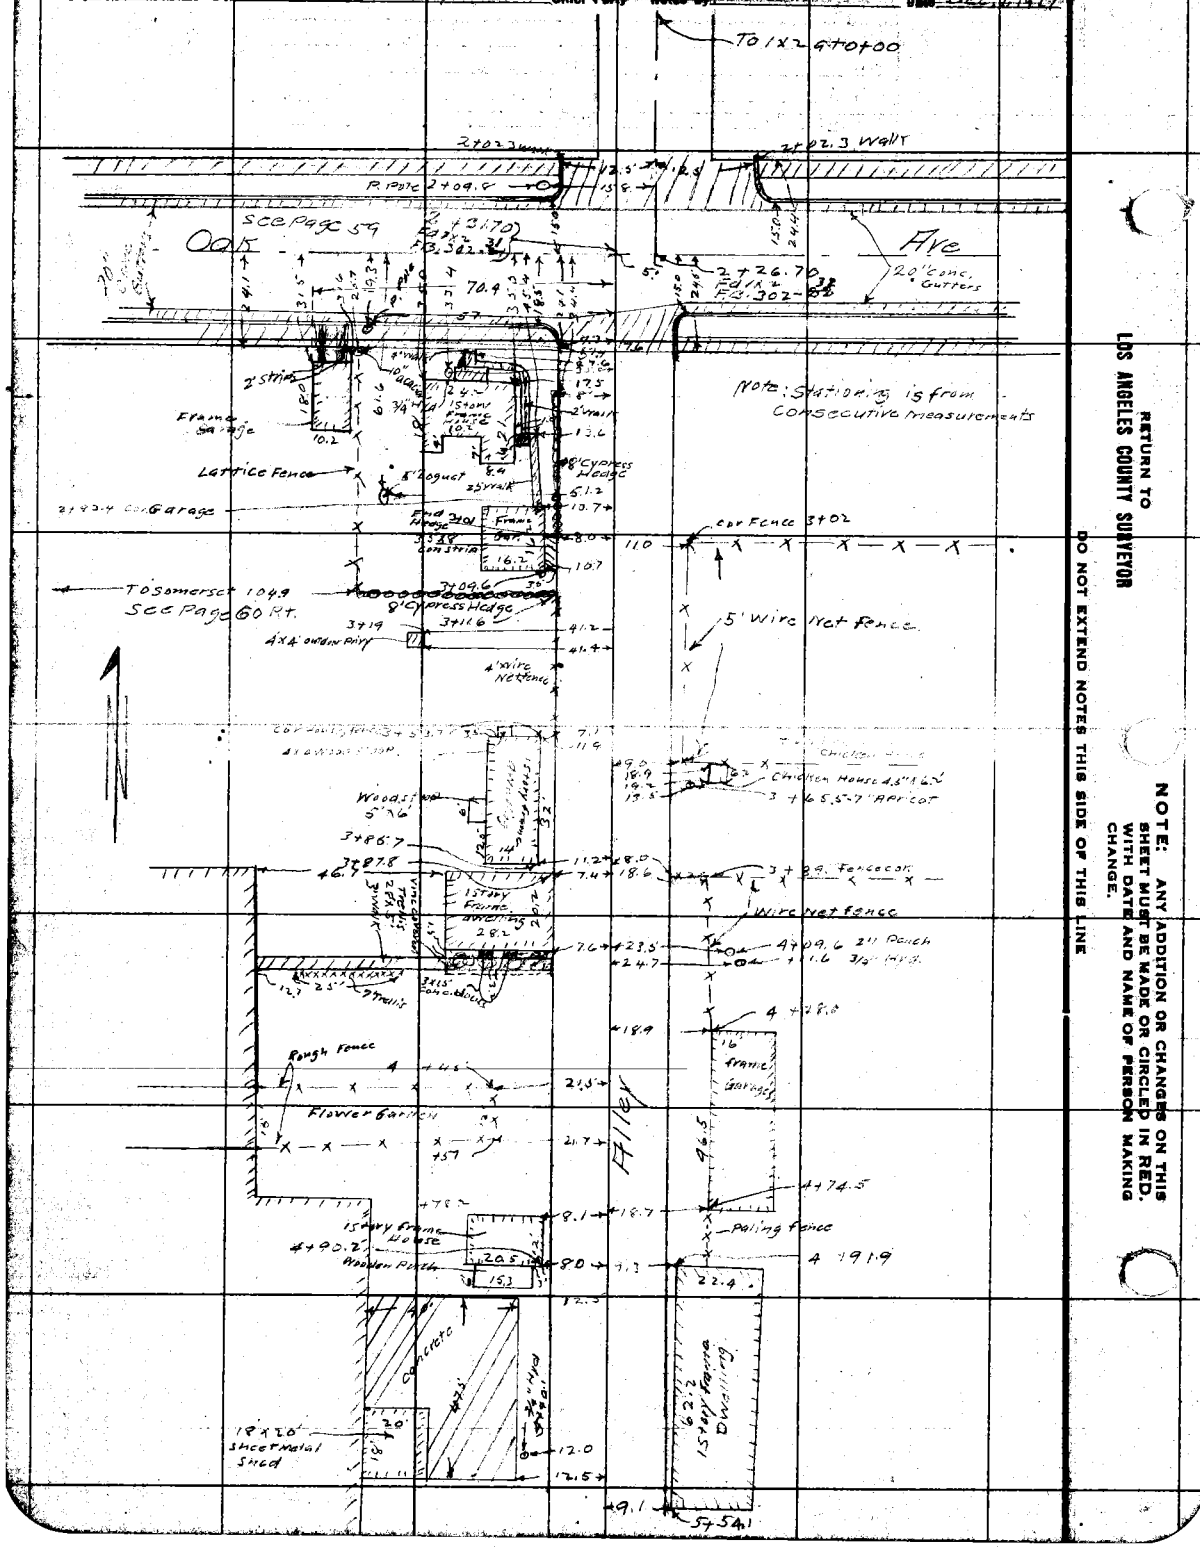

RETURN TO LOS ANGELES COUNTY SURVEYOR

NOTE: ANY ADDITION OR CHANGES ON THIS SHEET MUST BE MADE OR CIRCLED IN RED. WITH DATE AND NAME OF PERSON MAKING CHANGE.

DO NOT EXTEND NOTES THIS SIDE OF THIS LINE

Date ____ Notes by M. Hayes Chief Party M. H. F.B. 302 PG. 73

Plotted by Clyde	W. O. No. 4158 D. S. D. No.
Date Dec. 1927	Location Alley, Bellflower
Map No. B-117	Surveyed by M. Hayes
Plotting Ck'd by Finley	Date Dec. 12, 1927
Date Dec. 1927	Indexed A. C. Johnson

NOTE: ANY ADDITION OR CHANGES ON THIS SHEET MUST BE MADE OR CIRCLED IN RED, WITH DATE AND NAME OF PERSON MAKING CHANGE.

DO NOT EXTEND NOTES THIS SIDE OF THIS LINE

RETURN TO LOS ANGELES COUNTY SURVEYOR

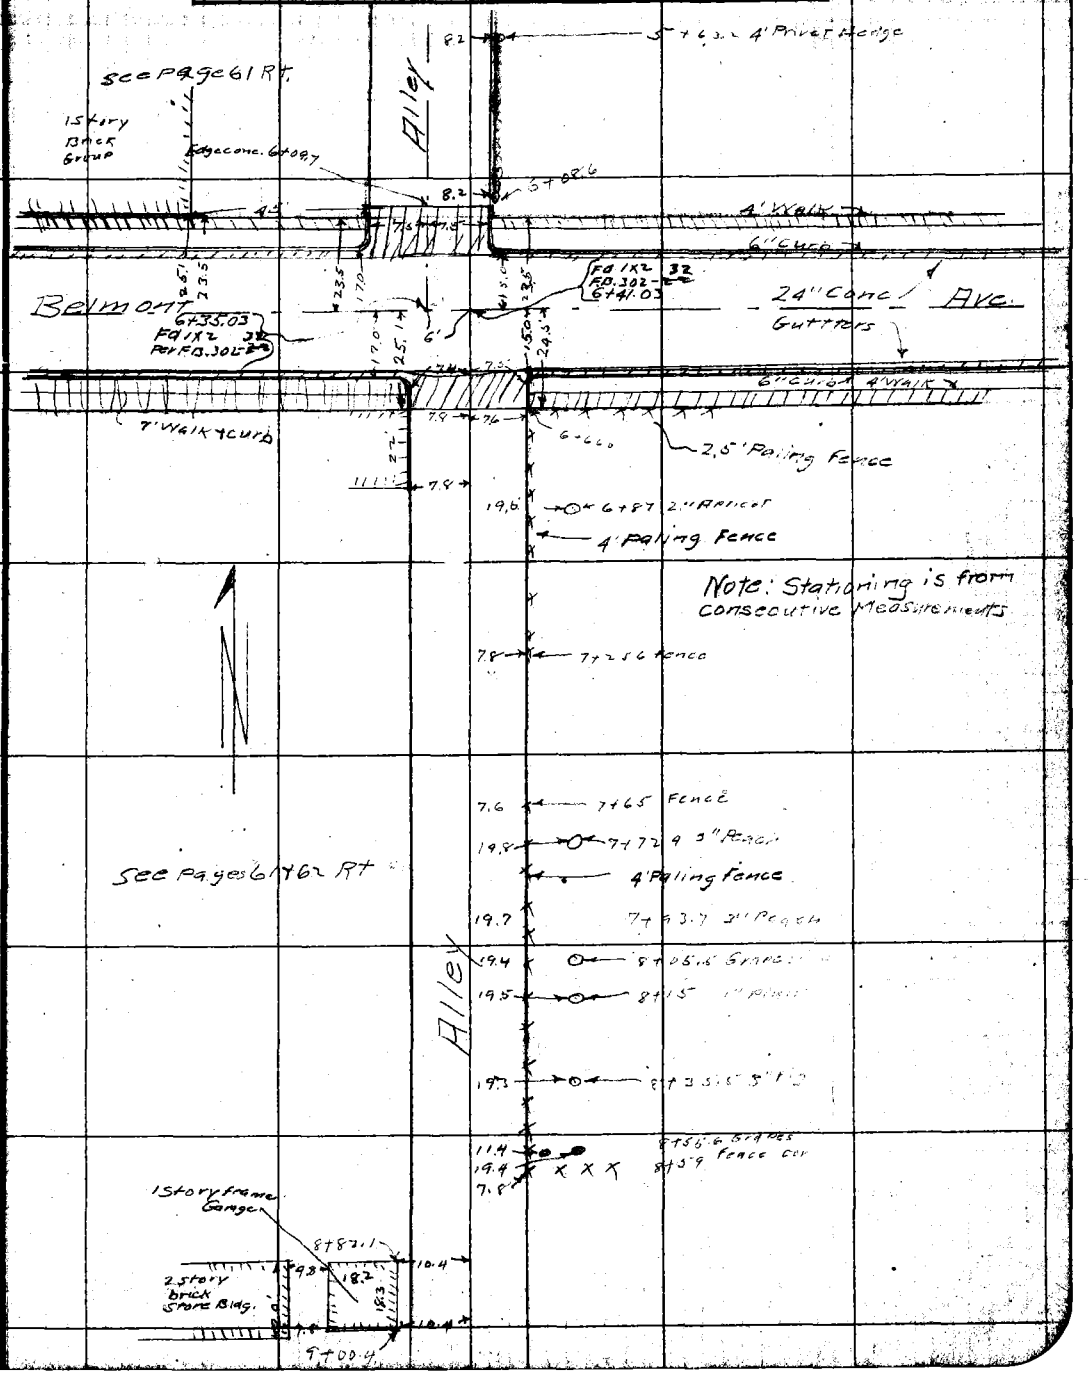

F.B. 302 PG. 74 M. Hayes Chief Party Notes by M.H. Date Dec 12-27

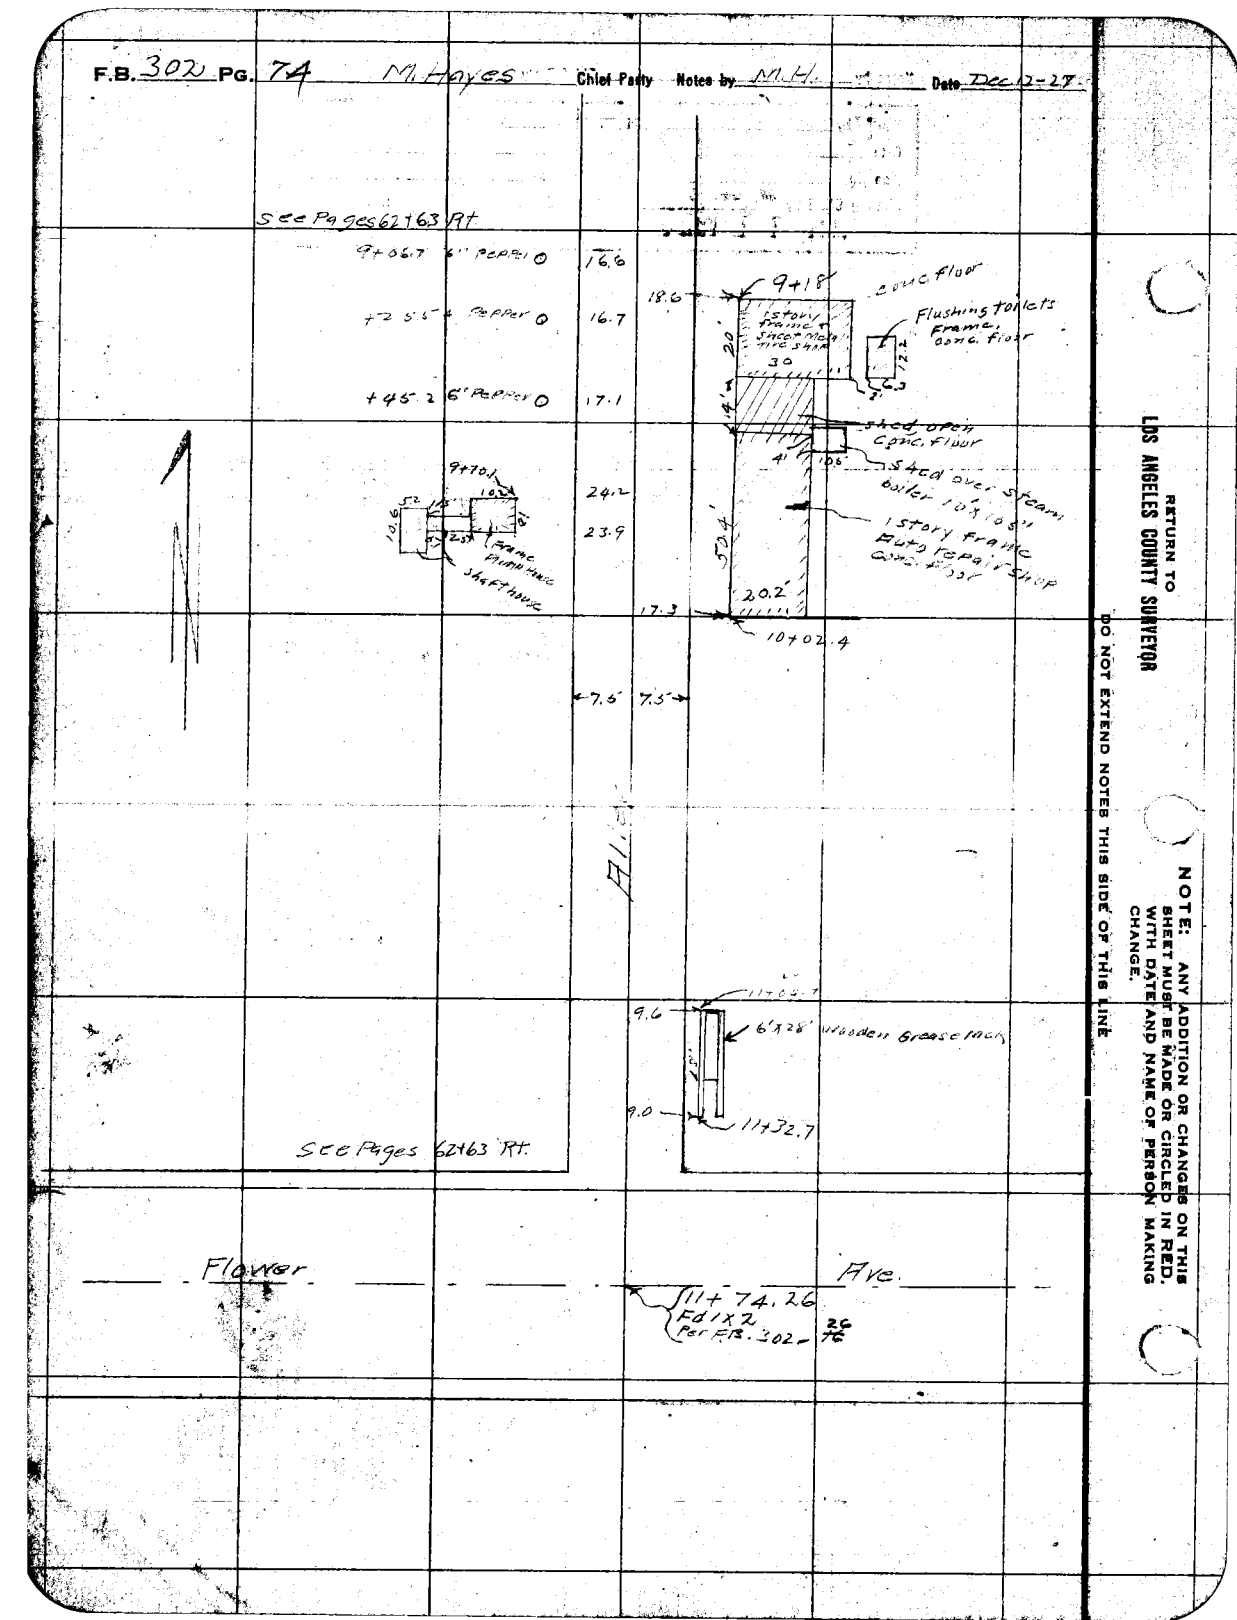

RETURN TO
LOS ANGELES COUNTY SURVEYOR

DO NOT EXTEND NOTES THIS SIDE OF THIS LINE

NOTE: ANY ADDITION OR CHANGES ON THIS SHEET MUST BE MADE OR CIRCLED IN RED, WITH DATE AND NAME OF PERSON MAKING CHANGE.

Date _____ Notes by _____ Chief Party _____ F. B. 302 PG. 75

Plotted by Beebee
Date Apr 28
Map No. B-117
Plotting C'k'd by R. W. S.
Date JUL 11 1928

W. O. No. 4159 D. S. O. No. _____
Location _____
Surveyed by _____
Date Feb. 9, 1928
Indexed A. C. Johnson

Notes: ANY ADDITIONS OR CHANGES ON THIS SHEET MUST BE MADE OR CIRCLED IN Red. WITH DATE AND NAME OF PERSON MAKING CHANGE.

RETURN TO LOS ANGELES COUNTY SURVEYOR

Do not extend notes this side of this line

20 Conc. Pavement
ARTESIA
40'
40'
From bot Page 70
AVE
20 Conc. Pavement
50.5
50.8
R=40'
52+82.91 L+T
See Page 70
8-3
R=35'
Gas valve 53+14.4
9'x45° St. Sign 53+16.0
P. Pole 718.4
24.0
Gas Pumps
Roof extends 4' Past Pumps
38.1
737.4
53+13.6 P. Pole
3' Conc. Slab
Oil Pump
14.5' Driveway Underroof
Frame & Stucco Service Station
Conc. Sta. 738.6
54.2
49.2
4' x 14.2' Flushing Toilet & Conc. Floor
760. Filling Pipe
53+85
Conc. Slab 10.6' x 7'
Grease Pit 9' x 3.7' x 4.5' Deep
4" Conc. Walls
Light, Air Water Stand 796.1
16' Conc. Triangle
46.0
32.7
45.0
796.0
54
21.6
54+05 T. Pole
40.0
713.3 4" Apple
21.7
718.1 Deadman
39.9
731.8 4" Apple
54+63.4 Guy Pole
21.1
+86.4 Deadman
20.5'
55
19.5'
19.4
55+21 P. Pole
729.5 T. Pole

F.B. 302 Pg. 96

Chief Party Notes by Date

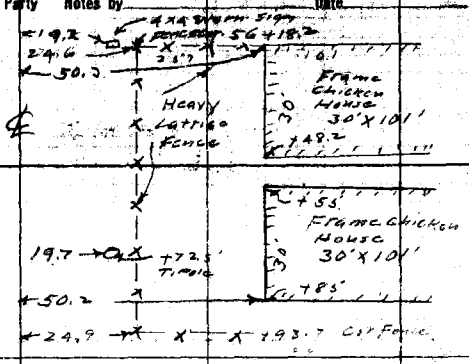

AVE.

40' 40'

Proposed Width

19.4

57+69.5' P. Pole

SOMERSET

59+09.4 T. Pole
+11.8 P. Pole

19.5'

+18 P. Pole
+18 Diagonal

20.9
38.3

Fd 1x2 See Page 52
59+43.1A

RAMONA AVE

RETURN TO
LOS ANGELES COUNTY SURVEYOR
Do not extend notes this side of this line

Notice: ANY ADDITIONS OR CHANGES ON THIS SHEET MUST BE MADE OR CIRCLED IN Red. WITH DATE AND NAME OF PERSON MAKING CHANGE.

Date _____ Notes by _____ Chief Party _____ F. B. 302 PG. 77

Plotted by Geshee
Date Apr 28
Map No. 3-117
Plotting C'k'd by R. W. S.
Date JUL 11 1928

W. O. No. 4159 D. S. O. No.
Location Somerset Ave.
Surveyed by M. Holmes
Date Feb 9 1928
Indexed A. C. Johnson

N

60

60+24
36'
30.8'
1 Story frame Grocery Store
22'
5' Conc. Slab
5'
30.8
60+96

30.8 O ← +44 5" Appl

6" Woven Wire Fence
60+32 Cat Fence
30.5
39.7
+77.8 5" Appl

19.4
46.3 O
O +63.6 2" Appl
19.4 O ← +77.5 Appl
46.2 → O ← +83.2 Appl
30.5 → +83.6 3" "

SOMERSET AVE

30.6 → O ← 61+04 4" Appl

30.2 O 61+64 5" Appl
30.2 O 61+83.7 5" Appl

30.0 O ← 19.5 → O 62+03.5 5" Appl
19.5 → O ← +09.5 T. Pole

62+23.7 Fence X X X 24.9
+28 2" Cypress 25.9
+33.5 Peach O 35.8
+45.2 Peach O 36.0
+47 T. Pole O 21.9
49.3 → O +24.5 4" Appl
9.5 → O +42 T. Pole

+55.5 2" Peach O 35.9
+61 1" Cypress O 25.7
+73 Fence X X 25.3

62+96.7 Fence X X X 15.3

Notes: ANY ADDITIONS OR CHANGES OF THIS SHEET MUST BE MADE OR CIRCLED IN RED WITH DATE AND NAME OF PERSON MAKING CHANGE.

Do not extend notes this side of this line

RETURN TO LOS ANGELES COUNTY SURVEYOR

F.B. 302 Pg. 78 M. Hayes Chief Party Notes by M.H. Date Feb 9, 1954

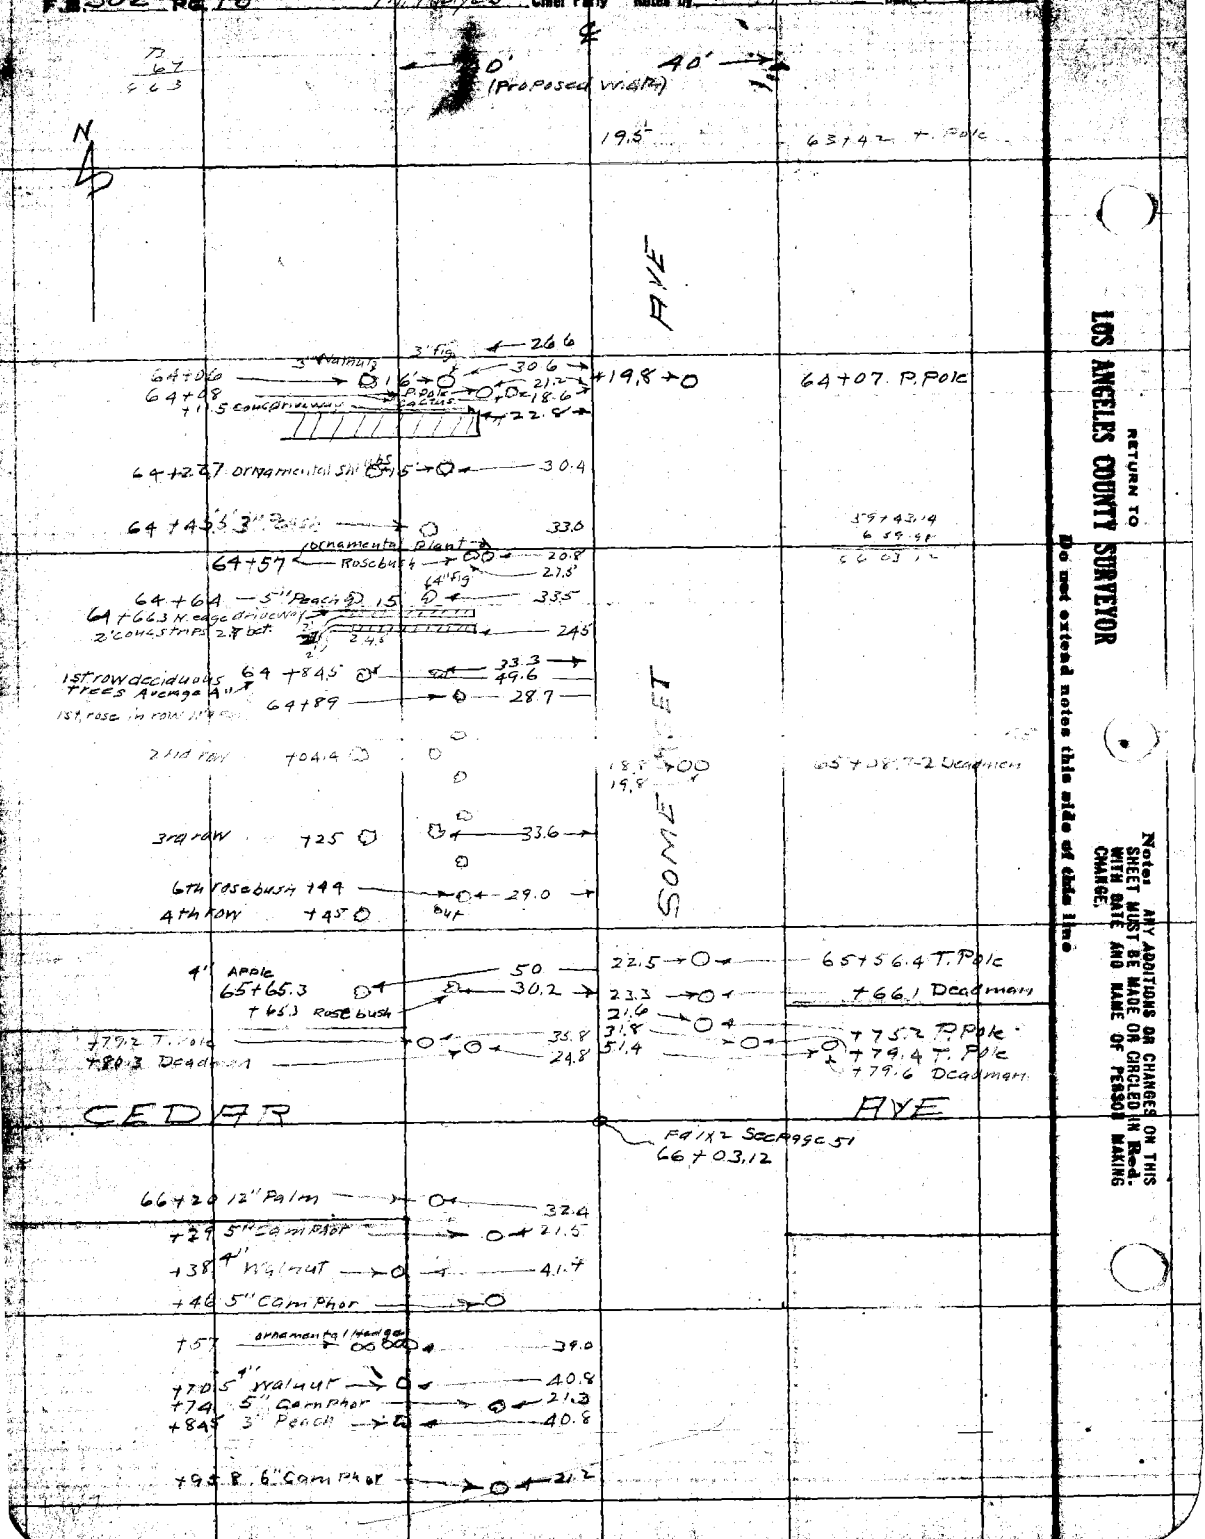

RETURN TO
LOS ANGELES COUNTY SURVEYOR
Do not extend notes this side of this line

Notes: ANY ADDITIONS OR CHANGES ON THIS SHEET MUST BE MADE OR CIRCLED IN Red. WITH DATE AND NAME OF PERSON MAKING CHANGE.

Date _____ Notes by _____ Chief Party _____ F. B. 302 PG. 79

Plotted by Baehee
Date Apr 28
Map No. B-117
Plotting C'k'd by R. W. S.
Date JUL 1 1928

W. O. No. 4159 D. S. O. No. _____
Location Somerset Ave
Surveyed by Mikayes
Date Feb 9 1928
Indexed A. C. Johnson

Notes: ANY ADDITIONS OR CHANGES ON THIS SHEET MUST BE MADE OR CIRCLED IN Red. WITH DATE AND NAME OF PERSON MAKING CHANGE.

RETURN TO LOS ANGELES COUNTY SURVEYOR

Do not extend notes this side of this line

67+27 ornamental shrubs — 32.7
+17.2 " " — 32.2
+46.3 beg fence — 29.9
+52.3 A Pole — 23.7
+56.3 4" Peach — 37.4 — 20' — +59.4 A Pole
+75.7 Peach — 37.4
+76. Willow — 46.2 — 21.1 — +81.1 T. Pole
Horizontal beard Fence →
68
68+27 4' Blackberry beg — 37.4
SOMERSET AVE
69
69+05 Fence — 30.2
5' Wire Net Fence →
+35 Fence — 30.3
+44 15" Camphor — 22.1
+49 15" Peach — 35.0
20.8 — 69+28.5 T. Pole
19.6 — 69+52 A Pole
10-3" Peach Trees in row Average 20' apart
10-5" Camphor trees Average 20' apart

F.B. Pg. 80 M. Hayes Chief Party Notes by M.H. Date 2-9-28

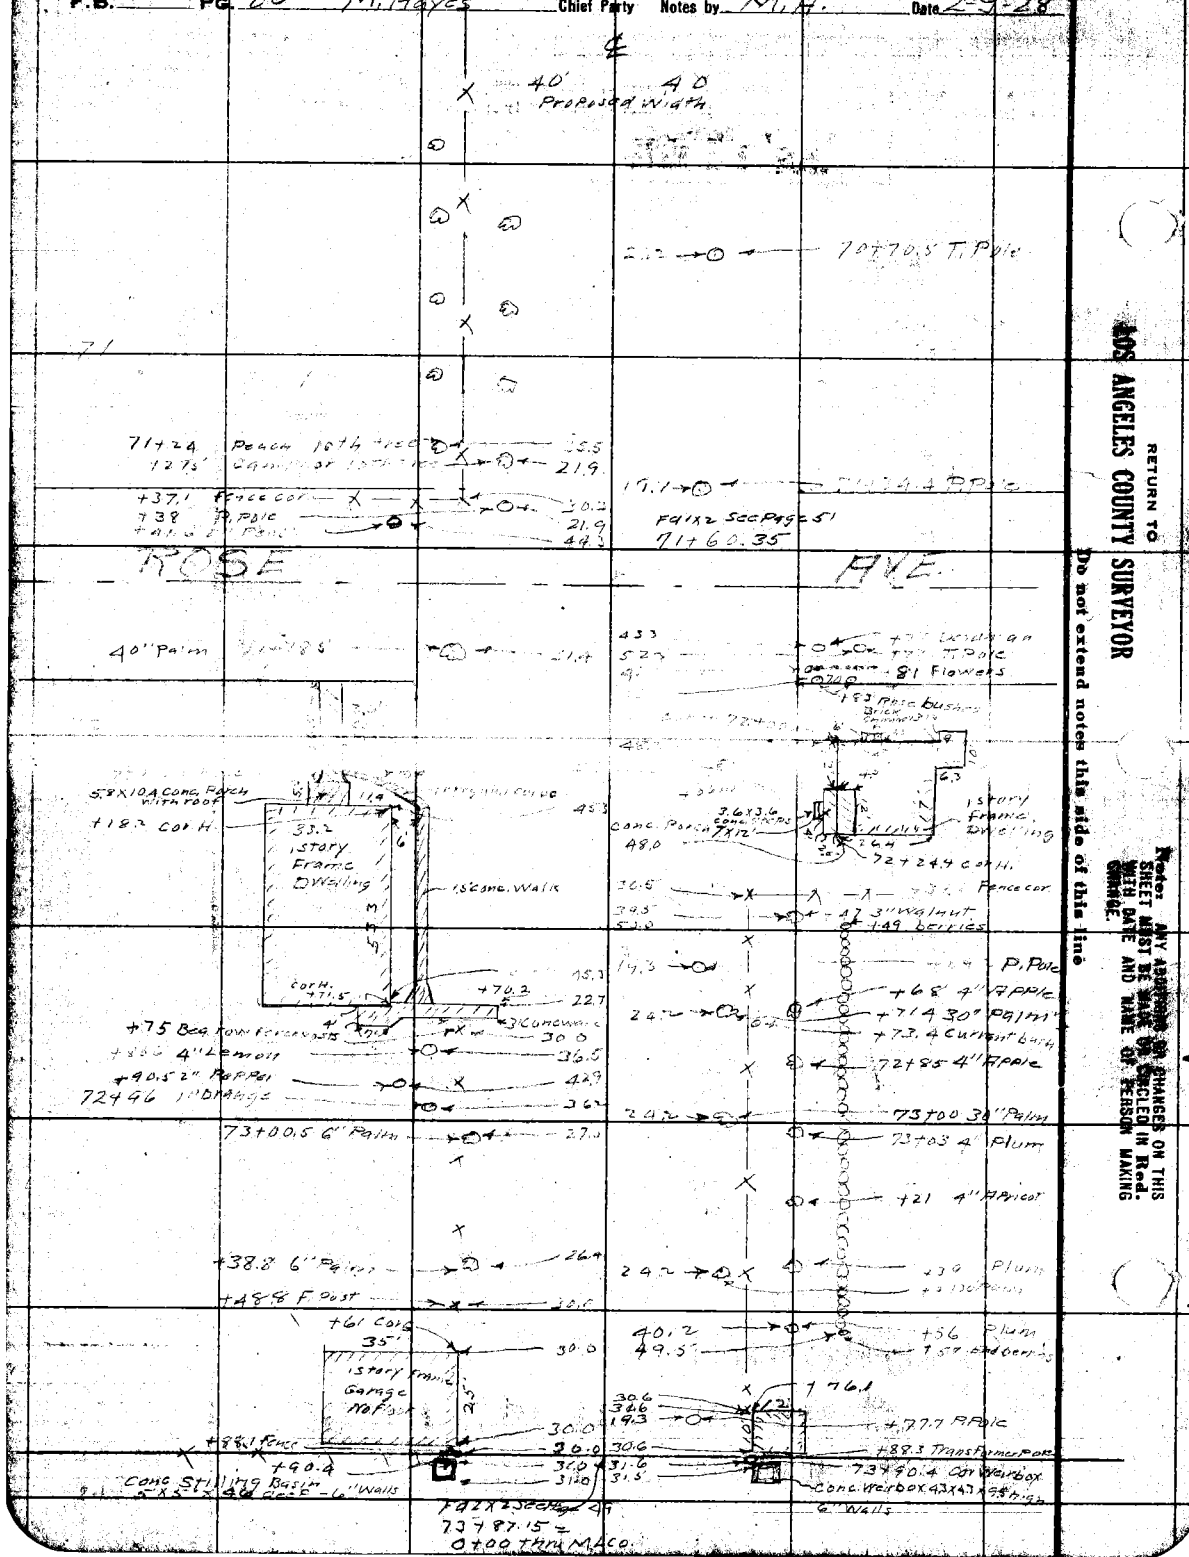

RETURN TO
LOS ANGELES COUNTY SURVEYOR

Do not extend notes this side of this line

Note: ANY ALTERATIONS OR CHANGES ON THIS SHEET MUST BE MADE OR ENCLOSED IN Red. WITH DATE AND NAME OF PERSON MAKING CHANGE.

Chief Party M. Hayes F. B. 302 PG. 81

Date May 28
Map No. 3-117
Plotted by R. W. Wood
Date JUL 11 1928

W. O. No. 4159 D. S. O. No.
Location Somerset Ave
Surveyed by Hayes & Carlson
Date Jan. 17, 1928
Indexed A. C. Johnson

Notes and offsets to the Center of trees

Topography Notes

Notice: ANY ADDITIONS OR CHANGES ON THIS SHEET MUST BE MADE OR CIRCLED IN Red. WITH DATE AND NAME OF PERSON MAKING CHANGE.

RETURN TO LOS ANGELES COUNTY SURVEYOR

Do not extend notes this side of this line

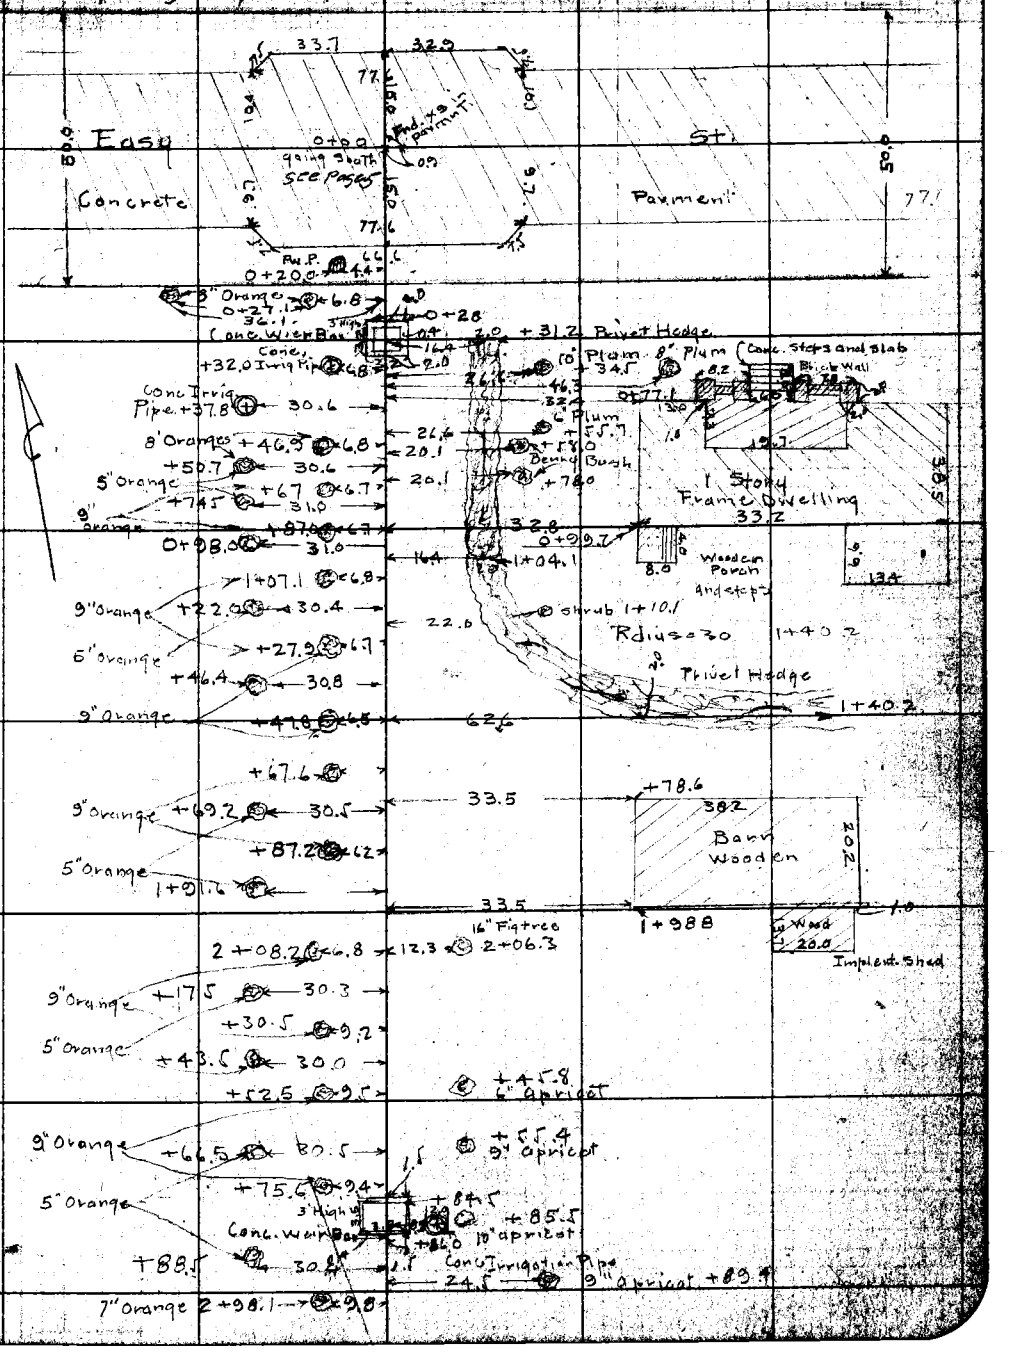

F.B. 302 PG. 82 M. Hayes Chief Party Notes by Carlson Date 1-13-28

3 + 14.5 20.1
5' Orange + 24.0 9.9
8' Orange + 38.4 30.5
+48.2 9.5

10" apricot
24.5 24.4 +25.2
25.0 24.9 +49.1
10" apricot
24.0 25.0 +72.4
10" apricot
24.5 24.7 3 + 97.2

+63.5 21.0
+72.5 9.0
4" Orange
+87.2 30.7
8" Orange
3 + 97.2 9.5

4 + 09.2 29.2
+19.8 9.6
5" Orange
+32.9 30.0
+44.7 9.7

10" apricot
25.0 24.9 4 + 19.9
24.9 +44.5

+57.1 29.1
5" Orange
+67.8 9.5
9" Orange
+80.3 29.5
4 + 94.1 9.4

5" Orange 3.4 16.4 8" Orange 23.4 +67.7
5" Orange 8.4 + 83.0
6" Orange 8.5 16.4 8" Orange 23.5 4 + 92.9

5 + 06.9 29.1
6" Orange
+16.0 9.1
8" Orange
+29.1 29.1
8" Orange
+40.3 9.5

8.4
5" Orange 8.5 16.4 8" Orange 23.6
5" Orange 8.6
6" Orange 8.4 16.5 8" Orange 24.0

5 + 03.0
+15.7
+28.1
+46.0

+53.5 29.3
5" Orange
+64.2 9.4
+77.2 29.7
7" Orange
+88.2 9.6

8.5
8.9 16.4 9" Orange 23.9
8.5
8.3 16.3 9" orange 23.5

+52.3
64.5
74.0
88.4

6 + 00 29.6
6" Orange
6 + 13.8 9.5
+25.5 29.6
9" orange
+37.0 9.6
5" orange +49.4 29.7

8.4
8.2 16.2 8" Orange 23.4
8.1
8.4 16.1 8" orange 23.2
8.4

6 + 5.0
+12.5
+23.2
+36.0
+47.7

RETURN TO
LOS ANGELES COUNTY SURVEYOR
Do not extend notes this side of this line

Notes: ANY ADDITIONS OR CHANGES ON THIS SHEET MUST BE MADE OR CIRCLED IN Red. WITH DATE AND NAME OF PERSON MAKING CHANGE.

Date 1-13-28 Notes by Carlson Chief Party W. Hayes F. B. 302 PG. 88

Plotted by Carlson Mar '28
Date
Map No. B-117
Plotting C'k'd by R.W.S.
Date JUL 11 1928

W. O. No. 4159 D. S. O. No.
Location Somerset Ave.
Surveyed by Hayes-Carlson
Date Jan. 13 - 1928
Indexed A. C. Johnson

Notes: ANY ADDITIONS OR CHANGES ON THIS SHEET MUST BE MADE OR CIRCLED IN Red. WITH DATE AND NAME OF PERSON MAKING CHANGE.

RETURN TO LOS ANGELES COUNTY SURVEYOR

Do not extend notes this side of this line

	6	+61.2	9.3		8.3	16.0	9" orange 22.9	6	+	60.1
7" orange		+72.5	29.4		8.4				+	72.0
		+83.0	9.4		8.5	16.1	7" orange 22.5		+	84.5
5" orange	6	+96.5	29.5		8.1			6	+	96.5
	7	+09.0	9.4		8.4	16.8	8" orange 23.0	7	+	08.5
3" orange		+22.3	29.4		8.1				+	20.2
4" orange		+33.7	9.2		8.4	16.1	6" orange 23.4		+	32.0
		+45.5	29.4							
		+56.5	9.4		8.5	16.0	7" orange 23.2		+	56.1
8" orange		+68.1	29.7		8.6				+	67.5
7" orange		+80.5	9.5		8.3	15.9	8" orange 23.1		+	81.0
	7	+92.5	29.7		8.4			7	+	93.0
	8	+05.8	9.2		8.2	16.0	9" orange 23.2	8	+	05.3
6" orange		+16.8	29.9		8.3				+	17.5
5" orange		+30.6	9.0		8.1	16.2	8" orange 23.4		+	29.0
		+41.2	29.6		8.4				+	40.5
		+54.0	9.5		8.5	16.0	8" orange 23.0		+	53.0
9" orange		+65.5	29.7		8.3				+	65.2
4" orange		+77.4	9.9		8.2	16.5	10" orange 23.4		+	76.8
		+89.3	29.5		8.4			8	+	89.0
	9	+02.0			8.3	16.4	10" orange 23.5	9	+	00.0
8" orange		+11.0	28.9		8.4			9	+	13.0
6" orange		+24.5	9.5		8.5	16.3	22.8		+	24.5
		+36.3	28.5		8.3				+	36.5
		+48.5	9.4		8.4	16.4	22.4		+	48.5
9" orange		+61.2	28.7		8.2				+	61.2
4" orange		+72.4	9.6		8.6	16.0	22.7		+	72.4
		+85.0	28.8		8.5				+	85.9
4" orange	9	+96.1			8.6	15.0	22.5	9	+	96.0
6" Orange	10	+09.0	29.0		8.5			10	+	09.2
3" orange		+20.8	9.5		8.4	15.5	22.7		+	19.8
		+32.2	29.7		8.5				+	31.2
5" orange	10	+45.1	9.4		8.3	15.9	22.6	10	+	44.0

F.B. 302 PG. 84 Chief Party Notes by Carlson Date 1-13-28

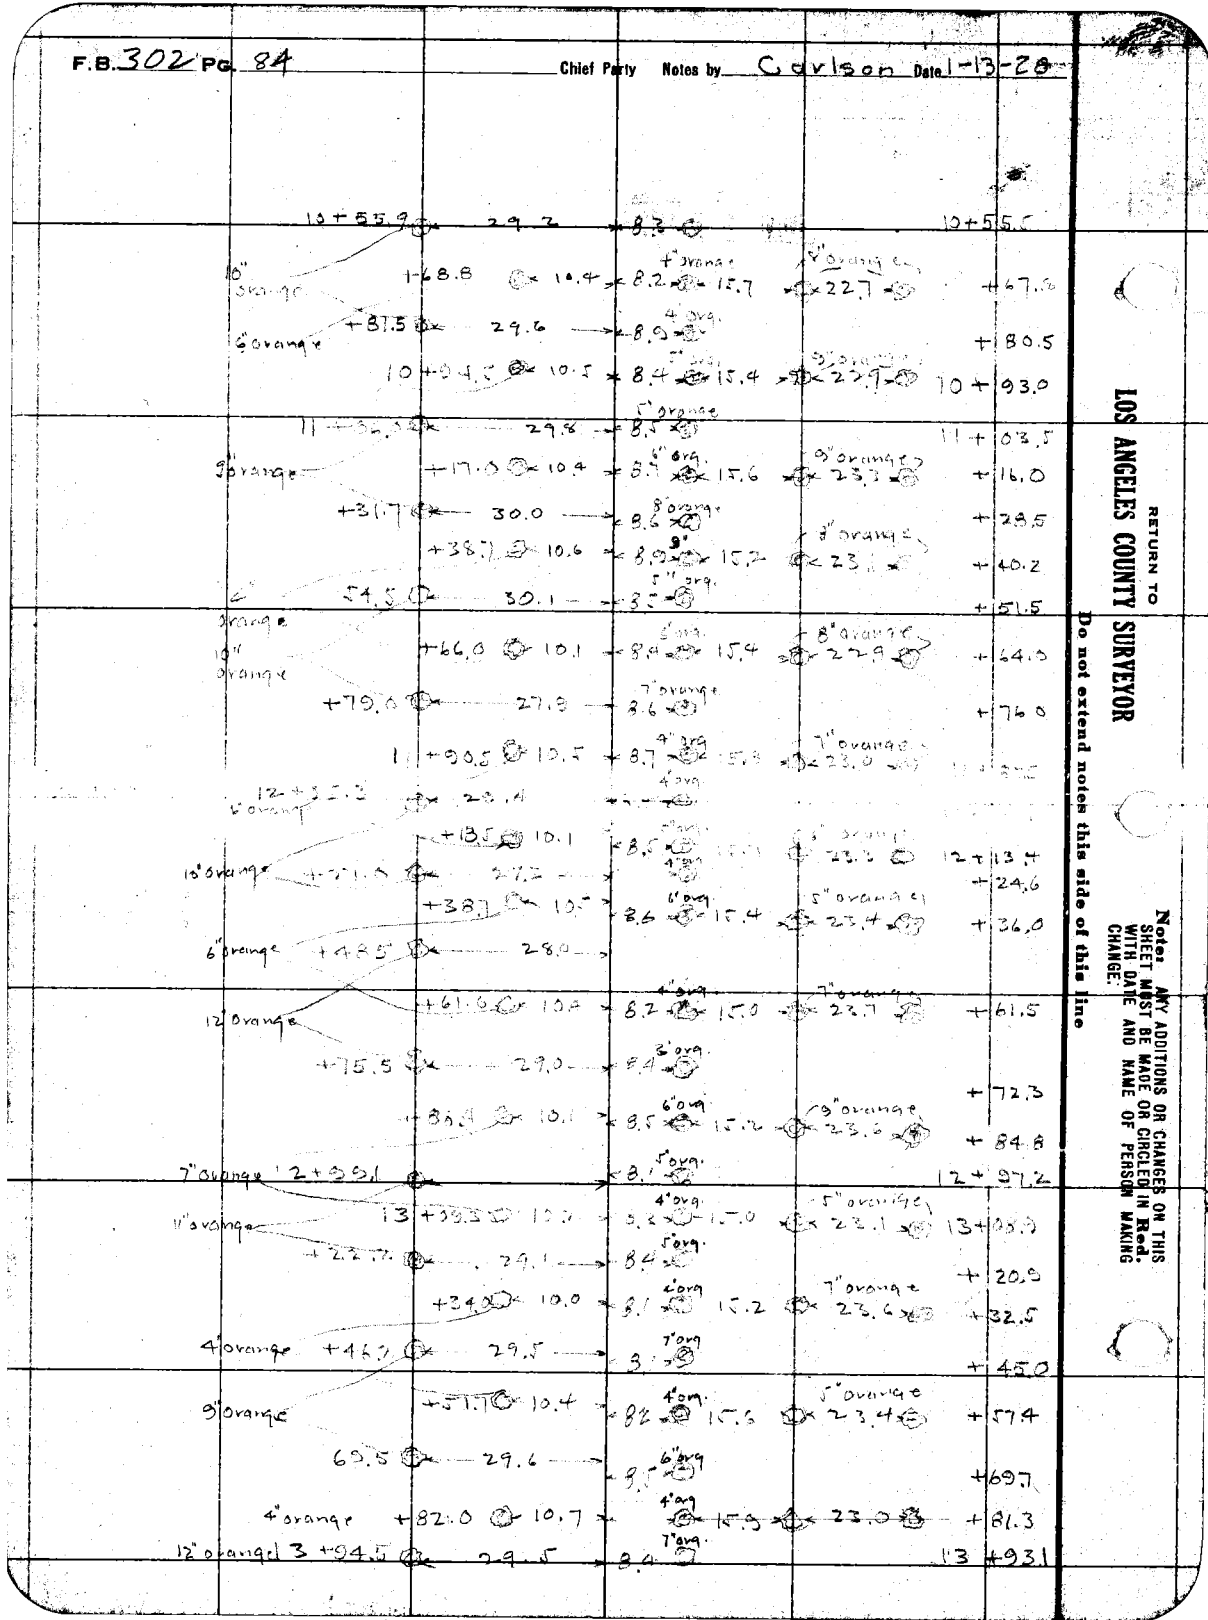

Date 1413-28 Notes by Garrison Chief Party M. Hayes F. B. 302 PG. 85

Plotted by Graml Mar '28
Date
Map No. B-117
Plotting C'k'd by R. W. S.
Date JUL 11 1928

W. O. No. 4159 D. S. O. No.
Location Somerset Ave
Surveyed by Hayes + Garrison
Date Jan 13 - 1928
Indexed A. C. Johnson

Notes: ANY ADDITIONS OR CHANGES ON THIS SHEET MUST BE MADE OR CIRCLED IN Red. WITH DATE AND NAME OF PERSON MAKING CHANGE.

Do not extend notes this side of this line

RETURN TO LOS ANGELES COUNTY SURVEYOR

F.B. 302 Pg. 86 — Chief Party — Notes by — Date 1-17-28

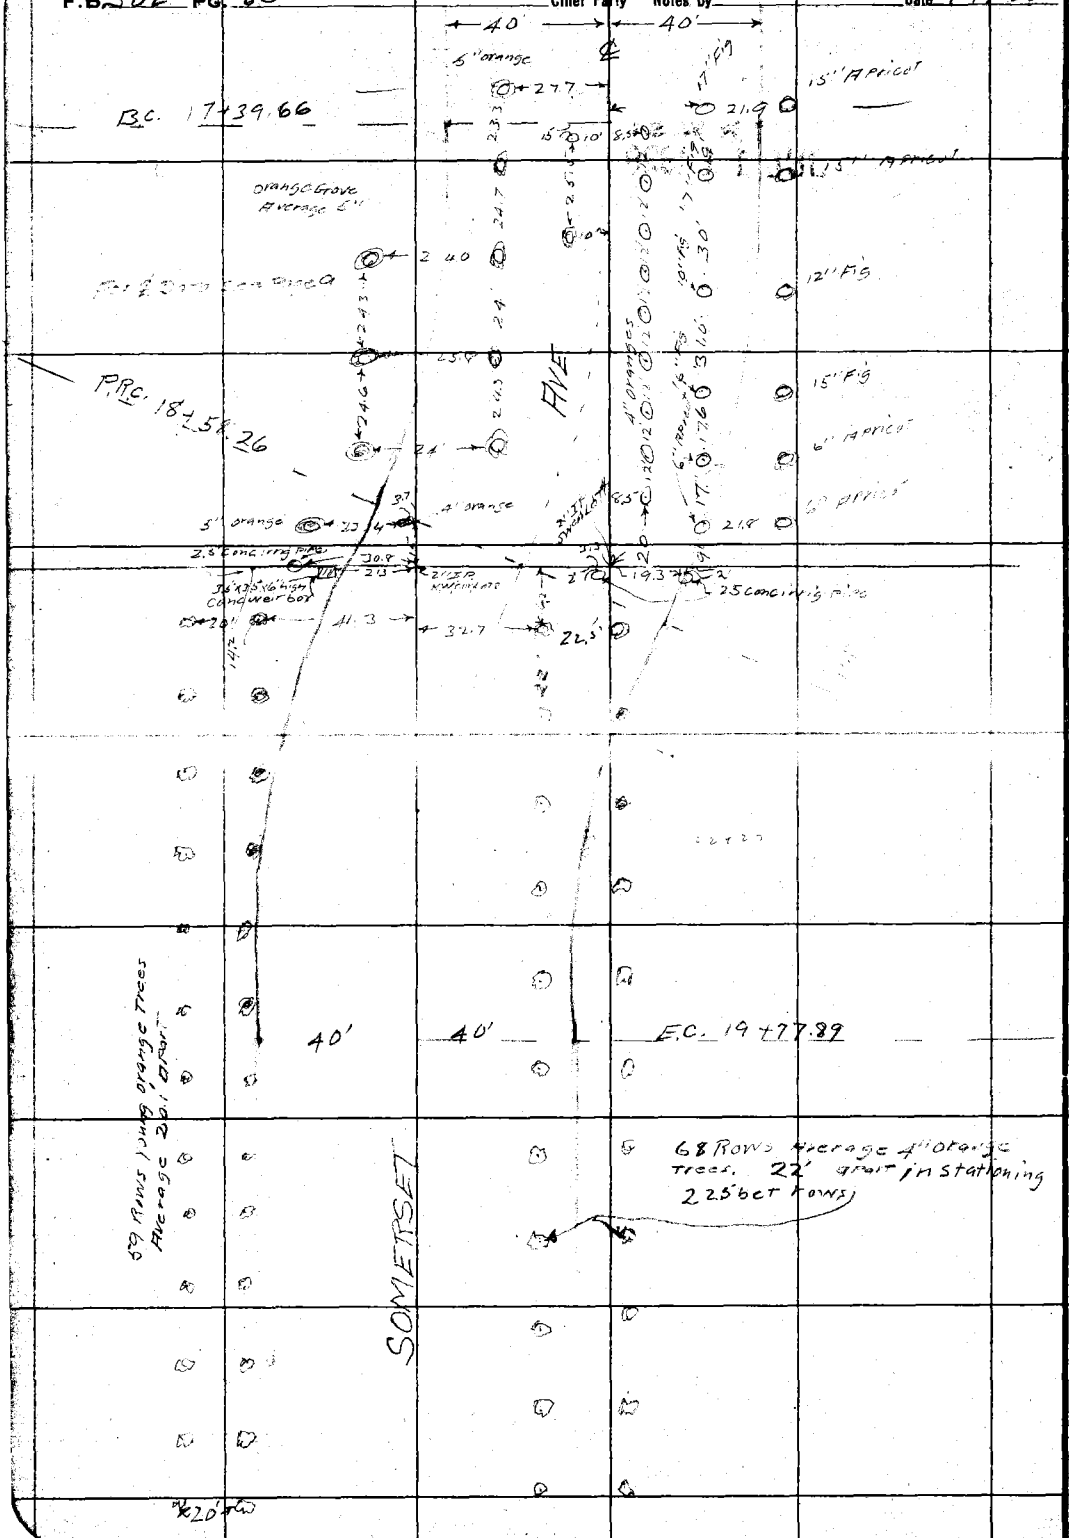

RETURN TO
LOS ANGELES COUNTY SURVEYOR

Do not extend notes this side of this line

Notes: ANY ADDITIONS OR CHANGES ON THIS SHEET MUST BE MADE OR CIRCLED IN Red. WITH DATE AND NAME OF PERSON MAKING CHANGE.

Date _____ Notes by _____ Chief Party _____ F. B. 302 PG. 87

Plotted by Crawl
Date Mar '28
Map No. 13-117
Plotting C'k'd by R. W. S.
Date JUL 11 1928

W. O. No. 4159 D. S. O. No. _____
Location SOMERSET AVE.
Surveyed by M. HAYES
Date Jan 17 1928
Indexed A. C. Johnson

Notes: ANY ADDITIONS OR CHANGES ON THIS SHEET MUST BE MADE OR CIRCLED IN Red. WITH DATE AND NAME OF PERSON MAKING CHANGE.

Do not extend notes this side of this line

RETURN TO LOS ANGELES COUNTY SURVEYOR

40' & 40'

2' conc. irrig. Fnce

234/0.6

34.3

AVE

SOMERSET

CONTINUOUS

End grove 3 0+ 44.2

18' Gum 30+97.5'

57.0

F.B. 302 · PG. 88 — Chief Party — Notes by M. H. — Date Jan 17, 1924

31+05	60" Gum Stump & Tree	+ 0.4	49.8
+15.8	36"	+ 0.9	48.6
+22.5	36" Gum	+ 5.4	50.0
	30"		41.0
+45	3'		40.8
+53.5	5'		33.6
+70.6	4' Gum		
+86.6	5' Gum Stump & Tree		8.7
+86.6	7' Gum		33.
			24.
31 +94.4			32.6
32+01			23.6
+09	Gum stump 3'		39.0
+18			39.0
+26.4	Gum Tree 7'		34.5
+42	24" Gum		1.6
+42	30" "		2.3
+57.8	72" Base Sign		4.7

FIVE

SOUTH FIRST

40'

40'

Note: These trees have been Cut and large Sprouts have grown from the Stumps

32+93.8 12" Gum

33 +03			25.2
33 +03	20 Gum		27.0
+13	24" Gum Tree		12.3
+15	48" "		21.4
+15	42" "		37.3
+23.4	48" "		46.5
+38.7	66" Gum		31.
+46.2	72" "		13.5
+46.2	42" "		22.5

32.3 — 22.3 — 33+53.9 End Tie

Fd 2" IP & W. cor Lots 33+66.38

FIFTH — 6" Curb — 6.5' Conc Walk — 5" Fire Hyd 33+86.0 — 0.5 in gr. above ground — 58.15 — A 60° — 53.7 — 9.3 — 200

ST. — 6" Curb — 5.5' — 5.5' — 5.5' — 5' Conc Walk — 5' Conc Walk — 5' Conc Walk

Date _____ Notes by _____ Chief Party _____ F. B. 302 PG. 89

Planned by Crawl
Date Mar '28
Map No. B-117
Plotting C'd by R. W. S.
Date JUL 11 1928

W. O. No. 4159 O. S. O. No. _____
Location _____
Surveyed by _____
Date Jan 17, 1928 A. C. Johnson
Indexed

Notes: ANY ADDITIONS OR CHANGES ON THIS SHEET MUST BE MADE OR CIRCLED IN Red. WITH DATE AND NAME OF PERSON MAKING CHANGE.

Do not extend notes this side of this line

RETURN TO LOS ANGELES COUNTY SURVEYOR

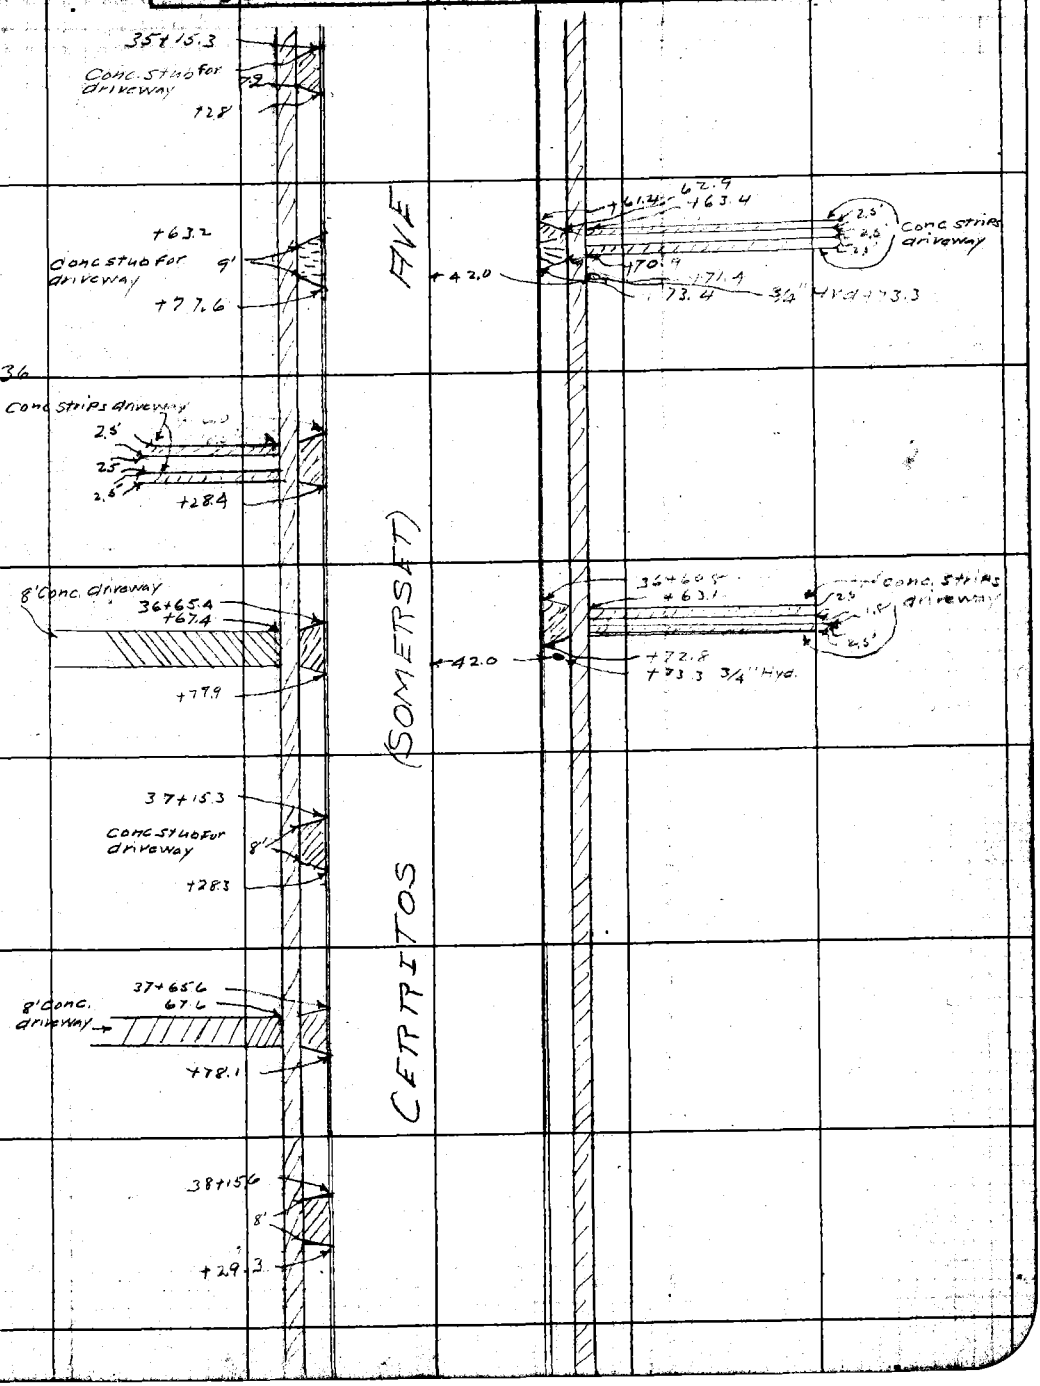

F.B. 302 Pg. 90 Chief Party Notes by Date 1-17-28

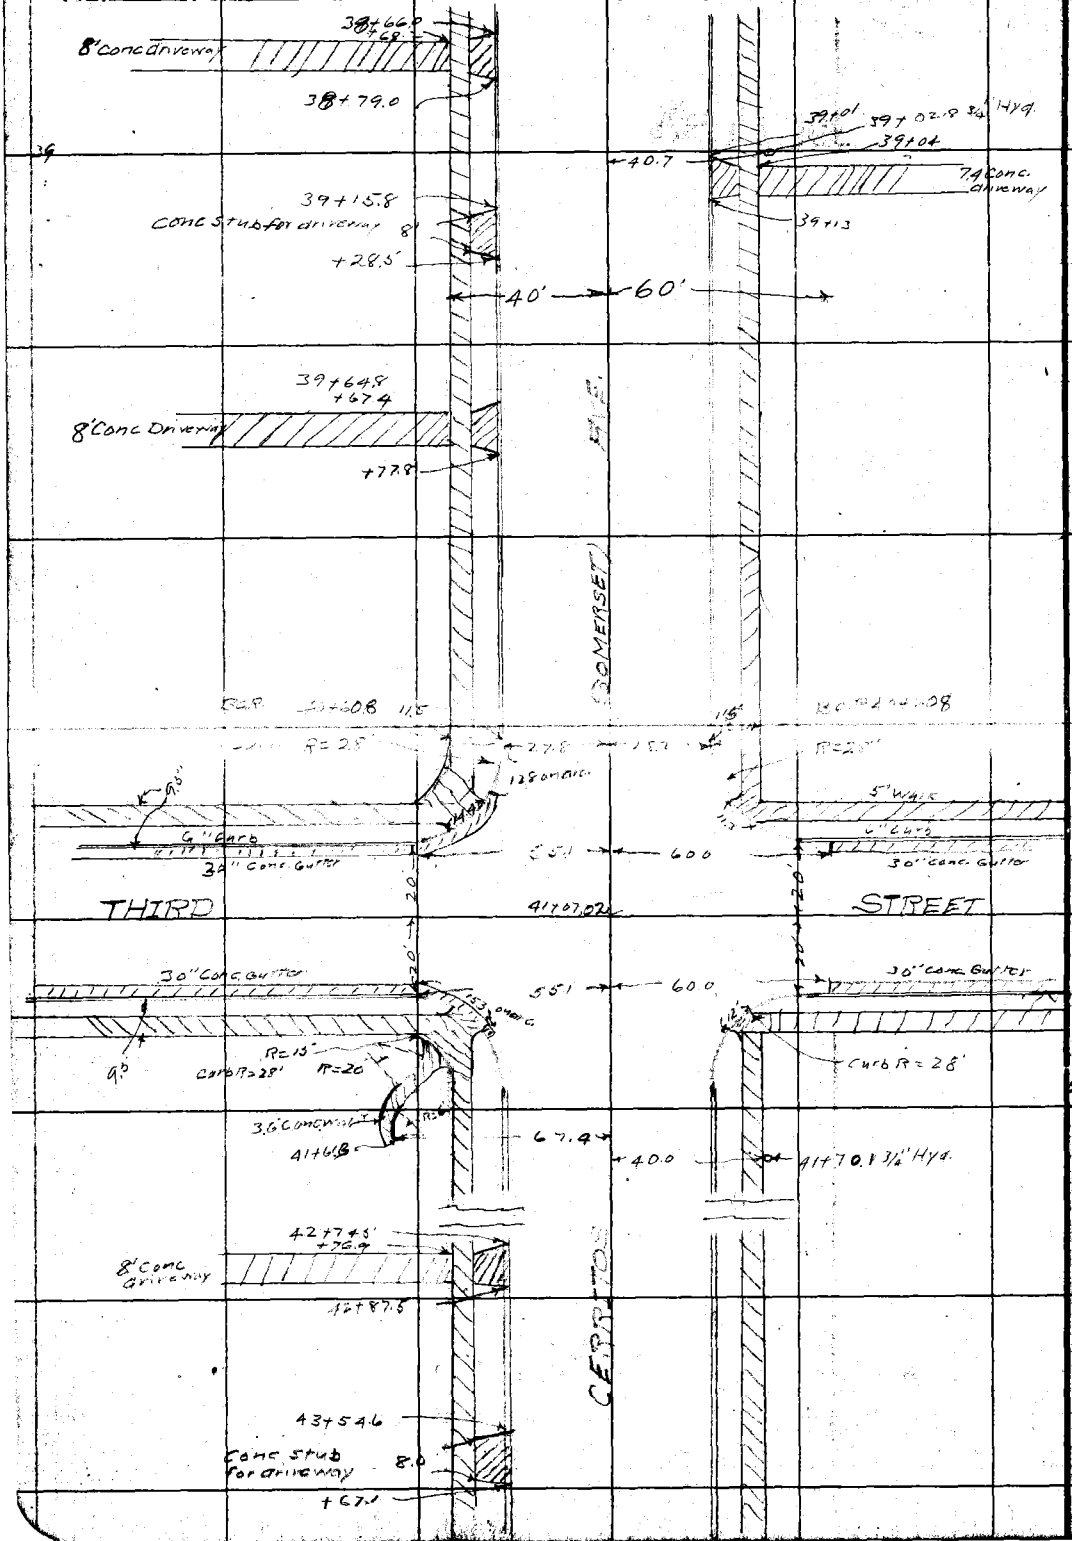

RETURN TO
LOS ANGELES COUNTY SURVEYOR
Do not extend notes this side of this line

Notes: ANY ADDITIONS OR CHANGES ON THIS SHEET MUST BE MADE OR CIRCLED IN Red. WITH DATE AND NAME OF PERSON MAKING CHANGE.

Date _____ Notes by MH Chief Party M. Hayes F. B. 302 PG. 91

Plotted by Grant
Date Mar '28
Map No. B-117
Plotting C'k'd by P. W. S.
Date JUL 11 1928

W. O. No. 4159 S. A. O. No. _____
Location Somerset Ave
Surveyed by M. Hayes
Date Jan 18, 1928
Indexed A. C. Johnson

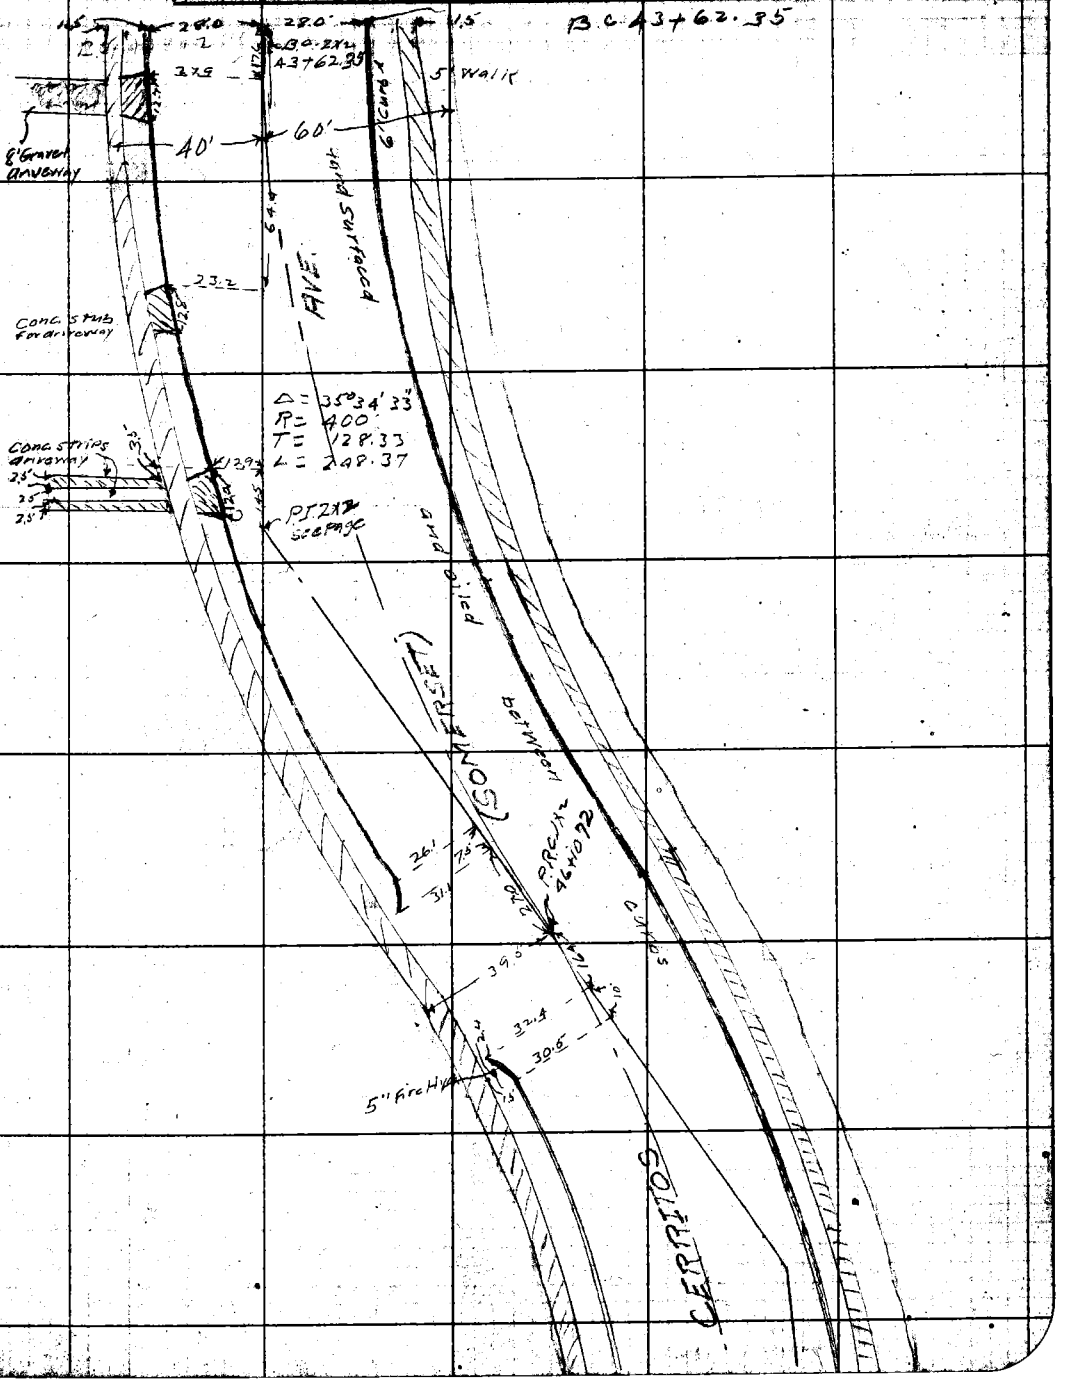

Notes: ANY ADDITIONS OR CHANGES ON THIS SHEET MUST BE MADE OR CIRCLED IN Red. WITH DATE AND NAME OF PERSON MAKING CHANGE.

RETURN TO LOS ANGELES COUNTY SURVEYOR

Do not extend notes this side of this line

F.B. 302 Pg. 92 Chief Party Notes by M. H. Date 12/19/28

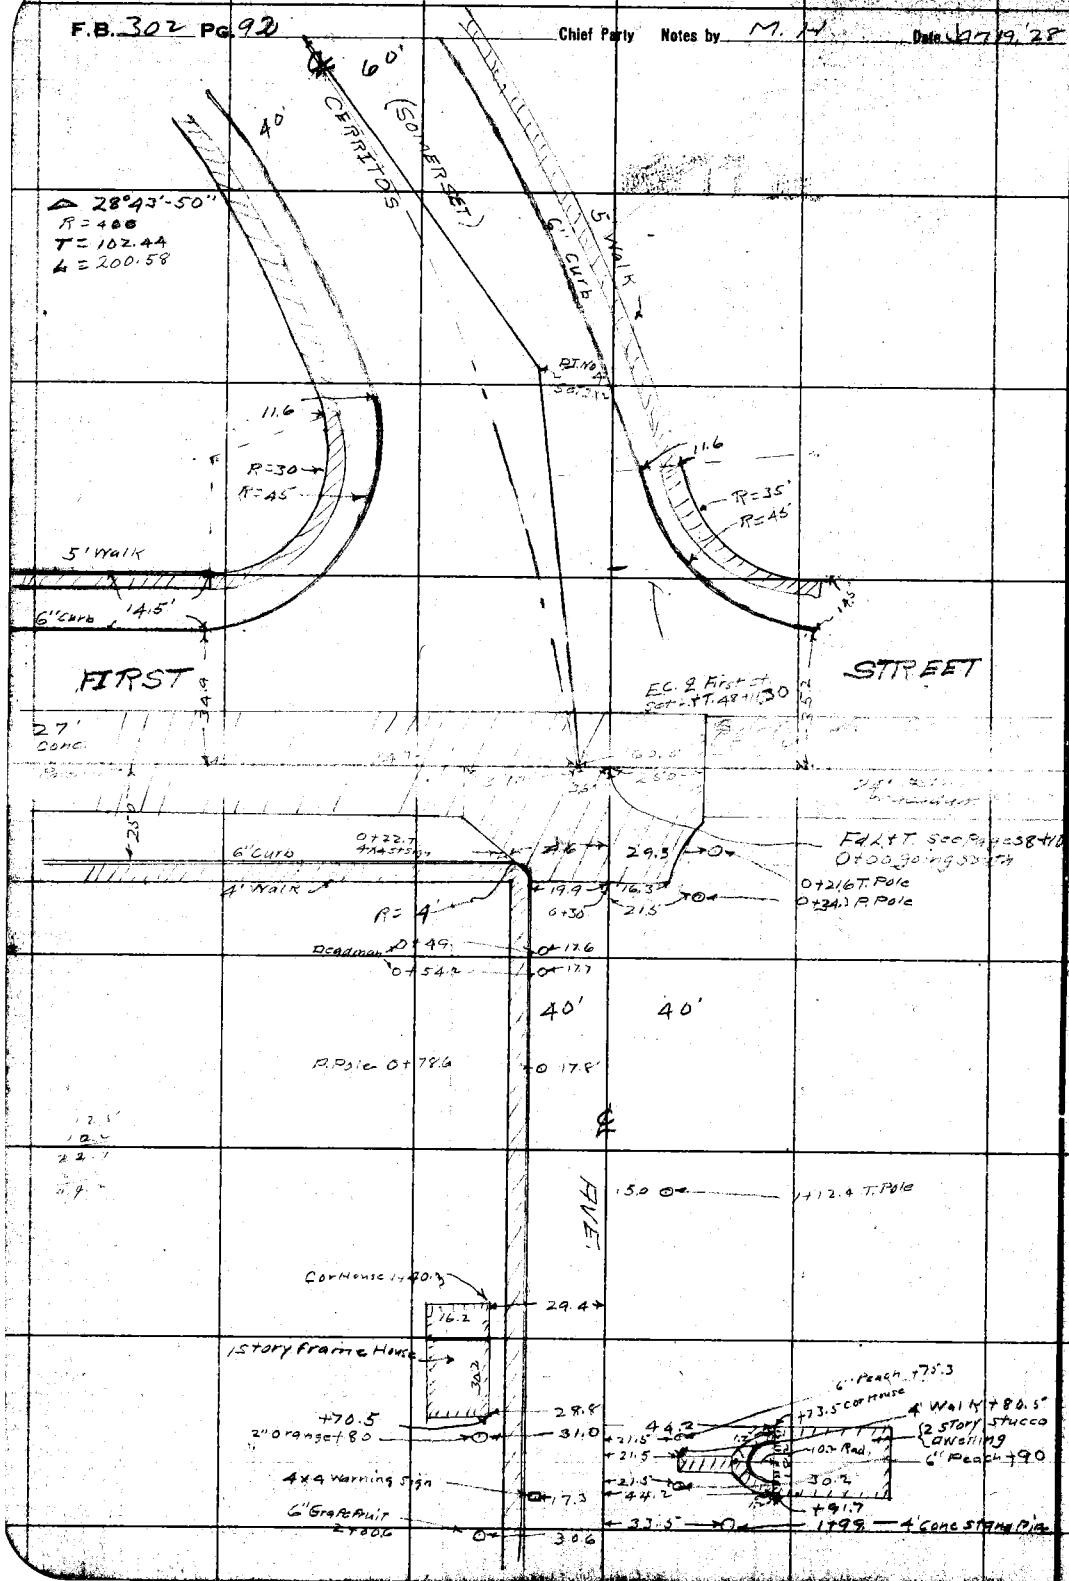

Date: Notes by: M.H. Chief Party: M. Hayes F. B. 302 PG. 93

Plotted by: Geary
Date: Mar 28
Map No. B-117
Traced by: P. W. S.
Date: JUL 1 1928

W. O. No. 4159 R. S. O. No.
Location Somerset Ave.
Surveyed by M. Hayes
Date Jan. 19, 1928
Indexed

Notes: ANY ADDITIONS OR CHANGES IN THIS SHEET MUST BE MADE OR CIRCLED IN RED, WITH DATE AND NAME OF PERSON MAKING CHANGE.

RETURN TO LOS ANGELES COUNTY SURVEYOR

Do not extend notes this side of this line

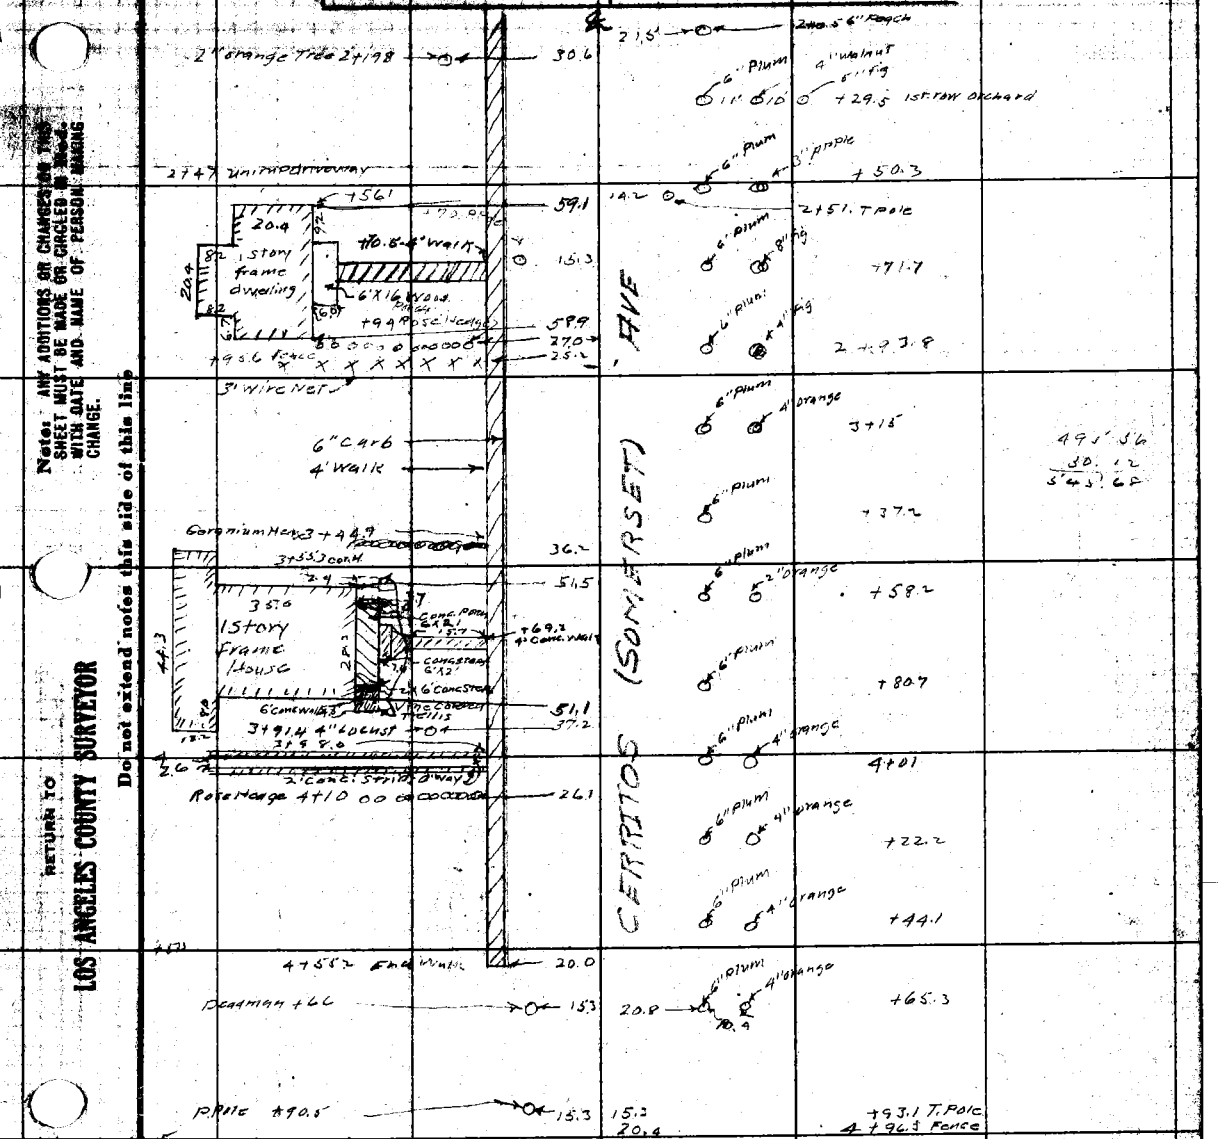

F.B. 302 Pg. 94

Chief Party Notes by M.H. Date 1-20-28

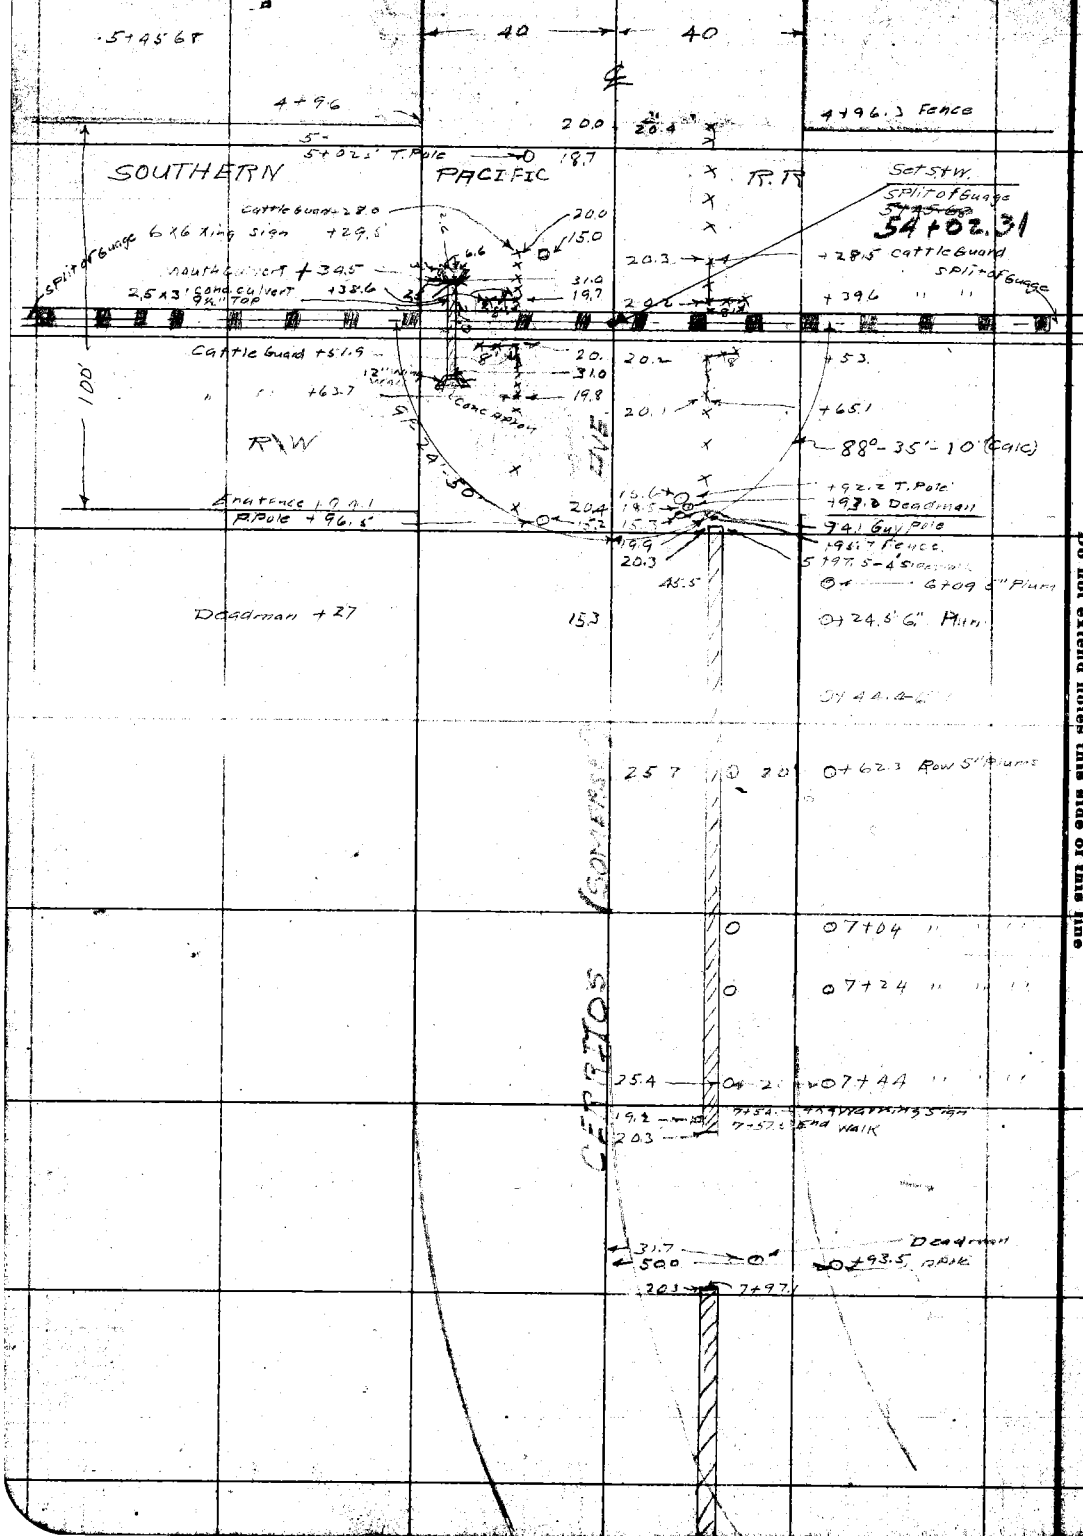

Date _____ Notes by M. H. Chief Party M. Hayes F. B. 302 PG. 95

Plotted by Crom/
Date Mar '28
Map No. B-117
Plotting C'k'd by R. W. B.
Date JUL 11 1928

W. O. No. 4159 C. O. No.
Location SOMERSET AVE.
Surveyed by M. Hayes
Date Jan 20 1928
Indexed A. C. Johnson

Notes: ANY ADDITIONS OR CHANGES ON THIS SHEET MUST BE MADE OR CIRCLED IN Red. WITH DATE AND NAME OF PERSON MAKING CHANGE.

RETURN TO LOS ANGELES COUNTY SURVEYOR

Do not extend notes this side of this line

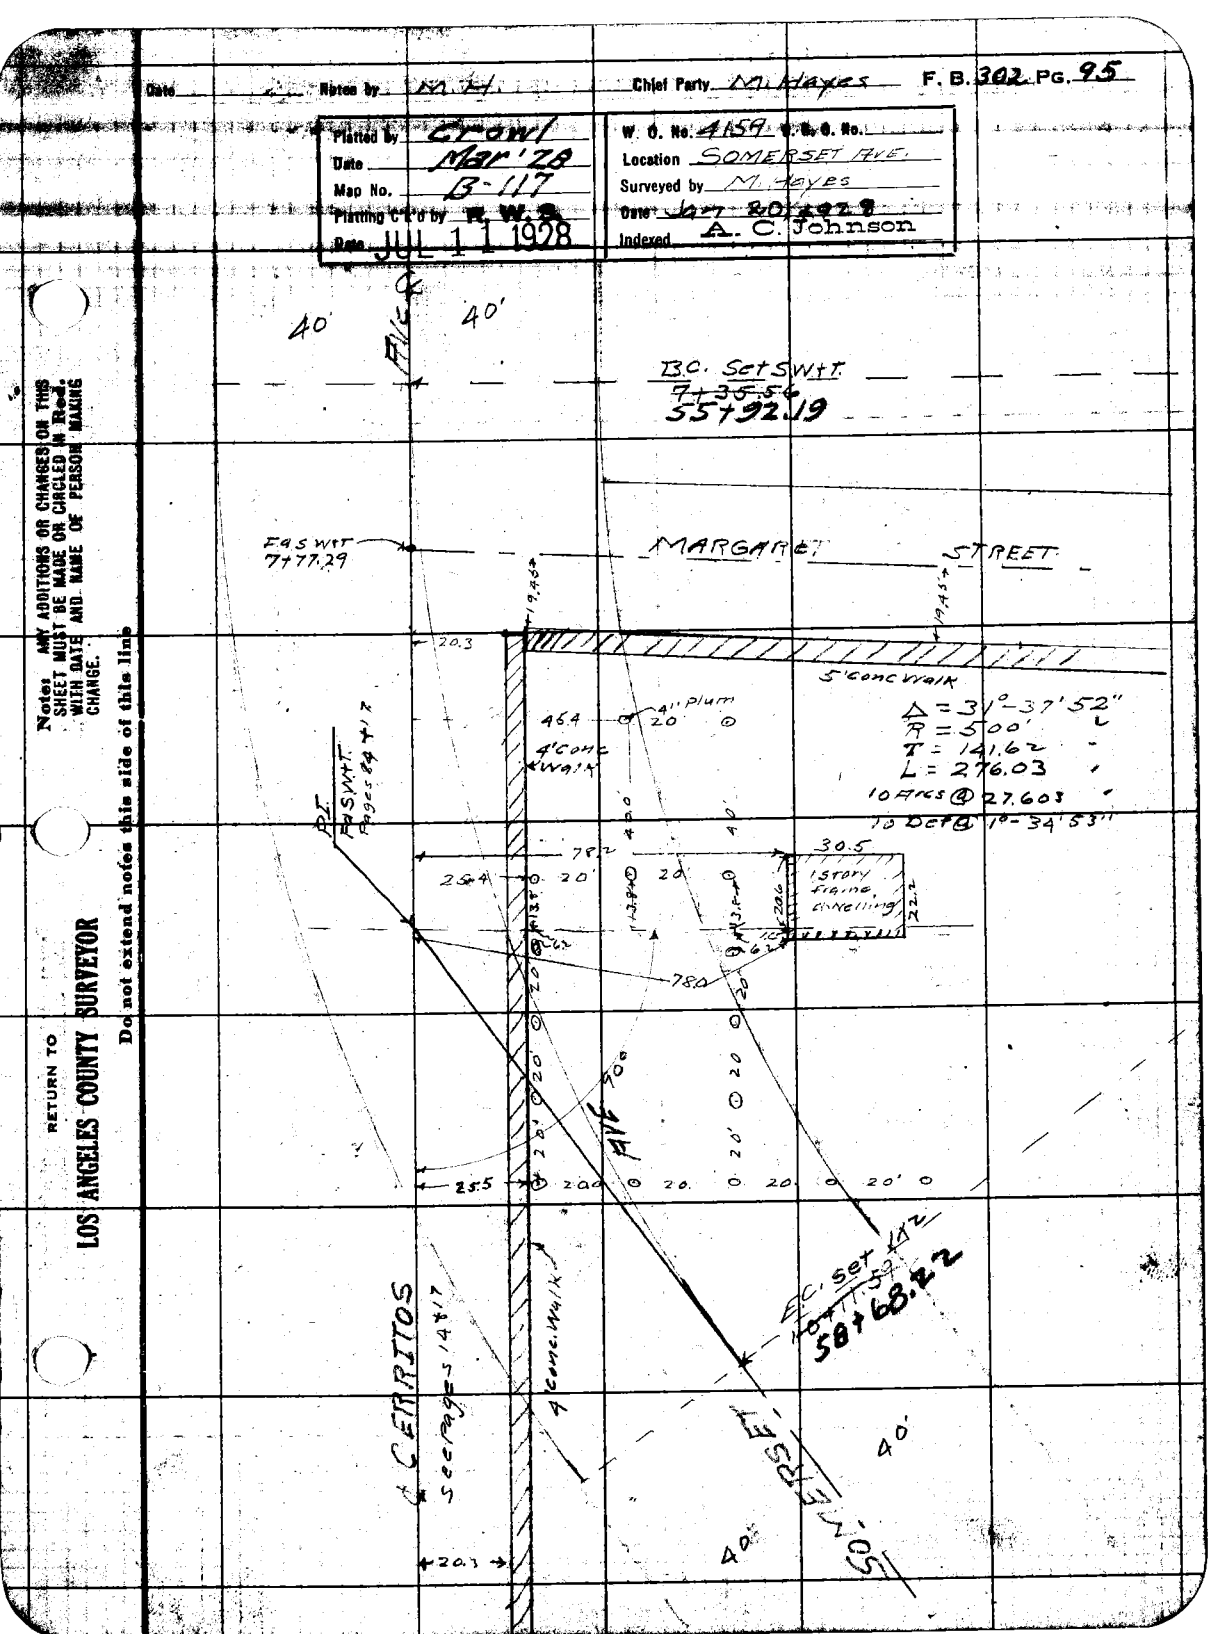

F.B. 302 PG. 96 M. Hayes Chief Party Notes by M.H Date 1-23-28

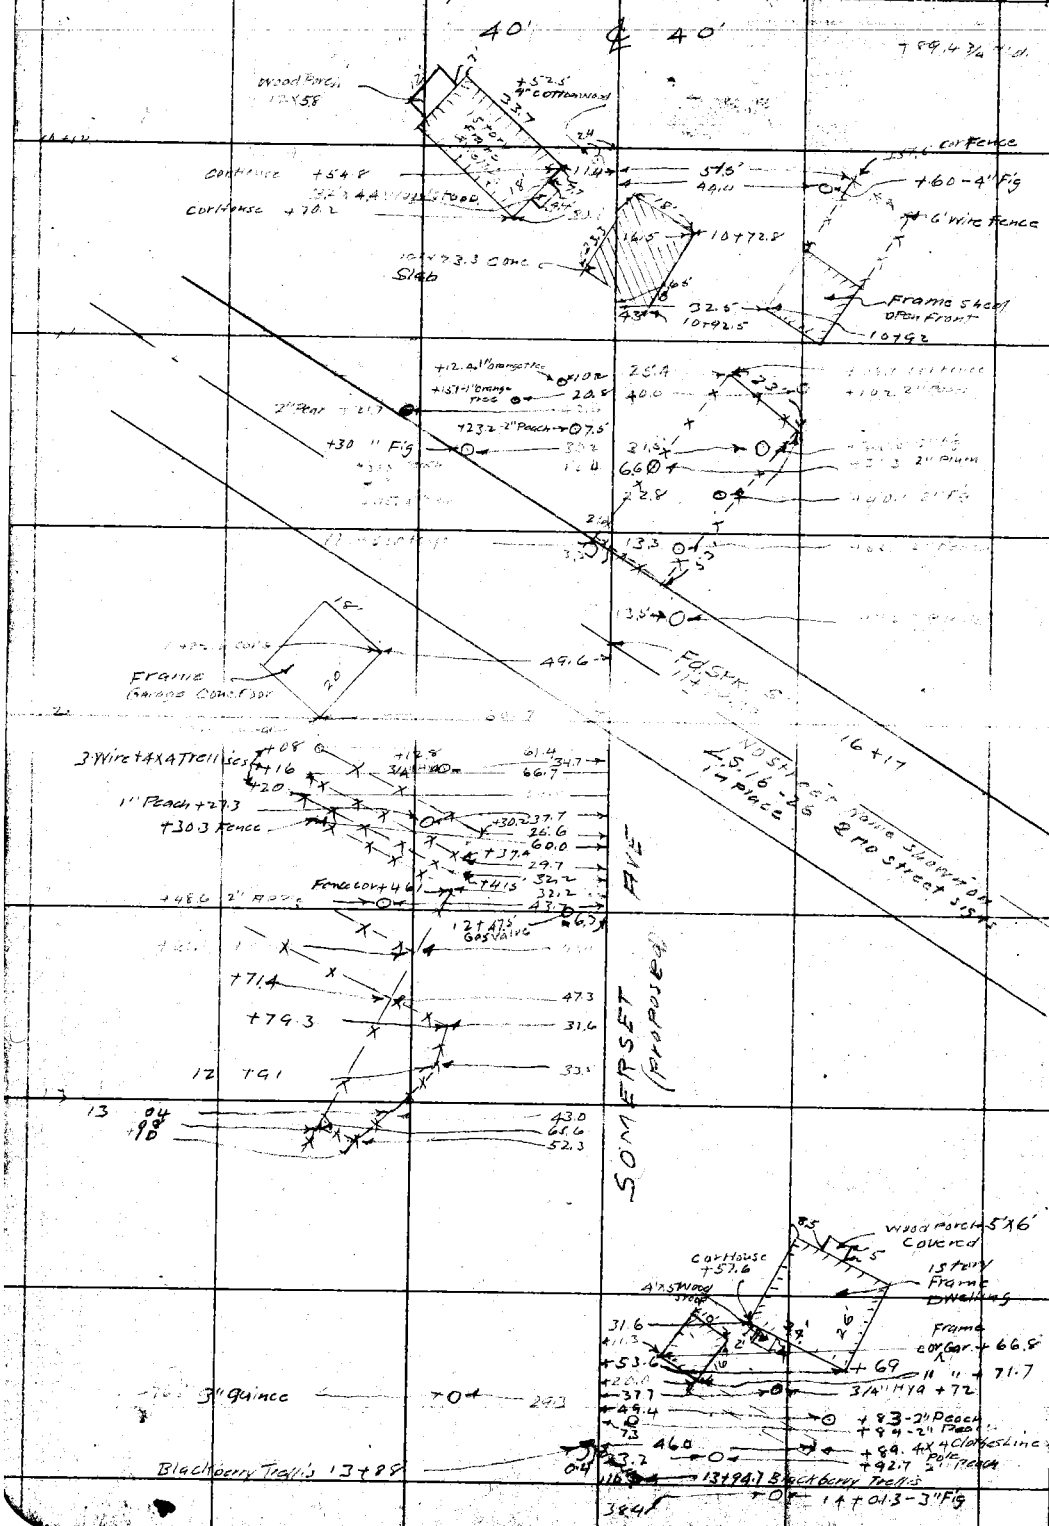
40'
℄
40'
Wood Bldg.
12 X 58
+5.2.5'
4" Cottonwood
Corthouse +54.8
Corthouse +70.2
Flood
Slab
Barn
Frame 54 on
Open Front
6' Wire Fence
+30 " Fig
+23.2 2" Peach
+12.4 1" Pomegranate
+15.1 1" Orange
2" Pear
Frame
Garage Condemned
3 Wire + 4 X Attachments
1" Peach +27.3
+30.3 Fence
Fence Corner
2" Apple
Gas Valve
Wood Porch 5'X6'
Covered
1 St'ry
Frame
Dwelling
Corthouse
+57.6
Frame
Car Gar. +66.8
3" Quince
Blackberry Trellis 13+88
Blackberry Trellis
1 4 + 01.3 - 3" Fig

Date _____ Notes by M. H. Chief Party M. Hayes F. B. 302 PG. 97

Platted by Crony
Date Mar. 28
Map No. B-117
Platting C'k'd by R. W. S.
Date JUL 11 1928

W. O. No. 4159 U. S. O. No.
Location Somerset Ave
Surveyed by M. Hayes
Date Jan 23, 1928
Indexed A. C. Johnson

Notes: ANY ADDITIONS OR CHANGES ON THIS SHEET MUST BE MADE OR CIRCLED IN Red. WITH DATE AND NAME OF PERSON MAKING CHANGE.

Do not extend notes this side of this line

RETURN TO LOS ANGELES COUNTY SURVEYOR

21.0 14+01 Blackberry Trellis
40.3 +13.5 " "
39.7 +16.7 3"x5" P. Pole

40' 40'

388.67 T=62°=
388.61

21.8 +17.4
9.2 Frame Garage House
7.0 Conc. Floor
3.8 3/4" Hyd +65.2
+71.2

154

SOMERSET AVE (Proposed) 388.61 to S/P.

Filed HALL

Fd. 2x2 see pages 8 & 9 15+68.10 Surface ROAD

3 Strand barbwire fence
Wild locust group 17+06 +97.7
4.6
15+88.1 4x4 Blackberry

Blackberry row 16+40.0
6" Plum 16+06
4" Plum +18
5" " +31
6" " +93
End berries +50
6" " +55

19.0 14.0 24.4 13.9 13.6 19.0 14.8

16+09.3 guince
17.9 3" Fig
+10 4" Fig
15.6 16.4 +27.7 Fig row
16.0 24.0 +49.2 5" Fig

15.0 18.4 16 +66.4
33.3 +82.4 4" Fig
38.7 +83 Corn House
38.4 24.0 1 Story Frame House

+94 2" willow group
Entrance 17+90

Old frame foundation Floor
17+20 Fence
Conc. 6.3'x5.4'x2.6' Conc. Floor Foundation
+24.5
+36.2
17+08.5
33.4
9.2
30.4

17+21.3 Fig
15.7 18.6 +44.5 - Row 2" guince

F.B. 302 Pg. 90 M. Hayes Chief Party Notes by M.H. Date 1-23-28

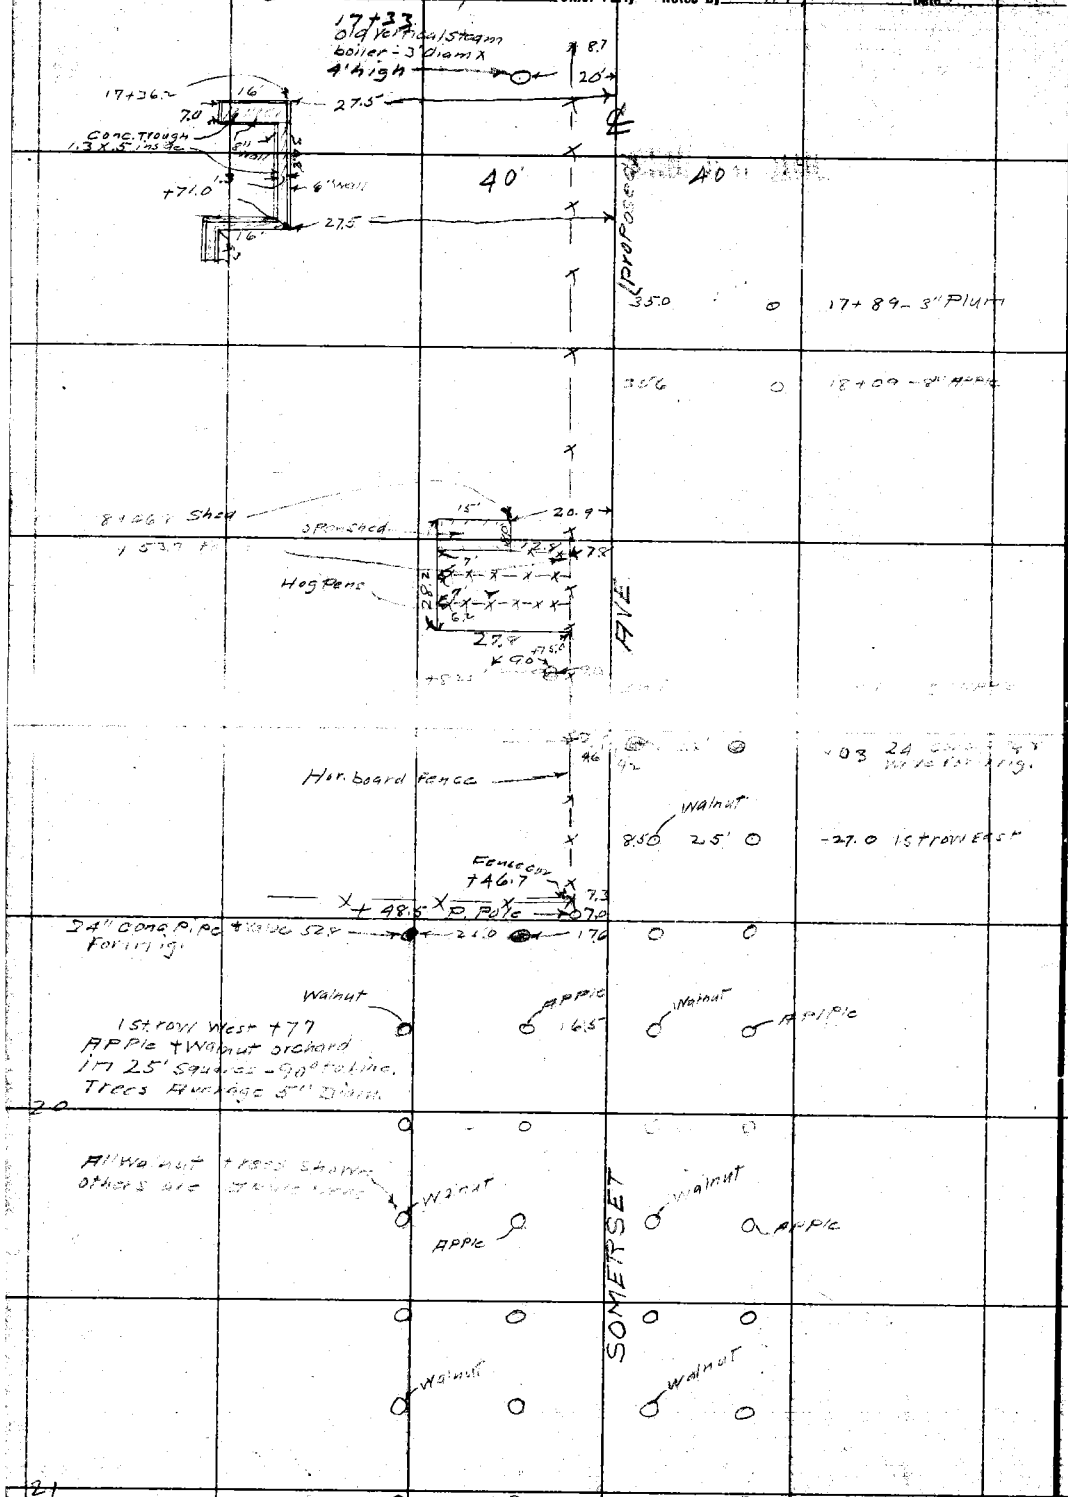

RETURN TO
LOS ANGELES COUNTY SURVEYOR
Do not extend notes this side of this line

Note: ANY ADDITIONS OR CHANGES ON THIS SHEET MUST BE MADE OR CIRCLED IN Red. WITH DATE AND NAME OF PERSON MAKING CHANGE.

Date _____ Notes by Milt. Chief Party M. Hayes F. B. 302 PG. 99

Platted by Crowl
Date Mar '28
Map No. B-117
Planning C'k'd by R. W. S.
Date JUL 11 1928

W. O. No. 4159 S. S. O. No. _____
Location Somerset Ave
Surveyed by M. Hayes
Date Jan 26, 1928
Indexed A. C. Johnson

Notes: ANY ADDITIONS OR CHANGES ON THIS SHEET MUST BE MADE OR CIRCLED IN Red. WITH DATE AND NAME OF PERSON MAKING CHANGE.

Do not extend notes this side of this line

RETURN TO LOS ANGELES COUNTY SURVEYOR

21

40' & 40'

Walnut

Walnut

(Proposed)

Walnut

Walnut

22

Walnut

Walnut

FIVE

Walnut

23

14th Row W. Side

End Apples 16th Row E. Side

23+16.2 Row 24 Corner Plums (Walnut Avenue)

Begin 11 Rows 6" Plums 25' Square

SOMERSET

29

Out

F.B. 302 Pg. 100 M. Hayes Chief Party Notes by M. H. Date 1-26-28

40' & 40'

OUT 0 0 0

25' OUT OUT 0 0

OUT 0 0 0

OUT 0 0 0

0 0 0 0 ← End Plums

25-19.5 Irrig

(Proposed)

26 0 0 0 0 ← Begin 12 Rows 5" Figs

0

0 0 0 0

EYLE

0 0 0 0

0 0 0 0

27

0 0 0 0

0 0 0 0

0

0

0 0 0 0

SOMERSET

0 0 0 0

28

25' 0 0 0 0 25'

0 25' 0 164.86 0 25' 0

RETURN TO
LOS ANGELES COUNTY SURVEYOR
Do not extend notes this side of this line

Note: ANY ADDITIONS OR CHANGES ON THIS SHEET MUST BE MADE OR CIRCLED IN Red. WITH DATE AND NAME OF PERSON MAKING CHANGE.

Date _____ Notes by M.H. Chief Party M. Hayes F. B. 302 PG. 101

Plotted by Crowl
Date Mar '28
Map No. B-117
Planimeted by R. W. B.
Date JUL 11 1928

W. O. No. 4159 U. S. C. No.
Location Somerset Ave
Surveyed by M. Hayes
Date Jan. 26, 1928
Indexed A. C. Johnson

Notes ANY ADDITIONS OR CHANGES ON THIS SHEET MUST BE MADE OR CIRCLED IN Red. WITH DATE AND NAME OF PERSON MAKING CHANGE.

Do not extend notes this side of this line

RETURN TO LOS ANGELES COUNTY SURVEYOR

40' & 40'

25' O 164 25' O End orchard 12 Th. row F. 55

Alfalfa
41+92
4x6 T. Pole → O 26.8

(Proposed) Field

Fd 2x2 See Page 42+13.25

WASHBURN CROSSING ROAD

15' Oiled Surface

AVE

35.4 O 42+45.5

O 766

20.5 O 776

36.7 O 787

20.4 O 797

43

Field

SOMERSET

20.2 O 43+16

+57.4 Fence online

Old lattice & Wire Net Fence

1230

+78.3' Walnut

43+91.4 Cor barn

40.6

32.2

1½ Story Frame barn

42

44

CULTIVATED

42.4

End lattice fence 44 x 39 online

15

44+33

Dilapidated Corral

43

RETURN TO

LOS ANGELES COUNTY SURVEYOR

Notes: ANY ADDITIONS OR CHANGES ON THIS SHEET MUST BE MADE OR CIRCLED IN **Red.** WITH DATE AND NAME OF PERSON MAKING CHANGE.

Do not extend notes this side of this line

F.B. 302 PG. 102 Chief Party Notes by M.H. Date 1-26-28

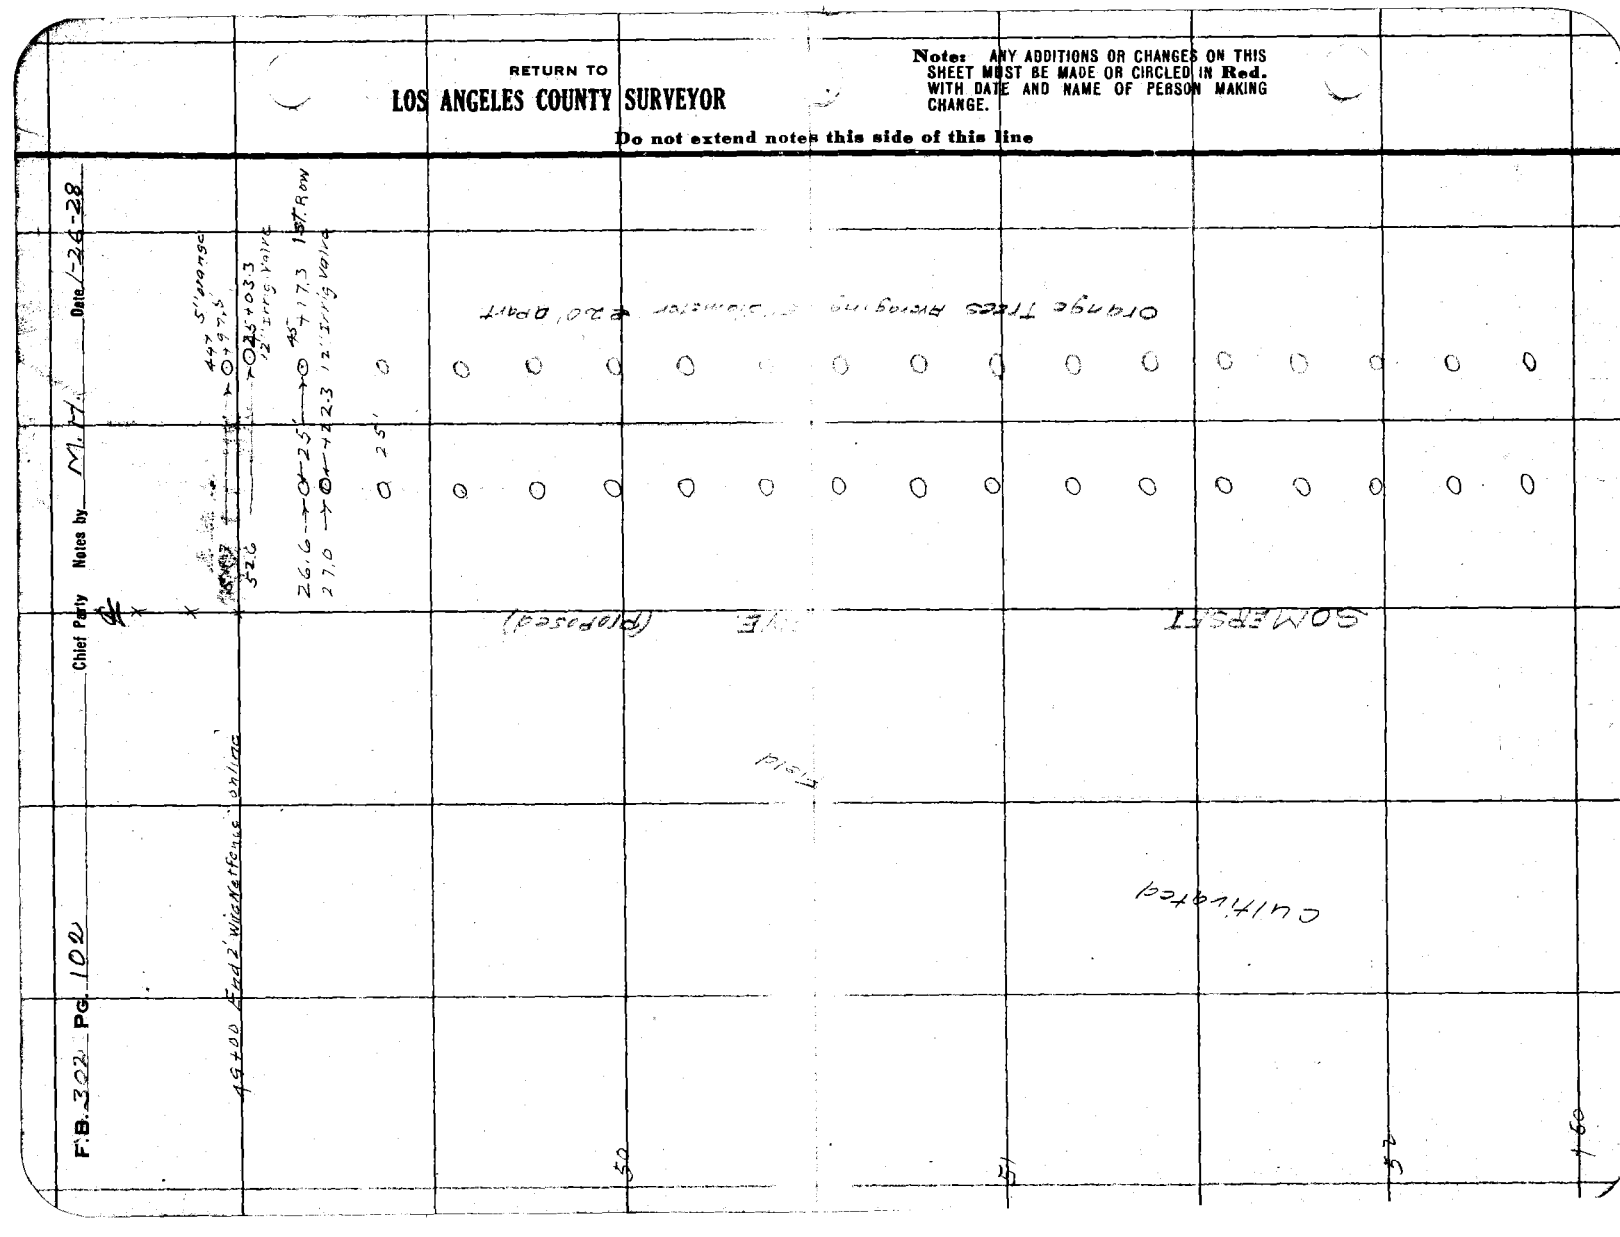

Date _____ Notes by _____ Chief Party _____ F. B. 302 Pg. 103

Platted by Crowl
Date Mar '28
Map No. B-117
Planimeter C'k'd by R. W. S.
Date JUL 11 1928

W. O. No. 4159 D. S. O. No. _____
Location Somerset Ave
Surveyed by M. Hayes
Date Jan. 26, 1927
Indexed A. C. Johnson

Notes: ANY ADDITIONS OR CHANGES ON THIS SHEET MUST BE MADE OR CIRCLED IN Red. WITH DATE AND NAME OF PERSON MAKING CHANGE.

RETURN TO
LOS ANGELES COUNTY SURVEYOR
Do not extend notes this side of this line

62+50

53

53+50

54

55+50

55

℄

(Proposed)

Field

SOMERSET AVE.

Cultivated

Averaging 5" diameter

Oranges Trees @ 20' apart

0 — 25 — 0

30.2 — 0 — 25.0 — 0 — 55 + 18.3 End Grove

— X — Barbwire — X — Fence — X — 55+37 On line of occupation — X — X —

10. → 55+52

89° 48'

89° 32'

F.B. 302 Pg. 104 M. Hayes Chief Party Notes by M.I.H. Date 1-26-28

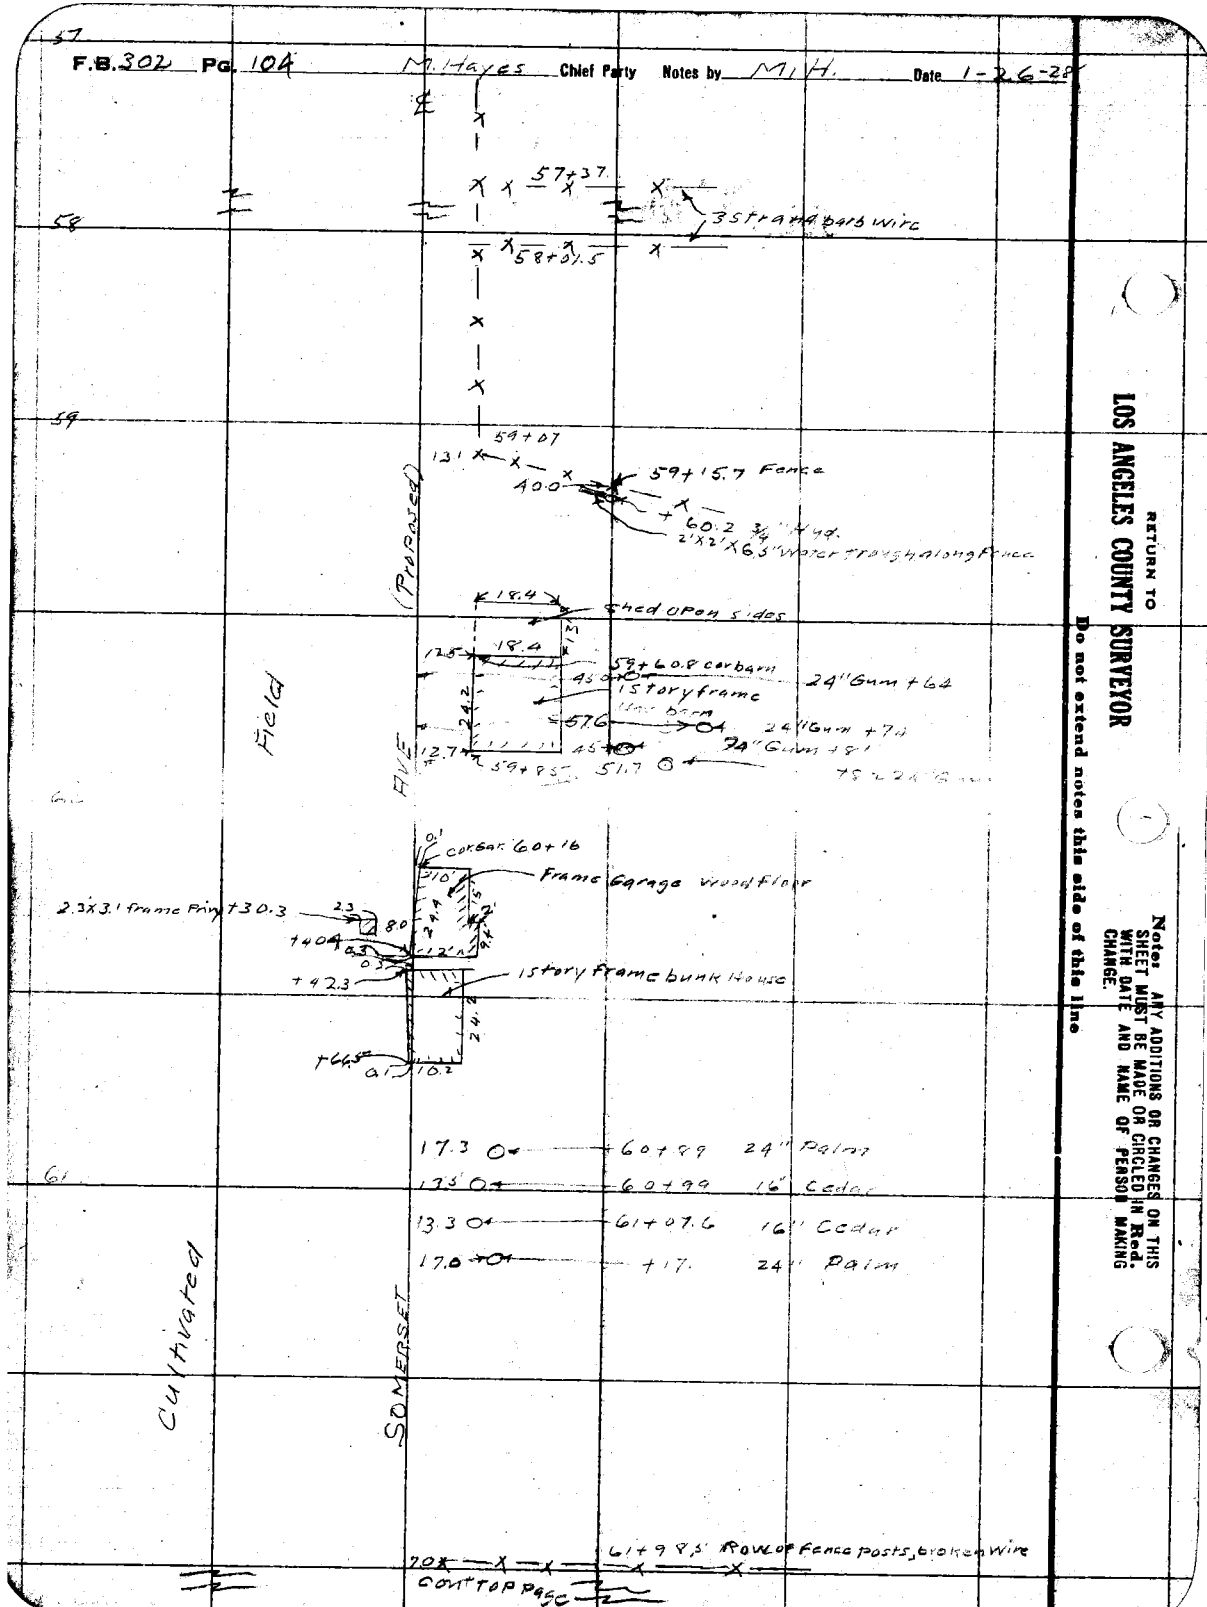

RETURN TO
LOS ANGELES COUNTY SURVEYOR

Do not extend notes this side of this line

Notes: ANY ADDITIONS OR CHANGES ON THIS SHEET MUST BE MADE OR CIRCLED IN Red. WITH DATE AND NAME OF PERSON MAKING CHANGE.

Date _____ Notes by _____ Chief Party _____ F. B. 302 PG. 105

Plotted by Crow
Date Mar '28
Map No. 3
Plotting C'k'd by R. W. S.
Date JUL 11 1928

W. O. No. 4157 U. S. C. No.
Location Somerset Ave
Surveyed by M. Hoyes
Date Jan. 27, 1928
Indexed A. C. Johnson

Notes: ANY ADDITIONS OR CHANGES ON THIS SHEET MUST BE MADE OR CIRCLED IN Red. WITH DATE AND NAME OF PERSON MAKING CHANGE.

Do not extend notes this side of this line

RETURN TO LOS ANGELES COUNTY SURVEYOR

40' 40' From Dot. Page

Cor. Gar. 67+30.3
2' 30.5
From C. Garage
30.8
4 Cor. House 67+56
50.5
10' 14' 1 story Frame Dwelling 30' 36' 24'
50.1 (Proposed)
6' Conc. Porch with Foot 67+21.4 to 67+14.4
Conc. Step 1'x6' 67+99 Gas Meter 3.0
11" Cypress 54.7
68+11.4
+31.7 Gas Meter 2.8 25.0 3.1
68+35.7 PP p/c
68+39.2 - 30" Willi Locust
15' Oiled ZINN
Fd 1 X 2 See Page 12 SURFACE 68+56.13 ROAD
4"x6" T Pole 68+80.3 30 0.2
Fence 783.6
19.7 68+87
FIVE
15' 69+53
Fence
Field
SOMERSET
±10' Wide Road Traveled
Alfalfa
Open

F.B. 302 PG. 106 M. Hayes Chief Party Notes by M.H. Date 1-27-28

From bot. Page

Barb Wire Fence + Road continuous to Sta. 69+63

80+84 3" Wild Locust

81 4" Wild Locust

81+45.5 4" " "

81+55 7" " "

81+80.8 Fence cor.

Fence

Field road

Road ± 10' wide

82+09 44" Elderberry Tree

Cultivated

FOSTER

Oiled

Fence cor. 82+07.26

ROAD

surface

SOMERSET

30.6

Peach

102+22.2 1st. Tree in R/W

Trees in orchard average 3" in diameter

Walnut

Peach

Walnut

OUT

RETURN TO
LOS ANGELES COUNTY SURVEYOR
Do not extend notes this side of this line

Notes: ANY ADDITIONS OR CHANGES ON THIS SHEET MUST BE MADE OR CIRCLED IN Red. * WITH DATE AND NAME OF PERSON MAKING CHANGE.

Date _____ Notes by M.H. Chief Party _____ F. B. 302 Pg. 107

Platted by Beebee
Date Mar 28
Map No. _____
Platting C'k'd by R. W. S.
Date JUL 11 1928

W. O. No. 4159 C. S. O. No. _____
Location Somerset Ave
Surveyed by M. Hayes
Date Jan 27, 1928
Indexed A. C. Johnson

Notes ANY ADDITIONS OR CHANGES ON THIS SHEET MUST BE MADE OR CIRCLED IN RED WITH DATE AND NAME OF PERSON MAKING CHANGE.

RETURN TO LOS ANGELES COUNTY SURVEYOR

Do not extend notes this side of this line

℄

40' 40'

SOMERSET AVE. (Proposed)

0 Walnut

out

0

0

0

out

0

out

0

0

0

0

0 Peach

Alternate Peach + Walnut Trees in 30' Squares

F.B. 302 Pg. 108 Chief Party Notes by M.H Date 1-22-58

40' ℄ 40'

O Walnut

O Peach

O Walnut

O Peach

1084+24 AA 1st row

+29

+32.

+36.

8' Gum Trees

Out

752.0 1st tree 1st row

754.0 1st tree 2nd row

Alternate Peach Tree Line 3 Spaces

Existing Peach Trees

Proposed

SOMERSET

Barb Wire Fence

2° 46'

2' Straight 1084+28.80

31.5

107+50

105

100

110

111

RETURN TO
LOS ANGELES COUNTY SURVEYOR

Do not extend notes this side of this line

Note: ANY ADDITIONS OR CHANGES ON THIS SHEET MUST BE MADE OR CIRCLED IN Red. WITH DATE AND NAME OF PERSON MAKING CHANGE.

Date _____ Notes by _____ Chief Party _____ F. B. 302 PG 109

Plotted By Peebee
Date Mar '28
Map No. C. 1.17
Plotting Checked By R. W. S.
Date JUL 11 1928

W. O. No. 4159 D. S. B. No.
Location Somerset Ave
Surveyed by M. Hayes
Date Jan. 27 1925
Indexed A. C. Johnson

Note: ANY ADDITIONS OR CHANGES ON THIS SHEET MUST BE MADE OR CIRCLED IN Red. WITH DATE AND NAME OF PERSON MAKING CHANGE.

Do not extend notes this side of this line

RETURN TO
LOS ANGELES COUNTY SURVEYOR

1+44 1+72 1+77 1+77+50

40' 40'

70
71
141

111+56.3
48" Sycamore

111+54 breakin 2nd row 71st tree
111+68 " 1st row 70th tree
111+82.5 1st tree 2nd row
111+99 1st tree 2nd row

SOMERSET AVE (PROPOSED)

Alternate Peach & Walnut trees in 30' Parkway

RETURN TO
LOS ANGELES COUNTY SURVEYOR

Note: ANY ADDITIONS OR CHANGES ON THIS SHEET MUST BE MADE OR CIRCLED IN Red. WITH DATE AND NAME OF PERSON MAKING CHANGE.

Do not extend notes this side of this line

F.B. 302 Pg. 110 Chief Party Notes by MJH Date 1-27-28

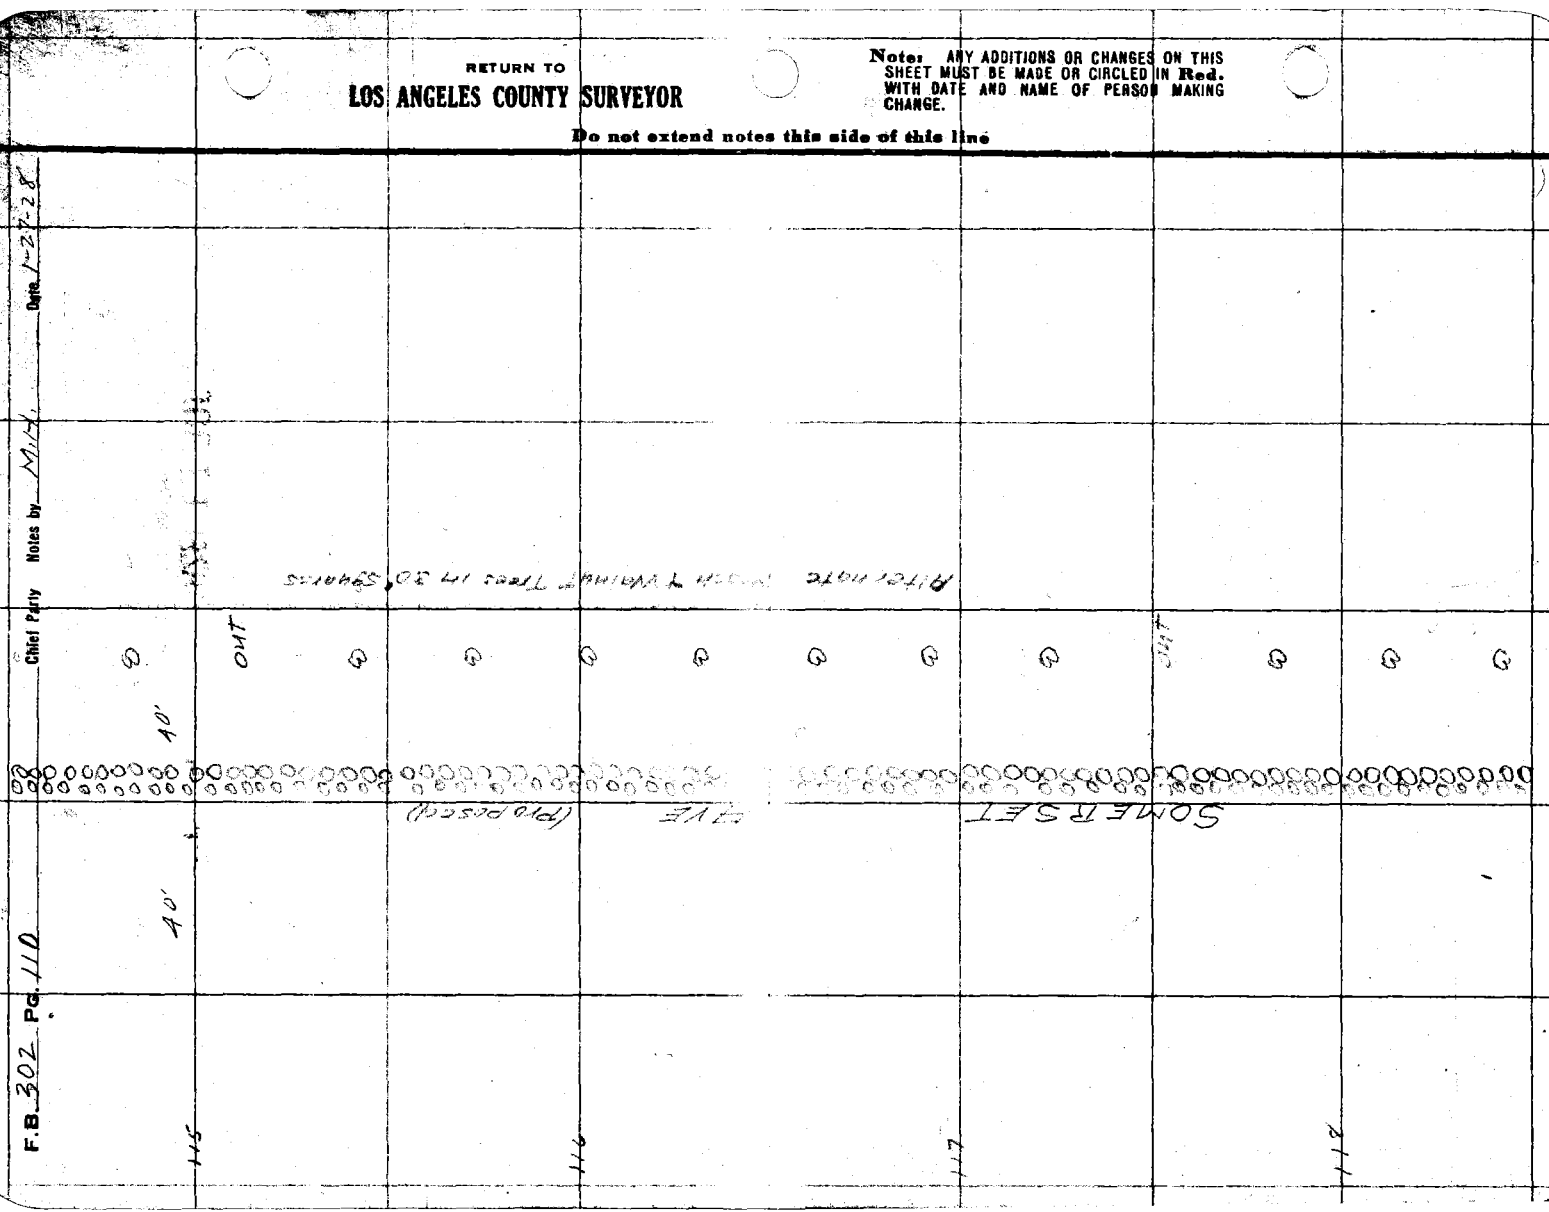

Date _____ Notes by M.H. Chief Party M. Hayes F. B. 302 PG 111

Plotted By Reeder
Date Mar '28
Map No. B-117
Plotting Checked by W. W. S.
Date JUN 1 1 1928

W. O. No. 4159 C. S. O. No. _____
Location Somerset Ave
Surveyed by M. Hayes
Date Jan. 27, 1928
Indexed A. C. Johnson

Notes: ANY ADDITIONS OR CHANGES OF THIS SHEET MUST BE MADE OR CIRCLED IN Red. WITH DATE AND NAME OF PERSON MAKING CHANGE.

RETURN TO LOS ANGELES COUNTY SURVEYOR
Do not extend notes this side of this line

40'

40'

179
197
376
141
517
42
4

Total 563 Gum Trees

Walnut

(Proposed)

Ave.

76° 55'

119+89 19 th tree in 1st row

Out

32

Field road

120+11.9

120+15.0 19 7th tree 2nd row

+31.5

120+22.0 6 15th tree in Orchard

Peach

SOMERSET

5.5' +49.2 on W. side Trees

6.5' +55 8" Gum

+69
+66
+70.5'
+73
+77
+80
+82.3
+84.4
+90.
+94.3
+95.0
+99.6

Irregular group Average 9" Gums

121+03 Begin double row

121+03

P.I. Apt F42 "T.P. See Page 121+49.05

13-10" Gums
11-10" Gums

121+34 End rows

121+46 10" Gum

121+49.0 on Fence

148 — 04½" Gum
— 29' —
40.6 33'

8" Gum
16" Gum
18" Gum

F.B. 302 Pg. 112 M.Hayes Chief Party Notes by M.H. Date 1-31-28

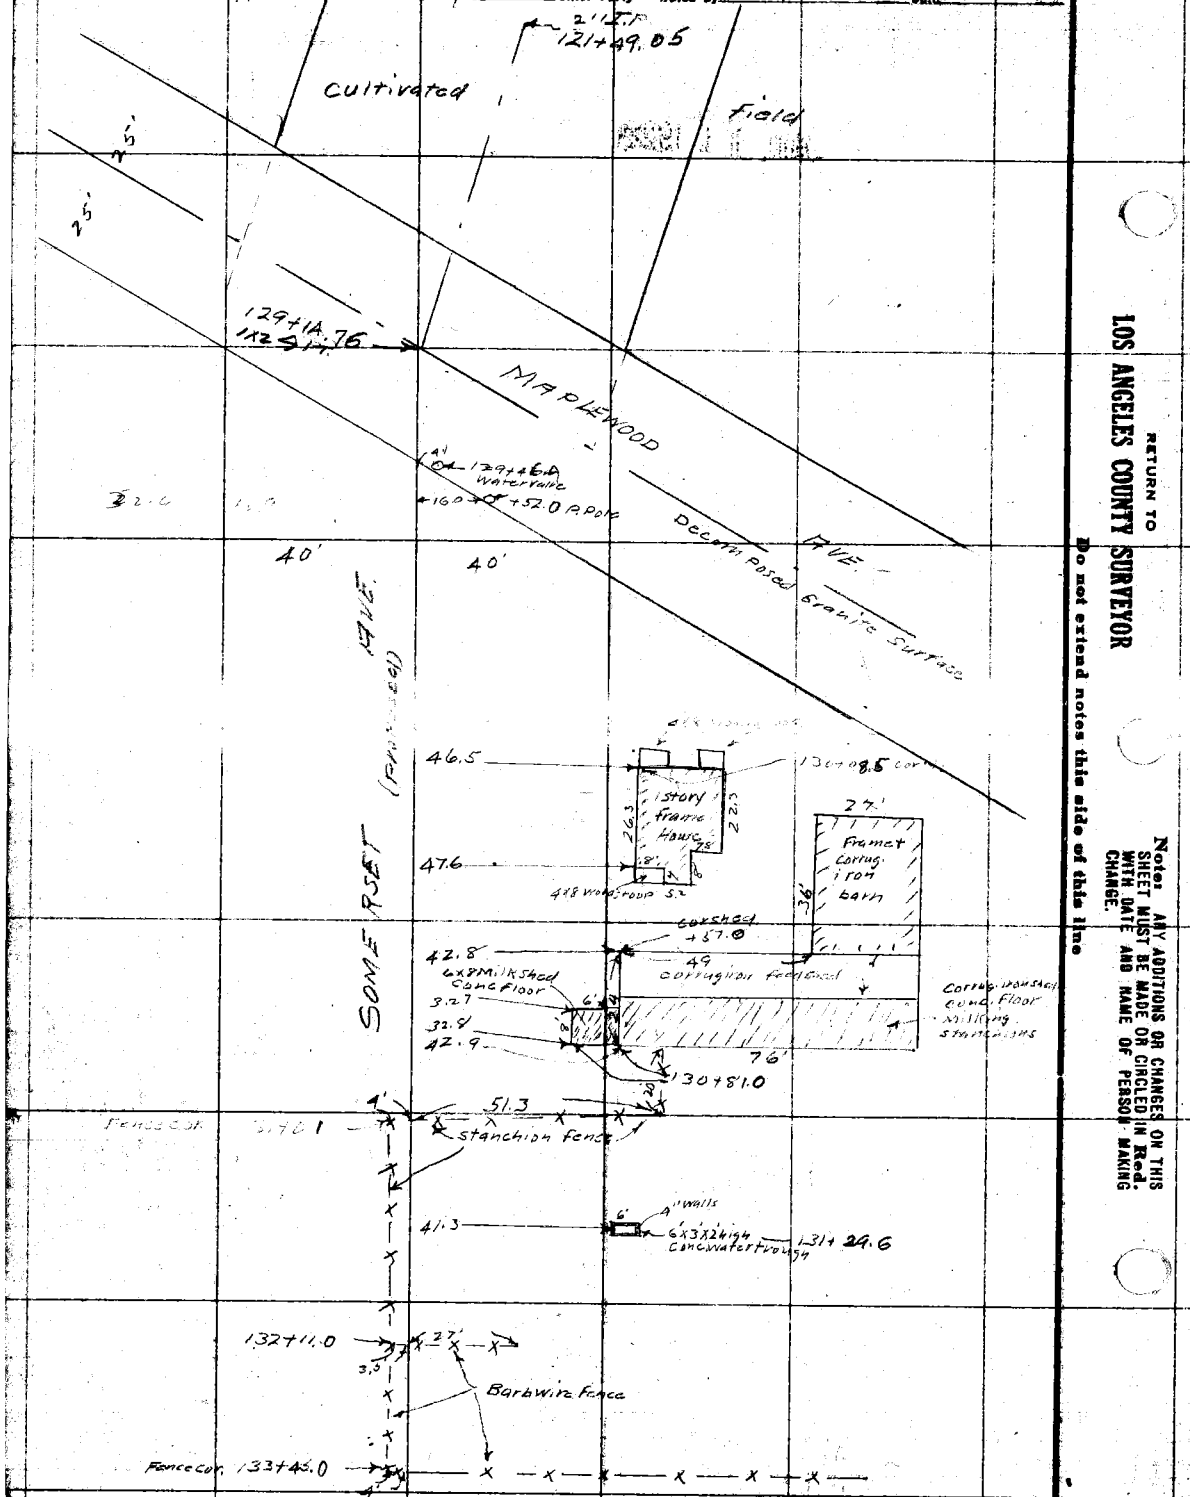

To Top Page 113

RETURN TO
LOS ANGELES COUNTY SURVEYOR

Do not extend notes this side of this line

Note: ANY ADDITIONS OR CHANGES ON THIS SHEET MUST BE MADE OR CIRCLED IN Red. WITH DATE AND NAME OF PERSON MAKING CHANGE.

Date _____ Notes by _____ Chief Party _____ F. B. 302 PG. 113

Plotted by Dawson
Date Mar '28
Map No. R. 1.17
Plotting C'k'd by R. W. S.
Date JUL 11 1928

W. O. No. 4157 U. S. C. No.
Location Somerset Ave
Surveyed by M. Hayes
Date Jan 31, 1928
Indexed A. C. Johnson

Notes: ANY ADDITIONS OR CHANGES ON THIS SHEET MUST BE MADE OR CIRCLED IN Red. WITH DATE AND NAME OF PERSON MAKING CHANGE.

Do not extend notes this side of this line

RETURN TO LOS ANGELES COUNTY SURVEYOR

from bot. Page 112

Dearman 142766.0 — 35.1 — 26 Ex AXA St. Sign + 69.0

P. Pole 142702 — 19.6 — C.S.P.K in P'ment 142798.27

WASHINGTON — 20' Conc. Pavement — ST — 2' oil Macadam

69.8' — 64.3

2' oil Macadam — 2' oil Macadam

143+38.1 8" Apple — 25.1 — 31.7 — 35.4 — 34.9 — 39.9

143+29.0 P. Pole — +30.0 36" Gum Stump — +31.4 Dearman — +39. 1st tree Average 8" Apple row

AM. +54.8 Dearman — 19.6 — 26.3 — +19.0 — FIVE

+59 — 20' — 3" Peach — 8" Apple — E.C. Conc. +68.3

+77.2 P. Pole — 19.7 — 27.2 — +80 — 20' — 4" Peach

End Macad. 143+84

+68.4 Fence Cor. — +63.5 2nd row — +85.3 3rd row

144+09.0 4th row

144 +40.6 7" Pear — 30.5 — SOMERSET

+31.8 5th row

+53.5 6th row

+60.3 — 7" Apples — 19.5 — 31.0

+77.3 — 8" Quince — 20' — 6" Apple — 31.2

+77.0 7th row

39.1 — 145+00 8th row

40' — 40' — Proposed

145+28 — 30.8

+48 P.P. — 19.8

7.0' — 70' — +77 — 19.4

+72.2

146+02 — 33.3

F.B. 302 Pg 14 M. Hayes Chief Party Notes by M. H. Date 2-4-28

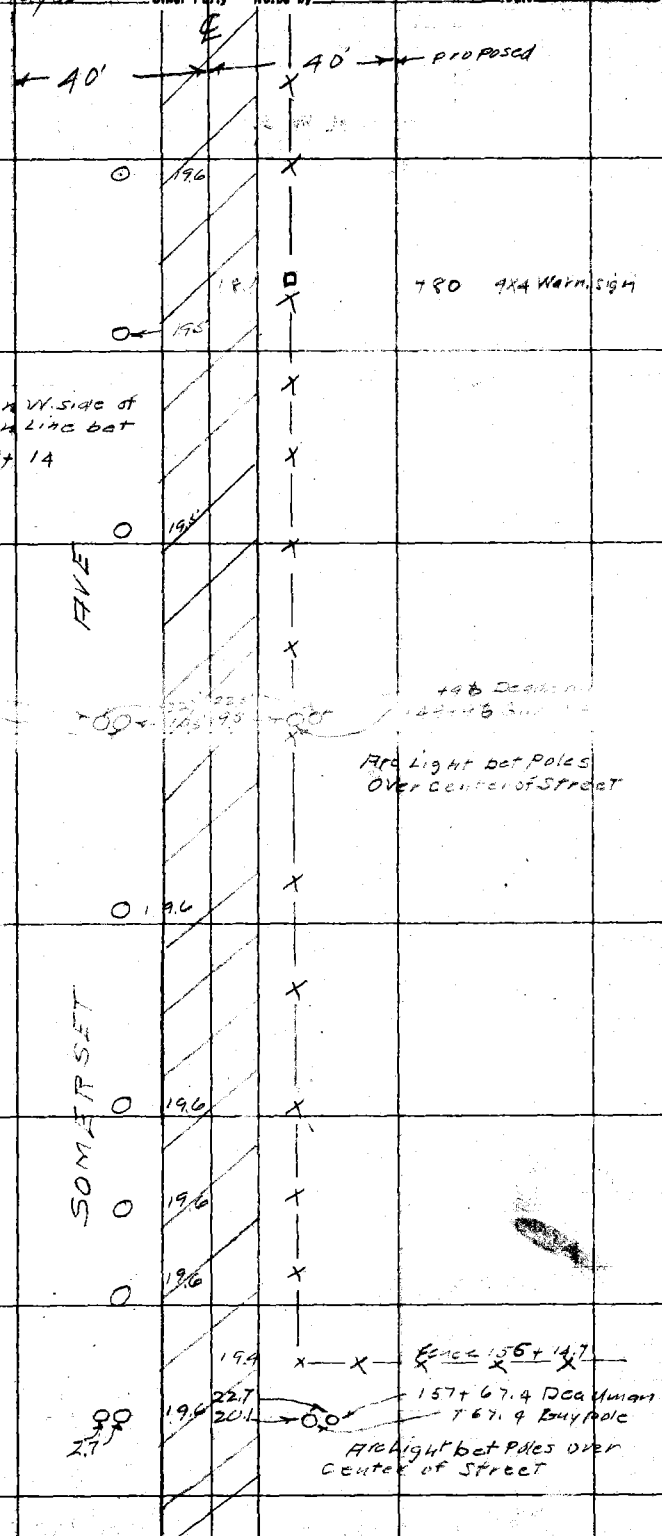

RETURN TO
LOS ANGELES COUNTY SURVEYOR
Do not extend notes this side of this line

Note: ANY ADDITIONS OR CHANGES ON THIS SHEET MUST BE MADE OR CIRCLED IN Red. WITH DATE AND NAME OF PERSON MAKING CHANGE.

Date _____ Notes by M.H. Chief Party M.Hayes F. B. 302 Pg. 116

Plotted by Beebee
Date Mar 28
Map No. B-117
Plotting C'k'd by R. W. S.
Date JUL 11 1928

W. O. No. 4159 U. S. O. No. _____
Location Somerset Ave
Surveyed by M. Hayes
Date Feb 11 1928
Indexed A. C. Johnson

Note: ANY ADDITIONS OR CHANGES ON THIS SHEET MUST BE MADE OR CIRCLED IN Red. WITH DATE AND NAME OF PERSON MAKING CHANGE.

RETURN TO LOS ANGELES COUNTY SURVEYOR

Do not extend notes this side of this line

P. Pole 154+46 O
40'
40'
proposed
R. Pole 160+65 O
Alley
R. Pole 162+15 O
Deadman +643
P. Pole 163+69.3
3'
226
19.7
+643 Deadman
163+64.3 Guy Pole
Arc Light bet Poles over center of Street
P. Pole 166+14
Fence 165+18
41.1
5" Peach 165+51
43.2
5" Apple +71
43.2
6" Apple +91
43.1
4 X 4 Warning sign)
166+43.3
Fence
166+44.7
42.2
18.8
P. Pole 166+64.3
SOMERSET

F.B. 302 Pg. 116 M. Hayes Chief Party Notes by M.H Date 2-1-28

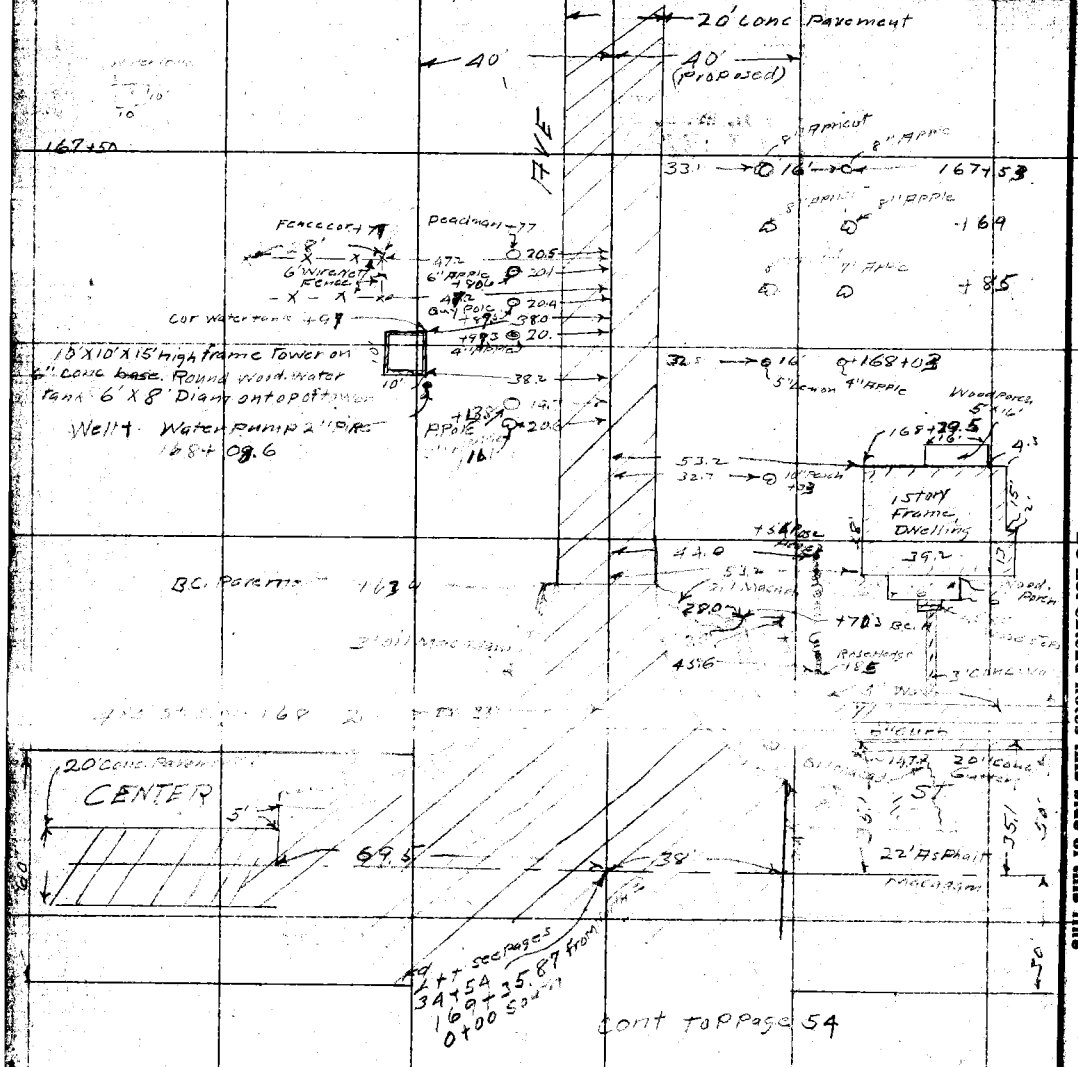

RETURN TO
LOS ANGELES COUNTY SURVEYOR
Do not extend notes this side of this line

Note: ANY ADDITIONS OR CHANGES ON THIS SHEET MUST BE MADE OR CIRCLED IN Red: WITH DATE AND NAME OF PERSON MAKING CHANGE.

Date _____ Notes by _____ Chief Party _____ F. B. 302 Pg. 117

Plotted by Crowl
Date Apr '28
Map No. 5117
Plotting C'k'd by R. W. S.
Date JUL 11 1928

W. O. No. _____ C. S. O. No. _____
Location Somerset Ave
Surveyed by M. Hayes
Date Apr 2 1928
Indexed A. C. Johnson

M. Hayes
E. E. Carlson
B. O'Mackin'el
H. W. Anderson

Notes: ANY ADDITIONS OR CHANGES ON THIS SHEET, MUST BE MADE OR CIRCLED IN Red. WITH DATE AND NAME OF PERSON MAKING CHANGE.

Do not extend notes this side of this line

RETURN TO LOS ANGELES COUNTY SURVEYOR

TO L.T.P. Artesia Ave
See Pages

179°

Center Line Data to Spring st herein.

For topo. notes See F.B. 289-3:10

2X2 in So. Line Somerset Aves
See Pages 49251

179-55 45E
359-43-00 (4)

No. Line

Note: Band tape #022 Standard with 22 lbs. tension at 84° F used from North Line Montana Land Co. to Spring St.

Montana Land Co

Note: Survey thru property of Montana Land Co. is new alignment and by agreement with them to be used for vacating and re-deeding

SOMERSET AVE

3172.08

5284.16

3172.29 T = 74° =

3172.08.

Fd Round 6" conc Mon. N.E. Cor South st & New York Ave

90° 05'

(Calc)

40'

SOUTH

Fd 6" Diam conc Mon with Sxt

San Antonio Dr.

See F.B. ~~[illegible]~~ 345-18

.05

.04

ST.

Fd conc Mon See page

30'

ser nail

ser nail by lead in conc. Mon. .04 S'ly & .03 E'ly.

30'

20°

05'

40'

89° 54'

Fd Round 6" conc Mon S. Cor. South st & New York Ave

5284.50 T = 74° = 5284.16

89° 54' 19"

359 37 15 (4)

To 2X2 at Apex See Page 119

RETURN TO

LOS ANGELES COUNTY SURVEYOR

Note: ANY ADDITIONS OR CHANGES ON THIS SHEET MUST BE MADE OR CIRCLED IN **Red.** WITH DATE AND NAME OF PERSON MAKING CHANGE.

Do not extend notes this side of this line

F.B. 302 Pg. 118 Chief Party Notes By M.W.H. Date 1-3-27

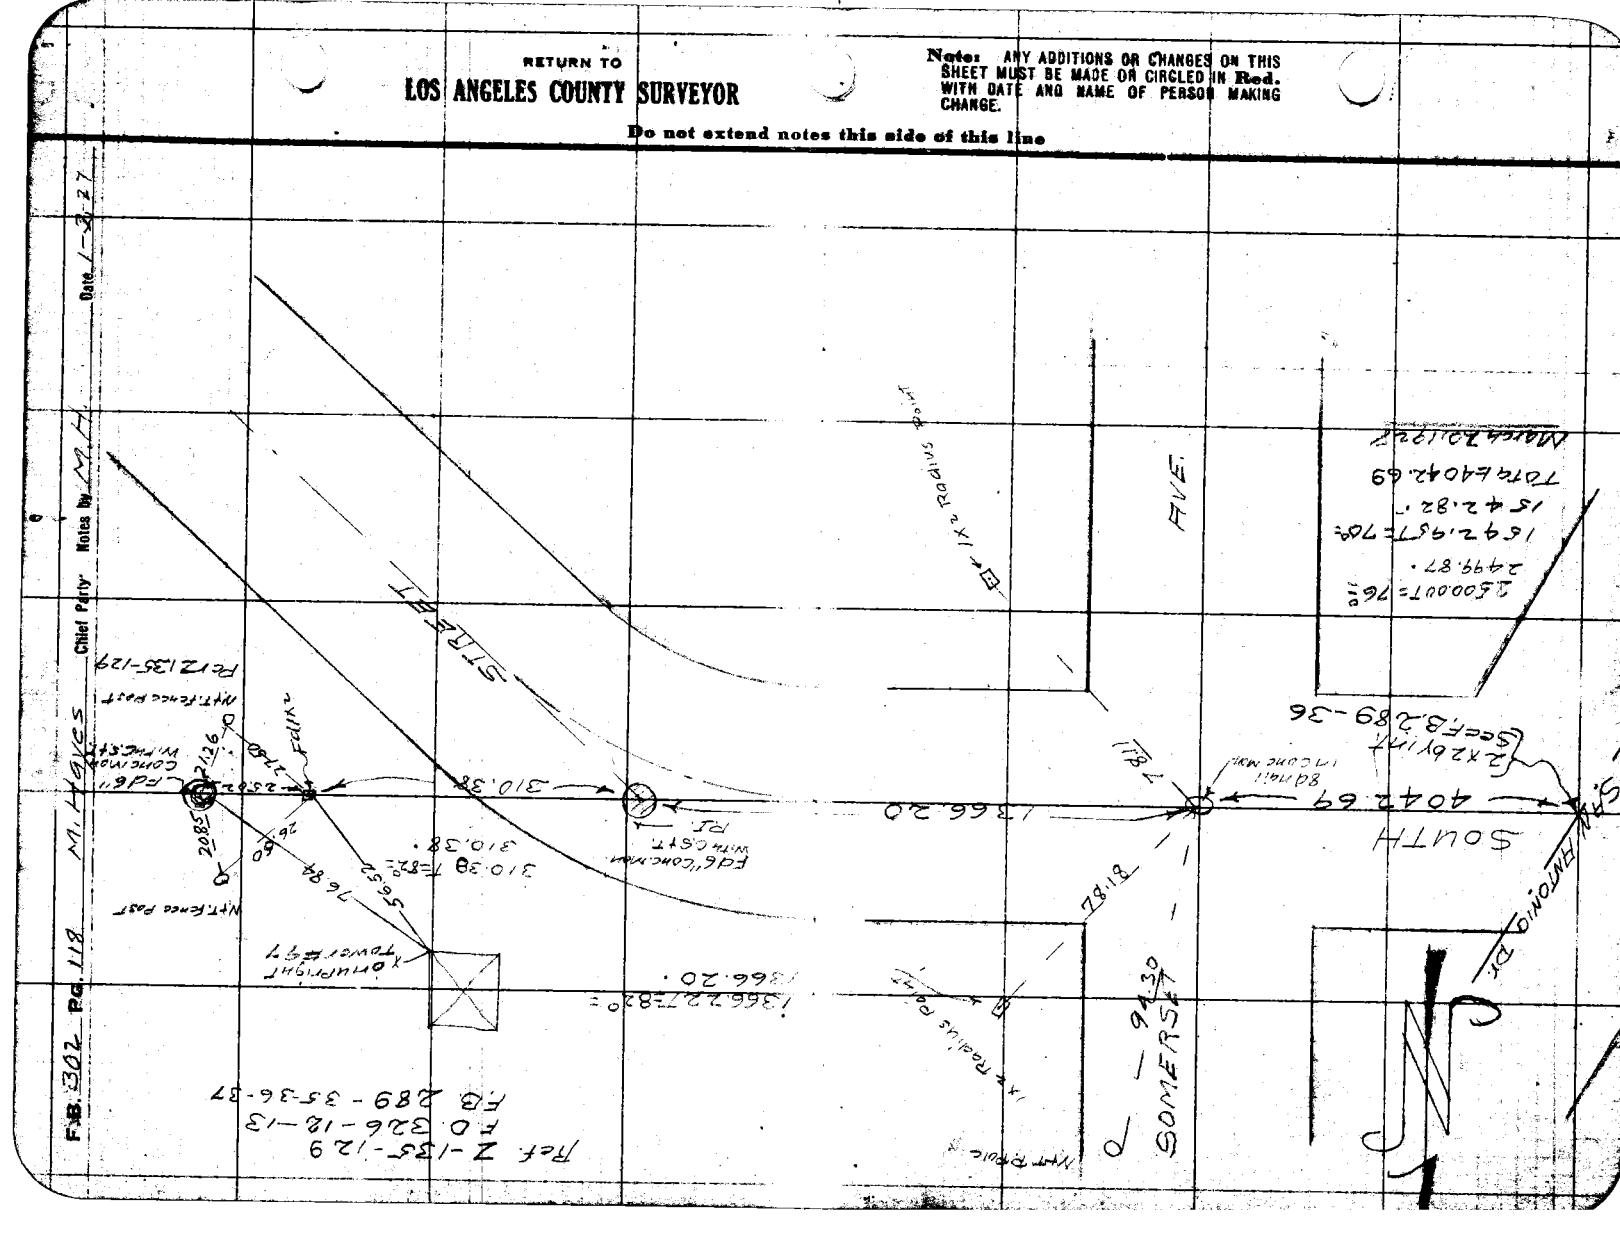
SOUTH
SAN ANTONIO DR.
SOMERSET
STREET
AVE.
1366.20
4042.69
Ref. Z-135-129
FD. 326-12-13
FB. 289-35-36-37
Ref 135-129
Set F.B. 289-36
Matches 70.12'E
Total 4042.69
1642.98 T=76°
1499.87
Δ 50000' = 76°

Date _____ Notes by _____ Chief Party _____ F. B. 302 Pg. 118

Platted by Crowl
Date Apr '28
Map No. _____
Platting C'k'd by _____
Date _____

W. O. No. 4157 C. S. O. No. _____
Location Somerset Ave
Surveyed by M. Hayes
Date Feb 3, 1928
Indexed A. C. Johnson

From Leftside Page 118

SOUTH - - - STREET

Notes: ANY ADDITIONS OR CHANGES ON THIS SHEET MUST BE MADE OR CIRCLED IN Red. WITH DATE AND NAME OF PERSON MAKING CHANGE.

Do not extend notes this side of this line

RETURN TO LOS ANGELES COUNTY SURVEYOR

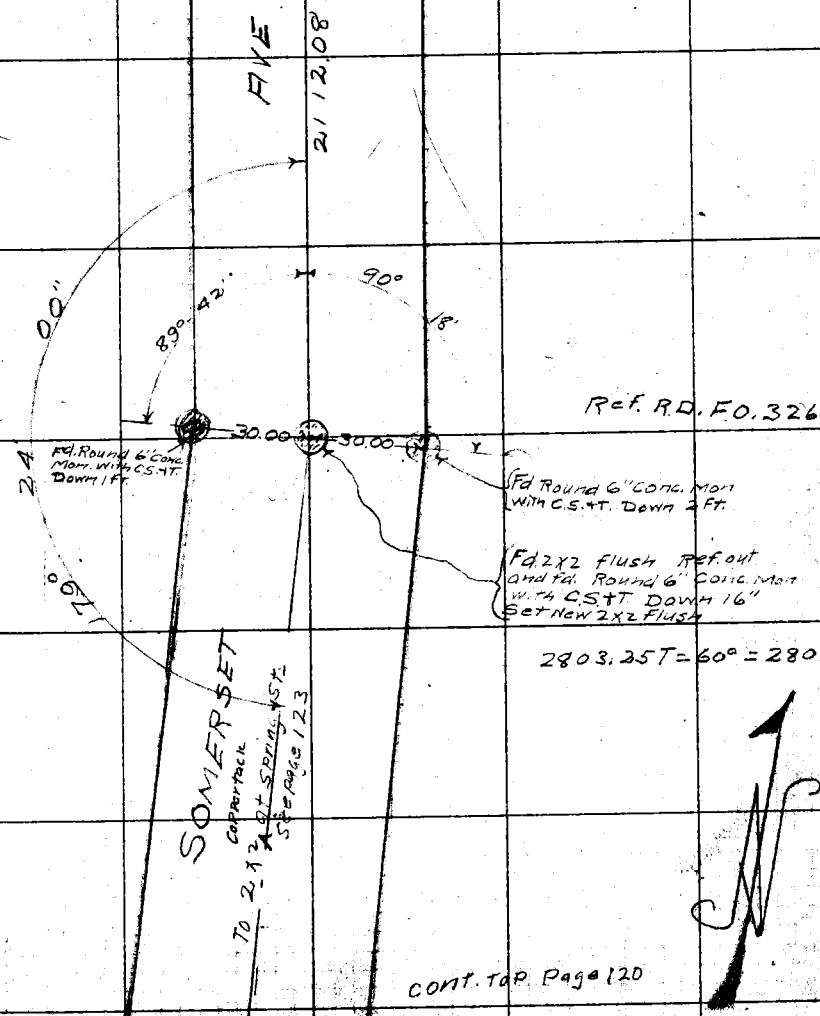

F.B. 302 Pg. 120

Chief Party Notes by:

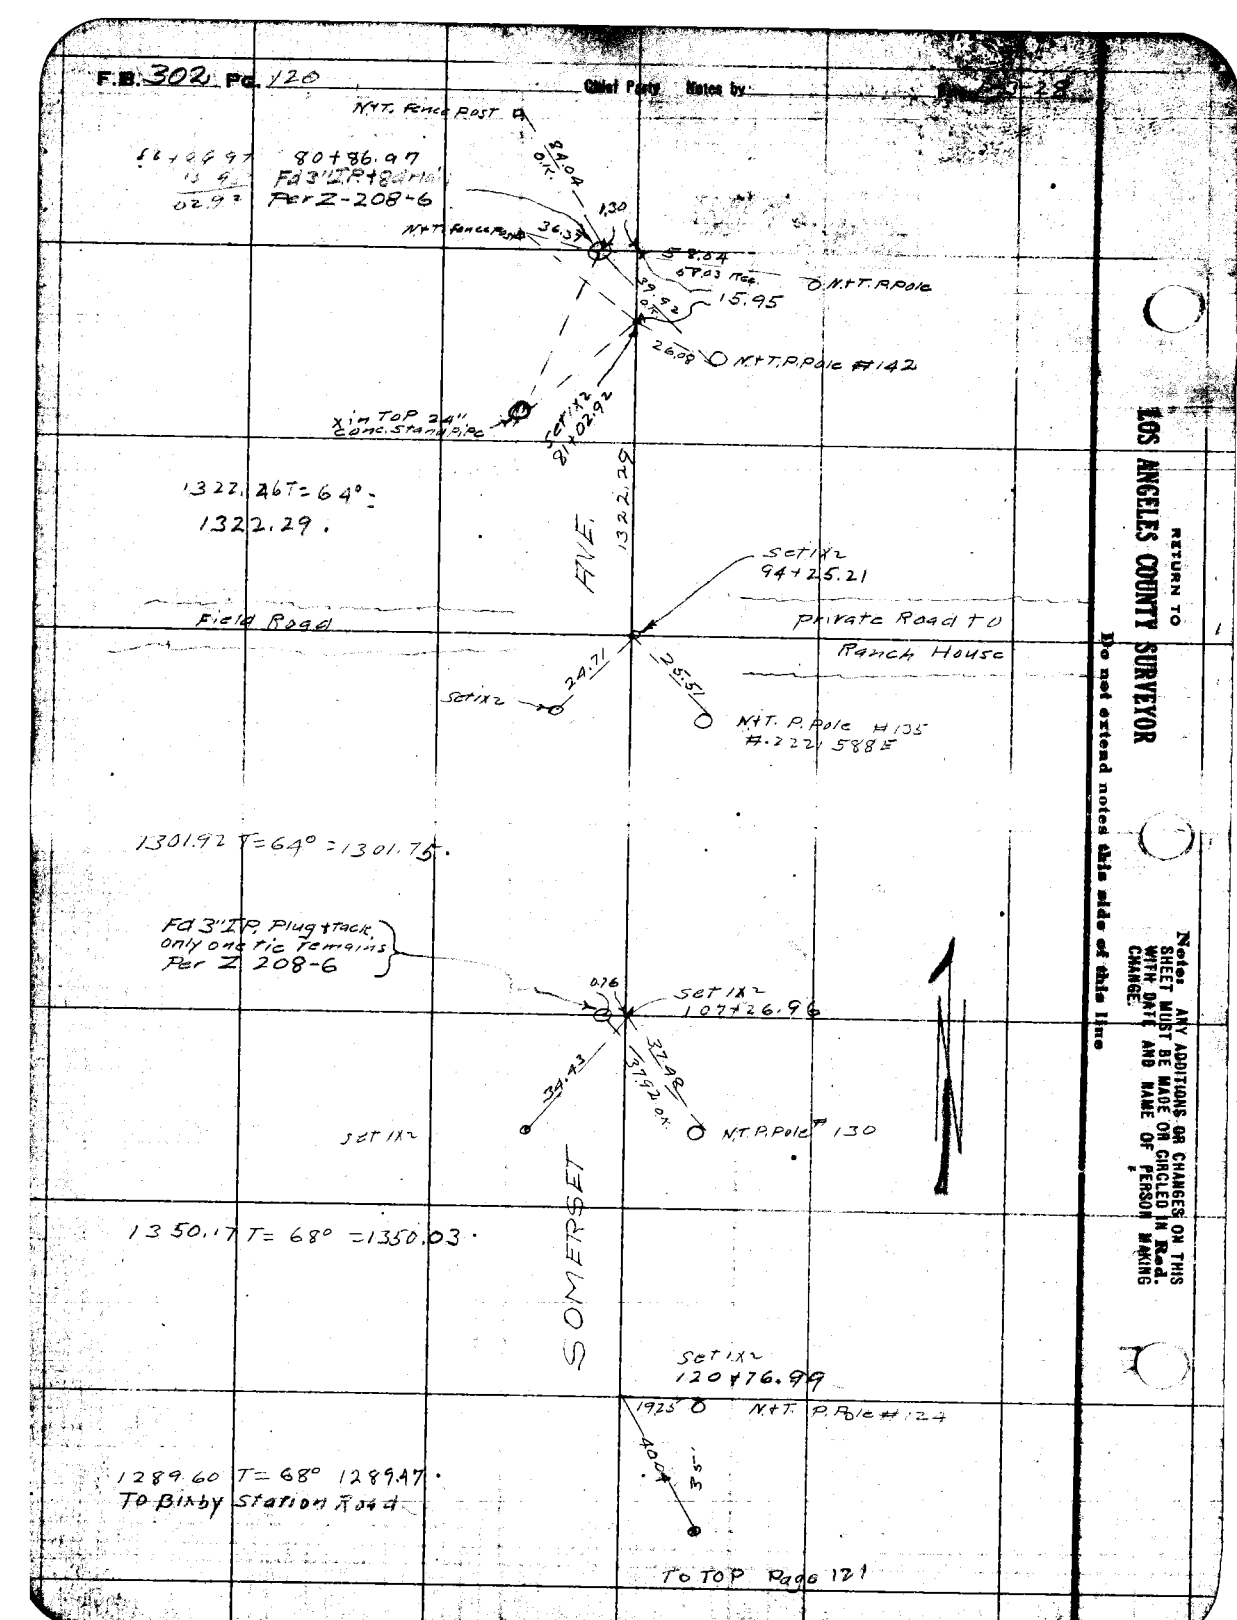

RETURN TO
LOS ANGELES COUNTY SURVEYOR
Do not extend notes this side of this line

Note: ANY ADDITIONS OR CHANGES ON THIS SHEET MUST BE MADE OR CIRCLED IN Red. WITH DATE AND NAME OF PERSON MAKING CHANGE.

Date _____ Notes by _____ Chief Party _____ F. B. 302 Pg. 124

Plotted by Crowl
Date Apr '28
Map No. _____
Plotting Checked by W. S.
Date JUL 1 1928

W. O. No. 4197 U. S. G. No. _____
Location Somerset Ave.
Surveyed by M. Hayes
Date Feb 6 1928
Indexed A. C. Johnson

Notes: ANY ADDITIONS OR CHANGES OR THIS SHEET MUST BE MADE OR CIRCLED IN Red. WITH DATE AND NAME OF PERSON MAKING CHANGE.

Do not extend notes this side of this line

RETURN TO LOS ANGELES COUNTY SURVEYOR

1289.60 T=68°=1289.47
From 1x2 Page 120

Set C.S. Mon
See Page 124 A
for New ties

.03 Wly.
Fd. 2x2 at Surface
Ref. Out 4 ang Fd. 4x4
3 Nail in 6" casing
Down 1 Ft.
Reset 2x2

Fd. N+T. Guy Pole

Ties Per F.R. 285-17

BIXBY STATION

See Pages 124+125

Fd. N+T. S9 Tel. Pole

Fd. N+T. P. Pole

ROAD

See Page 124

133+66.46

1328.81 T=64°=1328.63

AVE.

N. 4 Ts in fence Posts

146+95.10

1313.23 T=62°=1313.04

SOMERSET

90°

40' Long & Private Road

160+08.18

N+T. Guy Pole

F.B. 302 Pg. 122 — Chief Party — Notes by — Date 1-2-28

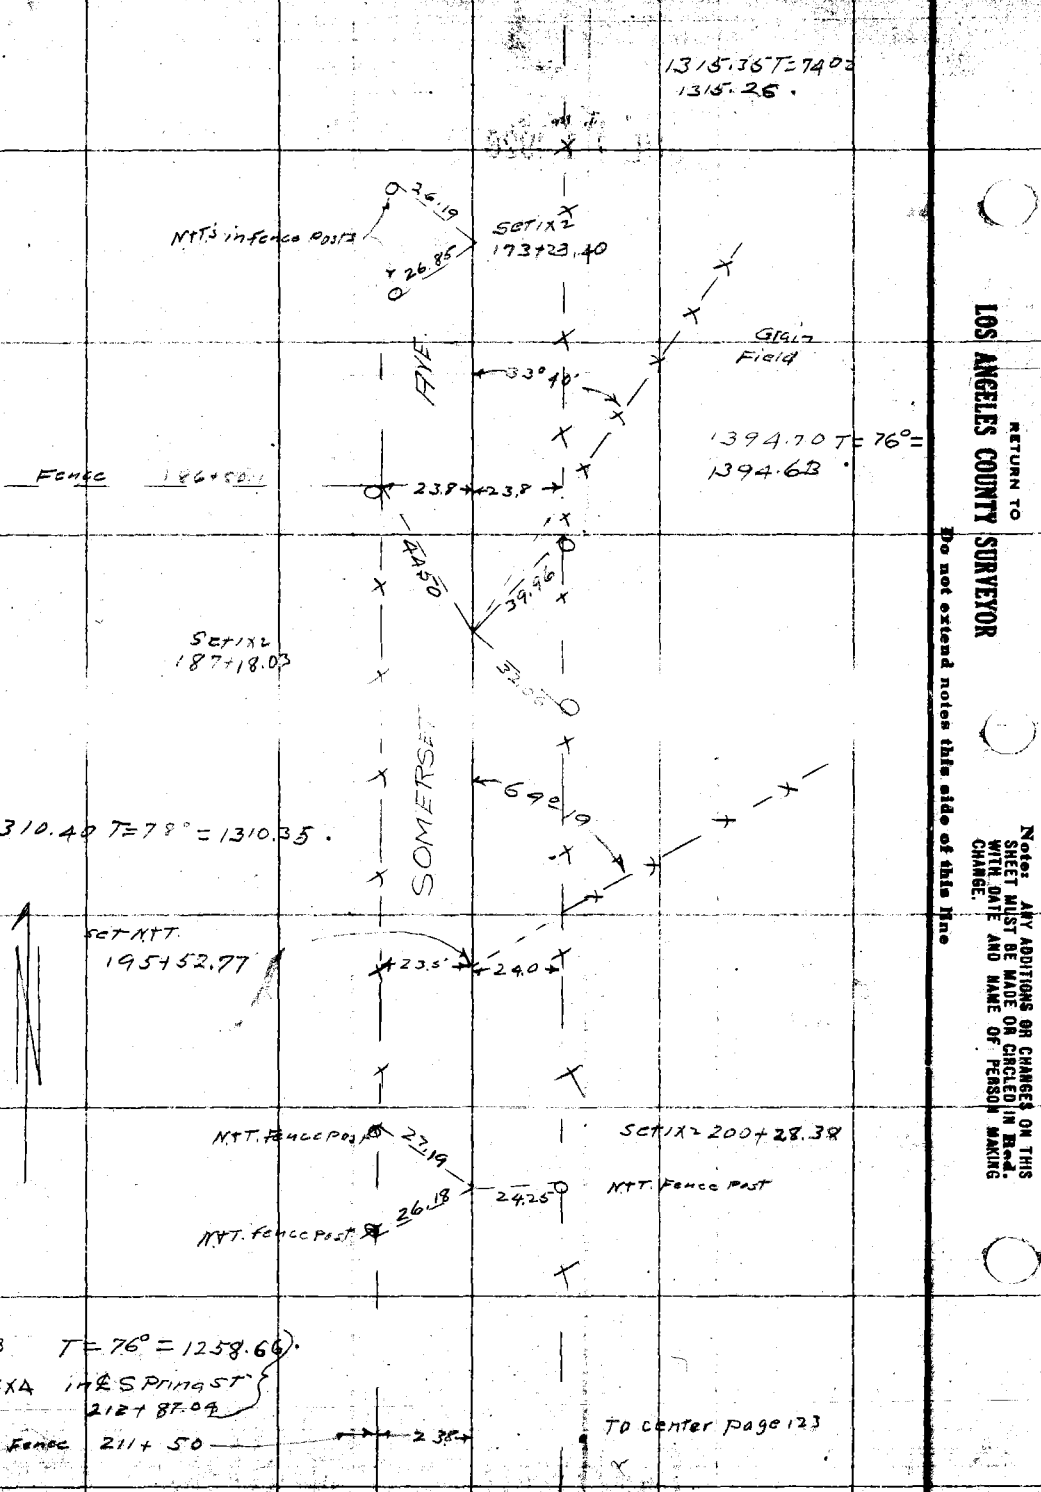

RETURN TO
LOS ANGELES COUNTY SURVEYOR
Do not extend notes this side of this line

Notes: ANY ADDITIONS OR CHANGES ON THIS SHEET MUST BE MADE OR CIRCLED IN Red. WITH DATE AND NAME OF PERSON MAKING CHANGE.

RETURN TO

LOS ANGELES COUNTY SURVEYOR

Notes: ANY ADDITIONS OR CHANGES ON THIS SHEET MUST BE MADE OR CIRCLED IN Red. WITH DATE AND NAME OF PERSON MAKING CHANGE.

Do not extend notes this side of this line

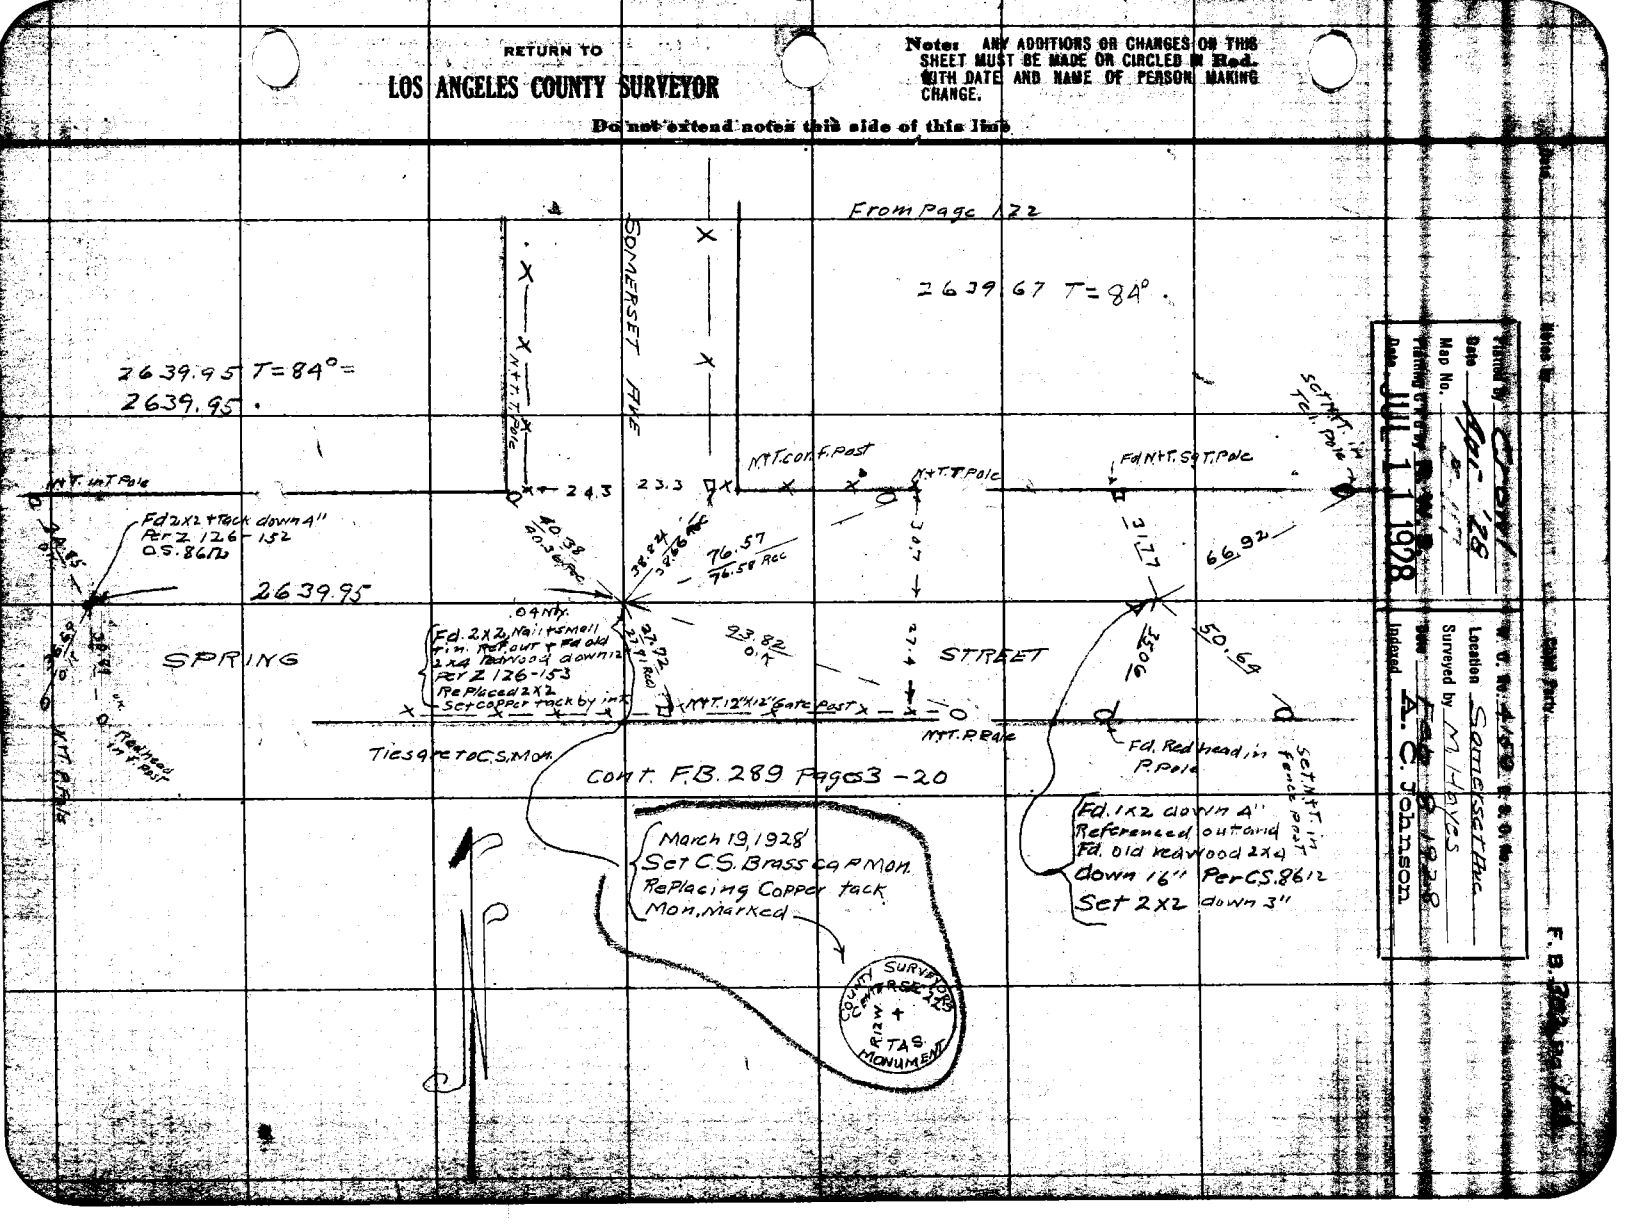











Drawn by

Checked by

Revised by

F. B. Book Page

RETURN TO

LOS ANGELES COUNTY SURVEYOR

Notes ANY ADDITIONS OR CHANGES ON THIS SHEET MUST BE MADE OR CIRCLED IN **Red.** WITH DATE AND NAME OF PERSON MAKING CHANGE.

Do not extend notes this side of this line

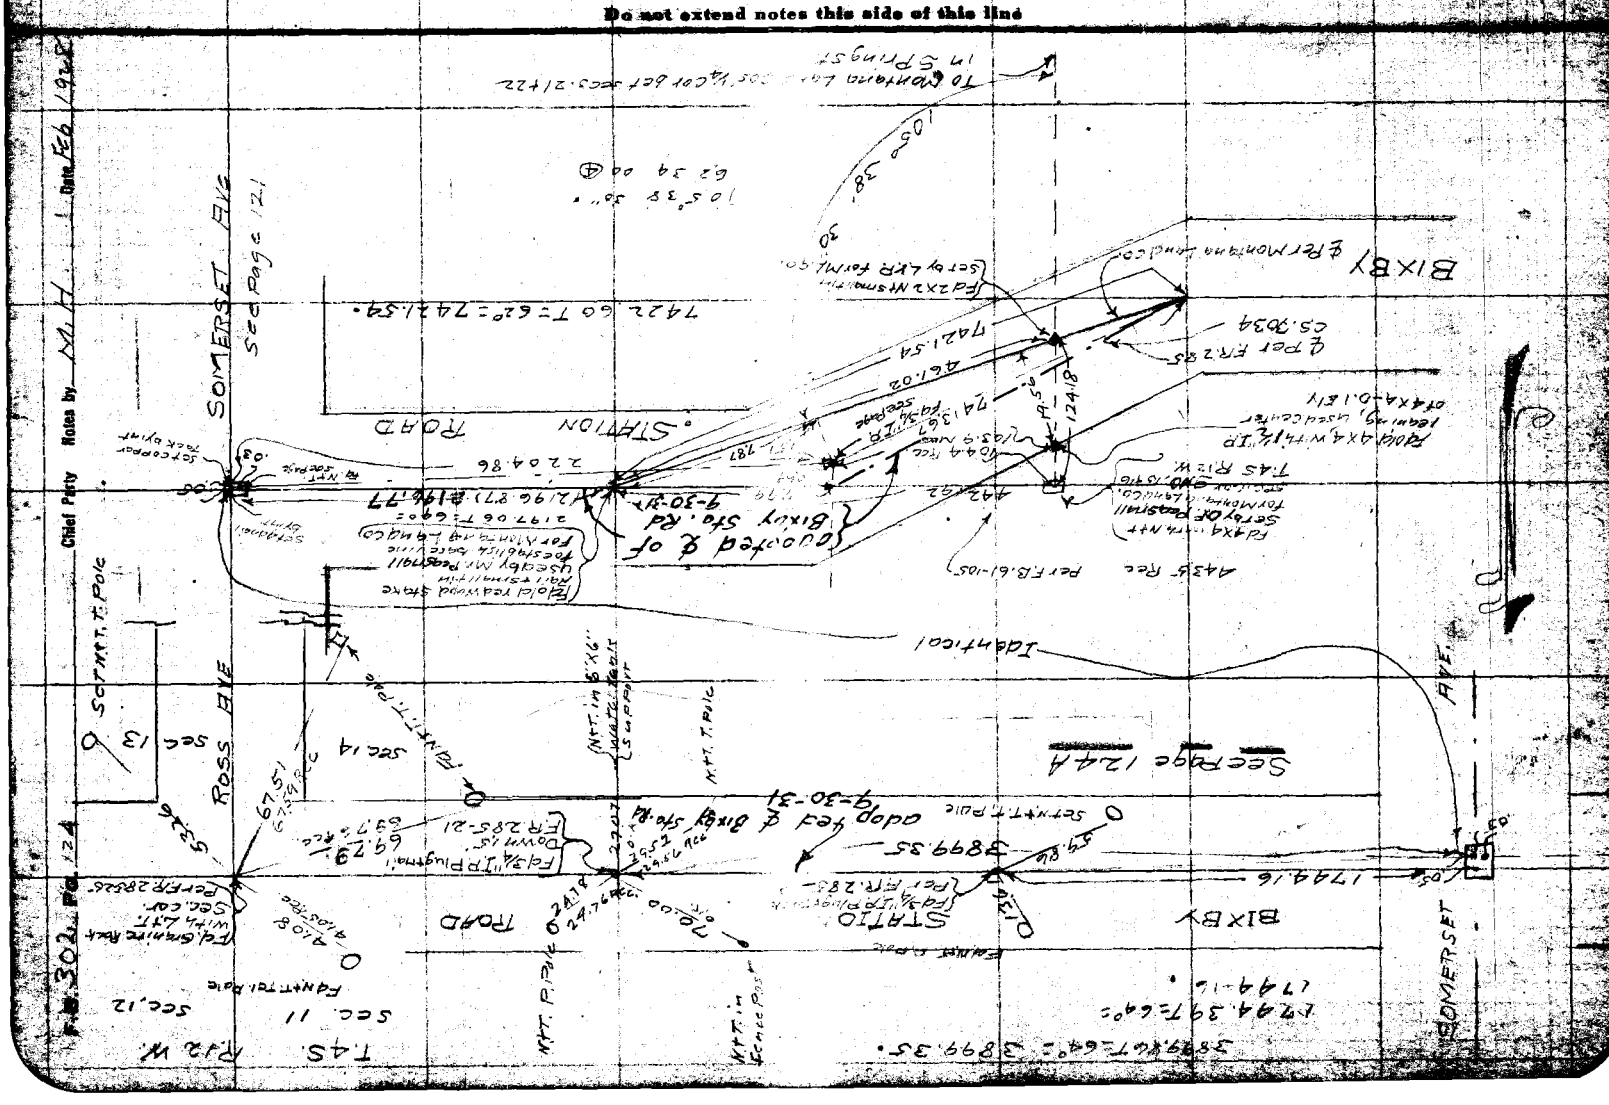
SOMERSET AVE
ROSS AVE
STATION ROAD
BIXBY
Set Page = 121
Chief Party
Notes by
Date FEB 1924
F.B. 302 Pg 124
T.4S. R.12W.
Sec. 11
Sec. 12
Sec. 13
Sec. 14
Set Page 1244
Fd. Bronze Mark with L.T.T. See. Cor.
Set FR 2835
Fd 3/4" IP Plugged Down .45'
Fd 3/4" IP Plugged
Fd 2x2 Mtn. Mon. Tie
Set by L&R for Mk. Cor.
Fd 4x4 Wood Stake
Set by Surveyor for Mk. Cor.
Fd 4x4 w/ Tin Tag

442.92
561
437.31

RETURN TO
LOS ANGELES COUNTY SURVEYOR

Notes ANY ADDITIONS OR CHANGES ON THIS SHEET MUST BE MADE OR CIRCLED IN Red. WITH DATE AND NAME OF PERSON MAKING CHANGE.

Do not extend notes this side of this line

Date
Notes by
Chief Party
F. B. 392 Pg 124

Plotted by CSW
Date Apr '28
Map No.
Filming Ck'd by R.W.S.
Date 11 1 1928

W. O. No. 4459 C. S. O. No.
Location Somerset Ave.
Surveyed by M. Hayes
Date 1927-1928
Inspected A. C. Johnson

6" diam Mon.
See Page 119

SOMERSET

Set C.S. Brass cap Mon. in conc. DOWN 10"
Replacing 4d nail in 2X2 See Page 124
Monument Marked X

N.T.T. P. Pole
43.56
C.S. Mon DOWN 10"
N.T.T. P. Pole
20.50
28.95
N.T. Guy Pole
Same point
47.81
N.T.T. P. Pole

COUNTY SURVEY
SEC. 10
SEC. 15
T. 4 S.
MONUMENT

Note. Section line adopted as ℄ of Bixby Sta. Rd. 9-30-31

Sec. Line

Granite rock
L.T.
See Page 124

BIXBY STATION RD.

0.57
See note A
Set 2X2 by int.

Set 2X2 by int.
0.5' N. & 0.5' W.
Old Redwood
437.31
2.49
3/4 IP
16° 42' 35"
Adopted
16° 21' 55"
2.12 Pr. See Page 126
164-22-0
297-27-40 (4)
89° 59' 30"
89-59-30
319-57-20 (4)
164-21-30
297-26-20 (4)

Ref. F.B. 302-124-125-126
F.P. 285-1 to 37
F.B. 20-70 to 75
C.S. 7034
F.B. 61-105
D.M. 1367-241
D2-266

Same Point
N.T.T. Guy Pole
43.76
N.T.T. P. Pole
28.88
2X2 Down 10"
29.55
N.T.T. Guy Pole
47.50
N.T.T. Guy Pole
C.S. Mon. in ℄ SPRING ST.
See Page 123

SUBDIVISION MAP
SHEET
Hayes
Compton, Inst.

RETURN TO

LOS ANGELES COUNTY SURVEYOR

Note: ANY ADDITIONS OR CHANGES ON THIS SHEET MUST BE MADE OR CIRCLED IN **Red.** WITH DATE AND NAME OF PERSON MAKING CHANGE.

Do not extend notes this side of this line

F.B. ____ PG. ____ Chief Party ____ Notes by ____ Date ____

RETURN TO

LOS ANGELES COUNTY SURVEYOR

Notes: ANY ADDITIONS OR CHANGES OF THIS SHEET MUST BE MADE OR CIRCLED IN Red. WITH DATE AND NAME OF PERSON MAKING CHANGE.

Do not extend notes this side of this line

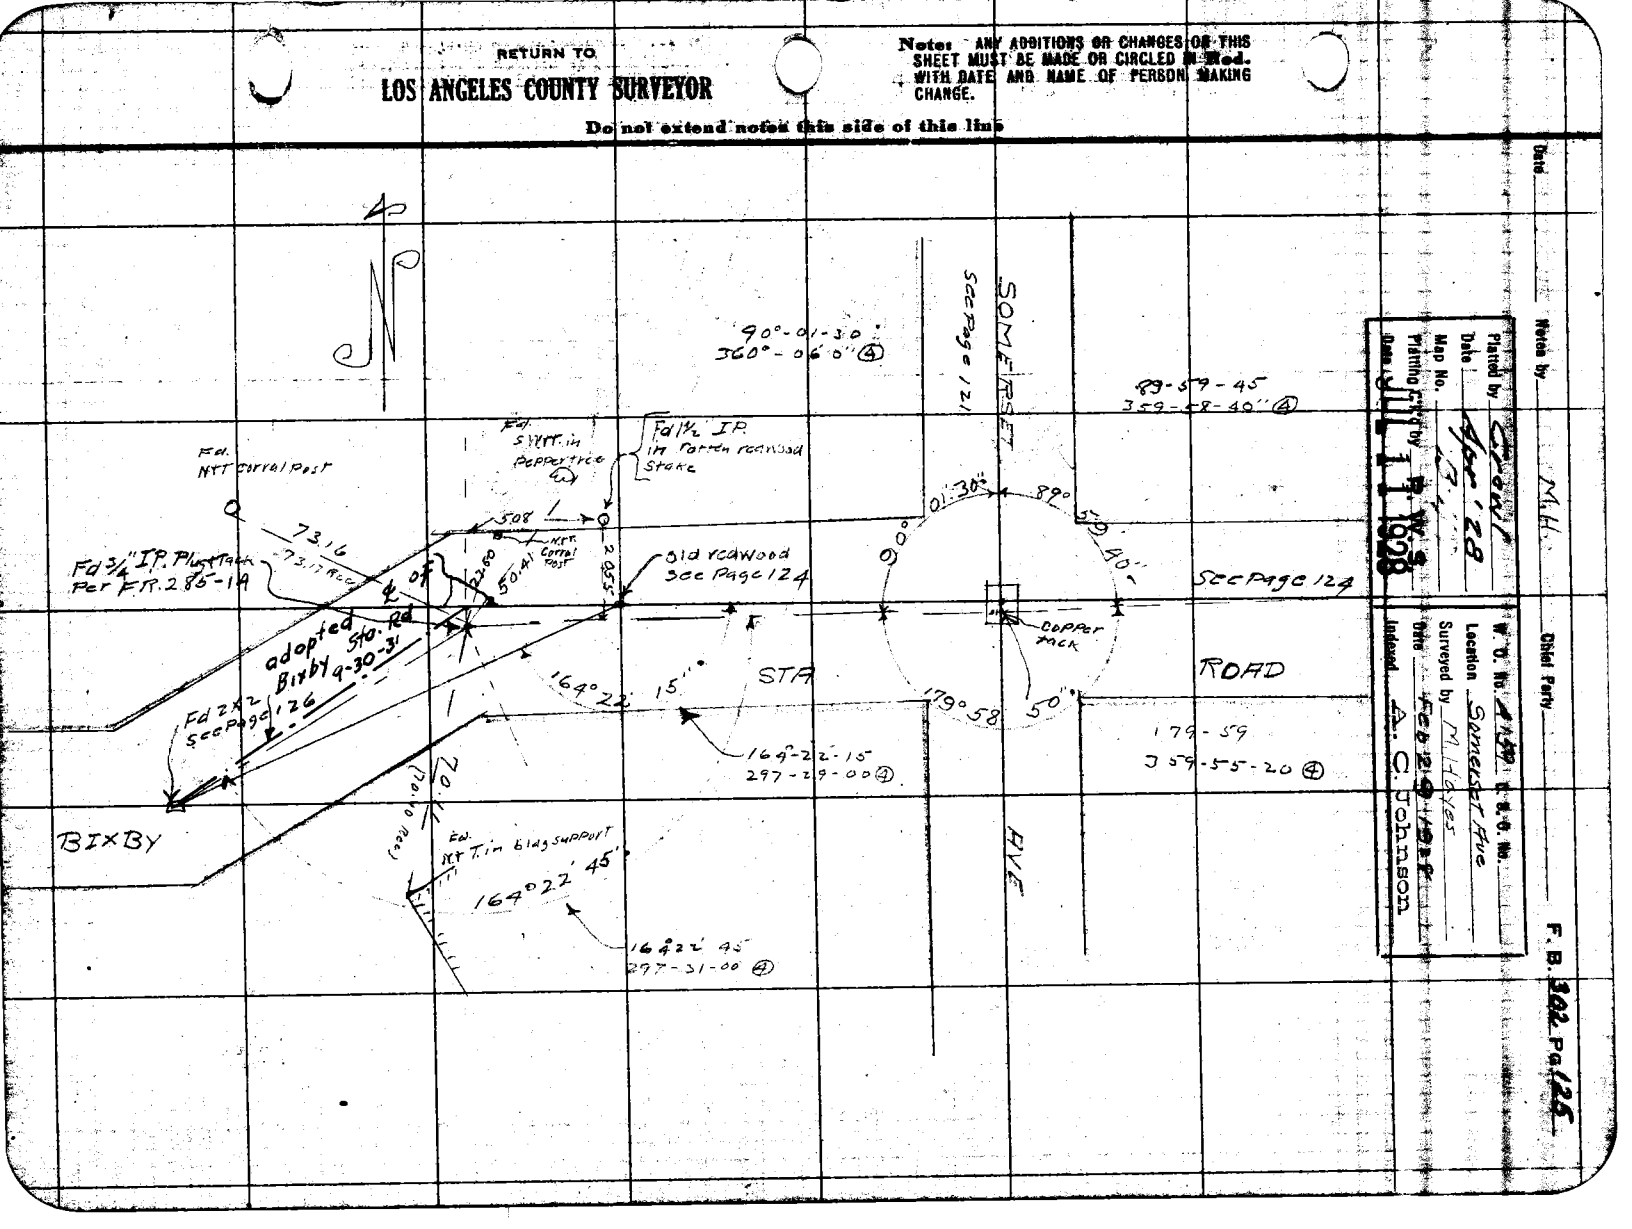

Date _____ Notes by _____ Chief Party _____ F. B. 202 Pg. 125

Plotted by Lyon '28 Date _____ Map No. _____ Planimetered by _____ Date JUL 11 1928

W. O. No. 4139 U. S. G. No. _____ Location Somerset Ave Surveyed by M. Hayes Date Feb 29 1928 Indexed A. C. Johnson

F.B. 302 Pg. 126 M. Hayes Chief Party Notes by M.H. Date 3-1-28

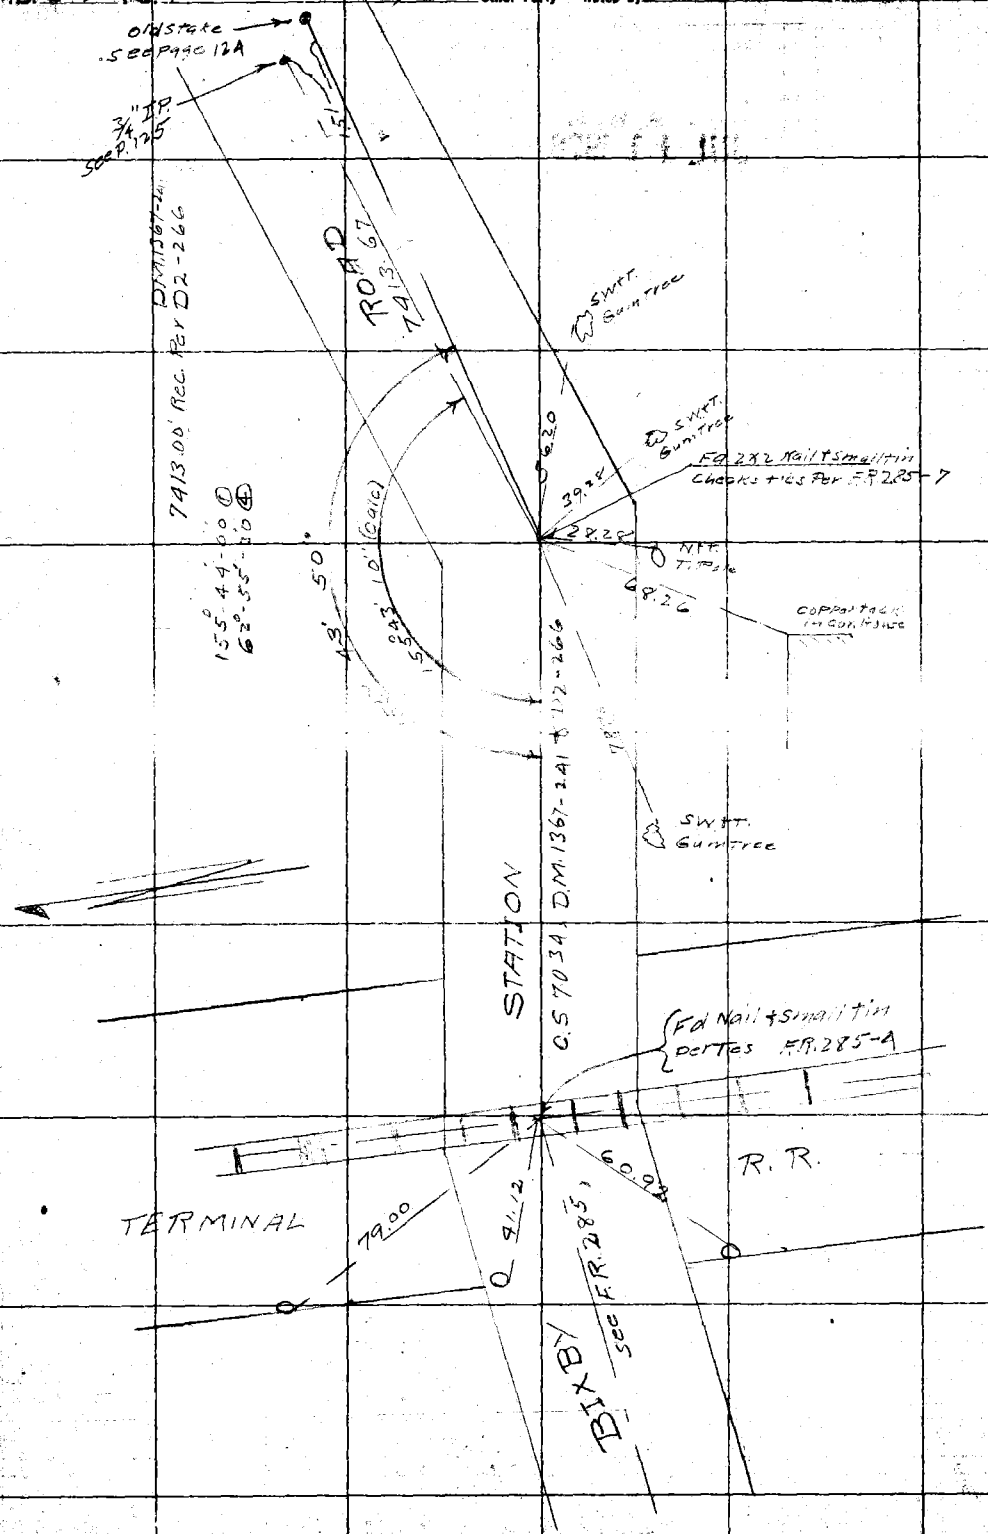

RETURN TO
LOS ANGELES COUNTY SURVEYOR
Do not extend notes this side of this line

Notes: ANY ADDITIONS OR CHANGES ON THIS SHEET MUST BE MADE OR CIRCLED IN Red. WITH DATE AND NAME OF PERSON MAKING CHANGE.

Date _____ Notes by M Chief Party M F.B. 302 Pg. 127

Platted by Bradstreet
Date Jan 3 '30
Map No. C.S. B-117-5 Sh #4
Platting C'k'd by R.W.S.
Date Jan 3 '30

W. O. No. 764 D. S. O. No. _____
Location San Antonio Dr.
Surveyed by F.J. McNeal
Date Dec - 1929
Indexed A. C. JOHNSON

COUNTY SURVEYORS + MONUMENT

Fd 4x4 per F.B. 309-46

Fd N+T in P.P.

Fd N+T Wier

Set nail by ties F.B. 302-50

SOMERSET AVE

21.63

34.78

Reset 2" I.P. with brass cap in Conc. 18" Down marked as shown above (@ Calc. Dist)

0.22

Fd C.S. Mon-12" Dn Per F.B. 302-50 Removed + Reset

31.95

BEACH

LONG

Fd brass cap mon. marked M.L.Co. 1928 - 24" Down-Removed

Fd X in Wier

ROSE

Set nail by ties F.B. 309-45

Set nail by ties F.B. 309-46

55.15

Set 2" I.P. with brass cap in Conc. 18" Down - marked as shown above (@ Calc. Dist)

0.56

14.44

Reset 1x2 Per F.B. 309-46 (Top broken off original)

Replaced by Rd. Dept. with Rd. Dept Brass Plate Conc. Mon. and Co. Sur. Well Cover F.Q. 271-2

55.44

64.23

CLARK AVE

Fd X on motor block

Fd X on side Conc stand pipe

Fd 4x4 with N+T marked Montana Land Co - 12" up

18.31

15' Offset Per F.B. 309-46

Fd 4x4 with N+T-8" Dn No Reference

18.25

OF

CERRITOS AVE

18.3

Fd 4x4 marked Montana Land Co - 24" up

Fd Granite Mon. Per F.B. 309-46

15.00

Fd 1x2 + t Per F.B. 309-46

CITY

Notes: ANY ADDITIONS OR CHANGES ON THIS SHEET MUST BE MADE OR CIRCLED IN Red. WITH DATE AND NAME OF PERSON MAKING CHANGE.

Do not extend notes this side of this line

RETURN TO LOS ANGELES COUNTY SURVEYOR

RETURN TO
LOS ANGELES COUNTY SURVEYOR

Note: ANY ADDITIONS OR CHANGES ON THIS SHEET MUST BE MADE OR CIRCLED IN Red. WITH DATE AND NAME OF PERSON MAKING CHANGE.

Do not extend notes this side of this line

F.B. 302 Pg. 128

Chief Party _____ Notes by _____ Date _____

Notes Ck'd by McPherson	Survey of Somerset Ave.	F.B. 304 Pg. 129
Map No. 8-1176	W. O. 4152 Tape No 067 St'd 66 of.	
Office Work Price-McPh	Surveyed by Evans	
Checked Drew	Notes H. C. Job Retyped 1/35	
Date Nov. 20-1935	Indexed 11-21-35	

(76 Bot pg. 120)

To B.C.

1296.25

105.00

90°

Set Nail

Set 1XR

Fd. cut spk. in conc. Mon. well (ch. FA. 159/46)

266.93

Set 1XR

S. Line Tr. 10542

39.99

39.98

105.00

Fd. Conc. Mon. cut spk ctr. R.D. FA. 159/46 18" dn.

Ctr. Sec. 27 Fd. conc. mon. cpr. nail ctr. 18" dn. Set by Vic Hays. 55 + 47.76 See FB. 289/15

50° Marginal

Tomen 180° limit East 0.5

To mons. ½ mi. West.

Identical

To Mon. Spring St. 180°

Fletcher St.

TR.

No

1054B.

Note: ANY ADDITIONS OR CHANGES ON THIS SHEET MUST BE MADE OR CIRCLED IN Red Ink WITH DATE AND NAME OF PERSON MAKING CHANGE.

Do not extend notes this side of this line

RETURN TO
LOS ANGELES COUNTY SURVEYOR
700 HALL OF RECORDS

FORM 247 3M 8-34

RETURN TO
LOS ANGELES COUNTY SURVEYOR
700 HALL OF RECORDS

Note: ANY ADDITIONS OR CHANGES ON THIS SHEET MUST BE MADE OR CIRCLED IN **Red Ink** WITH DATE AND NAME OF PERSON MAKING CHANGE.

Do not extend notes this side of this line

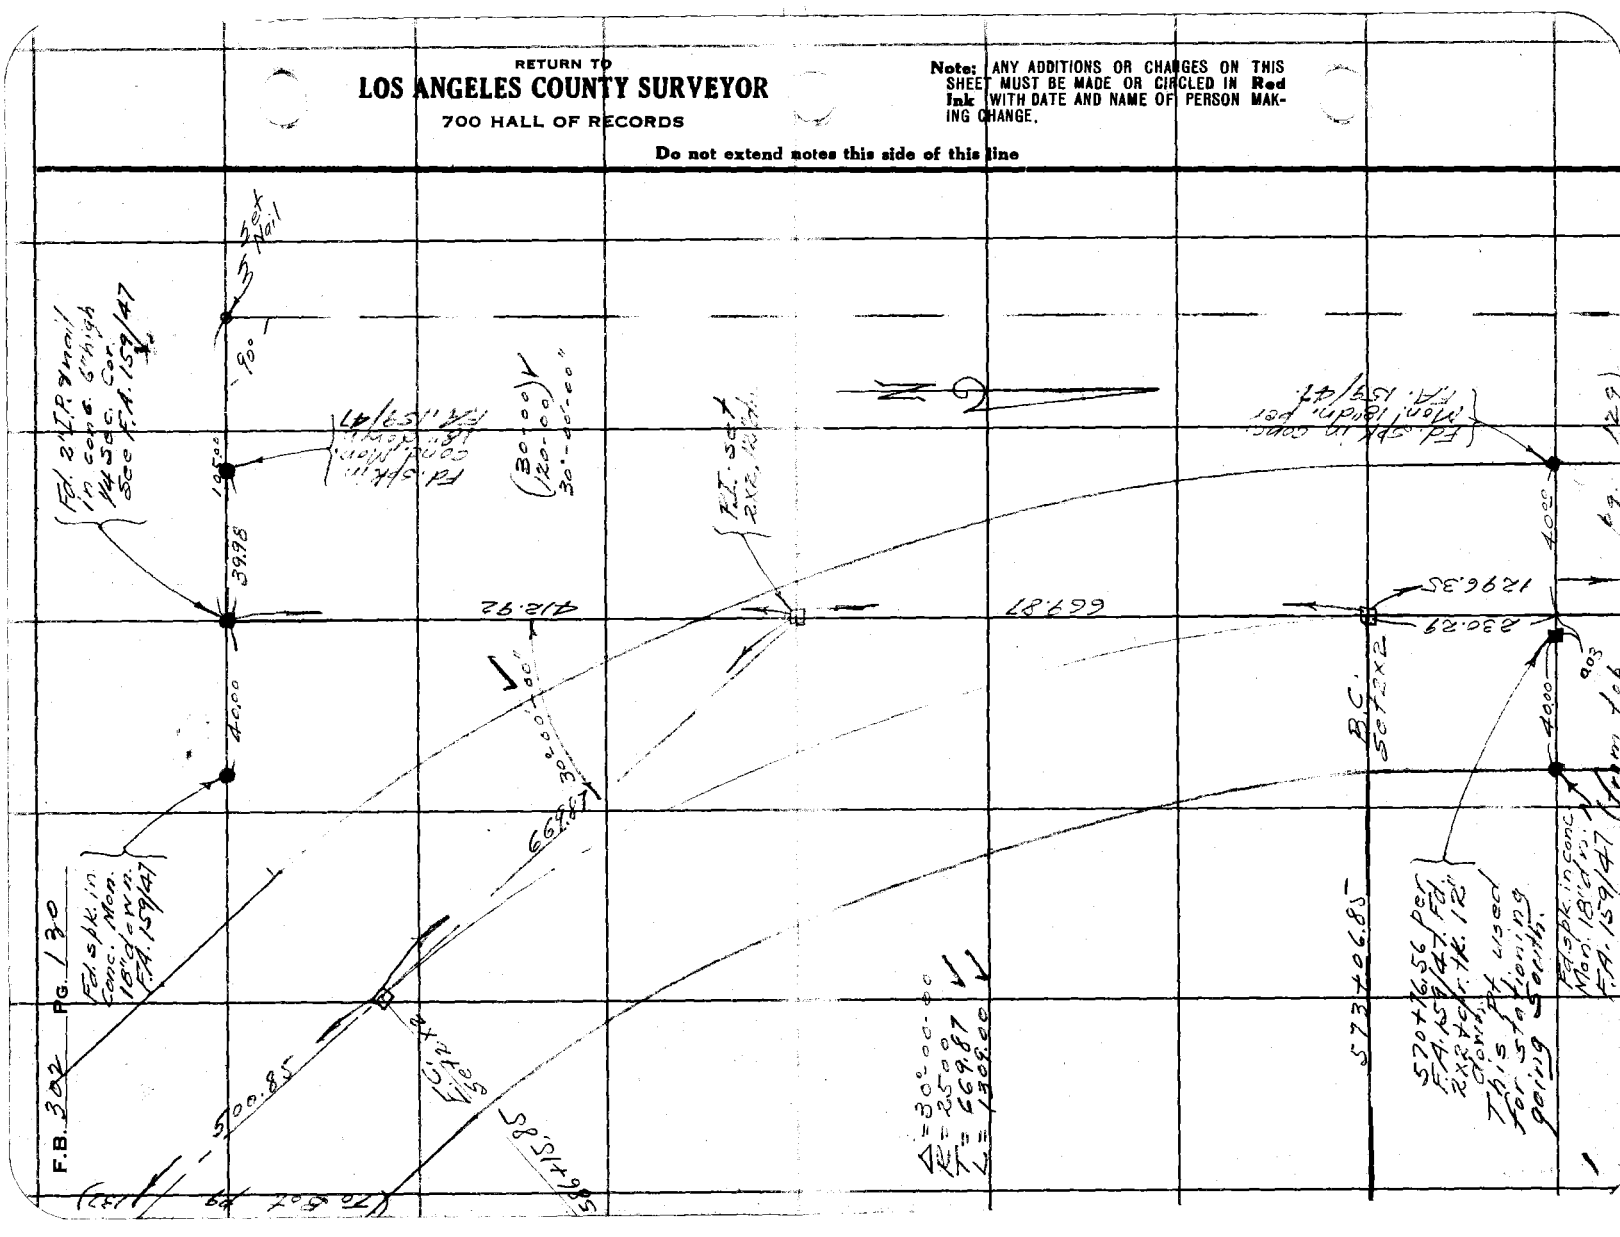

Notes Ck'd by	Survey of Somerset Ave
Map No.	W. O. 4159 Tape No 000 St'd 26 OF.
Office Work	Surveyed by L D Moore
Checked	Notes Date 2-21-35
Date	Indexed A. C. Johnson

F.B. 302 Pg. 131

To bottom pg 133

To bottom pg 132

Fd 2x2
302+04.78
FS 289-16
6" deep

SOMERSET
600.36

EC
Set 2x2
12" deep

AVE

Fd 2" I.P. & nail
in conc. 6" high
1/4 Sec. Cor.

669.88

30°-00'-00"

412.92

PI
Set 2x2
12" deep

669.71 @ 68° = 669.88

412.94 @ 68° = 412.92

Δ = 30°-00'-00"
R = 2500'
T = 669.88
L = 1309.00

(30°-00'-00")
(120°-00'-00")

33.99

From top pg.

Notes: ANY ADDITIONS OR CHANGES ON THIS SHEET MUST BE MADE OR CIRCLED IN Red Ink WITH DATE AND NAME OF PERSON MAKING CHANGE.

Do not extend notes this side of this line

RETURN TO
LOS ANGELES COUNTY SURVEYOR
700 HALL OF RECORDS

FORM 247 BM 2-34

F.B. 302 PG. 132

To bottom of pg 133

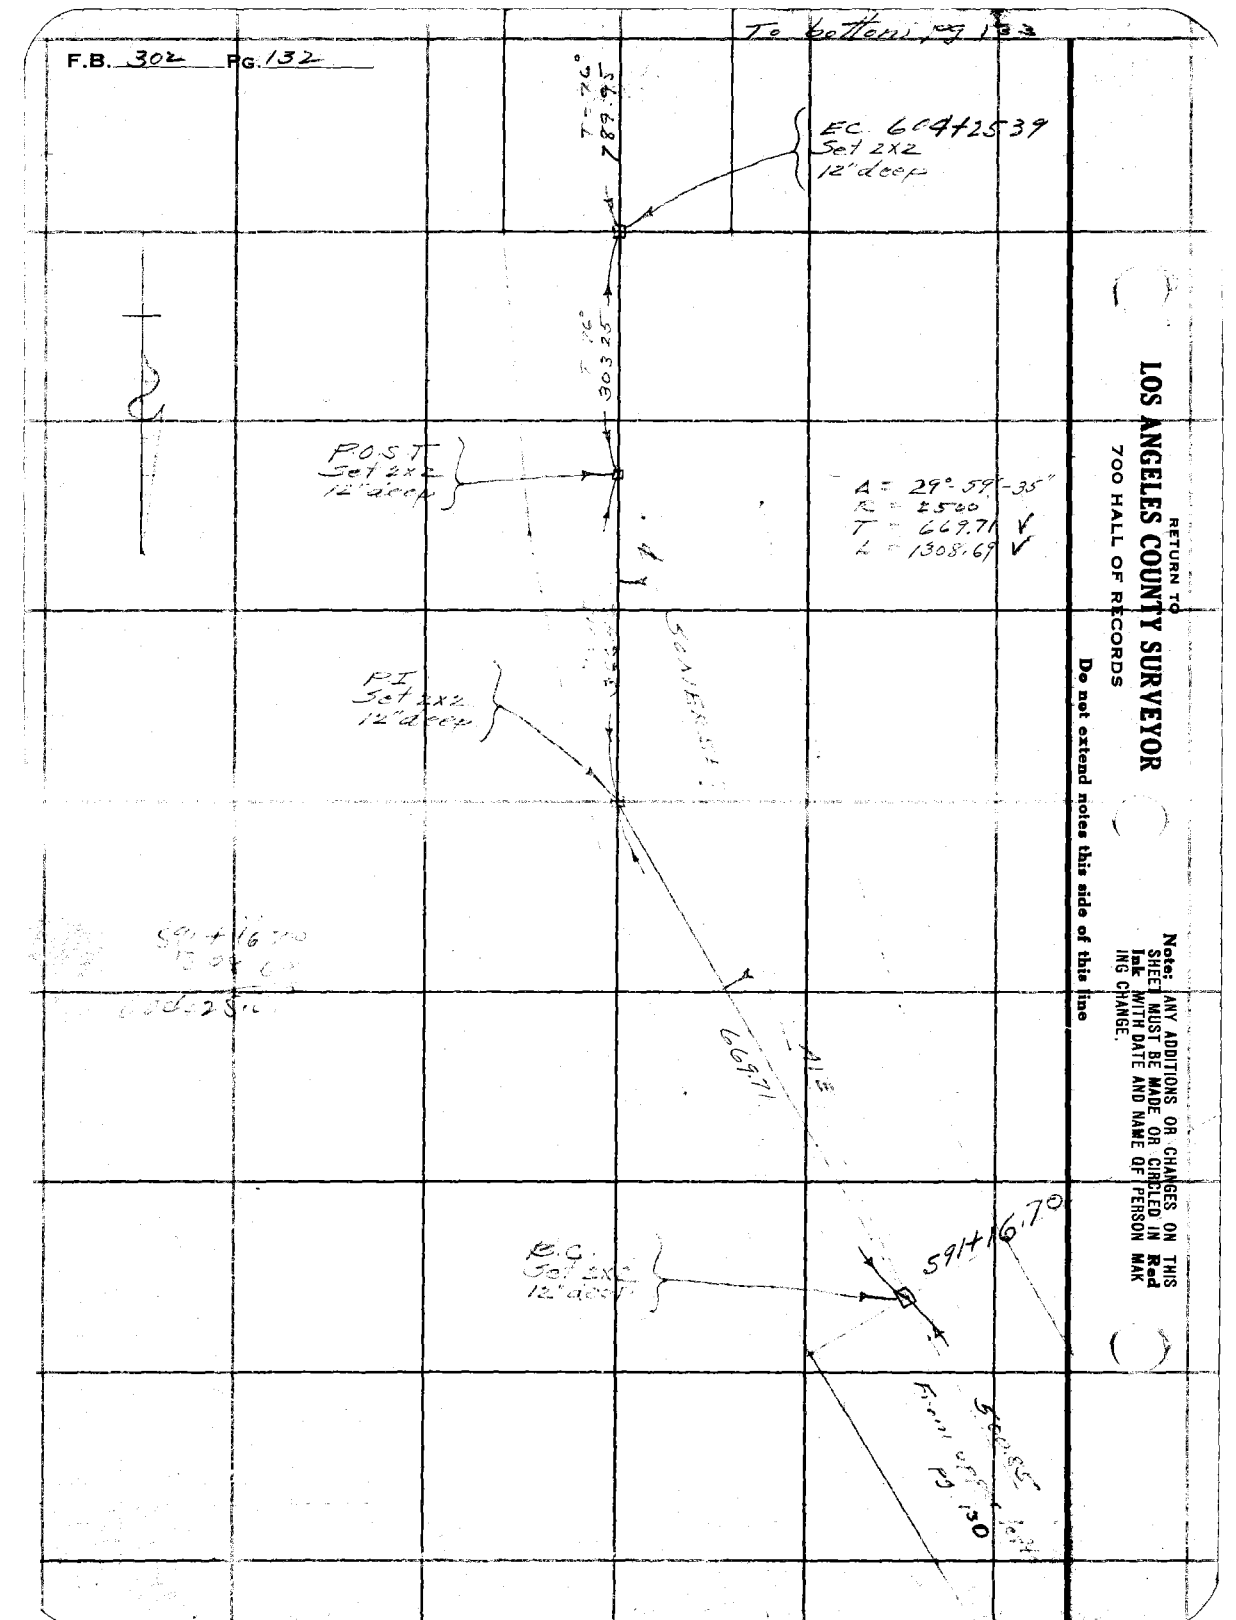

RETURN TO
LOS ANGELES COUNTY SURVEYOR
700 HALL OF RECORDS

Do not extend notes this side of this line

Note: ANY ADDITIONS OR CHANGES ON THIS SHEET MUST BE MADE OR CIRCLED IN Red Ink WITH DATE AND NAME OF PERSON MAKING CHANGE.

Notes	Ck'd by McPherson	Survey of Somerset Ave	F.B. 302 Pg. 188
Map	No. B-1176	W. O. 4156 Tape No 100 St'd 76 OF.	
Office Work	Price-McPh.	Surveyed by [illegible]	
Checked	DRew	Notes	Date 11-1-35
Date	NOV. 20-1935	Indexed	A. C. Johnson

To left Pg 184

634.90 as re-chained by L.D.M.

625+76.28 E.C Set 2x2 12"deep

298.70 T=16°

A=16°-59'-20" R=2000' T=298.70 L=593.02

163°-00'-40"

163°-00'-45" 292-02-45"

P.I Set 2x2 12"deep

2.12

Fd S T+W FB 397-42

Set S T+W

275.00 T=16°

P.O.S.T Set S T+W Removed

Forties See Pg. 179

428.65 calc.

1.93 calc.

ANAHEIM

428.58

P.O.S.T Set S T+W

619+83.26 B.C Set 2x2 12" deep

Fd S T+W FB 289-19

68°-57'-30"

23.70

(68°-57'-30" 292-02-45")

986.09 calc. ST

785.94

68°56'00" calc.

68°-57'-15"

per C.S. B-391 & F.B. 397-51,52.

1.50

MONUMENT

Fd C.S. Mon 18" deep FB 397-42

COUNTY SURVEYOR T 4 S

767.92 as Rechained by L.D.M.

612+15.34 P.O.T Set 2x2 12" deep

400.00

From top Pg 132

From top Pg 131

Note: ANY ADDITIONS OR CHANGES ON THIS SHEET MUST BE MADE OR CIRCLED IN Red Ink WITH DATE AND NAME OF PERSON MAKING CHANGE.

Do not extend notes this side of this line

RETURN TO LOS ANGELES COUNTY SURVEYOR 700 HALL OF RECORDS

FORM 247 5M 2-34

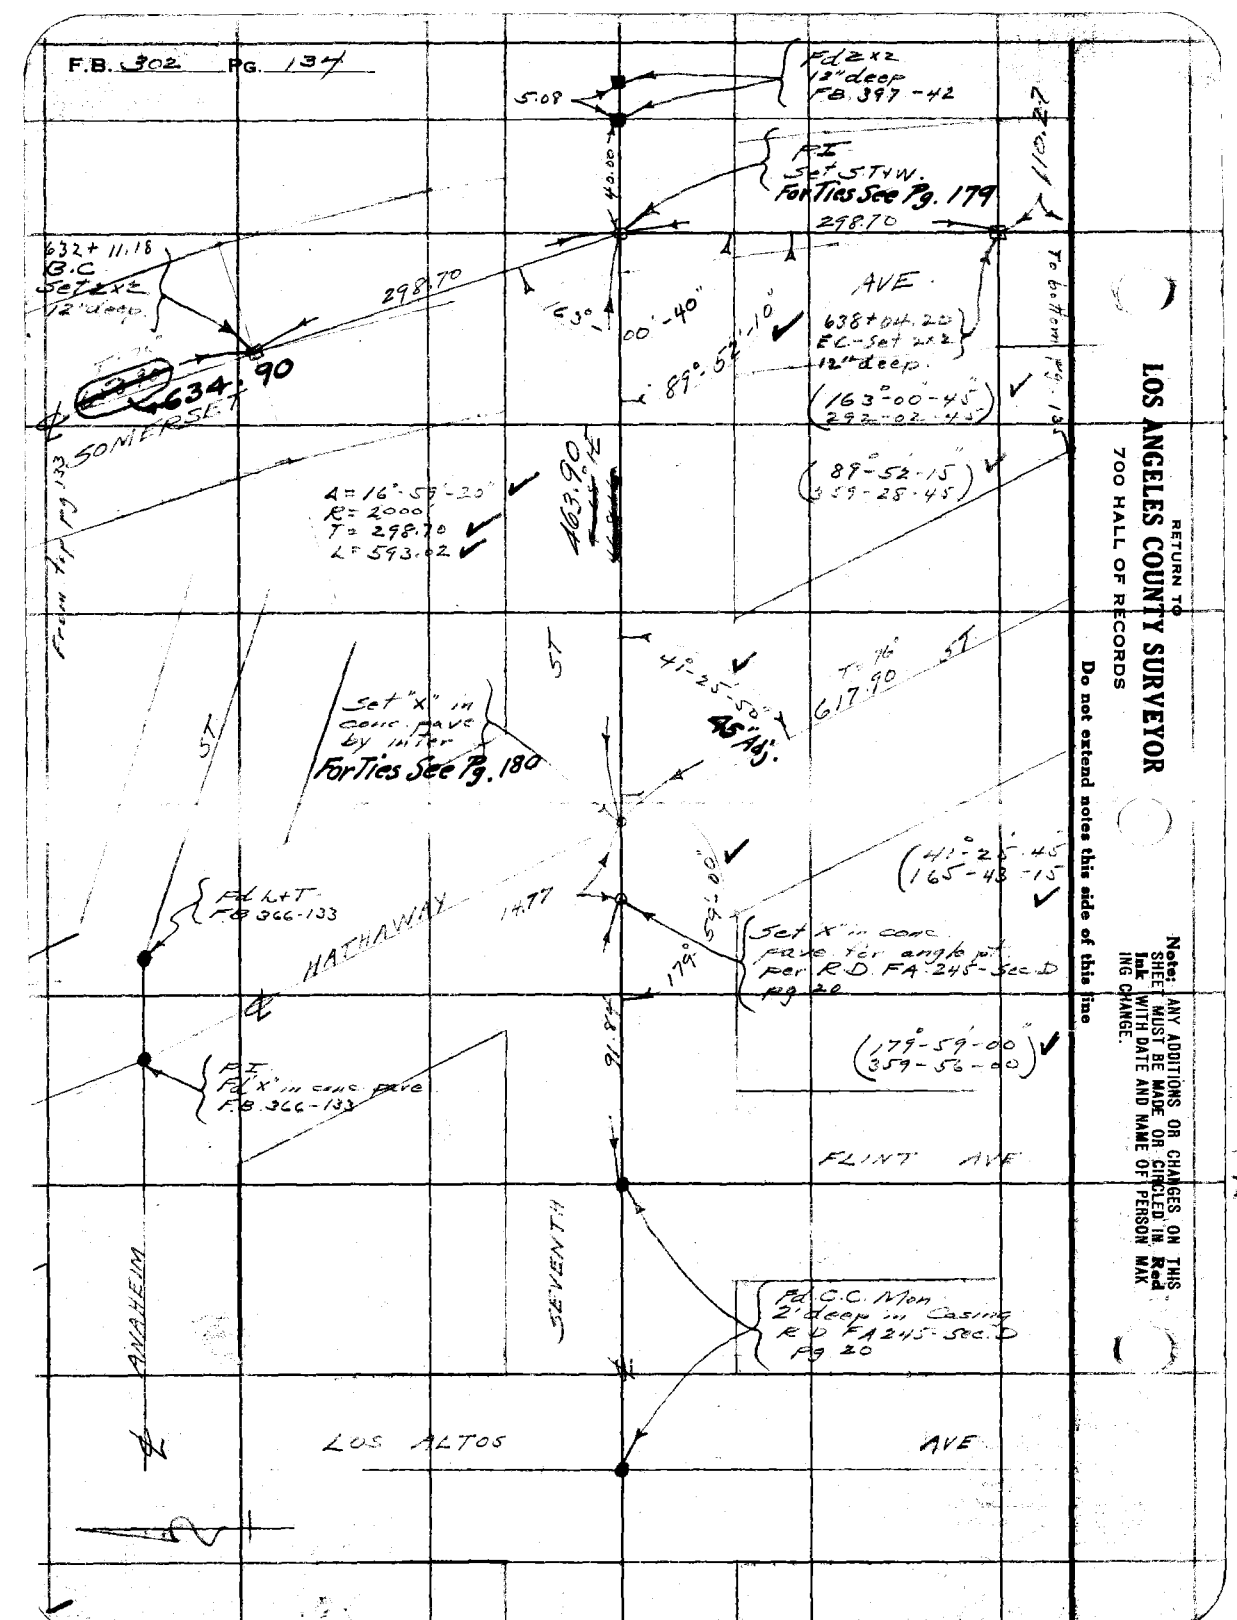

RETURN TO
LOS ANGELES COUNTY SURVEYOR
700 HALL OF RECORDS

Do not extend notes this side of this line

Notes: ANY ADDITIONS OR CHANGES ON THIS SHEET MUST BE MADE OR CIRCLED IN **Red Ink** WITH DATE AND NAME OF PERSON MAKING CHANGE.

Notes Ck'd by McPherson	Survey of Somerset Ave	F.B. 302	Pg. 185
Map No. B-117,6	W. O. 4459 Tape No 166' St'd 76 of.		
Office Work Price-McPh.	Surveyed by L. D. Moore		
Checked Drew	Notes D. Jones Date 11-4-35		
Date Nov. 20-1935	Indexed A. C. Johnson		

RETURN TO
LOS ANGELES COUNTY SURVEYOR
700 HALL OF RECORDS

Do not extend notes this side of this line

Note: ANY ADDITIONS OR CHANGES ON THIS SHEET MUST BE MADE OR CIRCLED IN Red Ink WITH DATE AND NAME OF PERSON MAKING CHANGE.

P.I. Falcon Ave & Spk. 11" ~~East~~ ~~West~~ of Sta. 639+14.47 P.O.T. Sec 13 Pg 23 F.B. 293-123.

639+14.47 Set C&pt in lead by tilt. For Ties See Pg. 180

48°32'35" Sec 13. 173

MANHATTAN AVE

131.17

20.63

Fd. C Spk.

S 55°05'00" E

Fd. Cross Mon. - Flush 737+84.23 Sta. Mon.

WINSLOW AVE

131°-17'-45"
(48°-11'-30")

HARTWAY

Fd. C&pt

50.00

Fd. Cross Mon. 737+84.23 Sta. Mon.

SOMERSET AVE
No. 27

From cont. Pg 134

FORM 247 5M 2-34

RETURN TO

LOS ANGELES COUNTY SURVEYOR

700 HALL OF RECORDS

Note: ANY ADDITIONS OR CHANGES ON THIS SHEET MUST BE MADE OR CIRCLED IN **Red Ink** WITH DATE AND NAME OF PERSON MAKING CHANGE.

Do not extend notes this side of this line

F.B. 302 PG. 136

Form 307 5M 10-34

PLEASE RETURN TO
LOS ANGELES COUNTY SURVEYOR
700 HALL OF RECORDS

NOTE: ANY ADDITIONS OR CHANGES ON THIS SHEET MUST BE MADE OR CIRCLED IN RED INK, WITH DATE AND NAME OF PERSON MAKING CHANGE

Do not extend notes this side of this line

STATION	B. S.	H. I.	F. S	ELEV.		
B.M. #40X	6,418	20.212		13 794	B.M. #40X - Fd spk in conc. mon, 18" dn. 40' East of Sta. 570+76.56 per State Hiwy Map. Sec. VII LA County Feeder Sheet 5.	
B.M. #40Y			6.702	13.510	B.M. #40Y - Fd. spk. in conc mon. 18" dn. 40' West of sta. 570+76.56 per same Map. El. 13.462	
℄ BC 573+06.85			4.4	15 8		
70'R.			5 0	15 2		
70'L.			4.5	15.7		
℄ 574+00			4.3	15.9		
70'R.			5.1	15.1		
70'L.			4.8	15 4		
℄ 575+00			4.8	15.4		
70'R.			5.3	14.9		
70'L.			4.8	15.4		
T.P.	3.668	19.609	4.271	15.941		
℄ 576+00			4.6	15 0		
70'R.			4.8	14 8		
70'L.			4.3	15 3		
577+00			4.6	150		
70'R.			4.8	14 8		
70'L.			4.3	153		
578+00			4.9	14.7		
40'R.			4.9	14.7		
40'L.			4.7	14.9		

Profile Notes Red. Platted Job No. 1556 Division No.
No. Date Date Survey of Sorensen Notes HE Date 11/4/35
X-Sec. Notes Chkd. Checked Survey by Indexed C. Johnson Date 11-5-35
No. Date Date Map No.

L. B. 302 PG. 137

Form 307 5M 10-34

PLEASE RETURN TO
LOS ANGELES COUNTY SURVEYOR
700 HALL OF RECORDS

NOTE: ANY ADDITIONS OR CHANGES ON THIS SHEET MUST BE MADE OR CIRCLED IN RED INK, WITH DATE AND NAME OF PERSON MAKING CHANGE

Do not extend notes this side of this line

L.B. 302 P.G. 138 | Job. No. 4453 Division No. _____ Notes Red ℄ Plotted _____ Profile _____
Survey of Somerset Ave Date _____ No. _____
Survey by _____ Notes ℄ Notes Chkd. _____ Checked _____ X-Sec. _____
Indexed C. Johnson Date 11/4/35 Date _____ Date _____ No. _____

STATION	B. S.	H. I.	F. S	ELEV.		
		19.✓609				
℄ 579+00			5.5	14.1		
70'R.			4.4	15.2		
70'L.			5.1	14.5		
℄ 580+00			5.3	14.3		
70'R.			5.0	14.6		
70'L			5.4	14.2		
T.P.	4.301	19.✓180	4.730	14.379		
℄ 581+00			4.5	14.7		
70'R.			4.3	14.9		
70L.			4.6	14.6		
℄ 582+00			4.5	14.7		
70'R.			4.5	14.7		
70'L			4.6	14.6		
℄ 583+00			4.8	14.4		
70'R.			4.9	14.3		
70'L			4.7	14.5		
℄ 584+00			4.6	14.6		
70'R.			4.7	14.5		
70'L.			5.1	14.1		

Form 307 5M 10-34

PLEASE RETURN TO
LOS ANGELES COUNTY SURVEYOR
700 HALL OF RECORDS

NOTE: ANY ADDITIONS OR CHANGES ON THIS SHEET MUST BE MADE OR CIRCLED IN RED INK, WITH DATE AND NAME OF PERSON MAKING CHANGE

Do not extend notes this side of this line

STATION	B. S.	H. I.	F. S	ELEV.		
		19.180				
℄ 585+00			5.2	140		
70' R.			5.1	141		
70' L.			4.7	145		
B.M. # 41 Y.	5.442	18.833	5.789	13.391	B.M. 41Y- Fd. spk in conc. Mon. 18" dn. 40' East of ℄ Sta. 583+89.59, per State Highway Map. Dist VII, L.A. County Feeder Sheet 5 El.=13.406	
℄ 586+00			5.0	138		
70' R.			5.2	136		
70' L			5.1	137		
E.C. ℄ 586+15.85			5.2	136		
℄ 587+00			6.0	128		
33' R.			6.2	126		
70' R.			7.2	116		
70' L.			5.3	13.5		
℄ 587+44			6.5	123		
43' R.			8.0	108		
64 R.			8.4	104		
70' R.			8.3	105		
70' L.			6.0	128		
℄ 588+00			8.5	103		
70' L			7.0	118		
16' R.			8.5	103		

Profile
No. _____ Notes Red. _____ Platted _____ Job No. 115 Division No. _____ L. B. 302 PG. 139
X-Sec. _____ Date _____ Date _____ Survey of Somerset Ave
No. _____ Notes Chkd. _____ Checked _____ Survey by E. Ellis Notes _____ Date 11/4/35
Date _____ Date _____ Map No. _____ Indexed C. Johnson

Form 307 5M 10-34

PLEASE RETURN TO
LOS ANGELES COUNTY SURVEYOR
700 HALL OF RECORDS

NOTE: ANY ADDITIONS OR CHANGES ON THIS SHEET MUST BE MADE OR CIRCLED IN RED INK, WITH DATE AND NAME OF PERSON MAKING CHANGE

Do not extend notes this side of this line

L.B. 302 P.G. 140 | Job. No. 4455 | Division No. | Profile | Notes Red | Plotted | No. | Date | Survey of Somerset Ave | Date | X-Sec. | Survey by L. Vaus | Notes | Notes Chkd. | Checked | No. | Indexed A. C. Johnson | Date 11/4/35 | Date | Date

STATION	B. S.	H. I.	F. S	ELEV.		
(588+00)		18.833				
43R.			7.6	11.2		
70'R.			7½	11.6		
℄ 588+25			8½	10.6		
16'R			7.6	11.2		
35 R.			7.4	11.4		
70'R.			7½	11.6		
28'L.			8¼	10.4		
51'L			6.7	12.1		
70'L.			10.7	8.1		
℄ 588+59			7.1	11.7		
T.P.	6.260	16.950	~~8.743~~ 8.260	10.690		
℄ 589+00			5.3	11.7		
35R.			5.6	11.4		
70'R.			5.5	11.5		
26'L			4.7	12.3		
35'L			3.7	13.3		
44'L			4.3	12.7		
52'L			7.6	9.4		
68'L			8.6	8.4		
78'L.			3.7	13.3		

Form 307 5M 10-34

PLEASE RETURN TO
LOS ANGELES COUNTY SURVEYOR
700 HALL OF RECORDS

NOTE: ANY ADDITIONS OR CHANGES ON THIS SHEET MUST BE MADE OR CIRCLED IN RED INK, WITH DATE AND NAME OF PERSON MAKING CHANGE

Do not extend notes this side of this line

STATION	B. S.	H. I.	F. S	ELEV.		
		16.950				
℄ 589+39			4.4	126	·	
℄ 589+84			4.4	126	·	
17'R.			5.9	111	·	
35'R.			6.5	105	·	
70'R.			5.6	114	·	
10'L.			8.0	90	·	
18'L			7.9	91	·	
32'L.			1.7	153	·	
50'L			1.9	151	·	
70'L.			4.4	126	·	
℄ 590+00			8.2	8.8	·	
℄ 590+13			8.4	8.6	·	
11'R.			8.3	8.7	·	
20'R.			8.0	90	·	
28'R.			6.6	10.4	·	
51'R.			6.6	10.4	·	
68'R.			6.1	109	·	Top ditch Bnk.
77'R.			9.8	72	·	Bot. " "
84'R.			9.2	7.1	·	" " "
162			2.8	14.2	·	

Profile
No. ____ X-Sec. No. ____
Notes Red. ____ Platted ____ Job No. 41-58 Division No. ____
Date ____ Date ____ Survey of Sawtelle Sch. Area
Notes Chkd. ____ Checked ____ Survey by L. Yates Notes ____ Date 11/4/35
Date ____ Date ____ Map No. ____ Indexed C. Johnson
L. B. 202 PG. 141

Form 307 5M 10-34

PLEASE RETURN TO
LOS ANGELES COUNTY SURVEYOR
700 HALL OF RECORDS

NOTE: ANY ADDITIONS OR CHANGES ON THIS SHEET MUST BE MADE OR CIRCLED IN RED INK, WITH DATE AND NAME OF PERSON MAKING CHANGE

Do not extend notes this side of this line

L.B. 302 P.G. 142 Job No. 458 Division No. Notes Red Plotted Profile
Survey of Somerset Ave. Date No.
Survey by Evans Notes Notes Chkd. Checked X-Sec.
Indexed C. Johnson Date 11/14/35 Date Date No.

STATION	B. S.	H. I.	F. S	ELEV.		
(590+13)		16.95				
36'L			2.8	14.2	.	
49'L			4.8	12.2	.	
70'L.			5.5	11.5	.	
590+50 L			3.4	13.6	.	
590+72 L			2.8	14.2	.	
14R.			2.9	15.0	.	
25R.			9.5	7.5	.	B.D. N. side.
33R.			9.8	7.2	.	Y of ditches
37R.			9.5	7.5	.	B.D. S. side.
50R.			4.1	12.1	.	T.B.
70R.			4.8	(12.0)	12.2	
14L			6.5	10.4	.	
34L			6.9	10.1	.	
70'L.			6.6	10.4	.	
T.P.	3.946	15.859	5.037	11.913	.	
B.M. #51.			3.449	12.410	.	B.M. #51. - Set cut spk. in tel. pole #B2022.Y, 147 S.E. of B.C. 591+16.70 El.=12.410 75' Lt. of Sta 592+45

Form 307 5M 10-34

PLEASE RETURN TO
LOS ANGELES COUNTY SURVEYOR
700 HALL OF RECORDS

NOTE: ANY ADDITIONS OR CHANGES ON THIS SHEET MUST BE MADE OR CIRCLED IN RED INK, WITH DATE AND NAME OF PERSON MAKING CHANGE

Do not extend notes this side of this line

STATION	B. S.	H. I.	F. S	ELEV.		
B.M. #"S" 1	8313	20.723		12.41	per pg.	
℄ 590+90			101	106.		
℄ 591+00			133	74.		
℄ 591+09			140	67.	B. Ditch N side	
9'R.			132	7.0	" " S "	
21'R.			57	150.		
37'R.			61	146.		
48'R.			86	121.		
70'R.			86	121.		
6'L.			130	91.	B. Ditch N side	
14'L.			100	107.	T.B.	
26'L.			108	9.9.		
70'L.			108	9.9.		
B.C. 591+16.70 ℄			142	6.5.		
591+21 ℄			138	6.9.	3 side ditch	
591+35 ℄			92	115.	Top Emt.	
23'R.			87	120.		
33'R.			70	137.		
48'R.			73	134.		
54'R.			84	123.		
70'R.			80	127.		

Profile
Notes Red. ℄ Platted Job No. 457 Division No.
No. Date Date Survey of Sanitation Dist. L.B. 302 Pg. 443
X-Sec. Notes Chkd. Checked Survey by ℄ Evans Notes ℄ Date 11/5/35
No. Date Date Map No. Indexed C. Job Date 11-7-35

Form 307 5M 10-34

PLEASE RETURN TO
LOS ANGELES COUNTY SURVEYOR
700 HALL OF RECORDS

NOTE: ANY ADDITIONS OR CHANGES ON THIS SHEET MUST BE MADE OR CIRCLED IN RED INK, WITH DATE AND NAME OF PERSON MAKING CHANGE

Do not extend notes this side of this line

L.B. 302 P.G. 140 | Job. No. 4159 Division No. | Notes Red | Plotted | Profile No.
Survey of Somerset + Alve | Date | Date | X-Sec. No.
Survey by Evans | Notes Chkd. | Checked
Indexed A. C. Johnson Date 11/5/35 | Date | Date

STATION	B. S.	H. I.	F. S	ELEV.		
(591+35)		20 723				
11'L.			13 9	6 8.	Bot. Ditch S. Side.	
24'L			13 7	7 0.	" " N.	
33'L			9 7	11 0.	T. Bnk.	
48'L			10 6	10 1.		
70'L.			11 2	(10 7)	9.7	
592+00 ℄			9 1	11 3.		
29'R.			9 4	11 3 1		
49'R.			8 6	12 1.		
59'R.			6 2	14 5.		
70'R.			6 0	14 7.		
59'L			9 6	11 1.	T. Bnk.	
71'L			14 0	6 7.	Bot ditch. S. side.	
℄ 592+37			9 5	11 2.		
593+00			9 0	11 7.		
35R.			6 9	13 8.		
70R.			4 5	16 2.		
45L.			9 9	10 8.		
70'L			10 2	10 5.		
594+00 ℄			5.5	15 2.		
32'R.			2 7	18 0.		
90R.			0,6	20.1.		

Form 307 5M 10-34

PLEASE RETURN TO
LOS ANGELES COUNTY SURVEYOR
700 HALL OF RECORDS

NOTE: ANY ADDITIONS OR CHANGES ON THIS SHEET MUST BE MADE OR CIRCLED IN RED INK, WITH DATE AND NAME OF PERSON MAKING CHANGE

Do not extend notes this side of this line

STATION	B. S.	H. I.	F. S	ELEV.		
(594+00)		J 20 723				
70'L			9 2	115.		
℄ 594+23		J	38	169.		
T.P.	11.421	30.500	1.644	19.079		
℄ 595+00			10 2	198.		
70'R.			7 5	230.		
70'L.			15.4	151.		
℄ 596+00			7 2	226.		
70R.			5 0	255.		
70'L			11 0	195.		
℄ 597+00			7 4	231.		
70R.			4 1	264.		
70'L			9 5	210.		
℄ 597+78			7 3	232.		
℄ 598+00			6 0	245.		
70'R.			3 7	268.		
70'L			7 8	227.		
℄ 598+55			3 9	266.		
℄ 599+00			4 6	259.		
70'R.			1 0	295.		
70'L			6 3	242.		

Profile Notes Red. E Platted Job No. 4159 Division No. L. B. 302 PG. 145
No. X-Sec. No.
Date Notes Chkd. Date Checked Date Survey of SEAVIEW Survey by E. YOUNG Notes E Date 11/5/35
Map No. Indexed A. C. Jobdrey

Form 307 5M 10-34

PLEASE RETURN TO
LOS ANGELES COUNTY SURVEYOR
700 HALL OF RECORDS

NOTE: ANY ADDITIONS OR CHANGES ON THIS SHEET MUST BE MADE OR CIRCLED IN RED INK, WITH DATE AND NAME OF PERSON MAKING CHANGE

Do not extend notes this side of this line

L.B. 307 P.G. 146 | Job No. 413 Division No. ____ Notes Red ____ Plotted ____ Profile ____
Survey of Somerset Ave. Date ____ Date ____ No. ____
Survey by E. Ayers Notes ____ Notes Chkd. ____ Checked ____ X-Sec. ____
Indexed A. C. Johnson Date 11/5/35 Date ____ Date ____ No. ____

STATION	B. S.	H. I.	F. S	ELEV.		
		30 500				
T.P.	7.703	34.525	3.678	30.822		
℄ 599+73			7 I	26.9		
℄ 600+00			6 4	28 1		
50 R.			5 5	27 0		
70' R.			5 2	27 3		
70' L			8 5	2 0		
℄ 601+00			3 3	31 2		
70 R.			2 3	32 2		
70' L			5 0	27 5		
℄ 601+44			2 6	31 7		
70' R.			1 3	32 2		
70' L			4 0	30 5		
℄ 602+00			1 2	33 3		
70' R.			0 0	34 5		
70' L			3 6	30 7		
T.P.	6.318	39.443	1.400	33.125		
℄ 602+45			5 4	34 0		
℄ 603+00			5 6	33 8		
70' R.			3 8	35 6		
70' L			9 3	30 1		

Form 307 5M 10-34

PLEASE RETURN TO
LOS ANGELES COUNTY SURVEYOR
700 HALL OF RECORDS

NOTE: ANY ADDITIONS OR CHANGES ON THIS SHEET MUST BE MADE OR CIRCLED IN RED INK, WITH DATE AND NAME OF PERSON MAKING CHANGE

Do not extend notes this side of this line

STATION	B. S.	H. I.	F. S	ELEV.		
		39.443				
℄ 604+00			7 8	31 6.		
70'R.			4 3	35 1.		
70'L			12 4	27 0.		
E.C.						
℄ 604+25.39			9 0	30 4.		
℄ 604+52			9 8	29 6.		
33'R.			8 0	31 4.		
70'R			5 4	34 0.		
43'L.			12 0	27 4.		
63'L			12 0	27 4.		
70'L			12 2	27 2.		
℄ 605+00			9 0	30 4.		
70'R.			3 1	35 5.		
20'L			9 9	29 5.		
48'L			11 0	28 4.		
70'L			10 3	29 1.		
℄ 606+00			7 0	32 4.		
70'R.			2 0	37 4.		
32'L			8 9	30 5.		
70'L			6 9	32.5.		
℄ 606+47			7 3	32 1.		

Profile No.
X-Sec. No.
Notes Red. HE Platted Job No. 4159 Division No.
Date Date Survey of
Notes Chkd. Checked Survey by Notes Date 1/5/35
Date Date Map No. Indexed A. C. Johnson
L. B. 302 PG. 47

Form 307 5M 10-34

PLEASE RETURN TO
LOS ANGELES COUNTY SURVEYOR
700 HALL OF RECORDS

NOTE: ANY ADDITIONS OR CHANGES ON THIS SHEET MUST BE MADE OR CIRCLED IN RED INK, WITH DATE AND NAME OF PERSON MAKING CHANGE

Do not extend notes this side of this line

L.B. 302 P.G. 148 | Job. No. 4137 | Division No. | Notes Red | Plotted | Profile | No.
Survey of Eaton Canyon Ave. | Date | Date | X-Sec. | No.
Survey by Los Angeles County Engineers | Notes | Notes Chkd. | Checked
Indexed A. C. Johnson | Date 11/5/35 | Date | Date

STATION	B. S.	H. I.	F. S	ELEV.		
		39.443				
℄ 607+00			4 2	3 + 5		
46'R			5.7	33.7		
70'R.			3.9	35.5		
70'L			2 3	37 1		
T.P.	11.795	48.741	2,497	36.946		
℄ 608+00			8 9	40 1		
70'R.			12 9	36 7		
70'L			5 9	42 5		
℄ 609+00			6 9	41.9		
15'R.			7 6	41 1		
70'R.			8 5	40 2		
70'L.			3 5	45 2		
℄ 609+12			6 7	42 0		
℄ 610+00			3 8	44 9		
70'R.			4 3	44 4		
40'L.			3 7	45 0		
70'L			2 1	46 6		
℄ 611+00			1 4	47 3		
70'R			1 8	46.9		

Form 307 5M 10-34

PLEASE RETURN TO
LOS ANGELES COUNTY SURVEYOR
700 HALL OF RECORDS

NOTE: ANY ADDITIONS OR CHANGES ON THIS SHEET MUST BE MADE OR CIRCLED IN RED INK, WITH DATE AND NAME OF PERSON MAKING CHANGE

Do not extend notes this side of this line

STATION	B. S.	H. I.	F. S	ELEV.		
		48.741				
43 L.			1 2	47 5 .		
70 L.			0 0	48 7 .		
T.P.	10 138	57 166	1.713	47.028.		
℄ 612+00			6 4	50 8 .		
70 R.			7 3	(49 2)	49.9	
70 L.			6 3	50 9 .		
℄ 613+00			38	53 4 .		
70 R.			4 3	52 9 .		
70 L			3 6	53 6 .		
℄ 614+00			2 5	54 7 .		
70 R.			2 8	54.4 .		
70 L			1 9	55.3 .		
℄ 615+00			1 5	55.7 .		
70 R.			2 0	55 2 .		
70 L			0 0	57 2 .		
T.P.	10.2.80	65 787	1.659	55 507.		
℄ 616+00			8 6	57 2 .		
70 R.			10 5	55 3 .		
70 L			7 3	58 5 .		

Profile No. ____ X-Sec. No. ____

Notes Red. ____ Platted ____ Job No. 4157 Division No. ____

Date ____ Date ____ Survey of Sewer 504 L.B. 332 Pg. 149

Notes Chkd. ____ Checked ____ Survey by Evans Notes ____ Date 11/5/35

Date ____ Date ____ Map No. ____ Indexed A. C. Johnson Date ____

Form 307 5M 10-34

PLEASE RETURN TO
LOS ANGELES COUNTY SURVEYOR
700 HALL OF RECORDS

NOTE: ANY ADDITIONS OR CHANGES ON THIS SHEET MUST BE MADE OR CIRCLED IN RED INK, WITH DATE AND NAME OF PERSON MAKING CHANGE

Do not extend notes this side of this line

L.B. 302 P.G. 13 | Job No. 4153 | Division No. | Notes Red | Plotted | Profile
Survey of Sewer, set + Grade | Date | Date | No.
Survey by Evans Notes [illegible] | Notes Chkd. | Checked | X-Sec.
Indexed A. C. Johnson Date 11/5/35 | Date | Date | No.

STATION	B. S.	H. I.	F. S	ELEV.		
		65.787				
℄ 617+00			8 3	57.5		
70' R.			9 9	55.9		
70' L			5 0	60.8		
℄ 618+00			6 8	59.0		
70 R.			8 9	56.9		
70 L.			3 4	62.4		
℄ 619+00			5 0	60.8		
70' R.			7 0	58.8		
70 L			1 9	64.9		
℄ 619+46			4 5	61.3		
80' R.			5 4	60.4		Top cut
34' L			3 2	62.6		
70' L			1 7	64.1		
℄ 619+80			3 1	62.7		" "
℄ B.C. 619+83 26			3 8	61.9		
10' R.			5 5	60.3		Bot "
25' R.			5 2	60.6		Edge pvmt
58' R.			5 7 0	60.09		℄ "
87 R.			6 6	59.2		Edge, "
7 L			3 0	61.1		Top Bnk

Form 307 5M 10-34

PLEASE RETURN TO
LOS ANGELES COUNTY SURVEYOR
700 HALL OF RECORDS

NOTE: ANY ADDITIONS OR CHANGES ON THIS SHEET MUST BE MADE OR CIRCLED IN RED INK, WITH DATE AND NAME OF PERSON MAKING CHANGE

Do not extend notes this side of this line

STATION	B. S.	H. I.	F. S	ELEV.		
(619+83 26)		65.787				
38 L			2.1	637.		
70 L			1 4	644.		
T.P.	7.090	69.28	3.589	62.198.		
℄ 619+88			8 8	60.5.	gutter Anaheim St.	
℄ 619+94			8 1	61.2.	Edge Pvmt.	
℄ 620+07			7 50	61.79.	℄ "	
		X. Sections		on Anaheim St		
620+07 ℄ Somerset. = 0+00 East on ℄ Anaheim			7 50	61 79	(0+00) going E.	
12' R.			7 8	61.5.	S. Edge Pvmt.	
19 R.			8 4	60 9.	S gutter	
27 R.			6 1	63.2.	T.C.	
12' L			7 8	61 5.	N. edge. Pvmt.	
18' L.			8 4	60 9.	N. Gutter	
24' L			6 3	63 0.	T.C.	
1+00			4 9	64.4.	going East. E Pvmt.	
12 R.			5 0	64.3.	S. Edge Pvmt.	
19 R.			5 4	63.9.	S gutter	
27 R.			2 8	66 5.	T.C.	
12' L			5 0	643.	N. Edge pvmt.	
18 L			5 7	63.6.	N. gutter	
24 L			3 2	66.0.	T.C.	

Profile
Notes Red. Platted
Date Date
Notes Chkd. Checked
Date Date
Map No. Indexed
Job No. 4153 Division No.
Survey of
Survey by
Notes
Date 11/13/35
L. B. 302 Pg. 67
No.
X-Sec.
No.

Form 307 5M 10-34

PLEASE RETURN TO
LOS ANGELES COUNTY SURVEYOR
700 HALL OF RECORDS

NOTE: ANY ADDITIONS OR CHANGES ON THIS SHEET MUST BE MADE OR CIRCLED IN RED INK, WITH DATE AND NAME OF PERSON MAKING CHANGE

Do not extend notes this side of this line

L.B. 302 P.G. 52 | Division No. 4153 | Job. No. 4153 | Profile
Survey of Somerset & Cty. Rd. | Plotted | No.
Survey by Evans & Lee | Notes | Date | Notes Red | Date | X-Sec.
Indexed C. Johnson | Date 11/5/35 | Notes Chkd. | Date | Checked | Date | No.

STATION	B. S.	H. I.	F. S	ELEV.		
		69.288				
2+00			2.1	67.2	& Pvmt.	(2+00 East on Anaheim
12R.			2.2	67.1	S. Edge Pvmt.	
19R.			2.5	66.8	S gutter	
27R.			+1.8	71.1	T.C.	
12'L			2.2	67.1	N. edge Pvmt.	
18'L			2.7	66.6	N. Gutter	
24'L			+0.7	70.0	T.C.	
3+00			+0.1	69.4	(3+00 east & Anaheim St Pvmt.)	
12R.			0.2	69.3	S. edge Pvmt.	
19R.			0.4	69.1	S Gutter	
27R.			+2.9	72.2	T.C.	
12L.			0.1	69.2	N. edge Pvmt.	
18L			0.4	68.9	N. gutter.	
24'L			+2.3	71.6	T.C.	
1+00 going W			10.2	59.1	& Anaheim St.	
12R.			10.5	58.8	N. edge pvmt.	
18R.			10.9	58.4	N. gutter	
24R.			8.8	60.5	T.C.	
12'L.			10.3	59.0	S. edge Pvmt.	

Form 307 5M 10-34

PLEASE RETURN TO
LOS ANGELES COUNTY SURVEYOR
700 HALL OF RECORDS

NOTE: ANY ADDITIONS OR CHANGES ON THIS SHEET MUST BE MADE OR CIRCLED IN RED INK, WITH DATE AND NAME OF PERSON MAKING CHANGE

Do not extend notes this side of this line

Profile No.___ X-Sec. No.___ Notes Red.___ Date___ Notes Chkd.___ Date___ Platted___ Date___ Checked___ Date___ Job No. 4159 Division No.___ Survey of Santa Ana Freeway Survey by Evans Notes L. C. Date 11/5/53 Map No.___ Indexed L. C. Job Date___ L. B. 302 PG. 53

STATION	B. S.	H. I.	F. S	ELEV.		
(℄ Anaheim 1+00 going W)		69.288				
19 L.			11.1	58.2	S gutter	
27 L			9.2	60.1	T.C.	
2+00			12.6	56.7	℄ Anaheim 2+00 going W.	
12 R.			12.7	56.6	N. edge pvmt.	
18 R.			13.2	56.1	N. gutter	
24 R.			11.3	58.0	T.C.	
12 L			12.8	56.5	S. edge pvmt.	
19 L			13.4	55.9	S. gutter	
27 L			11.2	58.1	T.C.	
		Going Ahead on ℄ Converse				
℄ 620+21			7.7	61.6	S. edge pvmt	
℄ 620+28			8.1	61.2	S. gutter	
℄ 620+36			6.9	63.3	T.C.	
℄ 620+62			6.5	62.8		
70 R.			7.9	61.4		
52 L			3.9	65.4	T.C.	
70 L.			5.9	63.4	S. gutter	
℄ 621+00			5.2	64.1		
70 R.			7.2	62.1		
70 L.			3.1	66.2		

Form 307 5M 10-34

PLEASE RETURN TO
LOS ANGELES COUNTY SURVEYOR
700 HALL OF RECORDS

NOTE: ANY ADDITIONS OR CHANGES ON THIS SHEET MUST BE MADE OR CIRCLED IN RED INK, WITH DATE AND NAME OF PERSON MAKING CHANGE

Do not extend notes this side of this line

L.B. 302 P.G. 154 Job No. 4159 Division No. ____ Notes Red ____ Plotted ____ Profile
Survey of Somerset Ave. Date ____ Date ____ No. ____
Survey by Evans Notes ____ Notes Chkd. ____ Checked ____ X-Sec.
Indexed A. C. Johnson Date 11/25/25 Date ____ Date ____ No. ____

STATION	B. S.	H. I.	F. S	ELEV.		
		69+288				
B.M. #52	9.780	76.585	2483	66.805	B.M. #52. - Set cut & pk. W. side Tel. P. #6111 U.S. on N side Anaheim St. 90± Left of Sta. 620+28 El. = 66.805	
℄ 622+00			92	67.4		
70' R.			12°	64.6		
70' L			7.1	67.5		
℄ 623+00			51	71.5		
70' R.			78	66.8		
70' L			38	72.8		
℄ 624+00			29	73.7		
70' R.			42	72.4		
70' L			15	75.1		
625+00			09	75.7		
70' R.			21	74.2		
70' L			05	76.1		
I.P.	8.250	82.460	2375	74.210		
E.C. 625+76.28			51	76.8		
70' R.			6.1	75.8		
70' L.			55	77.0		
626+00 ℄			56	76.1		
626+48 ℄			56	76.9		
627+00 ℄			49	77.6		

Form 307 5M 10-34

PLEASE RETURN TO
LOS ANGELES COUNTY SURVEYOR
700 HALL OF RECORDS

NOTE: ANY ADDITIONS OR CHANGES ON THIS SHEET MUST BE MADE OR CIRCLED IN RED INK, WITH DATE AND NAME OF PERSON MAKING CHANGE

Do not extend notes this side of this line

Profile No.____ Notes Red.____ Platted____ Job No. 415 Division No.____ L. B. 302 PG. 155
X-Sec. No.____ Date____ Date____ Survey of Sewer set Ave.
Notes Chkd.____ Checked____ Survey by Travis Notes A. C. Job Date 11/5/35
Date____ Date____ Map No.____ Indexed____

STATION	B. S.	H. I.	F. S	ELEV.		
(627+00)		82.460				
70'R.			55	77.0		
70'L.			43	78.2		
℄ 627+22			55	77.0		
℄ 628+00			41	78.4		
70 R.			45	78.0		
70 L.			41	78.4		
629+00			36	78.9		
70 R.			43	78.2		
70 L.			34	79.1		
T.P.	4.545	83.235	3.770	78.690		
℄ 630+00			48	78.4		
70'R.			51	78.1		
70'L			39	79.3		
℄ 631+00			48	78.4		
70'R.			55	77.7		
70'L			4.5	78.7		
℄ 632+00			46	78.6		
E.C. ℄ 631+11.18			44	78.8		
70'R.			57	77.5		
70'L.			42	79.0		

Form 307 5M 10-34

PLEASE RETURN TO
LOS ANGELES COUNTY SURVEYOR
700 HALL OF RECORDS

NOTE: ANY ADDITIONS OR CHANGES ON THIS SHEET MUST BE MADE OR CIRCLED IN RED INK, WITH DATE AND NAME OF PERSON MAKING CHANGE

Do not extend notes this side of this line

L.B. 302 P.G. 156 | Job. No. 4157 Division No. | Notes Red | Plotted | Profile
Survey of Somerset Ave | Date | No.
Survey by E.V. Jones & C. Johnson | Notes Chkd. | Checked | X-Sec.
Indexed | Date 11/15/35 | Date | No.

STATION	B. S.	H. I.	F. S	ELEV.		
		83.235 ✓				
℄ 633+00			4.6	78.6		
70' R.			5.2	78.0		
70' L			4.0	79.2		
℄ 634+00			4.1	79.1		
70' R.			4.8	78.4		
70' L.			4.0	79.2		
T.P.	4.463	83.583 ✓	4.115	79.120		
℄ 634+50			4.6	78.0		
70' R.			4.7	78.9		
38' L.			5.1	78.5		
54' L			6.0	77.6		
67' L			5.2	78.4		
70' L.			4.3	79.3		
℄ 634+65			4.9	78.7		
℄ 634+69			6.5	77.1		
634+76			7.1	76.5		
+89			6.6	77.0	N. edge pvmt.	
635+04			6.2	77.4	& int. 7th St. & Somerset Ave.	

Form 307 5M 10-34

PLEASE RETURN TO
LOS ANGELES COUNTY SURVEYOR
700 HALL OF RECORDS

NOTE: ANY ADDITIONS OR CHANGES ON THIS SHEET MUST BE MADE OR CIRCLED IN RED INK, WITH DATE AND NAME OF PERSON MAKING CHANGE

Do not extend notes this side of this line

Profile No.____ Notes Red.____ Platted____ Job No. 4152 Division No.____ L. B. 202 Pg. 157
X-Sec. No.____ Date____ Date____ Survey of Sonora Set Conc.
Notes Chkd.____ Checked____ Survey by Davis Notes ____ Date 11/5/35
Date____ Date____ Map No.____ Indexed C. Johnson

STATION	B. S.	H. I.	F. S	ELEV.		
		83.583				
	X		Sec. on ℄		7th St.	
635+04 & Sonora Jct = 0+00 East & West on ℄ 7th St.			62	774.	℄ 7th St.	
14R.			63	773.	S. edge Pvmt.	
30'R.			74	762.	S gutter	
32'R.			64	772.		
36'R.			68	768.		
40'R.			50	786.	T.C.	
14L.			66	770.	N. edge pvmt.	
27'L			71	765.	N. gutter	
28'L.			68	768.		
36'L			64	772.		
39'L			47	789.	T.C.	
1+00			60	776.	1+00 going E ℄ 7th St.	
14R.			63	773.	S. edge Pvmt.	
30'R.			71	765.	S gutter	
32R.			63	773.		
36R.			64	772.		
40R.			46	790.	T.C.	

Form 307 5M 10-34

PLEASE RETURN TO
LOS ANGELES COUNTY SURVEYOR
700 HALL OF RECORDS

NOTE: ANY ADDITIONS OR CHANGES ON THIS SHEET MUST BE MADE OR CIRCLED IN RED INK, WITH DATE AND NAME OF PERSON MAKING CHANGE

Do not extend notes this side of this line

L.B. 302 P.G. 158 | Job No. 4157 | Division No. | Notes Red | Plotted | Profile
Survey of Sewer Set Ave | Date | Date | No.
Survey by E. Sands | Notes | Notes Chkd. | Checked | X-Sec.
Indexed A. C. Johnson | Date 11/6/35 | Date | Date | No.

STATION	B. S.	H. I.	F. S	ELEV.		
(1+00)		83.583 ✓			1+00 going E. & 7th.	
14 L			6 3	77 3	N. edge Pvmt	
27 L			7 0	76 6	N gutter	
28 L			6 5	77 1		
36 L			6 2	77 4		
39 L			4 0	79 6	T.C.	
2+00			[illegible]	77 8	2+00 going E.	& 7th
14 R.			6 0	[illegible]	S. Edge pvmt.	
20 R.			6 4	77 9	S gutter	
32 R.			6 3	77 3		
36 R.			6 3	77 3		
40 R.			4 3	79 3	T.C.	
14 L			6 0	77 6	N. edge pvmt.	
27 L			6 6	77 0	N gutter	
28 L			6 0	77 5		
36 L			5 6	[illegible]		
39 L.			3 5	[illegible]	T.C.	
1+00 going West			6 2	77 1	& 7th St.	
14 R.			7 0	[illegible]	N. edge pvmt	
27 R.			7 4	[illegible]	N gutter.	

Form 307 5M 10-34

PLEASE RETURN TO
LOS ANGELES COUNTY SURVEYOR
700 HALL OF RECORDS

NOTE: ANY ADDITIONS OR CHANGES ON THIS SHEET MUST BE MADE OR CIRCLED IN RED INK, WITH DATE AND NAME OF PERSON MAKING CHANGE

Do not extend notes this side of this line

STATION	B. S.	H. I.	F. S	ELEV.		
		83 583				
28 R.			7 1	765		
36 R.			6 8	768		
39 R.			5 5	781	T. C.	
14 L.			6 2	76.8	S edge prmt	
30 L.			7.5	761	S. gutter	
32 L			6 9	767		
36 L			7 0	766		
40 L			5 6	780	T. C.	
2+00 ℄ Ave W.			7 °	766		
14 R.			7 1	765	N edge prmt.	
27 R.			7 9	757	N. gutter	
28 R.			7 6	760		
36 R.			7 4	762		
39 R.			6 5	771	T. C.	
14 L			7 2	764	S edge prmt.	
30 L			7 9	757	S. gutter	
32 L			7 4	762		
36 L			7 6	760		
40 L.			6 4	772		

Profile No. ____ X-Sec. No. ____

Notes Red. ____ Date ____ Notes Chkd. ____ Date ____

Platted ____ Date ____ Checked ____ Date ____

Job No. 4158 Division No. ____ Survey of Sawtelle Ave. Survey by Evans Notes ____ Map No. ____ Indexed A. C. Job Date 11/8/35

L. B. 3302 PG. 159

Form 307 5M 10-34

PLEASE RETURN TO
LOS ANGELES COUNTY SURVEYOR
700 HALL OF RECORDS

NOTE: ANY ADDITIONS OR CHANGES ON THIS SHEET MUST BE MADE OR CIRCLED IN RED INK, WITH DATE AND NAME OF PERSON MAKING CHANGE

Do not extend notes this side of this line

L.B. 302 P.G. 160 | Job. No. 419 | Division No. 4 Ave. | Notes Red | Plotted | Profile
Survey of Somerset | Date | Date | No.
Survey by Evans | Notes LE | Notes Chkd. | Checked | X-Sec.
Indexed A. C. Johnson | Date 11/5/35 | Date | Date | No.

STATION	B. S.	H. I.	F. S	ELEV.		
		22.583				
	Sur	Ahead			L. Sewer cut	
℄ 635+17			6 3		S. edge of road	
635+33			7 4		S. gutter	
+36			6 5			
+40			6 6			
+45			4 6			
℄ 635+50			4 5			
70R			5 2			
50L			4 1			
54L			4 9			
57L			4 0			
70'L			4.6			
℄ 636+00			4.8			
70R			5 0			
46L			4 1			
49L			5 3			
53L			3 3			
70L			4 6			
637+00 ℄			5 0			
70R.			5 0			

Form 307 5M 10-34

PLEASE RETURN TO
LOS ANGELES COUNTY SURVEYOR
700 HALL OF RECORDS

NOTE: ANY ADDITIONS OR CHANGES ON THIS SHEET MUST BE MADE OR CIRCLED IN RED INK, WITH DATE AND NAME OF PERSON MAKING CHANGE

Do not extend notes this side of this line

STATION	B. S.	H. I.	F. S	ELEV.		
(637+00)		83.583 ✓				
38'L			5.0	786.		
40'L			6.1	775.		
44'L			4.2	794.		
70'L			5.0	786.		
638+00 L			6.2	774.		
E.C.						
℄ 638+04.20			6.2	774.		
58'R.			5.0	786.	T.C.	
63'R.			7.3	763.	B.C.	
70'R.			7.8	758.		
20'L.			7.1	765.		
23'L			6.2	774.		
33'L			6.1	775.		
38'L			8.0	756.		
42'L			6.7	769.		
70'L			8.0	750.		
T.P.	5.521	82.129 ✓	6.975	76.608.		
℄ 638+51			4.7	774.	T.C.	
℄ +55			6.5	756.	B.cut.	
℄ 638+79			6.0	761.		
12'R.			5.99	761.4.	Nodge brmt.	
49'R.			5.37	76.76.	℄ "	

Profile No.
Notes Red. Date
X-Sec. No.
Platted Date
Notes Chkd. Date
Checked Date
Job No. 459 Division No.
Survey of Samerset Ave.
Survey by
Map No.
Notes Date
Indexed A. C. Job
L. B. 302 PG. 161

Form 307 5M 10-34

PLEASE RETURN TO
LOS ANGELES COUNTY SURVEYOR
700 HALL OF RECORDS

NOTE: ANY ADDITIONS OR CHANGES ON THIS SHEET MUST BE MADE OR CIRCLED IN RED INK, WITH DATE AND NAME OF PERSON MAKING CHANGE

Do not extend notes this side of this line

L.B. 302 P.G. 162 Job. No. 459 Division No. ___ Notes Red ___ Plotted ___ Profile ___
Survey of Sewers, Sec. 23, ... Date ___ No. ___
Survey by C. Johnson Notes ___ Notes Chkd. ___ Checked ___ X-Sec. ___
Indexed ... Date 11/5/34 Date ___ Date ___ No. ___

STATION	B. S.	H. I.	F. S	ELEV.		
(638+79)		82.129				
86 R.			5.18	76.95		
30' L.			7.0	75.1	Bldg.	
34' L			5.2	76.9	T.C.	
37 L.			5.2	76.9		
43 L			4.7	77.4		
70' L			6.5	75.6		
[illegible]			6.27	75.82	N. edge pvmt.	
℄ 639+14.47			6.4	75.72	℄ State St.	End of Survey

X Sec. on ℄ State St.

639+14.47 ℄ Somerset [illegible] E. & W. ℄ State St.			6.41	75.72	Notice ℄ State.	
20 R.			6.54	75.59	N edge pvmt.	
45 R.			6.9	75.4	N gutter	
47 R.			5.7	76.4	T.C.	
20 L.			6.57	75.56	S edge pvmt.	
38 L			7.2	74.9	gutter	
49 L			6.8	75.3		
0+26			5.99	76.14	℄ State St.	0+26 going west.
20 L.			6.16	75.97	S edge pvmt.	
38 L.			6.7	75.4	S. gutter	

Form 307 5M 10-34

PLEASE RETURN TO
LOS ANGELES COUNTY SURVEYOR
700 HALL OF RECORDS

NOTE: ANY ADDITIONS OR CHANGES ON THIS SHEET MUST BE MADE OR CIRCLED IN RED INK, WITH DATE AND NAME OF PERSON MAKING CHANGE

Do not extend notes this side of this line

Profile No.____ X-Sec. No.____ Notes Red.____ Date____ Notes Chkd.____ Date____ Platted____ Date____ Checked____ Date____ Job No. 4159 Division No.____ Survey of Lawndale Area Survey by Evans Notes A. C. Johnson Map No.____ Indexed____ Date 11/5/35 L. B. 302 Pg. 163

STATION	B. S.	H. I.	F. S	ELEV.		
		82.129				
38L			6.04	76.09	Top curb.	
49L.			5 80	7633	Back walk.	
		Inter polate		Rt side of Sec.		
1+00			492	7721	℄ State 1+00	West
20R.			5 14	76.99	N. edge	
45R.			6 1	760	gutter	
47R.			35	786	T.C.	
20'L.			512	77.01	S edge prmt.	
38'L.			59	76.2	S gutter	
38L			5 14	7699	Top curb	
49L.			484	77.29	back walk.	
2+00			423	77.90	℄ State	
20R.			450	7763	N. edge prmt.	
45R.			51	770	N gutter	
47R.			3 4	78.7	T.C.	
20'L			4 45	7768	S. edge prmt.	
38'L			5 3	768	S. gutter	
38L			4.38	7775	Top curb.	
49L.			4 13	78.00	Back walk.	

Form 307 5M 10-34

PLEASE RETURN TO
LOS ANGELES COUNTY SURVEYOR
700 HALL OF RECORDS

NOTE: ANY ADDITIONS OR CHANGES ON THIS SHEET MUST BE MADE OR CIRCLED IN RED INK, WITH DATE AND NAME OF PERSON MAKING CHANGE

Do not extend notes this side of this line

L.B. 302 P.G. 104 | Job No. 4159 | Division No. | Notes Red | Plotted | Profile
Survey of Sawtelle Ave. | Date | Date | No.
Survey by Evans | Notes | Notes Chkd. | Checked | X-Sec.
Indexed by C. Johnson | Date | Date | Date | No.

STATION	B. S.	H. I.	F. S	ELEV.		
		82.129 ✓				
0+20			6.82	75.31	0+20 going E. ℄ State.	
20'R.			7.00	75.13	S. edge pvmt.	
43R.			7.8	74.3	gutter	
47R.			6.6	75.5		
20'L.			6.57	75.26	N. edge pvmt.	
45'L			7.4	74.7	gutter	
47'L			5.4	76.1	T.C.	
0+24			6.57	75.26	going E. ℄ St. to	
20'R.			7.05	75.08	S. edge pvmt.	
43R.			7.9	74.2	gutter	
47R.			3.3	78.8	T.C.	
Interpolate for 14+					of 500.	
1400			8.58	73.55	℄ State St. going E.	
20R.			7.75	73.40	S edge pvmt.	
43R.			9.5	72.0	S. gutter	
47R.			4.7	77.4	T.C.	
20'L			8.73	73.40	N. edge pvmt.	
45L			9.7	72.4	N gutter.	
47L.			8.4	73.9	T.C.	

Form 307 5M 10-34

PLEASE RETURN TO
LOS ANGELES COUNTY SURVEYOR
700 HALL OF RECORDS

NOTE: ANY ADDITIONS OR CHANGES ON THIS SHEET MUST BE MADE OR CIRCLED IN RED INK, WITH DATE AND NAME OF PERSON MAKING CHANGE

Do not extend notes this side of this line

STATION	B. S.	H. I.	F. S	ELEV.		
		82.129				
2+00			11.44	70.69	℄ State St.	
20 R.			11.61	70.52	S edge pvmt.	
43 R.			12.8	69.3	S. gutter	
47 R.			9.6	72.5	T.C.	
20 L.			11.59	70.54	N. edge pvmt.	
45 L.			12.7	69.4	N. gutter	
47 L.			11.1	71.0	T.C.	
T.P.	3.012	80.664	4.477	77.652		
T.P.	1.353	71.611	10.406	70.258		
T.P.	0.87	61.463	11.018	60.593		
T.P.	2.189	53.751	9.901	51.562		
T.P.	7.500	57.016	4.235	49.516		
T.P.	3.934	56.275	4.675	52.341		
T.P.	3.720	56.888	3.107	53.168		
T.P.	4.215	55.945	5.158	51.730		
B.M. 45			2.885	53.060	B.M. 45 - Fd. spk. in W. side pepper tree S. side Anaheim St. 65.4' Rt. of old & Somerset Ave. per State Hgwy Map. Dist VII L.A. County Feeder Sheet 6. El. 53.001 53.06 .059 Error	

Profile
No. ____ Notes Red. ____ Platted ____ Job No. 458 Division No. ____
X-Sec. ____ Date ____ Date ____ Survey of Somerset + Alley
No. ____ Notes Chkd. ____ Checked ____ Survey by E. Watts Notes A. C. Jones
Date ____ Date ____ Date ____ Map No. ____ Indexed ____ Date 11/5/35

L. B. 302 Pg. 165

L.B. 302 P.G. 166 | Job. No. ____ Division No. ____ Notes Red ____ Plotted ____ Profile

Survey of ____ Date ____ Date ____ No. ____

Survey by ____ Notes ____ Notes Chkd. ____ Checked ____ X-Sec.

Indexed A. C. Johnson Date ____ Date ____ Date ____ No. ____

STATION	B. S.	H. I.	F. S	ELEV.	

Form 307 5M 10-34

PLEASE RETURN TO
LOS ANGELES COUNTY SURVEYOR
700 HALL OF RECORDS

Do not extend notes this side of this line

NOTE: ANY ADDITIONS OR CHANGES ON THIS SHEET MUST BE MADE OR CIRCLED IN RED INK, WITH DATE AND NAME OF PERSON MAKING CHANGE

Notes Ck'd by McPherson	Survey of Somerset Ave.	F.B. 302 Pg. 167
Map No. B-117,C.	W. O. 4159 Tape No ___ St'd ___ of.	
Office Work Price-MSP.	Surveyed by Moore	
Checked Drew	Notes Moore Date 11-5-35	
Date Nov. 20-1935	Indexed A. C. Johnson 11-21-35	

Note: ANY ADDITIONS OR CHANGES ON THIS SHEET MUST BE MADE OR CIRCLED IN Red Ink WITH DATE AND NAME OF PERSON MAKING CHANGE.

Do not extend notes this side of this line

RETURN TO
LOS ANGELES COUNTY SURVEYOR
700 HALL OF RECORDS

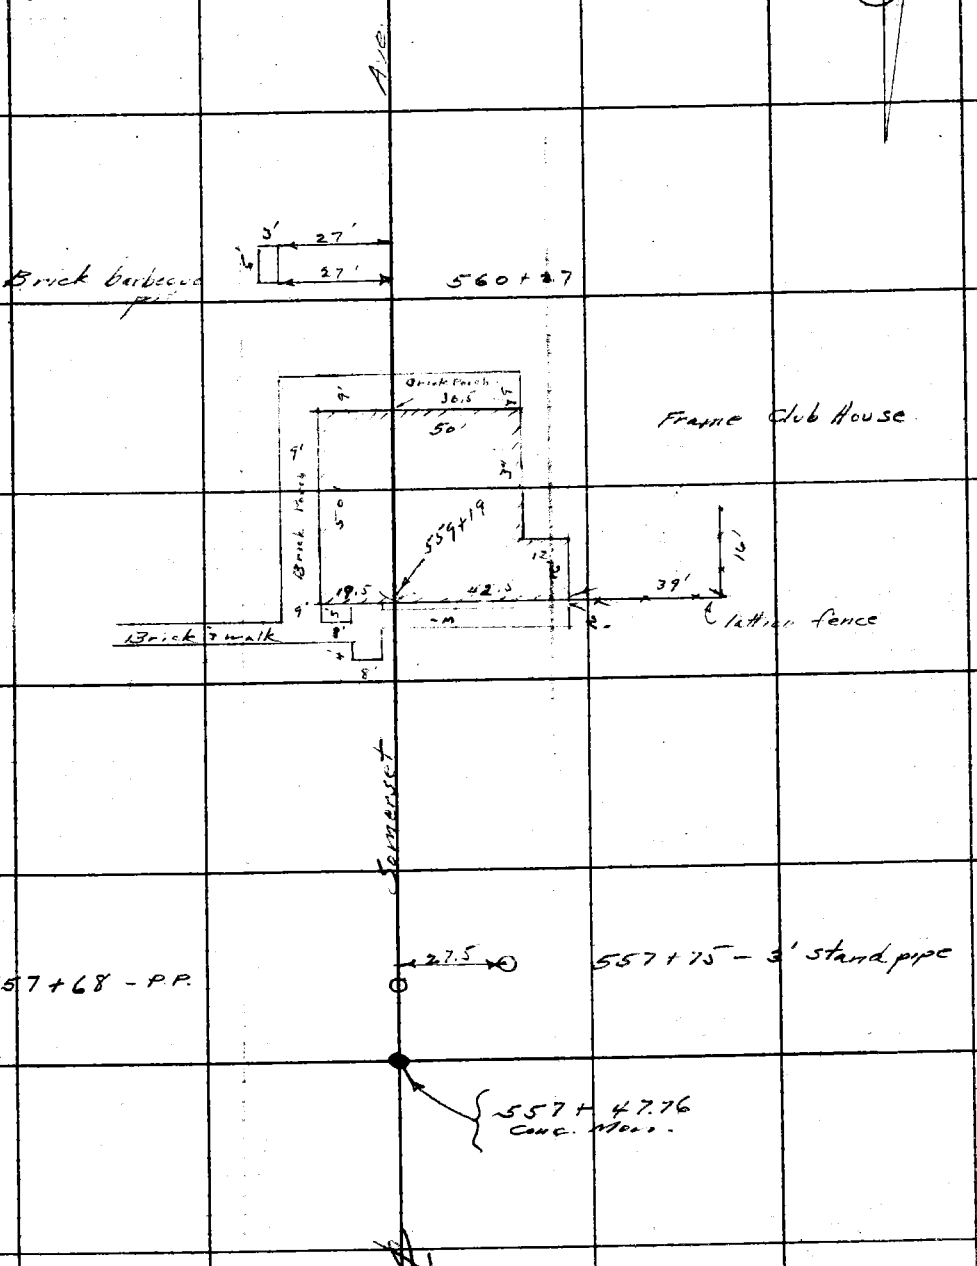

FORM 247 SM 2-34

F.B. 302 PG. 168

Sta	offset Left	offset Right		✓
557 + 81.5		13'	2" Poplar	
"		43'	" "	
"	15'		" "	
"	38'		" "	
557 + 93	1'		" "	
558 + 07.5	28'		6" Palm	
558 + 15	35'		2" Poplar	
558 + 18.5		32'	6" Palm	
558 + 40		12'	" "	
558 + 66		1'	" "	
558 + 72	48'		" "	
558 + 86	51		2" Poplar	
559 + 19	56		2" "	
559 + 19	28		1" Hydrant	
559 + 74		70'	2" Poplar	
" + 78		44'	2" "	
561 + 41	3'		Tel p	
563 + 27	2'		"	
565 + 17	1'		"	
" + "	44'		N. end rail fence	
567 + 06	1'		Tel p	
568 + [illegible]	17'		S. end rail fence	
568 + 51	1'		[illegible]	
572 + 59	1'		"	
573 + 07	2'		Tel p + Cor. wire fence runs East + South	
574 + 65		2'	Tel p + fence	
576 + 65		24'	" "	
577 + 87		46.5	" "	
587 + 97	24'		Cor. Wire fence runs E + S.W	
588 + 08	24'		3" Cottonwood	
588 + 10			L + fence	
588 + 16.5	53'		Cor.	
+ 28	17.5		3" Cottonwood	
+ 33	24		" "	
+ 48	on ℄		" "	
+ 54		10'	2" Shrub	
+ 54		65'	Fence Cor - runs W + NE	
+ 66	25		3" Cottonwood	
+ 66		33'	" "	
+ 78		21'	2" Shrub	
+ 80		50'	2" "	
+ 81		39'	3" cottonwood	
+ 85	10'		" "	
+ 90		59'	" "	
+ 98		26'	" "	
589 + 01		65'	" "	
+ 04		16'	" "	
+ 10		36'	" "	
+ 06	19'		" "	
+ 21		8'	" "	
"		52'	" "	
"	11.5		" "	
+ 27		67'	" apple	
+ "	1'		" Shrub	

RETURN TO
LOS ANGELES COUNTY SURVEYOR
700 HALL OF RECORDS

Do not extend notes this side of this line

Note: ANY ADDITIONS OR CHANGES ON THIS SHEET MUST BE MADE OR CIRCLED IN Red Ink WITH DATE AND NAME OF PERSON MAKING CHANGE.

Notes Cd by McPherson | Survey of Somerset Ave | F.B. 302 Pg 169
Map No. B-117,6 | W. O. 4157 Tape No ____ St'd ____ °F.
Office Work Price-McP. | Surveyed by Moore
Checked Drew | Notes Moore Date
Date Nov-20-1935 | Indexed A. C. Johnson

Sta	Left	Right	
589+38	23'	56'	3" cottonwood fence Cor - run E + NW
+ 40		1'	3" cottonwood
+ 44		18'	"
+ 48		33'	"
+ 51		56'	" Shrub
+ 59		6'	" Cottonwood
+ 61		44'	" " "
+ 71		25'	" " "
+ 74		57	" " "
+ 77	6.5		18" willow
+ 80		31'	3" cottonwood
+ 93		3'	18" willow
+ 96		4.5'	"
+ 97		48'	2" cottonwood
590 + 12		35'	3" "
+ 20	11'		18" willow
+ 28	5'		" "
+ 37	5.5		3" Pear
+		32'	"
+ 59		4'	3" cottonwood
+ 41	43'		24" willow
+ 43		10'	3" Pear
+ 49		11'	12" Willow
+ 50	38'		18" "
+ 57	15'		3" Pear
+ 59	25'		" "
+ 67	56'		" "
+ 65		20	2" "
+ 71	8.5		2" Pear
+ 73		18'	NW Cor. wooden bridge
+ 84	54'		3" "
+ 86		6'	NW Cor. Bridge
+ 86	15'		2" Pear
+ 95		27.5'	SW Cor Bridge
+ 95		2'	12" Willow
+ 98		36'	" "
591 + 06		31'	Pepper
+ 00		47	3" Acacia
+ 11		18'	SE Cor. Bridge
+ 17	16'		18" willow
+ 21	38'		3" Pear
+ 27	60'		" "
+ 35		55'	" Pepper
+ 37		37'	" "
+ 50			" Pear
+ 58	56'		" Pepper
+ 80		52'	" "
600 + 13		18'	2" Shrub
+ 19		1'	" "
+ 19		34'	" "
+ 31		54	" "
+ 42		12'	" "
+ 57		31'	" "
+ 61		18'	" "
+ 68		34'	" "
+ 73		1'	3" Acacia
+ 89		9'	2" Shrub
601 + 00		57	3" Acacia
600 + 01	21'		2" Shrub
+ 06	70'		" "
+ 09	9'		" "
+ 14	45'		" "
+ 24	50		" "

Note: ANY ADDITIONS OR CHANGES ON THIS SHEET MUST BE MADE OR CIRCLED IN Red Ink WITH DATE AND NAME OF PERSON MAKING CHANGE.

Do not extend notes this side of this line

RETURN TO
LOS ANGELES COUNTY SURVEYOR
700 HALL OF RECORDS

FORM 247 BM 2-34

F.B. 302 Pg. 170

Sta ✓	Left	Right	
600 + 29	6'		2" Shrub
+ 32	38'		" "
+ 42	50		" "
+ 43	30		" "
+ 54	64		" "
+ 58	47'		" "
+ 60	31'		" "
+ 80	12'		" "
+ 83	55'		" "
+ 89	23'		" "
601 + 03	47'		" "
+ 08	43		" "
+ 18	17		" "
+ 27	on ℄		" "
+ 27	12'		3" Acacia
	32'		2" Shrub
601 + 03		5'	2" Shrub
+ 05		36	" "
+ 18		69'	" "
+ 23		26'	" "
+ 25		47'	" "
+ 28		10'	" "
+ 38		25'	" "
+ 41		1'	" "
618 + 54		60'	2" Shrub
619 + 00		40	" "
+ 00		58	" "
+ 06		70'	" "
+ 12		22'	3" Pine
+ 17		[illegible]	2" Shrub
+ 35		130	" "
+ 35		70	" "
+ 36		12'	" "
+ 46		54	" "
+ 50		20'	" "
+ 52		38'	3" Acacia
+ 63		38'	24" Pepper
+ 66		71'	2" Shrub
+ 69		30'	pp
619 + 33	2'		2" Shrub
+ 41	18'		" "
+ 45	1'		" "
+ 56	7'		" "
+ 56	30'		" "
+ 56	43'		" "
+ 63	57'		" "
+ 71	9'		" "
+ 81	41		" "
+ 89	19'		24" Pepper
+ 93	20'		2" Shrub

Macadam pave - 24' wide - splits 12' + 12' either side of ℄ Anaheim St.

RETURN TO
LOS ANGELES COUNTY SURVEYOR
700 HALL OF RECORDS

Note: ANY ADDITIONS OR CHANGES ON THIS SHEET MUST BE MADE OR CIRCLED IN Red Ink WITH DATE AND NAME OF PERSON MAKING CHANGE.

Do not extend notes this side of this line

Notes Ck'd by McKeown
Map No. C.S. B-1176
Office Work Price - McKee
Checked Drew
Date Nov-20-1935

Survey of Somerset Ave
W. O. 4159 Tape No ____ St'd ____ OF.
Surveyed by Moore
Notes Moore Date 11-6-35
Indexed A. C. Johnson 11-6-35

F.B. 302 PG. 171

Sta	Left	Right	
620 + 12		42'	24" Pepper
+ 14		62'	2" Shrub
+ 27		37'	" "
+ 32		58'	" "
+ 33		6.5	2" Hydrant
+ 48		19'	2" Gum
+ 55		1'	2" "
+ 55		30'	2" Shrub
+ 57		66'	" "
+ 68		23'	" "
+ 79		4'	" "
+ 83		34'	2" Pepper
+ 83		69	" Shrub
+ 89		52'	" "
+ 96		12'	" "
621 + 09		11'	" loquot
+ 21		2'	" "
620 + 44	14'		24" Pepper
+ 61	15'		2" Shrub
+ 76	48'		" "
+ 81	32'		" "
+ 92	8		" Gum
621 + 00	60'		" Pine
+ 08	24'		" Shrub
+ 17	9'		" Pine
+ 21	59'		" loquot
+ 28	24'		" Shrub
+ 35	55'		" "
+ 37	38'		" Acacia
+ 49	49		" Shrub
+ 52	67		" Pine
630 + 07	66'		2" Shrub
+ 22	55'		" Olive
+ 31	63'		" Shrub
+ 33	42'		" Shrub
+ 52	35'		" Fruit tree
+ 53	67'		" Pine
+ 57	56'		" Shrub
+ 67	33'		3" Pine
+ 79	26'		3" Holly
+ 79	58'		" Acacia
+ 91	39'		2" Cypress
+ 91	59'		" Shrub
621 + 03	36'		" "
+ 14	48'		" Pine
+ 17	25'		" Fruit tree
+ 25	37'		" Cypress
+ 25	53'		" Shrub
+ 25	67'		" Holly
+ 34	21'		" Shrub
+ 49	Ca		" Cypress
+ 50	40'		" Shrub
+ 50	43'		" "
+ 54	68'		" "
+ 60	44'		" "
+ 65	28'		" "
+ 65	65'		" Pine
+ 73	60'		" Holly
+ 78	33'		" Pine
+ 85	60'		" Cypress
632 + 02	48'		" Pine

Note: ANY ADDITIONS OR CHANGES ON THIS SHEET MUST BE MADE OR CIRCLED IN Red Ink WITH DATE AND NAME OF PERSON MAKING CHARGE.

Do not extend notes this side of this line

RETURN TO
LOS ANGELES COUNTY SURVEYOR
700 HALL OF RECORDS

FORM 247 BM 2-34

F.B. 302 PG. 172

Sta	Left	Right	
632 + 21	47'		2" Shrub
+ 21	63		" "
+ 34	54		" Pine
+ 47	56		" Shrub
+ 62	47		3" "
+ 69	71		2" Pine
+ 76	43'		" Olive
+ 80	60		" Holly
+ 88	41		" Cypress
+ 98	50		" Pine
633 + 07	40		" Shrub
+ 11	61		3" Cypress
+ 21	49		2" Shrub
+ 26	33		" Acacia
+ 36	58		" Pine
+ 41	41		" Shrub
+ 55	6		" Loquot
+ 63	41		" Pine
+ 73	5		" "
+ 51	19		" Shrub
+ 52	32		3" Acacia
+ 89	31		2" Cypress
+ 93	43'		" Shrub
+ 95	52		" Holly
634 + 11	14		" Shrub
+ 11	31		" Pine
+ 15	47		" Loquot
+ 24	17		" "
+ 24	6		" Shrub
+ 28	30'		" Pine
✓ + 30	5'		" "
+ 34	42		" Cypress
+ 41	31		" Shrub
+ 48	17		" "
+ 48	47		" Acacia
+ 56	6		" Shrub
633 + 71		6'	2" Shrub
+ 78		28'	" "
+ 80		17'	" Pine
✓ + 86		40	" Cypress
+ 86		57	" Pine
+ 96		78	" Cypress
634 + 00		10'	" Holly
+ 02		35	" Olive
+ 05		4'	" Pine
+ 05		20	" Shrub
+ 13		53	" "
+ 17		31	" "
+ 24		65'	" "
+ 26		7'	" Olive
✓ + 26		22'	" Cypress
+ 29		41	" Pine
+ 34		53	" Shrub
+ 40		33'	" "
+ 50		8'	" "
+ 54		17'	" "
+ 64	℄	47	" Pepper
+ 83	69'		wire fence - runs parallel to 7th St.
+ 73			fence Cor - Runs E + W + N.
			2" pepper

Macadam Pave. - 28' wide - Splits 14' + 14' either side ℄ 7th St

635 + 22		57'	P.P.
+ 28		30'	2" Pepper
✓ + 45	℄		wire fence - parallel to 7th St
+ 42	20'		2" pepper
+ 54	56'		fence Cor. - Run. E + W + S.

RETURN TO
LOS ANGELES COUNTY SURVEYOR
700 HALL OF RECORDS

Note: ANY ADDITIONS OR CHANGES ON THIS SHEET MUST BE MADE OR CIRCLED IN Red Ink WITH DATE AND NAME OF PERSON MAKING CHANGE.

Do not extend notes this side of this line

Notes Ck'd by McPherson	Survey of Somerset Ave	F.B. 302	Pg. 173
Map No. B-1176	W. O. 4159 Tape No	St'd	of.
Office Work Price-McPh.	Surveyed by Moore		
Checked Drew	Notes Moore Date 11-6-36		
Date NOV. 20-1935	Indexed A. C. Johnson 11-6-35		

		Left	Right	
	637+93		32'	2" Sycamore
	638+25	3'		3" pine
	+43.5	40'		fence Cor. - Runs N+S ± parallel to Hathaway
	+46	38'		2" Sycamore
	+48	℄		wire fence - parallel to Hathaway
	+58	4'		2" pepper

Concrete pave. - 40' wide - ℄ of Hathaway Ave. splits 20'+20' either side

Angle at C.Spk. - inter ℄ Hathaway + ℄ Manila Ave - in S.E. gradient. ℣c C.S.Mon. at inter ℄ Manila + ℄ 4th St.

Ⓞ 48°-32'-30"
Ⓓ 194-10-15
4E° 32'-35

Note: ANY ADDITIONS OR CHANGES OF THIS SHEET MUST BE MADE OR CIRCLED IN Red Ink WITH DATE AND NAME OF PERSON MAKING CHANGE.

Do not extend notes this side of this line

RETURN TO
LOS ANGELES COUNTY SURVEYOR
700 HALL OF RECORDS

FORM 247 5M 2-34

RETURN TO

LOS ANGELES COUNTY SURVEYOR

700 HALL OF RECORDS

Note: ANY ADDITIONS OR CHANGES ON THIS SHEET MUST BE MADE OR CIRCLED IN **Red Ink** WITH DATE AND NAME OF PERSON MAKING CHANGE.

Do not extend notes this side of this line

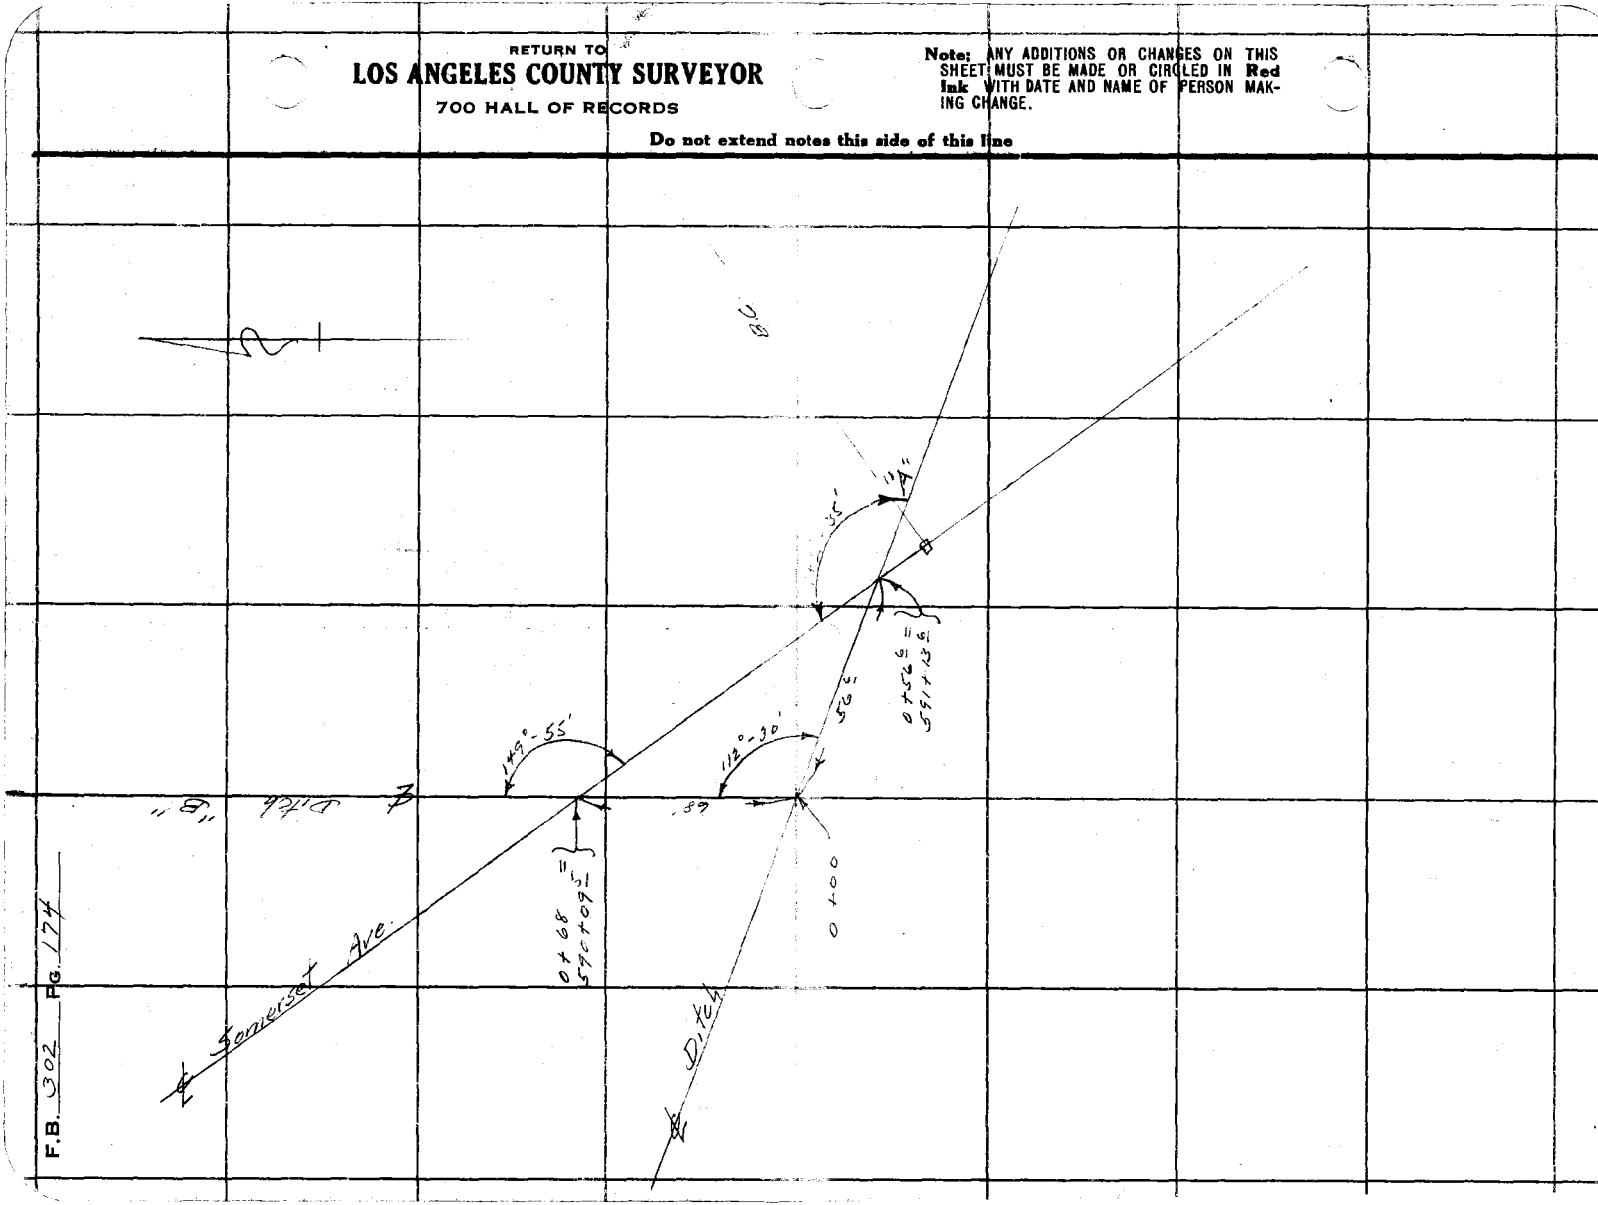

Form 307 5M 10-34

PLEASE RETURN TO
LOS ANGELES COUNTY SURVEYOR
700 HALL OF RECORDS

NOTE: ANY ADDITIONS OR CHANGES ON THIS SHEET MUST BE MADE OR CIRCLED IN RED INK, WITH DATE AND NAME OF PERSON MAKING CHANGE

Do not extend notes this side of this line

STATION	B. S.	H. I.	F. S	ELEV.		
B.M. 51	4.23	16.64		12.41	Spk. in P.P. 75' Left	592+45 - ℄ Somerset
0+00			98	6.8	inter. ℄ Ditch A + B.	
0+35			99	6.7	℄ Ditch A to West	
			87	7.9	4' L - Bottom bank	
			43	12.3	12' L Top "	
			43	12.3	25' L	
			92	7.4	4' R - Bottom "	
			66	10.0	10' R Top "	
			65	10.1	20' R	
1+00			97	6.9	℄ Ditch A to West	
			86	8.0	6' L - Bottom bank	
			41	12.5	11' L Top "	
			42	12.4	21' L	
			89	7.7	4' R - Bottom bank	
			44	12.2	11' R Top "	
			50	11.6	21' R	
0+05			94	7.2	℄ Ditch B to North	
+12			84	8.2	℄ " "	
+25			84	8.2	℄ " "	
			73	9.3	11' L	
			73	9.3	21' L	

Profile

No. Notes Red. Platted Job No. 4452 Division No. K L.B. 302 Pg. 175

No. Date Date Survey of Somerset Ave

X-Sec. Notes Chkd. Checked Survey by Moore Notes Moore Date 11-6-35

Date Date Map No. Indexed C. Johnson Date 11-6-35

Form 307 5M 10-34

PLEASE RETURN TO
LOS ANGELES COUNTY SURVEYOR
700 HALL OF RECORDS

NOTE: ANY ADDITIONS OR CHANGES ON THIS SHEET MUST BE MADE OR CIRCLED IN RED INK, WITH DATE AND NAME OF PERSON MAKING CHANGE

Do not extend notes this side of this line

L.B. 302 P.G. 176 | Job. No. 4109 | Division No. V | Notes Red | Plotted | Profile
Survey of Sunset Ave | Date | No.
Survey by Alvarez Notes Moore | Date | Checked | Date | X-Sec.
Indexed A. C. Goldman | Date | Notes Chkd. | Date | No.

STATION	B. S.	H. I.	F. S	ELEV.		
0+25		16 64	77	8	7' R -	Bottom Bank
			33	13	19' R -	Top "
			34	2	30' R	" "
			61	5	44' R	
0+68			80	6	℄ Ditch B to North	
			73	3	11' L -	Bottom Bank
			55	11	16' L -	Top "
			64	2	26' L	
			74	2	5' R -	Bottom bank
			29	13	19' R	Top "
			30	12	33' R.	" "
			46	1	43' R	Bottom "
			51	1	53' R	
1+00			76		℄ Ditch B to North	
			70		5' L -	Bottom bank
			31		14' L	Top "
			50		31' L	
			68		6' R	Bottom "
			15		17' R	Top "
			18		32' R	" "
			41		44 R	Bottom "
			48		54 R	

Form 307 5M 10-34

PLEASE RETURN TO
LOS ANGELES COUNTY SURVEYOR
700 HALL OF RECORDS

NOTE: ANY ADDITIONS OR CHANGES ON THIS SHEET MUST BE MADE OR CIRCLED IN RED INK, WITH DATE AND NAME OF PERSON MAKING CHANGE

Do not extend notes *this side* of this line

STATION	B. S.	H. I.	F. S	ELEV.		
2+00		16 64	83	83	℄ Ditch B to North	
			74	92	10' L -	Bottom Bank
			41	125	20' L	Top "
			41	125	32' L	
			78	88	8' R	Bottom "
			31	135	19' R	Top "
			33	133	34' R	
			46	120	40' R	
			49	117	50' R	
0+56½			100	66	℄ Ditch A to East	
			92	74	7' R -	Bottom Bank
			51	115	18' R	Top "
			50	116	30' R	
			91	75	7' L	Bottom "
			57	109	15' L	Top
			62	104	21 L	
			67	99	30' L	
1+00			100	66	℄ Ditch A to East	
			87	79	6' R	Bottom Bank
			51	115	13' R	Top "
			53	113	25' R	

Profile No. _____ Notes Red. _____ Platted _____ Job No. 435 Division No. 4 L. B. 302 PG. 177
X-Sec. No. _____ Date _____ Date _____ Survey of Somerset Notes Date 11-6-35
Notes Chkd. _____ Date _____ Checked _____ Date _____ Survey by W. Poole Notes Indexed C. Johnson Date 11-6-35
Map No. _____

Form 307 5M 10-34

PLEASE RETURN TO
LOS ANGELES COUNTY SURVEYOR
700 HALL OF RECORDS

NOTE: ANY ADDITIONS OR CHANGES ON THIS SHEET MUST BE MADE OR CIRCLED IN RED INK, WITH DATE AND NAME OF PERSON MAKING CHANGE

Do not extend notes this side of this line

L.B. 502 P.G. 178 Job No. 4453 Division No. 4 Notes Red Plotted Profile No.
Survey of Somerset Ave Date Date X-Sec. No.
Survey by Alvarez Notes Pickens Notes Chkd. Checked
Indexed A. C. Johnson Date Date Date

STATION	B.S.	H.I.	F.S	ELEV.		
1+00		16.4	8.1	8.5	8'L - Bottom bank	
			4.9	11.7	16'L - Top "	
			6.1	10.5	22'L	
			6.7	10.1	32'L	
2+00			9.8	7.4	℄ Ditch A to East	
			8.7	8.5	9'L - Bottom bank	
			6.0	11.2	17'L - Top "	
			6.8	10.4	25'L	
			7.0	10.2	35'L	
			9.2	8.0	7'R Bottom "	
			5.5	11.7	18'R Top "	
			5.7	11.5	28'R	
			1.0	15.2	Elev of wooden bridge.	
			4.23	12.11	B.M. Spk. in P.P. W.L. of 5+92+45	

Notes Ck'd by McPherson	Survey of Seamist Ave		F.B. 302 Pg. 179
Map No. B-117 G	W. O. 4159 Tape No	St'd	Of.
Office Work Price - McPh.	Surveyed by Nbeck		
Checked Drew	Notes Nbeck Date 11-6-35		
Date 11-20-1935	Indexed A. C. Johnson 11-7-35		

Note: ANY ADDITIONS OR CHANGES ON THIS SHEET MUST BE MADE OR CIRCLED IN Red Ink WITH DATE AND NAME OF PERSON MAKING CHANGE.

Do not extend notes this side of this line

RETURN TO
LOS ANGELES COUNTY SURVEYOR
700 HALL OF RECORDS

FORM 247 5M 8-34

Set N+T P.P "375862E

86.45

2x2 12" deep

P.E S.T+W

Set N+T PP "375861E

82.96

SEVENTH ST.

℄ per Bk. 134.

S.06

N0.°C

51.35

101.57

Set N+T F.P

Set N+T F.P

Ties

SCHIERSHT AVE.

P.T. 2x2 - 12" deep

223.67

Set S.T+W 15" pepper

℄ ANAHEIM

See Pg. 133

8.58

P.O.S.T S.T+W.

98.14

Set S.T+W 18" pepper

Set N+T P.P "6111 US

0

4.64

25.63

112.64

ST.

B.C. 619+83.26 2x2 - 12" deep.

Set S.T+W 18" pepper

RETURN TO

LOS ANGELES COUNTY SURVEYOR

700 HALL OF RECORDS

Note: ANY ADDITIONS OR CHANGES ON THIS SHEET MUST BE MADE OR CIRCLED IN **Red Ink** WITH DATE AND NAME OF PERSON MAKING CHANGE.

Do not extend notes this side of this line

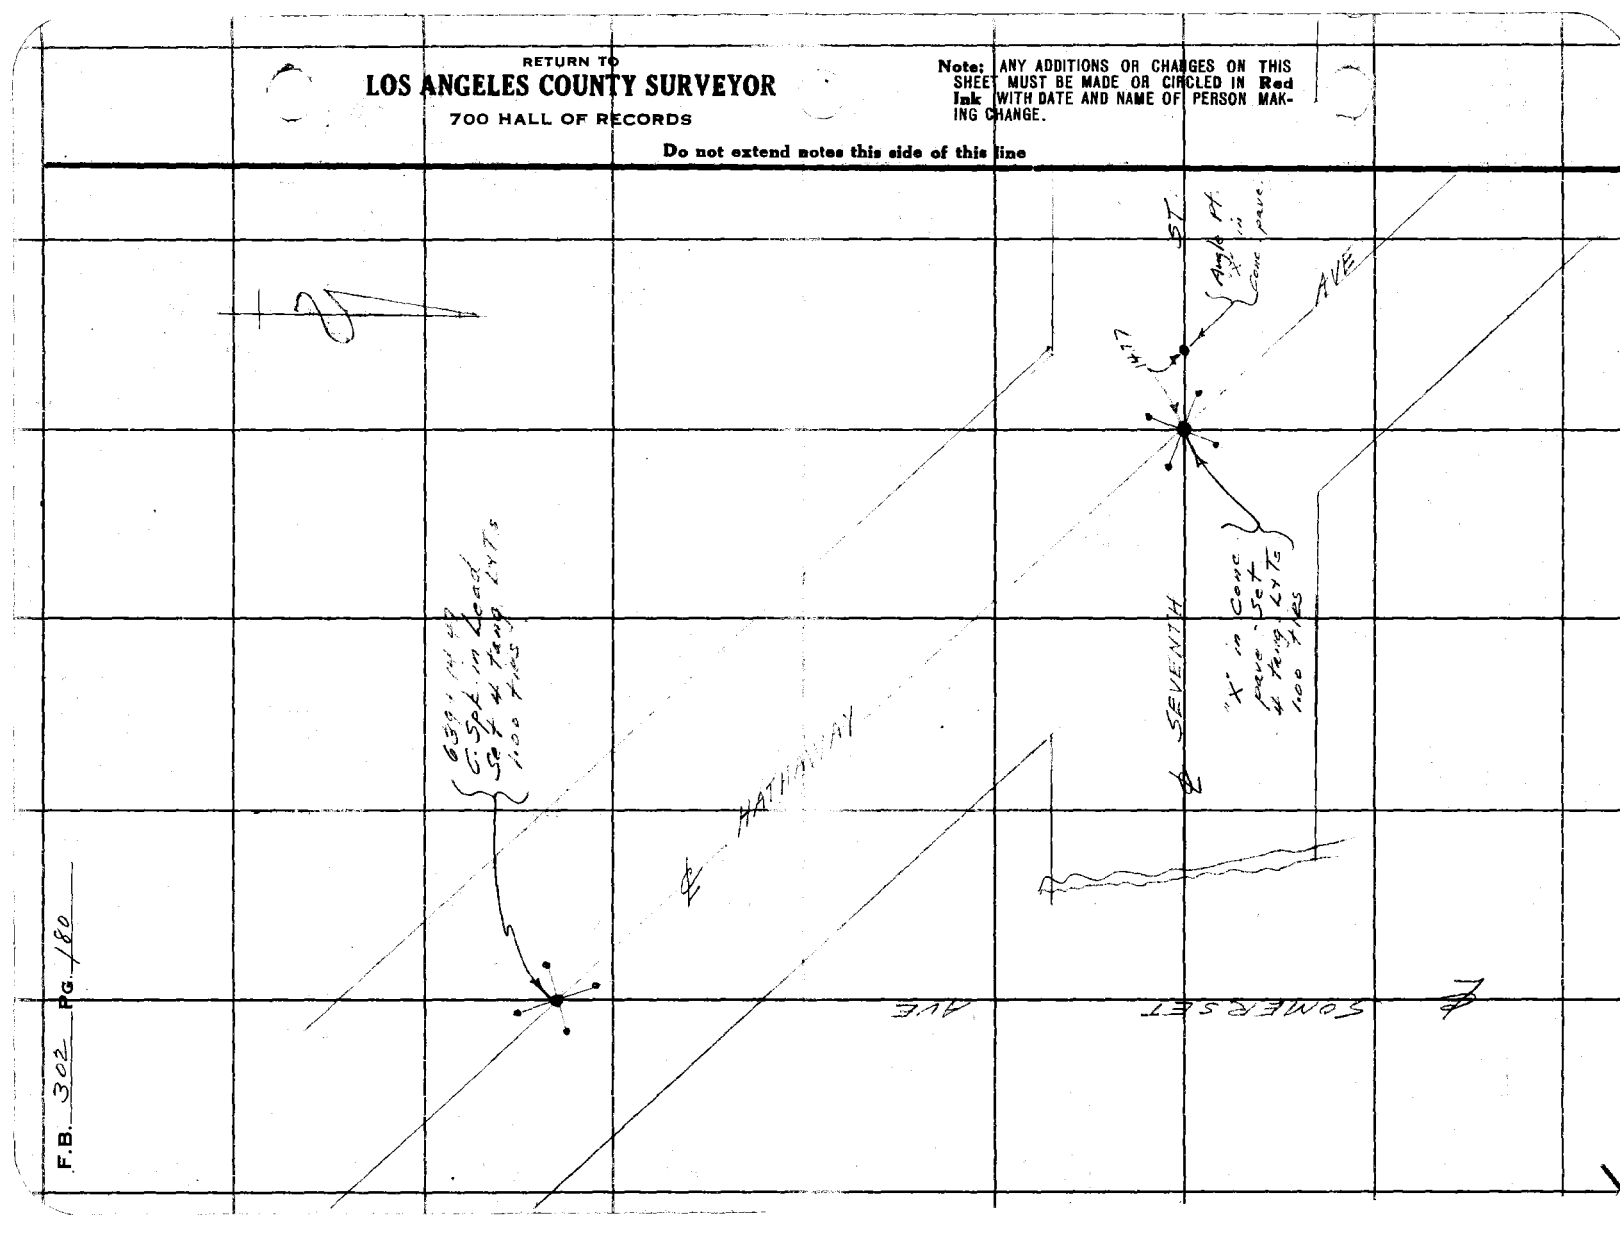

F.B. 302 PG. 180

Notes	Ck'd by McPherson	Survey of Somerset Ave.	F.B. 302 PG. 181
Map	No. B-1176	W. O. 4159 Tape No ___ St'd ___ OF.	
Office Work	Price-McPh.	Surveyed by Moore	
Checked	Drew	Notes Moore Date 11-6-35	
Date	11-20-1935	Indexed A. C. Johnson 11-7-35	

Pipe Lines - Somerset Ave — Realignment

617+74.2 - 2" Line - 1.3 deep - runs parallel to Anaheim

617+41.2 - 2" Line - 1.2 deep - " " " "

557+76 - 24" conc Line - top of pipe 1.5 deep - runs parallel to Stearns Ave

Note: ANY ADDITIONS OR CHANGES ON THIS SHEET MUST BE MADE OR CIRCLED IN Red Ink WITH DATE AND NAME OF PERSON MAKING CHANGE.

Do not extend notes this side of this line

RETURN TO
LOS ANGELES COUNTY SURVEYOR
700 HALL OF RECORDS

FORM 247 BM 2-34

RETURN TO

LOS ANGELES COUNTY SURVEYOR

700 HALL OF RECORDS

Note: ANY ADDITIONS OR CHANGES ON THIS SHEET MUST BE MADE OR CIRCLED IN **Red Ink** WITH DATE AND NAME OF PERSON MAKING CHANGE.

Do not extend notes this side of this line

F.B. 302 PG. 182

Notes Ck'd by K.B.M.	Survey of Misc. Surveys
Map No. B-117-364	W. O. 7000 Tape No. 078 St'd 68 °F
Office Work M.G.P.	Surveyed by Moore
Checked	Notes Moore Date 2-25-46
Date Mar 1946	Indexed 2-28-46

F.B. 302 PG. 183

CHECKING CENTER LINE

OF

ROSE AVE

at

Somerset Ave

MISCELLANEOUS SURVEYS

J.N. 7000

Moore
Lanigan
Natapoff
Cook

Note: Any Additions or Changes on This Sheet Must be Made or Circled in Red Ink With Date and Name of Person Making Change.

Do not extend notes this side of this line.

RETURN TO
LOS ANGELES COUNTY SURVEYOR
700 HALL OF RECORDS

FORM 247 BM 11-41

F.B. 302 PG. 184

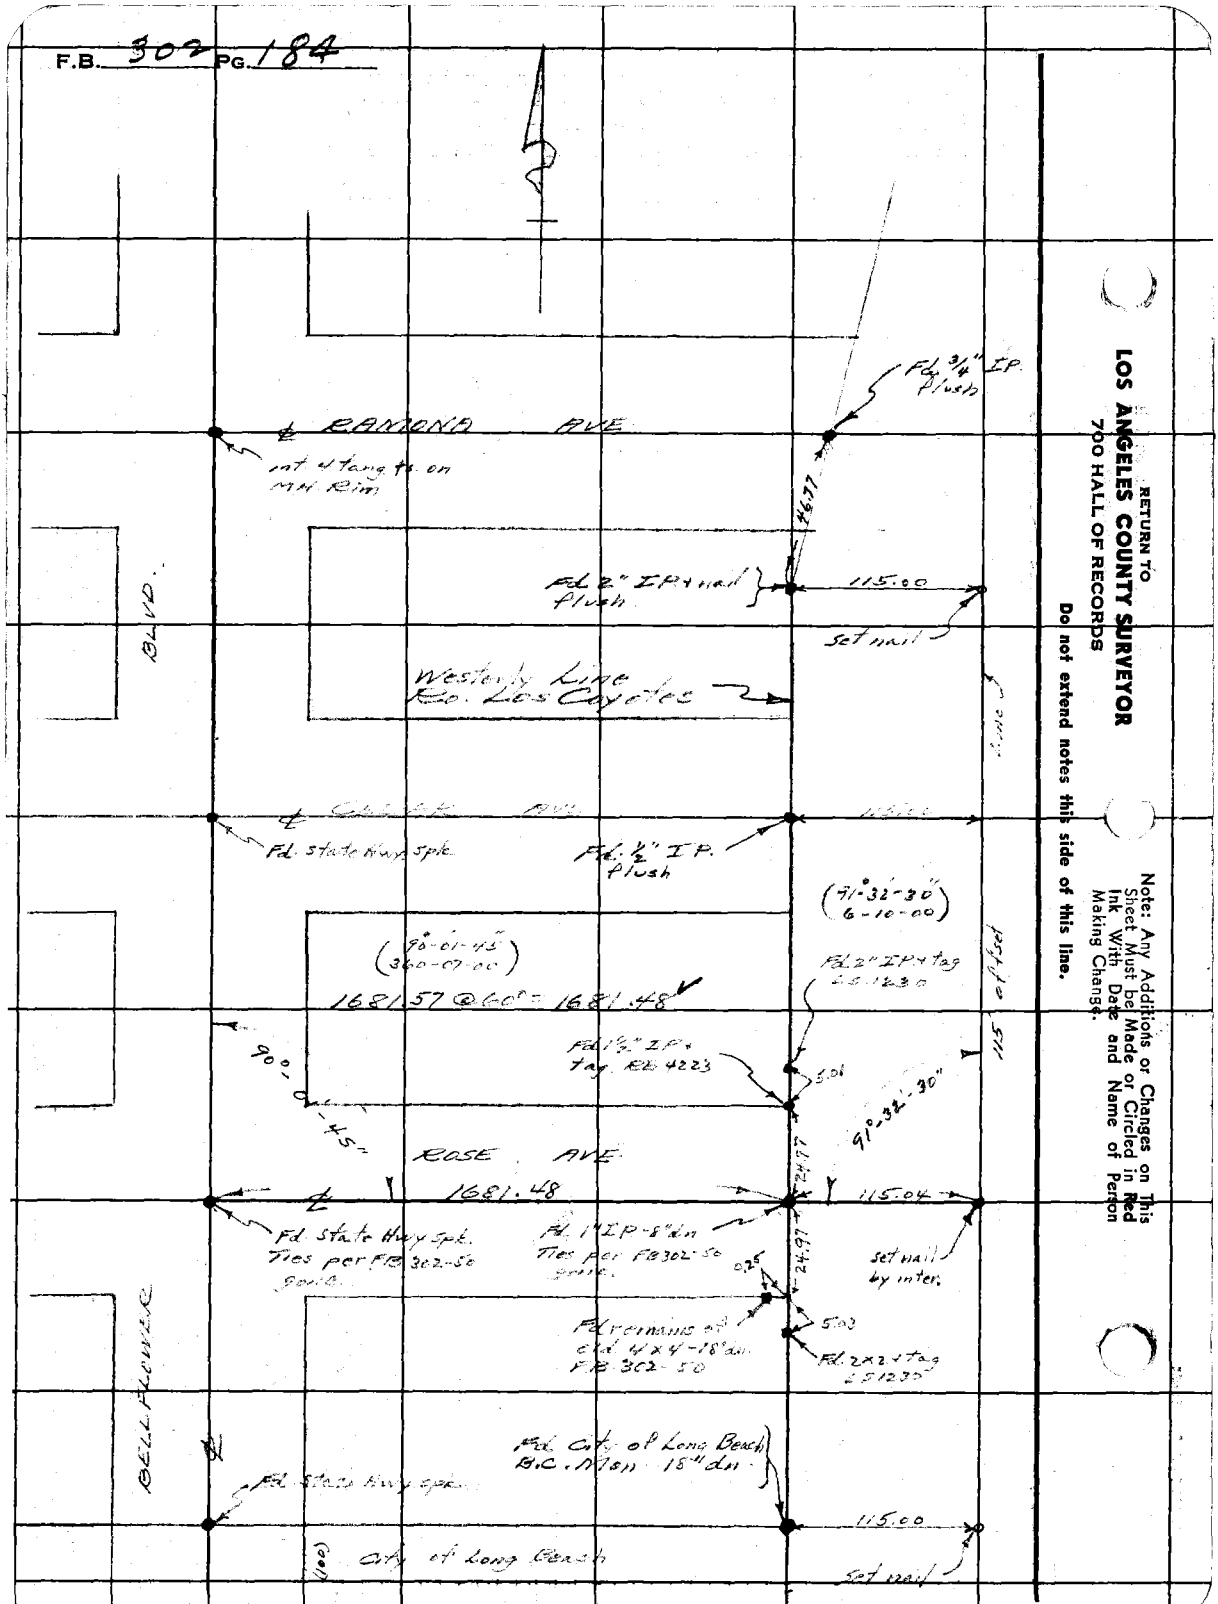

RETURN TO
LOS ANGELES COUNTY SURVEYOR
700 HALL OF RECORDS
Do not extend notes this side of this line.

Note: Any Additions or Changes on This Sheet Must be Made or Circled in Red Ink With Date and Name of Person Making Change.

FORM 247 10M 11-35

RETURN TO
LOS ANGELES COUNTY SURVEYOR
700 HALL OF RECORDS

Note: Any Additions or Changes on This Sheet Must be Made or Circled in Red Ink With Date and Name of Person Making Change.

Do not extend notes this side of this line

Notes Ck'd by_____
Map No._____
Office Work_____
Checked_____
Date_____

Survey of_____
W. O._____ Tape No._____ Std._____ °F.
Surveyed by_____
Notes_____ Date_____
Indexed_____

F.B._____ Pg._____

RETURN TO
LOS ANGELES COUNTY SURVEYOR
700 HALL OF RECORDS

Note: Any Additions or Changes on This Sheet Must be Made or Circled in **Red Ink** With Date and Name of Person Making Change.

Do not extend notes this side of this line

F.B. _____ PG. _____