306

RETURN TO

LOS ANGELES COUNTY SURVEYOR

Note: ANY ADDITIONS OR CHANGES ON THIS SHEET MUST BE MADE OR CIRCLED IN Red. WITH DATE AND NAME OF PERSON MAKING CHANGE.

Do not extend notes this side of this line

Date_____ Notes by_____ Chief Party_____ F.B._____ PG._____

Platted by_____
Date_____
Map No._____
Plotting C'k'd by_____
Date_____

W. O. No._____ D. S. O. No._____
Location_____
Surveyed by_____
Date_____
Indexed_____

F.B. 306 Pg. Index Chief Party Notes by Date

F.B. 306

PAGES: Index,1,2,3, ,5,6,7, ,
9 to 19 incl., ,21, ,23 to 60
incl., , ,63 to 76 incl., ,
76A, ,77 to 94 incl., , ,
97 to 122 incl., 123 to 144 incl.,
145 to 147 incl.,

RETURN TO
LOS ANGELES COUNTY SURVEYOR

Do not extend notes this side of this line

Notes: ANY ADDITIONS OR CHANGES ON THIS SHEET MUST BE MADE OR CIRCLED IN RED WITH DATE AND NAME OF PERSON MAKING CHANGE.

Moore

Plotted by [illegible]
Date Nov. 1927
Map No. 8973
Plotting C & D by [illegible]
Date Nov. 1927

W. O. No. [illegible]
Location Phillis Ave
Surveyed by L. D. Moore
Date [illegible]
Indexed A. C. Johnson

SURVEY
for
OPENING
of
PHILLIS AVE.
from
EAST LINE
SERENITY HEIGHTS TRACT
to
DOHENY DRIVE

W.O.# 4163

Party
Moore
Thayer
Gunderson
McHenry

Oct. 24-25-1927
Nov. 4-5-1927

RETURN TO LOS ANGELES COUNTY SURVEYOR
Do not detach notes this side of this line

F.B. 306 Pg. 2 — Moore Chief Party. Notes by Moore Date 11-4-27

cont'd on bottom pg 3

90°-00'-00"
4) 360-00-00
90°-00'-00"

Serenity Heights Tract

70-28-45
4) 281-54-38
70-28-31

0+00 going West = 1+82.52 from East Set S.T.W. by Propor.

Fd 2" pipe NW. Cor Lot 1 Tr. 6100

Found Rec. 90°-00'-00"

90°-00'-00"

113.94

70°-28'-30"

97.70

36.11

109.77

Set 2x2 6x Inter. SE Cor. Serenity Heights Tract

Set 1x2 by propor. SE Cor. Lot 26 Ser. Heights Tract

4+88.58 Fd 2x2 N.W. Cor. Lot 23

4+47.66 Fd 2x2 N.W. Cor. Lot 22

3+27.68 Fd 2x2 N.E. Cor. Lot 20

19.78

19.70

88°-55'

19.48

4+40.60 Fd 2x2 - Tk. S.W. Cor Lot 2

88-55-30
4) 355-41-30
88-55-22

WETHERLY ST.

Tract 6100

PHILLIS AVE

482.52

2+47.65 Fd 2x2 Nail N.W. Cor lot 18

19.78

19.32

2+40.53 Fd 2x2 Tk. S.W. Cor Lot 9

2+90.55 Fd 2x2 Tk. S.W. Cor Lot 8

19.32

Tr. 6100

Northerly Bdy. Ro. Rodeo de Las Aguas

1+27.60 Fd 2x2 Nail N.W. Cor lot 15

19.78

19.25

1+20.53 Fd 2x2 Tk. S.W. Cor Lot 10

19.26

0+80.52 Fd 2x2 Tk. S.W. Cor. Lot 11.

0+00 going West

Set Nail by Propor. between Ranch Line and S.E. Cor. Harratt Tr.

313.72

Fd 2" pipe

Fd L&T in Walk. S.E. Cor. Harratt Tr. M.B. 12-16

109.79

Set 1x2 by Inter.

HAMMOND ST.

109°-22' W. adj.

109.84

CENTRAL AVE.

Vol. 1 Pg 48

See

109-22-30
4) 77-29-45
19-22-26

88-45-30
4) 355-02-30
88-45-38

T = 62° F

Fd L&T. on top Conc. Wall. Sta 5 - Ro. Rodeo de Las Aguas S.W. Cor. Lazzarmond Add. M.B. 2-51

M.P. 107-210-211-212

RETURN TO LOS ANGELES COUNTY SURVEYOR

Do not extend notes this side of this line

Note: ANY ADDITIONS OR CHANGES ON THIS SHEET MUST BE MADE OR CIRCLED IN Red. WITH DATE AND NAME OF PERSON MAKING CHANGE.

Chief Party Moore F.B. 306 Pg. 3

Plotted by [illegible]
Date Nov. 1927
Map No. 8973
Plotting Chkd by [illegible]
Date Nov. 1927

W.O. No. 4163
Location Phillips Ave
Surveyed by L D Moore
Date [illegible]
Indexed A. C. Johnson

Notes: ANY ADDITIONS OR CHANGES ON THIS SHEET MUST BE MADE OR CIRCLED IN Red WITH DATE AND NAME OF PERSON MAKING CHANGE.

Do not extend notes this side of this line

RETURN TO LOS ANGELES COUNTY SURVEYOR

SUNSET BLVD.

Alley + conc Mon Set 21- Beverly Hills C.S. 8146

N'ly Bdy Re. Rodeo de Las Aguas

90-00-30
1) 360-02-00
90-00-30

70-28-30
1) 281-53-45
70-28-26

Void see pg. 4

Set x on N.W. Cor Portico FB 396-2

ALLEY

1217.36

Fd 2" pipe plug tk Set 21- Beverly Hills

1+37.42 End of Survey Set S. TTW by Inter.

Set Punch Mark in Tree per Tie FB 97-122

Hall A conc Walk

Set N+T. by Inter.

DOHENY DRIVE

685.55

85.13

Spk

Conc Apron

Set 1x2 by Inter

Fd 2x2 - S.W. Cor Lot 26 Serenity Heights Tr.

109-31-45
30 Adj.

1+07.40 Set 1x2 by Inter.

Fd 2x2 x th N.W. Cor Lot 20 Serenity Heights Tract

PHILLIPS AVE

107.40

109-31-15
1) 75-05-00

T=62°F

Serenity Heights Tract

contd from top pg 2

RETURN TO

LOS ANGELES COUNTY SURVEYOR

Note: ANY ADDITIONS OR CHANGES ON THIS SHEET MUST BE MADE OR CIRCLED IN **Red.** WITH DATE AND NAME OF PERSON MAKING CHANGE.

Do not extend notes this side of this line

Date

Notes by

Chief Party

F.B. 306 Pg. 1

Date 12-27-27 Notes by Moore Chief Party Moore F. B. 306 Pg. 5

Platted by [illegible]	W. O. No. 4463 R. O. O. No.
Date Dec. 1927	Location Phillis Ave
Map No. 8973	Surveyed by L D Moore
Platting C'k'd by Bonsall	Date 12-3-27
Date Dec 19 27	Indexed A. C. Johnson

PHILLIS AVE.

Notes ANY ADDITIONS OR CHANGES ON THIS SHEET MUST BE MADE ON CHECK IN Red. WITH DATE AND NAME OF PERSON MAKING CHANGE.

Do not extend notes this side of this line

RETURN TO LOS ANGELES COUNTY SURVEYOR

F.B. 204 Pg. 6 — Moore Chief Party — Notes by Moore — Date 12-7-27

cont'd on bottom of AC

& Phillis Ave produced.

Serenity Heights Tract

70-24-15 / 4)281-37-15 / 70-24-19 ✓

91-03-00 / 4)364-12-00 / 91-03-00 ✓

0+00 going West = 4+82.52 from East

Set 2x2 by Inter S.E. Cor Serenity Heights Tr. S.W. Cor Tr. 6100

Set S.T.&W. by proportion between N.W. Cor Tr. 6100 and S.W. Cor. Tr. 6100

145.82

137.37

70°-24'-20"

134.06

109.97

Fd 2x2 N.W. cor. Lot 23

19.79 / 12.11 / 12.17

Fd 2" pipe N.W. cor. Lot 1 Tr. 6100

4+47.66 Fd 2x2- N.W. Cor Lot 22

19.57

19.69

4+40.60 Fd 2x2 S.W. Cor Lot 2

3+27.68 Fd 2x2 N.E. Cor Lot 20

19.47

511.09

WETHERLY ST

AVE

482.52

Tract 6100

Concrete Walk

2+40.53 Fd 2x2+TK S.W. Cor Lot 7

19.52

2+47.65 Fd 2x3-No TK N.W. Cor Lot 16

19.56

2+00.55 Fd 2x2+TK S.W. Cor Lot 8

1+27.60 Fd 2x2- No TK N.W. Cor Lot 15

19.52

19.47

1+20.53 Fd 2x2+TK S.W. Cor Lot 10

0+80.52 Fd 2x2+TK S.W. Cor Lot 11

19.53

511.09

South Line Tr. 6100

Tract 6100

88°-40'

PHILLIS

4" Concrete Walk

Fd 2" pipe S.E. Cor Tr. 6100

0+00 going West set X+T by proportion between N.E. and S.E. cor. Tract 6100

26.95

26.69

Fd 4+T in Walk. S.E. Cor Harrath Tr. M.B. 12-16. N.E. Cor. Tr. 6100

110.08

70°-24'-40" Calc.

314.55

12.14

11.96

HAMMOND ST.

T = 62°F

88-46-45 / 4)355-06-45 / 88-46-41 ✓

RETURN TO LOS ANGELES COUNTY SURVEYOR

Do not extend notes this side of this line

Note: ANY ADDITIONS OR CHANGES ON THIS SHEET MUST BE MADE OR CIRCLED IN Red. WITH DATE AND NAME OF PERSON MAKING CHANGE.

Date 12-7-27 Notes By Moore Chief Party Moore F.B. 306 PG. 7

Drawn By Wade
Date Dec 1927
Map No. 8973
Checked By Roser
Date Dec 1927

W. O. No. 2163 D. S. O. No.
Location Phillips Ave
Surveyed by L. D. Moore
Date 12-7-27
Indexed A. C. Johnson

Motion, APPROBATIONS OR CHANGES ON THIS SHEET MUST BE MADE OR CIRCLED IN Red WITH DATE AND NAME OF PERSON MAKING CHANGE.

Do not extend past this line

LOS ANGELES COUNTY SURVEYOR

SECTION 26

BLVD

Set 2" pipe - Beverly Hills C.S. Pl.A.

CAROL DRIVE

Set 2x2 by Proportion between 124 Cor. Nor. & Sunset and 2" pipe - N.E. Cor. Beverly Hills.

72.96

S 8° 38' E

9.32 Pk.

Cut "X" in end of curb.

ALLEY

1+37.37

End of Survey Set S.T&W. by Inter

N. Line Beverly Hills 54 F 21

Fd 2" pipe - plug + tt. Set 21 - Beverly Hills N.E. Cor.

Set S.T&W by Parker Check Ties A.D. F.B. 27-122

Set "X" on M.H. cover per Ties F.C. 369-2

BLVD

4' Cone Walk

DOHENY DRIVE

82.62

68831

LOT

37.97

N 20° W

Fd 2x2 S.W. Cor. Lot 26 Serenity Heights Tr.

Fd 2x2 N.W. Cor. Lot 20. Serenity Heights Tract

88° 51' 00" Adj.

PHILLIS AVE

SUNSET

T = 62° F.

70-24-15
1) 281-37-15
70-24-19

Serenity Heights Tract.

88-56-45
1) 356-47-30
88-56-45

Contd from pg. 413

RETURN TO

LOS ANGELES COUNTY SURVEYOR

Note: ANY ADDITIONS OR CHANGES ON THIS SHEET MUST BE MADE OR CIRCLED IN **Red.** WITH DATE AND NAME OF PERSON MAKING CHANGE.

Do not extend notes this side of this line

Chief Party _____ Notes by _____ Date _____

F.B. 326 Pg. 8

Date _____ Notes By M. H. Chief Party M. Hayes F.B. 206 Pg. 9

Plotted by _____
Date _____
Map No. _____
Plotting C & G by _____
Date _____

W. O. No. 1589 C. O. No. _____
Location Artesia
Surveyed by M. Hayes
Date July 19, 1927
Indexed A. C. Johnson

NOTE: ANY ADDITION OR CHANGES ON THIS SHEET MUST BE MADE OR CIRCLED IN RED, WITH DATE AND NAME OF PERSON MAKING CHANGE.

DO NOT EXTEND NOTES THIS SIDE OF THIS LINE


Survey for Lights West side Main St.
in Artesia, between First St & Second St.
W.O. No. 1589
County Improvement No. 589
July 19, 1927

M. Hayes
E.E. Corliss
Subchief

F.B. 306 Pg. 10 M. Hayes Chief Party Notes by M.H. Date 7-19-27

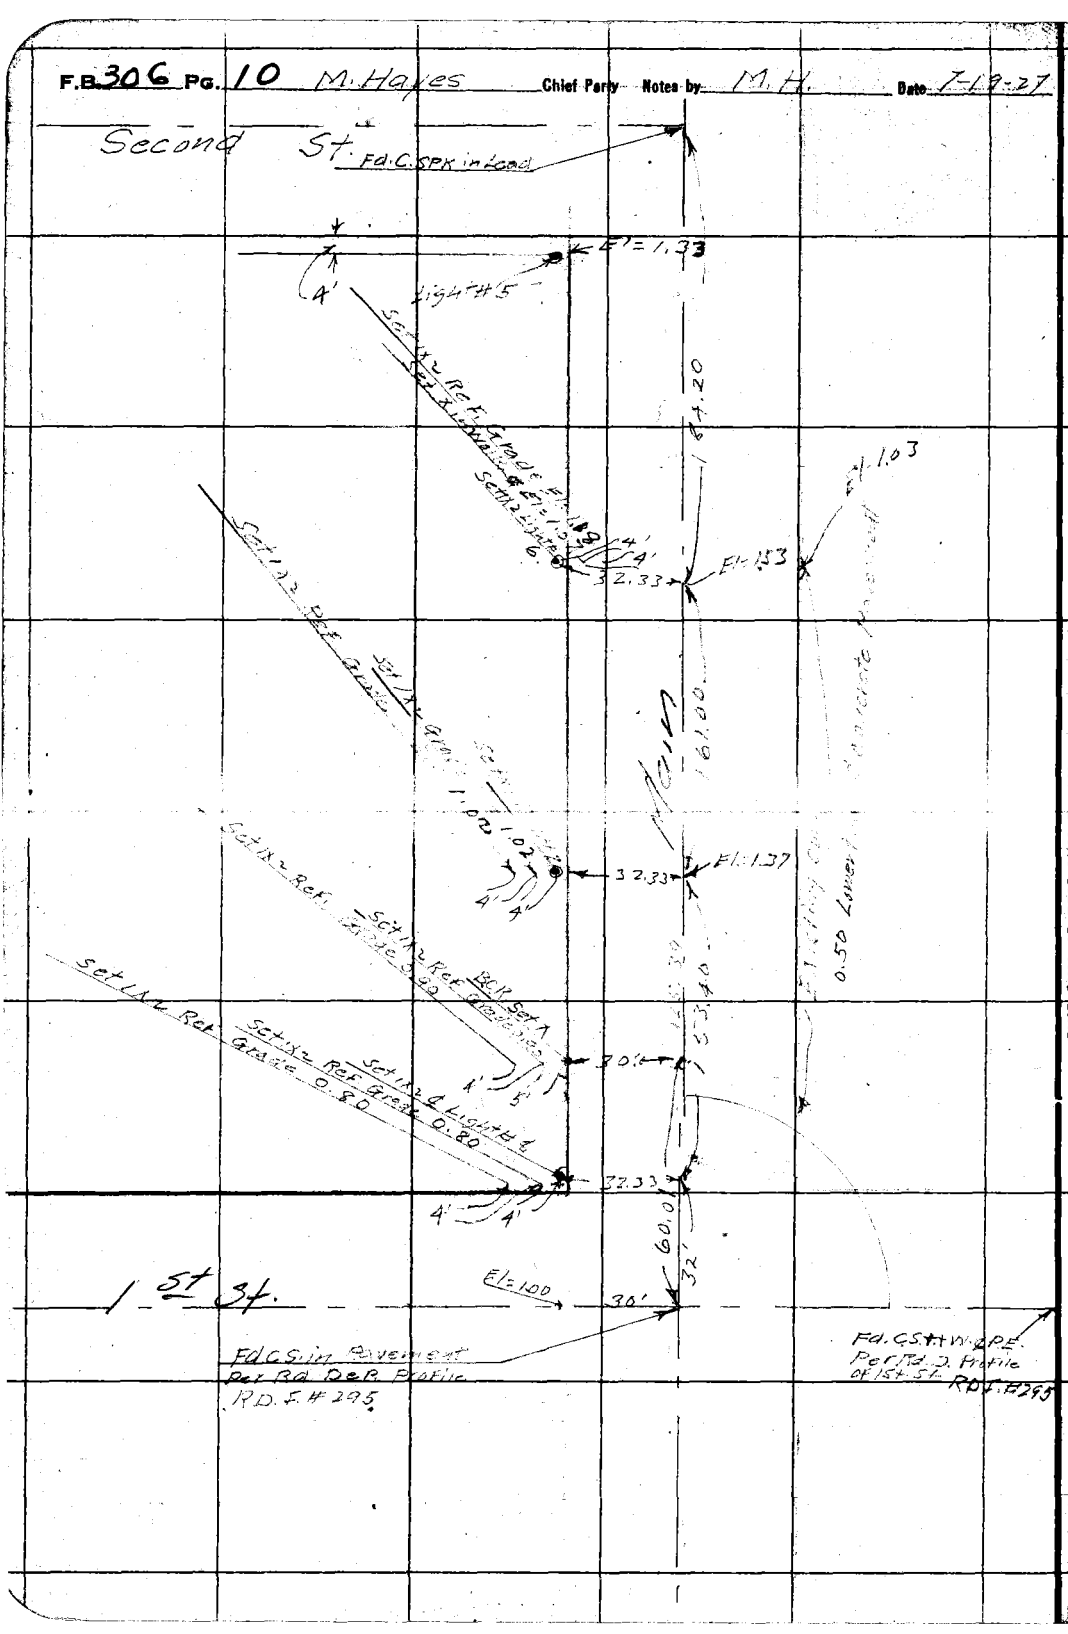
Second St.
Fd. C.S.P.K. in Road
E'=1.73
Light H 5
Set 1/2" Ref. Grade
Set 1/2" Ref. Grade
Set 1/2" Ref. Grade

Date ____ Notes by M.H. Chief Party M. Hayes F.B. 366 Pg. 11

Plotted by ____
Date ____
Map No. ____
Plotting C'k'd by ____
Date ____

W. O. No. 1641 S. C. O. No. ____
Location Lynwood 641
Surveyed by M. Hayes
Date July 5, 1921
Indexed A. C. Johnson

Easements Lighting District
County Improvement No 641

M. Hayes
L.F. Garrison, Inst.
S.B. Cooper, H.C.
R.O. Brackwell, R.C.

NOTE: ANY ADDITION OR CHANGES ON THIS SHEET MUST BE MADE OR CIRCLED IN RED, WITH DATE AND NAME OF PERSON MAKING CHANGE.

DO NOT EXTEND NOTES THIS SIDE OF THIS LINE

RETURN TO LOS ANGELES COUNTY SURVEYOR

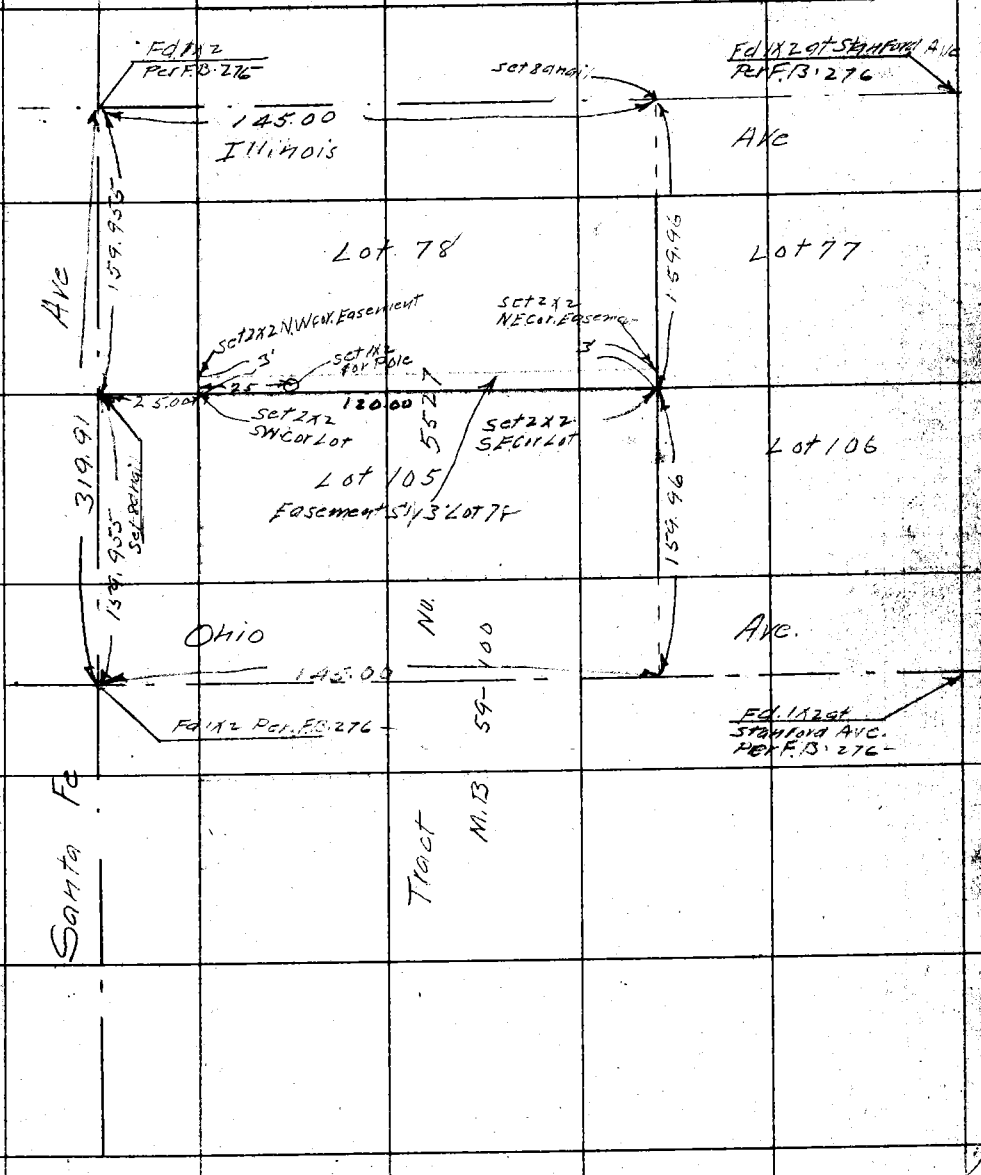

F.B. 306 Pg. 12 M. Hayes Chief Party Notes by M. H. Date 7-5-27

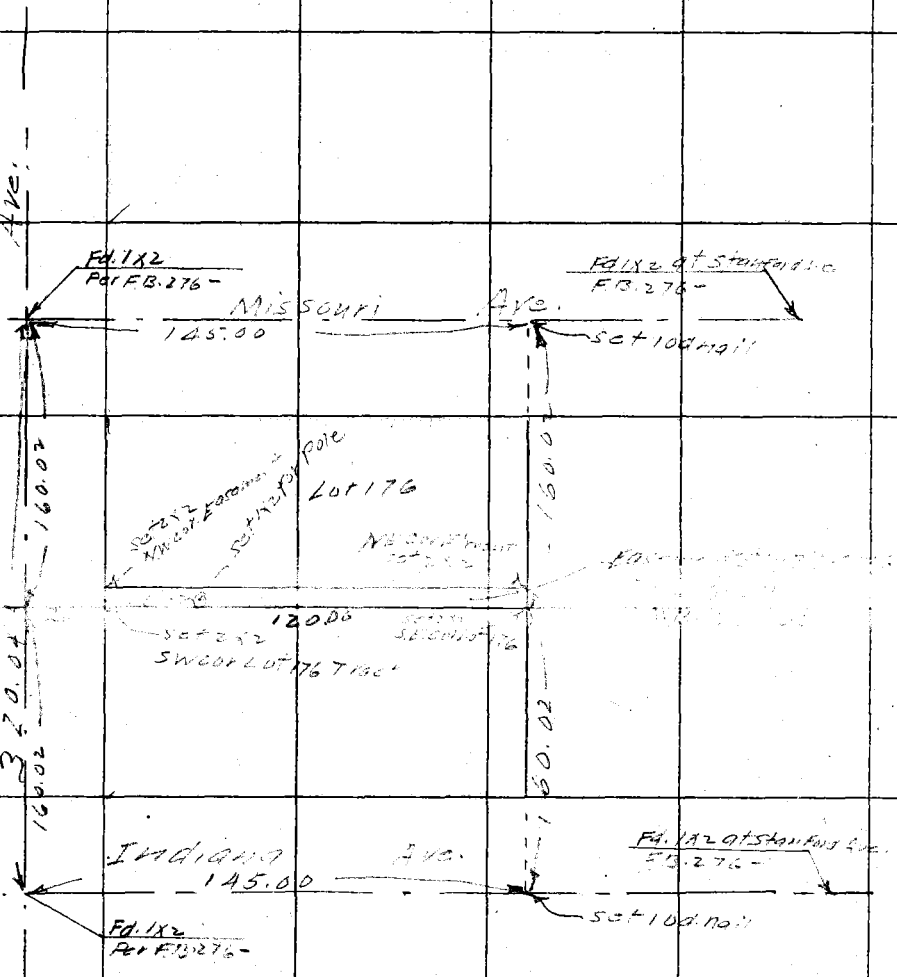

RETURN TO LOS ANGELES COUNTY SURVEYOR

NOTE: ANY ADDITION OR CHANGES ON THIS SHEET MUST BE MADE OR CIRCLED IN RED, WITH DATE AND NAME OF PERSON MAKING CHANGE.

DO NOT EXTEND NOTES THIS SIDE OF THIS LINE

Date 7-13-27 Notes by M. H. Chief Party M. Hayes F.B. 346 Pg. 13

Platted by
Date
Map No.
Platting C'k'd by
Date

W. O. No. 1641 D. S. O. No.
Location C.I.D. No. 691
Surveyed by
Date June 10, 1927.
Indexed A. C. Johnson

NOTE: ANY ADDITION OR CHANGES ON THIS SHEET MUST BE MADE OR CIRCLED IN RED. WITH DATE AND NAME OF PERSON MAKING CHANGE.

RETURN TO LOS ANGELES COUNTY SURVEYOR

DO NOT EXTEND NOTES THIS SIDE OF THIS LINE

Fd 2x2 Tack N.W. cor. Tract 4753

25.00 ← Set 8d nail

Fd 2x2 Tack Sec cor Lot 183 Tr. 4753

Long Beach Blvd

Fd L & T at Tweedy Rd per F.B. 129-15

Set 10d nail by int.

Ave

A 0.0 0

Set Punch Mark

Fd 2x2 Tack Sec cor Lot 178 Tract 4753

Tract 4753 M.B. 50-51

Lot 183

Set 2x2 N.E. cor Easement

Set 2x2 for Pole

Easement W'ly 3' Lot 183

Set 2x2 S.E. cor. Easement

3'

145.37

724.28

25.00

45.00

Set 2x2 S.W. cor Lot 183

Set 2x2 N.W. cor Lot 183

Missouri

Fd 1/2 Pen. B.C.

Set 8d Nail

Set Punch Mark

F.B. 306 PG. 14 M. Hayes Chief Party Notes by M.H. Date 7-6-27

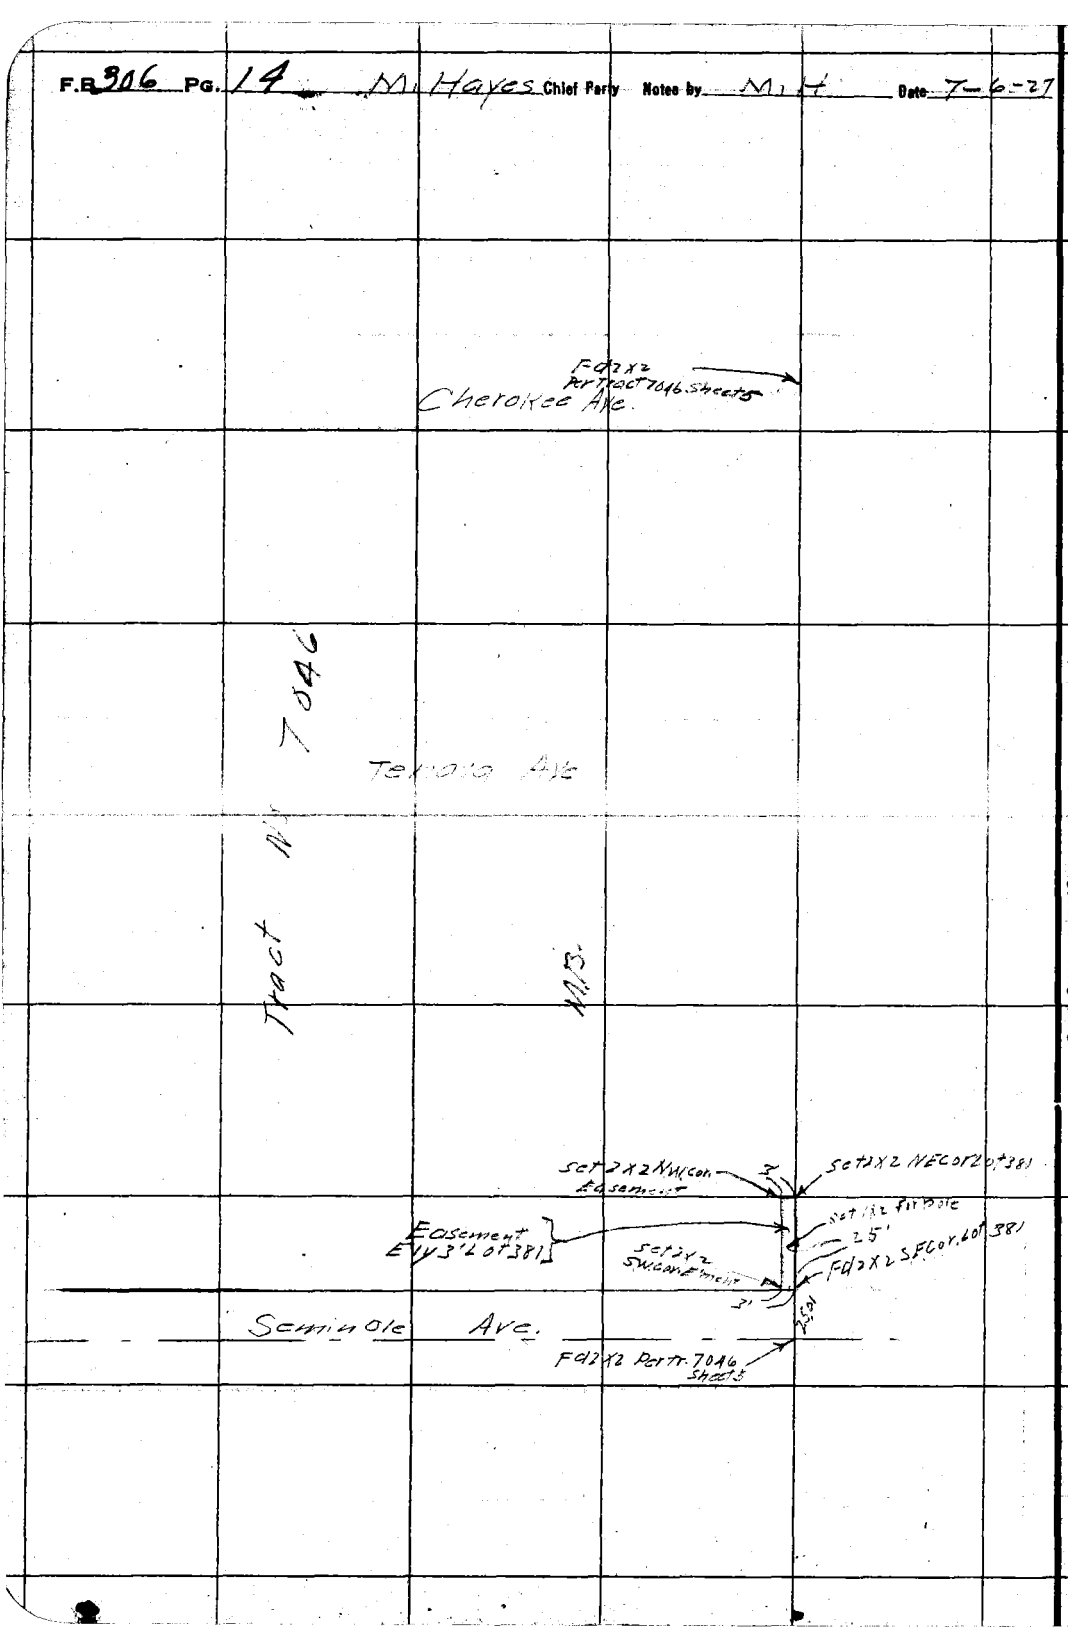

RETURN TO LOS ANGELES COUNTY SURVEYOR

DO NOT EXTEND NOTES THIS SIDE OF THIS LINE

NOTE: ANY ADDITION OR CHANGES ON THIS SHEET MUST BE MADE OR CIRCLED IN RED, WITH DATE AND NAME OF PERSON MAKING CHANGE.

Date 7-5-27 Notes by M.H Chief Party M. Hayes F.B. 306 Pg. 15

Platted by
Date
Map No.
Platting C'k'd by
Date

W. O. No. 1641 U. S. G. No.
Location C.I.D. No 641
Surveyed by M. Hayes
Date June 5, 1927
Indexed A. C. Johnson

NOTE: ANY ADDITION OR CHANGES ON THIS SHEET MUST BE MADE OR CIRCLED IN RED, WITH DATE AND NAME OF PERSON MAKING CHANGE.

DO NOT EXTEND NOTES THIS SIDE OF THIS LINE

RETURN TO LOS ANGELES COUNTY SURVEYOR

Long Beach Blvd.

Cherokee Ave.

105.20

Set 2x2 N.W. Cor Easement

Fd 2x2 tack

Fd 2x2 No tack

Easement E 1/3' of N'ly 48' of Lot 15

Set 1/2 Cir Dole

Set 2x2 S.W. Cor Easement

Lot 16

Lot 15

Set 2x2 S.W. Cor Lot 16

3'

8.00

1.5'

Tract 5227

M.B. 58-21

Lot 17

1044.1

Lot 18

80.01

56.70

Fd 2x2 tack

Fd 2x2 tack

Lot 22

Lot 19

F.B. 306 Pg. 16 M. Hayes Chief Party Notes by M.H. Date 7-7-27

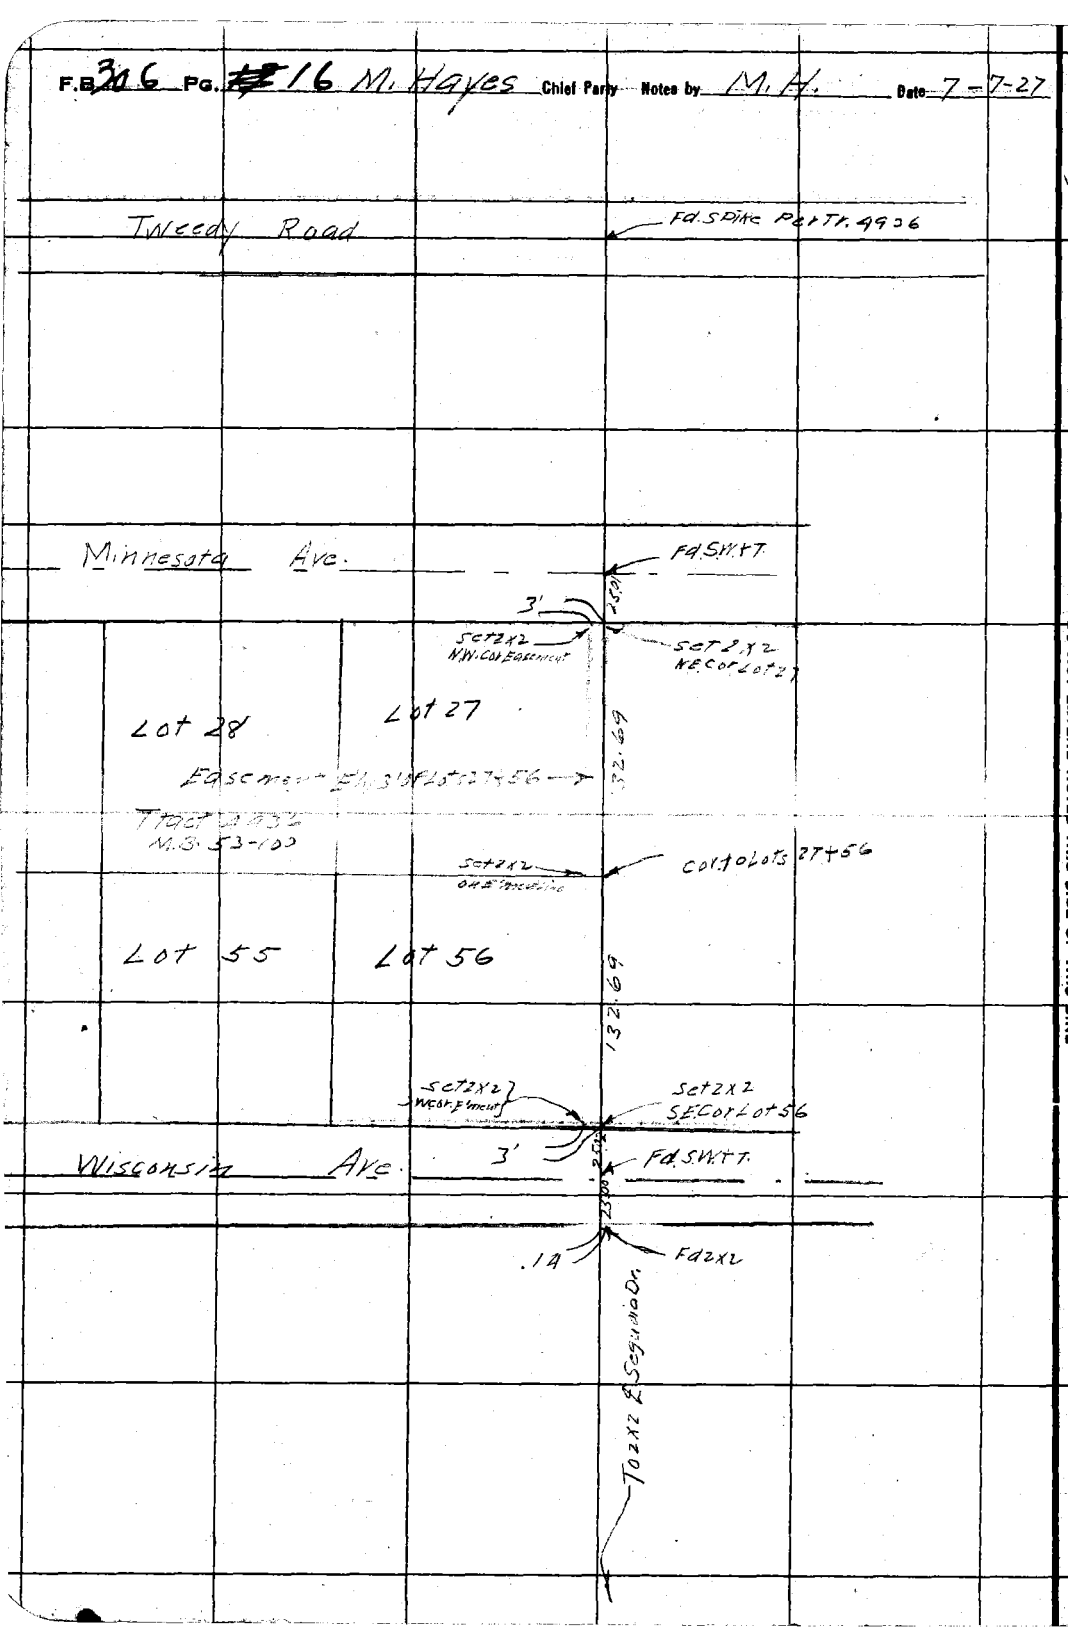

RETURN TO LOS ANGELES COUNTY SURVEYOR

DO NOT EXTEND NOTES THIS SIDE OF THIS LINE

NOTE: ANY ADDITION OR CHANGES ON THIS SHEET MUST BE MADE OR CIRCLED IN RED. WITH DATE AND NAME OF PERSON MAKING CHANGE.

Date 7-6-27 Notes by M. H. Chief Party M. Hayes F.B. 306 Pg. 17

Platted by
Date
Map No.
Platting C'k'd by
Date

W. O. No. 1641 U. S. G. No.
Location C.I. No 641
Surveyed by M. Hayes
Date May 6. 1927
Indexed A. C. Johnson

NOTE: ANY ADDITION OR CHANGES ON THIS SHEET MUST BE MADE OR CIRCLED IN RED, WITH DATE AND NAME OF PERSON MAKING CHANGE.

DO NOT EXTEND NOTES THIS SIDE OF THIS LINE

RETURN TO LOS ANGELES COUNTY SURVEYOR

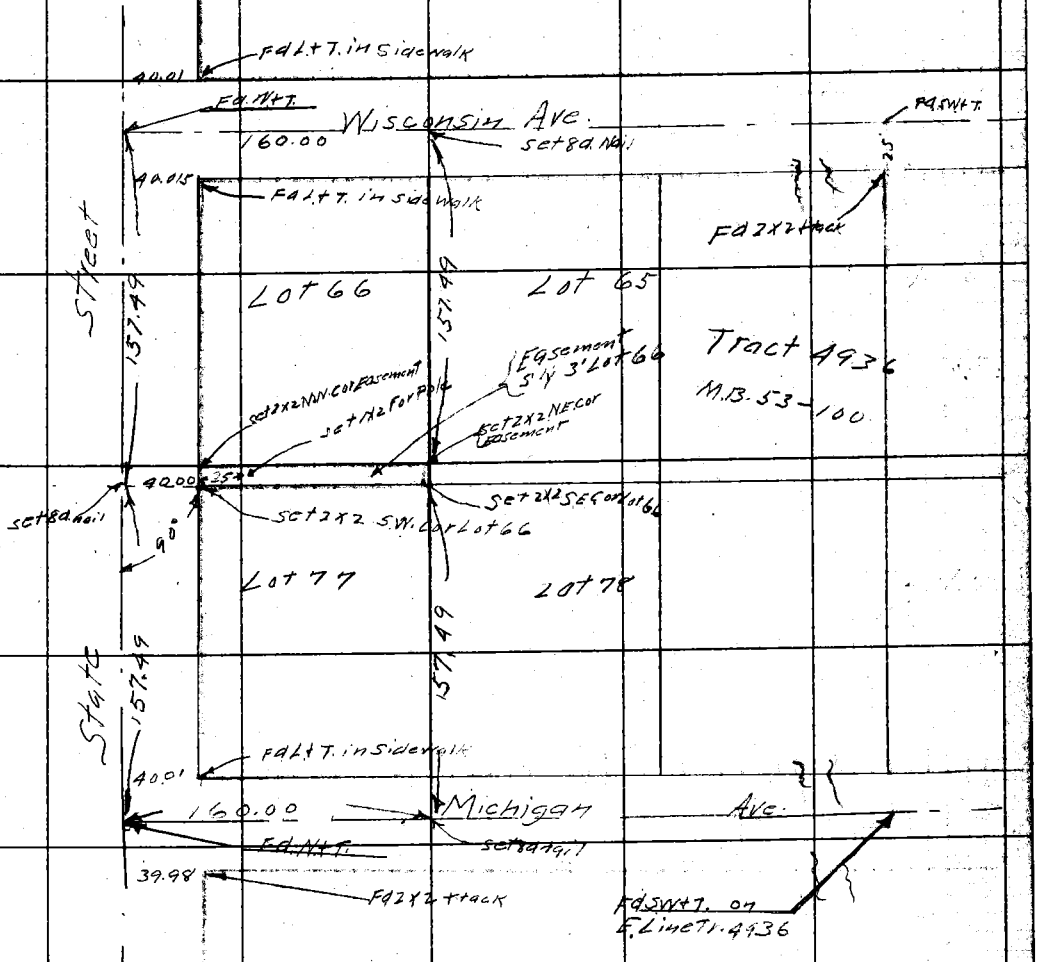

F.B. 306 Pg. 18 M. Hayes Chief Party Notes by M. H. Date 7-6-27

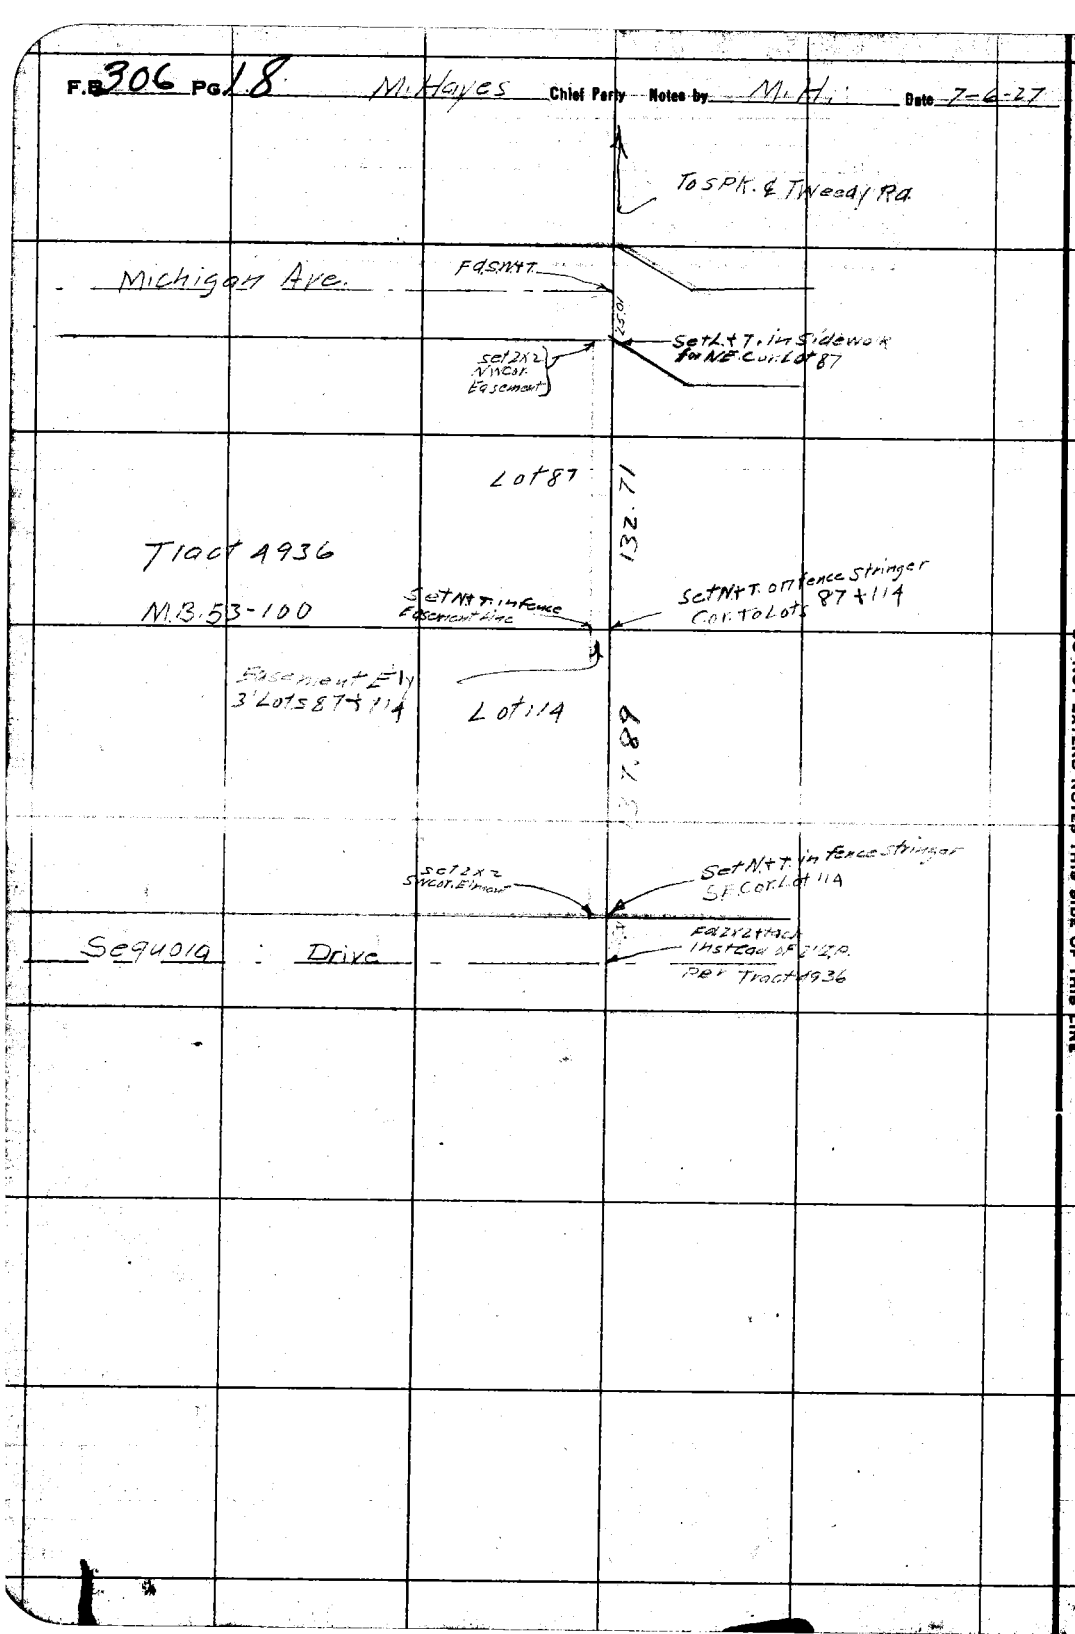

RETURN TO LOS ANGELES COUNTY SURVEYOR

DO NOT EXTEND NOTES THIS SIDE OF THIS LINE

NOTE: ANY ADDITION OR CHANGES ON THIS SHEET MUST BE MADE OR CIRCLED IN RED, WITH DATE AND NAME OF PERSON MAKING CHANGE.

Date _____ Notes by M. H. Chief Party M. Hayes F.B. 306 Pg. 19

Platted by	W. O. No. 1641 O. S. O. No.
Date	Location C.I. D No 691
Map No.	Surveyed by
Plotting C'k'd by	Date June 13, 1924
Sale	Indexed A. C. Johnson

NOTE: ANY ADDITION OR CHANGES ON THIS SHEET MUST BE MADE OR CIRCLED IN RED, WITH DATE AND NAME OF PERSON MAKING CHANGE.

DO NOT EXTEND NOTES THIS SIDE OF THIS LINE

RETURN TO LOS ANGELES COUNTY SURVEYOR

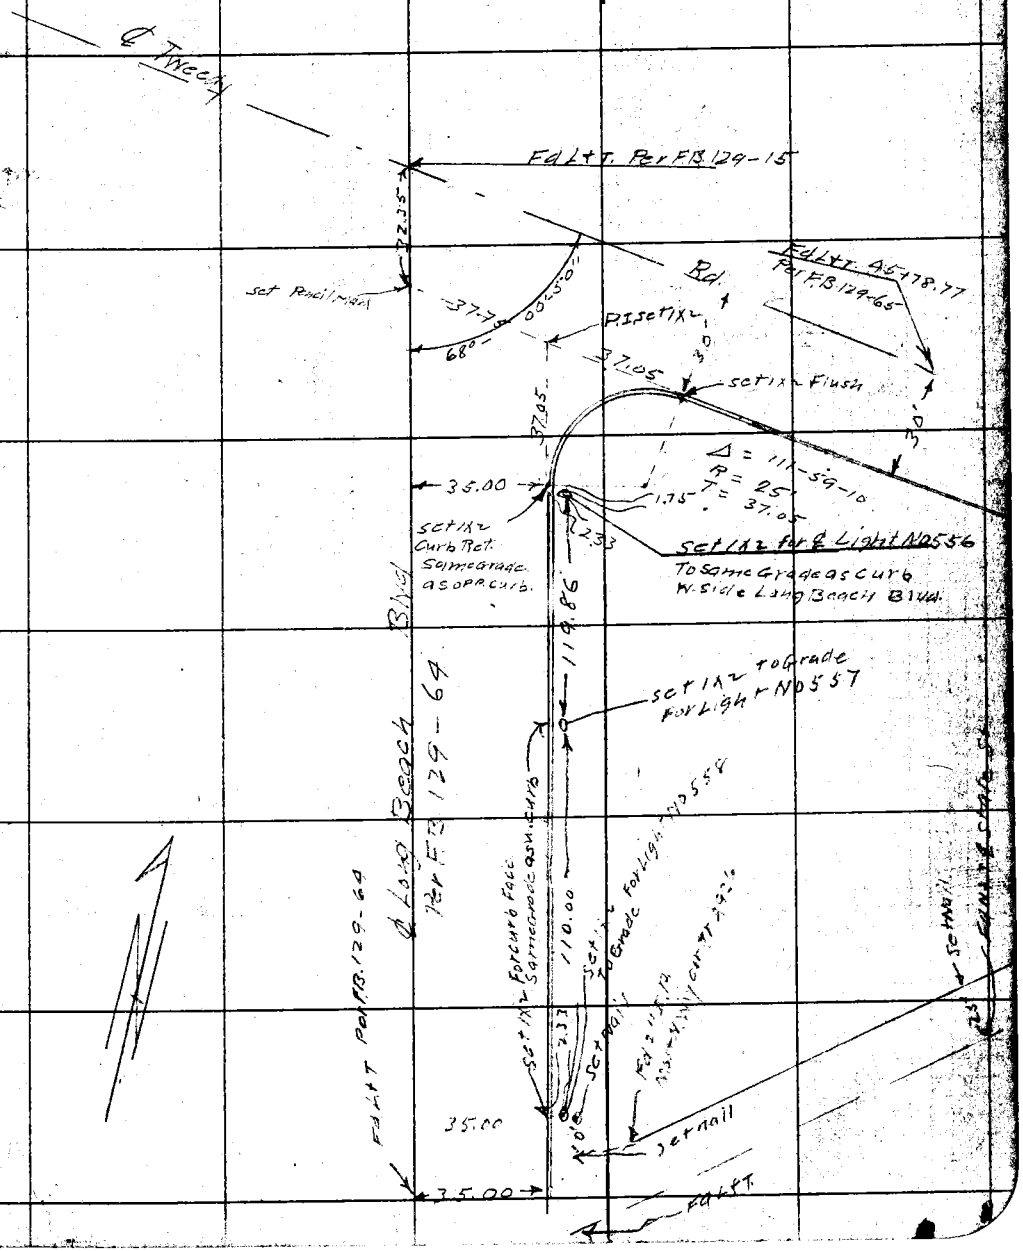

F.B. 306 PG. 20 Chief Party -- Notes by: Date:

RETURN TO
LOS ANGELES COUNTY SURVEYOR

NOTE: ANY ADDITION OR CHANGES ON THIS SHEET MUST BE MADE OR CIRCLED IN RED, WITH DATE AND NAME OF PERSON MAKING CHANGE.

DO NOT EXTEND NOTES THIS SIDE OF THIS LINE

Date Nov. 1928 Notes by HBT Chief Party HBT F.B. 306 Pg. 21

Platted by J. C. Hoyt	W. O. No. 1239 D. S. G. No.
Date June '29	Location Graves Ave
Map No. B-384-Sht 21	Surveyed by
Platting C'k'd by R. W. S.	Date Nov. 1928
Date MAR 17 1930	Indexed A. C. Johnson

Graves Avenue

Rockhold
PA Mahon
JL Fogerty
LE Muse
A.T. Mahon

Note

All angles turned 8 times
See Page 22 for Index Sketch
Tapes .04 ft. long - Note New Subdivision
" .007 " " P.L.
15°X5'

Notes: ANY ADDITIONS OR CHANGES ON THIS SHEET MUST BE MADE OR CIRCLED IN Red. WITH DATE AND NAME OF PERSON MAKING CHANGE.

Do not extend notes this side of this line

RETURN TO LOS ANGELES COUNTY SURVEYOR

F. B. 306 Pg. 22 H.E. Roethe Chief Party Notes by H.E.R. Date 10-[illegible]-58

RETURN TO
LOS ANGELES COUNTY SURVEYOR

Do not extend notes this side of this line

Note: ANY ADDITIONS OR CHANGES ON THIS SHEET MUST BE MADE OR CIRCLED IN Red. WITH DATE AND NAME OF PERSON MAKING CHANGE.

Date 11-16-28 Notes by HBR Chief Party HBR F.B. 306 Pg. 23

Platted by J. C. Hoyt
Date June '29
Map No. B-384-5th Sht
Platting C'k'd by P. W. S.
Date MAR 17 1930

W. O. No. 4239 D. S. O. No. 044
Location [illegible]
Surveyed by [illegible]
Date 11-16-28
Indexed A. C. Johnson

Notice: ANY ADDITIONS OR CHANGES ON THIS SHEET MUST BE MADE OR CIRCLED IN Red. WITH DATE AND NAME OF PERSON MAKING CHANGE.

Do not extend notes this side of this line

RETURN TO
LOS ANGELES COUNTY SURVEYOR

to bottom of page 24

(60')

Frame

Crown

(40')

F. B. 306 Pg. Chief Party Notes by [illegible] Date 11-19-25

RETURN TO
LOS ANGELES COUNTY SURVEYOR

Do not extend notes this side of this line

Note: ANY ADDITIONS OR CHANGES ON THIS SHEET MUST BE MADE OR CIRCLED IN Red. WITH DATE AND NAME OF PERSON MAKING CHANGE.

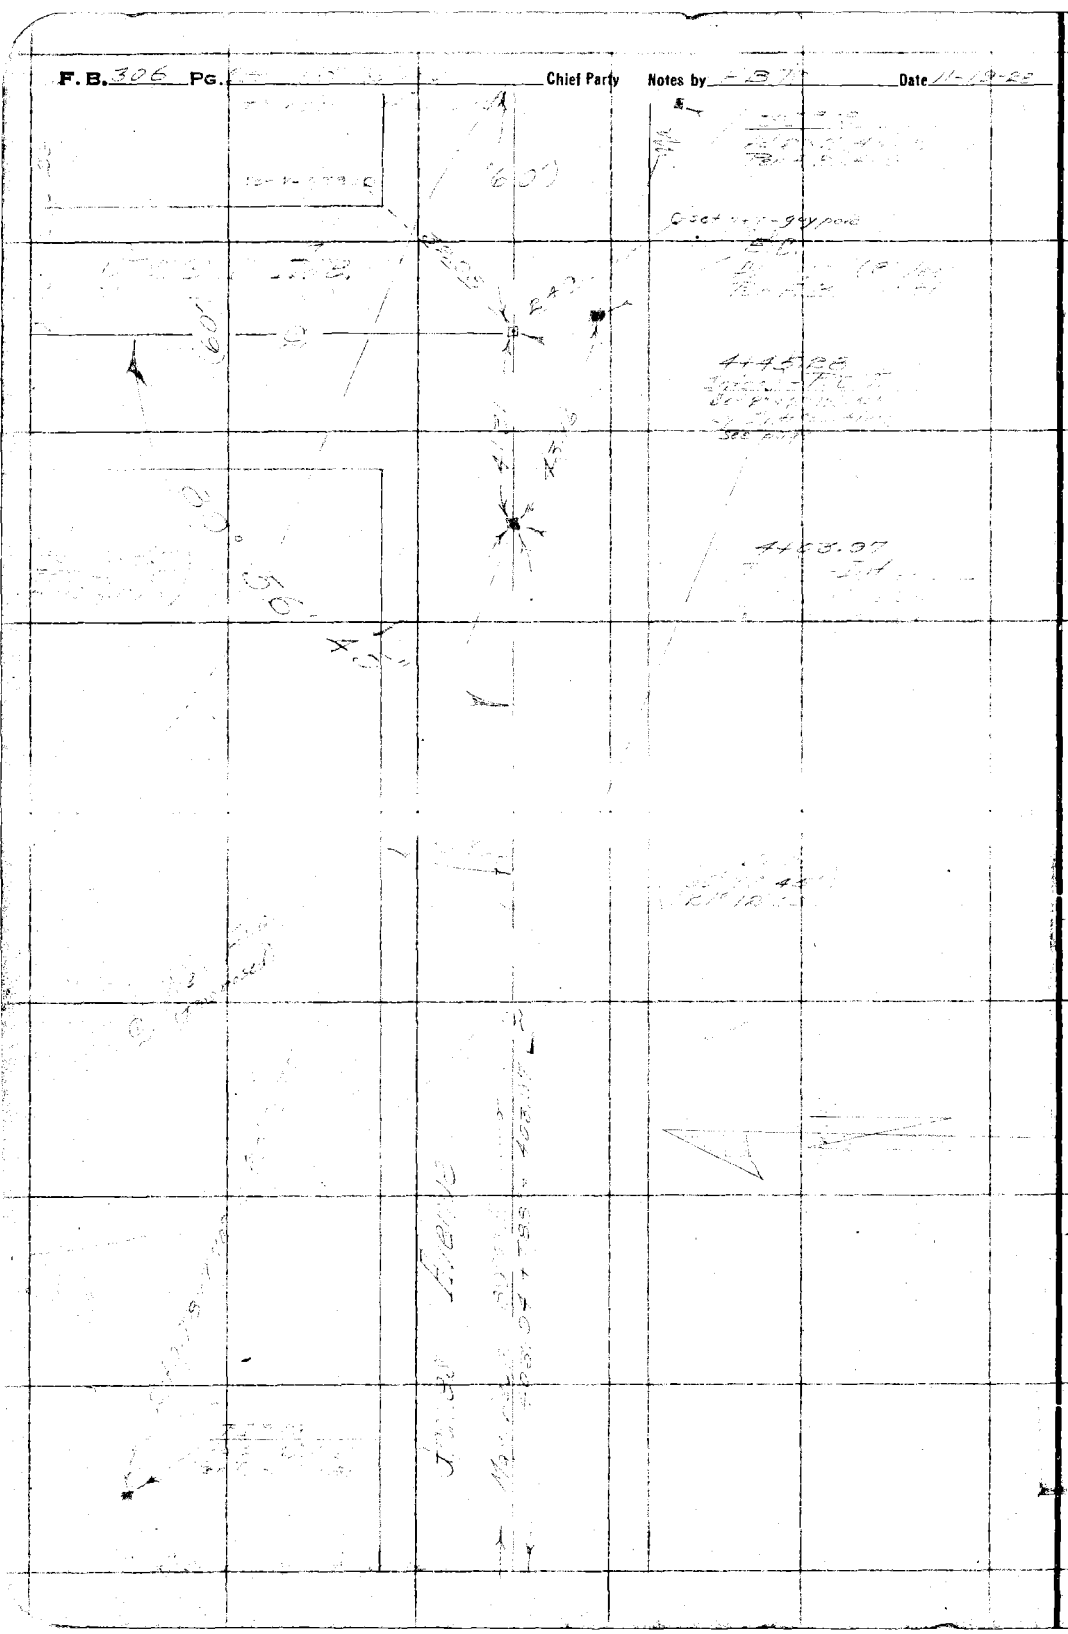

Date Notes by Chief Party F.B. 306 Pg. 25

Platted by J. C. Hoyt
Date June '29
Map No. B-384-Sht #1
Platting C'k'd by R. W. S.
Date MAR 17 1930

W. O. No. 4R307 T. S. O. No. C 44
Location
Surveyed by
Date 11-21-28
Indexed A. C. Johnson

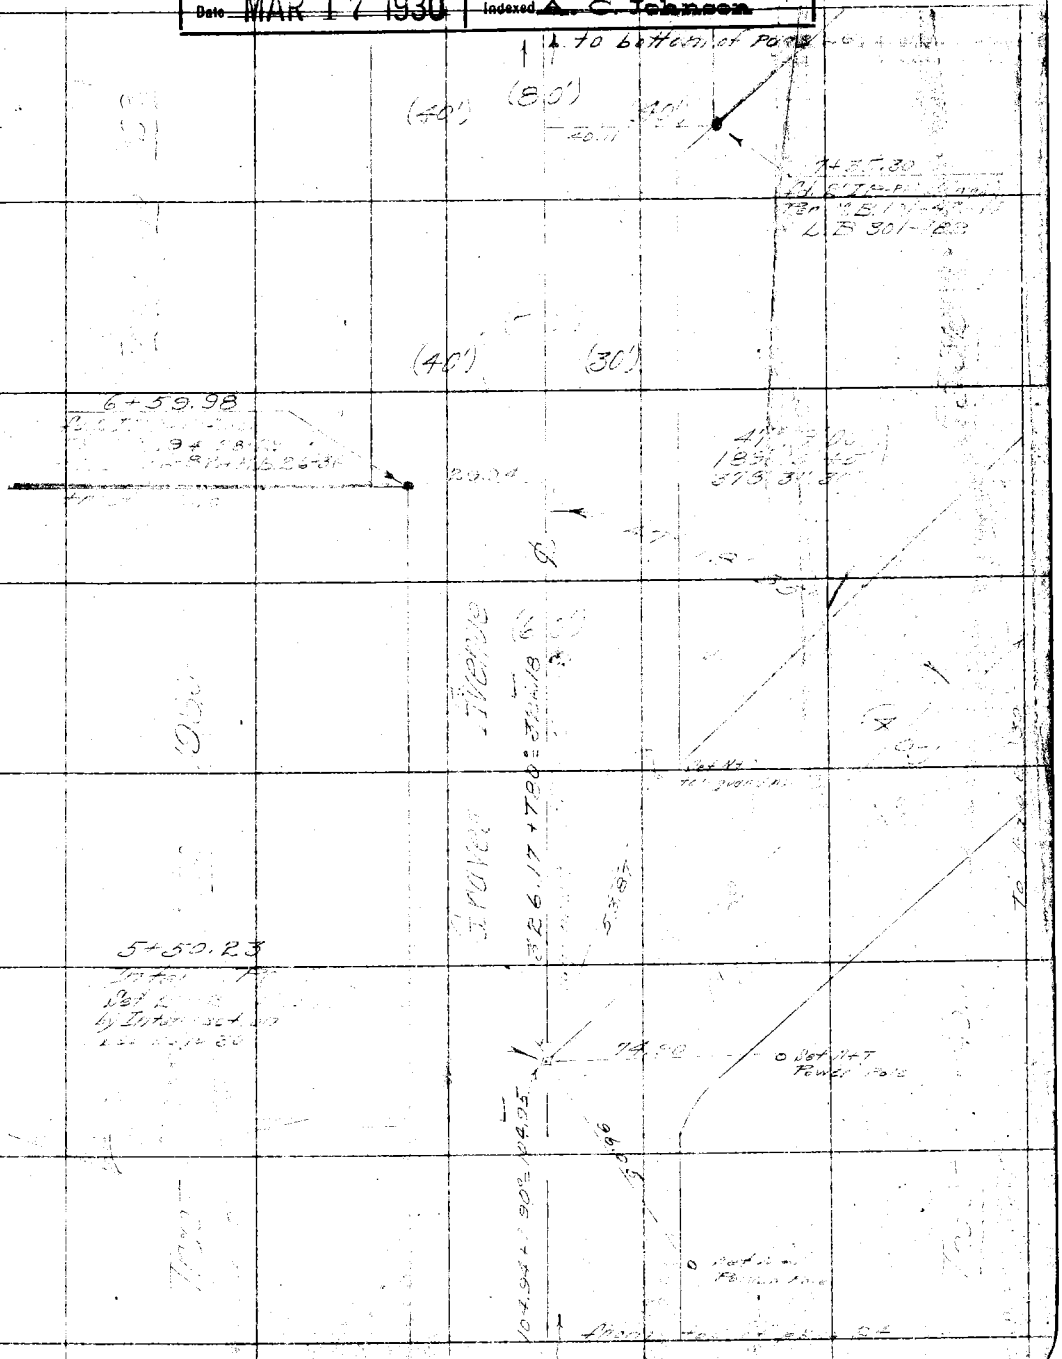

F. B. _____ PG. _____ Chief Party _____ Notes by _____ Date _____

RETURN TO
LOS ANGELES COUNTY SURVEYOR

Do not extend notes this side of this line

Note: ANY ADDITIONS OR CHANGES ON THIS SHEET MUST BE MADE OR CIRCLED IN Red. WITH DATE AND NAME OF PERSON MAKING CHANGE.

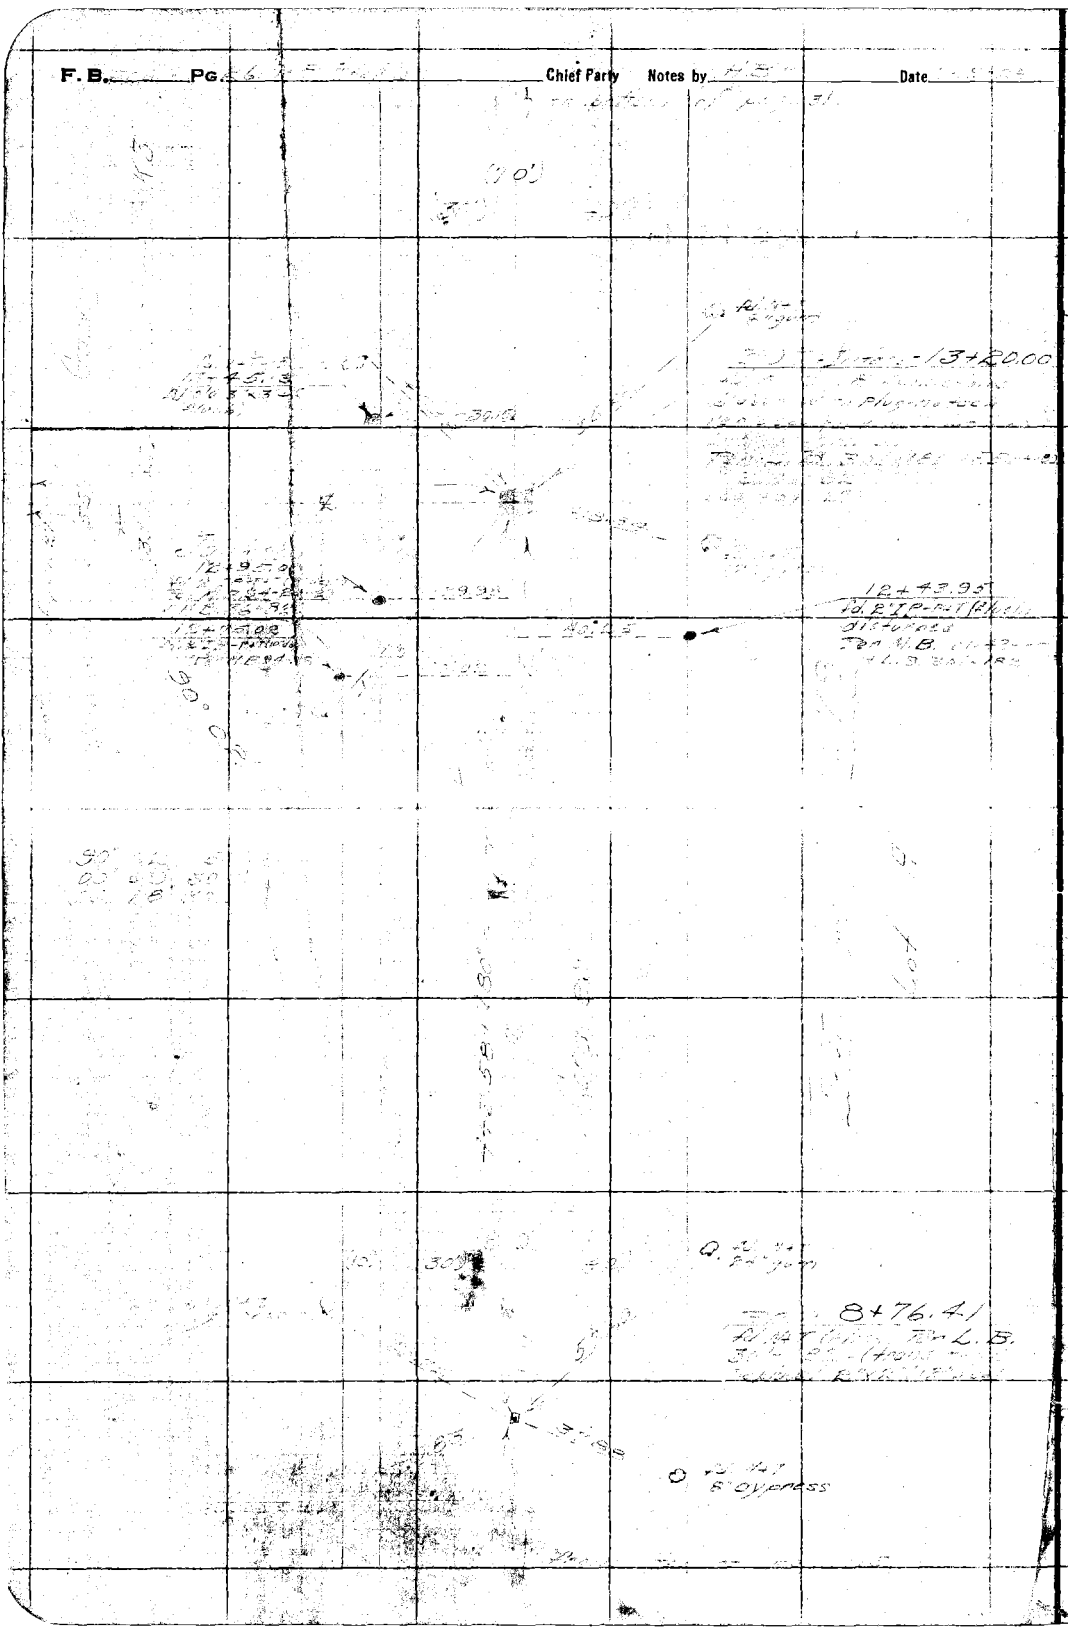

Date _____ Notes by _____ Chief Party _____ F.B. 306 Pg. 27

Platted by J. C. Hoyt	W. O. No. 4[illegible] D. S. O. No. 04
Date JUNE '24	Location
Map No. B-384-5th #1	Surveyed by
Platting Ck'd by R. W. S.	Date 11-[illegible]
Date MAR 17 1930	Indexed A. C. Johnson

Notes: ANY ADDITIONS OR CHANGES ON THIS SHEET MUST BE MADE OR CIRCLED IN Red. WITH DATE AND NAME OF PERSON MAKING CHANGE.

Do not extend notes this side of this line

RETURN TO LOS ANGELES COUNTY SURVEYOR

RETURN TO
LOS ANGELES COUNTY SURVEYOR

Note: ANY ADDITIONS OR CHANGES ON THIS SHEET MUST BE MADE OR CIRCLED IN **Red.** WITH DATE AND NAME OF PERSON MAKING CHANGE.

Do not extend notes this side of this line

F. B. 382 Pg 66 Chief Party Notes by HB Date 12-5

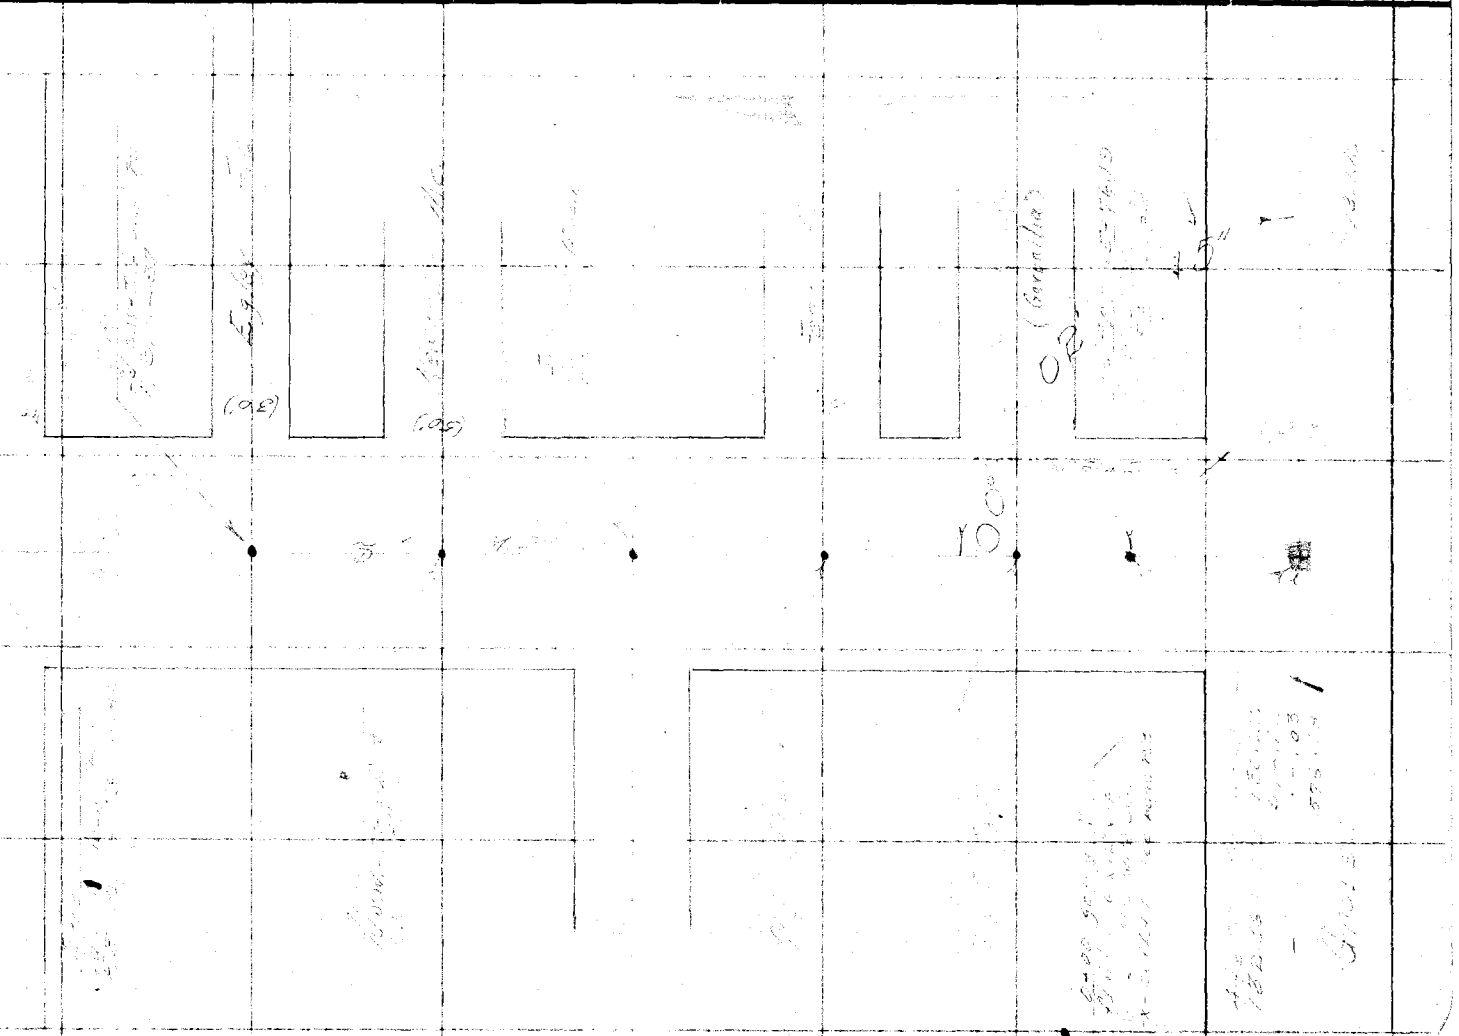

Date 11-20-28 Notes by [illegible] Chief Party [illegible] F.B. 306 PG. 29

Platted by J.C. Hoyt
Date June '29
Map No. 13-334-Sht #1
Platting Ck'd by R. W. S.
Date MAR 17 1930

W. O. No. 4239 D. S. O. No. 0+—
Location [illegible]
Surveyed by [illegible]
Date 11-20-28
Indexed A. C. Johnson

Notes: ANY ADDITIONS OR CHANGES ON THIS SHEET MUST BE MADE OR CIRCLED IN Red. WITH DATE AND NAME OF PERSON MAKING CHANGE.

Do not extend notes this side of this line

RETURN TO
LOS ANGELES COUNTY SURVEYOR

0+30-Going South
Set Nail (Spike)
0+30.18
Set Nail
2+16.03
Set Nail (Spike)
0+30.34
1+80.15
Set Nail (Spike)
1+80.22
Set Nail (Spike)
30.18
30.22
30.26
30.38
29.94
30.00
30.15
3+88.61
Set 2"x2" (Tin Lead) by
Rec. by R.S.
36
35
34
33
27
28
20
30
31
8+01.94
32
T 11° 00' 00"
R 20° 23' 15"
3° 13' 00"
360° 00"
N 56° 00' W
S 56° 00' E
S 33° 00' W
N 33° 00' E

RETURN TO
LOS ANGELES COUNTY SURVEYOR

Note: ANY ADDITIONS OR CHANGES ON THIS SHEET MUST BE MADE OR CIRCLED IN **Red.** WITH DATE AND NAME OF PERSON MAKING CHANGE.

Do not extend notes this side of this line

F. B. ____ Rg. ____ Chief Party ____ Notes by ____ Date ____

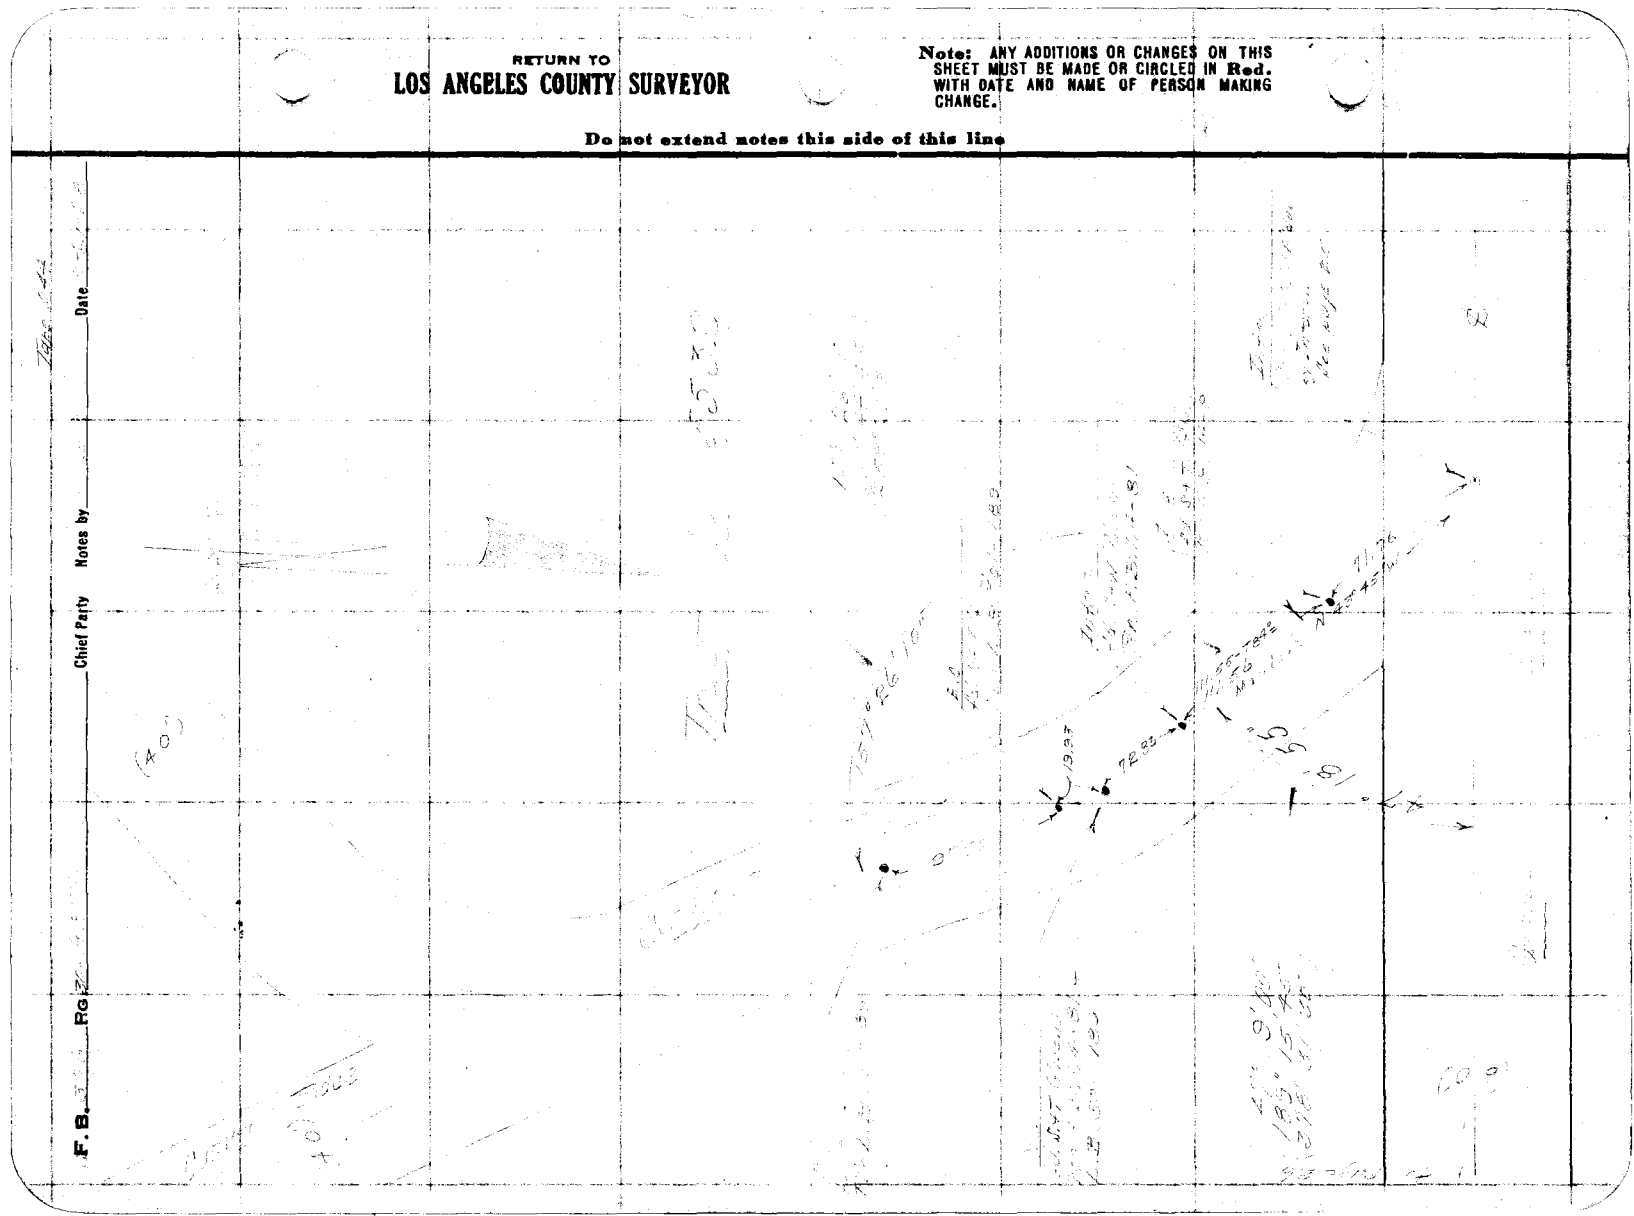

Date 11-22-28 Notes by H.E.T. Chief Party H.E.T. F.B. 306 Pg 31

Platted by J.C. Hoyt
Date June 29
Map No. B-384-Sh#1
Platting C'k'd by R.W.S.
Date MAR 17 1930

W. O. No. 4235 D. S. O. No. 044
Location
Surveyed by
Date 11-22-28
Indexed A. C. Johnson

Notes: ANY ADDITIONS OR CHANGES ON THIS SHEET MUST BE MADE OR CIRCLED IN Red. WITH DATE AND NAME OF PERSON MAKING CHANGE.

Do not extend notes this side of this line

RETURN TO LOS ANGELES COUNTY SURVEYOR

Lot 8 - Blk 3

9480.33
Rd. R. X But (Post)

39.23

Set N+T
in Cross

Set N+T
13" Spike

Set N+T
10" gum

17+63.45
Rd. R. X But (Post)
Cor. Sec.
M.B. 107-43+44

40.15

Lot 4 - Blk 3

Set N+T - 18 gum

P.C. 21+00.00

Tract

Tract

600.00 (S 51° - 03' E)

Rock top of slope

F. B. 306 Pg. 32 Chief Party Notes by [illegible] Date [illegible]

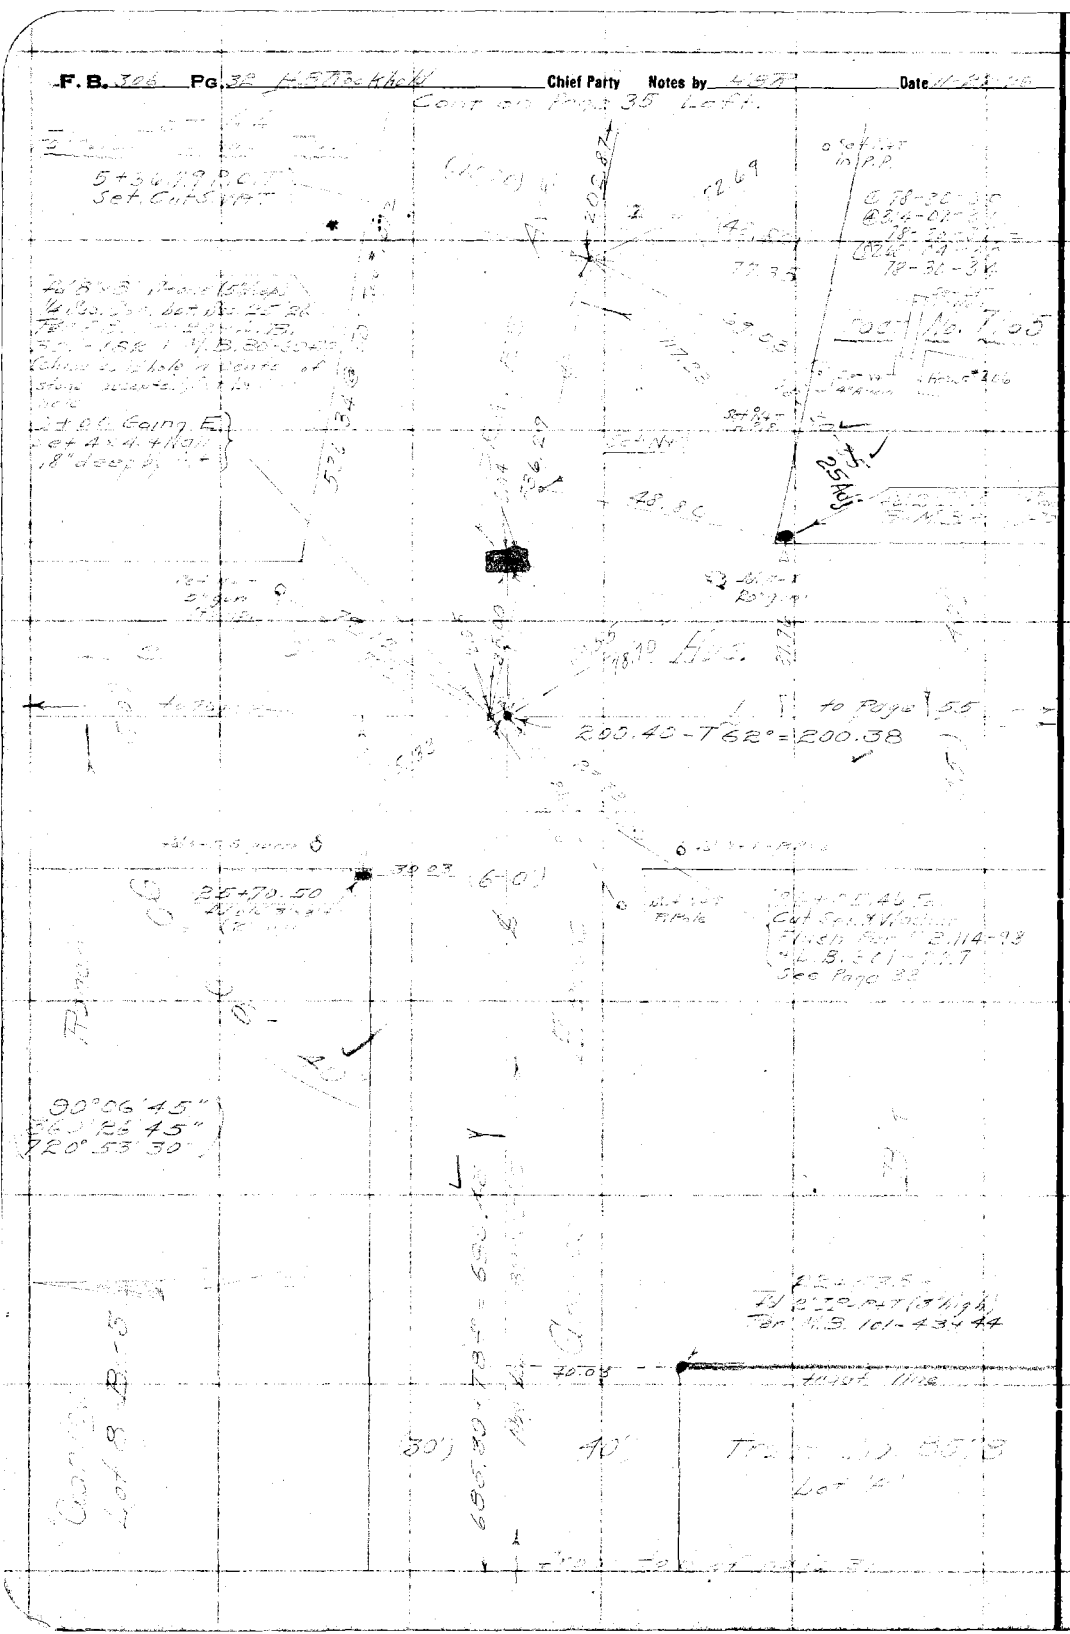
Cont'd from Page 35 Left
200.43-T62°=200.38
to Page 55
Set Cut X
Set 4"x4" Hub
8" deep

Date _____ Notes by _____ Chief Party _____ F.B. 306 Pg. 33

Platted by J.C. Hoyt
Date June '29
Map No. B-384-Sht 21
Platting C'k'd by R. W. S.
Date MAR 17 1930

W.O. No. 4239 D.S.O. No. 027
Location
Surveyed by
Date 22-29
Indexed A. C. Johnson

90° 06' 45"
360° 26' 45"
720° 53' 30"

90° 06' 40"

Groves Avenue

R+20.38
POT

POT-3+76.43

Notes: ANY ADDITIONS OR CHANGES ON THIS SHEET MUST BE MADE OR CIRCLED IN Red. WITH DATE AND NAME OF PERSON MAKING CHANGE.

Do not extend notes this side of this line

RETURN TO
LOS ANGELES COUNTY SURVEYOR

RETURN TO

LOS ANGELES COUNTY SURVEYOR

Note: ANY ADDITIONS OR CHANGES ON THIS SHEET MUST BE MADE OR CIRCLED IN **Red.** WITH DATE AND NAME OF PERSON MAKING CHANGE.

Do not extend notes this side of this line

F.B. 376 Pg. 34 Chief Party _____ Notes by _____ Date _____

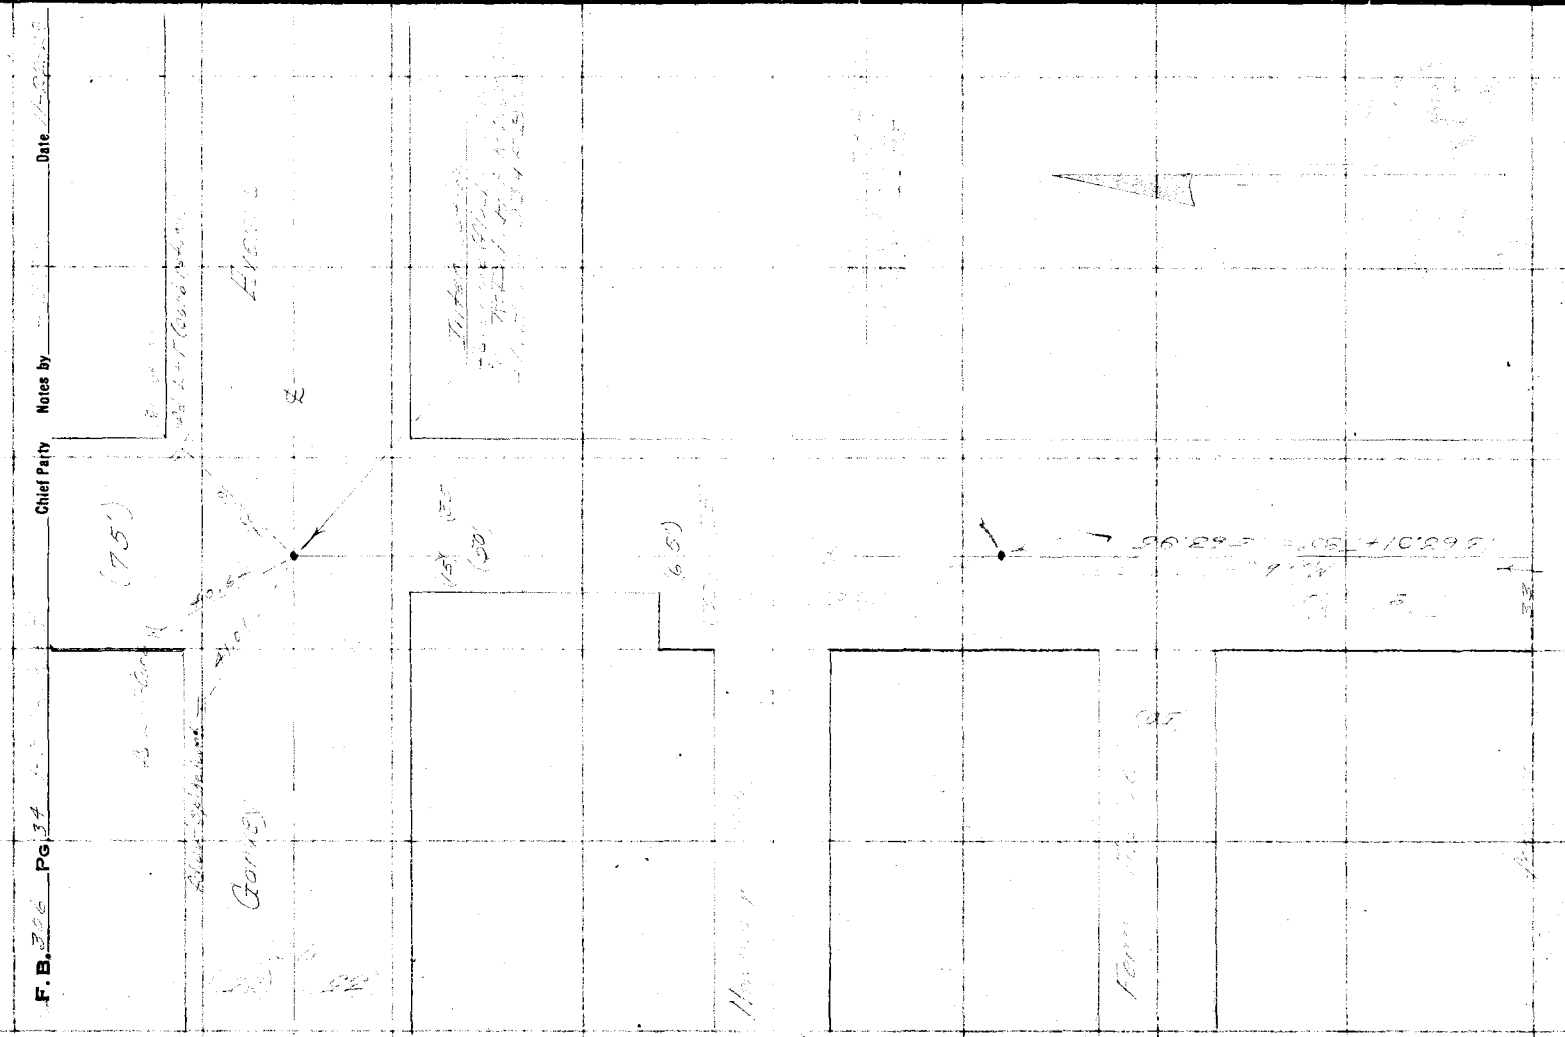

Date 1-20-30 Notes by _____ Chief Party _____ F.B. 306 Pg. 35

Platted by J.C. Hoyt	W. O. No. 46-32 D. S. O. No. 044
Date June 29	Location _____
Map No. B-384-Sh #1	Surveyed by _____
Platting C'k'd by R. W. S.	Date _____
Date MAR 17 1930	Indexed A. C. Johnson

Notes: ANY ADDITIONS OR CHANGES ON THIS SHEET MUST BE MADE OR CIRCLED IN Red. WITH DATE AND NAME OF PERSON MAKING CHANGE.

Do not extend notes this side of this line

RETURN TO
LOS ANGELES COUNTY SURVEYOR

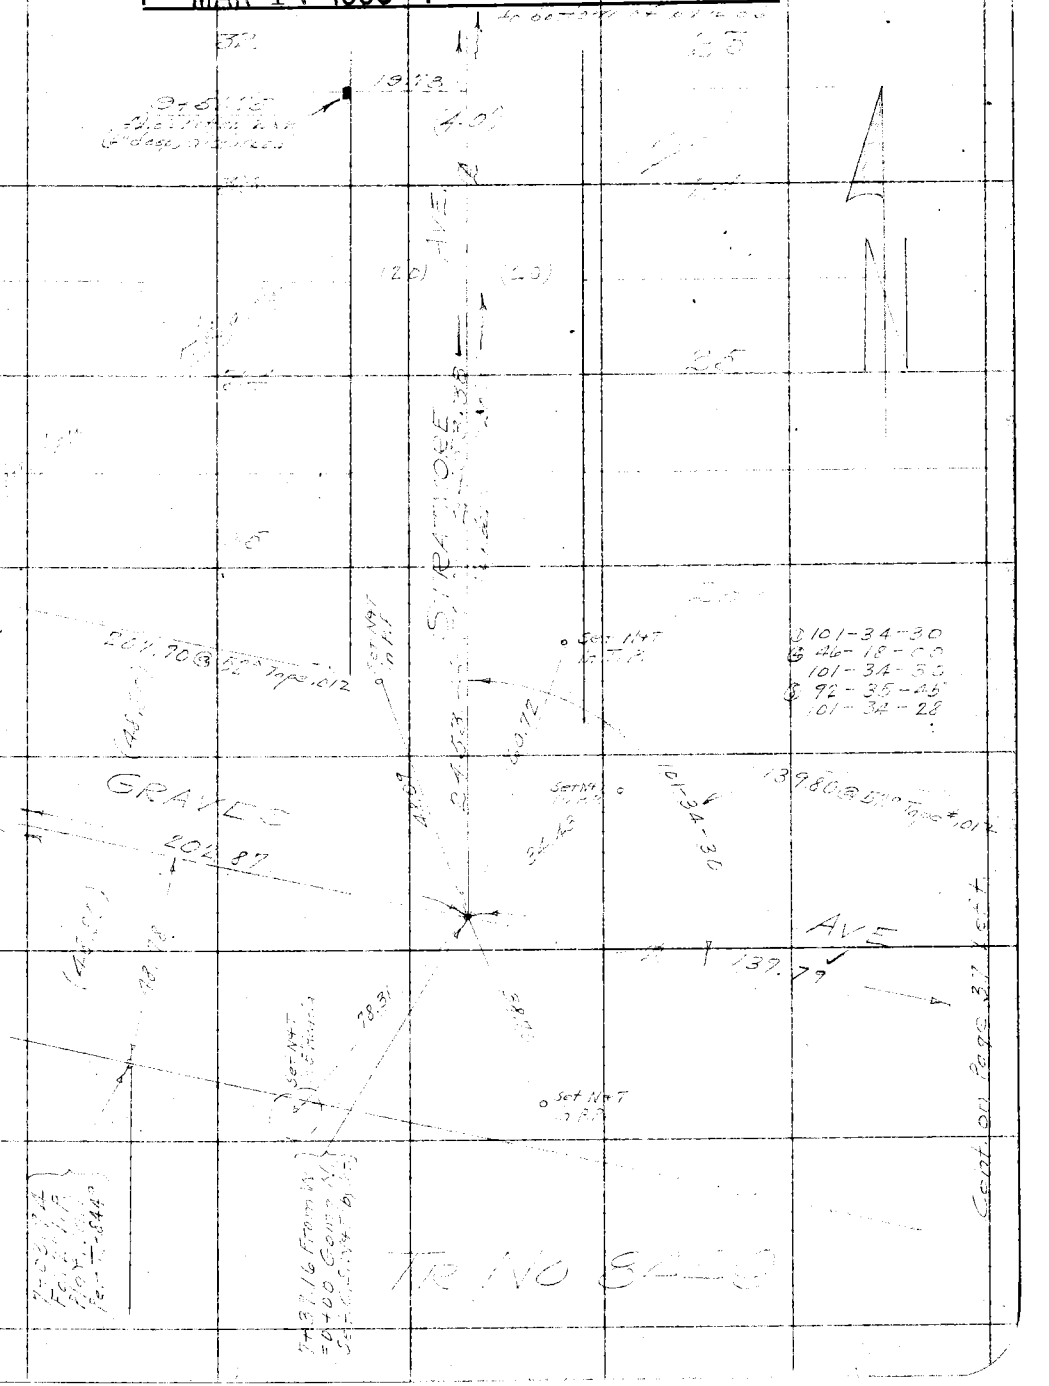
Cont. From Top Page 32
GRAVEL
Set Nail
Set Nail & Tag
Set Nail & Tag
Set Nail & Tag

F. B. 306 Pg. 26 Chief Party Notes by Date

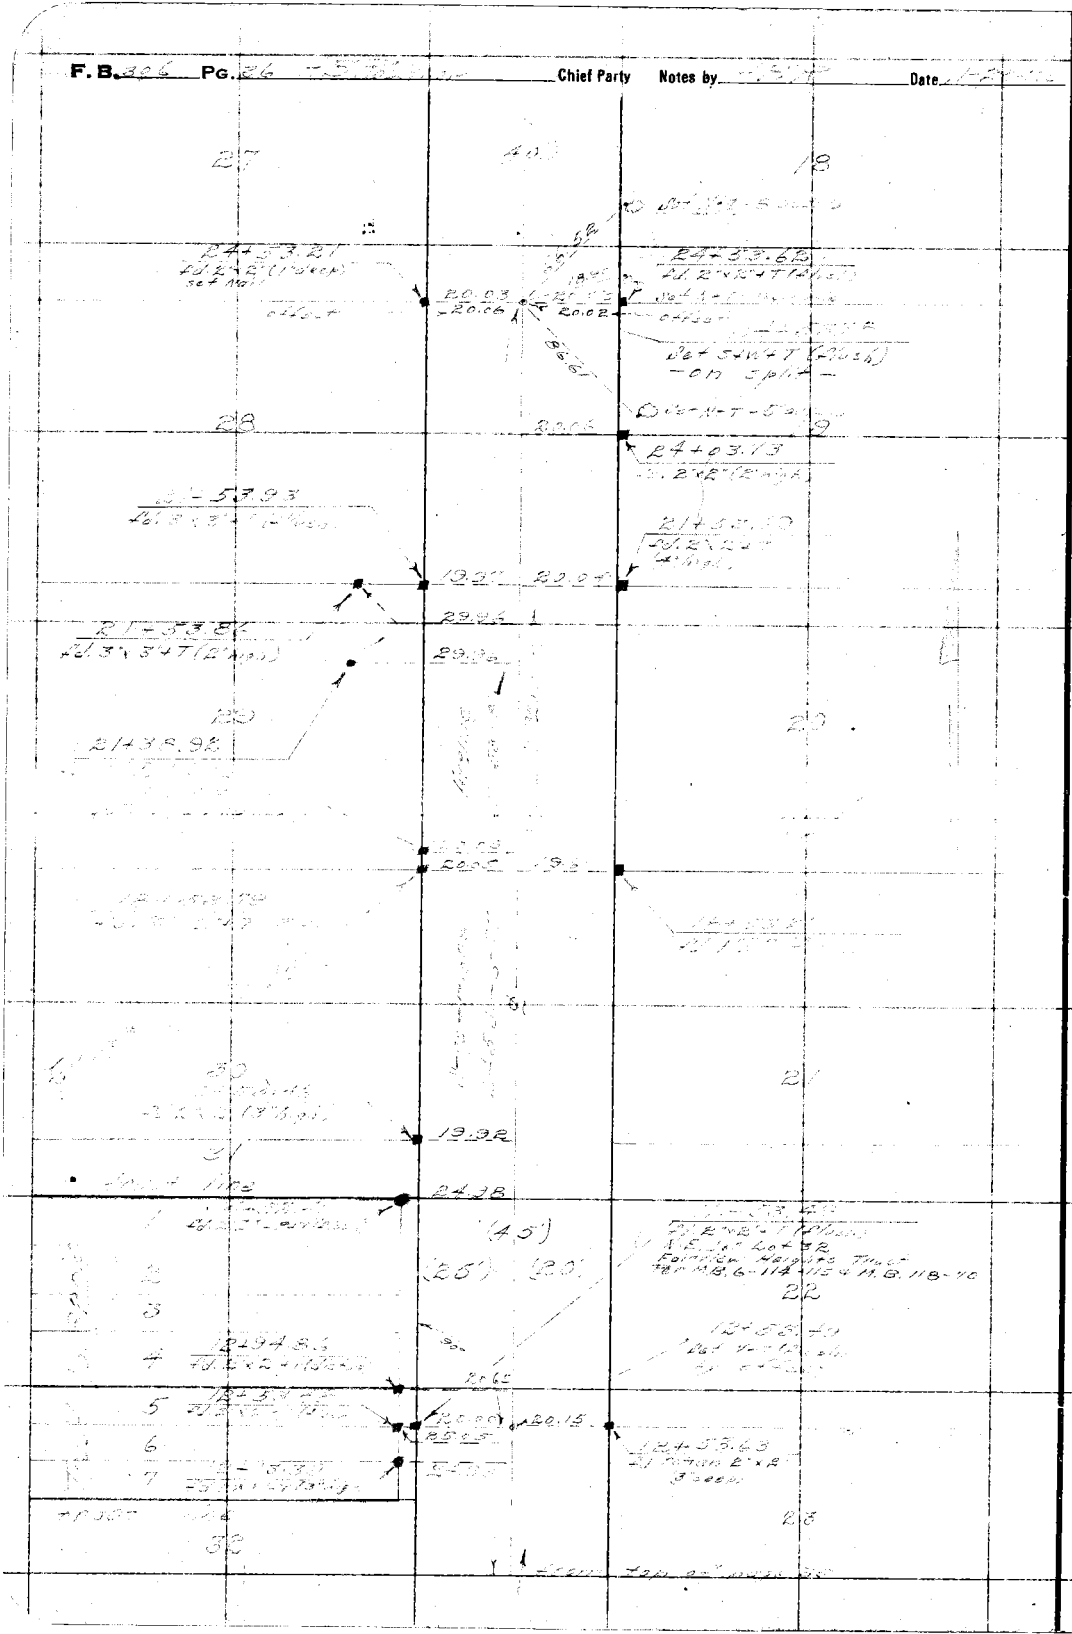

RETURN TO
LOS ANGELES COUNTY SURVEYOR

Do not extend notes this side of this line

Note: ANY ADDITIONS OR CHANGES ON THIS SHEET MUST BE MADE OR CIRCLED IN Red. WITH DATE AND NAME OF PERSON MAKING CHANGE.

Date 12-20-28 Notes by P.T.D. Chief Party P.T. Dunlop F.B. 306 Pg 37

Platted by J.C. Hoyt	W. O. No. 4239 O. S/O. No. 012
Map No. B-384-54 #21	Surveyed by P.T. Dunlop
Platting C'k'd by R.W.S.	Date 12-20-28
Date MAR 17 1930	Indexed A. C. Johnson

Notes: ANY ADDITIONS OR CHANGES ON THIS SHEET MUST BE MADE IN CUCLER or Red. WITH DATE AND NAME OF PERSON MAKING CHANGE.

Do not extend notes this side of this line

RETURN TO LOS ANGELES COUNTY SURVEYOR

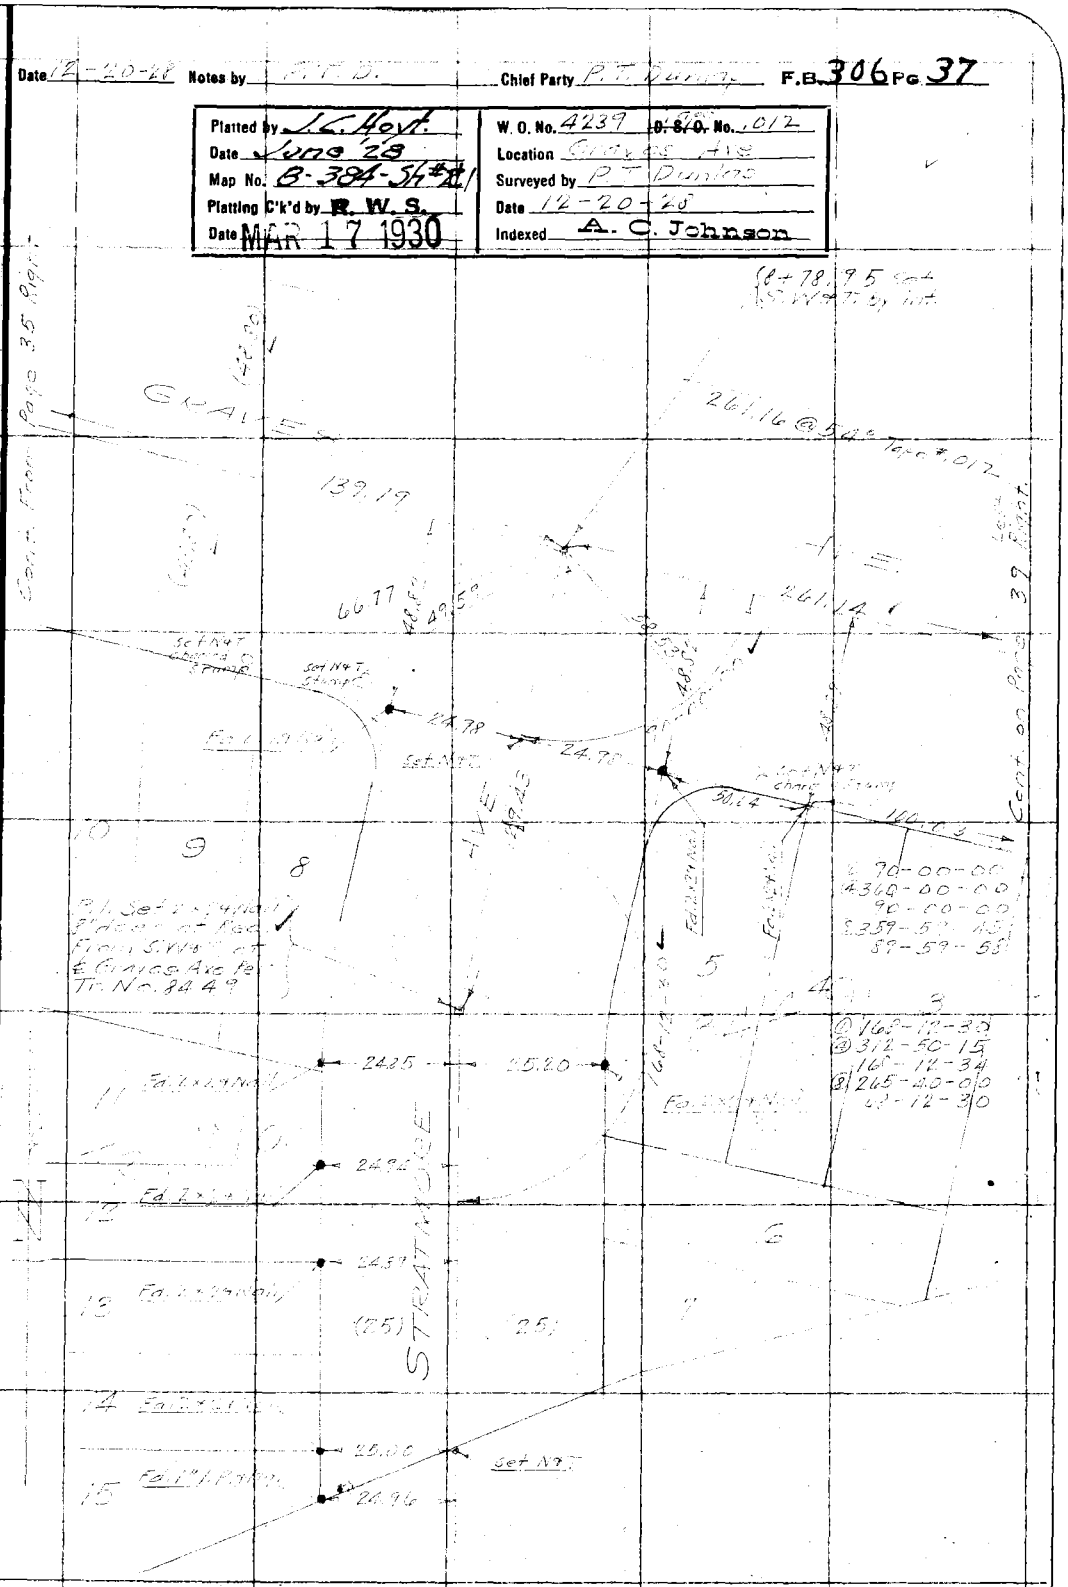
Cent. from Page 35 Rept.
Graves
139.19
66.77
49.59
261.14
24.78
Set N&T
Set N&T Chiseled
Fd L 3/4" Pipe
Fd L 3/4" Pipe
Set N&T
Set N&T Chiseled
Cent. on Page 39 Rept.
30.64
160.62
Fd L 3/4" Pipe
Fd L 3/4" Pipe
Fd L 3/4" Pipe

F.B. 306 Pg. 38 P.T. Dumas Chief Party Notes by P.T.D. Date 12-20-71

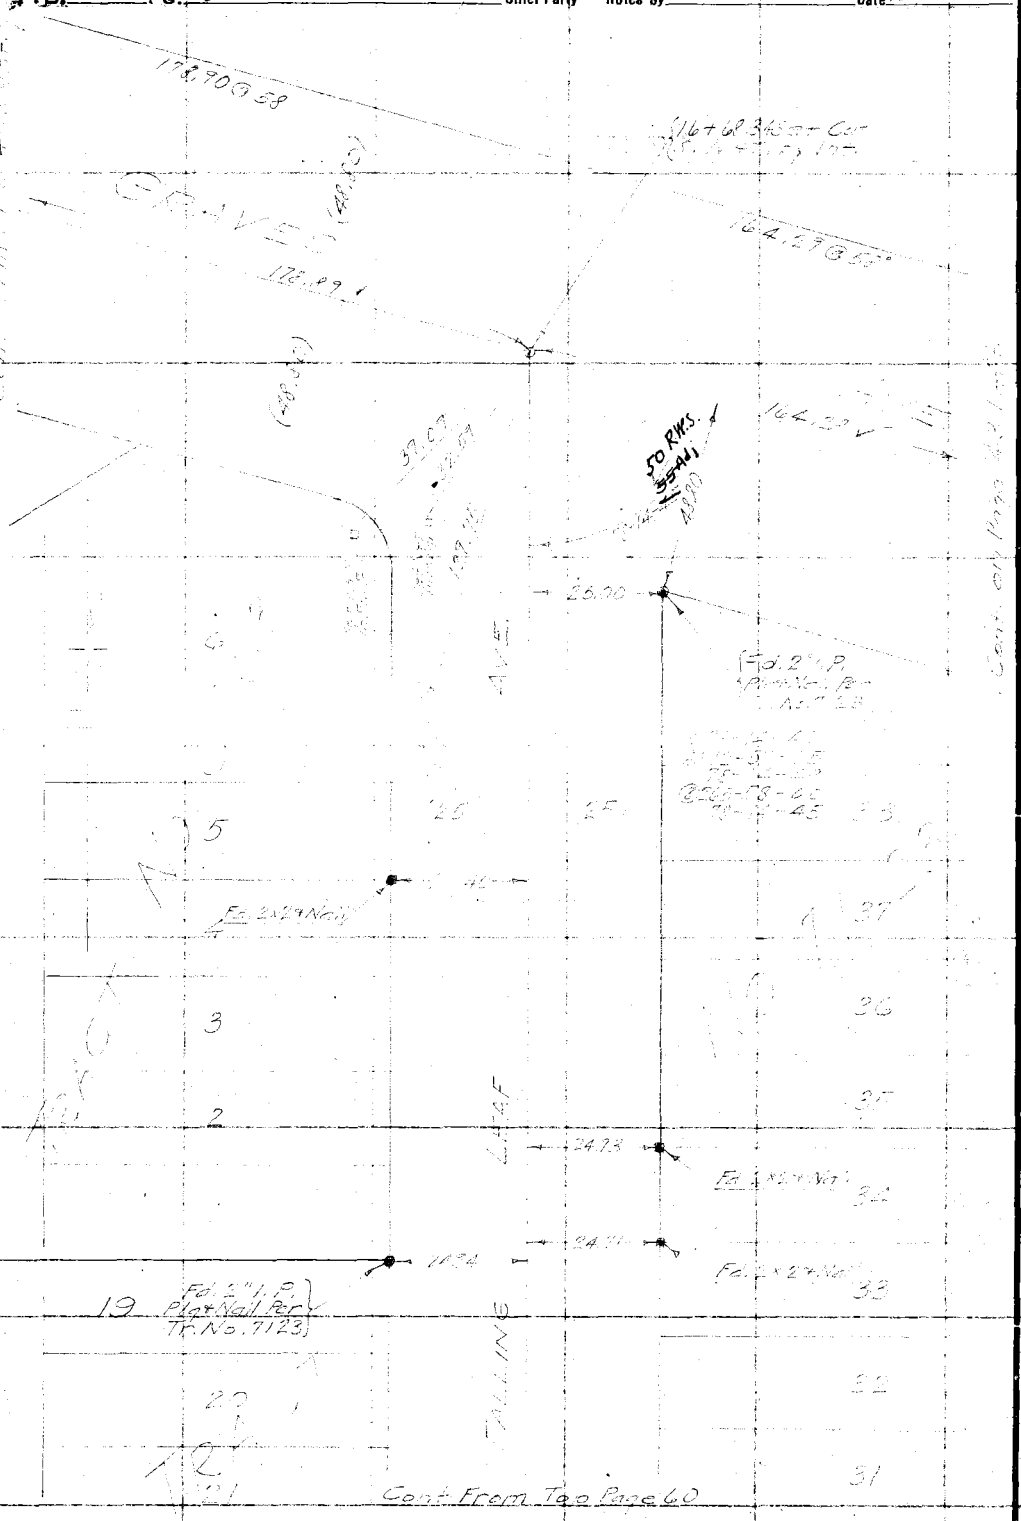
178.90 (S 58°
CRAVE (40' R/W)
178.89
(40' R/W)
164.29 (S 58°
164.29
50 R/W.
Subd.
ADD
26.00
Fd. 2" P.
Fd. 2" P.
Fd. 2" P.

Date 12-22-28 Notes by H.B.L. & R.H.D. Chief Party H.B. Rockwell F.B. 306 Pg. 39

Platted by J.C. Hoyt	W. O. No. 4239 B. S. O. No. 017
Date June '29	Location Grover Ave
Map No. B-384-5/#21	Surveyed by H.B. Rockwell
Platting C'k'd by R.W.S.	Date 12-28-28
Date MAR 17 1930	Indexed A. C. Johnson

Cont. on Bk. Page 40

24 44

25 43

26 42

41

FAIRVIEW HEIGHTS

TRACT

S. 2 Apn. 6.

Fd. 2" I.P. Bears N. 61° W. 2.80'

40

Fd. 2½" Nail

25.00

25.00

24.10

Fd. 1½" I.P. Bears N.

0.04' Fd. 2" I.P.

Cont. From Page 37

SEA. 1.5

26.14

49.10

45.04

48.30

OF ANT in C.P.

49.10

Fd. 1" I.P.

Fd. 1" I.P.

3 2

T.S. No. 8445

40.09 From W. Cor. Gov't Lot 3 of S.W. ¼ of Sec. 2

Fd. So. Cal. Edison Co. Brass Cap. Mon.

Cont. on Page 41

RETURN TO LOS ANGELES COUNTY SURVEYOR

Notes: ANY ADDITIONS OR CHANGES ON THIS SHEET MUST BE MADE OR CHECKED IN Red. WITH DATE AND NAME OF PERSON MAKING CHANGE.

Do not extend notes this side of this line

F.B. 306 Pg. 40 P.T. Dunlap Chief Party Notes by P.T.D. Date 12-26-28

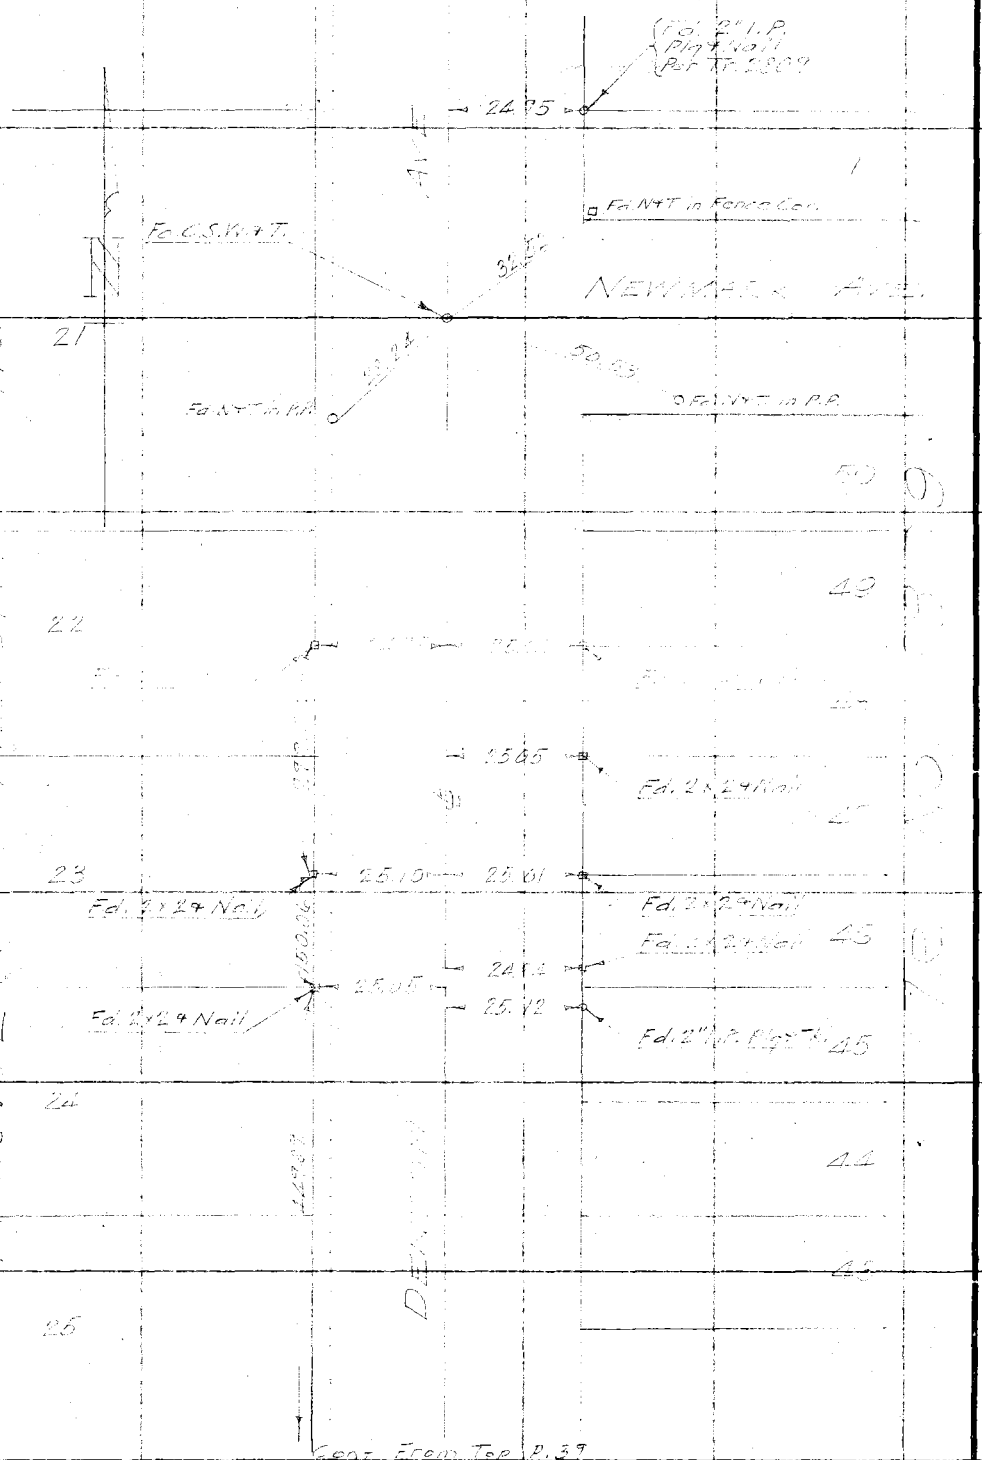

RETURN TO
LOS ANGELES COUNTY SURVEYOR

Do not extend notes this side of this line

Note: ANY ADDITIONS OR CHANGES ON THIS SHEET MUST BE MADE OR CIRCLED IN Red. WITH DATE AND NAME OF PERSON MAKING CHANGE.

Date [illegible] Notes by [illegible] Chief Party [illegible] F.B. 306 Pg. 41

Platted by J. C. Hoyt.	W. O. No. 4237 D. S. O. No. [illegible]
Date June '28	Location [illegible]
Map No. B-732-34 #1	Surveyed by [illegible]
Platting C'k'd by R. W. S.	Date [illegible]
Date FEB 17 1930	Indexed A. C. Johnson

Notes: ANY ADDITIONS OR CHANGES ON THIS SHEET MUST BE MADE OR CIRCLED IN Red. WITH DATE AND NAME OF PERSON MAKING CHANGE.

Do not extend notes this side of this line

RETURN TO LOS ANGELES COUNTY SURVEYOR

Cont. From Sheet 39

Cont. From Sheet 39

Cont. From Sheet 39


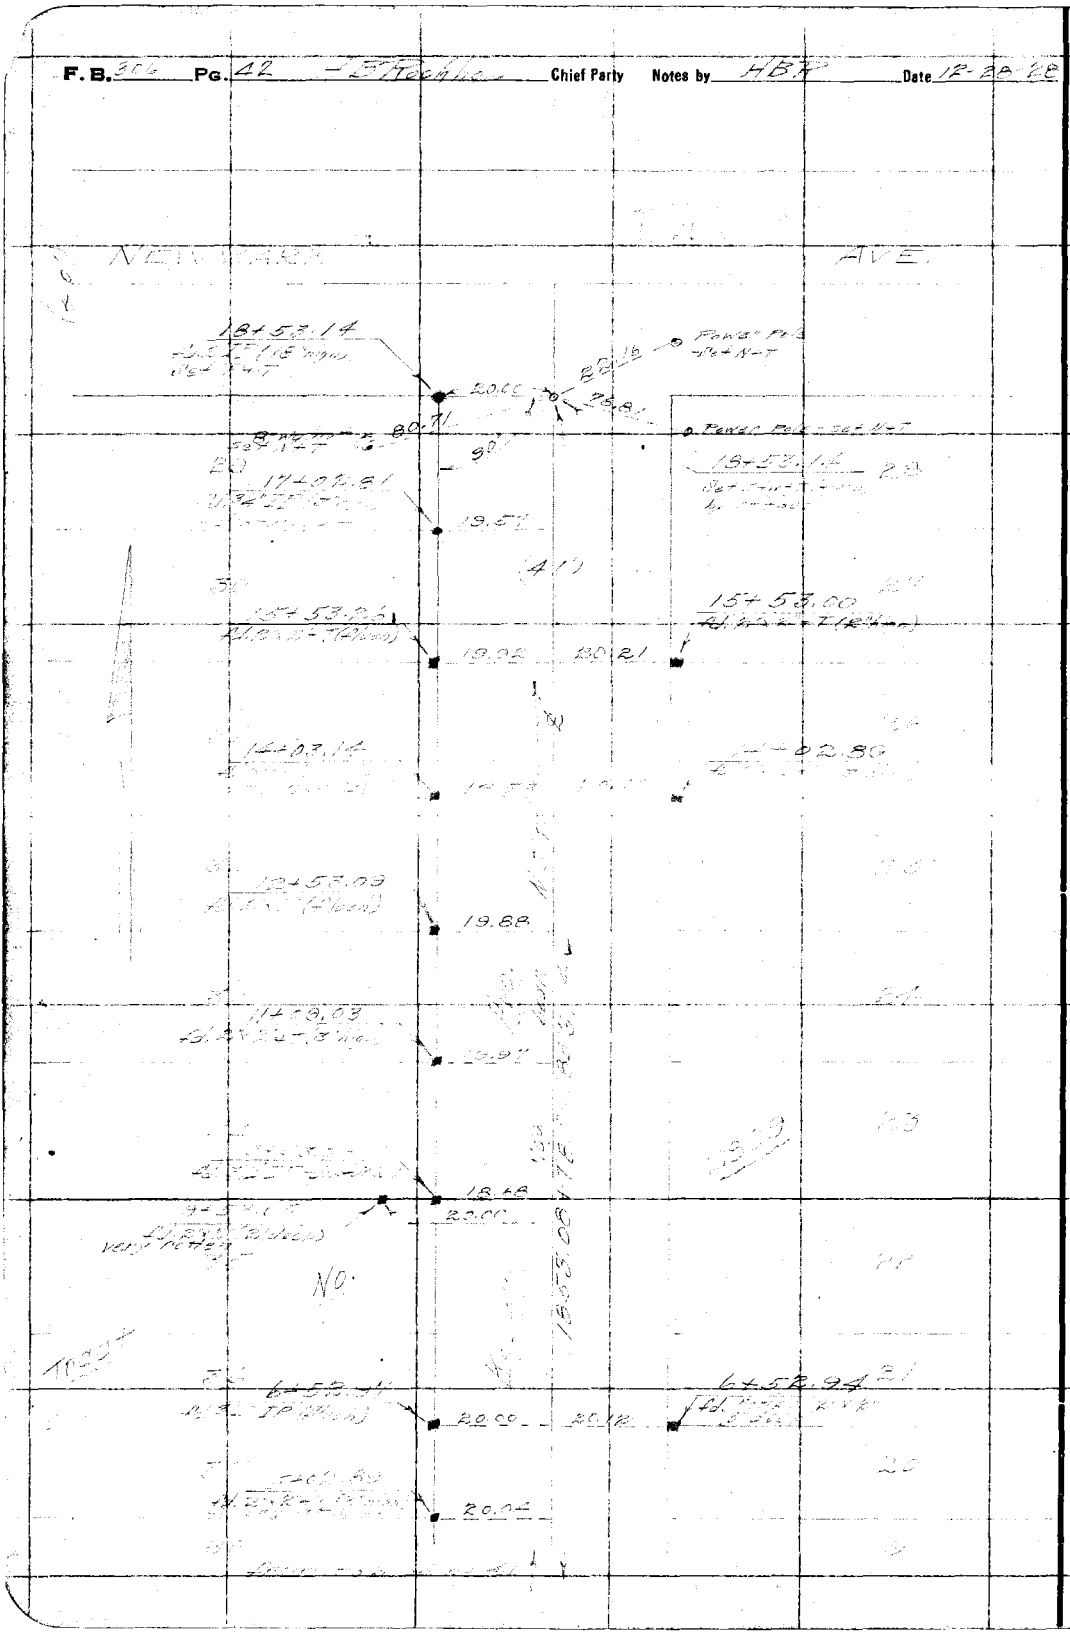

RETURN TO
LOS ANGELES COUNTY SURVEYOR

Do not extend notes this side of this line

Note: ANY ADDITIONS OR CHANGES ON THIS SHEET MUST BE MADE OR CIRCLED IN Red. WITH DATE AND NAME OF PERSON MAKING CHANGE.

Date 12-7-28 Notes by F.S. Chief Party [illegible] F.B. 306 Pg. 43

Platted by J.C. Hoyt	W.O. No. [illegible] B.S.O. No. 244
Date June 29	Location [illegible]
Map No. B-384-Sht #1	Surveyed by [illegible]
Platting C'k'd by R.W.S.	Date 12-7-28
Date MAR 17 1930	Indexed A. C. Johnson

Notes: ANY ADDITIONS OR CHANGES ON THIS SHEET MUST BE MADE OR CHECKED IN Red. WITH DATE AND NAME OF PERSON MAKING CHANGE.

Do not extend notes this side of this line

RETURN TO LOS ANGELES COUNTY SURVEYOR

5471.68

5471.23
Fd. 2"x2"x1' (3" high)

5471.55
A.C.E.Co. Brass Disc

Fd. A.C.E.Co. Brass Cap, Flush

Fd. Nail & Tag

Top Fd. Post

Fd. 2x2 Nail & Tag

Fd. 2x2 Nail 6" deep Per R.D.F.B. F.C. 306-5

F. B. 205 Pg. 44 Chief Party Notes by [illegible] Date [illegible]

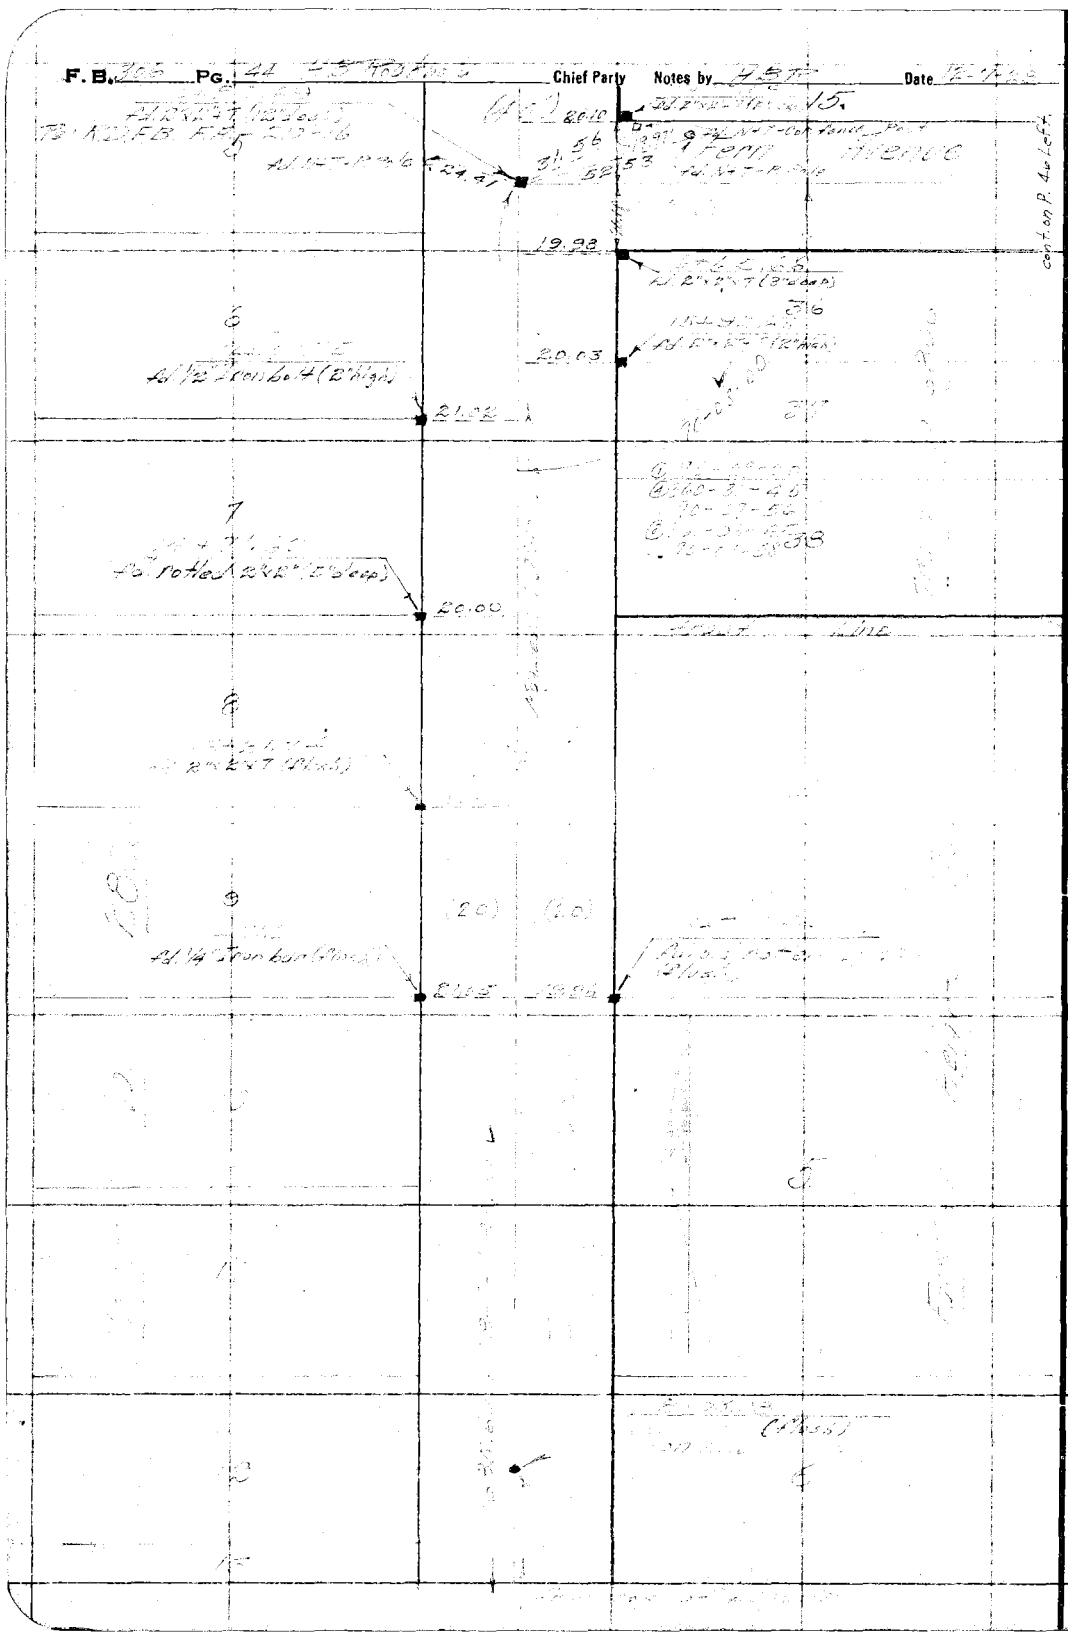

RETURN TO
LOS ANGELES COUNTY SURVEYOR

Do not extend notes this side of this line

Note: ANY ADDITIONS OR CHANGES ON THIS SHEET MUST BE MADE OR CIRCLED IN Red. WITH DATE AND NAME OF PERSON MAKING CHANGE.

Date _____ Notes by _____ Chief Party _____ F.B. 306 Pg. 45

Platted by J.C. Hoyt	W.O. No. _____ B.S.C. No. _____
Date June 29	Location _____
Map No. B-384-34 #1	Surveyed by _____
Platting C'k'd by R.W.S.	Date _____
Date MAR 17 1930	Indexed A. C. Johnson

Notes: ANY ADDITIONS OR CHANGES ON THIS SHEET MUST BE MADE OR CIRCLED IN Red. WITH DATE AND NAME OF PERSON MAKING CHANGE.

Do not extend notes this side of this line

RETURN TO LOS ANGELES COUNTY SURVEYOR

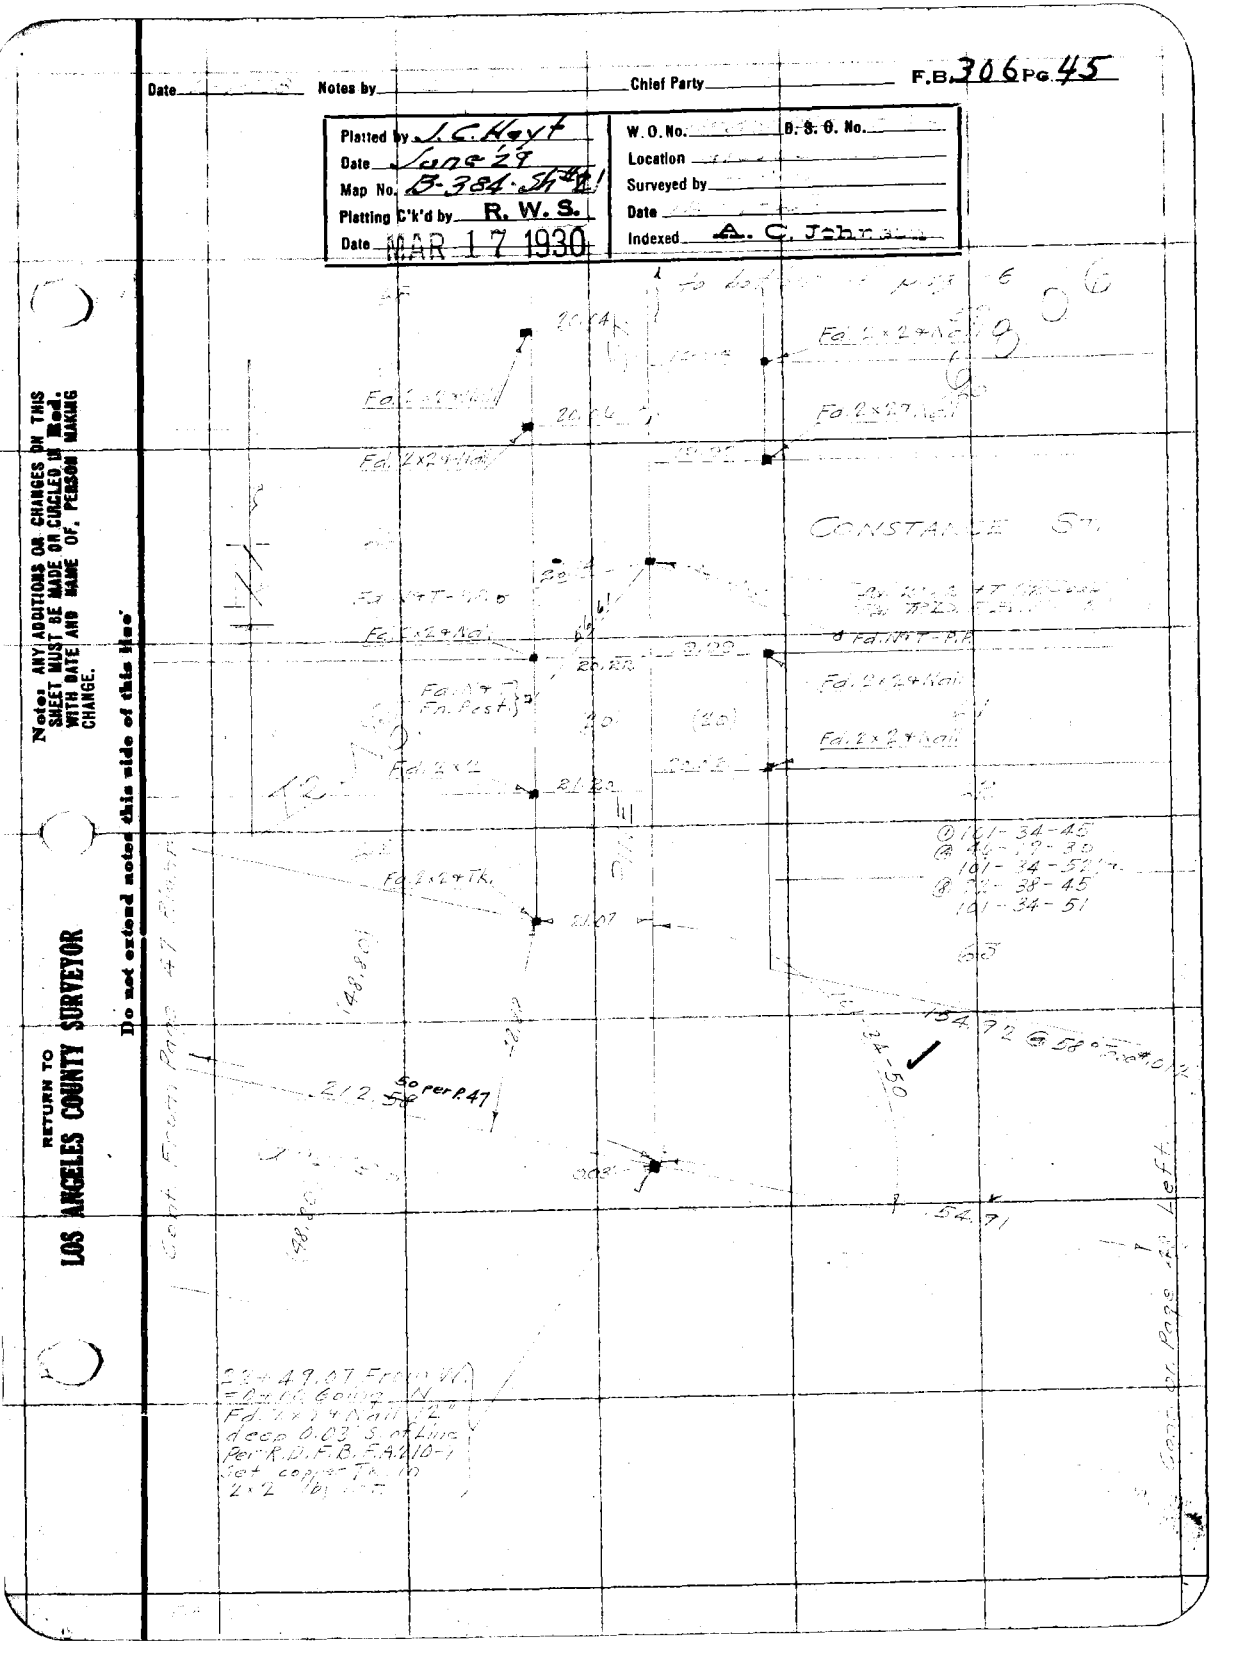
CONSTANCE ST.
Fd. 2x24 Nail
Fd. 2x24 Nail
Fd. 2x24 Nail
Fd. 2x24 Nail
Fd. 2x24 Nail
Fd. 2x2 Tk.
Fd. 2x24 Nail
Fd. 2x24 Nail
Fd. 2x24 Nail
Fd. 2x24 Nail
Fd. 2x24 Nail

F.B. 306 Pg. 46 P.T. Dunlap Chief Party Notes by P.T.D. Date 12-3-28

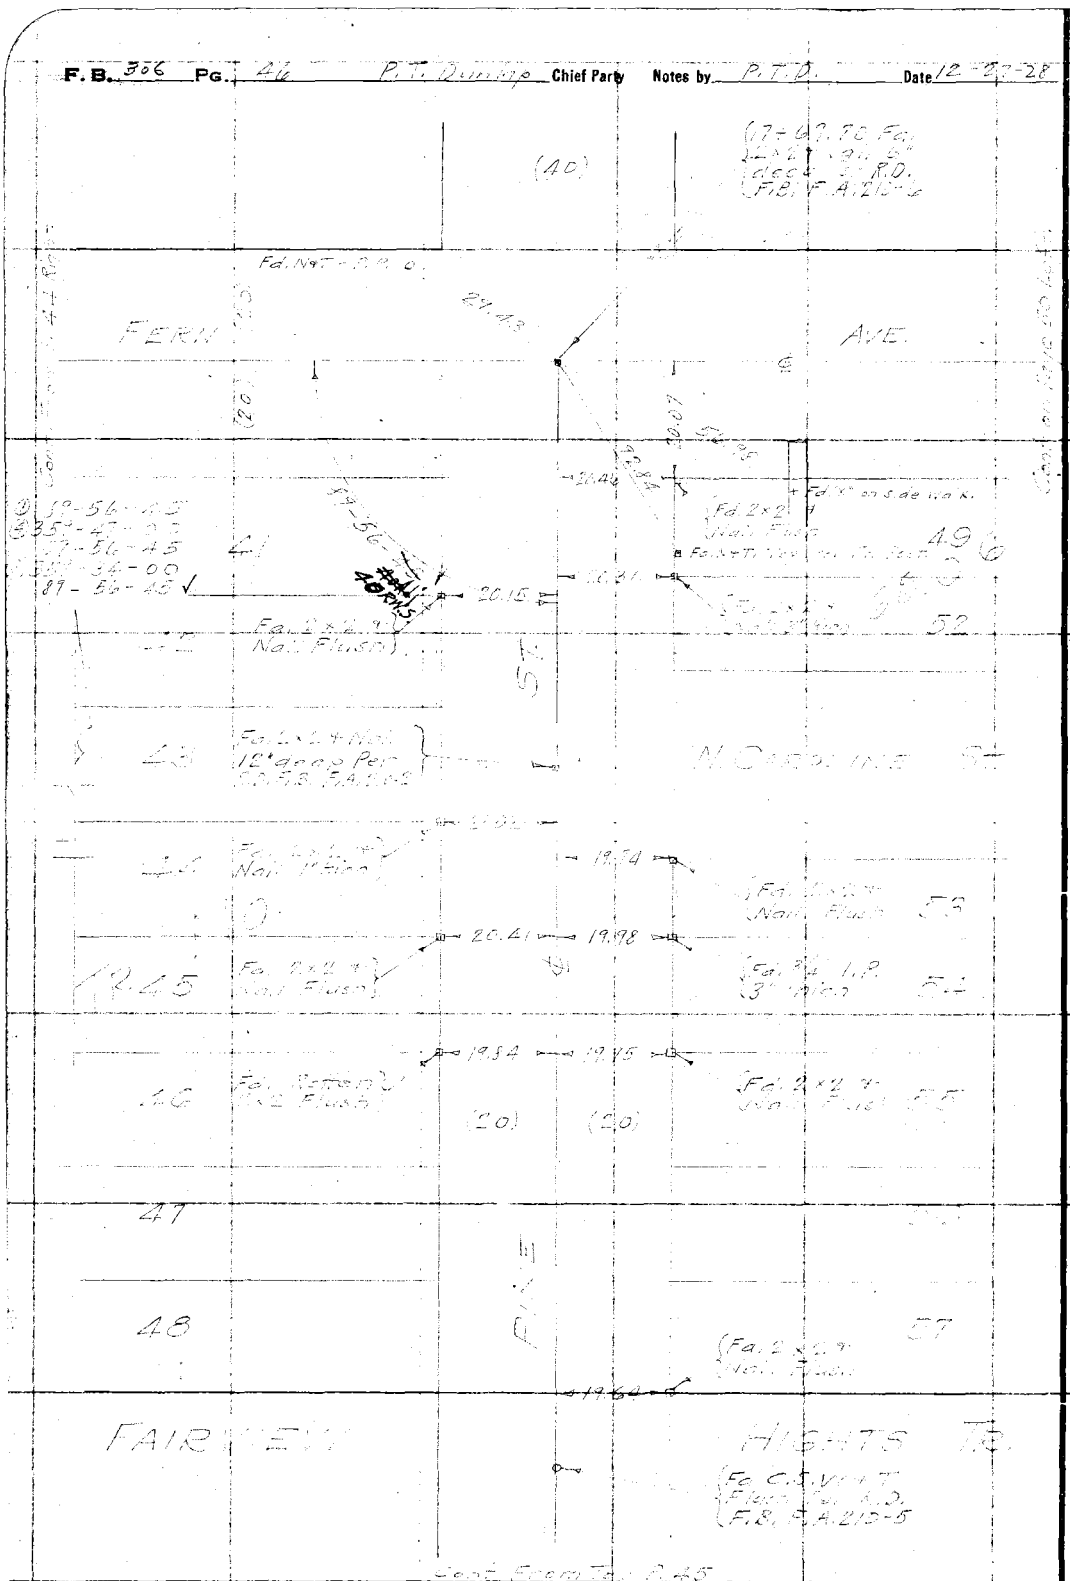
(40)
(7-49.50 Fd.
1/2" I.P.
case 5' R.D.
F.B. F A.215-6
Fd. Nail
FERN
AVE.
(20)
Fd. 2x2
Nail Flush
Fd. 1/2" I.P.
Flush
20.15
20.81
Fa. 2x2 Nail
Flush
Fa. 2x2 Nail
Flush
Fa. 2x2 Nail
Flush
Fa. 2x2 Nail
Flush
Fa. 2x2 Nail
Flush
Fa. 2x2 Nail
Flush
Fa. 2x2 Nail
Flush
Fa. 2x2 Nail
Flush
19.54
20.41
19.98
19.84
19.95
(20)
(20)
Fa. 2x2 Nail
Flush
Fa. 2x2 Nail
Flush
Date 12-[illegible]-28 Notes by [illegible] Chief Party [illegible] F.B. 306 Pg 47

Platted by J. C. Hoyt	W. O. No. 4239 U.S.O. No. 812
Date June '29	Location Grade Sep.
Map No. B-384-Sh1	Surveyed by P. T. Dinsmore
Platting C'k'd by R. W. S.	Date 12-[illegible]-28
Date MAR 17 1930	Indexed A. C. Johnson

Notes: ANY ADDITIONS OR CHANGES ON THIS SHEET MUST BE MADE ON CANCELED U. Rod. WITH DATE AND NAME OF PERSON MAKING CHANGE.

Do not extend notes this side of this line

RETURN TO LOS ANGELES COUNTY SURVEYOR

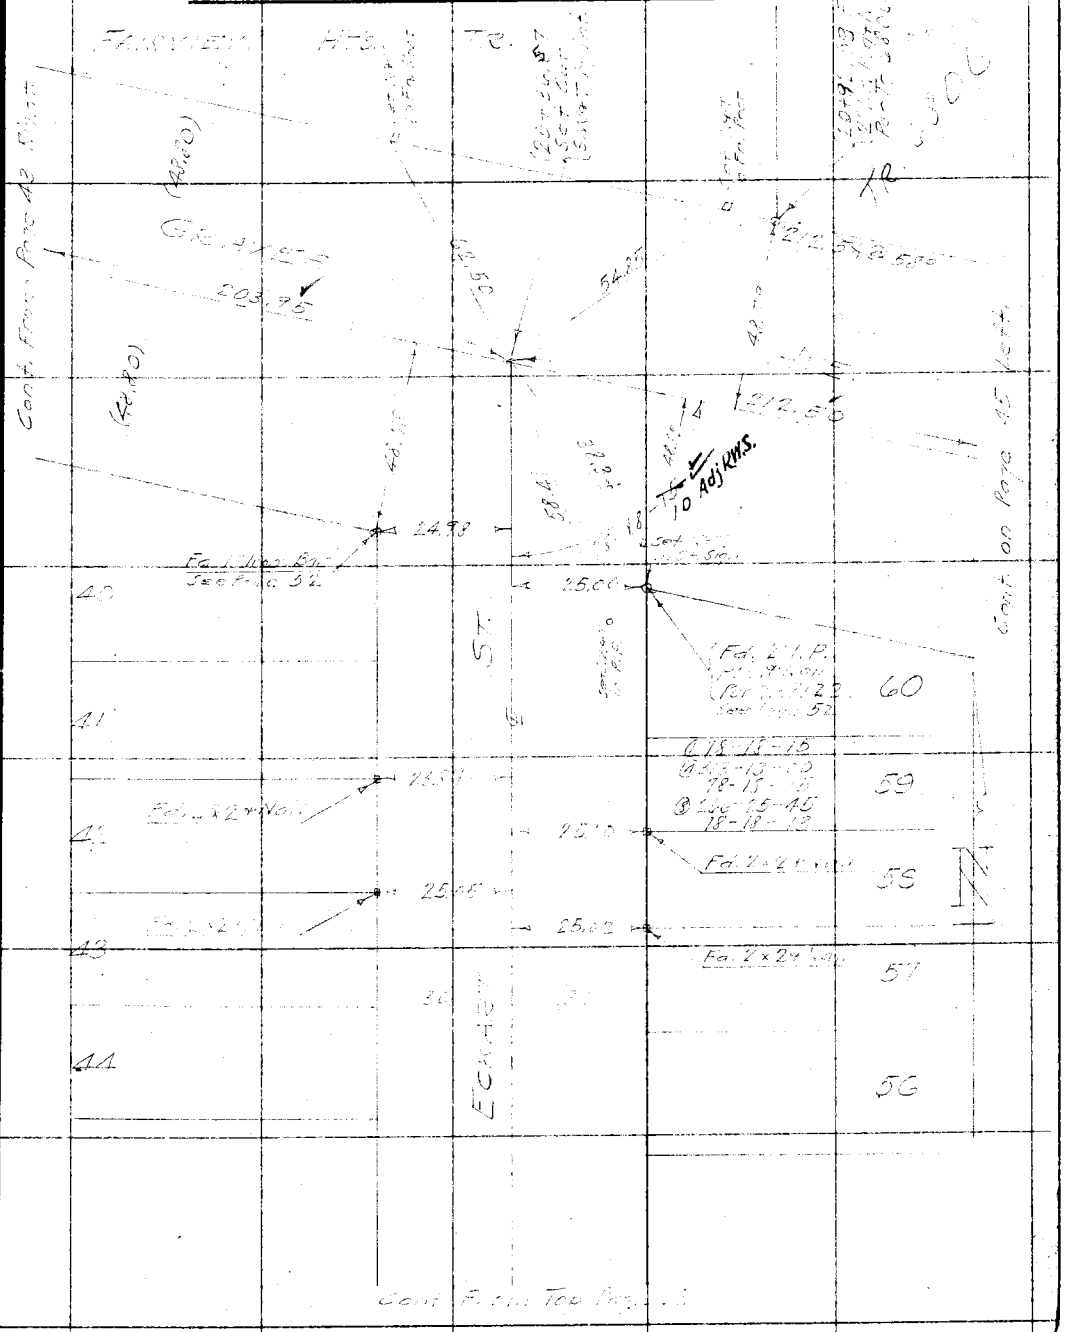


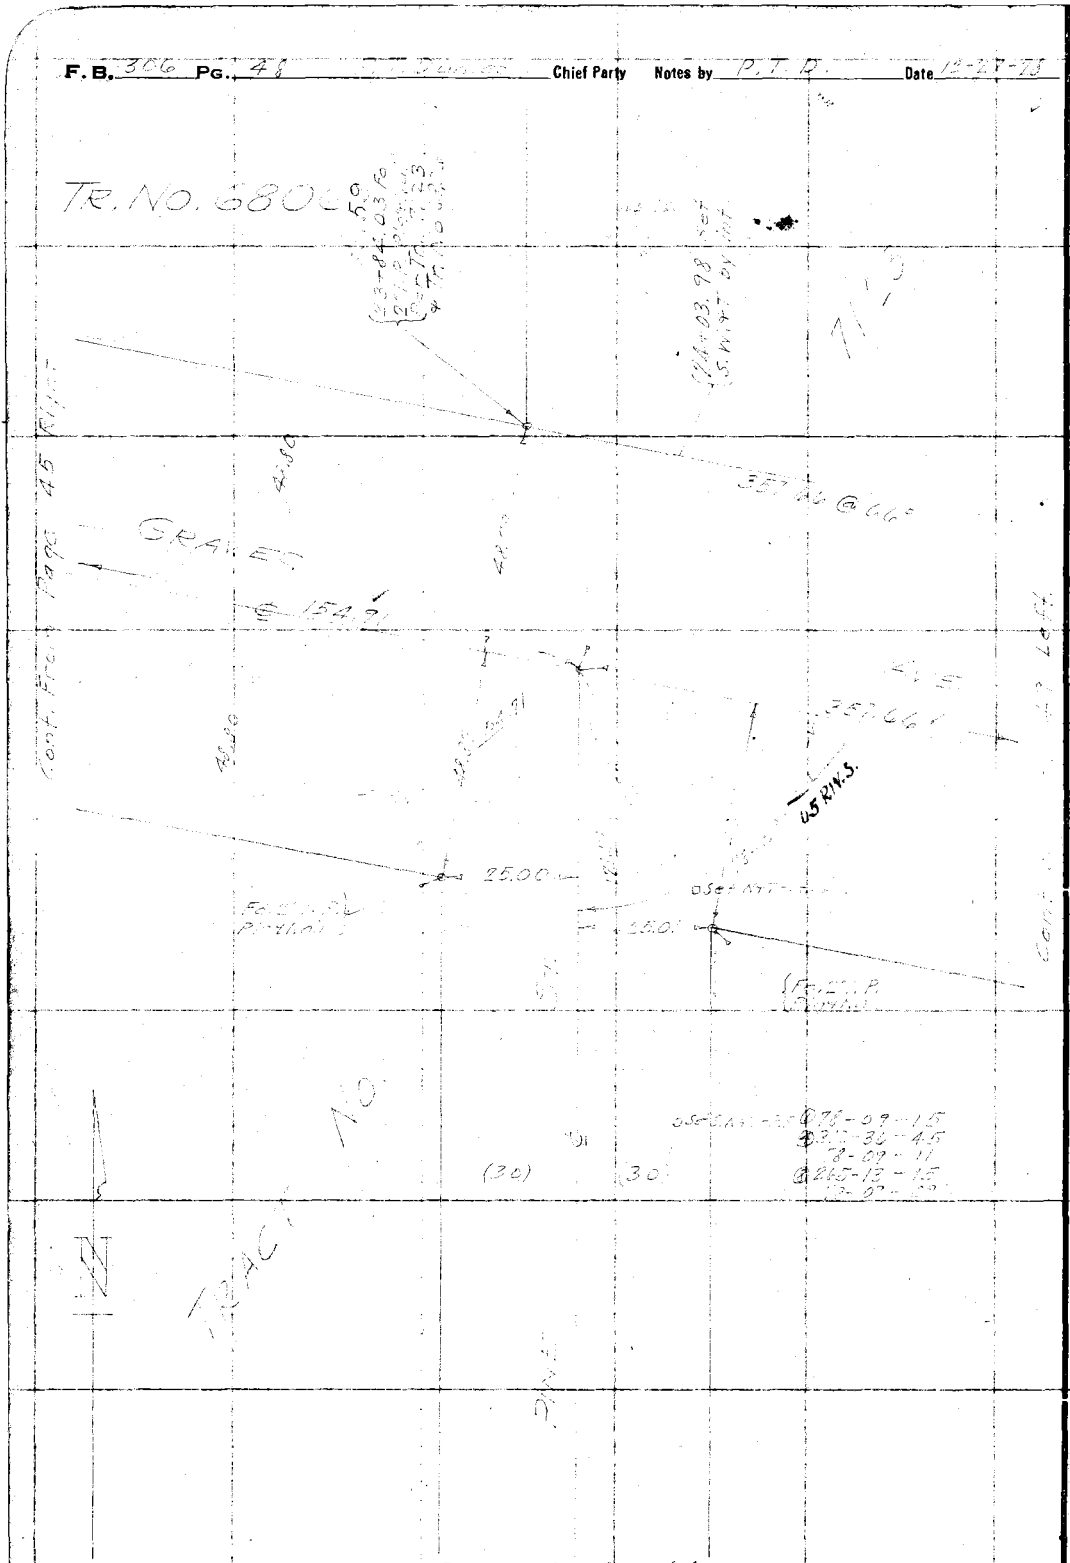

RETURN TO
LOS ANGELES COUNTY SURVEYOR

Do not extend notes this side of this line

Note: ANY ADDITIONS OR CHANGES ON THIS SHEET MUST BE MADE OR CIRCLED IN Red. WITH DATE AND NAME OF PERSON MAKING CHANGE.

Date 12-26-29 Notes by [illegible] Chief Party [illegible] F.B. 306 Pg. 49

Platted by J. C. Hoyt
Date June '29
Map No. C.S.B-384 Sh. 1
Platting C'k'd by R. W. S.
Date MAR 17 1930

W. O. No. 4239 D. S. O. No. [illegible]
Location [illegible]
Surveyed by P. T. Reed
Date [illegible]
Indexed A. C. Johnson

Cont. on Bot. Page 60

BLVD.

45

Cont. from Page 46 Rgt.

10 R.W.S.

AVE.

30 R.W.S.

SAN GABRIEL

Cont. on Top Page 65

Notes: ANY ADDITIONS OR CHANGES ON THIS SHEET MUST BE MADE OR CIRCLED IN Red. WITH DATE AND NAME OF PERSON MAKING CHANGE.

Do not extend notes this side of this line

RETURN TO LOS ANGELES COUNTY SURVEYOR

F. B. 306 Pg. 50 P.T. Davies Chief Party Notes by P.T.D. Date 1-4-29

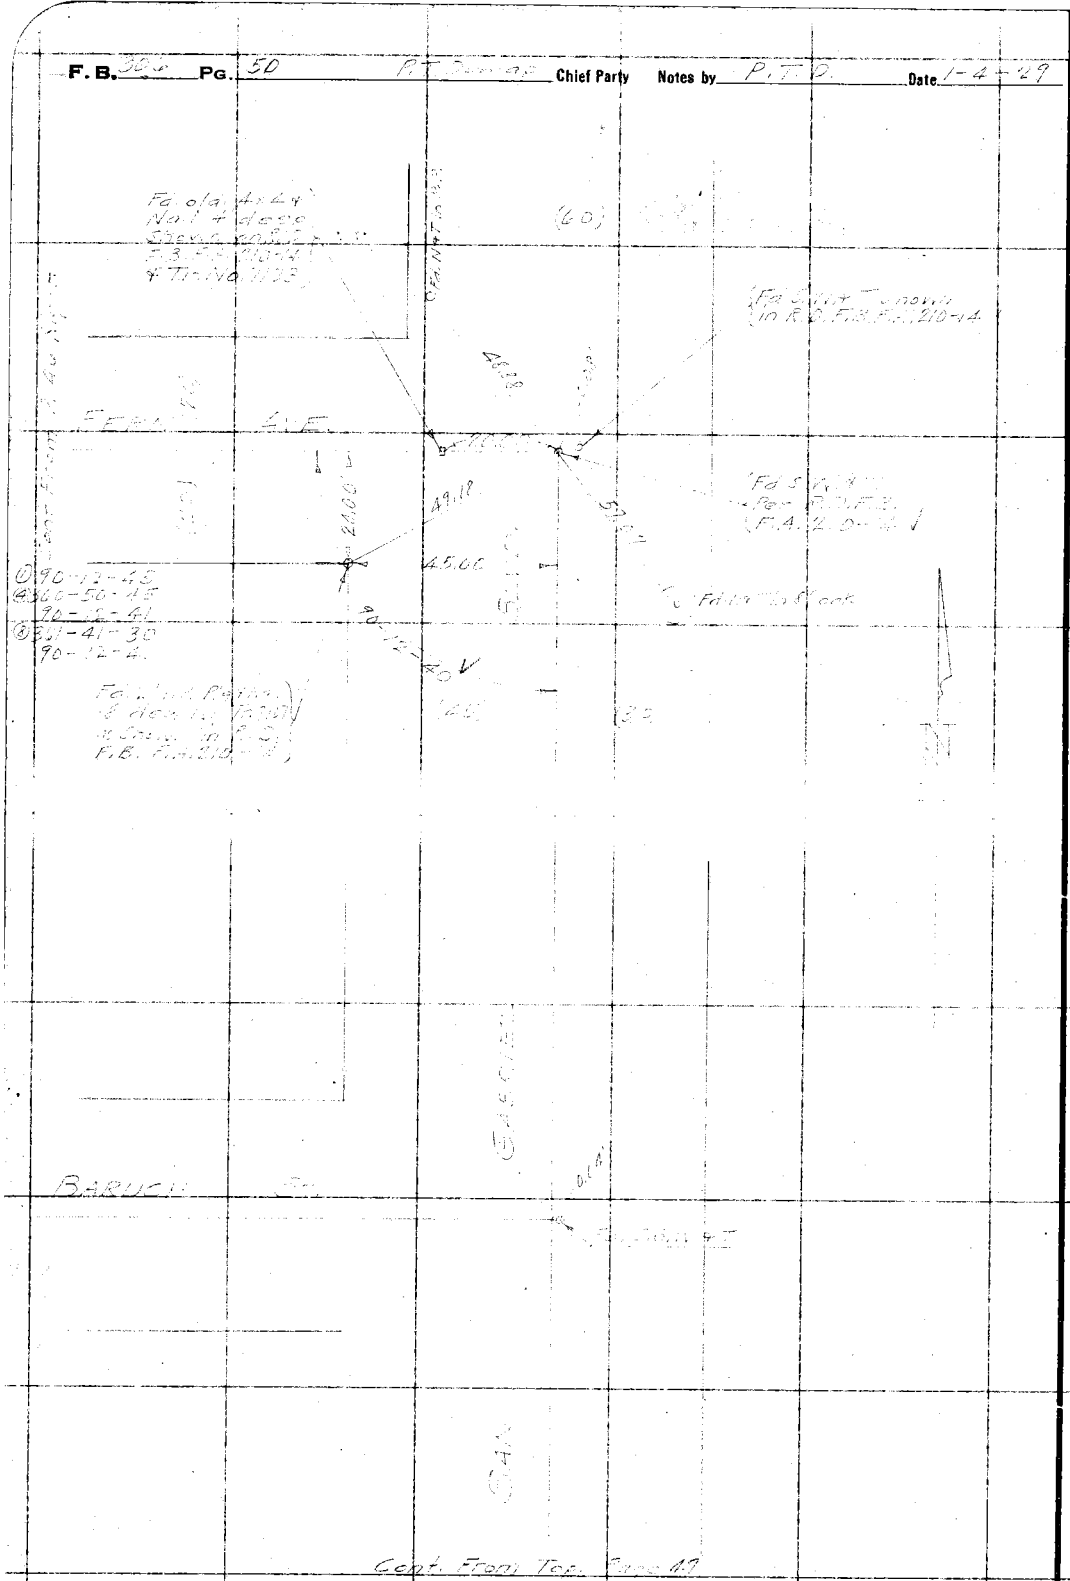

RETURN TO
LOS ANGELES COUNTY SURVEYOR

Do not extend notes this side of this line.

Note: ANY ADDITIONS OR CHANGES ON THIS SHEET MUST BE MADE OR CIRCLED IN Red. WITH DATE AND NAME OF PERSON MAKING CHANGE.

Date 1-2-29 Notes by P.T.D. Chief Party P.T. Dowling F.B. 306 Pg. 51

Platted by J.C. Hoyt	W. O. No. 4239 O. S. O. No. 612
Date June '29	Location Culver City
Map No. C.S.B. 384 Sht	Surveyed by P.T. Dowling
Platting C'k'd by R. W. S.	Date 1-2-29
Date MAR 17 1930	Indexed A. C. Johnson

Note: ANY ADDITIONS OR CHANGES ON THIS SHEET MUST BE MADE OR CIRCLED IN Red. WITH DATE AND NAME OF PERSON MAKING CHANGE.

Do not extend notes this side of this line

RETURN TO LOS ANGELES COUNTY SURVEYOR

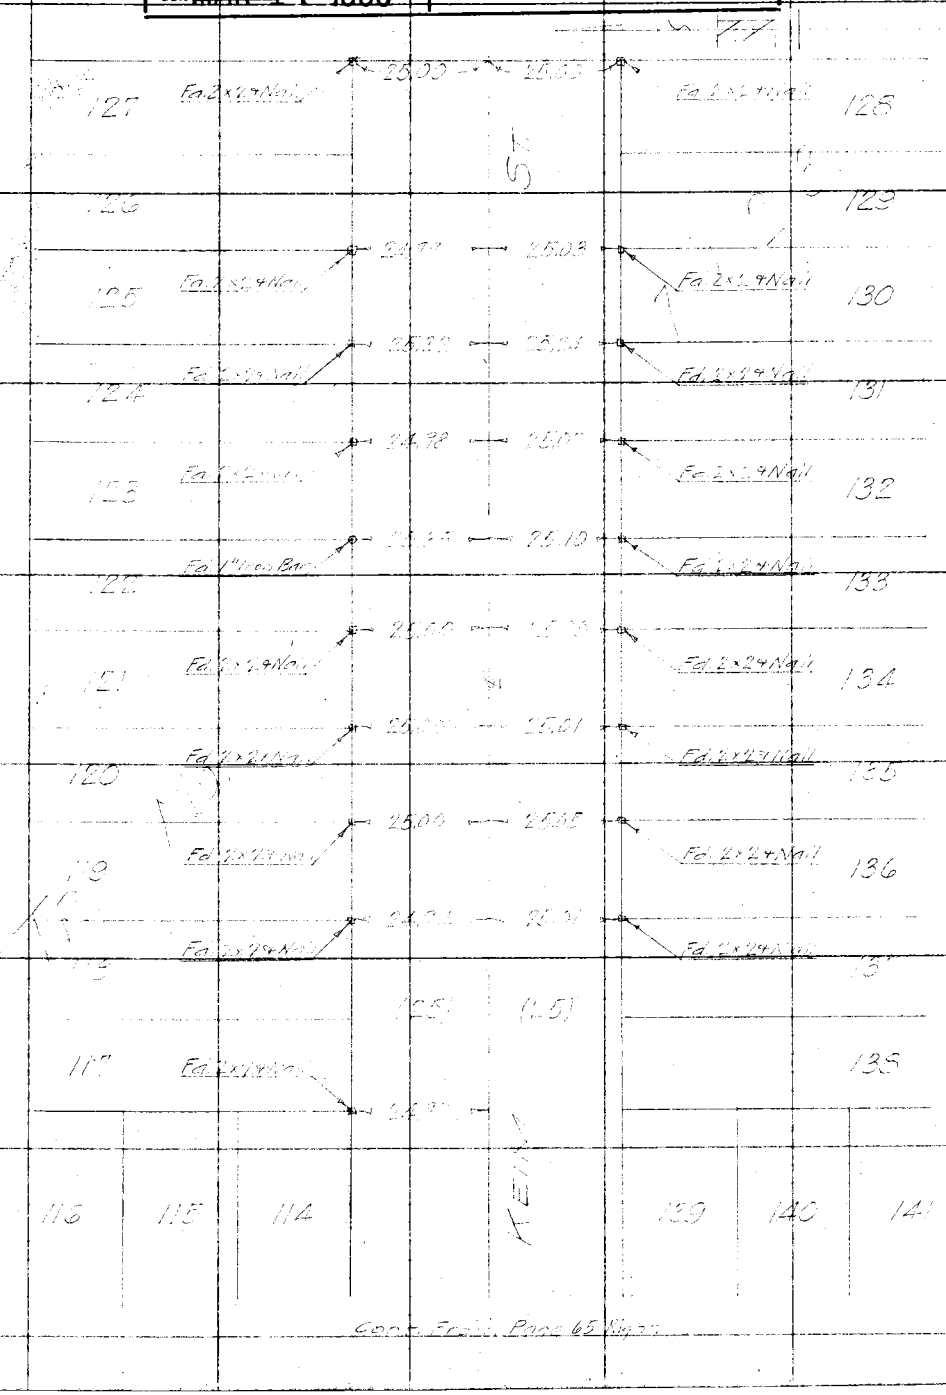

Cont. From Page 65 Nigh

RETURN TO
LOS ANGELES COUNTY SURVEYOR

Note: ANY ADDITIONS OR CHANGES ON THIS SHEET MUST BE MADE OR CIRCLED IN Red. WITH DATE AND NAME OF PERSON MAKING CHANGE.

Do not extend notes this side of this line


Cont. from Bk. Page 66

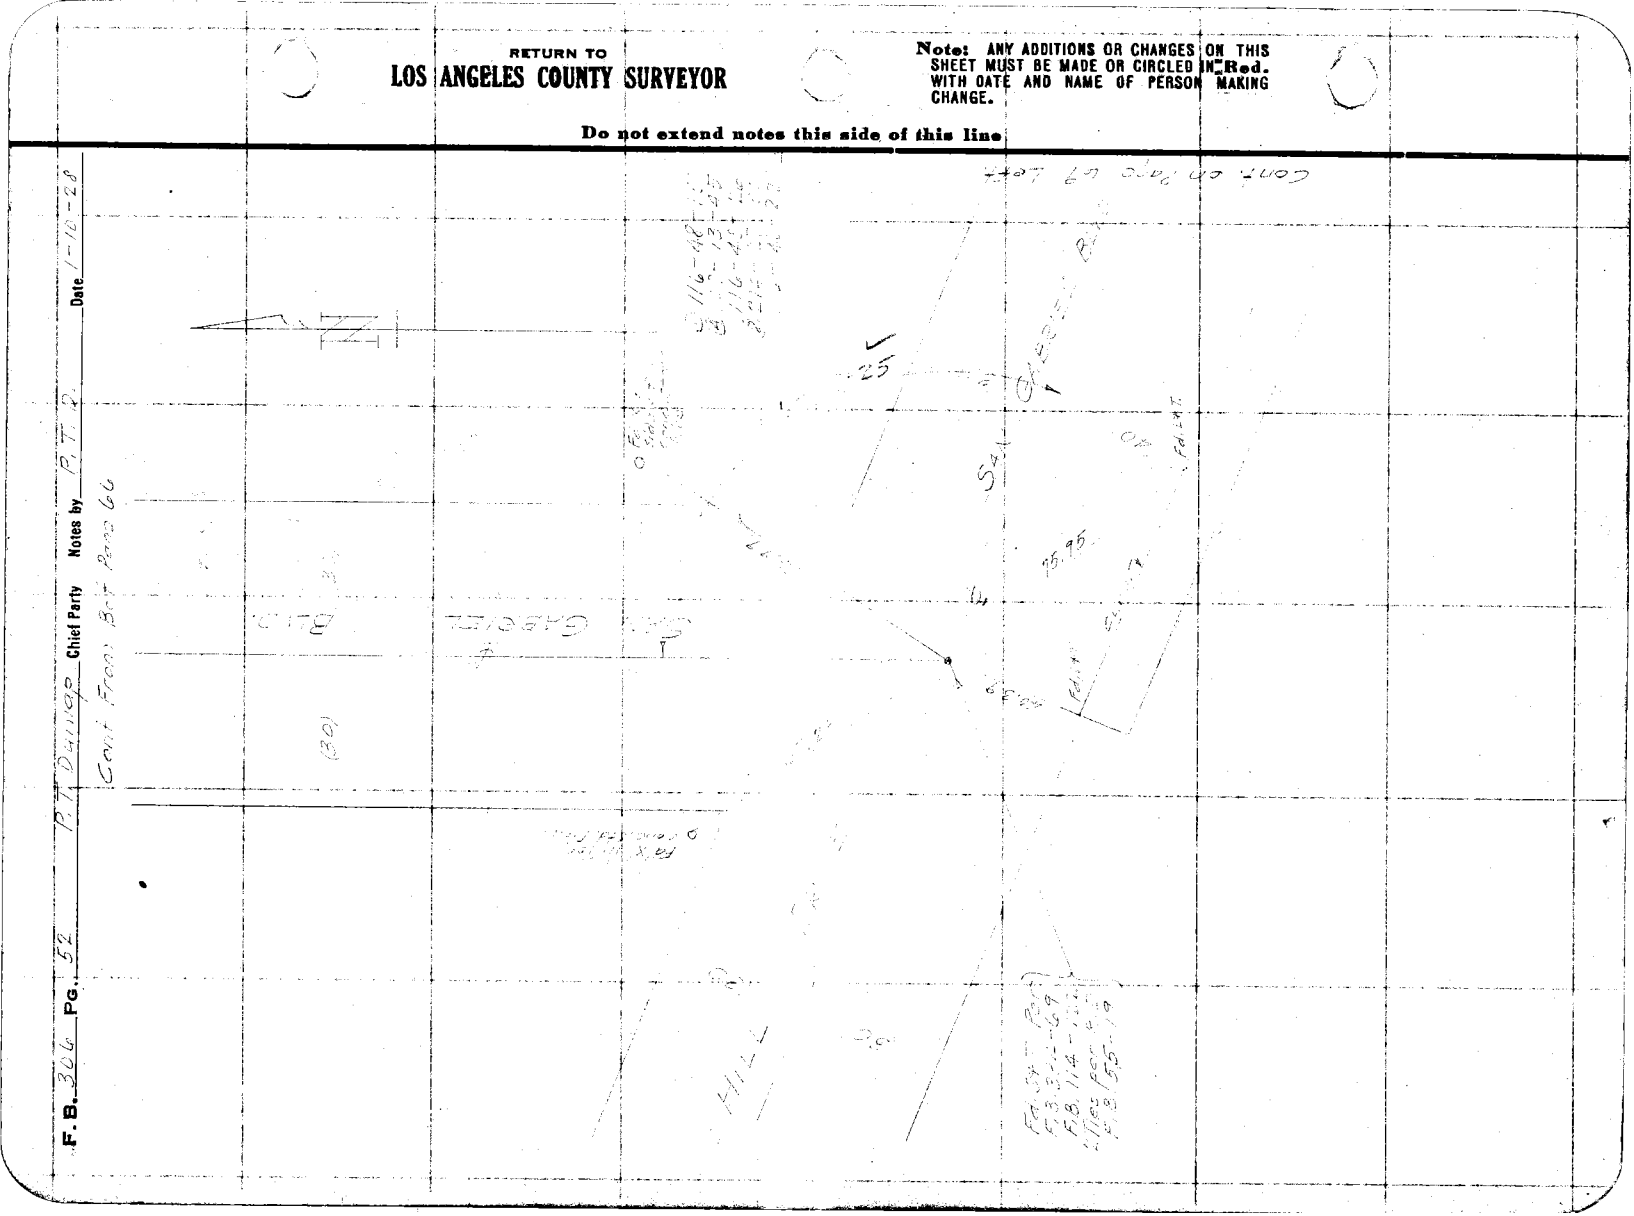

Date _____ Notes by _____ Chief Party _____ F.B. 306 PG. 53

Platted by	W. O. No.
Date	Location
Map No.	Surveyed by
Platting C'k'd by	Date
Date	Indexed

Note: ANY ADDITIONS OR CHANGES ON THIS SHEET MUST BE MADE OR CIRCLED IN Red. WITH DATE AND NAME OF PERSON MAKING CHANGE.

Do not extend notes this side of this line

RETURN TO
LOS ANGELES COUNTY SURVEYOR

BLANK

RETURN TO
LOS ANGELES COUNTY SURVEYOR

Note: ANY ADDITIONS OR CHANGES ON THIS SHEET MUST BE MADE OR CIRCLED IN Red. WITH DATE AND NAME OF PERSON MAKING CHANGE.

Do not extend notes this side of this line

Date

Chief Party Notes by

F.B. 306 Pg. 54

Date _____ Notes by _____ Chief Party _____ F.B. 306 Pg. 55

Plotted by J.C. Hoyt	W.O. No. _____ D.S.G. No. _____
Date Jul 29	Location _____
Map No. C.S.B. 384 Sh 1	Surveyed by _____
Plotting C'k'd by R. W. S.	Date _____
Date MAR 17 1930	Indexed A. C. Johnson

RETURN TO LOS ANGELES COUNTY SURVEYOR

Do not extend notes this side of this line

Note: ANY ADDITIONS OR CHANGES ON THIS SHEET MUST BE MADE OR CIRCLED IN Red. WITH DATE AND NAME OF PERSON MAKING CHANGE.

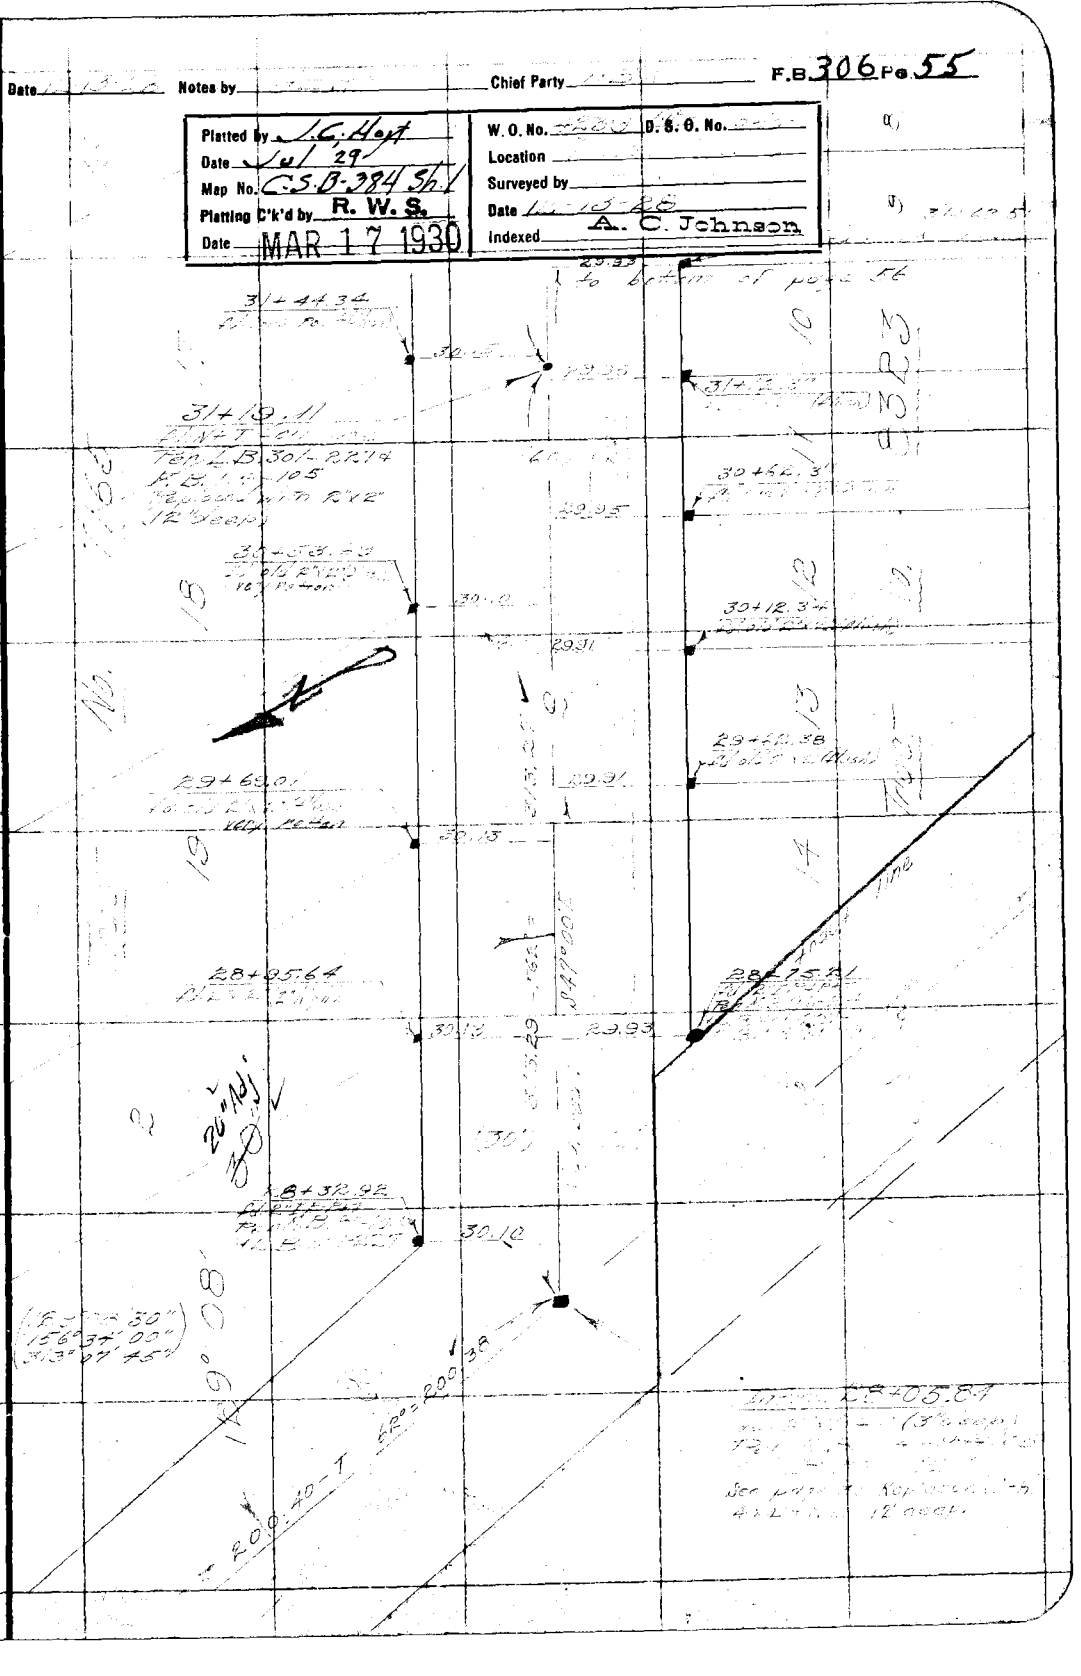

F. B. 306 Pg. 56 Chief Party Notes by Date

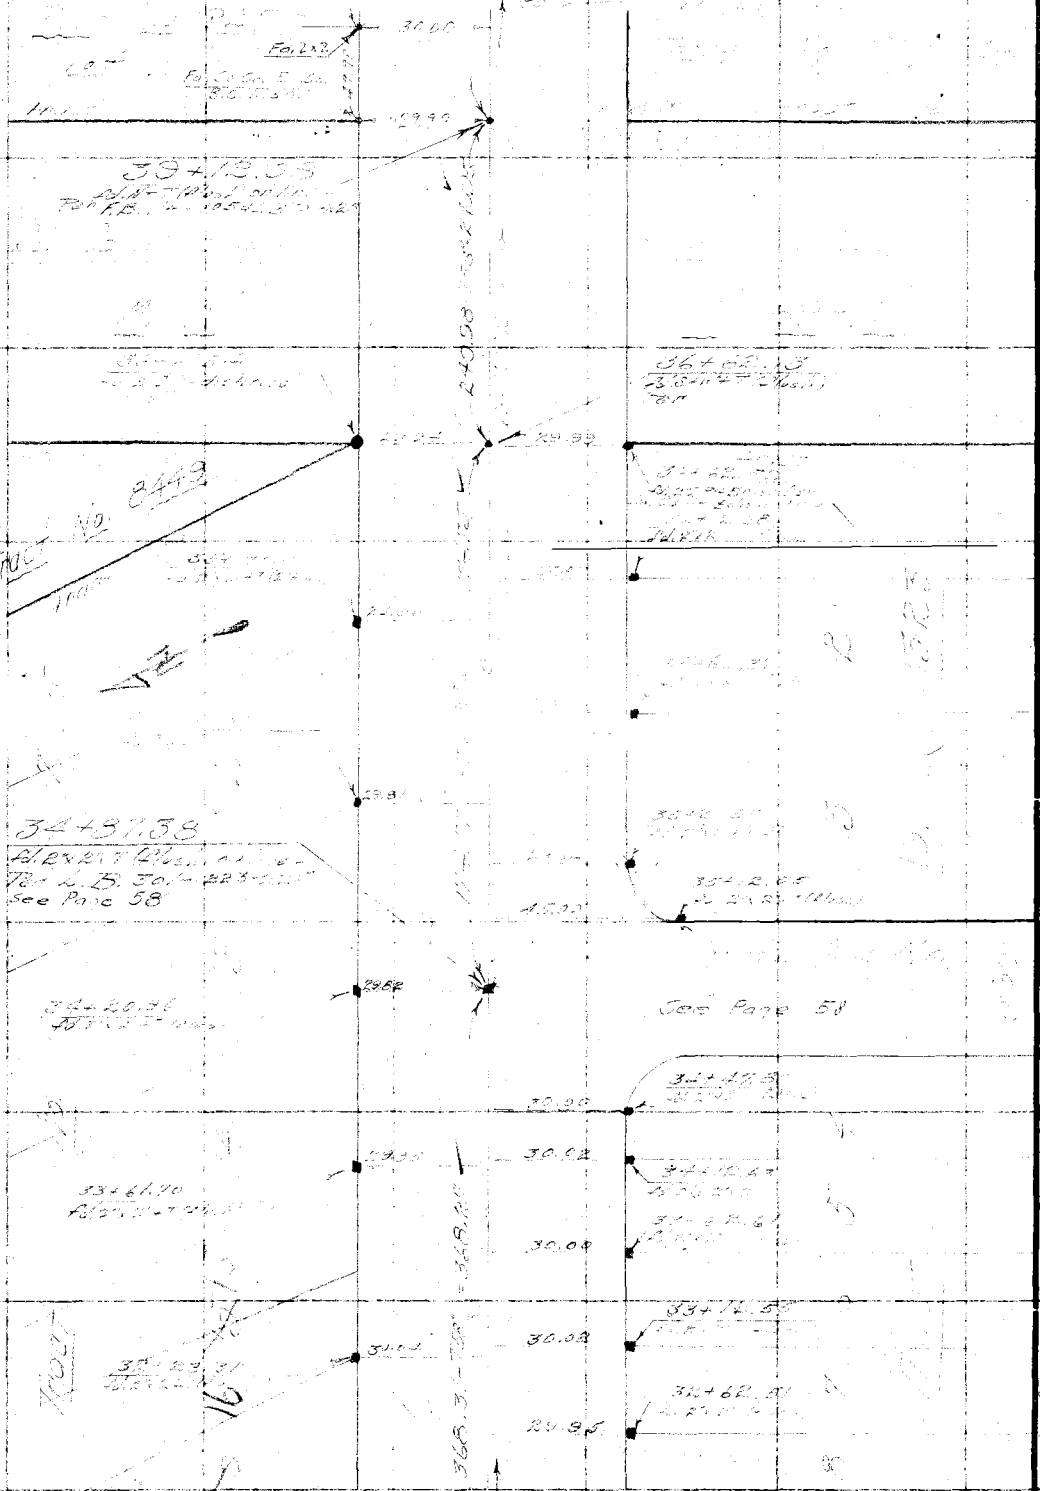

RETURN TO
LOS ANGELES COUNTY SURVEYOR

Note: ANY ADDITIONS OR CHANGES ON THIS SHEET MUST BE MADE OR CIRCLED IN Red. WITH DATE AND NAME OF PERSON MAKING CHANGE.

Do not extend notes this side of this line

Date _____ Notes by _____ Chief Party _____ F.B. 306 Pg. 57

Platted by: J.E. Hoff	W. O. No. _____ D. S. O. No. _____
Date: Jul. '29	Location _____
Map No. C.S. B-384 Sht 1	Surveyed by _____
Platting C'k'd by: R. W. S.	Date _____ A. C. Johnson
Date: MAR 17 1930	Indexed _____


Do not extend notes this side of this line

RETURN TO LOS ANGELES COUNTY SURVEYOR

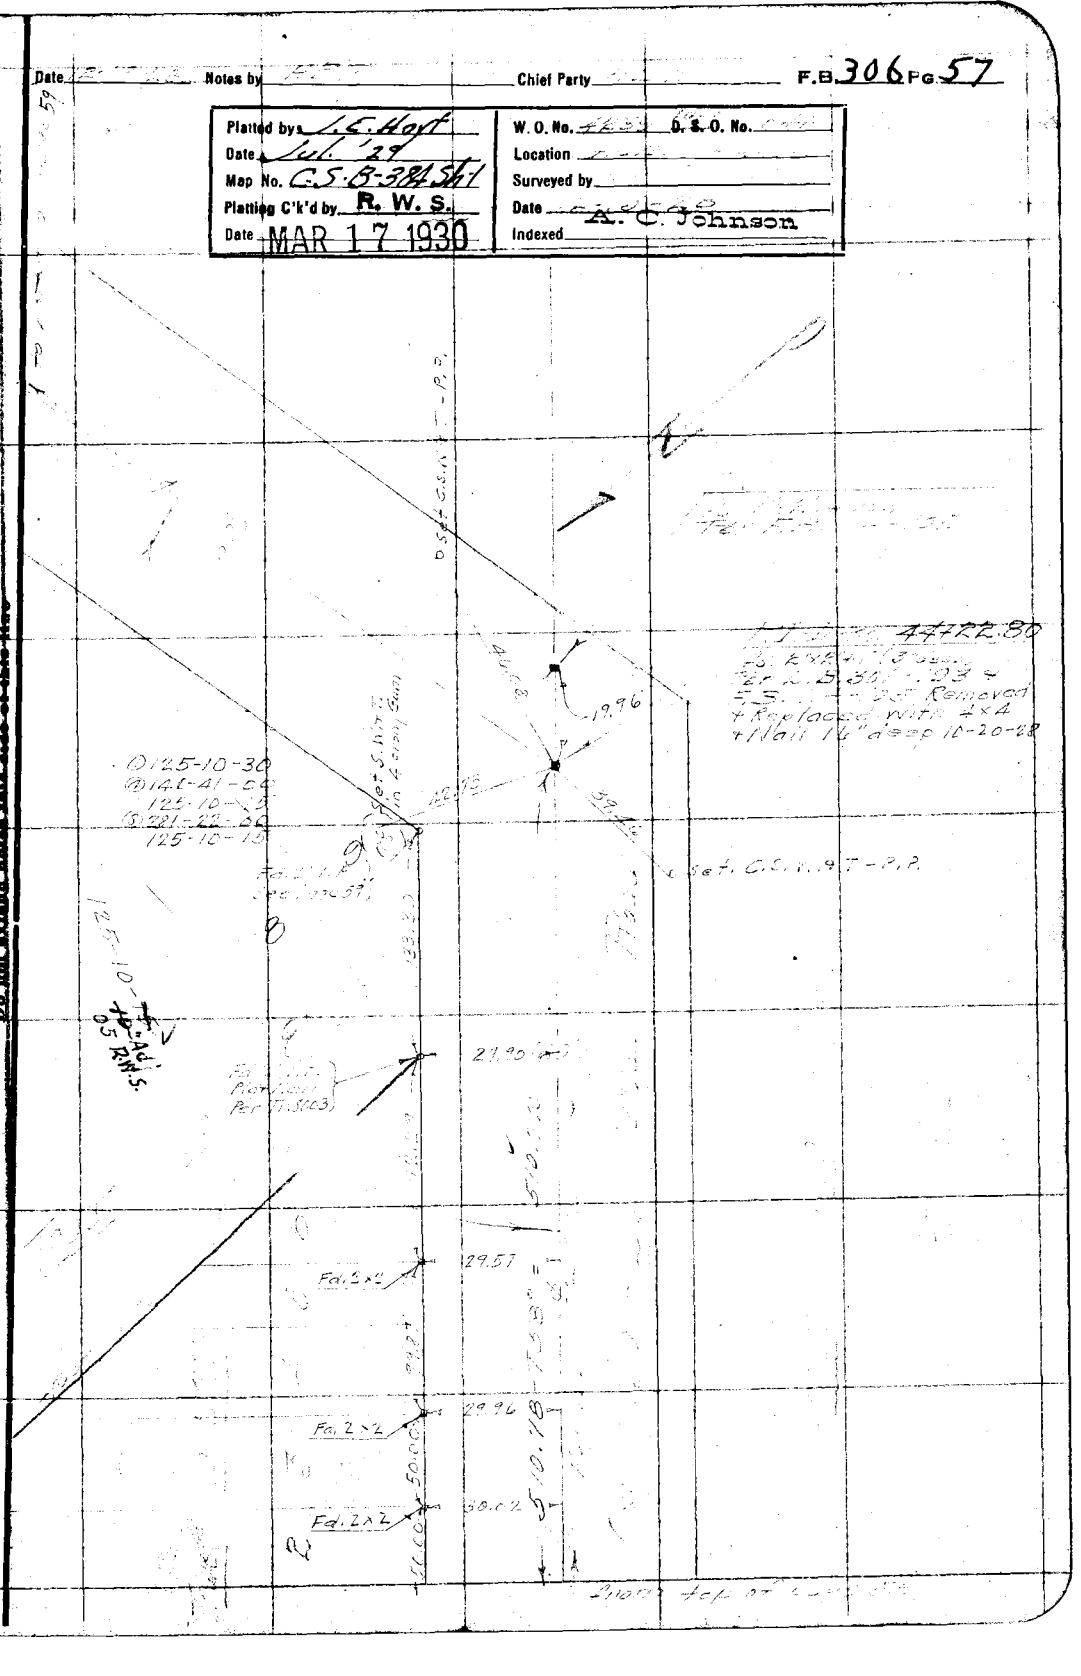

F.B. 306 Pg. 58 P.T. Dunton Chief Party Notes by P.T.D Date 12-19-49

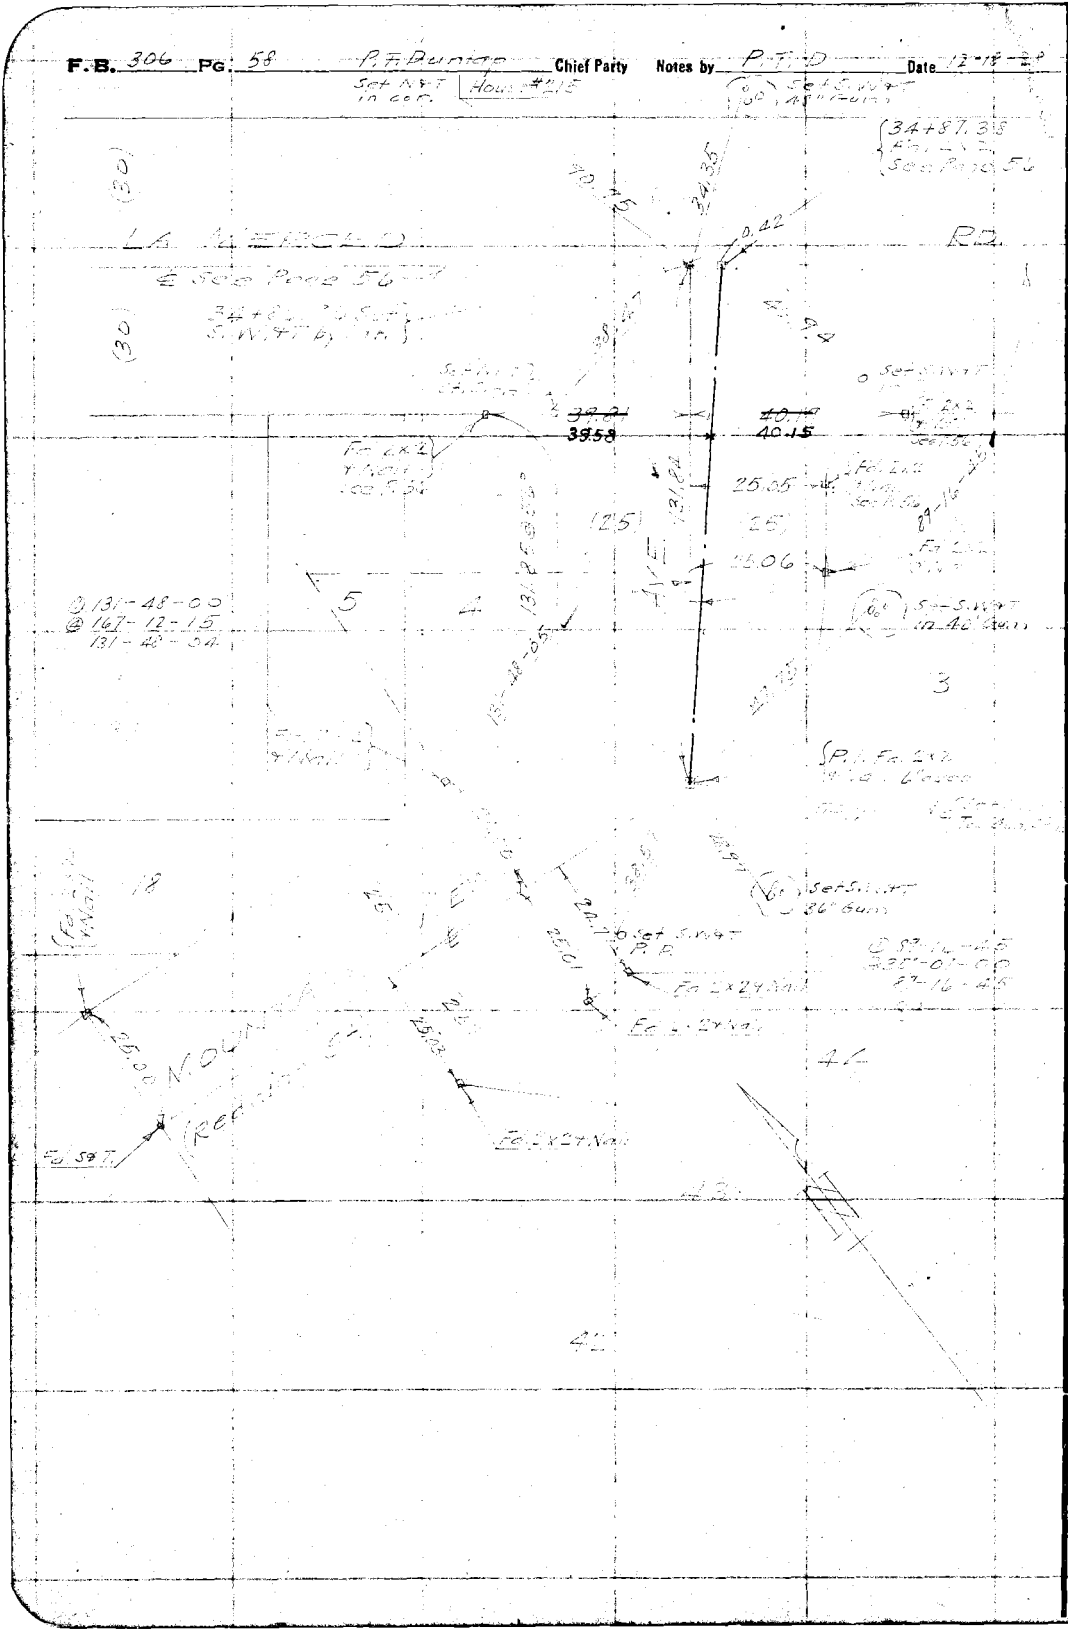
Set A&T in cor.
House #215
Set S.W.T
Set S.W.T
Set S.W.T

Date 4-22-25 Notes by P.T.D. Chief Party P.T. Dunton F.B. 306 Pg. 59

Platted by J. C. Heyt	W. O. No. 4237 D. S. O. No. 012
Date Jul '29	Location Grace Ave
Map No. C.S. B-384-Sh1	Surveyed by P.T. Dunton
Platting C'k'd by R. W. S.	Date 12-20-24
Date MAR 17 1930	Indexed A. C. Johnson

Notes: ANY ADDITIONS OR CHANGES ON THIS SHEET MUST BE MADE OR CHECKED BY Prof. WITH DATE AND NAME OF PERSON MAKING CHANGE.

Do not extend notes this side of this line

RETURN TO LOS ANGELES COUNTY SURVEYOR

Cont. Rot Pt. on N

AVE.

GRACE

15.00

Set N & T

24.99

24.79

24.76

Fd. 2x2 ct Nail

Fd. 2x2 ct Nail

Fd. 2x2 ct Nail

T 2 A

Fd. 2x2 ct Nail

Fd. 2x2 ct Nail

Fd. 2x2 ct Nail

F.B. 306 Pg. 60 P.T. Dunlap Chief Party Notes by P.T.D. Date 7-27-27

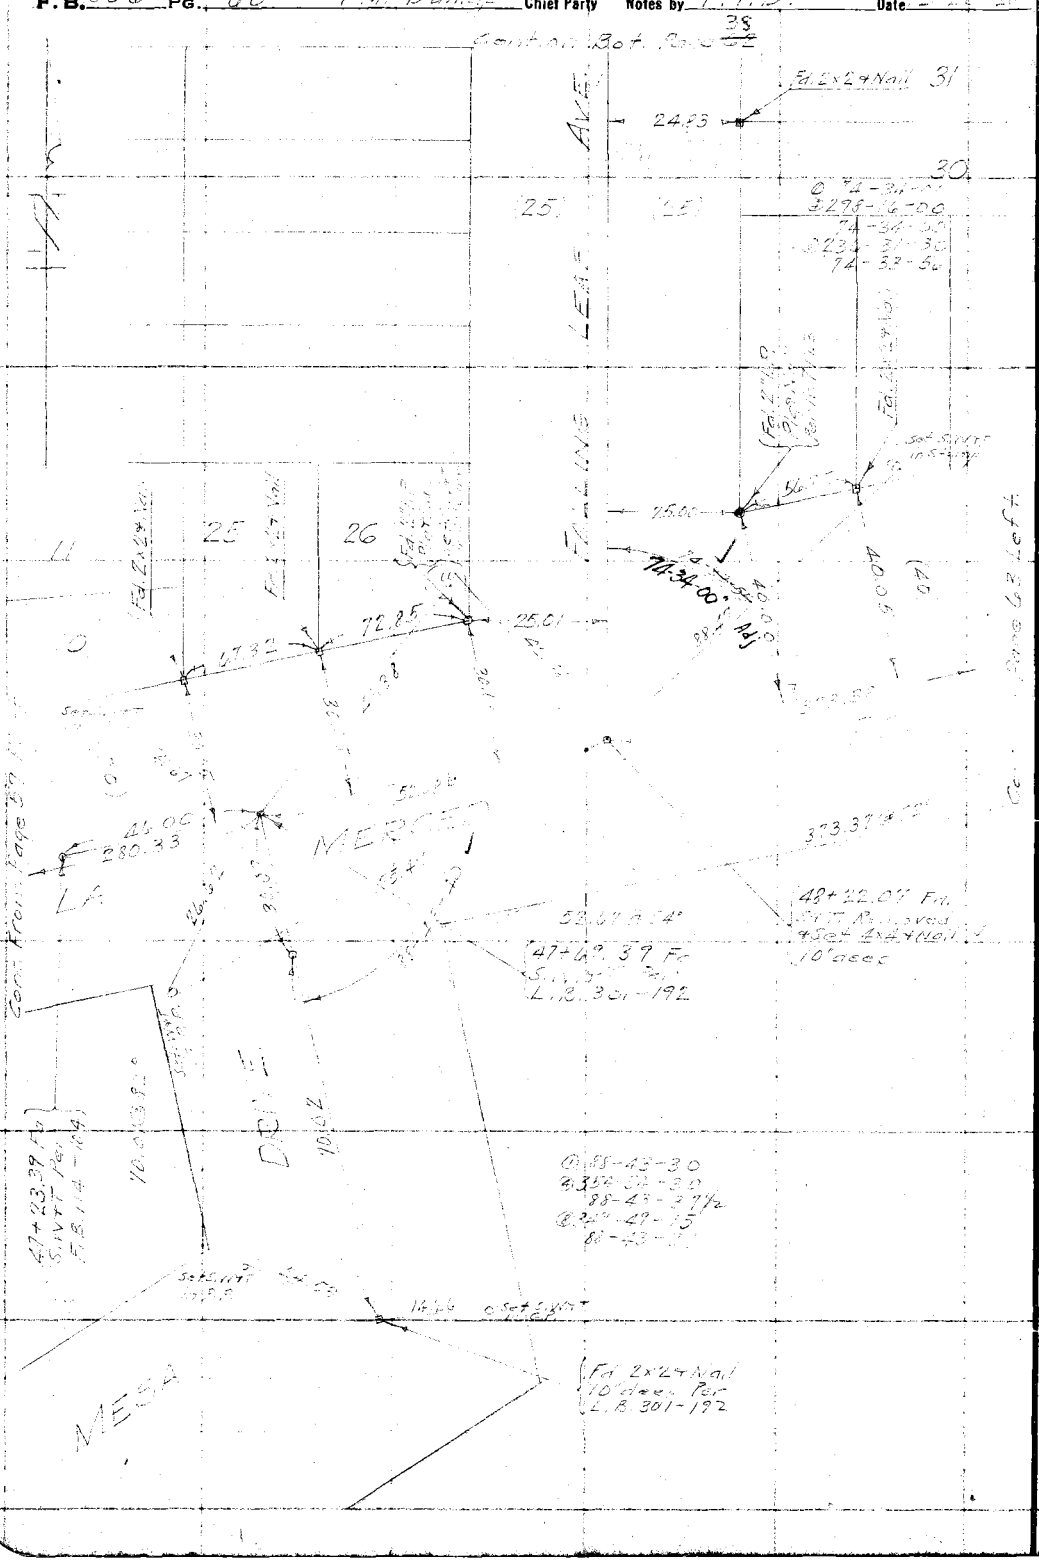
Centerline Bet. Rs. 38 & 39
AVE.
LEMAY
EMELINE
MERCED
MESA
DR.
LA
25
26
20
31
Fd 2x24 Nail
24.93
72.85
25.01
400.0
Set Spike
Fd 2x24 Nail
10' Offset
Fd 2x24 Nail
10' Offset Per
L.B. 301-192
Set 4x4 (10.0')
10' Offset
Set Spike
Fd 2x24 Nail

Date _____ Notes by _____ Chief Party _____ F.B. 306 Pg. 61

Platted by J.C. Hoyt	W. O. No. _____ D. S. O. No. _____
Date Jul '29	Location _____
Map No. C.S. B-334 Sh.1	Surveyed by _____
Platting C'k'd by R. W. S.	Date _____
Date MAR 17 1930	Indexed A. C. Johnson

Notes: ANY ADDITIONS OR CHANGES OF THIS SHEET MUST BE MADE OR CIRCLED IN Red. WITH DATE AND NAME OF PERSON MAKING CHANGE.

Do not extend notes this side of this line

RETURN TO
LOS ANGELES COUNTY SURVEYOR

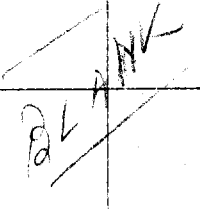

F. B. 306 Pg. 67 Chief Party Notes by Date

BLANK

RETURN TO
LOS ANGELES COUNTY SURVEYOR

Do not extend notes this side of this line

Note: ANY ADDITIONS OR CHANGES ON THIS SHEET MUST BE MADE OR CIRCLED IN Red. WITH DATE AND NAME OF PERSON MAKING CHANGE.

Date 12-18-28 Notes by P.T.D. Chief Party P.T. Dunlap F.B. 306 Pg. 63

Platted by J.C. Hoyt	W.O. No. 4239 S.O. No. 012
Date Jul '29	Location Graves Ave
Map No. C.S.B-384-Sh1	Surveyed by P.T. Dunlap
Platting C'k'd by R.W.S.	Date 12-18-28
Date MAR 17 1930	Indexed A.C. Johnson

Cont on Bk Page 57

58

57

56

55

54

43

44

45

46

47

25.05

25.00

25.00

25.13

25.14

25.00

25.01

St.

Ex. Line

R.D.

LA MERCED

Cont. from Page 60 Rec.

Cont on Page 64 Left

Set Nail

Set Nail & Tag

Set Nail in P.P.

Set Nail & Tag

Set 1" I.P. (Plug + Nail)

Fd. 1" I.P. No Tag

Fd. Nail

Fd. 1" I.P. No Tag

Set 1" I.P. (Plug + Nail)

Set Nail & Tag

Set 1" I.P. (Plug + Nail)

Fd. 1" I.P. No Tag

F.B. 306 Pg. 64 P.T. Dist. Chief Party Notes by P.T.D. Date 12-12-28

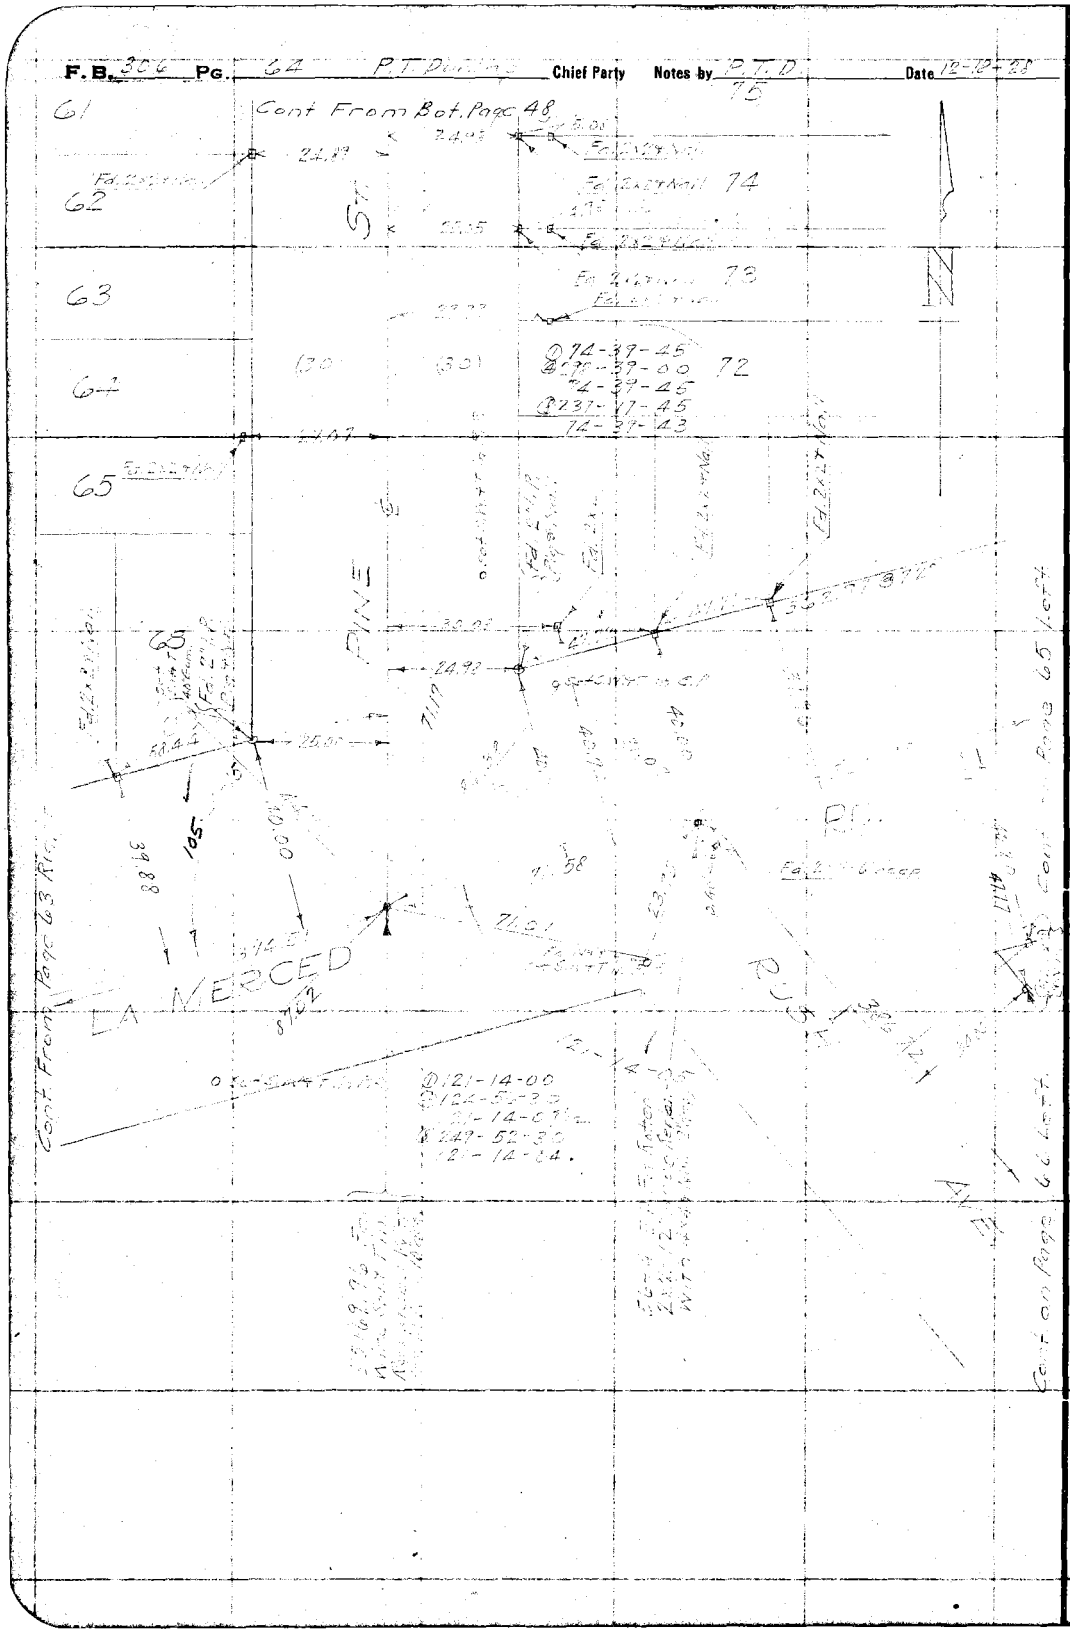
Cont From Bot. Page 48
61
62
63
64
65
74
72
73
75
PINE
LA MERCED

Date 2-19-28 Notes by P.T.D. Chief Party P.T. Dunlap F.B. 306 Pg. 65

Platted by J.F. Hoyt.	W. O. No. 4239 S. S. O. No. 012
Date 7/1/29	Location Graves Ave
Map No. C.S. B-384-5&1	Surveyed by P.T. Dunlap
Platting C'k'd by R.W.S.	Date 12-18-28
Date MAR 17 1930	Indexed A. C. Johnson

Cont. From Bot Page 47

Fd. 1" I.P. Pig
& Nail
Tr. No. 7123

Set 2" I.P. Pig
& Nail By Inf.
See Page 37

Fd. 1" I.P.
Pig & Nail
Tr. No. 7123

Cont. from Page 64 Right

Fd. 1x1 & Nail

Fd. 2x2 & Nail

@ 90-17-00
@ 361-07-45
90-16-56
@ 269-15-00
90-16-52½

Fd. 1" I.P.

Set S. N & T
In P.P.

Fd. 2x2 & Nail

Set S. N & T
By Inf.

@ 74-39-15
@ 233-37-15
74-39-19
@ 237-14-45
74-39-01

Set S. N & T
In P.P.

Fd. 2x2 & Nail

Fd. 2x2 & Nail

Cont. on top Page 66

Note: ANY ADDITIONS OR CHANGES ON THIS SHEET MUST BE MADE ON CIRCLED & Red. WITH DATE AND NAME OF, PERSON MAKING CHANGE.

Do not extend notes this side of this line

RETURN TO LOS ANGELES COUNTY SURVEYOR

F.B. 396 Pg. 66 P.T. Dumas Chief Party Notes by P.T.D. Date 12-20-28

Cont. from Sht. Page 65

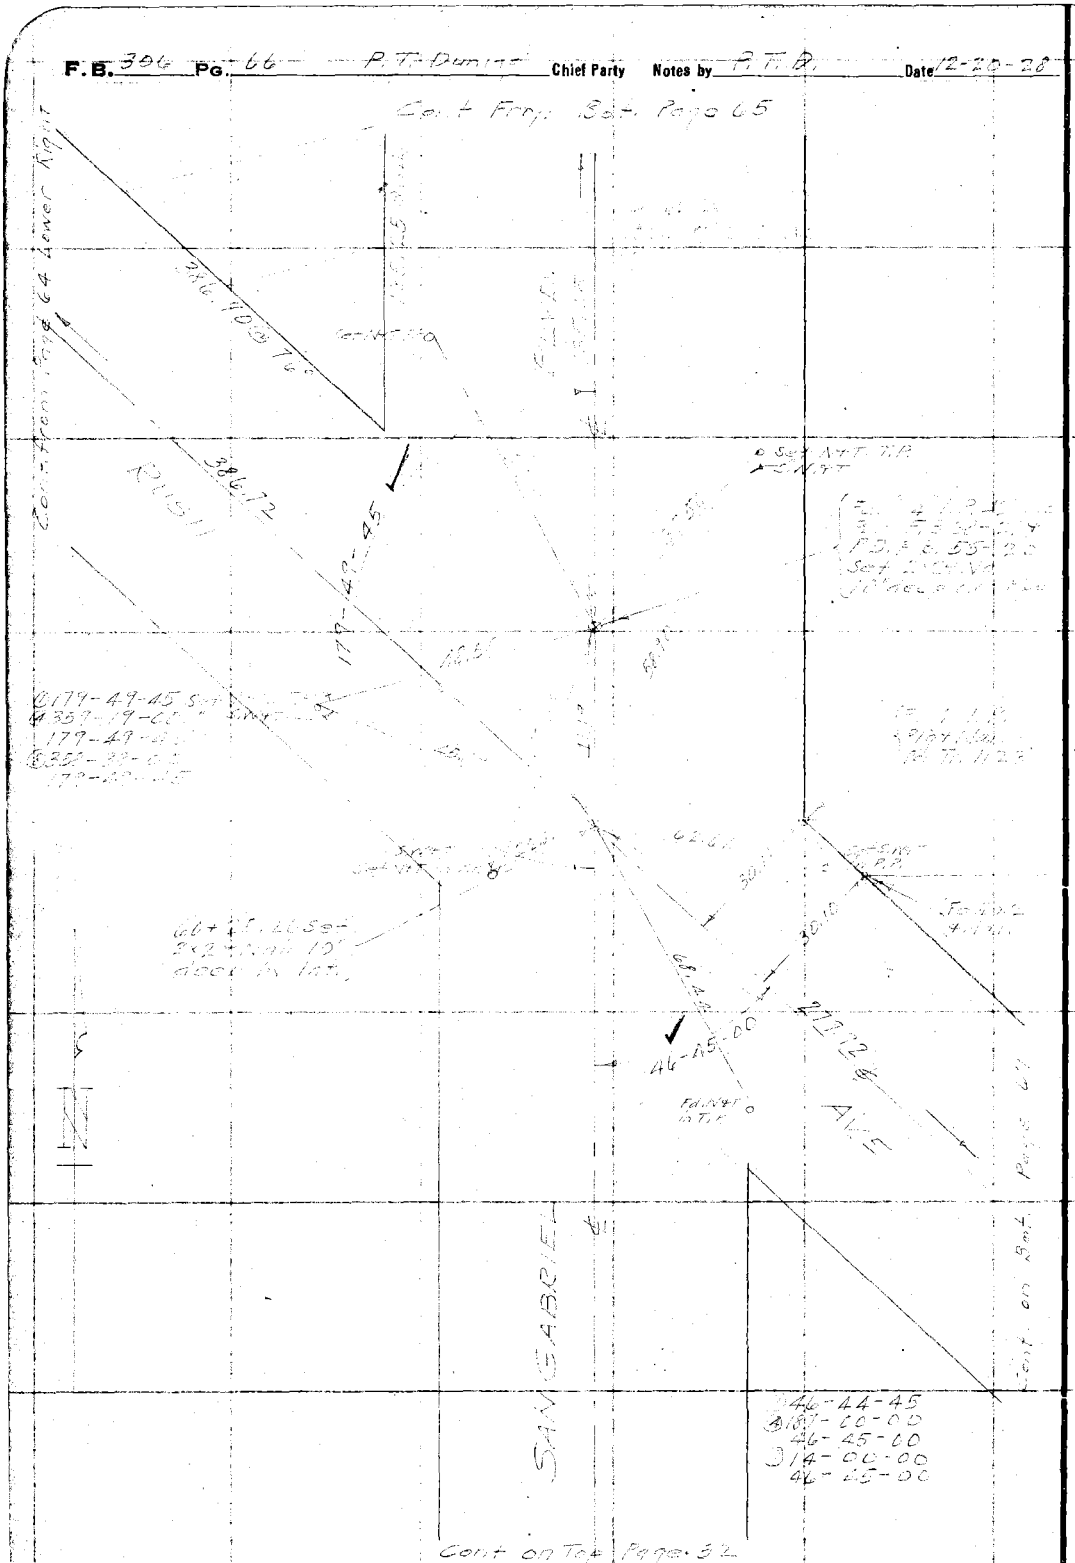

46-44-45
B187-00-00
46-45-00
314-00-00
46-45-00

RETURN TO
LOS ANGELES COUNTY SURVEYOR

Do not extend notes this side of this line

Note: ANY ADDITIONS OR CHANGES ON THIS SHEET MUST BE MADE OR CIRCLED IN Red. WITH DATE AND NAME OF PERSON MAKING CHANGE.

Date 1-8-27 Notes by P.T.D. Chief Party P.T. Dunlap F.B. 306 Pg. 67

Plotted by J. G. Hoyt	W. O. No. 4239 C. O. No. 012
Date Jul. 29	Location Grand Ave
Map No. C.S.B. 384-5/1	Surveyed by P.T. Dunlap
Plotting C'k'd by R. W. S.	Date 8-[illegible]-9
Date MAR 17 1930	Indexed

Cont. on Bot. Page 68

(30') (30')

149

147

146

Fd. 2x2

Fd. 1½ Sq.

Fd. 2x2

30.12

31.36

30.69

30.51

30.61

30.79

30.08

30.18

30.41

30.87

0.5 ft S. W. of T.P.

0.5 ft S. W. of T.P.

(63+ 05.18 4 ft Set 4 x 4 in. ... Face of ...

(63+ 02.69 F.... 6"x12" Granite Boulder with "T" in Top as shown on ... No. 7123 also ... Set 4 x 4 in. ...

(1) 137+ 10-30

(2) 136+ 12-00

(3) 134+ 44-00

(4) 133+ 20-30

Notes: ANY ADDITIONS OR CHANGES ON THIS SHEET MUST BE MADE OR CIRCLED IN Red. WITH DATE AND NAME OF PERSON MAKING CHANGE.

Do not extend notes this side of this line

RETURN TO LOS ANGELES COUNTY SURVEYOR

279.91

279.32

Cont. From Page 66 Rear

F. B. 306 Pg. 68 P.T. Dunlap Chief Party Notes by P.T.D. Date 1-8-29

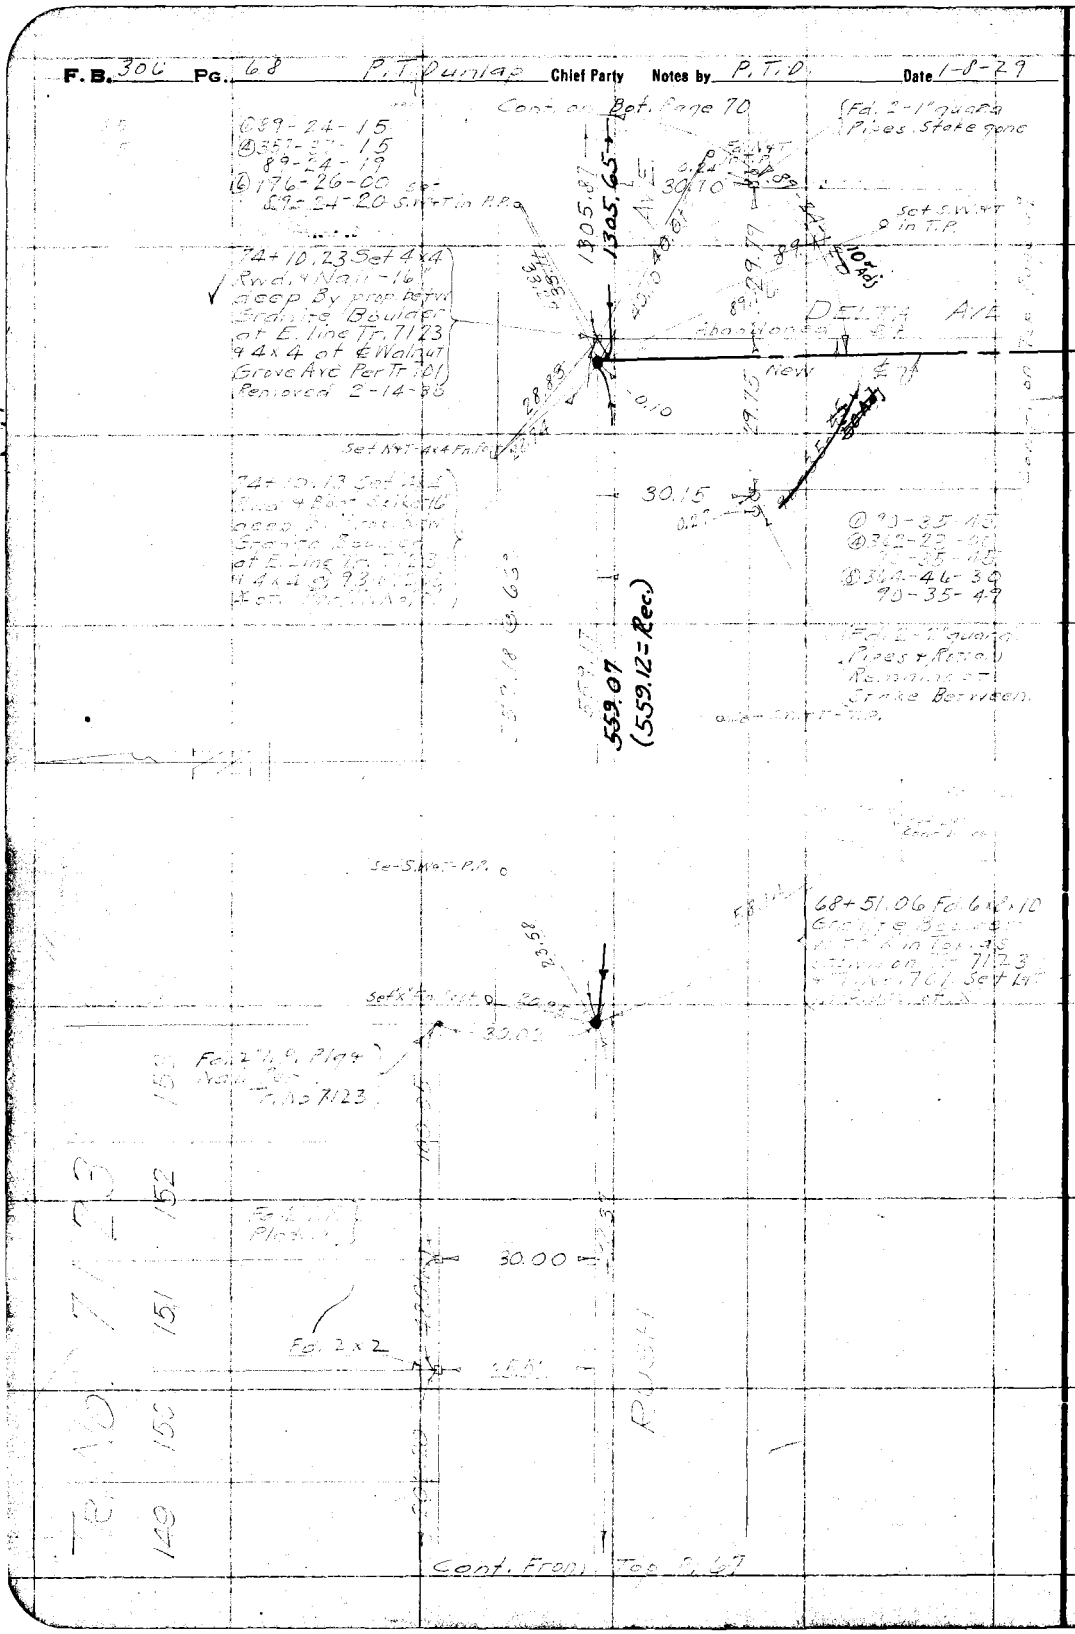

RETURN TO
LOS ANGELES COUNTY SURVEYOR

Do not extend notes this side of this line

Note: ANY ADDITIONS OR CHANGES ON THIS SHEET MUST BE MADE OR CIRCLED IN Red. WITH DATE AND NAME OF PERSON MAKING CHANGE.

Date 1-8-29 Notes by P. T. D. Chief Party P. T. Dunlap F.B. 306 Pg 69

Plotted by J. C. Hart	W. O. No. 4239 S. S. O. No. 1012
Date Jul '29	Location Graves Ave
Map No. C.S.B.384-5H1	Surveyed by P. T. Dunlap
Plotting C'k'd by R. W. S.	Date 1-8-29
Date MAR 17 1930	Indexed A. C. Johnson

Cont. From Page 68 Right

Adopted ℄

Fd. 2" I.P.

29.81 / 17.7

30.02

Fd. 3 x 2 +2-1" Bundy Pipes

14

at Fd. Cor.

15

10

AVE

25

Fd. Spike & Tag

(30)

(30)

30.94

28.36

Fd. 4 x 2 7 1" I.P.

24

63-11-15 Fd. 2"

25-45-00 42

63-11-15 Fd. 2½ Spike

45-30-15

63-11-17

Fd. 2" I.P. 30 deep 12.8 S.

Fd. Cross 2 x 2 14 deep

21.03

28.12

Adopted

New ℄

Fd. 1" I.P. Cond. to pipe at Lot Cor.

33

116-49-45

107-10-00

116-49-45

340-50-15 42

116-49-45

43

TRACT 8309

Fd. 2" I.P. & Nail Tr. No 8309

Fd. 2 x 2 + Tk.

63-11-15

30.03'

29.97

Fd. L x T in Conc. Gas Pipe & Base

40' Adj.

SAN GABRIEL BLVD.

(30)

(30)

(45)

12.1

Cent. ℄

80.82

Abandoned ℄

135'

Adopted ℄ of San Gabriel Blvd per F.B. 334-75

Fd. Rwd. 2 x 2 + Tk. 12" deep

Fd. 2 x 2 + Tk. 3" deep Per R.D. Fb. 55-9 & C.S. Fb. 334-75 Removed 2-14-30

Set 2 x 2 ¾ Nail Flush on Ncl ℄ Int by Int

Set ¾" I.P. in bit Top cone St. Pipe Valve

Cont. on Page 71 Left

Cont. From Page 52 Right

Notes: ANY ADDITIONS OR CHANGES MUST BE MADE OR CIRCLED IN INK WITH DATE AND NAME OF PERSON MAKING CHANGE.

Do not extend notes this side of the line

RETURN TO LOS ANGELES COUNTY SURVEYOR

F. B. 306 PG. 70 P.T.D. Chief Party, Notes by P.T.D. Date 8-29

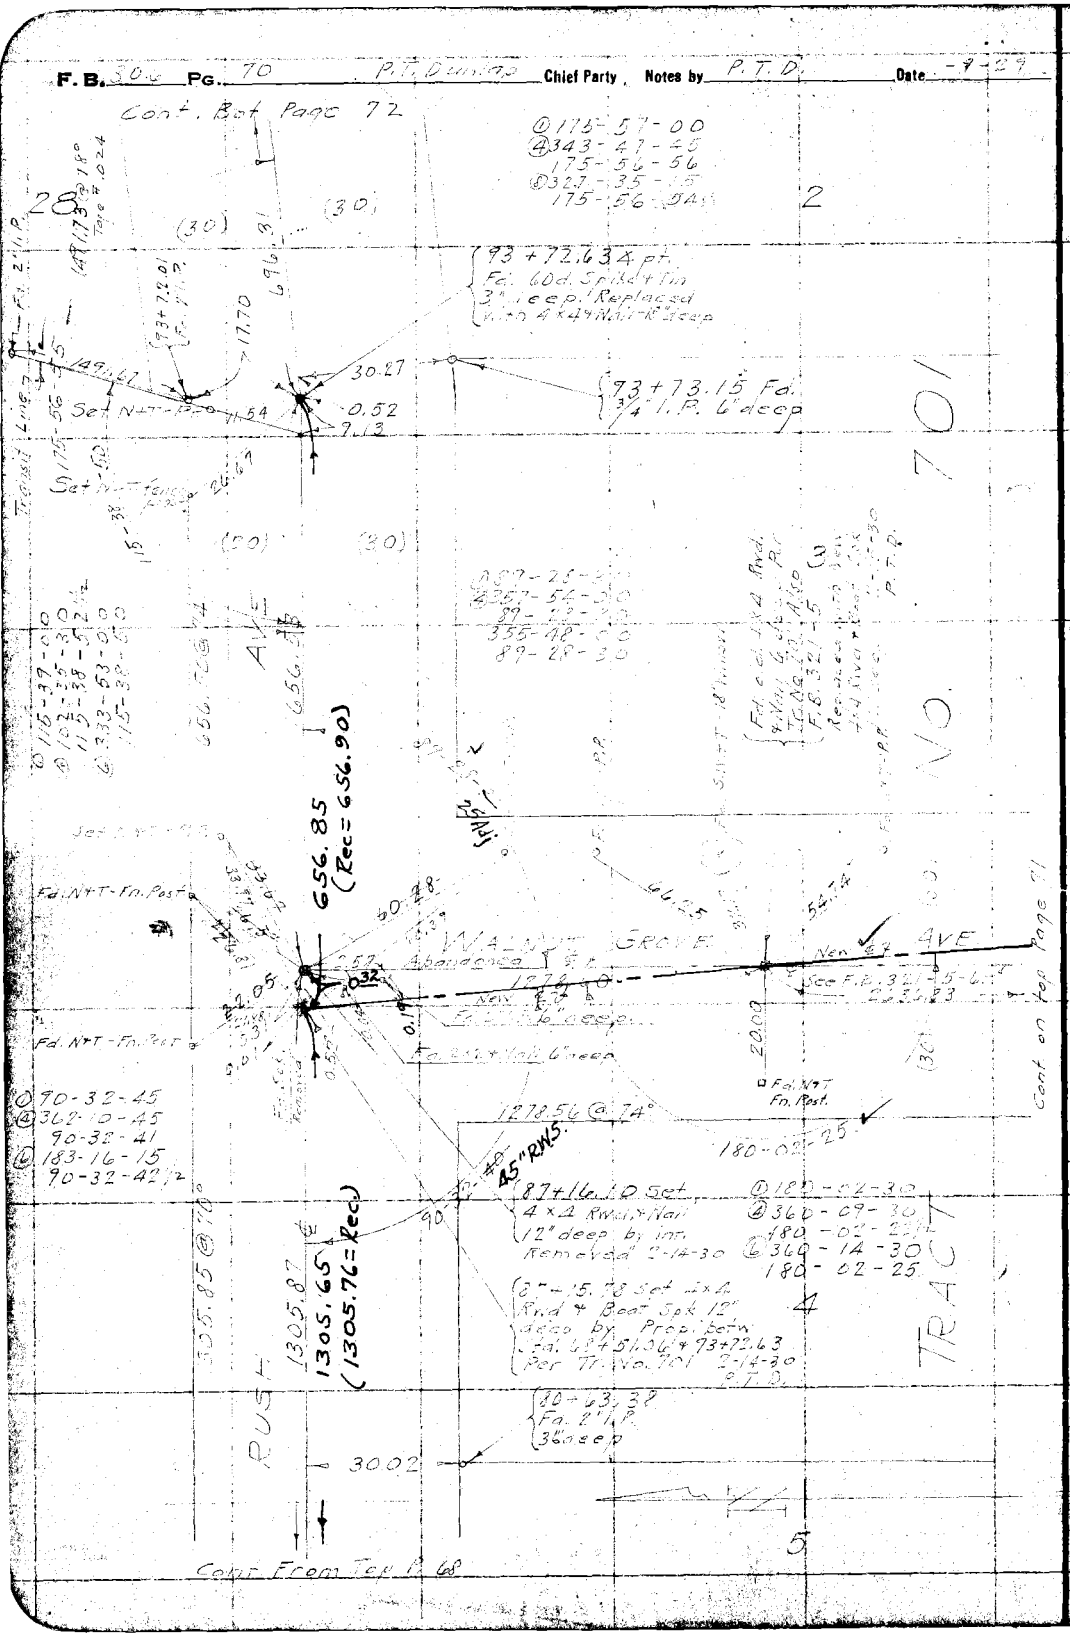
Cont. Bot Page 72
93+72.634 pt.
Fd. 60d. Spike & Tin
3" deep. Replaced
with 4"x4" N.M.T.-R" deep
93+73.15 Fd.
3/4" I.P. 6" deep
Set N+T-P.K. Nail
Fd. N+T-Fn. Post
656.85
(Rec=656.90)
WALNUT GROVE AVE
Abandoned
1774.10
Non Rad
See F.B. 306-45-47
Fd. 3/4" I.P. 6" deep
Fd. Bent 1" Pipe 6" deep
Fd. N+T
Fn. Post.
1278.56 @ 14°
180-02-25
45" RMS.
87+16.10 Set
4"x4" Rwd. & Nail
12" deep by Int.
Removed 2-14-30
87+15.78 Set 4"x4"
Rwd. & Beat Spk. 12"
deep by Prop. Int.
Ea. 0.32 + 51.36 + 73+72.63
Per Tr. No. 701 2-14-30
P.T.D.
80+63.38
Fd. 2" I.P.
3" deep
3002
1305.87
(1305.76=Rec.)
RUST
TRACT
NO. 701
Cont. From Top P. 68
Cont on Top P. 71
Fd. 2" I.P.
Fd. 3/4" Pipe
Fd. Nail & Tag
Set Nail & Tag
Set N+T-P.K.
Fd. Nail & Tag
Fd. N+T-Fn. Post
Fd. 3/4" I.P.
Fd. 3/4" Pipe
Fd. 3/4" I.P.
Fd. 3/4" Pipe
Fd. 3/4" I.P.
Fd. 3/4" Pipe

Date 1-9-29 Notes by P. T. D. Chief Party P. T. Dunlap F.B. 306 Pg. 71

Platted by J. G. Hoyt	W. O. No. 4239 B. S. O. No. 1012
Date Jul 29	Location Graves Ave.
Map No. CS. 6384 Sht	Surveyed by P. T. Dunlap
Platting C'k'd by R. W. S.	Date 1-10-29
Date MAR 17 1930	Indexed A. C. Johnson

Notes: ANY ADDITIONS OR CHANGES OF ANY SHEET MUST BE MADE ON CIRCLED OF ... WITH DATE AND NAME OF PERSON MAKING CHANGE.

Do not extend notes this side of this line

RETURN TO LOS ANGELES COUNTY SURVEYOR

Cont. From P. 70 Right

Adopted & per F.B. 321-5

WALNUT GROVE AVE

Cont. From Page 69 Right

Adopted & per F.B. 334-79

GABRIEL

BALDWIN AVE

Adopted & per Page 99

Set N&T Euclid Rail Post

Set N&T - 12" oak

Fd N&T - P.P.

Fd 2x4 Tack cone Std. Pipe

New P.I., Fd 2x2 & Nail, 4" o cop. Per F.B. 306-99

Fd. 2x4 Tack Nail Flush Per F.B. 334-79 F.B. 321-6 R.D. F.B. 55-18

Fd. 1" Iron Pipe Cone. Std. Pipe

Set C.S. N&T

Δ = 30-48-10
R = 1000'
T = 275.47
L = 537.61

F. B. 326 Pg. 72 P.T.D. Chief Party Notes by P.T.D. Date 7-29

Cont. on Bot Page 73

30

TRACT

(30) (30)

30.02

30.12

30.14

(30)

(30)

29

28

2

Cont From Top Page 73

Cont From Top F.B. 321-4

Cont From Top Page 73

RETURN TO LOS ANGELES COUNTY SURVEYOR

Do not extend notes this side of this line

Note: ANY ADDITIONS OR CHANGES ON THIS SHEET MUST BE MADE OR CIRCLED IN Red. WITH DATE AND NAME OF PERSON MAKING CHANGE.

Date 6-20-29 Notes by P. T. D. Chief Party Dunlap F.B. 306 Pg 73

Plotted By J.C. Hoyt
Date Jul '29
Map No. C.S. B.384 Sh1
Plotting C'k'd by R. W. S.
Date MAR 17 1930

W. O. No. 4239 Sub. W.O. No. 012
Location Graves Ave
Surveyed by P. T. Dunlap
Date 6-20-29
A. C. Johnson
Indexed

Notes: ANY ADDITIONS OR CHANGES ON THIS SHEET MUST BE MADE IN CIRCLES IN Red, WITH DATE AND NAME OF PERSON MAKING CHANGE.

Do not extend notes this side of this line

RETURN TO LOS ANGELES COUNTY SURVEYOR

33

Cont. on Bot P. 74

36

Set N+T - T.P.

Set N+T - P.P.

Set N+T - Cor Fn. Ros

1320.12

49.06

LOMA (30) AVE.

Cont. on P. 87 Right

35.57

1.07'

8.93

Set 1x2

19.95

95.44

Set N+T - P.P.

Set N+T - P.P.

Set 1x2

127+03.39 P.O.T.
Set 4x4 R.v.d. +
Bt. Spk. 18" deep
by int

(30) (30)

32

AVE 1336.09

89-59-45 E 30 RMS.
@ 359-59-09
89-59-45
@ 179-58-30
89-59-45

37

115+08.42 P.O.T.
Set 1x2 + Nail Flush

38

114+43.24 P.O.T.
Set 1x2 + Nail Flush

31

90' OC-OC
See F.B. 321-93A

42.98

See F.B. 321-93A+B.

Transit Line

RIVER AVE

16.05

(60)

NO.

TR

S 89°59'50" W 1374.30

RUSH

114+00.26 P.O.T.
Fd. 1x2 + Nail Flush
See F.B. 321-93A

39

113+84.21 P.O.T.
Set 4x4 R.v.d. +
Boot Spk. 18" deep
See F.B. 321-93A

30

Cont. From Top P. 72

F. B. 306 Pg. 74 Dunlap Chief Party Notes by P. T. D. Date 6-20-29

54 Cont. on Bot. Page 75 67

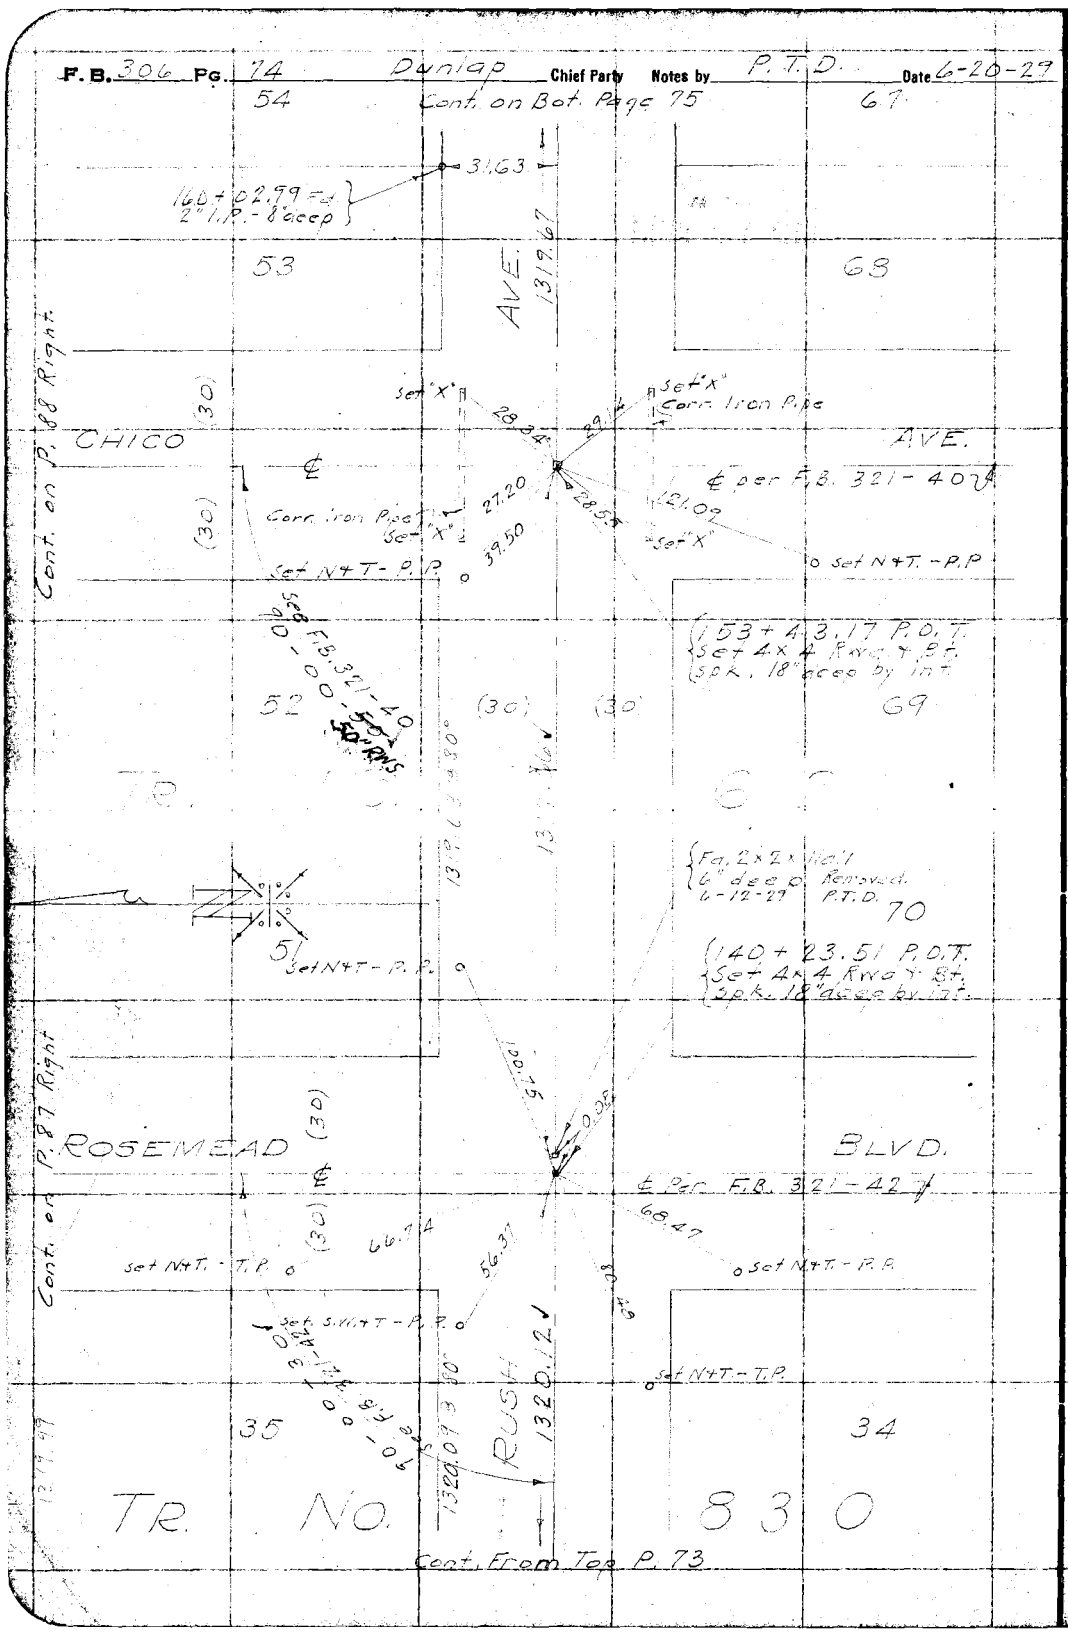

RETURN TO
LOS ANGELES COUNTY SURVEYOR

Do not extend notes this side of this line

Note: ANY ADDITIONS OR CHANGES ON THIS SHEET MUST BE MADE OR CIRCLED IN Red. WITH DATE AND NAME OF PERSON MAKING CHANGE.

Date 6-20-29 Notes by P. T. D. Chief Party Dunlap F.B. 306 Pg. 25

Platted by J. C. Hoyt	W. O. No. 4239 T.S.C. No. 012
Date 6/29	Location Graves Ave
Map No. C.S. B-3845h2	Surveyed by P. T. Dunlap
Platting C'k'd by R. W. S.	Date 6-20-29
Date MAR 17 1930	Indexed A. C. Johnson

Notes: ANY ADDITIONS OR CHANGES ON THIS SHEET MUST BE MADE OR CIRCLED IN Red WITH DATE AND NAME OF PERSON MAKING CHANGE.

Do not extend notes this side of this line

RETURN TO LOS ANGELES COUNTY SURVEYOR

184+81.45 Fai. 2×2 Flush

Cent. on Bot. P. 76

30.30

64

Set C.S. W+T-8" Walnut Root.

Set S.W.+T-18" Gum

57

MERCED

AVE.

Cent. on Bot. P. 77

Cent. on Top P. 77

69.29

66.54

1317.9 to

1.13

40.75

40.62

54.18

29.77

31.04

Set S.W+T - P.P.

Set S.W+T 15" Apple.

70-01-CC
340-03-45
90-00-56
80-05-30
90-00-55

56

90-00-55

1317.89 @ 0.4°

1317.46

65

N79+82.80 P.O.T.
Set 4×4 Rrwd + Bf.
Spk. 18" deep by
Prop. Bet. W & Potrero
Ave & Lexington Gdtn
Road. Per M.B. 15-182-183

Fd. 2×2 3" High

55

(30)

(30)

66

Set C.S. W+T-P.P.

POTRERO

AVE.

E Per F.B. 321-35

36.30

41.74

Set N+T - P.P.

Set N+T - G.P.

166+62.84 P.O.T.
Set 4×4 Rrwd + Bf.
Spk. 18" accc. by int.

40-00-F.B. 321-35

54

1319.67

RUSH

64

Cont. From Top P. 74

F. B. 306 Pg. 76 Duplap Chief Party Notes by P. T. D. Date 6-20-27

Cont. on Bot. Page 81

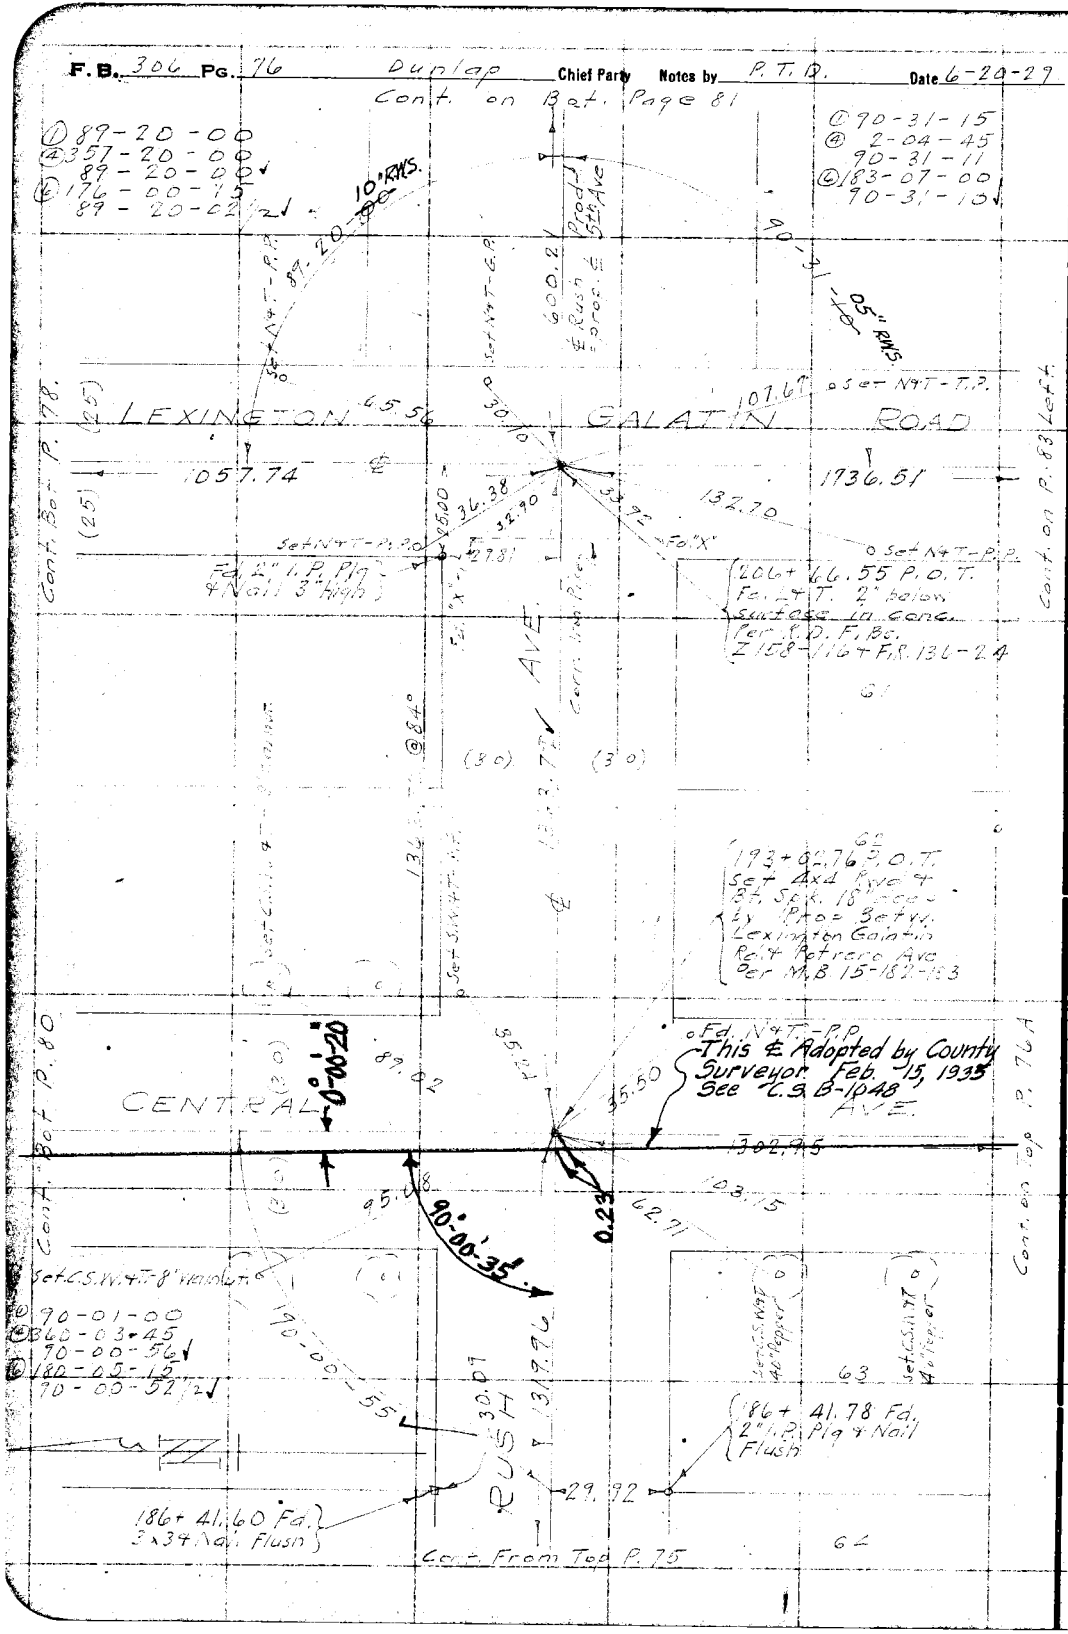

RETURN TO LOS ANGELES COUNTY SURVEYOR

Do not extend notes this side of this line

Note: ANY ADDITIONS OR CHANGES ON THIS SHEET MUST BE MADE OR CIRCLED IN Red. WITH DATE AND NAME OF PERSON MAKING CHANGE.

Date 12-21-29 Notes by Dunlap Chief Party P. T. D F.B. 306 Pg. 76A

Platted by J.C. Hoyt
Date 2/1/30
Map No. C.S.B-384-Sh2
Platting Ck'd by R. W. S.
Date MAR 17 1930

W. O. No. 4237 D. S. O. No. 1524 on this page only.
Location Slauson Ave
Surveyed by D. T. Dunlap
Date 12-21-29
A. C. Johnson
Indexed

Cont. From P. 76 Right

0°-00'-20"

This ℄ Adopted by County Surveyor Feb. 15, 1935. See C.S.B-1048

Fd. 1" I.P.

30.96

(30)

Set C.S. 1/4 T-P.P.

179°30'00"

1302.95

1303.3 Rad.

20' Adj.

179-30-30
358-01-45
179-30-26
357-02-30
179-30-25

Set C.S. 1/4 T-P.P.

ANGLE POINT
Fd. Rotten 2x2 - o.k. for ent. & West. cors on line
Set 4x4 R.M. & Boat Spike 18" deep at Pt. of Dist. & Rad. & Arc

135-02-30
180-10-15
135-02-34
90-15-15
135-02-32½

Set C.S. 1/4 T-P.P.

1342.84

1344.80

Fd. 4" Pipe

Set 1/4 T-P.P.

90-04-15
360-17-45
90-04-26
180-17-00
90-04-30

RM 35½

℄ 301.53

30.60

℄ PRADO

16.07.95

16.07.97 Set

36.05

36.04

Set 1/4 T-P.P.

Cont. on Bot. Page 83

LEXINGTON

Fd. 1/4 T in Cone 2' deep Witness Assmn't. Cor. Bears E.

Notes: ANY ADDITIONS OR CHANGES ON THIS SHEET MUST BE MADE OR CIRCLED IN Red. WITH DATE AND NAME OF PERSON MAKING CHANGE.

Do not extend notes this side of this line

RETURN TO LOS ANGELES COUNTY SURVEYOR

RETURN TO

LOS ANGELES COUNTY SURVEYOR

Note: ANY ADDITIONS OR CHANGES ON THIS SHEET MUST BE MADE OR CIRCLED IN **Red.** WITH DATE AND NAME OF PERSON MAKING CHANGE.

Do not extend notes this side of this line

F. B. _____ Pg. _____ Chief Party _____ Notes by _____ Date _____

Date 6-20-29 Notes by P.T.D. Chief Party Dunlap F.B. 306 Pg. 77

Platted by J.C. Hoff
Date Aug '29
Map No. C.S.B. 384 Sh 2
Platting C'k'd by R. W. S.
Date MAR 17 1930

W. O. No. 4239 ~~U. S. O.~~ No. 012
Location Graves Ave
Surveyed by P. T. Dunlap
Date 7-47
Indexed A. C. Johnson

76° 2½ W

Set C.S. W.4 T-8' Walnut

Fd. L & T. Per R. Dec. F.B. F.C. 835-28

(Set Cut Spk. & Washer in Lead. By Rec. from Ties Per M.B. 15-182-3

Set C.S. W.4 T-P.P.

Set C.S. W.4 T-P.P.

(30) GARVEY

1320.00

AVE.

1320.00

Set C.S. W.4 T-8' Conc.

Set N4T-T.P.

1320.00 @ 76°

AVE

5

16

17

25

24

NO.

(30) (30)

36

37

TRACT

MERCED

45

44

Col. From P. 75 Left

089-58-00
@359-51-15
89-57-49
@179-47-15
89-57-52

45" R.M.S.

Notes: ANY ADDITIONS OR CHANGES OF THIS SHEET MUST BE MADE OR CIRCLED IN Red, WITH DATE AND NAME OF PERSON MAKING CHANGE.

Do not extend notes this side of this line

RETURN TO LOS ANGELES COUNTY SURVEYOR

F.B. 306 Pg. 78 Dunlap Chief Party Notes by P.T.D. Date 6-20-27

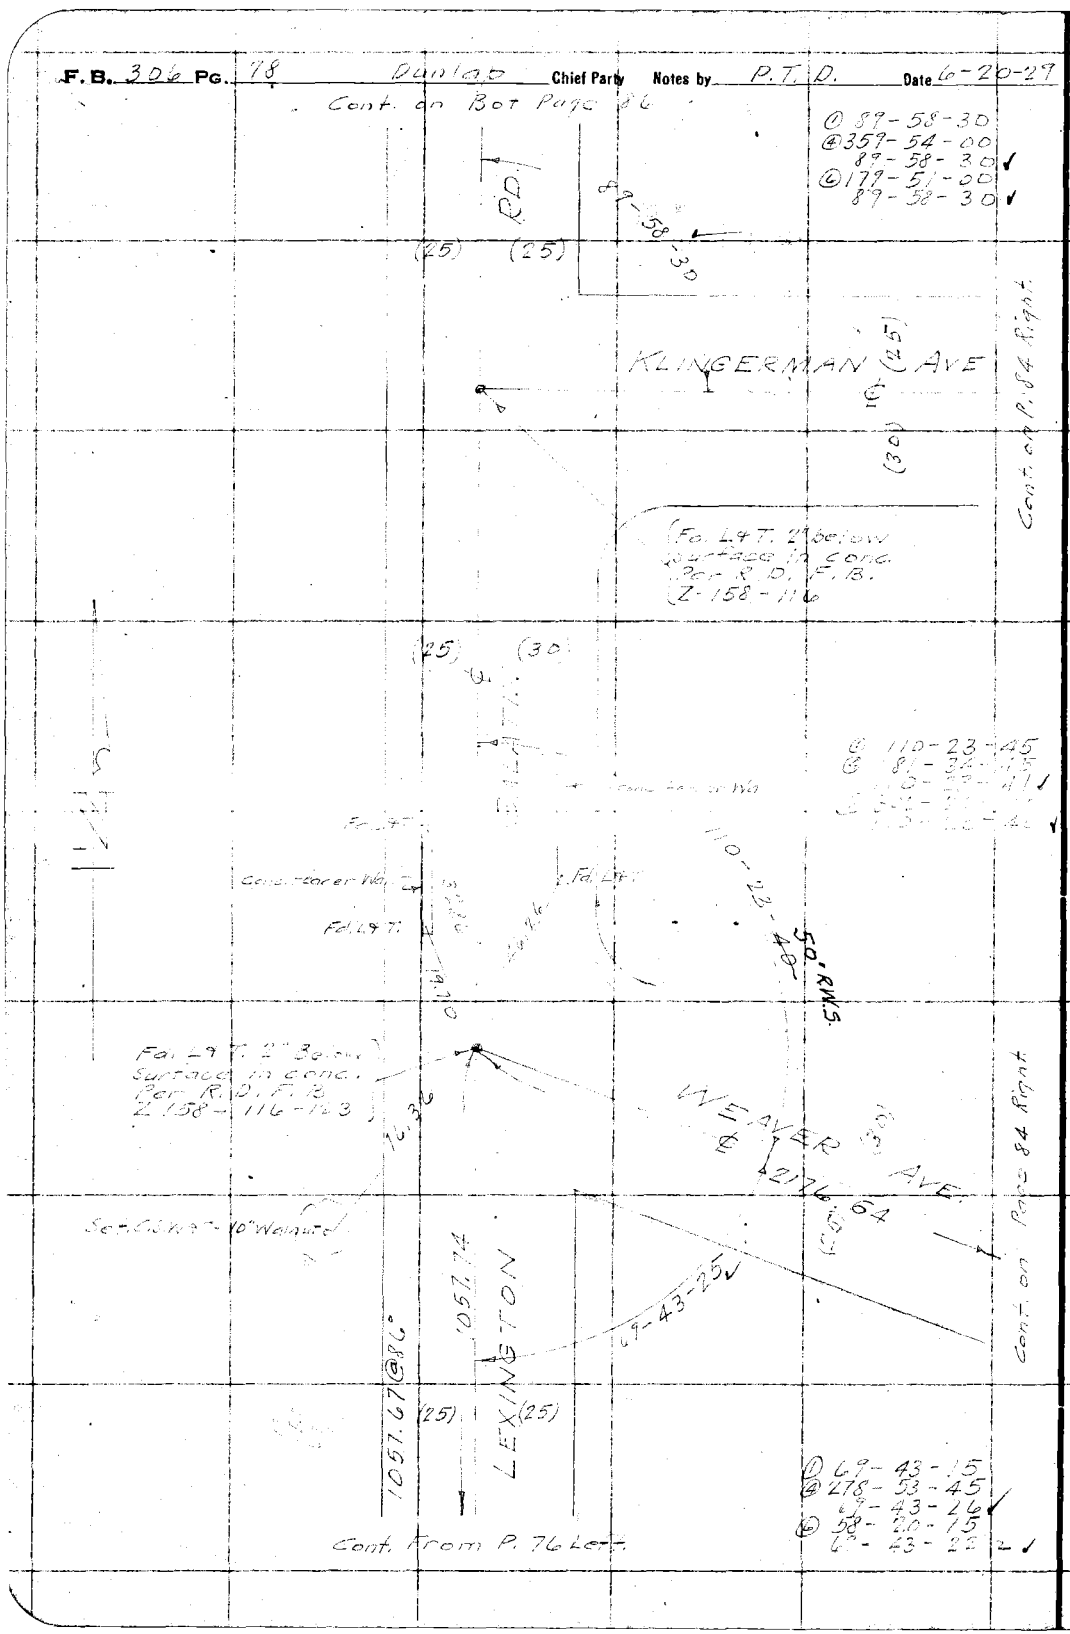

RETURN TO
LOS ANGELES COUNTY SURVEYOR
Do not extend notes this side of this line

Note: ANY ADDITIONS OR CHANGES ON THIS SHEET MUST BE MADE OR CIRCLED IN Red. WITH DATE AND NAME OF PERSON MAKING CHANGE.

Date 6-20-29 Notes by P.T.D. Chief Party Dunlap F.B. 306 Pg. 79

Platted by J.C. Hoyt
Date Aug '29.
Map No. C.S.B. 38 Sh 2
Platting C'k'd by R.W.S.
Date MAR 17 1930

W. O. No. 4239 [illegible] B. O. W. No. C12
Location Graves Ave
Surveyed by P.T. Dunlap
Date 6-29-29
Indexed A. C. Johnson

Cont. From P.75 Right

94 95

98 (30) AVE (30) 621

Fd. 2" I.P. P.P.& Nail See F.B. 321-28

0.34 - 22 - 90
0.17 - 75 - 90
134 - 22 - 97½
134 - 22 - 95

NO

3.16

Set N&T-P.P.C.

Set N&T-C.P.

TRACT

109

97

Fd. 2x2 Nail See F.B. 321-28

24.69 1.45 21.32 19.43

Set 2x2 Nail 12" deep by int.

0.11

MERGED

56.22

56.22 @ 87°

18

Fd. Roten 2x2 Nail Flush per F.B. 321-28 Removed & Replaced with 2x2 Nail 12" deep

Fd. N&T-P.P.

34.86

FAUCETT

& per F.B. 321-

42.41

84.55

Fd. 2x2

Set N&T-P.P.

Notes: ANY ADDITIONS OR CHANGES ON THIS SHEET MUST BE MADE OR CIRCLED IN Red. WITH DATE AND NAME OF PERSON MAKING CHANGE.

Do not extend notes this side of this line

RETURN TO LOS ANGELES COUNTY SURVEYOR

F. B. 306 Pg. 80 P. T. D. Chief Party Notes by Dunlap. Date 6-26-29

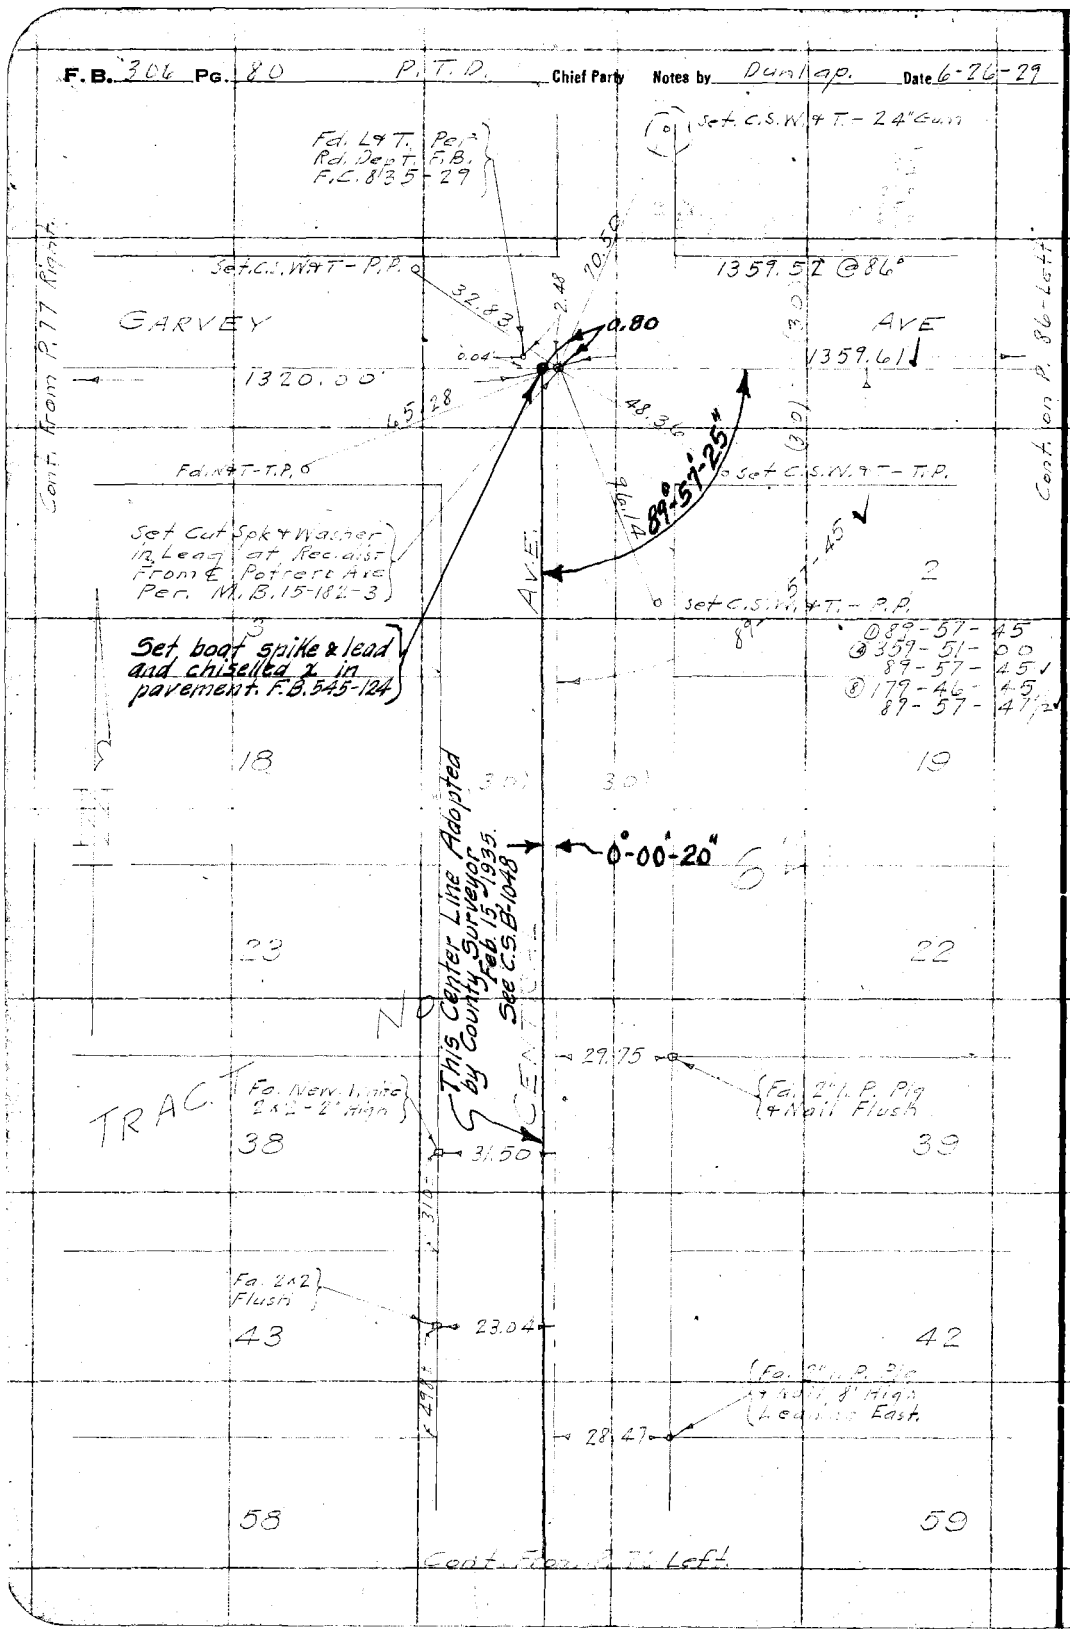

RETURN TO
LOS ANGELES COUNTY SURVEYOR
Do not extend notes this side of this line

Note: ANY ADDITIONS OR CHANGES ON THIS SHEET MUST BE MADE OR CIRCLED IN Red. WITH DATE AND NAME OF PERSON MAKING CHANGE.

Date 7-1-29 Notes by P. T. D. Chief Party Dunlap F.B. 306 Pg 87

Platted by J. C. Hoyt
Date Aug 29.
Map No. C.S.B. 384 Sh 2
Platting C'k'd by R. W. S.
Date MAR 17 1930

W. O. No. 4239 ~~B.S.B.~~ No. 012
Location Grapes Ave
Surveyed by P. T. Dunlap
Date 6-28-29
Indexed A. C. Johnson

Notes: ANY ADDITIONS OR CHANGES ON THIS SHEET MUST BE MADE IN CIRCLES AND WITH DATE AND NAME OF PERSON MAKING CHANGE.

Do not extend notes this side of this line.

RETURN TO LOS ANGELES COUNTY SURVEYOR

Cont. on Bot. P. 88

(Fd L & T. Per R.O.
F.Bs. F.B. 321-207
Lana. F.B. 335-25
See F.B. 321-48

89-54 E 366.51 F.B. 321-48

ROSEMEAD BLVD. (30)

Cont From P. 74 Left

AVE

(30)

(30)

See F.B. 321-48
89-54 E 30.00
25' R.W.S.

(Fd C.S.W. & T. Co. Bridge Per F.B. 321-47-48)

GARVEY

90-00-00
360-00-15
90-00-04
180-00-30
90-00-05

90-00-00
15' R.W.S.

LOMA AVE (30)

Cont From P. 73 Left

F.B. 306 Pg. 88 — Dunlap Chief Party — Notes by P. T. D. — Date 7-2-27

Cont. on P. 77 Left

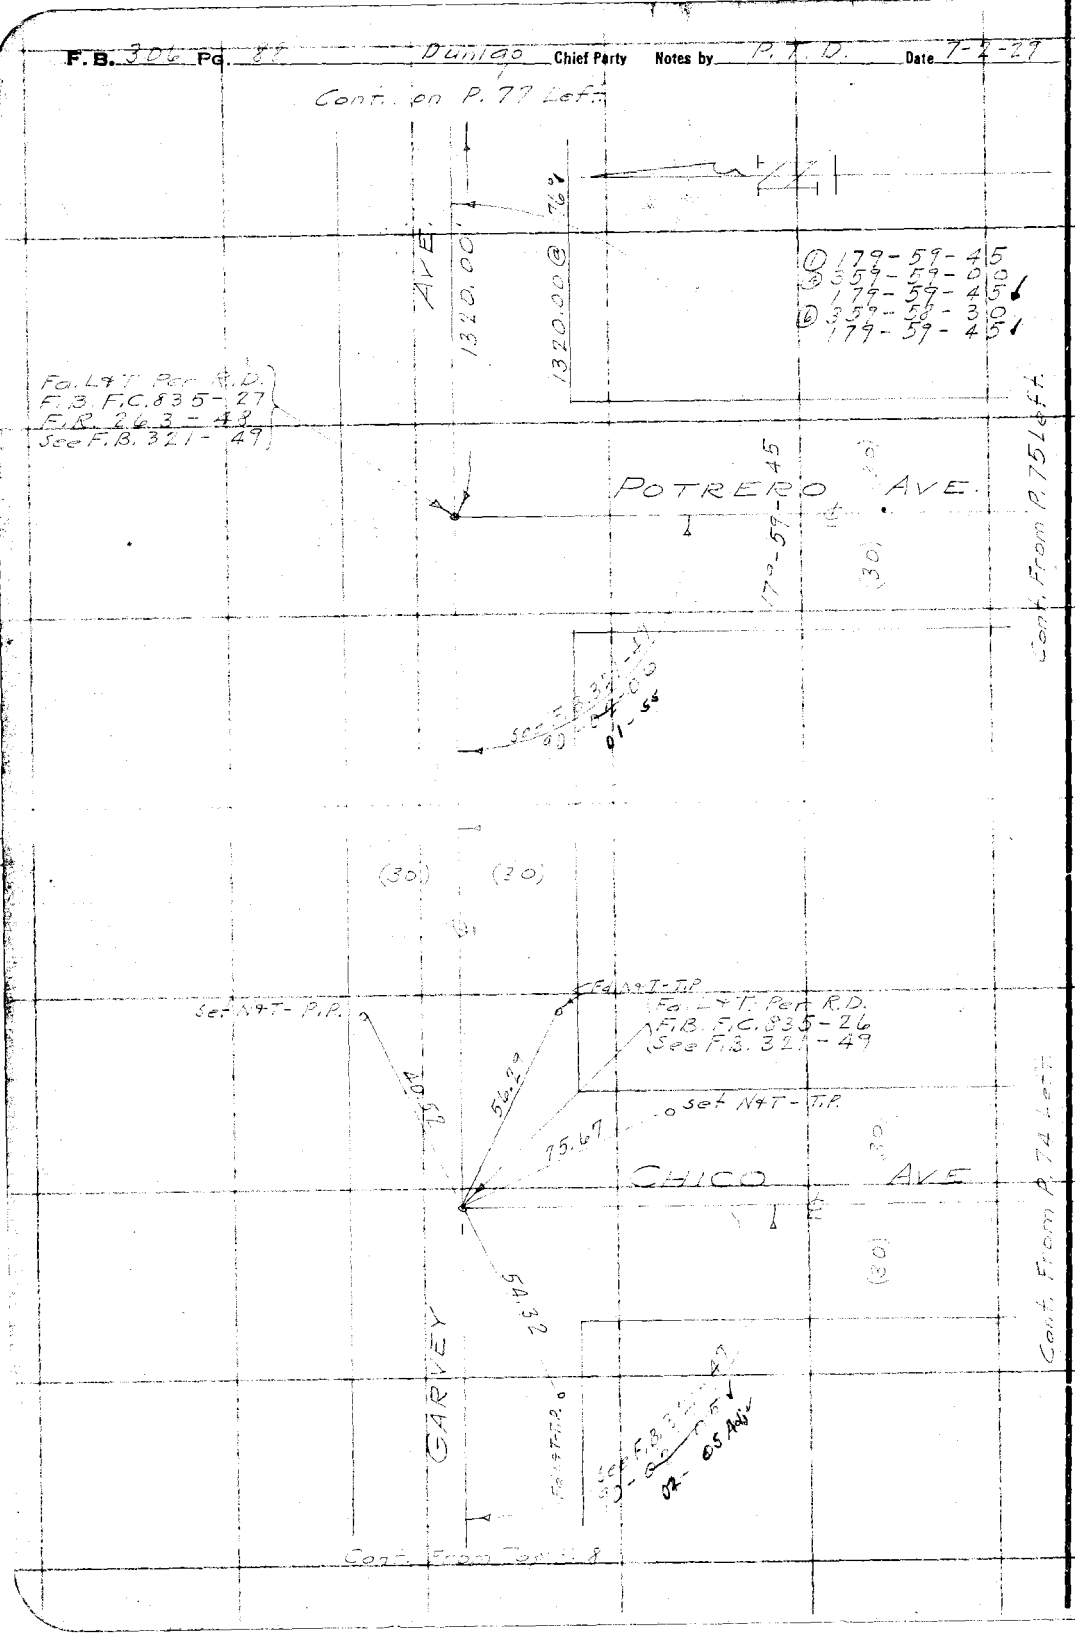

RETURN TO
LOS ANGELES COUNTY SURVEYOR

Do not extend notes this side of this line

Note: ANY ADDITIONS OR CHANGES ON THIS SHEET MUST BE MADE OR CIRCLED IN Red. WITH DATE AND NAME OF PERSON MAKING CHANGE.

Date 6-25-29 Notes by P.T.D. Chief Party Dunlap F.B. 306 Pg. 81

Platted by J.C. Hoyt	W. O. No. 4239 T.B.M. No. 012
Date Aug 29	Location Gravois Ave
Map No. C-5.B.381-Sh 2	Surveyed by P.T. Dunlap
Platting C'k'd by R.W.S.	Date 6-24-27
Date MAR 17 1930	Indexed A. C. Johnson

Cont. on Bot. Page 82

420.52 @ 86
420.53 @ 86

55

Set 2 x 2 & Nail 18" deep

50.00

50.00

0.06

Nothing Set

218+50.87 P.C.
Set 2 x 24 Nail 18" deep

93

Set 2 x 2 Nail Post

584.07 @ 86
584.08 @ 86

584.11

Ave.

5th

E

Prop

212+66.24 P.O.T
Set 2 x 24 Nail 18" deep

200.10 @ 86
200.08 @ 86

Push Ave.

Cont From Too Page 76

Notes: ANY ADDITIONS OR CHANGES ON THIS SHEET MUST BE MADE OR CIRCLED IN Red. WITH DATE AND NAME OF PERSON MAKING CHANGE.

Do not extend notes this side of this line

RETURN TO LOS ANGELES COUNTY SURVEYOR

F.B. 306 Pg. 82 Dunlap Chief Party Notes by P.T.D. Date 6-26-29

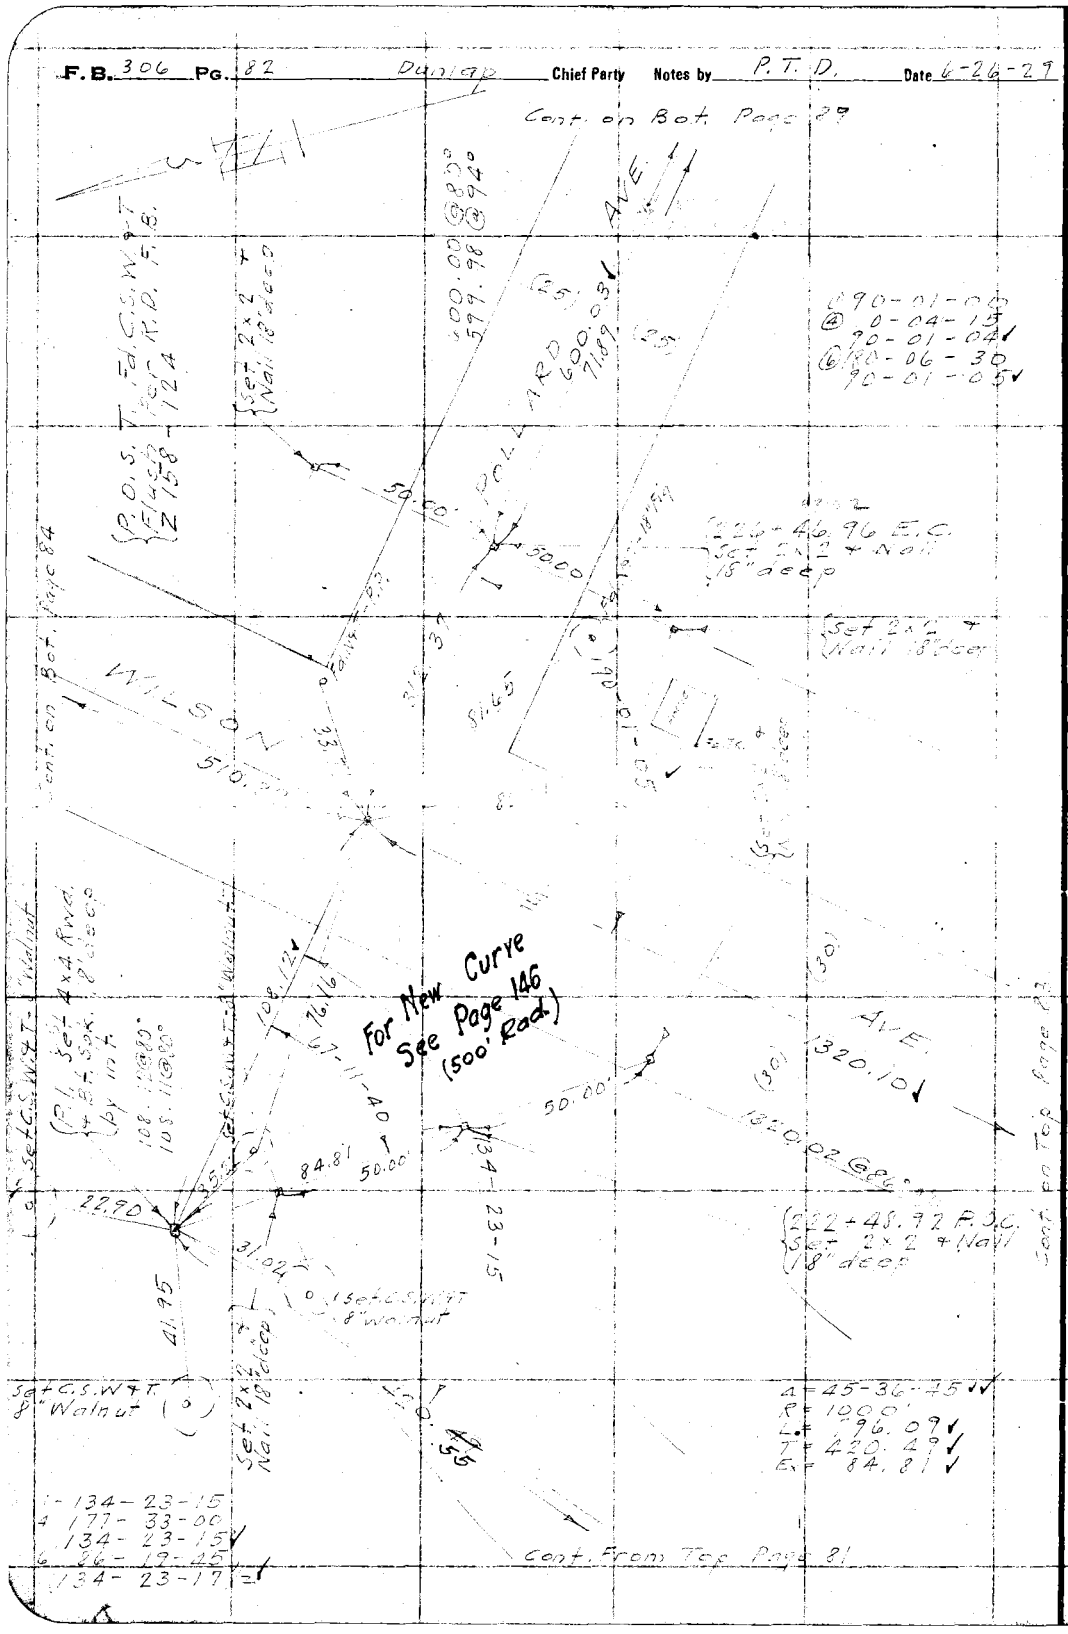

RETURN TO
LOS ANGELES COUNTY SURVEYOR

Do not extend notes this side of this line

Note: ANY ADDITIONS OR CHANGES ON THIS SHEET MUST BE MADE OR CIRCLED IN Red. WITH DATE AND NAME OF PERSON MAKING CHANGE.

Date 6-20-29 Notes by P. T. D. Chief Party Dunlap F.B. 306 Pg. 83

Platted by J. C. Hoyt
Date Aug 29
Map No. C.S.B. 384 Sh 7
Platting C'k'd by R. W. S.
Date ~~MAR~~ 17 1930

W.O. No. 4239 ~~U. S. O. No.~~ Tape No. 012
Location Graves Ave
Surveyed by P. T. Dunlap
Date 6-20-29
Indexed ~~A. C. Johnson~~

Cont. From P. 82 Right

Fd. C. S. W. & T. Flush Par R. D. F.B. Z 158-124

Ave.

1320.10

Fd. N & T - P.P.

40.27

30.15

(LE) T-LINES AVE.

81.72

Δ 45-06-45
Ⓑ 180-27-00
45-06-45
Ⓒ 270-40-30
45-06-45

Cont. From P. 76 Right

LEXINGTON

(35)

45-06-45

Set C.S.W. & T. Flush Par R.D. 1052.39 (@) Fd. N & T. - P.P.

1052.47

(30) (30)

WILSON

Fd. N & T - Pipe

Ⓓ 89-59-15
Ⓐ 359-57-15
89-59-20
Ⓔ 179-56-00
89-59-20

90°00'40" (Sup'd)

Fd. N & T - P.P.

GALATIN

1936.51

Ⓑ 2136.37 (Rad.) 65°

RD.

84.53

68.00

Fd. L & T 2' below surface in cone, base else Fd. L & T. 2' below, 0.08 North & 0.18' East also Fd. 4 nails in wooden plugs int. of which is 0.25' N.E. SEE DETAIL

DETAIL

Nail

Fd. L & T 1' Walk.

25.99

1936

29.37

R.W.S. 1800.00 6°55'

Ⓒ 179-59-45
Ⓐ 359-59-30
179-59-52½
Ⓔ 359-59-15
179-59-52½

Fd. N & T - P.P.

1607.95

Fd. N & T - T.P.

L & T 0.08'

0.25

0.16

Nail

L & T

Nail

Cont. From P. 764 Right

Notes: ANY ADDITIONS OR CHANGES ON THIS SHEET MUST BE MADE OR CIRCLED IN Red WITH DATE AND NAME OF PERSON MAKING CHANGE.

Do not extend notes this side of this line

RETURN TO LOS ANGELES COUNTY SURVEYOR

F. B. 306 Pg. 84 P. T. D. Chief Party Notes by Dunlap Date 6-25-29

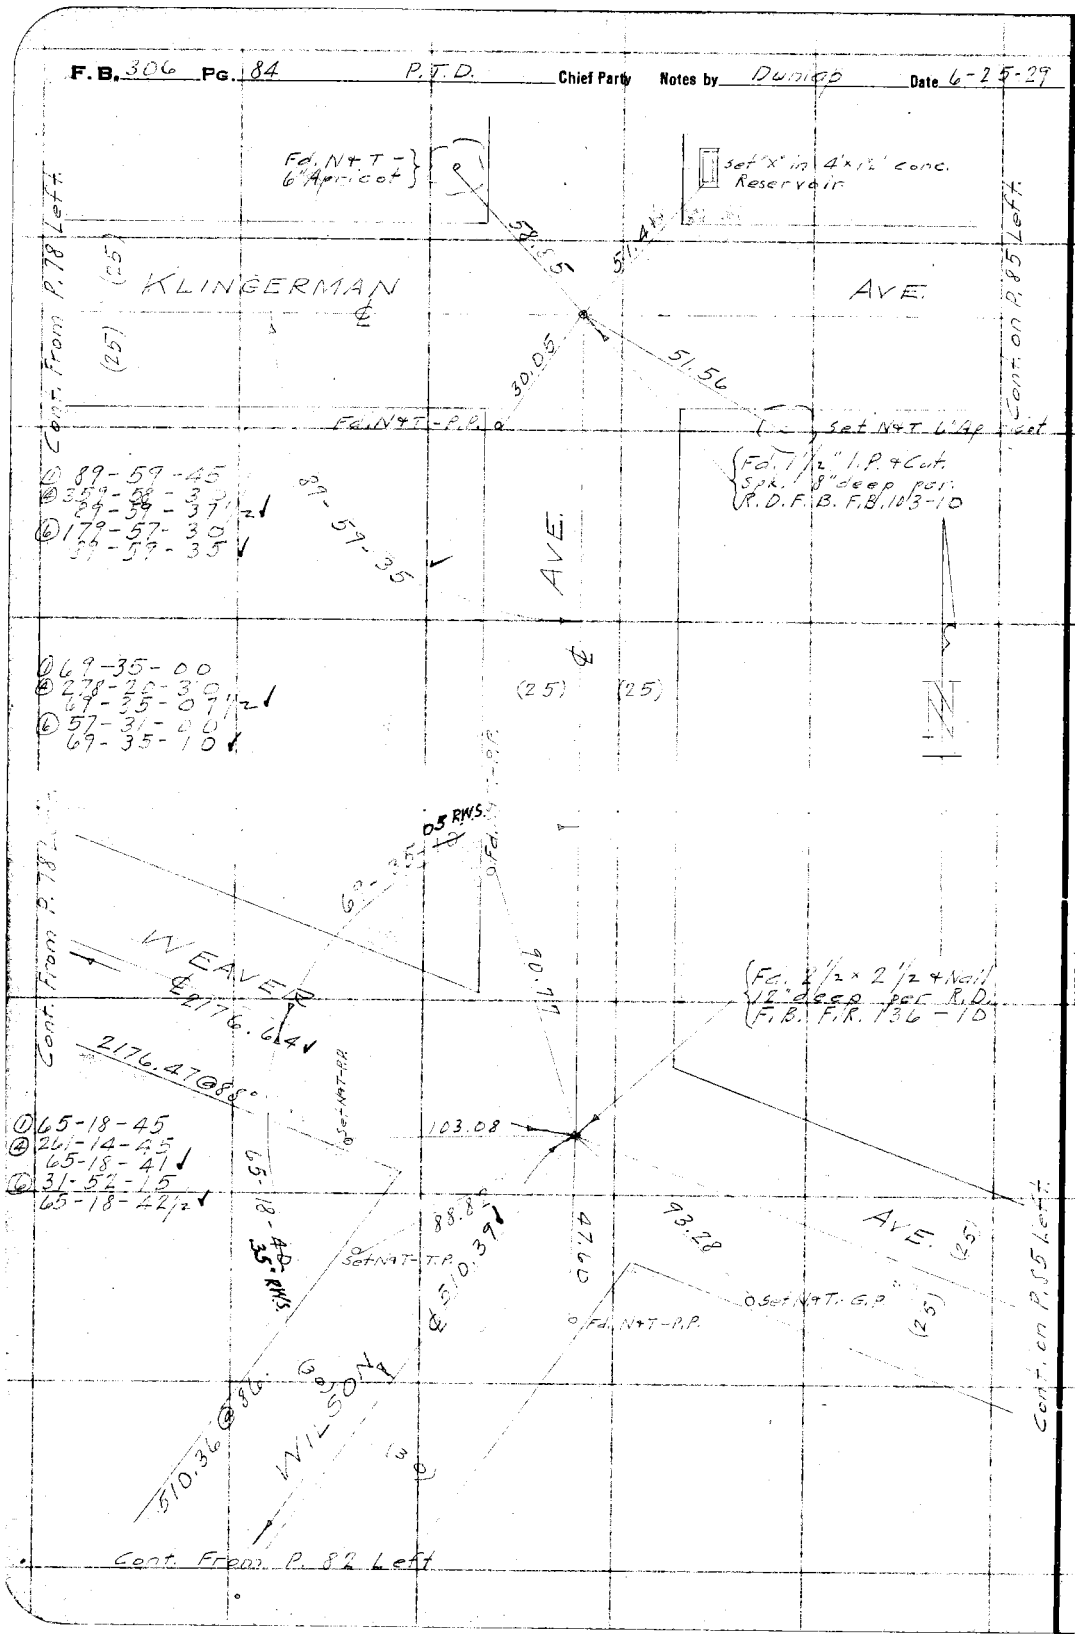

RETURN TO LOS ANGELES COUNTY SURVEYOR

Do not extend notes this side of this line

Note: ANY ADDITIONS OR CHANGES ON THIS SHEET MUST BE MADE OR CIRCLED IN Red. WITH DATE AND NAME OF PERSON MAKING CHANGE.

Date 6-25-29 Notes by P. T. D. Chief Party Dunlap F.B. 306 Pg. 85

Platted by J. C. Hoyt
Date Aug '29
Map No. C.S. B. 384-5&7
Platting C'k'd by R. W. S.
Date MAR 17 1930

W. O. No. 4239 [illegible] No. 012
Location Graves Ave
Surveyed by P. T. Dunlap
Date 6-25-29
Indexed A. C. Johnson

Cont. on P. 92 Left Center

89-58-30
359-52-45
89-58-26
89-58-30

30" R.W.S. 04-45
135-04-15
180-17-45
135-04-26
360-35-30
225.47
52.53
89-58-30
2.5 R.W.S.
(25)
AVE
(25)
Fd. C.S.W.&T. Flush Per R.D. F.B. Z 158-125
70.72
KINGERMAN
(25)
89-57-45
359-51-00
89-57-45
179-46-30
89-57-45
Cont. From P. 84 Right
(25)
(25)
Set Nail & Tin
0.06'
SLAUGHTER
(25)
AVE
(25)
Fd. C.S.W.&T. 2" Dia. Pipe Per R.D. F.B. Z 158-125
74.31
103.05
Fd. N&T-12" apple
114-39-10
114-39-10
98-36-45
114-39-10
327-55-00
114-39-10
Fd. N&T-8" Pipe Loose
53.88
Set N&T-6" apple
Fd. 2x2 & Nail 12" deep Per R.D. F.B. Z 158-125
AVE
(25)
WEAVER
(25)
80.95
47.40
Fd. 2" I.P. Flush Per Sand Dest. F.B. Z 158-125
Cont. From P. 84 Right
Fd. N&T-8" Walnut
Cont. on P. 89 Left

Notes: ANY ADDITIONS OR CHANGES ON THIS SHEET MUST BE MADE OR CIRCLED IN Red. WITH DATE AND NAME OF PERSON MAKING CHANGE.

Do not extend notes this side of this line

RETURN TO LOS ANGELES COUNTY SURVEYOR


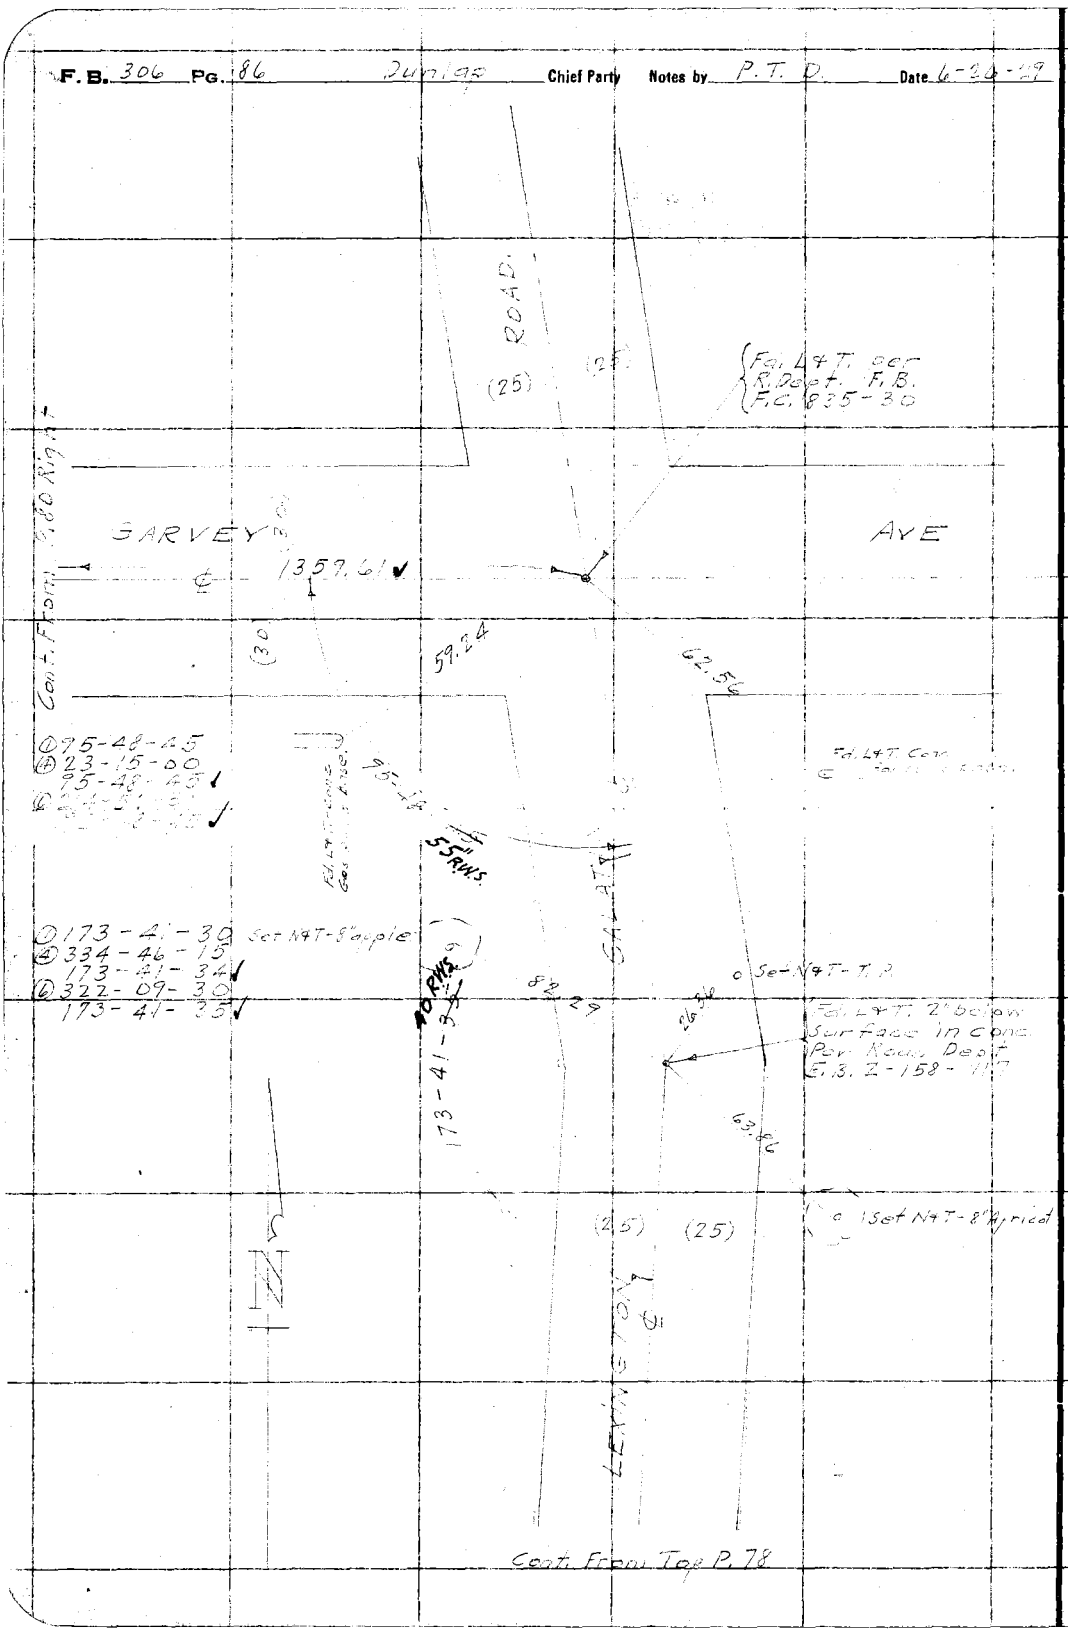

175-48-45
23-15-00
175-48-45
173-41-30
334-46-15
173-41-34
322-09-30
173-41-33

RETURN TO
LOS ANGELES COUNTY SURVEYOR
Do not extend notes this side of this line

Note: ANY ADDITIONS OR CHANGES ON THIS SHEET MUST BE MADE OR CIRCLED IN Red. WITH DATE AND NAME OF PERSON MAKING CHANGE.

Date 1-2-29 Notes by P.T.D. Chief Party Dunlap F.B. 306 Pg 89

Plotted by: A.C.Hoyt
Date: Aug '29
Map No. C.S.B-324 Sht 2
Plotting C'k'd by R.W.S.
Date MAR 17 1930

W.O. No. 4239 Topo B.O.E. No. 012
Location Graves Ave
Surveyed by P.T. Dunlap
Date 7-2-29
Indexed A.C. Johnson

Cont. on P. 91 Left.

Note: ANY ADDITIONS OR CHANGES ON THIS SHEET MUST BE MADE OR CHECKED IN RED WITH DATE AND NAME OF PERSON MAKING CHANGE.

Do not extend notes this side of this line.

RETURN TO LOS ANGELES COUNTY SURVEYOR

M.R. 600.00 (R) 600.0 0.7

244+47.09 P.O.T. Set 2×2 4 Nail 18" deep

43 - 43 TO 45

238+47.63 P.O.T. Set 2×2 4 Nail 18" deep

232+46.79 P.O.T. Set 2×2 4 Nail 18" deep

Fd. 2×2 4 Nail 6" deep

BLOCK E

BLOCK F

1

2

3

4

90-00 90-01 90-01 90-06 90-01 90-01

RYNS. 10" 00

600.04 600.03 600.03 600.03

F.B. 366 Pg. 90 Dunlap Chief Party Notes by P. T. D. Date 7-1-29

Cont. on Bot. P. 91

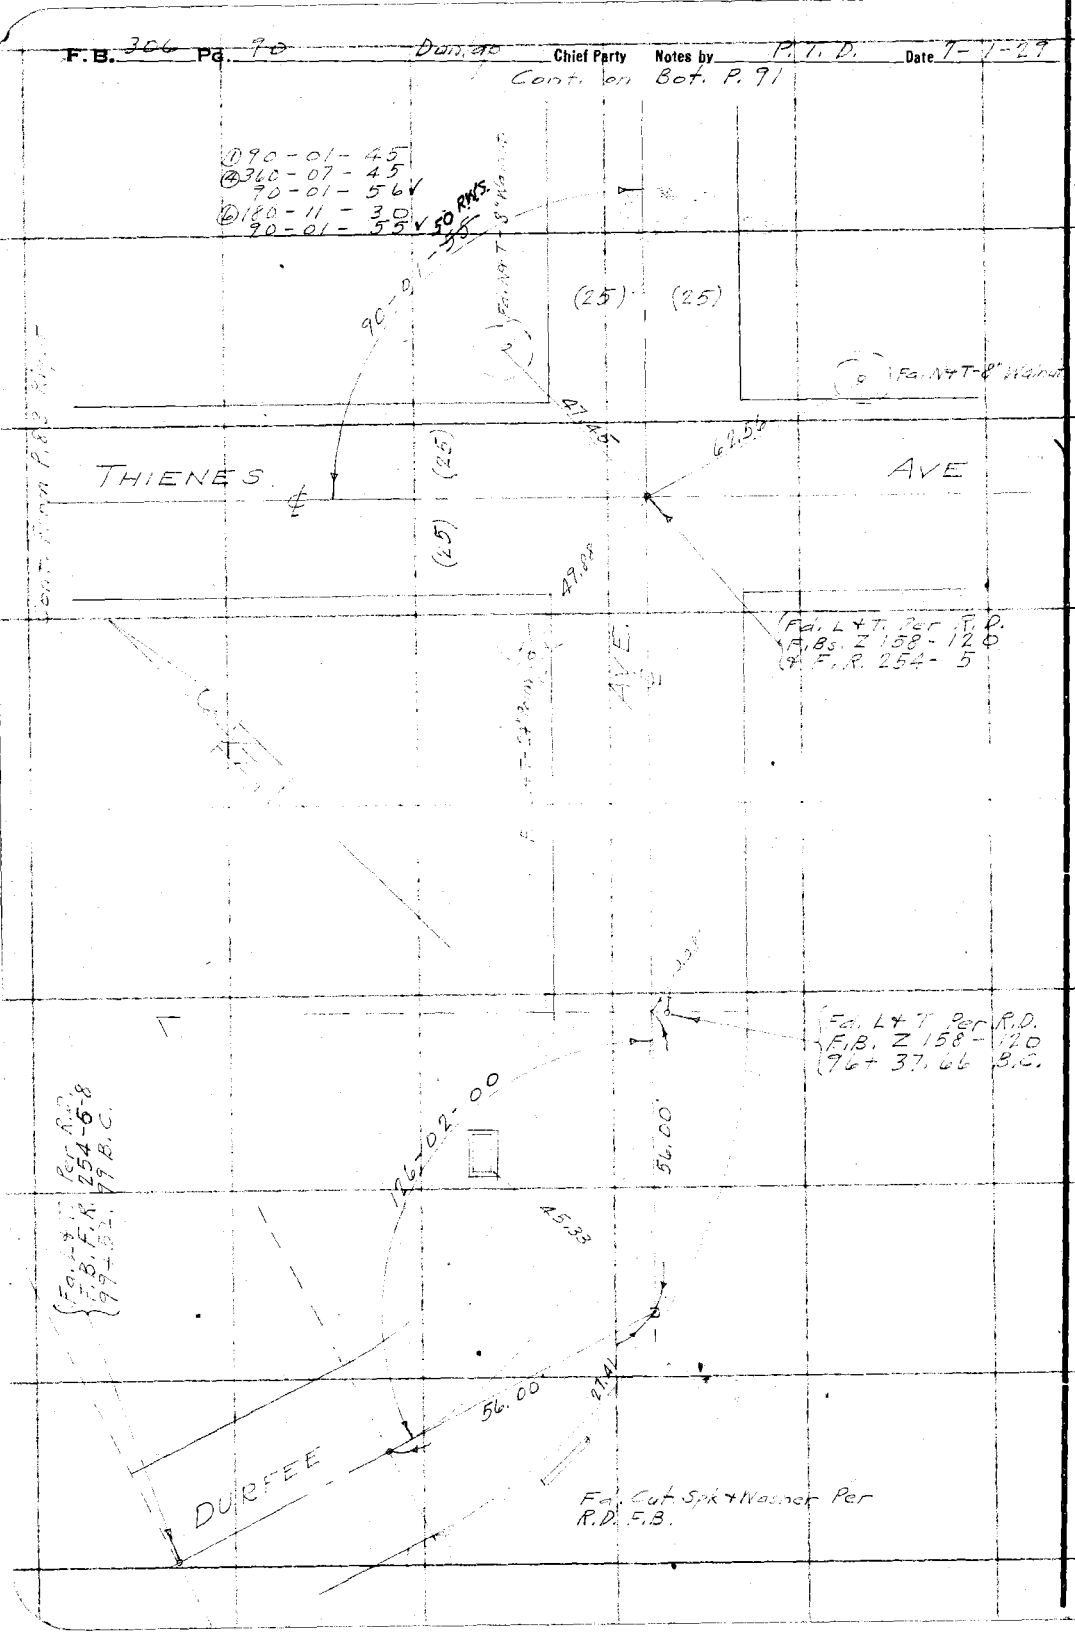

RETURN TO
LOS ANGELES COUNTY SURVEYOR

Do not extend notes this side of this line

Note: ANY ADDITIONS OR CHANGES ON THIS SHEET MUST BE MADE OR CIRCLED IN Red. WITH DATE AND NAME OF PERSON MAKING CHANGE.

Date 7-1-29 Notes by P. T. D. Chief Party Dunlap F.B. 306 Pg 91

Plotted by J.C. Hoff	W. O. No. 4239 Topo. No. 1612
Date Aug '29	Location Graves Ave
Map No. C.S. 8384-Sht 2	Surveyed by P. T. Dunlap
Plotting C'k'd by R. W. S.	Date 7-1-29
Date MAR 17 1930	Indexed A. C. Johnson

Cont. on Bot P. 92

D 90 - 05 - 30
A 360 - 22 - 30
90 - 05 - 37½ ✓
C 180 - 33 - 30
90 - 05 - 35 ✓

40 R.W.S.

90-05-35

SLAUGHTER AVE

Cont From P. 85 Rt. of T.

Set "X" on int.

229.61

Fd. L & T. P.

Fd. L & T. P. R. 2
Fi. Bs. 2-158-119
4 F. R. 254-4

Fd. N & T. - 8" Walnut

90-02-15

(25) (25)

Set C.S. L & T. 8" Walnut

Set N & T. T.P.

Fd. N & T. - Walnut

500.00 @ 94°
500.00 @ 94°

415.46 @ 94°
415.46 @ 94°

POLLARD

500.06

415.54 ✓

50.59

0.05

37.03

36.98

AVE.

1329.59 ✓

Top Page 94

66

29

46.04

46.80

38.38

Fd. No. T. 8" Walnut

DURFEE

247+47.14 P.O.T.
Set 2"x 12" Nail
Tree

253+62.68 P.O.T.
Fd. L & T. P.R.O.
Fi. B.S. 1-158-119
4 F.R. 254-4

253+62.17 P.O.T.
Set Chisel X on Int.

Set N & T - 8" apple
Stump of Swilled off
branch

Cont. From Top P. 90

Cont. From Top P. 89

RETURN TO
LOS ANGELES COUNTY SURVEYOR

Do not extend notes this side of this line

Notes: ANY ADDITIONS OR CHANGES ON THIS SHEET MUST BE MADE OR CIRCLED IN Red. WITH DATE AND NAME OF PERSON MAKING CHANGE.

F.B. 306 Pg. 92 Dun. 90 Chief Party Notes by P. T. D. Date 7-1-29

Cont. on Top P. 93.

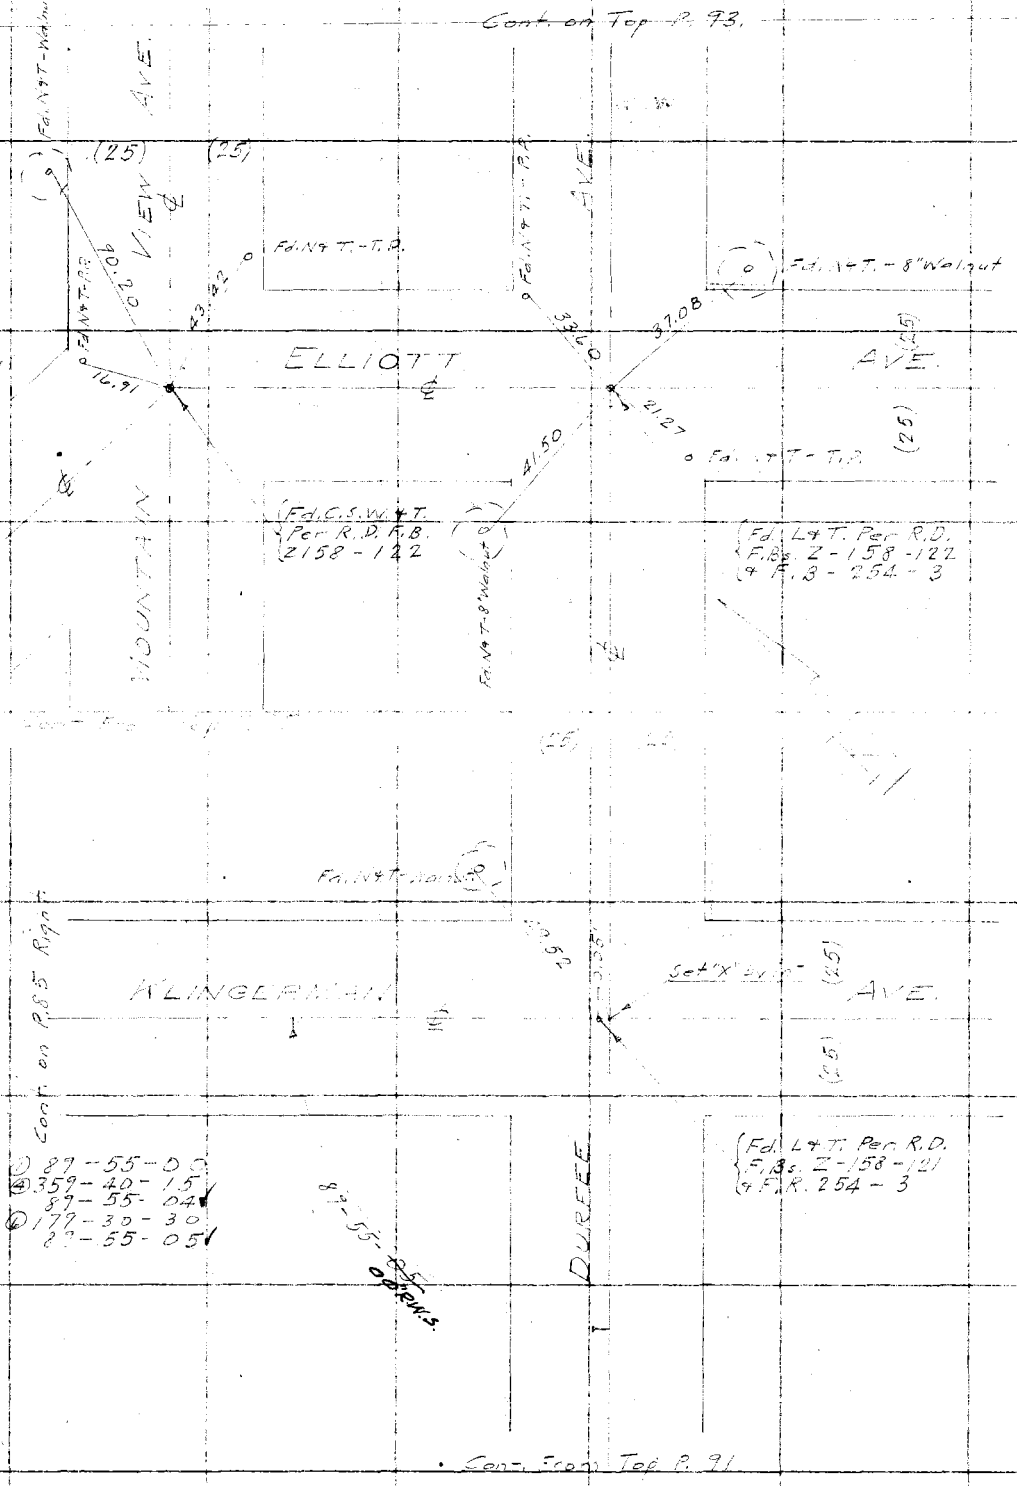

Cont. from Top P. 91

RETURN TO
LOS ANGELES COUNTY SURVEYOR

Do not extend notes this side of this line

Note: ANY ADDITIONS OR CHANGES ON THIS SHEET MUST BE MADE OR CIRCLED IN Red, WITH DATE AND NAME OF PERSON MAKING CHANGE.

Date 7-1-29 Notes by P. T. D. Chief Party Dunlap F.B. 306 Pg. 93

Platted by J.C. Hoyt	W. O. No. 4739 ~~B. O. O.~~ No. 212
Date Aug '29	Location Graves Ave
Map No. C.S. B. 384 Sh 2	Surveyed by P. T. Dunlap
Platting C'k'd by R. W. S.	Date 7-1-29
Date MAR 17 1930	Indexed A. C. Johnson

Notice: ANY ADDITIONS OR CHANGES ON THIS SHEET MUST BE MADE OR CIRCLED IN Red. WITH DATE AND NAME OF PERSON MAKING CHANGE.

Do not extend notes this side of this line

RETURN TO LOS ANGELES COUNTY SURVEYOR

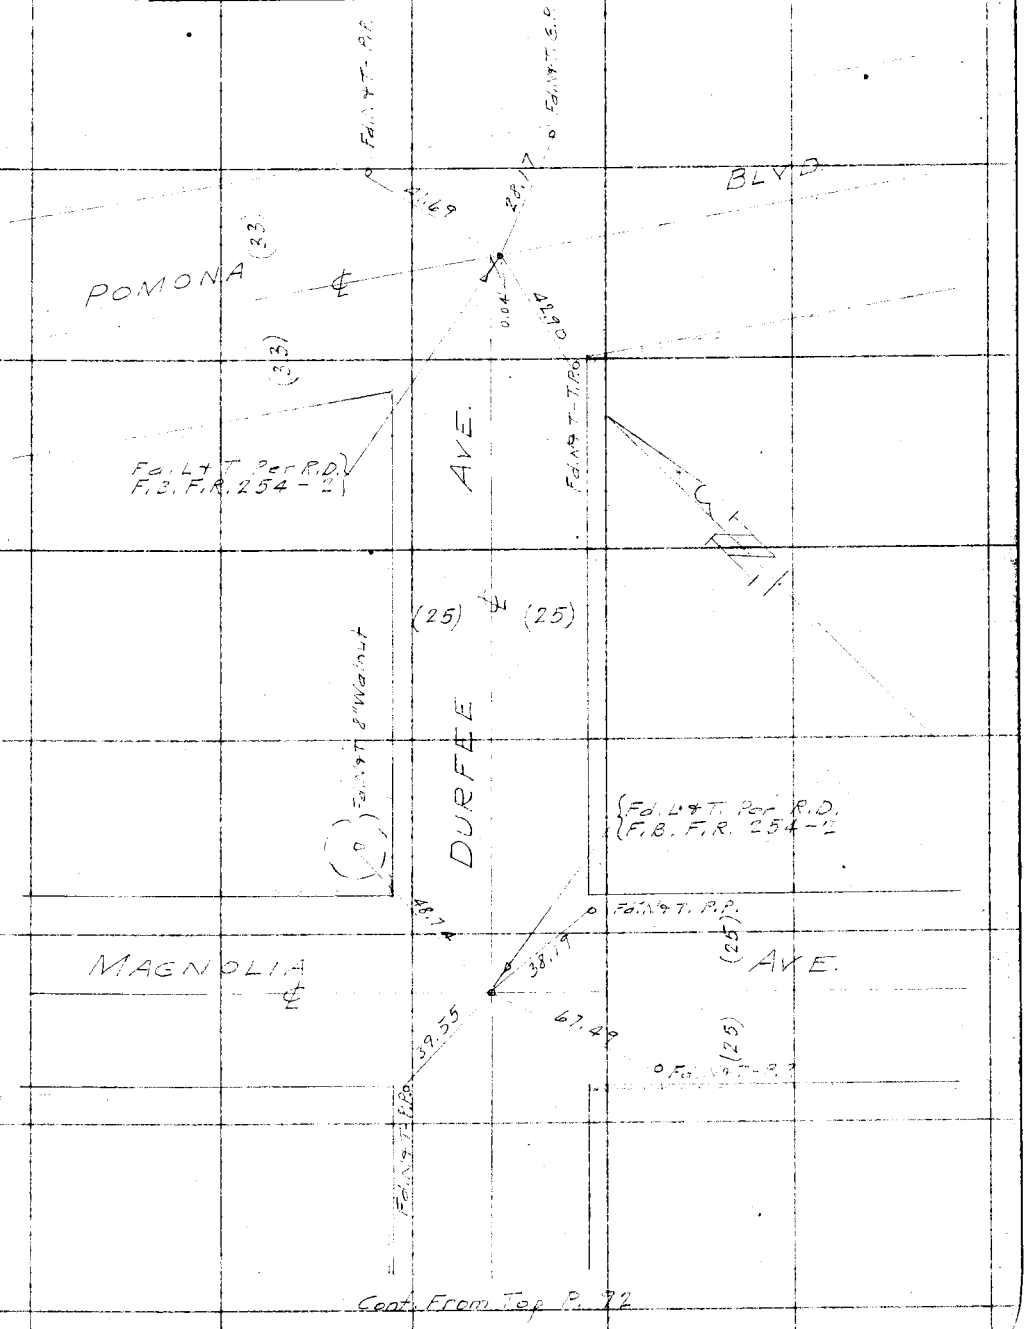

Cont. From Top P. 92

F. B. 306 PG. 94 Dunlap Chief Party Notes by P. T. D. Date 7-9-29

Cont. From P. 91 Right.

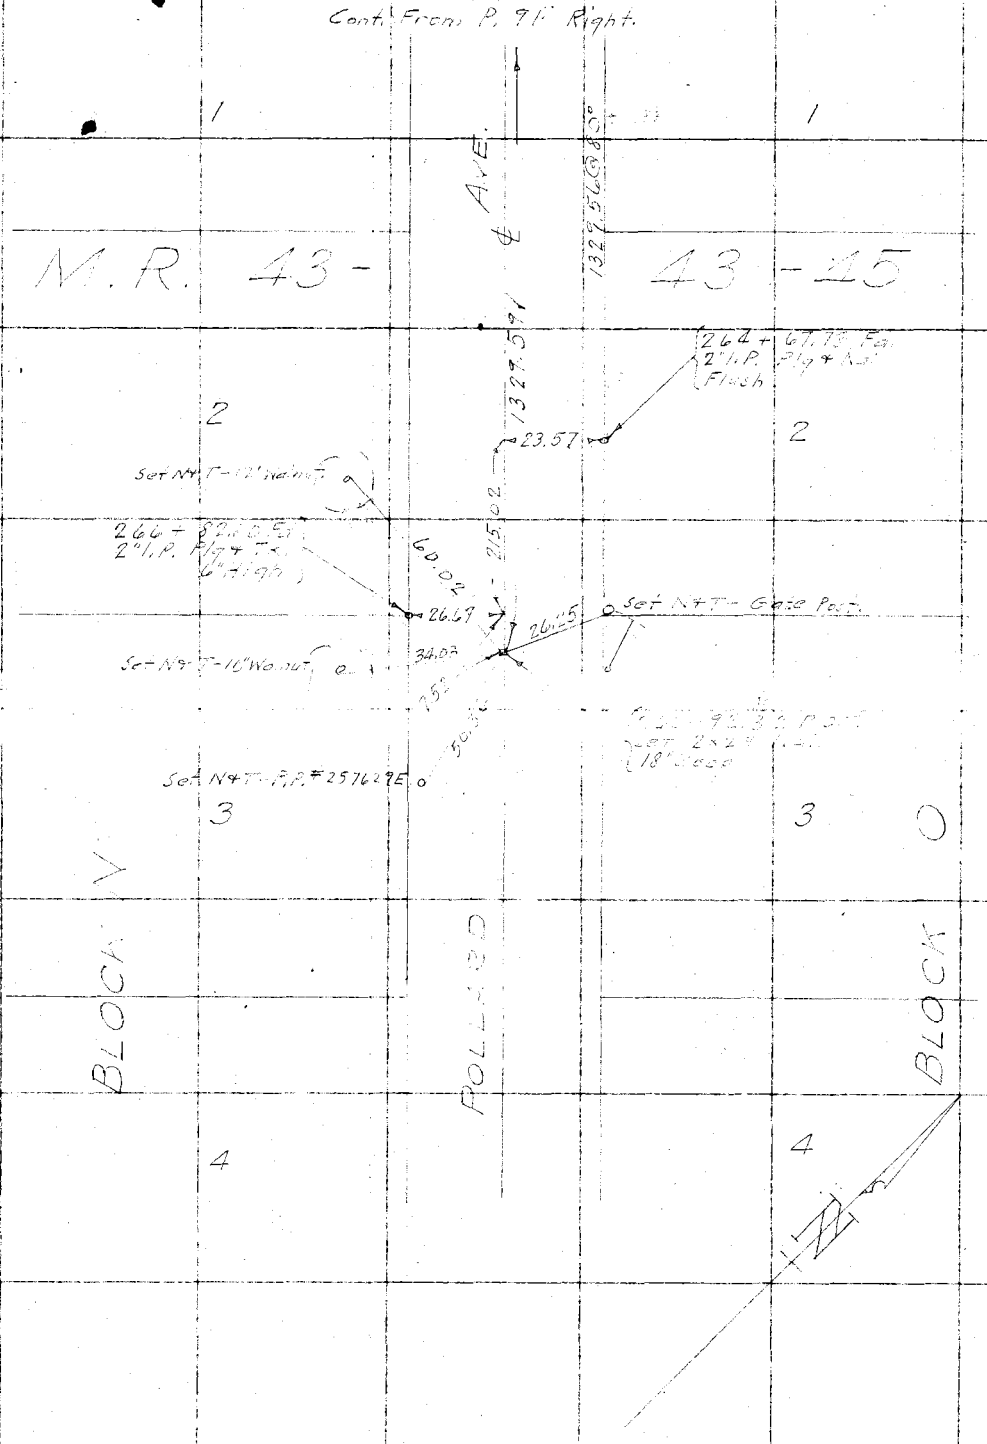

RETURN TO
LOS ANGELES COUNTY SURVEYOR

Do not extend notes this side of this line

Note: ANY ADDITIONS OR CHANGES ON THIS SHEET MUST BE MADE OR CIRCLED IN Red. WITH DATE AND NAME OF PERSON MAKING CHANGE.

Date _____ Notes by _____ Chief Party _____ F.B. 306 PG. 95

Platted by	W. O. No.
Date	Location
Map No.	Surveyed by
Platting C'k'd by	Date
Date	Indexed

Note: ANY ADDITIONS OR CHANGES ON THIS SHEET MUST BE MADE OR CIRCLED IN Red. WITH DATE AND NAME OF PERSON MAKING CHANGE.

Do not extend notes this side of this line

RETURN TO
LOS ANGELES COUNTY SURVEYOR

RETURN TO
LOS ANGELES COUNTY SURVEYOR

Note: ANY ADDITIONS OR CHANGES ON THIS SHEET MUST BE MADE OR CIRCLED IN Red. WITH DATE AND NAME OF PERSON MAKING CHANGE.

Do not extend notes this side of this line

F.B. 306 PG. 96

Chief Party _____ Notes by _____ Date _____

Date _____ Notes by _____ Chief Party _____ F.B. 306 Pg. 97

Platted by J.C. Hoff	W. O. No. 782 D. S. O. No. _____
Date Aug 29	Location 5th Ave
Map No. SS 83 84 S&2	Surveyed by [illegible]
Platting Ck'd by R. W. S.	Date February 7 & 8 1930
Date MAR 17 1930	Indexed A. C. Johnson

5th AVE.

CHANGE IN ℄ SAN GABRIEL BLVD
AND
MUSCATEL AVE.

Together With Property Lines

W.O. 782

S.V. Crum
C.E. Williams
W.L. Smith
C.F. Barrow
C.T. Wheeler

Notes: ANY ADDITIONS OR CHANGES ON THIS SHEET MUST BE MADE OR CIRCLED IN Red. WITH DATE AND NAME OF PERSON MAKING CHANGE.

Do not extend notes this side of this line

RETURN TO
LOS ANGELES COUNTY SURVEYOR

F.B. 326 Pg. 98 Chief Party Notes by C.V.C. Date 2/8/2

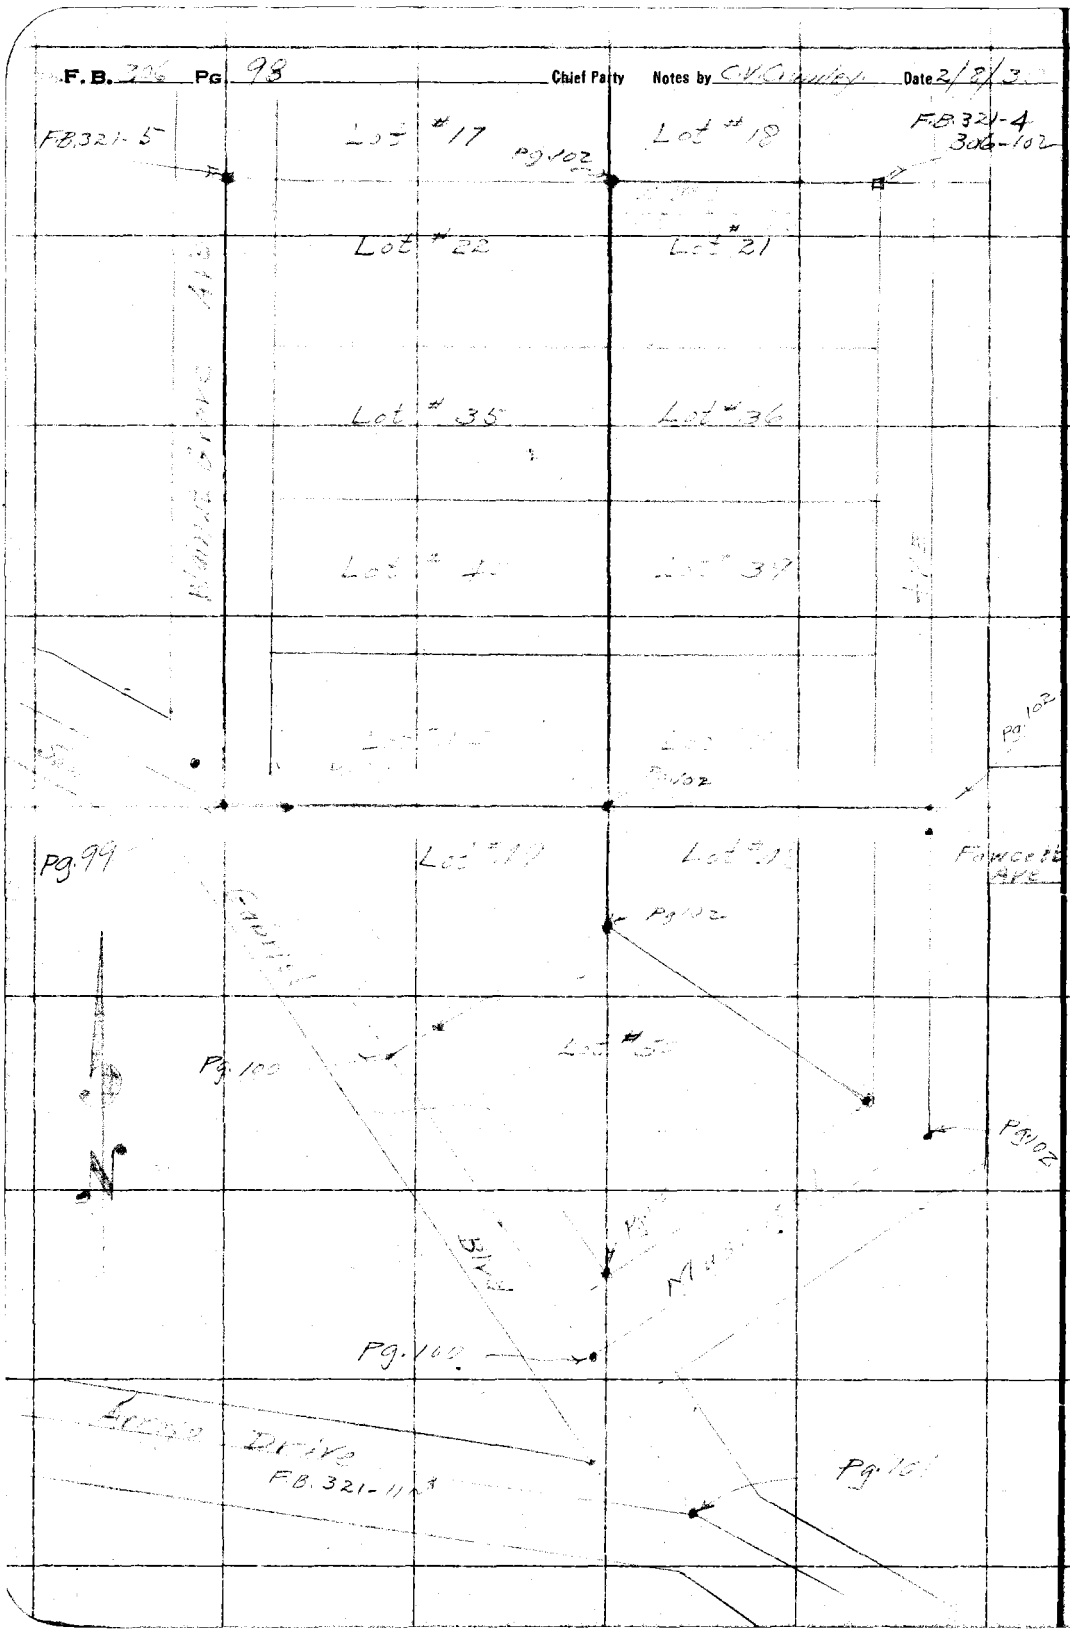

RETURN TO
LOS ANGELES COUNTY SURVEYOR

Do not extend notes this side of this line

Note: ANY ADDITIONS OR CHANGES ON THIS SHEET MUST BE MADE OR CIRCLED IN Red. WITH DATE AND NAME OF PERSON MAKING CHANGE.

Date _____ Notes by _____ Chief Party _____ F.B. 306 Pg. 99

Platted by J.A.White	W. O. No. 782 D. S. O. No.
Date Feb '30	Location 5th Ave
Map No. C.S.B-384-Sht	Surveyed by C.V. Crumley
Platting Ck'd by R. W. S.	Date Feb. 7 1930
Date MAR 17 1930	Indexed A. C. Johnson

To Common Point - 4X4 & Nail Per F.B. 321-5

Notes: ANY ADDITIONS OR CHANGES OR THIS SHEET MUST BE MADE OR CIRCLED IN Red. WITH DATE AND NAME OF PERSON MAKING CHANGE.

Do not extend notes this side of this line

RETURN TO LOS ANGELES COUNTY SURVEYOR

Proposed Walnut Grove Ave

Per F.B. 321-5

Proposed E. San Gabriel

Per F.B. 321-5

Fd. 2X4" on Surface Per F.B. 321-6

147° (Calc.)

Fd. Cor. N.T.

Prop.

617.76

623.61 Prop. Disc.

To 1X1 Pg. 102

N. 85. Prop. Ty Line

Fd. 3/4" I.P.

Fd. Remains of Original 2X2" Bit. Deep. Sta. 17+39.86 as per R.D.F.B. 55-18

Took Ctr. & used For Line See New 2X2 4" Deep

Fd. 3/4" I.P.

Proposed E. Per F.B. 321-6

Adopted E.

Fd. 3/4" I.P.

Stone Pile

Fd. Nail & T. P. #15931 E.

Set X in Side Standpipe 3' up

Ties

Fd. Nail & T. P. #15356 E.

Set Nail & T. P.

Fd. X Top Edge of Standpipe

BLVD

Cont'd To Top Pg 100

F. B. 326 Pg. 100 Chief Party Notes by [illegible] Date 2/7/30

Contd From Bottom Pg. 99

Adopted ℄

Set 2"X2" in W. Cor. of ℄ 12" Deep, Replacing old stake Fd.

356.97

Set S.W. & T. 90° off ℄ +7/100 2"X2"

Set N. & T.

Fd 2" ⌀ Plug + Nail

730.85 (calc.)

38.45

Set N. & T. P.P. #150313 E

Set S.W. & T. By Proportion Betw. S.W. & T. & P.S. at Arroyo Dr. & ℄ 2"X2" at ℄ P.E. Muscatel Ave.

1.35

Muscatel Ave

Fd L. & T. in Curb

Set N. & T. ℄ Cor. Sheet

Rec. distances used in proportioning were taken from Geo. Jones Survey of San Gabriel Blvd. See Bk. Rept. F.B. 357

For ℄ South of Muscatel See F.B. 321-10+11

Contd To Top Pg 101

RETURN TO LOS ANGELES COUNTY SURVEYOR

Do not extend notes this side of this line

Note: ANY ADDITIONS OR CHANGES ON THIS SHEET MUST BE MADE OR CIRCLED IN Red: WITH DATE AND NAME OF PERSON MAKING CHANGE.

Date _____ Notes by _____ Chief Party _____ F.B. 306 Pg. 101

Platted by D.A. White	W. O. No. 782 D. S. O. No. _____
Date Feb '30	Location 5th Ave
Map No. C.S.B-384-Sh1	Surveyed by C.V.C.
Platting Ck'd by R. W. S.	Date February 7 1930
Date MAR 17 1930	Indexed A. C. Coleman

Contd From Bottom Sh. No 1

San Gabriel

Adopted &

Notes: ANY ADDITIONS OR CHANGES ON THIS SHEET MUST BE MADE OR CIRCLED IN Red. WITH DATE AND NAME OF PERSON MAKING CHANGE.

Do not extend notes this side of this line

RETURN TO
LOS ANGELES COUNTY SURVEYOR

RETURN TO
LOS ANGELES COUNTY SURVEYOR

Note: ANY ADDITIONS OR CHANGES ON THIS SHEET MUST BE MADE OR CIRCLED IN **Red.** WITH DATE AND NAME OF PERSON MAKING CHANGE.

Do not extend notes this side of this line

Notes by C.V. Crumley Date 2/7/30

Chief Party

F.B. 306 PG 103

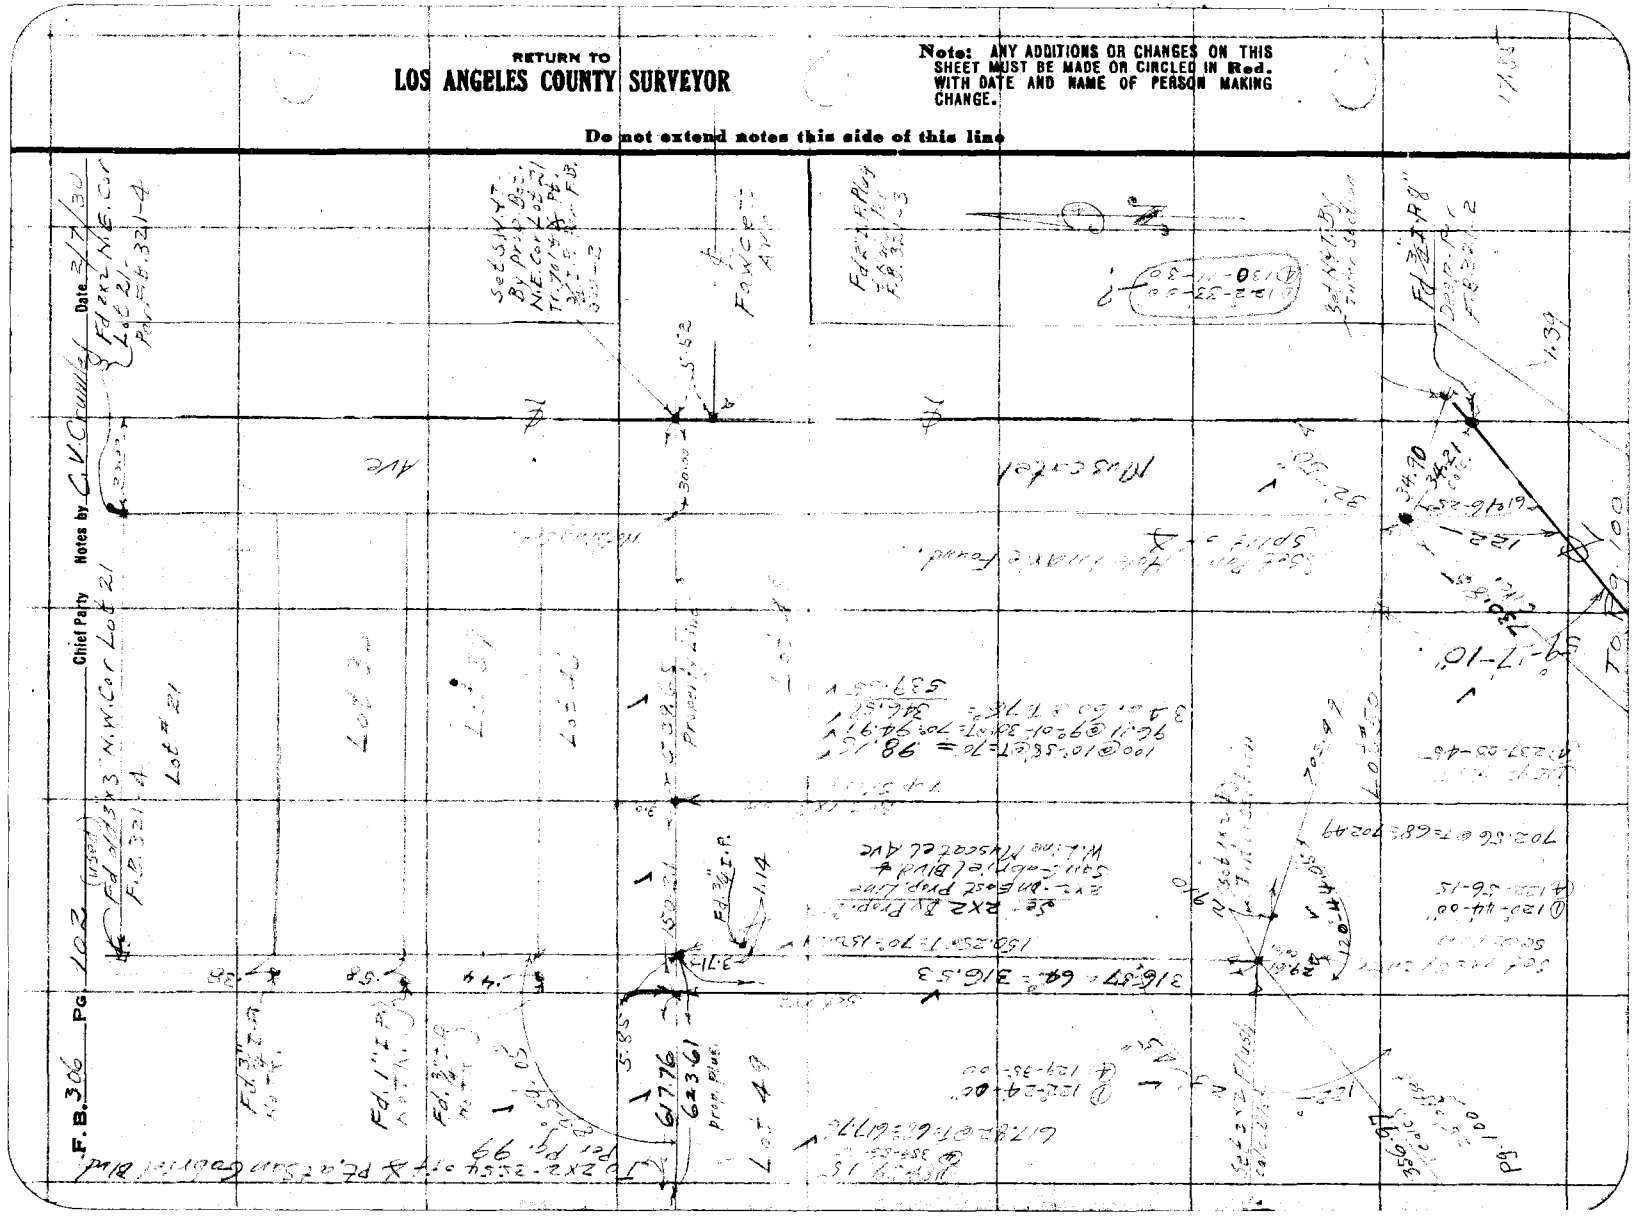

Date _____ Notes by _____ Chief Party _____ F.B. 306 Pg. 103

Platted by D.A. White	W. O. No. _____ D. S. O. No. _____
Date Feb '30	Location _____
Map No. C.S. B-384-Sh1	Surveyed by _____
Platting Ck'd by R. W. S.	Date _____
Date MAR 17 1930	Indexed A. C. Johnson

Notes: ANY ADDITIONS OR CHANGES OF THIS SHEET MUST BE MADE OR CIRCLED IN Red. WITH DATE AND NAME OF PERSON MAKING CHANGE.

Do not extend notes this side of this line

RETURN TO
LOS ANGELES COUNTY SURVEYOR

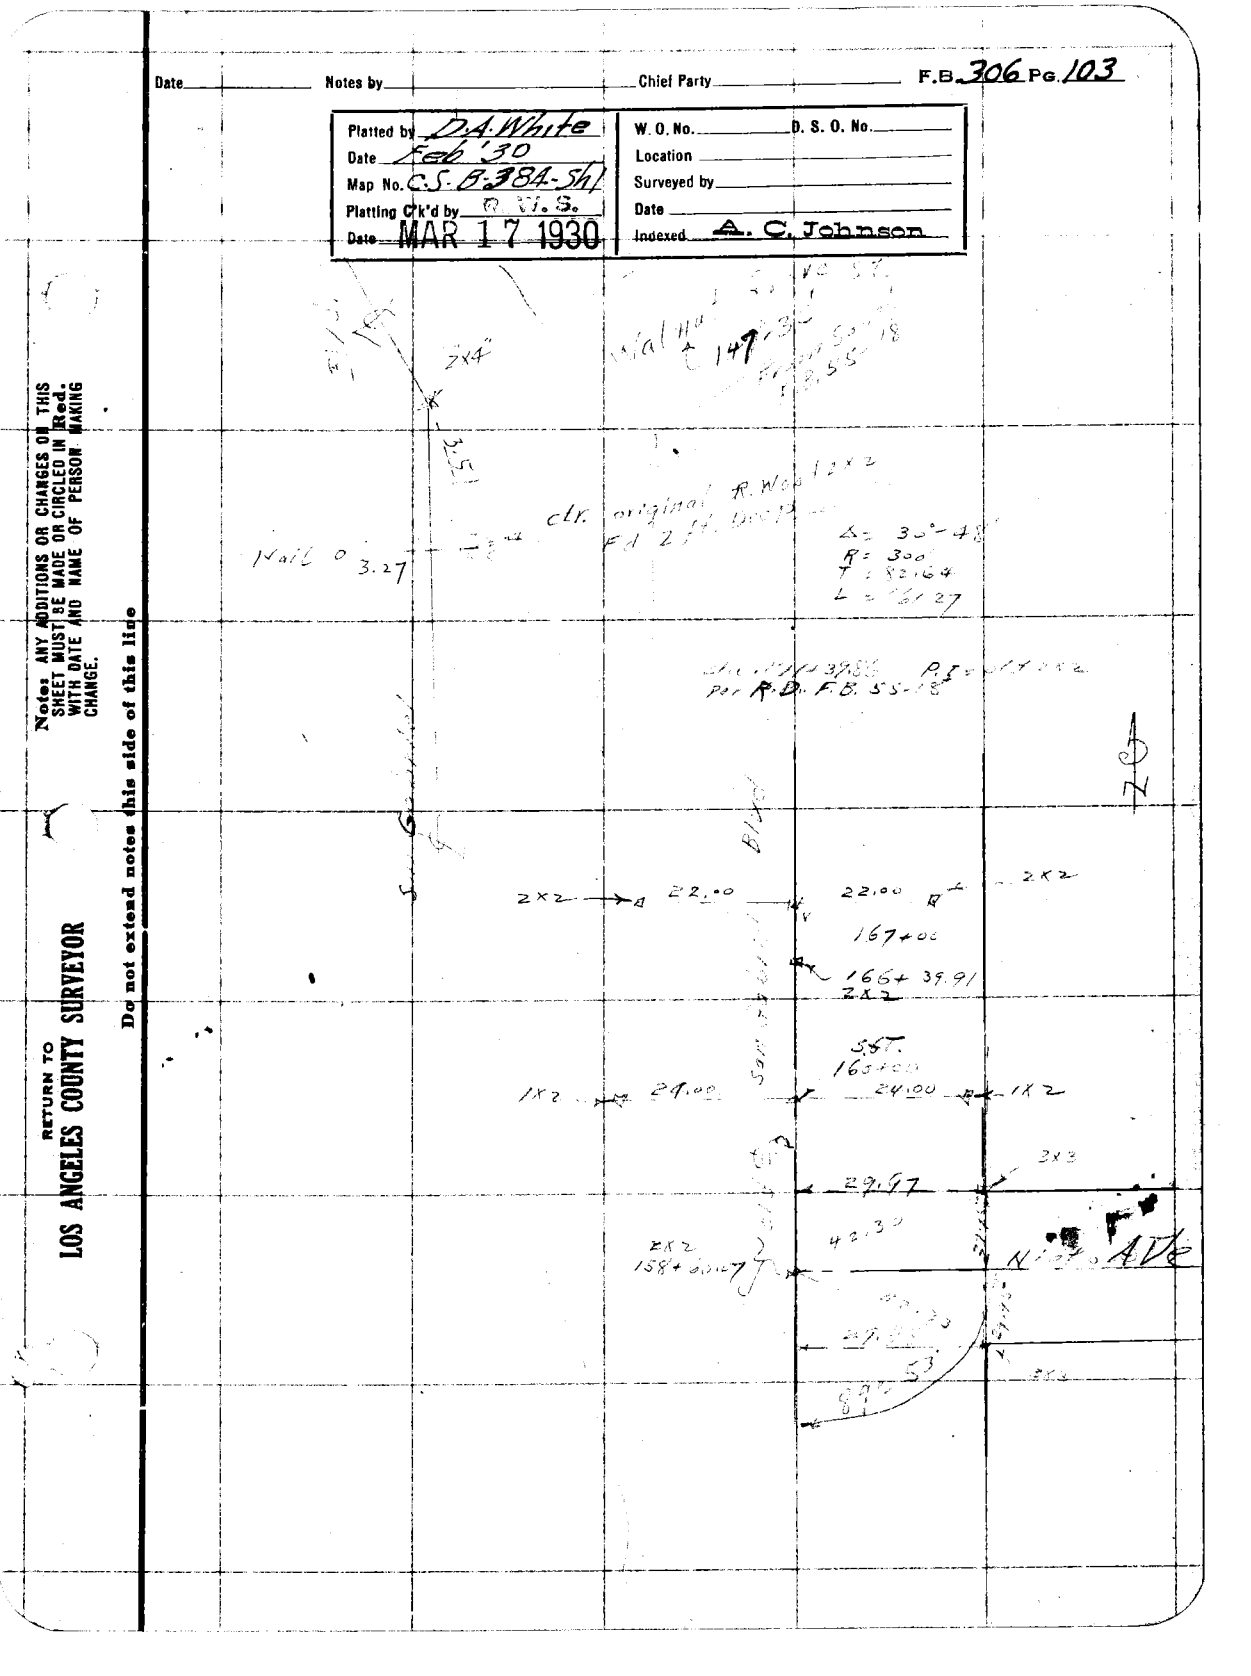

F.B. 306 PG 104 Chief Party Notes by Date

617.76 - T = 68° = 617.76 1x = W.
150.25 - T = 70° = 150.24 1x2 Top Slope = +4.19
150.00 - 10° 58' = 98.17 - T = 10° = 98.16 Elev. Diff.
96.18 - 95-21-30 - T = 94.18 - @T = 72° = 94.91
346.58 - 85° T = 78° = 346.58

346.58
94.91
98.16
150.24
617.89
1307.63-
35.54-
1343.19

346.58
94.91
98.16
539.65-

603.2 Prop.
617.76
5.85-

1307
89-59-45
4 | 359.80
89 59 05

604.97 Rec.
617.76
12.79

RETURN TO
LOS ANGELES COUNTY SURVEYOR

Do not extend notes this side of this line

Note: ANY ADDITIONS OR CHANGES ON THIS SHEET MUST BE MADE OR CIRCLED IN Red. WITH DATE AND NAME OF PERSON MAKING CHANGE.

Date 7-9-30 Notes by Moore Chief Party Moore F.B. 306 Pg. 105

Platted by	W. O. No. 937 Type
Date	U. S. C. No. 028
Map No.	Location Arroyo Ave
Platting C'k'd by	Surveyed by L. D. Moore
Date	Date 7-9-30
	Indexed A. C. Johnson 8-22-30

RIGHT of WAY
STAKES
ON
ARROYO AVE
from
WEST CITY BDY.
to
EAST CITY BDY.
CITY of WEST COVINA

Tape used #028 - Std. @ 68°F.

(Rowland Ave Folder)

RETURN TO LOS ANGELES COUNTY SURVEYOR
DO NOT REMOVE ANY PAGES FROM THIS BOOK
PLEASE NOTE ANY CHANGE ON THIS PAGE WITH DATE OF CHANGE
Please write on this side of white line

F.B. 306 Pg. 106 Moore Chief Party Notes by Moore Date 7-9-30

To bottom Pg. 107

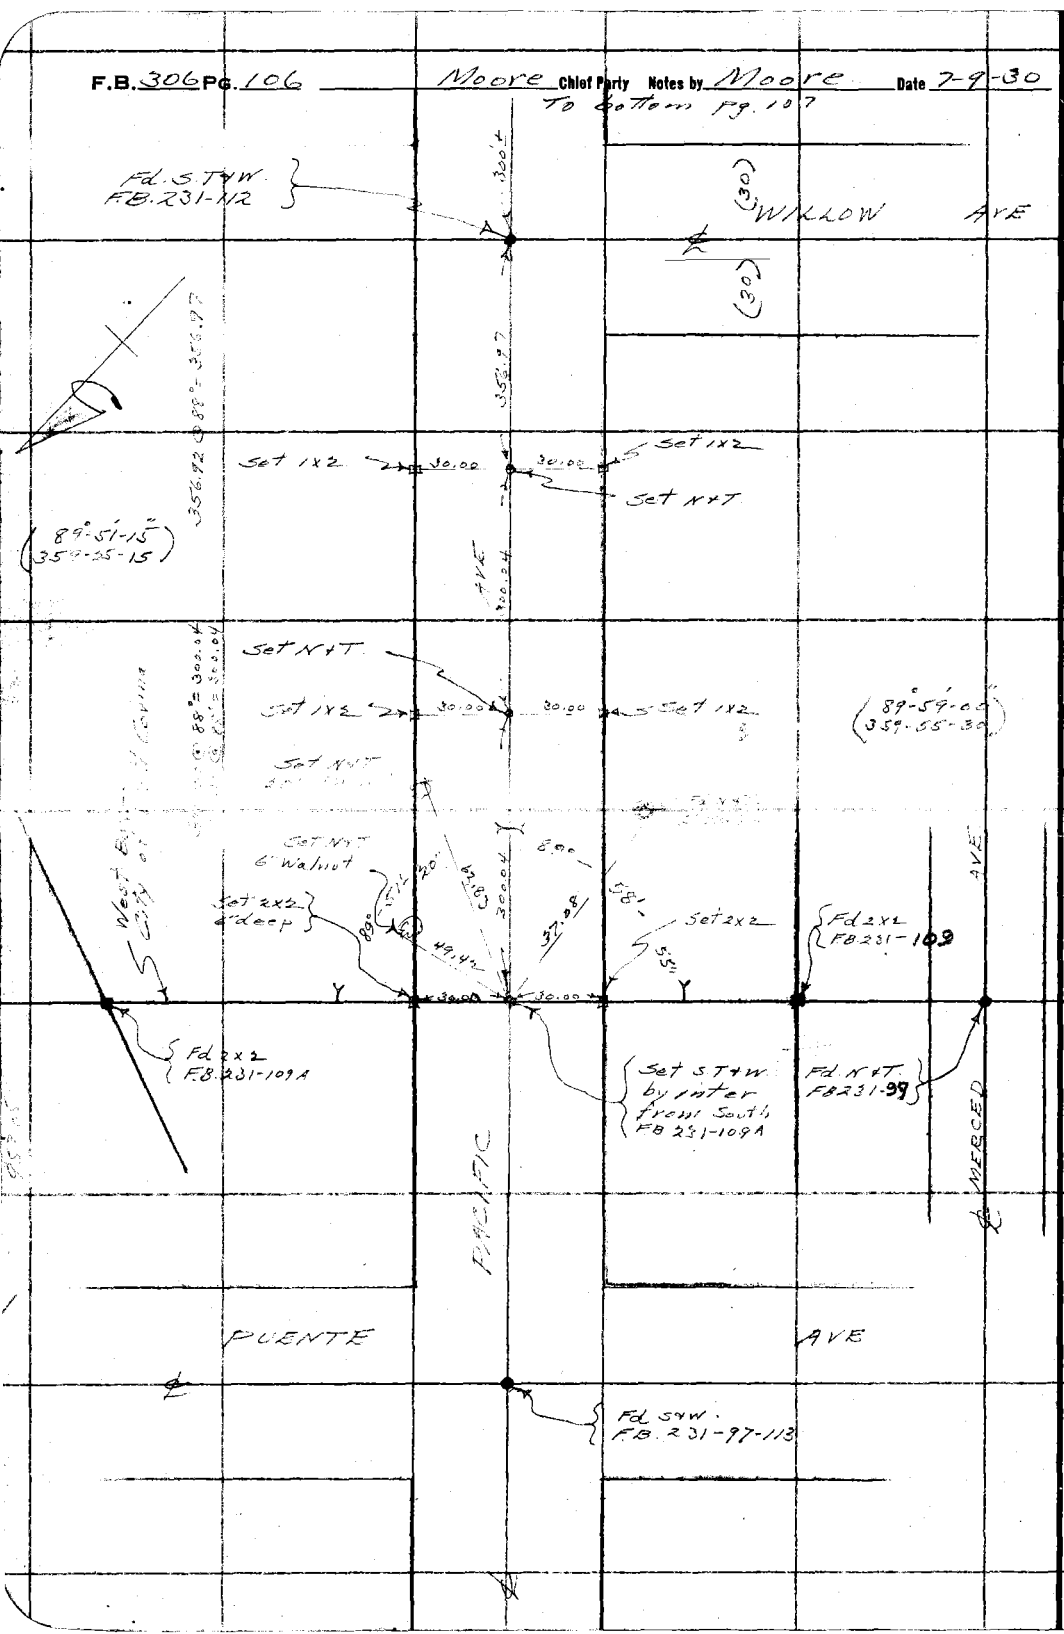

RETURN TO
LOS ANGELES COUNTY SURVEYOR

Do not extend notes this side of this line

Note: ANY ADDITIONS OR CHANGES ON THIS SHEET MUST BE MADE OR CIRCLED IN Red. WITH DATE AND NAME OF PERSON MAKING CHANGE.

Date 7-9-30 Notes by Moore Chief Party Moore F.B 306 PG. 107

Platted by	W. O. No. 937 U. S. G. No.
Date	Location Arroyo Ave
Map No.	Surveyed by L.D. Moore
Platting C'k'd by	Date 7-9-30
Date	Indexed A. C. Johnson

To bottom pg. 108

Set 1X2 — 30.00 — Set 1X2

30.00 — Set 1X2

300'±

1 1/2"

Set 1X2 — 30.00 — Set 1X2

30.00 — Set 1X2

300'±

Set 1X2 — 30.00 — Set 1X2

30.00 — Set 1X2

PACIFIC

LANE of this street See

For survey in

300'±

Set 2X2 on split of angle — 30.01 — 30.01 — Set 2X2 on split of angle

Fd STW. F.B 231-113

Set NAT.

Set 1X2 — 30.00 — 30.00 — Set 1X2

300'±

From top pg. 106

Note: ANY ADDITIONS OR CHANGES ON THIS SHEET MUST BE MADE OR CIRCLED IN Red. WITH DATE AND NAME OF PERSON MAKING CHANGE.

Do not extend notes this side of this line

RETURN TO LOS ANGELES COUNTY SURVEYOR

F.B. 306 Pg. 108 Moore Chief Party Notes by Moore Date 7-9-30

To bottom pg. 109

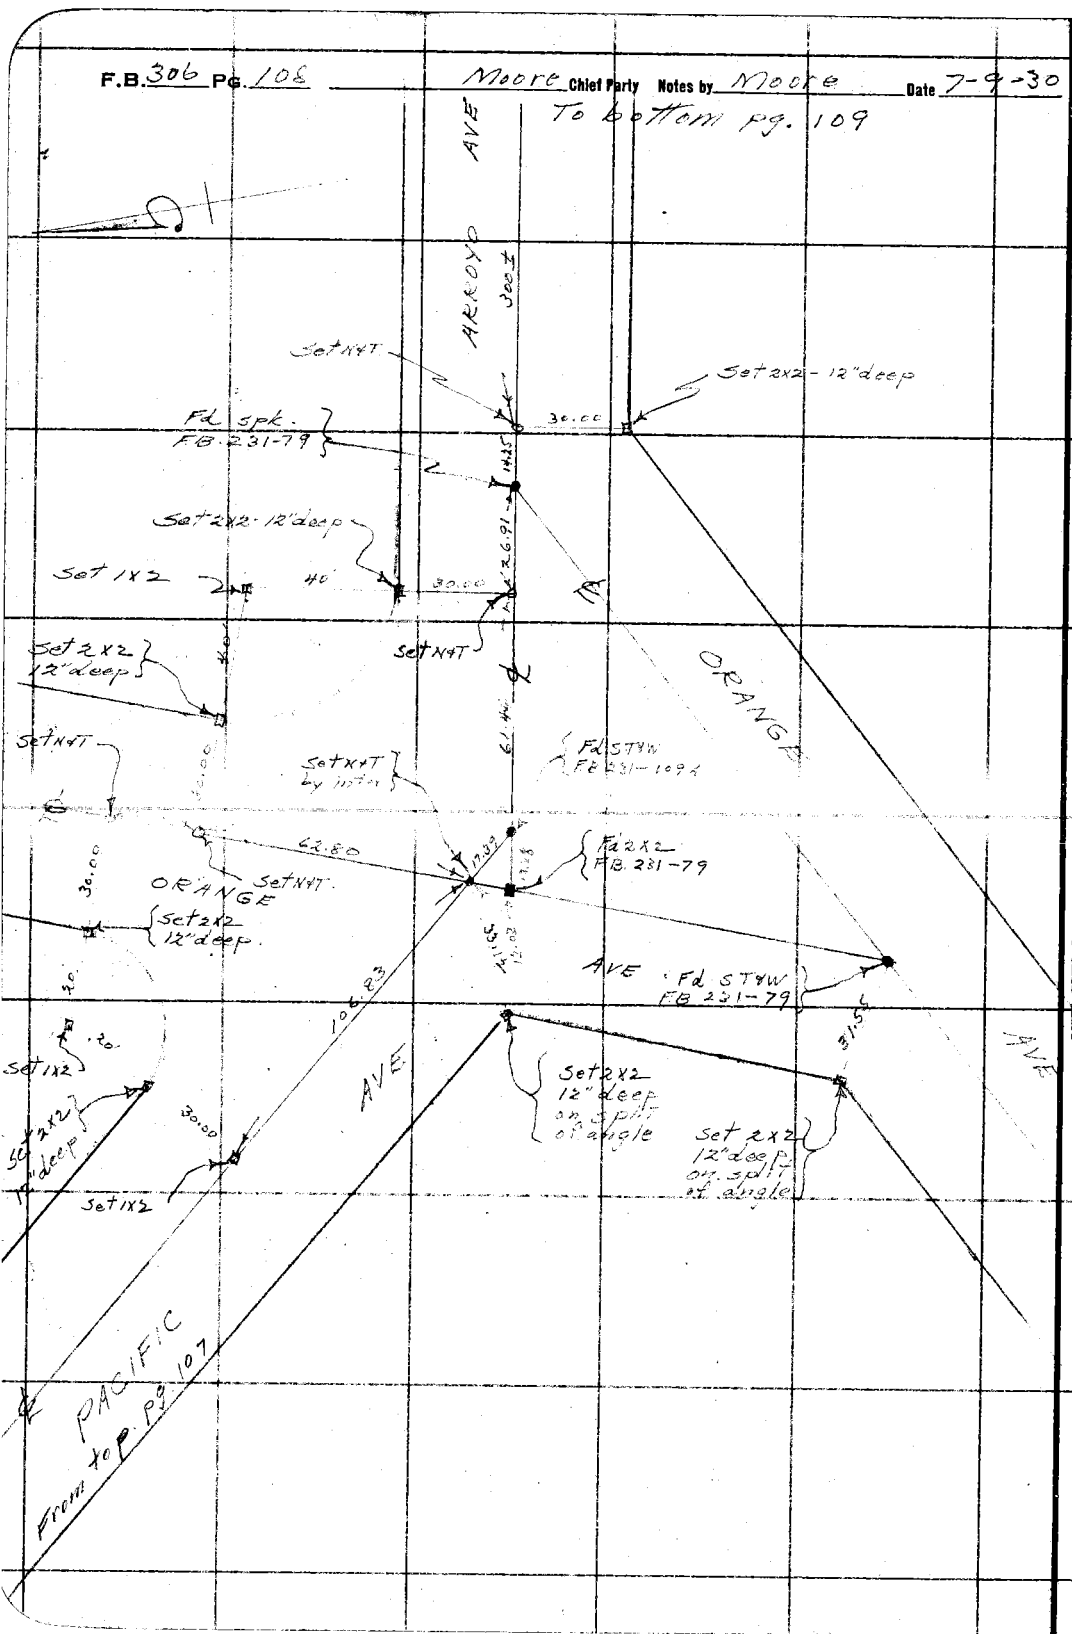

RETURN TO
LOS ANGELES COUNTY SURVEYOR

Do not extend notes this side of this line

Notes: ANY ADDITIONS OR CHANGES ON THIS SHEET MUST BE MADE OR CIRCLED IN Red. WITH DATE AND NAME OF PERSON MAKING CHANGE.

Date 7-10-30 Notes by Moore Chief Party Moore F.B. 306 Pg. 109

Platted by	W. O. No. 937 D. S. O. No.
Date	Location Arroyo Ave
Map No.	Surveyed by [illegible] Moore
Platting C'k'd by	Date 7-10-30
Date	Indexed A. C. Johnson

To La Mesa pg. 110

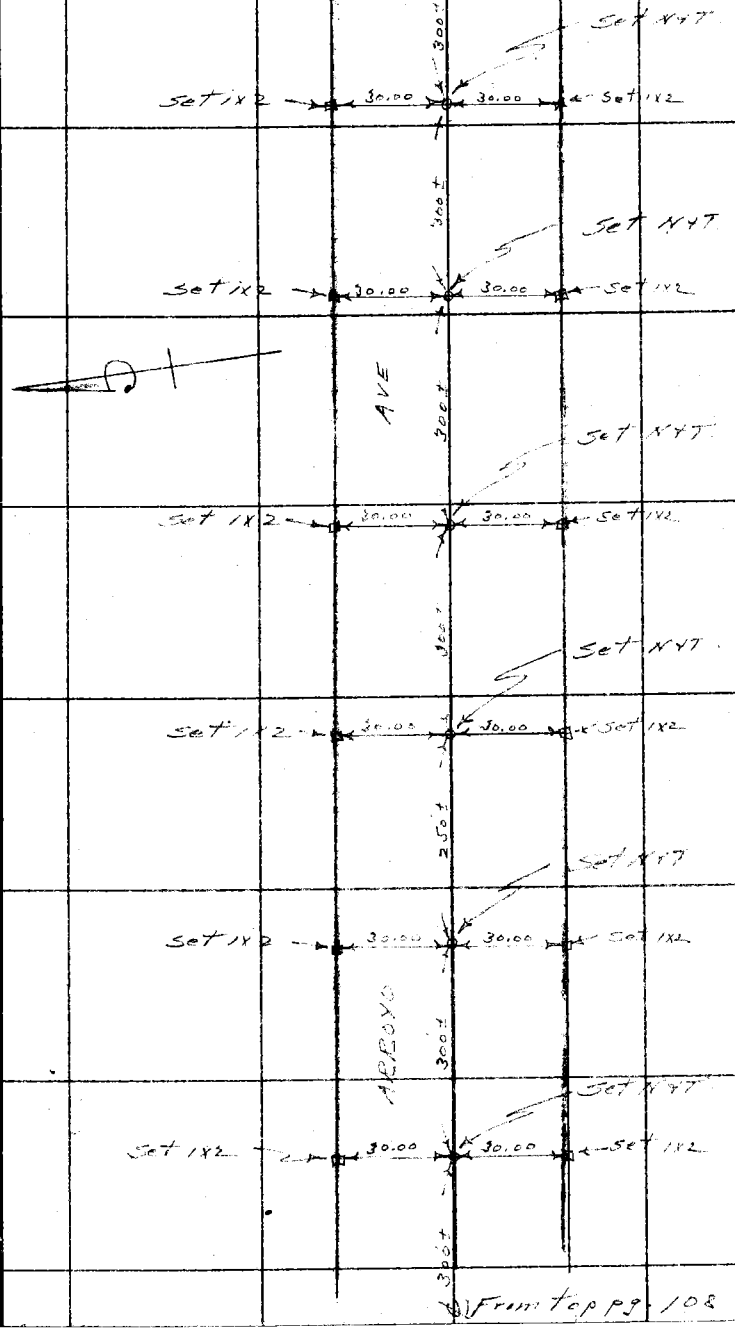

From top pg. 108

Note: ANY ADDITIONS OR CHANGES ON THIS SHEET MUST BE MADE OR CIRCLED IN Red. WITH DATE AND NAME OF PERSON MAKING CHANGE.

Do not extend notes this side of this line

RETURN TO LOS ANGELES COUNTY SURVEYOR

F.B. 306 Pg. 110 Moore Chief Party Notes by Moore Date 7-12-30

To bottom pg. 111

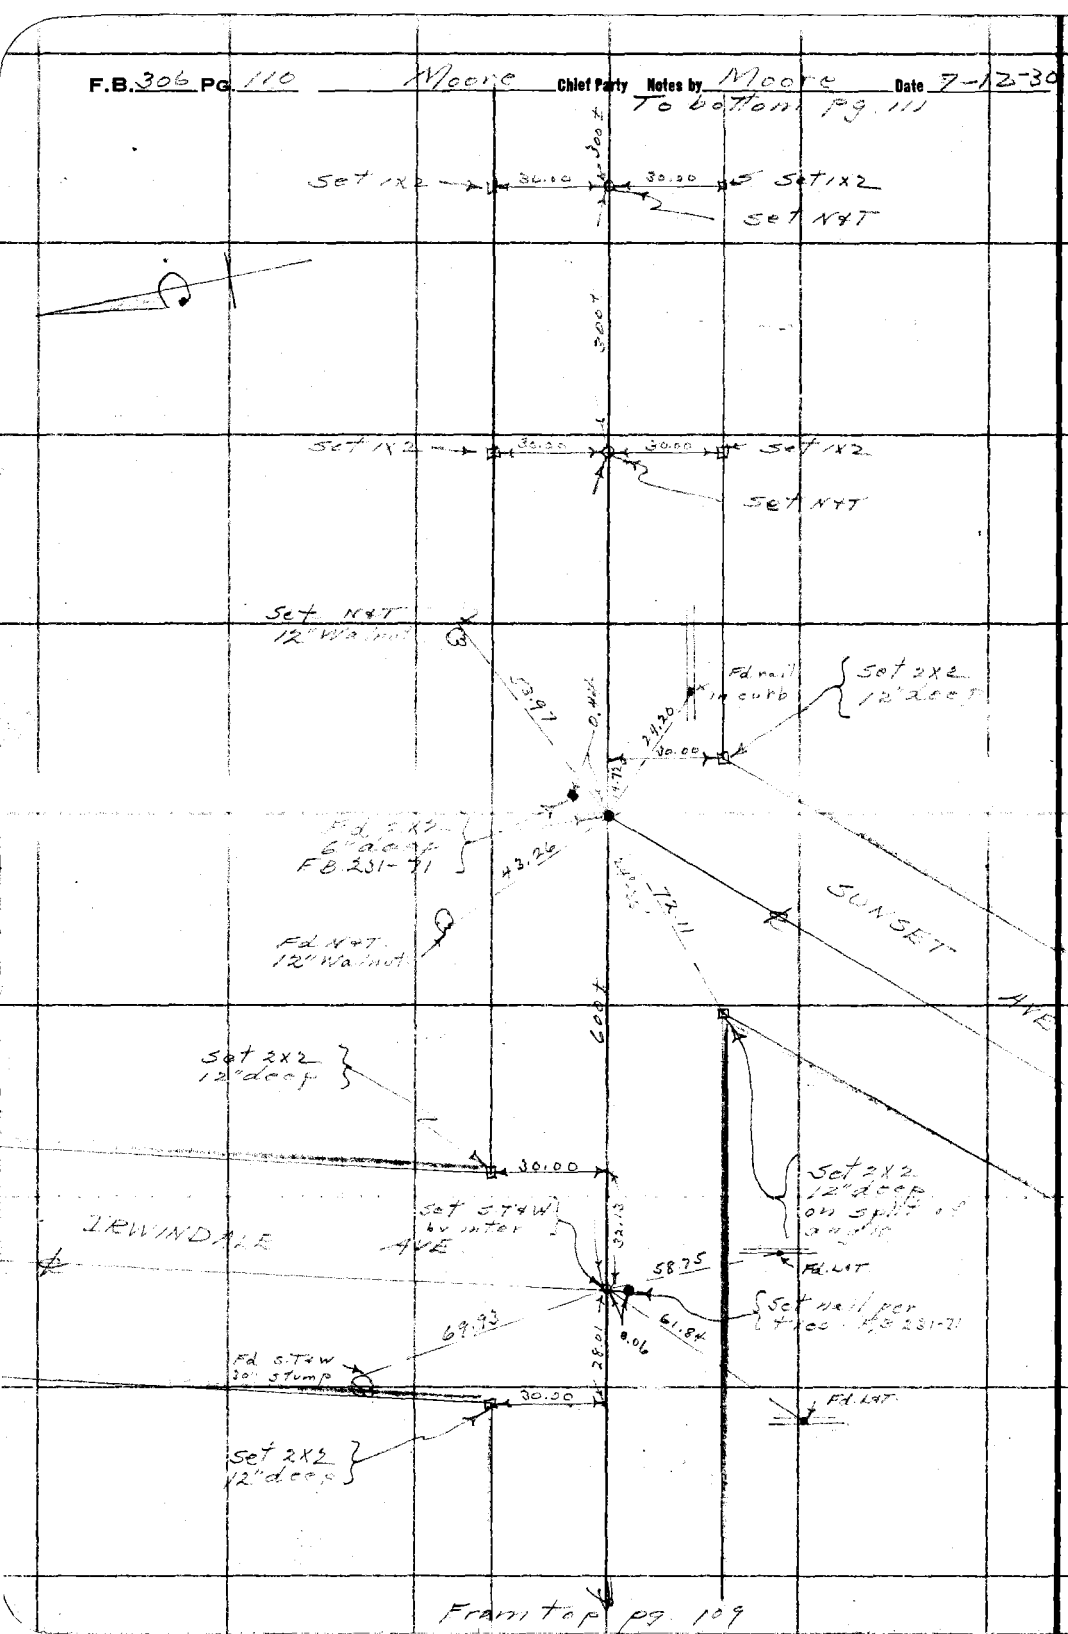

Fram top pg. 109

RETURN TO
LOS ANGELES COUNTY SURVEYOR

Do not extend notes this side of this line

Notes: ANY ADDITIONS OR CHANGES ON THIS SHEET MUST BE MADE OR CIRCLED IN Red. WITH DATE AND NAME OF PERSON MAKING CHANGE.

Date 7-12-30 Notes by Moore Chief Party L D M F.B 306 Pg. 111

Platted by	W. O. No. 937 U. S. O. No.
Date	Location Arroyo Ave
Map No.	Surveyed by L.D Moore
Platting C'k'd by	Date 7-12-30
Date	Indexed A. C Johnson

To bottom pg. 112

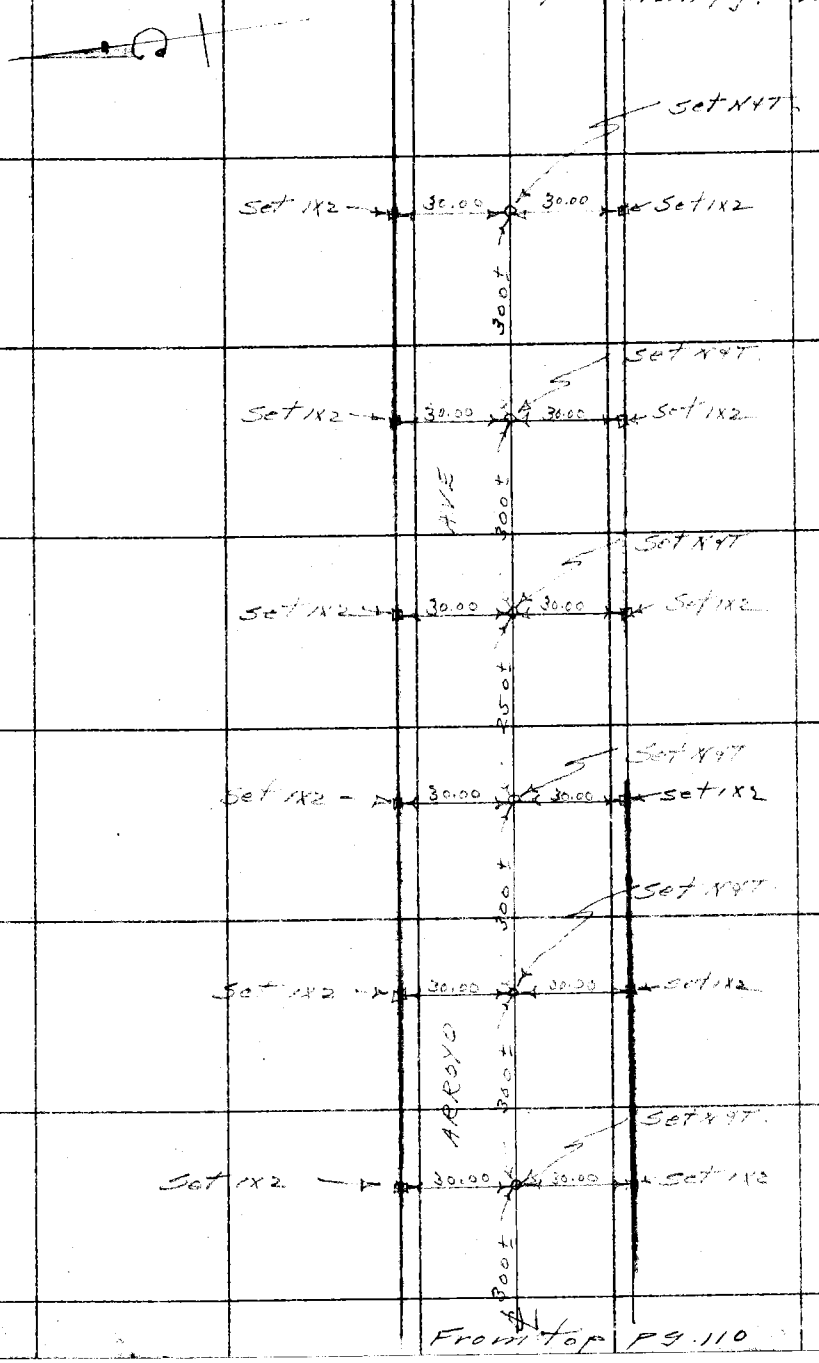

From top pg. 110

Notes: ANY ADDITIONS OR CHANGES ON THIS SHEET MUST BE MADE OR CIRCLED IN Red. WITH DATE AND NAME OF PERSON MAKING CHANGE.

Do not extend notes this side of this line

RETURN TO LOS ANGELES COUNTY SURVEYOR

F.B. 306 Pg. 112 Moore Chief Party Notes by Moore Date 7-16-30

To bottom pg. 113

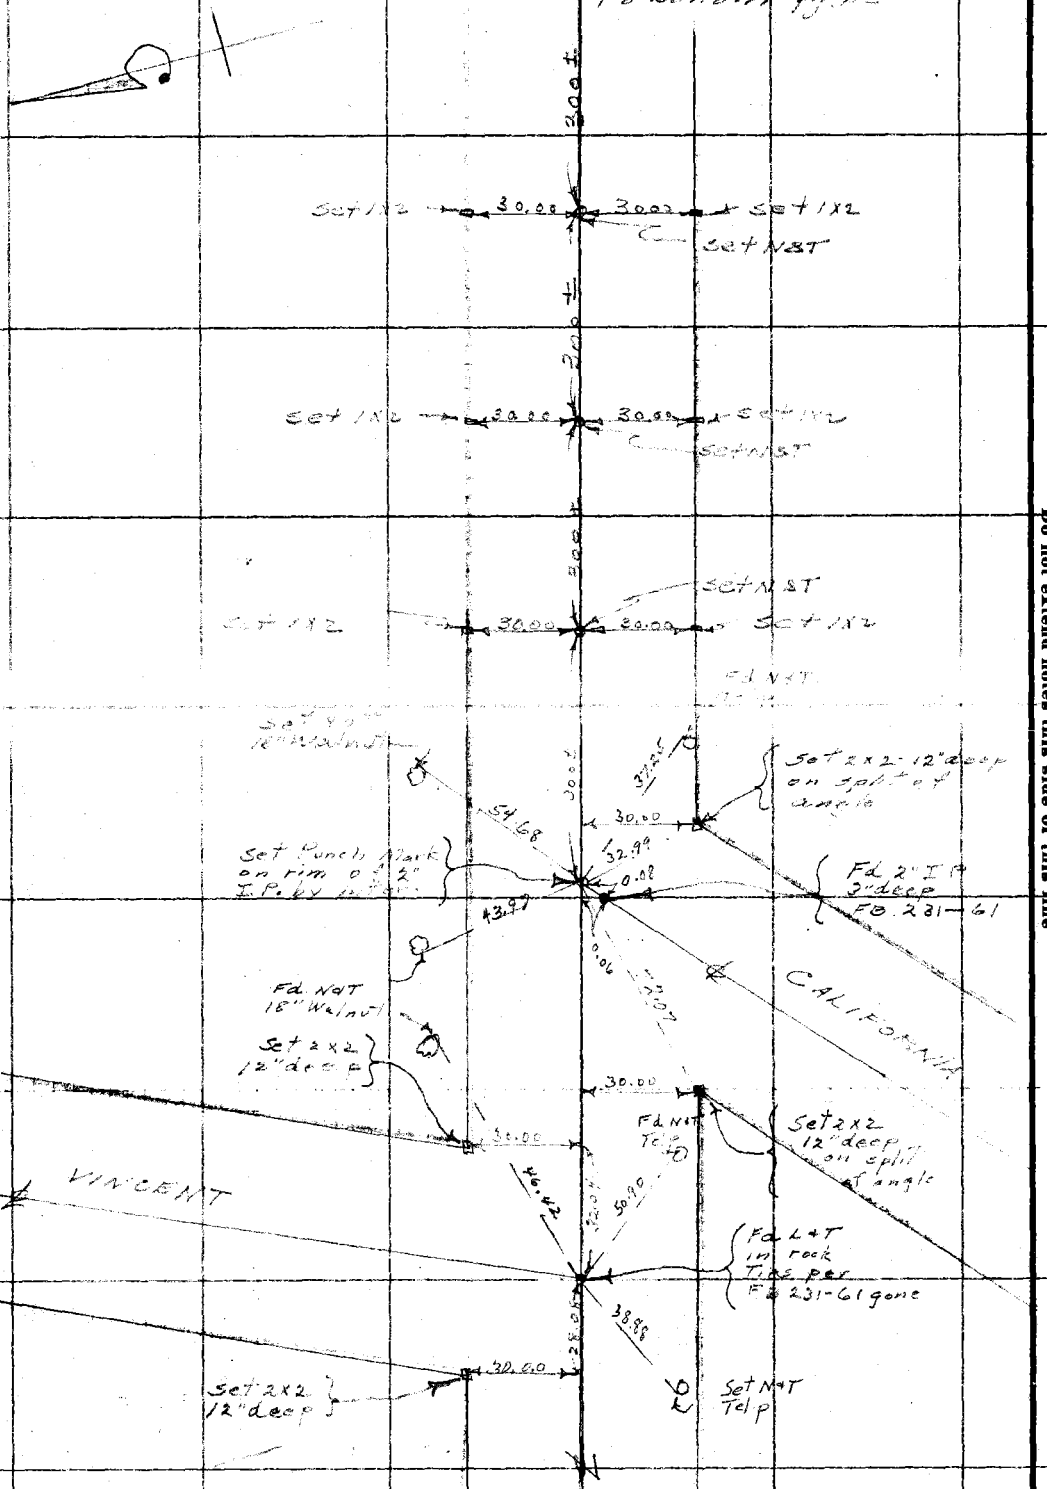

RETURN TO
LOS ANGELES COUNTY SURVEYOR

Do not extend notes this side of this line

Notes: ANY ADDITIONS OR CHANGES ON THIS SHEET MUST BE MADE OR CIRCLED IN Red. WITH DATE AND NAME OF PERSON MAKING CHANGE.

Date 7/22/30 Notes by Blanchard Chief Party Blanchard F.B. 306 PG. 113

Platted by	W. O. No. 937 U. S. G. No.
Date	Location Arroyo Ave
Map No.	Surveyed by E.H. Blanchard
Platting C'k'd by	Date 7/22/30
Date	Indexed A. C. Johnson

RETURN TO
LOS ANGELES COUNTY SURVEYOR

Notes: ANY ADDITIONS OR CHANGES ON THIS SHEET MUST BE MADE OR CIRCLED IN Red. WITH DATE AND NAME OF PERSON MAKING CHANGE.

Do not extend notes this side of this line

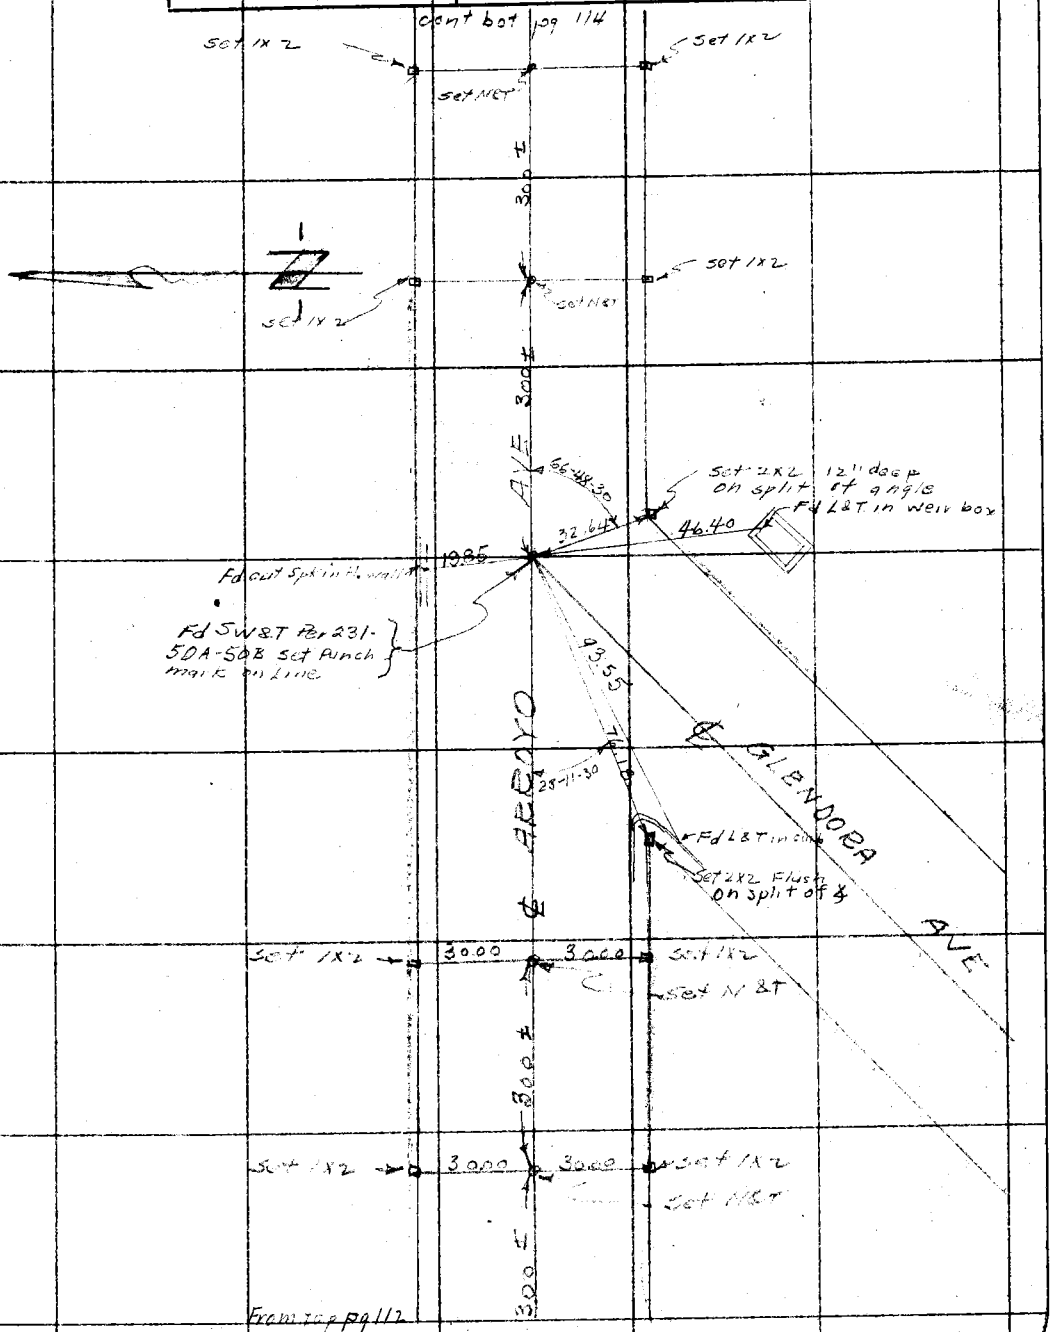

F.B. 306 PG. 114 Blanchard Chief Party Notes by FHB Date 7/25/30

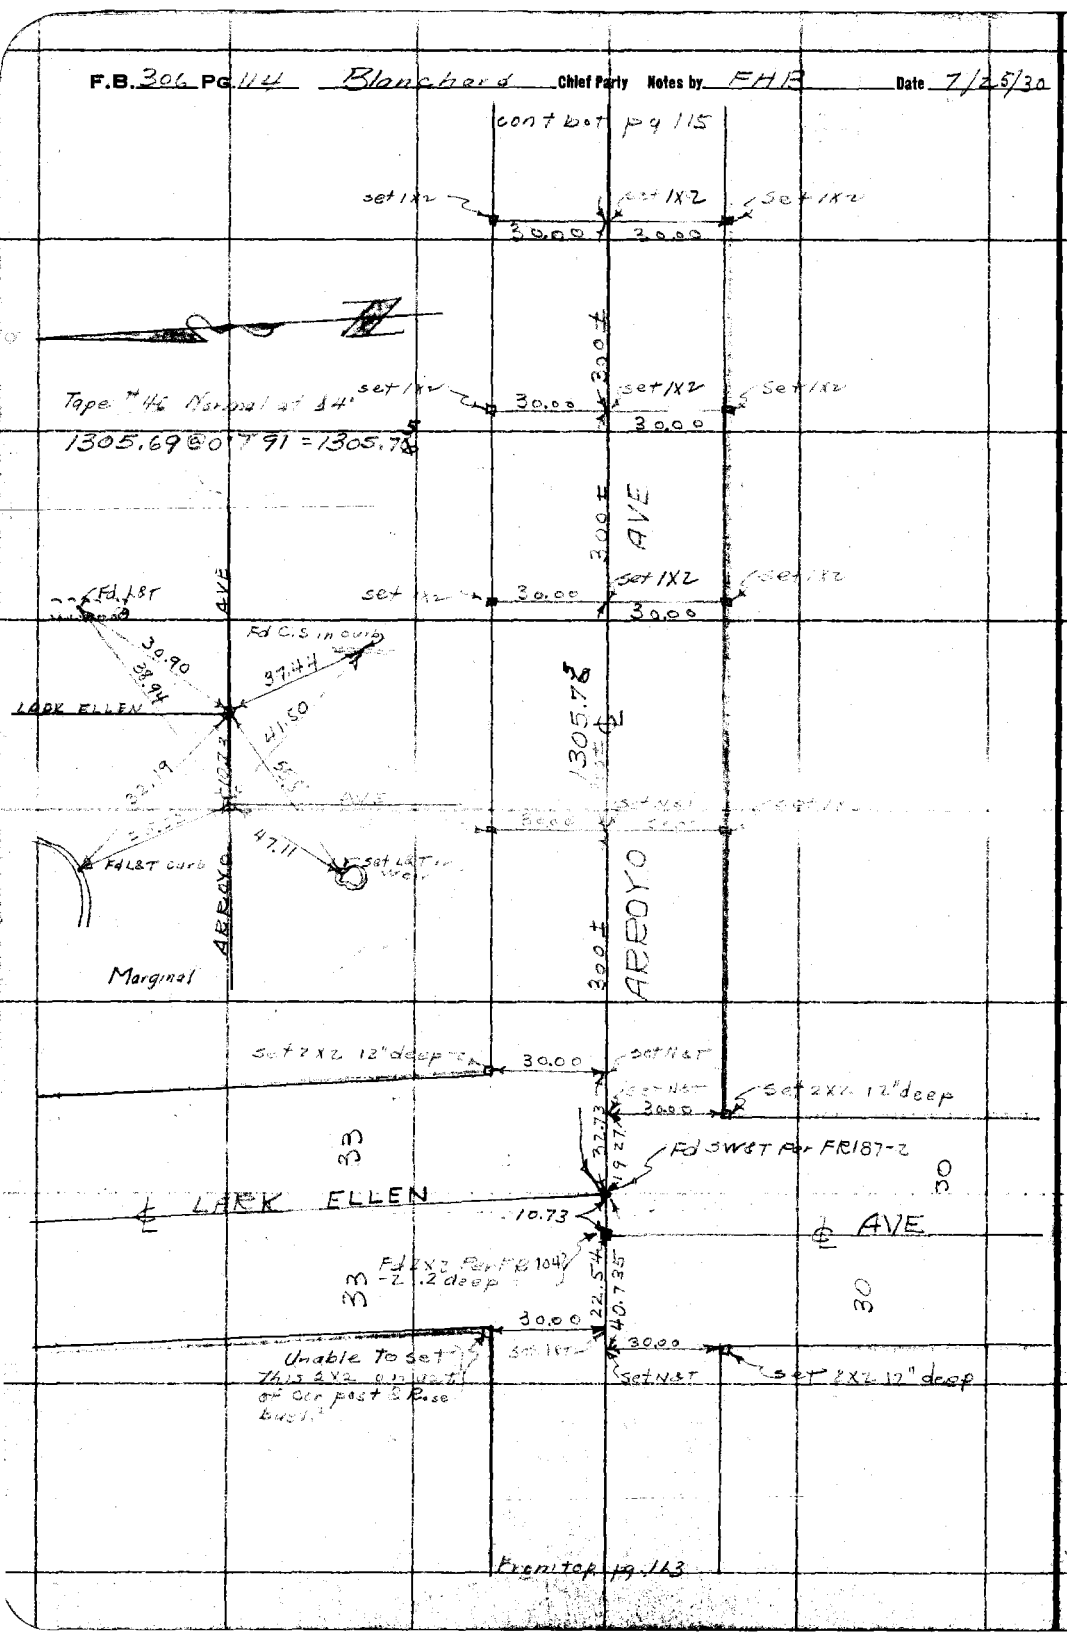

RETURN TO
LOS ANGELES COUNTY SURVEYOR

Do not extend notes this side of this line

Note: ANY ADDITIONS OR CHANGES ON THIS SHEET MUST BE MADE OR CIRCLED IN Red. WITH DATE AND NAME OF PERSON MAKING CHANGE.

Date 7/25/30 Notes by F.H.B. Chief Party Blanchard F.B. 306 PG. 115

Platted by	W. O. No. 937 D. S. O. No.
Date	Location Arroyo Seco
Map No.	Surveyed by F.H. Blanchard
Platting c'k'd by	Date 7/25/30
Date	Indexed R. C. Johnson

To bot pg 116

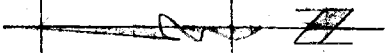

set 1x2

3.00 30.00

set 1x2

S.T 1x2 T.L

30.00 30.00

300.0± E.

set 1x2

S.T 1x2 T.L

30.00 30.00

300.0± C.L.

set 1x2

30.00 30.00

300.0± E.

Fd 6X6 conc post with 1" I.P. in center, this post is 6" above the ground and is loose

30.86

4.20

set 1x2

From Top pg 114

Notes ANY ADDITIONS OR CHANGES ON THIS SHEET MUST BE MADE OR CIRCLED IN Red. WITH DATE AND NAME OF PERSON MAKING CHANGE.

Do not extend notes this side of this line

RETURN TO LOS ANGELES COUNTY SURVEYOR

F.B. 306 Pg 116 Blanchard Chief Party Notes by Blanchard Date 7/26/30

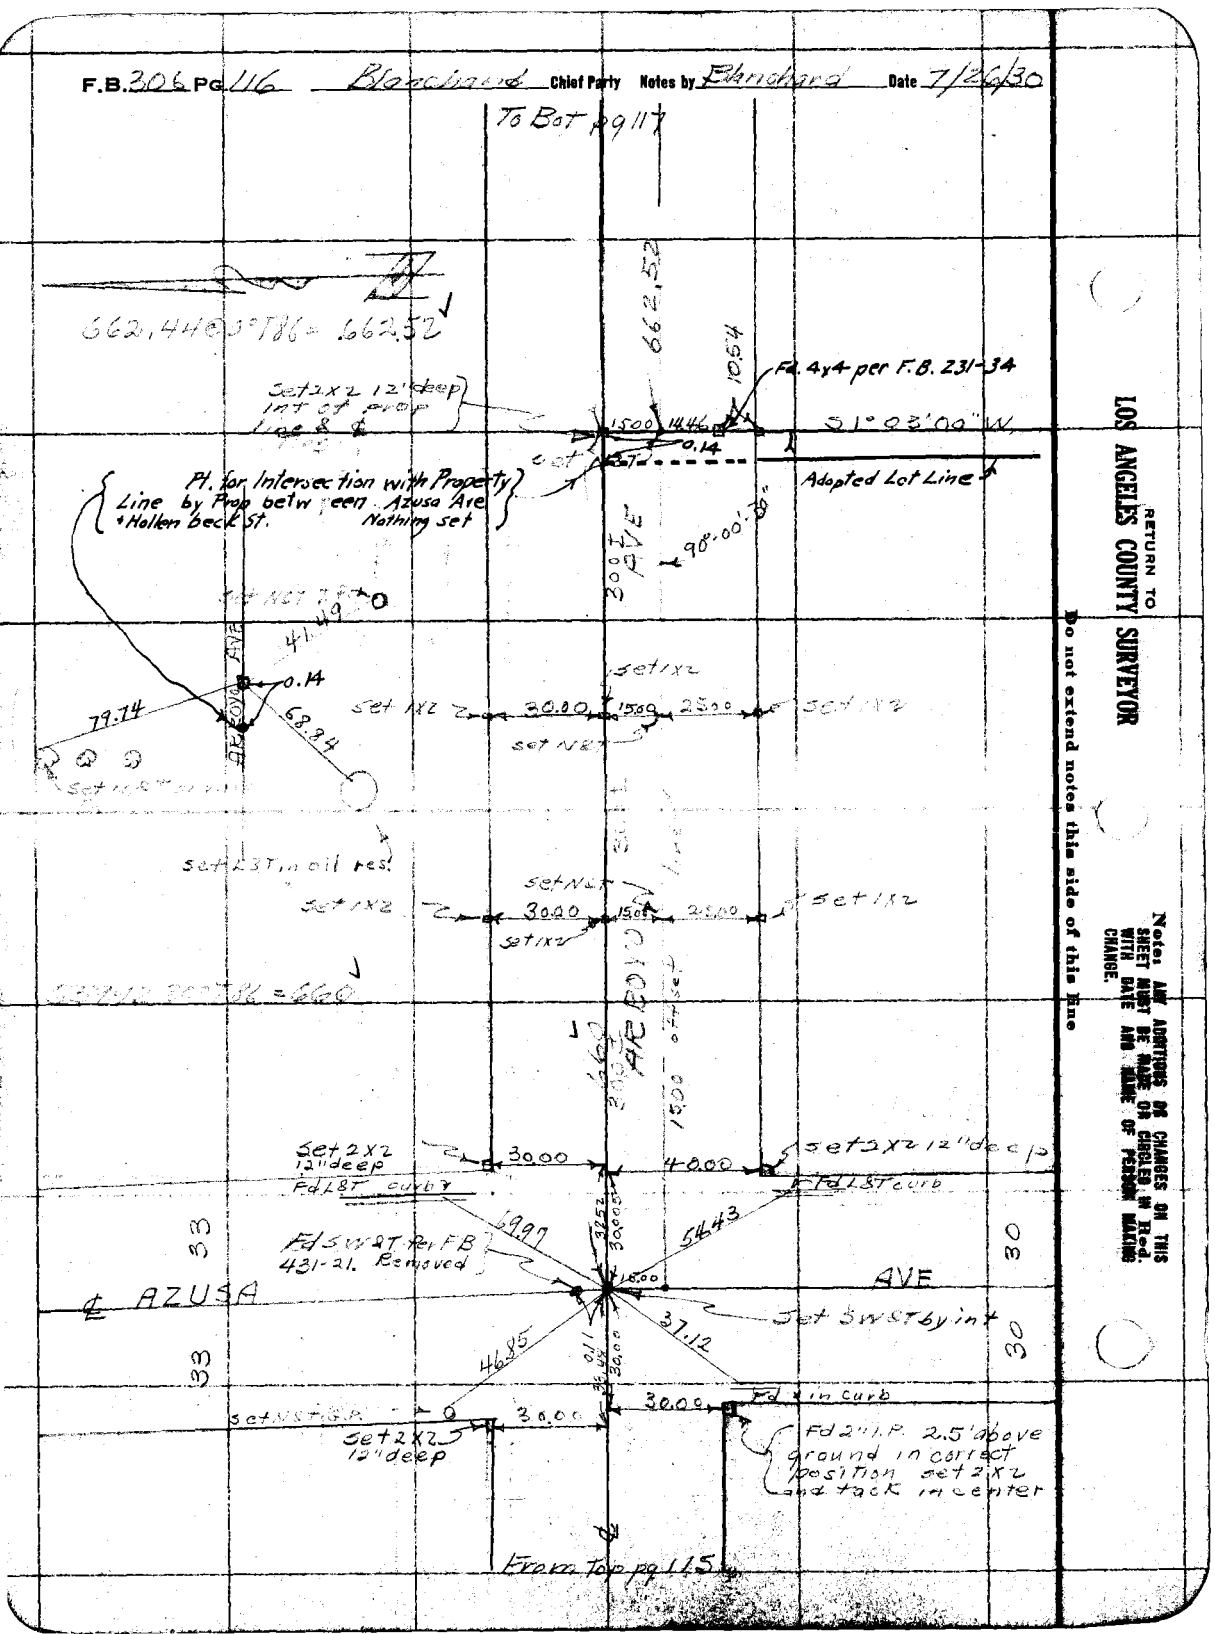

RETURN TO LOS ANGELES COUNTY SURVEYOR

Do not extend notes this side of this line

Note: ANY ADDITIONS OR CHANGES ON THIS SHEET MUST BE MADE OR CHECKED IN Red. WITH DATE AND NAME OF PERSON MAKING CHANGE.

Date 7/26/30 Notes by FHB Chief Party Blanchard F.B. 306 Pg 117

Platted by	W. O. No. 937 D. S. O. No.
Date	Location ARROYO AVE
Map No.	Surveyed by FH Blanchard
Platting C'k'd by	Date 7/26/30
Date	Indexed A. C. Johnson

Notes: ANY INFORMATION OR CHANGES ON THIS SHEET MUST BE MADE OR CIRCLED IN Red. WITH DATE AND NAME OF PERSON MAKING CHANGE.

Do not extend notes this side of this line

RETURN TO LOS ANGELES COUNTY SURVEYOR

Set N&T

HOLLENBECK AVE

1500 ft

Fd Granite rock with hole per FB 231-29

90°-59'-00
3°-52'-30
1346.50 @ 00 T 86 = 1346.66

58'-00"

1346.66

set 2X2 12" deep on line between 2" I.Ps

90°

AZUSA AVE

Fd 2" I.P. Plug & tack Flush S.E. cor. Lot 6 Per Phillips tract

EAST BOUNDRY OF PHILLIPS TRACT

Fd 2" I.P. Plug & tack N.E. Cor Lot 6 Per Phillips Tr.

30.01

Set N&T

2.14

Set N&T

280

40.00

WEST COVINA

set 2X2 12" deep by proportion between AZUSA & HOLLENBECK AVES

Set 1X2

30.00

15.00

Set N&T

25.00

Set 1X2

Set 1X2

ARROYO

642.52 offset

300

Set 1X2

30.00

15.00

Set N&T

25.00

Set 1X2

Set 1X2

1500

From tape pg 116

F.B. 306 Pg. 118 FH Blanchard Chief Party Notes by Blanchard Date 8/13/30

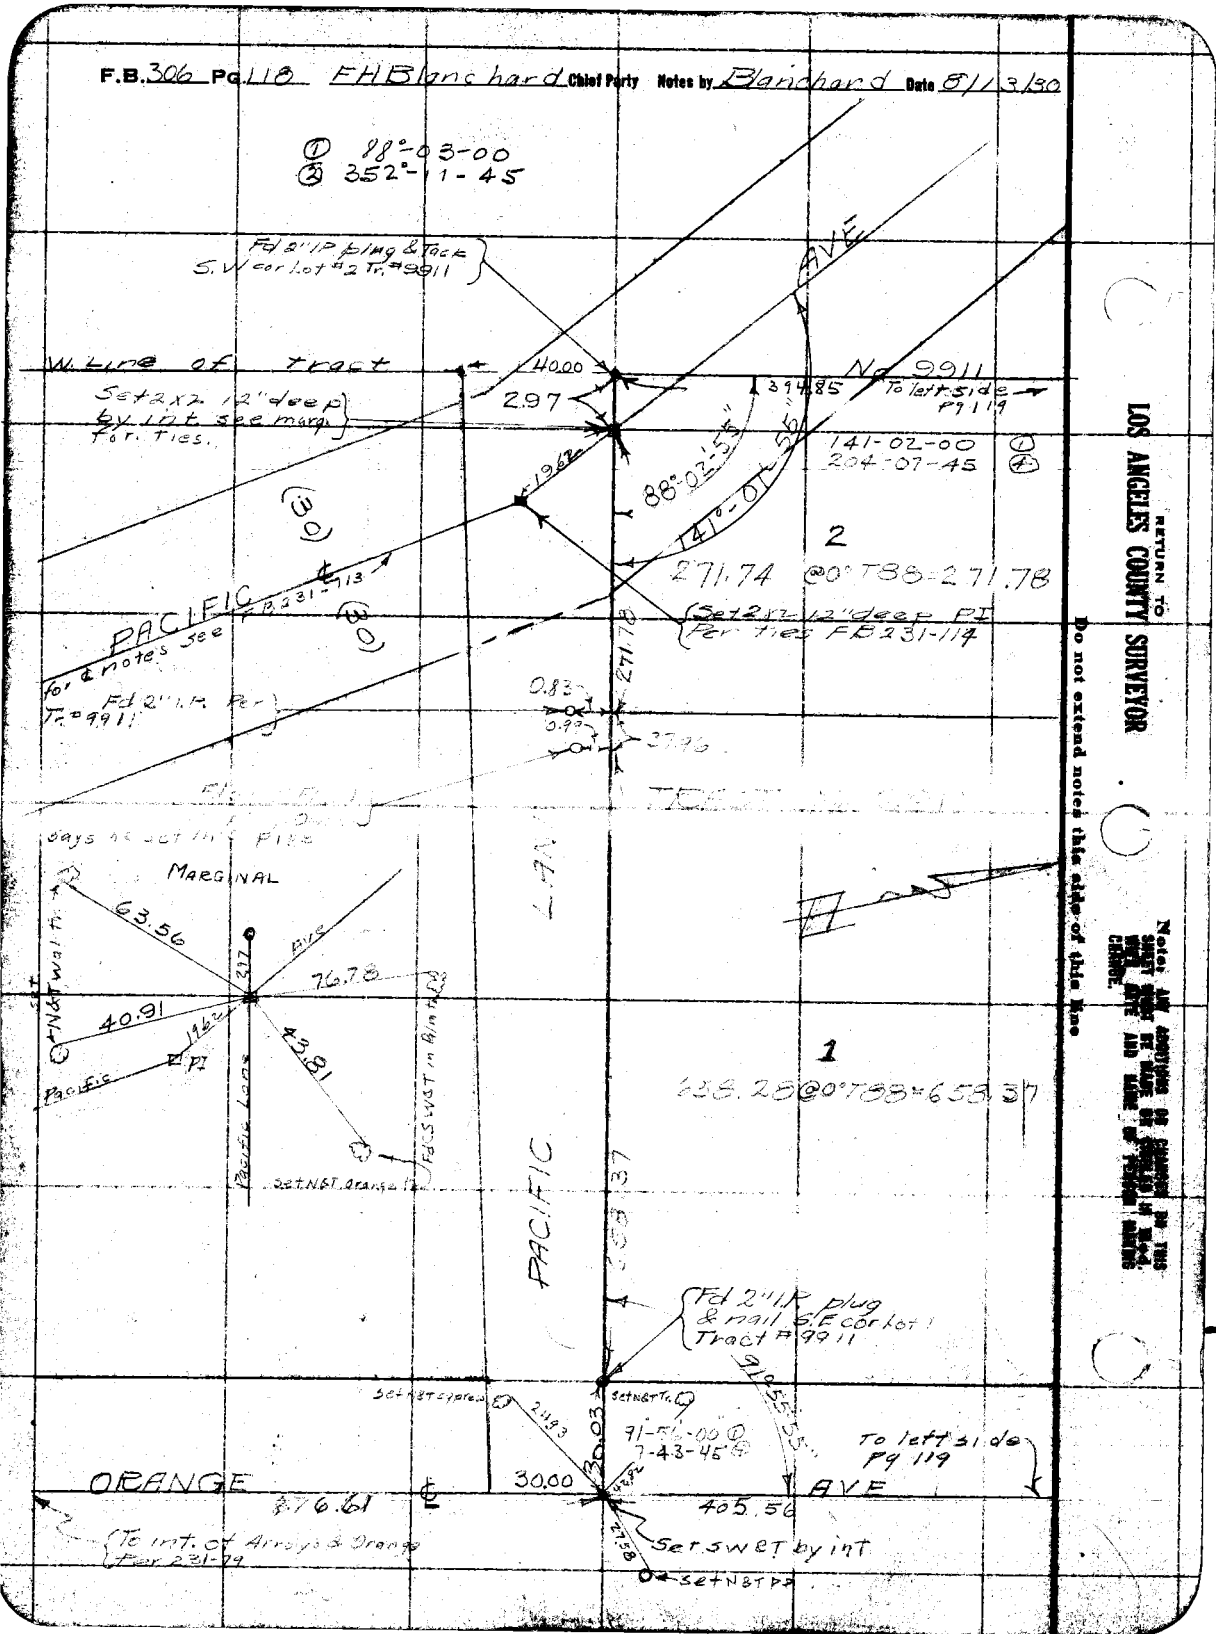

RETURN TO LOS ANGELES COUNTY SURVEYOR

Do not extend notes this side of this line


Date 8/21/30 Notes by Blanchard Chief Party Moore F.B. 306 Pg. 119

Platted by	W. O. No. 937 D. S. O. No.
Date	Location Arroyo Ave
Map No.	Surveyed by L.D. Moore
Platting C'k'd by	Date Aug 21 1930 C. Johnson
Date	Indexed

Notes ANY ADDITIONS OR CHANGES ON THIS SHEET MUST BE MADE OR CIRCLED IN Red. WITH DATE AND NAME OF PERSON MAKING CHANGE.

Do not extend notes this side of this line

RETURN TO LOS ANGELES COUNTY SURVEYOR

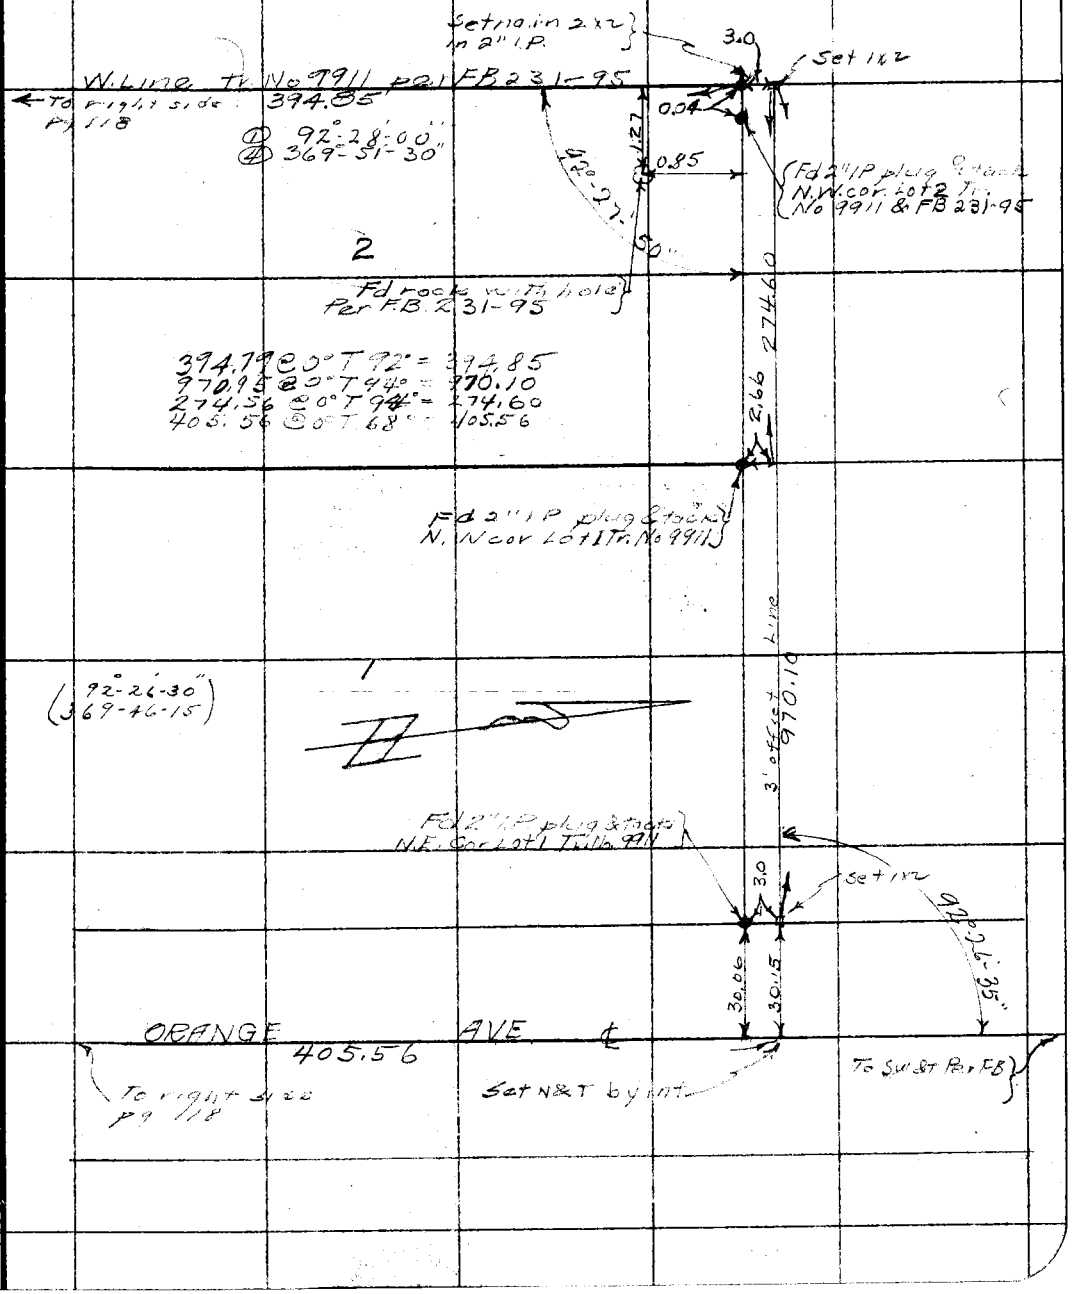

F.B. 306 Pg. 120 L.D. Moore Chief Party Notes by Blanchard Date 8/2/30

Con't from pg 121

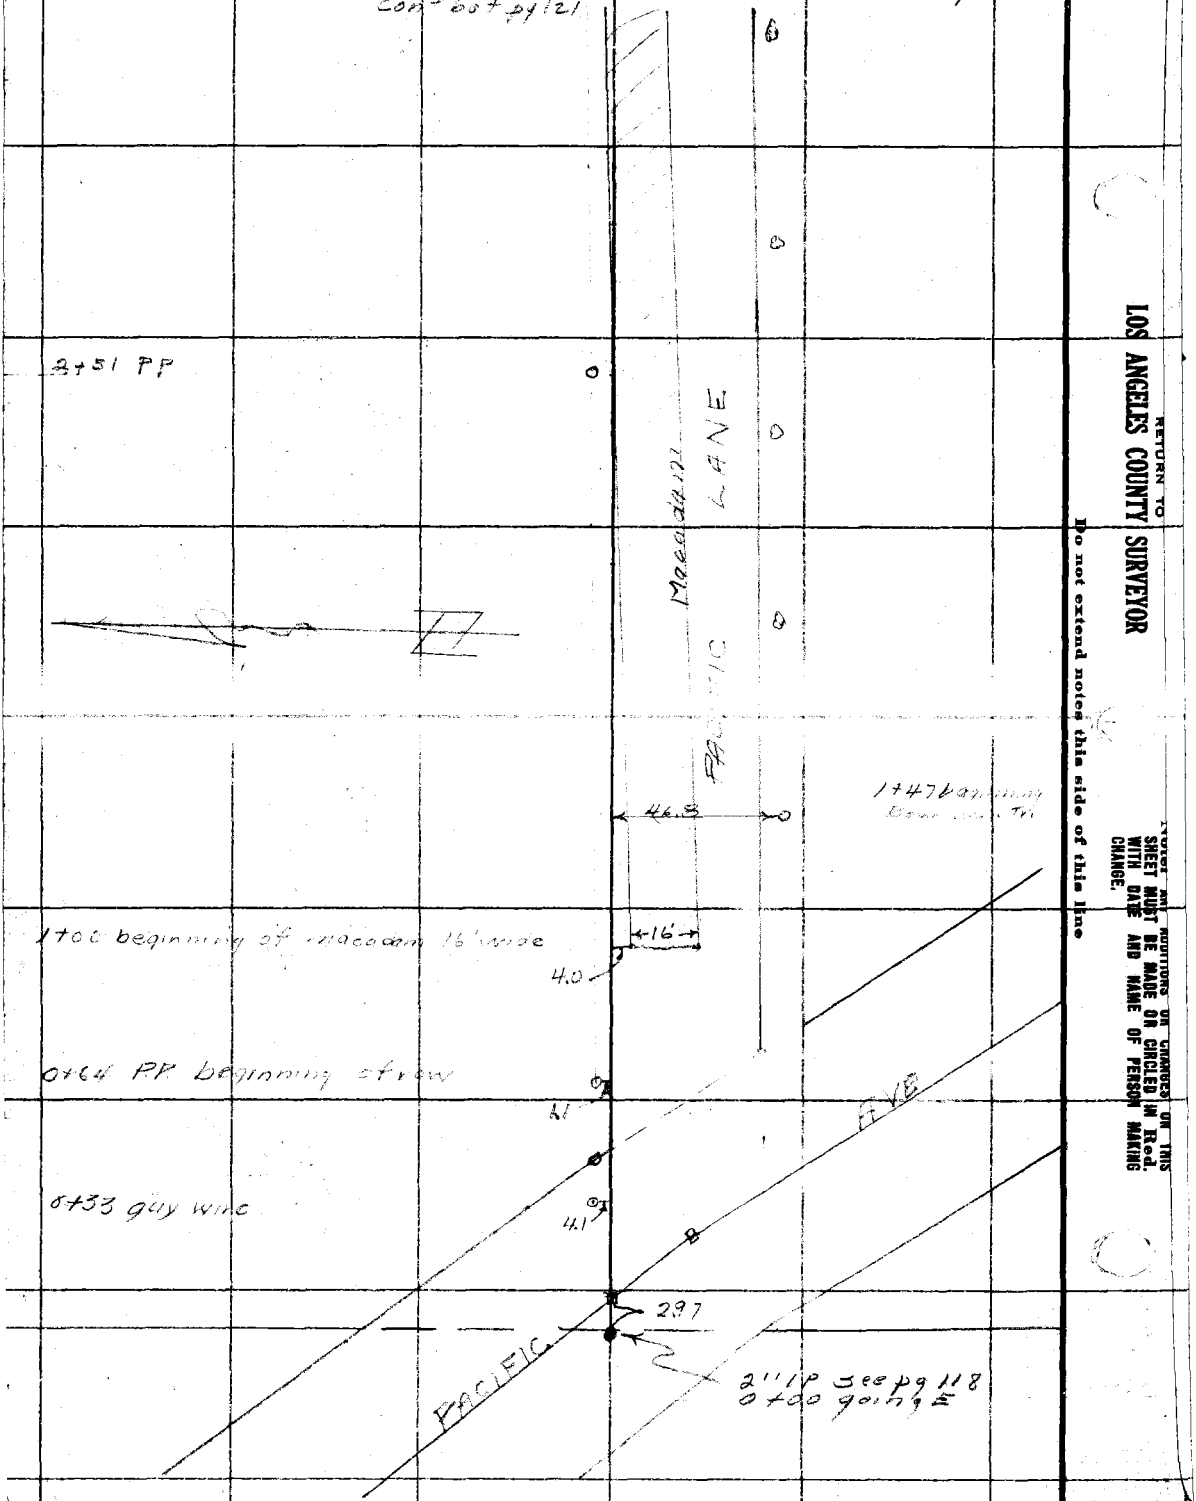

RETURN TO
LOS ANGELES COUNTY SURVEYOR

Do not extend notes this side of this line

ANY ADDITIONS OR CHANGES ON THIS SHEET MUST BE MADE OR CIRCLED IN RED, WITH DATE AND NAME OF PERSON MAKING CHANGE.

Date 8/21/30 Notes by Blanchard Chief Party L.D. Moore F.B. 306 Pg. 121

Platted by	W. O. No. 937 D. S. B. No.
Date	Location Arroyo Ave
Map No.	Surveyed by L.D. Moore
Platting C'k'd by	Date Aug 21 1930
Date	Indexed by C. Johnson

cont bot 122

7+00 PP

LANE

50'

Trs

WAY

6"

2" inval Tr.

4+74 PP

MacArthur

PACIFIC

cont from Tape 120

Notes: ANY ADDITIONS OR CHANGES ON THIS SHEET MUST BE MADE OR CIRCLED IN Red. WITH DATE AND NAME OF PERSON MAKING CHANGE.

Do not extend notes this side of this line

RETURN TO LOS ANGELES COUNTY SURVEYOR

F.B. 306 Pg. 122 L.D. Moore Chief Party Notes by Blanchard Date 8/21/30

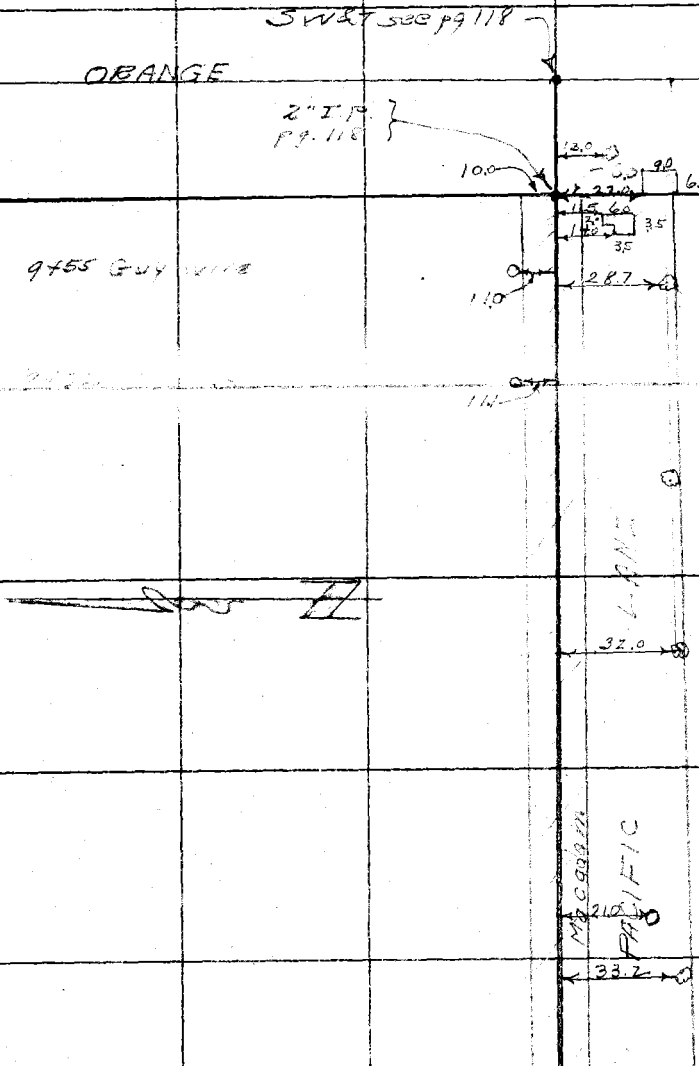

RETURN TO
LOS ANGELES COUNTY SURVEYOR

Do not extend notes this side of this line

Note: ANY ADDITIONS OR CHANGES ON THIS SHEET MUST BE MADE OR CIRCLED IN Red. WITH DATE AND NAME OF PERSON MAKING CHANGE.

Date _____ Notes by _____ Chief Party _____ F.B. 306 Pg. 123

Platted by H. H. REYNOLDS	W. O. No. 937 D. S. O. No.
Date OCT 1930	Location Arroyo Ave
Map No. C.S. 19-426	Surveyed by F. J. McNeal
Platting C'k'd by R. W. S.	Date Oct - 1930
Date NOV 5 1930	Indexed A. C. Johnson

Additional Improvements

ARROYO AVE

F.J. McNeal - Ch
E.S. Tombleson - T
C.E Redfern - H.C.
D.E. Holmes - R.C.

Note: ANY ADDITIONS OR CHANGES ON THIS SHEET MUST BE MADE OR CIRCLED IN Red. WITH DATE AND NAME OF PERSON MAKING CHANGE.

Do not extend notes this side of this line

RETURN TO LOS ANGELES COUNTY SURVEYOR

F.B. 306 Pg. 124 Chief Party Notes by [illegible] Date

To But. Pg-125

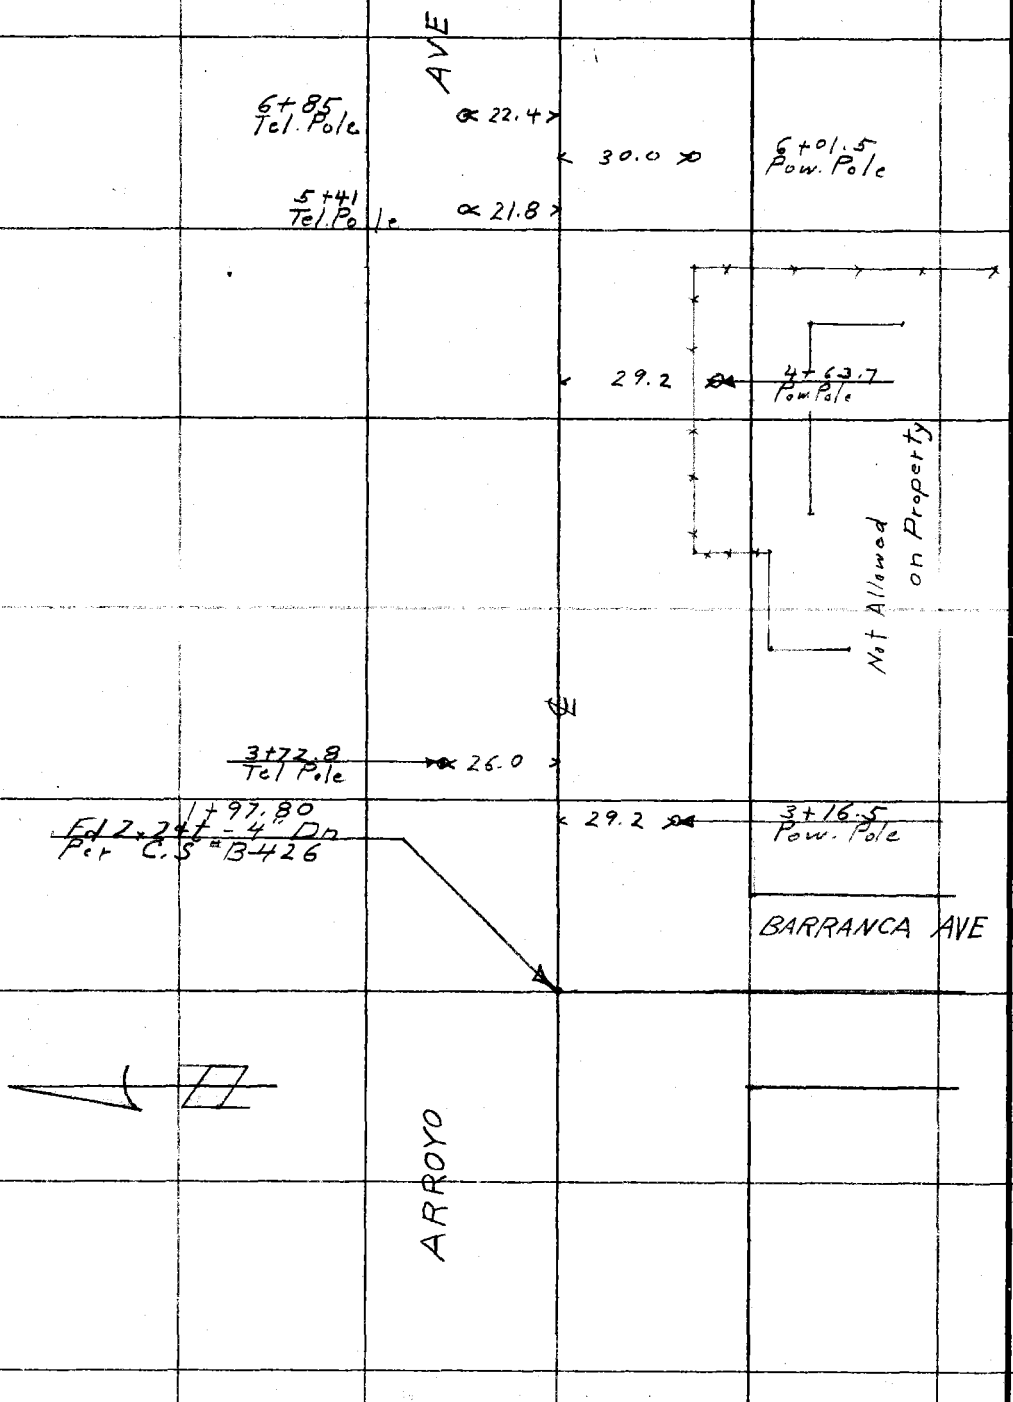

RETURN TO
LOS ANGELES COUNTY SURVEYOR

Do not extend notes this side of this line

Notes: ANY ADDITIONS OR CHANGES ON THIS SHEET MUST BE MADE OR CIRCLED IN Red. WITH DATE AND NAME OF PERSON MAKING CHANGE.

13+99.2

1.08

Date _____ Notes by M Chief Party _____ F.B. 306 Pg 125

Platted by H. H. REYNOLDS	W. O. No. 937 D. S. O. No.
Date OCT 1930	Location Arroyo Ave
Map No. C.S.B-426	Surveyed by F.J. McNeal
Platting C'k'd by R. W. S.	Date Oct -1930
Date NOV 5 1930	Indexed A. C. Johnson

Note: ANY ADDITIONS OR CHANGES ON THIS SHEET MUST BE MADE OR CIRCLED IN Red. WITH DATE AND NAME OF PERSON MAKING CHANGE.

Do not extend notes this side of this line

RETURN TO LOS ANGELES COUNTY SURVEYOR

To Bot Pg. 126

AVE

<9.>

14+71.5 Pow. Pole 20' Offset

Guy Wire & 14+68 Pole

<35 x 17.1>

Traveled Rd 8' wide

13+99.37 - 6" On-Per

Fd 2x2+t C.S.B-426

Fd 1x2+t-flush

1.08 20.00

30.0

13+27.2 Pow. Pole

12+84.6 Tel. Pole

23.2

29.3

11+89.5 Pow. Pole

11+15 Tel. Pole

22.8

29.3

10+41.0 Pow. Pole

9+73.1 Tel. Pole

22.2

29.0

8+86.3 Pow. Pole

8+29.2 Tel. Pole

22.0

ARROYO

29.5

7+44.0 Pow. Pole

From Top Pg. 124

F.B. 306 Pg. 126 Chief Party Notes by M Date

To Bot Pg - 127

AVE

Cercleon tank + Stand

11.8 × 11.8

33.0 ×
26.8 × 17+42.6
33.0 × 17+36.4

Offset

23.7 × 16+88 18" Walnut

Orange Grove Av, 4" Trees Spaced 24' apart

24.0 × 16+39.3 12" Walnut

4.6 × 16+18 Bend Pole

24.2 × 15+91.3

21.2 × 2" Valve 15+87.5

24.0 × 15+42.6 12" Walnut

20'

14+93.5

23.9 × 12" Walnut

25.1 × 14+79.5

Arroyo

Traveled Rd 8' wide

From Top Pg. 125

RETURN TO LOS ANGELES COUNTY SURVEYOR

Do not extend notes this side of this line

Notes: ANY ADDITIONS OR CHANGES ON THIS SHEET MUST BE MADE OR CIRCLED IN Red. WITH DATE AND NAME OF PERSON MAKING CHANGE.

Date _____ Notes by M Chief Party _____ F.B. 306 PG 127

Platted by H. H. REYNOLDS
Date OCT 1930
Map No. C.S.B. 426
Platting C'k'd by R. W. S.
Date NOV 5 1930

W. O. No. 937 O. S. O. No. _____
Location Arroyo Ave
Surveyed by F. J. McNeal
Date Oct. 1930
Indexed _____

To Bot. Pg. 128

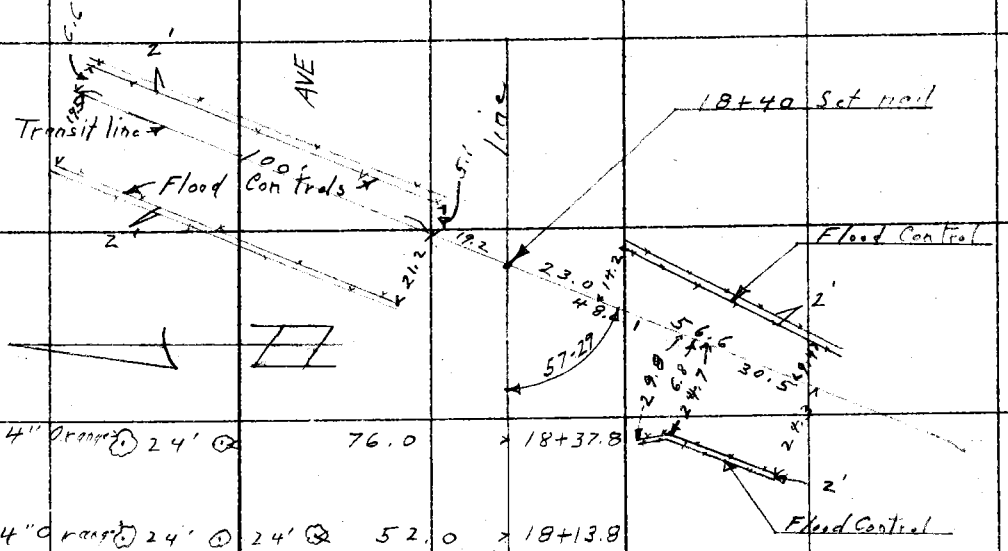

4" Orange ① 24' ② 76.0 × 18+37.8

4" Orange ① 24' ① 24' ② 52.0 × 18+13.8

4" Orange ③ 24' ① 24' ⑤ 24' ④ 27.4 × 17+89.4

4" Walnut

Offset

1-Story Frame Shack 14.0 12.3

32.2 ×

33.0 × 17+66.4

4" Orange ③ 24' ⑤ 24' ⑤ 24' ⑧ 27.3 × 17+66.1

ARROYO

20'

17+66.0 Pow. Pole

Traveled Rd. 8' wide

From Top Pg. 126

Note: ANY ADDITIONS OR CHANGES ON THIS SHEET MUST BE MADE OR CIRCLED IN Red. WITH DATE AND NAME OF PERSON MAKING CHANGE.

Do not extend notes this side of this line

RETURN TO LOS ANGELES COUNTY SURVEYOR

F.B. 306 Pg 128 Chief Party Notes by [illegible] Date

Traveled Rd. 8' Wide — To Bot. Pg. 129

31-06

AVE

21+71.5 — 30.8 — P.I. 21+55

Grove An 4" Trees Spaced 24' apart

Offset 30'

B.C. 20+95

19.4 — 20+69.5 Pow. Pole

Orange Spaced

20'

19+32 — 4" Oranges — 24' — 24' — 28.3 — 19.9 — 19+32 Pow Pole

19+08.6 — 4" Oranges — 24' — 27.9

18+83 — 4" Orange — 27.9

R = 40'

Traveled Rd 8' Wide

ARROYO

From Top Pg 127

RETURN TO LOS ANGELES COUNTY SURVEYOR

Do not extend notes this side of this line

Note: ANY ADDITIONS OR CHANGES ON THIS SHEET MUST BE MADE OR CIRCLED IN Red. WITH DATE AND NAME OF PERSON MAKING CHANGE.

Date _____ Notes by M Chief Party _____ F.B. 306 Pg 129

Platted by H. H. REYNOLDS
Date OCT 1930
Map No. C.S.B426
Platting C'k'd by R. W. S.
Date NOV 5 1930

W. O. No. 937 B. S. O. No. _____
Location Arroyo Ave.
Surveyed by F. J. McNeal
Date Oct -1930
Indexed _____

To Bot Pg 130

AVE

Offset

2"walnut ⊙ 49' ⊗ 18"Walnut 38.3 → 24+21.6

2-18"walnuts ⊙ 49' ⊗ 62.6 → 23+78.6

8" Walnut ⊙ 18"walnut ⊗ 37.5 → 23+36 ×10'D 23+68.4 Pow. Pole

18"Walnut ⊙ 49' ⊗ 2"Walnut 60.3 → 22+93.7

18"Walnut ⊙ 49' ⊗ 4" 35.8 → 22+51.3

18"Walnut ⊗ 64.5 → 22+18 ×9.6D 22+19 Pow. Pole

4" Oranges ⊙ 24' ⊗ 42.2 → 21+89.8

24" Irr Valves ⊙ 22.8 ⊗ 42.2 → 21+88.7

ARROYO

20'

From Top Pg. 128

Notes: ANY ADDITIONS OR CHANGES ON THIS SHEET MUST BE MADE OR CIRCLED IN Red. WITH DATE AND NAME OF PERSON MAKING CHANGE.

Do not extend notes this side of this line

RETURN TO LOS ANGELES COUNTY SURVEYOR

F. B. 306 Pg. 130 Chief Party Notes by MT Date

To Bot Pg 131

AVE

	27+56.0 <33.2	⊙ 2" Orange
	27+44.5 <11.3 ⊙	2" Orange
	27+21 <9.4 ⊙	2" Orange Tree
	27+10 > 33.2	⊙ 2" orange
	27+05 < 48.4	⊙ 2" Orange
8" walnut ⊙	80.3	26+75
		26+30 Guy Wire
	<7.8>	
	<10.8> 15.3°	26+27 Pow Pole + Guy Wire
10" Walnut ⊙	80.3	> 25+91
8" Fruit Tree ⊙	73.0	> 25+71
2-10" walnuts ⊙ 49'	⊙ 64.5	> 25+48
8" walnut ⊙	88.5	> 25+06 <10.P
		24.99 Pow Pole
2-12" walnuts ⊙ 49'	⊙ 63.5	> 24+62.5

Offset

ARROYO

20'

From Top Pg 129

RETURN TO LOS ANGELES COUNTY SURVEYOR

Do not extend notes this side of this line

Note: ANY ADDITIONS OR CHANGES ON THIS SHEET MUST BE MADE OR CIRCLED IN Red. WITH DATE AND NAME OF PERSON MAKING CHANGE.

Date _____ Notes by M Chief Party _____ F.B. 306 Pg 131

Platted by H. H. REYNOLDS
Date OCT 1930
Map No. C.S. B-426
Platting Ck'd by _____
Date NOV 5 1930

W. O. No. 937 D. S. O. No. _____
Location Arroyo Ave
Surveyed by F. J. McNeil
Date Oct 17 30
Indexed _____

To Bot Pg 133

90-55-30

Fd 2x2 ± Per C.S. # B-426

AVE

Offset

30'

B. Point
28+68.4 - Fd 2x2 ± Per C.S. # B-426

OREGON AVE

90-52-30

85.26 — 90.00 — 20.03

90°

10'

℄

Set Nail

A-Point Set Nail

Set upon A-Point
Sight on B-Point
All angles turned to Pt.

For Location of Trees in Draw
See Pg - 132

Offset

20'

ARROYO

From Top Pg. 130

Notes: ANY ADDITIONS OR CHANGES ON THIS SHEET MUST BE MADE OR CIRCLED IN Red. WITH DATE AND NAME OF PERSON MAKING CHANGE.

Do not extend notes this side of this line

RETURN TO
LOS ANGELES COUNTY SURVEYOR

F.B. 306 Pg. 132 Chief Party Notes by M Date

Set up on A-Point - Sight on B-Point
All angles turned to Right (See Pg-131)

Stadia	Hor. Angle	Vertical Angle	Horizont Dist.	Remarks
3.70 71 3	13-25	-14-53	66	6" Oak
3.71 72 3	19-40	-14-20	67	" "
4.70 71 4	35-40	-25-16	58	6" oak
1.85 86 1	49-30	-15-49	80	30" Oak
10.98 99 10	65-38	-3-54	99	6" Oak
11.17 18 10	82-00	-5-11	18	2-6" Oaks
6.03 104 5	88-58	-18-21	94	2-10" & 1-8" 1-6" Oaks
5.71 172 4	91-42	-17-19	157	10" Oak
9.62 63 9	340-50	-10-28	61	1-5" & 1-6" 1-8" Oaks
5.88 89 5	291-25	+4-34	89	1-12" & 1-20" Gum Trees

3M

RETURN TO LOS ANGELES COUNTY SURVEYOR

Do not extend notes this side of this line

Note: ANY ADDITIONS OR CHANGES ON THIS SHEET MUST BE MADE OR CIRCLED IN Red. WITH DATE AND NAME OF PERSON MAKING CHANGE.

Date _____ Notes by M Chief Party _____ F.B. 306 Pg 133

Platted by H. H. REYNOLDS
Date 1930
Map No. C.S.B-426
Platting C'k'd by R. W. S.
Date NOV 5 1930

W. O. No. 937 D. S. O. No. _____
Location Arroyo Ave
Surveyed by F. J. McNeal
Date Oct-1930
Indexed _____

To Bot. Pg - 134

Notes: ANY ADDITIONS OR CHANGES ON THIS SHEET MUST BE MADE OR CIRCLED IN Red. WITH DATE AND NAME OF PERSON MAKING CHANGE.

Do not extend notes this side of this line

RETURN TO LOS ANGELES COUNTY SURVEYOR

Lemon Grove Av. 4" Trees Spaced 24' apart

			38.2	AVE	31+94.0
				1.7 Rt	31+79.0 18" Irr. Valve
				Offset	
				1.8 Rt	31+41.7 18" Irr. Valve
	4 - 10" Peppers		21.4		31+40
	5 - 4' Peppers		20.9		31+06.3
				2.0 Rt	31+02 18" Irr. Valve
		out		2.4 Rt	30+61 18" Irr Valve
				ARROYO	
30+25.4	24'	24'	35.3	1.6 Rt 20	30+23.7 18" Irr. Valve
29+99.0	24'		58.4	1.8 Rt 6	29+83.8 18" Irr Valve
			83.0	29+74.0	
				30' 1.4 Rt	29+46.7 18" Irr Valve

From Top Pg 131

F.B. 306 Pg 134 Chief Party Notes by KL Date

To Bot Pg - 135

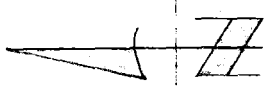

34+42.5

2" Valve

2" Breather

2" Pepper

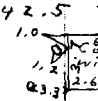

<0.3 <17.5

3+42 ← 3-18" Irr. Valve

39.9 34+35.5

Offset

18" Irr Valve <12.3 34+28.8

18" Irr. Valve <7.8 34+07.5

AVE

5-10" Peppers 21.6 33+78.3

3-18" Irr. Valves < 24.5 24.5 40.0 33+42.6

33+37.0

<6.7.0>

+1.4 33+34.7 18" Irr. Valve

<1.4 32+98.2 18" Irr. Valve

ARROYO

<1.8 32+59.0 18" Irr. Valve

20.3 32+42.4 Clump of 10-6" Gums

<1.8 32+33.9 18" Irr. Valve

30'

<1.9 32+11.7 18" Irr. Valve

38.2 31+94.0

Lemon Grove Av 4" Trees Spaced 24' apart

From Top Pg -133

RETURN TO LOS ANGELES COUNTY SURVEYOR

Do not extend notes this side of this line

Note: ANY ADDITIONS OR CHANGES ON THIS SHEET MUST BE MADE OR CIRCLED IN Red. WITH DATE AND NAME OF PERSON MAKING CHANGE.

Date _____ Notes by M Chief Party _____ F.B. 306 Pg 135

Platted by H. H. REYNOLDS	W. O. No. 937 D. S. O. No. _____
Date OCT 1930	Location Arroyo Ave
Map No. C-SB-426	Surveyed by E. J. McNeal
Platting C'k'd by R. W. S.	Date Oct - 1930
Date NOV 5 1930	Indexed [illegible]

To Bot Pg - 136

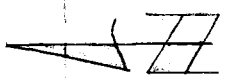

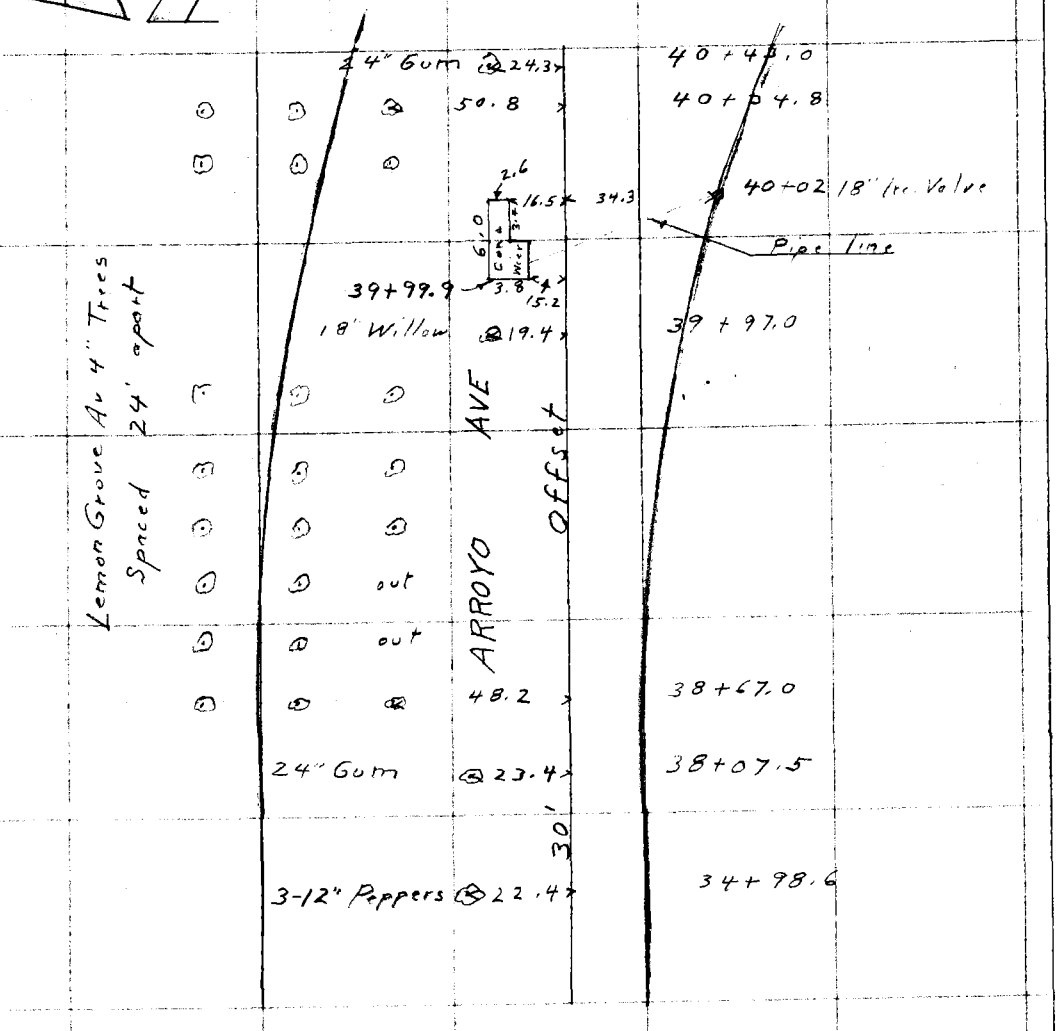

From Top Pg - 134

Notes: ANY ADDITIONS OR CHANGES ON THIS SHEET MUST BE MADE OR CIRCLED IN RED WITH DATE AND NAME OF PERSON MAKING CHANGE.

Do not extend notes this side of this line

RETURN TO LOS ANGELES COUNTY SURVEYOR

F.B. 306 Pg. 136 Chief Party Notes by KJ Date

To Bot Pg - 137

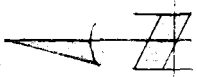

4-6"ϕ 5-4' Gums

25.2 × 43+54

3.7 Cone 2.7 Wier 15.9 ×

43+43 15.9 ×

Traveled Road 8' Wide

42+75

53.7 × 42+50

Lemon Grove Av. 4" Tr.

Spaced 24' apart

AVE

Offset

ARROYO

30'

51.2 × 40+ 58.5

From Top Pg 135

RETURN TO LOS ANGELES COUNTY SURVEYOR

Do not extend notes this side of this line

Note: ANY ADDITIONS OR CHANGES ON THIS SHEET MUST BE MADE OR CIRCLED IN Red. WITH DATE AND NAME OF PERSON MAKING CHANGE.

Date _____ Notes by FM Chief Party _____ F.B. 306 Pg 137

Platted by H. H. REYNOLDS	W. O. No. 937 D. S. O. No.
Date OCT 1930	Location Arroyo Ave
Map No. C.S.B. 426	Surveyed by F. J. McNeal
Platting C'k'd by R. W. S.	Date Oct - 1930
Date NOV 1930	Indexed

Notes: ANY ADDITIONS OR CHANGES ON THIS SHEET MUST BE MADE OR CIRCLED IN Red. WITH DATE AND NAME OF PERSON MAKING CHANGE.

Do not extend notes this side of this line

RETURN TO LOS ANGELES COUNTY SURVEYOR

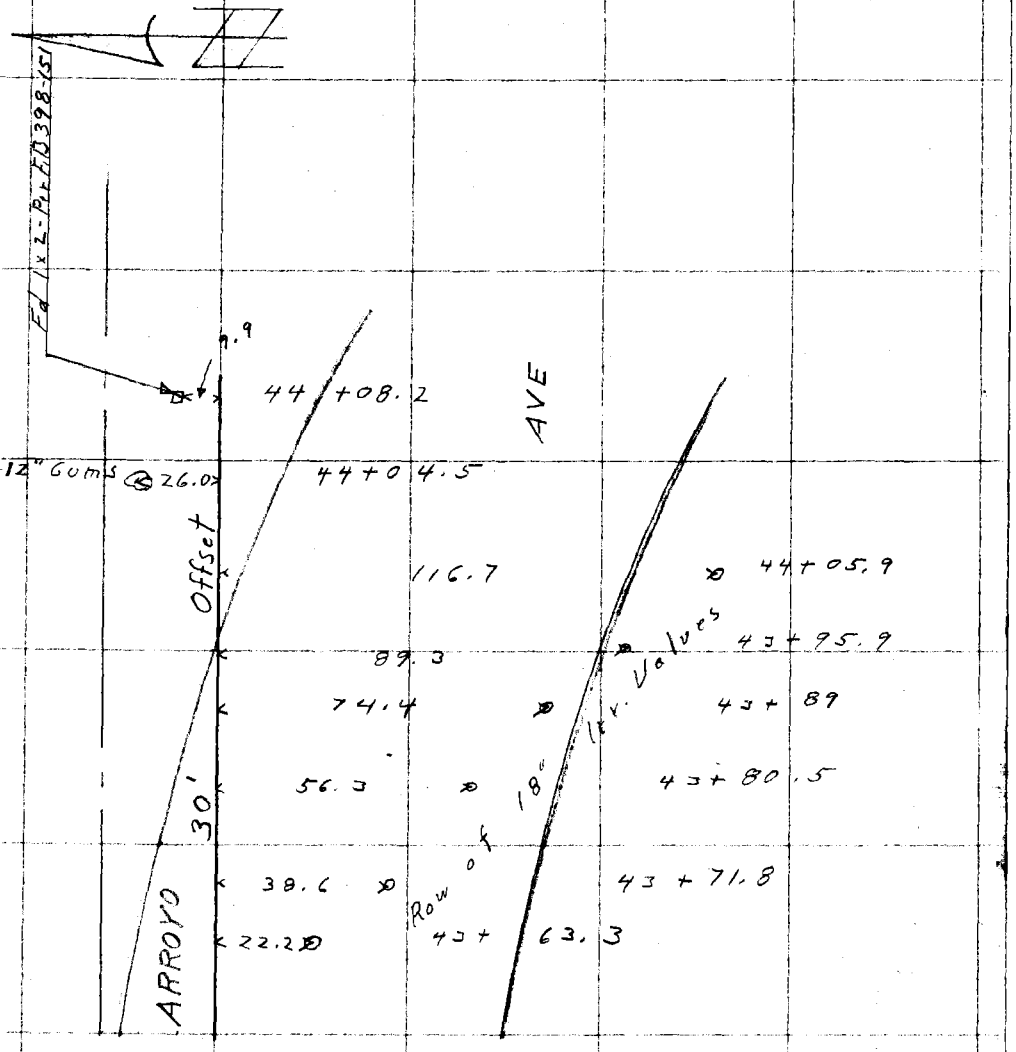

From Top Pg - 136

F.B. 306 Pg 138 Chief Party Notes by M Date

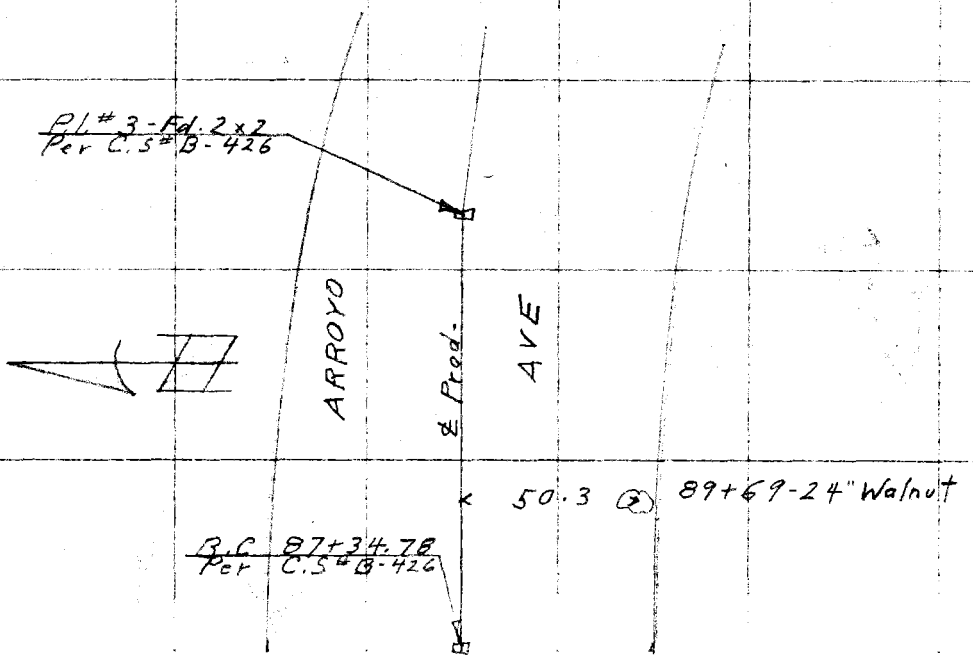

RETURN TO
LOS ANGELES COUNTY SURVEYOR

Do not extend notes this side of this line

Note: ANY ADDITIONS OR CHANGES ON THIS SHEET MUST BE MADE OR CIRCLED IN Red. WITH DATE AND NAME OF PERSON MAKING CHANGE.

Date _____ Notes by [illegible] Chief Party _____ F.B. 306 Pg 139

Platted by H. H. REYNOLDS
Date OCT 1930
Map No. C.S. B-426
Platting C'k'd by R. W. S.
Date NOV 5 1930

W. O. No. 937 D. S. O. No. _____
Location Arroyo Ave
Surveyed by E. J. McNeal
Date Oct-1930
Indexed A. C. Johnson

Notes: ANY ADDITIONS OR CHANGES ON THIS SHEET MUST BE MADE OR CIRCLED IN Red. WITH DATE AND NAME OF PERSON MAKING CHANGE.

Do not extend notes this side of this line

RETURN TO
LOS ANGELES COUNTY SURVEYOR

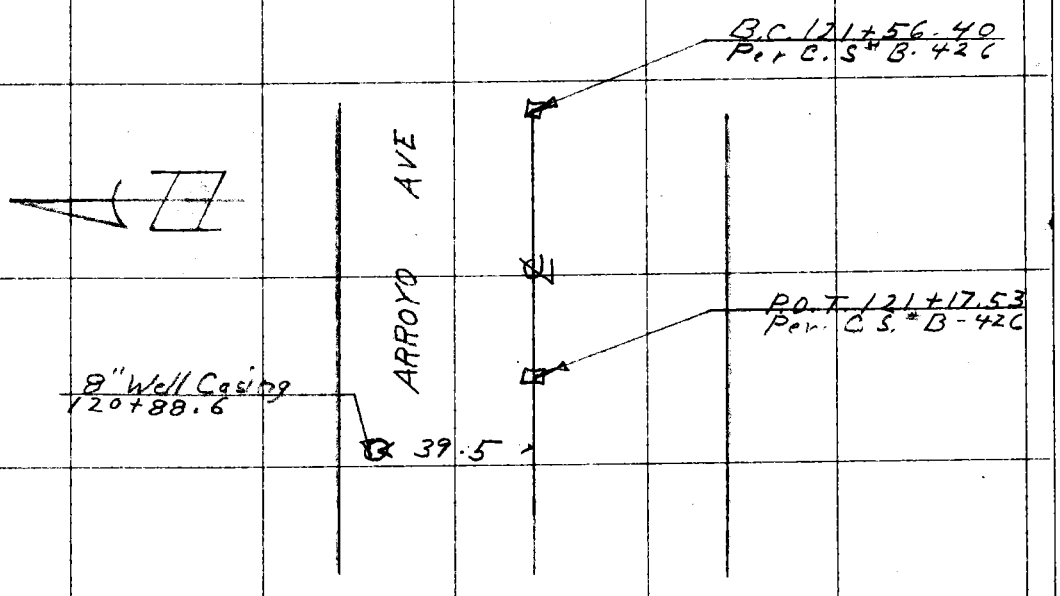

Location of 4' Wire Fences in Proposed R/W Arroyo Ave by Slope Ref. C.S.# B-426
Angles all turned to the right

F.B. 306 Pg. 140

Lost At	Sight At	Slope		Hor Ang	Vert A	Horiz. Dist.	Remarks
E.C. 161+76.37	B.C. 164+26.49	11.97	197	188-52	-6-50	194	S. Fence line
		5.59	60	180-00	-6-07	59	" " "
		4.60	61	24-24	+8-38	60	* " " "
		3.47	148	9-36	+6-43	146	" " "
		3.05	206	6-54	+6-33	203	" " "
		3.05	206	347-24	+7-32	202	N Fence line
		4.66	167	345-11	+8-03	164	" " "
		3.23	124	340-14	+7-58	122	" " "
		2.74	75	325-09	+7-45	74	" " "
		2.57	58	298-07	+7-31	57	" " "
		3.69	70	247-00	+2-30	70	" " "
		6.12	113	224-02	0-0	113	" " "
		11.59	160	214-17	0-0	160	" " "
B.C. 164+26.49	E.C. 161+76.37	3.70	71	200-42	+11-39	68	S Fence line
		8.31	132	190-47	+5-47	131	" " "
		8.90	191	187-41	+2-49	191	" " "
		7.28	229	186-03	+1-26	229	" " "
		11.76	277	185-25	0-0	277	" " "
		8.80	281	171-12	0-0	281	N. Fence line
		5.34	235	169-25	+1-0	235	" " "
		4.77	178	166-36	+1-34	178	" " "

Chief Party

Notes by

Date

RETURN TO
LOS ANGELES COUNTY SURVEYOR

Note: ANY ADDITIONS OR CHANGES ON THIS SHEET MUST BE MADE OR CIRCLED IN Red. WITH DATE AND NAME OF PERSON MAKING CHANGE.

Do not extend notes this side of this line

RETURN TO
LOS ANGELES COUNTY SURVEYOR

Note: ANY ADDITIONS OR CHANGES ON THIS SHEET MUST BE MADE OR CIRCLED IN **Red.** WITH DATE AND NAME OF PERSON MAKING CHANGE.

Do not extend notes this side of this line

Inst. At	Sight At	Stadia		Hor. Angle	Vert. Angle		Remarks
B.C. 164+26.49	E.C. 161+76.37	4.26 3	127	159-05	+4-47	126	N. Fence
		3.80 3	81	142-55	+11-08	78	" "
		2.56 2	57	106-15	+17-14	52	" "
P.I. #7	E.C. 170+85.50	4.28 4	29	97-37	-7-28	29	S. Fence
		2.37 2	38	37-20	0-0	38	S. Fence
		8.70 7	171	0-0	-6-04	169	S. Fence
		4.58 4	259	356-36	-7-18	255	" "
		9.33 6	334	339-52	-2-58	333	N. Fence
		10.31 8	232	336-20	-1-25	232	" "
		4.11 3	112	324-40	+4-09	111	" "
		2.67 2	68	305-23	+5-41	67	" "
		1.55 1	56	281-45	+6-54	55	" "
		1.57 1	56	261-18	+7-52	57	" "
	Fences are shown on C.S. B-426 - Along Here						
B.C. 175+26.39	P.O.T. 173+60.18	3.75 2	176	2-18	+7-57	173	S. Fence
		5.77 5	78	358-03	+4-20	78	" "
		8.31 8	32	329-41	0-0	32	" "
		11.57 11	58	215-12	-3-22	58	" "
		11.06 10	107	205-15	-6-23	106	End S. Fence
P.O.T. 178+32.13	E.C. 179+58.55	5.73 5	74	209-24	+11-41	71	N. Fence
		5.09 5	10	4-50	0-0	10	" "
E.C. 179+58.55	P.O.T. 182+34.22	10.16 10	17	70-18	0-0	17	" "
		11.30 11	31	40-45	-7-47	31	" "
		5.23 5	224	26-40	-12-26	214	" "
	N. Fence Clears R of W from here on						

Date _____ Notes by H.H. REYNOLDS Chief Party _____ F.B. 306 Pg 141

Plotted by H.H.R. Date OCT 1930 Map No. C.S. B-426 R. W. S.
Plotting ck'd by _____ Date NOV 1930

W. O. No. 237 D. S. O. No. _____ Location _____
Surveyed by _____ Date OCT-1930
Indexed _____

F. B. 306 Pg. 142

Inst At	Sight At	Stadia		Hor Angle	Vert. Angle		Remarks	
Sta 205+00	Sta 210+00	6.00 / 5	100	73-19	-6-06	100	4' wire Fence	
	Fence	Intersects		℄ @	Sta 207+97			
Sta 213+00	Sta 220+00	2.71 / 1	172	252-39	+3-33	171	℄ in	Fence
		6.39 / 6	40	0-0	0-0	40	Fence	line
		5.06 / 5	107	41-20	-3-19	107	℄ in Fence	
		9.89 / 6	390	7-13	0-0	390	Fence	line
Sta 221+00	Sta 223+00	5.64 / 4	165	170-10	+2-41	165	℄ in Fence	
		3.25 / 2	126	171-22	+2-42	126	"	"
		1.73 / 1	74	180-00	+3-03	74	Fence	line
		3.95 / 2	196	329-30	+2-28	196	"	"

Chief Party

Notes by

Date

Do not extend notes this side of this line

RETURN TO

LOS ANGELES COUNTY SURVEYOR

Note: ANY ADDITIONS OR CHANGES ON THIS SHEET MUST BE MADE OR CIRCLED IN Red. WITH DATE AND NAME OF PERSON MAKING CHANGE.

Date _____ Notes by CJ Chief Party _____ F.B. 306 Pg 143

Platted by	H. H. REYNOLDS	W.O. No.	937 D. S. O. No.
Date	OCT 1930	Location	Arroyo Ave
Map No.	C.S.B426	Surveyed by	F. J. McNeal
Platting Ck'd by	R. W. S.	Date	Oct - 1930
Date	NOV 5 1930	Indexed	

Ref CS #B426

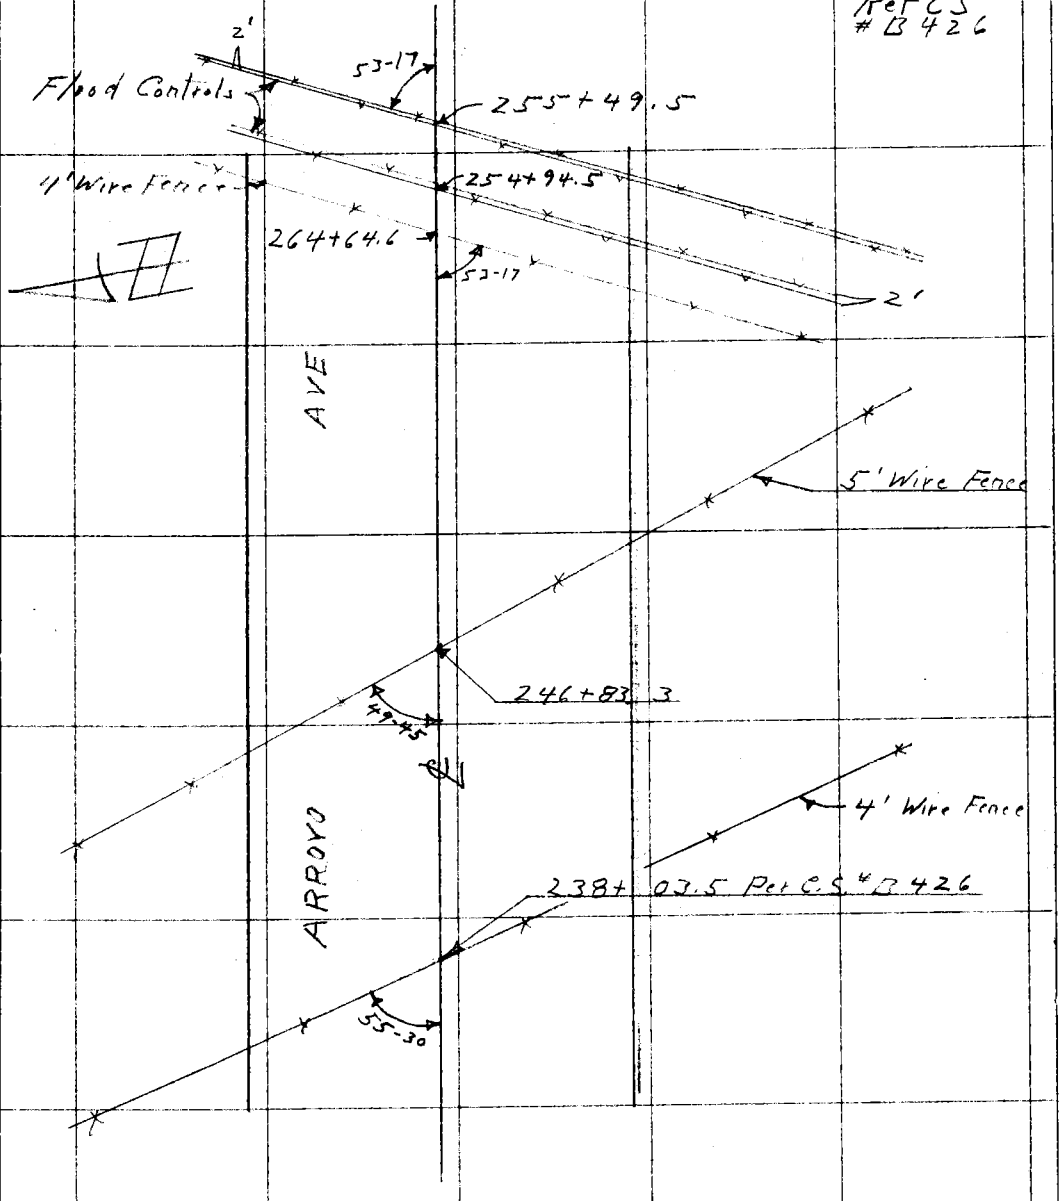

Notes: ANY ADDITIONS OR CHANGES ON THIS SHEET MUST BE MADE OR CIRCLED IN Red. WITH DATE AND NAME OF PERSON MAKING CHANGE.

Do not extend notes this side of this line

RETURN TO
LOS ANGELES COUNTY SURVEYOR

F.B. 306 Pg. 144 Chief Party Notes by [illegible] Date

Ref. C.S. #B-426

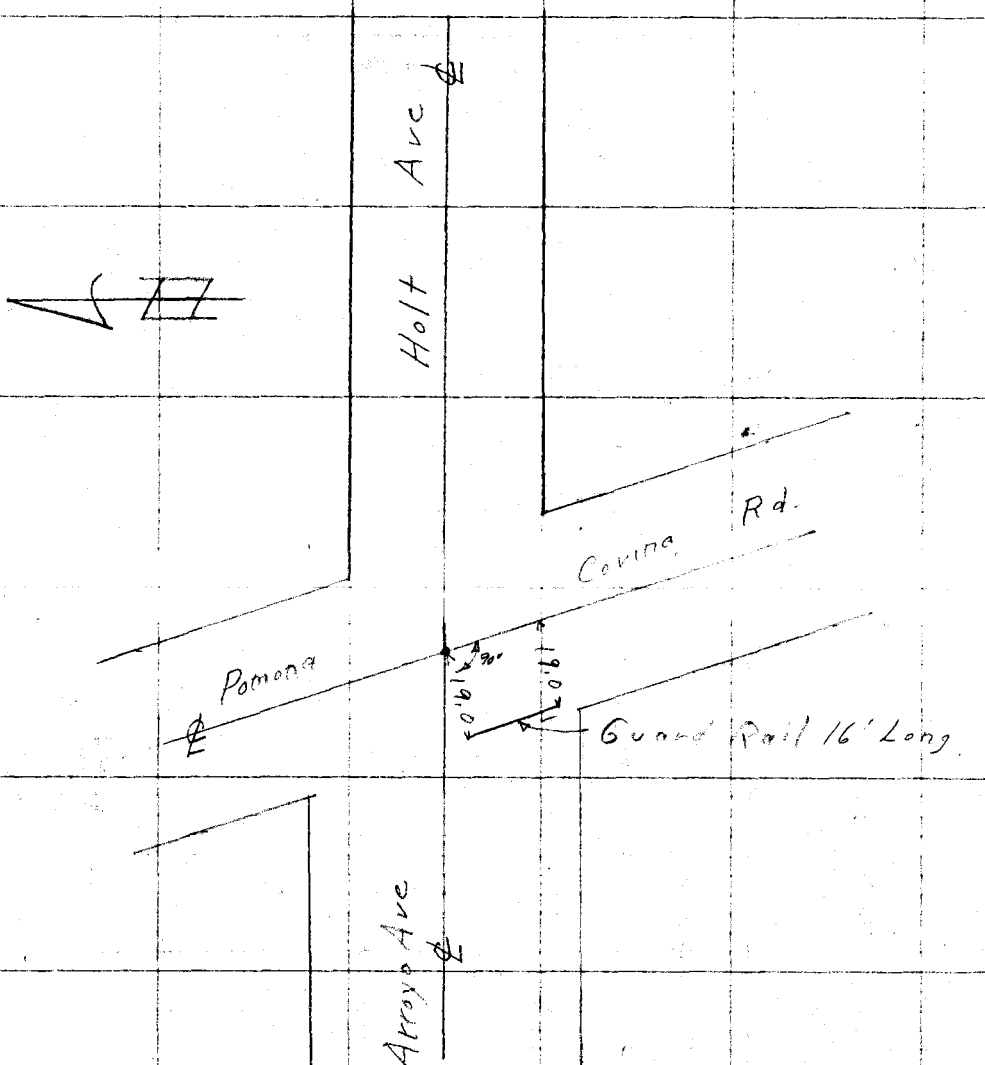

RETURN TO LOS ANGELES COUNTY SURVEYOR

Do not extend notes this side of this line

Note: ANY ADDITIONS OR CHANGES ON THIS SHEET MUST BE MADE OR CIRCLED IN Red. WITH DATE AND NAME OF PERSON MAKING CHANGE.

Notes Ck'd by McPherson	Survey of Graves Ave
Map No. B-384	W. O. #239 Tape No. 040 St'd 81° F.
Office Work White	Surveyed by C. D. Moore
Checked McPherson	Notes Moore Date 10-7-37
Date Oct. 1937.	Indexed A. C. Johnson 10-9-37

F.B. 309 PG. 145

STAKING
CURVE CHANGE
ON
GRAVES AVE
AT
TYLER AVE
AND
POLLARD AVE
Job # 4239

Moore
Scott
Rawson
Scott

Oct 7, 1937

Note: Any Additions or Changes on This Sheet Must be Made or Circled in Red Ink With Date and Name of Person Making Change.

Do not extend notes this side of this line

RETURN TO
LOS ANGELES COUNTY SURVEYOR
700 HALL OF RECORDS

FORM 247 10M 11-35

F.B. 306 Pg 146

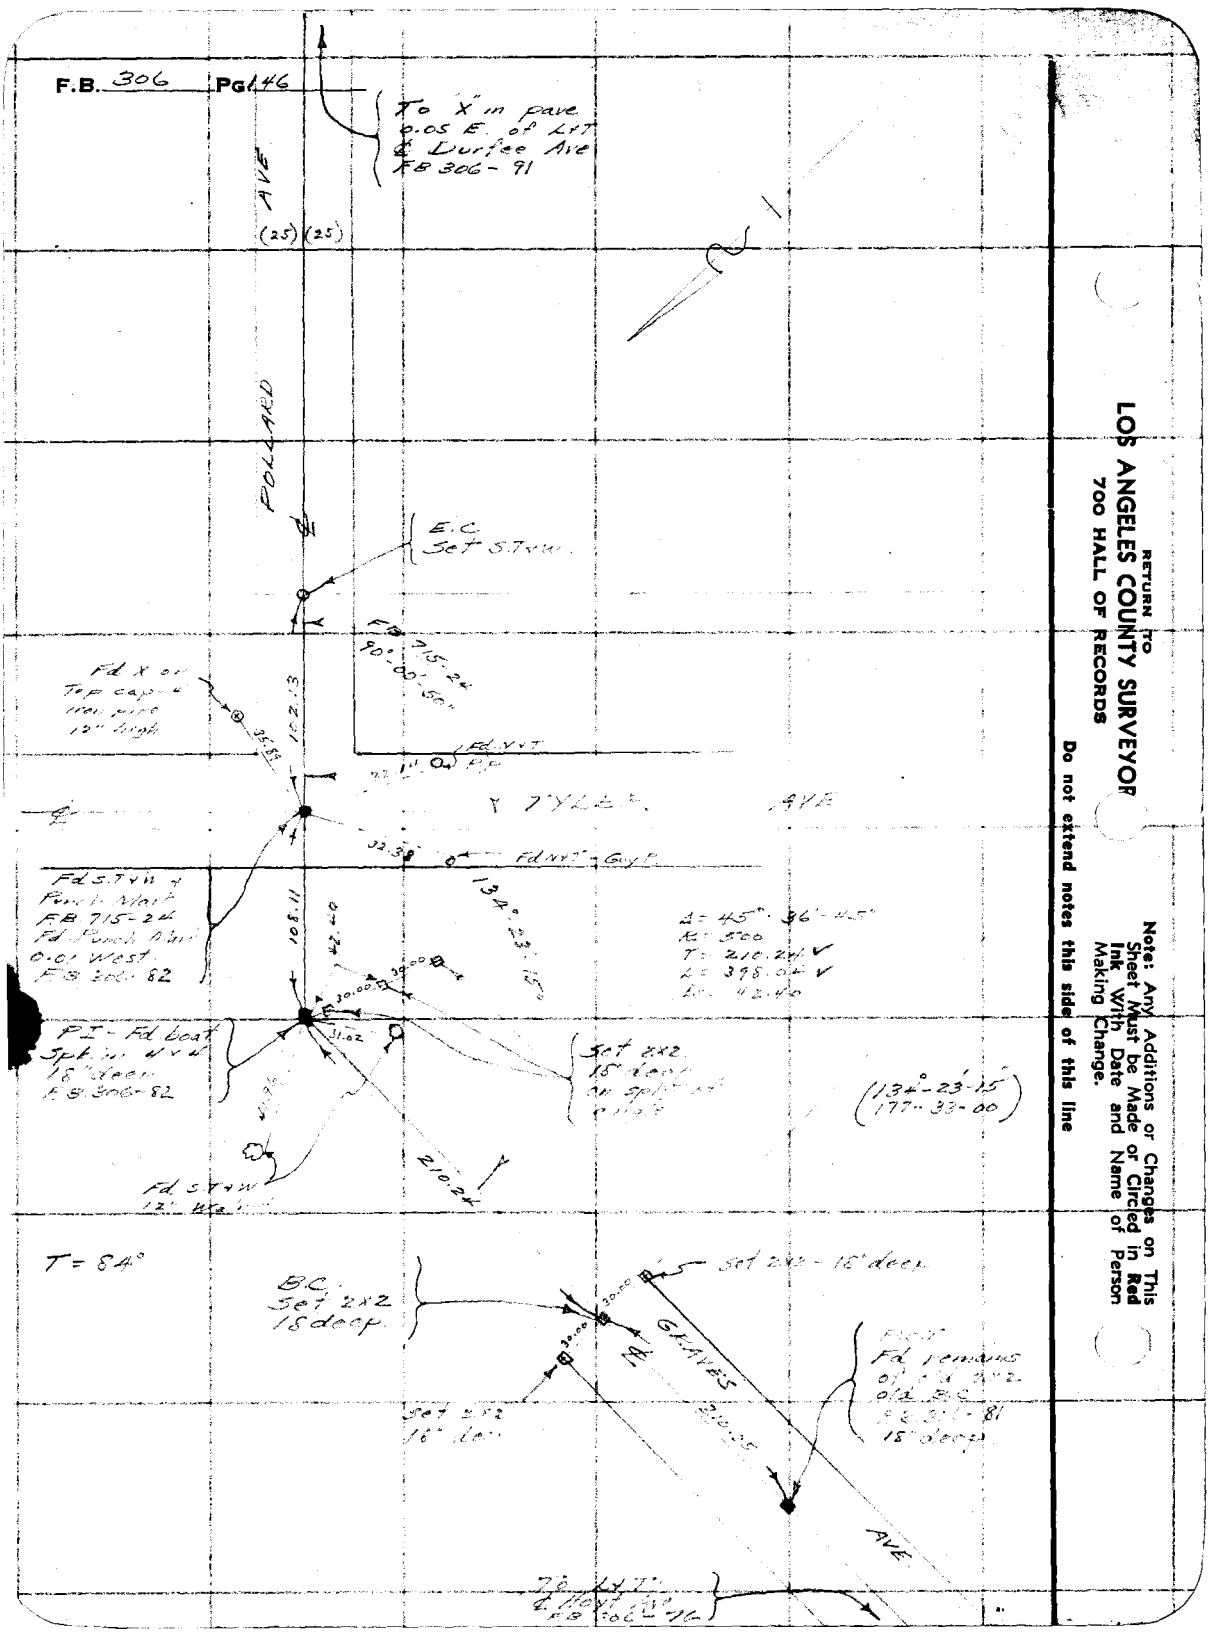

RETURN TO
LOS ANGELES COUNTY SURVEYOR
700 HALL OF RECORDS

Note: Any Additions or Changes on This Sheet Must be Made or Circled in Red Ink With Date and Name of Person Making Change.

Do not extend notes this side of this line

Notes Ck'd by McPherson	Survey of Graves Ave
Map No. B-384.	W. O. 4230 Tape No. St'd °F.
Office Work White	Surveyed by L D Moore
Checked McPherson	Notes Moore Date 10-7-37
Date Oct, 1937	Indexed J. S. Johnson

F.B. 306 PG. 147

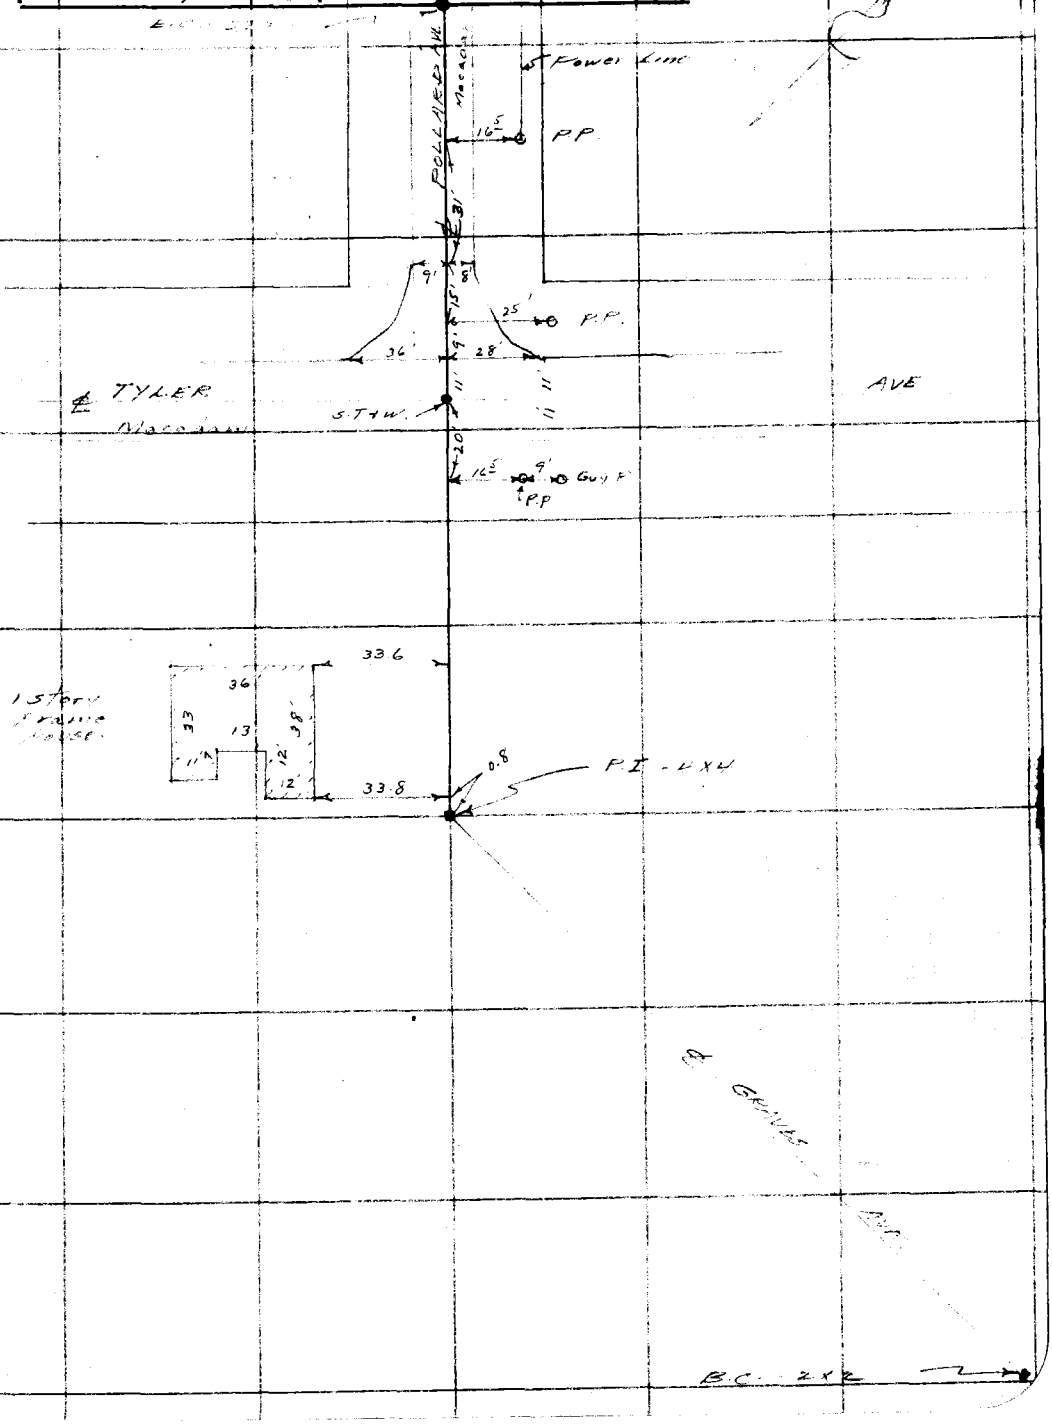

Note: Any Additions or Changes on This Sheet Must be Made or Circled In Red Ink With Date and Name of Person Making Change.

Do not extend notes this side of this line

RETURN TO
LOS ANGELES COUNTY SURVEYOR
700 HALL OF RECORDS

FORM 247 10M 11-35

RETURN TO
LOS ANGELES COUNTY SURVEYOR
700 HALL OF RECORDS

Note: Any Additions or Changes on This Sheet Must be Made or Circled in **Red Ink** With Date and Name of Person Making Change.

Do not extend notes this side of this line

F.B. 306 PG. 148

Notes Ck'd by	Survey of Rush St (1) Appraisal
Map No.	W. O. 5058 Tape No. 0100 St'd 68 °F
Office Work	Surveyed by Wm C. MACK
Checked	Notes W. C. M. Date 3-2-49
Date	Indexed A. C. Johnson 3-4-49

F. B. 306 PG. 149 (1)

J.N. 5058

Rush St. (1) Appraisal

Additional Topography

on

Portion (E'ly. 115 ft.) of Lot 8

of E. J. Baldwin's 2nd Subdivision

M.R. 70-92

also

Location of E'ly Line of said Lot 8

Party:

Mack, Chief

Salazar, T.

Beers, H.C.

Molinari, R.C.

Note: Any Additions or Changes on This Sheet Must be Made or Circled in Red Ink With Date and Name of Person Making Change.

Do not extend notes this side of this line.

RETURN TO LOS ANGELES COUNTY SURVEYOR 700 HALL OF RECORDS

FORM 247 5M 5-46

F. B. 306 PG. 150 @

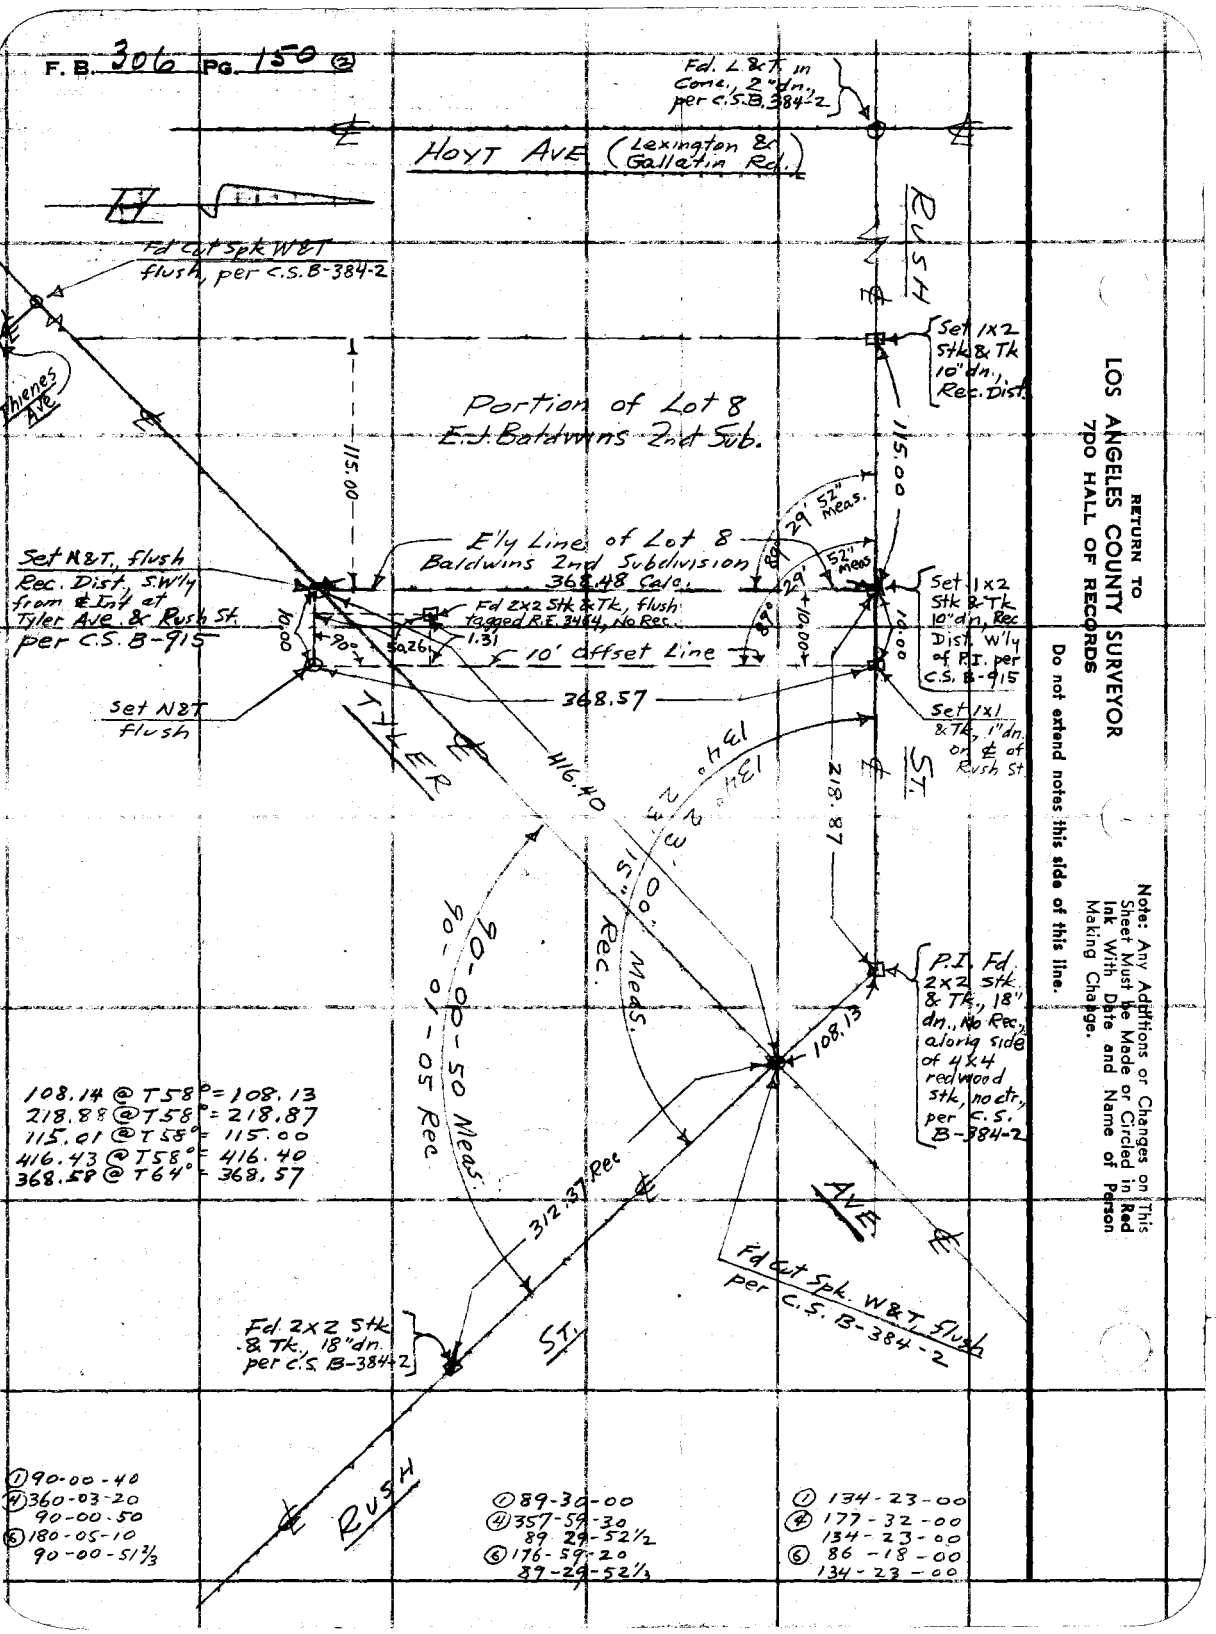

RETURN TO
LOS ANGELES COUNTY SURVEYOR
7DO HALL OF RECORDS

Do not extend notes this side of this line.

Note: Any Additions or Changes on This Sheet Must be Made or Circled in Red Ink With Date and Name of Person Making Change.

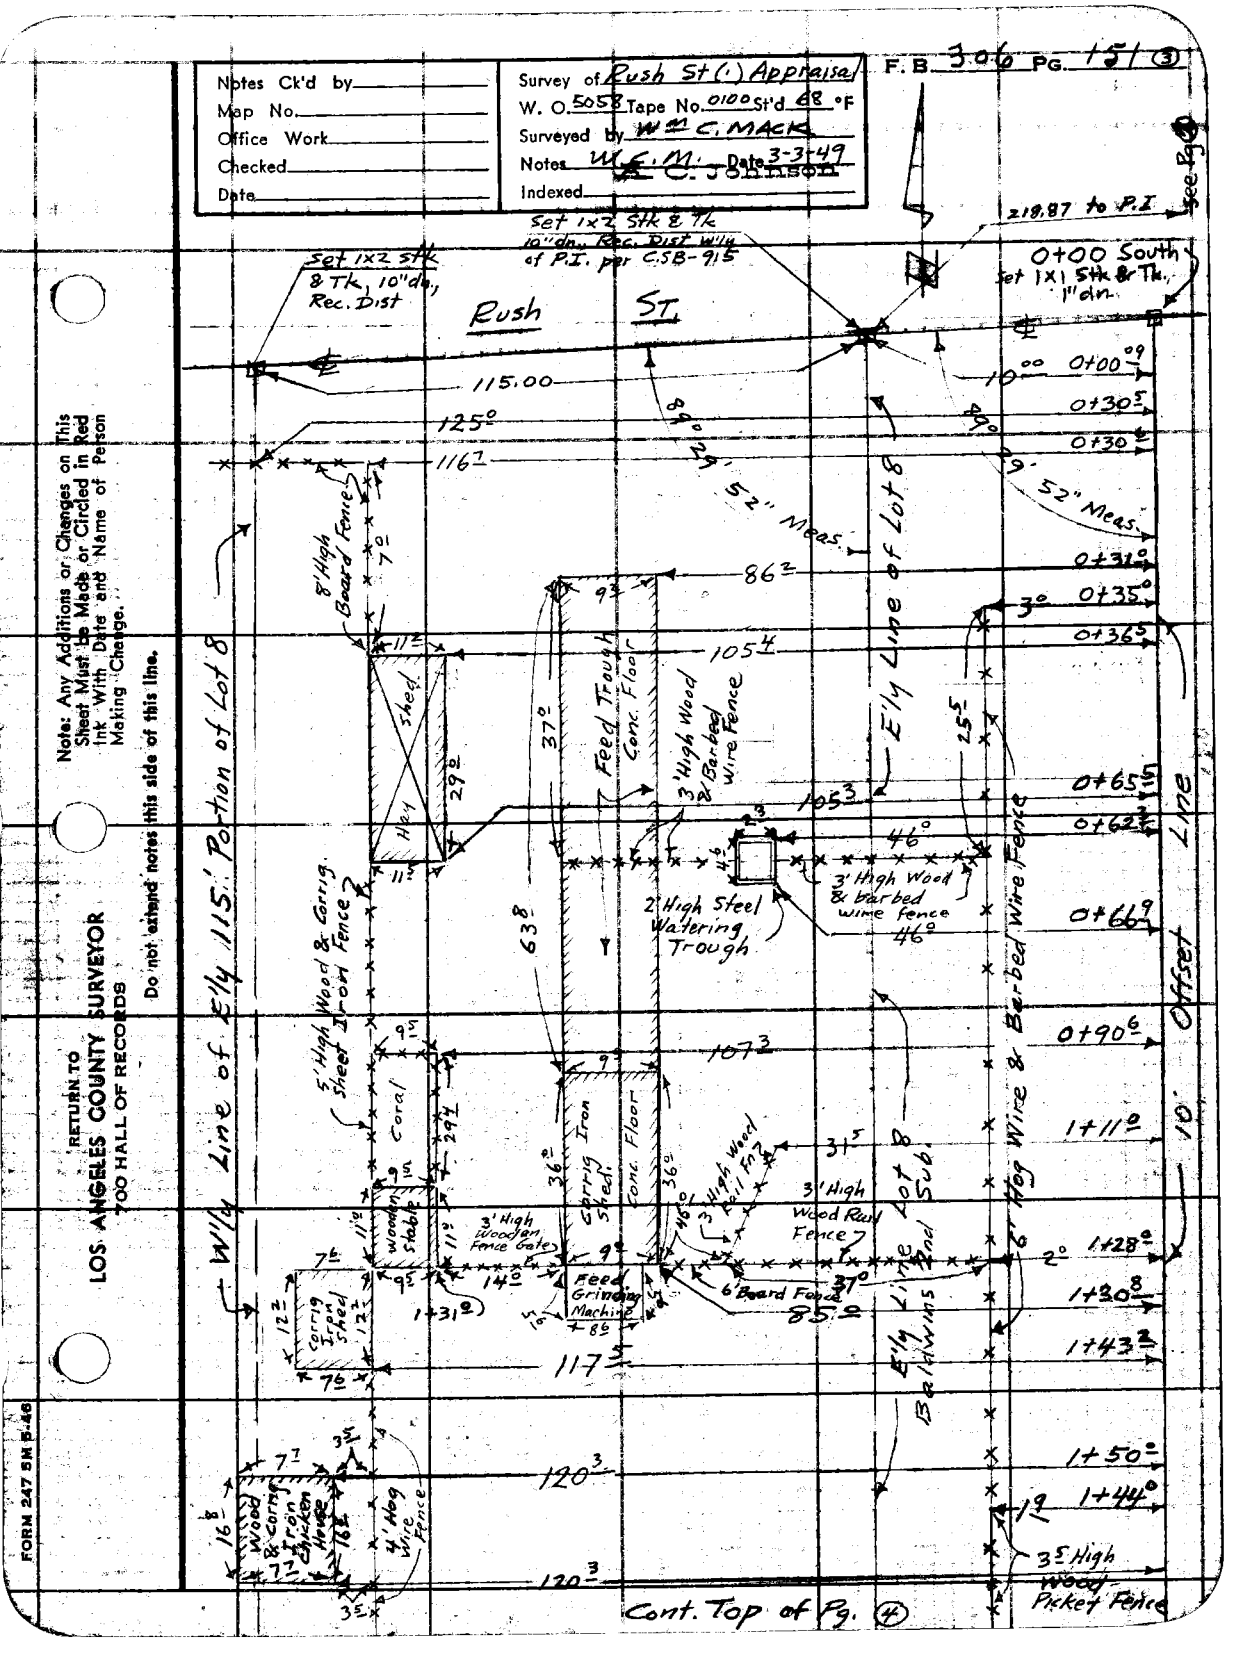
Notes Ck'd by
Map No.
Office Work
Checked
Date
Survey of Rush St (.) Appraisal
W. O. 5058 Tape No. 0100 St'd 68 °F
Surveyed by Wm C. MACK
Notes W. C. M. Date 3-3-49
C. C. Johnson
Indexed
F. B. 306 Pg. 151 (3)
See Pg.
219.87 to P.I.
0+00 South
Set 1x1 Stk & Tk., 1" dn.
Set 1x2 Stk & Tk. 10" dn., Rec. Dist Wly of P.I. per C.S.B. 915
Set 1x2 Stk & Tk, 10" dn., Rec. Dist
Rush St.
115.00
125°
116.7
8' High Board Fence
70
Shed
11.2
29.2
Hay
11.5
93
86.2
37°
Feed Trough Conc. Floor
3' High Wood & Barbed Wire Fence
105.4
105.3
E'ly Line of Lot 8
52" Meas.
0+31°
3°
0+35°
0+36.5
25.5
0+65.5
0+62.3
46°
3' High Wood & Barbed wire fence
46°
2' High Steel Watering Trough
63.8
0+66.9
W'ly Line of E½ 115' Portion of Lot 8
5' High Wood & Corrug. Sheet Iron Fence
9.5
107.3
0+90.6
1+11°
Coral
29.1
Corrug Iron Steel Conc. Floor
36°
3' High Wood Rail Fence
31.5
3' High Wood Rail Fence
Lot 8 Sub.
Baldwins End
E'ly Line
2' Hog Wire & Barbed Wire Fence
10' Offset
11.2
Wooden Stable
3' High Wood Fence Gate
14°
1+28°
2°
1+30.8
1+31.2
Feed Grinding Machine
6' Board Fence
37°
85.2
1+43.2
12.2
Corrug Iron Shed
7.6
117.5
1+50°
120.3
Wood & Corrug Iron Chicken House
16.8
18.2
4' Hog Wire Fence
1+44°
19
3.5' High Wood Picket Fence
Cont. Top of Pg. (4)
Note: Any Additions or Changes on This Sheet Must Be Made or Circled in Red Ink With Date and Name of Person Making Change.
Do not extend notes this side of this line.
RETURN TO
LOS ANGELES COUNTY SURVEYOR
700 HALL OF RECORDS
FORM 247 SM 5-46

F.B. 306 PG. 152 ④ Cont. from bot Pg. ③

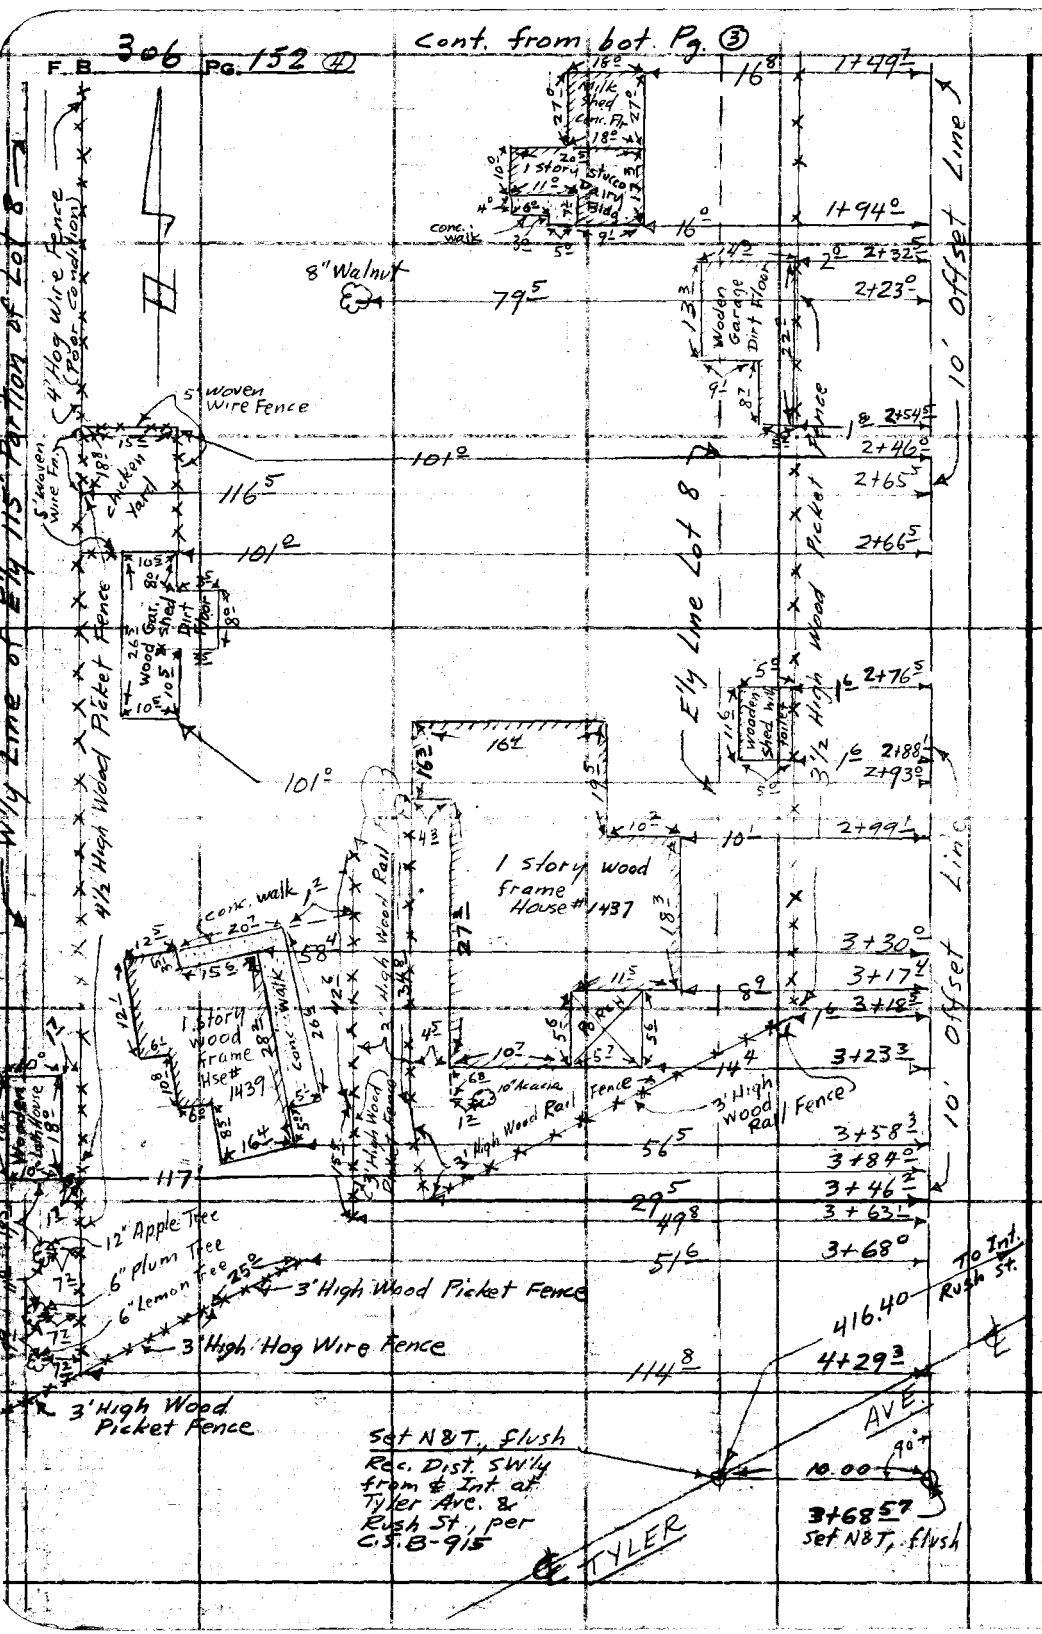

RETURN TO
LOS ANGELES COUNTY SURVEYOR
7DO HALL OF RECORDS

Do not extend notes this side of this line.

Note: Any Additions or Changes on This Sheet Must be Made or Circled in Red Ink With Date and Name of Person Making Change.

FORM 247 5M 5-46

RETURN TO
LOS ANGELES COUNTY SURVEYOR
700 HALL OF RECORDS

Note: Any Additions or Changes on This Sheet Must be Made or Circled in Red Ink With Date and Name of Person Making Change.

Do not extend notes this side of this line.

Notes Ck'd by____
Map No.____
Office Work____
Checked____
Date____

Survey of____
W. O.____ Tape No.____ St'd____ °F
Surveyed by____
Notes____ Date____
Indexed____

F.B. 376 PG. 153

RETURN TO
LOS ANGELES COUNTY SURVEYOR
700 HALL OF RECORDS

Note: Any Additions or Changes on This Sheet Must be Made or Circled in Red Ink With Date and Name of Person Making Change.

Do not extend notes this side of this line.

F. B. _____ Pg. _____