311

RETURN TO

LOS ANGELES COUNTY SURVEYOR

Note: ANY ADDITIONS OR CHANGES ON THIS SHEET MUST BE MADE OR CIRCLED IN Red. WITH DATE AND NAME OF PERSON MAKING CHANGE.

Do not extend notes this side of this line

Date_____ Notes by_____ Chief Party_____ F. B._____ Pg._____

Plotted by_____
Date_____
Map No._____
Platting ck'd by_____
Date_____

W. O. No._____ D. S. O. No._____
Location_____
Surveyed by_____
Date_____
Indexed_____

F.B. 311 Pg. Index Chief Party Notes by Date

F.B. 311

PAGES: Index, Index, 0, ,2 to 15 incl.,
,17, 18, 19, ,21 to 28 incl., ,
,31 to 46 incl., ,48 to 88 incl.,
88A, ,88C, 88D, 89 to 123 incl., ,
125, 126,

RETURN TO
LOS ANGELES COUNTY SURVEYOR

Do not extend notes this side of this line

Note: ANY ADDITIONS OR CHANGES ON THIS SHEET MUST BE MADE OR CIRCLED IN Red. WITH DATE AND NAME OF PERSON MAKING CHANGE.

Date _____ Notes by _____ Chief Party _____ F. B. 311 Pg. Index

Plotted by ~~Montana~~	W. O. No. ~~B. S. O. No.~~
Date March 1928	Location
Map No. B 150	Surveyed by
Plotting C'k'd by C.J. Terry	Date
Date March 1928	Indexed ~~A.~~ C. Johnson

Note: ANY ADDITIONS OR CHANGES ON THIS SHEET MUST BE MADE OR CANCLED IN Red. WITH DATE AND NAME OF PERSON MAKING CHANGE.

Do not extend notes this side of this line

RETURN TO LOS ANGELES COUNTY SURVEYOR

SURVEY OF
SUNSET BLVD
A & I 170
CITY LIMITS OF BEVERLY HILLS TO HORN AVE.

F.B. 311 Pg. 0 Chief Party Notes by C.V. Crumley Date 2/28

C.V. Crumley
H.S. Johnson
P.B. Cooke
G.E. Price

Sunset Blvd & Holloway Drive Survey
W.O. 4170

Tape .015" calibrated 20 lbs Pull at 84° Fah. was used
Temp. Corrections were made

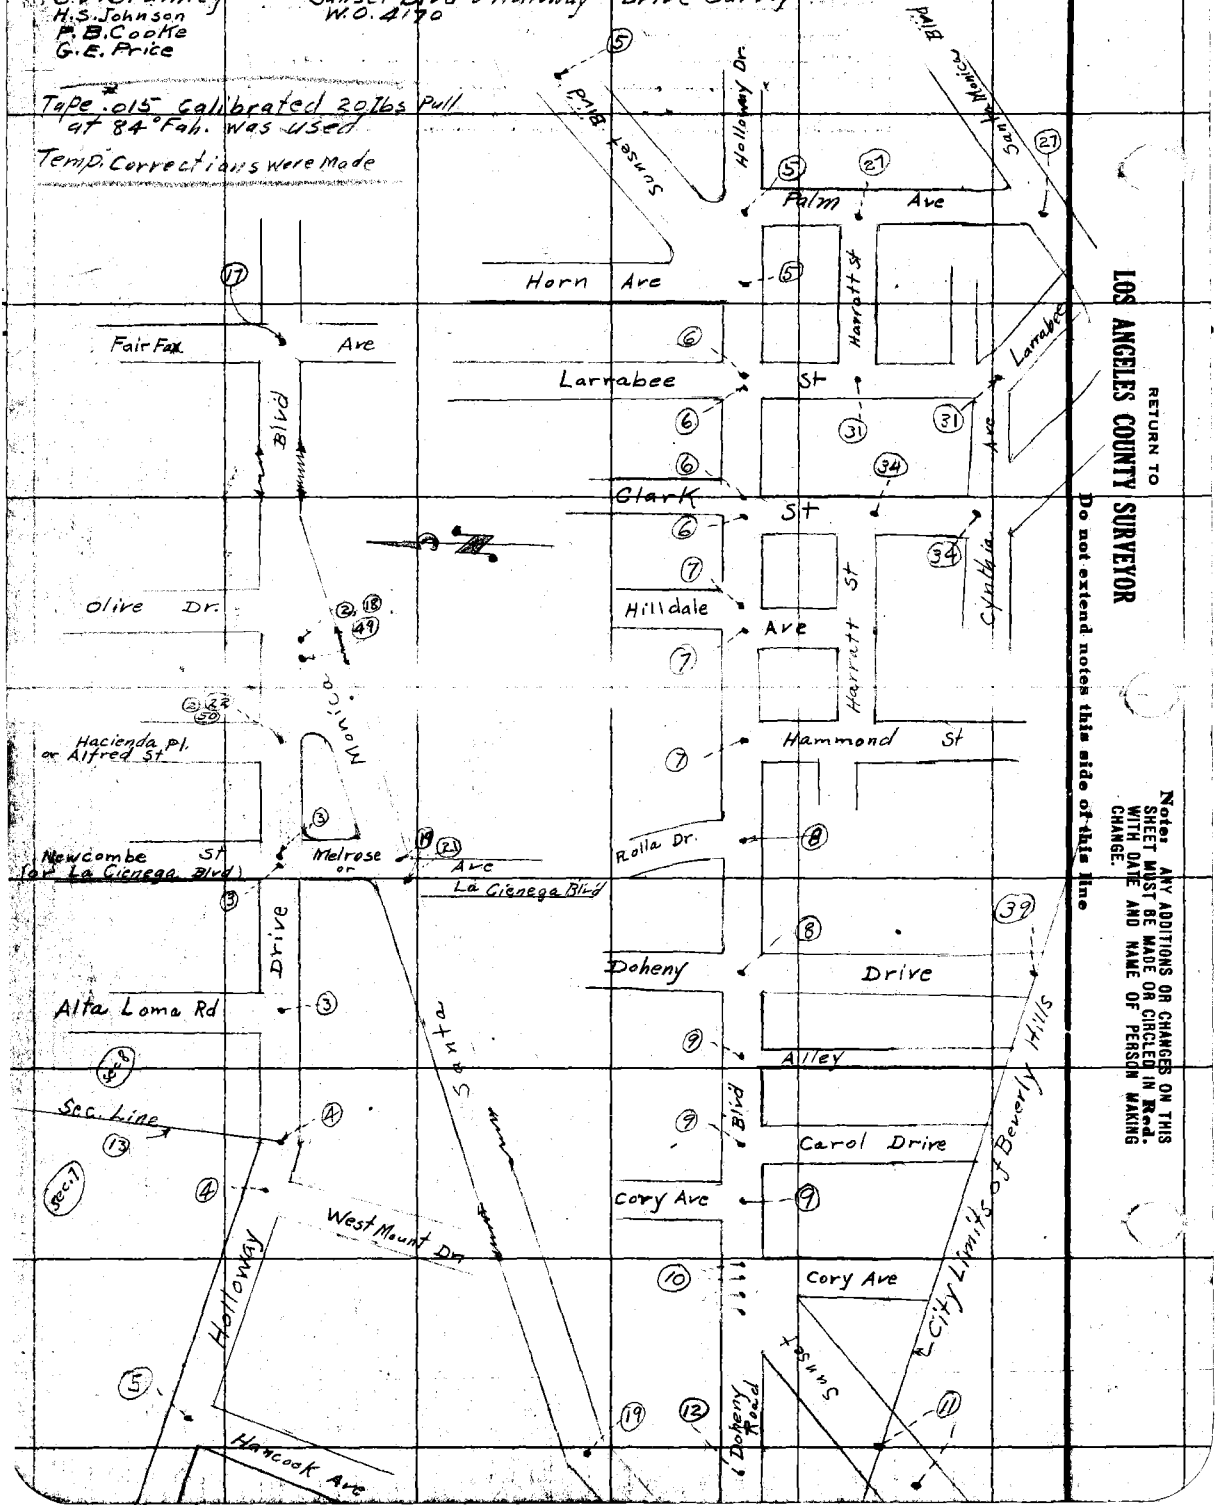

RETURN TO
LOS ANGELES COUNTY SURVEYOR
Do not extend notes this side of this line

Note: ANY ADDITIONS OR CHANGES ON THIS SHEET MUST BE MADE OR CIRCLED IN Red. WITH DATE AND NAME OF PERSON MAKING CHANGE.

Date _____ Notes by _____ Chief Party _____ F. B. 311 PG. 1

Plotted by Hopkins
Date March 1928
Map No. B 150
Plotting C'k'd by C.A. Terry
Date March 1928

W. O. No. _____ R. S. O. No. _____
Location _____
Surveyed by _____
Date _____
Indexed A. C. Johnson

Notes: ANY ADDITIONS OR CHANGES ON THIS SHEET MUST BE MADE OR CIRCLED IN Red. WITH DATE AND NAME OF PERSON MAKING CHANGE.

Do not extend notes this side of this line

RETURN TO
LOS ANGELES COUNTY SURVEYOR

F.B. 311 PG. 2 Chief Party Notes by Grumley Date 12/8/, 27

Continued on Bottom Pg 3

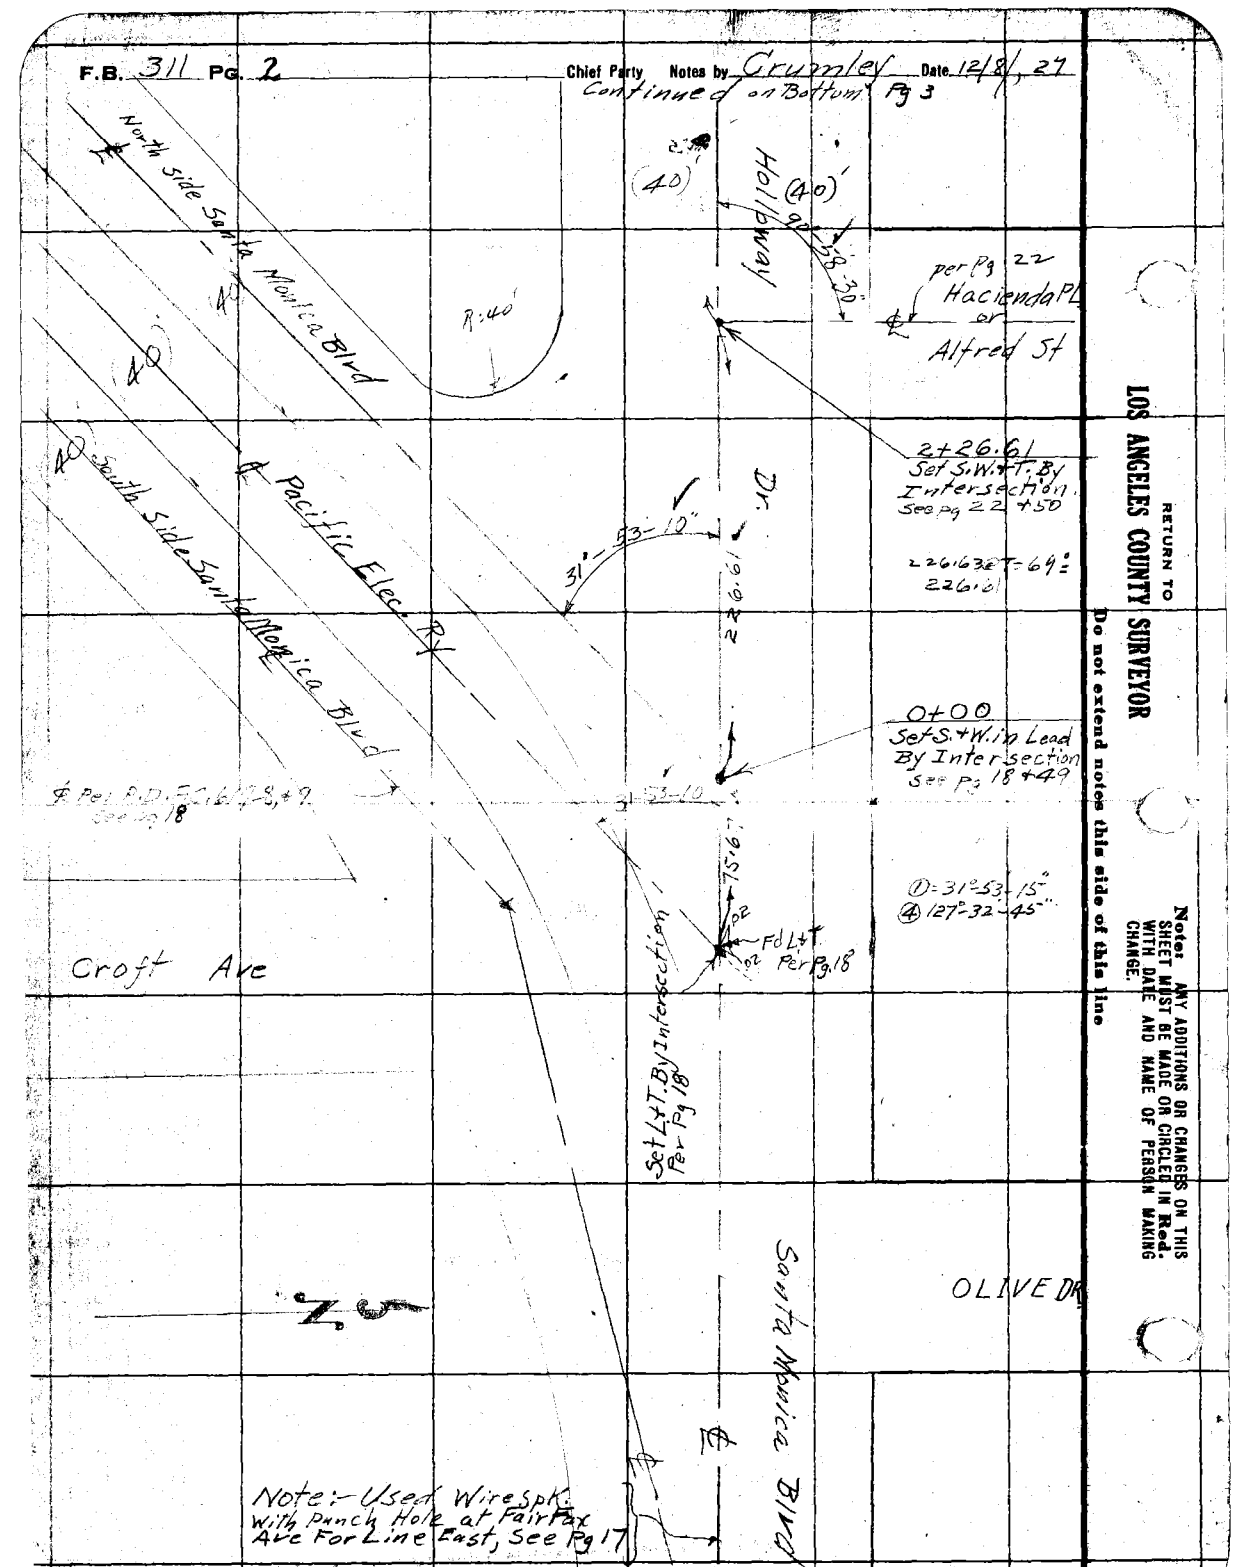

RETURN TO
LOS ANGELES COUNTY SURVEYOR

Do not extend notes this side of this line

Notes: ANY ADDITIONS OR CHANGES ON THIS SHEET MUST BE MADE OR CIRCLED IN Red WITH DATE AND NAME OF PERSON MAKING CHANGE.

Date: Notes by: Chief Party: F. B. 311 Pg. 3

Plotted by: Hopkins
Date: March 1928
Map No. B150
Plotting C'k'd by: C. J. [illegible]
Date: MAR

W. O. No. 4170 D. S. O. No.
Location Holloway Drive
Surveyed by C.V. Crumley
Date 12/21/27 & 2/11/28
Indexed A. C. Johnson

Continued on Bottom Pg 4

Note: ANY ADDITIONS OR CHANGES ON THIS SHEET MUST BE MADE OR CIRCLED IN Red. WITH DATE AND NAME OF PERSON MAKING CHANGE.

RETURN TO LOS ANGELES COUNTY SURVEYOR

Do not extend notes this side of this line

10+24.54 Set S.W. & T. F.B. 311-96

379.72'

set "X"

set "X"

5.00'

Alta Loma Road

Per Pg 24

See F.B. 332-9

11'

89°

89°10'

50"

~~10+24.47~~ Set "X" on Manhole Cover By Intersection Per Pg 24 & 55

Adopted ℄

HOLLOWAY DRIVE

(30)

1447.14'

(30)

5.0

5+79.40 Nothing Set

90°00'

05" Add.

90°-48'

Add.

~~5+79.33~~ Set "X" on Manhole Lid By Intersection Per Pg 23; 51 & 52

set "X"

Per Pg 21

Melrose Ave

℄

La Cienega Blvd

(30)

Newcombe St

℄

La Cienega Blvd

Per Pg 23

set "X"

set "X"

5+78.93 set Spike & Washer And Tin by Int. F.B. 311-95

~~5+78.96~~ Set "X" on Manhole Cover By Intersection See Pg 21 & 51 & 52

(40)

(40)

Cont'd From Top Pg 2

F.B. 311 Pg. 4 Chief Party Notes by C.V. Crumley Date 12/15/28

Continued on Bottom Pg 3

~~11+34.14~~ Set N.&T. See Pg. 61

~~11+33.97~~ Set X" Rim of M.H.

Fd 2 I.P. Plug & TK Per West Knoll Tr. ~~11+33.78~~

Fd 2x2

29.82

29.89

5.05

~~11+33.70~~

5.00

Fd 1" I.P. N.W. Cor. Lot #1 Block "A" West Knoll Tr. See Note At Sta ~~11+01.81~~

HOLLOWAY

Adopted ℄ CPC. 320

(30) (30)

14+59.05 Set S.W.&T. By Int. F.B. 311-96

West Mount Dr.

30'

℄

Per Pg 25

~~14+58.99~~ Set S.W.&T. Rec. (54.69) From Sec. Cor. Sta. 14+04.21 Per West Knoll Tr. See Pg 25 & 59

5.0

DRIVE

Angle Point 14+04.26 Set S.W.&T. By Int. F.B. 311-96

T. 1S. R. 14W.

(used for Line on Sec. Line) Sec. 7

~~11+03.6~~

Fd 2" I.P. Plug & TK

178° 51' 50"

178.79

23.94

See Pg 25 & 39

~~14+04.21~~ Set S.W.&T. By Intersection of ℄ From West & Section Line From North & Record Distance (329.49) From I.P. N.W. Cor. Lot #4 Block "A" West Knoll Tract

Used For Line East To Fairfax Ave Per Pg 17

℄ Per C.S. #7143

Sec. Line Per Pg 13

Cypress Tree 14+03

Sec. 8

T. 1S R. 14W.

100 Ft.

378.72

5.00

(30)

(30)

5.0

Continued From Top Pg 3

RETURN TO LOS ANGELES COUNTY SURVEYOR

Do not extend notes this side of this line

Notes: ANY ADDITIONS OR CHANGES ON THIS SHEET MUST BE MADE OR CIRCLED IN Red. WITH DATE AND NAME OF PERSON MAKING CHANGE.

Date _____ Notes by _____ Chief Party _____ F. B. 311 Pg. 5

Plotted by Hopkins
Date March 1928
Map No. B150
Plotting Ch'd by C. J. T.
Date MAR 1928

W. O. No. 4170 D. S. O. No.
Location Holloway Drive
Surveyed by C.V. Crumley
Date ~~Dec. 22, 27, 28~~, 1927
Indexed A. C. Johnson

Continued on Bottom Pg 6

Set S.W.&T.

See Pg 28 & 69

27+23.34 Set S.W.&T. by Int. F.B. 311-98

See Pg 27 & 68

~~25+80.47~~ Set S.W.&T. By Intersection

Per Pg 27

Palm Ave.

(54') (48') (33')

HOLLOWAY DRIVE

Adopted ℄

131.14 Adopted ℄

90°-23'-40"

24+25.08 Angle Point Set S.W.&T. F.B. 311-97

(30') (30')

177.52 to Corner

89°-36'

89°-19'-05"

269.22

Set "X"

Set "X"

Set "X"

.17

Adopted ℄ 296.30'

22' Hancock Ave.

(20')

Per Pg 26

21+55.35 Set S.W.&T. by Int. F.B. 311-97

Continued From Top Pg 4

Horn Ave.

per Pg 28

(25')

Δ = 4°04'46"
R = 445.00
T = 158.73
L = 319.05

P.C.C.

0.95

18.71

9.67

28.39

158.67

A9

41°-04'-45"

142.68

0.56

164.73

50

SUNSET BLVD

E.C.

10.87

Adopted ℄

Per Pg 28

Lot 1 Set S.W.&T. by Int. F.B. 311-98

E.C. of Sunset Set S.W.&T. F.B. 311-98

P.C.C. Set S.W.&T. F.B. 311-98

Corner of Lot 1 for Proportion

21+55.19 Set "X" on M.H. Cover By Intersection

See Pg 26 & 64

Notes: ANY ADDITIONS OR CHANGES ON THIS SHEET MUST BE MADE OR CIRCLED IN Red. WITH DATE AND NAME OF PERSON MAKING CHANGE.

Do not extend notes this side of this line

RETURN TO LOS ANGELES COUNTY SURVEYOR

F.B. 311 PG. 6 Chief Party Notes by C.V. Crumley Date 12/29/27

Continued on Bottom Pg 7

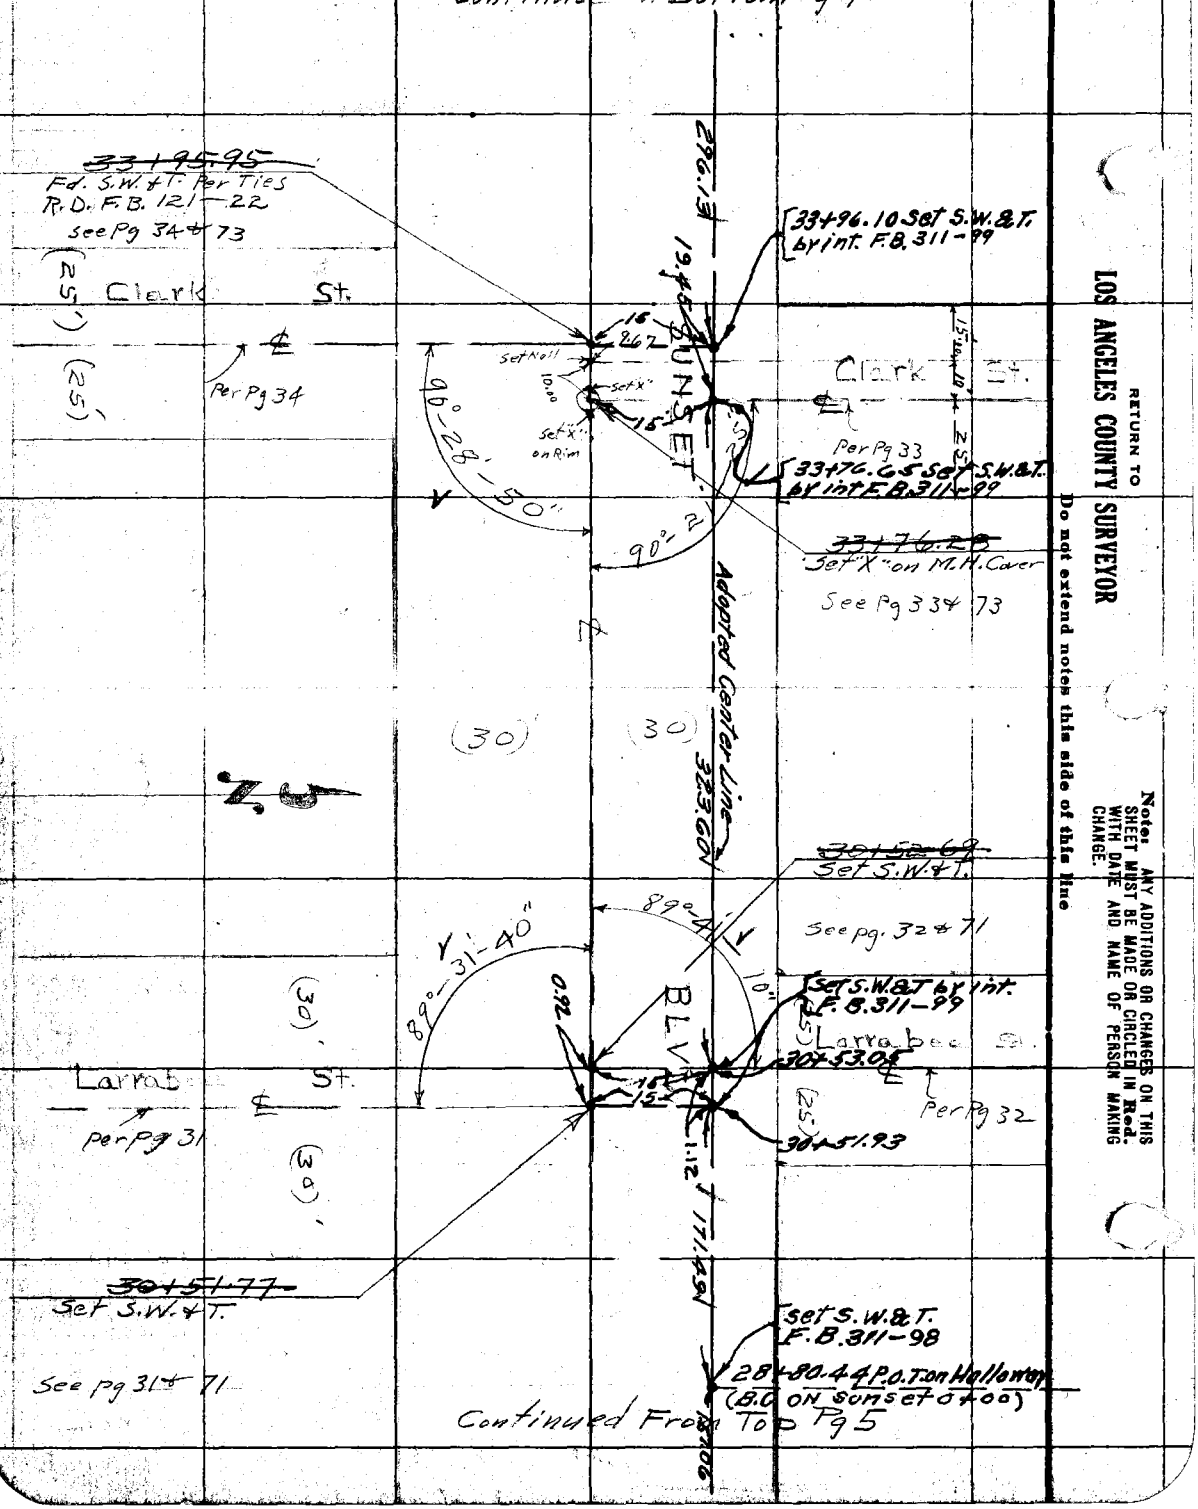

RETURN TO
LOS ANGELES COUNTY SURVEYOR
Do not extend notes this side of this line

Notes: ANY ADDITIONS OR CHANGES ON THIS SHEET MUST BE MADE OR CIRCLED IN Red. WITH DATE AND NAME OF PERSON MAKING CHANGE.

Date: Notes by: Chief Party: F. B. 311 Pg. 7

Plotted by: Hopkins
Date: March 1928
Map No. B 150
Plotting C'k'd by: C. J. T.
Date: MAR 1928

W. O. No. 4170 C. S. O. No.
Location: Sunset Blvd
Surveyed by: C. V. Crumley
Date: 12/30 & 31/27 & 1/3 & 4/28
Indexed: A. C. Johnson

Continued on Bottom Pg 8

Angle Point
40+12.83
Set S.W.&T. By int.
F.B. 311-100

N 37° 05" W
279.30'
N 0° 31' E
1500 N
Hammond St.
(22.5)
(22.5)
Per Pg 37
SUNSET
181.20'
Adopted
Center Line
N 26.72 W
(30)
(30)
Set "X" on M.H. By Ties R.D.F.B. 121-
See Pg 37 & 78

37+46.01
Set S.W.&T. Per Ties
R.D. F.B. 121-22
See Pg 36, 75 & 76
37+16.11 Set S.W.&T.
By int. F.B. 311-100

89° 19' 30"
(N5) Hilldale Ave
Per Pg 36
BLVD
15'
241.45'
23.88'
15'
Hilldale Ave.
(N5)
Per Pg 35
(N5)
90° 21' 25"

36+92.23 Set
S.W.&T. By int.
F.B. 311-100

36+91.86
Set "X" on M.H. L'd By Proportion Between E North Clark St. & E South Hammond St.
See Pg 35 & 75

Continued From Top Pg 6

RETURN TO LOS ANGELES COUNTY SURVEYOR

Do not extend notes this side of this line

Note: ANY ADDITIONS OR CHANGES ON THIS SHEET MUST BE MADE OR CIRCLED IN Red. WITH DATE AND NAME OF PERSON MAKING CHANGE.

F.B. 311 Pg. 8 Chief Party Notes by C.V.Crumley Date 12/4/27

Cont'd on Bottom Pg 9

RETURN TO
LOS ANGELES COUNTY SURVEYOR
Do not extend notes this side of this line

Note: ANY ADDITIONS OR CHANGES ON THIS SHEET MUST BE MADE OR CIRCLED IN Red. WITH DATE AND NAME OF PERSON MAKING CHANGE.

(30') Laheny (30')
Per Pg 39

Set "X"

178°-40'-00"

Set "X"

90°

05" Adj.

Drive
Per Pg 40

89°-33'-

52.17

Angle Point 46+56.72
Set "X" on Man Hole Cover
By Ties Per R.D. F.B. 121-23
see pg. 39 + 83

26'-52"

55 Adj.

E'ly 20-00" Curve

(30') (30')

See pg 38+80

Set Nail By Proportion
Between 2" I.P. Plug & Nail S.E. Cor. Lot 24 Tr. 5365 + L.S.B. 14-46 Sta. 41+48.64 And 2" I.P. Plug & Nail S.W. Cor. Lot 28, Tr. 5365 Per L.S.B. 14-46, Sta 50+43.25

42+90.23
Set S.W. & T.
Rec. Per L.S.B. 14-46

379.50

79°-40'-30"

Rolla Drive

Tang. Per Pg 38

90°

Calc. 5445

30

8.64

42+92.13
Set spike W. & T.
By int. F.B. 311-101

Cont'd From Top Pg 7

RETURN TO
LOS ANGELES COUNTY SURVEYOR

Note: ANY ADDITIONS OR CHANGES ON THIS SHEET MUST BE MADE OR CIRCLED IN **Red.** WITH DATE AND NAME OF PERSON MAKING CHANGE.

Do not extend notes this side of this line

Date _____ Notes by _____ Chief Party _____ F.B. 311 Pg. 87

Planned by Hopkins Date March 1925 Map No. B 1550 Sht 1 Plotting Cked by MAP Date 1-1-26

W.O. No. 4170 O.S.O. No. _____ Location Sunset Blvd Surveyed by C.V. Crumley & A.C. Johnson Date February 8 1927 Indexed

Carried on Rt. Side Pg 88

T.P.

30.1 52+96

+77.3 54.7

+72.6 45.6

+70.6 43.6 R=2'

+67 44.5

+63.3 44.6

52+58.7 44.6

Pergola

52+55 41.0

29.94

52+27.5 26.9 P.P.

Pilot Rocks

Ornamental Fish Pond

3.4 3.5 1.6 11.6 10.7 3.3 4.6 3.3 0+02 0+03.7 0+07.7 0+10.7 0+14 0+01.7 0+05.5

3/4 Hydt.

88.2

R=35'

10' conc Dr

out 58.15

52+47 8" Bottle Tree

Barb Wire Fence

52+35 B.C.

52+38 out 55.75

52+38.19 2" T.P. Pg. 41

5' Walk

11' Park

Sunset Blvd.

Flagstone Walk

52+10.2

52+02.3 41.56

one Story Frame Bldg 14.0

This gone see Pg 88 X C.V.C. 7/3/27

Lattice Fence

6"x6" Sign Post

51+97 30.27 29.56

8" Water Meter Box out 45.97

51+88 41.0

31.9 29.97 +80 +74 R=10'

out 45.00 51+86.65

8" Water Meter Box

51+86.64

122.37 @ T=68° = 122.36

50 49.30

5171.66

112.5

one story Stucco Garage

92.3

76.2

20.10

Cory Ave

51+56-58

5' Park

5' Walk

51+71.66

Set X" on M.H. Cover

See Pg 94 3

29.47 29.97 +69 51+68 R=10'

End cur 6

Light Standard

29.45

147.36

Contd. From Lt. Pg 86

Cont'd For Pg 43

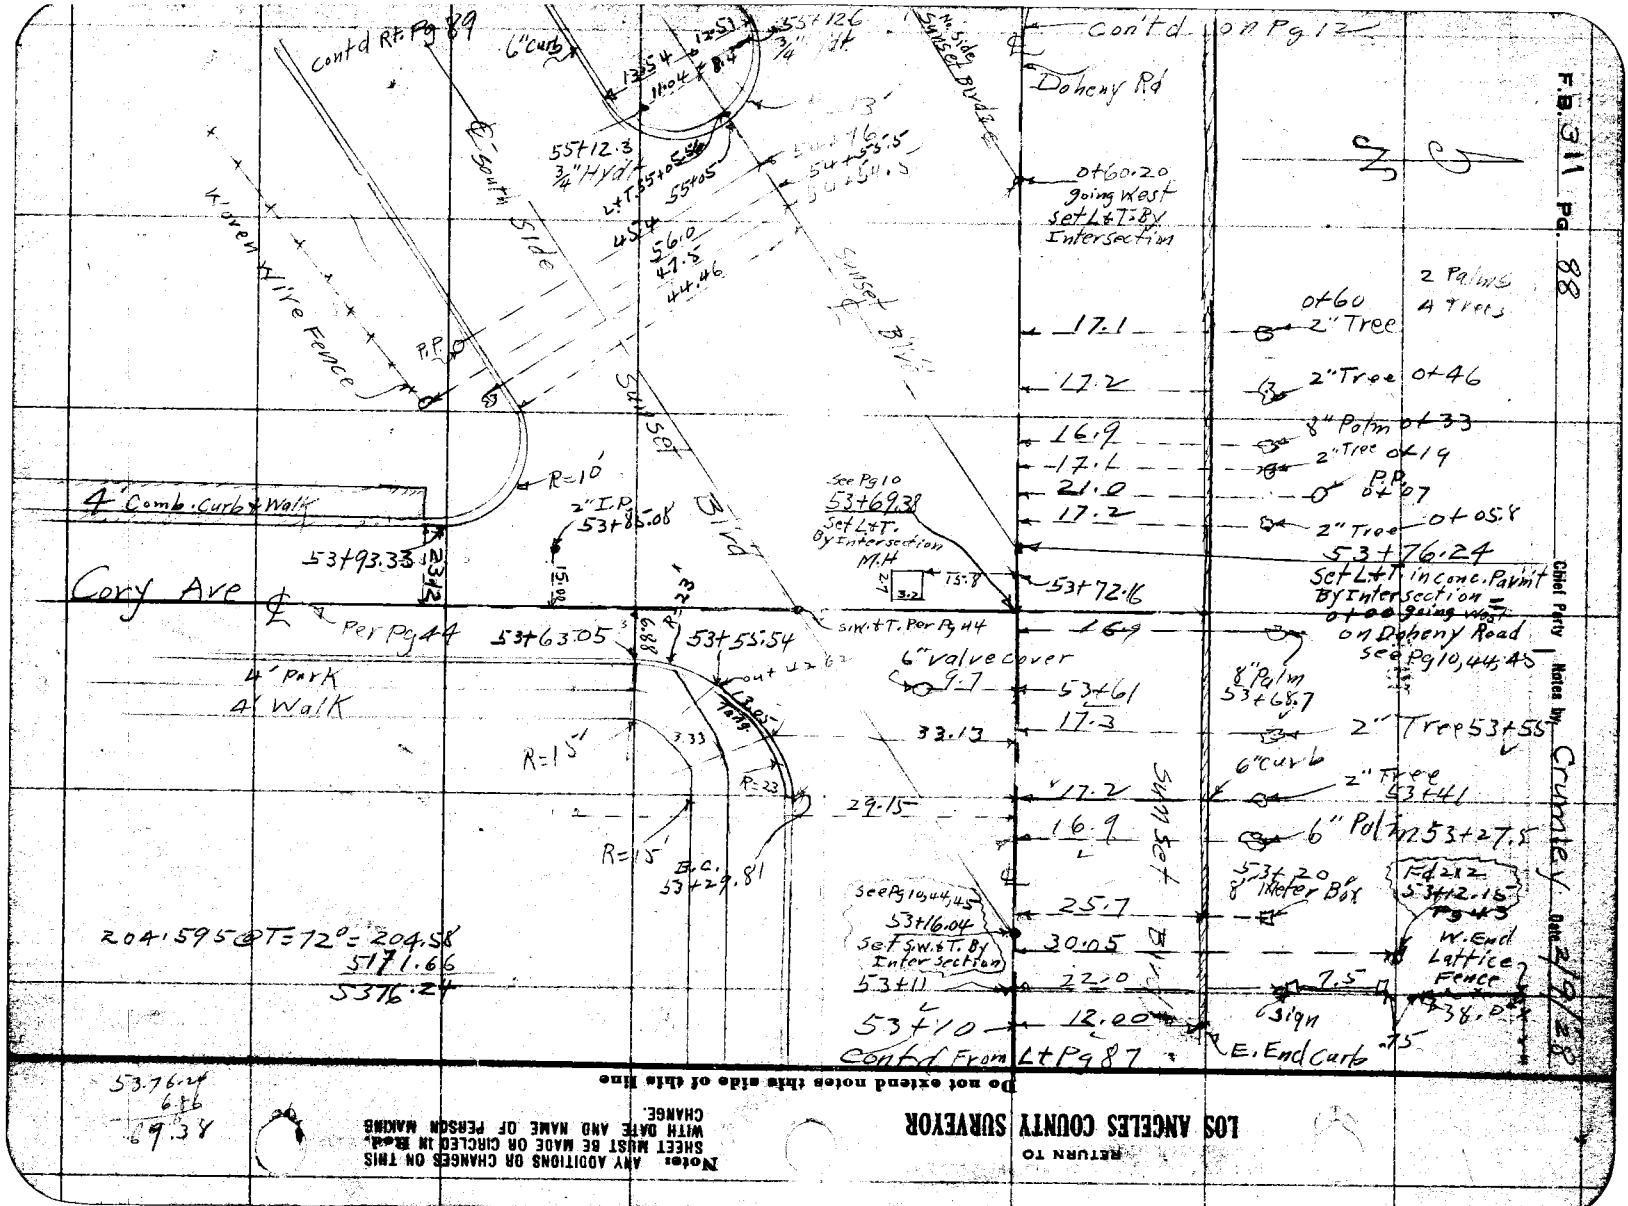

Do not extend notes this side of this line

LOS ANGELES COUNTY SURVEYOR

RETURN TO

Note: ANY ADDITIONS OR CHANGES ON THIS SHEET MUST BE MADE OR CIRCLED IN Red, WITH DATE AND NAME OF PERSON MAKING CHANGE.

Date _____ Notes by _____ Chief Party C. V. Crumley F.B. 311 Pg. 88X

Platted by	W. O. No. 4170 D. S. O. No.
Date	Location Sunset Blvd
Map No.	Surveyed by E. S. Tomblesen
Platting C'k'd by	Date 7/31/47
Date	Indexed A. C. Johnson

Notes: ANY ADDITIONS OR CHANGES ON THIS SHEET MUST BE MADE OR CIRCLED IN Red. WITH DATE AND NAME OF PERSON MAKING CHANGE.

Do not extend notes this side of this line

RETURN TO LOS ANGELES COUNTY SURVEYOR

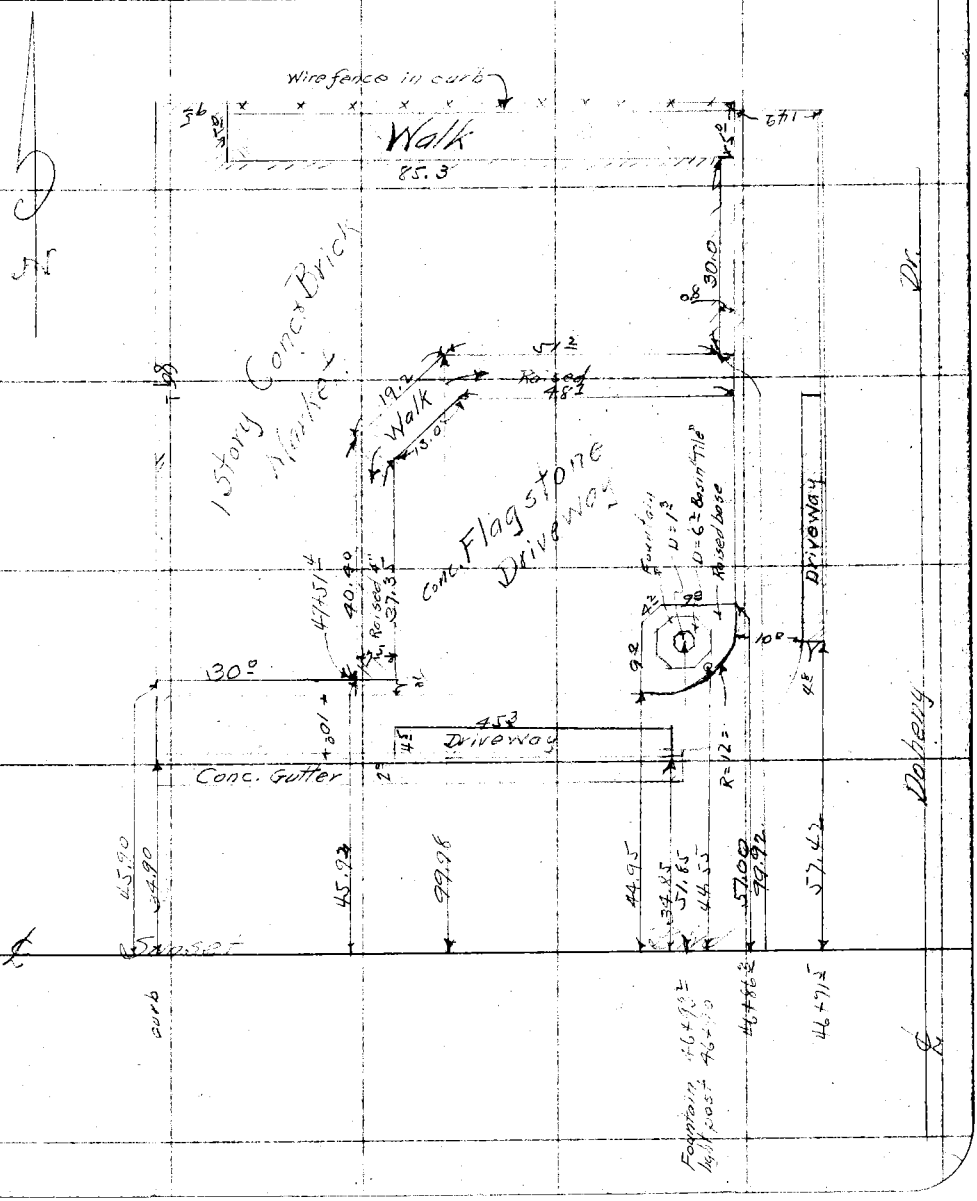

F. B. 311 Pg. 88B. Chief Party Notes by Date

RETURN TO
LOS ANGELES COUNTY SURVEYOR

Do not extend notes this side of this line

Note: ANY ADDITIONS OR CHANGES ON THIS SHEET MUST BE MADE OR CIRCLED IN Red. WITH DATE AND NAME OF PERSON MAKING CHANGE.

Date _____ Notes by _____ Chief Party _____ F. B. 311 Pg. 88 "C."

Plotted by _____
Date _____
Map No. _____
Plotting C'k'd by _____
Date _____

W. O. No. 4174 D. S. O. No. _____
Location Sunset Blvd.
Surveyed by C. V. Crumley
Date 7/3/29
Indexed A. C. Johnson

Notes: ANY ADDITIONS OR CHANGES ON THIS SHEET MUST BE MADE OR CIRCLED IN Red. WITH DATE AND NAME OF PERSON MAKING CHANGE.

Do not extend notes this side of this line

RETURN TO LOS ANGELES COUNTY SURVEYOR

Doheny Rd
℄
Pg. 12

54 +89 17.3 8" Palm
+76 17.0
+63 17.3 3" Poplar
+49 17.2 8" Palm
+36 17.3 2"
+22.0 17.2 2" Popla. = 0+46 Pg. 88

Sunset Blvd
℄
Pg. 45+10

54+09 16.9 8" Palm. = 0+33 Por Pg. 88
+94 17.1 4" Poplar = 0+19 " "
+81 17.2 3" Poplar = 0+05.8 Pg 88

53+76.69 ℄ 45.61
53+53 17.2
53+42 17.1 4" Poplar

14.1
1 Story Frame Bldg
14.0
10.0
14.1
10.0
14.0

53+18 46.00
Blvd ℄ 6" Curb
TR. 0.0
53+10
Sunset

Relocation of Real Estate office & Trees
See Pg 87+88
C.V.C. 7/3/29

F.B. 311 PG. 88D. Chief Party Notes by Date 5-18-88

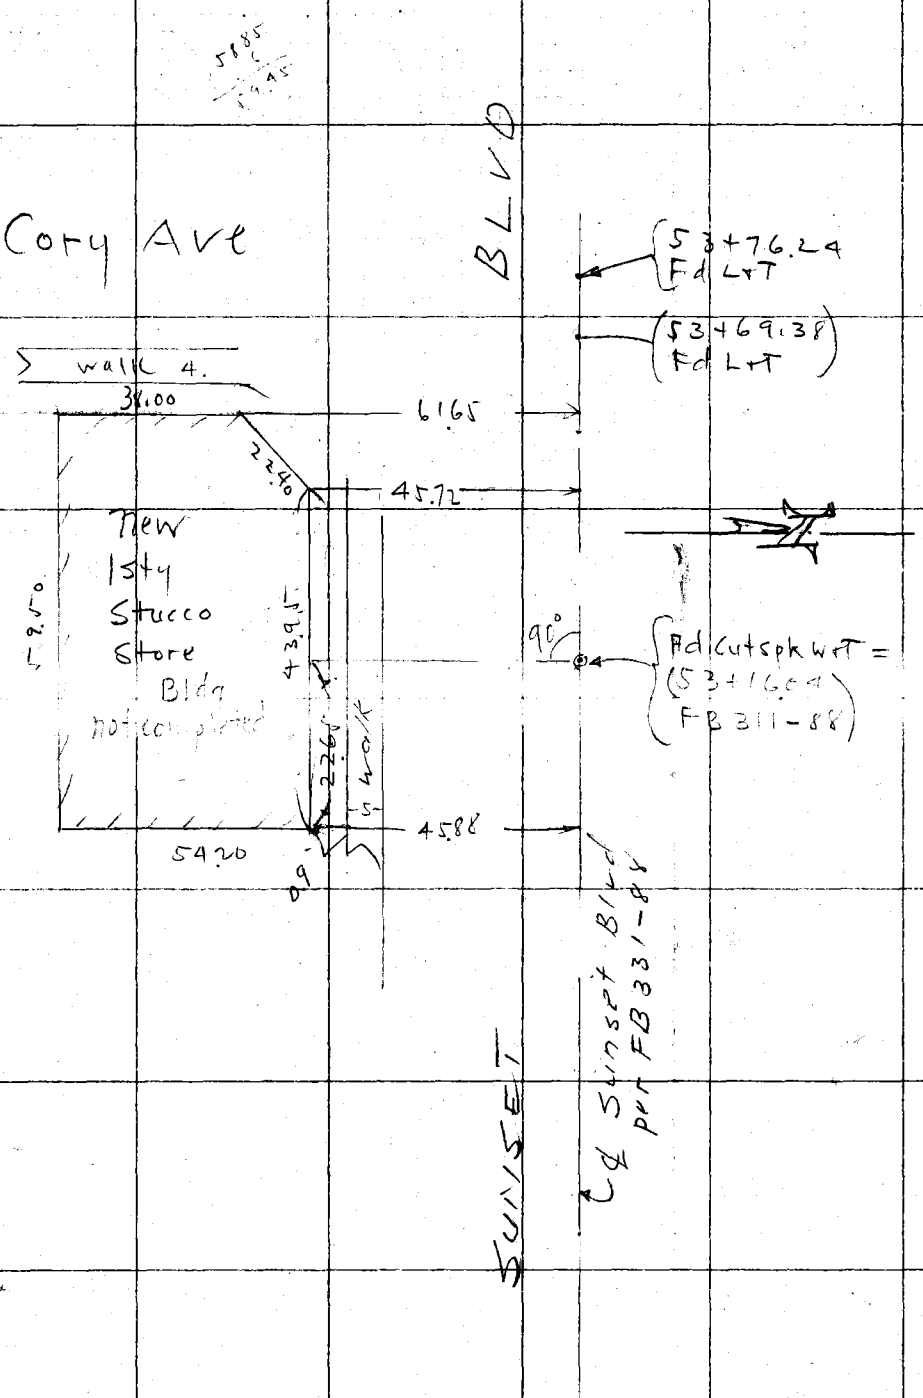

RETURN TO
LOS ANGELES COUNTY SURVEYOR
Do not extend notes this side of this line

Notes: ANY ADDITIONS OR CHANGES ON THIS SHEET MUST BE MADE OR CIRCLED IN Red. WITH DATE AND NAME OF PERSON MAKING CHANGE.

RETURN TO

LOS ANGELES COUNTY SURVEYOR

Notes: ANY ADDITIONS OR CHANGES ON THIS SHEET MUST BE MADE OR CIRCLED IN **Red.** WITH DATE AND NAME OF PERSON MAKING CHANGE.

Do not extend notes this side of this line

Date _____ Notes by _____ Chief Party _____ F. B. 311 PG. 89

Plotted by [illegible] Date March 1928

Map No. B 1570

Planting C'k'd by C. J. T. Date MAR 1928

W. O. No. 4170 S. D. No. 1117

Location Sunset Blvd

Surveyed by C. V. Crumley Date February 3, 1927

Indexed C. J. Tennison

Cont'd on Rt Side Pg 90

129.33 = 76° 12.32
337.24
L&T. 55+05.56

N. side Sunset Blvd

S. Side Sunset Blvd

Sunset Blvd

Bridle Trail

4" Palm 55+53.5

8" Tree 55+32

4" Palm 55+11 out 47.7

55+08.5 out 48.7

8" Meter Box 55+07.5 out 47.7

46.4

46.7

36.0

55+12.3 3/4" Hydt.

13.54 12.51 11.04 8.4

3" Hydt 55+12.6

36.0

55+17.30

54+95.40

3.58

R=15'

L&T. 55+05.56 Pg 45

6" curb

P.P.

Woven Wire Fence

45.4 54+76

56.0 54+55.75

47.5

8" Tree

44.46

Cory Ave

R=10'

12.04 12.04

17.26

17.13

17.00

0.87 17.24

17.20

6" Palm

2" Tree

0.74 6" Palm

0+60.20

L&T.

Pg 44/88

Pg 10

Pg 10

Pg 10

contd From Lower Lt Pg 88

Contd From Upper Lt Pg 87 See Pg 12

RETURN TO
LOS ANGELES COUNTY SURVEYOR

Note: ANY ADDITIONS OR CHANGES ON THIS SHEET MUST BE MADE OR CIRCLED IN Red. WITH DATE AND NAME OF PERSON MAKING CHANGE.

Do not extend notes this side of this line

F.B. 311 Pg. 90 Chief Party Notes by Crumley Date 2/9/28

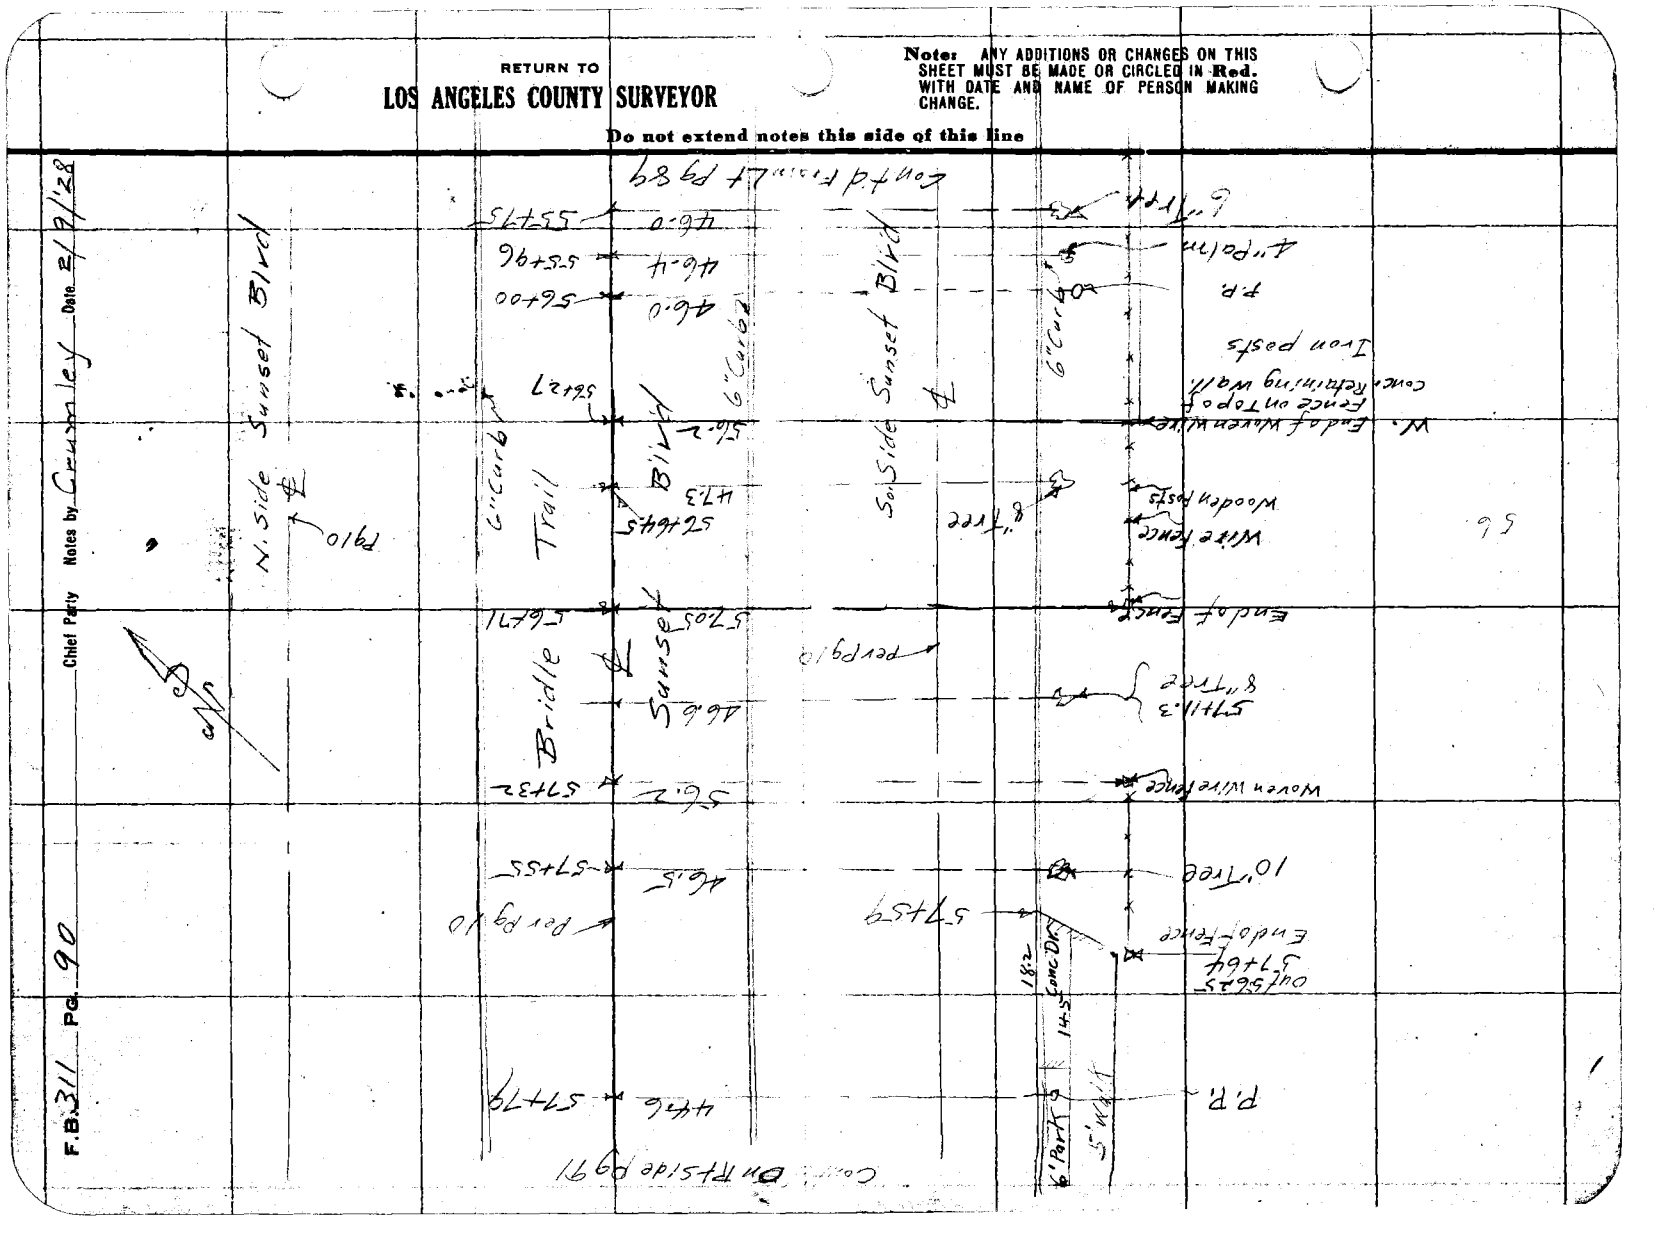
Cont'd from Lt Pg 89
N. Side Sunset Blvd
S. Side Sunset Blvd
Bridle Trail
Sunset
Cont'd on Rt Side Pg 91
Pole
Pole
Pole

RETURN TO
LOS ANGELES COUNTY SURVEYOR

Note: ANY ADDITIONS OR CHANGES ON THIS SHEET MUST BE MADE OR CIRCLED IN Red. WITH DATE AND NAME OF PERSON MAKING CHANGE.

Do not extend notes this side of this line

Cont'd on Rt side Pg 92

59+87.82
Conc Mon. with 3/4" I.P. & Nail, 6" Deep

Ranch Line of Beverley Hills

R=10'

City Limits R

See Page 125
59+51.09
Fd 4"x4" conc. Mon. with 3/4" I.P. & TK. 3½ ft Deep
See Pg 11, 26, 892

Per Pg 11

114.5

58+91.5

6" Tree

47.8

58+90.5

445.56 @ 75°
445.53
5505.56

2" Inlet Pipe To gas Tank

56.5

58+54.5

Conc Mon. 59+51.09

Light Standard

2.1

53.9

+51

Air & Water Stand

12.5

Conc. Dr.

55.16

58+50

2" Dia

58+47.6

So Side Sunset Blvd.

58+50.6

6" Tree

48.0

58+45

Per Pg 11

Per Pg 11

N. Side Sunset Blvd

Conc. Dr.

13.3

58+22.6

58+20

Sunset Blvd.

3/4" I+Y d/t

58.0

58+18

6" Water Meter Box

48.8

58+16

6" Tree

47.0

58+00

Cont'd From Lt Pg 90

Plotted by: Mapkens
Date: March 1928
Map No. B150
Platting C'k'd by: C.J.T.
Date: 1928

W. O. No. 4170 S. O. No.
Location: Sunset Blvd
Surveyed by: C.V. Crumley
Date: February 9, 1928
Indexed: A. C. Johnson

Notes by
Chief Party
F. B. 311 Pg. 91

RETURN TO

LOS ANGELES COUNTY SURVEYOR

Notes: ANY ADDITIONS OR CHANGES ON THIS SHEET MUST BE MADE OR CIRCLED IN **Red.** WITH DATE AND NAME OF PERSON MAKING CHANGE.

Do not extend notes this side of this line


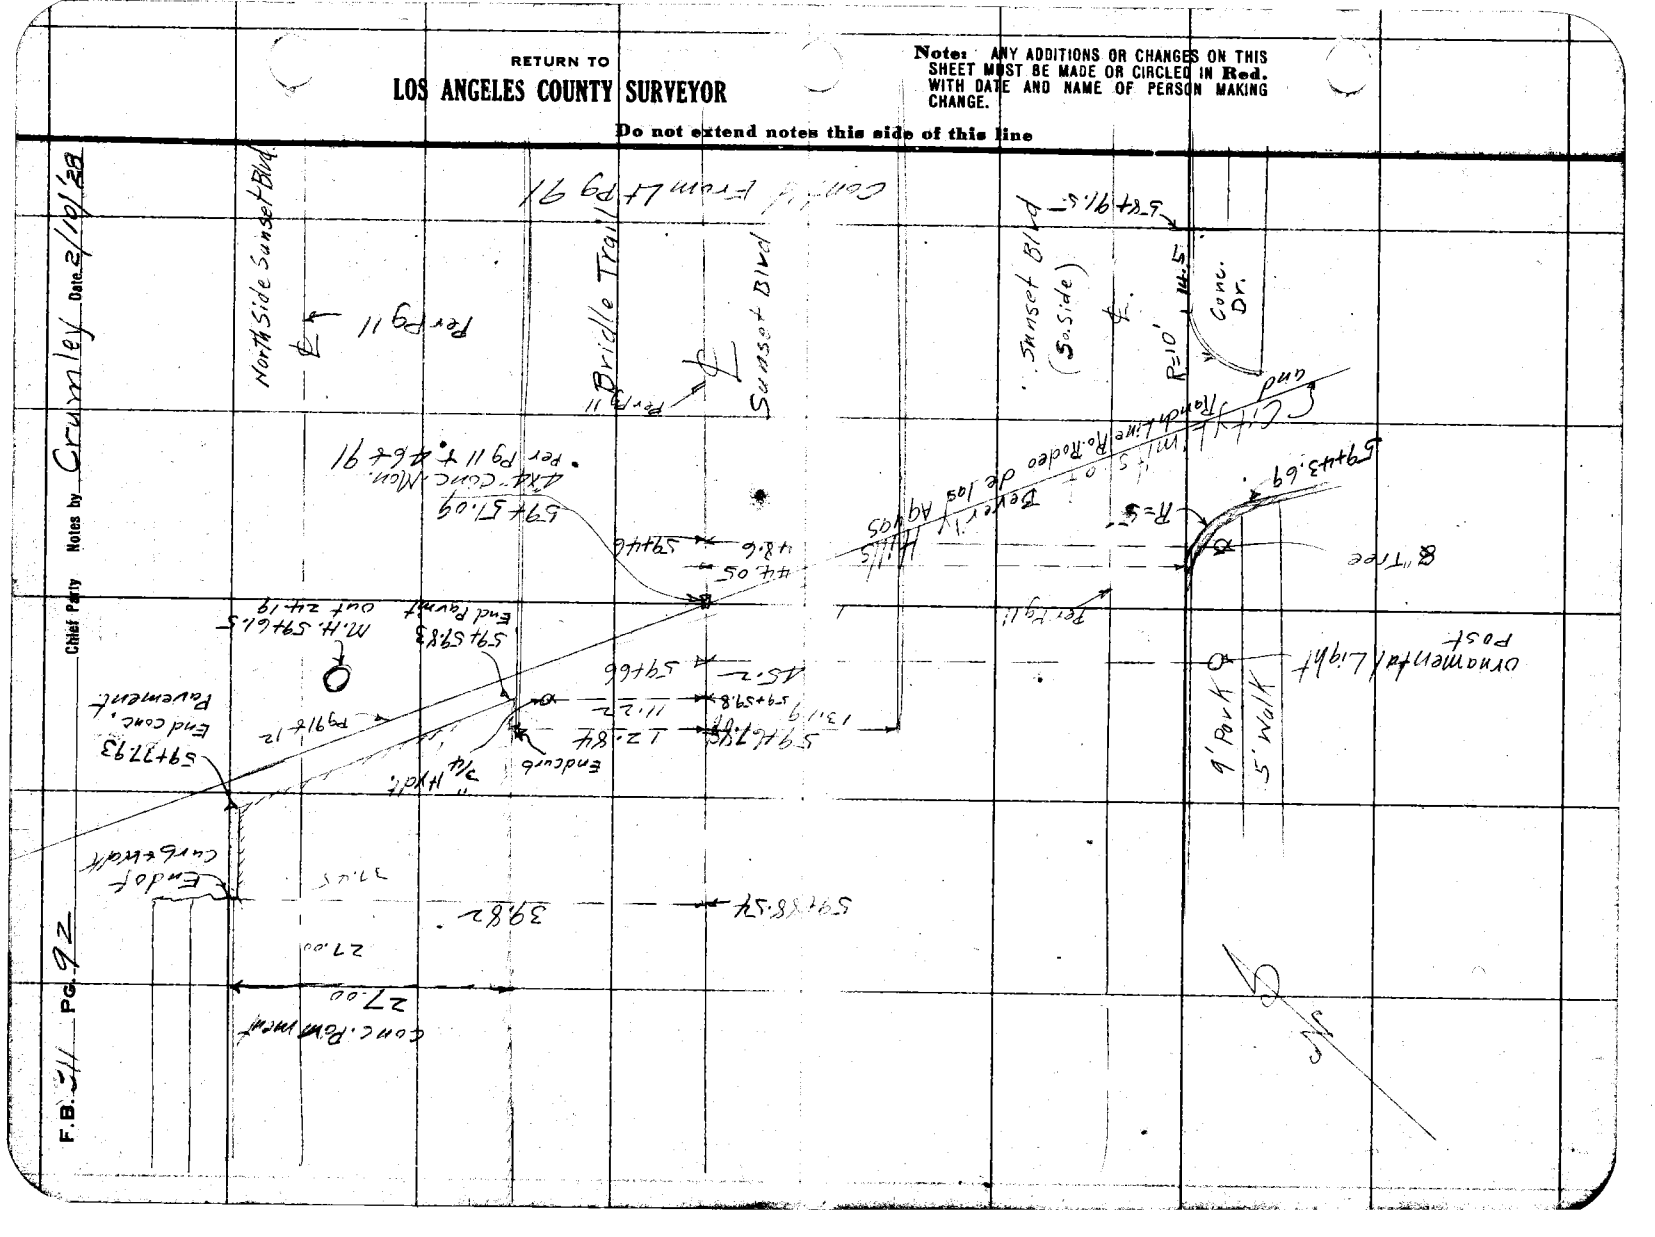
North Side Sunset Blvd
Bridle Trail
Sunset Blvd
Sunset Blvd (S. Side)
Conc. Dr.
R=10'
Ornamental Light Post
4' Walk
Conc. Pavement
End of curb & walk
End Pavement
End curb
Tangent Line
Beverly Hills
Rodeo de los Aguas
Pavement
Conc. Pavement
Conc. Pavement
Conc.

Date _____ Notes by L S H Chief Party L S H F. B. 311 Pg. 93

Platted by	W. O. No. 4170 D. S. O. No.
Date	Location Sunset Blvd + Holloway Dr.
Map No.	Surveyed by L S Hammond
Platting C'k'd by	Date July - 1928
Date	Indexed A. C. Johnson

Notes ANY ADDITIONS OR CHANGES ON THIS SHEET MUST BE MADE OR CIRCLED IN Red. WITH DATE AND NAME OF PERSON MAKING CHANGE.

Do not extend notes this side of this line

RETURN TO LOS ANGELES COUNTY SURVEYOR

SURVEY OF

SUNSET BLVD. AND HOLLOWAY DR.

LOCATION ADOPTED ℄ OF HOLLOWAY DR. FROM LA CIENEGA TO HORN AVE AND SUNSET BLVD. FROM HORN AVE TO DOHENY DR.

W.O. 4170

JULY-1928

BY:-

L.S.HAMMOND (chief)
F.H.BLANCHARD (Inst.)
D.W.REYNOLDS (Hd. ch.)
C.M.DUNLAP (Rr. ch.)

(For Location old ℄ see F.B. 311-1 To 28)

Band tape #030 used which is 100.000 @ 76°F pull 21½ lbs

F.B. 311 Pg. 94 LSH Chief Party Notes by LSH Date

INDEX

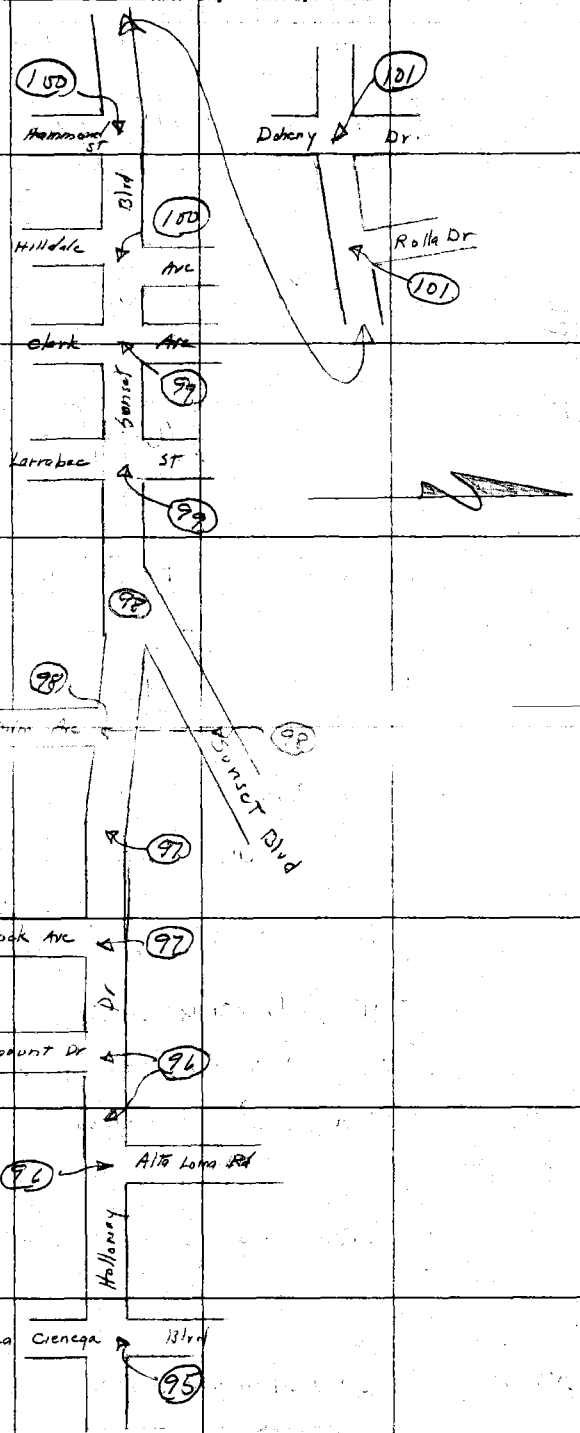

RETURN TO
LOS ANGELES COUNTY SURVEYOR

Do not extend notes this side of this line

Note: ANY ADDITIONS OR CHANGES ON THIS SHEET MUST BE MADE OR CIRCLED IN Red. WITH DATE AND NAME OF PERSON MAKING CHANGE.

Date 7-3-28 Notes by LSH Chief Party LSH F. B. 311 PG. 95

Plotted by Graw!
Date July 1928
Map No. B-150
Plotting C'k'd by Tarcy
Date July 1928

W. O. No. 4170 D. S. O. No.
Location Sunset Blvd
Surveyed by LS Hammond
Date July 1928
Indexed A. C. Johnson

Cont. bpt. page 96

Notes ANY ADDITIONS OR CHANGES ON THIS SHEET MUST BE MADE OR CIRCLED IN Red. WITH DATE AND NAME OF PERSON MAKING CHANGE.

RETURN TO LOS ANGELES COUNTY SURVEYOR

Do not extend notes this side of this line

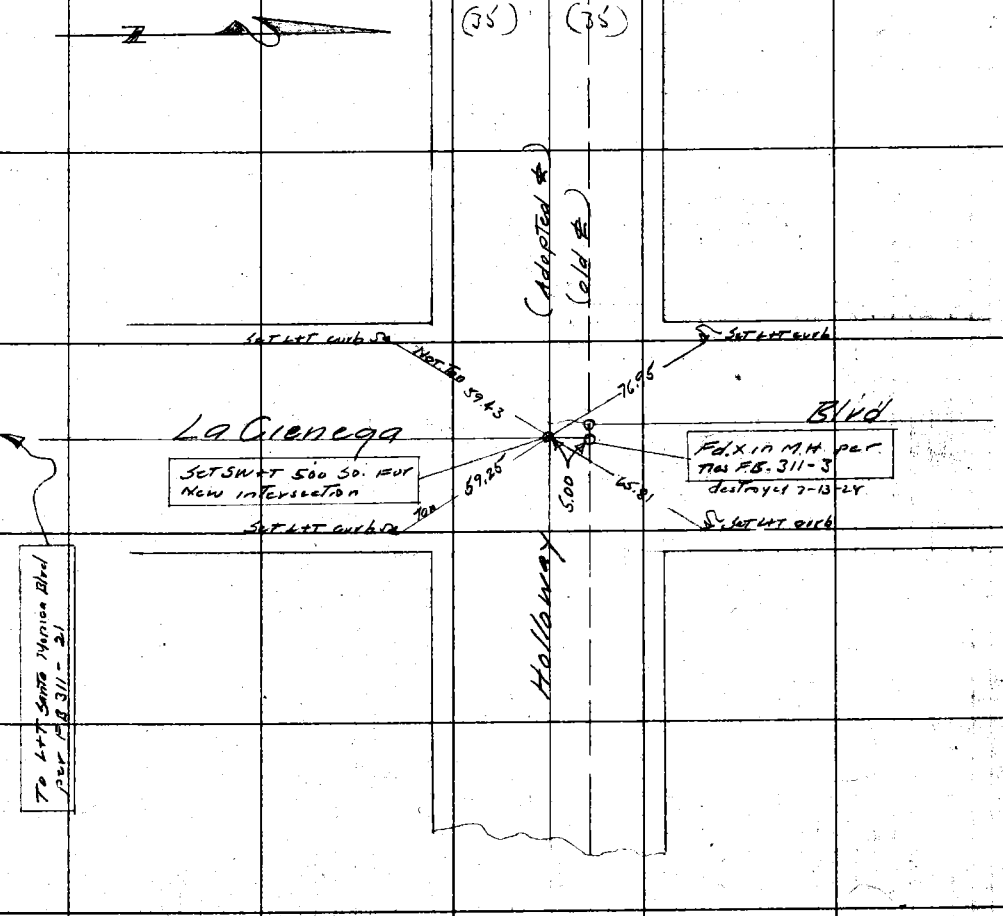

F.B. 311 Pg. 96 — LSH Chief Party — Notes by LSH — Date 7-3-28

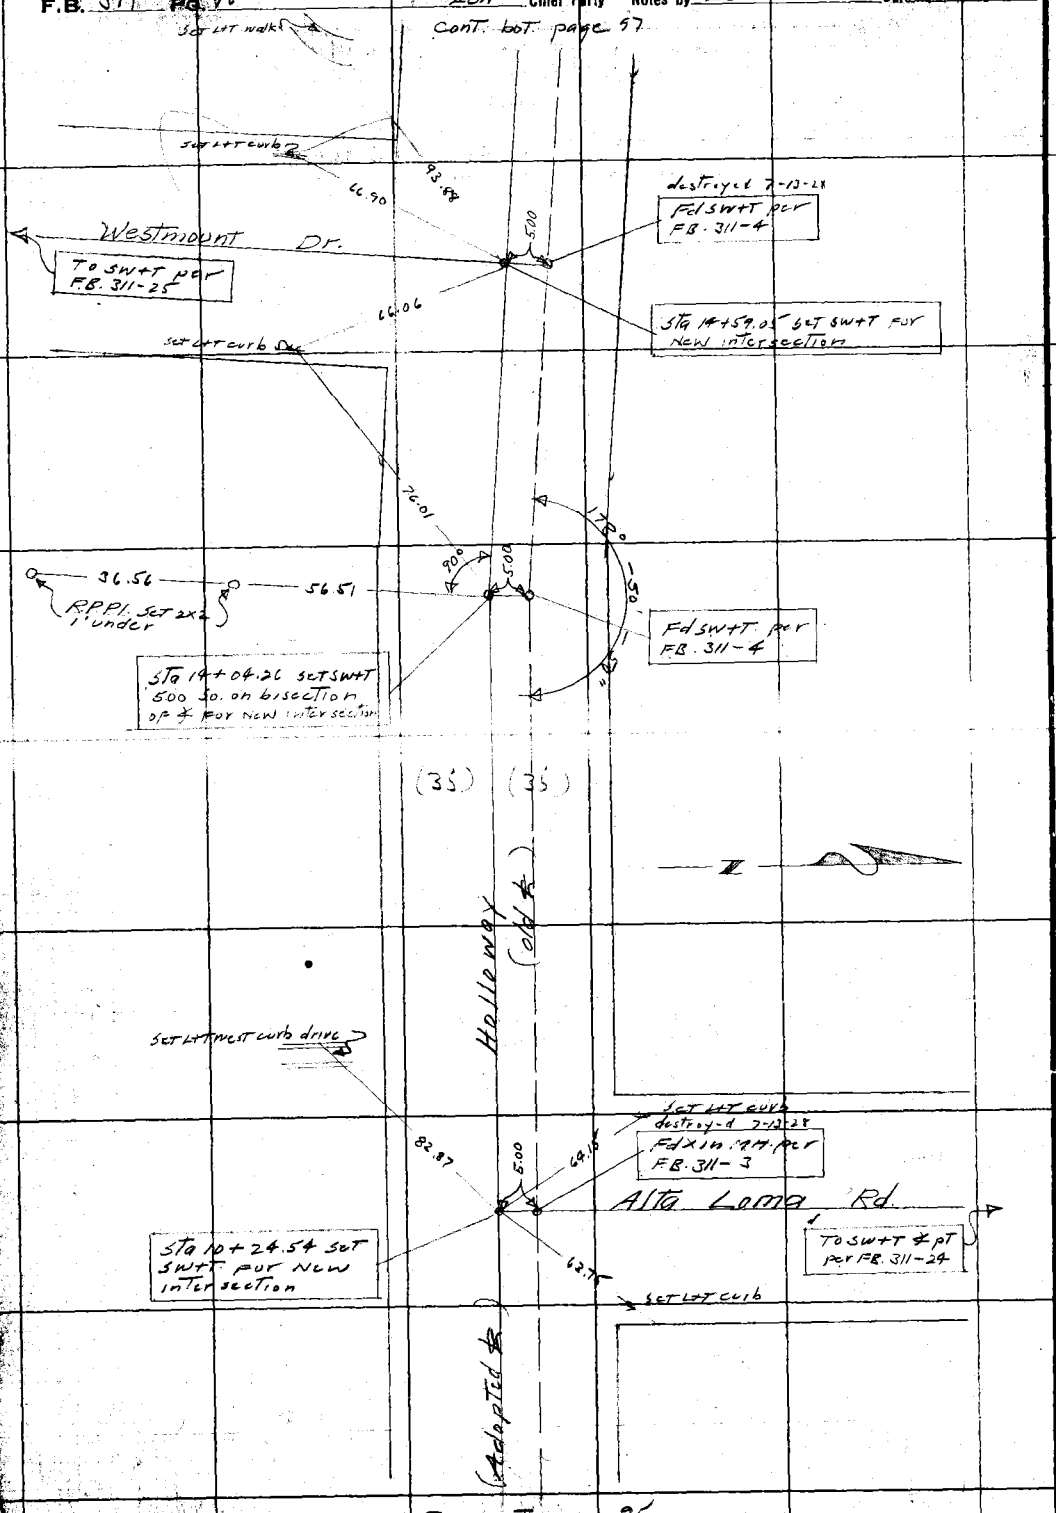

RETURN TO
LOS ANGELES COUNTY SURVEYOR
Do not extend notes this side of this line

Notes: ANY ADDITIONS OR CHANGES ON THIS SHEET MUST BE MADE OR CIRCLED IN Red. WITH DATE AND NAME OF PERSON MAKING CHANGE.

Date _____ Notes by _____ Chief Party _____ F. B. 311 Pg. 9

Plotted by Hopkins
Date March 1928
Map No. B 150
Plotting C'k'd by C. L. T.
Date MAR 1928

W. O. No. 4170 D. S. O. No.
Location Sunset Blvd
Surveyed by C. V. Crumley
Date January 6th & 10th, 1928
Indexed A. C. Johnson

Cont'd on Bottom Pg 10

72.11
51+71.66
Set Punch Hole + "X" in Man Hole Cover By Intersection
See Pg 43 & 87

90°-00'-35"

set "X"

set "X"

Carr Ave. (25') (25')
Per Pg 43

SUNSET

Carol Drive (35') (35')

89°-32'-50"

75
50+49.30
Set S.W. & T. By Intersection
See Pg 41 & 86

(30') (30')

ALPA

89°-32'-50"

73
49+51.28
Set S.W. & T. By Intersection
See Pg 41 & 84

Alley (10') (10')
Per Pg 41

Continued From Top Pg 8

Notes: ANY ADDITIONS OR CHANGES ON THIS SHEET MUST BE MADE OR CIRCLED IN Red. WITH DATE AND NAME OF PERSON MAKING CHANGE.

Do not extend notes this side of this line

RETURN TO LOS ANGELES COUNTY SURVEYOR

F.B. 311 Pg. 10 Chief Party Notes by C.V. Crumley Date 1/14/28

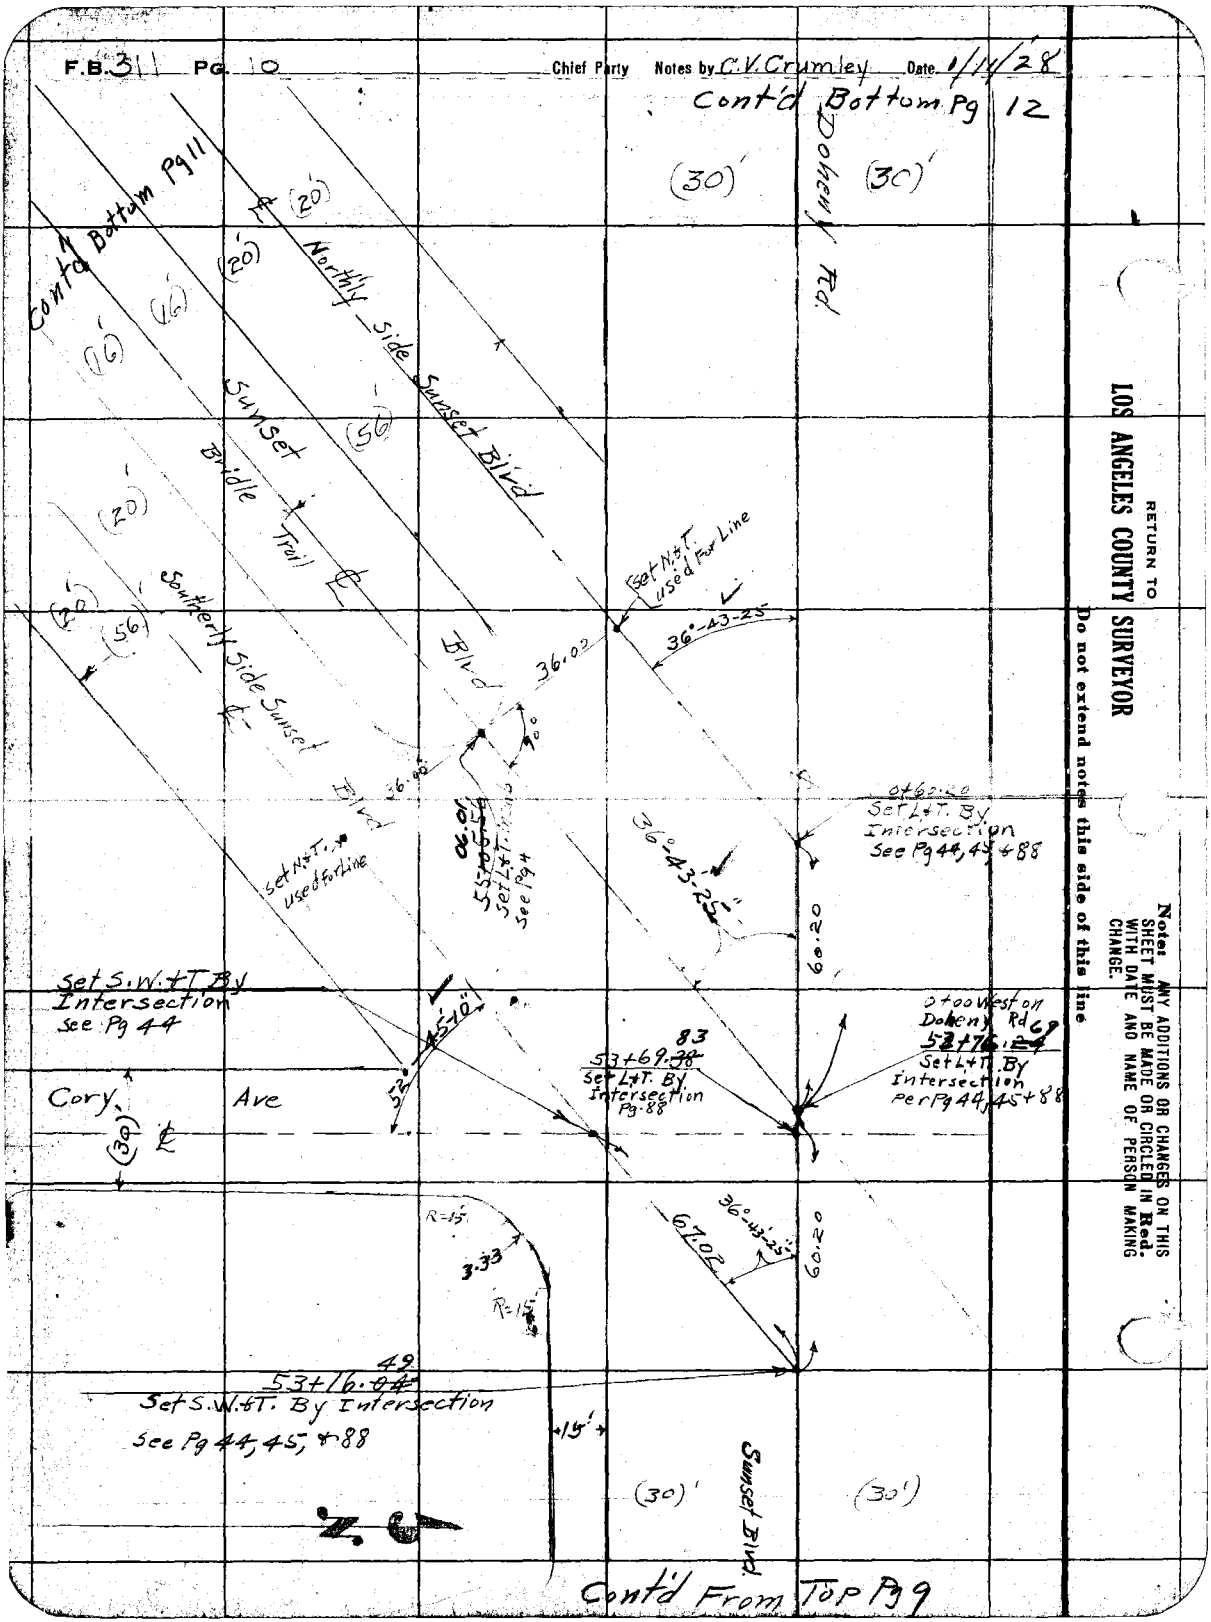

RETURN TO LOS ANGELES COUNTY SURVEYOR

Do not extend notes this side of this line

Note: ANY ADDITIONS OR CHANGES ON THIS SHEET MUST BE MADE OR CIRCLED IN Red. WITH DATE AND NAME OF PERSON MAKING CHANGE.

Date _____ Notes by _____ Chief Party _____ F. B. 311 PG. 11

Plotted by Hopkins
Date March 1928
Map No. B 150
Plotting C'k'd by C.J.T.
Date MAR 1928

W. O. No. 4170 D. S. O. No.
Location Sunset Blvd
Surveyed by C.V. Crumley
Date Jan. 16 1928
Indexed A. C. Johnson

Notes: ANY ADDITIONS OR CHANGES ON THIS SHEET MUST BE MADE OR CIRCLED IN Red. WITH DATE AND NAME OF PERSON MAKING CHANGE.

Do not extend notes this side of this line

RETURN TO LOS ANGELES COUNTY SURVEYOR

Used For Line Set N.+T.

36.00

36.00 set N.+T. used For Line

Found 2" I.P. No Tag 2½ ft. Deep per R.S. F.B. 121 - at B.C. of Curve See Pg 46

(24)' (20)' (16)' (16)' (20)' (20)'

Beverly Hills

South Side

Sunset ℄ 359.25

North Side

Sierra Drive

D = 56°-43'-00"
℄ = 226°-51-30"

56° 43'

150

See Pg 12 To Detail

59+51.09

Found 4"X4" Conc. Mon. with 3/4" I.P. & Tk 3½ ft. Deep. ℄ C.S. Per F.B. 121 - 8146 See pg 46 & 92 & 91

66.98

36.00 set N.+T.

36.00 set N.+T.

90°

Alley

City Limits of Beverly Hills

Ranch Line Ro. Rodeo de las Aguas

Sunset Blvd ℄

Sunset Blvd

(16)' (16)' (20)' (20)'

(20)' (20)'

County

Continued From upper Left cor. Pg 10

F.B. 311 PG. 12 Chief Party Notes by C.V. Crumley Date 12/15/27

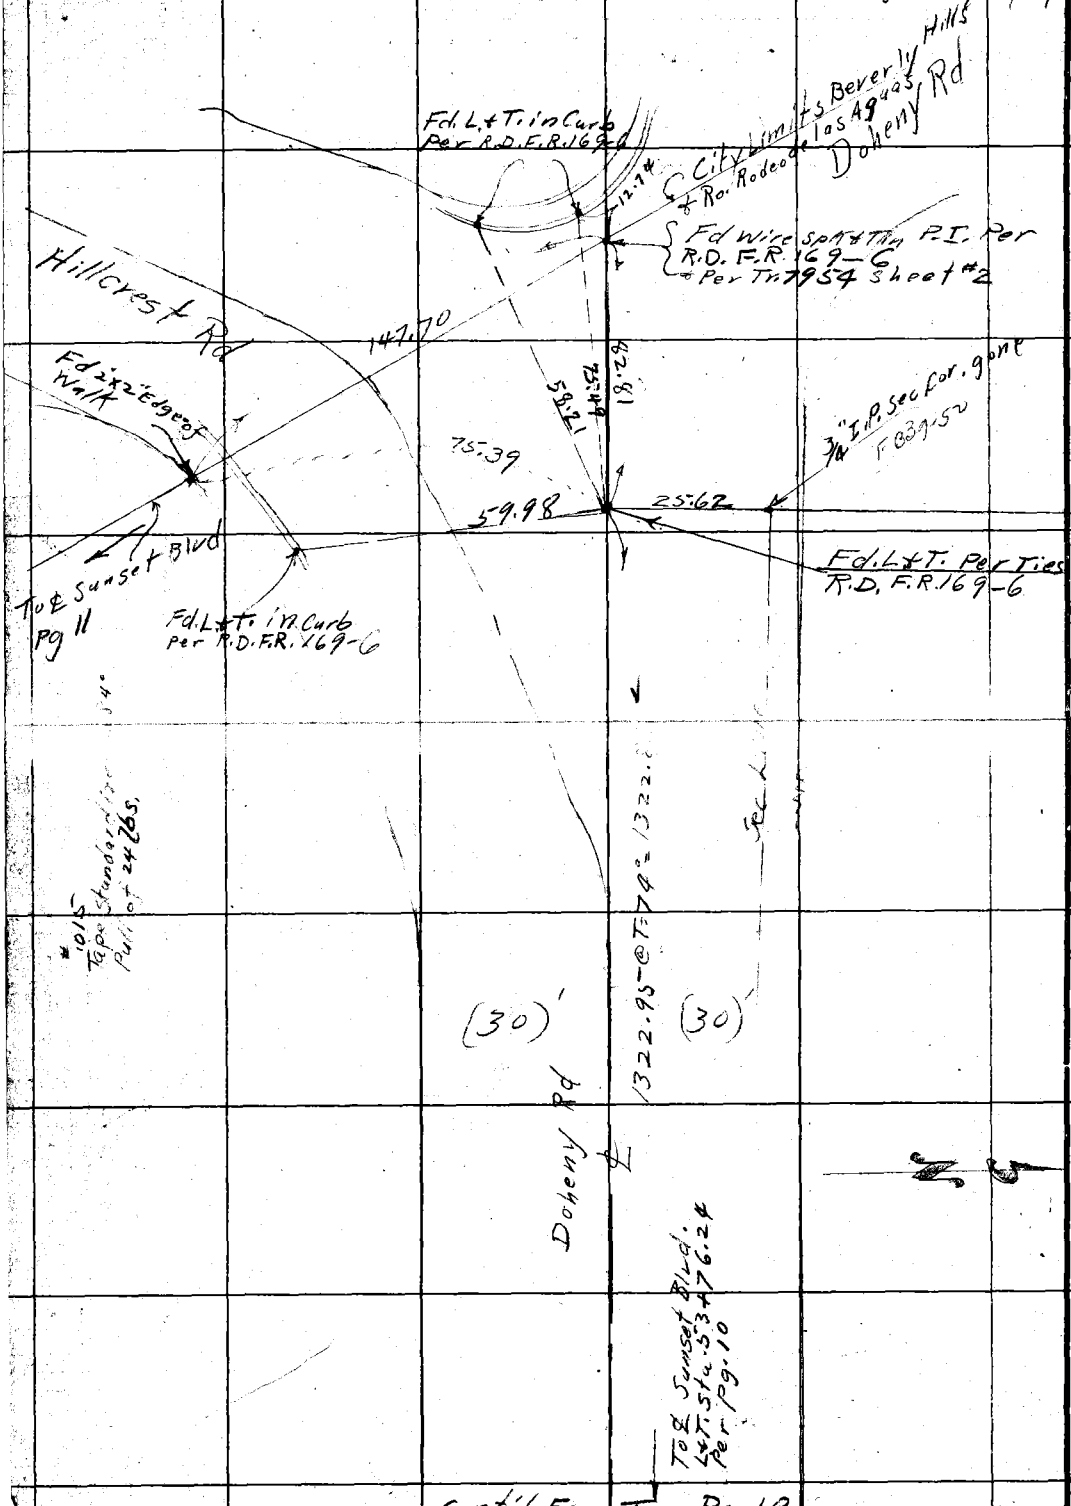

RETURN TO
LOS ANGELES COUNTY SURVEYOR

Do not extend notes this side of this line

Notes: ANY ADDITIONS OR CHANGES ON THIS SHEET MUST BE MADE OR CIRCLED IN Red. WITH DATE AND NAME OF PERSON MAKING CHANGE.

Date _____ Notes by _____ Chief Party _____ F. B. 311 Pg. 13

Plotted by Hopkins
Date March 1928
Map No. B 150
Plotting C'k'd by C. J. T.
Date MAR 1928

W. O. No. 4170 R. S. O. No. _____
Location Holloway Drive
Surveyed by C. V. GRUMLEY
Date December 12, 1927
A. C. Johnson
Indexed

Coast [illegible] Pg

Notes: ANY ADDITIONS OR CHANGES ON THIS SHEET MUST BE MADE OR CIRCLED IN Red. WITH DATE AND NAME OF PERSON MAKING CHANGE.

Do not extend notes this side of this line

RETURN TO LOS ANGELES COUNTY SURVEYOR

10+46.85

Fd. Witness pt. T. NW Cor. Lot 3 as per TT-2662

10.76

2.10 off Line

set Nail

18 Red

15.40

98°

7+36.37 set 1"x1" Near Side of So. Prop. Line

5+72.38 Set 1x2"

90°

Transit Line

40.00

5+72.38 Set 1x2"

Tang. = .00910967

.00911 .9955

set 1x1"

5.00

37.5 (Calc)

20.00

15.00

set Nail

4+39.21

Adopted Sec. Line

4+39.21 Fd. 1" I.P. at End of Row of Cypress Trees used For Line on Transit Line.

0°03'20" (Calc)

88° 43'

88° 42' 25"

Δ = 354° 52' 30"

Nine Quadrant

Δ = 90° 08' 30"

360° 33' 45"

90° 07' 30"

360° 30' 00"

90° 07' 40"

90° 08' 25"

5.00' off Line

89° Calc.

14

Fd. 2" I.P. Plug & TK. (used For Line)

5.00

178° 178° 51' 00" Adj.

50' 35' 50" 55"

Holloway Drive

0+00 North set Nail By Intersection

27.94

14+04.21

27.94

0.25

F.B. 311 Pg. 14 Chief Party Notes by Crumley Date 12/3/27

Cont'd Bottom Pg 15

21+33.98
Set 1X1 on Ridge

5.00

37.69 @ 12°-55' = 36.74

20+97.24
Set Nail

101.47 @ 35° 05' = 83.03
234.00 @ 20°-15' = 219.54
302.57

17+94.67
Set 1X1 on Side of Mountain

174.01 @ 21°-59' = 161.36
300.00 @ 11°28' = 294.01
455.37

5.00 offset Line?

Adopted Sec. Line

2.00

13+39.30
Set X

3.0

13+21.56
Fd 2" I.P. Plug & Nail 2" High
Sq. 3' Reference Monument (WITH)
Cor. of Sec. 4
on Line
(No Record)

9.78

3.0

Set Nail

18.00

10+65.62
Set 1"x2"

Fd 2"x2" Evidently N.W. Cor Lot #3, Tr. 2662 - M.B. 27-14 as per Tr. 6140 - M.B. 75-94

.09 (calc)

10.51

10+59.30

Transit Line?

2.0 ft offset

.07 (calc.)

20.0 offset

Fd ½ Gas pipe 18" above ground

10.68

10+58.67

20+

18.00

Fd 1" I.P. Bent over took offset at Base of Pipe E. Side of Cypress Tree

10.23

10+58.62

.38 (calc)

Continued From Top Pg 13

RETURN TO
LOS ANGELES COUNTY SURVEYOR
Do not extend notes this side of this line
Note: ANY ADDITIONS OR CHANGES ON THIS SHEET MUST BE MADE OR CIRCLED IN Red. WITH DATE AND NAME OF PERSON MAKING CHANGE.

Date _____ Notes by _____ Chief Party _____ F. B. 311 Pg. 15

Platted by Hopkins
Date March 1928
Map No. B 150
Platting C'k'd by C.J.T.
Date MAR 1928

W. O. No. 4170 D. S. O. No. _____
Location Holloway Drive
Surveyed by C.V. Crumley
Date Dec. 3, 1927
Indexed A. C. Johnson

Constant = ~~.00911067~~ .00911095-5 Tang. $\Delta = 0°-31'-20"$ Between Transit Line & Section Line Adopted

Notes ANY ADDITIONS OR CHANGES ON THIS SHEET MUST BE MADE OR CIRCLED IN Red. WITH DATE AND NAME OF PERSON MAKING CHANGE.

Do not extend notes this side of this line

RETURN TO LOS ANGELES COUNTY SURVEYOR

N

Ⓓ = 90°-37'-00"
Ⓐ = 362°-28'-00"

143.19 @ 31°-35' = 30.79

(used for Line South)
Set 2"x2" for Sly Cor Lot 33 Tr. 8037 as per

1801.82 @ 10°-35'-30" = 177.66

Note: Bearing of 62.07 Was Not Rec'd Was Assumed Horizontal Measurement

Tract Dist. 2.50 Per Dist. Rec'd

Set 1/2" on Sidewalk

13.67

Set 1x2" By Intersection

5.14

18.84

23.98

177.66

145.20 Rec.

(used for Line)
Ed 2"x2" Plug & Nail N.W. Cor. Lot 33 Tr. 8037

G 2.38 @ 9°-29' = 61.53

Ed 1" I.P. Plug & Nail, 3" High per Tr. 8037 (used for Line)

G 54

90°-37'00"

26+39.43
Set 1x1 E. of Holly Vista Sign

5.0

141.56 @ 20°-50' = 132.30

25+07.13
Set 1x1 So. Side Road

Transit Line

5.00 offset Line

Adopted Sec. Line

Ed 2"x2" Plug & Nail Flush, N. W. Cor. Lot 2 Tr. 2664 as per Tr. #8037

8232 @ 17°-47'-30" = 98.38
300.00 @ 10°-43' = 29.77
373.15

21+33.98
1x1 on Ridge
See Pg

5.00

Continued From Top Pg 14

F.B. 311 PG. 16 Chief Party Notes by Date

RETURN TO

LOS ANGELES COUNTY SURVEYOR

Do not extend notes this side of this line

Note: ANY ADDITIONS OR CHANGES ON THIS SHEET MUST BE MADE OR CIRCLED IN Red. WITH DATE AND NAME OF PERSON MAKING CHANGE.

Date _____ Notes by _____ Chief Party _____ F. B. 311 PG. 17

Plotted by Nopkins
Date March 1928
Map No. B150
Platting C'k'd by C. L. T.
Date MAR 1928

W. O. No. 4170 D. S. O. No.
Location Holloway Drive
Surveyed by C. V. Crumley
Date Dec. 8, 1927
Indexed A. C. Johnson

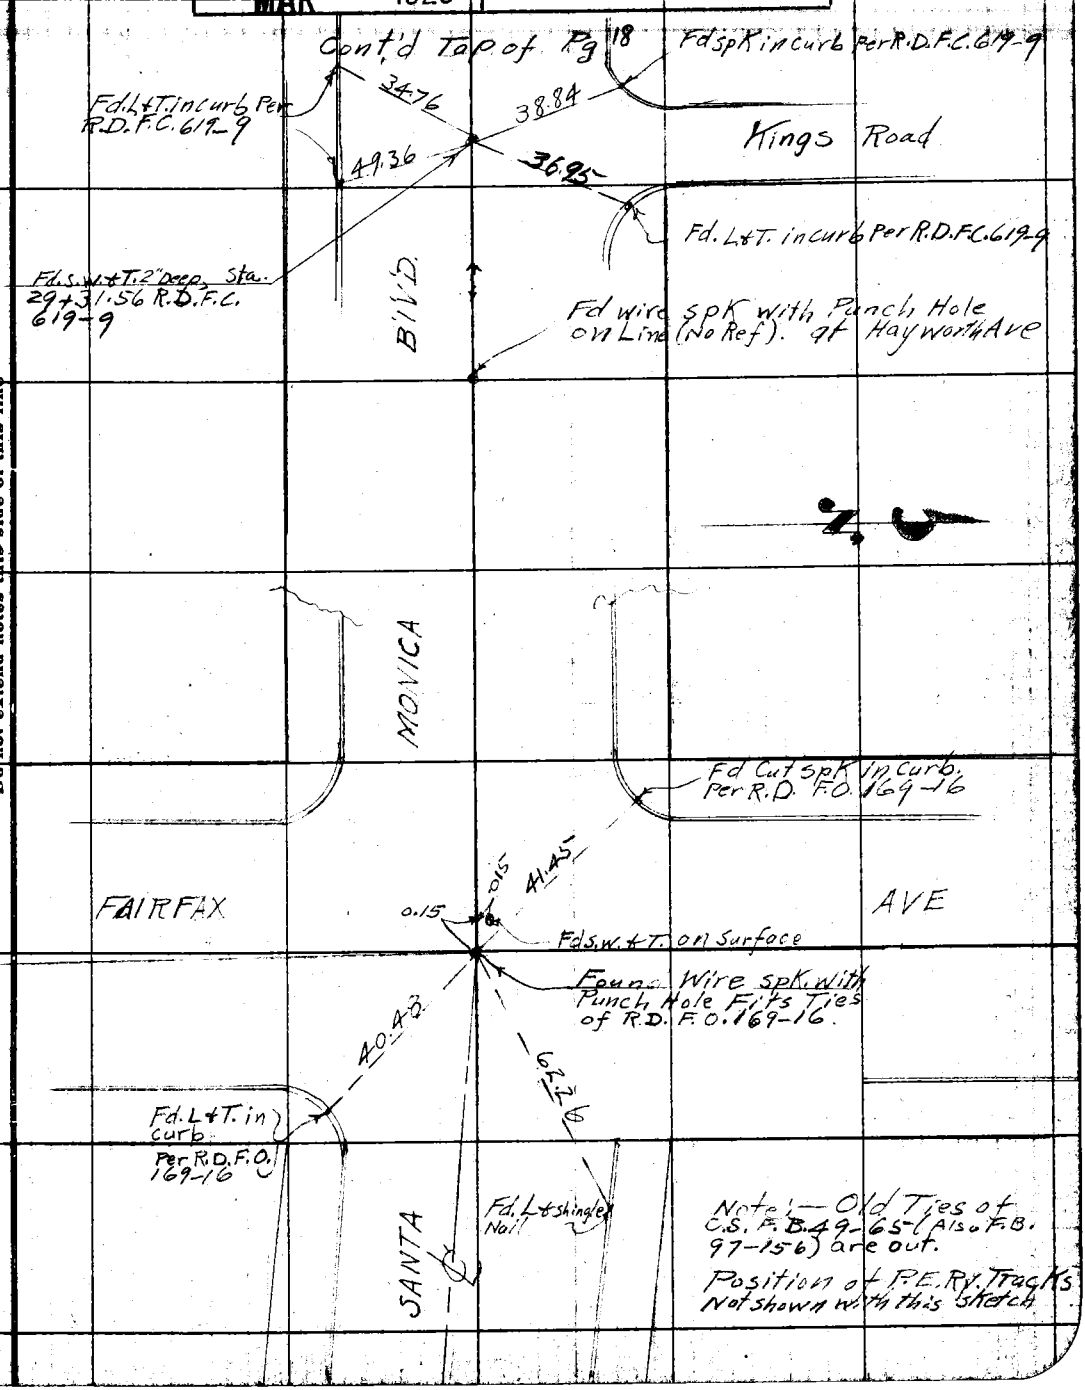

RETURN TO LOS ANGELES COUNTY SURVEYOR

Do not extend notes this side of this line

Note: ANY ADDITIONS OR CHANGES ON THIS SHEET MUST BE MADE OR CIRCLED IN Red. WITH DATE AND NAME OF PERSON MAKING CHANGE.

F.B. 311 Pg. 18 Chief Party Notes by Crumley Date Jan. 23, 1928

Continued From Top Pg 17

Olive St.

Santa Monica Blvd.

Fd cuts pk? in curb

37.44

Set L & T. on & P.E.R.V. By Intersection see pg 2 & 49

L & T. in Curb

30.26

42.62

.02

31°-53'-10"

P.I.

Croft Ave

Fd L & T. of N. & W. of Line

Set L & T. on & Prod. in curb

L & T. in Curb

75.67

Fd L & T. .025'

44.79

L & T. in curb

Fd. 1" I.P. C.C. & B.C. over 3.46 E. & 0.85 S. R.D. F.C. 619-8

Photostat

36.23

41.85

30.2

39.15

L & T. in Curb

35.525

L & T. in Curb

L & T. in Curb

Fd. S.W. & T. per R.D. F.C. 619-8

Note: ANY ADDITIONS OR CHANGES ON THIS SHEET MUST BE MADE OR CIRCLED IN Red. WITH DATE AND NAME OF PERSON MAKING CHANGE.

RETURN TO LOS ANGELES COUNTY SURVEYOR

Do not extend notes this side of this line

0+00 Set S. & W. in Lead By Intersection see pg 2 & 49

31°53'-10"

L & T. in Curb

53.47

37.72 80.00

40.00

Set N. & T.

47.92

L & T. Cor'd F.C. 619-8

Set N. & T.

(20')

(20')

(20')

(20')

(20')

(R)

Δ 31°-53'-10"

Δ 127-32-45"

Rly.

Electric

Hacienda Pl. or Alfred St. E

Dr.

Holloway

2+26.61 S.W. & T.

Continued on Top Pg 9

Cont'd Bottom Pg 22

Date _____ Notes by _____ Chief Party _____ F. B. 311 PG. 19

Platted by Hoskins
Date March 1928
Map No. B 158
Platting C'k'd by C. J. T.
Date MAR 1928

W. O. No. 4170 D. S. O. No. _____
Location Holloway Drive
Surveyed by C. V. Crumley
Date Dec. & 13 1927 & Jan. 23 1928
Indexed A. C. Johnson

Note: ANY ADDITIONS OR CHANGES ON THIS SHEET MUST BE MADE OR CIRCLED IN Red. WITH DATE AND NAME OF PERSON MAKING CHANGE.

RETURN TO LOS ANGELES COUNTY SURVEYOR

Do not extend notes this side of this line

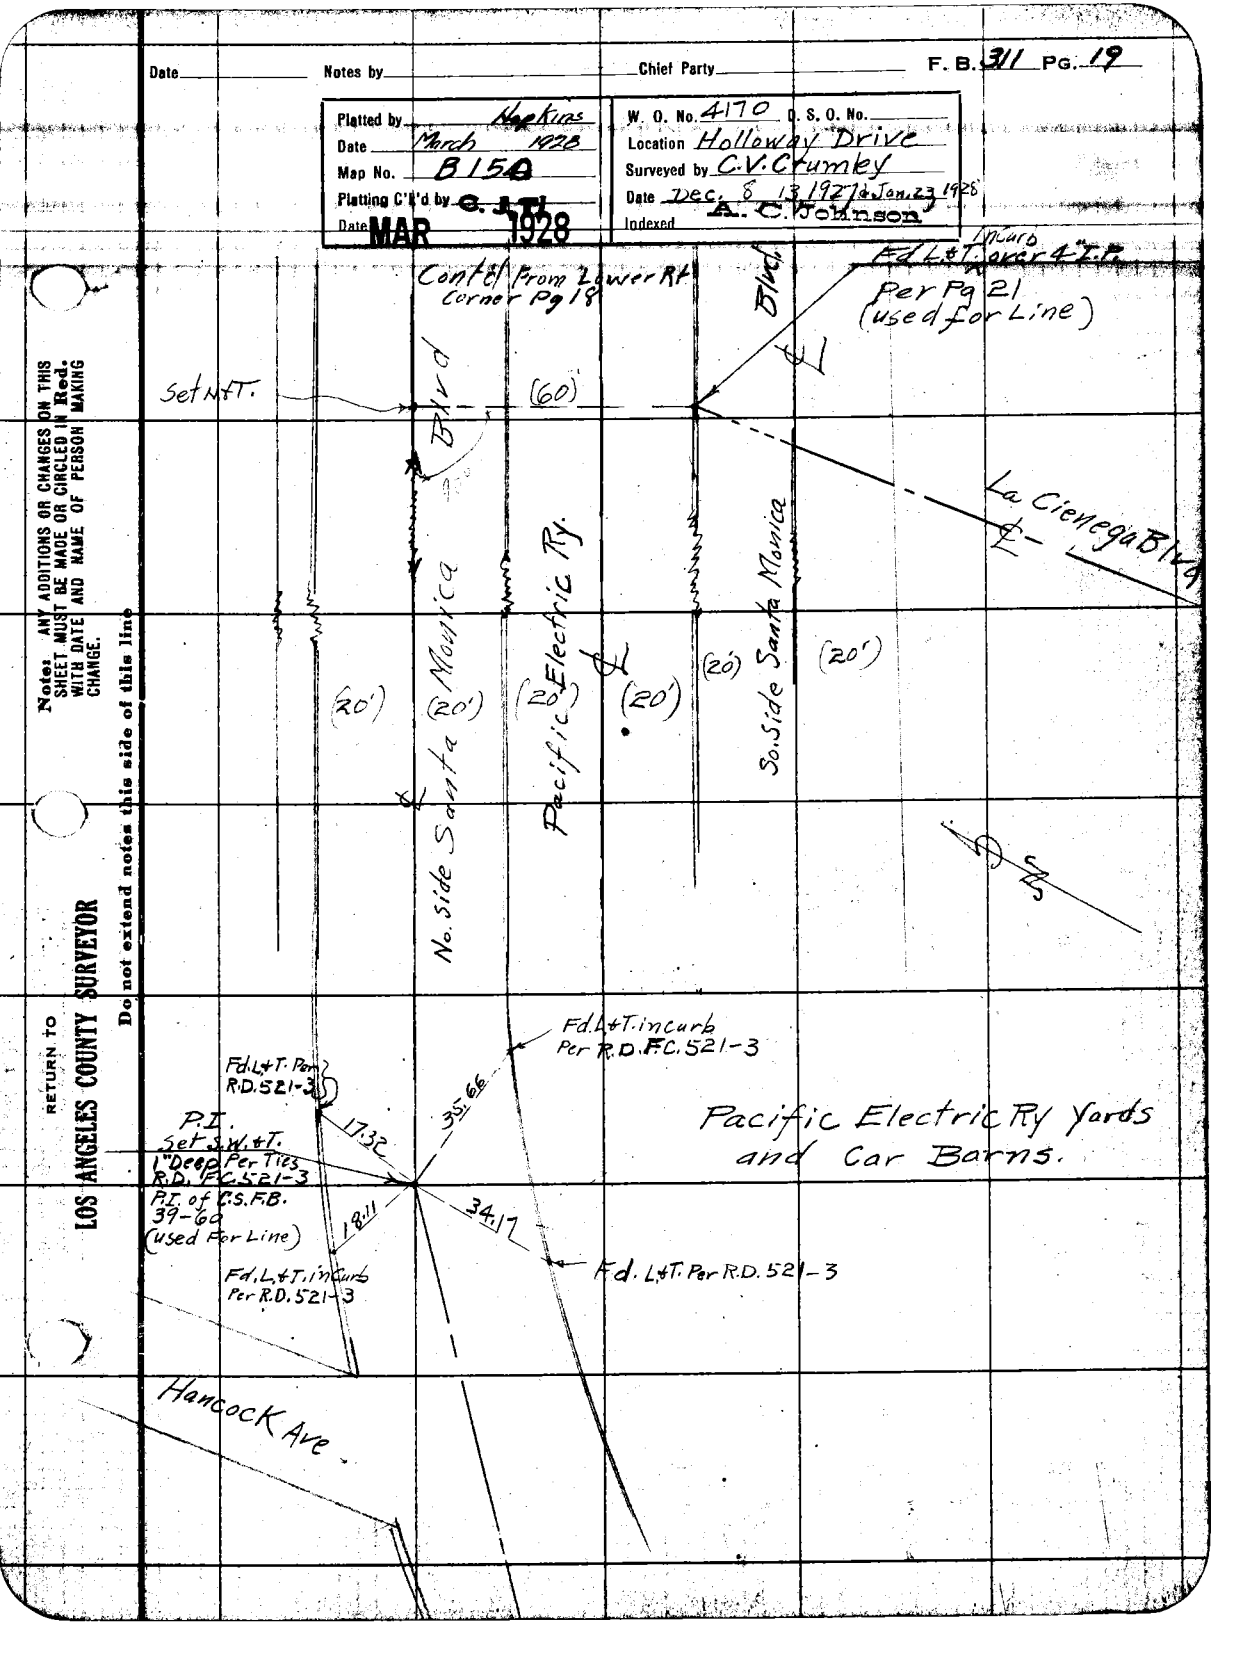

F.B. 311 PG. 20 Chief Party Notes by Date

121-52-45"

127-31-00

RETURN TO

LOS ANGELES COUNTY SURVEYOR

Do not extend notes this side of this line

Notes: ANY ADDITIONS OR CHANGES ON THIS SHEET MUST BE MADE OR CIRCLED IN Red. WITH DATE AND NAME OF PERSON MAKING CHANGE.

Date _____ Notes by _____ Chief Party _____ F. B. 311 PG. 21

Plotted by Hoskins
Date March 1928
Map No. B150
Plotting C'k'd by C.J.T.
Date MAR 1928

W. O. No. 4170 U. S. Q. No. _____
Location Holloway Drive
Surveyed by C.V. Crumley
Date Dec. 15, 1927
Indexed A. C. Johnson

Notes: ANY ADDITIONS OR CHANGES ON THIS SHEET MUST BE MADE OR CIRCLED IN Red. WITH DATE AND NAME OF PERSON MAKING CHANGE.

Do not extend notes this side of this line

RETURN TO LOS ANGELES COUNTY SURVEYOR

L & T. Wire spk

5+78.98 Set "X" on M.H. Lid By Intersection See Pg 3, 23, 51+52

Newcastle St.

Fd cut spk

HOLLOWAY DRIVE

5+79.33 Pg 25

set "X"

Fd L & T. in Curb

15' Park
5' Walk

Set N. & T.

(Fd L & T. in Curb)

Fd old 2½" Dia. Lot #7 West Knoll Tract (used for L

Δ = 90°-00'-00"
Δ = 360°-00-00

Δ = 121°-52'-45"
Δ = 487°-31-00

5' Walk
10' Park
MELROSE AVE
(La Cienega Ave)

Fd 3/4" I.P. B.C. Lot 6 West Knoll Tr.

Blvd

Set L & T. in Curb over E.T.R.? Fd. 4" I.P. with Cut spk, in Concrete, 2 ft. Deep under Curb, on ℄ of Melrose Ave Produced as Per C.S. 8081-F.B. 41-109 & Sheet 2 of West Knoll Tract

(40) Santa Monica

(40) Right of Way

See Pg 19

P.E. Rail Road

Fd. L & T.

Fd. L & T.

(Calc. From Tr. Map)

Set L & T. in Curb Calc. Dist. From L & T. over Mon. on La Cienega Blvd

Santa Monica Blvd

La Cienega Blvd

F.B. 311 Pg. 22 Chief Party Notes by C.V. Crumley Date 12/9/27

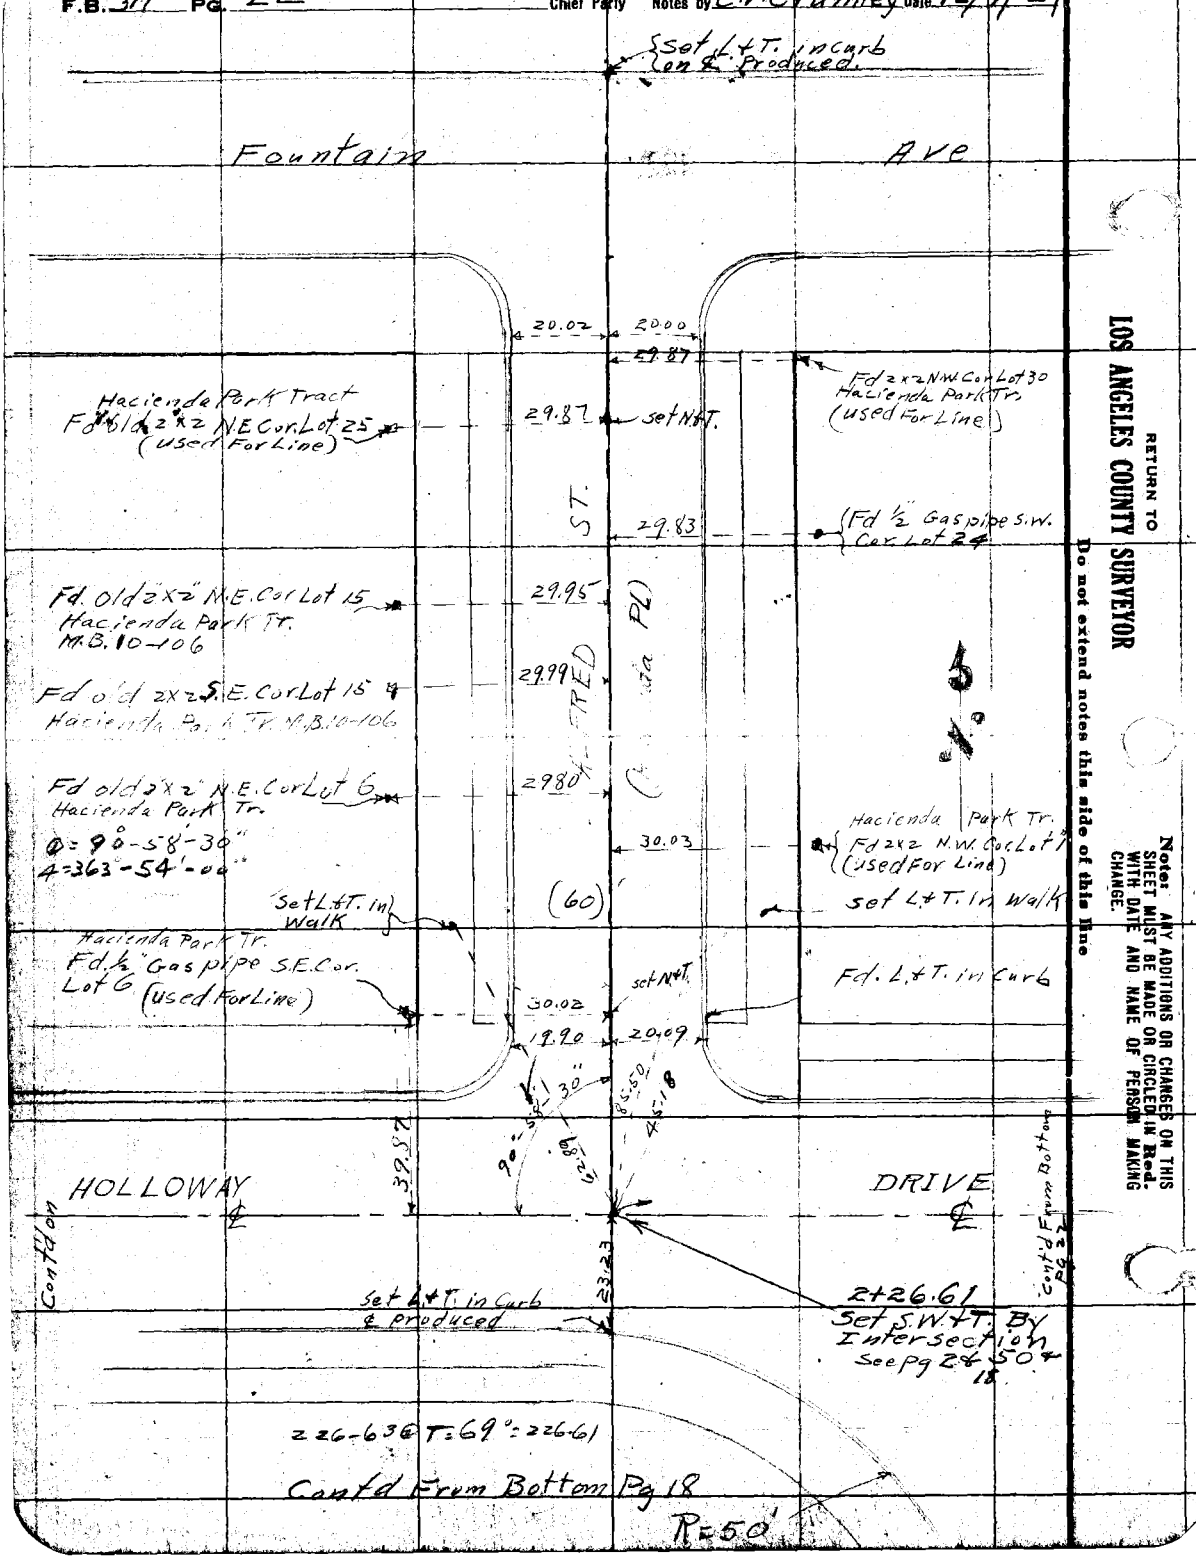

RETURN TO
LOS ANGELES COUNTY SURVEYOR
Do not extend notes this side of this line

Notes: ANY ADDITIONS OR CHANGES ON THIS SHEET MUST BE MADE OR CIRCLED IN Red. WITH DATE AND NAME OF PERSON MAKING CHANGE.

Date _____ Notes by _____ Chief Party: _____ F. B. 311 PG. 23

Plotted by Hakans
Date March 1928
Map No. B1.5-0
Plotting C'k'd by C. J. M.
Date MAR 1928

W. O. No. _____ D. S. O. No. _____
Location _____
Surveyed by _____
Date _____
Indexed A. C. Johnson

Note: ANY ADDITIONS OR CHANGES ON THIS SHEET MUST BE MADE OR CIRCLED IN Red. WITH DATE AND NAME OF PERSON MAKING CHANGE.

Do not extend notes this side of this line

RETURN TO LOS ANGELES COUNTY SURVEYOR

Blvd

Fd S.W.&T.

P.I. Fd S.W.&T.

20.37

38.27

41.77

50.75

Sunset

19.23

Fd L.&T. Per F.B. 8101-19 L.B. 414-49

Fd spk in curb Per L.A. City Engrs. F.B. 8101-19 L.B. 414-49

Fd L.&T. in Curb Per L.A. City F.B. 810 L.B. 44-49

Fd L.&T.

48.00 Tang

22.90

27.91 Tang.

Fd L.&T.

47.76 (L.A. Cienegas Blvd) WEST

Fountain AVE

Fd Wire spk

Fd S.W.&T. Per Ties L.A. City Engrs. F.B. 8101-19 L.B. 414-49

90-48-30

363-13-30

Fd L.&T. in Curb

20.04

20.04

29.77

30.12

Fd 1/2" Gas pipe

Fd 2" I.P.

30.00

Adj.

Set Punch Hole per Ties City of Los Angeles F.B. 8101-19

Fd spk in curb

42.72

HOLLOWAY

.03

DRIVE

5.00 Adopted

5.00

5.00

5+78.93 "X" in M.H. Cover Pg 21

Fd L.&T. In curb

37.40

47.59

0.375

0.40

Set "X" in Mh. By Intersection

5+79.40 Nothing set.

5+78.93 Set S.W.&T. F.B. 311-95

Fd L.&T. in Curb

F.B. 311 Pg. 24 Chief Party Notes by Crumley Date 12/21/'27

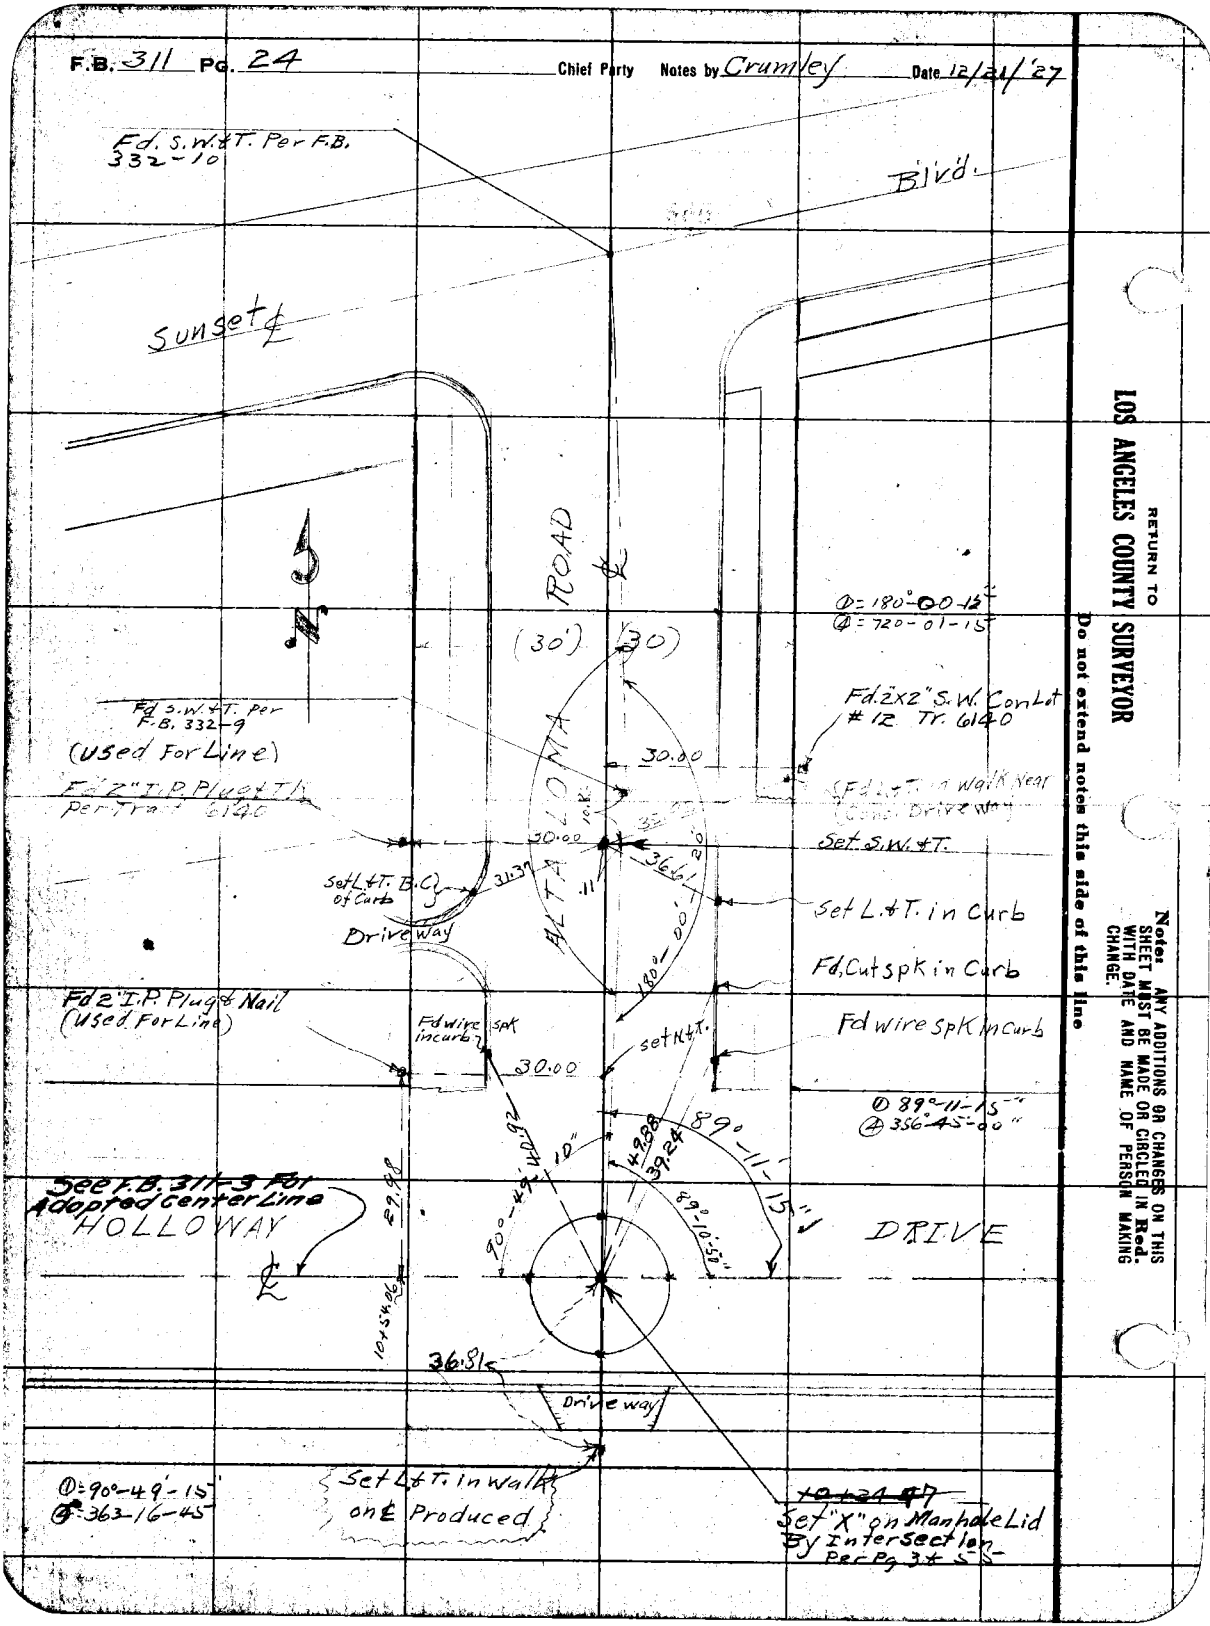

Date _____ Notes by _____ Chief Party _____ F. B. 311 PG. 25

Platted by Hopkins
Date March 1928
Map No. B 150
Plotting C'k'd by C. L. T.
Date MAR 1928

W. O. No. 4170 D. S. O. No. _____
Location Holloway Drive
Surveyed by C. V. Crumley
Date _____
Indexed A. C. Johnson

Notes ANY ADDITIONS OR CHANGES ON THIS SHEET MUST BE MADE OR CIRCLED IN Red. WITH DATE AND NAME OF PERSON MAKING CHANGE.

RETURN TO LOS ANGELES COUNTY SURVEYOR

Do not extend notes this side of this line

14+58.90
Set S.W. & T. 54.69 From ⊥ Point (Sec. Cor) As calculated From West Knoll Tract Map See Pg 44-59

14+04.21
Set S.W. & T. By Intersection of ℄ From West & Section Line From North & Record Dist. (329.49) From 1" I.P. N.W. Cor Lot 1, Block "A", West Knoll Tract. see Pg 44-59

HOLLOWAY DRIVE

See F.B. 311-4 For Adopted Center Line

(30')

℄

89° 24' 45"

73.06

54.69

54.52

94.70

Tangent

Δ = 89° 24' 45"
℄ = 357° 39' 00"

WESTMOUNT DRIVE

151.295

Set L. & T. in Curb

Set L. & T. in Walk

Δ = 178° 50' 45"
℄ = 715° 23' 30"

Set L. & T. in Curb

30.00

Fd. 2X2 + TK N.W. Cor Lot 25, West Knoll Tract

Set L. & T. in Curb

30.161

(used for Line)

Set L. & T. in Curb

15.37

30.00

Fd. 2X2" + TK A.T.B.C. Lot 25 West Knoll Tract.

Set S.W. & T. in Macadam

33.20

West Knoll Drive

Set L. & T. in Curb

Sec 1

Sec 24

14+03.60
2" I.P. Plug & TK

51° 00'

178°

21.84

30'

Ref Pg 13

F.B. 311 Pg. 26 Chief Party Notes by Crumley Date 12/22 & 27/ 1927

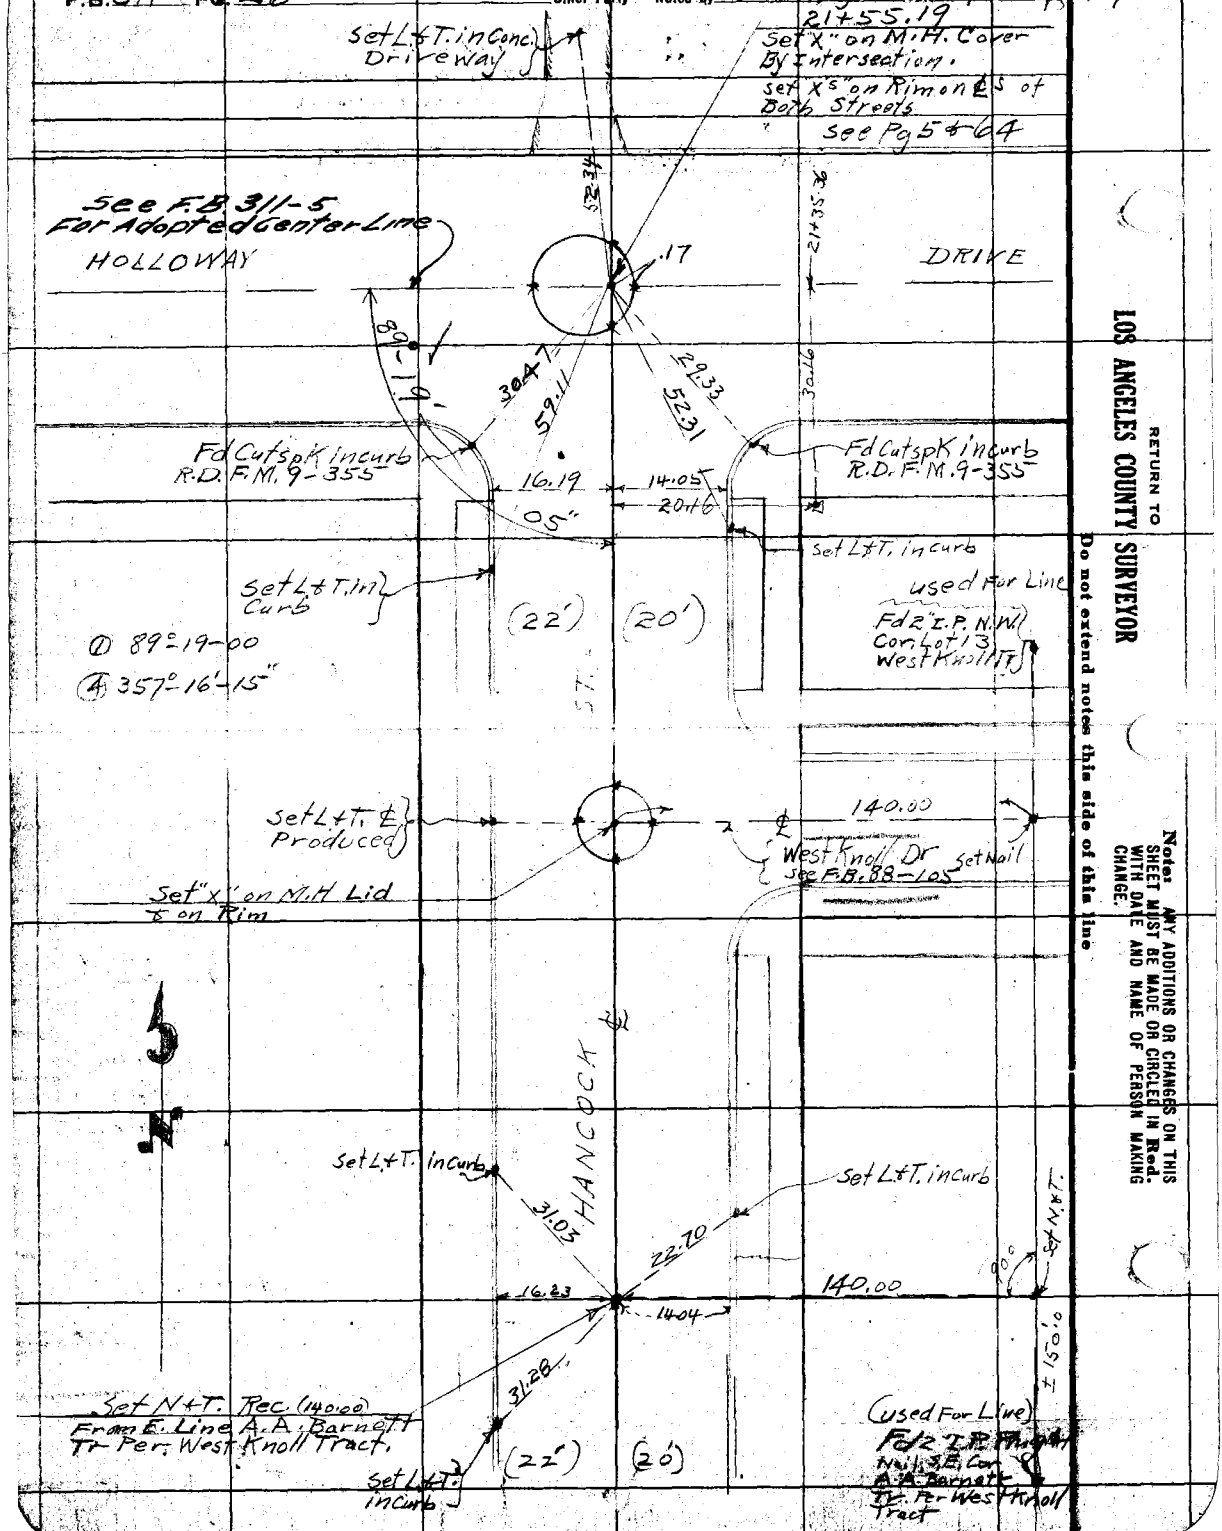

RETURN TO
LOS ANGELES COUNTY SURVEYOR
Do not extend notes this side of this line

Notes: ANY ADDITIONS OR CHANGES ON THIS SHEET MUST BE MADE OR CIRCLED IN Red. WITH DATE AND NAME OF PERSON MAKING CHANGE.

Date _____ Notes by _____ Chief Party _____ F. B. 311 PG. 27

Platted by Hopkins
Date March 1928
Map No. B 150
Platting C'k'd by C.L.H.
Date MAR 1928

W. O. No. 4170 D. S. O. No. _____
Location Holloway Drive
Surveyed by C.V. Crumley.
Date Dec. 27, 1927 & Jan. 19, 1928
Indexed A. C. Johnson

Note: ANY ADDITIONS OR CHANGES ON THIS SHEET MUST BE MADE OR CIRCLED IN Red. WITH DATE AND NAME OF PERSON MAKING CHANGE.

Do not extend notes this side of this line

RETURN to LOS ANGELES COUNTY SURVEYOR

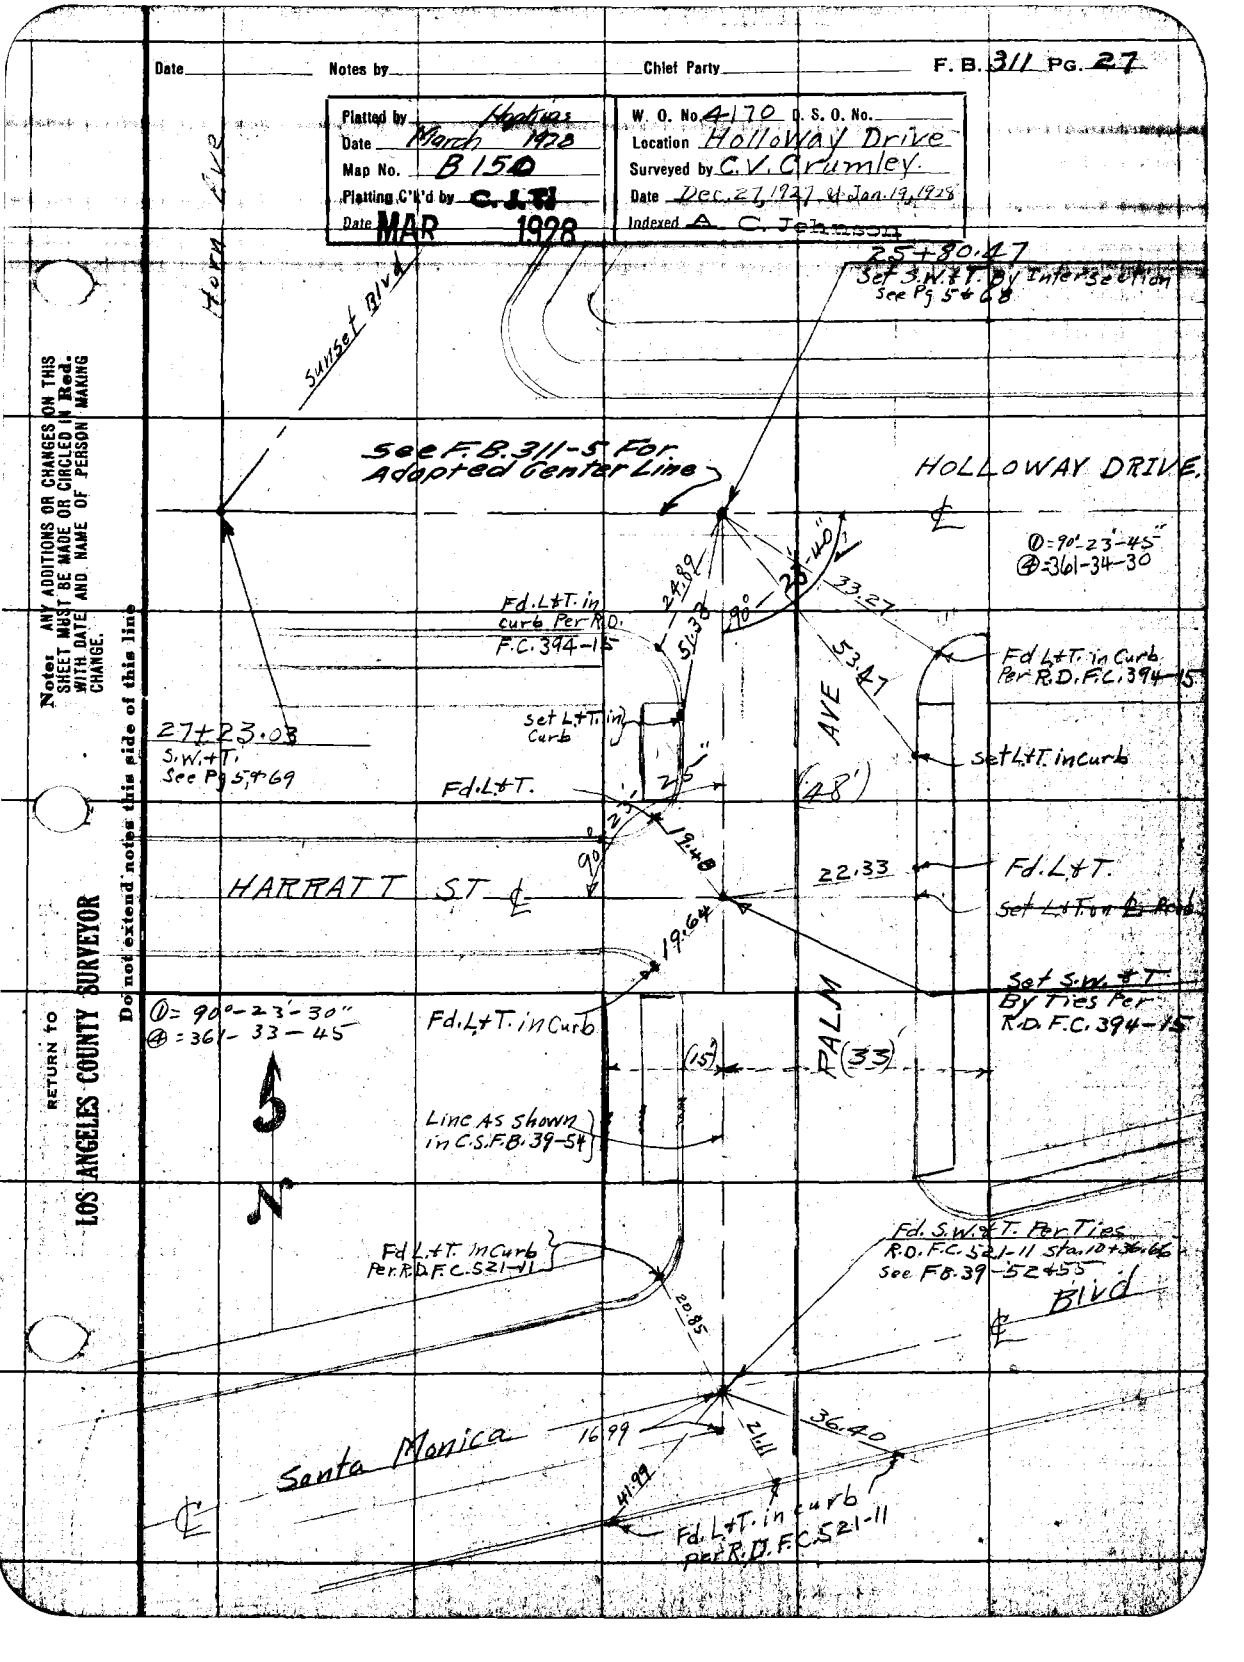

F.B. 311 Pg. 28 Chief Party Notes by C.V. Crumley Date 12/28/27

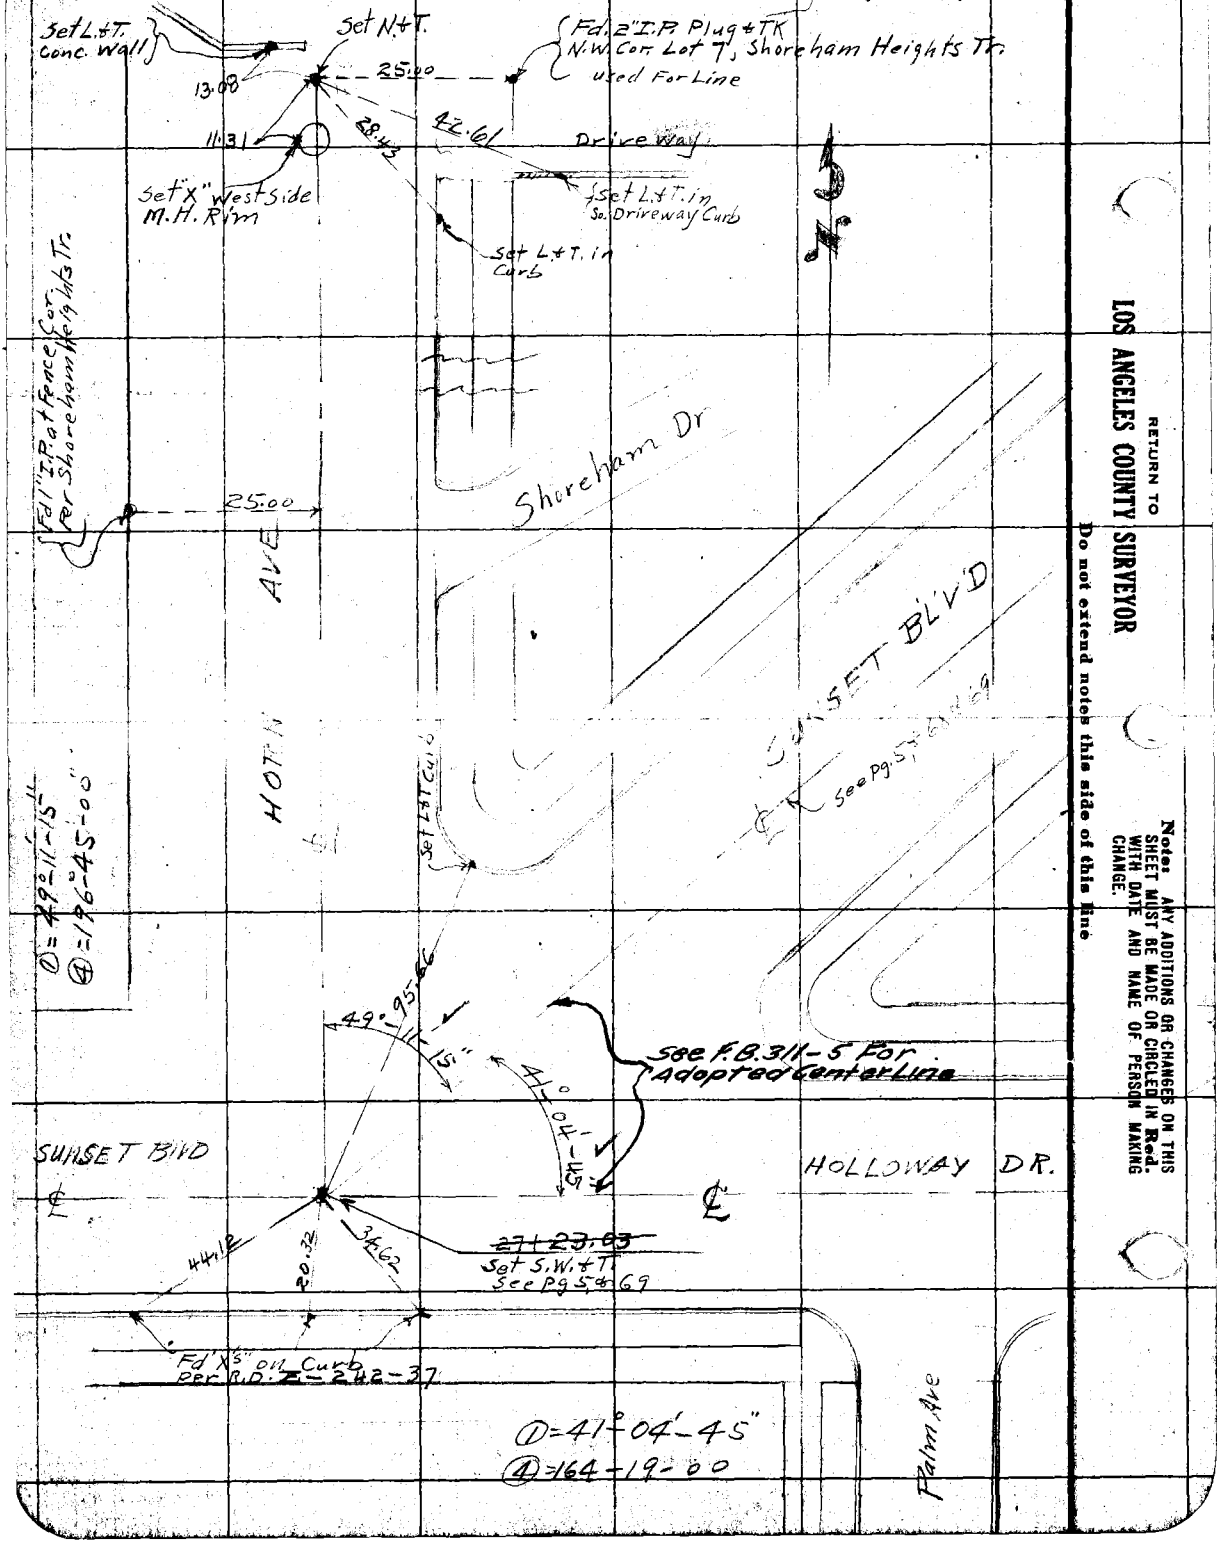

RETURN TO
LOS ANGELES COUNTY SURVEYOR
Do not extend notes this side of this line

Notes: ANY ADDITIONS OR CHANGES ON THIS SHEET MUST BE MADE OR CIRCLED IN Red. WITH DATE AND NAME OF PERSON MAKING CHANGE.

Date _____ Notes by _____ Chief Party _____ F. B. 311 Pg. 29

Plotted by _____	W. O. No. _____ O. S. O. No. _____
Date _____	Location _____
Map No. _____	Surveyed by _____
Plotting C'k'd by C. L. T.	Date _____
Date MAR 1928	Indexed A. C. Johnson

Notes: ANY ADDITIONS OR CHANGES ON THIS SHEET MUST BE MADE OR CIRCLED IN Red. WITH DATE AND NAME OF PERSON MAKING CHANGE.

Do not extend notes this side of this line

RETURN TO

LOS ANGELES COUNTY SURVEYOR

F.B. 311 PG. 30 Chief Party Notes by Date

RETURN TO

LOS ANGELES COUNTY SURVEYOR

Do not extend notes this side of this line

Notes: ANY ADDITIONS OR CHANGES ON THIS SHEET MUST BE MADE OR CIRCLED IN Red. WITH DATE AND NAME OF PERSON MAKING CHANGE.

Date _____ Notes by _____ Chief Party _____ F. B. 311 Pg. 31

Plotted by Hoduna
Date March 28
Map No. B 150
Plotting C'k'd by C. L. T.
Date MAR 1928

W. O. No. 4170 U. S. O. No.
Location Sunset Blvd
Surveyed by C. V. Crumley
Date December 27, 1927
Indexed A. C. Johnson

Notes ANY ADDITIONS OR CHANGES ON THIS SHEET MUST BE MADE OR CIRCLED IN Red. WITH DATE AND NAME OF PERSON MAKING CHANGE.

Do not extend notes this side of this line

RETURN TO LOS ANGELES COUNTY SURVEYOR

30+52.69 Set S.W.&T. See Pg 6, #71

Set L&T. Curb

LARRABEE ℄ - 51

68.97

28.67

Fd L&T. in curb Per R.D.Z-242-37

30+51.77 Set S.W.&T. See Pg 6, #71

Fd L&T. in Curb Per R.D. Z-242-37

68.77

28.43

92

See F.B. 311-6 For Adopted Center Line

℄ SUNSET ℄ BLVD

89°-31-45" 89°-31-45" 40.

Fd. L&T. Per R.D. Z-242-37

63.66

Set L&T. in Curb

Ⓓ = 89°-31-45"
Ⓐ = 358-06-45"

Ⓓ = 89°-30-45"
Ⓐ = 358-03-00"

Ⓓ = 90°-28-15"
Ⓐ 361-52-30

ST.

HARRATT ST

Set L&T. in Curb on Produced ℄

20.55-09

Set "X" on M.H. Rim on ℄ of Booth Sts.

LARRABEE

See R.D. F.C. 394-3+4

Fd 3/4" Iron Bolt 1.7 North & .32 West of 3/4" I.P.

Per C.S. 7143 F.B. 394-1

℄ Per R.D. F.C. 394-5

CYNTHIA ST

Ⓓ 80-04-15
Ⓐ 320-17-00

Fd L&T.

Ranch Line

CYNTHIA ST.

Fd L&T. in Curb F.C. 394-4

Fd L&T.

Fd L&T. on R.D. ℄ Prod.

Set L&T. on ℄ Prod.

2 Fd. 3/4" I.P. 8" Deep With a/d Rotten 3x3" (No T.K.) .18 South as per C.S. F.B. 39-61 & F.B. 28-28

See R.D. F.C. 394-3+4

Fd L&T. on Curb & Cynthia Prod. F.C. 394-4

(Set L&T. on Re. Line Prod.

Fd L&T. in Curb F.C. 394-4

F.B. 311 PG. 32 Chief Party Notes by C.V. Crumley Date 12/28/'27

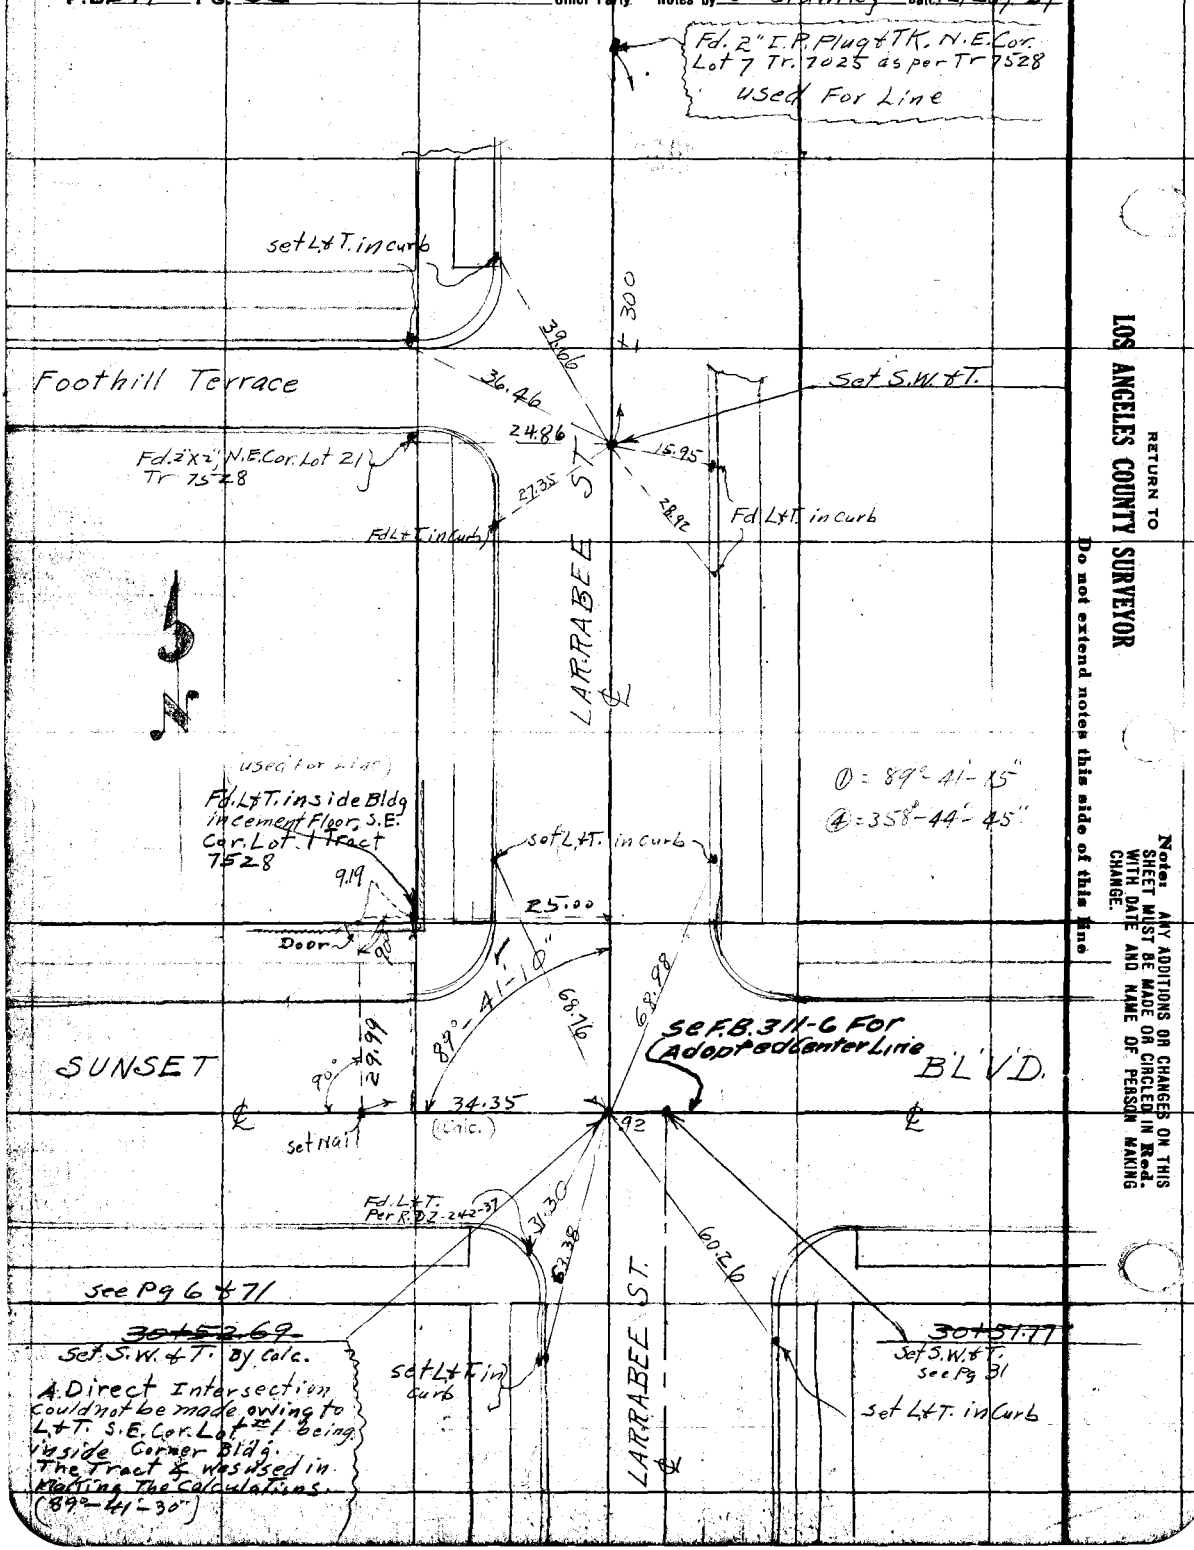

RETURN TO
LOS ANGELES COUNTY SURVEYOR
Do not extend notes this side of this line

Note: ANY ADDITIONS OR CHANGES ON THIS SHEET MUST BE MADE OR CIRCLED IN Red. WITH DATE AND NAME OF PERSON MAKING CHANGE.

Date _____ Notes by _____ Chief Party _____ F. B. 311 PG. 33

Platted by Hopkins
Date March 28
Map No. B150
Platting C'k'd by C. J. T.
Date MAR 1928

W. O. No. 4170 D. S. O. No.
Location Sunset Blvd
Surveyed by C. V. Crumley
Date December 29, 1927
Indexed A. C. Johnson

Found 1½" I.P.N.E. Cor. Lot 18 Ozeta Tr.

169.75

To the I.P. N.E. Cor. Blk 5 Sherman Heights Tract Per Ozeta Tract (used For Line)

Foot Hill Terrace

Set S.W. & T. Top of Hill + 840 From Sunset Blvd

Clark St

38.42
32.00
18.29
10.00
Set L & T. in Curb
33.93
26.40
44.44

15' 35'

CLARK ST.

Δ=90°-21'-30"
R=361'-25'-30"

25' 25'

10' W. of Center Line Per Ozeta Tr. & Sherman Heights Tr.

see Pg 6, 34, 73

Set L & T. in Walk

Set L & T. in Curb

~~32+95.95~~
Fd. S.W. & T. Per Ties R.D. F.B. 121-22, Sta 80+38.34

7.50R

72.15
90°
25'

SUNSET (80) BLVD (80)

see F.B. 311-6 For Adopted Center Line

9.67

set "x"

set "x"

Set Walk

10.00

(30')

(30')

Rec. As Calc. From Plats For F.B. 121-

Clark St 65.65

50.90

Set L & T. in Curb

Set L & T. in Curb

~~33+76.20~~
Set "X" on M.H. Cover With "x's" on Rim.

See Pg 6 & 73

RETURN TO LOS ANGELES COUNTY SURVEYOR

Notes ANY ADDITIONS OR CHANGES ON THIS SHEET MUST BE MADE OR CIRCLED IN Red. WITH DATE AND NAME OF PERSON MAKING CHANGE.

Do not extend notes this side of this line

F.B. 311 Pg. 34 Chief Party Notes by Crumley Date 12/29/27

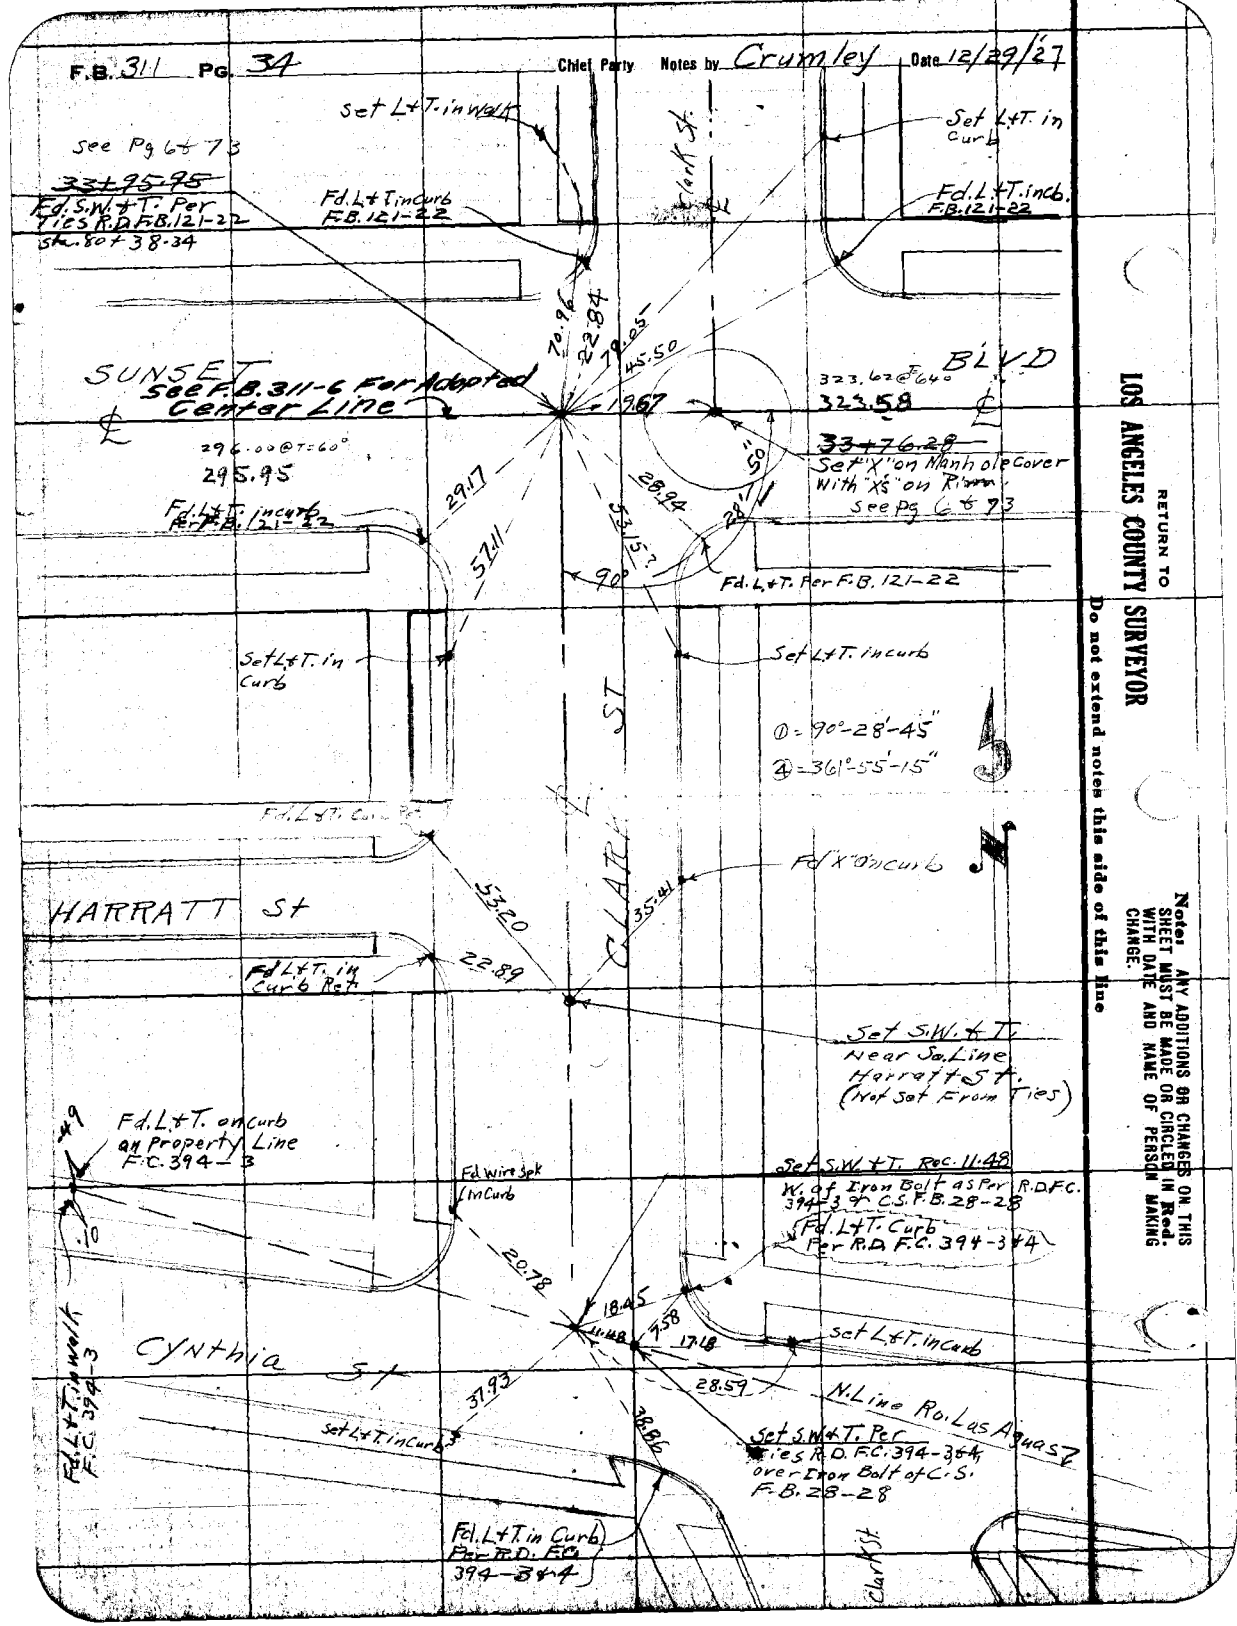

RETURN TO
LOS ANGELES COUNTY SURVEYOR
Do not extend notes this side of this line

Notes: ANY ADDITIONS OR CHANGES ON THIS SHEET MUST BE MADE OR CIRCLED IN Red. WITH DATE AND NAME OF PERSON MAKING CHANGE.

Date _____ Notes by _____ Chief Party _____ F. B. 311 PG. 35

Plotted by Hopkins	W. O. No. 4170 D. S. O. No.
Date March 28	Location Sunset Blvd
Map No. B150	Surveyed by C.V. Crumley
Plotting C'k'd by C. J. T.	Date Dec. 30 & 31, 1927
Date MAR 1928	Indexed A. C. Johnson

Notes: ANY ADDITIONS OR CHANGES ON THIS SHEET MUST BE MADE OR CIRCLED IN Red. WITH DATE AND NAME OF PERSON MAKING CHANGE.

Do not extend notes this side of this line

RETURN TO LOS ANGELES COUNTY SURVEYOR

Set L&T. in Curb

Lot 13

To ℄ Clark St.

315.63

23.83

T=60°
315.58

Set S.W.&T. Proportioned Distance From ℄ Clark St. Near B.C. of Curve & Approx. So. Line Lot 13, Blk 1, Sherman Heights Tract.

22.45

21.25

Set L&T. in Curb

Lot # 12

Set L&T. in Curb

Ave

Hilldale

Δ = 90°-21'-30"

④ = 361°-25'-45"

(No Temp. Correction Applied Before Proportioning)

Note:- Hammond & Clark Sts. Chord Dist Between ℄'s = 636.21

Total Record Dist. Per Sherman Heights Tr = 636.39

Set L&T. in Curb

Set L&T. in curb

90°-21'-30"

75.00

83.80

78.62

SUNSET BLVD.

See F.B. 311-7 For Adopted Center Line

320.53

320.58 @ T= 60° To ℄ So. Hammond

24.15

315.58 To ℄ N. Clark

315.63 @ T=60°

295.96 @ T=60° = 295.91 To ℄ So. Clark

Fd. L&T. Per R.D. F.B. 121-22

28.75

56°-30'

67.70

28.28

61.02

Fd. L&T. in Curb F.B. 121-22

See Pg 7475

~~3711.601~~

~~3611.86~~

Set S.W.&T. Per R.D. F.B. 121-22

Set L&T. in Curb

Set L&T. in Curb

Hilldale Ave

Set "X" in Lid of Manhole at Proportion Between ℄ of North Clark St. & ℄ of So. Hammond St. (See Note Left of Ja's Pg)

See Pg 7, 3647

F.B. 311 Pg. 36 Chief Party Notes by Cromley Date 1/18/28

37+16.01
Set S.W. & T. Per R.D.F.B. 121-22
see Pg 7, & 75 & 76

Hilldale Ave

See F.B. 311-4 For Adopted Center Line

SUNSET BLVD

℄

24.15

89°19'30"

28.28

36+91.86
X" on M.H. Cover
Pg 7, 35 & 75

Fd L&T. Cur 6 Ref. ℄ Per R.D. F.B. 121-22 T

28.75

Fd. L&T. in cur 6 Ref. Per R.D. F.B. 121-22

Δ = 89°19'-30"
℄ = 357-18-00

Edge of Walk

25.01
25.12

Fd Old 2x2 No Tk. S.W. Cor Lot 70 Sub. Div. Lot "A" M.B. C-79

Fd "X" in walk N.E. Cor. Lot 83 Sub. Div. Lot "A" of Lankershim Addition To Sherman Per L.S. Map 19-39 (used For Line)

25.00

25.11

Fd 2x2" (No Ref.) +o Nail

HILLDALE AVE

(50')

25.15

Fd 2x2" + Nail S.W. Cor Lot 74 Sub. Lot A M.B. C-79

Edge of Walk

25.05

25.05

Edge of Walk

HARRATT ST

set L&T. in Curb & Prod.

RETURN TO
LOS ANGELES COUNTY SURVEYOR

Do not extend notes this side of this line

Notes: ANY ADDITIONS OR CHANGES ON THIS SHEET MUST BE MADE OR CIRCLED IN Red. WITH DATE AND NAME OF PERSON MAKING CHANGE.

Date _____ Notes by _____ Chief Party _____ F. B. 311 Pg. 37

Plotted by Hoatson
Date March 28
Map No. B150
Plotted C'k'd by C. J. T.
Date MAR 1928

W. O. No. 4170 D. S. O. No.
Location SUNSET BLVD
Surveyed by C. V. Crumley
Date Jan. 3 4 18, 1928
Indexed A. C. Johnson

Notes: ANY ADDITIONS OR CHANGES ON THIS SHEET MUST BE MADE OR CIRCLED IN Red. WITH DATE AND NAME OF PERSON MAKING CHANGE.

RETURN TO LOS ANGELES COUNTY SURVEYOR

Do not extend notes this side of this line

1/2" Dowel
Fd 2" I.P. S.E. Cor. Lot 24 Tract 5365 See Pg 38

36.49
36.50

30.12
30.20

Fd. L & T. in old Conc. Cul't Hdwall Flush with Roadway Per R.D. F.B. 121-

67.00

Set L & T. in Conc. Retaining Wall

SUNSET

Set "X"

20.42

19.96

90°

See F.B. 311-7 For Adopted Center Line

~~40+12.39~~

Set "X" on Manhole Cover By Ties Per R.D. F.B. 121-

27.84

37.85

Fd. L & T. in Curb Per R.D. F.B. 121-

Fd. L & T. in Curb Per R.D. F.B. 121-

See Pg 7 & 78

22.12

Fd. 2x2 S.W. Cor. Hammond St.

Set L & T. in curb

71.43

Set L & T. in Curb

Fd 2x2

.63

22.48
17.11

HAMMOND ST.

(45')

Fd. 2x2 N.E. Cor. Lot 4 Harratt Tr.

Fd L & T. in Walk

Δ = 90° - 37' - 00"
Δ = 362° - 28' - 30"
This Angle shown in Wrong Quadrant Checked in Field
Δ 89° - 23' - 00"
Δ 357 - 31 - 30
Δ 715 - 03 - 30
S.W. Quad
C.V.C. - 7/13/29

Harratt St

Harratt St

Fd old 2x2 ~~Comp~~ Cor. N.E. Lot 4 Harratt Tr

23.24

Fd L & T. K. in Walk S.E. Cor Harratt Tr. Per Tr. 6100 F.B. 306-6

22.48

22.49

(See F.B. 306-6) Phyllis St

Fd L & T. Cor. of School Property in Walk

Fd 2" I.P. (Plug & Nail) S.E. Cor. Tr. Clog Per Cs. F.B. 306-6 (Used for Line)

22.50

Set Nail

N'ly Bdy R.R. Rockade Los Angeles

F.B. 311 Pg. 38 Chief Party Notes by C.K. Crumley Date 2/10/28

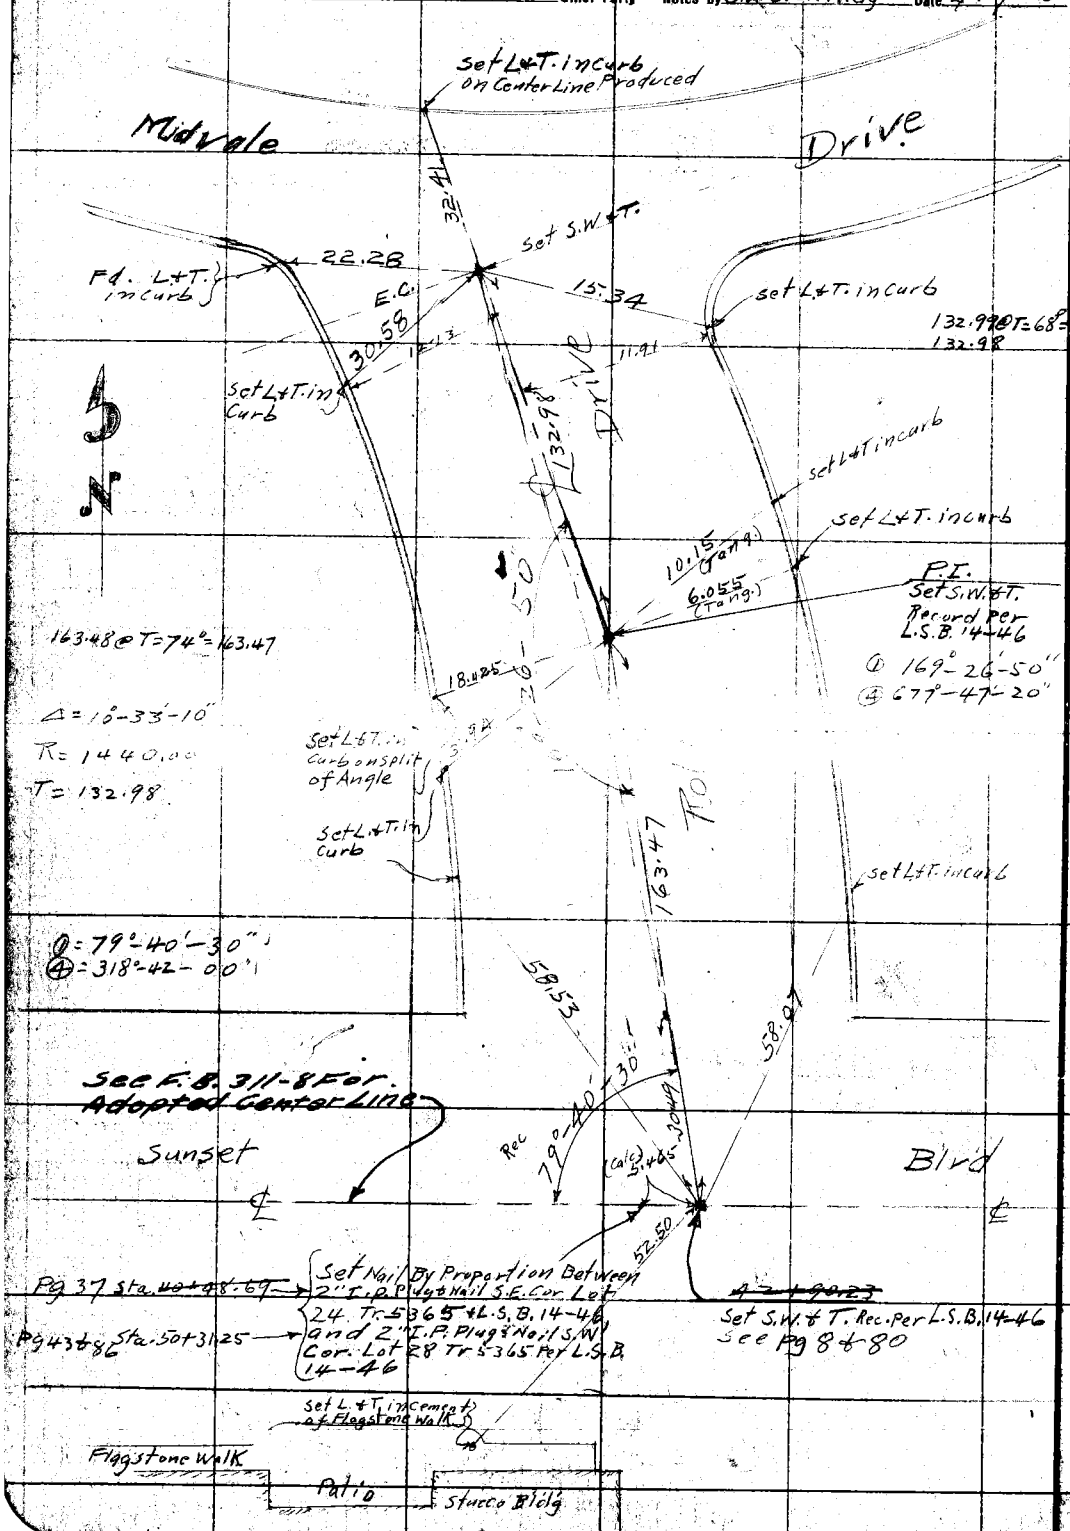

RETURN TO
LOS ANGELES COUNTY SURVEYOR

Do not extend notes this side of this line

Note: ANY ADDITIONS OR CHANGES ON THIS SHEET MUST BE MADE OR CIRCLED IN Red. WITH DATE AND NAME OF PERSON MAKING CHANGE.

Date _____ Notes by _____ Chief Party _____ F. B. 311 PG. 39

Plotted by Hoskins
Date March 20
Map No. B 150
Plotting C'k'd by C.J.T.
Date MAR 1928

W. O. No. 4170 Q. S. Q. No.
Location SUNSET BLVD.
Surveyed by C.V. CRUMLEY
Date December 4, 1927
Indexed A. C. Johnson

Notes: ANY ADDITIONS OR CHANGES ON THIS SHEET MUST BE MADE OR CIRCLED IN Red. WITH DATE AND NAME OF PERSON MAKING CHANGE.

Do not extend notes this side of this line

RETURN TO LOS ANGELES COUNTY SURVEYOR

Set L.&T. Curb

Fd X" in Curb Per R.D. F.B. 121-

Fd L.&T. in Hdwall Flush with Parm't Per R.D. F.B. 121-

59.27
51.80

Fd X" in Curb Per R.D. F.B. 242-38

49.33

Δ = 90°-26'-45"
Δ = Set 47-30

SUNSET BLVD

See F.B. 311-7 For Adopted Center Line

~~46+34.11~~
~~46+36.72~~

set X"

set X"

set X"

set X"

0.26

90

Set X" On Manhole Cover Per Ties R.D. F.B. 121-23

See Pg 8, 40, 83

DOHENY DR.

67.67

67.57

Fd Nail in Curb Ref Per R.D. F.B. 121-

Set L.&T. in Curb

Set L.&T. in Curb

Fd L.&T. in Curb

Fd Nail in Wall Per F.B. 306-6 & R.D. F.B. 97-

Fd cut spk in Curb Per F.B. 306-6 & R.D. F.B. 97-

41.98

47.83

32.96

Alley

32.22

Fd 2" I.P. Plug & Nail Per F.B. 306-6

Fd S.W.&T. Per C.S. F.B. 306-6

36.48

Ranch Line

Fd cut spk in Curb Per C.S. F.B. 306-6 & R.D. F.B. 97-

4 Pt.

F.B. 311 PG. 40 Chief Party Notes by Crumley Date 12/4/27

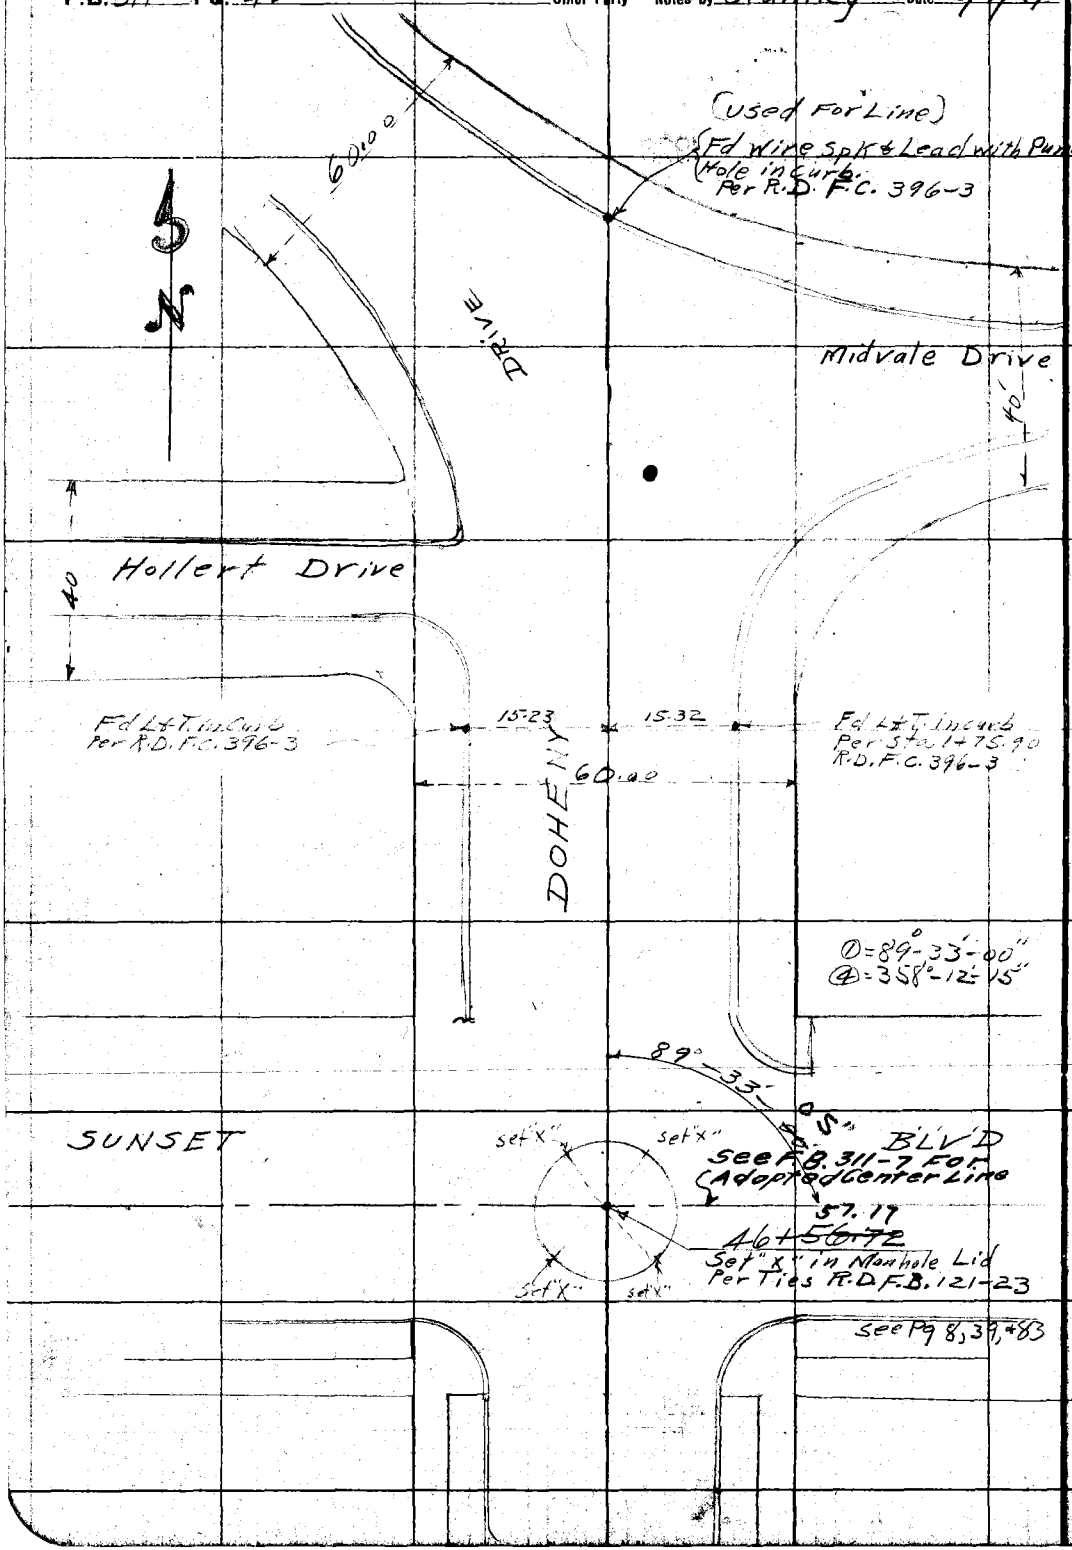

RETURN TO
LOS ANGELES COUNTY SURVEYOR
Do not extend notes this side of this line

Notes: ANY ADDITIONS OR CHANGES ON THIS SHEET MUST BE MADE OR CIRCLED IN Red. WITH DATE AND NAME OF PERSON MAKING CHANGE.

Date _____ Notes by _____ Chief Party _____ F. B. 311 PG. 41

Plotted by Hopkins
Date 28
Map No. B 150
Plotting C'k'd by C. J. T.
Date MAR 1928

W. O. No. 4170 D. S. O. No.
Location Sunset Blvd
Surveyed by C.V. Crumley
Date Jan. 6, 1928
Indexed

Notes ANY ADDITIONS OR CHANGES ON THIS SHEET MUST BE MADE OR CIRCLED IN Red. WITH DATE AND NAME OF PERSON MAKING CHANGE.

Do not extend notes this side of this line

RETURN TO LOS ANGELES COUNTY SURVEYOR

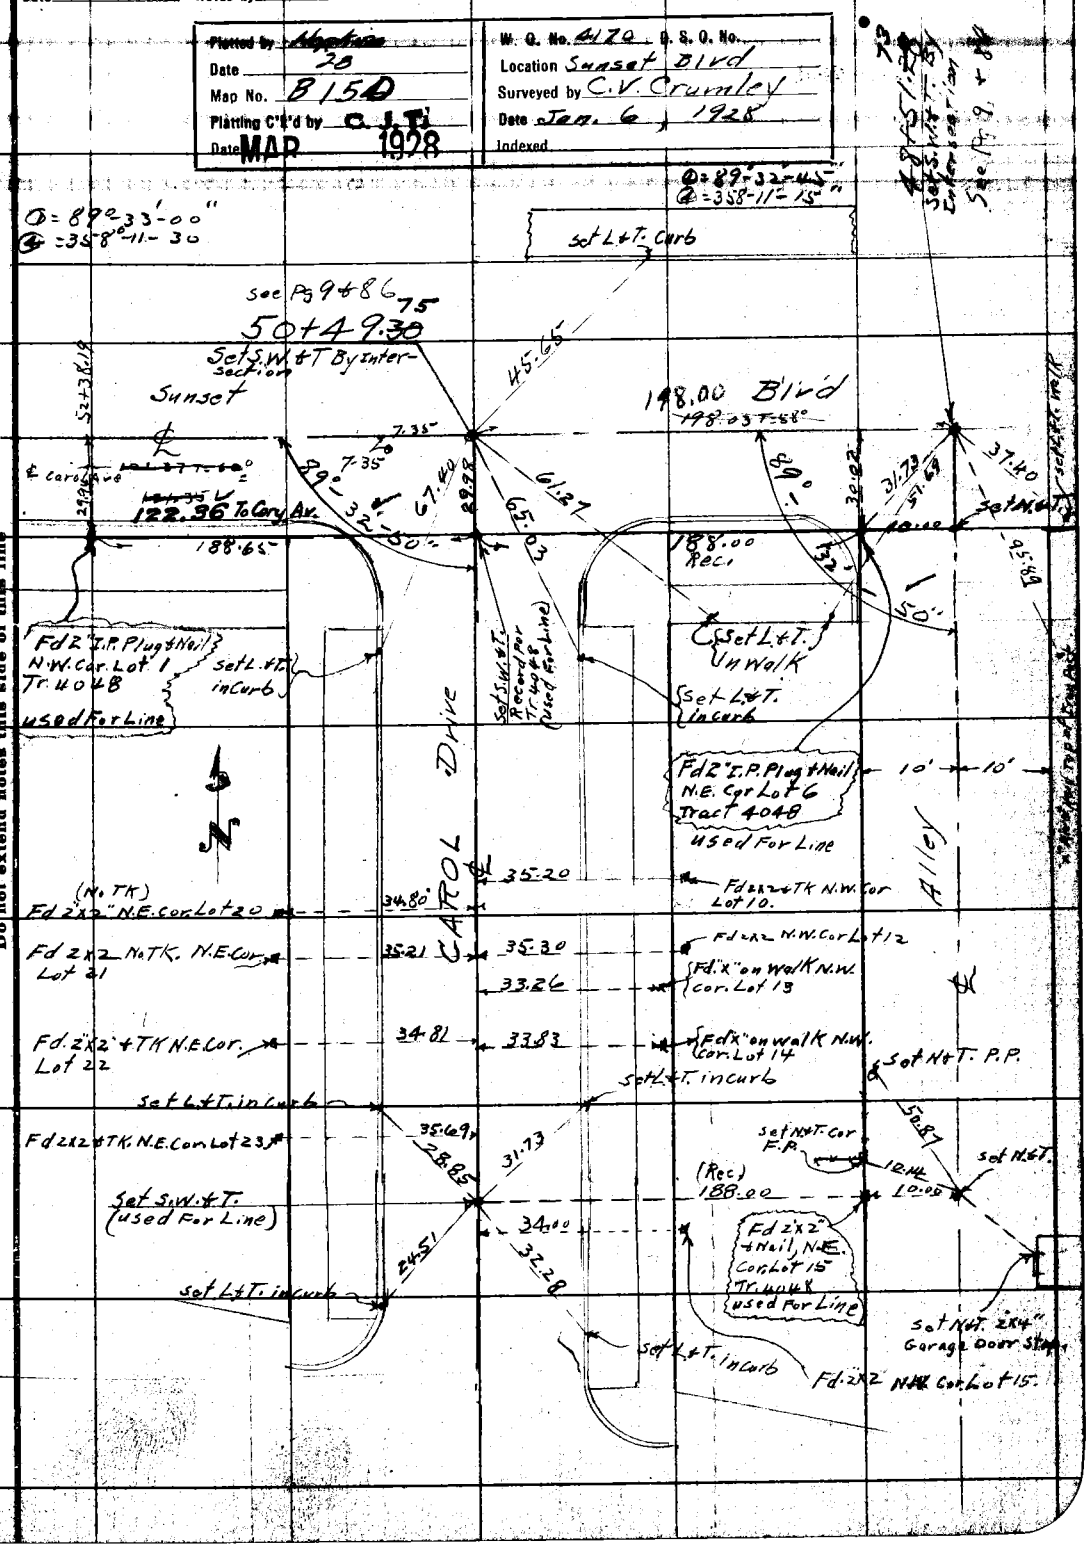

F.B. 311 Pg. 42 Chief Party Notes by C.V. Crumley Date 1/10/28

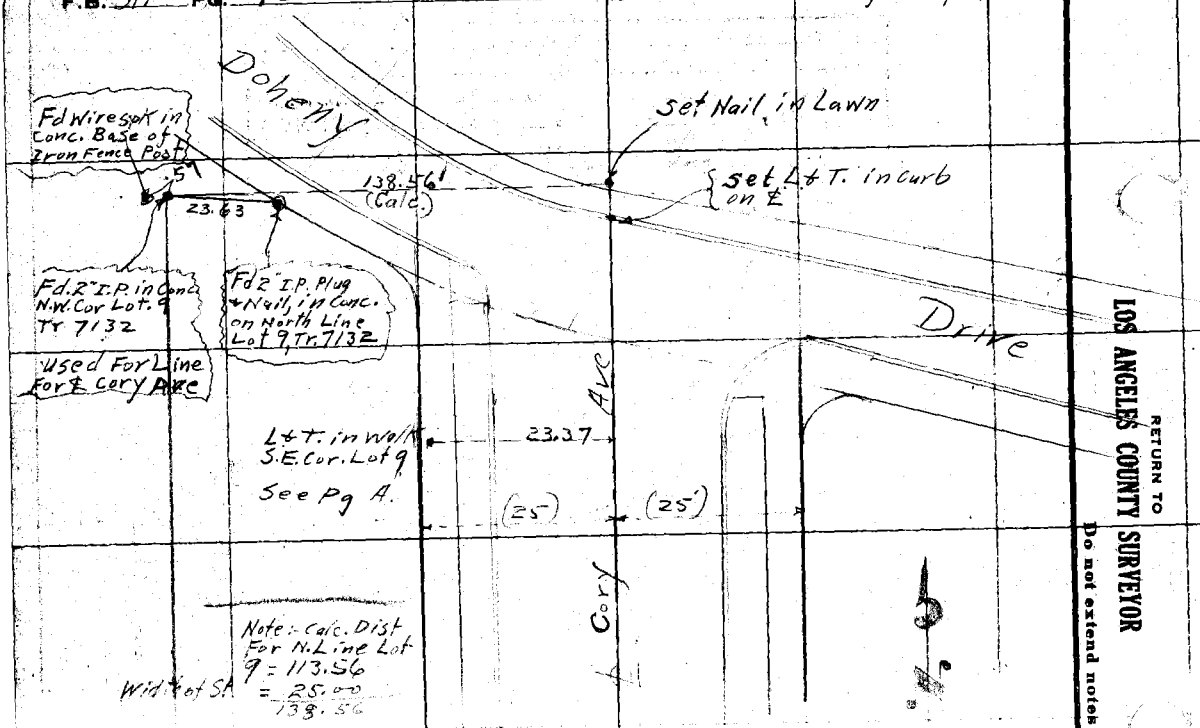

Note:- Calc. Dist For N. Line Lot 9 = 113.56
Width of S.A. = 25.00
138.56

Contd From Top Pg 43

RETURN TO LOS ANGELES COUNTY SURVEYOR

Do not extend notes this side of this line

Notes: ANY ADDITIONS OR CHANGES ON THIS SHEET MUST BE MADE OR CIRCLED IN Red. WITH DATE AND NAME OF PERSON MAKING CHANGE.

Date _____ Notes by _____ Chief Party _____ F. B. 311 PG. 43

Plotted by Hopkins
Date March 1928
Map No. B 150
Plotting C'k'd by C. J. Tl
Date MAR 1928

W. O. No. 4170 C. S. Q. No. _____
Location Sunset Blvd.
Surveyed by C. V. Crumley
Date January 10, 1928
Indexed A. C. Johnson

Cont'd from Topg 42

(25') (25')

Fd L & T. in walk S.E. Cor Lot 9 Tr 7132 — 23.37
Fd L & T. in walk — 23.35 ℄
Fd L & T. in walk — 23.41
Fd L & T. in walk ℄ E. Cor. Lot 8 — 23.46 — 24.48 — Fd L & T. in walk S.W. Cor. Lot 17 Tract 7132
Fd L & T. in walk — 23.46
Fd L & T. in walk S.E. Cor. Lot 7 — 23.46 — 24.50 — Fd L & T. in walk at S.W. Cor Lot 16
Fd L & T. in walk S.E. Cor. Lot 6 — 23.48 — 24.47 — Fd L & T. in walk at S.W. Cor Lot 15

Hollert Dr

Cory ℄

Fd L & T S.E. Cor Lot 5 in walk — 23.56 — 23.48 — Fd L & T. S.W. Cor Lot 14 in walk
In walk Fd L & T. S.E. Cor. Lot 4 — 23.56 — 23.43 — Fd L & T. S.W. Cor Lot 13
8.09 Set Nail South side old L & T.
Set L & T. in curb
Fd 2" I.P. S.W. Cor Lot 3 Tr 7132
Fd C.W. Cooke 2x2" S.E. Cor. Lot 2
25.00
Set L & T. in Curb
50+31.25
Fd 2" I.P. S.W. Cor Lot 28 Tr 7132 Per Tr. 7132
(used For Line & Proportion)
140.49
140.50
Set S.W. L & T. By Proportion Between 2x2" & 2" I.P.
(used For Line & Proportion)
50.00
52.60
29.67
122.36 to ℄ Carol Dr.
To L & T. at ℄ P.I. — 204.63 @ I = 62°
90°-00'
Set "X"
Set "X"
72.11
51+71.66
Set Punch Hole "X" By Intersection in M.H. Cover
Set "X" Rim of M.H.
SUNSET ℄
BLVD ℄
Δ = 90°-00'-45"
Δ = 360°-02'-15"
Steep 9 & 83
This dist per Road Dept. F.B.F.A. 170-11
Set L & T. on ℄ prod in curb & Walk
11.15

Notes ANY ADDITIONS OR CHANGES ON THIS SHEET MUST BE MADE OR CIRCLED IN Red. WITH DATE AND NAME OF PERSON MAKING CHANGE.

Do not extend notes this side of this line

RETURN TO LOS ANGELES COUNTY SURVEYOR

F.B. 311 PG. 44 Chief Party Notes by C.V. Crumley Date 1/11/28

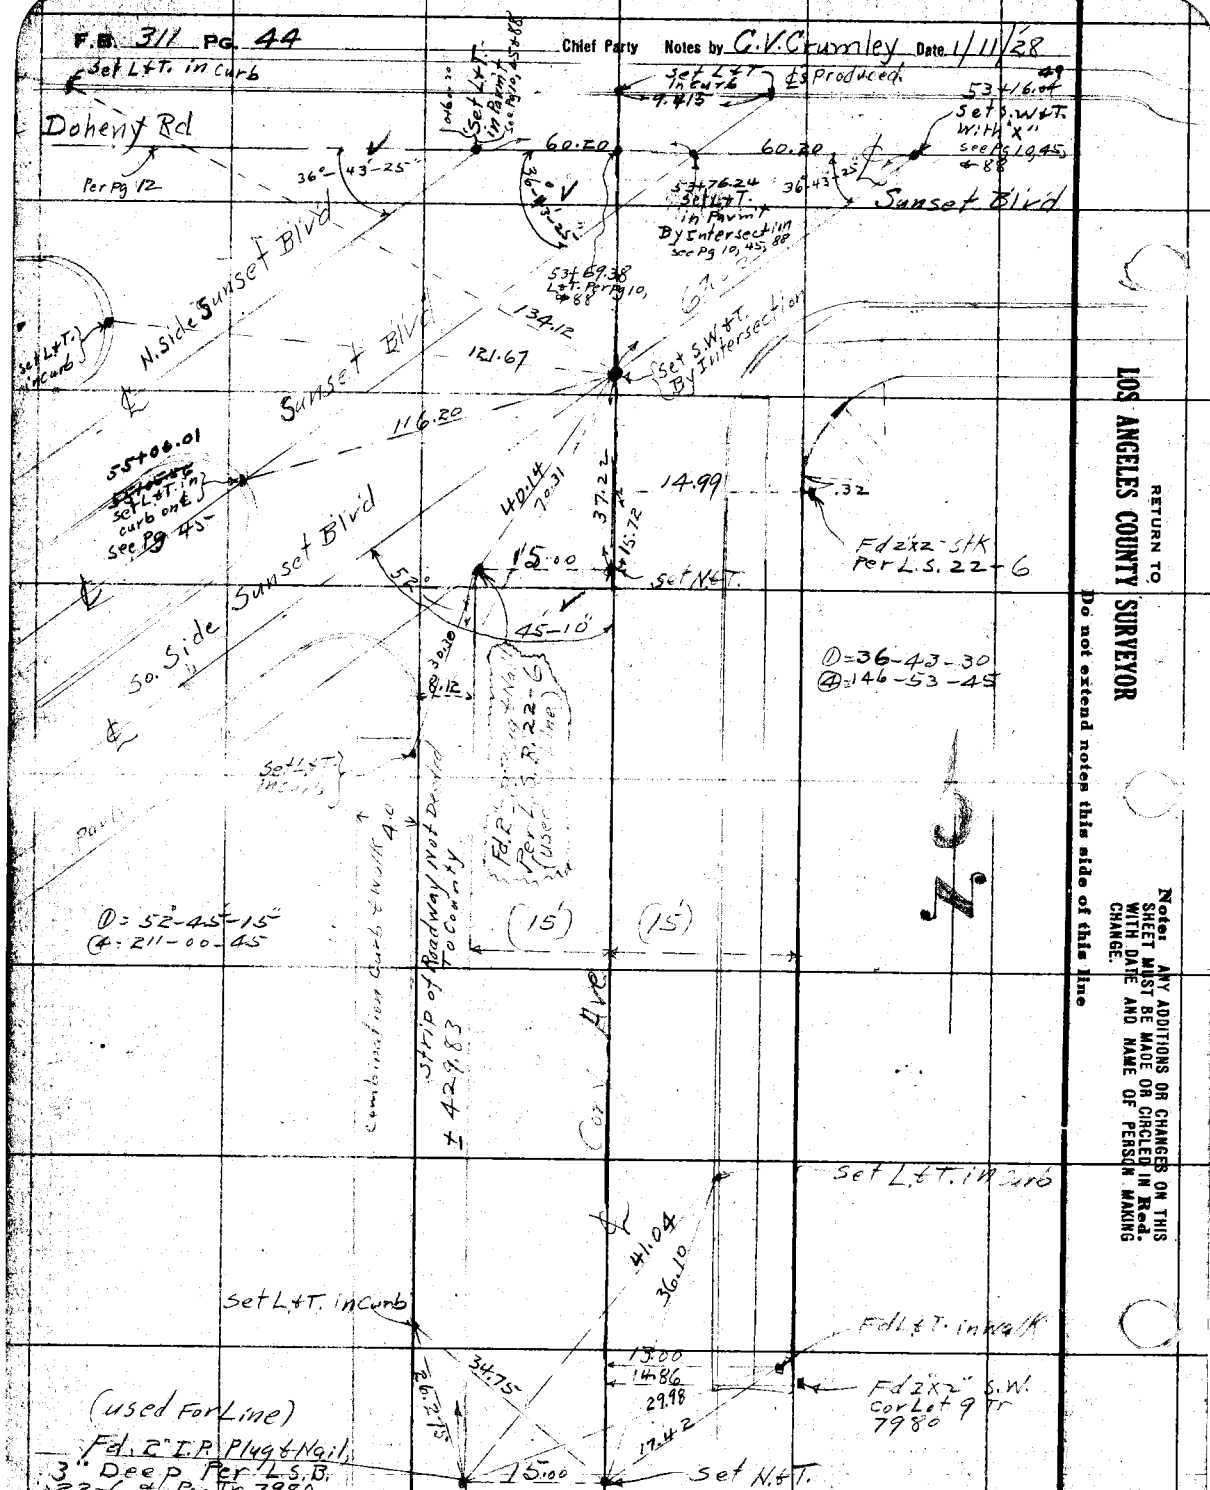

RETURN TO
LOS ANGELES COUNTY SURVEYOR
Do not extend notes this side of this line

Notes: ANY ADDITIONS OR CHANGES ON THIS SHEET MUST BE MADE OR CIRCLED IN Red. WITH DATE AND NAME OF PERSON MAKING CHANGE.

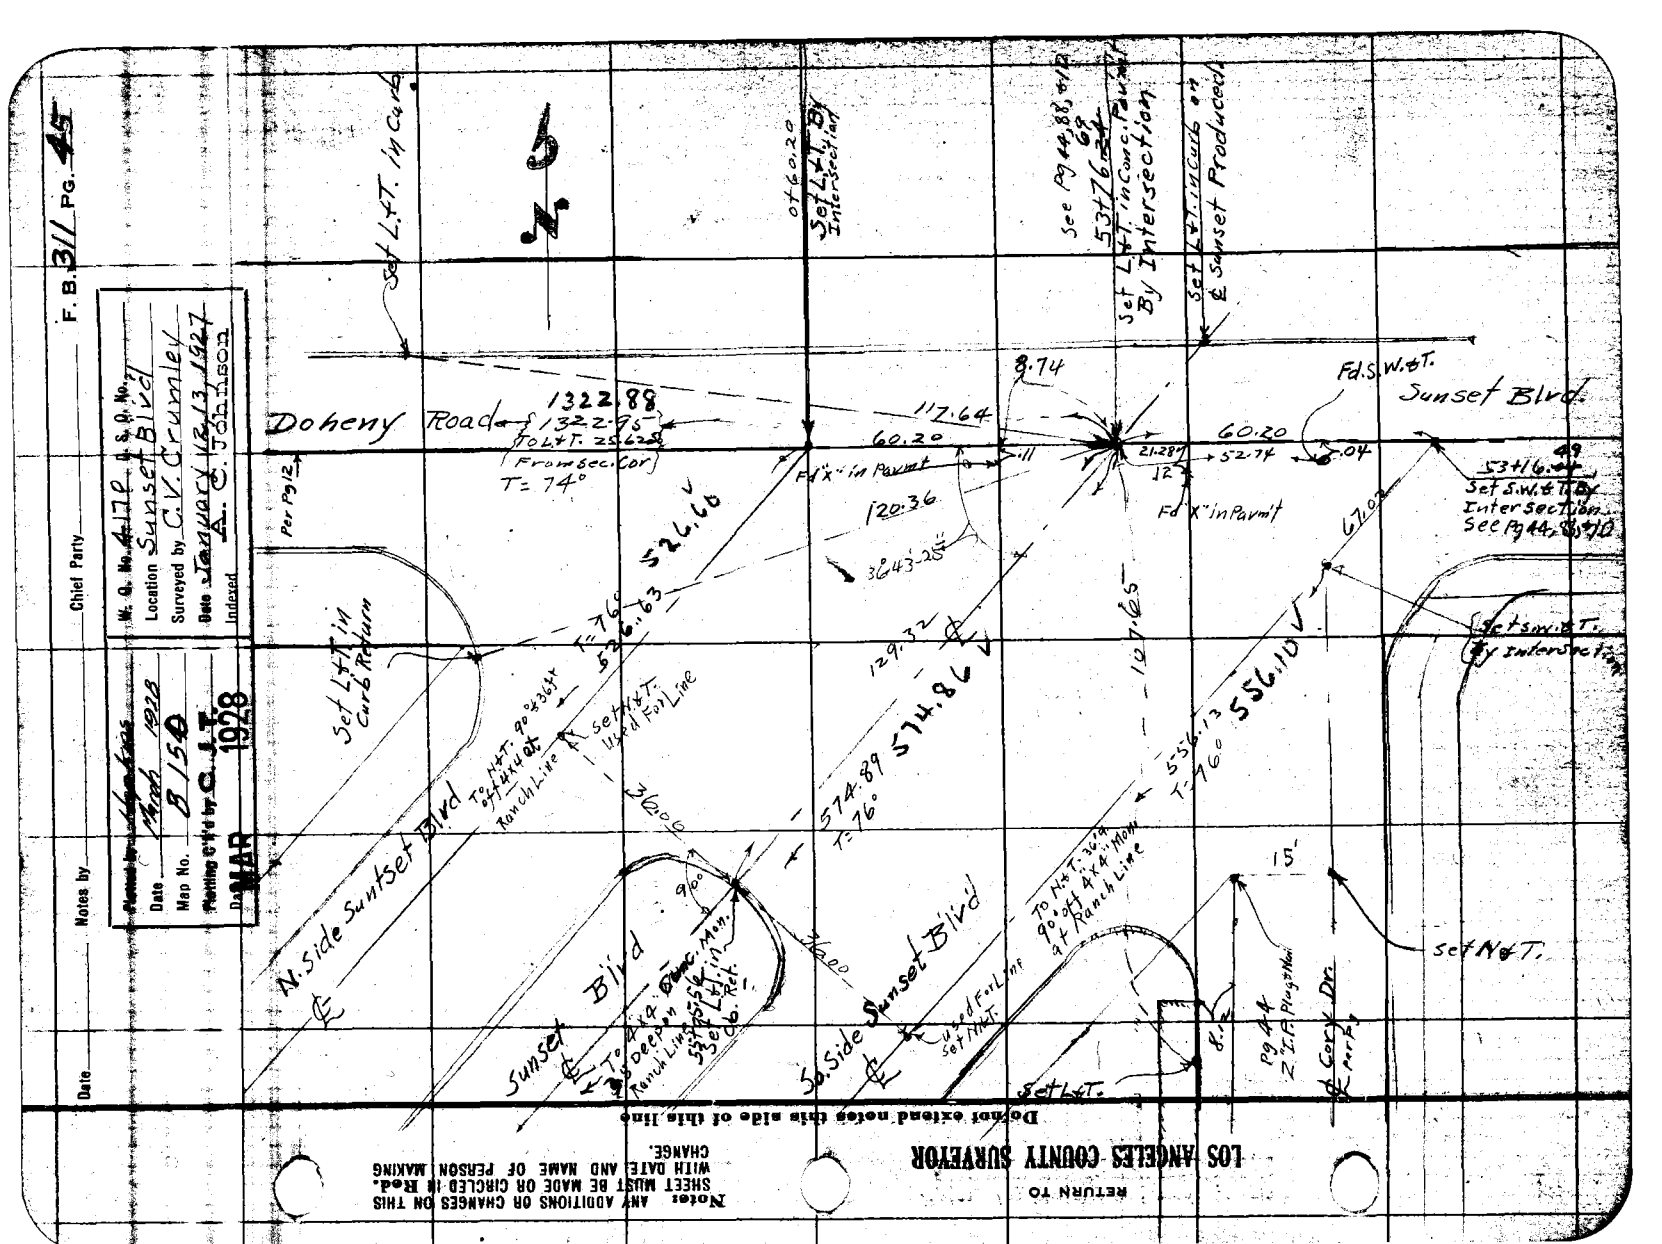
F. B. 311 Pg. 45
Chief Party
Notes by
Date
W. O. No. 4178 & S.P. No.
Location Sunset Blvd
Surveyed by C.V. Crumley
Date January 13, 1927
Indexed
Plotted by Hopkins
Date Mch 1928
Map No. B 150
Plotting Ck'd by C.J.T.
Date MAR 1928
Set L.F.T. in Curb
Doheny Road
1322.88
1322.95
To L.F.T. 2562.58
From Sec. Cor
T = 74°
Per Pg 12
Fd X" in Pavmt
117.64
60.20
8.74
Fd S.W.B.T.
Sunset Blvd.
21.28
12
5-2.74
.04
120.36
3643.28"
526.63
526.6
T = 76°
Set L.F.T. in Curb & Return
N. Side Sunset Blvd
To N & T. 90° 3.61 ft at Ranch Line
Set N & T. Used For Line
574.89
574.8
T = 76°
129.32
127.65
556.13
556.10
T = 76°
67.02
Set S.W.B.T. By Intersection
See Pg 44, 8 & 10
Set S.W.B.T. By Intersection
Set N & T.
Sunset Blvd
Used For Line
Set N & T.
15'
Set L.F.T.
Pg 44 2" I.P. Plug & Mon
Gerry Dr.
Set L.F.T. By Intersection
See Pg 44, 88 & 12
53+76.82
Set L.F.T. in Curb
E Sunset Produced
53+76.82
Set L.F.T. By Intersection
of 60.20
RETURN TO
LOS ANGELES COUNTY SURVEYOR
Don't extend notes this side of this line
Notes: ANY ADDITIONS OR CHANGES ON THIS SHEET MUST BE MADE OR CIRCLED IN Red. WITH DATE AND NAME OF PERSON MAKING CHANGE.

F.B. 311 Pg. 46 Chief Party Notes by Crumley Date 1/11/28

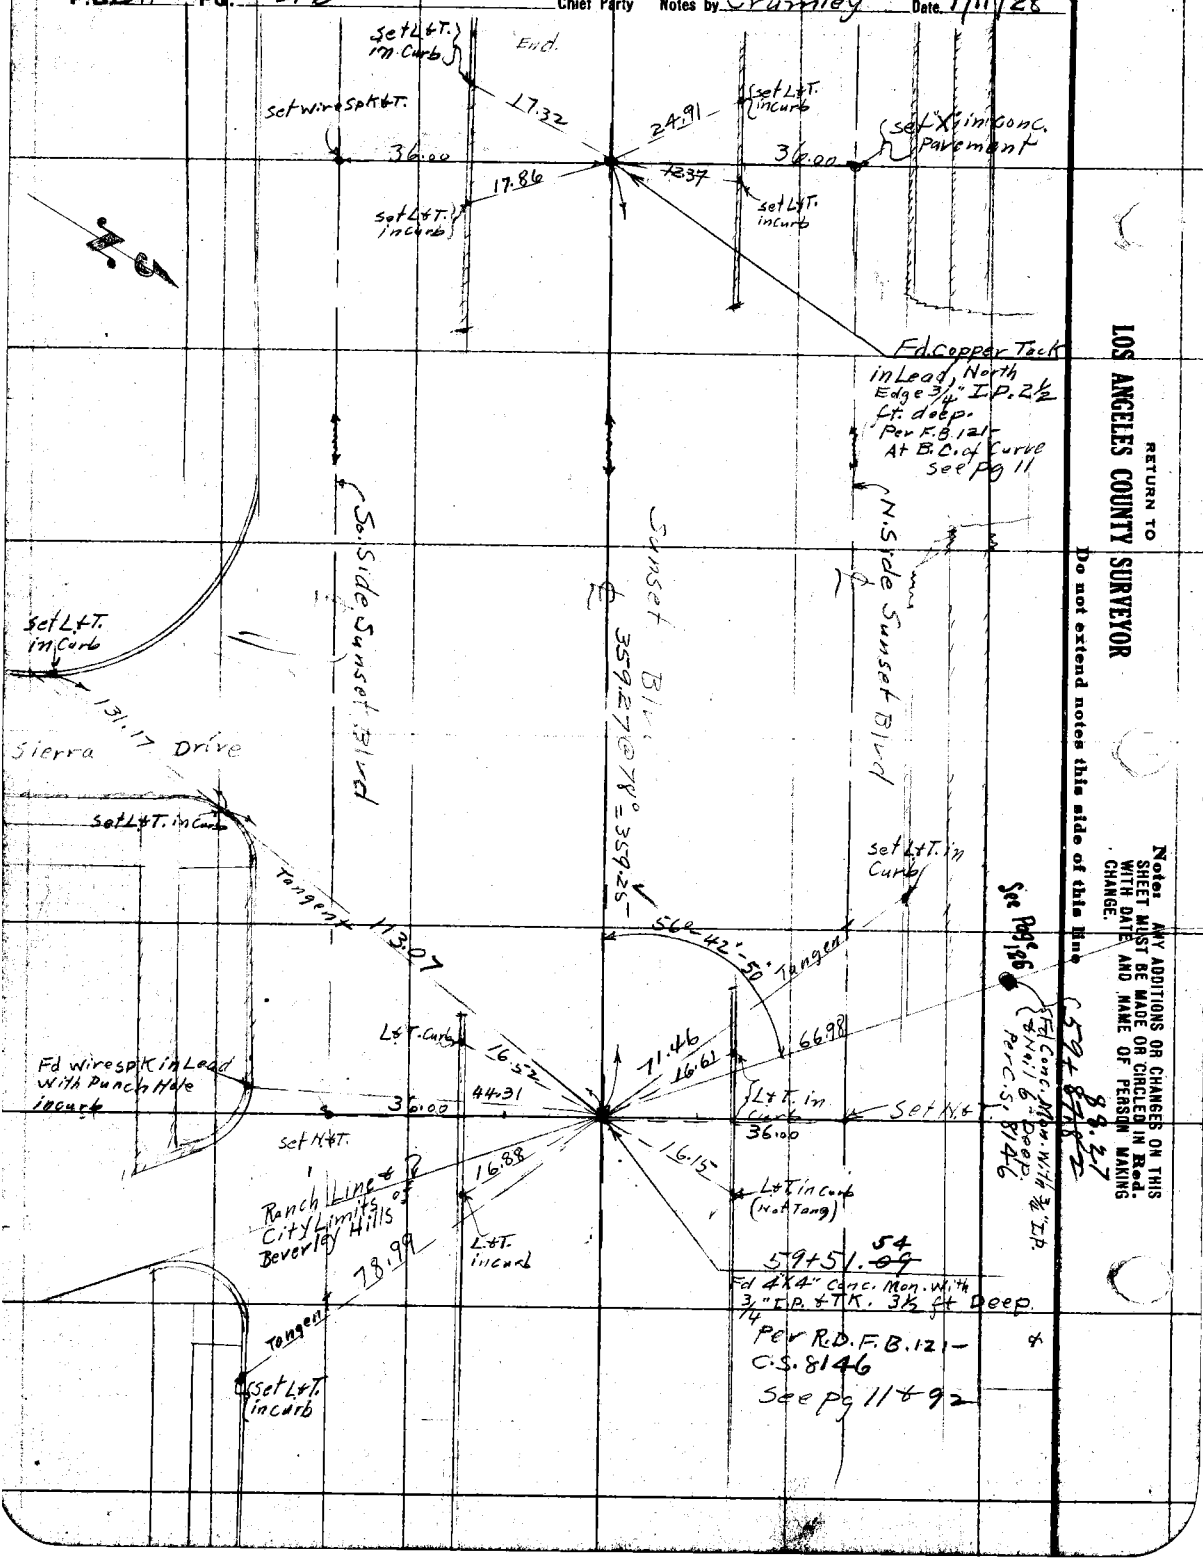

RETURN TO
LOS ANGELES COUNTY SURVEYOR
Do not extend notes this side of this line

Notes: ANY ADDITIONS OR CHANGES ON THIS SHEET MUST BE MADE OR CIRCLED IN Red. WITH DATE AND NAME OF PERSON MAKING CHANGE.

Date _____ Notes by _____ Chief Party _____ F. B. 311 PG. 47

Plotted by _____
Date _____
Map No. _____
Plotting C'k'd by C. J. T.
Date MAR 1978

W. O. No. _____ O. S. O. No. _____
Location _____
Surveyed by _____
Date _____
Indexed A. C. Johnson

Note: ANY ADDITIONS OR CHANGES ON THIS SHEET MUST BE MADE OR CIRCLED IN Red. WITH DATE AND NAME OF PERSON MAKING CHANGE.

Do not extend notes this side of this line

RETURN TO
LOS ANGELES COUNTY SURVEYOR

RETURN TO

LOS ANGELES COUNTY SURVEYOR

Notes: ANY ADDITIONS OR CHANGES ON THIS SHEET MUST BE MADE OR CIRCLED IN **Red.** WITH DATE AND NAME OF PERSON MAKING CHANGE.

Do not extend notes this side of this line

Date

Chief Party Notes by

F.B. 311 PG. 48

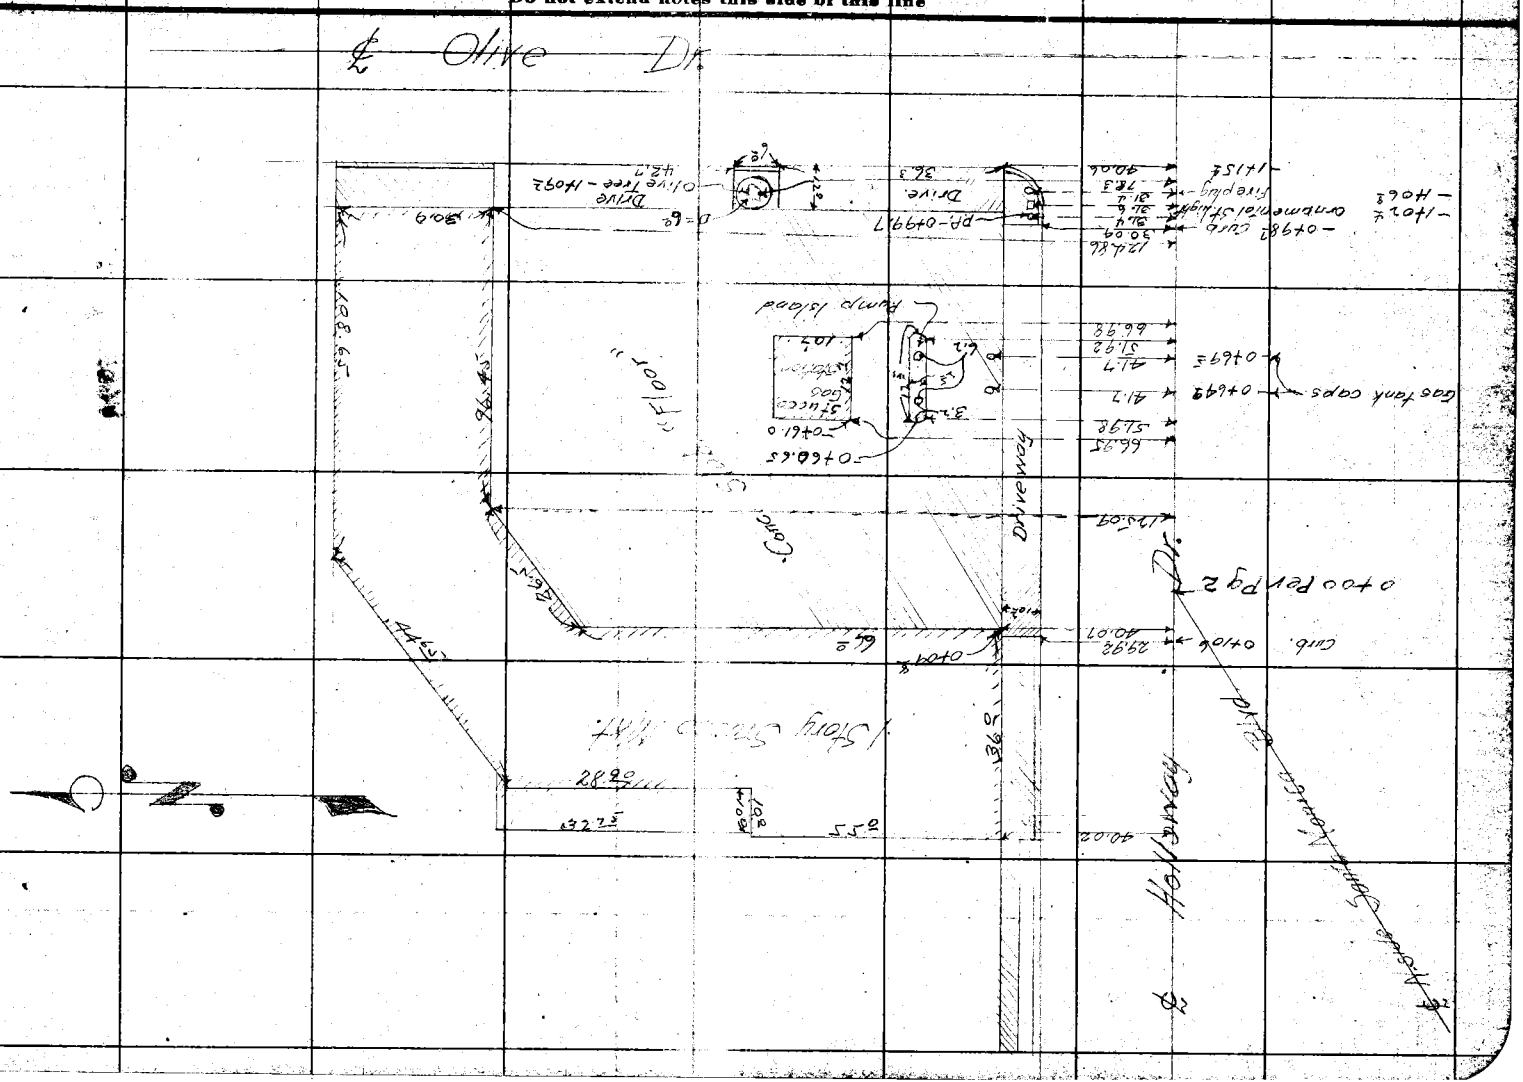
Olive Dr.
Olive tree - 1.09 E
Driveway
Ramp Island
Curb
Gas tank caps
Curb
Fireplug
Ornamental Shrubs
Curb
Curb
Curb

RETURN TO
LOS ANGELES COUNTY SURVEYOR

Notes: ANY ADDITIONS OR CHANGES ON THIS SHEET MUST BE MADE OR CIRCLED IN Red. WITH DATE AND NAME OF PERSON MAKING CHANGE.

Do not extend notes this side of this line

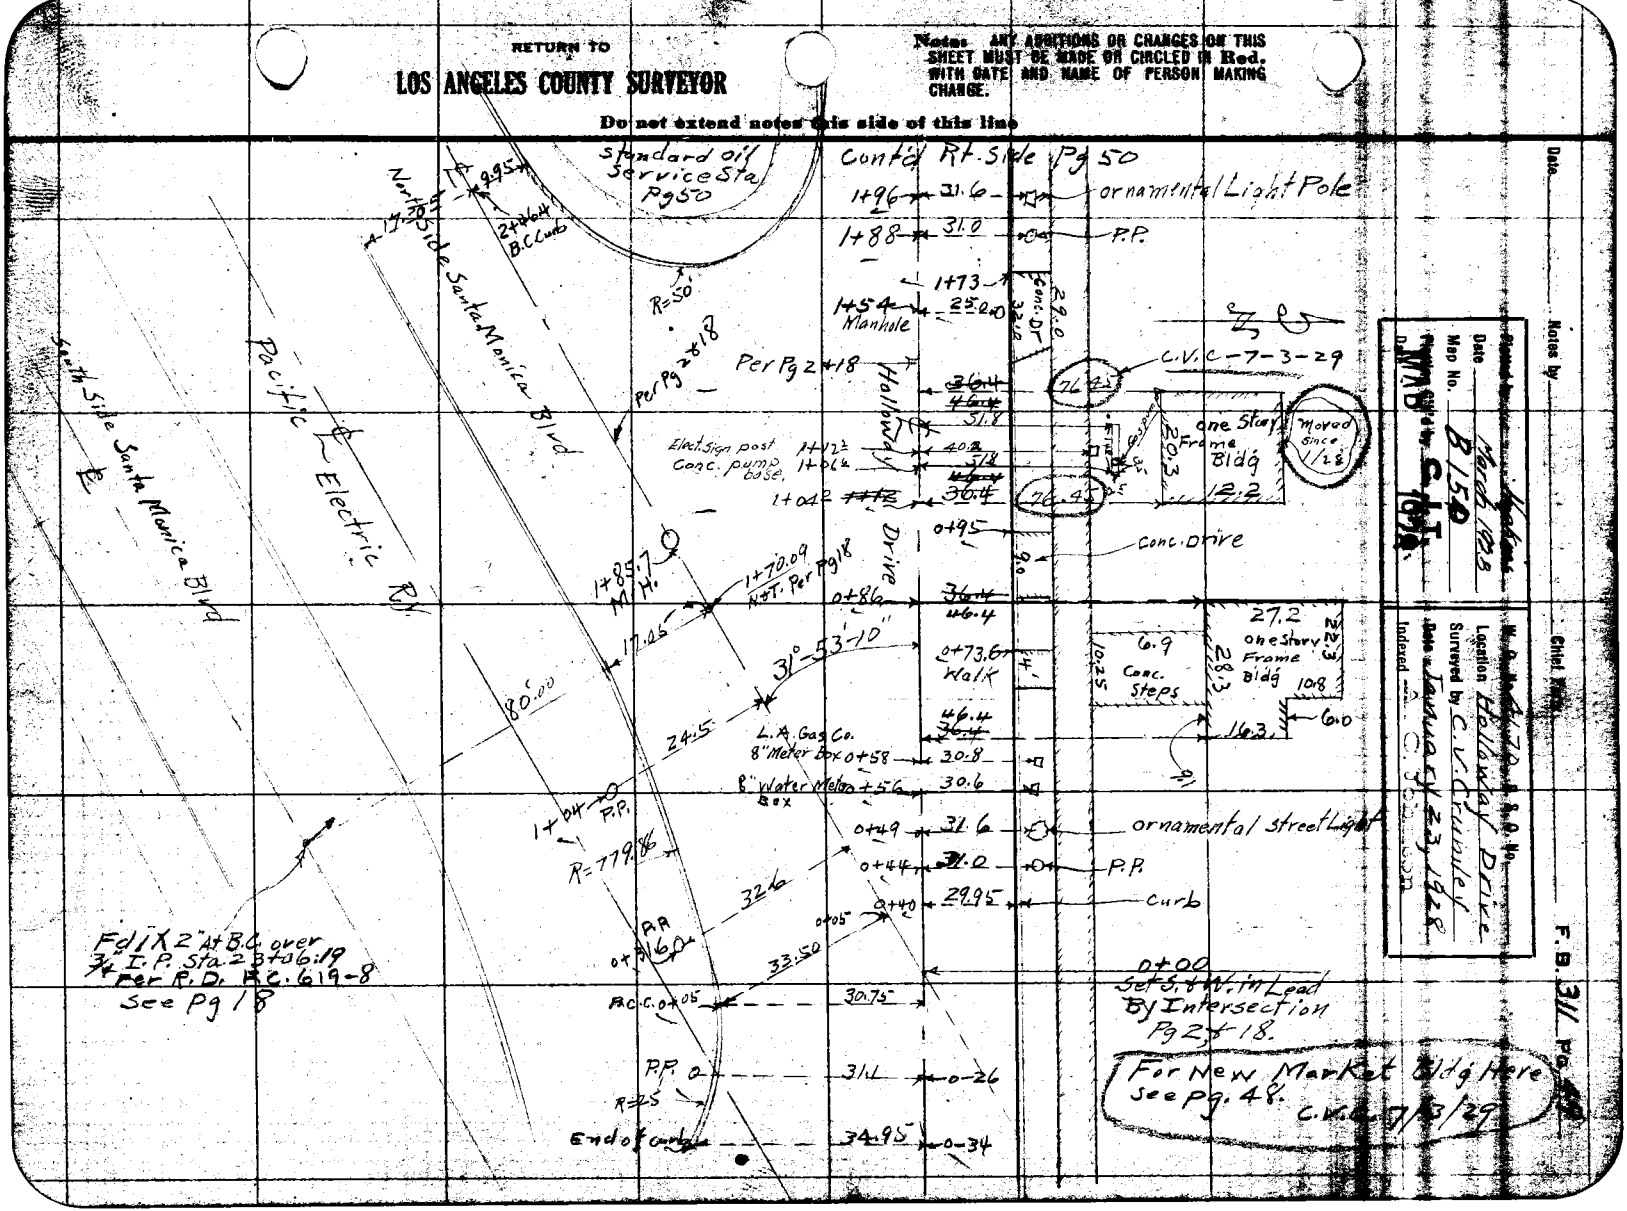

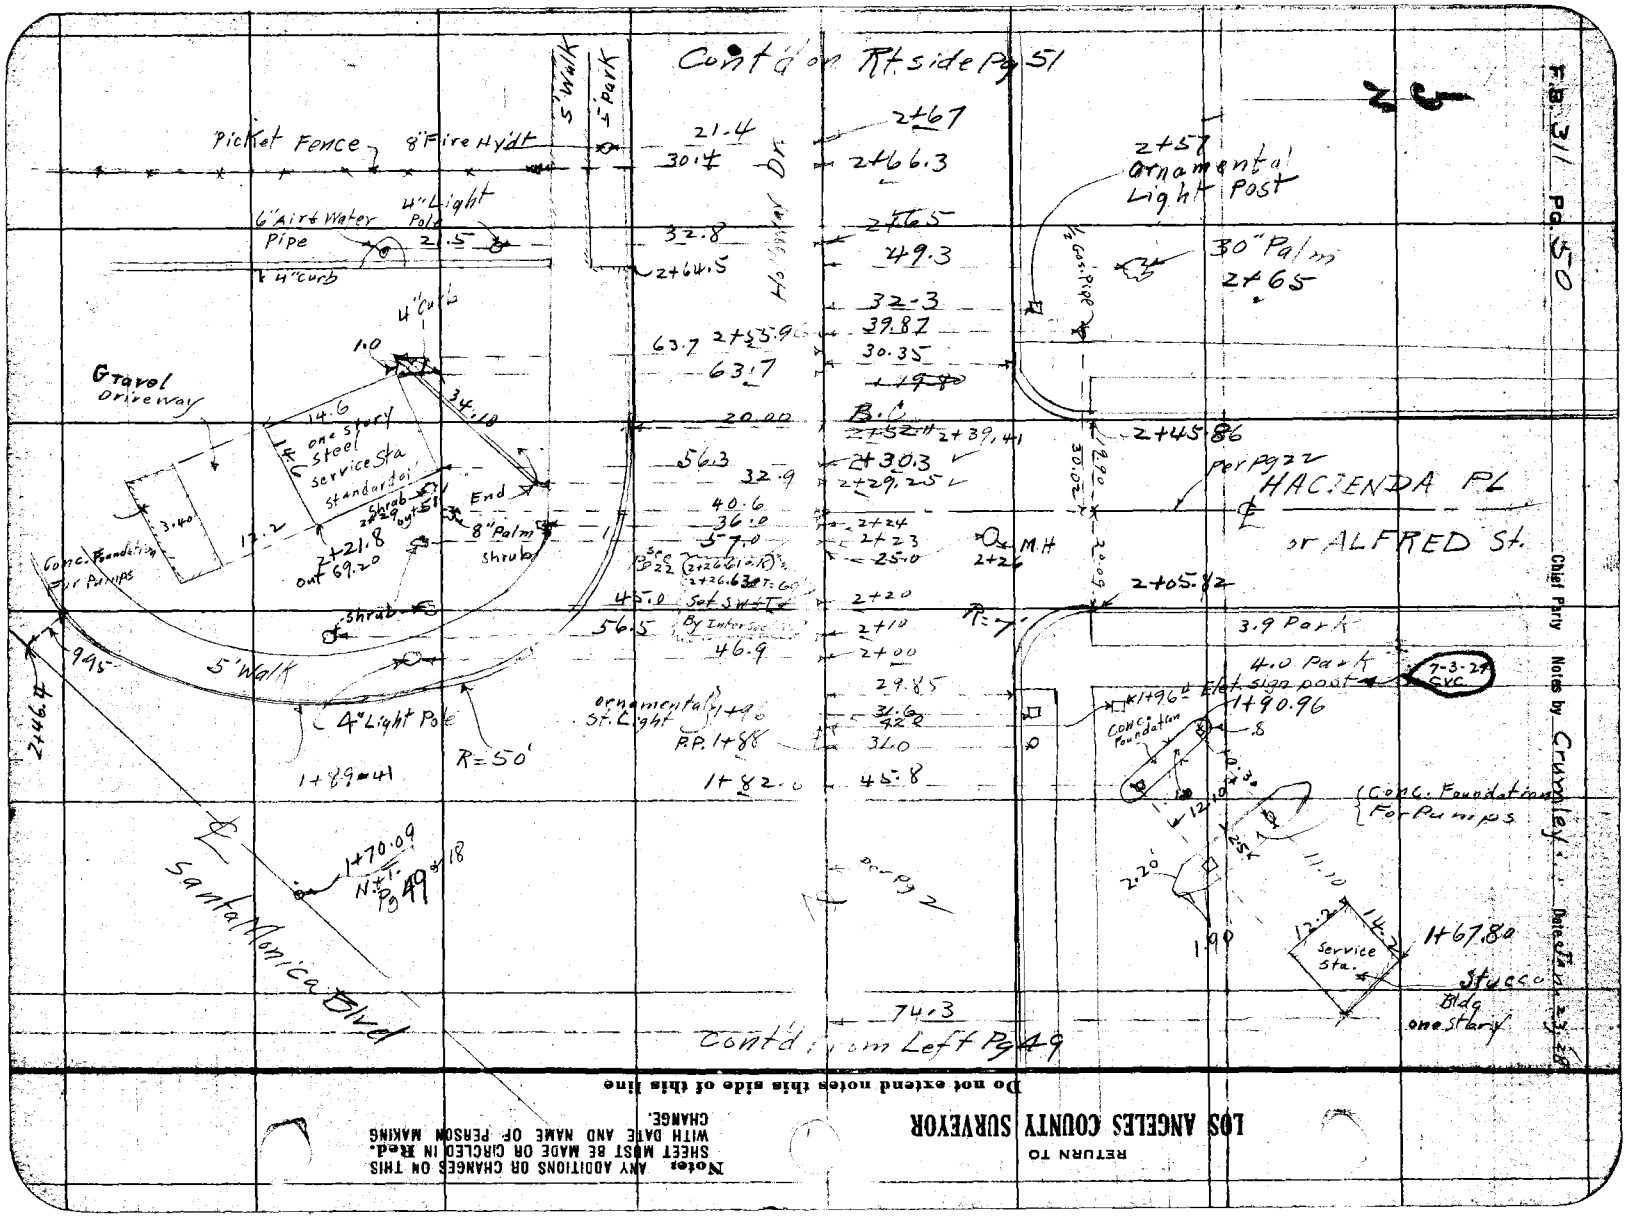
Cont'd on Rt side Pg 51
Picket Fence
8' Fire Hydt
5' Walk
5' Park
21.4
30.1
Ho Linda Dr
2+67
2+66.3
2+65
49.3
32.8
2+64.5
6" Air & Water Pipe
4" Light Pole
21.5
4" curb
4" curb
1.0
Gravel Driveway
14.6
34.10
one story steel service sta. standard
Shrub
End
8" Palm
shrub
3.4±0
17.2
2+21.8
out 69.20
Conc. Foundation for Pumps
Shrub
99.5
5' Walk
4" Light Pole
R=50'
1+89.41
2+46.2
1+82.0
ornamental St. Light
P.P. 1+88
1+90
63.7
2+55.9
63.7
20.00
56.3
32.9
40.6
36.0
5'-7.0
45.0
56.5
46.9
29.85
32.6
42.2
32.0
45.8
74.3
Cont'd from Left Pg 49
2+39.41
2+30.3
2+29.25
2+24
2+23
25.0
MH
2+20
2+10
2+00
R=7'
2+57
Ornamental Light Post
30" Palm
2+65
Gas. Pipe
2+45.86
30.02
20.09
2+05.82
per Pg 22
HACIENDA PL
or ALFRED St.
3.9 Park
4.0 Park
7-3-29 C.V.C.
1+96± Telef. sign post
1+90.96
Conc. Foundation
Conc. Foundations For Pumps
12.0
11.10
2.20
1.90
12.2
14.2
Service Sta.
1+67.80
Stucco Bldg one story
Santa Monica Blvd
1+70.09
N'ly Pg 49
per Pg 2
Chief Party
Notes by Crumley
Dates 7-31-29
F.B. 371 Pg. 50
26
RETURN TO
LOS ANGELES COUNTY SURVEYOR
Do not extend notes this side of this line
Note: ANY ADDITIONS OR CHANGES ON THIS SHEET MUST BE MADE OR CIRCLED IN Red. WITH DATE AND NAME OF PERSON MAKING CHANGE.

RETURN TO

LOS ANGELES COUNTY SURVEYOR

Note: ANY ADDITIONS OR CHANGES ON THIS SHEET MUST BE MADE OR CIRCLED IN Red. WITH DATE AND NAME OF PERSON MAKING CHANGE.

Do not extend notes this side of this line

18 96
38 - 31
20 64

Notes by

Date

Chief Party

F. B. 311 Pg. 51

Plotted by Mendoza Date March 1958

Map No. B150

Plotting C.N.d.No. C.I.T. 1000

Date MAR

W.O. No. 4170 F. S. O. No.

Location

Surveyed by C.K. Crumley

Date 4-24-57

Indexed

Checked

To Nail 1.575 From X

Cont'd on Rt side Pg 52

Pg 28

La Cienega Blvd

Melrose Ave

Pg 21

(La Cienega)

℄ New Combo ℄ Ave

Nail 1.575 1.60

5+78.99 @ T=70° = 5+78.96 o.k.

Set X" in M.H. Cover. By intersection See Pg 3+21+23

5+64.03

B+Pg 2

R=30'

R=70'

5+58.73

Guy Pole

5+57

41.4

29.90

5+48.65

39.59

½" I.P.

5+48

30.7

P.P

20.06

30" Palm

5+39

48.1

R=20'

T.P.

21.6

6.29

40.12

5+28.89

M.H.

old "x"

4+74

25.0

T.P

21.4

4+09

41.01

38

ornament Light Post

3+95

31.3

P.P

3+89

31.2

T.P

32.3

3+88

63.0

3+78

1/4/1944

25.2

44.8

2.8

Foster & Kleiser Sign

3+60

44.8

25.1

3+51

66.4

5' Walk

5' Park

Wire Fence

T.P.

21.7

2+88

6" Curb

No walk

Drive

31.1

2+67.1

Cont'd From Left Pg. 50

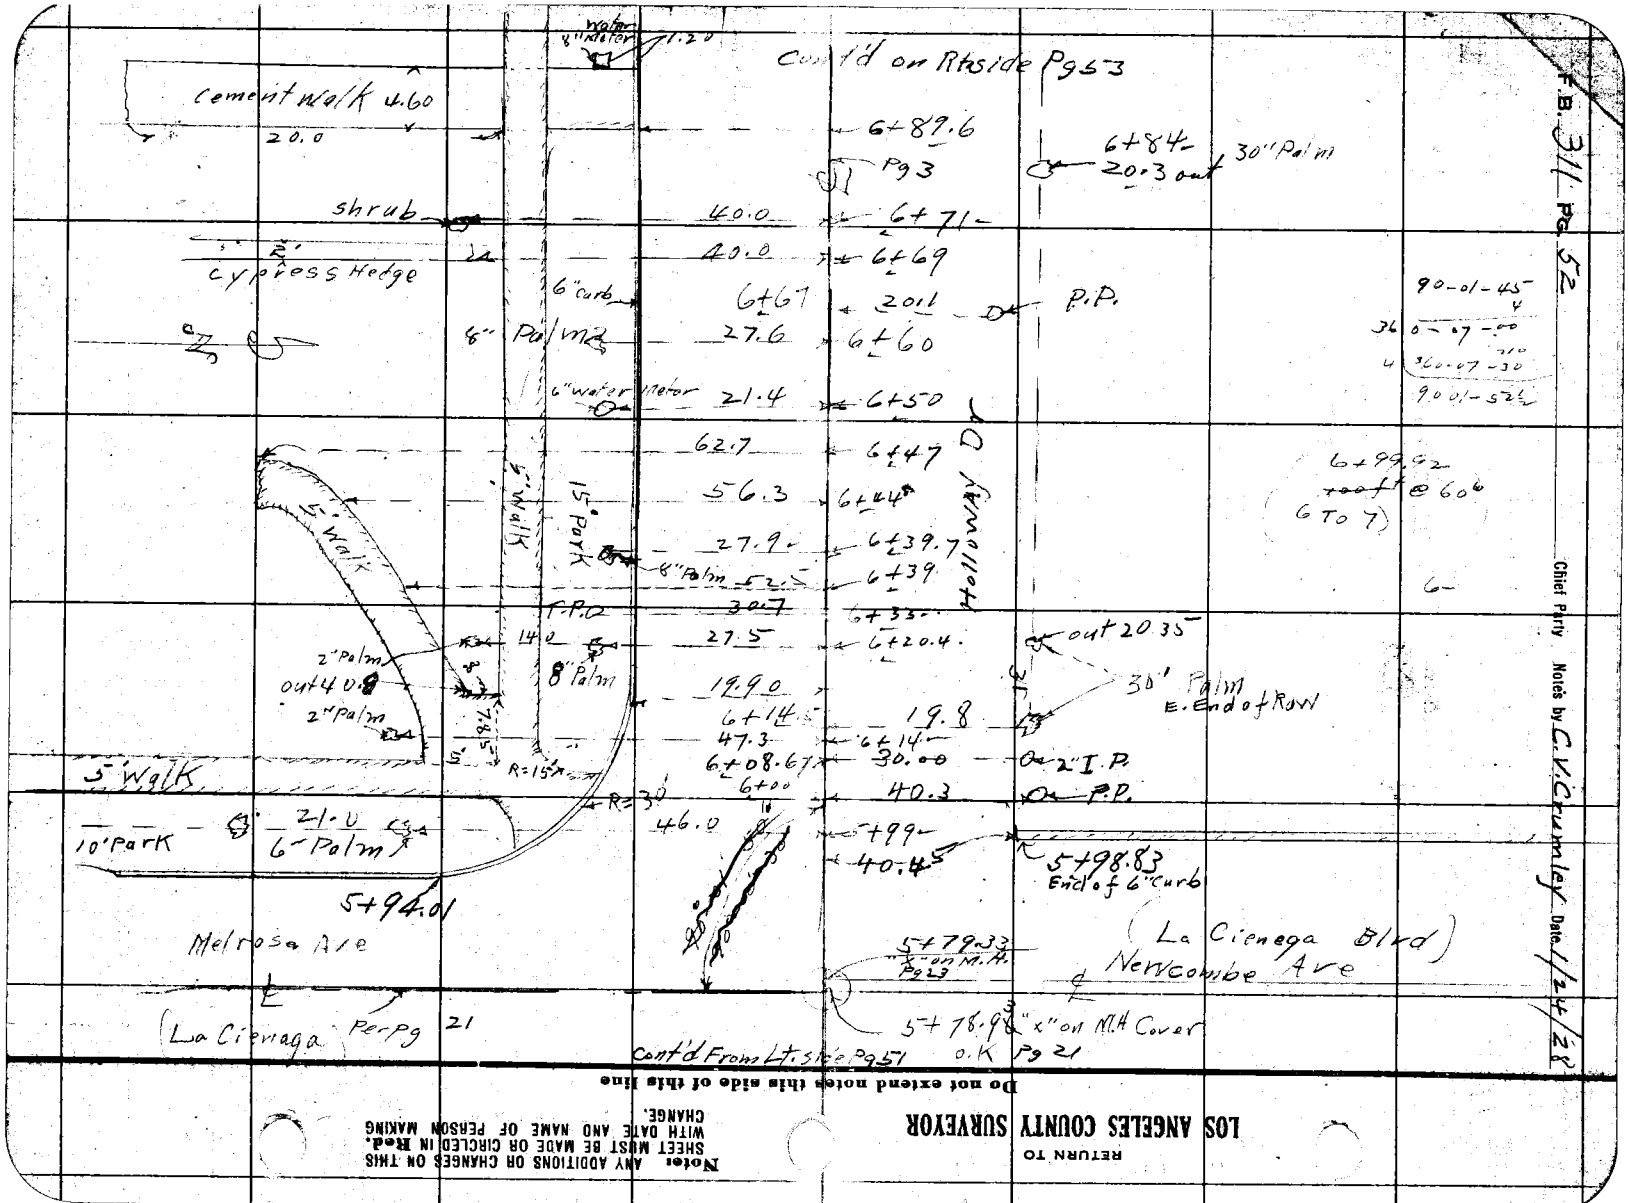

Do not extend notes this side of this line

LOS ANGELES COUNTY SURVEYOR

RETURN TO

Note: ANY ADDITIONS OR CHANGES ON THIS SHEET MUST BE MADE OR CIRCLED IN Red. WITH DATE AND NAME OF PERSON MAKING CHANGE.

RETURN TO
LOS ANGELES COUNTY SURVEYOR

Notes: ANY ADDITIONS OR CHANGES ON THIS SHEET MUST BE MADE OR CIRCLED IN Red. WITH DATE AND NAME OF PERSON MAKING CHANGE.

Do not extend notes this side of this line

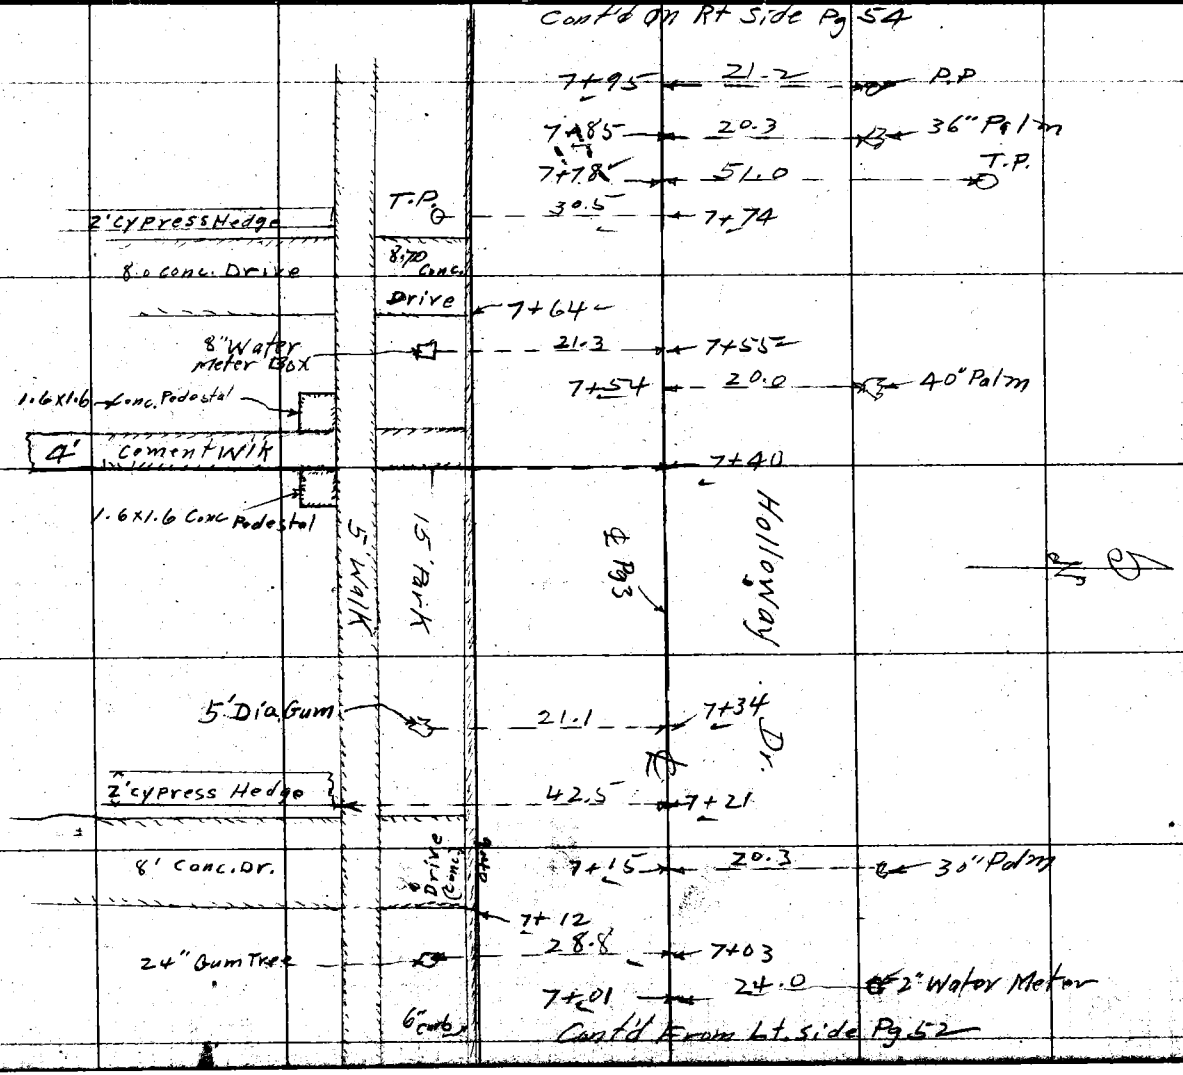

Date _____ Notes by _____ Chief Party _____ F. B. 311 Pg. 53

Plotted by Hand 1928
Date _____
Map No. B 150
Plotting C'k'd by C. J. T.
Date MAR 1928

W. O. No. 4170 & 8.0 Hy
Location Holloway Dr
Surveyed by C.V. Crumley
Date Jan. 25 1928
Indexed A. C. Johnson

RETURN TO
LOS ANGELES COUNTY SURVEYOR

Note: ANY ADDITIONS OR CHANGES ON THIS SHEET MUST BE MADE OR CIRCLED IN Red. WITH DATE AND NAME OF PERSON MAKING CHANGE.

Do not extend notes this side of this line

F.B. 311 Pg. 54 Chief Party Notes by Crumley Date 12/5/28

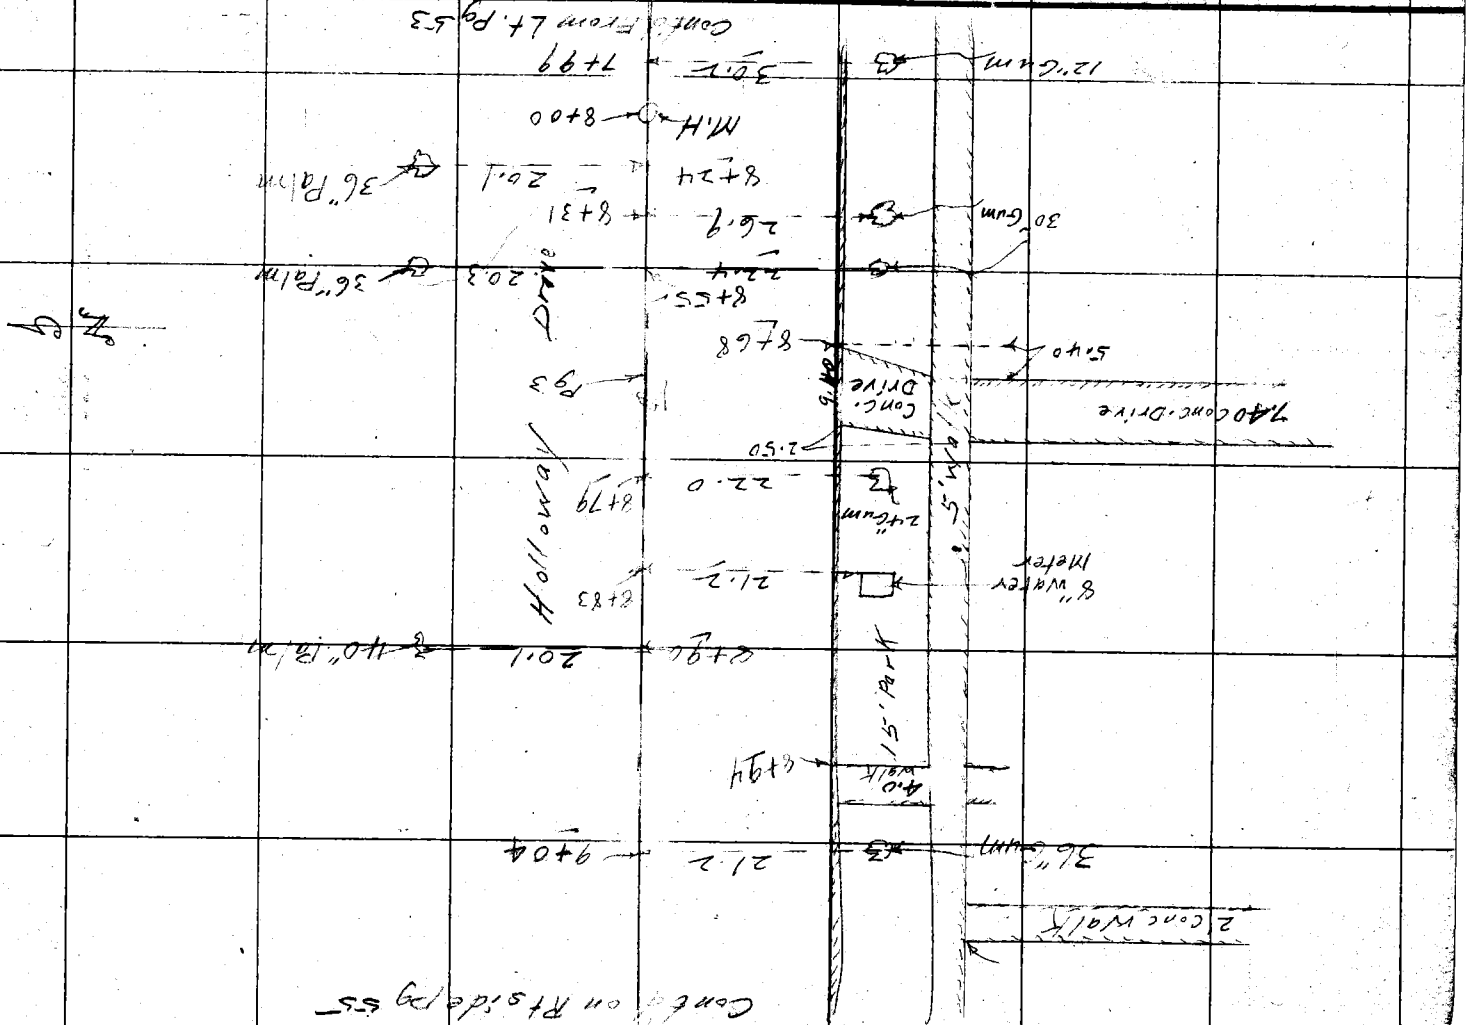

RETURN TO

LOS ANGELES COUNTY SURVEYOR

Notes: ANY ADDITIONS OR CHANGES ON THIS SHEET MUST BE MADE OR CIRCLED IN **Red.** WITH DATE AND NAME OF PERSON MAKING CHANGE.

Do not extend notes this side of this line

Date _____ Notes by _____ Chief Party _____ F. B. 311 Pg. 55

Planned by Mark Haynes Date 1928

Map No. B 150

Platting C'k'd by C.L.T. Date MAR 1928

W. O. No. A-170 R. & S. No. _____

Location Holloway Drive

Surveyed by C.V. Grimley Date Jan. 25 1928

Indexed _____

Cont'd Rt. Pg 56

out 37.6
10+47
6" Acacia

10+54.06 — 29.98 — Fd 2" I.P.

out 40.0 Shrub 10+51

10+46 6"x6" Sign Post & Fire Hydt.

10+45 — 30.3 — 4.2

29.81

5' Walk

10+48.5

10+44.13 6" Curb

Shrub out 40.0 10+42

10+30

8" Water Meter

21.7 — 10+33

10+24.47 O.K. Set "X" on M.H. Cover By Intersection See Pg 3+24

℄ ALTA LOMA Road

7.4 Conc Dr.

6" Carb

10+21

19.95 — 10+20

8.8°

1" Carob Tree

28.0 — 10+09

10+03 — 30.30 — 10+03.91 6" Curb

8" Water Meter Box — 21.4

Mo. Hall/Khare 445:54 @ 24

1" Carob Tree — 28.0 — 9+89

9+68 — 22.5 — P.P.

445:51
578.96
1024.47

2" Carob Tree — 28.0 — 9+65

9+63 — 20.0 — 36" Palm

8" Water Meter Box — 21.8 — 9+60

2" Carob Tree — 27.9 — 9+40

Holloway Drive

9+28 — 20.3 — 36" Palm

7.50 Conc. Dr.

Conc. Dr.

9+21

Cont'd from Lt pg 54

RETURN TO
LOS ANGELES COUNTY SURVEYOR

Note: ANY ADDITIONS OR CHANGES ON THIS SHEET MUST BE MADE OR CIRCLED IN **Red.** WITH DATE AND NAME OF PERSON MAKING CHANGE.

Do not extend notes this side of this line

F.B. 311 Pg. 56 Chief Party Notes by Crumley Date Jan 25 19 ??

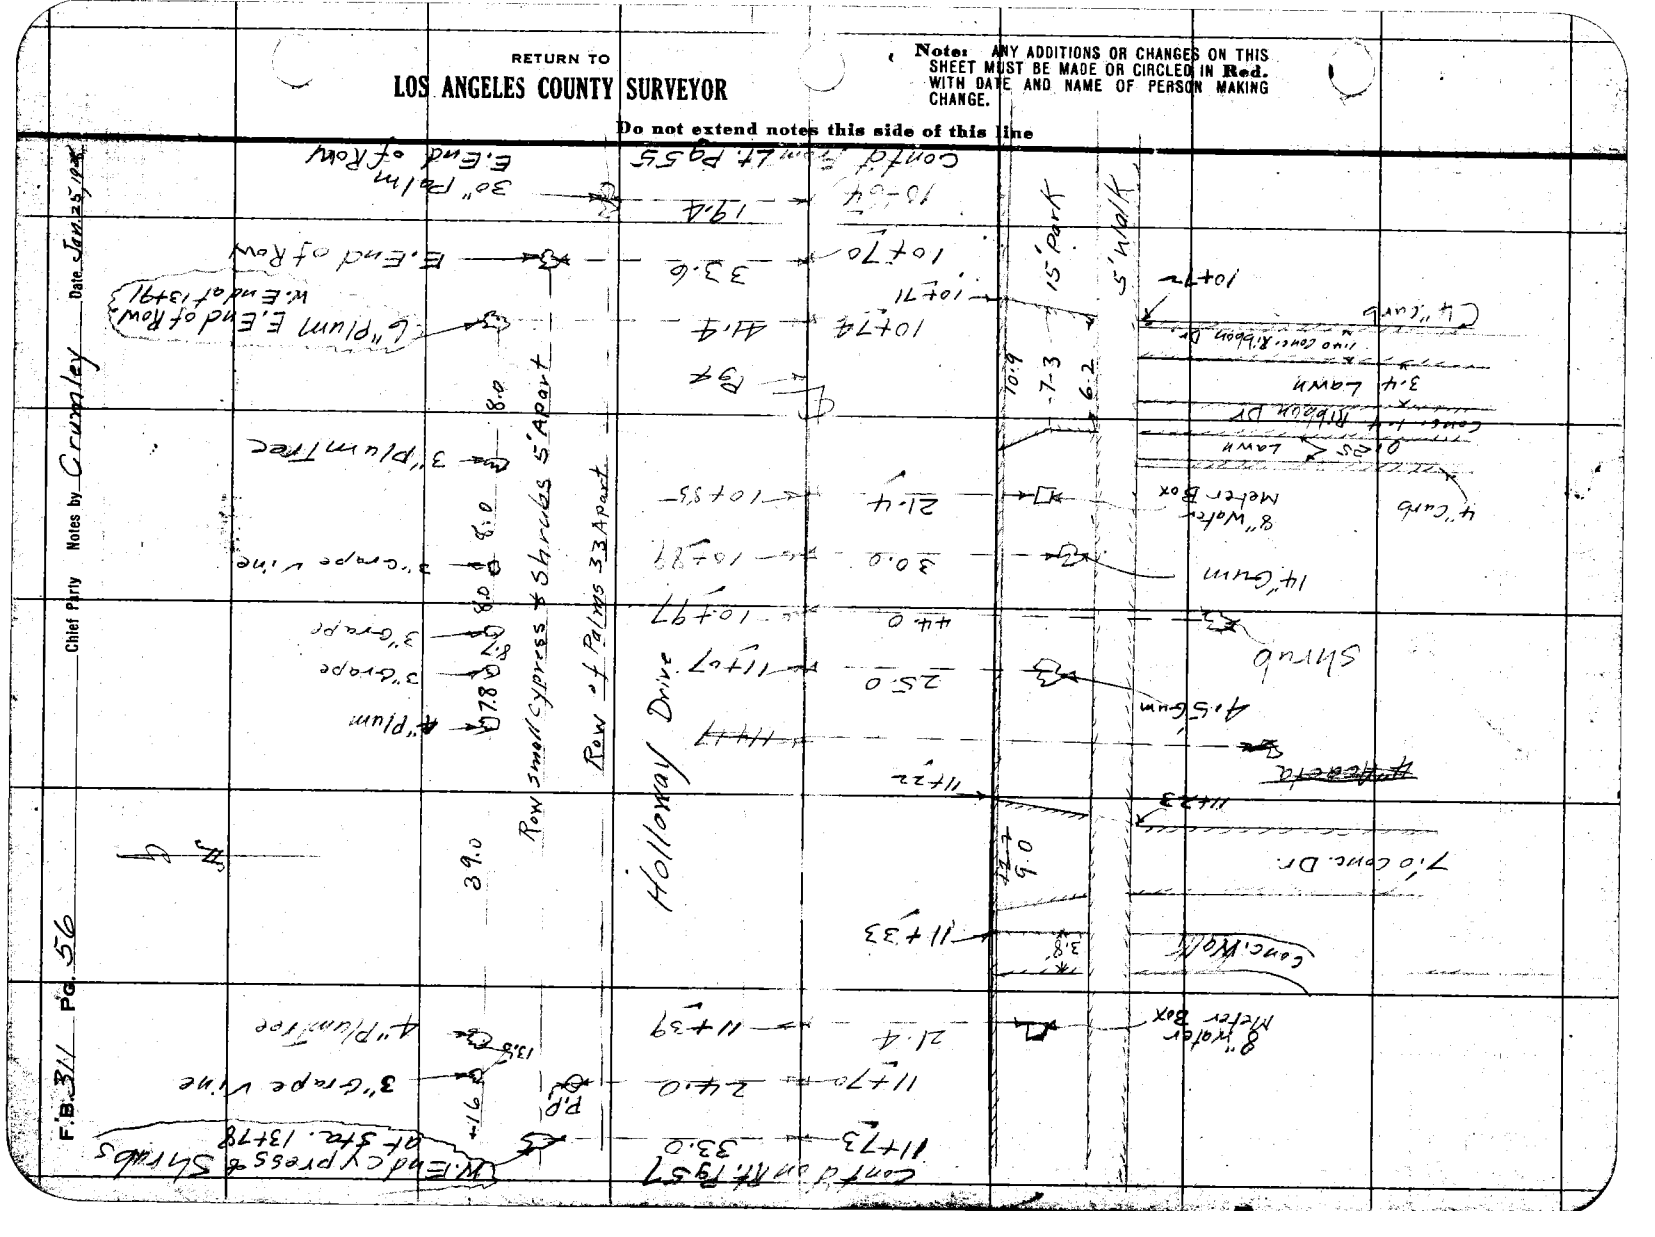

RETURN TO

LOS ANGELES COUNTY SURVEYOR

Note: ANY ADDITIONS OR CHANGES ON THIS SHEET MUST BE MADE OR CIRCLED IN **Red.** WITH DATE AND NAME OF PERSON MAKING CHANGE.

Do not extend notes this side of this line

Date _____ Notes by _____ Chief Party _____ F. B. 311 Pg. 57

Plotted by Hughes
Date Mar. 29
Map No. B150
Plotting C'k'd by C.L.T.
Date MAR 1998

W. O. No. 4110 R. S. O. No. _____
Location Holloway Drive
Surveyed by C.K.C. Fuller
Date Jan. 25 - Feb. 28
Indexed by _____

Contd on Rt side pg 58

3.5 Walk
12+68.5
10" Acacia
4"x4" Flag Pole
8" Water Meter Box
14" Acacia
4' walk
8" Water Meter Box
10" Acacia
6" Acacia
2" orange

2' walk
12+69
22.5 — 12+63
51.5 — 12+55
21.0 — 12+53
22.5 — 12+49
12+42 M.H.
13.5'
8.0
CMC Dr.
12+24
23.0 — 12+06
2' walk
12+02
21.4 — 12+00
23.7 — 11+92
11+91 — 30.5
11+89 — 52.4
23.3 — 11+80
55.3 — 11+76
Contd From Lt. Pg 56

Row of Cypress & Shrubs 5' Apart ±
Row of 30" Palms 33' Apart ±
Holloway Drive
Pg 4

42'
4" Plum
15'
6" Plum
24'
6" Plum
30'
6" Poplar
11.0
4" Plum
11+93
10'
24" Conc. Storm Drain
6" Acacia
6" Cypress
16'

RETURN TO
LOS ANGELES COUNTY SURVEYOR

Note: ANY ADDITIONS OR CHANGES ON THIS SHEET MUST BE MADE OR CIRCLED IN **Red.** WITH DATE AND NAME OF PERSON MAKING CHANGE.

Do not extend notes this side of this line

F.B. 311 Pg. 58 Chief Party Notes by C.V. Crumley Date 1/25/28

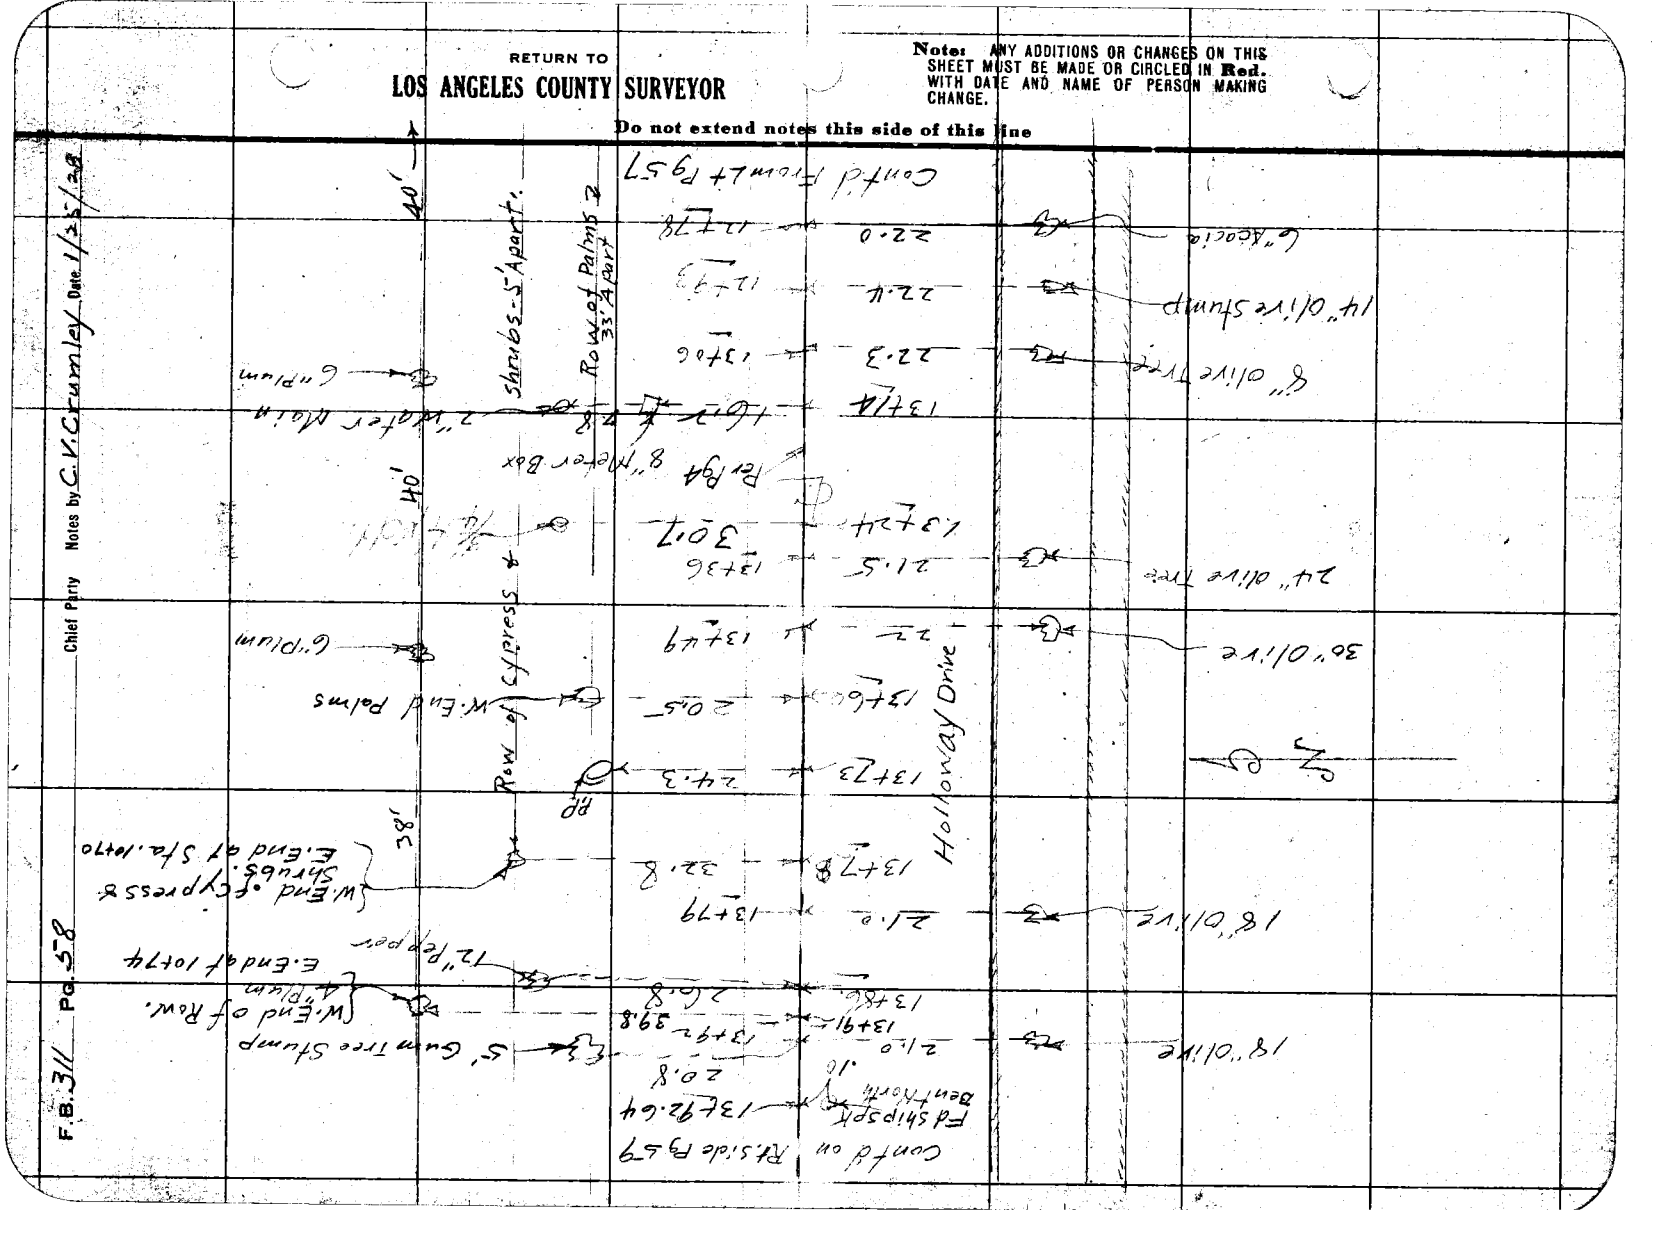

RETURN TO
LOS ANGELES COUNTY SURVEYOR

Notes: ANY ADDITIONS OR CHANGES ON THIS SHEET MUST BE MADE OR CIRCLED IN Red. WITH DATE AND NAME OF PERSON MAKING CHANGE.

Do not extend notes this side of this line

Date _____ Notes by _____ Chief Party _____ F. B. 311 Pg. 59

Planted by _____
Date _____
Map No. B 150
Platting C'k'd by C. J. T.
Date MAR 1998

W. O. No. 4172 R. S. O. No. _____
Location Holloway Drive
Surveyed by C.V. Crumley
Date _____
Indexed _____

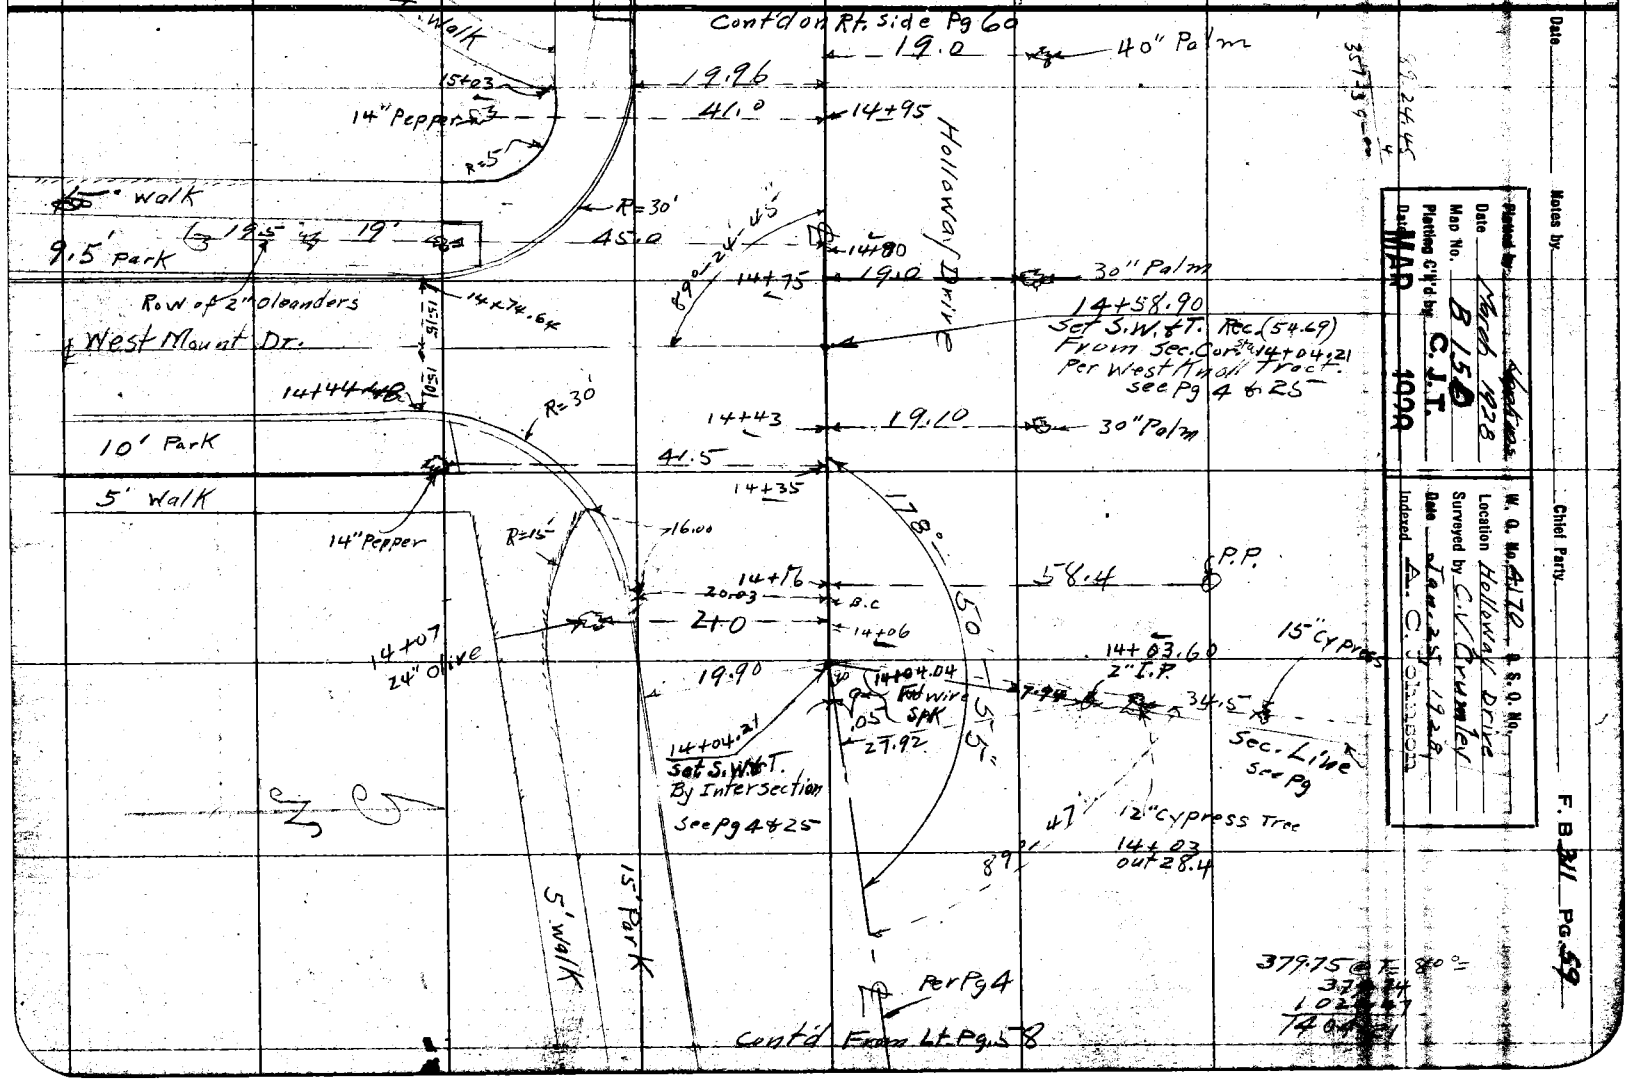

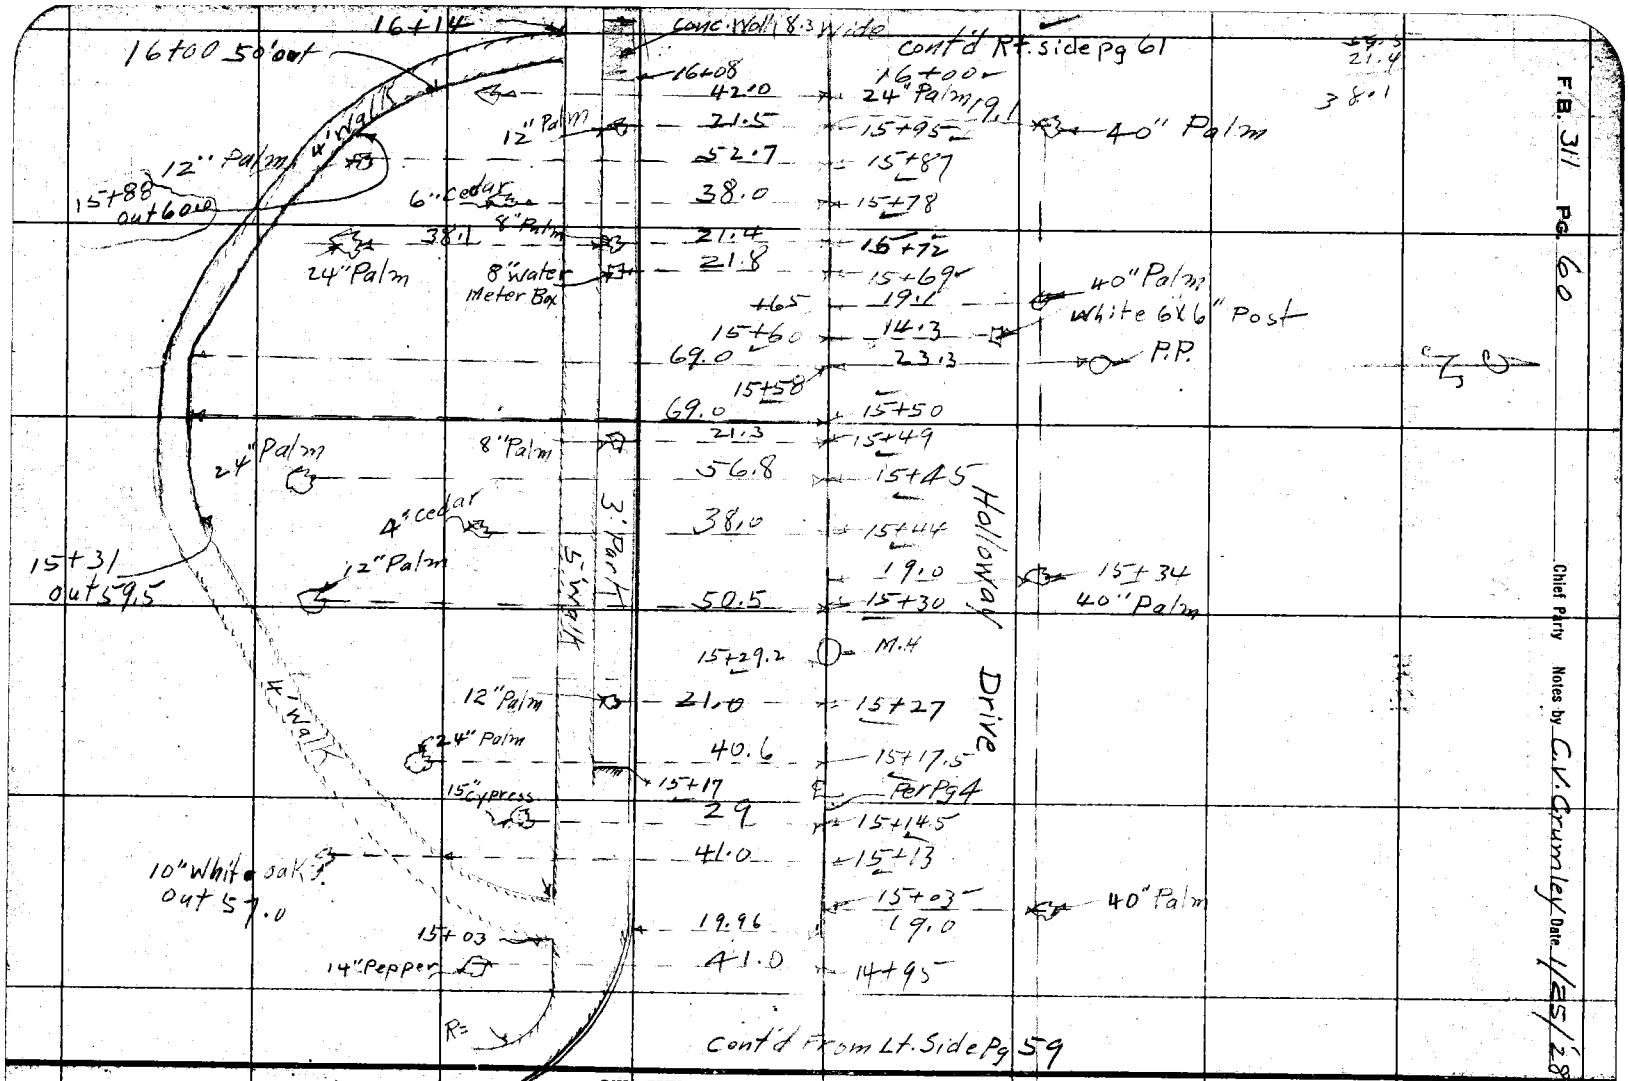
16+14
16+00 50' out
Conc. Wall 8.3 Wide
Cont'd Rt. Side Pg 61
16+08
42.0
24" Palm
16+00
12" Palm
21.5
15+95
40" Palm
12" Palm w/ Walk
52.7
15+87
15+88
out 6.0
6" Cedar
38.0
15+78
8" Palm
38.1
21.4
16+72
24" Palm
8" Water Meter Box
21.8
15+69
40" Palm
+65
19.1
White 6"x6" Post
15+60
14.3
69.0
23.3
P.P.
15+58
69.0
15+50
24" Palm
8" Palm
21.3
15+49
56.8
15+45
3' Path
5' Walk
Holloway Drive
4" Cedar
38.0
15+44
15+31
out 59.5
12" Palm
19.0
15+34
40" Palm
50.5
15+30
15+29.2
M.H.
12" Palm
21.0
15+27
24" Palm
40.6
15+17.5
15+17
Per Pg 4
15" Cypress
29
15+14.5
41.0
15+13
10" White Oak
out 57.0
15+03
19.0
40" Palm
19.96
15+03
14" Pepper
41.0
14+95
R=
Cont'd From Lt. Side Pg 59
West Mount Ave
Notes: ANY ADDITIONS OR CHANGES ON THIS SHEET MUST BE MADE OR CIRCLED IN Red. WITH DATE AND NAME OF PERSON MAKING CHANGE
RETURN TO
LOS ANGELES COUNTY SURVEYOR
Do not extend notes this side of this line
F.B. 311 Pg. 60
Chief Party
Notes by C.V. Crumley Date 1/25/28

RETURN TO

LOS ANGELES COUNTY SURVEYOR

Note: ANY ADDITIONS OR CHANGES ON THIS SHEET MUST BE MADE OR CIRCLED IN **Red.** WITH DATE AND NAME OF PERSON MAKING CHANGE.

Do not extend notes this side of this line

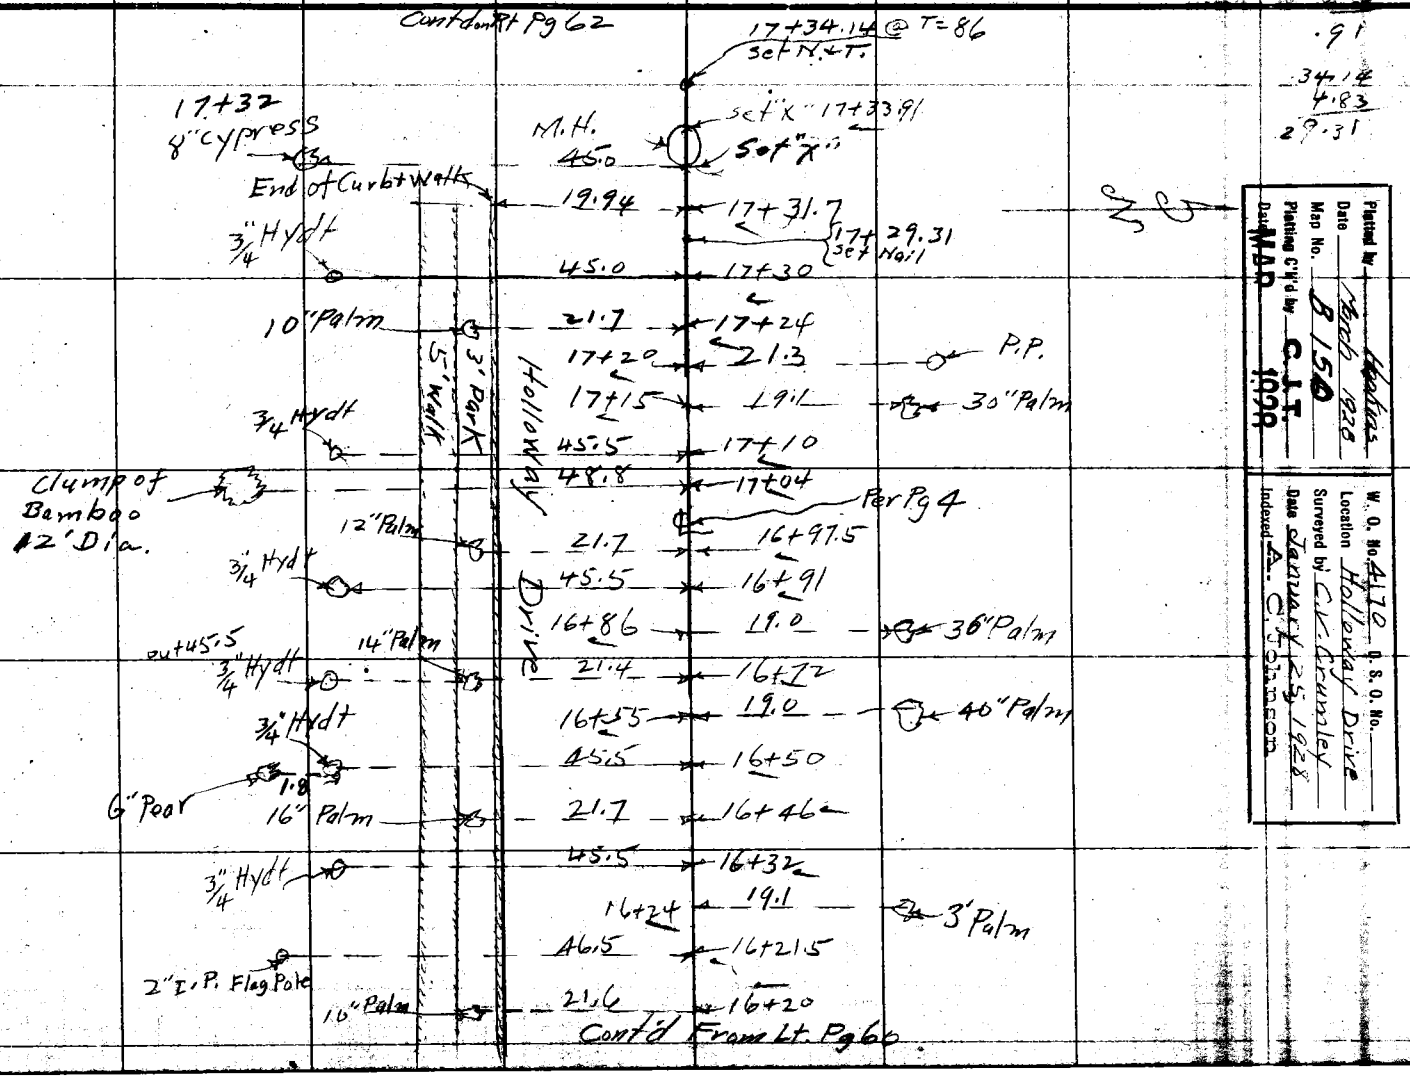

34-14
2
.91
34.14
4.83
29.31

Plotted by Hodges
Date 1929
Map No. B 150
Plotting C'k'd by C.J.T.
Date MAR 1929

W. O. No. 4170 O. S. O. No.
Location Holleway Drive
Surveyed by C.V. Crumley
Date January 25, 1928
Indexed by C. J. Johnson

Notes by

Date

Chief Party

F. B. 311 Pg. 61

F.B. 311 Pg. 62

Chief Party Notes by C.V. Grumley Date 1/25/28

Cont'd on Rt. side pg 63

Lantana Hedge

4'

6" Cypress

30.0 — 18+94

30.2 — 18+69.5

Woven Wire Fence

Per Pg 5

1'X1.5' Water Meter Box — 20.4 — 18+56

3' Palm — ~~38.0~~ 46.2 — 18+52

Relocated C.V.C. 7-3-29

12" Pepper — 21.0 — 18+42

10" Palm

18+39.2 — 18.0 — ~~38.0~~ 31.5 — ~~18+36~~

10" Palm

10" Palm — 37.0 — 17+81

Holloway Drive

6" Tree — 34.0

10" Pepper — 21.5 — 17+78

C.V.C. 7/3/29 — Shrub 17+71

4' Century Plant — 35.0 — 17+66

17+64

18.3 — 6" Bottle Tree

4" Avocado

4" Cypress — 55.0 — 40.3

17+60

25.0 — 42.0 — 17+46

4" Lemon

Row of 8" Bottle Trees

17+36 — 18.1

Woven Wire Fence — 30.0 — 17+34

C.V.C. 7-3-29

Shrub Hedge along inside of fence to Sta. 18+69

Cont'd From Lt. side pg 61

74.14
65.86

Do not extend notes this side of this line

RETURN TO

LOS ANGELES COUNTY SURVEYOR

Note: ANY ADDITIONS OR CHANGES ON THIS SHEET MUST BE MADE OR CIRCLED IN Red, WITH DATE AND NAME OF PERSON MAKING CHANGE.

RETURN TO
LOS ANGELES COUNTY SURVEYOR

Note: ANY ADDITIONS OR CHANGES ON THIS SHEET MUST BE MADE OR CIRCLED IN Red. WITH DATE AND NAME OF PERSON MAKING CHANGE.

Do not extend notes this side of this line

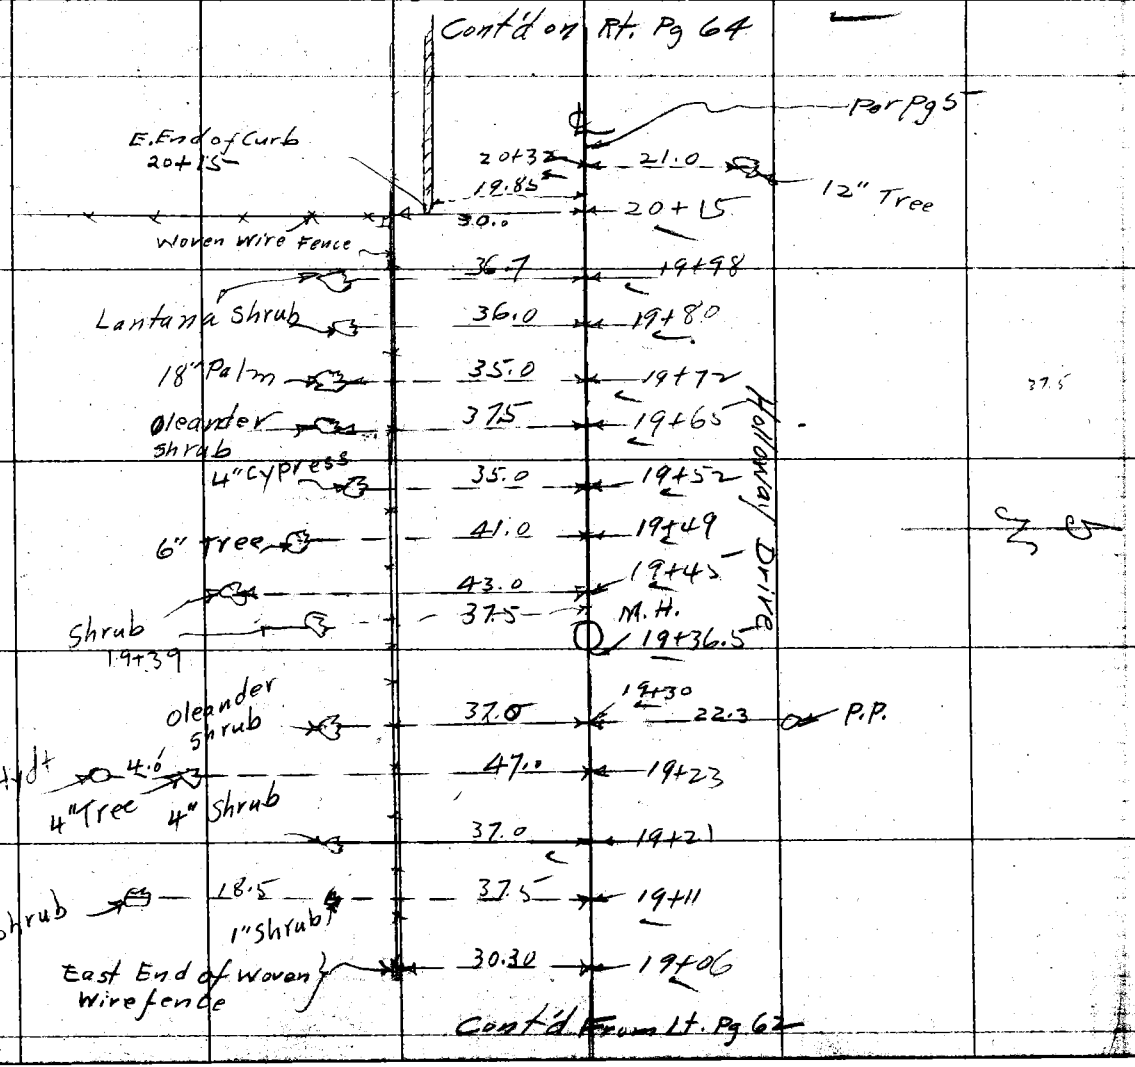

Date _____ Notes by _____ Chief Party _____ F. B. 311 PG. 63

Date 1928
Map No. B 156
Plotting C'k'd by C. I. T.
Date MAR 1928

W. O. No. 4470 D. S. O. No. _____
Location Holloway Drive
Surveyed by C.K. Crumley
Date January 25, 1928
Indexed _____

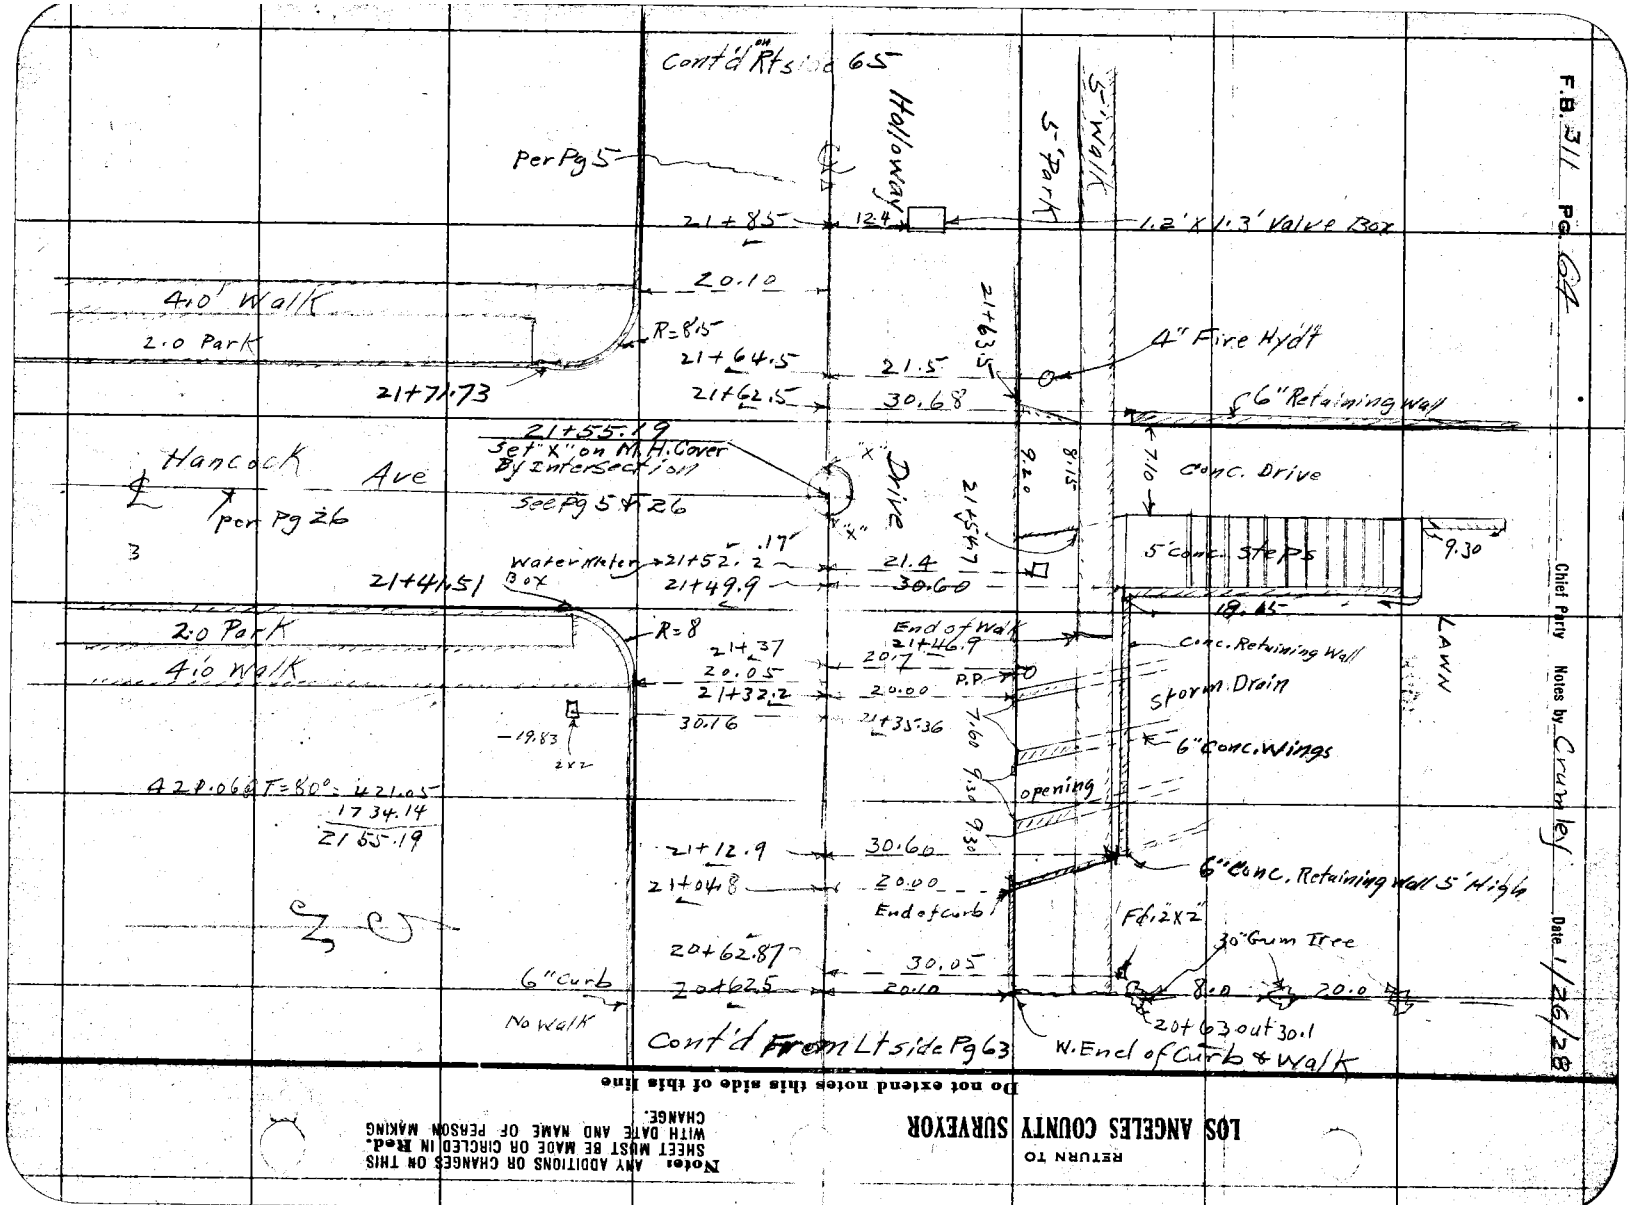

F.B. 311 Pg. 64

Chief Party Notes by Crumley Date 1/26/28

RETURN TO
LOS ANGELES COUNTY SURVEYOR

Do not extend notes this side of this line

Note: ANY ADDITIONS OR CHANGES ON THIS SHEET MUST BE MADE OR CIRCLED IN Red. WITH DATE AND NAME OF PERSON MAKING CHANGE.

RETURN TO

LOS ANGELES COUNTY SURVEYOR

Notes ANY ADDITIONS OR CHANGES ON THIS SHEET MUST BE MADE OR CIRCLED IN **Red.** WITH DATE AND NAME OF PERSON MAKING CHANGE.

Cont'd on R.t. Pg 66 **Do not extend notes this side of this line**

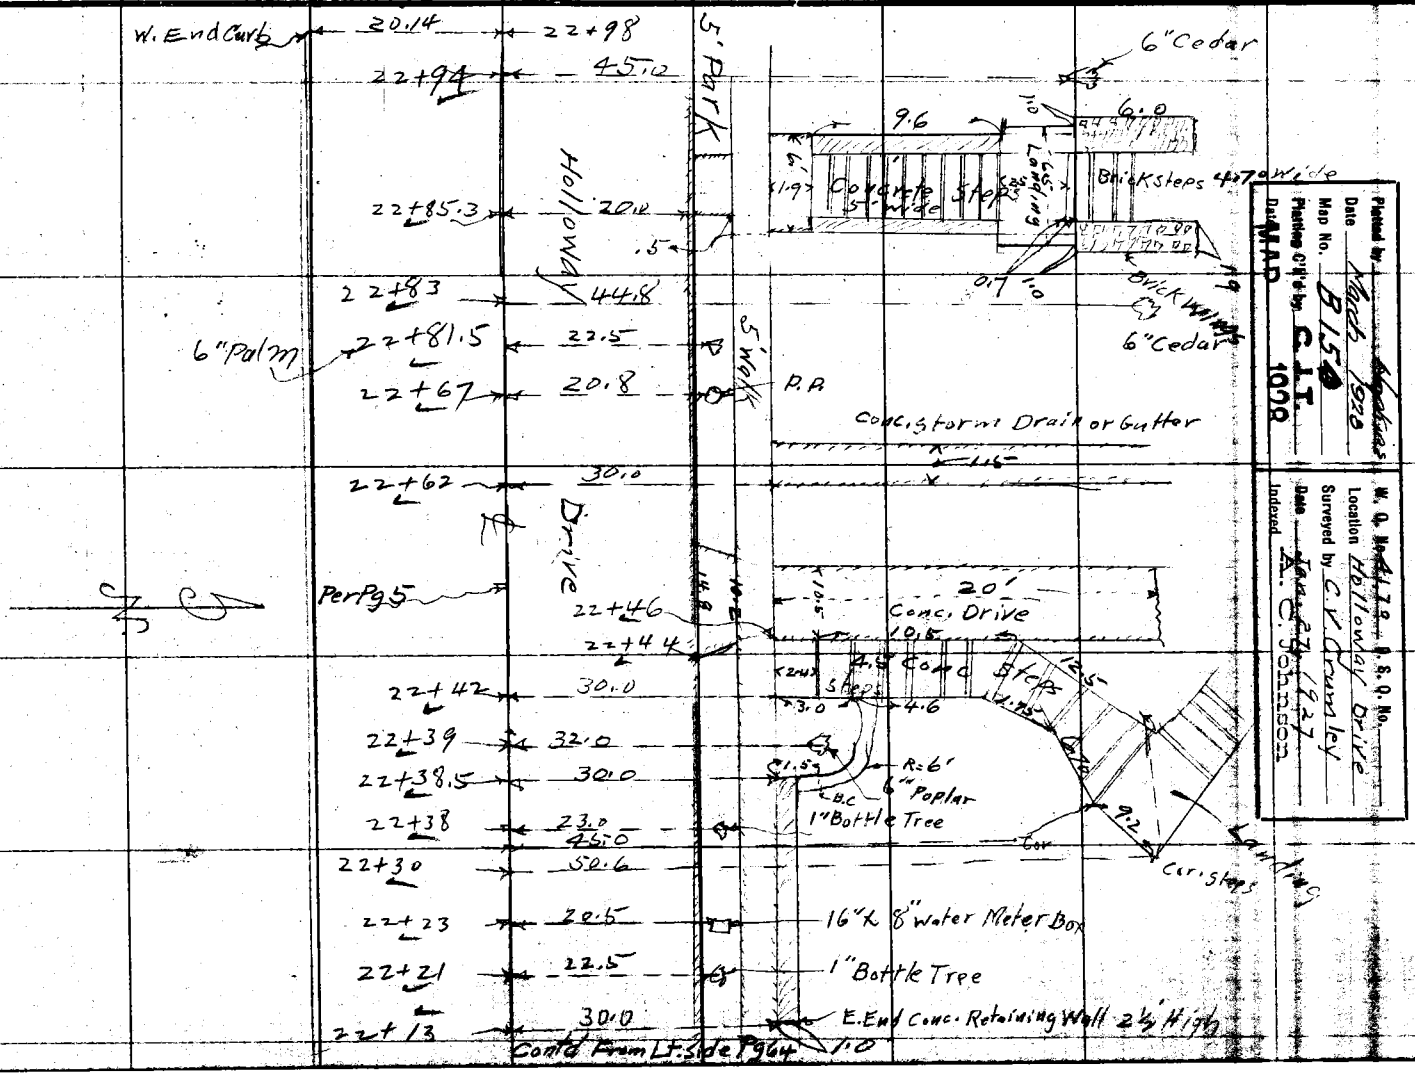

Date _____ Notes by _____ Chief Party _____ F. B. 2K Pg. 45


W. O. No. 4178 I. & S. O. No. _____
Location Hollowday Drive
Surveyed by C.V. Crumley 12/27
Date _____
Indexed A. C. Johnson

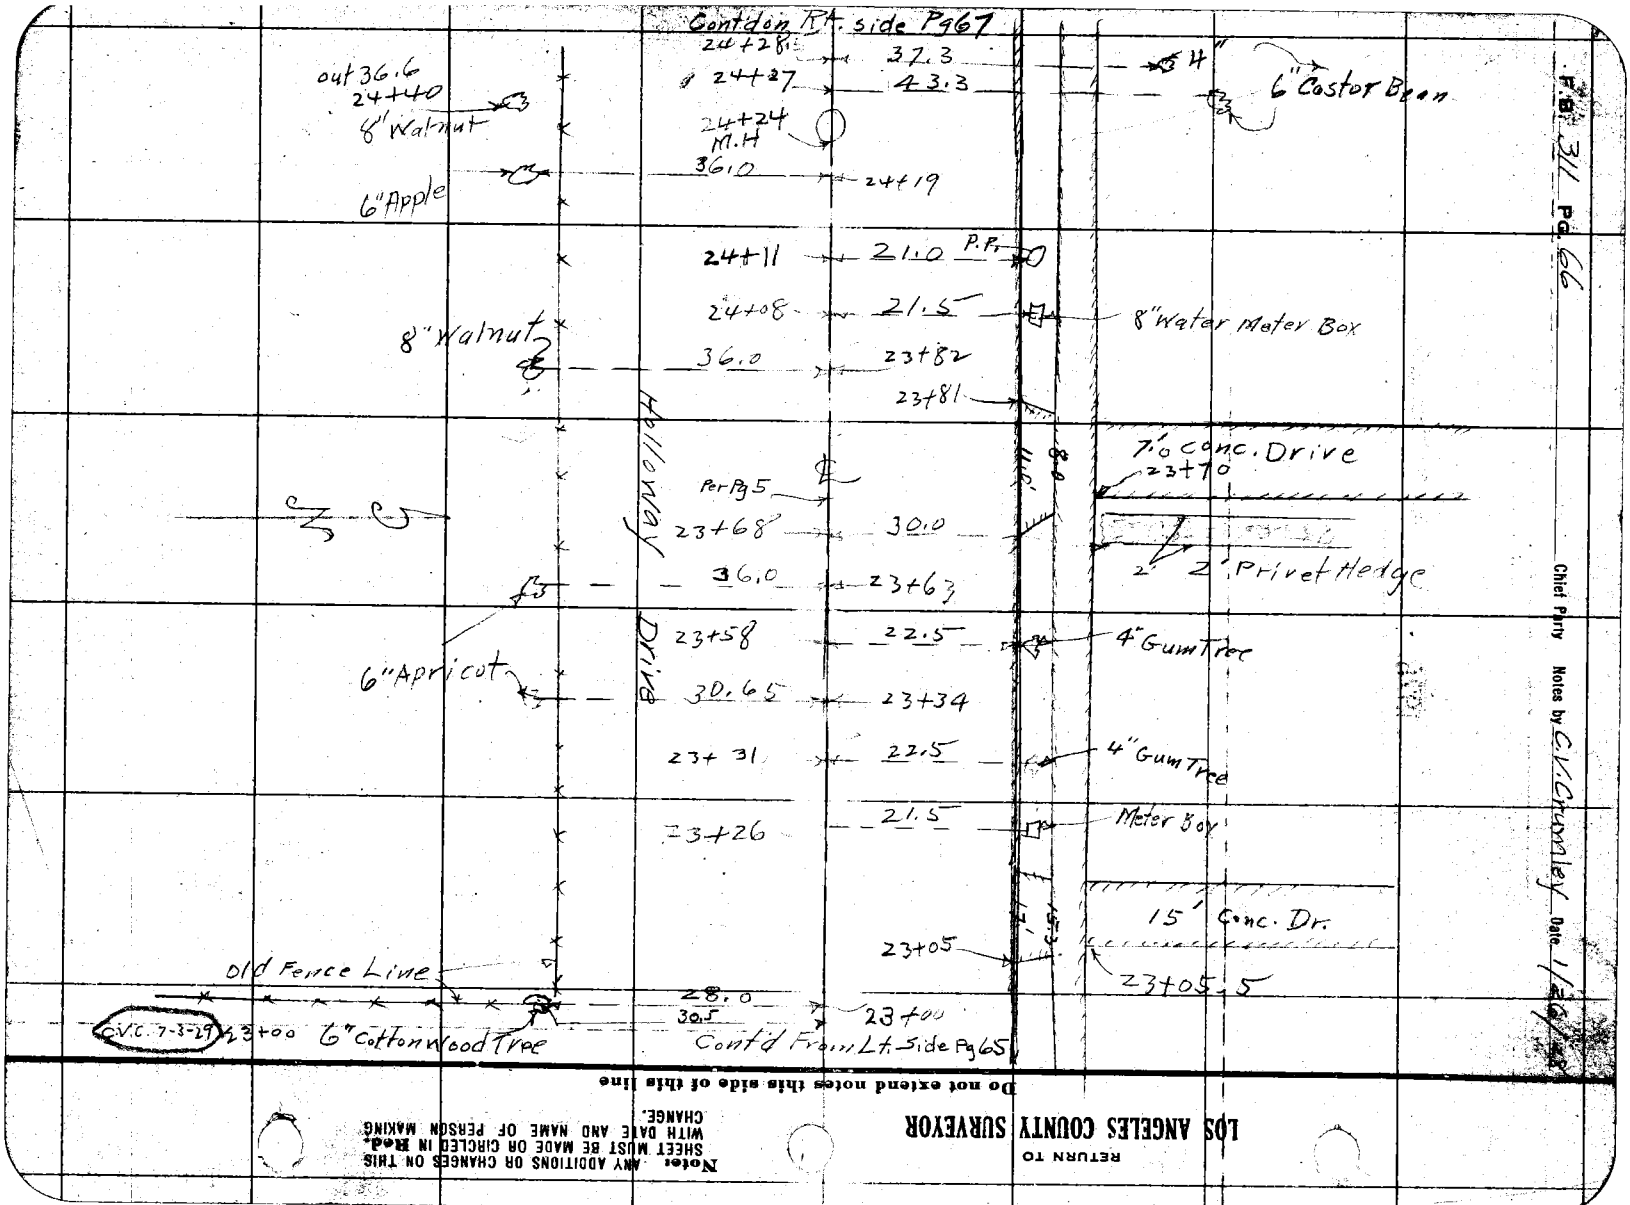
Contdon Rt. side Pg67
24+28
37.3
24+27
43.3
out 36.6
24+40
8" Walnut
24+24
M.H
36.0
24+19
6" Apple
6" Castor Bean
24+11
21.0
P.P.
24+08
21.5
8" Water Meter Box
8" Walnut
36.0
23+82
23+81
7'6 Conc. Drive
23+70
Per Pg 5
23+68
30.0
36.0
23+63
2' Privet Hedge
6" Apricot
23+58
22.5
4" Gum Tree
30.65
23+34
23+31
22.5
4" Gum Tree
23+26
21.5
Meter Box
15' Conc. Dr.
23+05
23+05.5
Old Fence Line
28.0
30.5
23+00
C.V.C. 7-3-29
23+00
6" Cottonwood Tree
Contd From Lt. Side Pg65
Chief Party
Notes by C.V. Crumley Date 1/29
LOS ANGELES COUNTY SURVEYOR
RETURN TO
Do not extend notes this side of this line
Note: ANY ADDITIONS OR CHANGES ON THIS SHEET MUST BE MADE OR CIRCLED IN Red. WITH DATE AND NAME OF PERSON MAKING CHANGE.

RETURN TO
LOS ANGELES COUNTY SURVEYOR

Notes: ANY ADDITIONS OR CHANGES ON THIS SHEET MUST BE MADE OR CIRCLED IN Red. WITH DATE AND NAME OF PERSON MAKING CHANGE.

Do not extend notes this side of this line

5' walk
2.0 Park R=9
25+58.86
6' Park
5' Walk
Cont'd on Rt side pg 68
19.82
57.19
Curb R=30
Walk R=17 & 22
25+41
2 266
73
25+42
6' Park 8' R=
5' Walk
4' Walk
4' Palm
W. End
28.7
25+41
21.1
P.P
4' Palm
21.0
43.9
25+37
R=4'
2.5
2.7
6' R
39.8
45.6
25+23
25+19
Holloway Drive
6' Porch
13.5
2.7
Bay window
one story Frame Dwelling
34.5
43.3
2.1
6.1
2.10
6.1
10.2
21.9
47.8
Const
Per Pg 5
39.5
24+74
E. End of Acacia
14' Row
27.8
24+68.
W. End Fence
28.9
24+48
P.P.
24.16
24+44
Cont'd From Lt. Side Pg 66
5' Walk
5' Park
27
46.7
2.1
24
4.5

Date
Notes by
Chief Party
F. B. 341 Pg. 47

Plotted by
Date
Map No.
Plotting Ch'd by
Date MAP 1978

W. O. No. 4170 R. S. O. No.
Location Holloway Drive
Surveyed by C.V. Crumley 1977
Date
Indexed

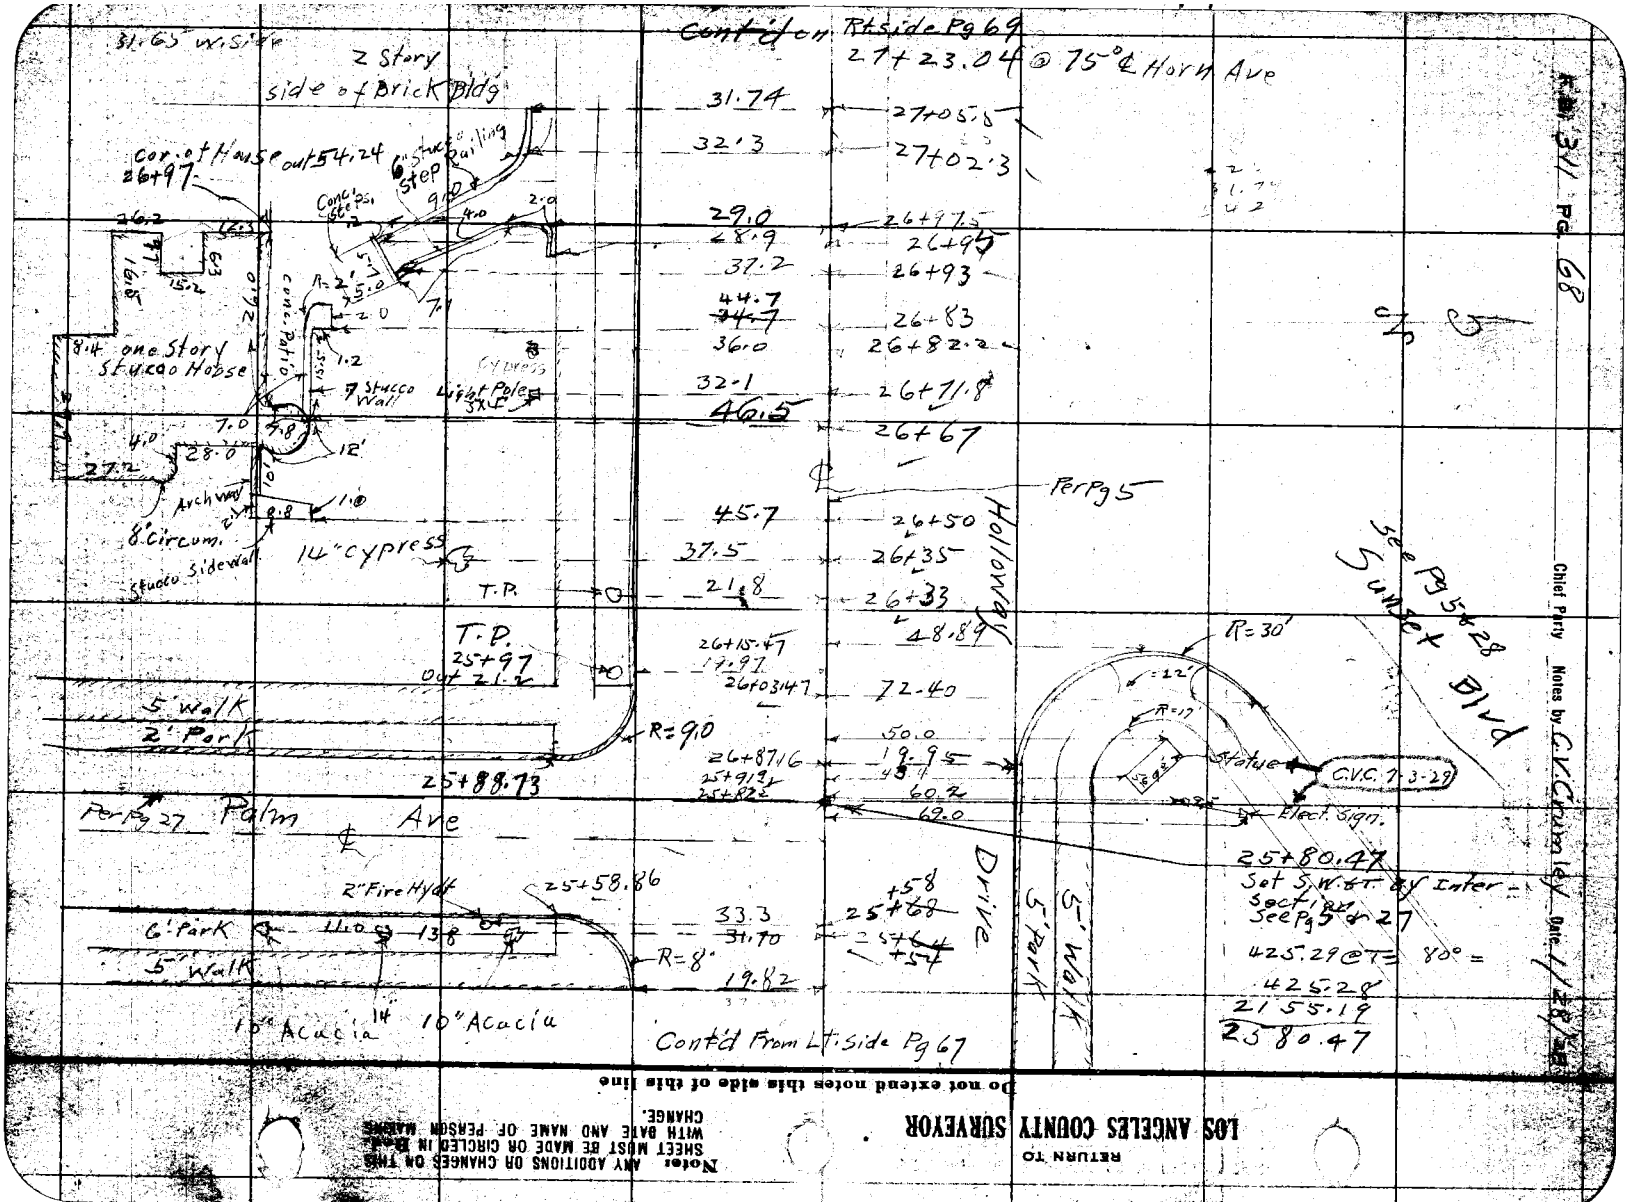
Contd on Rt side Pg 69
27+23.04 @ 75° & Horn Ave
31.65' w. side of 2 Story Brick Bldg
31.74
32.3
29.0
28.9
37.2
44.7
34.7
36.0
32.1
46.5
45.7
37.5
21.8
72.40
50.0
19.95
60.2
69.0
27+05.0
27+02.3
26+97.5
26+95
26+93
26+83
26+82.2
26+71.8
26+67
26+50
26+35
26+33
48.89
26+15.47
17.97
26+03.47
26+87.16
25+91.91
25+82.2
25+88.73
25+80.47
Set S.W.St. by Inter. Sect. Ref. See Pg 5 & 27
425.29 @ T = 80° =
425.28
21 55.19
2380.47
25+58.86
+58
25+69
+54
+57
33.3
31.70
19.82
R=30'
R=17'
R=9.0
R=8'
22°
Statue
C.V.C. 7-3-29
Elect. Sign.
Per Pg 5
Per Pg 27
Sunset Blvd
See Pg 5
Palm Ave
Drive
5' Walk
2' Park
6' Park
5' Walk
2" Fire Hydt
Cor. of House out 54.24
26+97
6" Stucco Railing
Step
9.0
4.0
2.0
Concrete
Cypress
Light Pole
Stucco Wall
8.4 one Story Stucco House
16.2
15.2
6.3
10.2
Concrete
7.1
5.5
1.2
7.0
7.8
12'
28.0
27.2
Archway
6.8
1.0
8' Circum. Stucco Sidewalk
14" Cypress
T.P.
T.P.
25+97
Out 21.2
10" Acacia
14
10" Acacia
Contd From Lt side Pg 67
Chief Party
Notes by C.V.C. Date 1/28/29
Pg 68
Do not extend notes this side of this line
LOS ANGELES COUNTY SURVEYOR
RETURN TO
Note: ANY ADDITIONS OR CHANGES ON THIS SHEET MUST BE MADE OR CIRCLED IN RED WITH DATE AND NAME OF PERSON MAKING CHANGE.

27 3303
36.7
86 3

RETURN TO
LOS ANGELES COUNTY SURVEYOR

Note: ANY ADDITIONS OR CHANGES ON THIS SHEET MUST BE MADE OR CIRCLED IN Red. WITH DATE AND NAME OF PERSON MAKING CHANGE.

Do not extend notes this side of this line

Cont'd on Rt. side Pg 70

20.08
27+99 42.58

Open Shed over Conc. Greasing pit

Conc. Dr

25.30

1.9.9

9.3

36.0

one story Office Service

24.5

Roofed Driveway

15.2

Pumps

Roofed drive

Gas Tank

inlet pipe

End of Curb

13.0

6.80

27+59 "L.K.A." Post Roof support out 32.9

P.P.

21.3

27+88

40.5

Sunset

27+72

20.1

27+77

3.2.4

3' Conc Walk

7.10

3.0

1.0

3.2

Wall

5' Walk

4' Part

27+57.2

27+57

27+56

27+54.6 End Walk

27.8

27+53.5

47.8

27+49

27+48

28.88

27+53.1

2 Story Stucco Bldg

100.0

2.0

4" Curb

27+41.2

21.5

31.84

27+38.2

27+36

P.P.

Dirt Drive

4" Curb

7.5

1.6

Conc Dr

9.5

Ref Pg 5

31.65

27+26.5

27+23.08

See Pg 5428

Set S.W.St. By Intersection

Horn AVE

56

21.0

2 story Brick Store Bldg

31.74

142.57 @ 75°-0'

142.6

Sunset Blvd

See Pg 5428


26+86.3













Indexed

RETURN TO

LOS ANGELES COUNTY SURVEYOR

Note: ANY ADDITIONS OR CHANGES ON THIS SHEET MUST BE MADE OR CIRCLED IN **Red.** WITH DATE AND NAME OF PERSON MAKING CHANGE.

Do not extend notes this side of this line

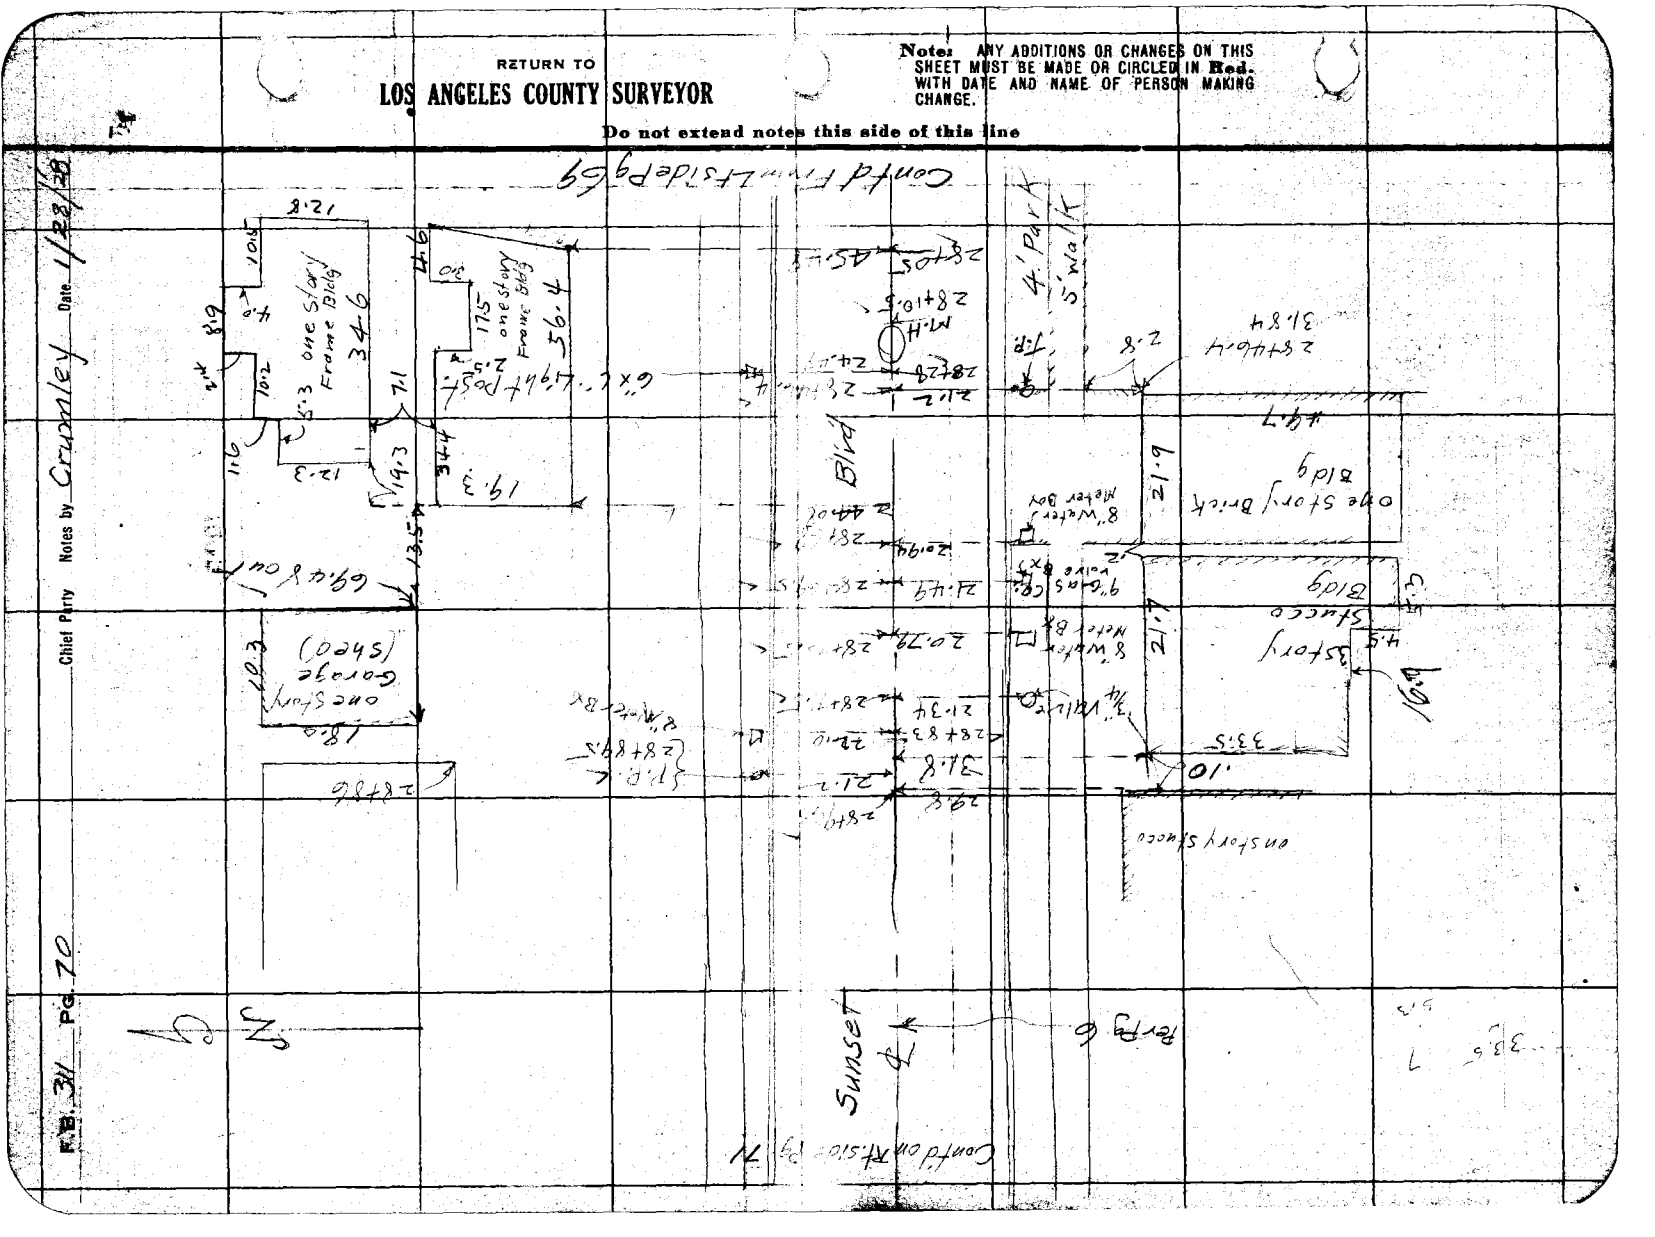

RETURN TO

LOS ANGELES COUNTY SURVEYOR

Notes: ANY ADDITIONS OR CHANGES ON THIS SHEET MUST BE MADE OR CIRCLED IN Red. WITH DATE AND NAME OF PERSON MAKING CHANGE.

Do not extend notes this side of this line

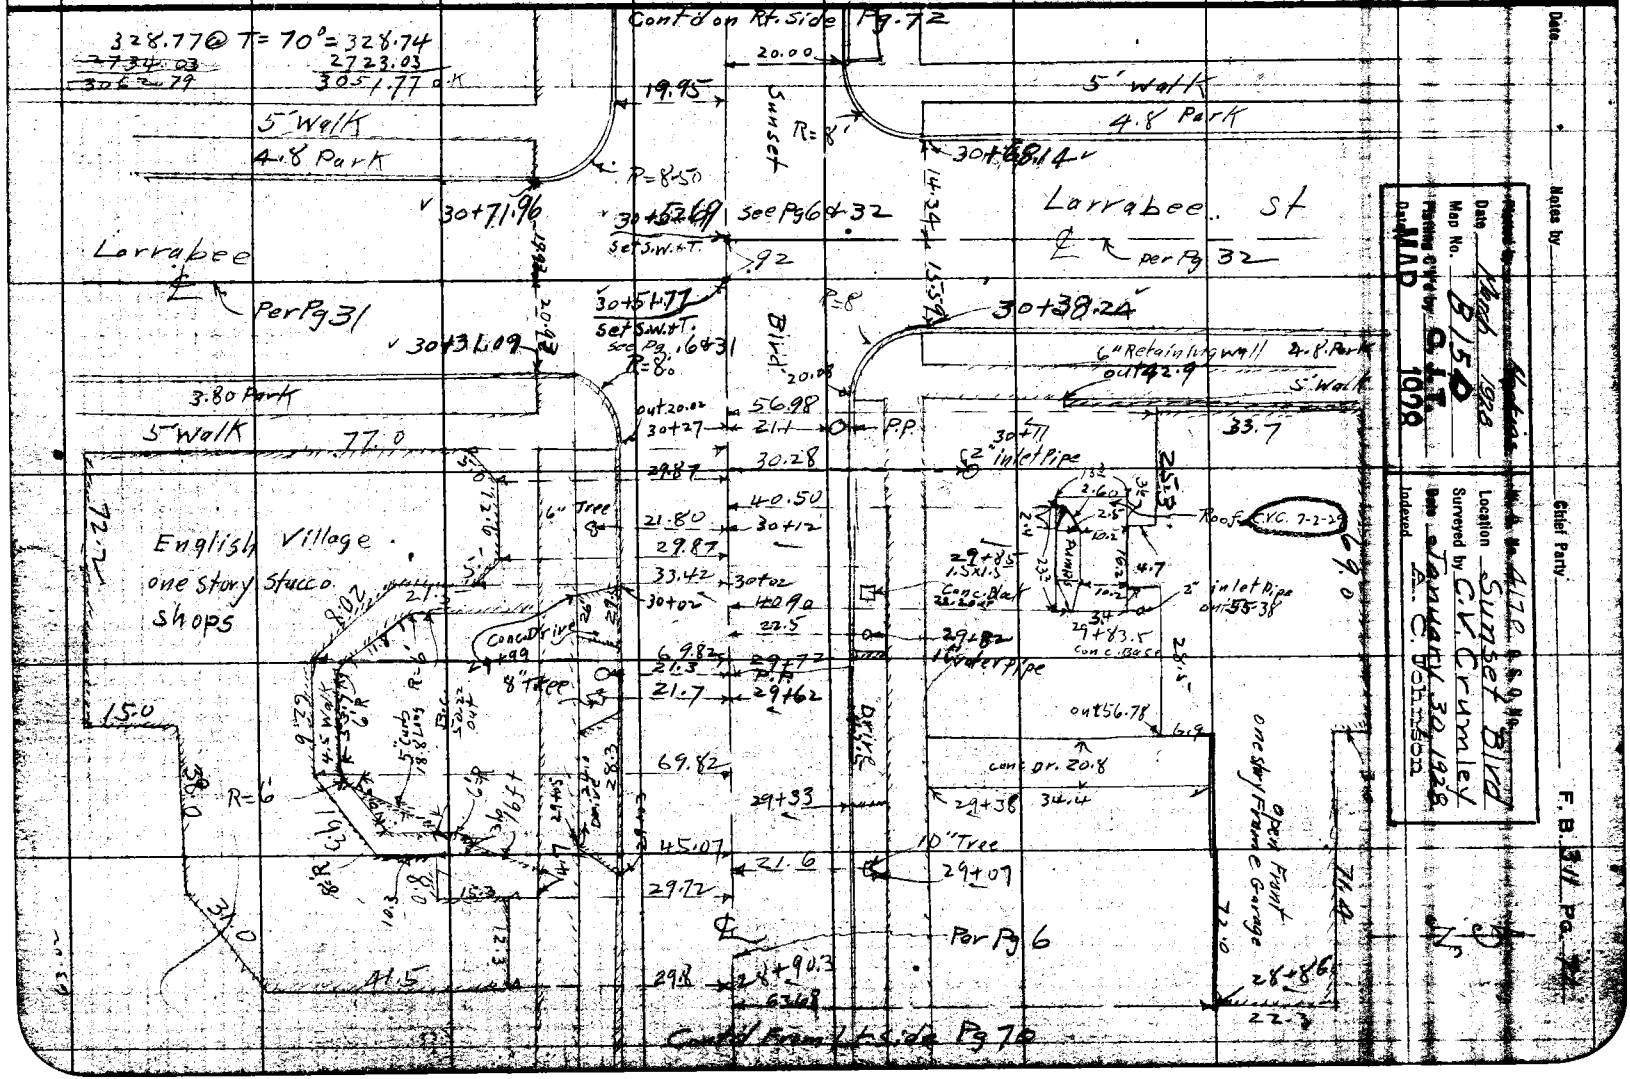


Date: 1928 Chief Party:

Map No. B 150

Plotting Chkd by: G.T. 1098

Date: MAP

Location: Sunset Blvd

Surveyed by: C.V. Crumley

Date: January 30, 1928


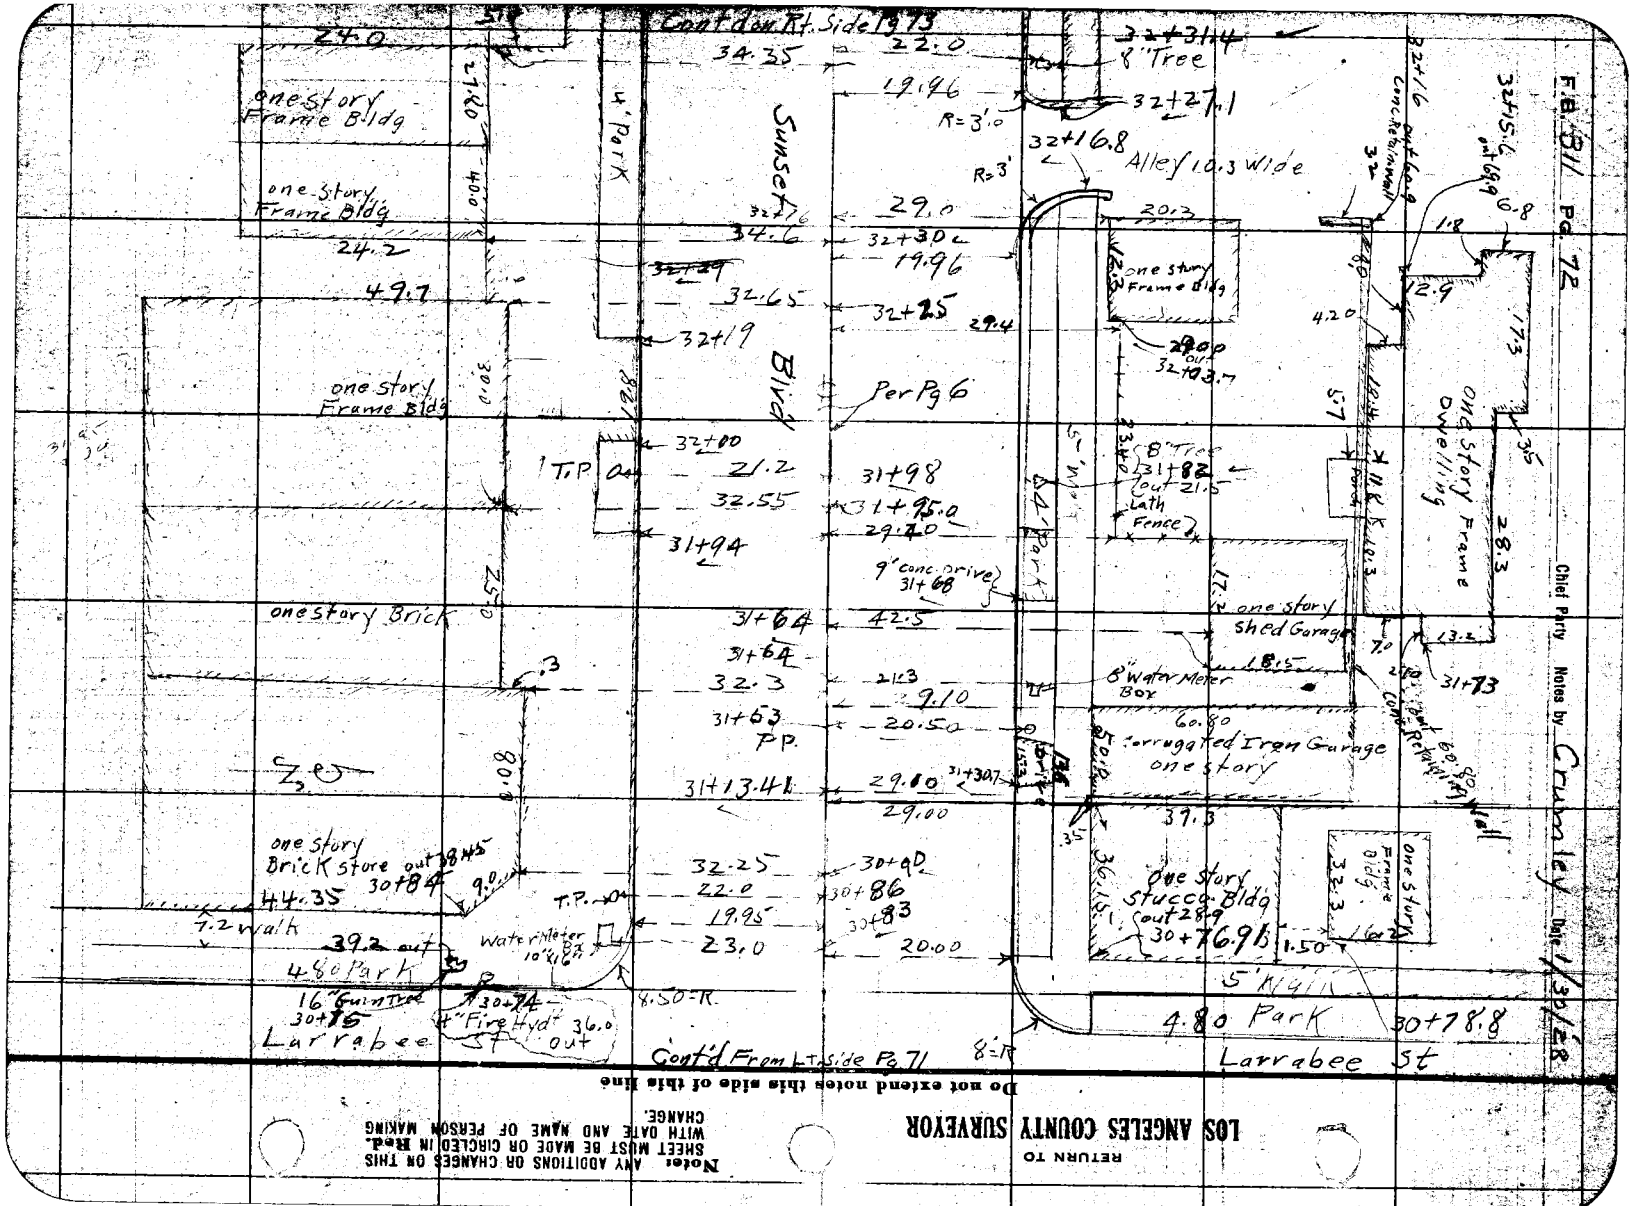
F.B. 311 Pg. 72
Chief Party
Cont'd on Rt. Side Pg 73
Sunset Blvd
Per Pg 6
Alley 10.3 Wide
one story Frame Bldg
one story Brick
one story Brick store out
one story Stucco Bldg out
one story Frame Dwelling
one story Frame Bldg
one story Shed Garage
Corrugated Iron Garage one story
8" Tree
8" Water Meter Box
Lath Fence
9' conc. drive
Water meter
4" Fire Hydr
16" Gum Tree
Cont'd From Lt. Side Pg 71
Larrabee St
4.80 Park
5' Walk
7.2 walk
RETURN TO
LOS ANGELES COUNTY SURVEYOR
Do not extend notes this side of this line
Notes: ANY ADDITIONS OR CHANGES ON THIS SHEET MUST BE MADE OR CIRCLED IN Red. WITH DATE AND NAME OF PERSON MAKING CHANGE.

RETURN TO
LOS ANGELES COUNTY SURVEYOR

Note: ANY ADDITIONS OR CHANGES ON THIS SHEET MUST BE MADE OR CIRCLED IN Red. WITH DATE AND NAME OF PERSON MAKING CHANGE.

Do not extend notes this side of this line

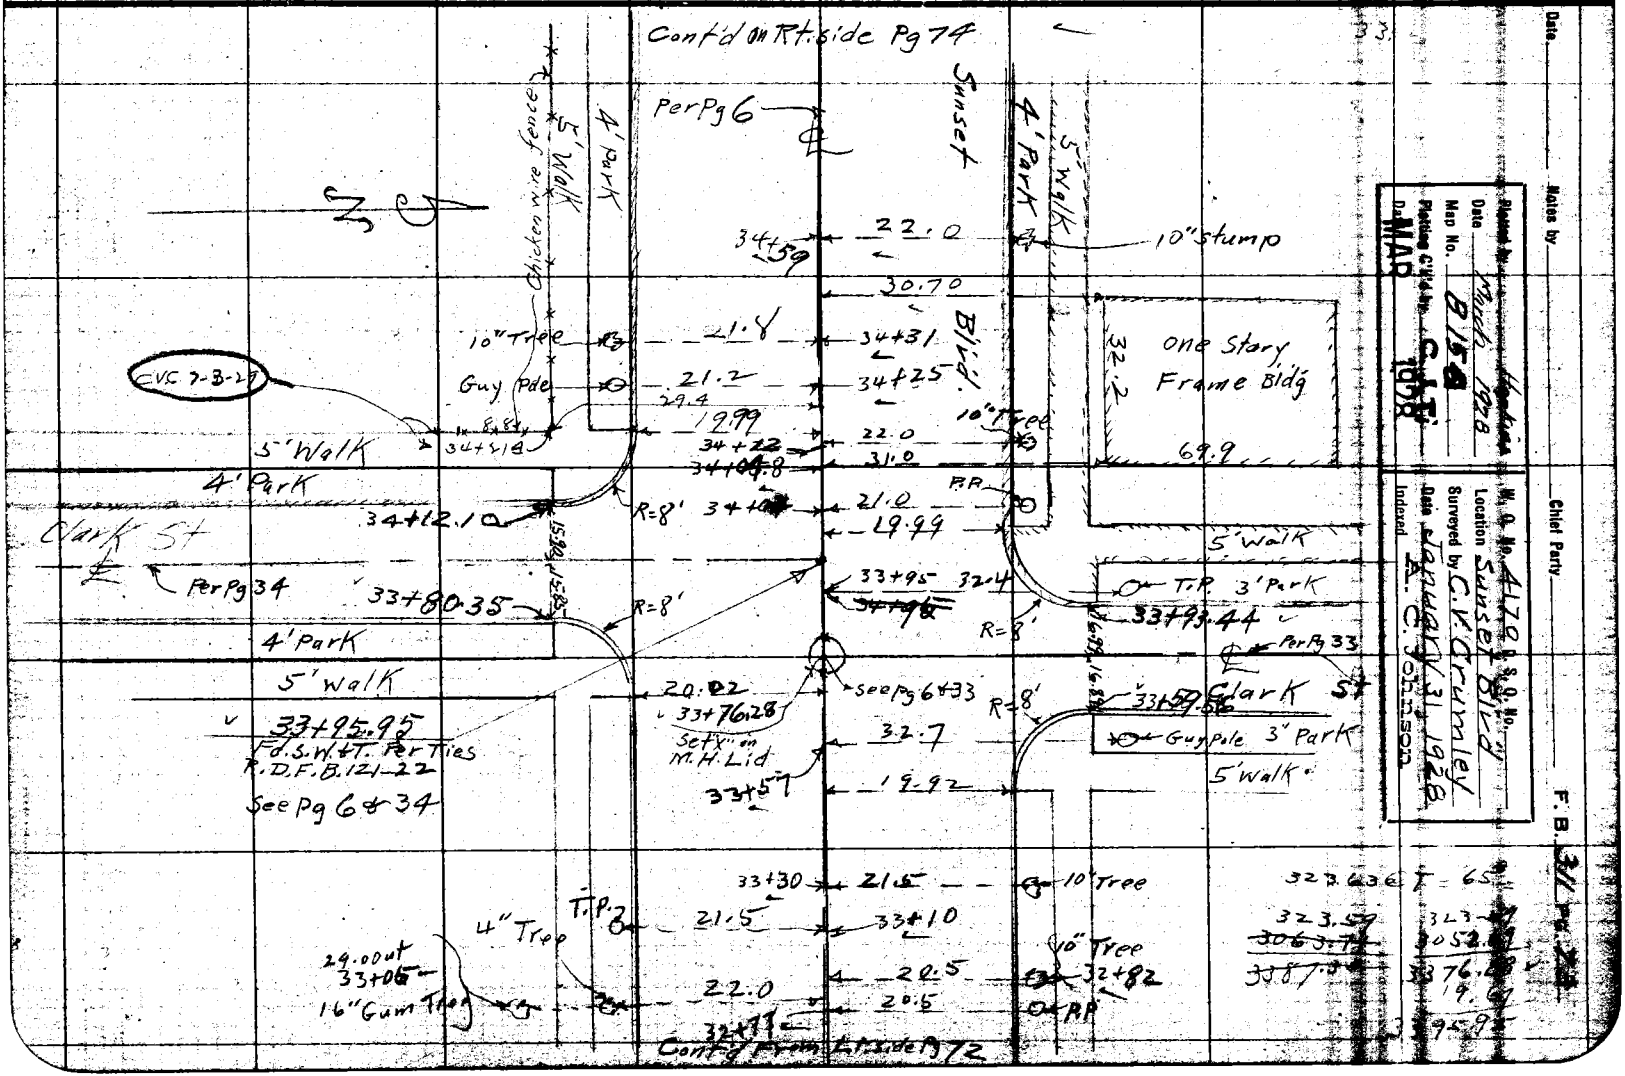

Date _____ Notes by _____ Chief Party _____ F. B. 311 Pg. 23

Planned by Hughes Date March 1928 Map No. B 15 a Plotting C'k'd by C.F.T. Date 10-18 MAP

W. O. No. 4170 & S.D. No. 27 Location Sunset Blvd. Surveyed by C.V. Crumley Date January 31, 1928 Indexed A. C. Johnson

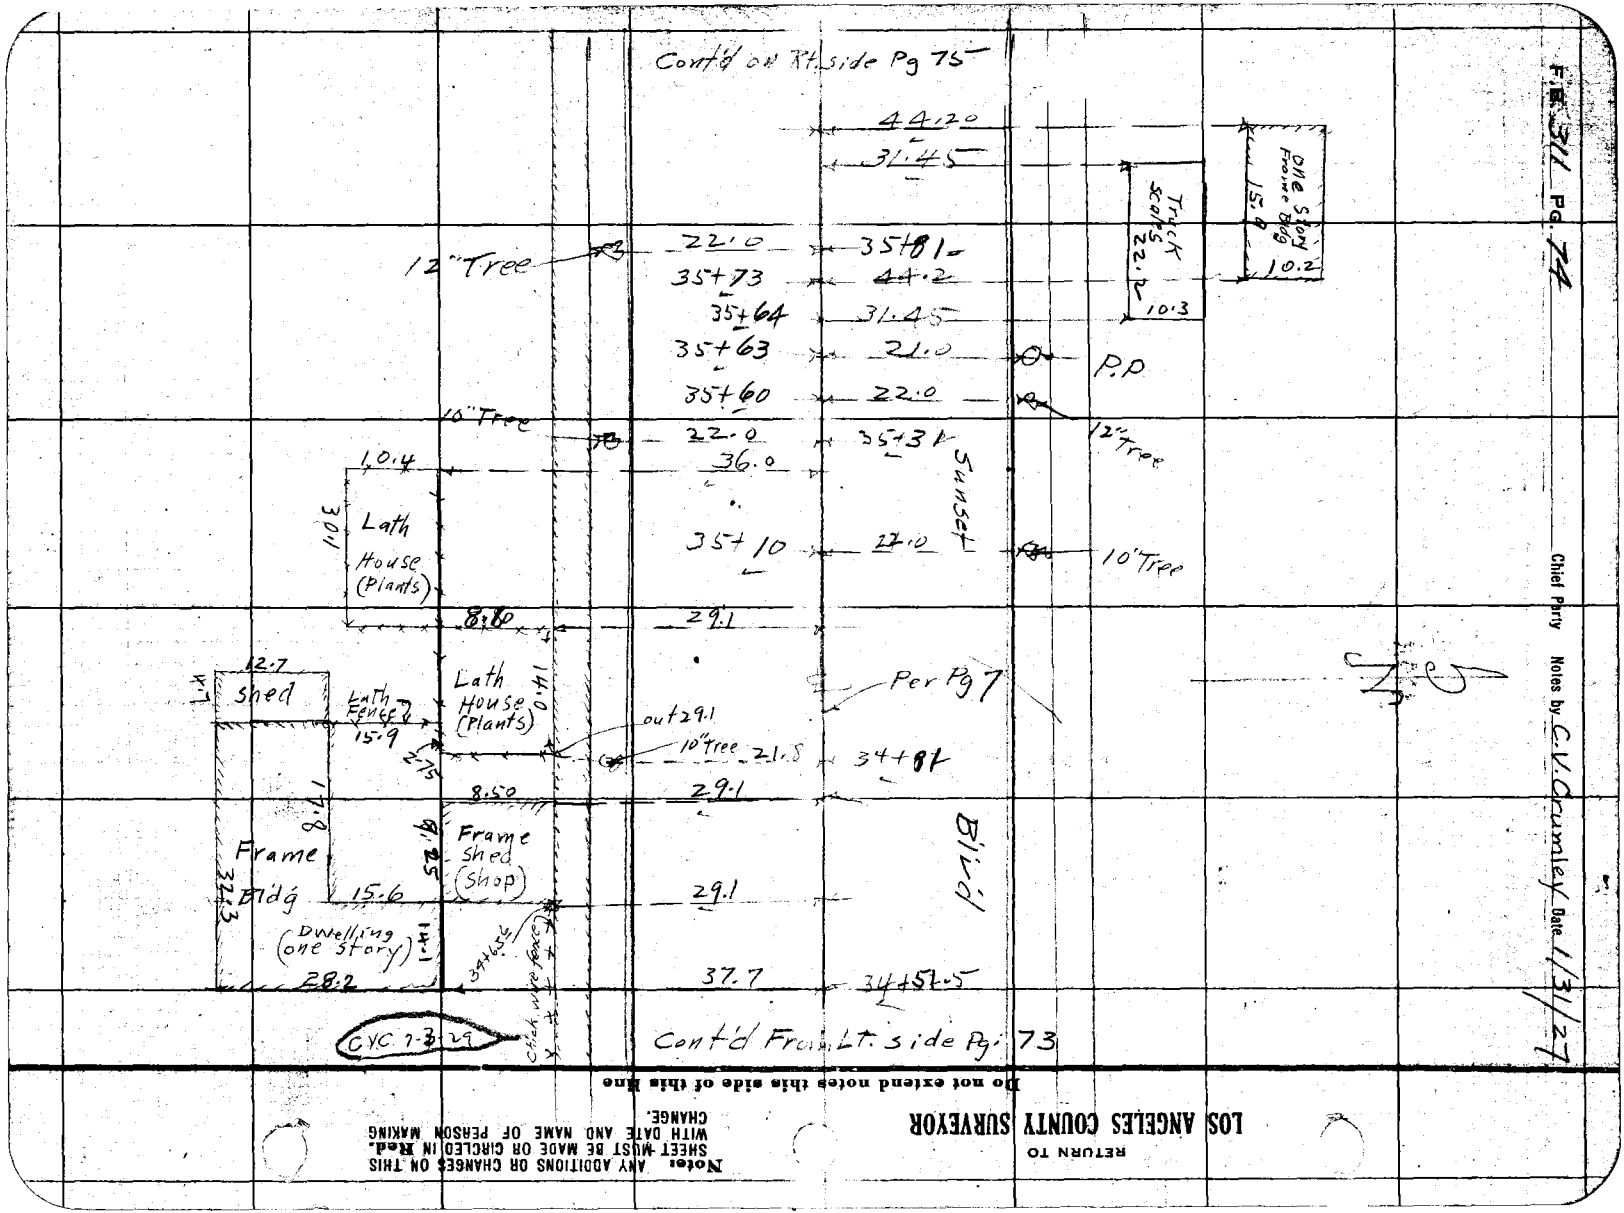

F.B. 311 Pg. 74

Chief Party Notes by C.V. Crumley Date 1/31/27

LOS ANGELES COUNTY SURVEYOR

RETURN TO

Do not extend notes this side of this line

Note: ANY ADDITIONS OR CHANGES ON THIS SHEET MUST BE MADE OR CIRCLED IN Red, WITH DATE AND NAME OF PERSON MAKING CHANGE.

RETURN TO
LOS ANGELES COUNTY SURVEYOR

Notes: ANY ADDITIONS OR CHANGES ON THIS SHEET MUST BE MADE OR CIRCLED IN Red. WITH DATE AND NAME OF PERSON MAKING CHANGE.

Do not extend notes this side of this line

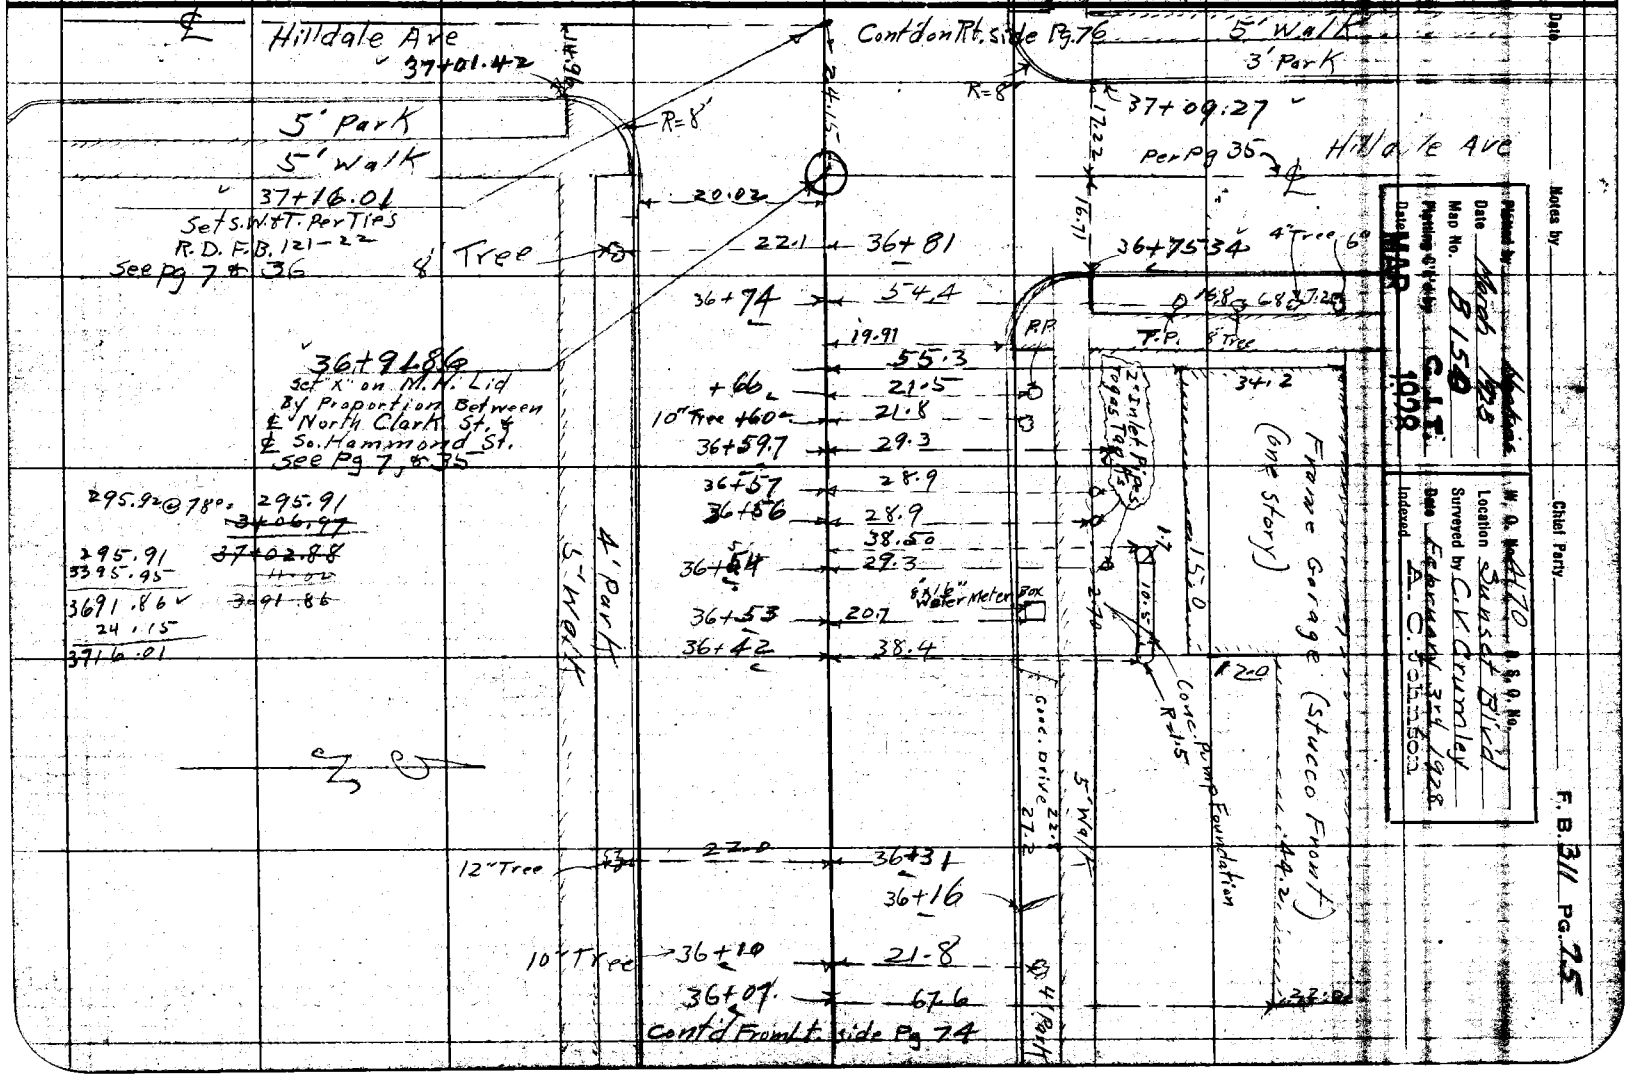

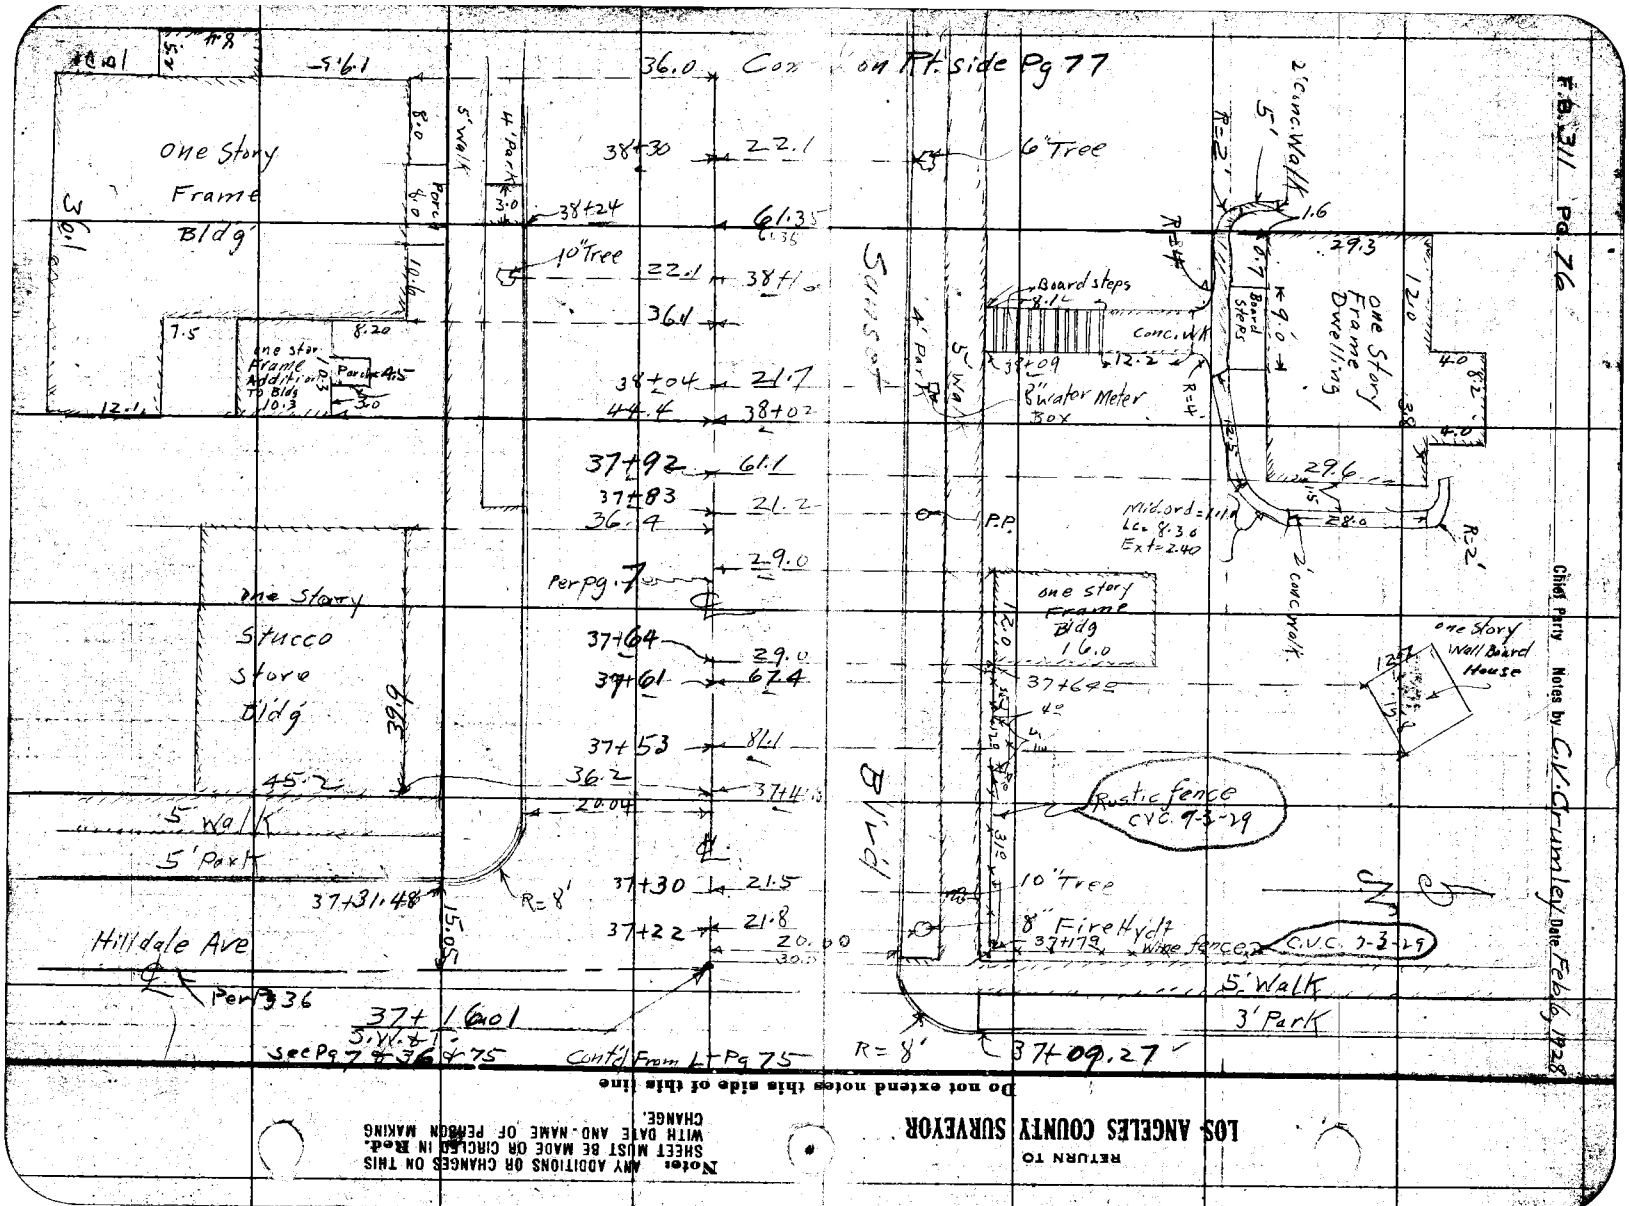
F.B. 311 Pg. 76
Chief Party Notes by C.V. Crumley Date Feb 6, 1928
Con on Rt. side Pg 77
One Story Frame Bldg
One Story Stucco Store Bldg
One Story Frame Addition To Bldg
One Story Frame Dwelling
One Story Frame Bldg
One Story Wall Board House
Board steps
Conc. Wk
8" Water Meter Box
Rustic fence CVC. 9-3-29
Wire fence CVC. 9-3-29
10" Tree
6" Tree
8" Fire Hydt
P.P.
Hilldale Ave
Per 336
Sec Pg 74 & 75
Cont'd From Lt Pg 75
37+09.27
37+16.01
37+31.48
Los Angeles County Surveyor
Return To
Do not extend notes this side of this line
Notes: Any additions or changes on this sheet must be made or circled in red. With date and name of person making change.

RETURN TO

LOS ANGELES COUNTY SURVEYOR

Note: ANY ADDITIONS OR CHANGES ON THIS SHEET MUST BE MADE OR CIRCLED IN **Red.** WITH DATE AND NAME OF PERSON MAKING CHANGE.

Do not extend notes this side of this line

Cont'd on Rt. side Pg 78

10" Conc. Retaining Wall

39+38

8" Water Meter Box

21.5

29.0

B.C.

R=3'

18.0

Per Pg 7

Conc. Drive

10'

39+32.4

18.0

Out 58

1.42

12.8

5.7 High B.C.

39+21

29.0

39+16

21.8

21.6

8" Water Meter Box

R=3'

Board Steps

Conc. Steps

5.1

3.8

27

Frame Dwelling one Story

Porch 10'

20.2

10" Tree

Sunset

39+11

20.8

P.P.

38+94

58.7

38+83

40.5

50² 8" Tree

38+80

22.0

38+87

Camphor Tree CVC. 7-2-27

2' I. P. Flag Pole

38+78.5

28.85

24.60

10" Conc Retaining Wall 7.8 high

Blvd

Lattice Fence

10" Tree

29.8

38+66

12" Apricot Tree

38+67

CVC. 7-2-27

5.83

5.3

out 29.4

Board Steps 10.0

4' Conc Walk

31.3

12.1

one Story Frame Dwelling

5' Walk

4' Parkway

6" Water Meter Box

+52

21.7

38+58

12.1

6' Cypress

36.8

38+47

38+43

66.1

LC=0.6 Ext=1.00 Mid.ord.=1.0

12.3

24.3

38+39.5

29.5

38+38.5

Ext=NO Mid.ord=1.0 LC=0.30

2' Conc. Wall

Cont'd From Lt. Pg 76

Planted by Mark Andrews Date 1928

Map No. B 158

Plotted by C.M. Date MAR 1928

Notes by

Date

Chief Party

F. B. 311 Pg. 77

W. O. No. 4472 D. S. O. No.

Location Sunset & Bluff

Surveyed by C.K. Crumley Date February 1928

Indexed A. C. Johnson

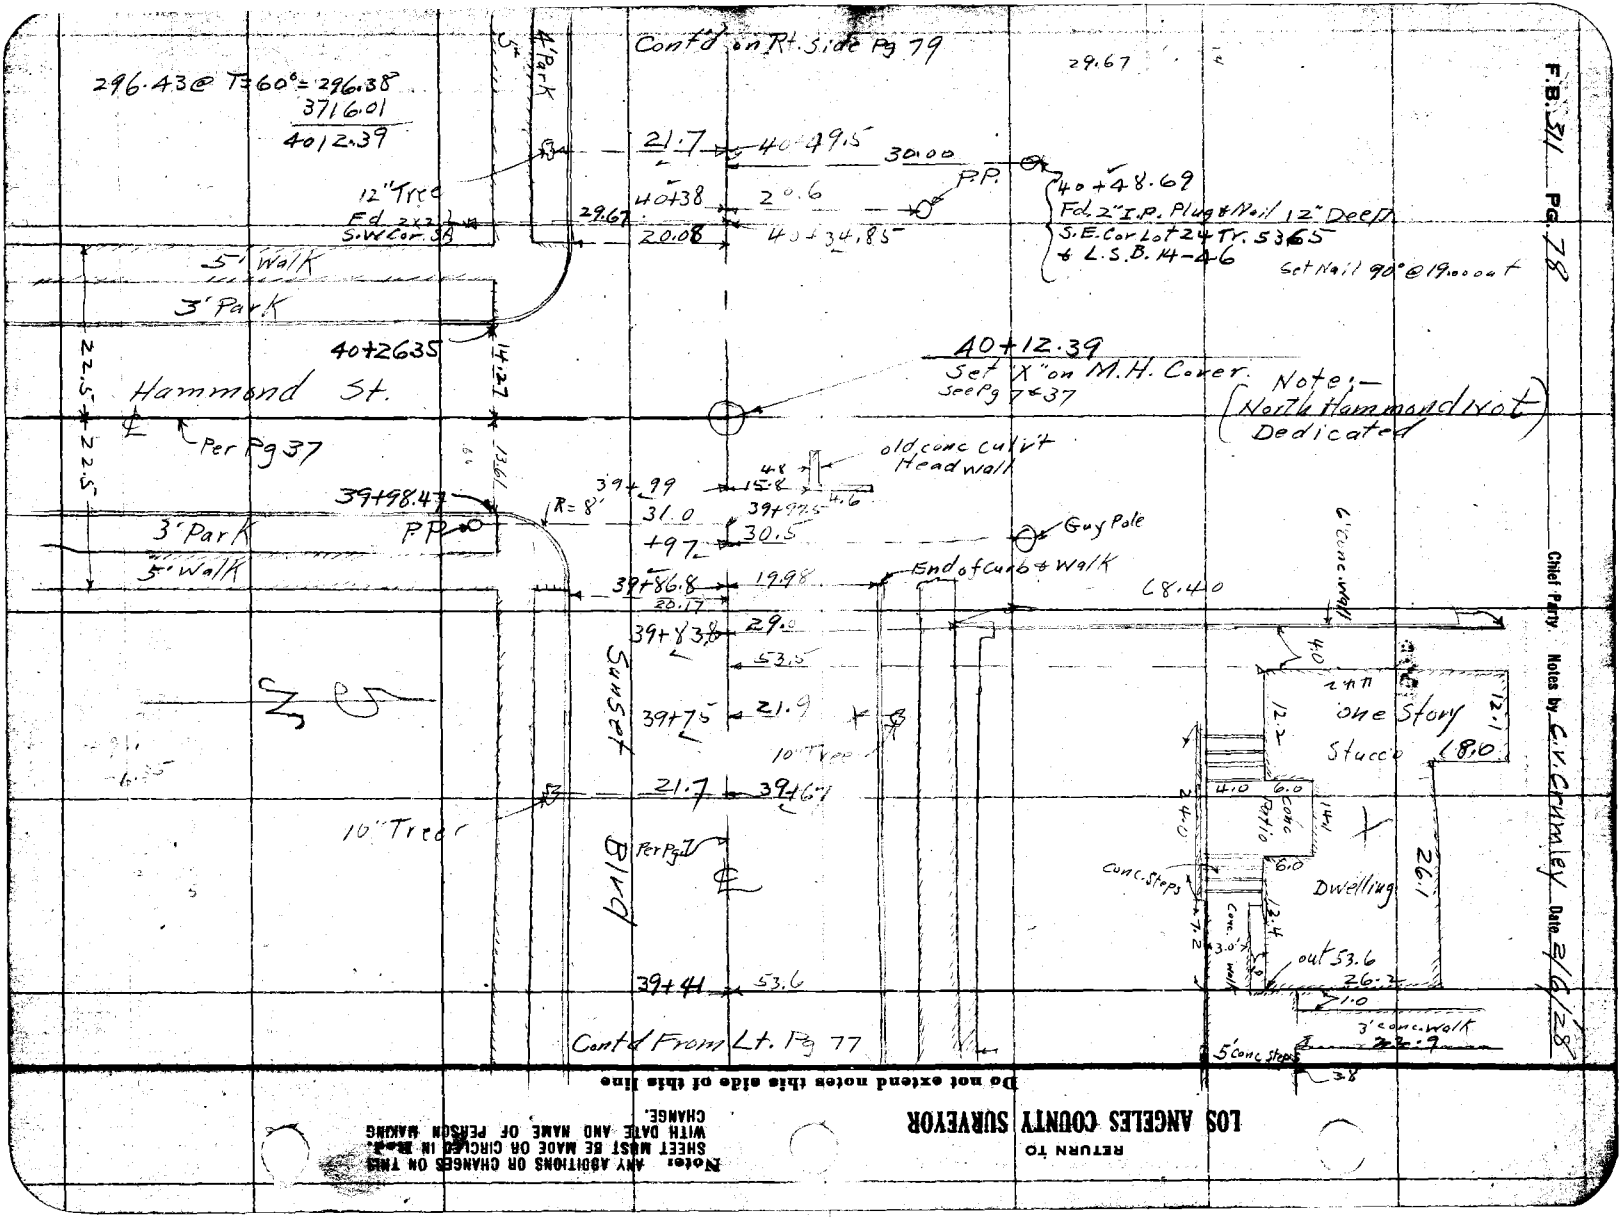
F.B. 371 Pg. 78
Chief Party Notes by C.V. Crumley Date 2/6/28
LOS ANGELES COUNTY SURVEYOR
RETURN TO
Do not extend notes this side of this line
Note: ANY ADDITIONS OR CHANGES ON THIS SHEET MUST BE MADE OR CIRCLED IN RED WITH DATE AND NAME OF PERSON MAKING CHANGE.
Cont'd on Rt. Side Pg 79
296.43 @ T 360° = 296.38
3716.01
4012.39
12" Tree
Fd 2x2 S.W. Cor. SB
5' Walk
3' Park
Hammond St.
Per Pg 37
40+26.35
41.27
22.5
22.5
39+98.47
PP
3' Park
5' Walk
R = 8'
39+99
31.0
39+97.5
30.5
+97
39+86.8
20.17
19.98
39+73.8
29.0
53.5
39+75
21.9
10' Tree
21.7
39+46.1
10' Tree
Per Pg 77
Sunset Blvd
39+41
53.6
Cont'd From Lt. Pg 77
4' Park
21.7
40+49.5
30.00
P.P.
40+38
20.6
29.67
20.08
40+34.85
29.67
40+48.69
Fd 2" I.P. Plug & Nail 12" Deep
S.E. Cor Lot 24 Tr. 5365
& L.S.B. 14-46
Set Nail 90° @ 19.00 on ℄
40+12.39
Set X on M.H. Cover.
See Pg 7 & 37
Note:-
old conc culvt Headwall
4.8
15.8
4.6
Guy Pole
End of Curb & Walk
C8.40
6" Conc. Wall
40
24.0
one Story Stucco
12.1
18.0
12.1
4.0
6.0
Conc Patio
14.1
Conc. Steps
6.0
Dwelling
26.1
12.4
Conc. Wall
3.0
out 53.6
26.3
1.0
3' conc. walk
5' Conc. Steps
3.8

RETURN TO
LOS ANGELES COUNTY SURVEYOR

Notes: ANY ADDITIONS OR CHANGES ON THIS SHEET MUST BE MADE OR CIRCLED IN **Red.** WITH DATE AND NAME OF PERSON MAKING CHANGE.

Do not extend notes this side of this line

Date _____ Notes by _____ Chief Party _____ F. B. 311 Pg. 77

Plotted by Manuel Mendoza
Date
Map No. B 154
Planning C'k'd by C.T.T.
Date MAR 1929

W. O. No. 4170 P. S. No.
Location Sunset Blvd
Surveyed by C. V. Crumley
Date February 1929
Indexed A. C. Sellers

Cont'd on Rt. Side Pg 80

C.V.C. 7-3-29

30.90

Box Shed

12.40

16.0

30.8

41+55

41+52

21.9

6" Tree

10" Tree

21.7

41+50

41+10

26.3

T.P.

21.0

41+06

6" Tree

41+02

21.8

16" Tree

22.0

41+00

26.2

Sunset

40+82

34.3

45.5

44.4

Per Pg 7

44.4

45.7

Blvd.

33.8 cont. steps

44.3

45.5

40+58

21.0

40+50

8" Tree

Cont'd From Rt Side Pg 78

46.42

Sunset Blvd

1 Story Stucco "The Bad Egg"

22.3

48.44

40+93

16.2

6.5

16.0 one story Frame Bldg

11.2

23.2

Gone, C.V.C. 7-3-29

Vine Trellis

11.0

7.5

7.3

151

12.3

Stone & Adobe Landing

2.9

2.3

5.1

Shed.

36.4

story Stucco

8.5

2.8

2.3

1.9

12.4

3.5

1.6

4.0

15.2

Stone Chimney

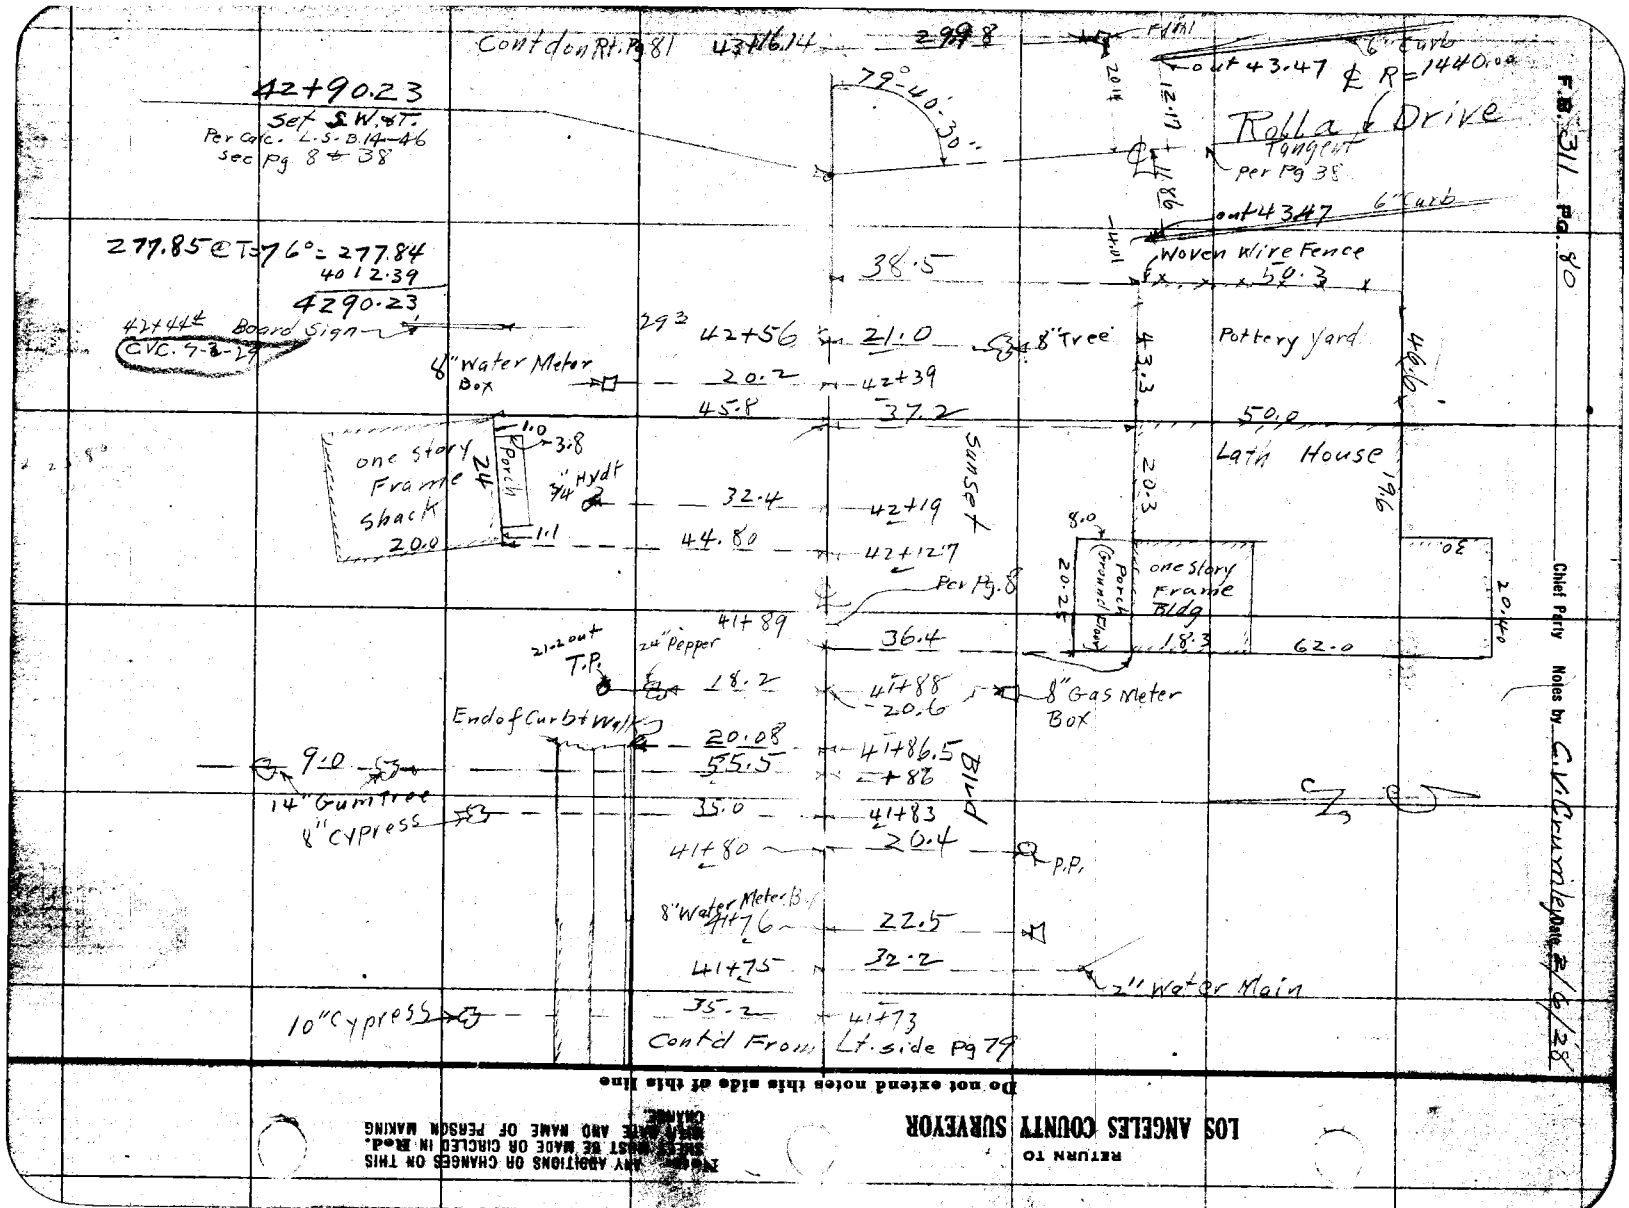

F.B. 311 Pg. 80


RETURN TO
LOS ANGELES COUNTY SURVEYOR

Do not extend notes this side of this line

NOTE: ANY ADDITIONS OR CHANGES ON THIS SHEET MUST BE MADE OR CIRCLED IN RED, WITH DATE AND NAME OF PERSON MAKING CHANGE

RETURN TO

LOS ANGELES COUNTY SURVEYOR

Note: ANY ADDITIONS OR CHANGES ON THIS SHEET MUST BE MADE OR CIRCLED IN **Red.** WITH DATE AND NAME OF PERSON MAKING CHANGE.

Do not extend notes this side of this line

Date _____ Notes by _____ Chief Party _____ F. B. 311 Pg. 81

Plotted by Mack 1928
Date
Map No. B 1.5
Platting C'k'd by C.J.T.
Date MAR 1928

W. O. No. 4470 U. S. O. No.
Location Sunset & Bird
Surveyed by C.V. Crumley
Date February 7, 1928
Indexed A. C. Jensen

8"x16" Water Meter Box
Contd on Rt side Pg 82
21.2 44+02.5
64.8
21.2 44+00 Two 6" Trees
one story Stucco Bldg
Shattice Screen Fence
2.0 ½ I.P. Light standard
22.2 43+99
24.4 43+98
45.5
4"x4" Sign Post
Sunset
Per Pg 8
one story Frame Bldg
one story Stucco Bldg
16.1
16.3 45.75 43+71
4" Palm
56.40
44.3 43+61
C.V.C. 7-3-29
1 story Fr Office
45.75
14.4 4.20
one story Stucco Bldg
43+51
21.4
8" Tree
12" Tree
56.45
21.3 43+49 51.8
Scales C.V.C. 7-3-29
I.P.
Bird
43+46.2
43+33
Flagstone Path
Flagstone Walk
43+26 20.5 P.P.
45.5 43+11
N. & T.
Cont'd From Lt. Pg 80
N. & T. at St. (Rolla Dr)
274.29
274.2

F.B. 311 Pg. 82 Chief Party Notes by C.V. Crumley Date 2/7/28

RETURN TO
LOS ANGELES COUNTY SURVEYOR

Do not extend notes this side of this line

Notes: ANY ADDITIONS OR CHANGES ON THIS SHEET MUST BE MADE OR CIRCLED IN Red WITH DATE AND NAME OF PERSON MAKING CHANGE.

County Rt. Pg 83
45+88
31.6
4" Tree
45+57
31.8
6" Tree
45+25.74
31.5
6" Tree
45+57.50
31.6
4" Shrub
45+32.67
22.4
20.30
6" Shrub
45+32.55
31.5
4" Shrub
45+19
31.6
Continental Heights
P.O.C.
45+00
Wire Fence
8" Tree
E. End Concrete
2" x 12" Boardwalk
40" Palm
40" Palm
45+20.4
44+90
6" Tree
Sunset
45.00
24.0
21.5
44+79
Tip
Quonset M.H.
44+44
21.2
8" Tree
Bird
Per Pg 8
44+10.5
45.00
Contd. From Left Side Pg 81
30.50
One Story
Frame
With Stucco
Front
10.10
2.10
60.0
2.10
10.10
30.50

RETURN TO

LOS ANGELES COUNTY SURVEYOR

Note: ANY ADDITIONS OR CHANGES ON THIS SHEET MUST BE MADE OR CIRCLED IN **Red.** WITH DATE AND NAME OF PERSON MAKING CHANGE.

Do not extend notes this side of this line

Total 644.36@T=76 = 644.33

364.78@T=76 =

Cont'd on Rt. Pg 64

46+93

out 42.5' Shrub

P.P.

1" Hydt

30" Palm

5' Walk

5' Park

open Storm Drain

28.90

out 37.3

46+77.90

covered 20.70

20.06

Cold Cont. Headwall Flush with Pavement

46+75.92

Set "X" on M.H. Cover

see Pg 8, 39640

Doheny Drive ℄

Per Pg 39

out 33.5

2.8

20.02

46+36.91

6" conc. curbing

33.7

Catch Basin

5' Park

5' Walk

30" Palm

G.P.

R=9'

5.5.3

46+34

20.07

19.95

46+32

58.8

46+26

28.2

31.5'

46+14.3

T.P.

21.7

46+12

31.5

46+01.6

22.7

30.9

46+00

6" Tree

6" Tree

2"X12" Board Curb

6" Conc Curb

Cont'd from Lt. Pg 82

644.36@T=76 =

644.33

40 12.39

4656.72

one Story Frame Bldg

3.2 conc. walk

16.3'

12.3

21.4

47+07

22.0

16" Tree

46+99

46+85

4" Vent Pipe

30.3

46+87

20.06

21.3

P.P

R=9'

7.0

21.0

46+81

46+79.5

End 6" Curb

9.0

7.0

27.82

46+71.57

Curb Basin

15.0'

Doheny Dr.

Per Pg 40

Sunset Blvd

89°33'30"

10.4

3.3 Catch Basin

46+44

out 37.67

R=16'

46+41.46

Per Pg 8

Display Lot

4" Tree

Notes by

Date

Chief Party

F. B. 311 PG. 82

Plotted by Myrtle 12-28

Date

Map No. 8/50 C.L.T.

Plotting C'k'd by

Date MAR 1928

W. O. No. 4172 & S.P. No.

Location Sunset Blvd

Surveyed by C.V. Crumley 1928

Date February 1928

Indexed A. C. Johnson

D 003

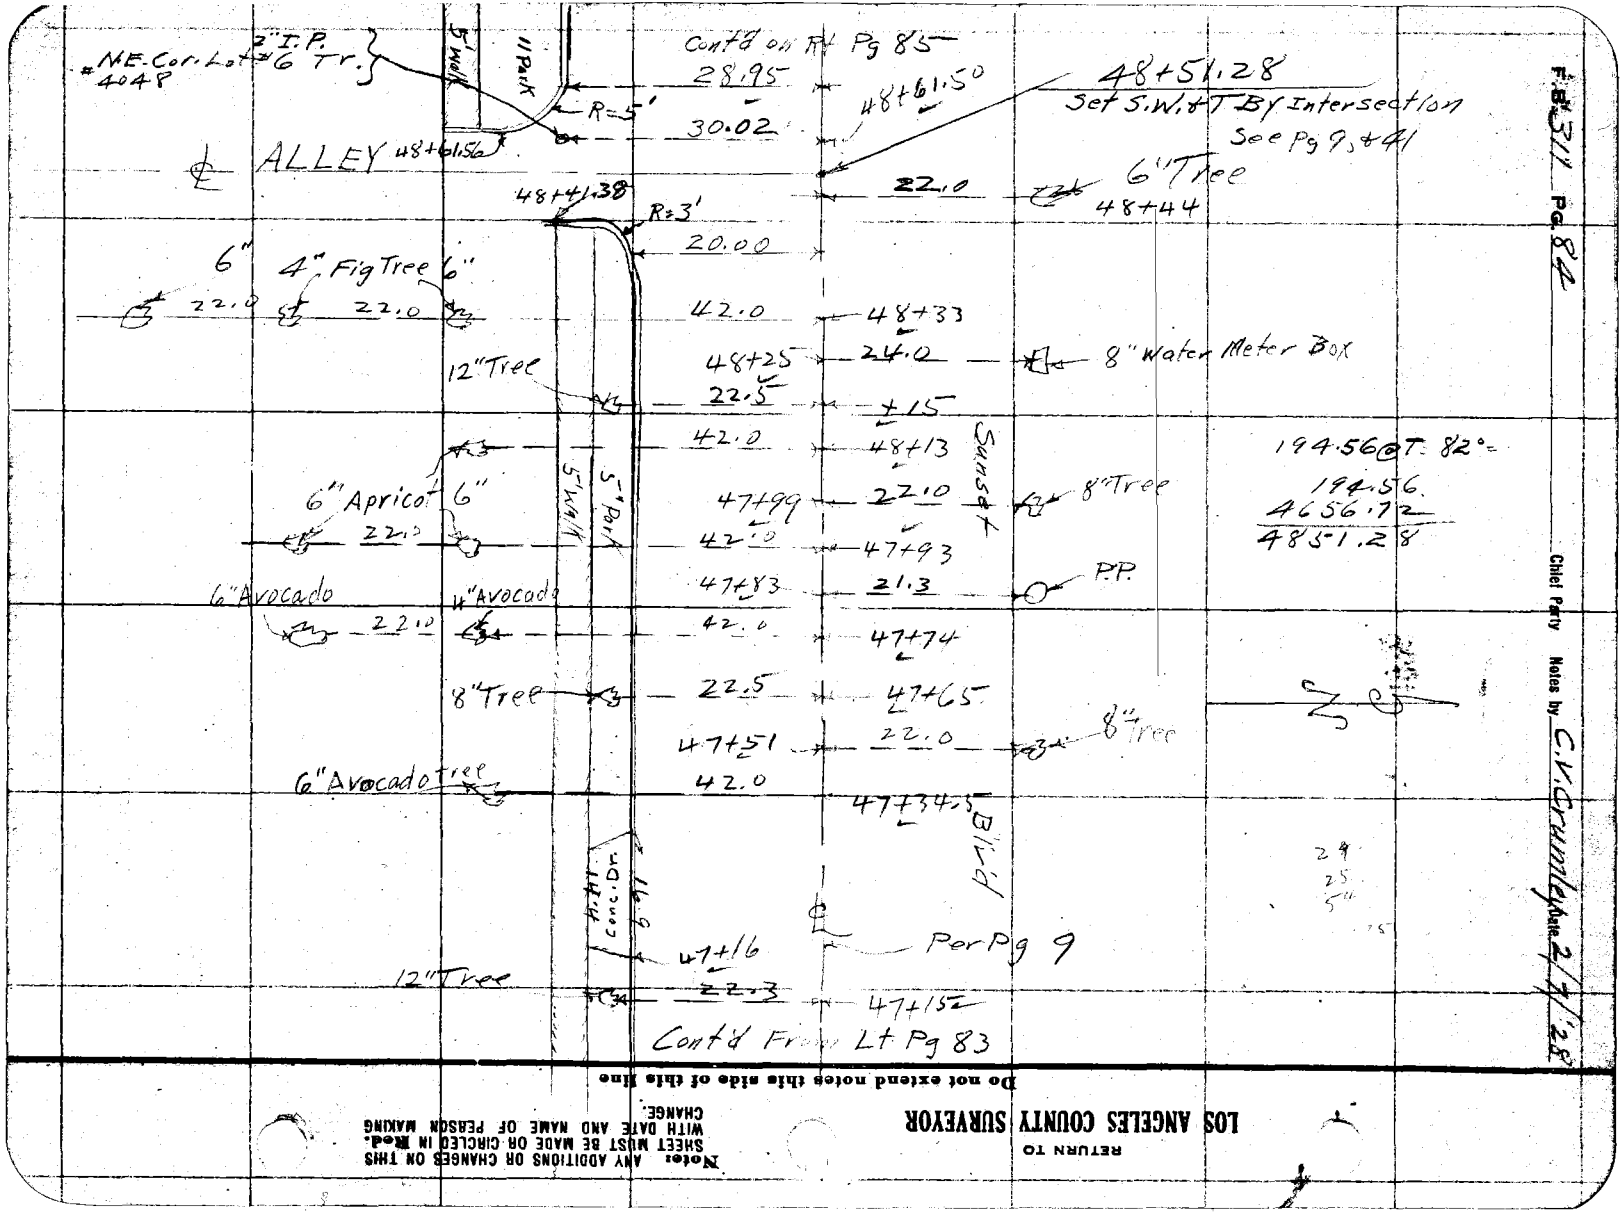

Do not extend notes this side of this line

LOS ANGELES COUNTY SURVEYOR

RETURN TO

Note: ANY ADDITIONS OR CHANGES ON THIS SHEET MUST BE MADE OR CIRCLED IN Red. WITH DATE AND NAME OF PERSON MAKING CHANGE.

RETURN TO

LOS ANGELES COUNTY SURVEYOR

Note: ANY ADDITIONS OR CHANGES ON THIS SHEET MUST BE MADE OR CIRCLED IN **Red.** WITH DATE AND NAME OF PERSON MAKING CHANGE.

Do not extend notes this side of this line

Date _____ Notes by _____ Chief Party _____ F. B. 31/Pg. 85

Plotted by Brock Hopkins Date 1928

Map No. B/5e Plotting C'k'd by C. J. T. Date MAR 1928

W. O. No. 4-1720 S. O. No. _____

Location Sunset Blvd

Surveyed by C.V.C. Crumley Date February 7, 1928

Indexed A. C. Johnson

Contd on Rt. Pg 86

P.P.

29.8 — 50+13

79.5 — 5-0+12

5'-0

5'-0

52.0

La Fon Sign

2.4

2.1

25'-0

2.0

5' Walk

11' Park

Sunset

Blvd

5" Water & Curb Combined

Ptr Pg 9

49+75.5 — 35.00

48.4 — 46.2

48.4 — 49+67.6

8" Water Meter Bx

49+64.5 — 25.0

49+56 — 36.0

60.0 — 49+45.5

60.6 — 49+44.4

La Fon Sign

8.2

64.6 — 49+38 — 21.0

49+36 P.P.

49+33.5 — 45.88

68.32 — 49+32.5 — 31.28

49+31 — 36.6

68.12 — 87.0 — 49+02

48+92 — 22.0 — 6" Tree

2.9

2.7

2.7

Foster & Meiser Sign

ReLocated 7/3/29 C.V.C.

This is gone

48+68.2

50.7

M. H. 48+71

63.7

54.0 — 44+69

30.4 — 48+67

Contd From Rt Pg 84

Arch

Light

6.6

14'

12.0

1½ Story Stucco

25'-15

25.5

10'

9.5

Light

Bldg

37.15

13.8

23.7

3'-5

Sign Display Light on Ground

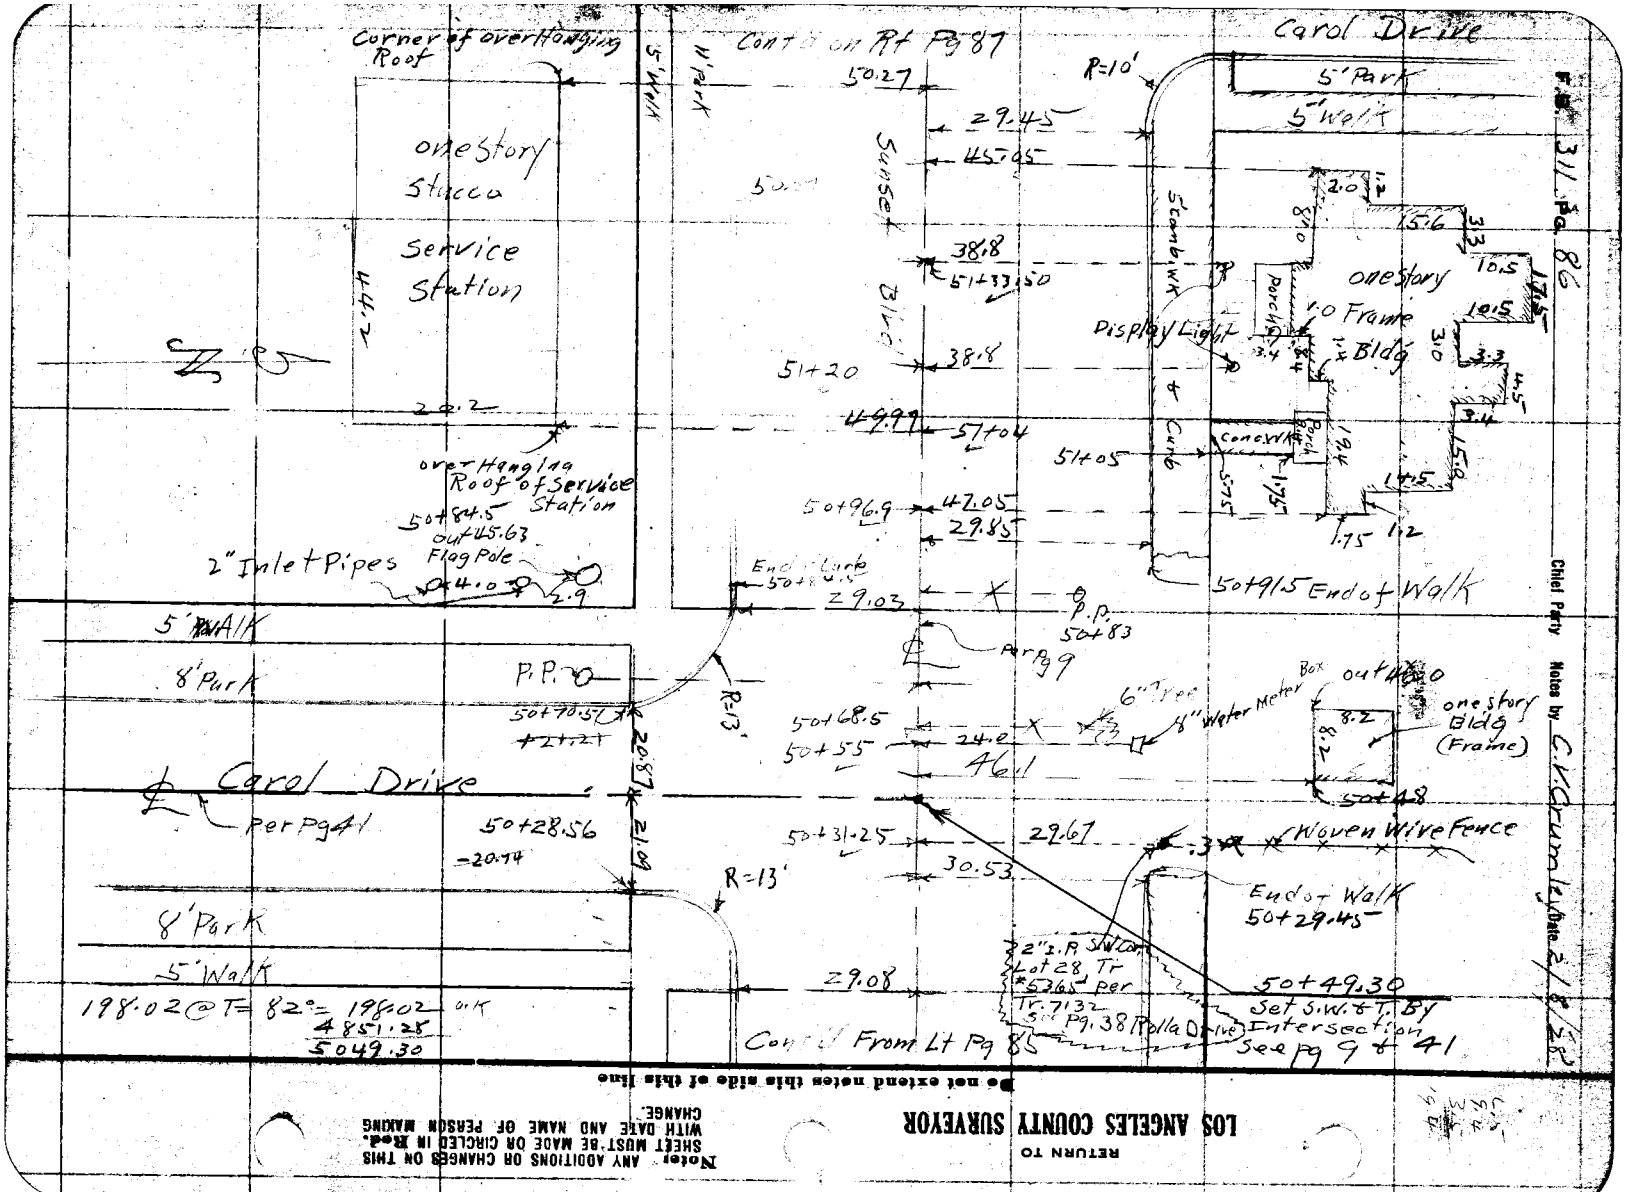
Carol Drive
Corner of overhanging Roof
one story Stucco Service Station
20.2
Over Hanging Roof of Service Station
50+84.5 out 45.63
2" Inlet Pipes
Flag Pole
4.0
2.9
5' Walk
8' Park
P.I.
50+70.5
+21.21
R=13'
20.87
21.09
℄ Carol Drive
Per Pg 41
50+28.56
-20.74
8' Park
5' Walk
198.02 @ T= 82°= 196.02 O.K
485.1.28
5049.30
Cont'd From Lt Pg 85
29.08
50+49.30
Set S.W.& T. By Intersection
See Pg 9 of 41
2" I.P. S.W.& T. Lot 28 Tr 6265 per Tr. 7132 Sur Pg. 38 Rolla Drive
Woven Wire Fence
Cont'd on Rt Pg 87
50.27
29.45
45.45
38.8
51+33.50
51+20
49.99
57+04
51+05
50+96.9
47.05
29.85
50+91.5 End of Walk
29.03
P.P. 50+83
Per Pg 9
50+68.5
50+55
24.0
46.1
50+31.25
29.67
30.53
50+29.45
6" Tree
8" Water Meter Box
out 46.0
one story Bldg (Frame)
8.2
2.8
50+48
Carol Drive
5' Park
5' Walk
R=10'
Sunset
Blvd.
5' Sidewalk
Curb
one story Frame Bldg
Display Light
Porch
Conc. Walk
F.B. 311 Pg. 86
RETURN TO
LOS ANGELES COUNTY SURVEYOR
Do not extend notes this side of this line
Note: ANY ADDITIONS OR CHANGES ON THIS SHEET MUST BE MADE OR CIRCLED IN Red. WITH DATE AND NAME OF PERSON MAKING CHANGE.

Date 7-11-28 Notes by L S H Chief Party L S H F. B. 311 PG. 97

Plotted by Crowl	W. O. No. 4170 D. S. O. No.
Date July 1928	Location Holloway Dr
Map No. B-150	Surveyed by L S Hammond
Plotting C'k'd by Jenny	Date July 1928
Date July 1928	Indexed A. C. Johnson

Notes: ANY ADDITIONS OR CHANGES ON THIS SHEET MUST BE MADE OR CIRCLED IN Red. WITH DATE AND NAME OF PERSON MAKING CHANGE.

RETURN TO LOS ANGELES COUNTY SURVEYOR

Do not extend notes this side of this line

Cont. bot. page 98

Dr.

Set C.S.+T Acacia Tr

49.0 C

Δ Tr 58.35

Lot 1

59.96

Set copper tk in Vert. window of Hse

Sta 24+25.08 ℄ pt Set S.W.+T

S.W. Cor Lot 9 Not set

72.38

Set L+T drive

Tr. 4960

Lot 9

Holloway Terrace

Adjusted

(35) (35)

Fd 2x2 per F.B. 311-64

Set L+T curb

67.89

TOX in M.H. Cor at West Knoll per F.B. 311-26

Hancock Ave

Fd X in M.H. Cor per F.B. 311-5

60.72 Set L+T drive

66.92

Set L+T curb

Sta 21+55.39 Set S.W.+T for New Intersection

Holloway

Cont. From top page 96

F.B. 311 Pg. 98 LSH Chief Party Notes by LSH Date 7-12-24

Cont bot page 99

(45) (45)

Δ = 41-04-45
R = 445
T = 166.73

BC STA 28+80.44
SET SWHT

Old St

SUNSET

Note
For Ties To points on
This page See page 102

destroyed 9-13-24
Fd SWHT per
FB. 311-5

SET SWHT

38°-55'-15"
Adopted

Horn Ave

To NHT per
FB. 311-28

SET SWHT

SET SWHT

PI SET SWHT

166.73

To SWHT per
FB. 311-5

SET SWHT

31°-43'-45"

Palm Ave

131.14

SET SWHT
EC STA 77.5

SET SWHT by
Intersection

Old St

SET NHT
OF Old BC

S 2°

destroyed 2-11-24
Fd SWHT per
FB. 311-5

STA 254+80.06
SET NHT

(35) (35)

48-31-45
196-07-15
48-31-45

cont. From Top page 97

RETURN TO
LOS ANGELES COUNTY SURVEYOR
Do not extend notes this side of this line

Note: ANY ADDITIONS OR CHANGES ON THIS SHEET MUST BE MADE OR CIRCLED IN Red WITH DATE AND NAME OF PERSON MAKING CHANGE.

Date 7-12-28 Notes by L S H Chief Party L S H F. B. 311 Pg. 99

Plotted by Croul
Date July 1928
Map No. 15-150
Plotting C'k'd by Terry
Date July 1928

W. O. No. F170 S. O. No.
Location Sunset Blvd
Surveyed by L S Hammond
Date July 1928
Indexed

cont bot page 12

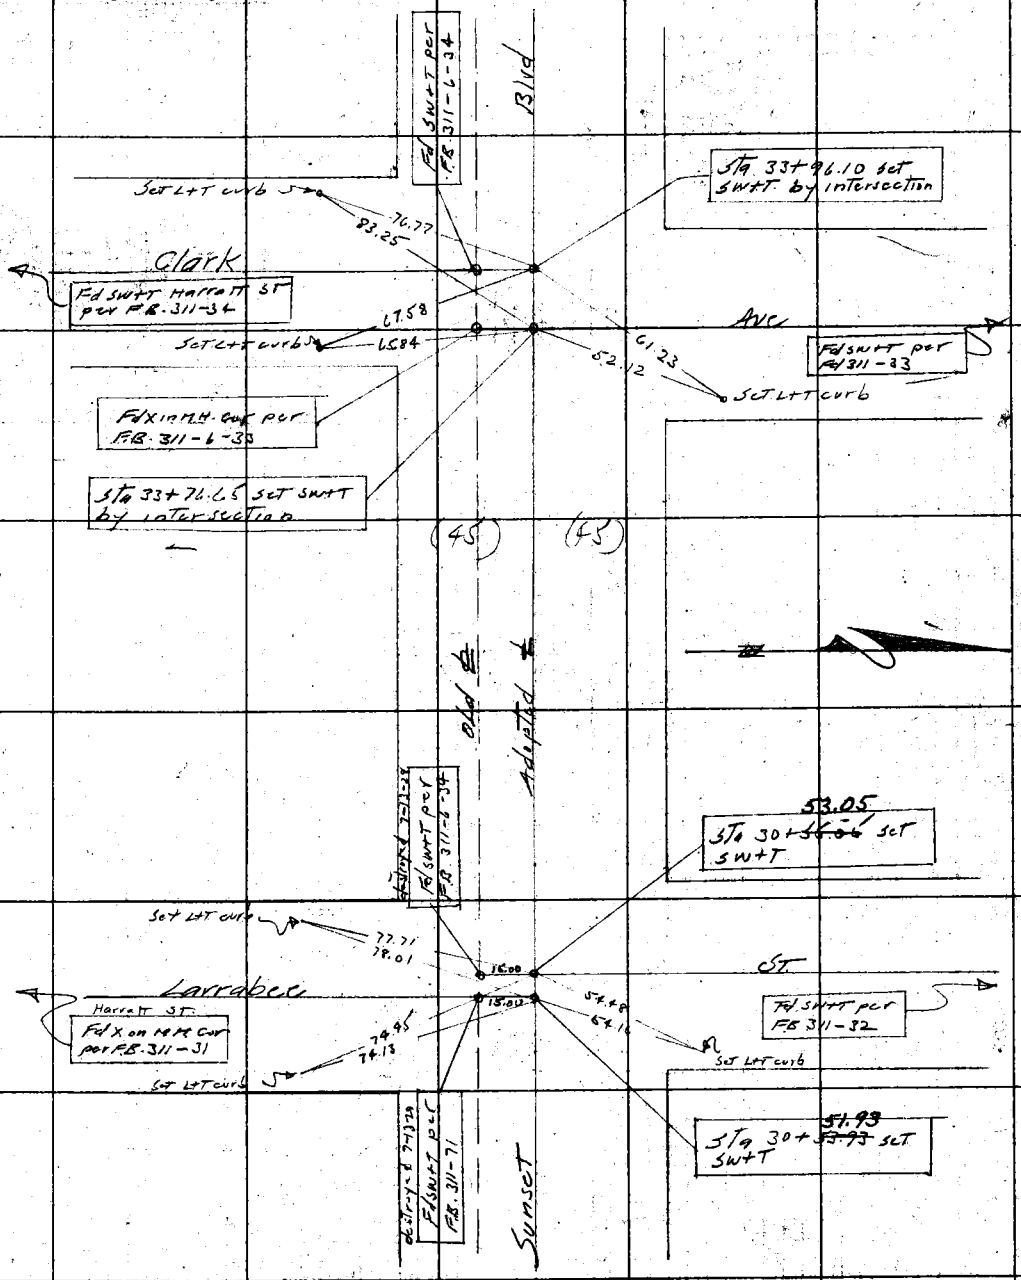

cont From top page 98

RETURN TO
LOS ANGELES COUNTY SURVEYOR

Do not extend notes this side of this line

Notes — ANY ADDITIONS OR CHANGES ON THIS SHEET MUST BE MADE OR CIRCLED IN Red, WITH DATE AND NAME OF PERSON MAKING CHANGE.

F.B. 311 Pg. 100 Chief Party Notes by CJH Date 7-11-24

Cont. bot. page 101

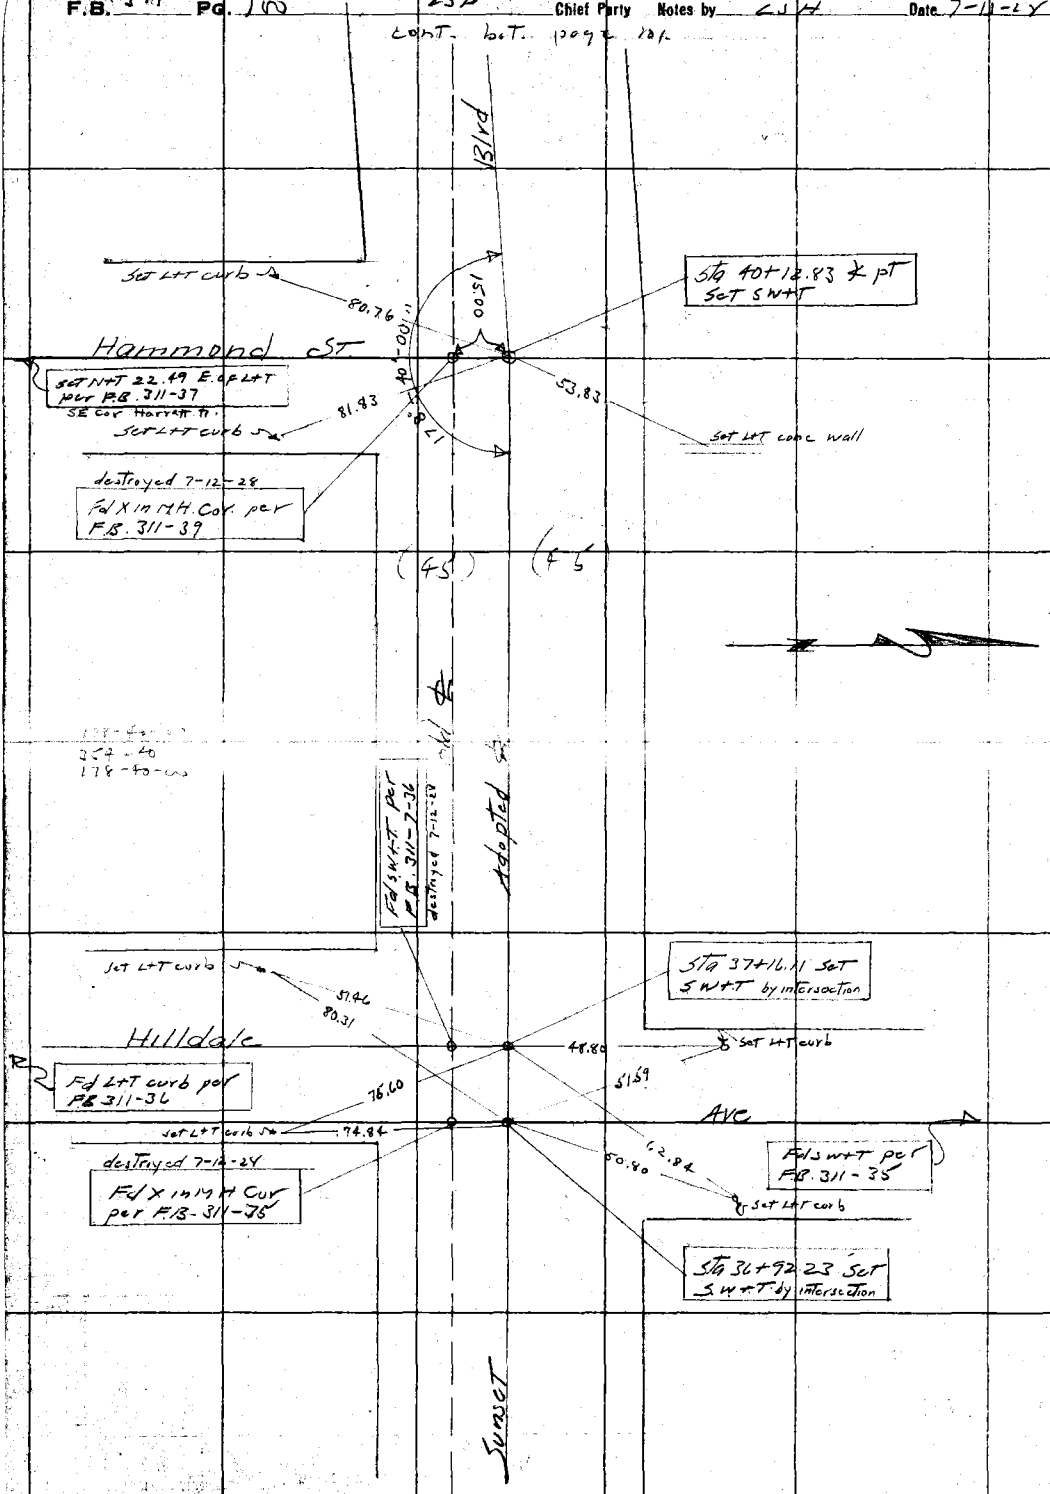

cont From Top page 99

RETURN TO
LOS ANGELES COUNTY SURVEYOR
Do not extend notes this side of this line

Notes: ANY ADDITIONS OR CHANGES ON THIS SHEET MUST BE MADE OR CIRCLED IN Red. WITH DATE AND NAME OF PERSON MAKING CHANGE.

Date 7-13-28 Notes by LSH Chief Party LSH F. B. 311 PG. 101

Plotted by Crowl	W. O. No. 6170 D. S. O. No.
Date July 1928	Location Sunset Blvd
Map No. B-150	Surveyed by LS Hammond
Platting C'k'd by Jarry	Date July - 1928
Date July 1928	Indexed A. C. Johnson

Notes ANY ADDITIONS OR CHANGES ON THIS SHEET MUST BE MADE OR CIRCLED IN Red. WITH DATE AND NAME OF PERSON MAKING CHANGE.

Do not extend notes this side of this line

RETURN TO LOS ANGELES COUNTY SURVEYOR

Blvd

(45) (45)

Sta 46+57.17 Fd X in M.H. Cov. per FB 311-39

Dohony Dr.

1"=20'
5"=20'
1'=20'

Old ℄ Adopted ℄

Sta 42+92.13 Set SW+T

8" Fd Lat curb

80.12

Rolla Dr.

44.64

8" Fd Lat curb

Destroyed 7-12-28 Fd SN+T per FB. 311-38

Fd SN+T per FB. 311-38

Sunset

cont. From Top page 1W

F.B. 311 Pg. 102 LSH Chief Party Notes by LSH Date 7-13-28

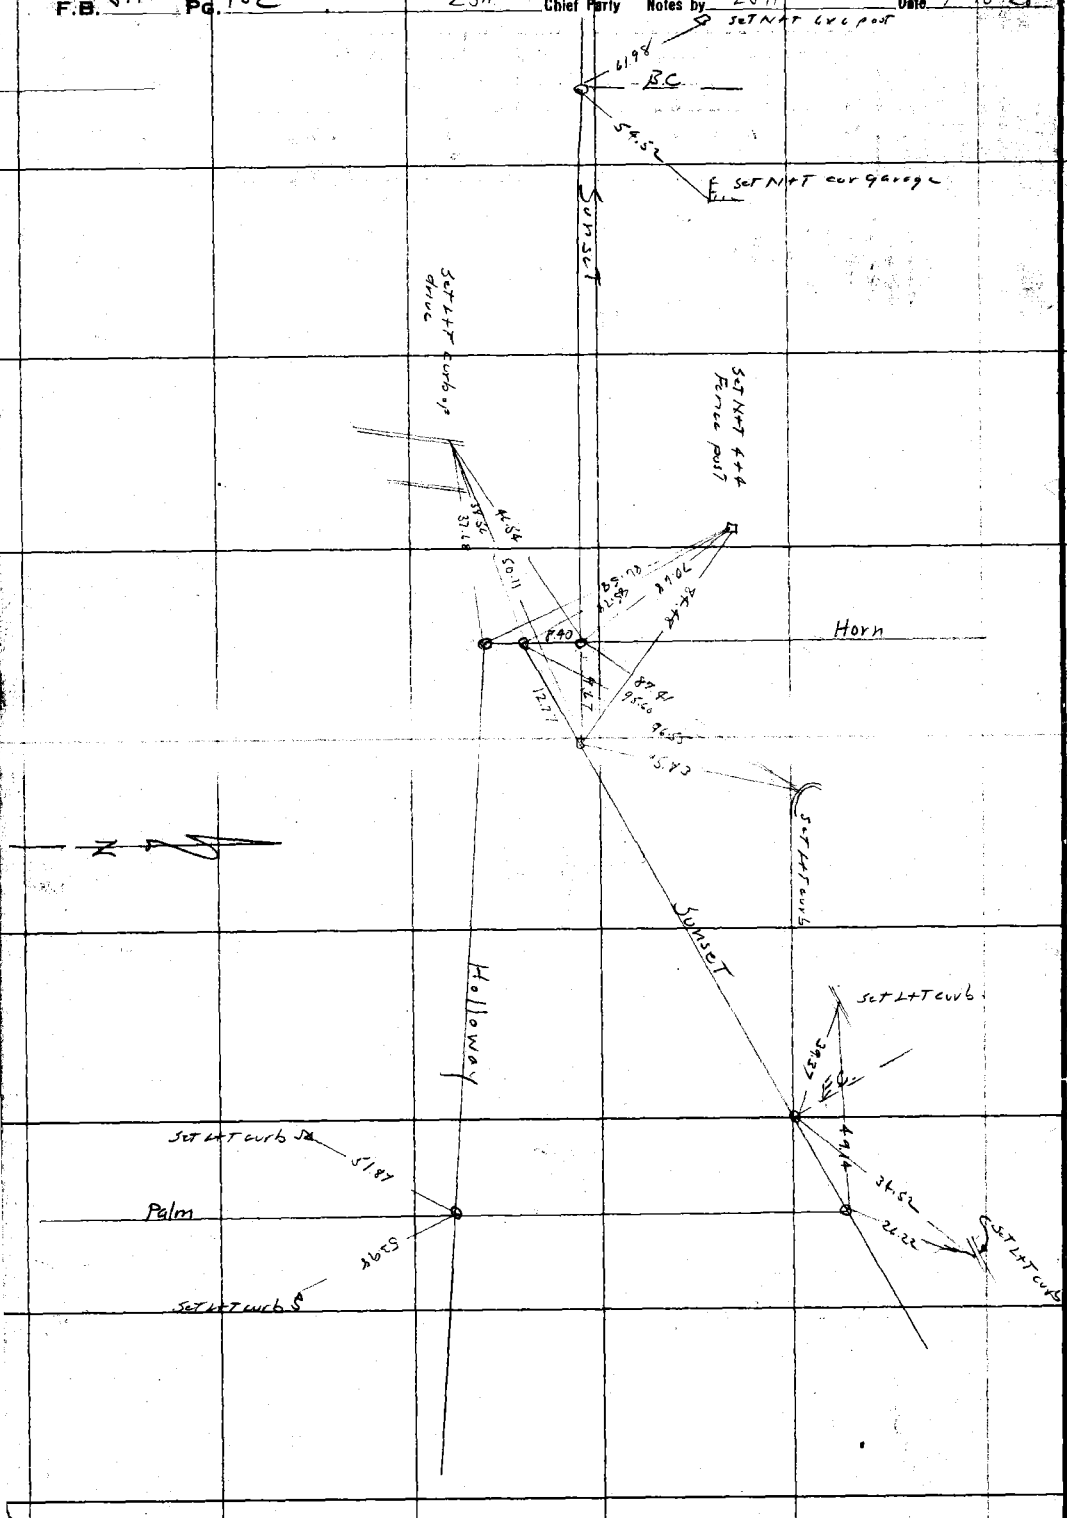

RETURN TO
LOS ANGELES COUNTY SURVEYOR
Do not extend notes this side of this line

Notes: ANY ADDITIONS OR CHANGES ON THIS SHEET MUST BE MADE OR CIRCLED IN Red. WITH DATE AND NAME OF PERSON MAKING CHANGE.

V059 - 21 84

Date _____ Notes by _____ Chief Party _____ F.B. 311 Pg. 103

Platted by _____
Date _____
Map No. _____
Platting C'k'd by _____
Date _____

W. O. No. 4170 Topo No. 059
D. S. O. No. Standard 84°
Location Sunset Blvd
Surveyed by C V Crowley
Date May 18, 1959
Indexed _____

Notes: ANY ADDITIONS OR CHANGES OR THIS SHEET MUST BE MADE OR CIRCLED IN Red. WITH DATE AND NAME OF PERSON MAKING CHANGE.

Do not extend notes this side of this line

RETURN TO
LOS ANGELES COUNTY SURVEYOR

F.I.S.W.&T. Per F.B. 311 - 35

Fd 1½" I.P. Plug & T.K. (Used)
E.C. of Lot #21
Tract #7628

164.77 T=65°
164.75 ✓
(Rec.=164.90)

Fd S.W.&T. Per F.B.

Tie's Down Fd Tang. Curve
35 P.C.C. 2.85 N 4-26?

ST.

Found S.W.&T.

154.08 @ T=74°
154.07 ✓

① 90°-38'-45"
② 362-34-30
③ 725-09-00
90-38-40

Set 2x2" on line Produced Apparent West 169.87 From offset Line to Lot Above St. Set by Tatter

Fd 1"x2"

Set N.&T. Cor. Garage

Fd L&T.

7.44
7.58
89-21-05
31.24
7.59
8.35
7.26
7.50
Alley 22.84
17.52
.06
.02
5.12
164.75 ✓
154.07 ✓
169.87

Curb
7.58
22.38
17.00
16.86
7.58
7.50
Fd L.&T.
Fd L.&T.

① 89°-21-15"
② 357-24-30
③ 714-48-45
89-21-05

Set Nail & Tack Prod M20°E Centerline
34.97
4.94
(Fd 2x2 N.W. Cor Lot #2)

Clark
167.02 ✓
167.04 @ T=70° = 167.02 ✓

T=80°
166.31 ✓
5.10
(Fd 2x2 N.W. Cor. Lot #1)

Seq. Fd L.&T. S.W. Cor. Lot #1, Tract #7528

Lot Lines
Variable
Offset

Survey of Alley N'ly & Nor'ly of Tract #7528 & Nor'ly of Sunset Blvd

Alley

Set Nail
curb
5.11
5.10
5.02
curb

Sunset
07
154.38 ✓
T=80°
Blvd
164.75 ✓
169.52
T=80°
Set Nail
.35

30.03
2.49
2.43

Set L.&T. curb
Set L.&T. in curb

Fd 3" on M.H. Rim FB 311-33

Set S.W.&T. By Intersection

Set L.&T. Intersection & Prod
.09 S
Set L.&T. Intersection

F.B. 311 Pg 104 Chief Party Notes by C. V. Crumley Date 5/21/29

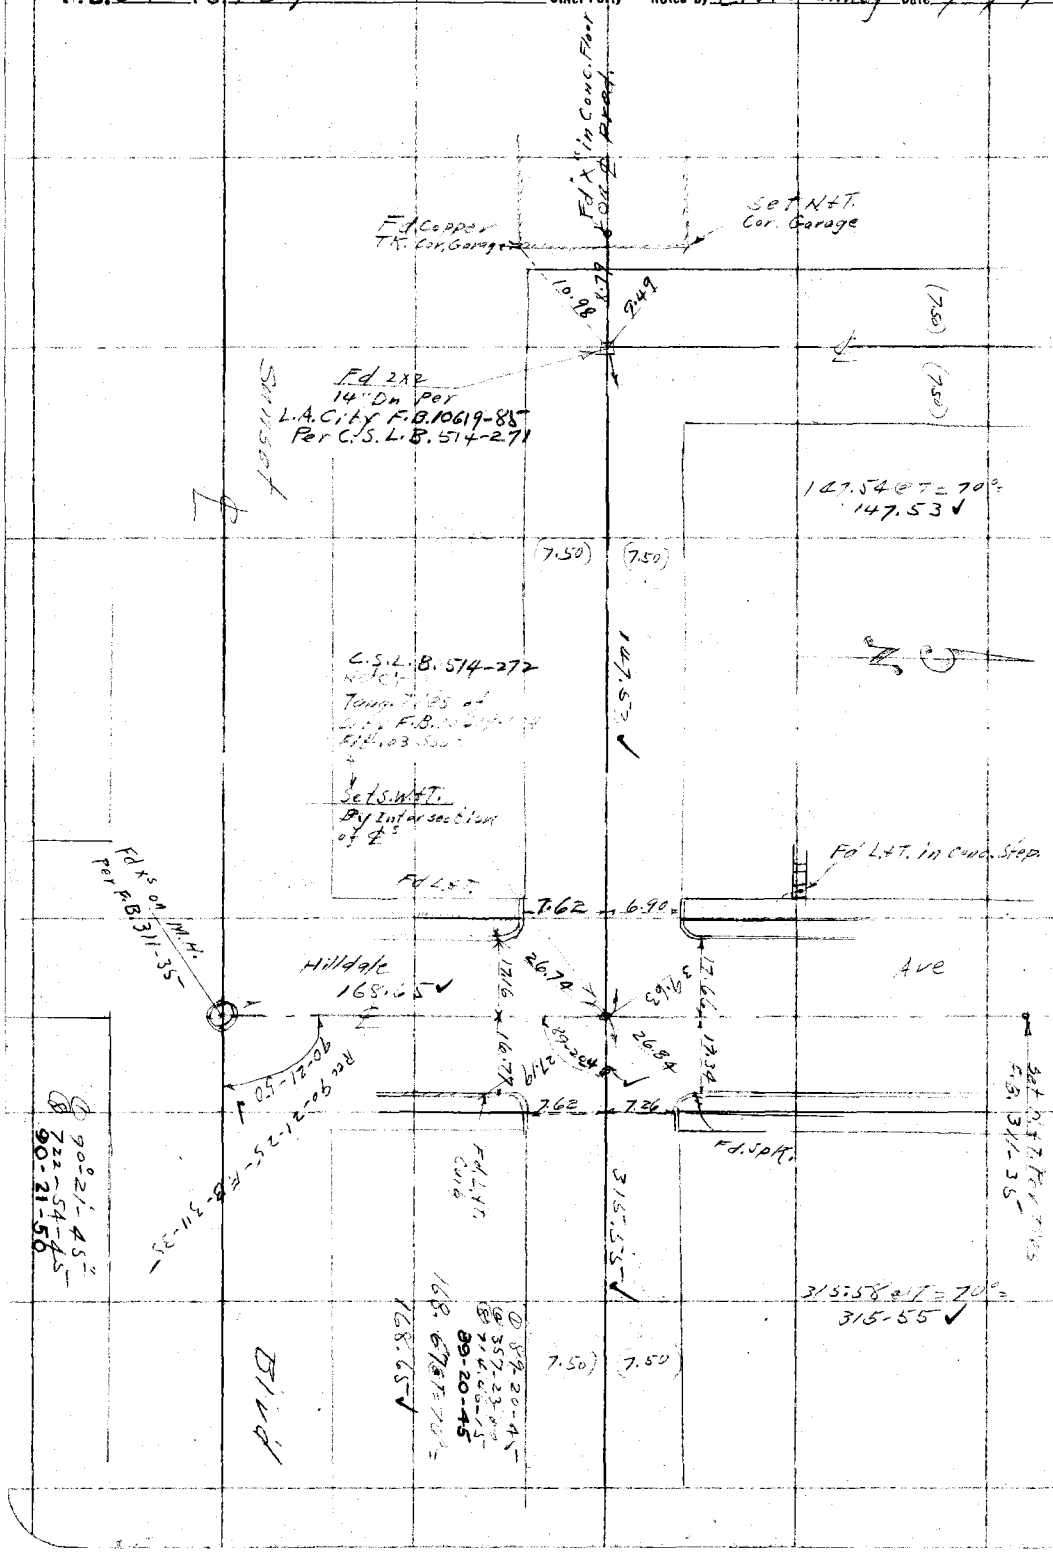

Date _____ Notes by _____ Chief Party _____ F.B. 311 Pg 105

Platted by _____	W. O. No. 4167 D. S. O. No. _____
Date _____	Location Sunset Blvd
Map No. _____	Surveyed by C. [illegible]
Platting C'k'd by _____	Date Sept 1927
Date _____	Indexed A. C. Johnson

Notes: ANY ADDITIONS OR CHANGES ON THIS SHEET MUST BE MADE OR CIRCLED IN Red. WITH DATE AND NAME OF PERSON MAKING CHANGE.

Do not extend notes this side of this line

RETURN TO LOS ANGELES COUNTY SURVEYOR

SUNSET BLVD

ADDITIONAL TOPOGRAPHY

F. B. 311 Pg. 160 Chief Party Notes by C. V. Crumley Date 3-27-29

ADDITIONAL TOPOGRAPHY
ON
SUNSET BLVD.

W. S. J. E. J. G.

C. V. Crumley
C. G. Williams
W. L. Scott
J. J. Phillips
E. L. Klumber

Sept 19 to 23, 1929

Note:- Previous (or old) Center Line Used

RETURN TO
LOS ANGELES COUNTY SURVEYOR

Do not extend notes this side of this line

Note: ANY ADDITIONS OR CHANGES ON THIS SHEET MUST BE MADE OR CIRCLED IN Red. WITH DATE AND NAME OF PERSON MAKING CHANGE.

Date _____ Notes by _____ Chief Party _____ F.B. 311 Pg. 107

Platted by	W. O. No. 476AA S. O. No.
Date	Location Sunset Blvd
Map No.	Surveyed by C V Crumley
Platting C'k'd by	Date Sept 18, 1924
Date	Indexed

Notes: ANY ADDITIONS OR CHANGES OF THIS SHEET MUST BE MADE OR CIRCLED IN Red. WITH DATE AND NAME OF PERSON MAKING CHANGE.

Do not extend notes this side of this line

RETURN TO
LOS ANGELES COUNTY SURVEYOR

B.C. 7+40.33

RETURN TO
LOS ANGELES COUNTY SURVEYOR

Note: ANY ADDITIONS OR CHANGES ON THIS SHEET MUST BE MADE OR CIRCLED IN **Red.** WITH DATE AND NAME OF PERSON MAKING CHANGE.

Do not extend notes this side of this line

F.B. 311 Pg. 108 Chief Party Notes by C.K. Gormley Date 4/19/57

Cont'd from Pg. 107

Flower Box

1.2 x 1.2 Post

54.50

1 Story Frame Store Bldg

94.6

B.C. 8+75.32
Fd. S & W. Per F.B. 332-19

8+62.1c

69.85

8+41.0

4.2

6" Acacia

B.C. 8+75.32
Fd. S & W. Per F.B. 332-7&19

San Sant

4-2" Rov. Small Shrubs

7+87.0

40.8

7+68

5' Gum Tree-out 56.0

P.I. # 2. Per F.B. 332-7&19
Fd. S & W.

Cont'd from Sheet Pg. 107

Date _____ Notes by _____ Chief Party _____ F.B. 311 Pg. 109

Plotted by	W. O. No. 7134-1 D. S. O. No.
Date	Location Sunset Blvd
Map No.	Surveyed by G.V. Crowder
Platting C'k'd by	Date Sept 19, 1947
Date	Indexed A. D. Johnson

49

Note: ANY ADDITIONS OR CHANGES ON THIS SHEET MUST BE MADE OR CIRCLED IN Red. WITH DATE AND NAME OF PERSON MAKING CHANGE.

Do not extend notes this side of this line

RETURN TO
LOS ANGELES COUNTY SURVEYOR

Sunset
Pg. F.B. 332-19
℄

Blvd
℄

Flower Box 101.0e

Lantana Hedge
6' Wide

1.3 Wide
Flower Box

4" Trees

Shrubs

Shrubs

Shrubs

RETURN TO
LOS ANGELES COUNTY SURVEYOR

Note: ANY ADDITIONS OR CHANGES ON THIS SHEET MUST BE MADE OR CIRCLED IN **Red.** WITH DATE AND NAME OF PERSON MAKING CHANGE.

Do not extend notes this side of this line

F.B. 311 PG. X110 Chief Party Notes by C.W. Crumley Date 2-19-29

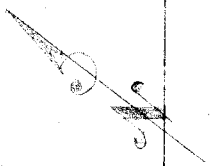

Cont'd To LS Side Pg. 5 111

14+57.00

60.74

50.7

Light Pole

60.0

1 Story Frame Office & Store Bldg.

60.55

0.70

7.90

10.10

109.5

13+49.4

51.70

Stone Set Blind Per E.R. 372-20

13+03.6

49.90

54.70

7.25

1 Story Frame

100.5

94.90

9.90 M.

59.9

60.85

Frame

Rt. Side Pg. 109

Cont'd To Left Pg. 8 1/2

F.B. 3/1 Pg 7/11

Date _____ Notes by _____ Chief Party _____

Plotted by	W. O. No. 4[illegible] T.O. S. O. No.
Date	Location [illegible]
Map No.	Surveyed by [illegible]
Platting C'k'd by	Date Sept. 17, 1947
Date	Indexed A. C. Johnson

Do not extend notes this side of this line

LOS ANGELES COUNTY SURVEYOR
RETURN TO

Note: ANY ADDITIONS OR CHANGES ON THIS SHEET MUST BE MADE ON CHECKED IN RED, WITH DATE AND NAME OF PERSON MAKING CHANGE.

RETURN TO
LOS ANGELES COUNTY SURVEYOR

Note: ANY ADDITIONS OR CHANGES ON THIS SHEET MUST BE MADE OR CIRCLED IN **Red.** WITH DATE AND NAME OF PERSON MAKING CHANGE.

Do not extend notes this side of this line

Cont'd To Lt Side 113

F.B. 311 Pg. 112 Chief Party Notes by C.V. Gumley Date 2/1/23

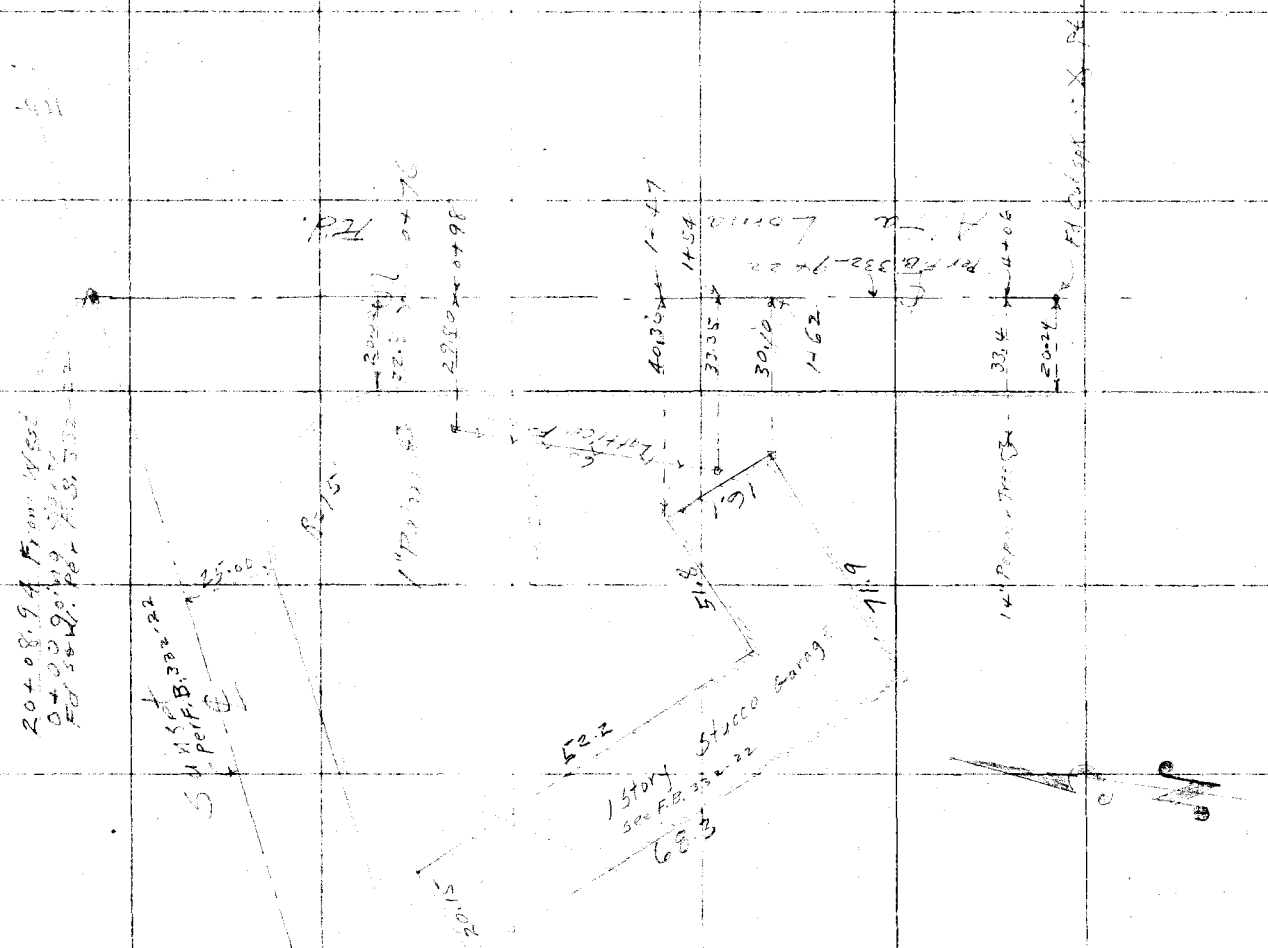
P.I.
P.I.
P.I.

F.B. 311 PG 113

Cont'd To Left Side Pg 8 N4

22+75 — 41.9 — 40.0 — 22+33 — 41.0 — 23+31 — 41.0 — 23+25 — 40.0 — 23+13 — 45.0 — 22+76 — 45.0 — 22+81 — 45.0 — 22+63 — 45.0 — 22+59 — 48.1 — 22+55.6 — 46.9 — 22+47 — 48.1

Fnd 2" I.P. 23+37

2" cypress

Row of Shrubs

Note: For Station Ties Here See F.B. 332-23

Shrubs

4" Tree

Gasoline Tank inlet pipe — 52.6 — 20+84

Vent Pipe 1" — 52.6 — 20+83.4

Gasoline Pump — 52.1 — 20+77.4

11.00 — 39.72

Platforms of Scales — 51.15

Weighmasters office 10'x12' 1 story frame

9.5'

51.25 — 20+45.9

6"x6" Stile — 20+40.9

Cont'd From Rt Side Pg 112

W. O. No. 41-1A D. S. O. No.
Location Sunset Blvd
Surveyed by W. Simmons
Date Sept 20 1927
Indexed

Platted by
Date
Map No.
Plotting C'k'd by
Date

Chief Party
Notes by
Date

Do not extend notes this side of this line

RETURN TO
LOS ANGELES COUNTY SURVEYOR

Note: ANY ADDITIONS OR CHANGES ON THIS SHEET MUST BE MADE OR CIRCLED IN Red. WITH DATE AND NAME OF PERSON MAKING CHANGE.

RETURN TO
LOS ANGELES COUNTY SURVEYOR

Note: ANY ADDITIONS OR CHANGES ON THIS SHEET MUST BE MADE OR CIRCLED IN **Red.** WITH DATE AND NAME OF PERSON MAKING CHANGE.

Do not extend notes this side of this line

F.B. 311 Pg. X 114 Chief Party Notes by C.K.Spurlock Date 9/20/27

Cont'd to Left Side Pg. X 115

26+62

26+40

26+32.0

26+15

26+58.5 - out 46.0

26+45.5 - out 60.8

5" Fir 26+43 - out 44.2

26+33 - out 37.0

26+28 - out 37.0

5" Fir 26+49.0 - 26+07

Sta. 25+69.23 Per F.B. 332-10 & 24 Pg. 597.

P.I.

R=197'

Sunset Blvd

15+ory Stucco Bldg Per F.B. 332-23

24.5

5.0

4.0

23+9

10" Maple

Stone Steps

Sunset Blvd Per F.B. 332-23

Cont'd Left Side Pg X 113

F.B. 311 PG 115

Chief Party _____

Notes by _____

Date _____

W. O. No. AL6744 A.D. S. O. No.	
Location	Stucco Bldg
Surveyed by	C.K. Clemens
Date	Sept 28, 1951
Indexed	A. C. Johnson
Platted By	
Date	
Map No.	
Plotting Ck'd by	
Date	

Cont'd To Left Side Pg 116

Cont'd From Rt Side Pg 114

Sundry Bill Per F.B. 332-25

2 story & Basement Stucco Bldg

Note: Alley will Lower Walk Straight - Awning Walk

End Walk 27+97.10

End Walk 27+99.5

27+96.43

27+52.5

27+25

End Walk 26+92.9

26+82

26+81.5

Conc. Walk & Steps

Stucco Wall

2x2 Ornamental Light Pillar

12" Palm out 47.0

10" Palm out 48.0

Ornamental Light Pillar

Private Walk

Do not extend notes this side of this line

RETURN TO
LOS ANGELES COUNTY SURVEYOR

Notes: ANY ADDITIONS OR CHANGES ON THIS SHEET MUST BE MADE ON CIRCLED IN Red. WITH DATE AND NAME OF PERSON MAKING CHANGE.

RETURN TO
LOS ANGELES COUNTY SURVEYOR

Note: ANY ADDITIONS OR CHANGES ON THIS SHEET MUST BE MADE OR CIRCLED IN **Red.** WITH DATE AND NAME OF PERSON MAKING CHANGE.

Do not extend notes this side of this line

F.B. 311 Pg. 116 Chief Party Notes by C.K. Chumley Date 9-24-57

cont'd to 1-2218 Pg. 11

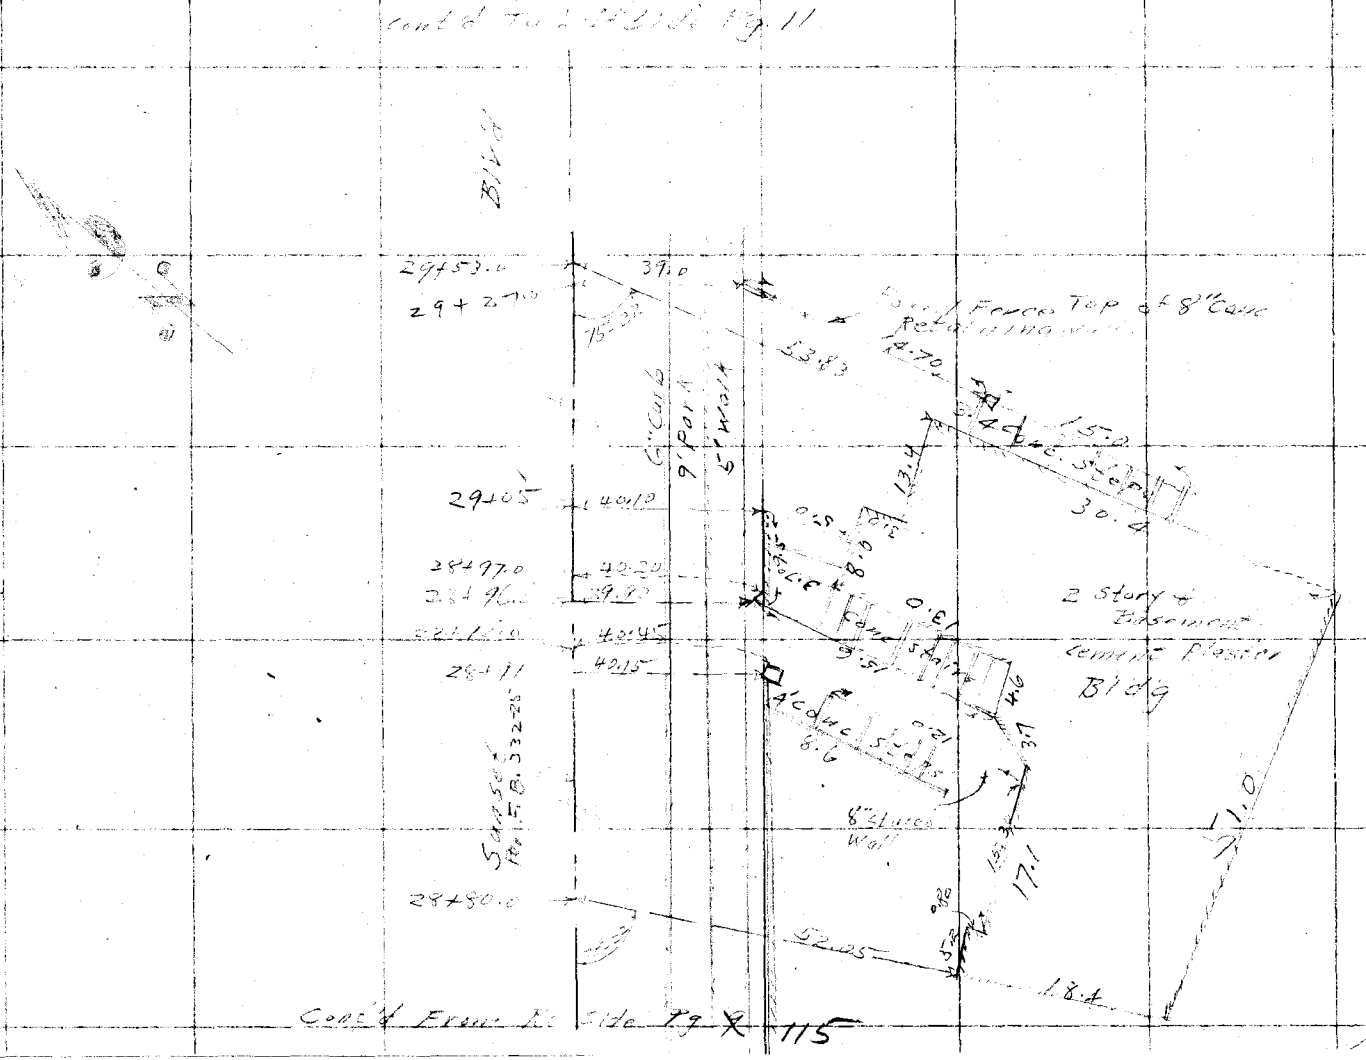

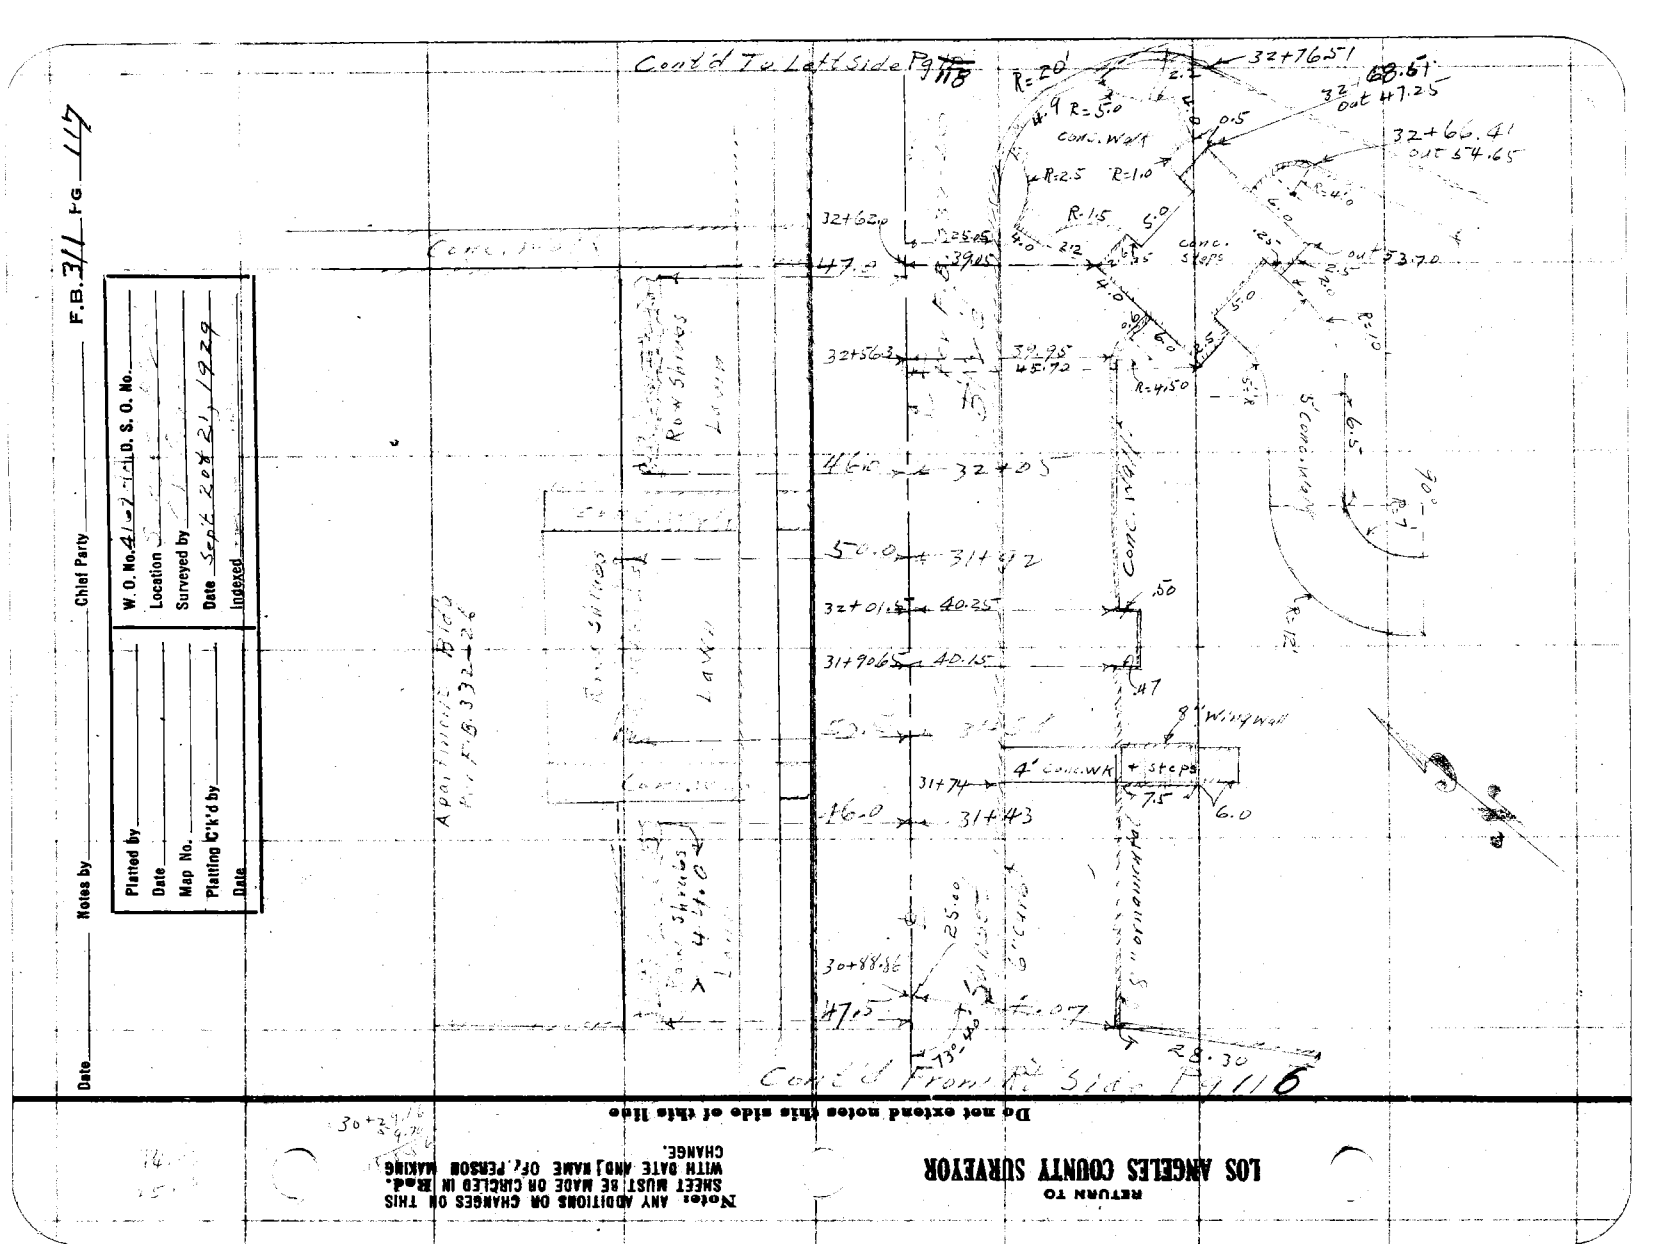
Cont'd To Left Side Pg 118
32+76.51
68.61
32+66.41
out 54.65
out 47.25
conc. walk
conc. steps
32+62.0
32+56.3
39.25
45.72
46.5
32+20.5
50.0
31+87.2
32+01.5
40.25
31+90.65
40.15
Conc. Walk
Conc. Steps
Asphalt Pkg
Lawn
Rock & Shrubs
8' Wing Wall
4' conc. wk + steps
31+74
31+43
46.0
30+88.86
47.05
25.00
73°40'
28.30
Cont'd From Rt. Side Pg 116
Date
Notes by
Chief Party
Platted by
Date
Map No.
Platting C'k'd by
Date
W. O. No. 4127-CD. S. O. No.
Location
Surveyed by
Date Sept 20 & 21, 1929
Indexed
Do not extend notes this side of this line
LOS ANGELES COUNTY SURVEYOR
RETURN TO
Note: ANY ADDITIONS OR CHANGES ON THIS SHEET MUST BE MADE ON CIRCLED IN Red. WITH DATE AND NAME OF PERSON MAKING CHANGE.

RETURN TO
LOS ANGELES COUNTY SURVEYOR

Note: ANY ADDITIONS OR CHANGES ON THIS SHEET MUST BE MADE OR CIRCLED IN **Red.** WITH DATE AND NAME OF PERSON MAKING CHANGE.

Do not extend notes this side of this line

F.B. 211 Pg. 118 Chief Party Notes by C.K. Crowley Date 2/2/25

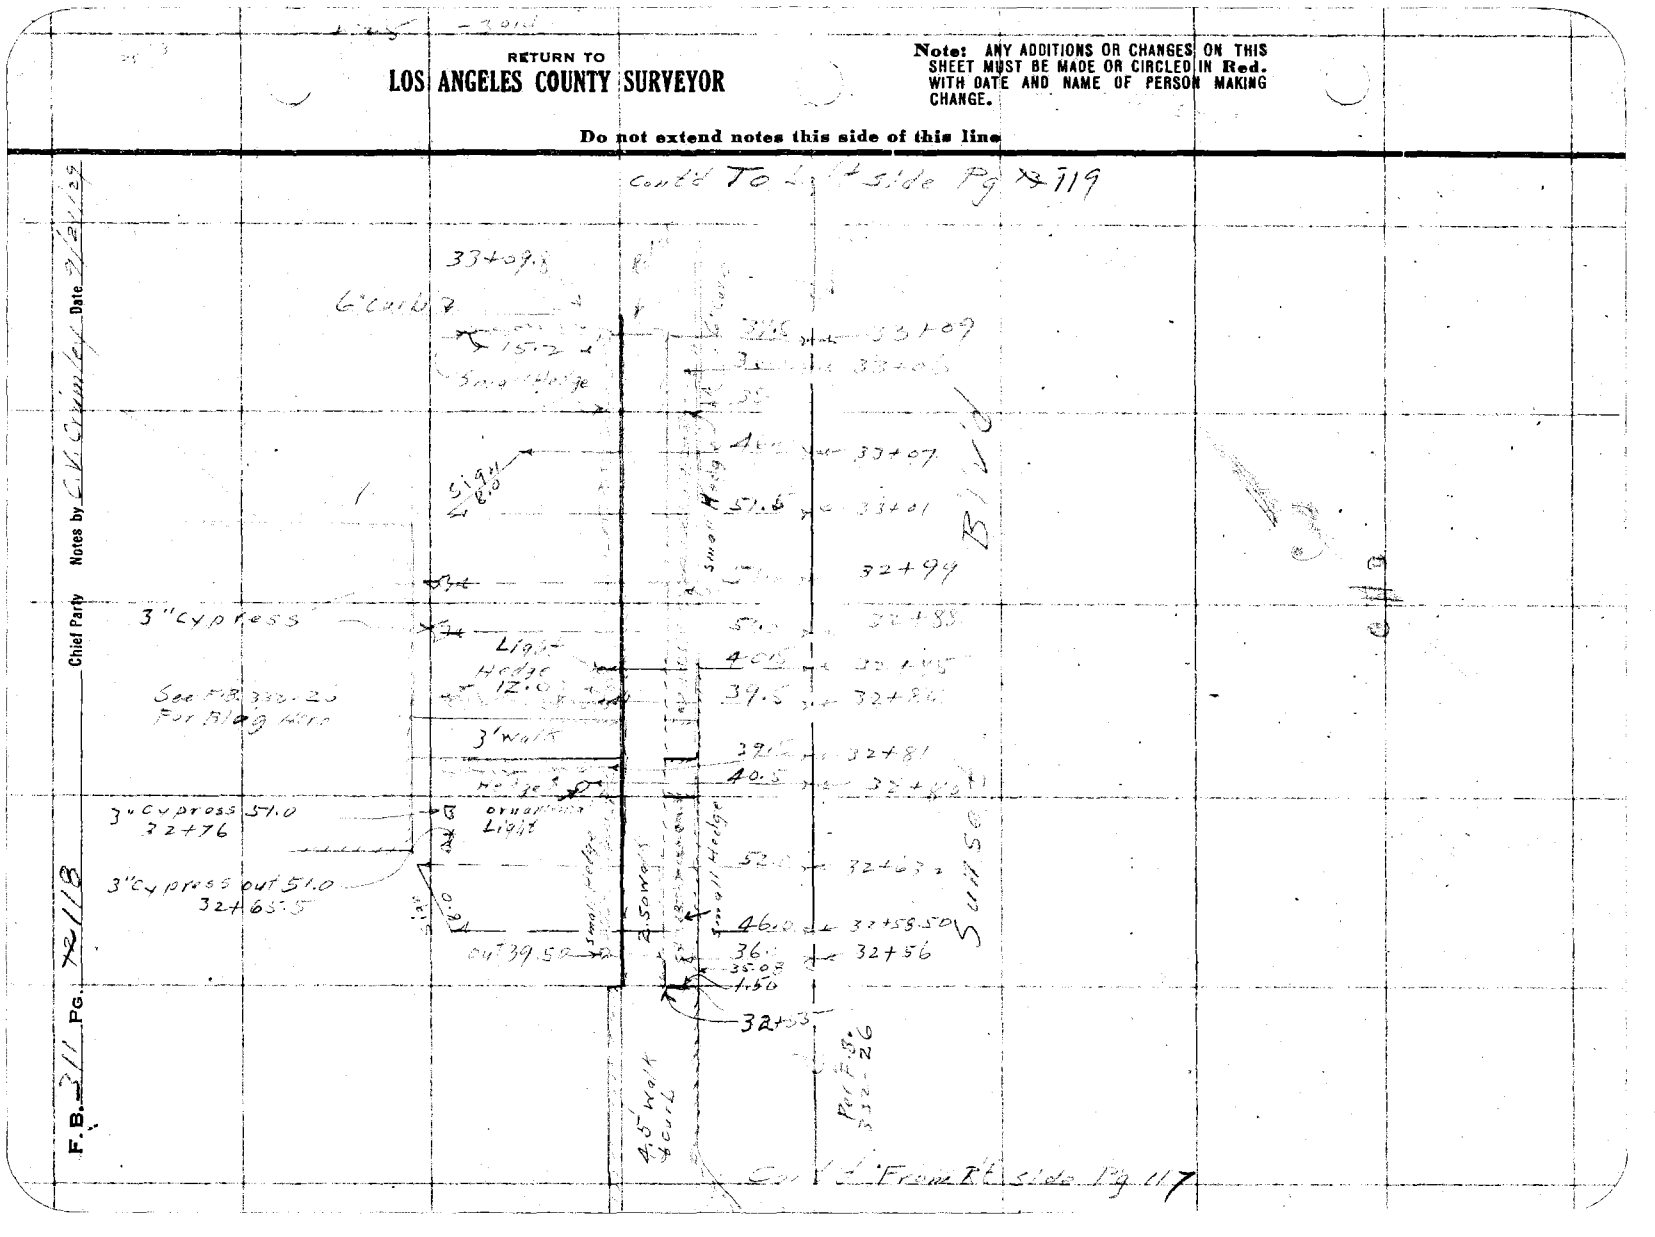

Date _____ Notes by _____ Chief Party _____ F.B. 311 Pg. 73 119

Platted by	W. O. No. 4169-1 D. S. O. No.
Date	Location Sunset Blvd
Map No.	Surveyed by C.V. Lundin
Platting C'k'd by	Date Sept 24, 1929
Date	Indexed A. C. Johnson

Notes: ANY ADDITIONS OR CHANGES ON THIS SHEET MUST BE MADE OR CIRCLED IN Red. WITH DATE AND NAME OF PERSON MAKING CHANGE.

Do not extend notes this side of this line

RETURN TO
LOS ANGELES COUNTY SURVEYOR

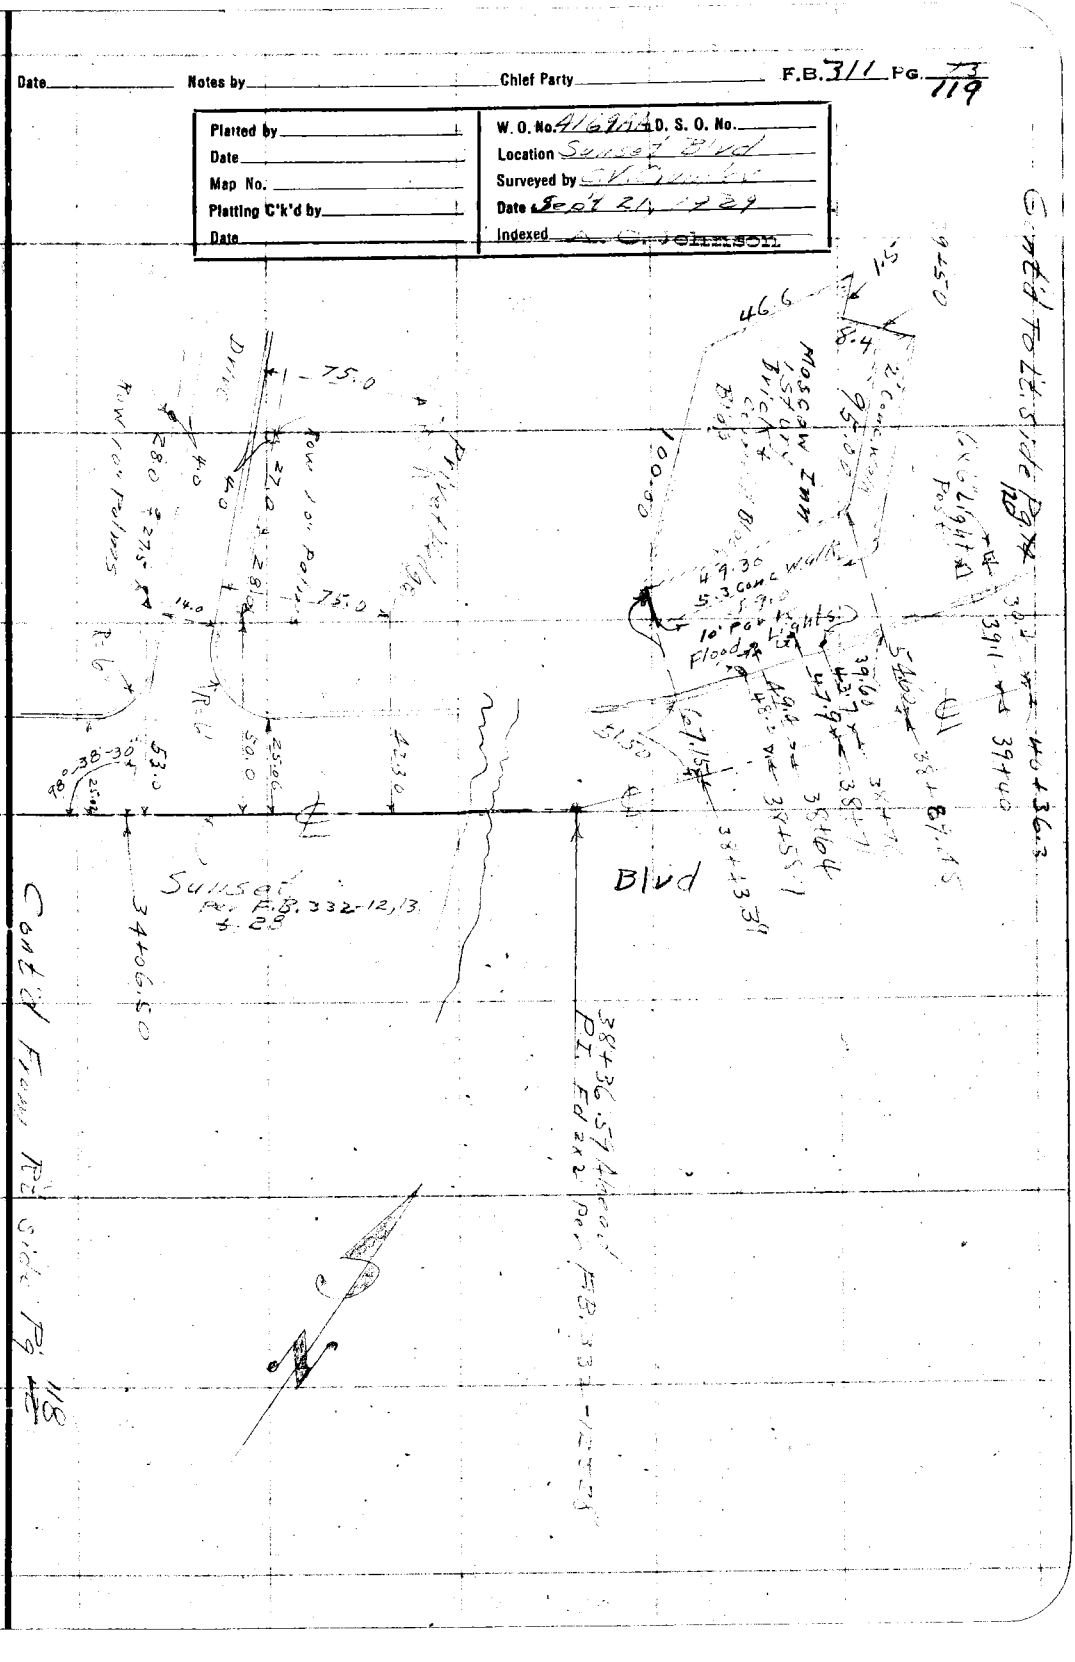
Sunset Blvd
Sunset
Per F.B. 332-12,13
& 29
Contact From R.P. Sick R.P. 118
Pow 100' Poles
Pow 100' Poles
Pow 100' Poles

RETURN TO
LOS ANGELES COUNTY SURVEYOR

Note: ANY ADDITIONS OR CHANGES ON THIS SHEET MUST BE MADE OR CIRCLED IN **Red.** WITH DATE AND NAME OF PERSON MAKING CHANGE.

Do not extend notes this side of this line

F.B. 311 Pg. 120 Chief Party Notes by C.V.C. Crowley Date 9/21/34

Cont'd from Pg 121

P.I. #6.1
Per F.B. 332-13
+29

.40+10 — 50.0
41+91 — 52.0
41+ — 51.0 — Base
41+ — 49.0 — Base
41+49 — 44.5
.41+29 — 42.4 — Base
.41+05 — 40.5 — E. End of Bridge
.40+85 — 46.8 — 4" Redwood
.40+65 — 52.8 — 5"
.40+42 — 46.0 — 6" Redwood
.40+27 — 51.5 — 3" Redwood
.40+21 — 44.8 — 4" Redwood Tie

E.C. 40+11.35
Fd. S.W.E.T. Per
F.B. 332-28

W. End of Bridge
Per F.B. 332-28

Cont'd from Pg 119

RETURN TO
LOS ANGELES COUNTY SURVEYOR

Note: ANY ADDITIONS OR CHANGES ON THIS SHEET MUST BE MADE OR CIRCLED IN **Red.** WITH DATE AND NAME OF PERSON MAKING CHANGE.

Do not extend notes this side of this line

Date _____ Notes by _____ Chief Party _____ F.B. 377 PG 121

Planted by _____
Date _____
Map No. _____
Plotting C'k'd by _____
Date _____

W. O. No. 4[illegible] I.O. S. O. No. _____
Location Sprucest
Surveyed by [illegible]
Date Sept 24, [illegible]
Indexed _____

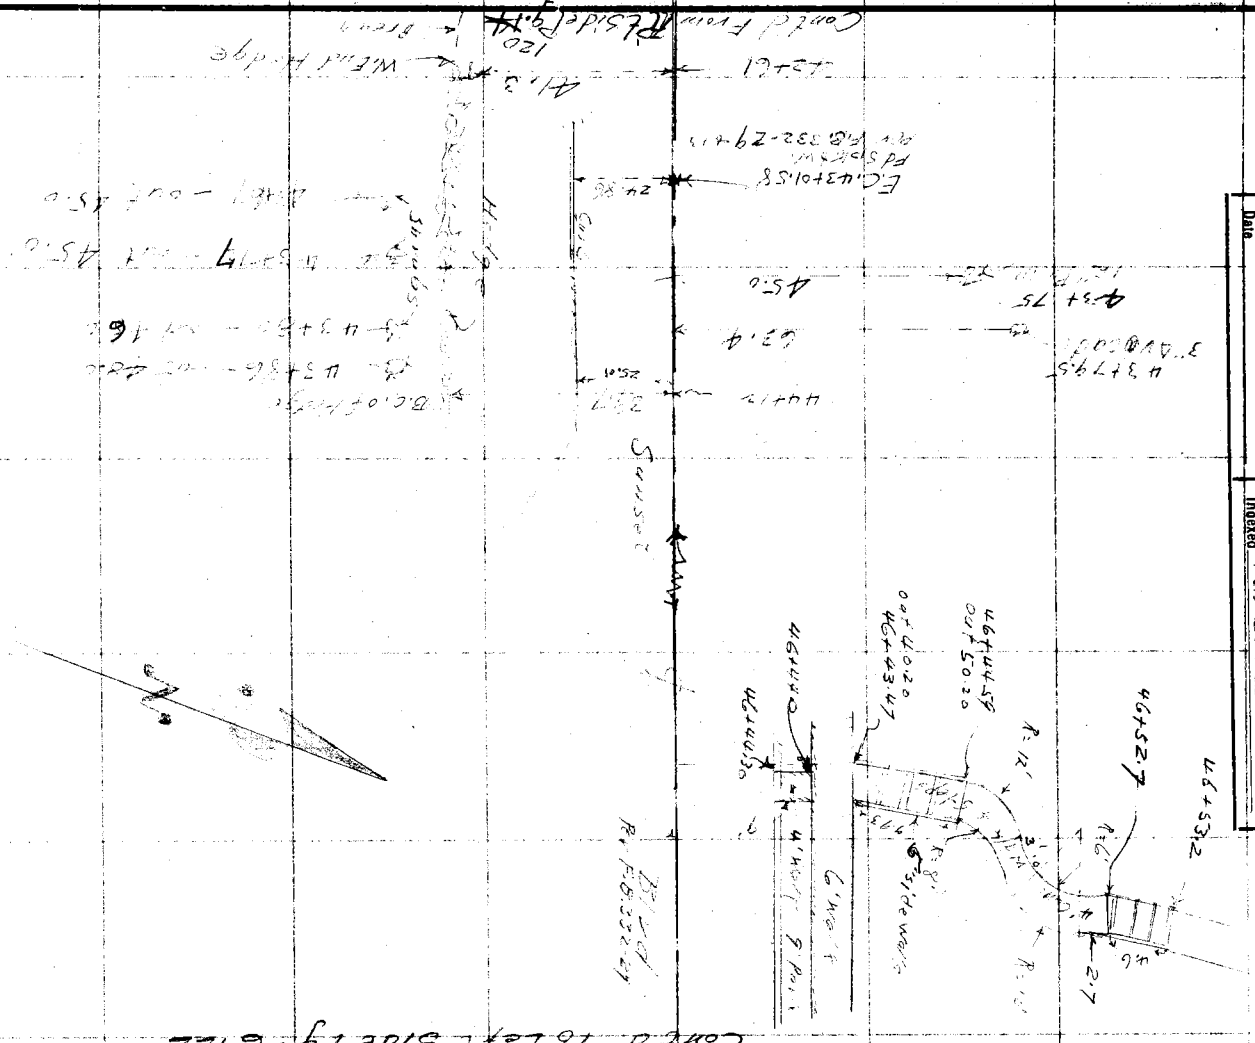

RETURN TO
LOS ANGELES COUNTY SURVEYOR

Note: ANY ADDITIONS OR CHANGES ON THIS SHEET MUST BE MADE OR CIRCLED IN **Red.** WITH DATE AND NAME OF PERSON MAKING CHANGE.

Do not extend notes this side of this line

F.B. 311 Pg. 56/122 Chief Party Notes by C.K. Chumley Date 9/23/

Cont'd To Left Side Pg 17






S 44° 17.2 E

Fd. 3/4" I.P.

S1+30.8

Cont'd From Rt side Pg. 121

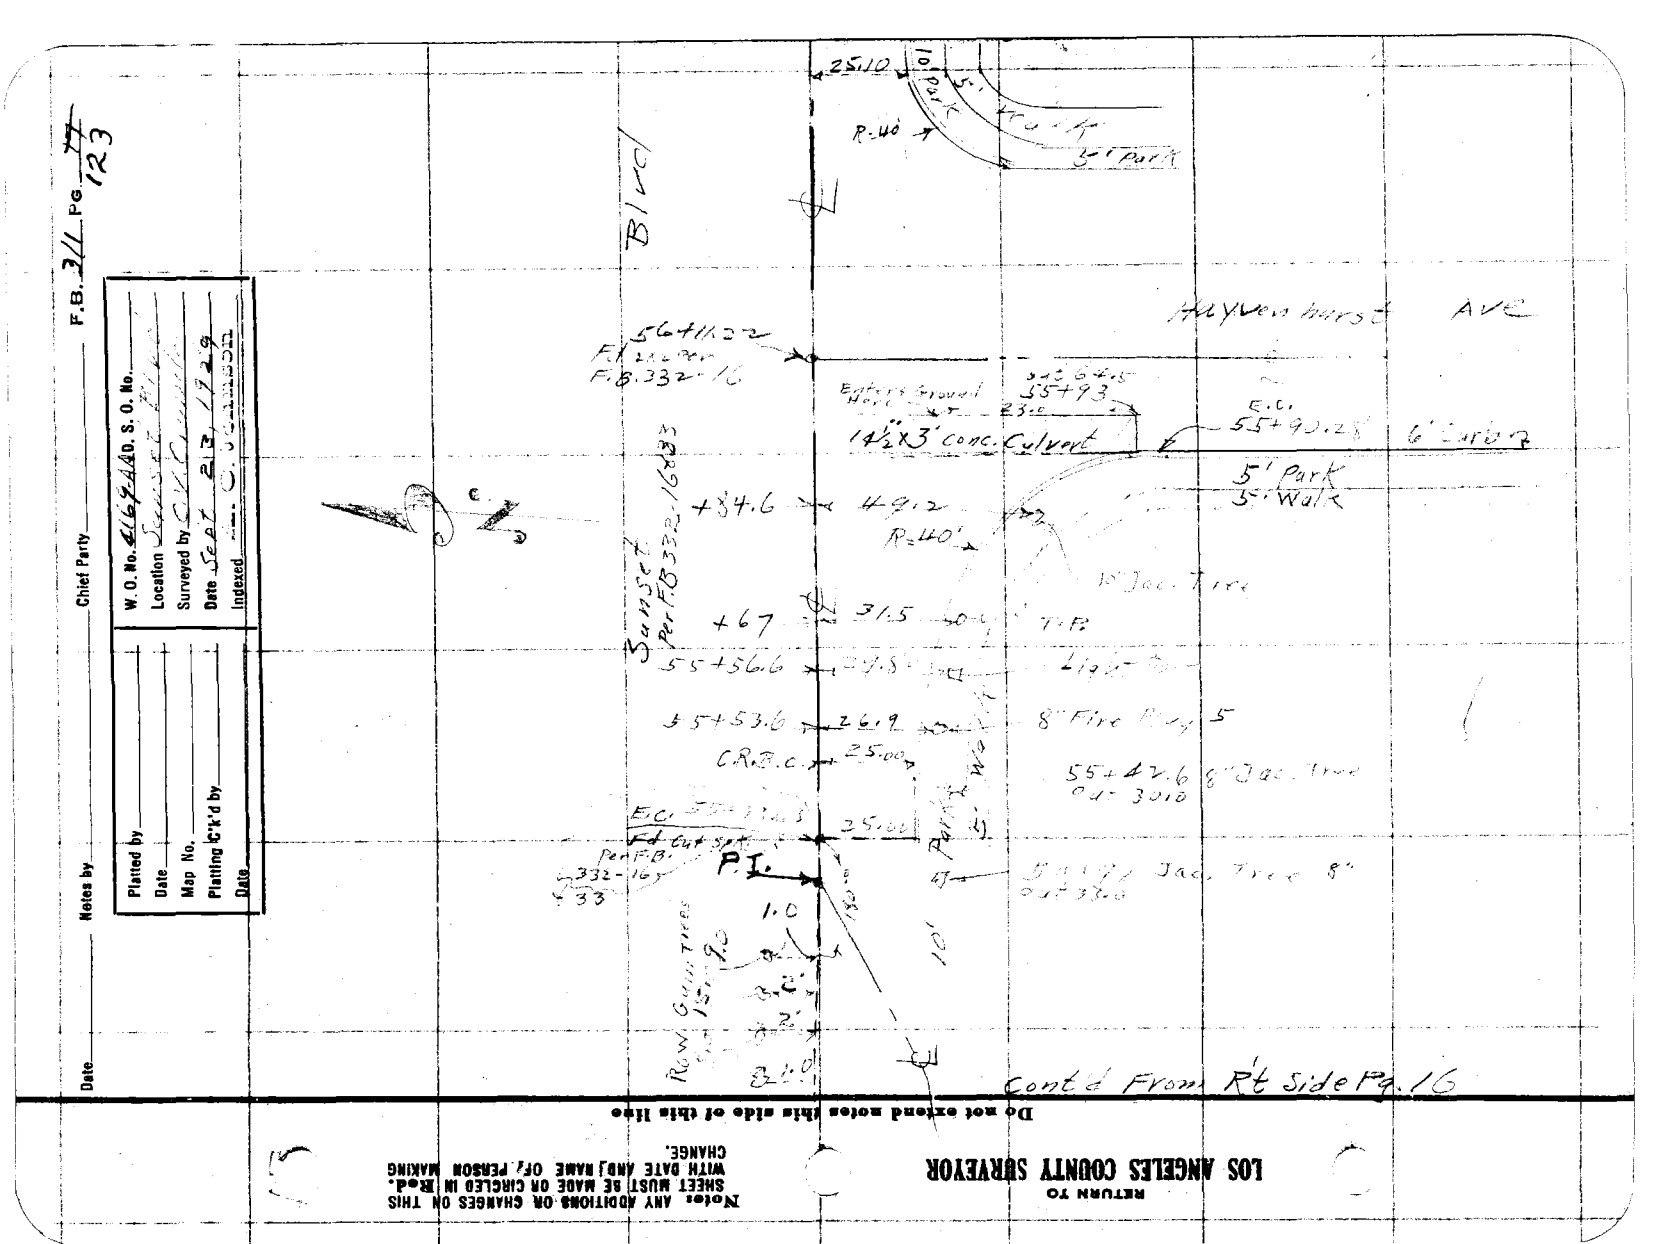
F.B. 311 Pg. 123
Chief Party
Notes by
Date
W. O. No. 4167-440 S. O. No.
Location Sunset Blvd
Surveyed by C.V.C.
Platted by
Date
Map No.
Plotting C'k'd by
Date
Blvd
Sunset
Per F.B. 332-16
E.C. 55+93.25
6' Curb
5' Park
5' Walk
14½x3' conc. Culvert
R=40'
49.2
+84.6
+67
55+56.6
55+53.6
31.5
26.9
C.R.B.C.
25.00
P.I.
1.0
8" Fire Plug
8" Jac. Tree
Cont'd From Rt Side Pg. 16
Do not extend notes this side of this line
LOS ANGELES COUNTY SURVEYOR
RETURN TO
Note: ANY ADDITIONS OR CHANGES ON THIS SHEET MUST BE MADE ON CIRCLED IN Red. WITH DATE AND NAME OF PERSON MAKING CHANGE.

F. B. 311 PG. 124 Chief Party Notes by Date

RETURN TO
LOS ANGELES COUNTY SURVEYOR

Do not extend notes this side of this line

Note: ANY ADDITIONS OR CHANGES ON THIS SHEET MUST BE MADE OR CIRCLED IN Red. WITH DATE AND NAME OF PERSON MAKING CHANGE.

Date _____ Notes by _____ Chief Party _____ F.B. 311 PG. 125

Platted by	W. O. No. 6029 D. S. O. No.
Date	Location Sunset Blvd
Map No.	Surveyed by Holmes
Platting C'k'd by	Date Aug 23, 1950
Date	Indexed A. C. Johnson

SUNSET BLVD

NORTHEASTERLY ~~ROAD~~ BOUNDARY

CITY OF BEVERLY HILLS

TIES to CONC. MON.

Ref FB 311-1-46-91
C.S. T3+150,

AXIS to 170

DDI No 29 Sheet 4

Note: ANY ADDITIONS OR CHANGES ON THIS SHEET MUST BE MADE OR CIRCLED IN Red. WITH DATE AND NAME OF PERSON MAKING CHANGE.

Do not extend notes this side of this line

RETURN TO LOS ANGELES COUNTY SURVEYOR

RETURN TO
LOS ANGELES COUNTY SURVEYOR

Note: ANY ADDITIONS OR CHANGES ON THIS SHEET MUST BE MADE OR CIRCLED IN Red. WITH DATE AND NAME OF PERSON MAKING CHANGE.

Do not extend notes this side of this line

F.B. 311 Pg. 126 Notes by M Hayes Chief Party M Date 8-23-30

Reset 6X6" Conc. Mon. L&T. in top. Oct. 24, 1930 M. Hayes

℄ Storm Drain

Set L&T. in wall

34.20

75.81 TM

Fd L&T. in curb 0.7' N.

SUNSET

Storm Drain

Δ= 42° 02'
R= 60'
T= 19.21
L= 36.68

N 47° E

Fd L&T. in curb BLVD.

South

Set L&T. in curb

℄ 33' R.O.W.

Fd 2½" I.P. in Conc. Mon. with 3½" I.P. Set nail in Center C.S. F.B. 311 Pg. 126

Fd 2½" I.P. in Conc. Mon. F.B. 311-126

Set L&T. in curb

Block Wall

10'

Date _____ Notes by _____ Chief Party _____ F.B. 311 Pg. 127

Platted by	W. O. No. D. S. O. No.
Date	Location
Map No.	Surveyed by
Platting C'k'd by	Date
Date	Indexed

Notes: ANY ADDITIONS OR CHANGES OF THIS SHEET MUST BE MADE OR CIRCLED IN Red. WITH DATE AND NAME OF PERSON MAKING CHANGE.

Do not extend notes this side of this line

RETURN TO
LOS ANGELES COUNTY SURVEYOR

RETURN TO

LOS ANGELES COUNTY SURVEYOR

Note: ANY ADDITIONS OR CHANGES ON THIS SHEET MUST BE MADE OR CIRCLED IN **Red.** WITH DATE AND NAME OF PERSON MAKING CHANGE.

Do not extend notes this side of this line

F. B. ____ Pg. ____

Chief Party ____ Notes by ____ Date ____