Survey of
W. O. Tape No. St'd °F.
Surveyed by
Notes Date
Indexed

F.B. Pg.

F.B. 320 Pg. Index

F.B. 320

PAGES: Index, 1 to 11 incl., , 13 to 70 incl.,
70A, 70B, 71 to 116 incl.,

RETURN TO
LOS ANGELES COUNTY SURVEYOR
700 HALL OF RECORDS

Do not extend notes this side of this line

Note: ANY ADDITIONS OR CHANGES ON THIS SHEET MUST BE MADE OR CIRCLED IN Red Ink WITH DATE AND NAME OF PERSON MAKING CHANGE.

Notes Ck'd by	Survey of
Map No.	W. O. Tape No. St'd. °F
Office Work	Surveyed by
Checked	Notes Date
Date	Indexed

F. B. PG.

Note: Any Additions or Changes on This Sheet Must be Made or Circled in Red Ink With Date and Name of Person Making Change.

Do not extend notes this side of this line.

RETURN TO
LOS ANGELES COUNTY SURVEYOR
726 LOS ANGELES COUNTY
ENGINEERING BLDG.

76F3095 247 10M 1-49

RETURN TO
LOS ANGELES COUNTY SURVEYOR
726 LOS ANGELES COUNTY
ENGINEERING BLDG.

Note: Any Additions or Changes on This Sheet Must be Made or Circled in Red Ink With Date and Name of Person Making Change.

Do not extend notes this side of this line.

F. B._____ PG._____

76F3098 247 10M 1-49

RETURN TO
LOS ANGELES COUNTY SURVEYOR
726 LOS ANGELES COUNTY
ENGINEERING BLDG.

Note: Any Additions or Changes on This Sheet Must be Made or Circled in Red Ink With Date and Name of Person Making Change.

Do not extend notes this side of this line.

Notes Ck'd by
Map No.
Office Work
Checked
Date

Survey of
W. O. Tape No. St'd °F
Surveyed by
Notes Date
Indexed

F. B. PG.

RETURN TO
LOS ANGELES COUNTY SURVEYOR
726 LOS ANGELES COUNTY
ENGINEERING BLDG.

Note: Any Additions or Changes on This Sheet Must be Made or Circled in Red Ink With Date and Name of Person Making Change.

Do not extend notes this side of this line.

F. B. _____ PG. _____

76F3098 247 10M 1-49

RETURN TO
LOS ANGELES COUNTY SURVEYOR
726 LOS ANGELES COUNTY
ENGINEERING BLDG.

Note: Any Additions or Changes on This Sheet Must be Made or Circled in Red Ink With Date and Name of Person Making Change.

Do not extend notes this side of this line.

Notes Ck'd by
Map No.
Office Work
Checked
Date

Survey of
W. O. Tape No. St'd °F
Surveyed by
Notes Date
Indexed

F. B. PG.

RETURN TO
LOS ANGELES COUNTY SURVEYOR
726 LOS ANGELES COUNTY
ENGINEERING BLDG.

Note: Any Additions or Changes on This Sheet Must be Made or Circled in Red Ink With Date and Name of Person Making Change.

Do not extend notes this side of this line.

F. B. _____ PG. _____

Date June 1928.
Map No. B-300
Date July 1928.

Location Kentucky Springs Rd
Surveyed by C.E.B. & party
Indexed A. C. Johnson

SURVEY OF KENTUCKY SPRINGS ROAD

From the summit of Vincent Grade, on the State Highway, in Sec. 23 T. 5 N. R. 12 W. to an intersection with Aliso Cñ. Rd. in the N.W.¼ of Sec. 24. T. 4 N. R. 12 W.

Surveyed by C.E. Brunty
April - July 1928

For Topography and level notes see Lab.

Party Composed of

C.E. Brunty	C.P.	4-10-28 to
F.S. Livingston	T.	4-10-28 to 5-21-28 Incl.
H.L. Wyatt	T.	6-5-28 to Incl.
A. Carrasco	H.C.	4-10-28 to 5-19-28 Incl.
G.D. Scott	H.C.	5-21-28 to Incl.
M.F. Volin	R.C.	4-10-28 to Incl.
A.R. Held	Ex.	4-10-28 to 5-19-28 and 6-6-28 to
E.C. Cook	Ex.	5-21-28 to 6-5-28 Incl.

Field Party Noted by Date

Mt. Sterlings Rd.
EB. 85
EB. 320
EB. 319

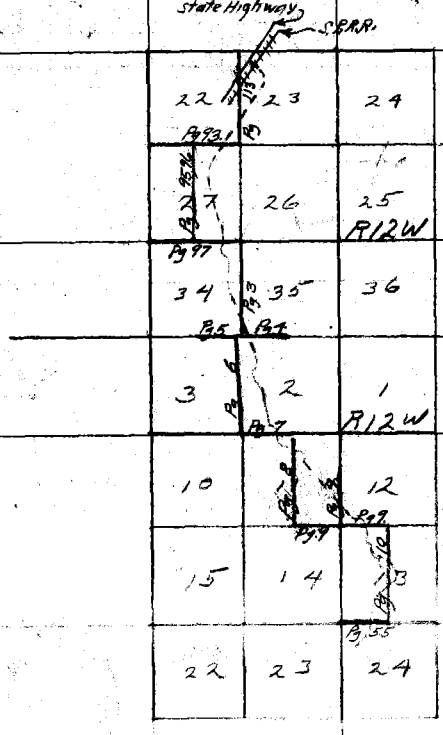

Note- All distances shown in Sec. line notes were taken with a 500 ft. 1/8" steel tape standard at 46°.

All distances shown in ℄ notes were taken with a 300 ft. 1/4" steel tape standard at 62°.

Standard pulls were used according to the County Surveyor's chart governing same.

For reference to Sec. Cors. See C.S. 9095, 9104 and 9226.

RETURN TO
LOS ANGELES COUNTY SURVEYOR
Do not extend notes this side of this line

Note: ANY ADDITIONS OR CHANGES ON THIS SHEET MUST BE MADE OR CIRCLED IN Red WITH DATE AND NAME OF PERSON MAKING CHANGE.

Date June 1928
Date July 1928.
Inspected A. C. Johnson

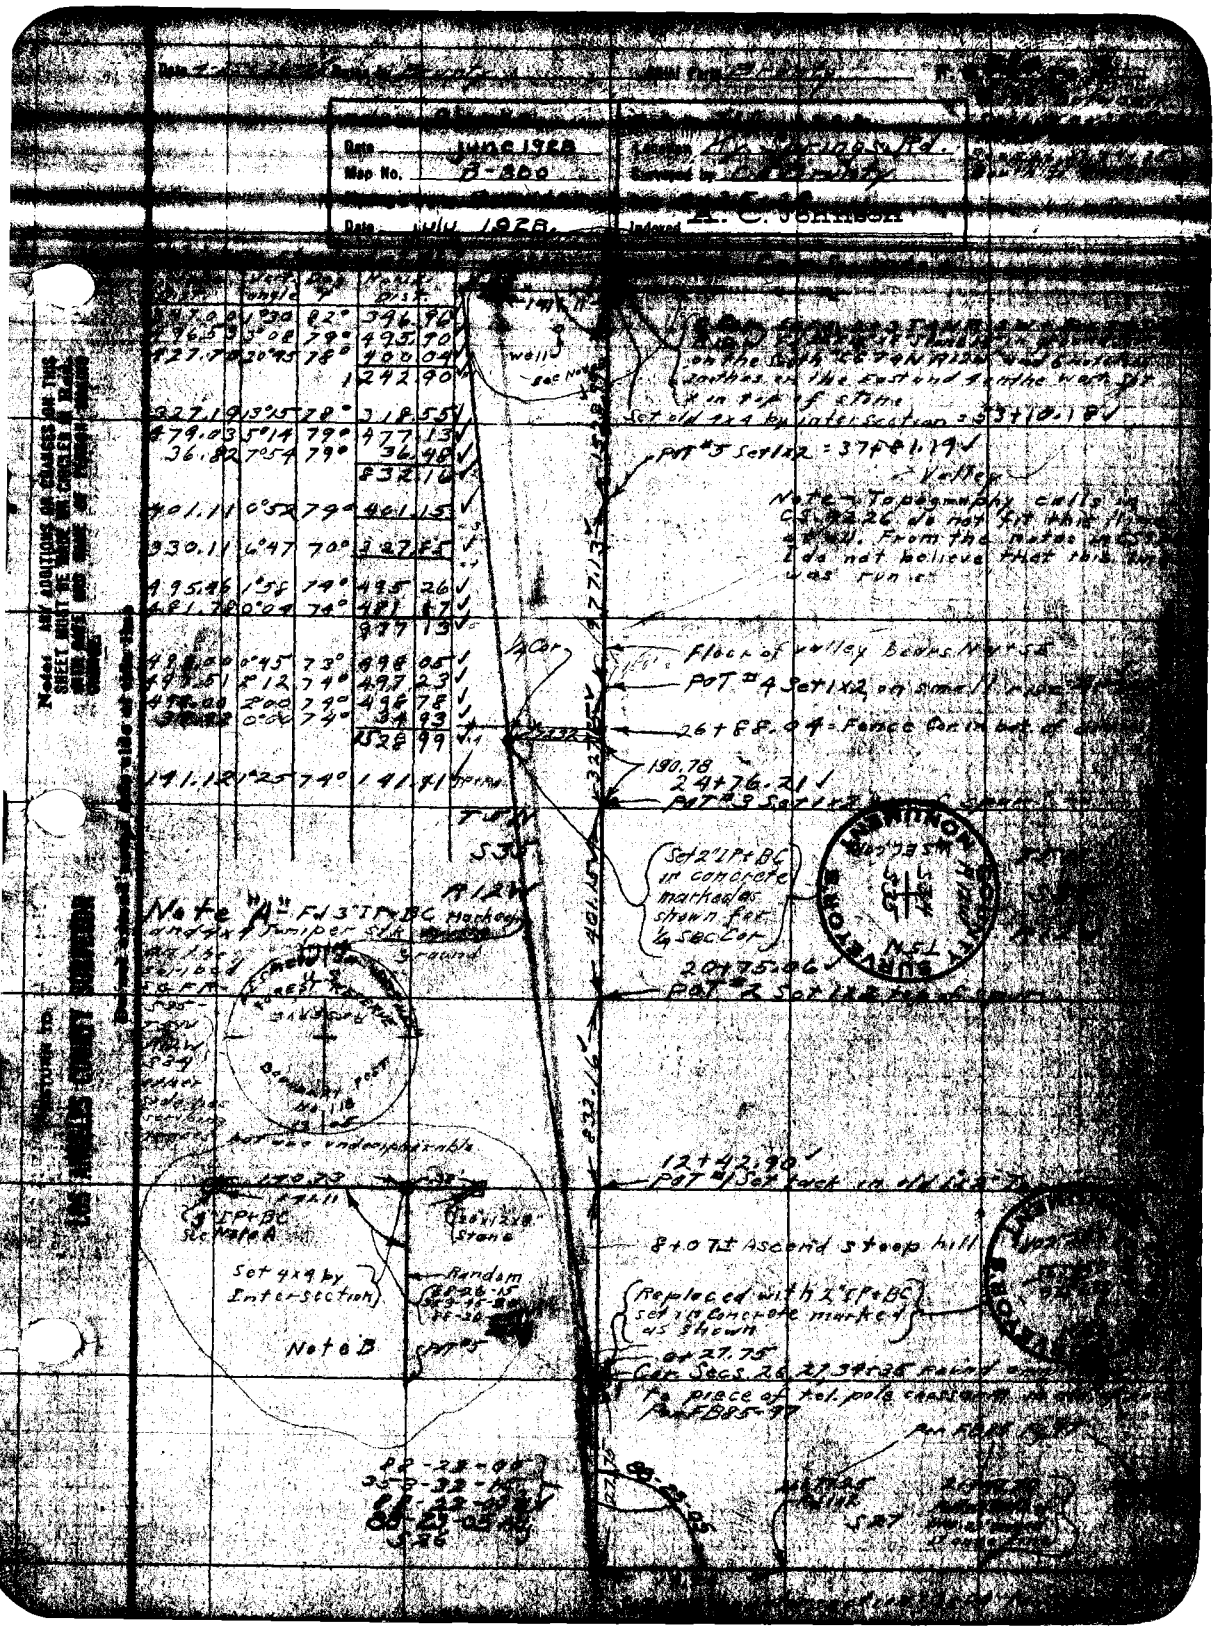
Note "A" Fd 3"I.P.+BC marked on aspen & juniper stks
Set 4x4 by Inter-section
Note B
Random
Set 2"I.P.+BC in concrete marked as shown for 1/4 sec. Cor.
Replaced with 2"I.P.+BC set in concrete marked as shown
Fd piece of tel. pole
Set 2"I.P.+BC
Note: Topography calls on C.S. 22 do not fit this line. From the notes I do not believe that this line was run.
Fence Cor in but of
Fence Cor
Fence Cor
Fence Cor

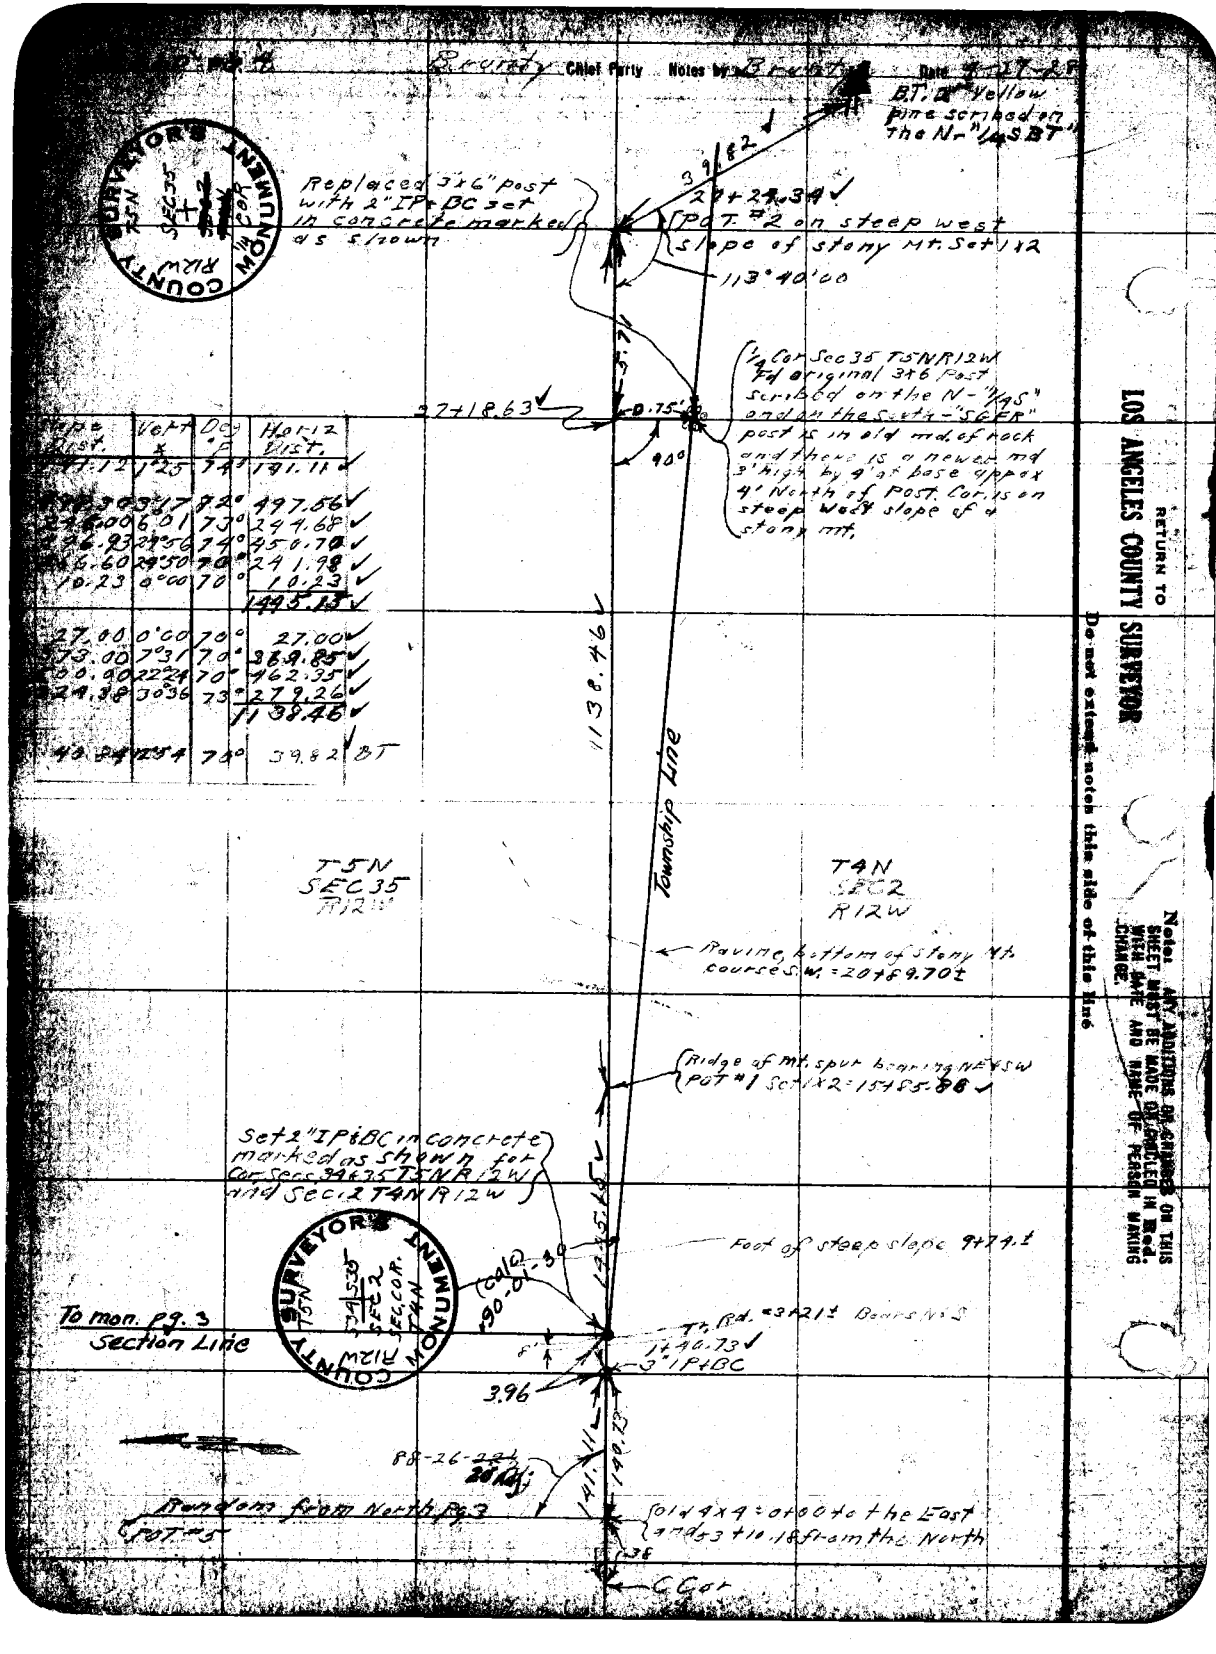

Sta.	Vert. ∠	Dec. ∠	Horiz. Dist.
	12	125	74°	181.11 ✓
			72°	497.56 ✓
			73°	249.68 ✓
			74°	450.70 ✓
			70°	241.98 ✓
			70°	10.23 ✓
				1493.13 ✓
			70°	27.00 ✓
			70°	369.85 ✓
			70°	462.35 ✓
			73°	279.26 ✓
				1138.46 ✓
			74°	39.82 BT

Date June 1928.

In end of rock, on dam of East bank of gully. Pine post scribed on the North "1/4S" and on the South "SC FR" Replaced 4x6 Pine post with 2" IP & BC set in concrete and bounded with stone B.C. marked as shown

MONUMENT COUNTY SURVEYOR'S R12W SEC34 T5N

T4N S3 R12W

Slope Dist.	Vert. ∠	Deg. F	Horiz. Dist.
499.39	0°22	88°	499.52 ✓
329.31	10°42	86°	327.47 ✓
			823.19 ✓
496.92	4°15	86°	497.68 ✓
384.50	3°45	82°	383.77 ✓
495.27	3°12	84°	494.62 ✓
			878.39 ✓
355.14	4°58	84°	353.89 ✓

90°

4965

POT #4 Sat 1x2 = 25+53.15 ✓

353.89 ✓

POT #3 Sat 1x2 = 21+99.24 ✓

878.39 ✓

T5N S34 R12W

POT #2 Sat 1x2 = 13+20.87 ✓

497.68 ✓

POT #1 Sat 1x2 = 8+23.19 ✓

823.19 ✓

20"x12"x8" Stone = 0+00.38

0.38

Random Azimuth North

old 4x4 Stk. = 353+10.18 from N. and 0+00.0 the S, E+W

T4N S2 R12W

180°

Wit. Cor. Sec. 3 & 34 T5N R12W

Page No. 6 — Chief Party Brumley — Notes by Brumley — Date 5-2 to 3-28

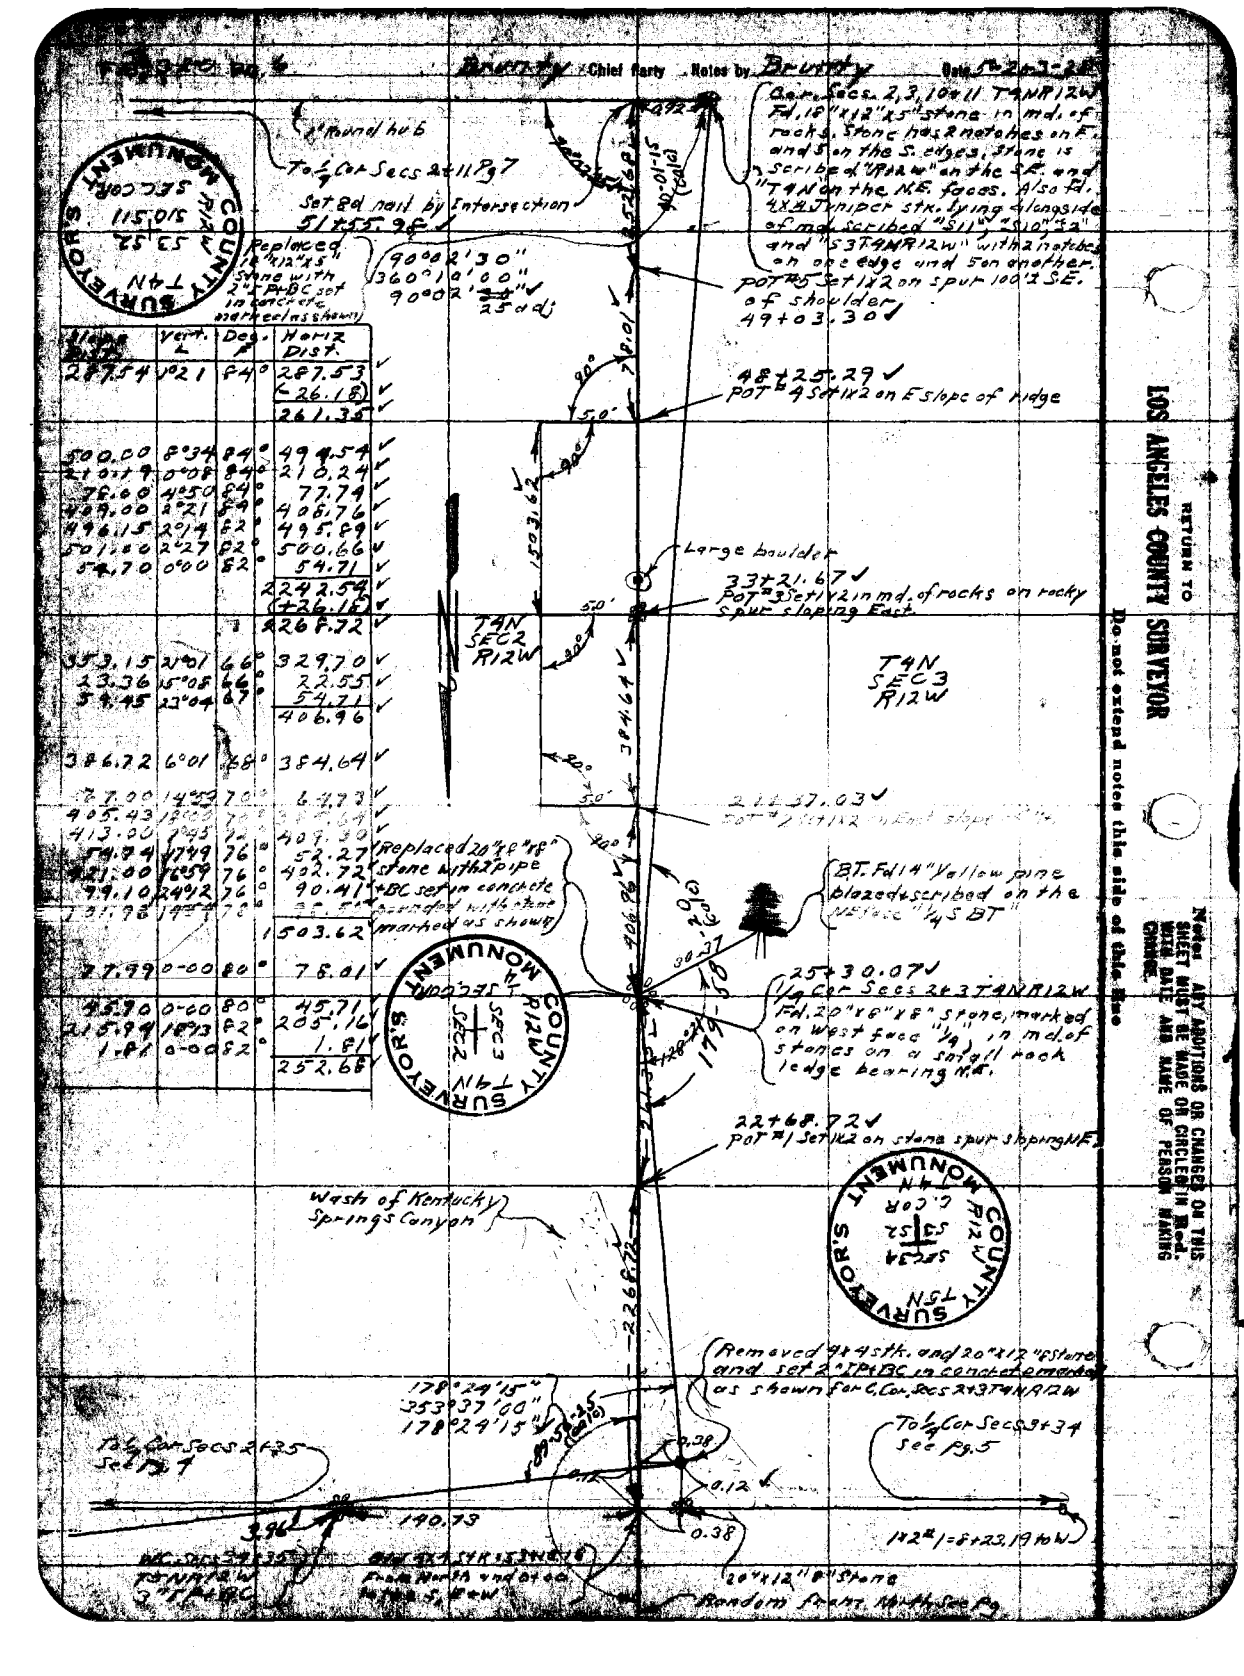

Date 5-31-28 Noted by Brumby Chief Party Brumby F. B.

Date June 1928. Location Kentucky Springs Rd
Map No. B-300 Surveyed by C.E. Brumby
Date 11/14/1928. Indexed A. C. Johnson

1/2 = 5280.99 POT's

26.77

1/2" Round Sandstone Nub = 5271.62

26-42-00
106-18-00
26-42-00

To mon. R.P.

T4N S11 R12W

$X = \frac{\sin 26-42-00}{\sin 63-17-45} \cdot 5271.62$ B.

$X = \frac{4493190}{4933387} \cdot 5271.62 = 2651.88$

$X = \frac{\sin 56-03-20}{\sin 39-54-15} \cdot 2218.95$

$X = \frac{7666673}{6415054} \cdot 2218.25 = 2651.88$ K

Note - In Δ A all three angles were turned, and in Δ B only 2 angles were turned

Note - Set 1" round greasewood hubs for POT's in order to avoid errors, as some one has run a line between the centers of the 2 adjoining 1/2 POT's

1/4 Line 5271.62 to South P.C.

63-17-45 Calc

1/4 Cor Secs 2+11 T4N R12W 0700 to the South P.C.

98-00-15
360-01-00
90-00-15

Set 1" round greasewood hub on top of bluff

Set 1" round greasewood hub top of second point W. of Sec Cor

Cor Secs 2+11 T4N R12W

Std. nail and tag from Mon. Line

2651.88 Calc

39-59-15
59-37-00
39-59-15

Set 1" round greasewood hub top of first point W. of Sec Cor

90-02-30
360-10-00
98-02-30

T4N S2 R12W

2218.95 Line from North P.C.

50-03-15
200-13-30
50-03-20

Sec. Line

Parcel No. 6

RETURN TO LOS ANGELES COUNTY SURVEYOR

Do not detach notes from this sheet

Notes and Additions or Changes on this sheet are to be made with red ink

F. B. [illegible] Page [illegible] Bruntz Chief Party Noted by Bruntz Date 5-5-26

POT #5 Set 1x2
=5247.94

C.T. Fd. 6" Scrub oak blazed & scribed on NW face "1/4 S BT"

Set 1/2" round scrub oak hub = 5247.62 from N.
=0.32 to the East.

Treading East see P. 9

D.T. Fd 4" Scrub Oak blazed & scribed on E face "1/4 SBT"

Replaced 26"x16"x5" stone with 2" IP+BC set in concrete marked as shown

1/4 Cor Secs 1 & 14 T4N R12W Fd. 28"x16"x5" stone bounded by stones, Marked on N. Face 1/4 "a mal of rock bears N 1 1/2" distant.

43+68.18
POT #4 Set 1x2 on W slope of spur

POT #3 Set 1x2 top knob in broken country

SEC 11 T4N R12W

POT #2 Set 1x2 on table land on N. side of Tr. Rd.

1/4 Line

POT #1 Set 1x2 on top of bluff on mesa

Replaced 18"x10"x8" stone with 2" IP+BC set in concrete marked as shown

1/4 Cor Secs 2+11, T4N R12W Fd 18"x10"x8" stone marked on the N face "1/4 S" A rd. of rocks 1' Northof Cor. Fd Bore & Shovel Bearing Blazed Bush 4ft Set Stkd. Easterly direction also when

Cor Secs 2, 3, 10 & 11 T4N R12W See P. 7

Slope Dist.	Vert ∠	Dec. F	Horiz. Dist.
441.00	2°17	80°	440.75
497	6°06	80°	494.76
122.90	3°57	80°	122.64
			1058.15
500.00	1°09	82°	500.02
499.88	1°44	82°	499.77
326.38	1°15	82°	326.38
			1326.17
274.00	1°34	83°	273.97
495.34	1°19	82°	495.33
14.79	0°00	82°	14.79
			784.09
467.00	0°57	84°	467.06
464.02	6°59	86°	461.59
25.17	4°10	86°	251.12
			1179.77
434.00	4°27	88°	432.81
490.35	17°32	86°	467.69
29.14	20°45	86°	27.26
			927.76

RETURN TO LOS ANGELES COUNTY SURVEYOR

Do not extend notes this side of this line

Notes, ANY ADDITIONS OR CHANGES MUST BE MADE ON CHECKER'S SHEET WHETHER MADE IN OFFICE OR IN FIELD WITH DATE AND NAME OF PERSON MAKING CHANGE.

Date 5-10-28 Notes by Gravity Field Party Brunty

Plotted by Clark — Co. No. 766

Date June 1928. — Location Ry. Spur R.R.

Map No. B-300 — Surveyed by C.E.B. County

Checked by Brewster — Date 5-19-28

Date July 1928. — Indexed A. C. Johnson

Stone, 24"x8"x8", set in concrete, marked as shown

Granite stone, 24"x8"x8", on North face, 1/4 North of West Cor. Ft. Ar's shown on West Ft.

S12

Replaced 18"x12"x8" stone with 2" I.P. & C. set in concrete marked as shown

Set 1"x2"

BT. Ft. 1" Pipe blazed & stamped on the West face "T4N R12W S12 BT"

95°37'30"
182°30'30"
95°37'30"
360° Adj

90°11'30"

90°59'30"
3°37'30"
90°59'30"
360° Adj

2617.40 Calc

1/4 Wit. Cor. Secs 11 & 12 T4N R12W Fd 18"x12"x12" granite stone with 1/4 & C on west face. Mds. of tracks 1/4 W. of Sec.

95°16'45"
182°07'00"
95°16'45"
360° Adj

32°01'30"
128°08'30"
32°01'30"
360° Adj

89°58'30"
359°14'30"
89°58'30"
360° Adj

52°46'

Replaced 18"x14"x12" Stone with 2" I.P. & C. set in Concrete, marked as shown. T4N R12W

BT. Ft. 10" Wrk Chorn, blazed, stamped on the S.E. face "T4N R12W S11 BT"

S11

90°17'00"

95°22'15"

4 times 372°1'0"

95°22'15"

51°56'00"

Va. Line

SURVEYOR'S MONUMENT — T4N R12W — S12 S13 — 1/4 Wit. Cor. — SEC. COR.

SURVEYOR'S MONUMENT — T4N R12W — S11 S12 S13 S14 — 1/4 Wit. Cor. — SEC. COR.

SURVEYOR'S MONUMENT — T4N R12W — S10 S11 S14 S15 — 1/4 Wit. Cor. — SEC. COR.

Brunty Chief Party Notes by Brunty Date 5-11-12, 1914

SEC 24 T4N R12W

¼ Cor Secs 13 & 24 T2N R12W F 5319-55

73.79

89-23-50 (calc)

Cor Secs 13, 18, 23 & 24 T4N R12W F 5319-Pyl. 1914-55

52+43.4 Set ½ at intersection 90°35'30" 362°20'00" 90°35'00"

47+01.63 POT "7 Set ½ on spur sloping W

38+79.59 POT "6 Set ½ in saddle ridge bearing E&W

25+08.85 POT "5 Set ½ on W slope of Mt.

20+61.66 POT "4 Set ½ on W. slope of Mt.

15+49.61 POT "3 Set ½ on hillside

9+37.45 POT "2 Set ½ on divide between Aliso and Dry Springs Canyons

3+59.69 POT "1 Set ½ on spur

SEC 13 T4N R12W

¼ Line

Fd. Original Mark of ¼ Sec. Corner Surface Mound of Stones Replaced with L.T.F. & B.C. Mk. as shown. Concrete.

Note:- This mark in red ink is copied from C.B. 319-55 A.D. Price

Fd. Rock 6x6x4" above ground Mk. with 2 Chiseled "+" on E. side. Replaced with L.T.F. & B.C. Mk. as shown.

SEC COR

Fd. Rock 6x6" above ground Mk. with 2 Chiseled "+" on E. side. Replaced with L.T.F. & B.C. Mk. as shown.

SURVEYOR'S MONUMENT ¼ Cor. Sec. 13 + Sec. 24 T.4N. R.12W. LOS ANGELES COUNTY

SURVEYOR'S MONUMENT

Slope Dist	Vert ∠	Deg F	Horiz Dist.
62.65	17°33	64°	59.63
			137
367.70	15°19	65°	354.69
38.00	0-00	66°	38.00
309.00	13°49	70°	300.11
253.86	15°31	72°	244.65
			582.76
402.00	5°32	70°	401.30
95.22	25°32	65°	176.18
35.97	15°27	68°	34.68
			612.16
479.00	10°14	78°	483.78
29.55	17°00	80°	28.22
			512.05
453.45	2°16	76°	447.193
73.00	17°22	70°	69.68
203.80	28°34	68°	179.02
479.00	26°29	62°	428.78
308.33	14°55	75°	300.67
814.62	18°48	82°	792.59
			1370.74
50.00	9°36	84°	49.32
334.43	10°29	80°	329.92
			382.04
497.00	0°29	86°	497.11
48.94	21°25	84°	44.73
			541.94
77.12	16°26	82°	73.99

¼ Cor

BT. 18" Pine blazed "Scribed on the N.W. side "¼ S WC BT"

89°42'45" 324°51'00" 89°42'45" 40 Adj.

To Cor Secs 11, 12, 13 & 14 Pg. 9

18.00

(calc) 90°

2.20

59.63

54°.15

44°11'00 Sec. Line

Nothing set To mon. Pg. 9

To ¼ Mit. Cor. Secs 11 & 12 Pg. 9.

BT. Fd. 9" Pine blazed "Scribed on the S.W. side "¼ S WC BT"

¼ Mit Cor Secs 12 & 13 T4N R12W

T4N R12W SEC 12

1¼2= 0+00 to South = 5348.60 from West

RETURN TO LOS ANGELES COUNTY SURVEYOR

Do not extend beyond this line

Notice ANY ADDITIONS OR CHANGES ON THIS SHEET MUST BE MADE OR CIRCLED IN Red WITH DATE AND MADE OF PERSON MAKING CHANGE.









Date 6-14-28 Notes by Brunty Chief Party Brunty F. B. [illegible]

Checked by Clarke
Date June 1928
Map No. B-30a
Checked by Bowden
Date July 1928.

U. S. No. 716 I. S. No.
Location Kyle Springs Rd.
Surveyed by C.E. Brunty
Date June 14, 1928
Indexed A. C. Pearson

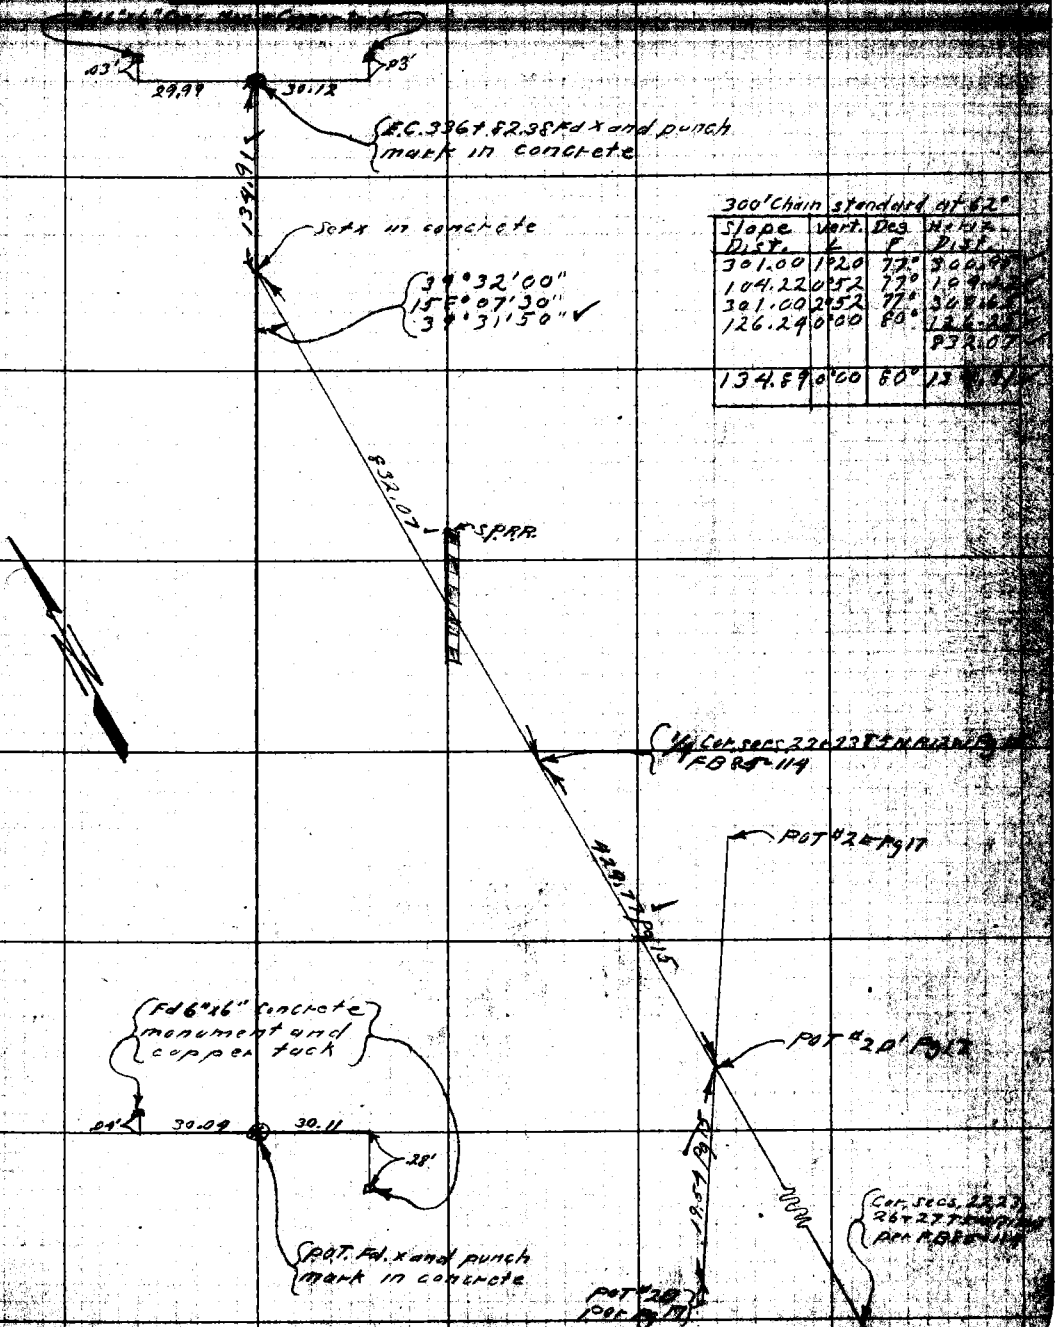

Notice: Any alteration or removal of the survey monument or mark shown hereon may be punishable as a misdemeanor under the provisions of Section 8284 of the Business and Professions Code.

LOS ANGELES COUNTY SURVEYOR

Do not extend lines over title or data block

RETURN TO

LOS ANGELES COUNTY SURVEYOR

Note: ANY ADDITIONS OR CHANGES ON THIS SHEET MUST BE MADE OR CIRCLED IN **Red**, WITH DATE AND NAME OF PERSON MAKING CHANGE.

Do not extend notes this side of this line

Chief Party _____ Notes by _____ Date _____

Map 224 Rd. 12

Notes by Brunty Chief Party Brunty F. B. [illegible] Pg. [illegible]

Plotted by Clarke
Date June 1928
Map No. B-300
Platting Checked by [illegible]
Date July 1928

Location Del Amo & S. P. No. [illegible]
Del Amo & Springs Rd.
Surveyed by C E Brunty
Plotted & Computed by A. C. Johnson
Indexed

Dist.	Bearing	Chord	Dist.
300.00	0-00 62		300.00
267.00	0-00 62		267.00
300.00	0-00 62		300.00
293.46	0-00 62		293.46
			1100.46
177.21	3°37 62		177.18
300.00	13°46 62		299.83
45.38	0-00 62		45.38
			522.39
82.28	2°11 62		82.15
46.54	32°03 64		39.46
			221.61

Note: SHEET MUST BE RETURNED TO CHIEF OF SURVEYS, ROOM 1148, CITY HALL, WITH NOTES ON BACK OF FIELD BOOK.

RETURN TO LOS ANGELES COUNTY SURVEYOR

Do not extend notes this side of this line

Pt #2 Set 2x2 522.39

599.13

10 Tail 15 Pot 3.4 Set 4x2

90-27'00"

Set 2x2

522.39

BC = 3+06.79 Set 1x2

See detail sketch

2+22.61 Pot 1A Set Nail in center of [illegible]

S.P.R.R.

Split 4 inches opposite mon. for [illegible]

Top Cut 2+99.2

Spot "A" Set Nail at split of [illegible]

Punch mark in sidewalk

Top cut 1+99.2

Pt #1

96.31'

60'

221.61

Set 4x4

83-51-30

335-28-30

83-51-22½

83-51-30 Adj

Found 4x4 [illegible] replaced by [illegible]

Set 4x4

30.00

30.17

30.00

83-51-30 Adj.

Found X+ punch mark in concrete

30.00

30.17

30.00

1100.46

94.51

90°

90°

Fd 4"x4" Concrete monument + copper tack

Fd X+ Punch mark in concrete

Pt #1 Set Nail in concrete + 0.00 Radius at corner

[illegible]

F.B. 320 Pg. 27 Brunty Chief Party Notes by Brunty Date 6-6-28

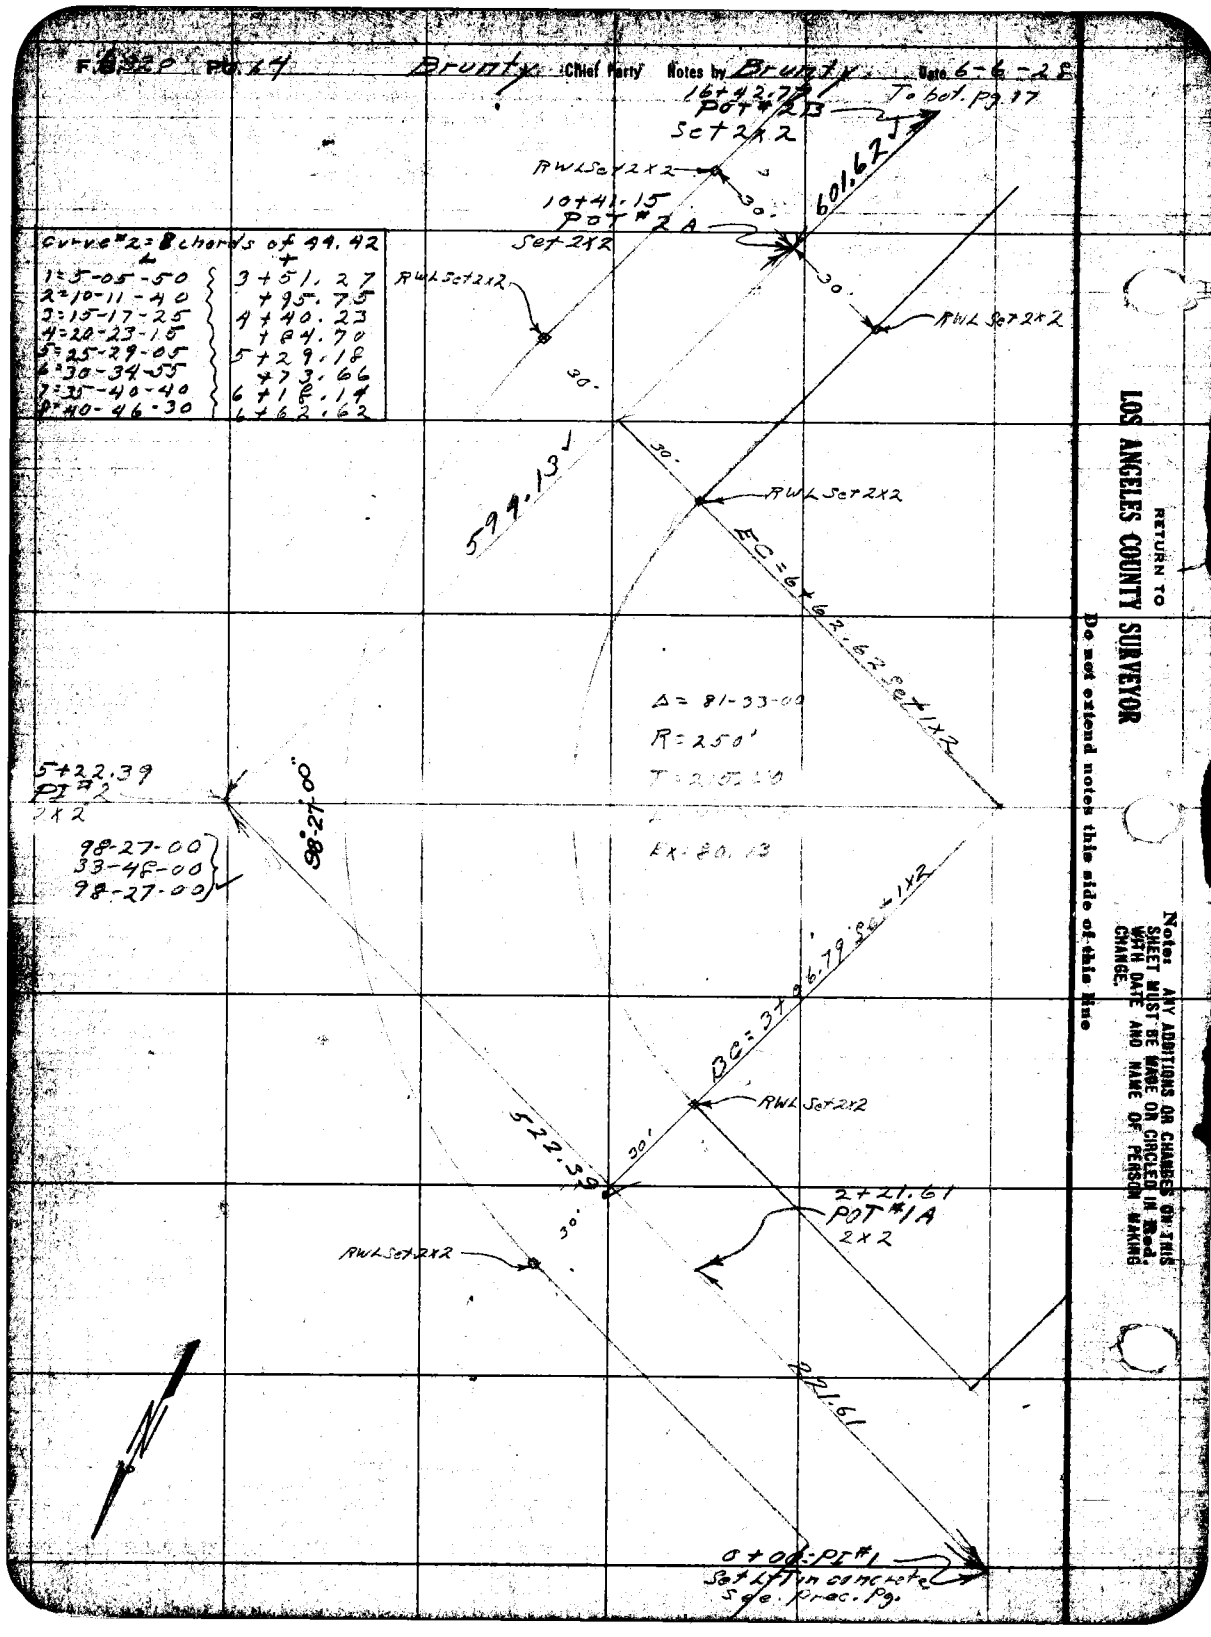

Curve #2 = 8 Chords of 44.42	
Δ	+
1 = 5-05-50	3+51.27
2 = 10-11-40	3+95.75
3 = 15-17-25	4+40.23
4 = 20-23-15	4+84.70
5 = 25-29-05	5+29.18
6 = 30-34-55	5+73.66
7 = 35-40-40	6+18.14
8 = 40-46-30	6+62.62

RETURN TO
LOS ANGELES COUNTY SURVEYOR
Do not extend notes this side of this line

Note: ANY ADDITIONS OR CHANGES ON THIS SHEET MUST BE MADE OR CIRCLED IN Red WITH DATE AND NAME OF PERSON MAKING CHANGE.

Date 6-13-28 Noted by Brunty Field by Brunty F. B. 342 Pg. 45

Plotted by Clarke
Date June 1928.
Map No. B-300
Platted C'k'd by Browder
Date July 1928.

W. O. No. 716 R. S. O. No.
Location Ky Springs Rd
Surveyed by E C Brunty
Date June 13 1928
Indexed

1928	1928	Record
324.59	324.59	324.59
300.97	300.97	300.97
128.80	128.80	128.80
		429.77
19.54	19.54	19.54

300 ft. Standard at 62°F

429.77

19.54

35+93.20
POT 20
See pg 17

POT 20 = 34+44.78
See pg 17

80°29'30"
121°55'00"
30°29'30"
30°29'20" Adj.

32+94.33
POT 26
See pg 17
2 x 20

S 22

S 23

88°52'20"

88°52'10" Adj.

60°37'30"

Set nail by Int.
See next pg.

Adopted Sec. Line

Con. Secs. 23 23 26 27
T 5 N R 13 W
in concrete Post

Set nail by Intersection

To 2" Pipe B/C.
Page 16

Found 2" Pipe, Ads. 93

Notice: Any alteration of this map without the written consent of the Surveyor will void any use of this map

Property of LOS ANGELES COUNTY SURVEYOR

Do not extend notes onto this side of this map

Brunty Chief Party Notes by Brunty Date 6-19-28

Fd 1x2"6 FB 85-94

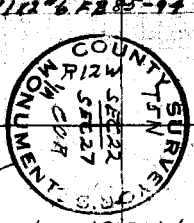

90°04'00"
360°16'30"
90°04'07½"
90°04'10" Adj.
Fd 2x2 ¼ Cor
FB 85 Pg 94

Replaced 2x2 stake with 2" I Pr BC in conc. marked as shown
Set Nail by intersection

.30

Fd 1x2"11 A FB 85-96
Sec Pg 22

RETURN TO
LOS ANGELES COUNTY SURVEYOR
Do not extend notes this side of this line

Notes: ANY ADDITIONS OR CHANGES ON THIS SHEET MUST BE MADE OR CIRCLED IN Red. WITH DATE AND NAME OF PERSON MAKING CHANGE.

S27

60-38-30
742.39 CC

Section Line

1596.55 Rec per F.B. 85-93

S22

62+96.86
POT "2A
17.18

56+97.42
POT "2I
Pg. 18

1.59

133.76

55+31.23
POT "2H
Set 2x2
Pg. 18

60-34-20
(Calc)

2254.77

Fd 1x2"3 FB 85-93

1297.73

1992.30

493.07

Fd 1x2"4 FB 85-93

1078.57 Rec. F.B. 85-93

Fd 1x2"5 FB 85 Pg 93

2.96

Cor Secs 22, 23, 26 & 27 Rel PB 85-114 loc prec pg

Slope Dist.	Vert. ∠	Deg. F.	Horiz Dist
321.00	7-48	91°	298.27 ✓
195.71	5-39	92°	194.80 ✓
			493.07 ✓
321.00	5-55	93°	299.46 ✓
192.97	2-24	94°	192.84 ✓
			492.30 ✓
254.72	0-17	94°	254.77 ✓
133.73	0-00	94	133.76 ✓

Date 6-28 Notes by Brunty Field Party Brunty

Date June 1928.
Map No. B-300
Date July 1928.

Location Ky Springs Rd
Surveyed by C.E. Brunty
Indexed A. C. Johnson

300.12-38-102	300.76	
298.32-38-101	298.90	
152.20-00-101	151.89	
	751.55	
300.12-04-101	300.01	
301.00-38-100	300.95	
299.98-00-100	300.05	
	600.50	
301.00-35-100	301.05	
300.54-37-100	300.57	
	601.62	
301.00-00-99	301.07	
293.02-51-98	293.06	
	594.13	

Cor Secs 15, 22, 23 & 27 Sec 19, 15

POT #2 E Set 2x2 = 32+44.38

POT #2 D' Set 2x2 = 32+74.79

POT #2 D Set 2x2 = 29+44.38

POT #2 C = 22+43.27 Set 2x2

POT #2 B Set 2x2 = 16+42.77

POT #2 A 2x2 = 10+41.15

PT #2 = 5+22.37 2x2

RWL Set 2x2

2556.44 ± 6.25

600.80

19.54

30.00

75

300.01

30-29-20 Adj

229.77

600.50

2827.77

601.62

594.13

Notes: ANY ADDITIONS OR CHANGES IN THIS SHEET MUST BE MADE ON CIRCLES OF RED. WITH DATE AND NAME OF PERSON MAKING CHANGE.

RETURN TO LOS ANGELES COUNTY SURVEYOR

Do not extend notes this side of this line

RETURN TO
LOS ANGELES COUNTY SURVEYOR
Do not extend notes this side of this line
Note: ANY ADDITIONS OR CHANGES ON THIS SHEET MUST BE MADE OR CIRCLED IN Red WITH DATE AND NAME OF PERSON MAKING CHANGE.

Bk. 247 Pg. 18

Brunty Chief Party. Notes by Brunty Date 6-6-28

Course	Bearing	Dec	Horiz. Dist.
		E	
298.30	S 0-40	10E	301.06
298.31	S 1-17	10E	298.33
			599.39
133.73	S 0-00	9E	133.76
301.00	S 0-45	10E	301.06
299.78	S 1-35	10E	299.76
			600.82
301.00	S 0-26	10E	301.07
300.05	S 0-51	10E	300.11
			601.18
301.00	S 0-00	10E	301.09
299.18	S 0-27	10E	299.29
			600.38
301.08	S 0-03	10E	301.08
299.872	S 1-16	10E	299.72
			600.80

POT. #2 L Set 2x2 = 68+97.36

62+96.86
POT #2K Set 2x2
RWL Set 2x2

58+31.23
POT #2J Set 2x2
To mon. pg. 15
RWL Set 2x2

See pg 16

Section Line
RWL Set 2x2
To monument pg. 16

54+97.47
POT #2I Set 2x2
RWL Set 2x2

50+96.65
POT #2H Set 2x2
RWL Set 2x2

44+95.47
POT #2G Set 2x2
RWL Set 2x2

38+95.13
POT #2F Set 2x2
RWL Set 2x2

32+94.33
POT #2E
2x2

From 20'

2556.44

Date 6-6-28 Notes by Brunty Chief Party Brunty P. B. Bk. pg. 66

Plan

Date June 1928. Location Ky Springs Rd

Map No. B-300 Surveyed by C.F. Brunty

Date July 1928. Indexed A. C. Johnson

P.I.'s	L	F	Plat
301.00	1-65	102	300.91
300.07	1-19	104	300.87
			600.78
301.00	1-52	104	300.92
299.55	1-03	104	299.58
			600.50

EC=78+86.39 Set 5 w 4

Curve "J" = 8 chords of 103.28

1=2-57-35	71+63.11
2=5-55-10	72+66.43
3=8-52-50	73+69.76
4=11-50-25	74+73.08
5=14-48-00	75+76.41
6=17-45-35	76+79.74
7=20-43-15	77+83.06
8=23-40-50	78+86.39

Δ = 47-21-40

R = 1000'

T = 438.56

L = 826.61

Ex = 91.95

78+11.76 POST #3 1x2

205.23

76+06.47 POST #3A 1x2

158.64

74+98.34 PI #3 Set 2x2

Top of Shf 3

L.B. 394 - 131

132-38-15

170-33-00

132-38-15

132-38-20 Adj.

132-38-20

EC=78+59.78 Set 1x2

PWL Set 2x2

30'

PWL Set 2x2

PWL Set 2x2

30'

PWL Set 2x2

POT #2L = 68+97.36 2x2

30'

PWL Set 2x2

600.50

POT #2K = 62+96.86 2x2

P.B. 22 Pgs. 21

Brophy Chief Party Notes by: Brophy Date: 6-5-25

Dist	Delta	D	Horiz. Dist
301.00	2-50	10	300.89
275.43	0-00	10	275.51
157.70	0-00	10	157.21
			753.61
299.84	0-00	10	299.91
301.00	1-50	10	300.92
44.18	4-07	10	44.08
			644.91
301.00	5-59	10	297.38
300.48	1-15	10	300.48
258.89	8-39	10	256.00
			853.86
205.25	0-00	92	205.29
158.80	2-50	92	158.64

POST #3F = 106+49.63

753.61

RWL Set 2x2

30'

100+64.14

POT # 3E 2x2

RWL Set 2x2

644.91

93+10.53

POT # 3D

= 1x2 ☒ 4 LB. 394-226

RWL Set 2x2

RWL Set 2x2

853.86

86+65.62

POT # 3C

= 1x2 ☒ 3 LB. 394-225

RWL Set 2x2

RWL Set 2x2

P.I. #4

3416.00 to P.I. #4

EC = 78+86.39 Set Sin x T

78+11.76

POST # 3B

1x2 ☒ 2 LB. 394-225

205.25

76+06.47

POST # 3A

= 1x2 ☒ 1 LB. 394-225

158.64

P.T. #3 = 74+98.34

RETURN TO LOS ANGELES COUNTY SURVEYOR

Do not extend notes this side of this line

Notes: ANY ADDITIONS OR CHANGES ON THIS SHEET MUST BE MADE ON CIRCLED IN Red. WITH DATE AND NAME OF PERSON MAKING CHANGE.

Date June 1968. Location Ky Springs Rd
Map No. B-300 Surveyed by C F Brantley
Date 11/4 1968. Indexed A. C. Johnson

22229	936	104	279.20
301.04	10+04	106	301.04
279.41	10+79	100	279.45
			580.49

RWL Set 2x2

30°

RWL Set 2x2

PC = 111+43.16

202.35

Curve #4 = 6 chords of

1 : 2-9 4-45
2 : 5-29-30
3 : 6-14-12
4 : 10-58-54
5 : 13-43-48
6 : 16-28-24

Δ = 32-56-00
R = 1400'
T = 285.71
L = 575.04
Ex = 42.81

105+63.83
PT #4
Topg. Sht. 3 Set 2 x 2
L.B. 394-151

147-03-15
228-12-30
147-03-07½
147-03-10 Adj.

147-03-10 Adj.

219.20

POT #5 = 106+44.63
= N 2 E 6 L.B. 394-226

PC = 105+63.17
5.46

30°

RWL Set 2x2

520.49

30°

RWL Set 2x2

POT #6 = 100+76.11
= N 2 E 6 L.B. 394-226

Notes: All distances are shown in feet and decimals of a foot.

Permit issued under the rules of this Board

LOS ANGELES COUNTY SURVEYOR

Bk. 32 Pg. 2.2 — Brunty, Chief Party — Notes by Brunty — Date 6-5-28

Sta.	Dist.	Deg.	Horiz. Dist.
	102.63	3°42	102.45
	299.66	0°00	299.74
	102.42	0°00	102.51
			402.25

Curve #5 = 4 chords of 60.74

	L	T
1 = 1-44-25	112+90.80	
2 = 3-28-50	113+51.54	
3 = 5-13-15	114+12.29	
4 = 6-57-40	114+73.04	

POST 3 Set 2x2, 120+16.53

RWL Set 2x2

Replaced 2x2 Stake per FB 85-5 with 2" I.P. 30 marked as shown

30' (calc.) 52.46

30'

RWL Set 2x2

EC = 114+73.04 Set 1x2

88-54-00 Adj.

90°

51.90

1x2 # 11 FB 85 Pg 96

Section Line

114+05.26 POST #5A Set 2x2

Cor. Secs 26, 27, 34 & 35 T 10 S R 12 W See Pg 3

To mon. page 3

See next pg

57.32

113+52.15 PT #5 Set 2x2 Top 9, Sht 3. L.B. 394-153

166-04-45
304-18-45
166-04-40

Δ = 13-55-20
R = 1000'
T = 122.14
L = 242.99
Ex = 7.43

C 1x2 intersection Pg 3

BC = 112+30.05 Set 1x2

RWL Set 2x2

30

102.45

112+49.70 POST #4A Set 2x2

90°

RWL Set 2x2

EC = 111+43.16 Set 1x2

102.25

PT #4 = 108+63.83 2x2

COUNTY SURVEYOR'S MONUMENT — 15TN R12W — SEC. COR. — S 26 27 S 25 34

RETURN TO LOS ANGELES COUNTY SURVEYOR

Do not extend notes this side of this line

Notes: ANY ADDITIONS OR CHANGES OR THIS SHEET MUST BE MADE OR CIRCLED IN RED WITH DATE AND NAME OF PERSON MAKING CHANGE.

Date 6-7-28 Notes by Brunty Chief Party Brunty F. B. 22 Pg 22

Checked by Clarke
Date June 1928.
Map No. B-300
Plotted by Crowder
Date July 1928.

M. B. No. 716 B. P. No.
Location Ky. Springs Rd
Surveyed by C E Brunty
Date June 7 1928
Indexed A. C. JOHNSON

Set 2x2 Pg 22

To Man page 22

1443.60 calc

88°54'00"
365°36'15"
88°54'03"
88-54-00 Adj

1207/16.53 POT #5B Pg. 22

POST #5A Set 2x2 Pg 22

2820.66

608.27 calc

59.22

57.32

1137.52 POT #5 Pg. 22

119.94

S 88°54' E

300ft standard at 62° F

Set 1x2

Slope Dist.	Vert. ∠	Deg. F	Horiz. Dist.
301.00	7-00	94°	298.82
250.93	5-38	94°	249.77
			548.59
233.00	4-00	94°	232.46
234.15	2-07	94°	234.04
28.27	0-00	94°	28.28
			494.70
92.56	11-43	94°	90.65
124.86	16-13	95°	119.94
57.31	0-00	95°	57.32

90.63

1253.88

494.70

Fd 1x2 #3 PB85 Pg 97

Fd 1x2 #4 PB85 Pg 97
.03'S of line, moved onto line

598.39

Section Line

88°23'03"

2.05

Fd Nail on line

88-23-03 adj

0.78 calc.

27.74 (Rec'd)
27.73

1x2 Intersection Pg 3

Cor Secs 26,27,34 & 35
T 5 N R 12 W SBCM Pg 3

Notes: ANY ADDITIONS OR CHANGES ON THIS SHEET MUST BE MADE OR CIRCLED IN Red, WITH DATE AND NAME OF PERSON MAKING CHANGE.

RETURN TO LOS ANGELES COUNTY SURVEYOR

Do not extend notes this side of this line

F.B. 329 Pg. 24 — Brunty — Chief Party — Notes by Brunty — Date 6-5-28

Slope Dist.	Vert. Δ	Dec. °	Horiz. Dist.
187.84	4-50	94°	187.21
301.00	2°81	97°	300.88
298.76	2-06	96°	298.63
97.94	0-00	98°	97.96
			697.47
301.00	3°35	102	300.49
298.05	8-50	105	298.09
67.03	1-55	100	67.01
			665.59

Curve #6 = 8 chords of 83.745

	←	+
1:	2-24-00	124+49.56
2:	4-48-00	125+33.33
3:	7-12-00	126+17.10
4:	9-36-00	127+00.87
5:	11-59-55	127+84.64
6:	14-23-55	128+68.41
7:	16-47-55	129+52.18
PC:	19-11-55	130+35.95

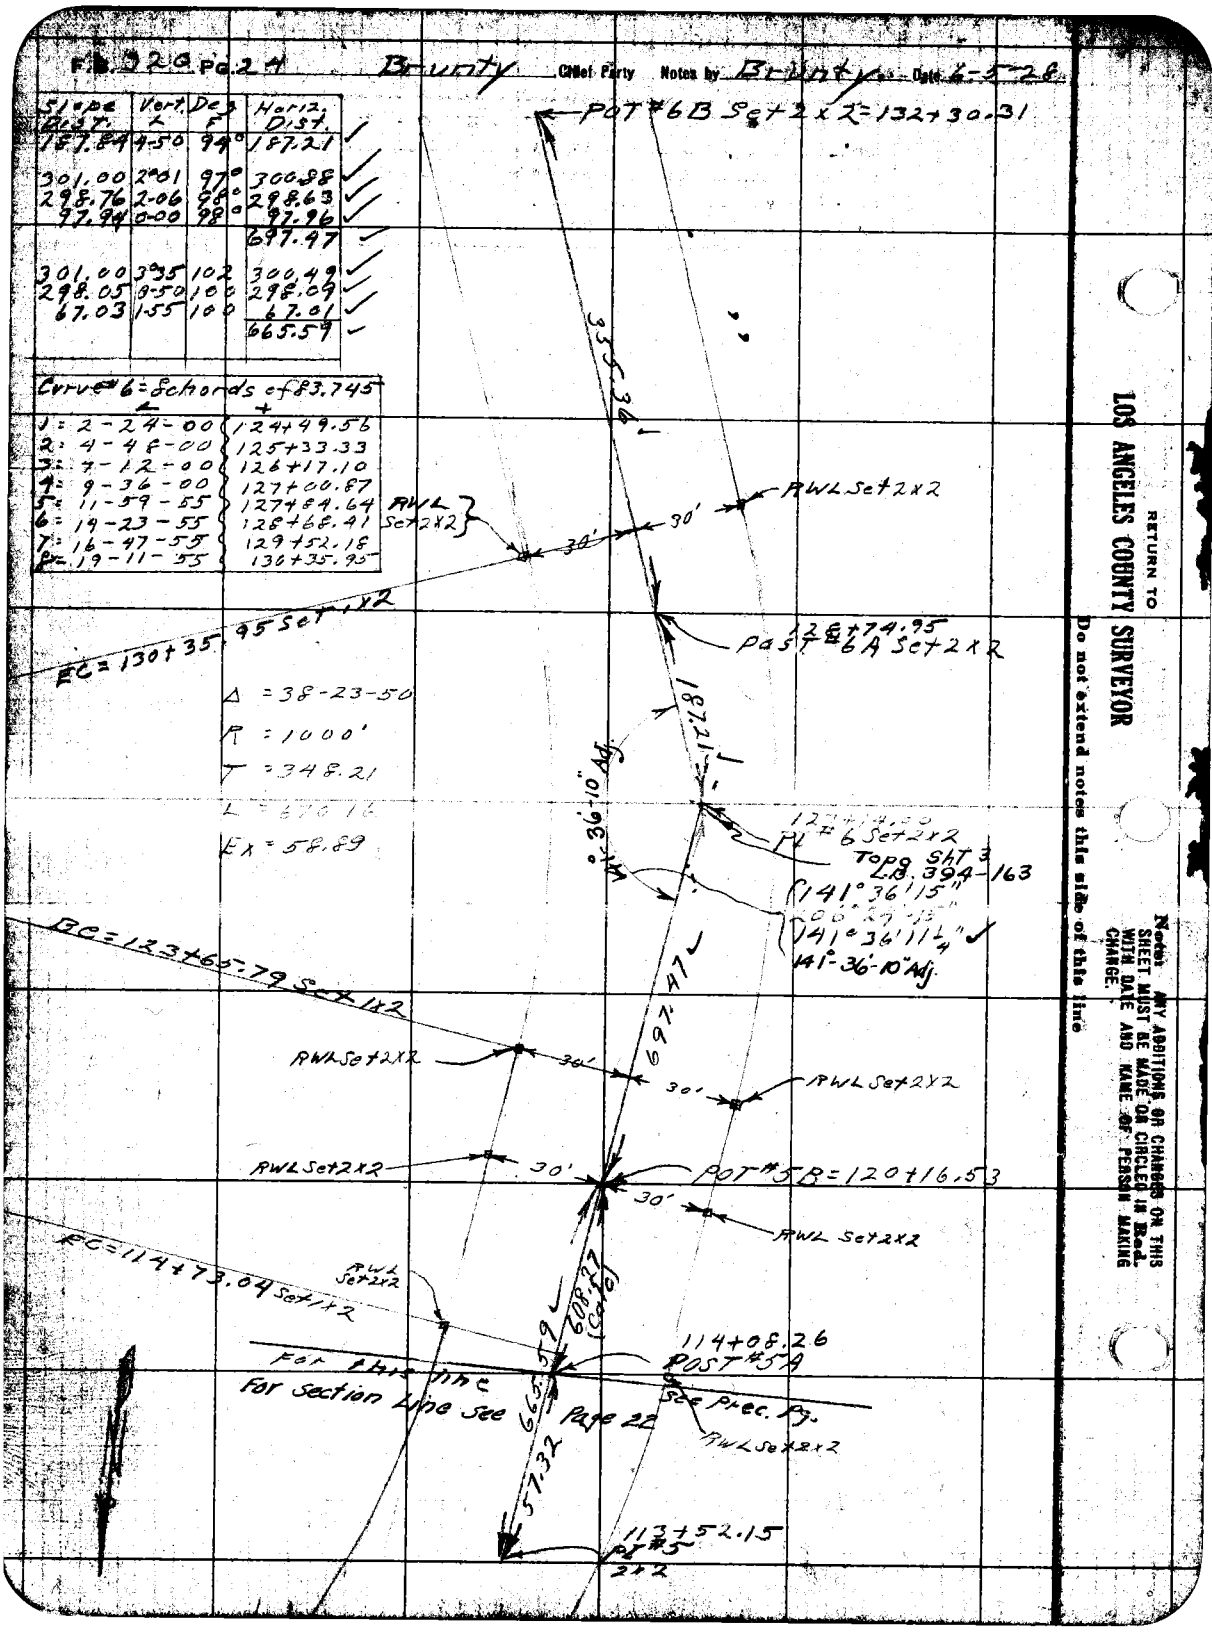

RETURN TO
LOS ANGELES COUNTY SURVEYOR
Do not extend notes this side of this line

Notice: ANY ADDITIONS OR CHANGES ON THIS SHEET MUST BE MADE OR CIRCLED IN Red, WITH DATE AND NAME OF PERSON MAKING CHANGE.

Notes by Brunty Plotted from Brunty F. B. 388 Pg. 2

Checked by Clarke
Date June 1928
Map No. B-300
Drawn by Brownlee
Date July 1928.

W. O. No. 316
Location Ry. Sp. Imperial
Surveyed by C.E. Brunty
Date June & 1928
Indexed A. C. Johnson

Along	Course	Ties	Ties
301.00	4°00	100	300.32
125.48	2°27	90	125.39
			425.73
301.00	3°33	90	300.47
55.126	0°22	90	54.89
			355.36

Set 2x2 = Adj

EC = 139+74.65 Set 2x2

Curve #7 = 8 chords of 22.50

1 = 2-22-20	133+94.85
2 = 4-44-45	134+77.71
3 = 7-07-05	135+60.53
4 = 9-29-30	136+43.36
5 = 11-51-50	137+26.18
6 = 14-14-10	138+09.00
7 = 16-36-35	138+91.83
8 = 18-58-55	139+74.65

Topg Sht 4
L.B. 394-169
136+56.09
PT #7
Set 2x2

142-02-15
208-09-00
142-02-15
142-02-10 Adj

Δ = 37-57-50
R = 1000'
T = 343.98
L = 662.59
E = 57.50

BC = 133+13.06 Set 1x2

RWL Set 2x2

RWL Set 2x2

RWL Set 2x2

POT #6 B = 132+70.91

RWL Set 2x2

POT #6 A = 128+79.16

EC = 139+90.45

Notes ANY ADDITIONS OR CHANGES ON THIS SHEET MUST BE MADE BY CIRCLED IN Red. WITH INITIALS AND NAME OF PERSON MAKING CHANGE.

Do not write on this side of this sheet

RETURN TO LOS ANGELES COUNTY SURVEYOR

Page 26 — Chief Party — Notes by — Date 6-4-28

Sta Pos	Dist	Vert Δ	Pos ⊥	Horiz Dist
233.32		0°53'	490	233.32
299.37		12°45"	100'	299.16
120.02		0°00	100'	120.00
				419.16

Post #8
146+70.78

RWL Set 2x2

30'

30'

RWL Set 2x2

EC=145+17.65 Set 1/2"

99.70

Curve #8 = 6 chords of 78.99

1°	2-15-50	141+22.61
2°	7-31-35	142+01.62
3°	6-47-25	142+80.63
4°	9-03-15	143+59.63
5°	11-19-00	144+38.64
6°	13-34-50	145+17.65

Δ = 27-09-40
R = 1000'
T = 241.57
L = 474.05
Ex = 28.77

152-50-15
251-21-00
152-50-15
152-50-20 Adj

PT #6 = 142+85.17

Post Set 2x2

Topo Sht 4
L.B. 394-173

152-50-20 Adj

132.20

Appl #6
1x2 #12 L.B. 394-227

235.35

EC=140+43.60 Set 1/2"

140+49.82
Post #7A
Set 2x2

RWL Set 2x2

96'

30'

RWL Set 2x2

419.15

EC=139+74.65

PT #7 = 136+56.04

RETURN TO
LOS ANGELES COUNTY SURVEYOR

Do not extend notes this side of this line

Notes: ANY ADDITIONS OR CHANGES ON THIS SHEET MUST BE MADE OR CIRCLED IN Red WITH DATE AND NAME OF PERSON MAKING CHANGE.

Map B-9-28 Name in Pencil Party Burnett F. B. & M. Ty.

Clarke

Date June 1926.

Map No. B-300

Snowden

Date July 1926.

W. O. No. 716 R. & S. No.

Location Ky. Spr. 1093 No

Surveyed by C.E. Burnett

Ann. June 4, 1926

Indexed

215.21	7°49'	100°	215.21
299.44	2°57'	100°	299.44
298.99	0°09'	100°	298.56
113.79	2°20'	100°	113.69
			412.25
290.57	3°15'	100°	290.17
104.54	1°39'	100°	104.53
			394.70
132.47	3°50'	100°	132.20

RWL Set 2x2

28-06-30
112-26-30
28-06-35

BC = 156+53.16 Set 1x2

POT PC = 153+82.47 Set 1x2

POT PSB = 150+83.03 Set 2x2

POT PSA = 146+70.78 = 142+13

EC = 145+17.65

PI C = 142+85.17 Set 2x2

POT PI B

30' 30' RWL Set 2x2

RWL Set 2x2

RWL Set 2x2

Chief Party Notes by Bruntz Date 6-4-28

POT #9C Set 3x2 173+46.51

Tomon. Pg. 4 Township Line Radial to East 1495.23

POT #9B Set 2x2 by Intersection 170+27.89

Set P.S. 3+9 1740.73 L&C 3" P&BC wit cor Secs 34 & 35 T5NR12W

89°56.5 (Calc)

0.38 Cor Secs 2 & 3 T4NR12W LACS Mon Pg. 6

Random to East Pg. 5

Old 9x4 otog to EW.S and 53+10.18 From North Pgs 3, 4, 5 & 6

RWL Set 2x2

190.73 RWL Set 2x2

80-48-30
323-14-30
80-48-35

S 96.90

To mon. Pg. 4

POT #9A Set 2x2 1647+30.99

30' 30' EC 159+56.12 Set 1x2

Slope Dist.	Vert ∠	Deg F	Horiz. Dist.	
186.11	0°41	92°	186.14	✓
300.36	2°15	94°	300.19	✓
296.87	2°11	93°	296.71	✓
			596.90	
297.30	2°19	92°	297.12	✓
299.08	2°15	92°	299.17	✓
31.32	0°13	93°	31.33	✓
			627.62	
208.08	0°00	100°	208.13	✓

Curve	#9 = chords of 75.72	∠	
1°	2	10-10	157+28.90
2°	4	20-20	158+07.69
3°	6	30-35	158+80.38
4°	8	40-45	159+56.12

Δ = 17-21-30
R = 1000'
T = 152.65
L = 302.96
Ex = 11.59

9-10 set (Calc) 627.52

Set #6

158+05.81 PT #9

#8 15 1x2

18.91

41.38-30

59

RWL Set 2x2

162°-38'

Topg. Sht 4 RWL Set 2x2

L.B. 394-175 162-38-30 290-34-00 162-38-30

Tomon. Sec. 3

S 2°-18'-30" E

PC = 156+53.16 Set 1x2

Spot #8 P = 155+97.68

RETURN TO
LOS ANGELES COUNTY SURVEYOR
Do not extend notes this side of this line

Notes: ANY ADDITIONS OR CHANGES ON THIS SHEET MUST BE MADE ON CIRCLE IN RED WITH DATE AND NAME OF PERSON MAKING CHANGE.

6-4-28 Notes by Brunty Chief Party Brunty

Blanks

Date June 1928
Map No. B-300
Drawn by Brunty
Date July 1928.

No. R. Bk. 74 Pg. & No.
Location Ly Springs Rd
Surveyed by C.E. Brunty
Date June 1928
Indexed A. C. Johnson

Horiz. Dist.	Deflection L	Deflection R	Horiz. Dist.	RWL Set 2x2
197.67	1°18	90°	197.67	✓
298.96	1°49	90°	297.97	✓
40.64	0°00	92°	40.65	✓
			338.62	

Set 2x2
Sta 1+97.67 = PC
Set 2x2
Sta 1+94.83
30
30
RWL Set 2x2
Set 2x2
PoT = 10A = 177+67.67
RWL Set 2x2
205.73
EC = 177+12.36 Set MR

Curve #10 = 4 chords of 74.63

	L	T
1 = 2-05-20		174+88.21
2 = 4-16-35		175+49.06
3 = 6-24-55		176+37.71
4 = 8-33-15		177+12.36

RWL Set 2x2
175+64.16
PT = 10
Set 2x2
Top of Sht 4
L.B. 394-179
14.20
15.75
162-53-30
291-33-30
162-53-30
162-53-30 Adj
162-53-30 Adj
RWL Set 2x2

Δ = 17-06-30
R = 1000'
T = 150.42
L = 298.60
Ex = 11.25

172.67
Set 1+72
PC = 174+13.76
30'
RWL Set 2x2
POT = 9C = 173+66.51
Set 2x2
30
RWL Set 2x2
338.62
Set 3+38.62

Property of LOS ANGELES COUNTY SURVEYOR
Return to
Blank Notebook Furnished upon Application

F.B. 528 Pg. 30 — Brady — Chief Party — Notes by Brady — Date 6-4-58

POT #11A = 182+96.35

Slope Dist.	Vert. ∠	Dir. ∠	Horiz. Dist.
244.83	1°04'	88°	244.83
205.79	1°49'	90°	205.73

292.42 ✓

EC = 182+40.83 Set 1x2

Curve #11 = 6 chords of 77.52	∠	+
1 =	2-13-15	178+53.14
2 =	4-26-35	179+30.68
3 =	6-39-50	180+08.22
4 =	8-53-05	180+85.75
5 =	11-06-25	181+63.29
6 =	13-19-40	182+40.83

Δ = 26-39-20
R = 1000'
T = 236.90
L = 465.23
Ex = 27.68

Topg. Sht 4
L.B. 394-181
180+12.50
PI 11
Set 2x2

193-20-40

153-20-45
25-3-22-45
153-20-40 ✓Δ

244.83 ✓

BC = 177+75.60 Set 1x2

177+67.67
POT #10A Set 2x2

205.73 ✓

PI #10 Set 2x2 = 179+64.18

RETURN TO
LOS ANGELES COUNTY SURVEYOR
Do not extend notes this side of this line

Notes: ANY ADDITIONS OR CHANGES ON THIS SHEET MUST BE MADE OR CIRCLED IN Red. WITH DATE AND NAME OF PERSON MAKING CHANGE.

Notes by Brunty Chief Party Brunty F. B. 224 Pg. 34

Clerk
Date June 1928.
Map No. 8-300
Checked by Boulder
Date July 1928.

W. O. No. 716
Location Kentucky Springs Rd.
Surveyed by C.E. Brunty
Date 6-1-28
Indexed A. C. Johnson

Course	Dist.	Angle	Bearing	Dist.
				B.S.
	171.31	2°10	86°	171.22
	158.79	0°46	86°	158.60
				330.02
	301.00	2°34	86°	300.75
	230.45	2°02	86°	230.34
				531.09
	297.00	3°42	86°	296.43
	264.70	1°46	86°	264.61
	298.38	1°37	86°	298.27
	26.20	0°00	86°	26.20
				885.71
	243.37	5°07	95°	242.46
	82.08	5°31	98°	81.66
				324.12
	298.78	11°54	92°	292.42

Notes: ANY ADDITIONS OR CORRECTIONS MUST BE MADE BY CROSSING OUT, INITIALING AND DATING WITH DATE AND NAME OF PERSON MAKING CHANGE.

Do not extend notes this side of this line

RETURN TO LOS ANGELES COUNTY SURVEYOR

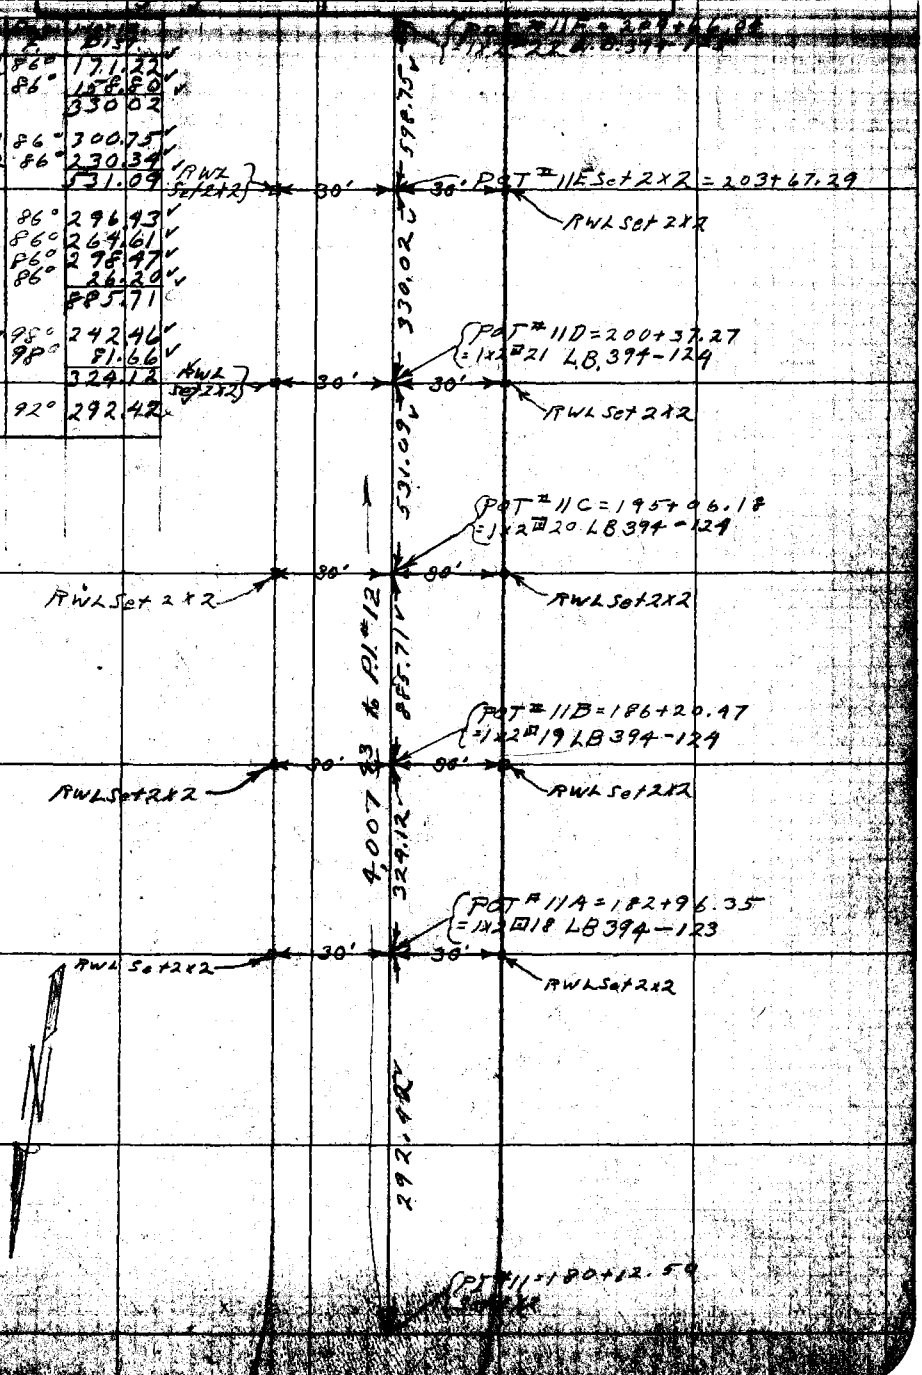

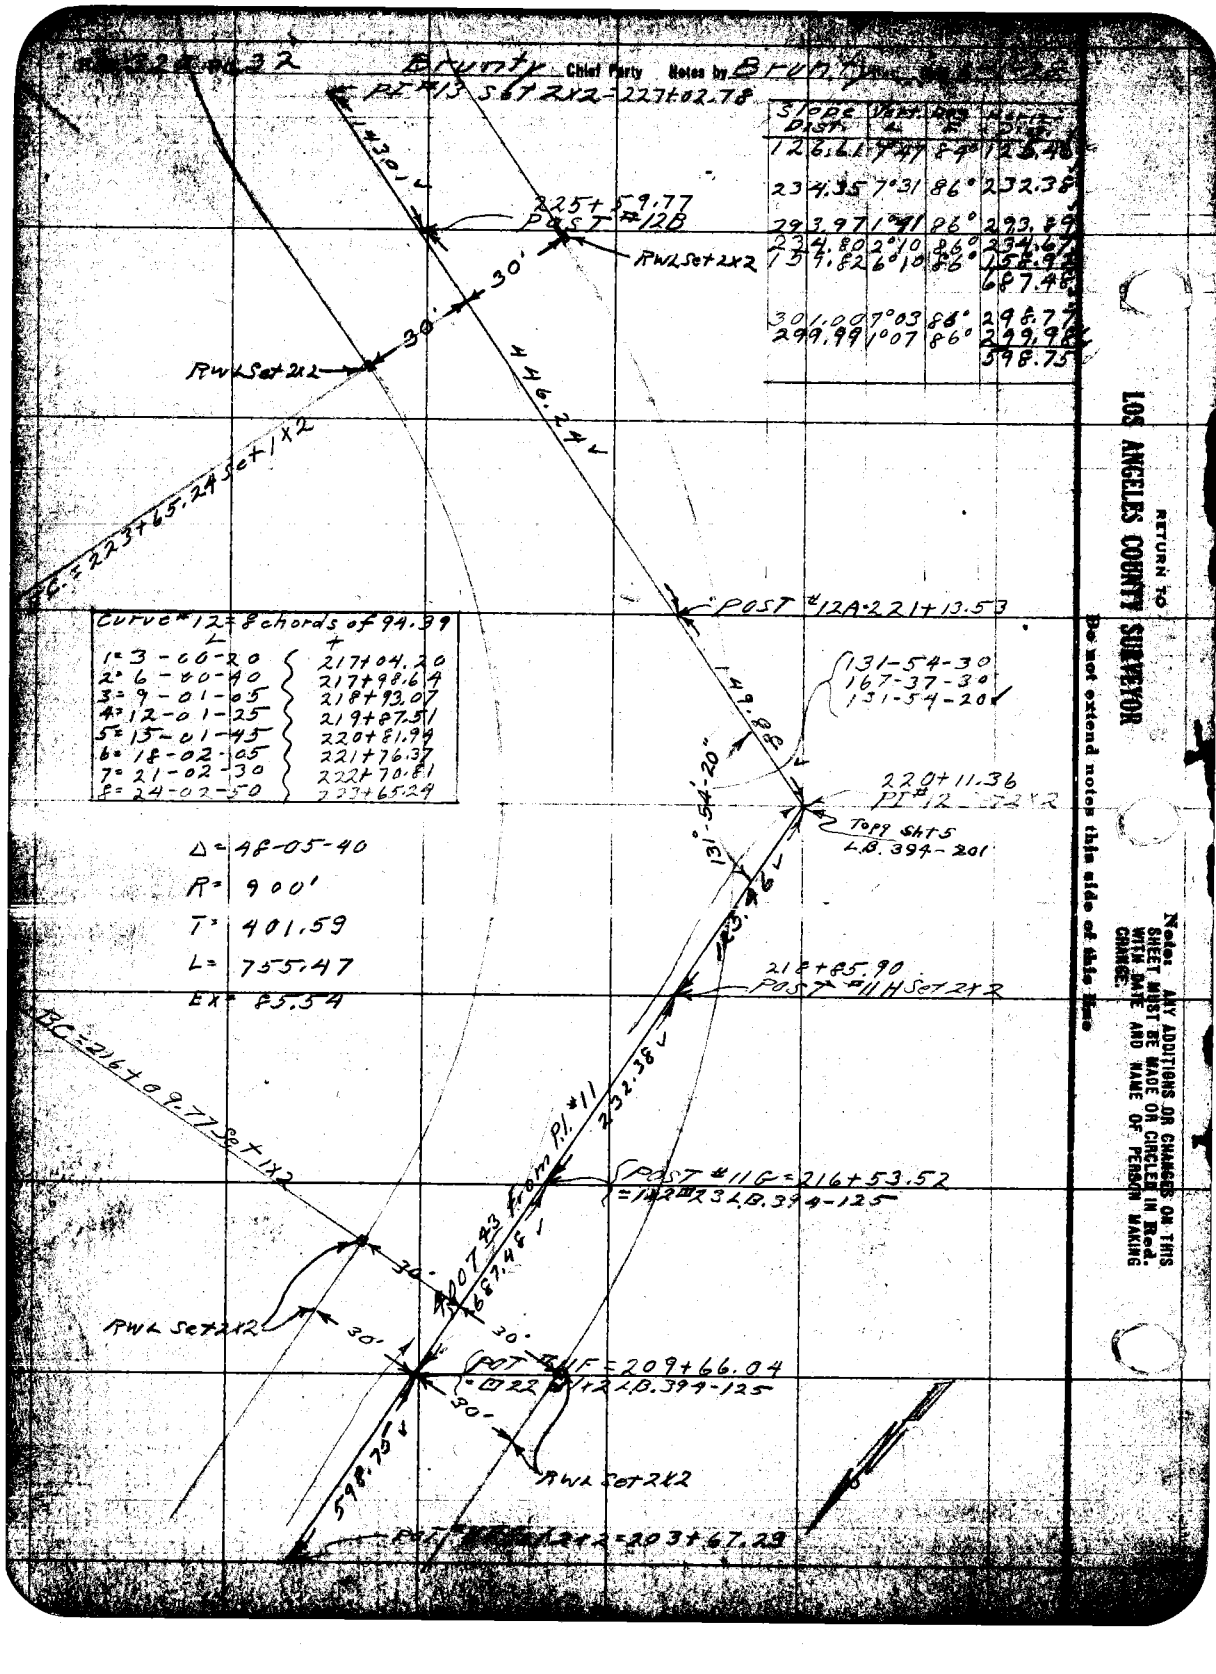
Chief Party
Notes by
225+09.77
POST #12B
RWL Set 2x2
RWL Set 2x2
RWL Set 2x2
POST #12A 221+13.53
220+11.36
PI #12
Topo Sht 5
L.B. 394-201
POST #11G = 216+53.52
#11 2x2 L.B. 394-125
POST #11F = 209+66.04
#11 2x2 L.B. 394-125
RWL Set 2x2
RWL Set 2x2
RWL Set 2x2
POST #11H Set 2x2
Curve #12 = 8 chords of 94.39
Δ = 48-05-40
R = 900'
T = 401.59
L = 755.47
E = 85.54
131-54-30
167-37-30
131-54-20
RETURN TO
LOS ANGELES COUNTY SURVEYOR
Do not extend notes this side of this line
Notes: ANY ADDITIONS OR CHANGES ON THIS SHEET MUST BE MADE OR CIRCLED IN Red WITH DATE AND NAME OF PERSON MAKING CHANGE.

Alaska

Date June 1928.
Map No. B-300

Location Ay Springs Rd
Surveyed by C E Brunty

Date July 1928.
Indexed A. C. Johnson

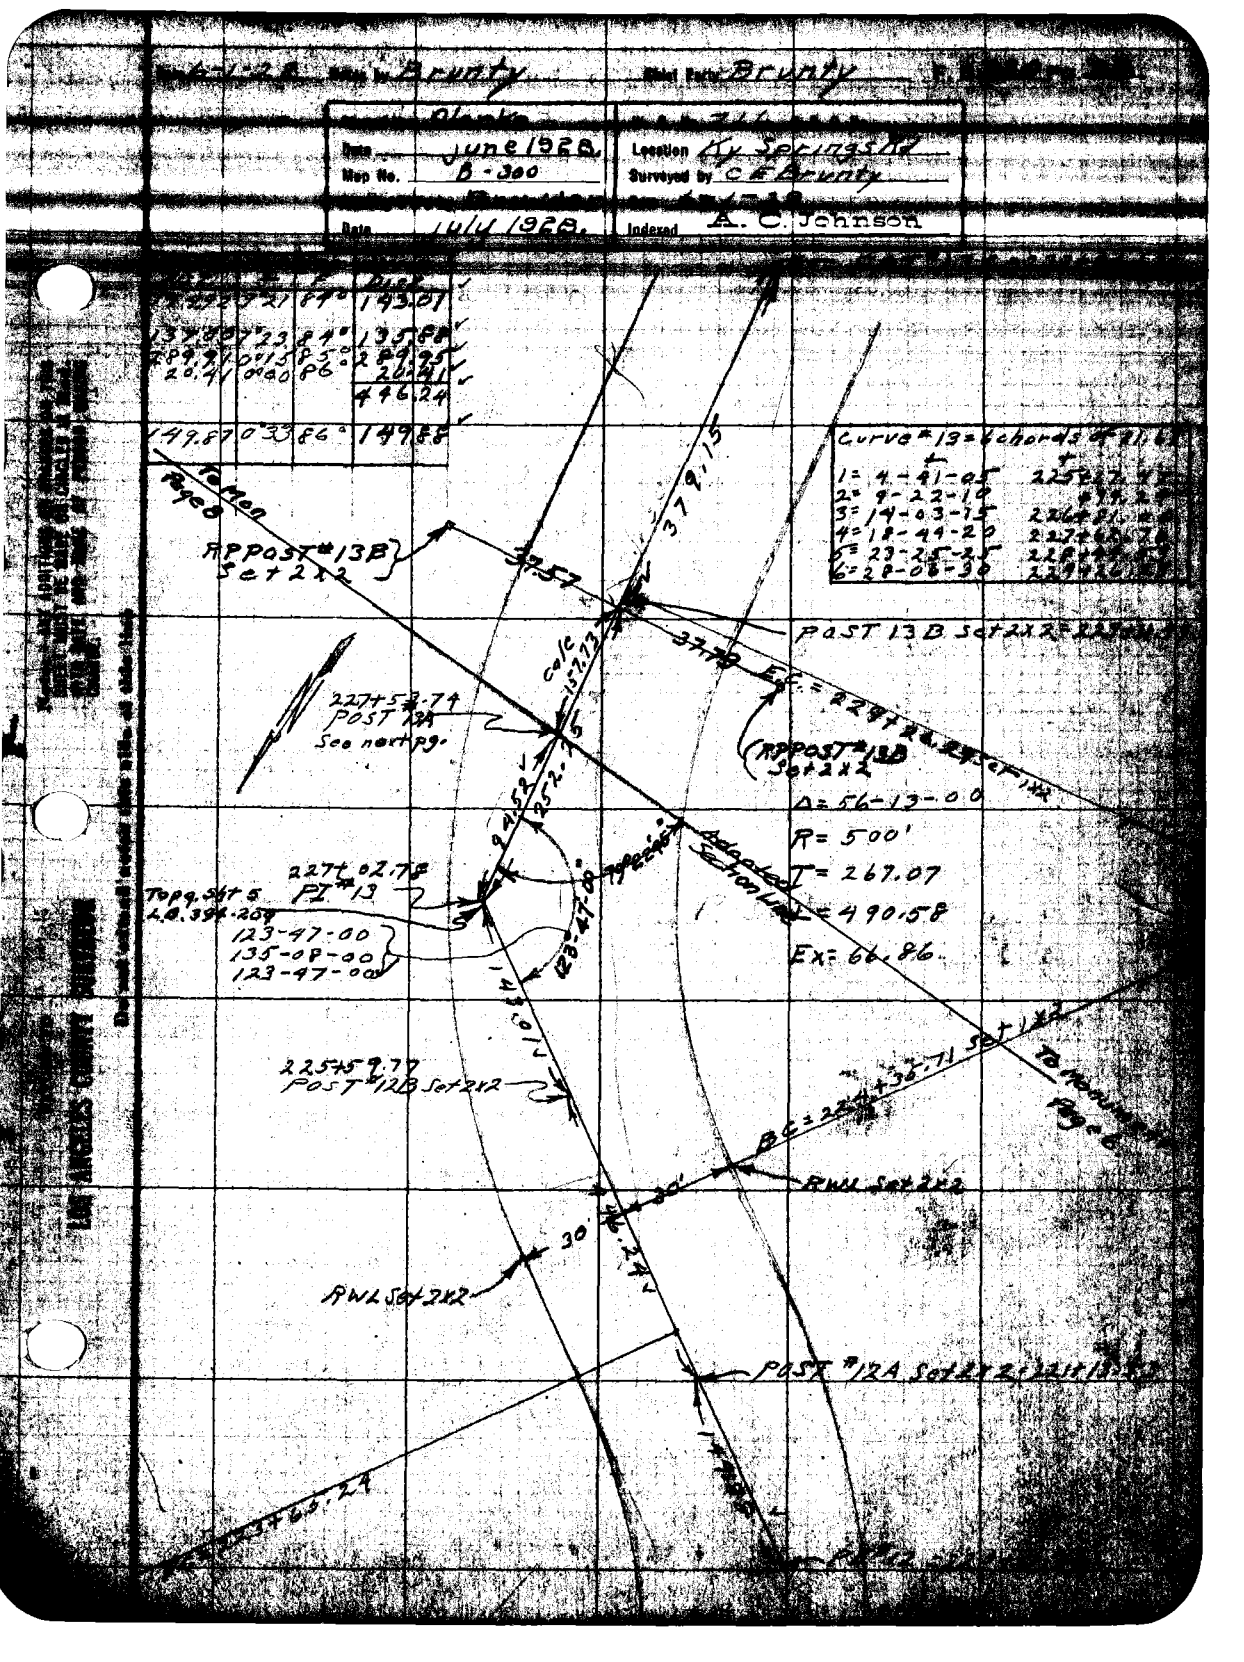

Bk 27 Pg. 24 — Brudy — Chief Party — Notes by Brudy — Date 5-31-24

Name Dist.	Ver. Δ	D=3 R	Horiz. D/SP.
248.62	0°55'	3°	248.67
286.50	0°55'	3°	286.51
92.65	0°50'	3°	92.64
			379.15
252.34	0°17'	1°	252.25
230.00	0°58'	1°	230.01
90.09	2°16'	1°	90.03
			320.04
94.86	1°37'	1°	94.52

POT #14A = 227+75.06

Y Section Line See Pg. 35

248.62

PC = 236+86.96 Set 1x2

Curve #14 = 4 chords of 76.22

1 4-22-20	234+58.07
2 6-44-35	235+34.36
3 13-06-55	236+10.66
4 27-29-10	236+86.96

RWL Set 2x2

5+01.22

5.78

PT #14 = 235+39.29

Topg Sht 5 L.B. 394-215

145-01-40" Adj.

145-01-45
220-07-00
145-01-45
145-01-40" Adj.

Δ = 34-58-20
R = 500
T = 157.52
L = 305.19
E = 24.27

379.15

RC = 233+81.77 Set 1x2

RWL Set 2x2 — 30' — POT #13C Set 2x2 = 232+90.62

30'

RWL Set 2x2

79-22-45
317-31-90
79-22-45

Cor Secs 2,3 NW 1/2 SW 1/4

79°22'45"

POST #13B Set 2x2 = 229+11.97

To Mea. Pt. B

326.04

227+53.74

POST #13A Set 2x2 by Intersection

Adopted Sec. Line

To Mea. Pt.

Cor Secs 2,3, 10 & 11 T1N R11W

Pg. 7

PC #13 Set 2x2 = 227+32.75

Return to LOS ANGELES COUNTY SURVEYOR

Do not extend notes this side of this line

Note: ANY ADDITIONS OR CHANGES ON THIS SHEET MUST BE MADE OR CIRCLED IN Red, WITH DATE AND NAME OF PERSON MAKING CHANGE.

Date June 1928.
Map No. B-300
Date July 1928.
Location Kyrenington
Surveyed by C.E. Brandy
Indexed A. C. Johnson

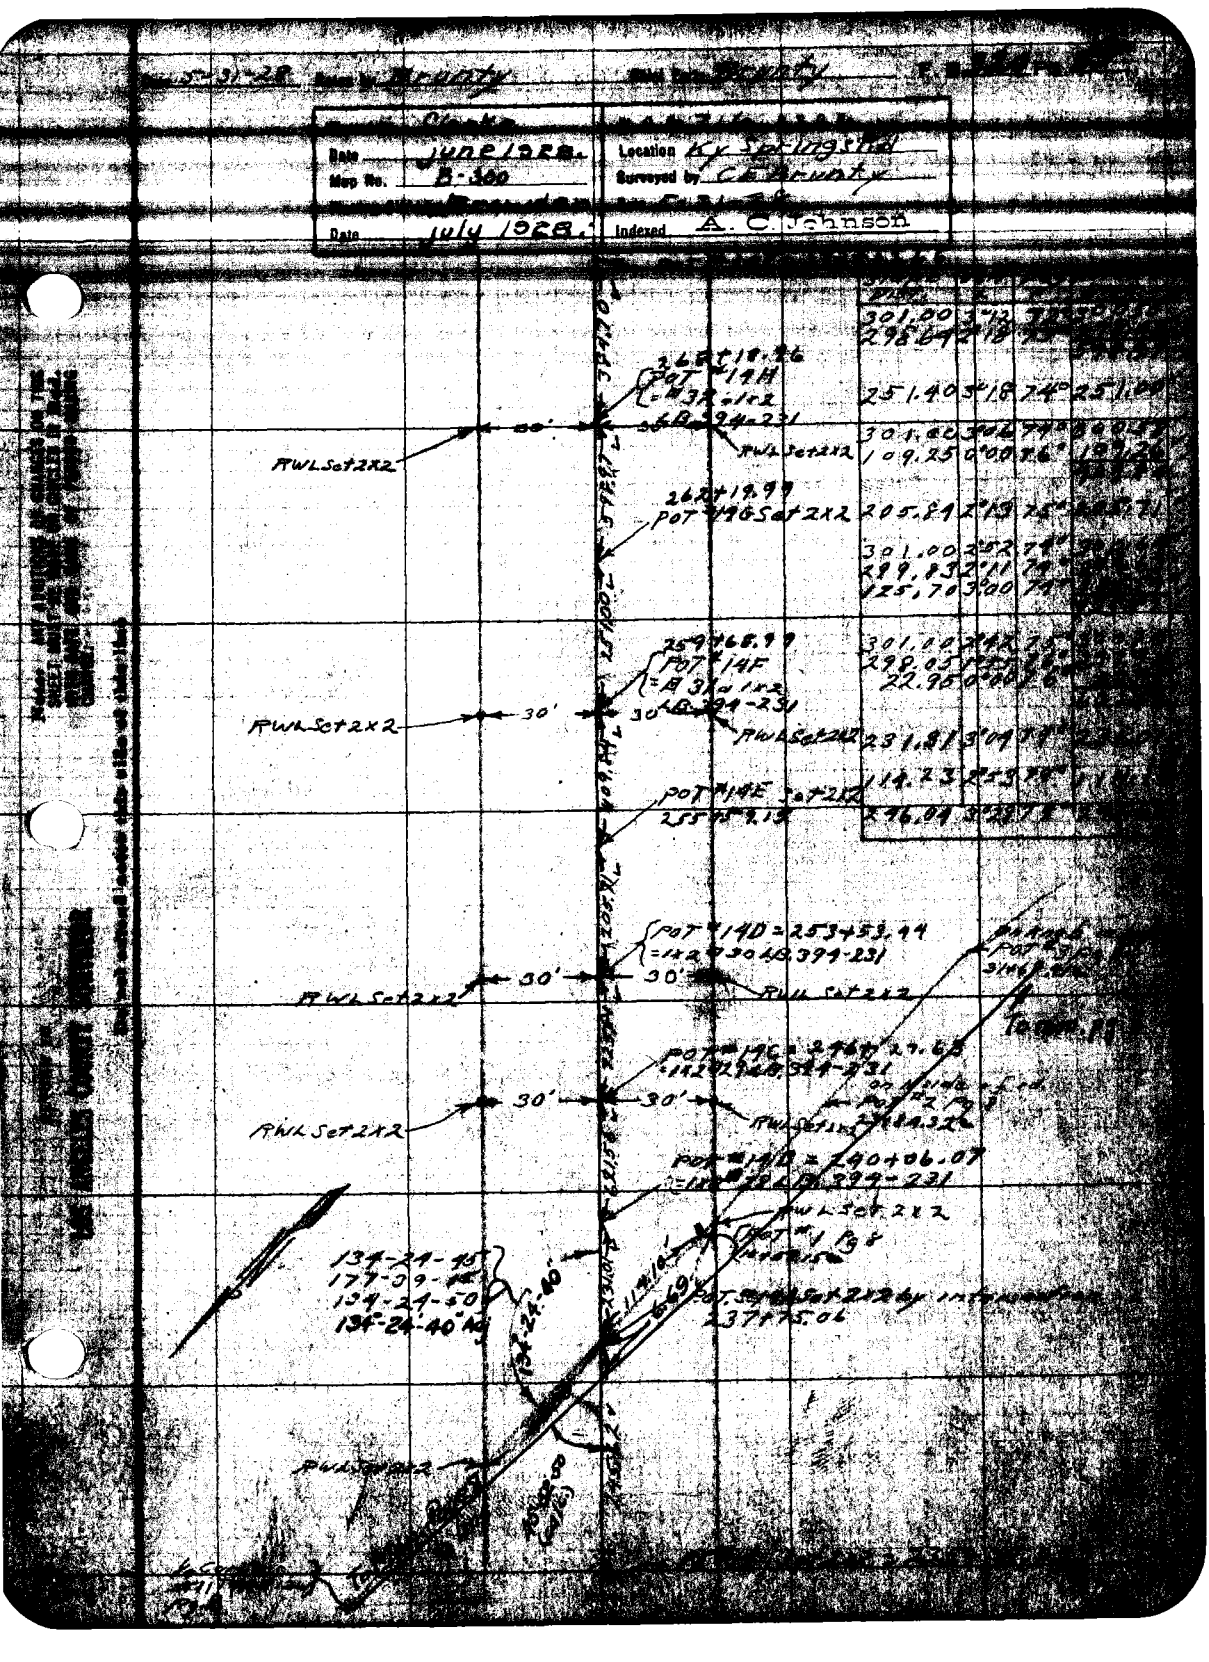

RETURN TO
LOS ANGELES COUNTY SURVEYOR
Do not extend notes this side of this line

Notes: ANY ADDITIONS OR CHANGES ON THIS SHEET MUST BE MADE OR CIRCLED IN RED AND INITIALED WITH DATE AND NAME OF PERSON MAKING CHANGE.

S.B. 22 Pg. 36 — Brunty, Chief Party — Notes by Brunty — Date 5-30-28

PC = 16+278+25.02

Sta. or Dist.	Δ	D	Deg. or R	Notes
69.61	3°48	92°	61.52	
262.77	2°00	90°	262.86	
299.60	8°41	56°	295.32	
283.92	8°38	84°	283.72	
282.07	7°30	84°	281.56	
			860.82	
299.75	2°28	72°	299.56	
85.13	0°00	72°	85.14	
			38470	

PC = 276+02.16 Set 1x2

Curve #15 = 2 chds of 66.47

Δ	Sta
1° 2-48-40	275+35.64
2° 7-37-20	276+02.16

Δ = 15-14-40
R = 500
T = 66.91
L = 133.03
Ex = 1.45

PWL 34.45 — 164-45-20" Adj.

Topg Sht 2
L.B. 394-111
164-45-30
299-02-00+
164-45-30 ✓
164-45-20" Adj.

PT #15 = 275+35.64

25.55

Cor. Secs. 11, 12, 13+14 T4N R12W Pg 9 To Mon. Page 9

To Mon. Page 9

Section Line

69.52 ✓

45-40-40 ✓
182-43-00 ✓
45-40-40 ✓
45-40-55 Adj

Sec. 272+62.13 Set 1x2

272+66.52 Page 9 Set 2x2 by Intersection

Section Line Mon

2.86 ✓

2.61

Adopted

N 55° 40' 55" E 710 ✓

PRT #191 Set 2x2 = 272+03.66

To Mon. Page 9

Cor. Secs. 1, 6, 12 T4N R12W Pg 9

To Mon. Page 9

384.10 ✓

268+18.96
PRT #44 Set 1x2 = #32



Date 5-30-28
Indexed A. C. Johnson

Los Angeles County Surveyor

Notes: All courses are true bearings unless otherwise noted. The mark "Set" indicates that the point was set in this survey.

POT #16 A-283+45.55

Top of Shale
L.B. 294-111

12.24

RWL Set 2x2

PT #16
=278+25.02

154-22-40 Adj.

154-22-40 Adj.

RWL Set 2x2

12.24

154-22-40 Adj.

Curve #16 = Radius of 55.87

	Δ	Sta.
1	3-12-10	277+67.22
2	4-24-20	278+22.10
3	9-36-30	278+77.98
4	12-48-40	279+34.92

Δ = 25-37-20
R = 500
T = 113.70
L = 223.60
E = 12.76

EC = 279+34.92 Set 2x2

BC = 277+11.32 Set 2x2

277.72

POT #16 A-283+45.55

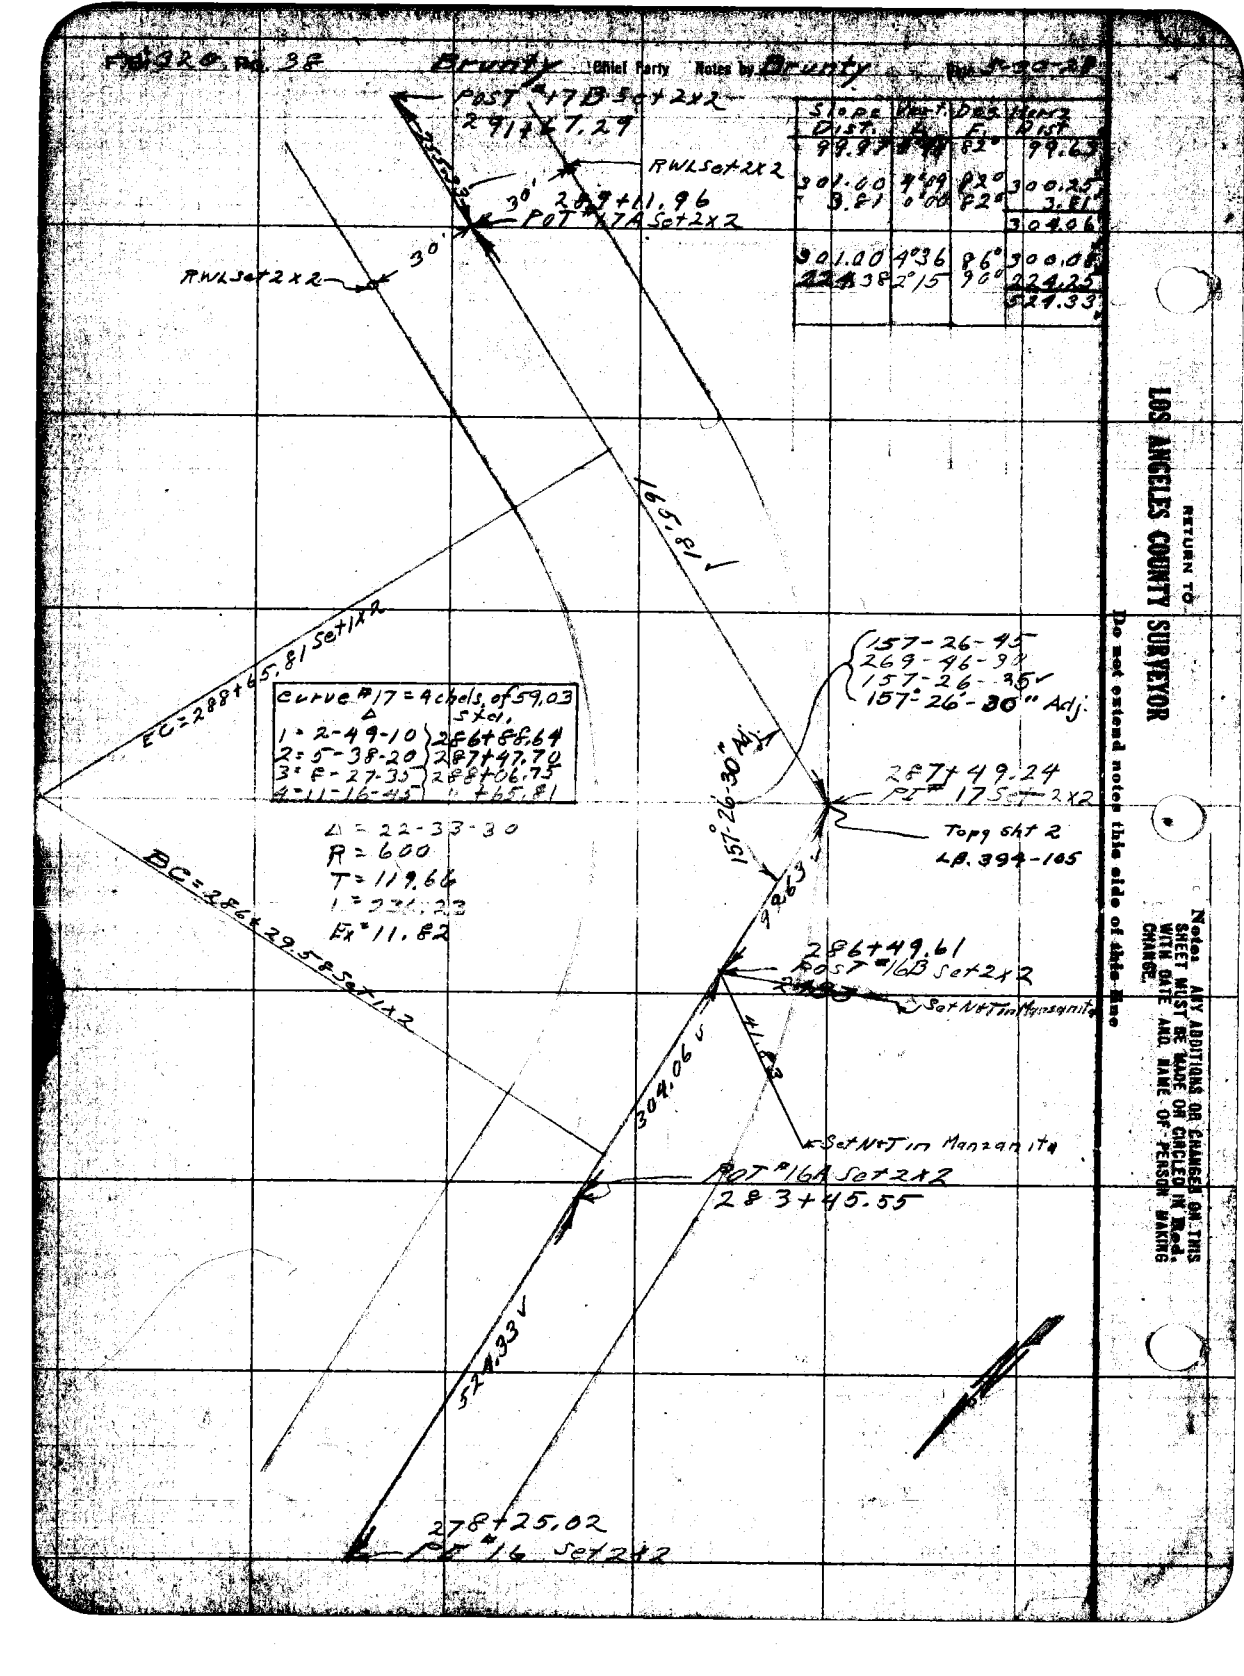
Rpt 220 Pg. 38
Brunty (Chief Party) Notes by Brunty
POST #17B Set 2x2
291+27.29
RWLS set 2x2
30'
288+41.96
POT #17A Set 2x2
30'
RWLS set 2x2
SLOPE DIST. | Hor. Dist. | Deg. | Hor. Dist.
99.83 | 99.63
301.00 | 3.81 | 7°49' | 0°00' | 82° | 72° | 300.25 | 3.81
304.06
301.00 | 224.38 | 4°36 | 2°15 | 86° | 90° | 300.08 | 224.25
524.33
EC = 288+65.81 Set 1x2
Curve #17 = 4 chols. of 59.03
Δ
1 = 2-49-10 | 288+65.81
2 = 5-38-20 | 287+47.70
3 = 8-27-35 | 286+06.75
4 = 11-16-45 | 284+65.81
Δ = 22-33-30
R = 600
T = 119.64
L = 234.23
Ex = 11.82
BC = 286+29.58 Set 1x2
165.81
157-26-45
269-46-37
157-26-35
157°-26'-30" Adj.
157°-26'-30" Rt.
287+49.24
POT #17 Set 2x2
Topg sht 2
LB. 394-105
9.63
286+49.61
POST #16B Set 2x2
Set Nail in Manzanita
41.83
Set Nail in Manzanita
304.06'
POT #16A Set 2x2
283+45.55
524.33'
278+25.02
POT #16 Set 2x2
RETURN TO
LOS ANGELES COUNTY SURVEYOR
Do not extend notes this side of this line
Notice: ANY ADDITIONS OR CHANGES ON THIS SHEET MUST BE MADE ON CIRCLED IN RED WITH DATE AND NAME OF PERSON MAKING CHANGE.

Date 5-29-28 Notes by Brunty Chief Party Brunty F. B. 320 Pg. 39

Plotted by Clarke
Date June 1928
Map No. B-300
Plotting Chkd by Crowder
Date July 1928.

W. O. No. 746 L. S. No.
Location Ft Springs Rd.
Surveyed by C.E. Brunty
Date 5-29-28
Indexed

Sta.	Dist.	Deg	Rad.
291+67.29 PT	187.60	90°	187.60
255+40	1°37	82°	255.33
168+89	9°40	82°	165.81

POST 18.B

POST 18A

N+T in scrub oak

N+T in Pine tree

Top of Sht 2
L.B. 394-93
Sect 2 YR:
PT #18
293+54.89
134-27-45
177-51-00
134-27-45
134-27-50 Adj.

134-27-50 M.S.

Curve #18 = 4 chords of 99.18

	Δ	Sta
1	5-41-30	292+44.35
2	11-23-00	293+43.73
3	17-04-35	294+43.07
4	22-46-05	295+42.42

Δ = 45-32-10
R = 500
T = 209.85
L = 397.38
EX = 42.25

291+67.29
POST 47.B Sta 2+2

PC 291+45.04

R=255.33

288+11.96
POT TXS of 212

165.81

Notes: ANY ADDITIONS OR CHANGES ON THIS SHEET MUST BE MADE ON CHECKED IN Red. WITH DATE AND NAME OF PERSON MAKING CHANGE.

Do not extend under this side of this line

Return to LOS ANGELES COUNTY SURVEYOR

F.B. 5224 Pg. 40 — Chief Party — Notes by Brady — Date 5-29-28

PI = 20+56.42 = 3614.09.46

Stake Dist.	Hor. Z	Dec. E	Hor. Z Dist.
249.69	8°51	86°	249.92 ✓
256.88	6°04	84°	255.48 ✓
239.69	4°96	70°	238.78 ✓
167.78	3°25	73°	167.49 ✓
87.00	15°32	76°	83.69 ✓
288.96	10°99	79°	284.54 ✓
236.23	9°18	83°	235.13 ✓
219.80	0°95	83°	219.81 ✓
			823.17 ✓
2.89	0°00	85°	2.89 ✓
7.05	0°00	85°	7.05 ✓

300+02.88 POST #2 19 Set 2x2 5-30-28

1x2" 0+00 to S.

1/4 W.T. Cor Secs. 1 & 12 T1N R12W

238.28

208.72 ✓

11°00'

POST #7 1+2

167.39

POST #6B Set 1x2

Sec. Line 16 mon. Pg. 9

BC = 296+75.22 Set 1x2

Curve #19: 6 chords of 46.66

Δ	Sta
1 = 5-57-10	297+22.47
2 = 11-54-15	" +69.22
3 = 17-51-20	298+15.97
4 = 23-48-20	" +62.71
5 = 29-45-35	299+09.46
6 = 35-42-45	" +56.21

Δ = 71-25-30
R = 935
T = 161.75
L = 280.99
Ex = 52.11

102-81-00
50-04-00
102-31-00 ✓

Topg SAT 2 L.B. 394-91 29+37.47 PI #3 Set 2x2

108-34-30
74-12-00
106-34-30 ✓

POST #5 RS Set 2x2 by Intersection 298+34.56

POST #6A Set 1x2

77-31-00 (calc)

To mon. Pg. 9

249.92

POST #3 1+2

295+84.65 POST #1 RS Set 2x2

43-57-15

Z 30+54.89 POST #2 Set 2x2

Notes: ANY ADDITIONS OR CHANGES ON THIS SHEET MUST BE MADE OR CREDLED IN RED WITH DATE AND NAME OF PERSON MAKING CHANGE.

LOS ANGELES COUNTY SURVEYOR

RETURN TO

Do not extend notes this side of this line

Date 5-22-28 Notes by Brunty Chief Party Brunty F. B. 220 Pg. 44

Plotted by Clarke
Date June 1928.
Map No. B-300
Plotting C.S.'d by Brawder
Date July 1928.

W. O. No. 716 C. S. O. No.
Location Ky Springs Rd.
Surveyed by C.E. Brunty
Date 5-22-28
Indexed A. C. JOHNSON

Dist.	Δ	R	Dist.
122.38	77°25'	77°	121.58 ✓
103.62	11°23'	86°	101.60 ✓
208.64	12°49'	86°	208.42 ✓

Sta 30+22.2

121.58

30+16.09
POT = 20 A Sta 2+2

30

30

RWL Sta 2+2

121.18

FC = 301+99.91 Sta 1+2

Topg Sta 1+2
L.P. 394-89
PI = 20 Sta 2+2
30.1+09.48

142-06-00
208-24-30
142-06-10

142-06-10

Curve #20 = 4 Chds. of 99.33

Δ	Sta
1: 4-44-15	300+51.09
2: 9-28-25	301+00.70
3: 14-12-40	" +50.30
4: 18-56-55	" +99.91

Δ = 37-53-50
R = 300
T = 103.00
L = 198.43
Ex = 17.19

101.60

103.00 @ 15°45 = 99.13

56.83

POST Sta 2+2
300+02.88

PC = 300+01.48 Sta 1+2

61.92 @ 229°12' = 56.83
APPOST = 191.56 Sta 2+2

99.13

APPOST = 191
Sta 2+2

79°52'30"

208.42

PT = 299+92.90 Sta 1+2

Notes: ALL CENTERLINE TIE SHEET MUST BE CHECKED WITH DATE AND INITIAL OF PERSON MAKING CHANGE.

Do not extend notes this side of this line

RETURN TO LOS ANGELES COUNTY SURVEYOR

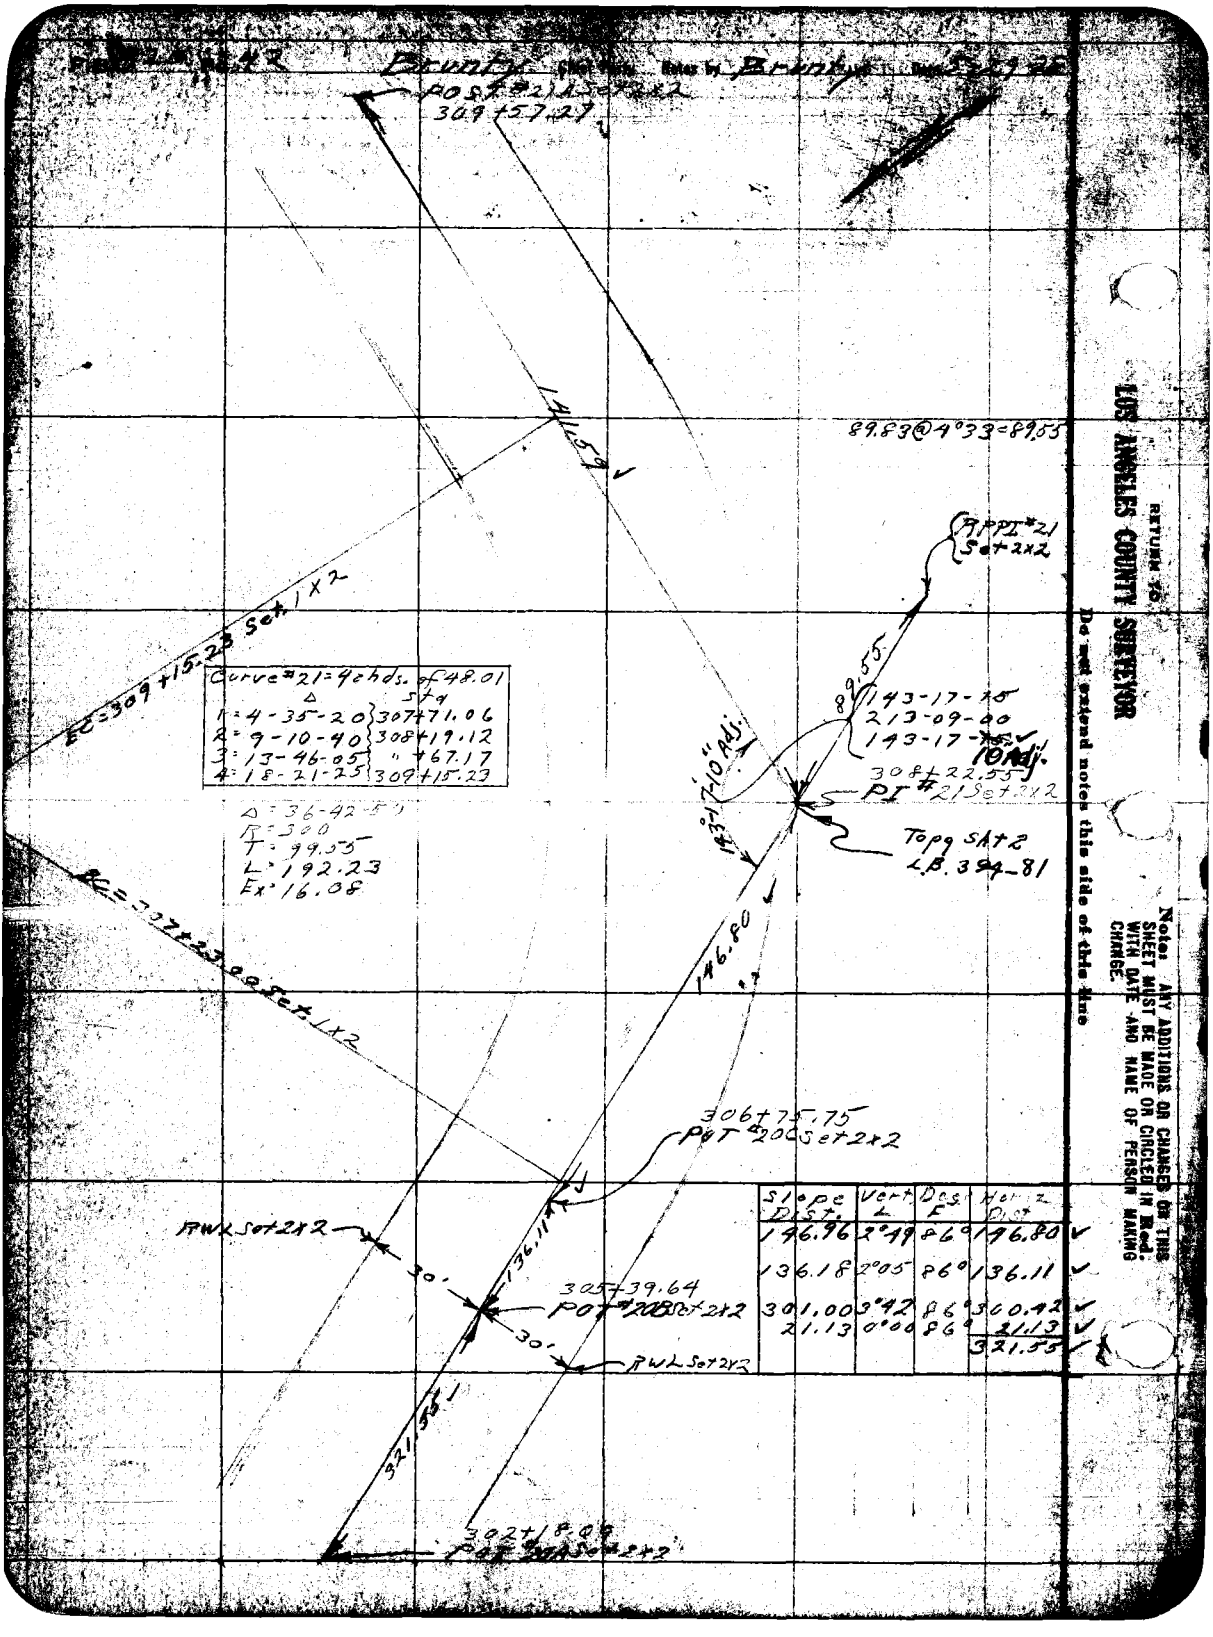

Slope Dist.	Vert ∠	Dec ∠	Horiz Dist.	
146.96	2°19	86°	146.80	✓
136.18	2°05	86°	136.11	✓
301.00	3°42	86°	300.92	✓
21.13	0°00	86°	21.13	✓
			321.55	✓

RETURN TO
LOS ANGELES COUNTY SURVEYOR
Do not extend notes this side of this line

Notes: ANY ADDITIONS OR CHANGES ON THIS SHEET MUST BE MADE OR CIRCLED IN Red: WITH DATE AND NAME OF PERSON MAKING CHANGE.

Date 5-23-28 Notes by Beverly Chief Party Beverly F.B. 226 Pg. 43

Checked by Clarke
Date June 1928.
Map No. B-300
Plotting C'k'd by Browder
Date July 1928.

W.O. No. 716 S.O. No.
Location Big Springs Rd
Surveyed by C.E.B. - Beverly
Date May 25th - June 29th 1928
Indexed A. C. Johnson

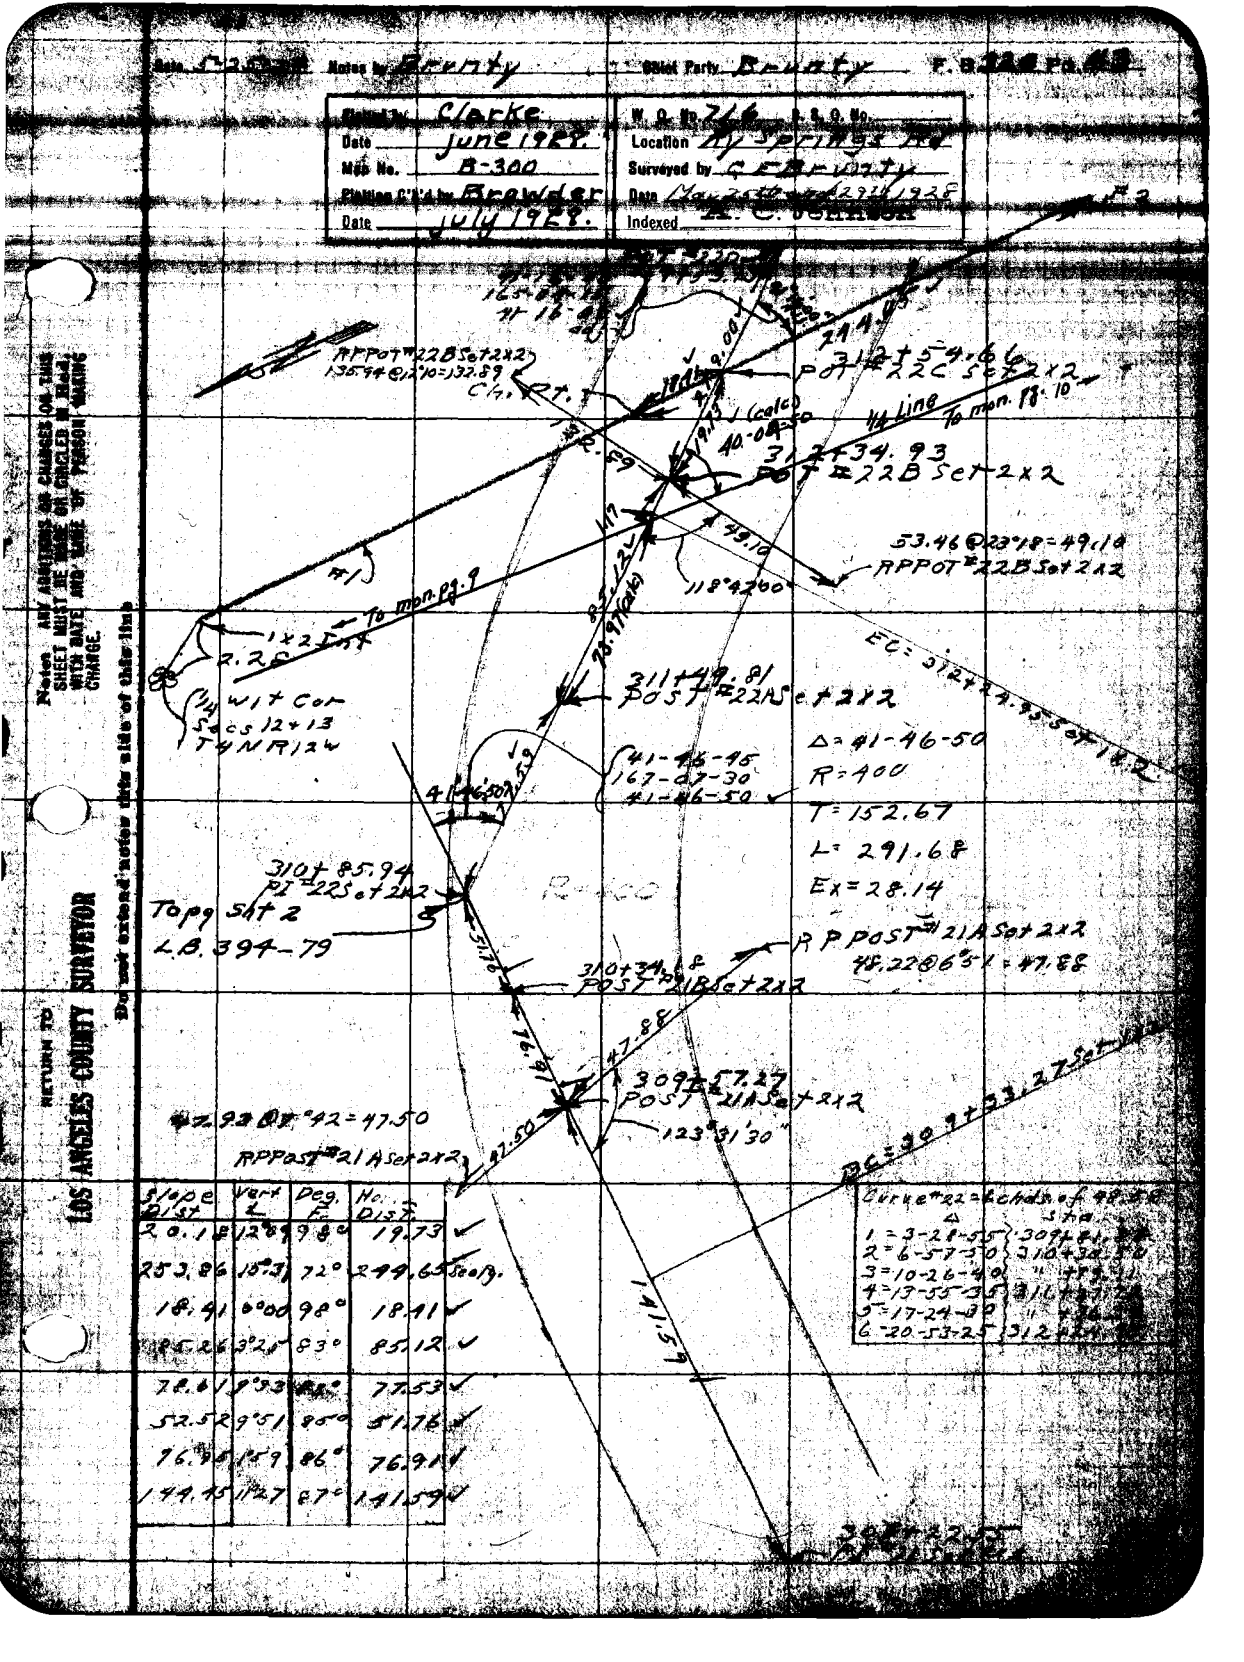
RPPOT "22B Set 2x2
135.94 @ 270 = 132.89
C/L
RT.
184.
Pt 16.00
Pt 16.00
214.
POT "22C Set 2x2
314+54.66
To man. 18.10
14 Line
40.04
314+34.93
POT "22B Set 2x2
53.46 @ 23°18 = 49.10
RPPOT "22B Set 2x2
118°42'00"
To man. pg. 9
1x2 Set
2.22
1/4 W1T Cor
Secs 12+13
T4N R12W
311+49.81
POST "22A Set 2x2
Δ = 41-46-50
R = 400
T = 152.67
L = 291.68
Ex = 28.14
41-46-50
167-07-30
41-46-50
EC = 312+44.95 Set 1x2
310+85.94
PI "22B Set 2x2
Topg Sat 2
L.B. 394-79
RPPOST "21A Set 2x2
48.22 @ 65 = 47.88
310+34.18
POST "21B Set 2x2
309+57.27
POST "21A Set 2x2
123°31'30"
2.92 @ 42 = 47.50
RPPost "21A Set 2x2
Pt 22.00
Pt 22.00
Pt 22.00

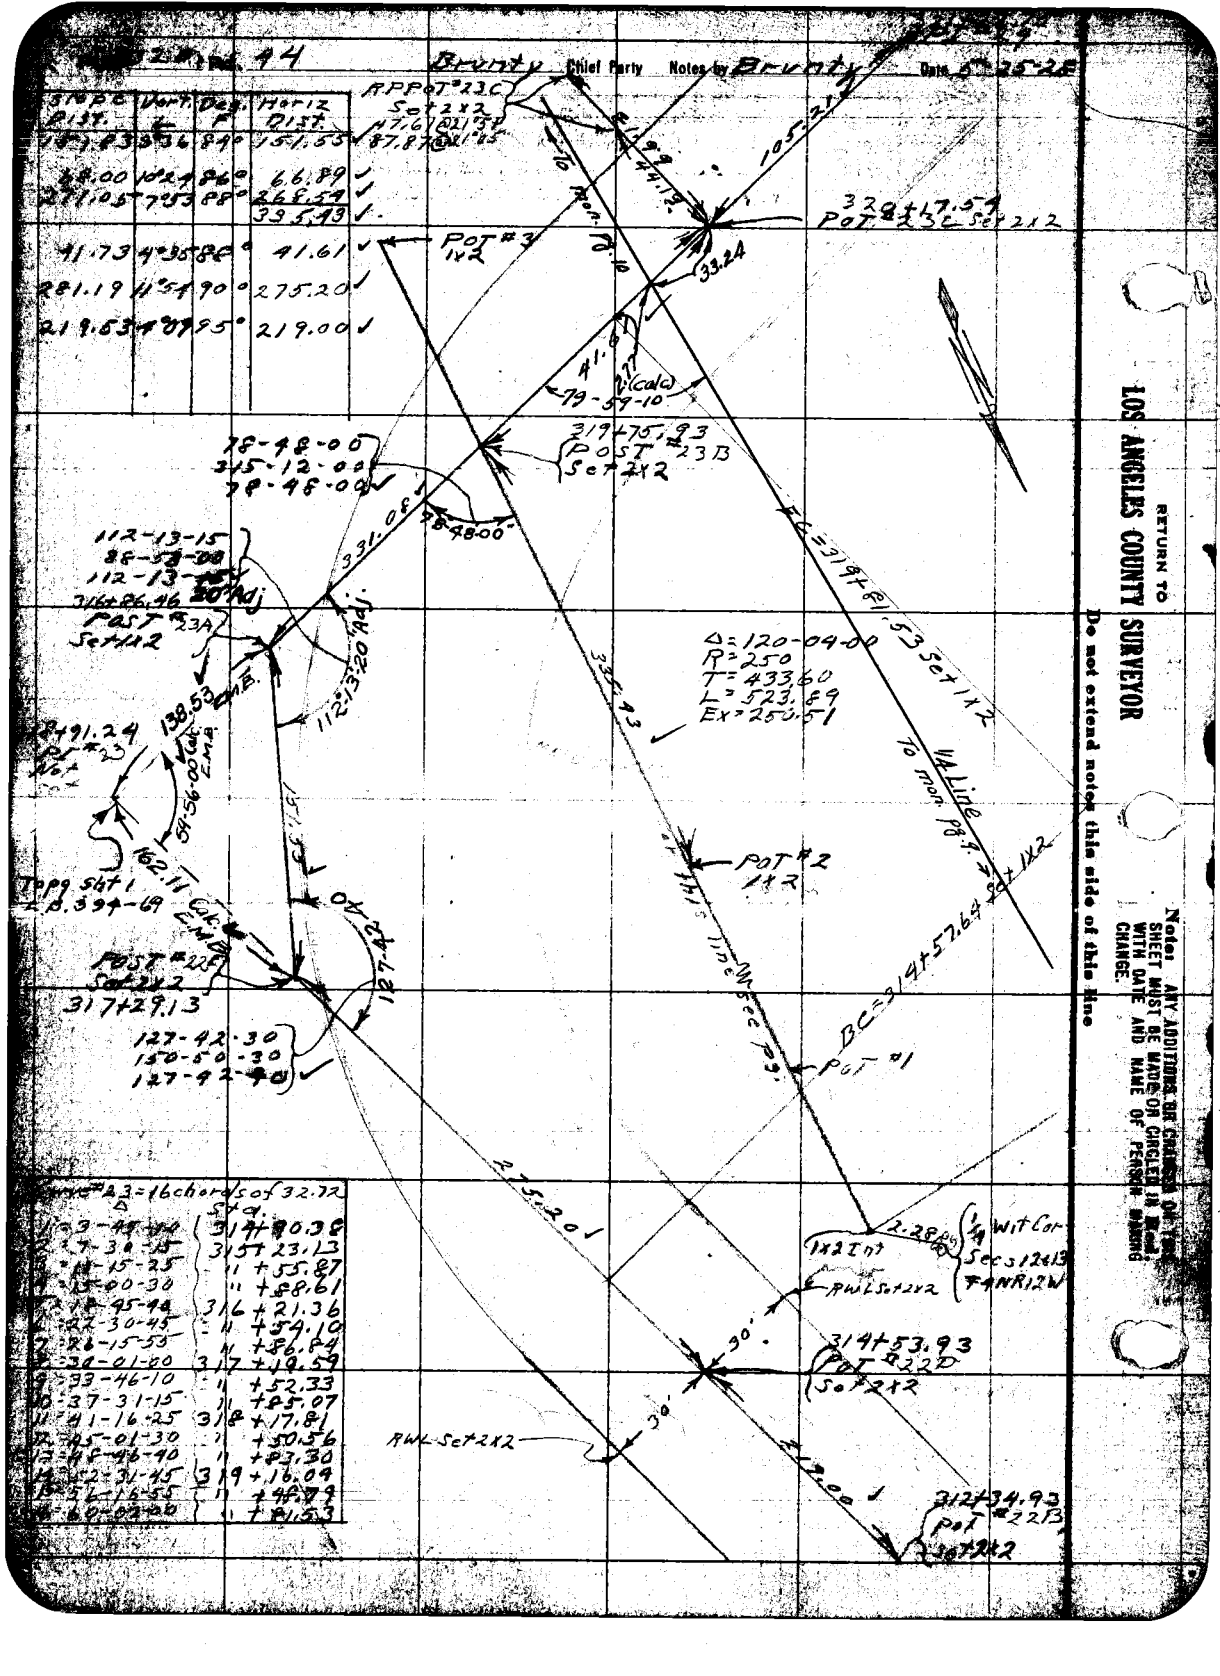

Sta P.C.	Dist.	Var.	Deg.	Min	Sec	Horiz. Dist.
314+83.53						
	48.00	N	2	46	0	66.89
271.05		S	75	38	0	268.54
						335.43
	41.73		4	35	0	41.61
281.19			11	54	0	275.20
219.53			7	07	0	219.00

Curve #23 = 16 chords of 32.72

	Δ	Sta.	
1	3-44-40	314	+80.38
2	7-30-25	315	+23.13
3	11-15-25	"	+55.87
4	15-00-30	"	+88.61
5	18-45-44	316	+21.36
6	22-30-45	"	+54.10
7	26-15-53	"	+86.84
8	30-01-30	317	+19.59
9	33-46-10	"	+52.33
10	37-31-15	"	+85.07
11	41-16-25	318	+17.81
12	45-01-30	"	+50.56
13	48-46-40	"	+83.30
14	52-31-45	319	+16.04
15	56-16-55	"	+48.79
16	60-02-40	"	+81.53

Date 5-24-28 Notes by Brunty Chief Party Brunty F. B. [illegible] Pg. [illegible]

Plotted by Clarke
Date June 1928.
Map No. B-300
Plotting Checked by Brunty
Date July 1928.

W. O. No. 716 [illegible]
Location Ky. Spr. 179's Rd
Surveyed by Brunty
Date 5-24-28
Indexed A. C. Johnson

Sta.	Ang.	Dec.	Dist.
Dist.			
105.71	5°51	18°	105.21 ✓
900.00	5°43	9 4°	29 F.57 ✓
35.50	23°40	8 0°	32 51 ✓
			331.08 ✓

PI 24 Sta 2+2
329+46.67

163.13 ✓

321+82+92
PI 24 Sta 2+2

EC = 322+05.82 Sta 1+82

42.71 ✓

Curve #24 = 4 chords of 42.16

	Δ	Sta.
1 =	3-01-10	320+79.31
2 =	6-02-25	321+21.48
3 =	9-03-35	321+63.65
4 =	12-04-50	322+05.82

Δ = 24-09-40
R = 400
T = 85.61
L = 168.68
Ex = 9.06

Topg Sta 1
48.394-65
321+22.75
PI 24 Sta 2+2

155-50-20 Rt

155-50-15
263-21-40
154-50-25 ✓

105.21 ✓

BC = 320+37.14 Sta 1+2

320+17.54
PI 23C
Sta 2+2

POST 23B Sta 2+2
319+75.93

316+86.46
POST 23A
Sta 2+2

Notice: ANY ALTERATIONS OR CHANGES ON THIS SHEET MUST BE NOTED ON CIRCLED IN Red. WITH DATE AND NAME OF PERSON MAKING CHANGE.

RETURN TO LOS ANGELES COUNTY SURVEYOR

Do not extend notes this side of this line

Fd. 220 Pg. 46 Brunty Chief Party Notes by Brunty Date 5-29-28

Slope Dist.	Vert L	Deg F	Horiz Dist.
63.61	4°29	98°	163.15
62.86	4°19	98°	62.71

325+80.52
POST #25 B Sof2x2

196.90

324+44.12
POST 25A Sof2x2

100.59

EC=324+01.70 Sof1x2

Curve #25=4 chds of 28.42

	Δ	Sta
1	3-37-15	323+16.39
2	7-14-30	" +44.83
3	10-51-45	" +73.26
4	14-29-00	324+01.70

R=2865'
T=558.12
L=1113.75
Fx=7.36

Topo sht 1
L.B. 394-63

323+46.07
S87°52 25 E
54.95
28.48

RPPT #25 Sof2x2
30.82 @ 21°27'
71.39 @ 26°29

151-02-00
244-56-00
151-02-00

151-02-00

163.15

BC=322+87.95 Sof1x2

321+82.92
POST #24A
Sof2x2

62.71

321+22.75
PT #24
Sof2x2

RETURN TO
LOS ANGELES COUNTY SURVEYOR
Do not extend notes this side of this line

Note: ANY ADDITIONS OR CHANGES ON THIS SHEET MUST BE MADE OR CIRCLED IN Red. WITH DATE AND NAME OF PERSON MAKING CHANGE.

Date 5-25-28 Noted by Brunty Chief Party Brunty F. B. 320 Pg. 42

Plotted by Clarke
Date June 1928.
Map No. B-300
Blueprint Checked by Bannister
Date 7/14/1928.

W. O. No. 7/6 S. P. No.
Location Ry Spr-Inds Rd
Surveyed by C E Brunty
Page 5-22-28
Indexed

Notes: ANY ADDITIONS OR CHANGES ON THIS SHEET MUST BE MADE IN CIRCLES IN RED, WITH DATE AND INITIALS OF PERSON MAKING CHANGE.

Do not extend notes this side of this line

RETURN TO LOS ANGELES COUNTY SURVEYOR

139.55	5°09'30"	139.52	
137.19	6°17'24"	137.10	
100.52	0°34'97"	100.54	

329+35.98

RP POST #26B Set 2x2 89.10@18°41

227.57

84.38

75°41'

326+98.39 POST #26B Set 2x2

52.52

326+45.87 POST #26A

152-53-15
251-32-30
152-53-10

70.23

RP POST #26B Set 2x2 79.51@19°31

EC=327+19.46 Set 1x2

Δ = 112-07-00
R = 150
T = 222.87
L = 293.52
Ex = 118.65

BC=324+25.94 Set 1x2

68.29 Calc.

324+44.12 POST #25A Set 2x2

94-59-40
19-59-00
94-59-40

100.54

Curve #26 = 8 chds of 36.66

	Δ	Sta
1	3-00-25	324+62.63
2	19-00-50	" +99.33
3	21-01-20	325+36.00
4	28-01-45	" +72.74
5	35-02-10	326+09.37
6	42-02-35	" +46.01
7	49-03-05	" +82.37
8	56-03-30	327+19.38

POT #25 Set 2x2 323+44.07

B320 Pg. 46 — Bruntz, Chief Party — Notes by Bruntz — Date 5-24-26

Slope Dist.	Vert. ∠	Dep. ∠	H. Tr. Dist.
49.78	1°00	87°	49.31 ✓
237.55	0°46	88°	237.57 ✓
52.40	10°30	90°	52.52 ✓

331+64.37 POST #27B Set 2x2

Curve #27 = Echds of 33.52

	Δ	Sta
1 =	6-24-50	327+82.22
2 =	12-49-45	328+15.60
3 =	19-14-35	" +49.39
4 =	25-39-25	" +82.98
5 =	32-04-20	329+16.56
6 =	38-29-10	" +50.15
7 =	44-54-05	" +83.73
8 =	51-18-55	330+17.32

328+97.56 POST #27A Set 2x2

77-22-15
309-26-30
77-22-10

Mpg. Sta 1.
18.394-57
PT #27 Set 2x2
329+35.96

48.31

PC #27 Set 2x2

EC = 330+17.32 Set #27

Δ = 102-37-50
R = 150
T = 187.33
L = 268.69
Ex = 89.99

EC = 327+48.63 Set 1x2

237.57

326+96.39 POST #26B Set 2x2

52.52

326+45.87 POST #26A Set 2x2

81
66
61
51
72.52

RETURN TO LOS ANGELES COUNTY SURVEYOR

Do not extend notes this side of this line

Notice: ANY ADDITIONS OR CHANGES ON THIS SHEET MUST BE MADE OR CIRCLED IN Red. WITH DATE AND NAME OF PERSON MAKING CHANGE.

Date 5-24-28 Notes by Brunty Chief Party Brunty F. B. 320 Pg. 5

Plotted by Clarke
Date June 1928.
Map No. B-300
Plotting Checked by BOWDEN
Date 10/4/1928.

Co. Co. No. 716
Location Ky Springs Rd
Surveyed by CEBrunty
Date 5-24-28
Indexed A. C. Johnson

Notice: ANY ADDITIONS OR CHANGES ON THIS SHEET MUST BE MADE OR CHECKED IN RED, WITH DATE AND NAME OF PERSON MAKING CHANGE.

Do not extend notes this side of this line

Return to LOS ANGELES COUNTY SURVEYOR

Set 2x2 [illegible]

295.74	5°31'38"	295.79
269.71	5°28'56"	269.81
67.68	3°27'56"	67.57

116.05

335+91.94
POST #28 Set 2x2
86°16'45"

APPOST #28B Set 2x2
73.91 @ 17°02' = 70.67

70.67

272.22

EC = 336+08.49 Set 1x2

Δ = 114-58-50
R = 275
T = 431.50
L = 551.87
Ex = 236.68

BC = 330+56.62 Set 1x2

Curve #28 = 12 chds. of 45.94

Δ	Sta.
1: 4-47-25	331+02.61
2: 9-54-35	" +48.60
3: 14-22-20	" +94.59
4: 19-09-50	332+40.58
5: 23-57-15	" +86.57
6: 28-44-40	333+32.56
7: 33-32-10	" +78.54
8: 38-19-35	334+24.53
9: 43-07-05	" +70.52
10: 47-54-30	335+16.51
11: 52-42-00	" +62.50
12: 57-29-25	336+08.49

328+97.56
POST #27A
Set 2x2

267.57

228+35.96
POST #27
Set 2x2

122.63 Calc.

65-01-10

Calc. Point

Adj.

323.75 Calc.

324+37

150°14'30" Adj.

APPOST #27B Set 2x2
73.48 @ 27°36'40" =
79.02 @ 20°44'=79.87

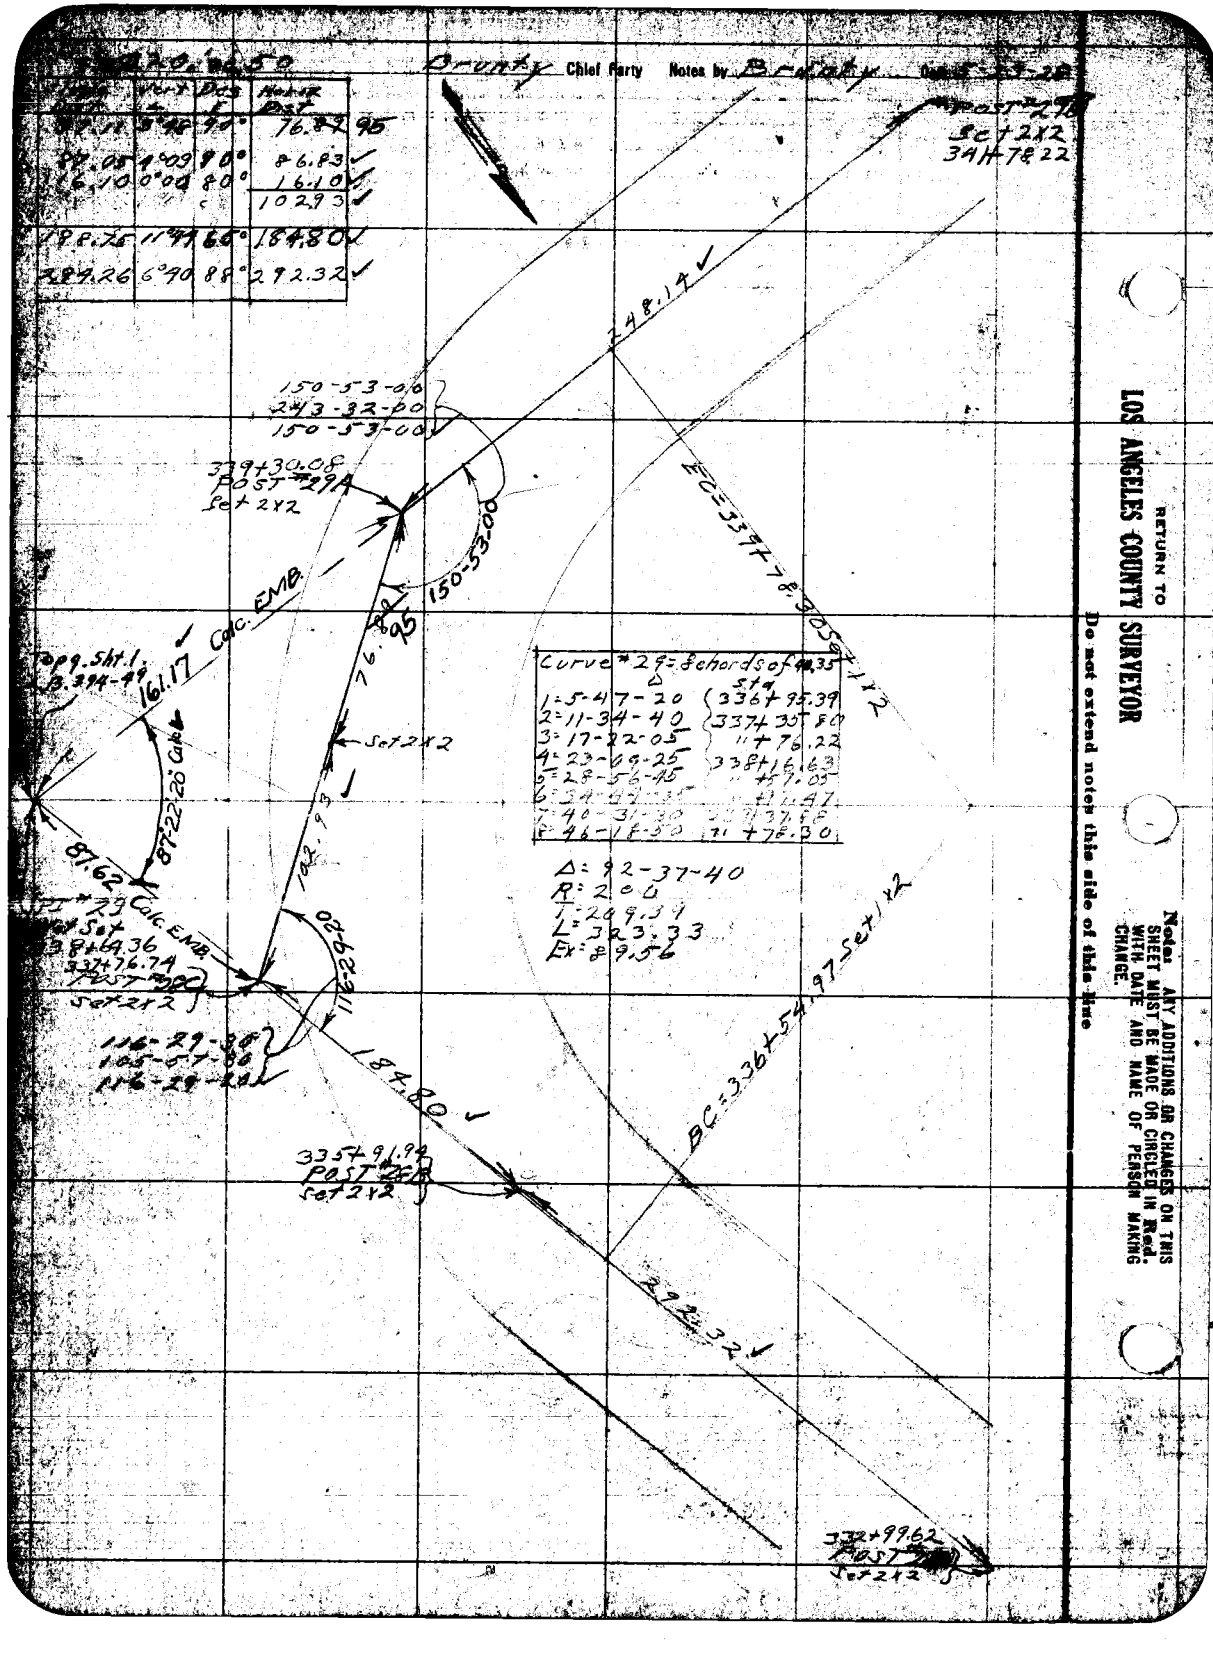

Point	Bearing	Dist	Notes
			Post #28 Set 2x2 334+78.22
			248.14
	150-53-00		
	243-32-00		
	150-53-00		
339+30.08			Post #29A Set 2x2
			EC=337+83.05
			Set 2x2
			Curve #29: Δ 92-37-40
1: 5-47-20			(336+95.39
2: 11-34-40			(337+30.60
3: 17-22-05			11+76.22
4: 23-09-25			338+16.63
5: 28-56-45			+45.09
6: 34-22-05			+71.41
7: 40-31-30			+97.56
8: 46-18-50			71+78.30
			Δ: 92-37-40
			R: 200
			T: 209.31
			L: 323.33
			Ex: 89.56
Sta 29 Calc. EMB			
338+69.36			
337+76.74			
Post #29			
Set 2x2			
	87-22-20	87.62	Calc
		109. Sht. 1	
		B. 394-99	
		161.17	Calc. EMB.
		76.95	
		Set 2x2	
		102.93	
	116-29-20		
	116-29-20		
	116-29-20	184.80	
		97 Set 1x2	
337+91.94			Post #28 Set 2x2
			BC=336+54
			292.32
332+99.62			Post #28 Set 2x2

RETURN TO
LOS ANGELES COUNTY SURVEYOR
Do not extend notes this side of this line

Note: ANY ADDITIONS OR CHANGES ON THIS SHEET MUST BE MADE OR CIRCLED IN Red. WITH DATE AND NAME OF PERSON MAKING CHANGE.

Date 5-23-28 Notes by Brunty Chief Party Brunty P. B. 320 Pg. 27

APPOST #30B Set 2x2

Plotted by Clarke
Date June 1928.
Map No. B-300
Checked by Browder
Date July 1928.

N. O. No. P. S. O. No.
Location
Surveyed by
Date
Indexed A. C. Johnson

Curve #30 : 8 chords of 46.

Δ	Sta.
1 = 4-25-50	340+50.28
2 = 8-51-45	" +96.68
3 = 13-17-35	341+43.04
4 = 17-43-25	" +89.48
5 = 22-09-20	342+35.93
6 = 26-35-10	" +82.37
7 = 31-01-05	343+28.81
8 = 35-26-55	" +75.09

LOS ANGELES COUNTY SURVEYOR
Do not detach! Leave this side of this Map

F.B. 220 Pg. 52 — Bruntz Chief Party. Notes by Bruntz Date 5-23-38

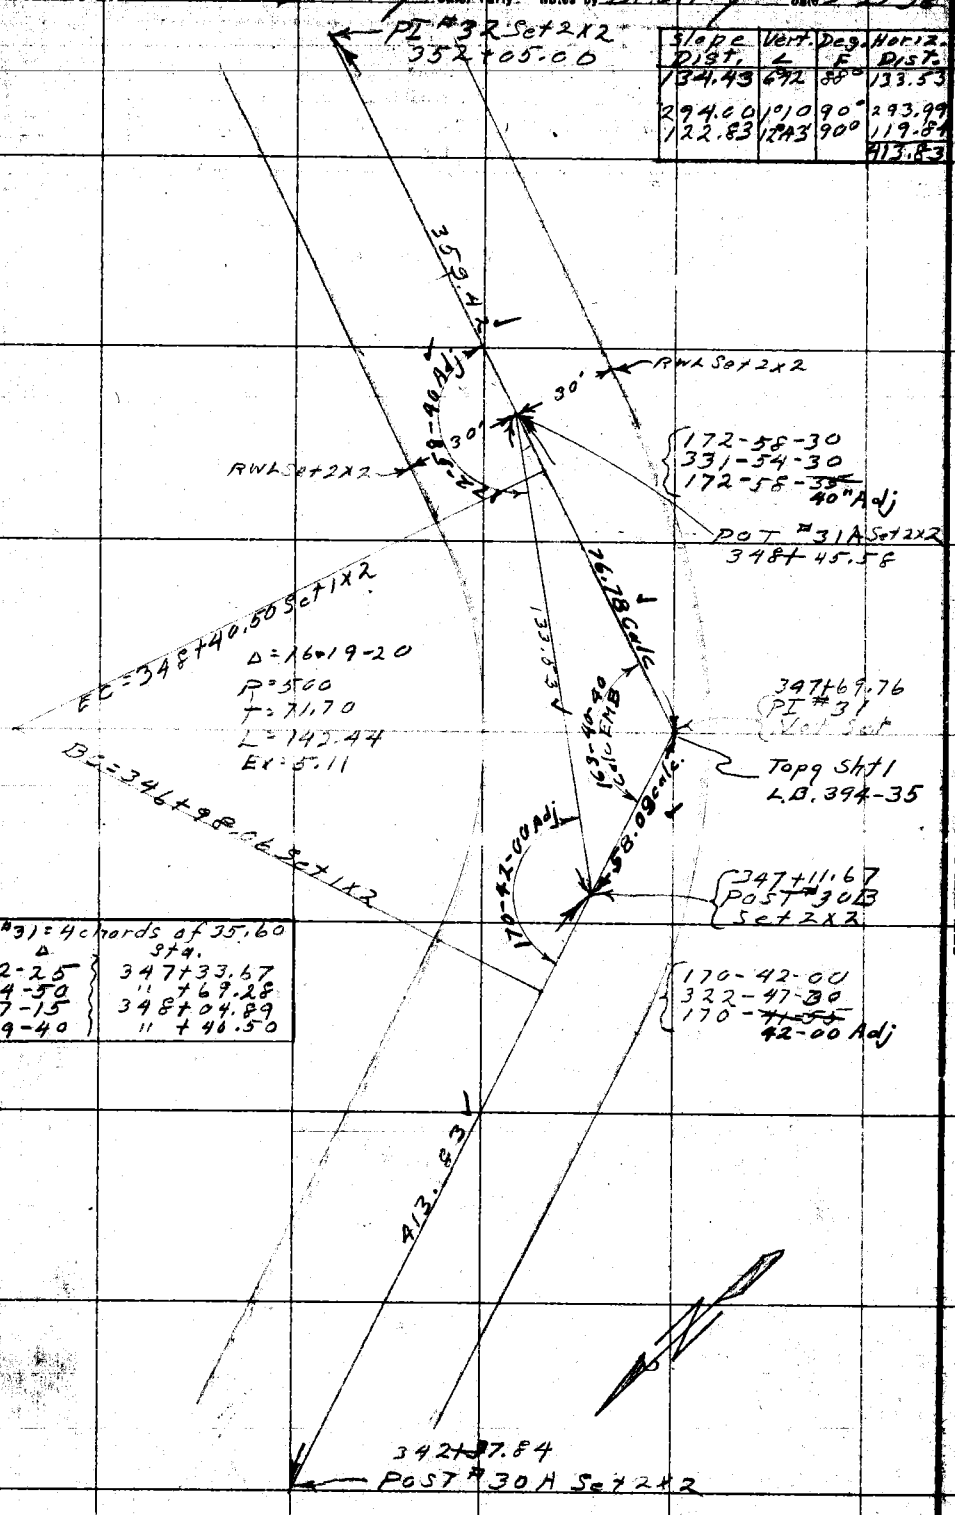

Slope Dist.	Vert. ∠	Deg. F	Horiz. Dist.
134.43	6°12	88°	133.53 ✓
294.00	1°10	90°	293.99 ✓
122.83	1°43	90°	119.84 ✓
			413.83 ✓

Curve #31 = 4 chords of 35.60	Δ	Sta.
	2-02-25	347+33.67
	4-04-50	" 769.25
	6-07-15	348+04.89
	8-09-40	" +46.50

RETURN TO LOS ANGELES COUNTY SURVEYOR

Do not extend notes this side of this line

Note: ANY ADDITIONS OR CHANGES ON THIS SHEET MUST BE MADE OR CIRCLED IN Red WITH DATE AND NAME OF PERSON MAKING CHANGE.

Date 5-23-28 Notes by Brunty Chief Party Brunty F. B. 320-53

Plotted by Clarke
Date June 1928
Map No. B-300
Meridian City by Browder
Date July 1928.

W. O. No. 716 R. & S. O. No.
Location Ky. Springs Rd
Surveyed by C.E. Brunty
Date 5-23-28
Indexed A. C. Johnson

Course	Dist.	Δ	Bearing	Remarks
	139.00	12°29'	S9°E	130.86
	228.63	1°41'	S8°E	228.57
				359.42

Post 32A

Δ=102-51-20
R=250
T=313.48
L=448.79
Ex=150.96

EC=357+40.31 Set 1/2

A16.48

40.39 @ -35
Pop 9 Shot

6x12x3

PI 32
352+05.00

77-08-45
30P-35-00
77-08-45 40 Adj

BC=348+91.52 Set 1/2

359.42

Curve #32 = 10 chords of 44.82

	Δ	Sta.	
1	5-04-35	349	+36.40
2	10-17-10	"	+81.28
3	15-25-40	350	+26.16
4	20-34-15	"	+71.04
5	25-42-50	351	+15.92
6	30-51-25	"	+60.79
7	36-00-00	352	+05.67
8	41-08-30	"	+50.55
9	46-17-05	"	+95.43
10	51-25-40	353	+40.31

Note: ANY ADDITIONS OR CHANGES ON THIS SHEET MUST BE MADE OR CIRCLED IN Red. WITH DATE AND NAME OF PERSON MAKING CHANGE.

Do not extend notes this side of this line

RETURN TO LOS ANGELES COUNTY SURVEYOR

FB 320 Pg 54

Chief Party Brunty Notes by Brunty Date 5-19-2E

Slope Dist	Vert Ang	Horiz Dist
237.61	325 84°	237.22
178.94	5°23 82°	178.17
277.00	2°17 88°	276.82
141.72	9°21 89°	139.86
		416.68

POST #33B Set 2x12
361+96.79

369.85

155-53-30
263-39-30
155-53-30

127°17'30"

357+76.89
POST #33A Set 2x2
118.00

72.28

72.28@080
RPPost #33A Set 2x2
118.00@000

3-40

228.62 Calc.

Topg Sht 1
L.B. 394-29.
357+19.32
PI #33 Not set

Curve #33 = 12 chords of 42.34

	Δ	Sta
1 =	4-02-45	357+21.92
2 =	8-05-35	" +64.30
3 =	12-08-20	358+06.67
4 =	16-11-10	" +49.05
5 =	20-13-55	" +91.42
6 =	24-16-40	359+33.80
7 =	28-19-30	" +76.17
8 =	32-22-15	360+18.54
9 =	36-25-05	" +60.92
10 =	40-27-50	361+03.29
11 =	44-30-40	" +45.67
12 =	48-33-25	" +88.04

Δ = 97-06-50
R = 300
T = 339.77
L = 508.49
Ex = 153.26

97.64 calc.

356+21.68
POST #32B
Set 2x2

106-59-30
67-58-00
106-59-30

354+43.51
POST #32A
Set 2x2

416.68

352+05.60
PK #32 Set 2x2

EC = 358+88.04 Set 1x2

EC = 353+29.55 Set Spk. w/Tag

RETURN TO
LOS ANGELES COUNTY SURVEYOR

Do not extend notes this side of this line

Notes: ANY ADDITIONS OR CHANGES ON THIS SHEET MUST BE MADE OR CIRCLED IN RED WITH DATE AND NAME OF PERSON MAKING CHANGE.

Date 5-19-28 Notes by Bruaty Chief Party Bruaty F. B. 320 Pg. 56

Drawn by Clarke
Date June 1928
Map No. B-300
Checked by Alexander
Date 11/4 1928.

W. O. No. 7116 D. P. No.
Location Ky. Springs Rd.
Surveyed by C.E. Bruaty
Date 5-19-28
Indexed A. C. Johnson

Dist.	Δ	R	Dist
151.11	24°53'	84°	151.11 ✓
221.07	7°09'	84°	221.07 ✓
300.00	3°56'	84°	299.33 ✓
70.51	10°00'	84°	70.42 ✓
			369.85

Post #34 Set 2x2
367+16.96

Curve #34	Δ	Sta.	chords of 75'
1	3-46-00	362+85.94	
2	7-32-00	363+31.96	
3	11-18-00	" +77.98	
4	15-04-00	364+24.00	
5	18-50-05	" +70.03	
6	22-36-05	365+16.05	
7	26-27-05	" +62.07	
8	30-08-05	366+48.09	

207.14

365+03.82
POST #34A
Set 2x2

154-22-00
257-28-00
154-22-00 ✓

154-28-00

EC=366+08.89 Set 1x2

Δ: 60-16-10
R: 350
T: 203.17
L: 368.17
Ex: 54.70

364+43.09
PI Not Set
#34

98.90 Calc.

119-43-50
Calc. Ems.

151.11

75.28 Calc.

Top of Hill
L.B. 394-25

95

145-21-50
225-27-30
145-21-50 ✓

363+67.81
POST #33C
Set 2x2

BC=362+39.92 Set 1x2

221.07

RP POST #33B Set 2x2
56.25 84°54'

361+46.74
POST #33B
Set 2x2

56.04

70°01'00

RP POST #33B Set 2x2
49.10 0°00

49.10

360+96.89
POST #33A
Set 2x2

Notes: ANY ADDITIONS OR CHANGES ON THIS SHEET MUST BE MADE OR CIRCLED IN Red. WITH DATE AND NAME OF PERSON MAKING CHANGE.

Do not extend notes this side of this line

RETURN TO LOS ANGELES COUNTY SURVEYOR

F.B. 320 Pg. 56 Brunty Chief Party Notes by Brunty Date 5-19-18

Slope Dist.	Vert. ∠	Hor. Dist.
199.91	3°23'	199.56
207.65	4°06'	207.14
15.08	0°00'	15.08
84.19	15°49'	84.78

RPPost #35B 3-72x2
24.19 @ 6°11' = 24.05

37+40.38
Post #35B
Set 2x2

220.41 calc

R = 38.19

Curve #35 = 8 chords of 12.29

	Sta
PC	36+61.89
	36+04.22
	746.54
	728.87

Cor Secs 13 & 23
T 4 N R 12 W
Fd Pt Rock in Conc.
F.B. 319-55

91-11-45
91-46-30
91-11-40

91-11-40

To Map Page 10

369+19.97
Post #35A Set N 47° by Int.

Adopted Section Line

Pot #1 Fd 1x2

147-10-00
230-39-30
147-39-50

1x2 Intersection of sec line & line from 1/4 W Cor Secs. 12 & 13

Cor Secs. 13 & 24
T 4 N R 12 W
F.B. 319-55

To Map Page 10

See F.B. 319-55 84.78

Pot #2 Fd 1x2

Pot #3 Fd 1x2

Top of Shaft
L.B. 394-21

369+06.54
Pt #35 Set 2x2

Δ = 32-20-10

R = 300
T = 86.98
L = 169.31
Ex = 12.35

147-39-50

Random Start North

30.0

Δ = 36-54-56
R = 300
T = 99.56
L = 177

196.58

RWL Set 2x2

30

367+10.96
Pot #34B Set 2x2

RPPot #34B 3-72x2
35.54 @ 20°11'33.72

207.14

365+03.82
Post #34A Set 2x2

RETURN TO
LOS ANGELES COUNTY SURVEYOR
Do not extend notes this side of this line

Notes: ANY ADDITIONS OR CHANGES ON THIS SHEET MUST BE MADE OR CANCELED IN Red. WITH DATE AND NAME OF PERSON MAKING CHANGE.

Date 5-19-28 Notes by Brunty Chief Party Brunty F. B. 320 Pg. 67

Plotted by Clarke
Date June 1928.
Map No. B-300
Plotted by Bernardo
Date July 1928.

W. O. No. 716 R. S. No.
Location Ivy Springs Rd.
Surveyed by C.E. Brunty
Date 5-4-28
Indexed A. C. Johnson

Chord	Radius	Δ	Length
184.36	150	58°	184.36
184.91	200	78°	184.91
41.46	0°00	78°	41.46
12.10	0°00	84°	12.10
238.49			

Notice: ANY ADDITIONS OR CHANGES ON THIS SHEET MUST BE MADE OR CIRCLED IN Red, WITH DATE AND NAME OF PERSON MAKING CHANGE.

Do not extend notes this side of this line

LOS ANGELES COUNTY SURVEYOR

"KEYDIN" TO

380+84.00 POT #36B Set 1x2

30.

R.W.L. Set RRR

707.80

136-35-15
186-21-00
136-35-15
136-35-25 Adj.

373+06.29 POST #36A Set 2x2

136-35-25 Adj.

Curve #36 = 8 chords of 72.6	Δ	Sta.
1 = 4-33-15		370+99.16
2 = 9-06-35		371+46.86
3 = 13-39-50		+84.56
4 = 18-13-10		372+42.26
5 = 22-46-25		+89.91
6 = 27-19-45		373+37.63
7 = 31-53-00		+85.34
8 = 36-26-10		374+33.04

Tom Set 1
L.P. 394.17

To Pl. 36

94.90 Calc.

136-35-25 Adj.

E.C. = 374+39.05 Set 1x2

#36

AE M.T. Set
372+72.95

To Pl. 36

10°07-30" Calc. E.A.D.

Δ = 72-52-40
R = 300
T = 221.49
L = 381.59
Ex = 72.91

184.36

132.57 Calc. E.A.D.

150-31-55 Adj.

P.C. = 370+51.46 Set 1x2

POST #35B Set 2x2
371+40.36

150-31-55
207-00
150-31-55
150-31-55 Adj.

238.49
220.41 Calc

369+19.97
POST #35A Set Nail + Tag

184.08

380+08.54
POST #34A Set 2x2

P.B. 320 Pg. 58 — Brunty Chief Party — Notes by Brunty — Date 5-19-88

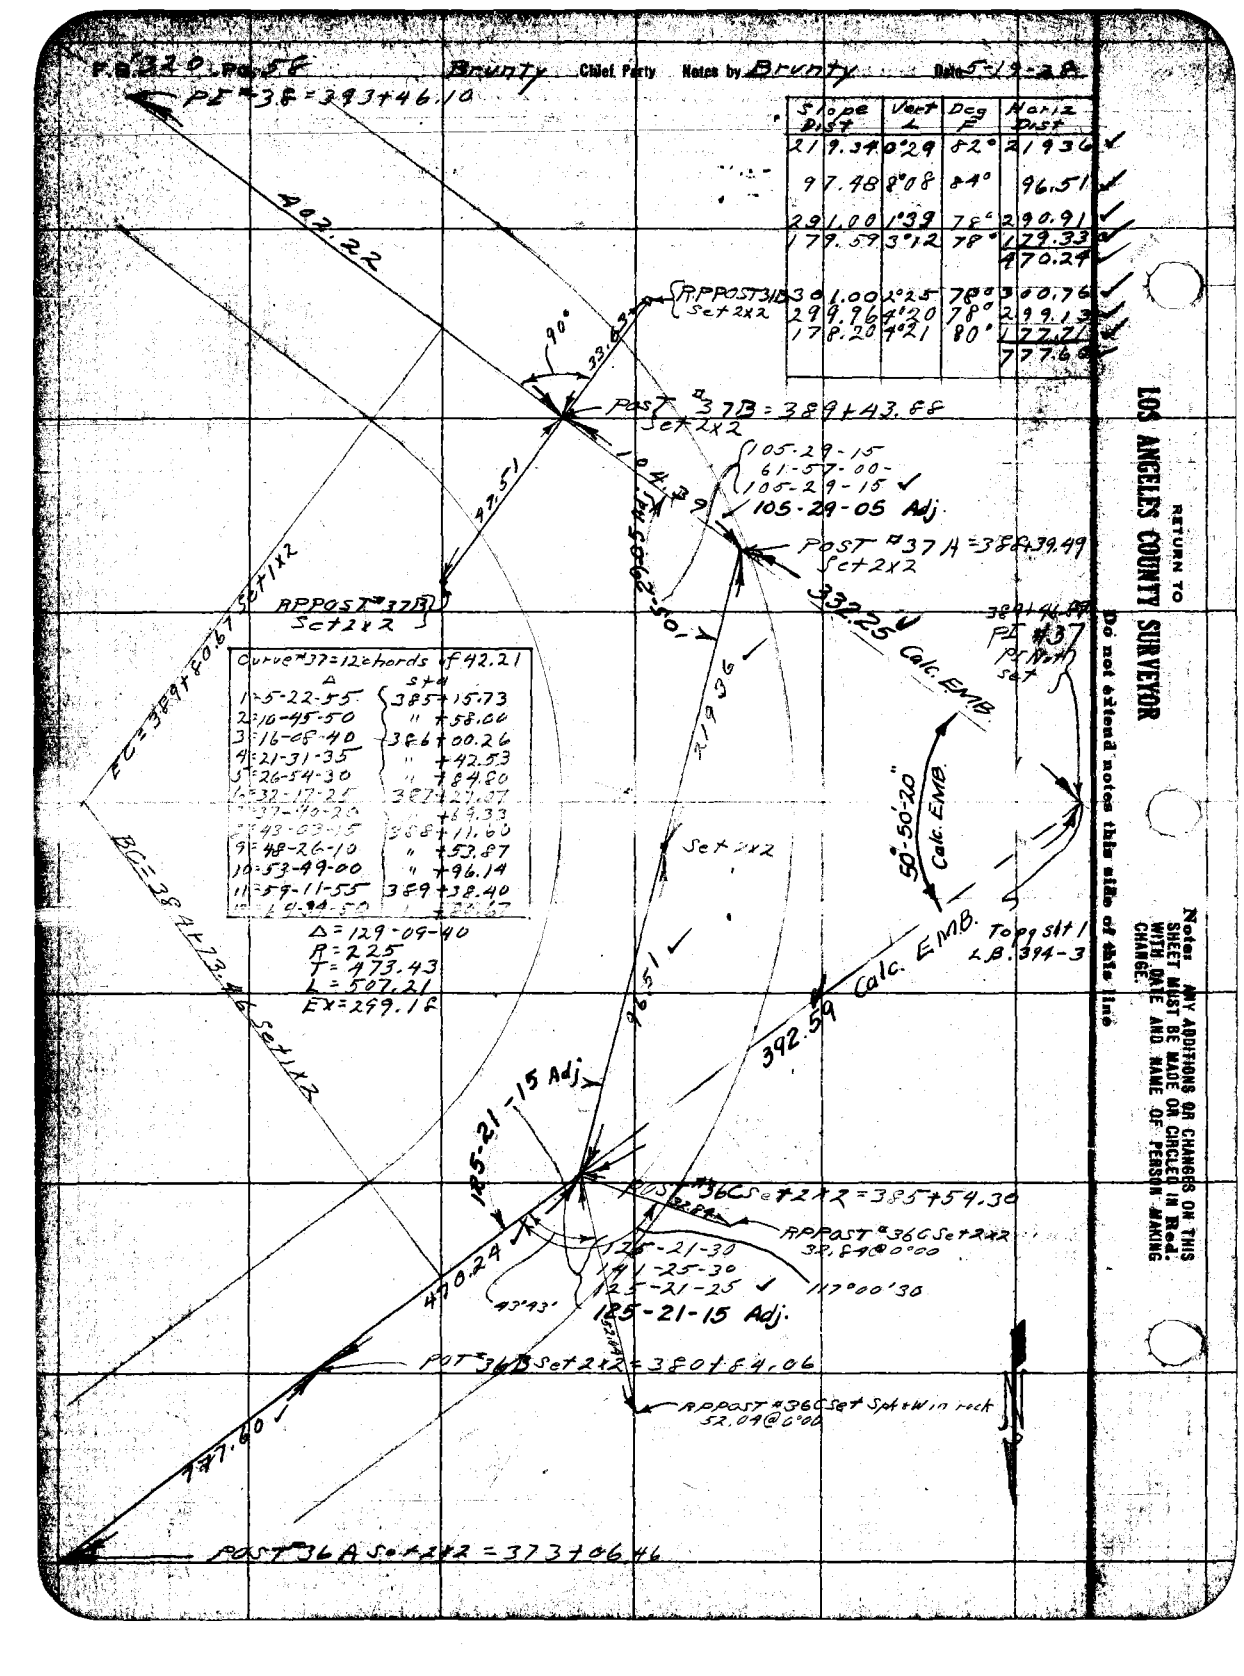

Slope Dist	Vert Δ	Deg R	Horiz Dist
219.34	0°29	82°	219.36 ✓
97.48	8°08	84°	96.51 ✓
291.00	1°39	78°	290.91 ✓
179.59	3°12	78°	179.33 ✓
			970.29
301.00	2°25	78°	300.76 ✓
299.96	4°20	78°	299.13 ✓
178.20	7°21	80°	177.71 ✓
			777.60 ✓

RETURN TO
LOS ANGELES COUNTY SURVEYOR
Do not extend notes this side of this line

Notes: ANY ADDITIONS OR CHANGES ON THIS SHEET MUST BE MADE OR CIRCLED IN Red. WITH DATE AND NAME OF PERSON MAKING CHANGE.

Plan by Beatty Notes by Beatty Field Party Beatty F. B. [illegible]

Date June 1928
Map No. B-200
Location Ky. Springs Rd
Surveyed by C. E. Beatty
Date July 1928.
Indexed A. C. Johnson

Dist.	Δ	D	T	L
2560	13°8'	30°	2 57.88	✓
146.26	27°7'	8.0°	7 44.54	✓
			402.22	✓
105.31	79°4	80°	104.39	✓

POT 38A Sta 394+37.40

247.72 ✓

EC 394+49.62 Sta 1-22

Δ=83-06-50
R=175
T=155.19
L=253.76
Ex=58.86

Curve #38=6 chords of 42.21

Δ	Sta
1: 6-53-35	392+33.27
2: 13-51-10	" 775.58
3: 20-46-40	393+17.89
4: 27-42-15	" 60.20
5: 34-37-50	394+02.51
6: 41-33-25	" 49.82

Topg Sht 38 Div 3 Also Canyon Rd

L.B. 393-103-109

393+46.10
PI #38
Nine Station

96°53'15"
27°32'30"
96°53'10" ✓

96-53-10

402.22 ✓

EC 391+90.94 Sta 1-22

389+83.86
POT 38A Sta 1-22

LOS ANGELES COUNTY SURVEYOR

Property of

Do not extend notes outside of this line

T. 3S R. 4W 60 Bruntz Chief Party Notes by Bruntz Date 5-19-28

Topy 6ft 2B Dir 2 Abbs Canyon Rd
L.A. 393-105

RW L Set 2x2
Rd. F.B. 3.19.

427.99

POT #39A

C.A. 33.95 = POT #39 B F.B. 319-56 Fd 2x2
F.B. 319-85

Also

231.58

76°55'30"
307°41'30"
76°55'20" ✓

103°04'40"

POT #39 D
Fd 2x2 F.B. 3.19-86

R=175

Δ=103-04-40
R=175
T=220.37
L=314.83
Ex=106.36

PC #39 = 397+22.53
= POT #39 C
F.B. 319-86 Fd 2x2

R=250

Δ=76-55-20
R=250
T=198.58
L=335.64
Ex=69.27

POST #38A Set 2x2
395+37.40

PC = 398+58.53 Set 1x2

185.13

BC = 395+02.22 Set 1x2

BC = 395+23.85 Set 1x2

Slope Dist.	Vert L	Deg E	Horiz Dist.
185.86	5°09	60°	185.13 ✓
248.89	5°38	60°	247.72 ✓

Curve #39B = 6 chords of 52.28

Δ	sta
1= 8-35-25	395+54.69
2=17-10-45	396+07.16
3=25-46-10	" +59.63
4=34-21-35	397+12.11
5=42-56-55	" +64.58
6=51-32-20	398+17.05

Curve #39H = 6 chords of 55.82

Δ	sta
1= 6-24-35	395+79.89
2=12-49-15	396+35.83
3=19-13-50	" +91.77
4=25-38-25	397+47.71
5=32-03-05	398+03.65
6=38-27-40	+59.59

247.72

POT #38 = 399+46.10
Set Mag Spk. + Tin

RETURN TO LOS ANGELES COUNTY SURVEYOR

Do not extend notes this side of this line

Notes: ANY ADDITIONS OR CHANGES ON THIS SHEET MUST BE MADE OR CIRCLED IN Red WITH DATE AND NAME OF PERSON MAKING CHANGE.

Date 7-26-28 Notes by Brunty Chief Party Brunty F. B. 320 Pg 44

Plotted by Clarke

Date June 1928
Map No. B-300
Plotted by Brewster
Date 10/4 1928.

Location Kentucky Springs Rd.
Surveyed by C.E. Brunty
Computed by A. C. Johnson
Indexed

Notice: ANY ADDITIONS OR CHANGES ON THIS SHEET MUST BE MADE ON CIRCLED IN Red. WITH DATE AND NAME OF PERSON MAKING CHANGE.

Do not extend notes this side of this line

Return To LOS ANGELES COUNTY SURVEYOR

1/4 Cor. Rd. 9+6 90° pine post in md. of rock. Post scribed on the N- "11 W" " " S- "SCER"

Md. and post is on top of East bank of gully. Replaced 4"x6" pine post with 2" IP + BC set in concrete marked as shown

POT #4 Set 1x2 = 25+53.15

353.89

POT #3 Set 1x2 = 21+99.26

T 4 N
S 3
R 12 W

878.39

POT #2 Set 1x2 in flat = 13+20.87

T 5 N
S 34
R 12 W

497.68

POT #1 Set 1x2 = 8+23.19

123.19

(20+12.16" Stone = 0+00.38

4x4 = 0.100 to Above and 2 Nails Southerly

0.38

88.26 - 2½ 20 adj

180°

T 4 N
Sec 2
R 12 W

3" IP + BC

T 5 N R 12 W
S 35

Dist.	Δ	R	T	L
499.39	0°23'	88°	11.50	123.19
322.31	1°42'	86°	125.00	123.19
498.92	9°15'	86°	497.68	
384.50	3°45'	82°	393.74	
495.27	3°12'	89°	494.60	878.87
355.14	9°59'	89°	353.81	


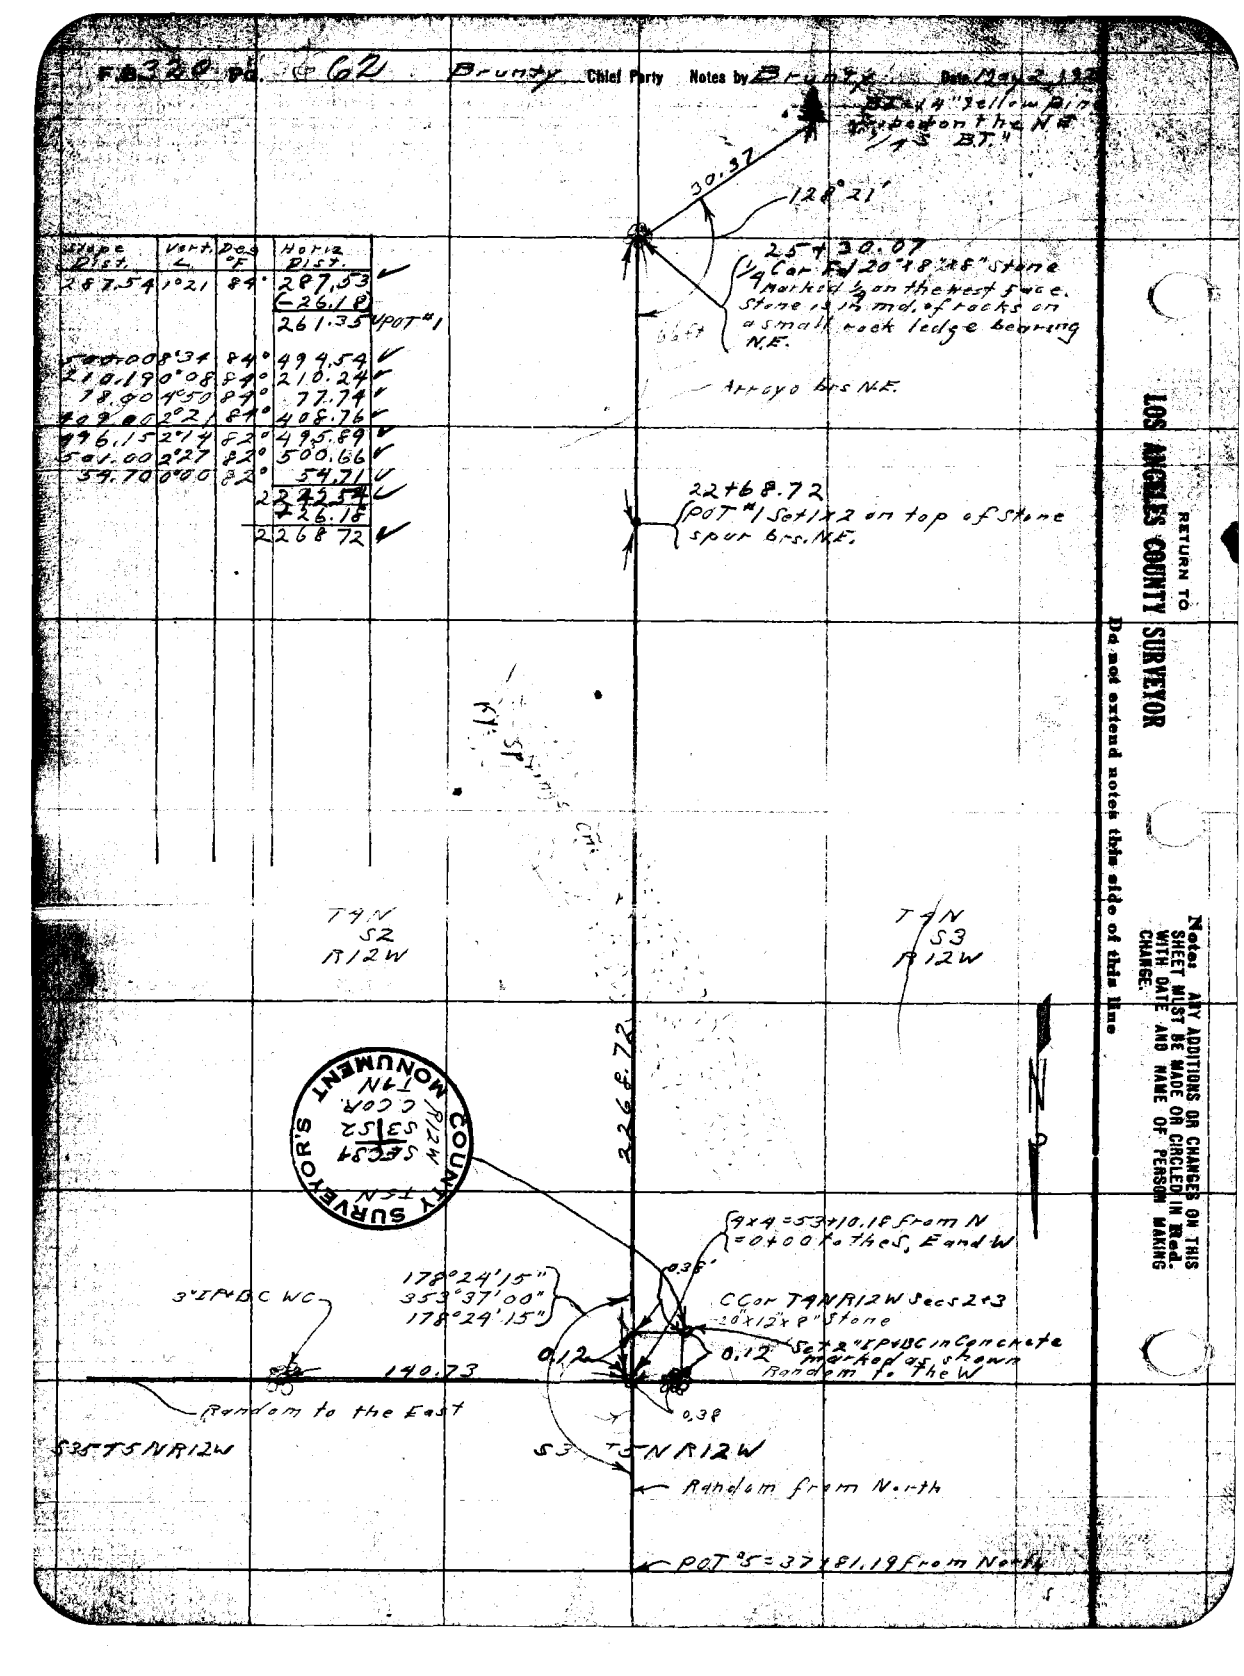

Grade Dist.	Vert. ∠	Deg °F	Horiz. Dist.
287.54	1°21	84°	287.53
			(-26.18)
			261.35 #POT #1
500.00	8°31	84°	494.54
210.19	0°08	84°	210.24
78.90	1°50	84°	77.74
409.00	2°21	84°	408.76
496.15	2°14	82°	495.89
501.00	2°27	82°	500.66
54.70	0°00	82°	54.71
			2243.54
			26.18
			2268.72

RETURN TO
LOS ANGELES COUNTY SURVEYOR

Do not extend notes this side of this line

Notes: ANY ADDITIONS OR CHANGES ON THIS SHEET MUST BE MADE OR CIRCLED IN Red. WITH DATE AND NAME OF PERSON MAKING CHANGE.

Date _____ Notes by _____ Chief Party _____ F. B. 324 Pg. 67

Date June 1928.
Map No. B-300
Date July 1928.

Location _____
Surveyed by _____
Date _____
Indexed A. C. Johnson

Notes. ANY ADDITIONS OR CHANGES NOW THIS SHEET MUST BE MADE OR CIRCLED IN Red. WITH DATE AND NAME OF PERSON MAKING CHANGE.

Do not extend notes this side of this line

LOS ANGELES COUNTY SURVEYOR

Return to

Granite stone scribed on N. face "1/4 S.W.C." Md. of rocks 1/2 North of W.C. H.B.T. See Next Pg.

99°11'00"
176°49'00"
44°11'00"
OK

228

See next pg

89°43'00"

S 12

S 12

Fd 18"x14"x12" granite stone scribed on the W face "1/4 W.C." Md. of rocks 1/2 W of Cor.

45°16'45", OK
135°07'00"
45°16'45"

OK
90°11'22 1/2"

OK 32°01'30"
128°06'30"
32°01'37 1/2"

1/4 W

OK

45°37'30"
132°30'30", OK
45°37'30"

Sec Cor

90°54'30"
3°37'30"
90°54'22 1/2"
OK

S 11

44-54-40

45-22-15
64 times 272-14-00
45-22-20

90°17'00"

INT

1/4 Cor

31°56'00"

POT #1

F.B. 320 Pg. 64 BT #1 Chief Party Notes by BHN Date 5-18-28

Note- temperature changes due to Thunder storm 300 ft standard at 76°

Slope Dist.	Vert ∠	Deg F	Horiz	
52.65	17°33	64°		BT
367.70	15°19	65°		#1
38.00	0°03	66°		
309.00	13°49	70°		
253.86	15°21	72°		#2
402.00	9°32	70°		
135.22	25°32	68°		
35.97	15°21	68°		#3
499.00	19°14	78°		
27.65	17°00	80°		#4
773.25	21°16	86°		#5
73.00	17°22	70°		
205.80	28°39	68°		
179.00	26°29	67°		
205.33	10°05	78°		
41.62	18°48	82°		#6
500.00	9°36	29°		
334.43	10°29	80°		#7
97.00	0°29	86°		
98.01	21°25	79°		#8
7.12	16°26	82°		1/4 Cor

1/4 Cor Secs 13 & 24

Sec 24

Cor Secs 13, 14, 23 & 24

POT #8 Set 1x2 by 4 inches.

90°35'00
362°20'00
90°35'00

POT #7 Set 1x2 ems put sloping W

POT #6 Set 1x2 in saddle of rock bearing E & W.

POT #5 Set 1x2 W slope of 4 ft.

POT #4 Set 1x2 W slope of 4 ft.

Sec 13

POT #3 Set 1x2 top of spur

POT #2 Set 1x2 on divide between Hot Springs Cn. and Iso Cn.

Random on South

POT #1 Set 1x2

164°30'

89°43'00
35°51'15
89°43'00 adj

1.00

Random from West

1x2

2.28

49°11'00"

1/4 WC

54°15'

B.T. Fd 28" Pine Blazed & scribed on the South 1/4 S W C B.T.

B.T. Fd 9" Pine Blazed & scribed on the South 1/4 S W C B.T.

S 1.2

RETURN TO LOS ANGELES COUNTY SURVEYOR

Do not extend notes this side of this line

Note: ANY ADDITIONS OR CHANGES ON THIS SHEET MUST BE MADE OR CIRCLED IN Red. WITH DATE AND NAME OF PERSON MAKING CHANGE.

Notes Brunty Chief Party Brunty F.B. 330 Pg. 63

Plotted by Chandler
Date June 1928.
Map No. B-300
Plotting Verified by Chandler
Date July 1928.

Location Hyde Springs Rd
Surveyed by C.E. Brunty
Drawn by [illegible]
Indexed A. C. Johnson

Dist	∠	F	Dist
446.00	2°17	E0°	440 75
497.47	6°06	P00	499 76
122.90	3°37	A0°	122 64
			1058 15
500.00	0°09	R20°	500 02
499.86	1°44	R20°	499 77
326.38	1°15	R2°	326 38
			1326 17
271.00	1°34	S3°	273 97
495.34	5°19	S2°	495 33
19.79	0°00	E2°	19 79
			7840 9
467.00	0°57	S8°	467 06
464.02	6°04	S6°	461 54
251.17	4°46	S8°	251 17
			1179 77
434.04	4°27	S80°	432 61
490.35	17°32	S6°	467 69
29.14	20°45	P6°	27 26
			927 76

Notes: ANY ADDITIONS OR CHANGES ON THIS SHEET MUST BE MADE IN Red. WITH DATE AND NAME OF PERSON MAKING CHANGE.

Do not extend notes outside of this line

RETURN TO LOS ANGELES COUNTY SURVEYOR

5275.94

B.T. Fd 6" Scrub oak Set Nail "1/4 S BT"

1.32

52°17"

6.90

B.T. Fd 4" Scrub oak Set Nail "1/4 S BT"

26.77

7.99

165°09'

89°43'

Cor Secs 11-12-13-14 Fd 2 1/2" I.P. 3' Steel with 1/4 in the N face bounded with stones and a md. on rock on the N side

Set 1/2 round Scrub oak hub

927.76

26-42-00
106-48-00
26-42-00

43748.15
POT #4 Set 1x2 on W slope of spur

1179.77

SUTAN

31768.41
POT #3 Set 1x2 on knob in broken country

To Cor Secs 11, 12, 13 & 14

2844.09

23784.32
POT #2 Set 1x2 on table land on N side of R.R.

31-56-15
127-44-30
31-56-00

326.12

10458.16
POT #1 Set Nail & Tag on top of bluff

1053.15

90°00'45"
269°01'00"
90°00'15"

Cor Secs 24-11-14-13

S

FIELD BOOK 320 PG. 66 Brunty Chief Party Notes by Brunty Date 5-7-28

Distances By Stadia

1/4 WC

Intersection set 1x2

POT #7 Set 1x2

#6B Set 1x2

POST

POT #

PI #

#6A Set 1x2

Note 6A + 6B were set afterward in order to make a 4 intersection

#6 Set 1x2

7.30
3.00 @ 104 =

S12

S13

#5 Set 1x2

6.83
2.00 @ 627' =

BT Fd 1" Pipe scribed "T4NR12WS12BT"

#4 Set 1x2

43.1

163°00'2'

1/4 WC

9.33
2.00 @ 17°16 =

12.00 @ =

Fd 1" & 12" x 6" Stone bounded by stones, stone has 4 notches on top & scribed on face scribed T4NR12W S11 BT

BT Fd 1/2" [illegible] scribed T4NR12W S11 BT

11.1

52°46

#3 Set 1x2

To POT #1 = 10+58.15

S11

5.52
2.00 @ 0°06 = 353.

S14

#2 Set 1x2

1914 @ 732 =

#1 Set 1x2

90-17-00
361-08-00
90-17-00

5.79
5.00 @ 7°34 = 77

From POT #1 N 42 13.97 Marked 1" from North

1/2" round hub 62+71.62 from North

1/4 Cor Secs 11 & 14

RETURN TO LOS ANGELES COUNTY SURVEYOR

Do not extend notes this side of this line

Notice: ANY ADDITIONS OR CHANGES ON THIS SHEET MUST BE MADE OR CIRCLED IN Red. WITH DATE AND NAME OF PERSON MAKING CHANGE.

Notes by Brunty Chief Party Brunty F.B. [illegible] Pg. [illegible]

Computed by [illegible]
Date June 1988
Map No. B-300
Plotting Checked by [illegible]
Date July 1988

Location Ky Springs Rd
Surveyed by C E Brunty
Office Maps by R. C. Johnson
Indexed

Set 8" x 8" mon by Intersection

To ¼ Cor

1" round hub

90°02'25"

Cor Secs 2, 3, 10 & 11 T1N R12W SBM & [illegible]
stone in md of stacks. Stone scribed [illegible]
SE face "R12W" NE face "T1N" 2 miles
on the East edge & Shadhees on [illegible]
South edge. Also fd 4x4 Juniper stk
W 1.0 ft from side scribed
"S11 S14 has 2 notches" S11
0.92' S on the East " S3 T1N R12W"
on the South " S2"

Set 1x2

Slope Dist.	Vert ∠	Deg °F	Horiz Dist
353.15	21°01	66°	329.70
23.36	25°08	66°	22.55
59.45	23°04	67°	54.71
			406.96 #2
284.72	6°01	68	284.64 #3
67.00	14°59	70°	64.73
405.13	18°00	70°	385.64
113.60	7°45	72°	109.30
34.74	17°19	76°	33.22
421.06	15°39	76°	390.72
99.10	24°12	76°	90.41
101.96	14°54	78°	98.55 #4
			1509.62
77.88	0°00	80°	76.01 #5
45.71	0°00	80°	45.71
215.94	18°13	#2°	205.16
1.81	0°00	—	1.81
			252.68

Set Nail in mon

Set 1x2

45.71 POT #5 Set 1x2 on spur 100 S.E. of shrub

178.01

252.68

POT #4 Set 1x2 on East side of

5' 90°

1509.62

Large Boulder

90° 5'

33+21.67
POT #3 Set 1x2 in rock mound
spur bearing East

90° 5'

406.96

29+37.63
POT #2 Set 1x2 on East slope of pit

Set 1x2

BT

30.37

¼ Cor 25+30.07

POT #1 = 23+46.72

Notice ANY ADDITIONS OR CHANGES ON THIS SHEET MUST BE MADE OR CHECKED IN Black WITH DATE AND NAME OF PERSON MAKING CHANGE.

RETURN TO LOS ANGELES COUNTY SURVEYOR

Do not extend notes onto other side of this map

F.B. 320 Pg. 68 Bounty Chief Party Notes by Bounty Date 5-4-28

BT

BT (rollen over)

1/4 Cor Sec 6 28 11 T4N R12W
Fd 18"x10"x8" stone, W
marked on the N face
1/4 S" Md. of rocks 1 ft N
of cor. Fd two 5" cherry
bushes with blazes.
Could not discern any
scribing. Cherry bushes
died when blazed and
one has fallen over

39-54-15
39-37-00
39-54-15

176°

176°

Set 1" round
greasewood
on top of mesa

Note - Set 1 round
greasewood hub
under to avoid
a rattlesnake
has home line between
the centers of two
Hds. and have 162
ft on the ties

S2 T4N R12W

Set 1" round
greasewood hub
on second spur
East of cor

29°56'30"
89°56'30"
29°56'30"
40

Set 1" round
greasewood hub
on first spur
East of cor

90°02'30"
360°10'00"
90°02'30"
25

50°03'22½
20

3218.95

Set Nail by Tnt.
0.92
Cor Sec 2, 3, 10 & 11
T4N R12W

Point Tr.

RETURN TO
LOS ANGELES COUNTY SURVEYOR
Do not extend notes this side of this line

Notes: ANY ADDITIONS OR CHANGES ON THIS SHEET MUST BE MADE OR CIRCLED IN Red WITH DATE AND NAME OF PERSON MAKING CHANGE.

Surveyed By _____ Chief Party _____ F. B. 332 Pg. 62

Date June 1928 Location Bryan
Map No. 8-300 Surveyed by _____
Plotted by _____ Traced by _____
Date 11/14 1928 Indexed A. C. Johnson

-03 27.99 30.12 S .69' Plug & Conc. Mon. & Copper Pack
EC. 3361 82.38
Fd Punch mark in end X in conc.
1348 R
Set X in concrete
39-32-00
152-09-30
39-31-50
SPAR
301.00 120 77°
104.22 52 77°
301.00 252 77°
126.24 100 80°
134.89 100 80°
832.07 R
1/4 Cor Secs 22 & 23
Fd 6x6 Conc. Mon & Copper Pack
04 30.09 30.11 S 89 E
Fd Punch mark in conc.

Property of the County of Los Angeles. Do not remove from the office of the Surveyor.
SUBJECT MATTER OF RECORDS ON THIS CHART ARE AND SHALL REMAIN THE PROPERTY OF THE COUNTY OF LOS ANGELES
Surveyor to the
LOS ANGELES COUNTY SURVEYOR
Do not extend notes into this area of this map

F.B. 320 Pg. 70 Bruntz Chief Party. Notes by Bruntz Date 6-13-28

58.63	N-39	80°	57.59 C
R=1.00	1-19	80°	300.97
128.80	1-05	80°	126.80
			427.77 L
19.59	0-00	80°	19.59 C

1/66-20-5-23-23
FB85 Pg 114

Pat #2D'
Set 1/2 by Tag

Pat #2E

Fd 1/2" IP FB85 Pg 114

Fd 1/2" IP
FB85 Pg 93

Cor Secs 22 23
26 27 T5N
R12W

2.86

Set Nail & Tag Int

Random Pat FB85 Pg 93

.50

Pat #2J

2½ for by Cor
FB85 Pg 93

Set Nail by Int

RETURN TO
LOS ANGELES COUNTY SURVEYOR

Do not extend notes this side of this line

Note: ANY ADDITIONS OR CHANGES ON THIS SHEET MUST BE MADE OR CIRCLED IN Red WITH DATE AND NAME OF PERSON MAKING CHANGE.

Date _____ Notes by _____ Chief Party _____ F.B. 320 Pg. 70 A

Platted by Bert McAtee	W. O. No. _____ D. S. O. No. _____
Date May 1929	Location _____
Map No. B-153	Surveyed by _____
Platting C'k'd by D.M. Finley	Date _____
Date June 1929	Indexed A. C. Johnson

DEXTER CANYON PARK

SECTION LINE SURVEY TO ESTABLISH PARK BOUNDARY, LOCATED IN SEC. 32-T3N-R14W.

4-19-29

Evans - Dep.
Martin - T
Wilson - H.C.
Taylor - R.C.
Stewart - Ex.

Note: ANY ADDITIONS OR CHANGES ON THIS SHEET MUST BE MADE OR CIRCLED IN Red. WITH DATE AND NAME OF PERSON MAKING CHANGE.

Do not extend notes this side of this line

RETURN TO
LOS ANGELES COUNTY SURVEYOR

F. B. 320 Pg. 70B Chief Party Notes by Date

INDEX MAP OF DEXTER CANYON PARK.

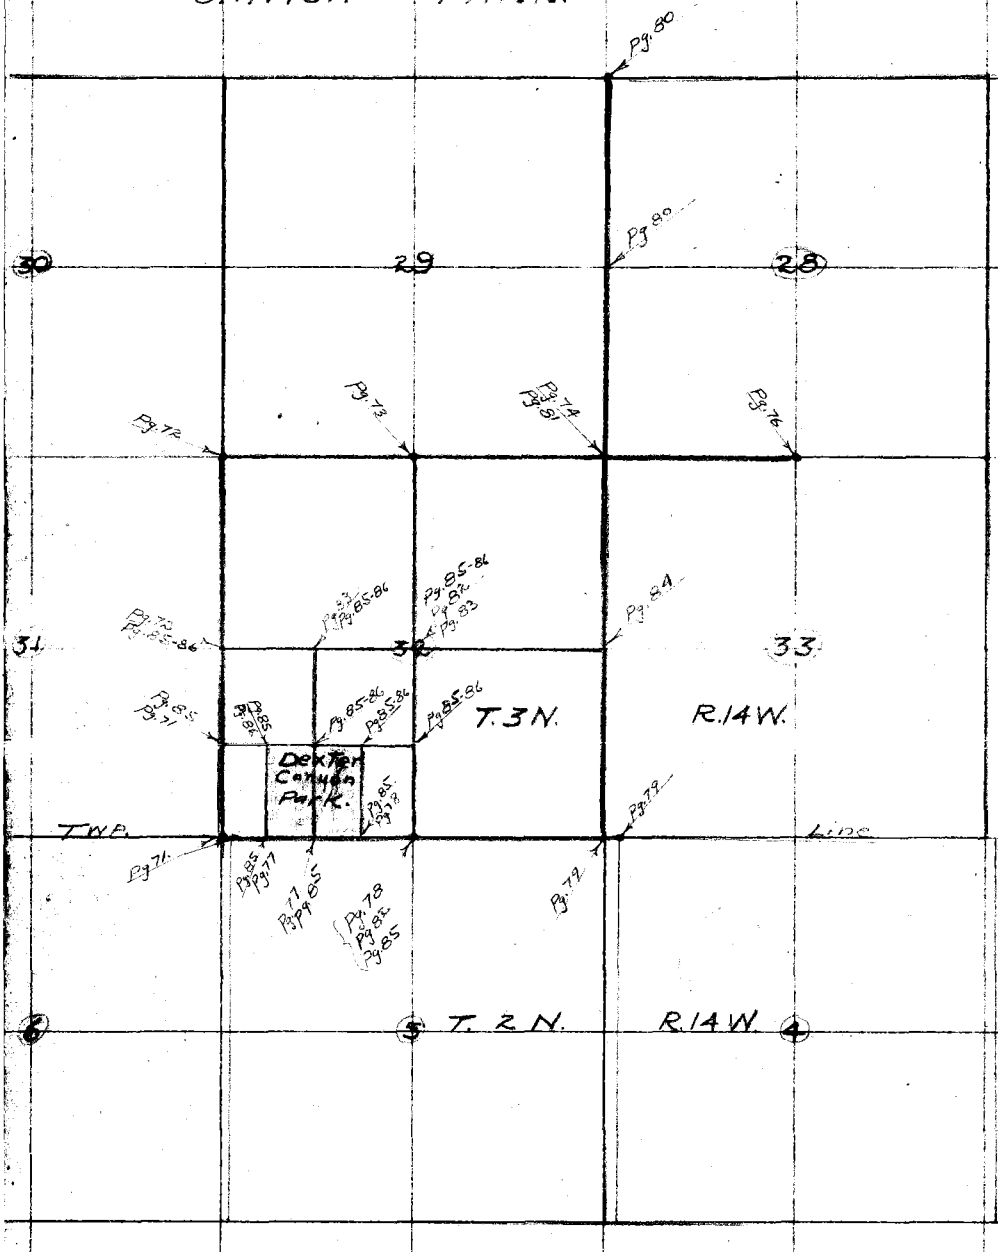
Pg. 80
Pg. 80
30
29
28
Pg. 72
Pg. 73
Pg. 74
Pg. 91
Pg. 76
Pg. 85-86
Pg. 82
Pg. 83
Pg. 84
31
32
33
Pg. 85-86
Pg. 85-86
Pg. 85-86
Pg. 85-86
Pg. 85-86
Pg. 85
Pg. 85
Pg. 85

Date _____ Notes by _____ Chief Party _____ F.B. 320 Pg. 71

Platted by McAtee	W. O. No. 783 D. S. O. No.
Date MAY 1929	Location Dexter Can. Park.
Map No. B-163	Surveyed by Evans
Platting C'k'd by D.M. Finley	Date 4-19-29
Date June 1929.	Indexed A. C. Johnson

To B.of. P972

(76 T-2) #2-4

14+79.35 set 2x2 on small ridge

13+23.08 set 2x2 - NW Cor. SW 1/4 of SW 1/4 of Sec. 32 by proportion. 89°-22-30.

165.70 @ 6-22-T66° = 164.67

220.10 @ 3°-20-T60 = 219.21

See pg. 85 Z

.66457' to N.W. Cor. of Dexter Canyon Park. Pg. 83, 85, 86.

B.A.O.

Set 1x2 13+46.8

per L.S. 165 Fd. 2" I.P. 13+07.03

2.65

5.13

90°-37-30"

T.3N. - R.14W.

SEC. 31

12+59.64 set 2x2 + Cir. Hk. by Transiting L.n.

SEC. 32.

S. 1/4 This Line 1618.78 Used. Per P1

461.39 @ 7-12-T60 = 457.70

89.82 @ 5°-13-T66 = 89.44

470.29 @ 4°-46-T66 = 468.63

243.89 @ 0-0-T66 = 243.87

1259.64

① (59-26-45) ② (356-39-45)

59°-26'-37½"

53°-12'-50"

① 53°-12'-45" ② 319°-17'-15"

53°-12'-52½"

COUNTY SURVEYORS MONUMENT T.3N-R.14W. S.31 S.32 S.6 T.2N. R.14W.

To 1643.96 per P977

replaced with 2" I.P. (Pk) in conc. 6" high Mkd

Fd. Iron bar with X center per L.S. 16-S 0+00 going N. 0+00 going E. See C.S. B-107 & Tr. 7342

89°-27-55"

54°-46-36" 25' Adj.

664.42 To S.W. Cor. Dexter Canyon Park

S. Line Sec. 32

TWP LINE

0.27

1762.02 Fd. 2" I.P. + cap per Tr. 7342

C.S. Mon. per F.B. 268-85, 88 and F.B. 283-22, 23.

To B.of.

① 89°-28 ② 176°-47-30

89°-27'-55".

164.62 @ 10-09-T60 = 162.02

Sec 5 & 6

T.2N.-R.14W. S.B.M. N.W. Cor. Tr. No. 7342.

SEC. 6

T2N-R14W

SEC. 5.

Note: ANY ADDITIONS OR CHANGES ON THIS SHEET MUST BE MADE OR CIRCLED IN Red. WITH DATE AND NAME OF PERSON MAKING CHANGE.

Do not extend notes this side of this line

RETURN TO LOS ANGELES COUNTY SURVEYOR

F.B. 328 Pg. 72 Chief Party Notes by Date 4-22-29

SEC. 30. S2+92.34 from S. Fd. 10"X10" Stone 6" high, 5 notches on E. #1 notch on S. as per C.S. 7848-17

SEC 29.

To sight on ridge Sec. line Prod. S

3/4 IP 6" high

0.5'

(calc) 2674.75

T. Δ "A" p9.73

E.N. Line Sec 32 2659.78'

To 1/4 Cor. p9.73

Replaced with 2" IP+BC. 6" high Mkd. in Conc.

(calc) 89°-48'-05"

90°-11'-55"

① (90°-12'-00") ⑥ (91°-11'-45") 90°-11'-57½"

COUNTY SURVEYOR'S MONUMENT T.3.N. S39.29 S 37.32 R.14W

403.80 @ 5°-52 = 401.69
230.49 @ 3°-18 = 230.11
228.30 @ 4°-09 = 227.70
292.41 @ 6°-24 = 290.59
483.50 @ 6°-11 = 480.69
450.67 @ 5°-03 = 448.92
497.98 @ 4°-50 = 496.21
64.28 @ 4-16 = 64.10
2640.01'
T58° = .31'
2639.70'

② (90-29-45) ⑤ (361-59-00) 90°-29'-45".

To Δ "A" per p9.73

SEC. 31

SEC. 32.

① (45°-28-45") ⑥ (272°-52-30") 45°-28-45"

45°-28-45"

90°-29'-45"

89°-17-05"

R20.40 @ 22°-12 = 204.06

2646.52 - fd 2½"X2½" stake 4ft high in N.E. of rock per C.S. 7982 - S.E. cor. of Love Pine Placer Claim per claim notice in tin can.

86°-28'

(calc) 203.67

12.58

2645.64 set 1XR on line bet. Sec. Cors.

2640.81 Fd 1X2-12" high scribed 1/4 on S. side

6.47

6.30

℄ of Sec. 2658.87' To Center of SEC. 32 Transit Line 2

To T.3. Pg. 82, 83

2646.17 - set 1XR by proportion for West 1/4 Cor. Sec 32 0+00 going East

326.22 @ 12°-10-30 = 318.88
499.04 @ 2°-19 = 498.63
355.88 @ 0°-34 = 355.86
1173.37'
T66° = .08'
1173.29'

300.00

90°-42'-55"

witness cor. set 2" IP+BC. Marked 4" high, in Conc. on top of low ridge W. side Kagel Can.

COUNTY SURVEYOR'S MONUMENT W.C. 300.00' N. To 1/4 COR.

From 2XR 14+77.35 p9.71

Cont'd p9.71

RETURN TO LOS ANGELES COUNTY SURVEYOR

Do not extend notes this side of this line

Note: ANY ADDITIONS OR CHANGES ON THIS SHEET MUST BE MADE ON CIRCLED IN Red. WITH DATE AND NAME OF PERSON MAKING CHANGE.

Date _____ Notes by _____ Chief Party _____ F.B. 320 Pg. 73

Platted by • McAtee	W. O. No. 783 D. S. O. No.
Date May 1929	Location Dexter Can. Park
Map No. B-153	Surveyed by Evans
Platting C'k'd by O.M. Finley	Date 4-24-29
Date June 1929	Indexed E. C. Johnson

Notes: ANY ADDITIONS OR CHANGES ON THIS SHEET MUST BE MADE OR CIRCLED IN Red. WITH DATE AND NAME OF PERSON MAKING CHANGE.

Do not extend notes this side of this line

RETURN TO LOS ANGELES COUNTY SURVEYOR

To Dist. Bdy. Sec. 29 (Ex. 81)

To Bdy (pg. 74)

To 1X2 25+31.36 pg. 74

Transit Line Sec. 29 to 32

76.88

75.30 @ 19-36 = 70.94
498.13 @ 11-01 = 488.95
153.81 @ 10-00 = 151.47
494.11 @ 5-00 = 492.23
1203.59
T70° = .05
1203.54

13+28.02
Set 2X2 on ridge.

496.29 @ 0-45 = 496.25
27.63 @ 32-34 = 23.29
347.12 @ 9-05 = 342.77
466.67 @ 15-01 = 450.93
T74° = 1313.24
.02
1313.22

SEC. 29

SEC. 32

Tel. 12+58.74 Perp. 80

56'-05"
55'-55"

(D) (53°-56)
(A) (32°-35-30)
53°-55-55"

"A" - Set 2X2 on top of ridge.

92°-12'-25"

0+14.80
Set 1X2

18.00 @ 34°-41 = 14.80

COUNTY SURVEYORS MONUMENT
S.29.
T.3 N.
R.14 W.
S.32

Fd. 6X8" stone, 6" high - mkd. + on S. side. See C.S. 7848-18
see C.S. 7848-18
0+00 going E.
0+00 going S.

Replaced with 2" I.P. B.C. in Conc. 12" high. mkd.

18.50 @ 35°-59 = 14.97

Transit Line To 1X2 Set by Br. of Sec.

2603.73 To Center of Sec. 32 Pg. 82, 83

(D) (1°-16'-45")
(A) (5°-07'-15")
1°-16'-48½"

(D) (90°-24-15)
(A) (361°-36-30)
90°-24'-07½"

From top of pg. 72

1°-16'-55"
3 short sights

55"

90°-10'-45"

44°-43'-15"

90°-10'-45"

23'-55"

To 1X2 26+52.64 Perp. 72

44°-43-15
(68°-17-30)
44°-43'-15"

F.B. 320 Pg. 74 Chief Party Notes by Date

(To B&T pg. 75)

To "B" per pg. 75

To ¼ Cor. Pg. 76

To IX2 3846.8 k 9-pg. 75

31-16-00"

31-16 (187-36) 31°-16'-00"

SEC. 33

SEC. 28

2895.35'

2878.11 calc

91°-55'-50" (calc)

27+90.18 Set 1X2

S 30°-10' E

15.19 from W 98.95 from N

See line 7 See pg. 81

2673.24 To ¼ Sec. Cor. 4 Pg. 80

2673.24 To ¼ Sec. Cor. Pg. 84

See line 7 See pg. 81

Transit Line per pg 81

2598.64 - T62° 25'-58"-R

17°-45' (calc)

91°-07'-15" (calc)

87°

25+85.57 - rd. old 4X4 stake, 12" high in rock Mound. - MKd. "R 14 W - 5.72 on W" T 3 N - 5" (illegible) on E. S. side illegible S. (illegible) on N. Grant notes call for rock at Sec. Cor. - Not Fd.

1.45

Set 2 1/2" B.C. in Calc. 12" high, On stone spall W. side of rough draw, near head of draw. See pg. 81

Marked

SURVEYOR'S MONUMENT COUNTY T. 3 N. R. 14 W. S. 29, S. 28 S. 32 S. 33

66.66 @ 35°-53 = 54.01

25+31.52 - Set 1X2 top of ridge.

2688.71

SEC. 29

Transit Line

SEC. 32

From ¼ Cor. pg. 73

From top pg. 73

RETURN TO LOS ANGELES COUNTY SURVEYOR

Do not extend notes this side of this line

Note: ANY ADDITIONS OR CHANGES ON THIS SHEET MUST BE MADE OR CIRCLED IN Red. WITH DATE AND NAME OF PERSON MAKING CHANGE.

Date _____ Notes by _____ Chief Party _____ F.B. 320 Pg 75

Platted by McAtee	W.O. No. 783 D.S.O. No.
Date MAY 1929	Location Dexter - Inn Dk.
Map No. B-153	Surveyed by Evans
Platting C'k'd by O.M. Finley	Date 4-25-29
Date June 1929	Indexed ~~J. C. Johnson~~

(76 T. H. 9)

Notes: ANY ADDITIONS OR CHANGES ON THIS SHEET MUST BE MADE OR CIRCLED IN Red. WITH DATE AND NAME OF PERSON MAKING CHANGE.

Do not extend notes this side of this line

RETURN TO LOS ANGELES COUNTY SURVEYOR

To Bot. Pg. 76

SEC. 28

SEC. 33

48+70.39 Set 1X2

2685.35

30.97 @ 11°-11'-T76° = 302.12

23°-23'-15
149°-19'-00
23°-23'-10"

65°-12'-45
31°-17'-15
65°-12'-52½"

91°-R-4'-00"

120.00 (calc)

Sec. Line

36+68.29 Set 1X2

Baseline 525.56

65°-12'-50"

60°-08'-05"

4"B" Set 1X2

498.31 @ 10.26 = 490.07
38.59 @ 23.03 = 35.51
525.58
T70° .01
525.57

27+90.18

1X2 Set per PP 74

(60°-08'-00
360°-48'-30
60°-08'-05")

(88°-36'-00
171°-36'-00
88°-36'-00")

(From P.B. pg 74)

F. B. 320 Pg. 76 Chief Party Notes by Date

(76' Topo)
#24

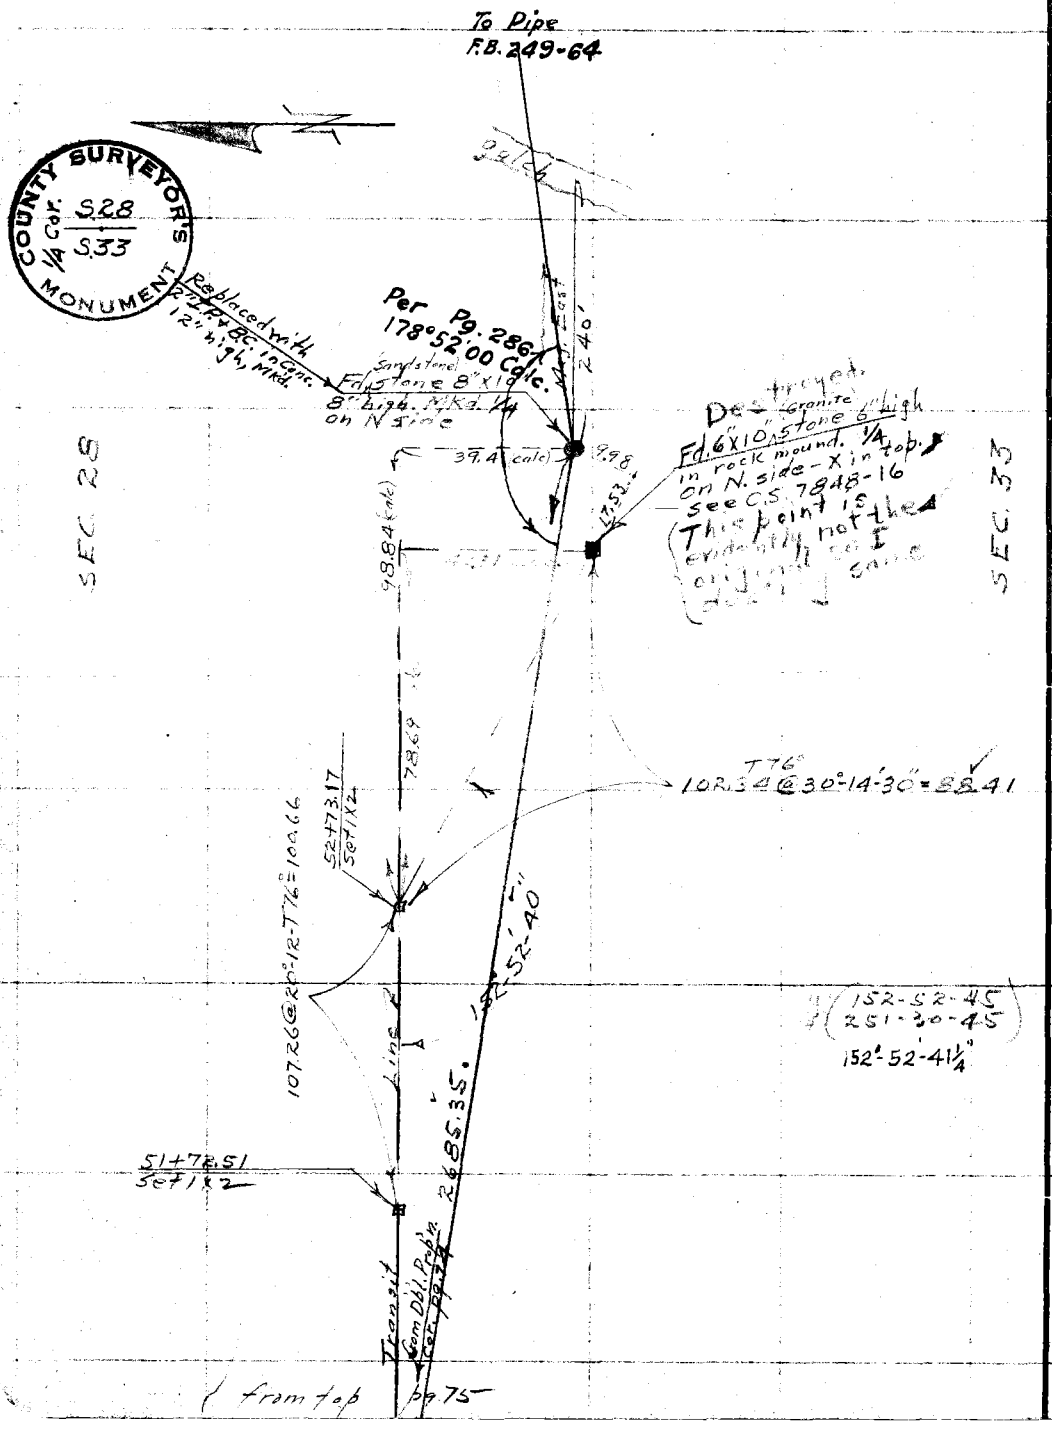

RETURN TO
LOS ANGELES COUNTY SURVEYOR

Do not extend notes this side of this line

Note: ANY ADDITIONS OR CHANGES ON THIS SHEET MUST BE MADE OR CIRCLED IN Red. WITH DATE AND NAME OF PERSON MAKING CHANGE.

Date _____ Notes by _____ Chief Party _____ F.B. 320 Pg. 77

Platted by McAtee	W. O. No. 783 D, S. O. No.
Date MAY 1929	Location Dexter Com. Park
Map No. B-153	Surveyed by [illegible]
Platting C'k'd by D.M. Finley	Date 4-26-29
Date June 1929	Indexed [illegible]

Notes: ANY ADDITIONS OR CHANGES ON THIS SHEET MUST BE MADE OR CIRCLED IN Red. WITH DATE AND NAME OF PERSON MAKING CHANGE.

Do not extend notes this side of this line

RETURN TO LOS ANGELES COUNTY SURVEYOR

(To Bk. pg. 78)

T. 3 N. R. 14 W. SEC. 32

T. 2 N. - R. 14 W. SEC. 5

664.42'

150.69 @ 7°43'30" - T58 = 149.30

16+63.95 Set 2x2

37°19'15"

(1) (6) (223°55'30" 37°19'15")

15+18.43 Set 1x2 on spur.

347.40 @ 14°49'-T58 = 335.81

89°27'20"

(see T. 7342) Fd. 2" I.P. with 14+74.11

530 @ 34°32' = 435.32

Q25

190.85 @ 4°19'-T60 = 190.29

1325.16

To 2x2 = 59.64 per p. 97

¼ of ¼ Sec. see p. 85

90°32'40"

SEC or of S.W.¼ of S.W.¼ Sec 32 set ~~2x2~~ by proportion

Replaced 2½ w. with 2" I.P. See F.B. 1424-44

13+28.84

13+28.14 ~~set 2x2~~ Destroyed May 1948 See F.B. 1424-44

32.51 @ 16°58' = 31.10

499.70 @ 1°43' = 499.48

309.43 @ 18°02' = 302.63

833.21

T60° = .09

833.12

90°21'40"

664.42'

C. Line Sec. 32

6+64.42

See p. 85 S.W. Cor. of E. ½ of S.W.¼ of S.W.¼ of Sec. 32 set 1x2 by Bolin

1324.12'

M'k'd. Replaced with 2" I.P. S.B.C. in Conc. 10" high

Fd. 2" I.P. flush per L.S. 1605

6+63.46

90°32'20"

Fd. 2" I.P. 3' S. 1.19' 5+31.17

96°

126.29

175.73 @ 16°32'-T60 = 168.44

44.34 @ 18°05' = 44.15

4+95.02 set 2x2 top of ridge.

664.42'

To S. W. Cor. Sec. 32 pg. 71, 85, 86

COUNTY SURVEYOR'S S.W. COR. DEXTER CAN. RECREATION PARK MONUMENT

(from Rt. Side pg. 71)

F.B. 320 Pg. 78 Chief Party Notes by Date

To Bot (pg 79)

To Cast Iron Mon. pg. 79.

Line 2

280.01 @ 2°-10 - T70 = 279.80

32+22.75 Set 1X2

S Transit Line

7.86 @ 0-0 = 7.86
230.26 @ 19-38 = 216.87
65.41 @ 28-44-30 = 57.35
327.90 @ 30-20 = 283.01
565.09
T70° = 02
565.07

Transit

2778.84 (calc)

0°-12'-58" (calc)

Fd old rock mound Marked Stone gone
52+58.01 from N.
= 24+77.80 from W.
see pg. 82

S Transit Line 2 per pg. 82

90°-20'-15"

T3N - R14W SEC 32

T2N - R14W SEC 5

146.28

26+57.66
Fd. 6"X10" Trans. Stone 8" high - 1/4 MKd. on N. side. Replaced rock md. on N. side. - See C.S. 78 48-1, L.S. 16-5 & Tr. 7342

1327.24 see pg. 85 To 1/4 Sec. Cor. 4 4 Pg. 86

E of Section

MKd. 2"IP or in Bot. Replaced with 2" IP & BC in Conc. 12" Bank of Wash Canyon

90°-33'-15"

446.54 @ 28°-44 - T58 = 408.73

COUNTY SURVEYOR'S MONUMENT T.3N. R.14W. 1/4 S.32 T.2N. R.14W. S.5

22+48.95 Fd 1X2 on line

664.42

89°-27'-05"

203.98 @ 0-0 = 203.98
231.80 @ 0-54 = 231.77
435.75
T58 = 05
435.70

To N.E. Cor. Dexter Canyon Park Pg. 86

1326.20 see pg. 85

19+93.26 S.E. Cor. of W. 1/2 of S.E. 1/4 of S.W. 1/4 of Sec. 32 - Set 1X2 by Prot. Tion.

MKd. Replaced with 2" IP & BC in Conc. 8" high

18+13.25 Set 2X2

90°-32'-55"

664.42

COUNTY SURVEYOR'S MONUMENT S.E. COR. OF DEXTER CANYON RECREATIONAL PARK.

(From top pg. 77)

RETURN TO LOS ANGELES COUNTY SURVEYOR

Do not extend notes this side of this line

Note: ANY ADDITIONS OR CHANGES ON THIS SHEET MUST BE MADE OR CIRCLED IN Red. WITH DATE AND NAME OF PERSON MAKING CHANGE.

Date _____ Notes by _____ Chief Party _____ F.B. 320 Pg 79

Platted by McAtee	W. O. No. 783 D. S. O. No. _____
Date MAY 1929	Location Dorer
Map No. B-15	Surveyed by Evans
Platting C'k'd by D.M. Finlen	Date 4-27-29
Date June 1929	Indexed A. C. Johnson

Note: ANY ADDITIONS OR CHANGES ON THIS SHEET MUST BE MADE OR CIRCLED IN Red. WITH DATE AND NAME OF PERSON MAKING CHANGE.

Do not extend notes this side of this line

RETURN TO LOS ANGELES COUNTY SURVEYOR

SEC. 33 T 3 N R 14 W

SEC. 4 T 2 N R 14 W

SEC. 32 T 3 N R 14 W

SEC. 5 T 2 N R 14 W

70 Tan
F. 4

(B) 89°-45-15
(C) 178°-31-45
89°-45-17½

54+36.50 N.E. Cor. Sec. 5.
Per L.S. 16-5
Fd. 4X4 Cast Iron Post 16" high
& cement filled. Marked
S 5R on N.W.
T 2N-5S. on S.W.
R 14W-S4. on S.E.
S.G.F.R. 33-T3N. S33 on NE.
see pgs. 104-105 Forest Reserve notes
see C.S. 9185-24-7848-4

54+29.85
Set N I T
in road.
129.00-T 100° = 129.02

Transit Line. 3
To ½ Sec. Cor. 53+00.83 from N.
Pg. 84
106+51.98 from N.

Set 1X2 by Intersn.
90°-50-05"

Replaced with 2" I.P. 18" in Cond. Stamped on W. edge Meridian Rd. near Junction with Little Tujunga Rd.

S.E. Cor. Sec. 32
Set 2X2 - 6" deep in Pile of rock.

Tran line Prod. 2

165.32 @ 33-55 = 137.19
385.56 @ 14-45 = 372.85
246.35 @ 8-49 = 243.44
753.48
T 70° = .03
753.45

46+76.40
Set 1X2 Top of ridge.

Set 2X2 on true line

14.59 @ 0-0 = 14.59
447.45 @ 10°-04 = 440.56
226.00 @ 7°-55 = 223.85
498.51 @ 24°-57 = 451.99
46.50 @ 22°-39 = 42.91
1173.90
T 70° = .05
1173.85

2778.84' Line

Transit Line

35+02.55
Set 1X2 top ridge

True Line

from Tab pg. 7(2)

F.B. 3320 Pg. 80 Chief Party Notes by Date

To Bat pg 81

175.87 @ 32°45 - T92 = 147.93
2.28 @ 0-0 = 2.28
150.21

To Sec Line pg 81

To Tract pg 81

52+48.7 6
Set 1x2

F.C. Howard searched for original ¼ sec. Cor. in this vicinity in Apr. 1946. See F.B. 1147-73.

R.L. Willey searched for original ¼ Sec. Cor. Mar. 7, 1950.

5346.49

True Sec. Line

Transit Line

SEC 28
T3N-R14W.

SEC. 29
T3N-R14W.

¼ Cor. Set 2" IP + BC. in Conc. 14" high

MKd

COUNTY SURVEYOR'S MONUMENT
¼ COR.
S28 | S29

26+73.00

35°16-15 20 Adj

36.17

3640.84 (calc) NO

To 1x2 - 0+14.80 per pg 73

To S.W. Cor. Sec. 32 per pg 71

This Line not used.

Adj 18.55

30°

2673.24

17+58.74 2
Set 1x2

124.43 @ 13-37 - T84° = 120.94

16+37.86 7B
Set 1x2

197.75 @ 15-11 = 480.37
50.00 @ 0-0 = 50.00
364.94 @ 7-18 = 361.98
892.35
T84° = .95
892.40

7+45.38
Set 1 x 2

498.82 @ 21-01 = 465.64
41.64 @ 0-0 = 41.64
238.50 @ 3-28 = 238.06
745.34
T84° = .04
745.38

0+09 going South
Fd. 6 x 12" soft granite Stone 12" high - No marks. Mound of rock 3' west
See C.S. 7848-16

COUNTY SURVEYOR'S MONUMENT
T3N R14W
S.20 | S.21
S.29 | S.28

MARKED

Replaced with 1½" IP in Conc. 12" high

28 29

SEC 21. 21 20 SEC 20

① (35°-16-15 / 211°-37-30) 35°-16-15"

① (30°-19'-15" / ② 181°-54-45 / 30°-19-07½")

RETURN TO
LOS ANGELES COUNTY SURVEYOR

Do not extend notes this side of this line

Note: ANY ADDITIONS OR CHANGES ON THIS SHEET MUST BE MADE OR CIRCLED IN Red. WITH DATE AND NAME OF PERSON MAKING CHANGE.

Date _____ Notes by _____ Chief Party _____ F.B. 320 Pg. 81

Platted by McAtee	W. O. No. 783 D. S. O. No. _____
Date MAY 1929	Location Dexter Can. Pk.
Map No. B-153	Surveyed by Evans
Platting C'k'd by D.M. Finley	Date 4-29-29
Date June 1929	Indexed A. C. Johnson

Note: ANY ADDITIONS OR CHANGES ON THIS SHEET MUST BE MADE OR CIRCLED IN Red. WITH DATE AND NAME OF PERSON MAKING CHANGE.

Do not extend notes this side of this line

RETURN TO LOS ANGELES COUNTY SURVEYOR

T76° Tab = (To Left side pg. 79)

To Intersn pg. 79

188.18

104+93.80 set 1X2

102.19 @ 17°38 - T92 = 9.74

103+96.40 set 1X2

109.75 @ 4°04 = 109.47
498.18 @ 6°01 = 495.44
412.00 @ 6°35 = 409.28
268.07 @ 3°47 = 267.49
441.51 @ 0°58 = 441.45
228.67 @ 12°00 = 223.67
272.55 @ 4°21 = 271.76
T 76° = 2218.56

33

To S.E. Cor Sec 32-2S-11W

set 1X2 81+77.84

45.00 @ 0° = 45.00
474.22 @ 6°00 = 471.62
82.20 @ 6°20 = 81.70
407.90 @ 8°31 = 403.40
170.97 @ 2°15 = 170.84
313.26 @ 0°49 = 313.23
214.00 @ 3°15 = 213.66
381.65 @ 9°57 = 375.91
497.93 @ 7°02 = 494.18
190.07 @ 16°32 = 189.88
20.74 @ 19°23'30" = 19.56
2778.98
T 78 104
2774.02

True Line 2673.25

Transit Line ℄ per pg 84

32

W 1/4 Cor pg. 84

26+15.19 from W
53+98.82 from N.
Set 2X2 bk Intersn

Transit Line pg 74

T 89°39'10"

89°39'10"

87°17'45"

S 1°42'35" E 2677.24

1X1 37+49.16 pg 74

89°12'25"

To 1/4 Sec. Cor. Pg. 73

2688.71 Sec. Line see pg. 74

6 Sec. Line see pg. 79

To 1/4 Sec. Cor. Pg. 76.

2685.35

186+00 @ 28°10 - T92 = 174.99

Set 2" IP 186 by Double Prop'n see pg. 74

72.34

53+45.99

Transit Line

2673.24 To 1/4 Sec. Cor. Pg. 80

91°07'15"

① (89°12'30")
⑥ (175°14'30")
89°12'25"

91°55'50"

28

29

(To Left pg. 80)

F. B. 320 Pg. 82 Chief Party Notes by Date

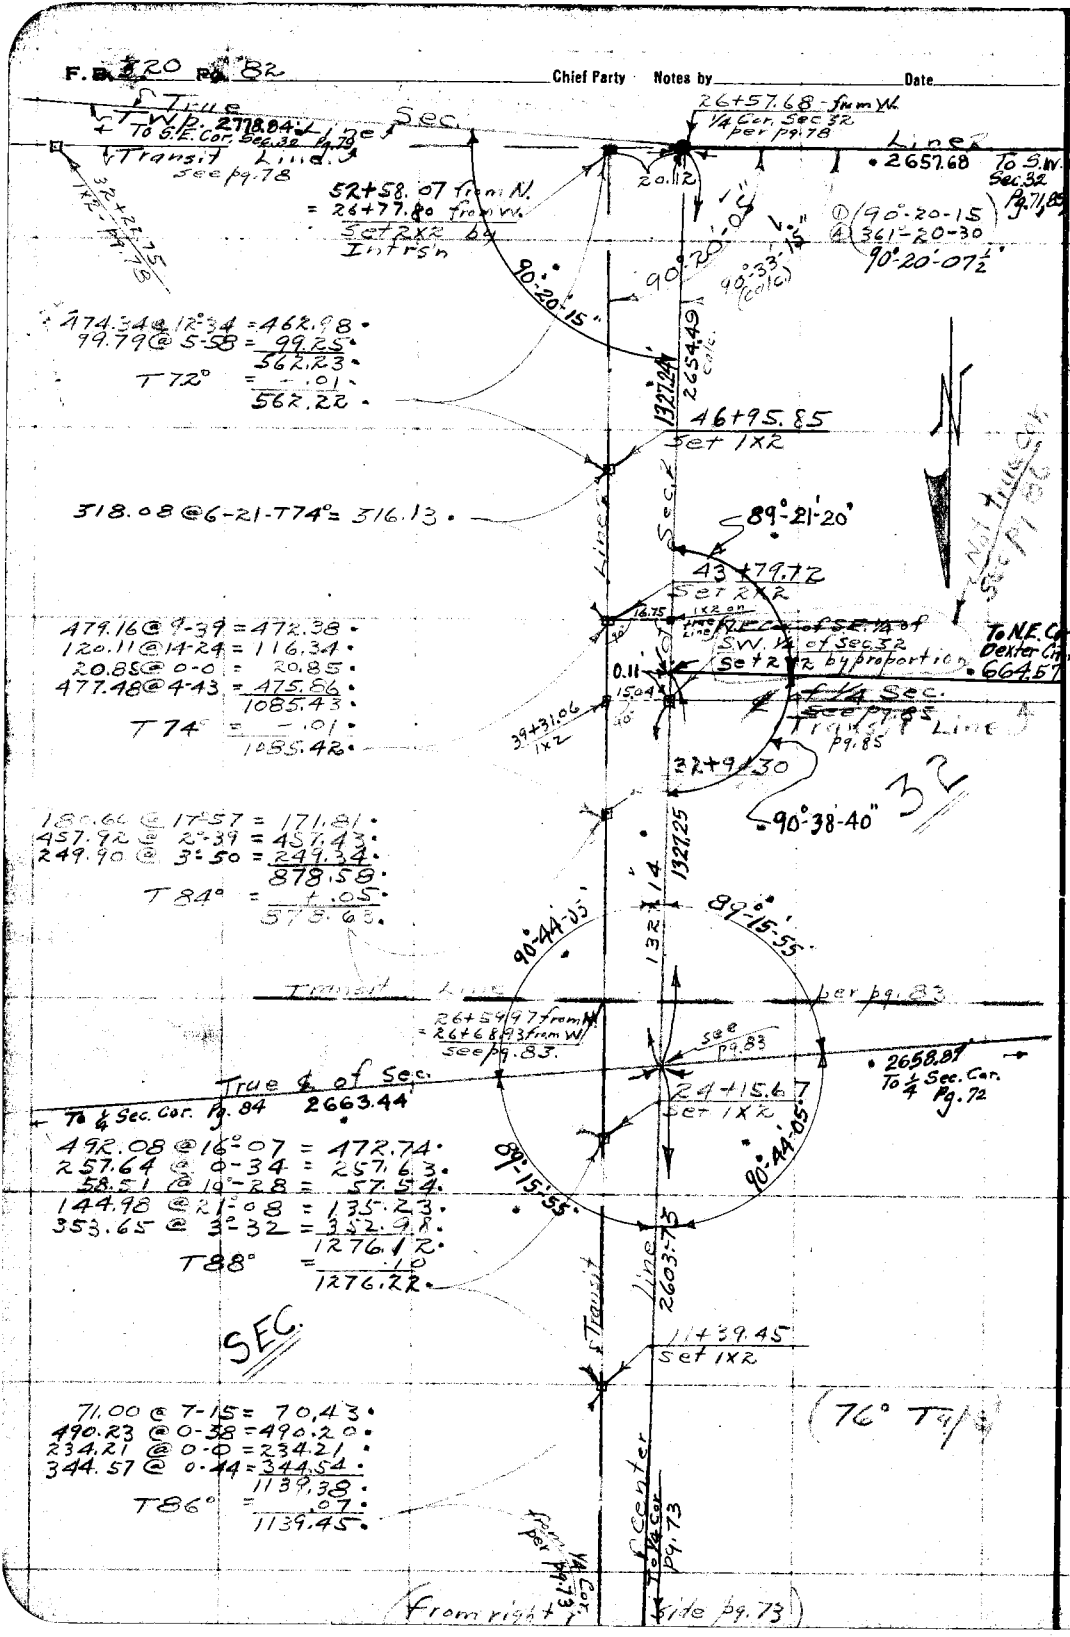

474.34 @ 12°-34 = 462.98
99.79 @ 5°-58 = 99.25
562.23
T 72° = -.01
562.22

318.08 @ 6°-21 - T74° = 316.13

479.16 @ 9°-39 = 472.38
120.11 @ 14°-24 = 116.34
20.85 @ 0°-0 = 20.85
477.48 @ 4°-43 = 475.86
1085.43
T 74° = -.01
1085.42

180.66 @ 17°-57 = 171.81
457.92 @ 2°-39 = 457.43
249.90 @ 3°-50 = 249.34
878.58
T 84° = +.05
878.63

492.08 @ 16°-07 = 472.74
257.64 @ 0°-34 = 257.63
58.51 @ 19°-28 = 57.54
144.98 @ 21°-08 = 135.23
353.65 @ 32°-32 = 352.98
1276.12
T 88° = .10
1276.22

71.00 @ 7°-15 = 70.43
490.23 @ 0°-38 = 490.20
234.21 @ 0°-0 = 234.21
344.54 @ 0°-44 = 344.54
1139.38
T 86° = .07
1139.45

Return to
LOS ANGELES COUNTY SURVEYOR
Do not extend notes this side of this line
Note: ANY ADDITIONS OR CHANGES ON THIS SHEET MUST BE MADE OR CIRCLED IN Red. WITH DATE AND NAME OF PERSON MAKING CHANGE.

Date _____ Notes by _____ Chief Party _____ F.B. 320 Pg. 83

Platted by McA+BB	W. O. No. 783 B. S. O. No.
Date MAY 1929	Location Dexter Cyn. Park
Map No. B-152	Surveyed by Evans
Platting C'k'd by D.M. Finley	Date 5-9-29
Date June 1929	Indexed A. C. Johnson

Note: ANY ADDITIONS OR CHANGES ON THIS SHEET MUST BE MADE OR CIRCLED IN Red. WITH DATE AND NAME OF PERSON MAKING CHANGE.

Do not extend notes this side of this line

RETURN TO LOS ANGELES COUNTY SURVEYOR

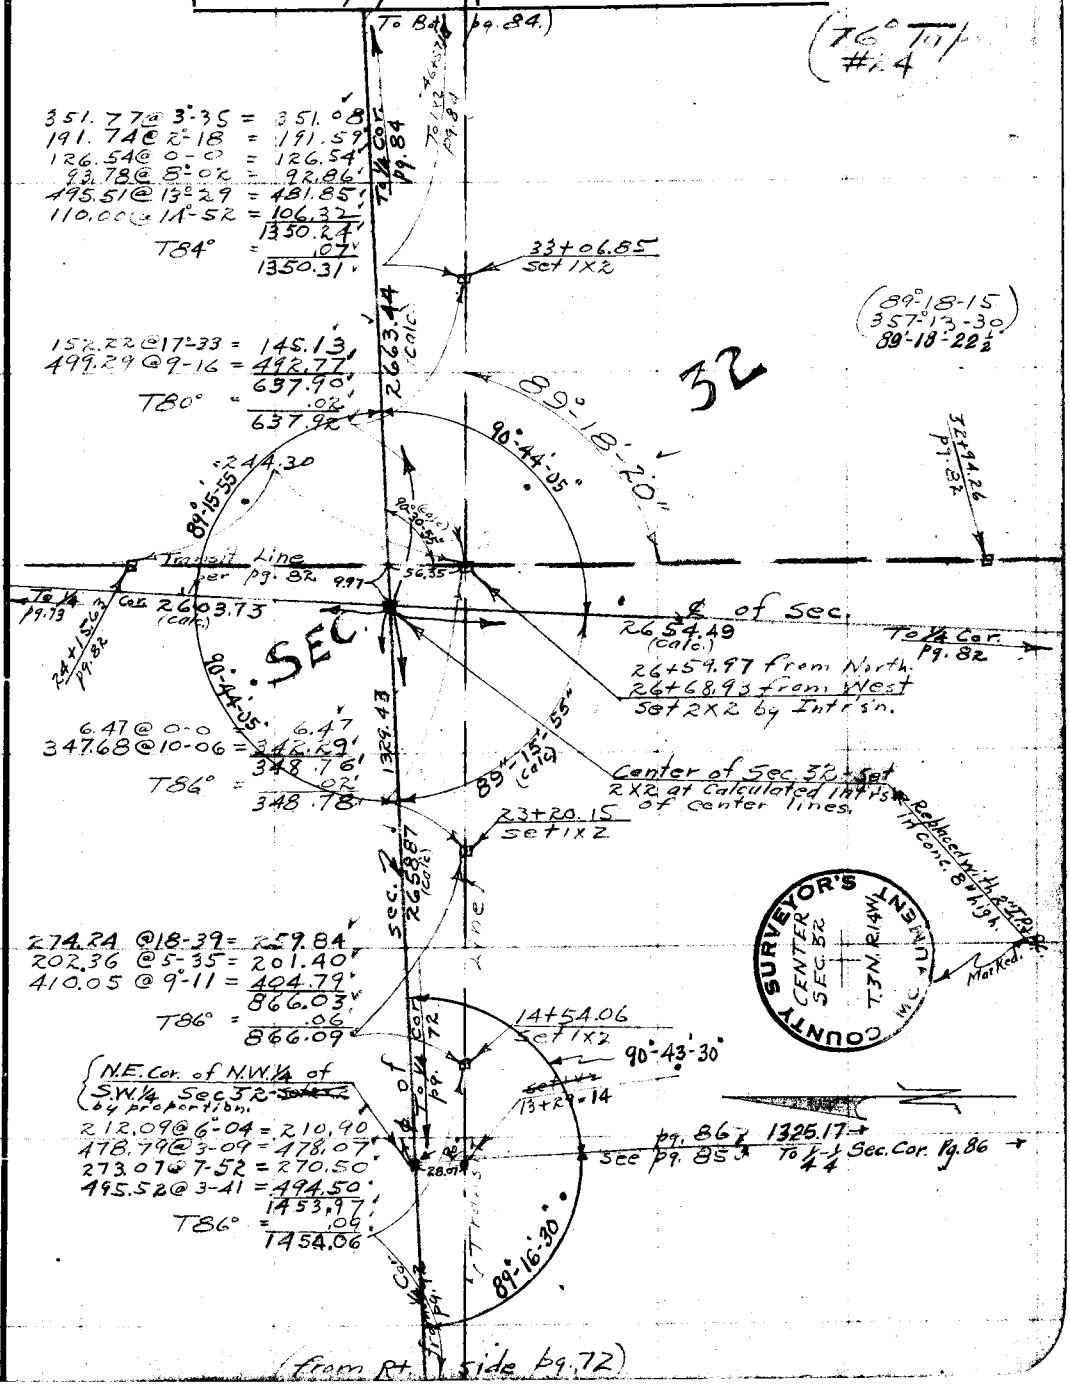

F.B. 320 Pg. 84 Chief Party Notes by Date

(To To/+)

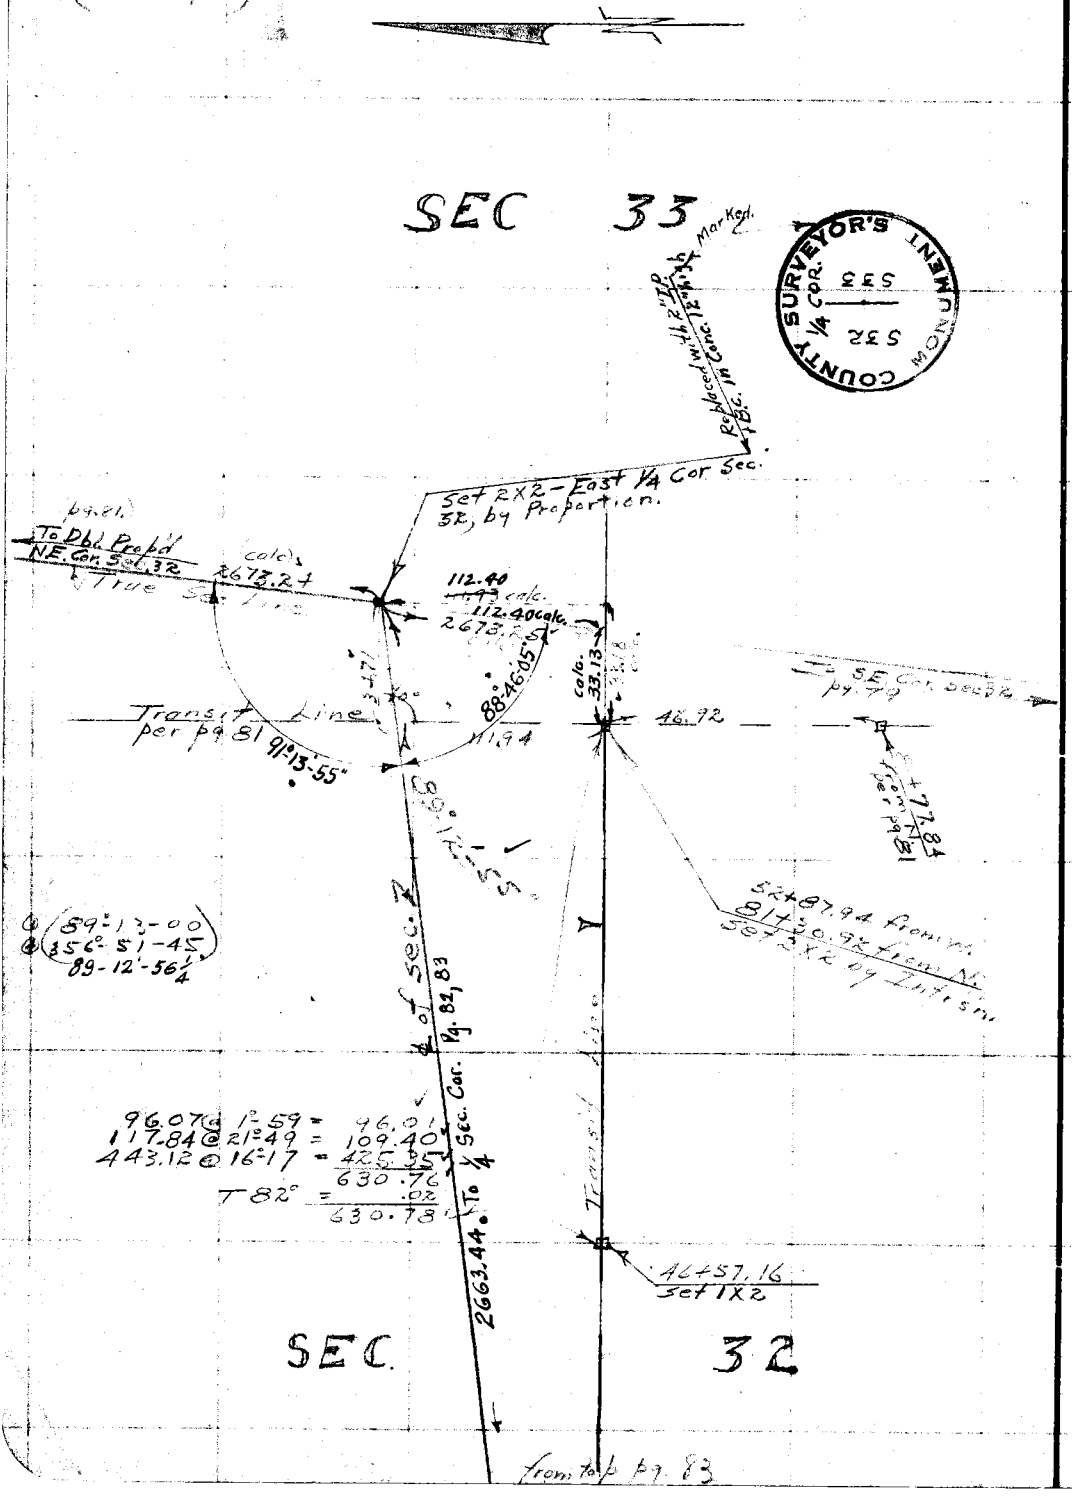

RETURN TO
LOS ANGELES COUNTY SURVEYOR

Do not extend notes this side of this line

Note: ANY ADDITIONS OR CHANGES ON THIS SHEET MUST BE MADE OR CIRCLED IN Red. WITH DATE AND NAME OF PERSON MAKING CHANGE.

Date _____ Notes by _____ Chief Party _____ F.B. 320 Pg. 85

Platted by McAtee	W. O. No. 783 D. S. O. No.
Date MAY 1929	Location Dexter Can. Pk
Map No. B-153	Surveyed by Evans
Platting C'k'd by D.M.Finley	Date 5-23-29
Date June 1929	Indexed C. Johnson

Note: ANY ADDITIONS OR CHANGES ON THIS SHEET MUST BE MADE OR CIRCLED IN Red. WITH DATE AND NAME OF PERSON MAKING CHANGE.

Do not extend notes this side of this line

RETURN TO LOS ANGELES COUNTY SURVEYOR

Center of Sec. 32 Established by intersection of straight lines drawn to 1/4 Corners see Pg. 83

(89°-21-45 357°-27-30 89°-21'-52½)

(89°-22-30 357°-30-30 89°-22-35")

of co going West NE. Cor of SE 1/4 of SW 1/4 of Sec. 32 set by proportion bet. center of Sec. 32 & S. 1/4 Cor. per p. 82. Not true Cor.

2654.28 (calc)

1327.14

1327.14

S. 1/4 Cor Sec. 32 p. 78

89°-21'-50"

89°-22'-15"

1328.84

S.E. Cor. of Dexter Park see p. 78

384.85 @ 4-36 = 383.61
171.57 @ 14-45 = 165.91
549.52
T 92° = .06
549.58

(221.76 @ 6°-18 T 92° = 220.44

199.65 @ 14°55 - T 92° = 192.94
376.02 @ 13°-09 T 70° = 366.15
559.09

N.E. Cor of N.W. 1/4 of S.W. 1/4 of Sec. 32 set by proportion between Sec. Cor. N. Sec. 32 & Center of Sec. per p. 83

1329.43

N.E. 1/4 of 1/4

1212.11 meas.

1/4 1/4

S.E. Cor of S.W. 1/4 of Sec. 32 set by proportion see p. 77

DEXTER CANYON PARK. S.E.

Line 5 Transit

see p. 86.

348.77 @ 0-0 = 348.77
217.14 @ 13°-07 = 211.47
560.24
T 70° = .08
560.22

(calc) 2653.88

73.02 @ T 26 = 72.41

1329.44

N.W. 1/4 of 1/4

S.W. 1/4 of 1/4

287.26 @ 8-33 = 284.07
412.88 @ 2-26 = 412.50
696.57
T 70° = .03
696.54
4

1323.08

2646.17

Note

Corners voided in red on this pg. were not correctly placed. See pg. 86 for correct location.

(89°-23-45 357°-34-45 89°-23-41¼)

(89°-23 357°-31-45 89°-22-56¼)

West ¼ Cor Sec. 32 set by proportion see p. 72

NW Cor of Sec. 32 set by proportion per p. 71

S.W. Cor Sec. 32 per p. 71

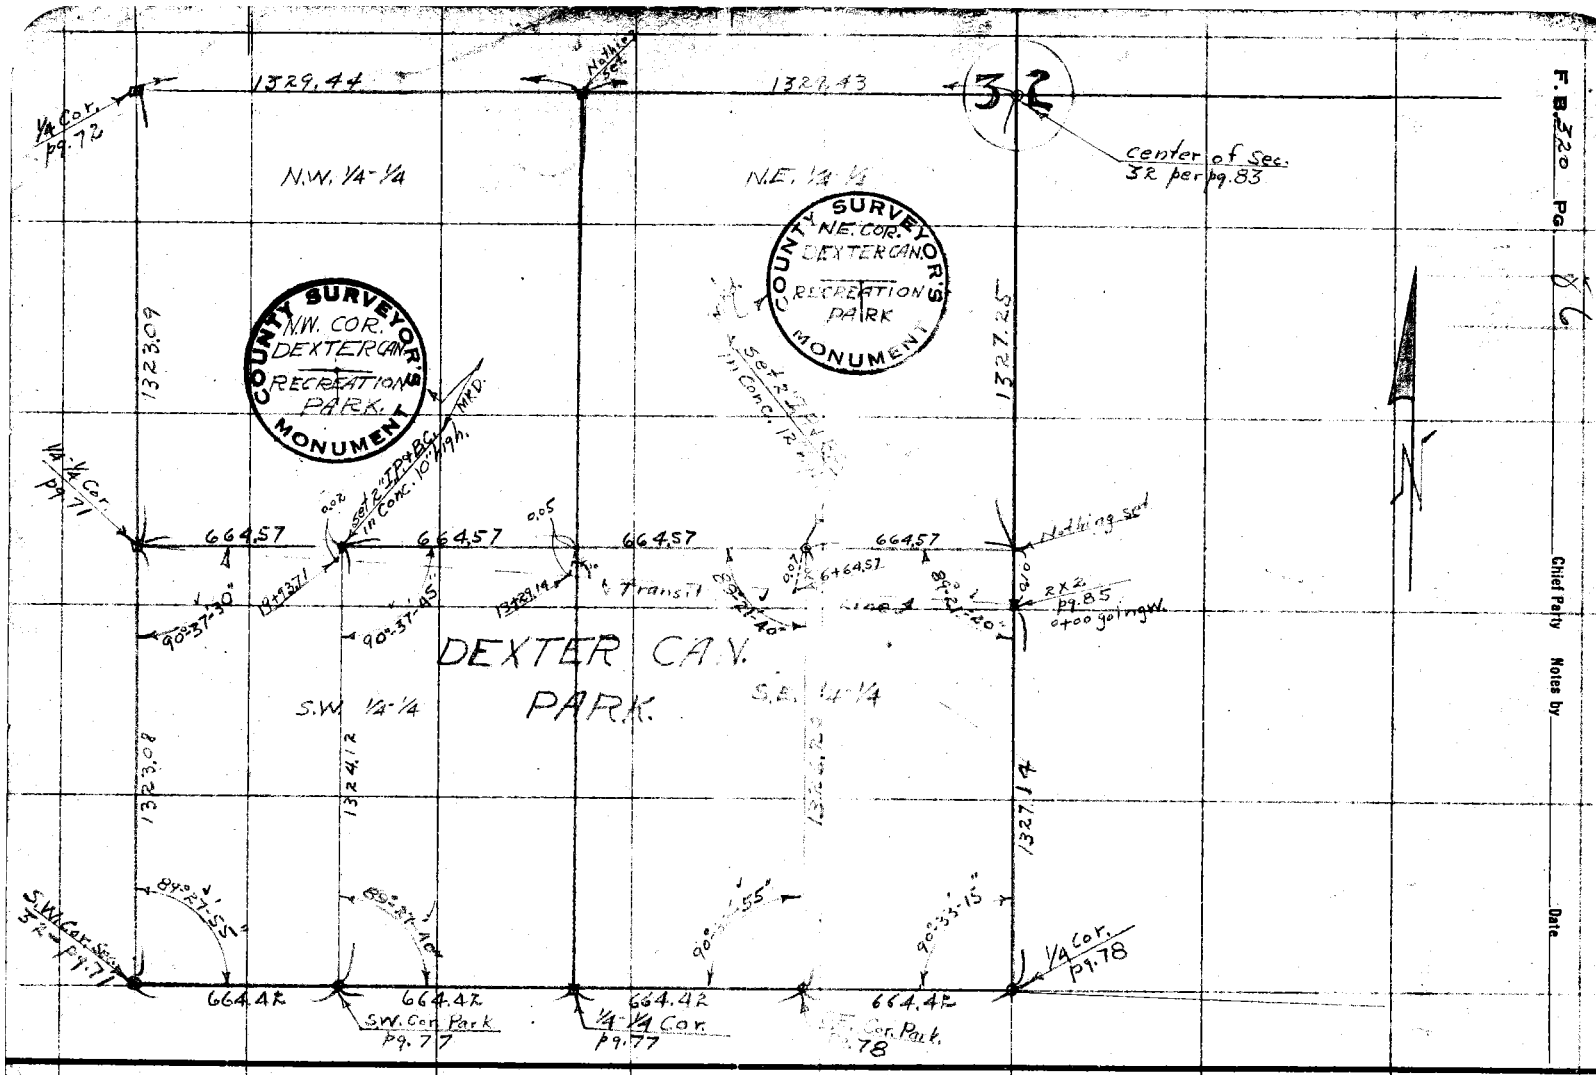
1329.44
1322.43
32
Center of Sec. 32 per pg. 83
N.W. 1/4-1/4
N.E. 1/4 1/4
COUNTY SURVEYOR'S MONUMENT
N.W. COR. DEXTER CAN. RECREATION PARK.
COUNTY SURVEYOR'S MONUMENT
N.E. COR. DEXTER CAN. RECREATION PARK
1323.09
1327.25
1/4 Cor. Pg. 72
1/4 Cor. Pg. 71
664.57
664.57
664.57
664.57
Nothing set
Set 2" IP on BC in Conc. 10' High.
Set 2" IP on Conc.
Transit
2X2 pg. 85
0+00 going W.
DEXTER CA.V.
PARK.
S.W. 1/4-1/4
S.E. 1/4-1/4
1323.08
1324.12
1327.14
S.W. Cor. Sec. 32 Pg. 71
664.42
664.42
664.42
664.42
S.W. Cor. Park Pg. 77
1/4-1/4 Cor. Pg. 77
Cor. Park
1/4 Cor. Pg. 78
F.B. 220 Pg. 8 & 9
Chief Party
Notes by
Date
LOS ANGELES COUNTY SURVEYOR
RETURN TO
Note: ANY ADDITIONS OR CHANGES ON THIS SHEET MUST BE MADE OR CIRCLED IN Red. WITH DATE AND NAME OF PERSON MAKING CHANGE.
Do not extend notes this side of this line

Notes Ck'd by D.M. Finley
Map No. B-153
Checked D.M. Finley
Date Apr. 1936.

Survey of Dexter Golf Park
W. O. 7783 Tape No 049 St'd 84 or.
Surveyed by Emmatt
Notes " Date 10/8/34
Indexed A. C. Johnson 11-3-34

F.B. 320 Pg. 67

Monument
S.W. Cor. Park
See F.B. 320 Pg. 66

Mon. N.W. Cor. Park (See F.B. 320 Pg. 66)

Note: See Revised Sketch for New Road Through Park

Concrete Incinerator

1" Magnolia

Shrubs

1 Story Frame Patrol Station

Corr. Iron Toilet and Shower

1" Flagpole

1½" Riser

Corrugated Iron Garage

Corr. Iron Supply Locker

Wire Mesh Fence

3" Pines

3/4" Water Hyd.

VOID

Note: ANY ADDITIONS OR CHANGES ON THIS SHEET MUST BE MADE OR CIRCLED IN Red Ink WITH DATE AND NAME OF PERSON MAKING CHANGE.

Do not extend notes this side of this line

RETURN TO
LOS ANGELES COUNTY SURVEYOR
700 HALL OF RECORDS

B. 320 Pg. 88

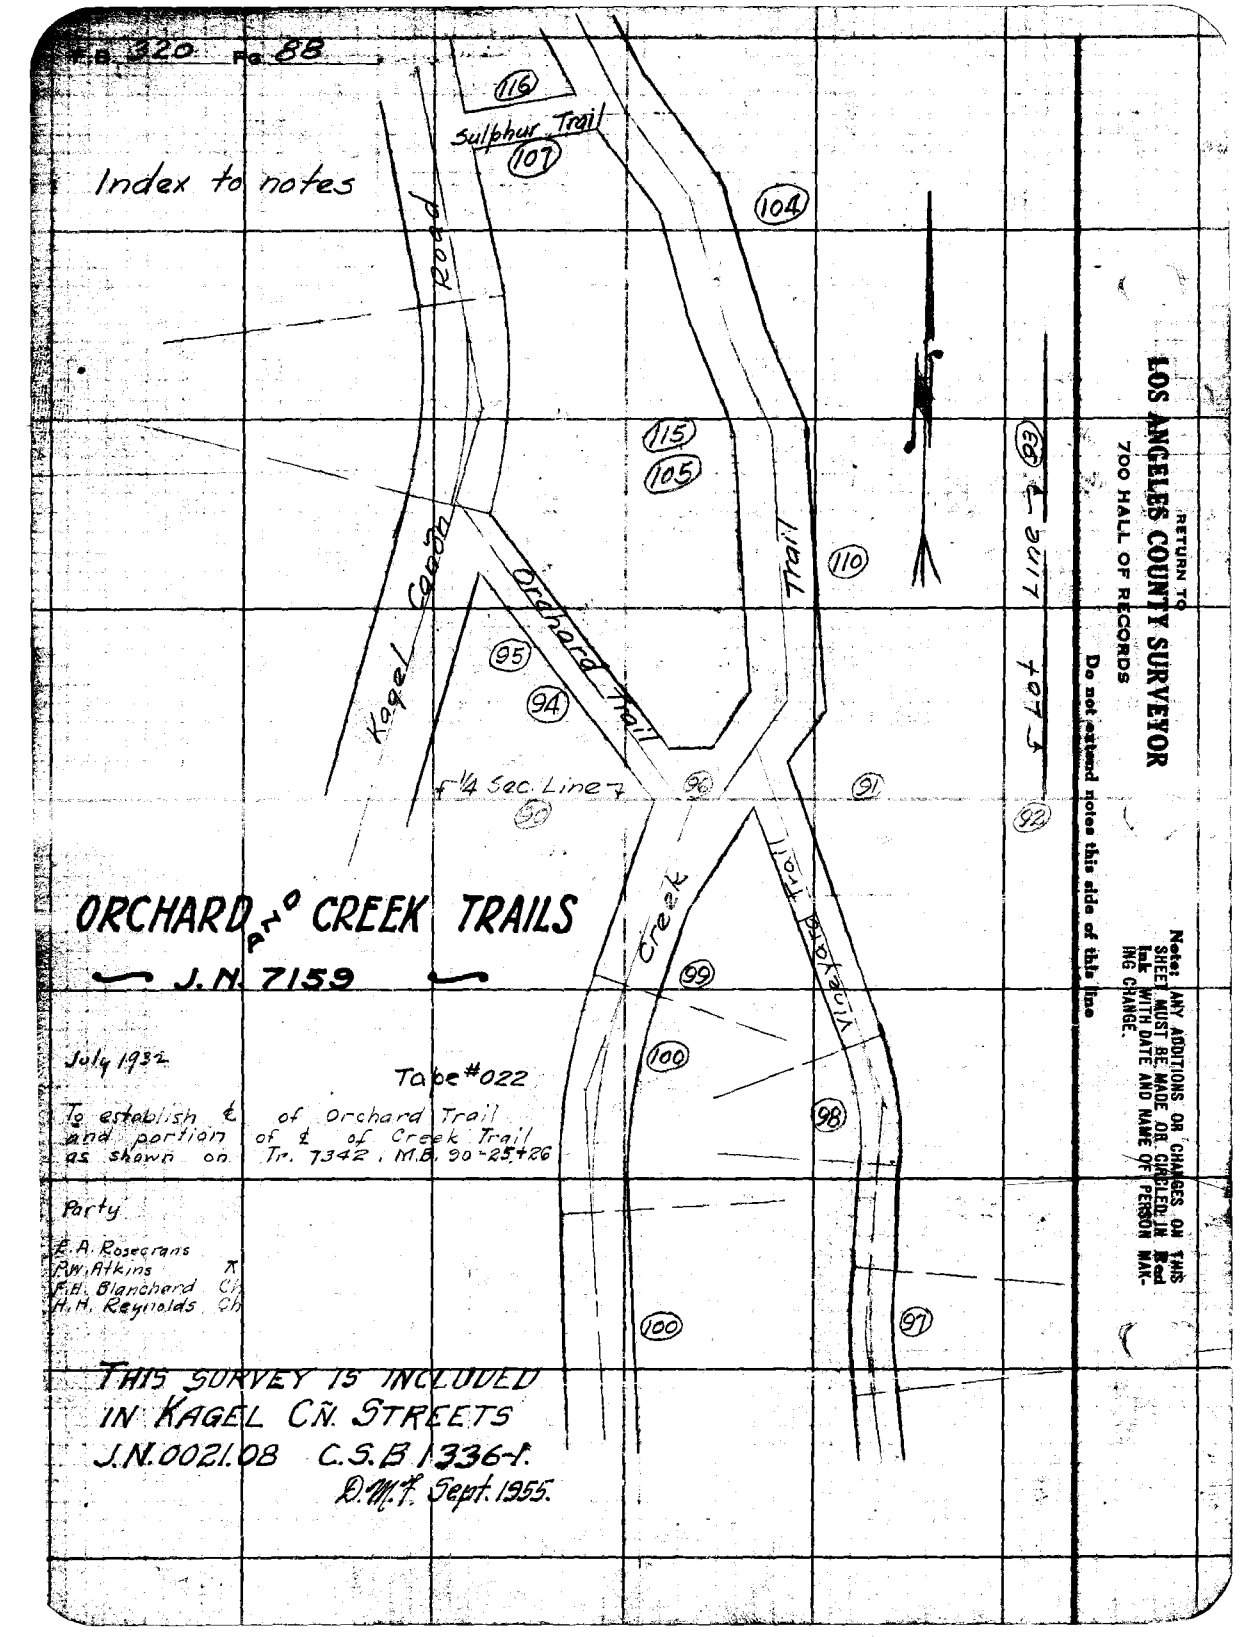

RETURN TO
LOS ANGELES COUNTY SURVEYOR
700 HALL OF RECORDS

Do not extend notes this side of this line

Note: ANY ADDITIONS OR CHANGES ON THIS SHEET MUST BE MADE OR CHARGED IN Red Ink WITH DATE AND NAME OF PERSON MAKING CHANGE.

ORCHARD & CREEK TRAILS

J.N. 7159

July 1932

Tape #022

To establish ℄ of Orchard Trail and portion of ℄ of Creek Trail as shown on Tr. 7342, M.B. 90-25+26

Party

E.A. Rosecrans
R.W. Atkins
F.H. Blanchard
A.M. Reynolds

THIS SURVEY IS INCLUDED IN KAGEL CN. STREETS J.N.0021.08 C.S.B 1336-1.
D.M.F. Sept. 1955.

Notes Ck'd by D. M. Finley	Survey of Orchard & Creek Trails
Map No. ~~B-1936~~ B-1936:1	W. O. 7159 Tape No. 222 St'd 84 °F.
Office Work	Surveyed by Personnel
Checked D. M. Finley	Notes Date 7-29-32
Date ~~Aug. '32~~	Indexed A. C. Johnson 7-30-32

F.B. 320 Pg. 89

Index to notes.

Orchard & Creek Trail

Conf. from top Pg. 88

Note: ANY ADDITIONS OR CHANGES ON THIS SHEET MUST BE MADE OR CIRCLED IN Red Ink. WITH DATE AND NAME OF PERSON MAKING CHANGE.

Do not extend notes this side of this line

RETURN TO
LOS ANGELES COUNTY SURVEYOR
700 HALL OF RECORDS

FORM 2.47 10M 8-31

RETURN TO

LOS ANGELES COUNTY SURVEYOR

700 HALL OF RECORDS

Note: ANY ADDITIONS OR CHANGES ON THIS SHEET MUST BE MADE OR CIRCLED IN **Red Ink.** WITH DATE AND NAME OF PERSON MAKING CHANGE.

Do not extend notes this side of this line

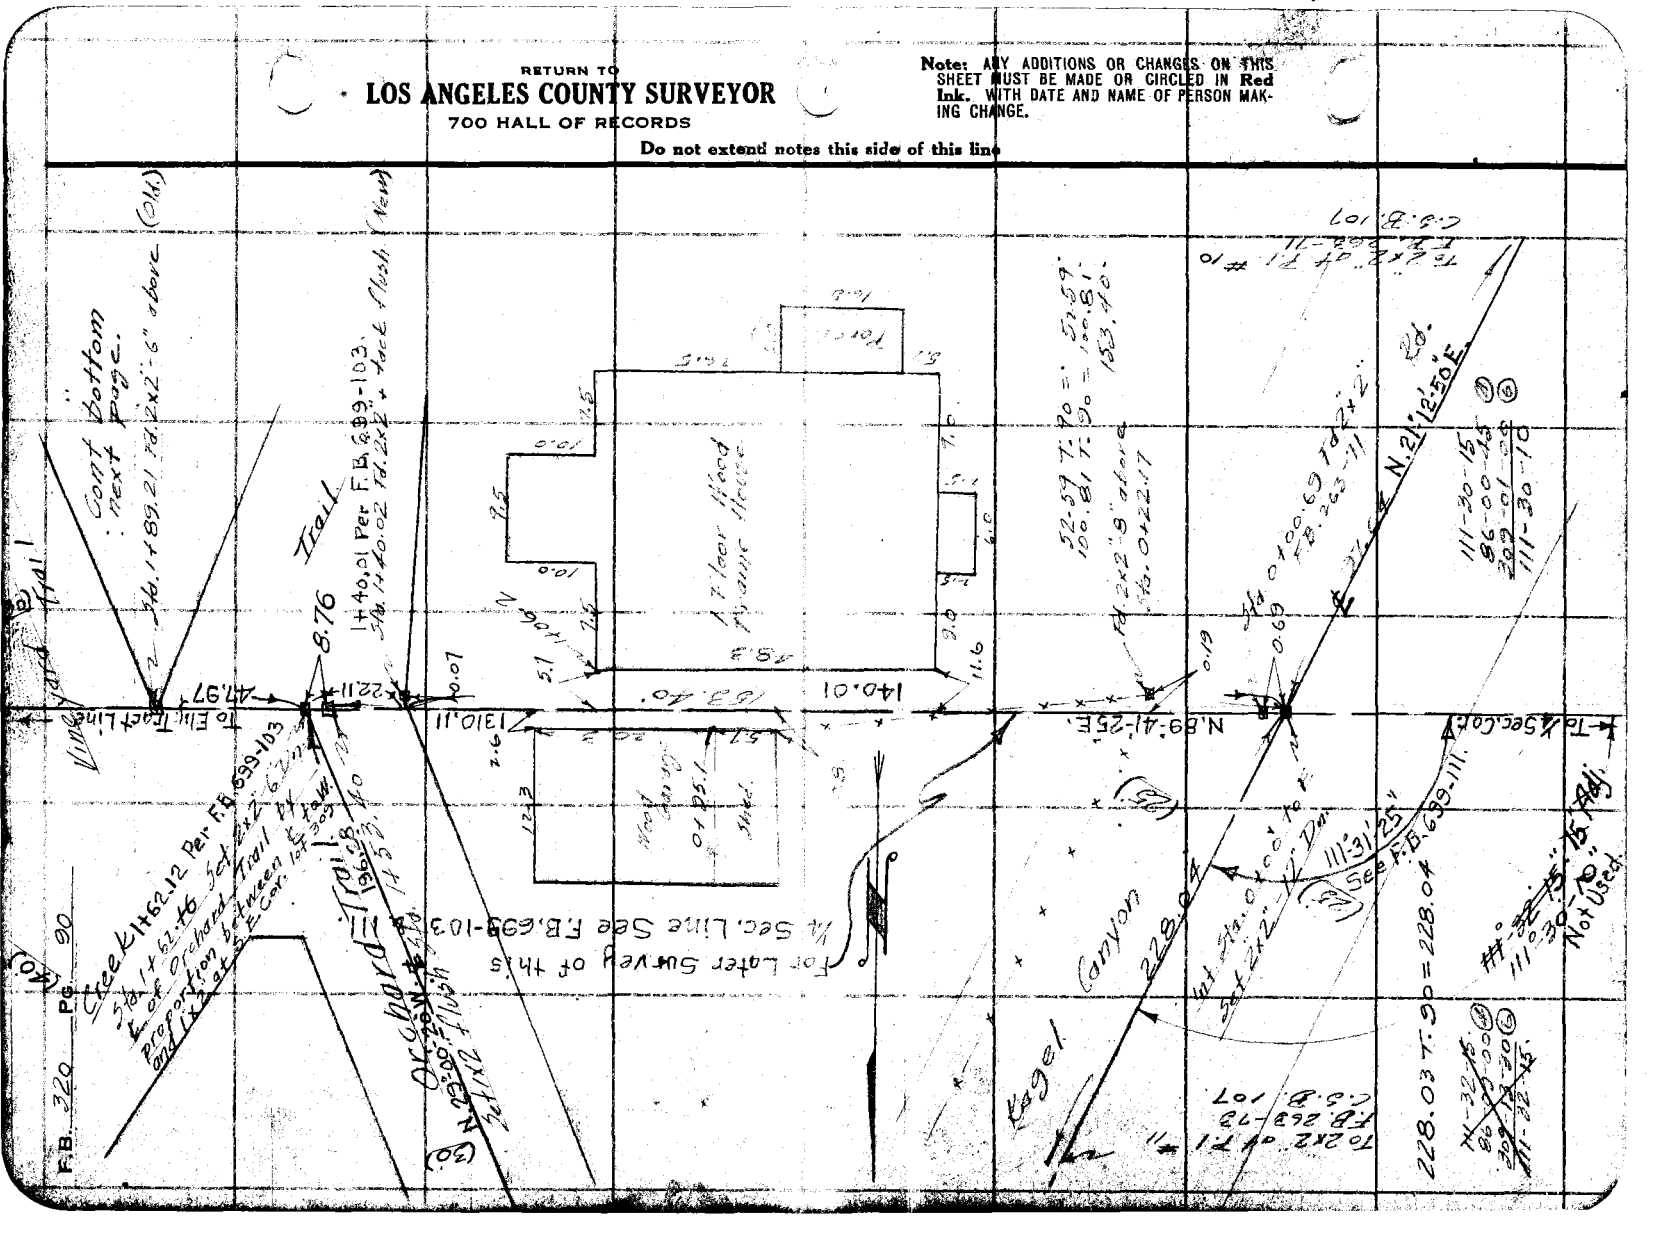

Notes Ck'd by D.M. Finley		Survey of Orchard & Creek Trails	F.B. 320 Pg. 91
Map No. ~~B-1936~~ B-1936-1		W. O. 7159 Tape No. 022 St'd 84 °F.	
Office Work		Surveyed by Rosecrans	
Checked D. M. Finley		Notes	Date 7-16-52
Date AUG '55		Indexed A. C. Johnson	

Cont. bottom next zone

Note: ANY ADDITIONS OR CHANGES ON THIS SHEET MUST BE MADE OR CIRCLED IN Red Ink. WITH DATE AND NAME OF PERSON MAKING CHANGE.

RETURN TO
LOS ANGELES COUNTY SURVEYOR
700 HALL OF RECORDS
Do not extend notes this side of this line

Sta. 4+30.16
Set 1"x2" Flush.

98.09 T 34 = 98.10'

38.10
161.25

Sta. 3+32.06
Set 1"x2" - Flush

11.5

3+38.05

2 Storey
Frame House

32.1

32.0

2.6
Conc. Steps
Conc. Ret. Wall
16.5
4.0
0.4
41.5

97.24 @ 14-50 T 34 = 34.01
+84.65
178.66

N. 2°-28'-25" E. 394.33
See Pg. 93
Lot Line

S.E. Cor. Lot 309
B+06.51
See Pg. 93

17.0

5.0
3.0
3.0
7.0
20.6

1 Floor
Frame Cabin

16.1
16.1

18.0

2+46.05

85.45 @ 7-51 T 30
= 84.65'

N. 89°-41'-25" E. 1810.11
178.66'
85.10

For Later Survey of this
1/4 Sec. Line See F.B. 699-91 & 103

2+21.41 Per F.B. 699-91.
Sta. 2+21.49 Fd. old 2x2" D.M.

N. 22°-53'-35" W. 175.70

For this & See F.B. 699-91

40' Creek.

11.32

2+10.09
See F.B. 699-91

Trail

47.97

Set 1"x2" flush Sta. 1+53.40
See preceding page

FORM 247 10M 8-31

F.B. 320 PG. 92

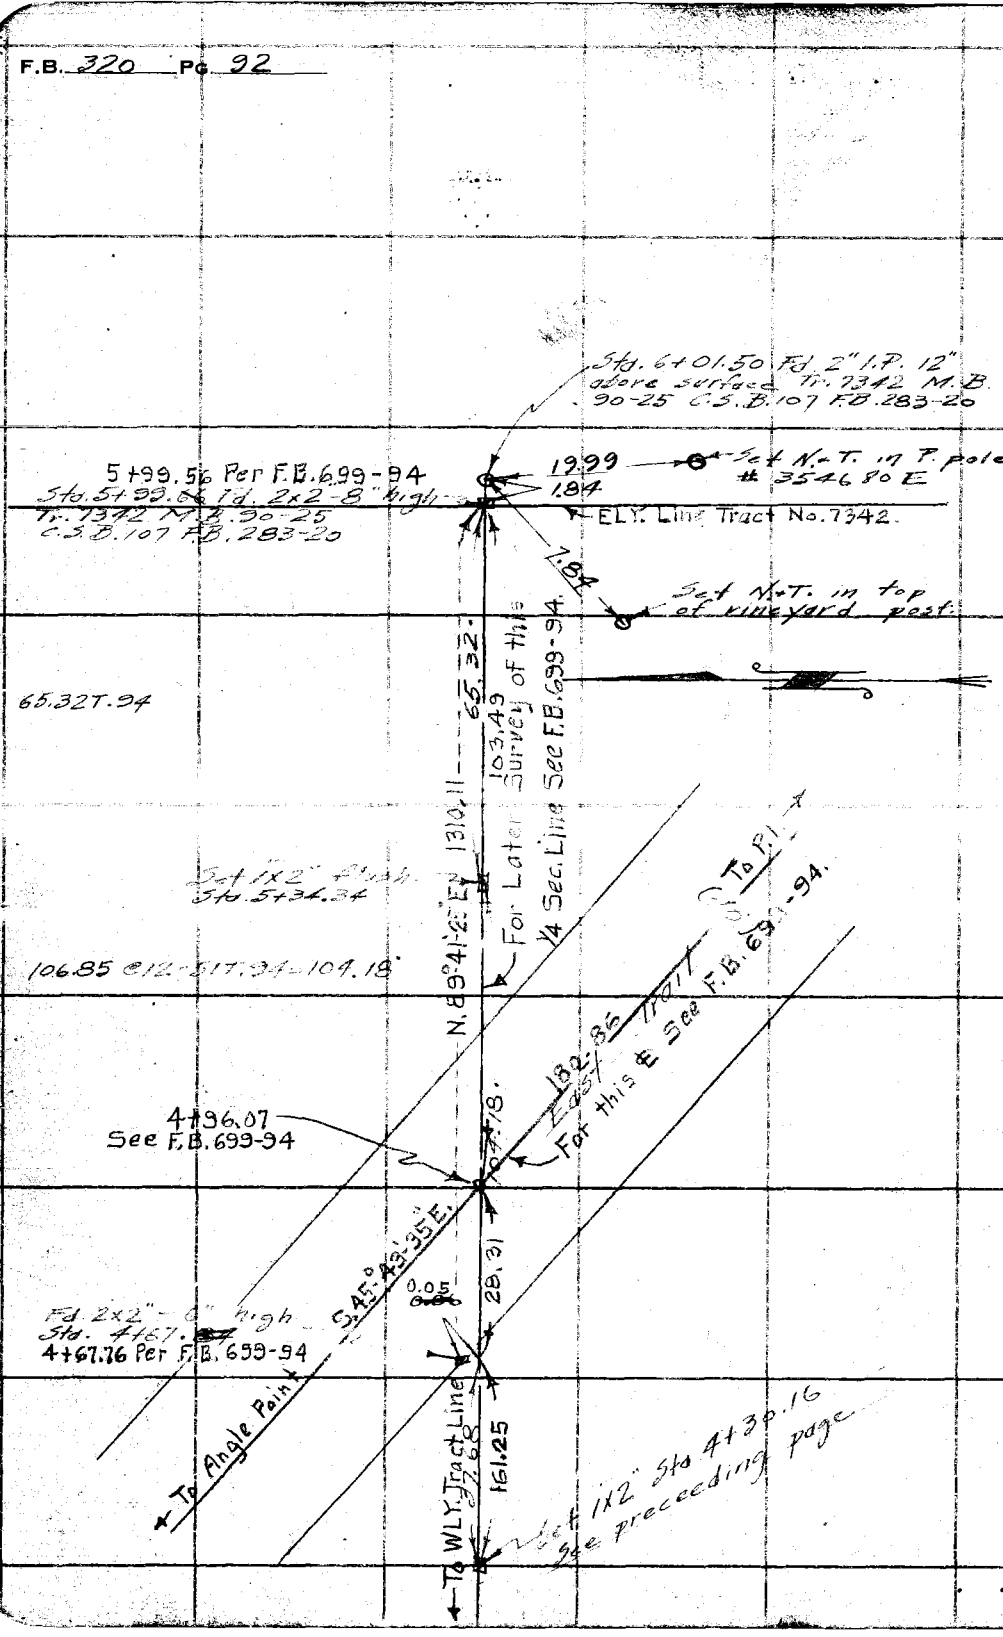

RETURN TO
LOS ANGELES COUNTY SURVEYOR
700 HALL OF RECORDS

Do not extend notes this side of this line

Note: ANY ADDITIONS OR CHANGES ON THIS SHEET MUST BE MADE OR CIRCLED IN Red Ink. WITH DATE AND NAME OF PERSON MAKING CHANGE.

Notes Co'd by D.M Finley	Survey of Orchard & Creek Trails	F.B. 320 Pg. 93
Map No. ~~B-180~~ B1336-1	W. O. 7159 Tape No. 022 St'd 64 °F.	
Office Work	Surveyed by Rosecrans	
Checked D. M. Finley	Notes	Date 7-18-32
Date AUG '55	Indexed A. C. Johnson	

Cont on lower left of page.

Note: ANY CORRECTIONS OR CHANGES ON THIS SHEET MUST BE MADE IN Red Ink. WITH DATE AND NAME OF PERSON MAKING CHANGE.

Do not extend notes this side of this line

RETURN TO
LOS ANGELES COUNTY SURVEYOR
700 HALL OF RECORDS

FORM 247 10M 8-51

14 2x2 - 3 ways

2+76.45

2+62.59

0.23

53.50

Note See Tr. 7342-4
M.B. 90-25

0.18

Fd. 2x2 - 5" up.

3+94.33

60.60

0.10

2+21.95 Fd. 2x2" - 5" up.

2+10.76 Fd. 2x2" - 5" up.

0.20

394.33
3963

N. 2°-28'-25" E.

0.23

1+82.32 Fd. 2x2" - 5" up.

1+71.06 Fd. 2x2" - 5" up.

0.15

0.23

3+54.25

0.18

3+35.94 Fd. 2x2" - 5" up.

Fd. 2x2 - 5" up.

1+24.73

0.22

1+43.28

Line

0.08

3+15.32 Fd. 2x2" - 5" up.

Fd. 2x2" - 5" up.

1+34.76 Fd. 2x2" - 5" up.

0.27

394.33

N. 2°-28'-25" E.

2+99.05 Fd. 2x2" - 5" up.

49.28

97.26

Adopted Lot

0.07

1+01.36 Fd. 2x2" 5" up.

2+75.45 Fd. 2x2" - 5" up.

Fd. 2x2" - 5" up.

0+95.06

92-47-00
11-08-00 (1)
196-42-15 (6)
92-47-02½

22°-47-00"

0+52.05 Fd. 2x2" 5" up.

0+45.79 Fd. 2x2" - 5" up.

3+32.06 Ft. M

Fd. 3/4" Iron Pipe 0.40 ft. N.

Fd. 3/4" Iron Pipe 0.10 ft. N.

1+06.51 Per R.B. 699

Set 1/2" Iron Pipe 0.40 ft. N. of Ang. Pt. in Line of Lot 4, Tract 10423 as per M.B. 990-25

Y4 Sec. Line

25.47

161.25

N. 89°-41'-25" E.

85.10

See Pg. 91

To 2x2" on E. of Kagel Canyon Rd. Pg. 90

See Pg. 92

28.21 @ 25-27=25.47'

Line 3+32.06 Ft. M

Per R.S. 91

F.B. 320 Pg. 94

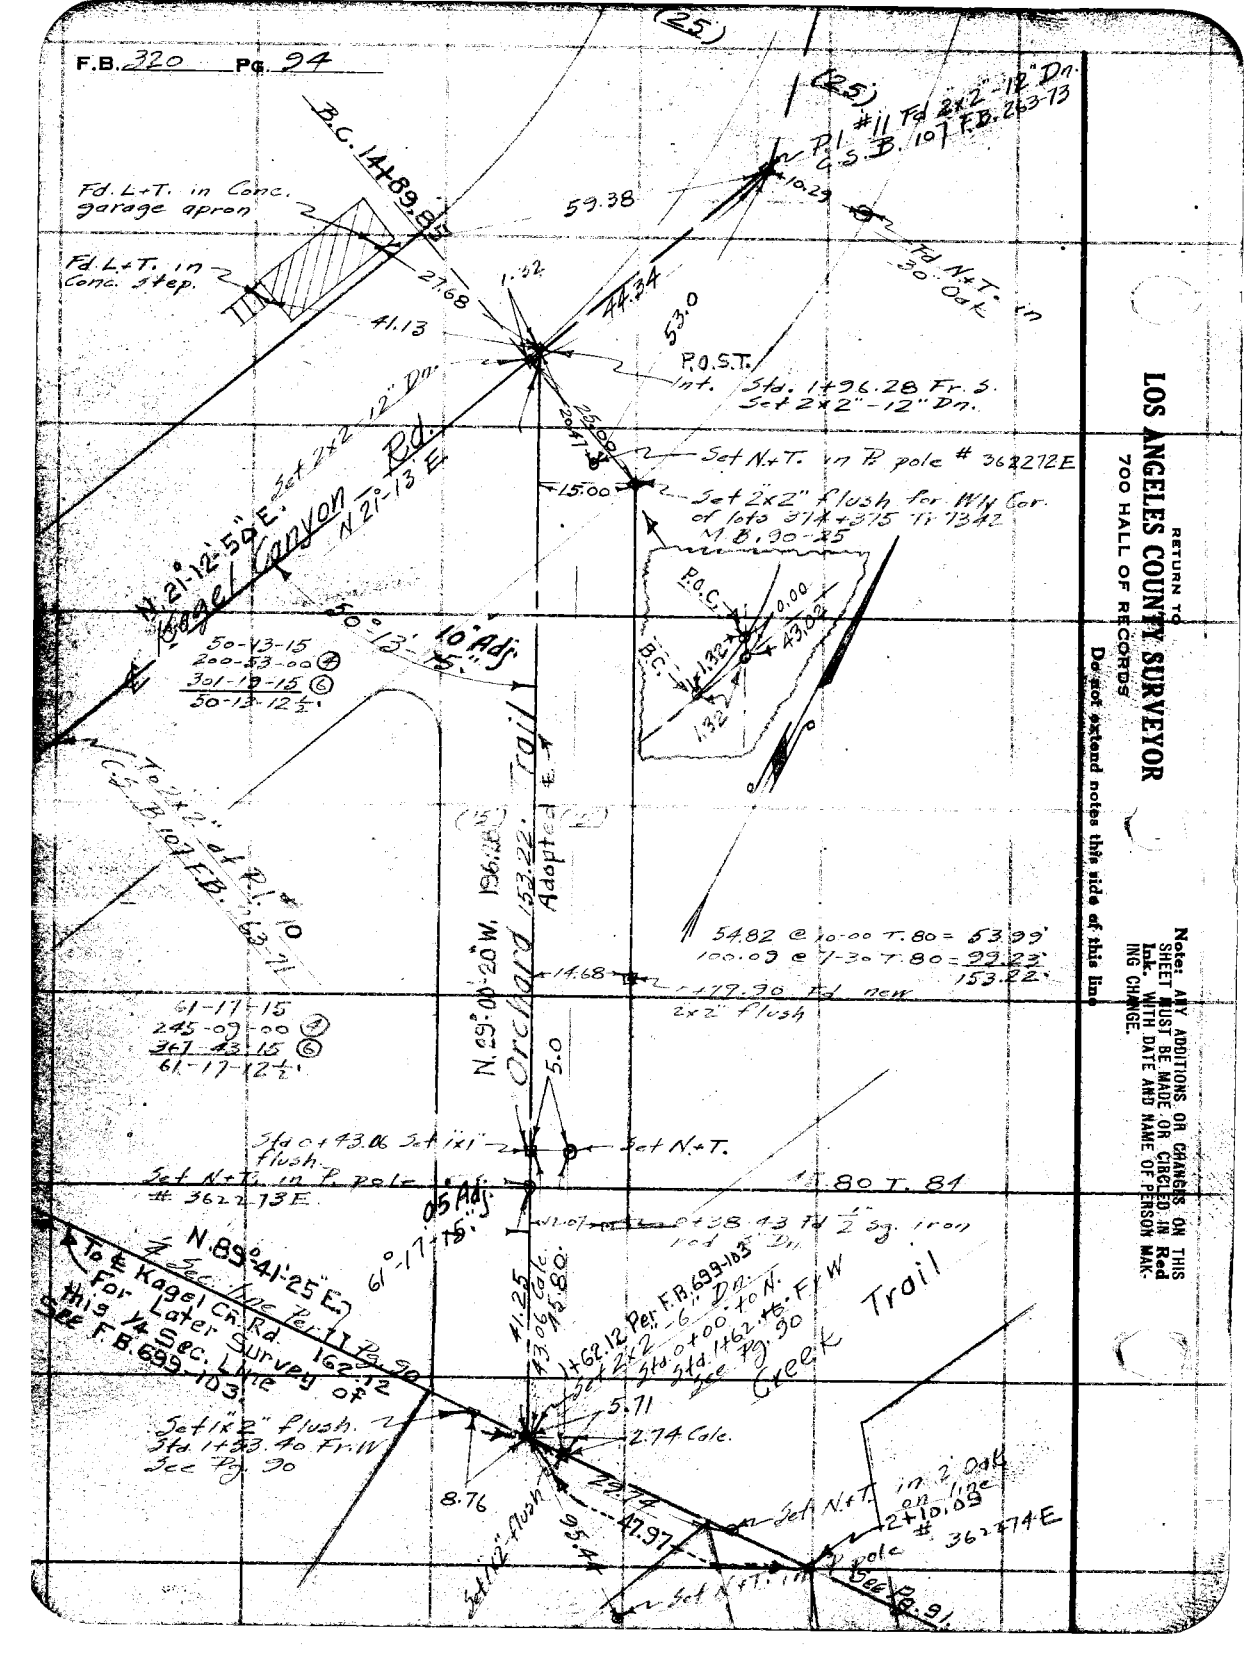

RETURN TO
LOS ANGELES COUNTY SURVEYOR
700 HALL OF RECORDS

Note: ANY ADDITIONS OR CHANGES ON THIS SHEET MUST BE MADE OR CIRCLED IN Red Ink. WITH DATE AND NAME OF PERSON MAKING CHANGE.

Do not extend notes this side of this line

Notes Ck'd by D.M. Finley		Survey of Orchard & Creek Trails	
Map No. ~~B-1336~~ B-1336		W. O. 7159	Tape No. 022 St'd 84 °F.
Office Work		Surveyed by Pasecrans	
Checked D. M. Finley		Notes	Date 7-19-22
Date Apr '35		Indexed A. C. Johnson	

F.B. 320 Pg. 95

Note: ANY ADDITIONS OR CHANGES ON THIS SHEET MUST BE MADE OR CIRCLED IN Red Ink. WITH DATE AND NAME OF PERSON MAKING CHANGE.

RETURN TO
LOS ANGELES COUNTY SURVEYOR
700 HALL OF RECORDS
Do not extend notes this side of this line

Orchard Trail Adopted & Pg. 94

Sta. 94

1+33.2

1+22.2

Woven wire iron post fence

Conc. curb.

beds

Flower

Rock

0+81.1

For location of fence & Cor See Pg. 90

1 Floor frame House

Conc. Porch

Conc. Steps

0+51.5

34.30

Acc. Line Pg. 90

Ref 2"x2"-6' Dr. Sta. 0+00 N 30° W 3.0 Ft. from Sta. 1+62.1 as preceding

1+62.1 Per F.B. 259-103

FORM 247 10M 4-31

RETURN TO
LOS ANGELES COUNTY SURVEYOR
700 HALL OF RECORDS

Note: ANY ADDITIONS OR CHANGES ON THIS SHEET MUST BE MADE OR CIRCLED IN **Red Ink.** WITH DATE AND NAME OF PERSON MAKING CHANGE.

Do not extend notes this side of this line

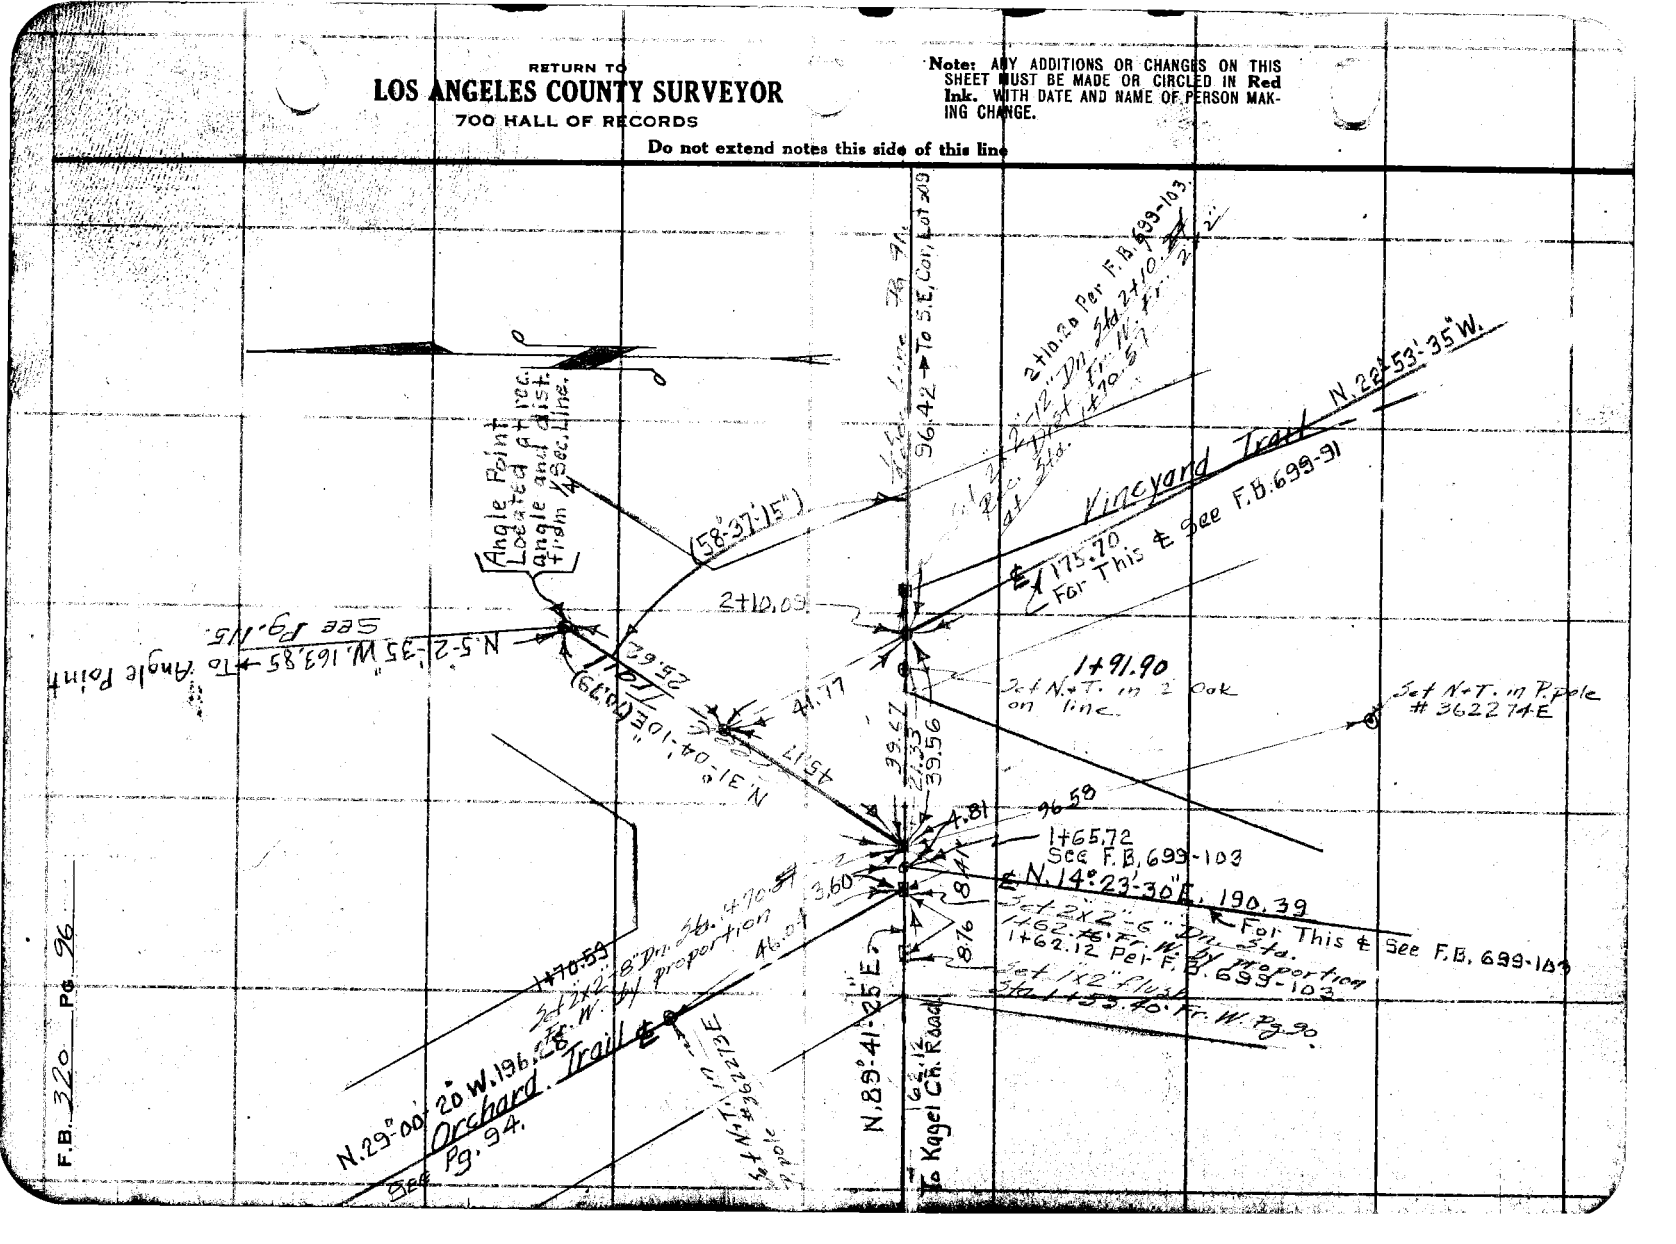

FORM 247 10M 5-31

RETURN TO
LOS ANGELES COUNTY SURVEYOR
700 HALL OF RECORDS

Note: ANY ADDITIONS OR CHANGES ON THIS SHEET MUST BE MADE OR CIRCLED IN **Red Ink.** WITH DATE AND NAME OF PERSON MAKING CHANGE.

Do not extend notes this side of this line

Notes C'k'd by R.M. Finley
Map No. [illegible]
Draft Work
Checked D.M. Finley
Date MAR 39

Notes
Date 7-20-32
Indexed A. C. Johnson

F.B. 320 Pg. 87
Cont. bottom next page

FOR ADOPTED & SEE F.B. 699-92

128.38 T.88

147.88 T.84

49.73

73.73

17.90

128.38'

This & Not Adopted Vineyard

Trial &

Trail.

S 89-00-40 E 147.88'

Set 1"x1" Plug

Set 1"x2"

Set 1"x2" Stake

Set 1"x2" Stake 3.11 High



F.B. 320 P¢ 98

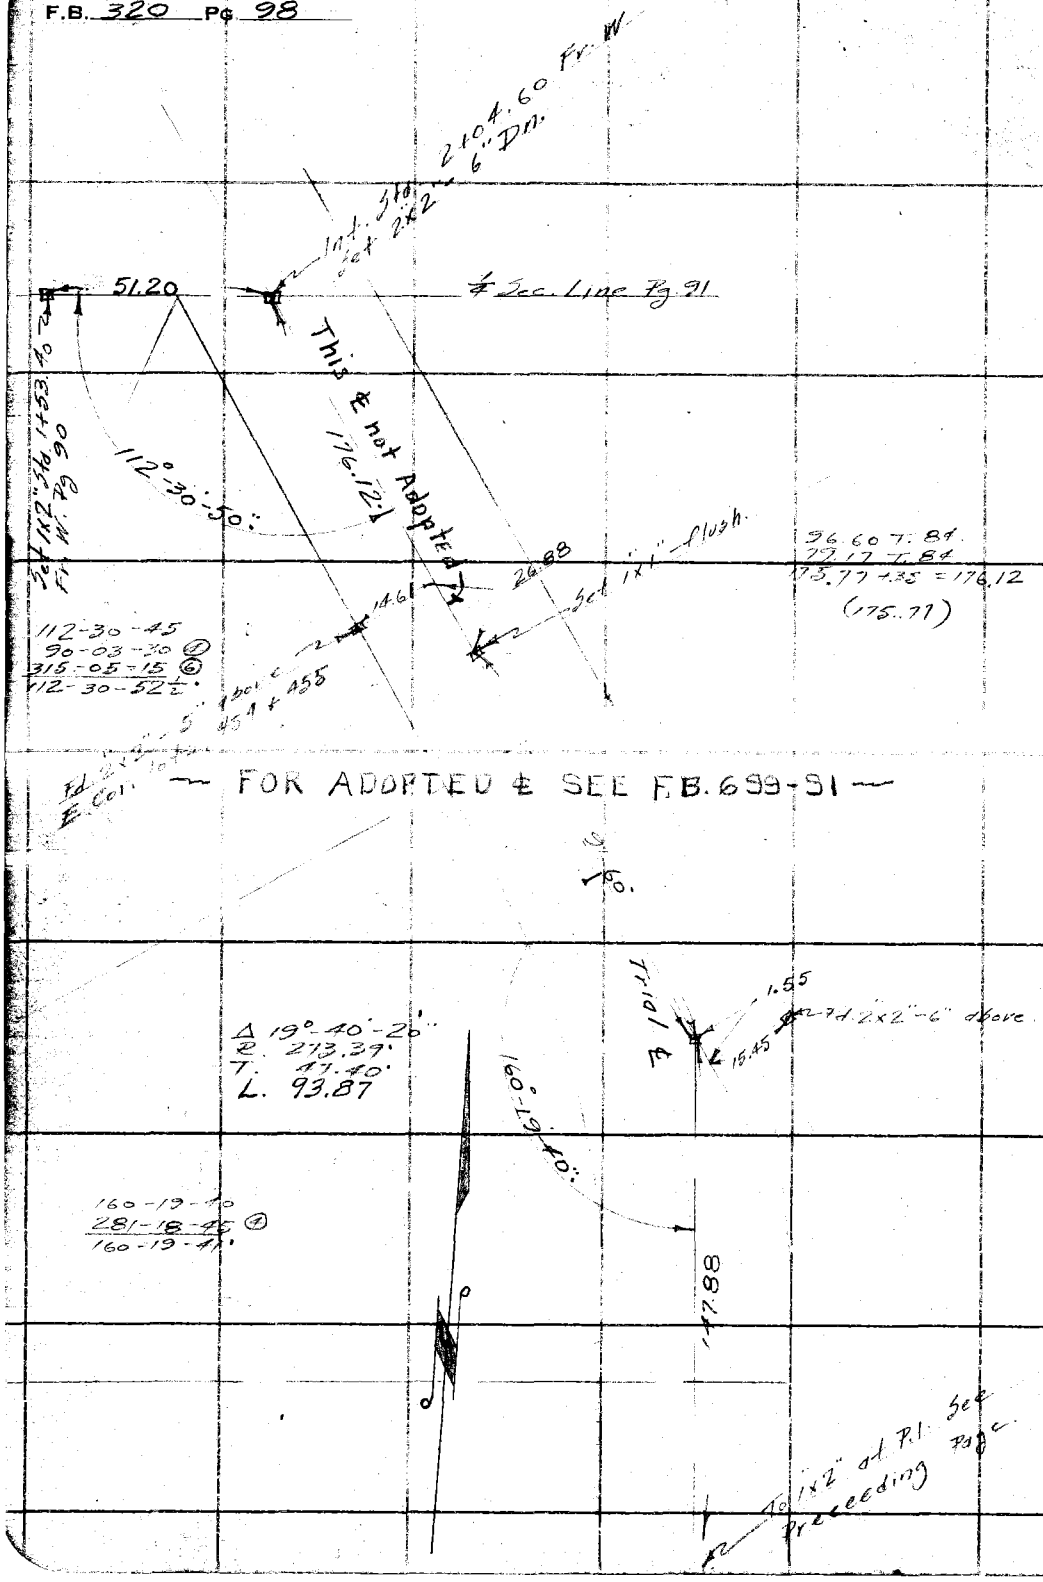

RETURN TO

LOS ANGELES COUNTY SURVEYOR

700 HALL OF RECORDS

Do not extend notes this side of this line

Note: ANY ADDITIONS OR CHANGES ON THIS SHEET MUST BE MADE OR CIRCLED IN Red Ink. WITH DATE AND NAME OF PERSON MAKING CHANGE.

Notes Ck'd by D M Finley	Survey of Orchard + Creek Trails
Map No. ~~B 388~~ 6-1736-1	W. O. 7157 Tape No. 022 St'd 84 °F.
Office Work	Surveyed by Rosecrans
Checked D. M. Finley	Notes Date 7-22-32
Date AUG 35	Indexed A. C. Johnson

F.B. 320 Pg. 99

Note: ANY ADDITIONS OR CHANGES ON THIS SHEET MUST BE MADE OR CIRCLED IN Red Ink: WITH DATE AND NAME OF PERSON MAKING CHANGE.

RETURN TO
LOS ANGELES COUNTY SURVEYOR
700 HALL OF RECORDS
Do not extend notes this side of this line

FORM 247 10M 8-31

Court bottom next page.

To S.W.+T. See next page

(20)

(20)

15.92

Fd 2x2" -4" above (old)

Δ 31°-12'-15"
R. 225.92'
T. 63.09'
L. 123.04

148-47-45
235-10-45
148-47-40°

45.44

148°-47'-40"

FOR ADOPTED ℄
SEE F.B. 699-103

℄ Trail

13.52

Fd 2x2" Flush (Old)

3.26

Set 1x2" Flush

14.90

Fd 2x2" (Old) Flush

Creek Trail

This ℄ Not Adopted

190.60

Fd 2x2" 3" above (Old)

190.60 T.84

24.02

15.98

Fd 2x2" Flush (New)

15.93

(15)

(15)

Vineyard Trail

Set 1x1-1/2 x 24" Spike 1.60 Pk. 2.21 Fr. M. Rec. 1.49 Fr. W.

(60.72) D.H. Fr. W. Pg 91

10.395
102.64

75-15-30
301-02-00
75-15-30°

75°-15'-30"

1+53.40

Std. See Pg. 90

Set 1x2" Flush Fr. W.

℄ Sec. Line Pg 90

7.37

F.B. 320 Pg. 100

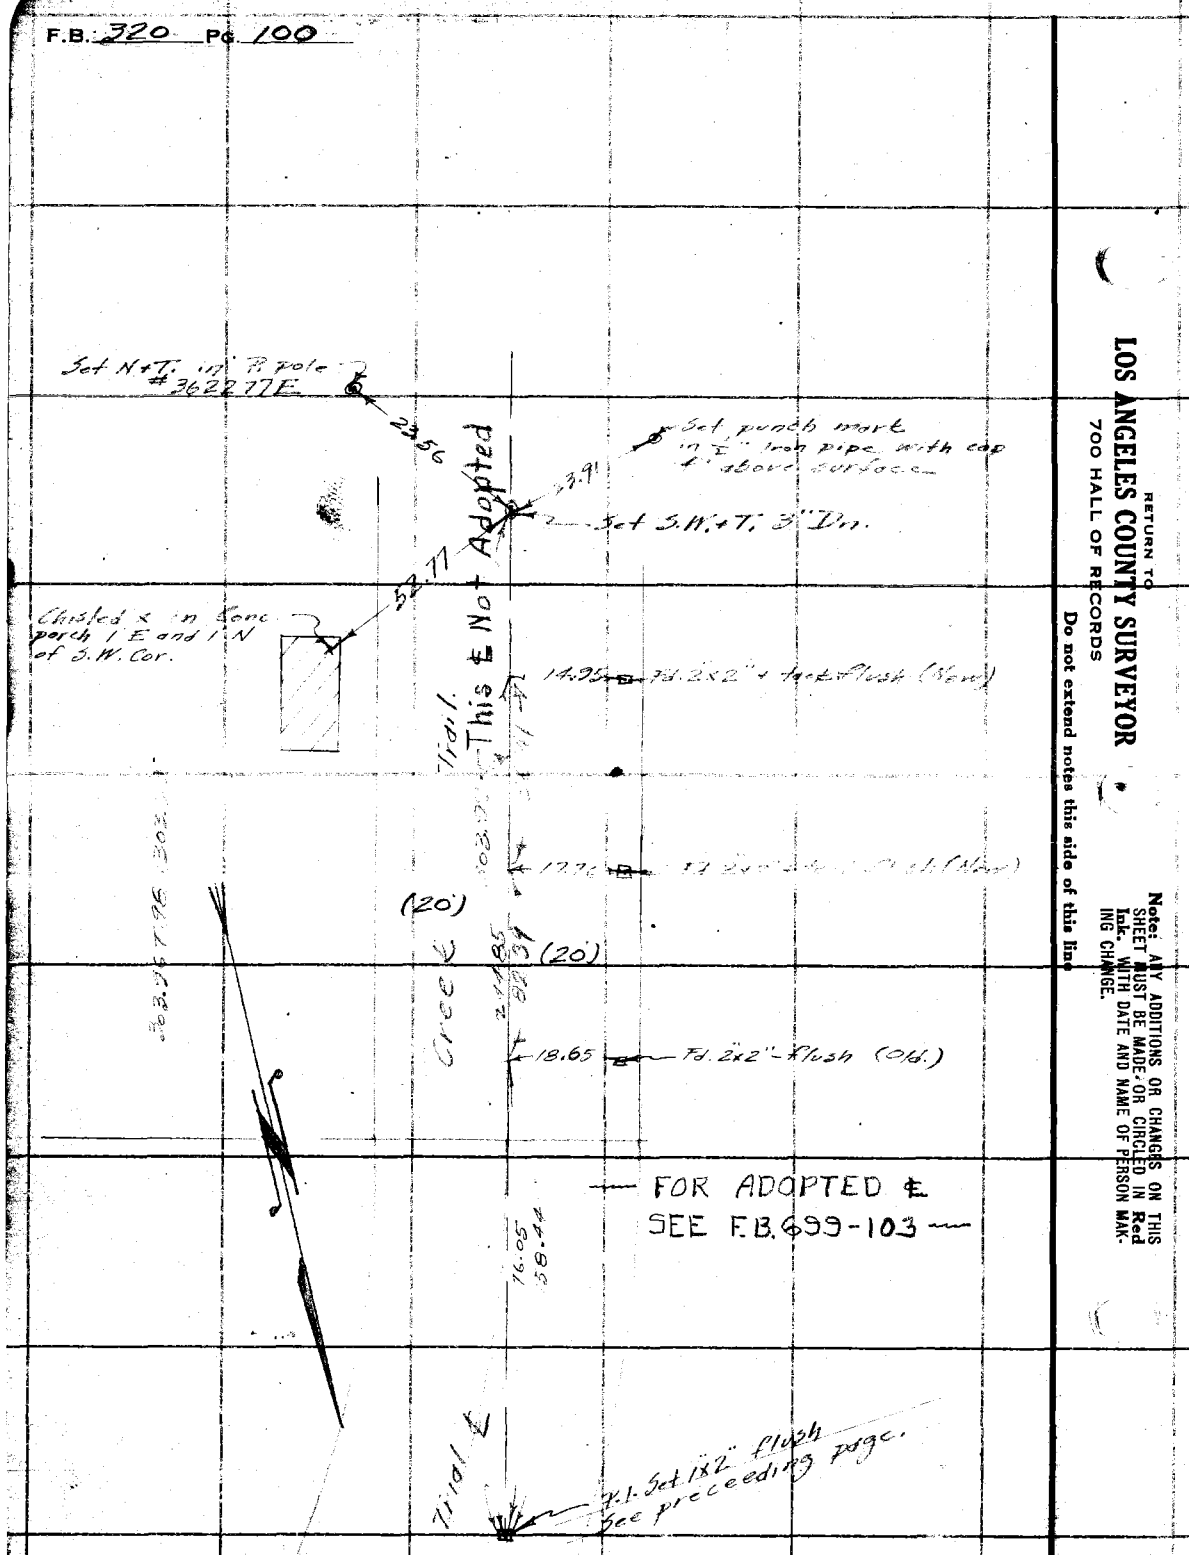

RETURN TO
LOS ANGELES COUNTY SURVEYOR
700 HALL OF RECORDS

Do not extend notes this side of this line

Notes: ANY ADDITIONS OR CHANGES ON THIS SHEET MUST BE MADE OR CIRCLED IN Red Ink. WITH DATE AND NAME OF PERSON MAKING CHANGE.

Notes Ck'd by	Survey of Orchard + Creek Trails
Map No.	W. O. 7159 Tape No. 022 St'd 84 °F.
Office Work	Surveyed by Escarcega.
Checked	Notes Date 7-28-32
Date	Indexed C. Johnson

F.B. 320 Pg. 101

Cont. bottom next page.

Fd 2x2 - 6 above

21.35

184.73 T. 84

184.73 T. 84

(20)

(20)

132°-48'-35"

132-49-30
1/1-14-15 ④
132-48-34.

Set 1x2" Sta. 2+67.19

6.39

4.35

Fd. 2x2" - 6" above

THIS LINE NOT USED FOR LATER SURVEY SEE PAGE 111

202.14 T. 74 = 202.13'

Trail

202.13'

Creek Trail

33.92

24.13

Fd 1" I.P. 6" above E ly Cor. lots 397 + 398

161°-00'-00"

161-00-00
284-00-00
161-00-00.

Set 1x1" Sta. 0+65.06 flush

20.40

Fd. old 2x2" flush 72°-31'-00"
E ly Cor. lots 398 + 399

24.00

Set 1x2" flush.

107-29-00
69-55-45 ④
107-28-36.

90°

4.00

Fd 2" I.P. plug + tack 6" above N W Cor. lot 397 Tr. 7342-4 M.B. 90-26

65.45 e 6 I.T. M = 65.06

Fd. 2x2" 4" above

173°-34'-50"

65.06

107°-29'-00"

4.00

58.76

198.03

49.70

Fd. 2x2-5" above

Set 1x2" - flush.

140.73

20.97

Set punch mark on Foot Bridge Sta 0+00

214.79 e 22-48 T. 98 = 198.03.

51.33 e 14-30 T. 98 = 49.70

Note: ANY ADDITIONS OR CHANGES ON THIS SHEET MUST BE MADE OR CIRCLED IN Red Ink. WITH DATE AND NAME OF PERSON MAKING CHANGE.

RETURN TO
LOS ANGELES COUNTY SURVEYOR
700 HALL OF RECORDS
Do not extend notes this side of this line

FORM 247 10M 8-31

F.B. 320 PG. 102

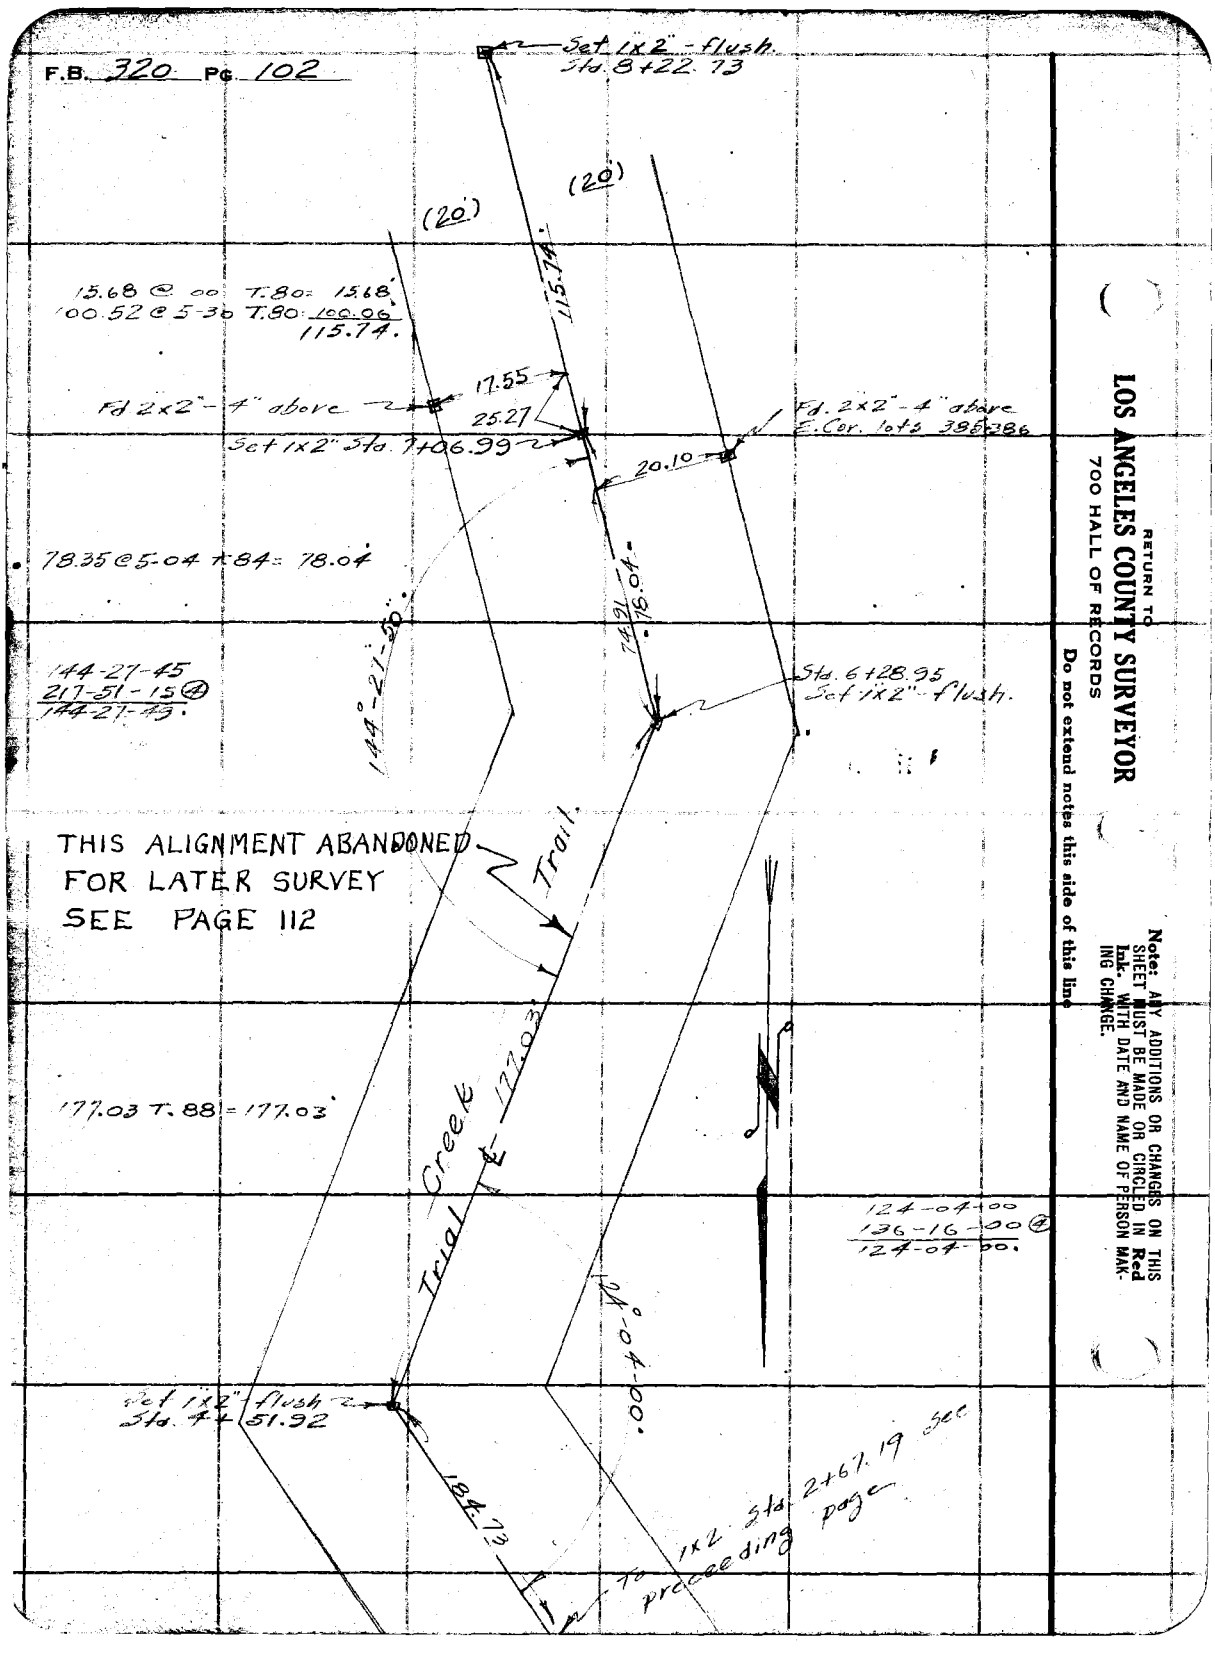

RETURN TO
LOS ANGELES COUNTY SURVEYOR
700 HALL OF RECORDS

Do not extend notes this side of this line

Note: ANY ADDITIONS OR CHANGES ON THIS SHEET MUST BE MADE OR CIRCLED IN Red Ink. WITH DATE AND NAME OF PERSON MAKING CHANGE.

Notes Ck'd by	Survey of Orchard + Creek Trail
Map No.	W. O. 7159 Tape No. 022 St'd 84 °F.
Office Work	Surveyed by Rosecrans
Checked	Notes Date 7-26-32
Date	Indexed A. C. Johnson

F.B. 320 Pg. 103

Cont. to next page

41°41'30"

137.07'

T 1x2" Sta. 11+61.82

138°-18'-08"

138-18-30

137.06 T.90 = 137.0'

Fd 2x2" - 3" above

41-41-30
166-46-00 ④
41-41-30'

Set 1x2" - flush
Sta. 10+24.75

2.34

15.66
15.98 T

45°29'

Creek

10.1

Fd 2x2" - 8" above

THIS ALIGNMENT ABANDONED. FOR LATER SURVEY SEE PAGE 113

42.12 T

70°-08'

23.26
8.48
24.73 T

Trail.

159°42'35"

Set Sta.

1x2" - flush
9+92.03

159-42-30
278-50-15 ④
159-42-34'

(20')

(20')

159.30'

58.70 @ .00 T. 86 = 58.70'
100.68 @ 2-20 T. 86 = 100.60'
159.30'

162-38-30

162°-38'-30"

Fd 2x2" - 4" above

17.16

Set Sta.

1x2" - flush
8+22.73

90°

0.58

115.74'

To 1x2" Sta. 7406.99 See preceding page

Notes: ANY ADDITIONS OR CHANGES ON THIS SHEET MUST BE MADE OR CIRCLED IN Red Ink WITH DATE AND NAME OF PERSON MAKING CHANGE.

Do not extend notes this side of this line

RETURN TO
LOS ANGELES COUNTY SURVEYOR
700 HALL OF RECORDS

FORM 247 10M 8-31

F.B. 320 PG. 104

Cont. bottom next page.

To 1x2" Sta. 14+41.79

42.12

176°-17'-04"

Set 1x2" flush Sta. 13+99.67

87.91 T.84

(20') (20')

87.91

176-17-00
345-08-15 (A)
176-17-04

15-42-30
62-30-00 (A)
15-42-30
Perfection 4

164-17-30 Calc.

THIS ALIGNMENT ABANDONED FOR LATER SURVEY SEE PAGE 114

Set 1x2" flush Sta. 13+11.76

59.27

158-18-30

40.6

Set 1x2" flush 12+61.49

Fd. 2" I.P. - 18" above

20.33

158-18-30
213-13-45 (A)
158-18-26

158°-18'-25"

Creek Trail

92.67

173°-07'-30"

113-07-30
332-30-00 (A)
173-07-30

Set 1x2" flush Sta. 11+61.82

127.07

To 1x2 Sta. 10+24.75
See preceding page

RETURN TO
LOS ANGELES COUNTY SURVEYOR
700 HALL OF RECORDS

Do not extend notes this side of this line

Note: ANY ADDITIONS OR CHANGES ON THIS SHEET MUST BE MADE OR CIRCLED IN Red Ink. WITH DATE AND NAME OF PERSON MAKING CHANGE.

Notes Ck'd by
Map No.
Office Work
Checked
Date

Survey of Orchard + Creek Trails
W. O. 7159 Tape No. 022 St'd 84 °F.
Surveyed by Rosecrans
Notes Date 1-27-32
Indexed C. Johnson

F.B. 320 Pg. 105

Note: ANY ADDITIONS OR CHANGES ON THIS SHEET MUST BE MADE OR CIRCLED IN Red Ink. WITH DATE AND NAME OF PERSON MAKING CHANGE.

RETURN TO
LOS ANGELES COUNTY SURVEYOR
700 HALL OF RECORDS
Do not extend notes this side of this line

FORM 247 10M 8-31

Vineyard Trail

Orchard Trail

Creek Trail

Set 1"x1" - 3" Dp. Sta. 16+05.64

Fd. old 2x2" leaning

3.56

4.50

(20')

(20')

20.62

Fd 2x2" - 4" above (new)

THIS ALIGNMENT ABANDONED. FOR LATER SURVEY SEE PAGE 115

Fd. 2"x2" - 4" above (new) Marked S.E. Cor lot 374

163.85 T. 86

163.85

18.2

12.17

45.8

Fd. 2"x2" - 4" above (new) Marked N.E. Cor lot 374

38.17

42.12

Set 1"x2" - flush Sta 14+41.79

1"x2" Sta. 13+99.67

To see preceding page

10.20

23.3

121°-12'-25"

143°-34'-15"

Set 1"x2" - flush Sta. 14+53.40 Ft. W. 8.90

Set 1"x2" - 5" Dp. Sta. 16+23.71 Ft. W. 10.79

Sta. 16+76.64 Ft. W. 50.32

Sta. 14+01.50 Ft. W. 52.32

Set 1"x2" flush Sta. 16+16.93 Ft. W.

143-34-15
214-17-00 ④
143-34-15.

121-12-30
124-49-45 ④
367-14-15 ④
121-12-27½.

18-41-30
74-15-45 ④
18-41-26.
Deflection 2

81°-18'-40"

RETURN TO
LOS ANGELES COUNTY SURVEYOR
700 HALL OF RECORDS

Note: ANY ADDITIONS OR CHANGES ON THIS SHEET MUST BE MADE OR CIRCLED IN **Red Ink.** WITH DATE AND NAME OF PERSON MAKING CHANGE.

Do not extend notes this side of this line

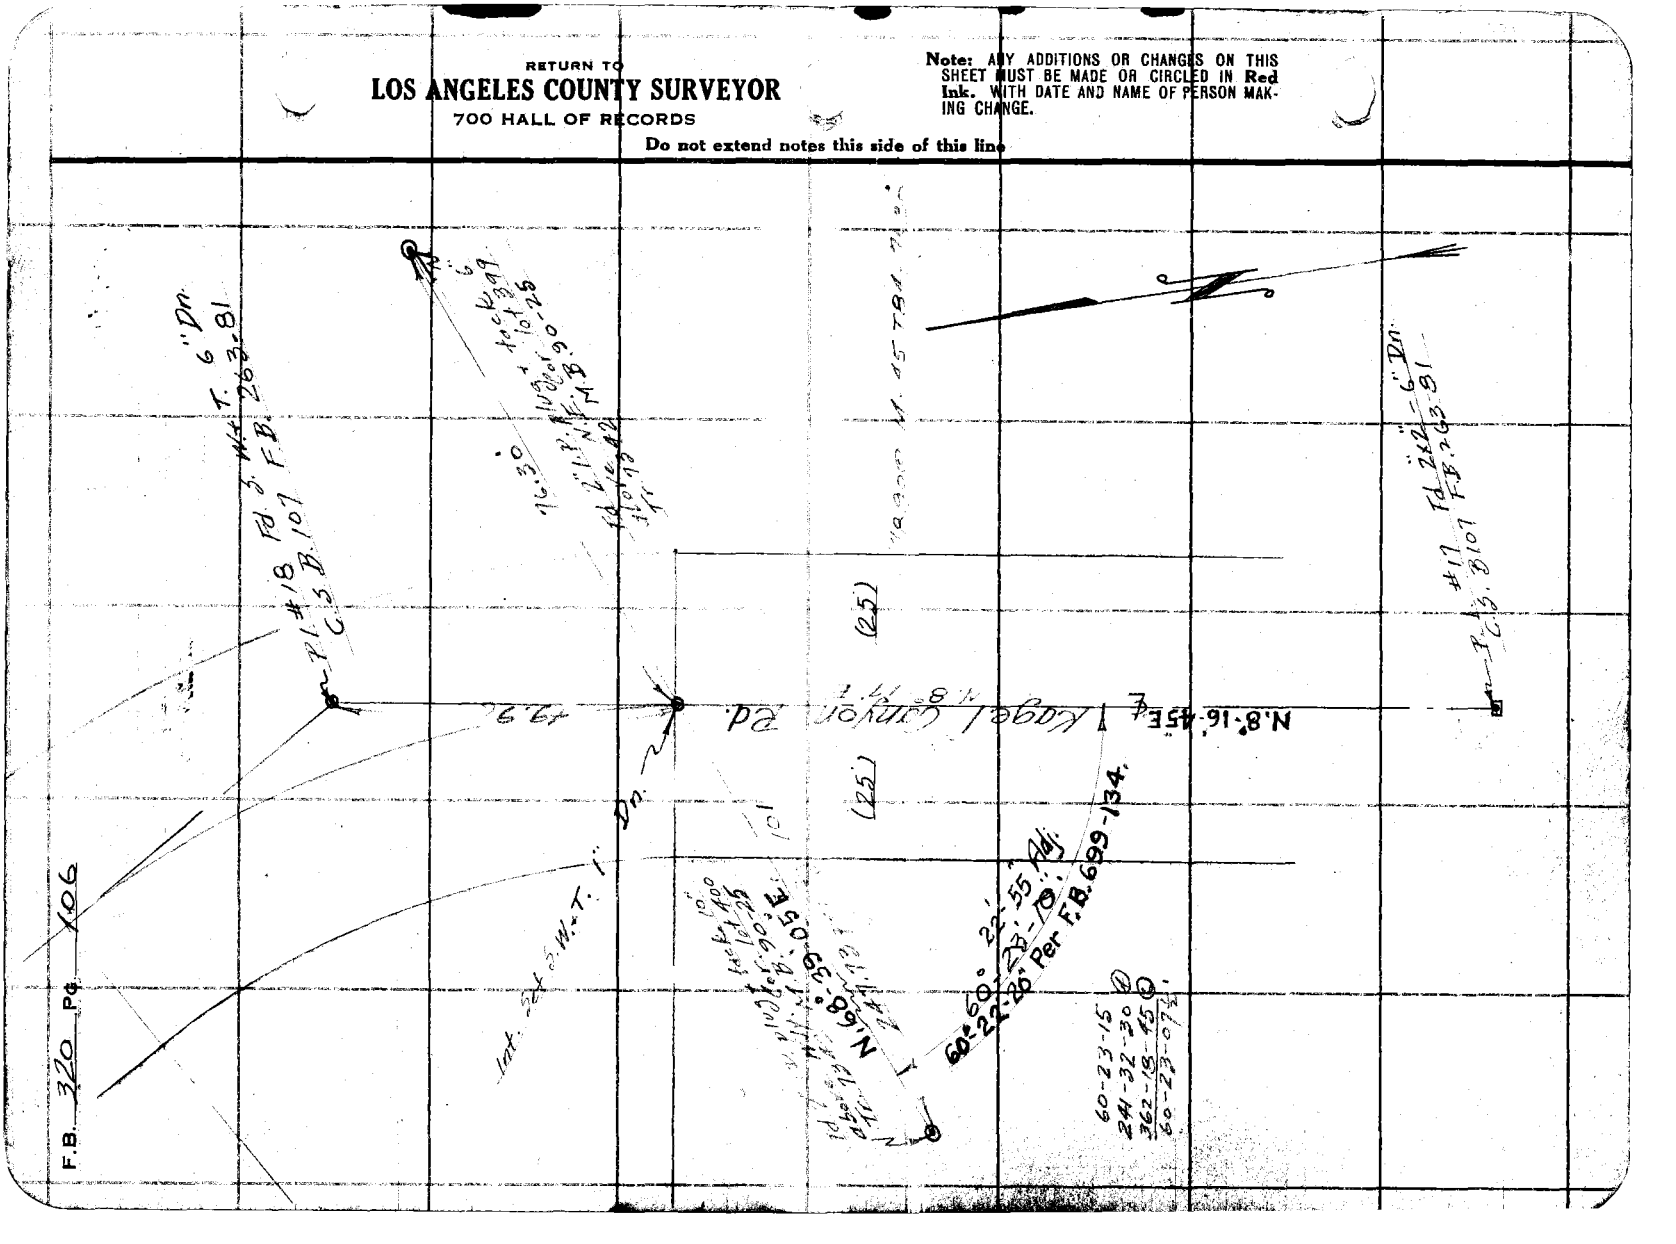

Notes Ck'd by D. M. Finley	Survey of Orchard + Creek Trails	F.B. 320 Pg. 107	
Map No. B-~~789~~ B-1336-1	W. O. 7159 Tape No. 022 St'd 84 °F.		
Office Work	Surveyed by [illegible] crews		
Checked D. M. Finley	Notes	Date 7-28-32	
Date AUG 55	Indexed A. C. Johnson		

Note: ANY ADDITIONS OR CHANGES ON THIS SHEET MUST BE MADE OR CIRCLED IN Red Ink. WITH DATE AND NAME OF PERSON MAKING CHANGE.

Do not extend notes this side of this line

RETURN TO
LOS ANGELES COUNTY SURVEYOR
700 HALL OF RECORDS

FORM 247 10M 8-31

P.I. #12 Fd 2"x2" -8" Dn
C.S. B.107 F.B. 263-75

Set N.+T. in P. pole # 362271E

(25)

N. 13° 19-25" W. 354.25 .27 Adj.

90°-44-00"

66.20

Sulphur Trail

— SEE PAGE 16 —

16+73.89 P.O.T.
Set 2x2 - 6 Dn. ?
by proportion.

354.23 T.94 = 354.25
142.39 T.94 = 142.40

142.40 N. 13°-20" W. 18.37

Fd. N.+T. in 2" Oak

F3°-37-00"

73.71

Set 1x2" Flush in Ground 12+78 37 Ft. N.

Set 1x2" 354.12 461.49 Ft. N. See Pg. 104

Trail

Creek

(20)

FOR LATER SURVEY OF THIS LINE SEE PAGE 116

90-44-00
362-56-00
92-71-00

145-28-00
221-52-00
152-49-00
145-28-00
145°-28-00"
(145°-27-45")
145.45' Adj.

113-37-00
74-28-15
221-42-00
113-37-00

Set 1x2" Std 13+11.76 See Pg. 104

74.91 @ 10-15 T. 94 = 73.71

Rd.

Kagel Canyon

P.I. #11 Fd 2"x2" -12" Dn
C.S. B. 107 F.B. 263-73

228.04

Fe 2"x2" -12" Dn
See Pg 90

F.B. 320 PG. 108

RETURN TO
LOS ANGELES COUNTY SURVEYOR
700 HALL OF RECORDS

Do not extend notes this side of this line

Note: ANY ADDITIONS OR CHANGES ON THIS SHEET MUST BE MADE OR CIRCLED IN Red Ink. WITH DATE AND NAME OF PERSON MAKING CHANGE.

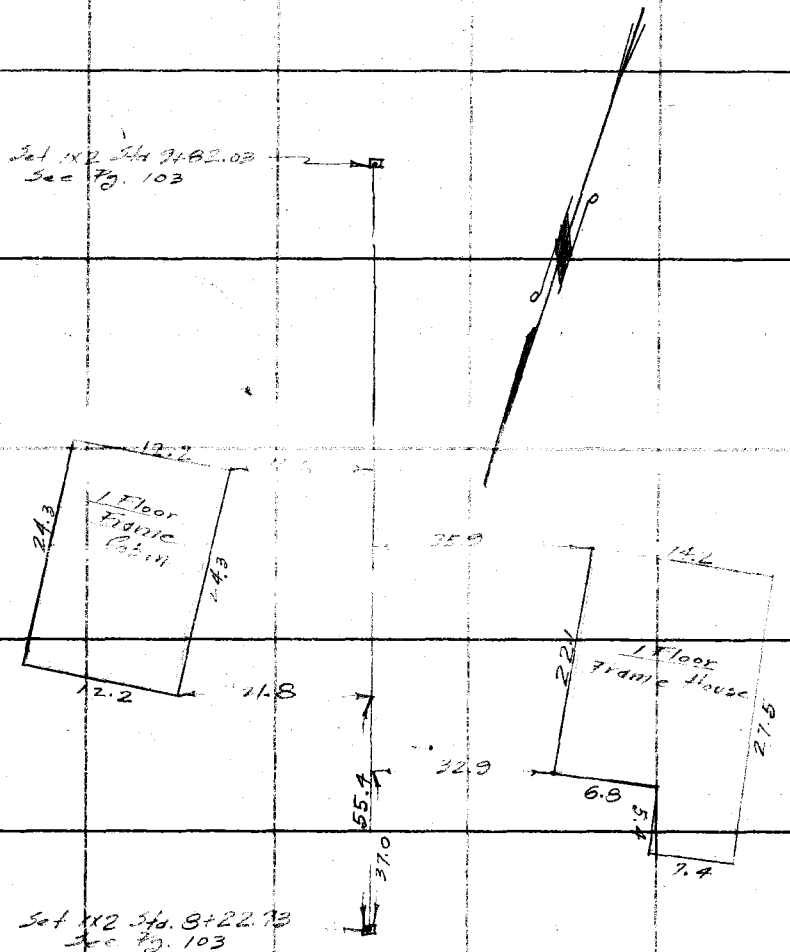

Notes Ck'd by D.M. Finley		Survey of Orchard + Creek Trails	F.B. 320 Pg. 108
Map No. ~~B-1386~~ B-1396-1		W. O. 7159 Tape No. 022 St'd 84 °F.	
Office Work		Surveyed by Rosecrans	
Checked D. M. Finley		Notes	Date 7-28-32
Date AUG 55		Indexed A. C. Johnson	

Notes: ANY ADDITIONS OR CHANGES ON THIS SHEET MUST BE MADE OR CIRCLED IN Red Ink WITH DATE AND NAME OF PERSON MAKING CHANGE.

Do not extend notes this side of this line

RETURN TO
LOS ANGELES COUNTY SURVEYOR
700 HALL OF RECORDS

FORM 247 10M 8-31

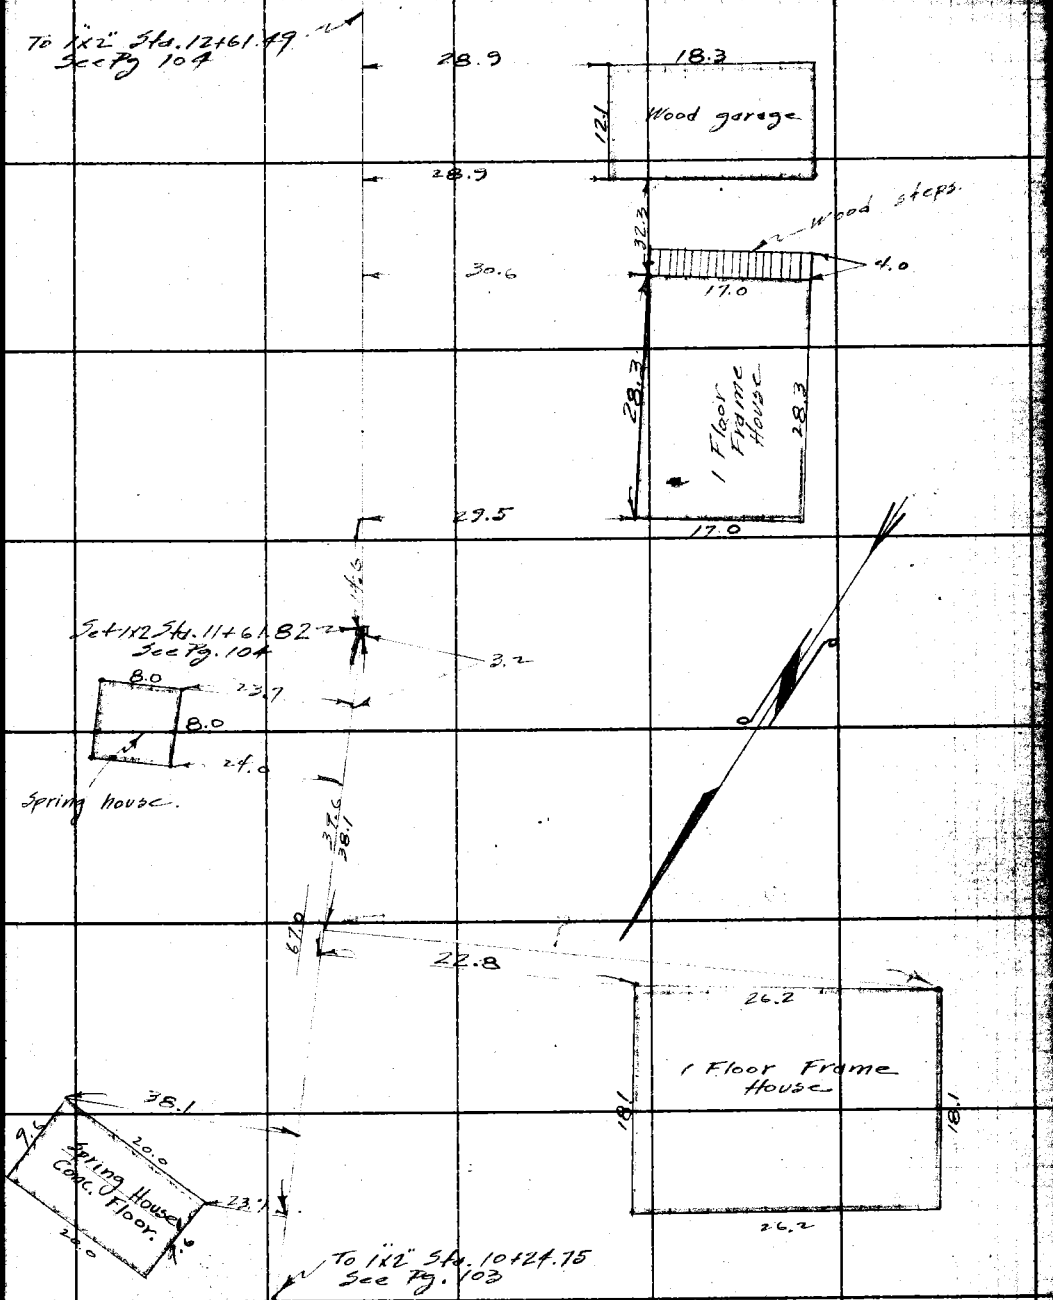

F.B. 320 Pg. 110

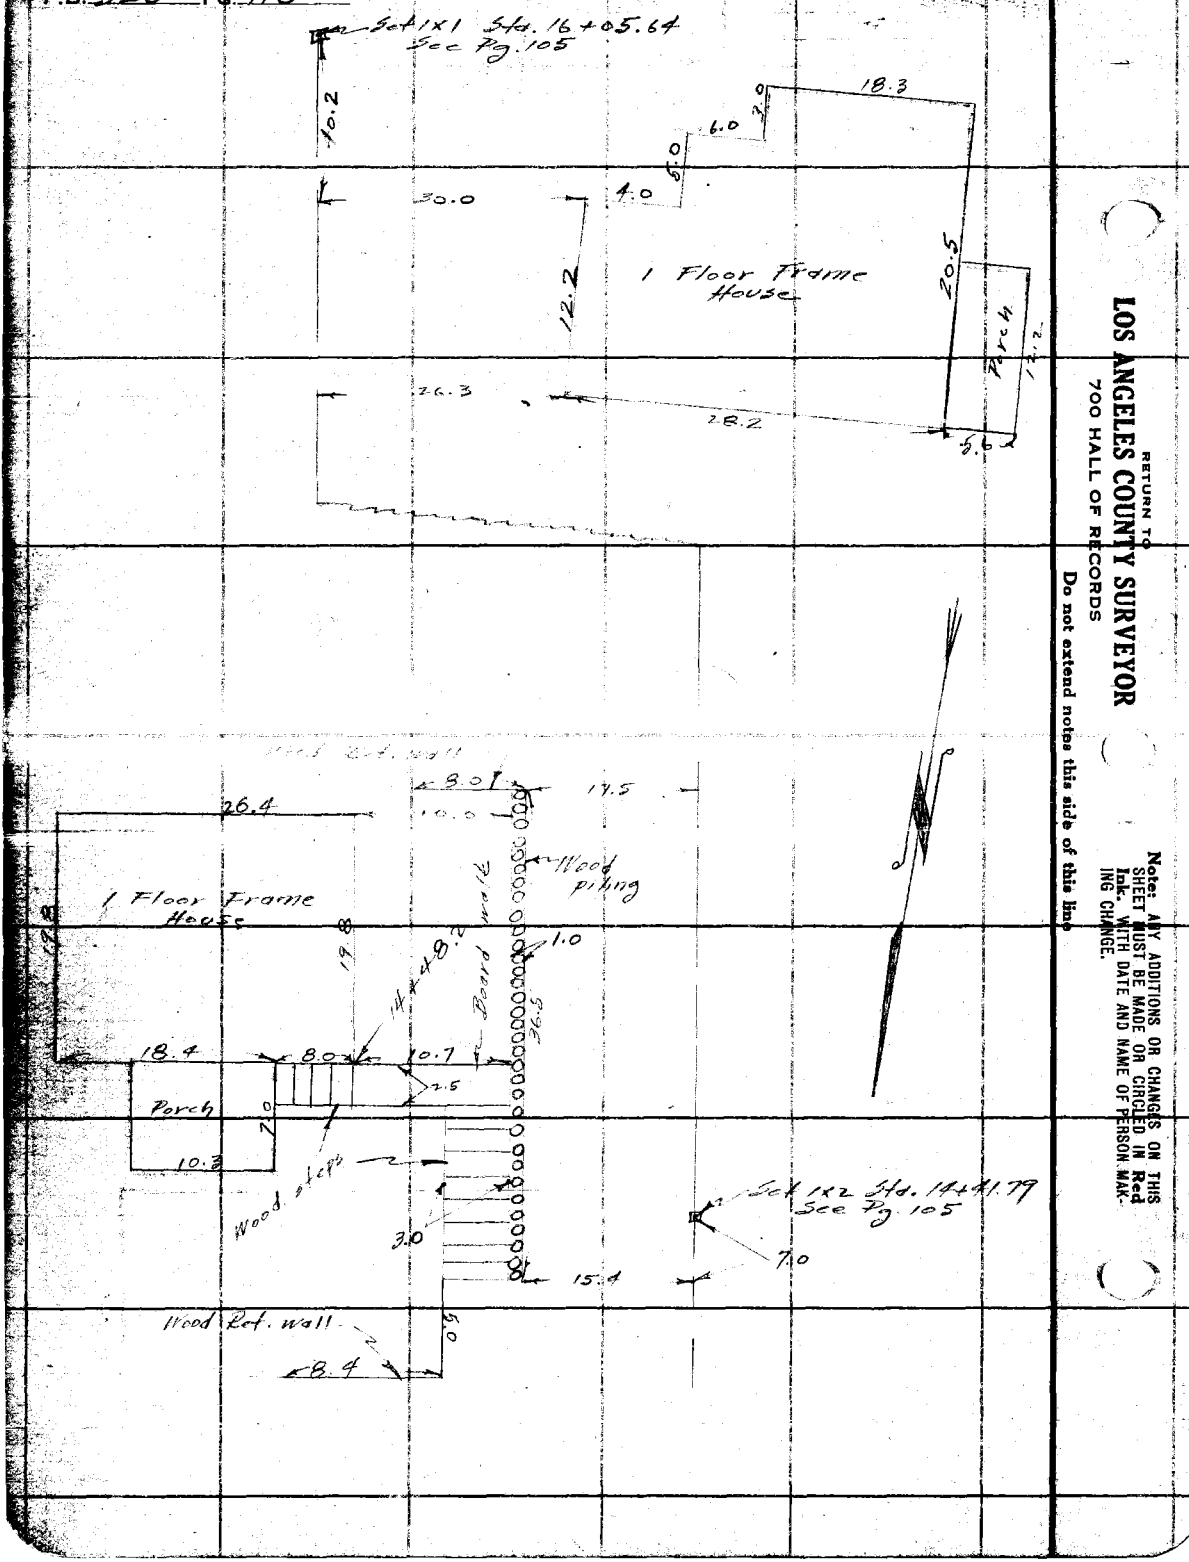

RETURN TO
LOS ANGELES COUNTY SURVEYOR
700 HALL OF RECORDS

Do not extend notes this side of this line

Note: ANY ADDITIONS OR CHANGES ON THIS SHEET MUST BE MADE OR CIRCLED IN **Red Ink**, WITH DATE AND NAME OF PERSON MAKING CHANGE.

Notes Ck'd by D. M. Finley	Survey of Orchard Creek Trails	F.B. 320	Pg. 111
Map No. B-1376-1	W. O. 7159 Tape No. 842 St'd 84 of.		
Office Work	Surveyed by Esserooms		
Checked D. M. Finley	Notes	Date 1-6-32	
Date AUG 55	Indexed A. C. Johnson		

Cont. bottom next page.

Note; Beron Mtn line to get bdry angle closure. Used record per east side line Tr. 7342. Used record per W. sideline on first line Between Sta. 10+24.73 and. 11+54.02 Pg 112.

132-48-30
171-14-15 @
76-51-30 @
132-48-35

184.74 T. 74 = 184.73'

Angle Point Located at record from Most NLY. Cor Lot 399 F.B. 1424-31.

Set N+T. in 10" oak.

Set N+T. in 10" oak.

Set ix2" Sta. 2+67.19

Fd. 2x2"-6" above

Set N+T. in 8" stump

Fd. 1" I.P. 6" above

202.15 T 68 = 202.13'

Creek Trail

LOT 398

LOT 399

Fd. 2x2" flush

Set 1x2" flush.

Sta. 0+65.06 Set ix2" flush

Angle Point. Located at record from Most NLY. Cor. of Lot 399. F.B. 1424-37

Fd. 2x2-4" up.

Set 1x2" flush.

Fd. 2" I.P. plug & tack .4' above N.W.E. Cor. Lot 399 Tr. 7342-4 M.B. 90-25.

Set punch mark on Set bridge Sta. 0+00

See F.B. 699-89.

RETURN TO
LOS ANGELES COUNTY SURVEYOR
700 HALL OF RECORDS
Do not extend notes this side of this line

Note: ANY ADDITIONS OR CHANGES OF THIS SHEET MUST BE MADE OR CIRCLED IN Red Ink, WITH DATE AND NAME OF PERSON MAKING CHANGE.

FORM 247 10M 8-31

F.B. 320 Pg. 112

Cont bottom next page.

2 Sta. 8+22.73 Set 1"x2" Flush

N. 12° W. N.11°36.55"W.

N.12°38.30"W. 115.48

184.97

15.29 @ 00 T 74 = 15.29
100.83 @ 6-25 T. 74 = 100.12
115.48

17.66

25.02

Sta. 7+07.25 Set 1"x2" Flush

Fd 2"x2" 4" above

Fd 2"x2" 4" above

20.00

78.42 @ 3-01 T. 74 = 78.30

Angle Point
Located at record from Most NLY. Cor. of Lot 399
F.B. 1424-31

144° 177-27-45
217-51-15 (A)
146-46-45 (C)
177-27-47½
144°-27'-47½"

78.30

14.99

Sta. 6+28.95 Set 1"x2" Flush.

0.06

144°-27'-47½" Adj.

177.03' Trail.

124-04-00
136-16-00 (A)
24-23-45 (C)
124-03-57½

177.04 T. 74 = 177.0'

Set N.T. # 44649 in P. Pole

S 23°52'50"W Creek

S 23°54'15"W 177.03'

2 Set N.T. in 10" Sycamore

38.69

0.02

22.00

Set 1"x2" flush Sta 4+51.92

Angle Point Located at rec. from Most NLY. Cor. Lot 399. F.B. 1424-31.

0.04

S 32°02'55"E 124.03

S 32°02'55"E 124.03

56.56

124.03-0.58

0.04-0.04=0.00

Fd 3.W.T. in C. marked B.M.

30 oak 35/10

1"x2" Sta. 2+67.19 See preceding page

Set N.T. in 30" tree

Sycamore most

10

RETURN TO
LOS ANGELES COUNTY SURVEYOR
700 HALL OF RECORDS

Do not extend notes this side of this line

Note: ANY ADDITIONS OR CHANGES ON THIS SHEET MUST BE MADE OR CIRCLED IN Red Ink. WITH DATE AND NAME OF PERSON MAKING CHANGE.

Notes Ck'd by D.M. Finley
Map No. ~~B-3862~~ B-1996-1
Office Work
Checked D. M. Finley
Date AUG '55

Survey of Orchard + Creek Trail
W. O. 7159 Tape No. 242 St'd 84 °F.
Surveyed by Escerra
Notes Date 1-9-33
Indexed C Johnson

F.B. 320 PG. 113

Cont. bottom next page

Sta. 11+54.02
Tie
See next page

Fd Gas Co. N+T. in 10" Sycamore

N.7°39'-45"W. 129.27

129.29 T. 60 = 129.27

166-46-00
250-09-00
41-41-30

8.81

Set N+T. in 6" Willow

Angle Point Located at rec. from ¼ Sec. Line F.B. 1424-33.

Sta. 10+04.15 flush

2.24

Fd. 2x2-3" above

N.45°-18'-15"W. 42.72

See F.B. 699-137

(43.54)

42.73 T. 66 = 42.72

Fd. 2x2-8" above

9+82.03 Set 1x2" flush

23.08

159-42-30
278-50-15
238-15-00
159-42-30

N.29°-00'-45"W. 159.30

Angle Point Located at rec. from ¼ Sec. Line F.B. 1424-33.

Creek Trail

159-42-30

159.31 T. 74 = 159.30

N.28°-52'-35"W. Fd. 1" I.P.

162-38-30
290-33-15
255-51-00
162-38-30

Set N+T. in 8" Willow

Fd 2"x2"-4" above

(159.32)

Sta. 8+22.12 1x2" Flush

4260

Angle Point Located at rec. from ¼ Sec. Line F.B. 1424-33.

To 1x2 Sta. 7+07.25 See preceding page

8.79

Set N+T. in 10" Cot

N.55°-29'-30"W. (159.30)

Note: ANY ADDITIONS OR CHANGES ON THIS SHEET MUST BE MADE ON CIRCLED IN Red Ink, WITH DATE AND NAME OF PERSON MAKING CHANGE.

RETURN TO
LOS ANGELES COUNTY SURVEYOR
700 HALL OF RECORDS

Do not extend notes this side of this line

ADM 247 10M 8-31

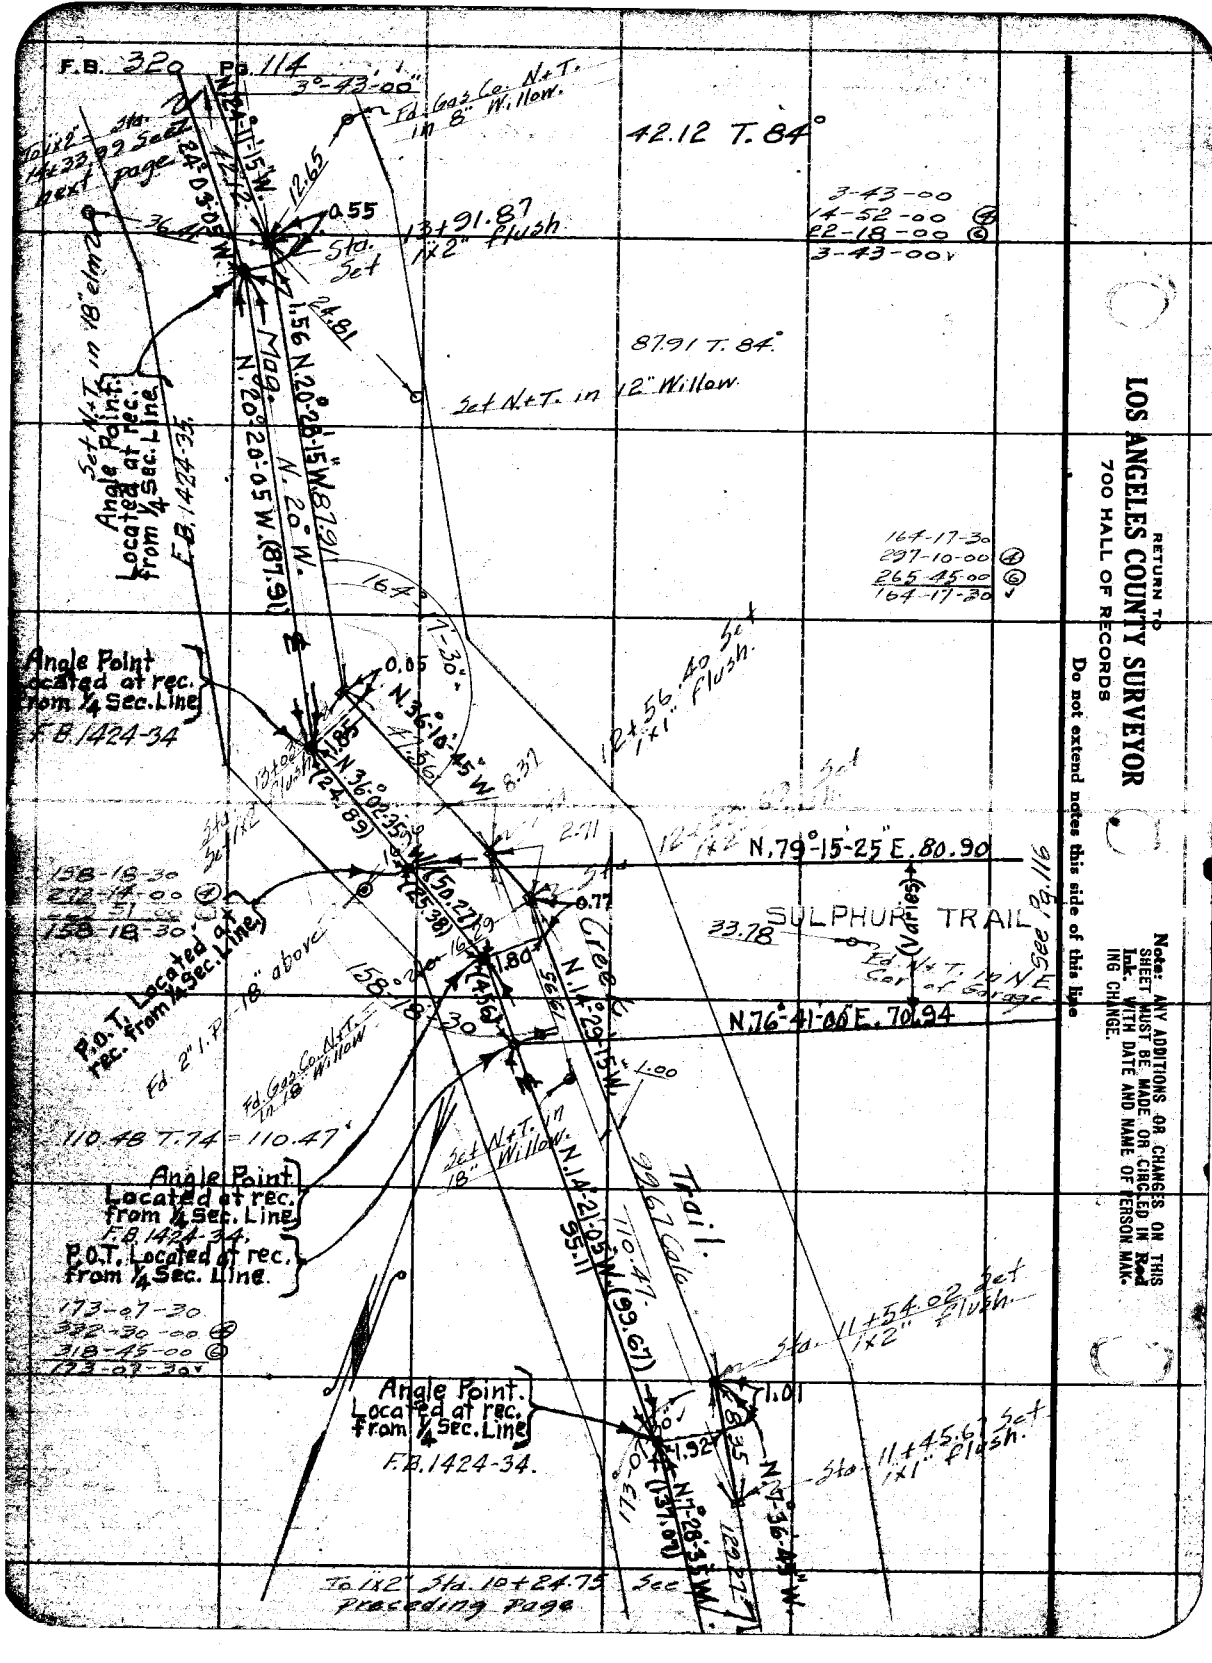
F.B. 320 Pg. 114
3°-43'-00"
Ed. Gas Co. N.&T. in 8" Willow.
42.12 T. 84°
3-43-00
14-52-00
22-18-00
3-43-00
87.91 T. 84°
Set N.&T. in 12" Willow.
164-17-30
297-10-00
265-45-00
164-17-30
Angle Point Located at rec. from 1/4 Sec. Line F.B. 1424-34
Set N.&T. in 18" elm
Mag. N. 20° 20' 05" W. (87.91)
N. 20° W.
164° 17' 30"
N. 36° 16' 45" W. 8.37
N. 36° 02' 25" W. (124.89)
N. 79° 15' 25" E. 80.90
SULPHUR TRAIL
N. 76° 41' 00" E. 70.94
198-18-30
212-14-00
158-18-30
158° 20' 30"
P.O.T. Located at rec. from 1/4 Sec. Line
Ed. 2" I.P. 18" above
Ed. Gas Co. N.&T. in 18" Willow
110.48 T. 74 = 110.47'
Angle Point Located at rec. from 1/4 Sec. Line F.B. 1424-34.
P.O.T. Located at rec. from 1/4 Sec. Line.
173-07-30
332-30-00
318-45-00
173-07-30
Angle Point Located at rec. from 1/4 Sec. Line F.B. 1424-34.
Set N.&T. in 18"
N. 14° 21' 05" W. (99.67)
N. 14° 28' 35" W.
Trail
To 1x2" Sta. 10+24.75 See preceding page
Sta. 11+54.02 Set flush 1x2"
Sta. 11+45.67 Set flush 1x1"
Sta. 13+91.87 Set flush 1x2"
Sta. 12+56.40 Set flush 1x1"
Sta. 12+22.77
Sta. 11+54.02 Set flush
Sta. 11+45.67 Set flush
RETURN TO
LOS ANGELES COUNTY SURVEYOR
700 HALL OF RECORDS
Do not extend notes this side of this line
Note: ANY ADDITIONS OR CHANGES ON THIS SHEET MUST BE MADE OR CIRCLED IN Red Ink WITH DATE AND NAME OF PERSON MAKING CHANGE.

Notes Ck'd by D.M. Finley
Map No. ~~B-1336~~ B-1336-1
Office Work
Checked D. M. Finley AUG
Date

Survey of Orchard Creek Trails
W. O. 7152 Tape No. 042 St'd 84 °F.
Surveyed by Boscrans
Notes Date 1-9-33
Indexed A. C. Johnson

F.B. 320' 115

NOTE: ANY ADDITIONS OR CHANGES ON THIS SHEET MUST BE MADE ON CIRCLED IN Red Ink. WITH DATE AND NAME OF PERSON MAKING CHANGE.

RETURN TO
LOS ANGELES COUNTY SURVEYOR
700 HALL OF RECORDS

Do not extend notes this side of this line

FORM 247 10M 8-31

To S.E. Cor. Lot 2
To 2"x2" leaning
To 2"x2" Sta. 6+10.53 Ft. N. See Pg. 92
Orchard Creek Trail
1/4 Sec. Line
Sta. 15+97.84 Set S.N.+T. flush.
Angle Point Located at rec. angle and dist. from 1/4 Sec. Line. F.B. 1424-35.
Sta. 14+33.99 Set 1"x2" flush.
Angle Point Located at rec. from 1/4 Sec. Line F.B. 1424-33.
Creek
Fd. new 2"x2" 4" above
To 2"x2" Sta. 13+91.87 See preceding page
Located by intersection.
See Pg. 93
See Pg. 94
121-13-15
124-52-45
367-17-15
121-13-12 1/2
143-34-15
214-17-00
141-25-30
143-34-15
161-18-30
285-14-00
247-51-30
161-18-30
163.85 T.84
N.5°29'45"W. 163.85
N.5°21'35"W. (163.85)
N.24°13'05"W. (42.12)
N.64°11'15"W. 42.12
N.30°56'04"E. 25.62
N.31°04'10"E. 25.62
N.89°30'43"E. 168.63

F.B. 320 Pg. 116

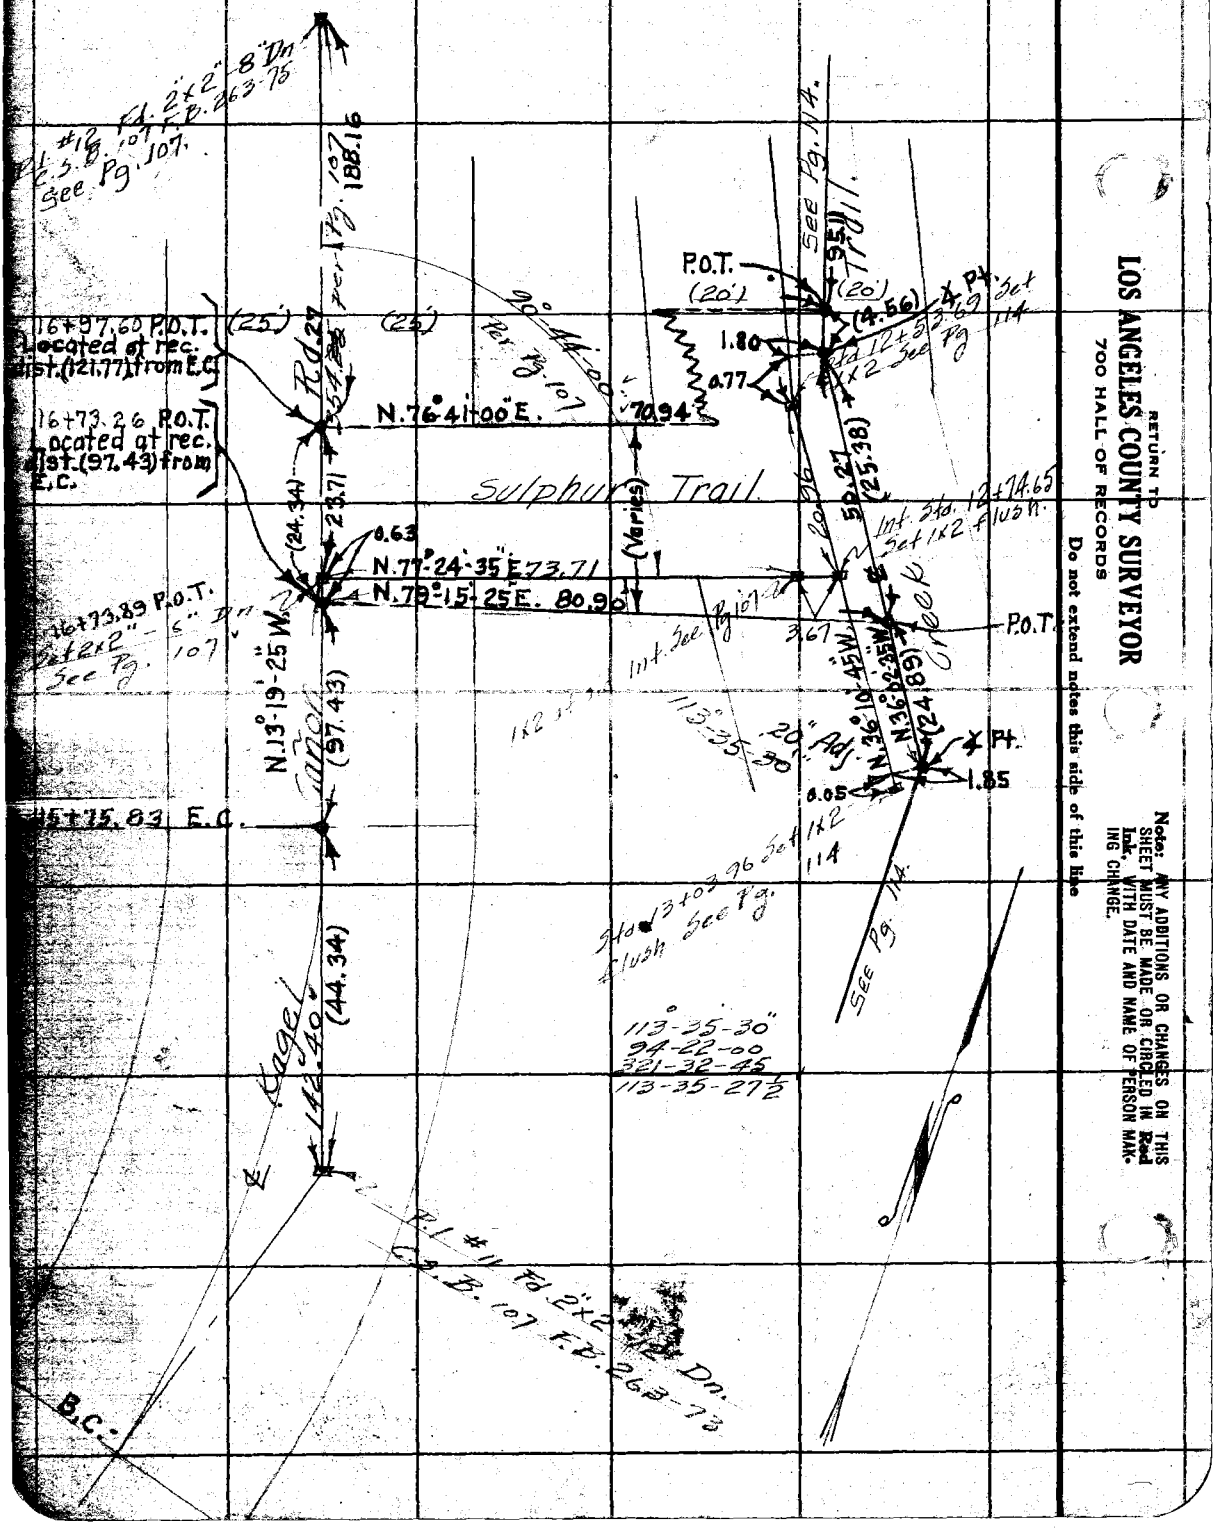

RETURN TO
LOS ANGELES COUNTY SURVEYOR
700 HALL OF RECORDS

Do not extend notes this side of this line

Note: ANY ADDITIONS OR CHANGES ON THIS SHEET MUST BE MADE OR CIRCLED IN Red Ink, WITH DATE AND NAME OF PERSON MAKING CHANGE.

Notes Ck'd by D.M. Finley	Survey of Waterworks Dist #21
Map No.	W. O. 8163 Tape No. 073 St'd 76 °F.
Office Work	Surveyed by L. D. Moore
Checked	Notes Moore Date 7-17-36
Date	Indexed 7-28-36

F.B. 520 PG. 125

SURVEY
For
L.A. Co. WATER WORKS DISTRICT #21
in the
N.W 1/4 of the S.W 1/4 of Sec. 32
T3N - R14W
in
KAGEL CANYON
Job # 8163

Moore
Scott
Lawson
Scott
Re-ty.

Note: Any Additions or Changes on This Sheet Must be Made or Circled in Red Ink With Date and Name of Person Making Change.

Do not extend notes this side of this line

RETURN TO
LOS ANGELES COUNTY SURVEYOR
7010 HALL OF RECORDS

FORM 247 10M 11-35

F.B. 320 PG. 126

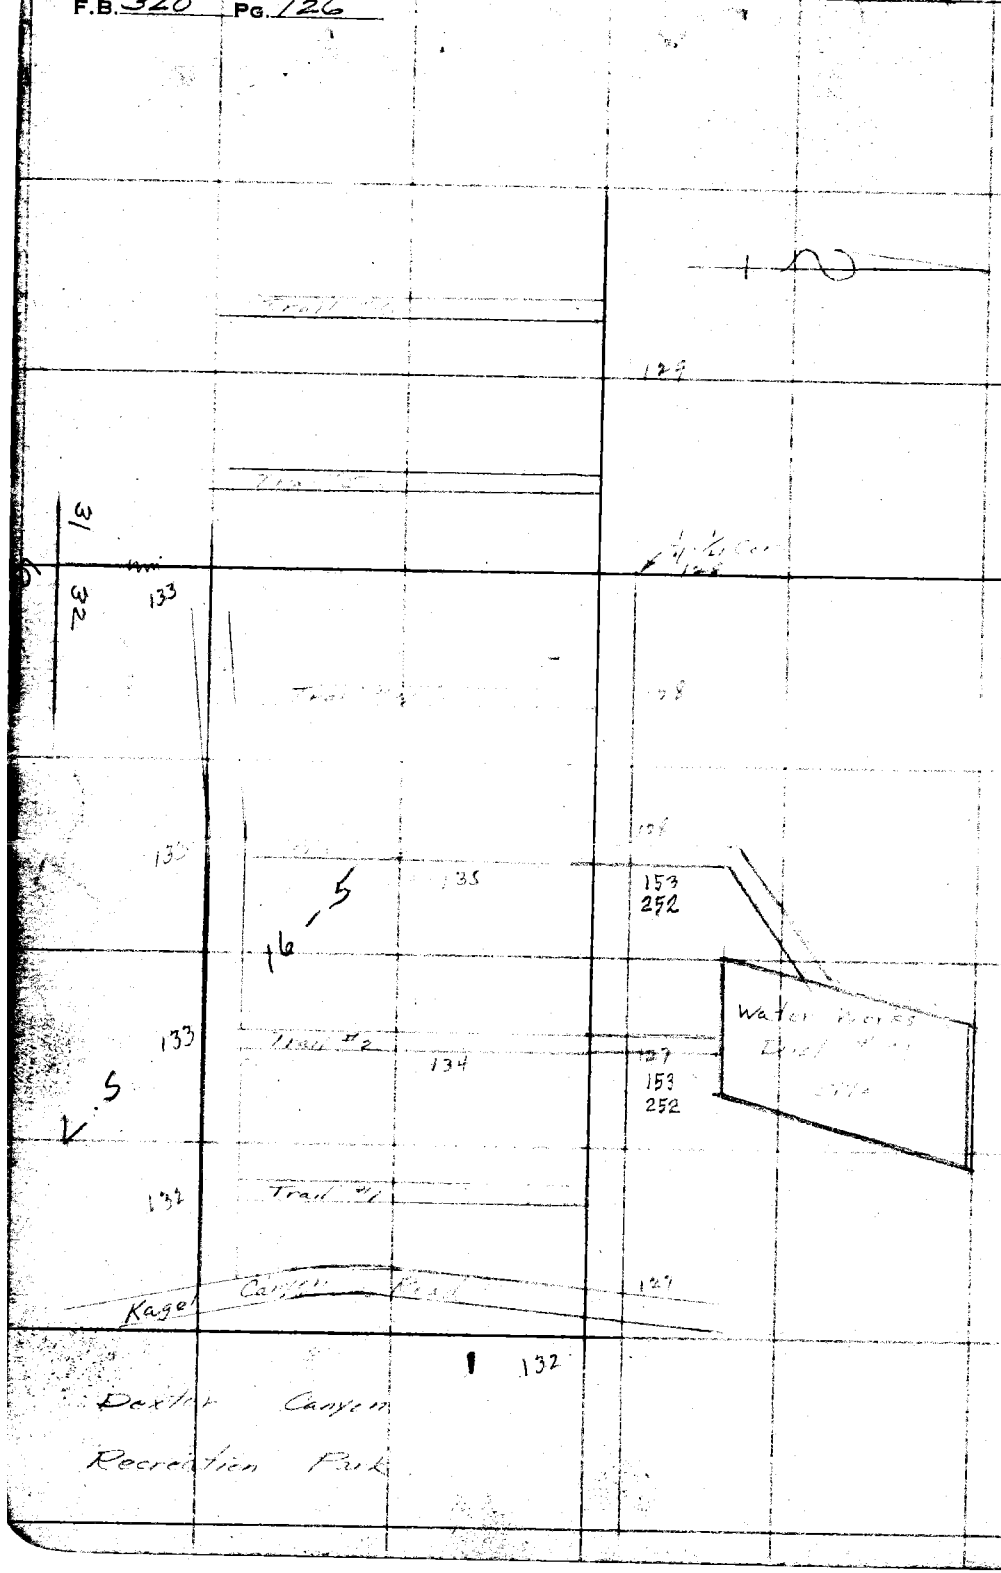

RETURN TO
LOS ANGELES COUNTY SURVEYOR
700 HALL OF RECORDS

Note: Any Additions or Changes on This Sheet Must be Made or Circled in Red Ink With Date and Name of Person Making Change.

Do not extend notes this side of this line

Notes Ck'd by D.M.Finley
Map No. B-1336-3
Office Work
Checked D. M. Finley
Date AUG 35

Survey of Water Works Dist #1 F.B. 320 PG. 127
W. O. 863 Tape No. 073 St'd 76 °F.
Surveyed by L.D. Moore
Notes Moore Date 7-17-36
Indexed

Note: Any Additions or Changes on This Sheet Must be Made or Circled in Red Ink With Date and Name of Person Making Change.

Do not extend notes this side of this line

LOS ANGELES COUNTY SURVEYOR
700 HALL OF RECORDS

L.S. 16-5

101

Trail #2

wire fence

102

113

Trail #1

114

Kagel Canyon
See F.B. 132

DEXTER CANYON PARK

53.66 @ 100° @ 21-23' = 49.92

Set 1x2

Pt A Set 1x2 Flush

151.26

Pt B Set 1x2 Flush

90°00'

116.80

17.23

664.64

84.38

266.77

17.50

57.84

17.01

7.25

Fd 2x2 No. Tk.

Fd 2" I.P. L.S. 16-5 F.B. 320-85

Fd C.S. Mon - 2" I.P. in B.C. in conc - 6" high and 3 stamped as shown F.B. 320-86

road

COUNTY SURVEY N.W. Corner Dexter Canyon Recreation Park

MONUMENT

(59) (51) (50) (52) (53) (54) (55)

FORM 247 10M 11-35

RETURN TO
LOS ANGELES COUNTY SURVEYOR
700 HALL OF RECORDS

Note: Any Additions or Changes on This Sheet Must be Made or Circled in **Red Ink** With Date and Name of Person Making Change.

Do not extend notes this side of this line

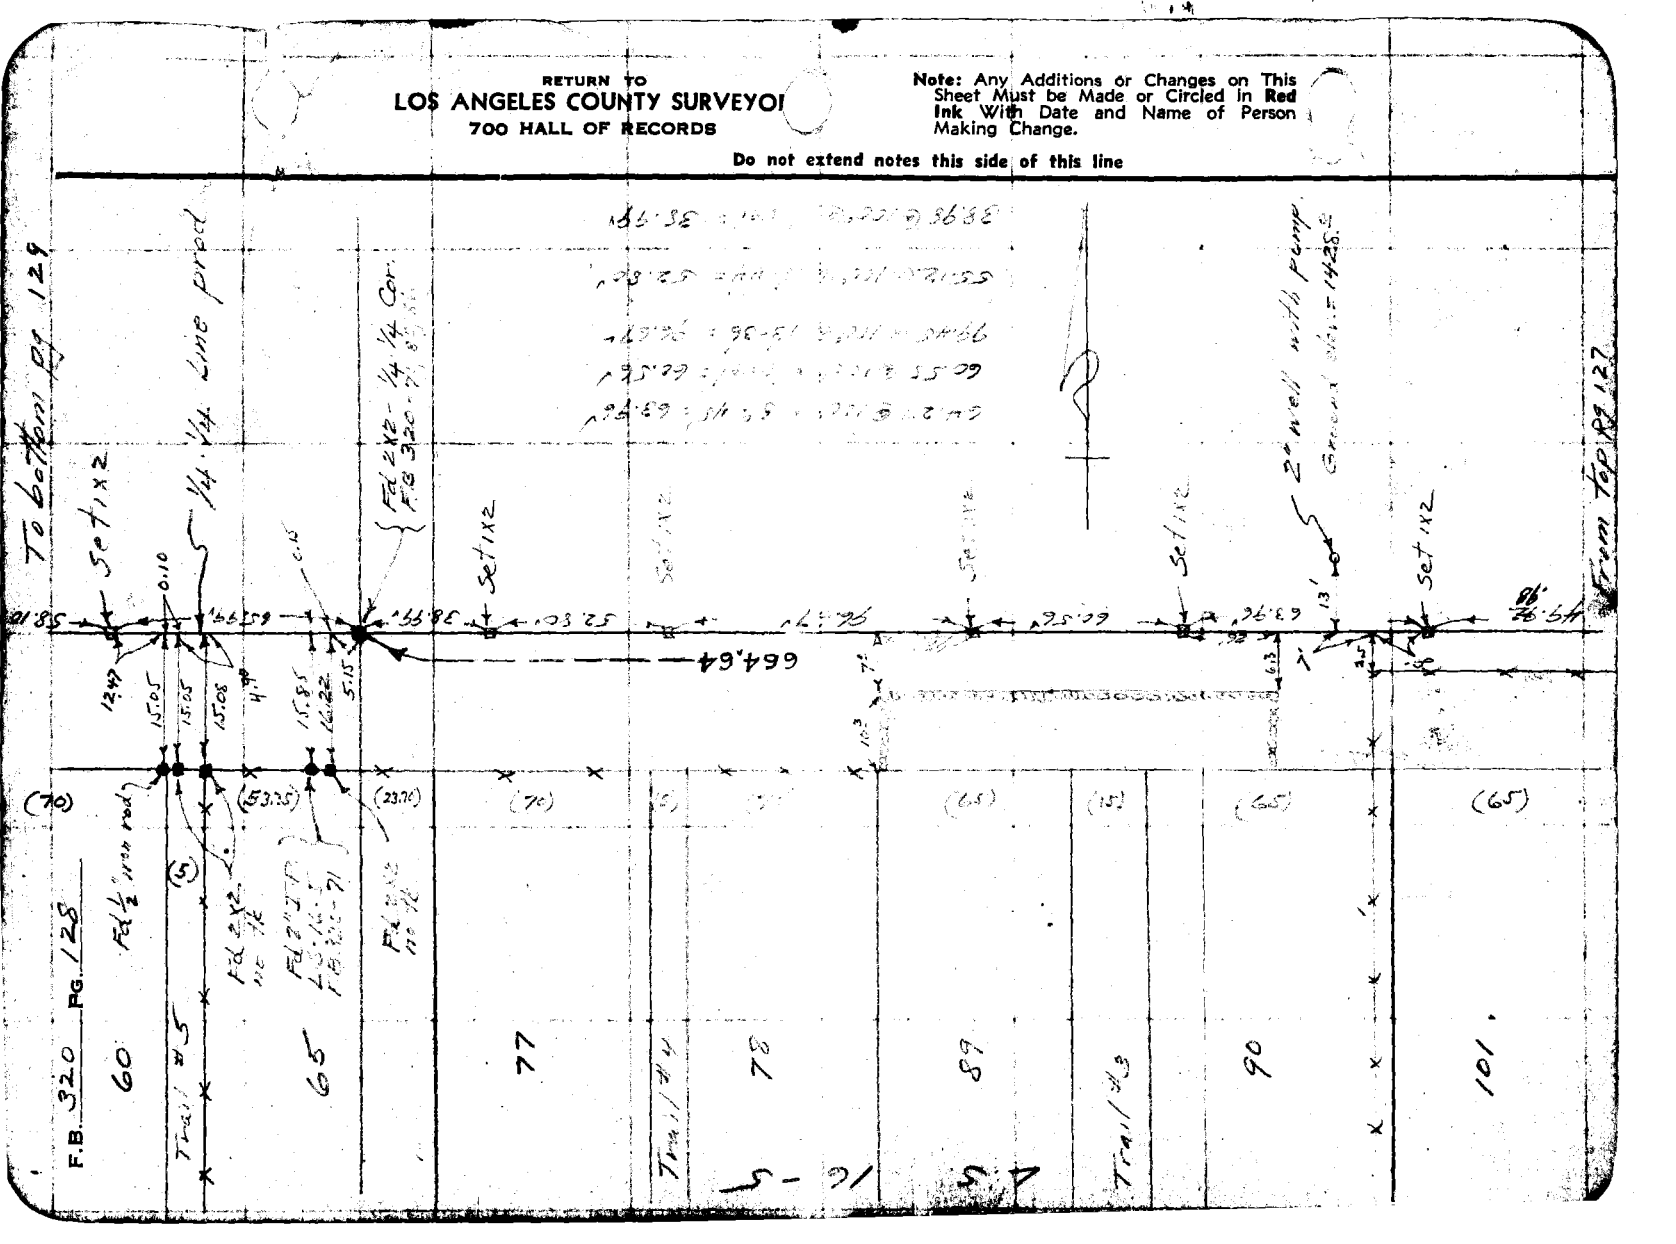

Notes Ck'd by D.M. Finley	Survey of Water Works Dist # 31	F.B. 520	Pg. 129
Map No.	W. O. 516-2 Tape No. 873 St'd 72° F.		
Office Work	Surveyed by L.D. Moore		
Checked	Notes D Keele Date 2-11-46		
Date	Indexed		

Note: Any Additions or Changes on This Sheet Must be Made or Circled in Red Ink With Date and Name of Person Making Change.

Do not extend notes this side of this line

RETURN TO
LOS ANGELES COUNTY SURVEYOR
700 HALL OF RECORDS

FORM 247 10M 11-35

67.92 @ 110° @ 13°-55' = 65.59 ✓
62.70 @ 110° @ 22°-07' = 58.10 ✓
89.71 @ 110° @ 24°-00' = 81.96 ✓
70.70 @ 110° @ 23°-31' = 65.57 ✓

Proposed tank site
Elev. = 1605'
X

Concrete tank
11' High — Ground elev. = 1578.0

15

Trail 7

16 - 44

43

1" I.P. 2x2 110 ft.

13.33

0.58

Pk. C. Set 1x2

T

R

N 50° - 19' W

44

4.85

Set 1x2

Trail 6

15.10

4.5

I.P. 2x2 110 ft.

59

0.92

Set 1x2

14.14

14.14

0.16

Set 5/8" Iron Pipe

1/4 1/4 Line prod

60

From Top Pg. 128

RETURN TO
LOS ANGELES COUNTY SURVEYOR
700 HALL OF RECORDS

Note: Any Additions or Changes on This Sheet Must be Made or Circled In **Red Ink** With Date and Name of Person Making Change.

Do not extend notes this side of this line

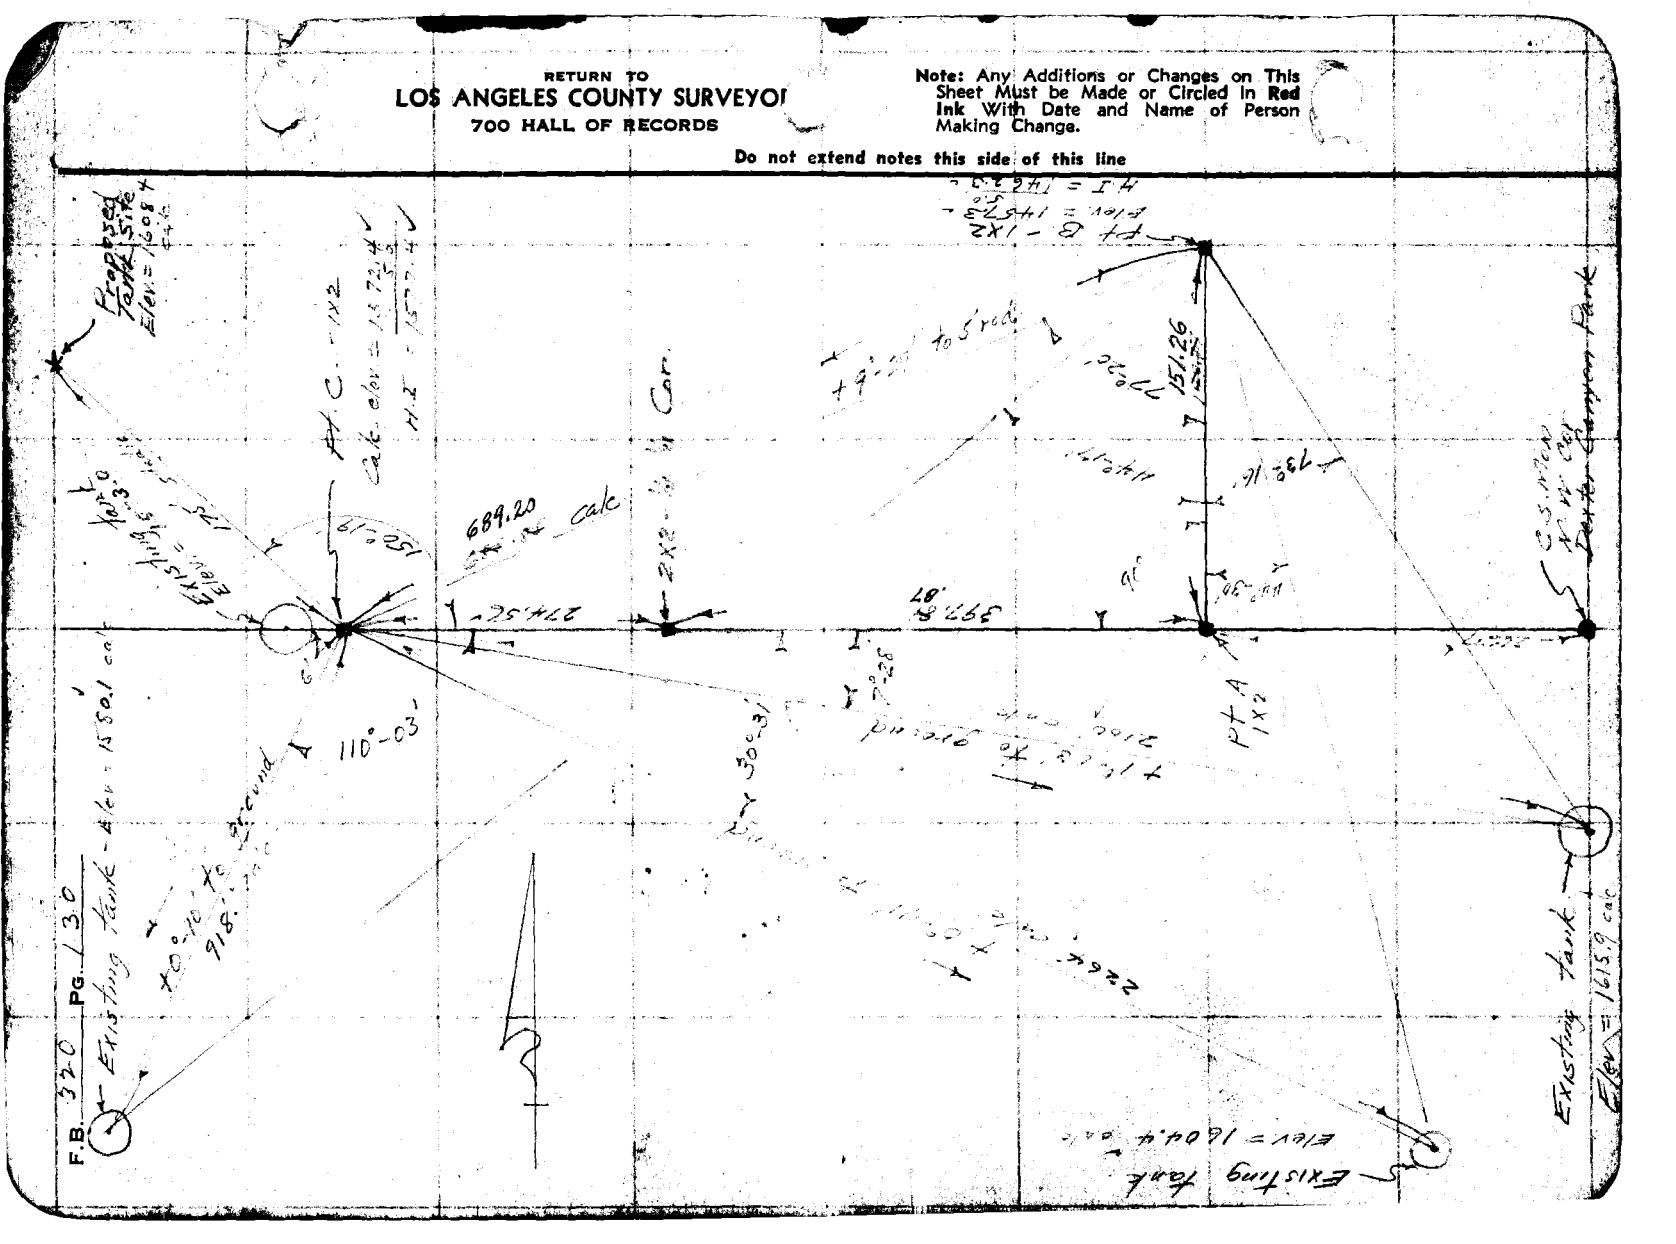

Notes Ck'd by D.M. Finley
Map No.
Office Work
Checked
Date

Survey of Water Works Dist 31
W. O. 8163 Tape No. 50' St'd 58° F.
Surveyed by L.D. Moore
Notes N Moore Date 2-23-36
Indexed

F.B. 320 Pg. 131

Note: Any Additions or Changes on This Sheet Must be Made or Circled in Red Ink With Date and Name of Person Making Change.

Do not extend notes this side of this line

RETURN TO
LOS ANGELES COUNTY SURVEYOR
700 HALL OF RECORDS

FORM 247 10M 11-35

298.18 @ 94 @ 3°-20' = 297.70

296.67 @ 94 @ 3°-20' = 295.77
84.35 @ 94 @ 3°-20' = 84.56
380.91

Kagel Canyon Road run by record angles and distances, see C.S. 7982 and L.S.B. 4-5.

95.95 @ 94 @ 3°-20' = 95.81

186.14 @ 94 @ 4° = 186.13

A = 25°-27'-40"

A = 41°-23'-10"

A = 70°-46'-25"

A = 30°-23'-50"

A = 19°-16'-40"

Tangent

Curve

Set 1x2

Set NY7

Set N Y T

Set Nothing

Fd 2x2 12 deep F.B. 283-22

Fd 3/4" pipe flush

Fd 3/4" pipe 0.4' high

Fd 1" pipe flush

Fd 1" pipe 0.3' high

Fd 1" pipe 0.2' high

Fd W Spk. N.T. 0.3' deep

Set N.T. by mist

Fd 3/4" pipe 0.2' high

Fd 3/4" pipe 0.3' high

Fd 1" pipe 0.3' high

Fd 1" pipe 0.2

RETURN TO
LOS ANGELES COUNTY SURVEYOR
700 HALL OF RECORDS

Note: Any Additions or Changes on This Sheet Must be Made or Circled in **Red Ink** With Date and Name of Person Making Change.

Do not extend notes this side of this line

SEE R.S. 111/7
For Final SE

and Fd 205
& 191

F.B. 320 Pg. 132 See Pg. 127

82°-22'-18¾"

To Bottom Pg 133

Notes Ck'd by D.M.Finley	Survey of Water Works Dist #21	F.B. 32c	Pg. 133
Map No.	W. O. 5161 Tape No. St'd °F.		
Office Work	Surveyed by L. D. Moore		
Checked	Notes Date 2-21-36		
Date	Indexed L. D. Jamison		

(63.44)

0.58 Calc.

1259.44 V

3.00 1018.79

Set nail

Set 1x2 w/ tack

25°11'

240.77 V

Fd 2x2 Top hill LB 32c-71

1/4 1/4 Cor. 2x2 pg 128

Fd 2x2 SW Cor. Sec 32 T2N R14W per 32c-71

206.44 @ 75° @ 12°53' = 202.15 V

39.09 @ 76° @ 5°56' = 38.62 V

240.77 V

121.24 @ 75° @ 12° = 118.42 V

57.67 @ 77° @ 4°21' = 55.61 V

173.73 V

Fd Set 1x2 - flush

(42.00)

(3.07)

Set N47

℄ Trail #2

See pg. 135

90°

(42.00)

Set N47

℄ Trail #2

See pg. 132

Fence to pg. 132

Note: Any Additions or Changes on This Sheet Must be Made or Circled in Red Ink With Date and Name of Person Making Change.

Do not extend notes this side of this line

RETURN TO
LOS ANGELES COUNTY SURVEYOR
700 HALL OF RECORDS

FORM 247 10M 11-35

F.B. 320 PG. 134

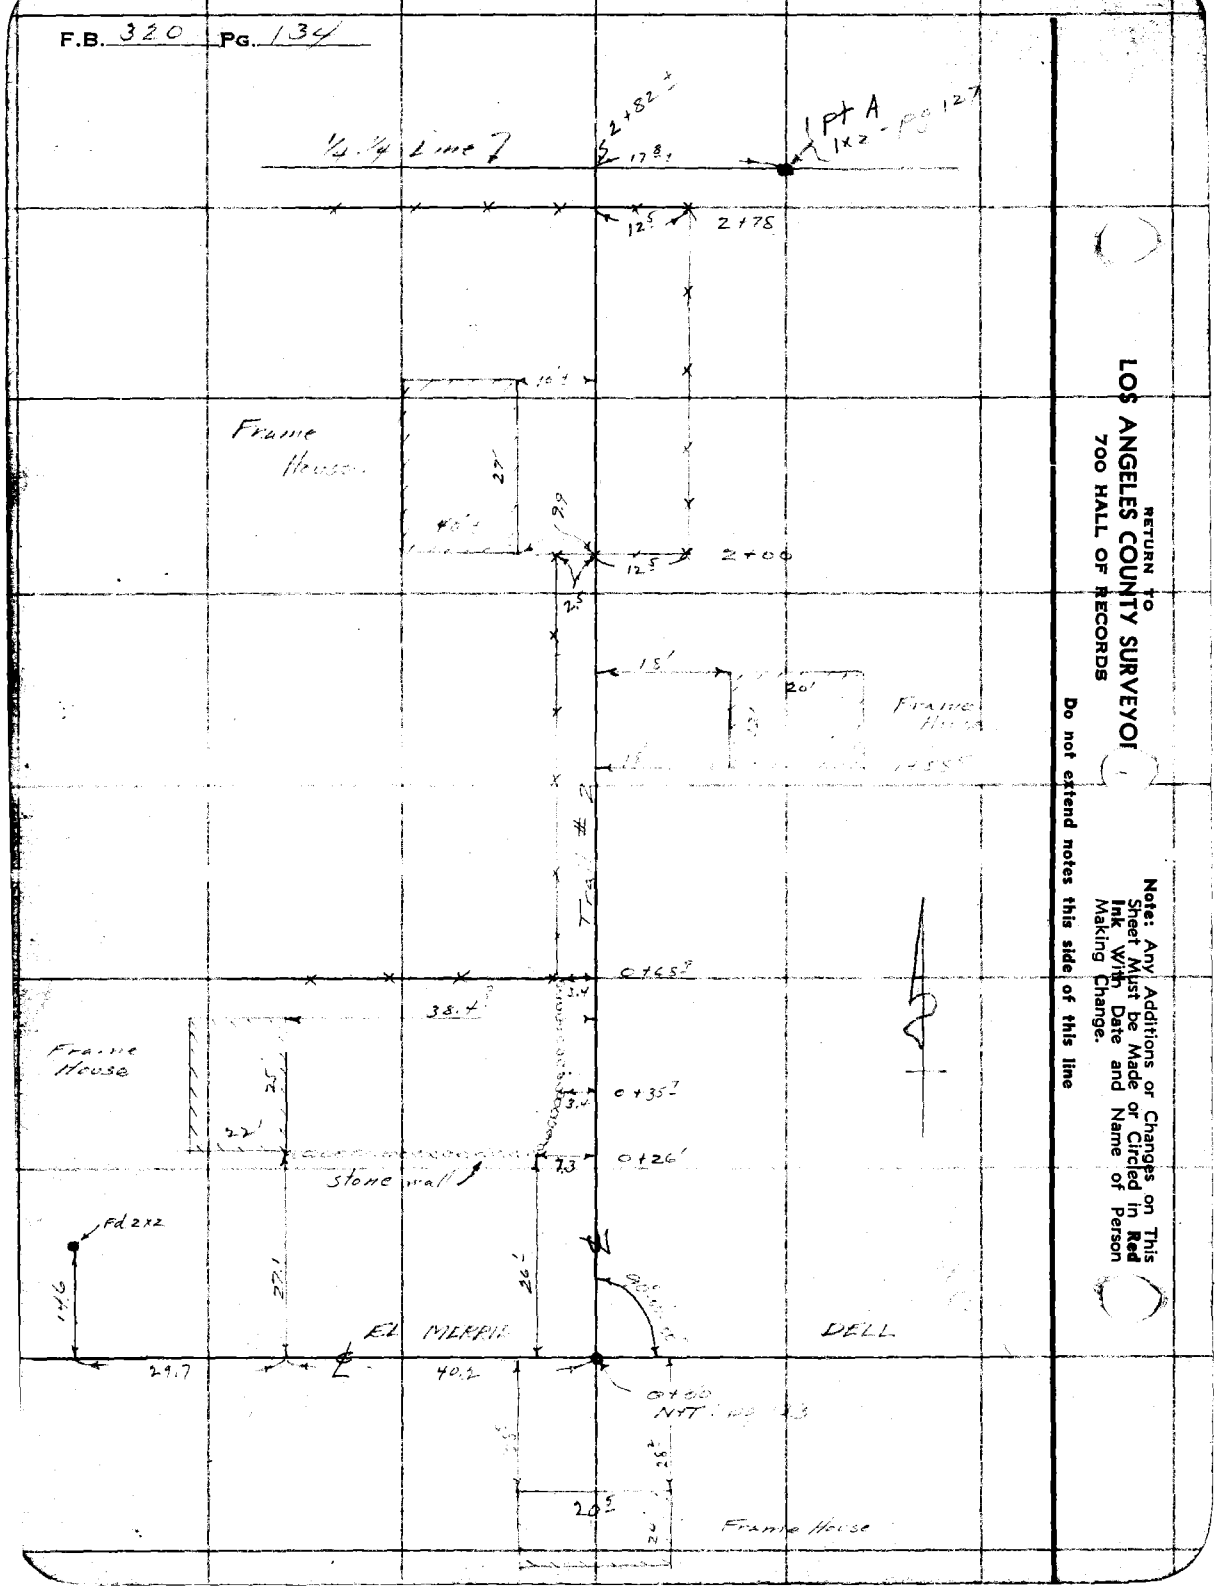

RETURN TO
LOS ANGELES COUNTY SURVEYOR
700 HALL OF RECORDS

Note: Any Additions or Changes on This Sheet Must be Made or Circled in Red Ink With Date and Name of Person Making Change.

Do not extend notes this side of this line

Notes Ck'd by D.M. Finley	Survey of Water Power Dist.	F.B. 320	Pg. 135
Map No.	W. O. 5[illegible]	Tape No.	St'd °F.
Office Work	Surveyed by L.D. Moore		
Checked	Notes Moore	Date 1/11/26	
Date	Indexed R. C. Johnson		

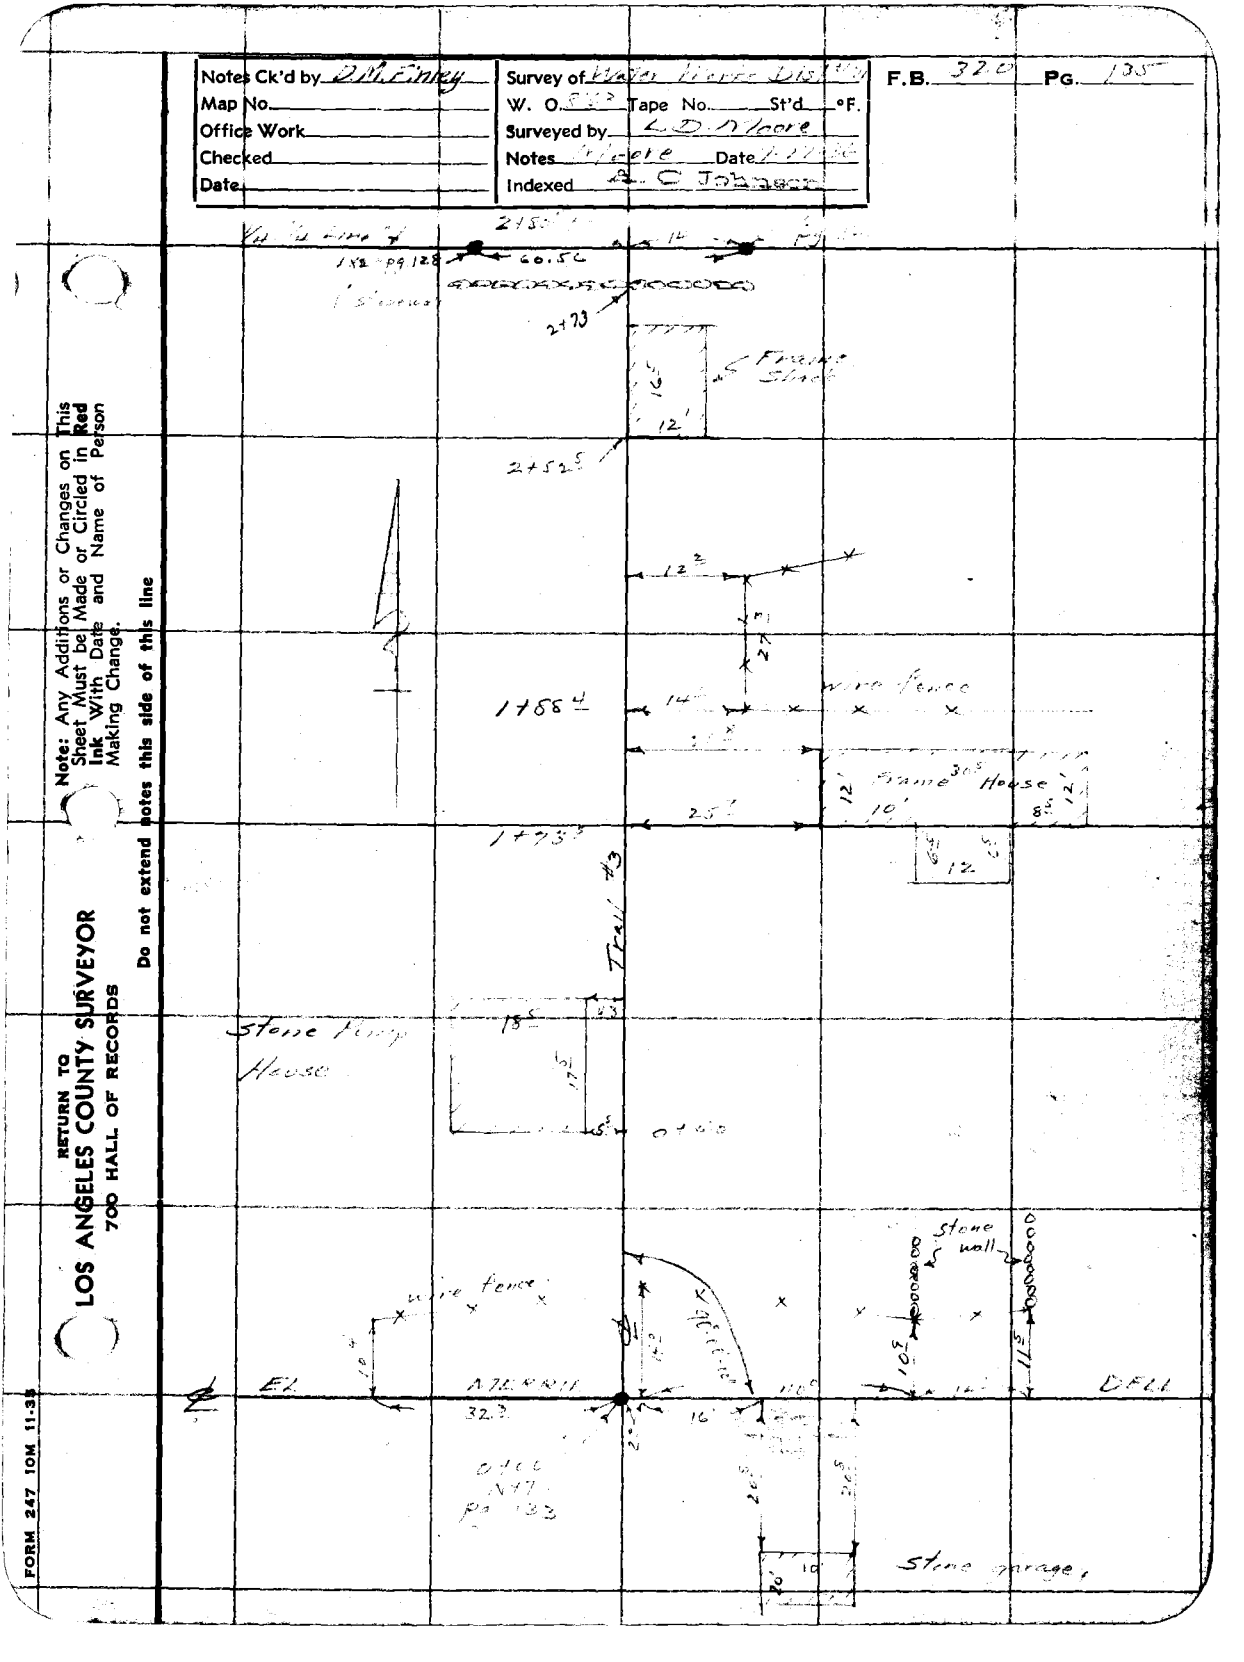

Note: Any Additions or Changes on This Sheet Must be Made or Circled in Red Ink With Date and Name of Person Making Change.

Do not extend notes this side of this line

RETURN TO
LOS ANGELES COUNTY SURVEYOR
700 HALL OF RECORDS

FORM 247 10M 11-38

RETURN TO
LOS ANGELES COUNTY SURVEYOR
700 HALL OF RECORDS

Note: Any Additions or Changes on This Sheet Must be Made or Circled in **Red Ink** With Date and Name of Person Making Change.

Do not extend notes this side of this line

F.B. 320 PG. 136

Form 307 5M 11-35

PLEASE RETURN TO
LOS ANGELES COUNTY SURVEYOR
700 HALL OF RECORDS

NOTE: ANY ADDITIONS OR CHANGES ON THIS SHEET MUST BE MADE OR CIRCLED IN RED INK, WITH DATE AND NAME OF PERSON MAKING CHANGE

Do not extend notes this side of this line

STATION	B. S.	H. I.	F. S.	ELEV.	
B.M. U.S. 1739				1227 286	✓ P.B.M. In Little Tujunga Cn. near mouth, 3.5 miles NE of San Fernando Rd., N. side of Cn. where road forks to ranch. Large culvert, in middle of N. head wall; Bronze tablet stamped "R-67-1929" Painted U.S.B.M. 1227 3. 40'S. of P.B.M. "R-67-1929" on W. end of S. head wall of small culvert, bottom of square hole. EL: 1227.45
	3 134	1230 420			
Reference B.M.	3 105	1230 525	97	1227 45	
T.P.	4 835	1230 120	5 27	1225 285	✓
T.P.	0 095	1227 085	3 13	1226 99	✓
T.P.	0 54	1216 03	11 635	1215 45	✓
T.P.	0 17	1206 275	9 925	1206 105	✓
T.P.	0 29	1195 345	11 22	1195 055	✓ spk.
T.P.	0 015	1184 96	10 40	1184 945	✓
T.P.	0 37	1173 405	11 925	1173 035	✓
T.P.	0 26	1161 55	12 115	1161 29	✓
T.P.	0 265	1150 08	11 735	1149 815	✓
T.P.	0 915	1139 895	11 10	1138 98	✓
T.P.	3 67	1137 805	5 76	1134 135	✓
T.B.M.	11 42	1142 215	7 01	1130 775	✓ set cut spk & washer in E end of N bridge girder 300' W. of stone & frame house Adj Elev 1130.84
T.P.	9 525	1151 025	0 715	1141 50	✓
T.P.	10 33	1160 92	0 435	1150 59	✓
T.P.	10 71	1169 93	1 70	1159 22	✓
T.P.	11 175	1180 53	0 575	1169 355	✓
T.P.	11 555	1191 57	0 515	1180 015	✓
T.P.	11 15	1202 64	0 08	1191 07	✓

Bench Levels from U.S.B.M. 1739 in Tujunga Canyon to [illegible] Water Works Dist. #21 [illegible] Canyon [illegible]

No. [illegible] Plotted [illegible] Job No. 8163 Division No. 4 F.B. 320 PG. 137

Date [illegible] Date [illegible] Survey of L.A.C. Water Works Dist #21

X-Sec. [illegible] Checked [illegible] Survey by A.D. Nacarrow Notes 2nd Date 7-16-36

Notes Chkd. DMF Date 7-19-36 Map No. [illegible] Inked C. Johnson Date 7-28-36

Form 307 5M 11-35

PLEASE RETURN TO
LOS ANGELES COUNTY SURVEYOR
700 HALL OF RECORDS

NOTE: ANY ADDITIONS OR CHANGES ON THIS SHEET MUST BE MADE OR CIRCLED IN RED INK, WITH DATE AND NAME OF PERSON MAKING CHANGE

Do not extend notes this side of this line

F.B. 320 Pg. 138 | Job No. 8163 Division No. 21 | Profile No. | X-Sec. No.
Survey of Water Works Dist #21 | Notes Red. | Plotted Date
Survey by L.O. Moore C. Johnson | Notes Scott | Notes Chkd. Date 7-27-36 | Checked Date
Indexed A.C. | Date | Date

STATION	B. S.	H. I.	F. S.	ELEV.	
		120264			
T.P.	12 12	1214 65	0 11	1203	53'
T.B.M	9 02	1222 825	0 845	1213	805' Nail Cut spk. in S. post of guard rail at intersection of Kagle Cyn Rd. & East Trail. Adj Elev = 1213.893
T.P.	9 13	1228 675	3 28	12	575'
T.P.	12 51	1240 795	0 09	12	585'
T.P.	10 52	1251 015	0 30	12	495'
T.P.	7 90	1258 79	0 12	12	895'
T.P.	10 84	1269 48	0 155	1252	64'
T.P.	10 845	1279 975	0 35	1269	13'
T.B.M.	8 95	1288 80	0 125	1279	85' Set Cut spk in P.P. #3622675 in front of Kagle Cyn Grocery
B.M.	12 18	1299 245	1 335	1287	065 Cut spk in oak tree marked BM #4 opp PP #3622655 per L.B. 640 - 117 Adj elev = 1287.186
T.P.	12 015	1311 16	0 10	1299	145'
T.P.	11 22	1322 31	0 07	1311	09'
T.P.	11 625	1333 68	0 255	1322	055'
T.P.	11 735	1345 335	0 08	1333	60'
T.P.	11 365	1356 63	0 07	1345	265'
T.P	10 67	1367 25	0 05	1356	58'
T.P.	6 21	1373 13	0 33	1366	92'
T.B.M. #10	11 35	1380 70	3 78	1369	35' Set cut spk. in top piling; S. side bridge adj 1369.497
T.P.	11 635	1392 28	0.055	1380	645'
T.P.	4 93	1397 16	0 05	1392	23'

Form 307 5M 10-34

PLEASE RETURN TO
LOS ANGELES COUNTY SURVEYOR
700 HALL OF RECORDS

NOTE: ANY ADDITIONS OR CHANGES ON THIS SHEET MUST BE MADE OR CIRCLED IN RED INK, WITH DATE AND NAME OF PERSON MAKING CHANGE

Do not extend notes this side of this line

Profile No. _____ Notes Red _____ Pict. _____
X-Sec. _____ Date _____ Date _____
Notes Chkd. _____ Chkd. _____ Survey of Water Works Dist. 21
Date 7-14-55 Map No. _____ Survey by Mapes Notes Scott Date 7-14-55
Job No. 8760 Division No. 1 L.B. 2 P. 26
Checked C. Jabroski Date 7-15-55

STATION	B. S.	H. I.	F. S	ELEV.		
		1397 16				
T.P.	12 01	1408 135	1035	1396 125		
T.P.	11 605	1419 645	0 095	1408 04		
T.P.	11 83	1431 46	0 015	1419 63		
T.P.	11 595	1443 03	0 025	1431 435		
T.P.	12 11	1455 03	0 11	1442 92		
T.P.	5665	1459 88	0 815	1454 215		
P# B	10 25	1467 35	2 78	1457 10	1 x 2 - Adj. elev = 1457.25	Adj. elev = 1457.327
BM	0 23	1467 405	0 175	1467 175	Fd. spk on W side of P.P. # 3547402	
T.P.	1 96	1460 70	8 665	1458 74		
T.P.	0 22	1460 11	0 81	1459 89		
T.P.	2545	1454 455	8 20	1451 91		
BM	3 24	1452 00	5 695	1448 76	Set cut spk. in ⌐ T.P., 50' E/N of int. Kogel/Cn. & Da Re - P	Adj. elev = 1448.92
T.P.	1 445	1453 43	0 015	1451 985		
T.P.	0 935	1442 715	11 65	1441 78		
T.P.	0 145	1431 55	11 31	1431 405		
T.P.	0 01	1420 11	11 45	1420 10		
T.P.	0 23	1408 37	11 97	1408 14		
T.P.	0 79	1397 40	11 76	1396 61		
T.P.	3 515	1389 045	11 87	1385 53		
B.M. #9			2 75			

320 P.G.140 Job. No.____ Division No.____ Notes Red____ Plotted____ Profile

Survey of____ Date____ Date____ No.____

Survey by____ Notes____ Notes Chkd.____ Checked____ X-Sec.

Indexed A. C. Johnson Date____ Date____ Date____ No.____

Form 307-5M 10-34

PLEASE RETURN TO
LOS ANGELES COUNTY SURVEYOR
700 HALL OF RECORDS

NOTE: ANY ADDITIONS OR CHANGES ON THIS SHEET MUST BE MADE OR CIRCLED IN RED INK. WITH DATE AND NAME OF PERSON MAKING CHANGE

Do not extend notes this side of this line

STATION	B.S.	H.I.	F.S	ELEV.	

Form 351

...ITTED TO
...COUNTY SURVEYOR
...RECORDS

NOTE: ANY ADDITIONS OR CHANGES
OR ERASURES MUST ALSO BE MADE OR
CHANGED IN RED INK, WITH DATE
AND NAME OF PERSON MAKING CHANGE

Do not extend notes this side of this line

Transit at	Back on	Horiz. Distance	Slope Distance	Horiz. Angle	Bearing or Azimuth	Vertical Angle	Elevation of Point	Date Mark	Difference Elevation	Height of Instrument	Vertical Distance	Notes
B	A						1457.3	5		1462.3		B-112
		1401	262'	5°	206.20	+ 3.02	1457.7	2				N.E.Cor.
		1401	295'	4°	202.15	+ 3.14	1458.8	3				Top. Bank
		058										
		13	259'	4°	205.05	+ 3.03	1458.3	4				"
		1462										
		2	201'	3°	205.15	+ 2.50		5				"
		382										
		2	181'	3°	215.15	+ 2.09	1459.8	6				"
		192						7				
		1	93'	1°	220.30	+ 0.19	1461.7					"
		122						8				
		6	23'	6°	306.35	—	1456.2					5 E.C.
		630						9				
		6	36'	6°	291.50	—	1456.1					Top. Bank
		956						10				
		2	57'	9°	8.25	—	1459.0					"
		1601						11				
		9	102'	9°	27.55	— 2.10	1453.0					"
		1125						12				
		10	136'	11°	35.25	— 2.08	1451.3					"
		2022						13				
		10	98'	10°	63.40	—	1451.6					"
		1659						14				
		8	60'	7°	72.25	—	1454.4					5 W.C.
		625						15				
		6	76'	6°	101.35	—	1456.1					Top. Bank
		902						16				
		2	103'	3°	153.35	+ 0.50	1458.3					"
		1358						17				
		3	159'	4°	175.15	+ 1.17	1459.9					"
		480						18				
		2	281'	3°	184.05	+ 2.00	1458.3					"
		362						19				
		6	268'	2°	150.00	+ 3.06	1456.0					MH
		1132										
		3	144'	4°	172.30	+ 2.00	1458.3					"
		1										
		2										

Plotted J.A.L. Date 4-16-57 Drawing No. 1
Checked

LOS ANGELES COUNTY SURVEYOR

NOTE: Any corrections or changes on this sheet must be initialed & circled in red ink with reason and name of person making change.

Do not extend notes this side of this line

Transit at	Sight on	Station	Distance	Angle	Minutes	Horizontal Distance	+ Vertical Angle	Elevation of Point	+ Rod Sight	+ Difference of Elevation	Notes	Vertical Distance	Remarks
		1166					—						
		11	64	11	—	12840	—	1455	3				
		2326						1452	2				
		2	138	2	30	25	+ 4 50	1457	3				
		254							1				
		5	64	9	2	97 50	—	1455	0				
		481							8				
		4	32	4	1	117 45	—	1455	8				
		0							2				
		0	74	0	1	73 40	—	1462	2				
		292						1464	3				
		1	143	2	0	186 20	+ 2 26	1466	3				
		295						1464	3				
		1	200	2	0	187 25	+ 2 44	1466	3				
		766						1464	3				
		1	267	2	0	187 —	+ 2 55	1464	3				
		443						1457	3				
		1	344	3	0	186 25	+ 3 27	1457	3				
		549						1456	3				
		2	350	4	0	192 35	+ 3 40	1456	3	+ 18 3		+ 22 3	
		390						1455	3				
		1	291	3	0	194 50	+ 3 24	1457	3				
		324						1460	3				
		1	225	2	0	197 50	+ 3 00	1464	3				
		652						1462	3				
		1	148	2	0	201 40	+ 2 41	1462	3				
		079						1462	3				
		0	80	0	0	201 40	—	1462	3				
		331						1459	2				
		1	32	3	1	206 50	—	1459	2				
		234						1459	3				
		2	35	7	1	29 30	—	1459	3				

Notes Ck'd by	Survey of Water Works Dist #21
Map No.	W. O. 8163 Topo No. St'd of.
Office Work	Surveyed by E. D. Moore
Checked	Notes Moore Date 11-6-36
Date	Indexed C. Johnson

F.B. 3210 Pg. 143

To Lathrop

188.11

PI #27
Set 2x2
flush

37.14-25"

Calc Δ = 30°-28'-
R =
T = 79.72
L =

Calc 379.26

℄ Kagel Canyon Road established by proportion between PI #23 and Ely. Prol of Sly. Line Lot 196 per L.S. 16-5 and C.S. 7982

SEE F.B. 1147
For Final ℄

PI #26
Set 2x2
flush

90°

21°-43'-25"

1x2 - pg. 131

Calc Δ = 19°19'-
R =
T = 58.97
L =

calc 147.46

Calc Δ = 28°-32'-30"
R = 343.96
T = 88.49
L = 171.34

1x2 - pg. 131

28°-09'-08"

42.59

PI #25
Set 2x2 - Flush

Calc Δ = 41°-29'-15"
R = 99.80
T = 37.70
L = 72.26

126.19

41°-50'-05"

PI #23
2x2 - pg. 131

N&T - pg 131

30.05

PI #24
Set S.T.T.W.

108.60
calc

Calc Δ = 70°-53'-45"
R = 99.59
T = 70.90
L = 122.24

70.90
28.65
42.25
27
41.95

PI #22
pg 131

Note: ANY ADDITIONS OR CHANGES ON THIS SHEET MUST BE MADE OR CIRCLED IN Red Ink WITH DATE AND NAME OF PERSON MAKING CHANGE.

Do not extend notes this side of this line

RETURN TO
LOS ANGELES COUNTY SURVEYOR
700 HALL OF RECORDS

FORM 247 SM 2-34

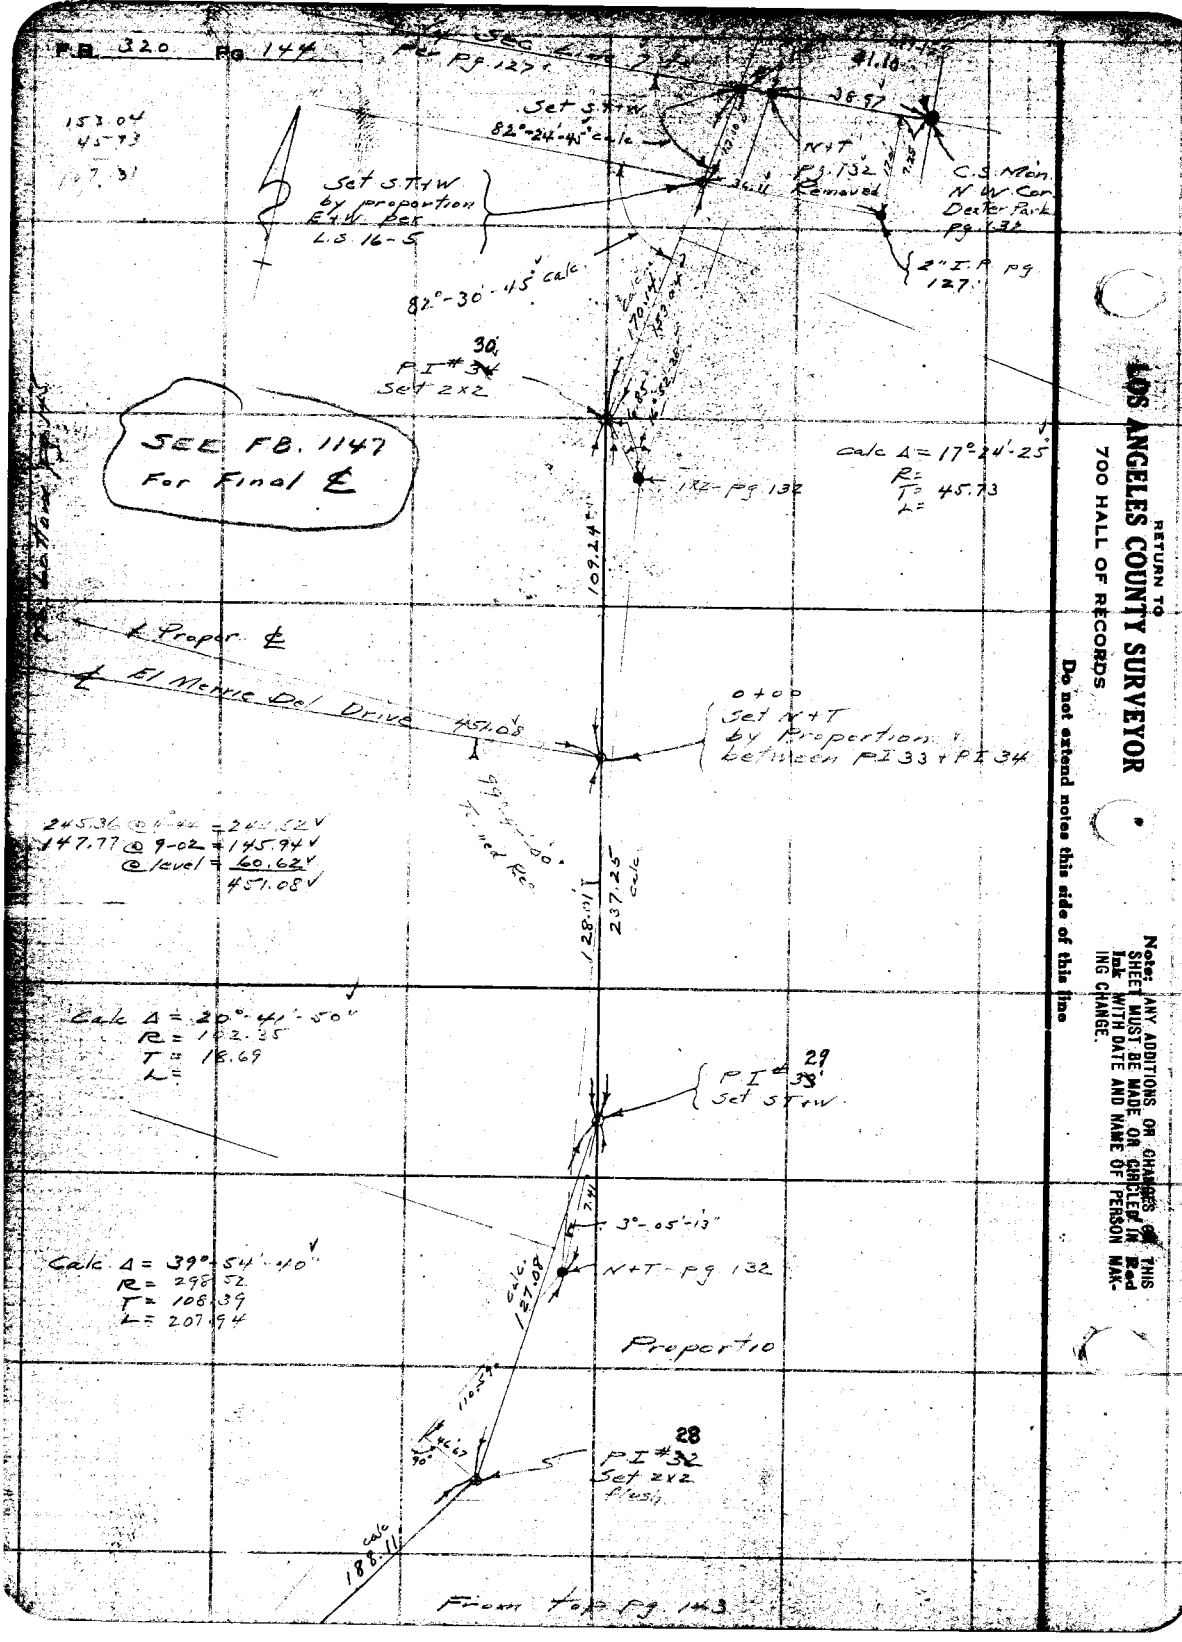

RETURN TO
LOS ANGELES COUNTY SURVEYOR
700 HALL OF RECORDS

Do not extend notes this side of this line

Note: ANY ADDITIONS OR CHANGES OF THIS SHEET MUST BE MADE OR CHARTED IN Red Ink WITH DATE AND NAME OF PERSON MAKING CHANGE.

Name Ck'd by
Map No.
Checked
Date

Survey of Water Works Dist #21 F.B. 320 Pg. 145
W. O. 8163 Tape No Sp'd Of.
Notes Date 11-9-36
Indexed

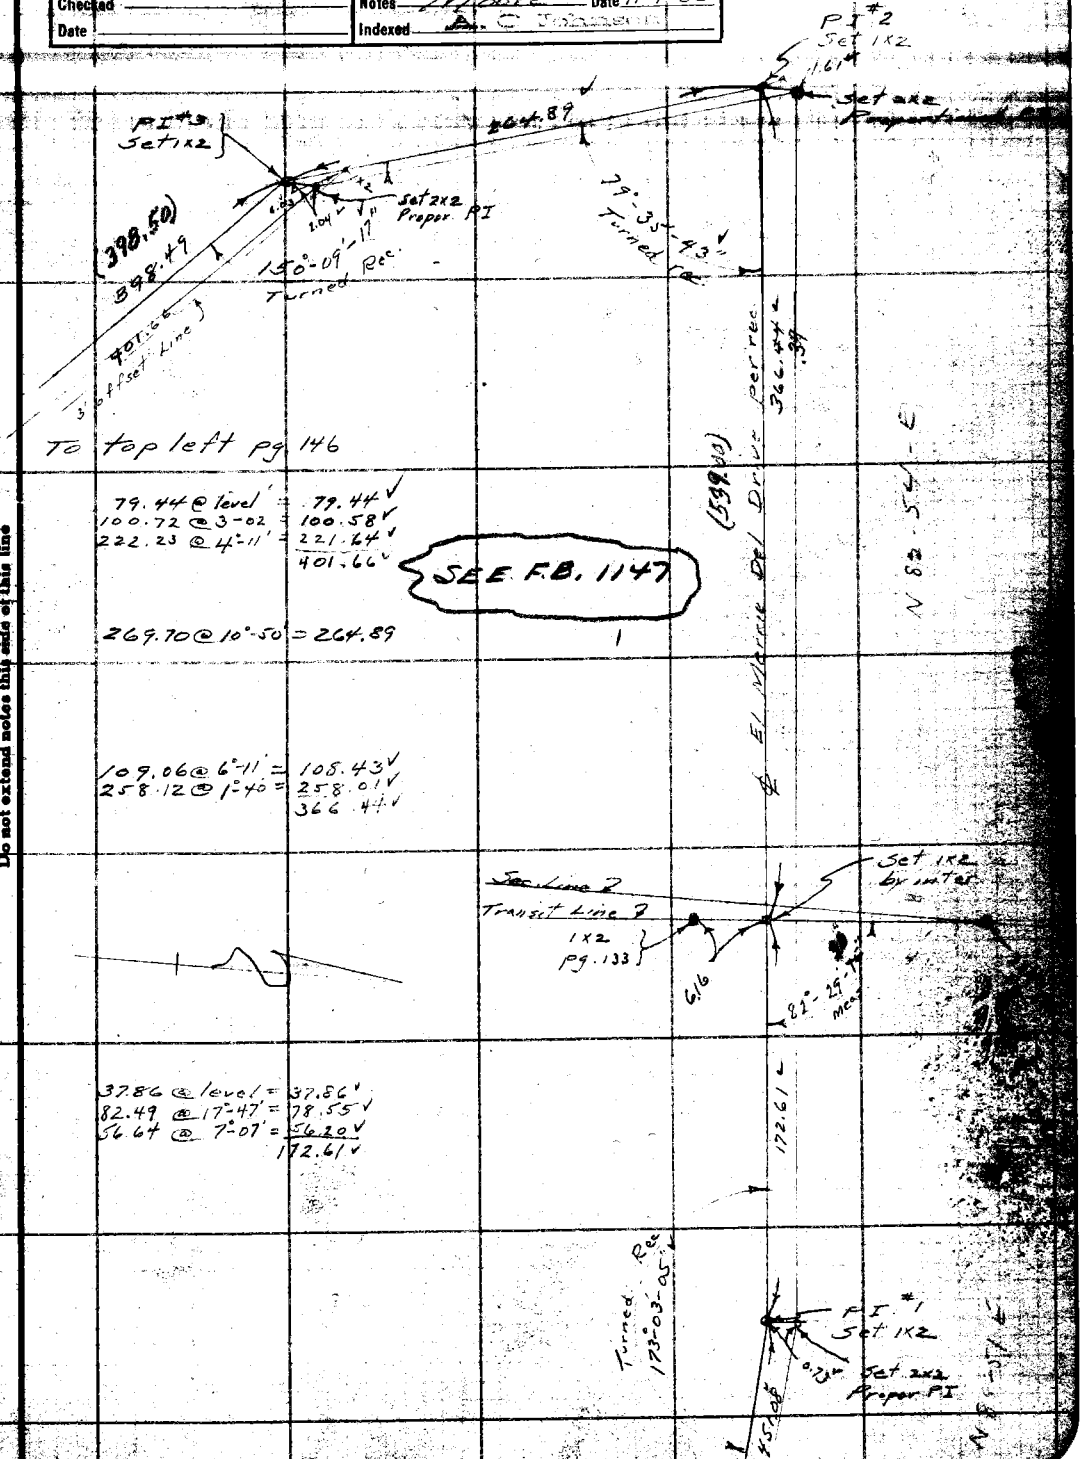

Note: ANY ADDITIONS OR CHANGES ON THIS SHEET MUST BE MADE OR CIRCLED IN Red Ink WITH DATE AND NAME OF PERSON MAKING CHANGE.

Do not extend notes this side of this line

RETURN TO
LOS ANGELES COUNTY SURVEYOR
700 HALL OF RECORDS

FORM 247 BM 2-34

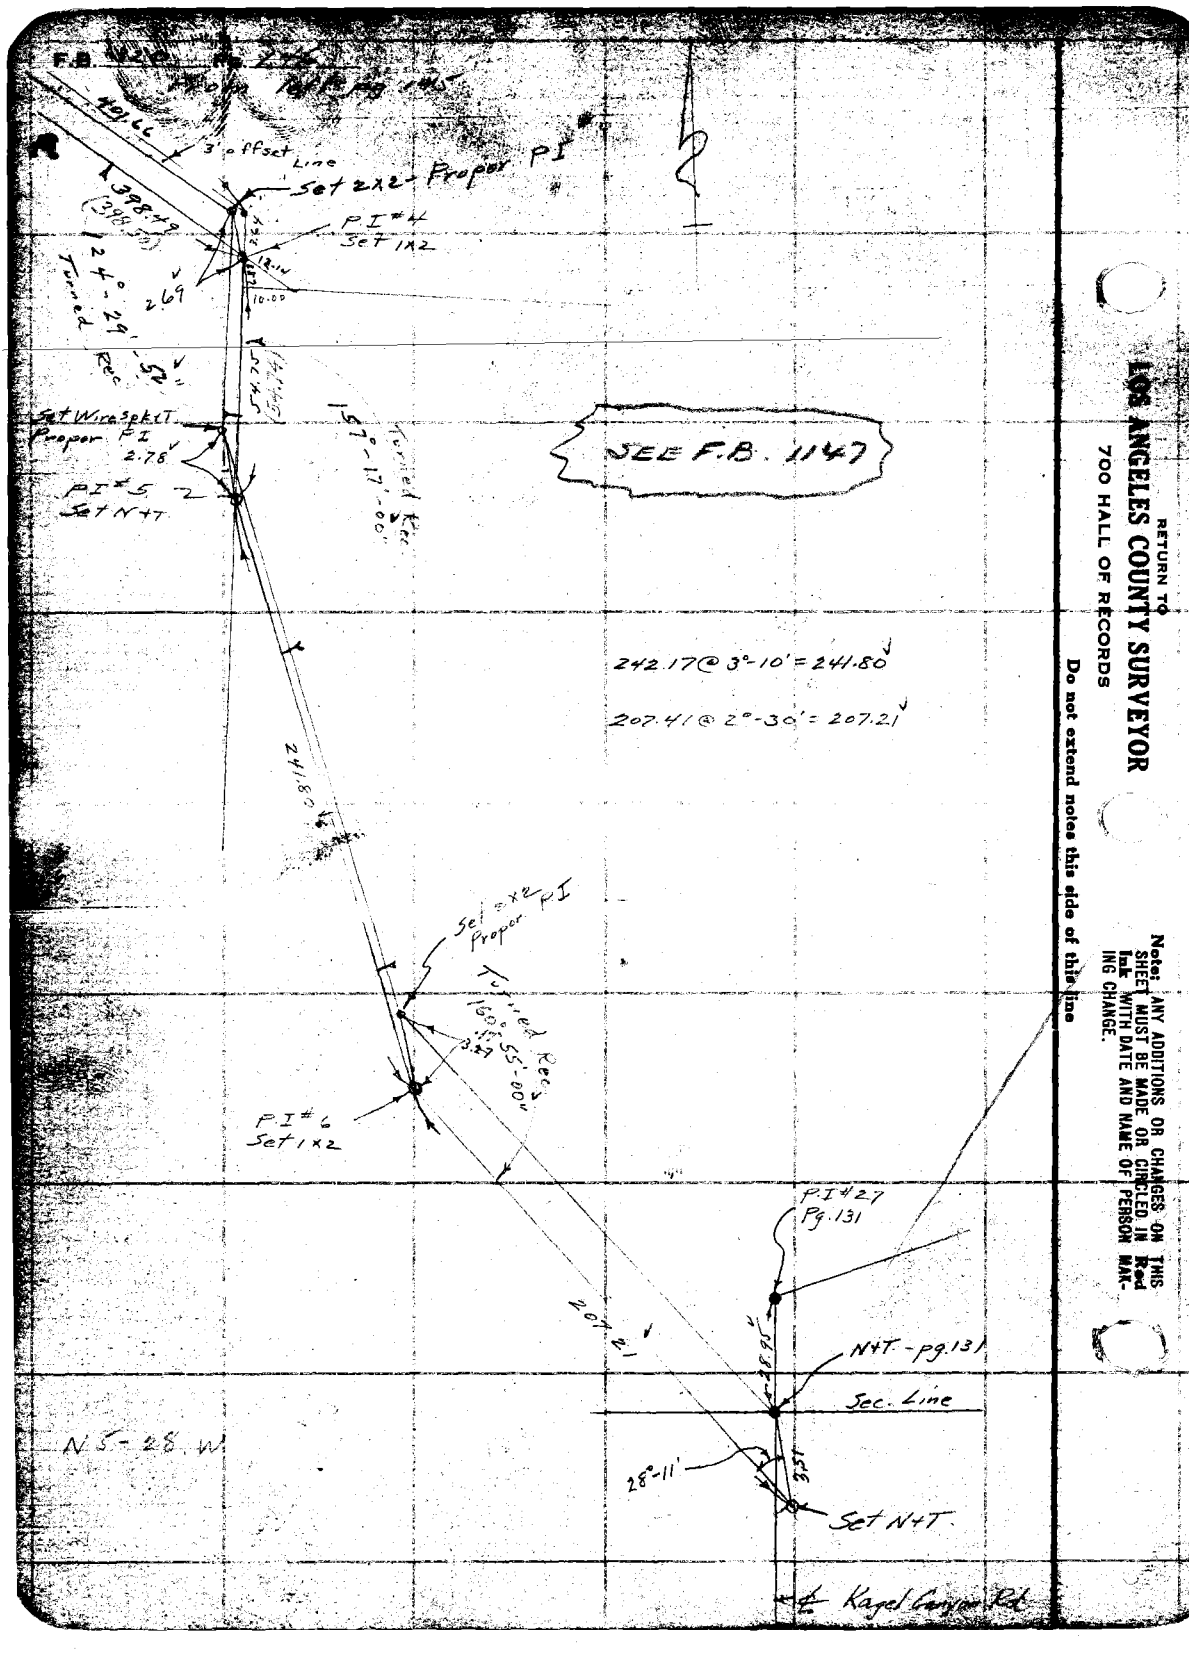

RETURN TO
LOS ANGELES COUNTY SURVEYOR
700 HALL OF RECORDS

Do not extend notes this side of this line

Note: ANY ADDITIONS OR CHANGES ON THIS SHEET MUST BE MADE OR CIRCLED IN Red Ink WITH DATE AND NAME OF PERSON MAKING CHANGE.

Noted Ck'd by	Survey of Water Works Dist #2
Map No.	W. O. 8163 Tape No St'd or.
Checked	Surveyed by L. D. Moore
Date	Notes Moore Date 11-10-36
	Indexed A. C. Johnson 12-3-36

F.B. 320 Pg. 147

To 1x2 - pg. 148

1x2 - pg 145

Sec. Line 2

Transit Line 2

1x2 - pg 133

6.16

6+23.47 Set 1x2

2x2 - pg 133

Propor. ℄ Meas. Δ = 38-36-10" R = 475.70 T = 169.64 L = 317.03

Shafer

18.49

330.00

Set 1x2 + 6+04.98 by Propor

24.5

Set nail by rec angle dist

0.96

Set N+T by Propor

Propor P.I. Set 2x2

169.58

Curve

8°-00'-00" N

Tangent

Trail # of

16.09

Set N+T

5+12.98

83°-03'-07" - tuned rec.

Meas Δ = 6°-57-20" R = 1020.07 T = 62.00 L = 123.83

Propor P.I. #1 2x2 - pg 145

62.00

3+65.15

3.07

Set N+T

Trail #3

Set N+T 3+56.08

SEE F.B. 1147

Del Drive

2+41.05 Set N+T by Propor.

Trail #2

40.97

2+00.08 Set N+T by propor.

El Merrie Del. Drive See pg. 151

El Merrie

1+00.03 Set N+T by Propor

Trail #1

Rd

Kagel

128.01

1+00 N+T by Propor pg 148

PI #33 STYN Pg 144

Note: ANY ADDITIONS OR CHANGES SHEET MUST BE MADE ON THIS link WITH DATE AND NAME OF ING CHANGE.

Do not extend notes this side of this line

RETURN TO LOS ANGELES COUNTY SURVEYOR 700 HALL OF RECORDS

Form 247 BM 2-34

F.B. 320 Pg 148

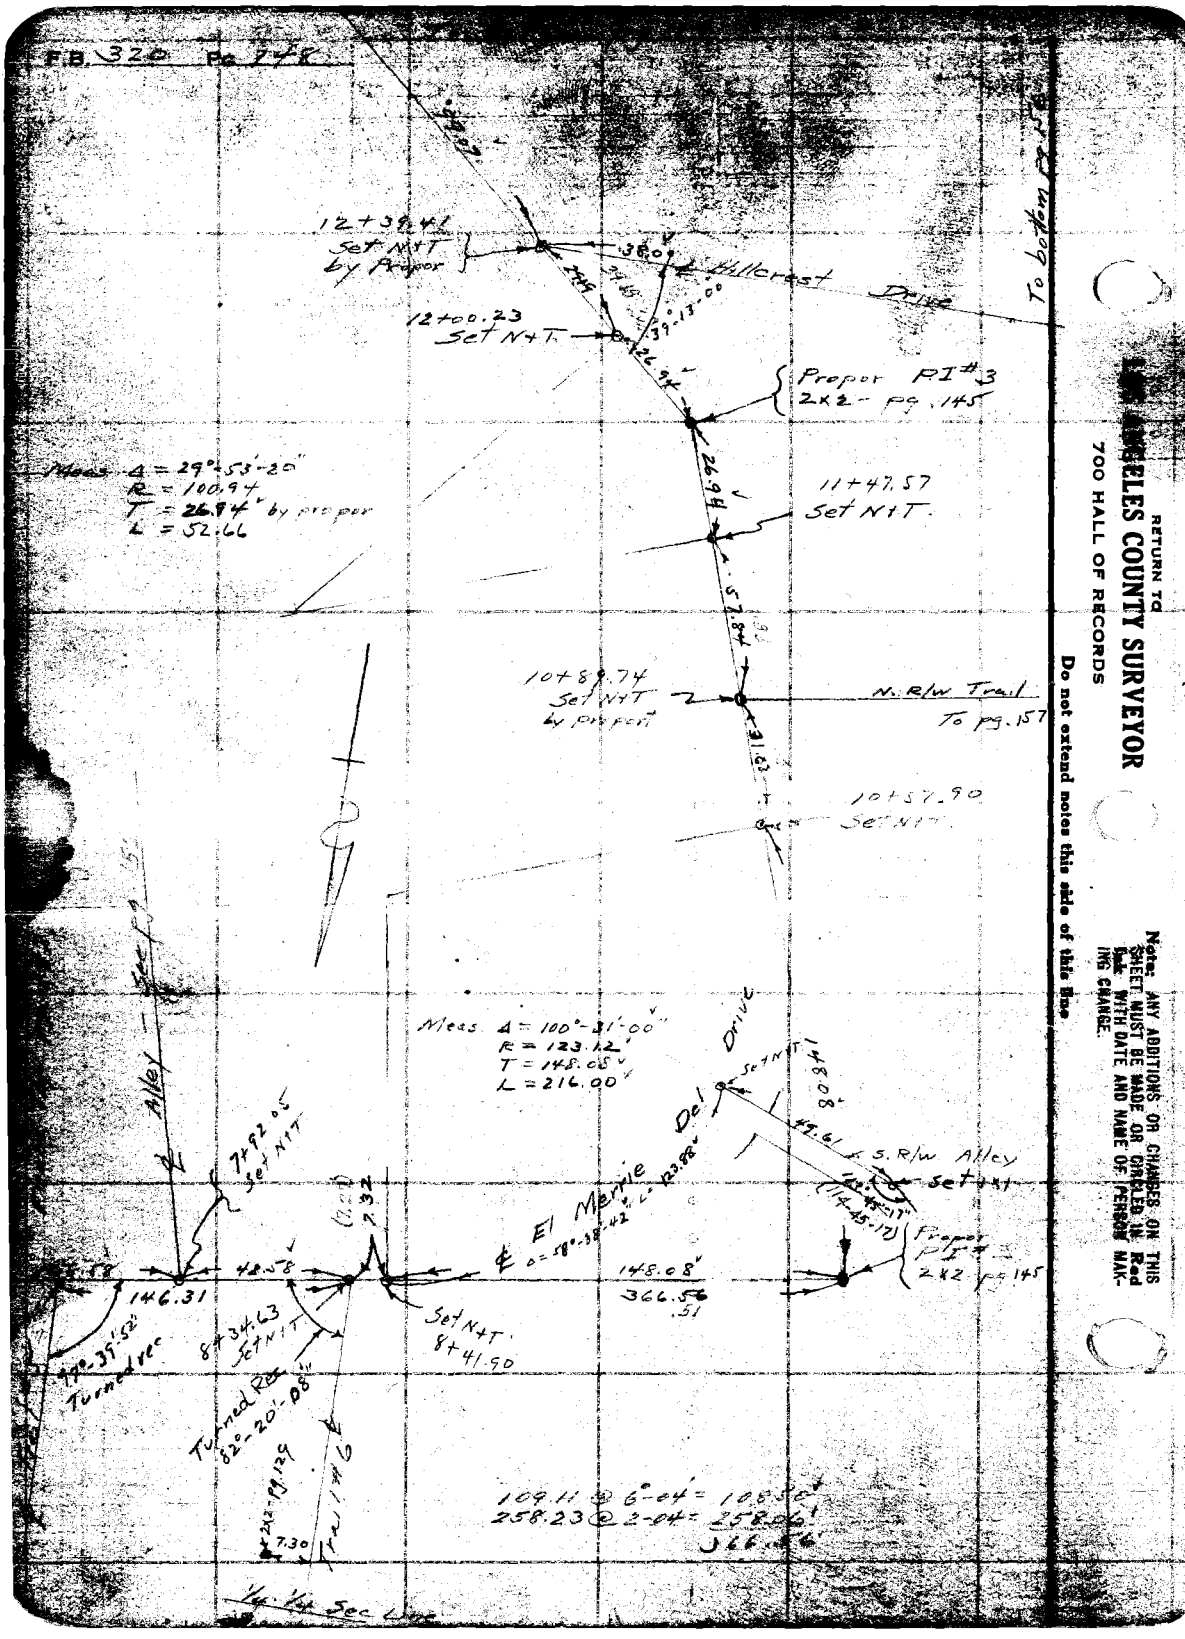

RETURN TO
LOS ANGELES COUNTY SURVEYOR
700 HALL OF RECORDS

Do not extend notes this side of this line

Note: ANY ADDITIONS OR CHANGES ON THIS SHEET MUST BE MADE OR CERTIFIED IN Red Ink WITH DATE AND NAME OF PERSON MAKING CHANGE.

Notes Ck'd by	Survey of Water Works Dist #21
Map No.	W. O. 8163 Tape No. St'd °F.
Office Work	Surveyed by L.D. Moore
Checked	Notes Mopre Date 11-12-36
Date	Indexed

F.B. 320 Pg. 149

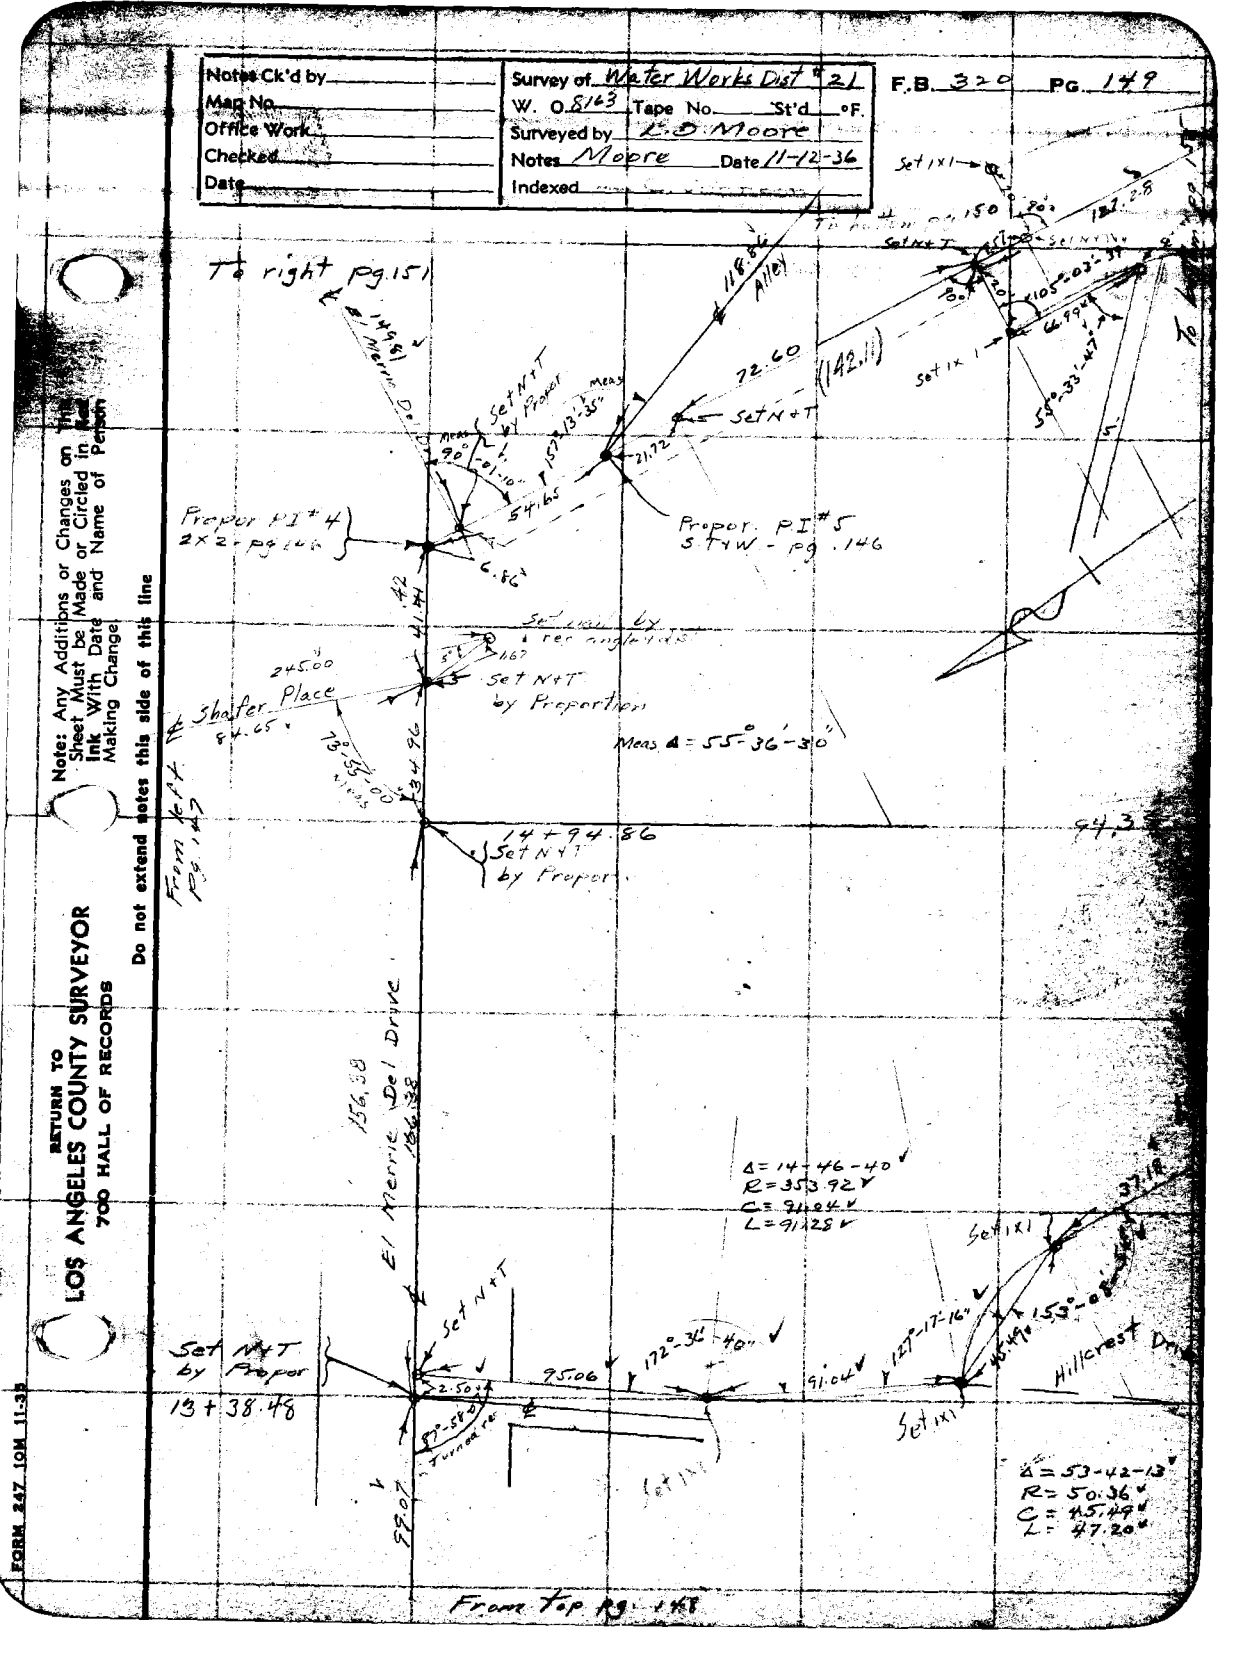

Note: Any Additions or Changes on this Sheet Must be Made or Circled in Red Ink With Date and Name of Person Making Change

Do not extend notes this side of this line

RETURN TO
LOS ANGELES COUNTY SURVEYOR
700 HALL OF RECORDS

FORM 247 10M 11-36

RETURN TO
LOS ANGELES COUNTY SURVEYOR
700 HALL OF RECORDS

Note: Any Additions or Changes on This Sheet Must be Made or Circled in Red Ink With Date and Name of Person Making Change.

Do not extend notes this side of this line

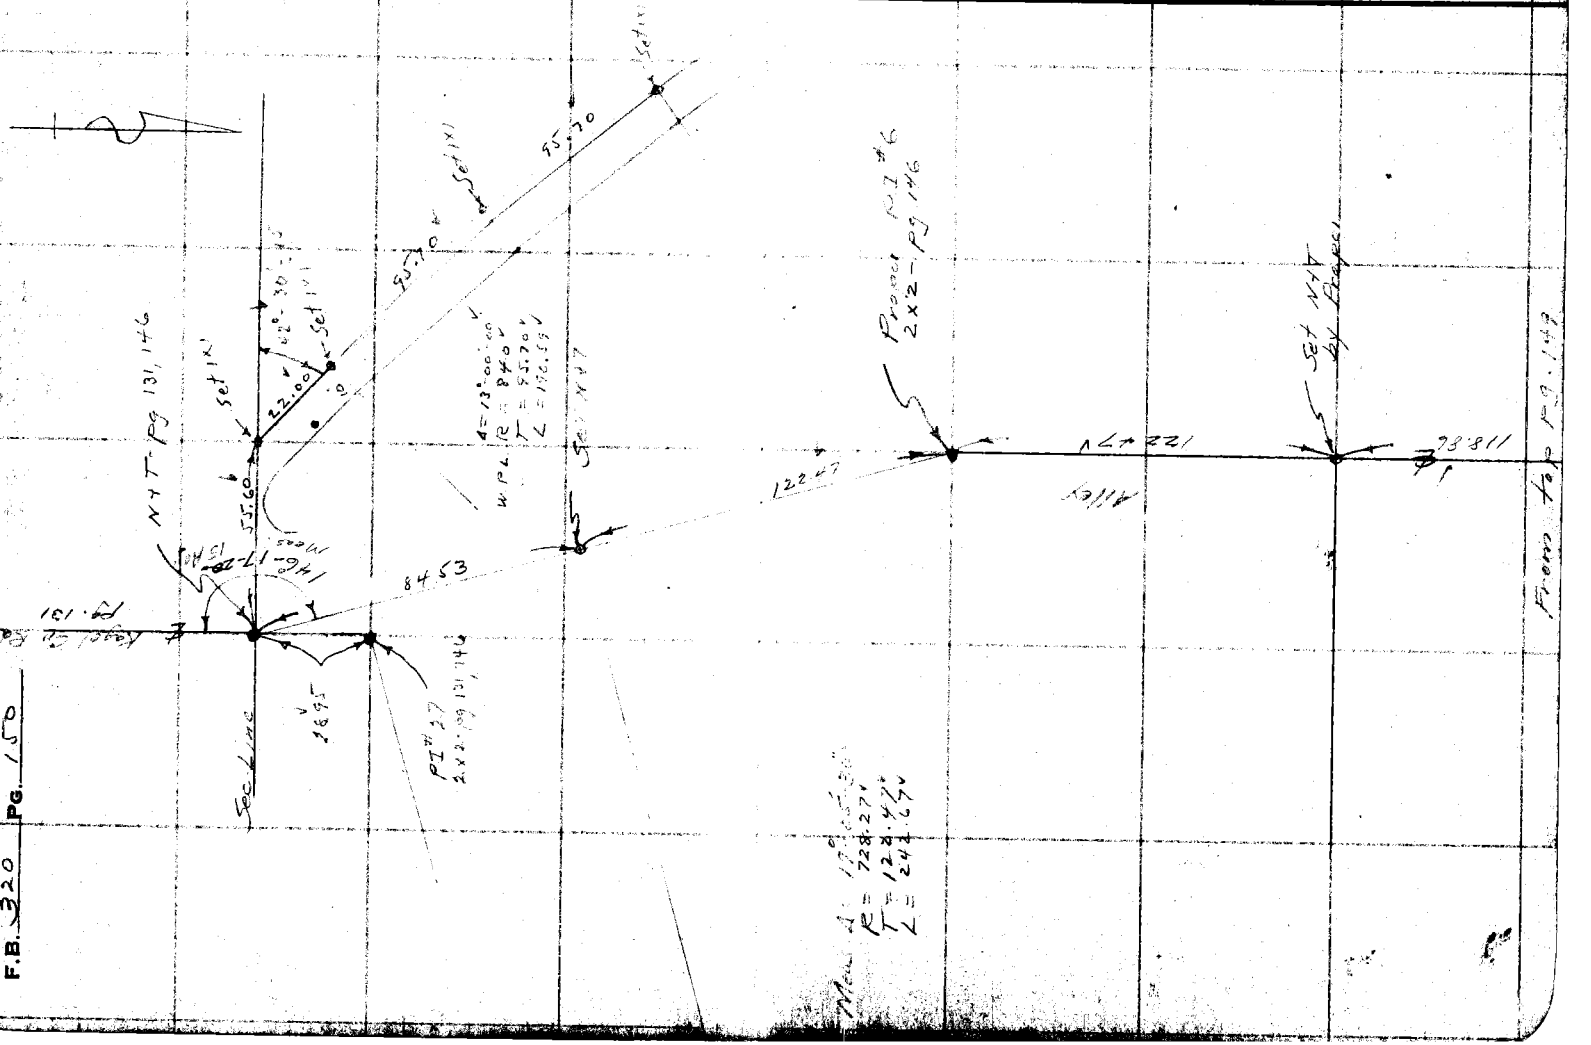

Notes Ck'd by		Survey of Water Works Dist #21	F.B. 320 PG. 151
Map No.		W. O. 8163 Tape No.	St'd °F.
Office Work		Surveyed by L D Moore	
Checked		Notes Moore Date 11-12-36	
Date		Indexed	

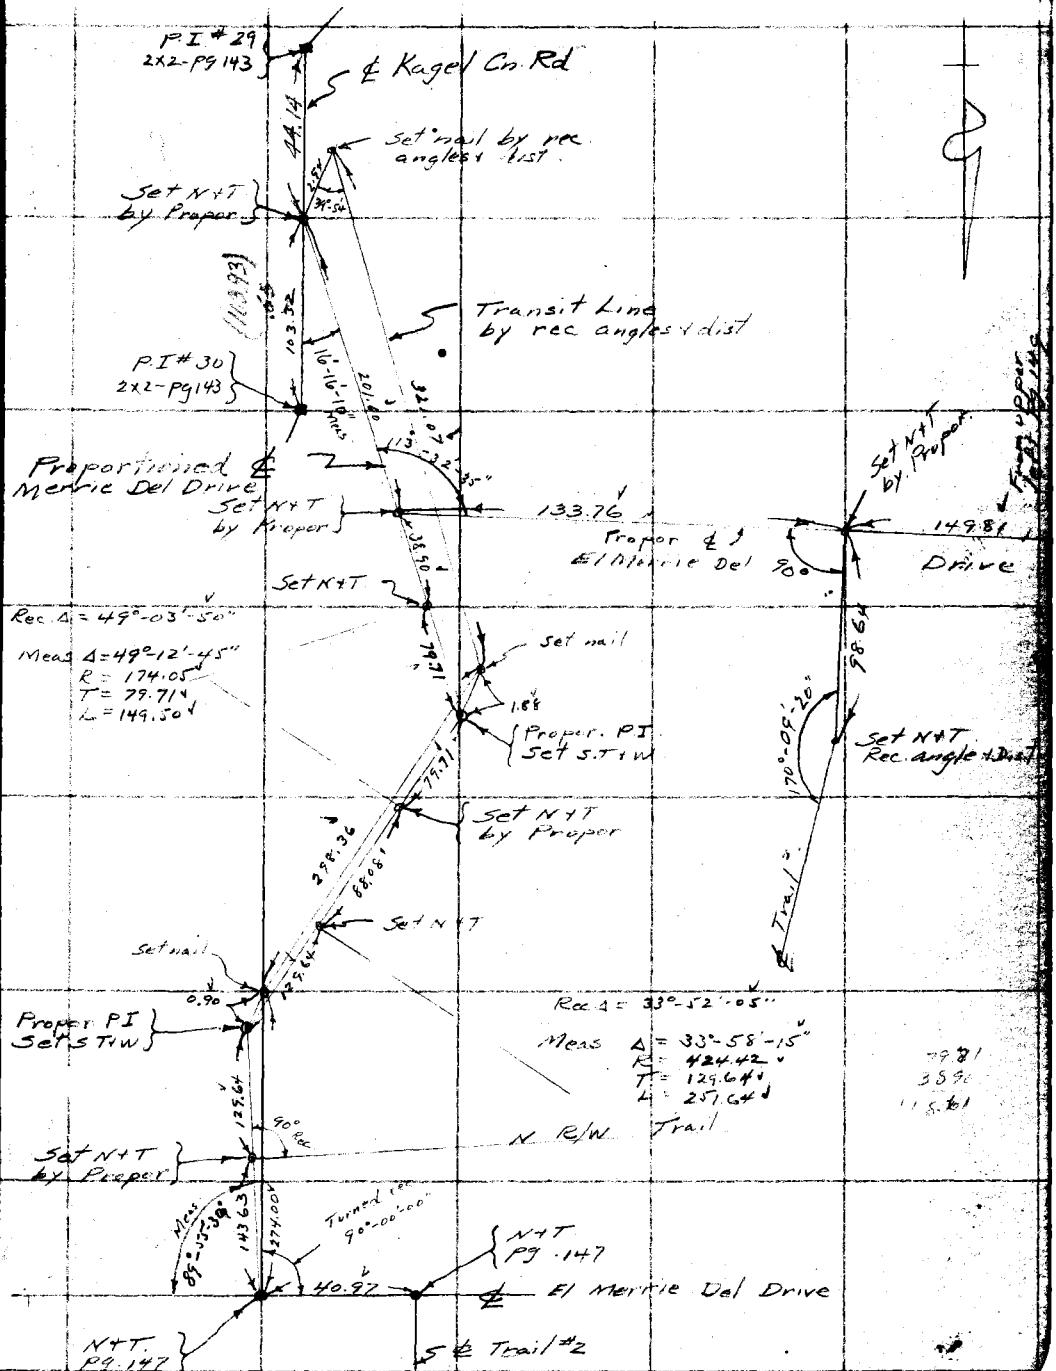

Note: Any Additions or Changes on This Sheet Must be Made in Red Ink With Date and Name of Person Making Change

Do not extend notes this side of this line

RETURN TO
LOS ANGELES COUNTY SURVEYOR
700 HALL OF RECORDS

FORM 247_10M_11-35

RETURN TO
LOS ANGELES COUNTY SURVEYOR
700 HALL OF RECORDS

Note: Any Additions or Changes on This Sheet Must be Made or Circled in Red Ink With Date and Name of Person Making Change.

Do not extend notes this side of this line

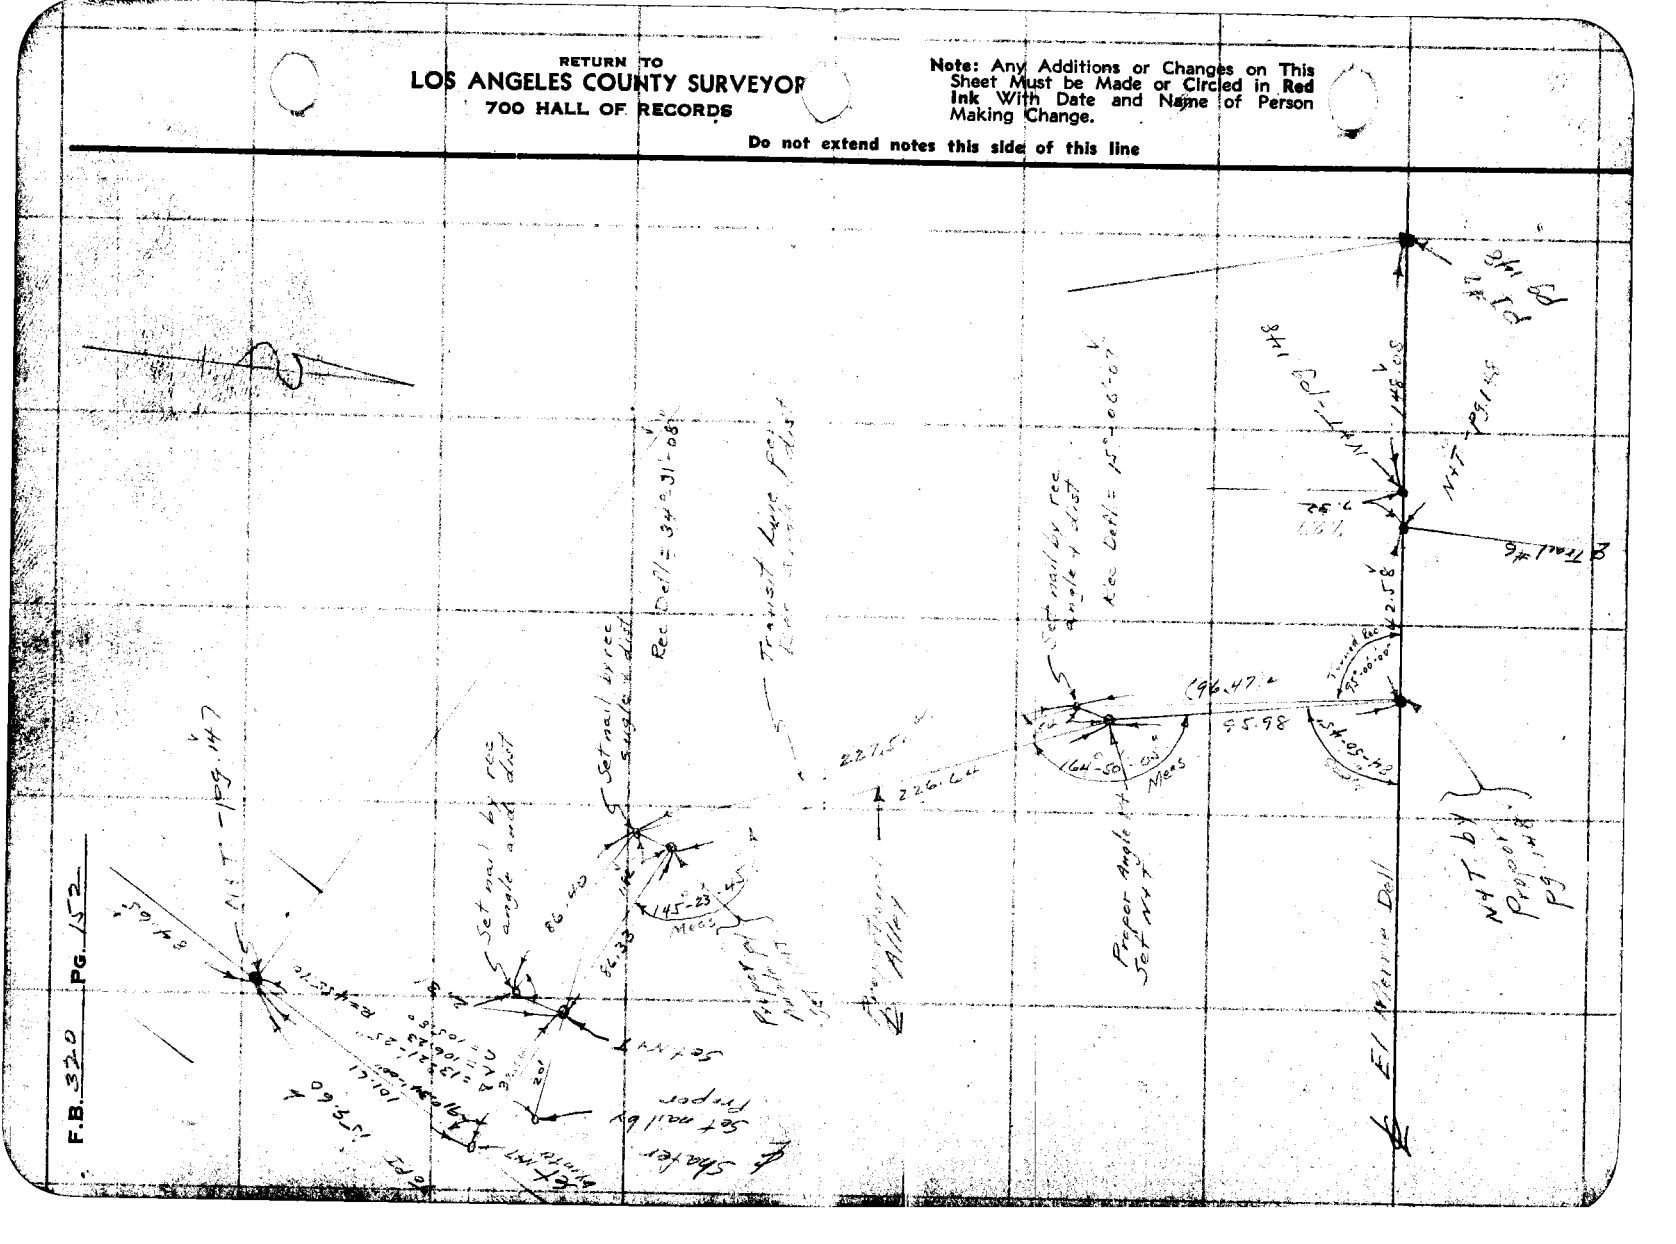
F.B. 320 PG. 152
Set nail by rec. angle & dist
Rec Dell = 34°31'08"
Transit Line
Proper Angle Set
Meas
Rec Dell = 15°06'07"
Set nail by rec. angle & dist
Transit Rec
Meas
Set nail by rec angle & dist
Proper Angle Set
Meas

Notes Ck'd by Finley
Map No. CSB-1223-2
Office Work F.A.Wood
Checked D.M. Finley
Date

Survey of Water Works Dist #21
W. O. 8163 Tape No. 54 St'd 84° F.
Surveyed by L O Moore
Notes Moore Date 11-18-36
Indexed

F.B. 320 Pg. 153

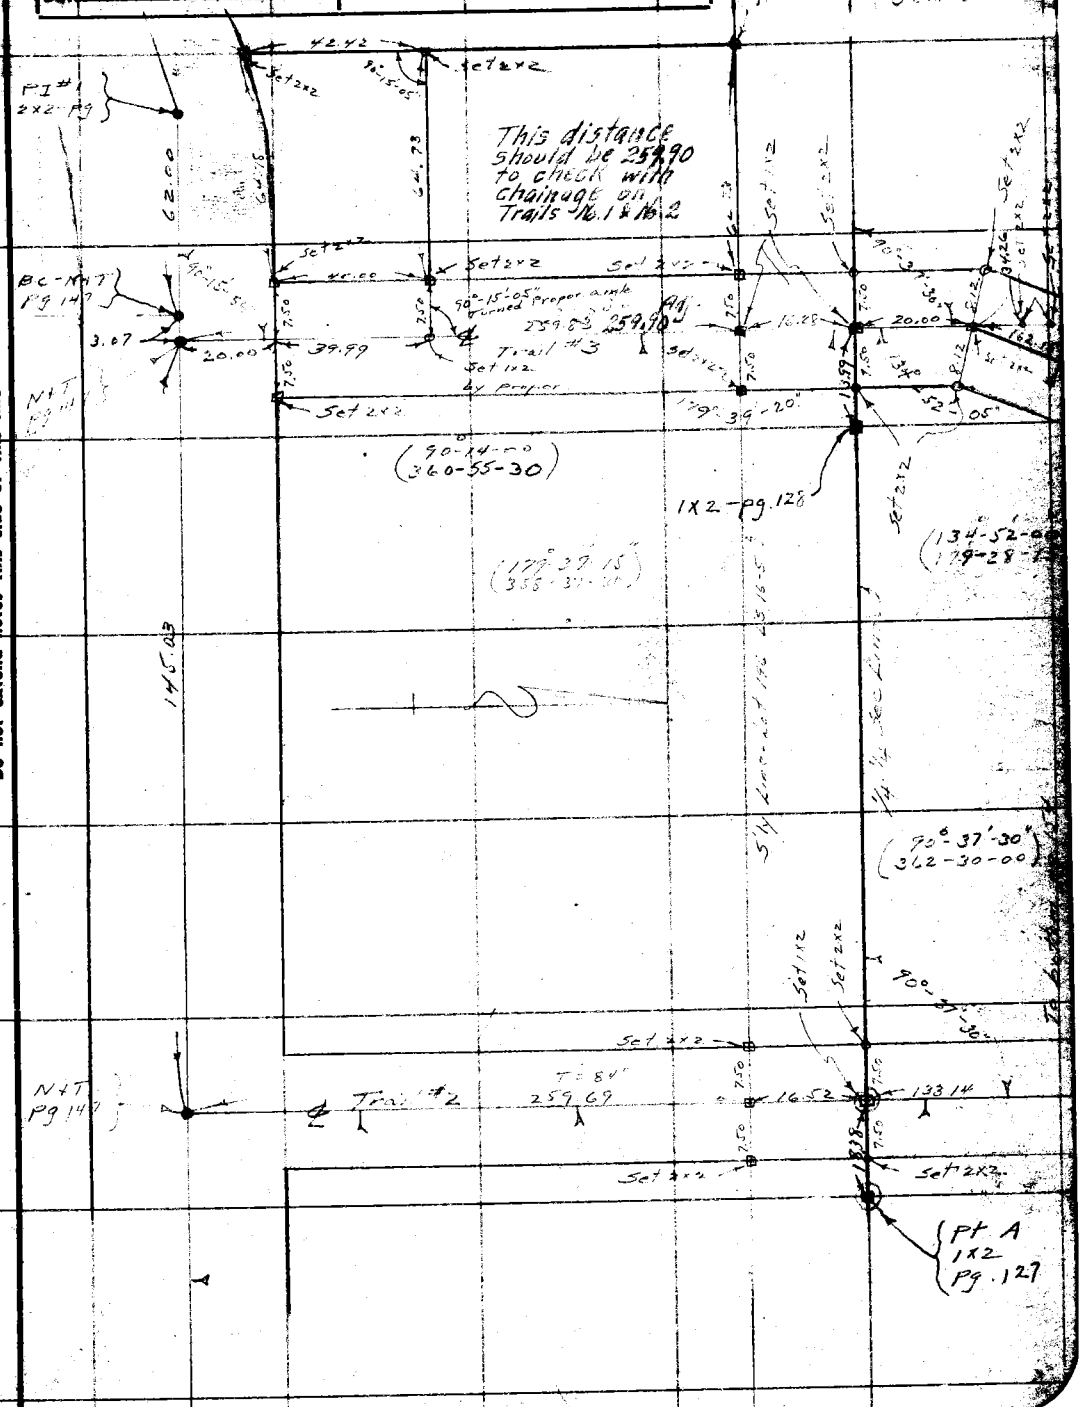

Note: Any Additions or Changes on This Sheet Must be Made or Circled in Red Ink With Date and Name of Person Making Change.

Do not extend notes this side of this line

RETURN TO
LOS ANGELES COUNTY SURVEYOR
700 HALL OF RECORDS

FORM 247 10M 11-36

F.B. 320 PG. 154

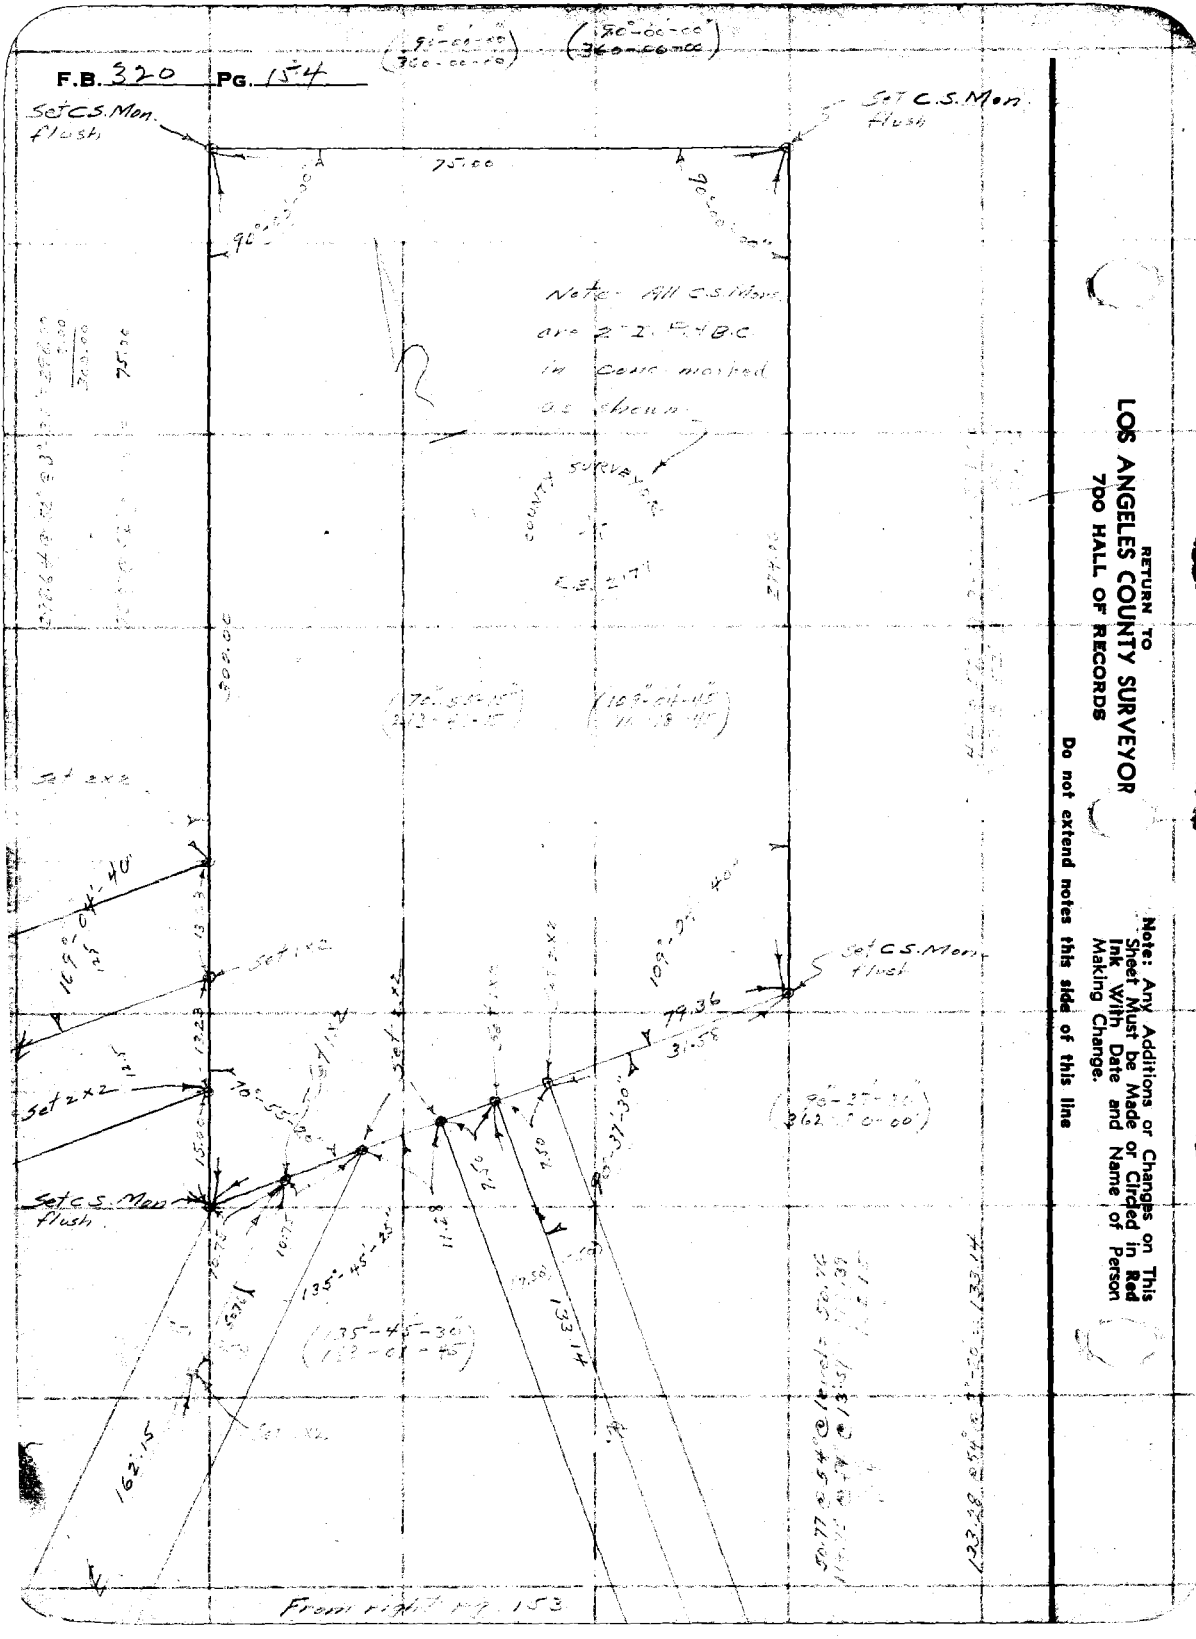

RETURN TO
LOS ANGELES COUNTY SURVEYOR
720 HALL OF RECORDS

Note: Any Additions or Changes on This Sheet Must be Made or Circled in Red Ink With Date and Name of Person Making Change.

Do not extend notes this side of this line

Notes Ck'd by	Survey of Water Works
Map No.	W. O. 8163 Tape No. St'd °F.
Office Work	Surveyed by L. D. Moore
Checked	Notes Moore Date 11-30-36
Date	Indexed

F.B. 320 Pg. 155

Note: Any Additions or Changes on This Sheet Must be Made or Circled in Red Ink With Date and Name of Person Making Change

Do not extend notes this side of this line

RETURN TO
LOS ANGELES COUNTY SURVEYOR
700 HALL OF RECORDS

FORM 247 10M 11-36

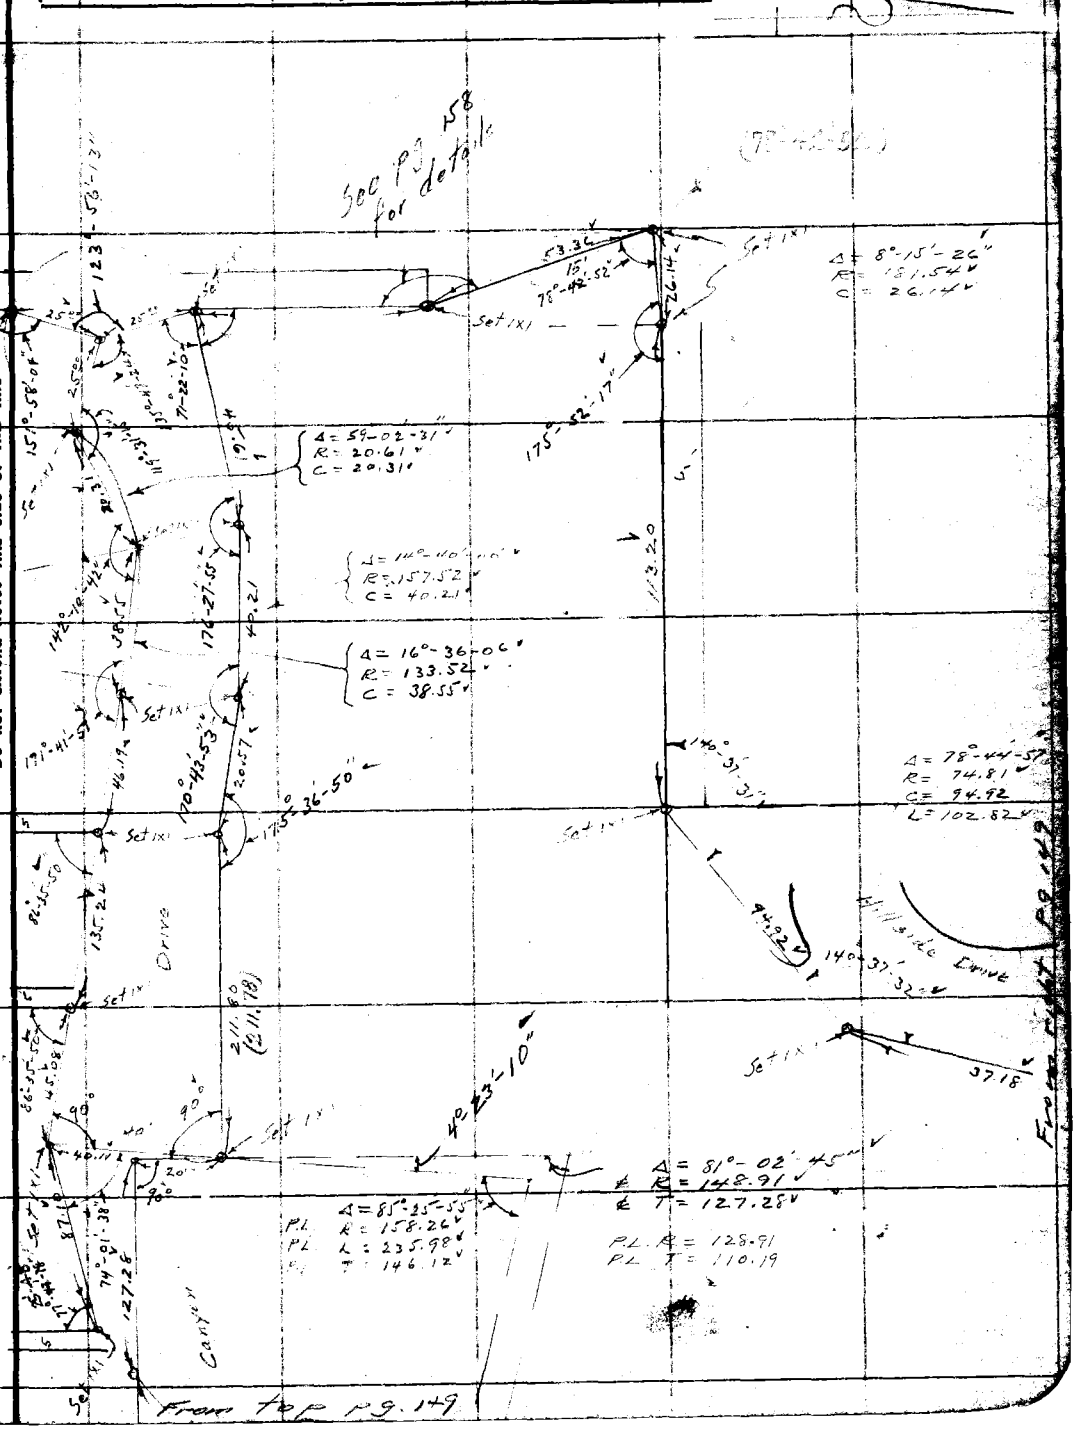

F.B. 320 Pg. 156

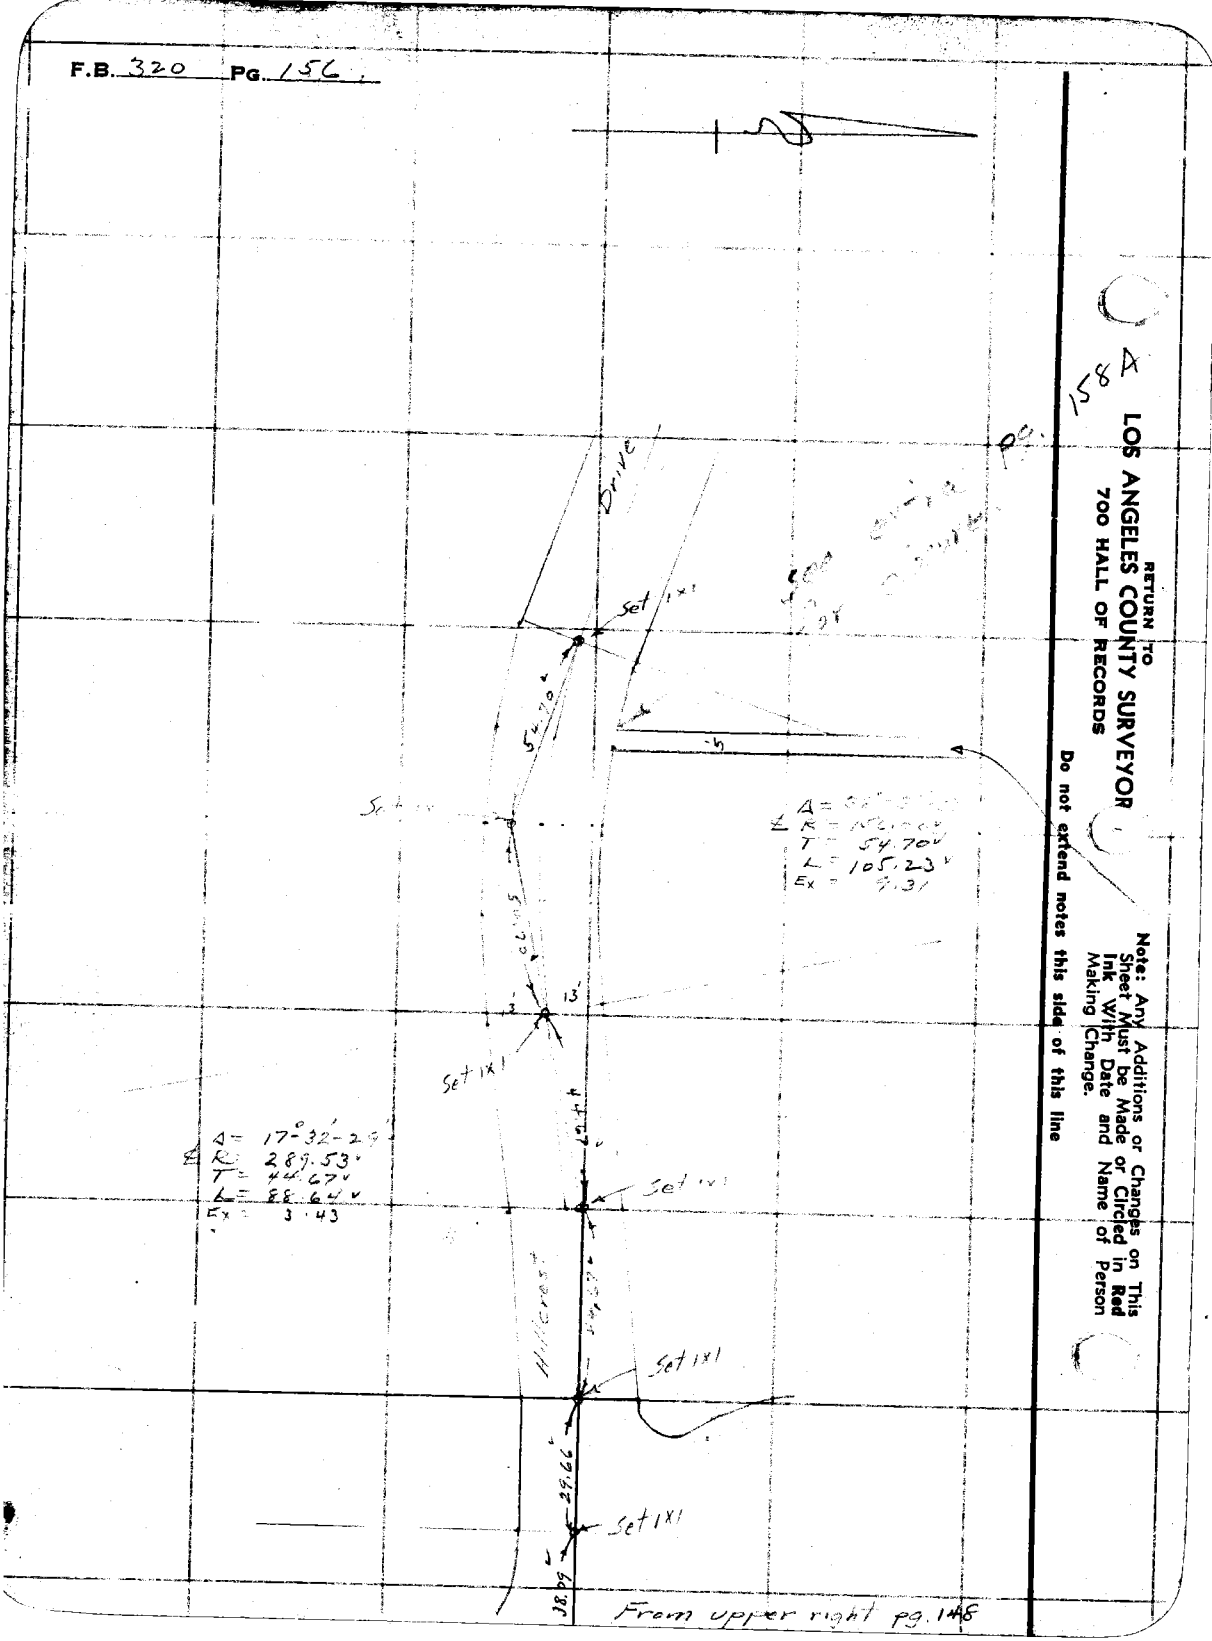

From upper right pg. 148

158A

RETURN TO
LOS ANGELES COUNTY SURVEYOR
700 HALL OF RECORDS

Do not extend notes this side of this line

Note: Any Additions or Changes on This Sheet Must be Made or Circled in Red Ink With Date and Name of Person Making Change.

Notes Ck'd by	Survey of Water Works Dist'n 1
Map No.	W. O. 5203 Tape No. St'd °F.
Office Work	Surveyed by L D Moore
Checked	Notes Moore Date 11-27-36
Date	Indexed

F.B. 320 PG. 152

RETURN TO
LOS ANGELES COUNTY SURVEYOR
7do HALL OF RECORDS

Note: Any Additions or Changes on This Sheet Must be Made or Circled in Red Ink With Date and Name of Person Making Change.

Do not extend notes this side of this line

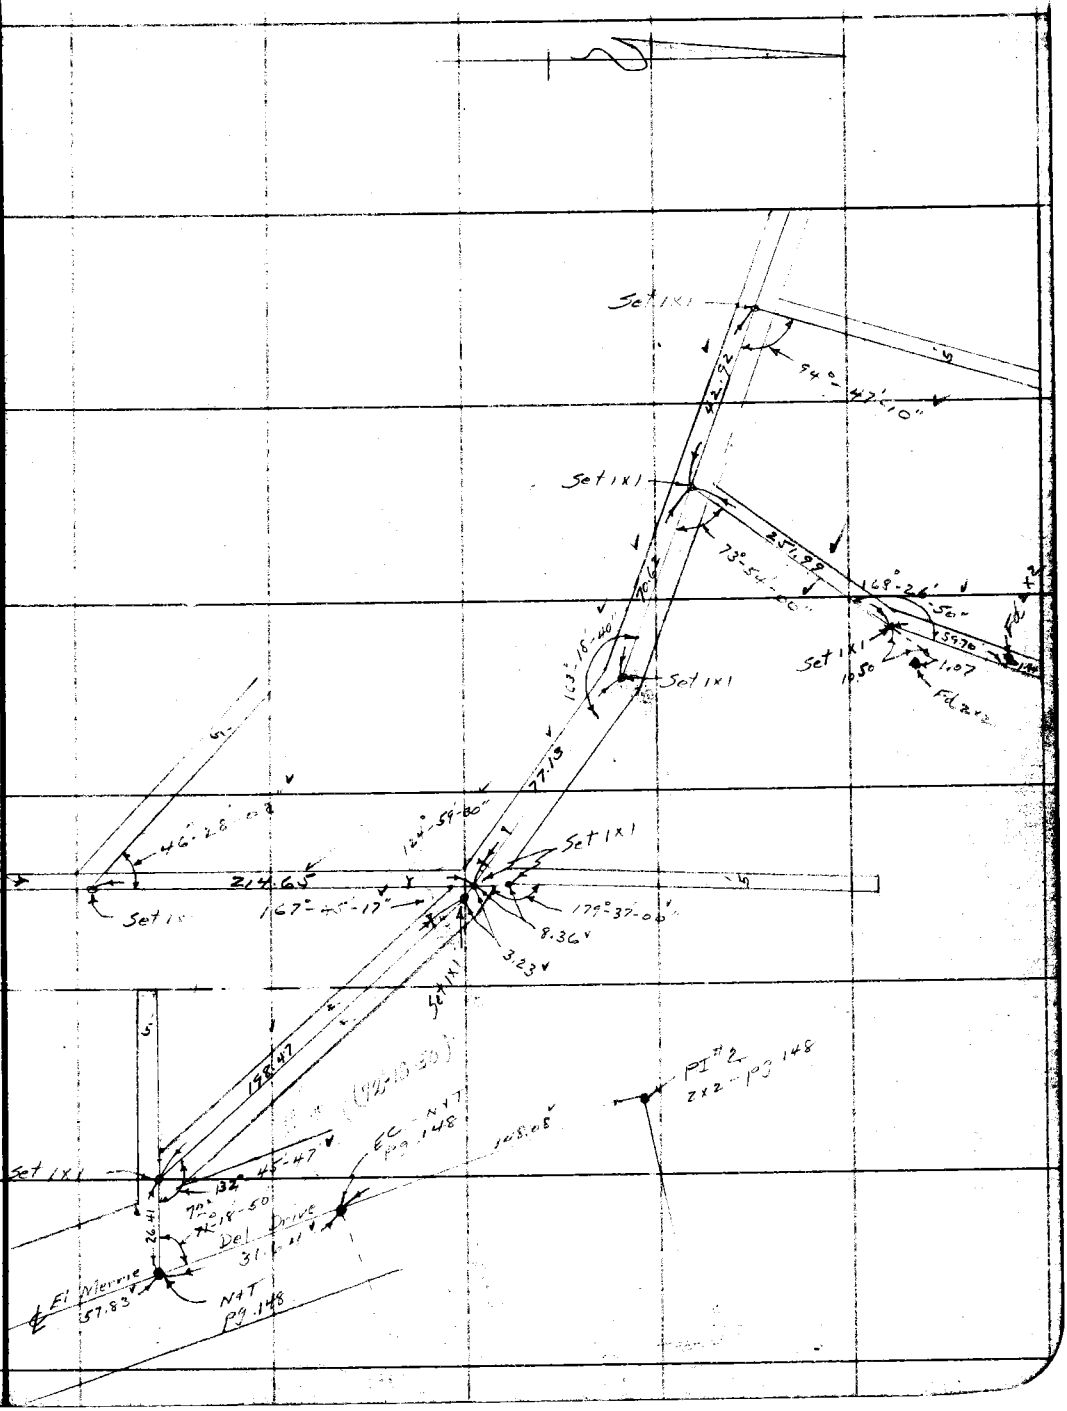

FORM 247 10M 11-35

F.B. 320 Pg. 158

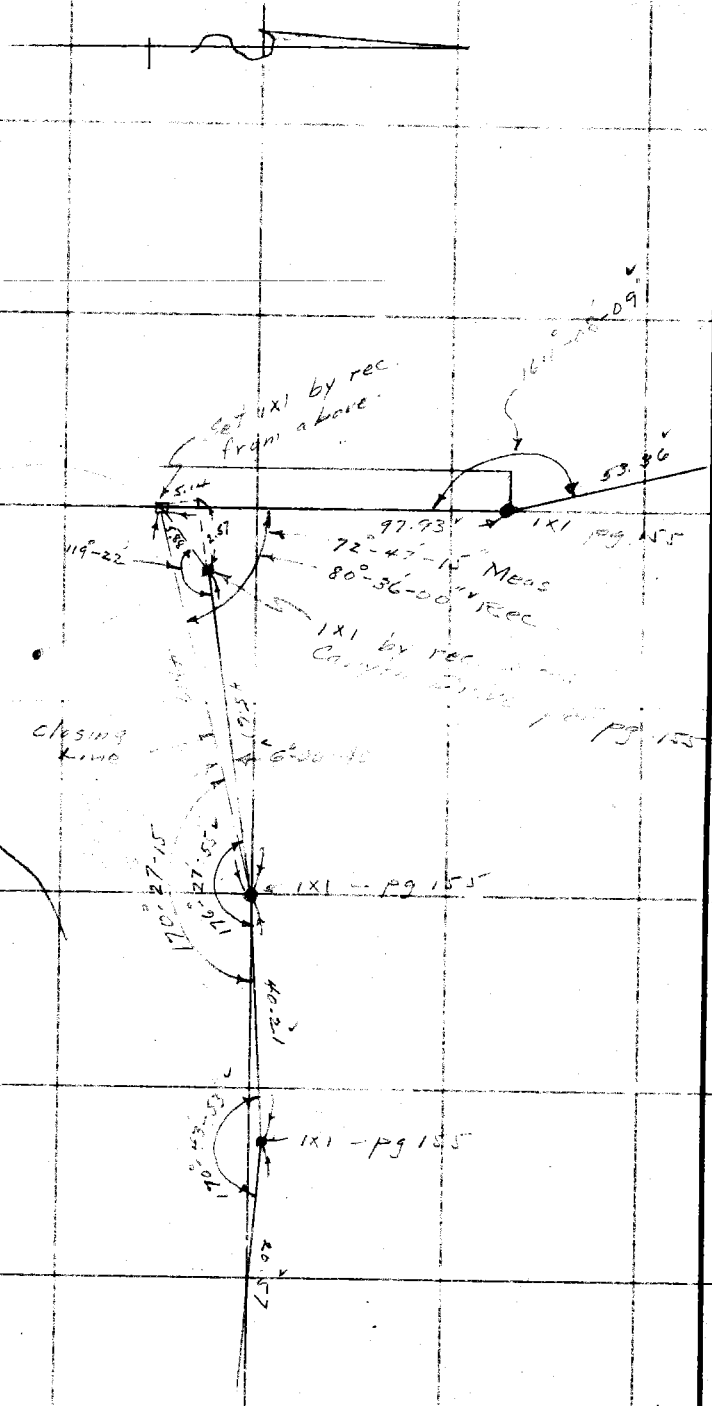

RETURN TO
LOS ANGELES COUNTY SURVEYOR
700 HALL OF RECORDS

Note: Any Additions or Changes on This Sheet Must be Made or Circled in Red Ink With Date and Name of Person Making Change.

Do not extend notes this side of this line

Notes Ck'd by	Survey of Water Works Dist 29
Map No.	W. O. 8172 Tape No. St'd °F.
Office Work	Surveyed by L. D. Trieoro
Checked	Notes Moore Date 12-9-36
Date	Indexed

F.B. 320 PG. 158A

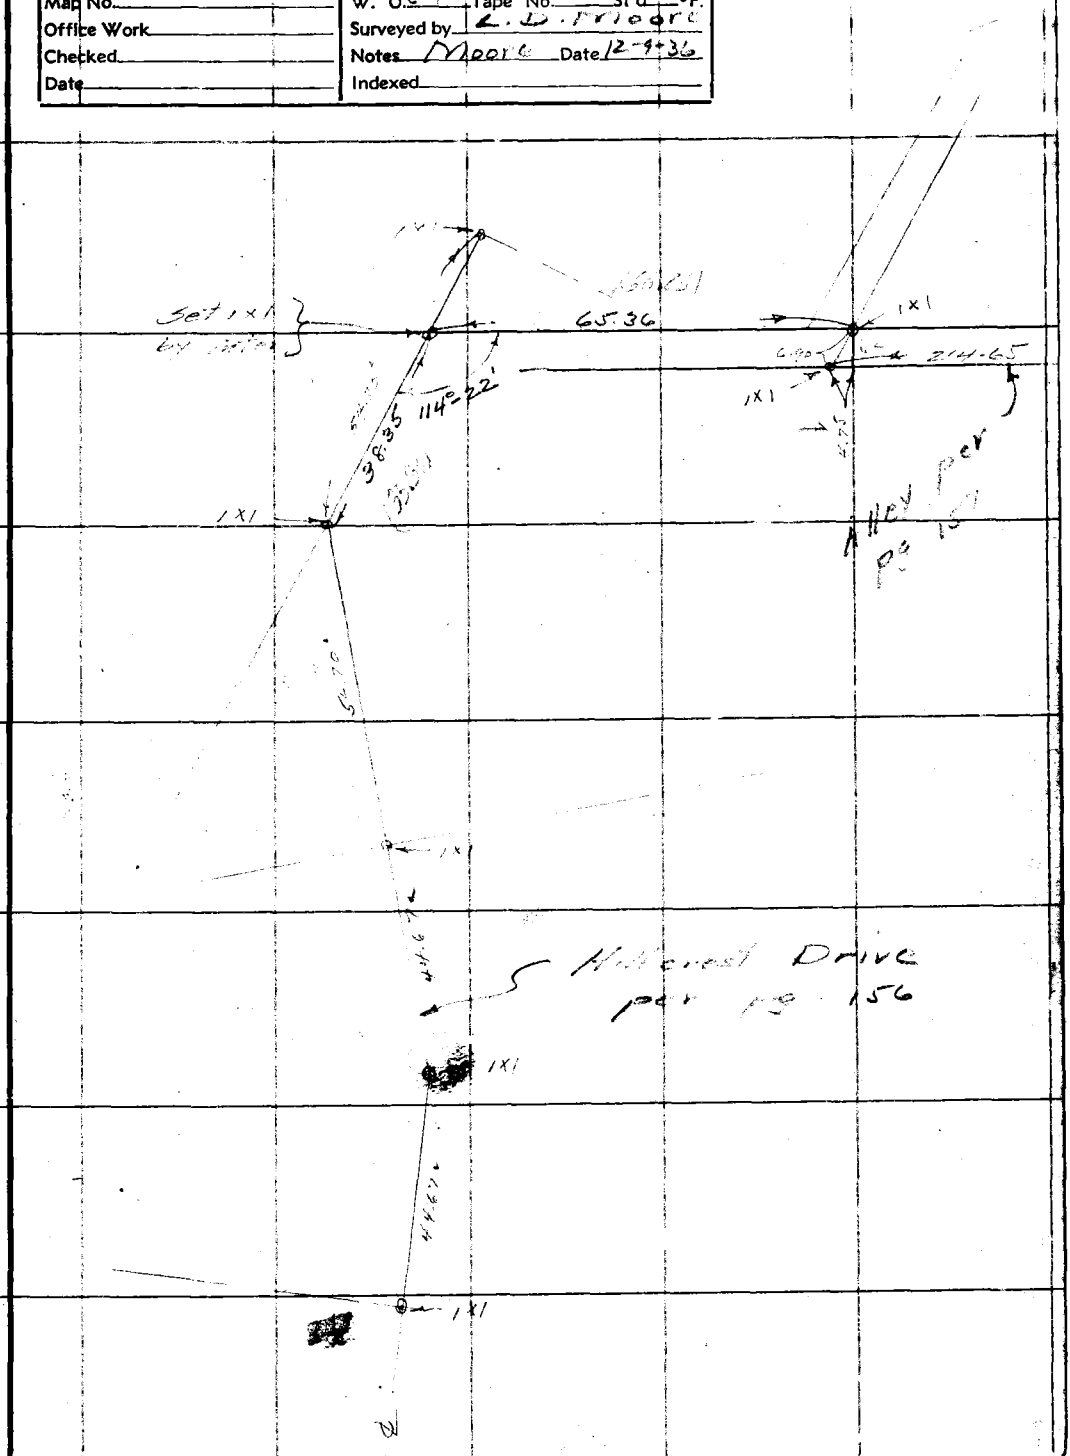

RETURN TO
LOS ANGELES COUNTY SURVEYOR
700 HALL OF RECORDS

Note: Any Additions or Changes on This Sheet Must be Made or Circled in Red Ink With Date and Name of Person Making Change.

Do not extend notes this side of this line

FORM 247 10M 11-35

RETURN TO
LOS ANGELES COUNTY SURVEYOR
700 HALL OF RECORDS

Note: Any Additions or Changes on This Sheet Must be Made or Circled in **Red Ink** With Date and Name of Person Making Change.

Do not extend notes this side of this line

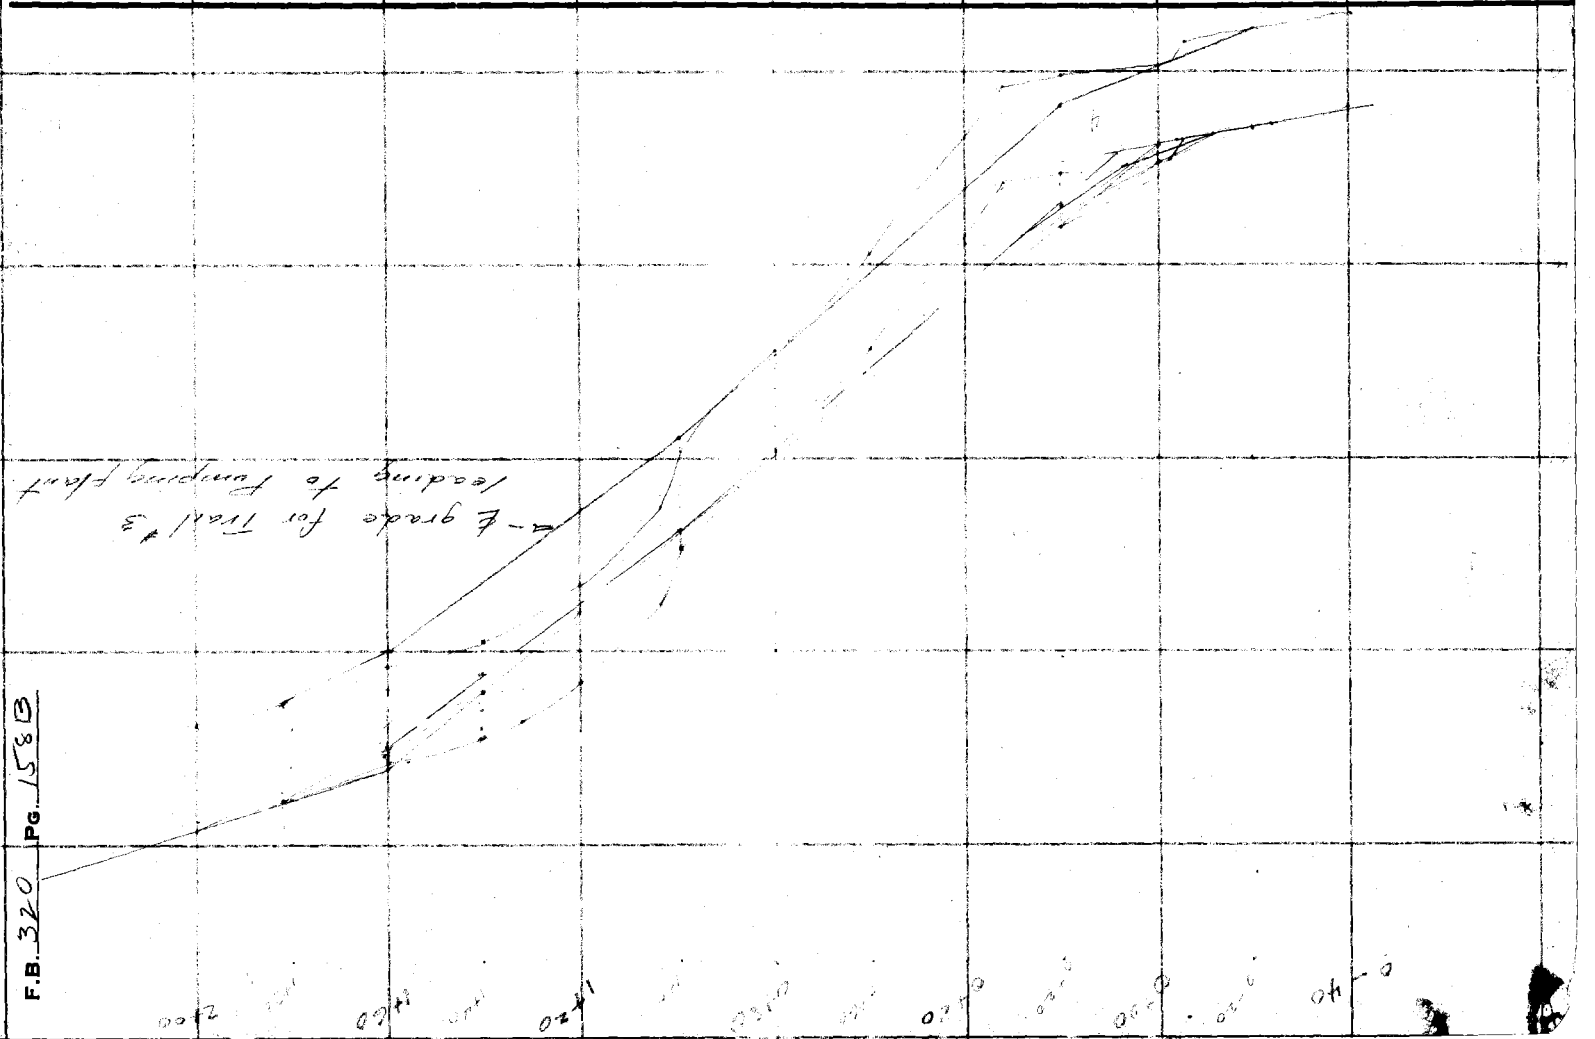

F.B. 320 PG. 158

Form 307 5M 11-35

PLEASE RETURN TO
LOS ANGELES COUNTY SURVEYOR
700 HALL OF RECORDS

NOTE: ANY ADDITIONS OR CHANGES ON THIS SHEET MUST BE MADE OR CIRCLED IN RED INK, WITH DATE AND NAME OF PERSON MAKING CHANGE

Do not extend notes this side of this line

STATION	B. S.	H. I.	F. S.	ELEV.		
BM #	2.85	1451.77		1448.92	Fd cut spk in ⌐ T.P. 50 E of Kagel Cn & [illegible] L.B. 320-139.	
T.P.	0.73	1440.9[illegible]	11.59	1440.18		
T.P.	0.[illegible]	1431.00	10.88	1430.08		
T.P.	0.20	14[illegible]	11.22	1419.11		
T.P.	[illegible]	1414.05	11.84	1409.45		
T.P.	10.82	1424.80	0.13	1413.98		
T.P.	11.[illegible]	1435.58	[illegible]	1424.37		
T.P.	11.96	1447.34	0.21	1435.38		
T.P.	11.94	1459.05	0.03	1447.11		
T.P.	4.31	1460.36	0.96	1455.99		
BM # 1	11.[illegible]	[illegible]	[illegible]	1458.78	Set C.S. Mon. 4' West of Tr. 1-6 & 23' North & El. Marmie Del (approx) S.E. Cor. Lot 5	
T.P.	5.49	1480.85	0.13	1470.36		
T.P.	11.[illegible]	1491.95	0.06	1480.79		
T.P.	10.76	1502.70	0.01	1491.94		
T.P.	11.05	1513.69	0.06	1502.64		
T.P.	11.66	1525.27	0.08	1513.61		
T.P.	11.40	1536.54	0.13	1525.14		
T.P.	10.62	1547.11	0.05	1536.49		
T.P.	11.04	1558.14	0.01	1547.10		

Profile No. ____ Notes Red. ____ Plotted ____ Job No. 8163 Division No. ____ F.B. 333 PG. 77

X-Sec. No. ____ Notes Chkd. ____ Date ____ Checked ____ Date ____ Survey of Water Works Dist # 21 Survey by [illegible] Date 11-19-36

Notes ____ Map No. ____ Indexed C. Johnson Date 12-2-36

Form 307 5M 11-35

PLEASE RETURN TO
LOS ANGELES COUNTY SURVEYOR
700 HALL OF RECORDS

NOTE: ANY ADDITIONS OR CHANGES ON THIS SHEET MUST BE MADE OR CIRCLED IN RED IN INK, WITH DATE AND NAME OF PERSON MAKING CHANGE

Do not extend notes this side of this line

F.B. 320 Pg 172 | Job No. 8163 Division No. Works Dist 21 | Profile | Notes Red. | Flotted | No. | Date | Date | Survey of [illegible] | Notes Chkd. | Checked | X-Sec. | Survey by A. C. Johnson | Notes | Date | Date | No. | Indexed

STATION	B. S.	H. I.	F. S.	ELEV.	
		1578 14			
T.P.	0 [illegible]	1568 16½	[illegible]	[illegible]	
T.P.	4 90[illegible]	1573 33	1.74	15[illegible]	
BM #2	10 22	1580 45	3 [illegible]	1570 13	Set C.S. Mon. on top of Spur. (West Side) 22' [illegible] existing Water Tower.
T.P.	8.08	1586 76	1 77	1578 [illegible]	
BM #1	2 73	1586 306	3 18½	1583 [illegible]	Set C.S. Mon. E. Side of Spur 15' from [illegible] 25' North picket fence. Near [illegible]
T.P.	0 77½	1580.19	[illegible]	[illegible]	
BM #2	1,305	1571 53½	9,96	1570 23	See above
T.P.	0 48½	1560 43½	11.58½	1550 [illegible]	
T.P.	0.26	1548 81	11 88½	1548 55	
T.P.	0.39	1537 64½	11.56	1537 [illegible]	
T.P.	0 205	1526 43½	11.41½	1526 23	
T.P.	0.225	1515 04½	11 61½	1503 82	
T.P.	0.35	1503 78	11 615	1503 43	
T.P.	0 495	1492 68	11.595	1492 [illegible]	
T.P.	0.35	1481 12	11 91	1480 77	
[illegible]	0 [illegible]	[illegible]	11 67	1469 [illegible]	
BM #3	0.165	1458 93½	0 80	1458 27	See pg. [illegible] Elev. [illegible]
T.P.	0.07	1447 28½	11 720	1447 21½	

Form 307 5M 11-35

PLEASE RETURN TO
LOS ANGELES COUNTY SURVEYOR
700 HALL OF RECORDS

NOTE: ANY ADDITIONS OR CHANGES ON THIS SHEET MUST BE MADE OR CIRCLED IN RED INK, WITH DATE AND NAME OF PERSON MAKING CHANGE

Do not extend notes this side of this line

STATION	B. S.	H. I.	F. S.	ELEV.	
		1447.285			
T.P.	0.37	1436.095	11.56	1435.725	
T.P.	0.36	1424.695	11.76	1424.335	
T.P.	0.25	1412.965	0.88	1412.715	
T.P.	11.635	1423.90	0.70	1412.265	
T.P.	11.26	1434.945	0.215	1423.685	
T.P.	10.315	1445.17	0.09	1434.855	
T.P.	0.24	1452.125	1.28	1451.885	
B.M.			3.22	1448.905	2½" Spk. in 4" T.P. Signal Co. Holder on P [illegible] 141 LB. 320-39. Elev 1448.92.
BM	2.077	1213.97		1211.893	Fd. Cut. Spk. in South post of guard rail at Int. of Vogel Ct. [illegible] Trail FB 32 [illegible]
T.P.	0.505	1203.040	11.435	1202.535	
T.P.	0.50	1191.86	11.68	1191.360	
T.P.	0.31	1180.74	11.43	1180.43	
T.P.	0.695	1172.025	9.20	1171.34	
BM"C"			6.975	1165.050	Set C.S.Mon. 1½ ft. Nof. S.W. Cor Lot 43 [illegible] 3ft. South of S.W. Cor Mrs Celeia Garcia
			5.04	1166.08	Out Side corner fence Lot Mrs Celia [illegible]
B.M."C"	0.595	1175.645		1165.05	C.S.Mon.
T.P.	11.60	1187.075	0.17	1175.475	

Profile
No. ____ Notes Red ____ Plotted ____ Job No. 8163 Division No. ____
X-Sec. ____ Date ____ Date ____ Survey of Kagel Canyon Notes F.B. 320 PG. 173
No. ____ Notes Chkd ____ Checked ____ Survey by ____ Notes ____ Date 1-20-36
Date ____ Date ____ Map No. ____ Indexed ____ Date ____

Form 307 5M 11-35

PLEASE RETURN TO
LOS ANGELES COUNTY SURVEYOR
700 HALL OF RECORDS

NOTE: ANY ADDITIONS OR CHANGES ON THIS SHEET MUST BE MADE OR CIRCLED IN RED INK, WITH DATE AND NAME OF PERSON MAKING CHANGE

Do not extend notes this side of this line

F. B. 370 PG. 174 | Job No. 8163 | Division No. | Notes Red. | Plotted | Profile No.
Survey of | Date | Date | X-Sec. No.
Survey by | Notes | Notes Chkd. | Checked
Indexed | Date | Date | Date

STATION	B. S.	H. I.	F. S.	ELEV.	
		1187 075			
	10 420	1208 625	0.035	1205	
T.P.		1220.18			
T.P.		1231 415			
T.P.		1243.15	0 07		
B.M.					S 1°02 52" W 1318 [illegible] = 3546795
T.P.		1245 710			
T.P.		1276.72			
T.P.					
T.P.		1278			
T.P.					
T.P.			0.04	1304 82	
T.P.					
T.P.					
T.P.					
T.P.					
T.P.					
T.P.					
T.P.					
T.P.	12,01	1399 82	0.20	1387.285	
T.P.	10 95	1410 555	29	1399 605	

Form 307 5M 11-35

PLEASE RETURN TO
LOS ANGELES COUNTY SURVEYOR
700 HALL OF RECORDS

NOTE: ANY ADDITIONS OR CHANGES ON THIS SHEET MUST BE MADE OR CIRCLED IN RED INK, WITH DATE AND NAME OF PERSON MAKING CHANGE

Do not extend notes this side of this line

STATION	B. S.	H. I.	F. S.	ELEV.		
		1410 555				
T.P.	11.405	1421 955	0.005	1410 550		
T.P.	11 695	1433 34	022	1421 735		
T.P.	0 73	1424 02	0.05	1233 29		
T.P.	1011	1433 855	0 225	1443 795		
BM #(5)	5 36	1457 025	2.70	1451 625	Set CS Mon on N. Line (Lot 292) in Row of Cypress 19½' West of N.W. Cor. of House	
			2.25	454 795	Elev on porch of House, for floor level	
TP	4 36	1466 [illegible]	6.99	1459 [illegible]		
TP	1475	1466 42	[illegible]	1454 945		
TP	1142	1476 805	1.035	1465 385		
TP	11.06	1487 71	0155	1476 65		
TP	1165	1499 02	0.30	148741		
T.B.M.	10 22	1508 67	0.70	1498 395	1 x 1	
T.P.	1 [illegible]	1519 [illegible]	0.025	1508 645		
T.P.	[illegible] 85	1530 695	0.03	1519 [illegible]		
T.P.	[illegible] 52	1541 57	0.145	1530 550		
T.P.	11.79	1553 140	0 225	1541.345		
T.P.	11.9	1564 [illegible]	0 22	1552 [illegible]		
[illegible]	[illegible] 52	1576 140	0 22	1564 [illegible]		
[illegible]	11 825	1587 245	0 12	1576 02		

Profile Notes Red Plotted Job No. 2163 Division No.
No. Date Date Survey of Water Works Dist. No. 21
X-Sec. Notes Ckkd. Checked Survey by Notes Date 11-20-36
No. Date Date Map No. Indexed Date

F.B. 330 PG. 175

Form 307 5M 11-35

PLEASE RETURN TO
LOS ANGELES COUNTY SURVEYOR
700 HALL OF RECORDS

NOTE: ANY ADDITIONS OR CHANGES ON THIS SHEET MUST BE MADE OR CIRCLED IN RED INK, WITH DATE AND NAME OF PERSON MAKING CHANGE

Do not extend notes this side of this line

F. B. 320 Pg. 176 | Job No. 8163 Division No. Water Works Dist #21 | Notes Red | Plotted | Profile
Survey of | Date | No.
Survey by | Notes | Notes Chkd. | Date | Checked | X-Sec.
Indexed | Date | Date | Date | No.

STATION	B. S.	H. I.	F. S.	ELEV.	
	11.525	1599.190			
T.P.	2.225	1606.010	0.995	598.185	
B.M.	0.415	1603.295	3.130		Set C.S. on highest point of [illegible] East of [illegible]
T.P.	0.305	1591.69	11.91	1591.385	
T.P.	2.550	1580.28	[illegible]	[illegible]	
[illegible]	0.86	[illegible]	11.64	[illegible]	
[illegible]	2.285	[illegible]	[illegible]	[illegible]	
[illegible]	0.435	[illegible]	[illegible]	[illegible]	
[illegible]	0.005	[illegible]	11.68	[illegible]	
[illegible]	0.360	[illegible]	[illegible]	[illegible]	
[illegible]	2.68	[illegible]	11.72	[illegible]	
[illegible]	2.89	1508.715	[illegible]	[illegible]	
T.P.	2.90	1501.49	11.1[illegible]	1499.[illegible]	
T.P.	0.10	1490.29	11.295	1499.125	
T.P.	0.45	1479.16	11.585	1479.[illegible]	
T.P.	0.21	1468.215	11.155	1468.005	
T.P.	2.60	1459.455	11.36	[illegible].255	
T.P.	2.80	1556.00	6.255	1553.200	
TP	3.40	1549.955	9.445	1546.555	

Form 307 5M 11-35

PLEASE RETURN TO
LOS ANGELES COUNTY SURVEYOR
700 HALL OF RECORDS

NOTE: ANY ADDITIONS OR CHANGES ON THIS SHEET MUST BE MADE OR CIRCLED IN RED INK, WITH DATE AND NAME OF PERSON MAKING CHANGE

Do not extend notes this side of this line

STATION	B. S.	H. I.	F. S.	ELEV.		
		4 1849.??				
B.M.			1.1?	4 1848.??	Elev 4 48.92 Set in [illegible] Edge of Cr and Dexter Park Dr.	
B.M.	2.??	[illegible] 905		1869.99	Fd Cut Spk top of Mig St. S.W. Cor [illegible]	
T.P.	11.80	1389.405	3.30	1378.105	Set C.P. 32 J-32	
T.P.	11.70	1400.475	0.63	1388.775		
T.P.	10.515	1410.750	0.24	1400.235		
T.P.	2.33	1412.72	0.36	1410.39		
TBM	10.505	1429.765	0.46	1419.26	Boat Spk in N Side PP# 2.94668E Alley Pole	
T.P.	[illegible]	1440.3??	0.46	1429.305		
T.P.	10.905	[illegible]	0.13	1440.265		
T.P.	[illegible]	[illegible]	[illegible]	[illegible]		
T.P.	11.945	1472.53?	0.28	1460.615		
T.P.	12.365	1482.460	[illegible]	[illegible]		
			4.65	[illegible]	Cabinet Flow Line [illegible]	
T.P.	10.??	[illegible]	[illegible]	[illegible]		
			3.??	[illegible]	[illegible]	
T.P.	11.??	1504.365	0.11	1492.415		
T.P.	[illegible]	[illegible]	[illegible]	1504.365		
B.M. #1	5.68	[illegible]	4.34	1500.??	Set C.S. Mon. 7' E. and 4' N. of SW Cor. [illegible] Flush	

Profile Notes Red Plotted Job No. 5163 Division No.
No. Date Date Survey of STORM WORKS DIST #27
X-Sec. Notes Chkd. Checked Survey by Notes Date
No. Date Date Map No. Indexed

F. B. PG. 177

Form 307 5M 11-35

PLEASE RETURN TO
LOS ANGELES COUNTY SURVEYOR
700 HALL OF RECORDS

NOTE: ANY ADDITIONS OR CHANGES ON THIS SHEET MUST BE MADE OR CIRCLED IN RED INK, WITH DATE AND NAME OF PERSON MAKING CHANGE

Do not extend notes this side of this line

F. B. 2390 Pg. 178 | Job No. 283 | Division No. | Notes Red | Plotted | Profile
Survey of Water Works Dist #2 | Date | No.
Survey by A. C. [illegible] | Notes Nichols | Notes Chkd | Checked | X-Sec.
Indexed | Date | Date | Date | No.

STATION	B. S.	H. I.	F. S.	ELEV.	
		1574.27			
T.P.	2.25	[illegible]	6.69	1567.58	✓
T.P.	2.35	1571.68	[illegible]	[illegible]	✓
T.P.		[illegible]	[illegible]	[illegible]	✓
T.P.	[illegible]	1575.32	[illegible]	[illegible]	✓
T.P.	[illegible]	1568.53	[illegible]	[illegible]	✓
T.P.	[illegible]	1493.10	11.76	[illegible]	✓
T.P.	1.26	1484.51	9.89	[illegible]	✓
B.M.=B	0.355	[illegible]	5.30	[illegible]	16.5' West of S.W. Corner of Inlet Structure
			[illegible]	[illegible]	✓
T.P.	[illegible]	[illegible]	[illegible]	[illegible]	✓
		[illegible]			✓
		[illegible]			✓
	0.27	1447.27	[illegible]	[illegible]	✓
T.P.	1.33	1436.67	11.93	1435.34	✓
T.P.	0.75	1425.735	11.65	1424.98	✓
T.P.	0.46	1414.850	11.345	1414.39	✓
T.P.	0.34	1403.525	11.365	1403.18	✓
T.P.	0.355	1392.570	11.610	1392.21	✓
T.P.	0.845	1381.80	11.63	1380.95	✓

Form 307 5M 11-35

PLEASE RETURN TO
LOS ANGELES COUNTY SURVEYOR
700 HALL OF RECORDS

NOTE: ANY ADDITIONS OR CHANGES ON THIS SHEET MUST BE MADE OR CIRCLED IN RED INK, WITH DATE AND NAME OF PERSON MAKING CHANGE

Do not extend notes this side of this line

STATION	B. S.	H. I.	F. S.	ELEV.		
		381 805				
T. P.	0.450	370.355	11.90	1359.910		
T. P.	0.670	359.135	11.89	1358.465		
T.P.	0.435	347.970	11.605	1347.530		
T. P.	2.174	338.009	11.640	1336335		
T. P.	2.0	329.37	11.385	1325.99		
T. P.	0.315	315.765	11.340	1318.05		
T. P.	1.375	308.50	11.35	307.30		
T. P.	2.965	299.50	11.965	296.54		
T. P.	2.02	1291.045	1.37	1289.02		
B M			3.84	1287.205	Set Nail in 24" Tree Monument 314 #4 Elevation Existing Bench Mark #3627 Elev 1287.186	L.E. 640-117
B.M.	0.18	1447.10		1446.92	Set Cut Sqr. W. side of RR #35-4720E 25 ft. N.	
T.P.	11.640	1449.27	11.37	1437.63	C.S. Mon S.E. Cor (M.M.D. T21) Lot	
B.M.			0.360	1448.920	RR #35-4720E	

Profile Notes Red Plotted Job No. Division No.
No. Date Date Survey of
X-Sec. Notes Chkd. Checked Survey by Notes
No. Date Date Map No. Indexed Date Date

F. B. [illegible] PG. 179

Form 307 5M 11-35

PLEASE RETURN TO
LOS ANGELES COUNTY SURVEYOR
700 HALL OF RECORDS

NOTE: ANY ADDITIONS OR CHANGES ON THIS SHEET MUST BE MADE OR CIRCLED IN RED INK, WITH DATE AND NAME OF PERSON MAKING CHANGE

Do not extend notes this side of this line

F.B. 320 PG. 120 Job No. Division No. Notes Red Plotted Profile
Survey of No. Date Date No.
Survey by A. C. Johnson Notes Notes Chkd Checked X-Sec.
Indexed Date Date Date

STATION	B. S.	H. I.	F. S.	ELEV.	
B.M.	10.834	1398.237		1387.40	Set in oak tree marked B.M. Appx. [illegible] 320-138-16
T.P.	11.05	1399.175	0.42	1388.12	
			0.32	1388.85	
	11.61		0.34	1389.27	
			0.26	1389.15	
		1396.5	0.34	1389.73	
			0.35		
			0.37		
T.P.	10.72	1399.740	0.620		
T.P.	10.735	1409.250	0.765	1398.515	
T.P.	10.19	1419.715	0.23	1409.525	
T.P.	9.52	1418.999	0.24	1409.48	
B.M. 9			1.84	1417.135	Set C.S.Mon. N. and 3'W. of NW Cor. [illegible] Lot 14
			2.20	1416.79	
B.M. 9	0.715	1417.715			C.S.Mon.
T.P.	0.525	1418.049	1.10	1417.19	
T.P.	0.303	1420.[illegible]	[illegible]	[illegible]	
T.P.	[illegible]	[illegible]	[illegible]	[illegible]	

Form 307 5M 11-35

PLEASE RETURN TO
LOS ANGELES COUNTY SURVEYOR
700 HALL OF RECORDS

NOTE: ANY ADDITIONS OR CHANGES ON THIS SHEET MUST BE MADE OR CIRCLED IN RED INK, WITH DATE AND NAME OF PERSON MAKING CHANGE

Do not extend notes this side of this line

STATION	B. S.	H. I.	F. S.	ELEV.		
		1389.070				
T. P.	1.370	1390.170	11.710	1378.460		
T. P.	1.815	1366.355	11.525	1366.340		
T. P.	0.180	1355.105	11.430	1343.925		
T. P.	11.790	1355.585	1.310	1343.795		
T. P.	1.53	1372.213	1.905	1370.683		
B.M.			3.325	1367.488	Fd Cut Sqr in Top Pilling S See pg 188	
T.B.M.	0.70	1490.095		1389.395	1 X 1 See pg 188	
T.P.	0.00	1488.510	11.685	1487.410		
T.P.	0.72	1489.00	11.130	1477.11		
T.P.	0.00	1465.43	11.470	1466.43		
T.P.	0.535	1453.53	11.60	1452.83		
T.P.	1.67	1444.320	11.67	1442.650		
T.B.M.	2.45	1427.75	11.65	1425.30		
				1416.30	Elev Horse Shoe Corral Rifle Range	
T.P.	0.452	1432.335	11.313	1421.883		
T.P.	2.55	1411.760	11.41	1409.210		
			8.76	1400.00	Ground at Base of Flagpole	
T.P.	1.355	1403.175	9.94	1401.82		
			4.10	1399.07	Approx floor elev (Southern House)	

Profile No. ____ Notes Red ____ Plotted ____ Job No. ____ Division No. ____
X-Sec. No. ____ Date ____ Date ____ Survey of ____
Notes Chkd. ____ Checked ____ Survey by ____ Notes ____ Date ____
Date ____ Date ____ Map No. ____ Indexed ____

F. B. ____ Pg. 191

Form 307 5M 11-[illegible]

PLEASE RETURN TO
LOS ANGELES COUNTY SURVEYOR
700 HALL OF RECORDS

NOTE: ANY ADDITIONS OR CHANGES ON THIS SHEET MUST BE MADE OR CIRCLED IN RED INK, WITH DATE AND NAME OF PERSON MAKING CHANGE

Do not extend notes this side of this line

F. B. 320 Pg. 182 | Job No. 8163 Division No. V | Profile No. | X-Sec. No.
Survey of Water Mains, Dist. #[illegible]
Survey by [illegible] Notes [illegible] Plotted Date
Indexed [illegible] Date Notes Red Date Notes Chkd. Date Checked Date

STATION	B. S.	H. I.	F. S.	ELEV.	
		1403 125			
T.S. M			[illegible]	[illegible]	[illegible]
BM #2	11139	158162		[illegible] 23	C.S. BM #2 — Pg. 172
	10685	159133	0375	[illegible] 245	
	11362	160263 5	010	[illegible] 27	
Pt "D"	11535	161416	031	[illegible] 25	Pt D 1x2
Pt "E"	0975	161325	1011	16[illegible] 12	Pt E 1x2
	0255	160252 5	11555	160[illegible] 32	
	085	159210 5	11 32	15[illegible] 05	
	109	158145 5	11 71	15[illegible] 375	
B.M. # 2			11 26	15[illegible] 25	B.M. #2 El — 15[illegible] 3

Notes Ck'd by ALBERT E. TIMMONS	Survey of Water Works Dist #40 F.B. 320 Pg. 183
Map No. Filed - 19-67	W. O. 216 Tape No. 54 St'd 68° F.
Office Work ALBERT E. TIMMONS	Surveyed by V. D. Moore
Checked	Notes VMoore Date 12
Date	Indexed 12-9-36

Contour Interval 5'

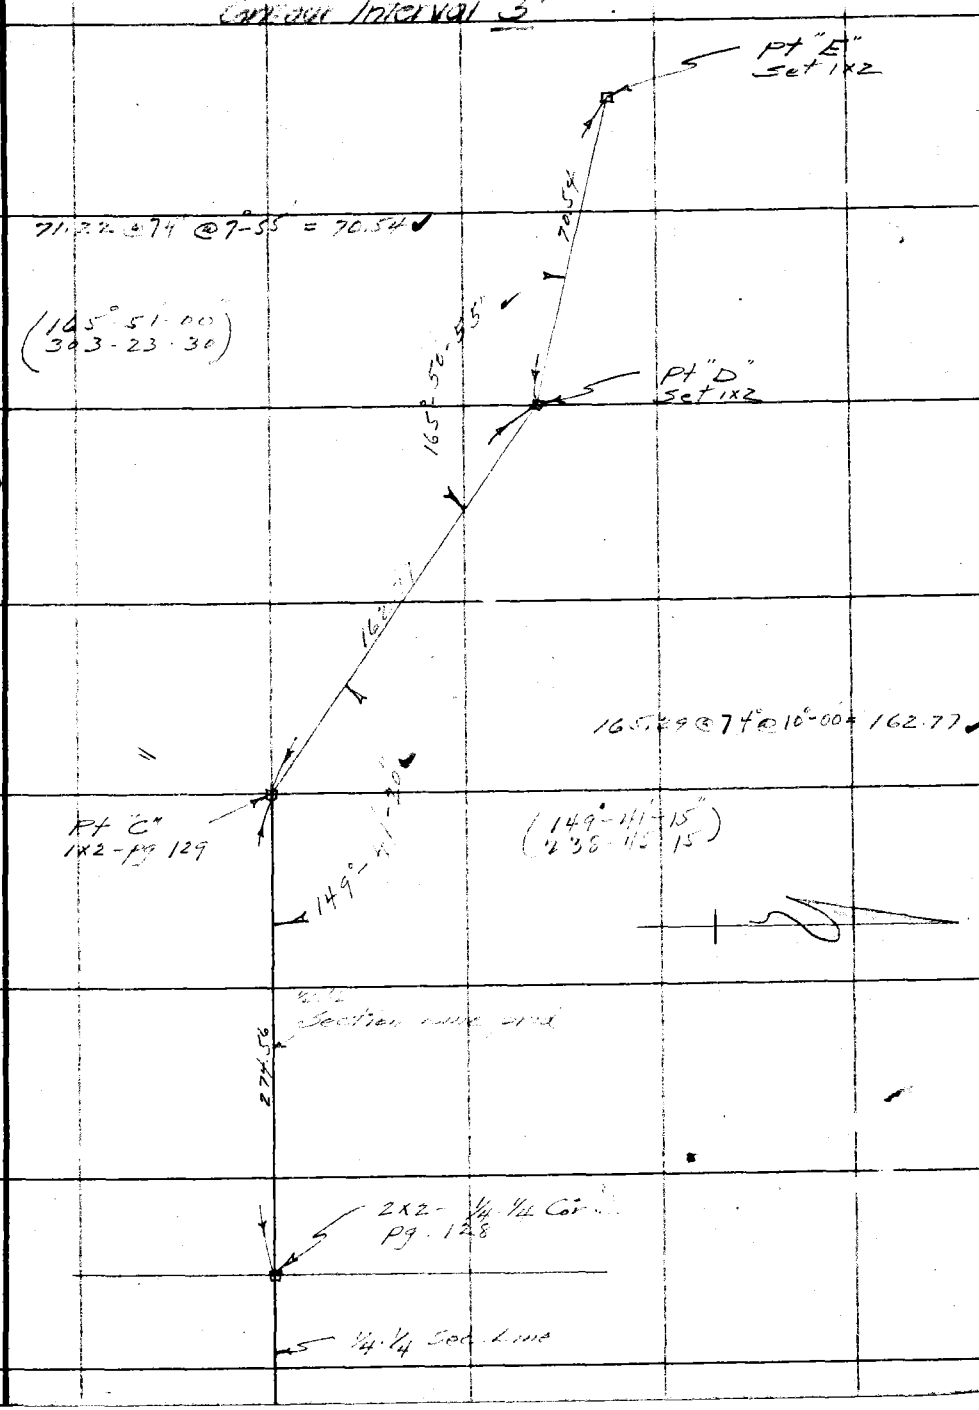

RETURN TO
LOS ANGELES COUNTY SURVEYOR
700 HALL OF RECORDS

Notice: Any Additions or Changes on This Sheet Must be Made or Circled in Red Ink With Date and Name of Person Making Change.

Do not extend notes this side of this line

FORM 247 10M 11-35

RETURN TO
LOS ANGELES COUNTY SURVEYOR
700 HALL OF RECORDS

Note: Any Additions or Changes on This Sheet Must be Made or Circled in **Red Ink** With Date and Name of Person Making Change.

Do not extend notes this side of this line

F.B. 320 Pg. 184

Form 32 16M 3-54

PLEASE RETURN TO
LOS ANGELES COUNTY SURVEYOR
700 HALL OF RECORDS

Do not extend notes this side of this line

Transit at	Sight on	Stadia Intercepts	Stadia Distance	Stadia Rod	Horizontal Angle Left	Horizontal Angle Right	Vertical Angle	Elevation of Point	+ Back Sight	+ Instrument Elevation	Elevation of Instrument	Number Occupied	
N E	P.T. D							1613	4.9		1618		
		1100											
		10	10	10	358 15	99	7 21	1595	2				
		1082											
		9	103	9	3 35	101	7 32	958	3				
		1078											
		77	80	11	358 50	79	4 40	1606	4				
		1078											
		77	75	11	7 30	78	4 28	009	5				
		1042											
		41	43	11	353 25	43	2 21	054	6				
		1042											
		41	43	11	— 50	43	2 54	049	7				
		425							8				
		420	6	4	281 —	2	—	132	9				
		1403											
		1	44	1	219 20	44	+ 5 03	208	10				
		1403											
		1	44	1	210 10	44	+ 5 —	208	11				
		256											
		2	87	2	198 10	86	+ 6 24	252	12				
		256											
		2	87	2	193 —	86	+ 6 17	254	13				
		1198											
		11	99	11	6 175 45	99	— —	064	14				
		1166											
		66	67	11	0 164 40	64	12 24	15 932	15				
		1143											
		43	44	11	0 141 50	38	21 23	920	16				
		1136											
		36	37	11	0 101 50	35	14 02	784	17				
		1137											
		37	38	11	0 83 20	35	15 02	974	18				
		1159											
		59	60	11	0 43 40	49	24 57	842	19				
		1146											
		46	100	11	0 22 40	35	12 33	57	20				
		1130											
		30	121	11	0 33 20	13	15 —	1064	21				
		1105											
		105	102	11	0 48 40	54	5 11	0	22				

LOS ANGELES COUNTY Surveyor

						Vertical Angle	Elevation of Point	Sight
						25	1529	
						19 47	86 3	
						19 12	86 8	
						26 49	74 1	
						18 39	77 2	
						7 49	91 4	
						4 48	1610	
						1 53	046	
						5 08	027	
						12 32	1378	
						13 24	869	
						17 26	708	
						15 41	798	
						10 57	872	
						4 39	921	

Notes Ck'd by		Survey of	
Map No.		W. O.	Tape No. St'd °F.
Office Work		Surveyed by	
Checked		Notes	Date
Date		Indexed	A. C. Johnson 9-28-37

F.B. 320 PG. 187

Location
of
Trails and Alleys
in
Tract 7342

Note: Any Additions or Changes on This Sheet Must be Made or Circled in Red Ink With Date and Name of Person Making Change.

Do not extend notes this side of this line

RETURN TO
LOS ANGELES COUNTY SURVEYOR
700 HALL OF RECORDS

FORM 247 10M 11-35

F.B. 320 PG. 188

Index

		Page
North Trail		189 - 190
Spring Trail	190-191,	196 - 198
Summit Trail		171 - 172
Forest Trail		193 - 194
Alta Trail		194
Creek Trail		195 - 200
Market Trail		199 - 195
Hillcrest Trail		201
Orchard Trail		200
Wildwood Trail		198, 202
La Cañada Trail		202
Vista del Valle		203 204
Park Trail		187
East Trail		204, 204, 205
Glenside Trail		204, 205
Zion Hill Trail		208
Grand View Trail		206
Mountain View Trail		206
Overlook Trail		205
West Trail		206

RETURN TO
LOS ANGELES COUNTY SURVEYOR
700 HALL OF RECORDS

Note: Any Additions or Changes on This Sheet Must be Made or Circled in Red Ink With Date and Name of Person Making Change.

Do not extend notes this side of this line

Notes Ck'd by	Survey of Water Works Dist 29
Map No.	W. O. 5144 Tape No. St'd °F.
Office Work	Surveyed by L. D. Moore
Checked	Notes N & T Date 12-7-56
Date	A. C. Johnson
	Indexed

F.B. 320 Pg. 189

To Bk. 320 pg. 190

RETURN TO
LOS ANGELES COUNTY SURVEYOR
700 HALL OF RECORDS

Note: Any Additions or Changes on This Sheet Must be Made or Circled in Red Ink With Date and Name of Person Making Change.

Do not extend notes this side of this line

FORM 247 10M 11-55

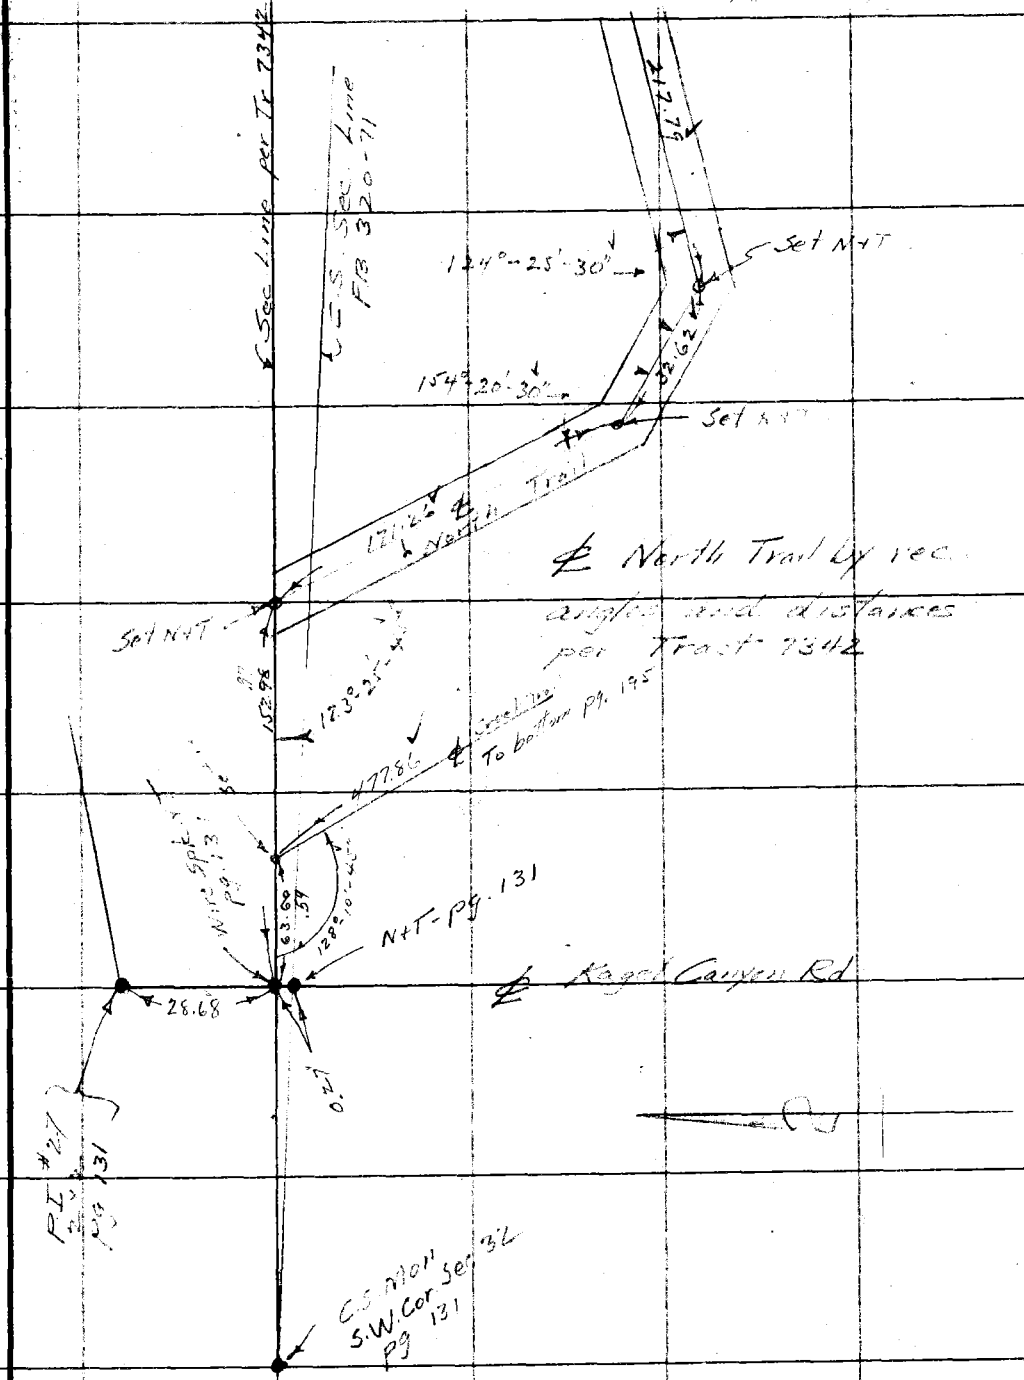

F.B. 320 Pg. 190

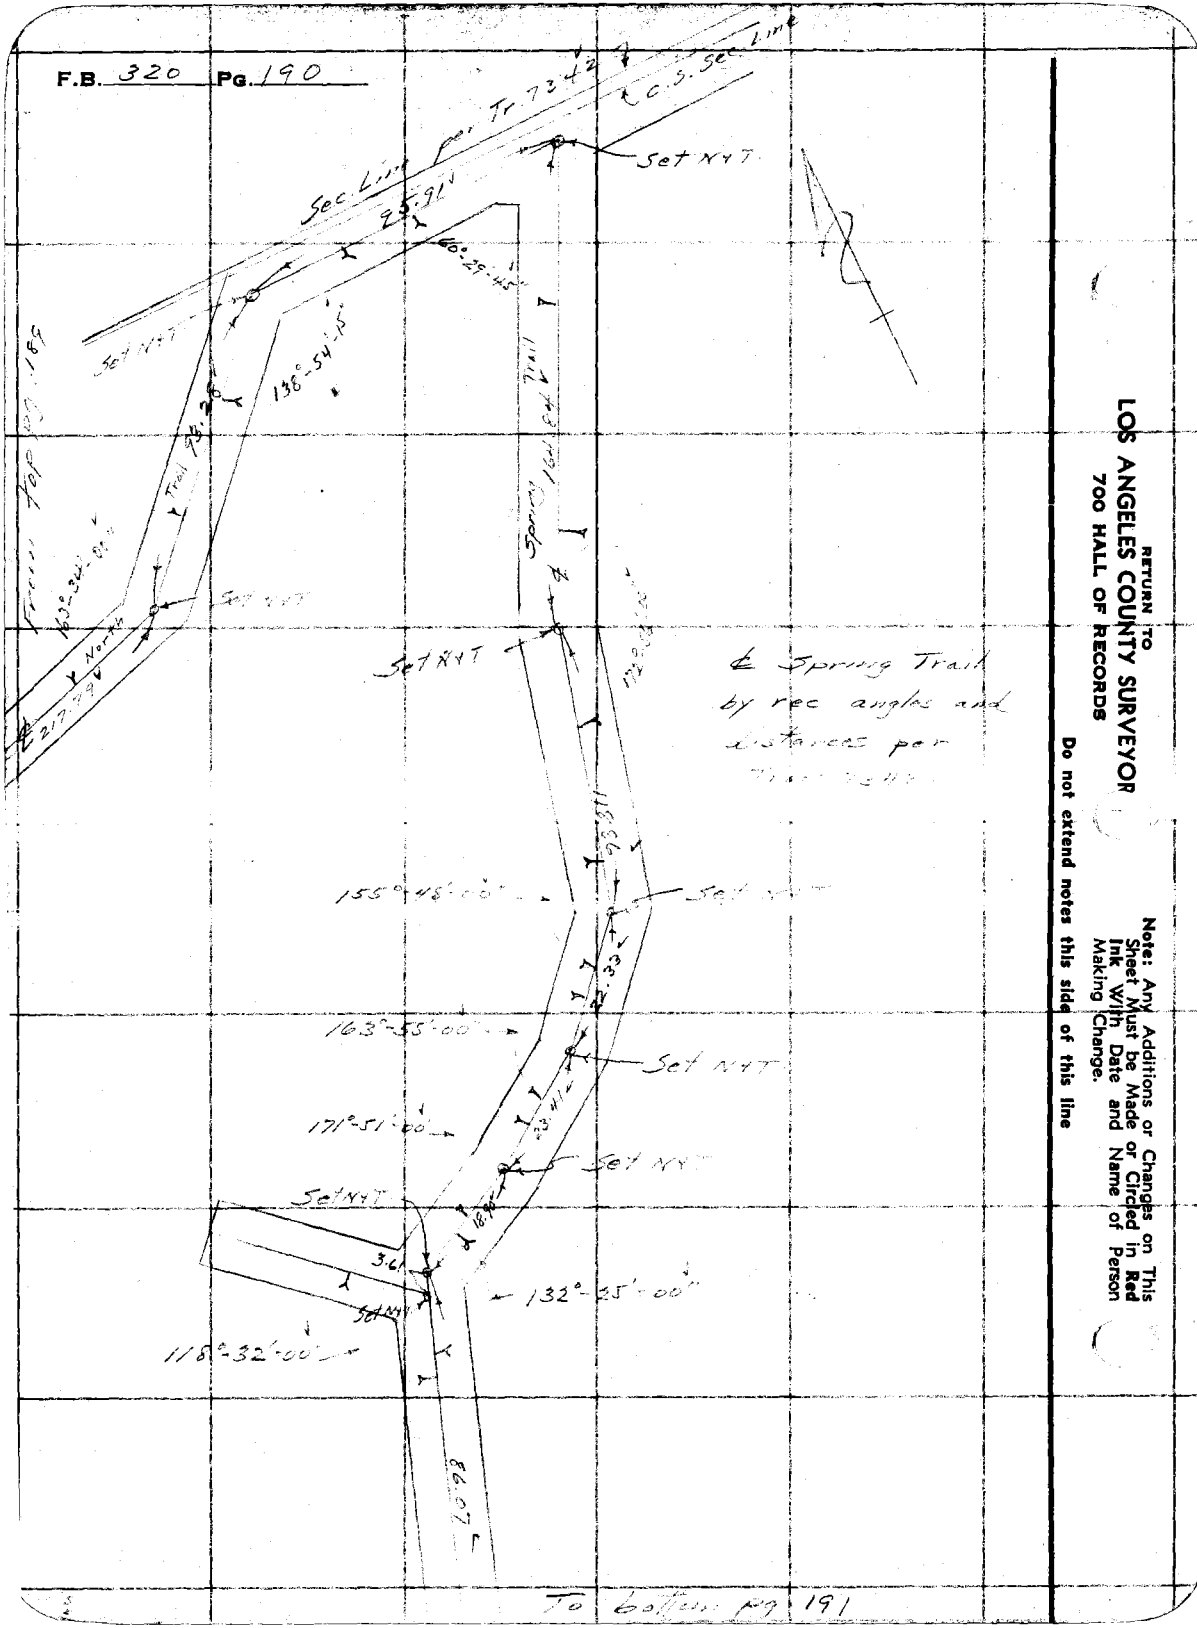

RETURN TO
LOS ANGELES COUNTY SURVEYOR
700 HALL OF RECORDS

Note: Any Additions or Changes on This Sheet Must be Made or Circled in Red Ink With Date and Name of Person Making Change.

Do not extend notes this side of this line

Notes Ck'd by	Survey of Water Works Dist #2
Map No.	W. O. 8174 Tape No. St'd °F.
Office Work	Surveyed by L D Moore
Checked	Notes Moore Date 12 5 36
Date	Indexed

F.B. 320 PG. 191

197

From lower 16" on page 196

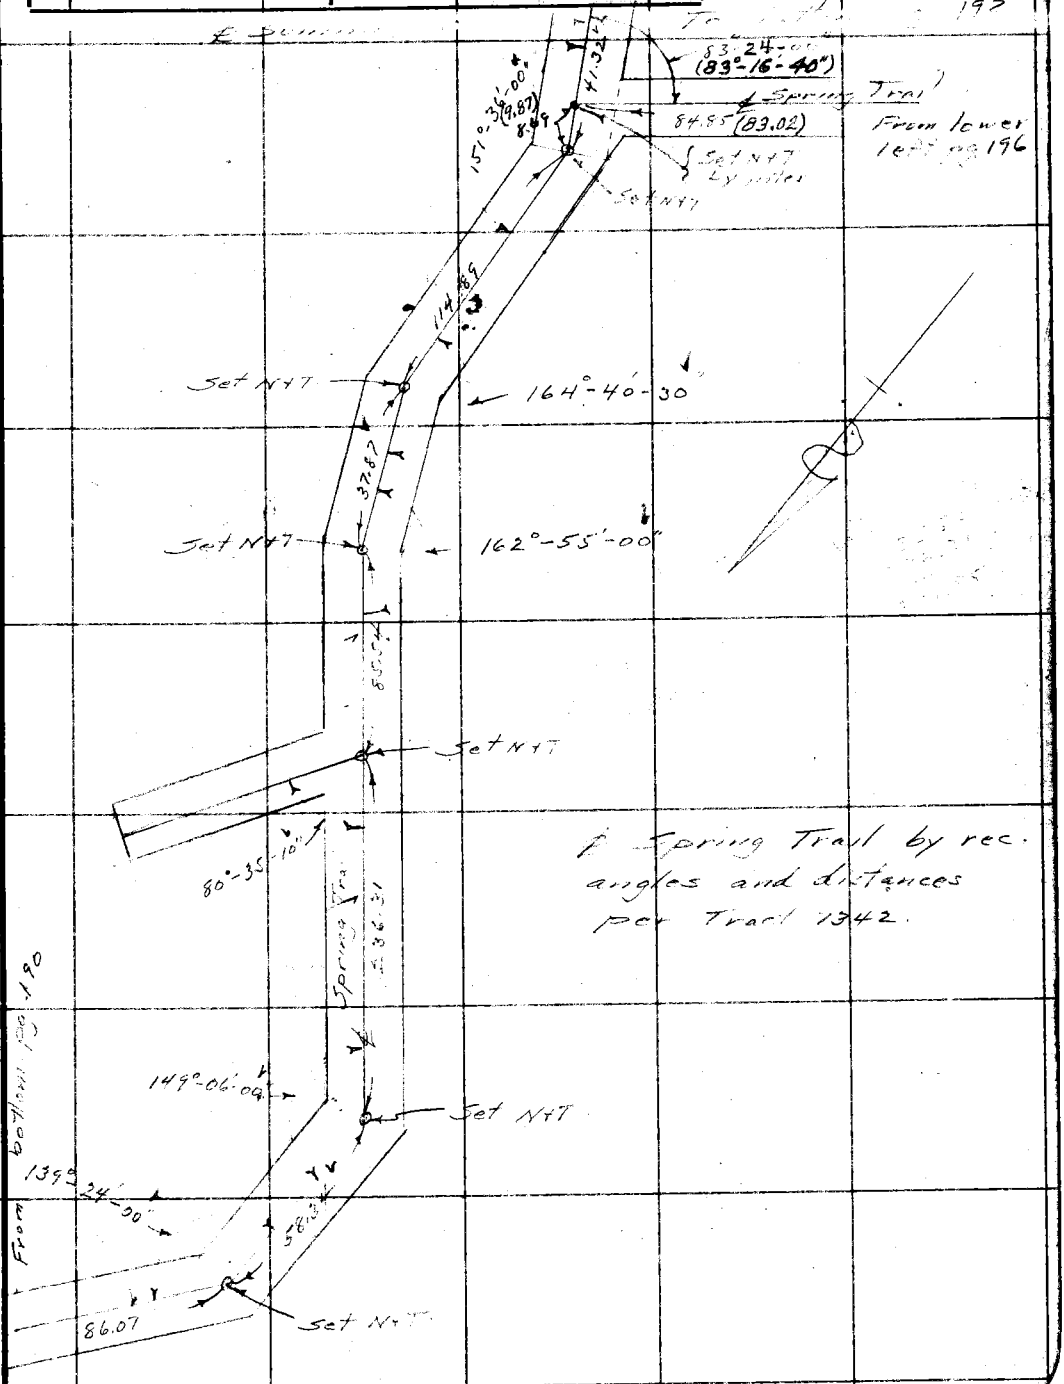

Spring Trail by rec. angles and distances per Tract 1342.

RETURN TO
LOS ANGELES COUNTY SURVEYOR
700 HALL OF RECORDS

Note: Any Additions or Changes on This Sheet Must be Made or Circled in Red Ink With Date and Name of Person Making Change

Do not extend notes this side of this line

FORM 247 10M 11-38

F.B. 320 PG. 192

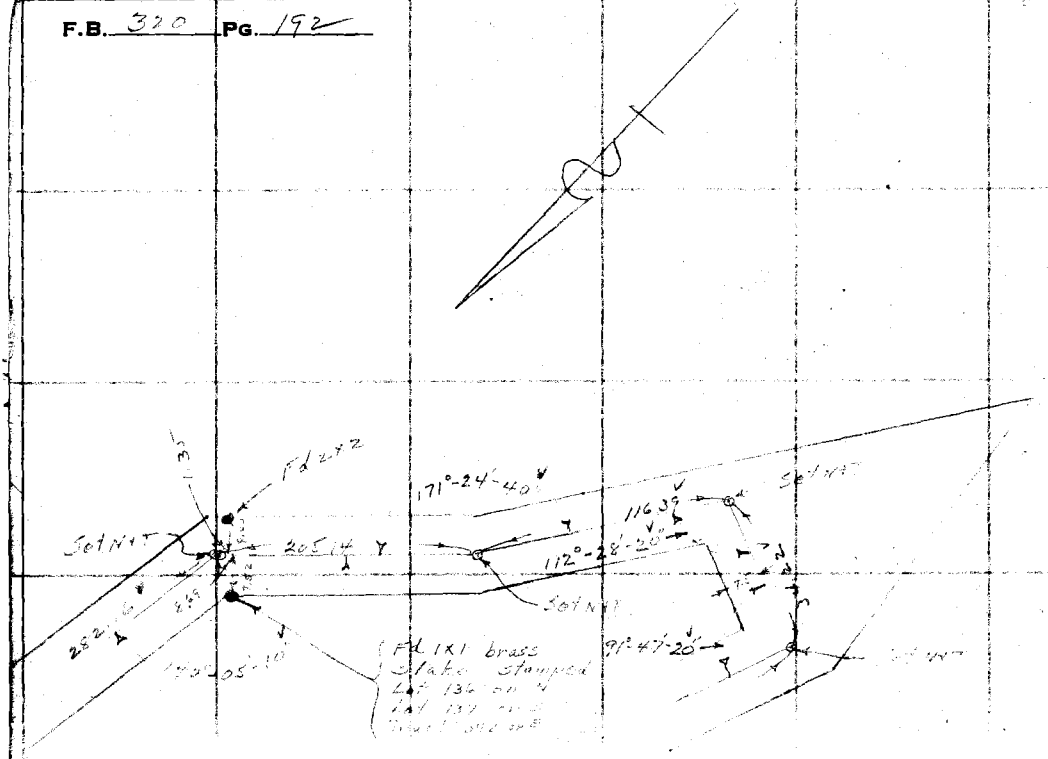
Set NAIL
Fd 2x2
3.5'
205.14'
171°-24'-40"
112°-28'-20"
116.39'
91°-47'-20"
Set NAIL
Fd 1x1 brass
Stake Stamped
Set NAIL
Set NAIL
Set NAIL

Notes Ck'd by	Survey of Malibu Lake Tract F.B. 320 PG. 193
Map No.	W. O. 8744 Tape No. St'd °F.
Office Work	Surveyed by L. D. Moore
Checked	Notes Traverse Date 12-16-26
Date	Indexed A. C. Johnson

To L.T. 27 P9

Malibu Canyon Rd.

151°-15'-40"

40'

Set X

151.02

Vision Trail 2153

145.16

63°-14'-50"

Set N+T

Forest Trail

Set N+T

E.C. F&N+T

35°-00'

52.53'

& Forest Trail by rec. angles & dist. per F.B. 230/2

PI 2.2 Ed 2x2 P9 131'

169°-15'-00"

121.13'

Set N+T.

121.42

Set N+T

170°-38'-00"

94.25

Set N+T

To top P9 194

Note: Any Additions or Changes on This Sheet Must be Made or Circled in Red Ink With Date and Name of Person Making Change.

Do not extend notes this side of this line

RETURN TO
LOS ANGELES COUNTY SURVEYOR
700 HALL OF RECORDS

FORM 247 10M 11-38

F.B. 320 PG. 174

From 667 Pg. 193

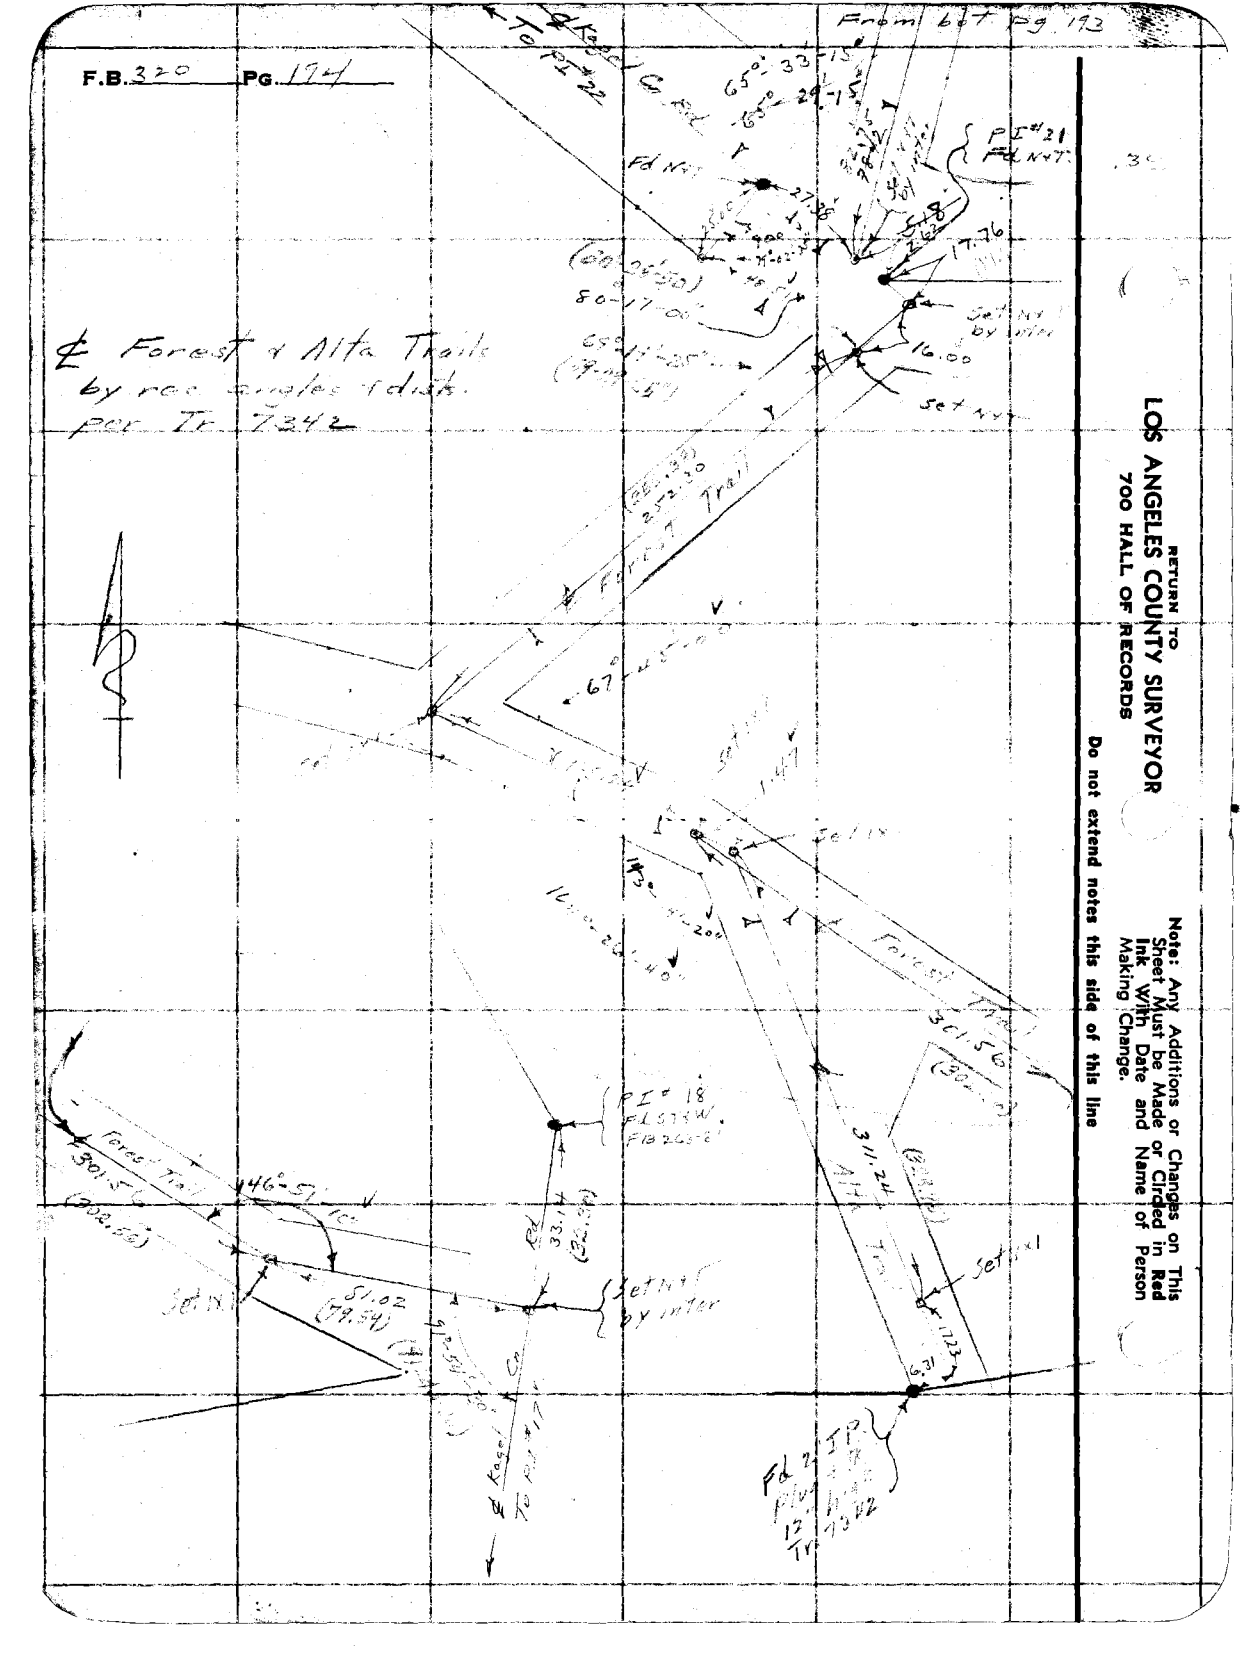
℄ Forest & Alta Trails
by rad angles & dist.
Pac Tr. 7342
℄ Forest Trail
℄ Forest Trail
℄ Forest Trail

Notes Ck'd by	Survey of Water Work Dist #21
Map No.	W. O. 8174 Tape No. St'd °F.
Office Work	Surveyed by L. D. Moore
Checked	Notes Moore Date 12-36
Date	Indexed A. C. Johnson

F.B. 320 Pg. 195

Note: Any Additions or Changes on This Sheet Must be Made or Circled in Red Ink With Date and Name of Person Making Change.

Do not extend notes this side of this line

RETURN TO
LOS ANGELES COUNTY SURVEYOR
700 HALL OF RECORDS

FORM 247 10M 11-35

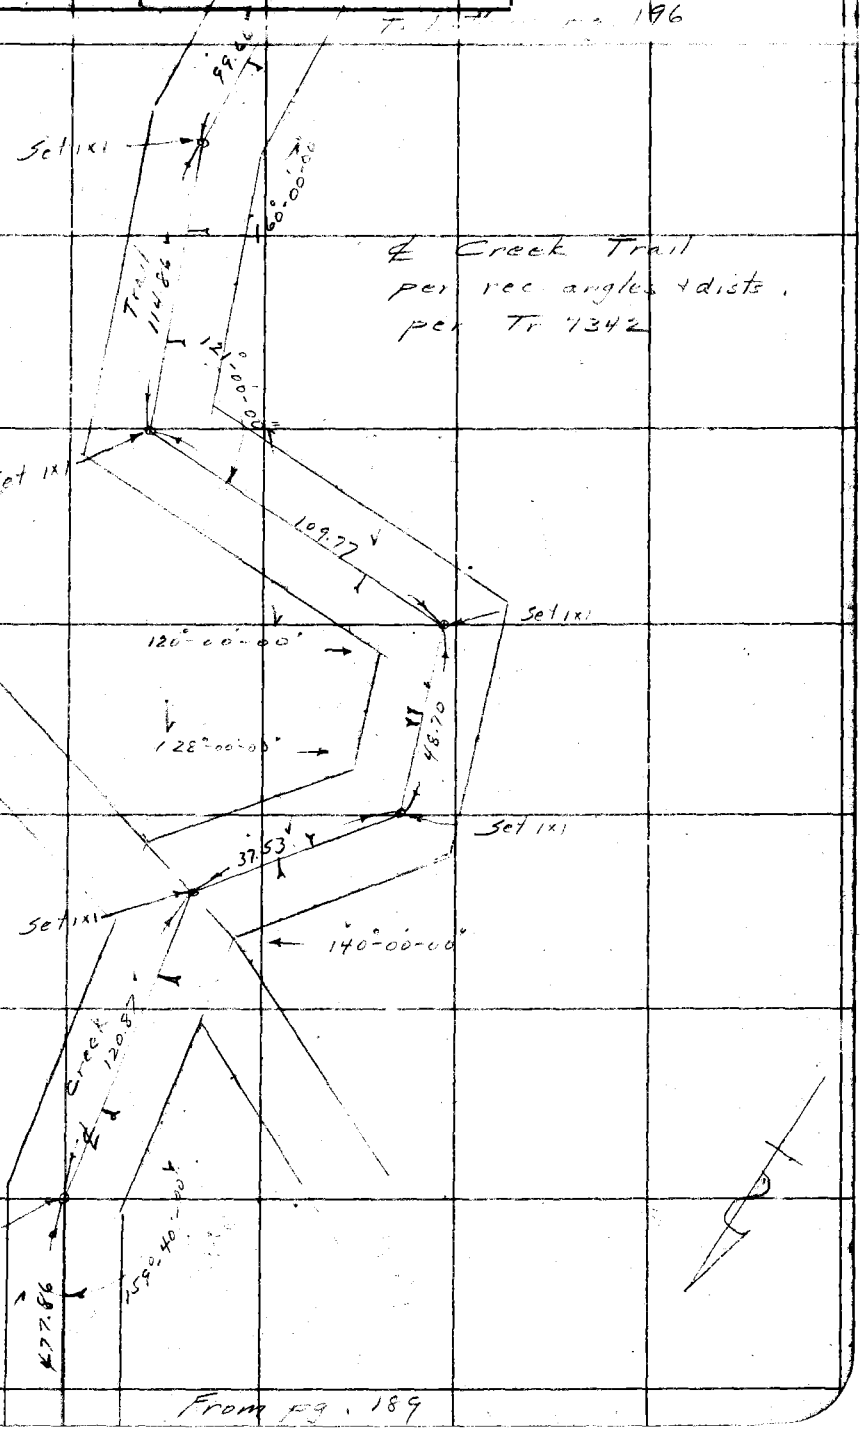

Creek Trail
per rec angles & dists.
per Tr 7342

From pg. 189

RETURN TO
LOS ANGELES COUNTY SURVEYOR
700 HALL OF RECORDS

Note: Any Additions or Changes on This Sheet Must be Made or Circled in Red Ink With Date and Name of Person Making Change.

Do not extend notes this side of this line

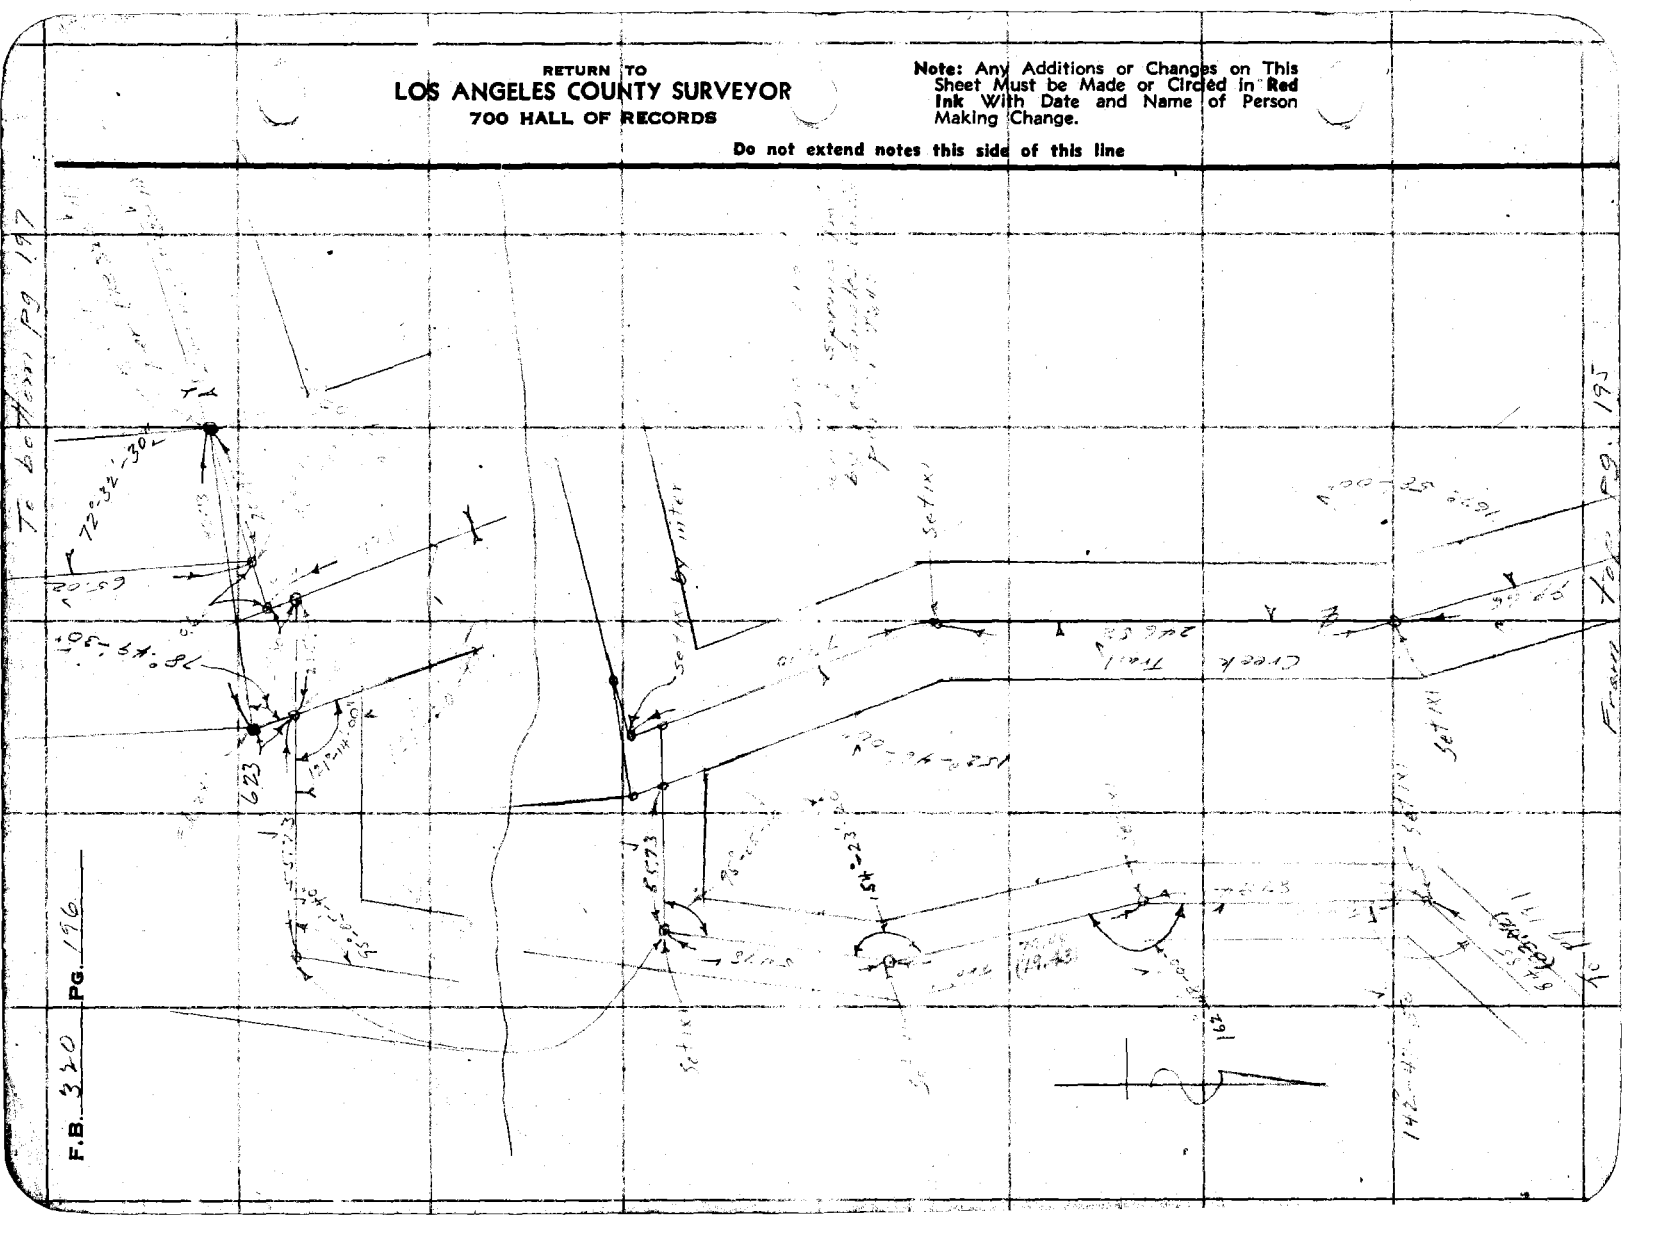
F.B. 320 Pg. 196
72°34'-30"
Creek Trail
Set IXI
Set Nail
Set Tack
Set Nail & Tag
Set IXI
Set Nail & Tag
Set IXI
Set Nail & Tag
Set IXI

Notes Ck'd by	Survey of Water Works Dist No 1
Map No.	W. O. 8114 Tape No. St'd °F.
Office Work	Surveyed by L. D. N. Moore
Checked	Notes Date 2-
Date	Indexed

F.B. 320 PG. 147

Note: Any Additions or Changes on This Sheet Must be Made or Circled in Red Ink With Date and Name of Person Making Change

Do not extend notes this side of this line

RETURN TO
LOS ANGELES COUNTY SURVEYOR
700 HALL OF RECORDS

FORM 247 10M 11-38

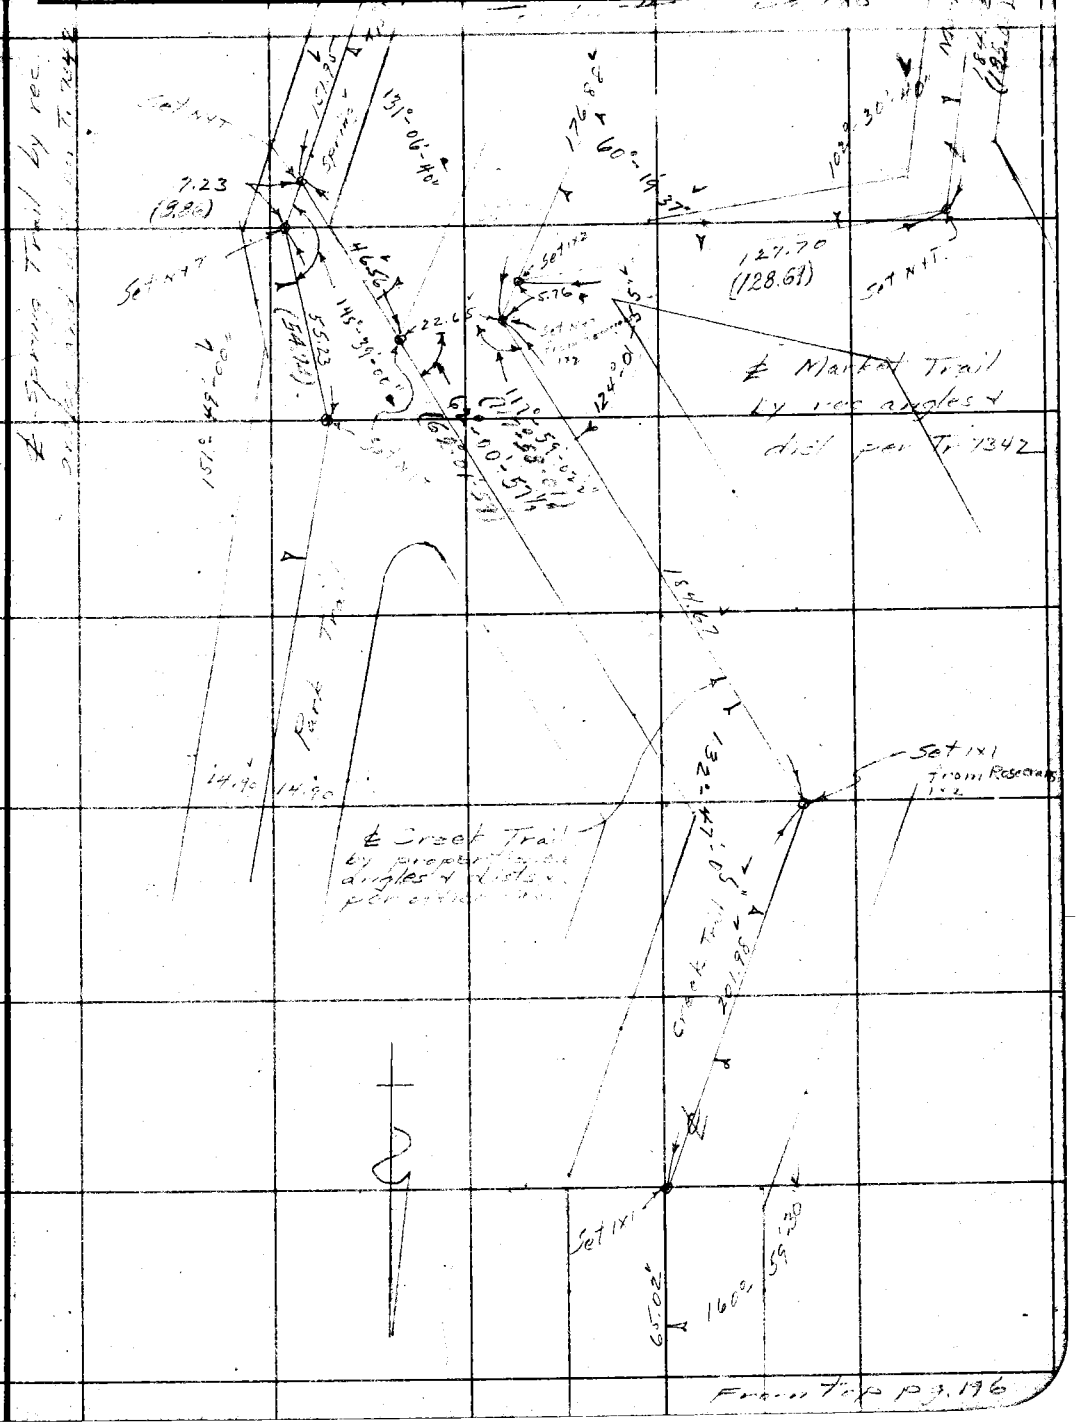

RETURN TO
LOS ANGELES COUNTY SURVEYOR
700 HALL OF RECORDS

Note: Any Additions or Changes on This Sheet Must be Made or Circled in Red Ink With Date and Name of Person Making Change.

Do not extend notes this side of this line

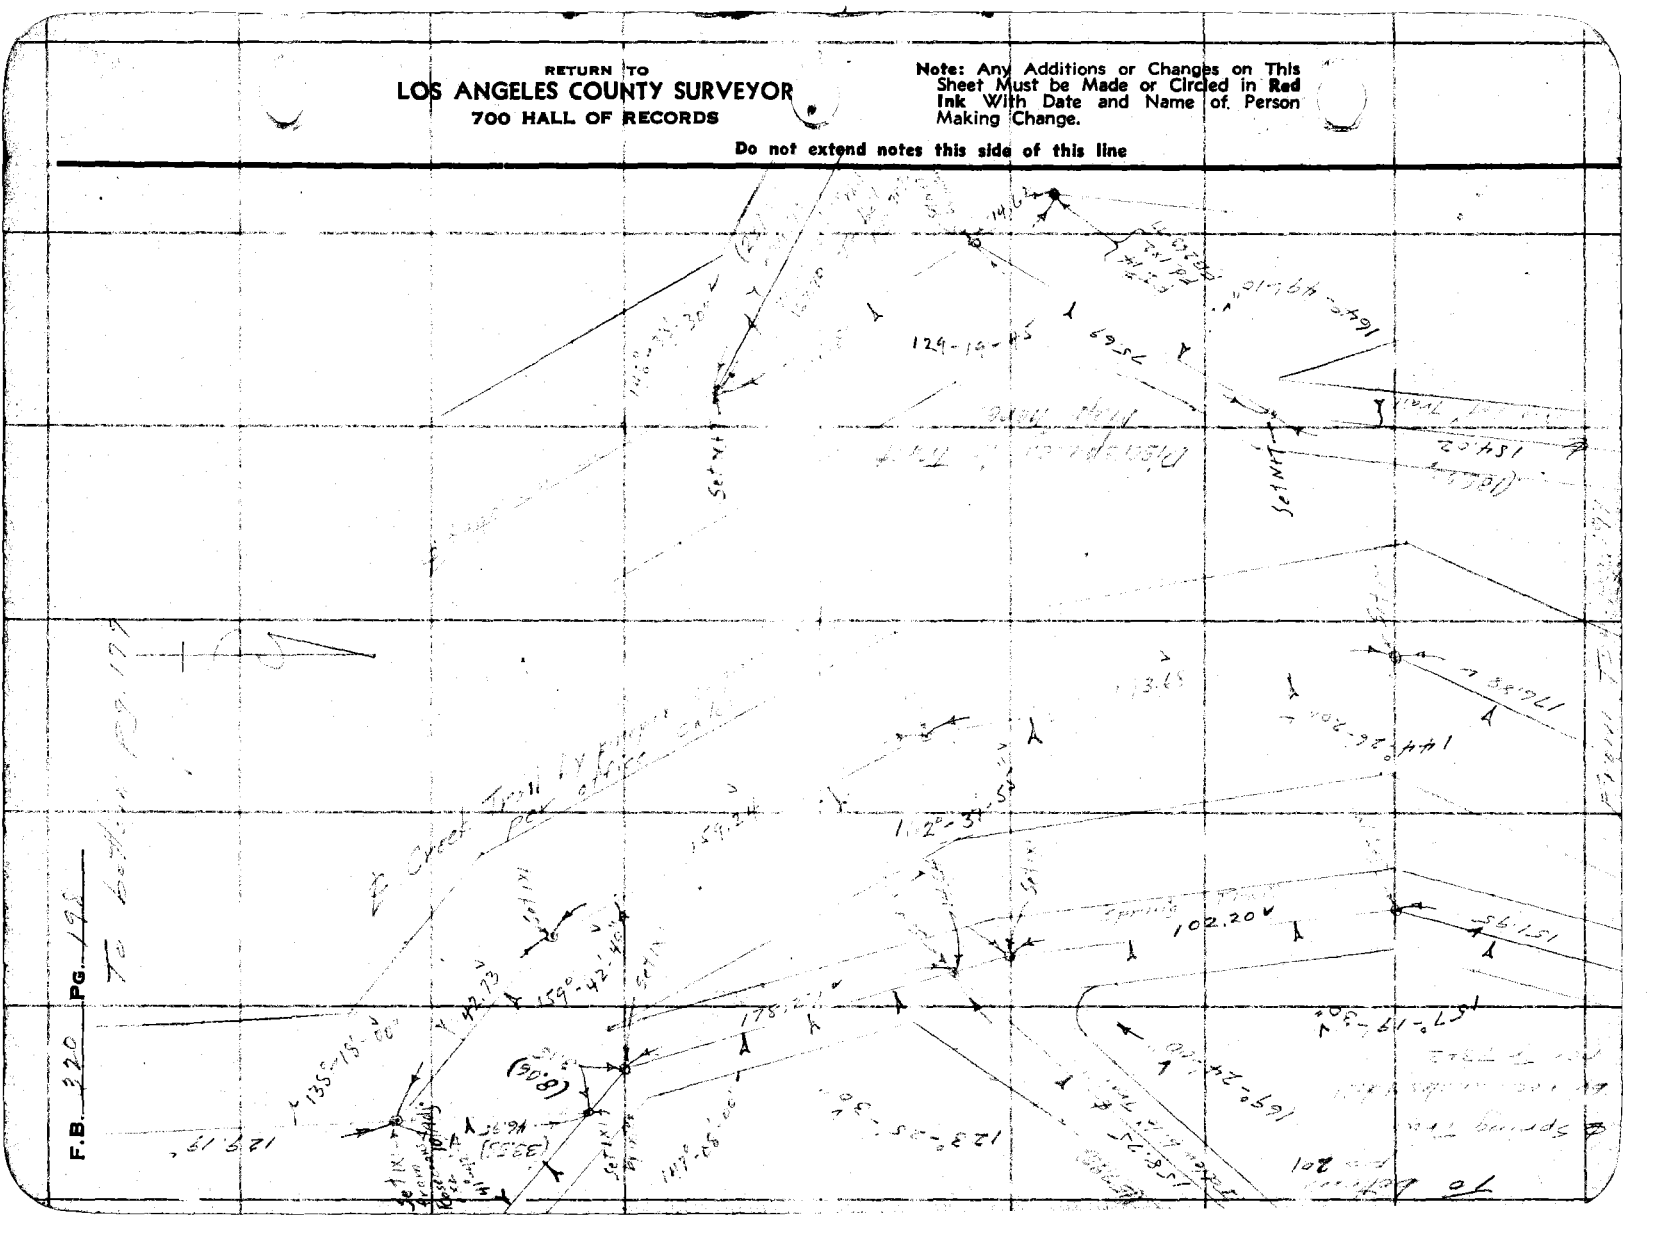

FORM 247 10M 11-35

RETURN TO
LOS ANGELES COUNTY SURVEYOR
700 HALL OF RECORDS

Note: Any Additions or Changes on This Sheet Must be Made or Circled in **Red Ink** With Date and Name of Person Making Change.

Do not extend notes this side of this line

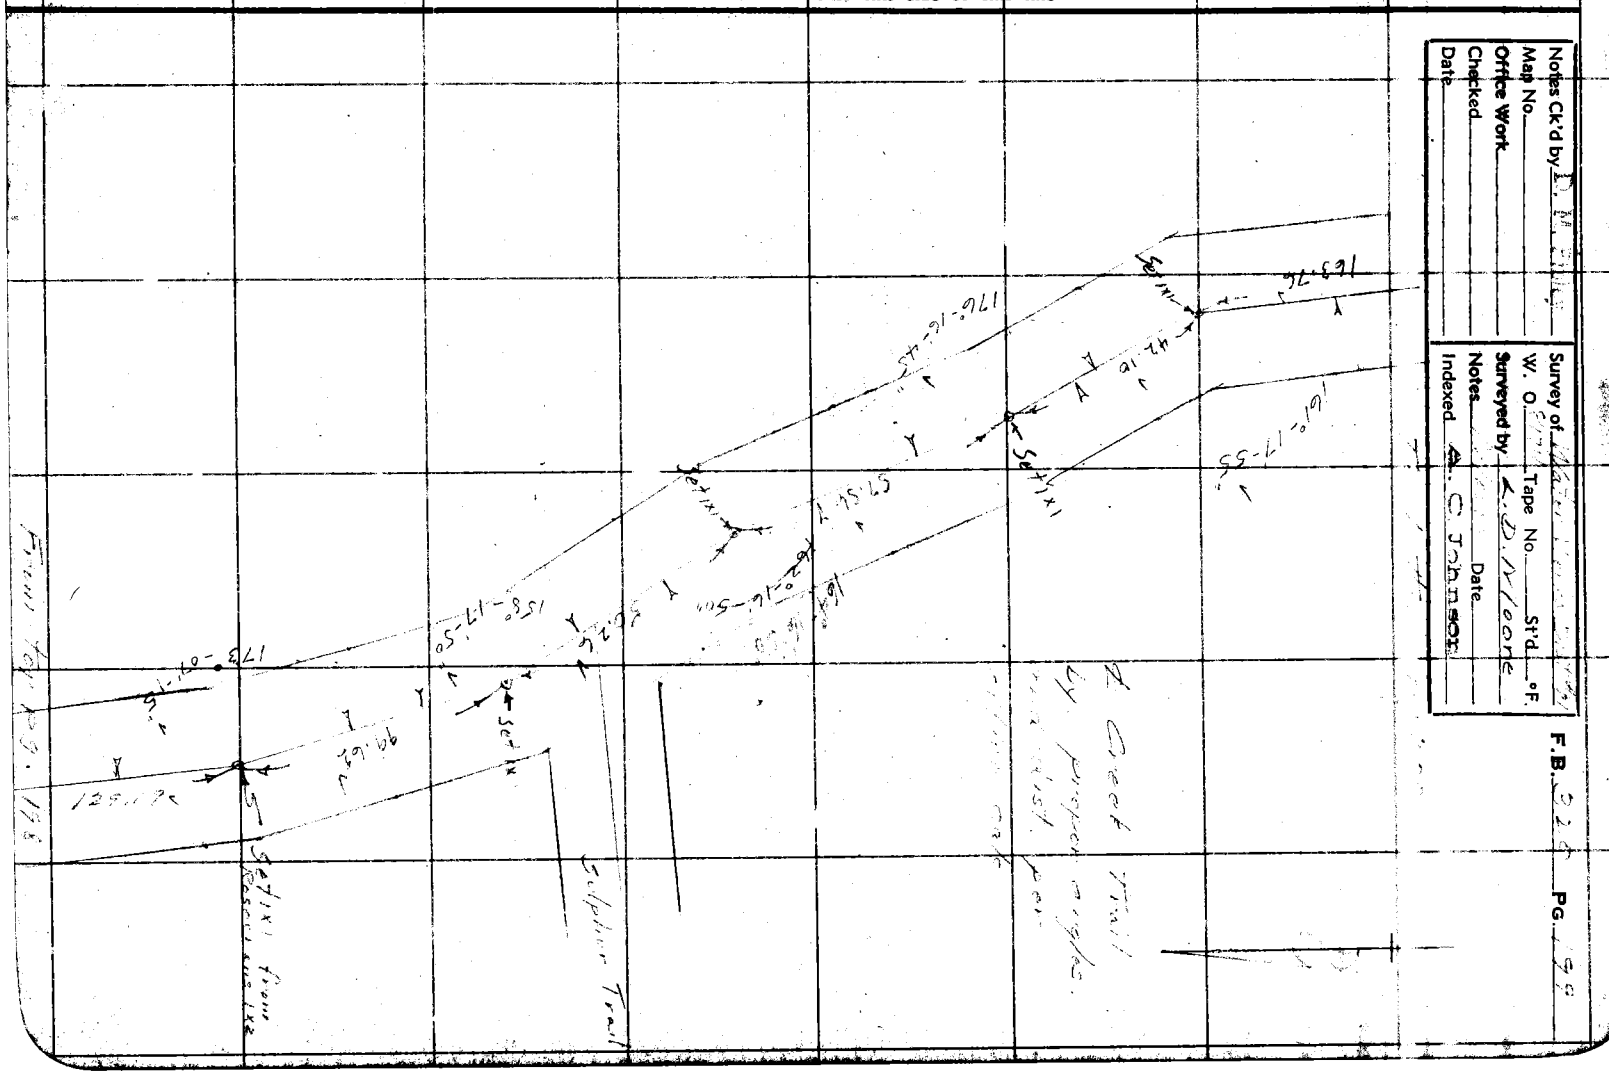
Set 1x1
Set Nail
Set 1x1 Flush
Set 1x1 Flush
Set 1x1 Flush
Set 1x1 Flush

RETURN TO
LOS ANGELES COUNTY SURVEYOR
700 HALL OF RECORDS

Note: Any Additions or Changes on This Sheet Must be Made or Circled in **Red Ink** With Date and Name of Person Making Change.

Do not extend notes this side of this line

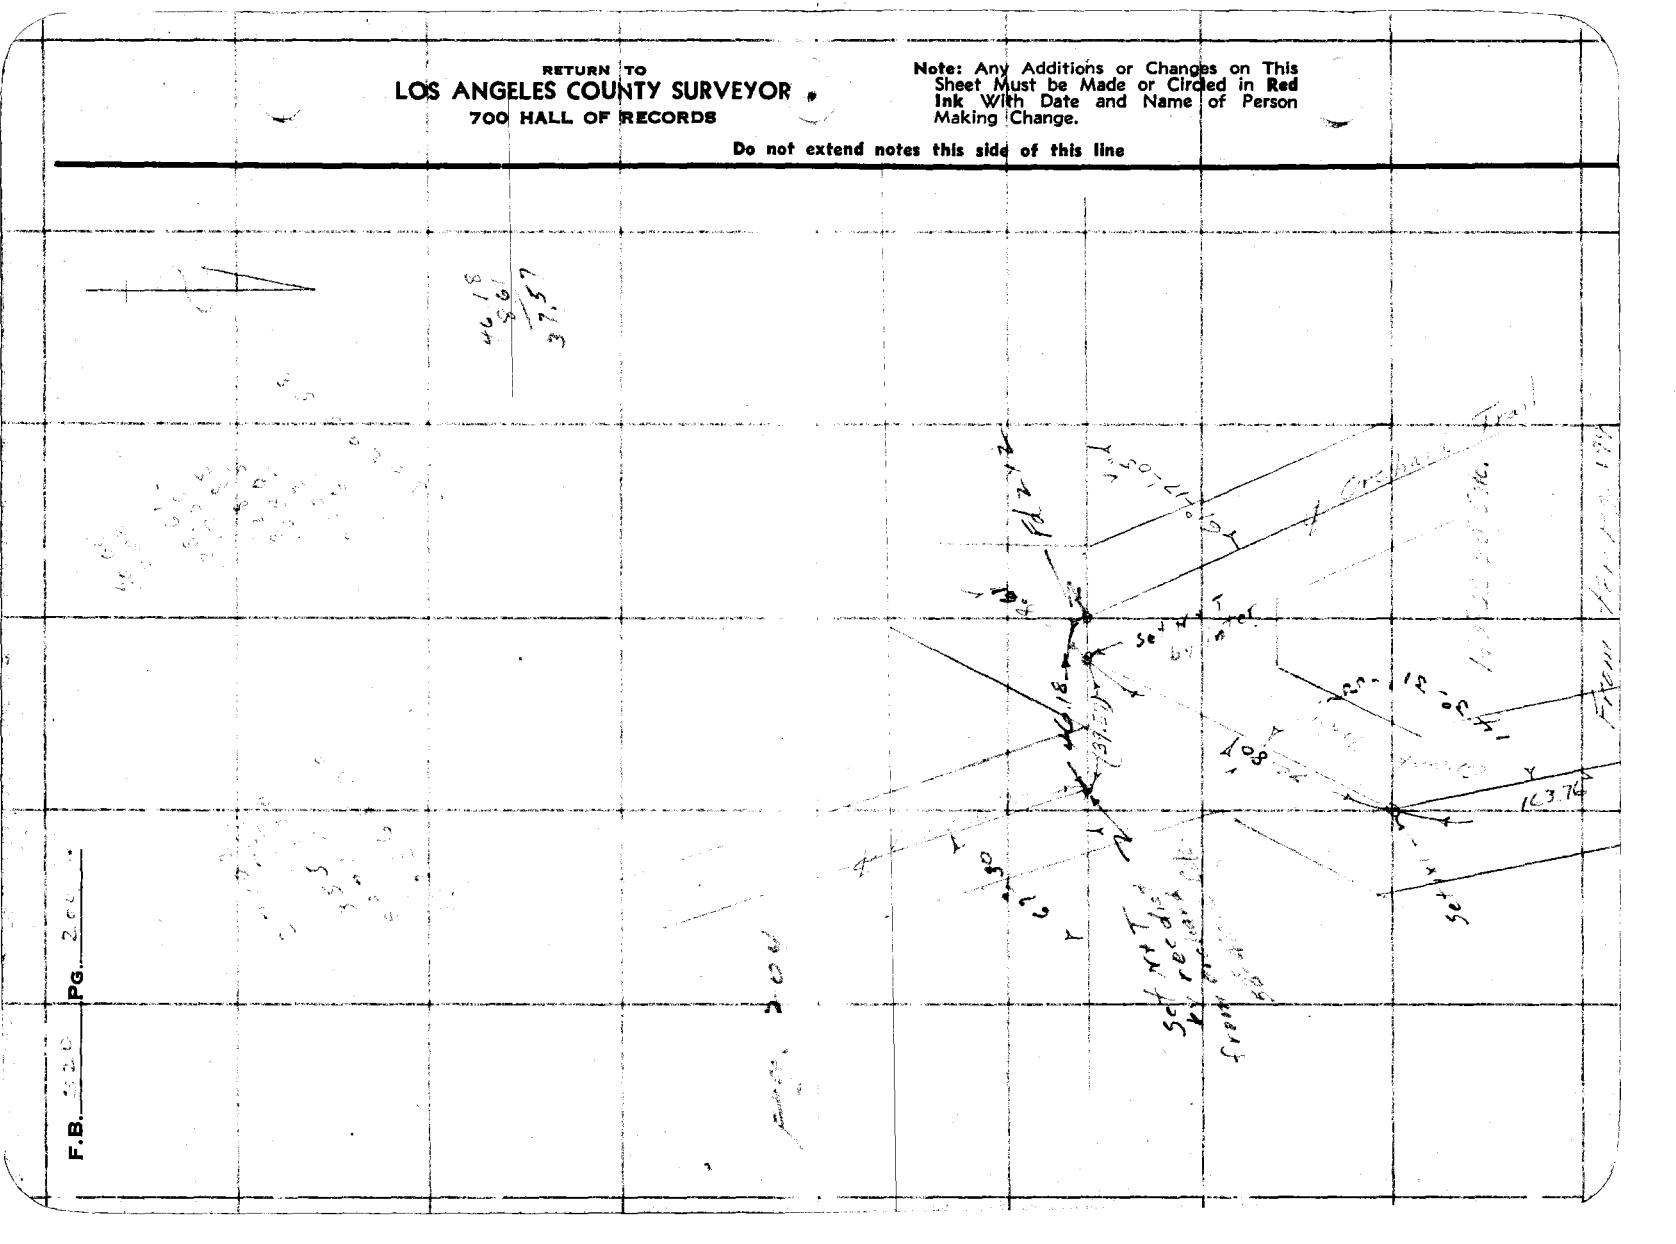

Notes Ck'd by D. M. Fisher	Survey of Water Works Dist. #	F.B.	Pg. 201
Map No.	W. O.	Tape No.	St'd °F.
Office Work	Surveyed by K. D. Moore		
Checked	Notes	Date	
Date	Indexed		

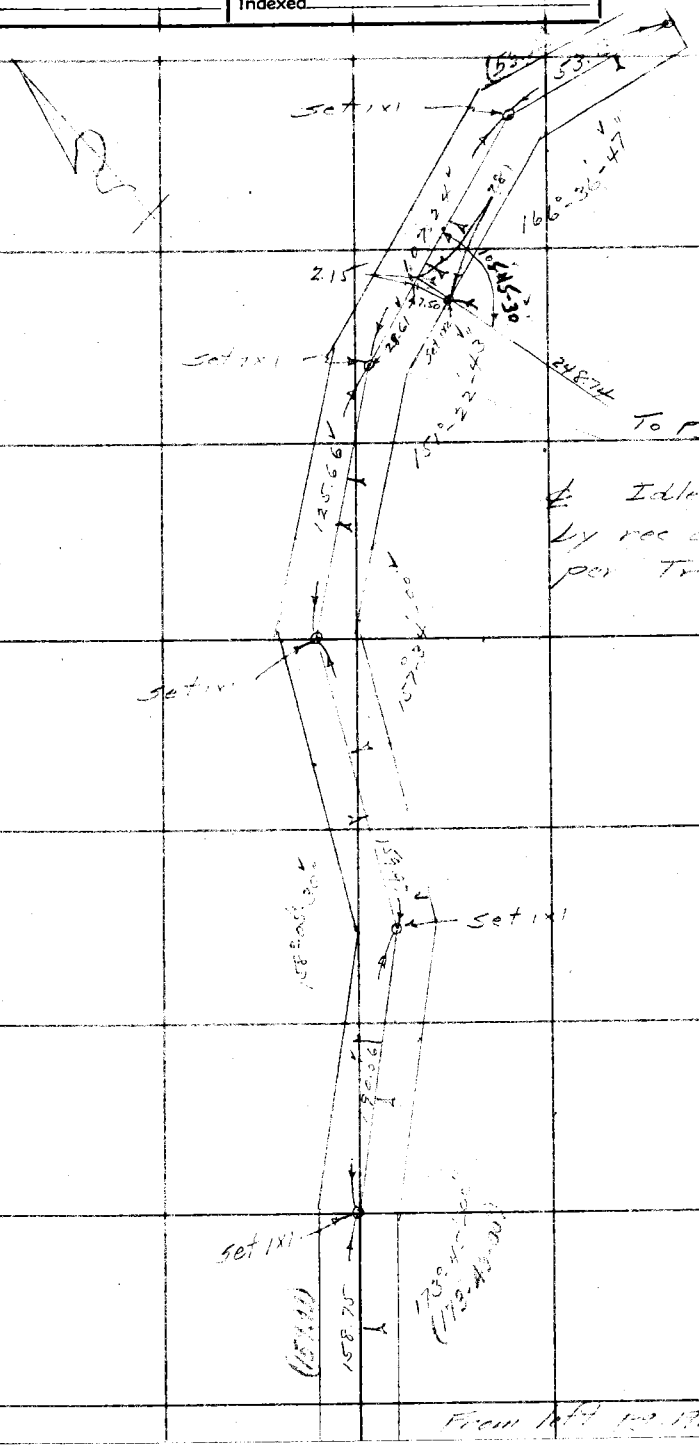

RETURN TO
LOS ANGELES COUNTY SURVEYOR
700 HALL OF RECORDS

Note: Any Additions or Changes on This Sheet Must be Made or Circled in Red Ink With Date and Name of Person Making Change

Do not extend notes this side of this line

FORM 247 10M 11-35

RETURN TO
LOS ANGELES COUNTY SURVEYOR
700 HALL OF RECORDS

Note: Any Additions or Changes on This Sheet Must be Made or Circled in **Red** Ink With Date and Name of Person Making Change.

Do not extend notes this side of this line

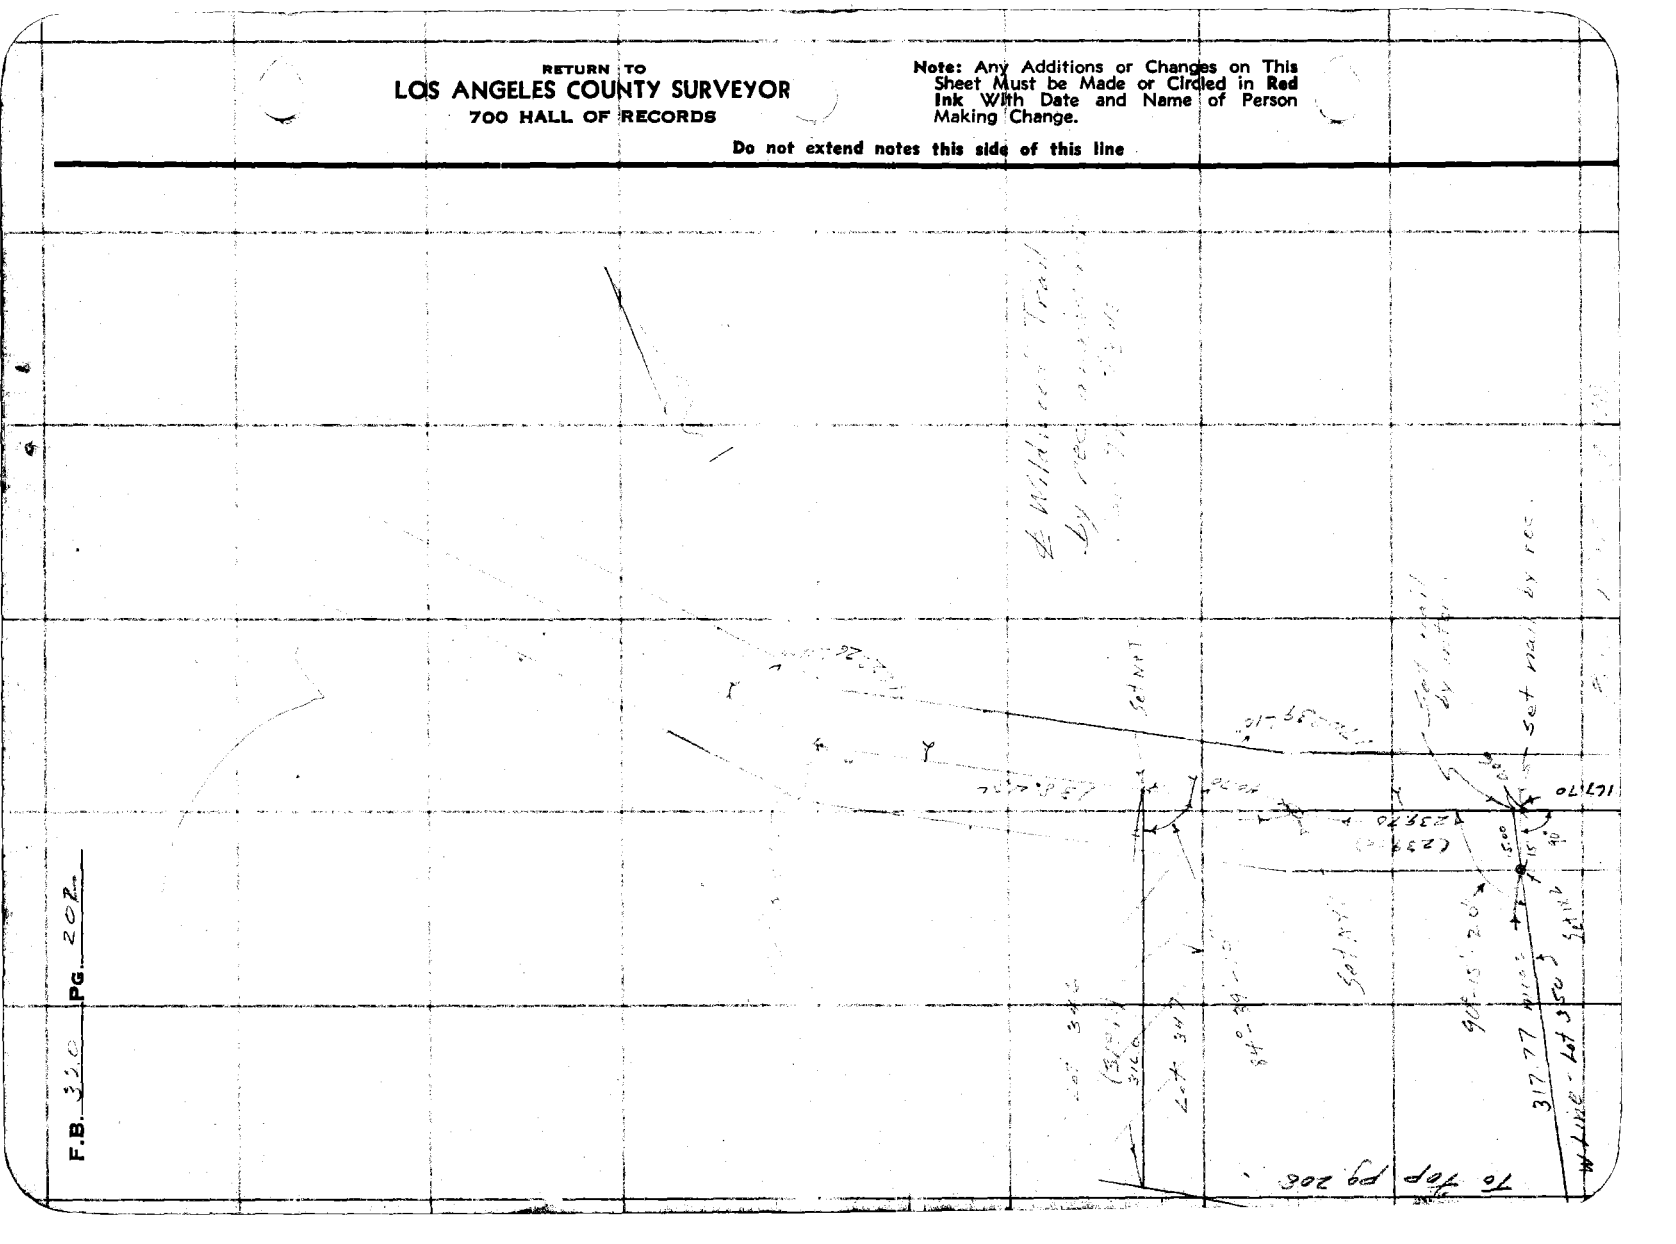

F.B. 330 PG. 202

Notes Ck'd by D. M. Tilley	Survey of Water Works Dist #21
Map No.	W. O. 8171 Tape No. St'd °F.
Office Work	Surveyed by L. S. D. W. Foote
Checked	Notes D. Foote Date 12-21-36
Date	Indexed A. C. Johnson

F.B. 326 PG. 203

Note: Any Additions or Changes on This Sheet Must be Made or Circled in Red Ink With Date and Name of Person Making Change.

Do not extend notes this side of this line

RETURN TO
LOS ANGELES COUNTY SURVEYOR
700 HALL OF RECORDS

FORM 247 10M 11-35

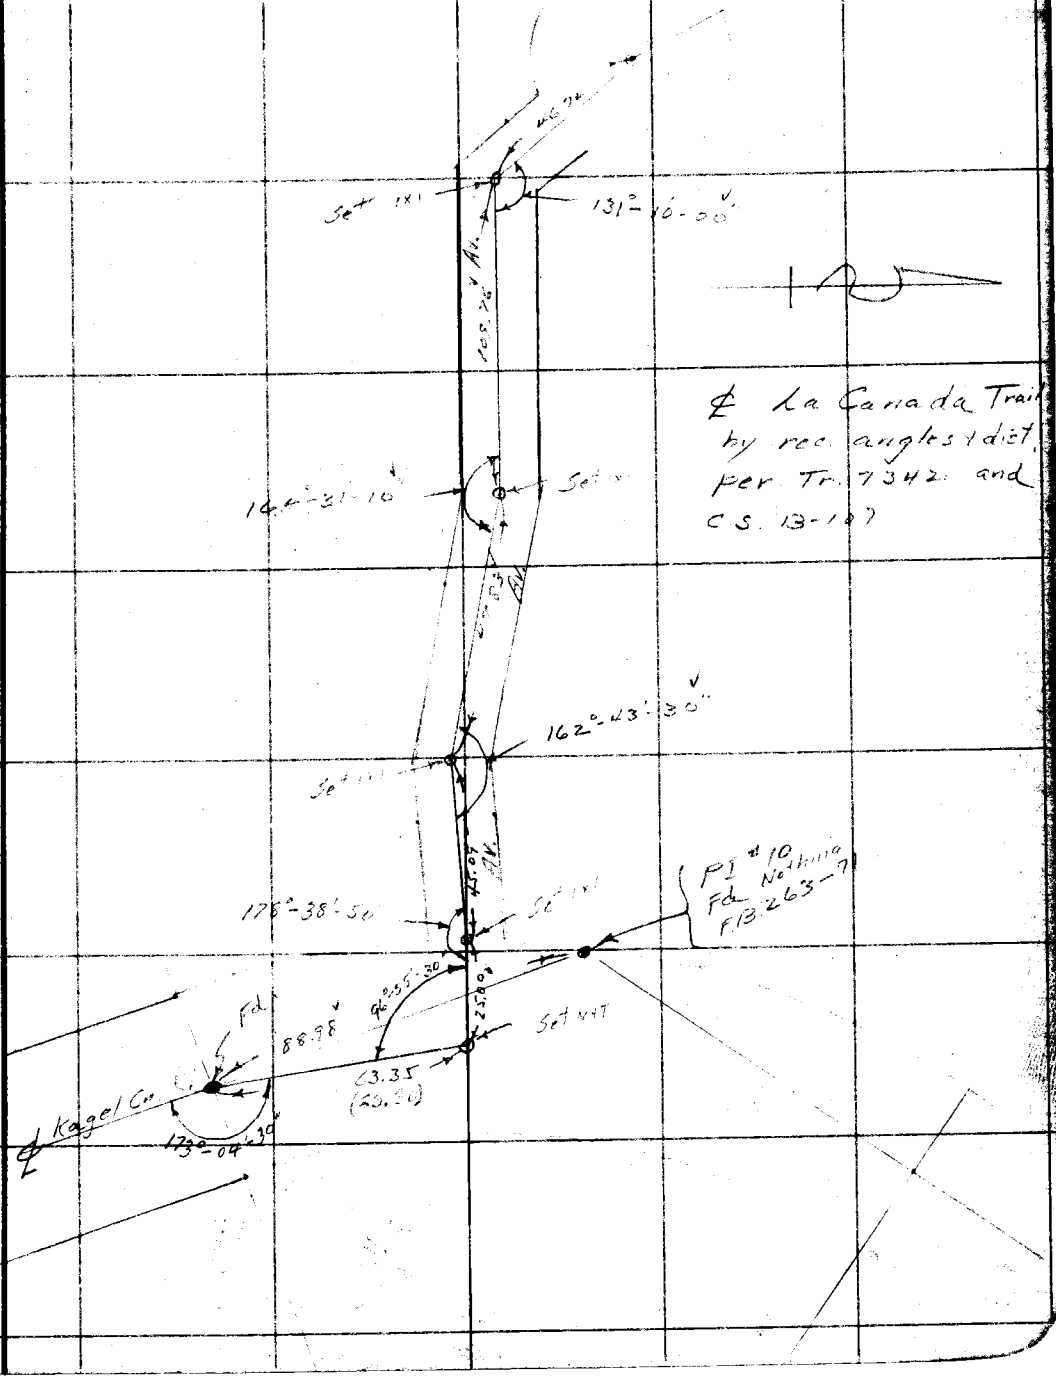

RETURN TO
LOS ANGELES COUNTY SURVEYOR
700 HALL OF RECORDS

Note: Any Additions or Changes on This Sheet Must be Made or Circled in Red Ink With Date and Name of Person Making Change.

Do not extend notes this side of this line

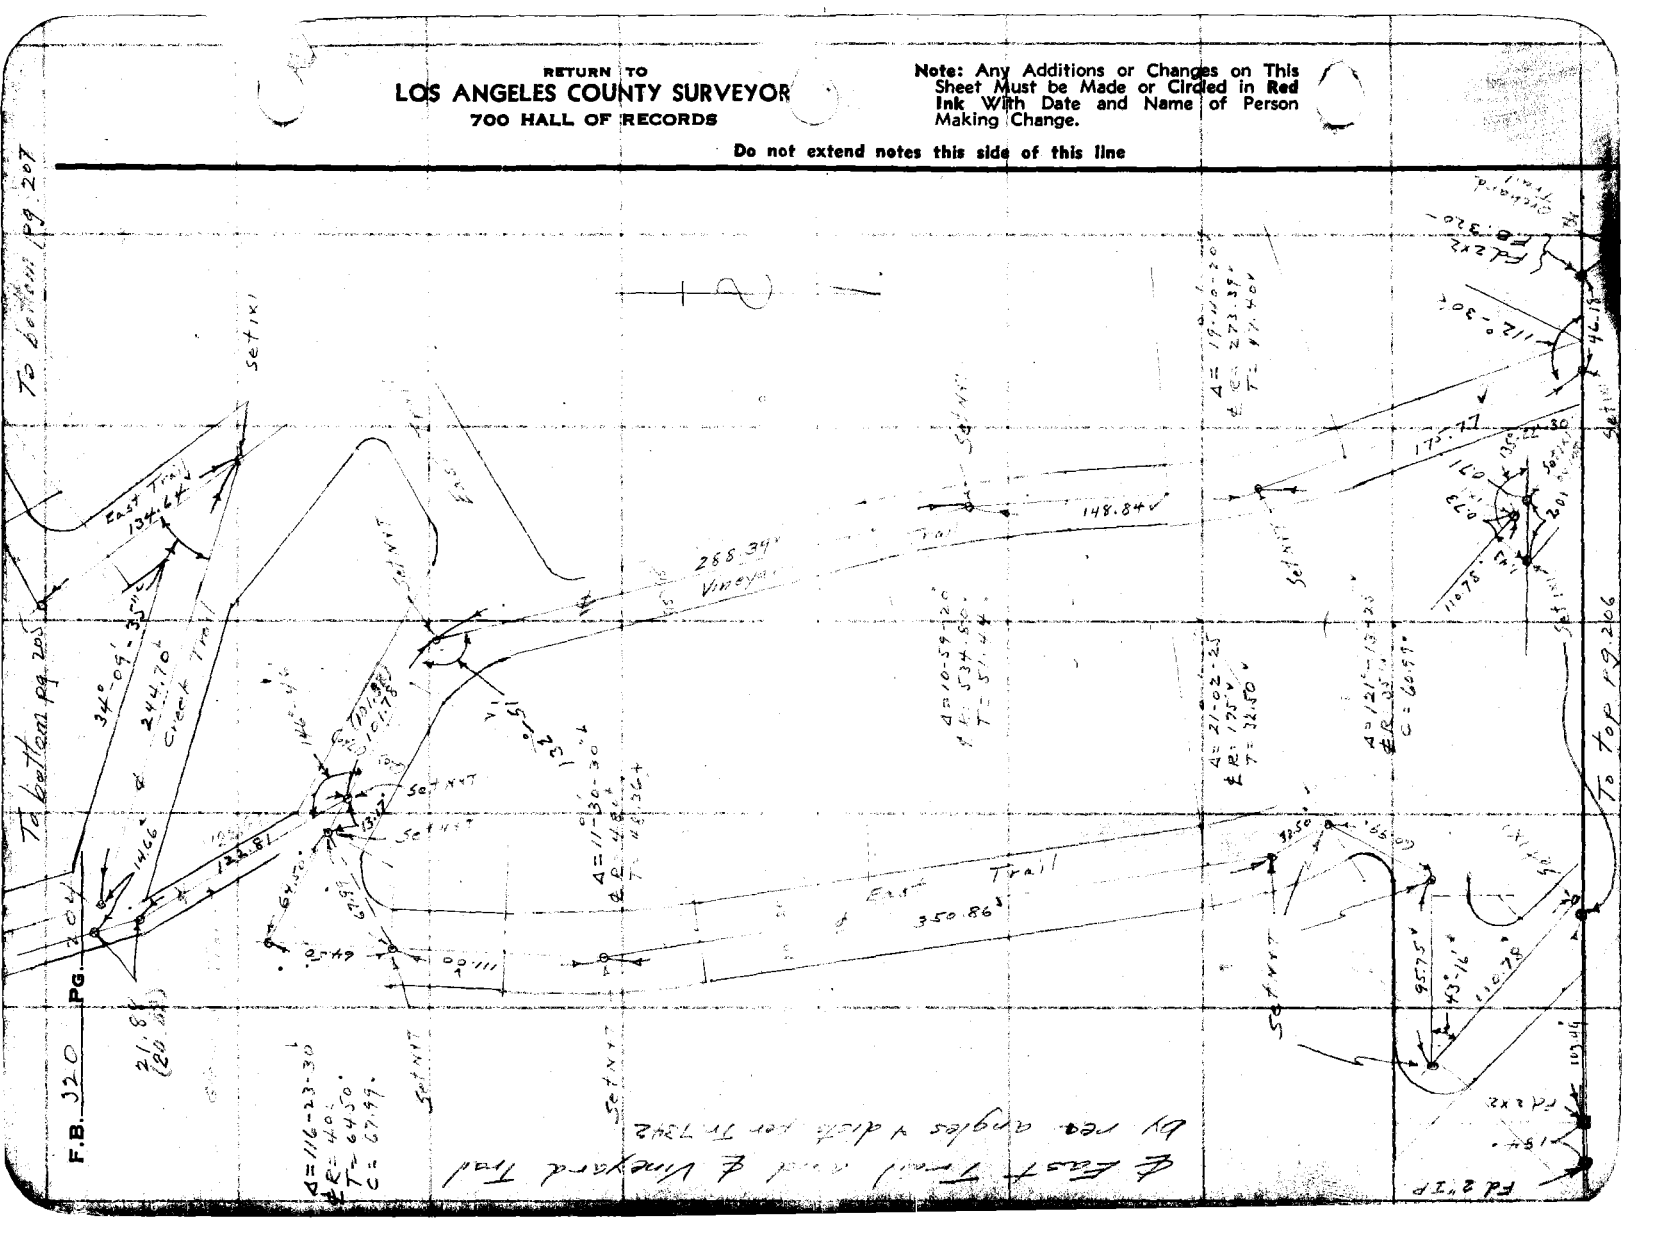

Notes Ck'd by D. M. Finley	Survey of Water Works Dist #21
Map No.	W. O. 8174 Tape No. St'd °F.
Office Work	Surveyed by L. D. Moore
Checked	Notes D'Moore Date 12-23-36
Date	Indexed

F.B. 320 Pg. 205

& Creek Trail by [illegible] angles and [illegible]

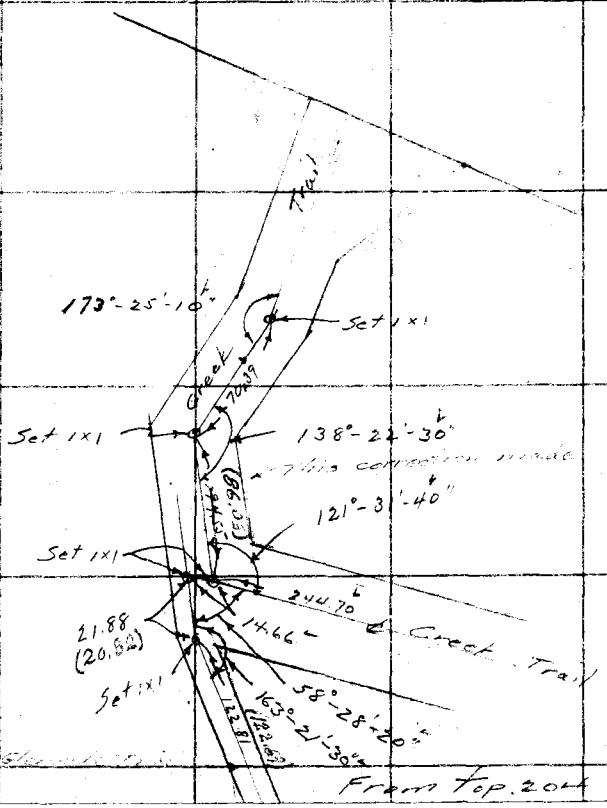

From Top. 204

RETURN TO
LOS ANGELES COUNTY SURVEYOR
700 HALL OF RECORDS

Note: Any Additions or Changes on This Sheet Must be Made or Circled in Red Ink With Date and Name of Person Making Change.

Do not extend lines this side of this line

FORM 247 10M 11-35

F.B. 320 PG. 206

Fd 2" IP Tr. 7342 FB320-92

Fd 2x2

1.84

103.49

Set NAIL

℄ Sec Line per F.B. 320-92

70.56

Set NAIL

135°-25'

173°-01'-36"

112.55

172°-32'-36"

Set NAIL

392.68

146°-24'-14"

Set NAIL

137.03

108-07-45

134°-47'-13"

Set NAIL

Fd 2x2

23.50

68°-36'-40"

RETURN TO
LOS ANGELES COUNTY SURVEY
700 HALL OF RECORDS

Note: Any Additions or Changes on This Sheet Must be Made or Circled in Red Ink With Date and Name of Person Making Change.

Do not ... end notes this side of this line

Notes Ck'd by D. M. Finley	Survey of Water Works Dist #21	F.B. 320	Pg. 207
Map No.	W. O. 5174 Tape No.	St'd °F.	
Office Work	Surveyed by L. D. Moore		
Checked	Notes LDMoore Date 12-27-56		
Date	Indexed A. C. Johnson		

Note: Any Additions or Changes on This Sheet Must be Made or Circled in Red Ink With Date and Name of Person Making Change.

Do not extend notes this side of this line

RETURN TO
LOS ANGELES COUNTY SURVEYOR
700 HALL OF RECORDS

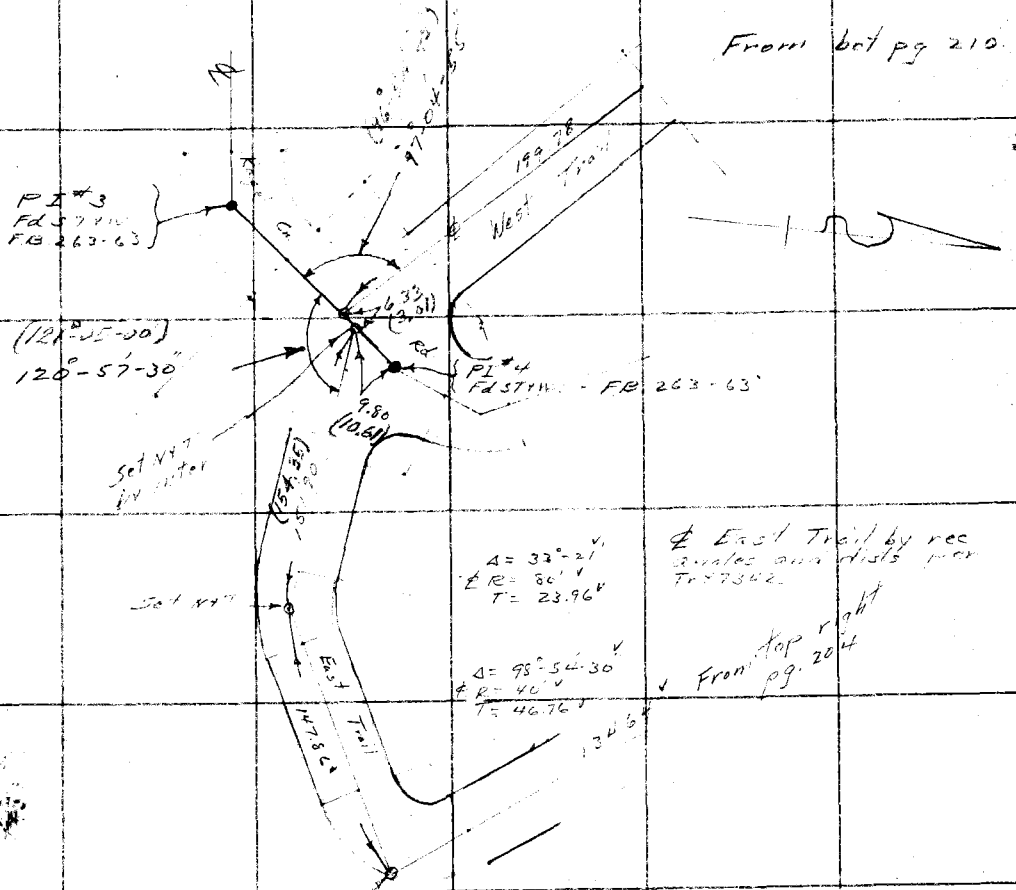

FORM 247 10M 11-38

RETURN TO
LOS ANGELES COUNTY SURVEYOR
700 HALL OF RECORDS

Note: Any Additions or Changes on This Sheet Must be Made or Circled in **Red** Ink With Date and Name of Person Making Change.

Do not extend notes this side of this line

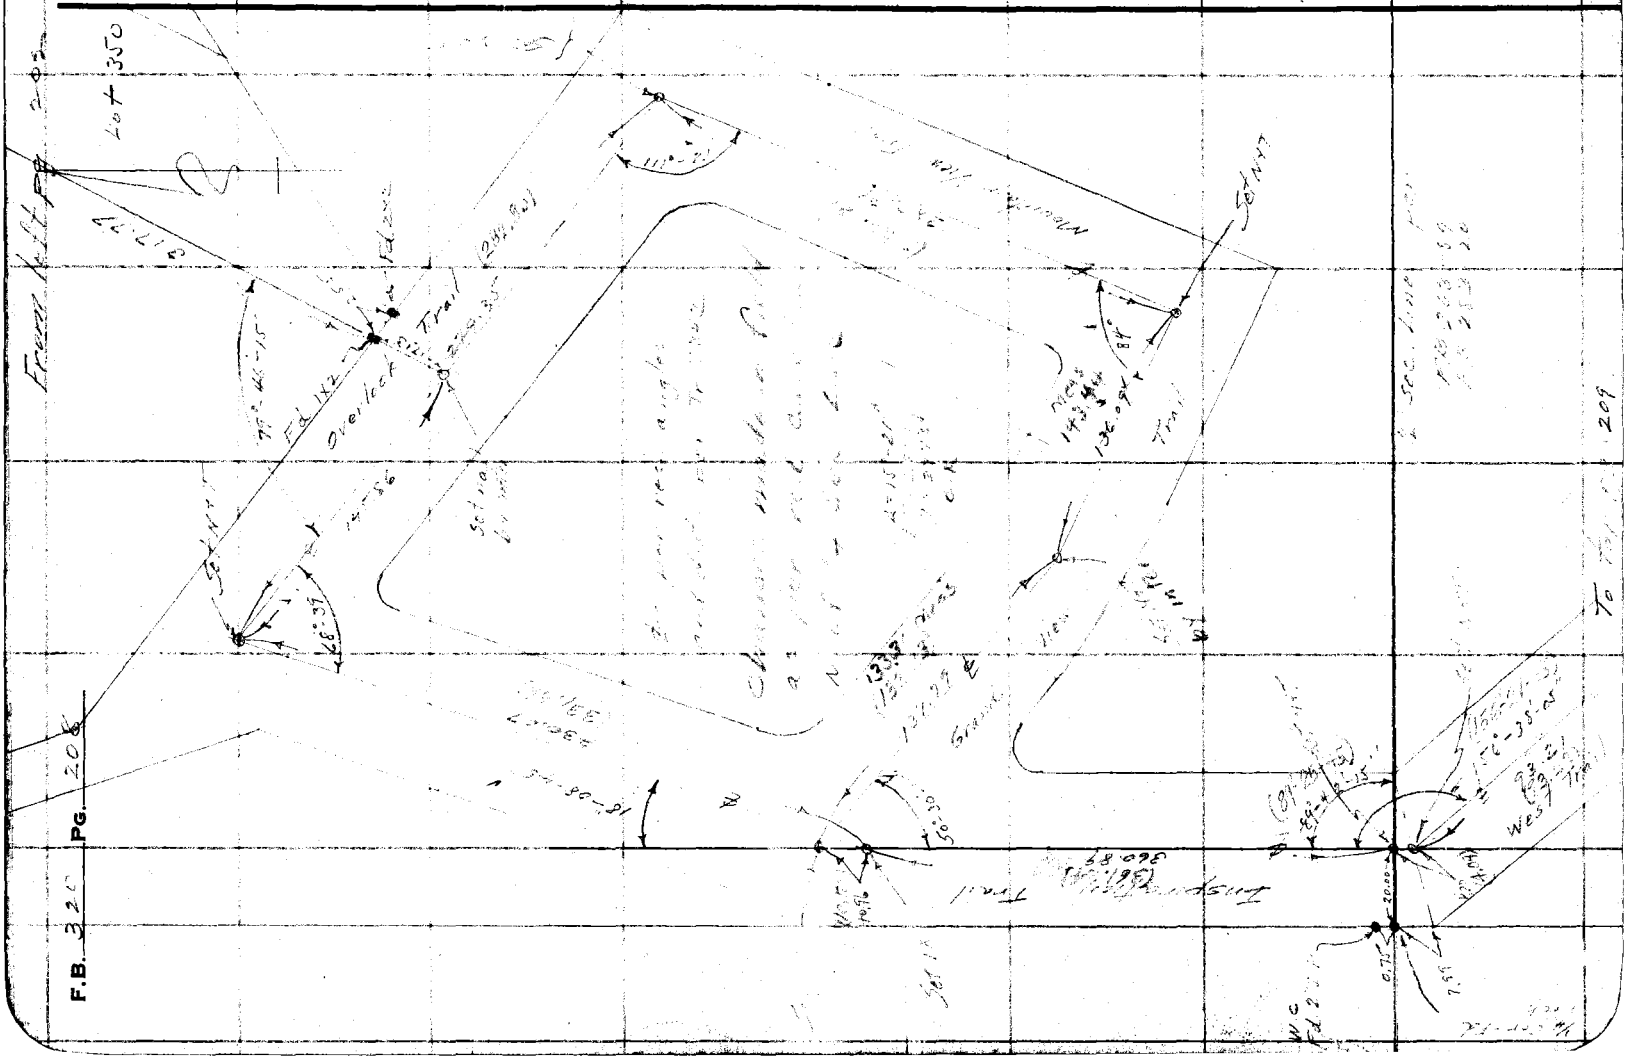

Notes Ck'd by D. N. Wiley	Survey of Water Works Dist. #21
Map No.	W. O. Tape No. St'd °F.
Office Work	Surveyed by K. D. Moore
Checked	Notes Date
Date	Indexed

F.B. 320 PG. 207

Note: Any Additions or Changes on This Sheet Must be Made or Circled in Red Ink With Date and Name of Person Making Change.

Do not extend notes this side of this line

RETURN TO
LOS ANGELES COUNTY SURVEYOR
700 HALL OF RECORDS

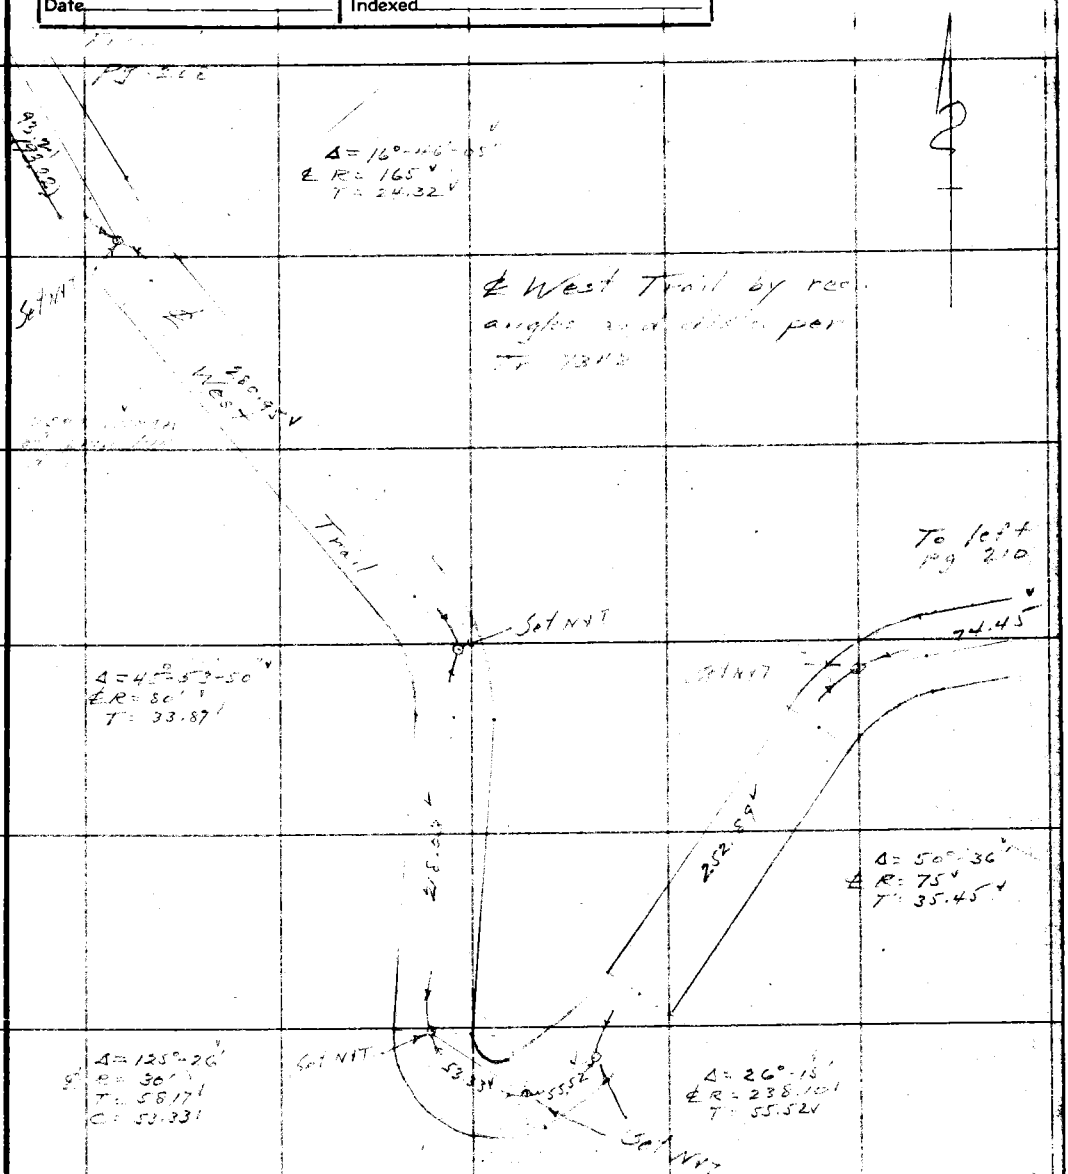

FORM 247 10M 11-38

F.B. 320 PG. 210

From right
Pg. 209

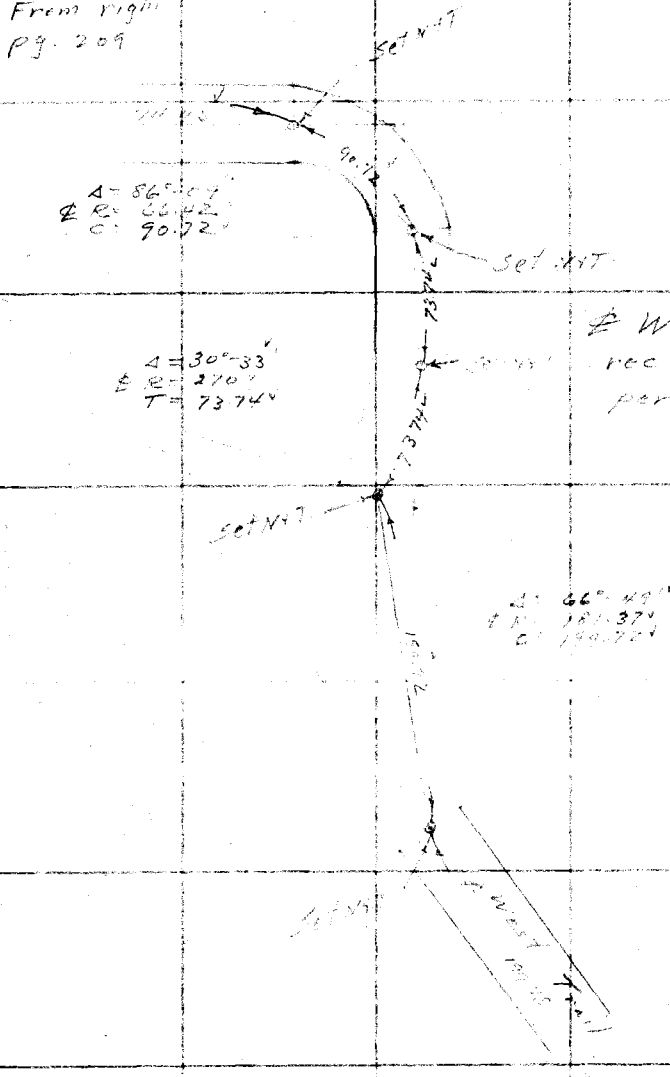

LOS ANGELES COUNTY SURVEYOR
700 HALL OF RECORDS

RETURN TO

Note: Any Additions or Changes on This Sheet Must be Made or Circled in Red Ink With Date and Name of Person Making Change.

Do not extend notes this side of this line

FORM 247 10M 11-38

RETURN TO
LOS ANGELES COUNTY SURVEYOR
700 HALL OF RECORDS

Note: Any Additions or Changes on This Sheet Must be Made or Circled in **Red Ink** With Date and Name of Person Making Change.

Do not extend notes this side of this line

Notes Ck'd by
Map No.
Offide Work
Checked
Date

Survey of Water Works Engr.
W. O. 5111 Tape No. St'd. °F.
Surveyed by L. Gonzales
Notes
Indexed A. C. Thomson Date 12-6-38

F.B. 320 PG. 211

RETURN TO
LOS ANGELES COUNTY SURVEYOR
700 HALL OF RECORDS

Note: Any Additions or Changes on This Sheet Must be Made or Circled in **Red Ink** With Date and Name of Person Making Change.

Do not extend notes this side of this line

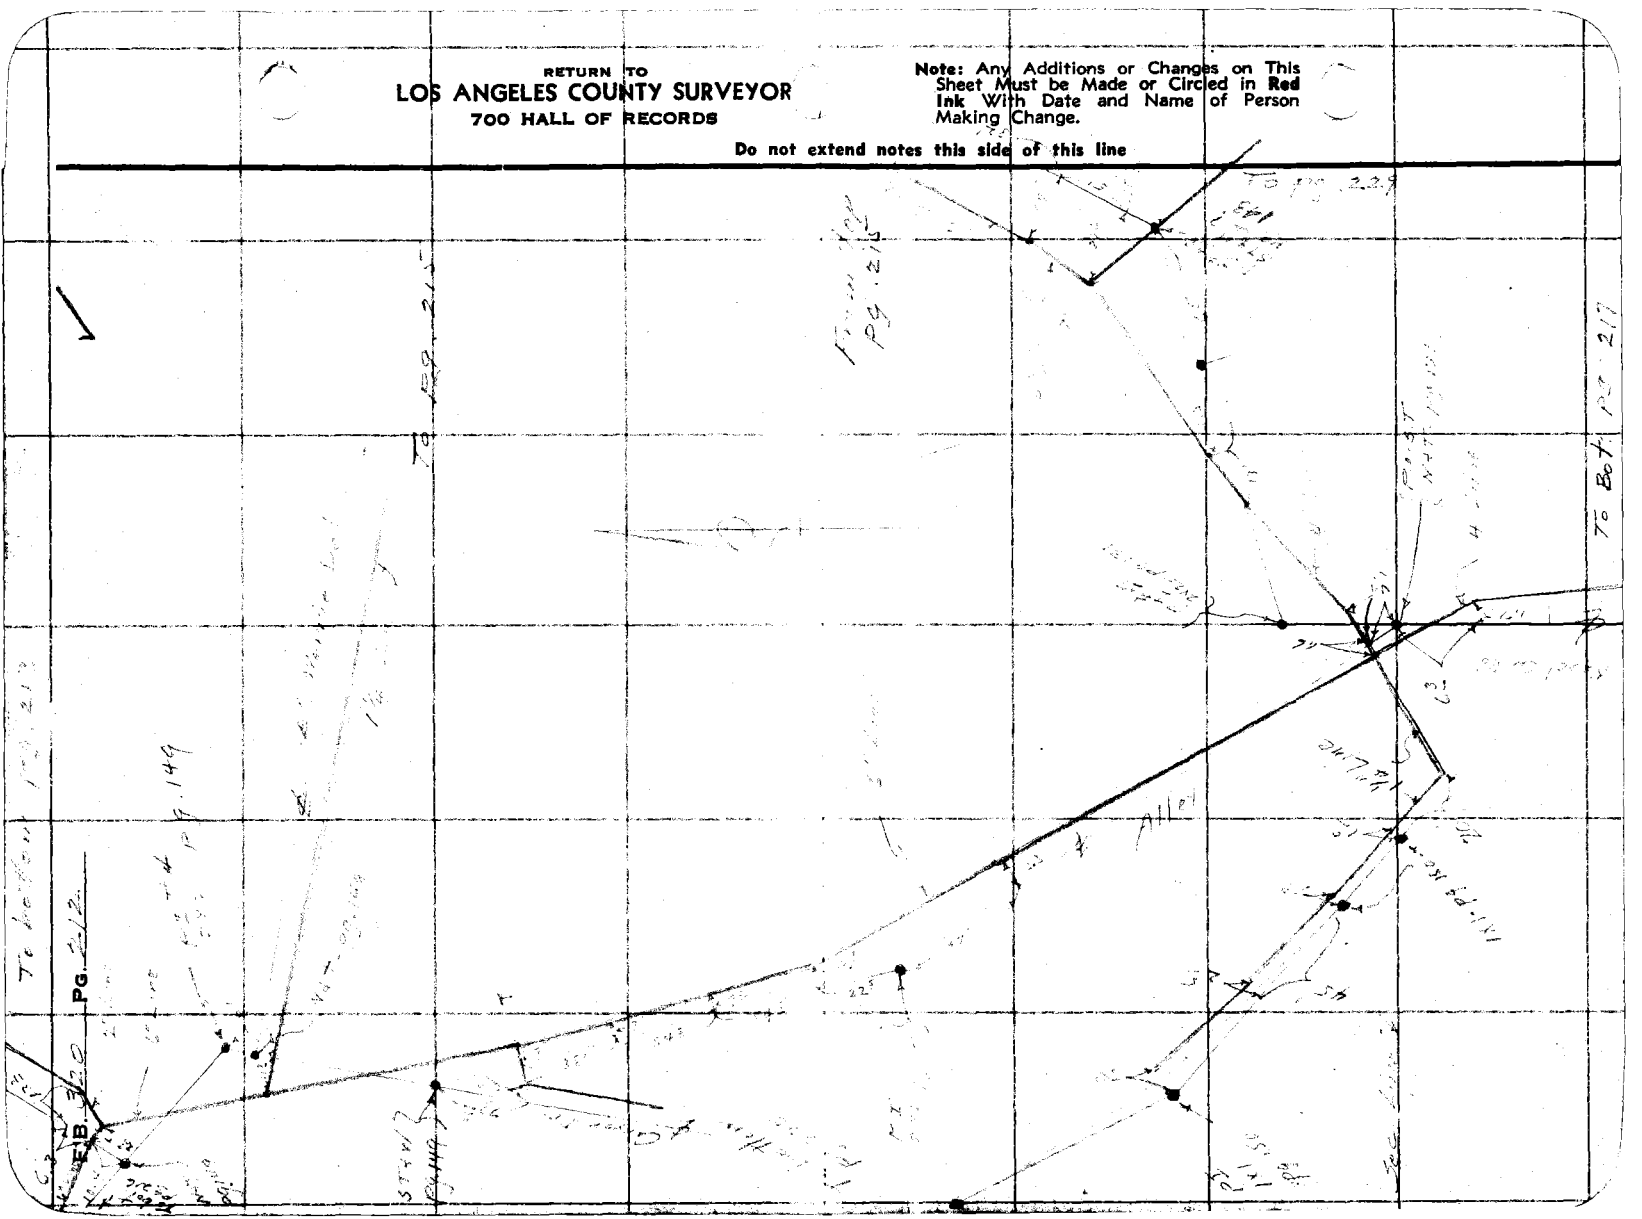

Notes Ck'd by	Survey of
Map No.	W. O. Tape No. St'd °F.
Office Work	Surveyed by
Checked	Notes Date
Date	Indexed

F.B. Pg.

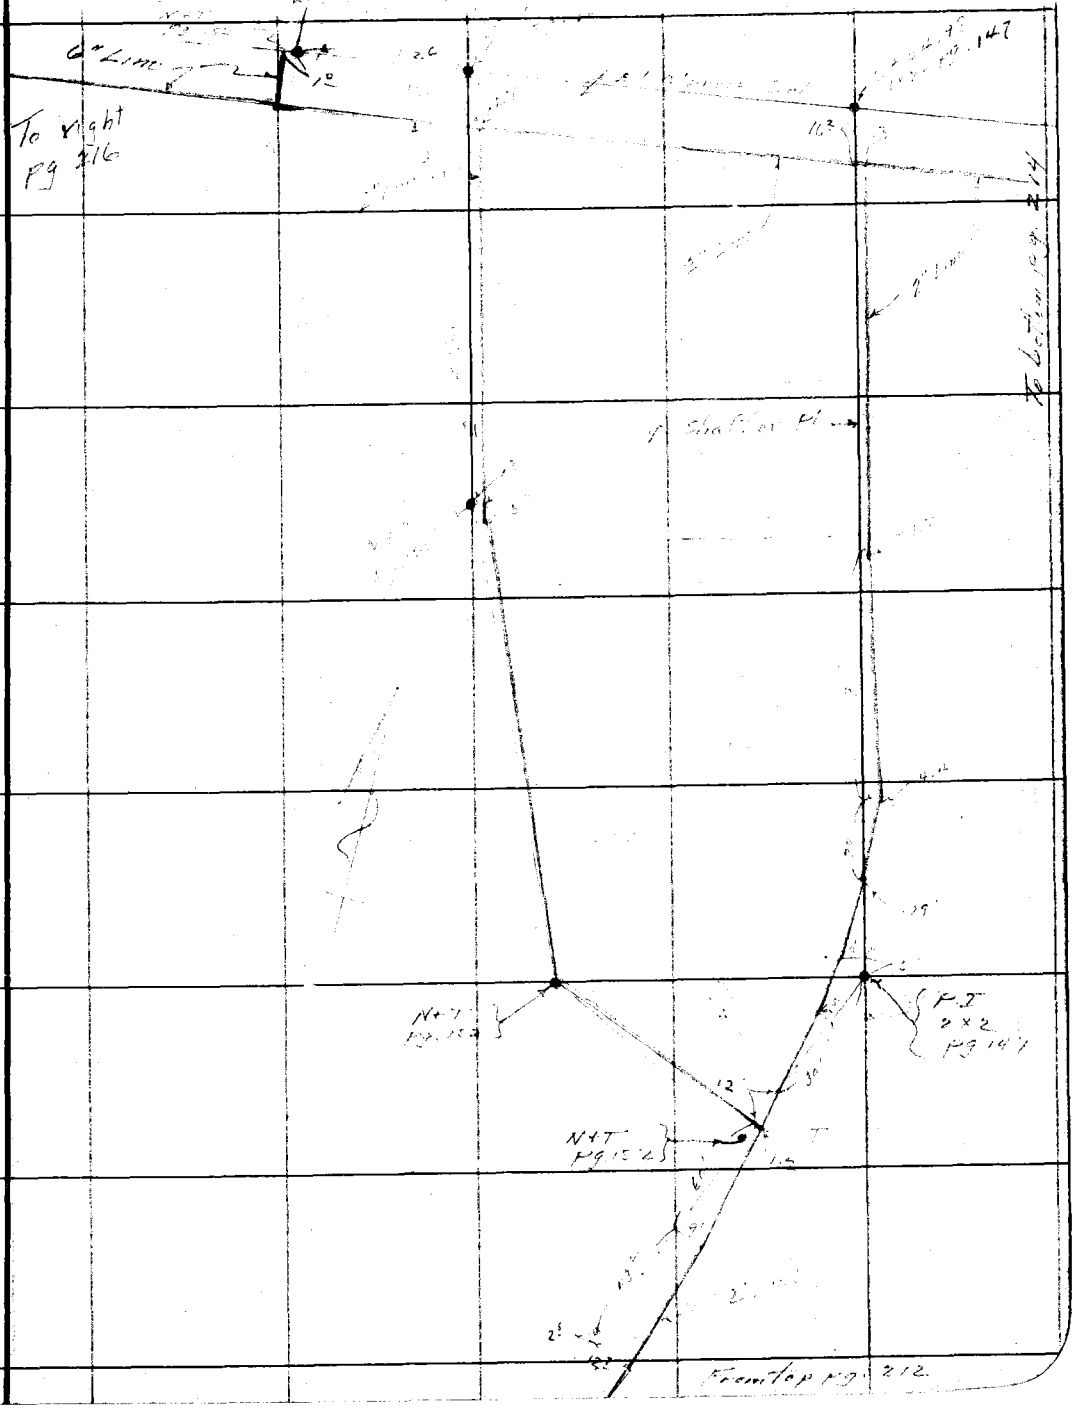

Note: Any Additions or Changes on This Sheet Must be Made or Circled in Red Ink With Date and Name of Person Making Change.

Do not extend notes this side of this line

RETURN TO
LOS ANGELES COUNTY SURVEYOR
700 HALL OF RECORDS

FORM 247 10M 11-35

RETURN TO
LOS ANGELES COUNTY SURVEYOR
700 HALL OF RECORDS

Note: Any Additions or Changes on This Sheet Must be Made or Circled in **Red Ink** With Date and Name of Person Making Change.

Do not extend notes this side of this line

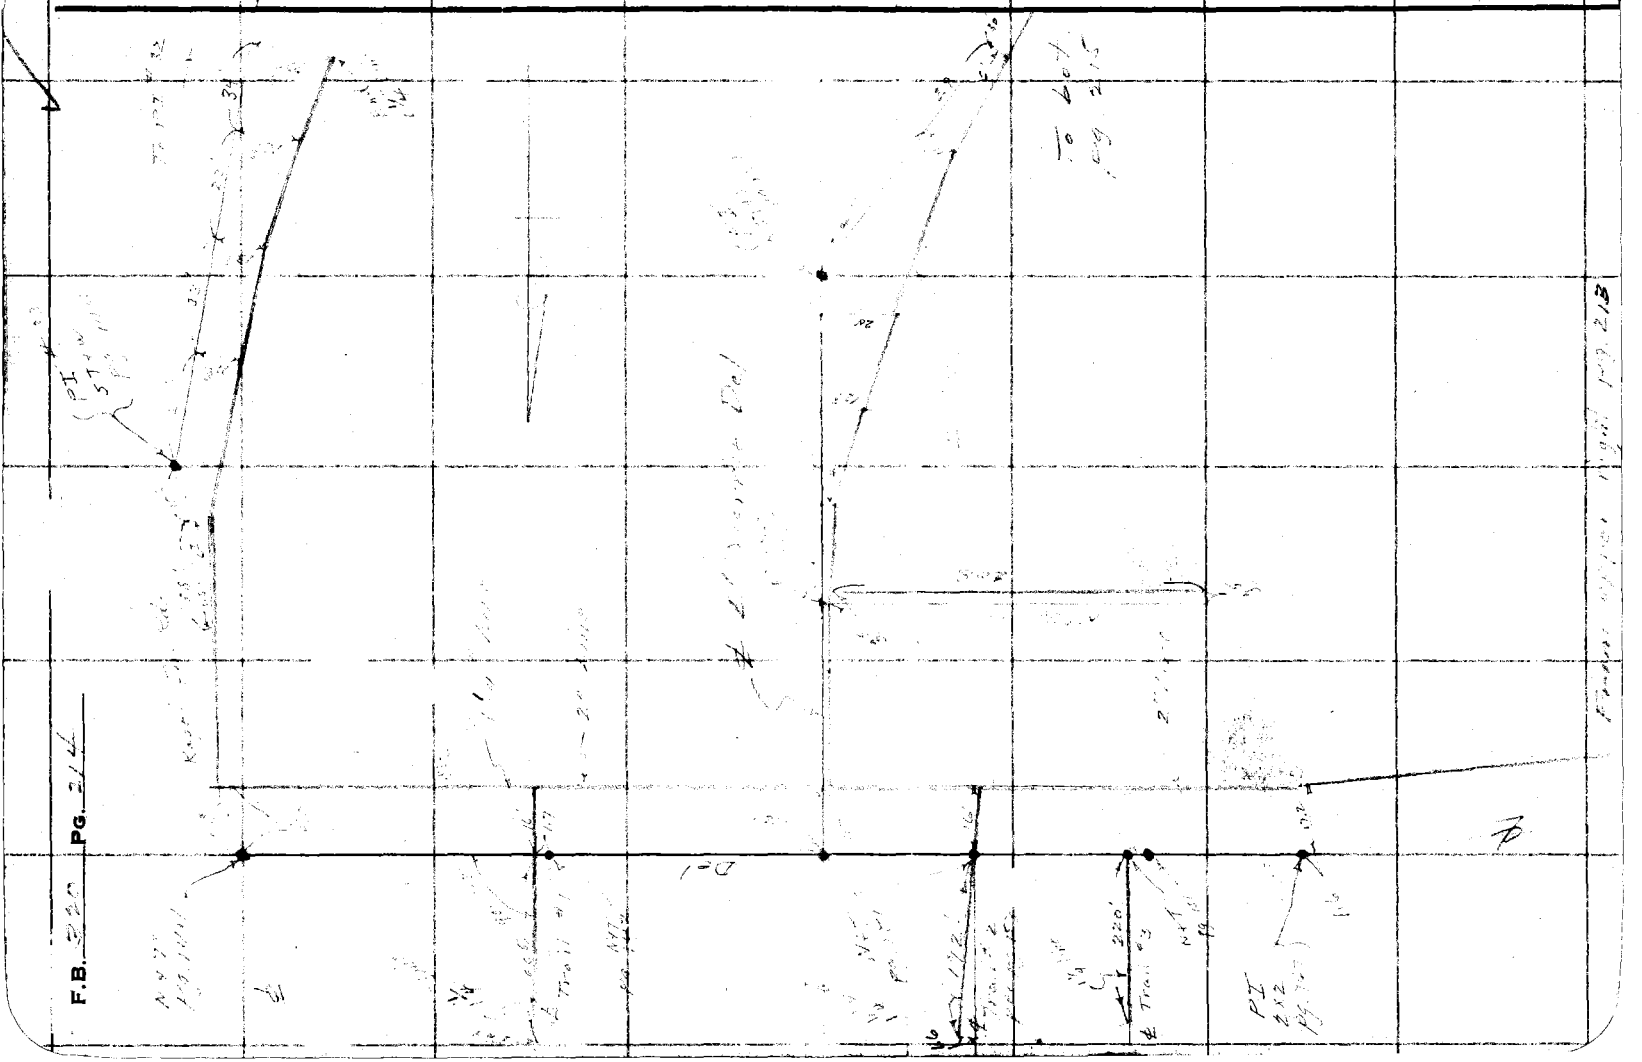


FORM 247 10M 11-35

RETURN TO
LOS ANGELES COUNTY SURVEYOR
700 HALL OF RECORDS

Note: Any Additions or Changes on This Sheet Must be Made or Circled in **Red Ink** With Date and Name of Person Making Change.

Do not extend notes this side of this line

Notes Ck'd by
Map No.
Offide Work
Checked
Date

Survey of
W. O. Tape No. St'd °F.
Surveyed by
Notes
Indexed Date

F.B. PG.

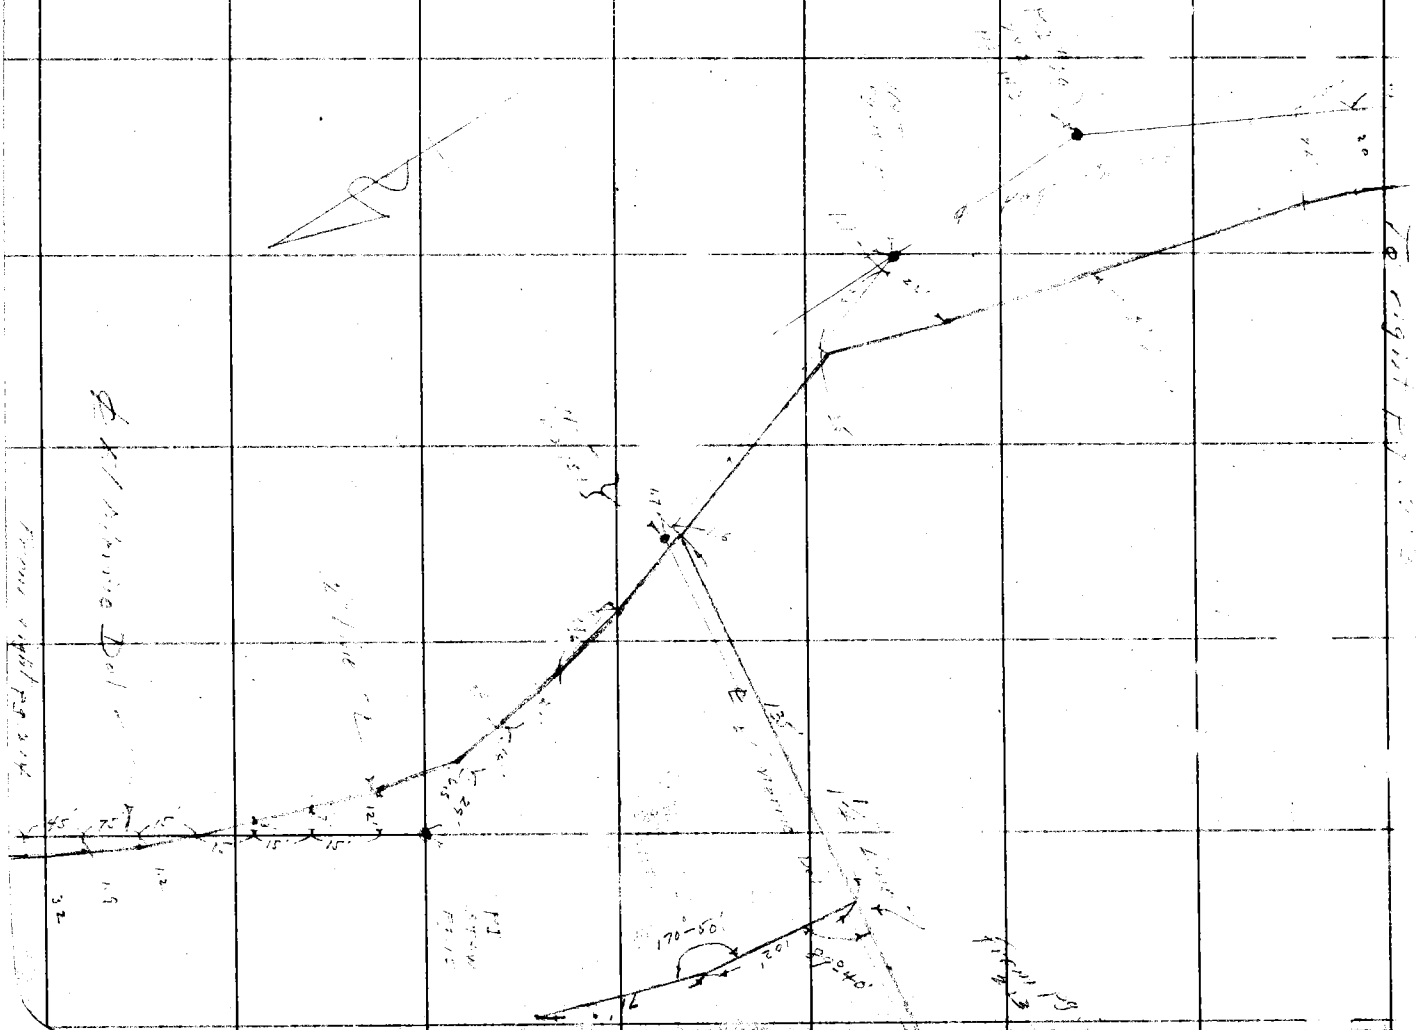

RETURN TO
LOS ANGELES COUNTY SURVEYOR
700 HALL OF RECORDS

Note: Any Additions or Changes on This Sheet Must be Made or Circled in **Red Ink** With Date and Name of Person Making Change.

Do not extend notes this side of this line


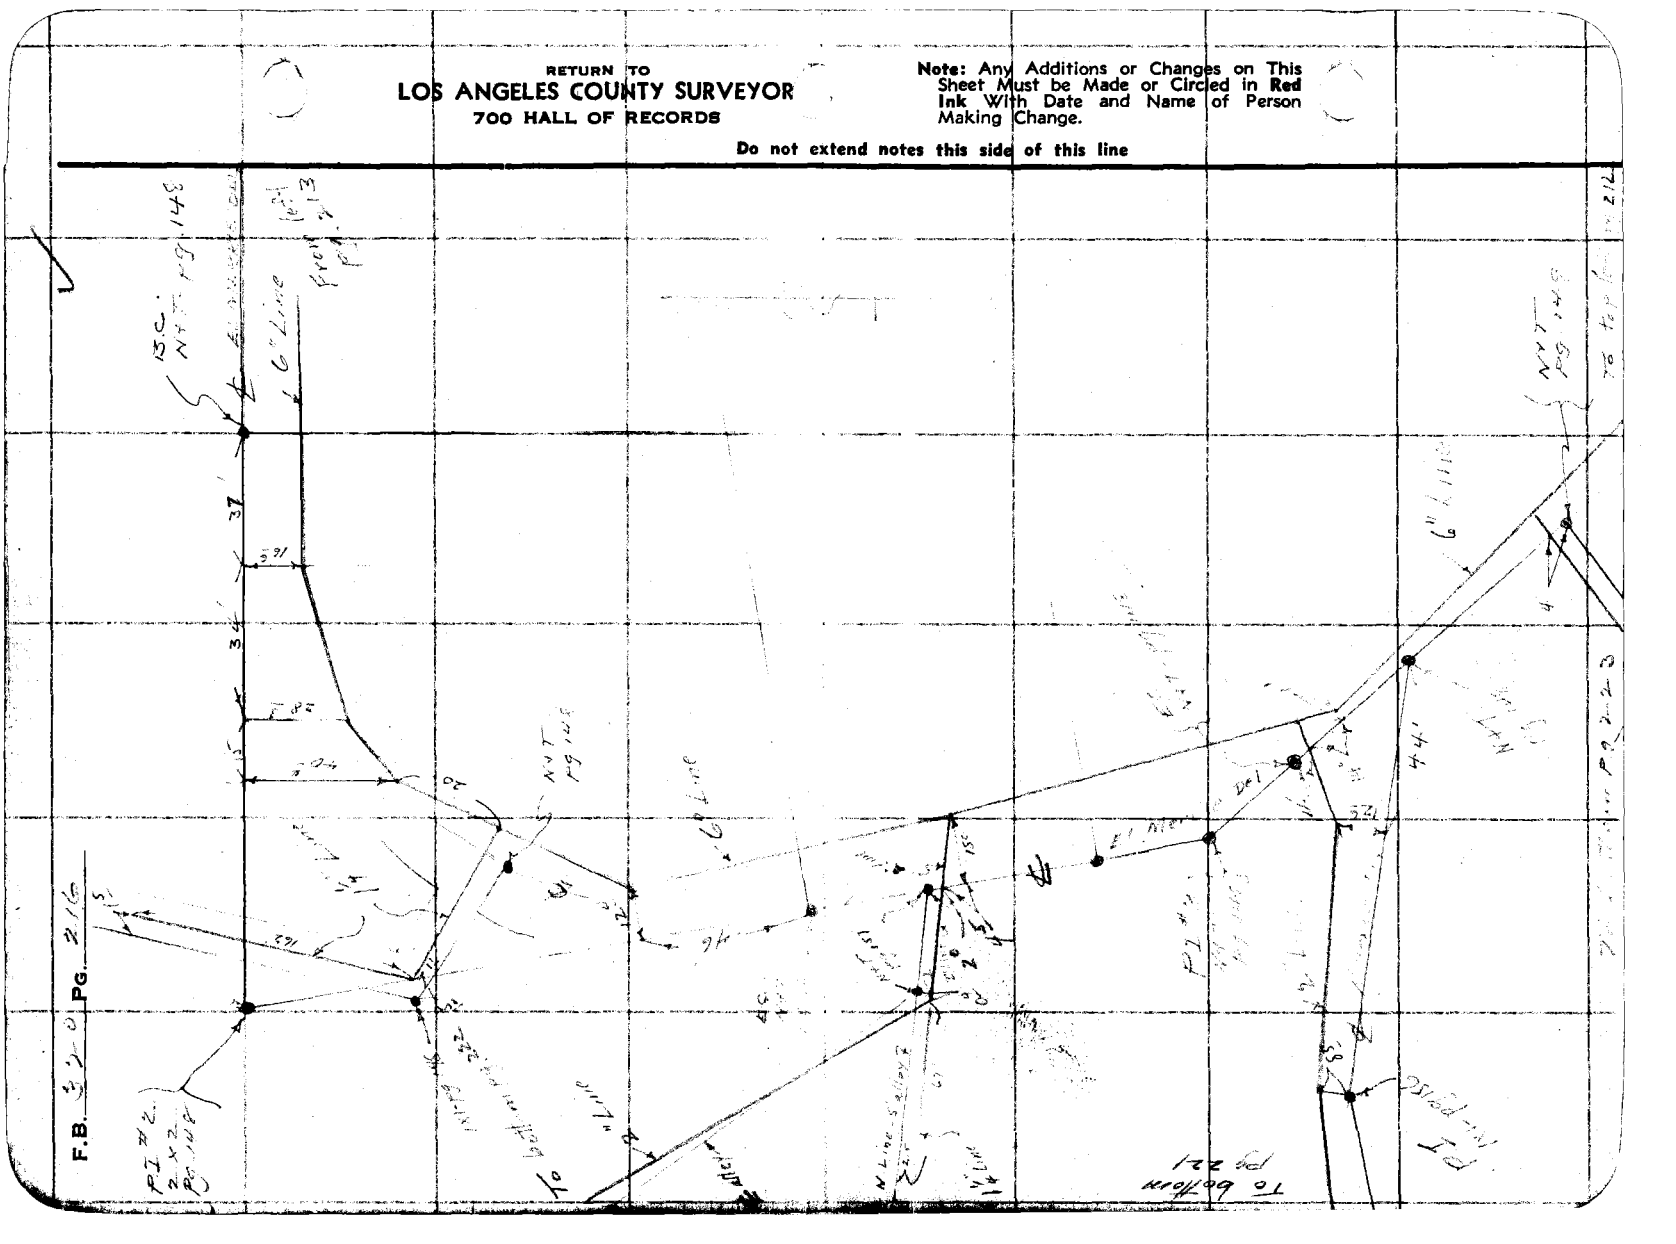

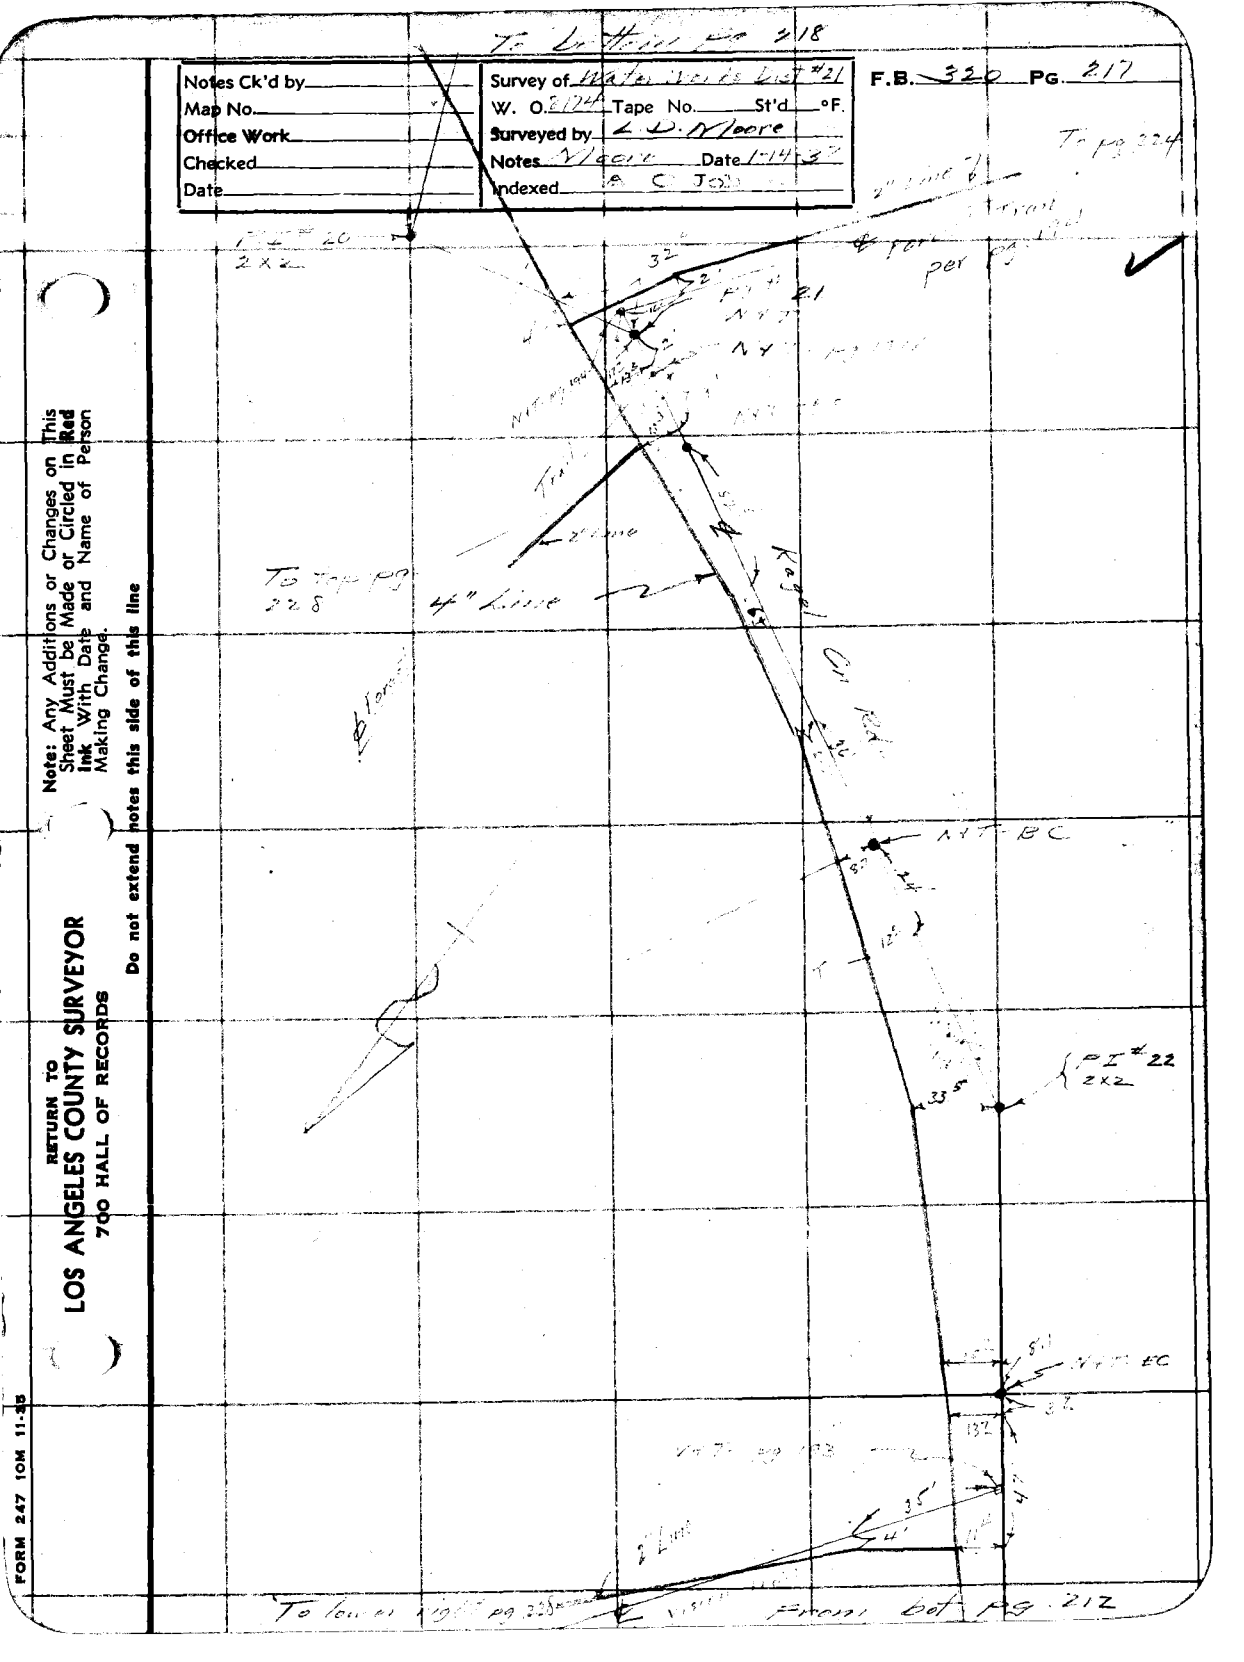
To Lo Hill Dr 2/18
Notes Ck'd by
Map No.
Office Work
Checked
Date
Survey of Water Works List #21
W. O. 2174 Tape No. St'd °F.
Surveyed by L. D. Moore
Notes Moore Date 1-14-37
Indexed A C Jo
F.B. 320 Pg. 217
To Pg 224
2" Line
per Pg
2 x 2
32
21
4" Line
To Top Pg 228
Kaiser
PI #22
2 x 2
To lower right Pg 228
From bot Pg 212
RETURN TO
LOS ANGELES COUNTY SURVEYOR
700 HALL OF RECORDS
Note: Any Additions or Changes on This Sheet Must be Made or Circled in Red Ink With Date and Name of Person Making Change.
Do not extend notes this side of this line
FORM 247 10M 11-35

F.B. 320 Pg. 218

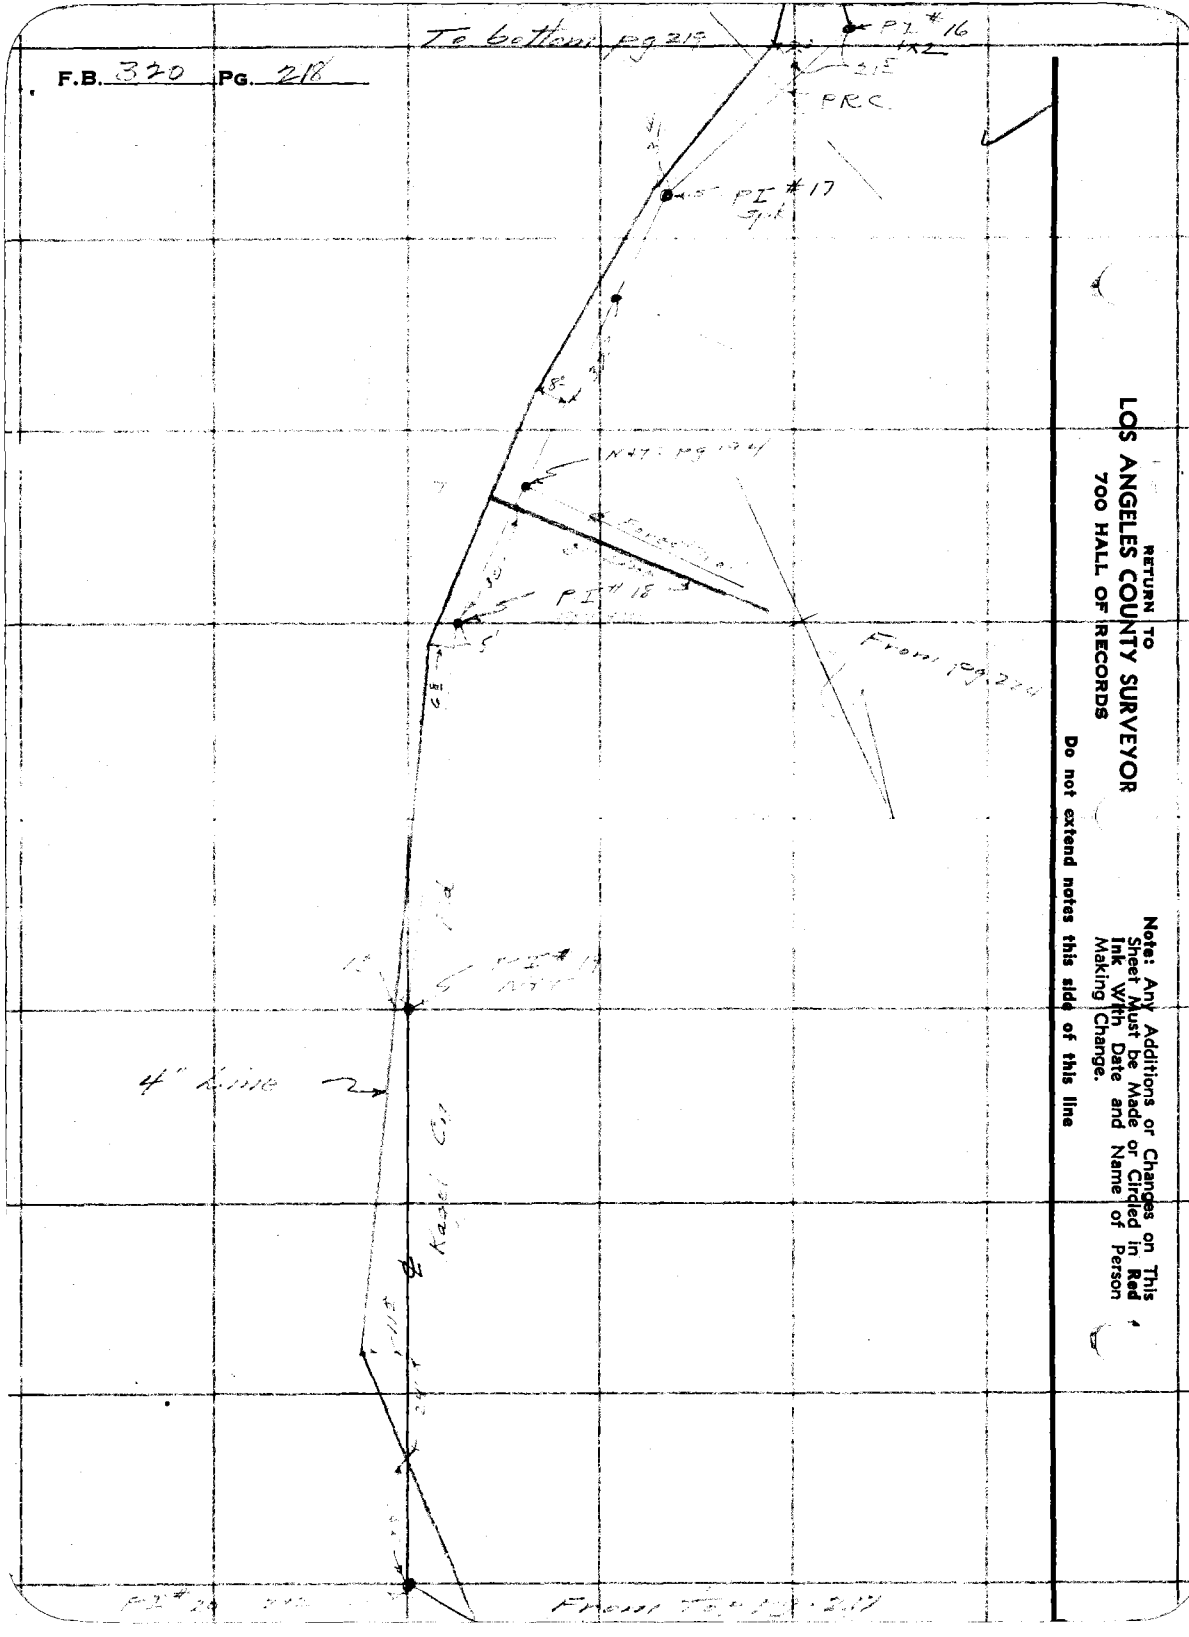

RETURN TO
LOS ANGELES COUNTY SURVEYOR
700 HALL OF RECORDS

Note: Any Additions or Changes on This Sheet Must be Made or Circled in Red Ink With Date and Name of Person Making Change.

Do not extend notes this side of this line

Notes Ck'd by	Survey of Water Works Dist 2
Map No.	W. O. 2174 Tape No. St'd °F.
Office Work	Surveyed by L.D Moore
Checked	Notes D Irvine Date 1-15-37
Date	Indexed A. C. Johnson

F.B. 320 Pg. 219

Note: Any Additions or Changes on This Sheet Must be Made or Circled in Red Ink With Date and Name of Person Making Change.

Do not extend notes this side of this line

RETURN TO
LOS ANGELES COUNTY SURVEYOR
700 HALL OF RECORDS

FORM 247 10M 11-35

RETURN TO
LOS ANGELES COUNTY SURVEYOR
700 HALL OF RECORDS

Note: Any Additions or Changes on This Sheet Must be Made or Circled in **Red Ink** With Date and Name of Person Making Change.

Do not extend notes this side of this line

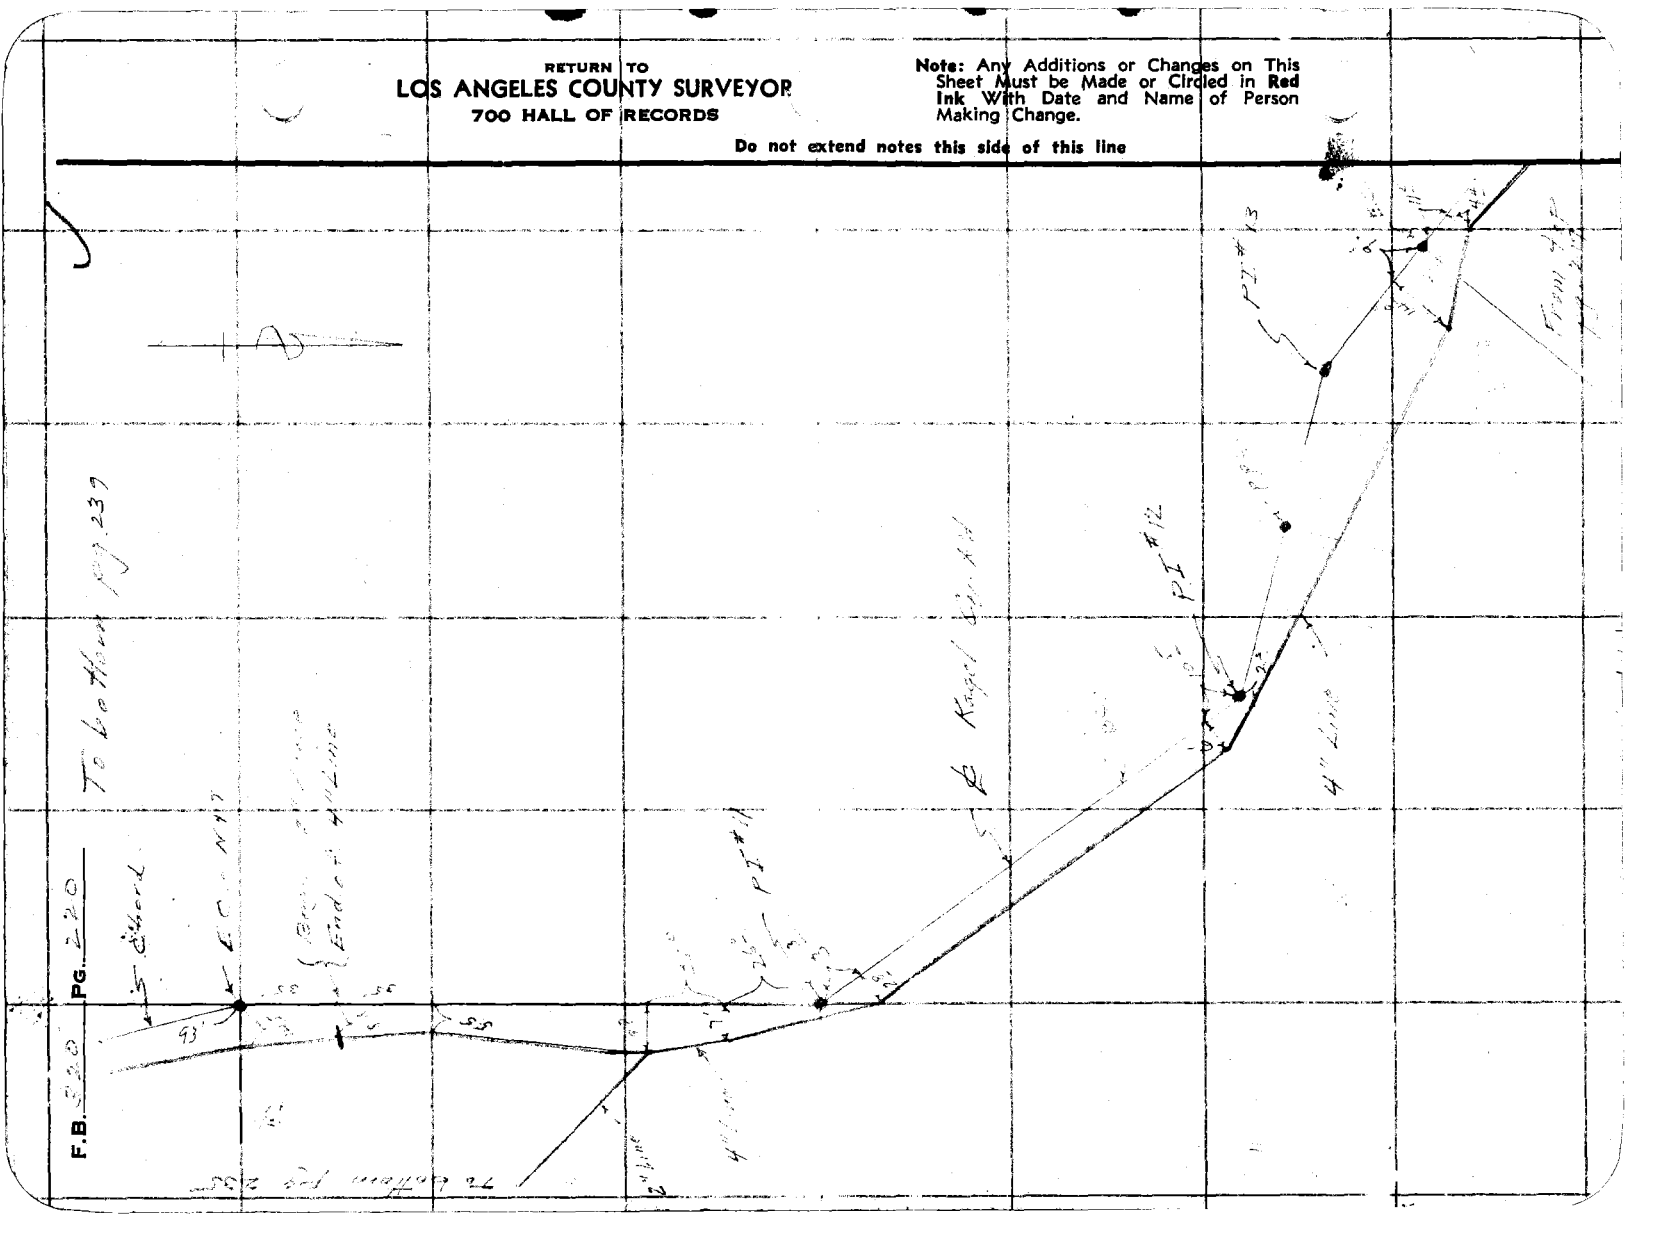

Notes Ck'd by	Survey of Water Lines in
Map No.	W. O. Tape No. St'd. °F.
Office Work	Surveyed by L D Moore
Checked	Notes Date 1-19-37
Date	Indexed A. C. Johns

F.B. 320 PG. 221

Note: Any Additions or Changes on This Sheet Must be Made or Circled in Red Ink With Date and Name of Person Making Change.

Do not extend notes this side of this line

RETURN TO
LOS ANGELES COUNTY SURVEYOR
700 HALL OF RECORDS

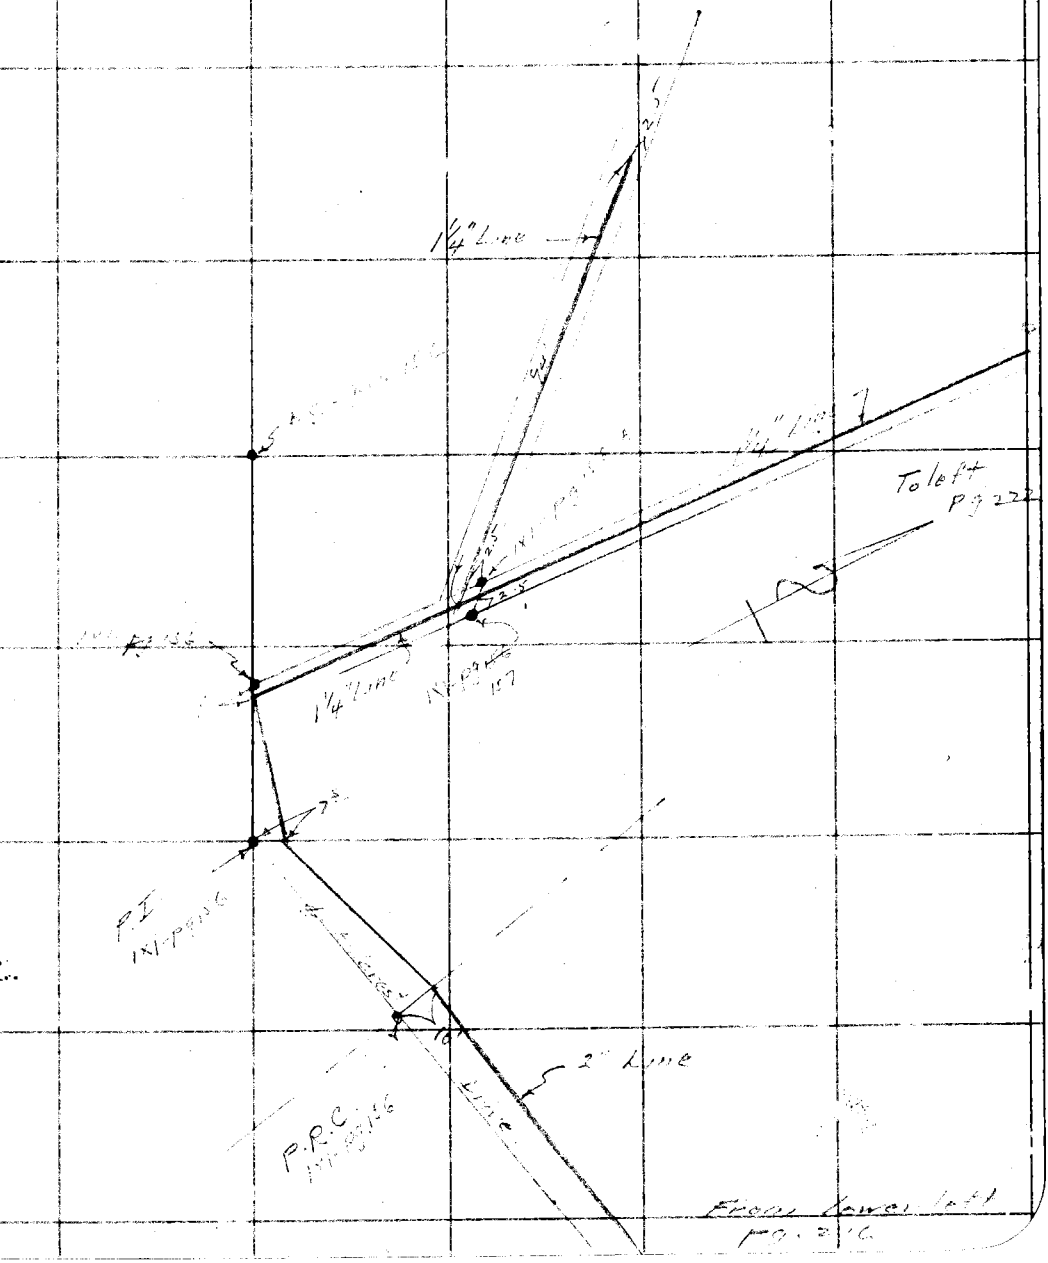

FORM 247 10M 11-35

RETURN TO
LOS ANGELES COUNTY SURVEYOR
700 HALL OF RECORDS

Note: Any Additions or Changes on This Sheet Must be Made or Circled in **Red Ink** With Date and Name of Person Making Change.

Do not extend notes this side of this line

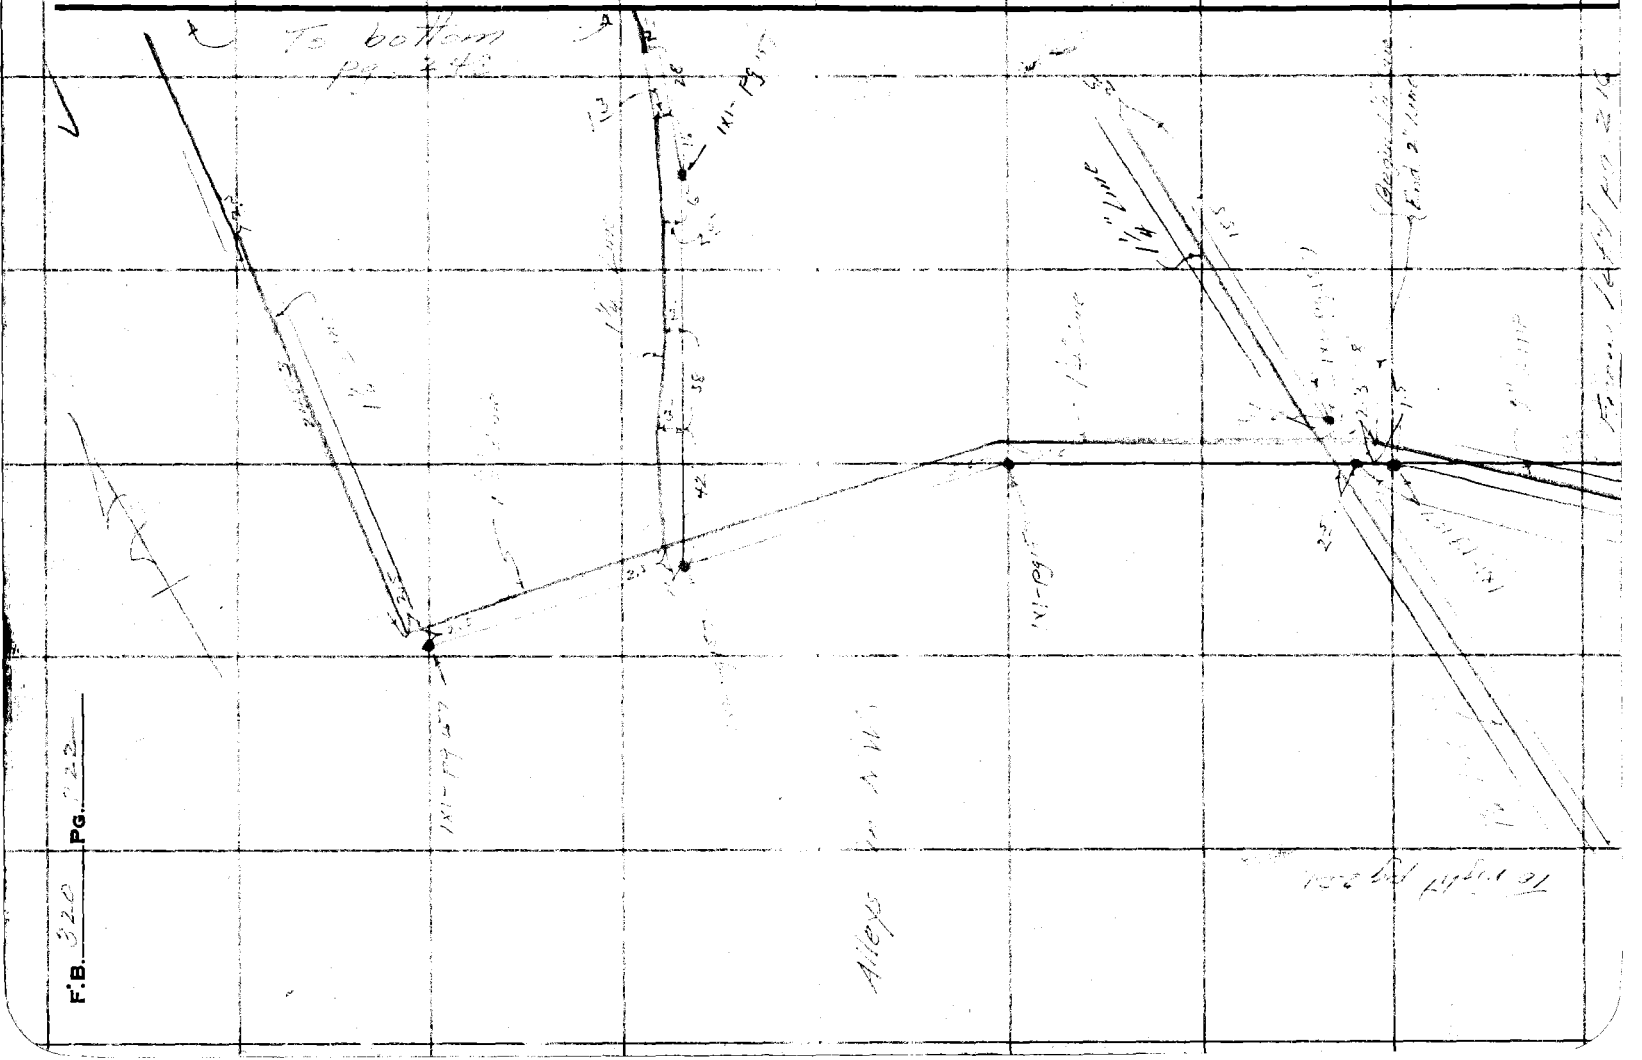

F.B. 320 Pg. 22

FORM 247 10M 11-35

RETURN TO
LOS ANGELES COUNTY SURVEYOR
700 HALL OF RECORDS

Note: Any Additions or Changes on This Sheet Must be Made or Circled in **Red Ink** With Date and Name of Person Making Change.

Do not extend notes this side of this line

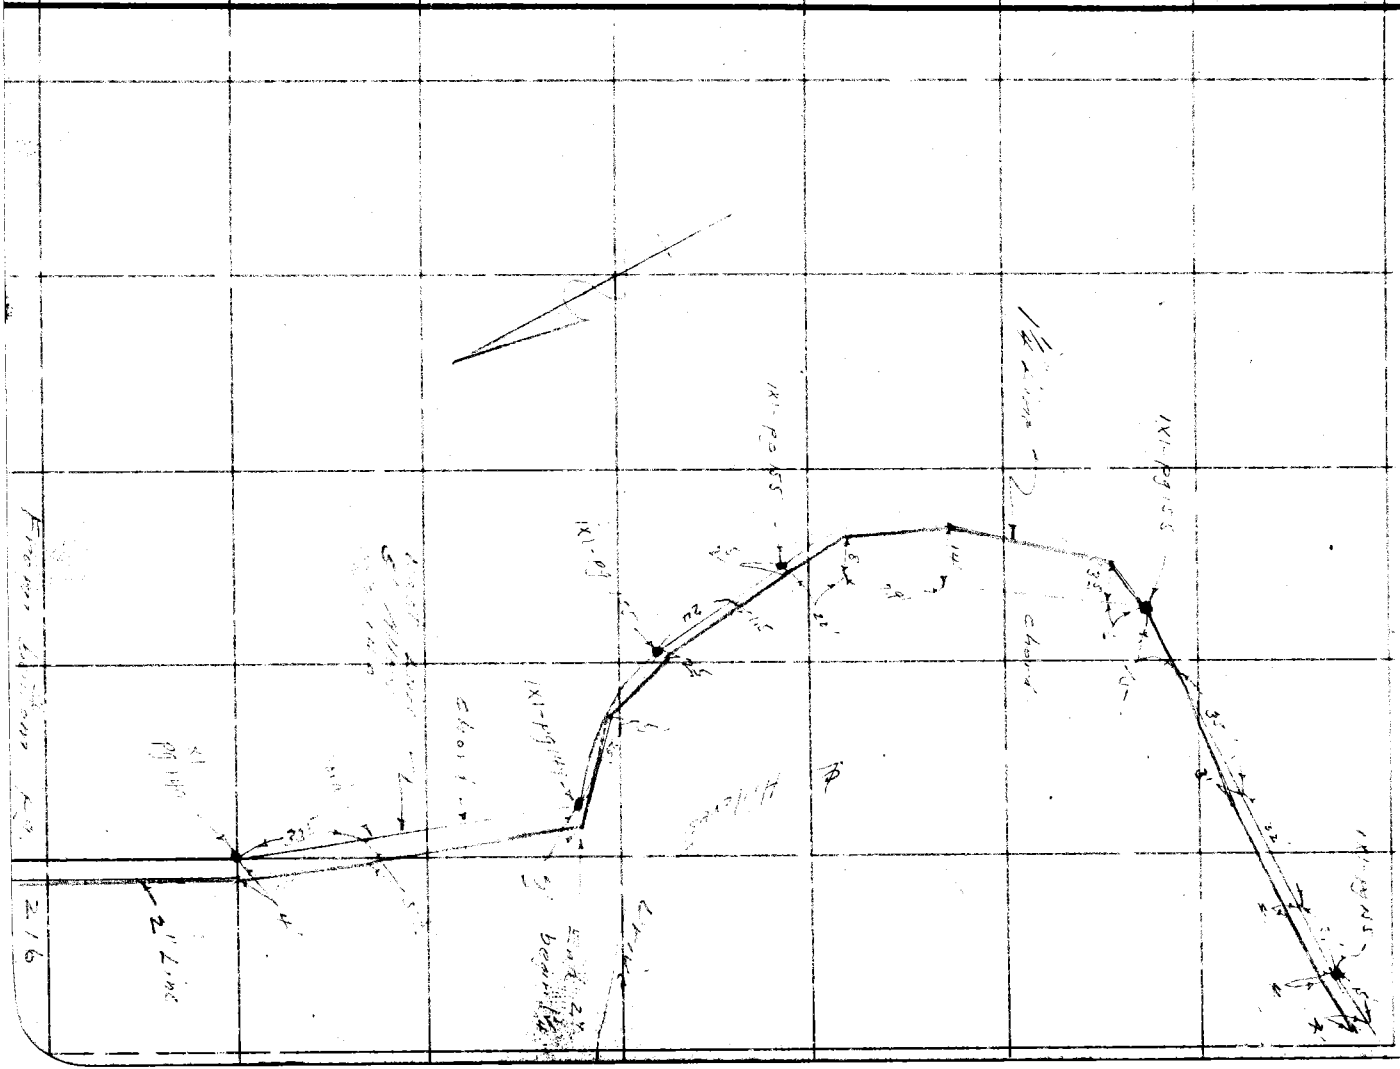

Notes Ck'd by
Map No.
Office Work
Checked
Date

Survey of
W. O. Tape No. Std. °F.
Surveyed by
Notes
Indexed Date
A. C. Johnson

F.B. PG.

RETURN TO
LOS ANGELES COUNTY SURVEYOR
700 HALL OF RECORDS

Note: Any Additions or Changes on This Sheet Must be Made or Circled in **Red** Ink With Date and Name of Person Making Change.

Do not extend notes this side of this line

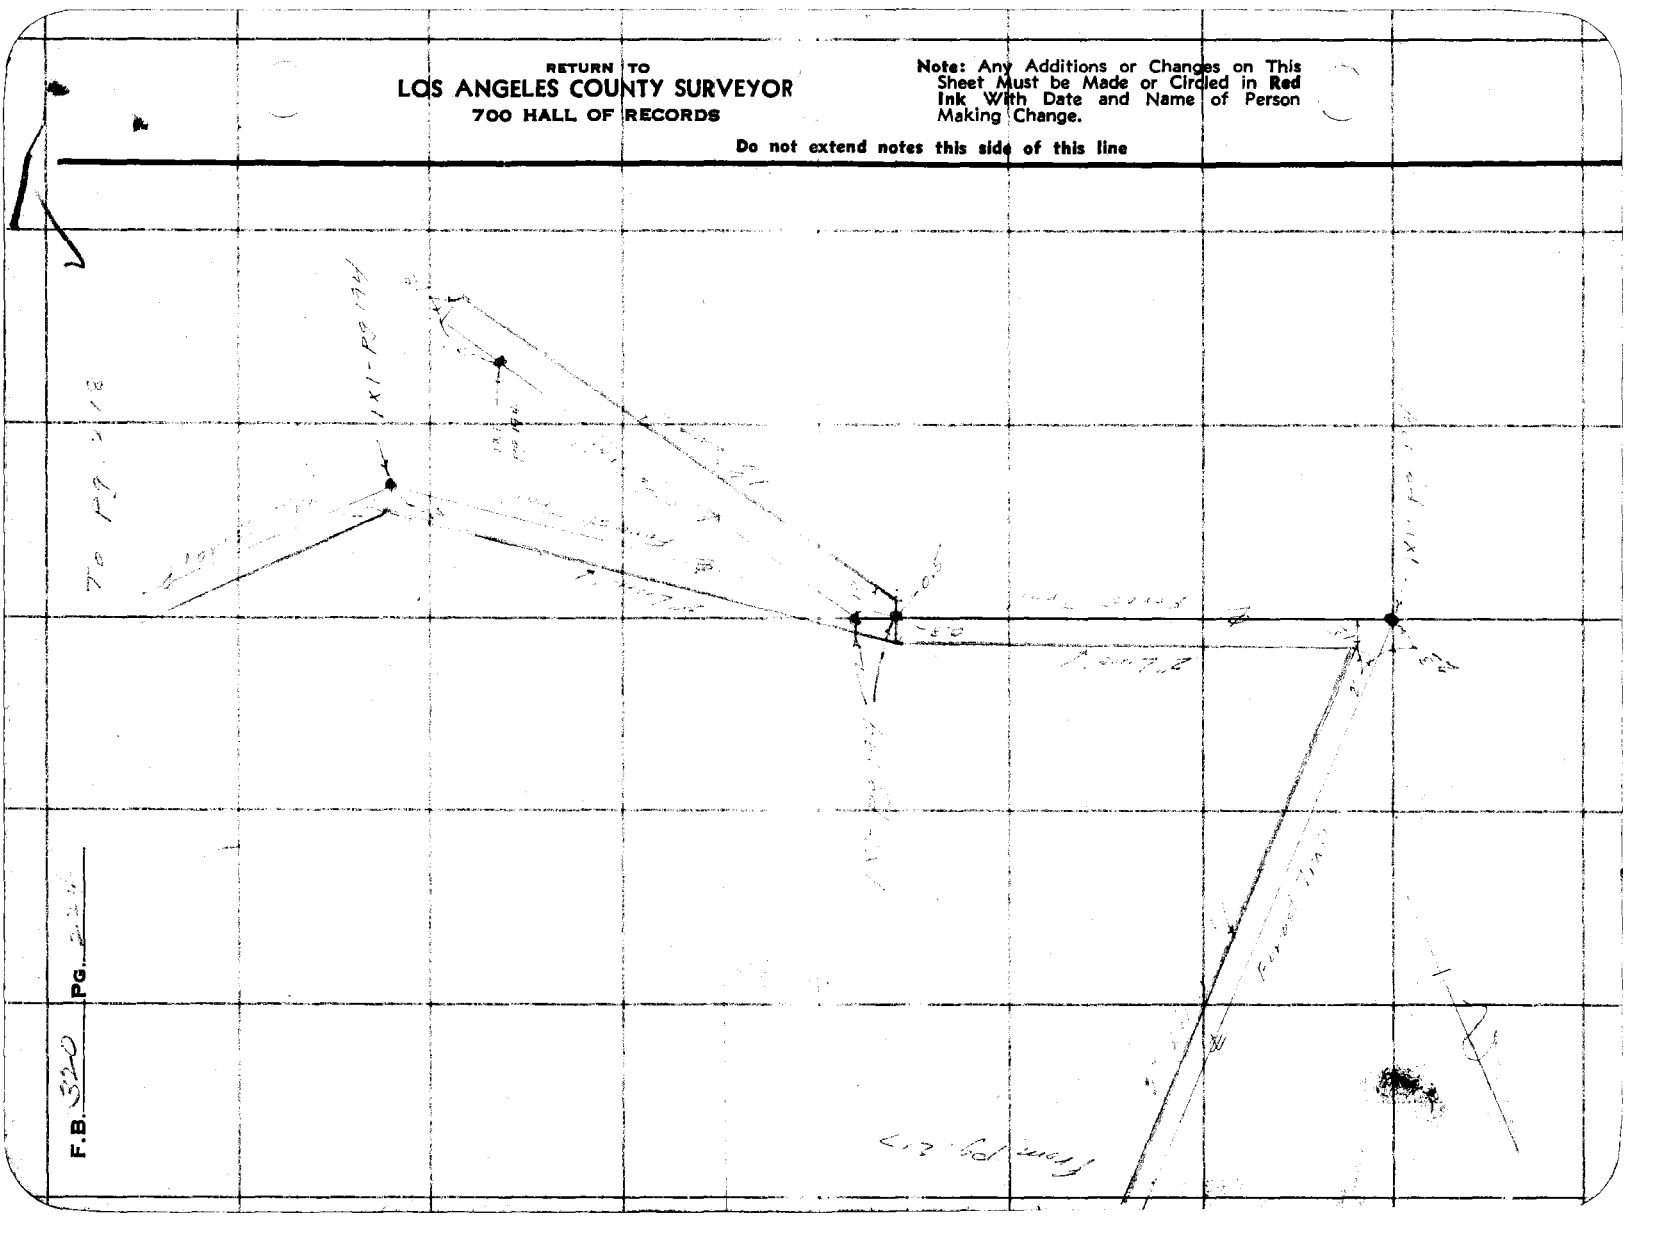

F.B. 320 PG.

Notes Ck'd by	Survey of
Map No.	W. O. Tape No. St'd °F.
Office Work	Surveyed by
Checked	Notes Date
Date	Indexed

F.B. 3 PG. 225

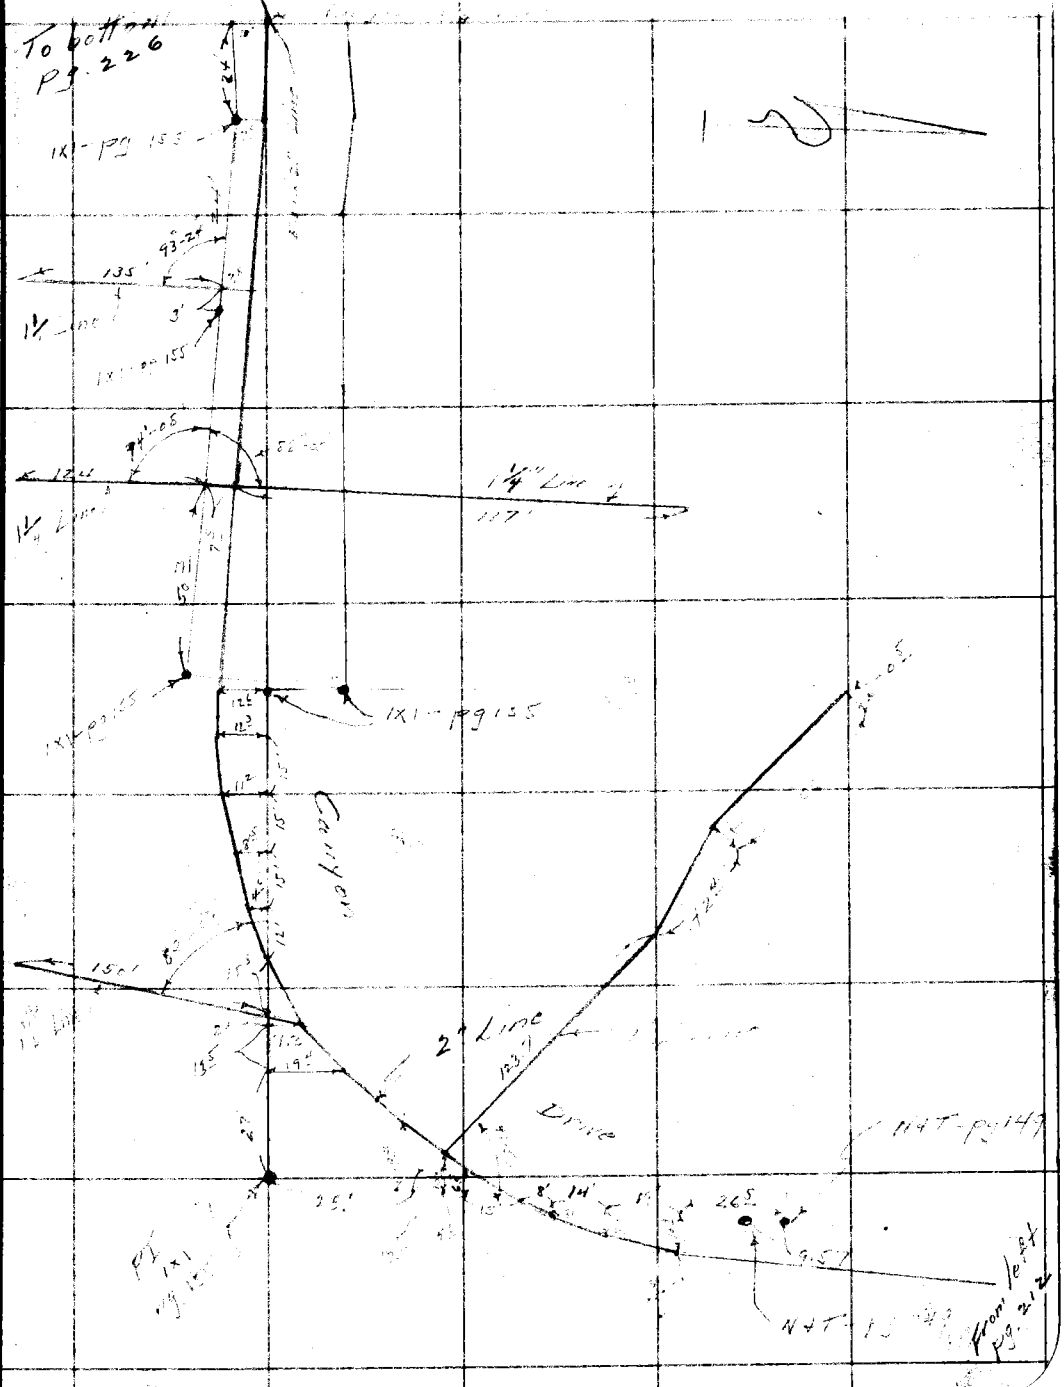

Note: Any Additions or Changes on This Sheet Must be Made or Circled in Red Ink With Date and Name of Person Making Change.

Do not extend notes this side of this line

RETURN TO
LOS ANGELES COUNTY SURVEYOR
700 HALL OF RECORDS

FORM 247 10M 11-38

RETURN TO
LOS ANGELES COUNTY SURVEYOR
700 HALL OF RECORDS

Note: Any Additions or Changes on This Sheet Must be Made or Circled in **Red Ink** With Date and Name of Person Making Change.

Do not extend notes this side of this line

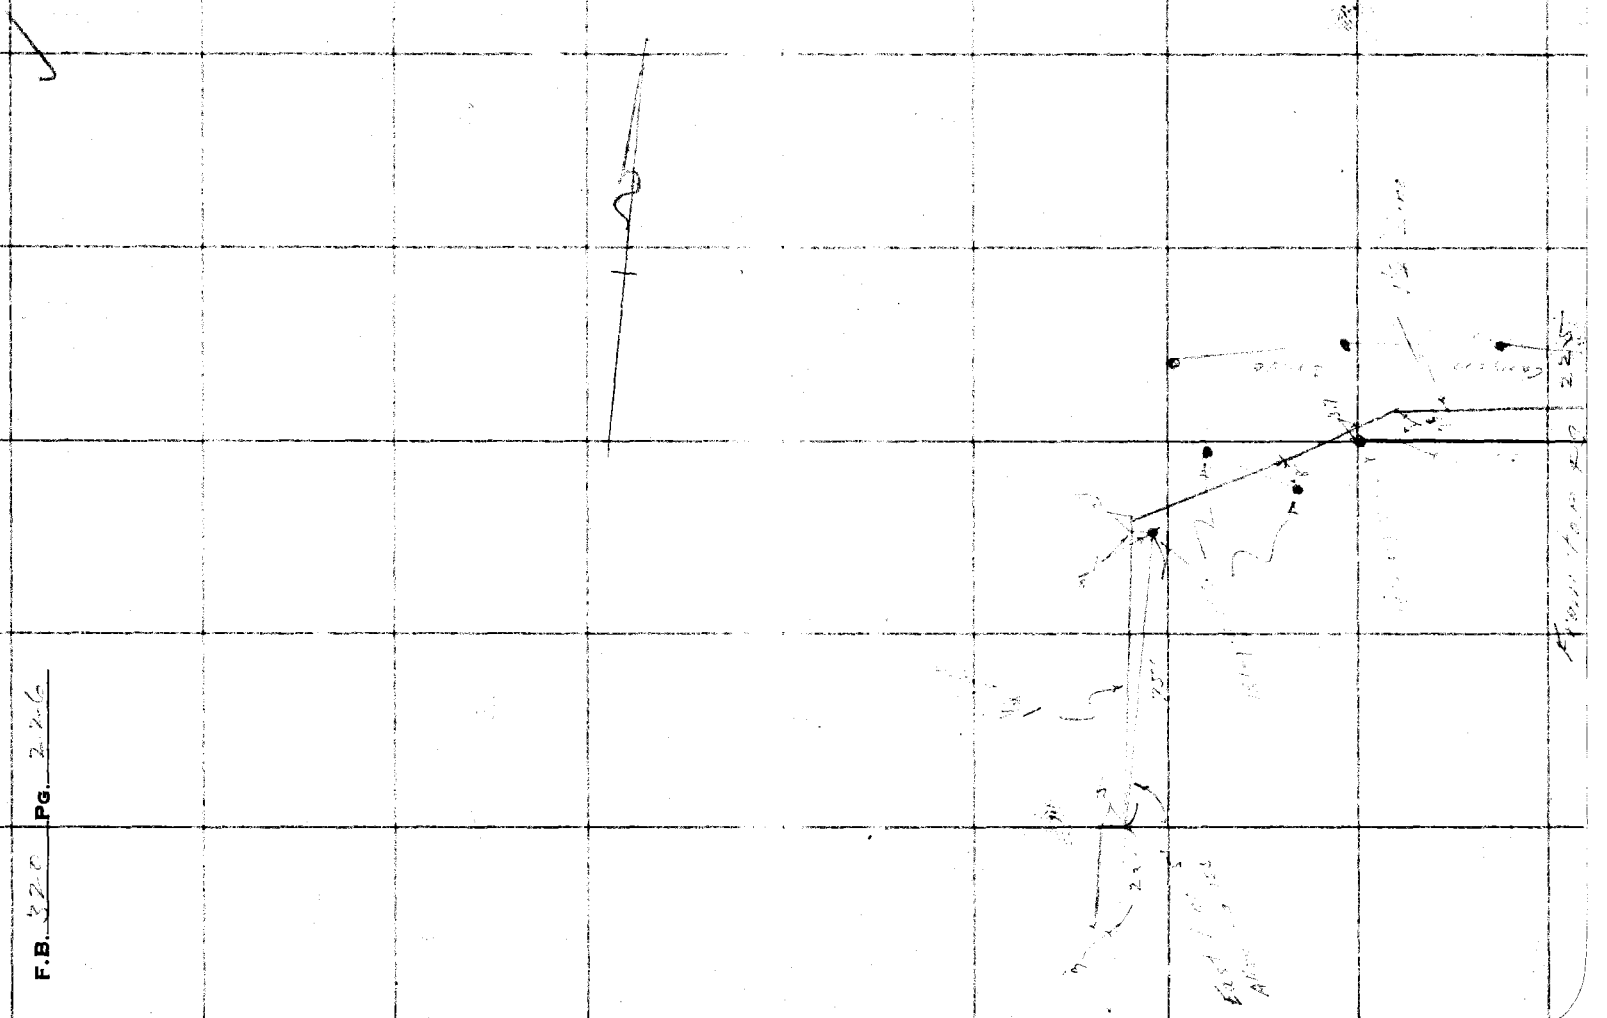


Notes Ck'd by	Survey of
Map No.	W. O. Tape No. St'd °F.
Office Work	Surveyed by L. D. Moore
Checked	Notes Date
Date	Indexed A. C. Tehan

F.B. PG.

Note: Any Additions or Changes on This Sheet Must be Made or Circled in Red Ink With Date and Name of Person Making Change.

Do not extend notes this side of this line

RETURN TO
LOS ANGELES COUNTY SURVEYOR
700 HALL OF RECORDS

FORM 247 10M 11-38

RETURN TO
LOS ANGELES COUNTY SURVEYOR
700 HALL OF RECORDS

Note: Any Additions or Changes on This Sheet Must be Made or Circled in **Red** Ink With Date and Name of Person Making Change.

Do not extend notes this side of this line

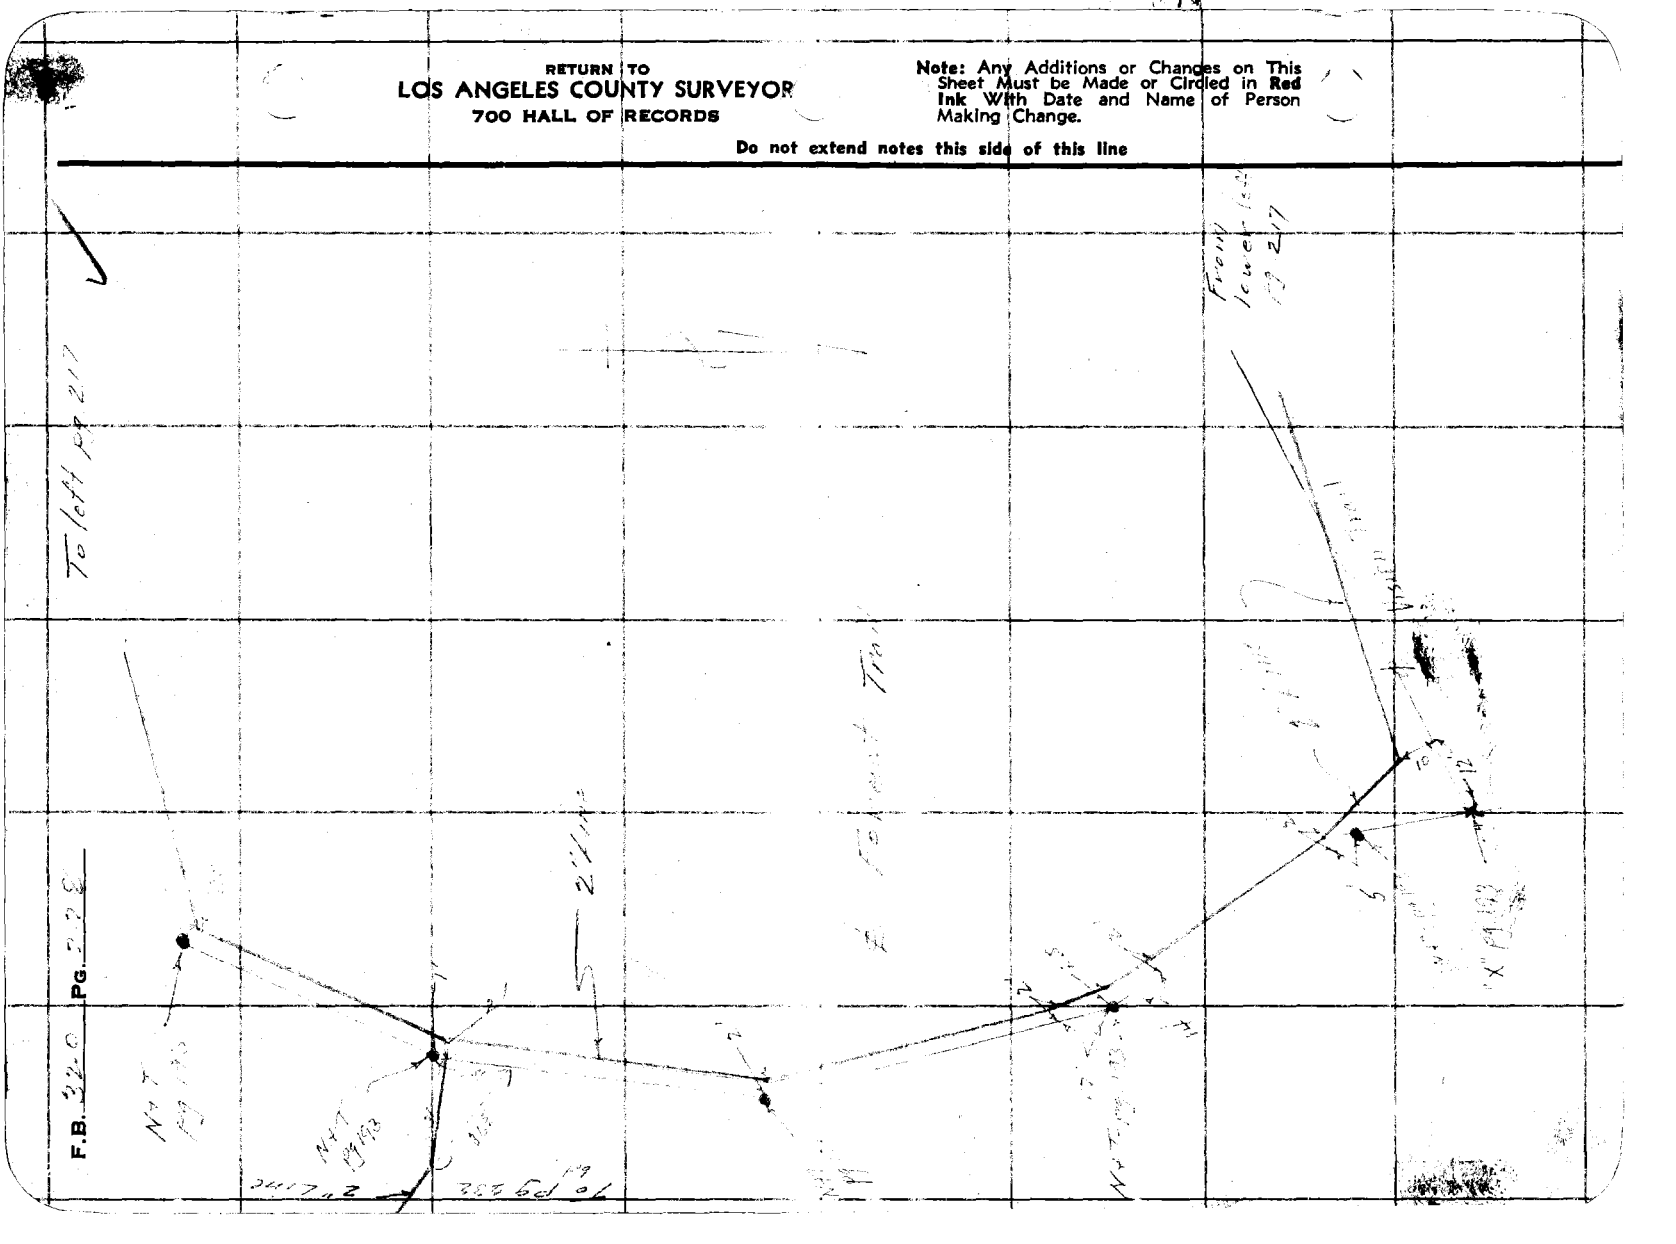

FORM 247 10M 11-35

RETURN TO
LOS ANGELES COUNTY SURVEYOR
700 HALL OF RECORDS

Note: Any Additions or Changes on This Sheet Must be Made or Circled in **Red Ink** With Date and Name of Person Making Change.

Do not extend notes this side of this line

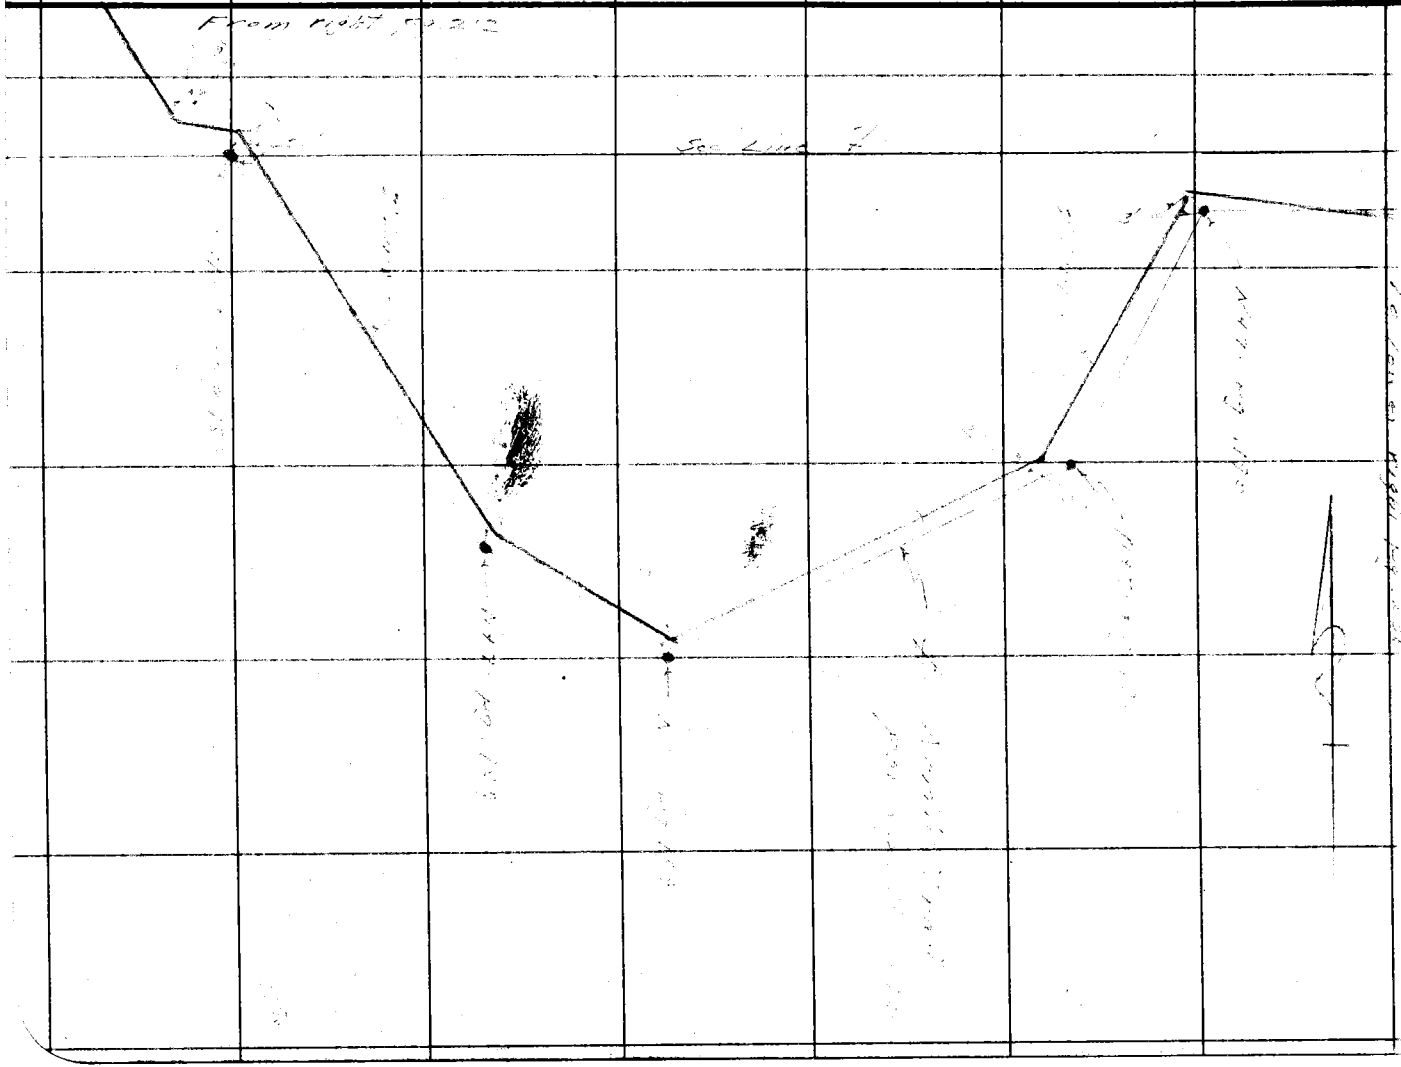

Notes Ck'd by
Map No.
Office Work
Checked
Date

Survey of
W. O. Tape No. St'd °F.
Surveyed by
Notes
Indexed Date

F.B. PG. 227

RETURN TO
LOS ANGELES COUNTY SURVEYOR
700 HALL OF RECORDS

Note: Any Additions or Changes on This Sheet Must be Made or Circled in **Red Ink** With Date and Name of Person Making Change.

Do not extend notes this side of this line

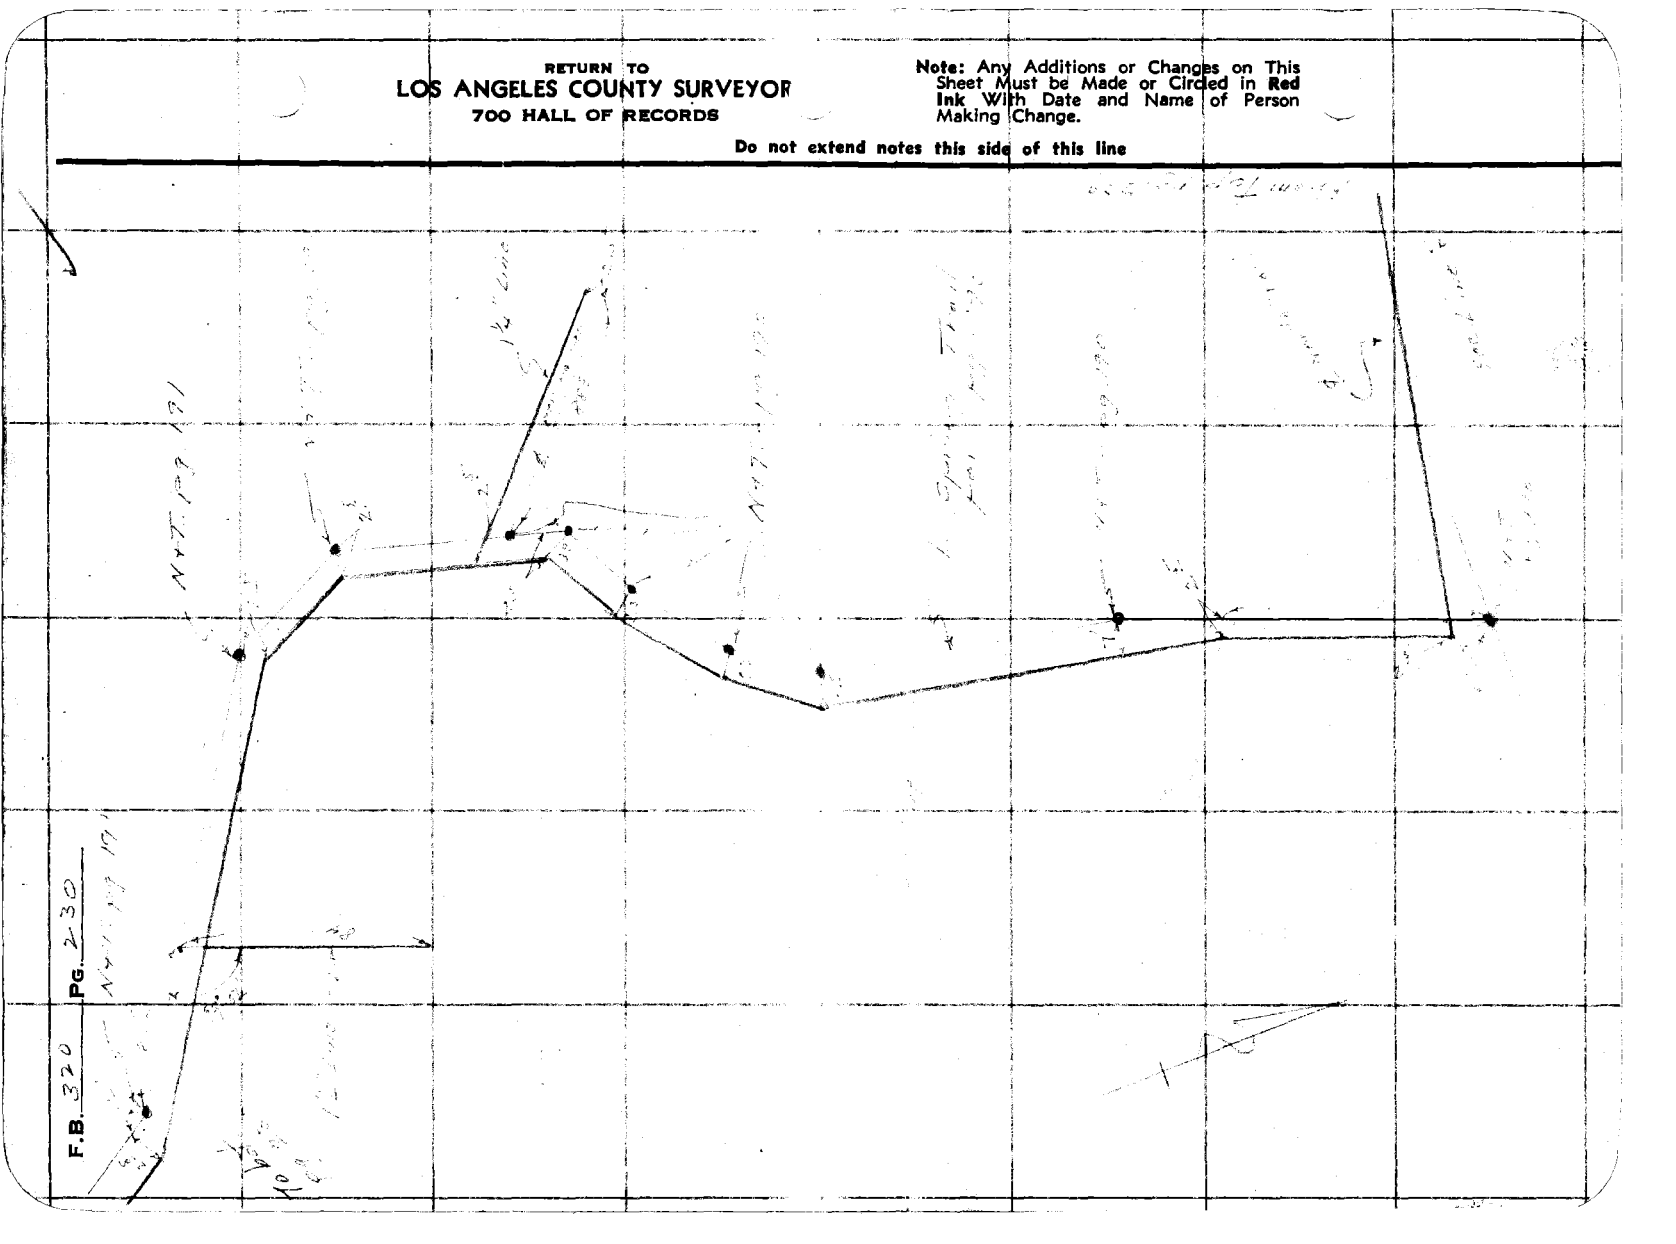

F.B. 320 Pg. 230

Notes Ck'd by	Survey of Water Works Lot [illegible]
Map No.	W. O. [illegible] Tape No. St'd F.
Office Work	Surveyed by L. D. Moore
Checked	Notes [illegible] Date [illegible]
Date	Indexed A. C. Tomlinson

F.B. 32-0 PG. 2-31

Note: Any Additions or Changes on This Sheet Must be Made or Circled in Red Ink With Date and Name of Person Making Change.

Do not extend notes this side of this line

RETURN TO
LOS ANGELES COUNTY SURVEYOR
700 HALL OF RECORDS

FORM 247 10M 11-38

RETURN TO
LOS ANGELES COUNTY SURVEYOR
700 HALL OF RECORDS

Note: Any Additions or Changes on This Sheet Must be Made or Circled in **Red Ink** With Date and Name of Person Making Change.

Do not extend notes this side of this line

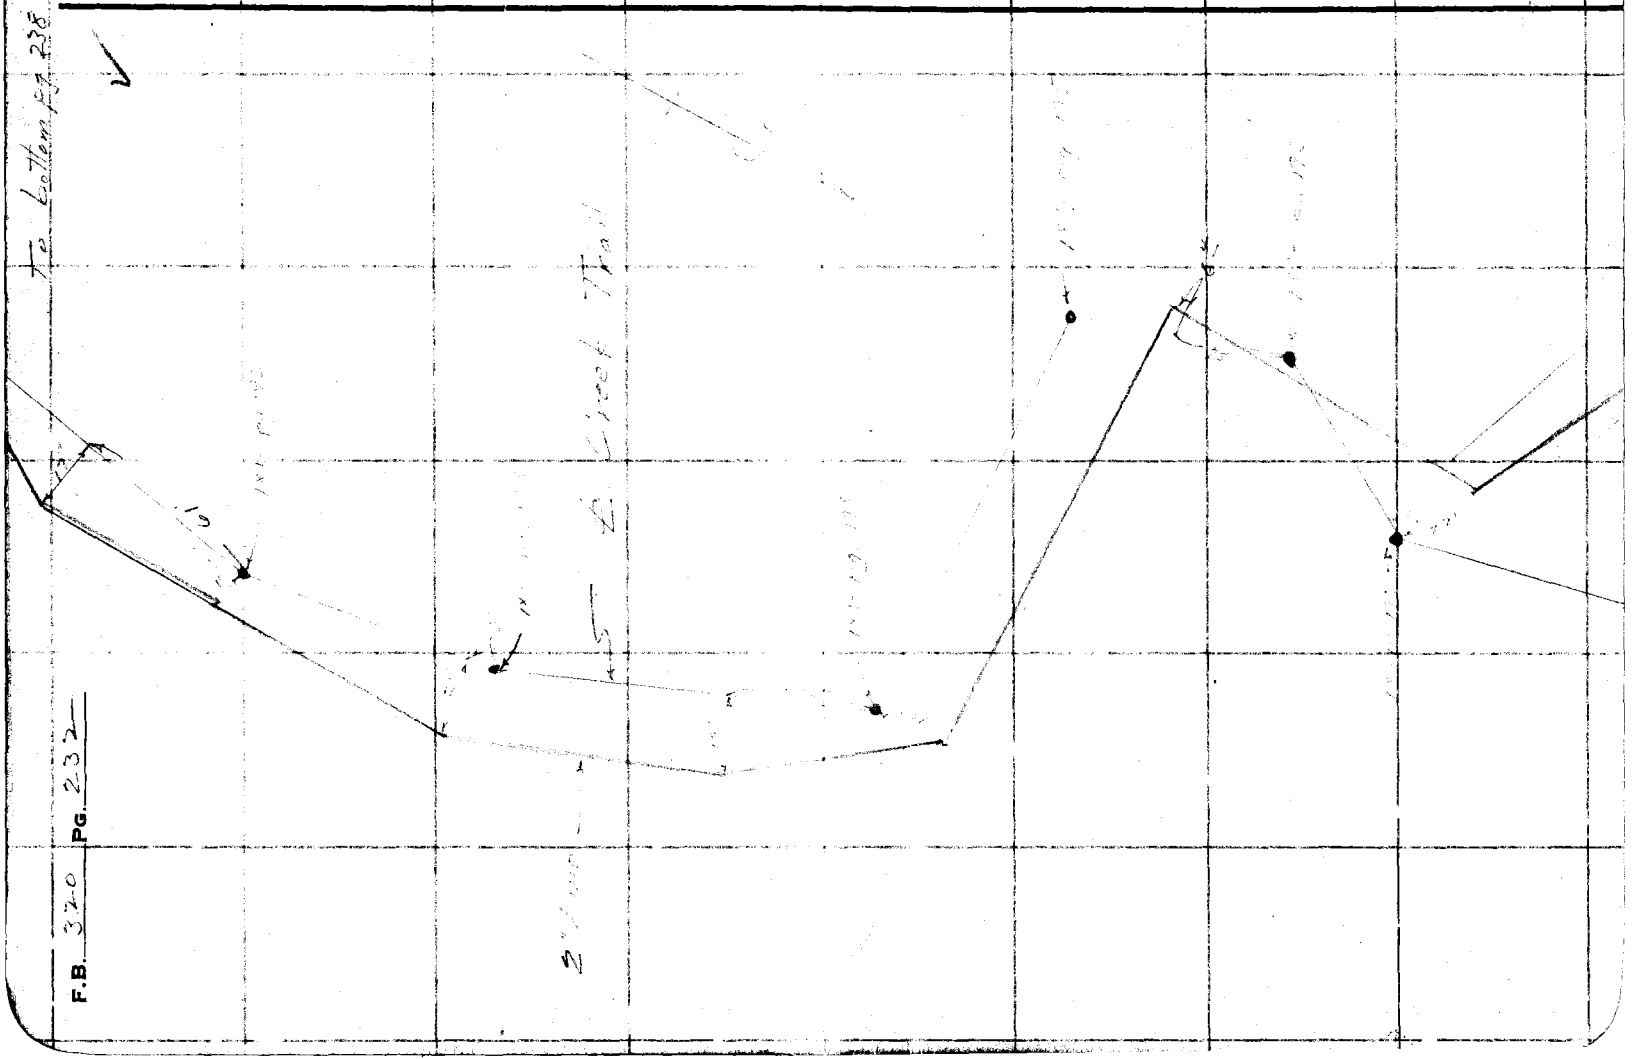

F.B. 320 PG. 232

FORM 247 10M 11-58

RETURN TO
LOS ANGELES COUNTY SURVEYOR
700 HALL OF RECORDS

Note: Any Additions or Changes on This Sheet Must be Made or Circled in **Red Ink** With Date and Name of Person Making Change.

Do not extend notes this side of this line

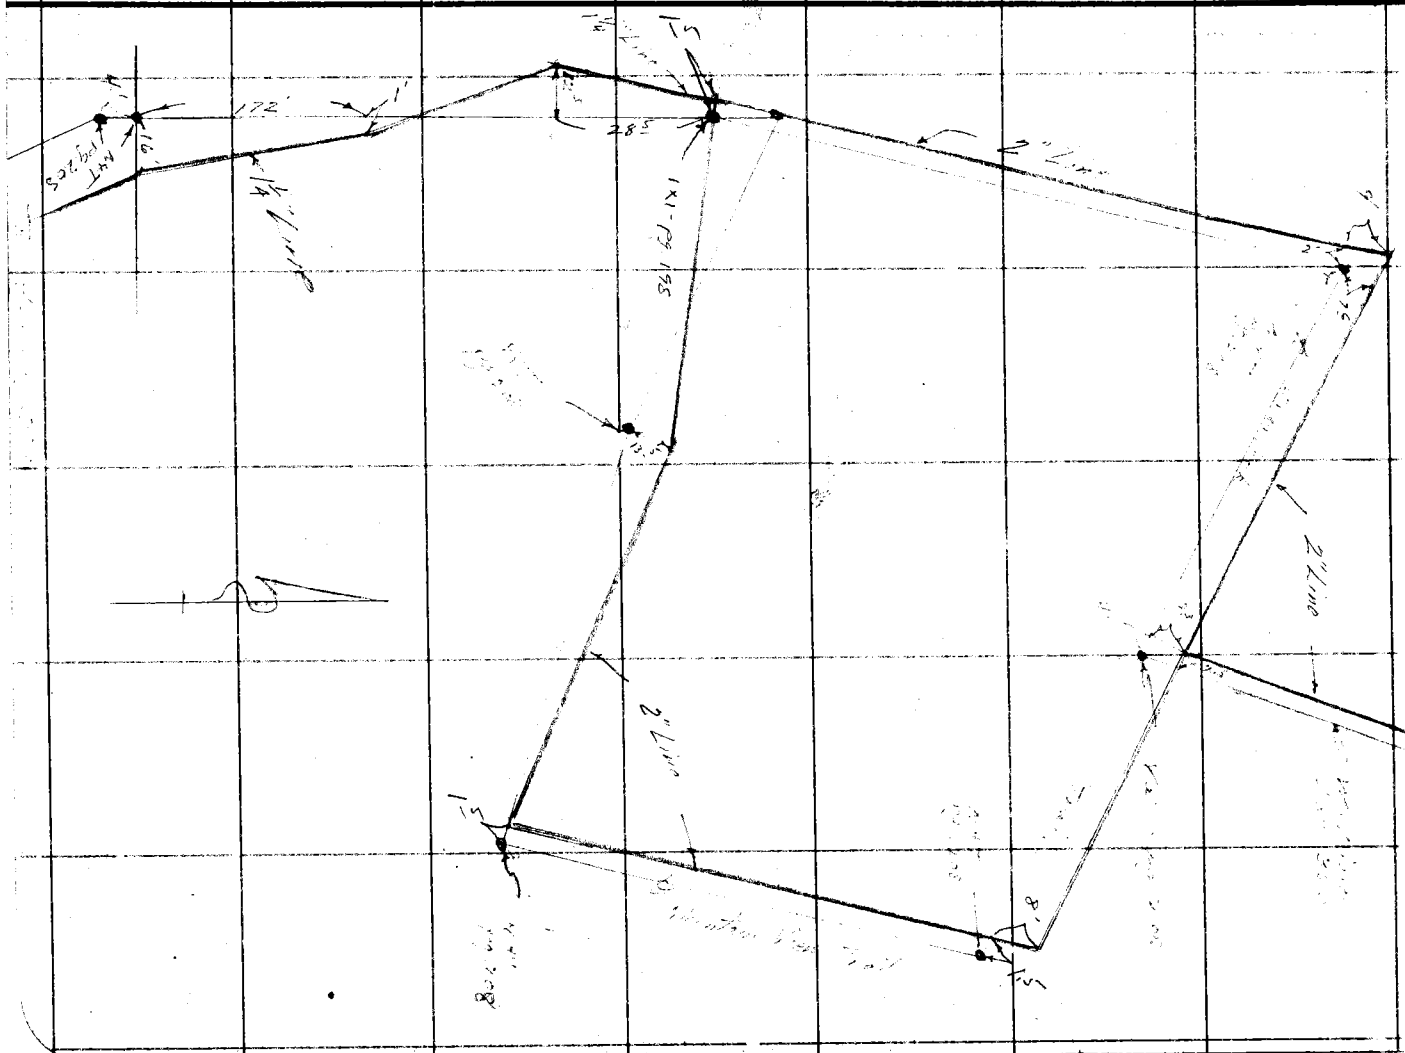

Notes Ck'd by
Map No.
Office Work
Checked
Date

Survey of
W. O. Tape No. St'd °F.
Surveyed by
Notes
Indexed Date

F.B. PG.

RETURN TO
LOS ANGELES COUNTY SURVEYOR
700 HALL OF RECORDS

Note: Any Additions or Changes on This Sheet Must be Made or Circled in **Red** Ink With Date and Name of Person Making Change.

Do not extend notes this side of this line

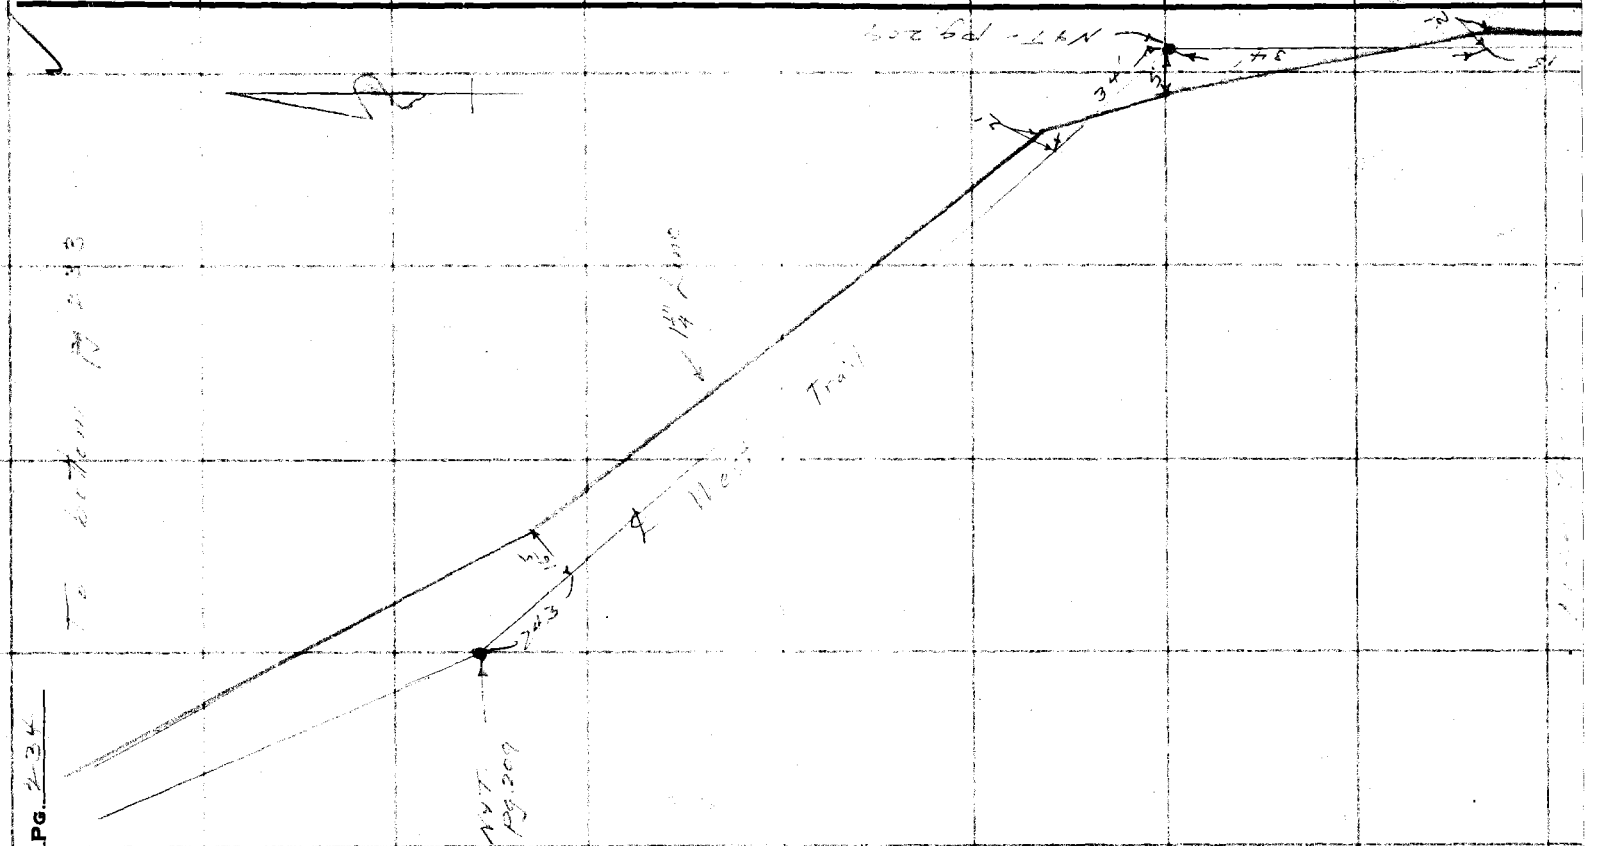

F.B. 320 PG. 234

Notes Ck'd by	Survey of
Map No.	W. O. Tape No. St'd °F.
Office Work	Surveyed by K. D. Wilson
Checked	Notes Date 2-11-37
Date	Indexed A. C. Johnson

F.B. 320 Pg. 235

Note: Any Additions or Changes on This Sheet Must be Made or Circled in Red Ink With Date and Name of Person Making Change.

Do not extend notes this side of this line

RETURN TO
LOS ANGELES COUNTY SURVEYOR
700 HALL OF RECORDS

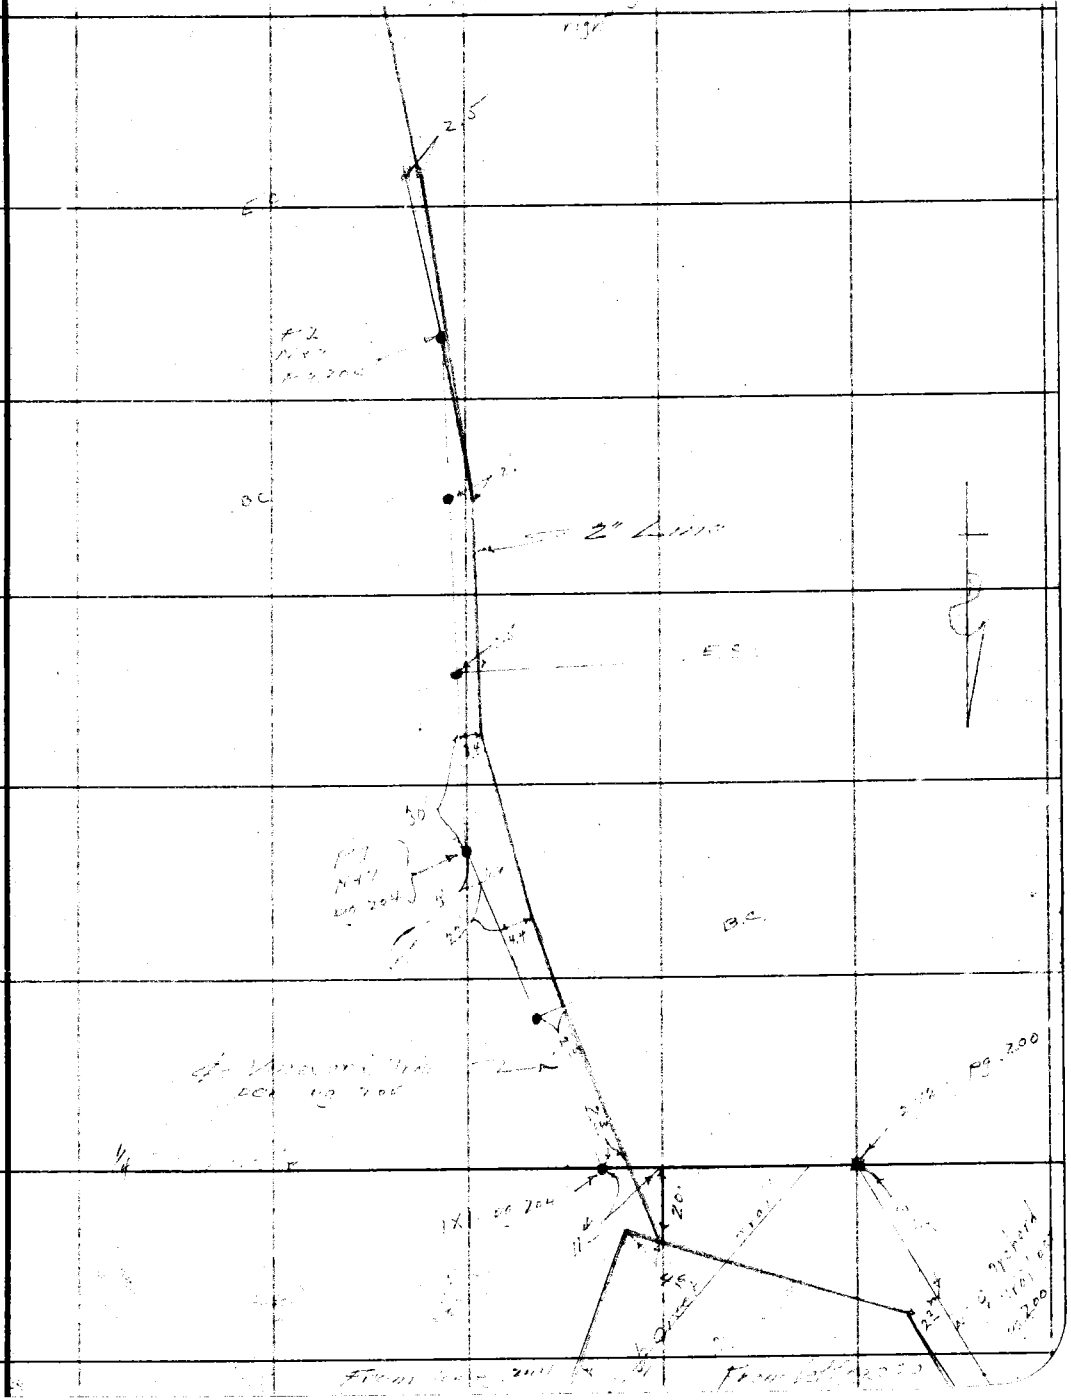

FORM 247 10M 11-36

RETURN TO
LOS ANGELES COUNTY SURVEYOR
700 HALL OF RECORDS

Note: Any Additions or Changes on This Sheet Must be Made or Circled in **Red Ink** With Date and Name of Person Making Change.

Do not extend notes this side of this line

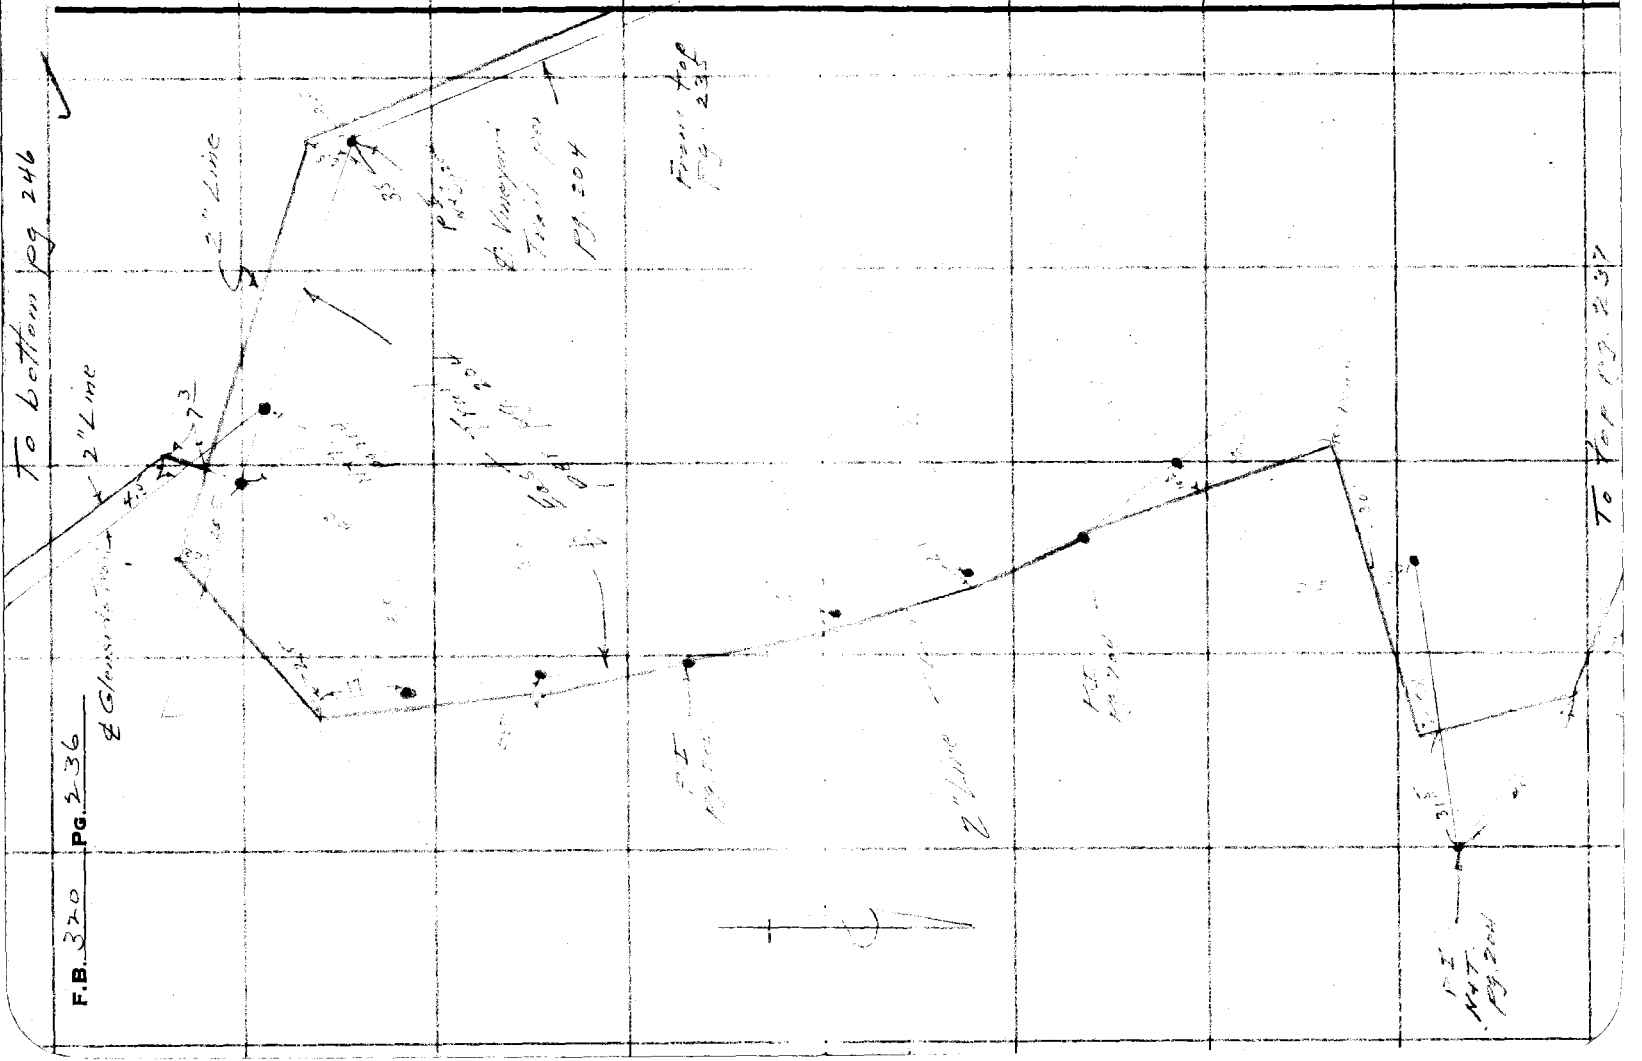

FORM 247 10M 11-35

RETURN TO
LOS ANGELES COUNTY SURVEYOR
700 HALL OF RECORDS

Note: Any Additions or Changes on This Sheet Must be Made or Circled in **Red Ink** With Date and Name of Person Making Change.

Do not extend notes this side of this line

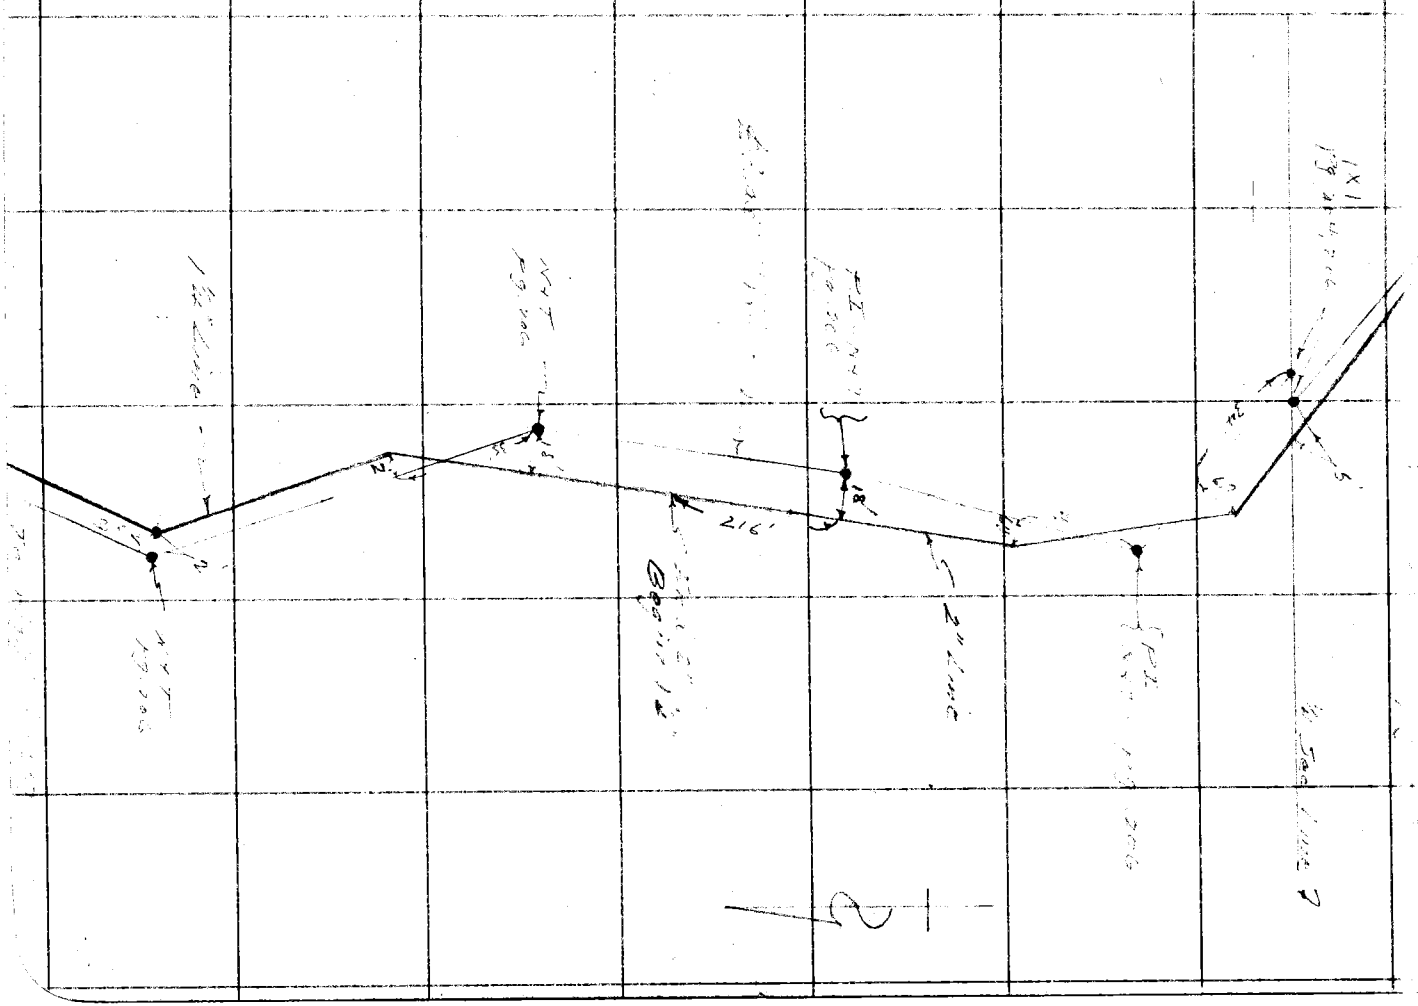

Notes Ck'd by
Map No.
Office Work
Checked
Date

Survey of
W. O. Tape No. St'd °F.
Surveyed by Date
Notes
Indexed

F.B. PG.

RETURN TO
LOS ANGELES COUNTY SURVEYOR
700 HALL OF RECORDS

Note: Any Additions or Changes on This Sheet Must be Made or Circled in **Red Ink** With Date and Name of Person Making Change.

Do not extend notes this side of this line

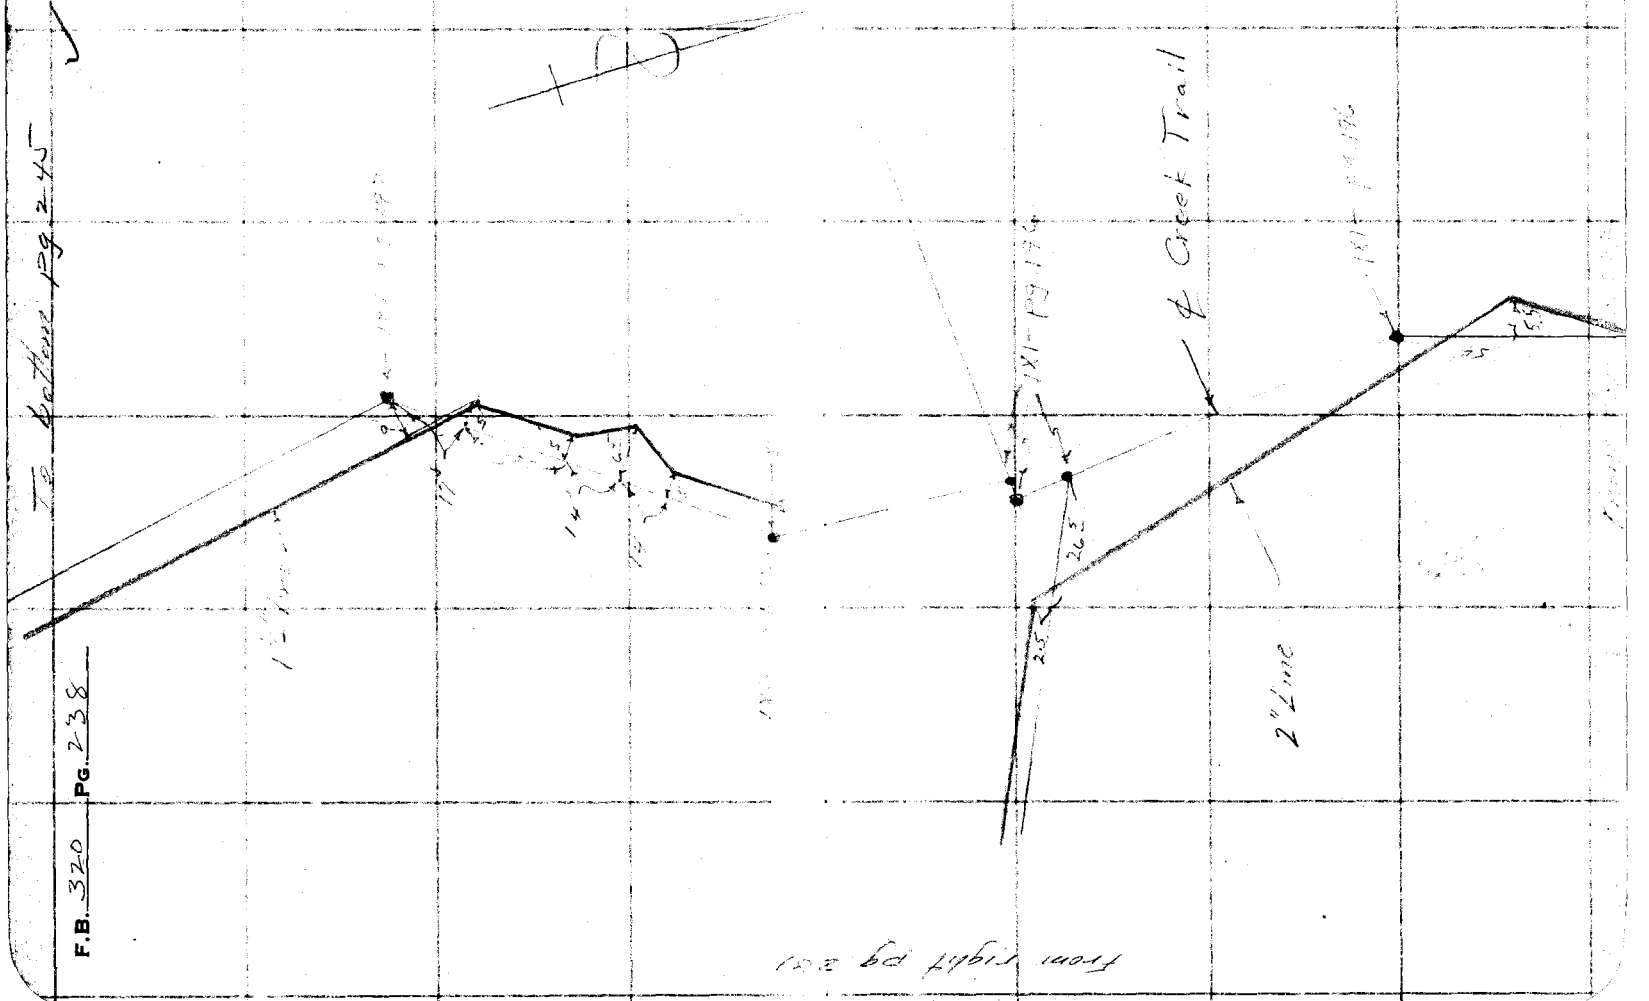

F.B. 320 PG. 238

Notes Ck'd by	Survey of Water Works Dist #21
Map No.	W. O. 8224 Tape No. St'd °F.
Office Work	Surveyed by L. D. Moore
Checked	Notes Moore Date 2-19-37
Date	Indexed A. C. Jensen

F.B. 320 Pg. 239

To bottom pg 240

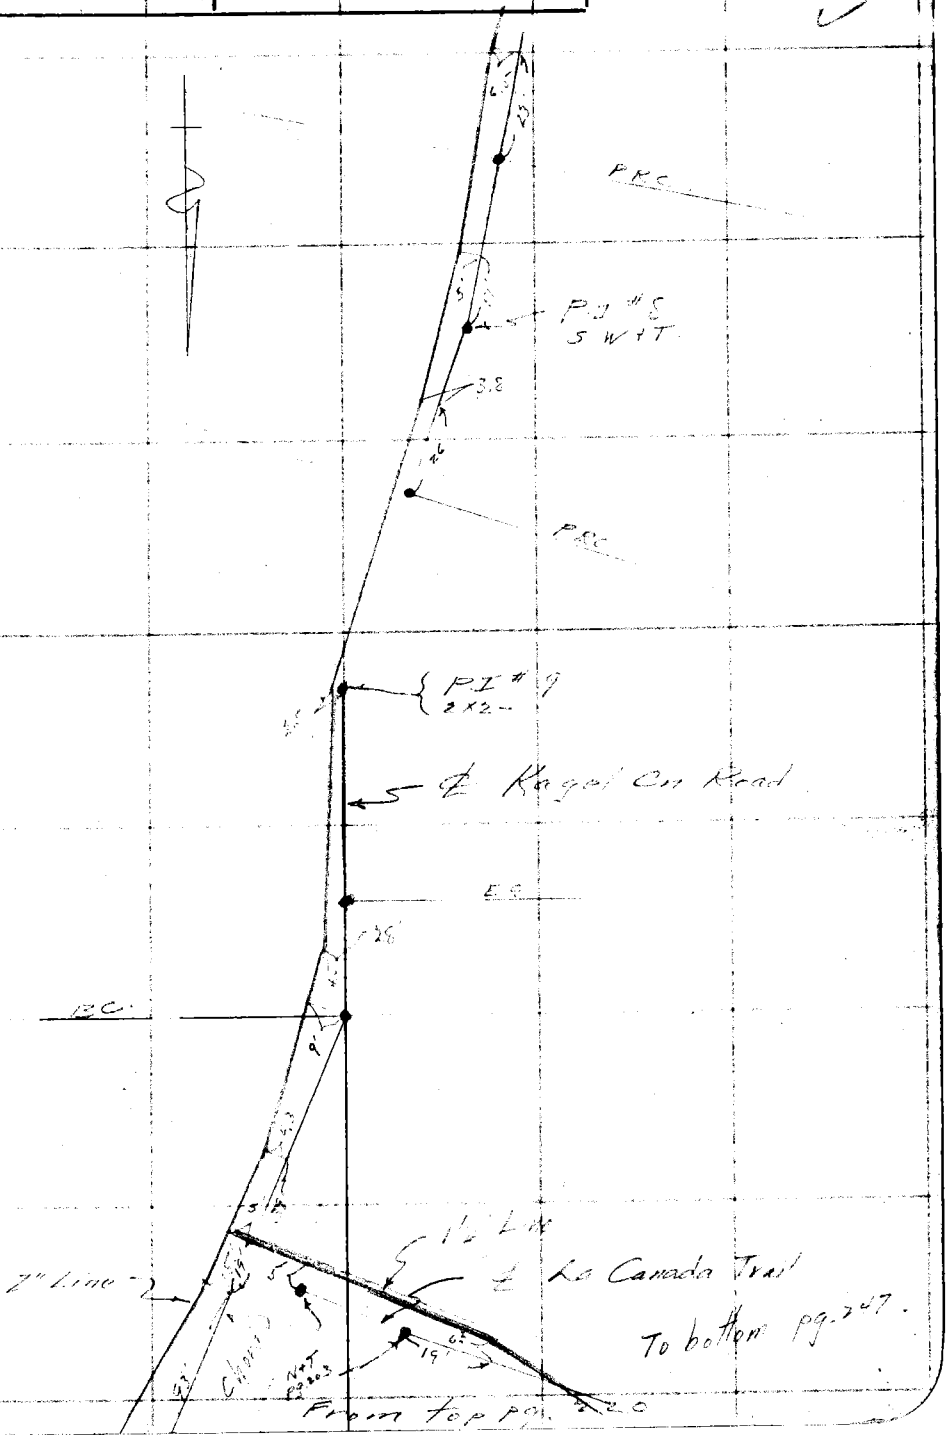

Note: Any Additions or Changes on This Sheet Must be Made or Circled in Red Ink With Date and Name of Person Making Change.

Do not extend notes this side of this line

RETURN TO
LOS ANGELES COUNTY SURVEYOR
700 HALL OF RECORDS

FORM 247 10M 11-35

F.B. 320 PG. 240

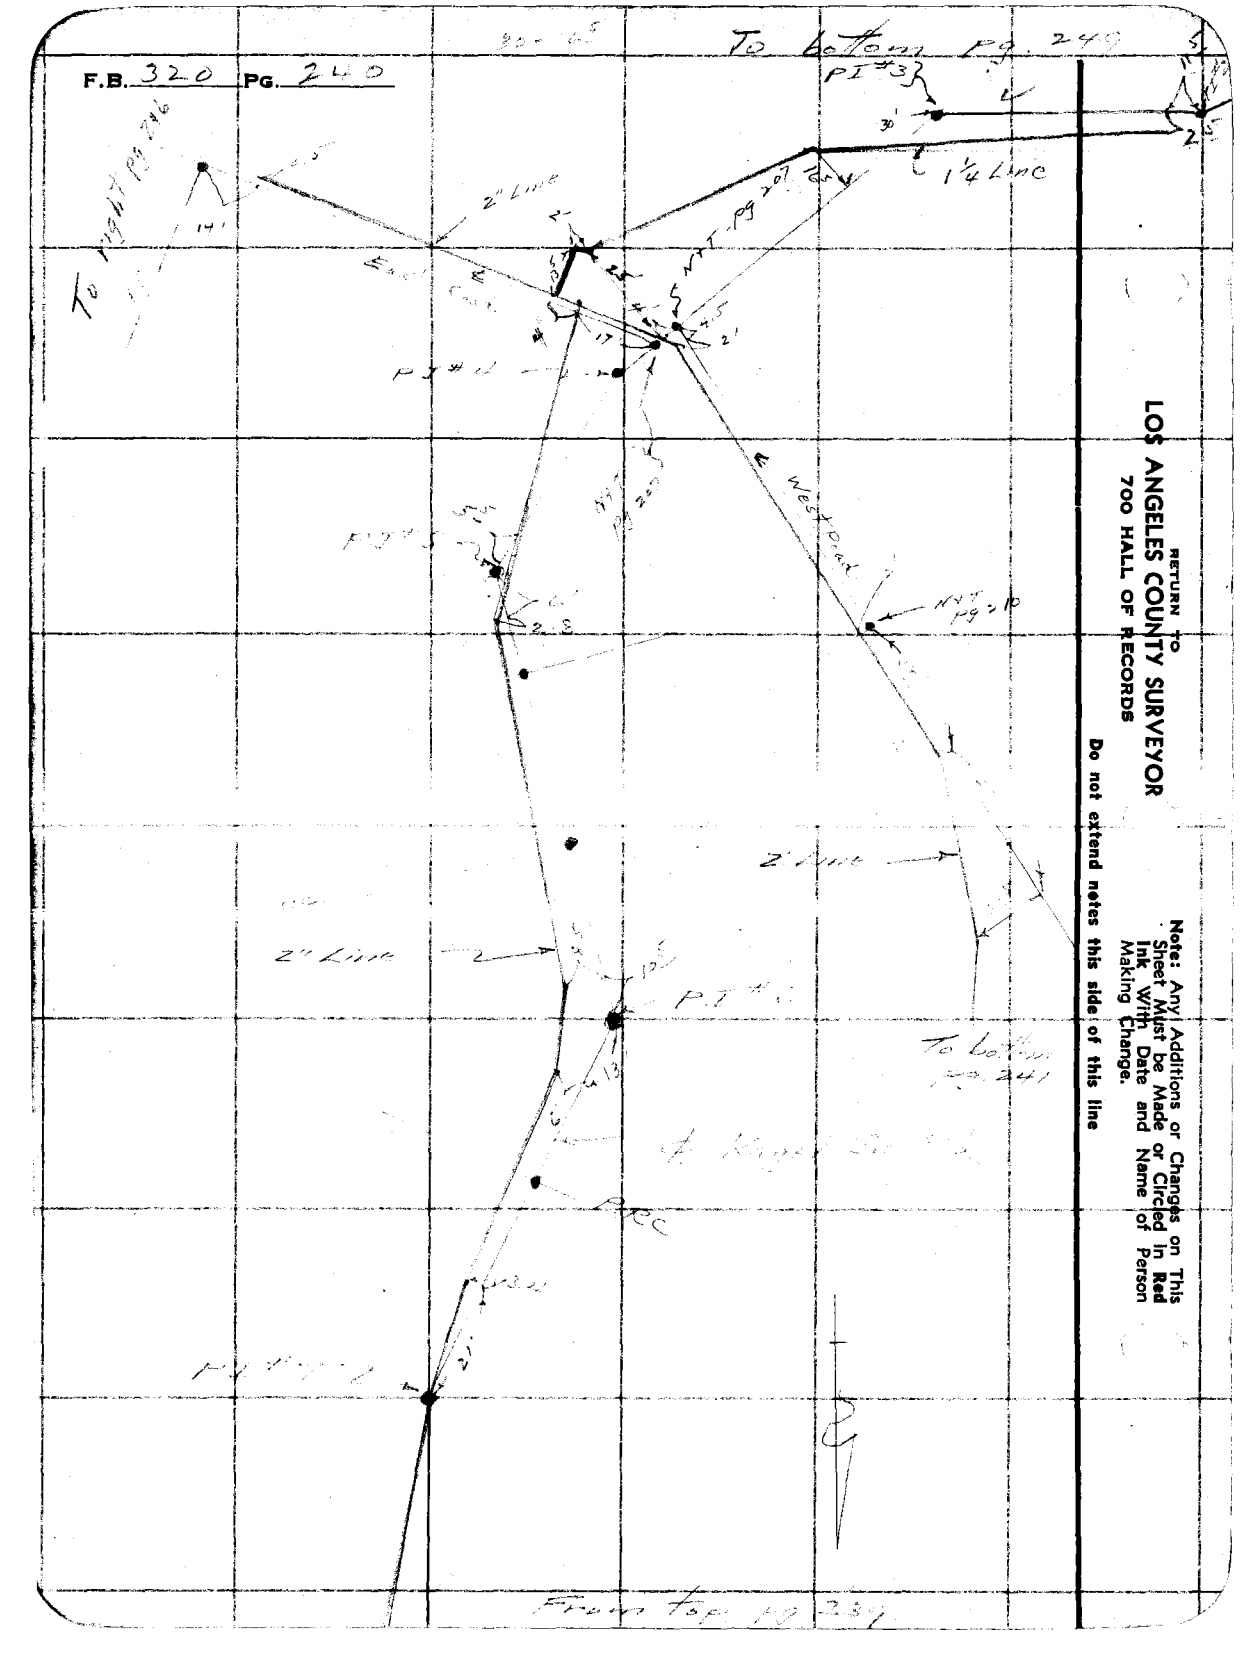

RETURN TO
LOS ANGELES COUNTY SURVEYOR
700 HALL OF RECORDS

Note: Any Additions or Changes on This Sheet Must be Made or Circled in Red Ink With Date and Name of Person Making Change.

Do not extend notes this side of this line

Notes Ck'd by	Survey of Water Works Dist #1
Map No.	W. O. 8174 Tape No. St'd °F.
Office Work	Surveyed by K. D. Moore
Checked	Notes Maggie Date 2-19-32
Date	Indexed

F.B. 320 Pg. 241

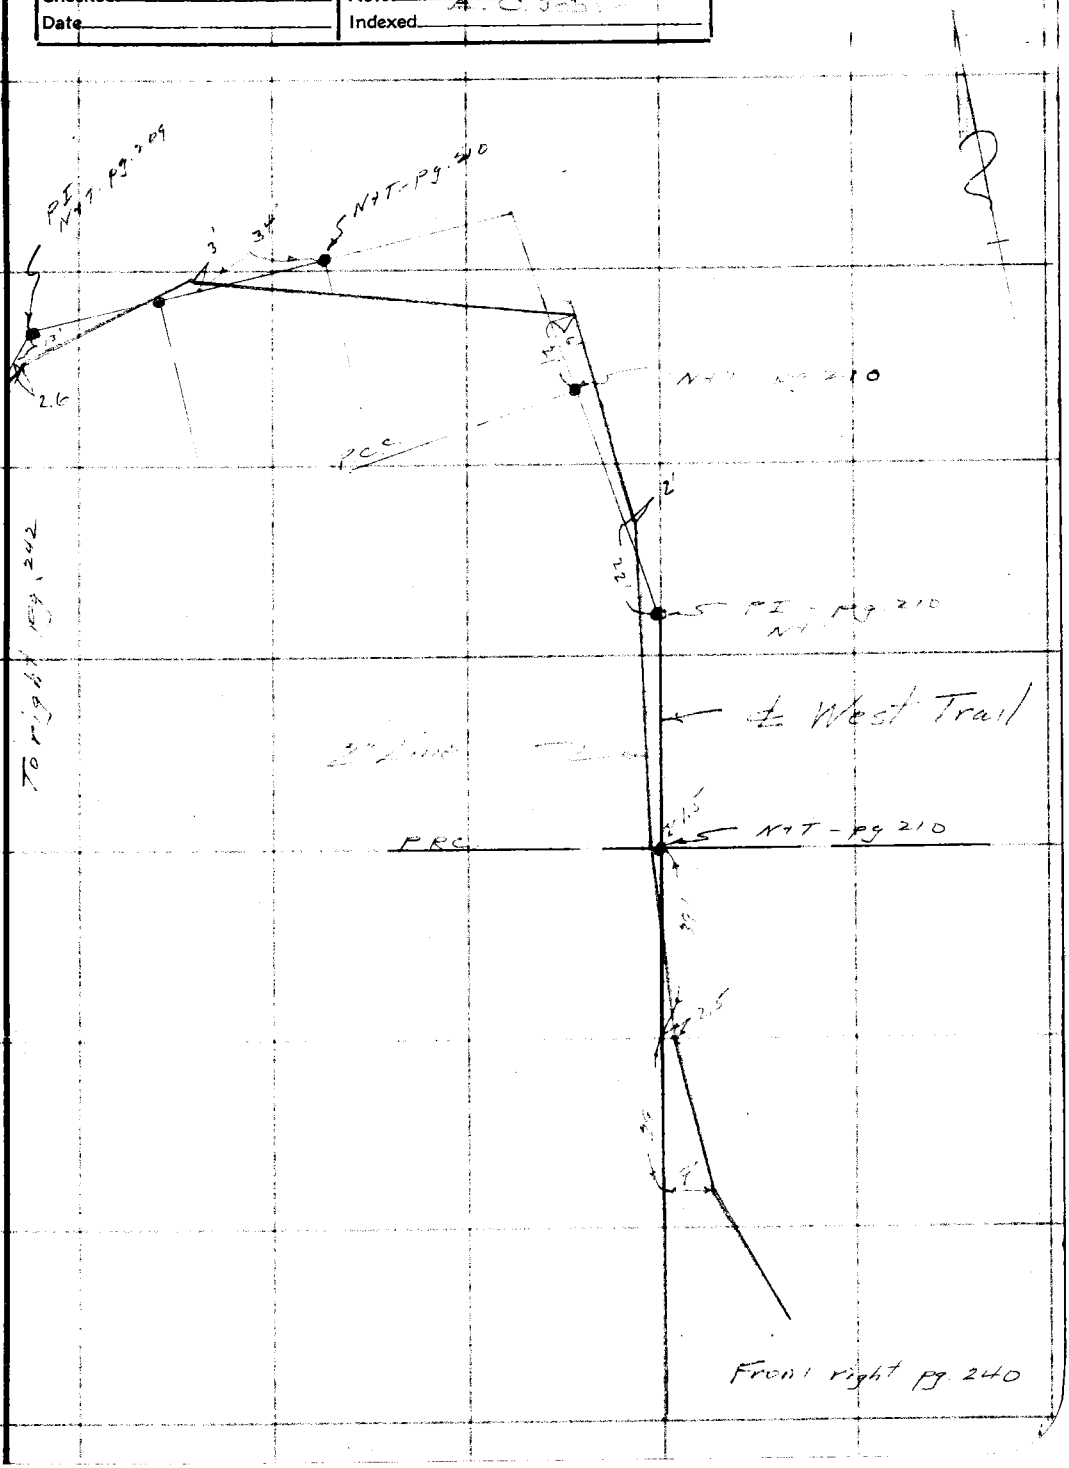

Note: Any Additions or Changes on This Sheet Must be Made or Circled in Red Ink With Date and Name of Person Making Change.

Do not extend notes this side of this line

RETURN TO
LOS ANGELES COUNTY SURVEYOR
700 HALL OF RECORDS

FORM 247 10M 11-38

RETURN TO
LOS ANGELES COUNTY SURVEYOR
700 HALL OF RECORDS

Note: Any Additions or Changes on This Sheet Must be Made or Circled in **Red Ink** With Date and Name of Person Making Change.

Do not extend notes this side of this line

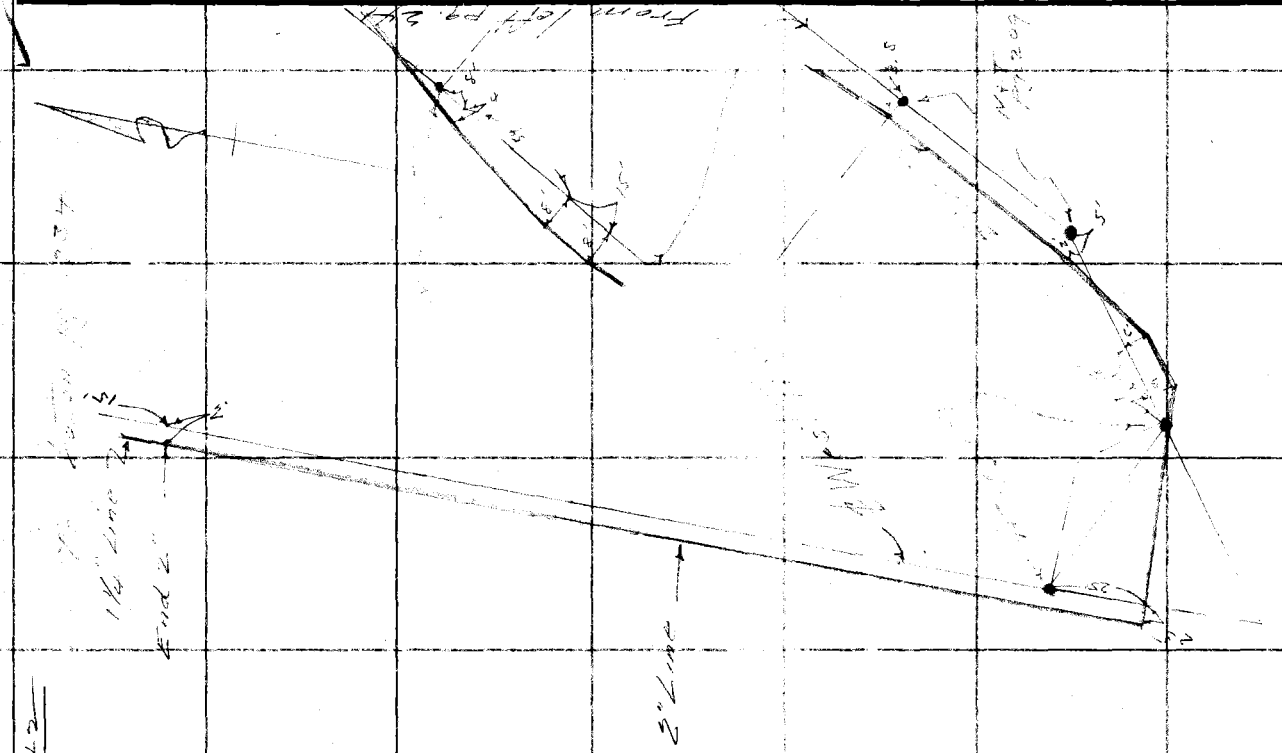


Notes Ck'd by	Survey of
Map No.	W. O. Tape No. St'd °F.
Office Work	Surveyed by
Checked	Notes Date
Date	Indexed A. O. Johnson

F.B. 320 PG. 243

Note: Any Additions or Changes on This Sheet Must be Made or Circled in Red Ink With Date and Name of Person Making Change.

Do not extend notes this side of this line

RETURN TO
LOS ANGELES COUNTY SURVEYOR
700 HALL OF RECORDS

FORM 247 10M 11-35

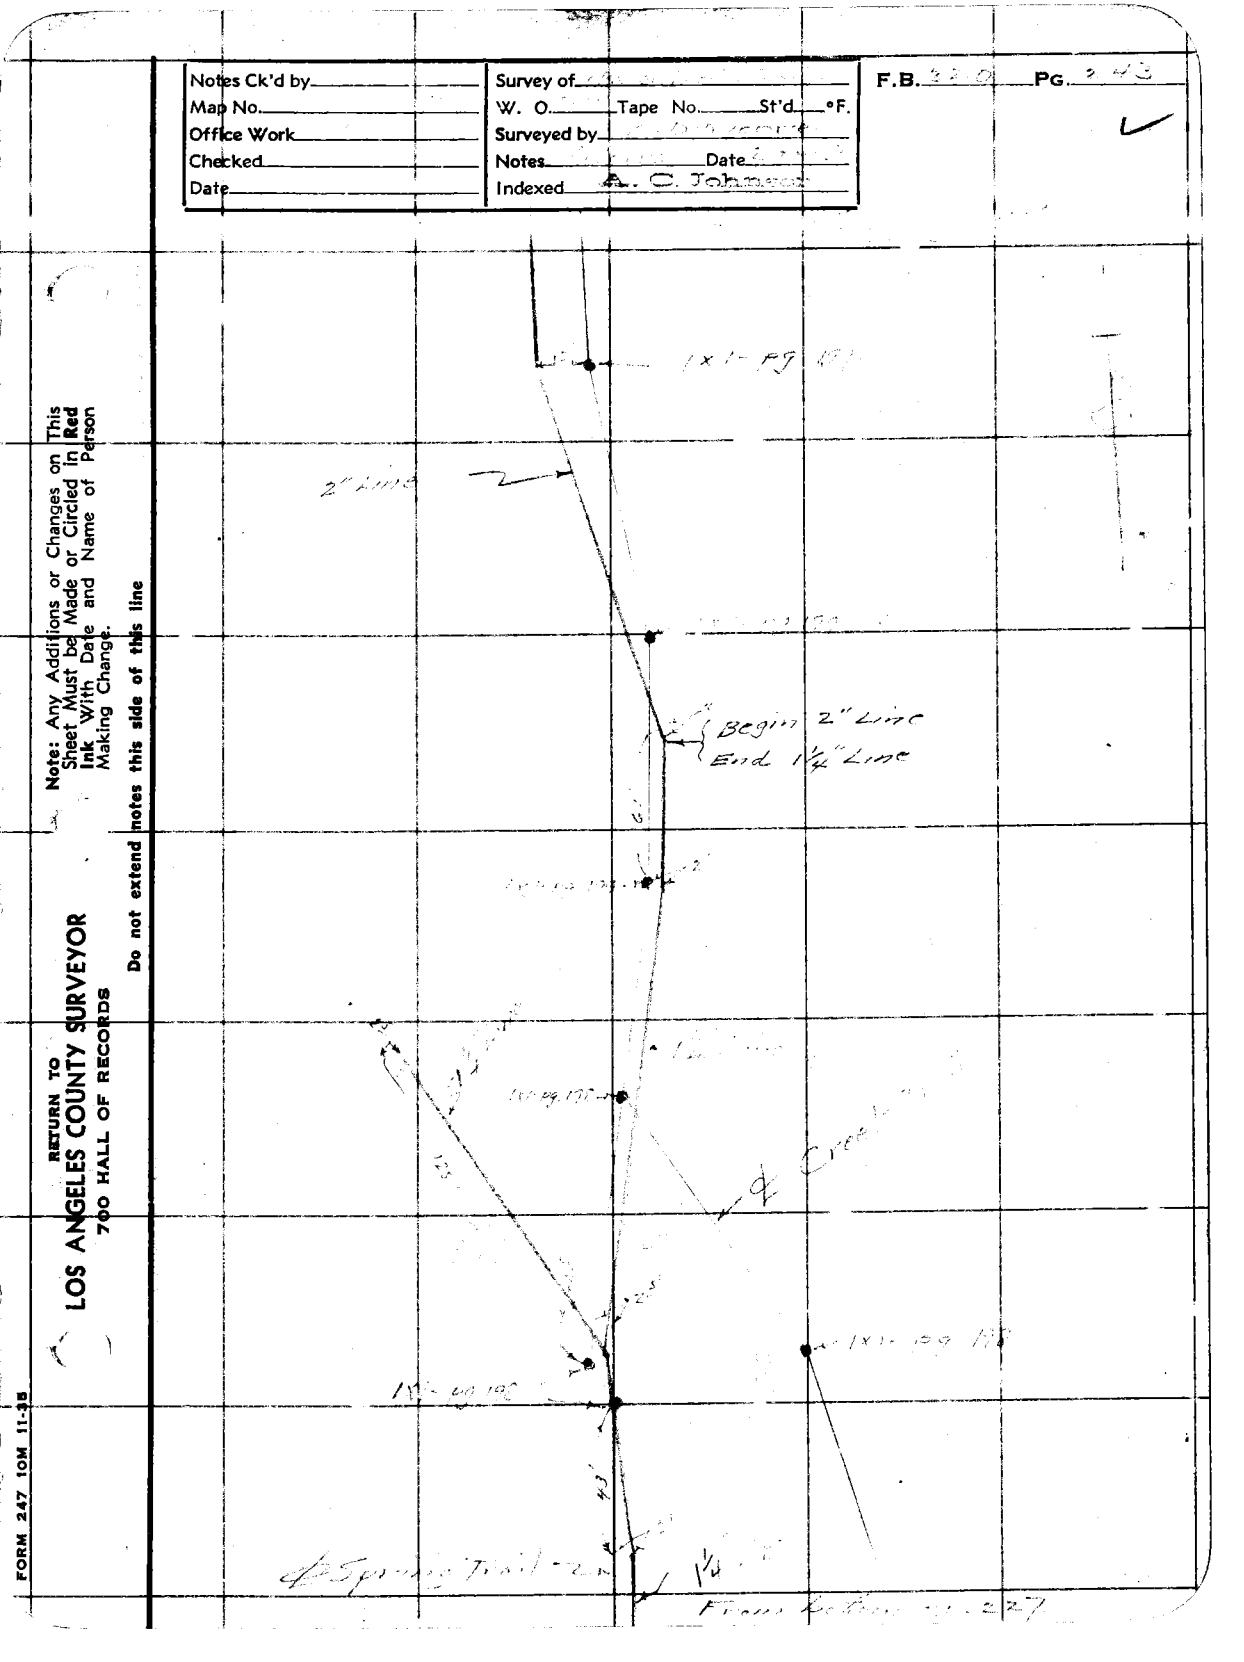

RETURN TO
LOS ANGELES COUNTY SURVEYOR
700 HALL OF RECORDS

Note: Any Additions or Changes on This Sheet Must be Made or Circled in **Red Ink** With Date and Name of Person Making Change.

Do not extend notes this side of this line

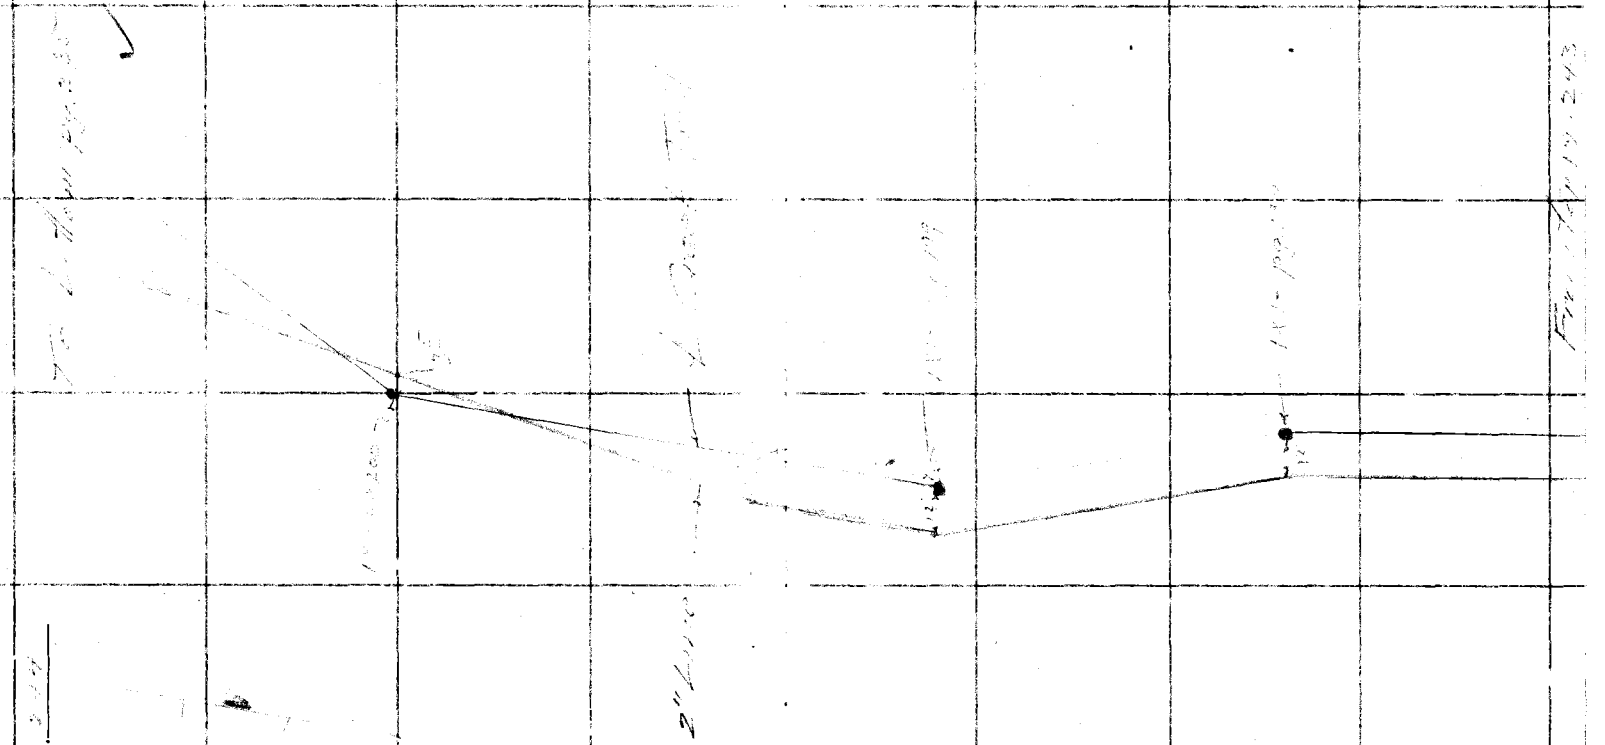

F.B. _____ PG. _____

Notes Ck'd by	Survey of Water Works Dist #21
Map No.	W. O. 8174 Tape No. St'd °F.
Office Work	Surveyed by L. D. Moore
Checked	Notes Arcie Date 3-3-37
Date	Indexed

F.B. 320 PG. 245

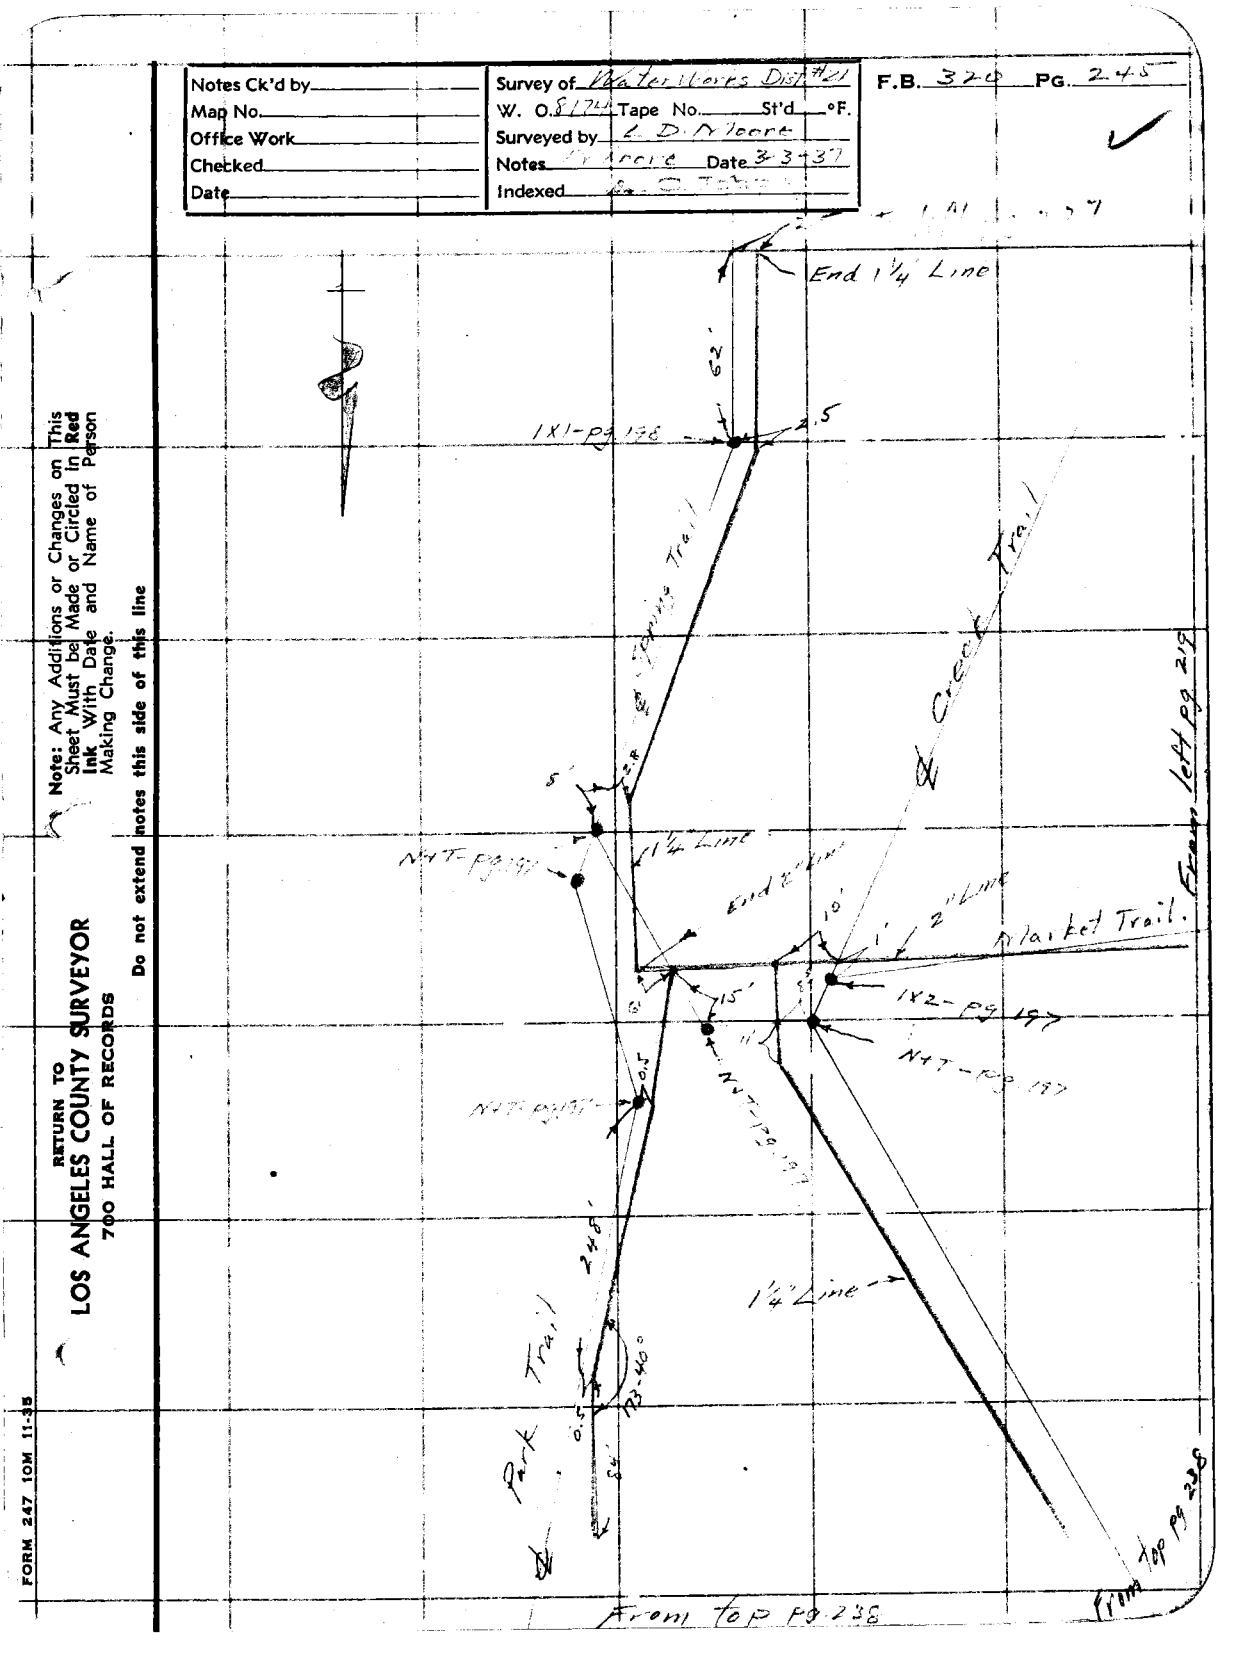

RETURN TO
LOS ANGELES COUNTY SURVEYOR
700 HALL OF RECORDS

Note: Any Additions or Changes on This Sheet Must be Made or Circled in Red Ink With Date and Name of Person Making Change.

Do not extend notes this side of this line

FORM 247 10M 11-35

RETURN TO
LOS ANGELES COUNTY SURVEYOR
700 HALL OF RECORDS

Note: Any Additions or Changes on This Sheet Must be Made or Circled in **Red** Ink With Date and Name of Person Making Change.

Do not extend notes this side of this line

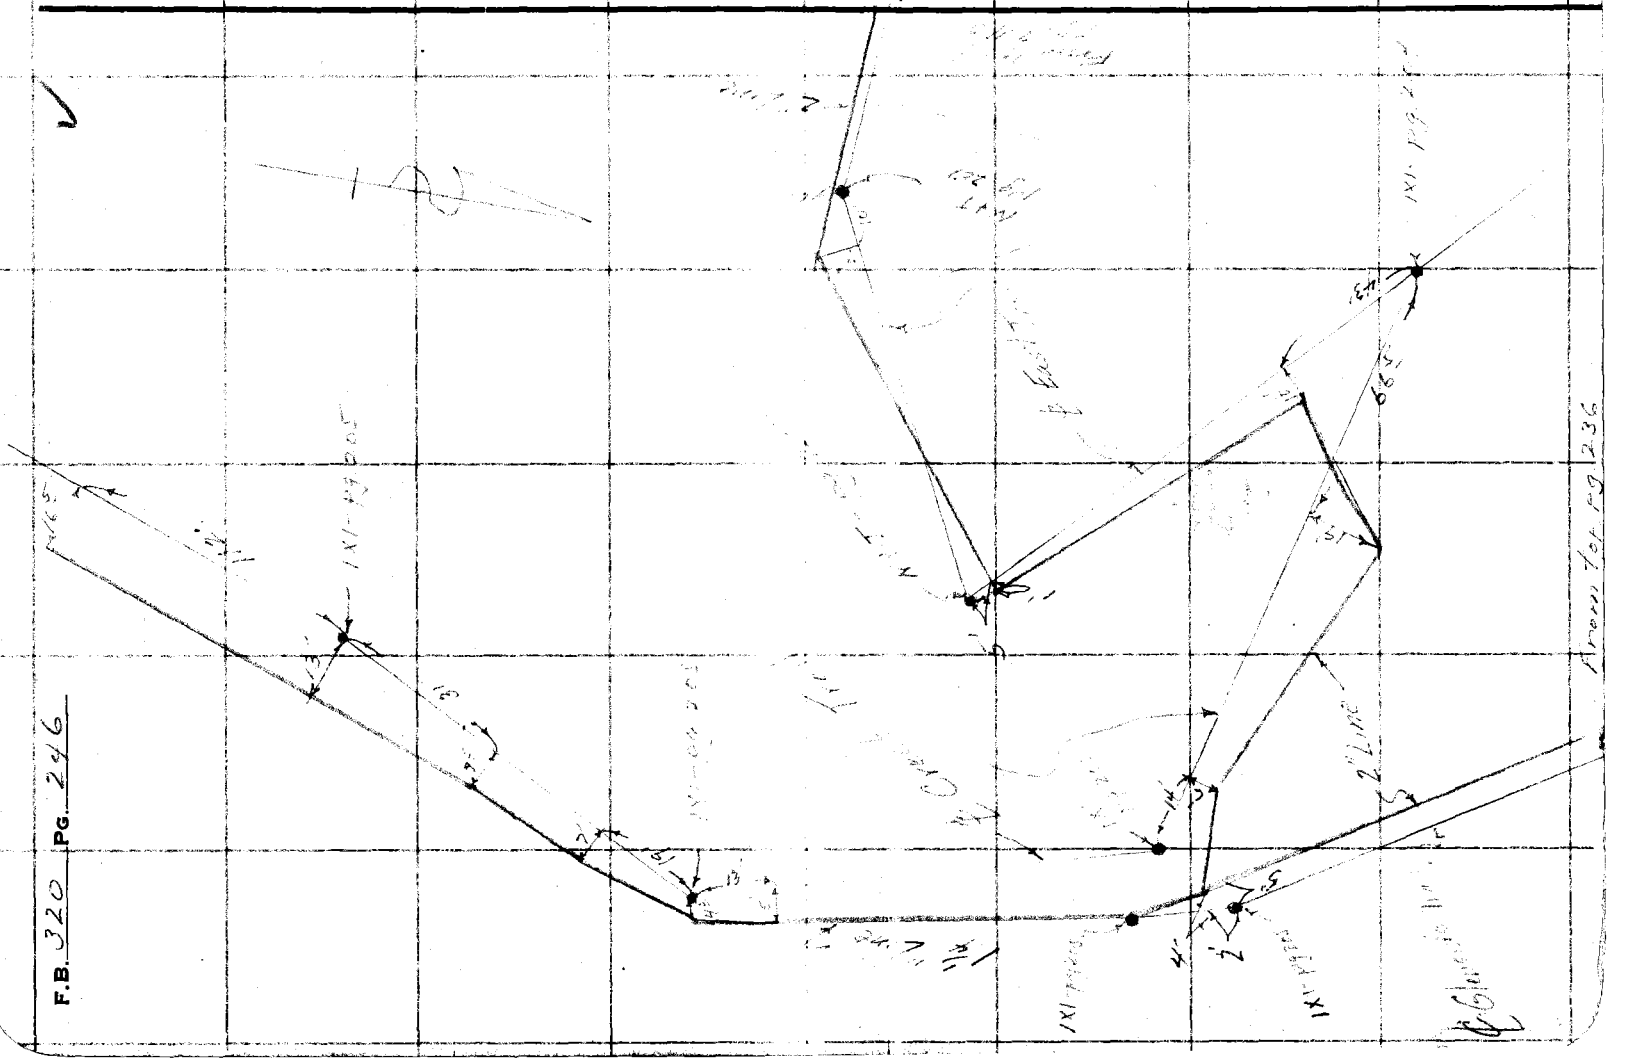

F.B. 320 PG. 246

Notes Ck'd by	Survey of Water Works Dist 29 F.B. 320 Pg. 247
Map No.	W. O. 8174 Tape No. St'd °F.
Office Work	Surveyed by L. D. Moore
Checked	Notes Moore Date 4-37
Date	Indexed A. C. Johnson

Note: Any Additions or Changes on This Sheet Must be Made or Circled in Red Ink With Date and Name of Person Making Change

Do not extend notes this side of this line

RETURN TO
LOS ANGELES COUNTY SURVEYOR
700 HALL OF RECORDS

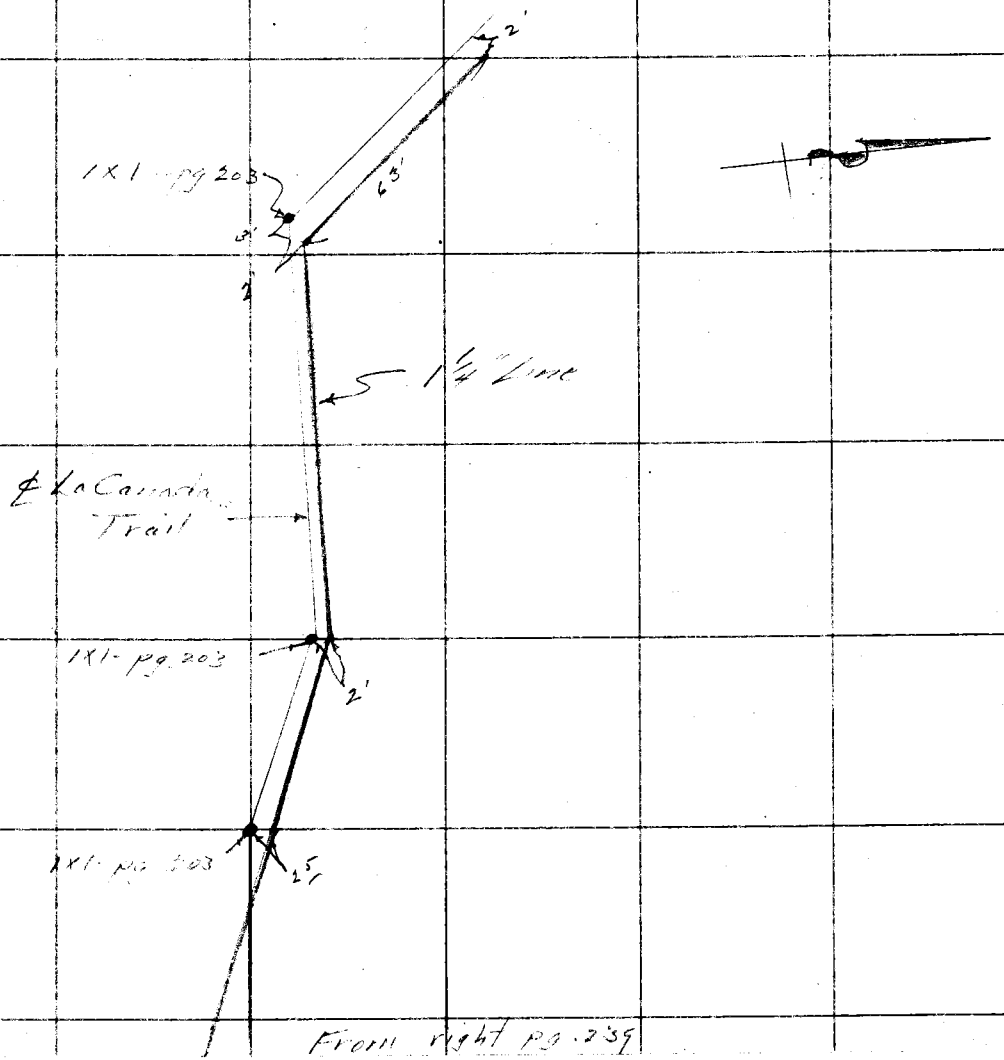

FORM 247 10M 11-38

RETURN TO
LOS ANGELES COUNTY SURVEYOR
700 HALL OF RECORDS

Note: Any Additions or Changes on This Sheet Must be Made or Circled in **Red** Ink With Date and Name of Person Making Change.

Do not extend notes this side of this line

F.B. 320 Pg. 248

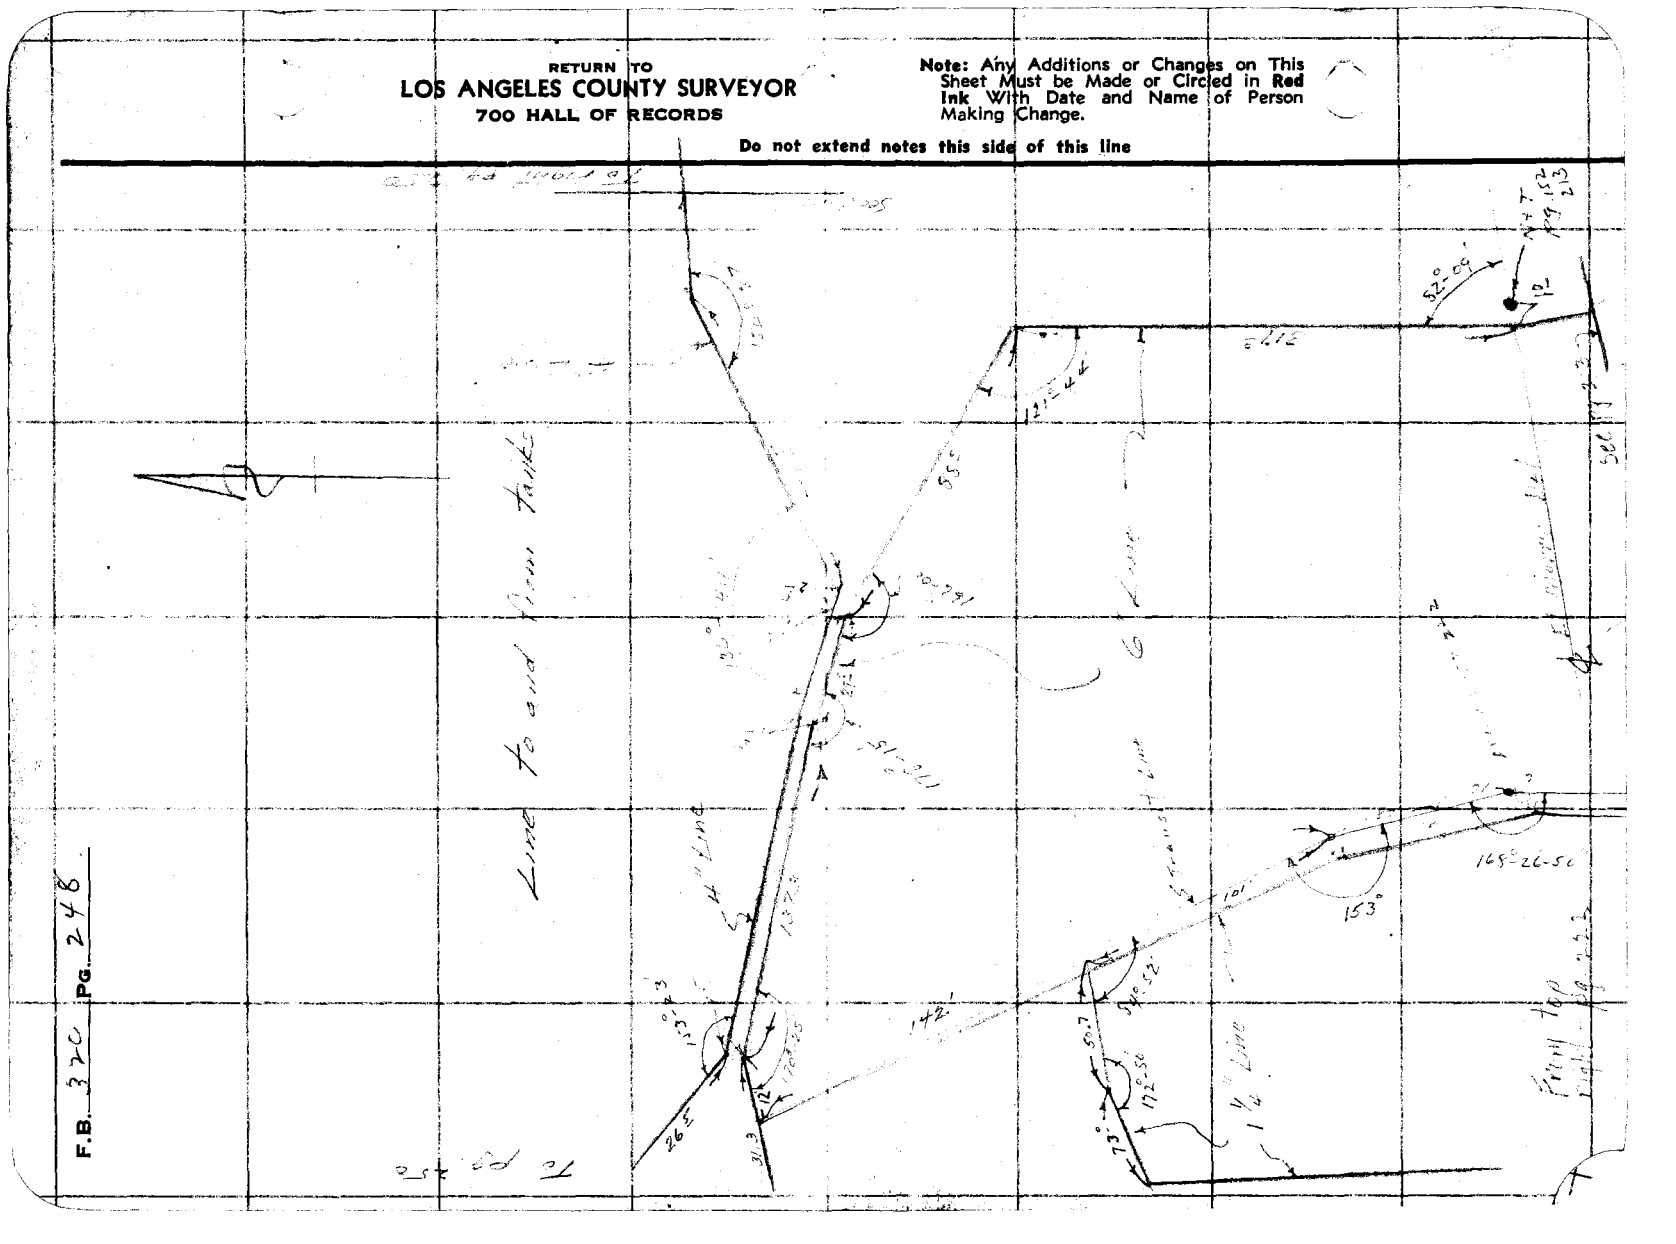

Notes Ck'd by	Survey of Water Works Dist 29
Map No. B-1223	W. O. 5161 Tape No. St'd °F.
Office Work F.A.W.	Surveyed by L. D. Moore
Checked	Notes Date
Date	Indexed A. C. Johnson

F.B. 320 PG. 249

Note: Any Additions or Changes on This Sheet Must be Made or Circled in Red Ink With Date and Name of Person Making Change.

Do not extend notes this side of this line

RETURN TO
LOS ANGELES COUNTY SURVEYOR
700 HALL OF RECORDS

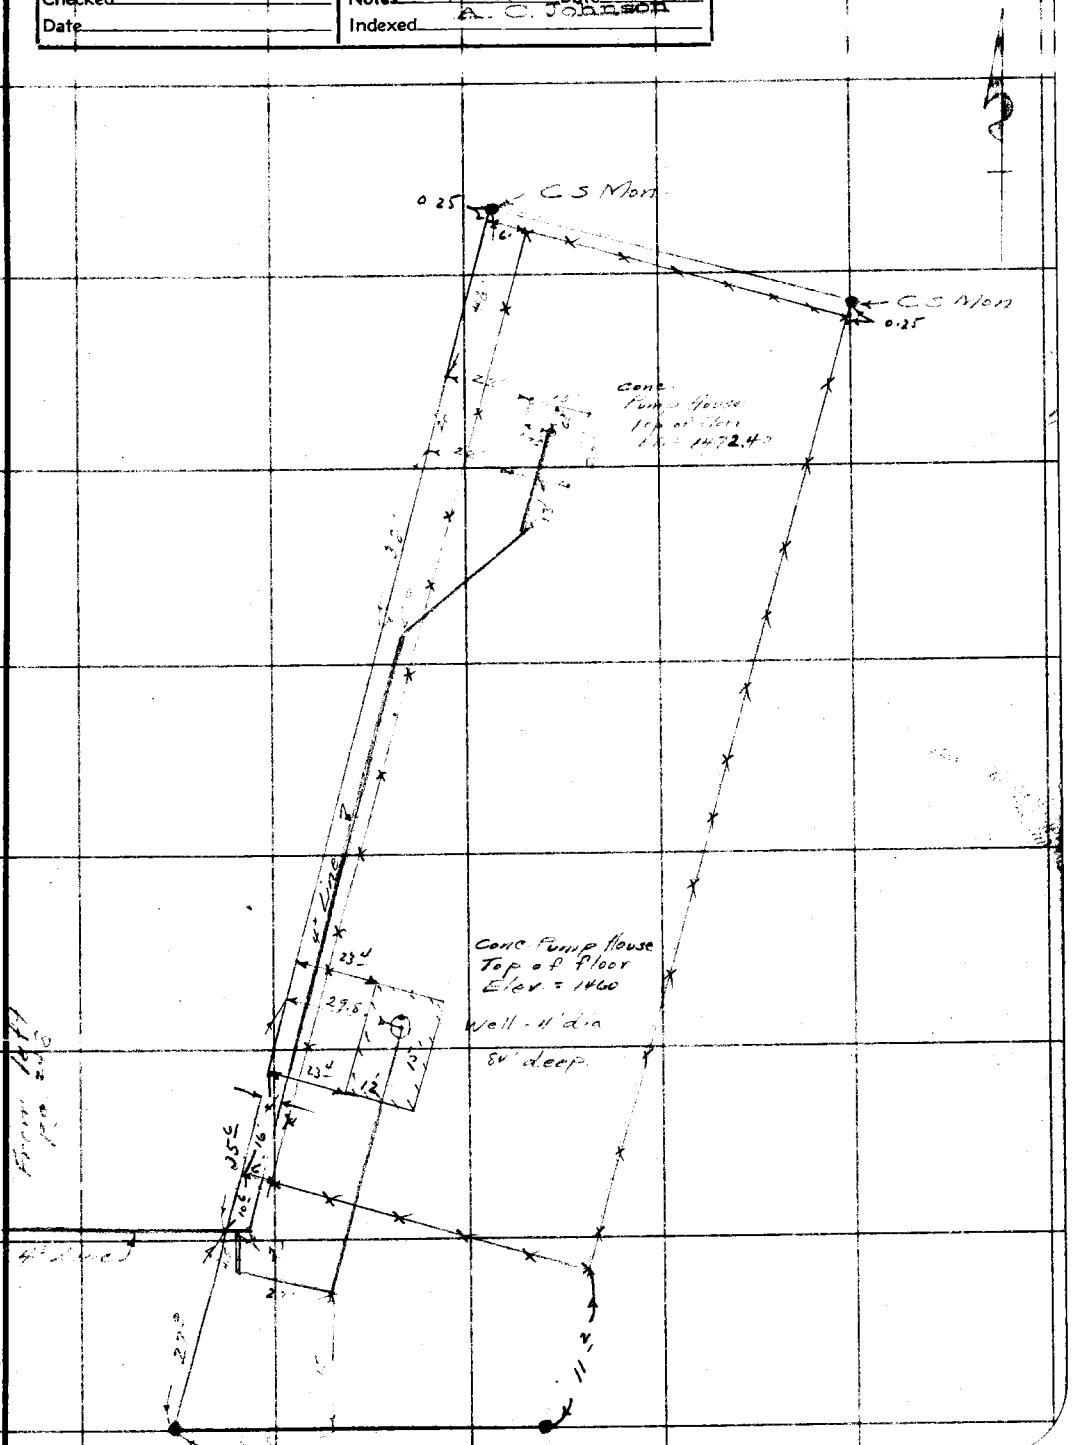

FORM 247 10M 11-35

RETURN TO
LOS ANGELES COUNTY SURVEYOR
700 HALL OF RECORDS

Note: Any Additions or Changes on This Sheet Must be Made or Circled in **Red Ink** With Date and Name of Person Making Change.

Do not extend notes this side of this line

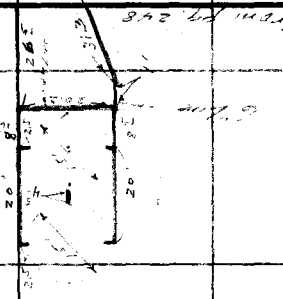

F.B. 320 PG. 250

Notes Ck'd by		Survey of	F.B. 320 Pg. 251
Map No.		W. O.	Tape No. St'd °F.
Office Work		Surveyed by	
Checked		Notes	Date
Date		Indexed	

Sketch Showing
Control Points for
Additional Topography
for
Water Works District 21
Job # 5162

Note: Any Additions or Changes on This Sheet Must be Made or Circled in Red Ink With Date and Name of Person Making Change.

Do not extend notes this side of this line

RETURN TO
LOS ANGELES COUNTY SURVEYOR
700 HALL OF RECORDS

FORM 247 10M 11-35

RETURN TO
LOS ANGELES COUNTY SURVEYOR
700 HALL OF RECORDS

Note: Any Additions or Changes on This Sheet Must be Made or Circled in **Red Ink** With Date and Name of Person Making Change.

Do not extend notes this side of this line

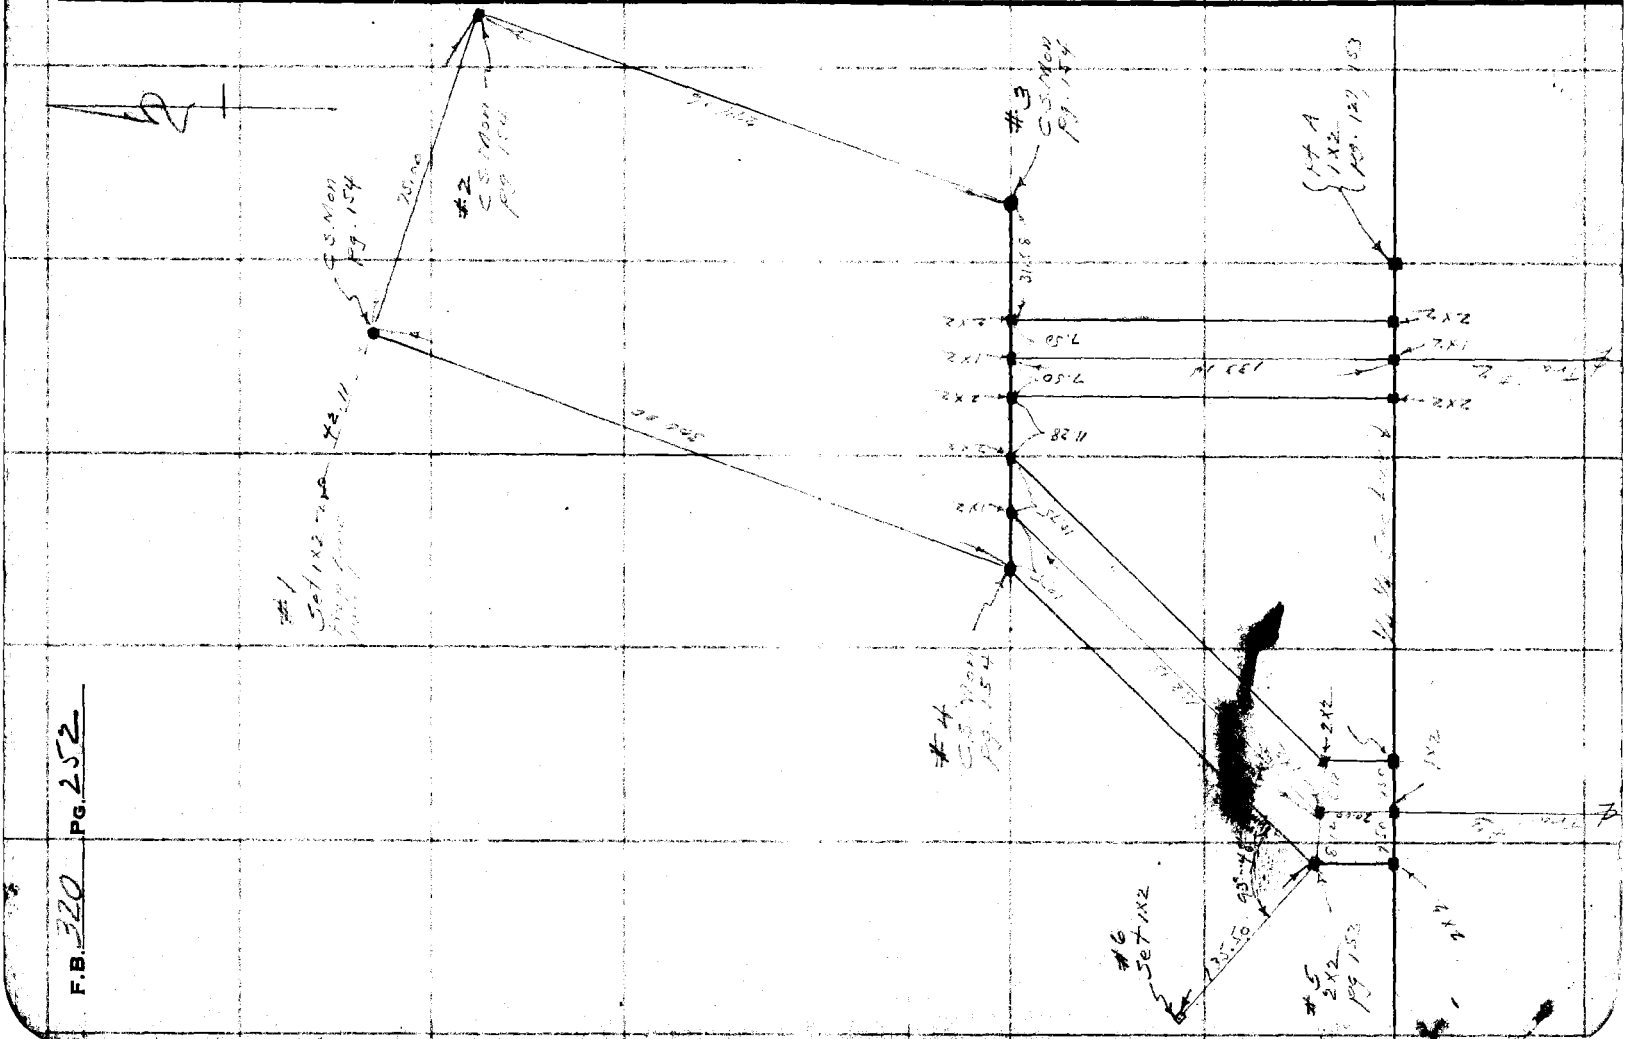

F.B. 320 PG. 252

Form 307 5M 11-35

PLEASE RETURN TO
LOS ANGELES COUNTY SURVEYOR
700 HALL OF RECORDS

NOTE: ANY ADDITIONS OR CHANGES ON THIS SHEET MUST BE MADE OR CIRCLED IN RED INK, WITH DATE AND NAME OF PERSON MAKING CHANGE

Do not extend notes this side of this line

STATION	B. S.	H. I.	F. S.	ELEV.		
B.M.	10 25	1477.58		1467 33	B.M. Adj. El. = 1467.33	Top W. Side of RP #3544740E F.B. 320—139 Note - This is Flood Control DSM El not known
#1			303	1474 55	#1 - 1X2	
			288	1474 70	C.S. Mon. - N.W. Cor. Pumping Lot	
#2			515	1472 43	#2 - " " N.E. " " "	
T.P.	041	1466 56	11 43	1466 13		
#3			1053	1456 03	#3 " " S.E. Cor " "	
T.P.	158	1456 54	11 60	1454 96		
#4			212	1454 42	#4 S.W. Cor " "	
#5			744	448.80	PT. #5 - 1X2	
T.P.	084	1446 16	11 22	1445 32		
T.P.	008	1434 96	11 38	1434 82		
T.P.	426	1428 88	10 34	1424 62		
#5			632	1422 56	#5 - 2X2	
#6			183	1420 05	#6 - 1X2	
T.P.	11 57	1440 48	0 21	1428 57		
T.P.	11 55	1451 53	0 50	1439 98		
T.P.	11 12	1462 53	0 11	1451 43		
	748	1469 04	099	1461 56		
B.M.			171	1467.33	Elev. = 1467.33 - Set above	

Profile Notes Red _____ Plotted J.A.L. Job No. 8163 Division No. V | F.B. 320 PG. 25

No. _____ Date _____ Date 4-16-37 Survey of _____

X-Sec. Notes Check J.A.L. Checked _____ Survey by _____ Notes _____ Date 4-15-37

No. _____ Date 4-16-37 Date _____ Map No. B-1225 Indexed A.C.J. Date _____

F. B. 320 Pg. 254 | Job No. | Division No. | Notes Red. | Plotted | Profile

Survey of | Date | Date | No.

Survey by | Notes | Notes Chkd. | Checked | X-Sec.

Indexed | Date | Date | Date | No.

Form 307 5M 11-35

PLEASE RETURN TO
LOS ANGELES COUNTY SURVEYOR
700 HALL OF RECORDS

NOTE: ANY ADDITIONS OR CHANGES ON THIS SHEET MUST BE MADE OR CIRCLED IN RED INK, WITH DATE AND NAME OF PERSON MAKING CHANGE

Do not extend notes this side of this line

STATION	B. S.	H. I.	F. S.	ELEV.

Transit	Stadia Intercepts	Stadia Distance	Vertical Angle	Horizontal Angle	Azimuth	Bearing	Remarks
#2	#1						
	740						
	5	241.	0 6	43 —			
	287						
	5	288.	0 6	45 40			
	5 1 3						
	3	214	0 6	45 55			
	265						
	1	166	0 6	52 10			
	383						
	2	184	0 6	67 45			
	264						
	1	167.	0 6	78 40			
	407						
	2	208	0 6	90 25			
	264						
	1	167.	0 6	103 35			
	376						
	6	180	0 6	118 50			
	531						
	3	232	0 6	123 40			
	578						
	4	179.	5 6	134 50			
	319						
	2	120.	5 6	147 40			
	197						
	1	98.	5 6	94 10			
	438						
	3	139.	5 6	90 30			
	198						
	1	99.	5 6	59 35			
	213						
	1	114	5 6	34 30			
	473						
	3	174	5 6	29 55			
	6 3						
	8	214	5 6	34 30			
	3 1 7						
	1	166	5 6	3 30			
	2						

Form 381 10M 3-34

PLEASE RETURN TO
LOS ANGELES COUNTY SURVEYOR
700 HALL OF RECORDS

NOTE: ANY ADDITIONS OR CHANGES ON THIS SHEET MUST BE MADE OR CIRCLED IN RED INK, WITH DATE AND NAME OF PERSON MAKING CHANGE

Grade Rod

Do not extend notes this side of this line

Transit at	Sight on	Stadia Intercepts	Stadia Distance	Stadia Rod	Horizontal Angle 0° to 360° Right	Horiz. Distance	+ − Vertical Angle	Elevation of Point	+ Back Sight	+ − Difference Elevation	Height of Instrument	+ Vertical Distance	REMARKS Left Right
#2	#1				° ′		° ′						
		355									1485 6		
		3	56.	10 6	4 55,			1475 0					1475 - F1
		330											
		3	31.	10 6	71 20,			"					" - BK
		354											
		3	55.	10 6	78 20,			"					" - B. Dr.
		339											
		3	40.	10 6	92 55,			"					" - BK
		372											
		3	73.	10 6	186 40,			"					" - F1.
		424											
		3	125.	10 6	183 20,			"					" - "
									6 6				
								1467 3			1473 9		B.M. Spk in PP #354740E
#2	#1	616											
		5	111.	3 9	330 40,			1470 0					1470 - Top bank
		616											
		5	111.	3 9	343 05,			"					" - S.H.
		590											
		5	91.	3 9	323 05,			"					" - F1
		569											
		5	70.	3 9	276 50,			"					" - "
		641											
		6	42.	3 9	255 35,			"					" - Top bank
		613											
		6	14.	3 9	213 55,			"					" - B.D
		634											
		6	35.	3 9	237 20,			"					" - Top bank
		585											
		5	86.	3 9	229 50,			"					" - F1
		614											
		5	115.	3 9	223 10,			"					" - "
		639											
		5	140.	3 9	204 10,			"					" - "
		580											
		4	184.	8 9	222 30,			1465 0					1465 - "
		589											
		4	190.	8 9	241 35,			"					" - "
		1140											
		10	141.	8 9	251 25,			"					" - "

Topography Description Legend:
Hill...S.H. Bottom Draw B.D. | Side of Draw S.D. | Bottom Wash B.W. | Top of Ridge T.R. | Toe of Slope T.S.
Intersection of Draw with Side S.D. | Top of Side T.S. | Bottom of Side B.S. | Top of Cliff T.Cl. | Bottom of Cliff B.Cl. | Top of Spur T.Sp. | Bottom Canyon B.Cn.
Plus combinations of these and all common abbreviations.
Sycamore | Eucalyptus

B-2 PG 23

ASP'T Interm.

Form 98 3M 3-48

RETURN REPORT TO
LOS ANGELES COUNTY SURVEYOR
700 HALL OF RECORDS

NOTE: ANY REFERENCE OR CHANGE ON THIS SHEET MUST BE MADE OR CIRCLED IN RED INK, WITH DATE AND NAME OF PERSON MAKING CHANGE

Grade Rod

Do not extend notes this side of this line

Transit at	Sight on	Stadia Intercepts	Stadia Distance	Vertical Angle	Horizontal Angle 0° to 360° Right	Horiz. Distance	+ Vertical Angle	Elevation of Point	+ Back Sight	± Difference Elevation	Height of Instrument	± Vertical Distance	Notes
#2	#1	1117						1465.0	1		1473.9		1465 — Top bank
		10	148.	8 9	251 25								
		1172							2				" — "
		11	73.	8 9	246 20								
		1108							3				" — Top bank
		10	109.	8 9	256 20								
		1133							4				" — "
		10	134.	8 9	269 40								
		1146							5				" — "
		10	147.	8 9	283 25								
		1168							6				" — "
		10	169.	8 9	302 20								
		1134							7				" — Top bank
		10	135.	8 9	320 15								" — "
#3	#4							1467.3	8 0.5		1467.5/8		B.M. — "
		527							9				
		4	128.	7 8	52 50			1460.0	10				1460 — Top bank
		642											
		5	143.	7 8	65 35				11				" — "
		3778											
		3	79.	7 8	57 30				12				" — "
		261											
		2	62.	7 8	84 10				13				" — "
		3720											
		3	71.	7 8	113 10				14				" — Top bank
		2357											
		3	98.	7 8	116 25				15				" — "
		1724											
		3	75.	7 8	118 30				16				" — Top bank
		376											
		3	76.	7 8	149 40				17				" — "
		379											
		3	80.	7 8	170 30				18				" — "
		524											
		4	125.	7 8	179 10				19				" — "
#3	#4							1454.4/8	20 3		1457.7		#4 — Top Curb
		587											
		6	108.	7 7	71 30			1455.5					1455 — Top bank
		1224											
		4	130.	7 7	48 0								" — "

Notes Re: Plotted J.A.Lyon Date 4-16-57
Bm 4-16-57 Tied to B-1423 Elevation 1467.58 Datum U.S.C.&G.S.
Bm B-1423 Elevation 1467.58 Datum U.S.C.&G.S.

Form 301 10M 3-34

PLEASE RETURN TO
LOS ANGELES COUNTY SURVEYOR
700 HALL OF RECORDS

NOTE: ANY ADDITIONS OR CHANGES ON THIS SHEET MUST BE MADE OR CIRCLED IN RED INK, WITH DATE AND NAME OF PERSON MAKING CHANGE

Do not extend notes this side of this line

Transit at	Sight on	Stadia Intercepts	Stadia Distance	Stadia Rod	Horizontal Angle 0° to 360° Right	Horiz. Distance	+ Vertical Angle —	Elevation of Point	+ Back Sight	+ Difference Elevation —	Height of Instrument	+ Vertical Distance —	REMARKS Station	Left	Right
#3	#4	566													
		536	67.	2 7	3.05			1455.0			1457.7		1455		FL.
		615	37.	2 7	340.40			"					"		
		524	16.	2 7	290.35			"					"		Top bank
		319	25.	2 7	146.55			"					"		B.D.
		577	20.	7 7	228.55			1450.0					1450		B.D.
		615	78.	7 7	316.50			"					"		Top Bank
		1192	116.	7 7	334.50			"					"		Top Cut.
		421	98.	7 7	340.40			"					"		Bot "
		1116	122.	7 7	354.40			"					"		Top bank
		10	117.	7 7	20.50			"					"		S.H.
#4	#3							1454.4	1 1		1455.5		#4-C.S. Mon. S.W. Cor.		
		1164	65.	10 5	146.—			1445.0					1445		Top bank
		1150	51.	10 5	191.10			"					"		S.H.
		1059	60.	10 5	123.40			"					"		Bot Cut
		974	75.	10 5	122.50			"					"		Top "
		1096	97.	10 5	107.20			"					"		Top bank
		1180	81.	10 5	46.25			"					"		B.D.
		1105	106.20	5	83.45			1435.0					1435		"
		1127	128.25	5	96.10			1430.0					1430		"
T.P.								1444.8		10.7					
									0 5		1445.3				

Add'n'l info on:

Traverse Rd. Tr. Rd. Fence ..... Fe. Int. Fence ..... V.Fe. Ditch ..... Di. Telephone Pole ..... T.P. Power Pole ..... P.P. Culvert ..... Cul. Edge of Road ..... E.Rd.

Saddle ..... Sa. Swale ..... Sw. Flat ..... Fl. Stream ..... Str. Trail ..... Tr. Pavement ..... Pvt.

Side of Canyon ..... S.Ca. Top of Bank ..... T.B. Bottom of Bank ..... B.B. Top of Cut ..... T.C. Bottom of Cut ..... B.C. Top of Fill ..... T.F. Bottom of Fill ..... B.F.

Intersection of Draw with ..... Int. Break in Slope ..... B.S. Steep Slope ..... S.S. Top of Cliff ..... T.Cl. Bottom of Cliff ..... B.Cl. Top of Spur ..... T.Sp. Bottom Canyon ..... B.Cn.

Topography Description Legend:
Hill ..... H. Draw ..... D. Bottom Draw ..... B.D. Wash ..... W. Bottom Wash ..... B.W. Ridge ..... R. Top of Ridge ..... T.R. Slope ..... S. Top of Slope ..... T.S. Draw ..... D.

Form No. [illegible]

Property of
LOS ANGELES COUNTY SURVEYOR
700 HALL OF RECORDS

NOTE: - ANY ABBREVIATION OR CHANGE ON THIS SHEET MUST BE MADE OR CIRCLED IN RED INK, WITH DATE AND NAME OF PERSON MAKING CHANGE

Do not extend notes this side of this line

Transit at	Sight on	Stadia Intervals	Stadia Distance	Stadia Rod	Horizontal Angle 0° to 360° Right	Horiz. Distance	+ −	Vertical Angle	Elevation of Point	+ Rod Sight	+ −	Difference Elevation	Height of Instrument	+ −	Vertical Distance	B.M.	Rod	Dist.	Remarks
#5	#4	590			° '			° '		1									
		5	91.	5 3	352 45				1440				1445			1440			
		377	78							2									
		3		5 3	358 35				"							"			
		480	81.	5 3	9 15				"	3						"			
		4																	
		374	75.	5 3	12 55				"	4						"			
		3																	
		273	74.	5 3	28 30				"	5						"			
		2																	
		374	95	5 3	42 55				"	6						"			
		3																	
		263								7									
		2	64.	10 5	55 50				1435							1435			
		527								8									
		1	54.	10 5	0 20				"							"			
		257								9									
		2	58.	10 5	20 50				"							"			
		564								10									
		1	65.	10 5	38 30				"							"			
		891								11									
		18	92	10 5	46 45				"							"			
#5	#4									12									
									1422	10 4			1433			#5			
		359								13									
		3	60	3 0	324 15				1430							1430			
		136								14									
		4	37.	3 0	8 —				"							"			
		129								15									
		1	30	3 0	4 10				"							"			
		441								16									
		4	42	3 0	39 15				"							"			
		256								17									
		2	57.	3 0	41 50				"							"			
		565								18									
		5	66	3 0	43 25				"							"			
		565								19									
		5	66	5 2	44 10				1427	8									
		454								20									
		4	85	3 0	51 20				1430							1434			
		397																	
		7	94	3 0	60 —														

Plotted J.A.L. Jan 4-16-37
Traced [illegible] Jan 4-16-37
Checked [illegible] Jan 4-16-37
Book No. B-1223 Page [illegible]

Form 301 IGM 3-34

PLEASE RETURN TO
LOS ANGELES COUNTY SURVEYOR
700 HALL OF RECORDS

NOTE: ANY ADDITIONS OR CHANGES ON THIS SHEET MUST BE MADE OR CIRCLED IN RED INK, WITH DATE AND NAME OF PERSON MAKING CHANGE

Do not extend notes this side of this line

Transit at	Sight on	Stadia Intercepts	Stadia Distance	Stadia Rod	Horizontal Angle 0° to 360° Right	Horiz. Distance	+ Vertical Angle −	Elevation of Point	+ Back Sight	+ Difference Elevation −	Height of Instrument	+ Vertical Distance	REMARKS Station	Left	Right
#5	#4	369													
		3	7.0	5 3	56 05			1427.7			1433			Ed. Fl.	
		251						427.8						"	"
		2	5.2	5 2	53 10										
		559						1425						1425 — B.D.	
		5	6.0	8 0	57 25									" — S.H.	
		438												" — Top Fill	
		4	3.9	8 0	59 10									" — Bot "	
		204												" Toe Slope	
		2	.5	8 0	21 45										
		320												Bot. wall	
		3	2.1	8 0	356 25										
		239												" " conc.	
		2	4.0	8 0	303 45									Ed. Platform	
		766												Bot D. wall	
		7	6.7	8 7	68 50			1424.3						Bot D. E Ed. Rd	
		381												Bot D. w Ed. Rd.	
		3	8.2	9 0	90 25			1424.0						Bot D. +	
		351						423.9						VD. Bot Main Wash	
		3	5.2	9 1	80 30										
		451						422.4							
		4	5.2	10 6	77 50										
		631						421.2							
		6	3.2	11 8	108 45										
		627						421.3							
		6	2.8	11 8	134 25										
		744	45					419.7							
		2	44	13 3	184 —										
PTA	West 1/4 1/4							1448.5	8.4		1457.2		PT. A - 1X2		
		211													
		1	112.	2 2	116 30			1455.3					1455 — Top bank		
		204													
		1	10.5	2 2	135 30									"	Fl
		439													
		3	14.0	2 2	153 05									"	"
		502													
		4	10.3	7 2	190 40			1450						1450 —	"
		348													
		3	4.9	7 2	172 55			"						"	"

Form 881 (5M) 3-34

RETURN TO
LOS ANGELES COUNTY SURVEYOR
700 HALL OF RECORDS

NOTE: ANY ADDITIONS OR CHANGES ON THIS SHEET MUST BE MADE OR CIRCLED IN RED INK, WITH DATE AND NAME OF PERSON MAKING CHANGE

Do not extend notes this side of this line

Transit at	Sight on	Stadia Intercepts	Stadia Distance	Stadia Rod—	Horizontal Angle 0° to 360° Right	Horiz. Distance	+ / −	Vertical Angle	Elevation of Point	+ Back Sight	+ / −	Difference Elevation	Height of Instrument	+ / −	Vertical Distance	STATION	BENCH MARK Elev.	Sight
P.T.A	West ¼ ¼ Cor	4.31	32	7.2	63 35				1450.0	1			1457.2			1450		
		4																
		9.35	40	12.2	355 45				1445.0	2						1445		
		9																
		9.64	60	12.2	272 25				"	3						"		
		9																
		11.52	53	17.2	53 10				1440.0	4						1440		
		11	48	17.2	0 00				1440.0	5						1440		
			58	22.2	0 00				1435.0	6						1435		
			73	27.2	0 00				1430.0	7						1430		
										8								
										9								
Notes Red. _____ Plotted J.A.L. Division No. 6 F.B. 1302 Pg. 17
Date _____ Job No. 1265
Date 4-16-37 Survey of Water Works Dist #21
Recd. _____ Surveyed _____ Notes Wood Date 4-15-37
Surveyed by Weese Notes Wood Date 4-15-37
Bk. No. B-1223 Indexed A.C. Johnson

Form No. 108 3-48

PLEASE MAIL THIS SHEET TO

LOS ANGELES COUNTY SURVEYOR

ROOM 130, HALL OF RECORDS

NOTE: ANY ADDITIONS OR CHANGES ON THIS SHEET MUST BE MADE OR CIRCLED IN RED INK, WITH DATE AND NAME OF PERSON MAKING CHANGE

Do not extend notes this side of this line

Transit at	Shot on	Stadia Distance	Stadia Distance	Stadia Rod	Horizontal Angle 0° to 360° Right	Horiz. Distance	+ − Vertical Angle	Elevation of Point	+ − Rod Sight	+ − Elevation	Point at Instrument	+ − Vertical Distance	Remarks
					° '		° '						
									1				
									2				
307 5M 11-85

PLEASE RETURN TO
LOS ANGELES COUNTY SURVEYOR
700 HALL OF RECORDS

NOTE: ANY ADDITIONS OR CHANGES ON THIS SHEET MUST BE MADE OR CIRCLED IN RED INK, WITH DATE AND NAME OF PERSON MAKING CHANGE

Do not extend notes this side of this line

Profile No. _____ Sec. _____ Map _____ Notes Red _____ Plotted _____ Date _____ Checked _____ Date 12-13-36 Job No. 5163 Division No. V Survey of _____ Survey by _____ Map No. _____ Indexed _____ Notes _____ Date 11-25-36 Date 11-30-36 F.B. 320 Pg. 145 263

STATION	B. S.	H. I.	F. S.	ELEV.		
BM	#41	145333		144892	BM Cr. spk. in ℄ Tel P. 50' N. of inter. Kagel Cn. & Dexter Park ℄ B.320-137	
0+00			40	14533'	℄ - inter ℄ Kagel Cn Rd	
			29	14508'	23'R - West edge Pvt. (oiled)	
			15	14518'	50'R	
			47	14486'	23'L - T.F.	
			127	14406'	60'L - B.F.	
0+14			69	14464'	℄ [illegible] Dr. Drive	
			62	14471'	12'R - N edge rd. (dirt)	
			37	14496'	23'R - T.F.	
			21	14512'	50'R	
			65	14468'	3'L - S. edge rd	
			58	14475'	7'L - T.F.	
			93	14440'	16'L - B.F.	
			137	14396'	50'L	
0+36			114	14419'	℄	
			114	14419'	9'R - N edge rd.	
			105	14428'	50'R - B.F.	
			120	14413'	3'L - S. edge rd	
			131	14402'	16'L - End Fill.	
			154	14379'	50'L	

℄ Point of Intersection of Kagel Canyon Rd. & Dexter Park Drive

For ℄ see F.B. 320-147-150

Form 307 5M 11-35

PLEASE RETURN TO
LOS ANGELES COUNTY SURVEYOR
700 HALL OF RECORDS

NOTE: ANY ADDITIONS OR CHANGES ON THIS SHEET MUST BE MADE OR CIRCLED IN RED INK, WITH DATE AND NAME OF PERSON MAKING CHANGE

Do not extend notes this side of this line

F. B. 320 Pg. 7 | Job No. 5763 Division No. L Profile
Survey by A. Cooper Notes Moore Date X-Sec.
Indexed A. C. Johnson Date Notes Chkd. L. Keagle Checked No.
Date 12-1-36 Date

STATION	B. S.	H. I.	F. S.	ELEV.	
		1453 33			
T.P	0 06	1441 63	11 76	1441 57	
0+50			22	143[illegible]	4'
			18	[illegible]	9'R - N. edge rd.
			20	1439 6	5'R
			21	[illegible]	5'L - S. " "
			60	[illegible]	5'L
0+87			109	[illegible]	5'L
			82	1438 [illegible]	6'L - S. " "
			83	1438 [illegible]	℄
			77	[illegible]	9'R - N " "
			87	1438 [illegible]	50'R
1+00			87	1438 [illegible]	50'R
			97	1438 [illegible]	7'R - N. " "
			99	1437 [illegible]	℄
			99	1437 [illegible]	5'L S " "
			122	1429 [illegible]	50'L
1+06.03			106	1438 [illegible]	℄ - intersect ℄ Trail #1
T.P.	5 20	1435 37	11 46	1430 17	
1+50			5 20	1430 [illegible]	℄
			53	1430 1	8'L - S. edge rd.

Form 307 5M 11-35

PLEASE RETURN TO
LOS ANGELES COUNTY SURVEYOR
700 HALL OF RECORDS

NOTE: ANY ADDITIONS OR CHANGES ON THIS SHEET MUST BE MADE OR CIRCLED IN RED INK, WITH DATE AND NAME OF PERSON MAKING CHANGE

Do not extend notes this side of this line

STATION	B. S.	H. I.	F. S.	ELEV.		
1+50		1435 37	84	1427 0	50'L	
			47	1430 7	9'R - N. edge rd	
			33	1432 1	16'R	
			08	1434 6	50'R	
2+00.05			50	1430 4	℄ - inter ℄ El Marrie Del to Sou	
			43	1431 1	9'R - N edge rd	
			25	1432 9	19'R	
			03	1435 1	50'R	
			54	1430 0	10'L - S. " "	
			80	1427 4	50'L	
2+41.85			45	1430 9	℄ - inter ℄ Trail "2"	
2+50			48	1430 6	℄	
			41	1431 3	7'R N. edge rd	
			29	1432 5	17R- B. rock wall	
			05	1434 9	20'R T " "	
			02	1435 2	50'R	
			55	1429 9	14'L - S. edge rd	
			62	1429 2	34.5'L - N.W. Cor. house	
			88	1426 6	50'L	
2+87			101	1425 3	℄ + N. edge Rd	
			104	1425 0	4'R -	B rock wall

Profile
No.
X-Sec.
No.
Notes Red.
Date
Notes Ch'd L. Kaaa
Date 12-1-14
Plotted
Date
Checked
Date
Job No 8163 Division No. V
Survey of Water Works Dist #37
Survey by Meere Notes Meere Date 11-25-36
Map No.
Indexed
Date
F.B. 320 Pg. 295

Form 307 5M 11-35

PLEASE RETURN TO
LOS ANGELES COUNTY SURVEYOR
700 HALL OF RECORDS

NOTE: ANY ADDITIONS OR CHANGES ON THIS SHEET MUST BE MADE OR CIRCLED IN RED INK, WITH DATE AND NAME OF PERSON MAKING CHANGE

Do not extend notes this side of this line

F. B. 329 Pg. 7722 | Job No. 8163 Division No. V | Notes Red L. Keagle Plotted | Profile No.
Survey of 2668 Water Works Dist #21 | Date 12-1-36 Date 12-2-36 | X-Sec. No.
Survey by Nieere Notes Nieere | Notes CHRD. Checked
Indexed C. Johnson Date | Date Date

STATION	B. S.	H. I.	F. S.	ELEV.		
2+87		1435 37	63	1434 1.	5'R - T Rock wall	
			45	[illegible]	20'R - T " "	+ S. edge house
			55	[illegible]	15'L - S edge rd.	
			93	261	20'L - T rock wall	
			98	256	50' L - T "	
2+89			103	251	℄ + N edge Rd.	
			105	249	4'R -	13. rock wall
			105	249	20'R - S " house +	
			97	257	15'L - S " rd.	
			98	256	20'L - T rock wall	
			126	228	22' L - B " "	
			133	221	5'L B " "	
3+00			113	241	℄ + End Cut bank	
T.P	721	1431 69	1089	1342 76		
3+00			75	242	21.5 R BC + S edge house	
			84	233	2.5 L - N. edge rd.	
			84	233	15' L - S " "	
			86	231	20' L end rock wall	
			98	219	50'L	
3+02			97	218	50'L	
			89	22 [illegible]	15'L - S. edge rd	

Form 307 5M 11-35

PLEASE RETURN TO
LOS ANGELES COUNTY SURVEYOR
700 HALL OF RECORDS

NOTE: ANY ADDITIONS OR CHANGES ON THIS SHEET MUST BE MADE OR CIRCLED IN RED INK, WITH DATE AND NAME OF PERSON MAKING CHANGE

Do not extend notes this side of this line

STATION	B. S.	H. I.	F. S.	ELEV.		
3+02		1431 69	87	1423 0	2⁵ L - N edge rd	
			79	23 8	℄	
			31	28 6	13' R - T cut	
			31	28 6	21⁵ R - T. + S edge house	
3+08			95	22 2	℄	
			31	28 6	14' R - T. bank	
			38	27 9	50' R - T. "	
			102	21 5	3' L - N edge rd	
			102	21 5	15' L - S " "	
			102	21 5	22' L - Bow rock wall	
			102	21 5	50' L	
T.P	2 38	1422 17	11 90	1419 79		
3+20			25	19 4	℄ - C bank	
			38	18 4	50' R " "	
			29	19 1	3' L - N edge Rd.	
			31	19 1	15' L - S " "	
			27	19 5	19' L " "	
			12	21 0	23⁵ L - B rock wall - 1.6 high	
			23	19 0	50' L - " " " 2' "	
3+2[illegible]			35	18 7	℄ + S. end - Top rock wall	
			38	18 4	50' R " " "	

Profile No. ____ Notes Red L. L. Keagle Plotted ____ Job No. 8163 Division No. K
X-Sec. No. ____ Date 12-1-3 6 Date ____ Survey of Water Works Dist. # 21 F.B. 320 Page 26
Notes Cklstd. TIMMONS Checked ____ Survey by Moore Notes Moore Date 11-25-36
Date ____ Map No. ____ Indexed ____ Date ____

Form 307 5M 11-35

PLEASE RETURN TO
LOS ANGELES COUNTY SURVEYOR
700 HALL OF RECORDS

NOTE: ANY ADDITIONS OR CHANGES ON THIS SHEET MUST BE MADE OR CIRCLED IN RED INK, WITH DATE AND NAME OF PERSON MAKING CHANGE

Do not extend notes this side of this line

F.B. 320 Pg 150 | Job No. 5163 Division No. V | Notes Red. L. Kaagle Plotted | Profile No.
Survey of 298 Water Works Dist #21 | Date | Date | X-Sec. No.
Survey by Meade Notes C. Johnson Notes Checked | Date | Date
Indexed | Date | Date

STATION	B. S.	H. I.	F. S.	ELEV.		
3+27		1[illegible] 1[illegible]	42	1418 [illegible]	3[illegible] L	N. edge rd
			45	17[illegible]	[illegible] L	S " "
			50	17[illegible]	[illegible] L	Nend of B. rock wall
			52	17[illegible]	[illegible] L	" " " " "
3+47			76	17[illegible]	[illegible]	B. rock wall
			58	16[illegible]	[illegible] L	B " "
			93	12[illegible]	[illegible] L	B " "
			47	17[illegible]	[illegible] L	N edge rd
			49	17[illegible]	[illegible] L	S " "
			50	16[illegible]	5.0 L	
3+44			71	15[illegible]	[illegible]	
			86	13[illegible]	[illegible] R	Bottom of rock wall 2.5 high
			110	11[illegible]	[illegible] R	" " " 4.5 "
			105	11[illegible]	[illegible] R	" N " " 0.5 "
			74	14[illegible]	[illegible] L	N edge rd
			75	14[illegible]	[illegible] L	S " "
			77	14[illegible]	[illegible] L	B. rock wall
			51	17[illegible]	[illegible] L	T " "
			56	16[illegible]	[illegible] L	N edge house
3+50			80	14[illegible]	[illegible]	
3+55			88	13[illegible]	[illegible]	

Form 307 5M 11-35

PLEASE RETURN TO
LOS ANGELES COUNTY SURVEYOR
700 HALL OF RECORDS

NOTE: ANY ADDITIONS OR CHANGES ON THIS SHEET MUST BE MADE OR CIRCLED IN RED INK, WITH DATE AND NAME OF PERSON MAKING CHANGE

Do not extend notes this side of this line

Profile No. ____ Notes Rdd. ____ Plotted ____ Job No. 8163 Division No. ____
X-Sec. No. ____ Date 12-1-36 Date ____ Survey of ____
Notes Checked ____ Survey by ____
Date ____ Date ____ Map No. ____ Indexed ____ Notes ____ Date 12-25-36

F. B. 320 Pgs. 2, 3 and 229

STATION	B. S.	H. I.	F. S.	ELEV.		
3+50		1422 17	88	1413 4	4' R - wire fence	
			104	10 8	10' R	
			109	11 3	50' R	
			87	13 5	1' L - N edge rd	
			89	13 3	1½' L " "	
			95	12 7	28' L - E rock wall + NE Cor garage	
TP	254	1414 81	990	1412 27		
3+67			30	11 8	℄ of N edge rd	
			31	11 7	45' R - wire fence	
			46	10 12	16' R	
			34	11 4	50' R	
			32	11 6	11' L - S edge rd	
			29	11 9	14.5' L - E rock wall	
			59	8 9	22' L B " "	
			62	8 6	28' L " " " - 4 high & NW Cor garage	
			71	7 7	50 L	
3+86			51	9 7	℄ - Inter ℄ Trail #3	
1 89	13		54	9 4	℄	
			57	9 1	10' R	
			52	9 6	33.5 R - S.E Cor Rock Pump House	
			46	10 12	50' R	

Form 307 5M 11-35

PLEASE RETURN TO
LOS ANGELES COUNTY SURVEYOR
700 HALL OF RECORDS

NOTE: ANY ADDITIONS OR CHANGES ON THIS SHEET MUST BE MADE OR CIRCLED IN RED INK, WITH DATE AND NAME OF PERSON MAKING CHANGE

Do not extend notes this side of this line

F.B. 3220 Pg. 75 | Job No. 8163 Division No. K | Notes Red. W. L. Keagle Plotted | Profile No.
Survey by Nicol & Nicol Notes Checked
Indexed Fin. C. Tabor Date Date

STATION	B. S.	H. I.	F. S.	ELEV.	
3+89 E&C		1414 8'	54	1403 4	11' L - S. edge rd
			56	9 10	10' L - T rock wall
			70	7 8	25' L - B " "
			76	7 1	50' L
4+57 E&C			63	8 5	E
			49	9 9	55' R
			63	8	20' L - B. rock wall - E.
			55	9 10	1' L - T. " "
			70	7 8	2' L - B. " "
			90	5 3	30' L E edge conc apron
TP	7 10	1414 4'	7 51	1406 3	
4+63 E			49	9 5	E. + E. edge - Top conc. curb
			37	10 2	50 R " " " "
			47	9 15	4' L + " " " " " 5 cut
			67	7 5	45' L + " " Bottom " " " "
			86	5 8	56 L - w. edge conc. apron
4+79 E			47	9 7	E of W edge Top conc. curb
			36	10	50' L " " " " " "
			47	9 7	15' L " " " " " - Sand
			70	1407 4	CL16
			78	6	50' L

Form 307 5M 11-35

PLEASE RETURN TO
LOS ANGELES COUNTY SURVEYOR
700 HALL OF RECORDS

NOTE: ANY ADDITIONS OR CHANGES ON THIS SHEET MUST BE MADE OR CIRCLED IN RED INK, WITH DATE AND NAME OF PERSON MAKING CHANGE

Do not extend notes this side of this line

STATION	B. S.	H. I.	F. S.	ELEV.	
4+80		1440 4°	57	1408 7	℄
			54	9 10	9° R - S E. Cor. Garage
			36	10 8	50' R
			78	6 16	50' L
4+91			54	1409 0	℄
			53	9 1	9° R - S.W Cor. gar.
			37	10 7	17° R - S edge house
			70	7 4	50' L
T.P.	1081	1423 5°	163	1412 77	
5+12 E℄			102	13 14	℄
			90	1414 6	16' R - S edge house
			134	10 12	3' R - Begin Cut bank
			148	8 8	50' L
5+21			70	16 6	℄
			74	16 12	16' R - S.W Cor house
			80	15 6	50' R - W edge house
			70	1414 6	21' L - T cut
			105	13 1	22' L - "
			111	12 5	50' L
5+50			44	19 12	50' L
			47	18 12	33' L - E. cut

Profile
No.
X-Sec.
No.

Notes Red L. Kenagle Plotted Job No. 5163 Division No. K
Date 12-1-36 Date Survey of Water Works
Notes Checked Checked Survey by Kellerer Notes Date 11-22-36
Date Date Map No. Indexed Date

F. B. 320 PG. 29

Form 307 5M 11-35

PLEASE RETURN TO
LOS ANGELES COUNTY SURVEYOR
700 HALL OF RECORDS

NOTE: ANY ADDITIONS OR CHANGES ON THIS SHEET MUST BE MADE OR CIRCLED IN RED INK, WITH DATE AND NAME OF PERSON MAKING CHANGE

Do not extend notes this side of this line

F. B. 320 Pg. 154 Job No. 5143 Division No. V Notes Red Plotted Profile No.
Survey of 272 Water Works District No. 29 Date Date
Survey by Duncan Notes Notes Checked X-Sec. No.
Indexed C. Johnson Date Date Date

STATION	B. S.	H. I.	F. S.	ELEV.	
		1423 52			
T.P.	11.93	1414 74	0.23	1402 35	
57+00			11.3	23 8	3'L - T.P.
			2.5	27 2	2'
			7.1	27 3	18'R
			11.0	23 4	15'R
57+65			0.0	34 2	2'L
			0.4	34 3	1'R
			5.6	29 1	5'R
			8.4	1431 3	18'L
			9.9	25 10	3'L - T.P.
			13.0	21 2	3'L
			13.0	21 2	3'L
57+83			8.3	26 4	5'L
			5.5	29 4	3'L
			1.2	33 5	1'L
T.P.	11.93	1416 42	0.25	1401 49	
57+93			9.3	31 1	2'L
			6.1	40 2	24'R
			8.1	35 8	5'R
6+00			8.1	1435 3	4'L

Form 307 5M 11-35

PLEASE RETURN TO
LOS ANGELES COUNTY SURVEYOR
700 HALL OF RECORDS

NOTE: ANY ADDITIONS OR CHANGES ON THIS SHEET MUST BE MADE OR CIRCLED IN RED INK, WITH DATE AND NAME OF PERSON MAKING CHANGE

Do not extend notes this side of this line

STATION	B. S.	H. I.	F. S.	ELEV.		
6+00		1454 4	120	1436 4	30' L	
			149	31 5	48' L - E. edge Macadam rd	appx
			180	28 4	80' L - " "	" "
			27	43 7	24 R	
			20	44 4	50' R	
6+			80	38 4	℄ inter ℄ Sha	Drive
6+14			72	39 2	℄	
			96	1436 8	20 L - N + E edge Macadam	
			101	32 2	45' L - W "	" "
			178	28 6	80' L "	" "
			406	47 10	35' R	
			420	48 14	50' R	
6+25			47	41 7	℄	
			67	39 5	10' L N. edge	" "
			93	1437 1	24 L - S "	" " + E bank
			66	39 8	25 L - T. bank	
			106	35 8	50' L	
T.P.	8.46	1454 66	022	1446 20		
6+25			63	48 4	32 R	
			45	50 2	50' R	
6+50			90	45 7	℄	

Profile No. _____ X-Sec. No. _____

Notes Red. _____ Plotted _____ Job No. 846.3 Division No. 4

Date 12-1-36 Date _____ Survey of Water Works Dist #21 F.B. 320 PG. 27

Noted _____ Checked _____ Survey by Water Works Dist #21 Notes Water Date 11-27-36

Date _____ Date _____ Map No. _____ Indexed _____ Date _____

Form 307-SM 11-35

PLEASE RETURN TO
LOS ANGELES COUNTY SURVEYOR
700 HALL OF RECORDS

NOTE: ANY ADDITIONS OR CHANGES ON THIS SHEET MUST BE MADE OR CIRCLED IN RED INK, WITH DATE AND NAME OF PERSON MAKING CHANGE

Do not extend notes this side of this line

F.B. 320 Pg. 756 | Job No. 8162 Division No. V | Notes Redn. L. Kaylo Plotted | No. | Profile
Survey of 2772 Water Wells Dist. 21 | Date | Date | X-Sec.
Survey by Reeve Notes Clerk Notes Chkd. ALBERT G. FRANCIS Checked | No.
Indexed A. C. Johnson Date Date Date

STATION	B. S.	H. I.	F. S.	ELEV.		
[illegible]		1454 6	106	1444	1 5 5 L	N edge rd
			119	1442 8	1 6 5 L	S " " + B. bank
			[illegible]	44 0	1 [illegible]	T "
			147	40 0	1 5 0 L	
			36	81	1 2 1 R	
			21	52 0	1 5 0 R	
7+00			27	62 0	1 4 2	
		+	30	57	1 5 0 R	
			37	51 0	1 [illegible] L - N " "	
			38	14[illegible]	1 [illegible] L S " "	
			78	46 9	1 5 0 L	
7+32			30	54 2	1 2	+ T bank
			10	53 2	1 0 5 L	B "
			10	53 2	1 3 L - N " "	
			09	1453 8	1 [illegible] L S " "	
			56	49	1 5 0 L	
		+	60	60 2	1 5 0 R	
T P.	11 49	1465 3 5	077	1453 89		
7+50			111	54 3	1 [illegible] + N edge rd	
			109	54 5	1 2 R - B. bank	
			98	55 6	1 2 R T "	

Form 307 5M 11-35

PLEASE RETURN TO
LOS ANGELES COUNTY SURVEYOR
700 HALL OF RECORDS

NOTE: ANY ADDITIONS OR CHANGES ON THIS SHEET MUST BE MADE OR CIRCLED IN RED INK, WITH DATE AND NAME OF PERSON MAKING CHANGE

Do not extend notes this side of this line

STATION	B. S.	H. I.	F. S.	ELEV.	
7+50		1465.3	30	1462 1/4	50' R
			111	54 1/3	12' L - S. edge rd.
			167	48 1/2	50' L
7+92.05			92	55 5/8	℄ 20' Alley to S
8+20			96	55 5/8	℄
			96	55 5/8	35' R - N. edge rd
			94	56 1/8	7' R - B. bank
			84	57 1/8	9' R - T. "
			21	63 7/8	50' R
			99	55 5/8	7' L - S. edge rd
			110	54 1/4	10' L
			164	49 1/2	50' L
8+37			100	55 1/4	℄ - [illegible]
8+41.[illegible]			101	55 3/8	℄
			100	55 1/4	45' R - N. edge rd
			97	55 1/2	7' R - B. bank
			90	56 1/4	9 R - T. "
			40	61 1/4	39' R
			06	64 1/8	50' R
			106	54 1/8	7' L - S. edge rd
			168	48 1/2	50' L

Profile
No.
X-Sec.
No.
Notes Rod L. Keagle Plotted
Date 12-1-36 Date
Notes Chkd. Checked
Date Date
Job No. [illegible] Division No. K
Survey of [illegible]
Survey by [illegible] Notes [illegible] Date 11-27-36
Map No. Indexed
Date Date
F. B. 320 PG. 175

Form 307 5M 11-35

PLEASE RETURN TO
LOS ANGELES COUNTY SURVEYOR
700 HALL OF RECORDS

NOTE: ANY ADDITIONS OR CHANGES ON THIS SHEET MUST BE MADE OR CIRCLED IN RED INK, WITH DATE AND NAME OF PERSON MAKING CHANGE

Do not extend notes this side of this line

F. B. 320 PG. 158 | Job No. 5163 Division No. K Notes Red. G. L. Keagle Plotted Profile No.
Survey of 276 Water Works Dist #21 Date Date X-Sec. No.
Survey by Pearce Notes Pearce Notes Chkd. Checked
Indexed by C. Jensen Date Date Date

STATION	B. S.	H. I.	F. S.	ELEV.	
		3			
	7 76	1466 55	659	79	
			111	55 4	℄
			103	55 6	3'R - N. edge rd
			06	65 19	50'R
			116	54 9	1' L 5 " "
			130	53 15	13' L
			189	47 16	5' L
5+95			182	46 2	50' L
			131	53 14	1' L
			118	54 7	1' L - 5 " "
			110	55 15	℄ + N " "
			20	64 5	50'R
9+22			35	63 10	50'R - Edge bank
			117	54 18	℄ + N " rd
			129	53 16	1' L S " "
			135	52 17	19' L
			153	48 21	50' L
			191	47 14	50' L
			148	51 7	11.5' L - S " "
			138	52 2	℄ + N " "

Form 307 5M 11-35

PLEASE RETURN TO
LOS ANGELES COUNTY SURVEYOR
700 HALL OF RECORDS

NOTE: ANY ADDITIONS OR CHANGES ON THIS SHEET MUST BE MADE OR CIRCLED IN RED INK, WITH DATE AND NAME OF PERSON MAKING CHANGE

Do not extend notes this side of this line

STATION	B. S.	H. I.	F. S.	ELEV.		
9+40		1456 5	124	1454 1	15' R - T bank	
			185	48 0	33 R B draw	
			107	55 8	50' R Side hill	
T 1	01	1454 77	1189	1454 66		
9+76.9			58	49 0	℄ & W. edge rd	
			66	48 2	12' L E "	& B. Bank
			55	49 3	14' L	T "
			84	46 4	50' L	
			98	50 0	9' R T. bank	
			87	46 1	19' R ℄	
			185	36 3	33 R B draw	
			120	42 8	50' R Side hill	
10+03			101	44 7	℄ - T bank	
			105	44 3	3' L W edge rd	
			121	42 7	15' L E "	& B bank
			85	46 3	16 L	T "
			105	44 3	50' L	
			129	41 9	23' R - Top bank	
			291	25 2	50' R - B. "	
			300	24 8	65 R	
10+30			325	23 3	50' R - B. "	

No. Profile
Notes Red G. L. Keagle Plotted
Date 12-1-36 Date
No. X-Sec.
Notes Chkd Checked
Date Date
Job No 2162 Division No
Survey of Water Works Dist. #21
Survey by Arthur Hollis Notes Date 11-27-36
Map No Indexed Date
F.B. 720 PG. 37

Form 307 5M 11-35

PLEASE RETURN TO
LOS ANGELES COUNTY SURVEYOR
700 HALL OF RECORDS

NOTE: ANY ADDITIONS OR CHANGES ON THIS SHEET MUST BE MADE OR CIRCLED IN RED INK, WITH DATE AND NAME OF PERSON MAKING CHANGE

Do not extend notes this side of this line

F.B. 320 PG. 160 278 | Job No. 8163 Division No. V Notes Red. G. L. Keagle Plotted ____ Profile No. ____
Survey of Water Works Dist #2 Date ____ Date ____ X-Sec. No. ____
Survey by ____ Notes ____ Notes Chkd. ALBERT L. [illegible] Checked ____
Indexed ____ Date ____ Date ____ Date ____

STATION	B. S.	H. I.	F. S.	ELEV.	
10+35		1454.77	336	1421	21' R — 13 bank
			206	1448	L
			158	1450	T "
			164	1438	L — W edge rd
			173	1437	L " "
			135	1441	T "
			116	1443	L
T P	167	1444.63	11.79	1432	
10+57 P.C.			154	1429	L — 13k
			102	1434	T bank
			138	1434	W edge rd
			130	1433	E " " — 13 bank
			[illegible]	1437	T "
			40	1440	
			255	1419	14' R — 13 bank
			204	1429	21' R " "
			233	1421	T "
			151	1429	30' R — Side hill
11+00			182	1426	30' R " "
			247	1423	28' R — T bank
			280	1416	16' R — 13 "

Form 307 5M 11-35

PLEASE RETURN TO
LOS ANGELES COUNTY SURVEYOR
700 HALL OF RECORDS

NOTE: ANY ADDITIONS OR CHANGES ON THIS SHEET MUST BE MADE OR CIRCLED IN RED INK, WITH DATE AND NAME OF PERSON MAKING CHANGE

Do not extend notes this side of this line

STATION	B. S.	H. I.	F. S.	ELEV.		
11+00		1444 65	278	1416 8/	℄ - B Bank.	
			164	28 2/	15'L - T "	
			164	28 2/	16 L - W edge rd	
			177	26 10/	26'L - E "	+ B. bank
			124	32 1/	27' L	T "
			88	35 8/	50' L	
TP	193	1434 75	1183	1432 82		
11+47 [illegible]			211	13 6/	℄ - B. bank	
			112	23 5/	21' L - T "	
			115	23 2/	23 L - W edge rd	
			124	22 3/	30' L - E "	+ B bank
			7	27 6/	35' L -	T
			43	30 4/	50' L	
			205	18 2/	21 R - Beam bank	
			199	14 8/	29' R - T "	
			222	12 5/	50' R - B. bank	
11+73 [illegible]			221	12 6/	℄	
			222	12 5/	11' R - B bank	
			176	17 1/	15 R T "	
			170	17 2/	28 R - B "	
			152	19 5/	30 R T "	

No. _____ Profile _____ Notes Red L. Kangas Plotted _____ Job No. 8163 Division No. V
X-Sec. _____ Date 12-1-36 Date _____ Survey of. Basin Wells Dist #21
Notes Chkd. _____ Checked _____ Survey by Moore Notes Moore Date 11-21-36
Date _____ Date _____ Map No. _____ Indexed _____ Date _____

F. B. 320 PG. 7

Form 307 5M 11-35

PLEASE RETURN TO
LOS ANGELES COUNTY SURVEYOR
700 HALL OF RECORDS

NOTE: ANY ADDITIONS OR CHANGES ON THIS SHEET MUST BE MADE OR CIRCLED IN RED INK, WITH DATE AND NAME OF PERSON MAKING CHANGE

Do not extend notes this side of this line

F. B. 320 Pg. 162 Job No. 8163 Division No. K Notes Red. A. L. Keagle Plotted
Survey of 280 Water Works Dist #21 Date Profile No.
Survey by Notes Date X-Sec. No.
Indexed Notes Chkd. ALBERT E. [illegible] Checked Date

STATION	B. S.	H. I.	F. S.	ELEV.		
11+37.70		1434.42	105	1428.2	50' R - T. Lands	
			202	12 14	13' L - E	
			214	20 3	12' L - T	
			114	20 3	2' L - W edge	
			101	19 6	39' L - E	- B Lands
			104	24 3		T "
			69	21	2' L	
12+00 22 Lds			86	1	20' L	
			123	22	9' L -	T "
			171	17 6	35' L - E "	- B "
			168	17 9	27' L - W "	
			165	18	3' L - T 15 mi	
			230	11 2	1' L - B "	
			234	11 3	℄	
			232	11 5	1' R - 12 "	
			170	17 2	1' R - T "	+ E edge "
			171	17 6	36' R - B "	+ W " "
			100	24 2	44 R - T "	
FP	0.28	1423.02	1197	1422		
12+30			146	8 5	℄	
			111	8	12 R - 23 "	

Form 307 5M 11-35

PLEASE RETURN TO
LOS ANGELES COUNTY SURVEYOR
700 HALL OF RECORDS

NOTE: ANY ADDITIONS OR CHANGES ON THIS SHEET MUST BE MADE OR CIRCLED IN RED INK, WITH DATE AND NAME OF PERSON MAKING CHANGE

Do not extend notes this side of this line

STATION	B. S.	H. I.	F. S.	ELEV.		
12+50		1423 06'	130	1410 1/	20' R - T. Lamb + E. edge rd	
			118	11 1/2	35' R - B "	W " "
			80	15 1/	35' R - T "	
			50	18 1/	50' R	
			146	8 1/2	6' L - B. "	
			122	10 1/2	11' L - T " + W edge rd	
			119	11 1/2	25' L - B " + E "	
			95	13 1/2	20' L	
			44	18 1/	50' L	
12+64			72	15 1/2	50' L	
			96	13 1/2	19' L - T "	
			129	10 1/2	11' L B " + E "	
			130	10 1/	3' L - "	W " "
			30	10 1/	℄ T. "	
T.P.		1411 13'	1175	1411 31'		
			48	9 1/2	5' R - T. " + E "	
			44	9 1/2	27' R	W " "
			93	10 1/2	35' R - End cut - 130	
		+ 24		16 1/2	50' R	
13+00			74	6 1/2	℄	
			76	6 1/2	55' L - W. edge rd + B. "	

No. Profile
No. X-Sec.
Notes Rd. L. Kaugle Plotted Job No. 8103 Division No. V
Date 12-1-36 Date Survey of Watts Works E157 #21 11-27-36
Notes Chkd. Checked Survey by Moore Notes Moore Date 11-27-36
Date Date Map No. Indexed Date
F.B. 320 PG. 4-3 281

F. B. 320 PG. 164 Job No. 8163 Division No. V Notes Red. G. L. Keagle Plotted

Survey of 282 Water Works Dist #21 Date Date

Survey by Moore Notes N Moore Notes Chkd. Checked

Indexed A. C. Johnson Date Date Date

Profile No.

X-Sec. No.

Form 307 5M 11-35

PLEASE RETURN TO
LOS ANGELES COUNTY SURVEYOR
700 HALL OF RECORDS

Do not extend notes this side of this line

NOTE: ANY ADDITIONS OR CHANGES ON THIS SHEET MUST BE MADE OR CIRCLED IN RED INK, WITH DATE AND NAME OF PERSON MAKING CHANGE

STATION	B. S.	H. I.	F. S.	ELEV.	
13+50					
13+20					
			31	1410	
			93		

Form 307 5M 11-35

PLEASE RETURN TO
LOS ANGELES COUNTY SURVEYOR
700 HALL OF RECORDS

NOTE: ANY ADDITIONS OR CHANGES ON THIS SHEET MUST BE MADE OR CIRCLED IN RED INK, WITH DATE AND NAME OF PERSON MAKING CHANGE

Do not extend notes this side of this line

STATION	B. S.	H. I.	F. S.	ELEV.		
13+50		1414.13	11.8	1402.3	℄	
			11.7	2.4	2' L — S. edge road	
				2.4	3' " " "	
				2.3	17' L — E. Land	
				3.8	16' " " "	
				10.0	50' " Sidehill	
T.P.	1.08	1413.51	11.47	1402.66		
14+00			13.3	1400.2	℄ " S. edge road	
				1400.1	2' R Toe Slope	
			2.4	11.1	50' R Sidehill	
				1399.2	11' L — W. edge road & E. Land	
			9.2	1403.2	13' L — T. "	
			1.8	11.7	43' L	
			1.5	12.0	50' L	
14+50			16.7	1396.8	℄	
			11.7	96.8	4½' R — S. edge road	
				96.8	2' " Toe Slope	
			6.6	1406.9	50' R	
			17.2	1396.5	6' L — W. edge road	
			17.0	96.5	9' L — E. Land	
			13.2	1400.3	12' L — T. "	

Profile No. ____ Notes Red. L. Keag Plotted ____ Job No. 5163 Division No. V

X-Sec. No. ____ Date 12-1-36 Date ____ Survey of Whittier Blvd. Survey ____

Notes Cked. ALBERT E. [illegible] Checked ____ Survey by A. Meers Notes Meers Date 11-27-36

Date ____ Date ____ Map No. ____ Indexed [illegible] Date ____

F.B. 320 Pg. 283

Form 307 5M 11-35

PLEASE RETURN TO
LOS ANGELES COUNTY SURVEYOR
700 HALL OF RECORDS

NOTE: ANY ADDITIONS OR CHANGES ON THIS SHEET MUST BE MADE OR CIRCLED IN RED INK, WITH DATE AND NAME OF PERSON MAKING CHANGE

Do not extend notes this side of this line

B 320 PG. 1616 Job No. 4263 Division No. V Profile
Survey of 2814 Water Main Easements No. X-Sec.
Survey by Engr. C. Jacobsen Notes Red Plotted
Indexed Engr. Notes Date Date
Notes Checked
Date Date

STATION	B. S.	H. I.	F. S.	ELEV.		
		1412 [illegible]	[illegible]	140[illegible]		
			[illegible]	5		
T.P.	[illegible]	[illegible]	[illegible]	[illegible]		
			89	139[illegible]		
			[illegible]	93		
			97	93	11' R	Bottom portion
			[illegible]	87	12' R	
		+	23	1404	3' R	
		+	[illegible]	4	4' R	
			[illegible]	1393	1 L	R edge
			62	95	[illegible]	
			29	99	[illegible]	
T.P.	127	1391 78	11 71	[illegible]		
T.P.	0 82	1380 84	11 77	1381 91		
T.P.	4 19	1374 65	10 29	1371 55		
B.M.			5.14	1369 51	cut spot on top fitting S.E. corner Elev 1369.497 ABS Co. 138	

Notes Ck'd by aak	Survey of		F.B. 320 Pg. 285
Map No.	W. O.	Tape No. St'd OF	
Office Work	Surveyed by		
Checked	Notes TJS	Date	
Date	Indexed 11-18-58		

Note: Any Additions or Changes on This Sheets Must be Made in Red Ink With Date and Name of Person Making Change

Do not extend notes this side of this line

RETURN TO
LOS ANGELES COUNTY SURVEYOR
700 HALL OF RECORDS

FORM 247 5M 10-37

Dexter Can Park
Angular Tie To 1/4 Cor.
Sec 28/33 T.3N. R.14W.

J.N. 7783

T.J. Stevenson
H.W. Gunderman
M. Taylor
K.H. Gardner

F.B. 320 PG. 286

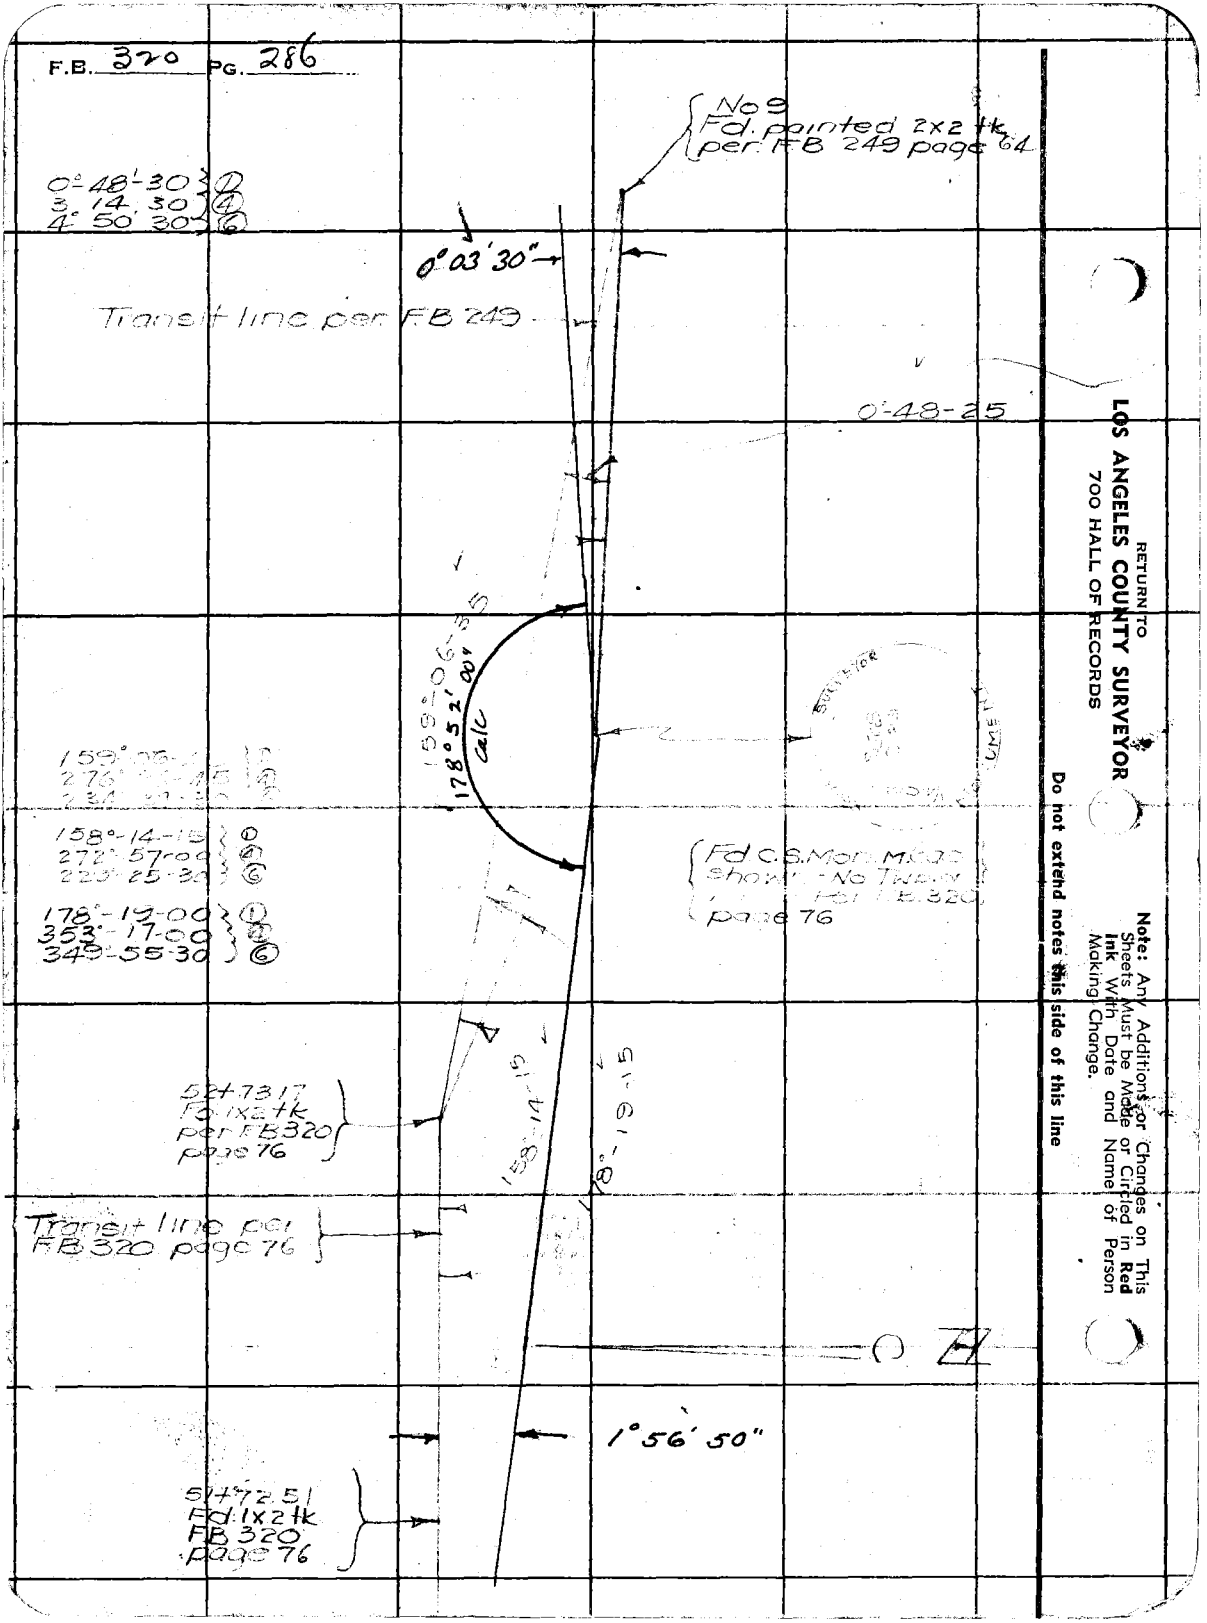

RETURN TO
LOS ANGELES COUNTY SURVEYOR
700 HALL OF RECORDS

Note: Any Additions or Changes on This Sheets Must be Made or Circled in Red Ink With Date and Name of Person Making Change.

Do not extend notes this side of this line

Notes Ck'd by		Survey of	
Map No.		W. O.	Tape No. St'd °F
Office Work		Surveyed by	
Checked		Notes	Date
Date		Indexed	

F. B. 320 Pg. 287

Note: Any Additions or Changes on This Sheet Must be Made or Circled in Red Ink With Date and Name of Person Making Change.

Do not extend notes this side of this line.

RETURN TO
LOS ANGELES COUNTY SURVEYOR
700 HALL OF RECORDS

FORM 247 SM 11-46

8 2.9 r @ 34°13

9.917462
1.917315

11.826435 = 67.05

268535
8246

260289

10.876218
11.826435

9.049783

9.997257
9.918973

11.916230 = 82.46

268535; 7.54; 2603. X

88 45 20 W
N 0 41 10 W

88.04101

2603.
7.52

75.06

150 15
18 21

7.55

2685.

2276.
805

12210

RETURN TO
LOS ANGELES COUNTY SURVEYOR
500 HALL OF RECORDS

Be sure extend notes this [illegible] of this line.

Note: Any Additions or Changes [illegible]
Sheet Must be Made in Ordered [illegible]
Ink with Date and Name of [illegible]
Mailing Charge.

320

F. B. _____ PG. _____