Date _____ Notes by _____ Chief Party _____ F.B. _____ Pg. _____

Plotted by	W. O. No. _____ O. S. O. No. _____
Date	Location
Map No.	Surveyed by
Plotting Ck'd by	Date
Date	Indexed

T. 12. 22E - 15 ½ rod.

LO

2

Microfilmed 10-9-84

25 Pg. INDEX Chief Party Notes by Date

F.B.No. 325

PAGES: Index, 1, 1A to 1H incl., 1L, 1K, 2, 3, 4, 5, 8 to 38 incl., 38A to 38H incl., 39 to 46 incl., 46A, 46B, 47 to 55 incl., 57 to 62 incl., 62A, 62B, 63 to 70 incl., 69A, 69B, 70A, 70B, 71, 72, 72A, 72B, 73 to 76 incl., 76A, 76B, 77 to 85 incl., 87 to 96 incl., 100, 102 to 120 incl., 122 to 127 incl, 126A, ,128 to 142 incl., 143, 144, 145,

RETURN TO LOS ANGELES COUNTY SURVEYOR

Do not extend notes this side of this line

Note: ANY ADDITIONS OR CHANGES ON THIS SHEET MUST BE MADE OR CIRCLED IN Red. WITH DATE AND NAME OF PERSON MAKING CHANGE.

Date 11-20-28 Notes by Moore Chief Party Moore F. B. 325 PG. 1

Plotted by	W. O. No. 4168 D. S. O. No.
Date	Location Florence Ave
Map No.	Surveyed by L D Moore
Plotting C'k'd by	Date 11-20-28
Date	Indexed A. C. Johnson

Notes: ANY ADDITIONS OR CHANGES ON THIS SHEET MUST BE MADE OR CIRCLED IN Red. WITH DATE AND NAME OF PERSON MAKING CHANGE.

Do not extend notes this side of this line

RETURN TO LOS ANGELES COUNTY SURVEYOR

SURVEY

for

FLORENCE AVE.

from

WEST BLVD

INGLEWOOD

to

LEONA BLVD

VENICE

W.O.# 4168

Party

Moore
Thayer - Newberry
Gunderson - Meisler
More - Stein

Feb., July, Oct. and Nov. 1928

100' Band tape #033 - 100' @ 76° and 21½lbs.

Streets in Inglewood - FB 325-1-20
Location Notes - FB 325-20-84
Topography - FB 325-85-127
FB 381-1-16

Microfilmed 10-9-84

F.B. 325 Pg 1A Moore Chief Party Notes by Moore Date 11-20-28

To pt. 18.

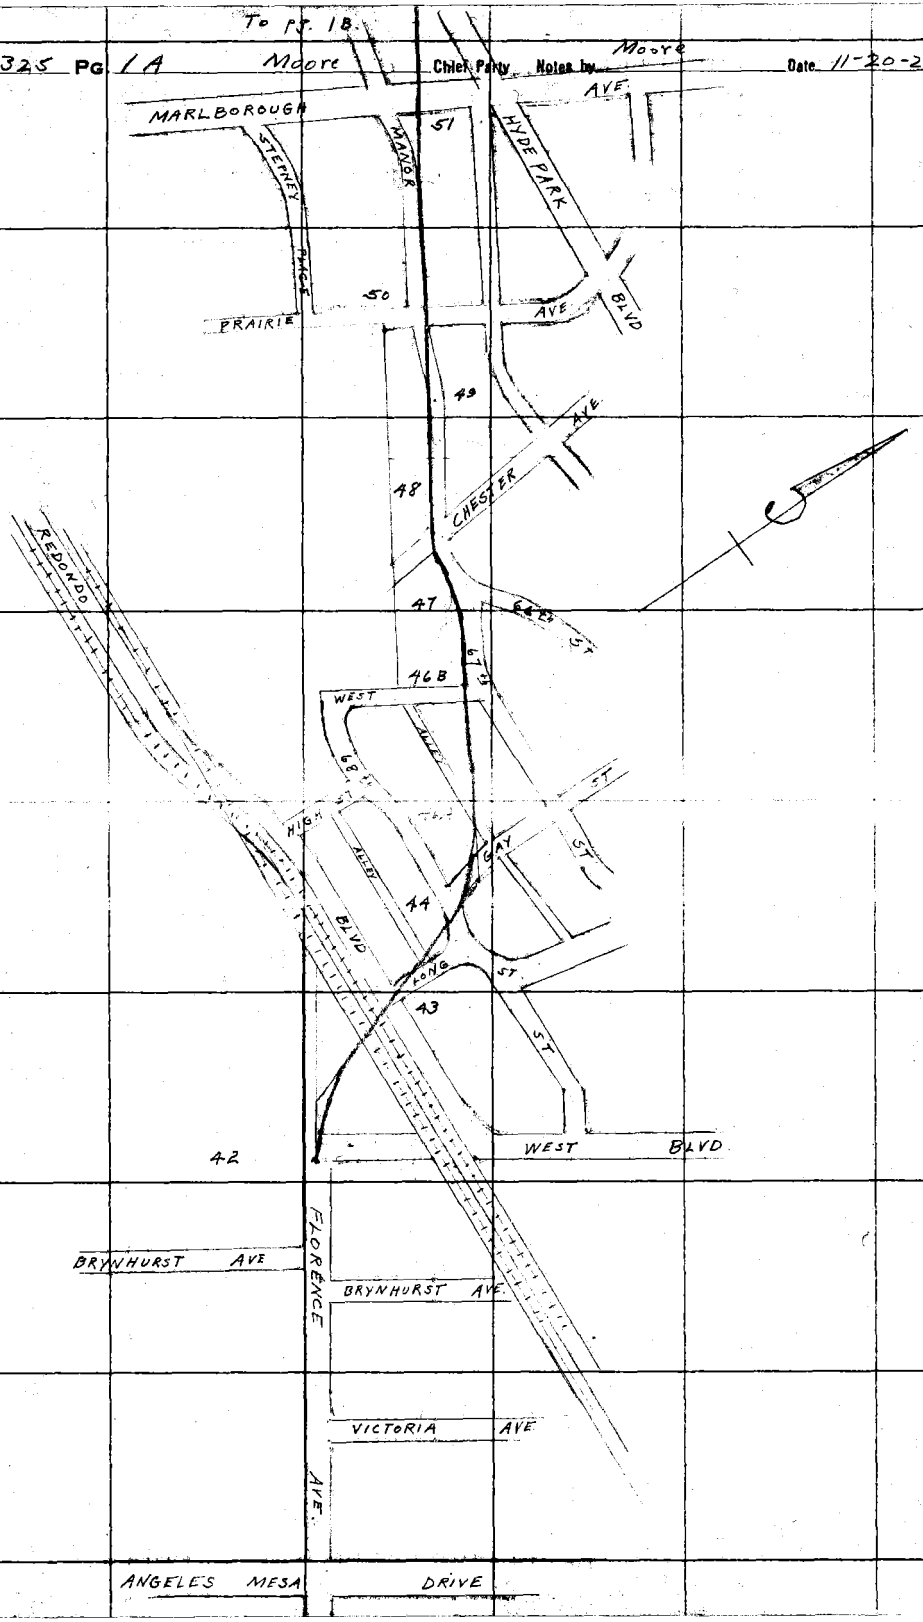

RETURN TO
LOS ANGELES COUNTY SURVEYOR
Do not extend notes this side of this line

Notes: ANY ADDITIONS OR CHANGES ON THIS SHEET MUST BE MADE OR CIRCLED IN Red. WITH DATE AND NAME OF PERSON MAKING CHANGE.

Date 11-20-28 Notes by Moore Chief Party Moore F.B. 325 Pg. 1C

Platted by	W. O. No. 4168 D. S. O. No.
Date	Location Florence Ave
Map No.	Surveyed by L.D. Moore
Platting Ck'd by	Date 11-20-28
Date	Indexed

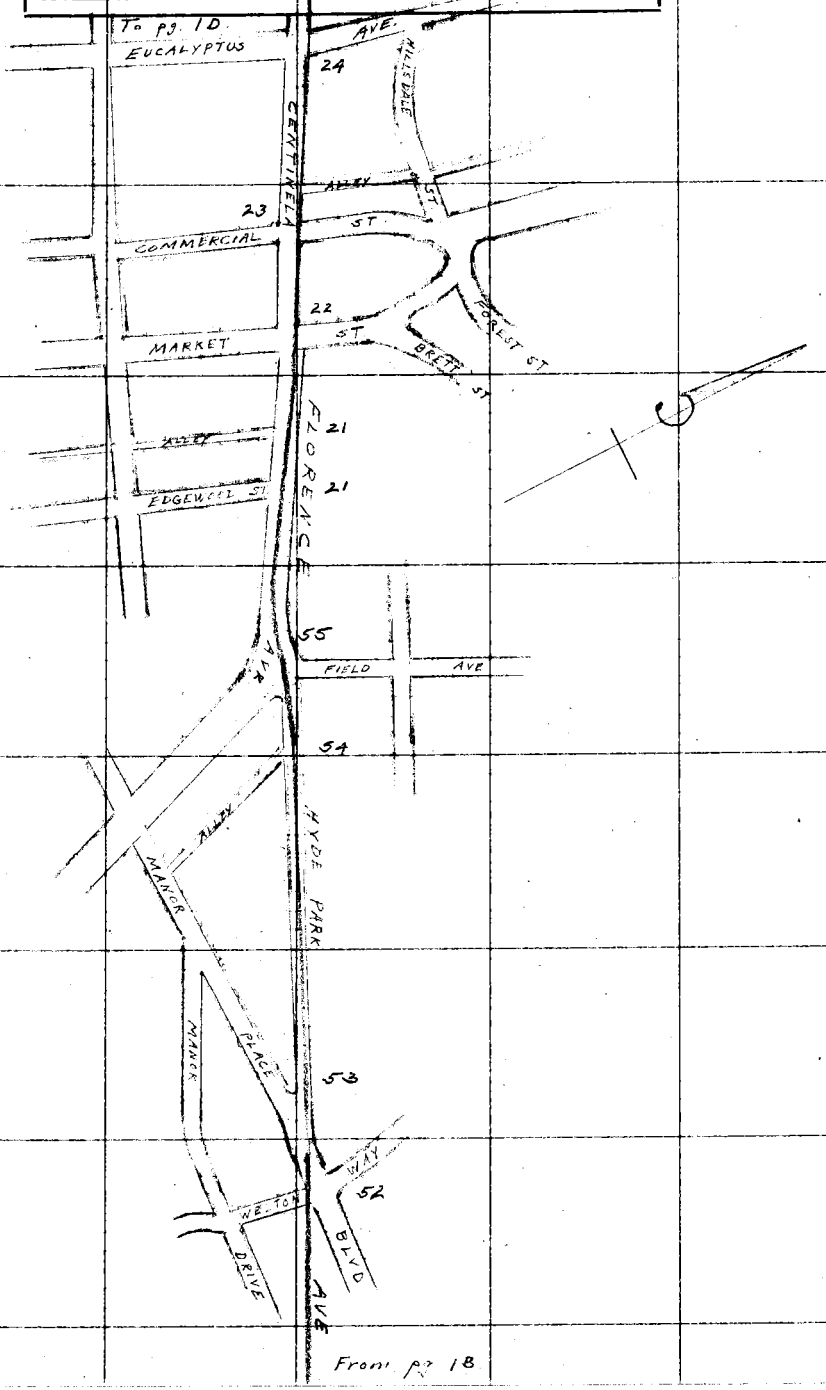

Notes: ANY ADDITIONS OR CHANGES ON THIS SHEET MUST BE MADE OR CIRCLED IN Red. WITH DATE AND NAME OF PERSON MAKING CHANGE.

Do not extend notes this side of this line

RETURN TO LOS ANGELES COUNTY SURVEYOR

F. B. 325 PG. 10 Moore Chief Party Notes by Moore Date 11-20-28

To Pg 1E

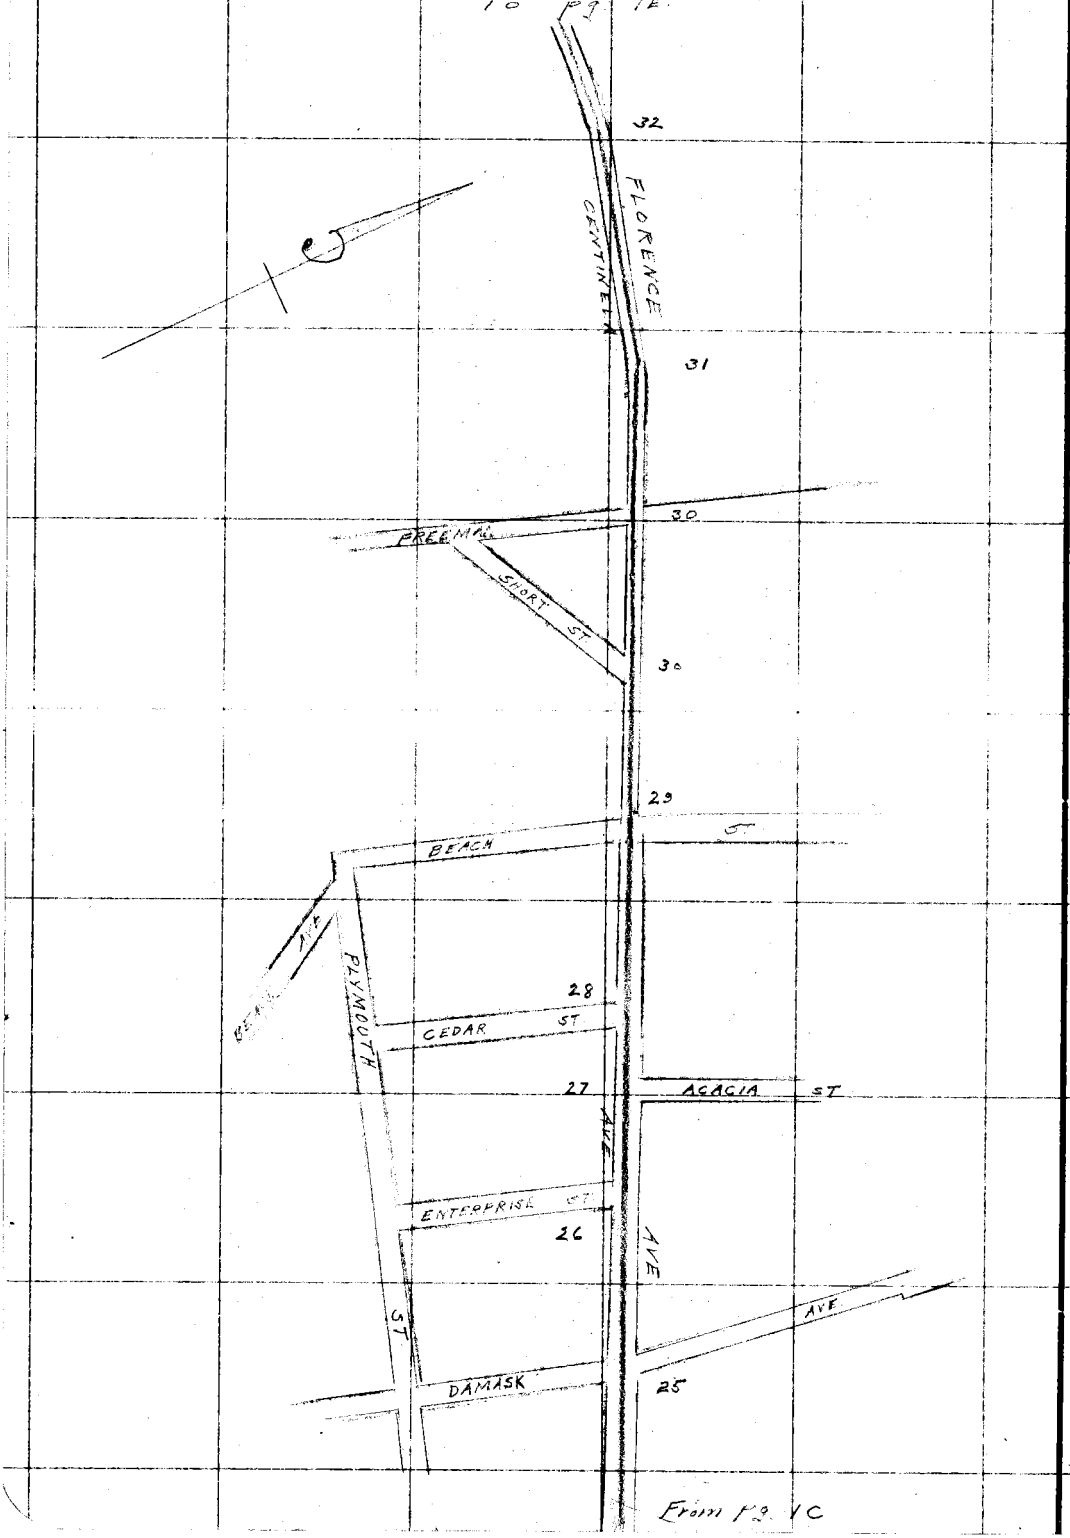

RETURN TO
LOS ANGELES COUNTY SURVEYOR

Do not extend notes this side of this line

Note: ANY ADDITIONS OR CHANGES ON THIS SHEET MUST BE MADE OR CIRCLED IN Red. WITH DATE AND NAME OF PERSON MAKING CHANGE.

Date 11-20-26 Notes by Moore Chief Party Moore F.B. 325 Pg. 1E

Platted by	W. O. No. 4168 O. S. O. No.
Date	Location Florence Ave
Map No.	Surveyed by [illegible]
Platting Ck'd by	Date 11-20-26
Date	Indexed

To Pg. 1F

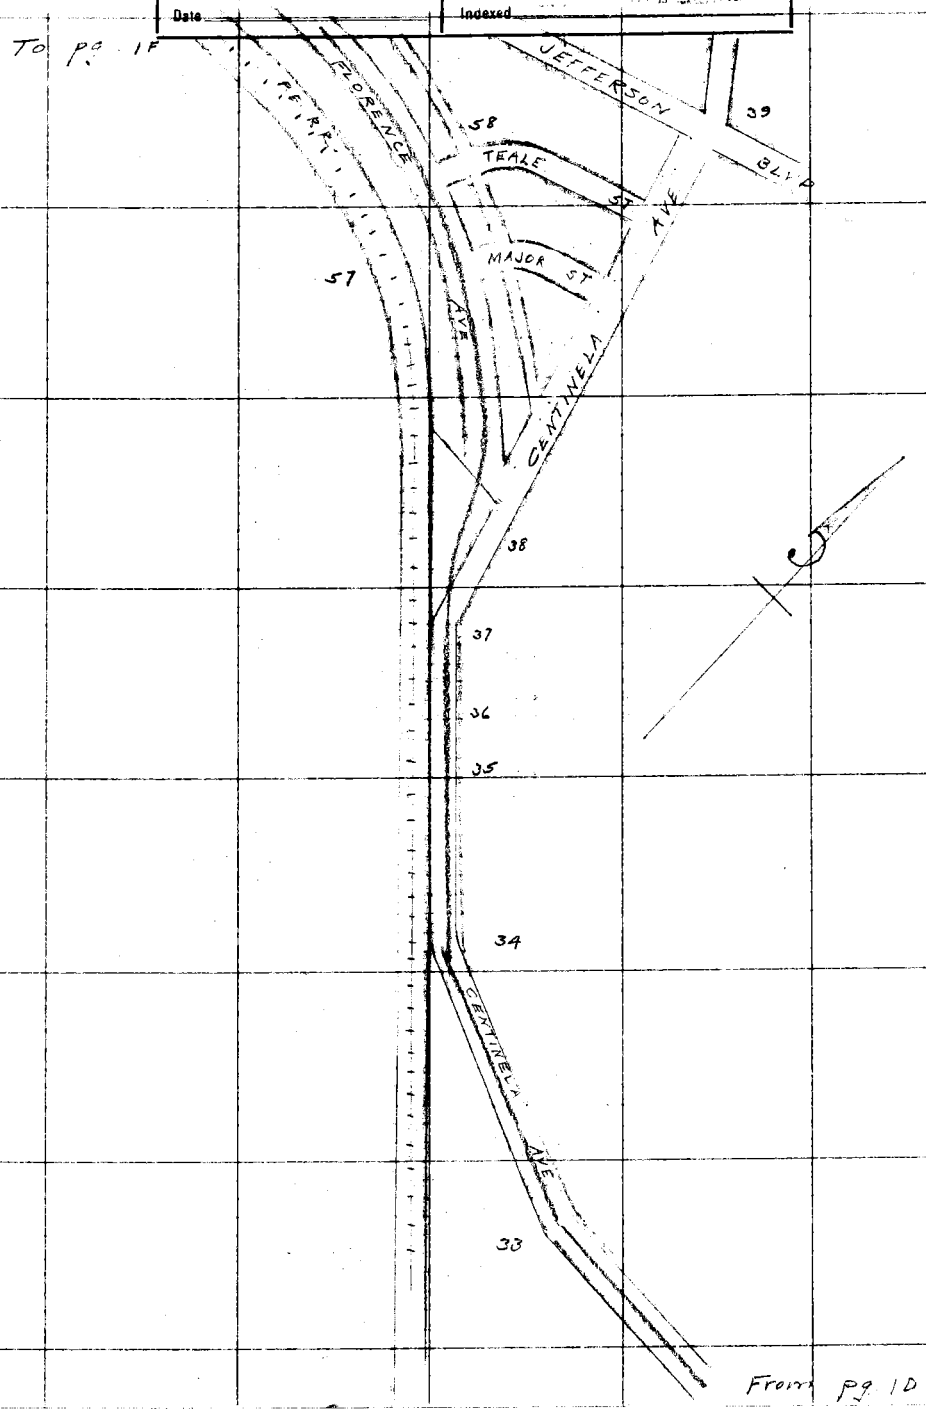

From Pg. 1D

Notes: ANY ADDITIONS OR CHANGES ON THIS SHEET MUST BE MADE OR CIRCLED IN Red. WITH DATE AND NAME OF PERSON MAKING CHANGE.

Do not extend notes this side of this line

RETURN TO
LOS ANGELES COUNTY SURVEYOR

F.B. 325 Pg. 1F Moore Chief Party Notes by Moore Date 11-20-28

To pg 1G

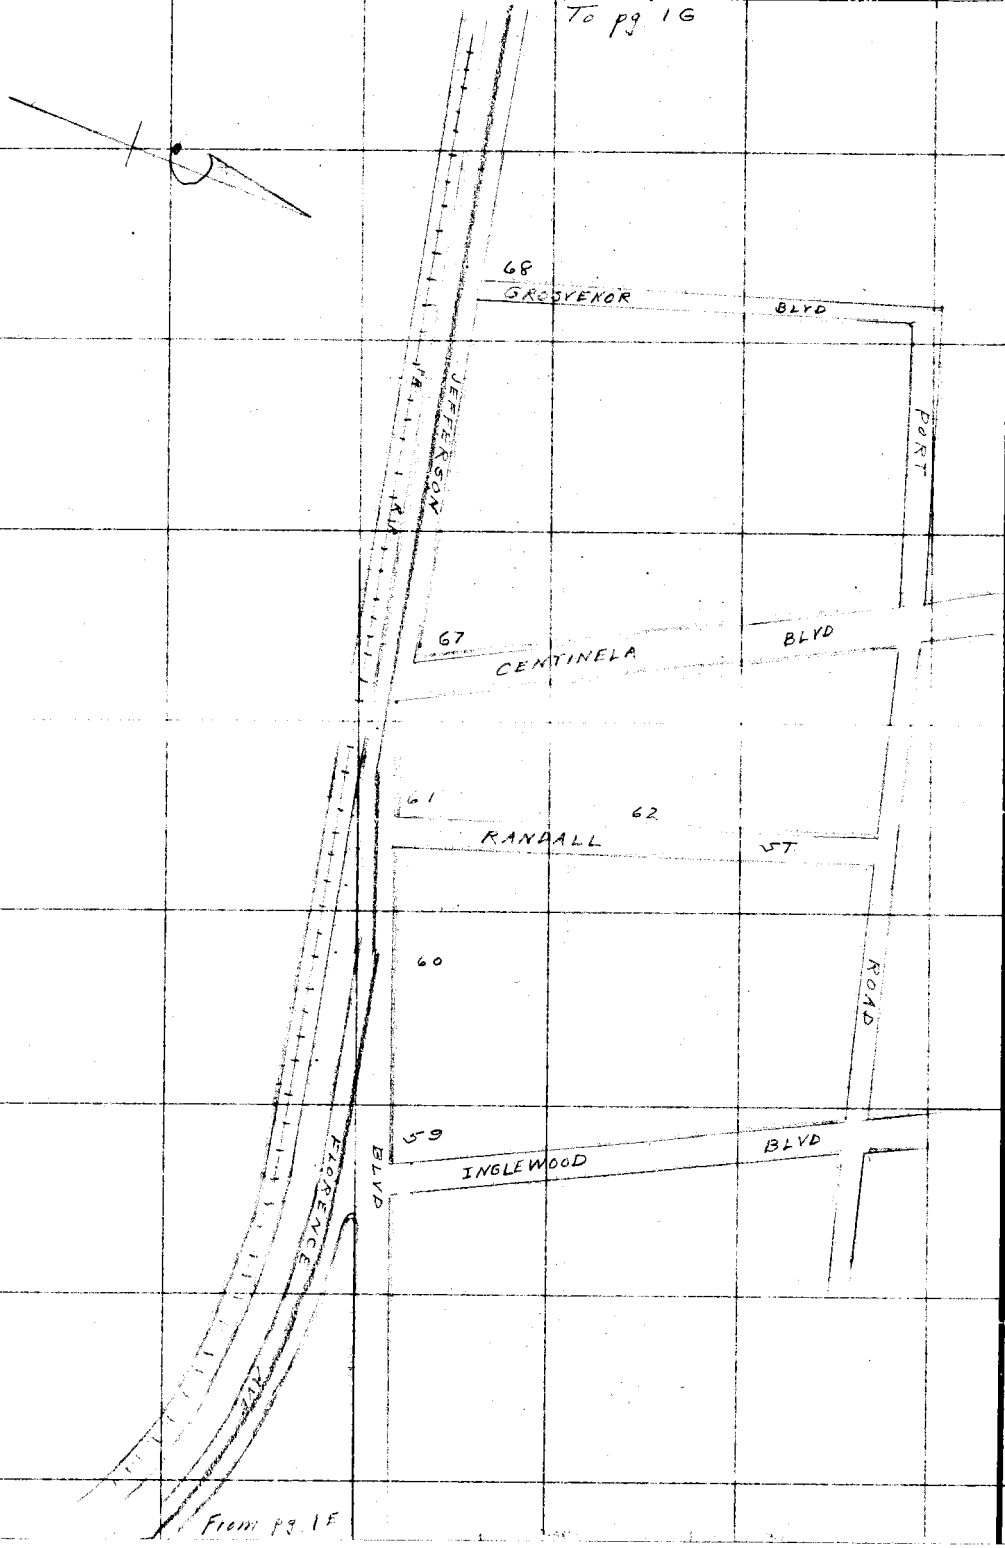

RETURN TO
LOS ANGELES COUNTY SURVEYOR

Do not extend notes this side of this line

Note: ANY ADDITIONS OR CHANGES ON THIS SHEET MUST BE MADE OR CIRCLED IN RED, WITH DATE AND NAME OF PERSON MAKING CHANGE.

Date 11-20-28 Notes by Moore Chief Party Moore F.B. 325 Pg. 16

Platted by	W. O. No. 4168 O. S. O. No.
Date	Location Florence Ave
Map No.	Surveyed by L D Moore
Platting Ck'd by	Date 11-20-28
Date	Indexed

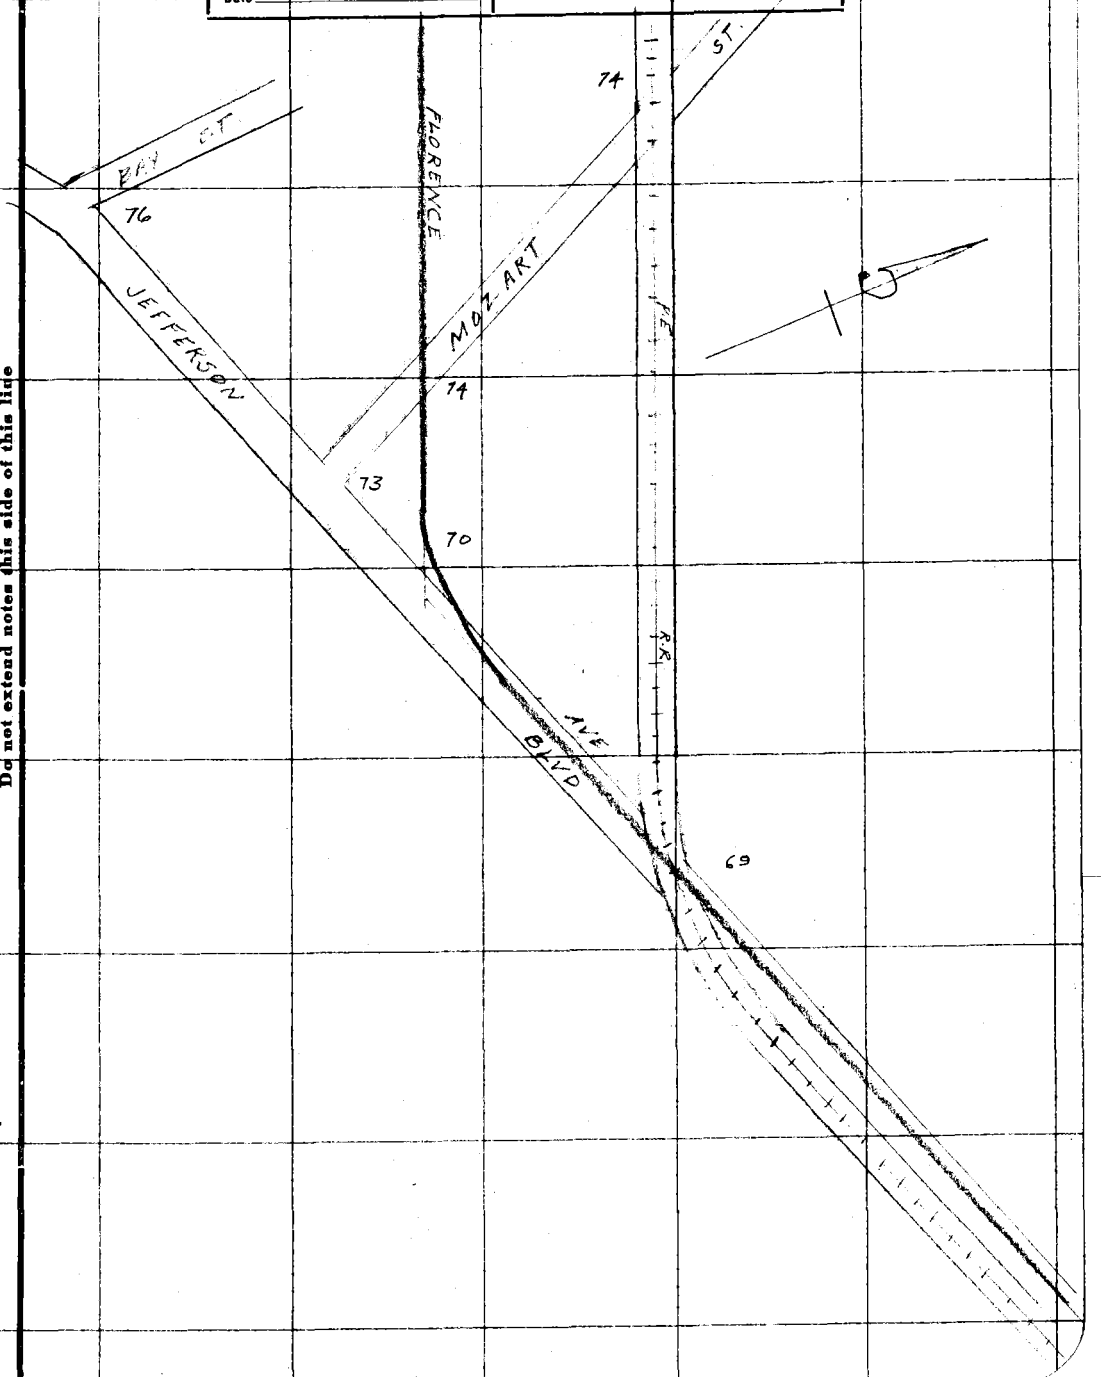

Notes: ANY ADDITIONS OR CHANGES OR THIS SHEET MUST BE MADE OR CIRCLED IN Red. WITH DATE AND NAME OF PERSON MAKING CHANGE.

Do not extend notes this side of this line

RETURN TO
LOS ANGELES COUNTY SURVEYOR

F.B. 325 Pg. 1H Moore Chief Party Notes by Moore Date 11-20-28

To Pg 11

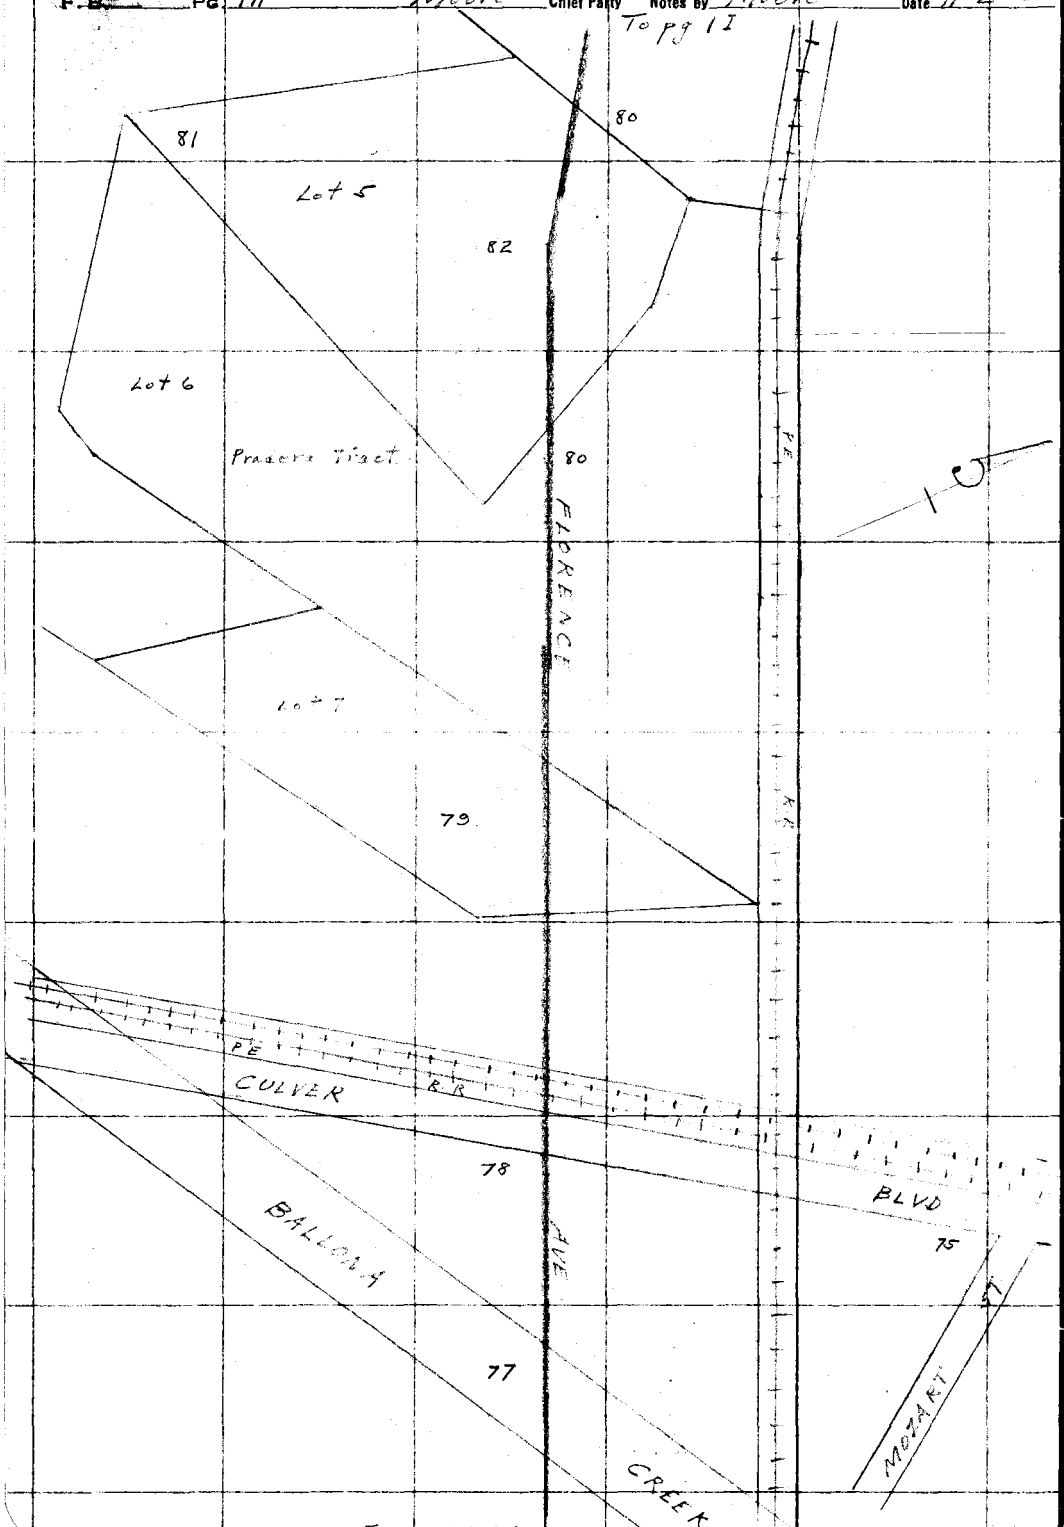

From Pg 1G

RETURN TO
LOS ANGELES COUNTY SURVEYOR

Do not extend notes this side of this line

Notes: ANY ADDITIONS OR CHANGES ON THIS SHEET MUST BE MADE OR CIRCLED IN RED. WITH DATE AND NAME OF PERSON MAKING CHANGE.

Date 11-20-28 Notes by Moore Chief Party Moore F.B. 325 Pg. 11

Platted by	W. O. No. 4168 S. O. No.
Date	Location Florence Ave
Map No.	Surveyed by L. D. Moore
Platting C'k'd by	Date 11-20-28
Date	Indexed

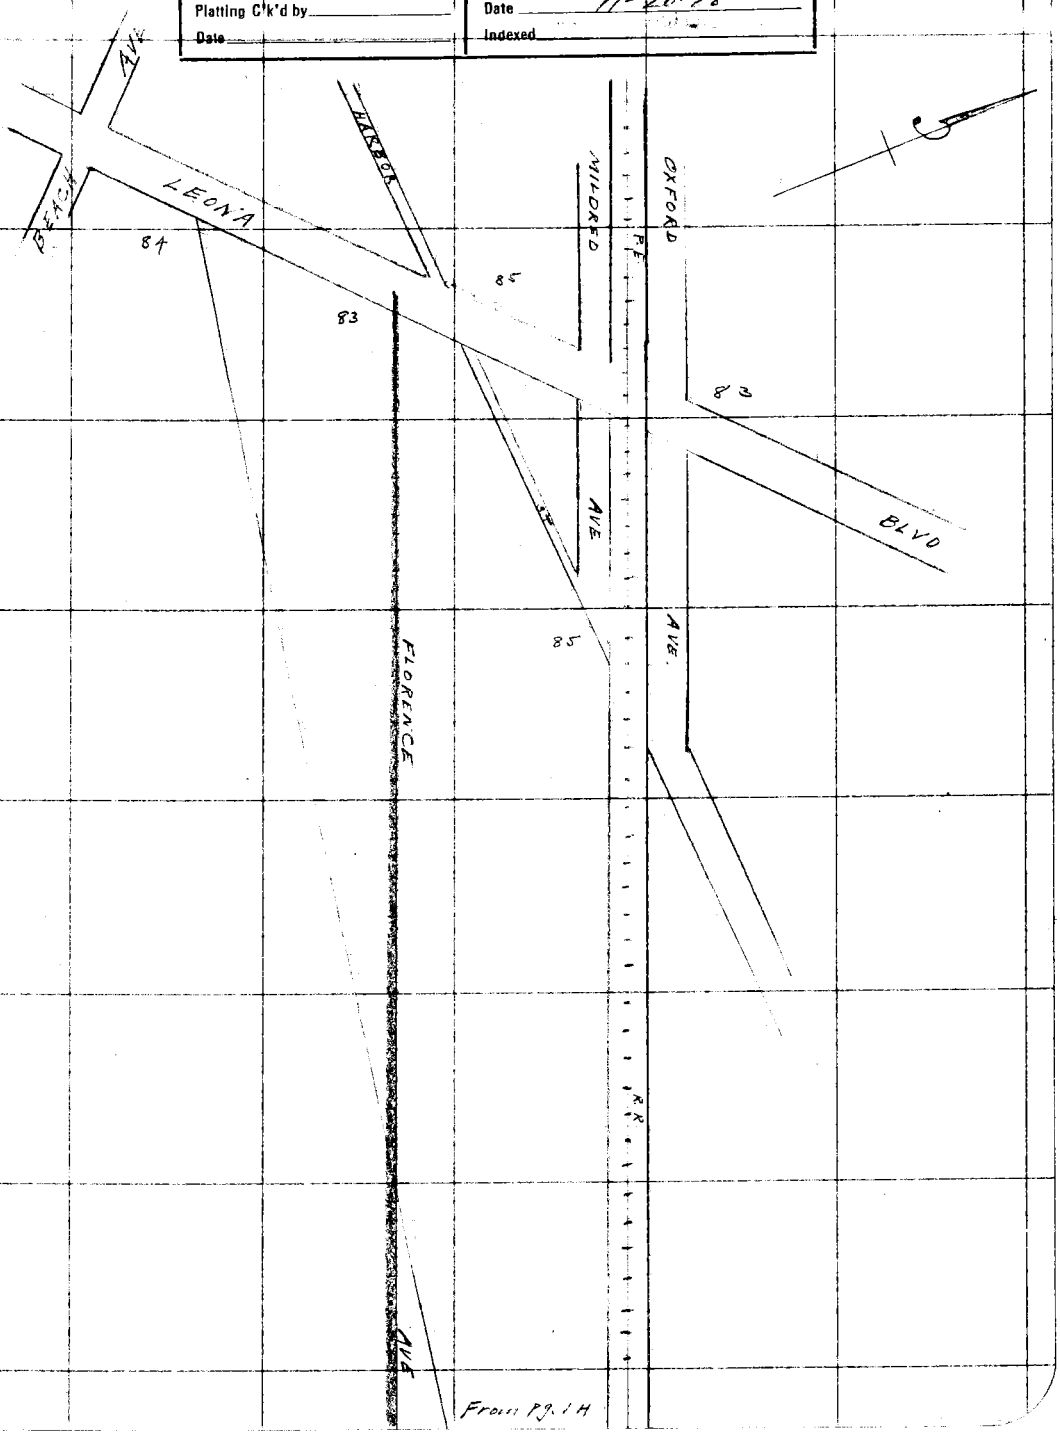

Note: ANY ADDITIONS OR CHANGES ON THIS SHEET MUST BE MADE OR CIRCLED IN Red. WITH DATE AND NAME OF PERSON MAKING CHANGE.

Do not extend notes this side of this line

RETURN TO
LOS ANGELES COUNTY SURVEYOR

RETURN TO

LOS ANGELES COUNTY SURVEYOR

Note: ANY ADDITIONS OR CHANGES ON THIS SHEET MUST BE MADE OR CIRCLED IN Red. WITH DATE AND NAME OF PERSON MAKING CHANGE.

Do not extend notes this side of this line

F.B. 325 PG. 10

Chief Party _____ Notes by _____ Date _____

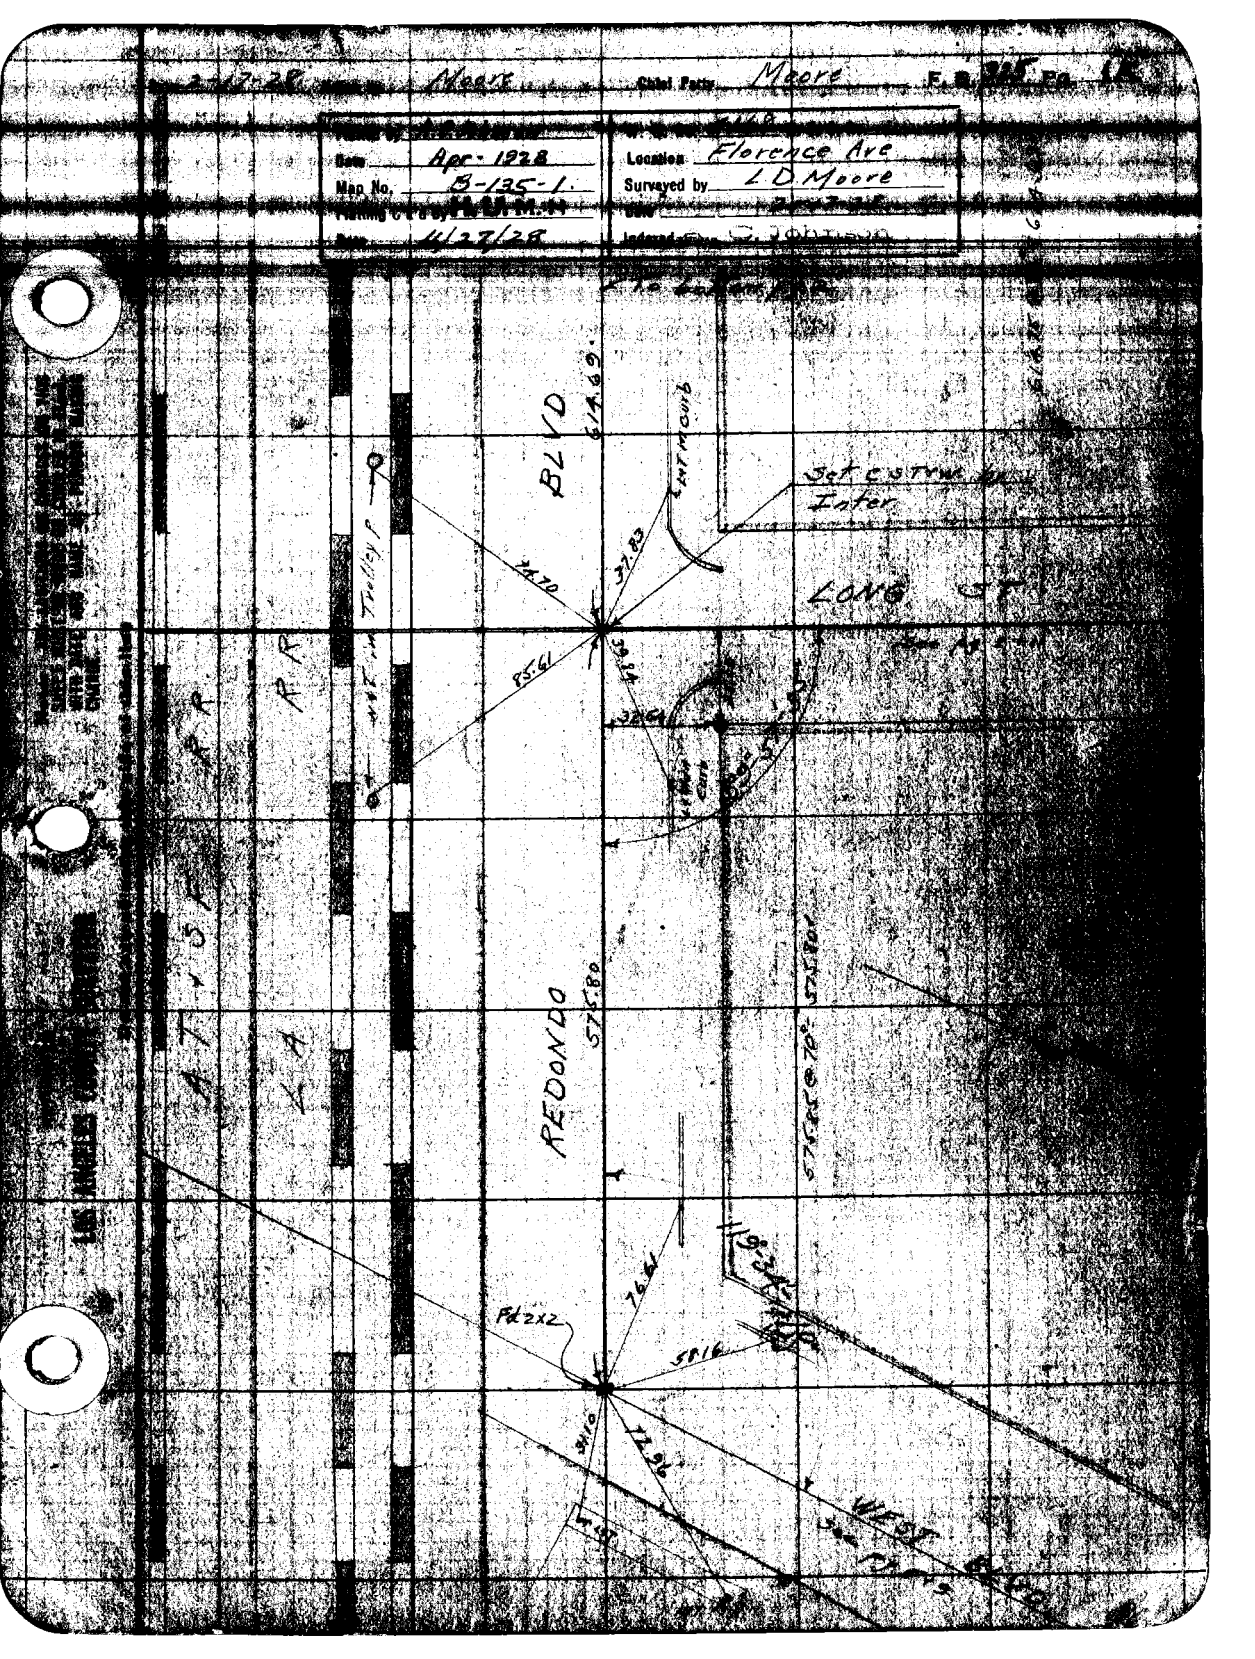
Moore
Chief Party Moore
Date Apr. 1928
Map No. B-135-1.
Date 4/27/28
Location Florence Ave
Surveyed by L.D. Moore
BLVD
LONG
REDONDO
Set C.S Tang. Inter
Pk 2x2
WEST
37.83
24.70
85.41
76.41
58.16
72.26

F.B. 325 PG 2 Moore Chief Party Notes by Moore Date 2-17-28

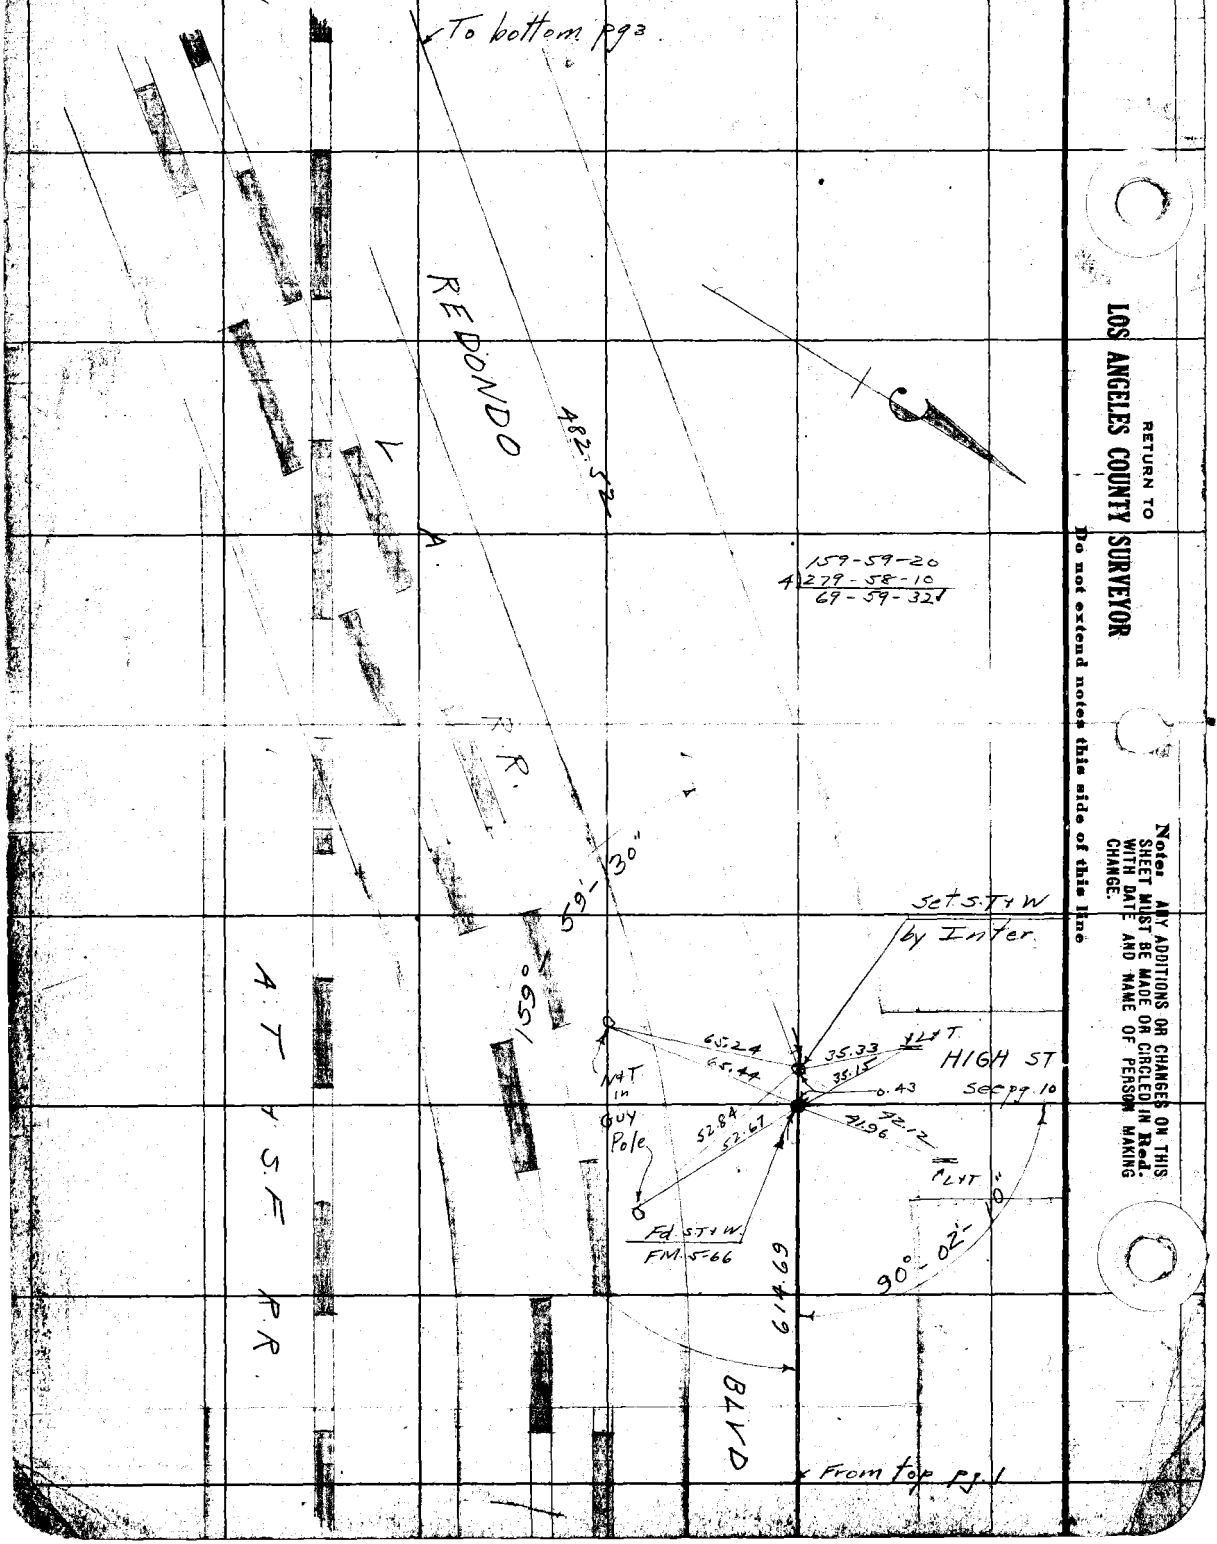

RETURN TO
LOS ANGELES COUNTY SURVEYOR
Do not extend notes this side of this line

Note: ANY ADDITIONS OR CHANGES ON THIS SHEET MUST BE MADE OR CIRCLED IN Red. WITH DATE AND NAME OF PERSON MAKING CHANGE.

Date 2-20-28 Notes by Moore Chief Party Moore F. B. 225 Pg. 3

Plotted by A.C. Johnson
Date Apr. 1928
Map No. B-135-1
Plotting C'k'd by H. U. M. H.
Date 12/3/28.

W. O. No. 2168 S. O. No.
Location Florence Ave
Surveyed by L. D. Moore
Date 2-20-28
Indexed A. C. Johnson

To bottom pg 4

R. R.

1402.24'

1402.40 @ .13' = 1402.27'

N+T in PP

Fd. Spk+Tin E.C.

23.86

28.05

32.52

N+T in Tel p.

N+T in Trolley Pole

N+T in Campbell Engr.

Rec 91.02

Set N+T Rec. dist from Spk+T Apparent E.C. C.S. 7115

63.36

34.79

N+T in PP

40.19

28.15

N+T in Guy Pole

Turned Rec 160° 00' 00"

N82.52

R. R.

A T & S. F.

From top pg 2

RETURN TO LOS ANGELES COUNTY SURVEYOR

Do not extend notes this side of this line

Notes: ANY ADDITIONS OR CHANGES ON THIS SHEET MUST BE MADE OR CIRCLED IN Red. WITH DATE AND NAME OF PERSON MAKING CHANGE.

RETURN TO

LOS ANGELES COUNTY SURVEYOR

Note: ANY ADDITIONS OR CHANGES ON THIS SHEET MUST BE MADE OR CIRCLED IN **Red.** WITH DATE AND NAME OF PERSON MAKING CHANGE.

Do not extend notes this side of this line

F.B. 325 Pg. 4

Moore Chief Party Notes by Meadre Date 2-20-28

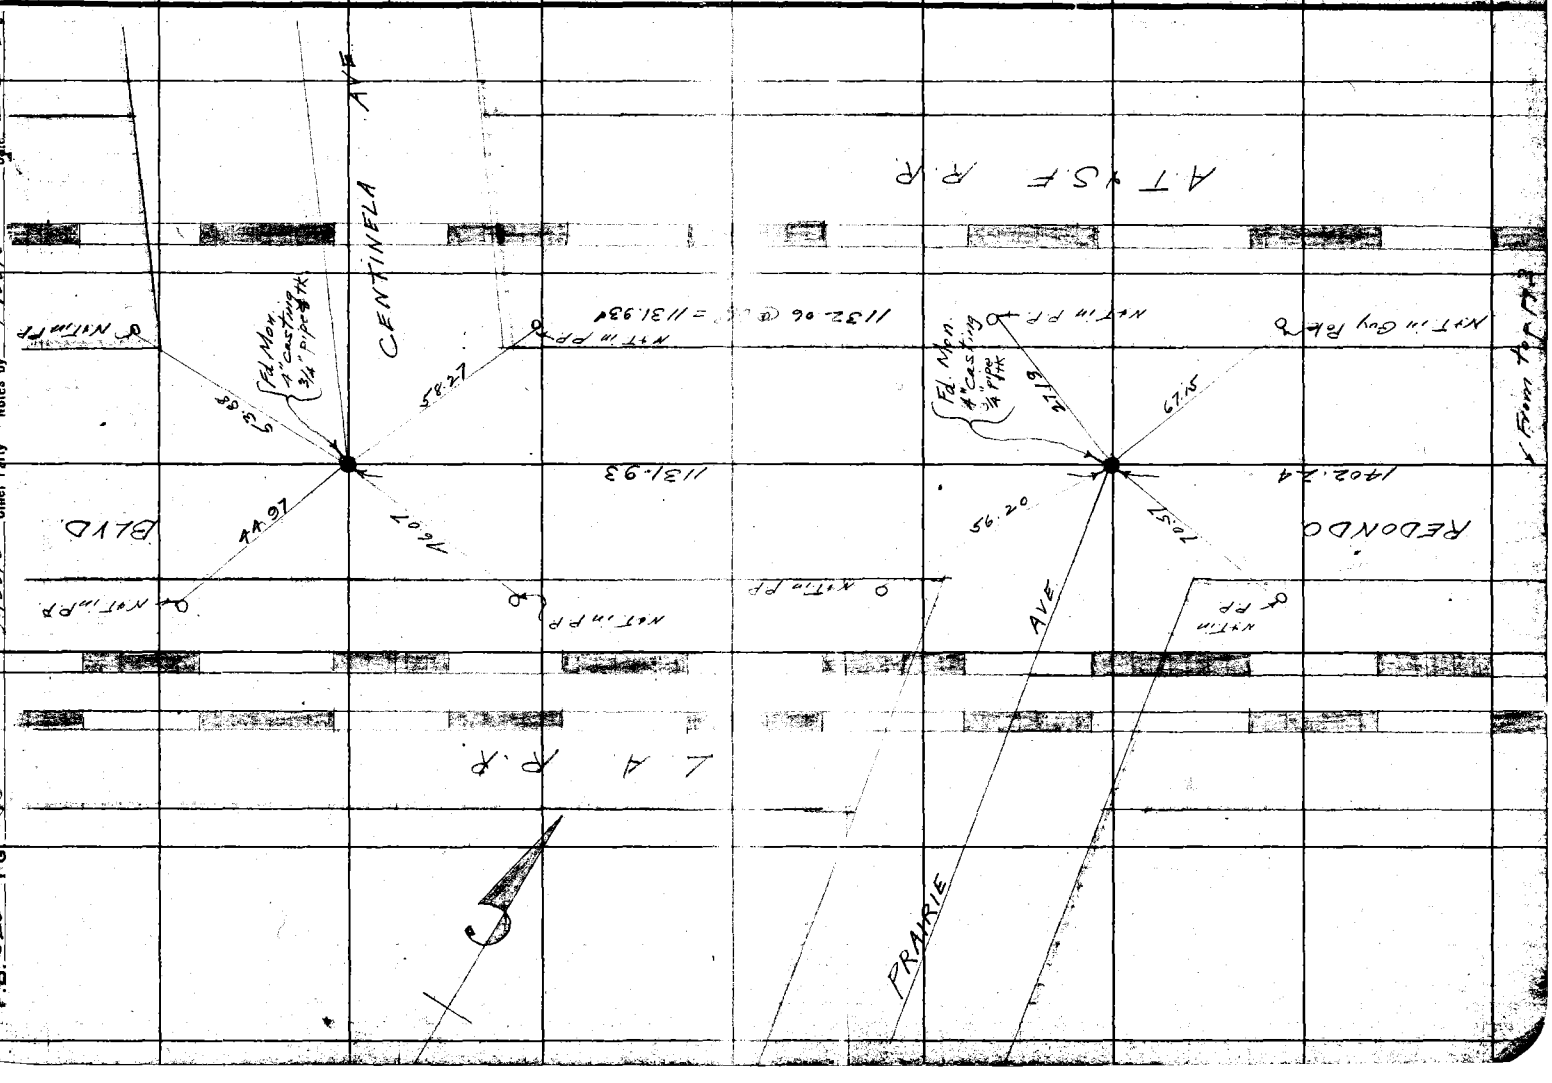

Date 2-16-28 Notes by Moore Chief Party Moore F. B. 325 PG. 5

Plotted by A. C. Johnson	W. O. No. 4168 D. S. O. No.
Date Apr-1928	Location Florence Ave
Map No. B-135-1	Surveyed by L. D. Moore
Plotting C'k'd by H. H. M. W.	Date 2-16-28
Date 12/3/28.	Indexed A. C. Johnson

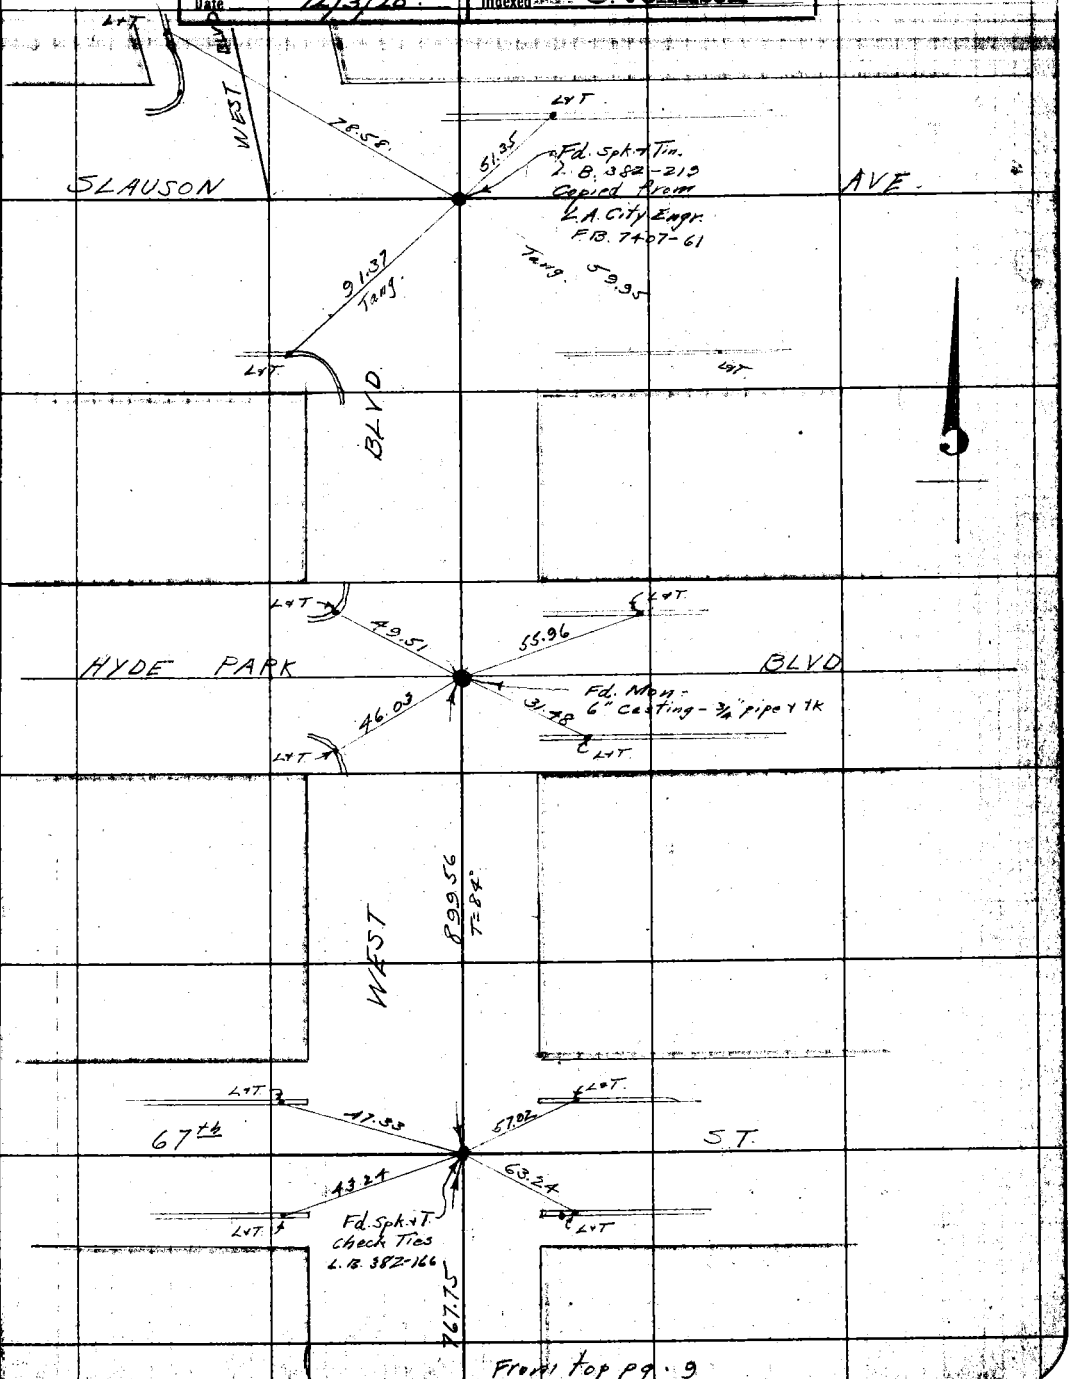

From Top pg. 9

Notes: ANY ADDITIONS OR CHANGES ON THIS SHEET MUST BE MADE OR CIRCLED IN Red. WITH DATE AND NAME OF PERSON MAKING CHANGE.

Do not extend notes this side of this line

RETURN TO LOS ANGELES COUNTY SURVEYOR

F.B. 325 PG. 6 Chief Party Notes by Date

RETURN TO
LOS ANGELES COUNTY SURVEYOR

Do not extend notes this side of this line

Notes: ANY ADDITIONS OR CHANGES ON THIS SHEET MUST BE MADE OR CIRCLED IN Red. WITH DATE AND NAME OF PERSON MAKING CHANGE.

Date _____ Notes by _____ Chief Party _____ F. B. 325 PG. 7

Plotted by	W. O. No. 4168 R. S. O. No.
Date	Location Florence Ave
Map No.	Surveyed by L. D. Moore
Plotting C'k'd by H. U. M. H.	Date
Date 4/27/28.	Indexed A. C. Johnson

Notes: ANY ADDITIONS OR CHANGES ON THIS SHEET MUST BE MADE OR CIRCLED IN Red. WITH DATE AND NAME OF PERSON MAKING CHANGE.

Do not extend notes this side of this line

RETURN TO

LOS ANGELES COUNTY SURVEYOR

F.B. 325 Pg 8 Moore Chief Party Notes by Moore Date 2-16-28

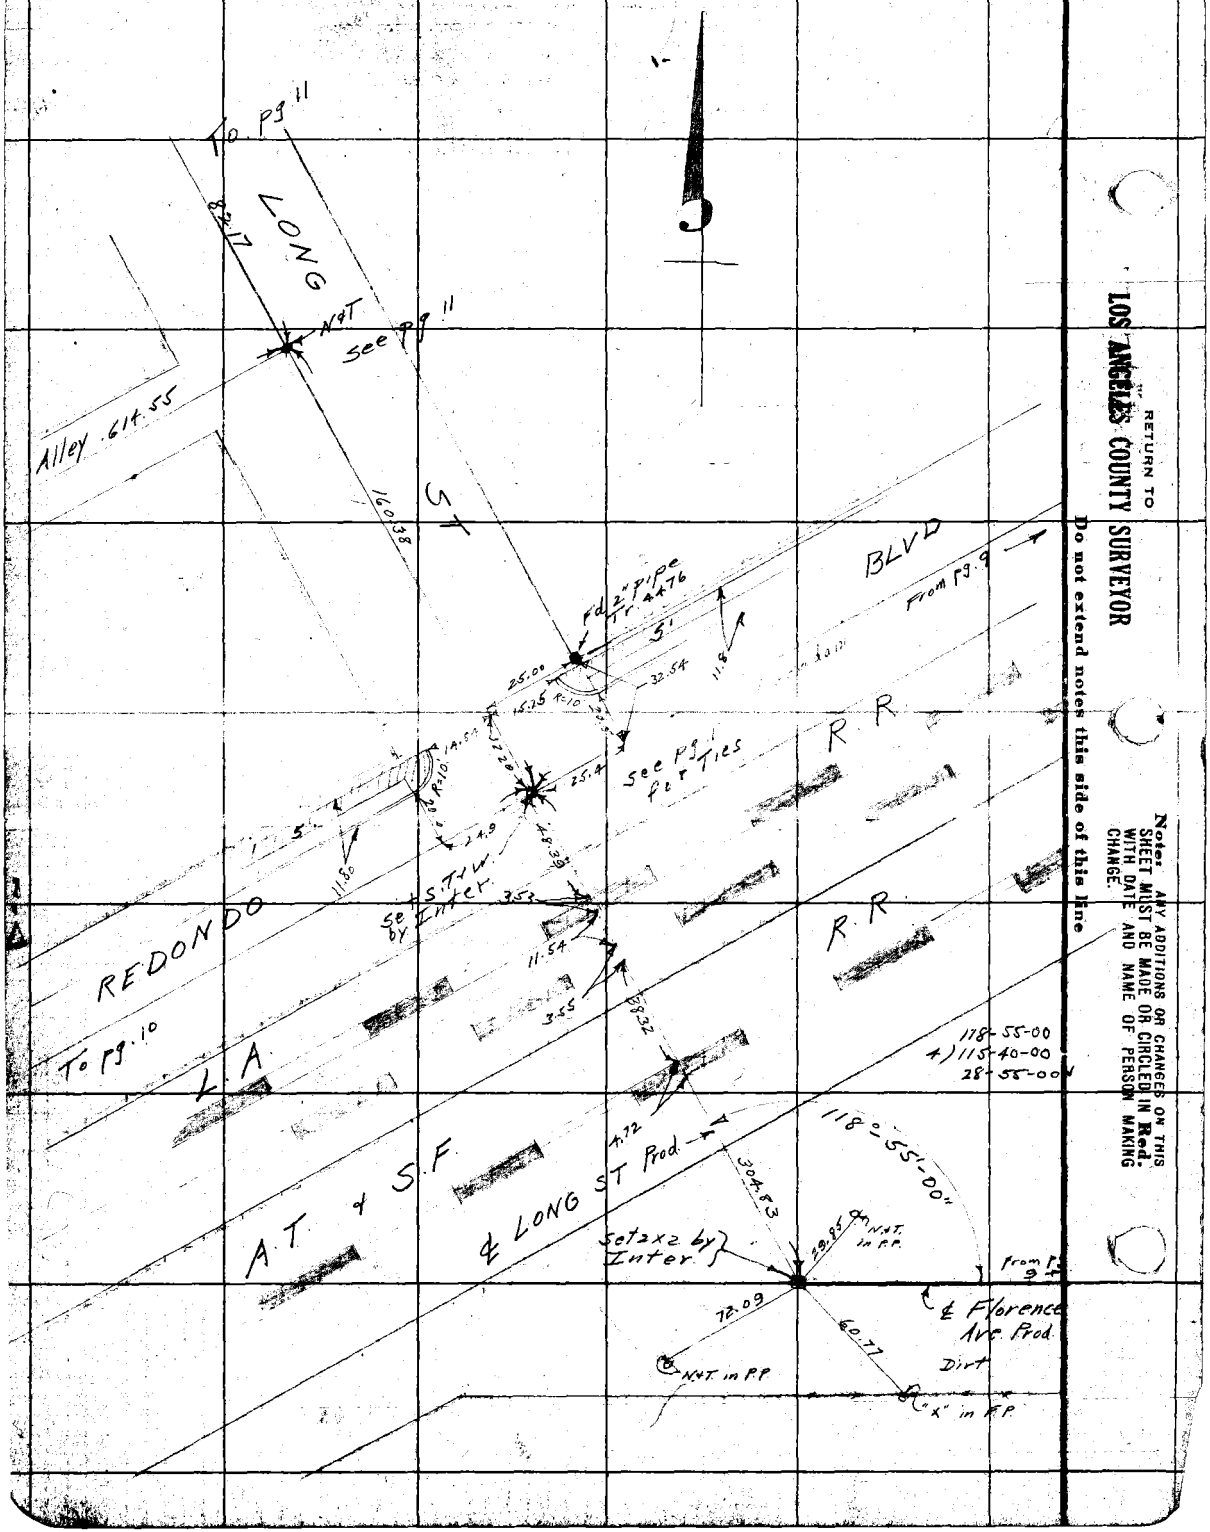

RETURN TO
LOS ANGELES COUNTY SURVEYOR
Do not extend notes this side of this line

Notes: ANY ADDITIONS OR CHANGES ON THIS SHEET MUST BE MADE OR CIRCLED IN Red. WITH DATE AND NAME OF PERSON MAKING CHANGE.

Date 2-16-28 Notes by Moore Chief Party Moore F. B. 346 Pg. 9

Plotted by A.C. Johnson
Date Apr. 1928
Map No. S-135-21
Plotting C'k'd by
Date 12/3/28.

W. O. No. 4168 A. & O. No.
Location Florence Ave
Surveyed by L.D. Moore
Date 2-16-28
Indexed C. Johnson

Notes: ANY ADDITIONS OR CHANGES ON THIS SHEET MUST BE MADE OR CIRCLED IN Red. WITH DATE AND NAME OF PERSON MAKING CHANGE.

Do not extend notes this side of this line

RETURN TO LOS ANGELES COUNTY SURVEYOR

BLVD. To Pg. 5

Fd 2x2

L.A. R.R.

A.T. & S.F. R.R.

119-34-10
118-16-40
29-34-10

Fd 2x2

LYT.

71st ST

Fd 1" pipe - 18" deep per T.ies L.A. City Engr. F.B. 8407-50 L.B. 382-164

INT. in House 5' up

WEST

89-23-10
357-32-50
89-23-10

BRYNHURST

VICTORIA

FLORENCE AVE.

LOS ANGELES MESA

437.04 T=84°

446.99 T=84°

To Pg. 8

Fd punch mark

Fd 6" Conc. Mon 8" deep. L.A. City Engr. F.B. 8407-50 L.B. 382-164

OH MH Rim Per L.A. City Engr. F.B. 8407-48 L.B. 382-164

F.B. 325 PG 10 Moore Chief Party Notes by Moore Date 2-24-28

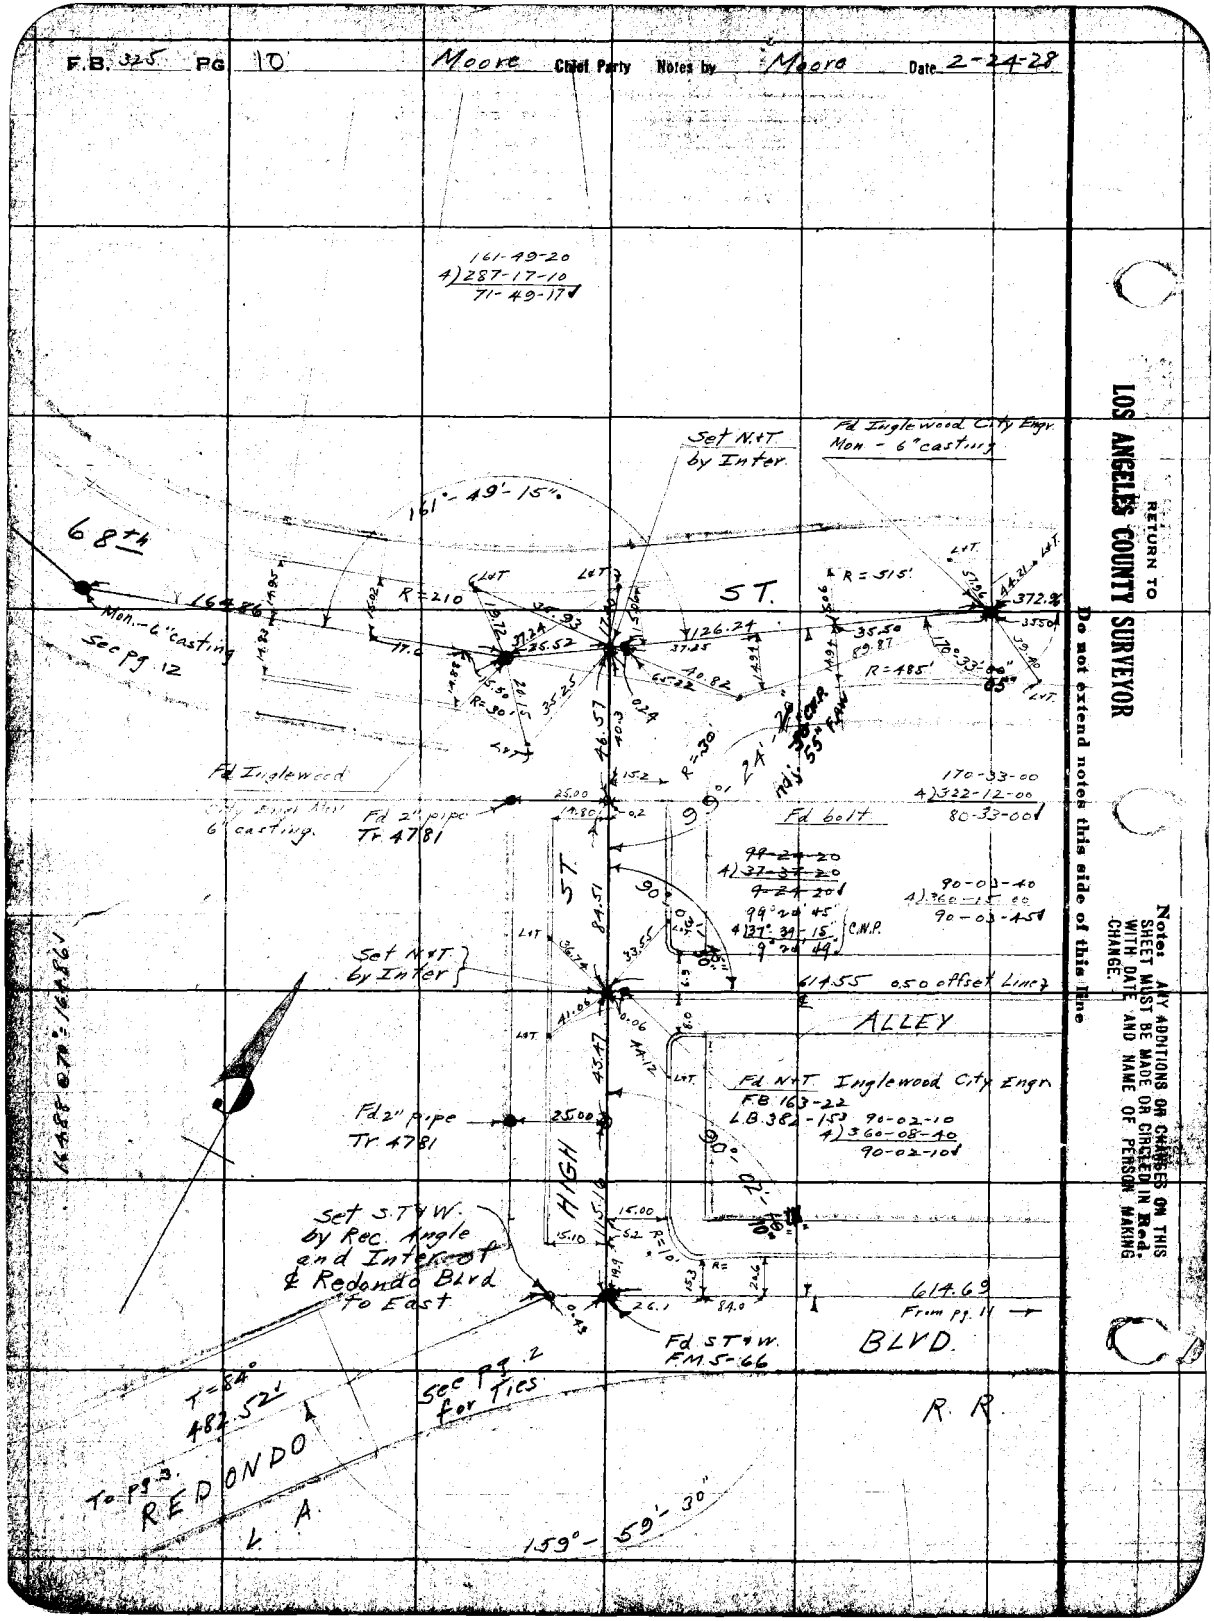

RETURN TO
LOS ANGELES COUNTY SURVEYOR
Do not extend notes this side of this line

Notes: ANY ADDITIONS OR CHANGES ON THIS SHEET MUST BE MADE OR CIRCLED IN Red. WITH DATE AND NAME OF PERSON MAKING CHANGE.

Date 2-24-28 Notes by Moore Chief Party Moore F. B. 325 Pg. 11

Plotted by R.C. Johnson
Date Apr. 1928
Map No. B-135-1
Tracing C'k'd by H.J.U.M.H.
Date 12/3/28.

W. O. No. 4166 R. & O. No.
Location Florence Ave
Surveyed by L.D. Moore
Date 2-24-28
Indexed A. C. Johnson

Notes: ANY ADDITIONS OR CHANGES ON THIS SHEET MUST BE MADE OR CINGLED IN Red. WITH DATE AND NAME OF PERSON MAKING CHANGE.

Do not extend notes this side of this line

RETURN TO LOS ANGELES COUNTY SURVEYOR

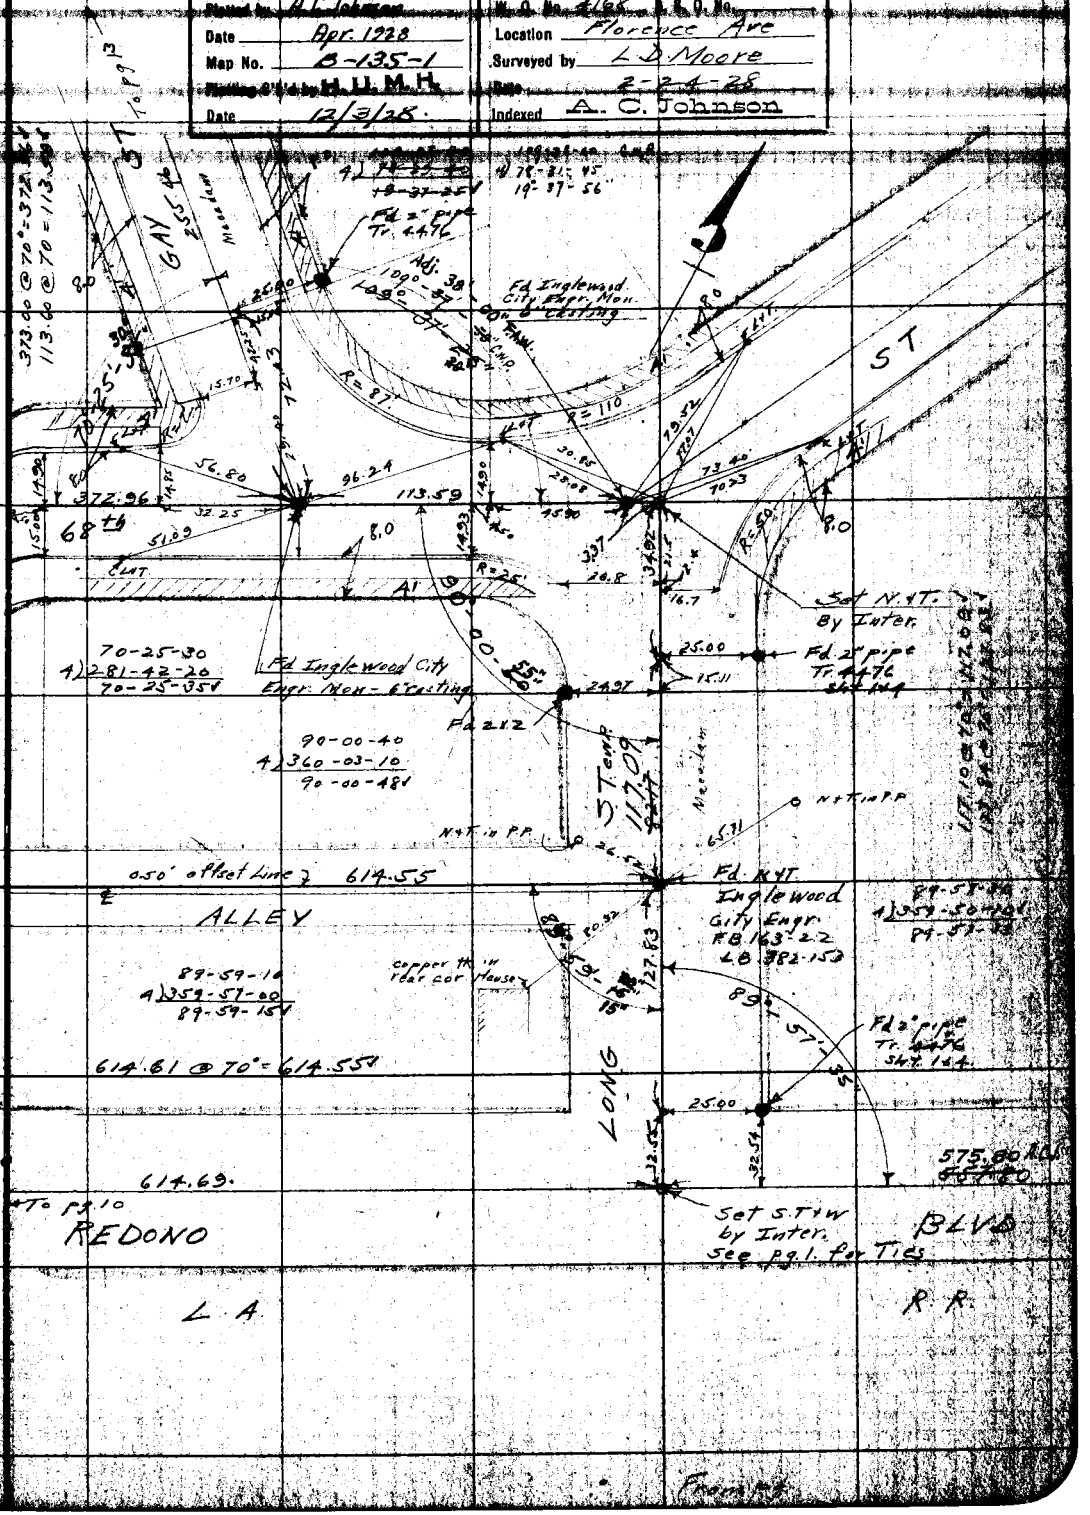

F.B. 325 PG 12 Moore Chief Party Notes by Moore Date 2-25-28

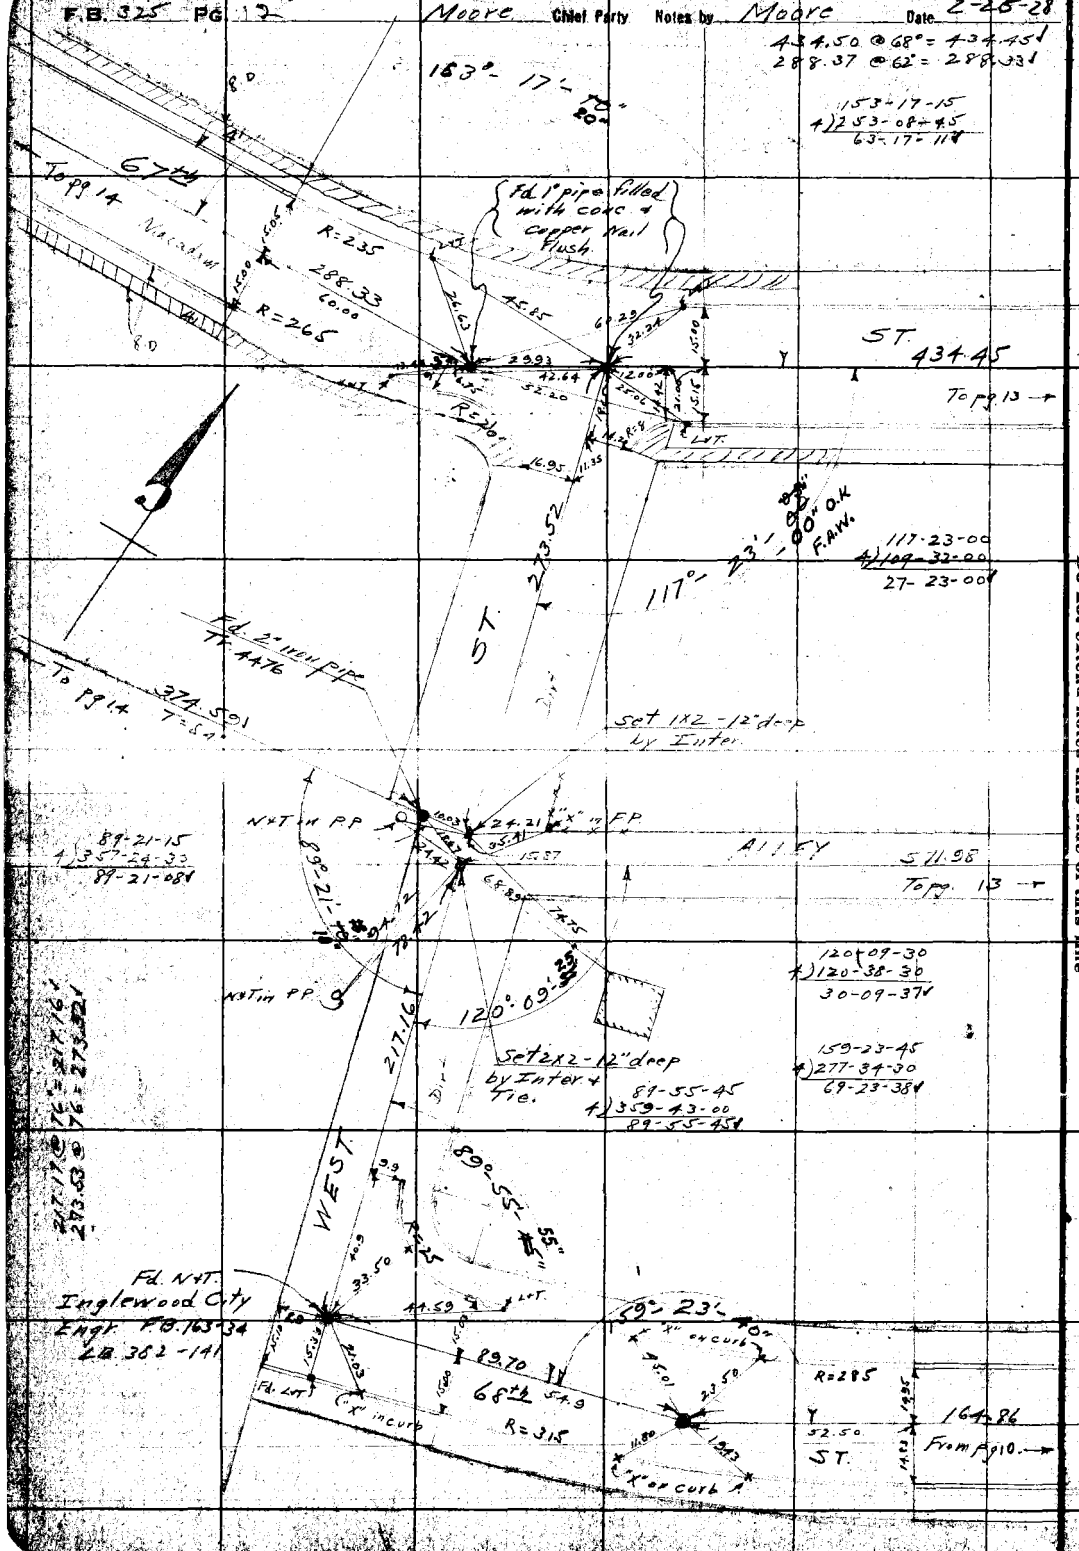
183° 17'
434.50 @ 68° = 434.45
288.37 @ 62° = 288.33
153-17-15
4) 253-08-45
63-17-11
To pg 14
67.74
Macadam
R=235
288.33
60.00
R=265
Fd. 1" pipe filled with conc. & copper nail flush
ST.
434.45
To pg 13
L.H.T.
F.A.W.
117-23-00
4) 109-32-00
27-23-00
117°
273.52
Fd. 2" IRON PIPE
TY 4476
To pg 14
374.501
Set 1X2-12"d-p by Inter.
N.T. in PP
24.21
"X" in FP
ALLEY
511.98
To pg. 13
89-21-15
4) 357-24-33
89-21-084
89°-21'-15"
120°-09'-30"
4) 120-38-30
30-09-374
159-23-45
4) 277-34-30
69-23-384
120° 09' 30"
217.16
Set 2X2-12" deep by Inter. & Tie.
89-55-45
4) 359-43-00
89-55-454
WEST
89°-55'-45"
Fd. N.T. Inglewood City Engr. F.B. 163-34 & 382-141
41.59
89.70
68°-24'
R=315
59°-23'
"X" on curb
"X" in curb
R=285
52.50
ST.
164.86
From pg 10.
Fd. 1" pipe

Date 2-25-28 Notes by Moore Chief Party Moore F. B. 325 PG. 13

Plotted by DC Johnson
Date Apr. 1928
Map No. B-135-1
Plotting C'k'd by H. L. M. H.
Date 12/3/28

W. O. No. 4168 S. & D. No.
Location Florence Ave
Surveyed by L D Moore
Date 2-25-28
Indexed A C Johnson

Notes. ANY ADDITIONS OR CHANGES ON THIS SHEET MUST BE MADE OR CIRCLED IN Red. WITH DATE AND NAME OF PERSON MAKING CHANGE.

Do not extend notes this side of this line

RETURN TO LOS ANGELES COUNTY SURVEYOR

67TH ST.

434.45

← To pg 12

Macadam

434.50 @ 68° = 434.45'

90-54-30
4) 363-38-00
90-54-30"

91-51-45
4) 367-27-15
91-51-49"

ALLEY 571.98

← To pg 12

572.01 @ 76° = 571.98'

108-49-45
4) 75-14-45
18-49-11"

108° 49' 30"
4) 75° 17' 30"
18° 49' 23"

FLORENCE AVE.

229.33

GAY

Pd. 1" pipe Inglewood City Engr. F.B. 188-75

Lyt

Lyt in sidewalk

R=8

R=30

R=3'

R=5'

90° 54'

91° 51'

108° 49'

Set 2x2x12" by Tms.

255.47 @ 78° 255.46'
229.35 @ 89° 229.33'

From top pg 11

F.B. 325 Pg 17 Moore Chief Party Notes by Moore Date 2-27-28

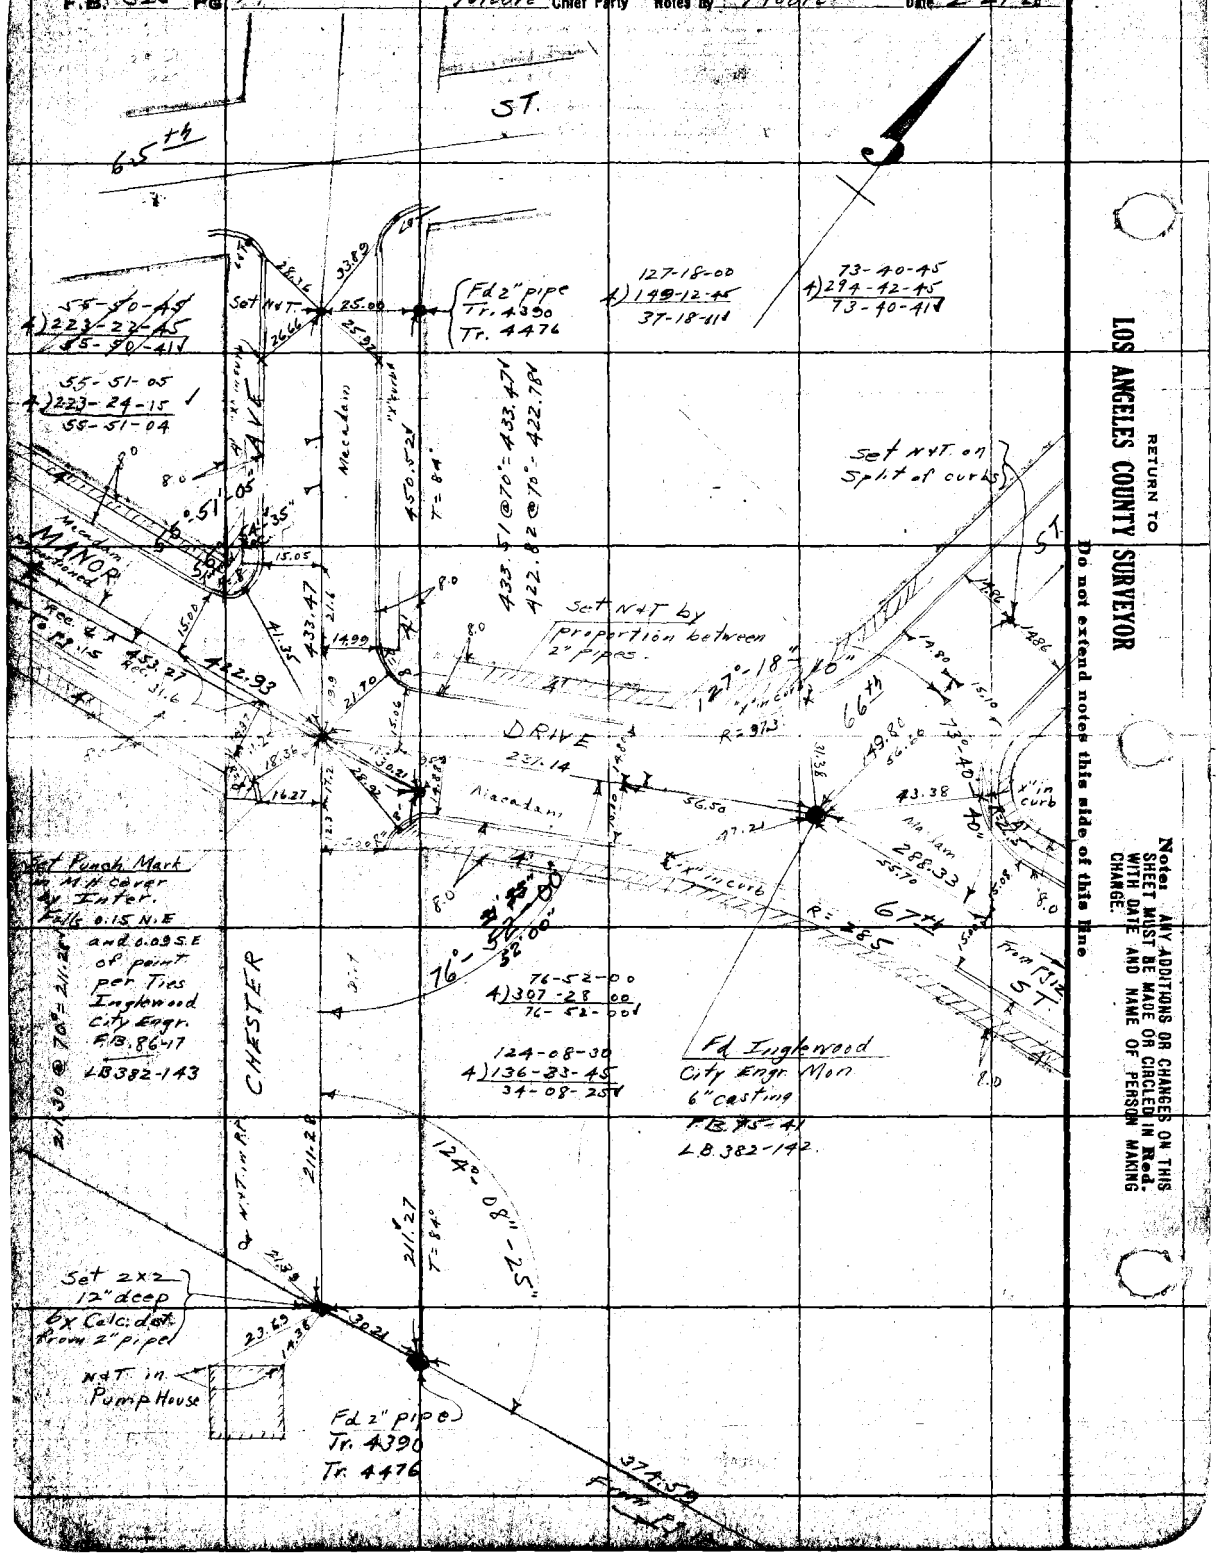

RETURN TO
LOS ANGELES COUNTY SURVEYOR
Do not extend notes this side of this line

Notes: ANY ADDITIONS OR CHANGES ON THIS SHEET MUST BE MADE OR CIRCLED IN Red. WITH DATE AND NAME OF PERSON MAKING CHANGE.

Date 2-28-28 Notes by Moore Chief Party Moore F. B. 325 Pg. 15

Plotted by A.C. Johnson
Date Apr-1928
Map No. B-135-1
Plotting Co's by H. U. M. M.
Date 12/5/28.

W. O. No. 4168 I. S. O. No.
Location Florence Ave
Surveyed by L.D. Moore
Date 2-28-28
Indexed A. C. Johnson

Notice: ANY ADDITIONS OR CHANGES ON THIS SHEET MUST BE MADE ON CIRCLED IN Red. WITH DATE AND NAME OF PERSON MAKING CHANGE.

Do not extend notes this side of this line

RETURN TO LOS ANGELES COUNTY SURVEYOR

65 ft

30.01

28.97

ST.

29.10

30.22

Set punch mark on A.H. cover per Inglewood City Engr. Ties - F.B. 173-5 L.B. 382-115

90-41-45
362-47-45
90-41-45

(Adj) 50" 55" F.A.W.

167-44-15
4) 310-37-00
77-44-15

AVE

279.03

Concrete

77-02-30
4) 1308-09-45
77-02-15

set 2x2-12" under by Proportion between ℄ Prairie and E. Prop. Line of Chester

90.01

15.00

15.10

Adj. 20'

Macadam

456.52

MANOR DRIVE

To F.B. 9-16

28.70

27.98

22.7

Macadam

R=315

266.30

32.89

37.72

266.83 Rec.

Macadam

167-40-40

Set N. & T. by Rec. dist and angle from E. Prop. Line of Chester

Set ℄ S. T. & W. by Inter.

Fd. 1" pipe with Inglewood City Engr F.B. 173-5 L.B. 382-118

345.38

Concrete

PRAIRIE

167-44-00
4) 310-39-30
77-44-30

167-40-45
4) 310-42-45
77-40-41

STEPNEY PLACE

45.37

Set N. & T. per Inglewood City Engr Ties - F.B. 121-3 L.B. 382-117.

48.73

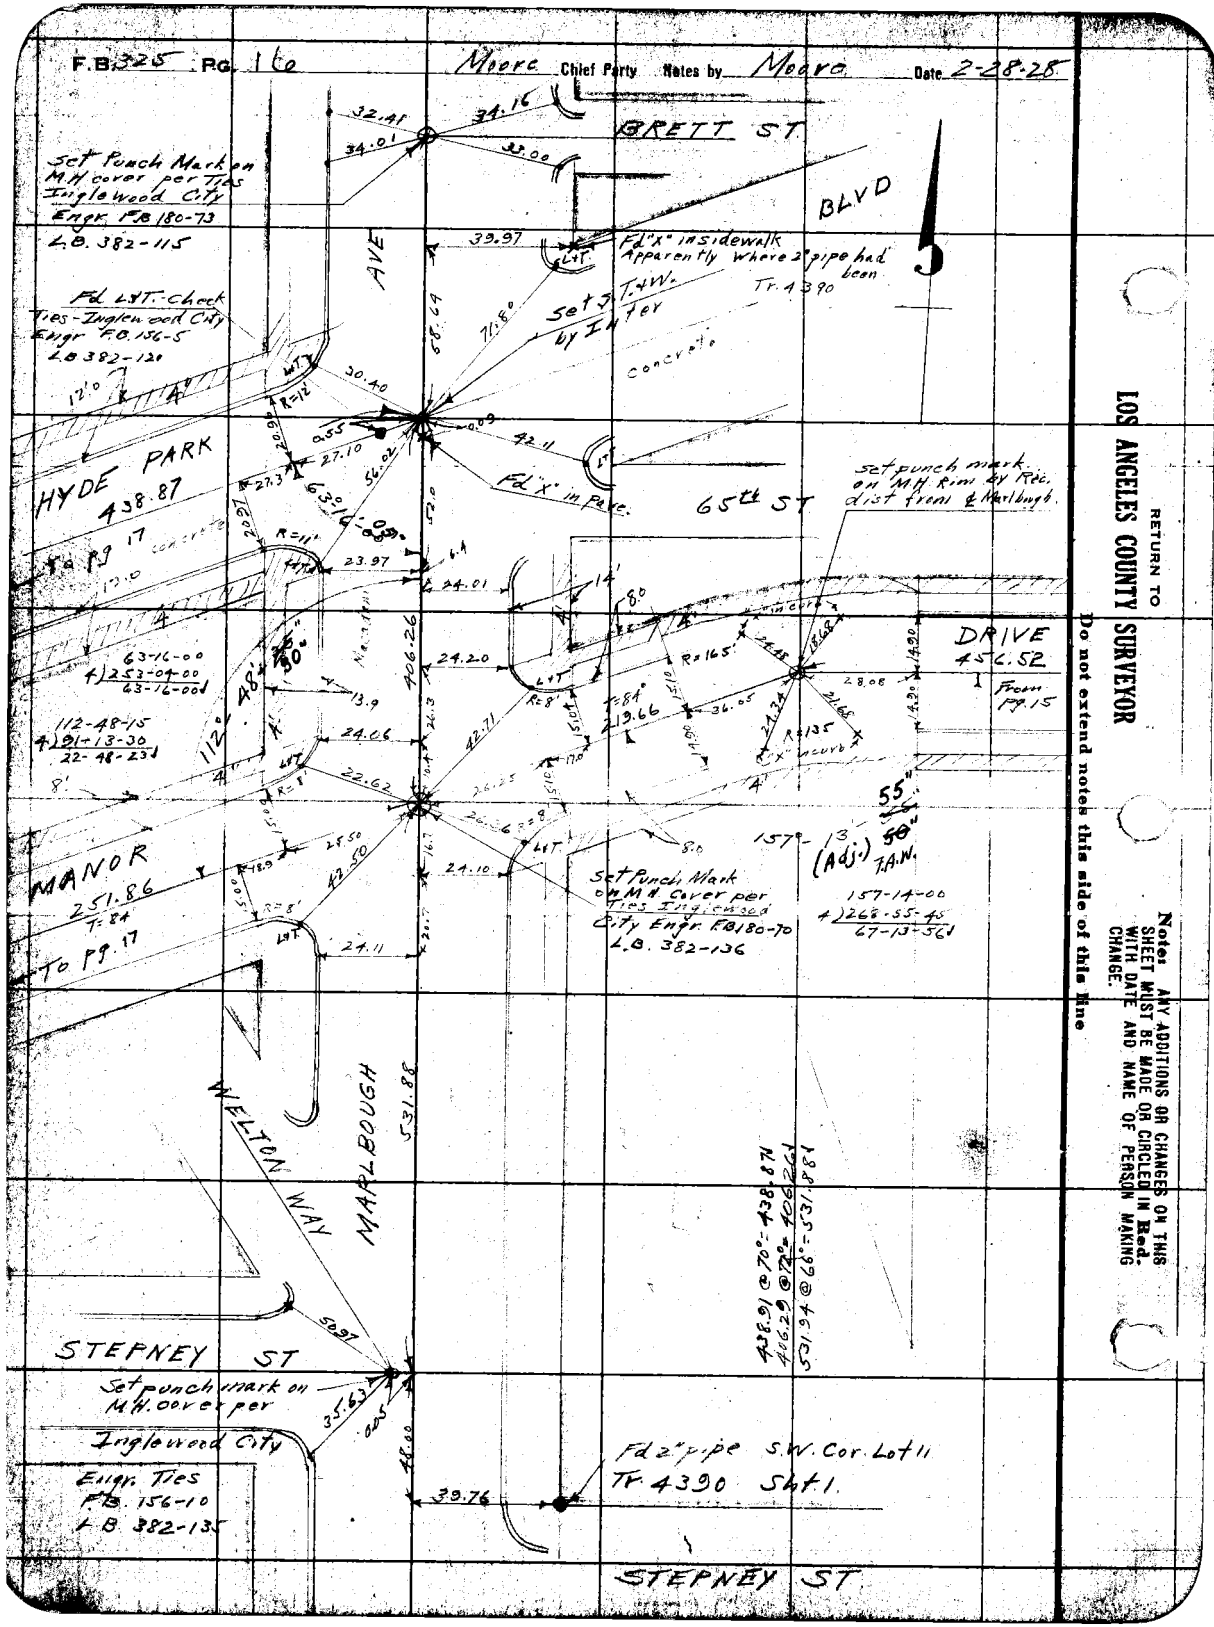
F.B. 325 Pg. 16
Moore Chief Party Notes by Moore Date 2-28-28
BRETT ST
BLVD
AVE
Set Punch Mark on M.H. cover per Ties Inglewood City Engr. F.B. 180-73 L.B. 382-115
Fd L.&T. Check Ties - Inglewood City Engr. F.B. 156-5 L.B. 382-120
Fd "X" insidewalk Apparently where 2" pipe had been Tr. 4390
Set T.&W. by Inter
concrete
HYDE PARK
438.87
To Pg 17
Fd "X" in Pave.
65th ST
Set punch mark on M.H. Rim by Rec. dist from. & Marlbrgh.
DRIVE
457.52
From Pg 15
MANOR
251.86
To Pg 17
Set Punch Mark on M.H. Cover per Ties Inglewood City Engr. F.B. 180-70 L.B. 382-136
MARLBOUGH
531.88
WALTON WAY
STEPNEY ST
Set punch mark on M.H. cover per Inglewood City Engr. Ties F.B. 156-10 L.B. 382-135
Fd 2" pipe S.W. Cor. Lot 11 Tr. 4390 S&T.I.
STEPNEY ST
438.87 @ 70° = 438.87
406.26 @ 72° = 406.26
531.94 @ 66° = 531.88
RETURN TO
LOS ANGELES COUNTY SURVEYOR
Do not extend notes this side of this line
Note: ANY ADDITIONS OR CHANGES ON THIS SHEET MUST BE MADE OR CIRCLED IN Red. WITH DATE AND NAME OF PERSON MAKING CHANGE.

Date 2-29-28 Notes by Moore Chief Party Moore F. B. 325 Pg. 17

Plotted by A.C. Johnson
Date Apr. 1928
Map No. B-135-1.
Plotting C'k'd by H.U.M.H.
Date 12/3/28

W. O. No. 4168 S & O No.
Location Florence Ave
Surveyed by L.D. Moore
Date 2-29-28
Indexed A. C. Johnson

Notes ANY ADDITIONS OR CHANGES ON THIS SHEET MUST BE MADE OR CIRCLED IN Red, WITH DATE AND NAME OF PERSON MAKING CHANGE.

RETURN TO LOS ANGELES COUNTY SURVEYOR

Do not extend notes this side of this line

HYDE PARK BLVD

MANOR PLACE

MANOR DRIVE

WELTON WAY

26-43-30
4)106-53-40
26-43-30

4)291-22-45
72-55-41½

Set L+T. by Inter.

concrete

733.86

1146

27.3

1252

1453.99@90°=1453.82 145382
250.71@70°=250.69'
88.26@70°= 88.25'
98.88@70°= 98.87'
737.93@64°= 737.84'
1111.54@70°= 1111.53'
733.96@64°= 733.85'

Fd. L+T. Ties per Inglewood City Engr. FB.53-15 L.B. 382-149-no good

Fd. L+T. Check Ties Inglewood City Engr. FB-164-27 L.B382-144

161-12-15
4)284-48-45
71-12-11¼

157-09-15
4)268-36-45
67-09-11¼

Set Punch Mark on M.M. Center per Inglewood City Engr. Ties FB.164-27 L.B.382-144

157°09'-15" 40+1.0 L.C.

To P.T. 18

737.84

MANOR

DRIVE

192.58

N.4T IN P.P.

Set S.T.+W by Line and one Tie Inglewood City Engr. F.B. 53-18

161-12'-10"

NAT in T.H.P.

72.77

47.14

98.67

Macadam

251.86

From P.B. &c

81-19-15
4)325-16-00
81-19-15

138.87

From P.B. &c

Fd 2" pipe Th. 4.35 E

Fd 2" pipe Th. 4.35 E

Fd 2" pipe Th. 4.35 E

88.25

20.00

16.05

19.0

36.0

24.7

21.03

21.16

25.6

21.31

14.42

13.65

12.9

12.5

"X" in curb

"X" in curb

"X" in curb

"X" in curb

"X" in curb

"X" in curb

Set Punch Mark on M.M. Center per Inglewood City Engr. Ties FB.164-27 L.B.382-144

F.B. 325 Pg 18 — Moore Chief Party — Notes by Moore — Date 2-29-28

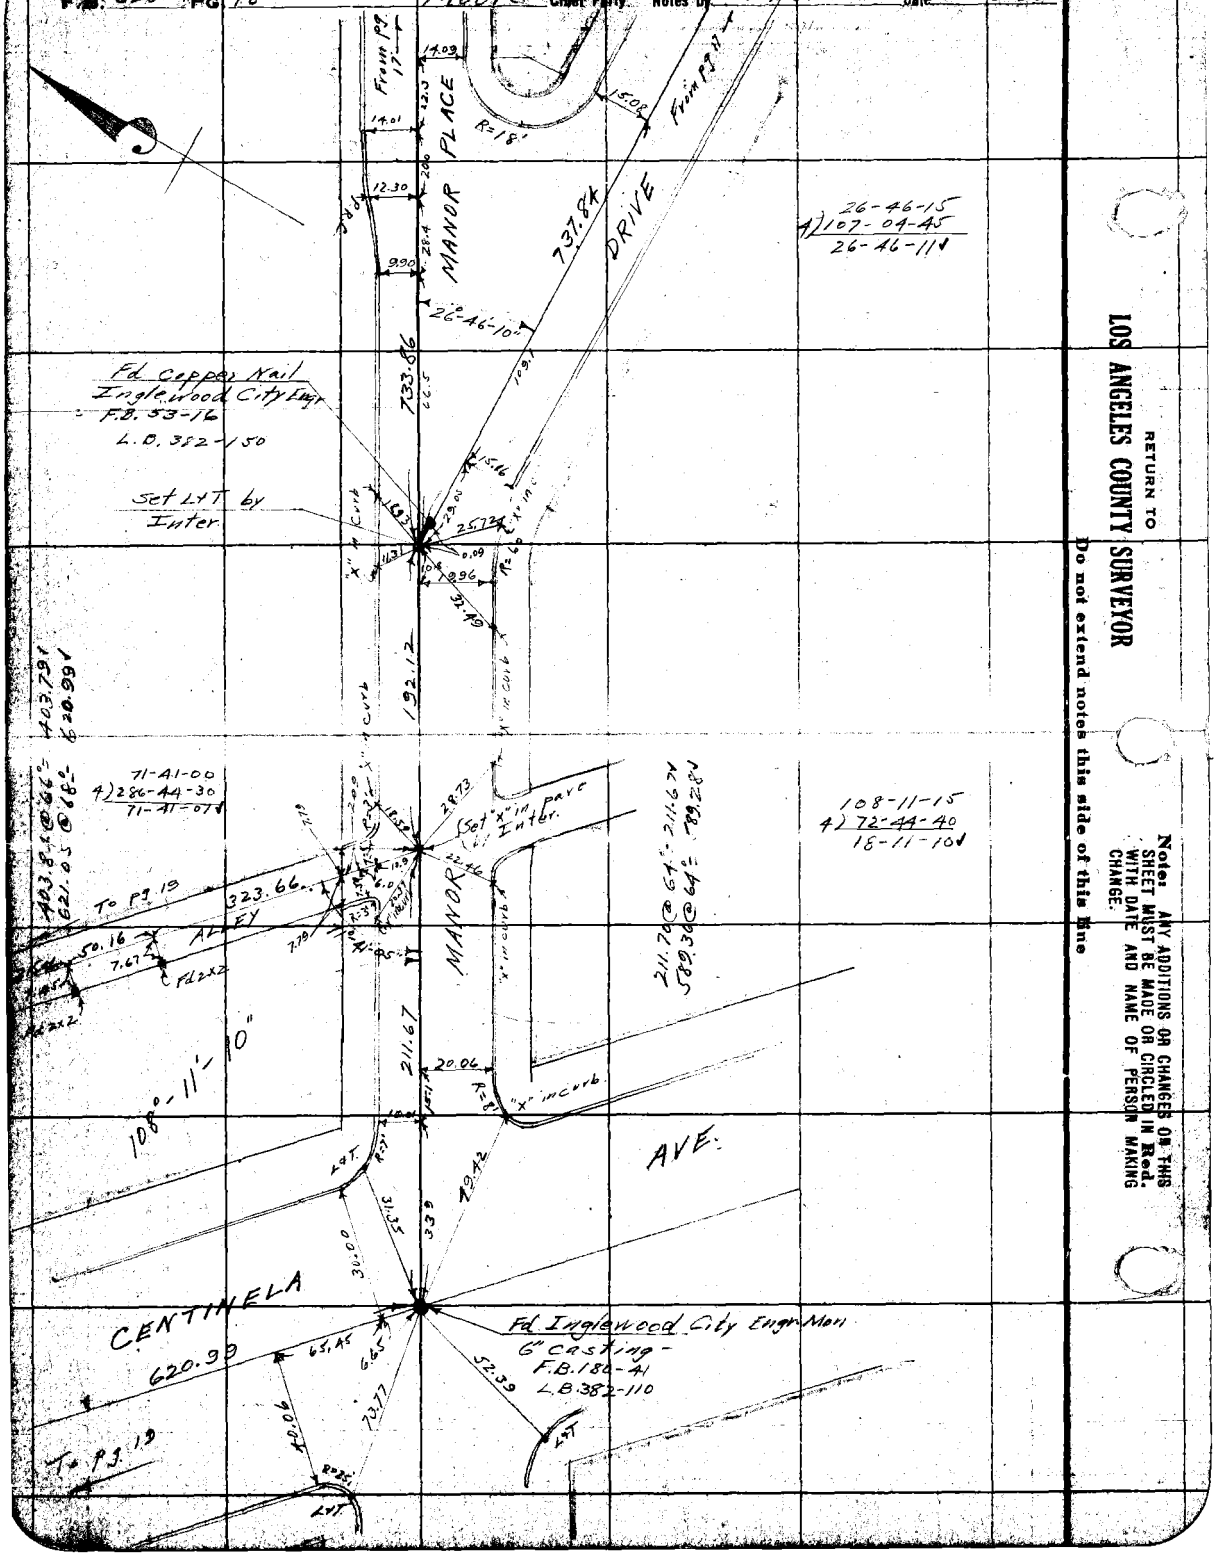

Date 3-1-28 Notes by Moore Chief Party Moore F. B. 325 Pg. 12

Plotted by D.C.Johnson
Date Apr. 1928
Map No. B-135-1
Plotting Checked, M., L., M., M.
Date 12/8/28.

W. O. No. 4168 L. & S. No.
Location Florence Ave
Surveyed by L.D. Moore
Date 3-1-28
Indexed A. C. Johnson

Notes: ANY ADDITIONS OR CHANGES ON THIS SHEET MUST BE MADE OR CIRCLED IN Red. WITH DATE AND NAME OF PERSON MAKING CHARGE.

Do not extend notes this side of this line

RETURN TO LOS ANGELES COUNTY SURVEYOR

T. pg. 21

Florence AVE conc. 662.47

662.52 @ 72° = 662.47

50' 50'

50.25 50.05 0.15 18.0

Fd 2" pipe Tr. 3.6 S0

142-31-45
4 | 210-06-45
142-31-40
F.A.W.

82-54-30 F.A.W.
4 | 331-36-15
82-54-35

Fd. Inglewood City Engr. Mon. 6" Cast Iron
FB 180-42
LB 382-133

Fd. Inglewood City Engr Mon. & Casting
FB-180-42
LB 382-133

142° 31' 40" Returned F.A.W.

82°54'35" Returned

39.92 36.71 10.20

38.85 38.85

54.43

55.84

49.30 55.64 49.06 49.04 22.24

R=110 23.51 8.982 8.578

Set Lat by Inter

Returned F.A.W. 134° 33' 45"

FIELD AVE 164.21 To pg. 8

Macadam

22.60 15.07 11.7 9.5 16.5 14.03 15.07 8.61 8.61 29.28

209.81 42°50' R=225

89°28' 89°28'

CENTINELA 620.99 conc.

From pg. 18

Fd LAT 134-33-45 F.A.W.
4 | 178-15-00
134-33-45

Set "X" in pave. by Inter

20.88 20.94 35' 35' 28.43 28.07 27.88

HYDE PARK From pg. 17

209.81 @ 64° 2244.01

44-57-30
4 | 179-50-15
44-57-34.4

4' Walk 12' Frontcurb

To pg. 15

F.B. 325 Pg 20 Moore Chief Party Notes by Moore Date 3-1-28

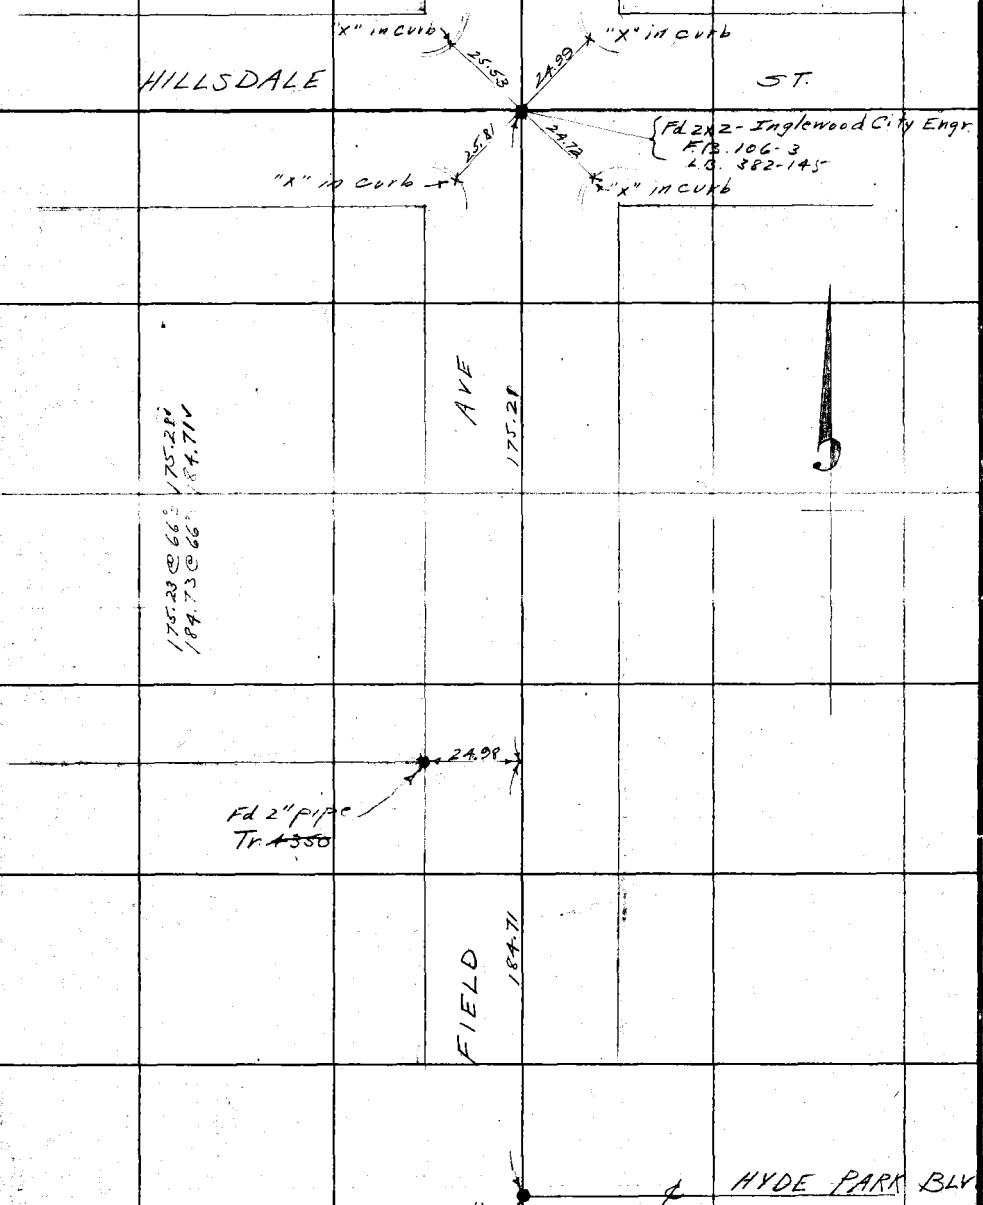

RETURN TO
LOS ANGELES COUNTY SURVEYOR
Do not extend notes this side of this line

Note: ANY ADDITIONS OR CHANGES ON THIS SHEET MUST BE MADE OR CIRCLED IN Red. WITH DATE AND NAME OF PERSON MAKING CHANGE.

Date 3-7-28 Notes by Moore Chief Party Moore F. B. 225 Pg. 21

Plotted by A.C. Johnson
Date Apr.-1928
Map No. B-135-1
Plotting C'k'd by H. L. M. M.
Date 12/3/28.

M. O. No. 4166 A. S. O. No.
Location Florence Ave.
Surveyed by L.D. Moore
Date 3-7-28
Indexed A. C. Johnson

Notes: ANY ADDITIONS OR CHANGES ON THIS SHEET MUST BE MADE OR CIRCLED IN Red. WITH DATE AND NAME OF PERSON MAKING CHANGE.

RETURN TO LOS ANGELES COUNTY SURVEYOR

Do not extend notes this side of this line

To bottom Pg. 22

97-36-00
4)30-23-30
7-35-58

Fd. L&T. Inglewood City Engr. FB 164-18 LB. 382-116

Fd. X2 - checks Ties Inglewood City Engr. FB. 164-18 L.B. 382-116

97° 35' 50"

256.55

AVE (AVE)

256.57 @ 70°

64+05.11 Set L&T. by Inter.

ALLEY 537.42

48.50

97-35-30
4)30-22-00
7-35-30

224.49

FLORENCE (CENTINELA)

224.51 @ 70°

35° 30"

Fd Inglewood City Engr Mon-6"casting-Check one Tie: FB. 186-43 L.B. 382-106.

484.47 @ 66° 184.41
537.47 @ 70° 537.42

40.38'

60.60

61+80.62 Set L&T by Inter

51.84

R=25

1803

484.81 ST.

61.74

EDGEWOOD

38.37

32.38

33.52

41.57

10.0

17.04

R=25

62.66

54.20

40.40

29.60

50'

50'

Fd Inglewood City Engr. Mon-6"casting Checks Ties L.B. 382-107

PLYMOUTH

561.68

642.47

From Top of Pg. 23

F.B. 525 Pg. 22 Moore Chief Party Notes by Moore Date 5-7-28

To bottom pg 23

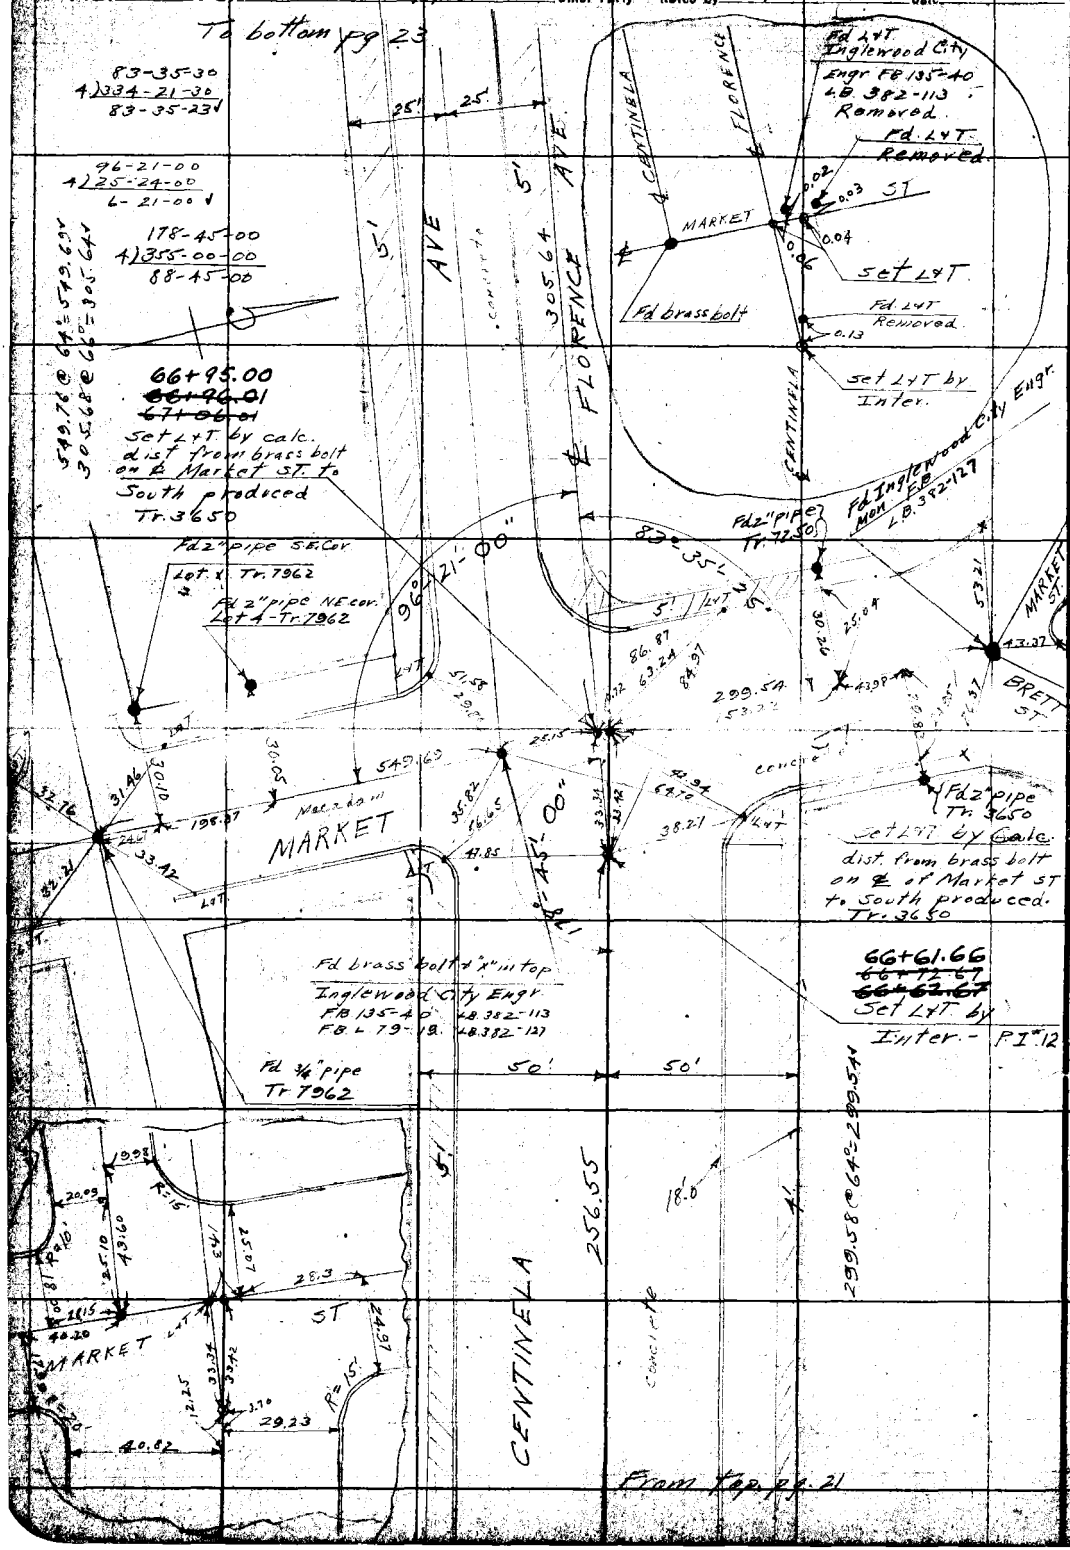

RETURN TO
LOS ANGELES COUNTY SURVEYOR
Do not extend notes this side of this line

Notes: ANY ADDITIONS OR CHANGES ON THIS SHEET MUST BE MADE OR CIRCLED IN Red. WITH DATE AND NAME OF PERSON MAKING CHANGE.

H.U.M.H. 7/20/29.

Date 3-8-28 Notes by Moore Chief Party Moore F. B. 325 PG. 23

Chaining done with 100.00 @ 84° per L.D.M. - A.C.J.

Date Jun 1928
Map No. 8-135-1
Plotting Chkd by H. U. M. H.
Date 12/3/28.

M. C. No. 4168 S. P. No.
Location Florence Ave
Surveyed by L. D. Moore
Date 3-8-28.
Indexed A. C. Johnson

To bottom pg 24

25' 25'

AVE

Concrete

AVE

Fd L&T Inglewood City Engr
FB
LB 382

Fd "X" Inglewood City Engr.
FB
LB 382
Set L&T by Inter 70+10.97

1987 1939

COMMERCIAL

558.72

Set N&T Macadam

54.38

55.51

Fd 2" pipe

N&T in Access

PLYMOUTH

83-39-00
4)334-36-36
83-39-0N

558.78 @ 66' = S58.72W

Tr.

Inter 70+11.65
Set L&T by Inter 70+01.65

19.93

96° 23'

Fd Inglewood City Engr Mon 6" casting
FB
LB 382-130

96-23-30
4)25-34-45
06-23-4N

CENTINELA concrete

FLORENCE

From top pg 22

Notes ANY ADDITIONS OR CHANGES ON THIS SHEET MUST BE MADE OR CIRCLED IN Red, WITH DATE AND NAME OF PERSON MAKING CHANGE.

H. U. M. H. 3/20/29.

RETURN TO LOS ANGELES COUNTY SURVEYOR

Do not extend notes this side of this line

F.B. 325 Pg. 24 — Moore Chief Party — Notes by Moore — Date 3-5-28

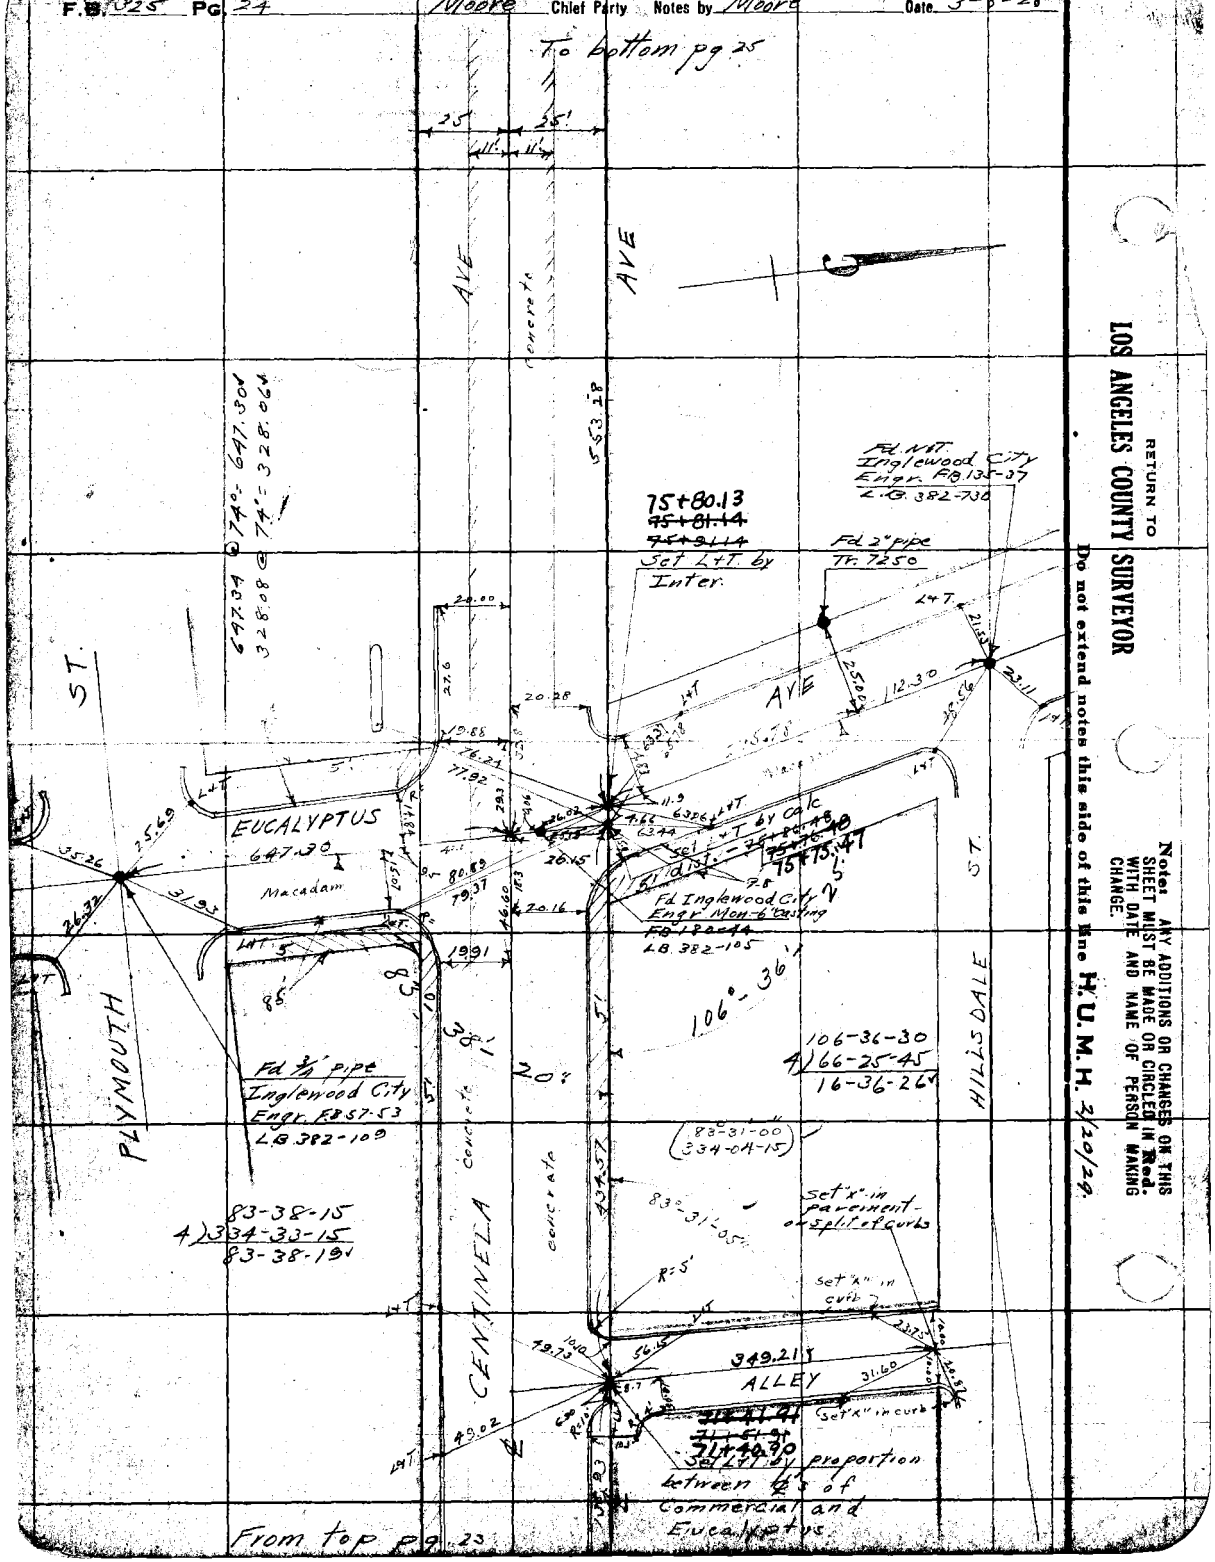

RETURN TO
LOS ANGELES COUNTY SURVEYOR

Do not extend notes this side of this line H.U.M.H. 2/20/29.

Notes: ANY ADDITIONS OR CHANGES ON THIS SHEET MUST BE MADE OR CIRCLED IN Red. WITH DATE AND NAME OF PERSON MAKING CHANGE.

Date 3-9-28 Notes by Moore Chief Party Moore F. B. 325 PG. 26

Plotted by [illegible]
Date Nov 1928
Map No. 13-435-1
Plotting Ck'd by H. U. M. H.
Date 12/3/28

W. O. No. 4468 - S. O. No.
Location Florence Ave
Surveyed by L. D. Moore
Date 3-9-28
Indexed A. C. Johnson

Notes: ANY ADDITIONS OR CHANGES ON THIS SHEET MUST BE MADE OR CIRCLED IN Red. WITH DATE AND NAME OF PERSON MAKING CHANGE.

H. U. M. H. 2/20/29.

RETURN TO
LOS ANGELES COUNTY SURVEYOR

Do not extend notes this side of this line

To bottom pg. 26

25' 25' 50'

AVE

CENTINELA

FLORENCE

PLYMOUTH

DAMASK

ST

Macadam

Concrete

Oiled Screenings

563.21 @ 66° = 563.14'

563.14'

553.28'

709.27'

874.22'

96-22-30
4) 25-30-00
6-22-30 V

73-24-15
4) 293-37-15
73-24-15 V

Fd 3/4" pipe Inglewood City Engr FB. L74-10 L.B. 382-138

Fd "X" in Pave.

Fd. L+T. Tract 9576.

Set S.T.W. by Inter

Set S.T.W. by Calc. dist. from L+T.

N+T in Pepper

N+T in Accacia

N+T in Top

"X" in top fire hyd.

709.33 @ 70° = 709.27
553.33 @ 70° = 553.28'
874.30 @ 70° = 874.22'

Frami top pg 24

F.B. 325 PG. 26 — Moore Chief Party — Notes by Moore. Date 3- -28

To bottom pg 27

11'. 11'.

25'. 25'. 50'.

AVE

AVE

278.61 @ 96° = 278.58'

278.58'

Concrete

Concrete

86+97.07
~~86+98.00~~
~~87+02.08~~
Set Stg W by
Calc dist from
"X"

ST.

Fd L4T

L4T

Spk

ENTERPRISE AVE

Macadam

33.12

34.8

56.10

43.02

37.00

56.64

23.0

15.15

58.05

Set "X"
by Enter

L4T

L4T

L4T

83° 38'

25.5'

18.35

32.90

Spk

Spk

Spk

PLYMOUTH

Fd 3/4" Pipe
Inglewood City Engr.
FB 176-7
L.B. 382-124

83-38-30
1) 334-33-30
83-38-231

CENTINELA

563.14

FLORENCE

℄

℄

From top pg. 25

RETURN TO
LOS ANGELES COUNTY SURVEYOR
Do not extend notes this side of this line

Notes: ANY ADDITIONS OR CHANGES ON THIS SHEET MUST BE MADE OR CIRCLED IN Red. WITH DATE AND NAME OF PERSON MAKING CHANGE.

H. U. M. H. 2/20/29.

Date 3-10-28 Notes by Moore Chief Party Moore F. B. 325 PG. 27

Plotted by [illegible]
Date Nov. 1928
Map No. B-135-1
Plotting C'k'd by H. U. M. H.
Date 12/3/28.

W. O. No. 4168 D. S. O. No.
Location Florence Ave
Surveyed by L. D. Moore
Date 3-10-28
Indexed A. C. Johnson

Notes: ANY ADDITIONS OR CHANGES ON THIS SHEET MUST BE MADE OR CIRCLED IN Red. WITH DATE AND NAME OF PERSON MAKING CHANGE. H. U. M. H. 2/20/29.

RETURN TO LOS ANGELES COUNTY SURVEYOR

Do not extend notes this side of this line

To bottom pg. 28

AVE. AVE. 284.62. 284.62 @ 66° = 284.62

Concrete

89+75.65
~~89+76.66~~
~~89+86.46~~
Set C.S. T/W by Calc. dist. from L&T

62.07 L&T 12 P R=135 88.25 52.86 L&T 49.9 25.00

ACACIA ST. AVE

51' 14.8 580' 14.96 15.00 14.97 31.65 25.00 14.97 L&T

96.60 53.22 L&T 48.0 77.33 R=135 66.86 L&T 127

Set N&T on split of curbs.

Fd. L&T Tr. 9576

89° 59' 15"

89-59-15
4)359-57-00
89-59-15
15"

278.58.

CENTINELA FLORENCE ELLAS

Street Screenings 5' 5'

25' 25' 50'

11.9 11.9

From Top pg. 26.

F.B. 325 Pg. 28 Moore Chief Party Notes by Moore Date 3-10-28

To bottom pg 29

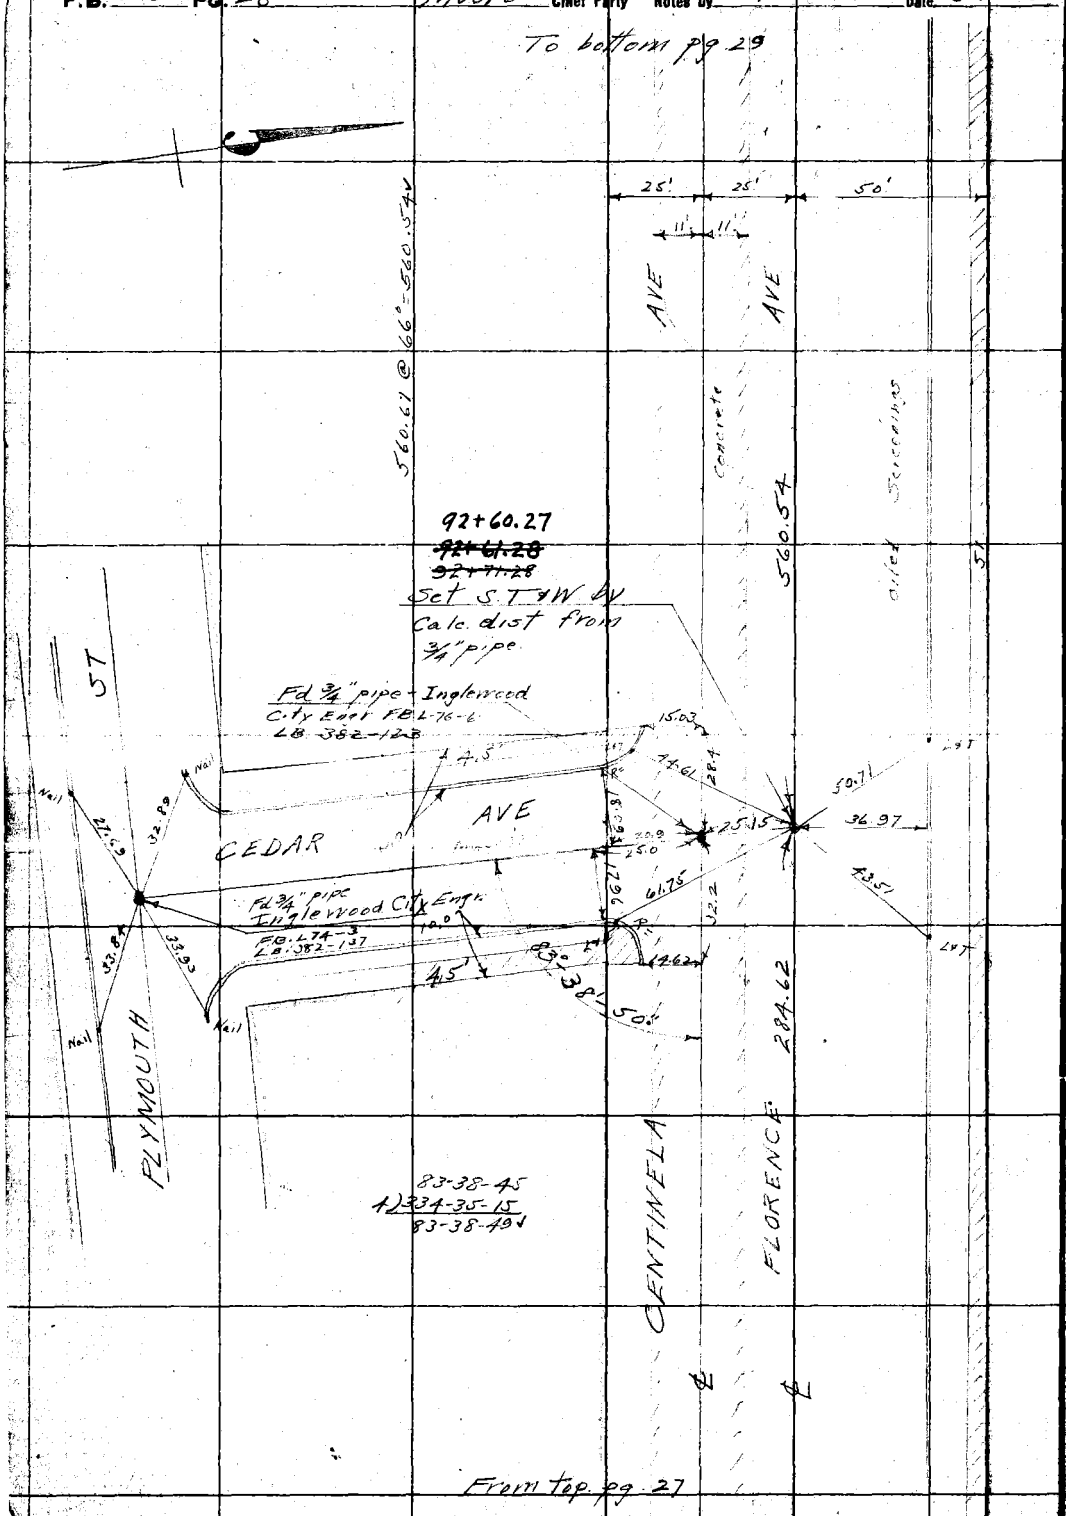

From top pg 27

RETURN TO
LOS ANGELES COUNTY SURVEYOR
Do not extend notes this side of this line

Notes: ANY ADDITIONS OR CHANGES ON THIS SHEET MUST BE MADE OR CIRCLED IN Red. WITH DATE AND NAME OF PERSON MAKING CHANGE.

H. U. M. H. 4/20/29.

Date 3-12-28 Notes by Moore Chief Party Moore F. B. 325 PG. 28

Plotted by [illegible]
Date NOV 1928
Map No. B-135-L
Plotting C'k'd by H. U. M. H.
Date 12/3/28.

M. C. No. 4168 R. & S. C. No.
Location Florence Ave
Surveyed by L. D. Moore
Date 3-12-28
Indexed A. C. Johnson

Notes. ANY ADDITIONS OR CHANGES ON THIS SHEET MUST BE MADE OR CIRCLED IN Red, WITH DATE AND NAME OF PERSON MAKING CHARGE.

RETURN TO LOS ANGELES COUNTY SURVEYOR

Do not extend notes this sht to this line H. U. M. H. 2/10/29.

To bottom pg. 30

473.17 @ 62° = 473.17

98+23.58
~~98+24.59~~
~~98+24.59~~
Set 2x2-12" deep by Inter.

AVE 25' 25' AVE

11' 11'

123.10

"x" in curb

BEACH AVE

Set 1x2 on split of curbs

13.58 24.92 33.39 24.92 37.15

"x" in curb

Set Punch Mark on M.H. cover by Inter.

Fd N&T Inglewood City Engr. FB. 125-3 L.B. 382-139

"x" in curb

N. HILL ST

BEACH

74.74 75.65 24.87 AVE

25.15 2.77 25.00 71.85

N&T.

2x2 in P.P.

81.32 31.02

N&T. in P.P.

Macadam

38.28 52.84 41.64 30.57

83° 39' 15"

90° 00' 00"

57.70 61.80 71.83 6.95 R=25'

78.38 77.42 24.87

98+20.81
~~98+21.82~~
~~98+21.82~~
Set 2x2-12" deep by calc. dist. from point on M.H.

90-00-00
4)360-00-00
90-00-00

2x2 in P.P.

Fd N&T Inglewood City Engr. FB. 125-4 L.B. 382-120

"x" in sidewalk

PLYMOUTH ST

83-39-15
4)334-37-00
83-39-15

560.54'

CANTINELA

concrete

FLORENCE

cedar fences

25' 25' 50'

From top pg. 28

F.B. 325 Pg. 30 Moore Chief Party Notes by Moore Date 3-12-28

T.o bottom pg 31.

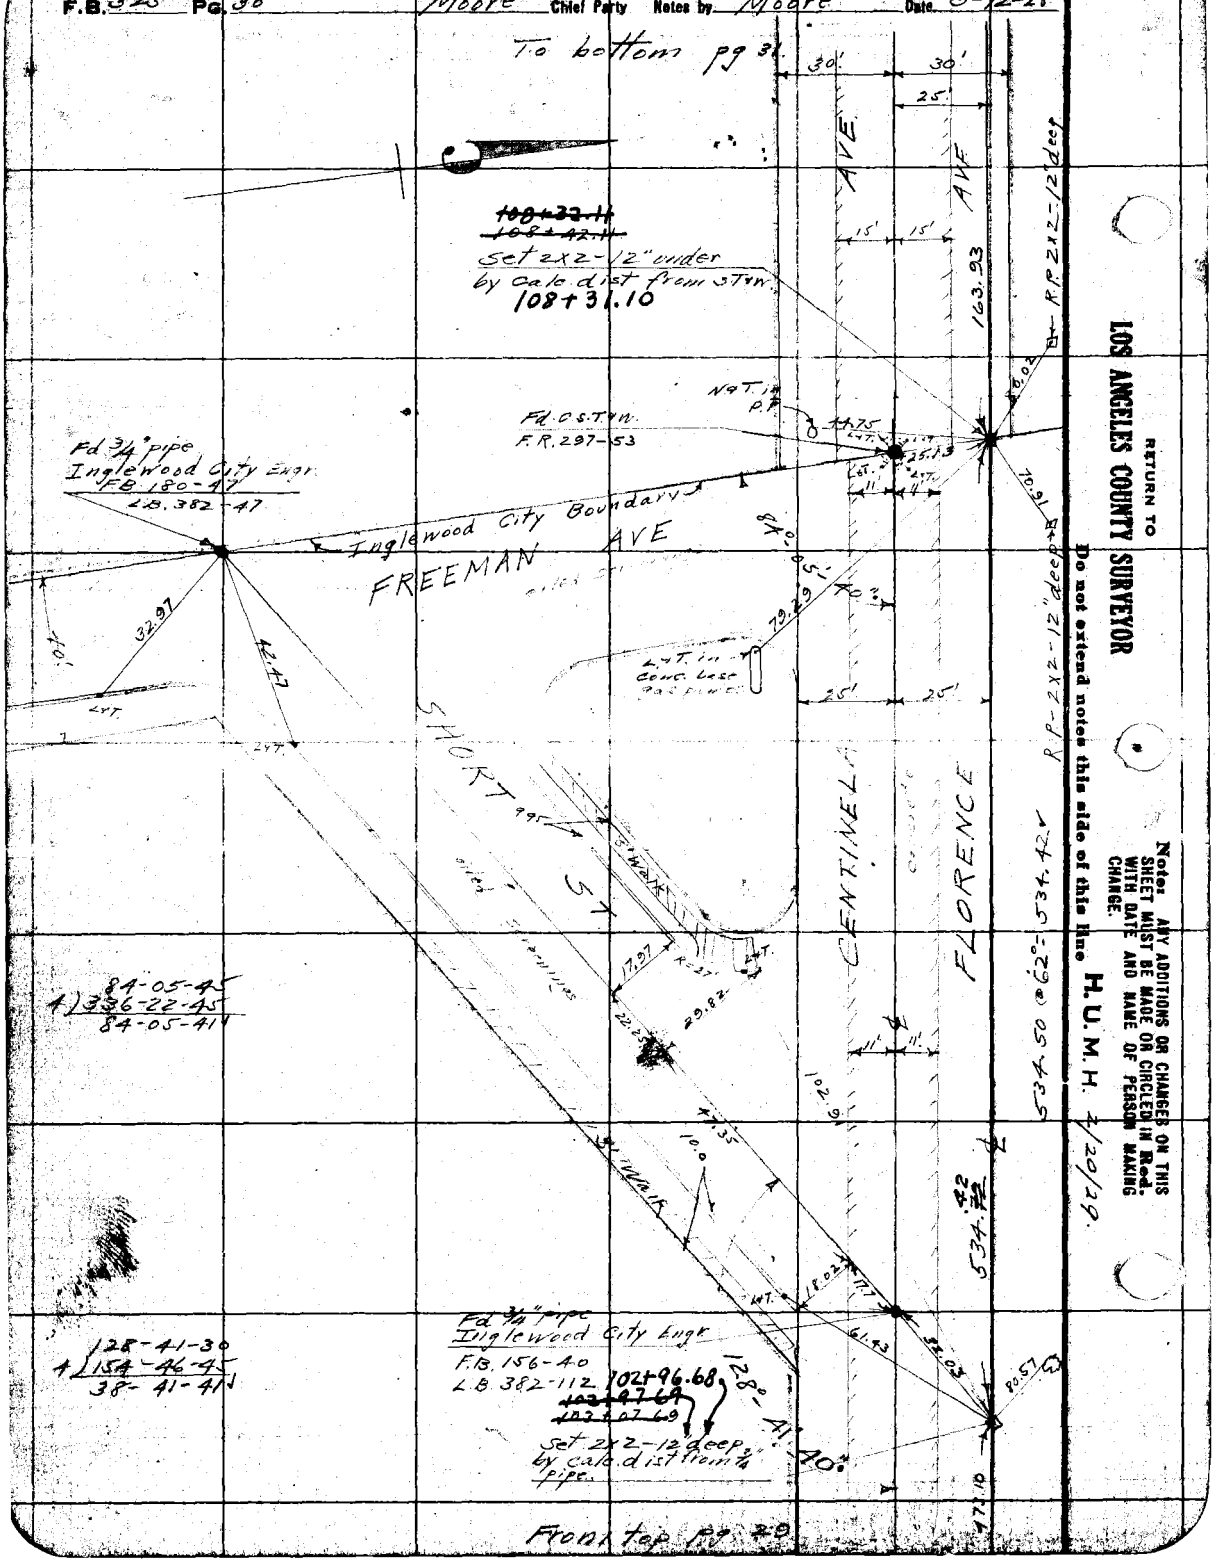

RETURN TO
LOS ANGELES COUNTY SURVEYOR

Date 3-13-28 Notes by Moore Chief Party Moore F. B. 325 Pg. 31

Plotted by [illegible]
Date Nov. 1928
Map No. B-135-2
Plotted by H. U. M. H.
Date 12/3/28.

W. O. No. 416 & S. & O. No.
Location Florence Ave
Surveyed by L. D. Moore
Date 3-13-28
Indexed A. C. Johnson

Note: ANY ADDITIONS OR CHANGES ON THIS SHEET MUST BE MADE OR CHGLED IN Red. WITH DATE AND NAME OF PERSON MAKING CHANGE.

H. U. M. H. 2/20/29.

Do not extend data this side of this line

RETURN TO LOS ANGELES COUNTY SURVEYOR

to bottom pg 32

FLORENCE AVE

50' 30' 50' 30'

400.65'

100.71 @ 63° = 400.65'

41.39 R.P.-2x2 12" deep

87.65'

69.84

43.31 R.P.-2x2 12" deep

116+30.86
~~116+31.07~~
~~116+41.87~~
Set S.T+W. P.O.T.

~~112+31.22~~
~~112+41.22~~
Fd. L+T.
FR. 297-53
112+30.21

41.60 R.P.-2x2 12" deep

68.24

~~111+58.47~~
~~111+68.47~~ E.C.
Set L+T.
111+58.46

170-38-00
322-32-45
80-38-11

170° 38' 10"

51.75'

73.45

52.91 R.P.-2x2 12" deep

53.21

73.70

R.P.-2x2 12" deep

43.78

Δ = 9°-21'-50"
R = 1000'.
T = 81.90'
L = 163.43'

163.91 @ 66° = 163.89'

9° 21' 00"

63.12

51.53

R.P.-2x2 12" deep P.I. #13

Set 2x2-12" deep by Inter.

Concrete

80.95

15' 15'

66.46

46.48

~~109+96.04~~
~~110+06.04~~ B.C.
Set 2x2-12" deep.
109+95.03

CENTINELA

FLORENCE AVE

30' 30' 25' 50' 50'

From top pg 30

F.B. ~~325~~ Pg. 32 Moore Chief Party Notes by Moore Date 3-14-28

To bottom pg 33

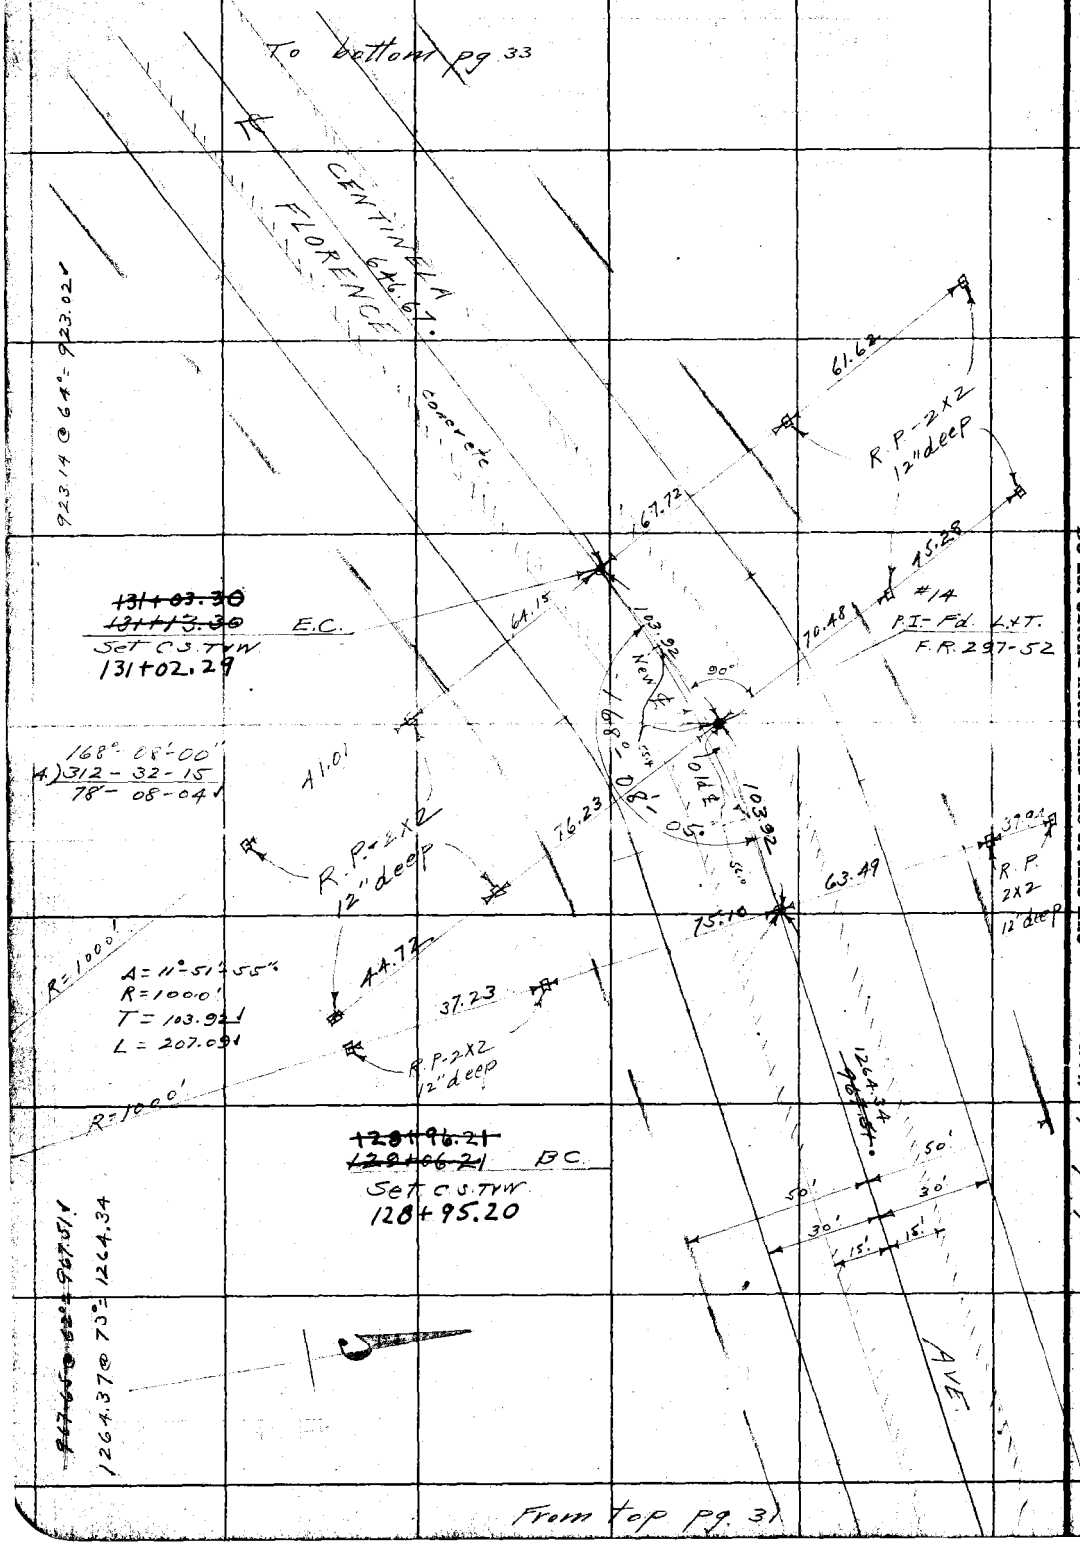

From top pg. 31

RETURN TO
LOS ANGELES COUNTY SURVEYOR
Do not extend notes this side of this line

Notes: ANY ADDITIONS OR CHANGES ON THIS SHEET MUST BE MADE OR CIRCLED IN Red. WITH DATE AND NAME OF PERSON MAKING CHANGE.

H.U.M.H. 2/20/29.

Date 3-22-28 Notes by Moore Chief Party Moore F. B. 325 PG. 33

Cleaned by [illegible] Date Dec. 19-28 Map No. 8-135-2 Plotting Checked by M. H. M. M. Date 12/3/28.

W. O. No. 4168 R. S. O. No. Location Florence Ave Surveyed by L. D Moore Date 3-22-28 Indexed A. C. Johnson

To bottom of 38A

30' 30' 50' 50' 15' 15'

~~140+91.47~~ ~~141+01.47~~ EC
Set S.T+W.
140+90.46

1204.07
1180.74

160-26-00
+) 281-44-00
70-26-00 ✓

65.36 RP-2X2 12" deep 78.04 85.40 40.42 RP-2X2 12" deep 35.42

Δ = 19°-34'-00" ✓
R = 1000'
T = 172.43 ✓
L = 341.50 ✓

P.I. # 15
Fd L+T
ER. 297-51

172.43 160.00 61.09 N 70°-26'-00" W 172.43 67.21 A1 90° 39.99 RP-2X2 12" deep

A1 RP-2X2 12" deep 73.96 72.90 CENTERLINE FLORENCE 646.67

62.69

~~137+49.97~~ ~~137+59.97~~ BC.
Set S.T+W.
137+48.96

AVE AVE

From Top Pg 32

RETURN TO LOS ANGELES COUNTY SURVEYOR

Do not extend notes this side of this line

Notes: ANY ADDITIONS OR CHANGES ON THIS SHEET MUST BE MADE OR CIRCLED IN Red. WITH DATE AND NAME OF PERSON MAKING CHANGE.

F.B. 325 Pg. 34 Moore Chief Party Notes by Moore Date 3-28-28

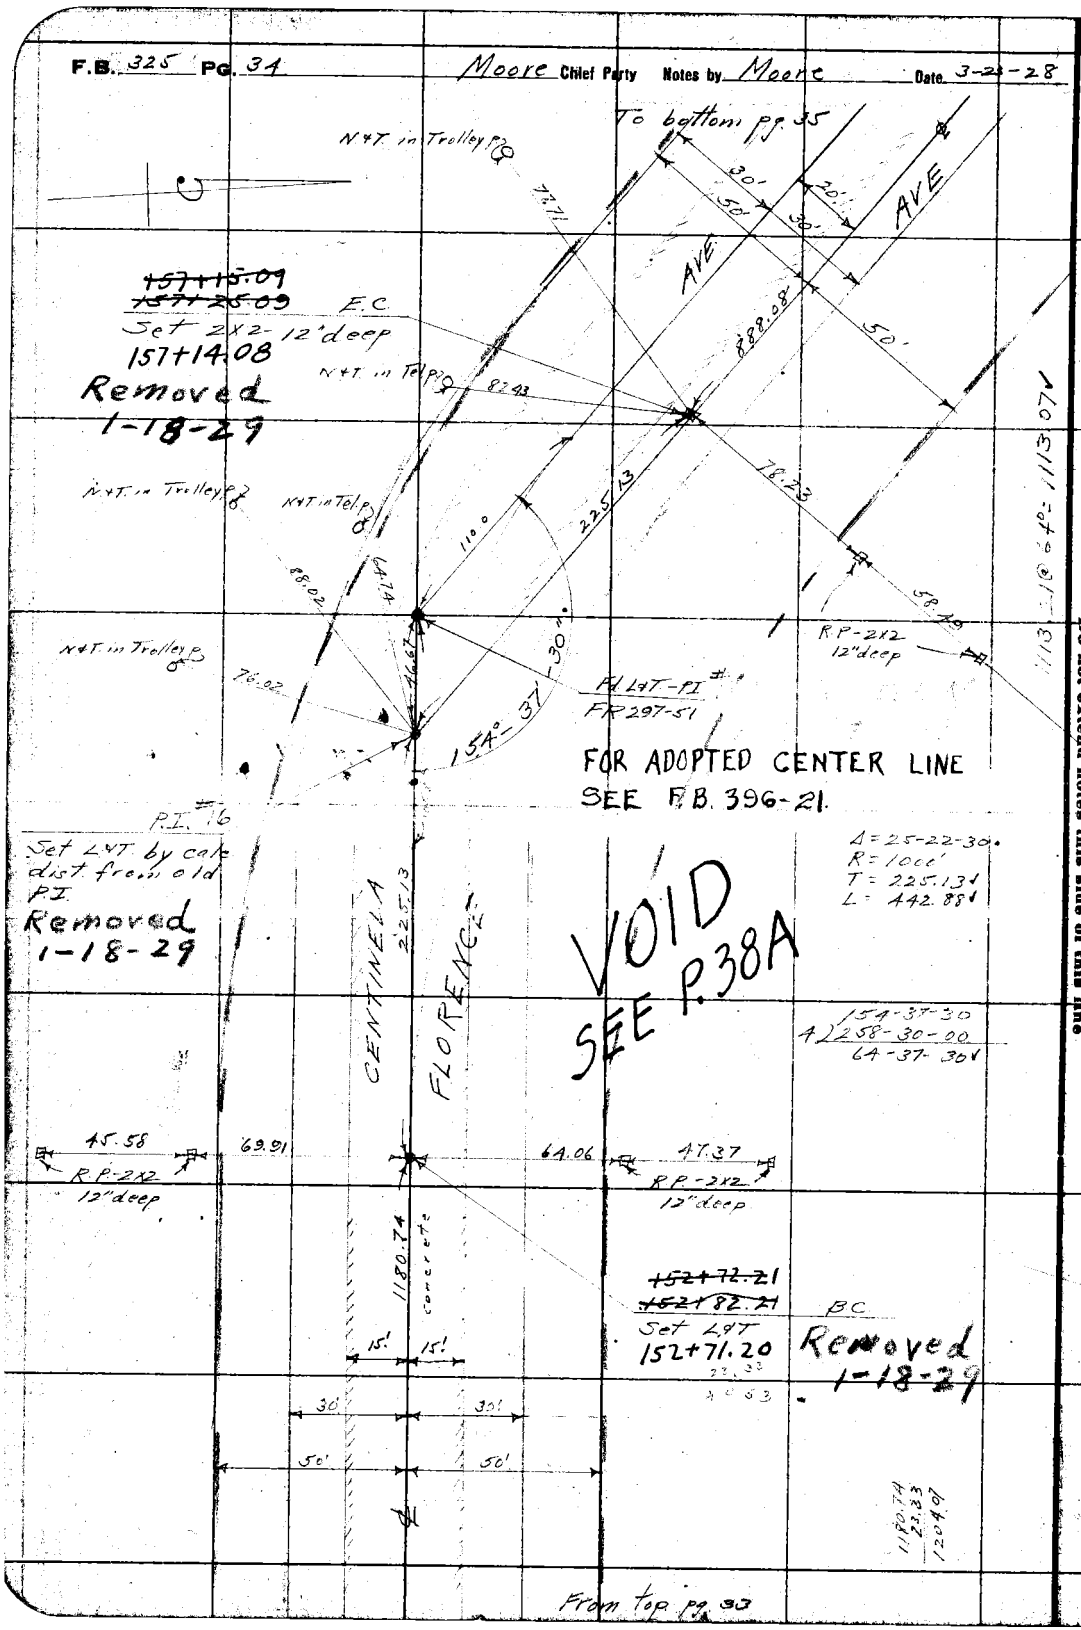

RETURN TO
LOS ANGELES COUNTY SURVEYOR
Do not extend notes this side of this line

Notes: ANY ADDITIONS OR CHANGES ON THIS SHEET MUST BE MADE OR CIRCLED IN Red. WITH DATE AND NAME OF PERSON MAKING CHANGE.

Date 3-23-28 Notes by Moore Chief Party Moore F. B. 325 Pg. 35

Plotted by Wood
Date Jan. 1928
Map No. 8-135-2
Plotting C'k'd by H.U.M.H.
Date 12/3/28.

W. O. No. 4166 R. & S. O. No.
Location Florence Ave
Surveyed by L. D. Moore
Date 3-23-28
Indexed A. C. Johnson

To bottom pg. 36

Notes: ANY ADDITIONS OR CHANGES ON THIS SHEET MUST BE MADE ON CIRCLED # Red. WITH DATE AND NAME OF PERSON MAKING CHANGE.

RETURN TO LOS ANGELES COUNTY SURVEYOR

Do not extend notes this side of this line

2534.09 @ 64 = 2533.76

AVE

2533.76

AVE

VOID
SEE P. 38B

CENTINELA

concrete

FLORENCE

50' 50'
30' 20' 10' 10'
15' 15'

166+02.16
~~166+03.17~~
~~166+13.17~~ P.O.T.
Set 2x2 - by offset from L.P.T. - 12" deep

N.&T. in Tel p.g.

Fd. L.P.T.
E.R. 297-50

57.16

20.00

66.59

53.41

R.P. - 2x2
12" deep

6.05

N.&T. in Trolley pole

90°

N 88° 08' E

From top pg. 34

F.B. 325 Pg. 36 Moore Chief Party Notes by Moore Date 3-28-35

To bottom pg 37

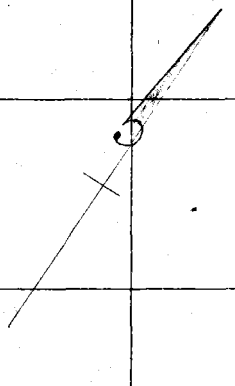

AVE

30'

30'

15'

15'

20'

50'

50'

556,046 Calc

90.81

16° 30'

AVE

FdC STHW
F.B. 335-9

To 8" conc. Mon. #2859
So. Bdy. Tr.
F.B. 335-9

22.81

191+35.92
~~191+36.93~~
~~191+46.93~~

Set 2x2 by C&C dist. from STHW 12" deep

To 8" conc. Mon.
NW. Cor. Sec. 35
T2S - R1W

ARIZONA

F.B. 335-8

VOID

SEE P. 38C

CENTINELA

concrete.

2533.76

FLORENCE

From top pg. 35

RETURN TO
LOS ANGELES COUNTY SURVEYOR
Do not extend notes this side of this line

Notice: ANY ADDITIONS OR CHANGES ON THIS SHEET MUST BE MADE OR CIRCLED IN Red. WITH DATE AND NAME OF PERSON MAKING CHANGE.

Date 3-26-28 Notes by Moore Chief Party Moore F. B. 225 Pg. 37

Plotted by [illegible]
Date Dec. 1928
Map No. 8-135-2
Plotting C'k'd by [illegible]
Date 12/3/28

W. O. No. 1168 S. B. B. No.
Location Florence Ave
Surveyed by L D Moore
Date 3-26-28
Indexed C. Johnson

Notes: ANY ADDITIONS OR CHANGES ON THIS SHEET MUST BE MADE OR CIRCLED IN Red. WITH DATE AND NAME OF PERSON MAKING CHANGE.

RETURN TO LOS ANGELES COUNTY SURVEYOR

Do not extend notes this side of this line

To pg. 38.

VOID
SEE P.38D

197+37.74
Set L&T. by calc. dist from fd. L&T.

Fd L&T.
FR 297-50

299.44
Concrete

Line of Tan. of Curve - FLORENCE Ave

AVE

15' 15' 30'

120'
Δ = 23°37'30"
R =
T =
L =

156-22-30
4) 265-32-00
66-22-30

N 0° 0' E
156.01'

CENTINELA
555.04 Calc.
104.1
590.81
FLORENCE
20'
15' 15'
30' 30'

From top pg 36

F.B. 325 PG. 38 Moore Chief Party Notes by Moore Date 3-26-28

To pg 39 + 57

To P.T.

AVE

To pg 57

BC

1324.07'

1532.60

CENTINELA

VOID

SEE P. 381

1324.22 @ 68° = 1324.07'

156° 22' 30"

239.44

Set PT. by Calc dist from PT.

15'

15'

30'

30'

line of Tan. of curve FLORENCE AVE

RETURN TO

LOS ANGELES COUNTY SURVEYOR

Do not extend notes this side of this line

Notes: ANY ADDITIONS OR CHANGES ON THIS SHEET MUST BE MADE OR CIRCLED IN Red. WITH DATE AND NAME OF PERSON MAKING CHANGE.

Date / Notes by [illegible] Chief Party [illegible] F.B. 325 Pg. 38A

Platted by Wood	W. O. No. 4165 D. S. O. No.
Date Jan-1929	Location [illegible]
Map No. B-139	Surveyed by [illegible]
Platting C'k'd by H. U. M. H.	Date 1-18-29
Date 2/20/29.	Indexed

Notes: ANY ADDITIONS OR CHANGES ON THIS SHEET MUST BE MADE OR CIRCLED IN Red. WITH DATE AND NAME OF PERSON MAKING CHANGE.

Do not extend notes this side of this line

RETURN TO LOS ANGELES COUNTY SURVEYOR

N&T Trolley P 29

Adopted C/L per F.B. 396-21

N&T Trolley P 29

N&T Tel P

N&T Trolley P 29

N&T Trolley P 29

N&T Trolley P 29

N&T Tel P

N&T Trolley P 29

N&T Trolley P 29

N&T Tel P

N&T Tel P

N&T P.P.

Ave 856.39 Sole Ave

197+37.41 - E.C. Set L+T.

R.P. 2x2 12 deep.

54.21

425.13

P.I. F.R. 297-51 See F.B. 325-34

FOR ADOPTED CENTER LINE SEE F.B. 396-21

P.I. #16 Set L+T by calc. dist. from old P.I.

Δ = 25° 22' 30"
R = 1000'
T = 225.13
L = 442.88

CENTERLINE 225.13 Compute

72.38

72.24

R.P. 2x2 12 deep

152+94.53 - E.C. Set L+T.

1202.07

FLORENCE

30' 30'

From top p. 38

RETURN TO

LOS ANGELES COUNTY SURVEYOR

Note: ANY ADDITIONS OR CHANGES ON THIS SHEET MUST BE MADE OR CIRCLED IN Red. WITH DATE AND NAME OF PERSON MAKING CHANGE.

Do not extend notes this side of this line

F.B. 325 Pg. 38B

Chief Party Wade

Notes by [illegible] Date 1-18-29

To Location, pg 33C

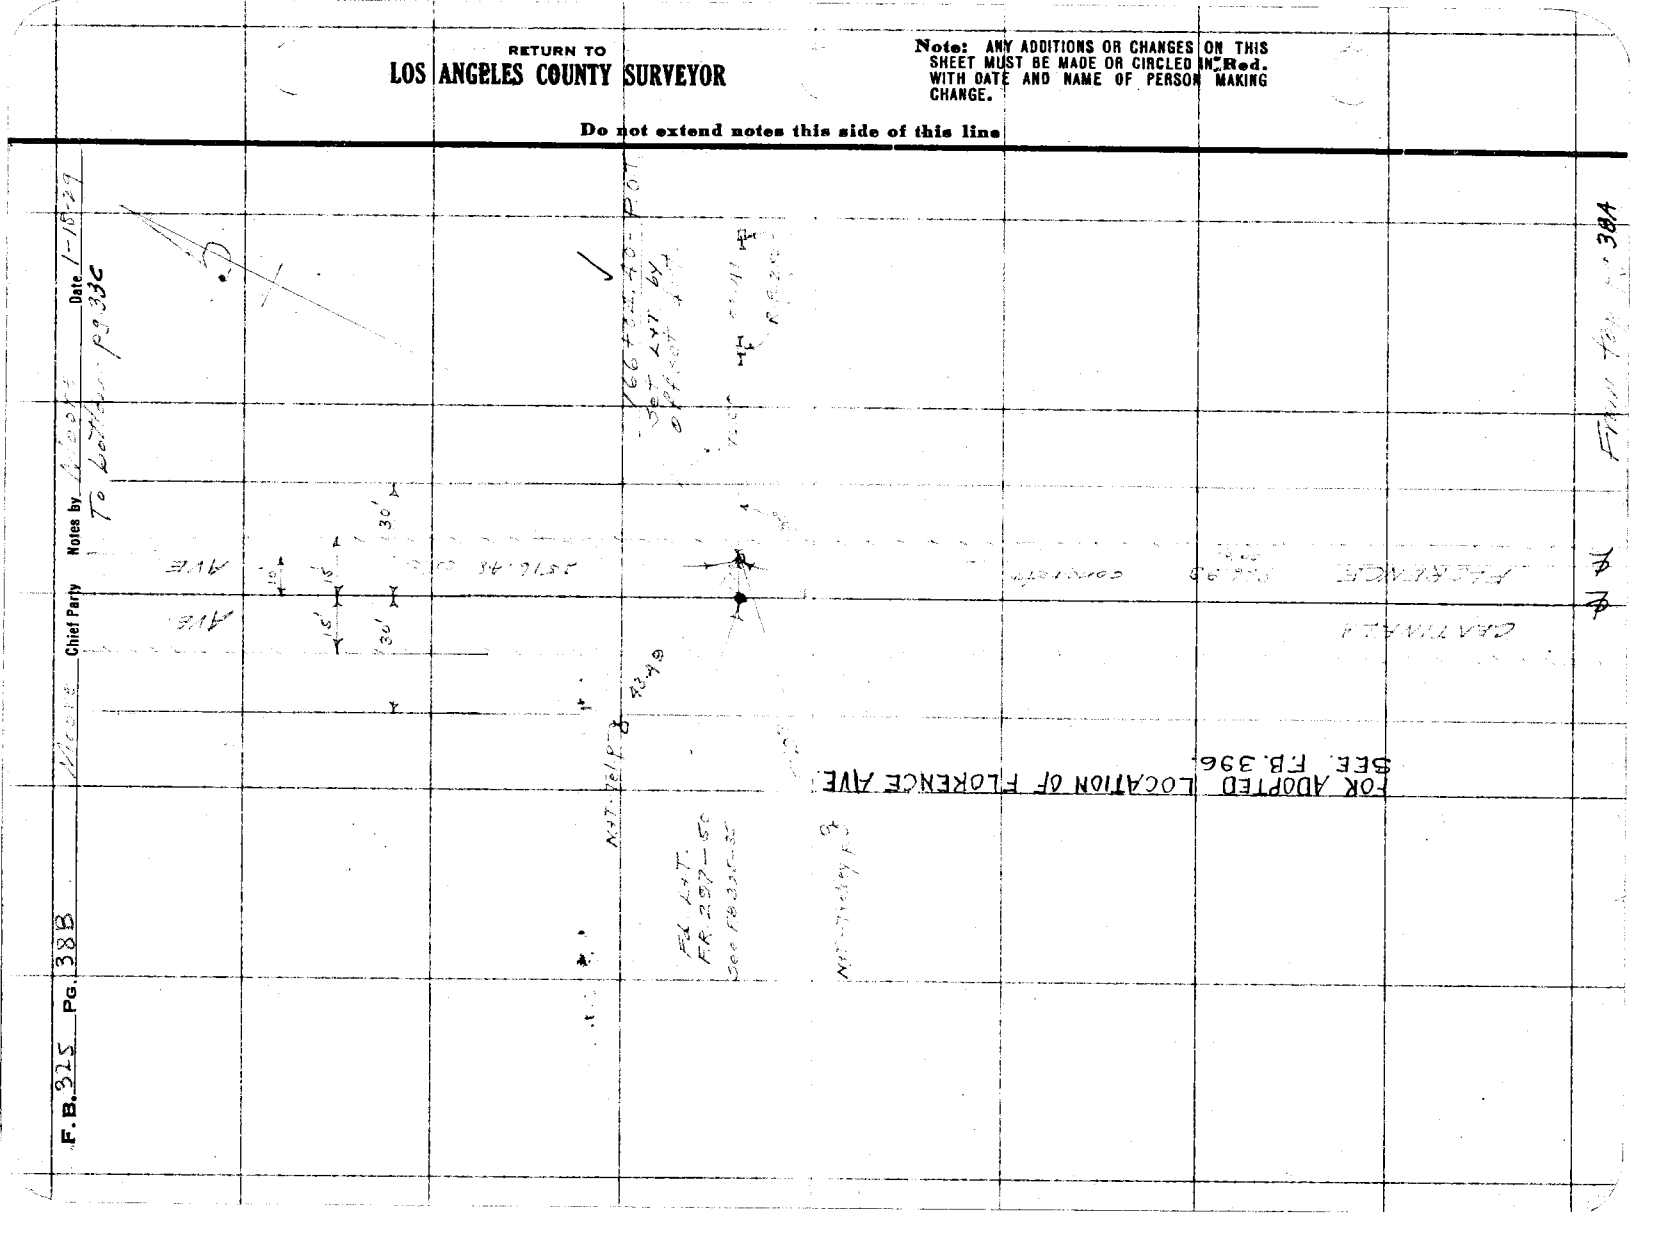

Date 1-10-29 Notes by Moore Chief Party Moore F.B. 335 Pg. 38 C

Platted by Wood	W. O. No. 4166 D. S. O. No.
Date 2-135-2 Jan 1929	Location Florence Ave
Map No. 8	Surveyed by L. E. Moore
Platting C'k'd by H. U. M. H.	Date 1/16/29
Date 2/20/29	Indexed A. C. Johnson

To bottom pg 38D

(11°20' 15" 11-22-25) 11-05-41

N+T P.P. 11°-05'-40"

194.24

{ 1251+18.5 P.C. Set 2 x 2 - 12" deep

RP-2x2 12" deep

FOR ADOPTED LOCATION OF FLORENCE AVE. SEE F.B. 396.

419.18 (Chained)

N+T Trolley P.P.

10.00

N+T P.P.

N+T Trolley P.P.

55.7A

Set N+T per office data

{ P.I. Set L+T per office data

Δ = 11°-05'-40"
R = 2000'
T = 194.24
L = 387.27

AVE.

N+T Trolley P.P.

Set L+T by others

Fd C.S.T+W F.B. 335-9 See F.B. 335-34

N+T P.P.

58.57

RP-2x2 12" deep

{ 1917+20.68 P.C. Set L+T

10'
15' 15'
36' 30'

From top pg 38B

RETURN TO LOS ANGELES COUNTY SURVEYOR

Note: ANY ADDITIONS OR CHANGES ON THIS SHEET MUST BE MADE OR CIRCLED IN Red. WITH DATE AND NAME OF PERSON MAKING CHANGE.

Do not extend notes this side of this line

F.B. 325 PG. 38 D Moore Chief Party Notes by Moore Date 1-18-29

To bottom pg 38E

1ST-SAN B.C. See pg

FOR ADOPTED LOCATION OF FLORENCE AVE. SEE F.B. 396.

Fd. L+T F.B. 297-50 See F.B. 325-37

Control point set 2x2 by dale 4 ft. on splt of angle

+ 30' + 30' +

419.12 CENTERLINE

FLORENCE AVE

From top pg. 38C

RETURN TO LOS ANGELES COUNTY SURVEYOR

Do not extend notes this side of this line

Note: ANY ADDITIONS OR CHANGES ON THIS SHEET MUST BE MADE OR CIRCLED IN Red. WITH DATE AND NAME OF PERSON MAKING CHANGE.

Date 1-11-27 Notes by Moore Chief Party A. Moore F.B. 325 Pg. 38E

Plotted by Wood
Date Jan. 1927
Map No. B-135-2
Platting Ck'd by H. U. M. H.
Date 2/20/27

W. O. No. 4168 D. S. O. No. 03
Location Florence Ave
Surveyed by A. P. Moore
Date 1-11-27
Indexed by C. J. Collins 2-27

To Pg. 38F.

N 10° W 900' TO 85.02 N+T-I.P.

+2.42 of N+T-I.P.

60.00

N+T I.P.

95.58

Set L+T by Inter

Fd L+T FB 330-31

FOR ADOPTED LOCATION OF FLORENCE AVE. SEE F.B. 396

Semi-tangent FLORENCE AVE

Set X in pvmt. by inter Reference

(12° 32' 00" 50-58-00 12-92-00)

Adj. line

N.T. I.P.

203.36

107+ P.C.C. B.C. Set 2 1/2" I.P. corp.

64.63

65.06

48.92

R.P. 2 x 2 12 deep

CENTINELA

From top of 38D

RETURN TO LOS ANGELES COUNTY SURVEYOR

Notes: ANY ADDITIONS OR CHANGES OF THIS SHEET MUST BE MADE OR CIRCLED IN Red. WITH DATE AND NAME OF PERSON MAKING CHANGE.

Do not extend notes this side of this line

F.B. 325 PG. 38 F Moore Chief Party Notes by Moore Date 1-19-29

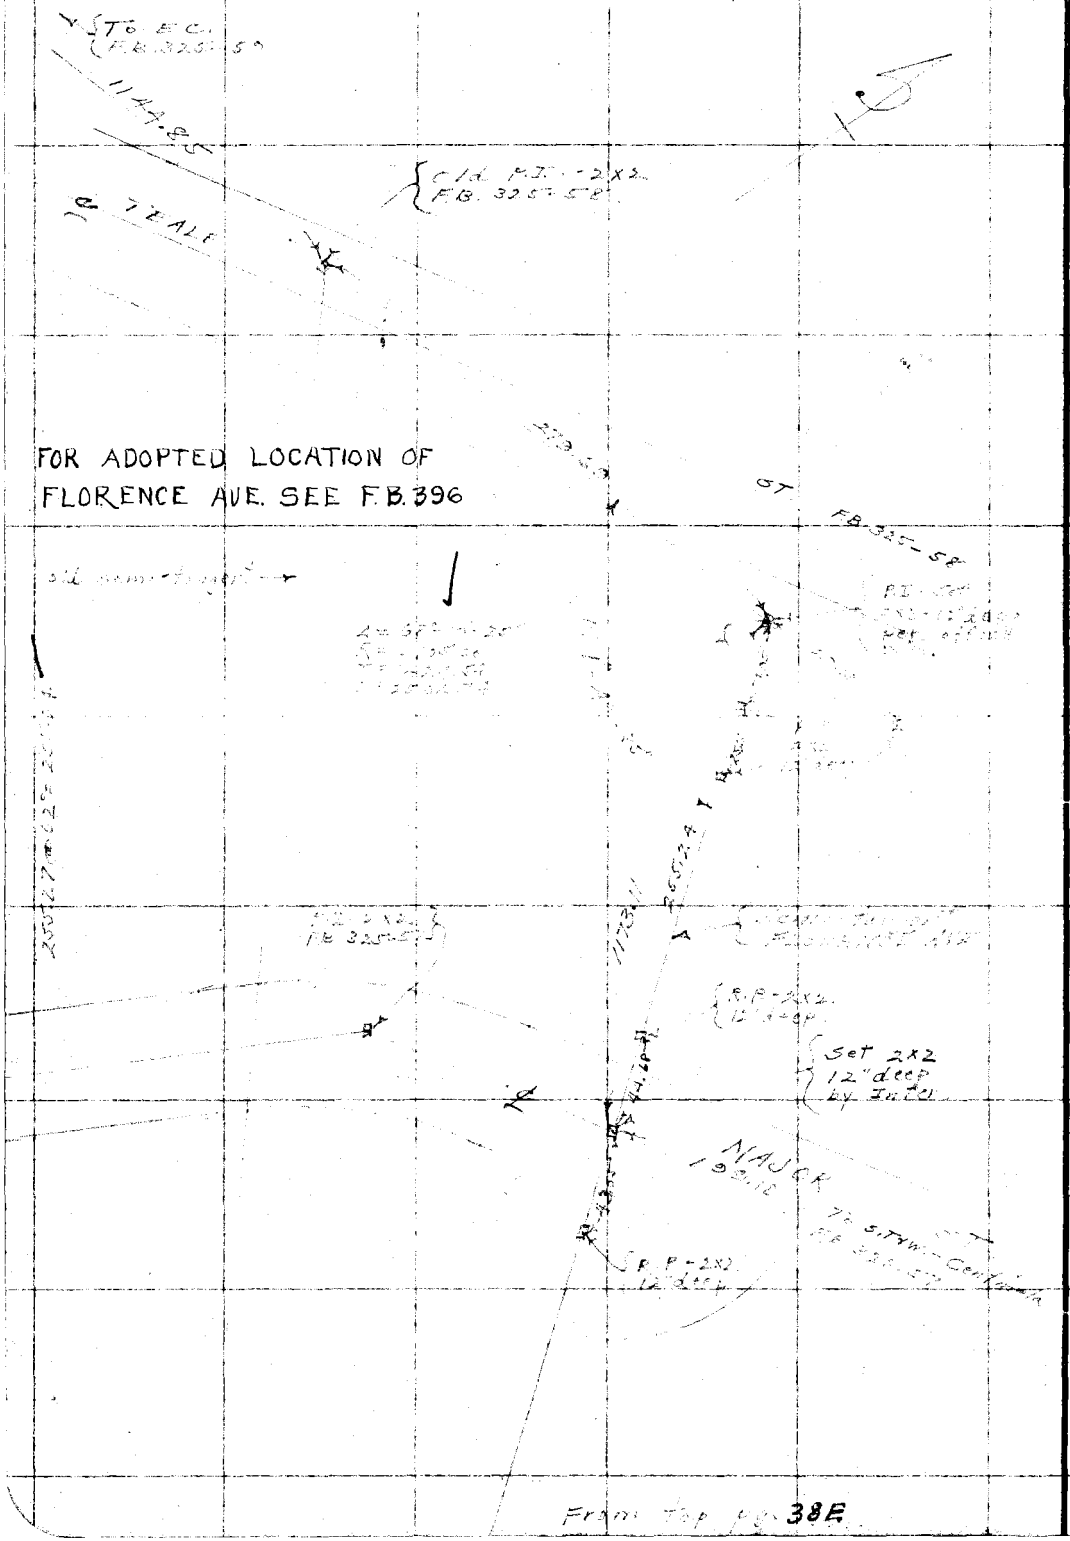

RETURN TO
LOS ANGELES COUNTY SURVEYOR

Do not extend notes this side of this line H.U.M.H. 2/20/29.

Note: ANY ADDITIONS OR CHANGES ON THIS SHEET MUST BE MADE OR CIRCLED IN Red. WITH DATE AND NAME OF PERSON MAKING CHANGE.

Date 3-21-29 Notes by Moore Chief Party [illegible] F.B. 325 Pg. 38G

Platted by Wood	W. O. No. 4166 D. S. O. No. [illegible]
Date 3/25/29	Location Florence Line
Map No. B-135-3	Surveyed by L A Moore
Platting Ck'd by H. U. M. H.	Date 3-21-29
Date 3/27/29	Indexed [illegible]

Notes: ANY ADDITIONS OR CHANGES ON THIS SHEET MUST BE MADE OR CIRCLED IN Red. WITH DATE AND NAME OF PERSON MAKING CHANGE.

Do not extend notes this side of this line

RETURN TO LOS ANGELES COUNTY SURVEYOR

To pg. 38H

Rancho La Ballona

L+T Pg. 38D

E.C. 185+05.15 2 x 2 Pg. 38C

Rancho Tajauta Centinela

P.I. L+T Pg. 38C

N+T-Pg. 38C

L+T-P.C. Pg. 38C

This line is Void. See F.B. 396-99

Fd 6" cast iron pipe in monument well. Sta #1 Rancho La Ballona E 371-29 feet from face and off fence

Fd 2x2 - leaning 45° straightened up and used for one 2x2 on line 1.04 off fence

L.C. Mapleton Hills Country Club

This point not in

Centinela Ave

Florence

Set L+T on C.L. of Florence

F. B. 325 Pg 381 Moore Chief Party Notes by Moore Date 3-21-29

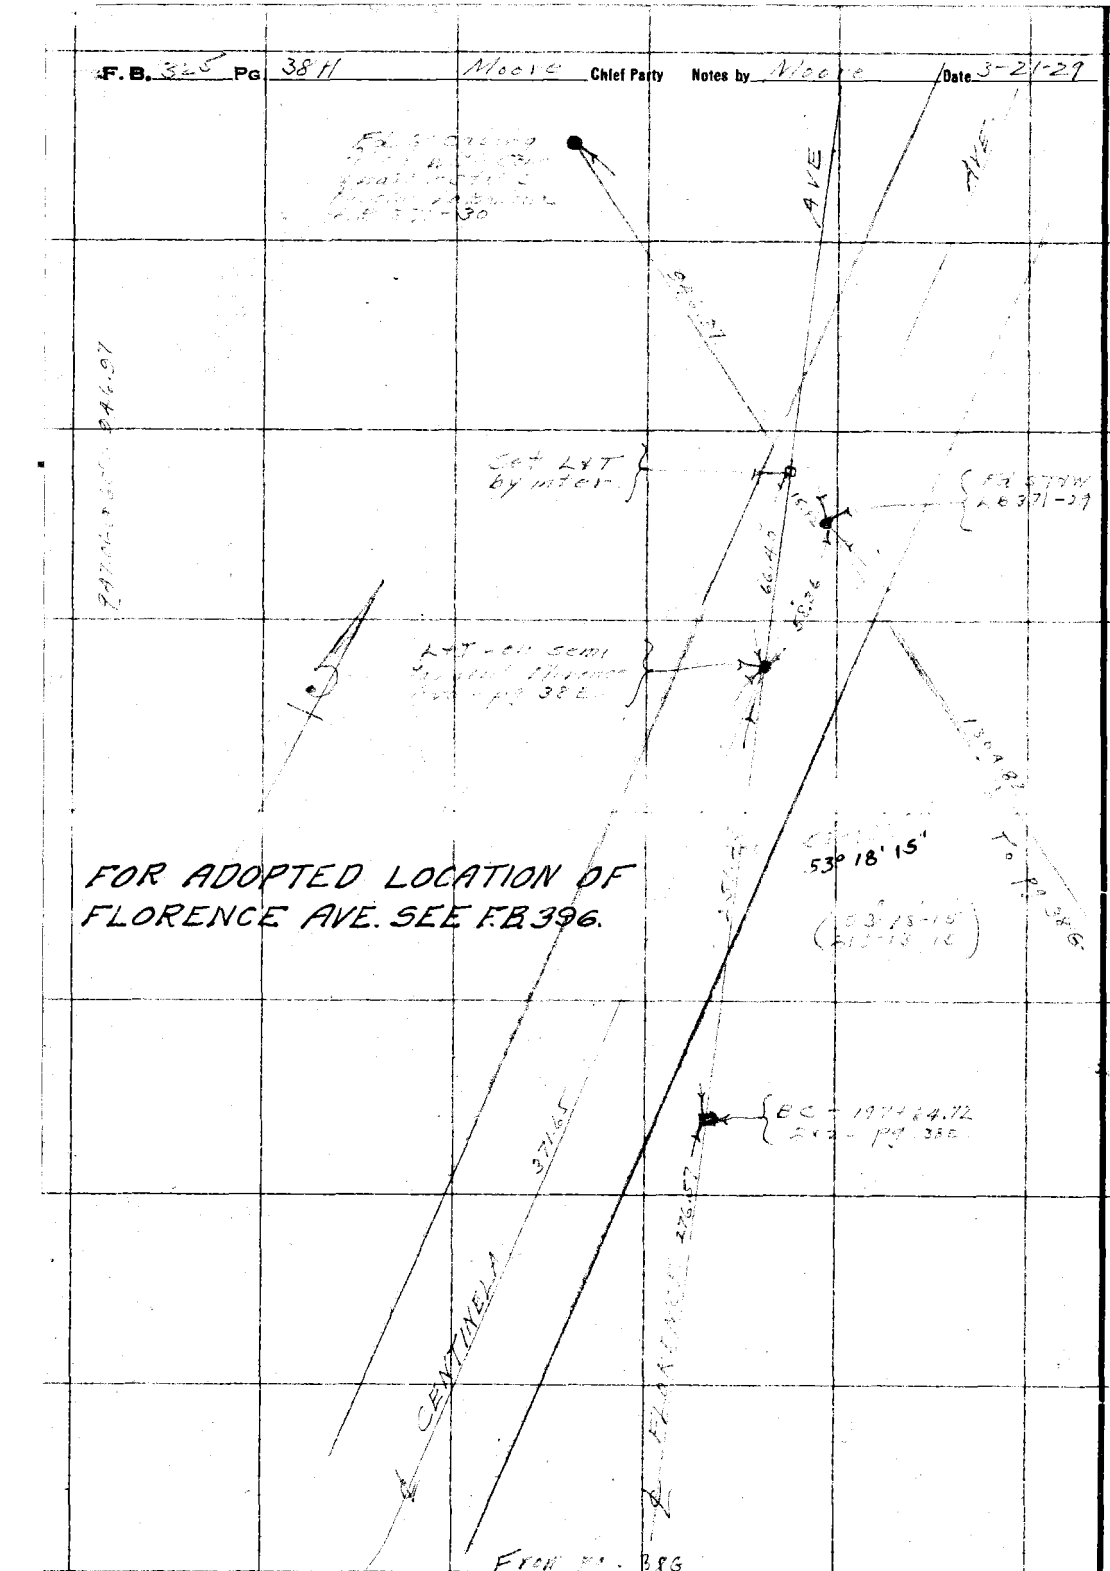
4 AVE
Set L&T by inter-
P.C. Sta 1+00
Sta 1+00
Sta 1+00
L&T - on semi
53° 18' 15"
Sta 1+00
Sta 1+00
Sta 1+00

Date 3-28-28 Notes by Moore Chief Party Moore F. B. 325 Pg. 39

Plotted by Wood
Date Jun 1929
Map No. B-135-2
Plotting Checked by H. J. M. H.
Date 12/3/28.

W. O. No. 1168 S. P. O. No.
Location FLORENCE AVE
Surveyed by L. D. Moore
Date 3-26-28
Indexed A. C. Johnson

Notes: ANY ADDITIONS OR CHANGES ON THIS SHEET MUST BE MADE OR CIRCLED IN Red. WITH DATE AND NAME OF PERSON MAKING CHANGE.

Do not extend notes this side of this line

RETURN TO LOS ANGELES COUNTY SURVEYOR

CENTINELA AVE

To P.63

95° 57' 55"

828.52'

Fd C.S.T.H.W.
F.C. 661-7

Set C.S.T.H.W. by Inter.

Fd 1" Pipe
F.R. 300-23
F.C. 661-10

542.01'

JEFFERSON

1145.23

1144.85

Fd 1 x 2
F.C. 661-6
see P. 59

F.C. 222+89.46
see P. 59

FLORENCE AVE

122° 55' 15"

2195.98' Used

To 19+40 P.I.

Set 2 x 2 by Inter.

122-55-15
4) 131-41-00
32-55-15

Δ = 57° 04' 45"
R = 2105.08
T = 1144.85
L = 2097.12

R=2105.08

For New Curve Data
See Pages 38E & 38F

1321.07

R.R.

CENTINELA AVE

FOR ADOPTED LOCATION OF FLORENCE AVE. SEE F.B. 396

P.E.

Set L.&T. by cale. dist. from Fd. L.&T.

299.77

Set L.&T. by cale. dist. from L.&T.

Fd. L.&T. F.R. 297-50

49.91

FLORENCE

CENTINELA

156-22'-30"

120'

55'

29'

10-32-15
4) 42-08-15
10-32-00

F.B. 325 PG. 40 Moore Chief Party Notes by Moore Date 3-28-28

FdC.S.TYW.
FR.297-19

FdC.S.TYW.
FR.297-49

AVE

JEFFERSON 2195.98'

154

88°-45'-33"

E
To pg. 39

88-45-30
4355-02-15
88-45-344

CENTERLINE

From p.938

RETURN TO
LOS ANGELES COUNTY SURVEYOR
Do not extend notes this side of this line

Note: ANY ADDITIONS OR CHANGES ON THIS SHEET MUST BE MADE OR CIRCLED IN Red. WITH DATE AND NAME OF PERSON MAKING CHANGE.

Date _____ Notes by Moore Chief Party Moore F. B. 325 Pg. 41

Plotted by _____
Date _____
Map No. B-135-1
Plotting Ck'd by H. H. M. H.
Date 12/3/28.

W. O. No. 4168 C.S.D. No. 033
Location Florence Ave
Surveyed by L. D. Moore
Date _____
Indexed _____

LOCATION SURVEY
for
FLORENCE AVE
from
EAST BOUNDARY
CITY of INGLEWOOD
to
FIELD AVE.

W.O.# 4168

Party
Moore
Thayer
Gunderson
More
Auer

June 1928

Tape #033. — 100.00 @ 74° F. with 21 lb. pull

Notes ANY ADDITIONS OR CHANGES ON THIS SHEET MUST BE MADE OR CANCELED IN Red. WITH DATE AND NAME OF PERSON MAKING CHANGE.

Do not extend notes this side of this line

RETURN TO LOS ANGELES COUNTY SURVEYOR

F.B. 325 Pg. 42 Moore Chief Party Notes by Moore Date 6-5-28

RETURN TO
LOS ANGELES COUNTY SURVEYOR
Do not extend notes this side of this line

Notes: ANY ADDITIONS OR CHANGES ON THIS SHEET MUST BE MADE OR CIRCLED IN Red. WITH DATE AND NAME OF PERSON MAKING CHANGE.

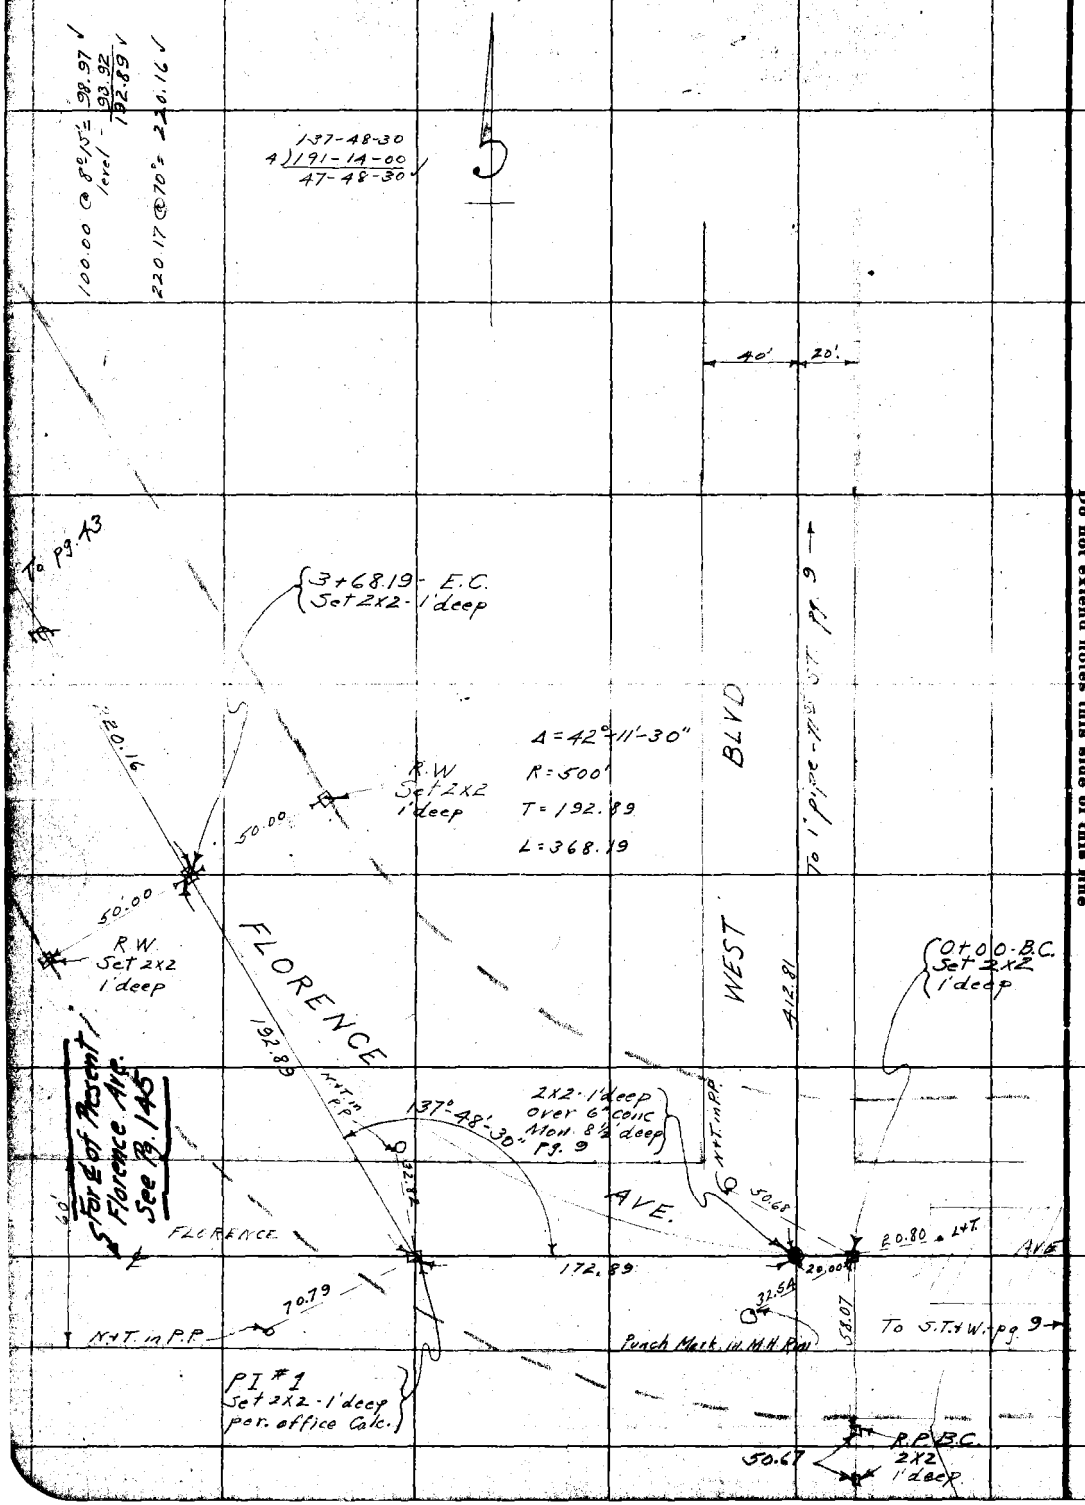

Date 6-6-28 Notes by Moore Chief Party Moore F. B. 325 Pg. 43

Plotted by Blackwood
Date June 13 1928
Map No. B-135-1
Planimeter C'rs by H. U. M. M.
Date 12/3/28

M. B. No. A168 C.S.B. No. 033
Location Florence Ave
Surveyed by L D Moore
Date 6-6-28
Indexed

Notes ANY ADDITIONS OR CHANGES ON THIS SHEET MUST BE MADE OR CIRCLED IN Red. WITH DATE AND NAME OF PERSON MAKING CHANGE.

Do not extend notes this side of this line

RETURN TO LOS ANGELES COUNTY SURVEYOR

To pg AA

18-53-30
30
25 25
FLORENCE ST.
102.06 S 70° E 102.06
102.06
50'
50'
18-53-30
4) 75-38-30
18-53-231

6+55.81
Set C.S.T+W
by Inter.

71-09-00
4) 284-35-15
71-08-49

"X" in Conc Walk
25.49
53.43
54.90
63.83
64.16
L+T. in Curb
5.73
L+St. in Curb
REDONDO BLVD.
21.84
24.03
C.S.T+W
pgs. 148
To S.T+W
HIGH ST.
pg. 24.10
5+88.35
Set C.S.T+W
by Inter.
To 2X2
WEST BLVD
pg. 149
L.A. R.R.
30.11
71.10
5+37.29
5+33.56
5+21.35
5+17.62
N+T. in Trolley P.
N+T. in Trolley P.
A.T. + S.F. R.R.
71° 08'
4+77.05
4+72.10
220.16
AVE

From pg 42

F.B. 325 Pg. 44 Meore Chief Party Notes by Meore Date 6-6-28

To Pg. ~~45~~ 46A

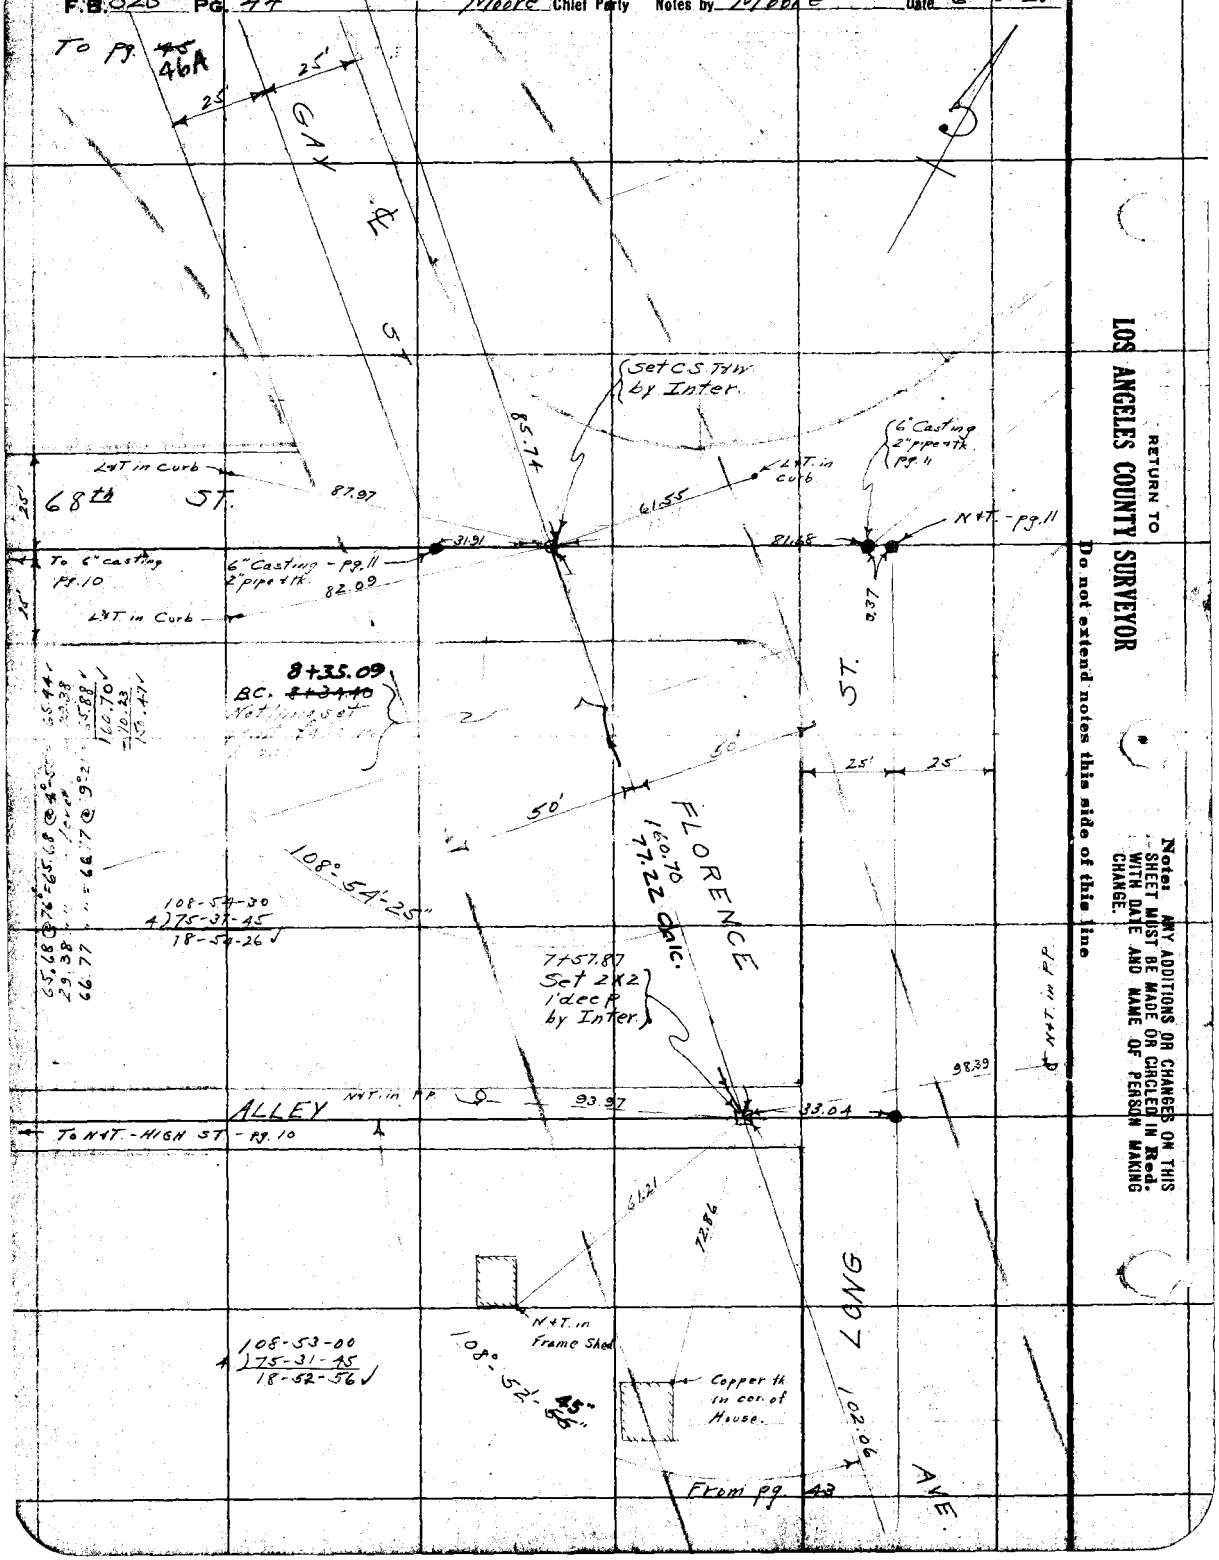

RETURN TO
LOS ANGELES COUNTY SURVEYOR

Do not extend notes this side of this line

Notes: ANY ADDITIONS OR CHANGES ON THIS SHEET MUST BE MADE OR CIRCLED IN Red. WITH DATE AND NAME OF PERSON MAKING CHANGE.

Date 6-6-28 Notes by Moore Chief Party Moore F. B. 325 Pg. 45

Plotted by [illegible] Co. No. 446 Co. No. 423
Date June 13-1928 Location Florence Ave
Map No. Surveyed by L. D. Moore
Plotting C'k'd by Date A. C. Johnson
Date Indexed

Notes ANY ADDITIONS OR CHANGES ON THIS SHEET MUST BE MADE OR CIRCLED IN Red. WITH DATE AND NAME OF PERSON MAKING CHANGE.

RETURN TO LOS ANGELES COUNTY SURVEYOR

Do not extend notes this side of this line

N.&T. in Peach

P.I. #6

79.56

50'

69.75

187.46

12+78.54 E.C. Set 2x2 1'deep

ALLEY

5°

20°24'00" 2835.4 feet RADIUS

56.91

70.96

L&T. in Walk.

GAY ST.

L&T. in curb

L&T. in curb

86.88

2x2 - 1'deep

To 2x2 WEST ST. Pg. 12

Set 2x2 1'deep by Inter

FLORENCE AVE

P.I. #2 Set 2x2 1'deep by Inter.

Set C.S.T.y.M. by Inter

48.69

N.&T. in Peach

29-29-00
4) 117-56-00
29-29-00

38°-18°-20"

137°-34'-

A = 42°-25'-20"
R = 500'
T = 194.05
L = 370.20

137-34-45
4) 190-18-45
47-34-41

138-18-15
4) 193-13-30
48-18-22

25.09

27.26

31.63

114.00

R.P. 2x2 1'deep

Set N.a 1'deep per office calc.

32.00

Set N.

GAY ST. AVE

25'

25'

152.19

To 6" casting Pg. 11

From Pg. 44

1D 9 46A

SEC

F.B. 325 PG. 46 — Moore Chief Party — Notes by Moore — Date 6-6-28

17+46.26 P.O.T. Set 1x2 by offset dist. — To pg 47

25.00

50' 25 25'

19°45" calc. 93.30 adj. F.A.W.

AVE

S 89°

20'

WEST ST

To 2x2 - Alley pg. 12

16+62.44 Set 2x2 1'deep P.

L&T. in curb

1" pipe filled with conc. & copper nail Flush with pave

67.60

L&T. in curb

L&T. in curb

FLORENCE

N&T. in Garage

N&T in Pf.

31.27

34.26

N&T. in Fence Post

14+66.00 - P.O.T. Set 2x2-1'deep

187.46

From pg. 45

187.46 @ 72° = 187.46
61.42 @ 72° = 61.42 @ 8°-0'-30" = 60.81
61.34 @ 72° = level = 61.34
59.75 @ 72° = 59.75 @ 17°-4'-30" = 56.92
17.37
196.44

See pg 48

RETURN TO LOS ANGELES COUNTY SURVEYOR

Do not extend notes this side of this line

Notes: ANY ADDITIONS OR CHANGES ON THIS SHEET MUST BE MADE OR CIRCLED IN Red. WITH DATE AND NAME OF PERSON MAKING CHANGE.

Date 10-15-28 Notes by Moore Chief Party Moore F. B. 326 Pg. 44

Plotted by [illegible]
Date Nov. 1928
Map No. H. U. M. H.
Plotting Ch'd by [illegible]
Date 12/3/28.

W. O. No. 4468 Sup. O. No. 933
Location Florence Ave
Surveyed by L. D. Moore
Date 10-15-28
Indexed A. C. Johnson

Notes: ANY ADDITIONS OR CHANGES ON THIS SHEET MUST BE MADE OR CIRCLED IN Red. WITH DATE AND NAME OF PERSON MAKING CHANGE.

RETURN TO. LOS ANGELES COUNTY SURVEYOR

Do not extend notes this side of this line

(37°-30'-30") (138-02-00)

25' 25'

GAY

12+75.96
~~12+75.28~~
Set 2x2 1' deep by Inter.

89.62

N+T F.P.

2x2 - 1' deep pg. 13

ALLEY

146.10

To 2x2 West 5T. pg. 12

N+T-F.P.

N+T-P.P.

34-30-30"

FLORENCE

114.53

(36°-40'-15") (146-40-45)

N.+T. Eucalyptus

22.25

138.61 114.00

ST.

11+61.43
E.C. ~~11+60.78~~
Set 2x2 1' deep

59.50

N+T-Peach Tree

36.36

36°-40'-10"

Set nx2 1' deep per office Calc

N+T-Fig tree

38.22

Set N 32.00

1170A

N+T F.P.

"X" in curb

29.45

18.52

20.26

66.55

35.14

52.18

Δ = 37°-23'-40"
R = 500'
T = 169.22
L = 326.35

(142°-36'-15") (210-25-15)

P.I. #2
Set 2x2 1' deep by Inter.

F.A.W. 15" Adj. pg. 11

To 6" Cast Iron pipe

85.14

AVE

From pg. 44

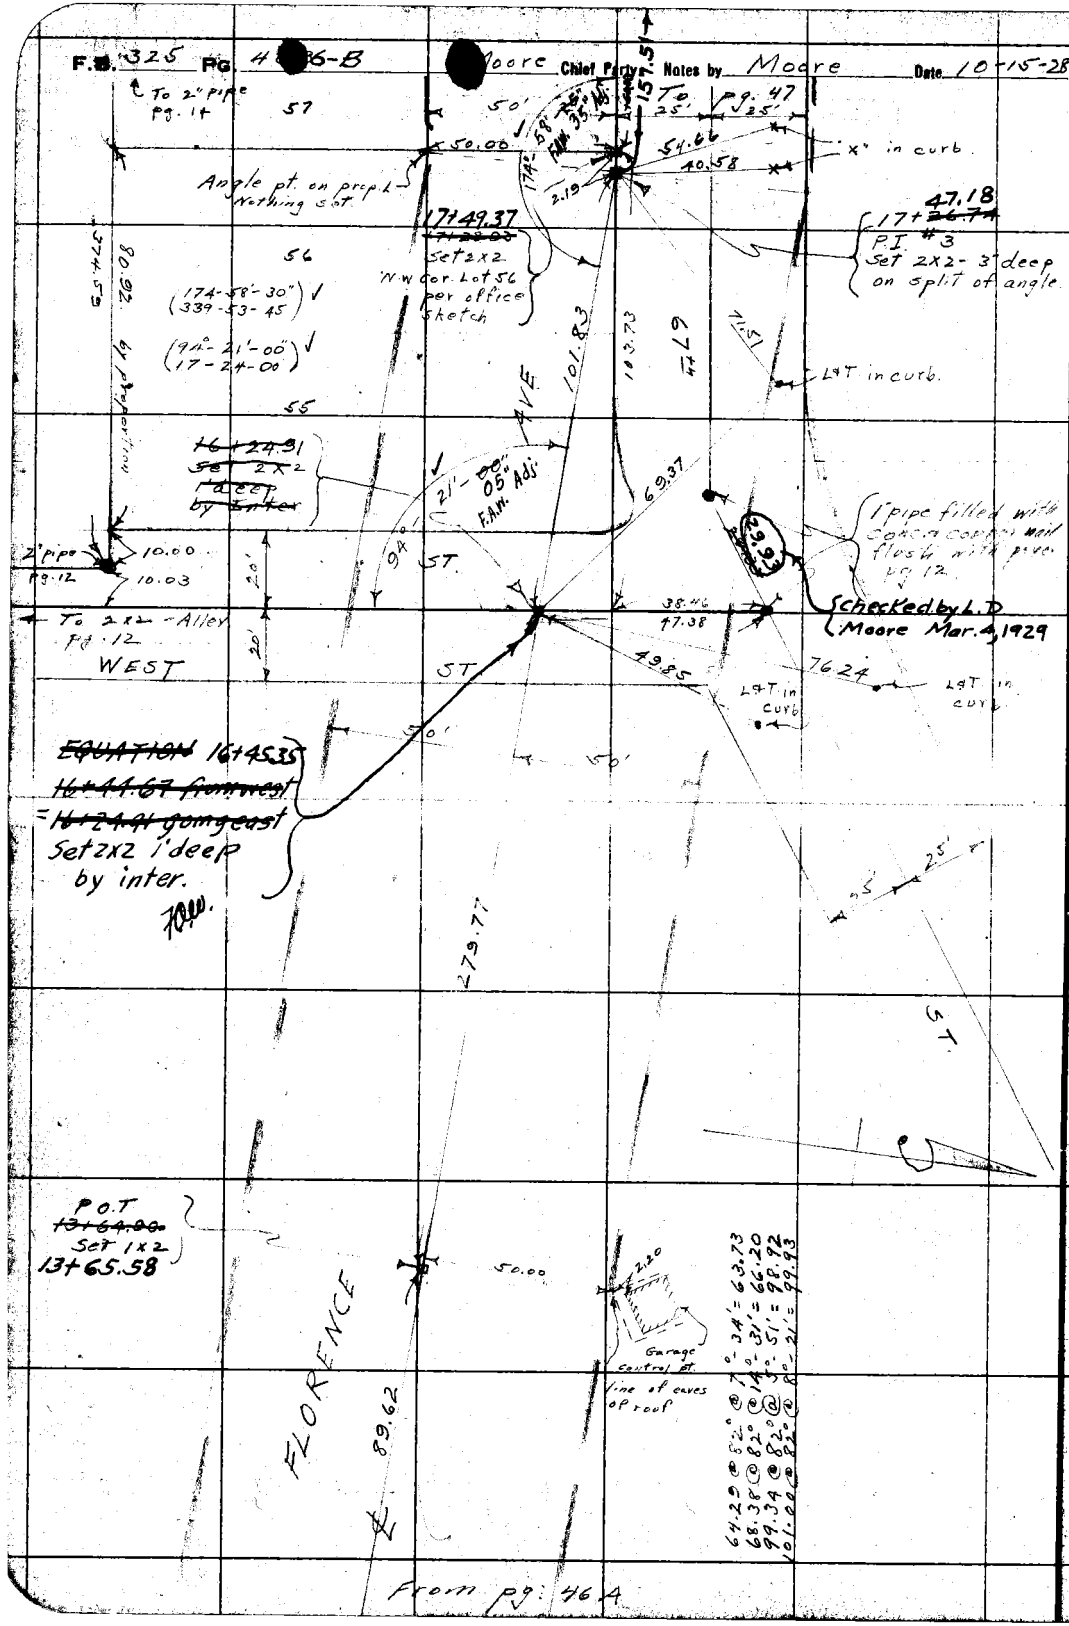
F.B. 325 Pg 4 6-B
Moore Chief Party Notes by Moore Date 10-15-28
To 2" pipe Pg. 11
57
50.00
Angle pt. on prop. l. Nothing set
171+49.37
Set 2x2 N.W. cor. Lot 56 per office sketch
56
(174-58'-30") (339-53-45)
(94°-21'-00") (17-24-00)
55
Set 2x2 1' deep by Inter
2" pipe Pg. 12
10.00
10.03
To 2x2 - Alley Pg. 12
WEST
20'
94° ST.
21-00 05 Adj. F.A.M.
69.37
38.46
47.38
49.85
7624
50'
EQUATION 16+45.35
16+44.67 from west
= 16+24.91 going east
Set 2x2 1' deep by inter.
279.77
ST.
P.O.T.
13+64.00
Set 1x2
13+65.58
FLORENCE
89.62
50.00
2.20
Garage control pt.
Line of eaves of roof
64.29 @ 52.5° @ 17°-34' = 63.73
68.38 @ 82° @ 14°-31' = 66.20
99.34 @ 82° @ 20°-51' = 98.92
101.00 @ 82° @ 80°-21' = 99.43
From pg. 464
To pg. 47
54.66
40.58
x" in curb
47.18
17+26.74
P.I. #3
Set 2x2 - 3' deep on split of angle
L&T in curb.
1" pipe filled with concrete control mark flush with pvmt. Pg. 12
Checked by L.D. Moore Mar. 4, 1929
L&T in curb
RETURN TO LOS ANGELES COUNTY SURVEYOR
Do not extend notes this side of this line
Notice: ANY ADDITIONS OR CHANGES ON THIS SHEET MUST BE MADE OR CIRCLED IN Red. WITH DATE AND NAME OF PERSON MAKING CHANGE.

Date 6-7-28 Notes by Moore Chief Party Moore F. B. 325 Pg. 47

Plotted by Wood
Date Nov. 1928
Map No. B-135-1
Plotting C'k'd by H. H. M. H.
Date 12/3/28.

W. O. No. 3468 "S" O. No. 033
Location Florence Ave
Surveyed by L. D. Moore
Date 6-7-28
Indexed ... C. Johnson

Notice: ANY ADDITIONS OR CHANGES OR THIS SHEET MUST BE MADE OR CIRCLED IN Red. WITH DATE AND NAME OF PERSON MAKING CHANGE.

RETURN TO LOS ANGELES COUNTY SURVEYOR

Do not extend notes this side of this line

To Pg. 48

50'
25'
25'
MANOR
93.50
FLORENCE

19+89.46 E.C.
Set 2x2
deep

Equation
20+05.39 from N.E.
= 19+89.46 going S.W.

19+89.46 EC
Set 2x2
1' deep

"X" in curb.
6" casting
2" pipe v Nail
Pg. 14.
55.98
40.18
72.59
L&T in Driveway
13.62
House #917
L&T in Driveway
52.92
95.12
25.43
66.64
PI #4
Set L&T
in walk by
Calc dist. for
25' offset on
split of angle
159.01'
110"
Pg. 14
50.92
82.92
To L&T Pg. 14
57.30
40.41
"X" in curb
54.46

Δ = 20-58-50
R = 50' 275'
T = 50.58 50.92
L = 100.09 100.70

19+04.69
B.C
Set 2x2-1' deep.

18+79.84
B.C. Set
2x2-1' deep

AVE
57
(157.51)
As Rechained by L. D. Moore
on Mar. 4, 1929.

133.58 @ 64° = 133.58

From Pg. 46

F.B. 325 PG. 48 Moore Chief Party Notes by Moore Date 5-7-28

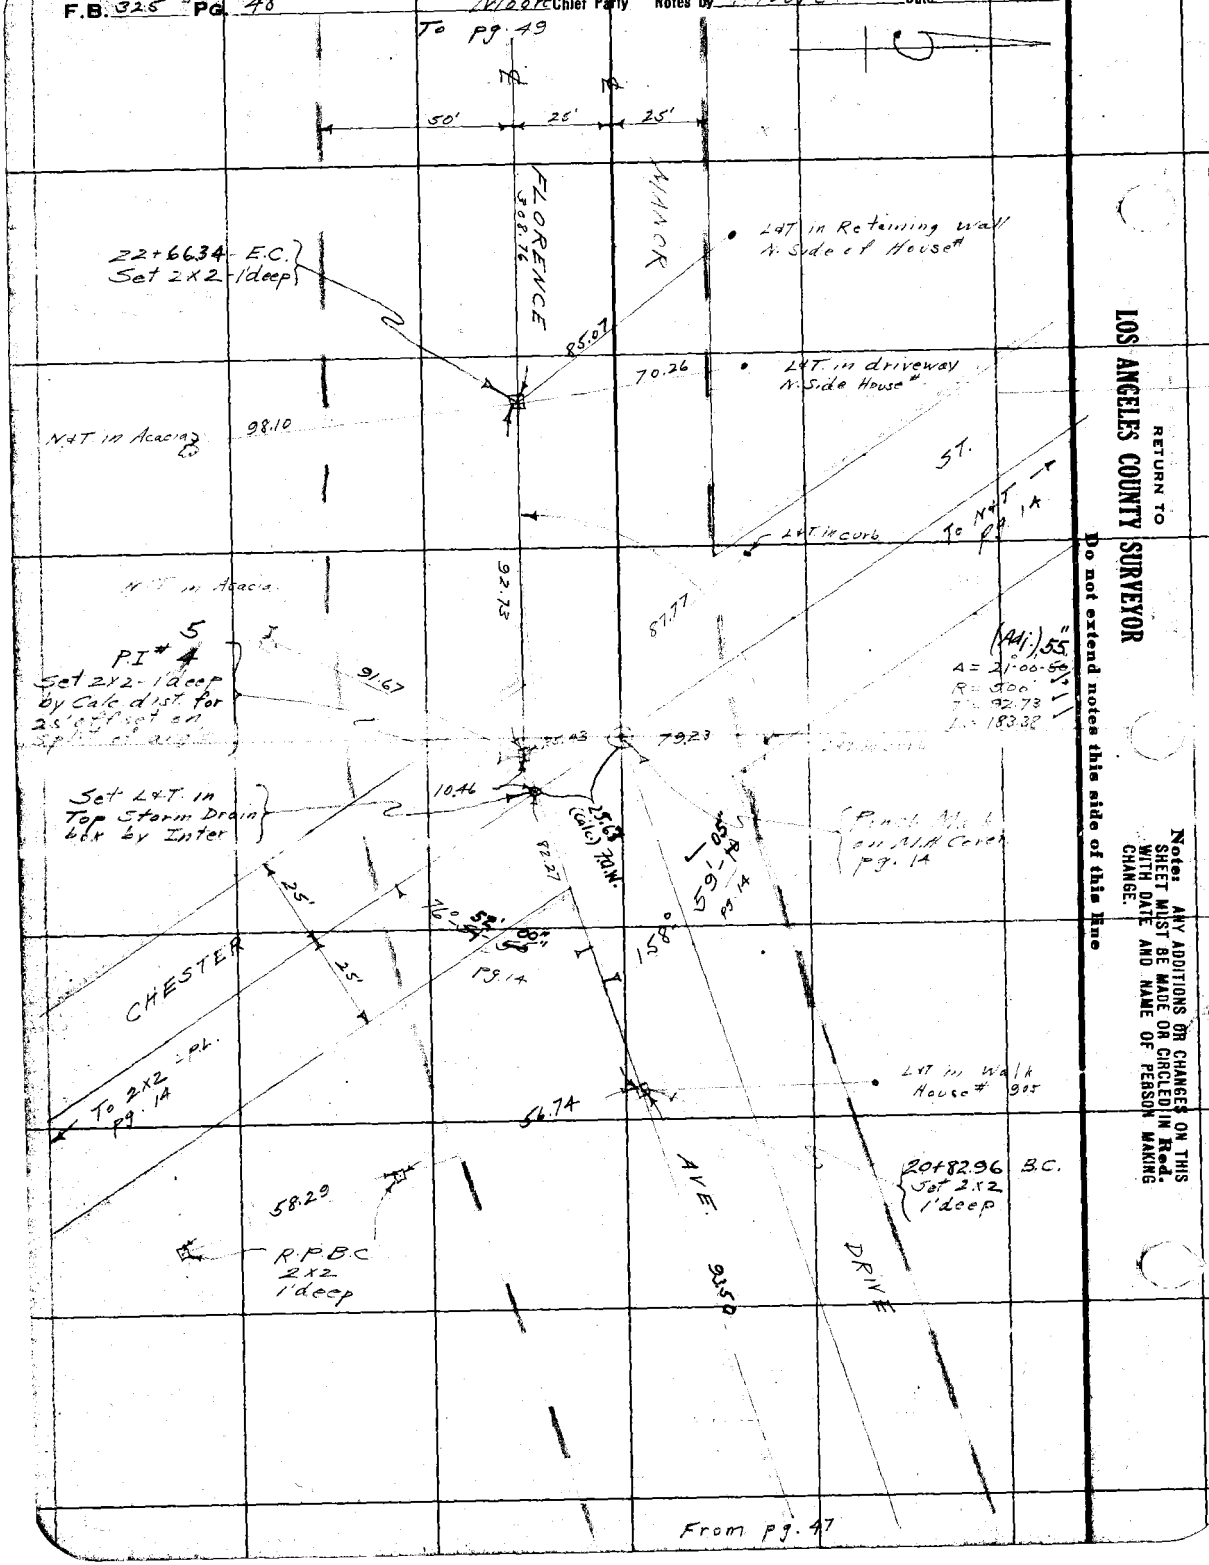

(All) 55"
Δ = 21°00-55"
R = 500
T = 92.73
L = 183.32

RETURN TO
LOS ANGELES COUNTY SURVEYOR
Do not extend notes this side of this line

Notes: ANY ADDITIONS OR CHANGES ON THIS SHEET MUST BE MADE OR CIRCLED IN Red. WITH DATE AND NAME OF PERSON MAKING CHANGE.

Date 6-7-28 Notes by Moore Chief Party Moore F. B. 325 Pg. 49

Plotted by Wood
Date Nov. 1928
Map No. B-125-1
Plotting C'd'd by M. U. M. M.
Date 12/5/28

W. O. No. 4166 Co. No. 031
Location Florence Ave
Surveyed by L. D. Moore
Date 6-7-28
Indexed A. C. Johnson

To pg. 50

Notes: ANY ADDITIONS OR CHANGES ON THIS SHEET MUST BE MADE OR CIRCLED IN Red. WITH DATE AND NAME OF PERSON MAKING CHANGE.

Do not extend notes this side of this line

RETURN TO LOS ANGELES COUNTY SURVEYOR

E MANOR

286.42

FLORENCE

25+75.10
PI #6
Set 2x2
per office
calculation

Lot in drive way

2x2 - PI
Pg. 15.

96.08

Lot in Walk in Front of House # 817

26.18

83.72

25.00

N 11° 24' 25" E

91.55

Lot in Porch House # 825

177-24-15
349-37-45
87-29-26

AVE

308.76

DRIVE

50'

25'

25'

308.77 @ 70° = 307.76'
286.43 @ 70° = 286.42'

From pg. 48

F.B. 325 PG. 50 — Moore Chief Party — Notes by Moore — Date 6-7-28

To pg. 51

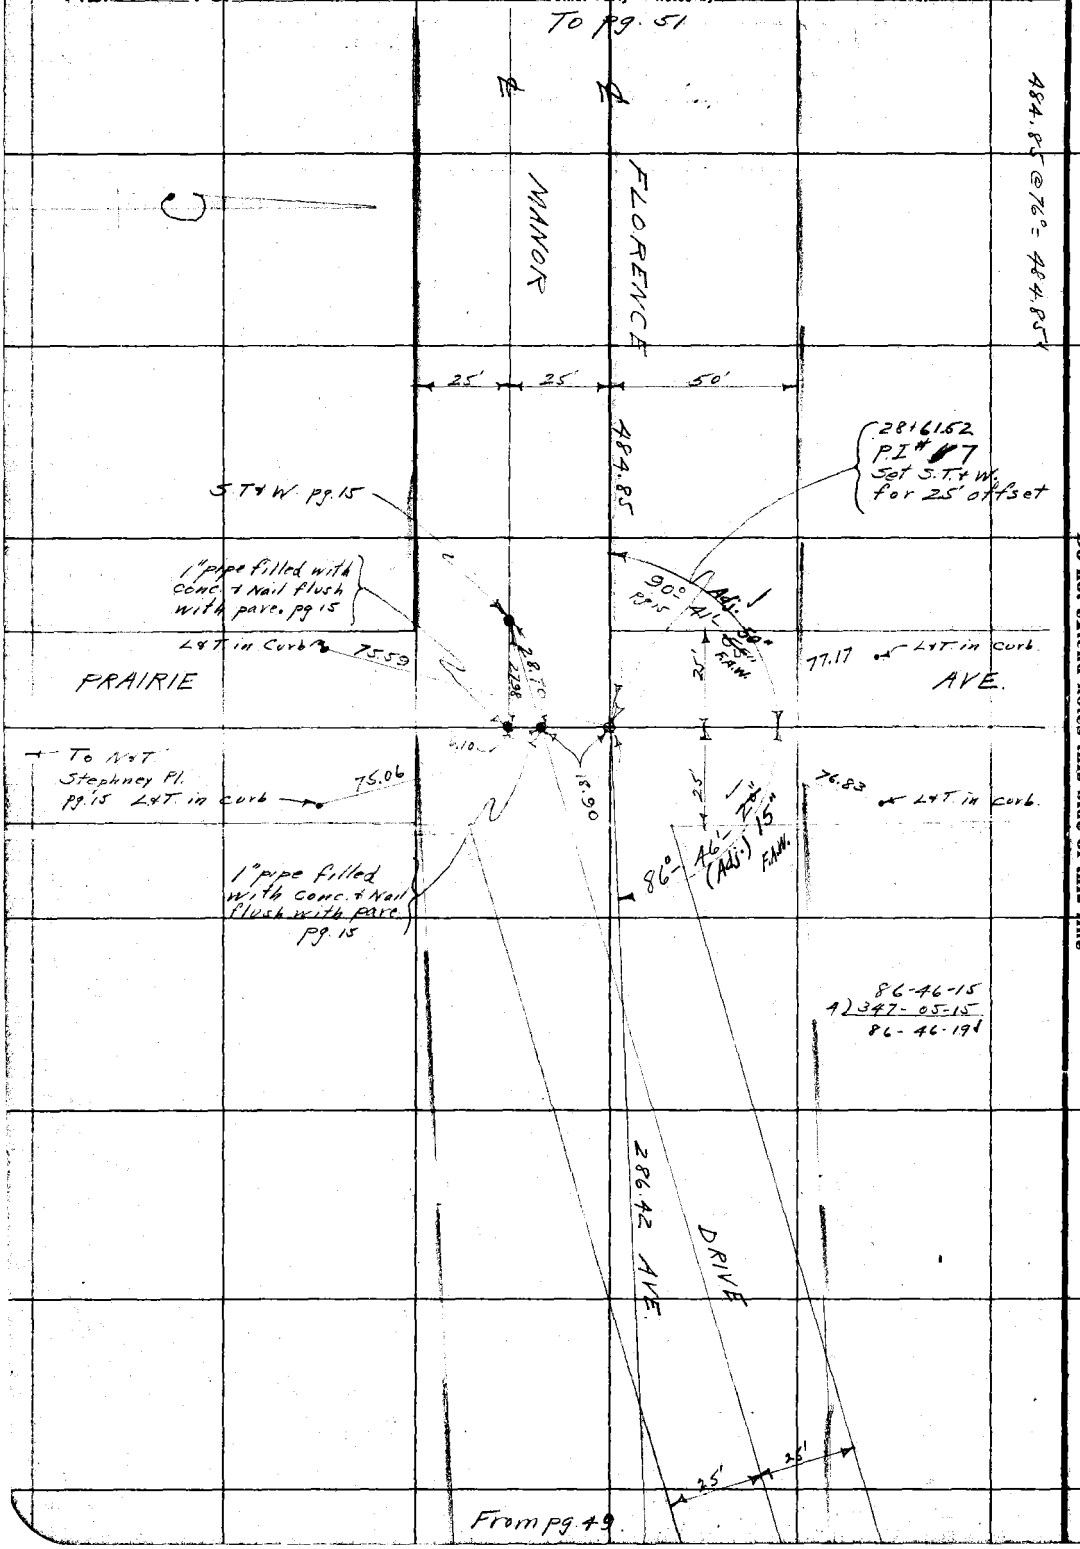

RETURN TO
LOS ANGELES COUNTY SURVEYOR
Do not extend notes this side of this line

Notes: ANY ADDITIONS OR CHANGES ON THIS SHEET MUST BE MADE OR CIRCLED IN Red. WITH DATE AND NAME OF PERSON MAKING CHANGE.

Date 6-7-28 Notes by Moore Chief Party Moore F. B. 325 Pg. 51

Plotted by Wood
Date Nov. 1928
Map No. B-135-1
Planting C'k'd by H. U. M. H.
Date 12/3/28

W. O. No. 4168 Maps
C. S. No. 0.32
Location Florence Ave
Surveyed by L. D. Moore
Date 6-7-28
Indexed A. C. Johnson

Notes ANY ADDITIONS OR CHANGES ON THIS SHEET MUST BE MADE OR CIRCLED IN Red. WITH DATE AND NAME OF PERSON MAKING CHANGE.

RETURN TO LOS ANGELES COUNTY SURVEYOR

Do not extend notes this side of this line

35+48.85
P.I. # 18
Set C.S.T.W. by calc dist from Manor Drive

MANOR

To pg. 52

50'
50'
29.56

36+00.24
P.O.T.
Set 2x2
1' deep

Lgt. in curb

85°-20'-05" calc.
51.39
71.74
71.19
110.01 calc.
71.14

Punch Mark on M.H. Cover pg. 16

MARLBOUGH

67°-11'-30" pg. 16
Lgt. in M/C Rd

84.24
90°-02'-25" calc.

AVE

To S.T.W. Hyde Park pg. 16

Lgt. in curb

FLORENCE

212.66 pg. 16

202.48 (calc.)

DRIVE

Punch Mark on M.H. Cover pg. 16

3314637
P.O.T.
Set 2x2
1' deep.
by offset

Lgt. in drive way

69.10
pg. 16
S 57°-13'-55" E
25.00
87.79
N 90°
73.74
Tangent
23°-46'-05"
R 60.00

712
copper tk 4' up in Gen. House.
"X" in cor. Fence post

AVE

25' 25' 50'

From pg. 50

F.B. 3225 Pg. 52 — Moore Chief Party — Notes by Moore — Date 6-8-28

To pg. 53

HYDE PARK WAY

℄ FLORENCE

159.57

L+T Pg 17

N+T. in Fig tree

78.45

83.6

70.73

96.54

38+96.99
Set C.S.T.+W by Inter

L+T in cut

I BLVD

35'

N+T in P.P.

WELTON

24' 35"

167.19

To Punch Mark M.H.-Pg 17

AVE

52-24-45
209-38-15
52-24-34

37+29.80
P.O.T.
Set N+T. on roof of Shed.

129.56

From pg. 51

Δ 49.11 @ 12°34' = 420.71
R 83.34 @ 8°12' = 627.44
T 24.57 @ 16°19' = 245.57

Δ 47.65 @ 22°17' = 167.19

RETURN TO
LOS ANGELES COUNTY SURVEYOR

Notice: ANY ADDITIONS OR CHANGES ON THIS SHEET MUST BE MADE OR CIRCLED IN Red. WITH DATE AND NAME OF PERSON MAKING CHANGE.

Do not extend notes this side of this line

Date 6-8-28 Notes by Moore Chief Party Moore F. B. 225 PG. 53

Plotted by Wood
Date Nov. 1928
Map No. B-135-1
Plotting C'k'd by H. U. M. H.
Date 12/2/28.

W. O. No. 4468 S. S. O. No.
Location Florence Ave
Surveyed by L. D. Moore
Date 6-8-28
Indexed A. C. Johnson

Notes ANY ADDITIONS OR CHANGES ON THIS SHEET MUST BE MADE OR CIRCLED IN Red. WITH DATE AND NAME OF PERSON MAKING CHANGE.

Do not extend notes this side of this line

RETURN TO LOS ANGELES COUNTY SURVEYOR

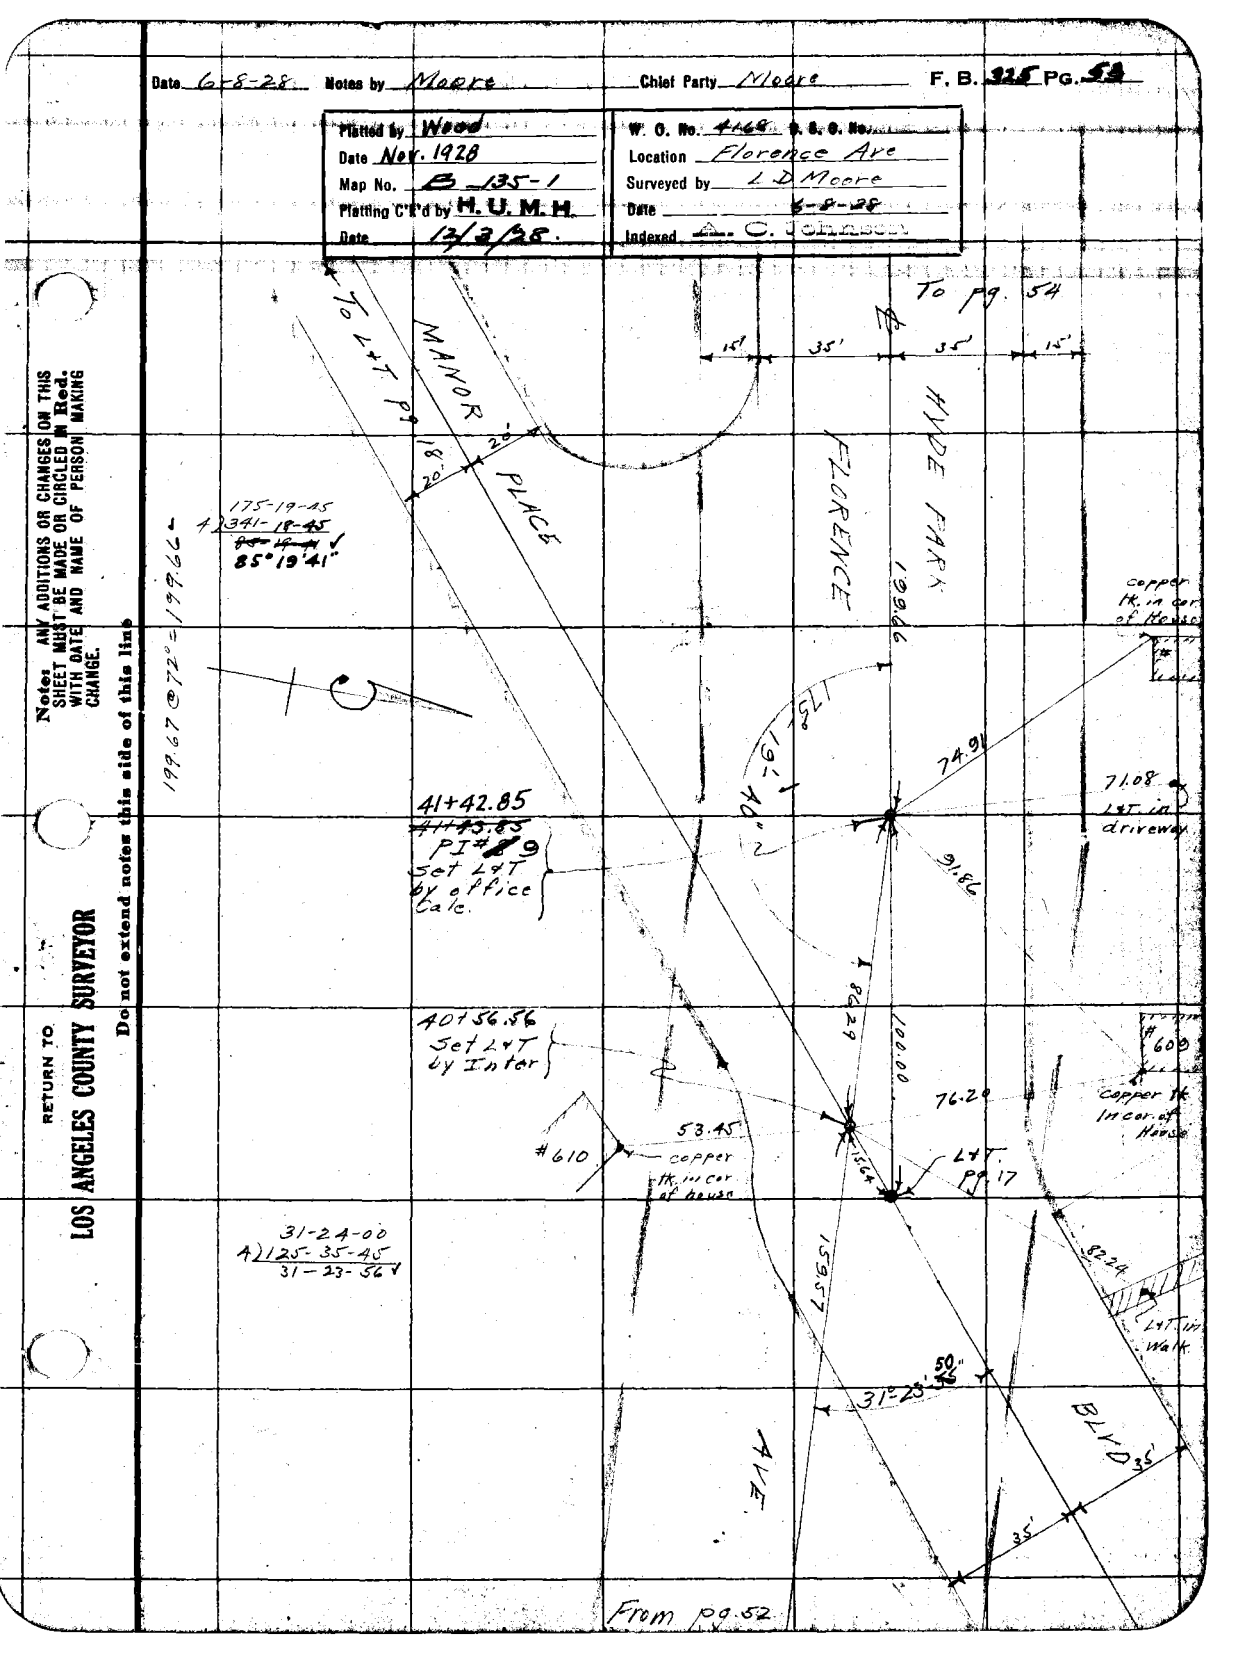

F.B. 325 Pg. 54 Moore Chief Party Notes by Moore Date 6-8-28

To Pg. 55

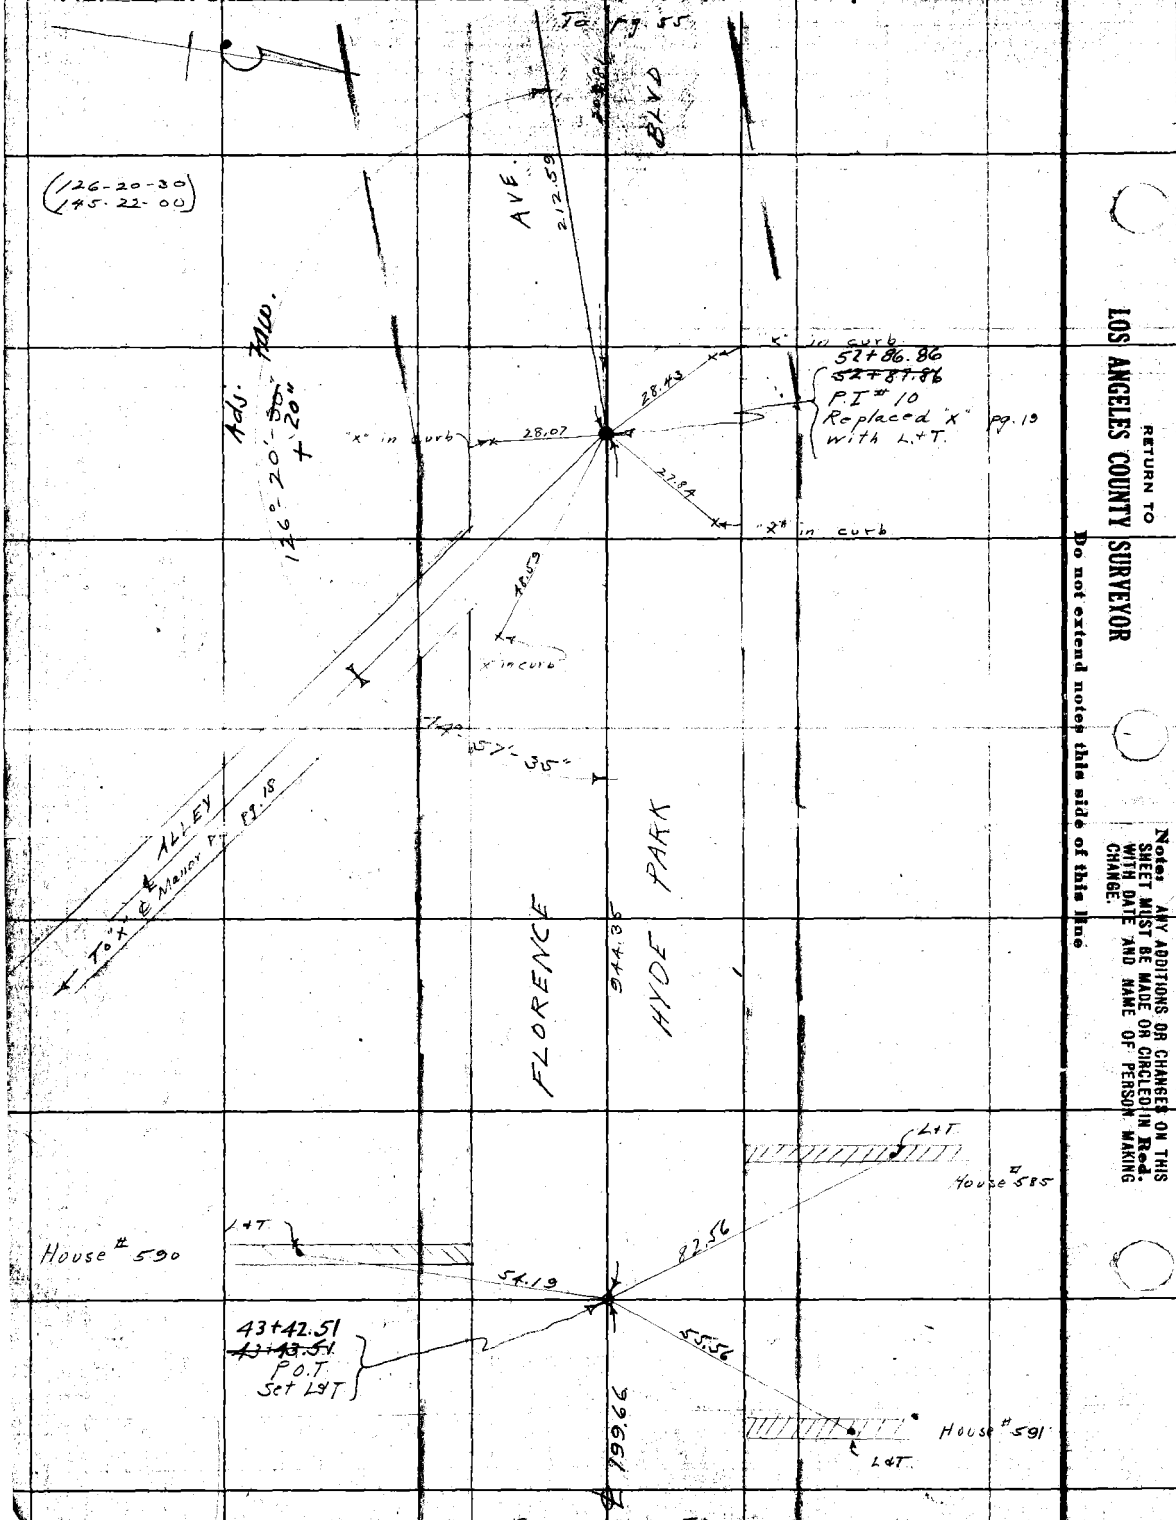

RETURN TO
LOS ANGELES COUNTY SURVEYOR
Do not extend notes this side of this line

Notes: ANY ADDITIONS OR CHANGES ON THIS SHEET MUST BE MADE OR CIRCLED IN Red. WITH DATE AND NAME OF PERSON MAKING CHANGE.

Date 10-12-28 Notes by Moore Chief Party Moore F. B. 225 PG. 55

Plotted by Wood
Date Dec. 1928
Map No. B-135-1
Plotting C'k'd by [illegible]
Date 12/3/28.

M. O. No. 4168 T.S.O. No. 933
Location Florence Ave
Surveyed by L. D. Moore
Date 10-17-28
Indexed [illegible]

Notes: ANY ADDITIONS OR CHANGES ON THIS SHEET MUST BE MADE OR CIRCLED IN Red. WITH DATE AND NAME OF PERSON MAKING CHANGE.

Do not extend notes this side of this line

RETURN TO LOS ANGELES COUNTY SURVEYOR

To pg 22

AVE

561.68

AVE

(163-40-45
294-43-15)

"x" in curb

E.C. 56+18.94
~~56+19.99~~
Set L+T
(Removed 11-10-30)
W. A Miller

Fd 2" pipe - pg. 19
Tr. 3650
Held to for E.C.

33.39

50.25

41.29

"x" in curb

42.69

Δ = 16°-19'-~~10~~05"
R = 253.80
T = 36.39
L = 72.29

49.00

36.39

35.11

"x" in curb

Adj 163°-40'-55" P.A.M.

P.I. #11
Set L+T.
by Inter.
(Removed 11-10-30)
W.A. Miller

40.47

46.00

L+T in curb

59.84

BC. - 55+46.65
~~55+47.66~~
Set L+T
(Removed 11-10-30)
W.A. Miller

82°-54'-55"

64.40

55.67

"x" in curb

FIELD AVE

142°-31'-10"

26.15

18.77

47.20

43.17

C.E. Mon
Pg. 12

33.65

32.19

C.E. Mon
Pg. 19

To pg 20

L+T
Pg. 19

134°-38'-55"

68.18

41.19

Adj. 2°-25'-00" P.A.M.

Returned
80-46-20"
~~80-46-55"~~ P.A.M.

L+T in curb

54+99.45
~~55+00.46~~
Set L+T
by Inter.
(Removed 11-10-30)
W.A. Miller

CENTINELA

FLORENCE AVE

212.59

209.81

BLVD

PARK

HYDE

~~80-46-00~~
~~243-43-45~~
(80-46-15
323-05-15)

From pg 18

See page 143 for Revised E of FLORENCE AVE

From pg 54

RETURN TO

LOS ANGELES COUNTY SURVEYOR

Note: ANY ADDITIONS OR CHANGES ON THIS SHEET MUST BE MADE OR CIRCLED IN **Red.** WITH DATE AND NAME OF PERSON MAKING CHANGE.

Do not extend notes this side of this line

Date

Notes by

Chief Party

F.B. 325 Pg. 56

Date 6-29-28 Notes by Moore Chief Party Moore F. B. 385 Pg. 57

Plotted by Wood
Date Jan 1930
Map No. 13-135-2
Planimeter by H. U. M. H.
Date 12/3/28.

W. O. No. 4168 R. & S. O. No.
Location Florence Ave
Surveyed by L. D. Moore
Date 6-29-28
Indexed A. C. Johnson

Type Square 21° 076°

To Pg. 58

(134-30-38) (186-02-00) (68-53-25) (275-33-45) Set 2x2 1½ deep by calc. dist.

FLORENCE AVE

MAJOR

P.O.S.T. Set 2x2 - 1½ deep by Inter.

R.P.O.S.T. 2x2 - 1½ deep

ALLEY

375.02 To Pg 58

65.54 Set 1x2

40.00

69.78

Fd 3/4 I.P.

Fd 2x2

P.I. - Set 2x2 - 1½ deep by rec. dist from B.C.

R.P.P.I. 2x2 1½ deep

℄ Semi tangent From Pg 38

Δ = 43°-29'-30"
R = 340'
T = 135.62

135.62

Set 1x2

BC Fd 3/4 I.P. 40.08 40.04 Fd 3/4 I.P. BC leaning

Tract 6265

Fd 2x2 10.15 39.96 20.03 39.97 Fd 2x2

ALLEY ALLEY

(88°-45'-15" 355°-01'-15") 11'

197.88

50'

88°-45'-20"

Set C.S.T.Y.N. by Inter.

300.02 AVE

From B. 38E CENTINELA 900.26

℄ To Pg. 38

To Pg. 58

30'

62.51 66.50

N.&T. in F.P. N.&T. in P.P. N.&T. in F.P.

Notes: ANY ADDITIONS OR CHANGES ON THIS SHEET MUST BE MADE ON CIRCLED IN Red. WITH DATE AND NAME OF PERSON MAKING CHANGE.

RETURN TO LOS ANGELES COUNTY SURVEYOR

Do not extend notes this side of this line

F.B. 325 Pg. 58 Moore Chief Party Notes by Moore Date 6-30-28

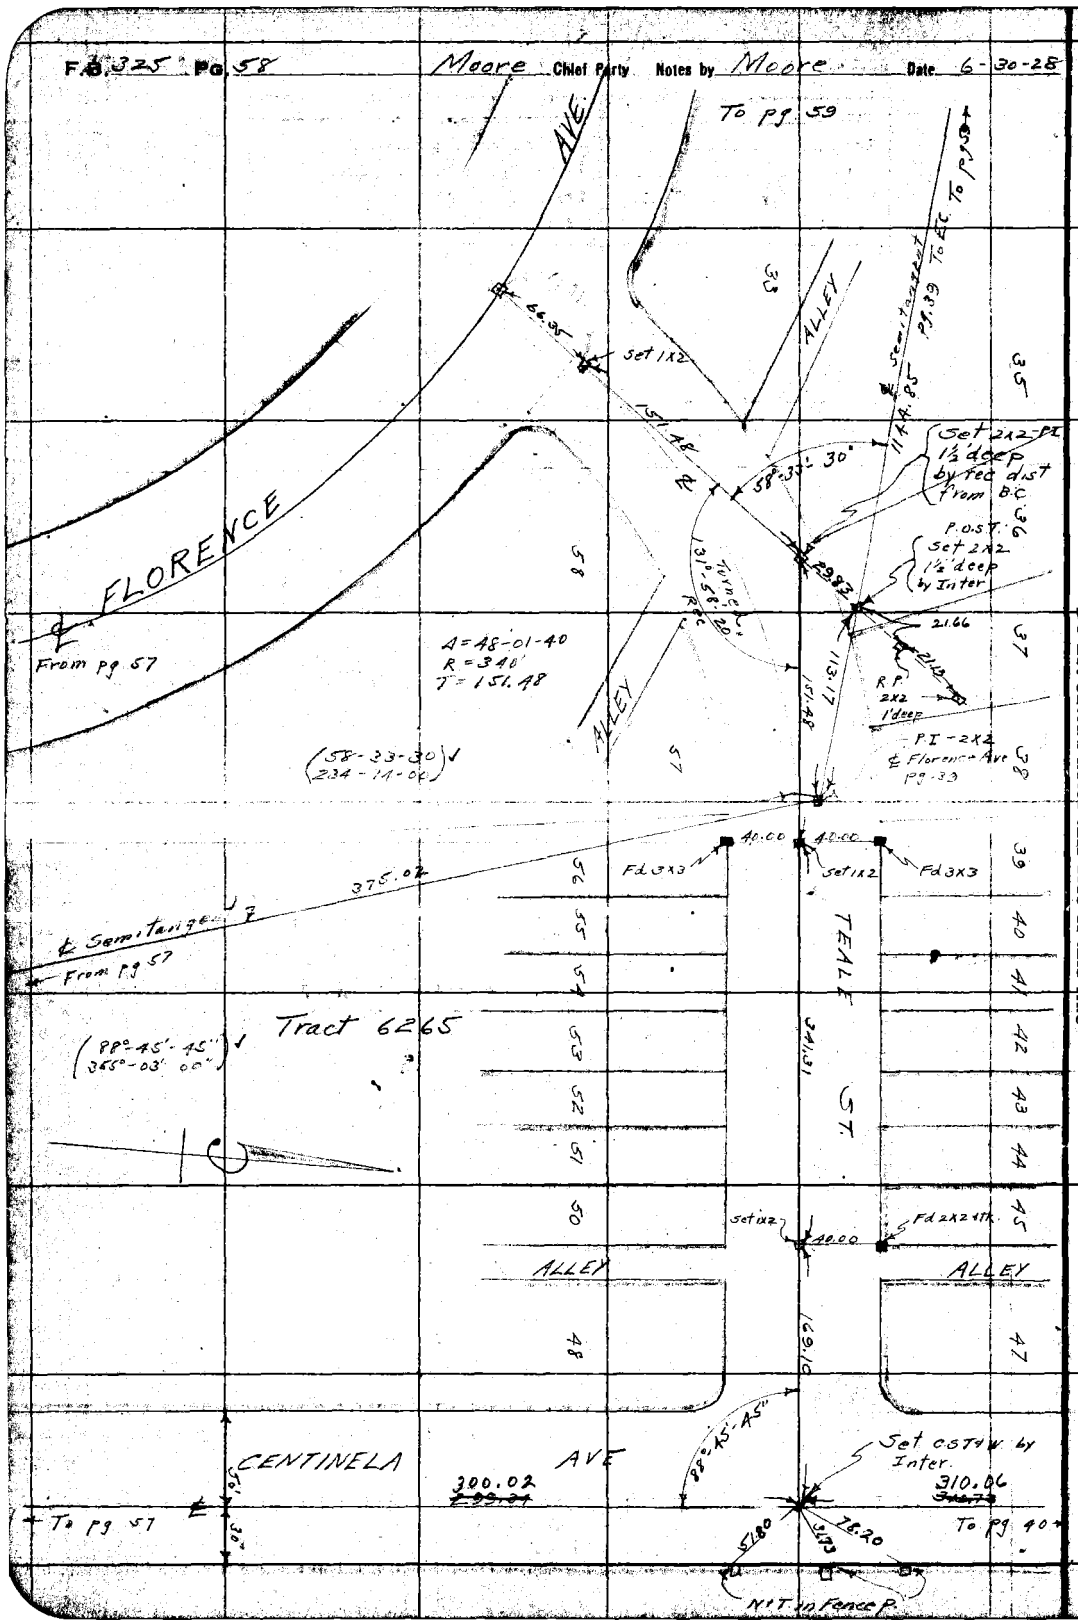

RETURN TO
LOS ANGELES COUNTY SURVEYOR
Do not extend notes this side of this line

Notes: ANY ADDITIONS OR CHANGES ON THIS SHEET MUST BE MADE OR CIRCLED IN Red. WITH DATE AND NAME OF PERSON MAKING CHANGE.

Date 7-2-28 Notes by Moore Chief Party Moore F. B. 385 Pg. 59

Plotted by Inlow
Date Jan. 1929
Map No. B-135-7
Plotted by [illegible]
Date 3/27/29

Location Florence Ave
Surveyed by L D Moore
Date 7-2-28
Indexed A. C. Johnson

Notes ANY ADDITIONS OR CHANGES ON THIS SHEET MUST BE MADE OR CIRCLED IN Red, WITH DATE AND NAME OF PERSON MAKING CHANGE.

RETURN TO LOS ANGELES COUNTY SURVEYOR
Do not 'extend' notes this side of this line

To Pg. 61

222+89.84
Fd 1x2-6"deep
F.C. 661-6
See pg. 39

542.34

Used 1985.85 448.98

N+T in P.P

Fd 2" pipe S.E. Cor. Lot 352 TT. 9488

40.07
R.P. 2x2 12" deep

Fd 2x2 6" deep

Set S.T+W by Inter

44.98
14.95
10.00
ALLEY

E.C. Set 2x2 1/2 deep
222+89.46

N+T in P.P

Fd. S.T+W Removed

96-10-40
24-42-40
96°10'40"

FOR ADOPTED LOCATION OF FLORENCE AVE. SEE F.B. 396

N+T in Telp

BLVD

Set S.T+W by Inter

INGLE WOOD O.K.C.

See pg. 58

242.65

137.55

14.5

21.25

JEFFERSON

5' walk

50'

45'

Used 1511.42

From Pg 58

F.B. 325 Pg. 60 Moore Chief Party Notes by Moore Date 7-2-27

50' 45'

Set S.T&W Pg. 61

S.T&W Pg. 61

.33

Used

FLORENCE AVE

Set S.T&W See Pg. 59

4493

1495

10.00

Fd 2" pipe S.E. Cor Lot 355

Fd 2x2 N.W. Cor Lot 311

Fd 2x2 N.E. Cor Lot 315

N.T. in P.P.

10.01

80.09

.02

.01

35.23

ALLEY

Set 1/2

not in P.P.

Fd S.T&W Removed

0.06

JANETTE ST.

Tract 9483

BLVD

ROAD

L.T.

43.46

58.11

Fd Wire spk & Tin

INGLEWOOD BLVD

45.76

Spk

43.13

185.91'

Set S.T&W Pg. 59

Fd S.T&W Removed

45'

0.03

JEFFERSON

1511.12

PORT

RETURN TO
LOS ANGELES COUNTY SURVEYOR
Do not extend notes this side of this line

Notes: ANY ADDITIONS OR CHANGES ON THIS SHEET MUST BE MADE OR CIRCLED IN Red. WITH DATE AND NAME OF PERSON MAKING CHANGE.

Date 7-2-28 Notes by Moore Chief Party Moore F. B. 225 Pg. 61

Plotted by [illegible]
Date Dec. 1928
Map No. 19-135-2
Plotting Checked by M. M.
Date 3/27/29

M. C. No. 1168 A. & S. No.
Location Florence Ave
Surveyed by L. D. Moore
Date 7-2-28
Indexed A. C. Johnson

From pg. 60

Notes: ANY ADDITIONS OR CHANGES ON THIS SHEET MUST BE MADE OR CIRCLED IN Red, WITH DATE AND NAME OF PERSON MAKING CHANGE.

RETURN TO LOS ANGELES COUNTY SURVEYOR
Do not extend notes this side of this line

403.84 N
263.77 W

403.84 N
S 42.34 E
2.00
263.77 W

263.77
57.9 N
N&T. in P.P.
Fd 3X3
45.15
0.08
0.27
Fd S.T&W
Set S.T&W by Inter.
232+35.13
RANDALL ST.
See Pg 62
30.46
45.22
Fd 3X3
56.91
N&T. in Tel.P
AVE
BLVD
(89-12-00)
356.47.15
89° 11' 45"
89° 11' 60"
Tract 9483
Tract 6265
R. R.
403.84
50'
45'
SEE P. 62A For Curve Data.
N&T. in Tel.P
0.06
Fd S.T&W FC 661-7
0.33
Set S.T&W by Inter.
31.97
N&T. in P.P
P.E.
ALLEY
N&T. in Sign Post
For curve - see pg. 62A
50'
20'
542.34
Used
FLORENCE
JEFFERSON
10°32'-15"
Adj pg 62

From pg 63

F.B. 325 Pg. 62 Moore Chief Party Notes by Moore Date 7-5-28

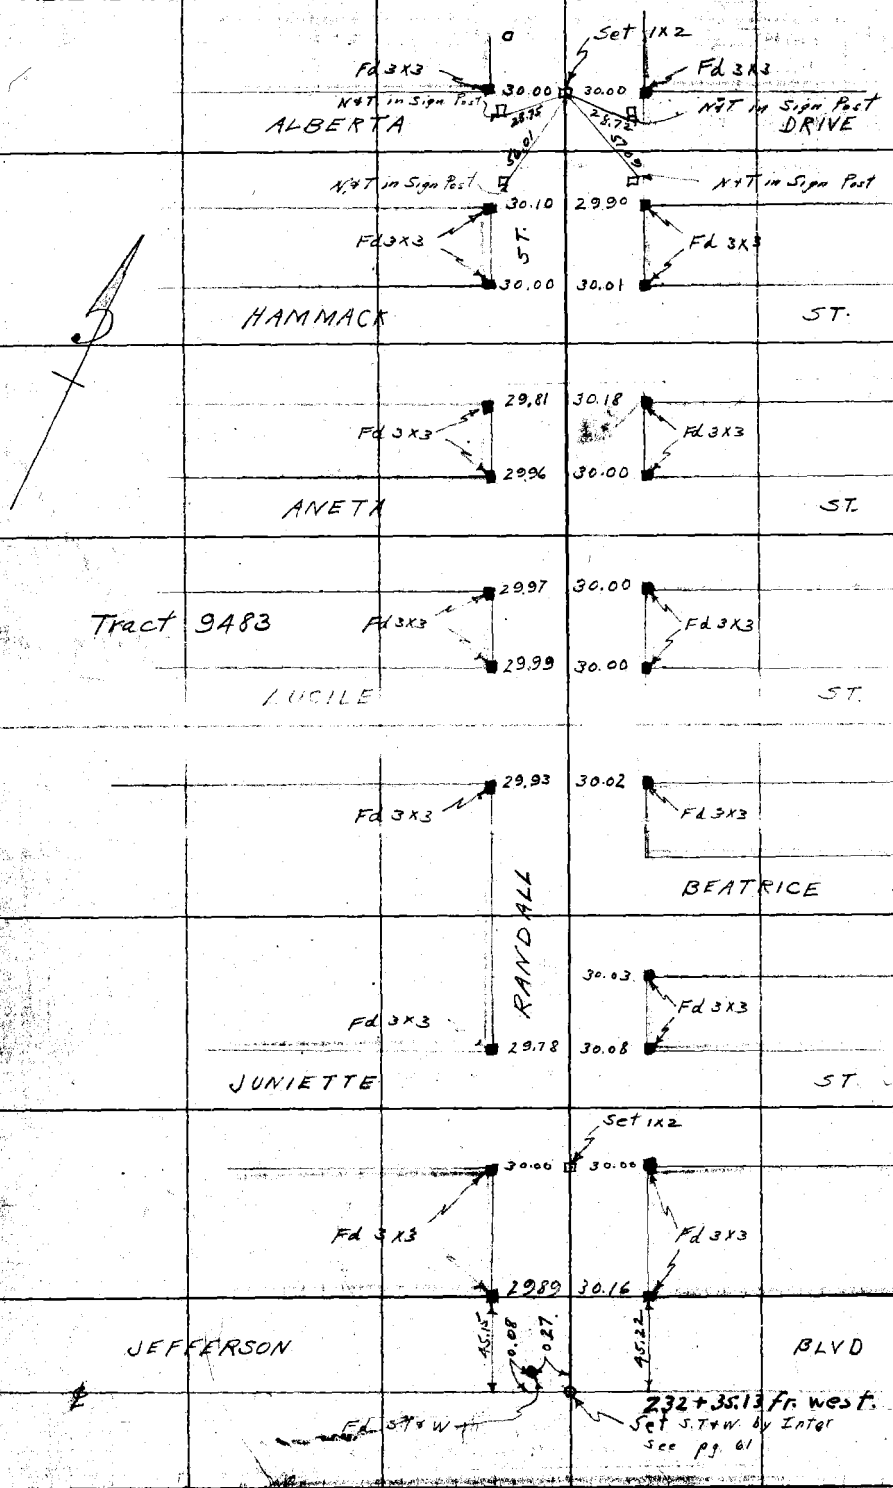

RETURN TO
LOS ANGELES COUNTY SURVEYOR
Do not extend notch this side of this line

Notes. ANY ADDITIONS OR CHANGES ON THIS SHEET MUST BE MADE OR CIRCLED IN Red. WITH DATE AND NAME OF PERSON MAKING CHANGE.

Date 1-31-29 Notes by A Moore Chief Party A Moore F.B. 325 Pg. 621

Platted by Wood	W. O. No. 4166 D. S. O. No.
Date Dec. 1928	Location Florence Ave
Map No. B-135-2	Surveyed by L. D. Moore
Platting C'k'd by H. U. M. H.	Date 1-31-29
Date 2/27/29	Indexed

Note: ANY ADDITIONS OR CHANGES ON THIS SHEET MUST BE MADE OR CIRCLED IN Red. WITH DATE AND NAME OF PERSON MAKING CHANGE.

Do not extend notes this side of this line

RETURN TO LOS ANGELES COUNTY SURVEYOR

50'

To Randall st pg 61

N & T-P.P.

229+23.49

Set S+W

N & T-P.P.

Δ = 10°-32'-30" Rt
R = 1015
T = 92.20
L = 183.89

92.20

P.I. STA 229+23.49 Pg. 61

FOR ADOPTED LOCATION OF FLORENCE Ave. SEE F.B. 396.

RP-S 12 12" deep

55.69

P.C. 227+39.60

Set 2X— 12" deep

N & T-P.P.

From E.C. 199.57

F.B. 325 Pg. 62B Allen Chief Party Notes by Allen Date 5-31-29

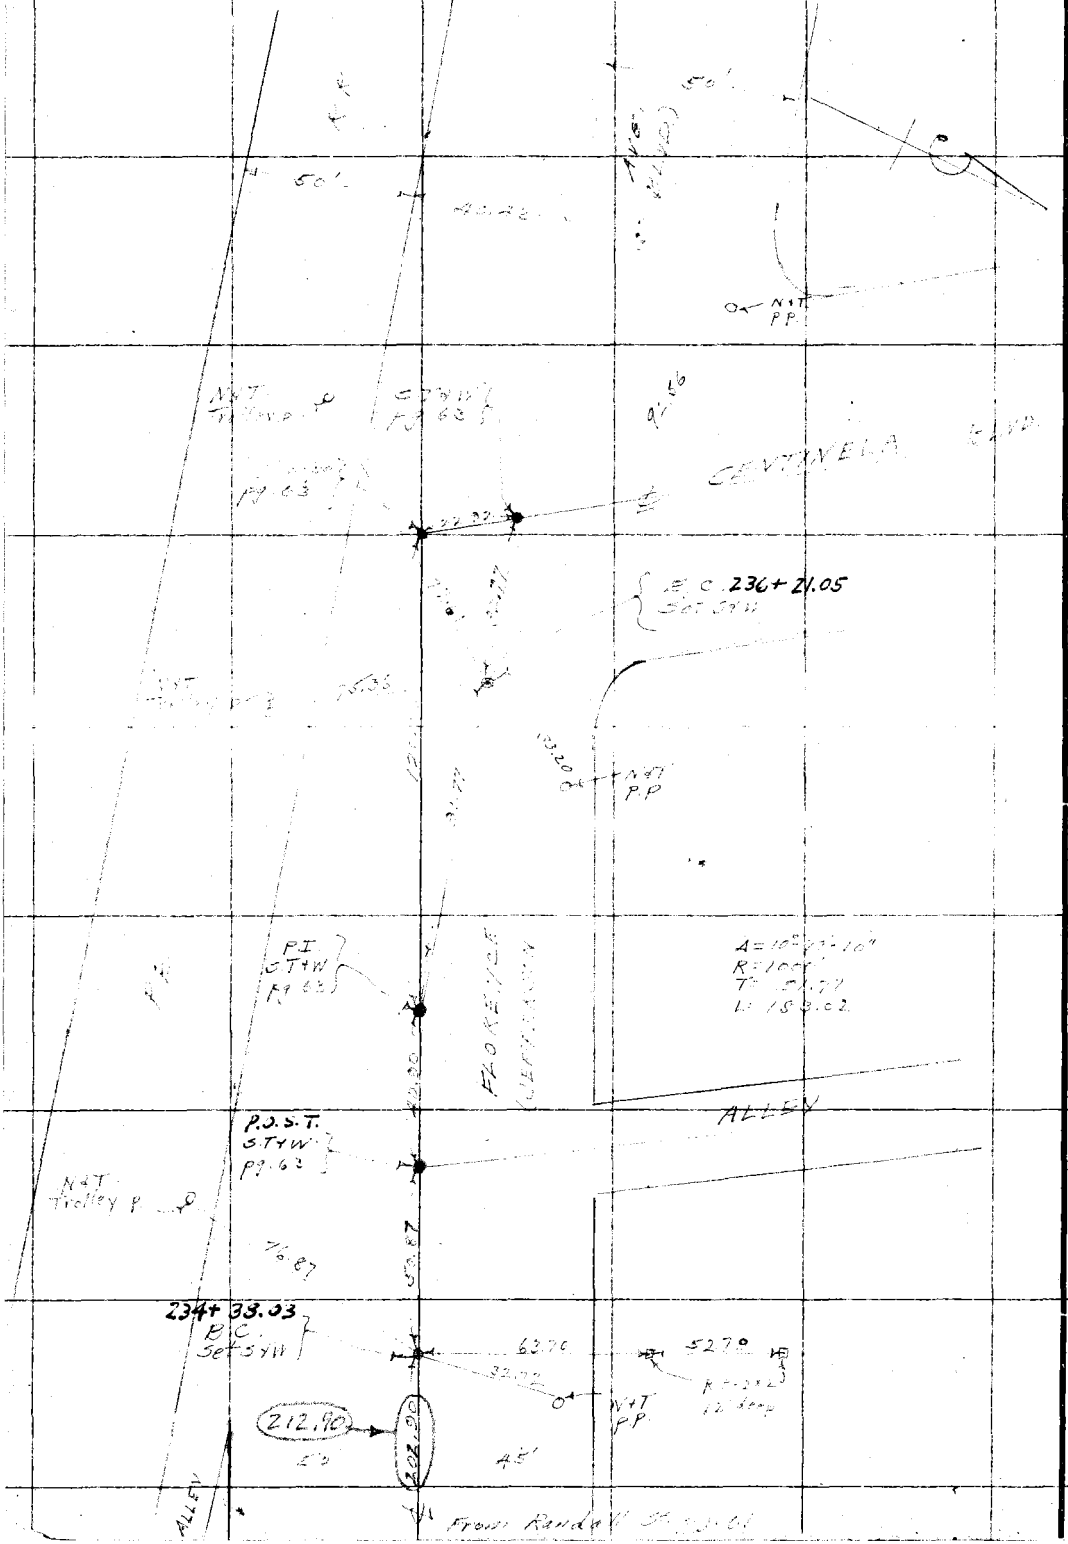

RETURN TO
LOS ANGELES COUNTY SURVEYOR

Do not extend notes this side of this line.

Note: ANY ADDITIONS OR CHANGES ON THIS SHEET MUST BE MADE OR CIRCLED IN Red. WITH DATE AND NAME OF PERSON MAKING CHANGE.

Date 7-5-28 Notes by Moore Chief Party Moore F. B. 225 Pg. 64

Date Dec. 1928
Map No. B-135-3
Date Feb-1929

Location Florence Ave
Surveyed by L. D. Moore
Date 7-5-28
Indexed A. C. Johnson

Notes: ANY ADDITIONS OR CHANGES ON THIS SHEET MUST BE MADE ON CIRCLED BLUE PRINT AND NAME OF PERSON MAKING CHANGE.

RETURN TO LOS ANGELES COUNTY SURVEYOR

Do not extend notes this side of this line

R.R.

Tract 10038

BLVD

ROAD

CENTINELA

BLVD

Fd L+T FR. 297-45 FB 285-97

Fd 1" Pipe FB. 285-97 FR. 297-46 FR-300-76A

N.+T. in Trolley pole

N.+T. in P.P.

N.+T. in Tel.p

Fd. S.T+W F.O. 335-2

P.E.

P.L.

Adopted C.L.

Tract 9483

See P. 67

For curve See pg. 628

JEFFERSON

ST

ALLEY

JUNIETTE

Fd 2x2

Set 1x2

R.O.S.T. Set S T+W by Inter.

Trolley P.

N.+T. in P.P.

58'-20'

ALLEY

(95-57-30) (23-57-15) 95°58'19"

PG 61

F.B. 325 Pg. 64 — Moore Chief Party — Notes by Moore — Date 7-6-28

To pg. 70A

To N+T at Apt. at Bay St - Checks ties per F.R. 300-69

F.R. 300-63-69 Z

New 2787 Old 2719

255+45.49

N+T - Guy. P

Fd L+T F.O. 335-1

N+T Guy P.

255+04.40

Fd Nail F.O. 335-4

N+T - Guy P.

N+T - P.P.

FOR ADOPTED CENTER LINE OF JEFFERSON BLVD SEE F.B. 396-73 to 76

Adopted ℄ JEFFERSON BLVD R.D.I. 300

See. P. 70

C.S. 7174 and ZR 152 FLORENCE

(90-43-15) (2-53-00)

Southwesterly line of Francisco Machado 15.64 A

Fd S.T+W F.O. 335-3

N+T - Trolley P

Fd 3x3 1' deep F.O. 335-3

247+16.88

Fd 2x2

GROSVENOR 176.25 BLVD

Fd N+T

N+T - P.P.

N+T E.P.

Set S & W. by inter.

247+09.88

FORT ROAD

Front P.B. 6-3

RETURN TO LOS ANGELES COUNTY SURVEYOR

Do not extend notch this side of this line

Notes ANY ADDITIONS OR CHANGES ON THIS SHEET MUST BE MADE OR CIRCLED IN Red. WITH DATE AND NAME OF PERSON MAKING CHANGE.

Date 9-27-28 Notes by Moore Chief Party Moore F. B. 226 Pg. 65

Plotted by [illegible]
Date Dec. 1928
Map No. B-135-3
Plotting C'k'd by Blackmar
Date Feb-1929

W. O. No. 4168 + S. O. No.
Location Florence Ave
Surveyed by L. D. Moore
Date 9-27-28
Indexed A. C. Johnson

To pg. 66

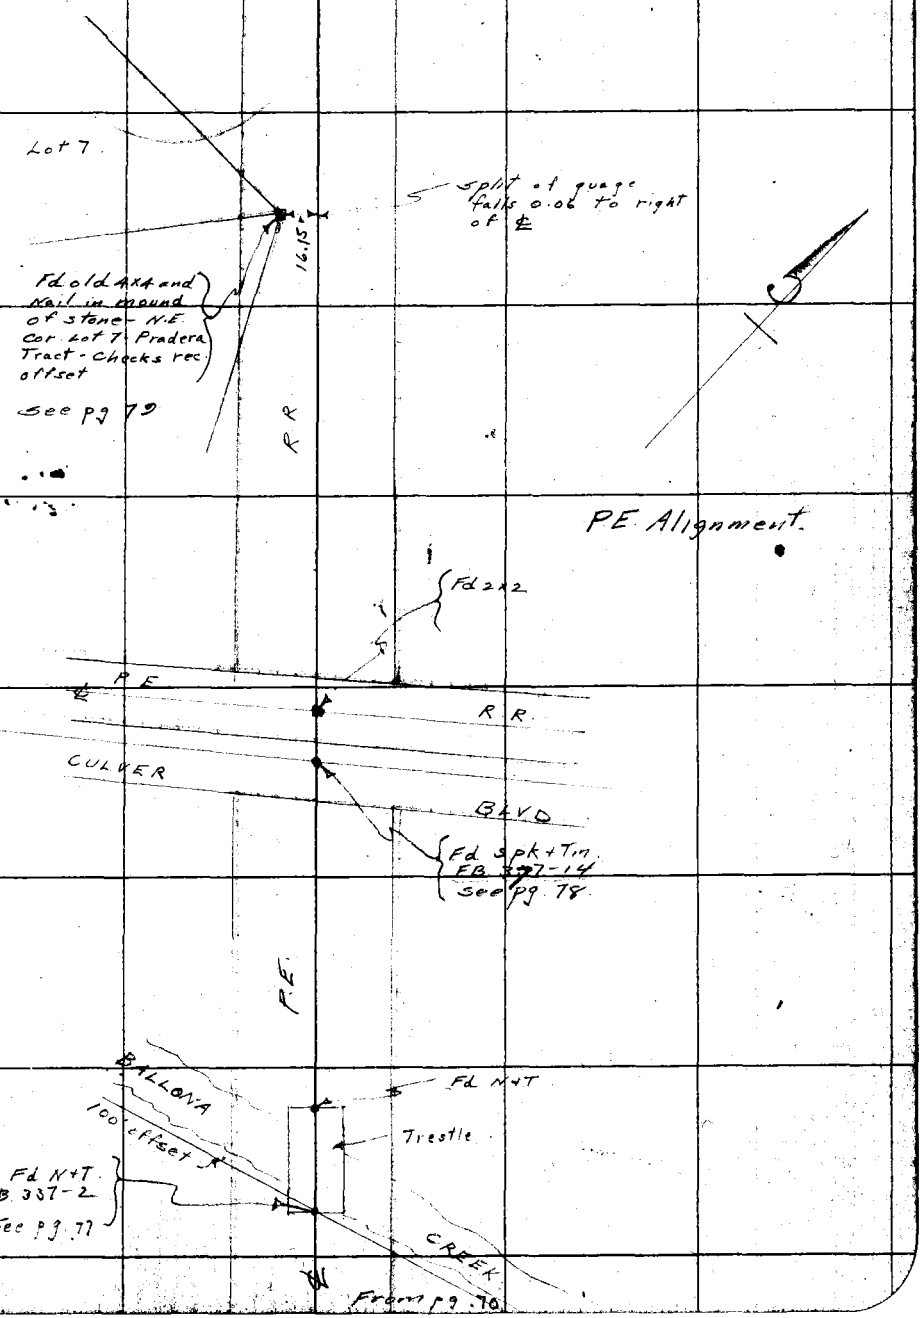

Notes: ANY ADDITIONS OR CHANGES ON THIS SHEET MUST BE MADE OR CIRCLED IN Red. WITH DATE AND NAME OF PERSON MAKING CHANGE.

Do not extend notes this side of this line

RETURN TO LOS ANGELES COUNTY SURVEYOR

F.B. 325 Pg. 66 Moore Chief Party Notes by Moore Date 9-27-28

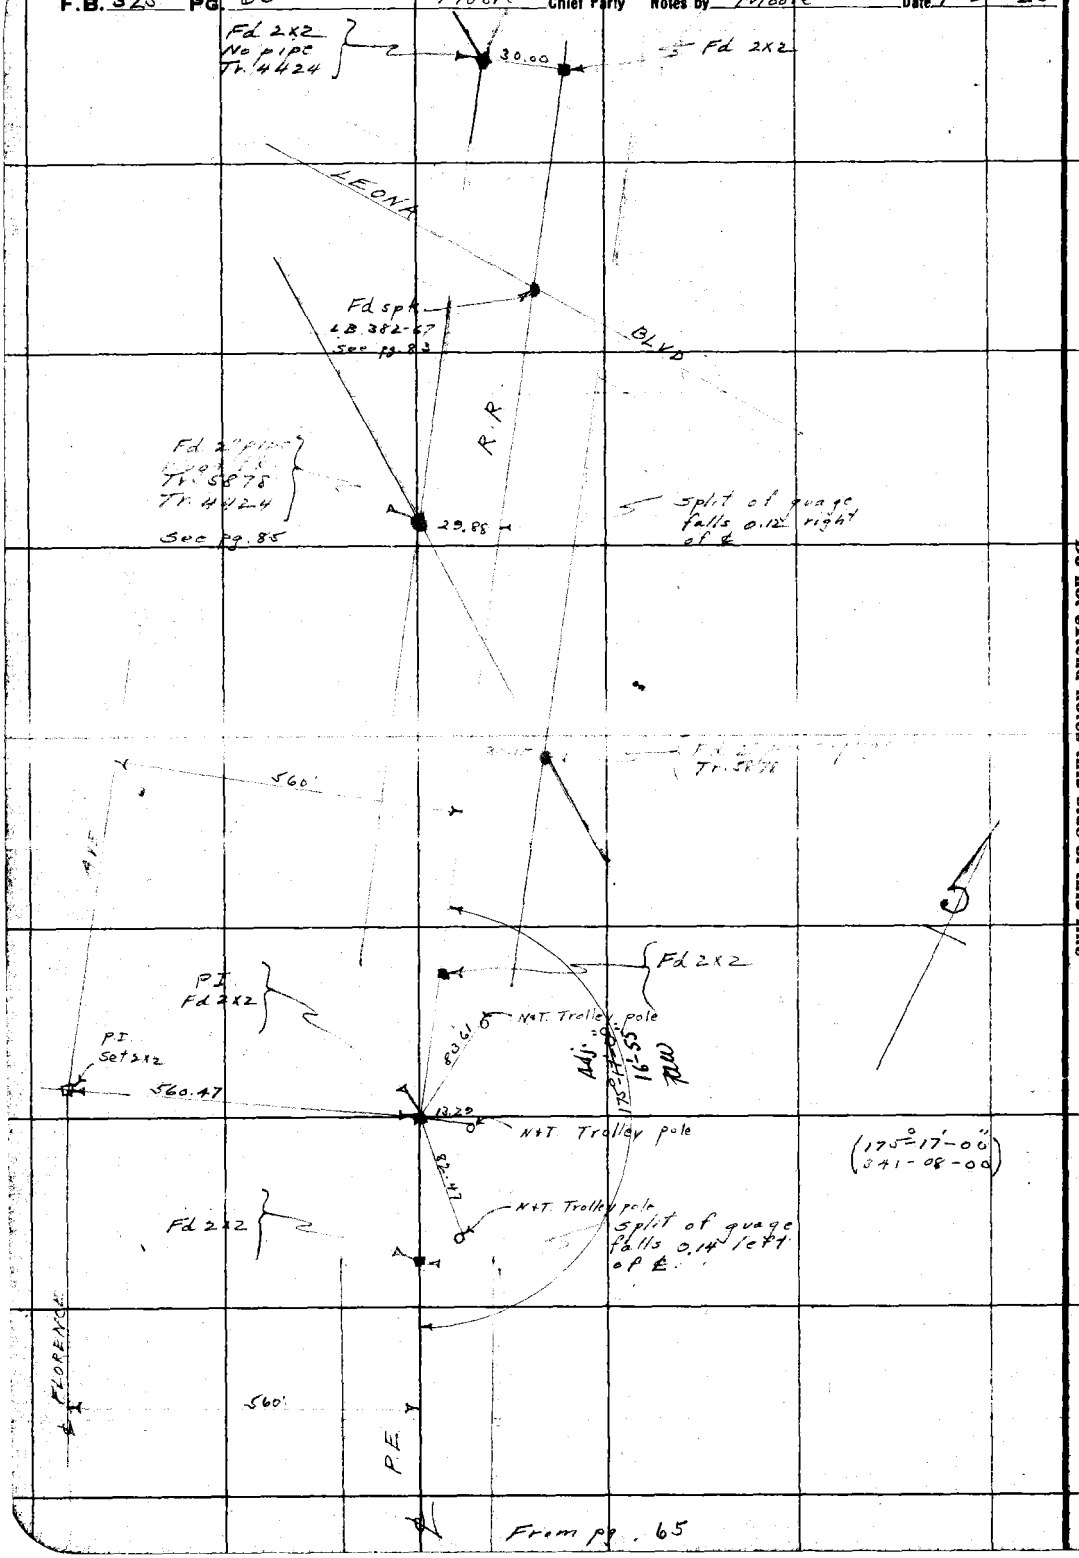

RETURN TO
LOS ANGELES COUNTY SURVEYOR
Do not extend notes this side of this line

Notes: ANY ADDITIONS OR CHANGES ON THIS SHEET MUST BE MADE OR CIRCLED IN Red. WITH DATE AND NAME OF PERSON MAKING CHANGE.

Date 11-8-26 Notes by Moore Chief Party Moore F.B. 335 Pg. 67

Platted by Wood	W.O. No. 4168 D.S.G. No. 033
Date Jan 11 1927	Location Florence Ave
Map No. B-135-3	Surveyed by L.D. Moore
Platting Ck'd by Blackmer	Date 11-8-26
Date 1-6-27	Indexed

Notes: ANY ADDITIONS OR CHANGES ON THIS SHEET MUST BE MADE OR CIRCLED IN Red. WITH DATE AND NAME OF PERSON MAKING CHANGE.

Do not extend notes this side of this line

RETURN TO LOS ANGELES COUNTY SURVEYOR

To Pg 68

T = 76°

50'

40.13

9.57

50

30°

32.1

55

R.R.

SEE FB. 396 FOR ADOPTED E

3 LVOJ

This

AVE

Void

N+T PP

N+T Trolley

1" p/pg Pg. 63

22.92

57.52

CENTINELA BLVD

To Pg 63

63

236+99.82

S.T+W Pg 63

Set S.T+W by Inter Removed

120.05

9.08

43.08

42.79

46.93

N+T PP

S.T+W. Pg. 63

FOR CURVE See P. 62B

85°

10'

10'

ALLEY

To Pg. 63

S.T+W. Pg. 63.

38.25

2.35

70.82

12.41

12.88

Removed Set S.T+W by Inter

67.03

N47.111 Trolley pole

Removed Angle point Set S.T+W by Inter.

JEFFERSON

FLORENCE

N47.111 PP

169°-30'-50"

95°-52'-20"

P.E.

50'

50'

45'

From Pg. 61

RETURN TO
LOS ANGELES COUNTY SURVEYOR

Note: ANY ADDITIONS OR CHANGES ON THIS SHEET MUST BE MADE OR CIRCLED IN Red. WITH DATE AND NAME OF PERSON MAKING CHANGE.

Do not extend notes this side of this line

F. B. 325 Pg. 68 Chief Party Notes by Alvarez Date 11-1-28

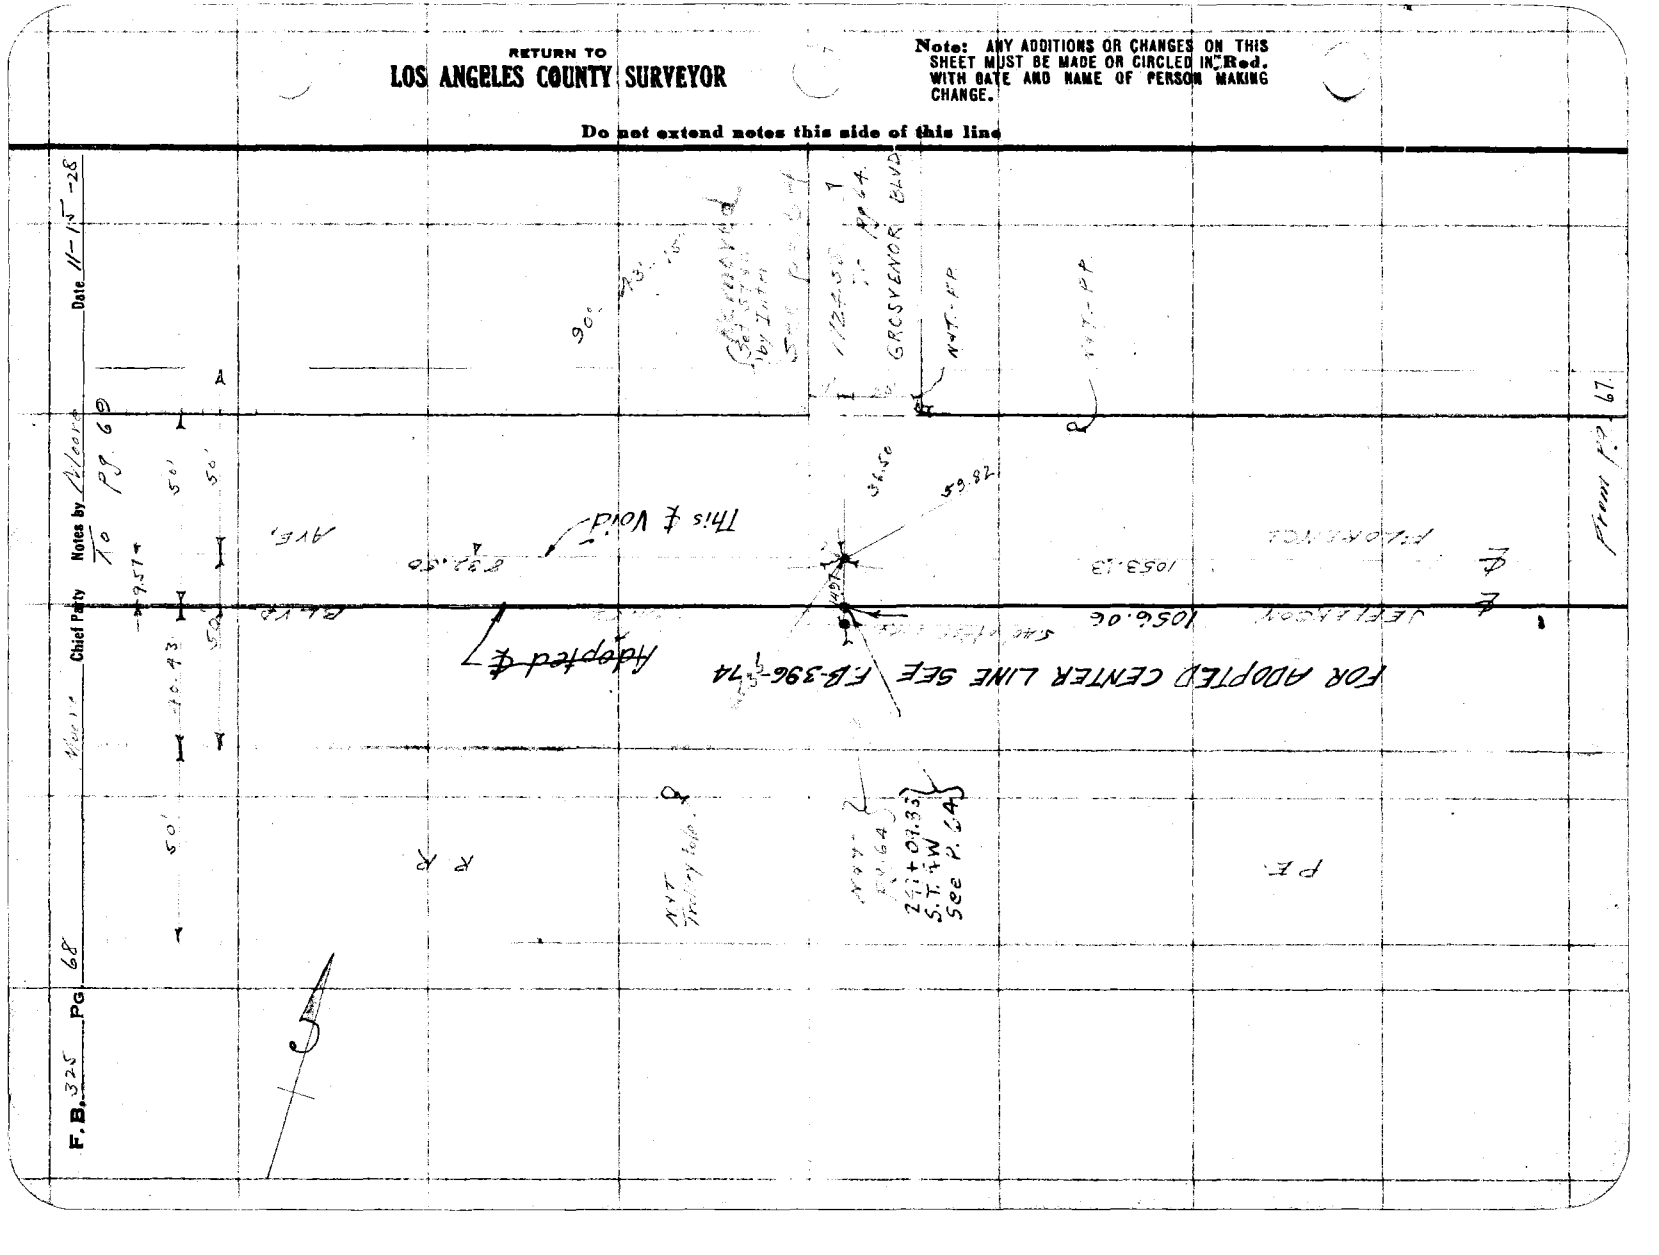

Date 11-8-28 Notes by Moore Chief Party Moore F.B. 325 Pg. 69

Platted by Wood	W. O. No. 4168 ~~S. O. No.~~ 033
Date Jan 1929	Location Florence Ave
Map No. B-135-3	Surveyed by L D Moore
Platting Ck'd by Blackmer	Date 11-8-28
Date Feb-1929	Indexed

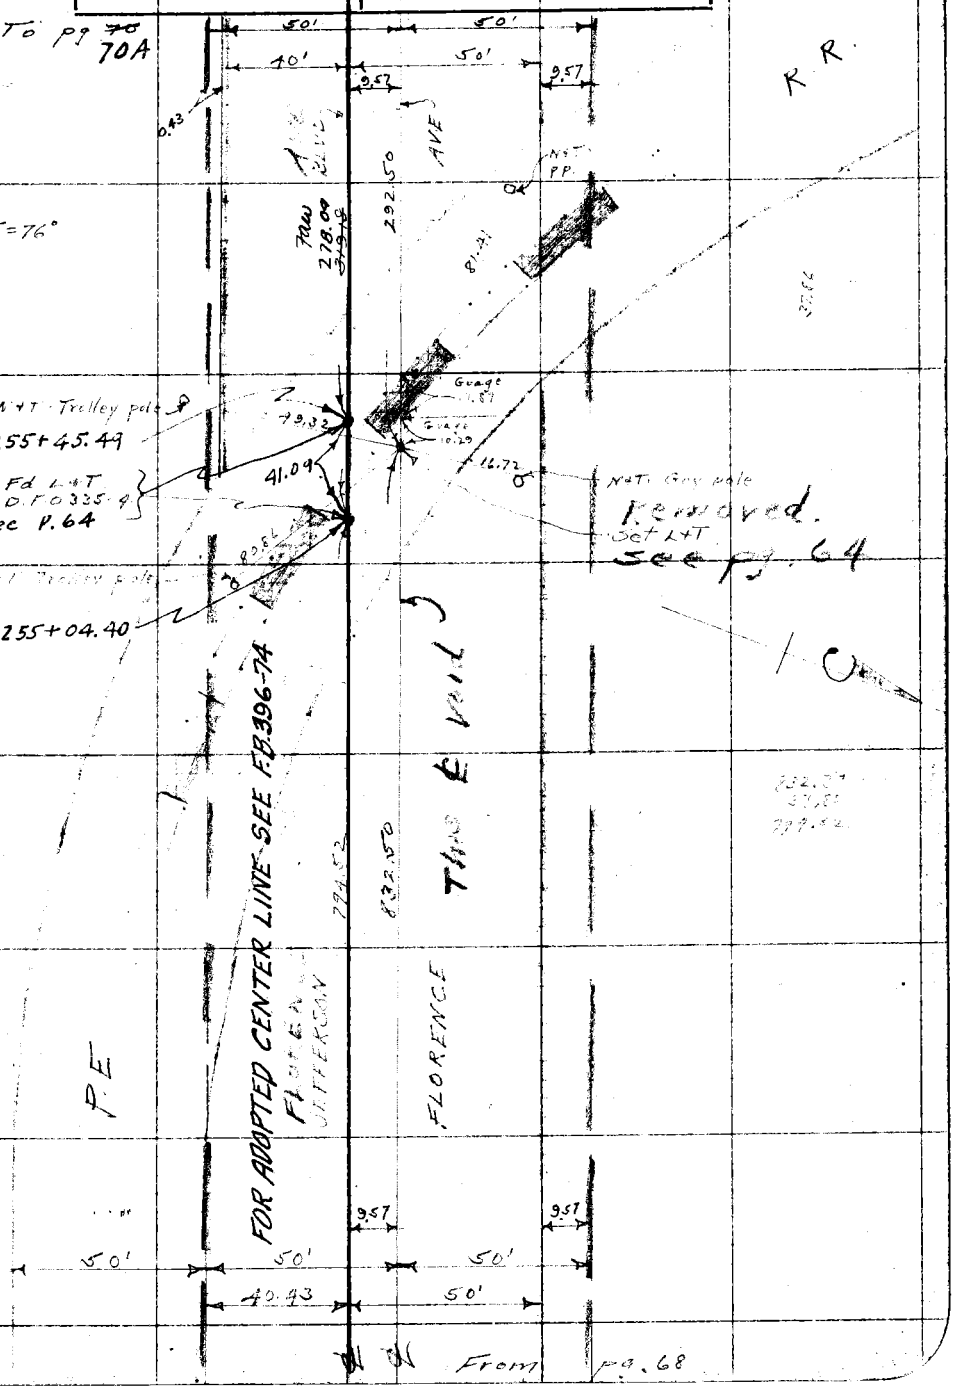

RETURN TO
LOS ANGELES COUNTY SURVEYOR

Do not extend notes this side of this line

Notes: ANY ADDITIONS OR CHANGES OF THIS SHEET MUST BE MADE OR CIRCLED IN Red. WITH DATE AND NAME OF PERSON MAKING CHANGE.

F. B. 325 Pg. 70 Moore Chief Party Notes by Moore Date 11-8-28

To pg. 73

R.P. 2x2 15' deep

Set 2x2 15' deep E.C.

229.03 To pg. 74

(40°-34-15" 142-17-00)

Iron & Hickson blvd

289.67

N47 Guard Post

84.15

N47 PP

3.4'-15"

AVE

36.83

26.60

T = 76°

A = 40° 34' 15"
R = 500'
T = 154.81
L = 354.05

RETURN TO LOS ANGELES COUNTY SURVEYOR

Do not extend notes this side of this line

Note: ANY ADDITIONS OR CHANGES ON THIS SHEET MUST BE MADE OR CIRCLED IN Red. WITH DATE AND NAME OF PERSON MAKING CHANGE.

Void See pg 70A

N47 Guard Post

87.36

N47 PP

676.22

FLORENCE

139° 29'-30"

Old angle point & Jefferson Blvd Fd N47 RO F0.335-4

N47 Guard Post

62.02

286.06

28.47

Set Nail by Letter

JAMIESON

80.26

Old ℄ 379.18

℄ 292.50

139°

N47 Trolley ℄

(179-29-30 357-58-00)

Set CT-RW by Curb

(139-25-45 197-43-00)

From pg 69

Date 3-5-26 Notes by Moore Chief Party Moore F.B. 325 Pg. 69A

Platted by Wood	W. O. No. 4168 D. S. O. No.
Date 3/23/29	Location Florence Ave
Map No. B-135-3	Surveyed by L. D. Moore
Platting C'k'd by H. M. M. H.	Date 3-6-26
Date 3/27/29	Indexed A. C. Johnson

To bottom pg 69B

N47 Trolley P

255+38.88. Set STAW by proportion between Gresham Blvd & Ray St

Set 4x4 15" deep

500.00

N47 Trolley P

N47 Guy P

29 5+55.49 L47 P

25 5+64.40 47-pg 69

See Page 69A 0/60 W.K.B. 3/27/29

SEE F.B. 396-75

N47 Trolley P

Set STAW by proportion between Gresham Blvd and Ray ST

Set 4x4 18" deep

500.00

N47 PP

96.77

N47 PP

Curve 88°10'00"

JEFFERSON

247+09.88 STAW

GRESHAM BLVD

Notes: ANY ADDITIONS OR CHANGES ON THIS SHEET MUST BE MADE OR CIRCLED IN Red. WITH DATE AND NAME OF PERSON MAKING CHANGE.

Do not extend notes this side of this line

RETURN TO LOS ANGELES COUNTY SURVEYOR

F.B. 325 Pg 69B Moore Chief Party Notes by Moore Date 3-8-29

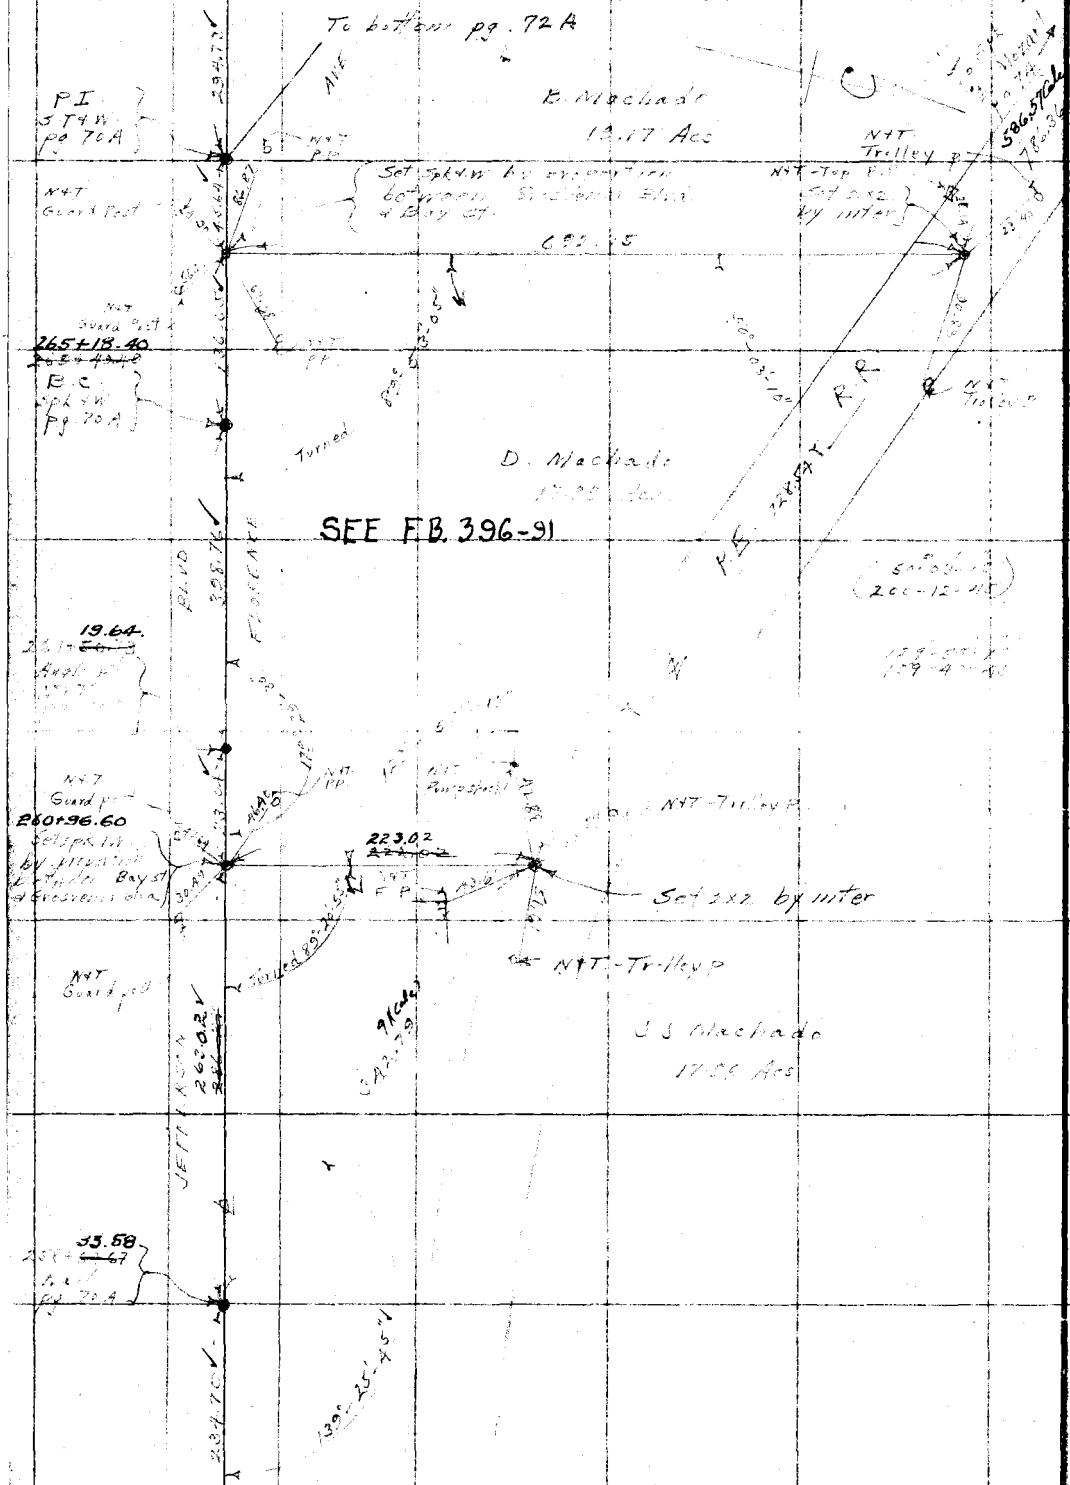

RETURN TO
LOS ANGELES COUNTY SURVEYOR
Do not extend notes this side of this line

Note: ANY ADDITIONS OR CHANGES ON THIS SHEET MUST BE MADE OR CIRCLED IN Red. WITH DATE AND NAME OF PERSON MAKING CHANGE.

Date 1-30-29 Notes by Moore Chief Party Nickle F.B. 325 Pg. 70A

Platted by Wood	W.O. No. 4168 D.S.O. No.
Date Jan. 1927	Location Florence Ave
Map No. 3-135-3	Surveyed by J. D. Moore
Platting C'k'd by Blackmer	Date 1-30-29
Date Feb-1927	Indexed A. C. Johnson

RETURN TO LOS ANGELES COUNTY SURVEYOR

Do not extend notes this side of this line

Note: ANY ADDITIONS OR CHANGES ON THIS SHEET MUST BE MADE OR CIRCLED IN Red. WITH DATE AND NAME OF PERSON MAKING CHANGE.

To pg 73

To pg 71

To pg 71

From pg. 64

SEE F.B. 396-75

To pg 71

Adopted ℄ of Florence Ave F.B. 396-75

18.40
265+49.44
B.C. Set S.T.+W.

19.64
261+50.73
Angle point in Sidewalk 2 1/2' E. of N4T Rd. Sta. 325+

33.58
258+67.67
Set Nail by Linter.

P.I. - Set S.T.+W. by Linter

N4T - Guard Post

N4T - P.P.

N4T - Trolley P.

N4T - FP

R.P.E.C. Set 1" I.P. 18" deep

P.E.C. 268+99.10 Set I.P. 18" deep

A = 40-03-45
R = 500'
T = 182.29
L = 349.41

139°-56'-15"

139°-25'-30"

139°-25'-31"

45°

7.40

5.60

68.01

64.23

38.30

34.16

66.21

95.25

50.73

69.27

42.96

28.76

60.00

40.00

JEFFERSON

BLVD

F. B. 225 Pg. 71 & 72 Chief Party Notes by Date

RETURN TO
LOS ANGELES COUNTY SURVEYOR
Do not extend notes this side of this line

Note: ANY ADDITIONS OR CHANGES ON THIS SHEET MUST BE MADE OR CIRCLED IN Red. WITH DATE AND NAME OF PERSON MAKING CHANGE.

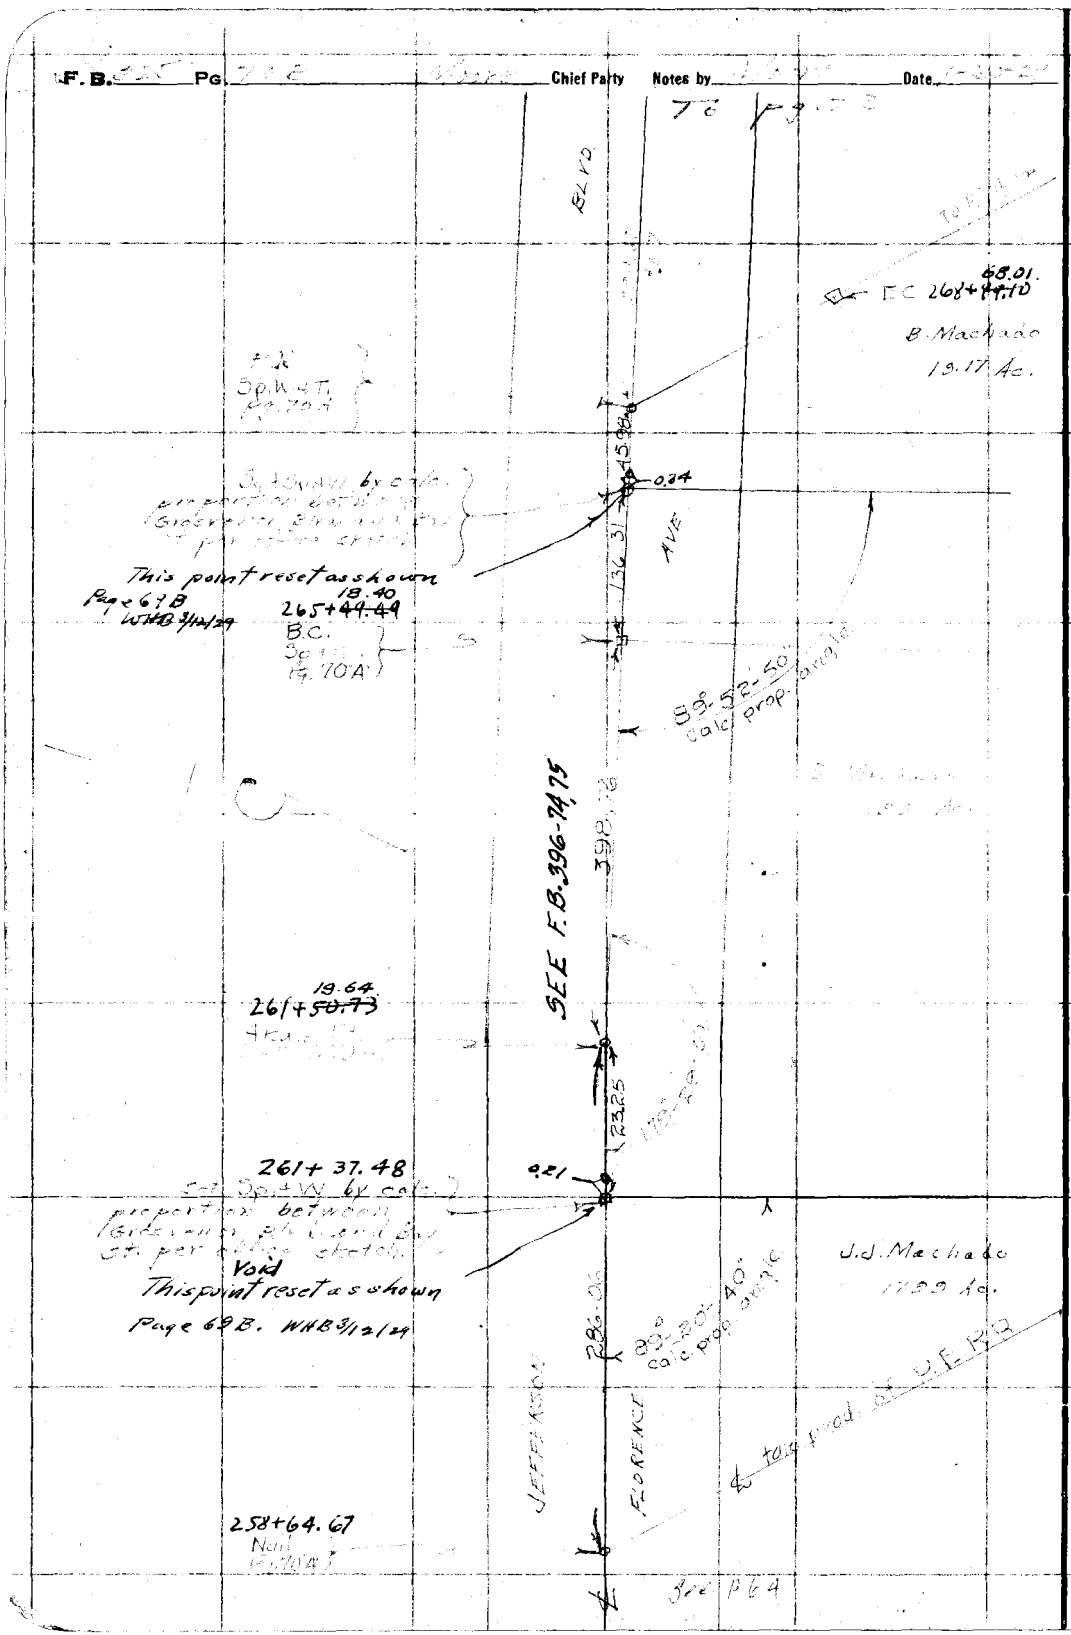

Date 11-15-28 Notes by Moore Chief Party Moore F. B. 325 PG. 71

Plotted by [illegible]
Date Jan 1929
Map No. B-135-3
Plotting C'k'd by Blackmore
Date Feb-1929

W. O. No. 4168 T.O. No. 913
Location Florence Ave
Surveyed by L D. Moore
Date 11-W-28
Indexed A. C. Johnson

T6 pg. 72

287.67 Taw

EC

AVE

B. Machado
19.17 Ac.

P.I.
S.T+W
pg. 70

51.17

Set S.T+W by calc proportion between Grosvenor Blvd and Bay St. per office sketch

133.64

20"

B.C.
S.T+W
pg. 70

89° 22' calc proportion angle

D Machado
17.99 Ac.

Taw 424.72

FLORENCE

Set S.T+W by calc proportion between Grosvenor Blvd and Bay St per office sketch

20° 40' calc proportion angle

89°

Taw 251.50

See pg. 10 B

J.J. Machado
17.99 Ac.

4 Tan. prod. of PE RR

S.T+W
pg. 70

292.50

Notes ANY ADDITIONS OR CHANGES ON THIS SHEET MUST BE MADE OR CIRCLED IN Red. WITH DATE AND NAME OF PERSON MAKING CHANGE.

Do not extend notes this side of this line

RETURN TO LOS ANGELES COUNTY SURVEYOR

F.B. 325 PG. 72 — Moore Chief Party — Notes by Moore — Date 11-15-28

To Bay St pg. 76

Lot 2
A Cota. 18.04 Ac.

Set S T & W by proportion between Grosvenor Blvd and Bay St per office sketch
This point reset
See Page 72B
WNB 3/12/29

900.04
0.64
BLVD.
791.45
89° 59' 20" calc proportionate
S. M. de Bernardo
20.93 Ac.

T = 76°
SEE F.B. 396-91

284+~~89.68~~ 53.28
Set 2x2 18" deep by Inter
60.18
I. 15° 17'
0.69

Set S T & W by proportion between Grosvenor Blvd and Bay St per office sketch
This point reset
See Page 72A
0.63
1141.25
(49° 59' 15")
(199 57 00)
49° 59' 15" A.
See Page 72A
P.O.T. 2x2 pg. 77
284+~~62.19~~ 62.68
31.59

T 89° 57' 00" Turned calc proportionate angle
J. Machado

(129° 58' 30")
(59 54 15)
I. 90° 02' 45"
Tangent calc angle
Tangent P.O.T. 90° 0' 5" 101
497.49
129° 58' 35"
0.42
0.56
59.30
~~59.93~~
274+~~34.64~~
Set 2x2 18" deep by Inter
See Page 72A

Set S T & W by proportion between Grosvenor Blvd and Bay St per office sketch
This point reset
See Page 72A

angle pt S T & W pg. 73
Void.

98.93
179° 29' 30"
JEFFERSON
198.46
B.
FLORENCE
A= 13° 05"
Machado

Void S T & W pg. 73
See pg. 73

MOZART
270.17
802.96
ST.
27I+~~37.40~~ 06.34
S T & W pg 74
See Page 72A
1917. Ac. WNB 3/12/29
289.67
25° 12' 30"
220.0

From pg. 71

RETURN TO LOS ANGELES COUNTY SURVEYOR

Do not extend notch this side of this line

Notes: ANY ADDITIONS OR CHANGES ON THIS SHEET MUST BE MADE OR CIRCLED IN Red. WITH DATE AND NAME OF PERSON MAKING CHANGE.

Date 3-8-29 Notes by Moore Chief Party Moore F.B. 325 Pg. 72A

Platted by Wood	W. O. No. 4168 D. S. O. No.
Date 3/23/29	Location Florence Ave
Map No. B-135-3	Surveyed by A. D. Moore
Platting Ck'd by H. U. M.	Date 3-8-29
Date 3/27/29.	Indexed

Note: ANY ADDITIONS OR CHANGES ON THIS SHEET MUST BE MADE OR CIRCLED IN Red. WITH DATE AND NAME OF PERSON MAKING CHANGE.

Do not extend notes this side of this line

RETURN TO LOS ANGELES COUNTY SURVEYOR

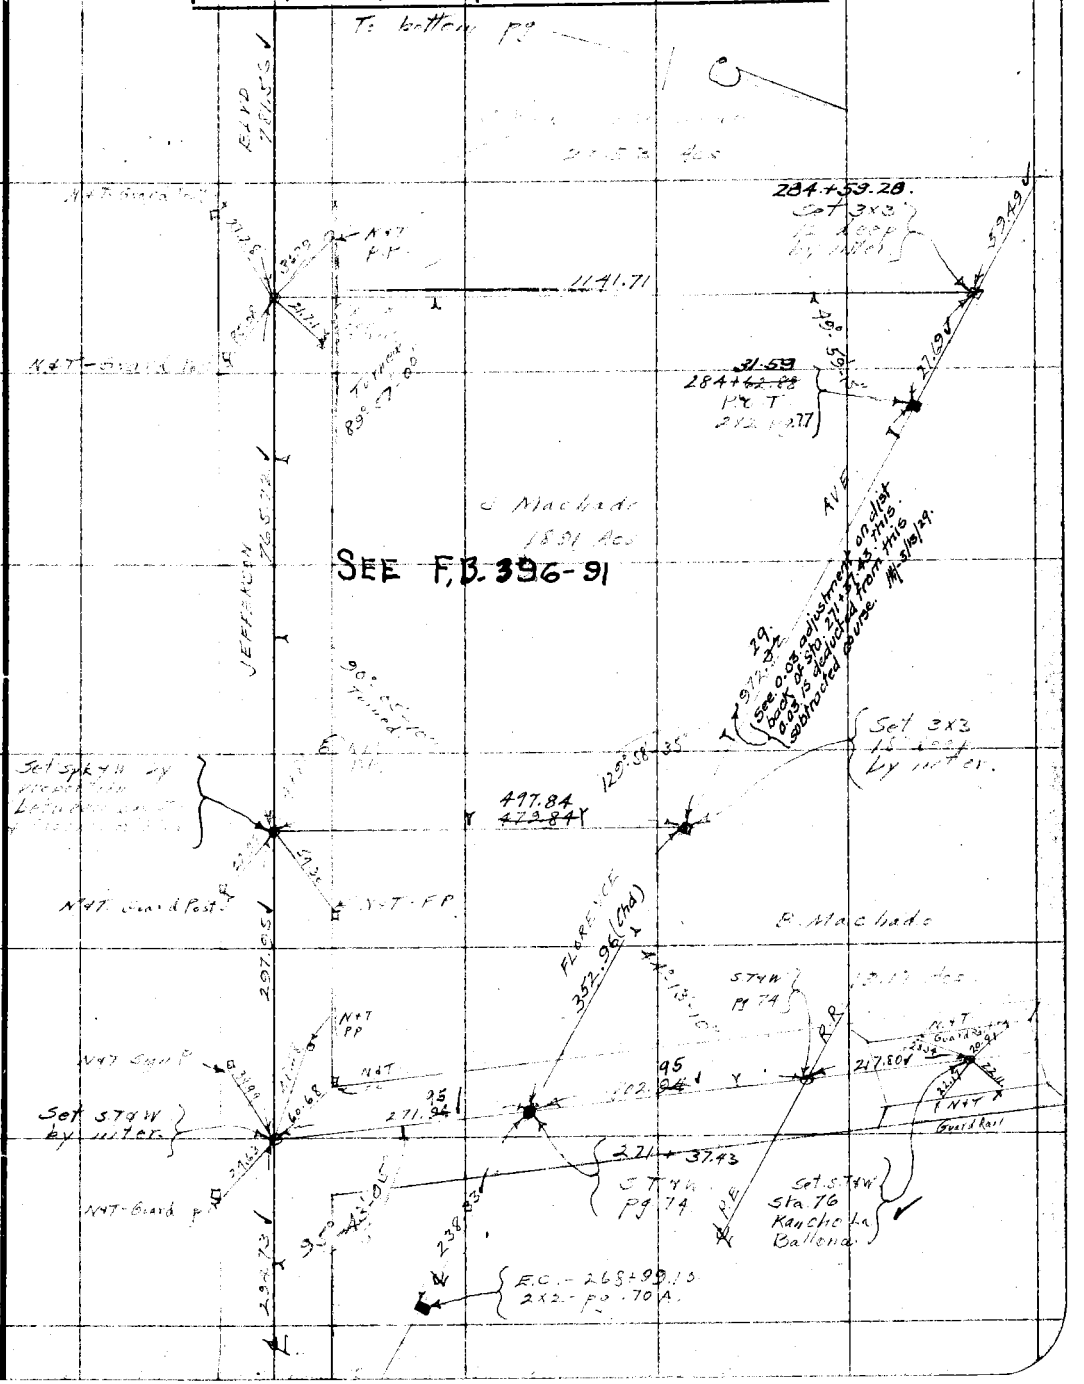

F.B. 325 Pg. 72B. Chief Party Notes by Date 3-7-27

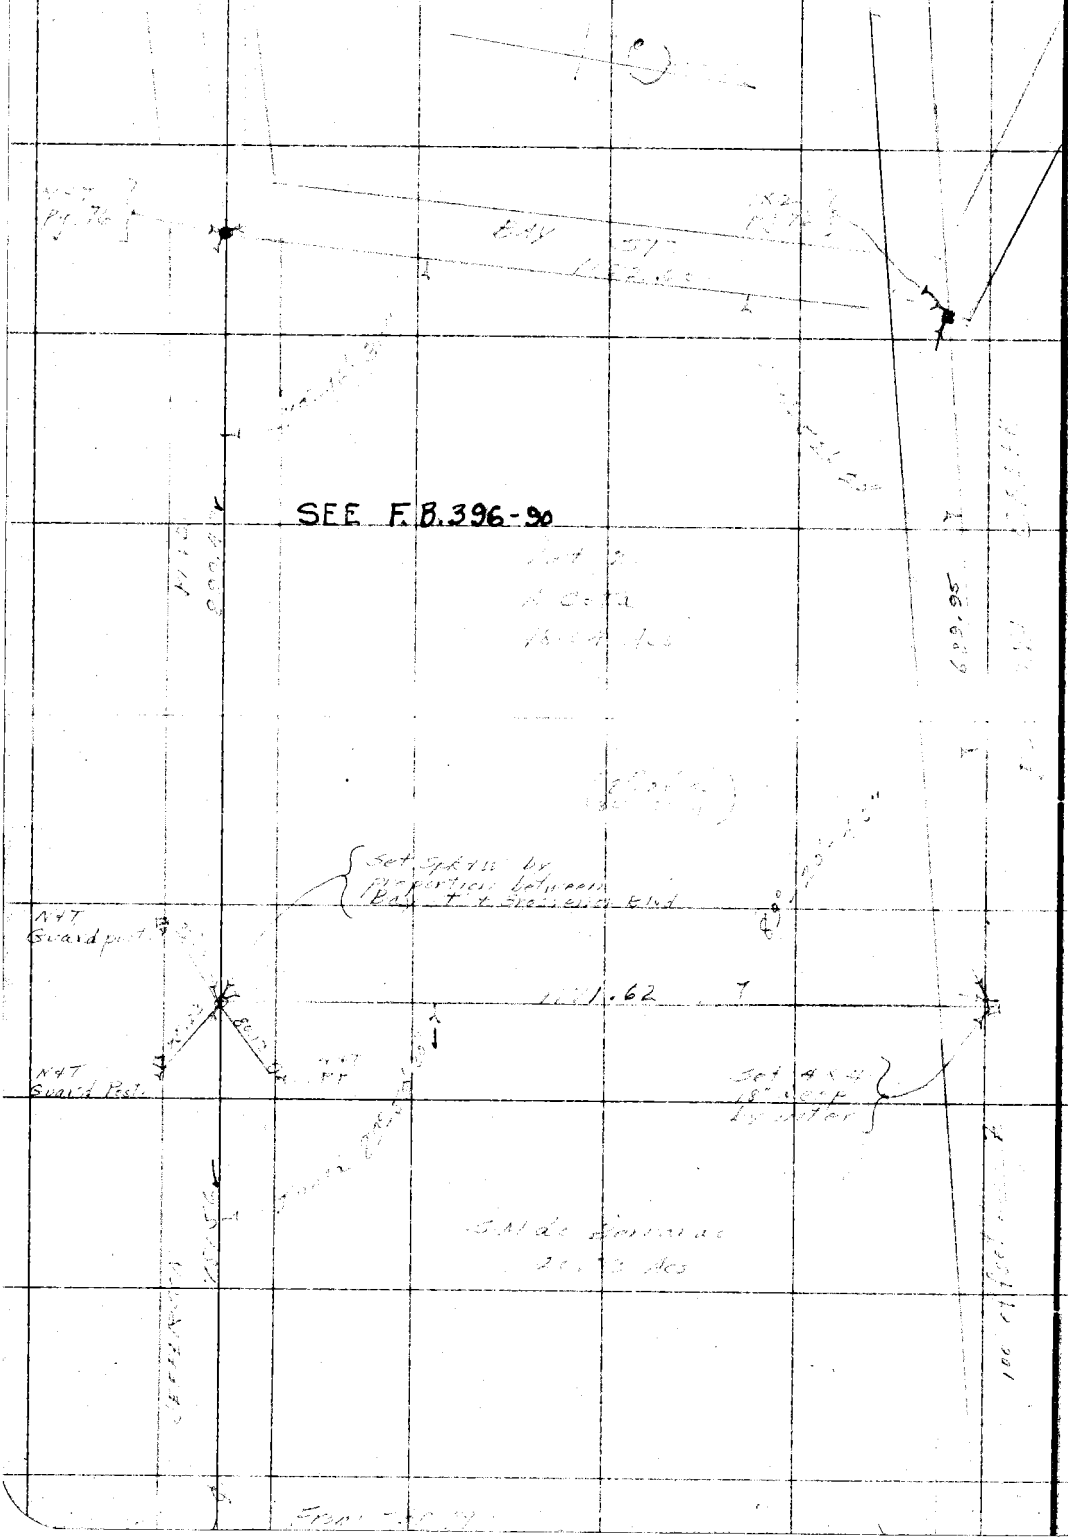

RETURN TO
LOS ANGELES COUNTY SURVEYOR

Do not extend notes this side of this line

Note: ANY ADDITIONS OR CHANGES ON THIS SHEET MUST BE MADE OR CIRCLED IN Red. WITH DATE AND NAME OF PERSON MAKING CHANGE.

Date 11-8-28 Notes by Moore Chief Party Moore F.B. 325 Pg. 73

Platted by Wood	W. O. No. 4168 S. O. No. 033
Date Jan 1929	Location Florence Ave.
Map No. B-135-3	Surveyed by J. D. Moore
Platting C'k'd by Blackmer	Date 11-8-28
Date Feb-1929	Indexed A. C. Johnson

Notes: ANY ADDITIONS OR CHANGES ON THIS SHEET MUST BE MADE OR CIRCLED IN Red. WITH DATE AND NAME OF PERSON MAKING CHANGE.

Do not extend notes this side of this line

RETURN TO LOS ANGELES COUNTY SURVEYOR

To pg 76

40' 50'

N+T Guard post

2546.93

BLVD

N+T in FP

Removed
New pt point
Florence Blvd
Set 5774W by
Inter & calc dist

68.52

179° 29' 30"

N+T in P.P

(179° 29' 30"
357 - 58 - 00)

N+T in Guard Post

SEE F.B. 396-90

JEFFERSON

T = 76°

40' 50'

40' 50'

This ℄ void.

N+T Guard Tribol

N+T PP

N+T - 1.7

86.45

48.50

60.68

MOZART ST

270.17

To bot. pg 74

Pointreset see Page 72A

Set Spike

Removed
Set 5774W
by Inter

0.03

0.07

24.16

1.77

N+T Guardpost

Fd N+T.
F.B. 5774W
Removed in
Setting Set N+T
1-30-29 J.T.

289.67

95° - 45' - 00"

90° - 12' - 30"

Adj.

40'

(90° - 12' - 30"
20 - 50 - 00)

From pg 70

F. B. 825 Pg. 74 Moore Chief Party Notes by Moore Date 11-8-28

To bottom pg 75

To P.T. 77

(44°-13'-00") (176.62-15)

44°-13'-05" calc.

N47 Tr. Pole

1313.18

186.48

0.24

42.58

Fd Spl T. (B 327-7)

~~271+02.36~~ Set STm by rec. ctl. & brng & PE from Culver Blvd. Angle checks rec. 05'

N47 Tr. Pole

37.03

N47 N.R. Sign

44°-13'-00" 176.62-15

1102.41 T.

P.T.

To P.T. Left side

SEE F.B. 394-99

44°-13'-05" calc.

N47 Cor. House

69.62

67.89

N47 Cor House

50.4

N47 Cor Pump House

95

271.34

270.17

N10°-E 429.03

06.34

271+37.48 Set STm by Inter

To P.T. 79

73

RETURN TO LOS ANGELES COUNTY SURVEYOR

Do not extend notes this side of this line

Note: ANY ADDITIONS OR CHANGES ON THIS SHEET MUST BE MADE OR CIRCLED IN RED WITH DATE AND NAME OF PERSON MAKING CHANGE.

Date 11-16-28 Notes by [illegible] Chief Party Moore F.B. 325 Pg. 75

Platted by [illegible]	W. O. No. 4168 D. S. G. No. 033
Date Jan 1929	Location Florence Ave
Map No. 8-135-3	Surveyed by L D Moore
Platting Ck'd by Blackmar	Date 11-16-28
Date Feb-1929	Indexed A. C. Johnson

Notes: ANY ADDITIONS OR CHANGES OF THIS SHEET MUST BE MADE OR CIRCLED IN Red. WITH DATE AND NAME OF PERSON MAKING CHANGE.

Do not extend notes this side of this line

RETURN TO LOS ANGELES COUNTY SURVEYOR

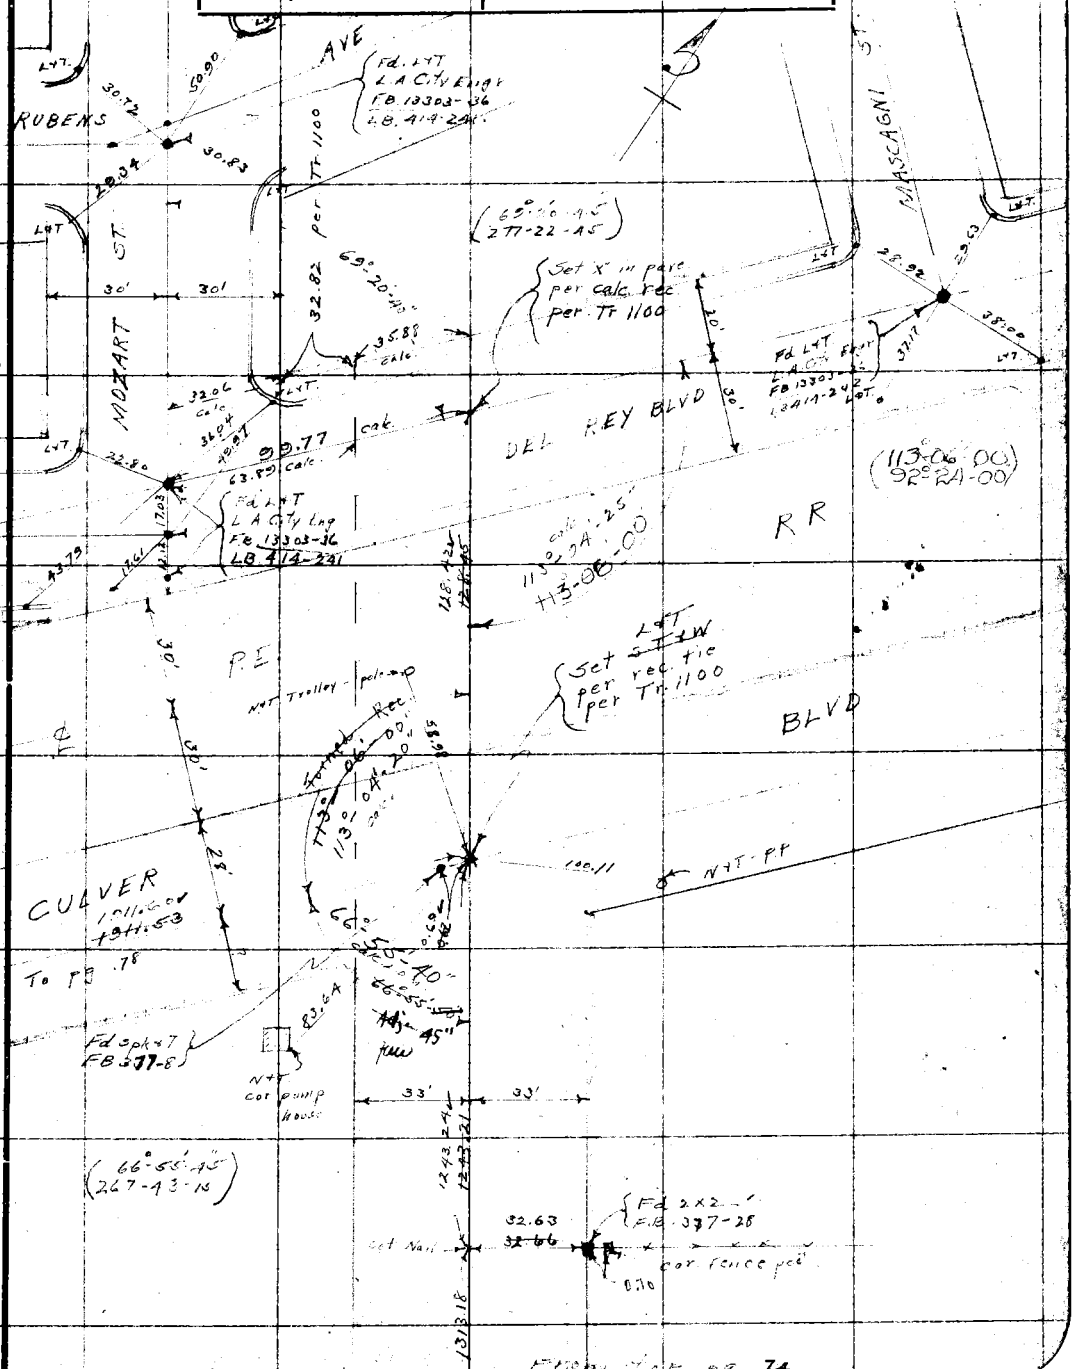

F. B. 325 Pg. 76. Moore Chief Party Notes by Moore Date 11-9-28

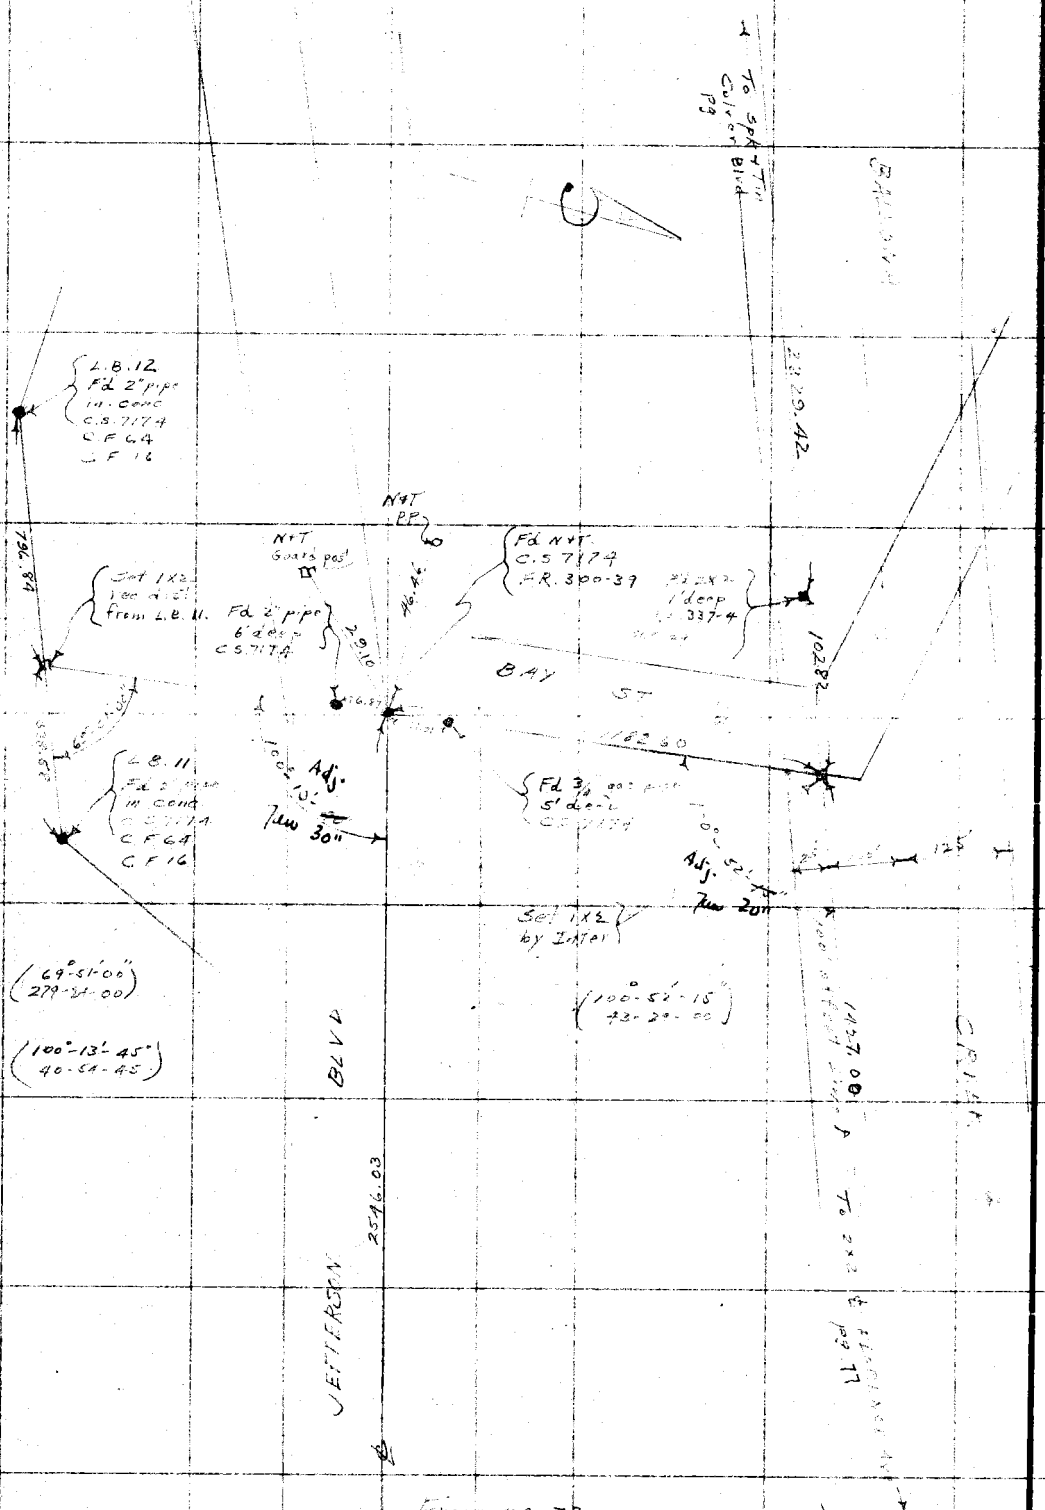

RETURN TO LOS ANGELES COUNTY SURVEYOR

Do not extend notes this side of this line

Note: ANY ADDITIONS OR CHANGES ON THIS SHEET MUST BE MADE OR CIRCLED IN Red. WITH DATE AND NAME OF PERSON MAKING CHANGE.

Date 1-22-29 Notes by Moore Chief Party Moore F.B. 325 PG. 76A

Platted by Wood	W. O. No. 4168 D. S. O. No.
Date Jun. 1929	Location Florence Ave
Map No.	Surveyed by J. D. Moore
Platting C'k'd by Blackmer	Date 1-22-29
Date Feb 1929	Indexed by J. Clarke

Notes: ANY ADDITIONS OR CHANGES ON THIS SHEET MUST BE MADE OR CIRCLED IN Red. WITH DATE AND NAME OF PERSON MAKING CHANGE.

Do not extend notes this side of this line

RETURN TO LOS ANGELES COUNTY SURVEYOR

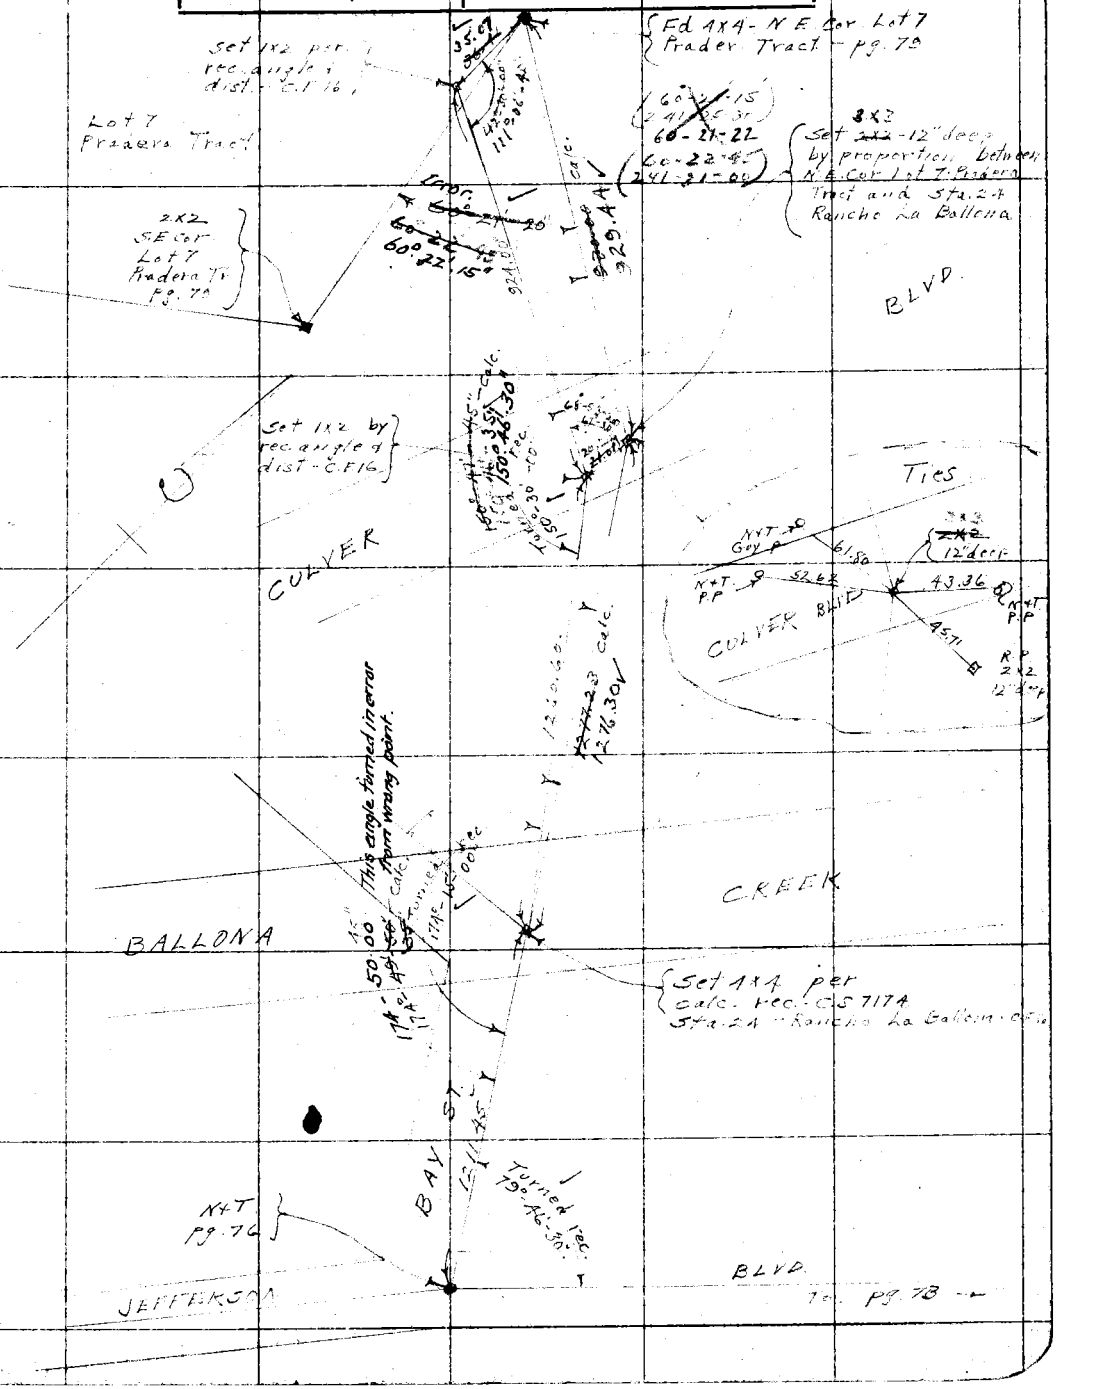

RETURN TO
LOS ANGELES COUNTY SURVEYOR

Note: ANY ADDITIONS OR CHANGES ON THIS SHEET MUST BE MADE OR CIRCLED IN Red. WITH DATE AND NAME OF PERSON MAKING CHANGE.

Do not extend notes this side of this line

F.B. 325 Pg. 76 Chief Party Notes by Moore Date 3-20-28

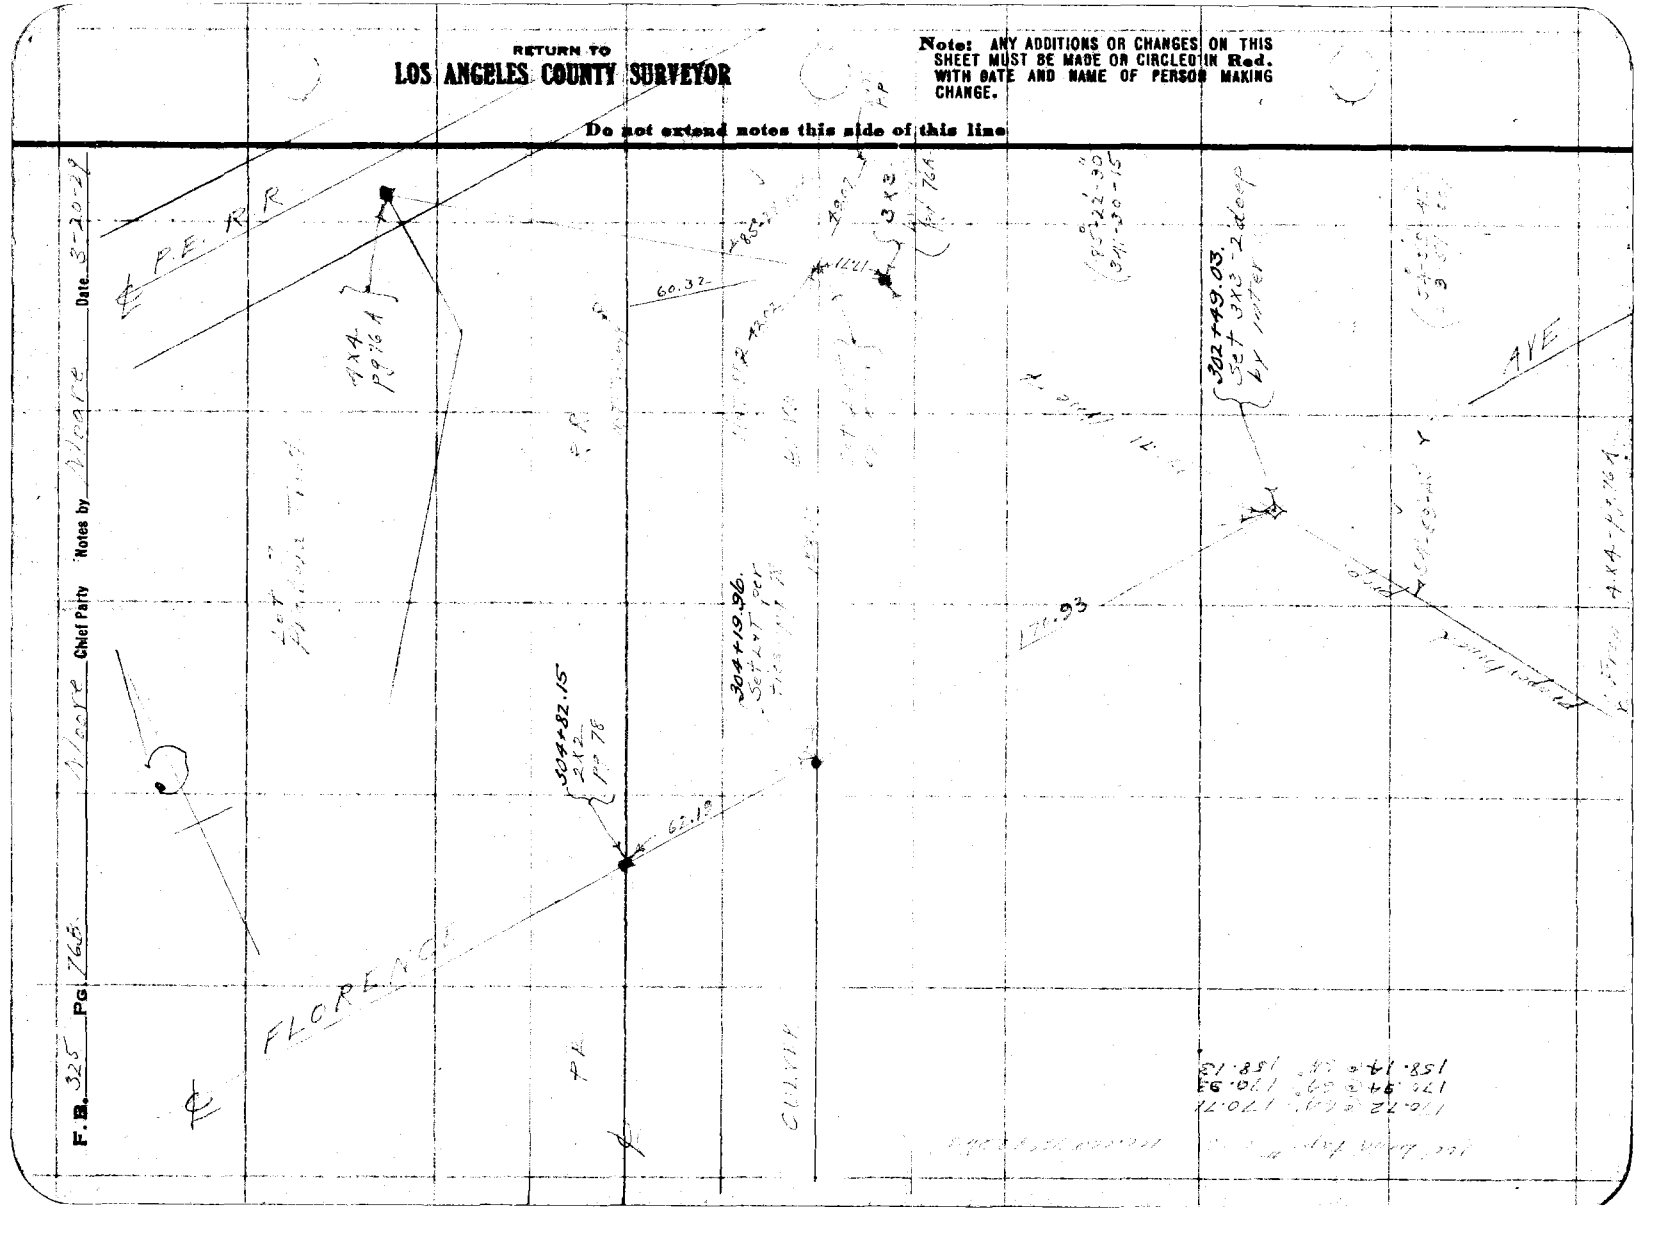

Date 10-2-28 Notes by Moore Chief Party Moore F. B. 325 Pg. 77

Platted by Wood
Date Jan. 1929
Map No. 8-135-3
Platting C'k'd by Blackmore
Date Feb. 1929

W. O. No. 4168 R.O.S. Sh. 433
Location Florence Ave
Surveyed by L. D. Moore
Date 10-2-28
Indexed

Notes: ANY ADDITIONS OR CHANGES ON THIS SHEET MUST BE MADE OR CIRCLED IN Red. WITH DATE AND NAME OF PERSON MAKING CHANGE.

Do not extend notes this side of this line

RETURN TO LOS ANGELES COUNTY SURVEYOR

Fd 2x2 - 1' deep F.B. 337-4

BALLONA

RP - 2x2 18" deep

1529.80 @ 75° = 1529.84
848.30 @ 70° = 848.27
322.00 @ 7°-51' = 87.18
So. 5.84 @ 72° = 305.83

1529.84

1595.36 To Pg. 78 Left side

AVE

24.60

288+58.69
287+67.62
Set 1x2 - P.O.T. Top of bank

40° - 42' - 35"

(40°-42'-30"
162-50-15
40-42-34)

92.25

59.18.77
285+49.86
284+62.68
Set 2x2 18" deep by Inter)

305.83

Fd 2x2 377-3

72.
284+62.99
Set 2x2 - P.O.T.

87.18

100' offset Line

92.25

FLORENCE

1323.29

RP - 2x2 18" deep

CREEK

848.27

R.R.

2335.20 To Pg. 78

From Left Pg. 74 Line

40°-42'-35"

Trestle

520-

Fd N+T F.B. 377-2

1713

Fd 2x2 - E.C. F.B. 377-2

PE

1296.48

From Pg. 74

F.B. 325 PG. 78 Moore Chief Party Notes by Moore Date 10-3-28

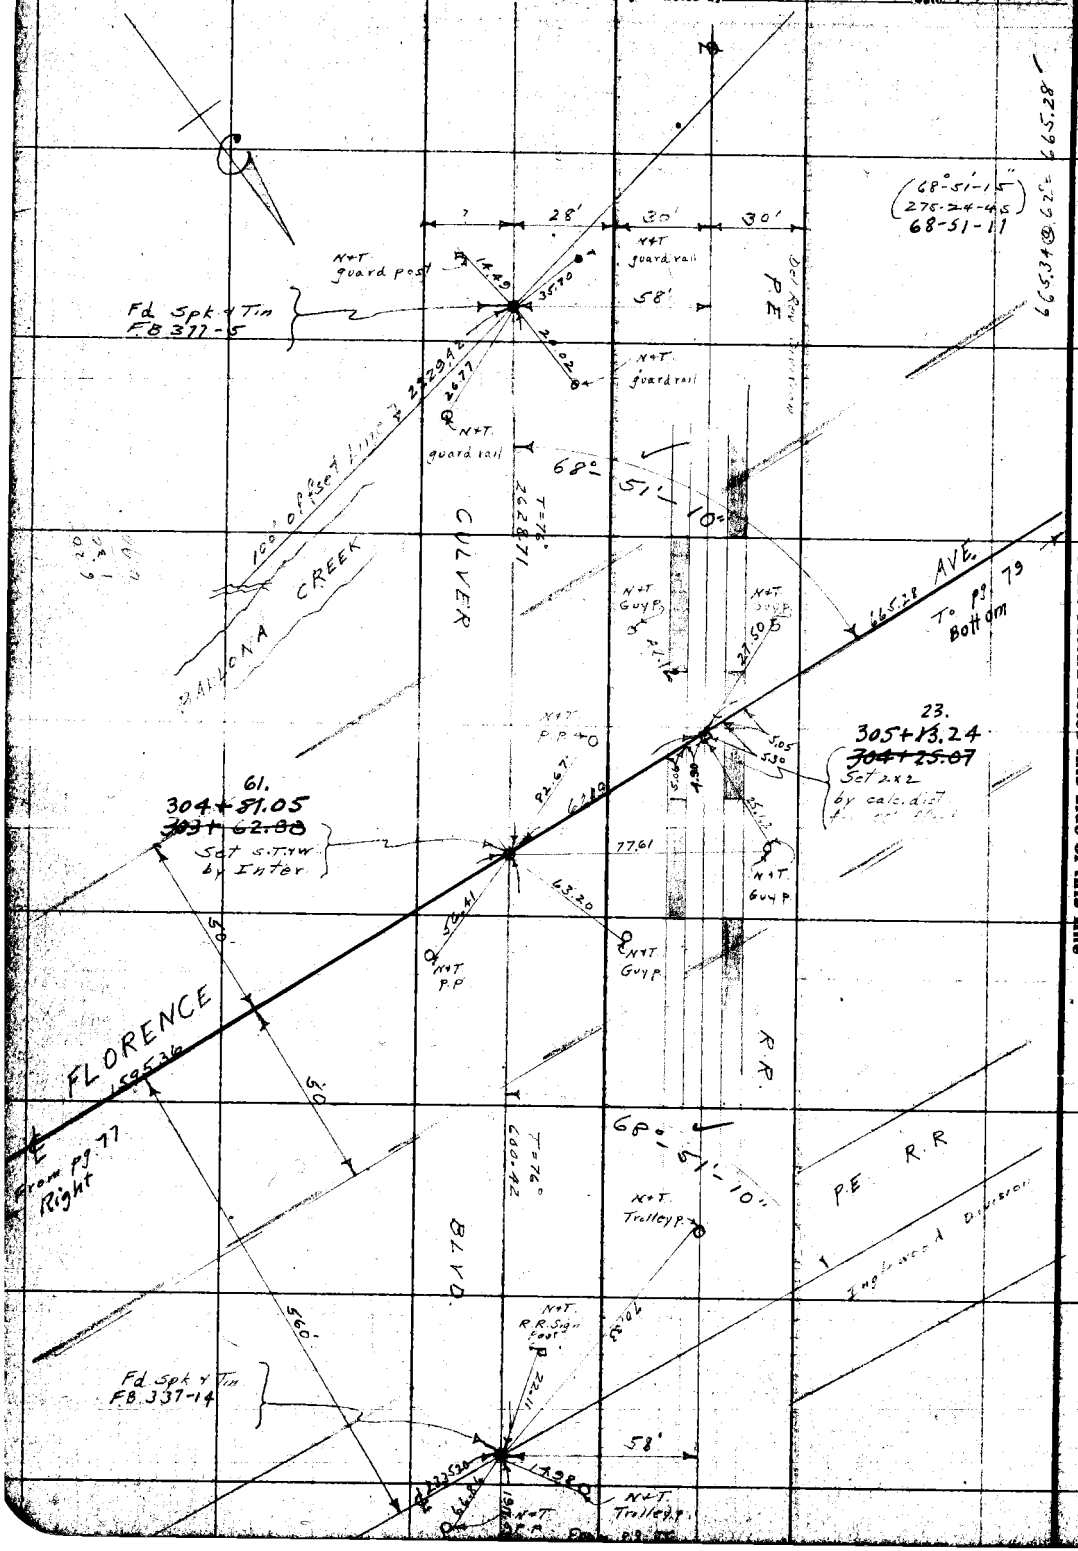

Date 10-22-28 Notes by Moore Chief Party Moore F. B. 325 PG. 79

Plotted by Wilson
Date Jan. 1929
Map No. B-135-3
Checked by Blackwood
Date Feb 1929

W. O. No. 4166 - 1 - 0 No. 632-769
Location Florence Ave
Surveyed by L. D. Moore
Date 10-22-28
Indexed A. C. Johnson

Notes: ANY ADDITIONS OR CHANGES ON THIS SHEET MUST BE MADE OR CIRCLED IN Red. WITH DATE AND NAME OF PERSON MAKING CHANGE.

RETURN TO LOS ANGELES COUNTY SURVEYOR

Do not extend notes this side of this line

Fd 10" casing filled with conc. & 3x4 4 tk. Flush

Fd 1x2 98.5 East of angle

Set 1x2 by Inter

Fd 2x2

S.W. Cor Lot 7 Fd 2" pipe & tk in conc. Flush

Fd 2x2

7.74

Fd 2" pipe & tk in conc 1' deep

737.13

T = 76°

preliminary 15' offset line by record

S 170.49 (calc.)

S 156.18

S 158.18

(126°-58'-15")
(147-52-45)
36-58-11

(179°-54'-00")
359-54-00
89-59-00

(53°-08'-45")
212-34-30
59-08-89

(40°-43'-45")
162-56-00
40-43-45

(86°-08'-30")
344-34-00
86-08-30

(127°-0'-0")
(148°-00'-15")

N.W. Cor Lot 7 Set 2x2 by proportion between 2" pipe & 4x4

Lot 7 Pradera Tract

57. 15.93.
318+47.07
317+58.85
Set 2x2 18" deep by Inter

R.P. 2x2 18" deep

2331.57

2447.58

60.00

Lot 6 Pradera Tract

Fd 2x2

7.74

Fd 2x2

Fd 2x2

Fd 2x2

F.B. 325 Pg. 80 — Moore Chief Party — Notes by Moore — Date 10-23-28

To pg. 84 → P.L. prod → Set 1x2 by Inter

Fd 2" pipe w/ Nail in conc N.W. Cor Lot 5 Pradera Tract

To pg. 83

1300.13

To pg 81

9x8

CA- ~~10~~

Adj. 104

(94°-04'-15" / 16-17-00) 4-04-15

Tape = or ~~-~~ .84

497.78 @ 72° = 497.74

2135.08 @ 72° = 2134.91

(21°-37-00" / 86-37-45) 21-36-55

497.74

21°-36'-55"

(153°-44'-45" / 254-59-00 / 63-44-45)

AVE

RR

1 ft. Fence Inset Line

1749.01

Lot 5 Pradera Tract.

36.91 78. 370+~~68.00~~ ~~3691+74.83~~ Set 2x2 18" deep by Inter

~~50.~~ 370+~~46.85~~ 09.26. ~~3691+52.68~~ Set 2x2 18" deep by Inter

27.45

PI# 2x2

Note. See pg 82 for curve data.

(75°-35'-30 / 302-22-00 / 75-35-30)

(154°-32'-15" / 258-11-00 / 64-32-45)

(84°-16'-45" / 337-07-15 / 84-16-49)

(57°-53'-45" / 201-35-15 / 57-53-49)

S 38° W 44'-45"

S 60 47

Fd 2" pipe in conc

Set 2x2 by proper between 2" pipe + 1x2 ~~68.22.44~~ 353+53.53 ~~352+65.36~~ Set 2x2 18" deep by Inter

84°-16-50"

Fd 2" pipe in conc Flush S.E. Cor. Lot 5 Pradera Tract

Adj. 40

Right

Lot 6 Pradera Tract.

231.27

922.14

FLORENCE

Notes: ANY ADDITIONS OR CHANGES ON THIS SHEET MUST BE MADE OR CIRCLED IN Red. WITH DATE AND NAME OF PERSON MAKING CHANGE.

RETURN TO LOS ANGELES COUNTY SURVEYOR

Do not extend notes this side of this line.

Date 10-23-28 Notes by Moore Chief Party Moore F. B. 325 Pg. 81

Plotted by Pyad	W. O. No. 4168 T.S.B. No. 233
Date Jan. 1929	Location Florence Arc
Map No. B-135-3	Surveyed by L D Moore 10-23-28
Platting Checked Blackmer	Indexed A. C. Johnson
Date Feb 1929	

Notes: ANY ADDITIONS OR CHANGES ON THIS SHEET MUST BE MADE OR CIRCLED IN Red. WITH DATE AND NAME OF PERSON MAKING CHANGE.

Do not extend notes this side of this line

RETURN TO LOS ANGELES COUNTY SURVEYOR

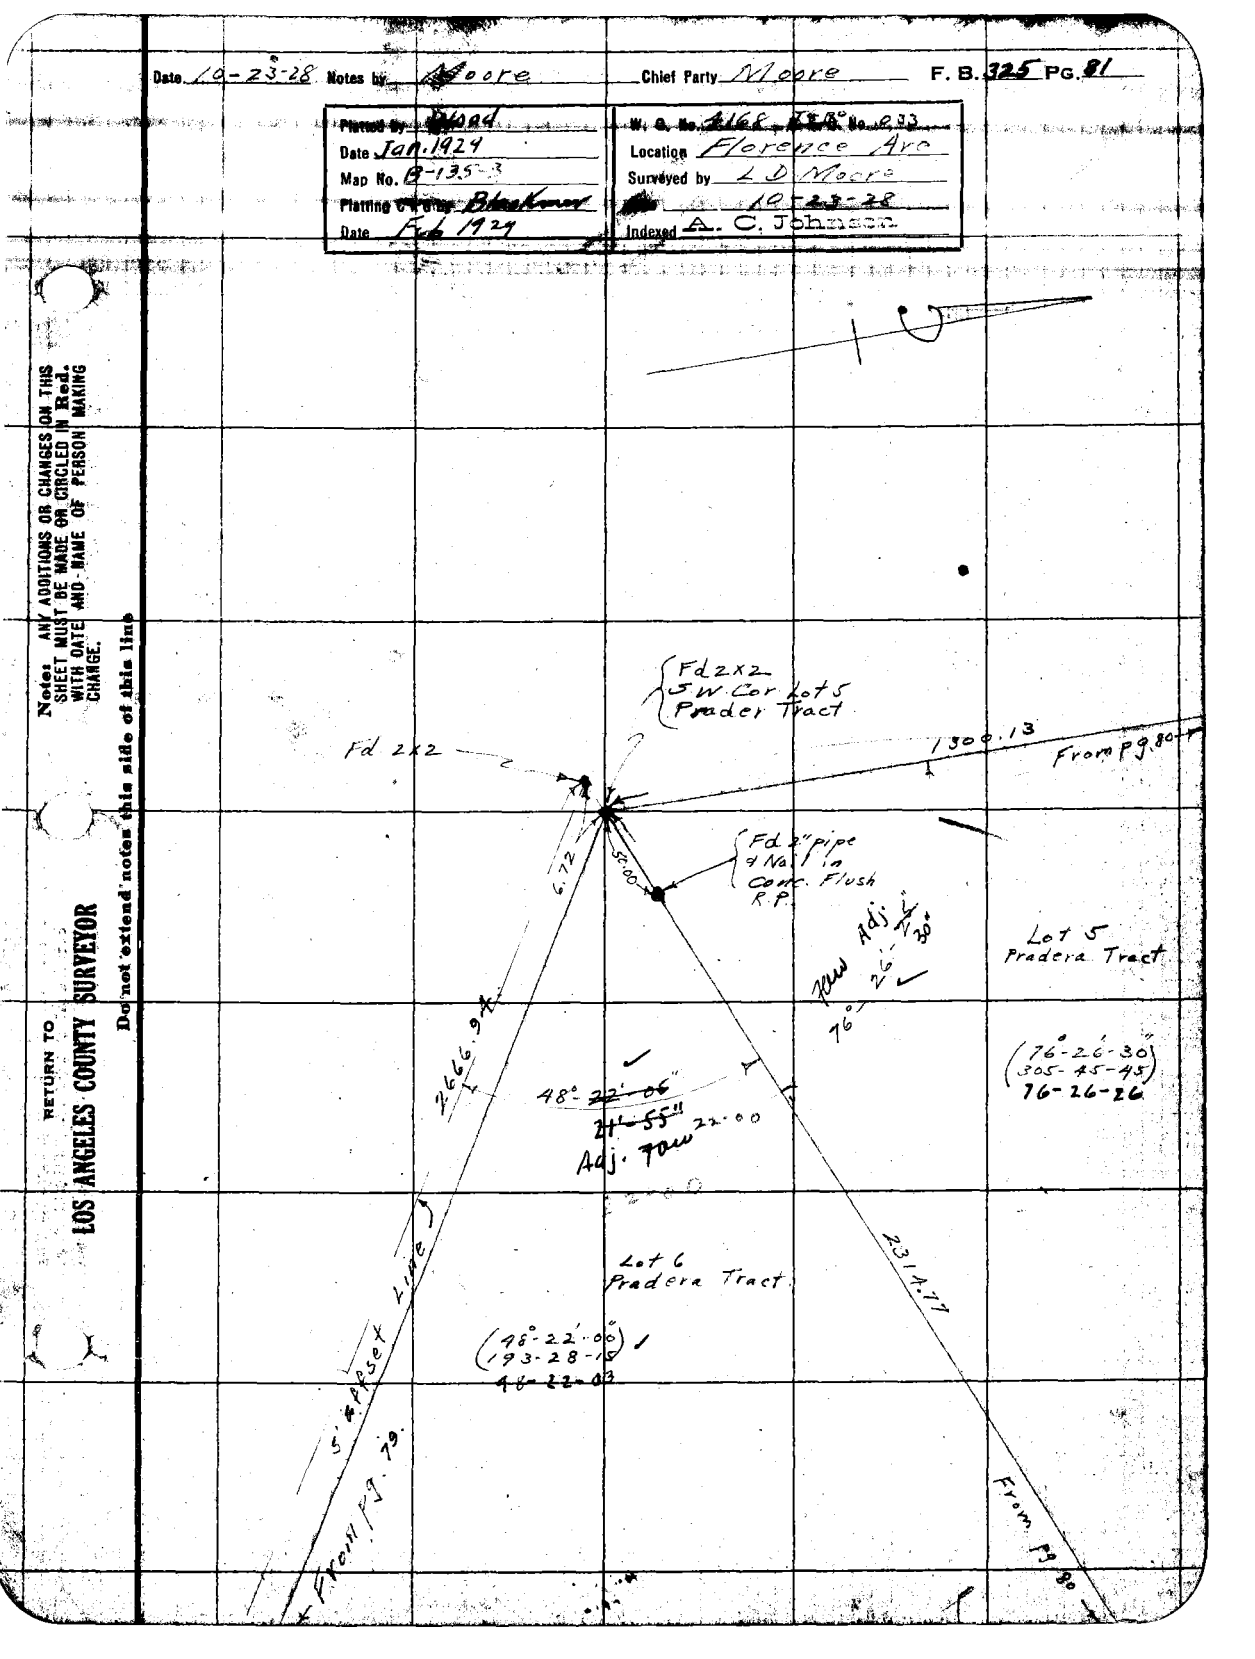

F.B. 825 PG. 82 — Moore Chief Party — Notes by Moore — Date 10-25-28

To pg. 80

365+70.26
~~366+07.35~~
E.C. ~~365+13.78~~
Set 2x2-18"deep

R19.57

560

63.85
R P-2x2
18"deep

69.69

67.02

64.70
R P-2x2
18"deep

R R

A: ~~4° 43' 00"~~ 4-43-05"
R ~~6500'~~ 6300'
T ~~259.47~~ 259.54'
L ~~551.86~~ 518.78'

P.I.#
Set 2x2-18"deep
by calc dist on
split of angle
from P.I. P.R. P.I.

259.47

16-55"
47' Hwy. Row

R P-2x2
18"deep

62.00

64.36

64.86

59.68

R.A-2x2
18"deep

560.47

P.I.
Fd 7.47
P.I. 66

175° 17' 00"

(175°-17'-00")
341-08-00
85-17-00

259.47

51.48
~~360+82.57~~
BC ~~359+44.40~~
Set 2x2-18"deep

53.65

87.06

67.17

56.87

R P-2x2
18"deep

R P-2x2
2x2

560'

P.F.

1122.11

From pg. 80

RETURN TO
LOS ANGELES COUNTY SURVEYOR
Do not extend notes this side of this line

Notes: ANY ADDITIONS OR CHANGES ON THIS SHEET MUST BE MADE OR CIRCLED IN Red. WITH DATE AND NAME OF PERSON MAKING CHANGE.

Date 11-7-28 Notes by [illegible] Chief Party [illegible] F.B. 325 Pg. 83

Platted by Wood	W. O. No. 4168 S.P.O. No. 633
Date Jun. 1929	Location [illegible] Ave
Map No. B-135	Surveyed by [illegible]
Platting Ck'd by Blackmer	Date 11-2-28
Date Feb 1929	Indexed

Notes: ANY ADDITIONS OR CHANGES OR THIS SHEET MUST BE MADE OR CIRCLED IN Red. WITH DATE AND NAME OF PERSON MAKING CHANGE.

Do not extend notes this side of this line

RETURN TO LOS ANGELES COUNTY SURVEYOR

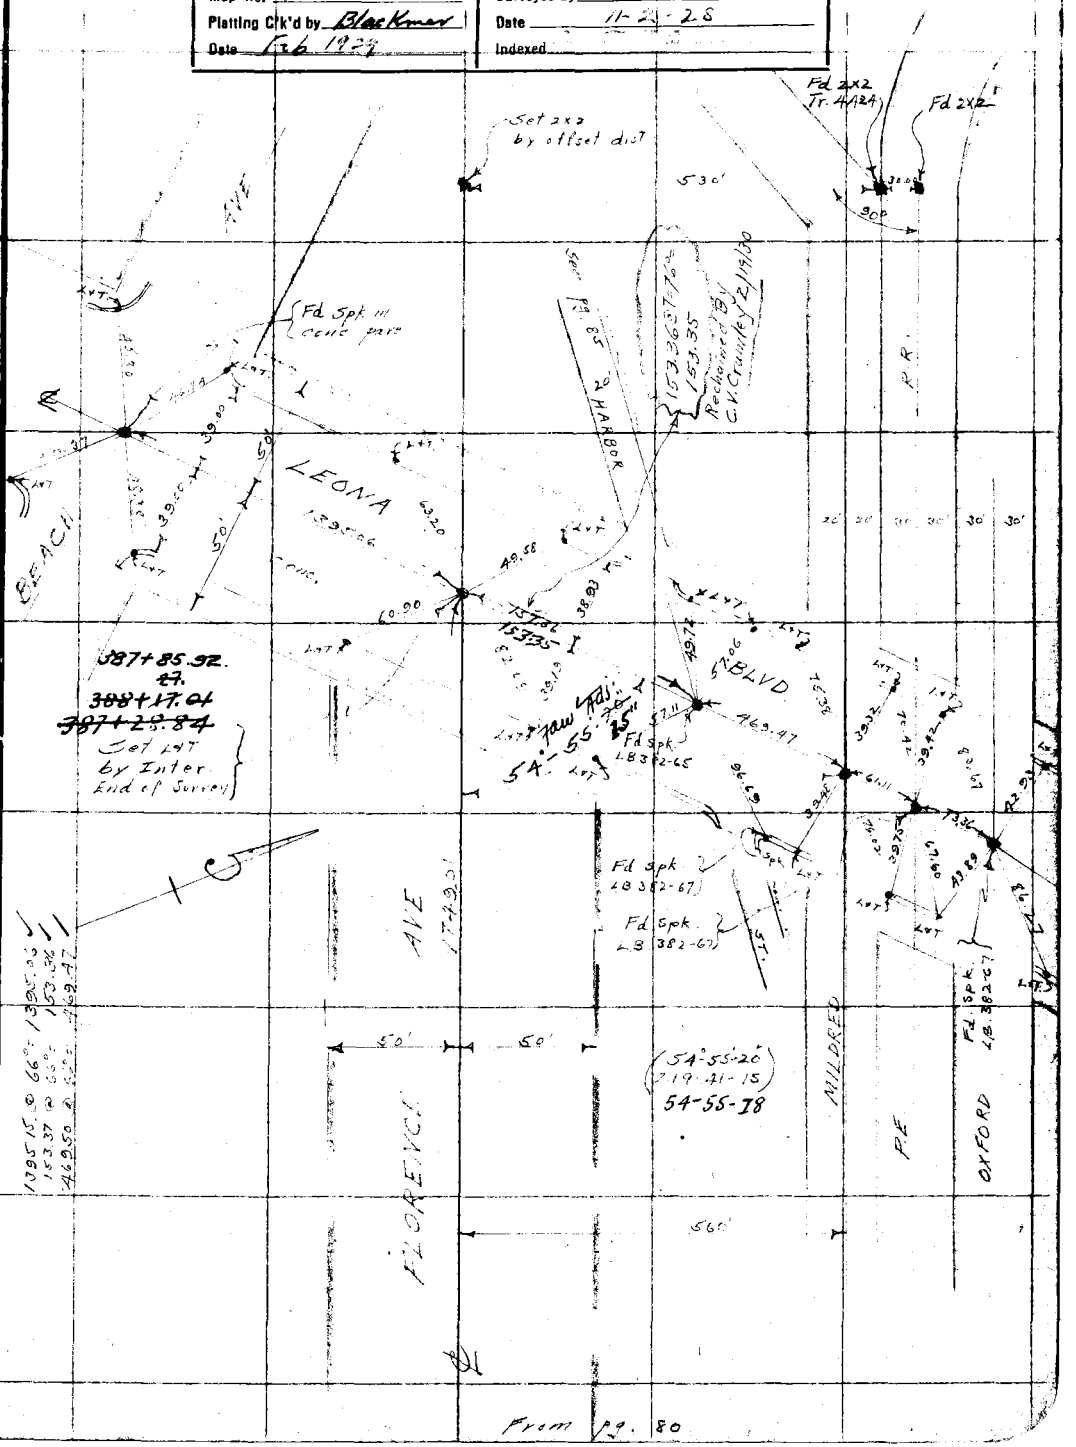

F.B. 325 Pg. 84 Moore Chief Party Notes by Moore Date 11-1A-28

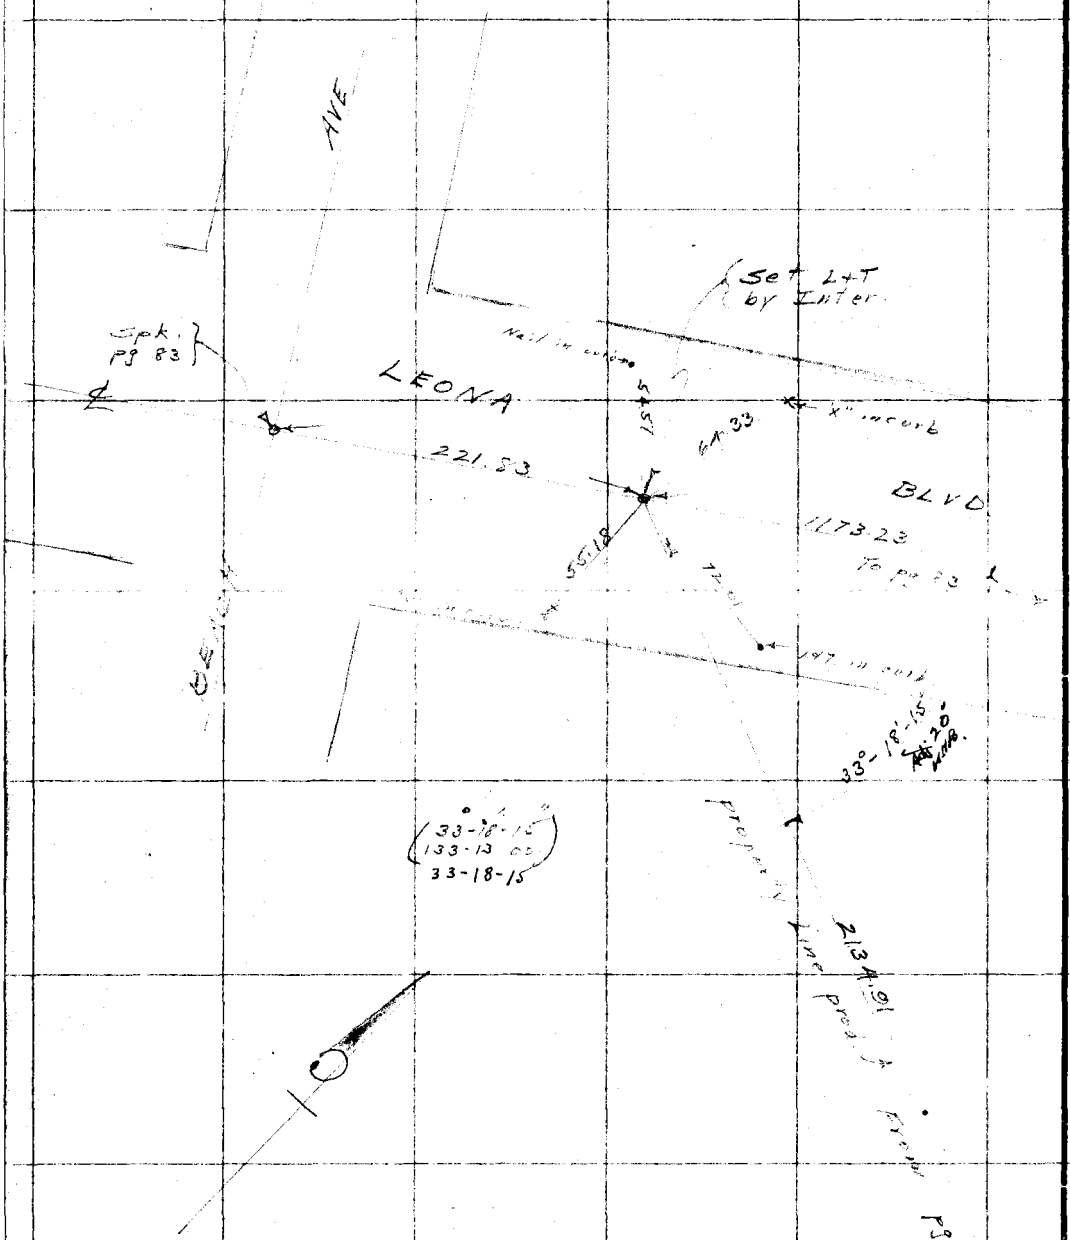

RETURN TO
LOS ANGELES COUNTY SURVEYOR

Do not extend notes this side of this line

Note: ANY ADDITIONS OR CHANGES ON THIS SHEET MUST BE MADE OR CIRCLED IN Red WITH DATE AND NAME OF PERSON MAKING CHANGE.

Date 11-19-28 Notes by Moore Chief Party Moore F. B. 325 Pg. 85

Plotted by Wood	W. O. No. 4168 C.S.O. No. c 33
Date Jan. 1929	Location Florence Ave
Map No. B-135-3	Surveyed by L D Moore
Plotting C'k'd by Blackmar	Date 11-19-28
Date Feb-29	Indexed A. C. Johnson

Fd N & T — 0.00 — Fd spk in cone.

1st Alley West of McKinley St.

10' 10' 30' 10' 10'

ST.

Tr. 4424.

LEONA

To L & T R/W Florence Ave Pg 83

157.36

(125°-58'-00" / 143-32-00) ~~35-58-00~~

T25° 146°-53'-00"

(146°-53'-00" / 227-32-00)

Fd Spk; L.B. 362-85 See Pg. 83

530.56

R

(33°-06'-45" / 132-27-00) 33-06-45

33°-06'-45"

HARBOR 1114.23

Spk Pg. 83

Tr. 4424

10' 10'

30'

30'

50' BLVD.

Fd 2" pipe plug & IX. S.E. Cor. Tr. 4424

N & T in Tie

Set IX

N & T Tel P

N & T Trolley P

RETURN TO LOS ANGELES COUNTY SURVEYOR

Notes ANY ADDITIONS OR CHANGES ON THIS SHEET MUST BE MADE OR CIRCLED IN Red. WITH DATE AND NAME OF PERSON MAKING CHANGE.

Do not extend notes this side of this line

F.B. 325 Pg. 86 Chief Party Notes by Date

RETURN TO

LOS ANGELES COUNTY SURVEYOR

Note: ANY ADDITIONS OR CHANGES ON THIS SHEET MUST BE MADE OR CIRCLED IN Red. WITH DATE AND NAME OF PERSON MAKING CHANGE.

Do not extend notes this side of this line

Date 11-17-28 Notes by Moore Chief Party Moore F. B. 325 Pg. 87

Plotted by	W. O. No. 1168 S. O. No.
Date	Location Florence Ave
Map No. B-125.3	Surveyed by L. D. Moore
Platting C'k'd by Blackman	Date 11-17-28
Date 3/1/29	Indexed A. C. Johnson

Notes. ANY ADDITIONS OR CHANGES ON THIS SHEET MUST BE MADE OR CIRCLED IN Red. WITH DATE AND NAME OF PERSON MAKING CHANGE.

Do not extend notes this side of this line

RETURN TO LOS ANGELES COUNTY SURVEYOR

TOPOGRAPHY
for
FLORENCE AVENUE
from
JEFFERSON AVENUE
to
LEONA BLVD.

Preceding topography in F.B. 325-100-121 and F.B. 381-1-16.

F.B. 325 Pg. 88 Moore Chief Party Notes by Moore Date 11-17-28

To pg. 89.

31.5 6+10.3 PP

38.8

3

38.8

4+96.0 Electric lighted Sign Board

31.5 4+57.9 PP

4+03.89 S.T+W pg. 61

RANDALL ST

AVE

asphalt with

31.5 2+98.2 PP

31.5 1+47.4 PP

15' 15'

0+00 going ahead for topography only S.T+W. pg. 61

1.5 31.5 PP

FLORENCE

From pg. 16 F.B. 381

RETURN TO
LOS ANGELES COUNTY SURVEYOR
Do not extend notes this side of this line

Note: ANY ADDITIONS OR CHANGES ON THIS SHEET MUST BE MADE OR CIRCLED IN Red. WITH DATE AND NAME OF PERSON MAKING CHANGE.

Date 11-17-28 Notes by Moore Chief Party Moore F. B. 325 Pg. 89

Platted by Jan 1929	W. O. No. 4168 D. S. O. No.
Date	Location Florence Ave
Map No. 3-135-3	Surveyed by L D Moore
Plotting C'k'd by Blackmer	Date 11-17-28
Date 2/11/29	Indexed A. C. Johnson

Notes: ANY ADDITIONS OR CHANGES ON THIS SHEET MUST BE MADE OR CIRCLED IN Red. WITH DATE AND NAME OF PERSON MAKING CHANGE.

Do not extend notes this side of this line

RETURN TO LOS ANGELES COUNTY SURVEYOR

T P Pg. 90

7+18.2 24.2

AVE

35.2 35.2

8+97.5 - Guy Wire
8+95.5 - Guy Wire

8+81.0 - P.P.

8+75.2 - Guy Wire

8+69.0

8+35.01 S.T+W Pg. 67

Macadam

25.9

8+31.9

conc.

BLVD

CENTINELA

8+07.3 - P.P.

8+00

asphalt with conc. base

7+73.0 - P.P.

7+64

7+39.0 - Electric Lighted Sign Board

7+31.5 24.9

FLORENCE

6+68.08 S.T+W Pg. 67

15' 15'

ALLEY

Angle point 6+55.20 S.T+W Pg. 67

From Pg. 88

F.B. 325 Pg. 90 — Moore Chief Party — Notes by: Moore — Date 11-17-28

To pg. 91

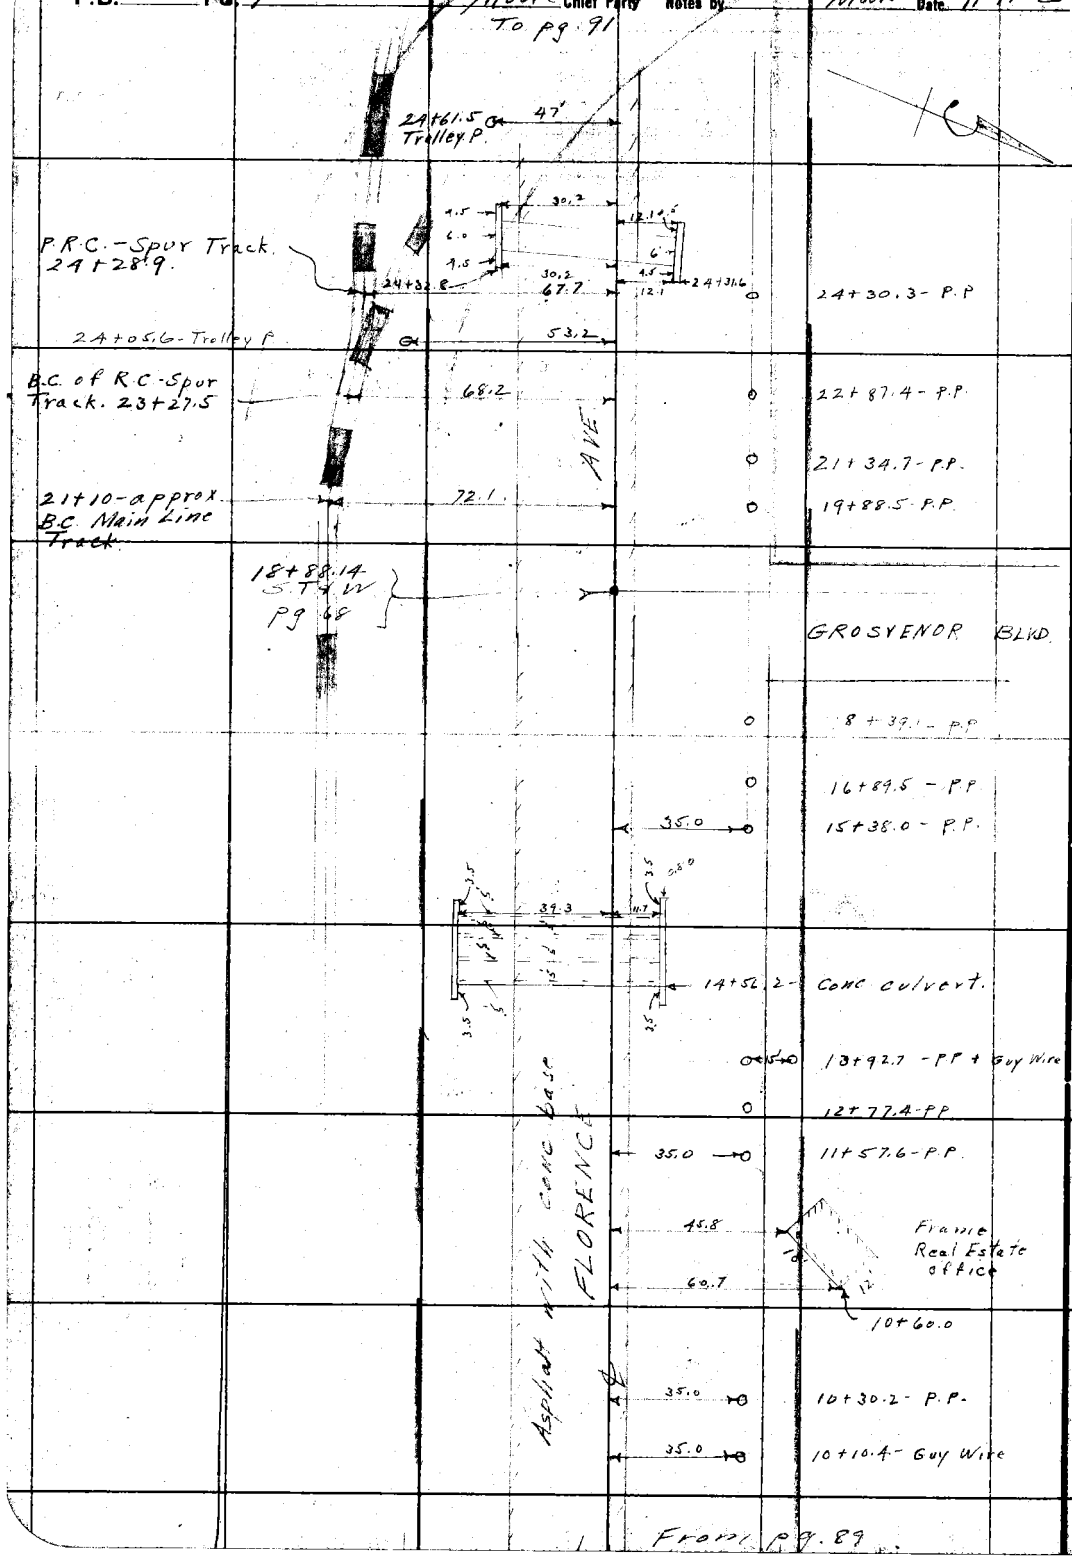

From pg. 89

RETURN TO
LOS ANGELES COUNTY SURVEYOR

Do not extend notes this side of this line

Notes: ANY ADDITIONS OR CHANGES ON THIS SHEET MUST BE MADE OR CIRCLED IN Red. WITH DATE AND NAME OF PERSON MAKING CHANGE.

Date 11-17-28 Notes by Moore Chief Party Moore F. B. 325 Pg. 91

Plotted by [illegible] Jun 1929
Date
Map No. B-135-3
Plotting C'k'd by Blackmar
Date 2/11/29

W. O. No. 4168 O. S. O. No.
Location Florence Ave
Surveyed by L. D. Moore
Date 11-17-28
Indexed A. C. Johnson

Notes: ANY ADDITIONS OR CHANGES ON THIS SHEET MUST BE MADE OR CIRCLED IN Red. WITH DATE AND NAME OF PERSON MAKING CHANGE.
Do not extend notes this side of this line
RETURN TO LOS ANGELES COUNTY SURVEYOR

To Pg. 92

30+63.0 End of Spur Track
30+59.0 - Trolley P.
58.0
48.4
FLORENCE AVE
51.5
54.0
14.1
18.2
8.3
42.1
22.0
22.1
Frame Slaughter House
30+50

Board Fence
33.6
44.9
14.6
29+85.4
39.6
9.0
29+52.3 P.P
29+49.5 - Trolley P.
48.0
base

29+38.7 Guy Wire
54.4
29+29.7 Trolley P.
35.5
51.3
28+79.1 - Trolley P.
28+74 - Trolley P.
28+39.3 - Trolley P.
47.7
conc
15
28+21
28+15
32.5
28+01.5 - P.P.
9.0
asphalt with

E.C. Spur Track
27+61
58.0
27+74.0
For Tracks, see pg. 69.

27+27.6 Trolley P.
Guy P.
11.4
36.8
27+38.7
27+20.64
L+T
Pg. 69
27+17.9 - Trolley P.
P.R.C. of Spur Track
26+82.3
60.3
16.0
Conc. Strip 1' wide

26+62.8
24.7
26+57.3 - R.R. Sign post
31.4
26+46.9 - Trolley P.
32.6
26+37.7 - Trolley P.
53.8
26+20.7
24.2
35.0
26+16.1 Guy Wire

25+86.2 - Trolley P.
45.5
35.0
50.0
25+90.6 - PP
25+85.2 - Guy Wire
25+27.3 - Trolley P.
55.1
25+24.0 Trolley P.
37.9

From Pg 90

F.B. 325 Pg. 92 Moore Chief Party Notes by Moore Date 11-17-28

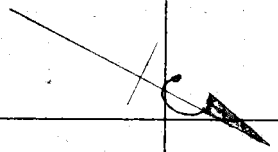

AVE To Pg. 93

last PP

40+43.41
2 x 2 - E.C.
Pg. 70

14.4

P.I.
S T & W

Lease

169.81

Cultivated Fields

B.C. - 36+89.36
S T & W pg 70

37+58.4 P.P.

36+08.0 PP

34+57.7 - P.P.

30.2

49.5

Electric lighted
Sign Board

33+77.6

73.6

33+61.7

33+07.7 - 1st of row of P.P

8.0

32+87.9 angle pt. in pave.

24.4

5.4

58'

Frame House

30'

61'

32+06.4

10'

53.0

14'

4'

Frame Shed

20'

52.5

31+50

9.0

31+47.1 - P.P.

Splint Fence with cons

From Pg. 91

RETURN TO
LOS ANGELES COUNTY SURVEYOR
Do not extend notes this side of this line

Notes: ANY ADDITIONS OR CHANGES ON THIS SHEET MUST BE MADE OR CIRCLED IN Red. WITH DATE AND NAME OF PERSON MAKING CHANGE.

Date 11-17-28 Notes by Moore Chief Party Moore F. B. 325 Pg. 23

Plotted by [illegible] Jun 1929	W. O. No. 4165 D. S. O. No.
Date	Location Florence Ave
Map No. B-135-3	Surveyed by L. D. Moore
Plotting C'k'd by Blackmer	Date 11-17-28
Date 3/11/29	Indexed A. C. Johnson

Notes: ANY ADDITIONS OR CHANGES ON THIS SHEET MUST BE MADE OR CIRCLED IN Red. WITH DATE AND NAME OF PERSON MAKING CHANGE.

Do not extend notes this side of this line

RETURN TO LOS ANGELES COUNTY SURVEYOR

To pg. 94

BALLONA AVE

61+28.0 Bottom of bank

61+06.2 - Top of bank.

60+90.24 - P.O.T. - 1x2 - pg.

Cultivated fields

Top of bank 60+84.0

Bottom of bank 60+54.0

Edge of bank 60+11.0

CREEK

58+76 Edge of bank

100' offset

Bottom of bank 58+11

Top of bank 57+97.4

2x2 - pg. - 57+84.41

Top of bank - 57+75.0

Bottom of bank - 57+46.0

line

71'

water section

FLORENCE

Cultivated fields

61.7

22.9

16.7

4.7

1 Story Frame House

50.1

23.4

18.2

35.4

43+42.4

MOZART ST

50.7

92+81.5

Frame Barn

Frame Pump House

70.4

42+66.2

42+72.44 S.T.W. pg. 74

Cultivated fields

From pg. 92

F.B. 325 Pg. 94 Moore Chief Party Notes by Moore Date 11-19-28

To pg 95

AVE.

52°-30'

Wooden irrig. flume 1'x1' - bottom 1½ above ground

84+88.1

90°

48.7

Cultivated fields

FLORENCE

℄ P.E.

77+75.6 - Guy P. → 14.0

22.2

77+59.8 - Guy pole

50'

77+54.8 - Trolley P. 20.3

77+43.8 Guy P. 48.2

77+47.79 2x2 Pg. 78

CULVER

R.R.

±18'

76+85.60 S.T.+W. pg. 78

85'

BLVD.

76+40 - P.P.

From pg. 93

RETURN TO LOS ANGELES COUNTY SURVEYOR

Do not extend notes this side of this line

Notes: ANY ADDITIONS OR CHANGES ON THIS SHEET MUST BE MADE OR CIRCLED IN Red. WITH DATE AND NAME OF PERSON MAKING CHANGE.

Date 11-19-28 Notes by Moore Chief Party Moore F. B. 326 PG. 95

Plotted by [illegible]	W. O. No. 1168 D. S. O. No.
Date Jan 1929	Location Florence Ave
Map No. B 125-3	Surveyed by L D Moore
Plotting C'k'd by Blackmore	Date 11-19-28
Date 2/11/29	Indexed A. C. Johnson

Notes: ANY ADDITIONS OR CHANGES ON THIS SHEET MUST BE MADE OR CIRCLED IN Red. WITH DATE AND NAME OF PERSON MAKING CHANGE.

Do not extend notes this side of this line

RETURN TO LOS ANGELES COUNTY SURVEYOR

To Pg. 96
135+36.27
E.C. - 138+61.05
2x2 7 Pg. 82

AVE.

P/I
1x2

135+76.73

B.C. - 133+17.19
Pg. 82

cultivated fields

116+65.94
S.T+W. - P.O.T
Pg. 79

FLORENCE

Frame House

Frame House

116+05.7

Frame shed

Glass Hot House

115+82.8

Frame Barn

Frame House and shed

Frame toilet
115+33.0

115+45

115+42

115+29.15
P.O.T.
1x2
Pg. 79

From Pg. 74

F.B. 325 PG. 96 Moore Chief Party Notes by Moore Date 11-19-28

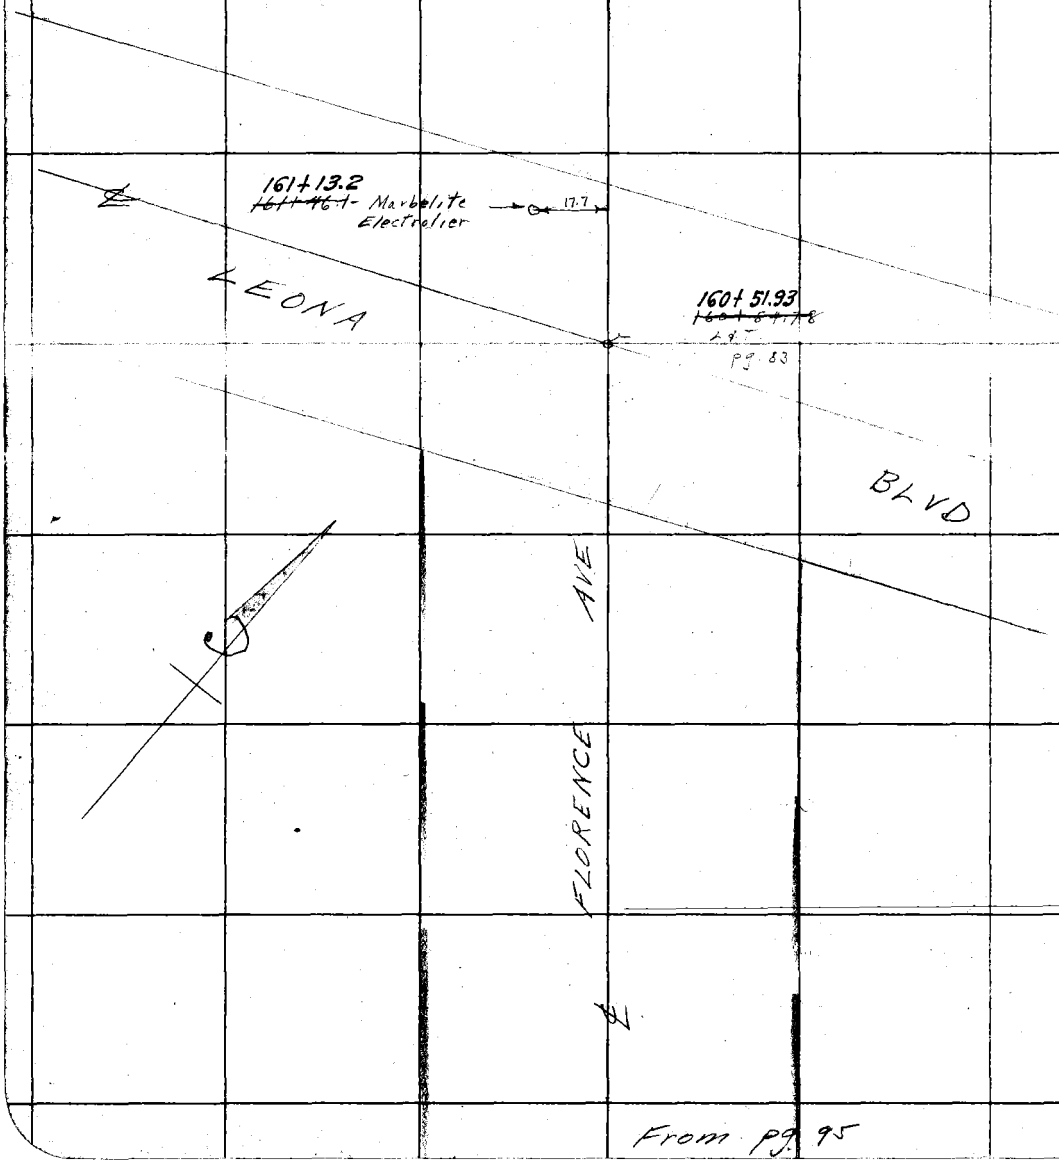

From pg. 95

RETURN TO
LOS ANGELES COUNTY SURVEYOR
Do not extend notes this side of this line

Note: ANY ADDITIONS OR CHANGES ON THIS SHEET MUST BE MADE OR CIRCLED IN Red. WITH DATE AND NAME OF PERSON MAKING CHANGE.

Date 11-19-28 Notes by Moore Chief Party Moore F. B. 325 Pg. 97

Plotted by	W. O. No. 4168 D. S. O. No.
Date	Location Florence Ave
Map No. B-135-3	Surveyed by L.D. Moore
Plotting C'k'd by Blackmer	Date 11-19-28
Date 3/11/29	Indexed

Notes ANY ADDITIONS OR CHANGES ON THIS SHEET MUST BE MADE OR CIRCLED IN Red. WITH DATE AND NAME OF PERSON MAKING CHANGE.

Do not extend notes this side of this line

RETURN TO LOS ANGELES COUNTY SURVEYOR

RETURN TO

LOS ANGELES COUNTY SURVEYOR

Note: ANY ADDITIONS OR CHANGES ON THIS SHEET MUST BE MADE OR CIRCLED IN **Red.** WITH DATE AND NAME OF PERSON MAKING CHANGE.

Do not extend notes this side of this line

F.B. 325 Pg. 98

Chief Party _____ Notes by _____ Date _____

Date _____ Notes by _____ Chief Party _____ F. B. 315 PG. 100

Plotted by A.C. Johnson	W. O. No. 4168 R. S. O. No.
Date Apr- 1928	Location Florence Ave
Map No.	Surveyed by L.D. Moore
Plotting C'k'd by M. H. M. H.	Date Mar 1928
Date 4/27/28.	Indexed A. C. Johnson

TOPOGRAPHY

for

FLORENCE AVE.

Note: ANY ADDITIONS OR CHANGES ON THIS SHEET MUST BE MADE OR CIRCLED IN Red. WITH DATE AND NAME OF PERSON MAKING CHANGE.

RETURN TO LOS ANGELES COUNTY SURVEYOR

Do not extend notes this side of this line

RETURN TO

LOS ANGELES COUNTY SURVEYOR

Note: ANY ADDITIONS OR CHANGES ON THIS SHEET MUST BE MADE OR CIRCLED IN **Red.** WITH DATE AND NAME OF PERSON MAKING CHANGE.

Do not extend notes this side of this line

Date

Notes by

Chief Party

F.B. 325 Pg. 101

Date 3-14-28 Notes by Moore Chief Party Moore F. B. 325 PG. 102

Plotted by A.C.Johnson	W. O. No. 7168 D. S. O. No.
Date Apr-1928	Location Florence Ave
Map No. B-135-1	Surveyed by L.D. Moore
Plotting C'k'd by H. U. M. H.	Date 3-14-28
Date 4/27/28	Indexed A. C. Johnson

To bottom pg 104

ST.

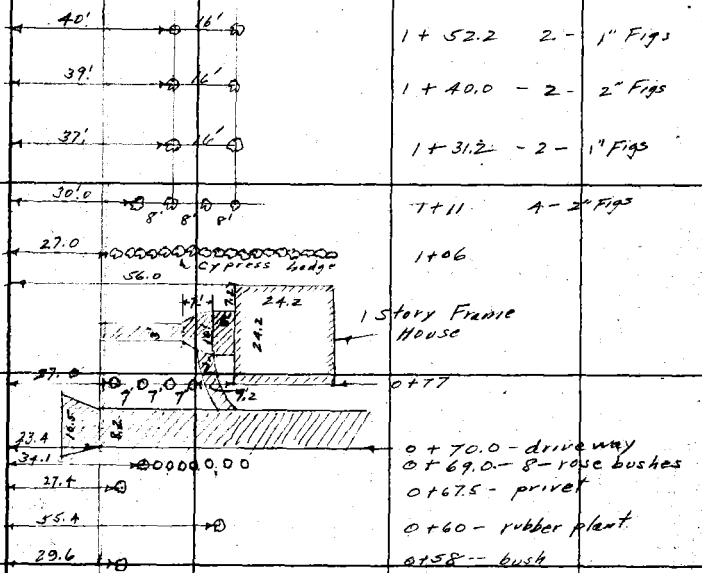

1 + 52.2 2 - 1" Figs

1 + 40.0 - 2 - 2" Figs

1 + 31.2 - 2 - 1" Figs

7 + 11 4 - 2" Figs

1 + 06

0 + 77

0 + 70.0 - driveway
0 + 69.0 - 8 - rose bushes
0 + 67.5 - privet
0 + 60 - rubber plant
0 + 58 -- bush

6 + 14

0 + 00 - PI
3/4" pipe

WEST ST

3/4" pipe

1

Notes: ANY ADDITIONS OR CHANGES ON THIS SHEET MUST BE MADE OR CIRCLED IN RED WITH DATE AND NAME OF PERSON MAKING CHANGE.

Do not extend notes this side of this line

RETURN TO LOS ANGELES COUNTY SURVEYOR

F.B. 325 Pg. 103 Moore Chief Party Notes by Moore Date 3-15-28

To bottom pg. 104

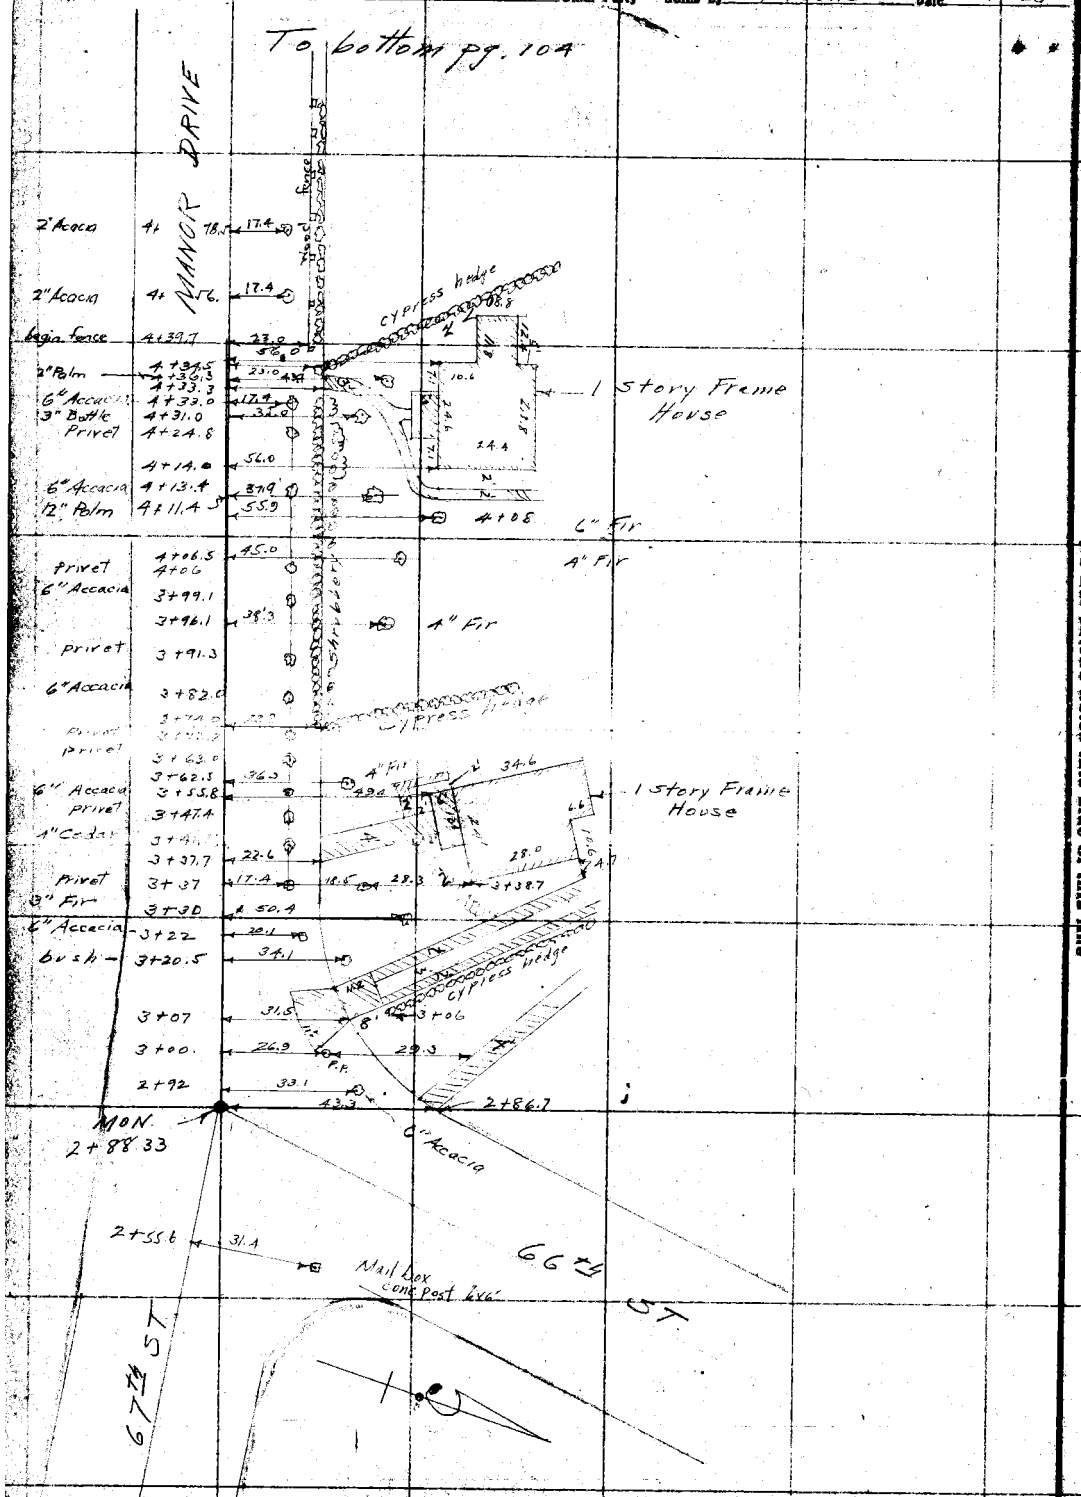

From Top pg. 102

RETURN TO
LOS ANGELES COUNTY SURVEYOR

Do not extend notes this side of this line

Notes: ANY ADDITIONS OR CHANGES ON THIS SHEET MUST BE MADE OR CIRCLED IN Red. WITH DATE AND NAME OF PERSON MAKING CHANGE.

Date 3-15-28 Notes by Moore Chief Party Moore F. B. 325 PG. 104

Plotted by A.C. Johnson
Date Apr- 1928
Map No. B-135-1
Plotting C'k'd by H. U. M. H.
Date 4/27/28.

W. O. No. 4168 D. S. O. No.
Location Florence Ave
Surveyed by L. D. Moore
Date 3-15-28
Indexed A. C. Johnson

To bottom pg. 105

Notes: ANY ADDITIONS OR CHANGES ON THIS SHEET MUST BE MADE OR CIRCLED IN Red, WITH DATE AND NAME OF PERSON MAKING CHANGE.
Do not extend notes this side of this line
RETURN TO LOS ANGELES COUNTY SURVEYOR

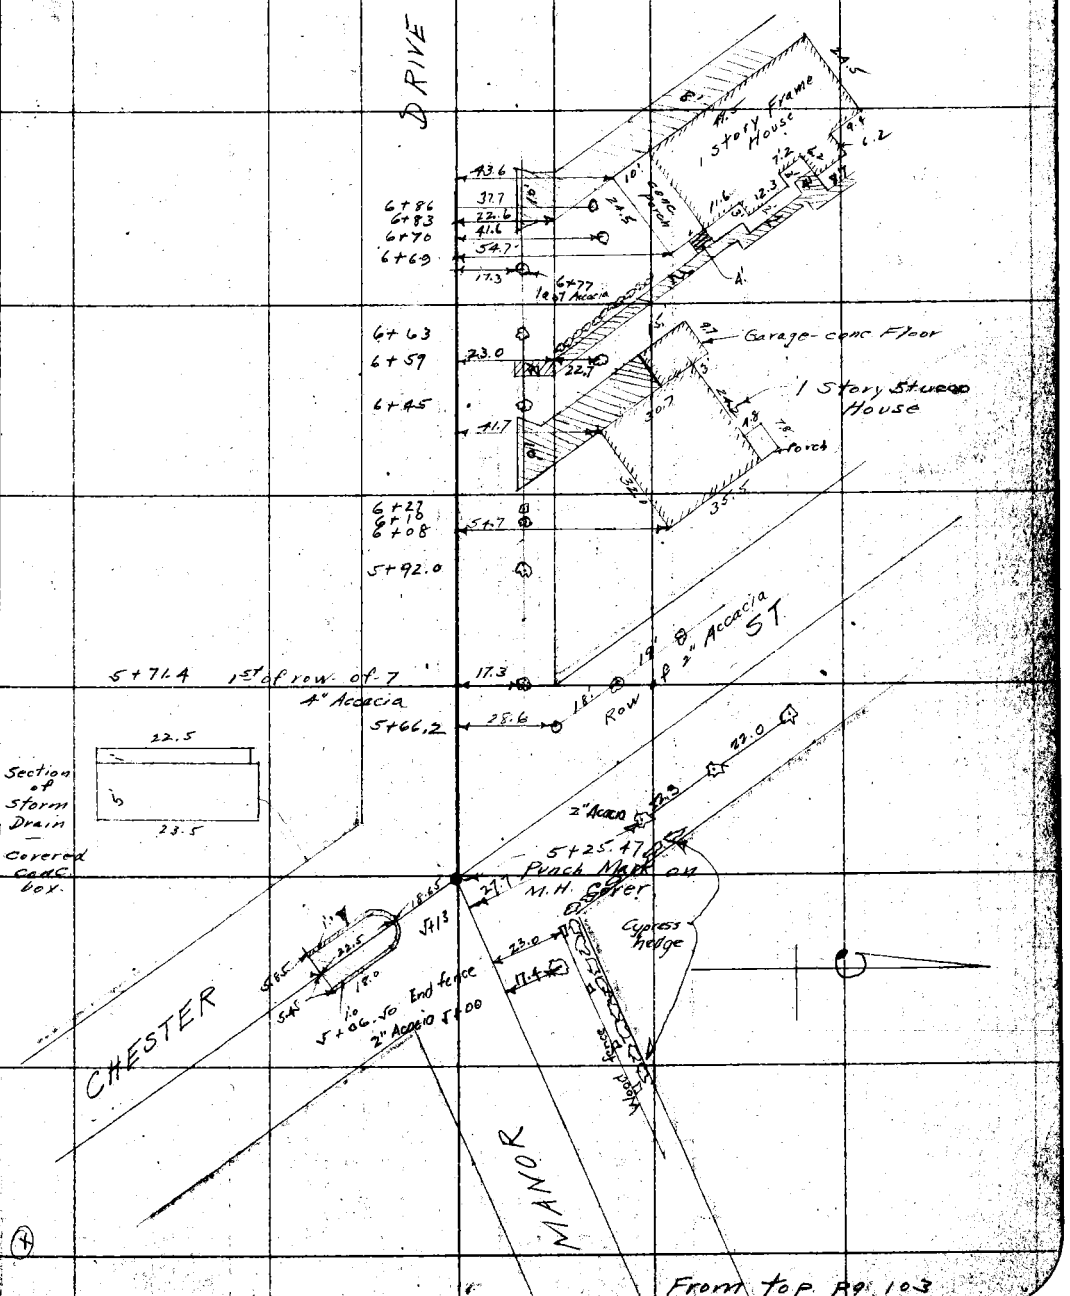

F.B. 225 Pg. 105 Moore Chief Party Notes by Moore Date 3-15-28

To bottom pg. 106

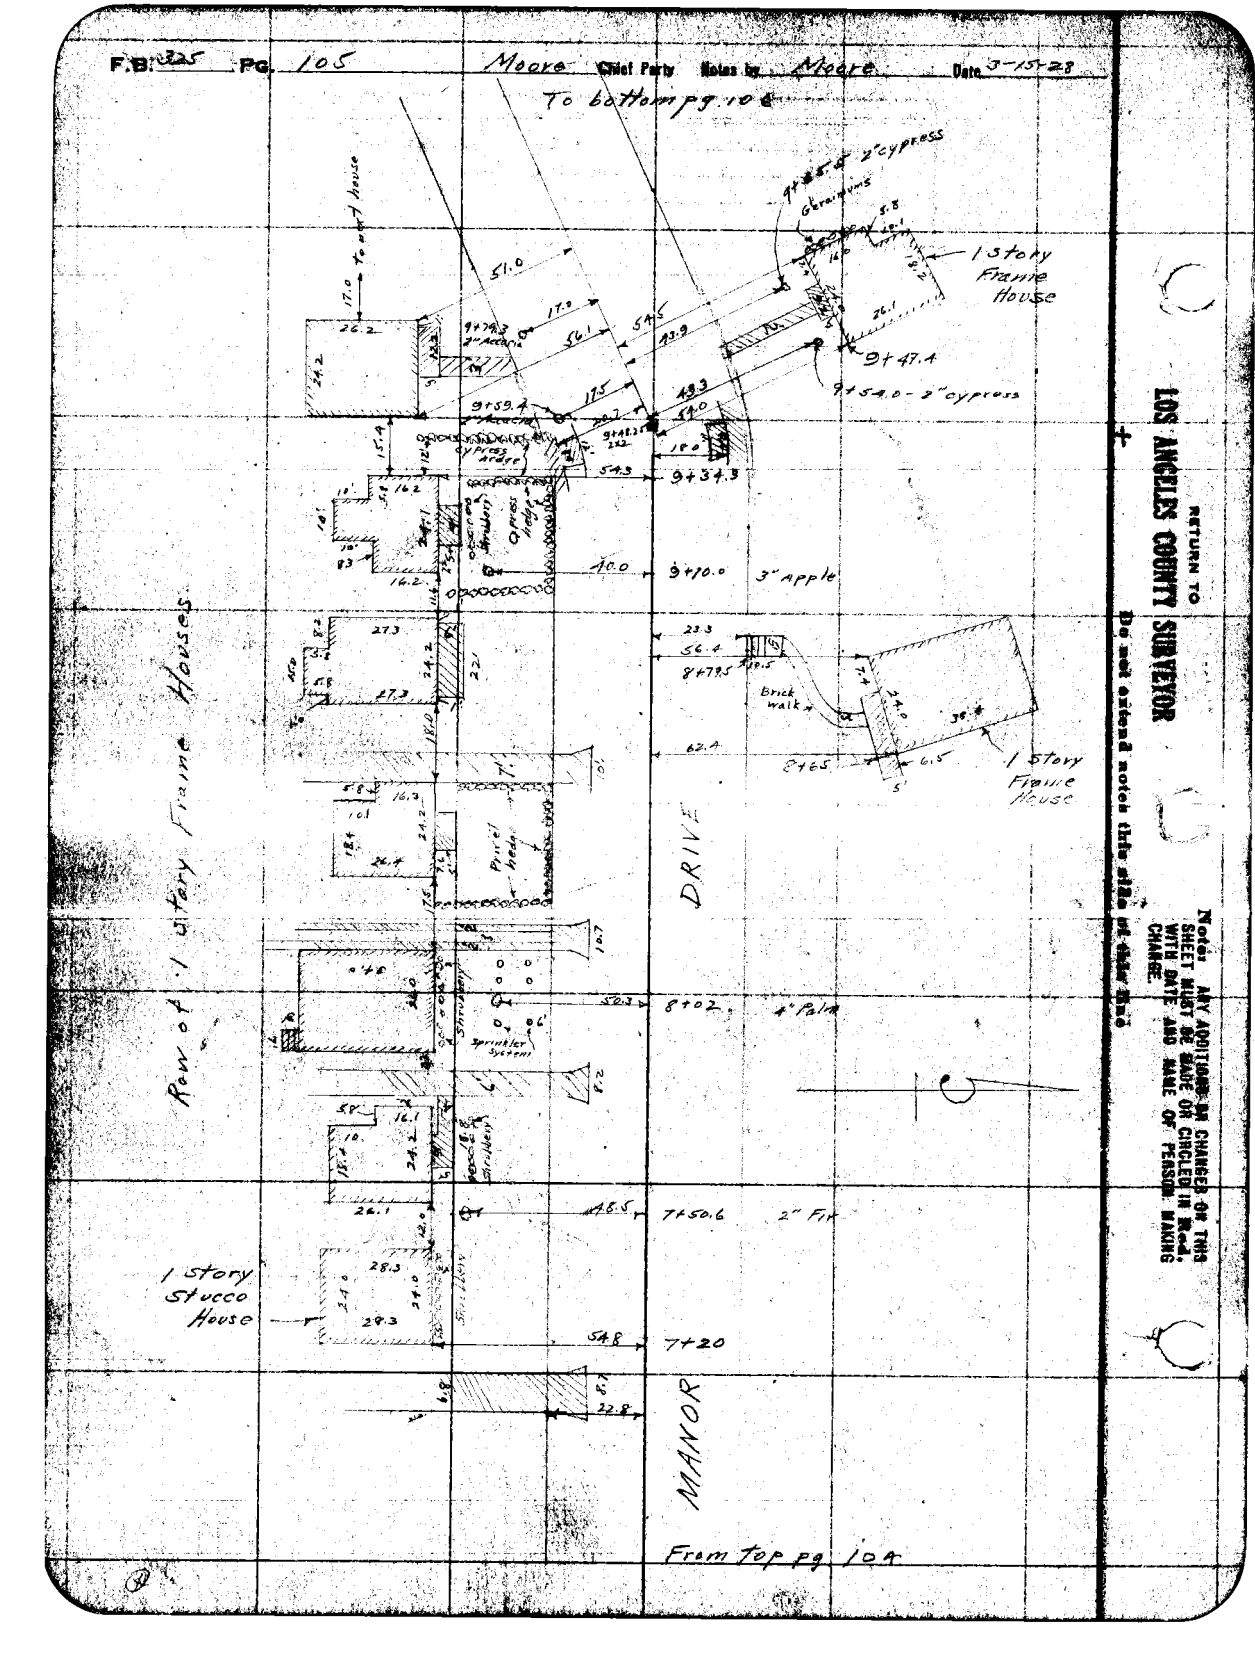

RETURN TO
LOS ANGELES COUNTY SURVEYOR

Do not extend notes this side of this line

Notice: ANY ADDITIONS OR CHANGES ON THIS SHEET MUST BE MADE OR CIRCLED IN Red, WITH DATE AND NAME OF PERSON MAKING CHANGE.

Date 3-16-28 Notes by Moore Chief Party Moore F. B. 325 Pg. 106

Plotted by A. C. Johnson	W. O. No. 4168 D. S. O. No.
Date Apr. 1928	Location Florence Ave
Map No. B-135-1	Surveyed by L. D. Moore
Plotting C'k'd by H. U. M. H	Date 3-16-28
Date 4/27/28.	Indexed A. C. Johnson

Notes: ANY ADDITIONS OR CHANGES FOR THIS SHEET MUST BE MADE OR CIRCLED IN Red. WITH DATE AND NAME OF PERSON MAKING CHANGE.

RETURN TO LOS ANGELES COUNTY SURVEYOR

Do not extend notes this side of this line

To bottom pg. 107

PRAIRIE AVE

DRIVE

MANOR

From top pg. 105

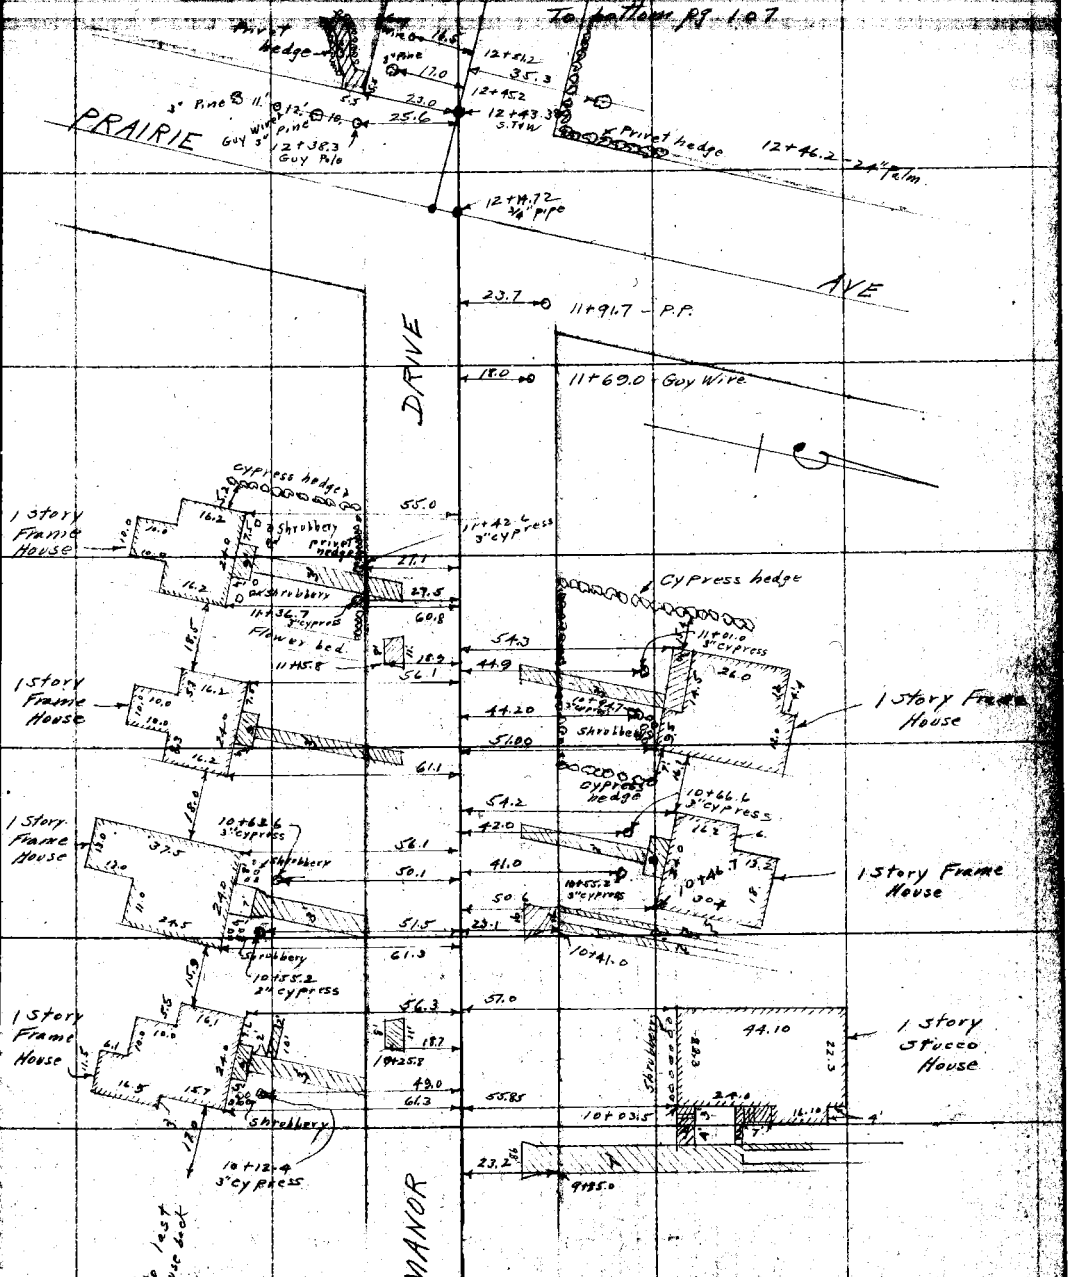

F.B. 325 Pg. 107 Moore Chief Party Notes by Moore Date 3-16-28

To bottom pg. 108

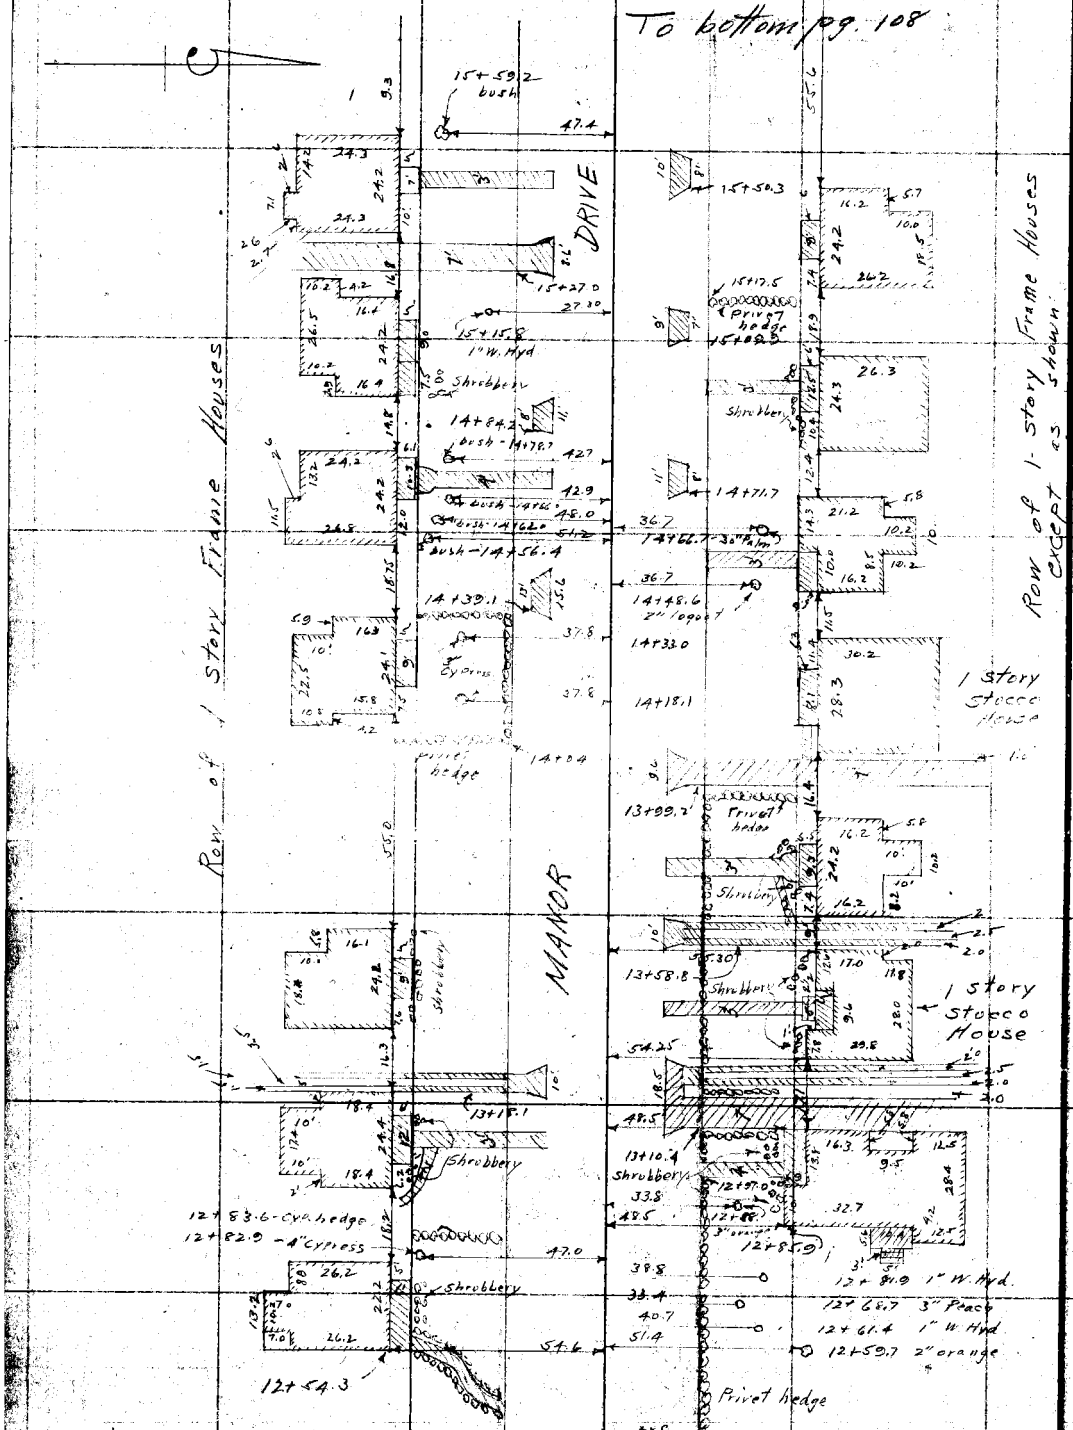

From top pg. 106.

RETURN TO
LOS ANGELES COUNTY SURVEYOR

Do not extend notes this side of this line

Notes: ANY ADDITIONS OR CHANGES ON THIS SHEET MUST BE MADE OR CIRCLED IN Red. WITH DATE AND NAME OF PERSON MAKING CHANGE.

Date 3-19-28 Notes by Moore Chief Party Moore F. B. 325 Pg. 106

Plotted by A.C. Johnson
Date Apr. 1928
Map No. B-135-1
Plotting Ch'k by H. H. M. Jr.
Date 4/26/28.

W. O. No. 4168 D. S. O. No.
Location Florence Ave
Surveyed by L.D. Moore
Date 3-19-28
Indexed A. C. Johnson

Notes: ANY ADDITIONS OR CHANGES ON THIS SHEET MUST BE MADE OR CIRCLED IN Red. WITH DATE AND NAME OF PERSON MAKING CHANGE.

RETURN TO LOS ANGELES COUNTY SURVEYOR

Do not extend notes this side of this line

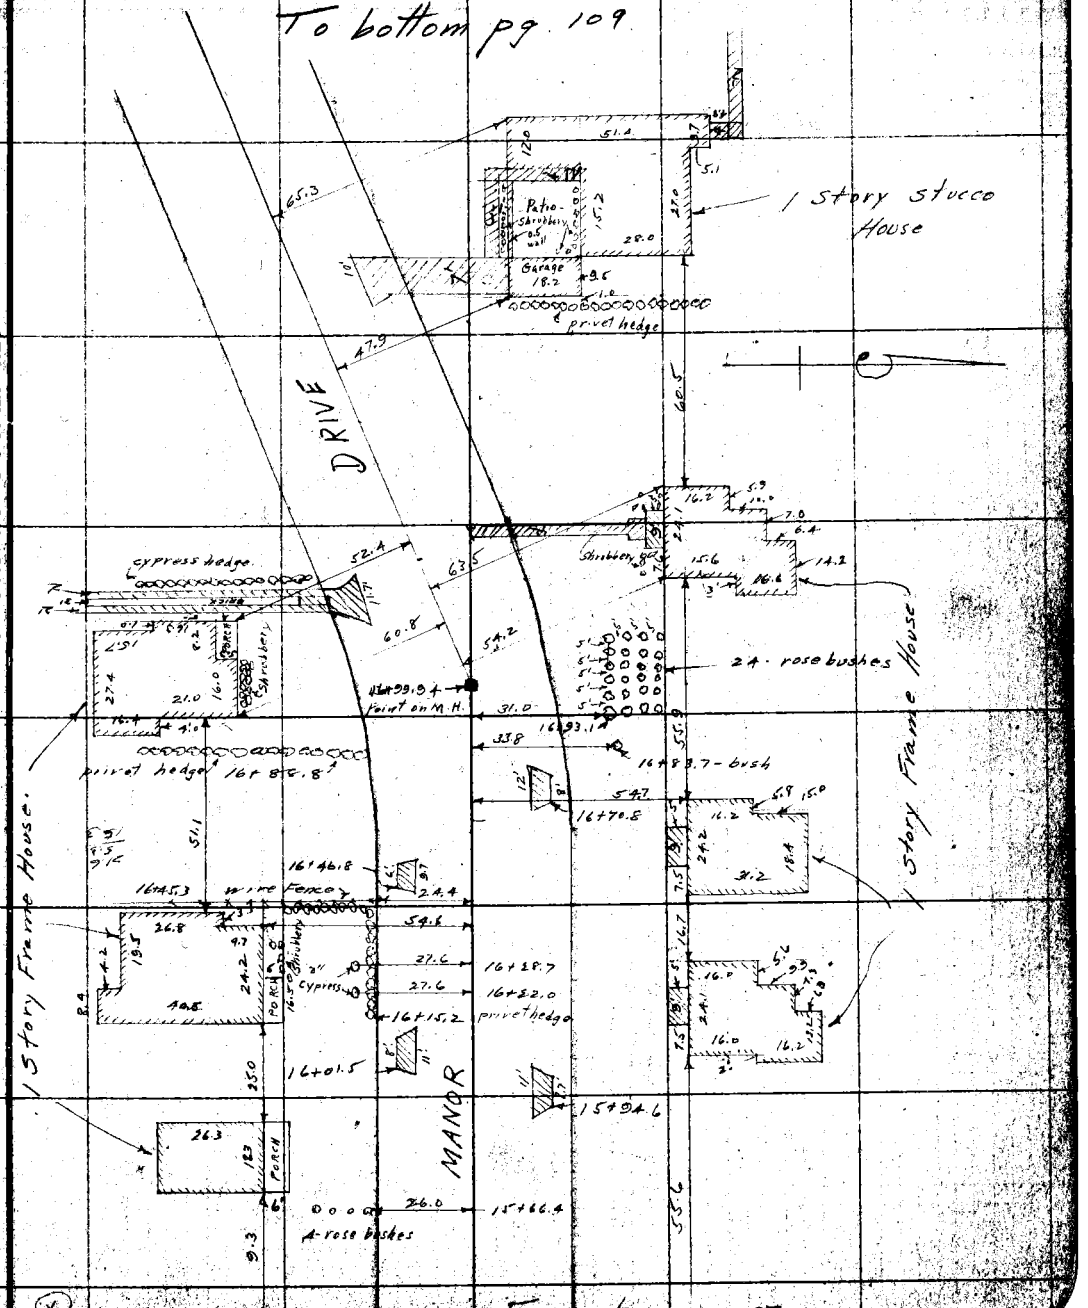

F.B. 1325 Pg. 109 Moore Chief Party Notes by Moore Date 5-20-25

To Pg. 110

DRIVE

MARLBOUGH

19+19.60
Punch Mark
on W. Curb

ST

DAHLIA

BED

16.5
Fire Hyd
18+77.5

1 Story
Frame
House

56.0
18+31.5

Shrubbery

65.4
18+07.1

MANOR

From Top Pg. 108

RETURN TO
LOS ANGELES COUNTY SURVEYOR
Do not extend notes this side of this line

Note: ANY ADDITIONS OR CHANGES ON THIS SHEET MUST BE MADE OR CIRCLED IN Red. WITH DATE AND NAME OF PERSON MAKING CHANGE.

Date 3-19-28 Notes by Moore Chief Party Moore F. B. 325 PG. 110

Plotted by A.C. Johnson
Date Apr. 1928
Map No. B-135-1
Plotting C'k'd by H. U. M. Th
Date 4/26/28.

W. O. No. 4168 U. S. O. No.
Location Florence Ave
Surveyed by L. D. Moore
Date 3-19-28
Indexed A. C. Johnson

Notes: ANY ADDITIONS OR CHANGES ON THIS SHEET MUST BE MADE OR CIRCLED IN Red, WITH DATE AND NAME OF PERSON MAKING CHANGE.

RETURN TO LOS ANGELES COUNTY SURVEYOR

Do not extend notes this side of this line

DRIVE

21+71.46 Punch Mark on M.H

WELTON WAY

0+00 Punch Mark on M.H

0+45.5 Guy Wire

0+72 P.P.

0+93

Board Fence

White Fence

Other Frame Garage

4" Accacia 21+42.6 27.4 2" cypress

21+34.6 17.2

4" Accacia 21+32.0 40.0 2 - rosebushs

21+24.2 16.0

21+21.3 69.4 2" Accacia 2" Mulberry

Shrubbery

21+13.4 30.7

21+10.6 27.4

4" Accacia 21+07.8 3" cypress Privet Hedge Board Fence

54.6

20+90.7 27.4 Frame Garage Conc. Floor 3" Plum 15 rose bushs

3" cypress 3" Plum 3" Plum 6" Apricot 3" Plum

20+83.0 27.4 Privet 22' 1 Story Frame House 24.0 Orange Tree

4" Accacia 20+79.4 3" cypress 3" Plum 3" Plum 20.2 Rose Bushes

privet Hedge 20+68.4 4" privet Shrubbery 6" Apple 3" Fig 3" Apple

2" privet 20+62.3 26.8 4" Accacia 20+59.0 4" Fig

privet 20+52.5 22' 1 Story Frame House

privet 20+45.0 1" Fig

4" Accacia 20+42.2 17.2

3 privet 20+38.9 26.8 2" cypress

rosebush 20+19.2 29.7 2" quince 2" Apple 2" orange

" 20+10.4 29.7 2" Fig

" 19+99 29.7 22' 1 Story Frame House board Fence

19+86.7 54.6

19+82.5 85.0 19+84.3 P.P. 69.6

19+78.0 65.6 10.0

19+67.8 38.3 Group of 2" Apple

19+53.6 60.0 18.4

23.7

19+38.6 — P.P.

MANOR MARLBOUGH ST.

19+19.60 Punch Mark on M.H Cover. From pg. 109

F.B. 325 Pg. 111 Moore Chief Party Notes by Moore Date 3-20-28

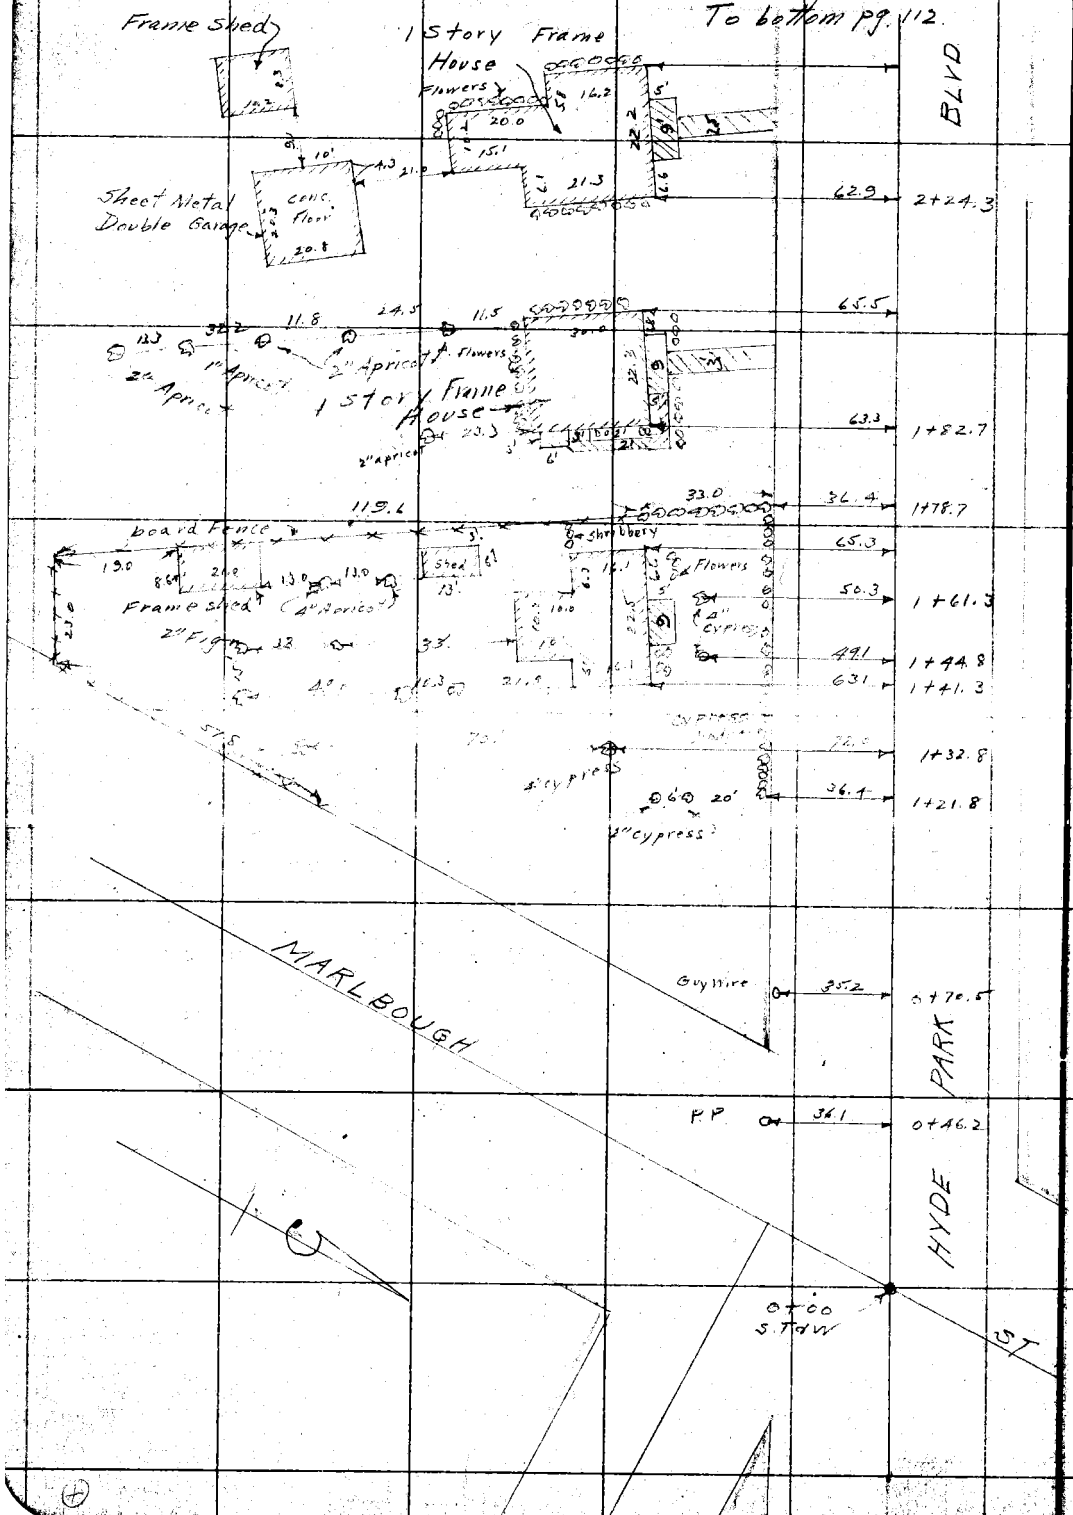

RETURN TO
LOS ANGELES COUNTY SURVEYOR
Do not extend notes this side of this line

Notes: ANY ADDITIONS OR CHANGES ON THIS SHEET MUST BE MADE OR CIRCLED IN Red. WITH DATE AND NAME OF PERSON MAKING CHANGE.

Date 3-20-28 Notes by Moore Chief Party Moore F. B. 325 Pg. 112

Plotted by A.C. Johnson
Date Apr 1928
Map No. B-135-1
Plotting C'k'd by H. U. M. H.
Date 4/26/28.

W. O. No. 4168 R. S. O. No.
Location Florence Ave
Surveyed by L. D. Moore
Date 3-20-28
Indexed A. C. Johnson

To bottom pg 113

BLVD

WELTON WAY

A+38.87
L47

Flowers
2' cypress
59.4
64.0
48.9
4+12.0
4+02

1 story Frame House
48.9
61.0
35.0
3+89.5
3+84.0
3+76.7

HYDE PARK

65.4

1 story Frame House
62.7
3+05.4

Flowers
board fence
privet
Rosebushes
28.4
37.0
2+97.0

13" Palm
3" cypress
25.5
65.4
2+88.4
2+86.1

Flowers
1 Story Frame House
13" Palm
3" cypress
25.5
44.1
62.8
2+71.6
2+69.7
2+63.2

Frame Garage
37.0
2+56.0

Flowers

From Top pg. 111.

Notes: ANY ADDITIONS OR CHANGES ON THIS SHEET MUST BE MADE OR CIRCLED IN Red. WITH DATE AND NAME OF PERSON MAKING CHANGE.

Do not extend notes this side of this line

RETURN TO LOS ANGELES COUNTY SURVEYOR

F.B. 325 PG. 113 Moore Chief Party Notes by Moore Date 3-20-28

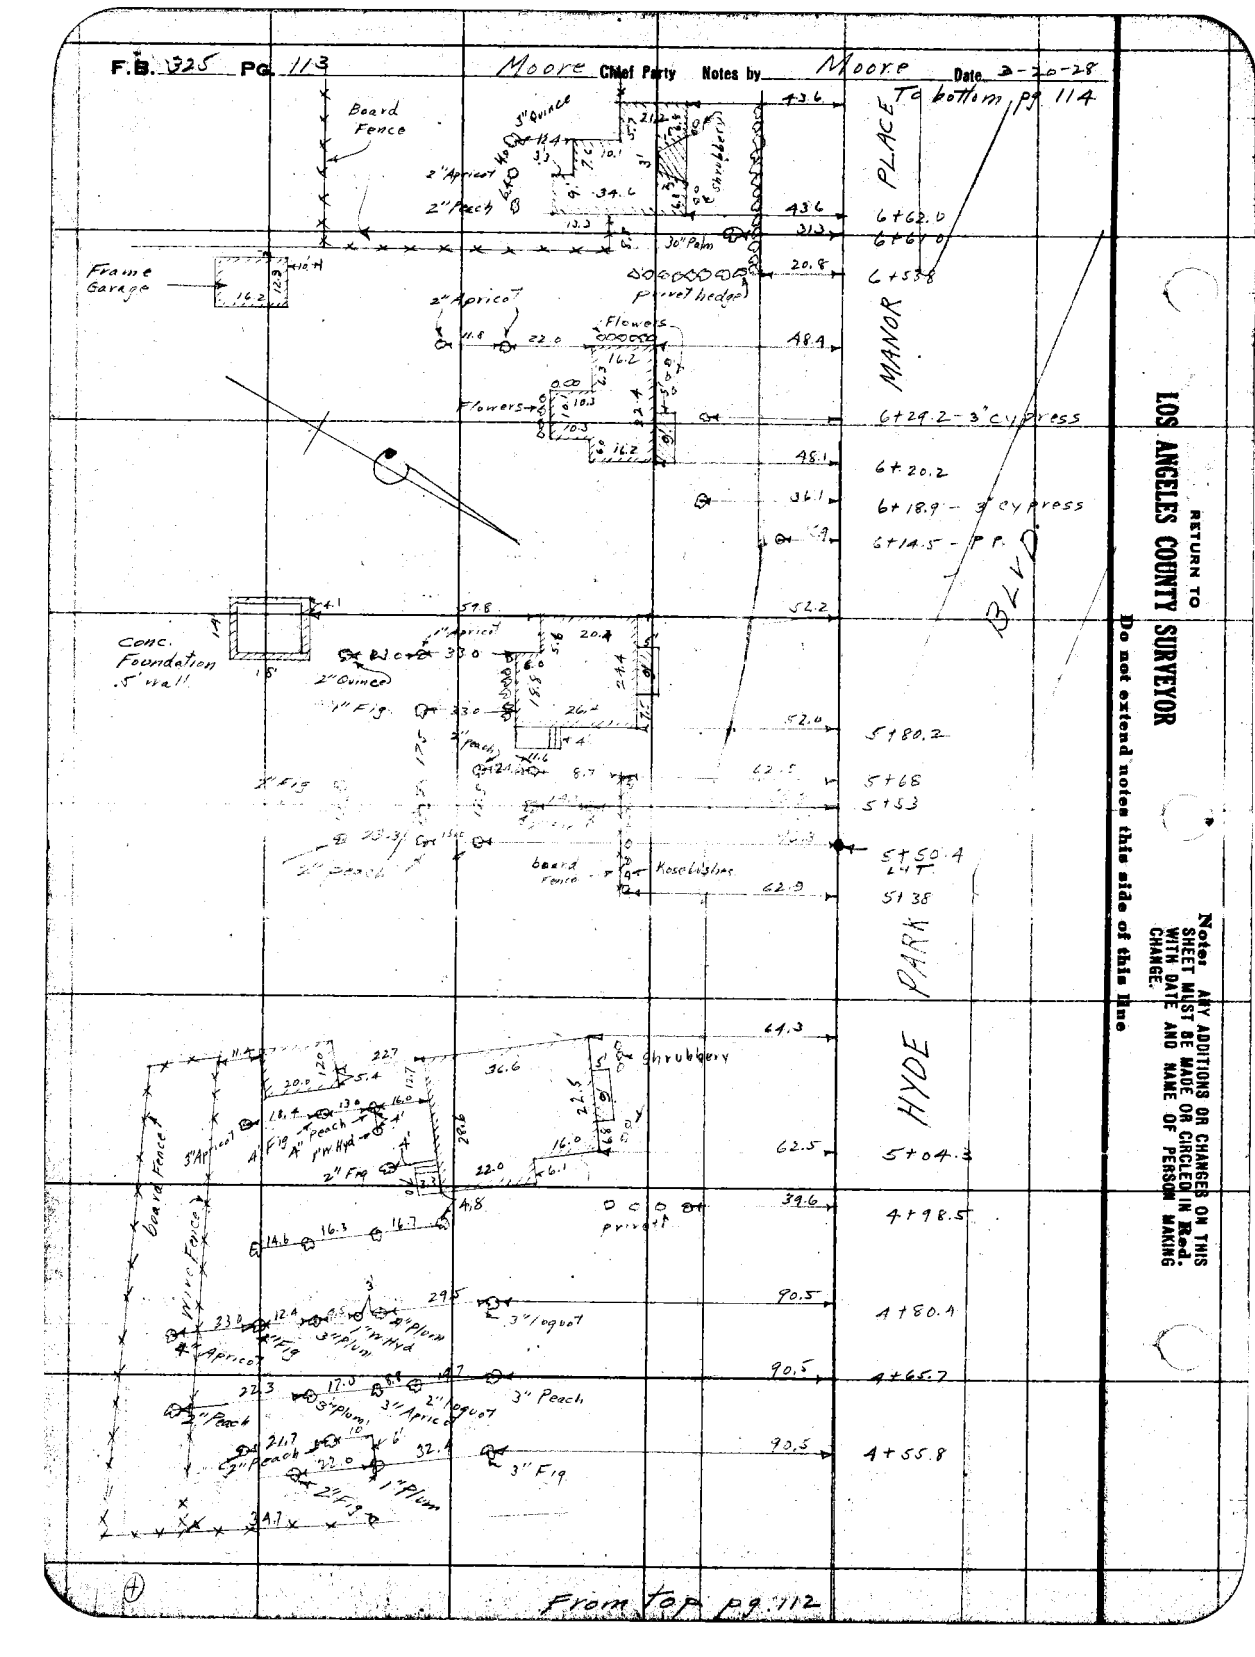

RETURN TO
LOS ANGELES COUNTY SURVEYOR
Do not extend notes this side of this line

Note: ANY ADDITIONS OR CHANGES ON THIS SHEET MUST BE MADE OR CIRCLED IN Red. WITH DATE AND NAME OF PERSON MAKING CHANGE.

Date 3-20-28 Notes by Moore Chief Party Moore F. B. 325 Pg. 114

Plotted by [illegible]
Date Apr-1928
Map No. B-135-1
Plotting C'k'd by H.U.M.H.
Date 4/26/28

W. O. No. 4168 D. S. O. No.
Location Florence Ave
Surveyed by L.D. Moore
Date 3-20-28
Indexed A. C. Johnson

Note: ANY ADDITIONS OR CHANGES ON THIS SHEET MUST BE MADE OR CIRCLED IN Red. WITH DATE AND NAME OF PERSON MAKING CHANGE.

Do not extend notes this side of this line

RETURN TO LOS ANGELES COUNTY SURVEYOR

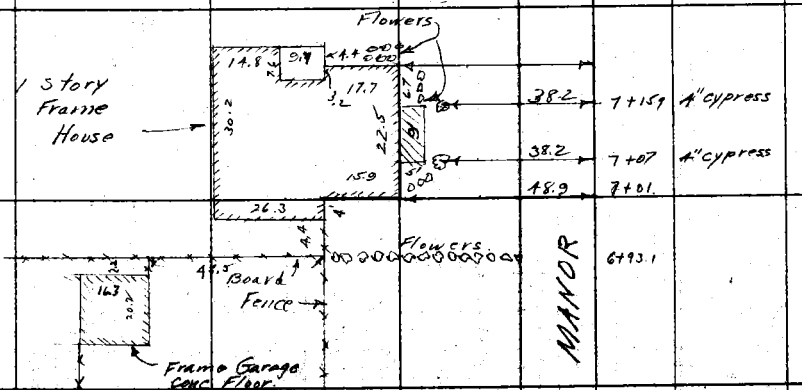

From top pg. 113

F.B. 325 Pg. 115 Moore Chief Party Notes by Moore Date 3-20-28

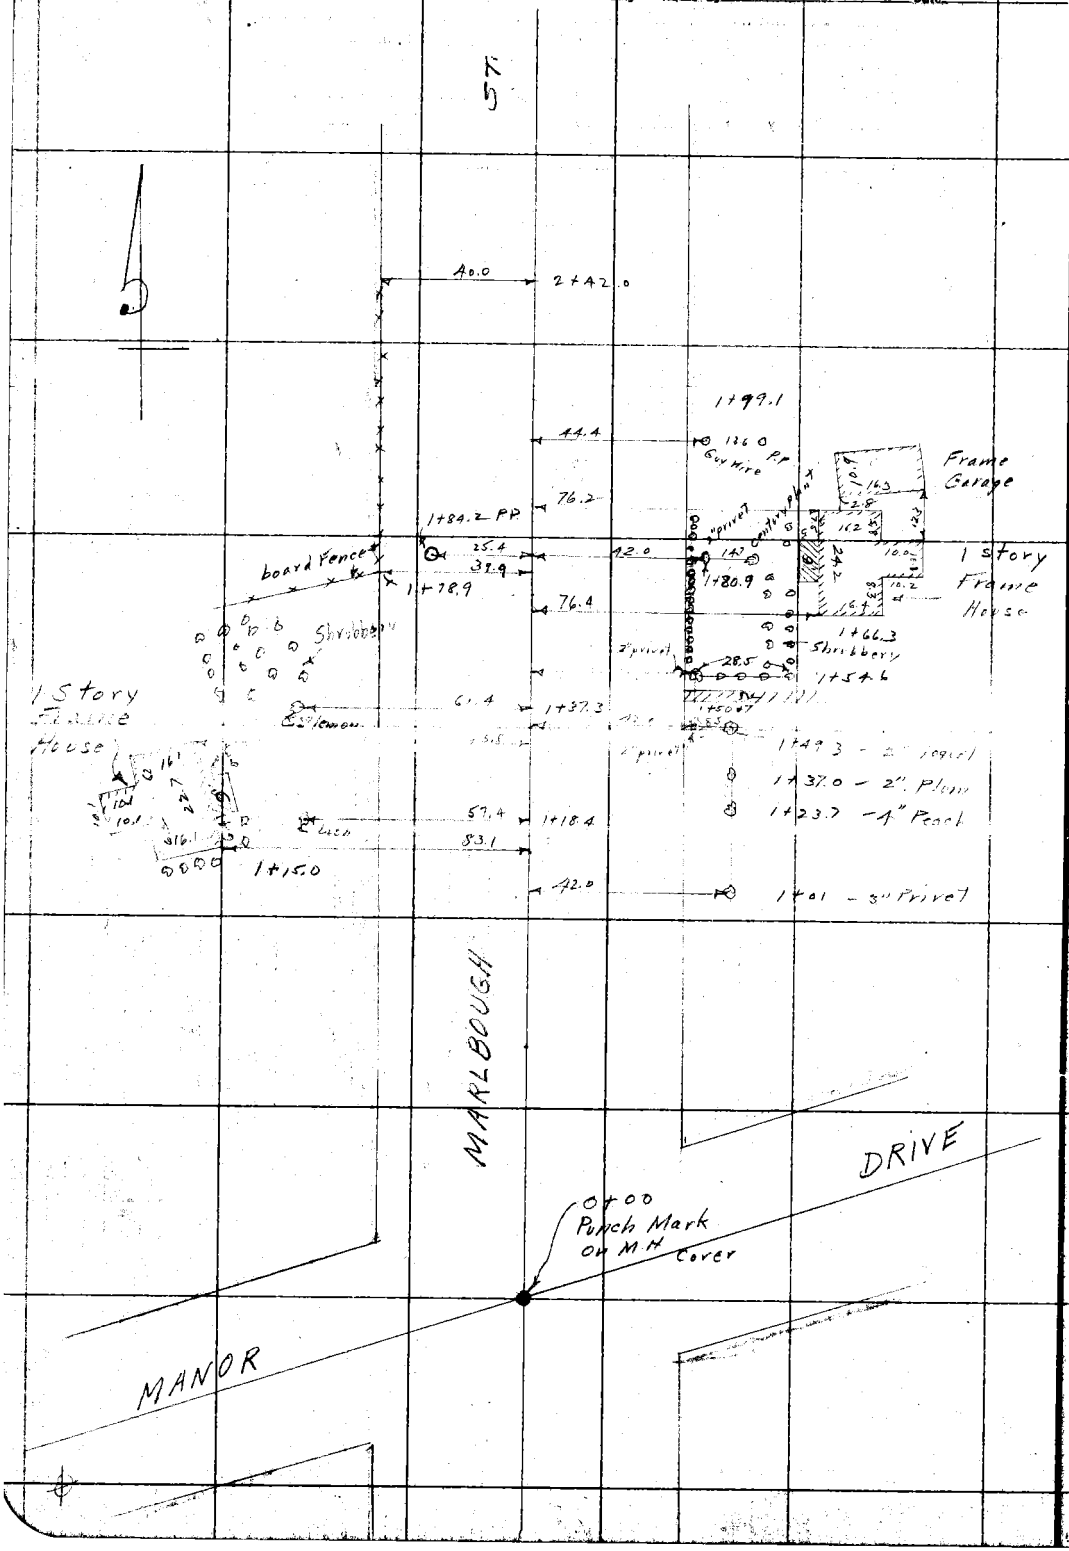

RETURN TO
LOS ANGELES COUNTY SURVEYOR
Do not extend notes this side of this line

Notes: ANY ADDITIONS OR CHANGES ON THIS SHEET MUST BE MADE OR CIRCLED IN Red. WITH DATE AND NAME OF PERSON MAKING CHANGE.

Date 3-21-28 Notes by Moore Chief Party Moore F. B. 325 Pg. 116

Plotted by A.C. Johnson	W. O. No. 1168 D. & O. No.
Date Apr - 1927	Location Florence Ave
Map No. 13-135-1	Surveyed by L.D Moore
Plotting C'k'd by H.L.M.H	Date 3-21-28 A.C. Johnson
Date 4/26/28.	Indexed

To bottom pg. 117

2" Peach — 7' 8" 11" Plm — 2 + 82.2

3" Peach — 74.5 — 2 + 73.9

2" Peach — 71.0 — 2 + 65.6

2" Peach — 76.9 — 2 + 57.9

MANOR PLACE

BLVD

Mail box Conc post 6"x6" — 28.1 — 1 + 72.3

PARK

0 + 00 L & T.

HYDE

Note: ANY ADDITIONS OR CHANGES ON THIS SHEET MUST BE MADE OR CIRCLED IN Red. WITH DATE AND NAME OF PERSON MAKING CHANGE.

Do not extend notes this side of this line

RETURN TO LOS ANGELES COUNTY SURVEYOR

F.B. 325 Pg. 117 — Moore Chief Party — Notes by Moore — Date 3-21-28

5+69.5 privet hedge

To bottom pg. 118

5+60.5

5+59.8 2" cypress

5+56.0 1" M Hyd

5+55.0 1" privet

5+44.4 3' Eucalyptus

5+38.0

5+37.5 2" cypress

5+34.7 1" Acacia

4+97.10

privet hedge

BLVD

4+59.3

4+48.1

privet hedge

4+22.8 3" cypress

4+16.9

4+09.3

privet hedge

PARK

3+77.0

HYDE

3+12.1 5" cypress

3+01 5" cypress

2+90.7

ROW OF 1 STORY FRAME HOUSES

From top pg. 116

RETURN TO LOS ANGELES COUNTY SURVEYOR

Do not extend notes this side of this line

Notes: ANY ADDITIONS OR CHANGES ON THIS SHEET MUST BE MADE OR CIRCLED IN Red. WITH DATE AND NAME OF PERSON MAKING CHANGE.

Date 3-21-28 Notes by Moore Chief Party Moore F. B. 325 PG. 118

Plotted by A. Calabrese
Date Apr - 1928
Map No. B-135-1
Platting C'k'd by H. U. M. H.
Date 4/26/28.

W. O. No. 4168 S. & O. No.
Location Florence Ave
Surveyed by L. B. Moore
Date 3-21-28
Indexed

To bottom pg. 119

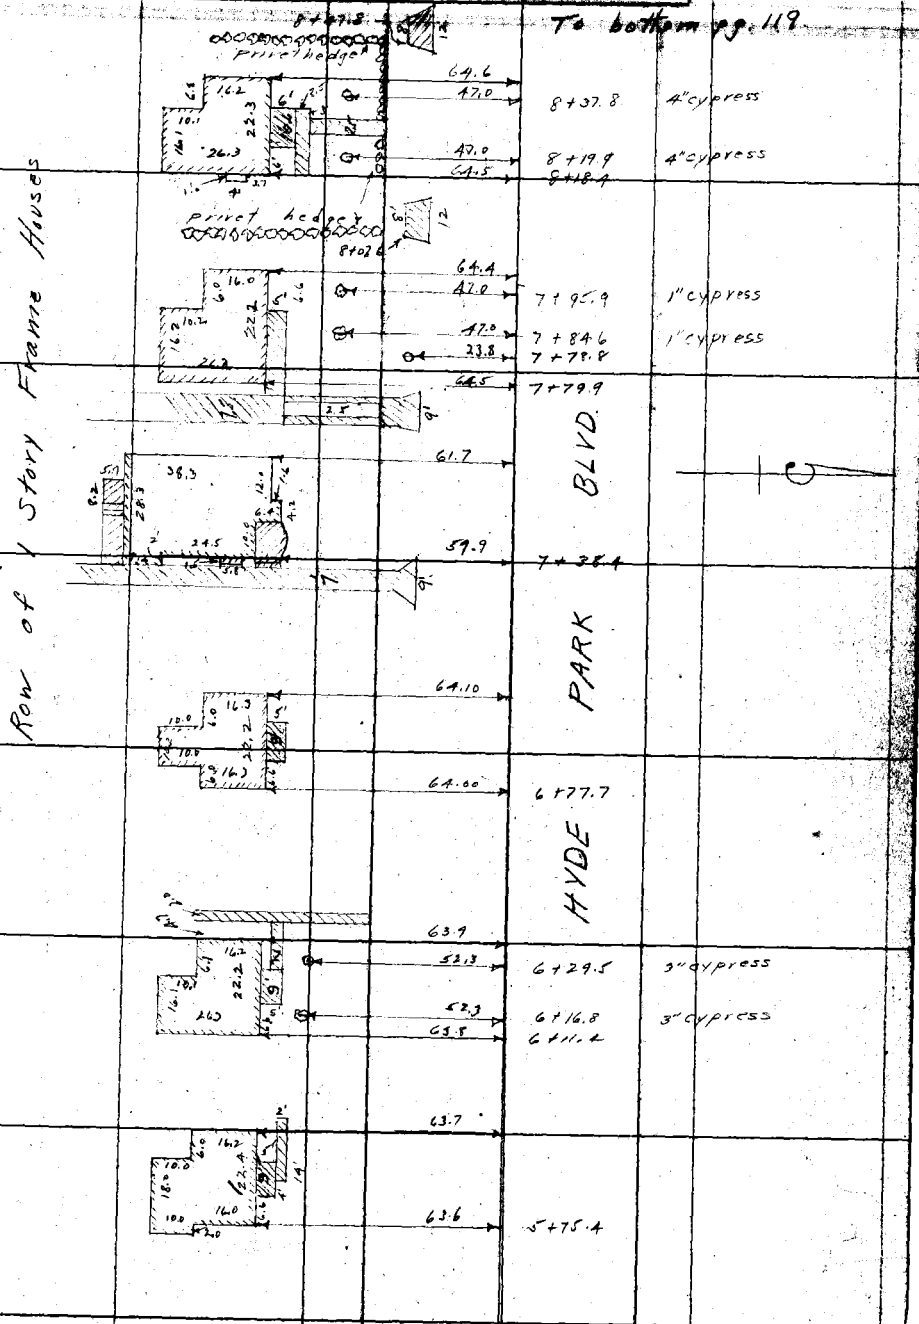

From top pg. 117

RETURN TO
LOS ANGELES COUNTY SURVEYOR
Do not extend notes this side of this line

Notes: ANY ADDITIONS OR CHANGES ON THIS SHEET MUST BE MADE OR CIRCLED IN Red, WITH DATE AND NAME OF PERSON MAKING CHANGE.

F.B. 325 Pg. 119 Moore Chief Party Notes by Moore Date 3-21-28

To bottom pg. 120

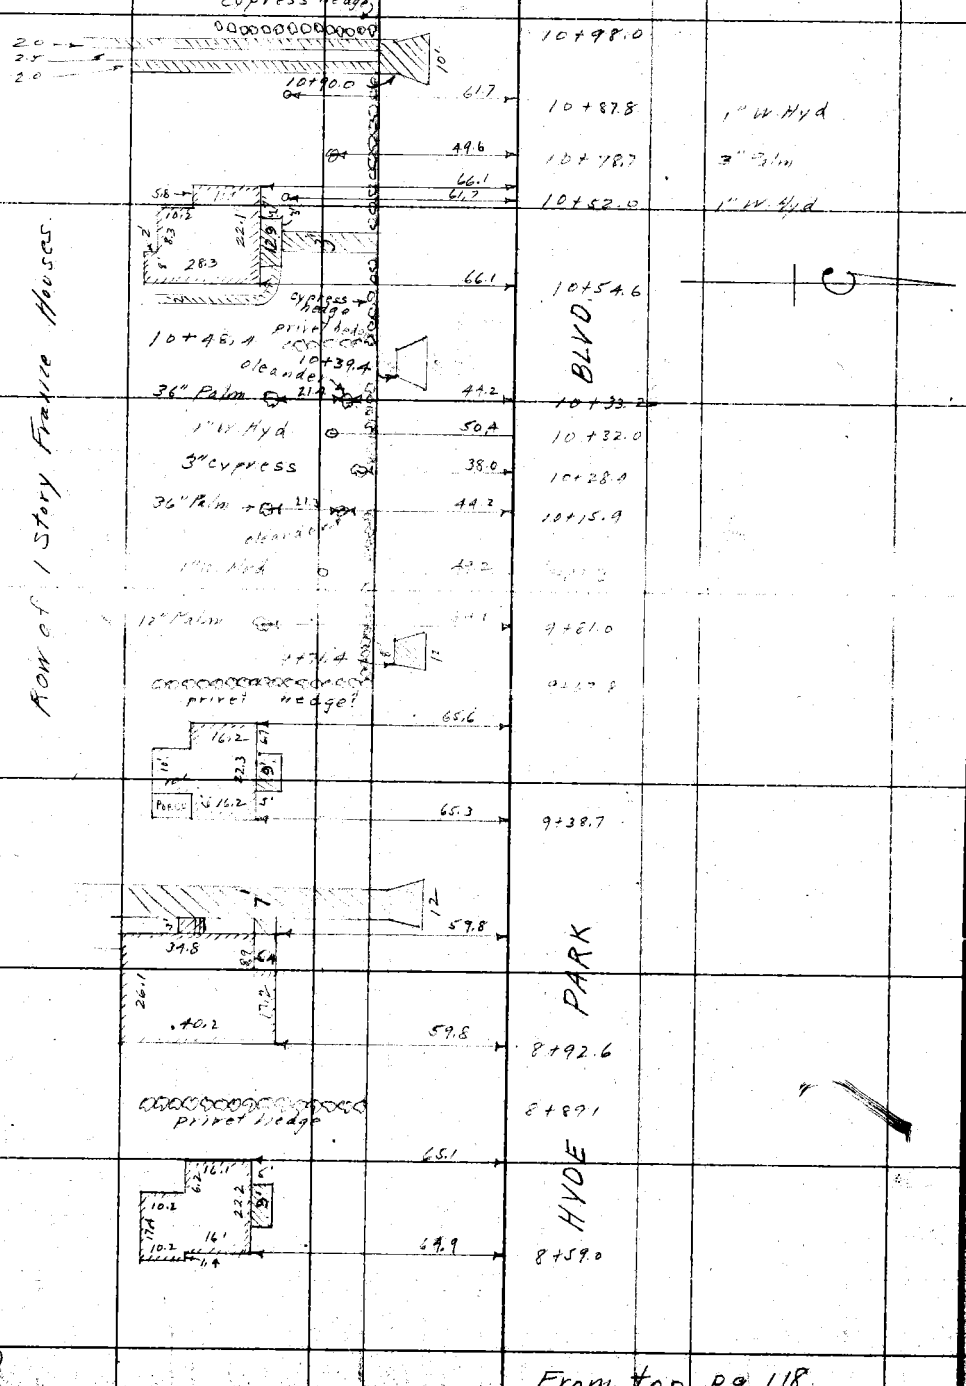

From top pg 118

RETURN TO
LOS ANGELES COUNTY SURVEYOR
Do not extend notes this side of this line

Notice: ANY ADDITIONS OR CHANGES ON THIS SHEET MUST BE MADE OR CIRCLED IN Red. WITH DATE AND NAME OF PERSON MAKING CHANGE.

Date 3-21-28 Notes by Moore Chief Party Moore F. B. 326 Pg. 120

Planned by A. C. Johnson
Date Apr. 1928
Map No. 13-135-1
Plotting C'k'd by H. U. M. H.
Date 4/26/28

U. S. No. 4168 L. A. C. No.
Location Florence Ave
Surveyed by L D Moore
Date 3-21-28
Indexed A. C. Johnson

Note: ANY ADDITIONS OR CHANGES ON THIS SHEET MUST BE MADE OR CIRCLED IN Red. WITH DATE AND NAME OF PERSON MAKING CHANGE.

Do not extend notes this side of this line

RETURN TO LOS ANGELES COUNTY SURVEYOR

AVE

Mon

L+T

14+53.8 Mon

FIELD AVE

BLVD

CENTINELA

34.9

13+84.6

1 story BRICK BLDG Stores

39.0

65.5

12.3

12.5

9.0

12.4

34.6

34.9

PARK

HYDE

ALLEY

From top Rg 119

RETURN TO

LOS ANGELES COUNTY SURVEYOR

Note: ANY ADDITIONS OR CHANGES ON THIS SHEET MUST BE MADE OR CIRCLED IN **Red.** WITH DATE AND NAME OF PERSON MAKING CHANGE.

Do not extend notes this side of this line

F.B. 323 Pg. 121

Moore Chief Party Notes by Moore Date

Date 3-21-28 Notes by Moore Chief Party Moore F. B. 335 PG. 122

Plotted by A.C. Johnson	W. O. No. 4168 S. S. O. No.
Date Apr. 1928	Location Florence Ave
Map No. B-135-1	Surveyed by L.D. Moore
Plotting C'k'd by U. M. H.	Date 3-21-28
Date 4/29/28	Indexed C. Johnson

Notes: ANY ADDITIONS OR CHANGES ON THIS SHEET MUST BE MADE OR CIRCLED IN Red. WITH DATE AND NAME OF PERSON MAKING CHANGE.

Do not extend notes this side of this line

RETURN TO LOS ANGELES COUNTY SURVEYOR

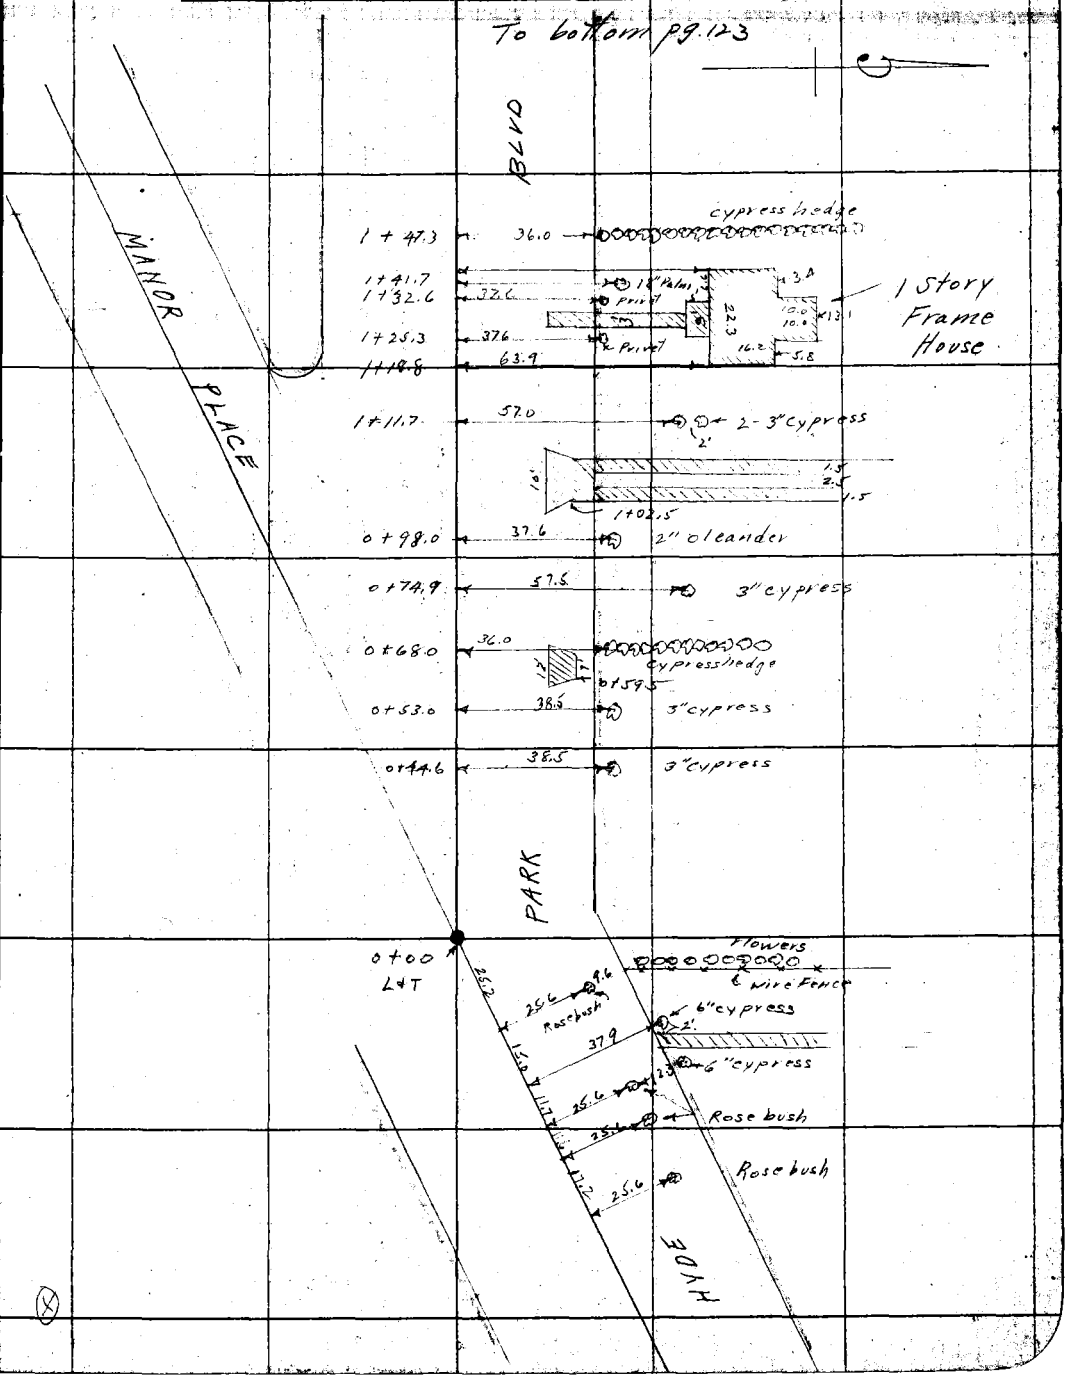

F.B. 325 Pg. 123 — Moore Chief Party — Notes by Moore — Date 3-21-28

To bottom pg 124

6+28.7 — privet hedge

3" Cypress — 6+14.6 — 63.2, 52.0
3" Cypress — 6+04.3 — 52.0
5+98.1 — 63.2

BLVD.

6" Cypress — 5+45.0 — 47.5
2" Cypress — 5+37.8 — 63.2, 53.3

5+19.2 — 63.2
3" Cypress — 5+15.6 — 47.5

HYDE PARK

Frame Houses

Row of 1 Story

3+20.5 — 2.0 — Chimney

2" Accacia, 2-2" Privet, 2-2" Privet, 2" Accacia — 3+73.1, 3+69.0, 3+63.0, 3+58.5, 3+52.5, 3+48.4 — 45.5, 23.1, 23.1, 64.2 — privet hedge

3+40.3 — 25.5 — 6" Accacia

3+22.2 — 25.5 — 6" Accacia

64.0

6" cypress, 6" cypress — 2+92.2, 2+84.8, 2+79.3 — 64.0

2+67.8

From top pg. 122

RETURN TO LOS ANGELES COUNTY SURVEYOR

Do not extend notes this side of this line

Notes: ANY ADDITIONS OR CHANGES ON THIS SHEET MUST BE MADE OR CIRCLED IN Red. WITH DATE AND NAME OF PERSON MAKING CHANGE.

Date 3-21-28 Notes by Moore Chief Party Moore F. B. 325 Pg. 124

Plotted by A.C. Johnson
Date Apr 1928
Map No. B-135-1
Plotting C'k'd by H. U. M. H.
Date 4/26/28

W. O. No. 4168 L. S. D. No.
Location Florence Ave
Surveyed by L. D. Moore
Date 3-21-28
Indexed

Notes: ANY ADDITIONS OR CHANGES ON THIS SHEET MUST BE MADE OR CIRCLED IN Red. WITH DATE AND NAME OF PERSON MAKING CHANGE.

Do not extend notes this side of this line

RETURN TO LOS ANGELES COUNTY SURVEYOR

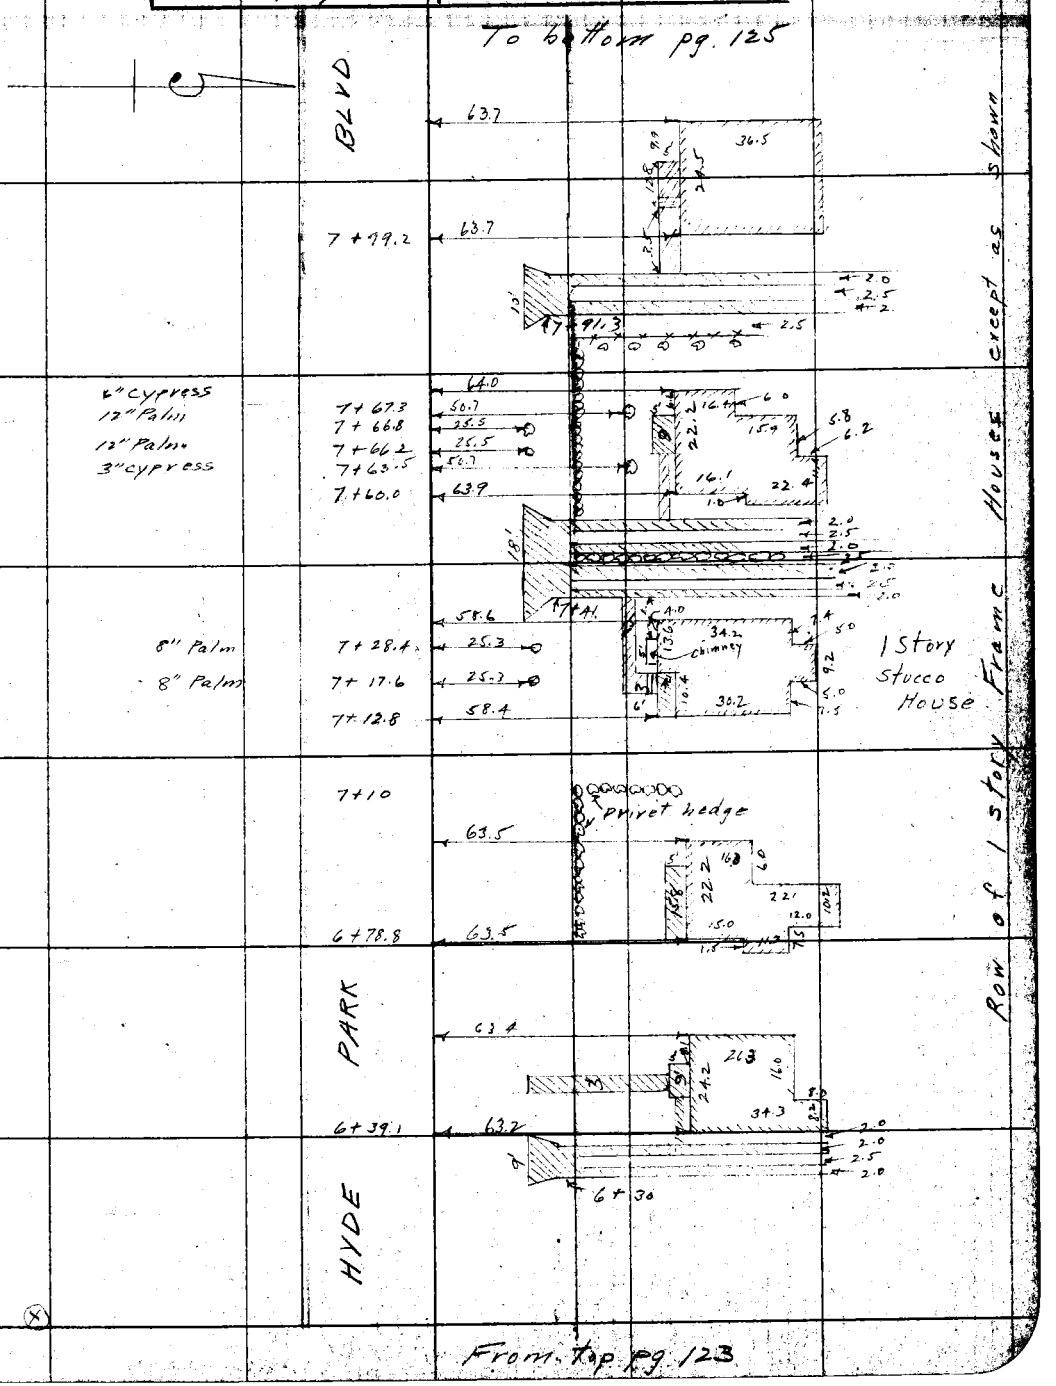

F.B. 325 Pg. 125

Moore Chief Party Notes by Moore Date 3-22-28

To bottom pg. 126

BLVD

10+61.1

1.0+62.4 cypress hedge

64.7

10+35.8

10+27.7

cypress hedge

64.9

10+18.0

6" Palm

2" cypress

10+03.3

9+93.5

9+91.9

52.9

64.7

2" Eucalyptus

9+67.2

9+61.1

64.6

64.4

9+47.5

PARK

privet hedge

9+08.1

64.4

8+84.4

64.4

8+68.6

privet hedge

3" cypress

3" cypress

8+56.5

8+41.3

8+32.8

65.2

51.0

51.0

65.2

HYDE

privet hedge

From Top pg. 124

Houses

1 Story Frame

ROW

RETURN TO
LOS ANGELES COUNTY SURVEYOR

Do not extend notes this side of this line

Notes: ANY ADDITIONS OR CHANGES ON THIS SHEET MUST BE MADE OR CIRCLED IN Red. WITH DATE AND NAME OF PERSON MAKING CHANGE.

Date 3-22-28 Notes by Moore Chief Party Moore F. B. 325 Pg. 124

Plotted by A.C. Johnson
Date Apr. 1928
Map No. B-135-1
Plotting C'k'd by H. U. M. H
Date 4/25/28

W. O. No. 4168 O. S. O. No.
Location Florence Ave
Surveyed by L. D. Moore
Date 3-22-28
Indexed

To pg. 127

Notes: ANY ADDITIONS OR CHANGES ON THIS SHEET MUST BE MADE OR CIRCLED IN Red. WITH DATE AND NAME OF PERSON MAKING CHANGE.

RETURN TO LOS ANGELES COUNTY SURVEYOR

Do not extend notes this side of this line

14+53.6 MON.

FIELD AVE

LYT.

10'

14+33.4 35.1 11.3 52.0

1 Story Brick Bldg Stores

See F.B. 325-126 For Building

72.4 10' 21.2

34.9 70.2

BLVD

PARK

2.0 3.0 2.0

13+08

12+67 33'0 privet hedge

33'0

13+52.6

9' 2.0 3.0 2.0

12+30.8

HYDE

11+87.8

privet hedge

11+56.4 33'0

9' 7'

11+49.2 0.50 conc wall 0.5 high

33.0

11+47.8

65.2

rose bushes 11+36.6 36.0 26.8

3" privet 1st of 5 rose bushes

11+17.0 57.9 3' 22.4 18.8 2.0 1 Story Frame House

11+16.5 65' 46 16.0 9.9

11+12.2 54.1 63 12.6

From top pg. 125

F.B. 325 Pg. 127 Moore Chief Party Notes by Moore Date 10-17-28

To Bot. Page 3 F.B. 381

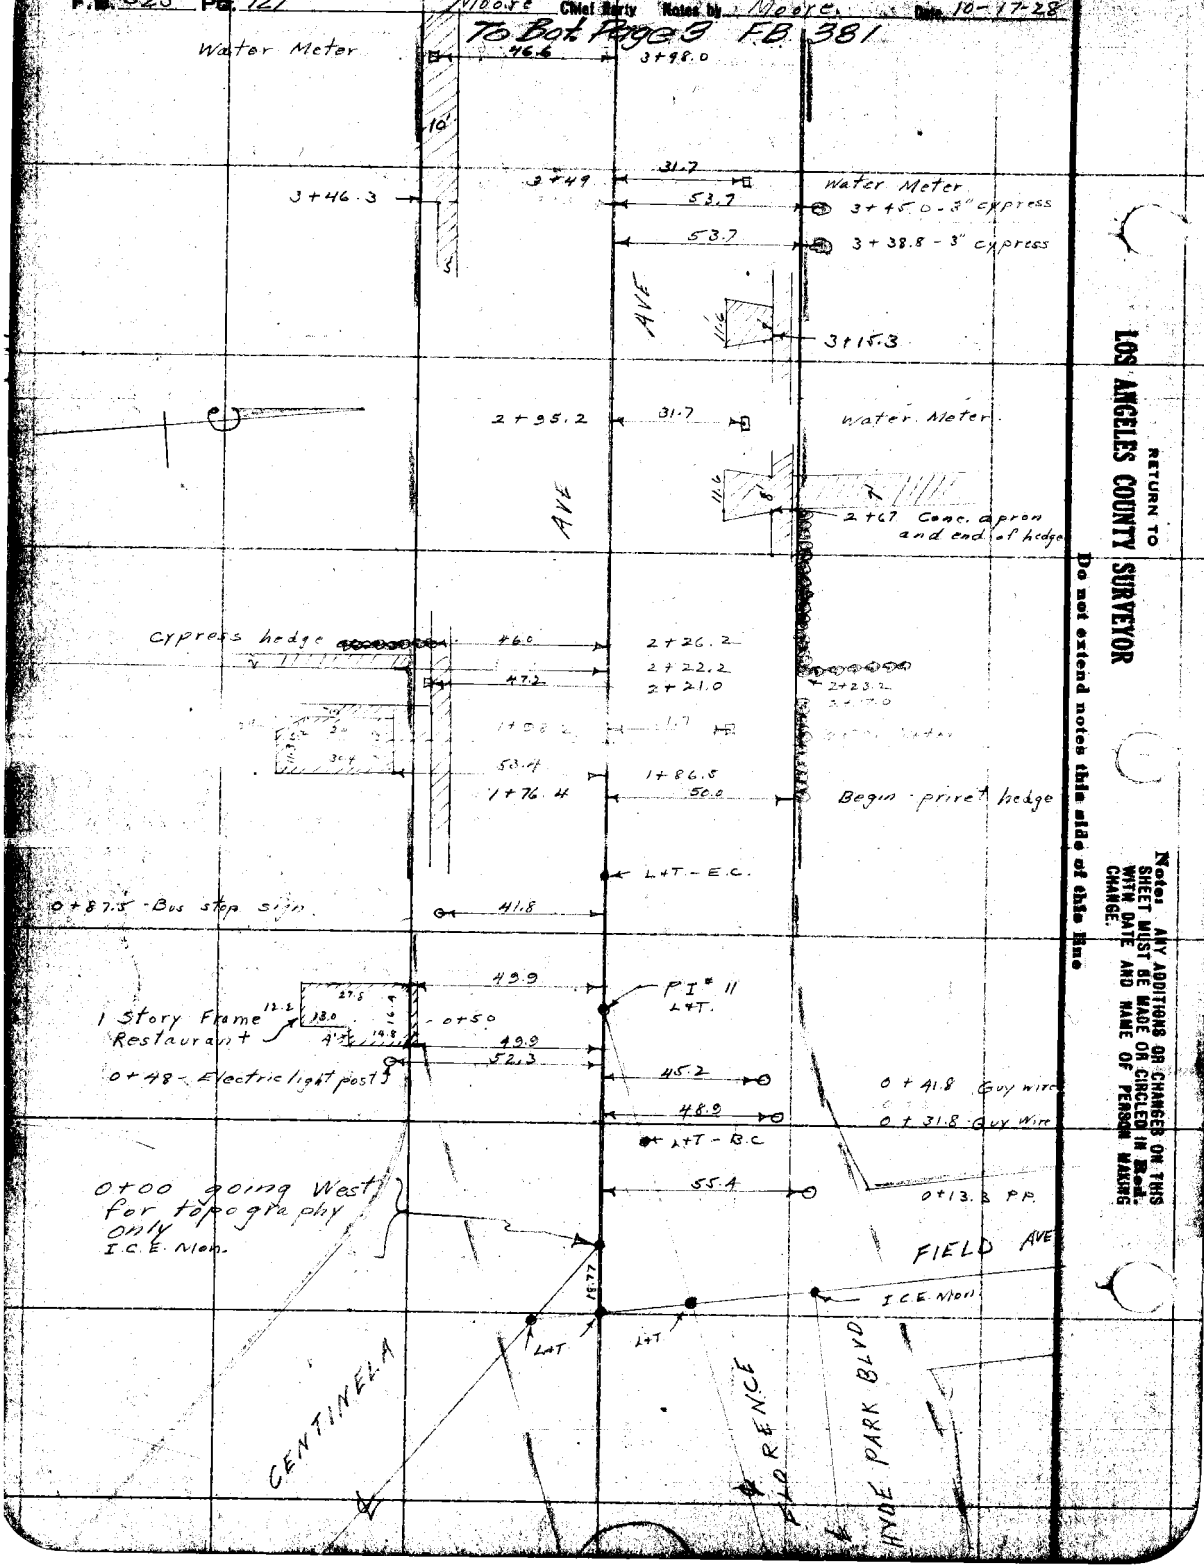

RETURN TO
LOS ANGELES COUNTY SURVEYOR
Do not extend notes this side of this line

Note: ANY ADDITIONS OR CHANGES ON THIS SHEET MUST BE MADE OR CIRCLED IN Red WITH DATE AND NAME OF PERSON MAKING CHANGE.

Date 10/25/30 Notes by RBE Chief Party RBE F.B. 325 Pg 126A

Plotted by
Date
Map No.
Plotting C'k'd by
Date

W. O. No. 416B S. B. O. No.
Location Florence Ave.
Surveyed by RB Emmott
Date October 25, 1930
Indexed A. C. Johnson

Fd 2" IP P+T See Page 20

FIELD AVE

24.98

Fd Inglewood City Engrs Mon. See Pgs. 19-55-126

184.71 per Pg. 20

89° 28' 15" ⊙

105.54 Calc.

89° 28' 15"

25.12

25.08

52.15

78.5

80.5

35.0

113

1 story Brick Stores

58.9

100

Per Pgs 54 + 55

72.15

60°

209.81

34.95

70.2

21.25

HYDE PARK BLVD.

Fd L+T P1. #10 See Pg. 54

RELOCATION OF BUILDING SHOWN ON PAGE 126

Notes: ANY ADDITIONS OR CHANGES ON THIS SHEET MUST BE MADE OR CIRCLED IN Red. WITH DATE AND NAME OF PERSON MAKING CHANGE.

Do not extend notes this side of this line

RETURN TO LOS ANGELES COUNTY SURVEYOR

RETURN TO

LOS ANGELES COUNTY SURVEYOR

Note: ANY ADDITIONS OR CHANGES ON THIS SHEET MUST BE MADE OR CIRCLED IN Red. WITH DATE AND NAME OF PERSON MAKING CHANGE.

Do not extend notes this side of this line

F. B. # _____ PG _____

Chief Party _____ Notes by _____ Date _____

Date _____ Notes by C. G. Williams Chief Party _____ F.B. 325 Pg. 128

Plotted by _____
Date _____
Map No. _____
Planting Ck'd by _____
Date _____

W. O. No. 4168 S. O. No. _____
Location Florence Ave
Surveyed by C. V. Crumley
Date June 24, 1930
Indexed A. C. Johnson 7-1-30

Notes: ANY ADDITIONS OR CHANGES ON THIS SHEET MUST BE MADE IN CIRCLED W. Req. WITH DATE AND NAME OF PERSON MAKING CHANGE.

RETURN TO LOS ANGELES COUNTY SURVEYOR

Do not extend notes this side of this line

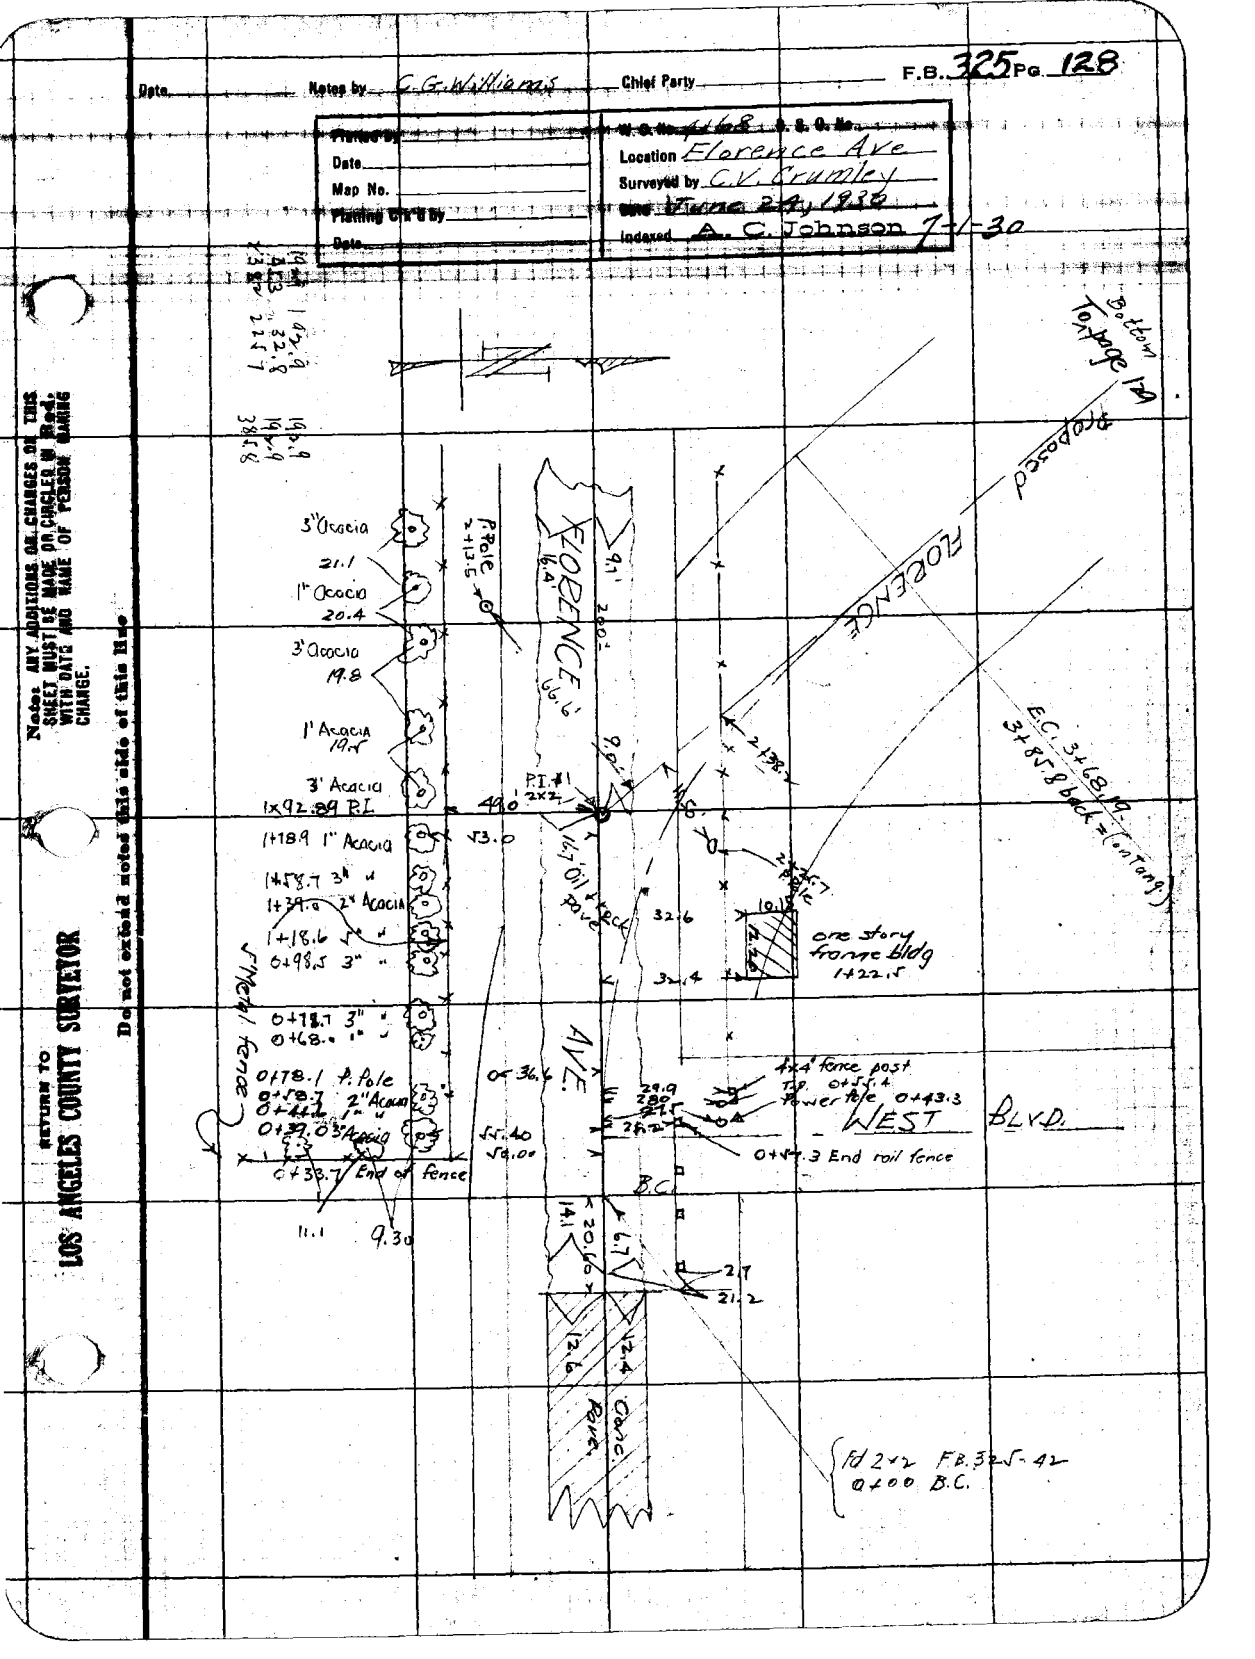

F. B. 325 Pg 129 Chief Party Notes by C.V. Crumley Date 6/25/30

Cont'd To Left Side Pg 130

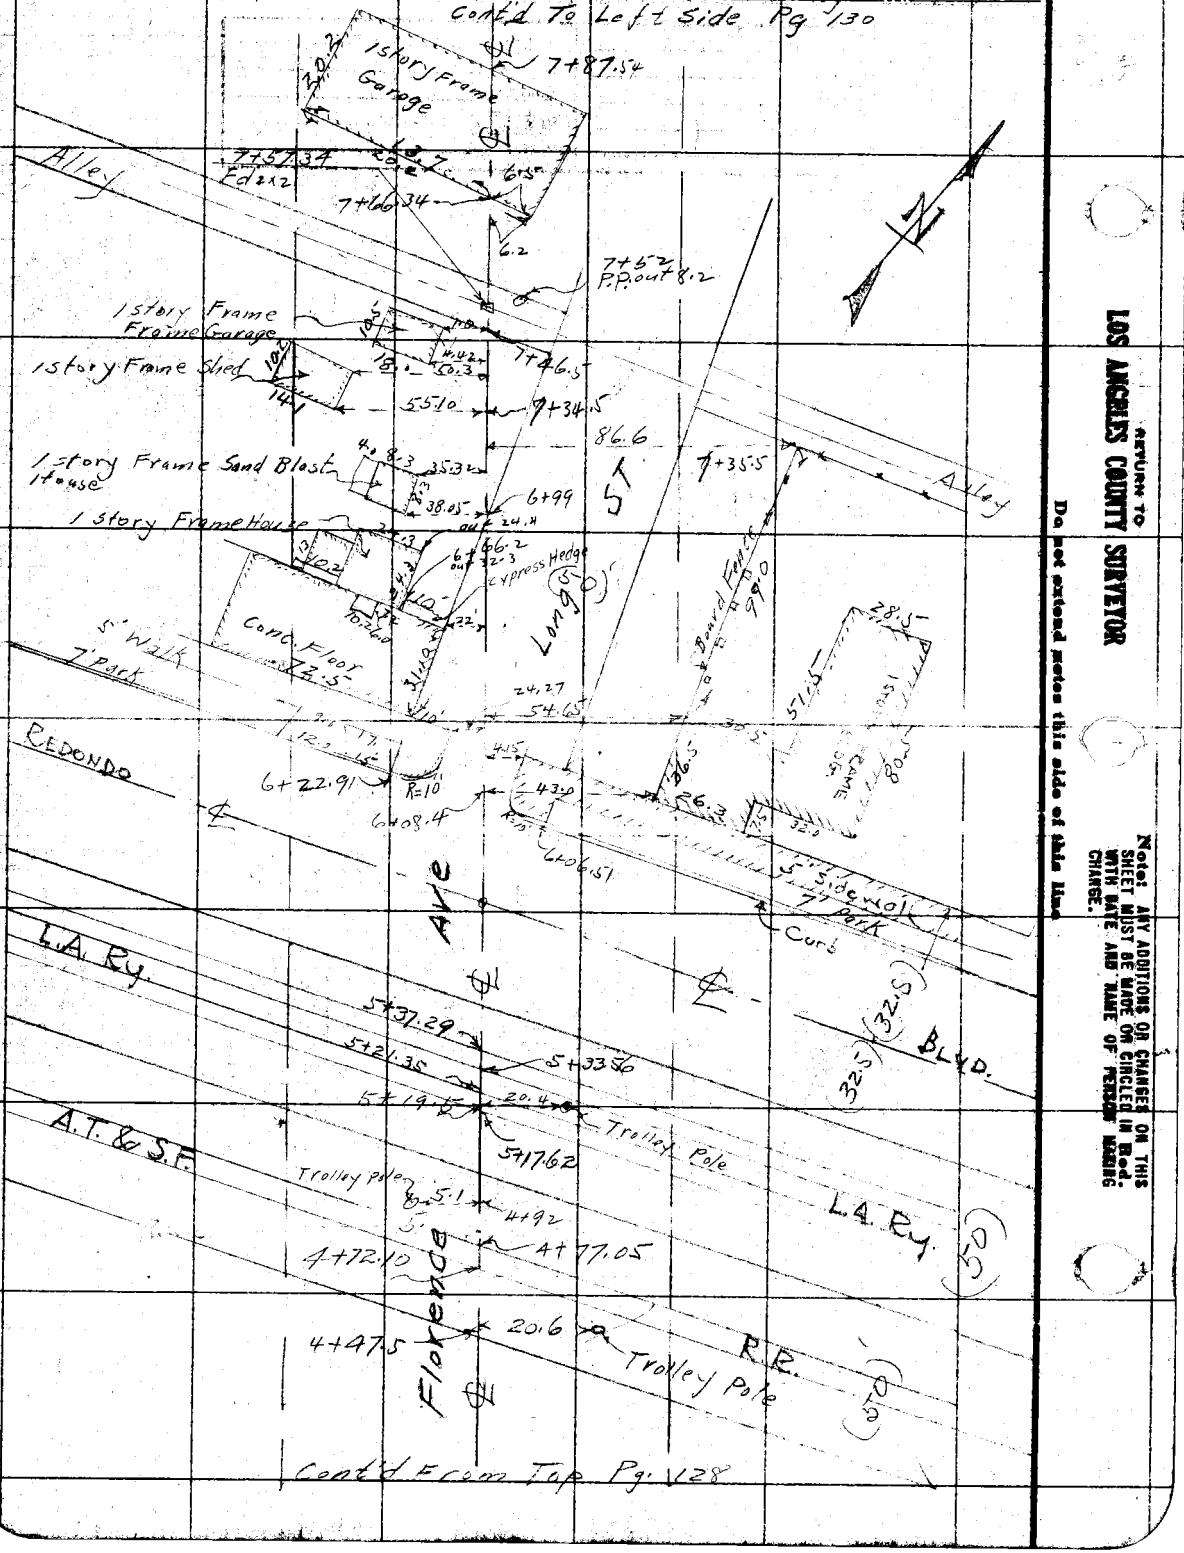

RETURN TO LOS ANGELES COUNTY SURVEYOR

Do not extend notes this side of this line

Note: ANY ADDITIONS OR CHANGES ON THIS SHEET MUST BE MADE OR CIRCLED IN Red. WITH DATE AND NAME OF PERSON MAKING CHANGE.

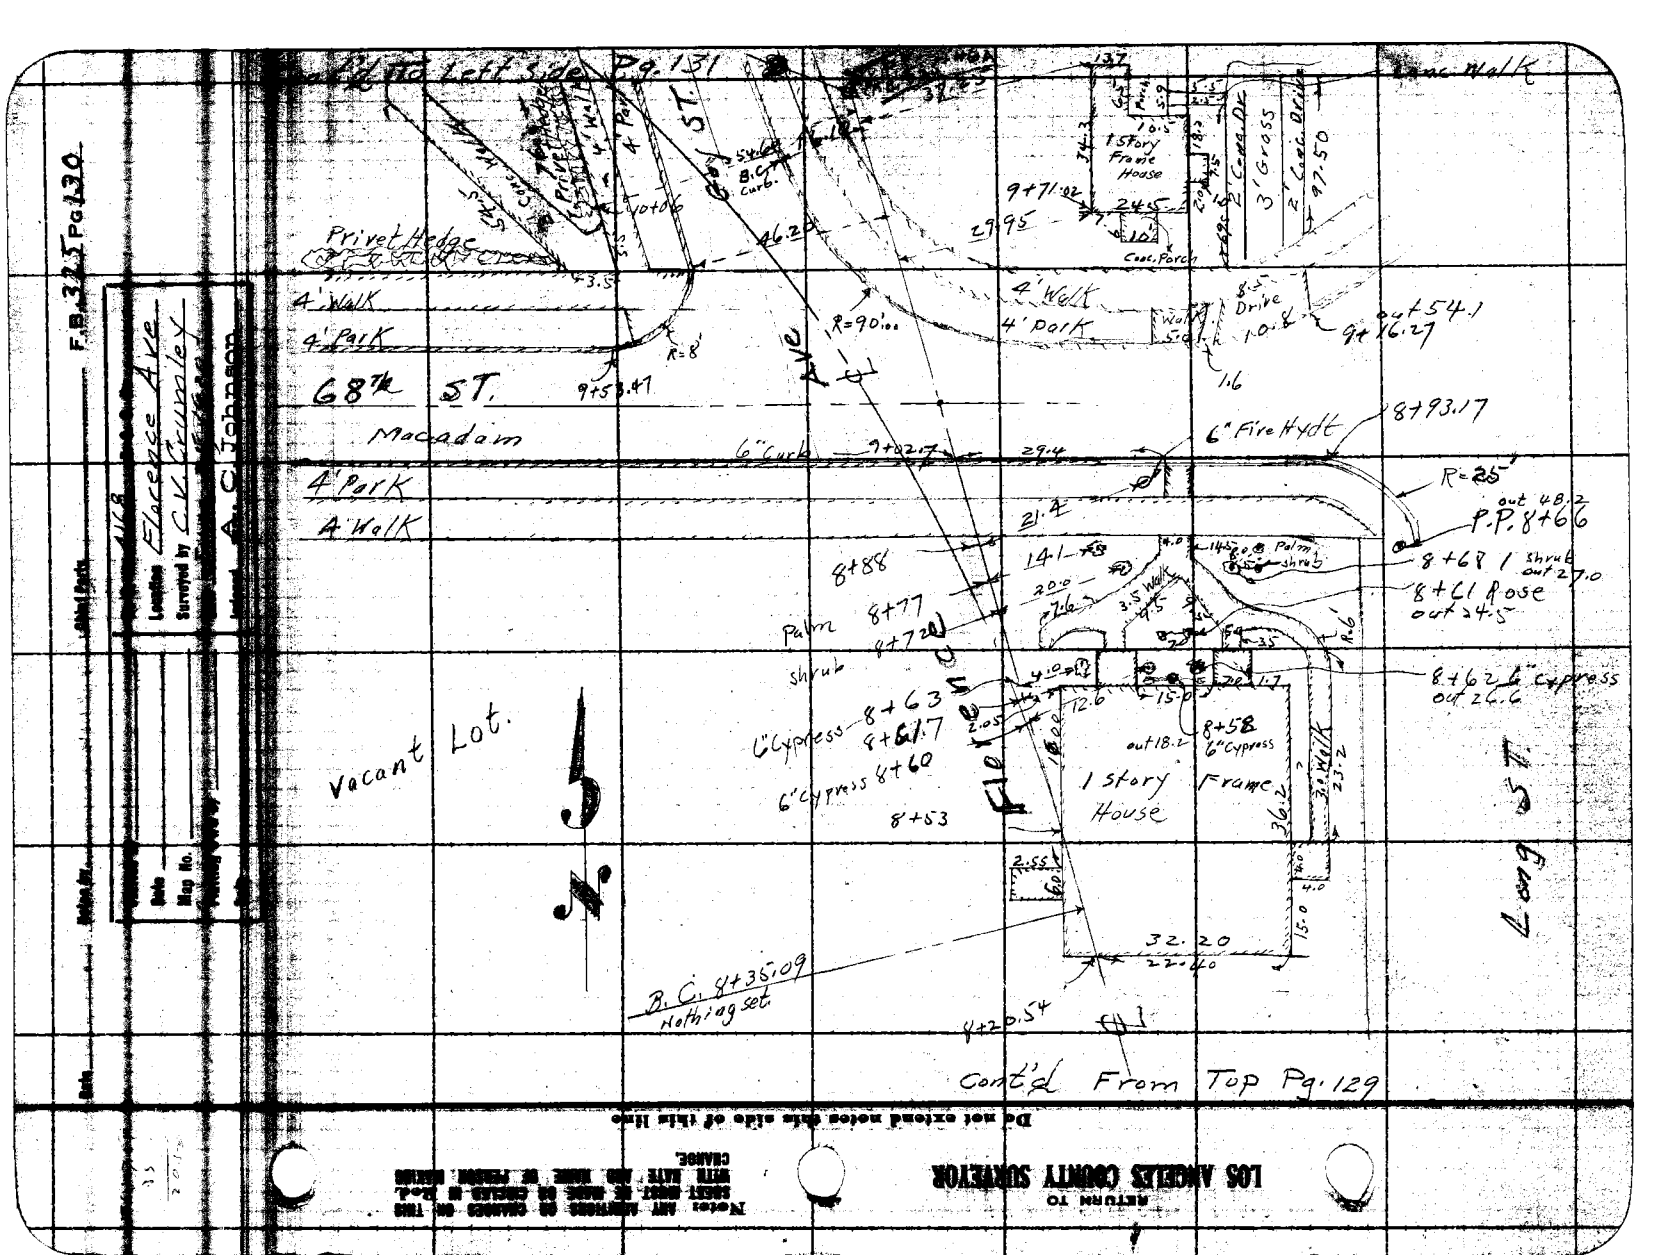
F.B. 325 Pg 130
Location Florence Ave
Surveyed by C.V. Crumley
Drawn by A. C. Johnson
Date
Map No.
Cont'd From Top Pg. 129
Cont'd From Top Pg. 131
Left Side
Vacant Lot.
1 Story Frame House
1 Story Frame House
Privet Hedge
4' Walk
4' Park
6" Curb
68th ST.
Macadam
Florence Ave
Fire Hydt
Palm
shrub
6" Cypress
Cypress
Concr. Walk
Drive
Cont. Porch
3' Gross
2' Conc. Drive
97.50
29.95
R=90'00
R=8'
R=25'
P.C. 9+53.47
P.P. 8+66
B.C. 8+35.09
Nothing set
9+20.54
9+71.82
9+16.27
8+93.17
8+88
8+77
8+68
8+61
8+63.5
8+62.6" Cypress
8+58
8+53
8+60
8+61.7
out 54.1
out 48.2
out 27.0
out 24.5
out 26.6
out 18.2
LOS ANGELES COUNTY SURVEYOR
RETURN TO
Do not extend notes this side of this line
Notes: ANY ALTERATIONS OR CHANGES ON THIS SHEET MUST BE MADE BY CHANGE IN RED. WITH ALTER AND NAME OF PERSON MAKING CHANGE.

RETURN TO
LOS ANGELES COUNTY SURVEYOR

Note: ANY ADDITIONS OR CHANGES ON THIS SHEET MUST BE MADE OR CIRCLED IN Red. WITH DATE AND NAME OF PERSON MAKING CHANGE.

E.C. 11461.43

Do not extend notes this side of this line

Cont'd To Left Side Pg 132

Notes by C.V. Crumley Date 6/25/30

Chief Party

11+43 Fence Cor.

11+32 — 6" Plum - out 18.3 -

11+23 — 6" Apricot - out 27.7 - 6" Fig out 7.7

11+07 — 6" Apricot - out 17.0

{11+00 — 6" Fig. (N.E. out 32.8 S.E. out 28.3) 1 Story Frame, S.E. Cor. 43.0 Garage

10+97 orange Tree out 14.8

Wire Fence 2.0

21.4

Fence 13.5

11+07 Row shrubs

Florence Ave

Gay St

Private

Row shrubs 8P 10" 4.5

out 45.6 Rose 10+71

10+45 Shrubs out 30.1

Garage

Orange

10+97.4

10+79 — Fence Begin Row shrubs - out 14.5

10+76

10+67

Curb

1 Story Frame House

6" Cypress

Rose

Rose

10+53.6

10+31.00

P.I. 10+04.31

2 R 2 Per Pg 130 & Per F.B. 329-46 A.

F.B. 329 Pg. 131

Cont'd From Rt Side Pg. 130

Cont'd To Left Side Pg. 133

F.B. 325 Pg. 132

Location Florence Ave
Surveyed by C.V. Crumley
Notes A. C. Johnson

Florence Ave

6" Gum Trees

12+00	9.3	11.0	11.0	
11+90	3.3	11.0	11.0	Row 6" Gum Trees
11+82	8.5			6" Gum Tree
11+75	14.4			

3" Apricot	44.4	11+62.2
6" Apricot	58.1	11+64.6
6" Fig	33.0	11+68.0
Clothes Line 4x4 Post	57.1	11+55 Sing
6" Apricot	46.3	11+49
2" Fig	71.0	11+54
6" Fig	60.8	11+38.1
	57.2	11+31.3
		Net. 11+43
	49.3	

E.C. 11+61.43 Ahead =
11+73.53 Back (along Semi-Tang.)

1 Story Frame Garage

14.0

Cont'd From Rt Side Pg. 131

12+75.9

123-34

Do not extend notes this side of this line

RETURN TO
LOS ANGELES COUNTY SURVEYOR

NOTE: ANY ADDITIONS OR CHANGES ON THIS SHEET MUST BE MADE ON CIRCLES IN RED. WITH DATE AND NAME OF PERSON MAKING CHANGE.

RETURN TO
LOS ANGELES COUNTY SURVEYOR

Note: ANY ADDITIONS OR CHANGES ON THIS SHEET MUST BE MADE OR CIRCLED IN Red. WITH DATE AND NAME OF PERSON MAKING CHANGE.

Do not extend notes this side of this line

63.0
30.0
3.5

Board Fence ?

Hen House

6" Apricot

23.0

Pen Pen Pen

½" Pipe Line ?

2" Fig

4" Plum 6" Peach

3" Walnut

Hen House Frame Storage

Pen Pen

℄ Lattice Fence

Berry Trellis

Pipe Line

6" Pear

2" Fig

Berry Trellis

Boat Shed Fence

Cont'd To Left side Pg 134

12+75.96
Ft. 2.2 on ℄ of Alley
Per F.B. 325-46A

55'

22'

Ave

12+63.0 Fence Line

12+61 P.P.

12+59

12+55

12+38

Florence

4" Plum Tree

19.0 19.0 19.0

6" Apricot 6" Peach 4" Quince

26.0

2" Peach

½" Water Pipe ?

6" Apricot 1" Fig

20.5 16.0

2" Plum 24.0

3" Peach 19.0

1" Grape

2" Peach

12+33

12+25

2" Peach

Berry Vines Berry Vine 6" Apricot

24.0 11.0 8.0 3.9 7.0 9.0

Grapes

39.0

12+14.5

Row Berries

12+04

Woven Wire Fence

110.0

12+02.5 31.8

Cont'd From Rt side Pg. 132

Alley

Woven Wire Fence

F.B. 325 Pg. 133

Orig. Party

Notes by C.V. Calumley Date 6/28/30

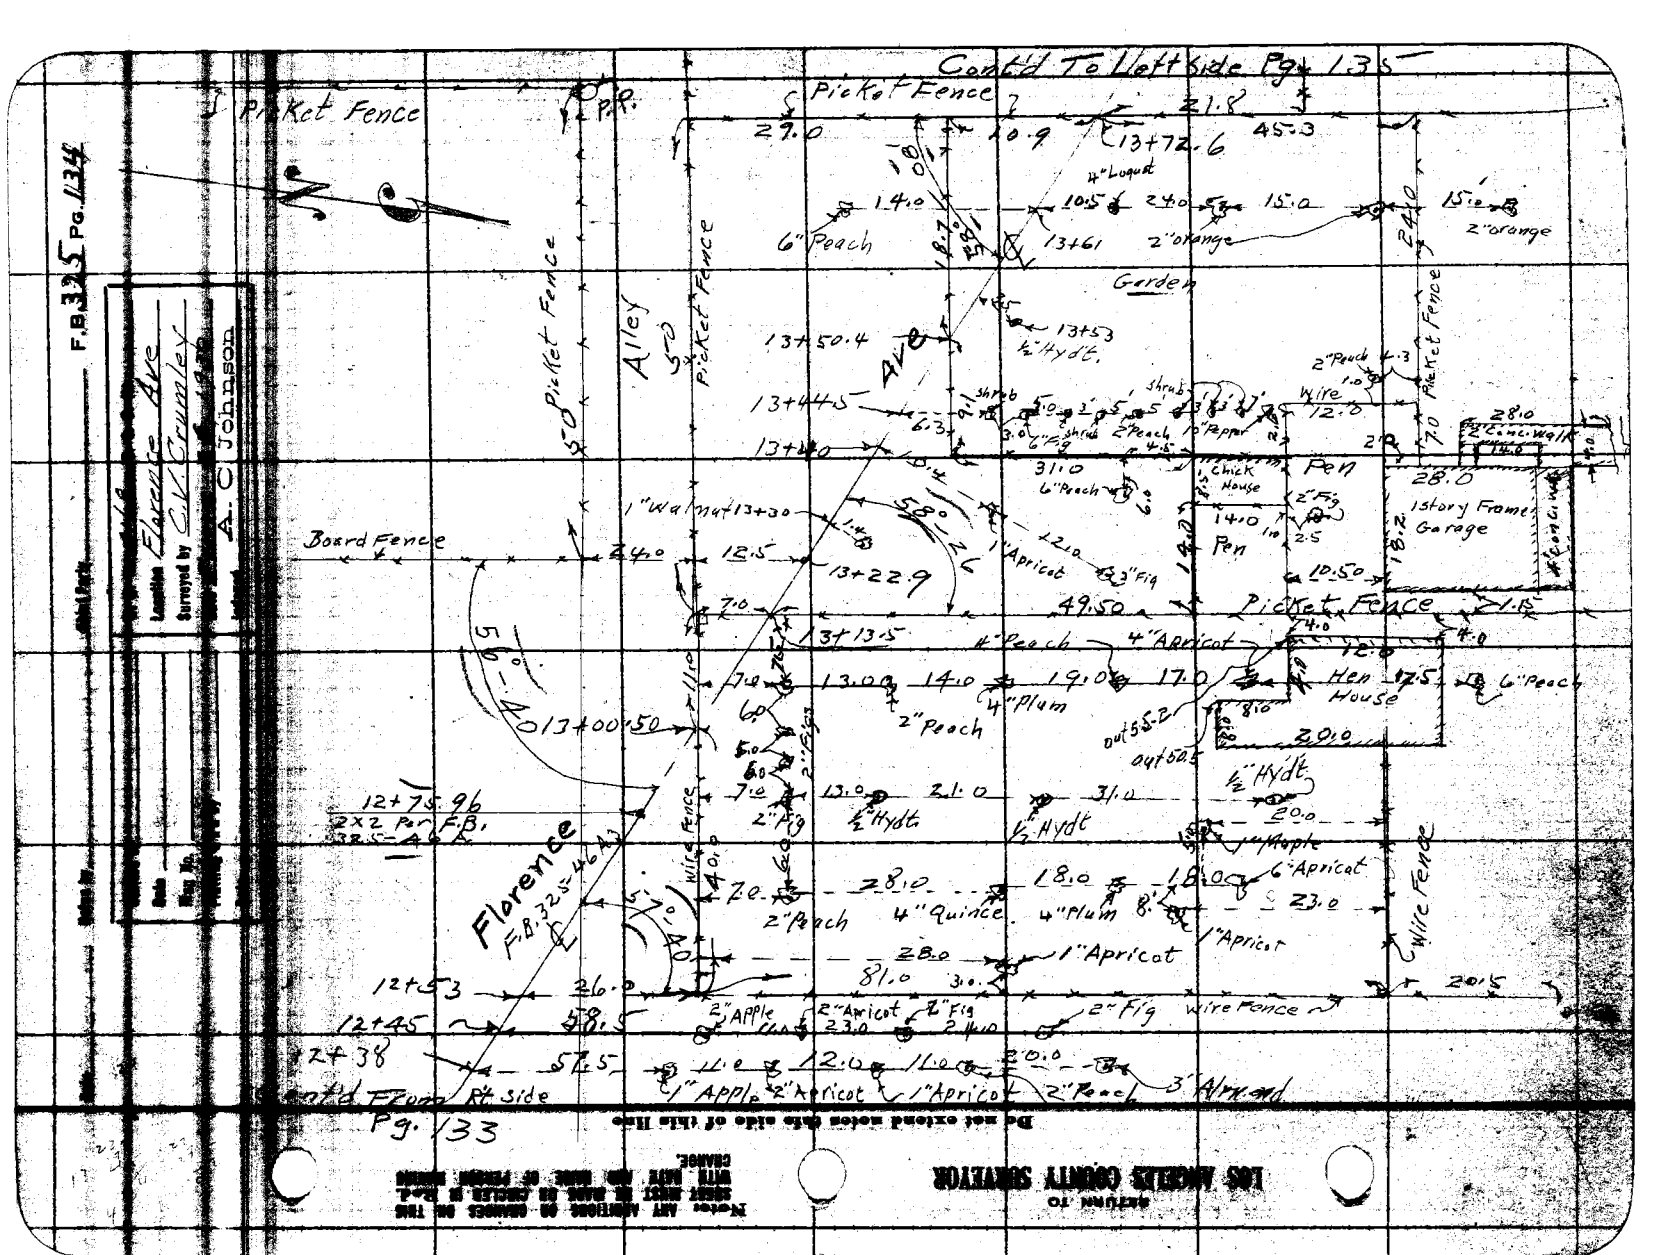
Contd To Left side Pg. 135
Picket Fence
P.P.
Picket Fence
21.8
27.0
10.9
13+72.6
45.3
4" Loquat
1.4.0
10.5
24.0
15.0
15.0
6" Peach
13+61
2" orange
2" orange
Garden
Alley
50'
Picket Fence
Picket Fence
13+50.4
13+53
½" Hydt.
Ave
13+44.5
Shrub
Shrub
2" Peach
Wire
12.0
28.0
2" Peach
1" Apple
Pen
31.0
6" Peach
1 Chick House
28.0
1 Story Frame Garage
Board Fence
24.0
12.5
13+22.9
1" Walnut
13+30
1" Apricot
3" Fig
14.0
Pen
10.50
49.50
Picket Fence
13+13.5
4" Peach
4" Apricot
4.0
12.0
7.0
13.0
14.0
19.0
17.0
Hen House
6" Peach
4" Plum
2" Peach
13+00.50
56° 40'
6p
out 55.2
out 50.5
20.0
½" Hydt
12+75.96
2x2 Por F.B. 32 C-46
½" Hydt
½" Hydt
Maple
6" Apricot
Florence
F.B. 32 C-46
Wire Fence
28.0
18.0
18.0
23.0
2" Peach
4" Quince
4" Plum
1" Apricot
1" Apricot
Wire Fence
12+53
26.0
81.0
1" Apricot
12+45
48.5
2" Apple
2" Apricot
2" Fig
2" Fig
Wire Fence
20.5
12+38
57.5
12.0
1.0
20.0
1" Apple
2" Apricot
1" Apricot
2" Peach
3" Almond
Contd From Rt side Pg. 133
F.B. 335 Pg. 134
Location Evanside Ave
Surveyed by C.V. Crumley
A. C. Johnson
Do not extend notes this side of this line
LOS ANGELES COUNTY SURVEYOR
RETURN TO
Notice ANY ADDITIONS OR CHANGES ON THIS SHEET MUST BE MADE BY PERSON MAKING CHANGE.
WITH AUTHORITY OF OWNER

RETURN TO
LOS ANGELES COUNTY SURVEYOR

Note: ANY ADDITIONS OR CHANGES ON THIS SHEET MUST BE MADE OR CIRCLED IN Red. WITH DATE AND NAME OF PERSON MAKING CHANGE. 7 12 7

Do not extend notes this side of this line

Notes by C.V. Crowley Date 6/27/30

O&M Party

F.B. 325 Pg. 135

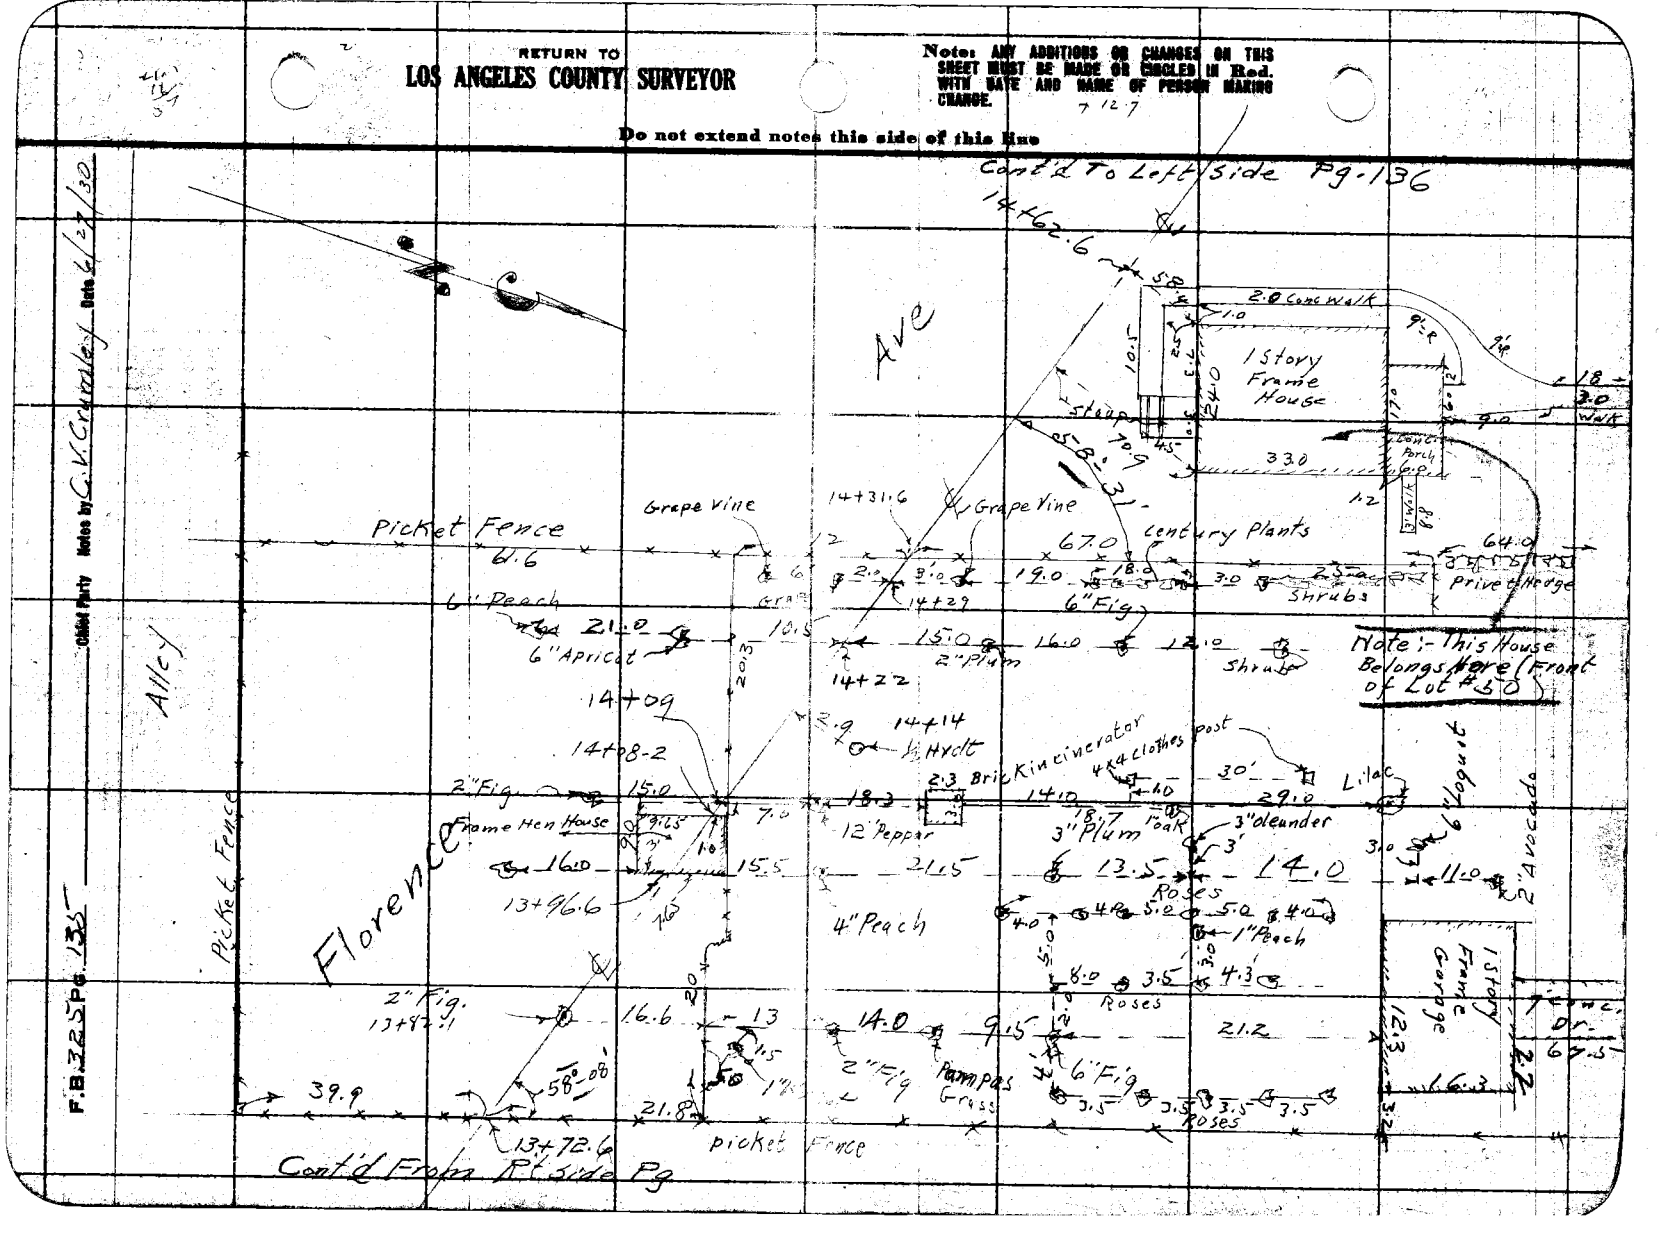

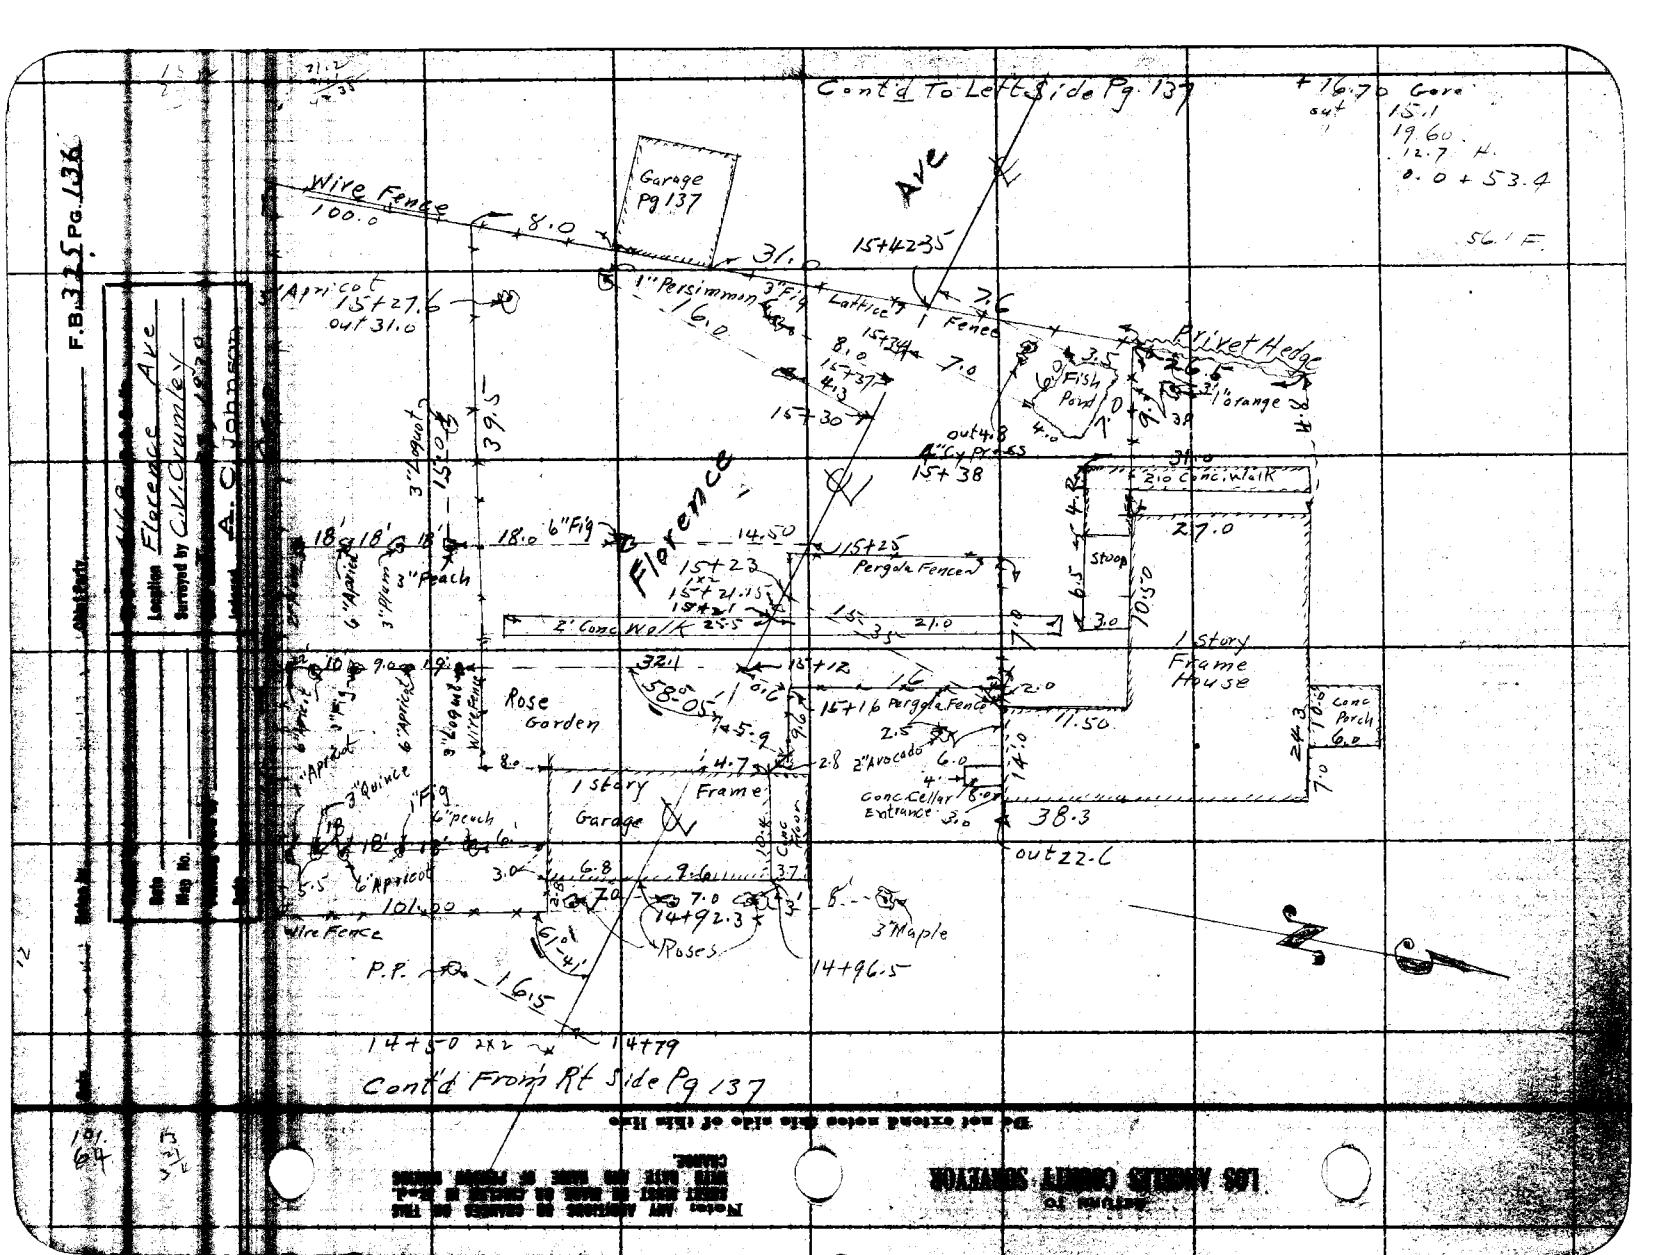
F.B. 325 Pg. 136
Location Florence Ave
Surveyed by C.V. Crumley
Cont'd To Left Side Pg. 137
Wire Fence
100.0
Garage Pg 137
Florence Ave
Apricot
1" Persimmon
3" Fig
Lattice Fence
Privet Hedge
Fish Pond
1" Orange
4" Cypress
3" Apricot
3" Plum
3" Peach
6" Apricot
6" Fig
2' Conc. Walk
Pergola Fence
Rose Garden
1 Story Frame House
Conc. Porch
Conc. Cellar Entrance
2" Avocado
1 Story Frame Garage
3" Quince
1" Fig
6" Peach
6" Apricot
Wire Fence
Roses
3" Maple
P.P.
Cont'd From Rt Side Pg 137
LOS ANGELES COUNTY SURVEYOR

RETURN TO
LOS ANGELES COUNTY SURVEYOR

Note: ANY ADDITIONS OR CHANGES ON THIS SHEET MUST BE MADE OR CIRCLED IN Red. WITH DATE AND NAME OF PERSON MAKING CHANGE.

Do not extend notes this side of this line

Notes by C.V.C. Crumley Date 6/27/30

Chief Party

F.B. 325 Pg. 137

Cont'd To Left side Pg. 138

Iron fence

56.3

148.30

2" Apricot

1" Apple

2" Fig

2" Peach

1" Fig

1" Fig

1" Apricot

Conc. Fish Pond

28.5

28.5

11.0

9.0

9.0

20.5

1.0

1.0

2.0

19.5

15+82 privet Hedge

15+77.2 Fence

Ave

3.0

.03

15+74.55

.83

2' Conc. Walk

Stoop 7.0

1 Story Frame House

3.0

7.0

Conc. porch

26.5

3' Conc Walk

24.3

6.0

16.4

1 Story Frame Garage

Conc. Dr.

1.0

19.6

12.40

6.0

15+68

65.50

16.40

24.3

26.7

24.3

1.5 Conc.

3' Gravel

1.5 Conc. Dr.

30.

39.0

Dr.

2' Conc. Walk

17.3

18.30

67th St. side walk

Curb

Wire Fence Pg. 136

15+37.5

Florence

Cont'd From Rt side Pg. 136

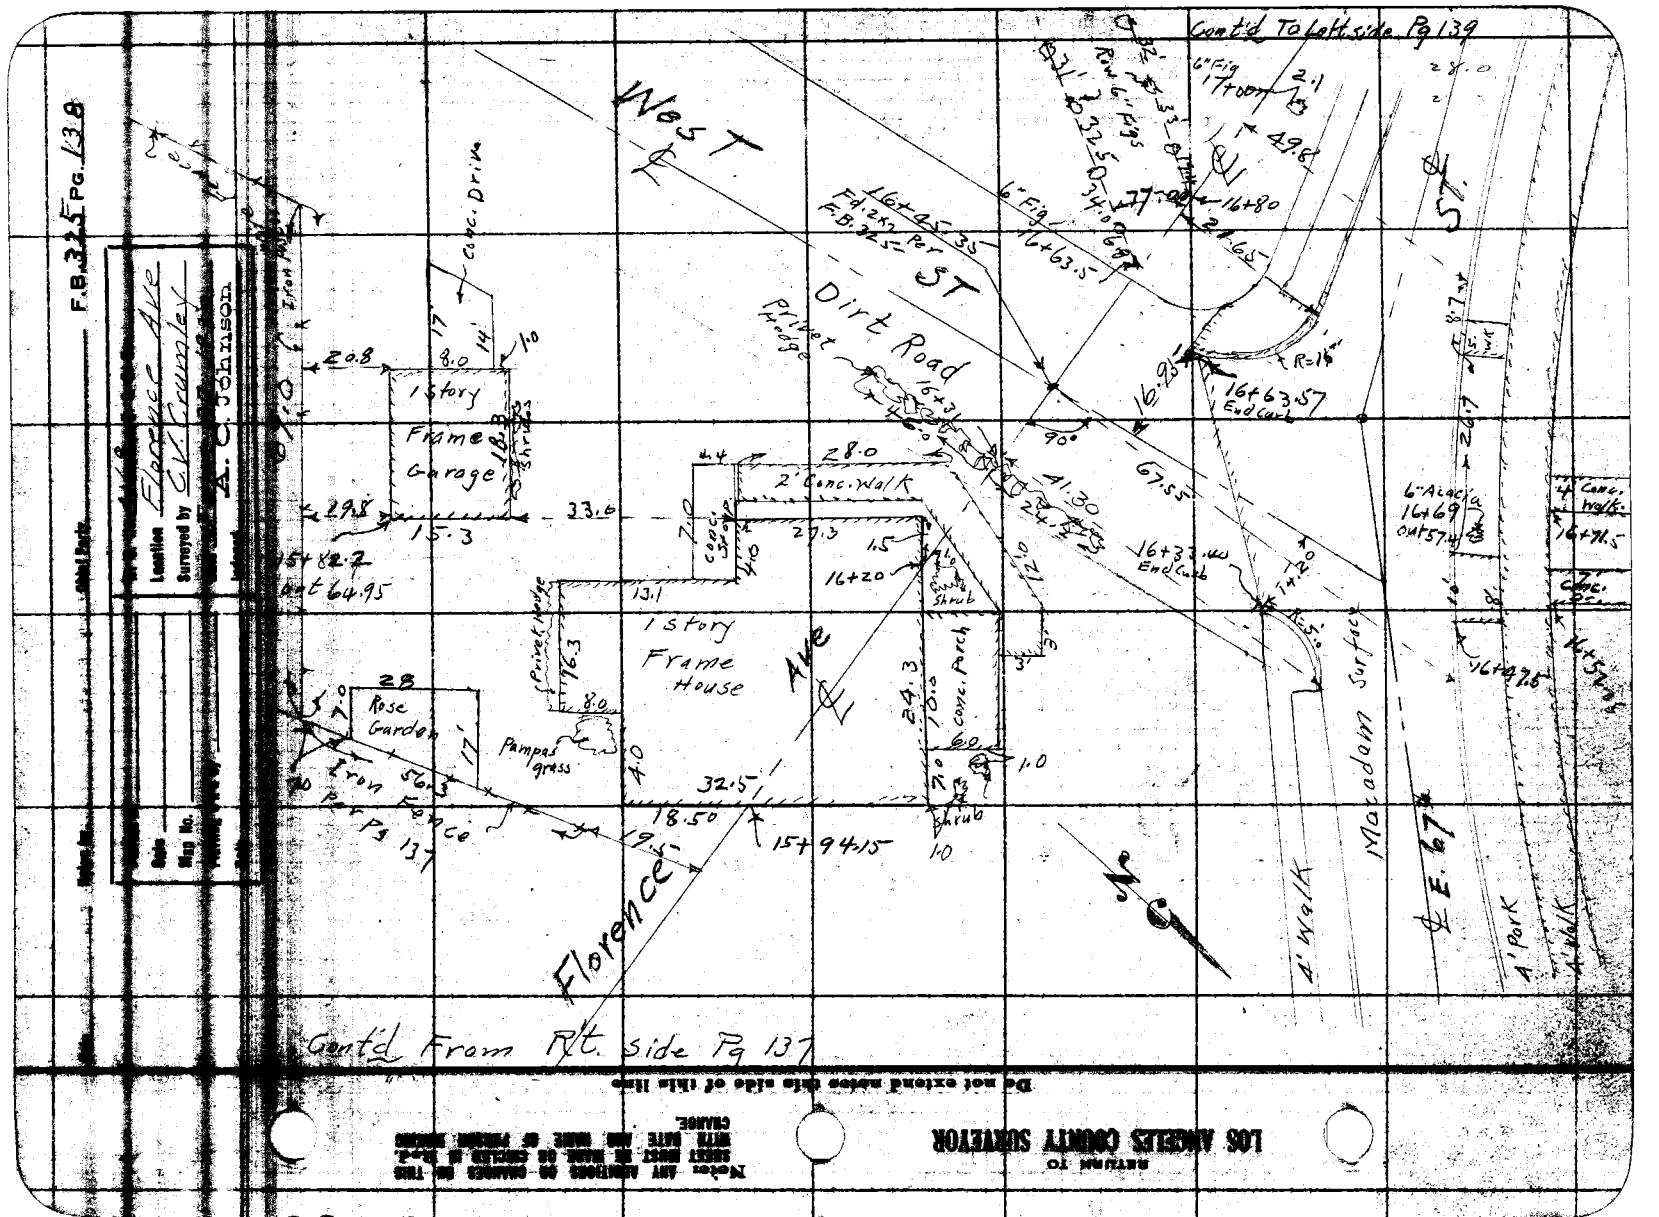

Do not extend notes this side of this line

RETURN TO
LOS ANGELES COUNTY SURVEYOR

Notice: ANY ADDITIONS OR CHANGES ON THIS SHEET MUST BE MADE BY CIRCLED IN Red. WITH INK AND MADE BY PERSON MAKING CHANGE.

RETURN TO
LOS ANGELES COUNTY SURVEYOR

Note: ANY ADDITIONS OR CHANGES ON THIS SHEET MUST BE MADE OR CIRCLED IN Red. WITH DATE AND NAME OF PERSON MAKING CHANGE.

Do not extend notes this side of this line

Cont'd To Left Side Pg. 140

Notes by C.K.C. Crumley Date 6/28/30

Other Party

F.B. 328 Pg. 139

See F.B. 325 - 102-104

Florence Ave

6TH ST

4' Walk
6" Curb
4' Park
6" Curb
4' Walk

18+00
17+95
17+81
17+68
17+55
17+49
17+44
17+41
17+34
17+29
17+25
17+19
17+14.85
17+17.35

40.30
50.8
53.8
52.7
40.10
30.3
23.2
21.9
20.9
27.7
69.0 Gross

49.5'
4" Figs
Grape Trellis
10'
9'
54
17+79 Cypress Hedge
Shrub
2'
1.5
18.7
3' Conc. Walk
Conc.
3'
Shrub
1.5
out 57
17+67
17+52
8' 8' 8'
Shrubs
17+49
8' Conc. Dr.
30'
17+47
outs 8 Shrubs & Flowers
17+46
out 64 Shrub
17+38
out 56.1
2" Tree

53.0
12" Fig
8" Fig
8" Fig
8" Fig
30.5
20'
79.0
2' Cypress Hedge
Row Shrubs
1" Palm
Fd 3/4" Pipe
Ft 0.26 E 0.46
40.10
6" Fig
Hydt
36.0
1 Story Frame House
24.3
Conc. Porch
Shrubs & Flowers
3" Cypress
3" Palm
Flower Bed
16.0
2' Conc. Dr.
69.0 Gross
3' Conc. Dr.
1 Story Frame Garage
12.0
18
Drive 17+12.15
Cont'd From Rt. Page
Rt. 0.28
17+
12-3" Cypresses
B.C. 17+31.52
R = 275'
B.C. 17+34.35
1" Gum
1" Gum
17+44
17+29
Cont'd From Rt. Side Pg. 138

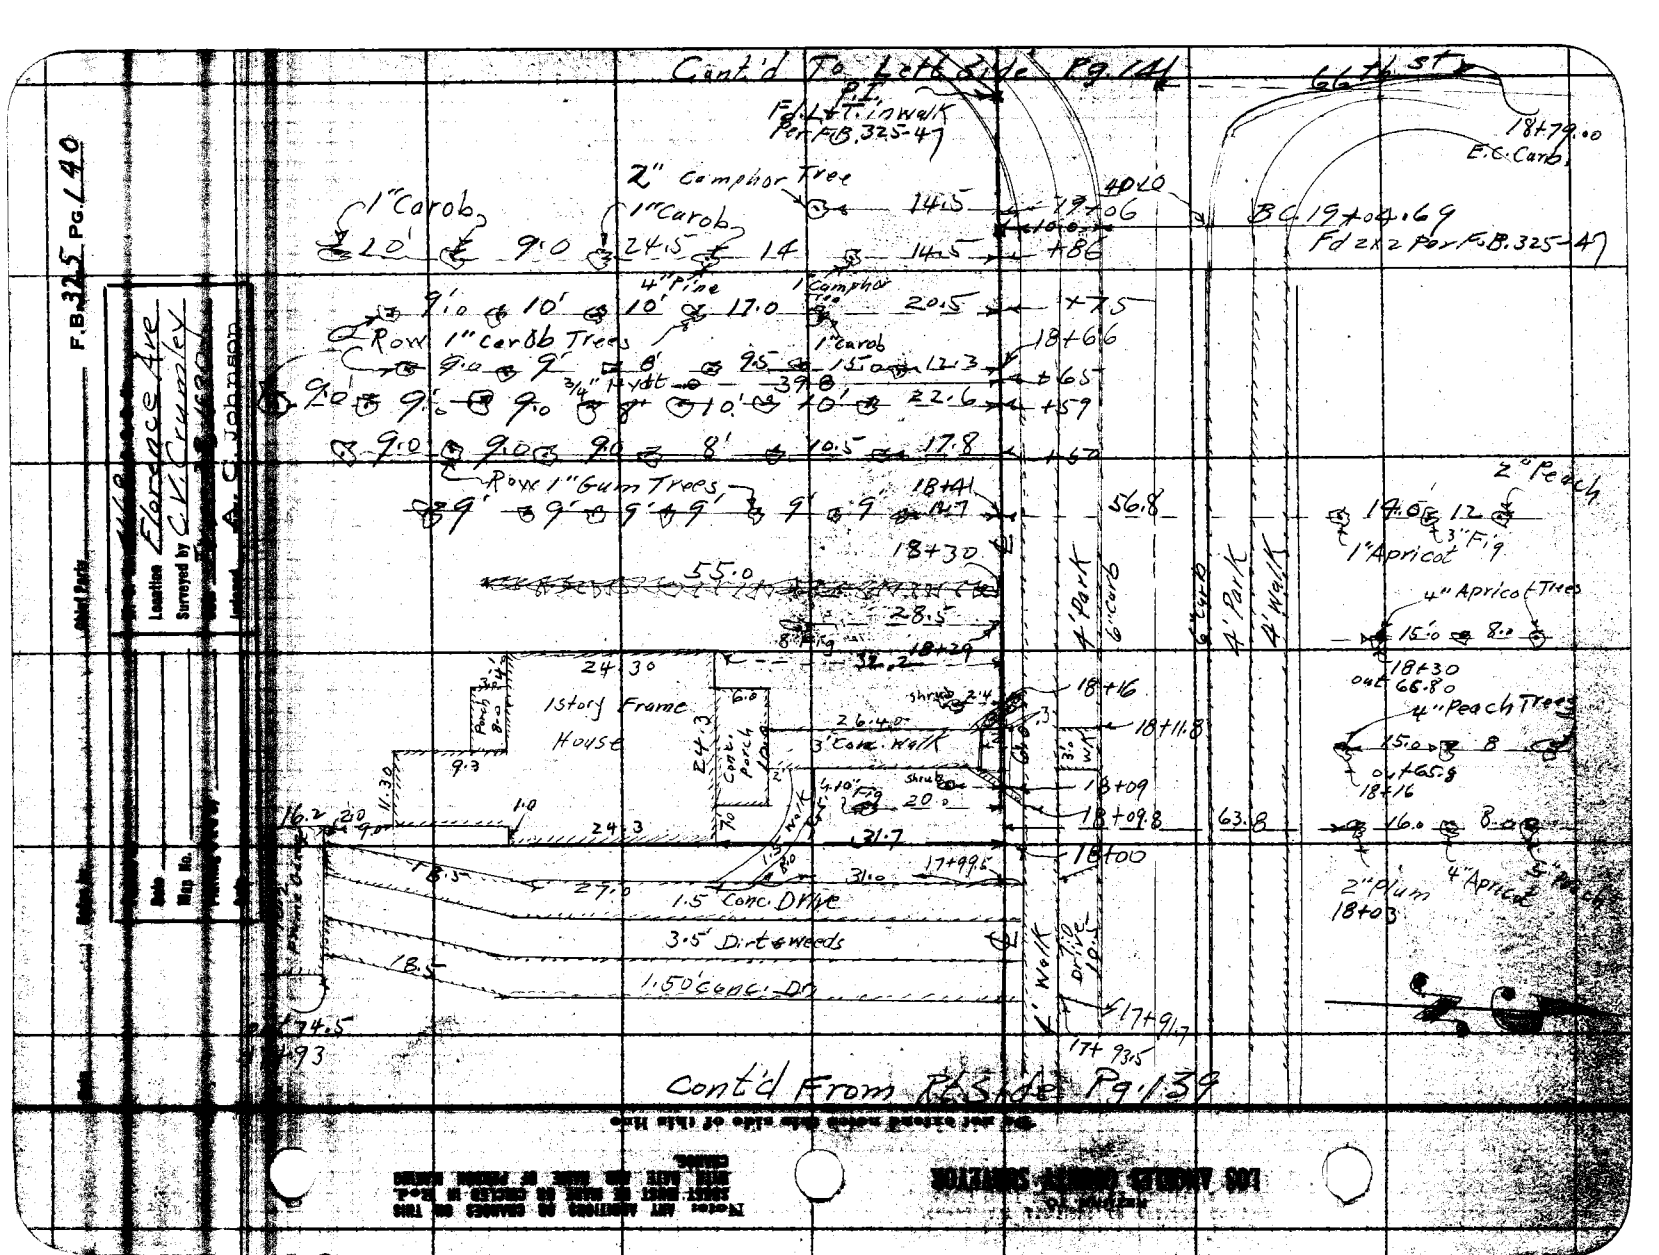
Cont'd To Left Side Pg. 144
66th St
F.B. 325 Pg. 140
Location Florence Ave
Surveyed by C.V. Crumley
Land A. C. Johnson
Added Parts
Date
Map No.
Plotted
Checked
F.B. 325-47
P.T.
F.L.+1'. Inwalk
2" Camphor Tree
1" Carob
1" Carob
4" Pine
1 Camphor Tree
1" carob
Row 1" carob Trees
3/4" Hydt
Row 1" Gum Trees
18+79.00
E.C. Carb.
BC 19+04.69
Fd 2x2 Por. F.B. 325-47
40.0
14.5
20.5
22.3
22.6
17.8
18+41
18+30
18+29
18+16
18+11.8
18+09
18+09.8
18+00
17+99.5
17+93.5
17+91.7
17+93
56.8
55.0
28.5
32.2
31.7
31.0
27.0
24.3
24.30
1 Story Frame House
Conc. Porch
Porch
Shrub
Fig
3" Conc. Walk
1.5 Conc. Drive
3.5' Dirt & weeds
1.50 Conc. Dr
4' Park
6" Curb
4' Walk
6" Curb
4' Walk
1' Walk
Drive
2" Peach
1" Apricot
3" Fig
4" Apricot Trees
18+30
out 66.80
4" Peach Trees
18+16
2" Plum
18+03
4" Apricot
63.8
Cont'd From Next Pg. 139

E.C. 10,005-67
E.C. 3970-N-67
+ 2.7 on 66-W
25.7 on 66 E.B.C.

RETURN TO
LOS ANGELES COUNTY SURVEYOR

Note: ANY ADDITIONS OR CHANGES ON THIS SHEET MUST BE NOTED AND INITIALED IN RED WITH DATE AND NAME OF PERSON MAKING CHANGE.

Do not extend notes this side of this line

Cont'd To Left Side Pg 142

Notes by C.V. Crumley Date 6/30/64

Chief Party

F.B. 325 Pg. 141

3" Sycamore 31.8 21+00
1" Birch 9.6 20+92
58.10 3" Sycamore 64.2 20+87
20.0 39.5 +68.5 20+82.96 B.C. 2 1/2 Per P948
3" Tree 20.1 20+45
1" Acacia
23.0 11.0 33.8 20+39.5
3/4" Hyd
2" Plum 23.3 20+29.5
+20 - 1" Plum 9.7
20+18 - 2" Plum 18.9
2" Fir
25.0 2" Acacia 28.0 30.9 20+15
2" Plum 24.6 20+08.5
2" Fir 44.4 20+05.5
71.7 20+01
2" Acacia 33.8 19+78.5
2" Tree 13.9 19+73
4" Fir 1" Spruce out 79.6
19+80 85.4
20.9 4" Pine out 32.2 19+84
Equation E.C. 19+89.46 Ahead = 10.00 29.90
20+05.39 From Back
Ed 2x2 12" Deep per F.B. 325-47
24.L 15.1
19+63 19+78 2" Acacia 42.0
2" Acacia out 66.6
19+58.4
± Hyd't

Florence Ave

E. Manor Drive

6" Curb
4' Park
4' Walk

Note: For Topog Here See F.B. 325-103

19+33.55 Ahead = 21+85.33 Per Pg 103

R. 673

P.C. 19+07.60 From SE

Cont'd Each Right Side Pg 140

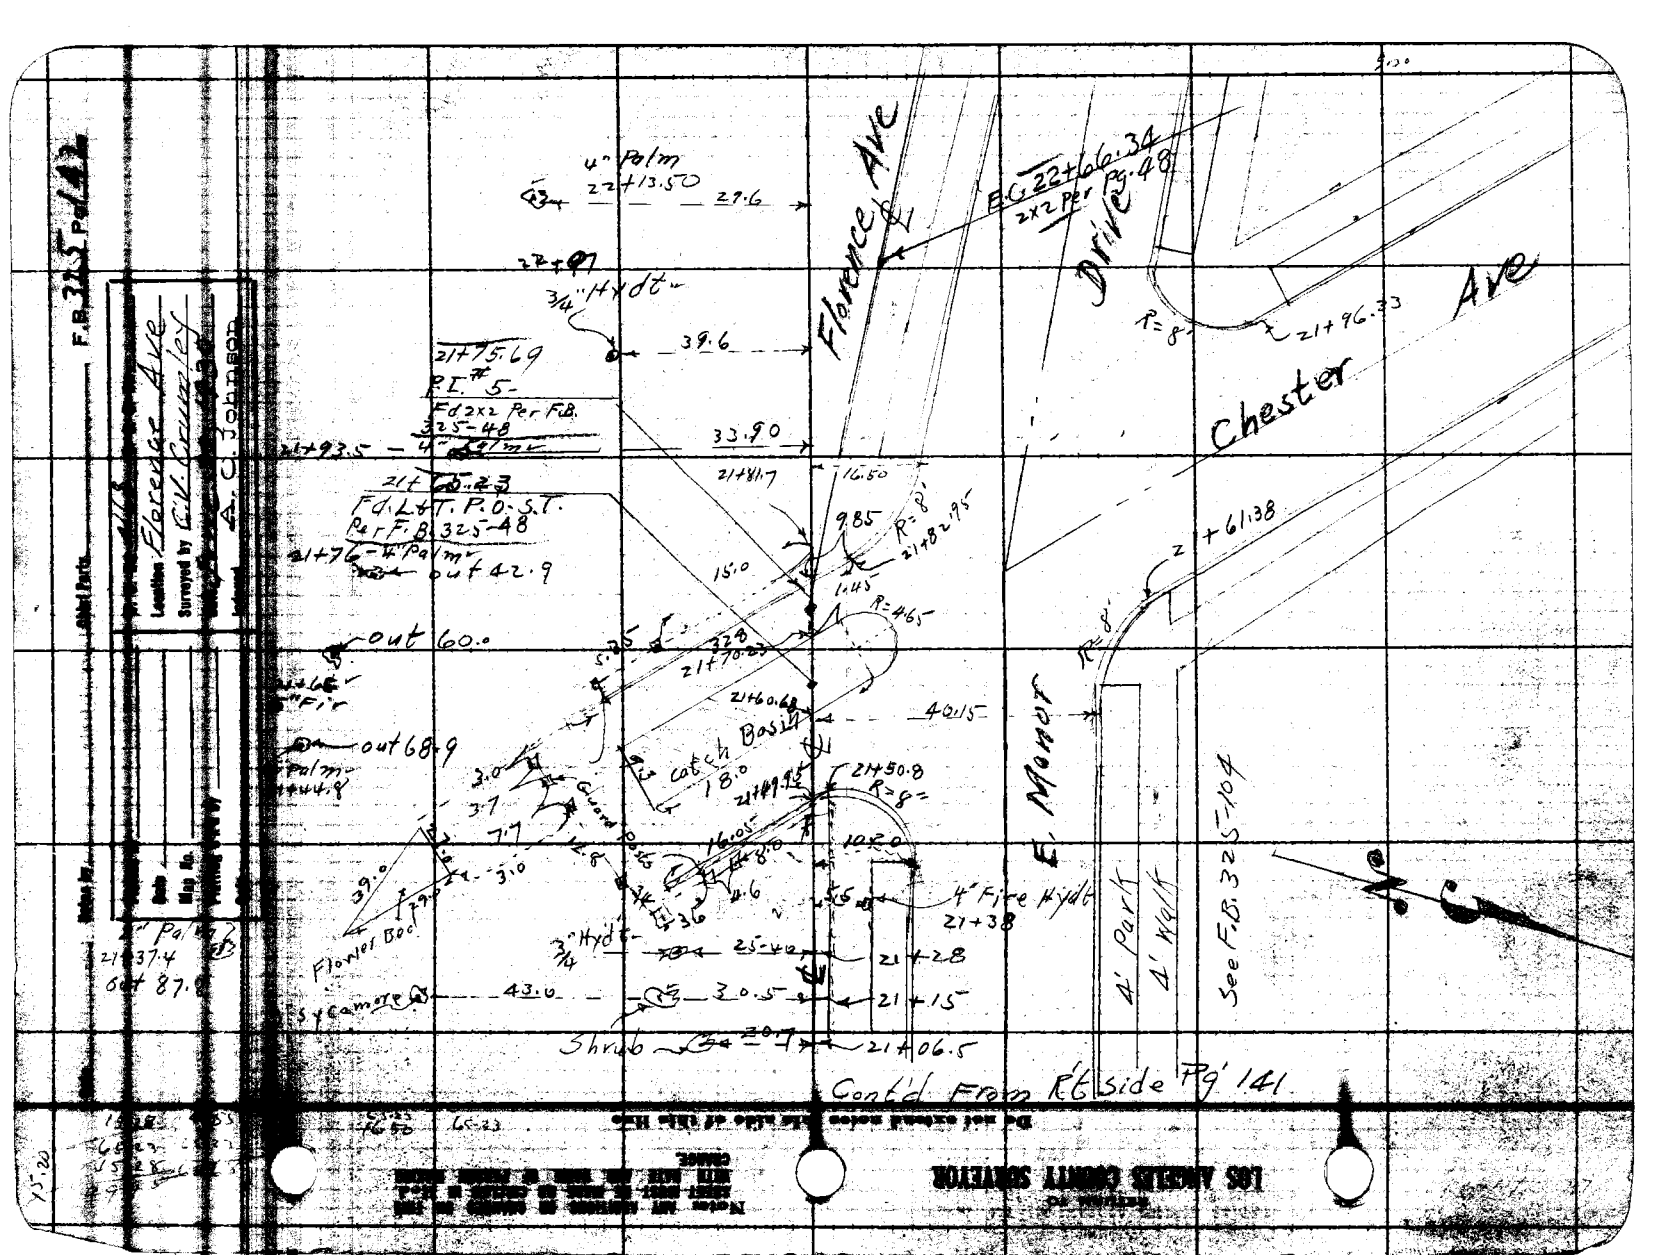
F.B. 325 Pg 42
Florence Ave
Drive
Chester Ave
E. Manor
4' Park
4' Walk
See F.B. 325-104
4" Palm
22+13.50
29.6
22+97
3/4" Hyd
39.6
21+75.69
P.I. #5-
Fd 2x2 Per F.B. 325-48
33.90
21+93.5
21+60.23
Fd L & T. P.O.S.T.
Per F.B. 325-48
21+76
4" Palm
out 42.9
out 60.0
out 68.9
Palm
21+44.8
21+37.4
out 87.8
21+81.7
16.50
9.85
R=8'
21+82.95
15.0
1.45
R=46.5
21+70.23
21+60.68
40.15
Catch Basin
18.0
21+49.95
21+50.8
R=8
16.05
10.20
4" Fire Hydt
21+38
3" Hyd
25.40
21+28
Flowering Box
43.6
30.5
21+15
Sycamore
Shrub
20.7
21+06.5
P.C. 22+66.34
2x2 Per Pg. 48
R=8'
21+96.33
2+61.38
Cont'd From Rt side Pg 141
LOS ANGELES COUNTY SURVEYOR

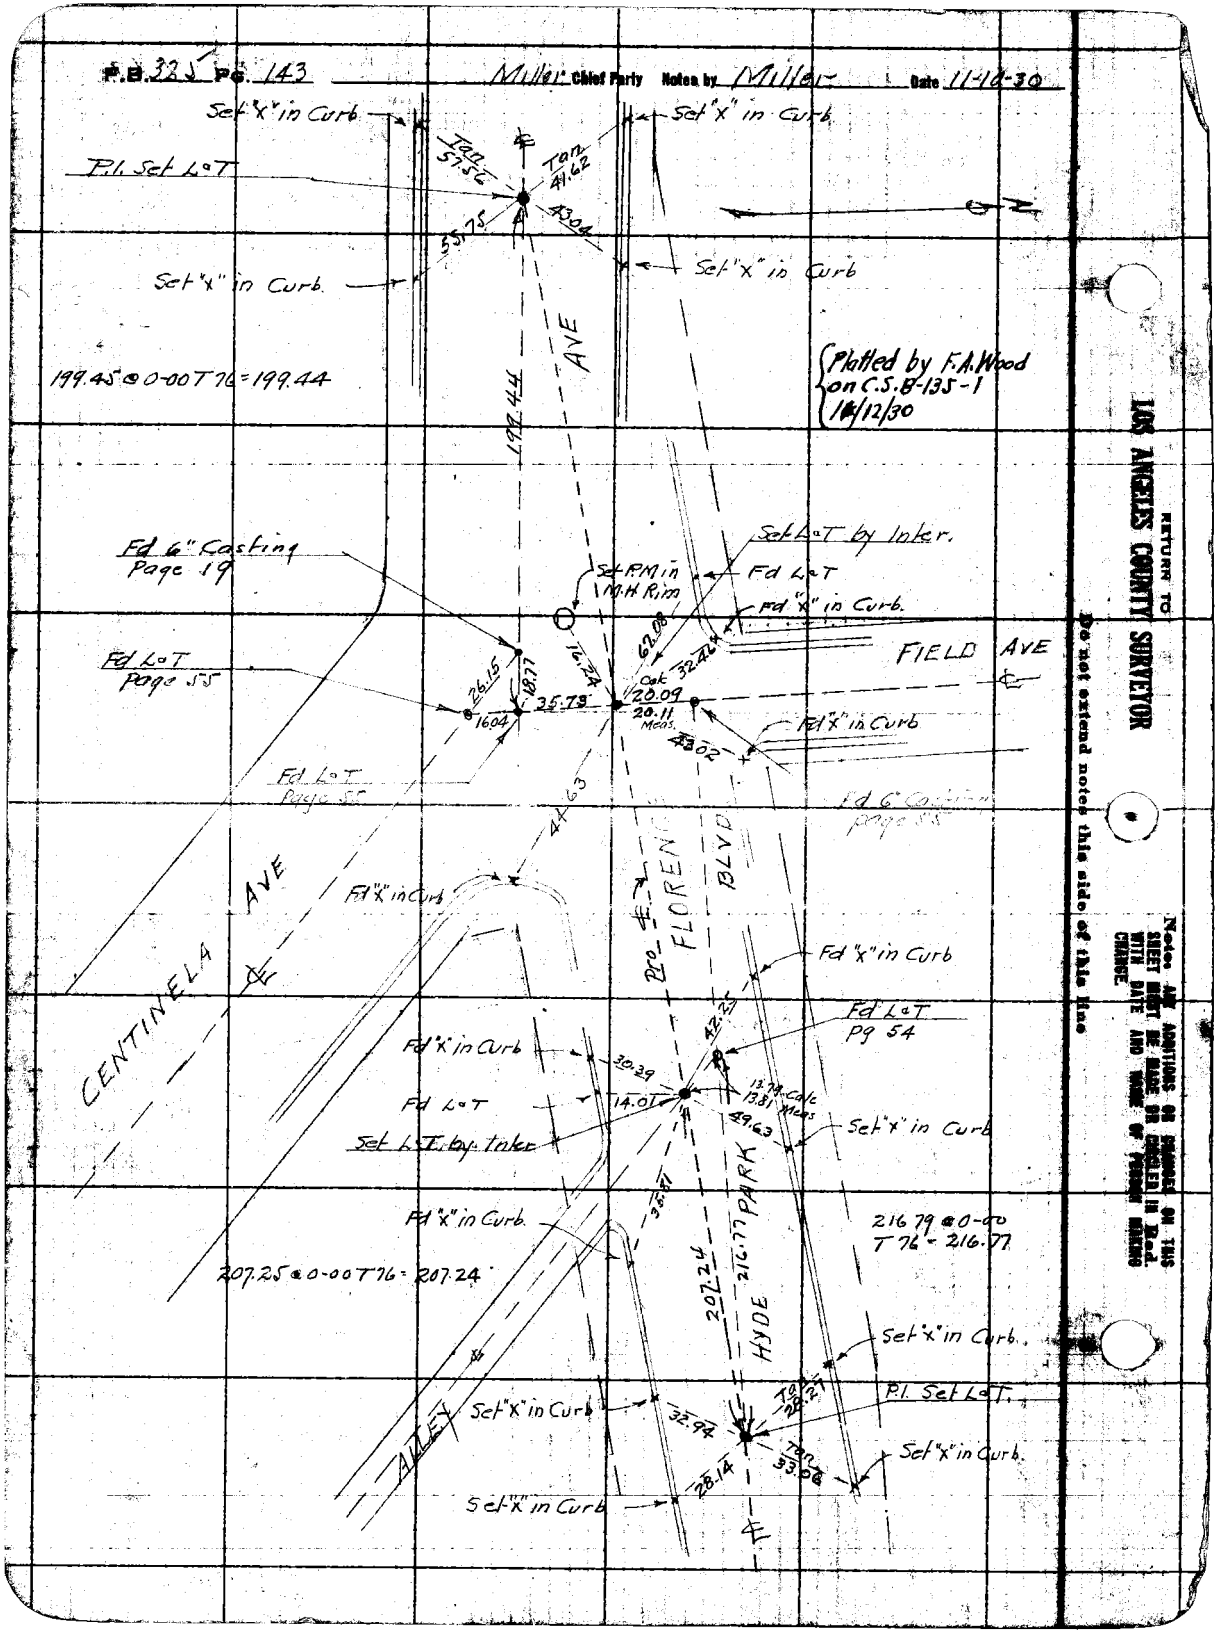
P.B. 32 J Pg. 143
Miller Chief Party Notes by Miller Date 11-16-30
Set "X" in Curb
P.I. Set L.&T.
Tan 57.56
Tan 41.62
43.04
55.75
Set "X" in Curb
Set "X" in Curb
Set "X" in Curb
199.45 @ 0-00 T 76 = 199.44
199.44
AVE
Platted by F.A. Wood on C.S.B-135-1 11/12/30
Fd 6" Casting Page 19
Set L.&T. by Inter.
Set P.M. in 10 M.H. Rim
Fd L.&T
Fd "X" in Curb
62.08
Calc 32.42
FIELD AVE
Fd L.&T Page 55
26.15
16.77
16.04
35.78
Calc 20.09
20.11 Meas.
43.02
Fd "X" in Curb
Fd L.&T Page 55
44.63
Fd 6" Casting Page 55
CENTINELA AVE
Fd "X" in Curb
Fd "X" in Curb
Fd L.&T pg 54
42.25
Fd "X" in Curb
30.39
Fd L.&T
14.01
13.74 Calc
13.81 Meas.
49.63
Set L.&T. by Inter.
Set "X" in Curb
Fd "X" in Curb.
207.25 @ 0-00 T 76 = 207.24
35.77
207.24
216.77 PARK
216.79 @ 0-00 T 76 = 216.77
HYDE
Set "X" in Curb.
P.I. Set L.&T.
ALLEY
Set "X" in Curb
32.94
Tan 28.27
Tan 33.58
28.14
Set "X" in Curb.
Set "X" in Curb
RETURN TO LOS ANGELES COUNTY SURVEYOR
Do not extend notes this side of this line
No Additions or Changes on this sheet may be made or erased in red with date and name of person making change.

Date 6-6-32 Notes by Moore Chief Party Moore F.B. 325 Pg. 144

Plotted by
Date
Map No.
Plotting Checked by
Date

W. O. No. 2126
Location Florence Ave.
Surveyed by L. S. Moore
Date 6-6-32
Indexed A. C. Johnson

CONNECTION
BETWEEN
ROAD DEPT. & - FLORENCE AVE EXT.
AND
C.S. & - PROPOSED FLORENCE AVE
AT
WEST BLVD.

Notice: ANY ADDITIONS OR CHANGES IN THE SURVEY DATA OR NOTES OF SURVEYS OF RECORD MUST BE MADE BY THE SURVEYOR OF RECORD HAVING MADE SAME.

Do not extend notes to this side of this line

RETURN TO LOS ANGELES COUNTY SURVEYOR

F.B. 325 Pg. 145 — Moore — Chief Party — Notes by: Moore — Date: 6-6-32

325

ANGELES MESA

Fd. Spk FB 325-9

VICTORIA AVE

(89°-23-15" / 357-33-15)

INTER of 4 Tan Punch Marks on M.H. Rim FB 325-9

BRYNHURST

Fd. Wire Spk 11' Lead Check Ties per FB 325-5

BLVD

Fd wire spk in lead R.D. Fo. 434-2 All ties per FB 325-9 42 going. Apparently this is position of 6" conc. Mon FB 325-3

Fd LYT

FLORENCE

ST

Fd LYT

20 Adj.

89°-33'

61.15

62.22

59.72 Tang

WEST BLVD

90°-20'

60.21

Fd C Spk In lead

20 Adj.

EDDIE PARK

67 FT

(90°-20-30" / 361-21-30)

Set 2x2 12" deep by inter

173.94

1.49

62.33

Curve Shown

Set 2x2 - 42 inches deep. This is 0.1' Southerly of old post Ho.

Fd 2x2 - 42 feet deep FB 325-42 Set 2x2-12" deep.

T=68°

197.46

31.88

41°-55'-00"

70.37

Set N+T

FLORENCE

R.O.E.

(41°-55-00" / 167-40-00)

Fd N+T PP

0.1'

To S.T+W & Long St FB 325-43

PP = -C+38.98 Fd 2x2 12" deep R.D. Fo. 434-2

65.33

62.87

31.44

Fd N+T-PP