Date_____ Notes by_____ Chief Party_____ F.B._____ PG._____

Platted by_____	W. O. No._____ D. S. O. No._____
Date_____	Location_____
Map No._____	Surveyed by_____
Plotting C'k'd by_____	Date_____
Date_____	Indexed_____

LOS ANGELES COUNTY SURVEYOR
Do not deface this card

52

F.B. 352 Pg. Index Chief Party Notes by Date

F.B. 352

PAGES: Index, Index, , 1, 2, 3, , 5 to 15 incl., , 17 to 27 incl., , 29 to 39 incl., , 41 to 73 incl., , 75 to 121 incl., , 123 to 128 incl., 129 to 197 incl., ,199 to 209 incl., ,211 to 228 incl.,

RETURN TO
LOS ANGELES COUNTY SURVEYOR
Do not extend notes this side of this line
Note: ANY ADDITIONS OR CHANGES ON THIS SHEET MUST BE MADE OR CIRCLED IN Red. WITH DATE AND NAME OF PERSON MAKING CHANGE.

Date _____ Notes by _____ Chief Party _____ F. B. 352 Pg. 1

Date NOV 30 1929
Map No. _____
Date _____

W. O. No. 796 R. & O. No. _____
Location Garvey Ave
Surveyed by Rodericus
Date March 1930
Indexed A. C. Jamison

GARVEY AVENUE

East of Elmonte.

W.O. 796

Party E.H. Rodericus
W.B. Miller
F.G. Gibson
E.W. Hoopes
D.J. Ordway

The Center line location of proposed Garvey Ave. was revised. July. 1930. For correct alignment notes of this Revised location see Pages 129 to 228. Some of the Notes. contained in these pages (ie. 1-128) are used for the Map. of Revised location which has been shown. on. C.S. Map. No. B-519. Sheets. 1 & 2.

H. U. M. H.

AUG 12 1930

NOTE: ANY ADDITIONS OR CHANGES ON THIS SHEET MUST BE MADE OR CIRCLED IN Red. GIVE DATE AND NAME OF PERSON MAKING CHANGE.

RETURN TO LOS ANGELES COUNTY SURVEYOR

Do not extend notes this side of this line

F.B. 352 Pg 2 Cascrans Chief Party Notes by Date May 1928

RETURN TO
LOS ANGELES COUNTY SURVEYOR

Notes ANY ADDITIONS OR CHANGES ON THIS SHEET MUST BE MADE OR CIRCLED IN Red. WITH DATE AND NAME OF PERSON MAKING CHANGE.

Do not extend notes this side of this line

Date _____ Notes by _____ Chief Party _____ F. B. 352 PG. 3

Plotted by M. J. M. H.
Date NOV 30 1929
Map No. _____
Plotting C'k'd by _____
Date _____

W. O. No. 796 C. S. O. No. _____
Location Garvey Ave
Surveyed by Rosecrans
Date Mar 1929
Indexed by A. C. Johnson

Index to field work.

Notes: ANY ADDITIONS OR CHANGES ON THIS SHEET MUST BE MADE OR CIRCLED IN Red. WITH DATE AND NAME OF PERSON MAKING CHANGE.

RETURN TO LOS ANGELES COUNTY SURVEYOR

Do not extend notes this side of this line

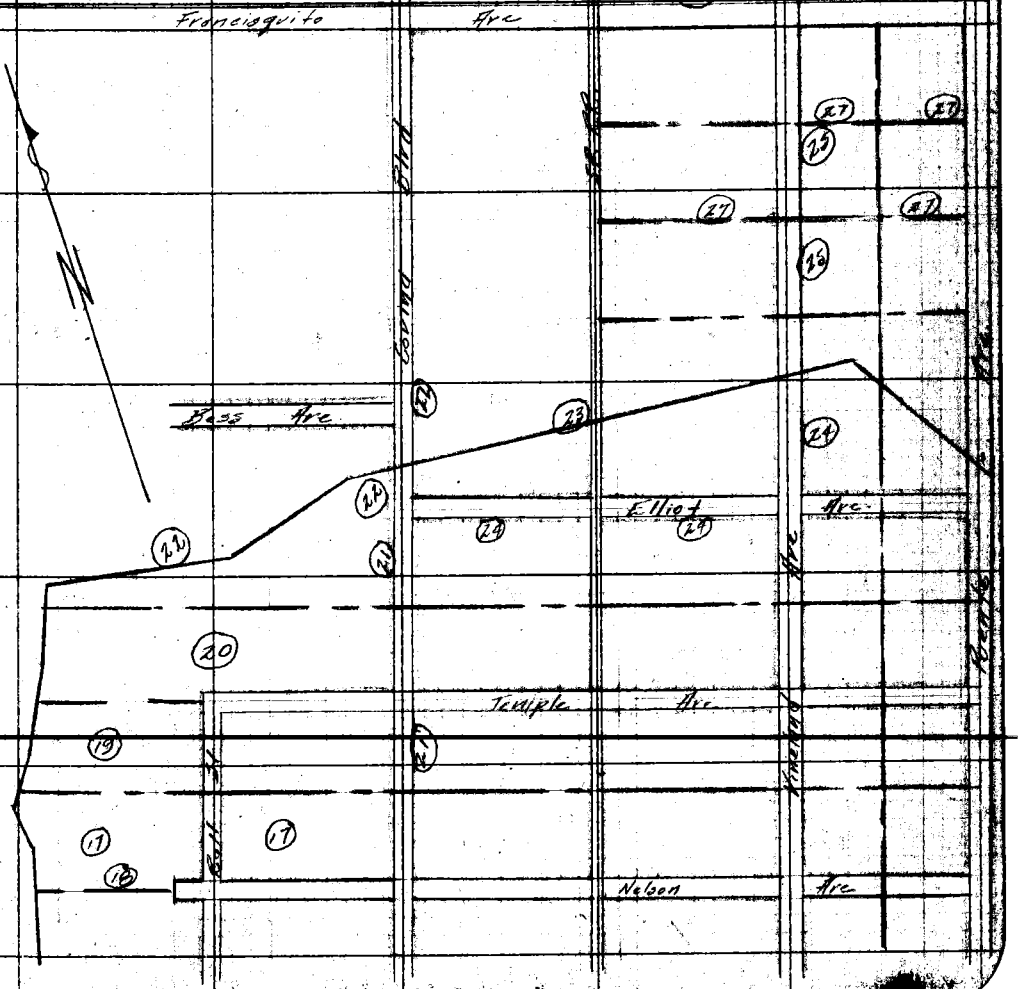

F.B. 352 Pg. 4 Escovedo Chief Party Notes by Date May 1928

RETURN TO
LOS ANGELES COUNTY SURVEYOR

Do not extend notes this side of this line

Note: ANY ADDITIONS OR CHANGES ON THIS SHEET MUST BE MADE OR CIRCLED IN Red, WITH DATE AND NAME OF PERSON MAKING CHANGE.

Date _____ Notes by _____ Chief Party _____ F. B. 352 PG. 5

H. H. M. H.
Date NOV 30 1929
Map No. B.457-1
Planning & Survey Unit
Date Oct. 1929

W. O. No. 776 Cont. No. 031
Location Garvey Ave
Surveyed by Rosecrans
Date 5-16-1929
Indexed A. C. Johnson

Standard at 84°

Notes: ANY ADDITIONS OR CHANGES ON THIS SHEET MUST BE MADE OR CIRCLED IN Red. WITH DATE AND NAME OF PERSON MAKING CHANGE.

Do not extend notes this side of this line

RETURN TO LOS ANGELES COUNTY SURVEYOR

Set N&T. in P. pole

Fd. N&T. in Tel. pole (old tie)

℄ Valley Blvd and ℄ Maxson Rd. Set L&T. by F.O. Proj. F.O. 216-5 See P. 13 for new intersection.

See Page 13.

Maxson Rd.

Set N&T in B Mnut.

Blvd.

Fd. N.&T. in 12" W. nut. (old tie)

Set cut sink & W. in 30" pole

Fd N.&T. in Tel pole

℄ Cogswell Rd and ℄ Valley Blvd Set L&T. by record distance from P.I. Per F.O. 216-2 0+00 to N See bottom next page.

Cogswell Rd

Set N&T in 18" W. nut

Set N&T. in 18" W. nut

To 4"x6" Conc. post in center line of Maxson Rd. 4' E. of ℄ Maxson Rd. & 4' N. of ℄ Cogswell Rd.

Valley

Set N&T. in P. pole (E side)

Found ℄ in Valley Blvd 17+20.37 per F.O. 216-2 Set N&T. by this.

Fd N&T. in F.O. old tie per F.O. 216-2

Set N&T. in 18" W. nut.

Fd N&T. in 10" W. nut. Old tie per F.O. 216-2

F.B. 352 PG. 6 Locations Chief Party Notes by Date 5-24-29

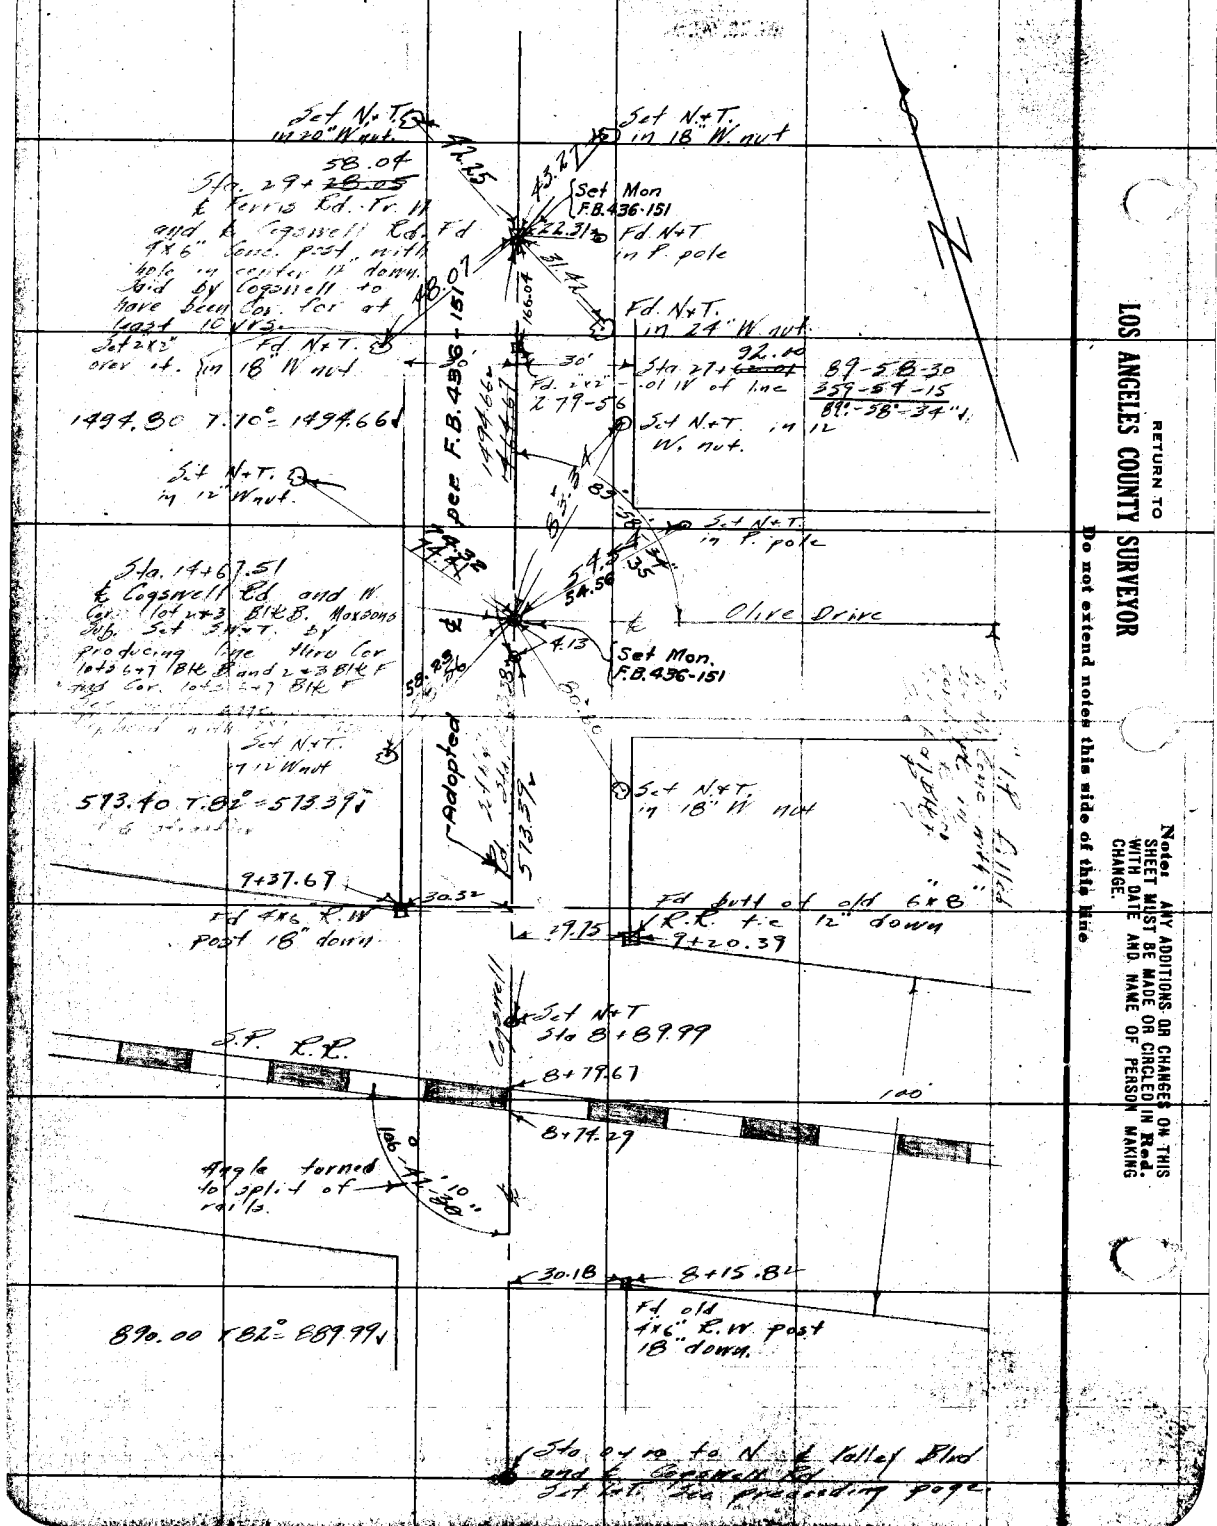

RETURN TO
LOS ANGELES COUNTY SURVEYOR
Do not extend notes this side of this line

Notes ANY ADDITIONS OR CHANGES ON THIS SHEET MUST BE MADE OR CIRCLED IN Red. WITH DATE AND NAME OF PERSON MAKING CHANGE.

Chief Party F. B. 352 PG. 7

Date NOV 30 1929
Map No. 8.457-1
Date Oct. 1929

W. O. No. 296 Topo. No. 031
Location Garvey Ave.
Surveyed by Rosecrans
Indexed A. C. Johnson

Notes. ANY ADDITIONS OR CHANGES ON THIS SHEET MUST BE MADE OR CIRCLED IN Red. WITH DATE AND NAME OF PERSON MAKING CHANGE.

Do not extend notes this side of this line

RETURN TO LOS ANGELES COUNTY SURVEYOR

Sta. 44+76.76 Top of old F.P. Set 1½" - 12 down

1.87 Fd 6" I. P. f. 11 d w/ 4 Cons. Sta. 32+44.53

To bottom of Page 76

377.25 T. 80° = 377.24 ℄

543.48 T. 80° = 543.47 ℄

Sta. 44+18.75 ℄ (Proposed Garvey Ave) Sta. 28+67.29 Set 1½" + 12" down.

Set N&T in P. pole

218.83

218.84 T. 76° = 218.85 ℄

Set N&T in 12" W. nut

To bottom of Page 185

℄ Gilman Rd.

30'

Sta. 49+39.92 ℄ Proposed Garvey Ave. Fd. P. P.

Sta. 26+18.76 Fd. 6" I. P. f. 11 d w/ 4 Conc. w/ 4 cut Spt. in center 1" down ℄ and ℄ Olive Pl. See P. 10

20'

662.05 T. 76° = 662.04 ℄

Sta. 35+37.80 ℄ Proposed Garvey Ave.

Fd rotten remains of old 4"x4" R. W. Stake 18" down Set 1½" nail & tag 1.3" down M.R. Set 0.0

Sta. 19+85.65 Fd. ¾" I.P. 3" down

1325.19 T. 70° = 1325.07 ℄

Sta. 28+74.85 ℄ Proposed Garvey Ave.

℄ Mission Rd. See P. 8

1323.41 T. 82° = 1323.39 ℄

Sta. 15+23.39 ℄ Olive Pl. and ℄ Mission Rd. Fd 2" I.P. 1' down See P. 8 for ties.

Sta. 6+61.60 Fd old remains of 4"x4" Post 2 down Set nail over ¼" down M.R. 31.50 E. Sta. 4+13.96 ℄ Proposed Garvey Ave.

661.66 T. 70° = 661.60 ℄

℄ Cogswell Rd and ℄ Olive Pl. Set 2"x2" Sta. 13+67.31 R.R. Sta. 0+00 to E.

See preceding page

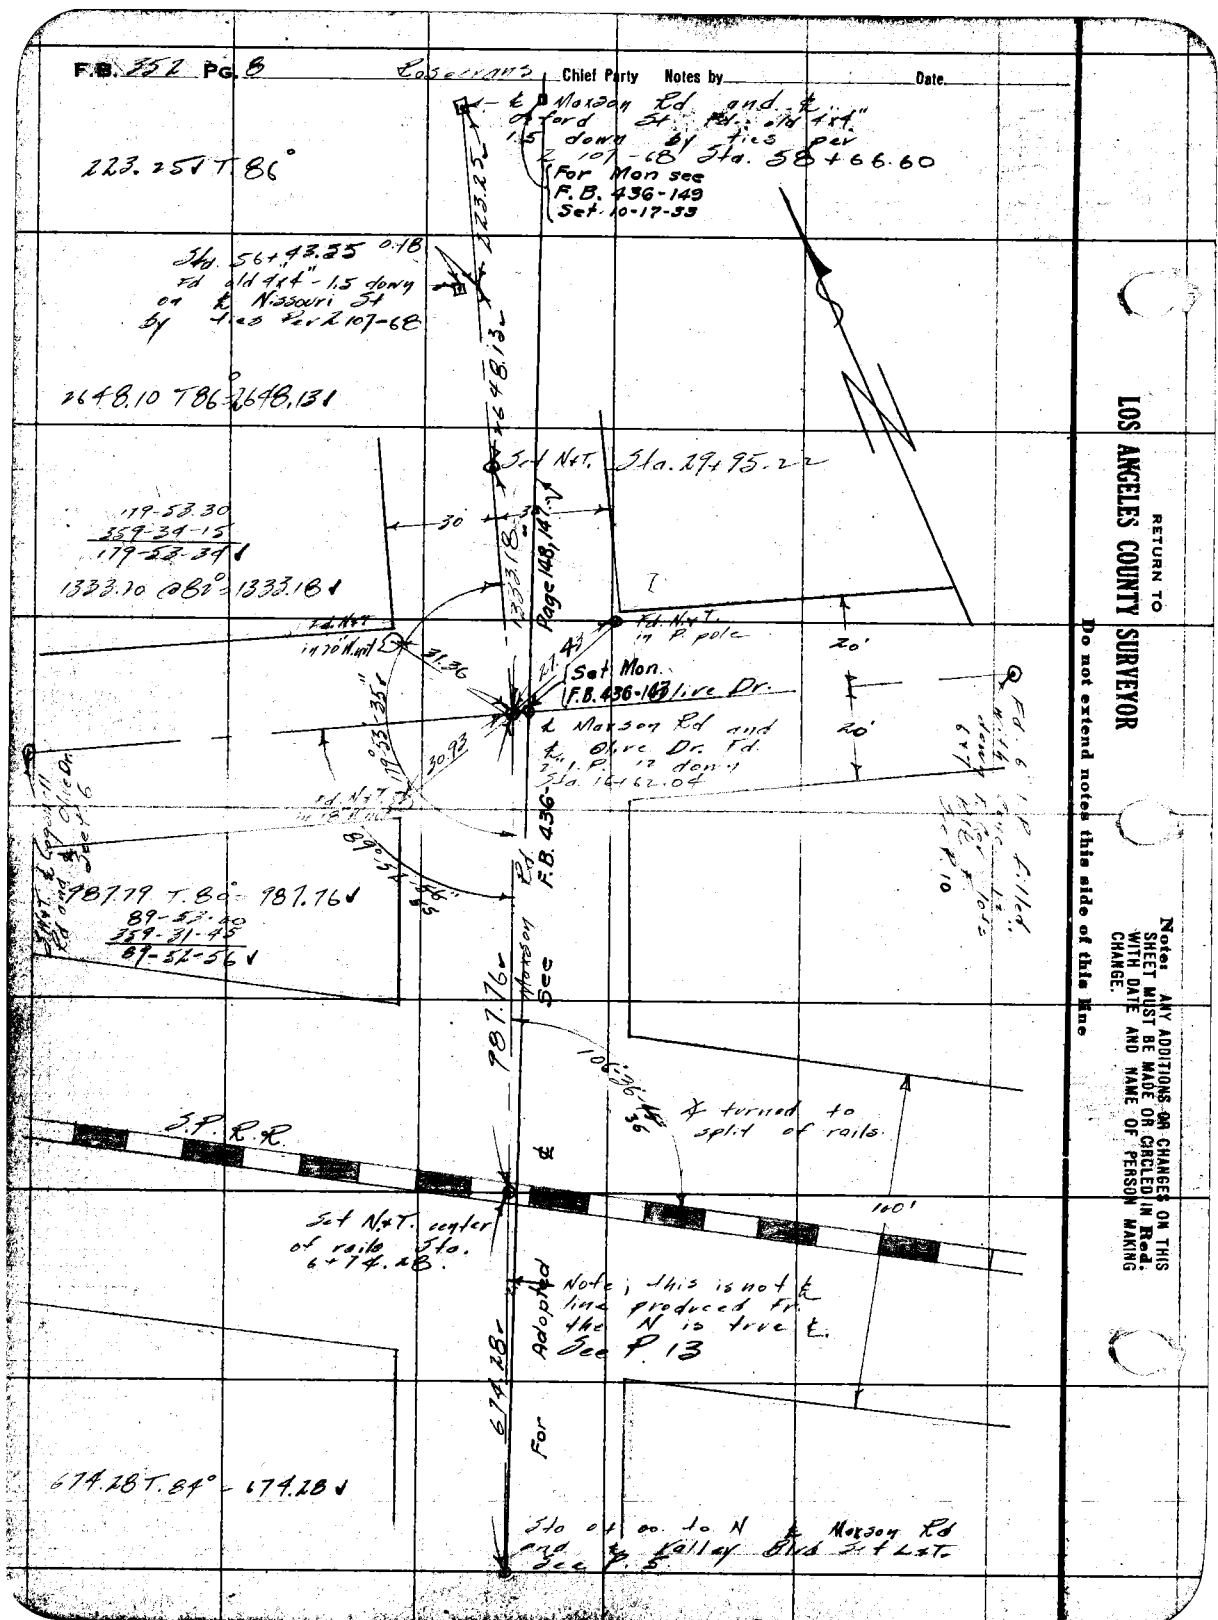
Rosecrans
Chief Party
Notes by
Date
℄ Marson Rd and ℄ of Ford St. Fd. old 4x4" 1.5 down by ties per 107-68 Sta. 58+66.60
For Mon see F.B. 436-149 Set 10-17-33
223.25 T 86°
Sta 56+43.25 0.1B Fd old 4x4" - 1.5 down on ℄ Nissouri St by Tie as per 2107-68
2648.10 T 86° 2648.13
Set N&T. Sta. 29+95.22
179-53-30
359-34-15
179-53-34
1333.10 @ 82° 1333.18
30
Page 148, 149
Fd N&T in P.P.
Fd N&T in 0.70" Mund
21.36
Set Mon. F.B. 436-147
℄ Marson Rd and ℄ Olive Dr. Fd. I.P. in dwy Sta. 16+62.04
Olive Dr.
20'
30.93
89°-54'-40"
987.79 T 89° 987.76
89-52-40
359-31-45
89-52-56
987.76
See F.B. 436-147 Marson Rd
℄
160'
℄ turned to split of rails
S.P.R.R.
Set N&T. center of rails Sta. 6+74.28
Note; This is not ℄ line produced thr N is true ℄. See P. 13
Adopted
674.28
For
674.28 T 84° 674.28
Sta 0+00 to N ℄ Marson Rd and ℄ Valley Blvd Set ℄ L&T.
See P. 5
RETURN TO
LOS ANGELES COUNTY SURVEYOR
Do not extend notes this side of this line
Note: ANY ADDITIONS OR CHANGES ON THIS SHEET MUST BE MADE OR CIRCLED IN Red. WITH DATE AND NAME OF PERSON MAKING CHANGE.

Date _____ Notes by _____ Chief Party _____ F. B. 352 PG. 9

Plotted by H.U.M.H.
Date NOV 30 1929
Map No. 8.457-1
Checked by Wood
Date Oct. 1929

W. O. No. 796 Cont. No. 4
Location Garvey Ave.
Surveyed by Rosecrans
Date 2-28-1929
Indexed A. C. J.

Scale 1" = 40'

Ed. old 4"x4" P.W. Stake 2' down & Maxson Rd. and & Ferris Rds. M.E. 31.50

Set Conc. Mon. See F.B. 436-151

Set N.+T. in 20" W. nut

31.46

30.98

0.30

Maxson Rd.

Fd. N.+T. Std. 29+95.22 See P.B.

8.82

26.7

17.06

Set N.+T. in 20" W. nut

Set N.+T. in 20" W. nut

Set N.+T. in 20" W. nut

Sta. 19+86.33 P.C.

30'

30'

30'

30'

30'

30'

30.00

20'

15

90-00-30
360-01-15
90-00-341

1323.15' T 84°

1323.15' Ferris Rd.

90-00-30

30'

166.04

Conc. Mon. See F.B. 436-151

Cogswell Rd.

Fd. iron stake Set for & Ferris Rds. for & Sec

& Cogswell Rd. and & Ferris Rd. Fr. M. Fd. 4" long past 12" dead Sec P. 6

& Cogswell Rd. and & Valley Blvd. Set

Notes: ANY ADDITIONS OR CHANGES ON THIS SHEET MUST BE MADE OR CIRCLED IN Red. WITH DATE AND NAME OF PERSON MAKING CHANGE.

Do not extend notes this side of this line

RETURN TO LOS ANGELES COUNTY SURVEYOR

F.B. 352 Pg. 10 Rosecrans Chief Party Notes by Date 5-27-48

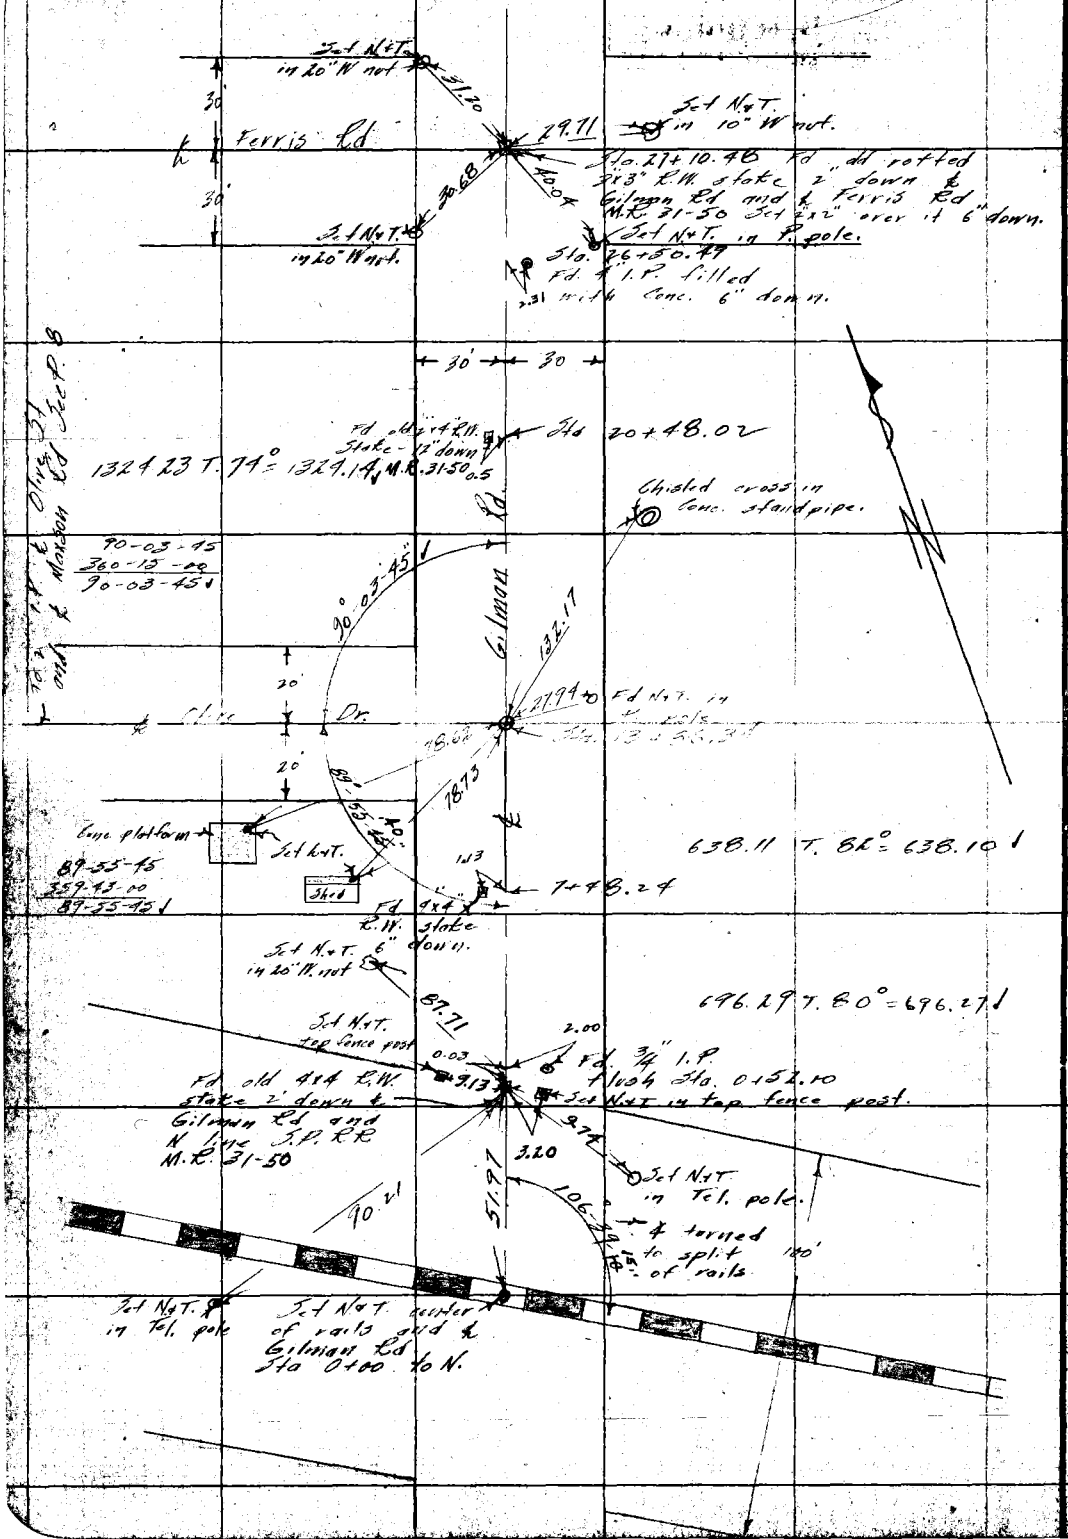

RETURN TO
LOS ANGELES COUNTY SURVEYOR
Do not extend notes this side of this line

Notice: ANY ADDITIONS OR CHANGES ON THIS SHEET MUST BE MADE OR CIRCLED IN Red. WITH DATE AND NAME OF PERSON MAKING CHANGE.

Date _____ Noted by _____ Chief Party _____ F. B. 352 PG. 11

Checked by H.U.M.
Date NOV 30 1929
Map No. B.457-1
Checked by Wood
Date Oct. 1929

W. O. No. 196 Sup. No. 1
Location Garvey Ave
Surveyed by Rodebaugh
Date 5-21-1926
Indexed A. C. JOHNSON

Notes: ANY ADDITIONS OR CHANGES ON THIS SHEET MUST BE MADE OR CHALKED IN Red. WITH DATE AND NAME OF PERSON MAKING CHANGE.

Do not extend notes this side of this line

RETURN TO LOS ANGELES COUNTY SURVEYOR

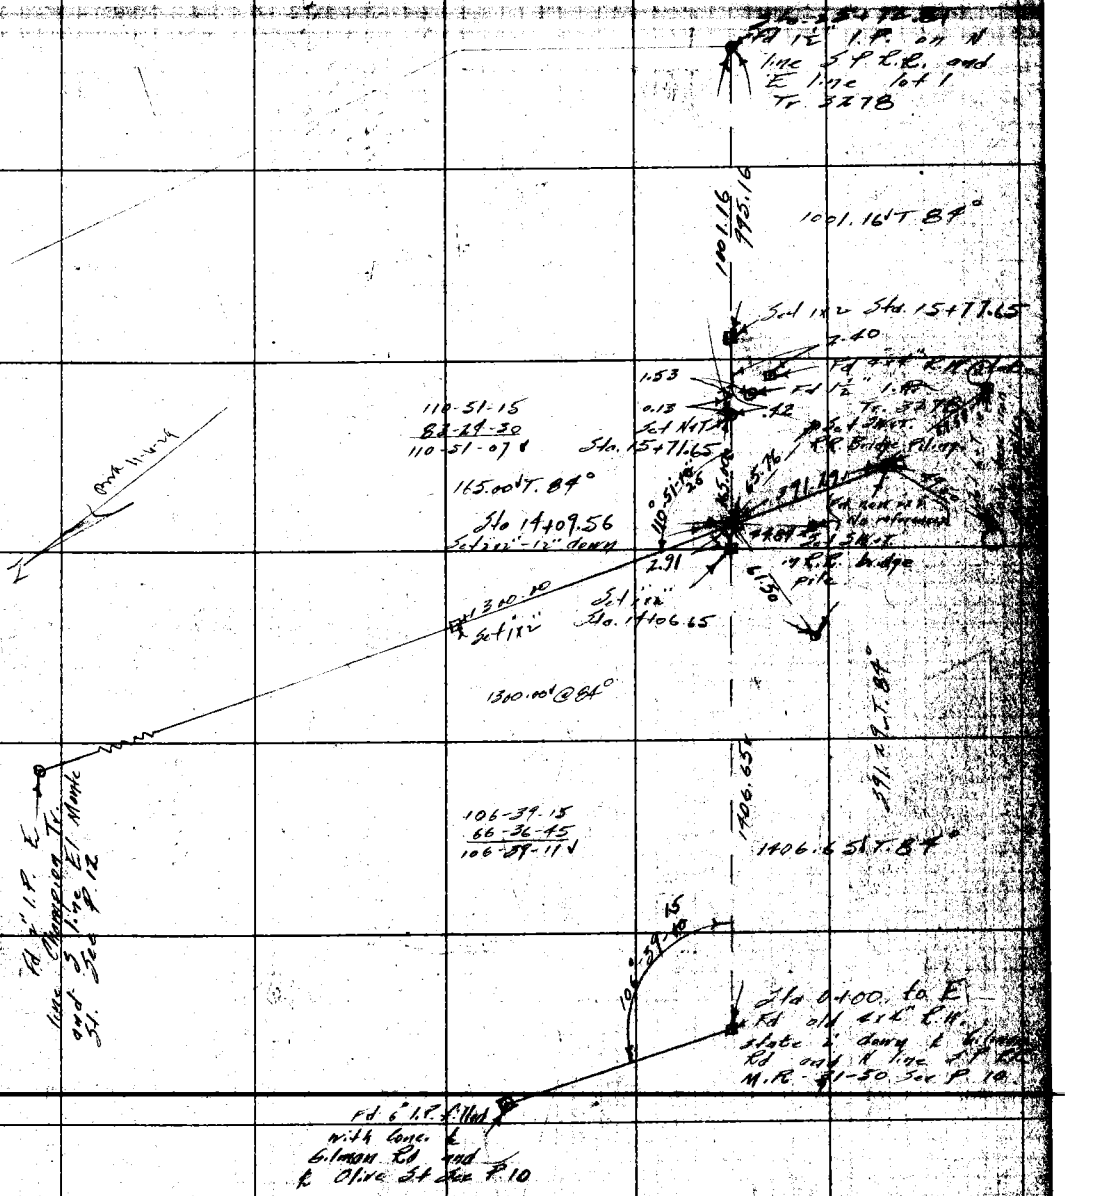

RETURN TO

LOS ANGELES COUNTY SURVEYOR

Note: ANY ADDITIONS OR CHANGES ON THIS SHEET MUST BE MADE OR CIRCLED IN **Red.** WITH DATE AND NAME OF PERSON MAKING CHANGE.

Do not extend notes this side of this line

F.B. 258 PG. 12 Chief Party Notes by Date 6-1-28

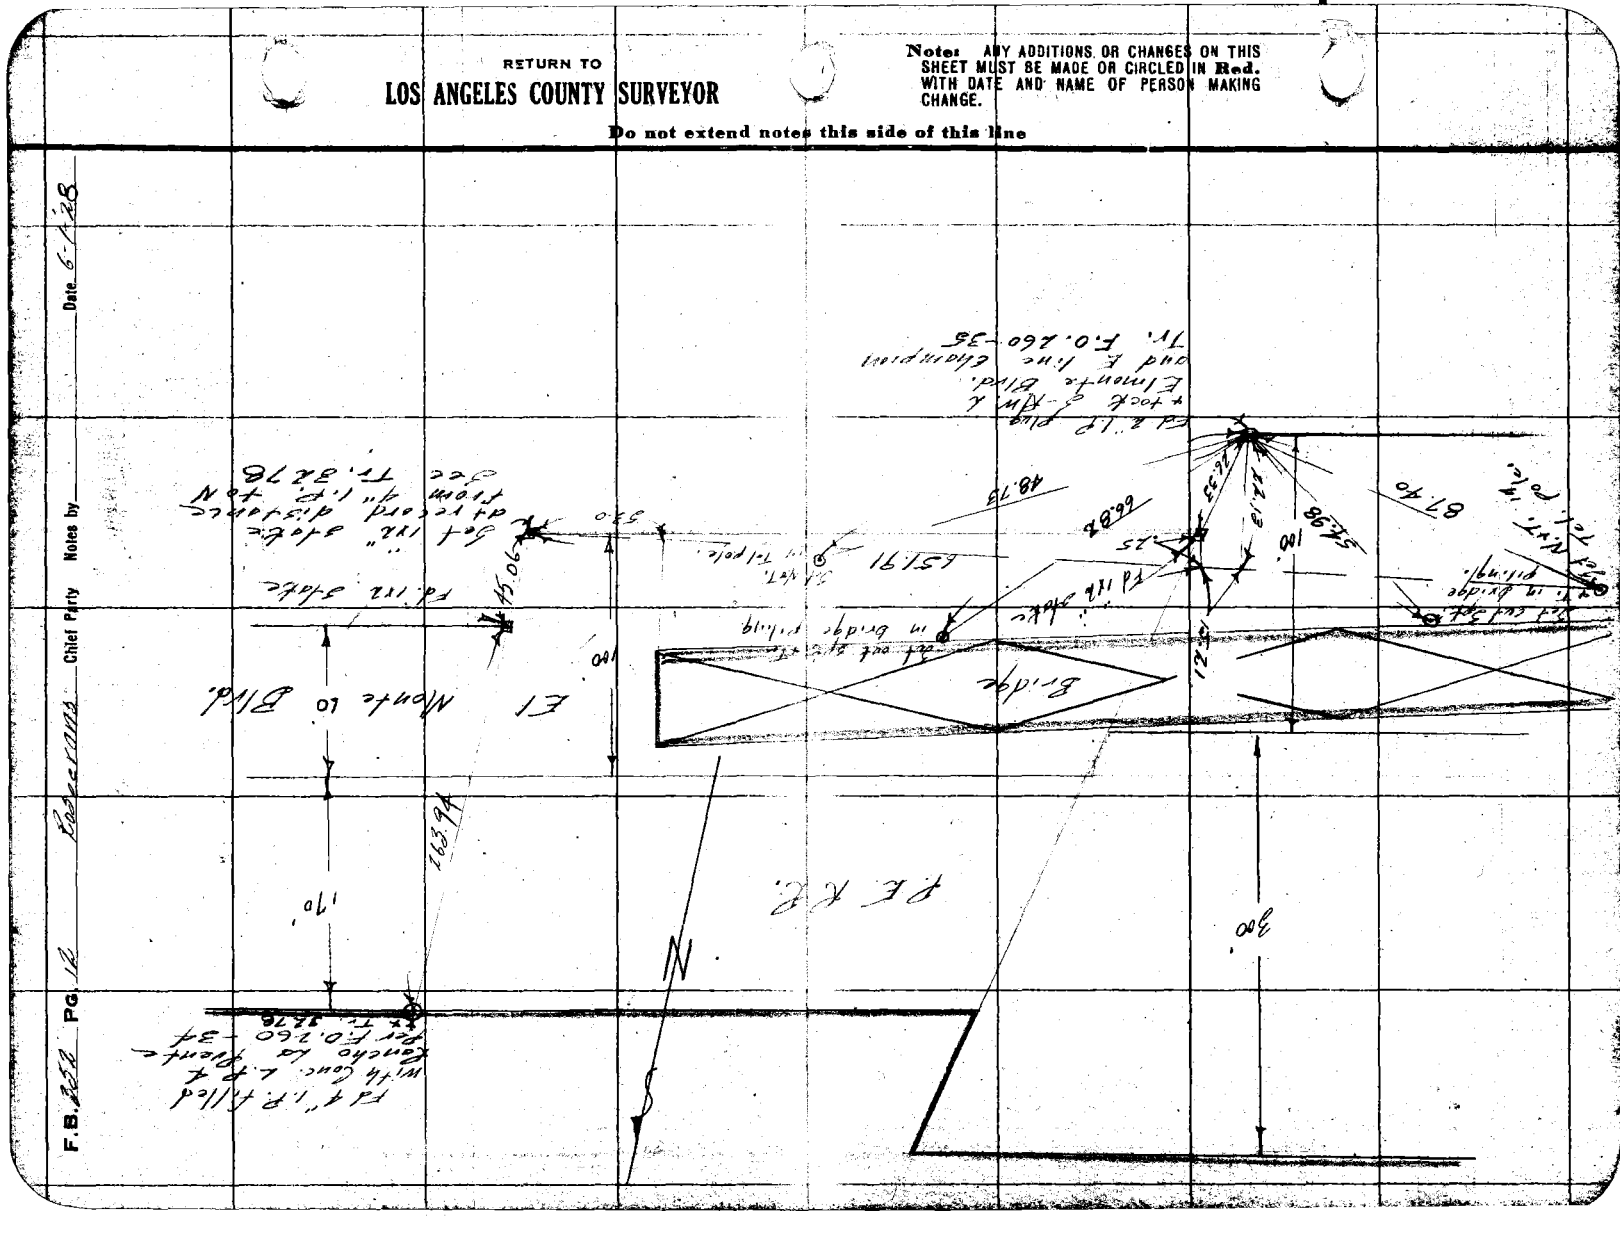
Bridge
El Monte Blvd.
N
S
E
W
100'
190'
300'

Date _____ Notes by _____ Chief Party _____ F. B. 352 PG. 13

Date NOV 30 1929
Map No. B.457-1
Date Oct. 1929

W. O. No. 186 Roll No. 1
Location Survey Line
Surveyed by Rockwood
Date 6-6-29
Indexed by C. Johnson

Notes. ANY ADDITIONS OR CHANGES ON THIS SHEET MUST BE MADE OR CIRCLED IN Red. WITH DATE AND NAME OF PERSON MAKING CHANGE.

Do not extend notes this side of this line

RETURN TO LOS ANGELES COUNTY SURVEYOR

Fd. old 4x4 "R.W. State & Maxson St. and & Maxson Rd. Sec P. 8.

Sta. 147.149

30

Fd old 4x4 "R.W. State & Maxson Rd and & Ferris Rd. Sec P. 9.

F.B. 436

Sta. 16+62.47 & Maxson Rd and & Olive St. Fd 1" I.P. 12 down See P 8

Maxson Rd

See

N.&T. in 18" W nut

Sta. 10+00.88 Fd 4x4 R.W. State 12" down Cor lots 74, 8 Blk B and lots 1 & 2 Blk. F-M.T. 31-50

N.&T. in 18" W nut

N.&T. in P pole

For Adoption

110' S.P.R.R.

N.&T. R.R. guard post

N.&T. R.R. guard post.

Sta. 6+22.18 Fd bottom of old 4x4" R.W. post 3 down S.P.R.R. R.W. 2x2" one ft 3 down

N.&T. in P. pole

N.&T. in 18" W nut

N.&T. in 8" W nut

Valley Blvd

N.&T. in P pole. Sta 0+00 to N & Valley Blvd and & Maxson Rd. Fnd L.&T.

Fd Sta 19+40.30 See P. 5.

Sta 4+42.47 See P. 5

85.95

N.&T. in Tel. pole

F.B. 352 Pg. 14 Rosecrans Chief Party Notes by Date 6-5-28

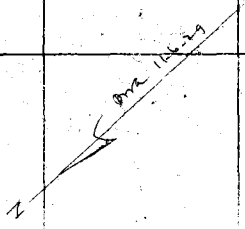

1300.00 2½" stake Sta 17+09.56 See P. 11

441.54

Set nail See P. 11

Set 2x2" 12" in Bk & Olive St produced and E line Marsain Sub.

P.I. P.R.C. Elmonte Blvd and E line Champion Tr. See P. 12

85°-52'-10" ✓

85-52-15
343-28-45
85-52-11 ✓

460.48'

460.48' ✓ T. 84°

441.54' ✓ T. 84°

2½" stake Sta 34+10.76 See P. 7

To P.R.C. of Maxwell Ln and E line Olive St See P. 7

RETURN TO
LOS ANGELES COUNTY SURVEYOR

Note: ANY ADDITIONS OR CHANGES ON THIS SHEET MUST BE MADE OR CIRCLED IN Red. WITH DATE AND NAME OF PERSON MAKING CHANGE.

Do not extend notes this side of this line

Date _____ Notes by _____ Chief Party _____ F. B. 352 Pg. 15

Date NOV 30 1929
Map No. B.487-1
Date Oct. 1929

M. D. No. 776 C.S. No. 931
Location Garvey Ave.
Surveyed by Roscrans
Date 6-3-1929
Indexed

Notes: ANY ADDITIONS OR CHANGES ON THIS SHEET MUST BE MADE OR CIRCLED IN Red. WITH DATE AND NAME OF PERSON MAKING CHANGE.

Do not extend notes this side of this line

RETURN TO LOS ANGELES COUNTY SURVEYOR

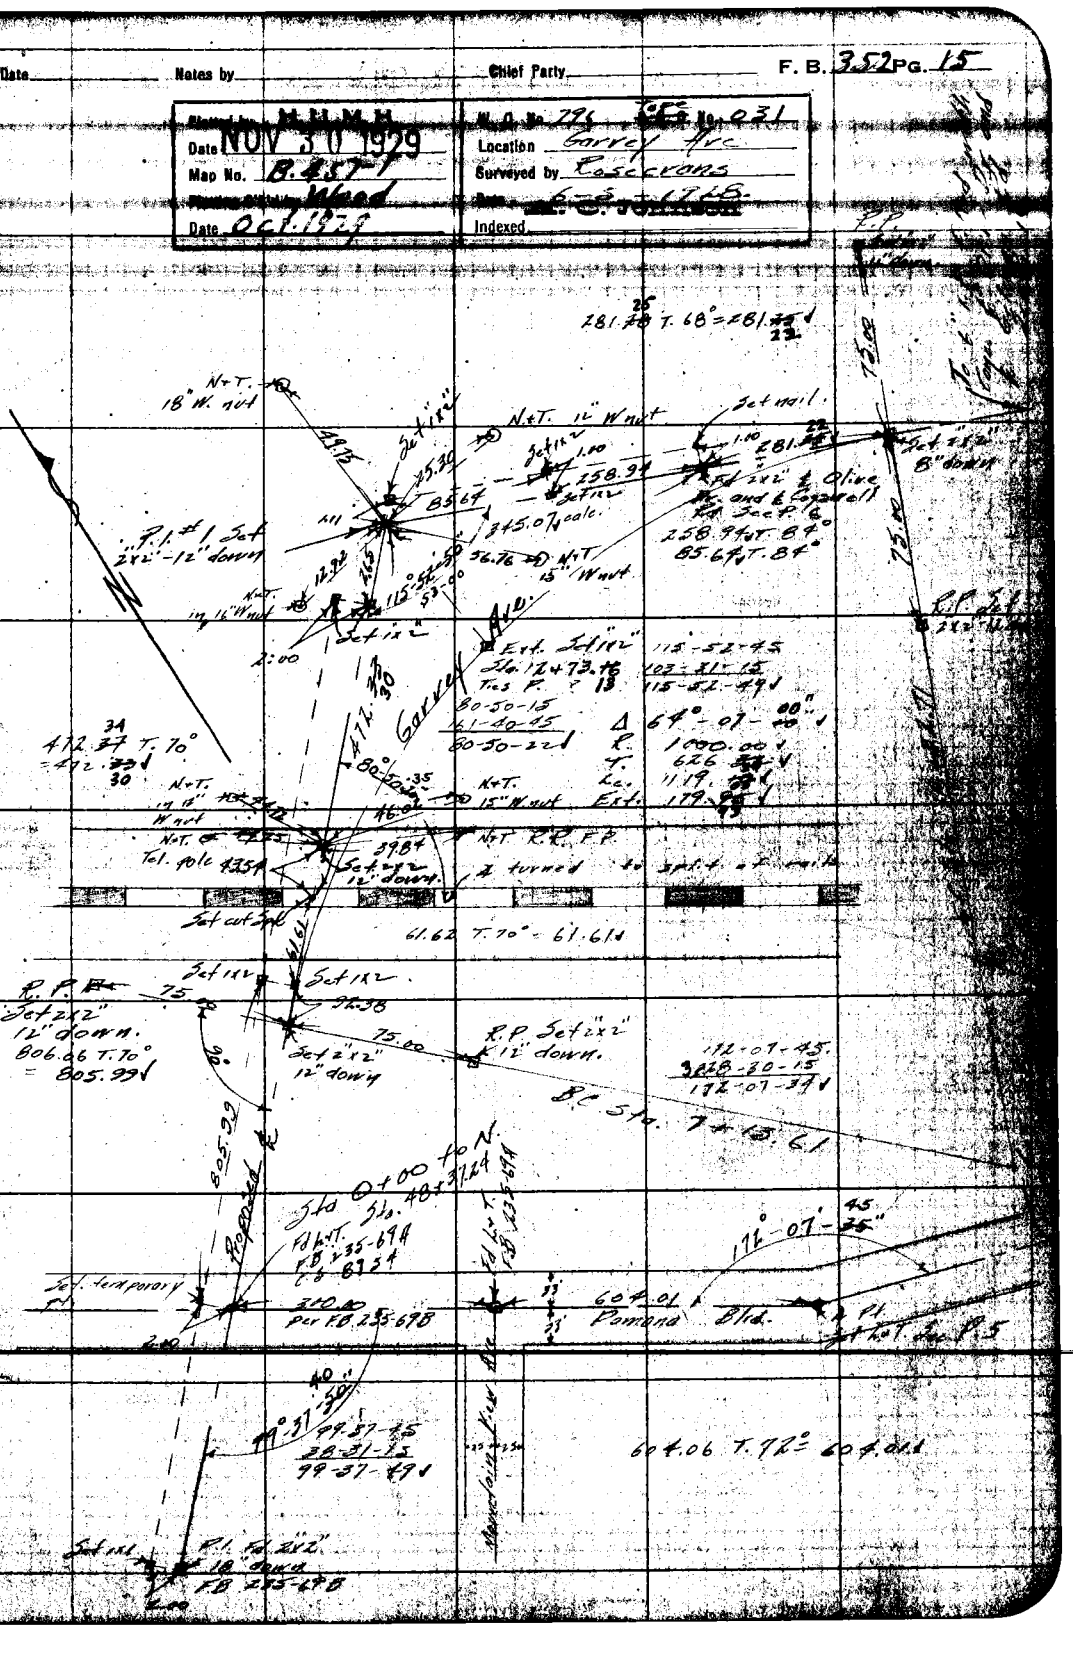

52 Pg. 16 Chief Party Notes by Date

RETURN TO
LOS ANGELES COUNTY SURVEYOR

Do not extend notes this side of this line

Note: ANY ADDITIONS OR CHANGES ON THIS SHEET MUST BE MADE OR CIRCLED IN Red. WITH DATE AND NAME OF PERSON MAKING CHANGE.

Date _____ Notes by _____ Chief Party _____ F. B. 352 PG. 17

Date NOV 30 1929
Map No. B.457-1
Checked Wood
Date Oct. 1929

W. O. No. 796 Page No. 1
Location Garvey Ave
Surveyed by Estevians
Date 6-29-26
Indexed A. C. Johnson

Notes ANY ADDITIONS OR CHANGES ON THIS SHEET MUST BE MADE OR CANCELED IN RED, WITH DATE AND NAME OF PERSON MAKING CHANGE.

Do not extend notes this side of this line

RETURN TO LOS ANGELES COUNTY SURVEYOR

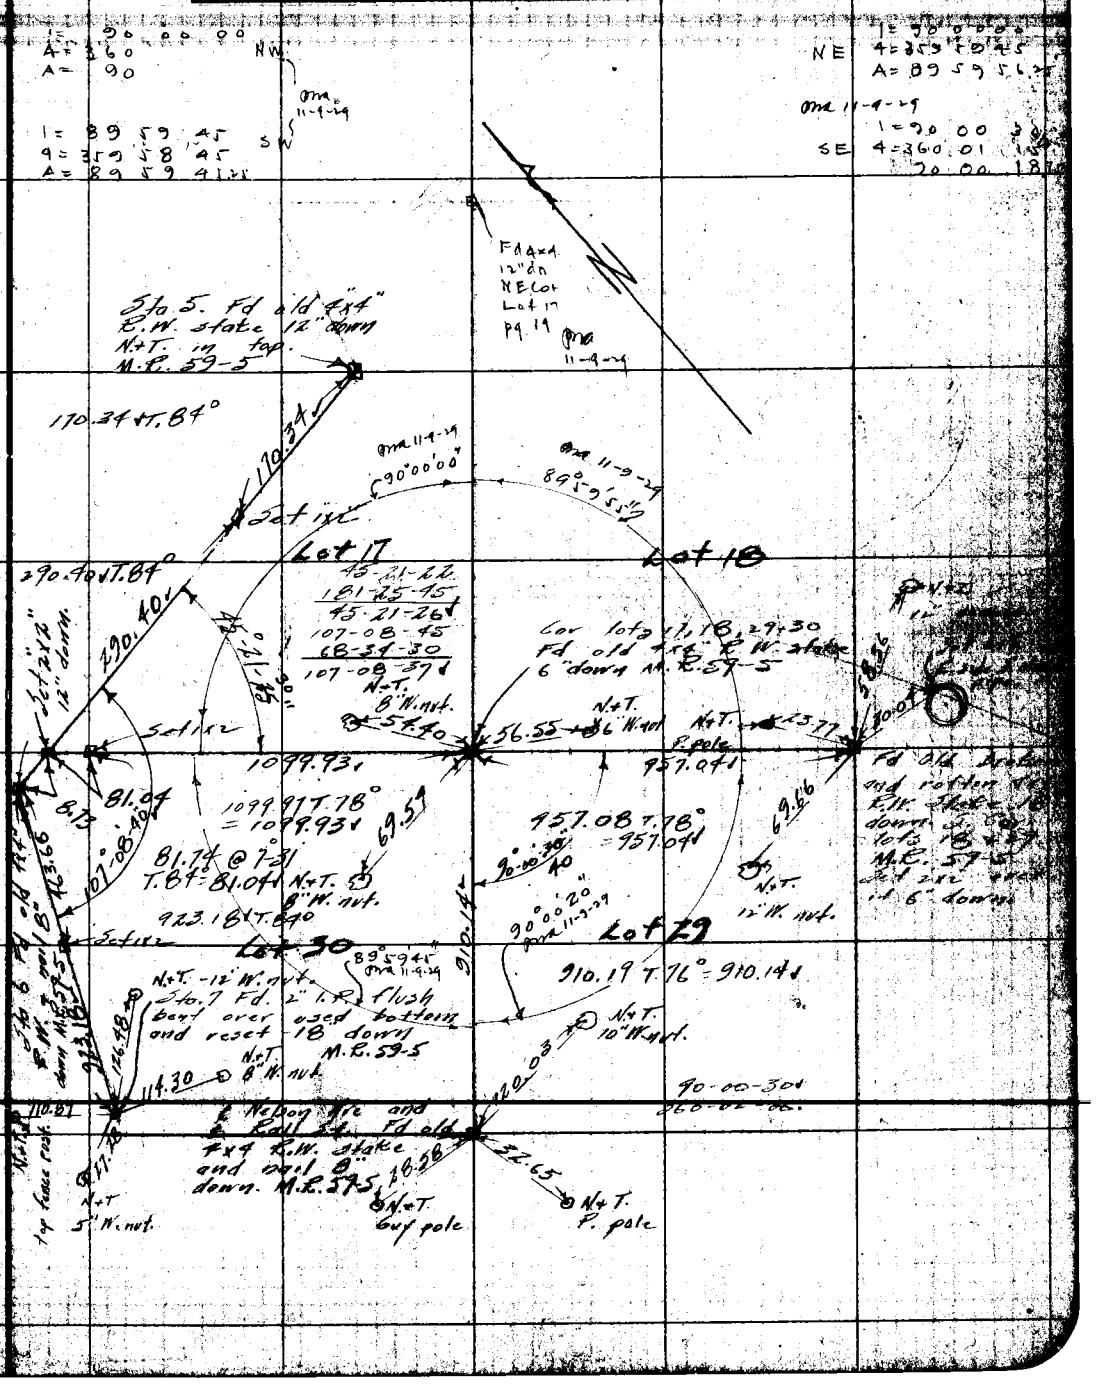

F.B. 352 Pg. 18 Loscerans Chief Party Notes by Date 6-25-26

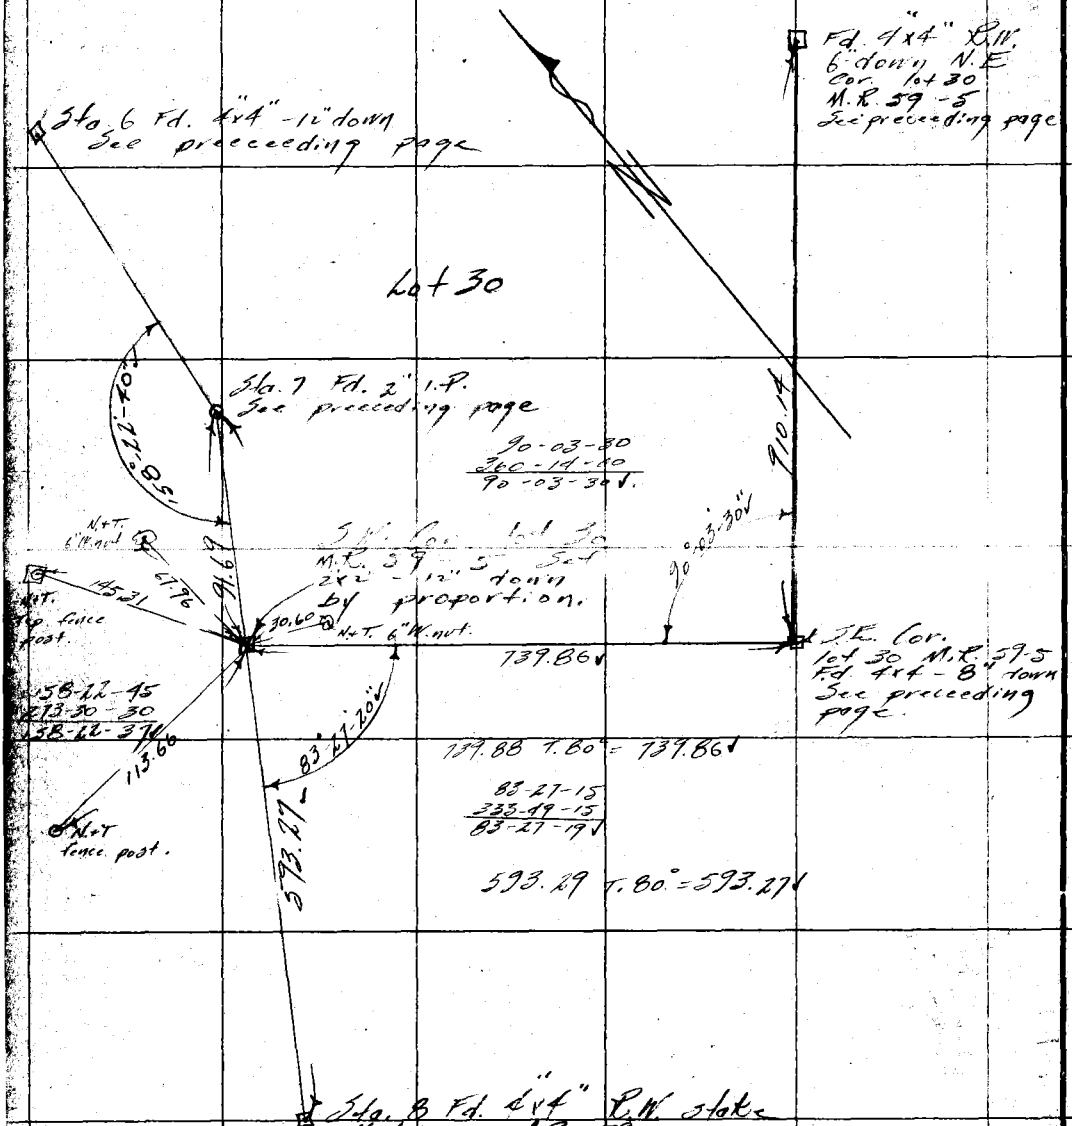

RETURN TO
LOS ANGELES COUNTY SURVEYOR
Do not extend notes this side of this line

Notes: ANY ADDITIONS OR CHANGES ON THIS SHEET MUST BE MADE OR CIRCLED IN Red. WITH DATE AND NAME OF PERSON MAKING CHANGE.

Date _____ Notes by _____ Chief Party _____ F. B. 352 PG. 19

Date NOV 30 1929
Map No. 8.457-1
Date 5-7-29

W. O. No. 196 Sht. No. 1
Location Gaffey Ave
Surveyed by Roberts
Date 4-15-28
Indexed A. C. Johnson

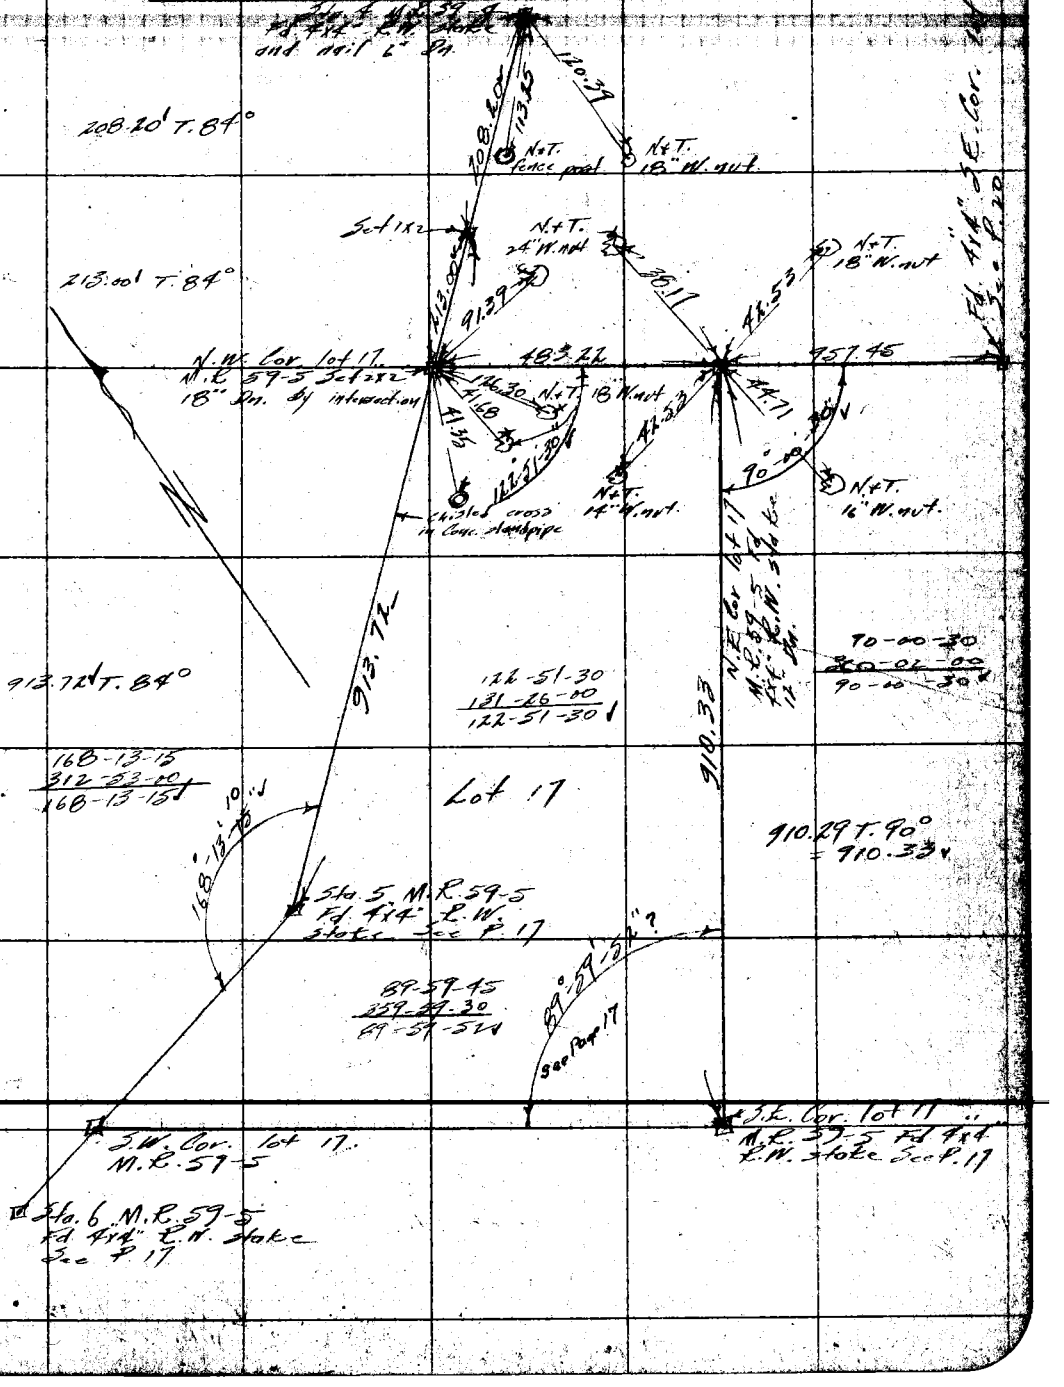

Notes: ANY ADDITIONS OR CHANGES ON THIS SHEET MUST BE MADE OR CIRCLED IN Red. WITH DATE AND NAME OF PERSON MAKING CHANGE.

Do not extend notes this side of this line

RETURN TO LOS ANGELES COUNTY SURVEYOR

F.B. 352 Pg. 20 Rosecrans Chief Party Notes by Date 6-25-28

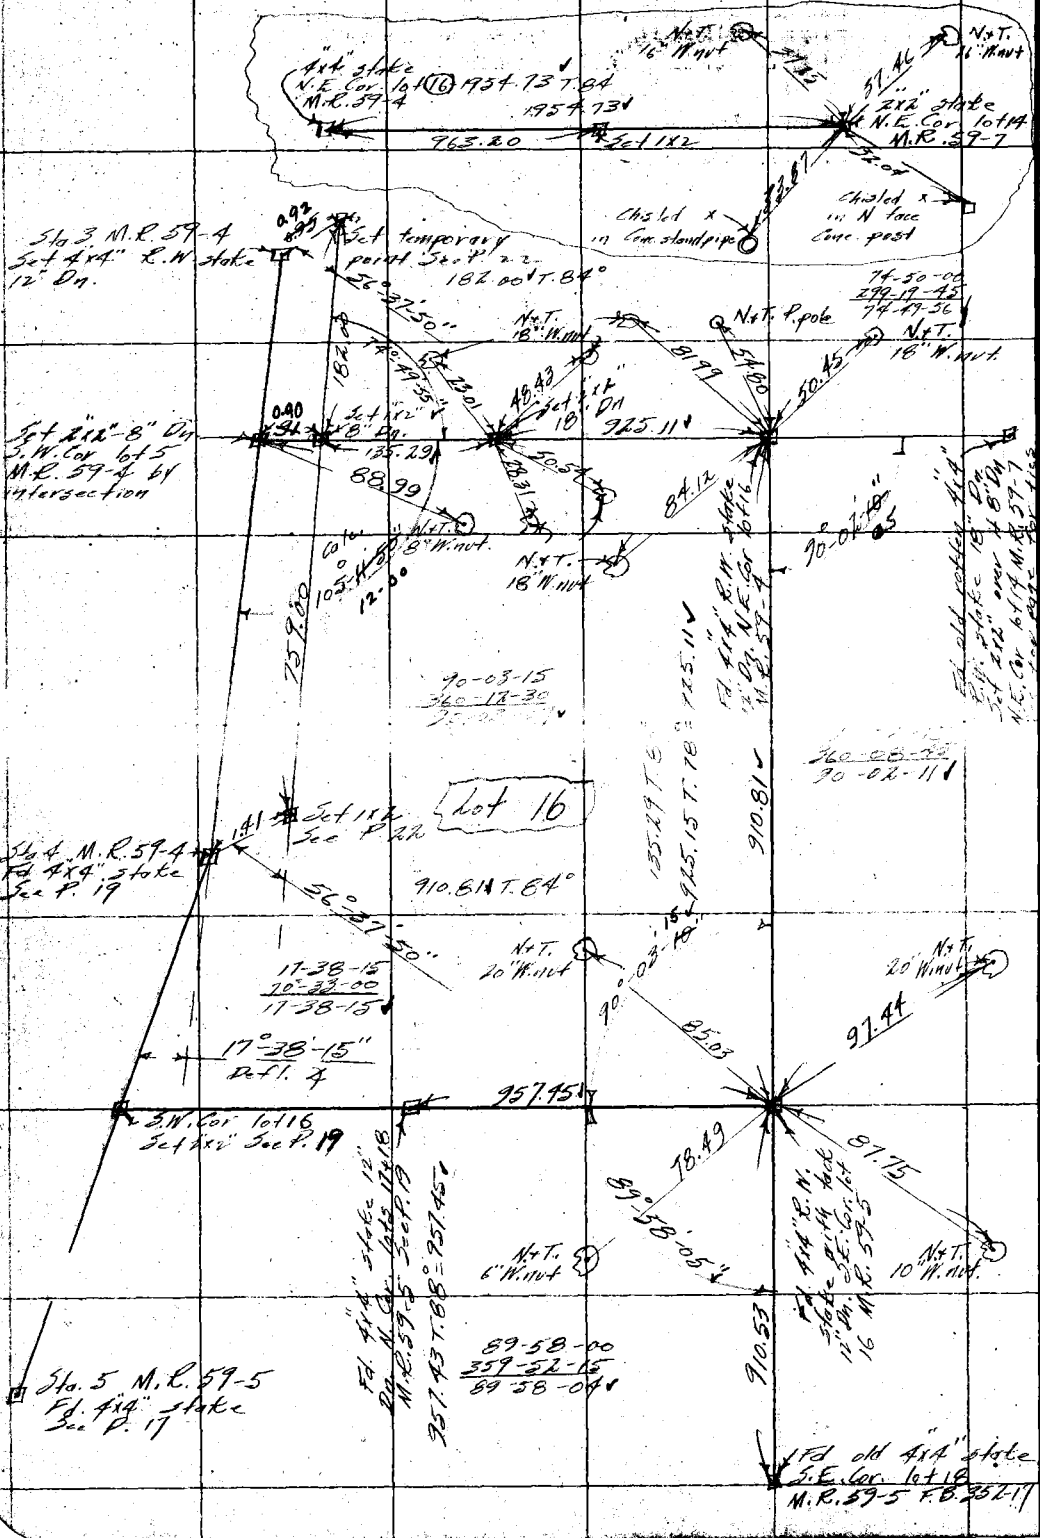

RETURN TO
LOS ANGELES COUNTY SURVEYOR
Do not extend notes this side of this line

Notice: ANY ADDITIONS OR CHANGES ON THIS SHEET MUST BE MADE OR CIRCLED IN Red. WITH DATE AND NAME OF PERSON MAKING CHANGE.

Date _____ Notes by _____ Chief Party _____ F. B. 352 PG. 21

Date NOV 30 1929
Map No. B. 457-1
Date Oct. 17-29

W. O. No. 296 Field Book No. 4
Location Garvey Ave
Surveyed by Rossiguol
Date 6-30-26
Indexed A. C. Johnson

Notes: ANY ADDITIONS OR CHANGES ON THIS SHEET MUST BE MADE OR CIRCLED IN Red. WITH DATE AND NAME OF PERSON MAKING CHANGE.

RETURN TO LOS ANGELES COUNTY SURVEYOR

Do not extend notes this side of this line

202.30' T. 82°

N+T. 18" W. mH

N+T. Pipe 101.08

80.22

Cont. to bottom Pg. 102

Set P.K. Nail

0.05

76.1'

Elliot Ave

30'

76.00

N+T. 10" W. mH

905.23

0.01

N.E. Cor. lot 16 M.R. 57-4 Fd 4"x4" R.W. stake 12" Dn. See P. 20

910.81

N.E. Cor. lot 16 M.R. 57-4 Fd Hub 12" Dn. See P. 20

Temple Ave

30'

910.53

0.27

Fd. old

30' 30'

Blvd.

Nelson Ave

30'

1895.58

Corina

1895.56 T. 86° 1895.58

30'

Corina Blvd.

30'

1.58

Fd. 2"x2" R.W. stake 6" Dn.

30.36

Fd. old 4"x4" R.W. Post 6" Dn.

3.40

F.B. 352 Pg. 22 Reference Chief. Party Notes by Date 6-20-29

Fd 3x3" stake 3" Dn no references

N+T. 4" acacia

Rose Ave

30

30

N+T. 18" acacia

N+T. P. pole

191.31 T 84°

Note: this point fellon 4x4 stk. Set Na. in 4x4 stk 12" dn Ona 11-15-29

Chiseled cross in iron top 12" Conc. valve

N+T. 30" acacia

N.E. Cor. lot 5 M.R. 59-4

Fd old rotten 4x4 R.M. stake 18" Sm. Set 2x6 11 over it 8" Dn.

N+T. 8" W. mot

N+T. 8" W. mot.

Set temporary point

N+T. 8" pepper

132.31 T 72° = 132.30 Ona 0.09

Sta. 1 M.R. 59-4 Set 4x4 12" Dn. using proportional distance between N.E. Cor. lot 4 and 4x4 at Sta. 4 line lot 5 produced W. Note removed na in this 11-15-29 stake. Ona

N+T. 20" acacia

N+T. 8" W. mot

299.36 T. 74° = 299.34 Set 1x2

N+T. 16" W. mot.

614.18 T. 61°

121-27-00
168-48-15
121-27-00

Set 1x2

N+T. 16" W. mot

Lot 5

Fd 1x1" - 12" Dn. Lot 21

E. Elliot Ave

30

30

499.98 T. 90° - 495.00

Set temporary point

0.47

Fd 2" I.P. plugged with 4 new 2x6"

Set temporary Pt.

N+T. 18" W. mot

Sta 2 M.R. 59-4 Set 4x4" E.W. stake 12" Dn. by proportion between N.E. Cor. lot 5 and Sta. 4 M.R. 59-4

N+T. 18" W. mot.

110-57-00
68-18-15
110-57-00

Corina Blvd

480.19 T 84°
278.81 T. 84°
759.00

Set 1x2"

56°-37'-30"

To 4x4" and tack in Corina Blvd. and in Temple Ave. Set P.K.

RETURN TO LOS ANGELES COUNTY SURVEYOR

Do not extend notes this side of this line

Notes: ANY ADDITIONS OR CHANGES ON THIS SHEET MUST BE MADE OR CIRCLED IN Red. WITH DATE AND NAME OF PERSON MAKING CHANGE.

Date _____ Noted by _____ Chief Party _____ F. B. 352 PG. 23

Date Oct. 1963 Location Garvey Ave.
Surveyed by Lose & Assocs
Indexed by C. Johnson

Notes: ANY ADDITIONS OR CHANGES ON THIS SHEET MUST BE MADE IN CIRCLE IN BACK, WITH DATE AND NAME OF PERSON MAKING CHANGE.

RETURN TO LOS ANGELES COUNTY SURVEYOR

Do not extend notes this side of this line

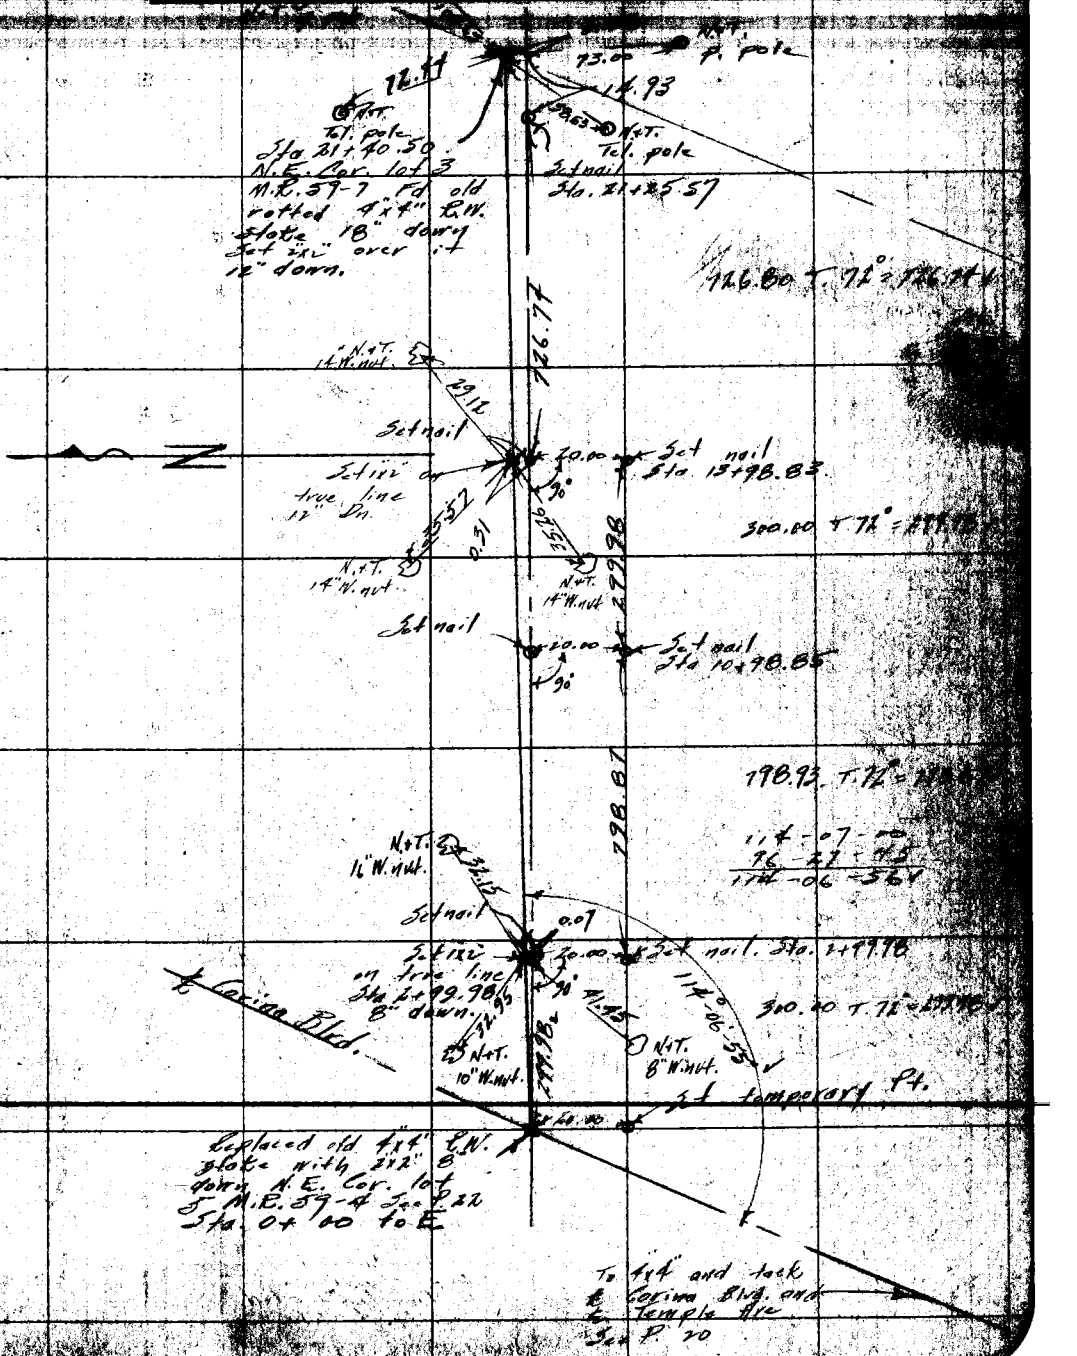

F.B. 352 Pg. 24 Cosecrans Chief Party Notes by Date 7-5-28

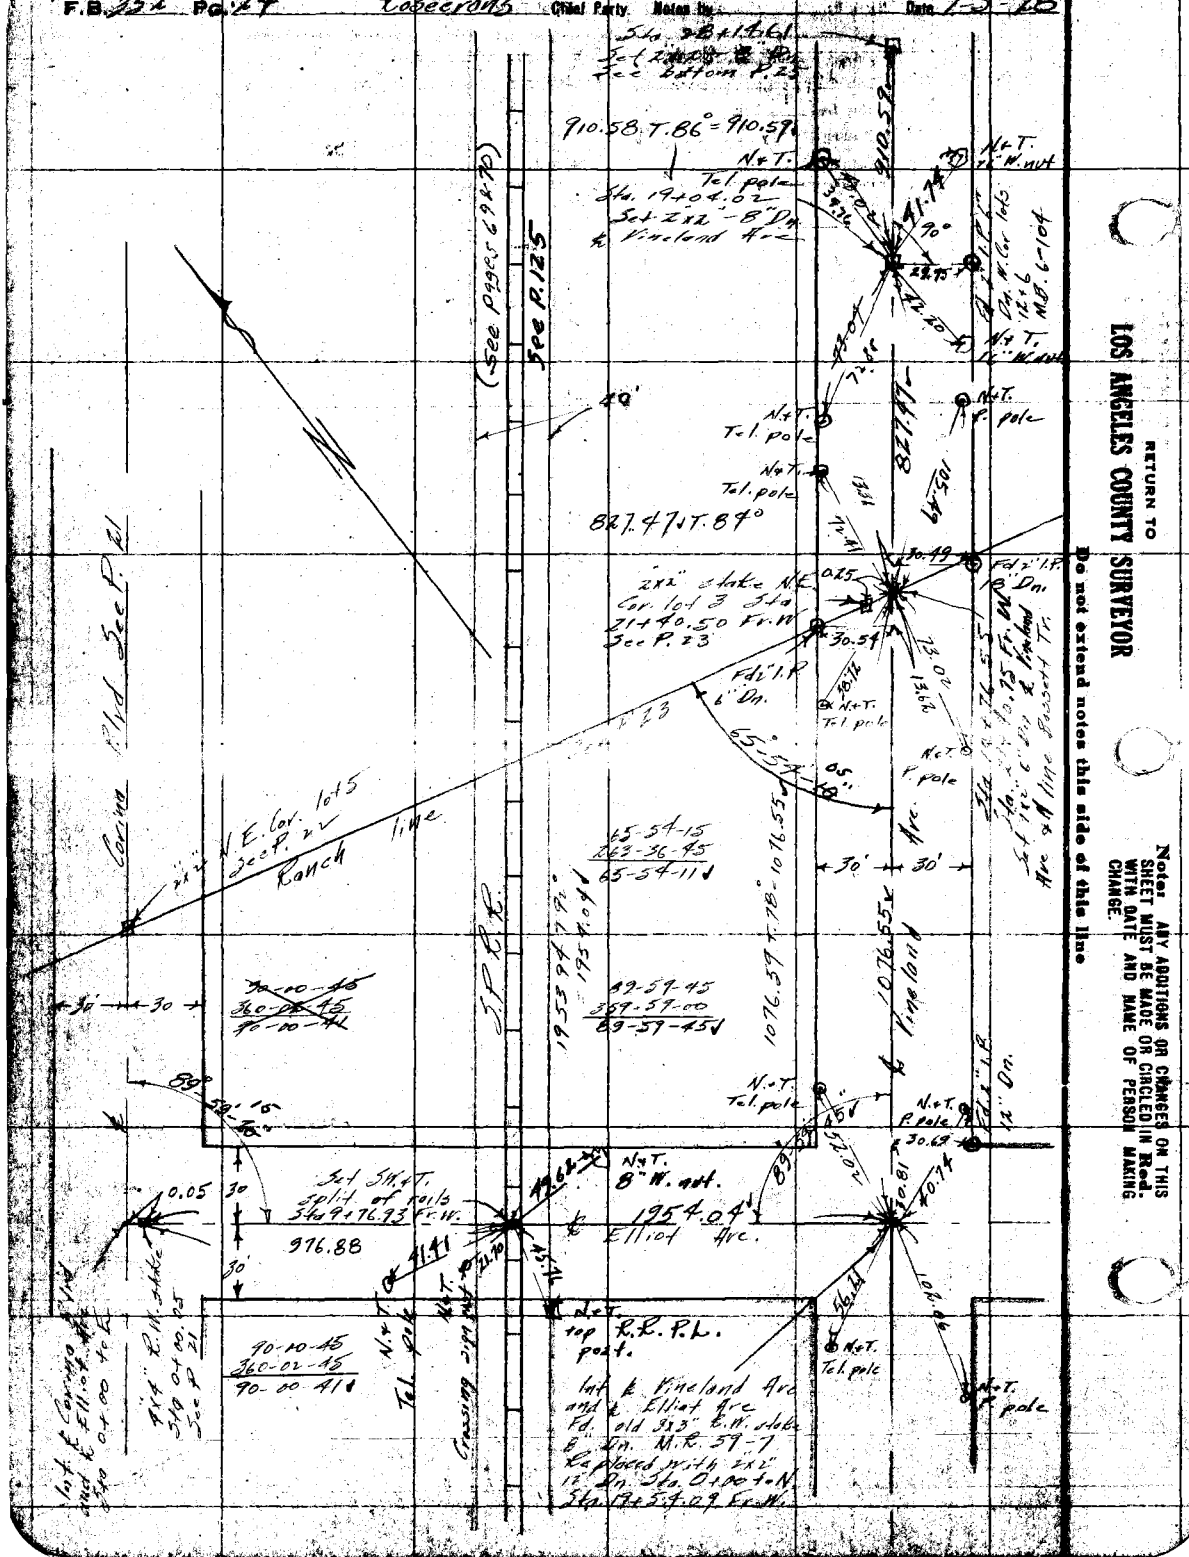

RETURN TO
LOS ANGELES COUNTY SURVEYOR

Notes: ANY ADDITIONS OR CHANGES ON THIS SHEET MUST BE MADE OR CIRCLED IN Red. WITH DATE AND NAME OF PERSON MAKING CHANGE.

Do not extend notes this side of this line

F. B. 352 PG. 25

Date

Chief Party

Location Early Ave

Surveyed by Engineers

Date 1-2-46

Indexed A. C. Johnson

Sta. 24+23.77 Ft. E.
of ℄ Frankgrove to Blvd
and ℄ Vineland Ave Rd.
2"x2" and nail Elev
Elev 9+77.66 Fr. W
See P. 26

910.33 T 90° = 910.37 W

910.37

N+T. Tel. pole

14.53

80.51

N+T. P. pole

Fd 2" I.P. N.E. Cor. lot 19 also E. Cor. lot 17 L.S. 21-48 M.B. 6-104

90°

Fd 2" I.P. plug & tack 3' dow W. Cor. lots 18+24 M.B. 6-104

3.00

17.99

Sta. 28+13.07 ℄ Vineland Ave Set 2½" - 8" down

37.53

N+T. Tel. pole

N+T. rail post. 456.86 T 70° = 156.81 W
130.62 T 90° = 130.62 W
70
354.20 W

392.20
S 0°16'00" E

N+T. rail post.

21.49

25.69

Sta. 32+25.47 ℄ Pk ℄ Vineland Ave set Spot in bridge floor by proportion between I.P. N.E. Cor. lot 19 and I.P. S.E. Cor. lot 17 Par U.S. Morgans Sub

N+T. rail post.

N+T. rail post

177.18-00
148.32 82
177.18-17 W

177°18'05"

244

184

460

Calc

N+T. 20" W. nut.

398.13 T 90° = 398.15 W
2.08
407.43 W

410.82

N+T. P. pole

Sta. 28+14.61 ℄ Vineland Ave Set 2½" - 8" Dn.

N+T. 20" W. nut.

Fd 2" I.P. plug & tack Set on ℄ E. Morgan for S.E. Cor. lot 17

To 2½" State hgt. ℄ Vineland Ave and ℄ E. Nict Ave Sta over lot See P. 24

N+T.

RETURN TO LOS ANGELES COUNTY SURVEYOR

Detail original sketch this side of this sheet

Notice ANY ADDITIONS OR CHANGES SHEET MUST BE MADE IN CAUTION WITH DATE AND NAME OF PERSON MAKING CHANGE.


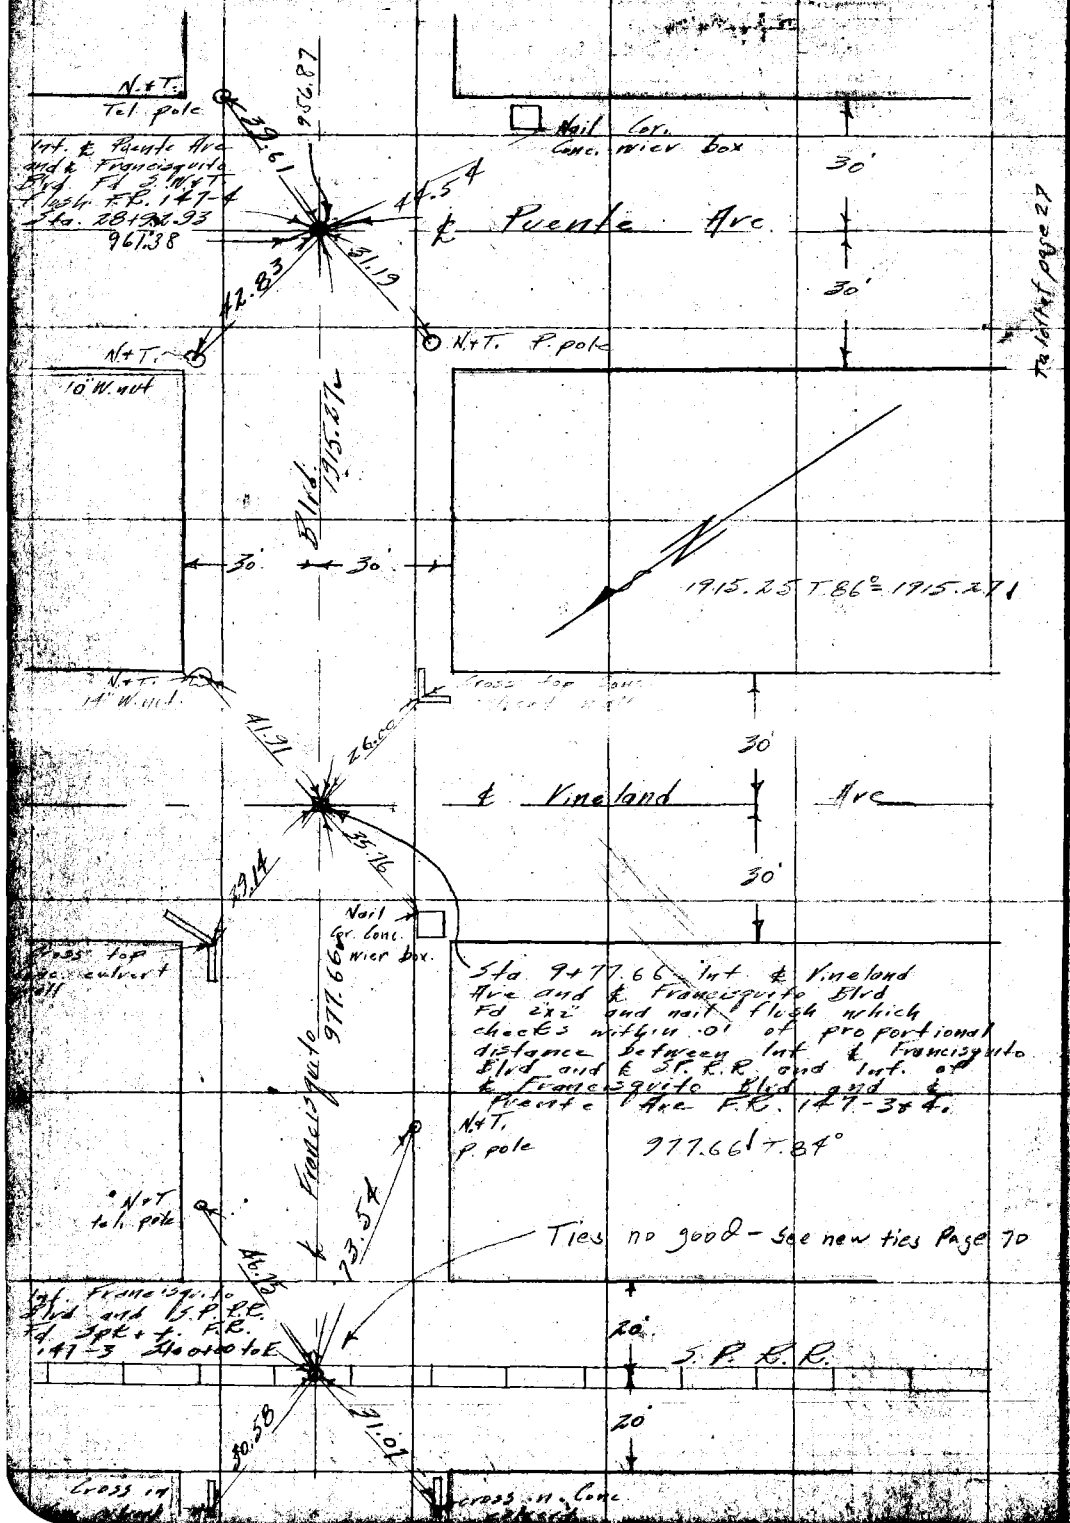

RETURN TO
LOS ANGELES COUNTY SURVEYOR
Do not extend notes this side of this line

Notes: ANY ADDITIONS OR CHANGES ON THIS SHEET MUST BE MADE OR CIRCLED IN Red. WITH DATE AND NAME OF PERSON MAKING CHANGE.

F. B. 352 PG. 27

Notes by

Chief Party

Date NOV 30 1929

Map No. B-457-1

Date Oct. 1929

Location Garvey Ave.

Surveyed by Cosee 443

Indexed

Sta. 10+00. 11 Set 2½" - 12" Dp. on ℄ Puente Ave opposite E Cor lots 13+17 M.B. 6-104 by proportion

Sta. 0+83.97 ℄ Nat. Ave. opposite E. Cor. lots M.B. 6-104

℄ 910.14' Puente Ave

Set N&T 369.99.88

Chaled. cross in Conc. standpipe

Fd. 2" I.P. 6" Dn. S.E. Cor. lot 13 M.B. 6-104

951.27' T.84°

Set 2½" - 12" Dp. N.E. Cor. lot 12 M.B. 6-104 by proportion

962.64' T.84°

1884.53' T.84°

Fd. 2" I.P. S.W. Cor. lot 12 M.B. 6-104 Sec P. 24

℄ Vineland Ave

2½" State B" Dn. Sta. 20+14.61 ℄ Vineland Ave Sec P. 25

1 2½" State Sta. 19+04.02 ℄ Vineland Ave. Sec P. 24

Void

601.88 T. 80° 601.88'

This point void

S. P. R. R.

977.25 T. 80° = 977.52

Set 2½ x T. 2" Dn. at angle of rails.

Notes ANY ADDITIONS OR CHANGES OF THIS SHEET MUST BE MADE BY CIRCLE & Num. WITH DATE AND NAME OF PERSON MAKING CHANGE.

From right of page 26

RETURN TO LOS ANGELES COUNTY SURVEYOR

Do not extend notes this side of this line

F.B. 352 Pg. 28 Chief Party Notes by Date

RETURN TO
LOS ANGELES COUNTY SURVEYOR

Notes: ANY ADDITIONS OR CHANGES ON THIS SHEET MUST BE MADE OR CIRCLED IN [illegible] WITH DATE AND NAME OF PERSON MAKING CHANGE.

Do not extend notes this side of this line

Date _____ Notes by _____ Chief Party _____ F. B. 352 PG. 29

Plotted by H. H. M. H.
Date NOV 30 1929
Map No. B.457-1
Checked by Wood
Date Oct. '29

W. O. No. 796 U. S. O. No. _____
Location Garvey Ave
Surveyed by Rockcrams
Date 6-16 1926
Indexed A. C. Johnson

Notes ANY ADDITIONS OR CHANGES ON THIS SHEET MUST BE MADE OR CIRCLED IN Red. WITH DATE AND NAME OF PERSON MAKING CHANGE.

Do not extend notes this side of this line

RETURN TO LOS ANGELES COUNTY SURVEYOR

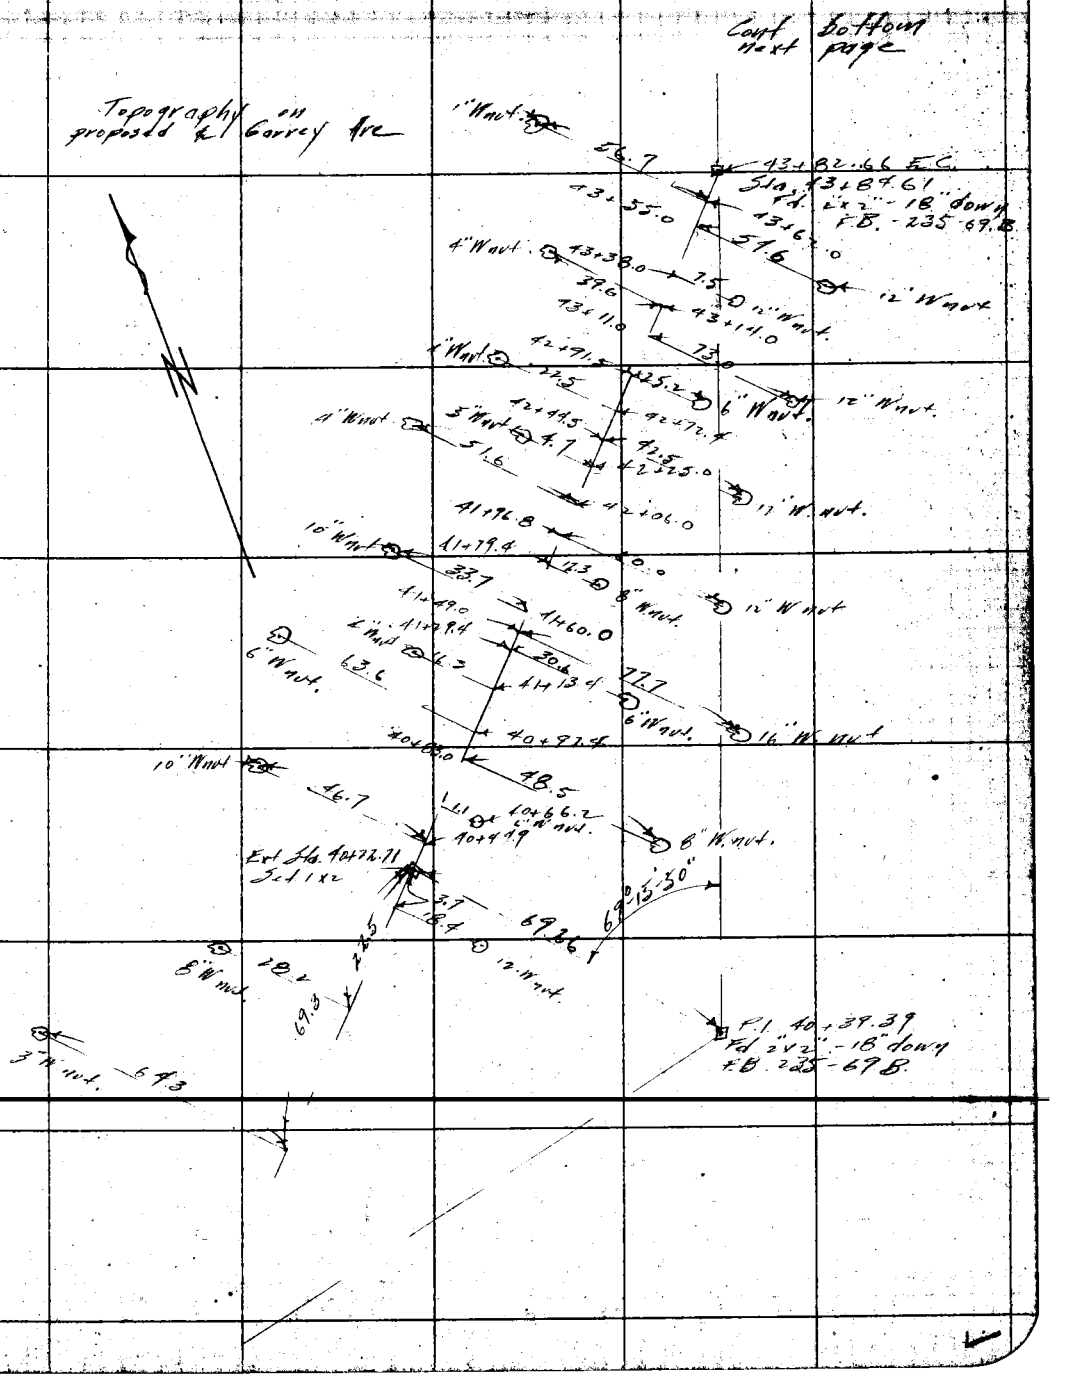

F.B. 352 PG. 30 Rosecrans Chief Party Notes by Date 6-16-28

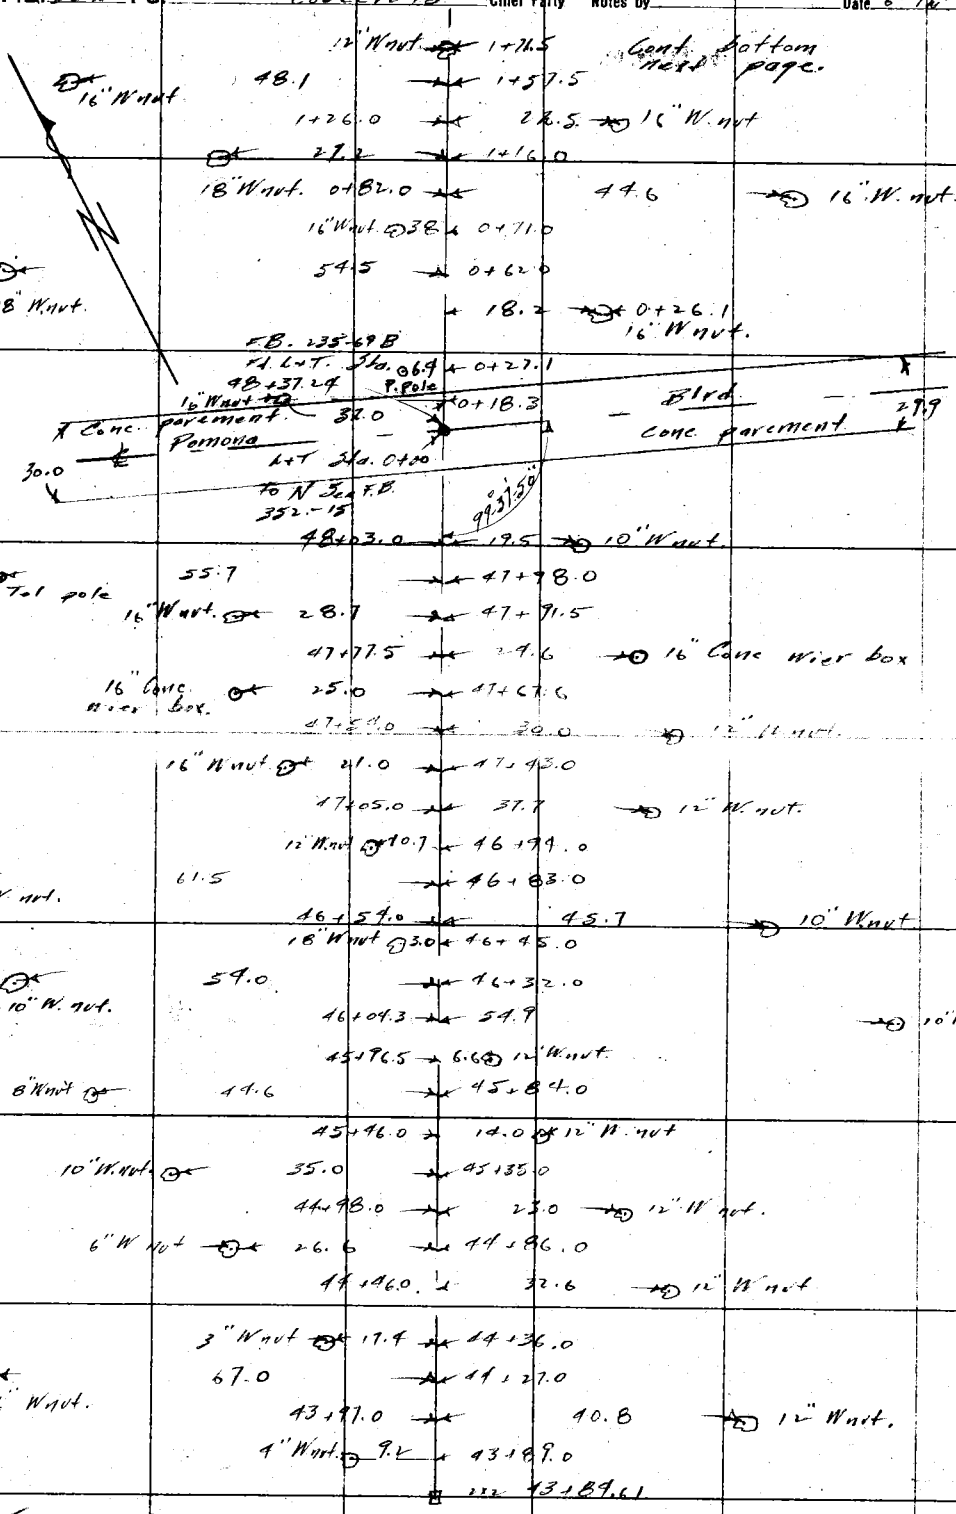

RETURN TO
LOS ANGELES COUNTY SURVEYOR
Do not extend notes this side of this line

Notes: ANY ADDITIONS OR CHANGES ON THIS SHEET MUST BE MADE OR CIRCLED IN Red. WITH DATE AND NAME OF PERSON MAKING CHANGE.

Date _____ Notes by _____ Chief Party _____ F. B. 352 PG. 31

Plotted by H.J.M.H.
Date NOV 30 1929
Map No. B.457-1
Plotting Checked by Weed
Date Oct. 1929

W. O. No. 776 L. S. O. No.
Location Garvey Ave.
Surveyed by Rosecrans
Date 6-12-1928
Indexed A. C. Johnson

Cont. bottom next page.

7+68.0 — 19.5 — 18"

16" W. nut — 16.5 — 7+56.0

7+32.0 — 56.2 — 16" W. nut.

Note: Stations N. of B.C. for topog only.

7+21.0 — 2.0 — 18" W. nut

El 2.2' B.C. Sta. 7+13.61

7+10.0

6+85.5 — 19.7 — 18" W. nut.

18" W. nut. — 35.5 — 6+75.0

6+48.0 — 37.0 — 18" W. nut.

16" W. nut — 18.0 — 6+38.5

6+10.0 — 53.4 — 14" W. nut.

12" W. nut — 1.0 — 6+03.0

54.7 — 5+78.0

18" W. nut — 5+67.0 — 15.7 — 18" W. nut

32.4 — 5+59.5

18" W. nut.

5+31.0 — 33.0 — 18" W. nut.

18" W. nut. — 10.0 — 5+12.5

60.6 — 5+00

4+91.0

4+67.0 — 11.2 — 18" W. nut — 51.5 — 18" W. nut

18" W. nut — 36.3 — 4+58.0

4+25.5 — 34.2 — 16" W. nut.

4+20.0 — 9.4 — 8" peach.

16" W. nut — 16.4 — 4+14.5

3+98.0 — 36.7 — 16" W. nut.

3+68.2 — 6.8 — 18" W. nut.

41.0 — 3+58.0

10" W. nut — 3+24.0 — 30.1 — 16" W. nut.

8" W. nut. — 18.3 — 3+11.0

1" peach — 32.7 — 2+87.0

2+78.0 — 52.5 — 16" W. nut

2+70.5 — 4.6 — 18" W. nut.

16" W. nut — 46.6 — 2+61.0

2+25.0 — 27.7 — 18" W. nut

18" W. nut — 22.4 — 2+14.5

1+81.0 — 19.6 — 18" W. nut

RETURN TO LOS ANGELES COUNTY SURVEYOR

Do not extend notes this side of this line

Notes: ANY ADDITIONS OR CHANGES ON THIS SHEET MUST BE MADE OR CIRCLED IN Red. WITH DATE AND NAME OF PERSON MAKING CHANGE.

F.B. 352 PG. 32 Cosgrave Chief Party Notes by Date 6-12-28

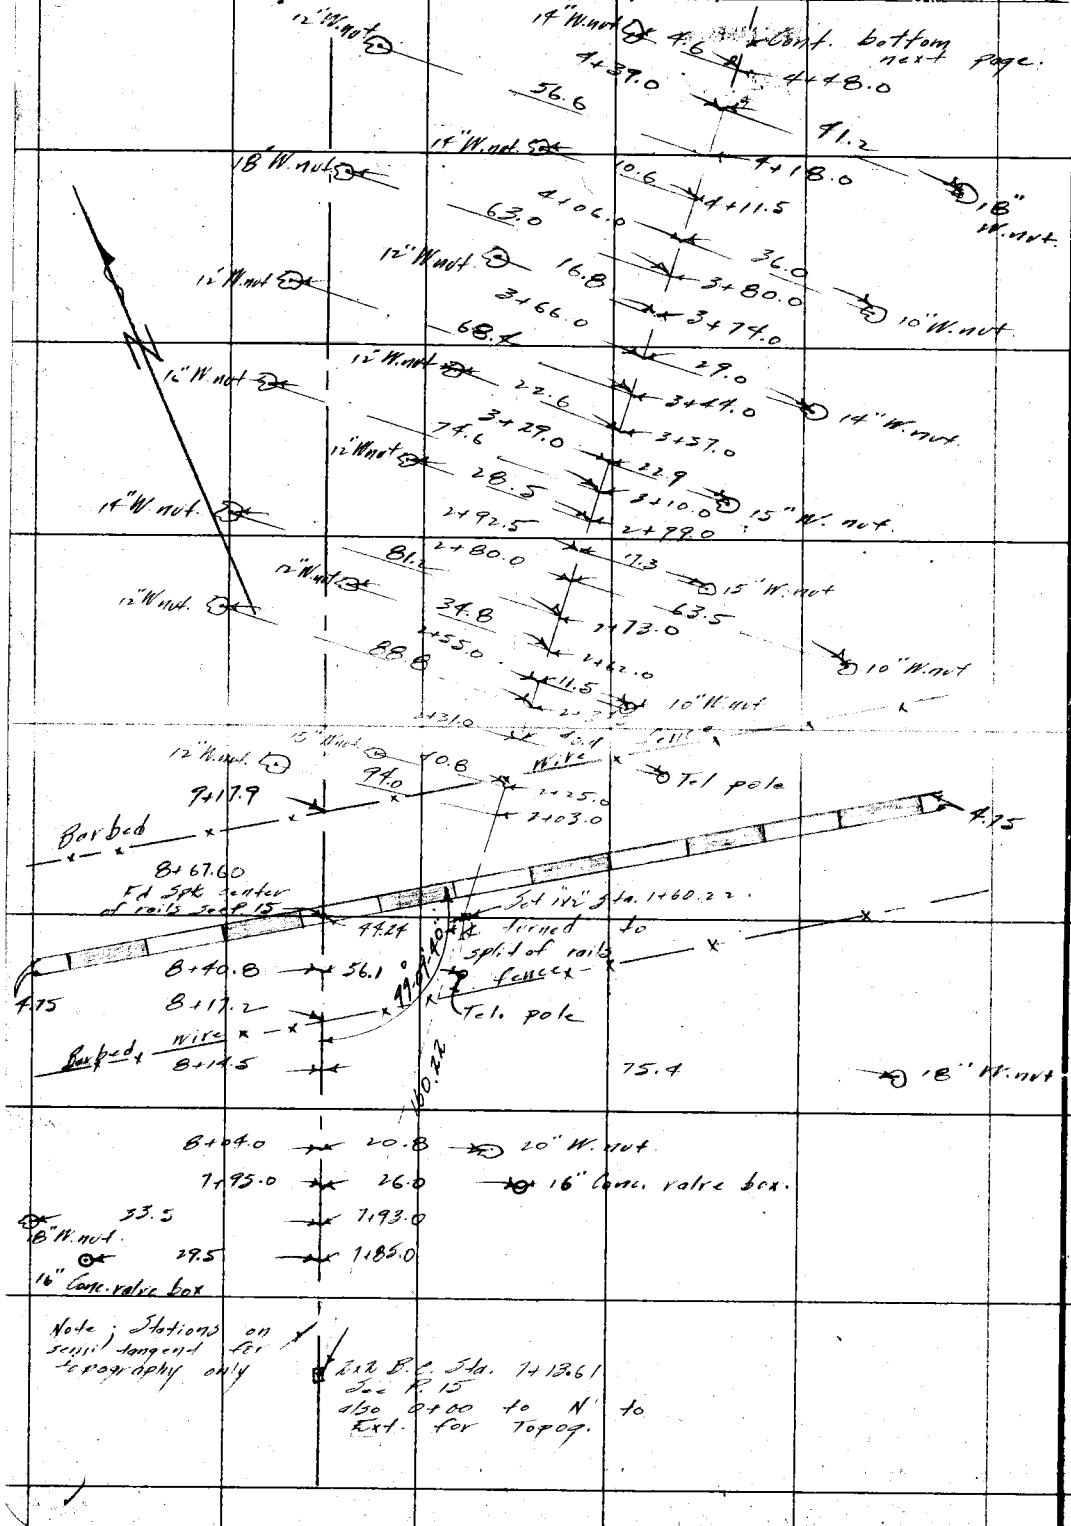

Note; Stations on survey tangent for topography only

Fd B.C. Sta. 7+13.61 See P. 15 also 0+00 to N' to Ext. for Topog.

RETURN TO
LOS ANGELES COUNTY SURVEYOR

Do not extend notes this side of this line

Note: ANY ADDITIONS OR CHANGES ON THIS SHEET MUST BE MADE OR CIRCLED IN Red. WITH DATE AND NAME OF PERSON MAKING CHANGE.

Date _____ Notes by _____ Chief Party _____ F. B. 352 PG. 33

Plotted by H. H. M. Jr.
Date NOV 30 1929
Map No. B. 457-1
Plotting C'k'd by Wood
Date Oct. 1929

W. O. No. 796 D. S. O. No.
Location Garvey Ave
Surveyed by Cisterans
Date 6-12-1928
Indexed A. C. Joanson

Cont. bottom next page.

12" W. nut 37.5 7+92.0 7+93.0 80.0 7+74.0 14.6 Tel pole 19.5 7+75.0 15" W. nut. 7+57.0 65.0 7+40.0 34.8 7+38.0 7+22.0 14" W. nut

12" W. nut 8" W. nut. 23.2 12" W. nut 14" W. nut 12" W. nut. 16" W. nut. 37.0 7+07.0 49.9 6+88.0 6.0 16" W. nut 14" W. nut 6+81.0 36.5 6+68.0 79.4 6+70.0 6+51.0 64.0

12" W. nut 16" W. nut 15" W. nut. 22.2 6+51.0 20.1 6+39.0 13" W. nut 12" W. nut. 6+17.0 64.7 14" W. nut 6+15.0 35.0 18" W. nut 49.8 6+00 18" W. nut. 5+82.0 5+66.0 7.7 16" W. nut.

℄ 34 12+73.16 Sec. 15 Ext. 2+52.33 12" W. nut 35.90 14.94 Sol. Nut 59.1 14" W. nut 89.6 35.7 46 30.0 5+34.0

12" W. nut 39.0 5+29.0 Sol. Nut. 18" W. nut. 5+23.0 6.0 16" W. nut 5+14.0 53.7 16" W. nut. 91.0 4+90.0 4+77.0 48.0 12" W. nut 51.0 4+54.0 15" W. nut.

2-12" R.C. Sta. 71+13.61 = 34+0.00 for 1 deg.

Notes ANY ADDITIONS OR CHANGES ON THIS SHEET MUST BE MADE OR CIRCLED IN Red. WITH DATE AND NAME OF PERSON MAKING CHANGE.

Do not extend notes this side of this line

RETURN TO LOS ANGELES COUNTY SURVEYOR

F.B. 352 Pg. 34 Rosecrans Chief Party Notes by Date 6-13-28

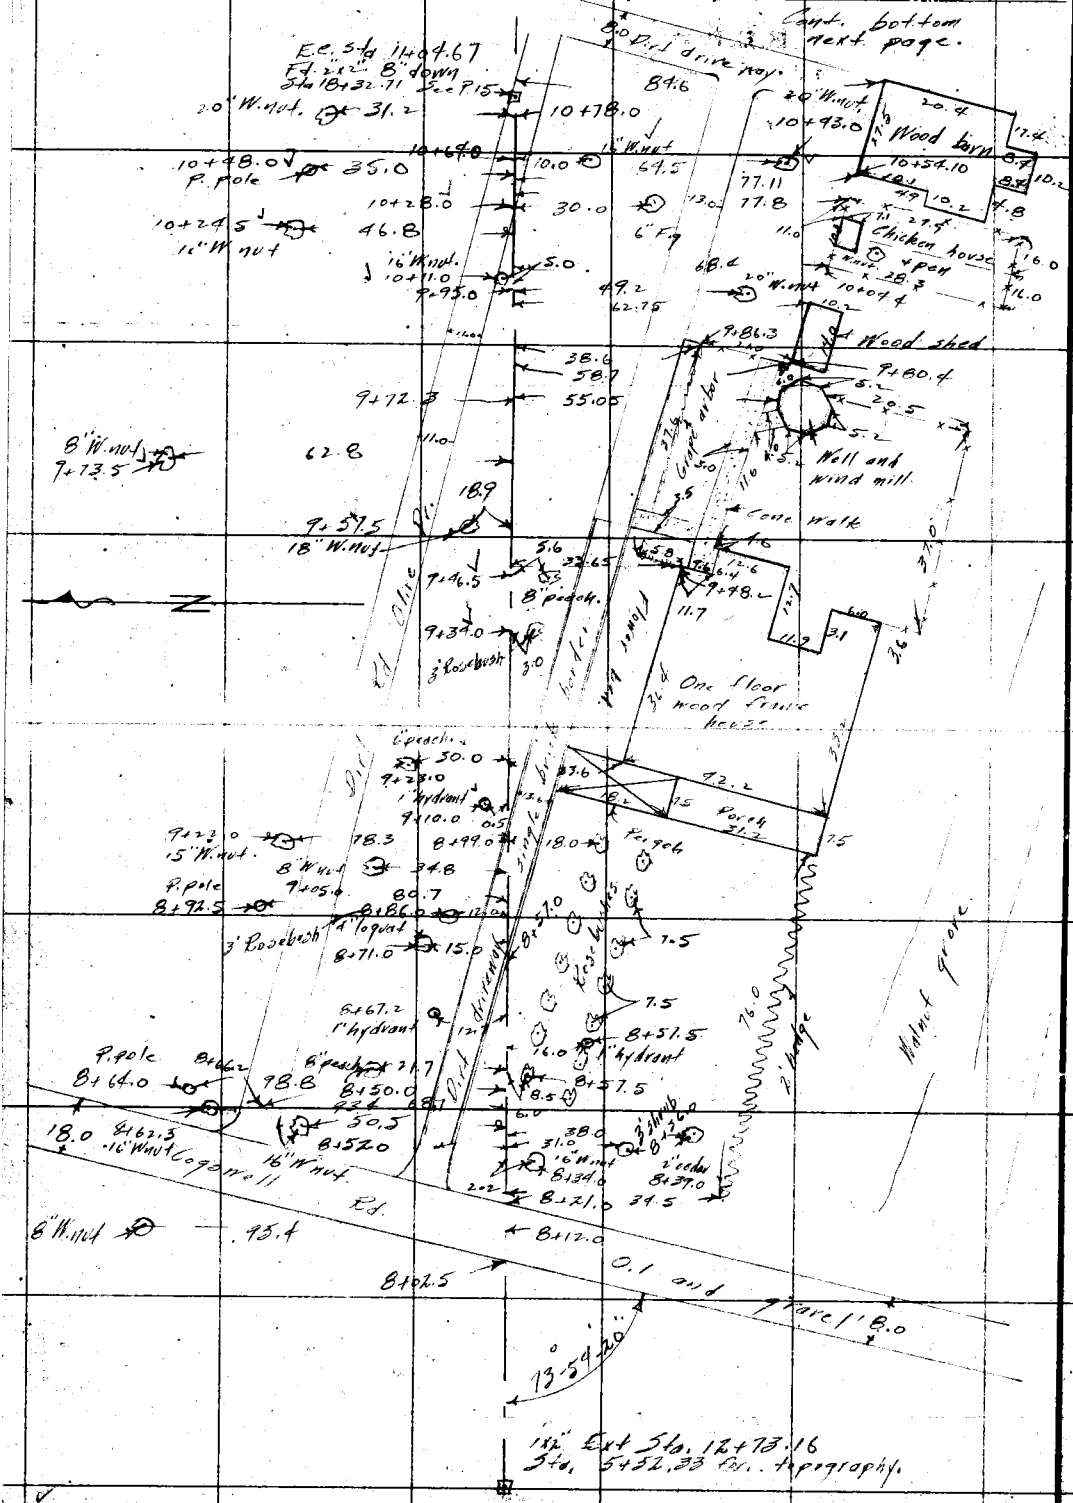

RETURN TO LOS ANGELES COUNTY SURVEYOR

Do not extend notes this side of this line

Notes: ANY ADDITIONS OR CHANGES ON THIS SHEET MUST BE MADE OR CIRCLED IN Red. WITH DATE AND NAME OF PERSON MAKING CHANGE.

Date _____ Notes by H. B. Miller Chief Party _____ F. B. 352 PG. 35

Plotted by H. U. M. H.
Date NOV 30 1929
Map No. ~~Indexed~~ B 457-1
Plotting Ck'd by Wood
Date Oct. 1929

W. O. No. 196 S. O. No.
Location Garvey Ave
Surveyed by Cosser and
Date 6-19-28
Indexed A. C. Johnson

Notes ANY ADDITIONS OR CHANGES ON THIS SHEET MUST BE MADE OR CIRCLED IN Red. WITH DATE AND NAME OF PERSON MAKING CHANGE.

Do not extend notes this side of this line

RETURN TO LOS ANGELES COUNTY SURVEYOR

Cont. for Cont. next page.

25+79 14.9 28.

25+73 22" W. Nut 22.4

3.6 16" Stand Pipe 25+57

6" W Nut

21.3 25+53

25+17 Phone P. 4x6 28. 18" W. Nut 22.5

21.2 25+40.0 20" W. Nut 14.3 16" Stand Pipe 25+17

24+61 18" W Nut 22.5

24.8 24.8

21.2 21½" W Nut 14.2 12" Stand Pipe 24+61.5

Power P. 18.3 24+33.5

24+05 Phone P. 4x6 29. 16" W Nut 22.

21.6 12" W Nut 14.2 16" Stand Pipe 24+05

23+49.5 18" W Nut 22.6

20.8 16" W. Nut 15. 16" Stand Pipe 23+49.5

22+93 Phone P. 4x6 29 16" W. Nut 22.7

21. 16" W. Nut 14. 16" Stand Pipe 22+94

Power P. 18.3 22+66

22+37.5 18" W. Nut 23.

21. 18" W. Nut 14.2 16" Stand Pipe 22+37.5

20" Stand Pipe 35.5 22+14.5

21+94.6 Phone P. 4x6 29. 26" W. Nut 23.

21.2 18" W. Nut 14. 16" Stand Pipe 21+89

21+35.5 28" W. Nut 23.5

21.1 16" W. Nut 14. 16" Stand Pipe 21+33

21+05.5 Power P. 18.

20+77.5 Phone P. 4x6 29.4 16" W. Nut 23.2

20.7 16" W. Nut 15. 16" Stand Pipe 20+78.5

18" W Nut 22.6

20.8 16" W. Nut 14.5 16" Stand Pipe 20+21.4

19+66 Phone P. 4x6 29.6 18" W Nut 22.8

21.5 14. 12" W. Nut 16" Stand Pipe 19+66

19+37.5 Power P. 17.8

16" Stand Pipe

19+10 18" W Nut 22.

36. 19+10

21.2 19+08.5

15" W. Nut

19+00.0 66.6 53.3

18+55.5 Phone P. 4x6 56.7

36. 16" Stand Pipe 18+55.5

21.2 16" W. Nut 18+58.12

22" S. C. Sta 18+31.71

Sc P 15

F.B. 352 Pg. 36 Rozzeroni3 Chief Party Notes by W.B. Miller Date 6-X-4-28

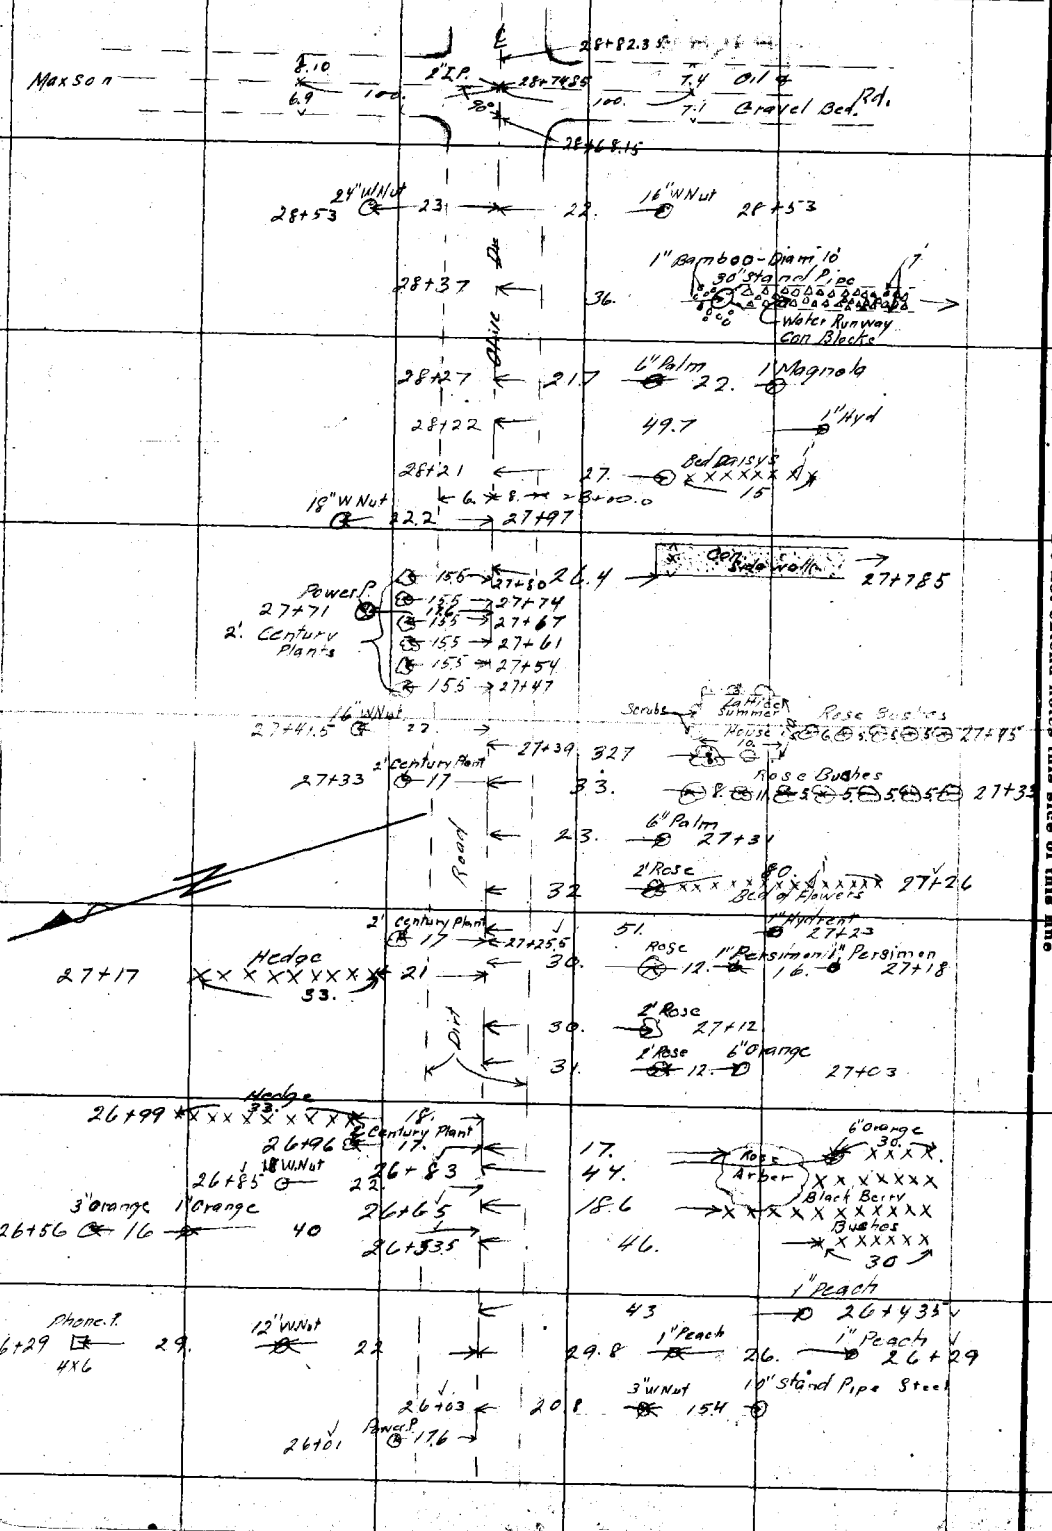

RETURN TO
LOS ANGELES COUNTY SURVEYOR
Do not extend notes this side of this line

Notes: ANY ADDITIONS OR CHANGES ON THIS SHEET MUST BE MADE OR CIRCLED IN Red. WITH DATE AND NAME OF PERSON MAKING CHANGE.

Date _____ Notes by W. B. Miller Chief Party _____ F. B. 352 PG. 37

Plotted by [illegible]
Date NOV 30 1929
Map No. B 457-1
Plotting C'd's by Weed
Date Oct. 1929

W. O. No. 796 R. S. O. No.
Location Garvey Ave
Surveyed by Rosecrans
Date 6-14-1926
Indexed [illegible]

Cont. bottom next page

22"WNut 22.2 → 36+105 22"WNut
36+05 ← 16.8
18"WNut 35+60 22.7 → 16.5 28"W Not 35+60
16"WNut 22. → 36+16
24"WNut 34+92 ← 26. 8"WNut
22.4 → 34+56
Pwr Pole 34+47 ← 26.6" 8"W.Nut
18" → 34+285
34+25 ← 16.2 16"W Not
24"WNut 34+02 ← 26.5 6"WNut
22. → 34+00 3"W Nut
33+57 ← 26.5
22"WNut 24.7 → 33+44 8"WNut
33+14 ← 26.
72 → 2 ← 33+00 16" stand Pipe
26"WNut 32+90 ← 36. 16" stand Pipe
22.2 → 32+88.5
32+45 ← 36.3
20"WNut 24.8 → 32+32 10"WNut
7"Plum 50.5 32+45 ← 27. 16"Stand Pipe
31+99 ← 36.4
12"WNut 31+76 22. ← 26.5 6"WNut 31+76
Gye Pole 31+64 ← 18. 16"Stand Pipe
31+54 ← 36.4
Power Pole 17.5 → 31+44.5
16"WNut 31+34 ← 26. 2"W. Nut
22. → 31+30.5
31+10 ← 36.4 16" Stand Pipe
24"WNut 30+64.5 22.5 → 36.6 16"Stand Pipe 30+64.5
30+41 7"Plum 49.2 ← 26. 6"WNut 30+41
30+18.5 ← 36.3 16" Stand Pipe
18"WNut 22.2 → 30+08
8"Plum 48.6 29+65 ← 25.4 6"W Nut
29+80 16"Stand Pipe 29+24
29+52 18"WNut 22. ← 27. 5"WNut 29+52
29+30 ← 36.2 16" Stand Pipe
16. → 29+04
Phone Pole 16"WNut 27.3 3"WNut 16"Valve 28+98
28+97 28.2 22.6
Power Pole 17.7 → 28+96

Notes ANY ADDITIONS OR CHANGES ON THIS SHEET MUST BE MADE OR CIRCLED IN Red. WITH DATE AND NAME OF PERSON MAKING CHANGE.

Do not extend notes this side of this line

RETURN TO LOS ANGELES COUNTY SURVEYOR

F.B. 352 Pg. 38 Roseerans Chief Party Notes by W.B. Miller Date 6-14-28

Cont bottom next page

6"W Nut 45.8 → 39+55

39+50.5 ← 17. ← 16"W Nut

Phone Pole
6"W Nut ← 18. → 39+34
← 44.7 → 39+34

12"W Nut 18"W Nut
xxxxxxxxxxxxxxxxxxxx 22.5 → 15.5 31.
39+20.5

2' 21.0 → 22.6 → 39+08.5
1"Fig 1"Fig 1"Fig
Grape Arber
xxxxxxxxxxxxxxxxxxxx ← 22.4 → 38+93.0 24"W.Nut
← 16 38+90.5

3"W Nut 22.4 → 22. → 38+79
1"Fig
Grape Arber
xxxxxxxxxxxxxxxxxxxx ← 22.3 → 38+71.0

4'Plumb 24.5 → 19.3 ← 46.4 18"W Nut 38+60.2
1"Fig 1"W.Nut
Grape Arber
xxxxxxxxxxxxxxxxxxxx ← 23.2 → 38+48

12' 12' ← 22. → 38+35
Roze Berlers
6"W.Nut Grape 1"Fig ← 15.8 18"W Nut 38+30.5

Peach Grape Plumb Grape 6"W Nut
15 15' 13' 9' ← 21.6 → 38+08.5

Grape Arber
xxxxxxxxxxxxxxxxxxxx ← 22. → 37+99.5
Rose Bushes 4'Rose
X 6' X 6' X 6' X ← 28.3 → 37+96

0 12' 0 12' 0 12' 0 12' 0 12' Shrub ← 23 → 37+80 ← 2.90

Shrubs
0 0 0 0 0 0 0 0 0 0 0 ← 37.5 → 37+56 16"W.Nut
Grape Arber 37+85.4
xxxxxxxxxxxxxxxxxxxx ← 26. → 37+82 16.5
6' Rose ← 22.4 → 37+80
Rose Hedge
x x x x x x x x x x ← 31.6 → 37+76
2.4
Iris Bed ← 22. → 37+75

One Story Frame House
Arch 41.5
Porch 19.9
3.5 Palm
Off Set 5.3.97
Hedge
3.5 Palm
2'
← 21.0 → 37+70.5
21.0 → 37+66
21.0 → 37+63.5
36.6 → ← 16. 24"W Nut 37+40
21.0 → 37+30

Plus 37+31.67 off Set 58.54
Hedge of 18"W Nut Flowers
22.3 → 37+10 10"W Nut
Power Pole 36+95.6 ← 15.4
18.0 → 36+85
16"W Nut
22.4 → 36+60 18"W Nut
36+50 ← 15.3

RETURN TO
LOS ANGELES COUNTY SURVEYOR
Do not extend notes this side of this line

Note: ANY ADDITIONS OR CHANGES ON THIS SHEET MUST BE MADE OR CIRCLED IN Red. WITH DATE AND NAME OF PERSON MAKING CHANGE.

Date _____ Notes by _____ Chief Party _____ F. B. 352 PG. 39

Plotted by [illegible]
Date NOV 30 1929
Map No. B.457-1
Plotting C'k'd by Wood
Date Oct. 1929

W. O. No. 796 D. S. O. No.
Location Garvey Ave
Surveyed by Rose & Hill
Date 6-14-28
Indexed A. C. Jamieson

Notes ANY ADDITIONS OR CHANGES ON THIS SHEET MUST BE MADE OR CIRCLED IN Red. WITH DATE AND NAME OF PERSON MAKING CHANGE.

Do not extend notes this side of this line

RETURN TO LOS ANGELES COUNTY SURVEYOR

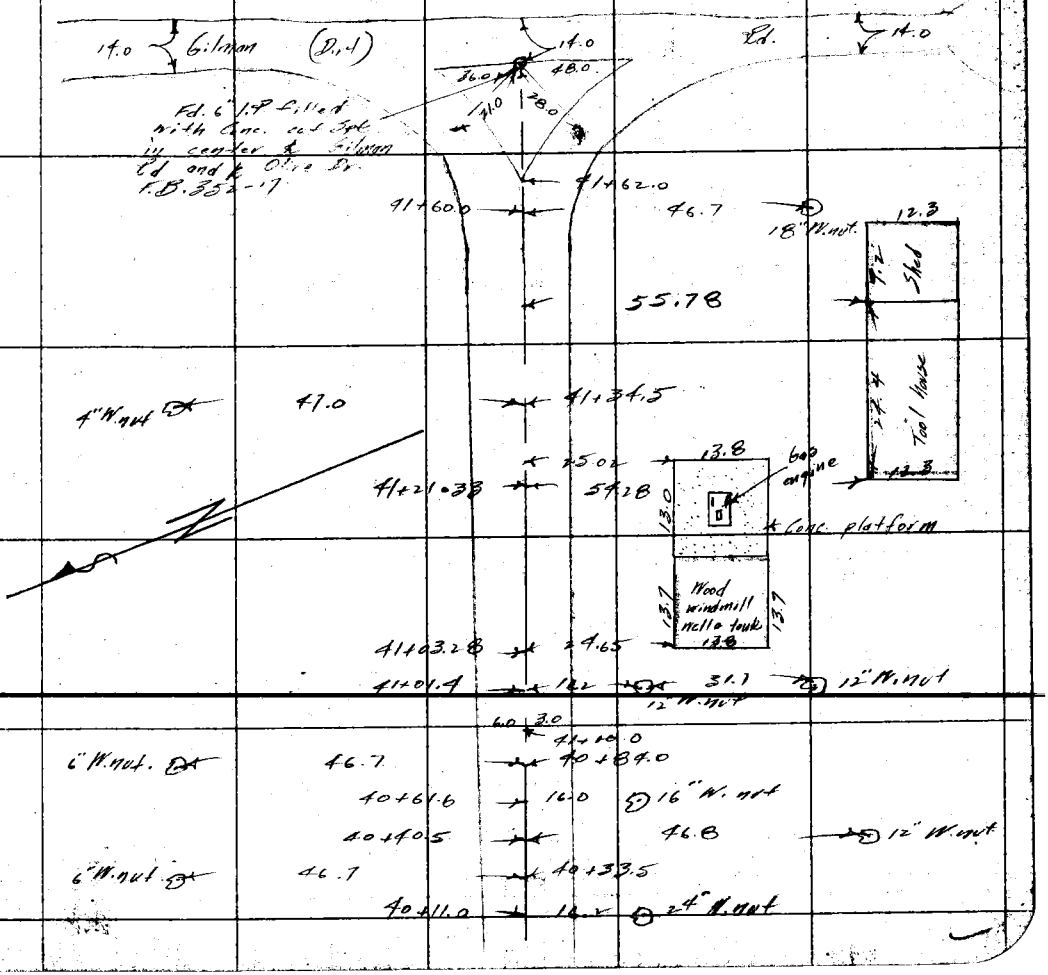

F.B. 352 PG. 40 Chief Party Notes by Date

RETURN TO

LOS ANGELES COUNTY SURVEYOR

Do not extend notes this side of this line

Note: ANY ADDITIONS OR CHANGES ON THIS SHEET MUST BE MADE OR CIRCLED IN Red. WITH DATE AND NAME OF PERSON MAKING CHANGE.

Date _____ Notes by _____ Chief Party _____ F.B. 352 Pg. 41

Platted by Wood	W. O. No. 796 D. S. O. No. _____
Date Oct. 1929	Location Gayley Ave.
Map No. B 457-2	Surveyed by _____
Platting Ck'd by H. U. M. H.	Date _____
Date NOV 30 1929	Indexed A. C. Johnson

Notes: ANY ADDITIONS OR CHANGES ON THIS SHEET MUST BE MADE OR CIRCLED IN Red. WITH DATE AND NAME OF PERSON MAKING CHANGE.

Do not extend notes this side of this line

RETURN TO LOS ANGELES COUNTY SURVEYOR

GAYLEY AVENUE

W.O. 796

Worked April 5 to 19, 1929

Worked June 4, to July 1, 1929

Party

A. M. [illegible] Asst

Jack [illegible] - Inst

E. C. [illegible] - Rod

[illegible] - Rod & Ax.

L. J. [illegible] - Ax.

F. B. 352 Pg. 42 A.W.V. & M.E.E.E. Chief Party Notes by A.W.V.E. Date

INDEX

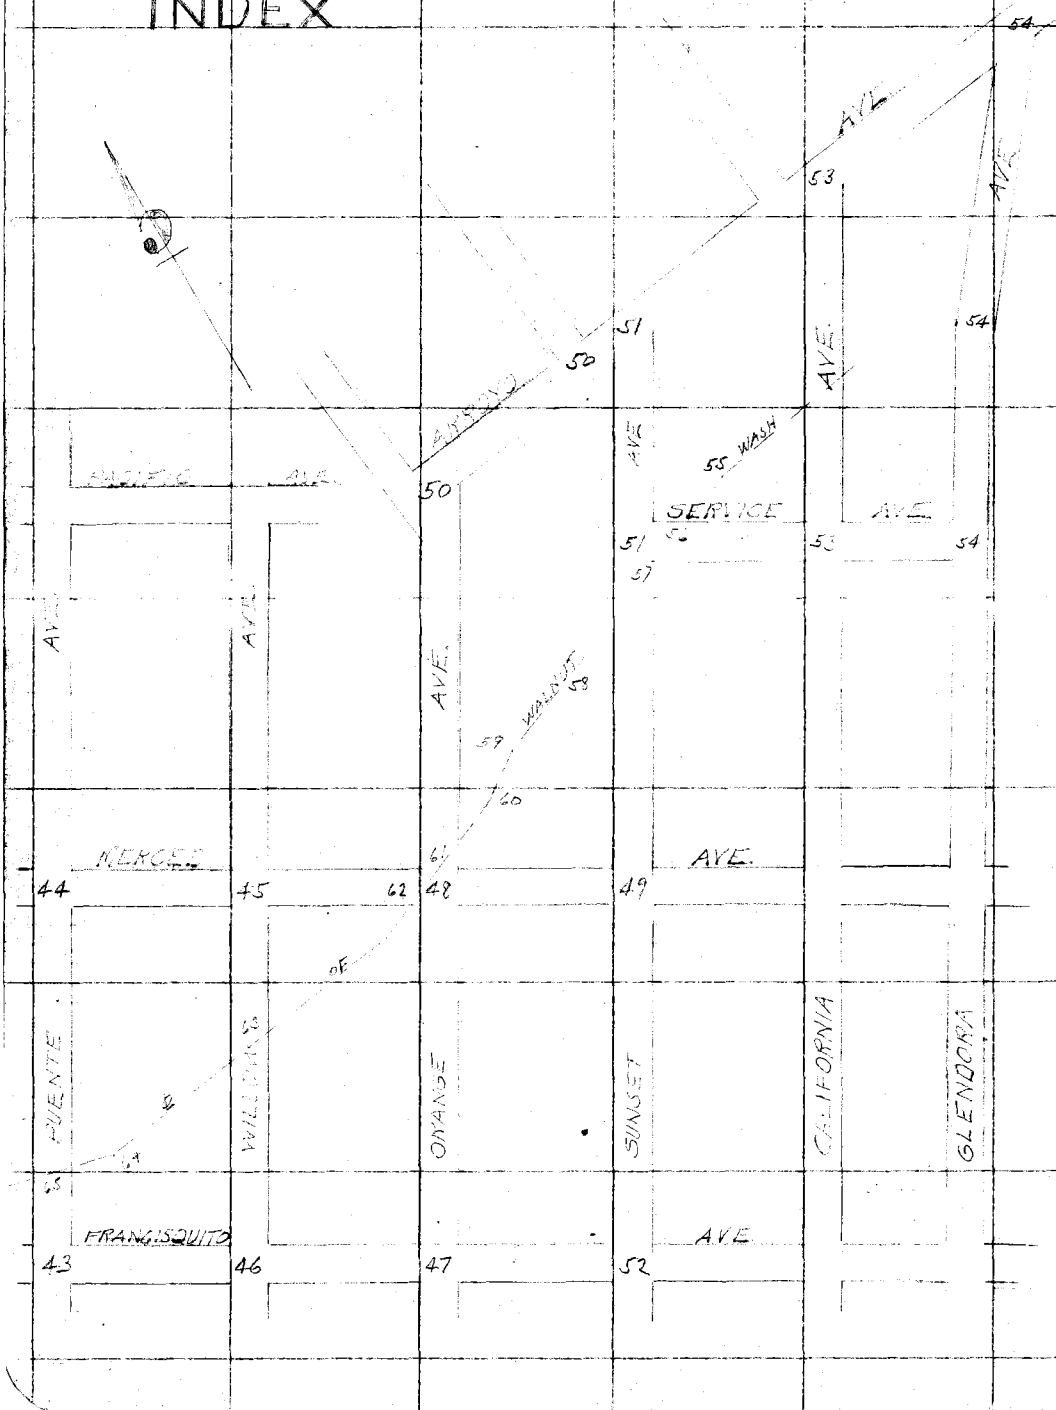
AVE.
PACIFIC
AVE.
MERCED
AVE.
PUENTE
WILLIAMS
ORANGE
SUNSET
CALIFORNIA
GLENDORA
AVE
SERVICE
AVE.
AVE
AVE
AVE

Date 4-5-29 Notes by A.W.V.F. Chief Party A.W. Vincent F.B. 352 PG. 43

Platted by Wood
Date Oct. 1929
Map No. B457
Platting C'k'd by H. U. M. H.
Date NOV 30 1929

W. O. No. 796 D. S. G. No. 044
Location 60 ft. AVE.
Surveyed by A.W. Vincent
Date 4-5-29
Indexed

Tape Standard at 64°

To bottom of page 44

179°55'00" (1)
719°40'00" (4)
1439°20'00" (8)
179°55'00" ✓

90°00'00" (1)
360°00'00" (4)
720°00'00" (8)
90°00'00" ✓

Fd. N.&T. in 12" Walnut

FRANCISQUITO

(30) (60) (30)

AVE.

42.80 39.63 31.18 44.53

Fd. N.&T. in P.P. Pole

Fd. N.&T. in P.P. Pole

To left at page 46

Fd. C.G. W.&T. (flush) Page 26

Fd. N.&T. in Conc. Well Box

(60) (30) (30)

1.A.C.W. S 1°58' - 1451.88' M

PLEASANT

177°09'00" (1)
708°36'15" (4)
1417°12'30" (8)
177°09'04" ✓

Fd. N.&T. in 14" Walnut

Fd. N.&T. in 14" Walnut

B 24.41 39.52 43.0

Fd. O.H. & T. on 2x2 (12" dia. ±)

Set N.&T. in 12" Walnut

1274.58

Fd. 2x2 - 8' deep by ties - Page 27

From upper left page 27

NOTE: ANY ADDITIONS OR CHANGES ON THIS SHEET MUST BE MADE OR CIRCLED IN Red. WITH DATE AND NAME OF PERSON MAKING CHANGE.

Do not extend notes this side of this line

RETURN TO LOS ANGELES COUNTY SURVEYOR

F.B. 352 Pg. 44 A.W.V. & W. Fleet Chief Party Notes by A.W.V.F. Date 4-5-29

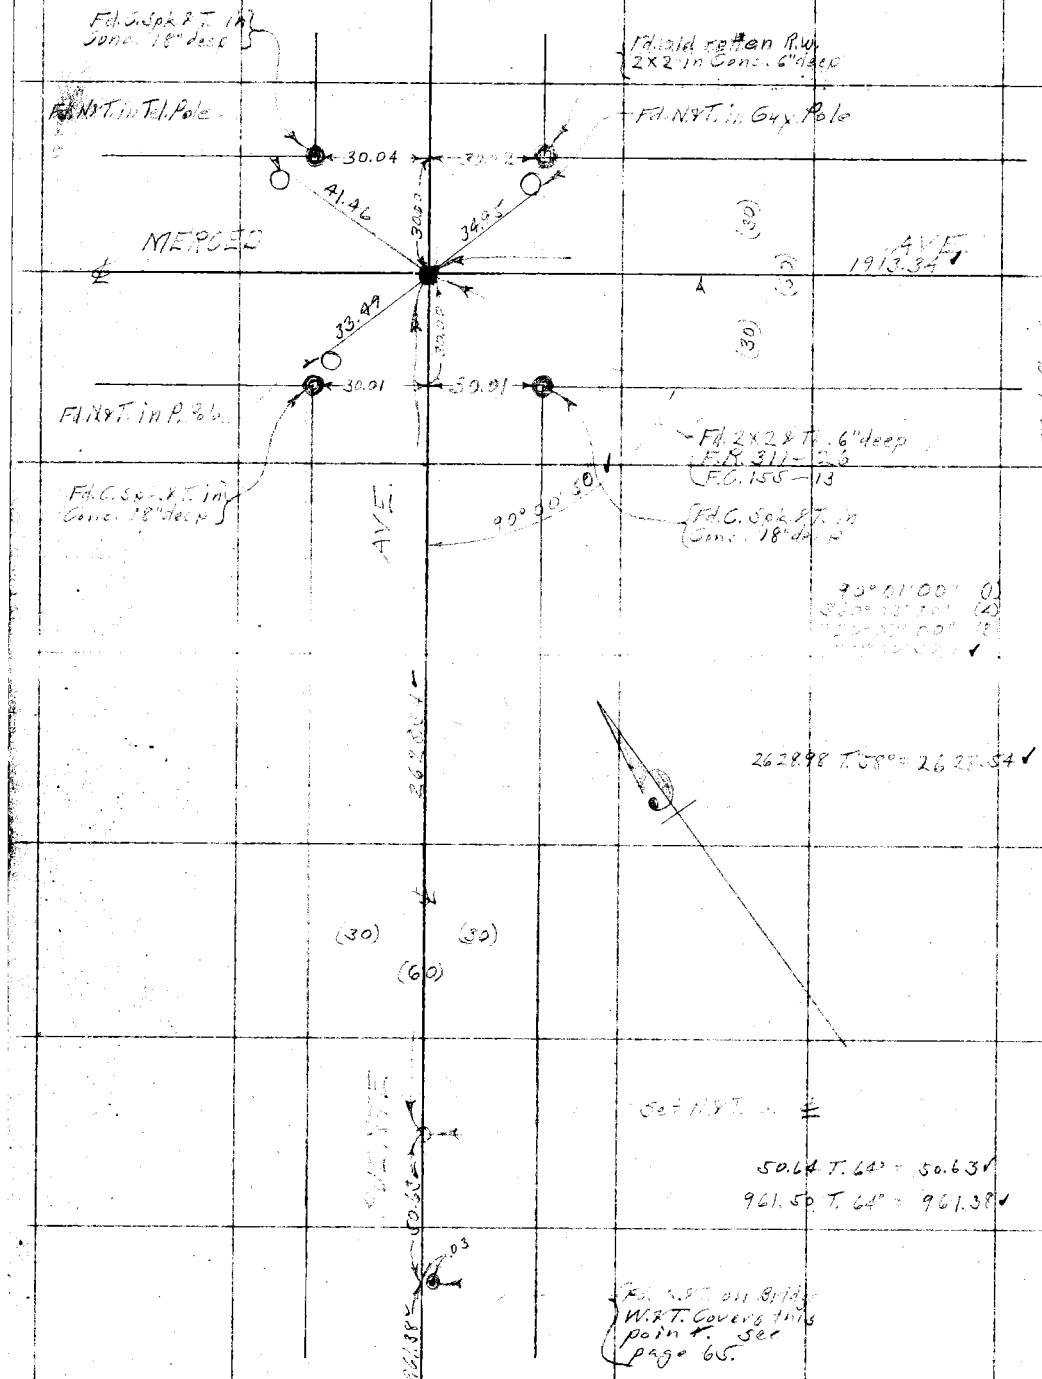

From top of page 43

RETURN TO
LOS ANGELES COUNTY SURVEYOR

Do not extend notes this side of this line

Note: ANY ADDITIONS OR CHANGES ON THIS SHEET MUST BE MADE OR CIRCLED IN Red. WITH DATE AND NAME OF PERSON MAKING CHANGE.

Date 4-8-29 Notes by A.W.V. Chief Party A.E. Hayes F.B. 352 Pg. 45

Platted by Wood
Date Oct. 1929
Map No. B45-2
Platting Ck'd by H.U.M.H.
Date NOV 30 1929

W.O. No. 796 B.S.C. No. 021
Location Goff's
Surveyed by A.W.V. Hicks
Date 4-8-29
Indexed Wm. G. Johnson

Notes: ANY ADDITIONS OR CHANGES ON THIS SHEET MUST BE MADE OR CIRCLED IN Red. WITH DATE AND NAME OF PERSON MAKING CHANGE.

Do not extend notes this side of this line

RETURN TO LOS ANGELES COUNTY SURVEYOR

From right of page 44

Fd. N.& T. in 16" Walnut

Fd. N.& T. in 14" Walnut

NIERCES

1913.34 ✓

(30) (60) (30)

48.28

61.80

AVE.

899.85 ✓

To left of page 48

31.64

N 23.24

89° 59' 30" ✓

179° 59' 50" ✓

Fd. N.& T. in Pole

Fd. N.& T. in Pole

Fd. Sp. & T. 3" deep per R.D.F.B. 91 82 F.C. 155-13

179° 59' 45" (4)
719° 59' 00" (4)
1439° 58' 00" (8)
179° 59' 45" ✓

1913.56 T. 66' = 1913.34 ✓

89° 59' 30" (2)
359° 59' 30" (4)
719° 59' 30" (8)
89° 59' 30" ✓

AVE.

900.00 T. 62' = 899.97 ✓

Set N.& T. (Flush)

(30) (60) (30)

Fd. 2 X 2 & Tk. (Flush) See page 63

WILLOW

See page 63

900.00 T. 32' = 899.97 ✓

Set 1 X 18 Tk. (Flush) by Inter. See page 63

Set N.& T. in 14" Walnut

Set N.& T. (Flush)

206.32

69.51

40.81

42.18

Set Chis. "X" in side of 30" Gen. Shoulder

Set Chis. "X" in side of 30" Gen. Shoulder

To top of page 46

F.B. 352 Pg. 46 A.W.V. & Fleet Chief Party Notes by A.W.V.F. Date 4-18-29

From bottom of page 45

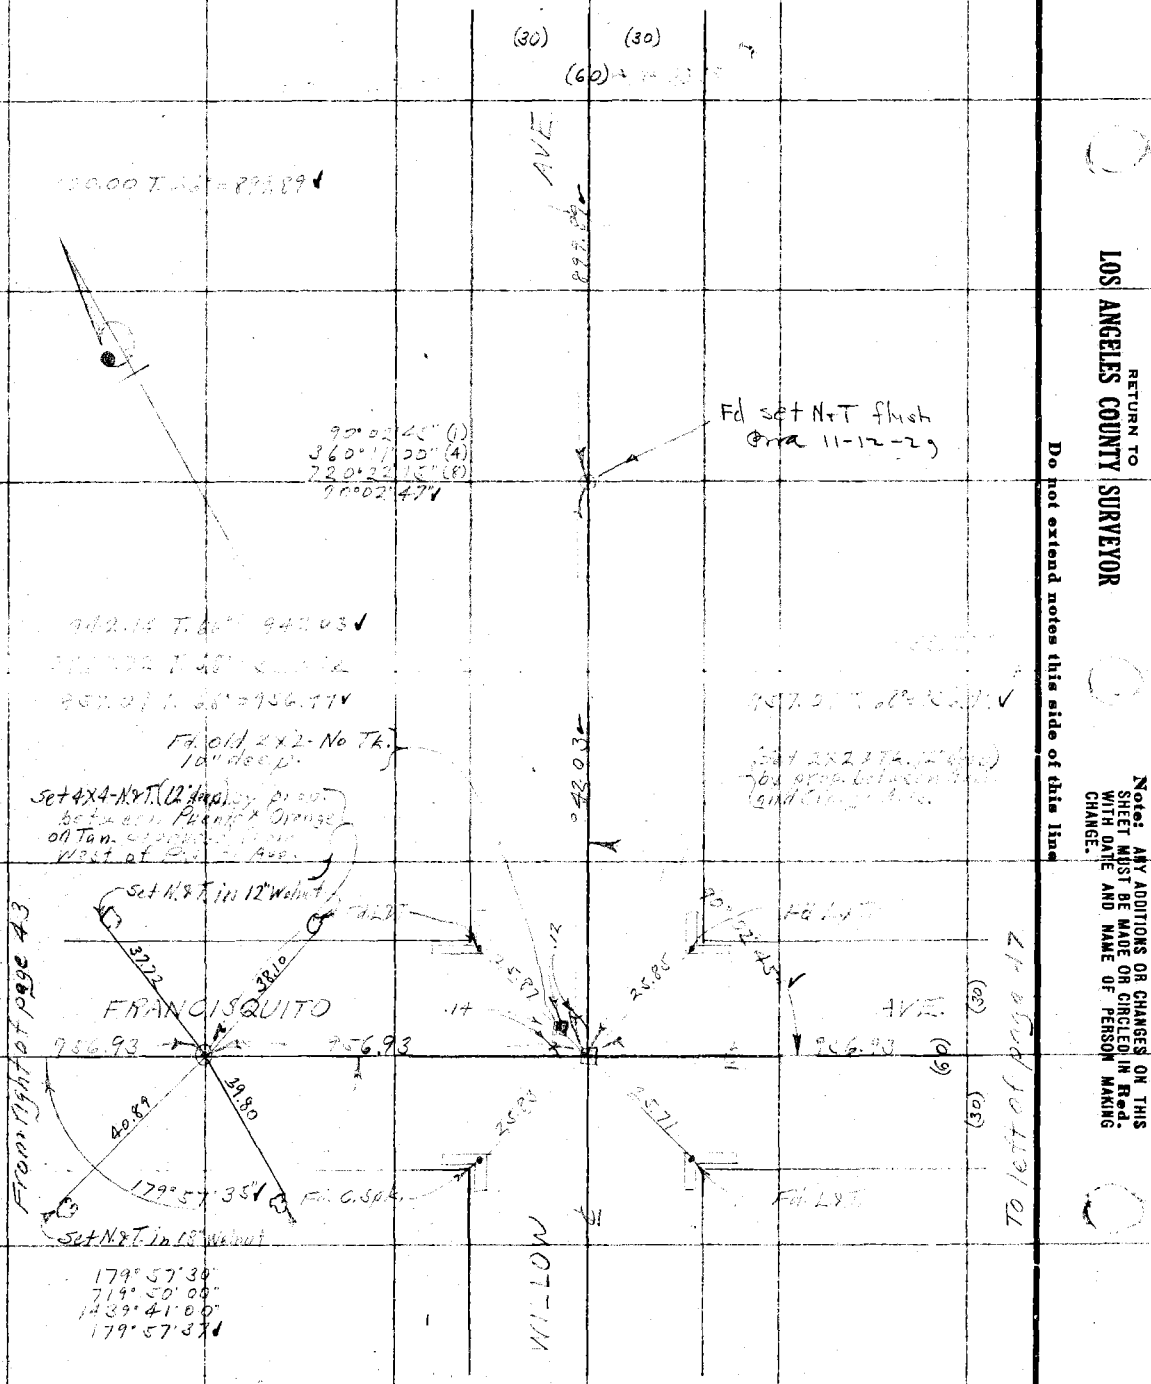

RETURN TO
LOS ANGELES COUNTY SURVEYOR

Do not extend notes this side of this line

Note: ANY ADDITIONS OR CHANGES ON THIS SHEET MUST BE MADE OR CIRCLED IN Red. WITH DATE AND NAME OF PERSON MAKING CHANGE.

Date 4-15-29 Notes by A.W.V.E. Chief Party A.W.V.E. Tape F.B. 352 Pg 47

Platted by Wood
Date Oct. 1929
Map No. B 45-3
Platting C'k'd by H. U. M. H.
Date NOV 30 1929

W. O. No. 796 S. S. O. No. 027
Location
Surveyed by A.W.V.E.
Date 4-15-29
Indexed A. C. Johnson

Notice: ANY ADDITIONS OR CHANGES ON THIS SHEET MUST BE MADE OR CIRCLED IN Red. WITH DATE AND NAME OF PERSON MAKING CHANGE.

Do not extend notes this side of this line

RETURN TO LOS ANGELES COUNTY SURVEYOR

TO bottom of P.L. 48

(60) (30)

AVE. (60)

899.86

956.99 T. 60° = 956.99

Set N.&T. in 15" walnut

179° 57' 00"
119° 45' 33"
143° 36' 15"
179° 57' 02"

913.30 T. 60° = 923.15

Fd. 1" I. Pipe P.&T. 12" deep. Accepted as Luzel's southwest F.B. 364-51

179° 57' 05"

Fd L.&T.

89° 59' 50"

Fd. L.&T.

38.93

39.54

FRANCISQUITO

956.93

953.95

914.72

AVE. (60)

(60)

(30)

37.59

36.14

25.83

25.21

Fd L.&T.

Set N.&T. in 18" walnut

Set 4X4-N.&T. 12" deep by proportion between Willow & Orange Aves. on Tan. between Sunset and Orange produced.

Fd. L.&T.

To lot 7 in Blk. 52

From Tick in E. line of Cane 16

F.B. 352 Pg. 48 A.W. Von Fleet Chief Party Notes by A.W.V.F. Date 4-15-29

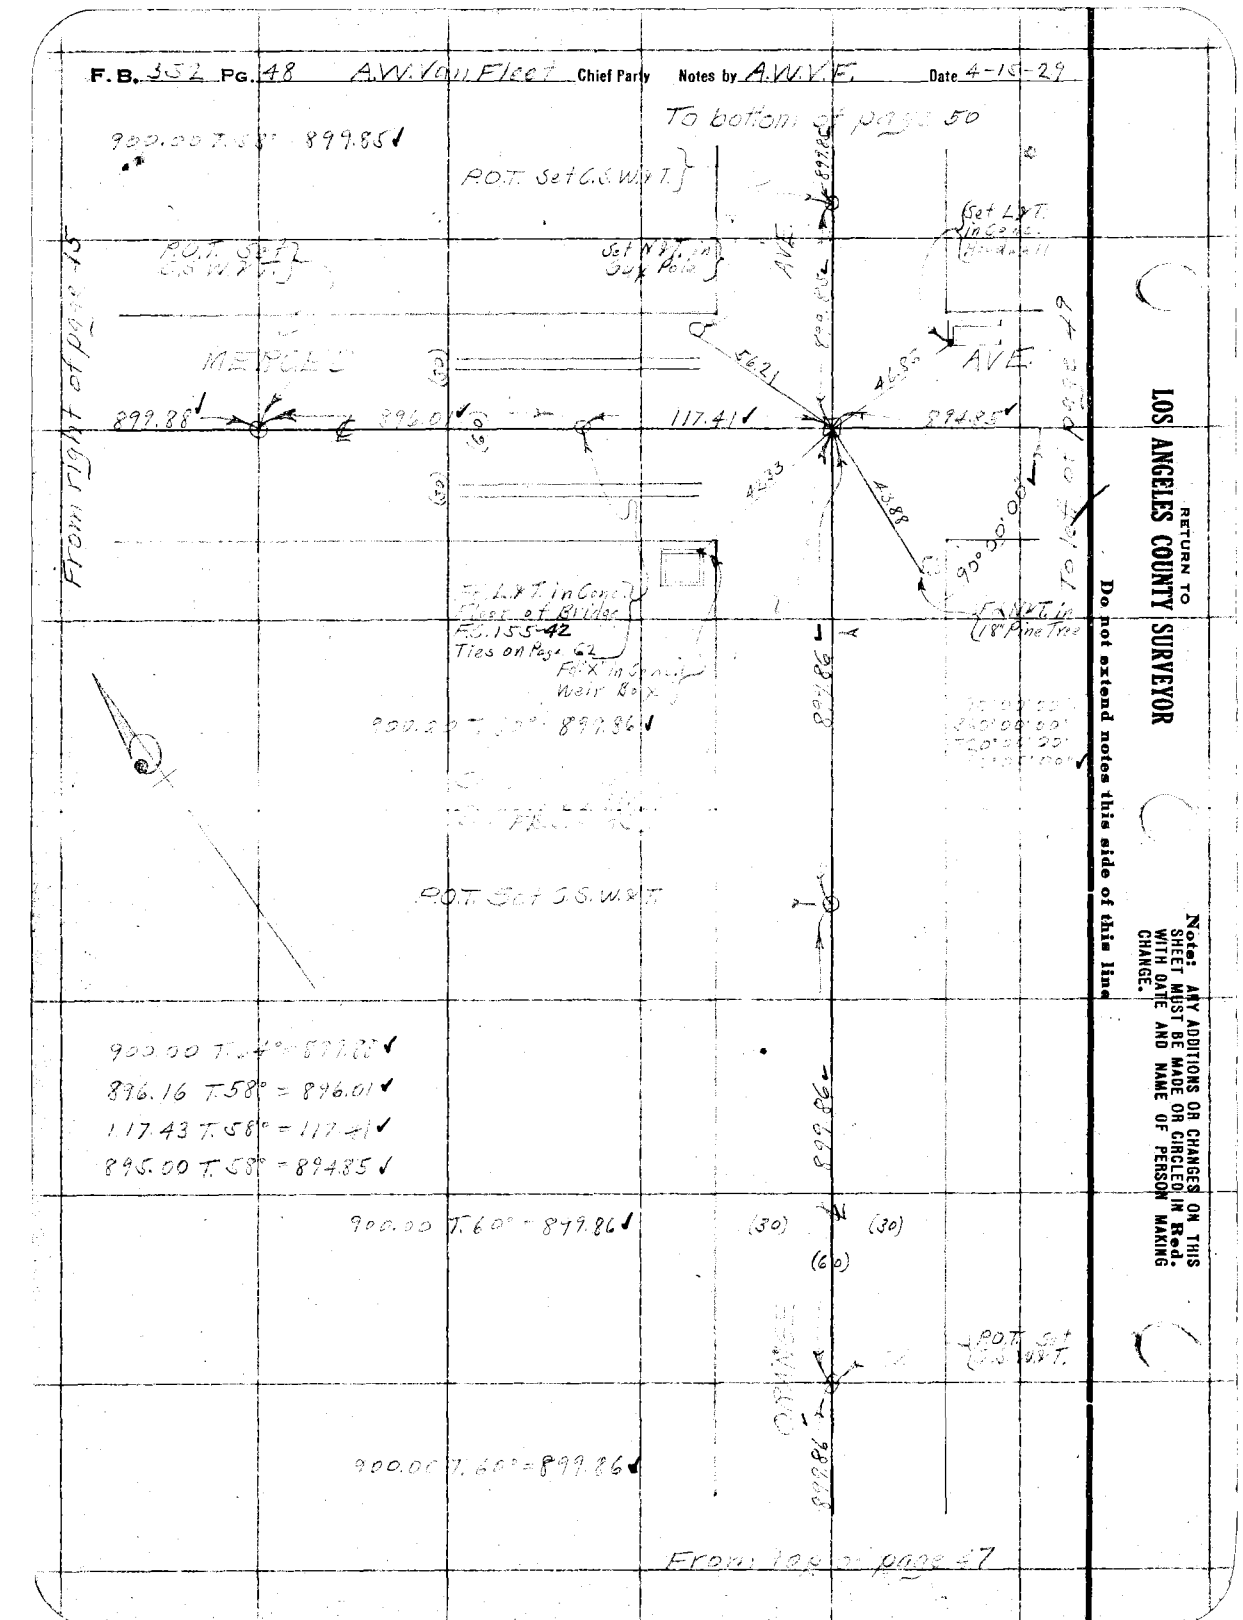

RETURN TO
LOS ANGELES COUNTY SURVEYOR

Do not extend notes this side of this line

Note: ANY ADDITIONS OR CHANGES ON THIS SHEET MUST BE MADE OR CIRCLED IN Red. WITH DATE AND NAME OF PERSON MAKING CHANGE.

Date 4-18-29 Notes by A.W.V.E. Chief Party A.W.V.E. F.B. 352 Pg 49

Plotted by Wood
Date Oct. 1929
Map No. B457-2
Platting C'k'd by H.U.M.H.
Date NOV 30 1929

W. O. No. 776 D. C. O. No. 027
Location Gardena
Surveyed by A.W.V.E. 1929
Date
Indexed A. C. Johnson

To bottom of page 51 also page 57

Tape No 04
3279.24 @ 70°T
3278.34 ✓
Bma
12-13-29

(50) (30) (60) AVE

89°59'30" (1)
359°57'30" (2)
359°55'30" (3)
89°59'26" ✓

3278.94 ✓

1019.58 T 58° = 1019.41 ✓

S 0°4'30" ✓

Fd. N & T. in 14" Walnut

Fd. N & T. in 12" Walnut

42.75 41.95

MERCED

399.85 ✓ 1019.41 ✓

(30) AVE. (60)

44.56

46.20

Fd. L & T. in Concrete Wall

Fd. L & T. in Concrete

Fd. 2 x 2 & N (1' down)
F.B. 364-38

From right of page 48

From top of page 52

Notes: ANY ADDITIONS OR CHANGES ON THIS SHEET MUST BE MADE OR CIRCLED IN Red. WITH DATE AND NAME OF PERSON MAKING CHANGE.

Do not extend notes this side of this line

RETURN TO LOS ANGELES COUNTY SURVEYOR

F. B. 352 Pg. 50 A.W.Van Fleet Chief Party Notes by A.W.V.F. Date 4-14-29

To left of page 51

900.00 T. 64° = 899.88 ✓
900.00 T. 64° = 899.88 ✓
729.85 T. 64° = 729.76 ✓

AVE

729.76 ✓

Fd Cut sqk w+T

Fd. N.P.T. in Power Pole

Fd. N.P.T. in 24" Walnut

Set N.P.T. in Guard Rail

38.15

50.92

0.13

2.11.12

180°50'30" (1)
163°29'00" (6)
326°43'30" (8)
130°50'26" ✓

8°39'38" ✓

Fd. N.P.T. in Tc.

932.66 T. 58° = 932.50 ✓

(60)

(30) (30)

Set C.S.W. & T.

900.00 T. 58° = 899.85 ✓

Set C.S.W. & T.

900.00 T. 58° = 899.85 ✓

From top of page 8

RETURN TO
LOS ANGELES COUNTY SURVEYOR

Do not extend notes this side of this line

Note: ANY ADDITIONS OR CHANGES ON THIS SHEET MUST BE MADE OR CIRCLED IN Red. WITH DATE AND NAME OF PERSON MAKING CHANGE.

Date 6-5-29 Notes by A.W.V.E. Chief Party A.W.V.E. F.B. 352 Pg. 51

Platted by Wood	W. O. No. 796 S. O. No. 027
Date Oct. 1929	Location Cor. of Ave.
Map No. B457-2.	Surveyed by A.W.V.E. Chief
Platting C'k'd by M. U. M. M.	Date 6-5-29
Date NOV 30 1929	Indexed C. Johnson

Note: ANY ADDITIONS OR CHANGES ON THIS SHEET MUST BE MADE OR CIRCLED IN Red. WITH DATE AND NAME OF PERSON MAKING CHANGE.

Do not extend notes this side of this line

RETURN TO LOS ANGELES COUNTY SURVEYOR

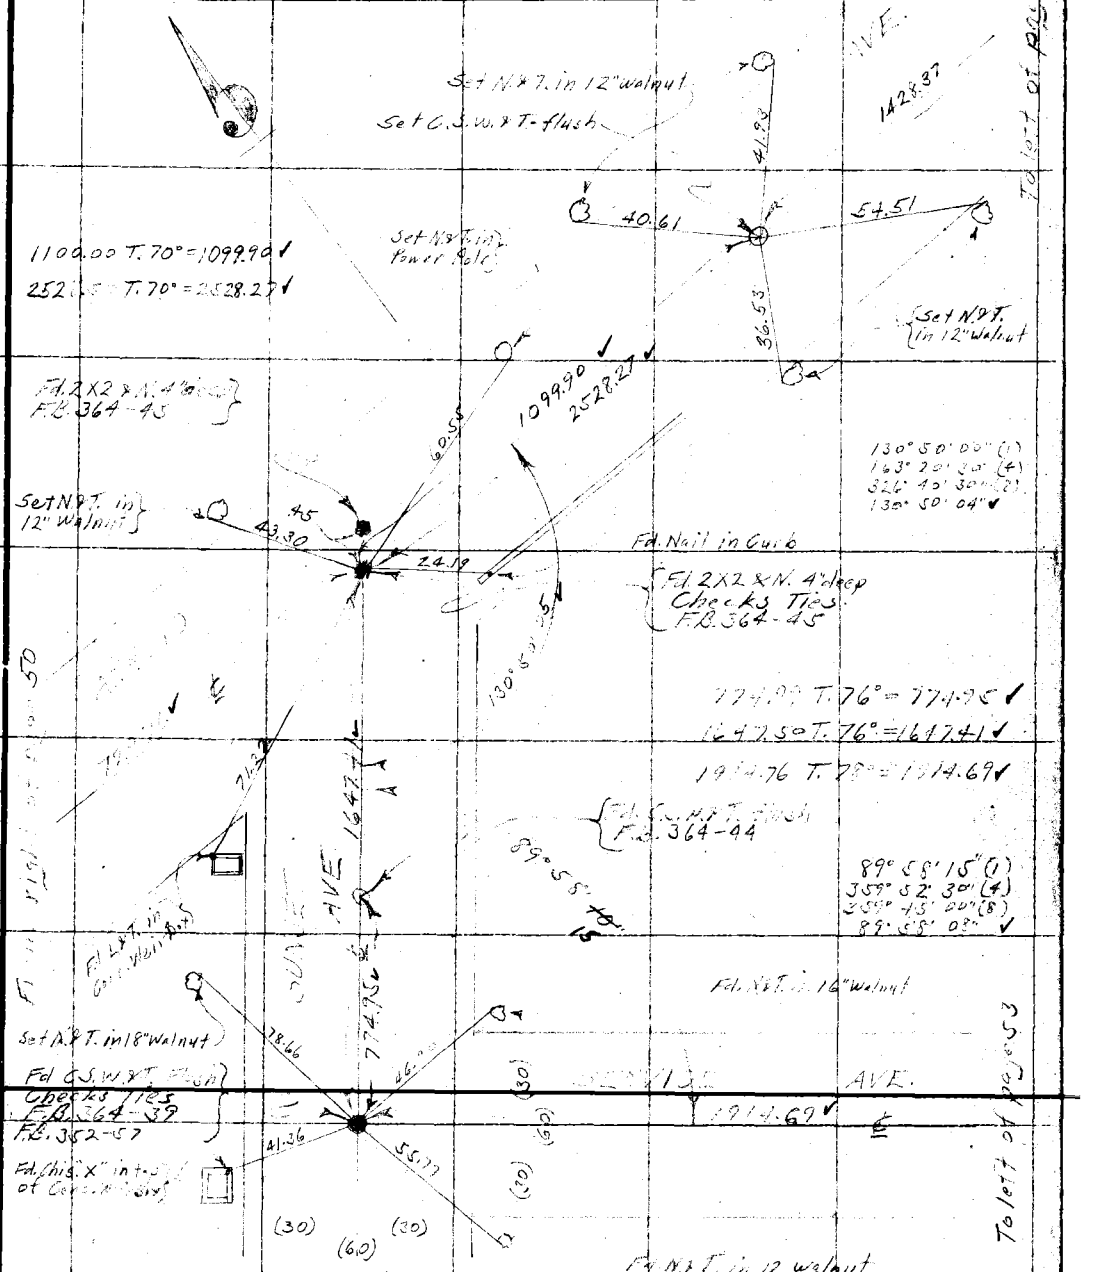

F. B. 352 Pg. 52 A.W.V. in Fleet Chief Party Notes by A.W.V.F. Date 4-19-28

To Continue of Page 49

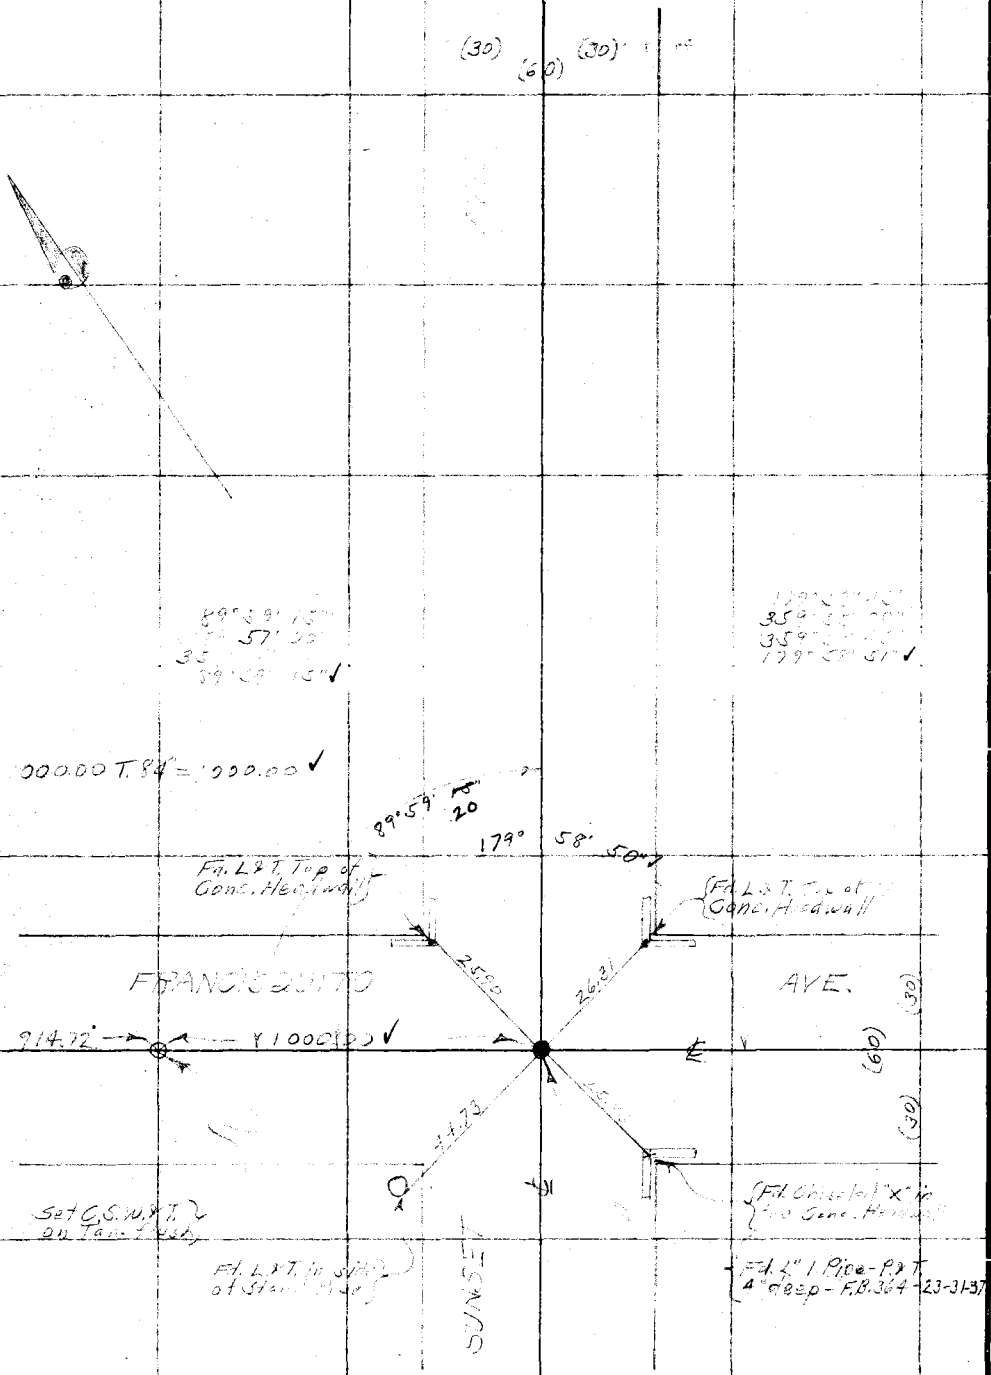

RETURN TO
LOS ANGELES COUNTY SURVEYOR

Do not extend notes this side of this line

Note: ANY ADDITIONS OR CHANGES ON THIS SHEET MUST BE MADE OR CIRCLED IN Red. WITH DATE AND NAME OF PERSON MAKING CHANGE.

Date _____ Notes by A.M.K.F. Chief Party A. [illegible] F.B. 352 Pg. 53

Platted by Wood	W. O. No. 796 B. O. O. No. 027
Date 9d. 1929	Location [illegible] AVE
Map No. B. 457-5	Surveyed by A.M.K.F. & [illegible]
Platting C'k'd by H. U. M. H.	Date 6-6-29
Date NOV 30 1929	Indexed [illegible]

Notes: ANY ADDITIONS OR CHANGES ON THIS SHEET MUST BE MADE OR CIRCLED IN Red. WITH DATE AND NAME OF PERSON MAKING CHANGE.

Do not extend notes this side of this line

RETURN TO LOS ANGELES COUNTY SURVEYOR

1000.00 T. 68° = 999.90 ✓
925.69 T. 68° = 925.69 ✓
Set C.S. & W.

AVE.

999.90 ✓

To left of P.O.

23.81

45.54

49.21

Fd. 1½" I.P. 1' deep - R.M. on rim of pipe at Intersection F.B. 364 - 41

Fd. N. & T. in 2" Walnut

Set N. & T. in 12" Walnut

Fd. N. & T. in 14" Walnut

72.06

926.59

43.98

37.27

Fd. N. & T. in Tel. Pole

130° 48' 30"

130° 48' 30"

1100.00 T. 72° = 1099.91 ✓
1100.00 T. 64° = 1099.86 ✓
1100.00 T. 64° = 1099.86 ✓
1302.13 T. 70° = 1302.01 ✓

Set C.S. W & T. - flush

1099.91

1428.37 ✓
1528.27 ✓

67.33
32.37
51.26

Set N. & T. in 14" Walnut

(60) (30) (30)

Set N. & T. in P. Pole

90° 00' 00" (1)
359° 59' 00" (4)
359° 59' 00" (8)
89° 59' 53" ✓

From right of P.O. 51

58.03

93.54

56.60

Fd. Swi Pch in C fl. by tie 0.04 N

This point set by Van Fleet.

Fd. 2 X 2 & N. flush ties F.B. 364 - 42

89° 59'

Set N. & T. in 5" Walnut
Fd. N. & T. in 14" Walnut

SERVICE (30)

1914.69 ✓

42.71

AVE

1302.01 ✓

From right of P.O. 51

(60)

(30)

45.51

52.72

57.25

Fd. L. & T. Conc. Weir Box

Set L. & T. in Curb

To left of P.O. 54

F.B. 352 Pg. 54 A.W. Van Fleet Chief Party Notes by A.W.V.F. Date 6-7-29

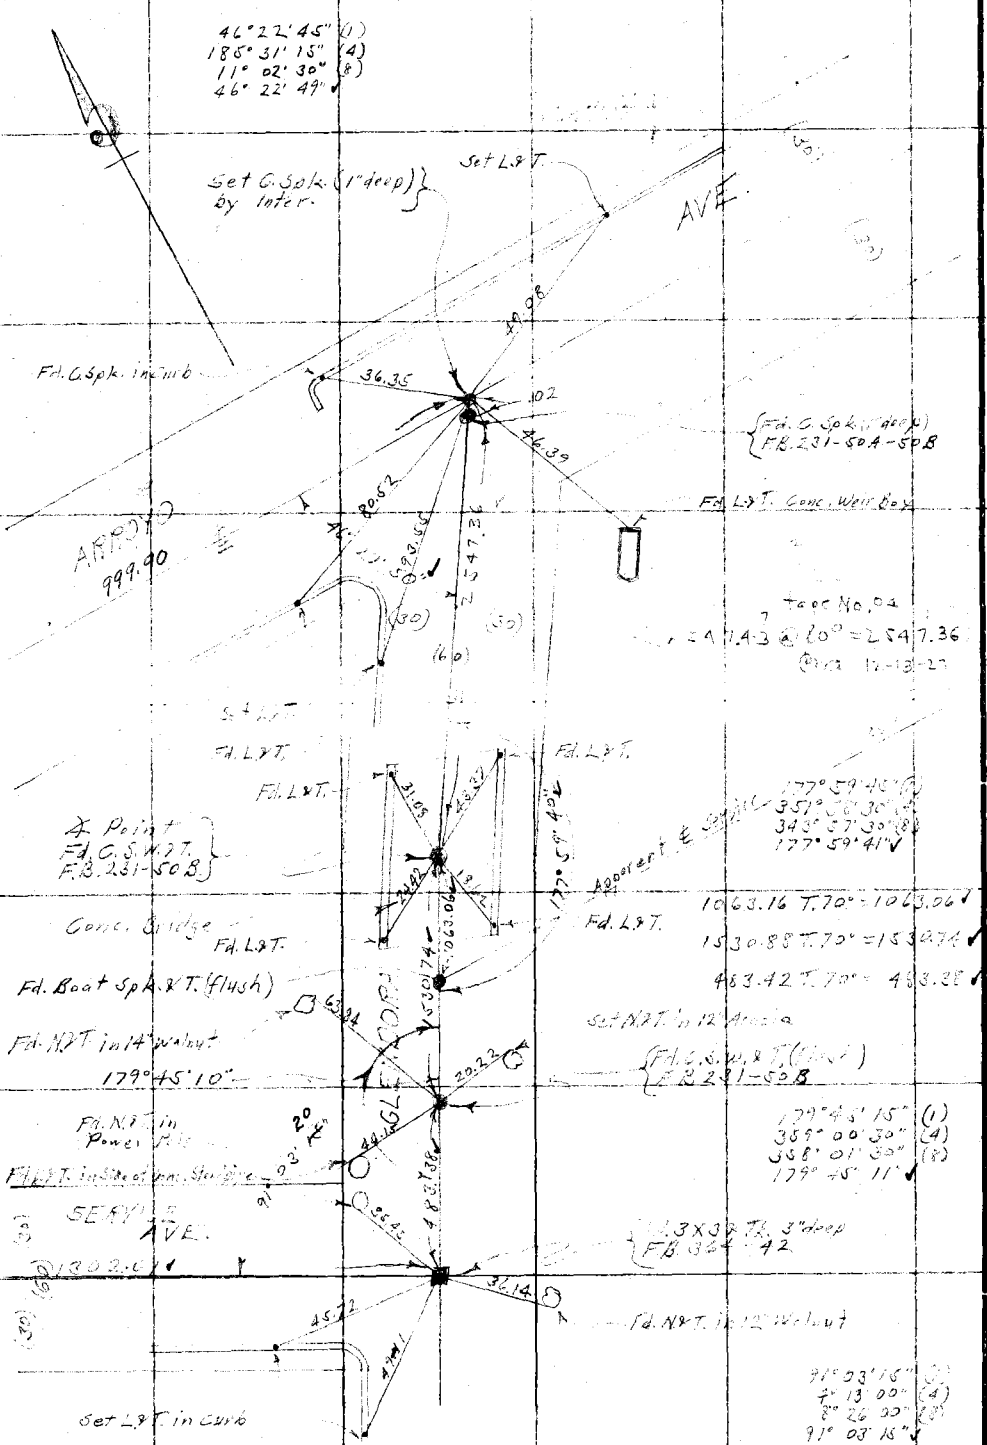

RETURN TO
LOS ANGELES COUNTY SURVEYOR
Do not extend notes this side of this line

Note: ANY ADDITIONS OR CHANGES ON THIS SHEET MUST BE MADE OR CIRCLED IN Red. WITH DATE AND NAME OF PERSON MAKING CHANGE.

Date 6-11-29 Notes by A.W.V.F. Chief Party A.W. Van Fleet F.B. 352 Pg. 55

Platted By Wood	W. O. No. 796 B. O. C. No. 027
Date Oct. 1929	Location
Map No. B.457-2	Surveyed by A.W. Van Fleet
Platting C'k'd by H. U. M. H.	Date 6-11-29
Date NOV 30 1929	Indexed

Notes: ANY ADDITIONS OR CHANGES ON THIS SHEET MUST BE MADE OR CIRCLED IN Red. WITH DATE AND NAME OF PERSON MAKING CHANGE.

Do not extend notes this side of this line

RETURN TO LOS ANGELES COUNTY SURVEYOR

To bottom of page 56

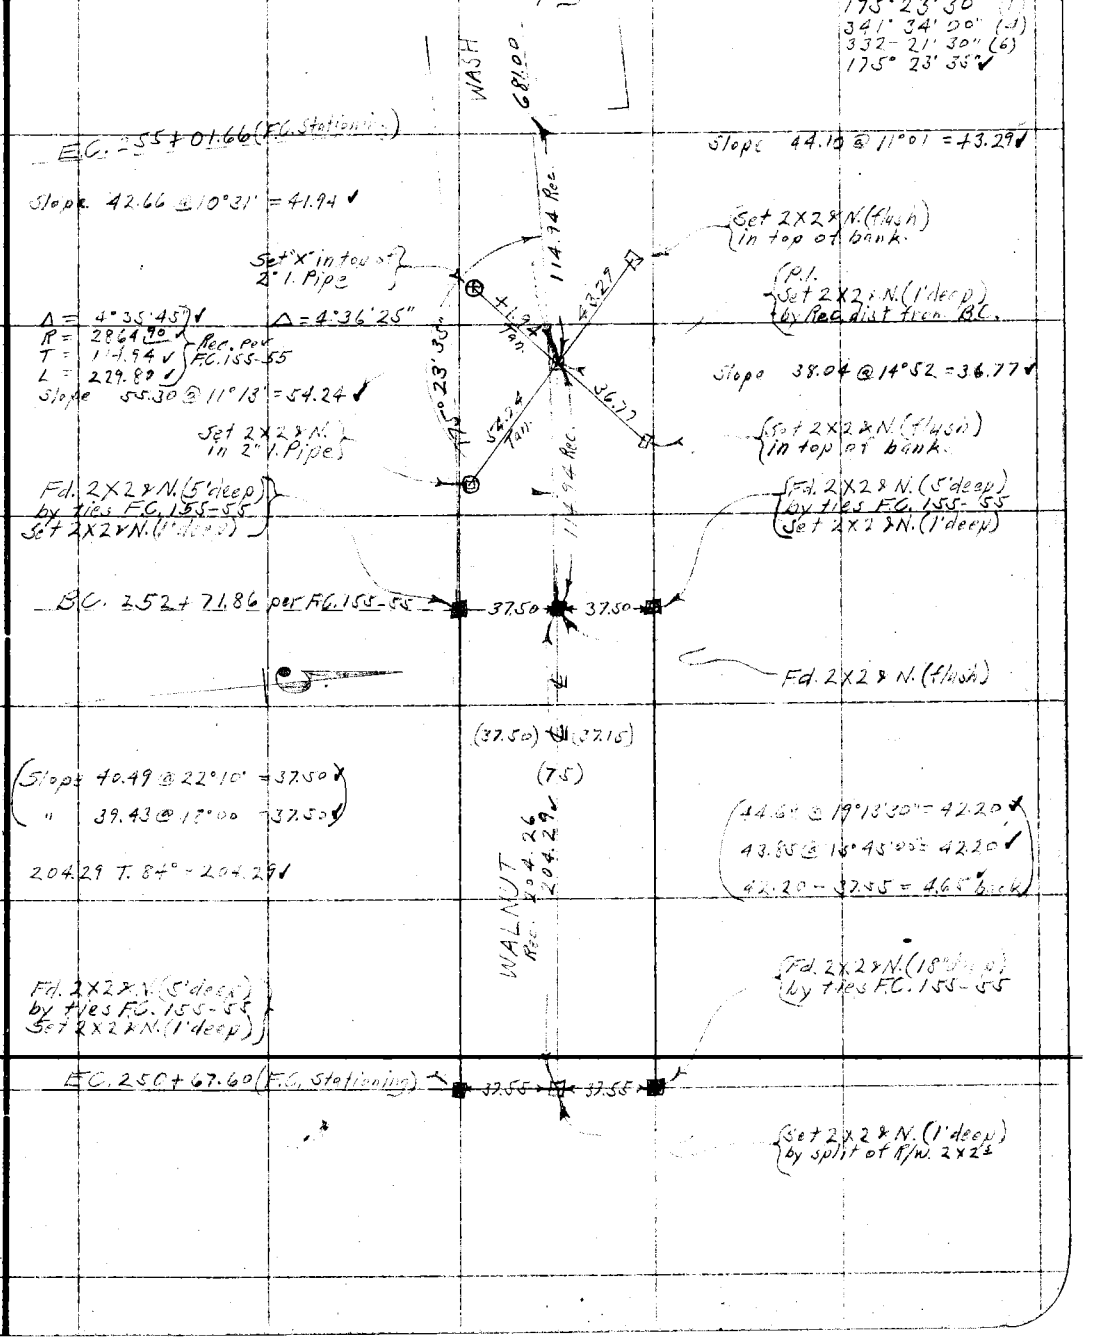

F.B. 352 Pg. 56 A.W. Von Fleet Chief Party Notes by A.W.V.F. Date 6-11-29

To bottom of page 57

88.62 T. 94° = 88.43 ✓

Slope 74.35 @ 7°09' = 73.77 ✓

WASH

P.C. 63 ✓

(Set 2×2 Tk. (flush) in top of bank)

Slope 36.00 @ 14° 5' = 34.89 ✓

(Set 2×2 Tk. in 2" I. Pipe in top of bank)

Set 2×2 Tk. (8" deep) by Inters.

73.77

34.89

Slope 62.69 @ 7°52 = 62.00 ✓

62.00

SERVICE

(60)

45

WALNUT

681.00 T. 84° = 681.00 ✓

48° 21' 45" (1)
193° 27' 00" (4)
290° 10' 00" (3)
48° 21' 45" ✓

(Set 2×2 Tk. (Flush) in top of bank)

(175)

(37.50) (37.50)

From top of page 55

RETURN TO LOS ANGELES COUNTY SURVEYOR

Do not extend notes this side of this line

Note: ANY ADDITIONS OR CHANGES ON THIS SHEET MUST BE MADE OR CIRCLED IN Red. WITH DATE AND NAME OF PERSON MAKING CHANGE.

Date 6-12-29 Notes by A.W.V.J. Chief Party A.W. Vanderlip F.B. 352 Pg. 57

Tape

Platted by Wood	W. O. No. 796 ~~D. C. S. No.~~ 027
Date Oct. 1929	Location Galveston Ave.
Map No. B.457-2	Surveyed by A.W.V. Fleet
Platting C'k'd by H. U. M. H.	Date 6-12-29
Date NOV 30 1929	~~Indexed~~ A. C. Johnson

Notes: ANY ADDITIONS OR CHANGES ON THIS SHEET MUST BE MADE OR CIRCLED IN Red. WITH DATE AND NAME OF PERSON MAKING CHANGE.

Do not extend notes this side of this line

RETURN TO LOS ANGELES COUNTY SURVEYOR

From 49+0 ✓

(30) (30) (60) SUNSET AVE. 327.89 WASH 1242.37 ✓

To bottom of page 58.

Fd. N&T in Guard Rail

34° 45' 15" (1)
139° 01' 00" (4)
208° 31' 00" (6)
34° 45' 10" ✓

1242.39 T. 82° = 1242.37 ✓

359.90 T. 102° = 359.94 ✓

75 14.02 1287 Fd. N&T in Truss Fd. N&T. in Truss

17 1287

F.C. S.T Flush. per F.C. 155-54

Set 2x2 x HK (8" deep by inter.) Fd. S.W.T from PK thence this on brdg.

Slope 29.1 Sec 10°45' = 28.03

Level 200'+

Slope 55.19 @ 14°38' = 53.40 ✓

255.39 T. 104° = 251.60 ✓

353.60'

3.54.24 ✓

AVE.

34° 45' 10" ✓

Slope 47.45 @ 10°28' = 46.66 ✓

{Fd. C.S.W.T. (Flush) See page 51

E.C. 262+96.43

Δ = 6° 51' 30"
R = 1910.1 ✓ (Rad. pt.)
T = 114.45 ✓ F.C. 155-54
L = 228.64 ✓

Set 2x2 x 8" T. (Flush) on top of Bank

46.66 228.03 173° 08' 00"

Set 2x2 x 8" T. (Flush) on top of Bank

27.44 Tan.

Set 2x2 x 8" T. (Flush) on top of Bank

WALL 117.47

Slope 48.58 @ 10°28' = 47.70 ✓

Slope 27.68 @ 15° = 27.44 ✓

B.C. 260+67.79 per F.C. 155-54

37.47 37.47

Fd. 2x2 & Nail (3.5 deep) by ties F.C. 155-54 Set 2x2 & N. (2 deep)

Fd. 2x2 (2" deep) by ties F.C. 155-54

From top of page 56

173° 09' 00" (1)
332° 35' 30" (4)
318° 53' 15" (6)
173° 08' 52" ✓

{See page 51

Set 2x2 x 8" T. (Flush) on top of Bank

(P.I. Set 2x2 & N. (1' deep) by tan. dist. from B.C.

Set 2x2 x 8" T. (Flush) on top of Bank

{Set 2x2 (1' deep) by split of N&W. 2x2's

F.B. 352 Pg. 58 A.W.V.M. Fleet Chief Party Notes by A.I.V.V.F. Date 6-12-29

To bottom of page 59

(37.50) (7.5)

Slope 43.36 @ 11°45' = 42.46 ✓

Slope 44.69 @ 9°37' = 44.30 ✓

172° 45' 00" (1)
330° 59' 30" (4)
316° 29' 30" (6)
172° 44' 55" ✓

Set 2X2 2N. in 2" I. Pipe in top of bank

Set 2X2 2N. in top of bank

Point Fd. 2X2 (8" deep) 279+91.25 per F.C. 155-49

172° 44' 55"

42.46 Ton.

44.30

42.29

49.78 Ton.

Set 2X2 2N. in top of bank

Set 2X2 2N. in top of bank

Slope 42.84 @ 9°12' = 42.29 ✓

Slope 50.41 @ 7°52' = 49.78 ✓

(7.5)

Slope 40.11 @ 13°05 = 39.97 ✓

Slope 39.68 @ 11°14 = 38.92 ✓

Set 2X2 2N. in top of bank

566.23 T. S2° = 566.22 ✓

179° 15' 00" (1)
357° 00' 15" (4)
355° 30' 30" (6)
179° 15' 05" ✓ (Rec. 179° 15' 10")

Set 2X2 2N. in top of bank

179° 15' 05"

39.07

38.92

45.76 Ton.

32.08 Ton.

Point Fd. 2X2-6" deep Floor Sanitary Sta. 274+24.78 F.C. 155-50

Set 2X2 2N. in top of bank

Set 2X2 2N. in 2" I. Pipe in top of bank

Slope 33.24 @ 15°12' = 32.08 ✓

Slope 46.36 @ 9°46 = 45.76 ✓

From top of page 57

RETURN TO LOS ANGELES COUNTY SURVEYOR

Do not extend notes this side of this line

Note: ANY ADDITIONS OR CHANGES ON THIS SHEET MUST BE MADE OR CIRCLED IN Red. WITH DATE AND NAME OF PERSON MAKING CHANGE.

Date 6-13-29 Notes by A.W.V.F. Chief Party A.W.Von Fleet F.B. 352 Pg. 59

Platted by Wood
Date Oct. 1929
Map No. B. 457-2
Platting C'k'd by H. U. M. H.
Date NOV 30 1929

W. O. No. 796 S. S. O. No. 027
Location Gaffey Ave.
Surveyed by A.W.Von Fleet
Date 6-13-29.
Indexed

To bottom of page 60

318.37 T. 88° = 318.38 ✓

WASH

318.38

Slope 44.77 @ 11°07 = 43.93 ✓

Slope 40.15 @ 12°12' = 39.24 ✓

Set 2X2 & N. in 2" I. Pipe in top of bank

E.C.

172°48'30" (L)
331°42'15" (R)
316°51'30" (L)
172°48'35" (R)

Δ = 7°11'20" ✓
R = 747.89 ✓
T = 46.98 ✓
L = 93.84 ✓
Rad. Pt's
F.C. 155-498

Set 2X2 & N. in top of bank (Flush)

P.I. Set 2X2 & N. (1' deep) by meas. tan. dist from B.C.

Set 2X2 & N. in top of bank (Flush)

Set 2X2 & N. in 2" I. Pipe in top of bank

B.C.

37.50 37.50

Fd. 2" I. Pipe, P & N. (5.5' deep) by ties. Sta. 283+57.60 pc. F.C. 155-49 Set 2X2 & N. (1' deep)

Fd. 2" I. Pipe, P & N. (6' deep) by ties. Sta. 282+57.60 F.C. 155-49

366.43 T. 84° = 366.43 ✓

Set 2X2 & N. (1' deep) by Split of I. Pipes

Slope 31.65 @ 10°13' = 31.13 ✓

Slope 35.87 @ 14°33 = 34.72 ✓

(75)

(37.50) (37.50)

From top of page 58

RETURN TO
LOS ANGELES COUNTY SURVEYOR

Do not extend notes this side of this line

Notes: ANY ADDITIONS OR CHANGES ON THIS SHEET MUST BE MADE OR CIRCLED IN Red. WITH DATE AND NAME OF PERSON MAKING CHANGE.

F. B. 352 Pg. 60 A.W.V.&H.Fleet Chief Party Notes by A.W.V.F. Date 6-13-29

To bottom of page 61

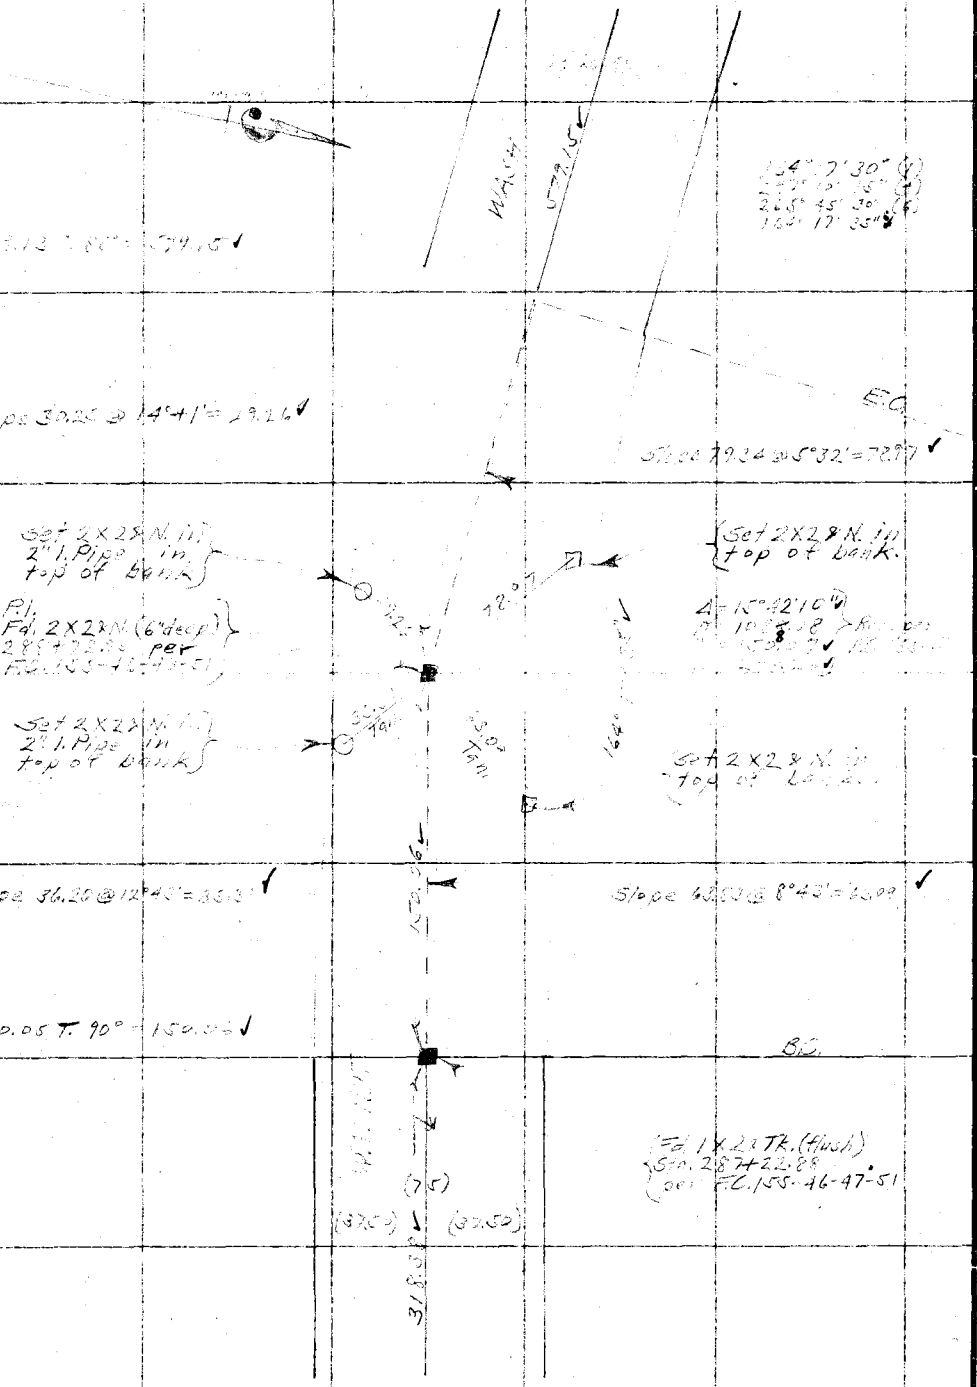

RETURN TO
LOS ANGELES COUNTY SURVEYOR

Do not extend notes this side of this line

Note: ANY ADDITIONS OR CHANGES ON THIS SHEET MUST BE MADE OR CIRCLED IN Red. WITH DATE AND NAME OF PERSON MAKING CHANGE.

Date 6-14-29 Notes by A.W.V.F. Chief Party A.W.Von Gal Jr. F.B. 352 Pg. 61

Tape

Plotted by Wood	W. O. No. 796 R. S. O. No. 027
Date Oct. 1929	Location Garvey Ave
Map No. B. 457-2	Surveyed by A.W.Von Gal
Plotting C'k'd by M.U.M.H.	Date 6-14-29
Date NOV 30 1929	Indexed A. C. Johnson

Fd. 3/4" I.P. (10" deep) per page 48

Set 2X2 x 7 Tk. (flush) in top of dam

ORANGE 179.42 N

Alameda Ave

To bottom of page 62

179° 33' 45" (1)
358° 14' 45" (4)
357° 27' 30" (6)
179° 33' 45" ✓

Slope 97.54 @ 2°01' = 97.48 ✓

" 32.80 @ 19°29' = 32.27 ✓

Set 2X2 x 7 Tk. (flush) in top of bank

See Page 120

146° 03' 00" (1)
224° 12' 00" (4)
156° 18' 00" (6)
146° 03' 00" ✓

Fd. 2X2 x 7 Tk. (8" deep) 300+ 96.34 per F.C. 155-45-46

Slope 99.98 @ 2°38 = 99.87 ✓

Level 74.54

174.41 x T. 94° = 174.42 ✓

Set L.P.T. in top of Flume Wall

Set L.P.T. in top of Wing Wall

46.18 T. 74° = 6-46.14 ✓

Set 2X2 x 8 N. (7" deep) by Spike at 2" Pipes Sta. 294+50.16 per F.C. 155-46

Fd. 2" I.P. (18" deep) F.C. 155-46

Fd. 2" I.P. pipe, 0.3 N. 2.5 deep F.C. 155-46

178° 15' 00" (1)
358° 00' 18" (4)
344° 30' 30" (6)
178° 15' 05" ✓

CHESTNUT

From top of page 60

RETURN TO
LOS ANGELES COUNTY SURVEYOR

Notes: ANY ADDITIONS OR CHANGES ON THIS SHEET MUST BE MADE OR CIRCLED IN Red. WITH DATE AND NAME OF PERSON MAKING CHANGE.

Do not extend notes this side of this line

F.B. 352 Pg. 62 A.W. Van Fleet Chief Party Notes by A.W.V.F. Date 3-14-29

To bottom of page 63

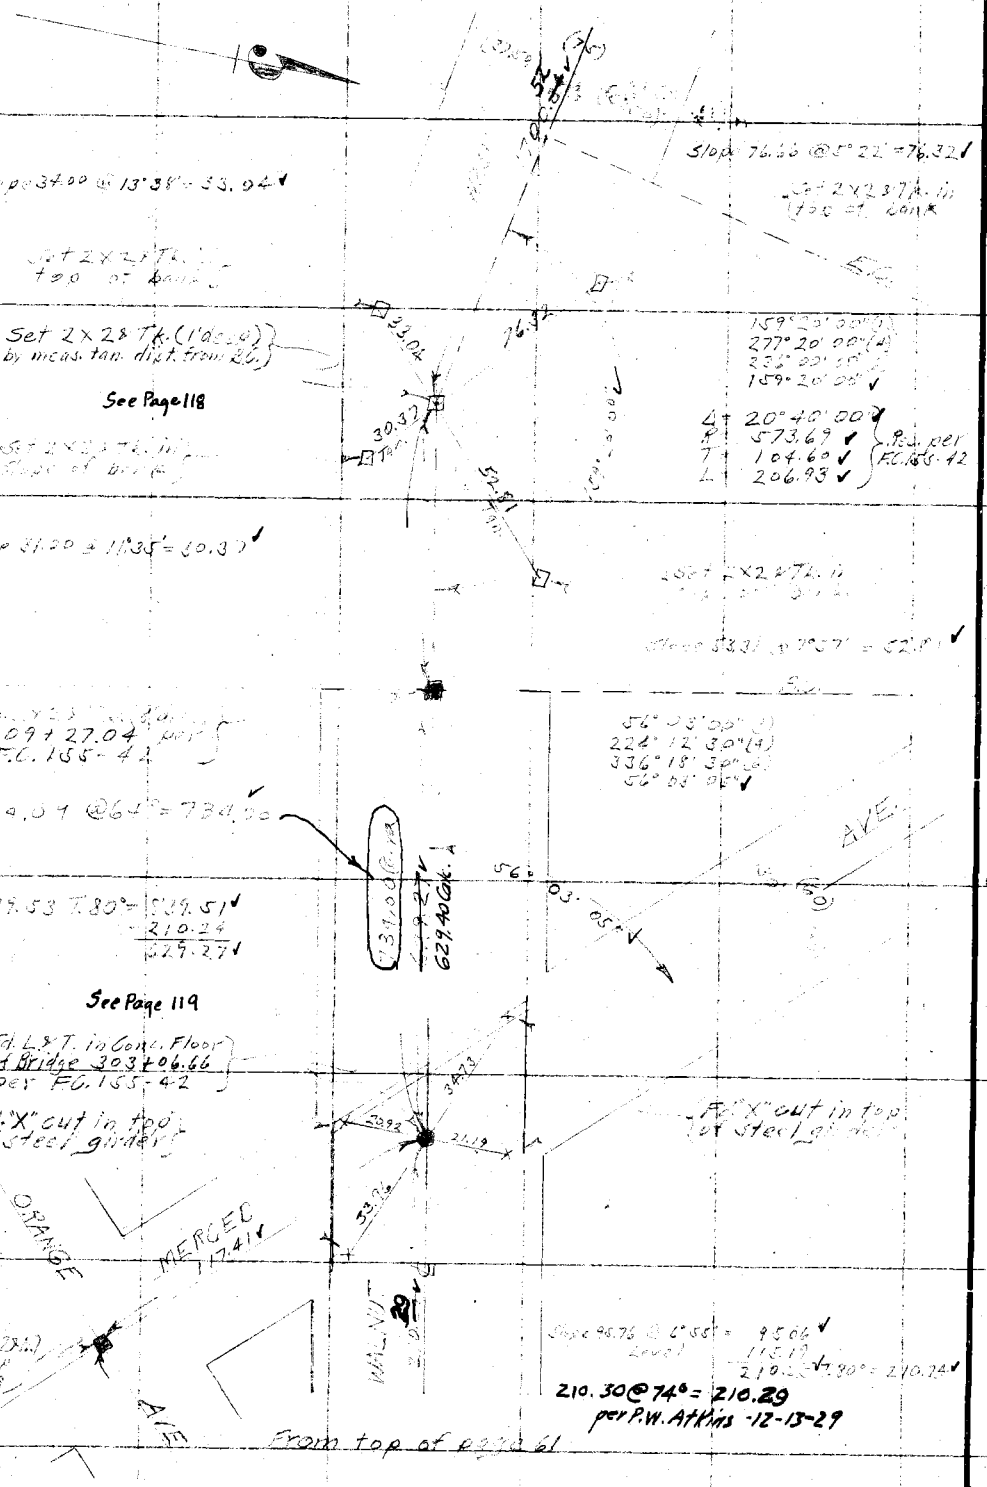

RETURN TO
LOS ANGELES COUNTY SURVEYOR

Do not extend notes this side of this line

Note: ANY ADDITIONS OR CHANGES ON THIS SHEET MUST BE MADE OR CIRCLED IN Red. WITH DATE AND NAME OF PERSON MAKING CHANGE.

Date 6-17-29 Notes by H.W.V.E. Chief Party A.W. Van Fleet F.B. 352 PG 63

Platted by Wood	W. O. No. 796 S. S. O. No. 027
Date Oct. 1929	Location Tract [illegible] Map 1
Map No. B-457-2	Surveyed by [illegible]
Platting C'k'd by M. U. M. M.	Date 6-17-29
Date NOV 30 1929	Indexed L. C. Johnson

Notes: ANY ADDITIONS OR CHANGES ON THIS SHEET MUST BE MADE OR CIRCLED IN Red. WITH DATE AND NAME OF PERSON MAKING CHANGE.

Do not extend notes this side of this line

RETURN TO LOS ANGELES COUNTY SURVEYOR

To bottom of page 64.

179°45'00" (1)
358°59'30" (4)
358°29'30" (6)
179°44'55" ✓

Set 2X2 x T. (illegible)
Top at Grade

WASH

61.80

206.32

Set 2X2 x T. (illegible)
Top at Grade

56.21 Tan

Slope 62.19 @ 6°27' = 61.80 ✓
" 56.50 @ 5°51' = 56.21 ✓

Set 1X1 x T. (illegible)
on line See page 45

206.31 T. 94° 206.32 ✓

See Page 116

54°36'45" (1)
218°27'15" (4)
327°40'30" (6)
54°36'45" ✓

AVE

This dist. is bet. pts. shown and was checked by H.W. Akins - 12-13-29

100.00 T 86° = 899.78 ✓
600.60 T 72° = 800.54 ✓
1700.52 ✓

From top of page 62

F.B. 352 Pg. 64 A.W.V. Van Fleet Chief Party Notes by A.W.V.F. Date 6-17-29

To bottom of page 63

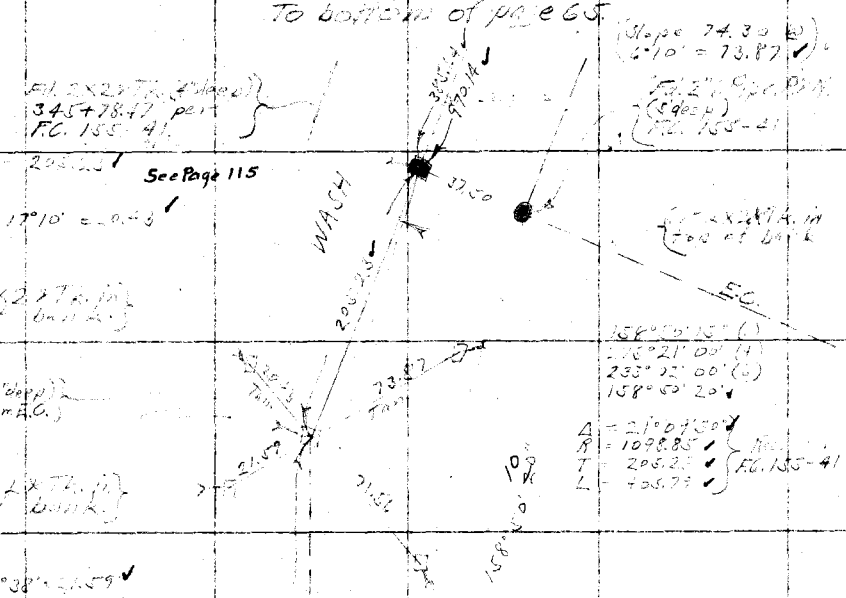

P.W. Atkinson 12-12-29
Tape No. 04
1639.40 @ 66° = 1439.21

From top of page 63

RETURN TO LOS ANGELES COUNTY SURVEYOR

Do not extend notes this side of this line

Note: ANY ADDITIONS OR CHANGES ON THIS SHEET MUST BE MADE OR CIRCLED IN Red. WITH DATE AND NAME OF PERSON MAKING CHANGE.

Date 9-18-29 Notes by A.V. V.F. Chief Party [illegible] F.B. 352 Pg. 65

Platted by Wood
Date Oct. 1929
Map No. B-457-7.
Platting C'k'd by H.U.M.H.
Date NOV 30 1929

W. O. No. 196 ~~S. Cr. No.~~ 621
Location [illegible]
Surveyed by [illegible]
Date 6-18-29
Indexed A. C. Johnson

To bottom of page 66
From page 77

Notes: ANY ADDITIONS OR CHANGES ON THIS SHEET MUST BE MADE OR CIRCLED IN Red. WITH DATE AND NAME OF PERSON MAKING CHANGE.

Do not extend notes this side of this line

RETURN TO LOS ANGELES COUNTY SURVEYOR

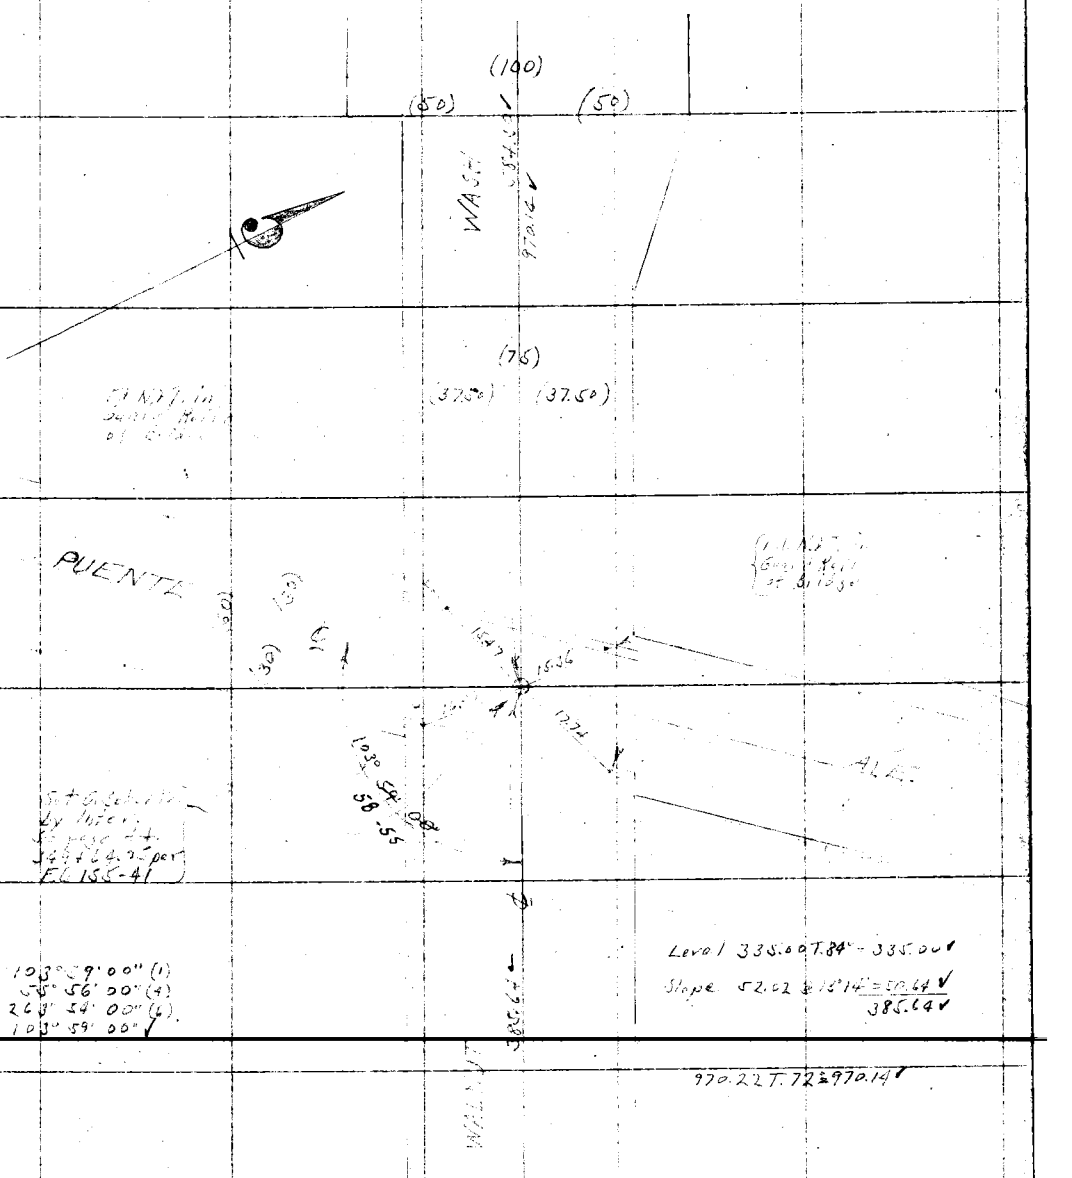

F.B. 352 Pg. 66 A.W.V.Van Fleet Chief Party Notes by A.W.V.F. Date 6-18-29

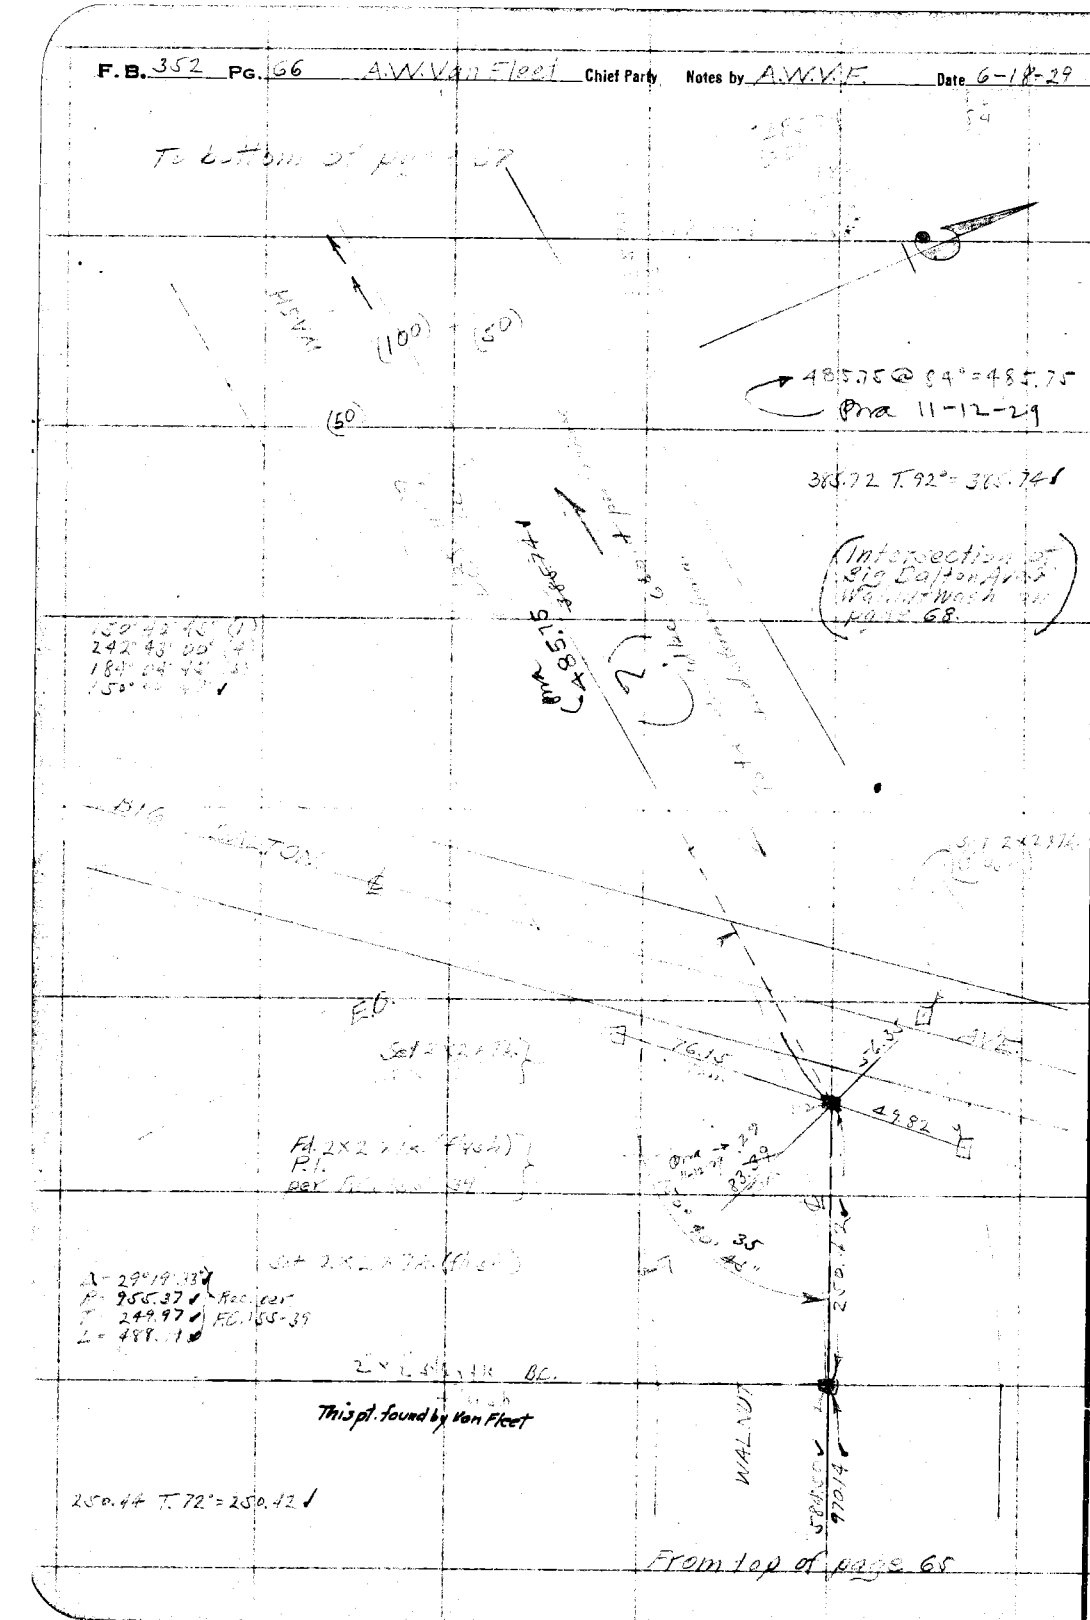

Δ = 29°19'33"
R = 955.37 Rec. (21-
T = 249.97 Rec. 155-39
L = 488.1

RETURN TO LOS ANGELES COUNTY SURVEYOR

Do not extend notes this side of this line

Note: ANY ADDITIONS OR CHANGES ON THIS SHEET MUST BE MADE OR CIRCLED IN Red. WITH DATE AND NAME OF PERSON MAKING CHANGE.

Date 6-18-29 Notes by A.M.W.H. Chief Party A.M.W.H. F.B. 352 Pg. 67

Platted by Wood
Date Oct. 1929
Map No. B. 457-2
Platting Chk'd by H. U. M. H.
Date NOV 30 1929

W. O. No. 796 ~~B. S. C. No.~~ 022
Location [illegible] Ave
Surveyed by [illegible]
Date 6-10-29
Indexed [illegible]

Notes: ANY ADDITIONS OR CHANGES ON THIS SHEET MUST BE MADE OR CIRCLED IN Red. WITH DATE AND NAME OF PERSON MAKING CHANGE.

Do not extend notes this side of this line

RETURN TO LOS ANGELES COUNTY SURVEYOR

(Intersection of Franklin Hgts Ave & Walnut Wash on pg 58)

Set L.S.T. 1 ft. from edge of Conc. Pavement

Set L.S.T. by Interv.

Set L.S.T. 1 ft. from edge of pavement

616.44 T. 90° = 616.46 ✓

(Fd. 2x2x 7 ft. (Flush) 3677.23 ft. per F.C. 155-39)

90°01'15" (1)
89°04'45" (4)
90°01'00" (6)
90°01'00" ✓

174.3 T. 90° = 174.31 ✓
110.8 T. 90° = 110.80 ✓

(Fd. 2x2x 7 ft. (Flush) 266+12.81 per F.C. 155-39)

Set N.S.T. in top of piling

Set 2x2x8 ft. (Flush)

(P.I. Fd. 2x2x 7 ft. (Flush))

Set 2x2x8 ft. (Flush) BC

Δ = 32°52'27" ✓
R = 590.84 ✓
T = 174.31 ✓
L = 338.00 ✓
Roper F.C. 155-39

147°07'45"
32°52'27"
180°00'00"
180°00'30" ?
147°07'45"

Set 2x2x8 ft. (Flush)

(Fd. 2x2x 7 ft. (Flush) 362+73.81 per F.C. 155-39)

WALNUT

From top of pg. 66

F. B. 352 Pg. 68 A.W. Van Fleet Chief Party Notes by A.W.V.F Date 6-20-22

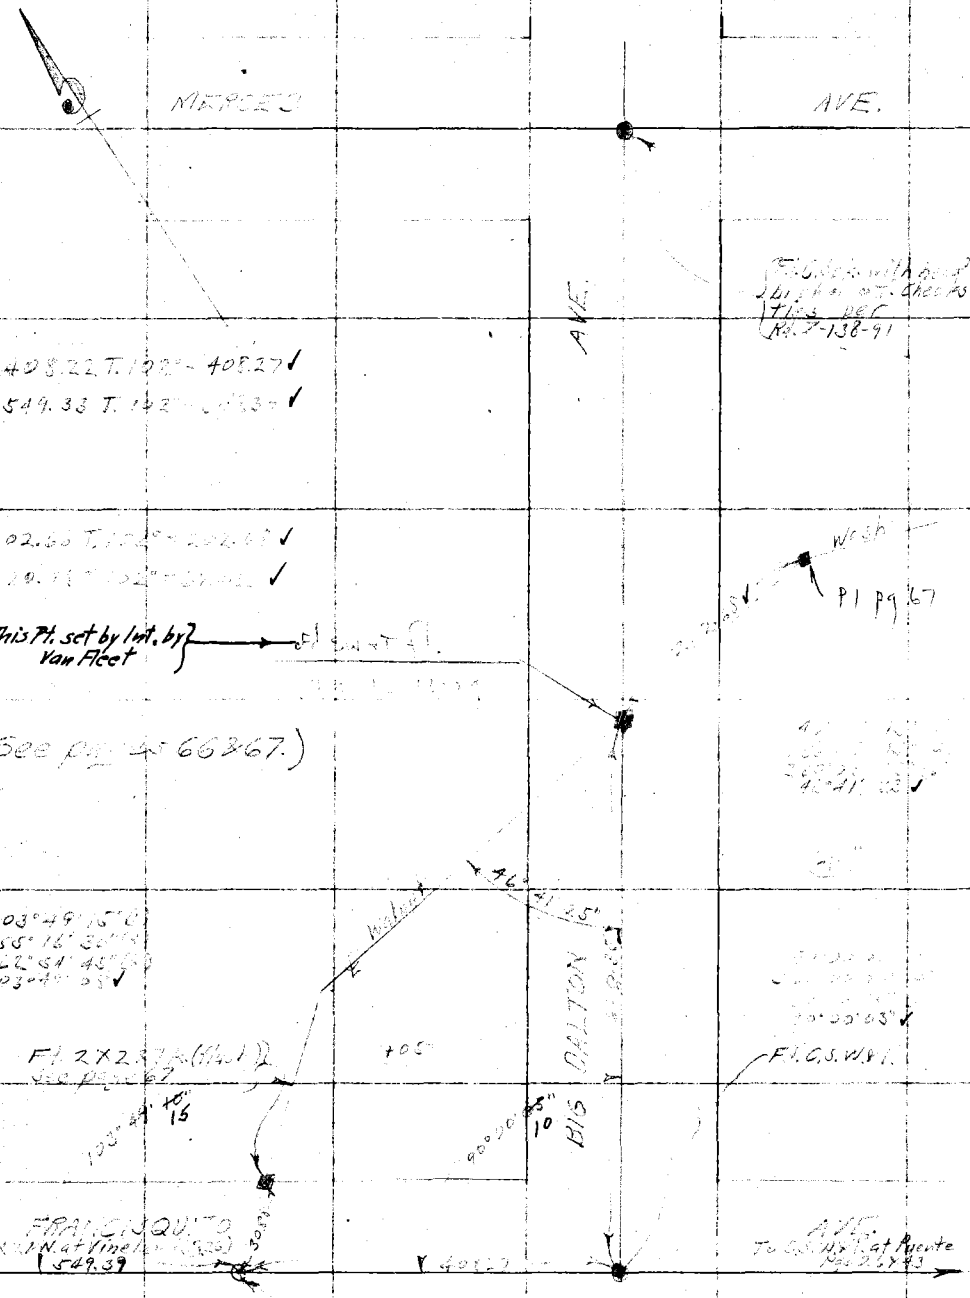

RETURN TO
LOS ANGELES COUNTY SURVEYOR

Do not extend notes this side of this line

Note: ANY ADDITIONS OR CHANGES ON THIS SHEET MUST BE MADE OR CIRCLED IN Red. WITH DATE AND NAME OF PERSON MAKING CHANGE.

Date 6-22-27 Notes by A.W. Von Tesl Chief Party A.W. Von Tesl Topo F.B. 352 Pg. 69

Platted by H U M H	W. O. No. 796 ~~O. & C. No.~~ 922
Date NOV 30 1929	Location
Map No. B.457-1	Surveyed by A.W. Von Tesl
Platting C'k'd by Wood	Date 6-22-27.
Date Oct. 1929	Indexed ~~etc.~~ C. JOHNSON

To p. Hom of page 70

From top of page 73

66°05'00" Void See P.125 ~~84.~~ 5570.3

(20) (40) (20)

See R.25 3248.53 3250.65 = 80638

WALNUT

Fd N+T Pin 1-14-27 Not on ℄

66°05'00" (1)
264°20'00" (4)
36°30'15" (5)
66°05'03" ✓

3250.65 N 94° = 3250.86 ✓

90°00'15" (1)
360°01'30" (4)
180°02'00" (6)
90°00'20" ✓

WILEY AVE.

Fd. 2"x2" Tk. (1'deep) by ties - Page 24

90°00'

30

ELLIOT AVE.

(60) (30) (30)

(60) (30) (30)

Notice: ANY ADDITIONS OR CHANGES ON THIS SHEET MUST BE MADE OR CIRCLED IN Red. WITH DATE AND NAME OF PERSON MAKING CHANGE.

Do not extend notes this side of this line

RETURN TO LOS ANGELES COUNTY SURVEYOR

F. B. 352 Pg. 70 A.W. VanFleet Chief Party Notes by A.W.V.F. Date 6-22-29

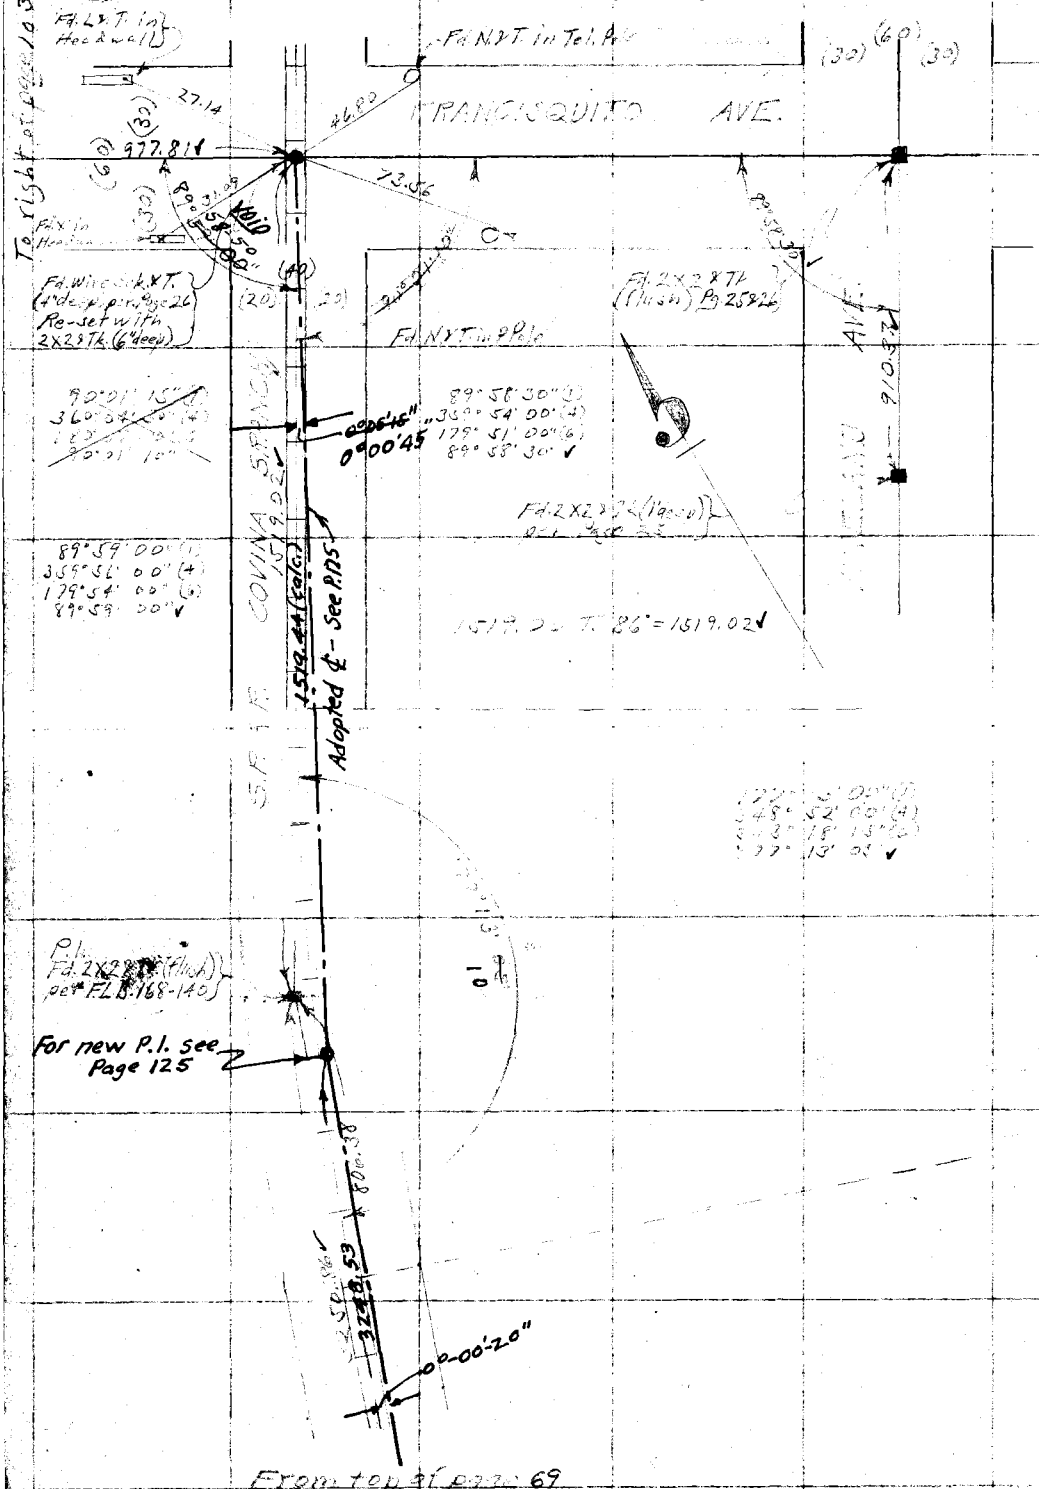

RETURN TO
LOS ANGELES COUNTY SURVEYOR

Do not extend notes this side of this line

Note: ANY ADDITIONS OR CHANGES ON THIS SHEET MUST BE MADE OR CIRCLED IN Red. WITH DATE AND NAME OF PERSON MAKING CHANGE.

Date 9-26-29 Notes by A.W.V.F. Chief Party A.W. Vanfleet F.B. 352 Pg. 71

Platted by H. U. M. H.
Date NOV 30 1929
Map No. B.457-1
Platting C'k'd by Wood
Date 9c6.1929

W. O. No. 796 D. C. O. No. 042
Location
Surveyed by A.W.V.F.
Date 6-26-29
Indexed A. C. JOHNSON

To bottom of page 72

(150)
(75) (75)

150° 53' 15" (1)
150° 30' 30" (2)
184° 21' 05" (3)
150° 46' 10" ✓

860.53

EG.

150.00

Δ = 20° 00' 00"
R = 574.62 ✓
T = 150.30 ✓
L = 293.46 ✓

FLB. 168-230

P/I
Fd. 2×2×Tk. (1' deep)

B.C.

From top of page 67

Notes: ANY ADDITIONS OR CHANGES ON THIS SHEET MUST BE MADE OR CIRCLED IN Red. WITH DATE AND NAME OF PERSON MAKING CHANGE.

Do not extend notes this side of this line

RETURN TO LOS ANGELES COUNTY SURVEYOR

F. B. 352 Pg. 72 A.W.Von Tied Chief Party Notes by A.W.V.F. Date 6-28-29

To bottom of page 73

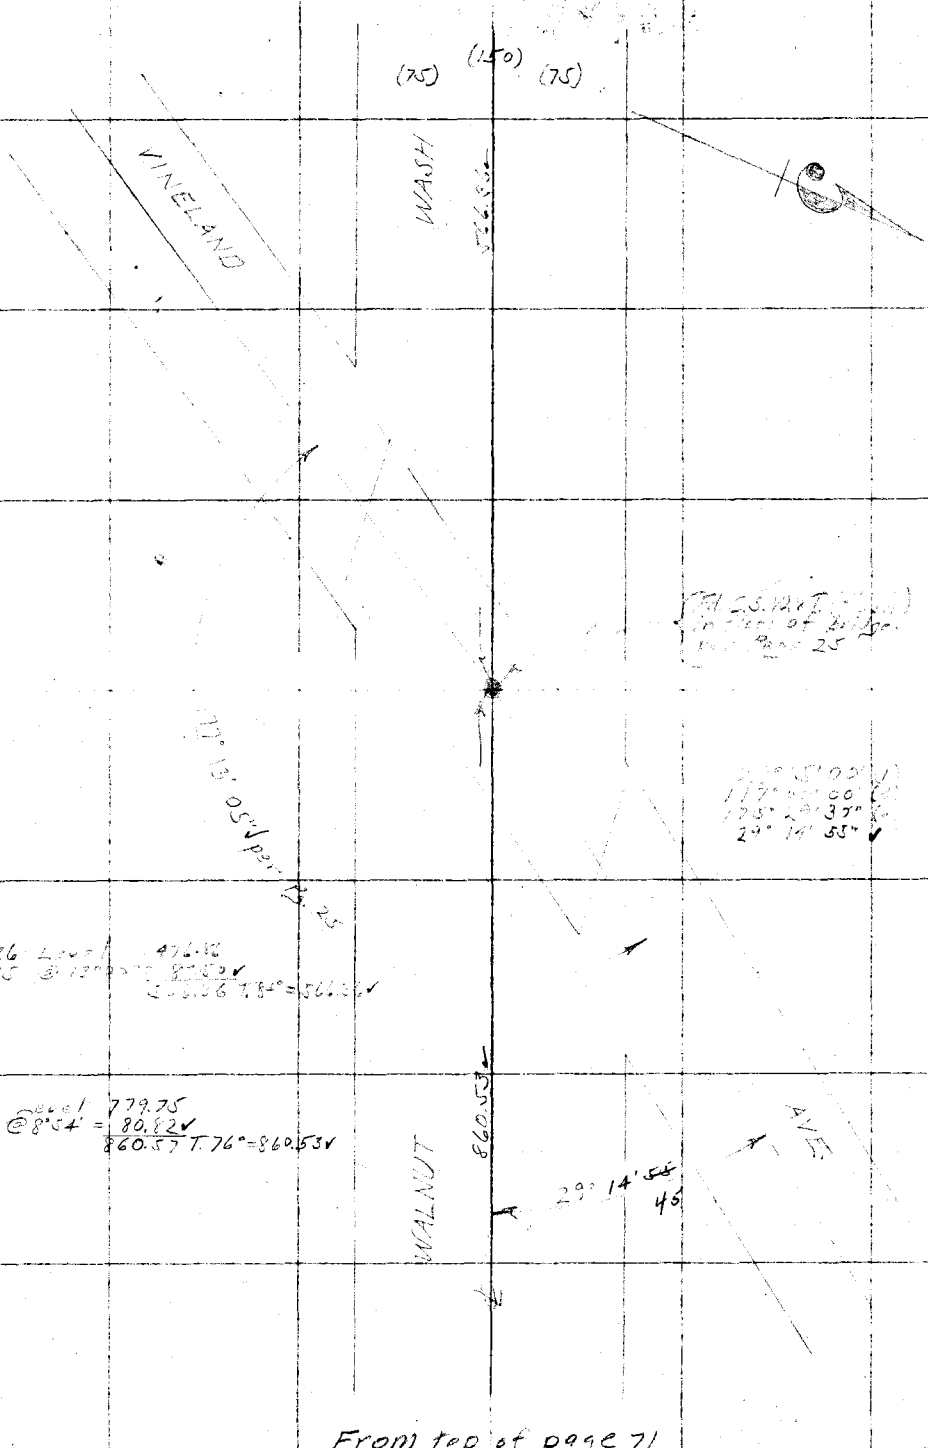

RETURN TO
LOS ANGELES COUNTY SURVEYOR

Do not extend notes this side of this line

Note: ANY ADDITIONS OR CHANGES ON THIS SHEET MUST BE MADE OR CIRCLED IN Red. WITH DATE AND NAME OF PERSON MAKING CHANGE.

Date 7-1-29 Notes by A.W.J. Chief Party A.W.J. F.B. 352 Pg. 73

Tape

Platted by H.U.M.H.
Date NOV 30 1929
Map No. B.457-1
Platting C'k'd by Woof
Date Oct. 1929

W.O. No. 796 B.O.C. No. 021
Location Soto St. Arc.
Date 7-1-29
Indexed A. C. Johnson

Notes: ANY ADDITIONS OR CHANGES ON THIS SHEET MUST BE MADE OR CIRCLED IN Red. WITH DATE AND NAME OF PERSON MAKING CHANGE.

Do not extend notes this side of this line

RETURN TO LOS ANGELES COUNTY SURVEYOR

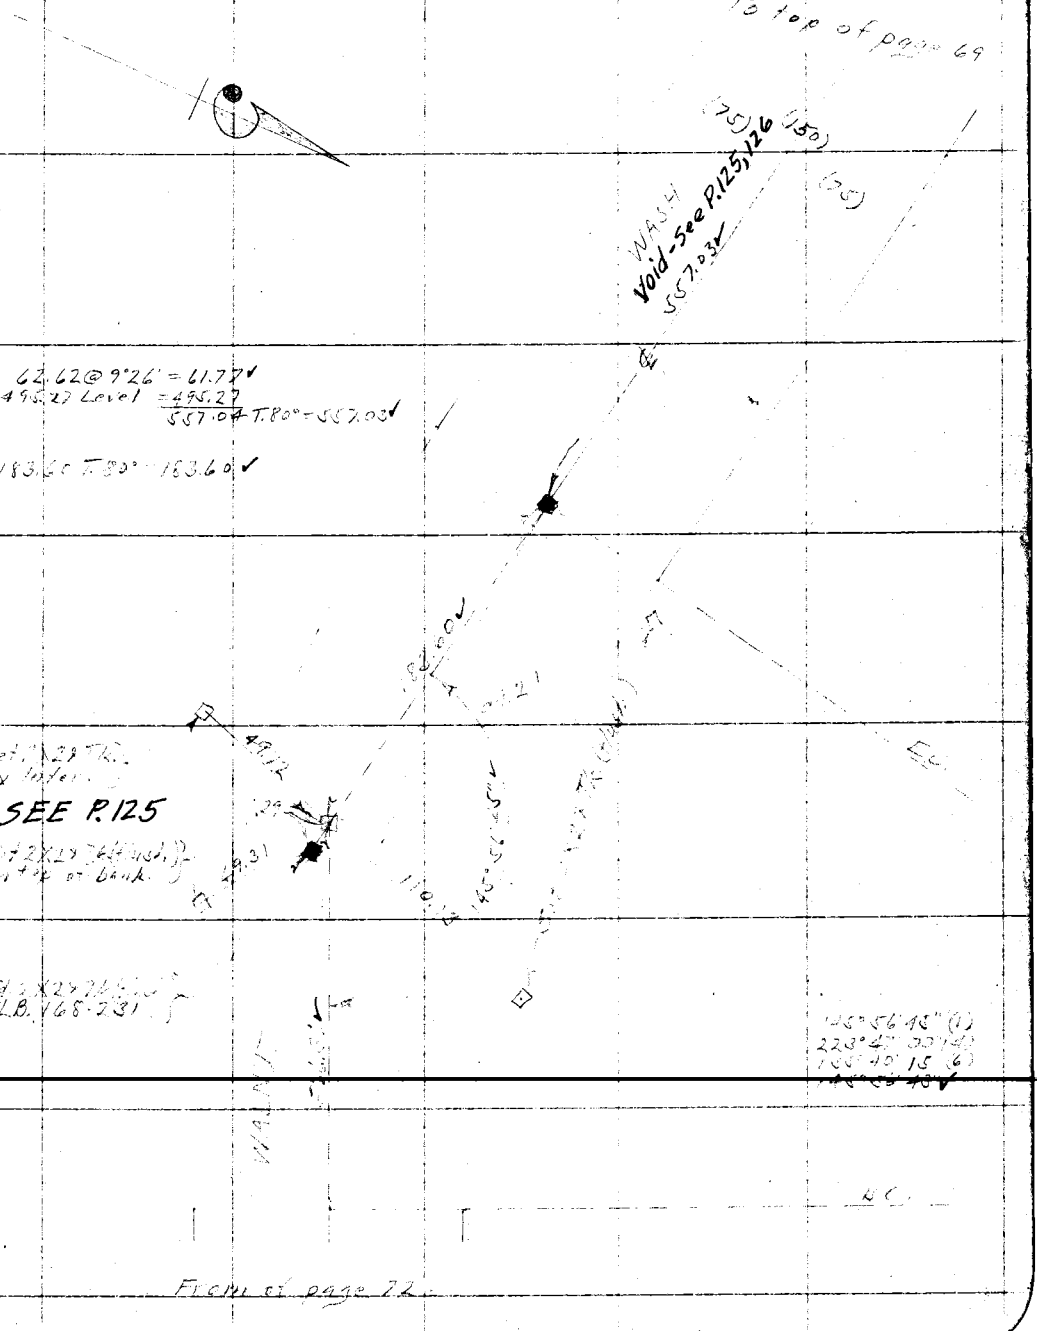

F. B. 352 Pg. 74 Chief Party Notes by Date

RETURN TO
LOS ANGELES COUNTY SURVEYOR

Do not extend notes this side of this line

Note: ANY ADDITIONS OR CHANGES ON THIS SHEET MUST BE MADE OR CIRCLED IN Red. WITH DATE AND NAME OF PERSON MAKING CHANGE.

Date _____ Notes by _____ Chief Party _____ F.B. 352 Pg. 75

Platted by H. U. M. H.	W. O. No. _____ D. S. O. No. _____
Date NOV 30 1929	Location _____
Map No. _____	Surveyed by _____
Platting C'k'd by _____	Date _____
Date _____	Indexed A. C. Johnson

Notes: ANY ADDITIONS OR CHANGES ON THIS SHEET MUST BE MADE OR CIRCLED IN Red. WITH DATE AND NAME OF PERSON MAKING CHANGE.

Do not extend notes this side of this line

RETURN TO LOS ANGELES COUNTY SURVEYOR

PROPOSED

℄

GARVEY AVENUE

M.O. 796

℄ - Pages 76 to 82 incl.)

(Topog. Pages 83 to 100 incl.)

This line is approved

F. B. 352 Pg. 76 A.W. VanFleet Chief Party Notes by A.W.V.F. Date 7-2-29

To bottom of page 77

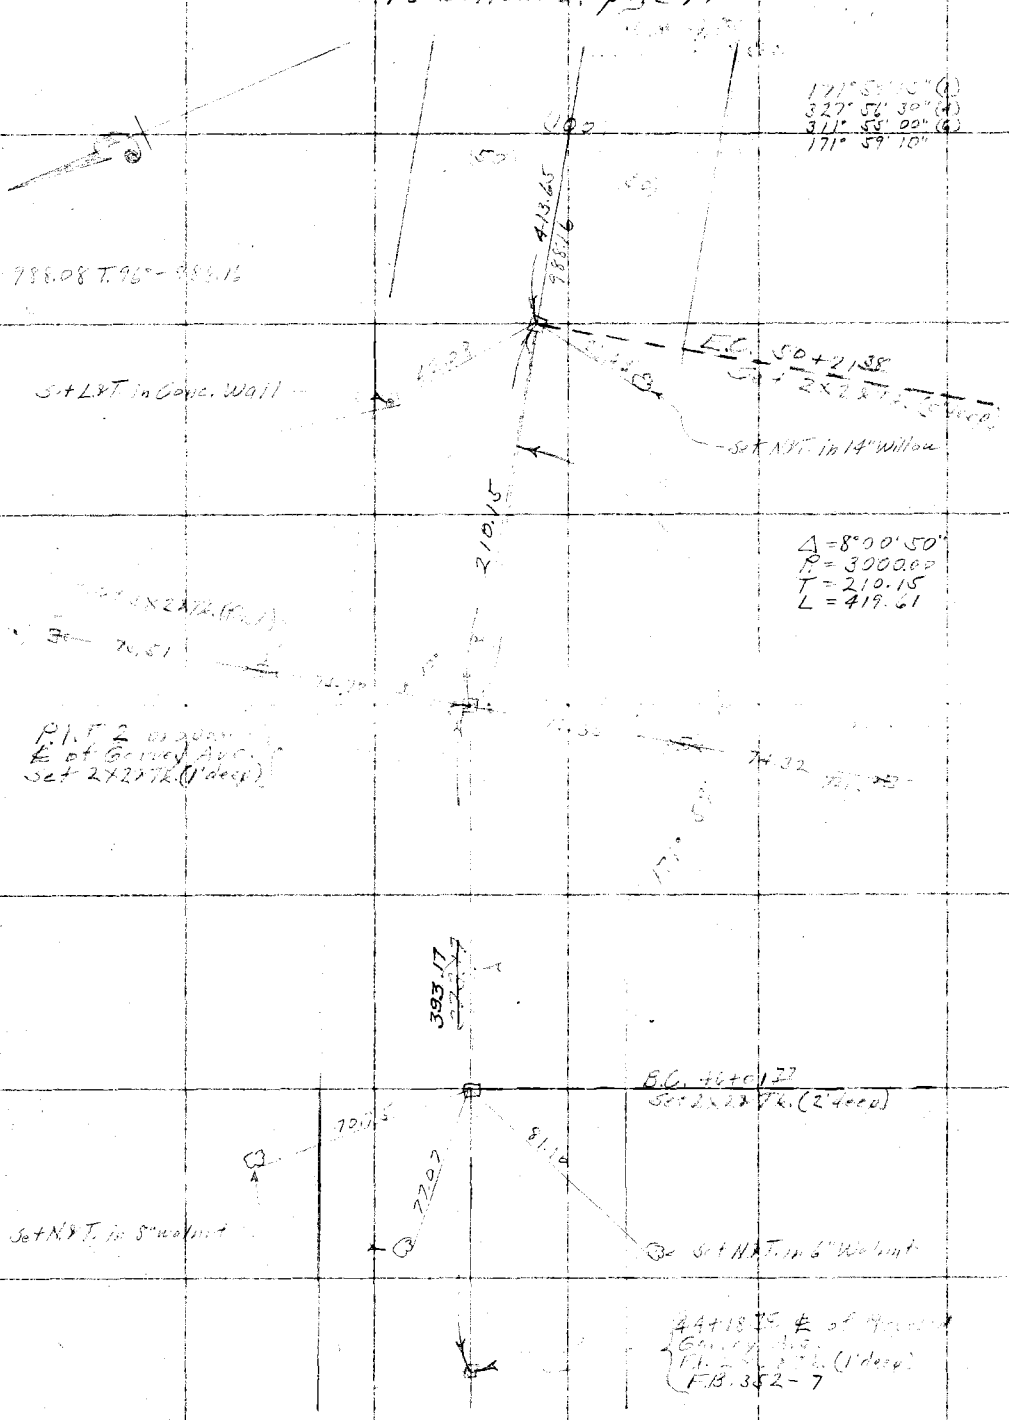

From top of page 2

RETURN TO
LOS ANGELES COUNTY SURVEYOR

Do not extend notes this side of this line

Note: ANY ADDITIONS OR CHANGES ON THIS SHEET MUST BE MADE OR CIRCLED IN Red. WITH DATE AND NAME OF PERSON MAKING CHANGE.

Date 7-[illegible]-29 Notes by A.W.H. Chief Party A.W.H. F.B. 352 Pg. 77

Plotted by H.U.M.H.
Date NOV 30 1929
Map No. B-457-1
Platting C'k'd by Wood
Date Nov. 1929

W. O. No. 796 D. S. O. No.
Location [illegible]
Surveyed by A.W. Hart & Asst
Date 7-3-29
Indexed A. C. Johnson

To bottom of page 78

1052.97 x 85° = 1053.00
1000.08 x 7.96° = 1000.08
861.27 x 88° = 861.54

(SCT 67+79.47
Set 2 x 2 x 28 (8" deep)
with Nail & Shot
of Necks

(SCT 57+99.39
Set 2x2 (8" deep)
[illegible]
of Necks

54+35.03
Set 2 X 28 Tk. (1 deep)
by Inters.

FENCE
R/W

E. Line
444.47

Meander Line
Set [illegible]

102° 28' 15" (1)
48° 33' 00" (4)
252° 49' 30" (6)
[illegible]

87.06

(Fd 2X2 (1 deep)
at Inters. of E & F
C Line St. with
Easterly R/W Line
[illegible]

132° 08' 15"

From top of page 76

RETURN TO
LOS ANGELES COUNTY SURVEYOR

Notes: ANY ADDITIONS OR CHANGES ON THIS SHEET MUST BE MADE OR CIRCLED IN Red. WITH DATE AND NAME OF PERSON MAKING CHANGE.

Do not extend notes this side of this line

F.B. 352 Pg. 78 A.W. Van Fleet Chief Party Notes by A.W.V.F. Date 7-5-29

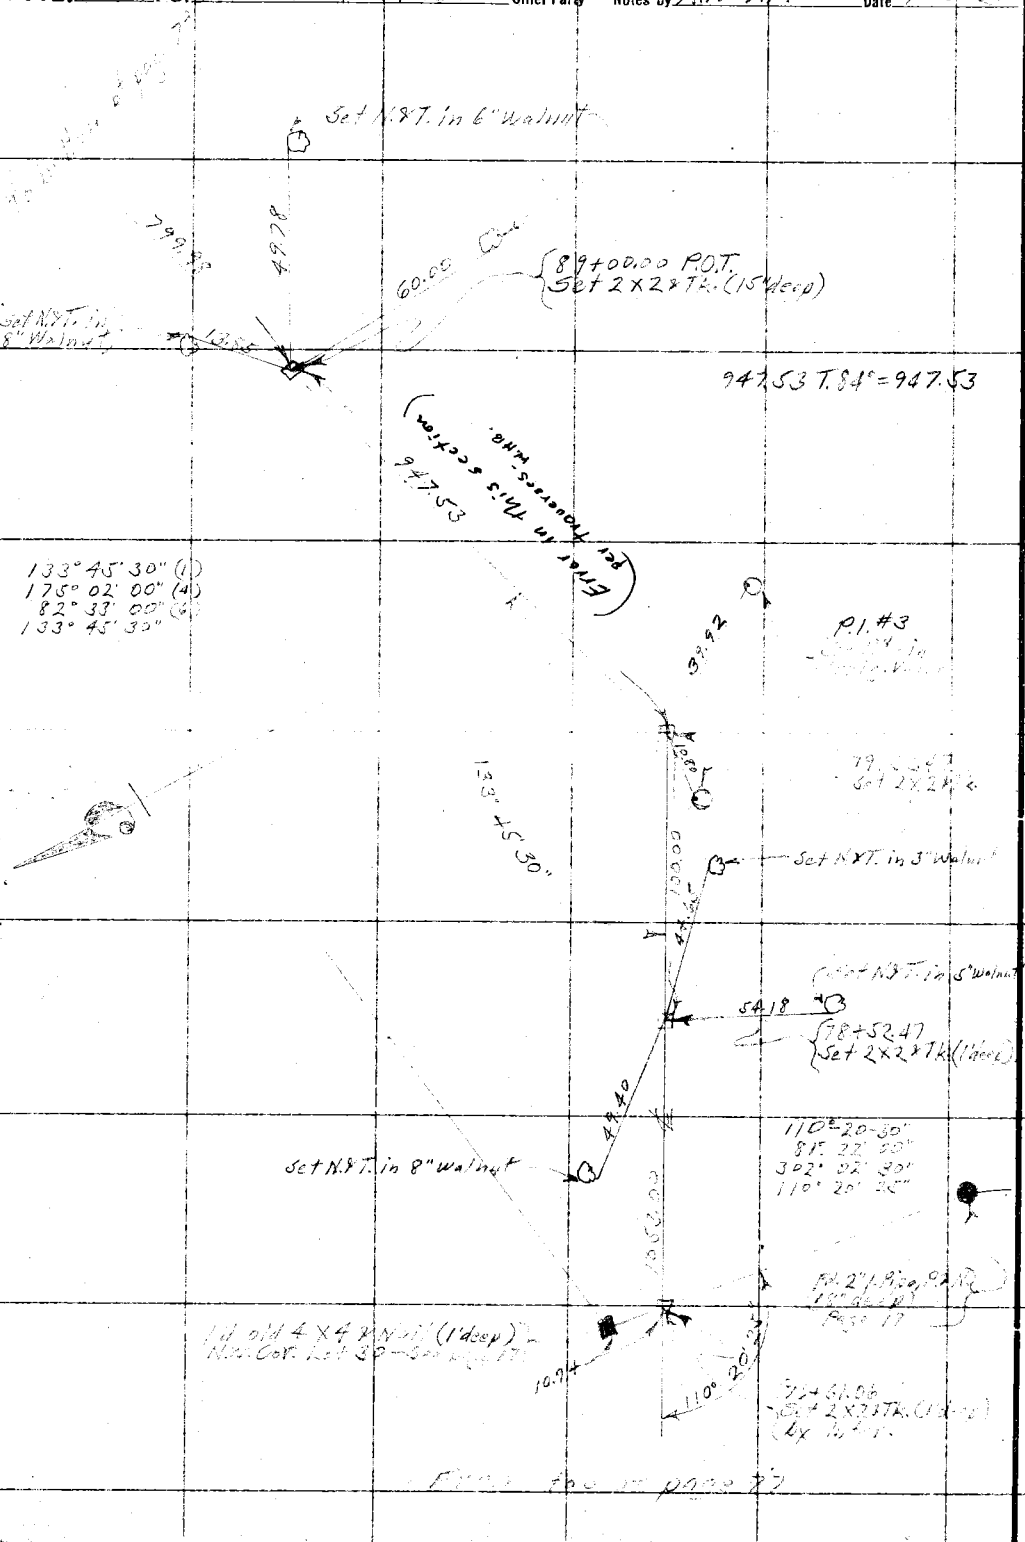

RETURN TO
LOS ANGELES COUNTY SURVEYOR
Do not extend notes this side of this line

Note: ANY ADDITIONS OR CHANGES ON THIS SHEET MUST BE MADE OR CIRCLED IN Red. WITH DATE AND NAME OF PERSON MAKING CHANGE.

Date 7-6-29. Notes by [illegible] Chief Party [illegible] F.B. 352 PG. 79

Platted by	W. O. No. 196 D. O. No. 022
Date	Location [illegible]
Map No.	Surveyed by [illegible]
Platting C'k'd by	Date 7-6-29.
Date	Indexed

To bottom of page 80

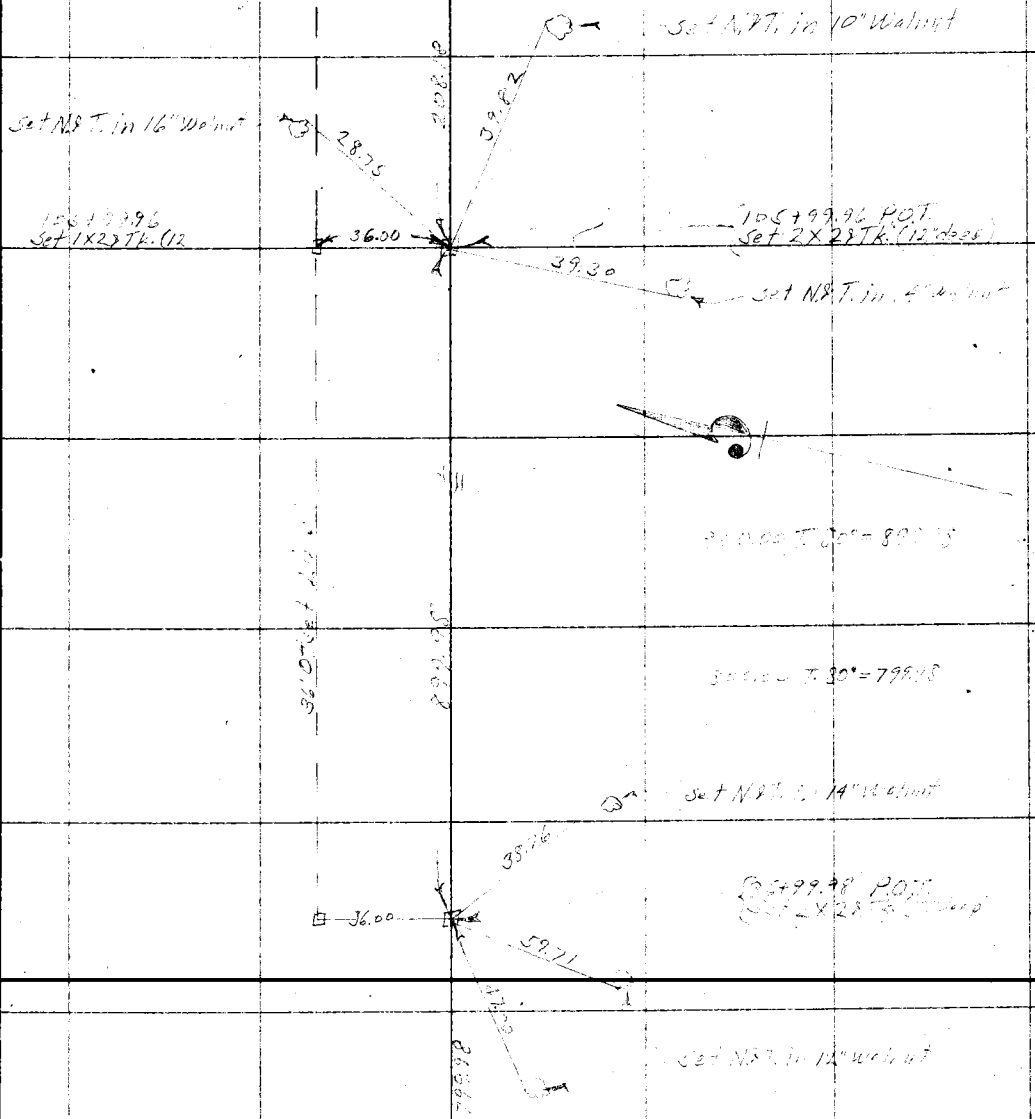

Exception at page 78

Notes: ANY ADDITIONS OR CHANGES ON THIS SHEET MUST BE MADE OR CIRCLED IN Red. WITH DATE AND NAME OF PERSON MAKING CHANGE.

Do not extend notes this side of this line

RETURN TO LOS ANGELES COUNTY SURVEYOR

F. B. 352 Pg. 80 Surv. Fleet Chief Party Notes by A.W.V.F. Date 7-11-29

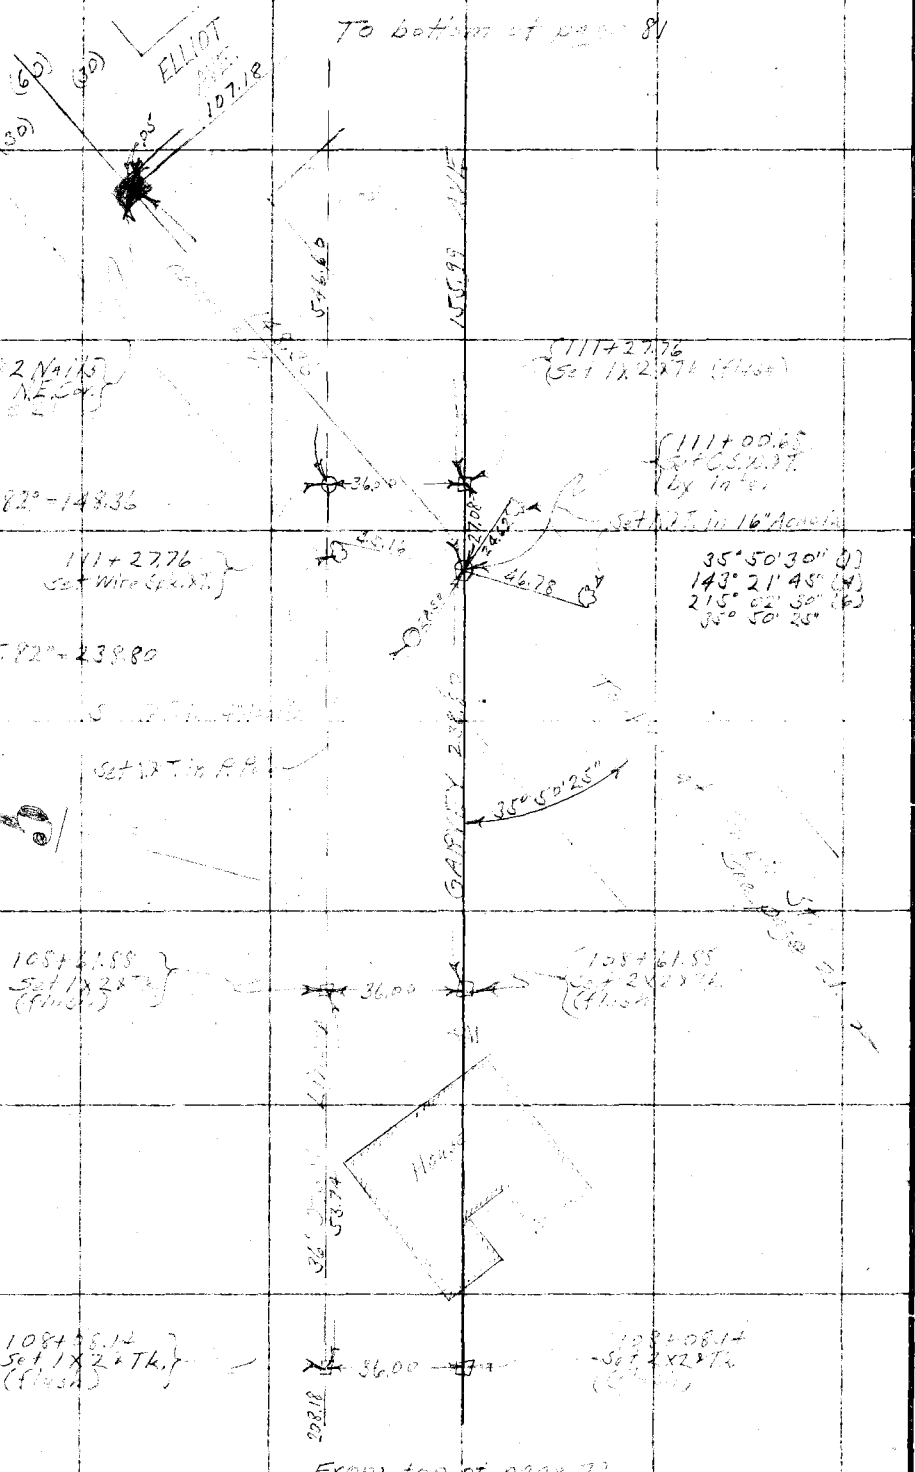

RETURN TO
LOS ANGELES COUNTY SURVEYOR

Do not extend notes this side of this line

Note: ANY ADDITIONS OR CHANGES ON THIS SHEET MUST BE MADE OR CIRCLED IN Red. WITH DATE AND NAME OF PERSON MAKING CHANGE.

Date 7-15-29 Notes by J.W.V.F. Chief Party A.W. Hamilton F.B. 352 Pg. 81

Platted by	W. O. No. 210 D. S. No. 027
Date	Location
Map No.	Surveyed by A.W. Hamilton
Platting C'k'd by	Date 7-15-29
Date	Indexed A. C. Johnson

To bottom of page 82

372.24

60.00 Offset Line

STATE

AVE.

GARVEY

116+74.36
Set 2X2 Tk (1 deep)

116+74.36
Set 1X2 (1 deep)

24.50

36.00

546.53 T. 104° = 546.60

107.18 T. 82° = 107.18

546.53

61.74

3326

125° 51' 15" (1)
143° 24' 45" (4)
35° 07' 15" (6)
125° 51' 12"

112+83.52
Set 2X2 (6" deep)
(by inter.

51' 10"

125

ELLIOT

107.18

104

(30)

(60)

(30)

Set 'X' on top of Conc. [illegible] Valves

From top of page 80

Notes: ANY ADDITIONS OR CHANGES ON THIS SHEET MUST BE MADE OR CIRCLED IN Red. WITH DATE AND NAME OF PERSON MAKING CHANGE.

Do not extend notes this side of this line

RETURN TO LOS ANGELES COUNTY SURVEYOR

F. B. 352 Pg. 82 A.W. Hoffacker Chief Party Notes by A.W.H.F. Date 7-15-29

To Bottom of page 83

RETURN TO
LOS ANGELES COUNTY SURVEYOR

Do not extend notes this side of this line

Note: ANY ADDITIONS OR CHANGES ON THIS SHEET MUST BE MADE OR CIRCLED IN Red. WITH DATE AND NAME OF PERSON MAKING CHANGE.

120+46.60
Set 1 X 2 Tr. (1 Mark)

60.50

From top of page 81

Date _____ Notes by _____ Chief Party _____ F.B. 352 PG. 83

Platted by	W. O. No. _____ D. S. O. No. _____
Date	Location
Map No.	Surveyed by
Platting C'k'd by	Date
Date	Indexed

Notes: ANY ADDITIONS OR CHANGES ON THIS SHEET MUST BE MADE OR CIRCLED IN Red. WITH DATE AND/ NAME OF/ PERSON MAKING CHANGE.

Do not extend notes this side of this line

TOPOGRAPHY

GARVEY AVENUE

W.O. 796

(Topog. Pages 83 to 100 incl.)

(℄ Pages 76 to 82 incl.)

This line is abandoned

RETURN TO LOS ANGELES COUNTY SURVEYOR

F.B. 352 Pg. 84 A.W. Van Fleet Chief Party Notes by A.W.V.F. Date 7-6-29

To bottom of page 85

45+26 6" walnut 8" walnut 50' 17' 31' 8" walnut 41+28

45+00 8" walnut 33' 6" walnut 6' 50' 6" walnut 45+02

44+75 6" walnut 10" walnut 50' 12' 30' 10" walnut 50' 10" walnut 44+25

AWVF

55' 8" walnut 44+50

44+27 10" walnut 8" walnut 50' 18' 30' 6" walnut 50' 8" walnut 44+27

44+00 Guy wire 14'

43+87 Sycamore 23' 17'

43+79 50' 25' 25' 12" walnut 50' 14" walnut 43+79

43+27-2-10" walnuts 50' 20' 29' 10" walnut 50' 8" walnut

GARVEY

42+78-2-8" walnuts 50' 21' 24' 12" walnut 50' 16" walnut 42+28

42+27-2-7" walnuts 50' 23' 24' 12" walnut 55' 10" walnut

42+21 R.R.S. 17° 14° 42+21 Guy Wire

℄ GILMAN RD.

41+79-10" walnut 48.0

41+79.92 Fd. 3/4" I.P. Flush with ground (22"x12")

GAYLE ST.

From top of page 83

RETURN TO LOS ANGELES COUNTY SURVEYOR

Do not extend notes this side of this line

Note: ANY ADDITIONS OR CHANGES ON THIS SHEET MUST BE MADE OR CIRCLED IN Red. WITH DATE AND NAME OF PERSON MAKING CHANGE.

Date [illegible] Notes by A.W.V.F. Chief Party A.W.V.F. F.B. 352 PG. 85

Platted By	W. O. No. 796 D. S. O. No.
Date	Indexed A. C. Johnson

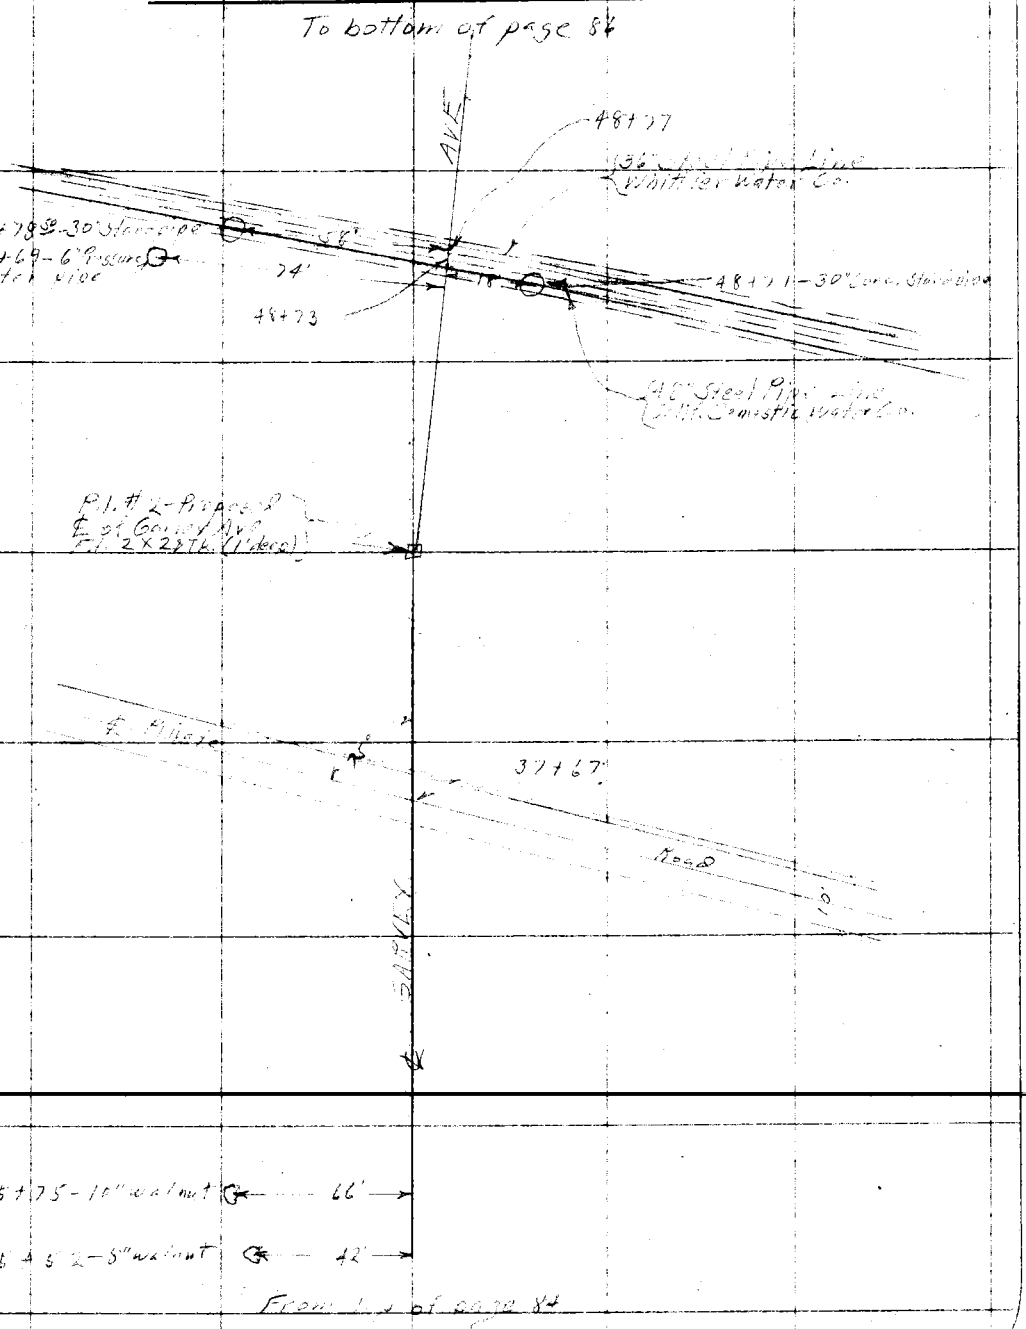

RETURN TO
LOS ANGELES COUNTY SURVEYOR

Notes: ANY ADDITIONS OR CHANGES ON THIS SHEET MUST BE MADE OR CIRCLED IN Red. WITH DATE AND NAME OF PERSON MAKING CHANGE.

Do not extend notes this side of this line

F.B. 552 Pg. 86 A.W. Van Fleet Chief Party Notes by A.W.V.F. Date 7-8-24

To bottom of page 87

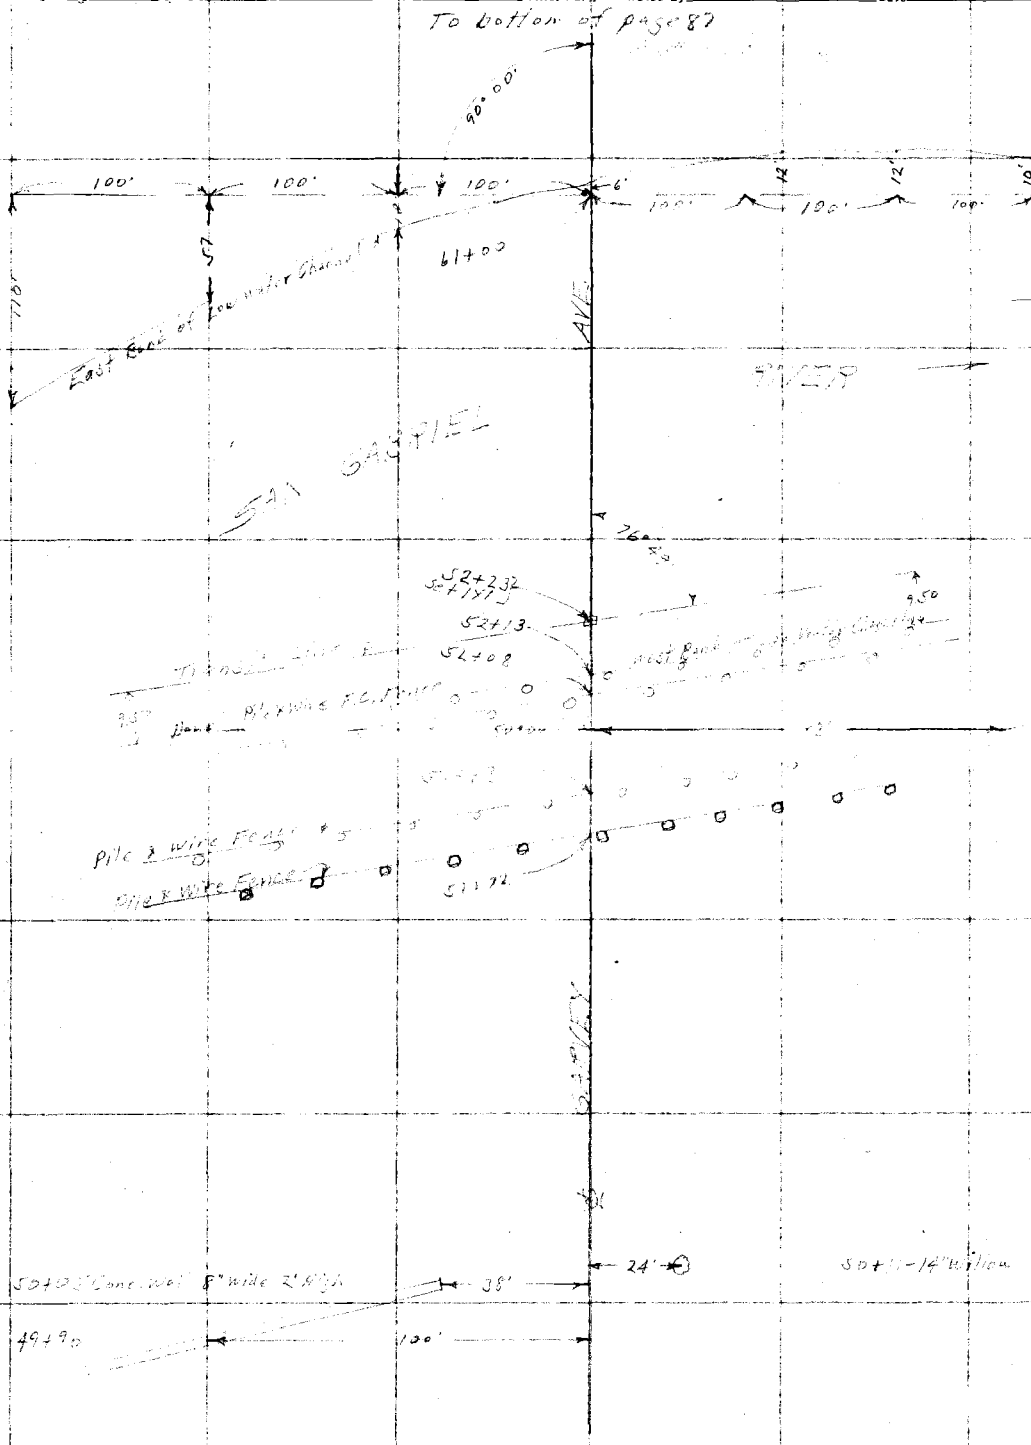

From top of page 85

RETURN TO
LOS ANGELES COUNTY SURVEYOR

Do not extend notes this side of this line

Note: ANY ADDITIONS OR CHANGES ON THIS SHEET MUST BE MADE OR CIRCLED IN Red. WITH DATE AND NAME OF PERSON MAKING CHANGE.

Date 7-8-29 Notes by A.M.V. Chief Party A.M. Van Fleet F.B. 352 Pg. 87

Platted by H.U.M.H.	W.O. No. 796 D.S.O. No.
Date	Location 6th ave Line
Map No.	Surveyed by A.M. Van Fleet
Platting C'k'd by	Date 7-8-29
Date	Indexed

To bottom of page 88

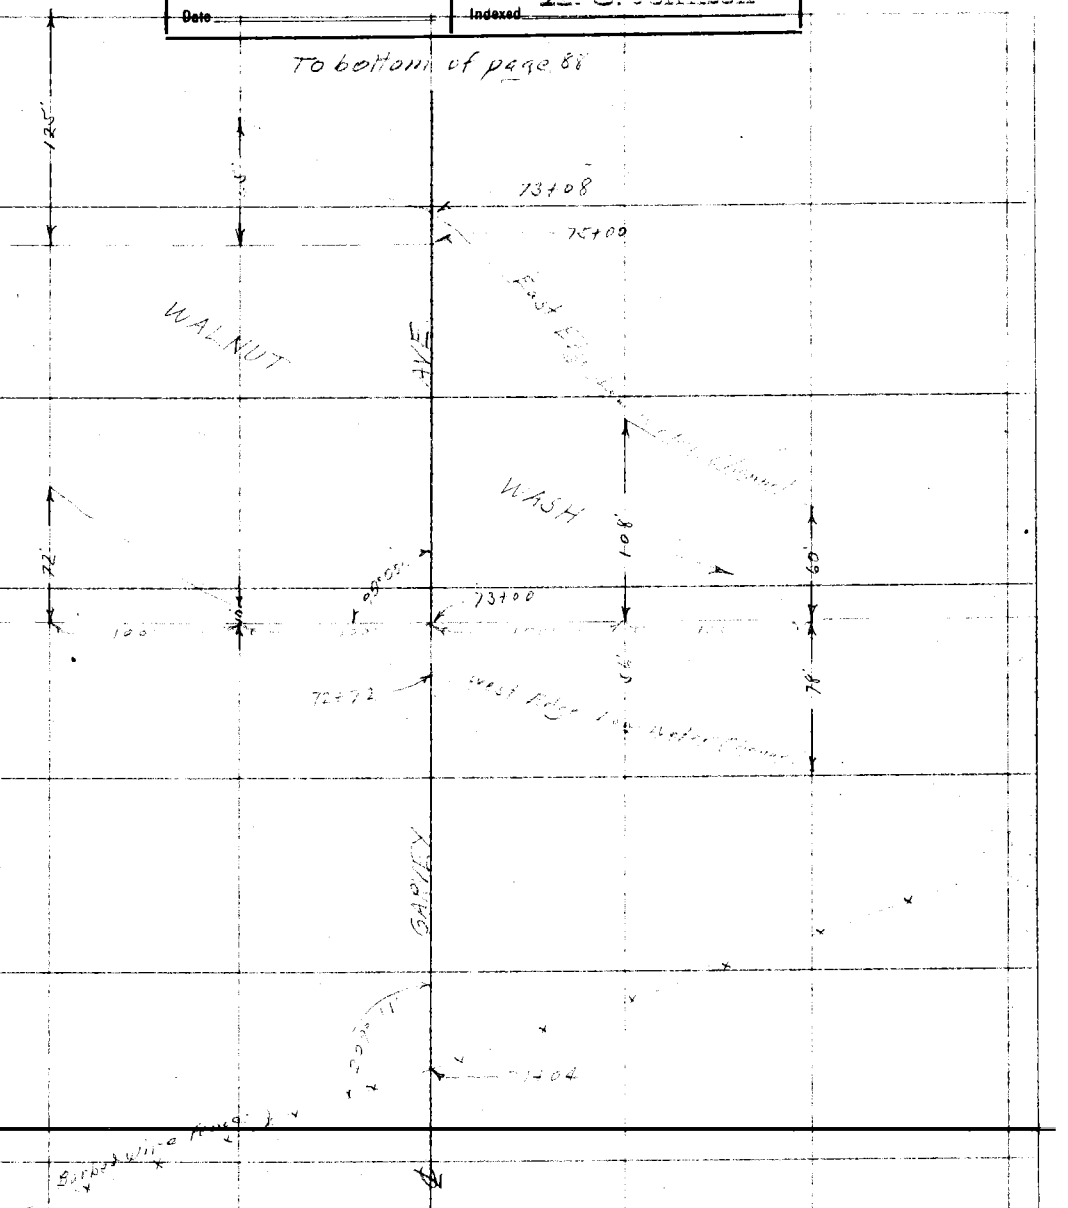

From top of page 86

Notes: ANY ADDITIONS OR CHANGES ON THIS SHEET MUST BE MADE OR CIRCLED IN Red. WITH DATE AND NAME OF PERSON MAKING CHANGE.

Do not extend notes this side of this line

RETURN TO LOS ANGELES COUNTY SURVEYOR

F.B. 352 Pg. 188 A.W. VanFleet Chief Party Notes by A.W.V.F. Date 7-8-29

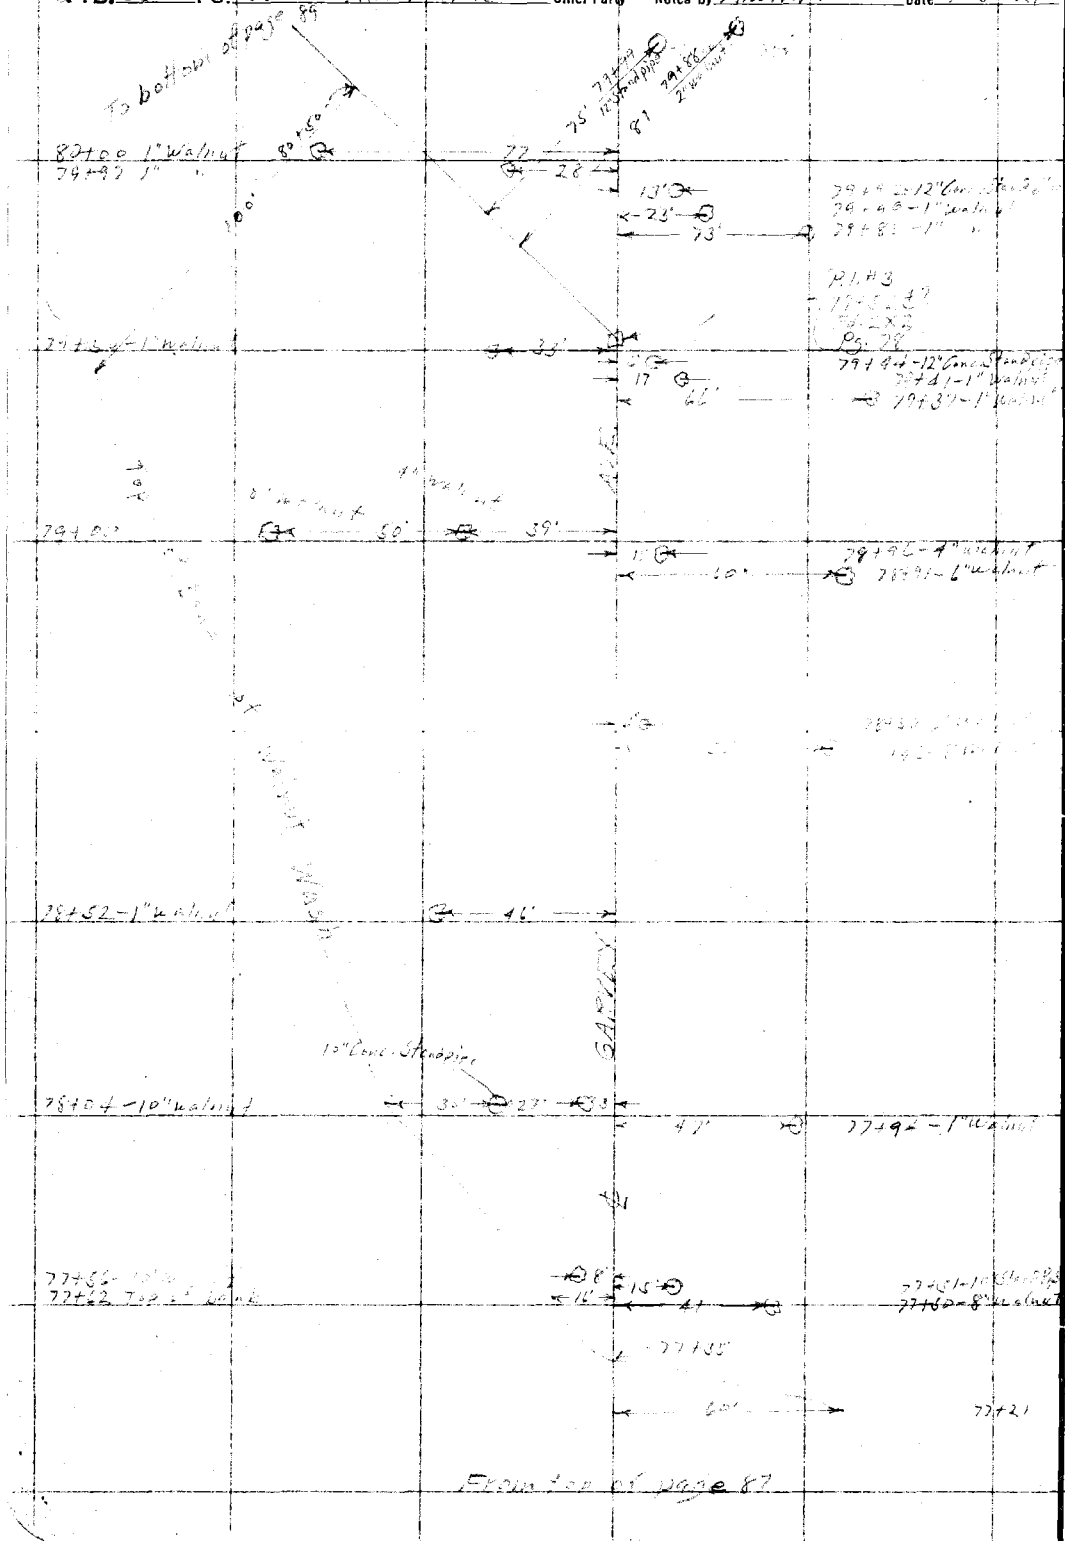

RETURN TO
LOS ANGELES COUNTY SURVEYOR

Do not extend notes this side of this line

Note: ANY ADDITIONS OR CHANGES ON THIS SHEET MUST BE MADE OR CIRCLED IN Red. WITH DATE AND NAME OF PERSON MAKING CHANGE.

Date 7-8-29 Notes by A.W.V.F. Chief Party A.W. Von Fleet F.B. 352 Pg. 89

Platted by H. U. M. H.	W. O. No. 796 D. S. O. No.
Date	Location Gurley Ave
Map No.	Surveyed by A.W. Von Fleet
Platting C'k'd by	Date 7-18-29
Date	Indexed C. J. Johnson

To bottom of page 90

83+21-12" walnut
28'
20'
83+14-8" Walnut
83+00 Top of Bank
67'
82+85-6" walnut
19'
48'
82+74-10" walnut
10'
82+47-3" walnut
82+28-12" Standpipe
82+18-12" walnut
35'
28'
78'
82+24-10" Walnut
82+00
54
40
81+77-1" walnut
3'
81+72-12" Conc. Standpipe
52'
70'
81+65-10" walnut
81+48-3" walnut
36'
32'
81+40-2" Walnut
81+19-6" walnut
81+06-12" Standpipe
6
72'
61'
81+20-1" walnut
80+77-10" walnut
45'
23'
80+40
15'
64'
15'

From top of page 88

Notes: ANY ADDITIONS OR CHANGES ON THIS SHEET MUST BE MADE OR CIRCLED IN Red. WITH DATE AND NAME OF PERSON MAKING CHANGE.

Do not extend notes this side of this line

RETURN TO LOS ANGELES COUNTY SURVEYOR

F.B. 362 Pg. 90 A.W. van Fleet Chief Party Notes by A.W.v.F Date 7-8-29

To bottom of page 91

86+67 — 1" walnut — 6" walnut — 6" walnut — 16" walnut — 69 — 69 — 64' — 5 — 3

86+31 — 12" Standpipe — 3" walnut — 3" walnut — 4" walnut — 69' — 43 — 26

85+97 — 1" walnut — 6" walnut — 8" walnut — 10" walnut — 69 — 69 — 55' — 15 — 3

85+63 — 12" walnut — 10" walnut — 10" walnut — 10" walnut — 69' — 52' — 16' — 69

85+29 — 6" walnut — 8" walnut — 10" walnut — 69' — 22" — 56'

84+58 — 12" walnut — 69' — 31' — 36

84+22 — 6" walnut — 10" walnut — 4" walnut — 30' — 70' — 2' — 67

83+88 — 10" walnut — 40' — 27' — 10" walnut

83+58 — 12" Standpipe — 85' — 79° — 58 — 6" walnut

83+52 — 2-1" walnut — 70' — 11'

GARVEY AVE.

From top of page 89

RETURN TO
LOS ANGELES COUNTY SURVEYOR
Do not extend notes this side of this line

Note: ANY ADDITIONS OR CHANGES ON THIS SHEET MUST BE MADE OR CIRCLED IN Red. WITH DATE AND NAME OF PERSON MAKING CHANGE.

Date 7-8-29 Notes by A.W.V.F. Chief Party A.W. Von Fleet F.B. 352 Pg. 91

Platted by H.U.M.H.	W. O. No. 796 D. S. O. No.
Date	Location
Map No.	Surveyed by A.W. Von Fleet
Platting C'k'd by	Date 7-8-29
Date	Indexed A. C. Johnson

To bottom of page 92

89+74 → 18' 100' 34' 34' →

89+51 14" walnut 12" Standard Dip 97 46 →

89+45 2" walnut 12" walnut 6" walnut 40' 32' 38' 31' 6" walnut 89+15

89+11 4" walnut 6" walnut 69 69 7' 62' 6" walnut

88+76 3" walnut 5" walnut 8" walnut 32' 69' 42' 22' 3" walnut

88+39 12" Standard 165 69' 69' 12' 6" walnut

88+05 2" walnut 69' 65' 12' 8" walnut

87+71 10" walnut 8" walnut 4" walnut 69' 69' 27' 42' 4" walnut

87+35 7" walnut 7" walnut 69' 44' 5' 6" walnut 69' 6" walnut

82+00 6" walnut 6" walnut 79° 28' 69' 34' 33' 6" walnut

From top of page 90

Notice: ANY ADDITIONS OR CHANGES ON THIS SHEET MUST BE MADE OR CIRCLED IN Red. WITH DATE AND NAME OF PERSON MAKING CHANGE.

Do not extend notes this side of this line

RETURN TO LOS ANGELES COUNTY SURVEYOR

F.B. 352 Pg. 92 A.W. Van Fleet Chief Party Notes by A.W.V.F. Date 7-8-24

To bottom of page 93

93+11 — 2-16" walnuts — 69' — 27 — 41' — 3 14" walnuts

92+75 — 14" walnut — 69' — 16" walnut — 69' — 2' — 14" walnut — 69' — 3

AVE.

92+06 — 16" walnut — 69' — 3" walnut — 69' — 14" — 6' — 54' — 3 16" walnut

91+70 — 2-12" walnuts — 69' — 45' — 25' — 12" walnut — 69' — 12" walnut

91+37 — 15 — 69' — 69' — 13' — 55' — 14" walnut

91+01 — 2-12" walnuts — 69' — 53' — 16' — 14" walnut

GARVEY

45' — 3 — 90+89 — 2" walnut

83' — 3 — 90+86 — 16" walnut

90+57 — 3-16 — 69' — 69' — 24' — 5' — 5" walnut — 4" walnut — 90+53

45' — 35' — 3 — 90+50

16" walnut

90+31 — 12" walnut — 69' — 54' — 4" walnut — Valve

90+21 — 4" walnut — 32' — Valve

5' — 16" walnut — 35' — 6" walnut — 90+15

92+00 — 18" walnut — 100'

89+93

Valve — 6" — 1 — 14" walnut — 69' — 2 — 12" walnut — 84+80

1" Service Pipe Line — 55°

Valve — 4" — 1" Service Pipe Line

From top of page 91

RETURN TO LOS ANGELES COUNTY SURVEYOR

Do not extend notes this side of this line

Note: ANY ADDITIONS OR CHANGES ON THIS SHEET MUST BE MADE OR CIRCLED IN Red. WITH DATE AND NAME OF PERSON MAKING CHANGE.

Date 7-8-29 Notes by A.L.M.F. Chief Party A.L. Hansen F.B. 352 Pg. 93

Platted by H.U.M.H.	W.O. No. 796 D.S.O. No.
Date	Location Gordon Ave
Map No.	Surveyed by A.L. Hansen
Platting C'k'd by	Date 7-8-29
Date	Indexed [illegible]

To bottom of page 94

96+25 69' 69' 59' 69' 20' 50'

95+78 69' 69' 69' 28' 20'

95+20 69' 69' 68' 69'

94+55 69' 69' 58' 31'

94+51 69' 69' 69' 59'

94+16 20' 69' 28' 21'

93+69 69' 17' 53'

93+44 58' 12' 69'

From top of page 92

Notes: ANY ADDITIONS OR CHANGES ON THIS SHEET MUST BE MADE OR CIRCLED IN Red. WITH DATE AND NAME OF PERSON MAKING CHANGE.

Do not extend notes this side of this line

RETURN TO LOS ANGELES COUNTY SURVEYOR

F. B. 552 Pg 94 A W Van Fleet Chief Party Notes by W B Miller Date 7/19/29

To bottom of page 95

From top of page 93

RETURN TO
LOS ANGELES COUNTY SURVEYOR

Do not extend notes this side of this line

Note: ANY ADDITIONS OR CHANGES ON THIS SHEET MUST BE MADE OR CIRCLED IN Red. WITH DATE AND NAME OF PERSON MAKING CHANGE.

Date 7/9/29 Notes by W. E. Miller Chief Party A. V. Vogt Jr. F.B. 352 Pg. 95

Platted by H. U. M. H.	W. O. No. 796 D. S. O. No.
Date	Location
Map No.	Surveyed by A. V. Vogt Jr.
Platting C'k'd by	Date 7/9/29
Date	Indexed C. Johnson

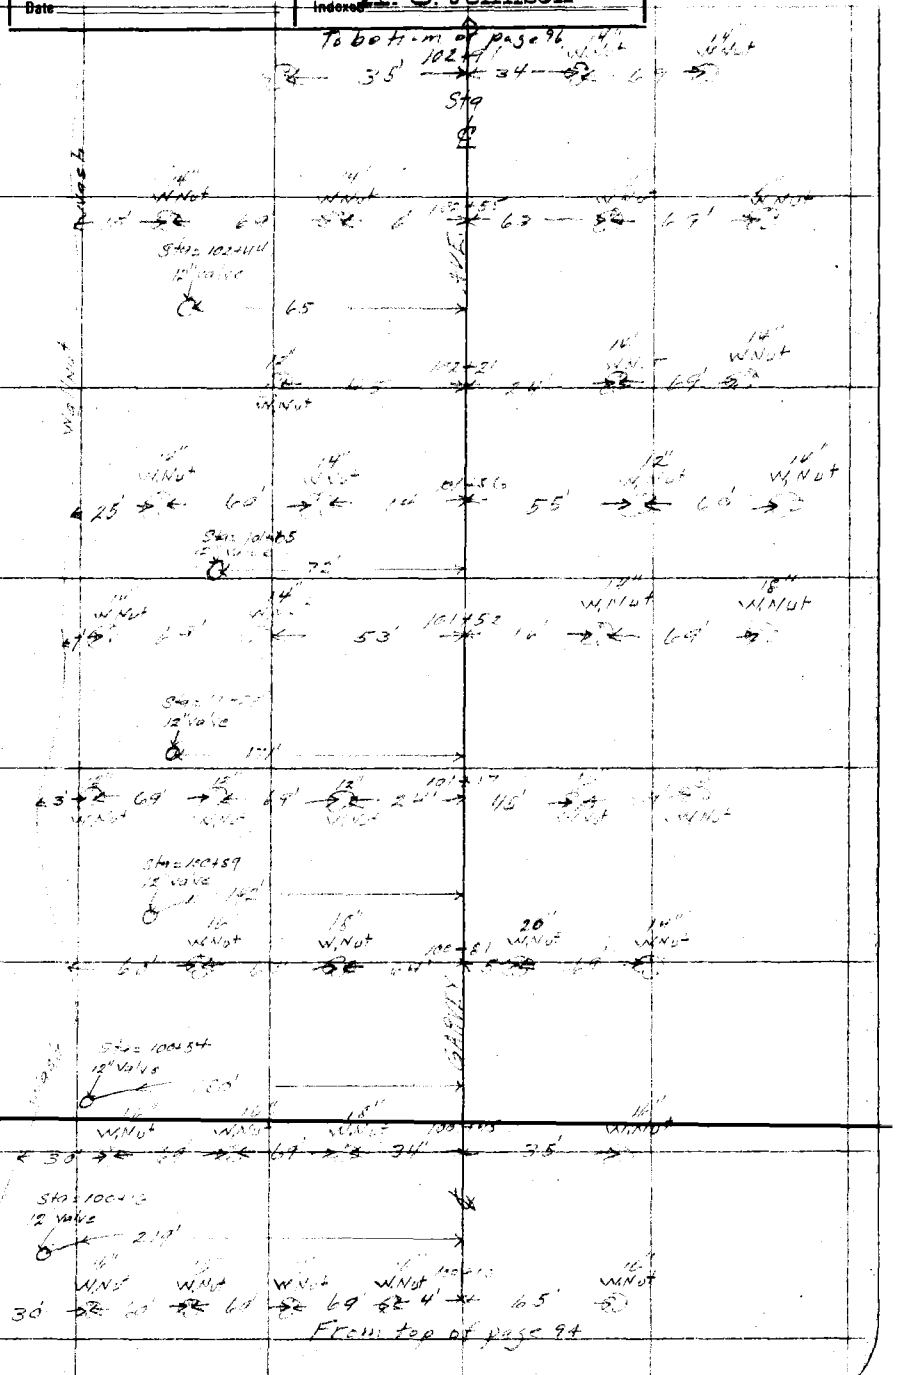

Note: ANY ADDITIONS OR CHANGES ON THIS SHEET MUST BE MADE OR CIRCLED IN Red. WITH DATE AND NAME OF PERSON MAKING CHANGE.

Do not extend notes this side of this line

RETURN TO LOS ANGELES COUNTY SURVEYOR

F. B. 552 PG. 96 + W Var. 5 Sec 1 Chief Party Notes by WB Miller Date 7/9/49

To bottom of page 97

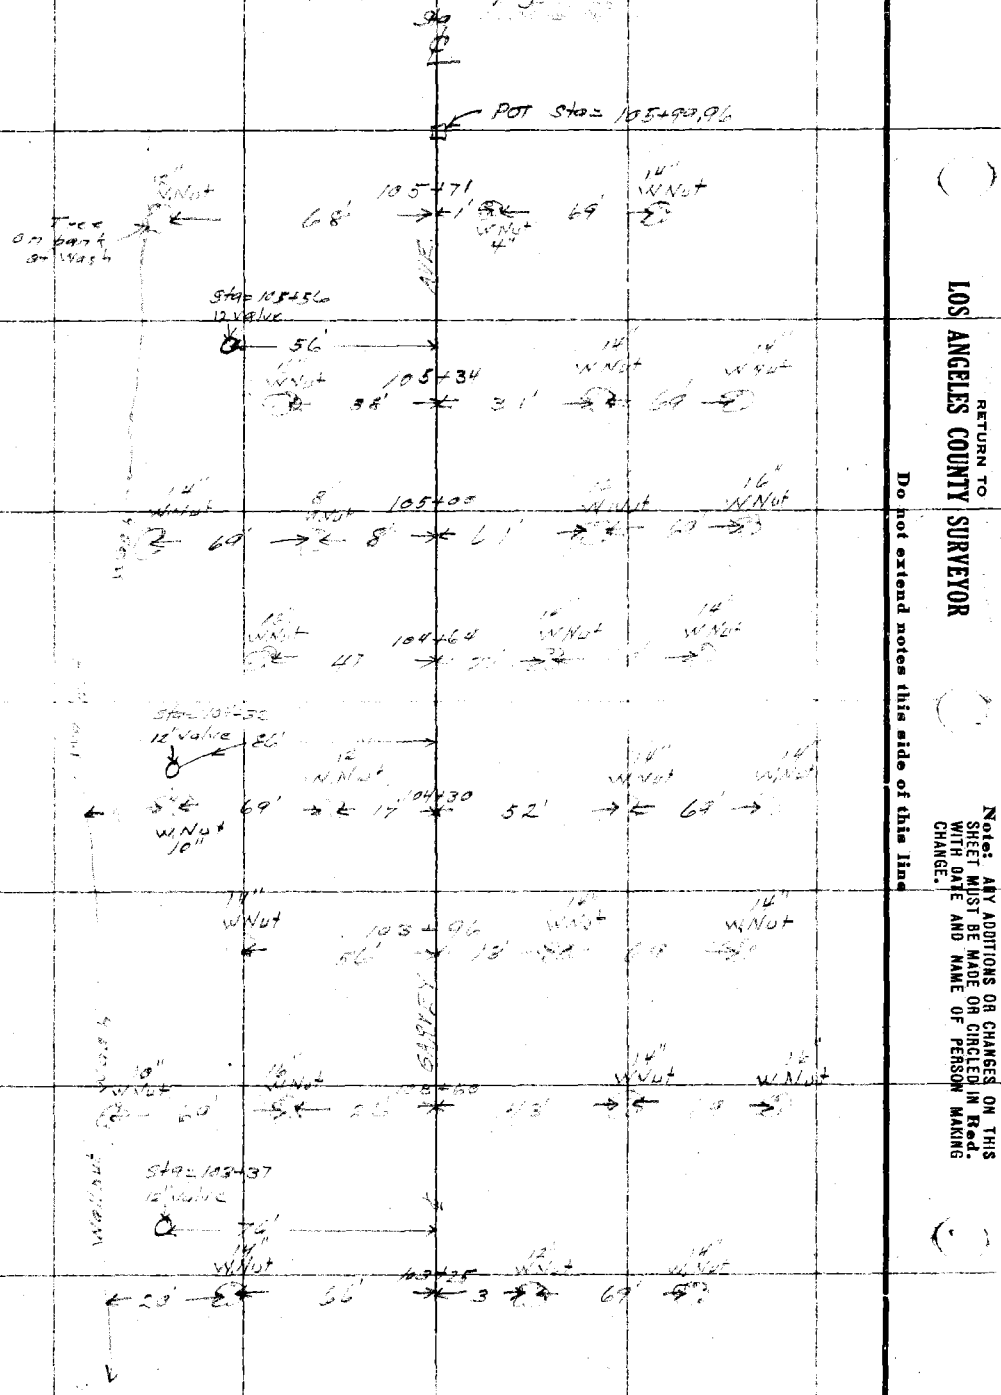

RETURN TO
LOS ANGELES COUNTY SURVEYOR

Do not extend notes this side of this line

Note: ANY ADDITIONS OR CHANGES ON THIS SHEET MUST BE MADE OR CIRCLED IN Red. WITH DATE AND NAME OF PERSON MAKING CHANGE.

Date _____ Notes by Svensen Chief Party _____ F.B. 352 Pg. 97

Platted by H. U. M. H.	W. O. No. 796 D. S. O. No. _____
Date _____	Location _____
Map No. _____	Surveyed by _____
Platting Ck'd by _____	Date 7-15-1924
Date _____	Indexed E. G. Johnson

Notes: ANY ADDITIONS OR CHANGES ON THIS SHEET MUST BE MADE OR CIRCLED IN Red. WITH DATE AND NAME OF PERSON MAKING CHANGE.

Do not extend notes this side of this line

RETURN TO LOS ANGELES COUNTY SURVEYOR

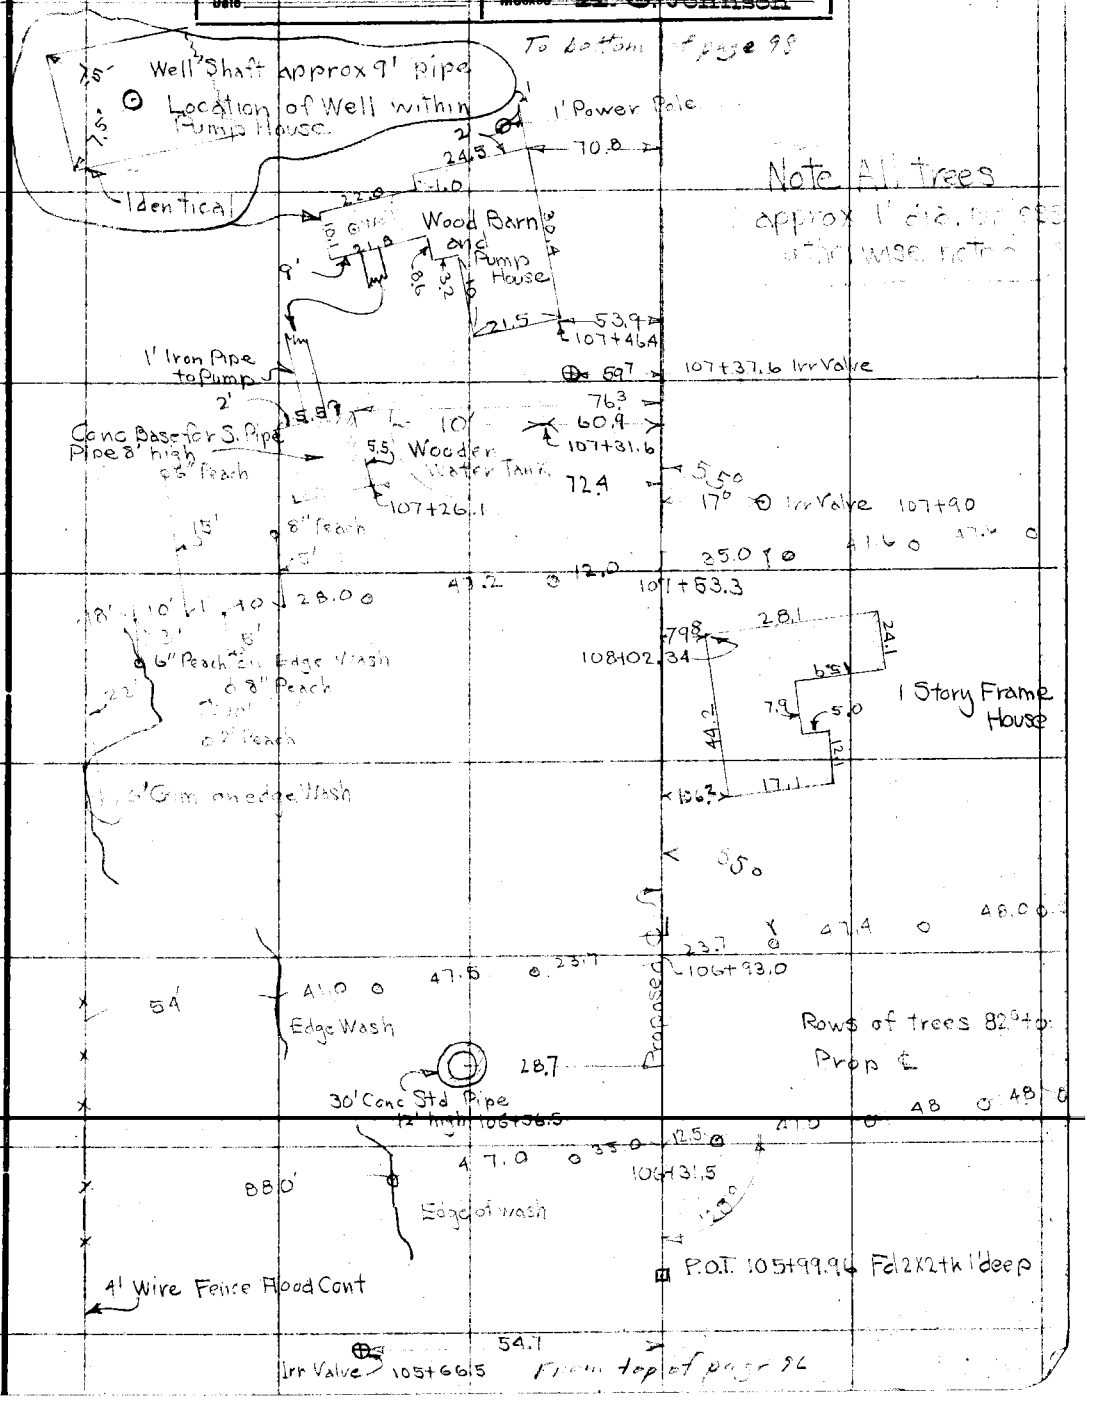

F.B. 352 Pg. 98 Svensan Chief Party Notes by Svensan Date

To bottom of page 99

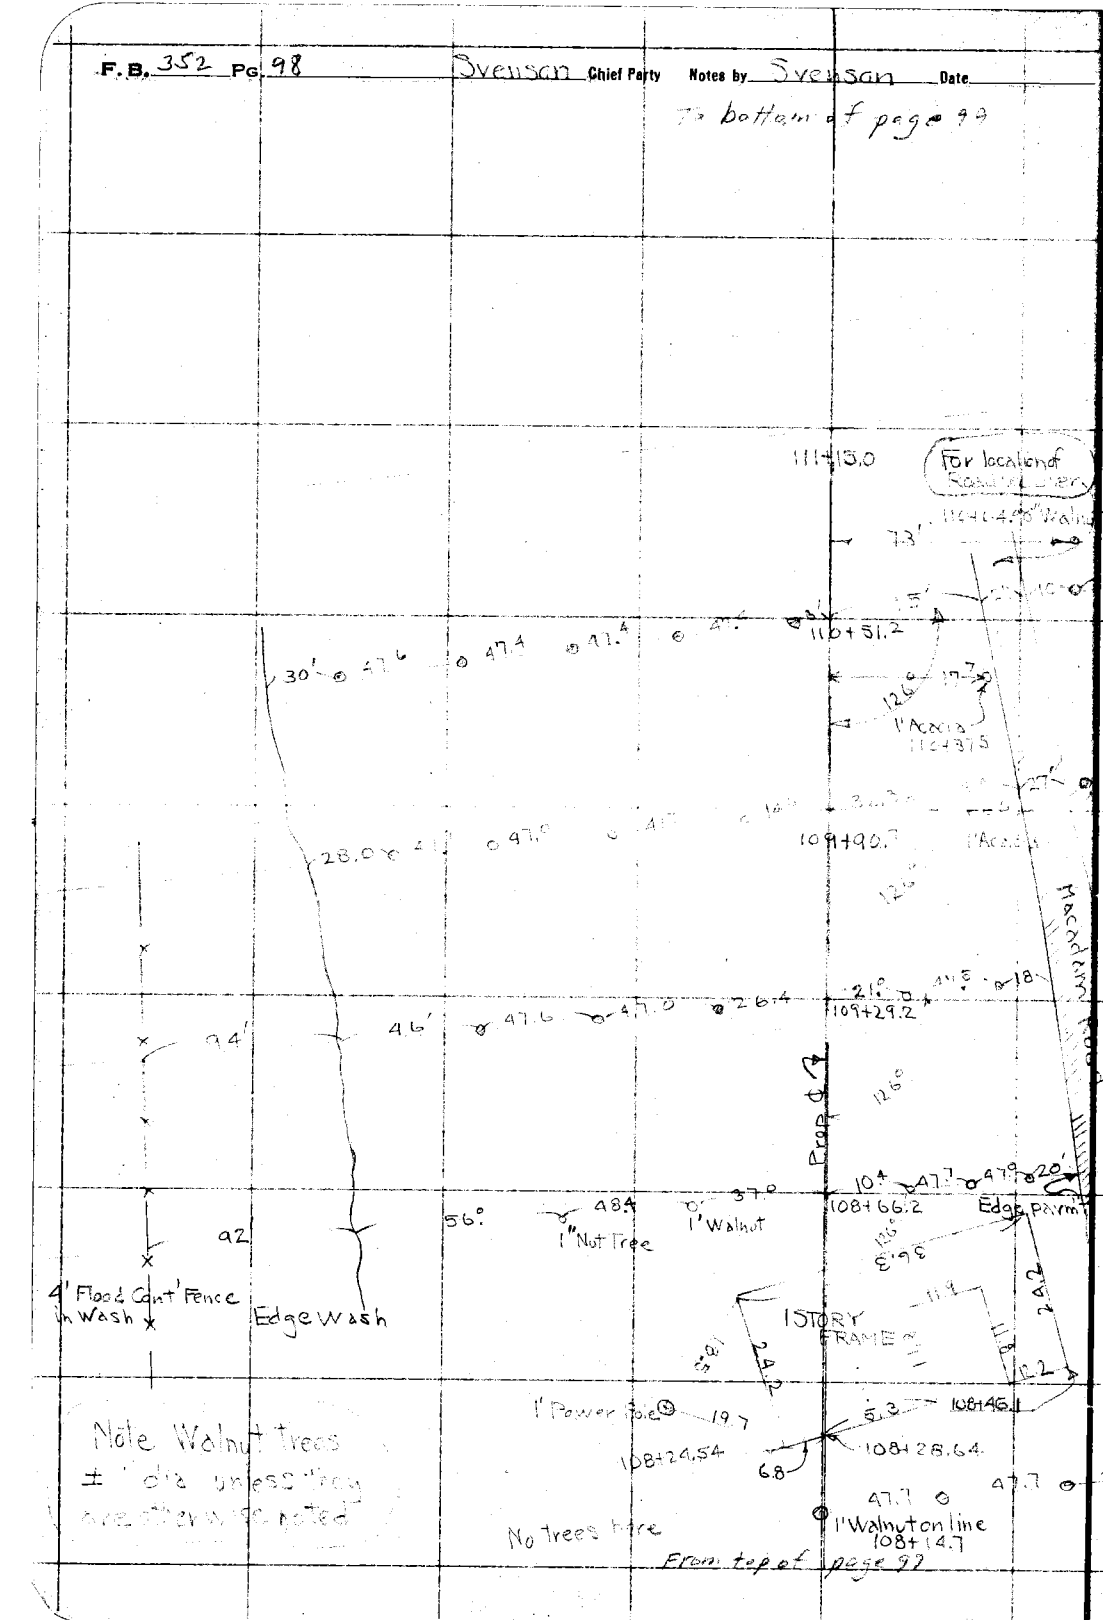

Note Walnut trees ± 1' dia unless they are otherwise noted

RETURN TO LOS ANGELES COUNTY SURVEYOR

Do not extend notes this side of this line

Note: ANY ADDITIONS OR CHANGES ON THIS SHEET MUST BE MADE OR CIRCLED IN Red. WITH DATE AND NAME OF PERSON MAKING CHANGE.

Date _____ Notes by Svenson Chief Party _____ F.B. 352 Pg 99

Plotted by H.U.M.H.	W.O. No. 196 D.S.O. No. _____
Date _____	Location Palm Ave
Map No. _____	Surveyed by Svenson
Plotting Ck'd by _____	Date 7-15-29
Date _____	Indexed _____

Notes: ANY ADDITIONS OR CHANGES ON THIS SHEET MUST BE MADE OR CIRCLED IN Red. WITH DATE AND NAME OF PERSON MAKING CHANGE.

Do not extend notes this side of this line

RETURN TO LOS ANGELES COUNTY SURVEYOR

To Bottom of Page 100

112+98.8

148.4

22.4 47.3 47.5 46.6

Edge Wash

1 Acacia

1378

1 Acacia 102.0

78°26'

℄ Elliot

112+83.75 Fd 2x2 Kon ℄

1 Acacia tree

125° 45' to Irr Valves

112+43.7

29.8

Parallel to trees

last valve 23'

new 1" Irr Valves

112+39

68.5

1 Acacia tree 111+63.0

111+95.5 8" Walnut

15'

22.5 46.8 47.0

111+77

24.0 Edge Wash

145

111+54° 6" Walnut tree

41.3 Edge Pavmt

111+23°

111+22° 1 Acacia

43.8

1 Walnut 111+12°

1" Walnut

111+15°

Fd SWT = 111+00.68

Edge Pavmt 110+76°

Edge Wash

1 Power Pole 110+74

Note Trees are 8" Walnut trees unless otherwise noted

From top of page 98

Maddalena Road

F.B. 352 Pg. 100 Svenson Chief Party Notes by Svenson Date

RETURN TO
LOS ANGELES COUNTY SURVEYOR

Do not extend notes this side of this line

Note: ANY ADDITIONS OR CHANGES ON THIS SHEET MUST BE MADE OR CIRCLED IN Red. WITH DATE AND NAME OF PERSON MAKING CHANGE.

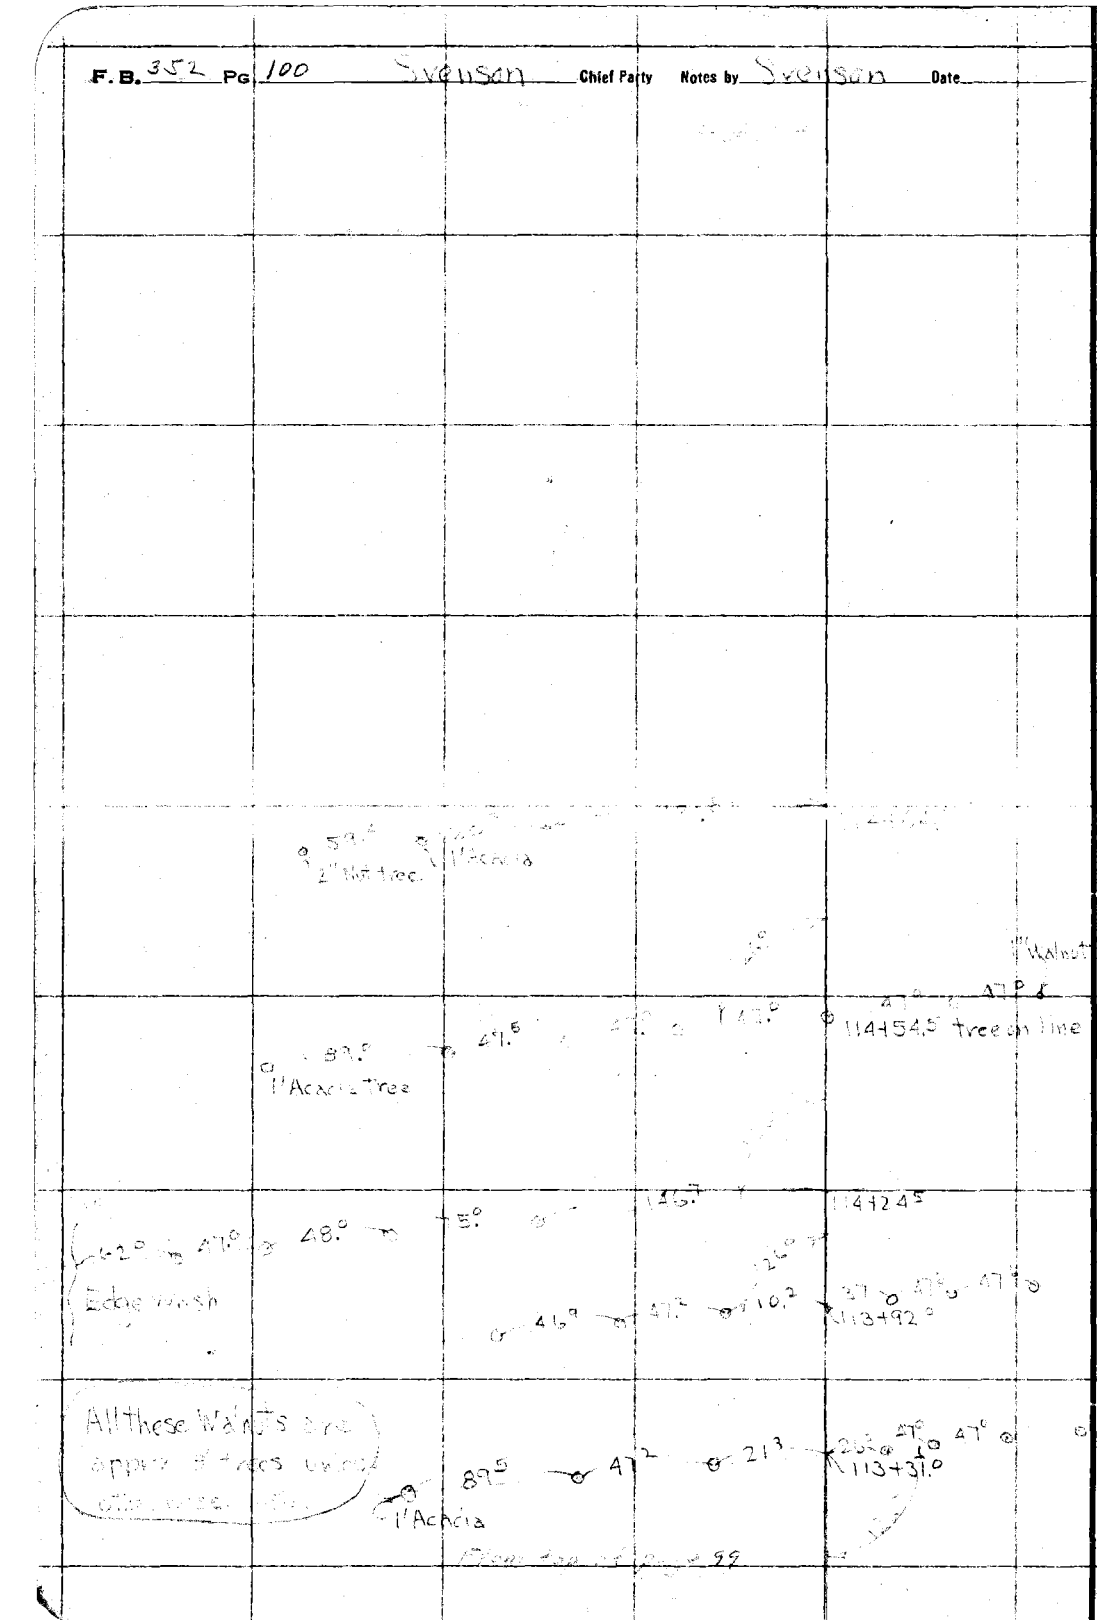

Date 7-22-29 Notes by A.W.V.F. Chief Party A.W. VanFleet F.B. 352 Pg 101

Platted by H.U.M.H.
Date NOV 30 1929
Map No. B-457-7
Platting C'k'd by Wood
Date Oct. 1929

W.O. No. 796 S.O.C. No. 027
Location Garvey Ave.
Surveyed by A.W. VanFleet
Date 7-22-29
Indexed A. C. Johnson

To bottom of page 104

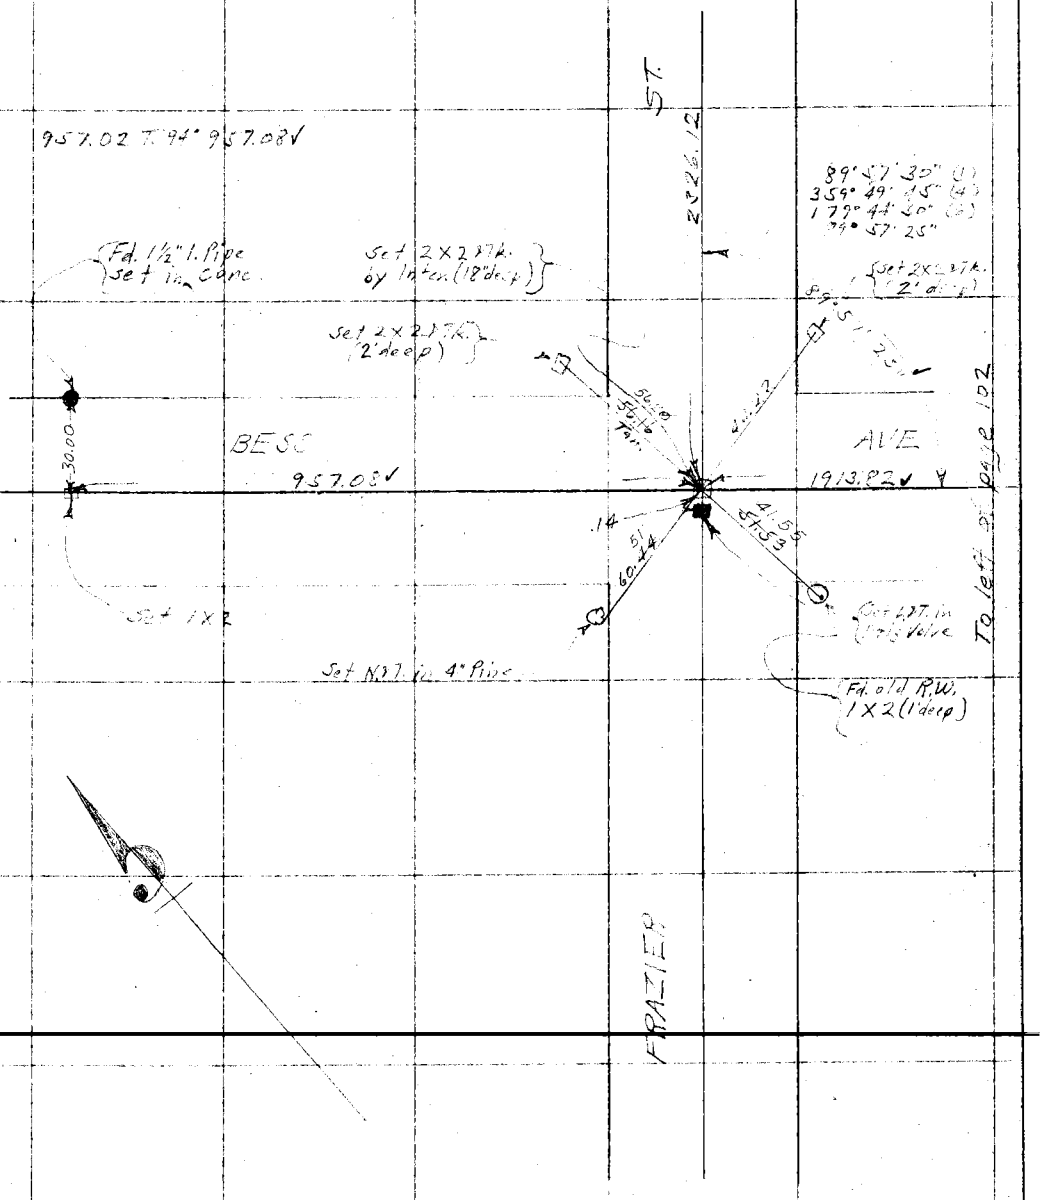

Notes: ANY ADDITIONS OR CHANGES ON THIS SHEET MUST BE MADE OR CIRCLED IN Red. WITH DATE AND NAME OF PERSON MAKING CHANGE.

Do not extend notes this side of this line

RETURN TO LOS ANGELES COUNTY SURVEYOR

F. B. 352 Pg. 102 A.W. Kaufhold Chief Party Notes by A.W.K.F. Date 7-23-29

To bottom of page 103

1414.64 T. 94° = 1414.73 ✓
863.92 T. 94° = 863.97 ✓
1913.70 T. 94° = 1913.82 ✓

99° 03' 00" (3)
320° 11' 30" (5)
180° 17' 30" (7)
99° 02' 55" ✓

BLVD.

1414.73

Fd C.S. W.S.T.

Set N.S.T.

863.92

Set N.S.T. in Tel. Pole

Set L.S.T. in Gas Pump Base

Set N.S.T. in Conc. Curb

RESS

AVE.

(Set N.S.T. in Conc. Curb)

(Set N.S.T. in Conc. Curb)

Set N.S.T. in Conc. Curb

(Fd. 3" I.P. (2" above ground) Page 22)

To N.S.T. in P. Pole

791.27 T. 94° = 791.42 ✓

179° 56' 00" (1)
359° 52' 00" (4)
359° 48' 15" (6)
179° 55' 02" ✓

COURT

TALBERT

(Fd. 2" x 2" x 24" (18" deep) Ex. Hes. - Page 22)

+ 202.1 30

Cont. to top of Page 21

Cont. from Page 101

RETURN TO LOS ANGELES COUNTY SURVEYOR

Do not extend notes this side of this line

Note: ANY ADDITIONS OR CHANGES ON THIS SHEET MUST BE MADE OR CIRCLED IN Red. WITH DATE AND NAME OF PERSON MAKING CHANGE.

Date 7-24-29 Notes by A.V.V.F. Chief Party A.V.Van Fleet F.B. 352 Pg 103

Tape

Plotted by H.U.M.H.
Date NOV 30 1929
Map No. B-457-1
Platting C'k'd by Wood
Date Oct. 1929

W. O. No. 776 No. 021
Location San Dimas
Surveyed by A.V.Van Fleet
Date 7-24-29
Indexed A. C. Johnson

Notes: ANY ADDITIONS OR CHANGES ON THIS SHEET MUST BE MADE OR CIRCLED IN RED WITH DATE AND NAME OF PERSON MAKING CHANGE.

Do not extend notes this side of this line

RETURN TO LOS ANGELES COUNTY SURVEYOR

977.73 T. 96° = 977.81

Fd Conc. Mon. (2" dia. p) 30.0

(Fd 2X2 8' Ac. (2 deep) By Ties F.B. 313-2

Fd. L&T

FRANCISQUITO

1913.67

AVE

977.81

From top of page 104

From top of page 70

Fd. L&T. in Conc. & pipe

Fd Conc. Mon. (2" dia. p) 29.99

180° 00' 30" (1)
360° 01' 15" (4)
180° 02' 00" (6)
180° 00' 23"

90° 00' 15" (1)
360° 01' 15" (4)
180° 02' 00" (6)
90° 00' 20"

1545.12 T. 90° = 1545.18

1545.16

Set N.S.T. in 20" Acacia

Set N.S.T. in 8" Pole

Fd. 1½" I. Pipe (6" deep) R.D. F.B. 45-37

29.42

94.22

348° 13' 15" (1)
348° 52' 45" (4)
343° 19' 00" (6)
177° 13' 45"
10

52.23

17½

Set N.S.T. in 14" Acacia

1547.73

COVINA

From top of page 102

F.B. 352 Pg. 104 Alvarado Fleet Chief Party Notes by A.L.V.F. Date 2-25-29

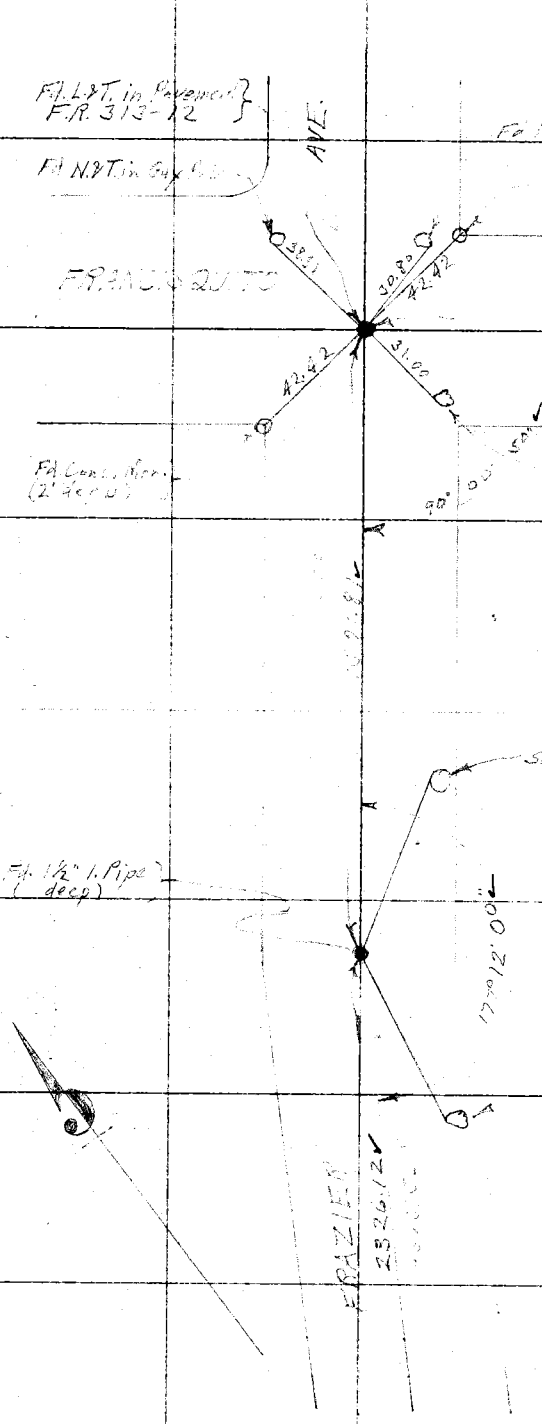

RETURN TO
LOS ANGELES COUNTY SURVEYOR

Do not extend notes this side of this line.

Note: ANY ADDITIONS OR CHANGES ON THIS SHEET MUST BE MADE OR CIRCLED IN Red. WITH DATE AND NAME OF PERSON MAKING CHANGE.

Date _____ Notes by _____ Chief Party _____ F.B. 352 Pg 105

Platted by H.U.M.H.	W. O. No. _____ D. S. O. No. _____
Date NOV 30 1929	Location _____
Map No. B-457-1	Surveyed by _____
Platting C'k'd by Wood	Date _____ Johnson
Date Oct. 1929	Indexed _____

RETURN TO
LOS ANGELES COUNTY SURVEYOR

Notes: ANY ADDITIONS OR CHANGES ON THIS SHEET MUST BE MADE OR CIRCLED IN Red. WITH DATE AND NAME OF PERSON MAKING CHANGE.

Do not extend notes this side of this line

PROPOSED

&

GARVEY AVENUE

W.O. 796

F.B. Page 105 to 122 Inst.

Top: FB. 397-59 to 171

Party

A.W. Van Fleet

W.B. Miller - Inst.

J.J. Phillips - H.C.

L.A. Gilman - R.C.

H.F. Irwin - R.C.

F.B. 352 Pg. 106 A.W. Van Fleet Chief Party Notes by A.W.V.F. Date 7-25-29

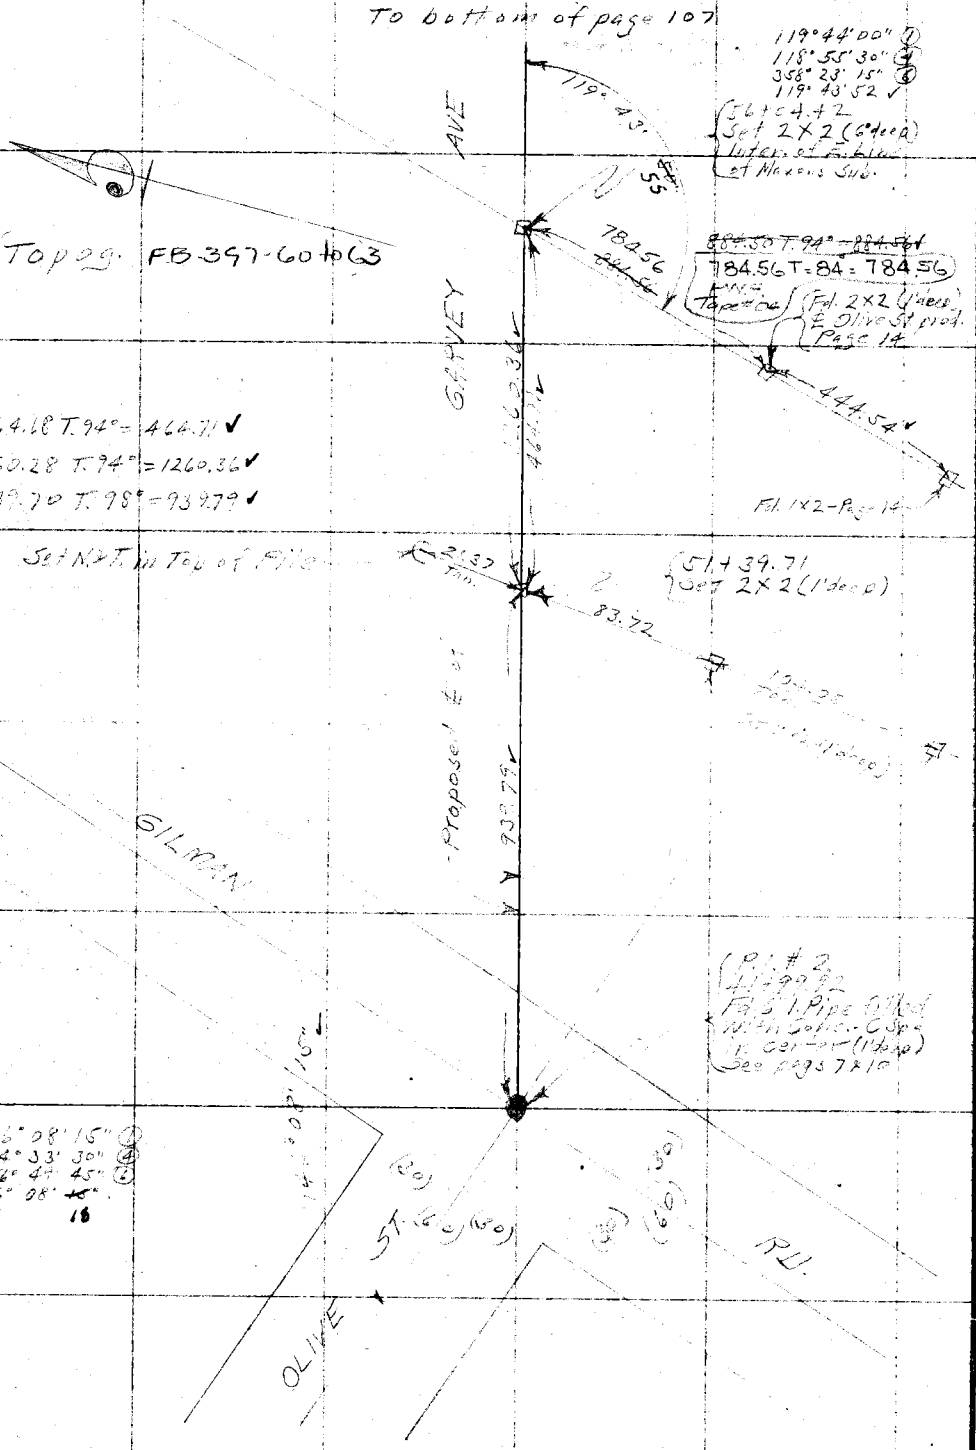

RETURN TO
LOS ANGELES COUNTY SURVEYOR

Do not extend notes this side of this line.

Note: ANY ADDITIONS OR CHANGES ON THIS SHEET MUST BE MADE OR CIRCLED IN Red. WITH DATE AND NAME OF PERSON MAKING CHANGE.

Date 7-25-29 Notes by A.W.V.F. Chief Party A.W. Van Fleet F.B. 352 Pg 107

Tape

Platted by M.U.M.H
Date NOV 30 1929
Map No. B.457-1
Platting Checked by W.O.C.
Date Oct. 1929

W. O. No. 296 Sup. No. 027
Location Sunset Ave.
Surveyed by A.W. Van Fleet
Date 7-25-29
Indexed C. Johnson

To bottom of page 108

1199.93 T. 90° = 1199.98 ✓

AVE.

727+02.05
Set 1X2 (flush)

799.98

684+00.03
Set 1X2 (flush)

799.93 T. 94° = 799.98 ✓

RIDGEWAY ST. (PAVED)

664+00.07
Set 1X2 (flush)

(Topo) FB. 397-64

(50) (100) (50)

From top of page 106

RETURN TO
LOS ANGELES COUNTY SURVEYOR

Do not extend notes this side of this line

Notes: ANY ADDITIONS OR CHANGES ON THIS SHEET MUST BE MADE OR CIRCLED IN Red. WITH DATE AND NAME OF PERSON MAKING CHANGE.

F. B. 352 Pg. 108 A.W. Van Fleet Chief Party Notes by A.W. Van Fleet Date 7-26-29

To bottom of page 109

430.68 T. S41°-W 430.68 ✓

AVE

430.68

(100)

(50) (50)

499.98 T. S41°-W 499.98 ✓

499.99

499.99

499.99 T. S41°-W 499.99 ✓

McDONNELL & SAYRE

Tr. Map FB 397-65

1199.97

From 1 to 107

RETURN TO
LOS ANGELES COUNTY SURVEYOR

Do not extend notes this side of this line

Note: ANY ADDITIONS OR CHANGES ON THIS SHEET MUST BE MADE OR CIRCLED IN Red. WITH DATE AND NAME OF PERSON MAKING CHANGE.

Date 12-22-27 Notes by A.W.V.T. Chief Party A.W. Vaughan F.B. 352 Pg. 109

Tape

Plotted by H.U.M.H.
Date NOV 30 1929
Map No. B. 457-1
Plotting Ck'd by Wood
Date Oct. 1927

W.O. No. 796 Sheet No. 022
Location Sec. 9 R.11 W.
Surveyed by A.W. Vaughan
Date 12-29-27
Indexed C. Johnson.

To Station 0+00 on page 110

105+99.95
Set 2x2 (1" deep)

1306.20 T. 80° = 1306.17 ✓

769.32 T. 74° = 769.27 ✓

22° 01' 30" (1)
90° 45' 30" (4)
136° 28' 45" (5)
22° 41' 27" ✓

769.27

22° 41' 25" ✓

152° 59' 00" ✓

152° 59' 00" (1)
251° 52' 00" (4)
197° 53' 45" (5)
[illegible] ✓

P.I. #3
98+30.68
Set 2x2x24" (1" deep)
Ties - page 101

98+00

(Top of ... FB 397-66-67)

From top of page 108

Note: ANY ADDITIONS OR CHANGES ON THIS SHEET MUST BE MADE OR CIRCLED IN Red. WITH DATE AND NAME OF PERSON MAKING CHANGE.

Do not extend notes this side of this line

RETURN TO LOS ANGELES COUNTY SURVEYOR

F. B. 357 Pg. 110 A.W. Van Fleet Chief Party Notes by A.W.V.F. Date 7-30-29

To bottom of page 111

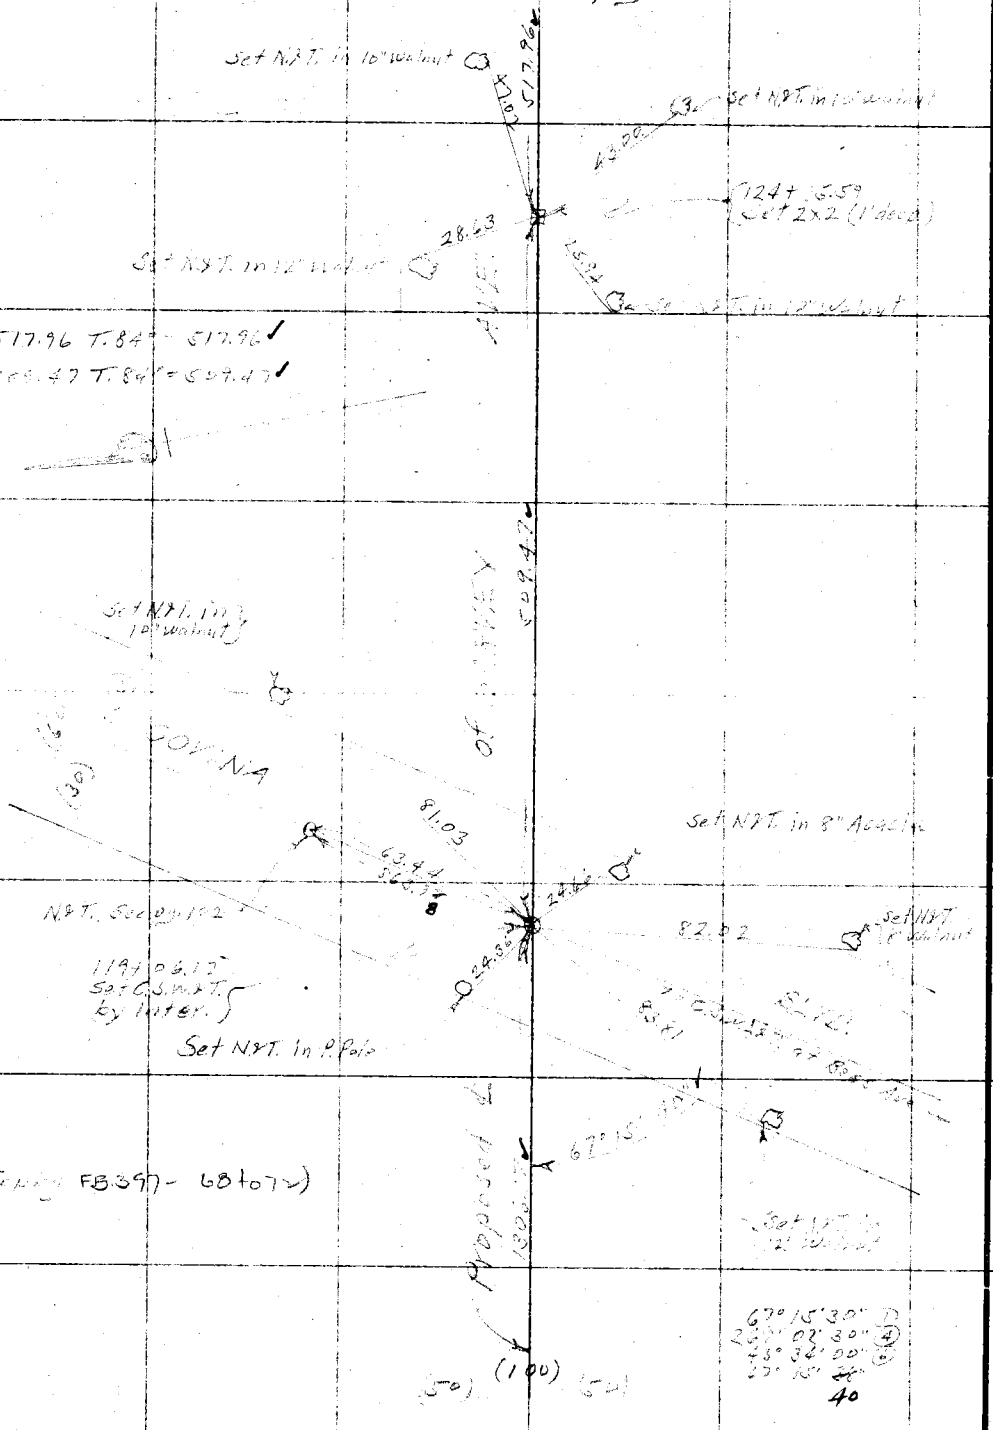

(Tie to FB 397 - 68 to 72)

RETURN TO
LOS ANGELES COUNTY SURVEYOR

Do not extend notes this side of this line

Note: ANY ADDITIONS OR CHANGES ON THIS SHEET MUST BE MADE OR CIRCLED IN Red. WITH DATE AND NAME OF PERSON MAKING CHANGE.

Date 7-30-29 Notes by A.W.V.F. Chief Party A.W. Van Fleet F.B. 352 Pg 111

Tape

Platted by H. U. M. H.	W. O. No. 796 [redacted] No. 027
Date NOV 30 1929	Location Garvey Ave
Map No. B. 457-1	Surveyed by A.W. Van Fleet
Platting Ck'd by Wood	Date 7-30-29
Date Oct. 1929	Indexed A. C. Johnson

To bottom of page 112

(30) (30) (60)

CALIF. ST. R.R.

67° 15' 20" (A)
268° 59' 45" (B)
93° 29' 15" (C)
67° 14' 57" (D)

OF CAL. ST.

Void

Void see P.125

67° 14' 55"

see P. 125

Set wire spike tin in x tie 6q in 129+ see pg 125 for angle

129+66.06 Set 2X2 Mon. by Inter. (destroyed pm 1-26-29 A)

see pg 125 for new point

0.29

Void-see P.125

36.39 In F.P. 21.35

129+33.55 Set 2X2 (1' deep)

30.76

26.24

Topog. FB 397-73 to 75

From top of page 110

Note: ANY ADDITIONS OR CHANGES ON THIS SHEET MUST BE MADE OR CIRCLED IN Red. WITH DATE AND NAME OF PERSON MAKING CHANGE.

Do not extend notes this side of this line

RETURN TO LOS ANGELES COUNTY SURVEYOR

F.B. 352 Pg. 112 A.W. Hartwell Chief Party Notes by A.W.H.T. Date 8-2-29

← To bottom of page 113

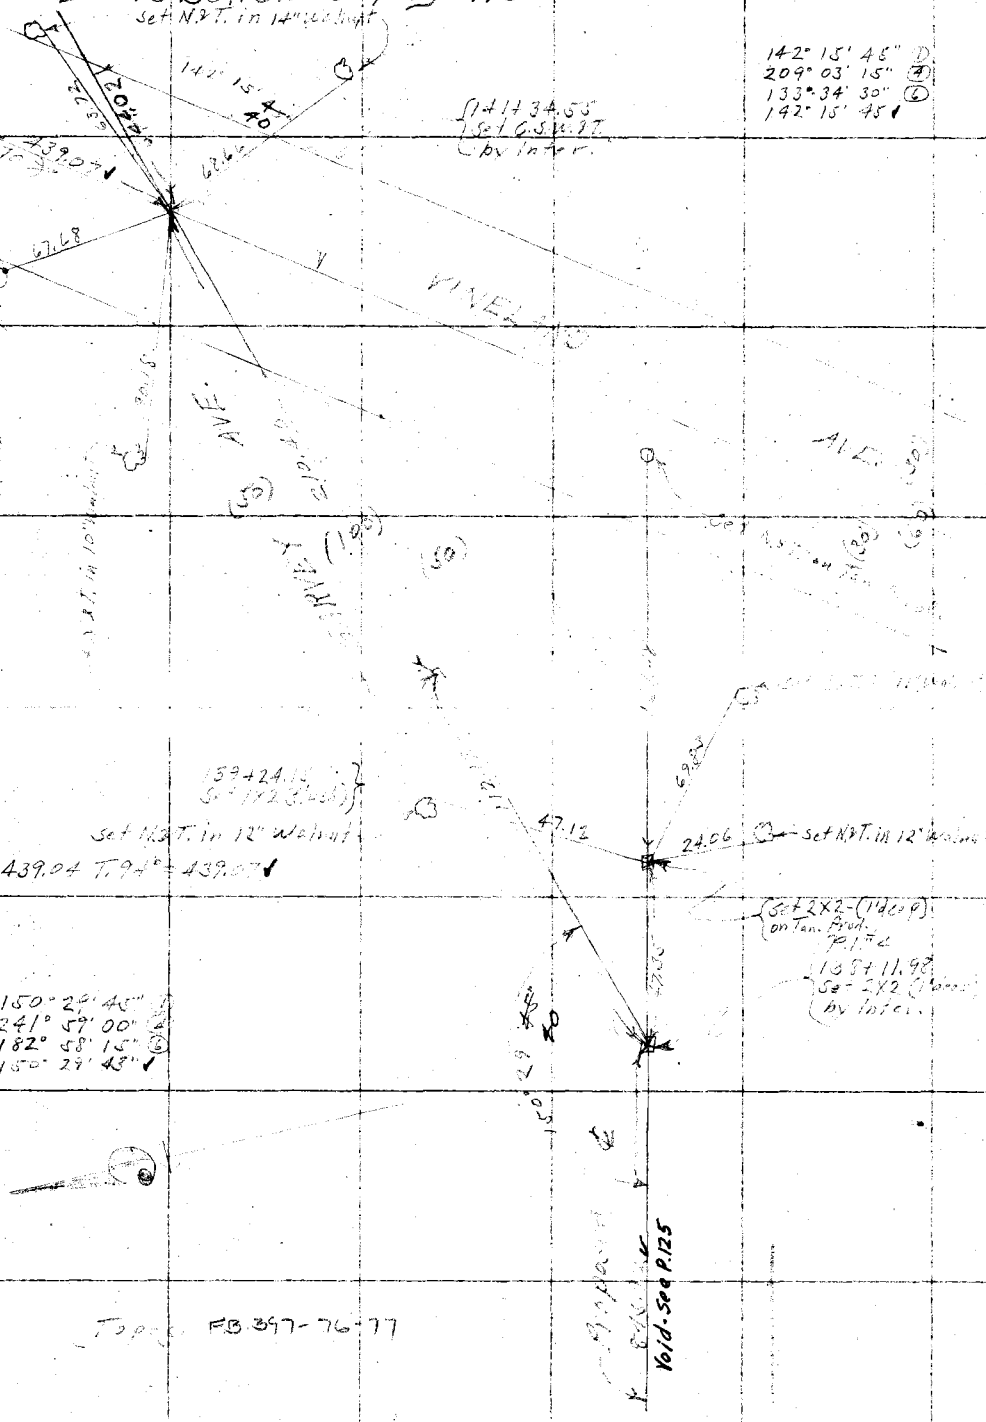

Top FB 397-76-77

RETURN TO
LOS ANGELES COUNTY SURVEYOR
Do not extend notes this side of this line.

Note: ANY ADDITIONS OR CHANGES ON THIS SHEET MUST BE MADE OR CIRCLED IN Red. WITH DATE AND NAME OF PERSON MAKING CHANGE.

Date 8-3-29 Notes by A.V. [illegible] Chief Party A.V. [illegible] F.B. 352 Pg. 113

Platted by Wood	W. O. No. 796 B. C. O. No. 027
Date Oct. 1929	Location [illegible]
Map No.	Surveyed by [illegible]
Platting Ck'd by H. U. M. H.	Date 8-3-29
Date NOV 30 1929	Indexed [illegible]

To bottom of page 114

785.18 T. 90° = 785.21 ✓

Set N.&T. in 14" Walnut

Set N.&T. in 14" Walnut

51.44

62.92

157+13.16
Set 2X2 (1 deep)

33.50

46.09

Set N.&T. in 14" Walnut

Set N.&T. in 12" Walnut

934.57 T. 88° = 934.59 ✓

934.59

42.59

38.47

147+78.57
Set 2 X 2 (1 deep)

32.13

From S. F.B. 397 - 78 to 83

644.02 T. 84° = 644.02 ✓

From top of page 112

Note: ANY ADDITIONS OR CHANGES ON THIS SHEET MUST BE MADE OR CIRCLED IN Red. WITH DATE AND NAME OF PERSON MAKING CHANGE.

Do not extend notes this side of this line

RETURN TO LOS ANGELES COUNTY SURVEYOR

F.B. 352 Pg. 114 A.W.V.(a) Fleet Chief Party Notes by A.W.V.F. Date 6-5 29.

To bottom of page 115

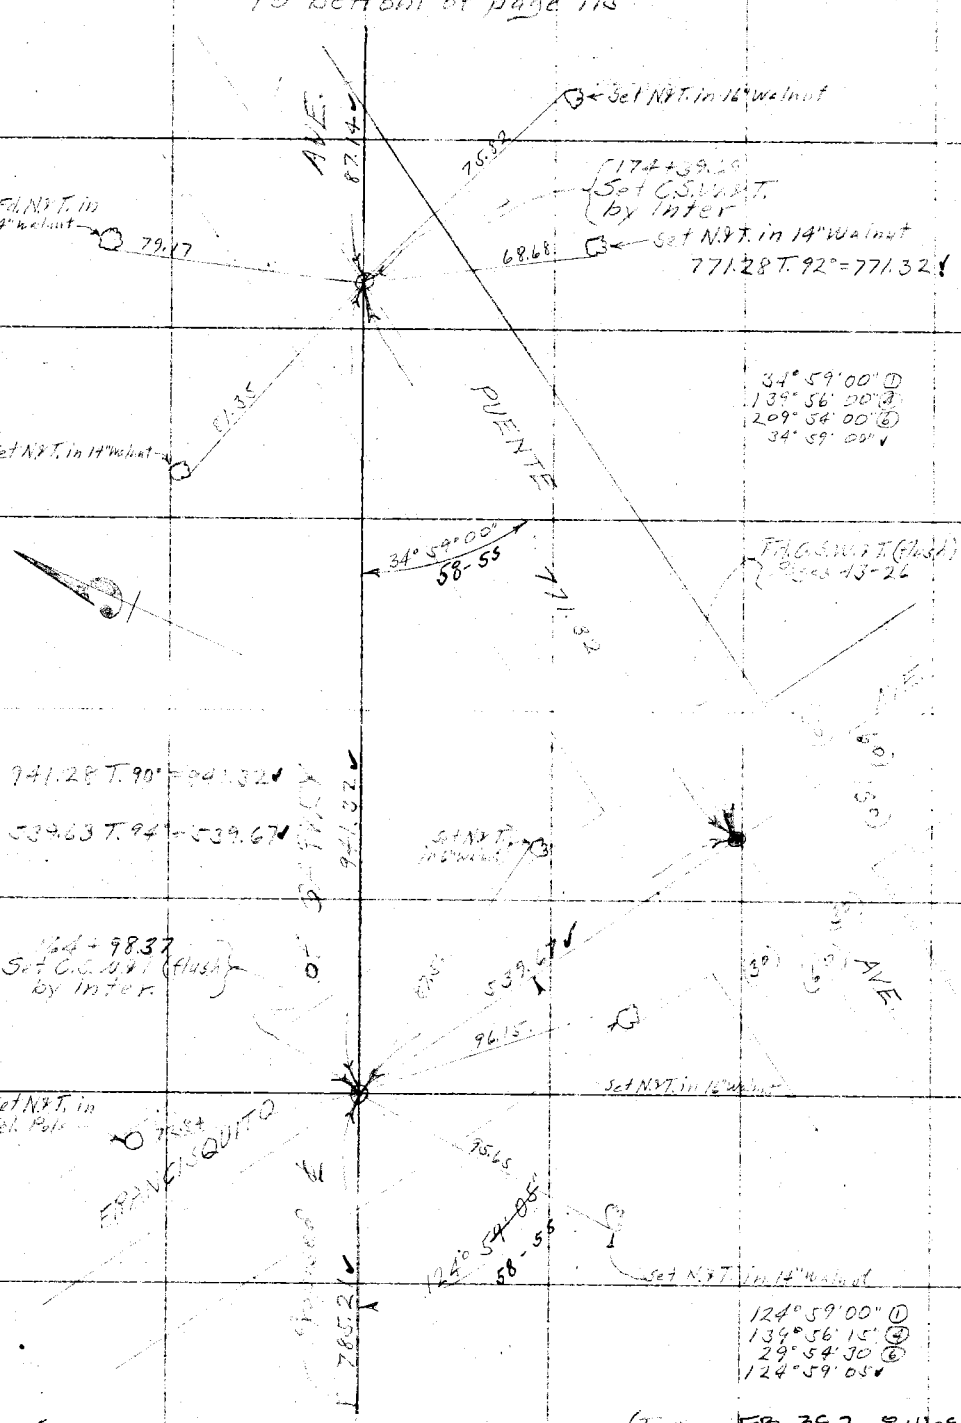

From top of page 113

(Tie) FB. 397 - 84+091
94+95

RETURN TO LOS ANGELES COUNTY SURVEYOR

Do not extend notes this side of this line.

Note: ANY ADDITIONS OR CHANGES ON THIS SHEET MUST BE MADE OR CIRCLED IN Red. WITH DATE AND NAME OF PERSON MAKING CHANGE.

4-5-29 D-5

Date 8-7-29 Notes by A.W.V.F. Chief Party A.W. Van Fleet F.B. 352 Pg 115

Tape

Platted by Wood	W. O. No. 796 D. G. No. 027
Date Oct. 1929	Location Gaviota Ave.
Map No.	Surveyed by A.W. Van Fleet
Platting Ch'd by H. U. M. H.	Date 8-7-29
Date NOV 30 1929	Indexed

Notes: ANY ADDITIONS OR CHANGES ON THIS SHEET MUST BE MADE OR CIRCLED IN Red. WITH DATE AND NAME OF PERSON MAKING CHANGE.

Do not extend notes this side of this line

RETURN TO LOS ANGELES COUNTY SURVEYOR

To bottom of page 114

104.71 T. 94° = 104.72 ✓

A.W.V.F.

104.72

80+00.72
Set 1X2 (Flush

Fd. 2X2 (4" deep
E.C. of Curb
Post Lt

E.C.

Set Chiseled "X" in Iron Fence Post

Set Chiseled "X" in Iron Fence Post

100.15 @ 5°12' = 99.69 ✓
21.70 Radial = 21.70
121.39 T. 94° = 121.40 ✓

121.40

158°50'00" ③
275°20'00" ④
23°00'00" ②
1°50'00" ✓

158°50'00"

46.96

178+78.33
Set 2X2 (6" deep)
by Intgr

44.67

92.44 ✓

92.81 @ 5°06' = 92.44 T. 92° = 92.44 ✓

Set Chiseled "X" in Fence Post

Set Chiseled "X" in Iron Fence Post

177+84.88
Set 1X2 (Flush)

(50)

(50)

Set N.&T. in 12" Walnut

Walnut

260.24 T. 92° = 260.05 ✓

Set N.&T. in 14" Walnut

81.90

160°07'30" ①
280°30' N ④
240°45'30" ⑥
160°07'35" ✓

P.I. #5
175+26.83
Set 2X2 (6" deep)
by Intgr.

76.39

94.12

27.13 T. 95° = 87.14 ✓

Set N.&T. in 16" Walnut

96.19

87.14

(Topog. FB 357-92-93)

Set N.&T. in Bridge Wing

From top of page 114

F. B. 352 PG. 116 A.W. VanFleet Chief Party Notes by A.W.VF. Date 7-16-27

To bottom of page 117

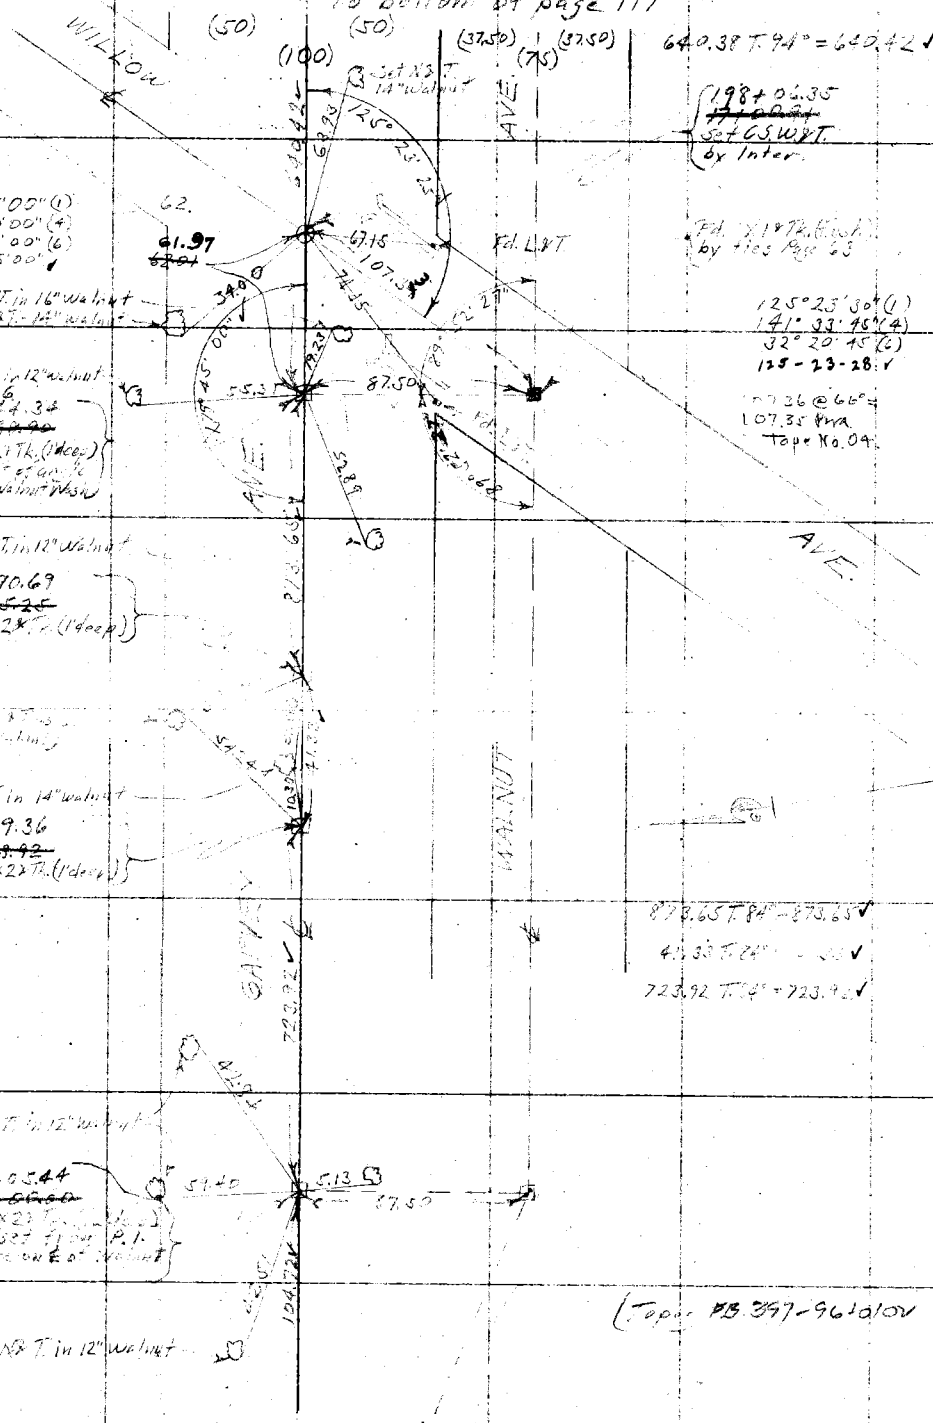

From top of page 115

RETURN TO
LOS ANGELES COUNTY SURVEYOR
Do not extend notes this side of this line

Note: ANY ADDITIONS OR CHANGES ON THIS SHEET MUST BE MADE OR CIRCLED IN Red. WITH DATE AND NAME OF PERSON MAKING CHANGE.

Date 7-12-29 Notes by A.W.V.E. Chief Party A.W. [illegible] F.B. 352 Pg 117

Plotted by Wood
Date Oct. 1929
Map No.
Plotting Ck'd by
Date NOV 30 1929

W. O. No. 796 D. S. O. No. 027
Location Garvey Ave.
Surveyed by A.W. Jo. Fleet
Date 7/12/29
Indexed C. J.

To bottom of page 118

(100)
(50) (50) (32.50) (37.50)

1043.99 T. 94° - 1044.06

1622.69 @ 66°
1623.50

AVE.
1044.06
WASH
GARVEY

Set N.& T. in 12" walnut
203+84.76
~~224+19.32~~
Set 2X2X Tk (1' above)

Δ 13°
23.60

Set N.& T. in 12" walnut

27.06

Set N.& T. in 18" walnut

Proposed ℄ of
1044.06

(From FB 397-103 to 105)

From top of page 116

Note: ANY ADDITIONS OR CHANGES ON THIS SHEET MUST BE MADE OR CIRCLED IN Red. WITH DATE AND NAME OF PERSON MAKING CHANGE.

Do not extend notes this side of this line

RETURN TO
LOS ANGELES COUNTY SURVEYOR

F. B. 352 Pg. 118 A.W. Van Fleet Chief Party Notes by A.W.V.F. Date 8-13-29

To bottom of page 119

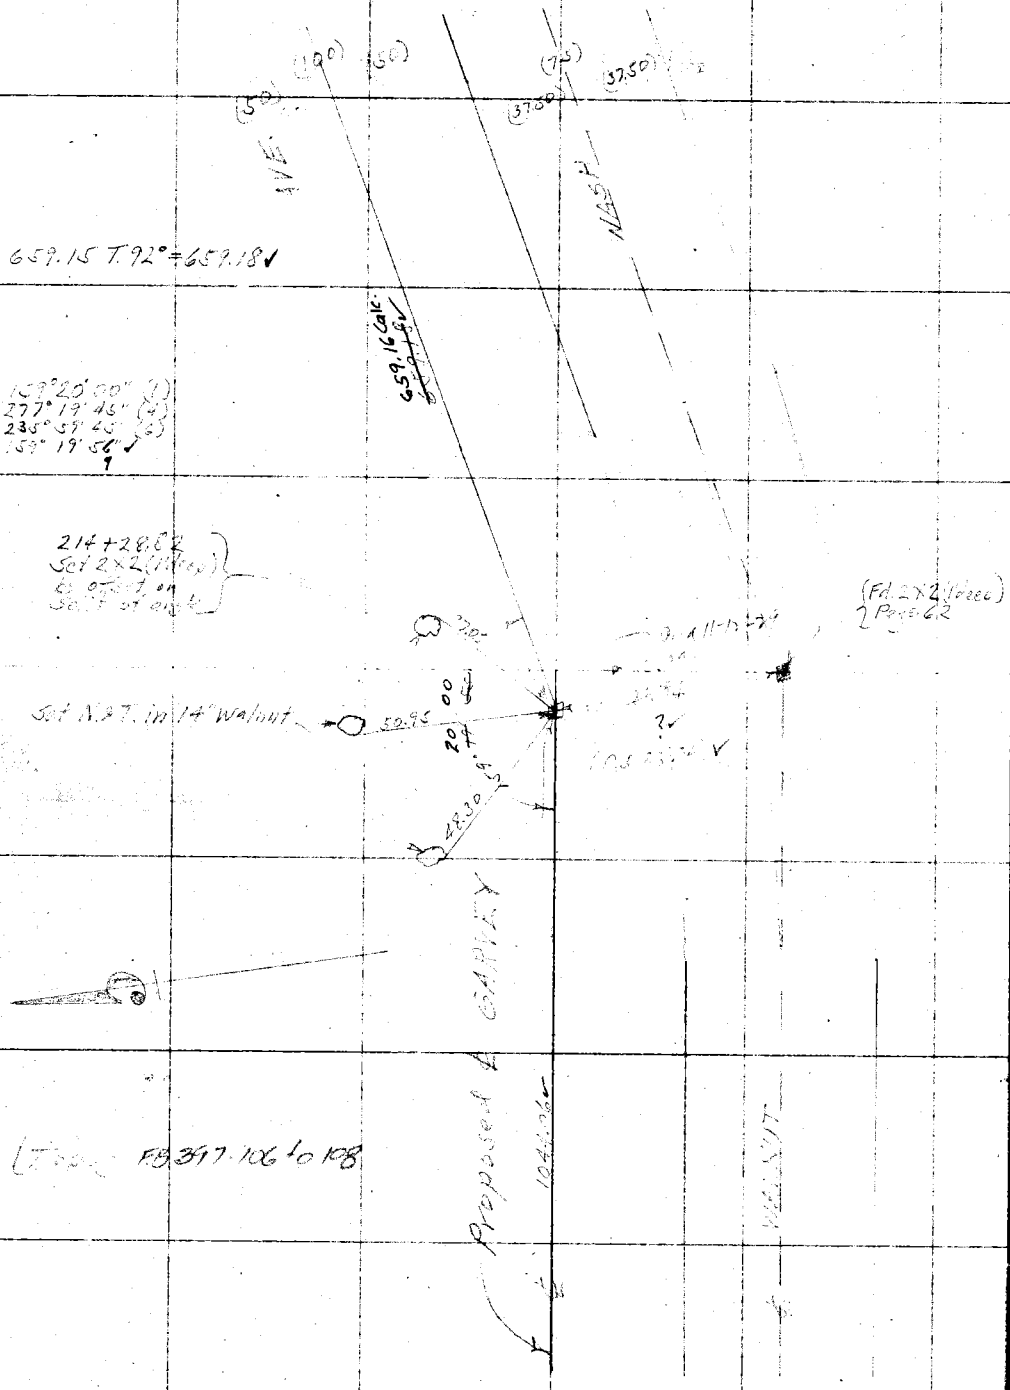

RETURN TO
LOS ANGELES COUNTY SURVEYOR

Do not extend notes this side of this line

Note: ANY ADDITIONS OR CHANGES ON THIS SHEET MUST BE MADE OR CIRCLED IN Red. WITH DATE AND NAME OF PERSON MAKING CHANGE.

Date 8-13-29 Notes by A.W. Von Fleet Chief Party A.W. Von Fleet F.B. 352 Pg. 119

Plotted by Wood
Date Oct. 1929
Map No.
Plotting C'k'd by H.U.M.H.
Date NOV 30 1929

W.O. No. 796 Sht. No. 022
Location Survey Ave.
Surveyed by A.W. Von Fleet
Date 8-13-29
Indexed C. Johnson

Tape

To bottom of page 120

(Topog. Pages FB 397-109-110)

340.19 T. 92° - 340.21 V

340.21

SURVEY AVE

MALLARD

60'

Set N.D.T. in Conc. Post

221+46.87 Set 1X2 (flush) by other

87.30

This point was reset by P.W. Atkins @ dist. shown in red. 12-13-29

S8.89 Calc.

28.50 105.48

34.91

Set N.D.T. in Conc. Post

220+88.00 Set C.S.J.V.R.T. by Interim

MENGED

Set N.D.T. in P.P.Hole

659.16 Calc.

105.44 T. 94° - 105.45 V

From top of page 118

RETURN TO
LOS ANGELES COUNTY SURVEYOR

Do not extend notes this side of this line

Notes: ANY ADDITIONS OR CHANGES ON THIS SHEET MUST BE MADE OR CIRCLED IN Red. WITH DATE AND NAME OF PERSON MAKING CHANGE.

F. B. 352 Pg. 120 A.W. Kru Feet Chief Party Notes by A.W.V.F. Date 8-15-29

To bottom of page 121

(Top of FB 397-111 to 114)

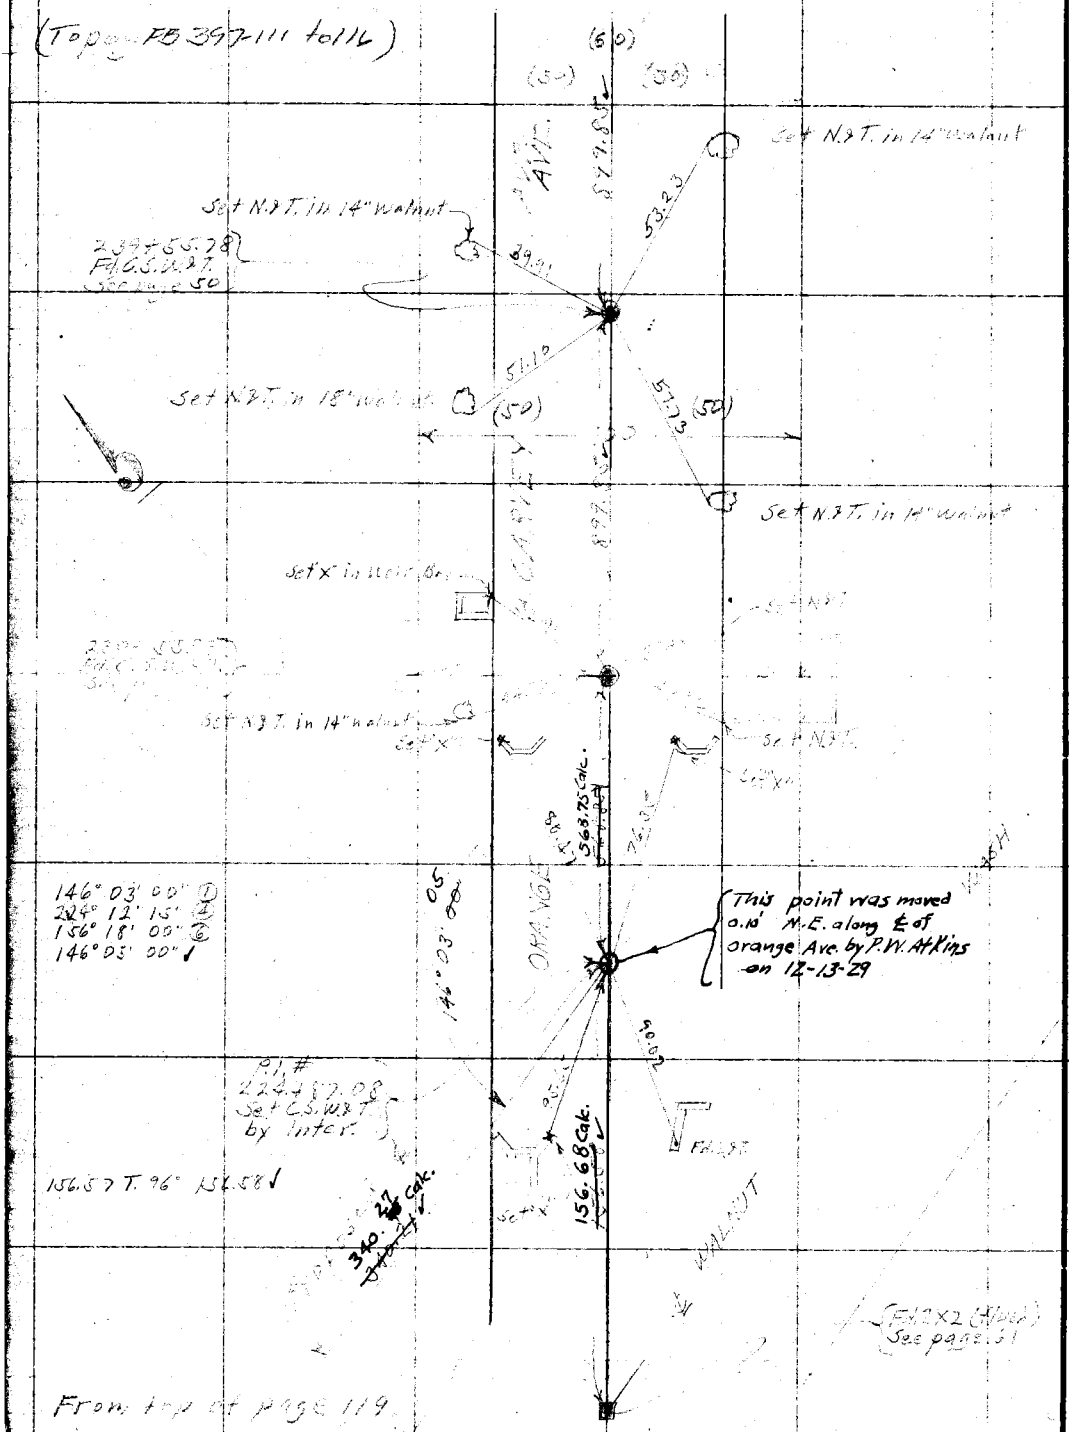

From top of page 119

RETURN TO LOS ANGELES COUNTY SURVEYOR

Do not extend notes this side of this line

Note: ANY ADDITIONS OR CHANGES ON THIS SHEET MUST BE MADE OR CIRCLED IN Red. WITH DATE AND NAME OF PERSON MAKING CHANGE.

Date 8-16-29 Notes by A.W.V.F. Chief Party [illegible] F.B. 352 Pg. 121

Tape

Platted by Wood
Date Oct. 1929
Map No.
Platting Extended H. U. M. H.
Date NOV 30 1929

W. O. No. 796 Corp. No. 022
Location [illegible]
Surveyed by [illegible]
Date 8-16-29
Indexed [illegible]

Notes: ANY ADDITIONS OR CHANGES ON THIS SHEET MUST BE MADE OR CIRCLED IN Red, WITH DATE AND NAME OF PERSON MAKING CHANGE.

Do not extend notes this side of this line

RETURN TO LOS ANGELES COUNTY SURVEYOR

(FB. 291-31)

ROOT AVE.

Fd. C.S.W.&T. C.S. 5905

(30)

(60)

ARROYO

End of Project 257+88.13 Fd. C.S. (16"deep) Page 50

(30)

PACIFIC AVE. C.S. 8908

86° 11' 40"

13.38

86° 11' 30" (1)
344° 46' 15" (4)
157° 09' 45" (6)
86° 11' 35"

168.32 T.94' = 168.33 ✓

127.56 T.94' = 127.56 ✓

Fd. 2X2 (18"deep)
FB. 231-29
FB. 364-40
C.S. 8908

127.57

1+00 57 45" ✓

256+19.80 Set C.S.W.&T. (8"deep) by Inter.

Fd. C.S.W.&T. (8"deep) FB. 231-29

142° 57' 45" (1)
211° 51' 00" (4)
137° 46' 15" (6)
142° 57' 45" ✓

248+55.63 Fd. C.S.W.&T. Page 50

(Top of Page FB 377. 117 to 121 W)

From top of page 120

F.B. 384 Pg. 122 Chief Party Notes by Date

RETURN TO
LOS ANGELES COUNTY SURVEYOR

Do not extend notes this side of this line

Note: ANY ADDITIONS OR CHANGES ON THIS SHEET MUST BE MADE OR CIRCLED IN Red. WITH DATE AND NAME OF PERSON MAKING CHANGE.

Date 11-4-29 Notes by Siva Chief Party Siva F.B. 352 PG. 123

Plotted by Wood
Date Nov. 1929
Map No. B-457-1
Plotting C'k'd by H. U. M. M.
Date NOV 30

W. O. No. 796 D. S. O. No.
Location Garvey Ave
Surveyed by P.W. Atkins Dep.
Date Nov. 5, 1929
Indexed A. C. Johnson

P.W. Atkins
C.C. Holland
C.E. Wittich

Transit
C.L. Berger & Sons
No. 15699

SURVEY to SHOW LOCATION of the intersection of East line Tr N° 3278 and ℄ GARVEY Av.

N

Fd old 2x3" stk & tk flush as shown on Tr No 3278 MB 36-41

Found 4" IP filled with conc. nail in top. as shown on MB 36-41 Tr N° 3278 FB 352-12

(621.60)

R.R

ST

PE

EL MONTE

(80')

Made search for this pt. Found 1"x2" stk & tk but no pipe

I = 182 31 00
Δ = 100 31 5
A = 182 30 48.75

I = 67 31 30
Δ = 270 05 45
A = 67 31 26.25

182°30'50" (182°31'(0") MB 36-41) (Tr. N° 3278 R)

EAST LINE TR. N° 3278 (467.40)

Found 4" IP filled with ● set in conc. Bolt in top. as shown on Tr N° 3278 MB 36-41

Note: see pg 128

Note: This line was established by proportion per MB 36-41

Set 2"x2" stk & tk 2 ft dn, by Int.

2x2-2 dn

68.03

℄ per FB 352-107 Adj. to conform to original chain.

AVE

(proposed)

(Contd on Pg 124)

GARVEY

(795.67)

Fd 2"x2" stk & tk flush (64+00.07 FB 352-107)

Fd 2"x2" stk & tk flush = (64+00.02 FB 352-107)

3046.75

3046.00

Contd on top pg 124

Note: ANY ADDITIONS OR CHANGES ON THIS SHEET MUST BE MADE OR CIRCLED IN Red. WITH DATE AND NAME OF PERSON MAKING CHANGE.

Do not extend notes this side of this line

RETURN TO LOS ANGELES COUNTY SURVEYOR

F.B. 352 Pg. 124 Chief Party Notes by PMA Date 11-6-29

b

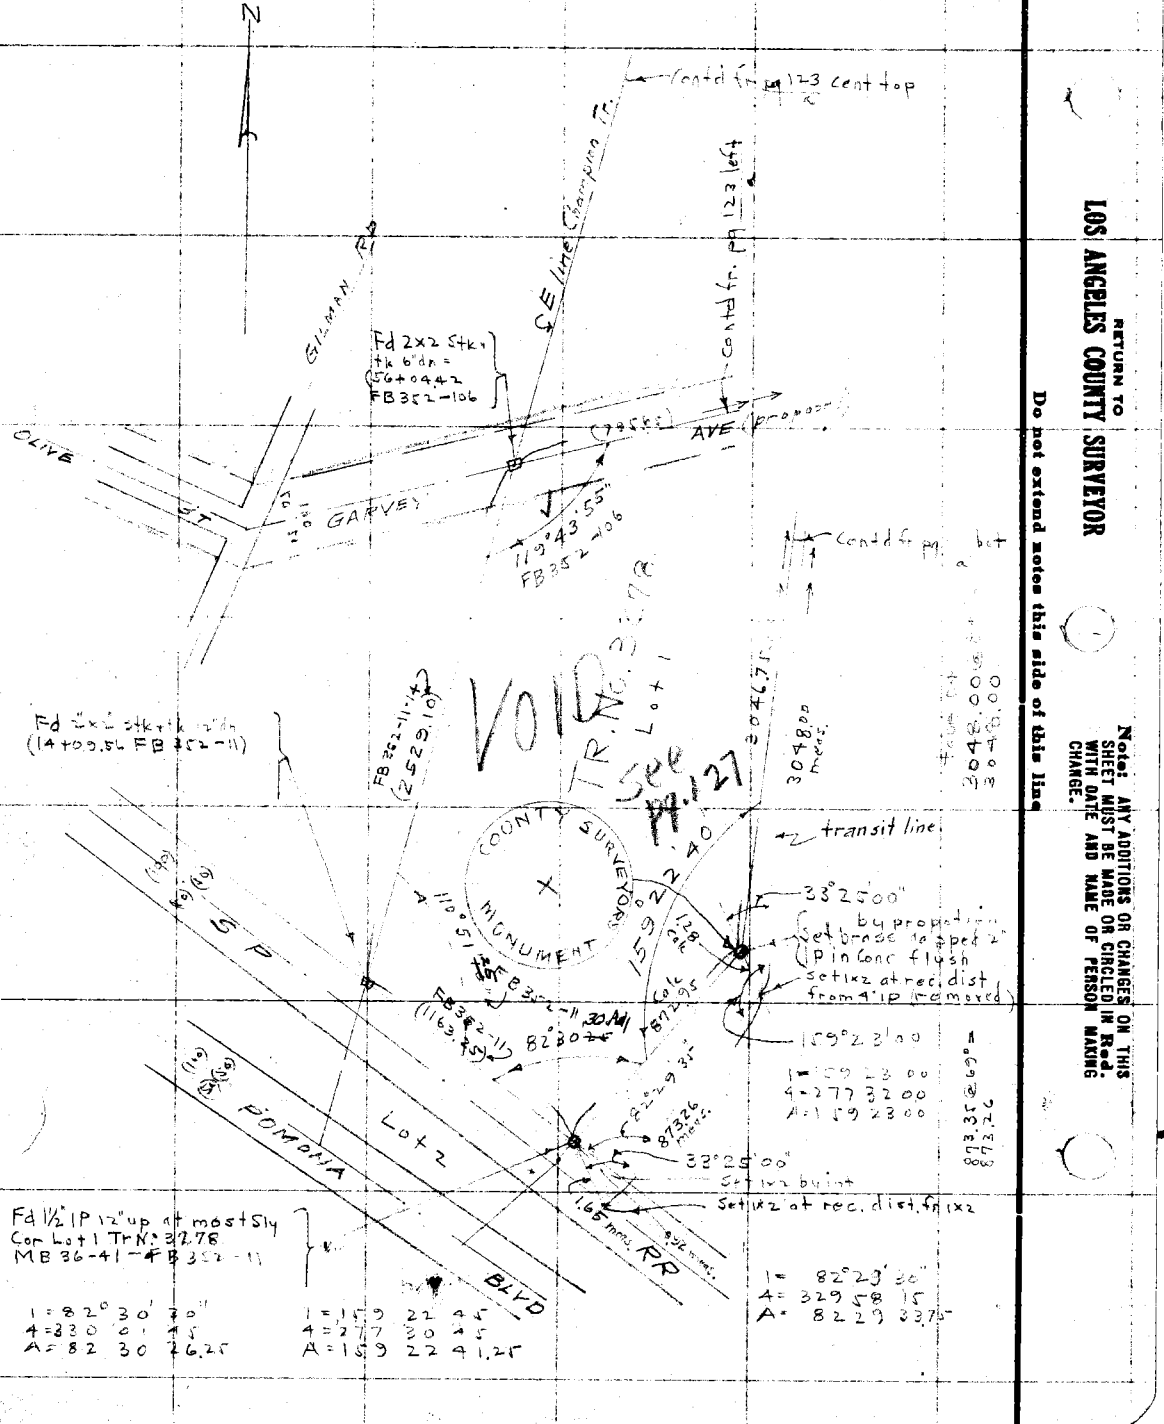

RETURN TO
LOS ANGELES COUNTY SURVEYOR

Do not extend notes this side of this line

Note: ANY ADDITIONS OR CHANGES ON THIS SHEET MUST BE MADE OR CIRCLED IN Red. WITH DATE AND NAME OF PERSON MAKING CHANGE.

Date 11-13-29 Notes by Dma Chief Party Dma F.B. 352 PG. 125

Platted by Wood
Date Nov. 1929
Map No. C.S.B. 457-1.
Platting Ck'd by H. U. M. H.
Date NOV 30 1929

W. O. No. 796 D. S. O. No. 04
Location Garvey Ave
Surveyed by PW Atkins Dep
Date 11-13-29
Indexed Geo. C. Johnson

Notes: ANY ADDITIONS OR CHANGES ON THIS SHEET MUST BE MADE OR CIRCLED IN Red. WITH DATE AND NAME OF PERSON MAKING CHANGE.

Do not extend notes this side of this file

RETURN TO LOS ANGELES COUNTY SURVEYOR

Fd 2x2 + tk FLB 168-140 flush

Fd 2x2 stk + tk fl. FC FLB 168-233

Fd 2x2 Stk + tk fl. FC FLB 168-233

Fd 2x2

66.06.00" Adj. Adj. to conform to Garvey Ave. Proj. as shown on Torrens Deeds. Inf. 11/27/29.

WALNUT WASH

Contd on pg 126 left

Fd N+T in tie on bridge

Set N+T in 1x2 stk nailed to x ties on bridge 104.32 NE fr. Lot line prod. per FC FLB 168-233

N+T qd tan across

Fd 1" IP fl. FC FLB 168-233

Set Wire spk + T in X tie fl. by Inf. = 129+

Fd 2x2 - fl. 129+23.55 Pg 111

Fd 2x2 - fl. 129+66.06 pg 111 Removed - 11/26/29

Garvey Ave

ELLIOT

Fd 2x2 at Vineland FB 352-24

Fd spk N+T at Elliot FB 352-69-24

P.I. pg 112 P.I. No 4

Fd 2x2 + tk

Fd 2x2 at Vineland FB 352-24

F.B. 352 Pg. 126 Chief Party Notes by Date 11-15-29

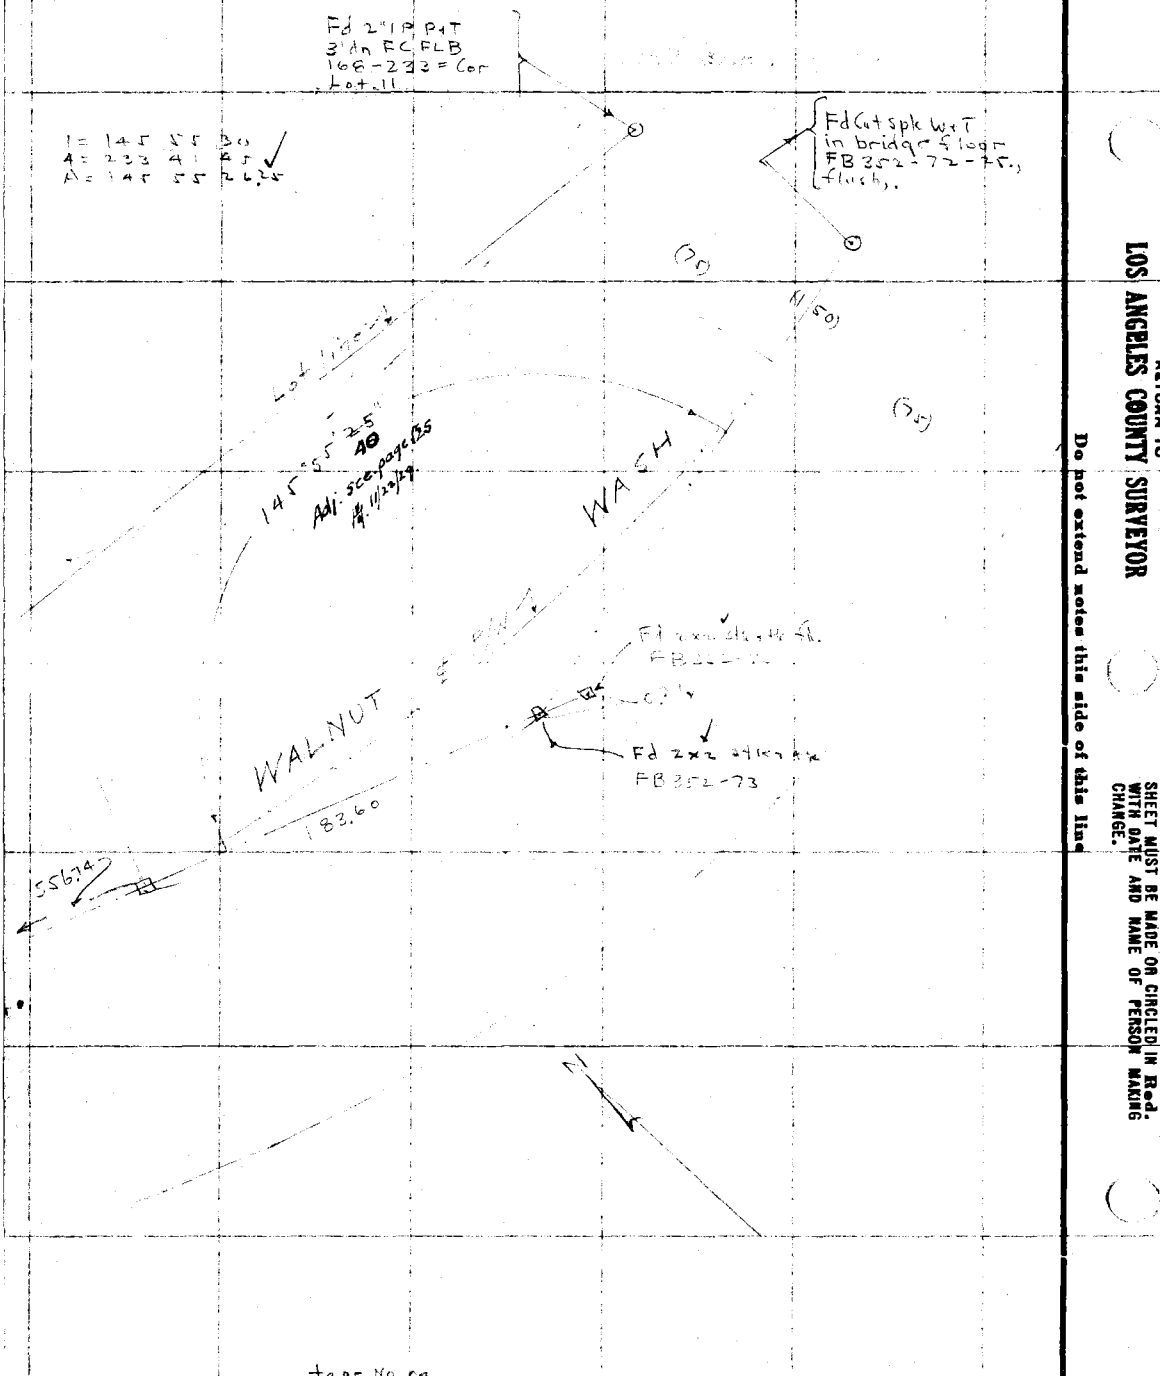

Tape No. 04
83.60 @ 54° = 183.60

RETURN TO
LOS ANGELES COUNTY SURVEYOR
Do not extend notes this side of this line

Note: ANY ADDITIONS OR CHANGES ON THIS SHEET MUST BE MADE ON CIRCLED IN Red. WITH DATE AND NAME OF PERSON MAKING CHANGE.

Date 11-26-29 Notes by Dma Chief Party Dma F.B. 352 Pg. 127

Platted by Wood	W. O. No. 796 D. S. O. No.
Date Nov. 1929	Location Garvey Ave
Map No. B-457-1	Surveyed by P W Atkins Dep
Platting C'k'd by H. U. M. H.	Date Nov. 26, 1929
Date NOV 30 1929	Indexed A. C. Johnson

I = 159 23 00
4 = 6 27 32
A = 159 23 00

Note: ANY ADDITIONS OR CHANGES ON THIS SHEET MUST BE MADE OR CIRCLED IN Red. WITH DATE AND NAME OF PERSON MAKING CHANGE.

Do not extend notes this side of this line

RETURN TO LOS ANGELES COUNTY SURVEYOR

Contd on bot pg 128

2529.13 @ 74° = 2529.13
3048.00 @ 84° = 3048.00
2658.54 @ 14° = 2658.54
8735.67 @ 172° = 8735.67

2529.13 (2529.10) R.P. 11-14

TR. NO. 2278

2658.54

3048.00

I = 159 23 15
4 = 27 33 15
A = 159 23 16.75

I = 82 29 45
4 = 329 58 45
A = 82 29 41.25

transit line

turned 1.47° 57' 12"

159° 23' 30"

0.36

Set 1x2 destroyed

Set brass capped 2" IP in conc. flush by proportion marked as shown in circle

COUNTY SURVEY MONUMENT

873.35 @ 74° = 873.26

Fd 2x2 pg 11-14

R 124 16.82 E

(100) (F.O.) (F.O.)

Adj. 82° 29' 50"

Calc. 145° 57' 12"

87333

873.26

set 1x2 destroyed

0.45

Fd 1½" IP pg 124

R R

F. B. 352 PG. 128 Chief Party Notes by Date 11-26-29

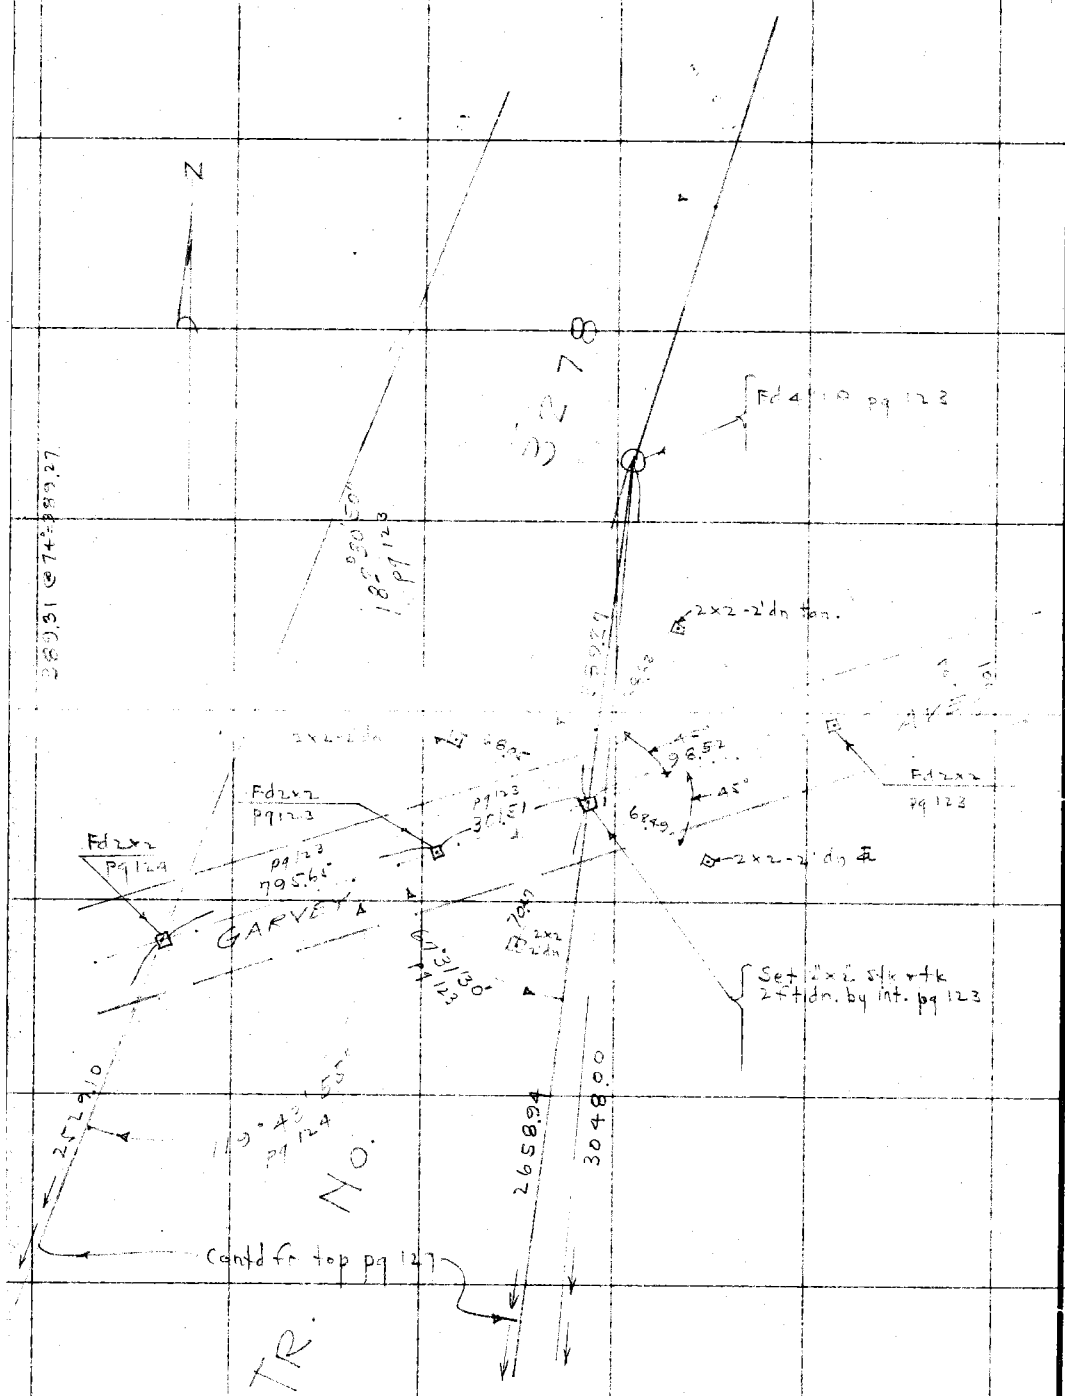

RETURN TO
LOS ANGELES COUNTY SURVEYOR

Do not extend notes this side of this line

Note: ANY ADDITIONS OR CHANGES ON THIS SHEET MUST BE MADE OR CIRCLED IN Red. WITH DATE AND NAME OF PERSON MAKING CHANGE.

Date _____ Notes by _____ Chief Party _____ F.B. 352 Pg. 129

Platted by	W. O. No. 796 D. S. O. No.
Date	Location Garvey Ave
Map No. C.S.B. 519-1	Surveyed by
Platting C'k'd by H. U. M. H.	Date
Date August 1930	Indexed E. W. Johnson

CENTER LINE

RELOCATION

OF

GARVEY AVE

W.O. 796

from

MOUNTAIN VIEW ROAD

to

GILMAN ROAD.

Party — Moore, Blanchard, McBride, Dey, Off

March 14-17 1930.

Note: ANY ADDITIONS OR CHANGES ON THIS SHEET MUST BE MADE OR CIRCLED IN Red. WITH DATE AND NAME OF PERSON MAKING CHANGE.

Do not extend notes this side of this line

RETURN TO LOS ANGELES COUNTY SURVEYOR

F.B. 352 PG. 130 Moore Chief Party Notes by Moore Date

To pg. 106

INDEX SKETCH

Numbers are page numbers

Topog. : pgs. 136-148

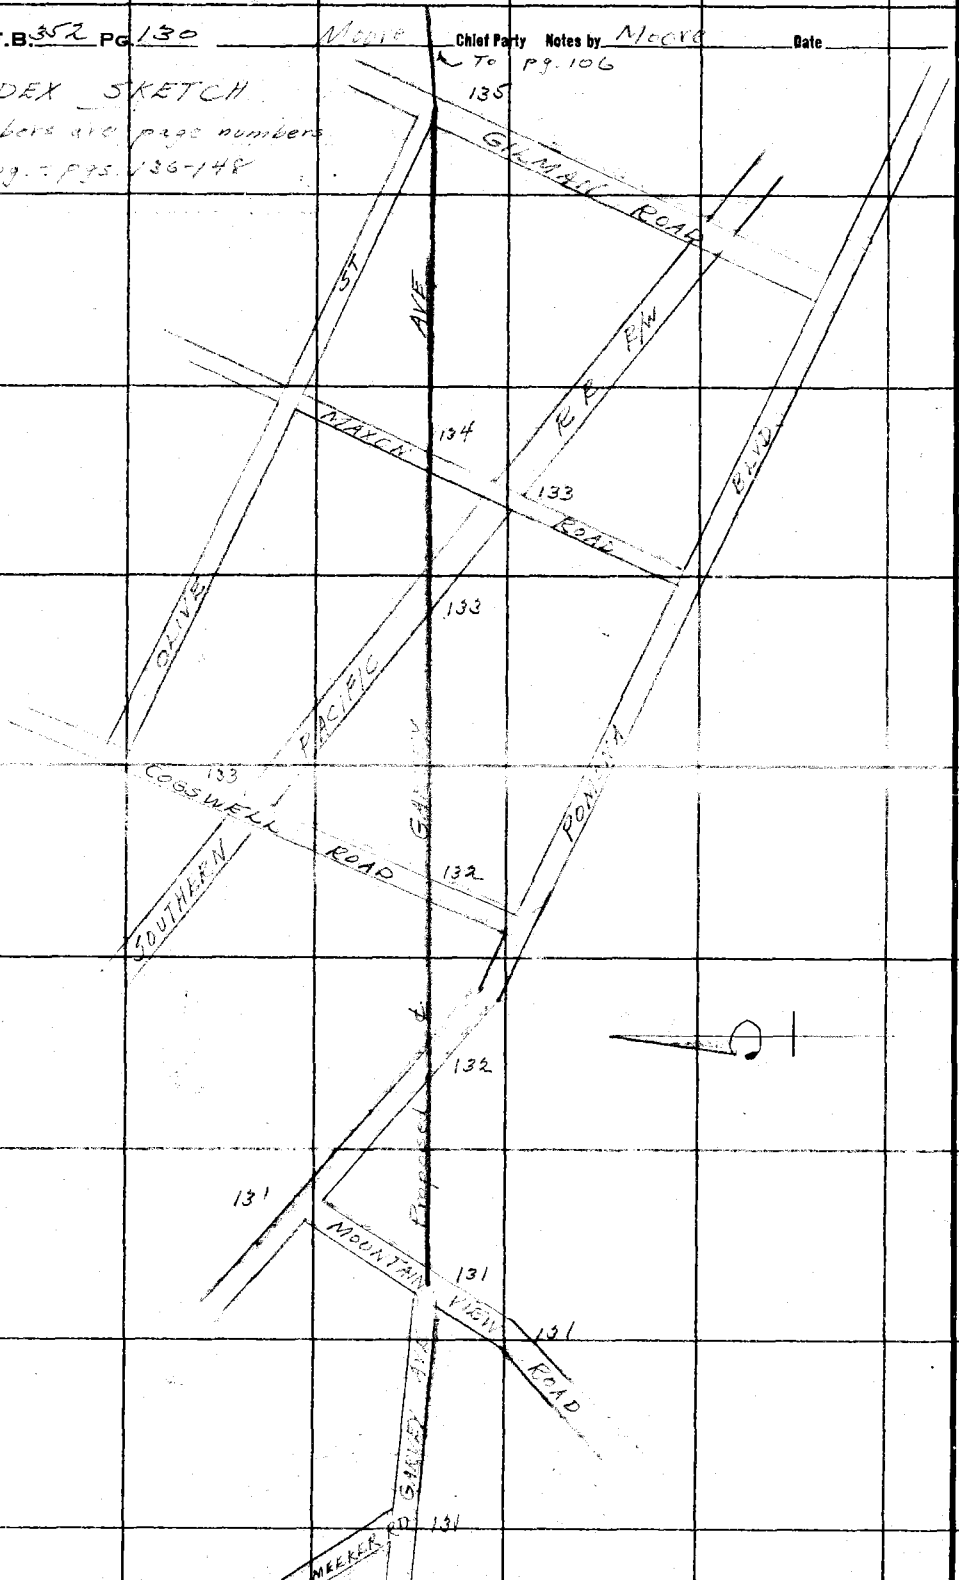

RETURN TO

LOS ANGELES COUNTY SURVEYOR

Do not extend notes this side of this line

Note: ANY ADDITIONS OR CHANGES ON THIS SHEET MUST BE MADE OR CIRCLED IN Red. WITH DATE AND NAME OF PERSON MAKING CHANGE.

Date 3-14-30 Notes by Moore Chief Party Moore F.B. 352 Pg. 131

Platted by H.U.M.H. JUN 1 - 1930
Date
Map No. B-519-1.
Platting C'k'd by Falo.
Date June. 1930.

W.O. No. 796 D.S.O. No. 026
Location Garvey Ave
Surveyed by
Date 3-14-30
Indexed A. C. Johnson

Notes: ANY ADDITIONS OR CHANGES ON THIS SHEET MUST BE MADE OR CIRCLED IN Red. WITH DATE AND NAME OF PERSON MAKING CHANGE.

Do not extend notes this side of this line

RETURN TO LOS ANGELES COUNTY SURVEYOR

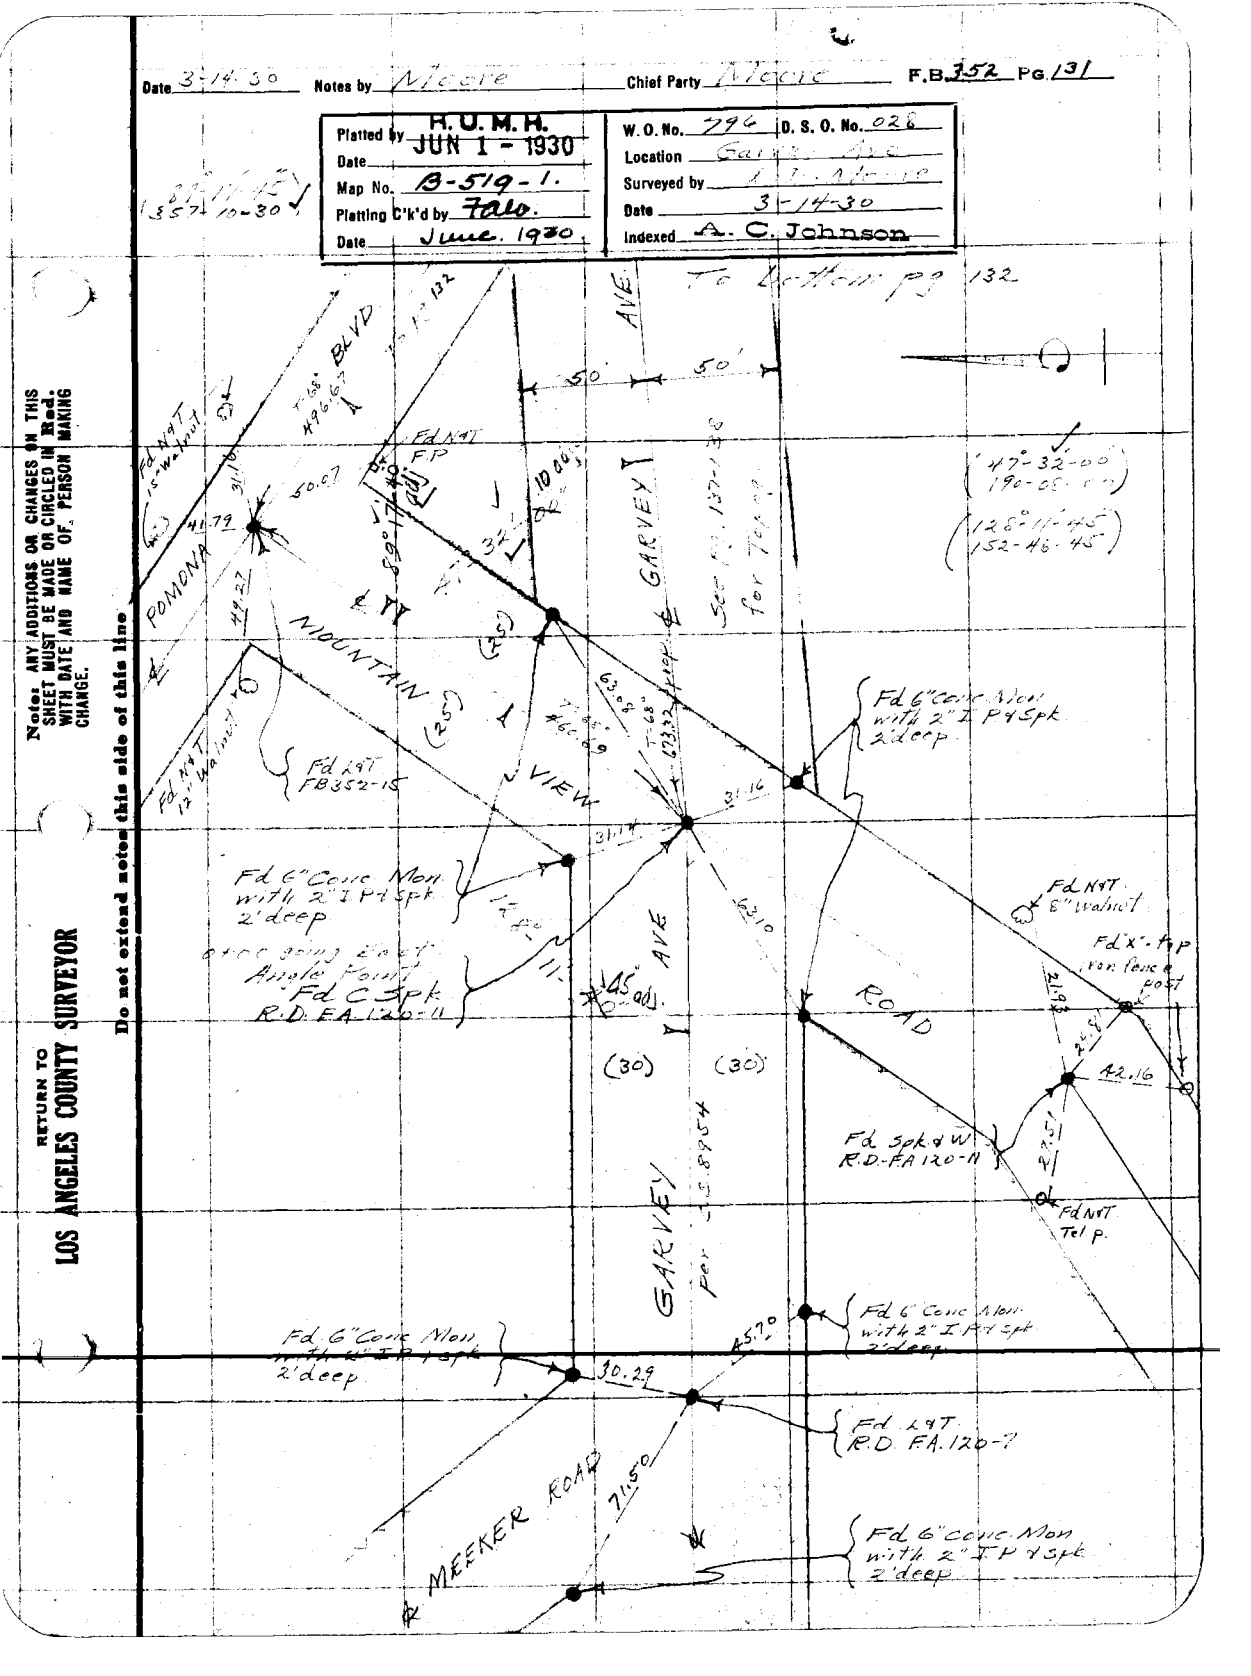

F.B. 352 Pg. 132 Moore Chief Party Notes by Moore Date 3-14-30

To bottom pg. 133

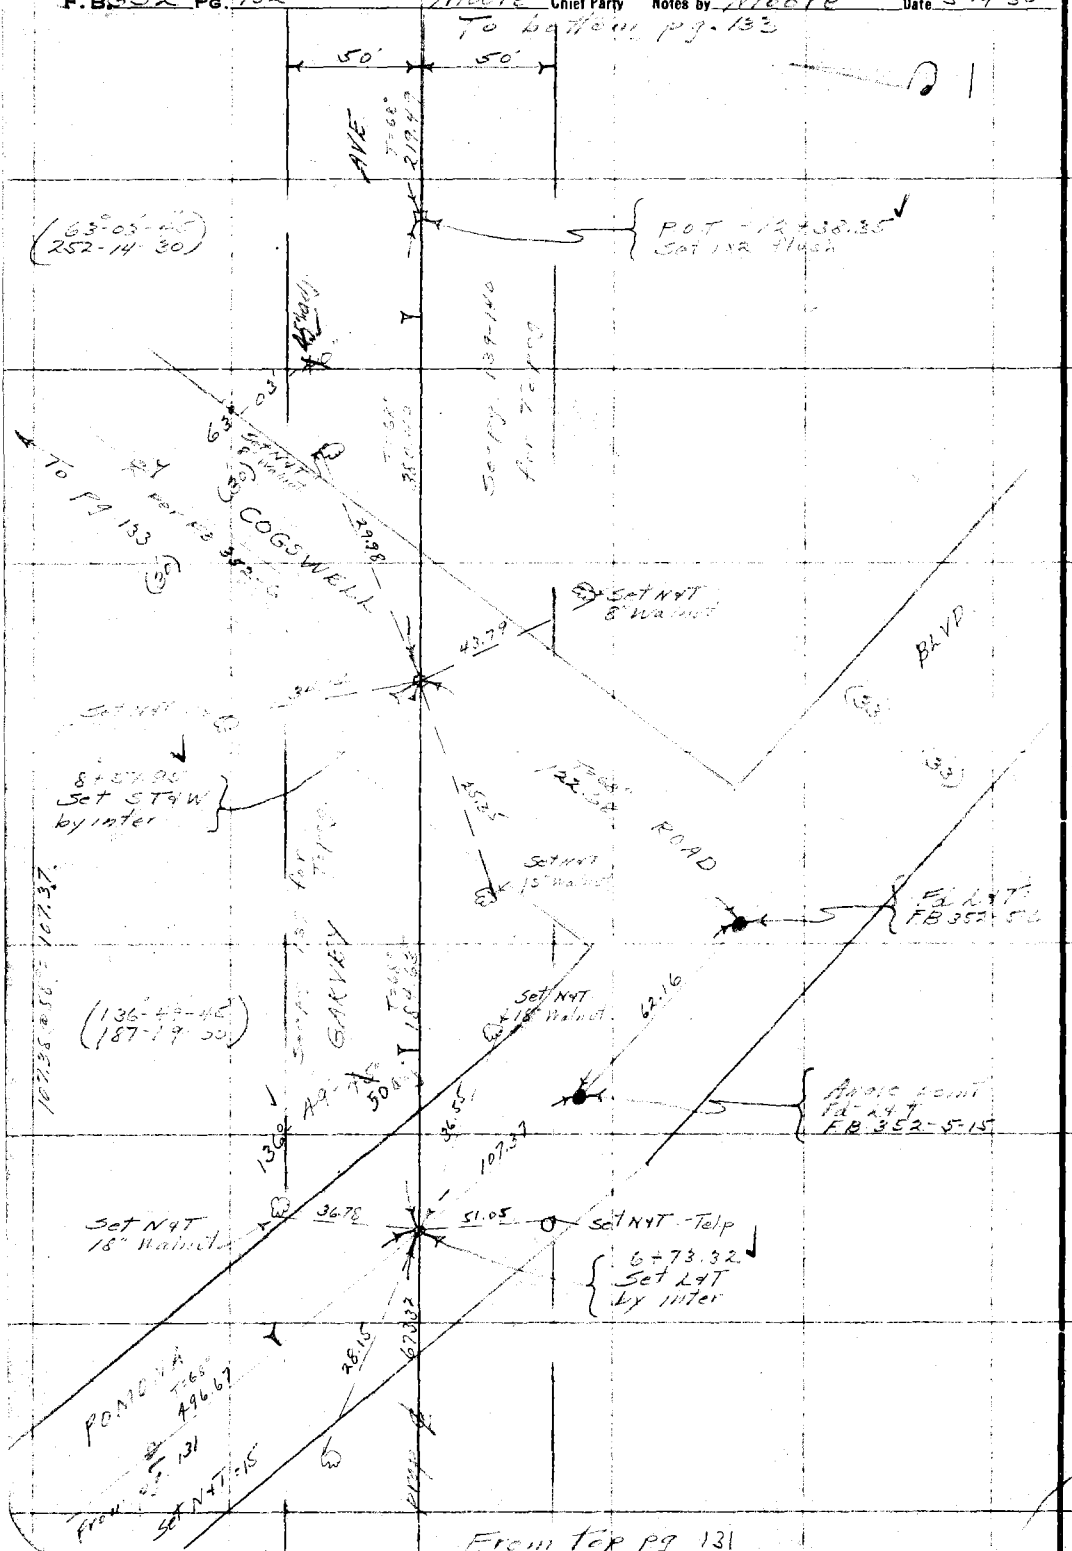

RETURN TO
LOS ANGELES COUNTY SURVEYOR

Do not extend notes this side of this line

Note: ANY ADDITIONS OR CHANGES ON THIS SHEET MUST BE MADE OR CIRCLED IN Red. WITH DATE AND NAME OF PERSON MAKING CHANGE.

From for pg 131

Date 3-17-30 Notes by A Moore Chief Party A Moore F.B. 252 Pg. 133

Platted by R.U.M.H.	W.O. No. 796 D.S.C.O. No. 028
Date JUN 1 - 1930	Location Garvey Ave
Map No. 13-519-1	Surveyed by A D Moore
Platting C'k'd by Faw.	Date 3-17-30
Date June 1930	Indexed A. C. Johnson

Notes: ANY ADDITIONS OR CHANGES ON THIS SHEET MUST BE MADE OR CIRCLED IN Red. WITH DATE AND NAME OF PERSON MAKING CHANGE.

Do not extend notes this side of this line

RETURN TO LOS ANGELES COUNTY SURVEYOR

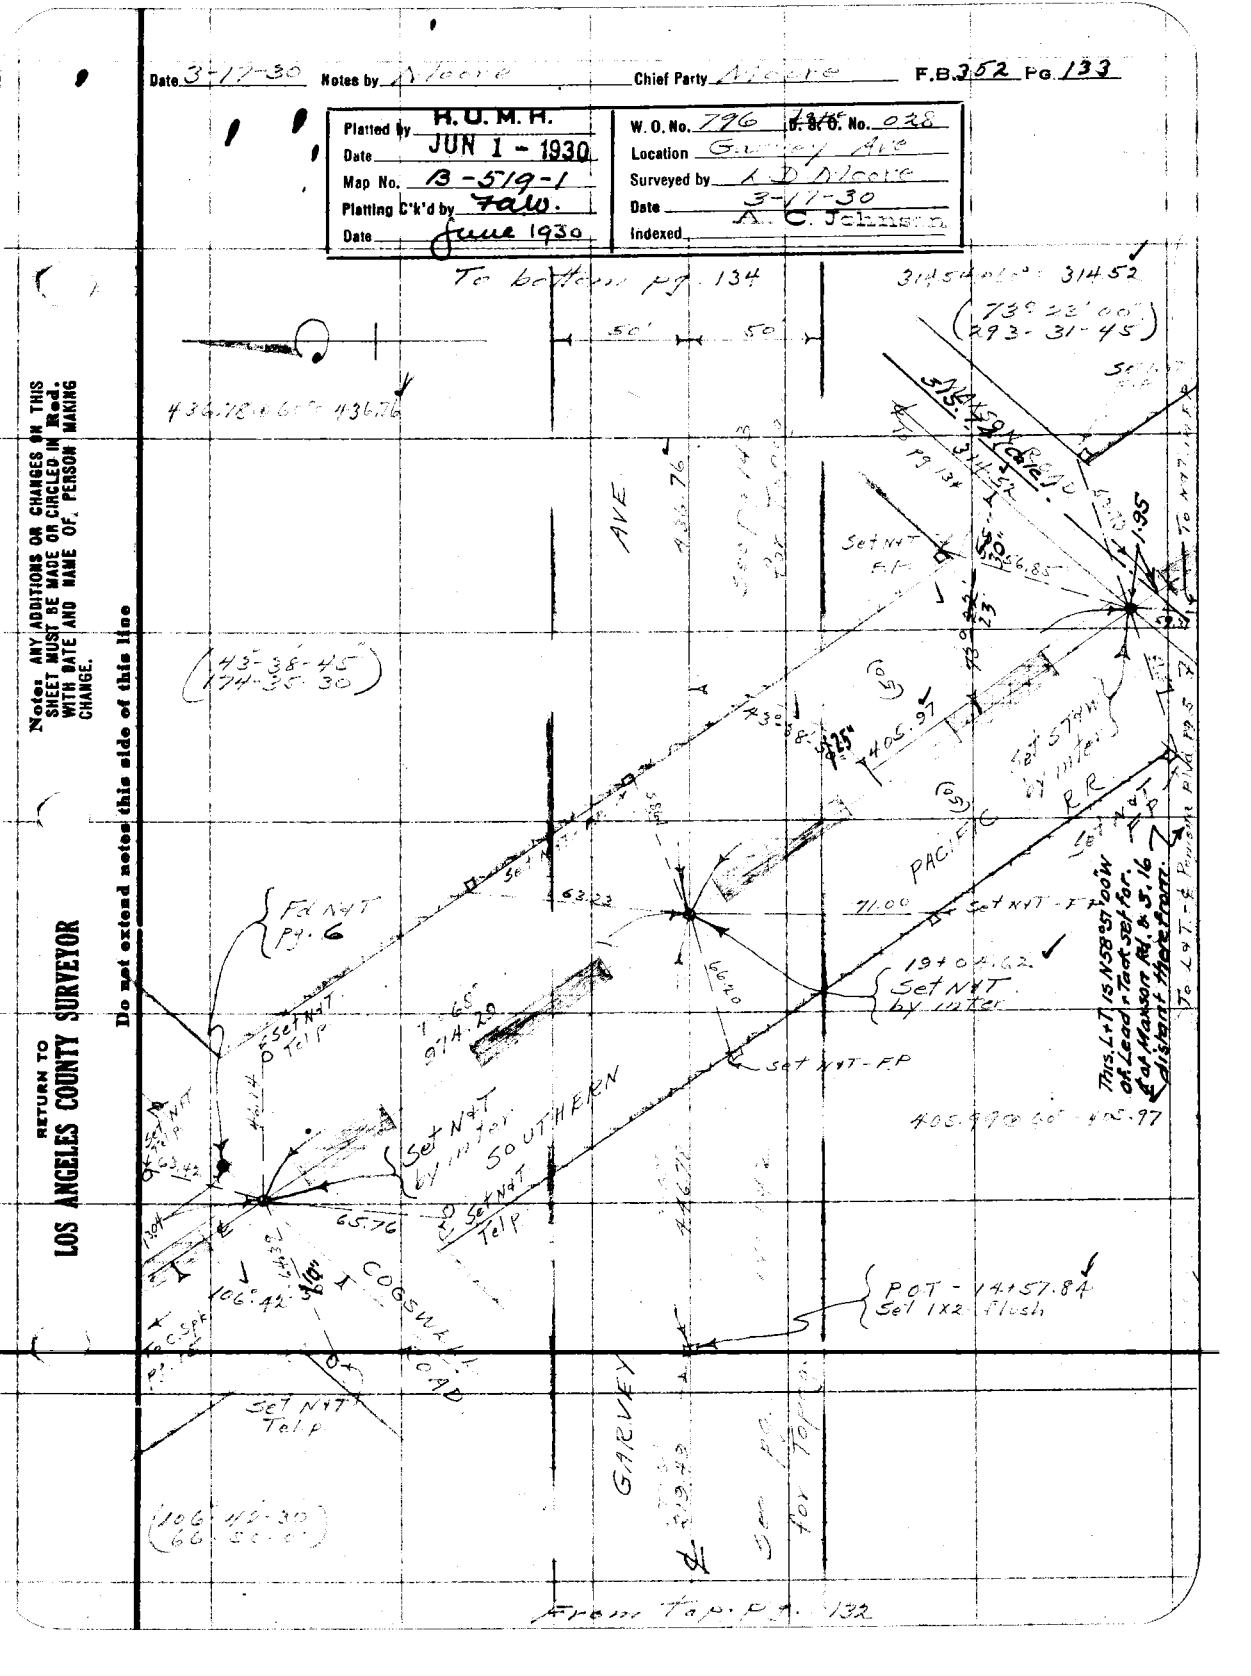


To bottom pg. 135

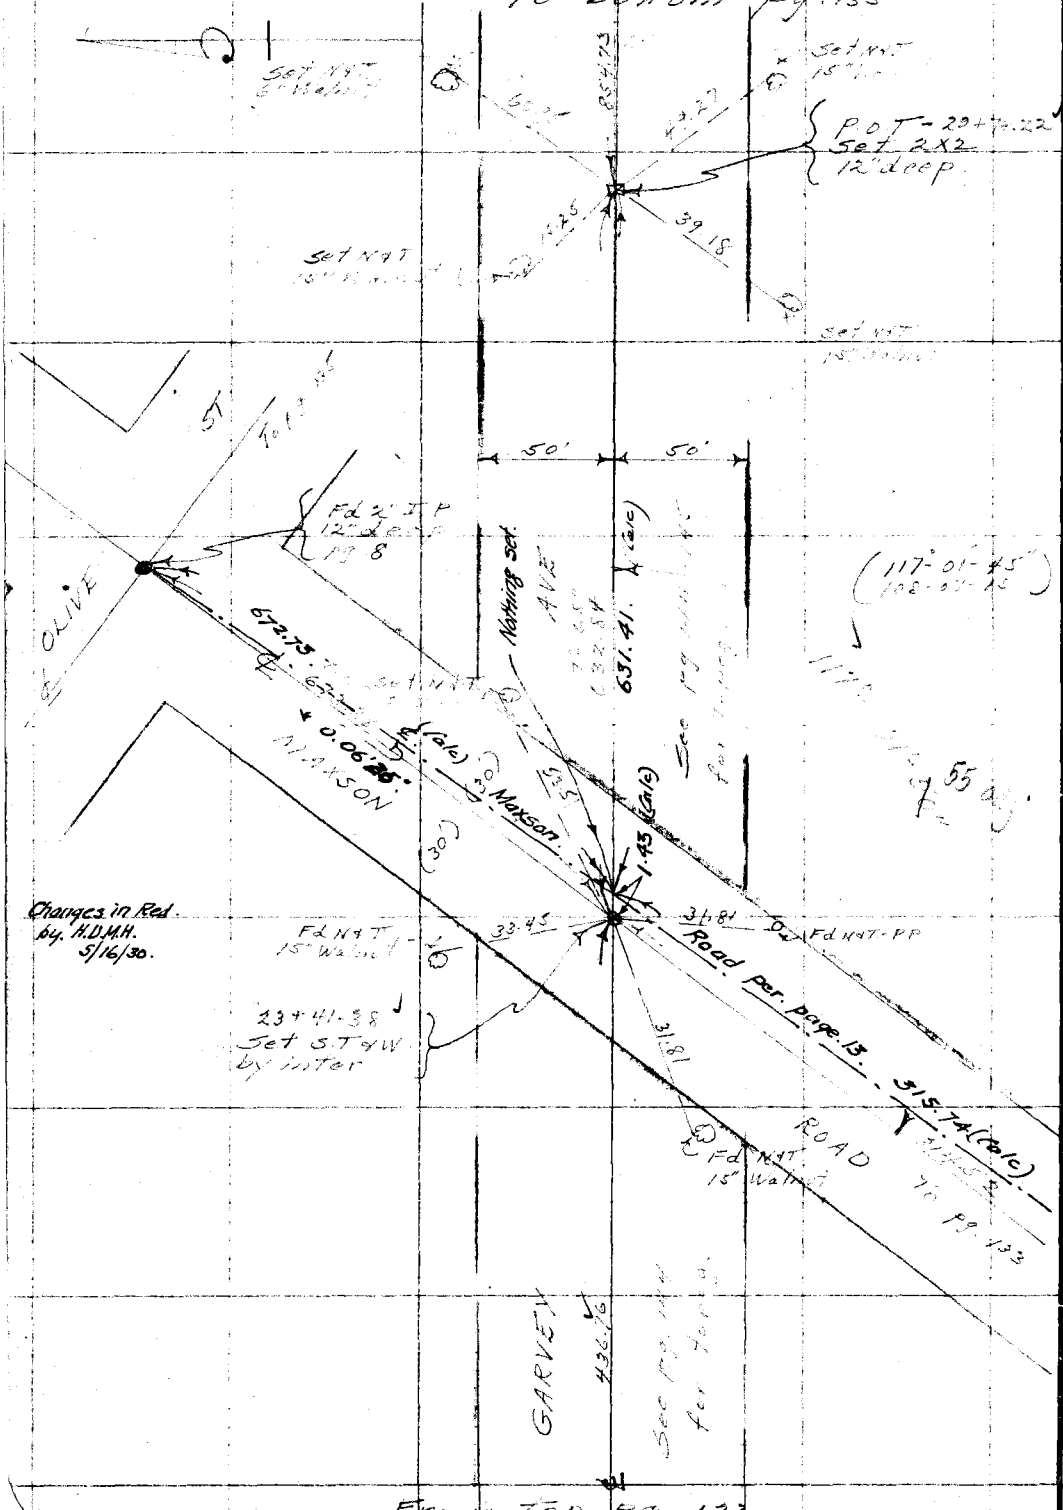

RETURN TO
LOS ANGELES COUNTY SURVEYOR

Do not extend notes this side of this line

Note: ANY ADDITIONS OR CHANGES ON THIS SHEET MUST BE MADE OR CIRCLED IN Red. WITH DATE AND NAME OF PERSON MAKING CHANGE.

Date 5-15-30 Notes by Moore Chief Party Moore F.B. 352 Pg 135

Platted by H.U.M.H. JUN 1 - 1930	W.O. No. 7776 U.S.O. No. 028
Map No. B-519-1	Surveyed by L.D. Moore
Platting C'k'd by Falb.	Date 5-18-30
Date June 1930.	Indexed A.C. Johnson

To 2+12. 51+39.71 = Pg 106
(51+18.30 from SW. = 51+21.34 going N.E. per C.S. B 457-5 Sht 1)


GILMAN

ROAD

(30')

(30')

To 147+8 Spkr Pg 10

(24-54-00 E 38-30)

To Pg 136

(63)

GAEVIEW

From Pg 136

Note: ANY ADDITIONS OR CHANGES ON THIS SHEET MUST BE MADE OR CIRCLED IN Red. WITH DATE AND NAME OF PERSON MAKING CHANGE.

Do not extend notes this side of this line

RETURN TO LOS ANGELES COUNTY SURVEYOR

F. B. 352 Pg. 136 Chief Party Notes by Date

TOPOGRAPHY
for
RELOCATION
GARVEY AVE
from
MONTEREY PARK ROAD
to
GRAND AVE

RETURN TO
LOS ANGELES COUNTY SURVEYOR

Do not extend notes this side of this line

Note: ANY ADDITIONS OR CHANGES ON THIS SHEET MUST BE MADE OR CIRCLED IN Red. WITH DATE AND NAME OF PERSON MAKING CHANGE.

Date 3-15-30 Notes by [illegible] Chief Party [illegible] F.B. 352 Pg. 137

Platted by H. U. M. H.	W. O. No. 775 D. S. O. No.
Date JUN 1 - 1930	Location Sa[illegible]
Map No. B-519-1	Surveyed by A. D. Moore
Platting C'k'd by Valo.	Date 3/18/30
Date June 1930	Indexed C. C. Jo[illegible]

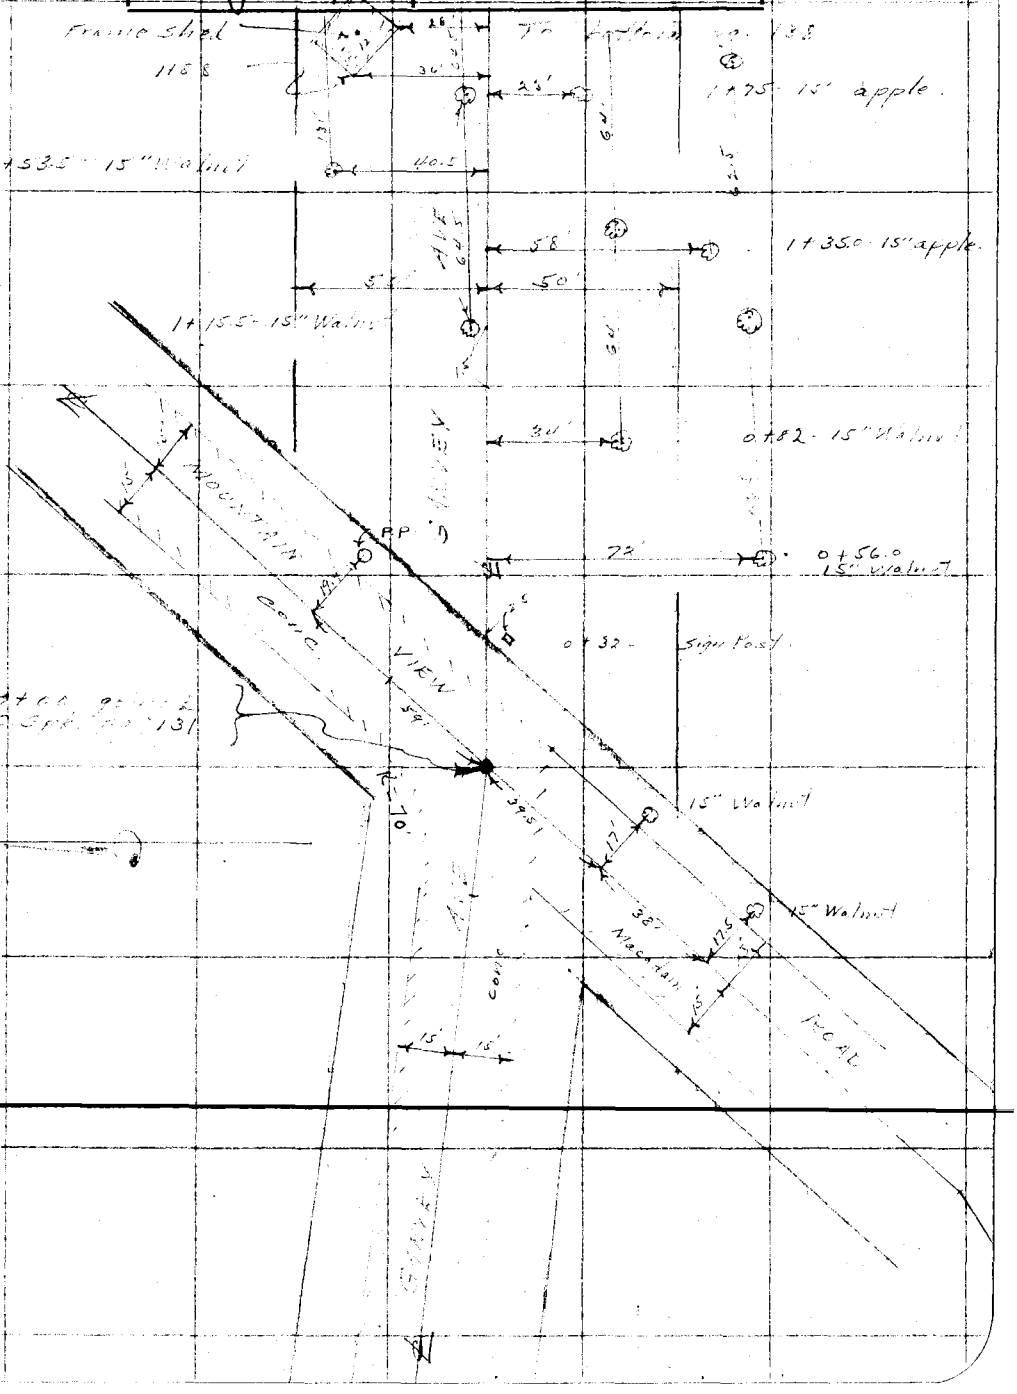

Note: ANY ADDITIONS OR CHANGES ON THIS SHEET MUST BE MADE OR CIRCLED IN Red. WITH DATE AND NAME OF PERSON MAKING CHANGE.

Do not extend notes this side of this line

RETURN TO LOS ANGELES COUNTY SURVEYOR


To bottom pg. 139

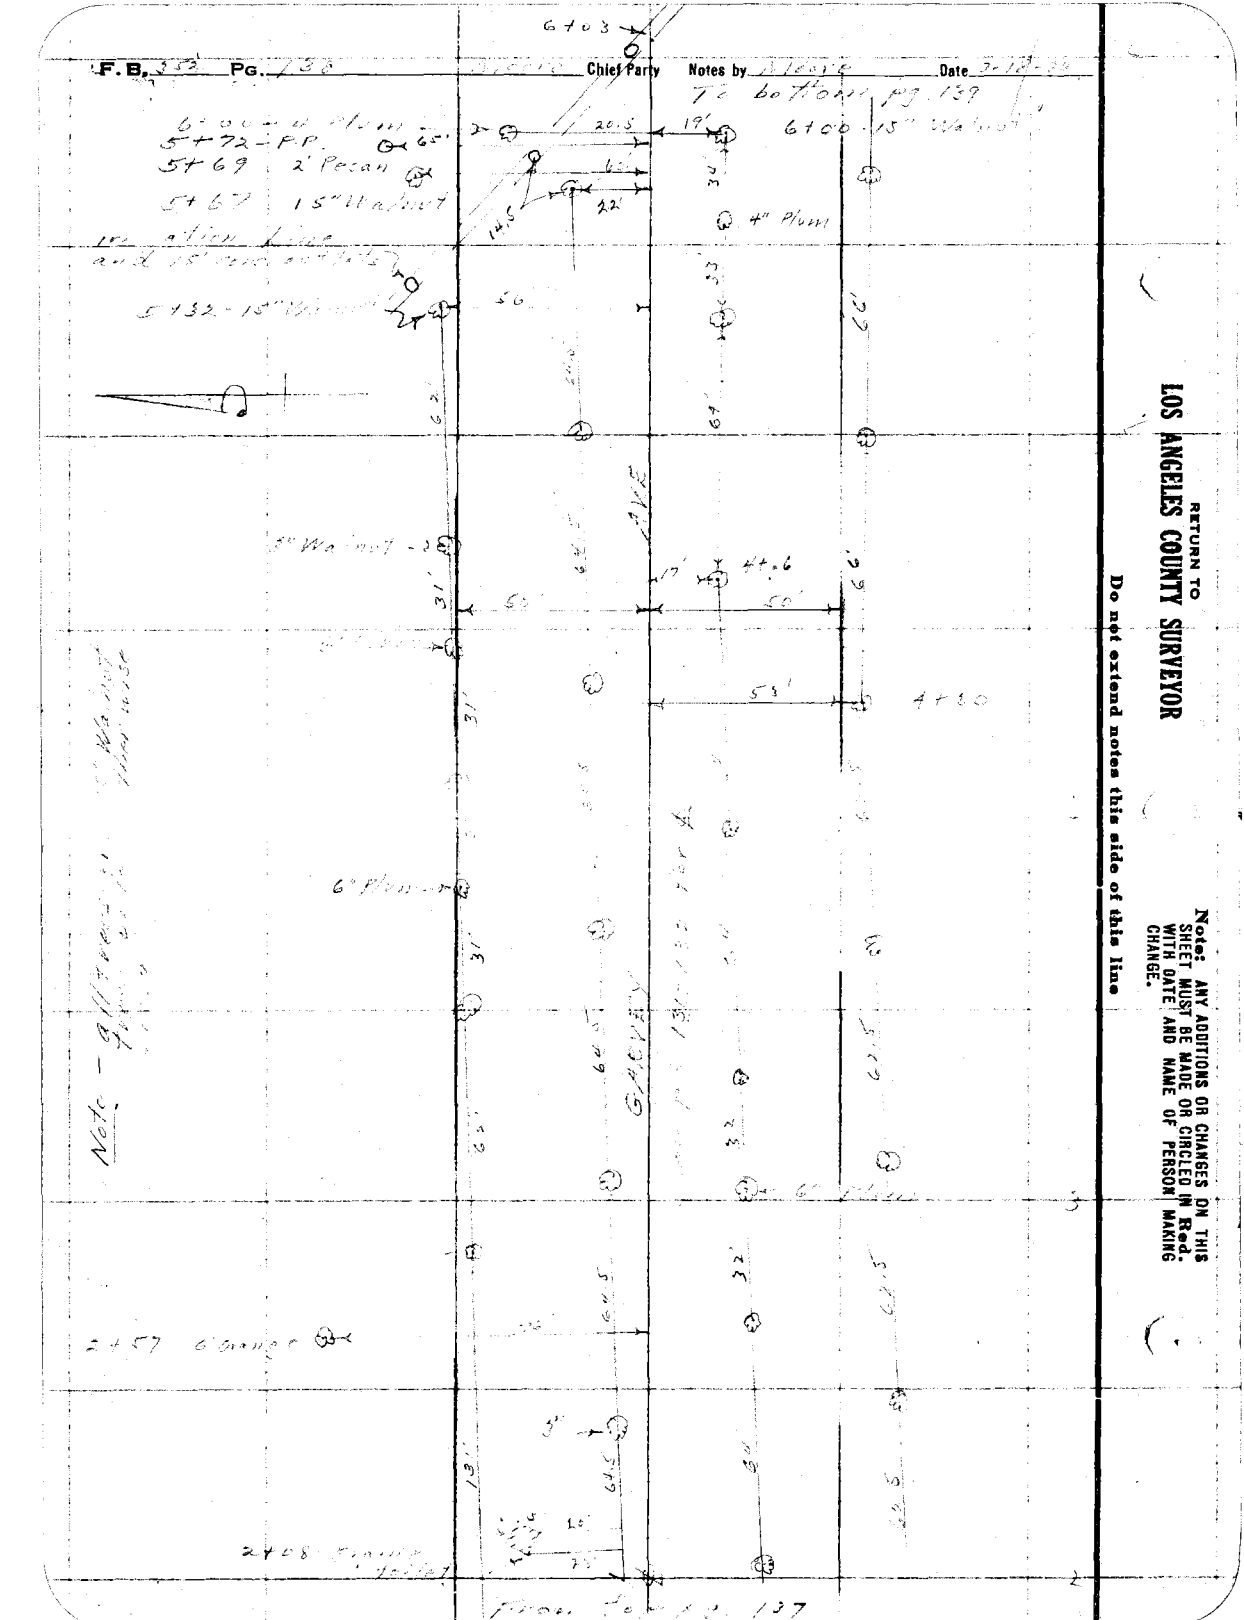

RETURN TO
LOS ANGELES COUNTY SURVEYOR

Do not extend notes this side of this line

Note: ANY ADDITIONS OR CHANGES ON THIS SHEET MUST BE MADE OR CIRCLED IN Red. WITH DATE AND NAME OF PERSON MAKING CHANGE.

Date 5-16-30 Notes by Moore Chief Party Nicol F.B. 352 Pg. 139

Platted by H.W.M. JUN 1 1930
Date
Map No. B.579-1.
Platting C'k'd by Kelso.
Date June 1930.

W.O. No. 196 D.S.O. No.
Location
Surveyed by
Date 5-18-30
Indexed C. Johnson

RETURN TO
LOS ANGELES COUNTY SURVEYOR

Notes: ANY ADDITIONS OR CHANGES ON THIS SHEET MUST BE MADE OR CIRCLED IN Red, WITH DATE AND NAME OF PERSON MAKING CHANGE.

Do not extend notes this side of this line

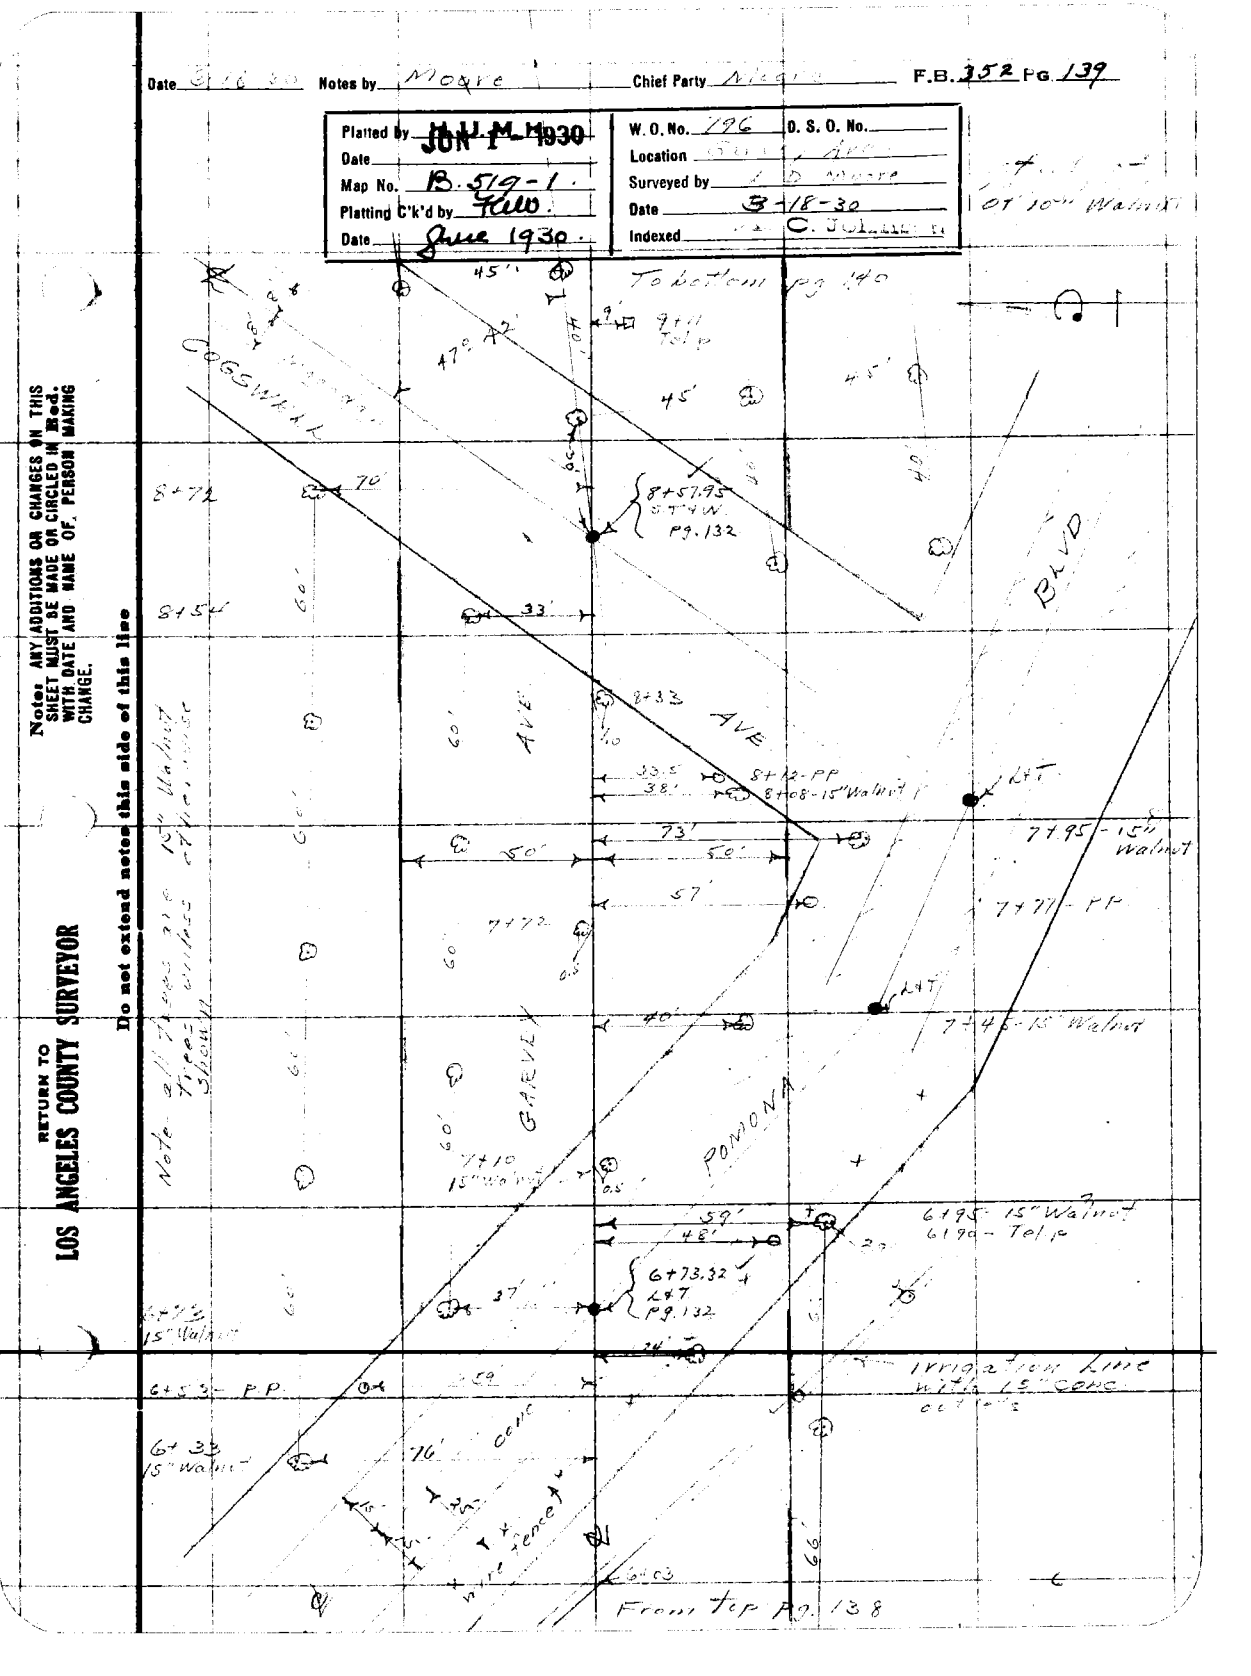

F.B. 382 Pg. 140 | Moore Chief Party | Notes by Moore | Date 3-18-30

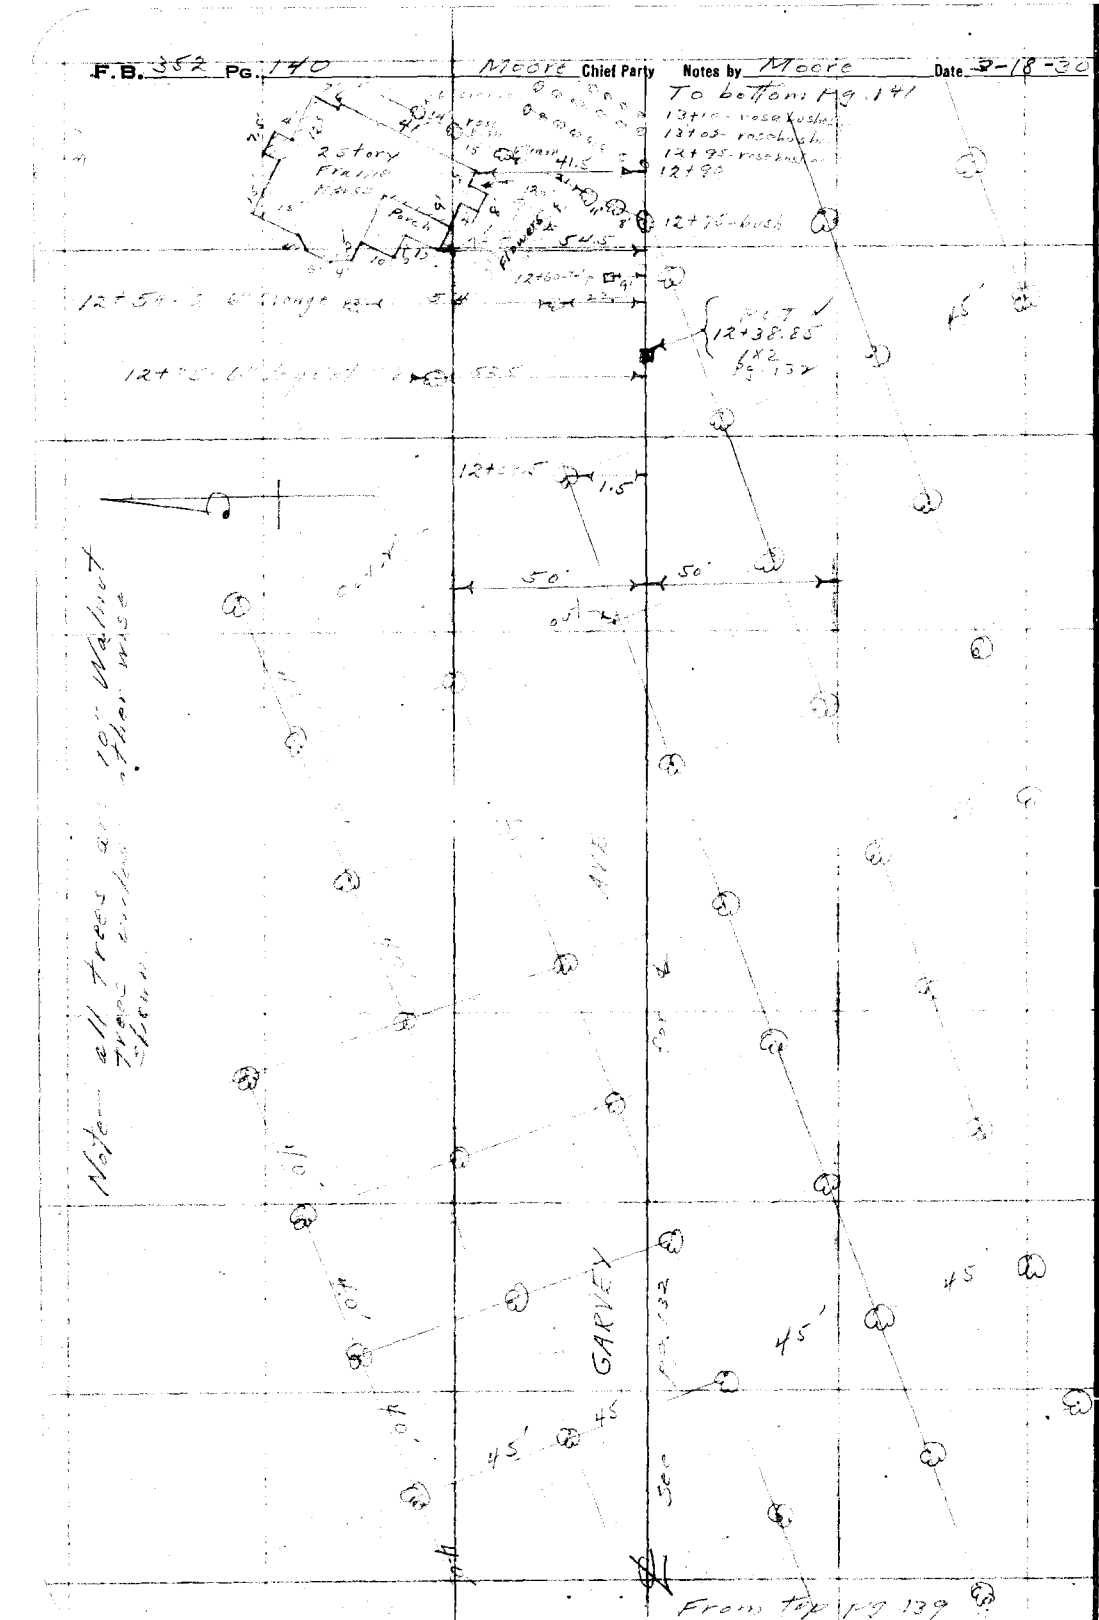

RETURN TO
LOS ANGELES COUNTY SURVEYOR

Do not extend notes this side of this line

Note: ANY ADDITIONS OR CHANGES ON THIS SHEET MUST BE MADE OR CIRCLED IN Red. WITH DATE, AND NAME OF PERSON MAKING CHANGE.

Date 3-11-30 Notes by [illegible] Chief Party Moore F.B. 352 Pg 141

Platted by H. U. M. H.	W. O. No. 796 D. S. O. No.
Date JUN 1 - 1930	Location [illegible]
Map No. B-519-7	Surveyed by [illegible]
Platting C'k'd by Tall.	Date 3-19-30
Date June 1930	Indexed [illegible]

To Lathrop pg. 105

AVE

15+33

66'

walnut

50'

50'

15+10

13'

40'

14+79

14+57.84

1 X 2

pg 13

14+01.5

64'

73'

13+68

13+48

40'

13+20

23'

12+96

GREEN

13

From Topp 140

Notes: ANY ADDITIONS OR CHANGES ON THIS SHEET MUST BE MADE OR CIRCLED IN Red. WITH DATE AND NAME OF PERSON MAKING CHANGE.

Do not extend notes this side of this line

RETURN TO LOS ANGELES COUNTY SURVEYOR

F. B. 352 Pg. 142 Moore Chief Party Notes by Moore Date 3-19-30

To Bottom Pg. 143

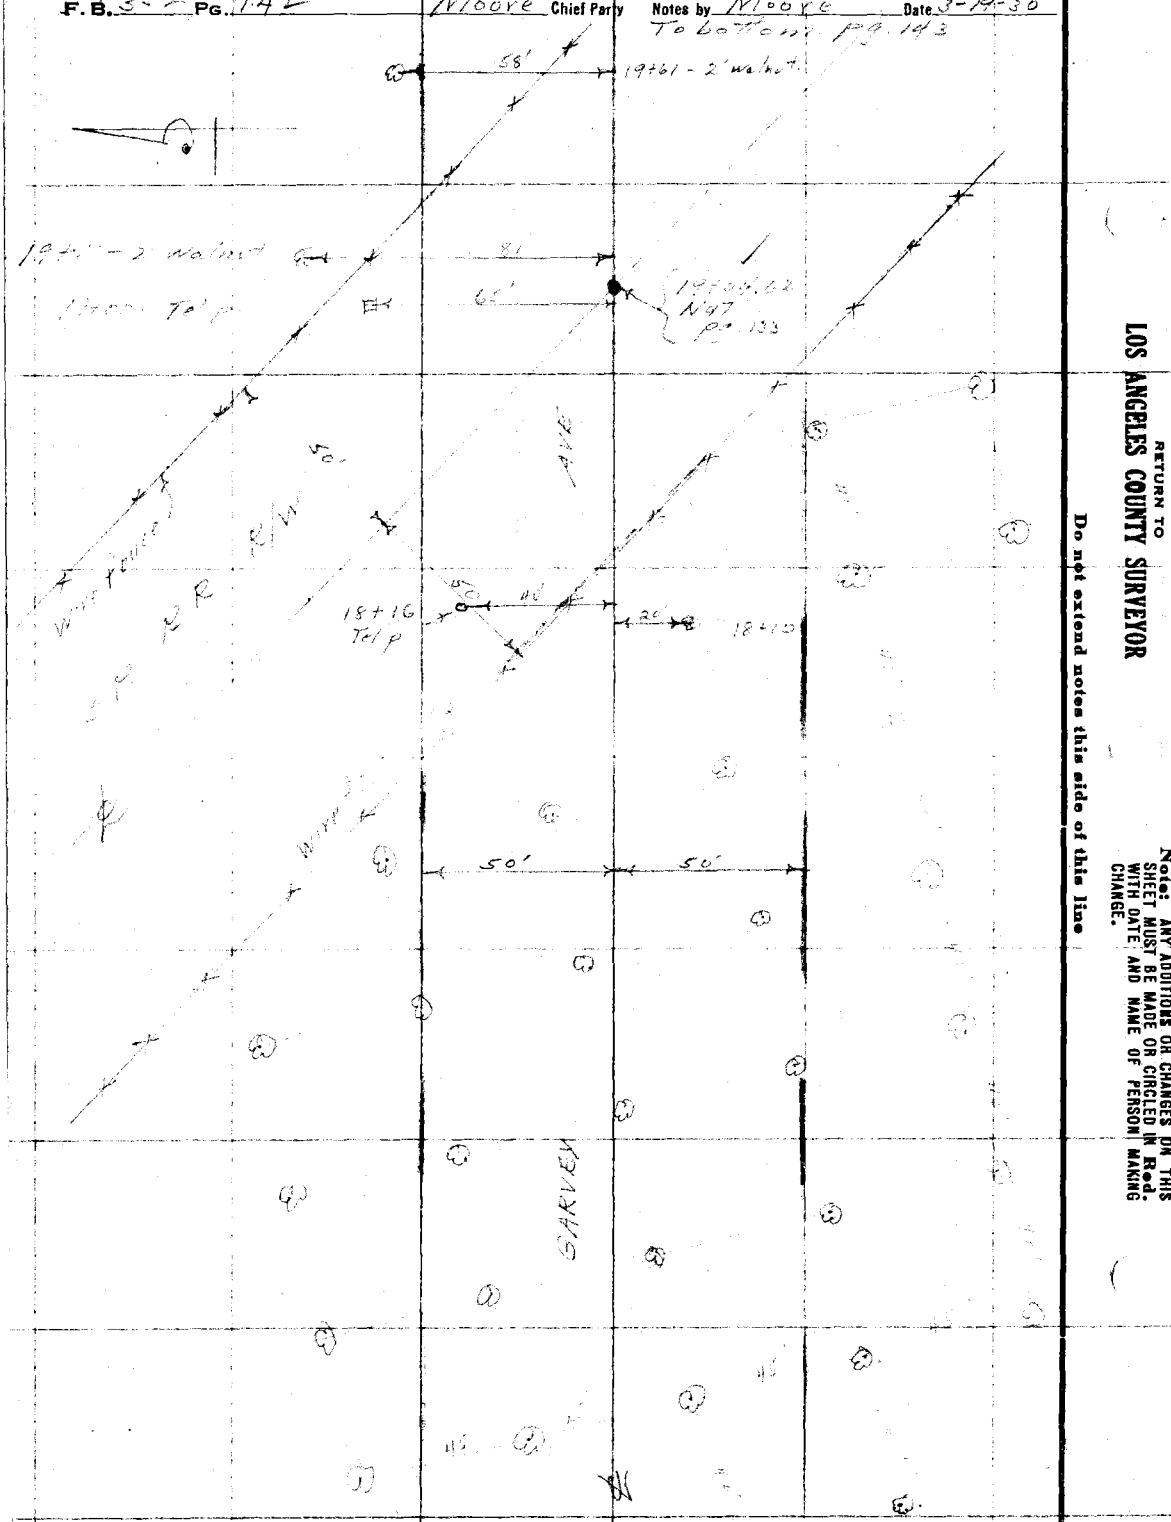
58'
19+61 - 2' walnut
81'
66'
19+09.62
N 37
Pg. 133
19+61 - 2 walnut
11 from Tel p
Tel p
18+16
Tel p
18+10
20'
50'
50'
50'
50'
WIRE FENCE

Date 3-[illegible]-30 Notes by [illegible] Chief Party [illegible] F.B. 352 Pg. 143

Platted by H.U.M.H. JUN 1 - 1930	W.O. No. 776 D.S.O. No.
Date	Location [illegible]
Map No. B-519-1	Surveyed by [illegible]
Platting C'k'd by Fold.	Date 3-17-30
Date June 1930	Indexed [illegible] C. Jones

To be [illegible] pg. [illegible]

50' 50' 50'

22+85 - 15" [illegible]

22+70 - 15" Walnut

11'

ALLEY

35'

22+45 - 15" Walnut

22+26 - 15" Walnut

33'

17'

22+02 - 15" Walnut

21+63 - 15" [illegible]

56' 56'

11'

21+43 [illegible]

34'

21+33 - 18" Walnut

21+15 12" Walnut

33'

41'

[illegible]

56'

[illegible]

12'

20+98 [illegible]

37'

20+32 - 5" Walnut

GRAVELEY

40'

20+05 - Tele. [illegible]

24'

19+74 - 8" Walnut

From Fou[illegible] 10/2

Notes: ANY ADDITIONS OR CHANGES ON THIS SHEET MUST BE MADE OR CIRCLED IN Red. WITH DATE AND NAME OF PERSON MAKING CHANGE.

Do not extend notes this side of this line

RETURN TO LOS ANGELES COUNTY SURVEYOR

F.B. 354 Pg. 144 Chief Party Notes by Moore Date 3-19-30

To be Plotted P. 245

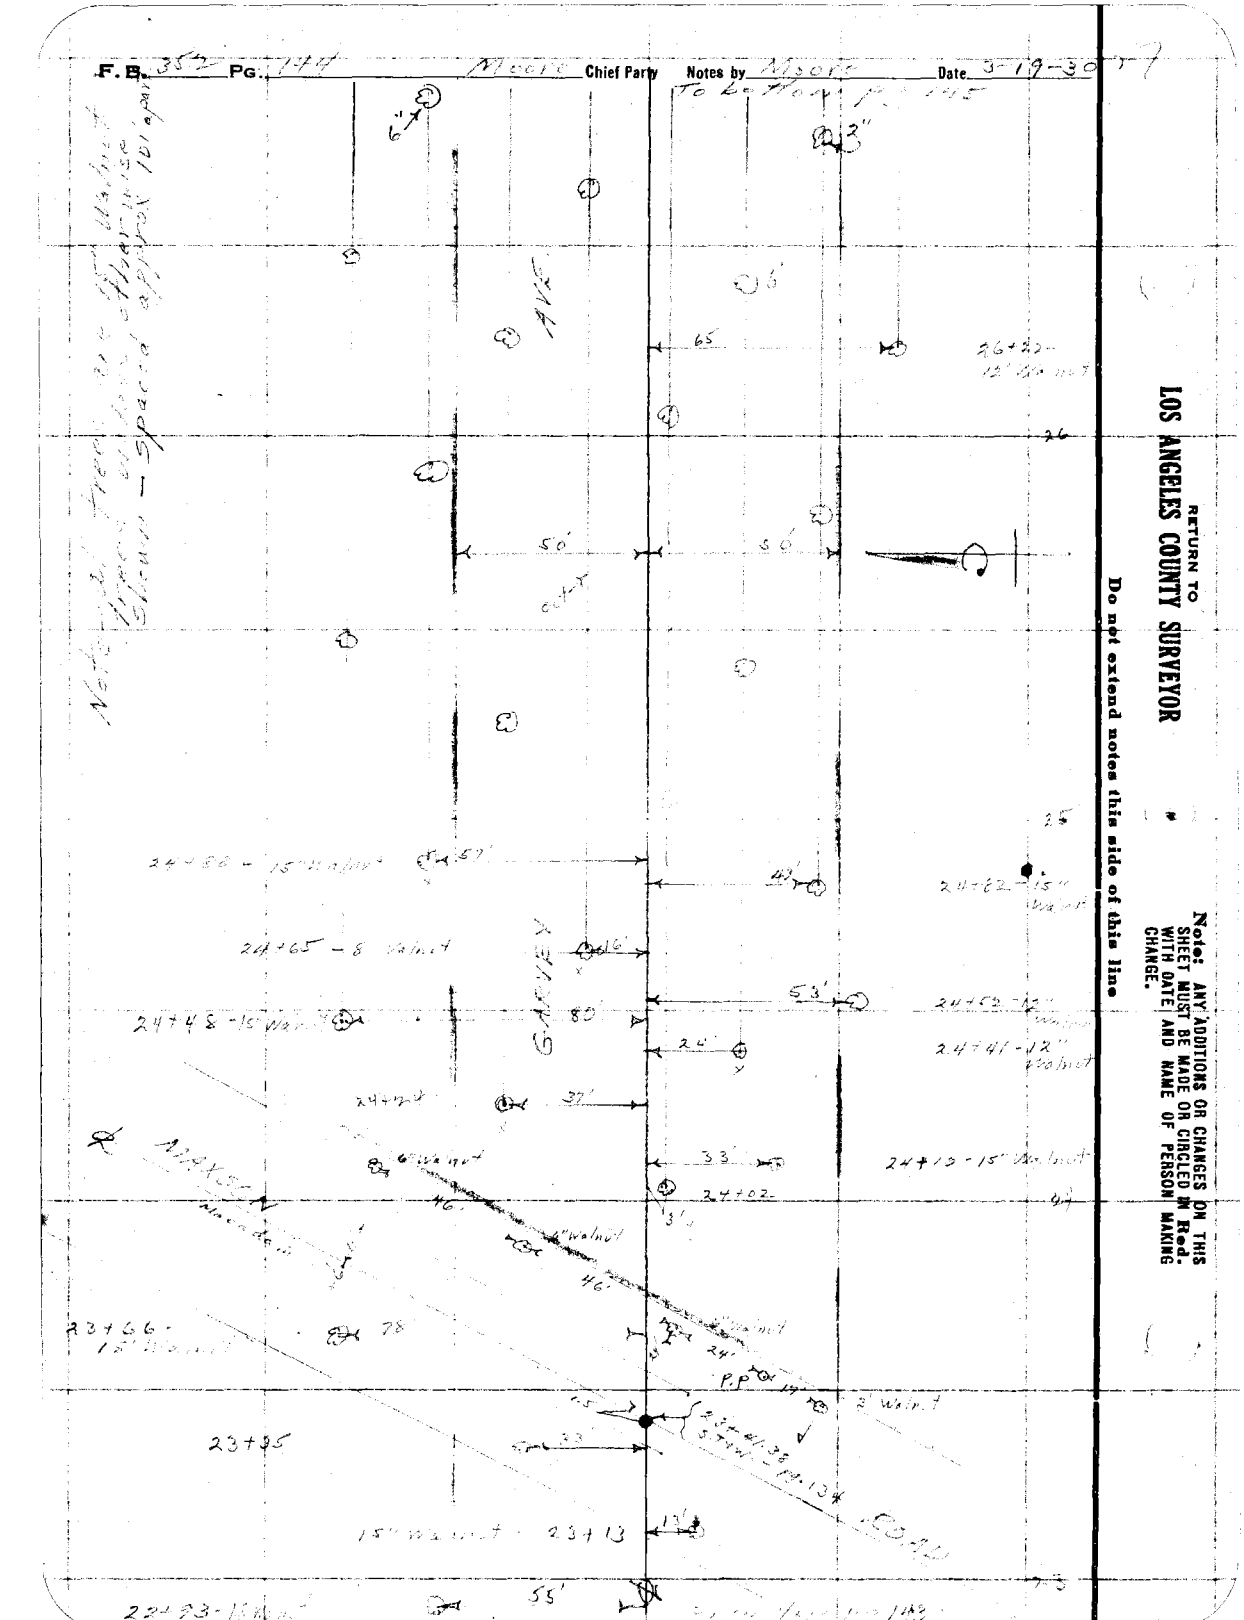

RETURN TO
LOS ANGELES COUNTY SURVEYOR

Do not extend notes this side of this line

Note: ANY ADDITIONS OR CHANGES ON THIS SHEET MUST BE MADE OR CIRCLED IN Red. WITH DATE AND NAME OF PERSON MAKING CHANGE.

Date 3-[illegible]-30 Notes by [illegible] Chief Party [illegible] F.B. 352 Pg 145

Platted by H.U.M.H.	W.O. No. 276 D.S.O. No.
Date JUN 1 - 1930	Location
Map No. B-519-1	Surveyed by A. D. Moore
Platting C'k'd by Falb.	Date 3-17-30
Date June 1930	Indexed A. C. Johns

To Lot Map pg. 146

30

4"

50' 50'

{ 2nd 1922 - 50?
3rd 1? 124

4"

Notes: ANY ADDITIONS OR CHANGES ON THIS SHEET MUST BE MADE OR CHECKED IN RED WITH DATE AND NAME OF PERSON MAKING CHANGE.

Do not extend notes this side of this line

RETURN TO LOS ANGELES COUNTY SURVEYOR

[illegible]

[illegible]

[illegible]

RETURN TO
LOS ANGELES COUNTY SURVEYOR

Note: ANY ADDITIONS OR CHANGES ON THIS SHEET MUST BE MADE OR CIRCLED IN **Red.** WITH DATE AND NAME OF PERSON MAKING CHANGE.

Do not extend notes this side of this line

F. B. 352 Pg. 150

Chief Party Notes by Date 3-14-30

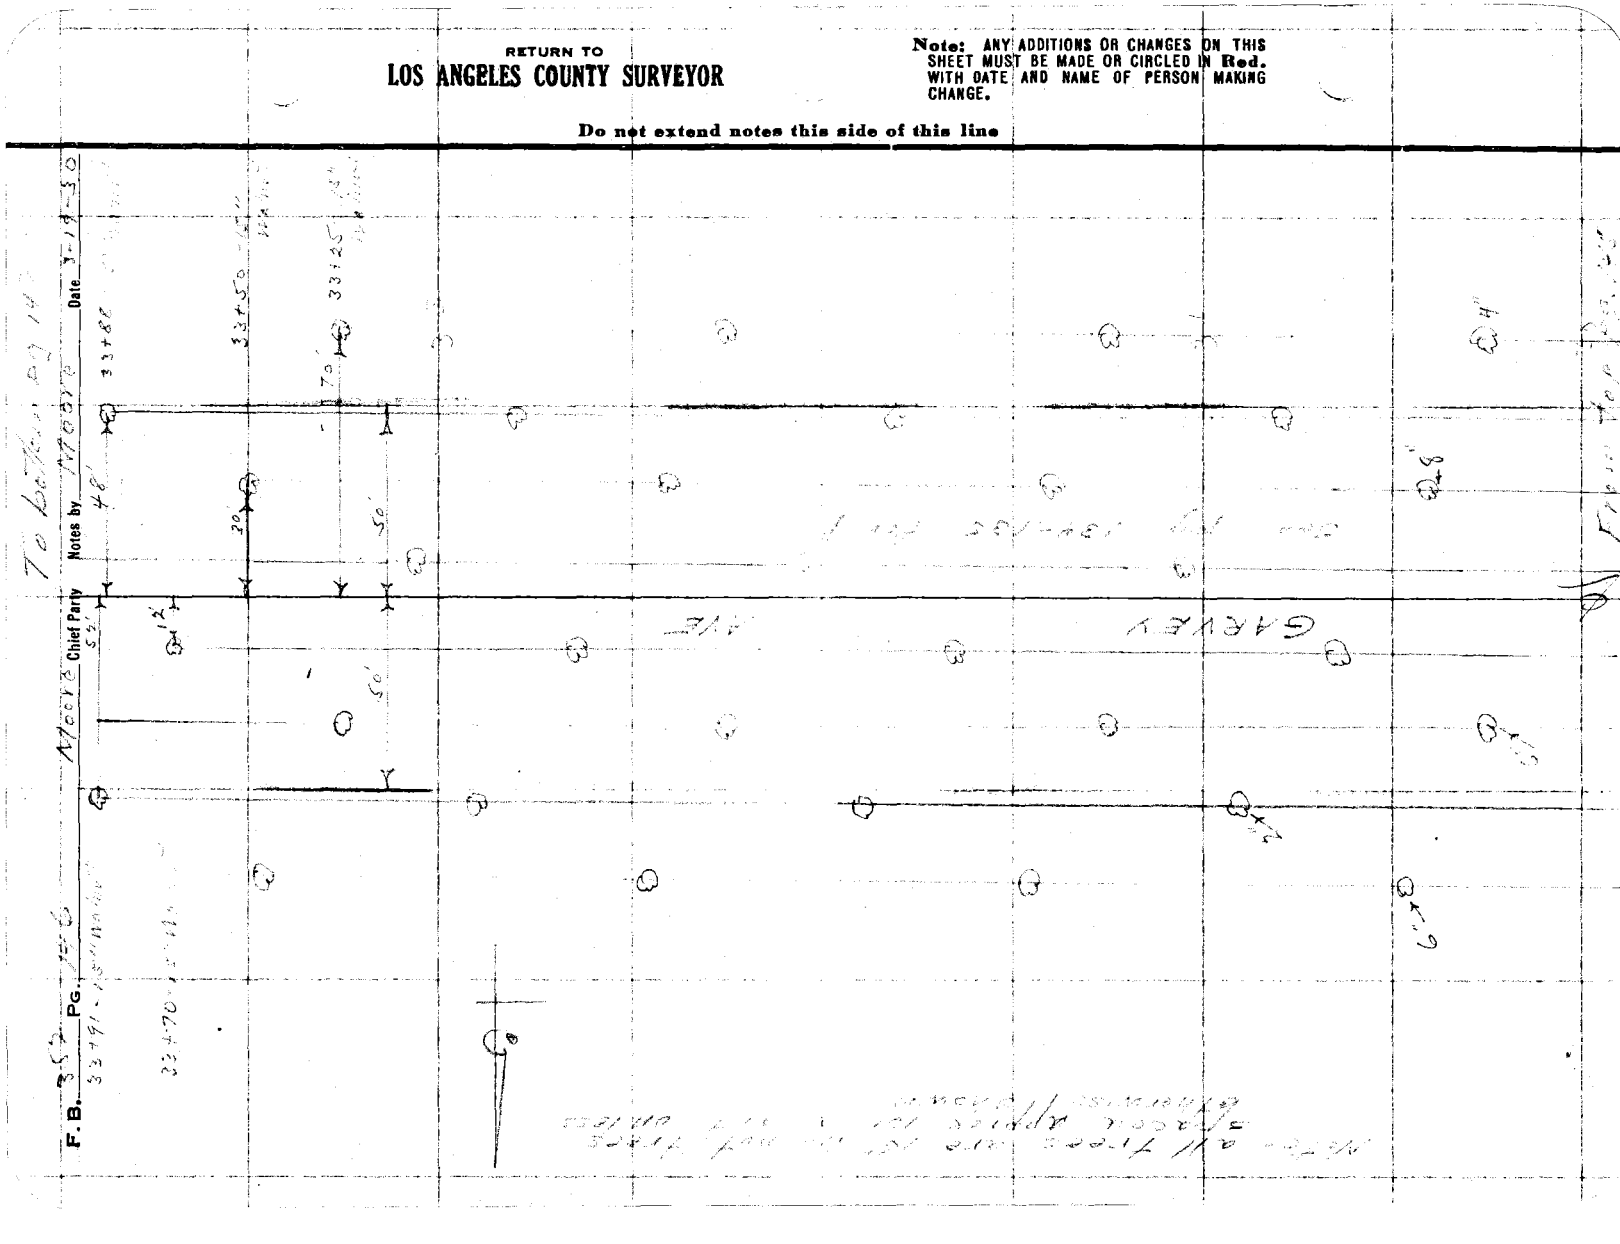

Date 3-[illegible]-30 Notes by [illegible] Chief Party [illegible] F.B. 352 Pg. 147

Platted by H.U.M.H.	W.O. No. [illegible] D.S.O. No.
Date JUN 1 - 1930	Location
Map No. B-579-1	Surveyed by [illegible]
Platting C'k'd by Falls	Date 3-[illegible]-30
Date June 1930	Indexed [illegible]

Notes: ANY ADDITIONS OR CHANGES ON THIS SHEET MUST BE MADE OR CIRCLED IN Red. WITH DATE AND NAME OF PERSON MAKING CHANGE.

Do not extend notes this side of this line

RETURN TO LOS ANGELES COUNTY SURVEYOR

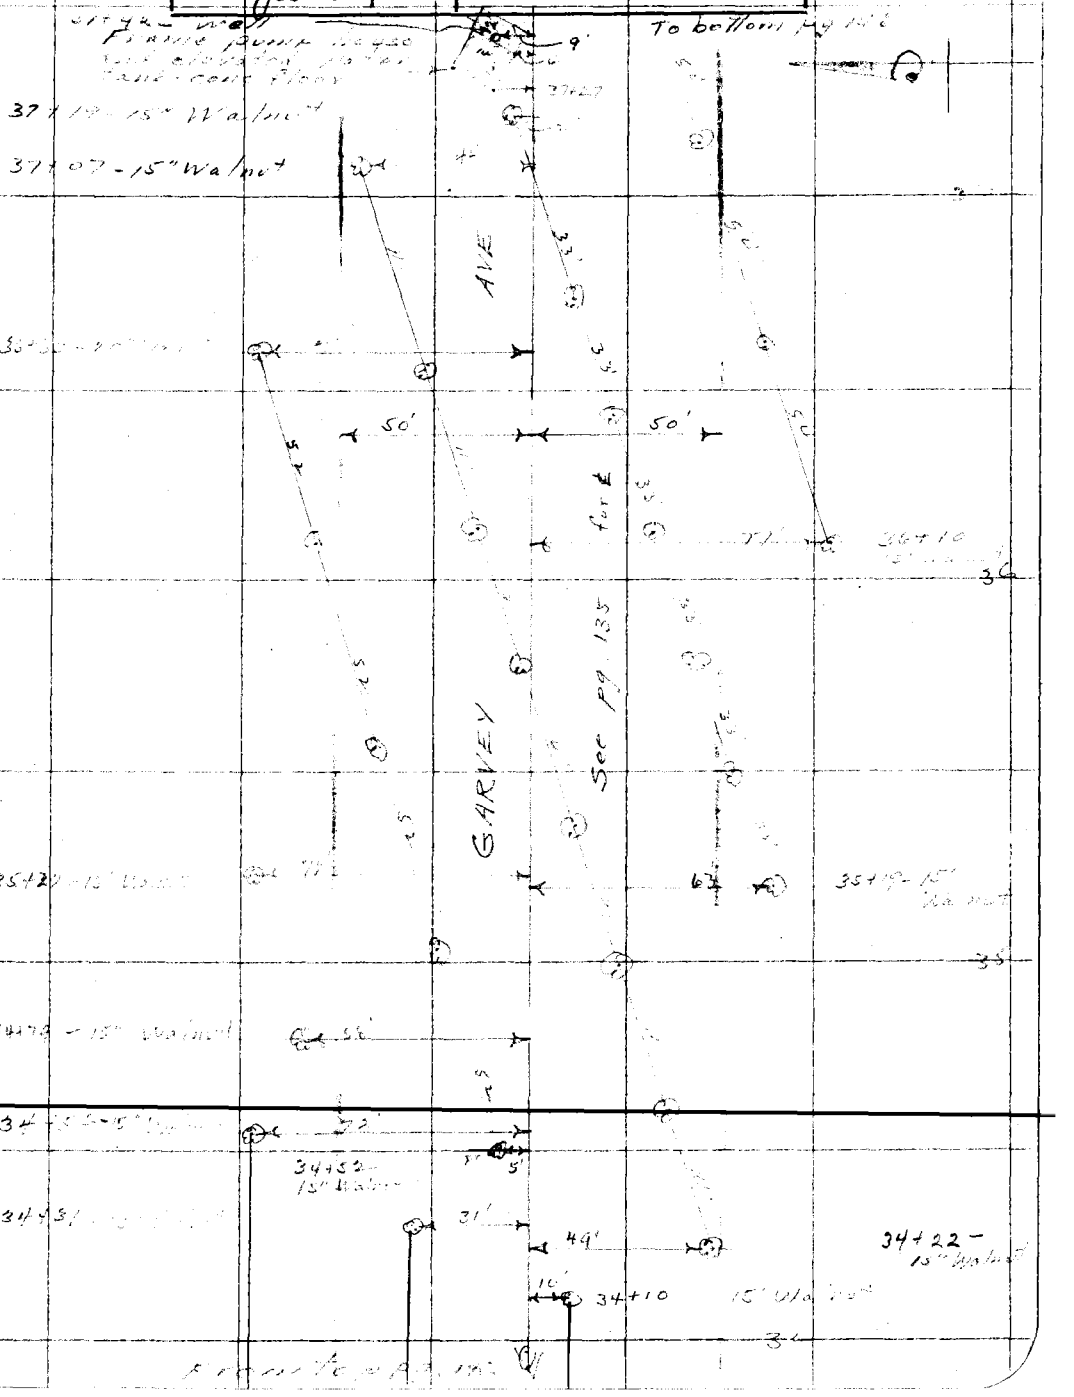

F.B. 352 Pg. 178 Moore Chief Party Notes by Moore Date 3-10-30

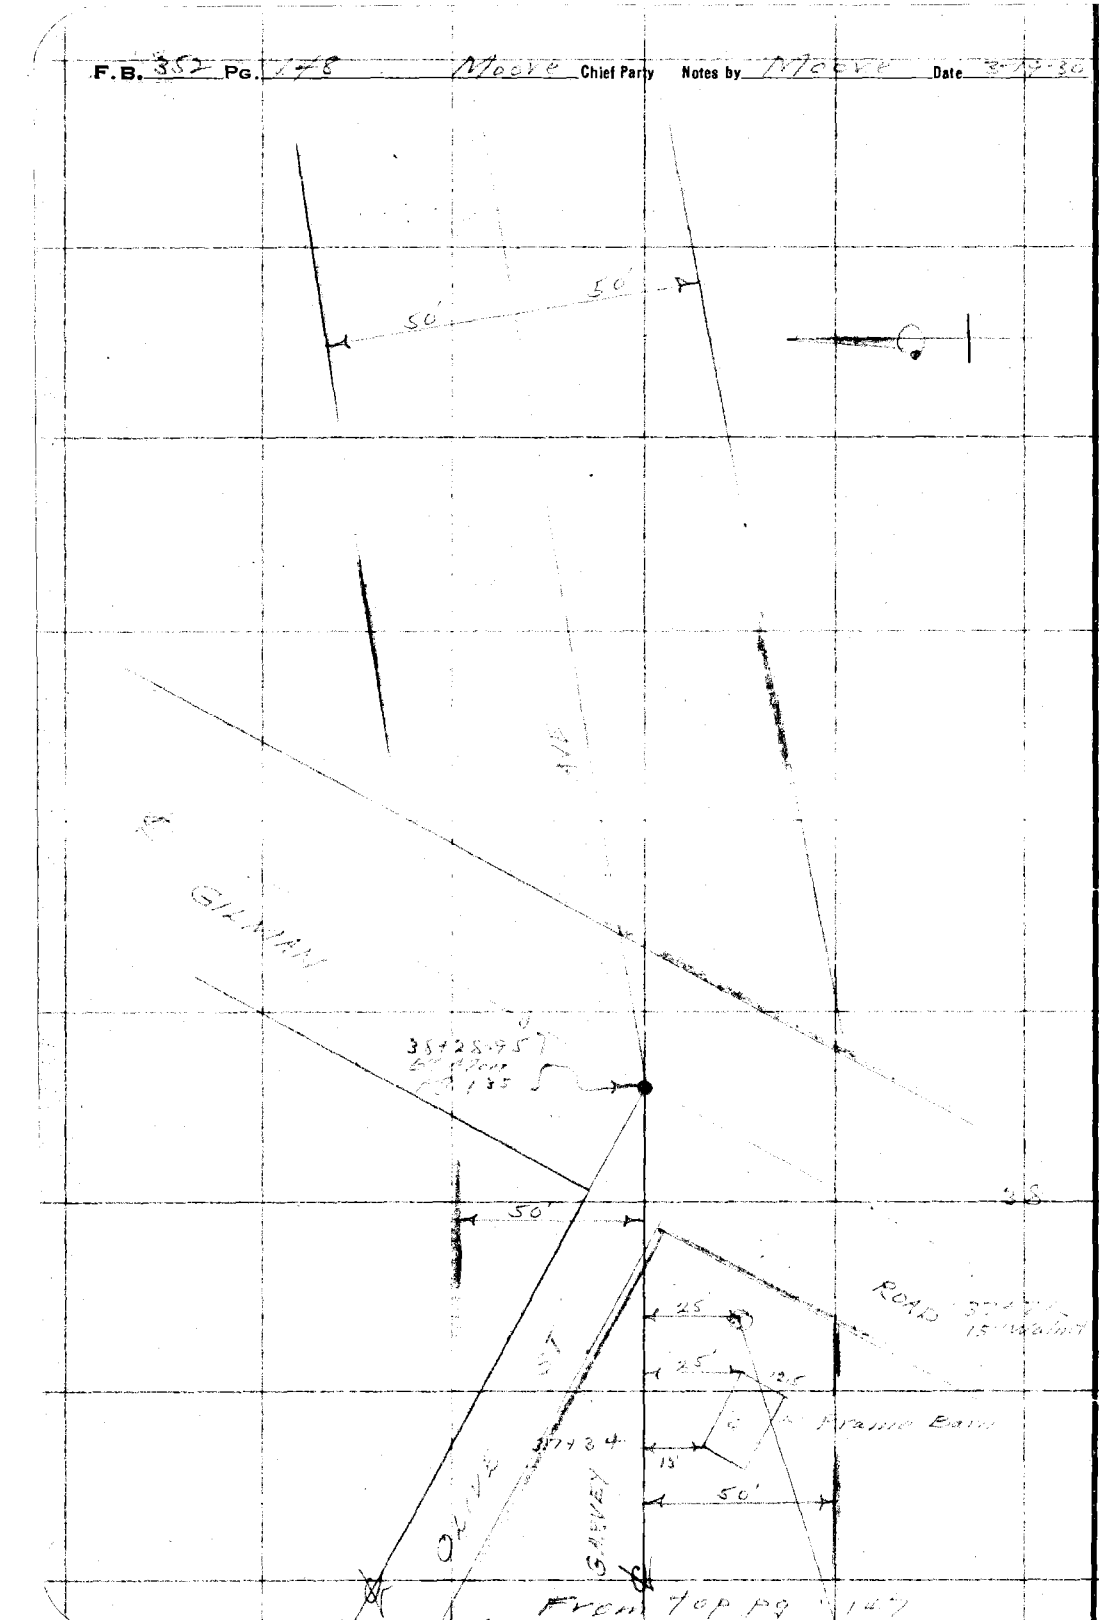

RETURN TO
LOS ANGELES COUNTY SURVEYOR

Do not extend notes this side of this line

Note: ANY ADDITIONS OR CHANGES ON THIS SHEET MUST BE MADE OR CIRCLED IN Red. WITH DATE AND NAME OF PERSON MAKING CHANGE.

Date 3-26-30 Notes by [illegible] Chief Party [illegible] F.B. 352 Pg. 149

Platted by D.A. White	W.O. No. 776 D.S.O. No.
Date June 1930	Location
Map No. CSB-519-2	Surveyed by
Platting C'k'd by H.U.M.H.	Date A. C. Johnson
Date AUG 12 1930	Indexed

CENTER LINE
RELOCATION
OF
GIDLEY AVE
from
[illegible]
OF
SAN PEDRO AVE
TO
PUEBLO AVE.
W.O. # 776

Mar. 30 - 31, 1930

[illegible]

Notes: ANY ADDITIONS OR CHANGES ON THIS SHEET MUST BE MADE OR CIRCLED IN Red, WITH DATE AND NAME OF PERSON MAKING CHANGE.

Do not extend notes this side of this line

RETURN TO
LOS ANGELES COUNTY SURVEYOR

RETURN TO
LOS ANGELES COUNTY SURVEYOR

Note: ANY ADDITIONS OR CHANGES ON THIS SHEET MUST BE MADE OR CIRCLED IN **Red.** WITH DATE AND NAME OF PERSON MAKING CHANGE.

Do not extend notes this side of this line

F.B. 352 Pg. 150 Notes by Meade Date
Chief Party To

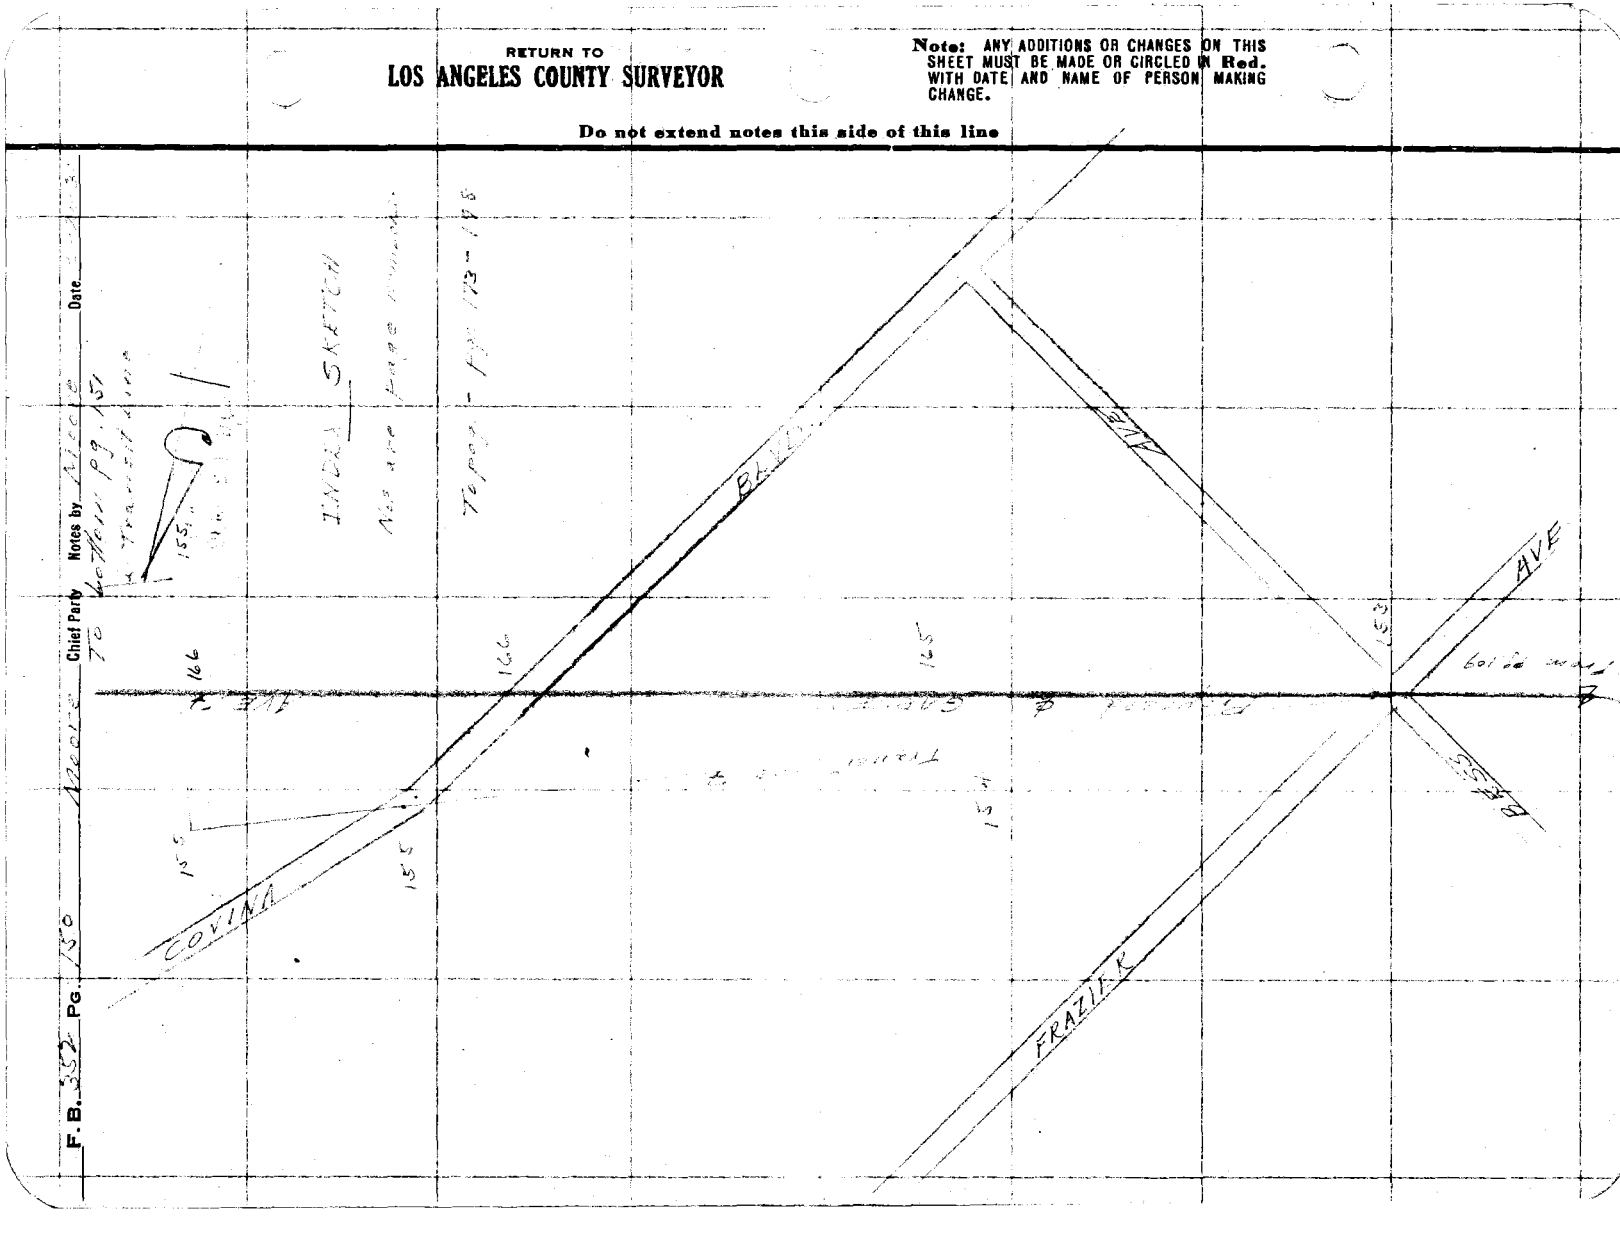

Date _____ Notes by _____ Chief Party _____ F.B. 352 Pg. 151

Platted by D.A. White	W. O. No. _____ B. S. O. No. _____
Date June 1930	Location _____
Map No. 13.519-2.	Surveyed by _____
Platting C'k'd by H. U. M. H.	Date 1-20-30
Date AUG 12 1930	Indexed A. C. Johnson

Notes: ANY ADDITIONS OR CHANGES ON THIS SHEET MUST BE MADE OR CIRCLED IN Red. WITH DATE AND NAME OF PERSON MAKING CHANGE.

RETURN TO LOS ANGELES COUNTY SURVEYOR

Do not extend notes this side of this line

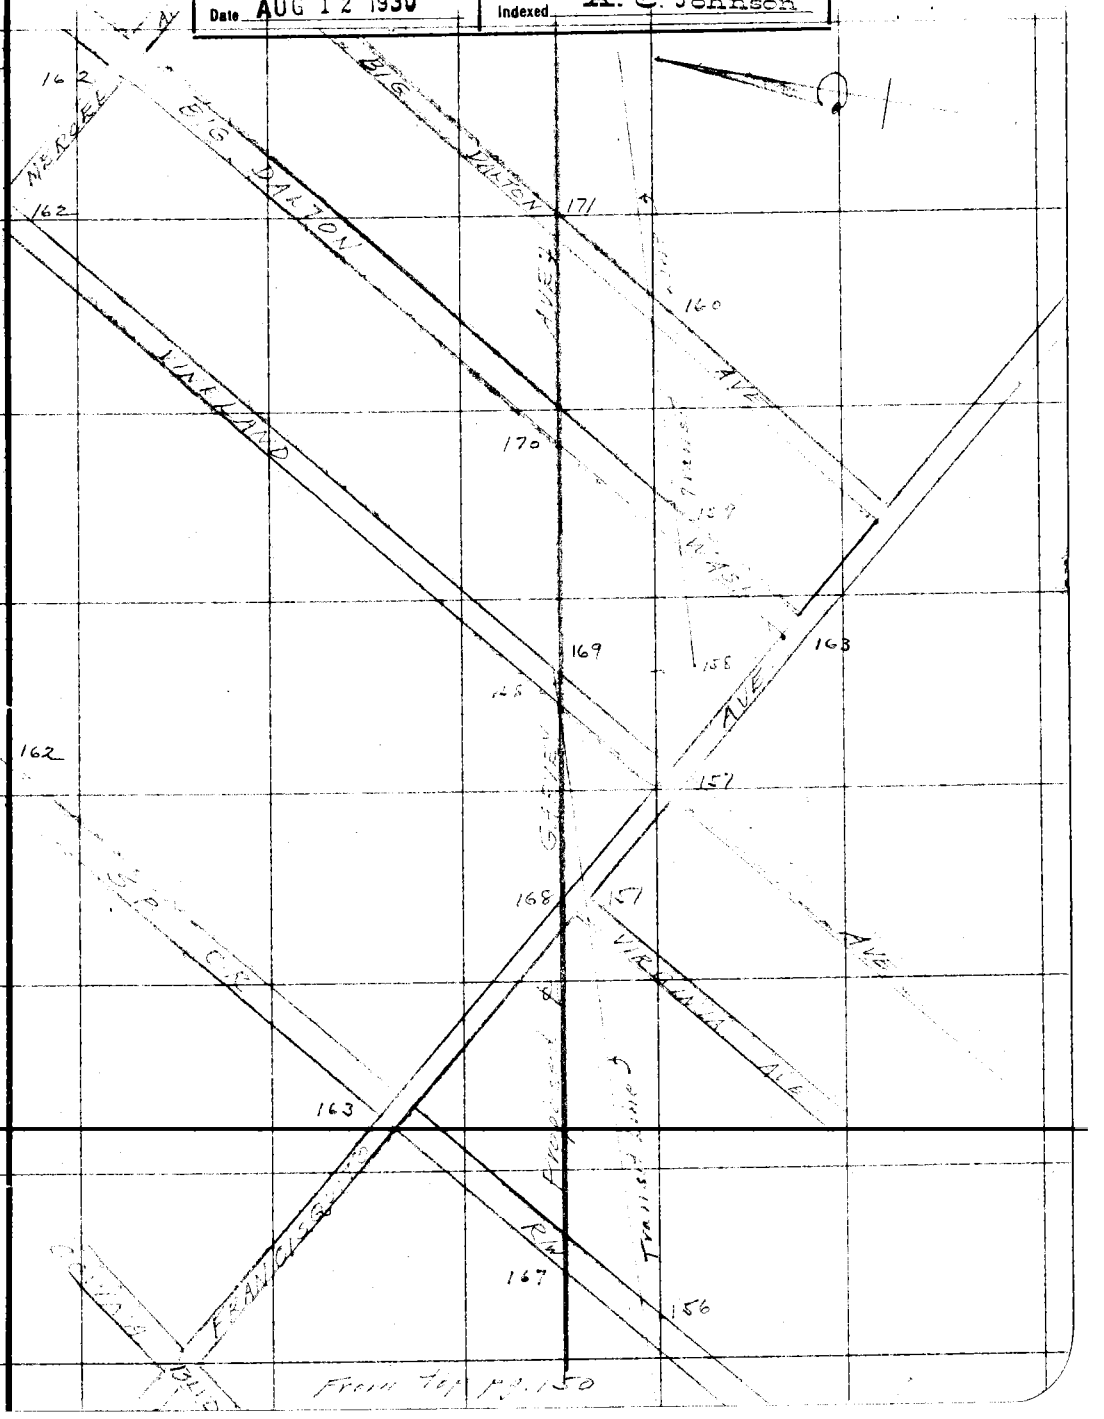

RETURN TO
LOS ANGELES COUNTY SURVEYOR

Note: ANY ADDITIONS OR CHANGES ON THIS SHEET MUST BE MADE OR CIRCLED IN **Red.** WITH DATE AND NAME OF PERSON MAKING CHANGE.

Do not extend notes this side of this line

F.B. 352 Pg. 132 Chief Party [illegible] Notes by [illegible] Date 3-22-33

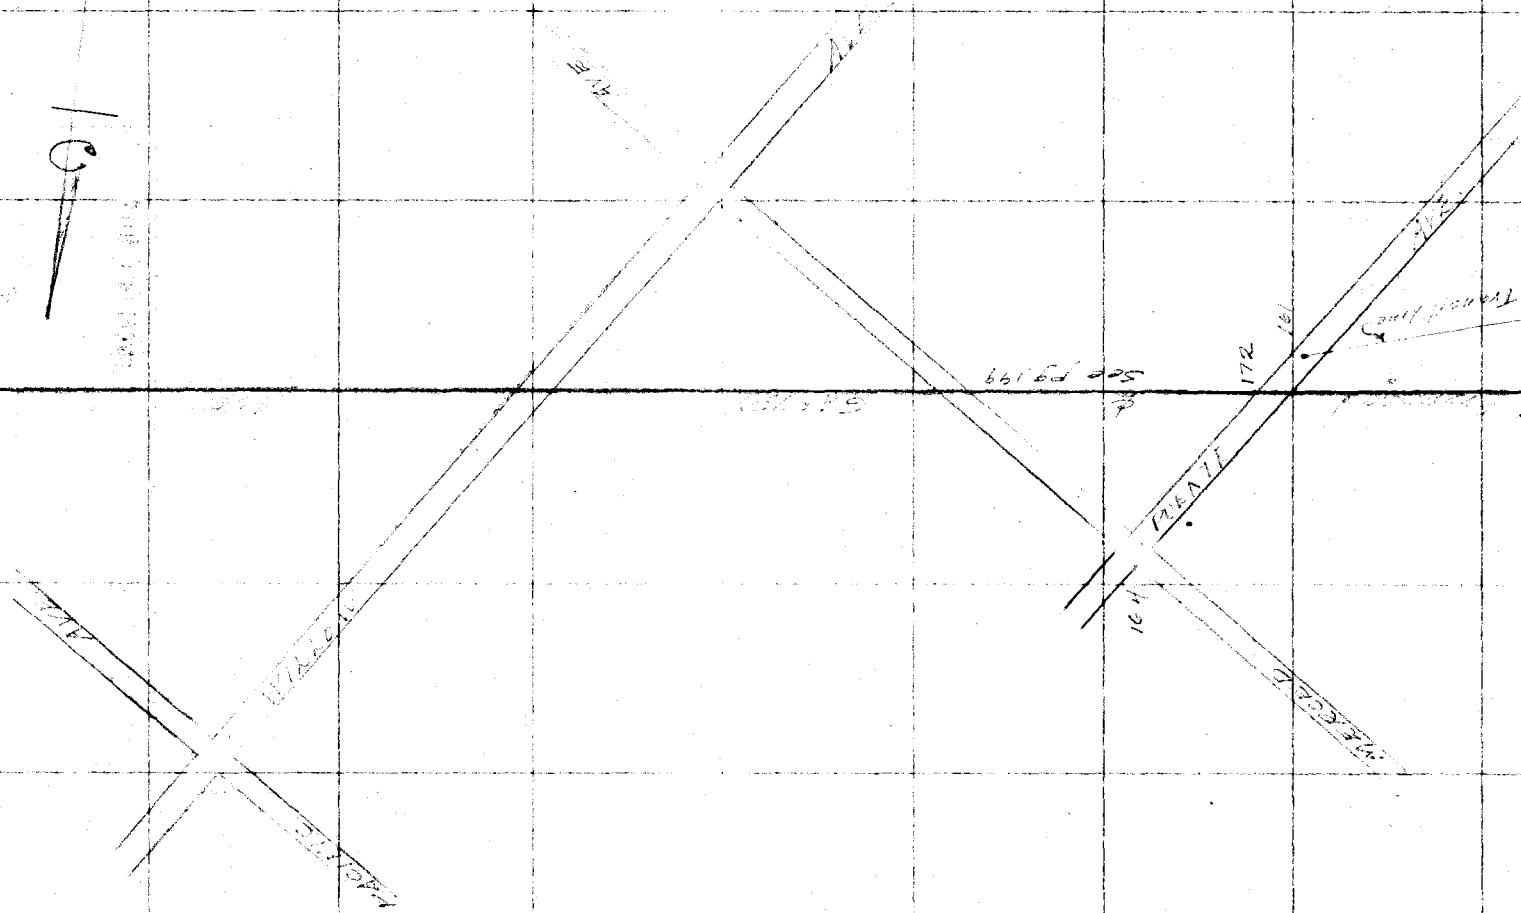

Date 3-20-30 Notes by N.Moore Chief Party [illegible] F.B. 352 Pg 153

Platted by D.A.White	W. O. No. 796 D. S. O. No. 028
Date June.1930	Location [illegible]
Map No. 13-519-2	Surveyed by [illegible]
Platting Ck'd by H. U. M. H.	Date 3-20-30
Date AUG 12 1930	Indexed A. C. Johnson

Notes: ANY ADDITIONS OR CHANGES ON THIS SHEET MUST BE MADE OR CIRCLED IN Red. WITH DATE AND NAME OF PERSON MAKING CHANGE.

Do not extend notes this side of this lide

RETURN TO LOS ANGELES COUNTY SURVEYOR

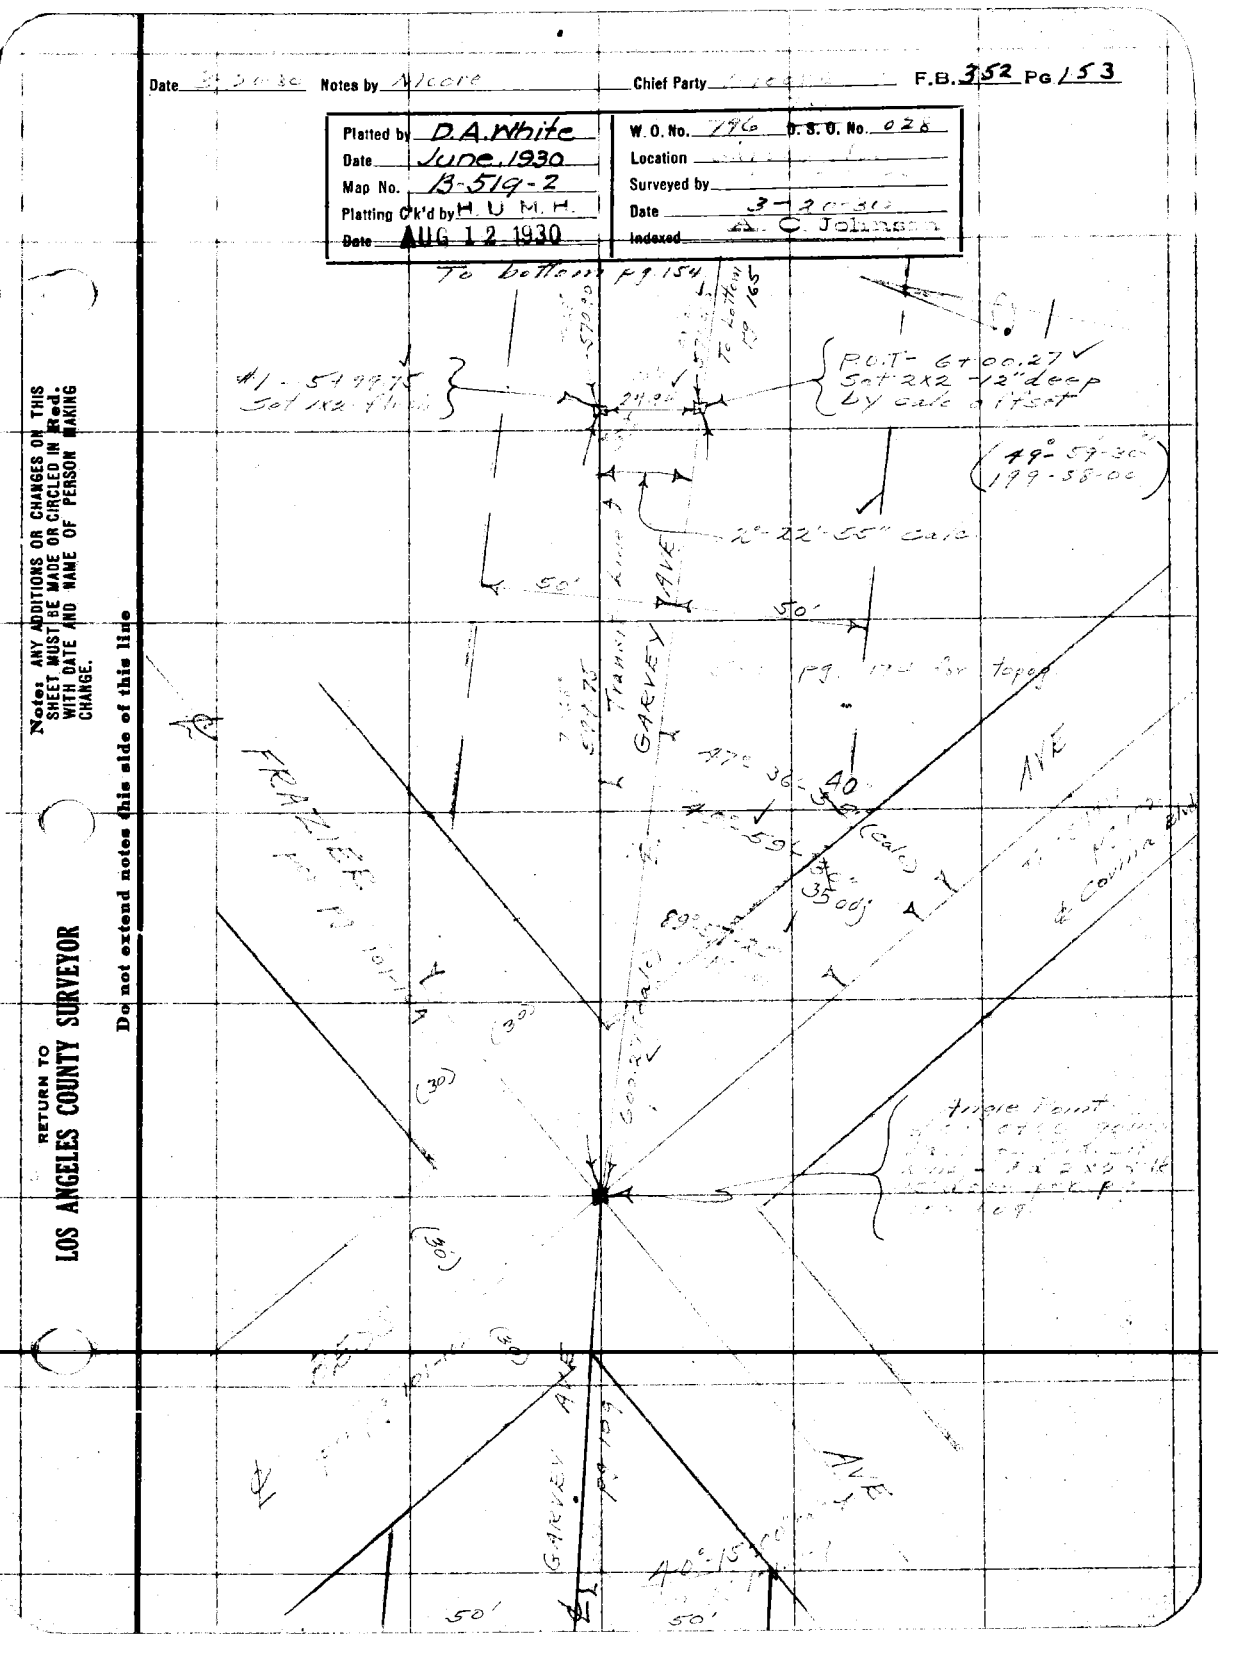

RETURN TO
LOS ANGELES COUNTY SURVEYOR

Note: ANY ADDITIONS OR CHANGES ON THIS SHEET MUST BE MADE OR CIRCLED IN **Red.** WITH DATE AND NAME OF PERSON MAKING CHANGE.

Do not extend notes this side of this line

F.B. 352 PG. 15 Chief Party Notes by Date 3-1-30

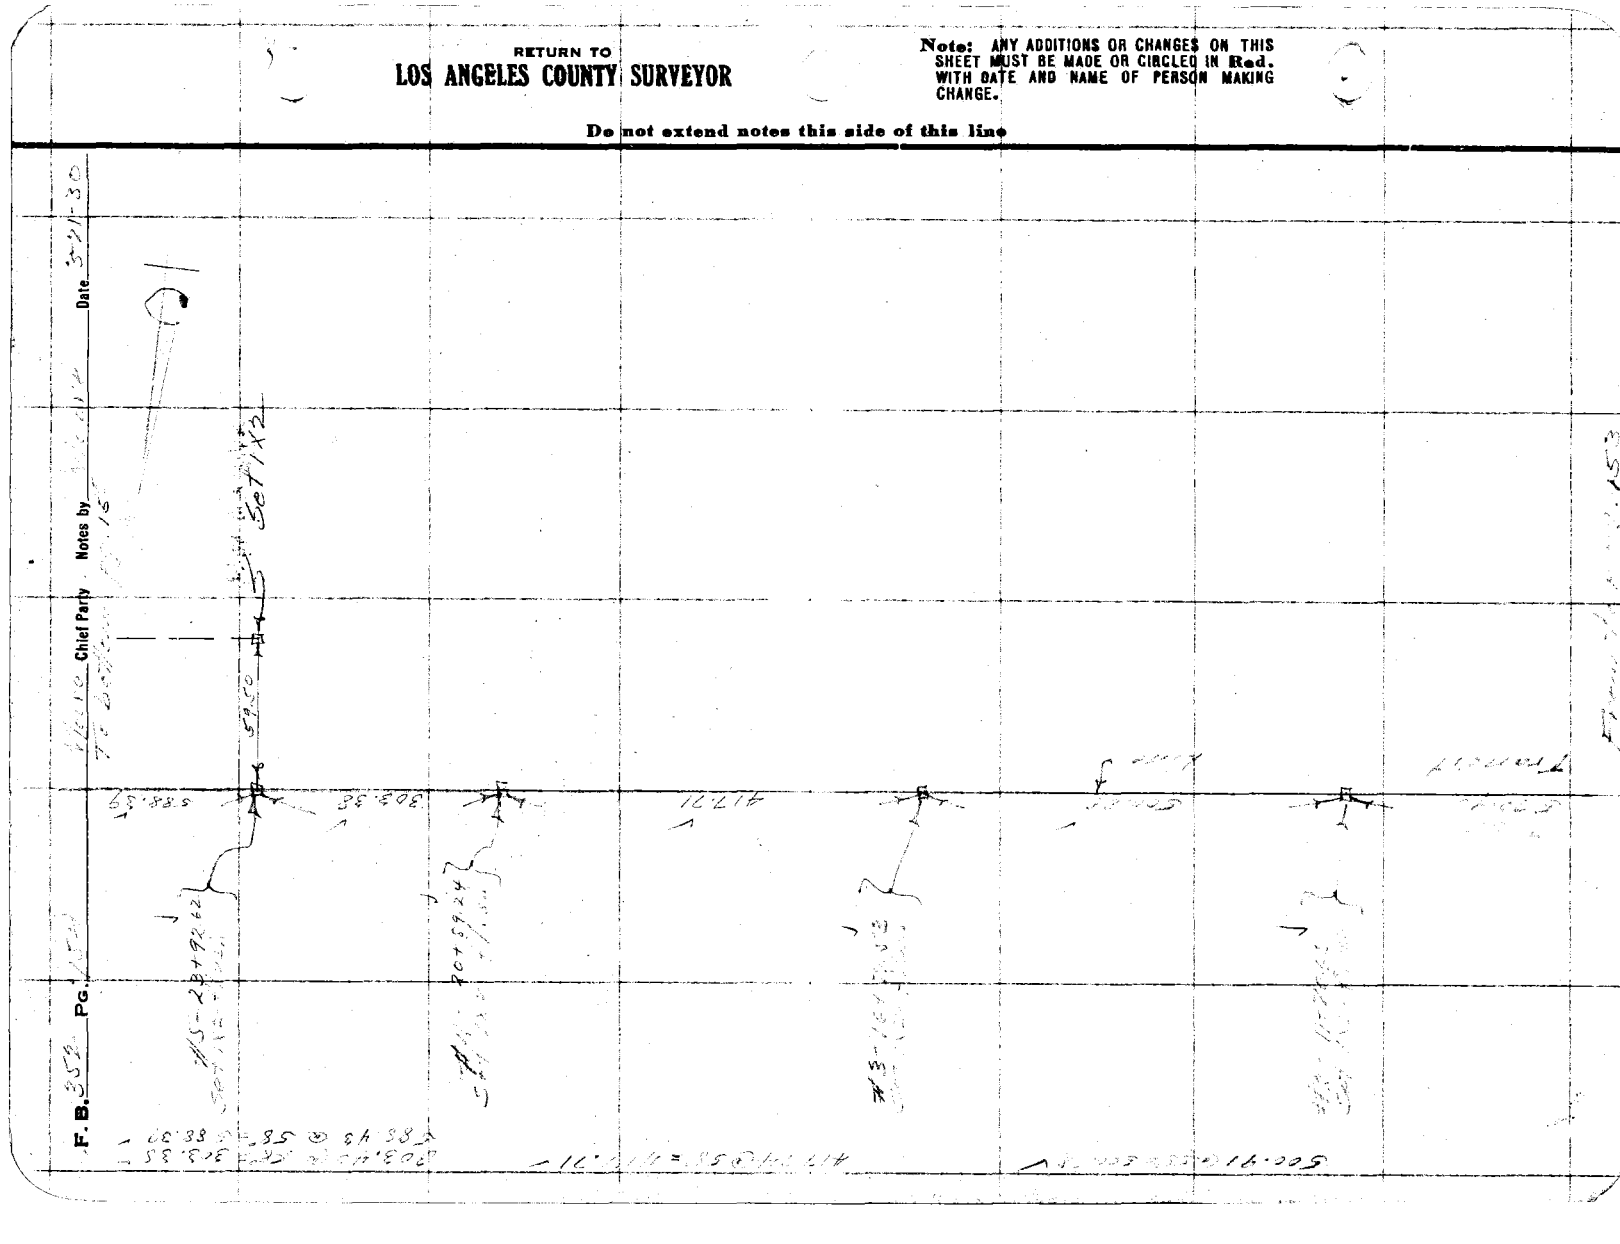

Date 5-21-30 Notes by [illegible] Chief Party [illegible] F.B. 352 PG 155

Platted by D.A.White	W. O. No. 146 U. S. O. No. 044
Date June, 1930.	Location [illegible]
Map No. B-519-2	Surveyed by [illegible]
Platting Ck'd by H. U. M. M.	Date 5-21-30
Date AUG 12 1930	Indexed J. C. Johnson

Notes: ANY ADDITIONS OR CHANGES ON THIS SHEET MUST BE MADE OR CIRCLED IN Red. WITH DATE AND NAME OF PERSON MAKING CHANGE.

Do not extend notes this side of this line

RETURN TO LOS ANGELES COUNTY SURVEYOR

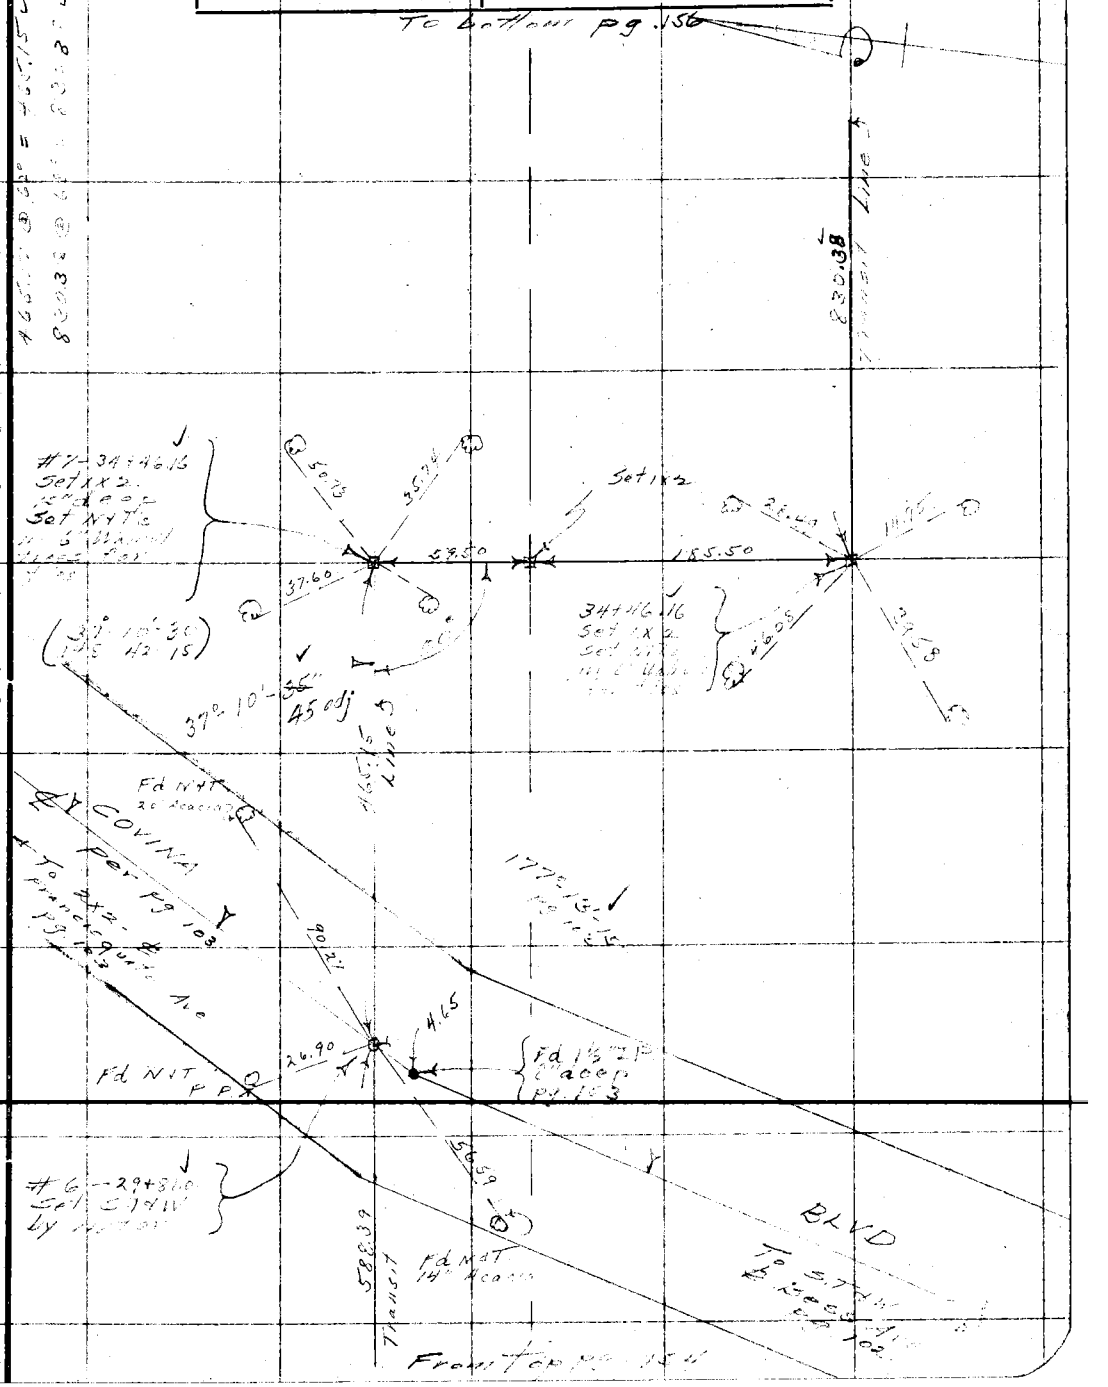

RETURN TO
LOS ANGELES COUNTY SURVEYOR

Note: ANY ADDITIONS OR CHANGES ON THIS SHEET MUST BE MADE OR CIRCLED IN **Red.** WITH DATE AND NAME OF PERSON MAKING CHANGE.

Do not extend notes this side of this line

F.B. 352 Pg. 156 Chief Party Moore Notes by Moore Date 3-21-30

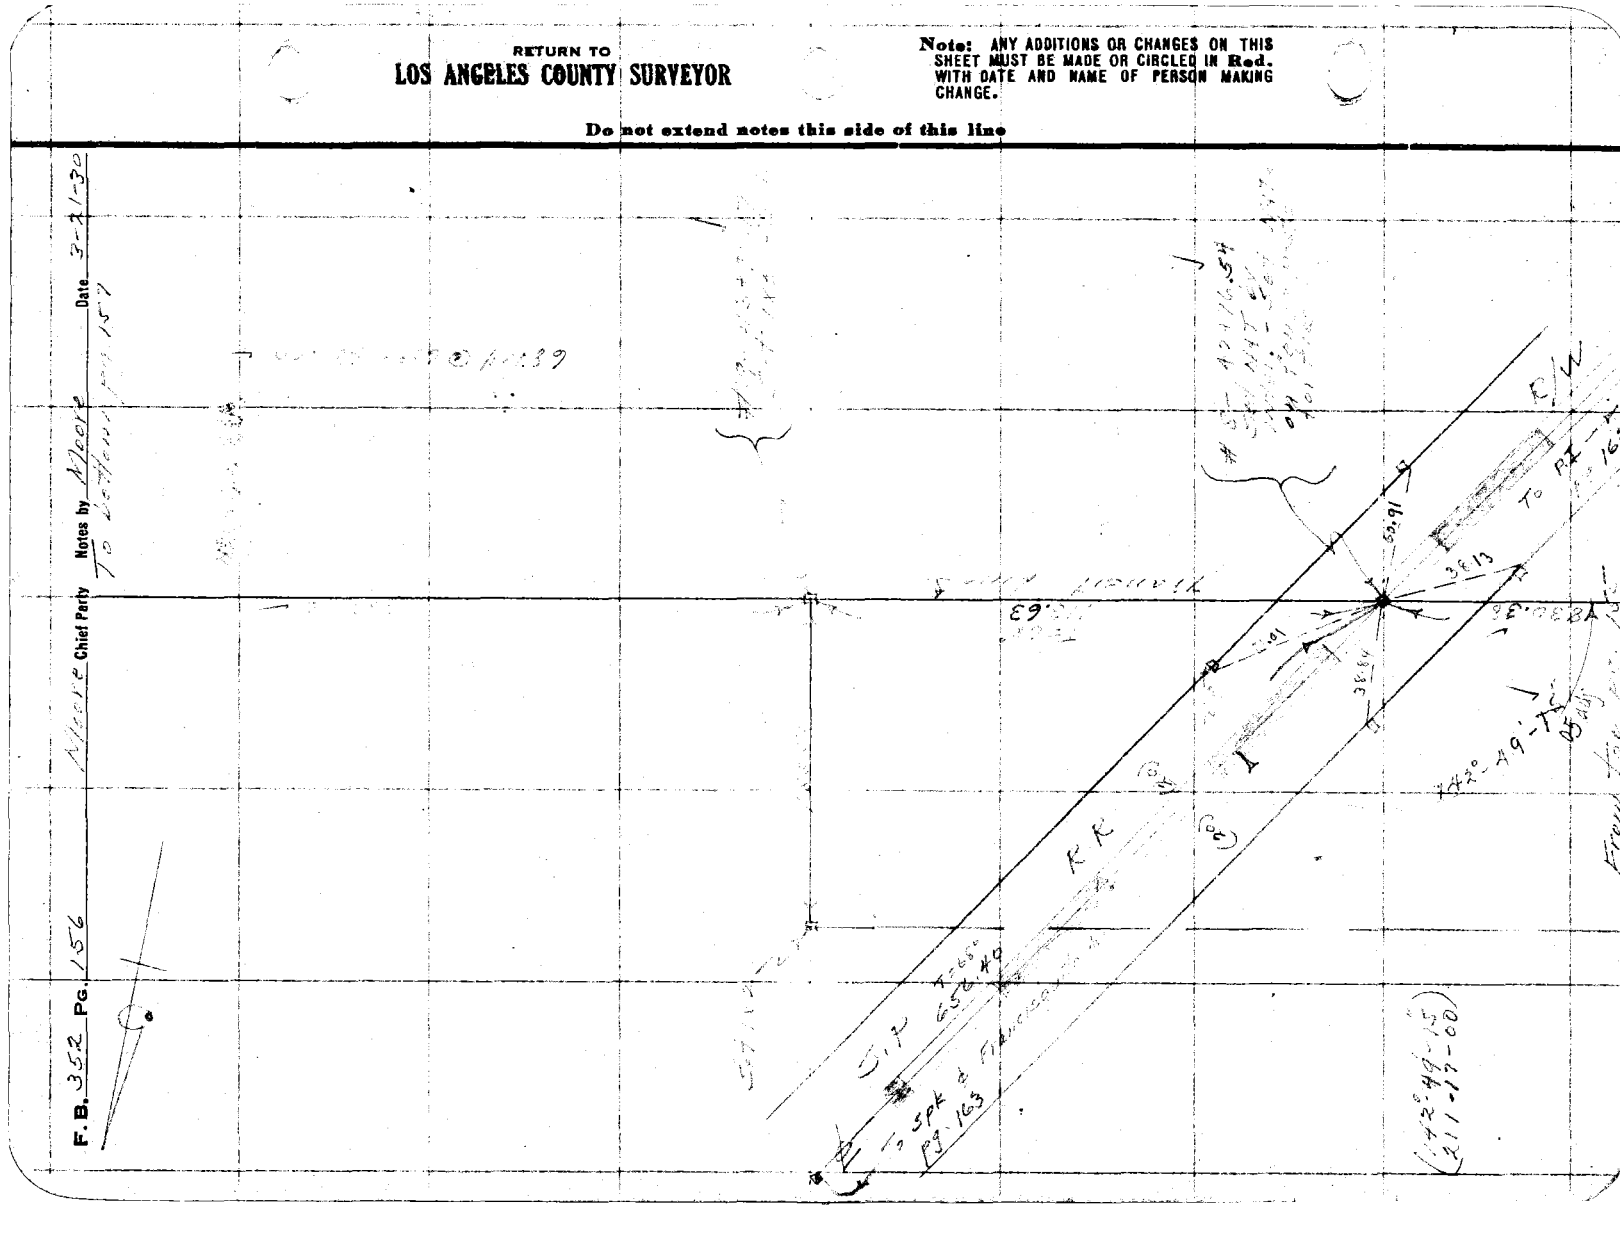

Date 3-22-30 Notes by N. Moore Chief Party N. Moore F.B. 352 Pg 157

Platted by D.A. White.	W. O. No. 296 U.S.C.&G.S. No. 628
Date June 1930.	Location [illegible]
Map No. 13-519-2	Surveyed by [illegible]
Platting Ck'd by H.U.M.H.	Date 3-22-30
Date AUG 12 1930	Indexed C. Johns

Notes. ANY ADDITIONS OR CHANGES OR THIS SHEET MUST BE MADE OR CIRCLED IN Red. WITH DATE AND NAME OF PERSON MAKING CHANGE.

Do not extend notes this side of this line

RETURN TO LOS ANGELES COUNTY SURVEYOR

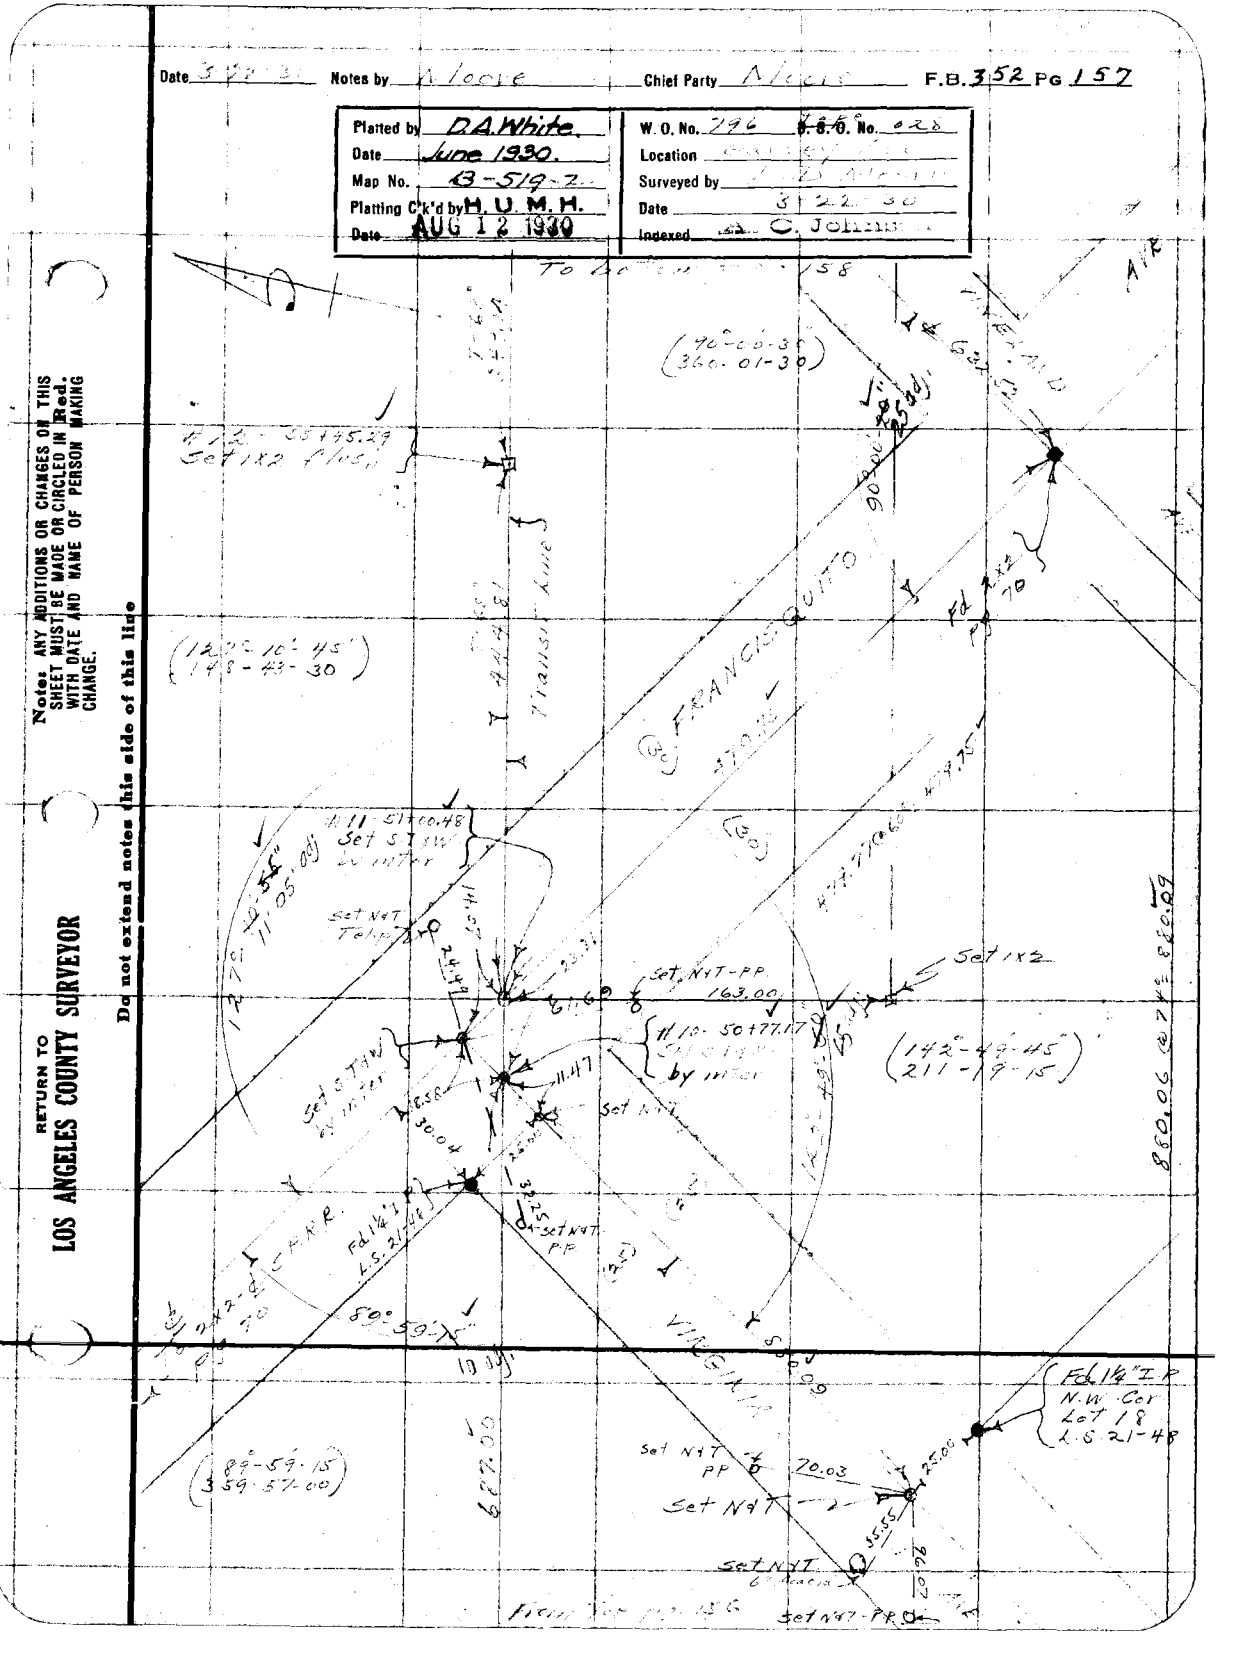

F.B. 352 Pg. 158 Moore Chief Party Notes by Moore Date 3-24-30

To bottom pg 159

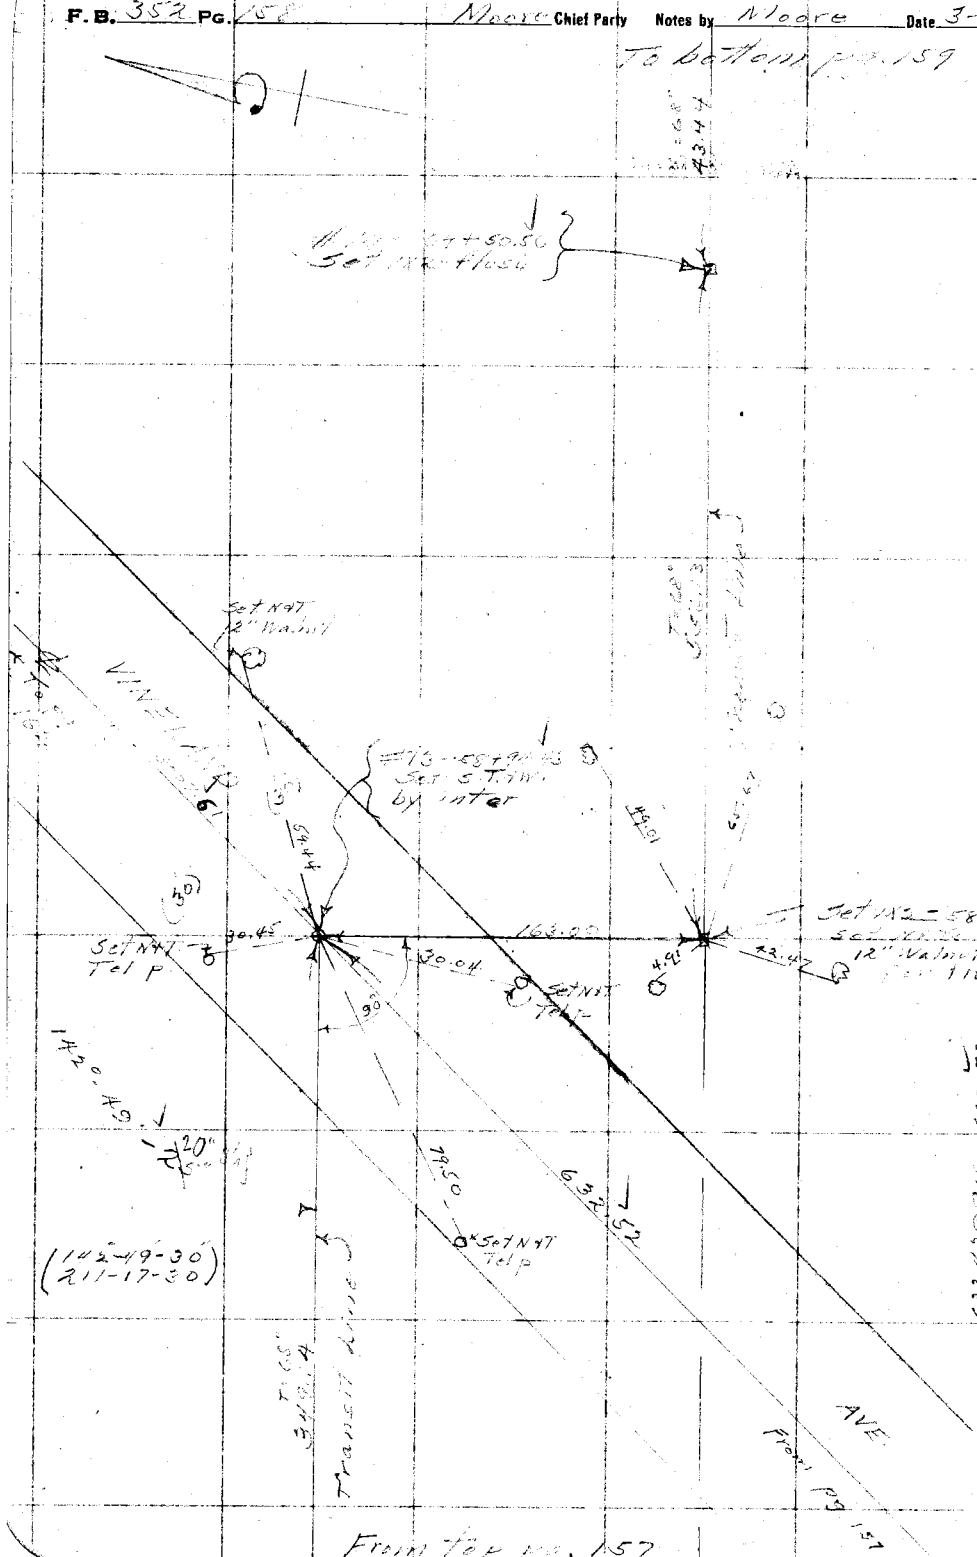
Set N&T
12" Walnut
Set N&T
Tel P
Set N&T
Tel P
Set N&T
Tel P

Date 3-25-30 Notes by Veale Chief Party Veale F.B. 352 Pg 159

Platted by D.A.White
Date June, 1930.
Map No. B-519-2
Platting C'k'd by H. U. M. H.
Date AUG 12 1930

W. O. No. 776 ~~B.S.C.~~ No. 028
Location Survey of
Surveyed by A. L. Veale
Date 2-24-30
Indexed C. Johnson

To bottom pg. 160

43.37 @ 68° @ 6°49' = 43.06
41.17 @ 68° @ 8°30' = 40.72
242.55 @ 68° @ 0°00' = 242.55
326.33

326.33

#16 69+38.04
Set 1x2 flush

179°04'
15" 04

Fd 2" I.P.
F.F.B. 133-34

12.08
29.79
35.94
29.79
38.08

Fd 2" I.P.
F.F.B. 133-34

Set 1x2 per F.F.B. 133-34 Set x on iron fence post for ties

BIG DALTON WASH

#15 64+94.00
Set 1x2 by inter
Set x on iron fence posts for ties

Transit line

444.65

Set 1x2 per F.F.B. 133-34
Set x on iron fence post for ties

22.85
24.15
30.85
27.46

141°53'-00"
20.31.36

45" 04

Fd 2" I.P.
F.F.B. 133-34

(179° 02'-45"
356.11.15)

907.98 @ 84° = 910.07
101.66 @ 5°49' = 101.66
1718.63 @ 84°45' = 1718.81

443.44

Fd 2" I.P.
F.F.B. 133-34

52.13
36.68
50.00
35.00
179°02'-45"
55" 04

910.07

From top pg. 158

From pg. 163

Notes: ANY ADDITIONS OR CHANGES ON THIS SHEET MUST BE MADE OR CIRCLED IN Red. WITH DATE AND NAME OF PERSON MAKING CHANGE.

Do not extend notes this side of this line

RETURN TO LOS ANGELES COUNTY SURVEYOR

F. B. 352 PG. 160 Moore Chief Party Notes by Moore Date 3-24-30

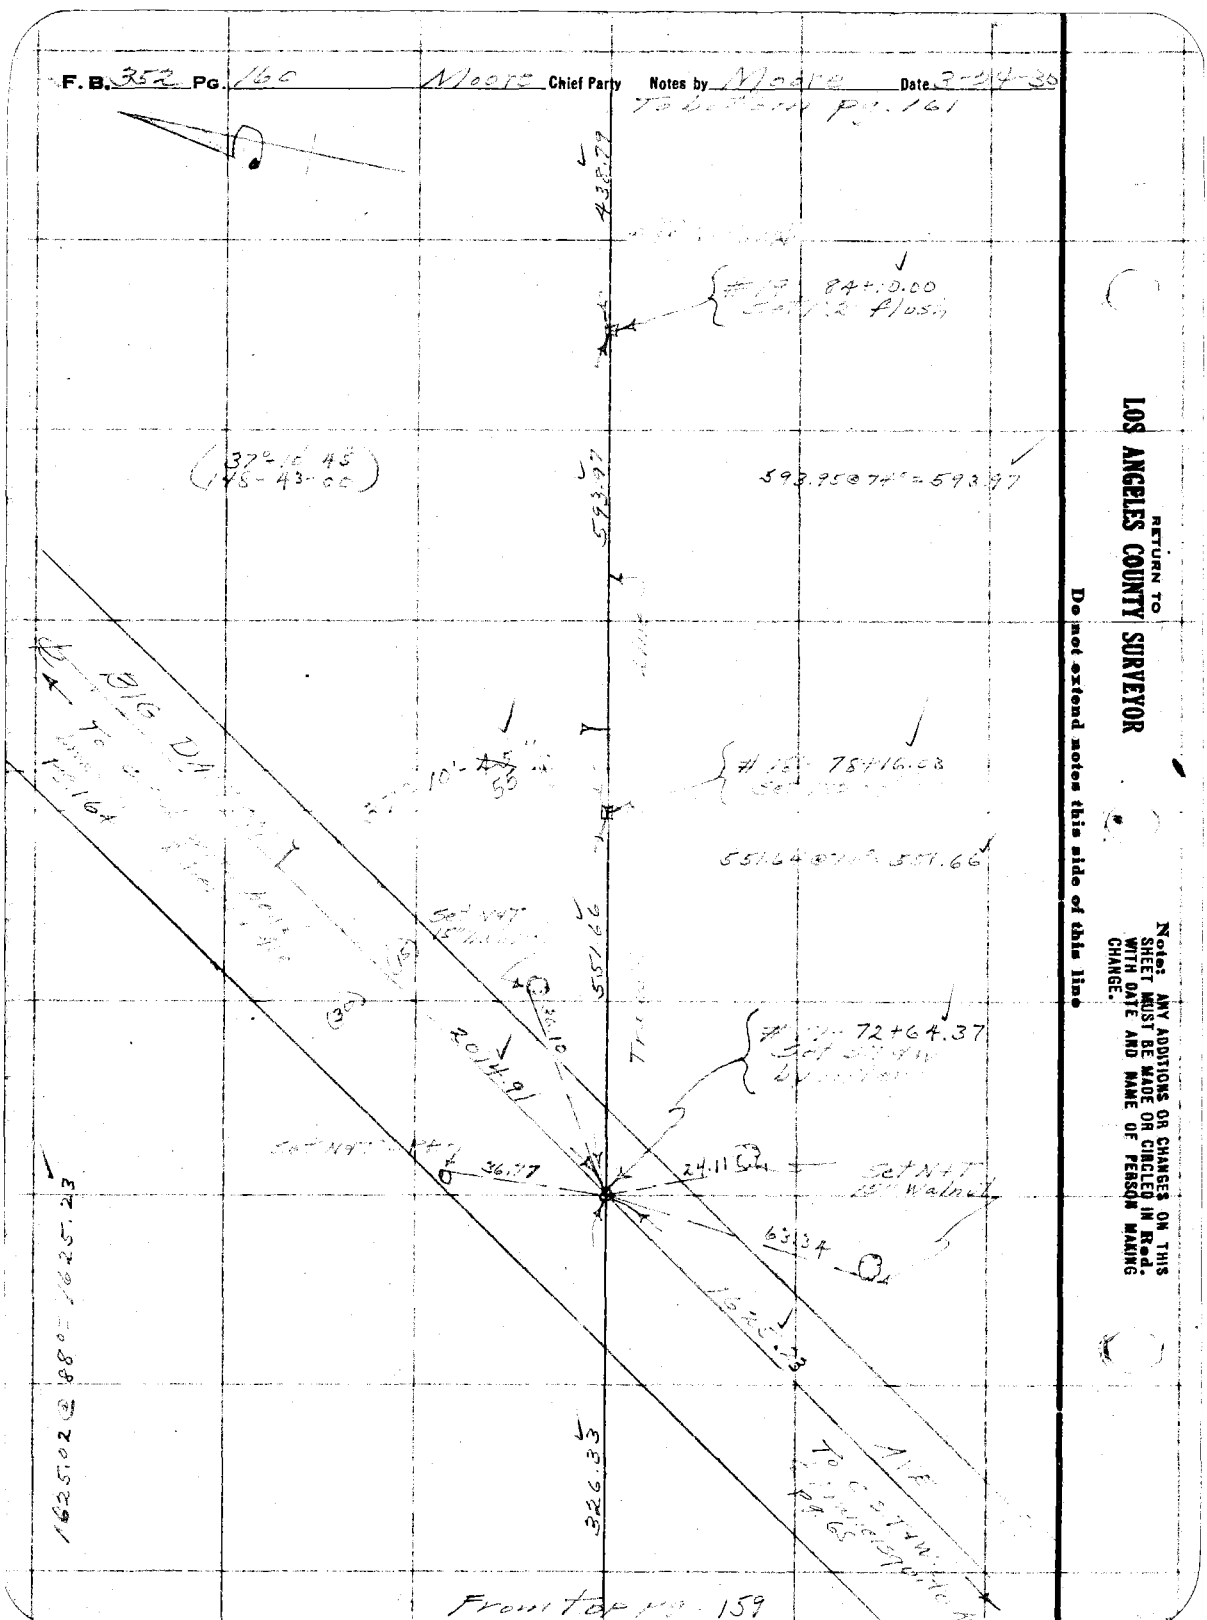

RETURN TO
LOS ANGELES COUNTY SURVEYOR

Do not extend notes this side of this line

Note: ANY ADDITIONS OR CHANGES ON THIS SHEET MUST BE MADE OR CIRCLED IN Red. WITH DATE AND NAME OF PERSON MAKING CHANGE.

Date 3-24-30 Notes by Adams Chief Party Adams F.B. 352 Pg. 161

Platted by D.A.White	W. O. No. 796 C. C. O. No. 028
Date June 1930	Location [illegible]
Map No. B-519-2	Surveyed by [illegible]
Platting C'k'd by H. U. M. H.	Date 3-24-30
Date AUG 12 1930	Indexed C. Johns

Notes: ANY ADDITIONS OR CHANGES ON THIS SHEET MUST BE MADE OR CIRCLED IN Red. WITH DATE AND NAME OF PERSON MAKING CHANGE.

Do not extend notes this side of this line

RETURN TO LOS ANGELES COUNTY SURVEYOR

PUENTE

753.10

Set N+T 4" Apricot

Set N+T PP

61.72

Set N+T 4" Apricot

AVE

37° 10' 05" 01

(37° 11' 00")
(148° 43' 45")

F.B. 352 Pg. 162 — Moore Chief Party — Notes by Moore — Date 3-25-30

To left pg. 164

Fd 1½" I.P. F.F.C. 1.33 + 3.5

Set N+T Guard rail

BIG DALTON WASH

910.22

To left pg 159

Set N+T by Hiller

463.73

463.63 @ 84° = 463.68

90° 00' 15" (360 - 01 - 15)

Fd N+T P.P.

Set N+T I.P.

Fd Nail & Tin Tag Party Chief's Ties. Ld. Sur. FB 91-79 Z-136-42

VINELAND AVE.

To left pg 158

Set N+T by Hiller

Fd N+T Tag

Fd N+T Guy P.

90° 00' 50"

(90° - 00 - 15) (360 - 03 - 15)

3639.46

To left pg. 163

Fd N+T Tel. P.

Fd N+T - Tel P.

3639.05 @ 84° = 3639.46

Set N+T on Curb

Fd N+T Guy P.

Set N+T Tel P.

COVINA BLVD.

Fd S. 79 W. Rd Zero Ft. Z-136-42

Fd N+T - PP

Set X in curb

RETURN TO LOS ANGELES COUNTY SURVEYOR

Do not extend notes this side of this line

Note: ANY ADDITIONS OR CHANGES ON THIS SHEET MUST BE MADE OR CIRCLED IN Red. WITH DATE AND NAME OF PERSON MAKING CHANGE.

Date 3-26-30 Notes by Mocine Chief Party Hoag F.B. 352 Pg 163

Platted by DA White
Date June, 1930
Map No. B-519-2
Platting Ck'd by H. U. M. H.
Date AUG 12 1930

W. O. No. 196 D. S. O. No. 22c
Surveyed by J. L. Mocine
Date 3-26-30
Indexed A. C. Johnson

Notes: ANY ADDITIONS OR CHANGES ON THIS SHEET MUST BE MADE OR CIRCLED IN Red. WITH DATE AND NAME OF PERSON MAKING CHANGE.

Do not extend notes this side of this line

RETURN TO LOS ANGELES COUNTY SURVEYOR

℄ To STAW - E. Fd Dalton Ave. - Pg 68

Fd NAT Guard rail

Fd NAT Guard rail

DALTON AVE

Fd L&T in pave. below bridge P5 07
Set STAW on bridge by inter.

Fd NAT Guard rail

Fd NAT Guard rail

AVE

KINSELLA AVE.

Fd 2x2 Pg 704/157

Pg 26 977.86

(96°-00'-00" 360-00-15)

(177°-14'-30" 348°-58-15)

Set Spk & Washer by Tel Pole

Fd NAT Tel P.

Fd NAT PP-LT

SP. RR 3639.46

R/W

177°-14'-35"

Set NAT-Top Pin

Fd NAT & Walnut Wood Pg 125

Fd 2x2 Pg 70

Fd NAT Top Pin

Fd NAT Top Pin

PI - Fd 2x2 Pg 125

Fd L&T

977.81

FRANCISQUITO

Fd X in conc. gutter & headwall

This 2x2 was evidently disturbed as original chaining on Francisquito checks calculations and distances of Virginia Ave Draw

F.B. 352 Pg. 164 Moore Chief Party Notes by Moore Date 3-26-30

To pg 202

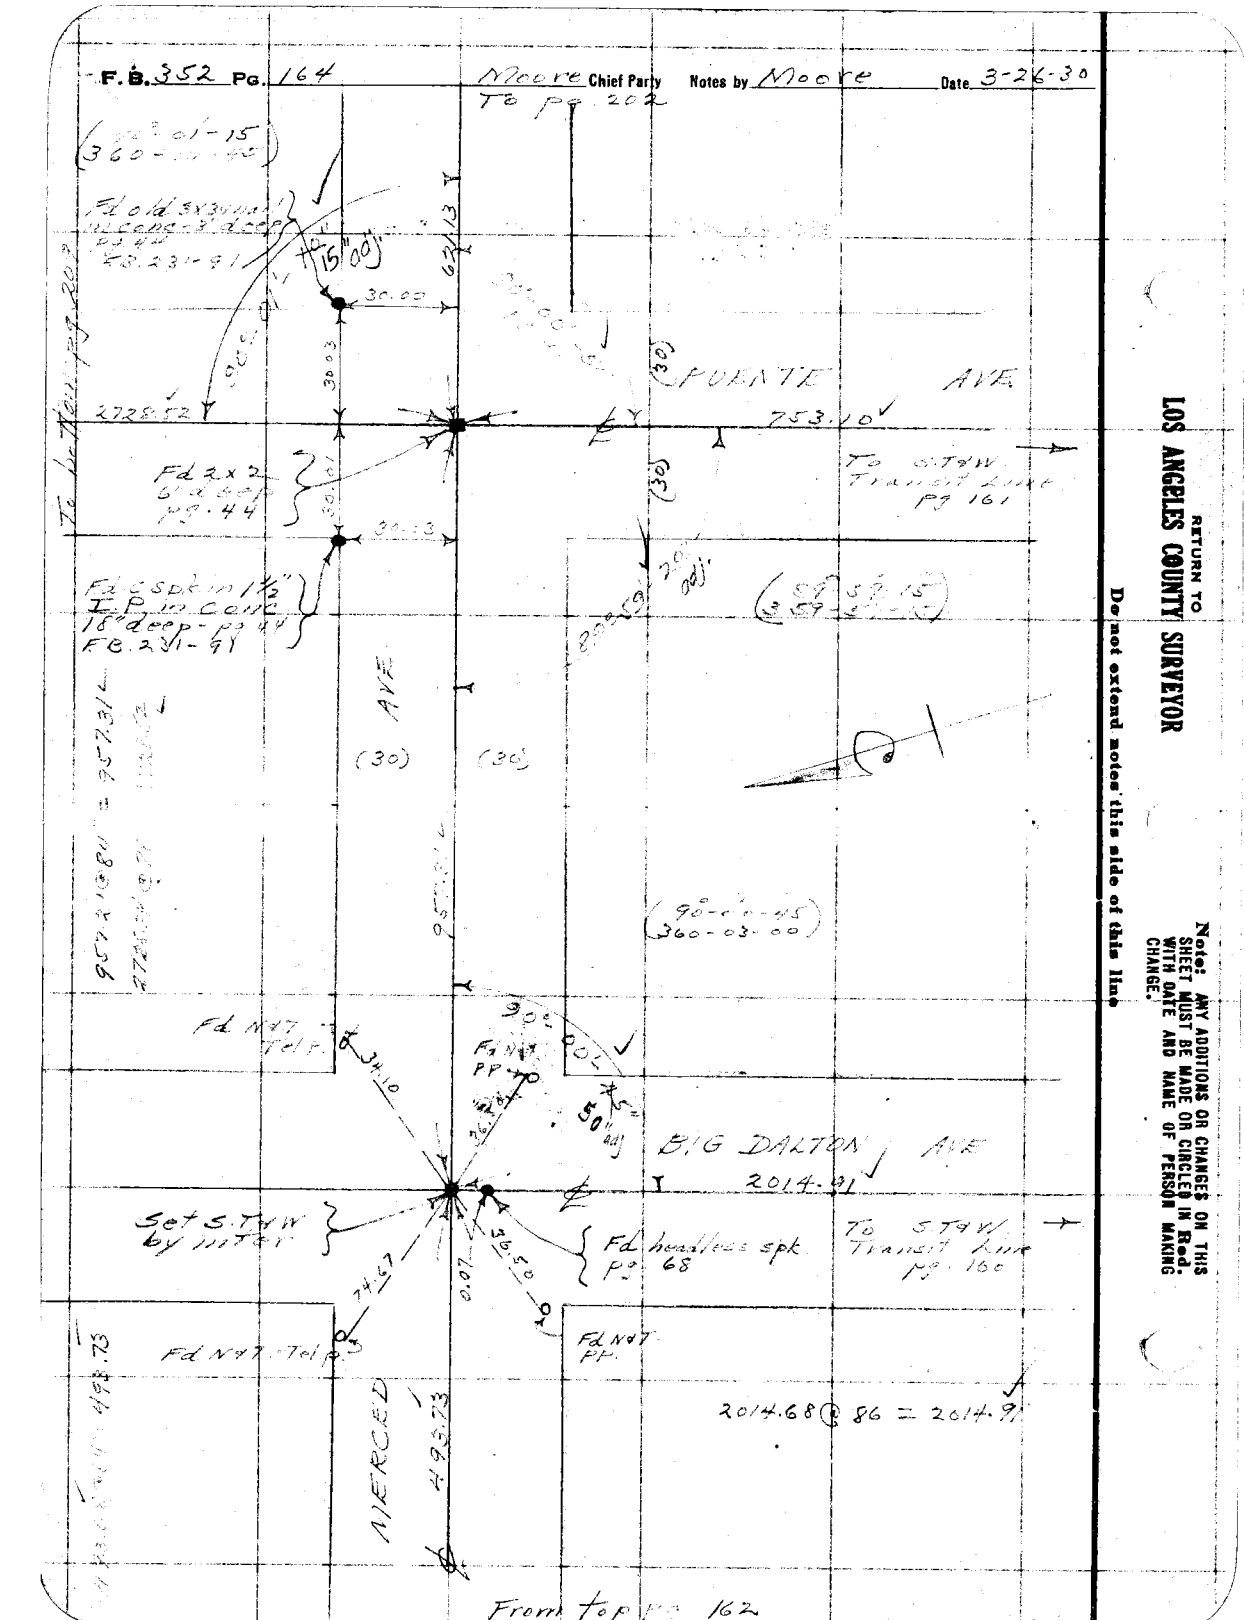

RETURN TO
LOS ANGELES COUNTY SURVEYOR

Do not extend notes this side of this line

Note: ANY ADDITIONS OR CHANGES ON THIS SHEET MUST BE MADE OR CIRCLED IN Red. WITH DATE AND NAME OF PERSON MAKING CHANGE.

Date 3-31-30 Notes by Moore Chief Party Moore F.B. 352 Pg 165

Platted by D.A.White	W.O. No. 796 U.S.C.&G.S. No. [illegible]
Date June, 1930	Location [illegible]
Map No. B-519-2	Surveyed by [illegible]
Platting C'k'd by H.U.M.H.	Date 3-31-30
Date AUG 12 1930	Indexed A. C. Johnson

Notes: ANY ADDITIONS OR CHANGES ON THIS SHEET MUST BE MADE OR CIRCLED IN Red, WITH DATE AND NAME OF PERSON MAKING CHANGE.

Do not extend notes this side of this line

RETURN TO LOS ANGELES COUNTY SURVEYOR

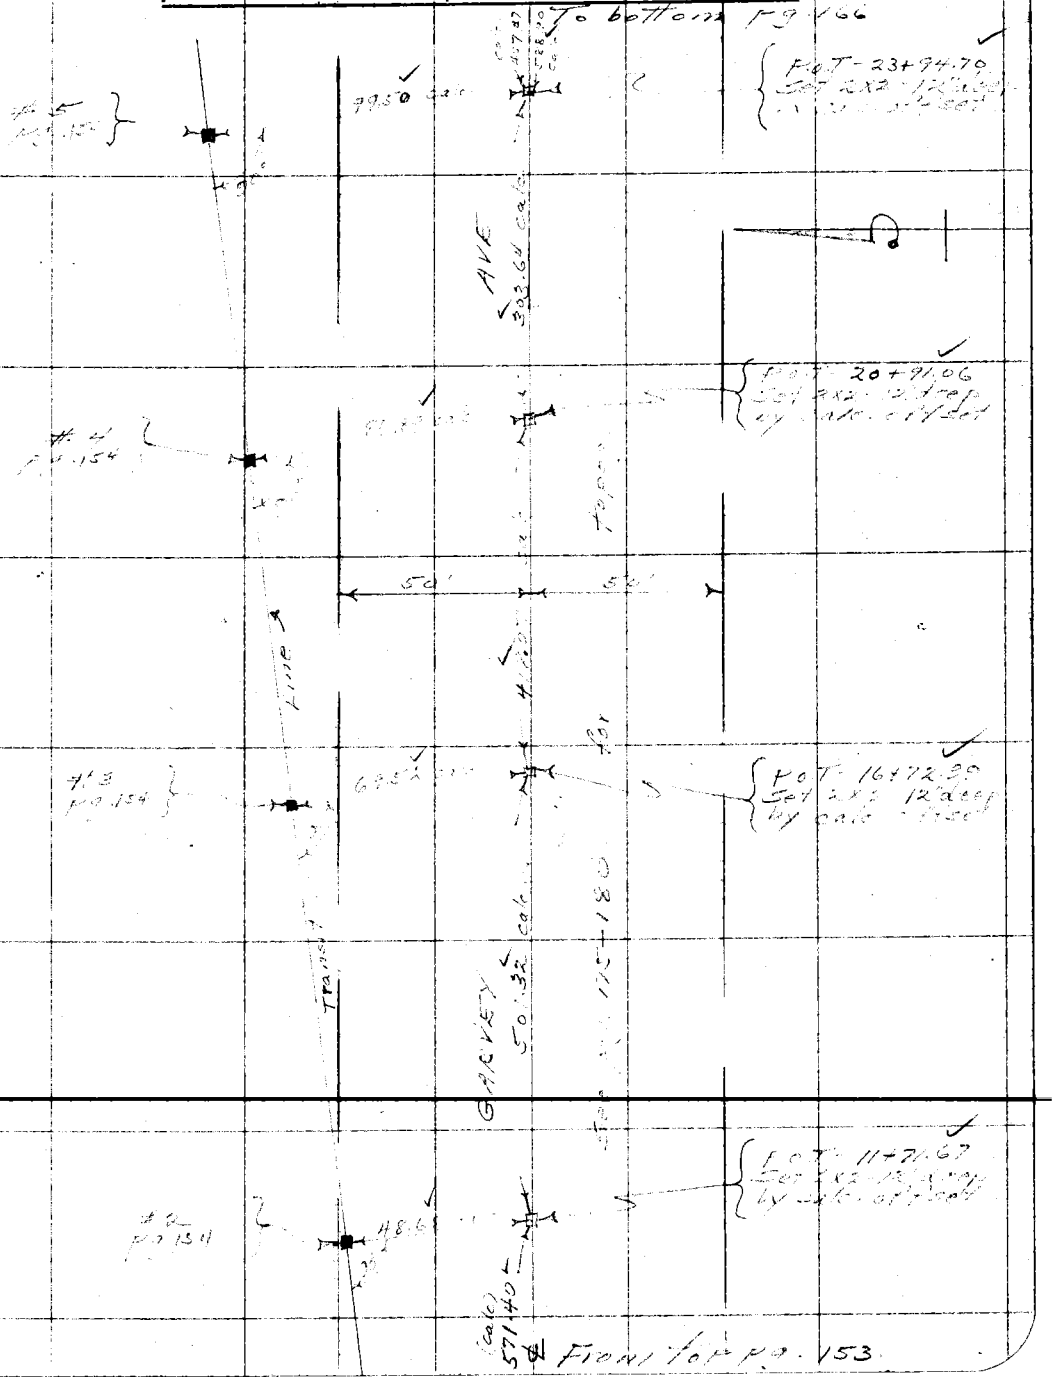
To bottom Pg 166
POT - 23+94.70
20+91.06
POT - 16+72.90
POT - 11+71.67
AVE
Fence
Trans.
Gravel
Fence
Fence
Fence
Trans.
Fence
Fence
Fence
Trans.
Fence
Fence
Fence
Trans.

RETURN TO
LOS ANGELES COUNTY SURVEYOR

Note: ANY ADDITIONS OR CHANGES ON THIS SHEET MUST BE MADE OR CIRCLED IN **Red.** WITH DATE AND NAME OF PERSON MAKING CHANGE.

Do not extend notes this side of this line

F.B. 352 PG. 166 Chief Party Moore Notes by Moore Date 3-31-36

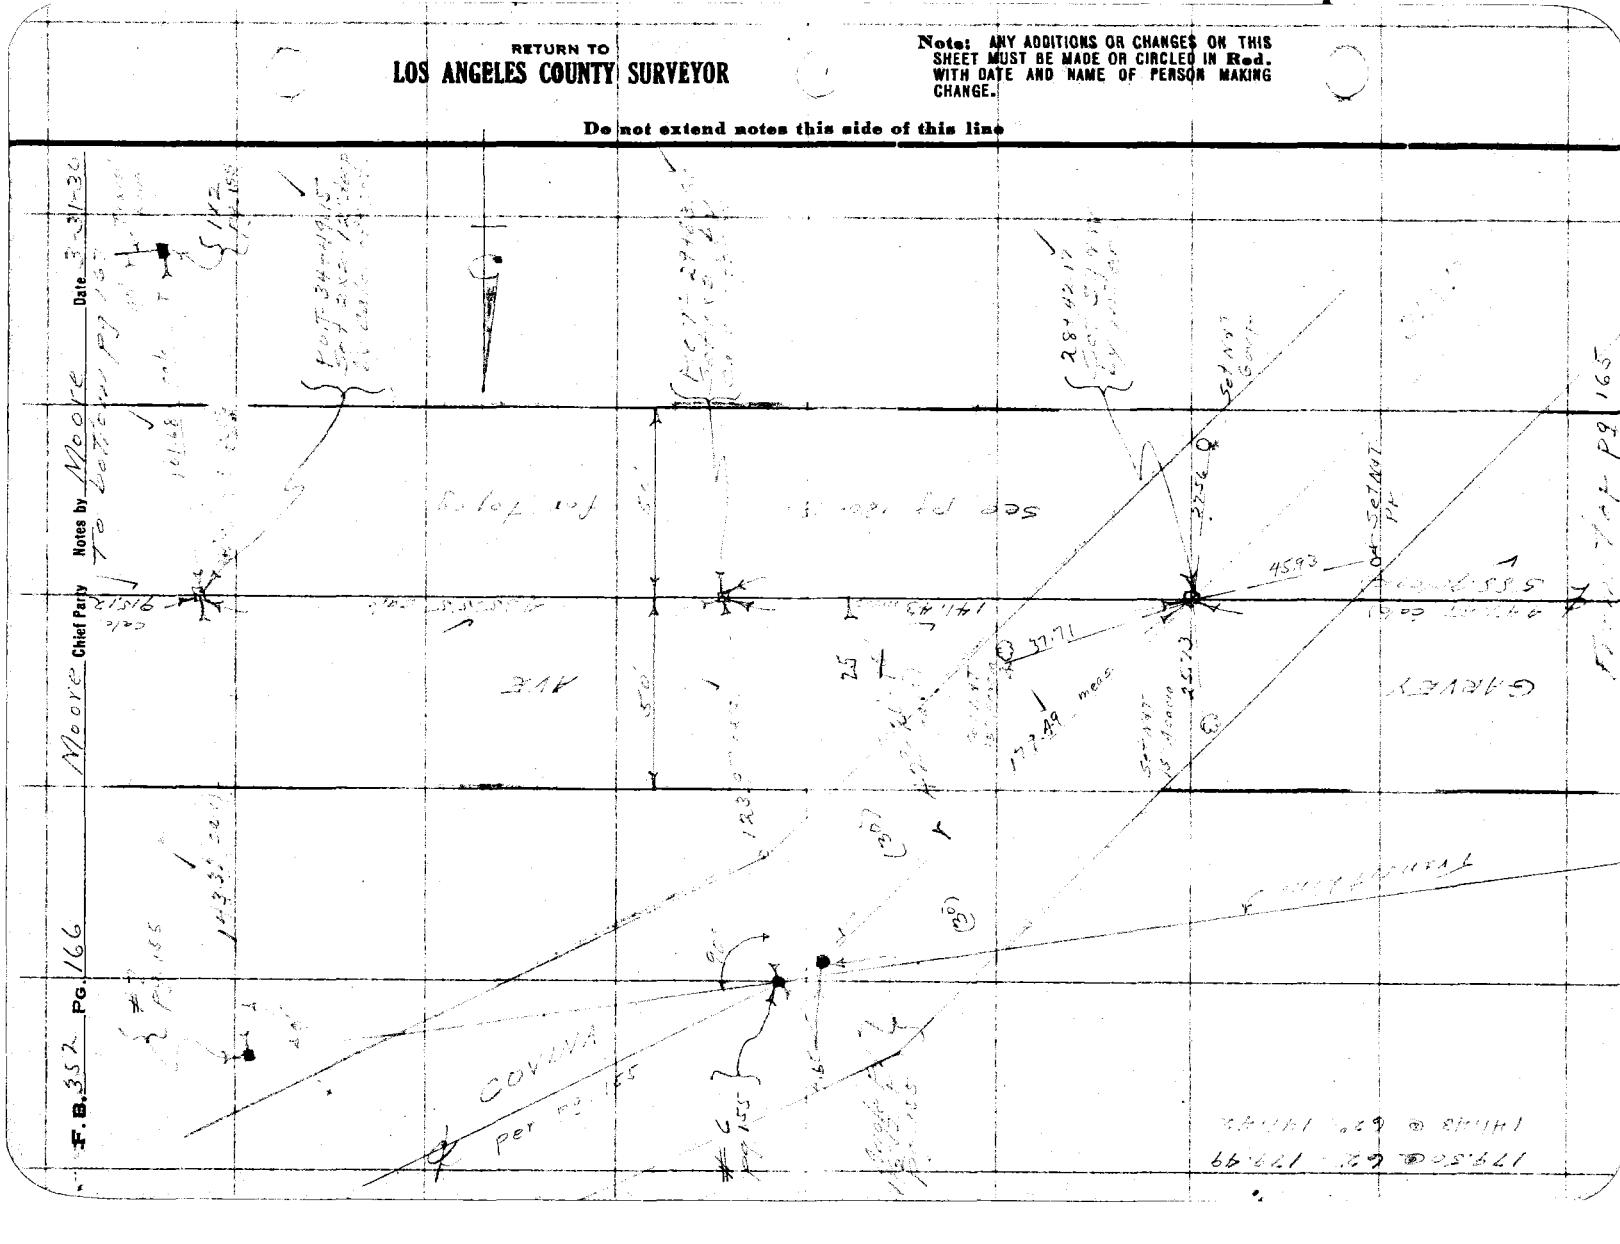
COVINA
per M 155
4593
Set Tack
Set Nail
Set Tack
Set Nail
Set Nail
Set Tack
Set Nail
Set Tack
Set Nail
Set Tack

Date 4-1-30 Notes by Alcorn Chief Party Alcorn F.B. 352 Pg. 167

Platted by D.A.White	W. O. No. 196 D. S. O. No. 028
Date June, 1930	Location [illegible]
Map No. B-519-2	Surveyed by L. D. Alcorn
Platting C'k'd by H. U. M. H.	Date 4-1-30
Date AUG 12 1930	Indexed A. C. Johnson

To bottom Pg. 168

50' 50'

Set NAT F.P.

P.O.T. 43+64.27 Set NAT by calc offset for intersection

45.56 30.19

Set NAT F.P. Set NAT Temp.

41.24

Set NAT F.P.

(calc)

8 Pg. 156

R/W

GARVEY AVE.

From Top Pg. 166

Notes: ANY ADDITIONS OR CHANGES OF THIS SHEET MUST BE MADE OR CIRCLED IN Red. WITH DATE AND NAME OF PERSON MAKING CHANGE.

Do not extend notes this side of this line

RETURN TO LOS ANGELES COUNTY SURVEYOR


To bottom pg. 167

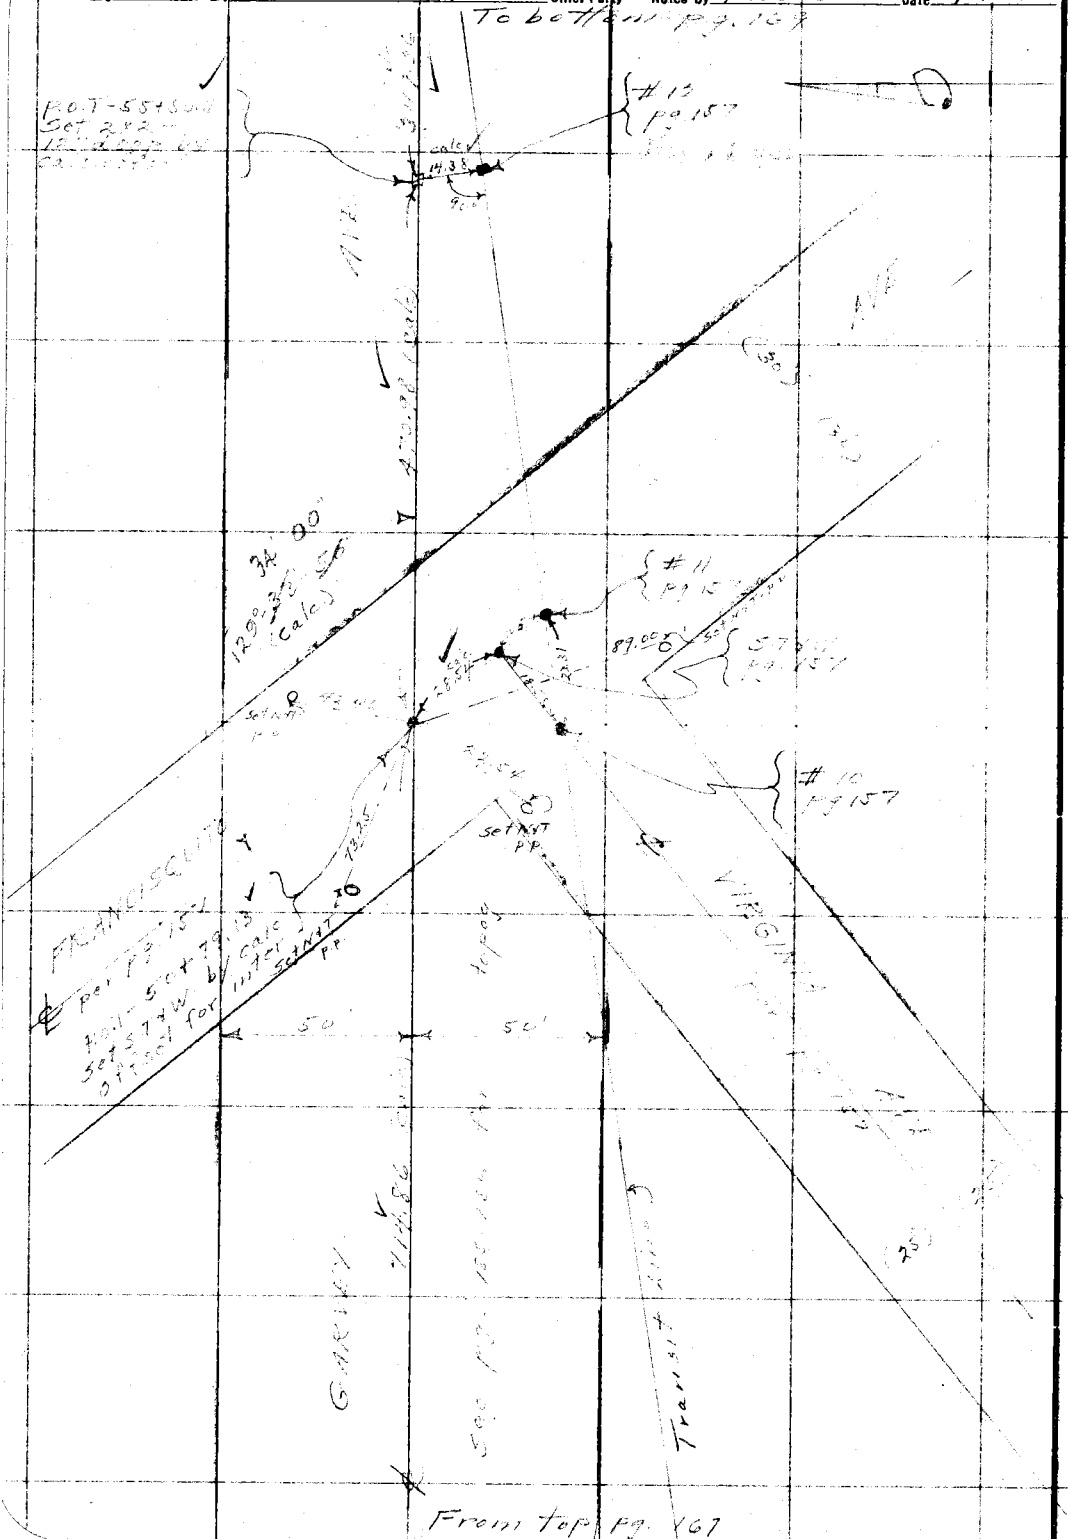

RETURN TO
LOS ANGELES COUNTY SURVEYOR

Do not extend notes this side of this line

Note: ANY ADDITIONS OR CHANGES ON THIS SHEET MUST BE MADE OR CIRCLED IN Red. WITH DATE AND NAME OF PERSON MAKING CHANGE.

Date 9-1-30 Notes by Woods Chief Party [illegible] F.B. 352 Pg 169

Platted by D.A. White	W.O. No. 776 D.C.O. No. 916
Date June, 1930	Location [illegible]
Map No. B-519-2	Surveyed by A.D. Nicol
Platting C'k'd by H.U.M.H.	Date 9-4-30 A.C. Johnson
Date AUG 12 1930	Indexed

To bottom pg 170

50' 50'

N 1° E 767.36'

Set NXT 15" Walnut

VINELAND

Set NXT Tel P

30.67

39.87 Set NXT P

P.O.T. S 55° 99' 37" E 163.00

Set STAW by Cal. 23° set for inter

#13 pg 151

1X3 pg 158

0.42 (calc)

S 44° 23' E 1410.72'

Set NXT Tel P

AVE

GARVEY

Figure Top. pg. 168

Note: ANY ADDITIONS OR CHANGES ON THIS SHEET MUST BE MADE OR CIRCLED IN Red. WITH DATE AND NAME OF PERSON MAKING CHANGE.

Do not extend notes this side of this line

RETURN TO LOS ANGELES COUNTY SURVEYOR

RETURN TO
LOS ANGELES COUNTY SURVEYOR

Note: ANY ADDITIONS OR CHANGES ON THIS SHEET MUST BE MADE OR CIRCLED IN **Red.** WITH DATE AND NAME OF PERSON MAKING CHANGE.

Do not extend notes this side of this line

F.B. 352 Pg. 170 Chief Party Moore Notes by Moore Date 4-1-30

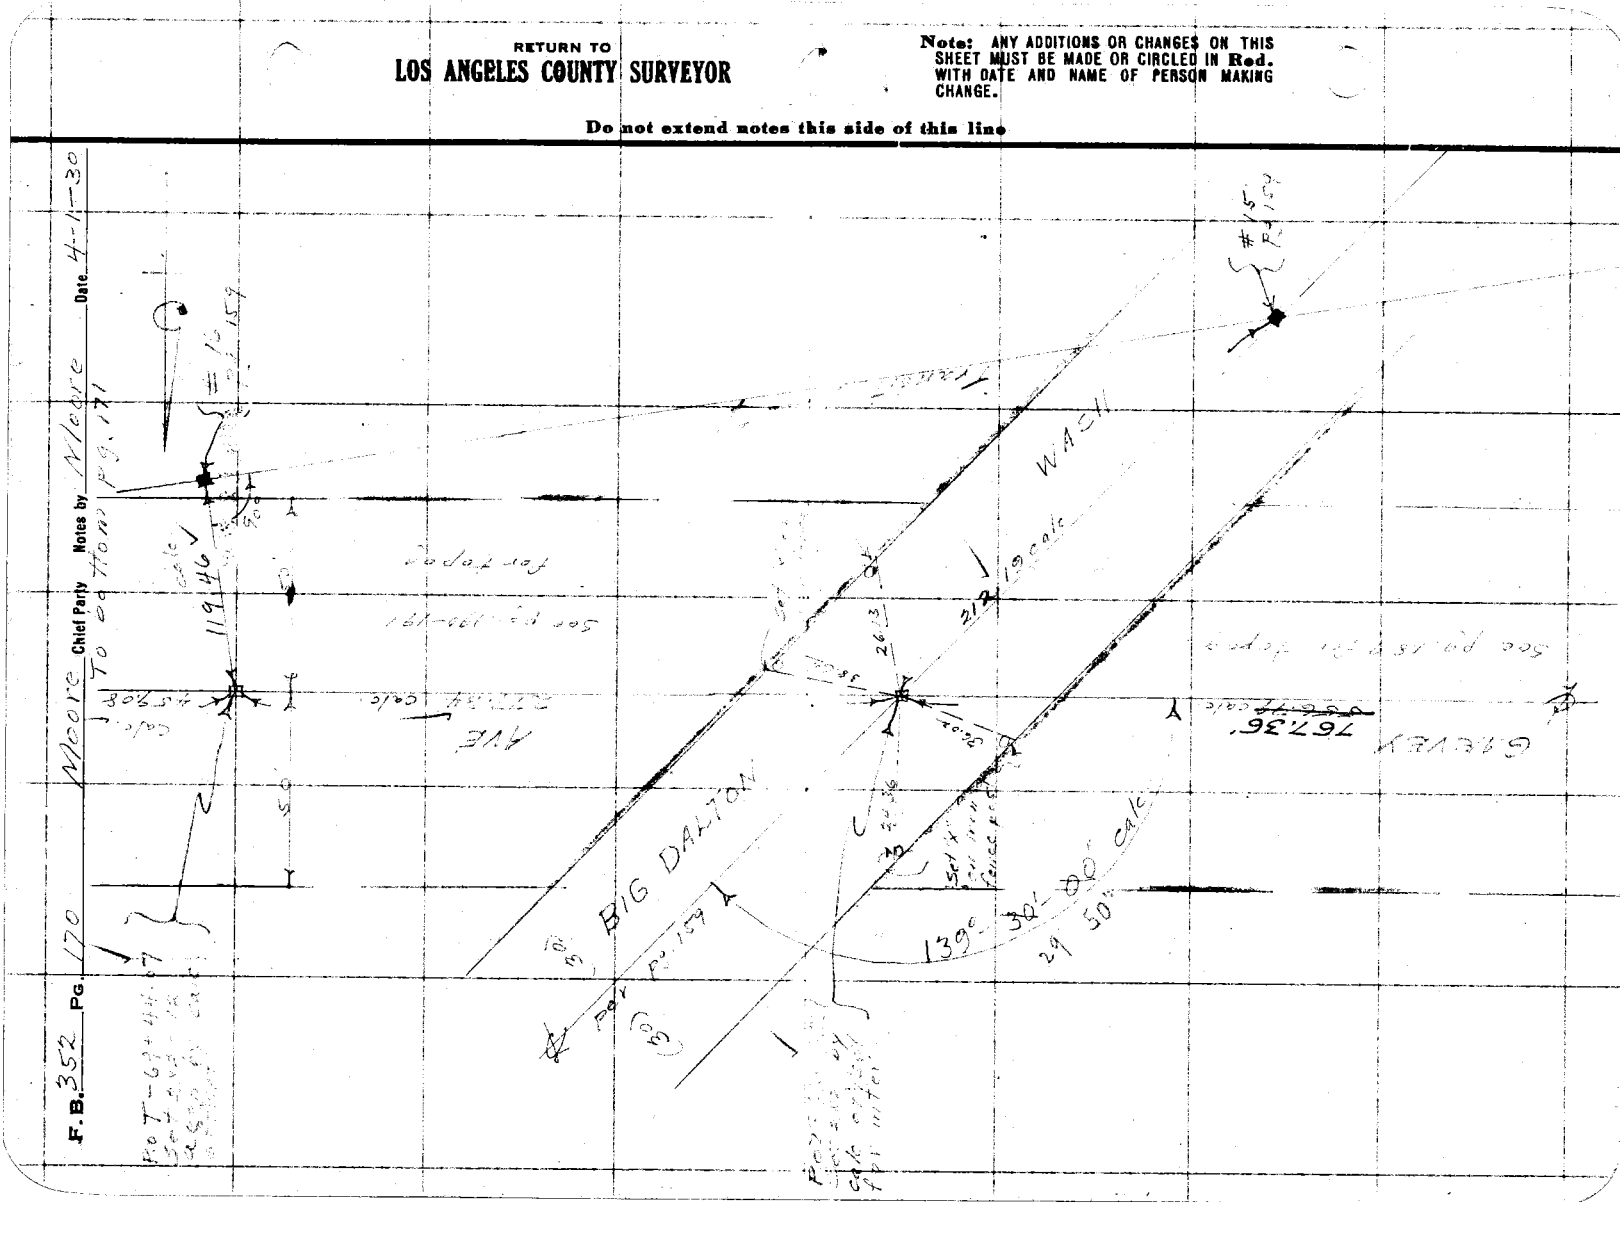
BIG DALTON
WASH
139° 30' 00" calc
29° 50"
R=159
R=159
60°
60°
119.46
76.36
calc
calc
calc

Date 11-1-30 Notes by Monroe Chief Party [illegible] F.B. 352 Pg 171

Platted by D.A. White	W.O. No. 796 D.S.O. No. 022
Date June, 1930	Location Savoy Ave
Map No. 9-519-2	Surveyed by [illegible]
Platting Ck'd by H.U.M.H.	Date 4-1-30
Date AUG 12 1930	Indexed by C. Johns

73 bottom pg. 172

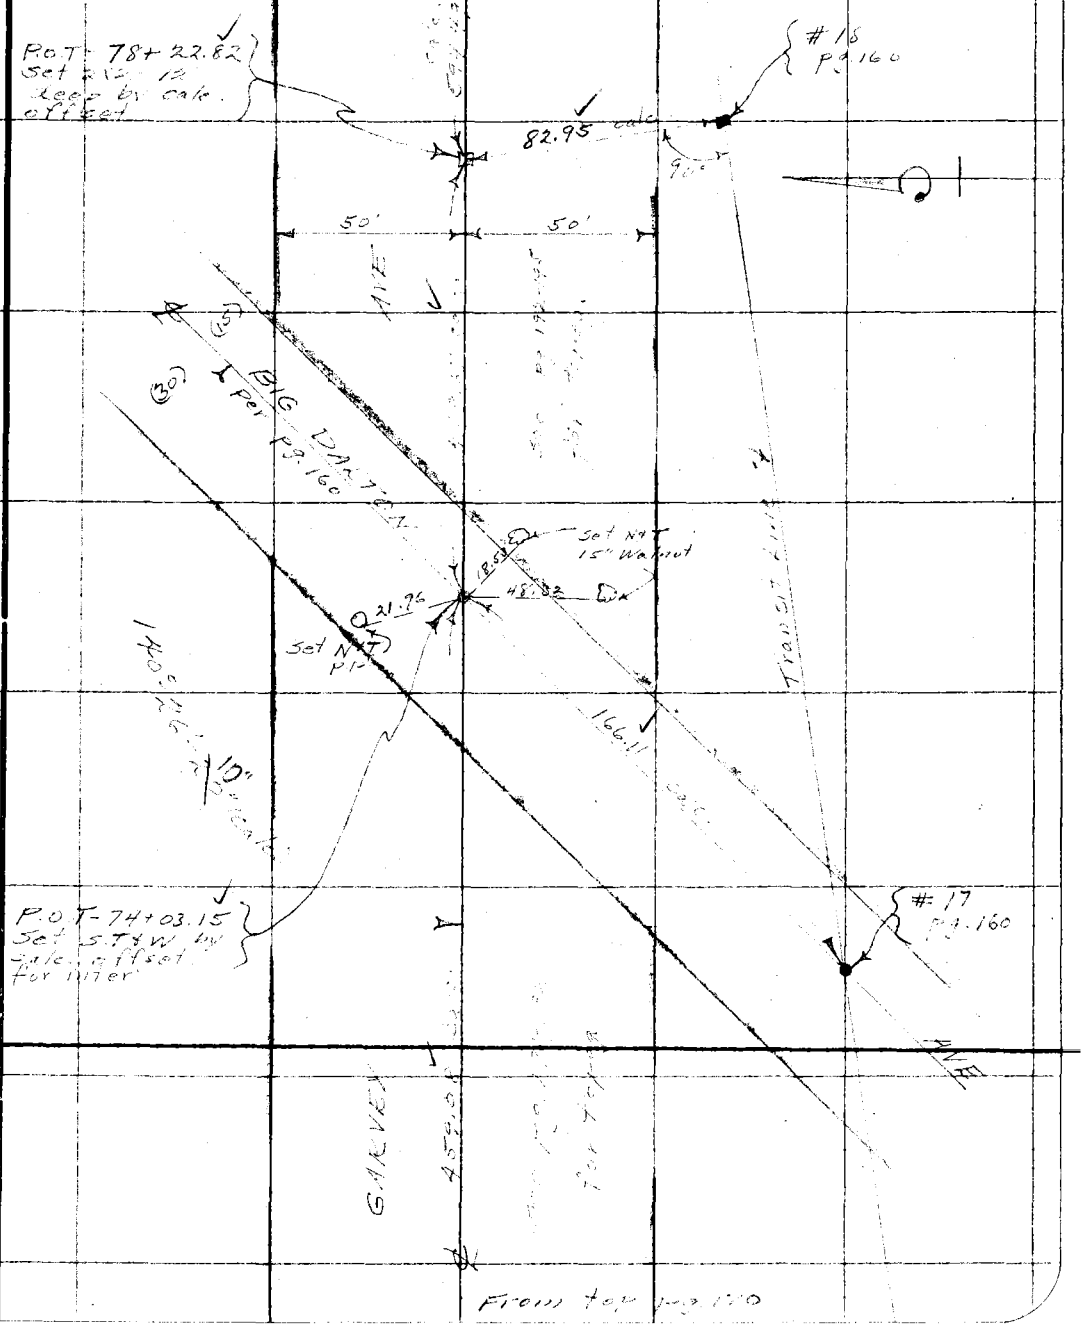

Notes: ANY ADDITIONS OR CHANGES ON THIS SHEET MUST BE MADE OR CIRCLED IN Red. WITH DATE AND NAME OF PERSON MAKING CHANGE.

Do not extend notes this side of this line

RETURN TO LOS ANGELES COUNTY SURVEYOR

F. B. 352 Pg. 172 Moore Chief Party Notes by Moore Date 4-1-30

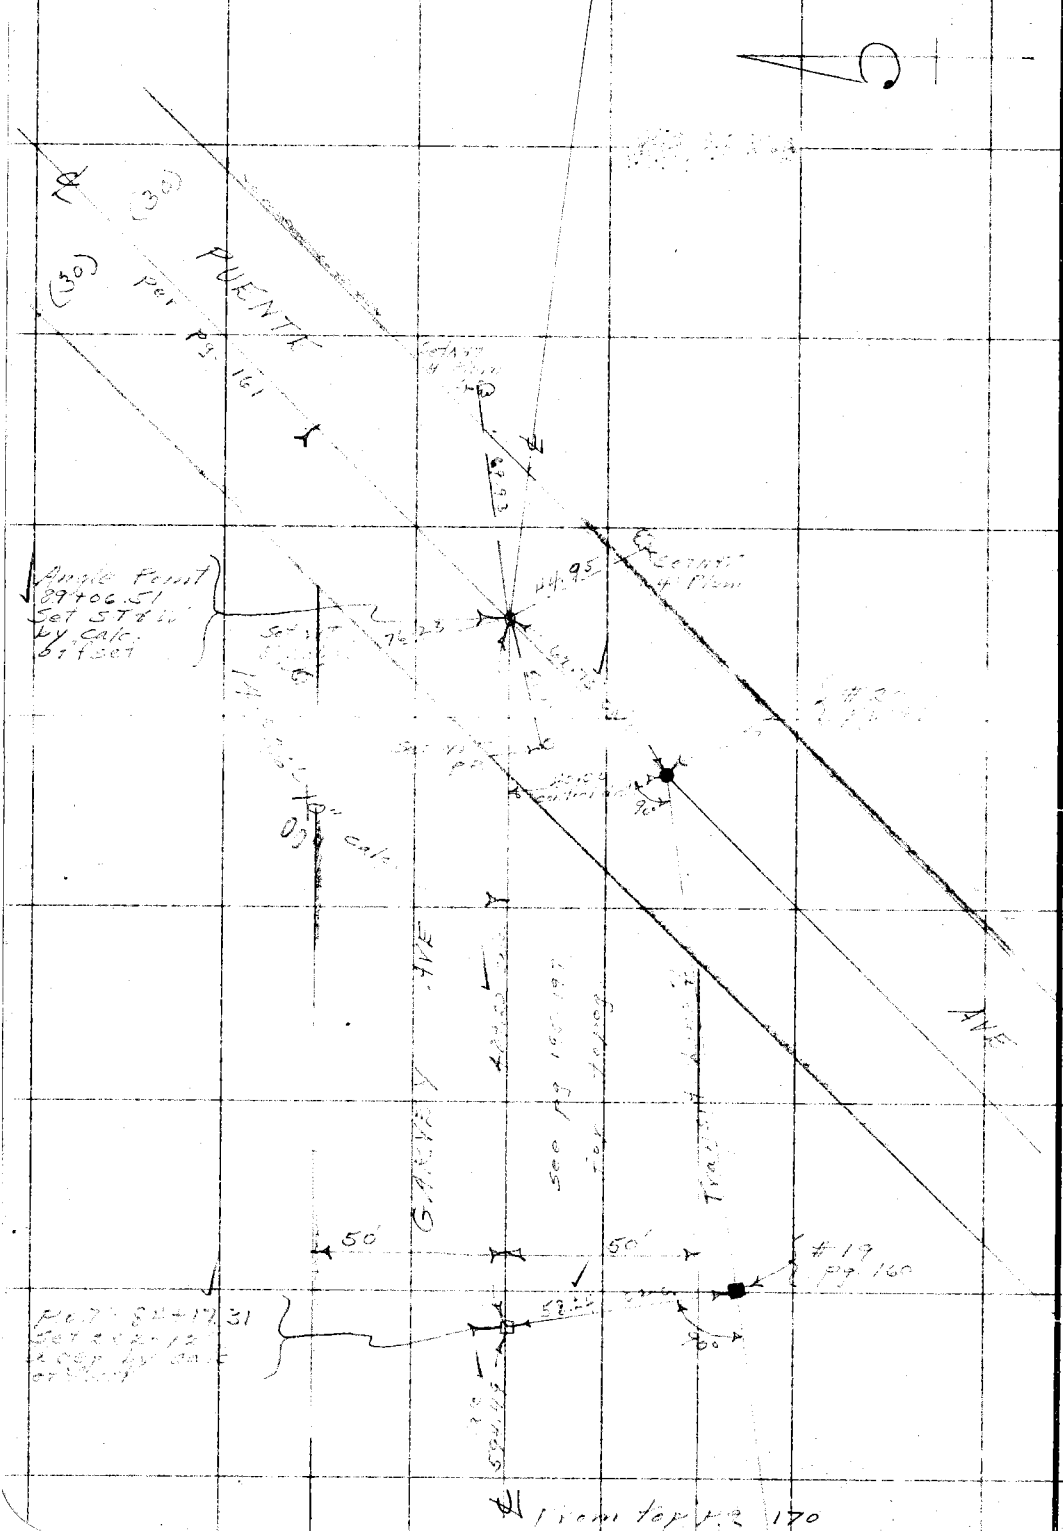
(30)
(30)
PUENTE
Per R.S. 161
Single Point
Set Stake
by Oak
Tree
Concrete
Post
Set Stake
Set Stake
Set Stake

Date 4-2-30 Notes by Merle Chief Party Merle F.B. 352 Pg 173

Platted by D.A.White	W.O. No. 796 D.S.O. No.
Date June, 1930.	Location Gay Ave. [illegible]
Map No. B-519-2.	Surveyed by
Platting C'k'd by H.U.M.H.	Date 4-2-30
Date AUG 12 1930	Indexed C. Jones

TOPOGRAPHY
for
RELOCATION
of
EAST TO
[illegible]
W.O. # 796

April - 1930

Chief
Topo
Right of Way
Bridge
Dep
Co.

Notes. ANY ADDITIONS OR CHANGES ON THIS SHEET MUST BE MADE OR CIRCLED IN Red. WITH DATE AND NAME OF PERSON MAKING CHANGE.

Do not extend notes this side of this line

RETURN TO
LOS ANGELES COUNTY SURVEYOR

F. B. 352 Pg. 174 Moore Chief Party Notes by Moore Date 4-2-30

To bottom pg. 175

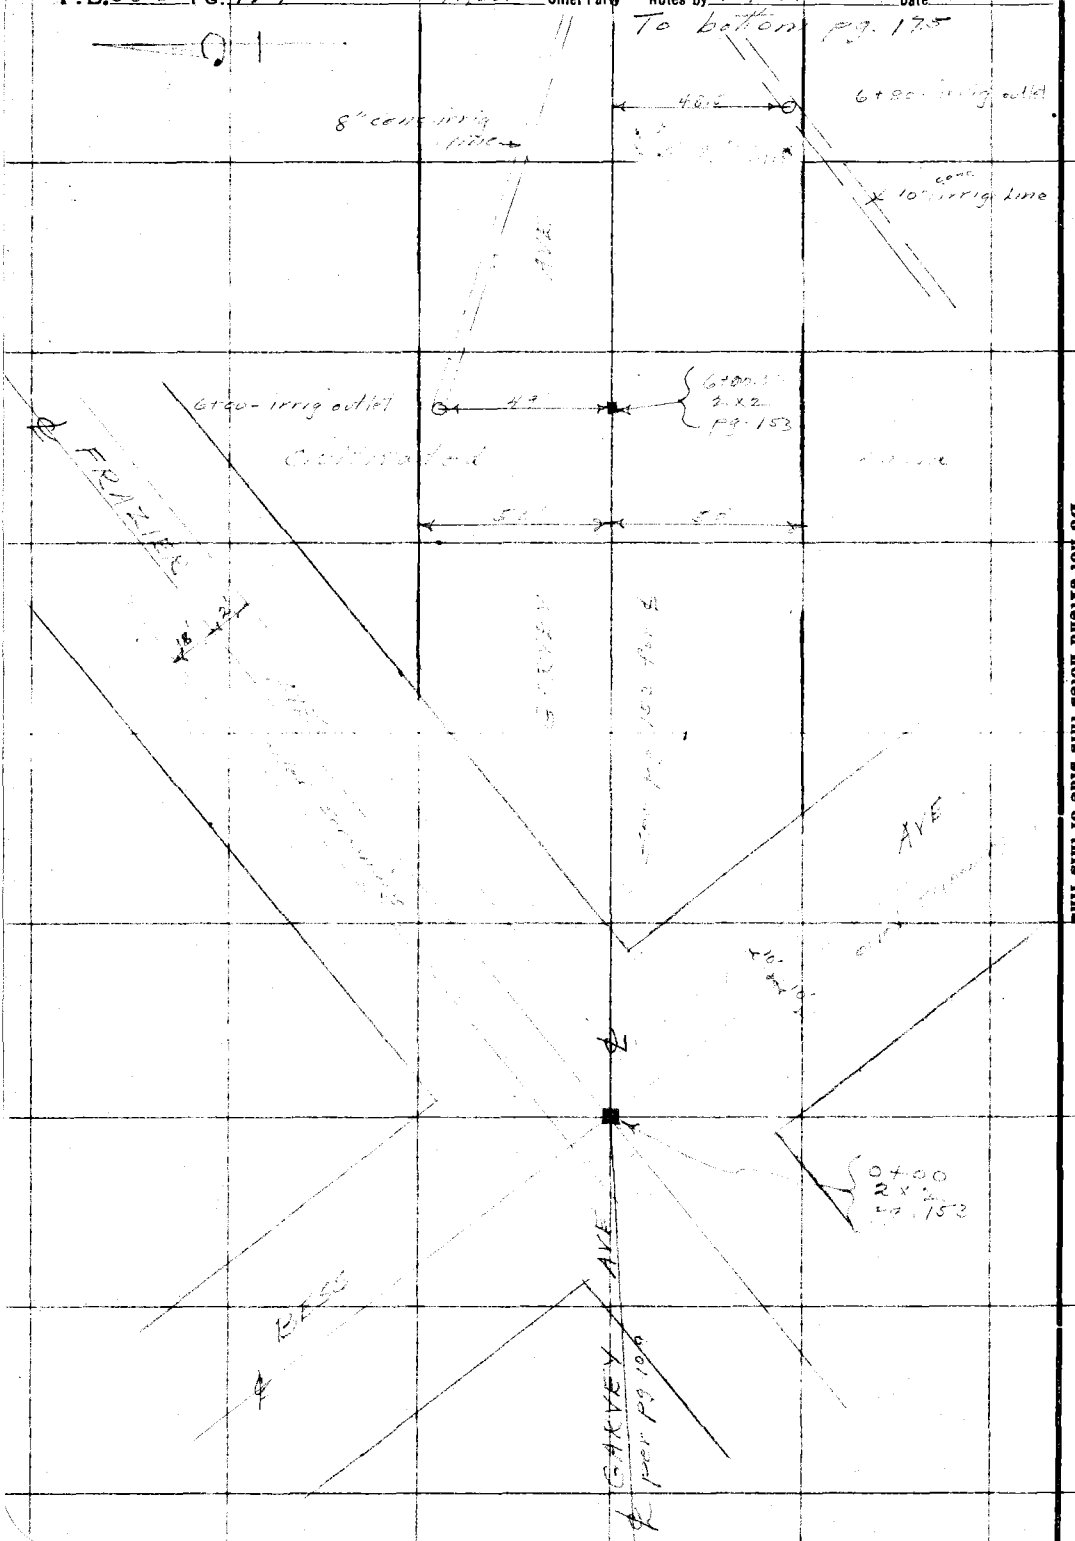

RETURN TO
LOS ANGELES COUNTY SURVEYOR

Do not extend notes this side of this line

Note: ANY ADDITIONS OR CHANGES ON THIS SHEET MUST BE MADE OR CIRCLED IN Red. WITH DATE AND NAME OF PERSON MAKING CHANGE.

Date 4-2-30 Notes by Moore Chief Party Moore F.B. 352 Pg. 175

Platted by D.A. White	W.O. No. 796 D.S.O. No.
Date June, 1930.	Location Sunset Ave
Map No. B-519-2	Surveyed by J.L. Moore
Platting C'k'd by H.U.M.H.	Date 4-2-30
Date AUG 12 1930	Indexed C. Johns

Notes: ANY ADDITIONS OR CHANGES ON THIS SHEET MUST BE MADE OR CIRCLED IN Red. WITH DATE AND NAME OF PERSON MAKING CHANGE.

Do not extend notes this side of this line

RETURN TO LOS ANGELES COUNTY SURVEYOR

To bottom pg. 1-5

Filed R.S. 2 x 2 Pg. 165

AVE

cultivated land

+ 9+20

50' 50'

Block

GARVEY

cultivated land

8" Water Line

From

8

7

F.B. 353 Pg. 176 Chief Party Notes by Alcorta Date 4-2-30

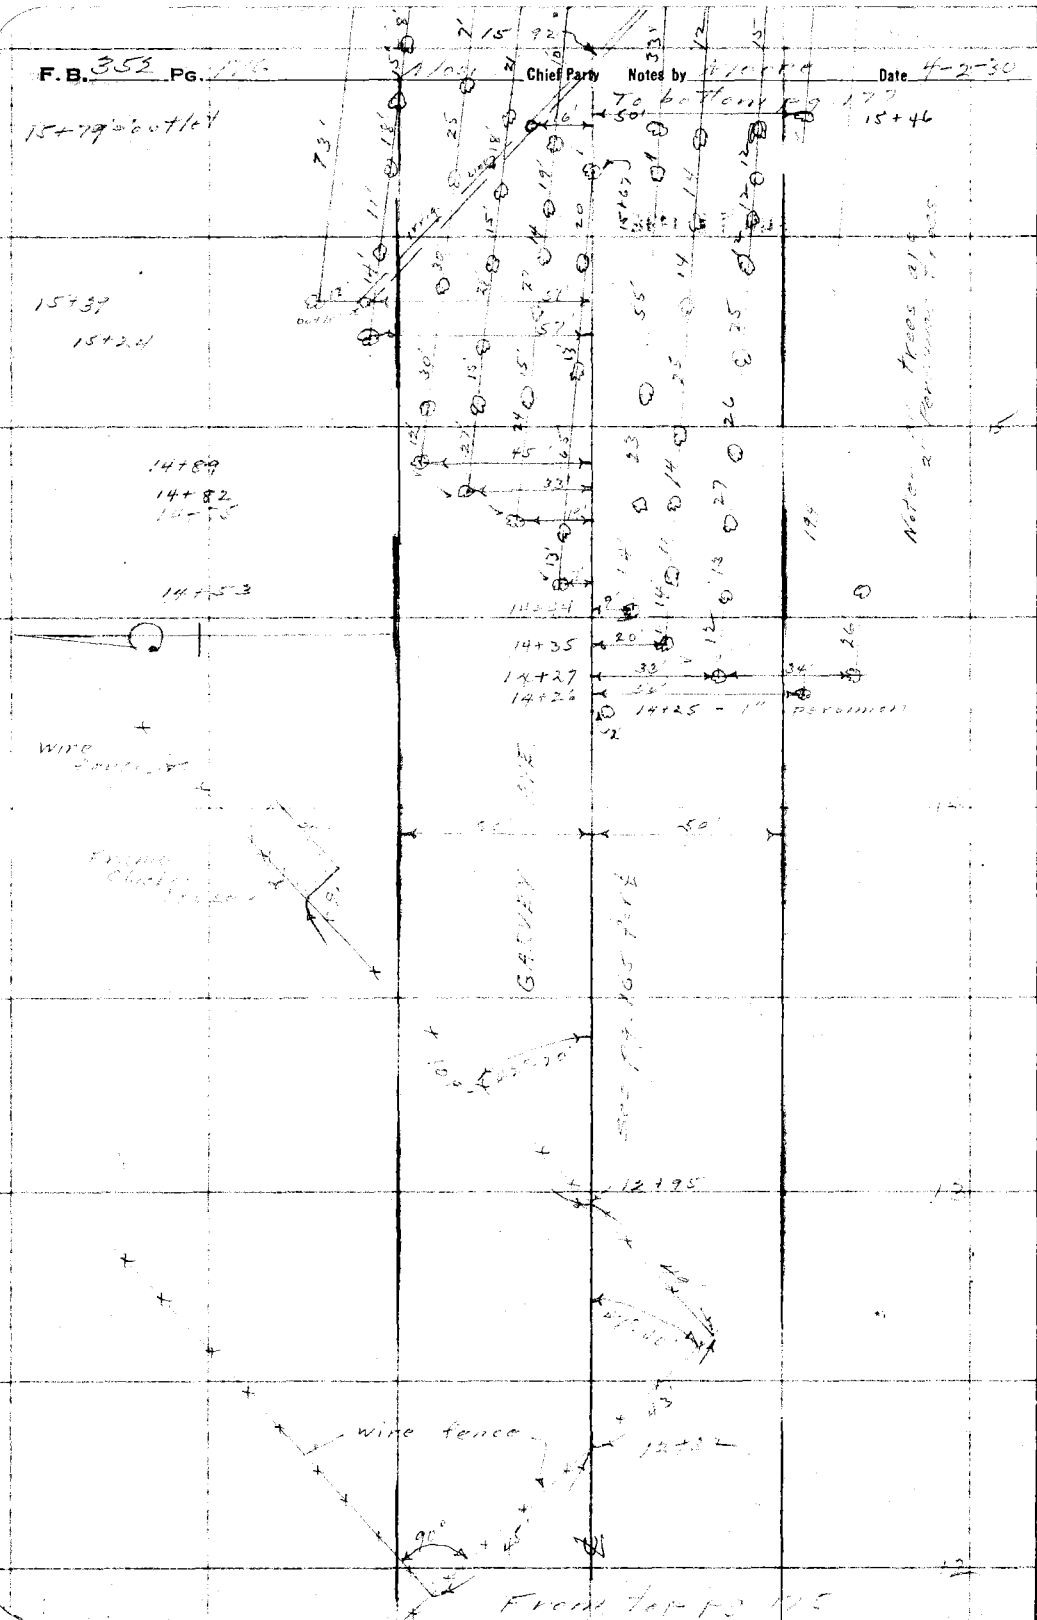

RETURN TO
LOS ANGELES COUNTY SURVEYOR

Do not extend notes this side of this line

Note: ANY ADDITIONS OR CHANGES ON THIS SHEET MUST BE MADE OR CIRCLED IN Red. WITH DATE AND NAME OF PERSON MAKING CHANGE.

Date 4-2-30 Notes by Moore Chief Party Moore F.B. 352 Pg 177

Platted by D.A.White
Date June, 1930
Map No. B-519-2.
Platting C'k'd by H. U. M. H.
Date AUG 12 1930

W. O. No. 796 D. S. O. No.
Location
Surveyed by
Date 4-2-30
Indexed

To bottom pg 178

Notes: ANY ADDITIONS OR CHANGES ON THIS SHEET MUST BE MADE OR CIRCLED IN Red. WITH DATE AND NAME OF PERSON MAKING CHANGE.

Do not extend notes this side of this line

RETURN TO
LOS ANGELES COUNTY SURVEYOR

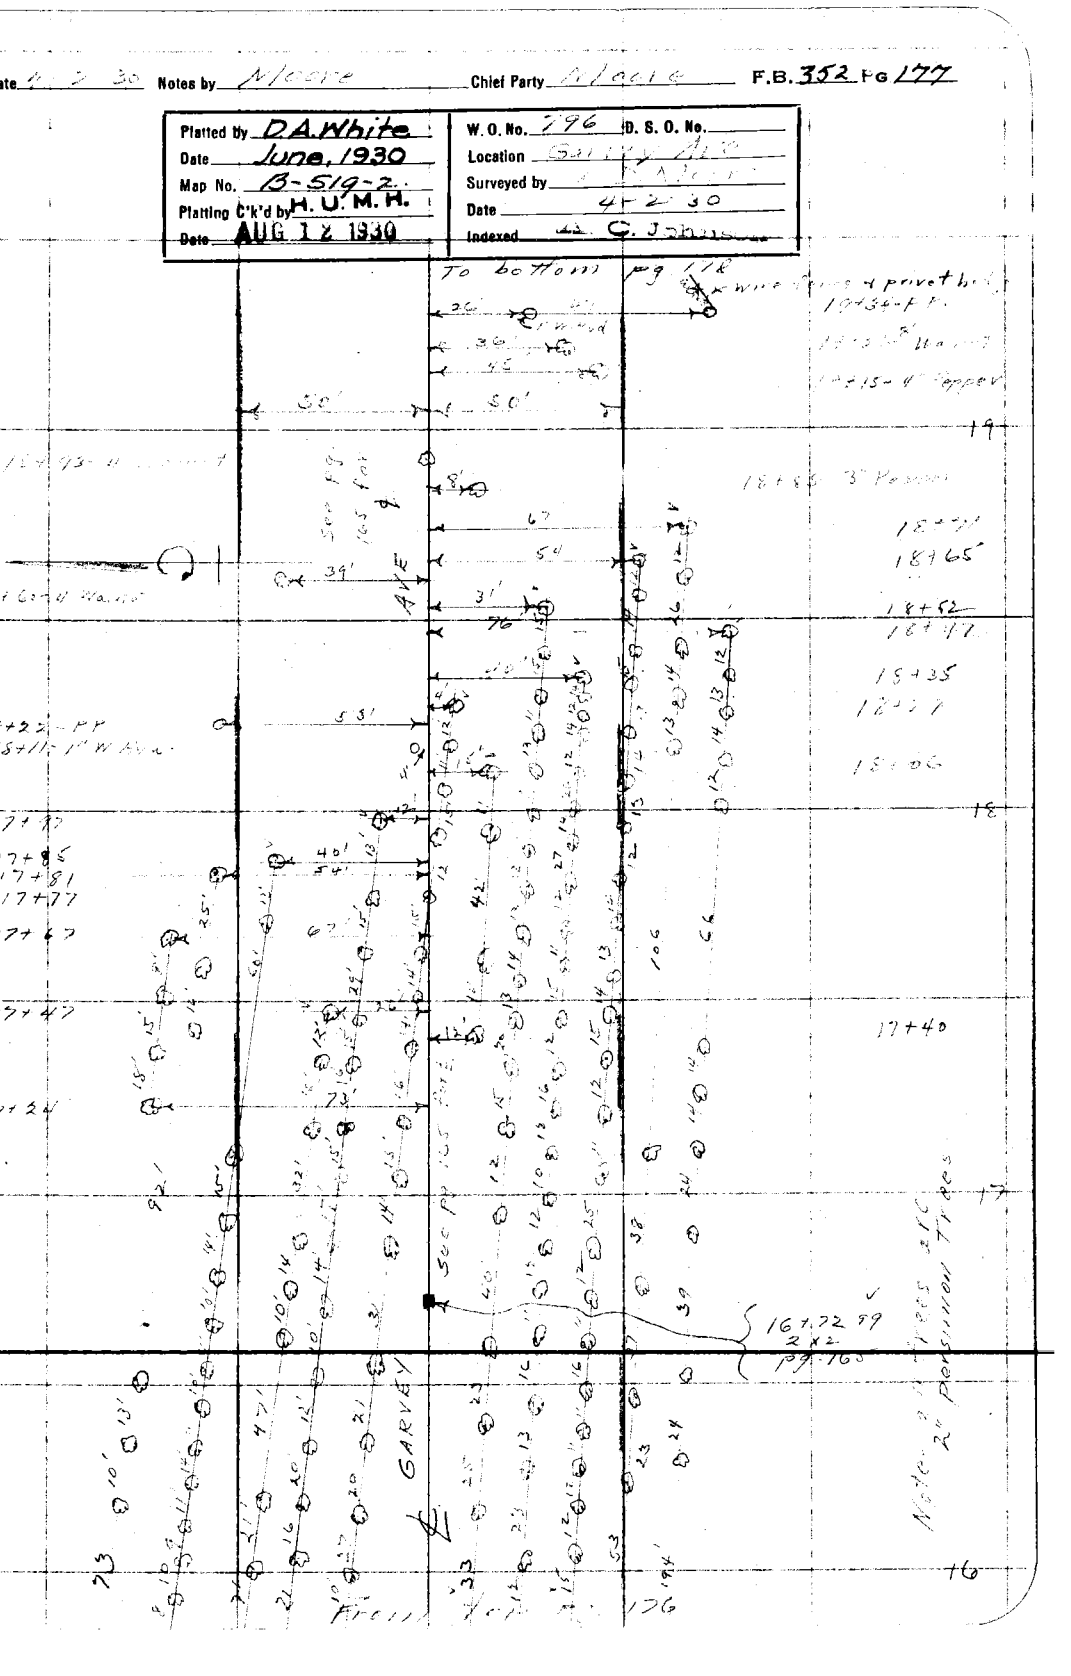

F.B. 352 Pg. 178 Moore Chief Party Notes by Moore Date 4-2-30

To bottom pg. 179

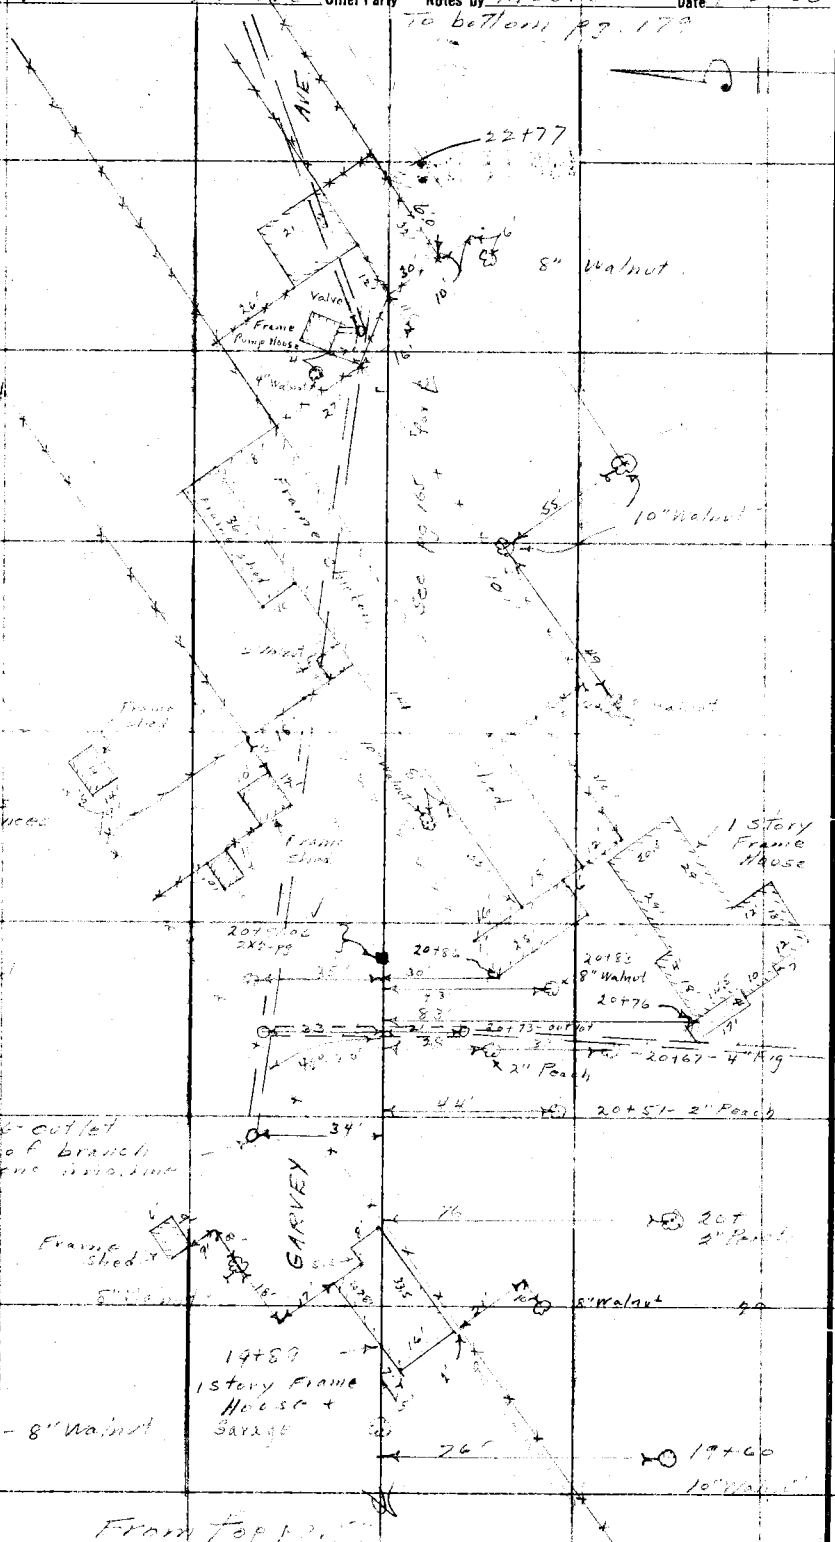

RETURN TO
LOS ANGELES COUNTY SURVEYOR

Do not extend notes this side of this line

Note: ANY ADDITIONS OR CHANGES ON THIS SHEET MUST BE MADE OR CIRCLED IN Red. WITH DATE AND NAME OF PERSON MAKING CHANGE.

Date 6-2-30 Notes by Moore Chief Party Moore F.B. 352 PG 179

Platted by D.A. White	W. O. No. 796 D. S. O. No.
Date June, 1930.	Location
Map No. B-579-2.	Surveyed by
Platting C'k'd by H. U. M. H.	Date 6-5-30
Date AUG 12 1930	Indexed → C. Johnson

Notes: ANY ADDITIONS OR CHANGES ON THIS SHEET MUST BE MADE OR CIRCLED IN Red. WITH DATE AND NAME OF PERSON MAKING CHANGE.

Do not extend notes this side of this line

RETURN TO LOS ANGELES COUNTY SURVEYOR

To Bottom Pg. 180

Frame shed

Stand pipe

Well

Frame Pump House

24+63 8" Walnut

24+54 - outlet

GARVEY

Sec Pg 161

23+93 - Stand pipe

23+93 8" Walnut

23+94.70 = x 24 Pg 165

23+87 - 8" Walnut

23+17 - 8" Walnut

23

Top Pg 178

F. B. 352 PG. 180 Moore Chief Party Notes by Moore Date 7-2-30

To bottom pg 181

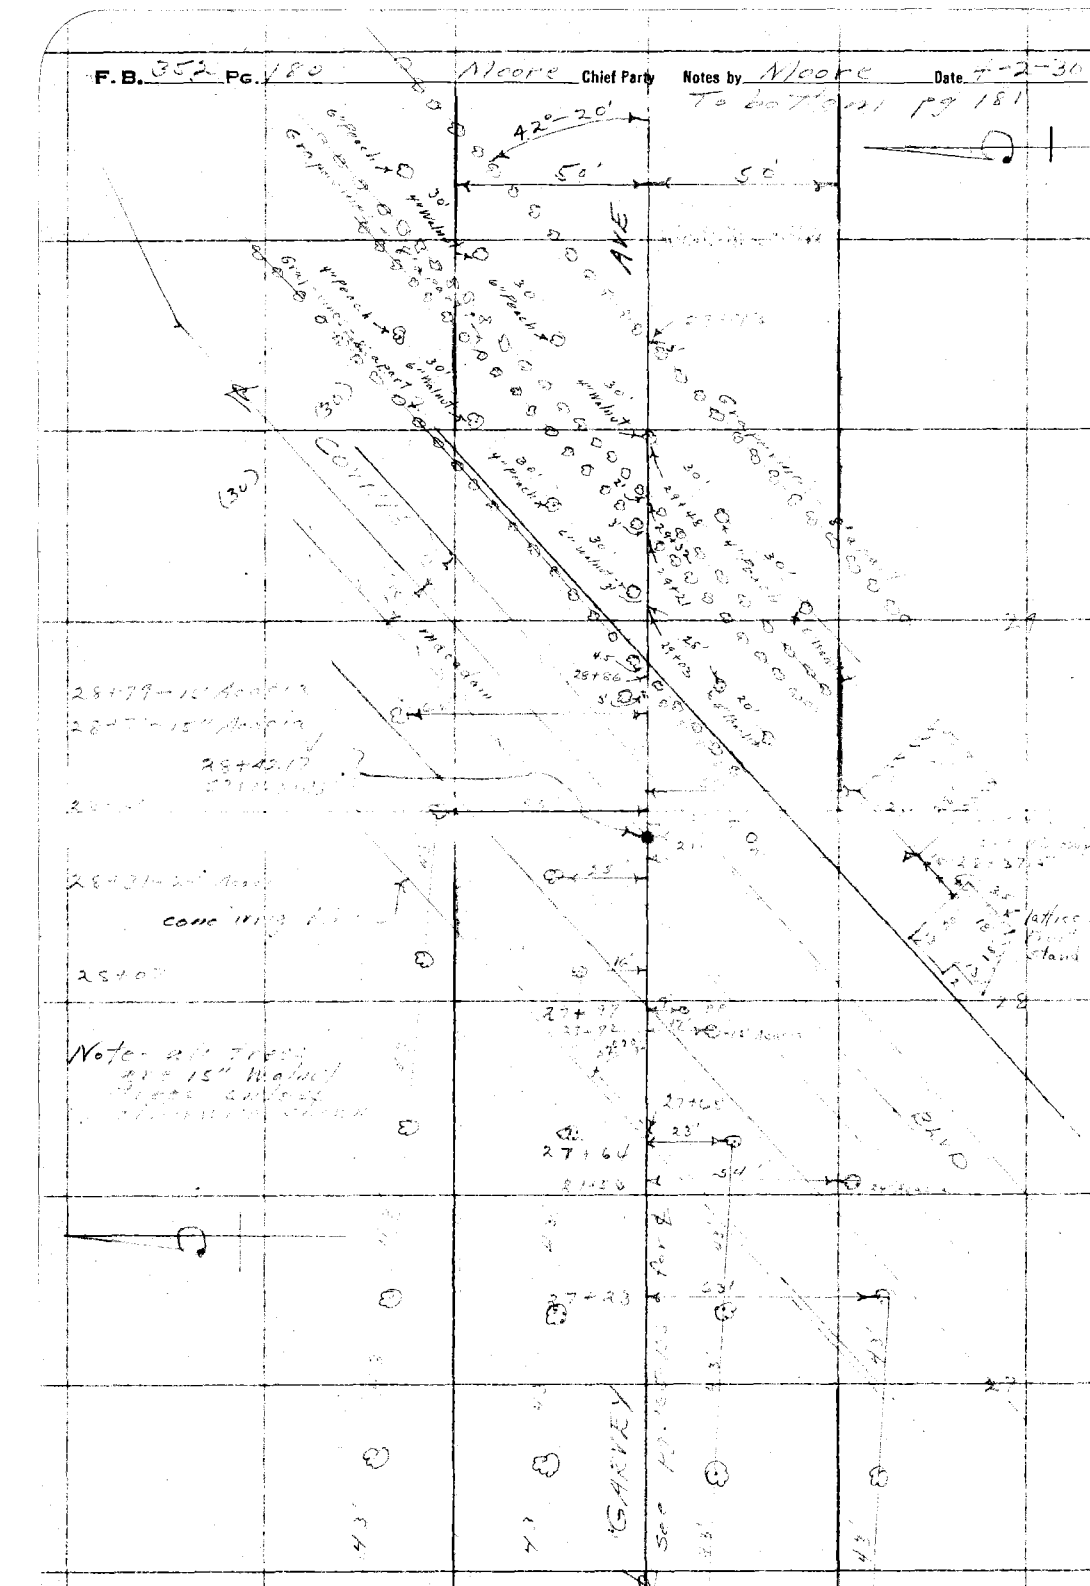
42°-20'
50'
50'
AVE
30'
6" Peach
6" Walnut
(30)
CONTINUE
20' Walnut
20' Walnut
20' Walnut

Date 4-3-30 Notes by [illegible] Chief Party [illegible] F.B. 352 Pg. 181

Platted by D.A.White	W. O. No. 796 D. S. O. No.
Date June, 1930	Location Garvey Ave
Map No. B-519-2	Surveyed by
Platting C'k'd by H. U. M. H.	Date 4-3-30
Date AUG 12 1930	Indexed by C. Johnson

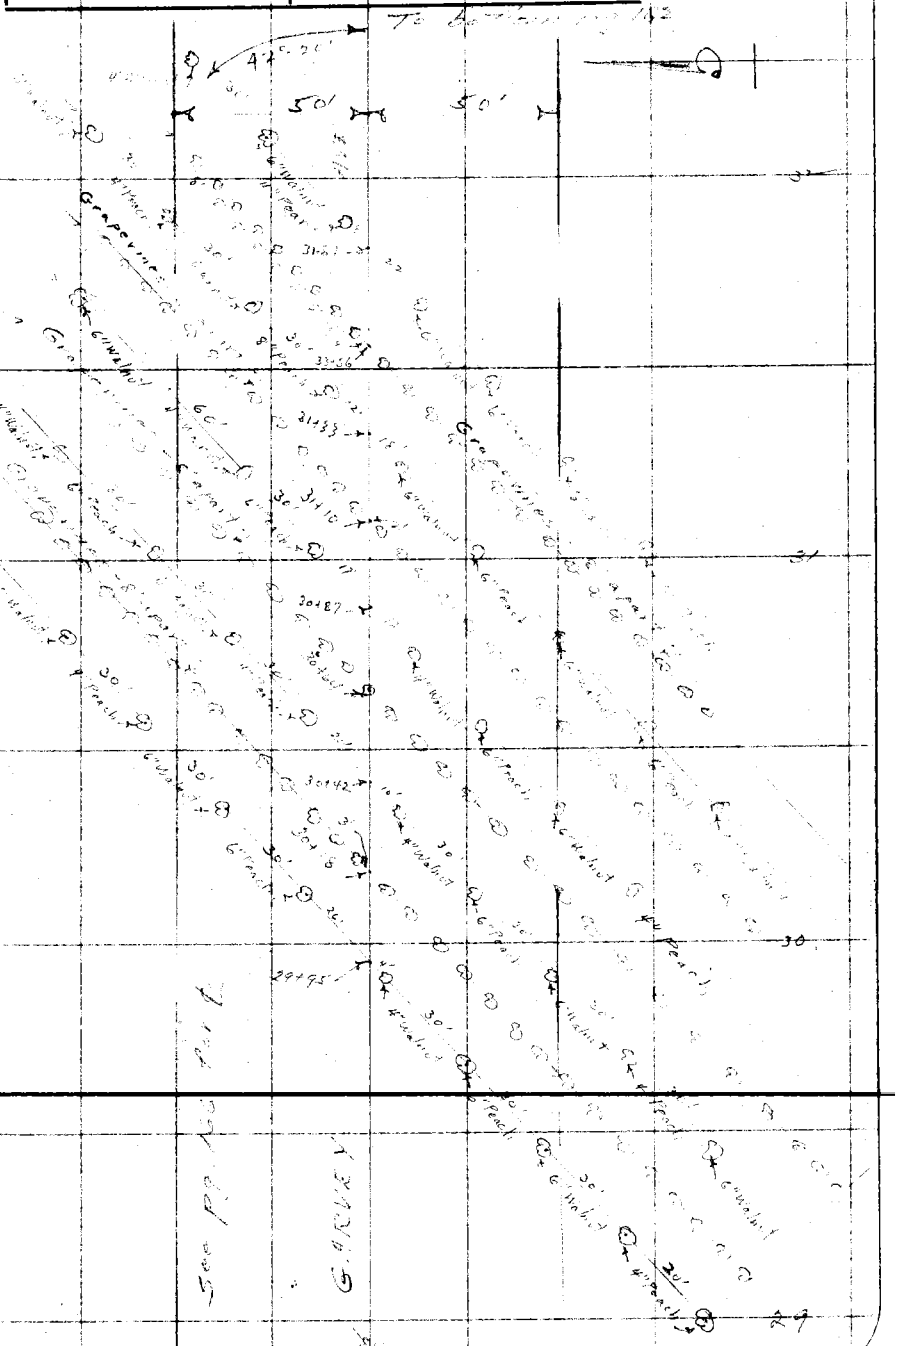
50'
50'
Grapevine
Walnut
Peach
Walnut
Peach
Walnut
Peach

RETURN TO
LOS ANGELES COUNTY SURVEYOR

Note: ANY ADDITIONS OR CHANGES ON THIS SHEET MUST BE MADE OR CIRCLED IN **Red.** WITH DATE AND NAME OF PERSON MAKING CHANGE.

Do not extend notes this side of this line

Date 4-3-30

Notes by

Chief Party

F.B. 362 Pg. 162

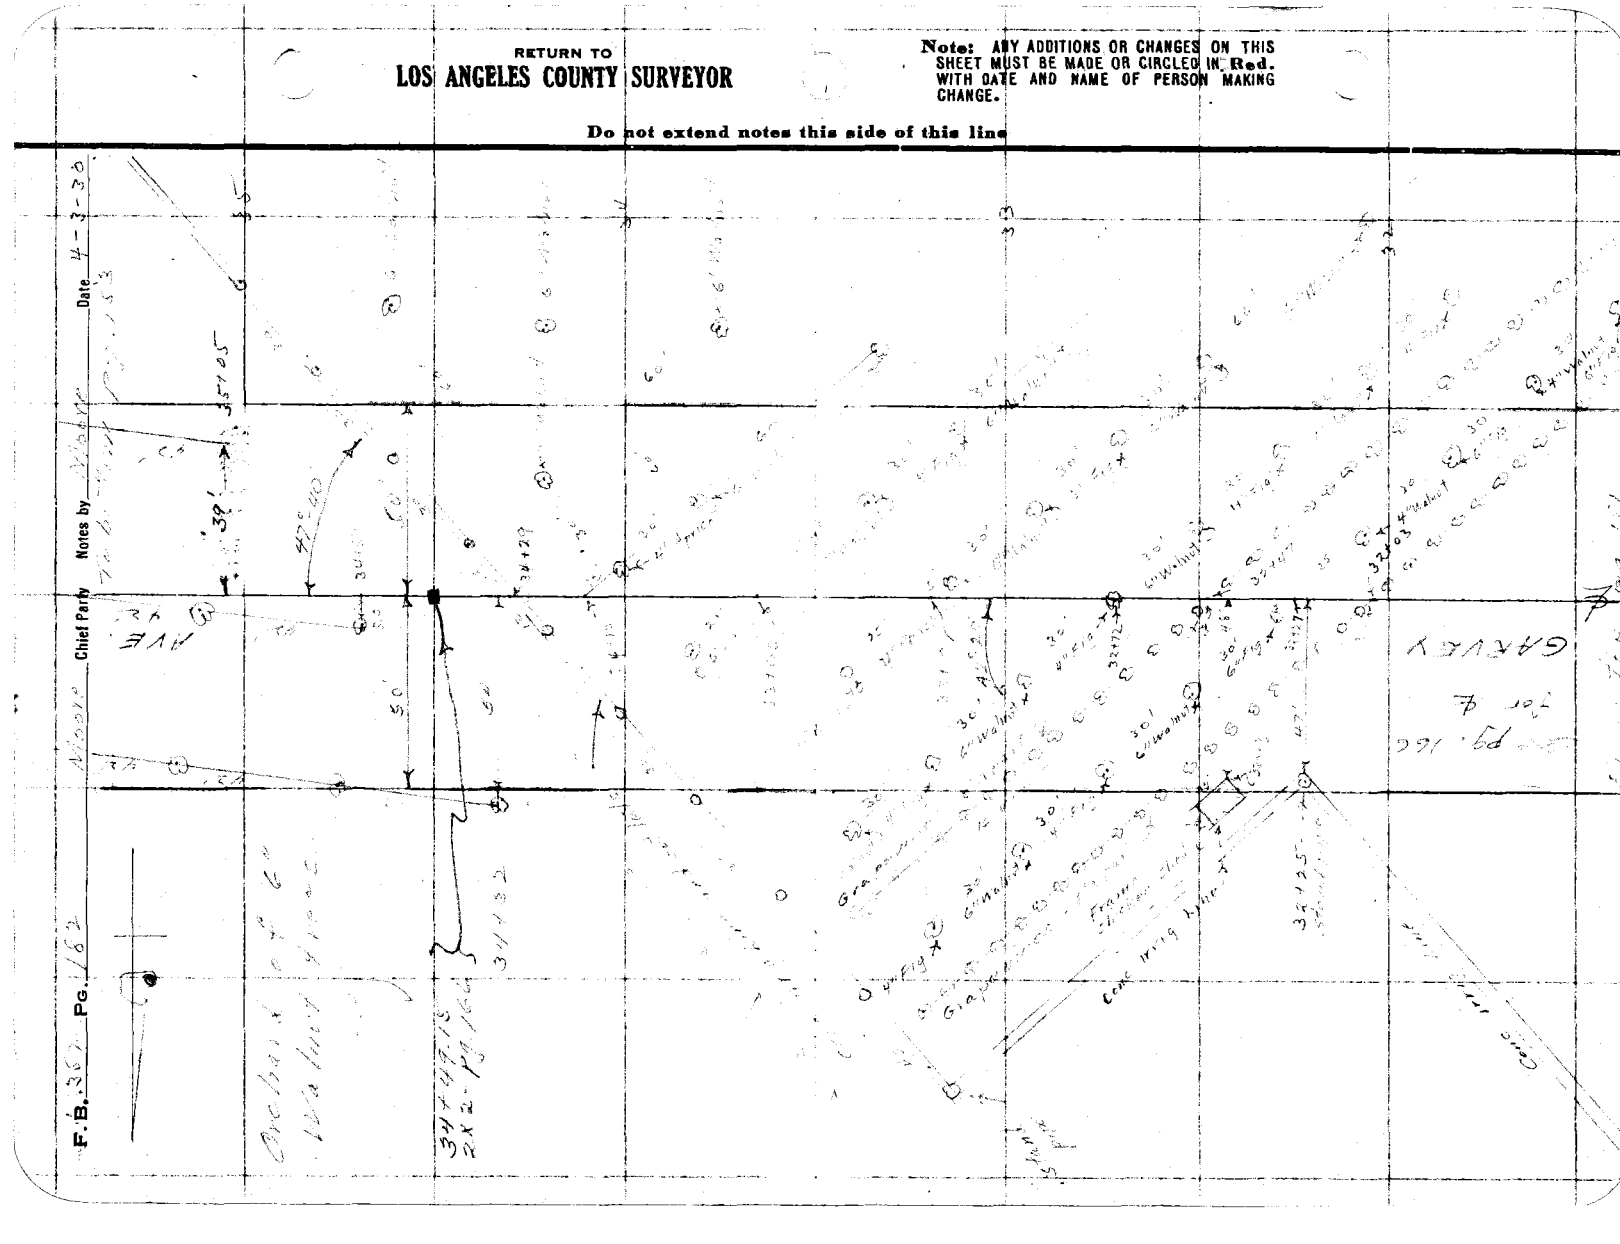
Orchard
Grapevine
Concrete Irrig. Line
Concrete
Gravel
Walnut
Fig
Grapevine
Gravel
Concrete Irrig. Line
Concrete
Walnut
Orchard
Walnut
Orchard
Walnut
Orchard

Date 4-3-30 Notes by Wood Chief Party Wood F.B. 352 Pg. 183

Platted by D.A.White	W.O. No. 796 D. S. O. No.
Date June, 1930	Location
Map No. B-519-2	Surveyed by
Platting C'k'd by H. U. M. H.	Date 4-3-30
Date AUG 12 1930	Indexed

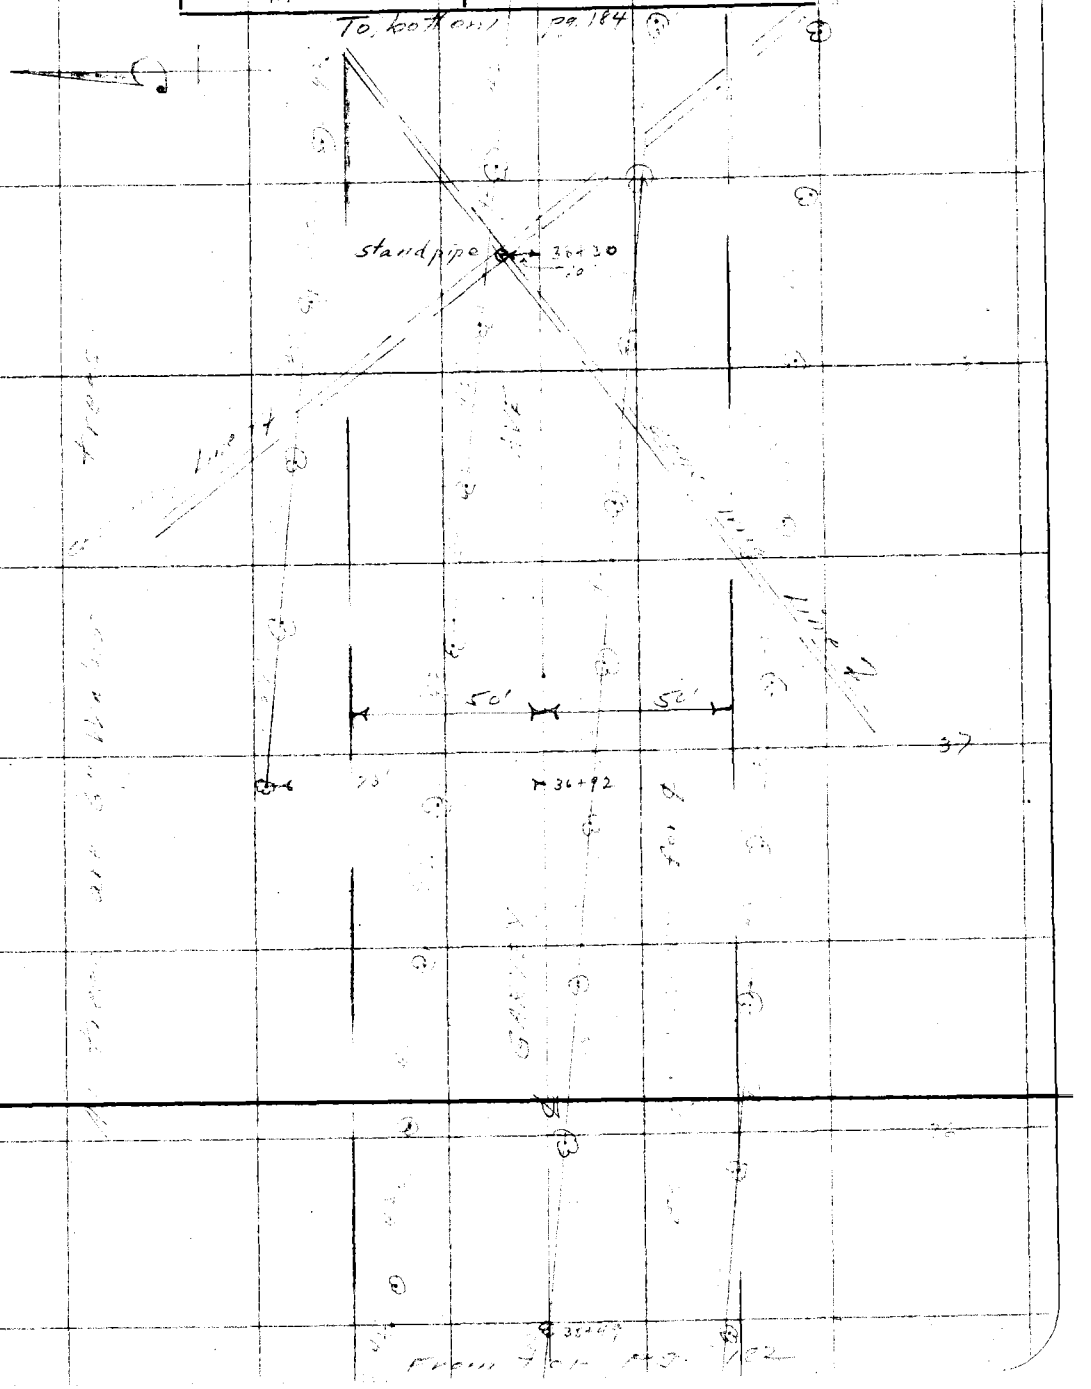

Note: ANY ADDITIONS OR CHANGES ON THIS SHEET MUST BE MADE OR CANCELED IN Red. WITH DATE AND NAME OF PERSON MAKING CHANGE.

Do not extend notes this side of this line

RETURN TO LOS ANGELES COUNTY SURVEYOR



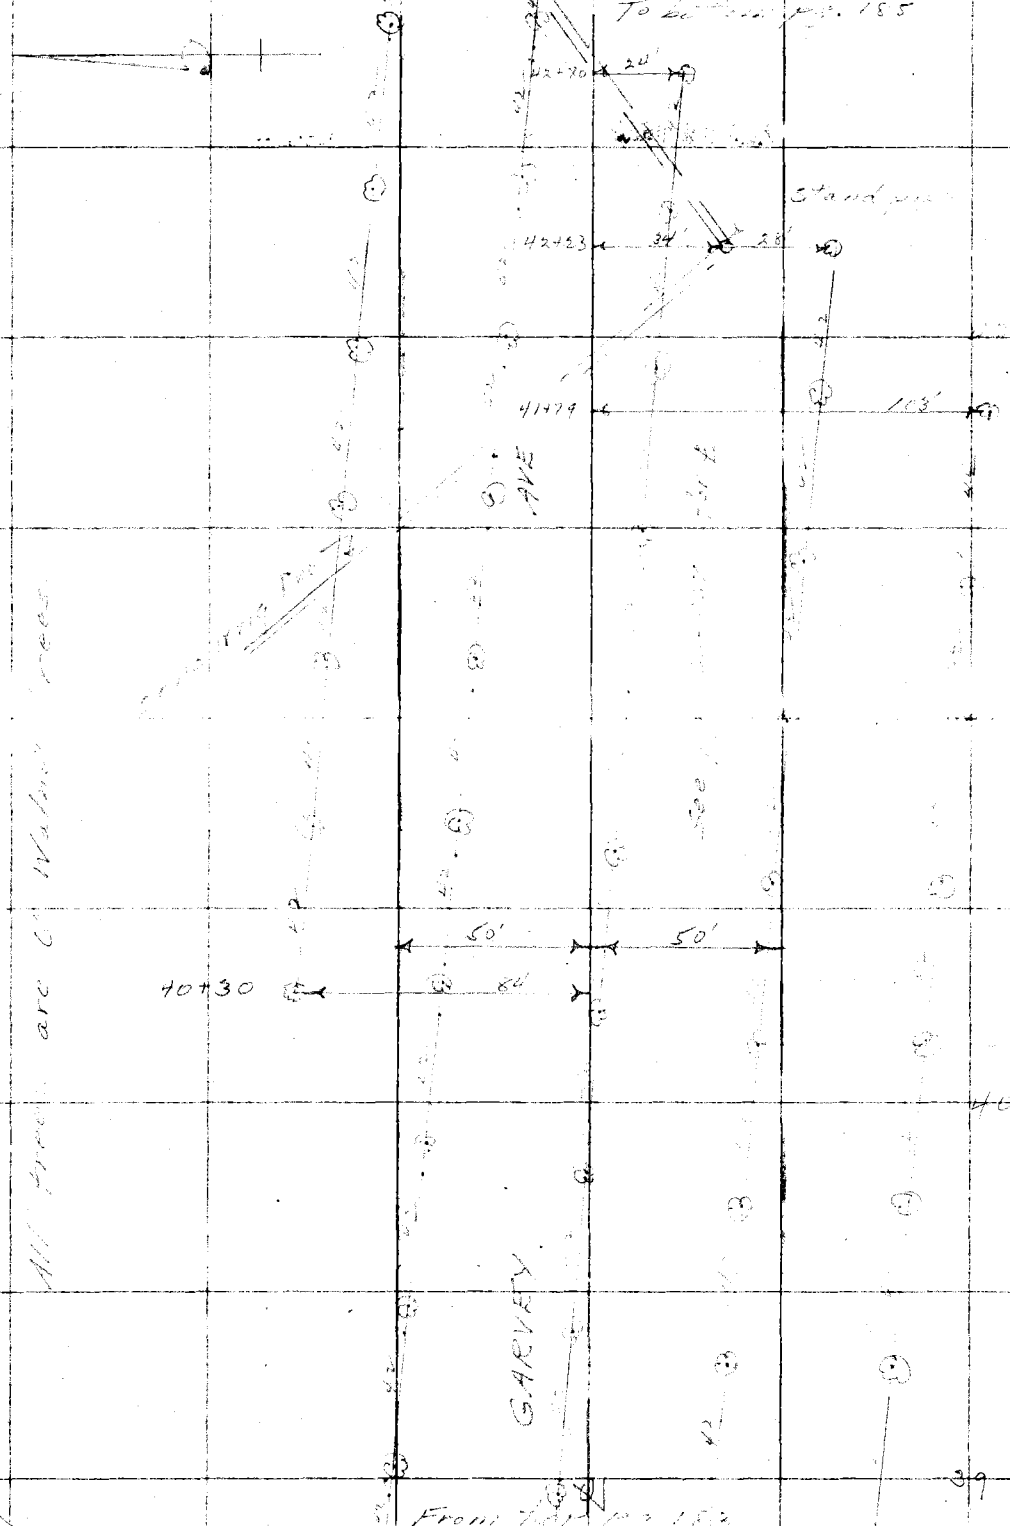

RETURN TO
LOS ANGELES COUNTY SURVEYOR

Do not extend notes this side of this line

Note: ANY ADDITIONS OR CHANGES ON THIS SHEET MUST BE MADE OR CIRCLED IN Red. WITH DATE AND NAME OF PERSON MAKING CHANGE.

Date 11-3-30 Notes by [illegible] Chief Party [illegible] F.B. 352 Pg 185

Platted by D.A.White	W. O. No. 796 O. S. O. No.
Date June, 1930	Location [illegible]
Map No. B-519-2	Surveyed by [illegible]
Platting C'k'd by H. U. M. H.	Date 11-7-30
Date AUG 12 1930	Indexed A. C. Johnson

Note: ANY ADDITIONS OR CHANGES ON THIS SHEET MUST BE MADE OR CIRCLED IN Red. WITH DATE AND NAME OF PERSON MAKING CHANGE.

Do not extend notes this side of this line

RETURN TO LOS ANGELES COUNTY SURVEYOR

To Latham 129/186

50' 50'

Adjusted Conc. Stk. with foundation around

49+05

40+00

47+47

GARVEY AVE.

See P.S. 16+68

43+95

43+64.2 Ahd P.S. 160

43+57

43+64.2

51'

43+66.7

43+31.7

43+18

Fr. Sta. A No. 184

F. B. 352 Pg. 486 Chief Party Notes by Date

To bottom pg 185

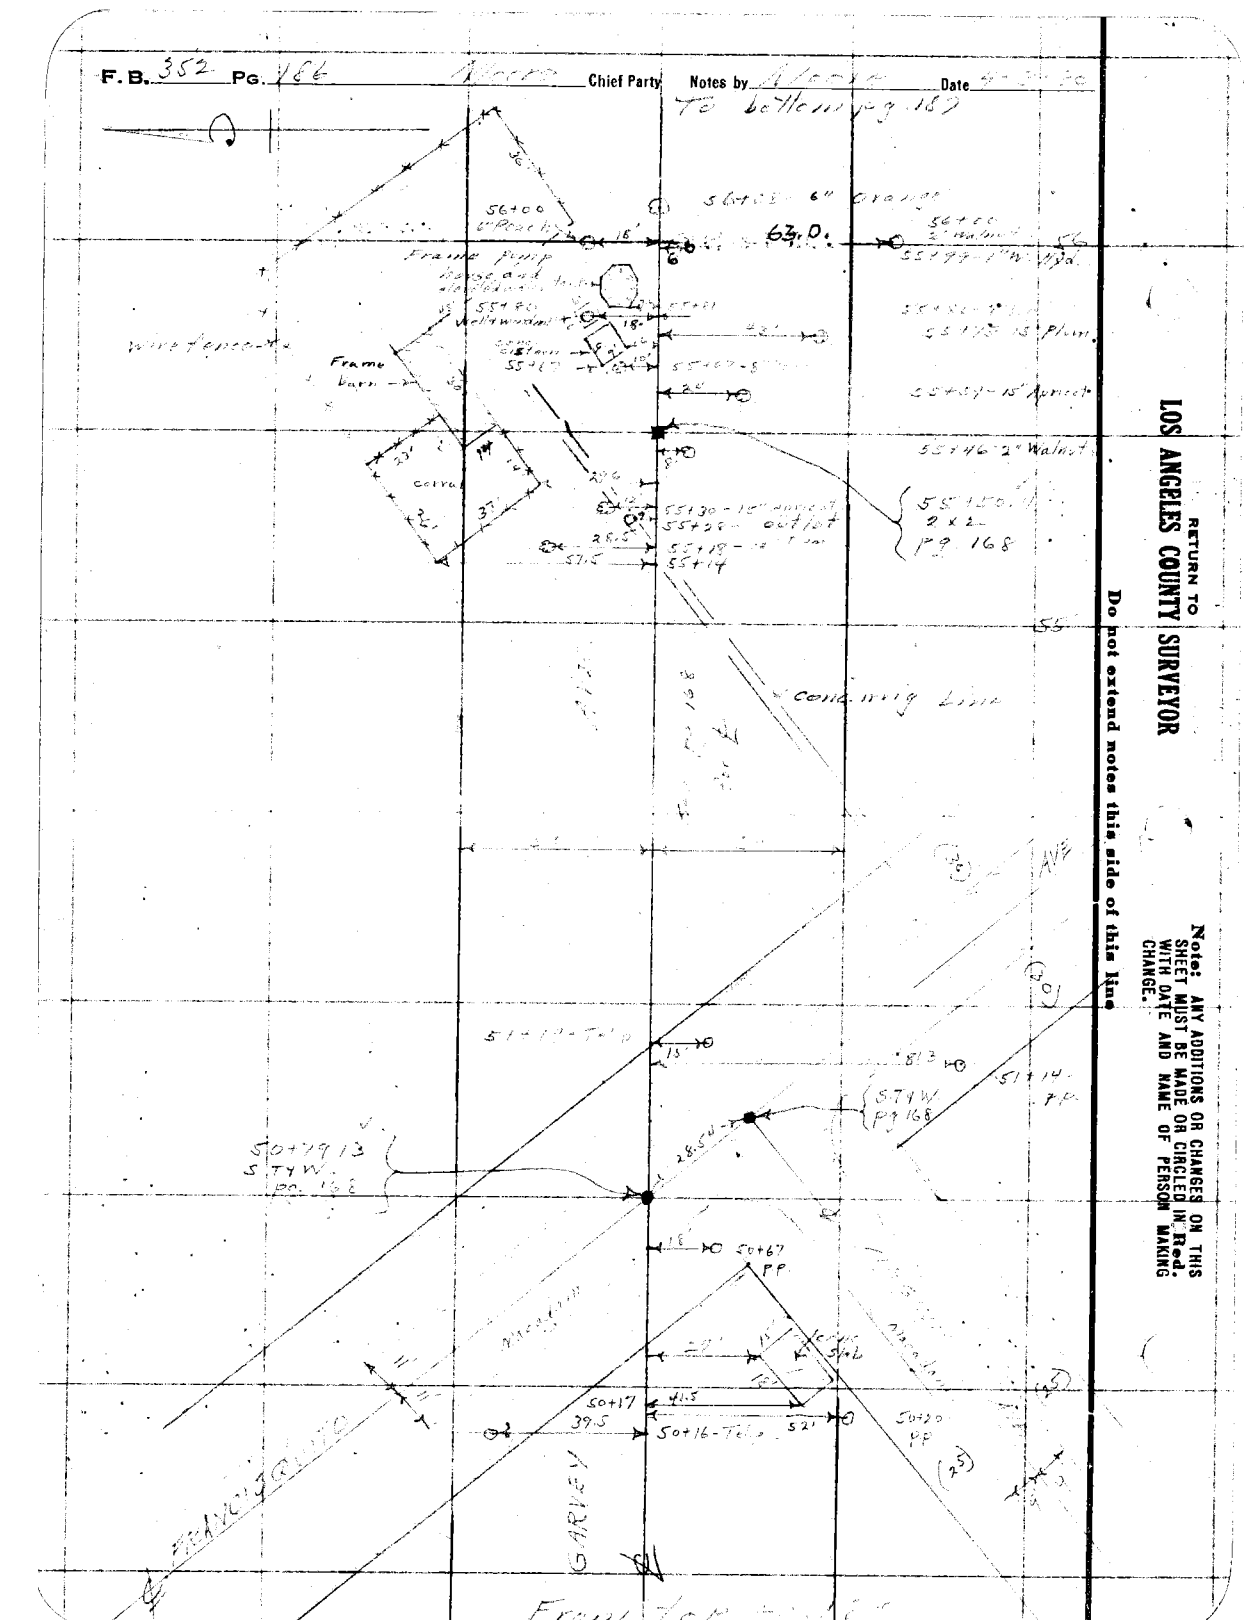

Date 4-5-30 Notes by [illegible] Chief Party [illegible] F.B. 352 Pg. 187

Platted by D.A.White
Date June, 1930.
Map No. 13-519-2.
Platting C'k'd by H.U.M.H.
Date AUG 12 1930

W.O. No. 786 D.S.O. No.
Location
Surveyed by
Date 11-3-30
Indexed A. C. Johnson

To bottom pg 186

58+[illegible] 15" Walnut

58+67 — 15" Walnut

58+[illegible] 15" Walnut

58+62-6" Walnut

57+[illegible] 8" Walnut

57+40-12" Walnut

57+20-20" Walnut

57+11-12" Walnut

56+79-15" Walnut

56+65

56+50-20" Walnut

56+42

56+22-6" Peach

56+92-15" Walnut

56+65 4" Walnut

56+46

1 Story Frame House

Garage

From bottom pg. 186

Notes: ANY ADDITIONS OR CHANGES ON THIS SHEET MUST BE MADE OR CIRCLED IN Red. WITH DATE AND NAME OF PERSON MAKING CHANGE.

Do not extend notes this side of this line

RETURN TO
LOS ANGELES COUNTY SURVEYOR

F. B. 352 Pg. 186 Moore Chief Party Notes by Moore Date 4-3-30

To bottom pg. 189

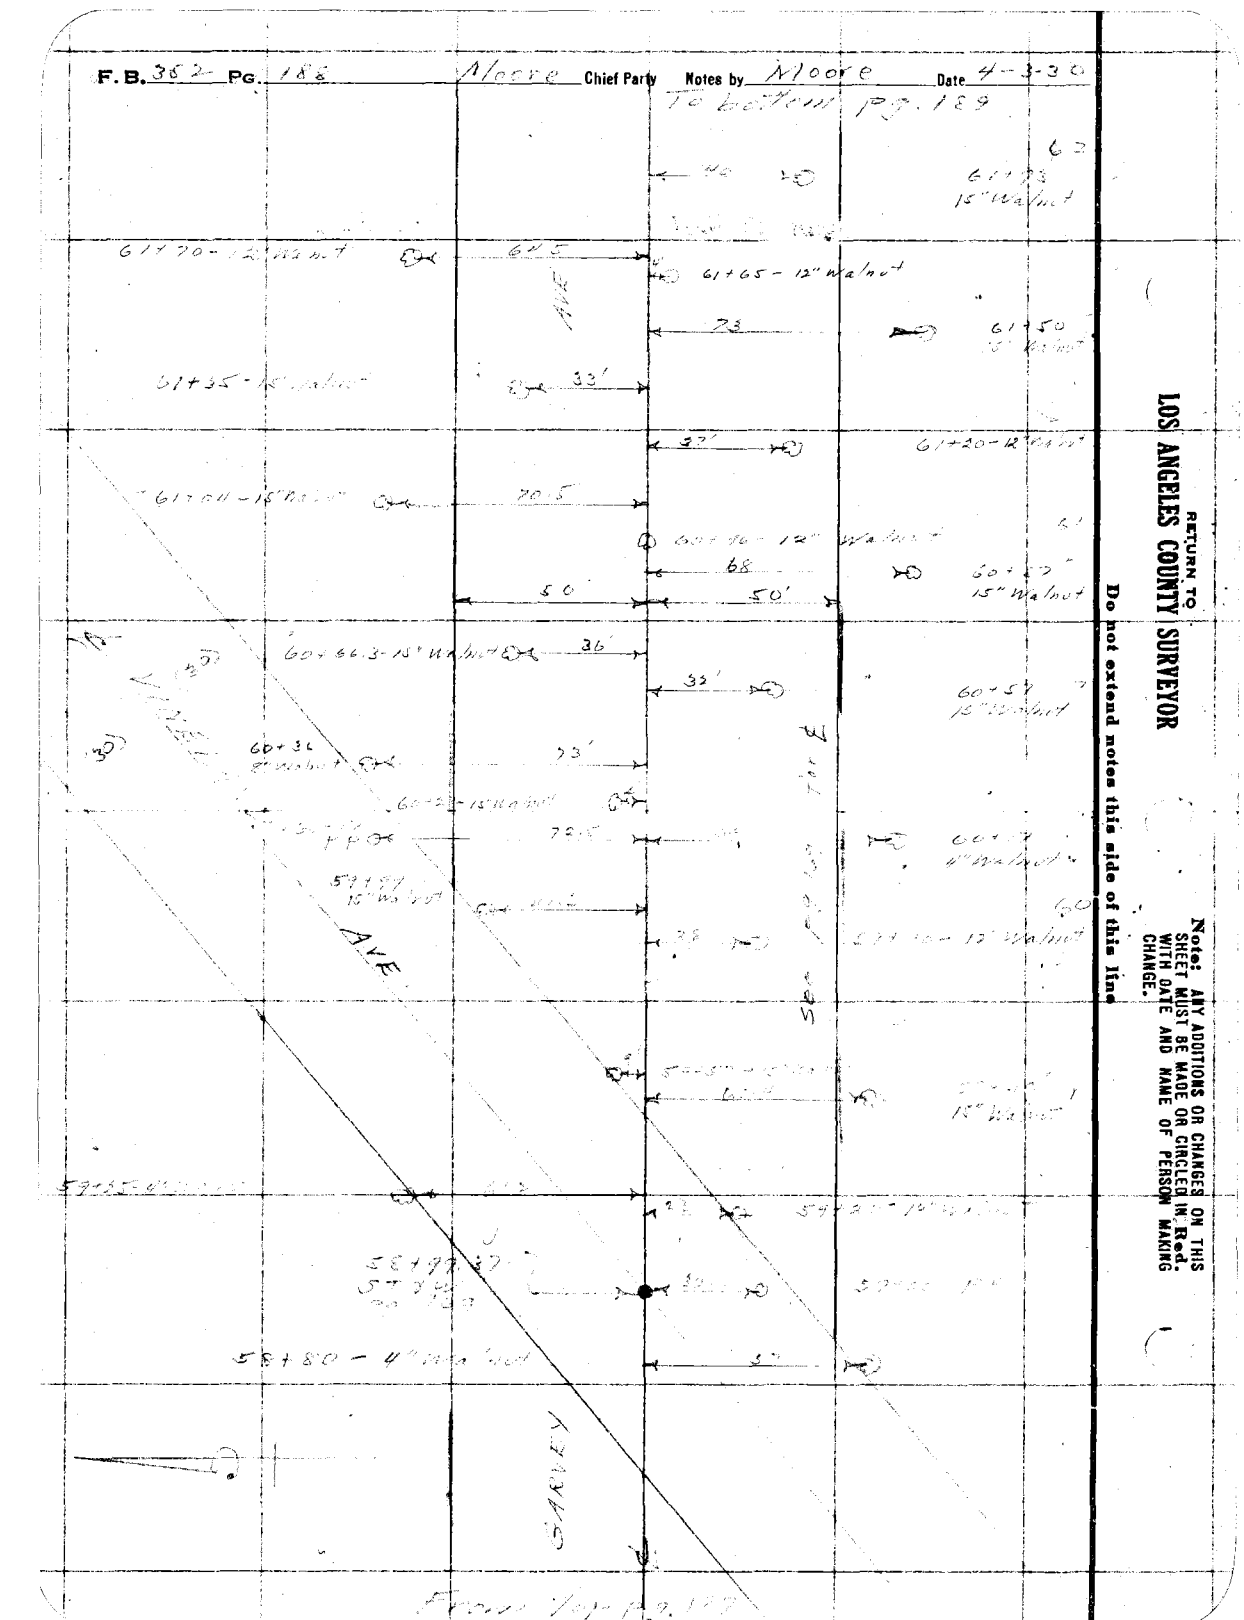

RETURN TO
LOS ANGELES COUNTY SURVEYOR

Do not extend notes this side of this line

Note: ANY ADDITIONS OR CHANGES ON THIS SHEET MUST BE MADE OR CIRCLED IN Red. WITH DATE AND NAME OF PERSON MAKING CHANGE.

Date 11-4-30 Notes by Moore Chief Party Mohle F.B. 352 Pg. 189

Platted by D.A.White	W.O.No. 796 D.S.O.No.
Date June, 1930	Location
Map No. B-519-2	Surveyed by
Platting C'k'd by H.U.M.H.	Date 11-4-30
Date AUG 12 1930	Indexed A. C. Johnson

Notes: ANY ADDITIONS OR CHANGES ON THIS SHEET MUST BE MADE OR CIRCLED IN Red. WITH DATE AND NAME OF PERSON MAKING CHANGE.

Do not extend notes this side of this line

RETURN TO LOS ANGELES COUNTY SURVEYOR

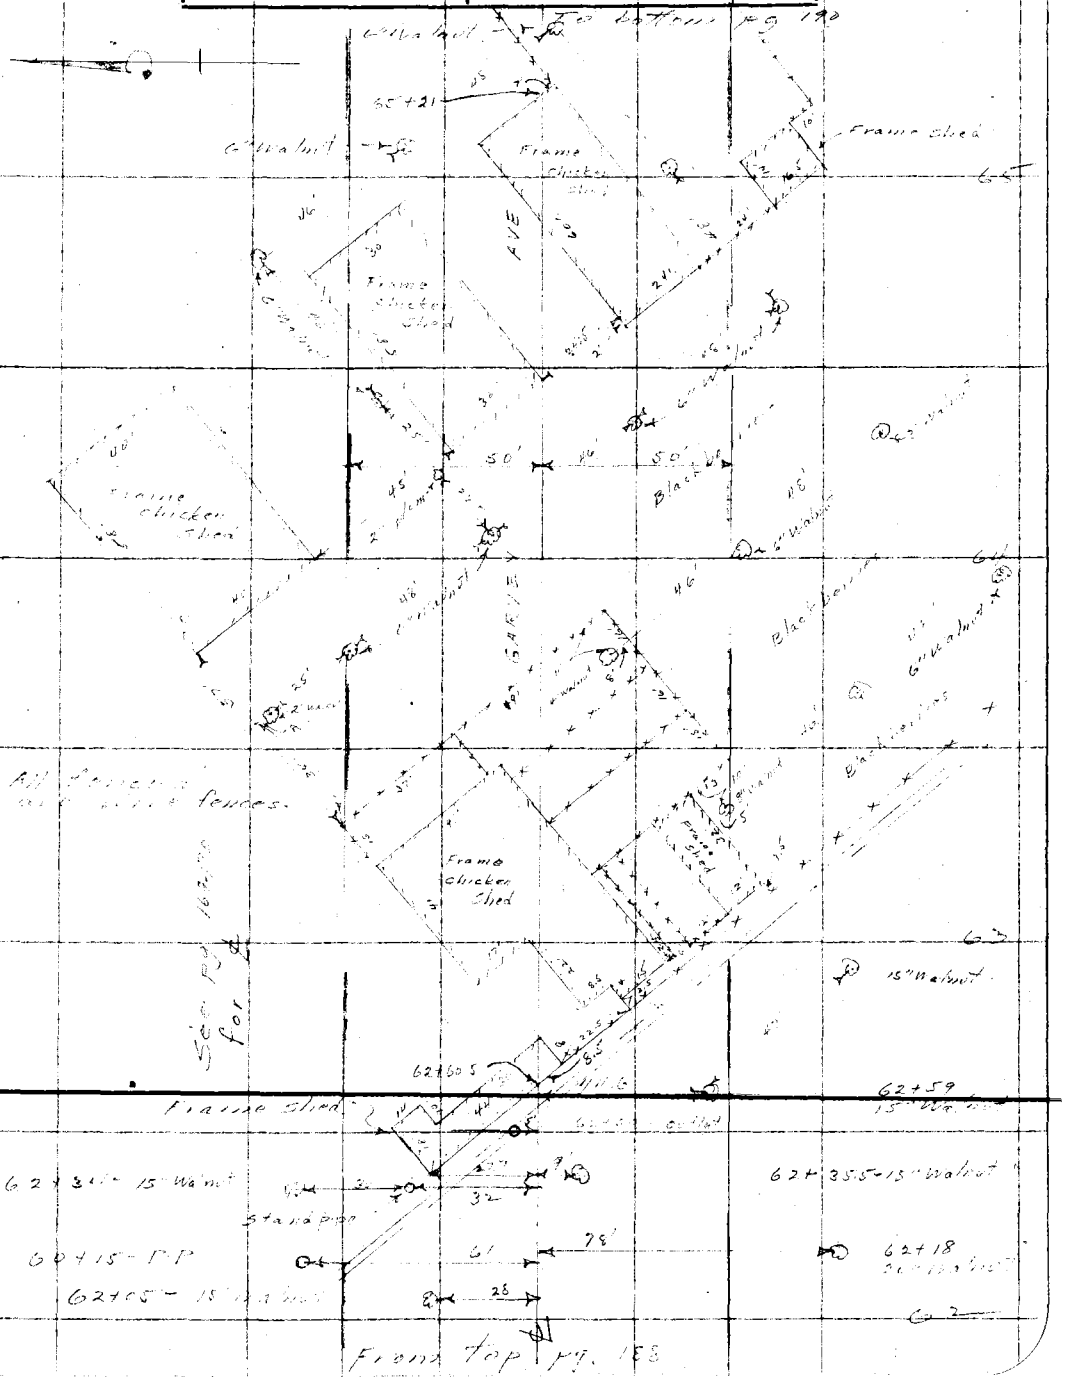



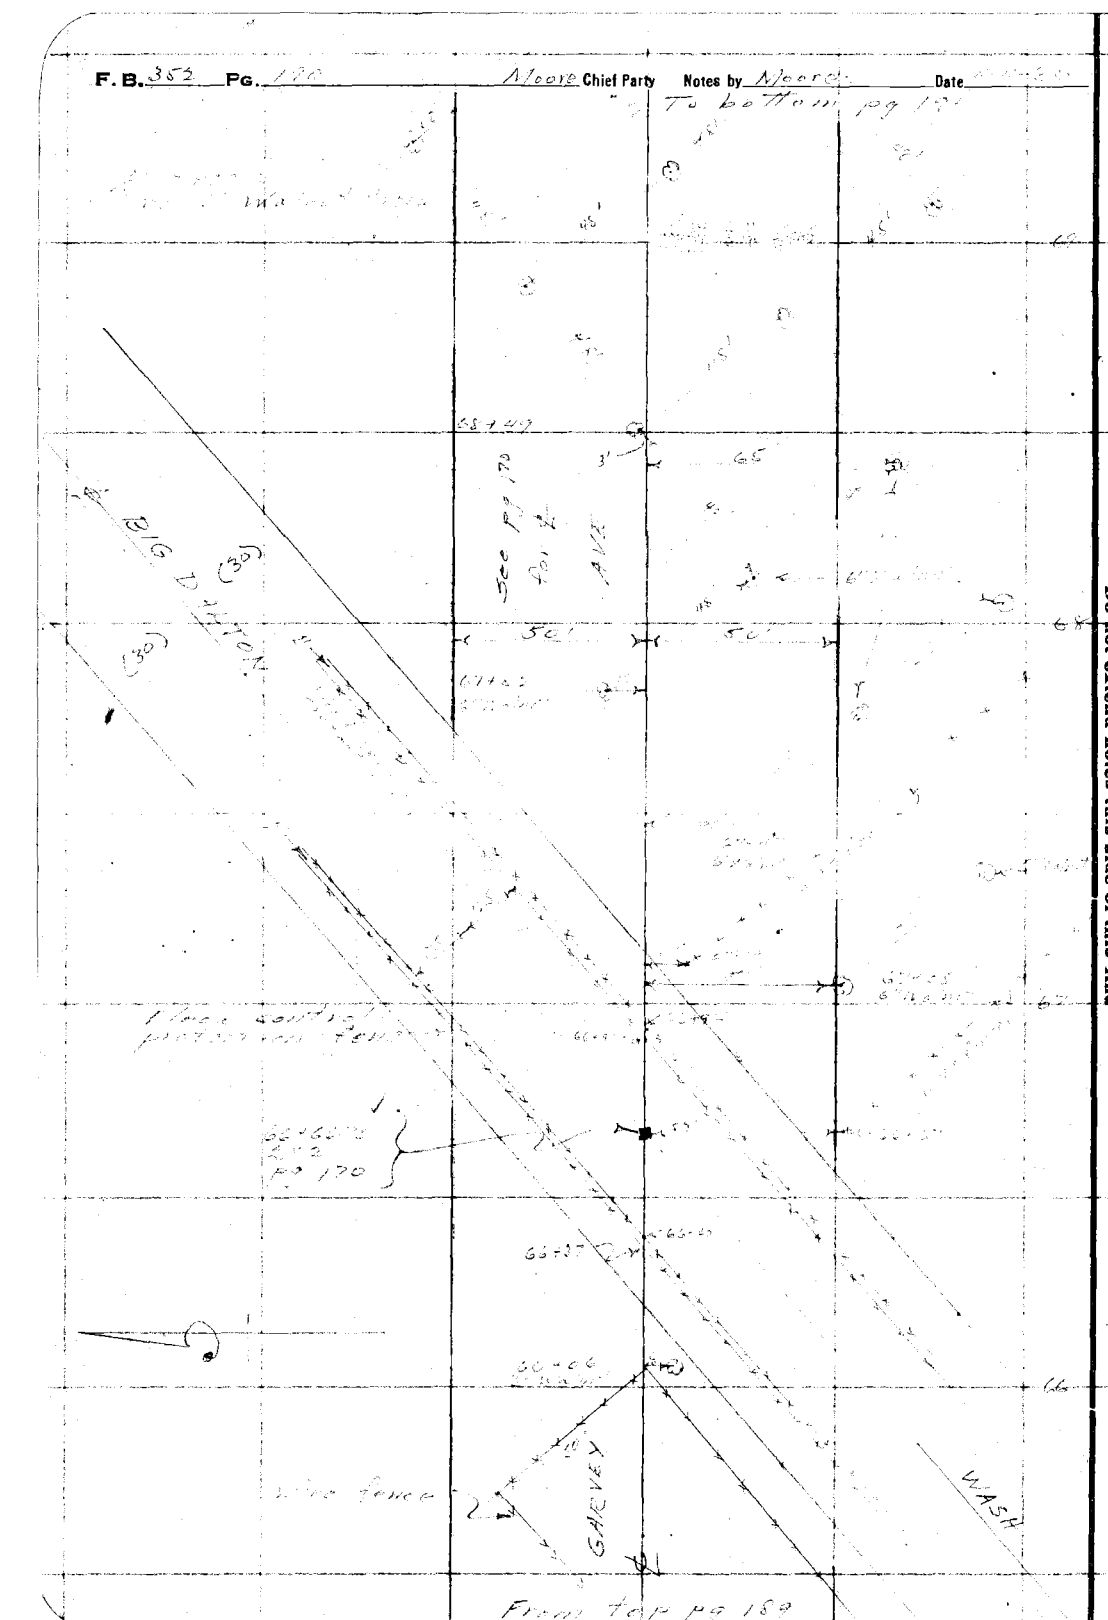

RETURN TO
LOS ANGELES COUNTY SURVEYOR

Do not extend notes this side of this line

Note: ANY ADDITIONS OR CHANGES ON THIS SHEET MUST BE MADE OR CIRCLED IN Red. WITH DATE AND NAME OF PERSON MAKING CHANGE.

Date 11-4-30 Notes by Moore Chief Party Moore F.B. 352 Pg. 191

Platted by D.A.White	W.O. No. 796 D.S.O. No.
Date June, 1930.	Location Section 4 R12
Map No. B-519-2	Surveyed by
Platting C'k'd by H.U.M.H.	Date 11-4-30
Date AUG 12 1930	Indexed A.C. Johnson

To bottom pg 192

72 + 82.5

1 Story Frame House

AVE

1 Story Frame House

1 Story Frame House

Air Pressure and Wire Fence

50' 50' 50'

Valve

Frame Shed

Frame Shed

Frame Shed

F.B. 352 PG. 192 Moore Chief Party Notes by Moore Date 4-9-30

To bottom pg 193

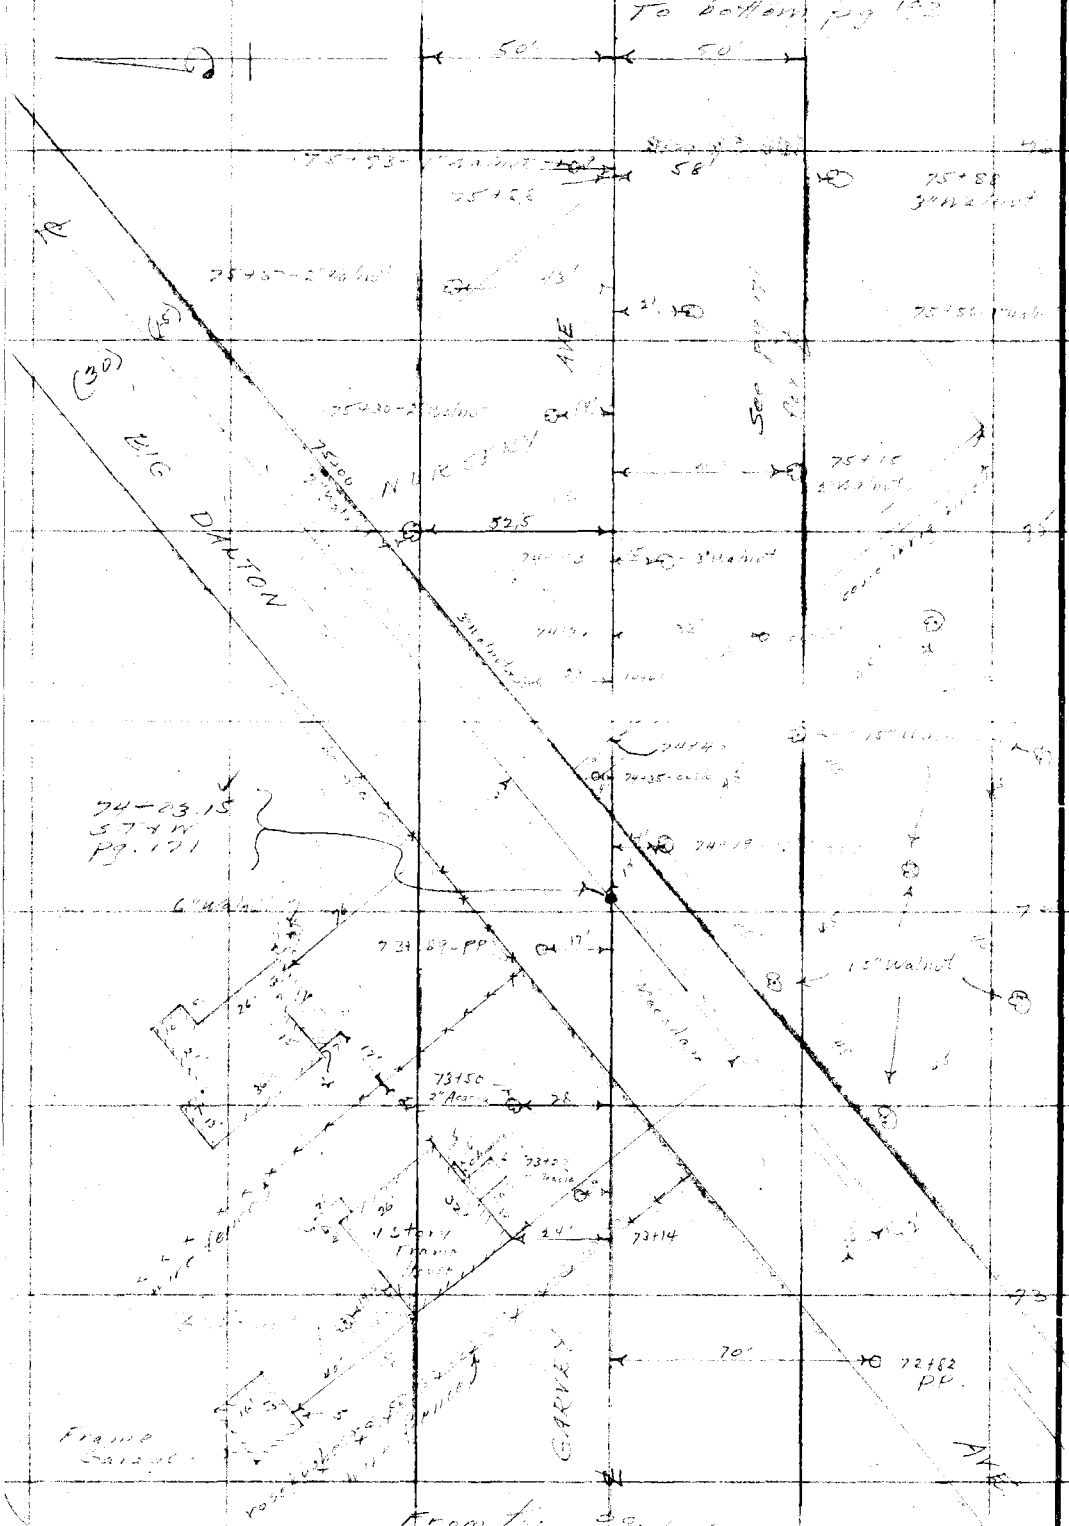

RETURN TO
LOS ANGELES COUNTY SURVEYOR

Do not extend notes this side of this line

Note: ANY ADDITIONS OR CHANGES ON THIS SHEET MUST BE MADE OR CIRCLED IN Red. WITH DATE AND NAME OF PERSON MAKING CHANGE.

Date 4-4-30 Notes by Alcorn Chief Party Alcorn F.B. 352 PG 193

Platted by D.A. White
Date June, 1930
Map No. B-519-2
Platting C'k'd by H.U.M.H.
Date AUG 12 1930

W.O. No. 770 D.S.O. No.
Location
Surveyed by
Date 4-4-30
Indexed A. C. Johnson

To bottom pg. 194

Notes: ANY ADDITIONS OR CHANGES ON THIS SHEET MUST BE MADE OR CIRCLED IN Red. WITH DATE AND NAME OF PERSON MAKING CHANGE.

Do not extend notes this side of this line

RETURN TO
LOS ANGELES COUNTY SURVEYOR

Frame Garage

Frame House

Police

From Top pg. 192

RETURN TO

LOS ANGELES COUNTY SURVEYOR

Note: ANY ADDITIONS OR CHANGES ON THIS SHEET MUST BE MADE OR CIRCLED IN **Red.** WITH DATE AND NAME OF PERSON MAKING CHANGE.

Do not extend notes this side of this line

Notes by Alocen Date 3-4-30

Chief Party Alocen

F. B. 3552 Pg. 194

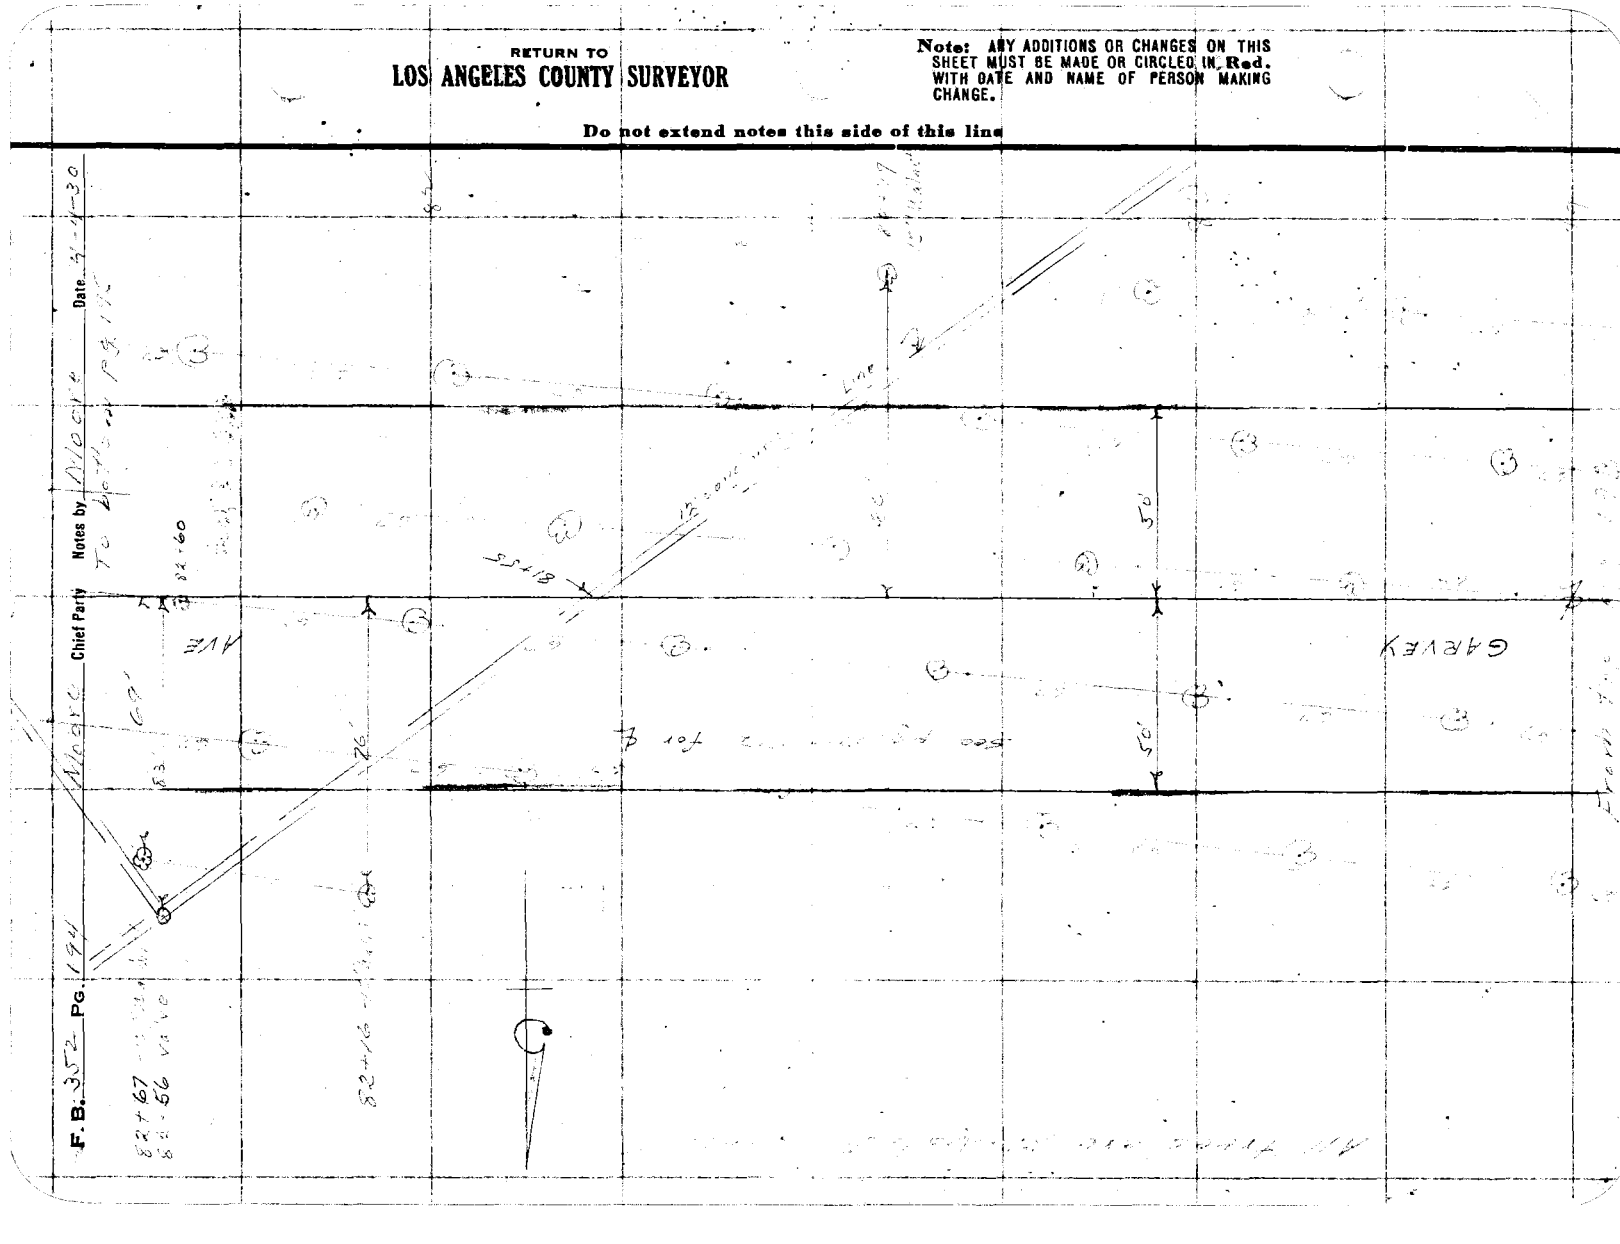

Date 4-4-30 Notes by Moore Chief Party Moore F.B. 352 Pg. 195

Platted by D.A.White.
Date June, 1930.
Map No. B-519-2.
Platting C'k'd by H.U.M.H.
Date AUG 12 1930

W.O. No. 296 D.S.O. No.
Location
Surveyed by
Date 4-4-30
Indexed J. C. Johnson

Notes: ANY ADDITIONS OR CHANGES ON THIS SHEET MUST BE MADE OR CIRCLED IN Red. WITH DATE AND NAME OF PERSON MAKING CHANGE.

Do not extend notes this side of this line

RETURN TO LOS ANGELES COUNTY SURVEYOR

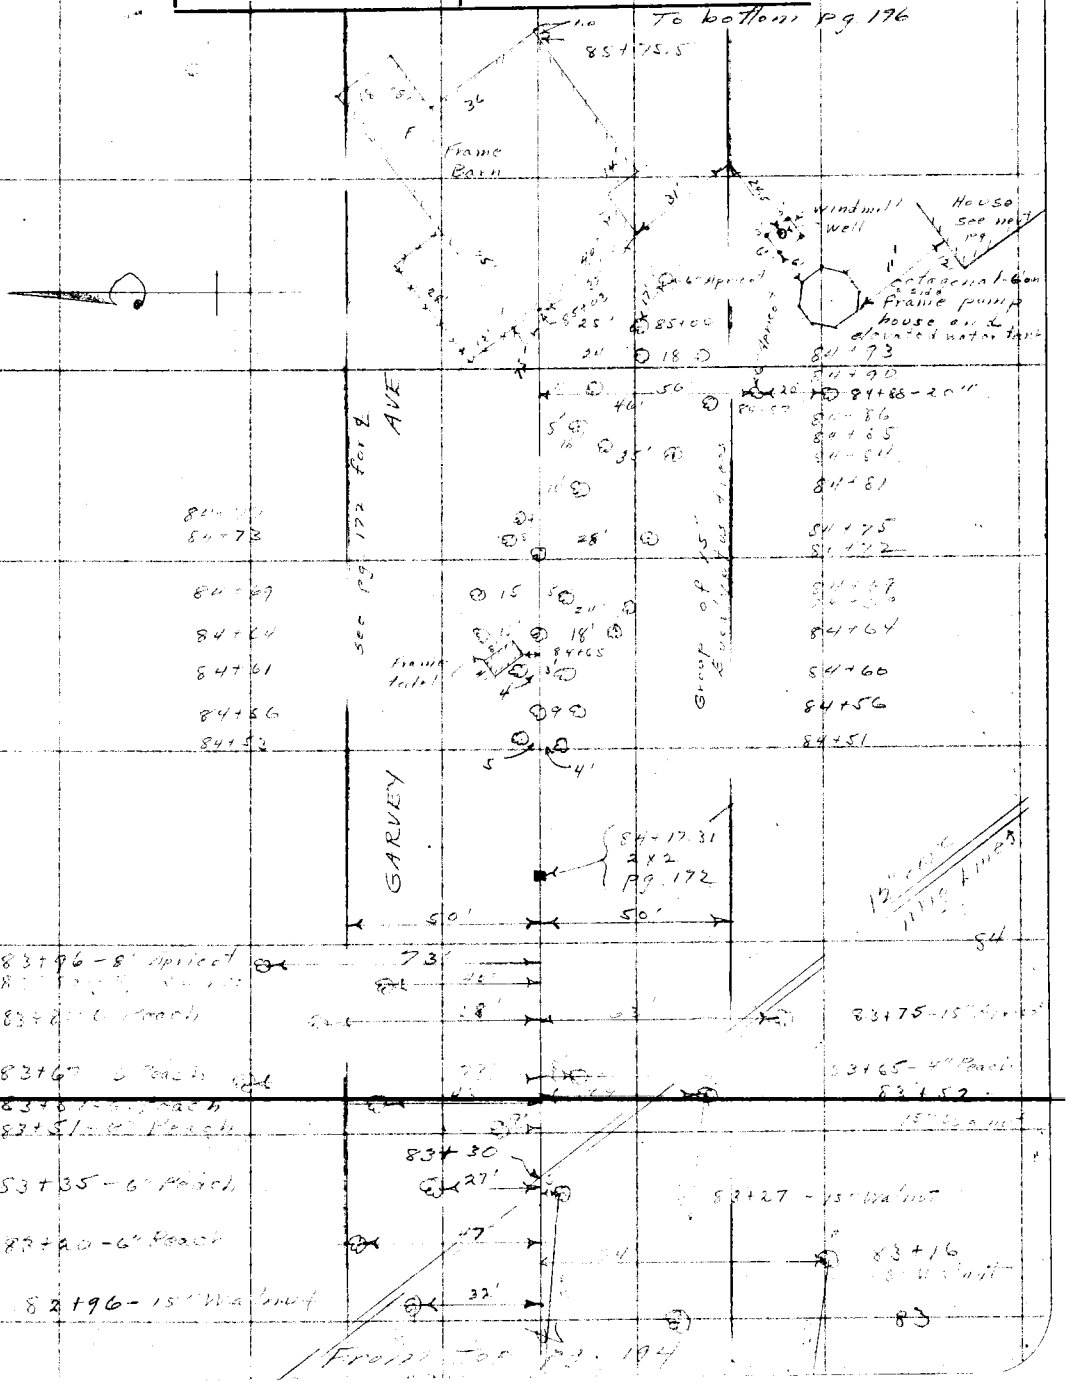
To bottom pg. 196
Frame Barn
windmill well
House See index pg.
Octagonal 1-Com Frame pump house over & abandoned water tank
Apricot
Apricot
Apricot

F. B. 352 Pg. 196 Moore Chief Party Notes by Moore Date 4-5-30

To bottom pg. 197

88+02 - 12" Walnut

19'

49'

87+97 - 12" Walnut

87+93 - 12" Walnut

56'

87+66 - 12" Walnut

87+58 12" Walnut

87+35 - 12" Walnut

25'

22'

50'

50'

87+36 12" Walnut

60'

87

ALLEY

86+67 - 12"

30'

24'

68'

24

86+39 12" Walnut

241

86+04

38.5

35'

4" Plm

86

Group of 20" poplar trees

85+72

85+70

85+67

85+64

85+61

27'

113'

67'

70'

19'

74'

50'

50'

1 Story Frame House

See pg 197 for survey

84+97

98'

From top of pg 195

RETURN TO
LOS ANGELES COUNTY SURVEYOR
Do not extend notes this side of this line

Note: ANY ADDITIONS OR CHANGES ON THIS SHEET MUST BE MADE OR CIRCLED IN Red. WITH DATE AND NAME OF PERSON MAKING CHANGE.

Date 4-5-30 Notes by Moore Chief Party Moore F.B. 352 Pg. 197

Platted by D.A. White	W.O. No. 796 D.S.O. No.
Date June, 1930	Location
Map No. B-519-2	Surveyed by
Platting C'k'd by H.U.M.H.	Date 4-15-30
Date AUG 12 1930	Indexed A. C. Johnson

Notes: ANY ADDITIONS OR CHANGES ON THIS SHEET MUST BE MADE OR CIRCLED IN Red. WITH DATE AND NAME OF PERSON MAKING CHANGE.

Do not extend notes this side of this flap

RETURN TO LOS ANGELES COUNTY SURVEYOR

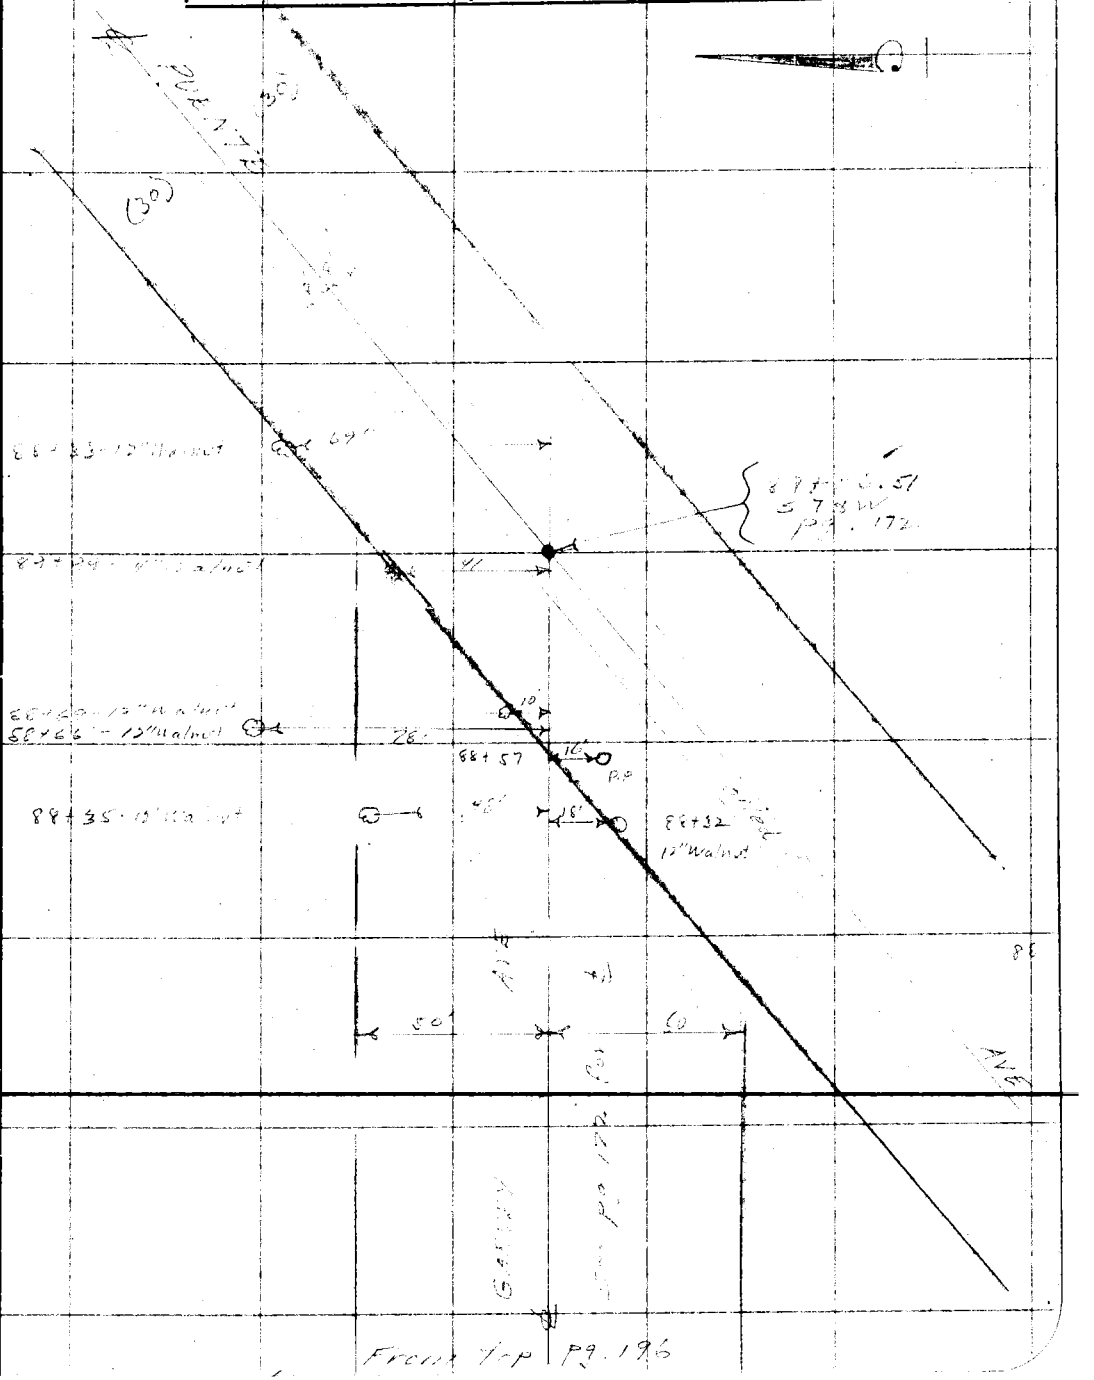

F. B. 352 Pg. 98 Chief Party Notes by Date

RETURN TO
LOS ANGELES COUNTY SURVEYOR

Do not extend notes this side of this line

Note: ANY ADDITIONS OR CHANGES ON THIS SHEET MUST BE MADE OR CIRCLED IN Red. WITH DATE AND NAME OF PERSON MAKING CHANGE.

Date _____ Notes by _____ Chief Party _____ F.B. 352 Pg 199

Platted by D.A.White	W. O. No. 296 D. S. O. No. _____
Date June, 1930.	Location _____
Map No. B-519-Z	Surveyed by _____
Platting C'k'd by H. U. M. H.	Date 4-15-30 A C Johnson
Date AUG 12 1930	Indexed _____

CENTRE LINE
DEDICATION
of
SIDNEY AVE
from
PLEASANT AVE
EAST TO
INTERSECTION
of
ARROYO BLVD & CRAGE AVE

11 M 116

April 15 1930

Party
Angle
Bearing &
Distance
Off

Notes: ANY ADDITIONS OR CHANGES ON THIS SHEET MUST BE MADE OR CIRCLED IN Red. WITH DATE AND NAME OF PERSON MAKING CHANGE.

Do not extend notes this side of this line

RETURN TO
LOS ANGELES COUNTY SURVEYOR

F. B. 352 Pg. 200 Moore Chief Party Notes by Moore Date 4-5-30

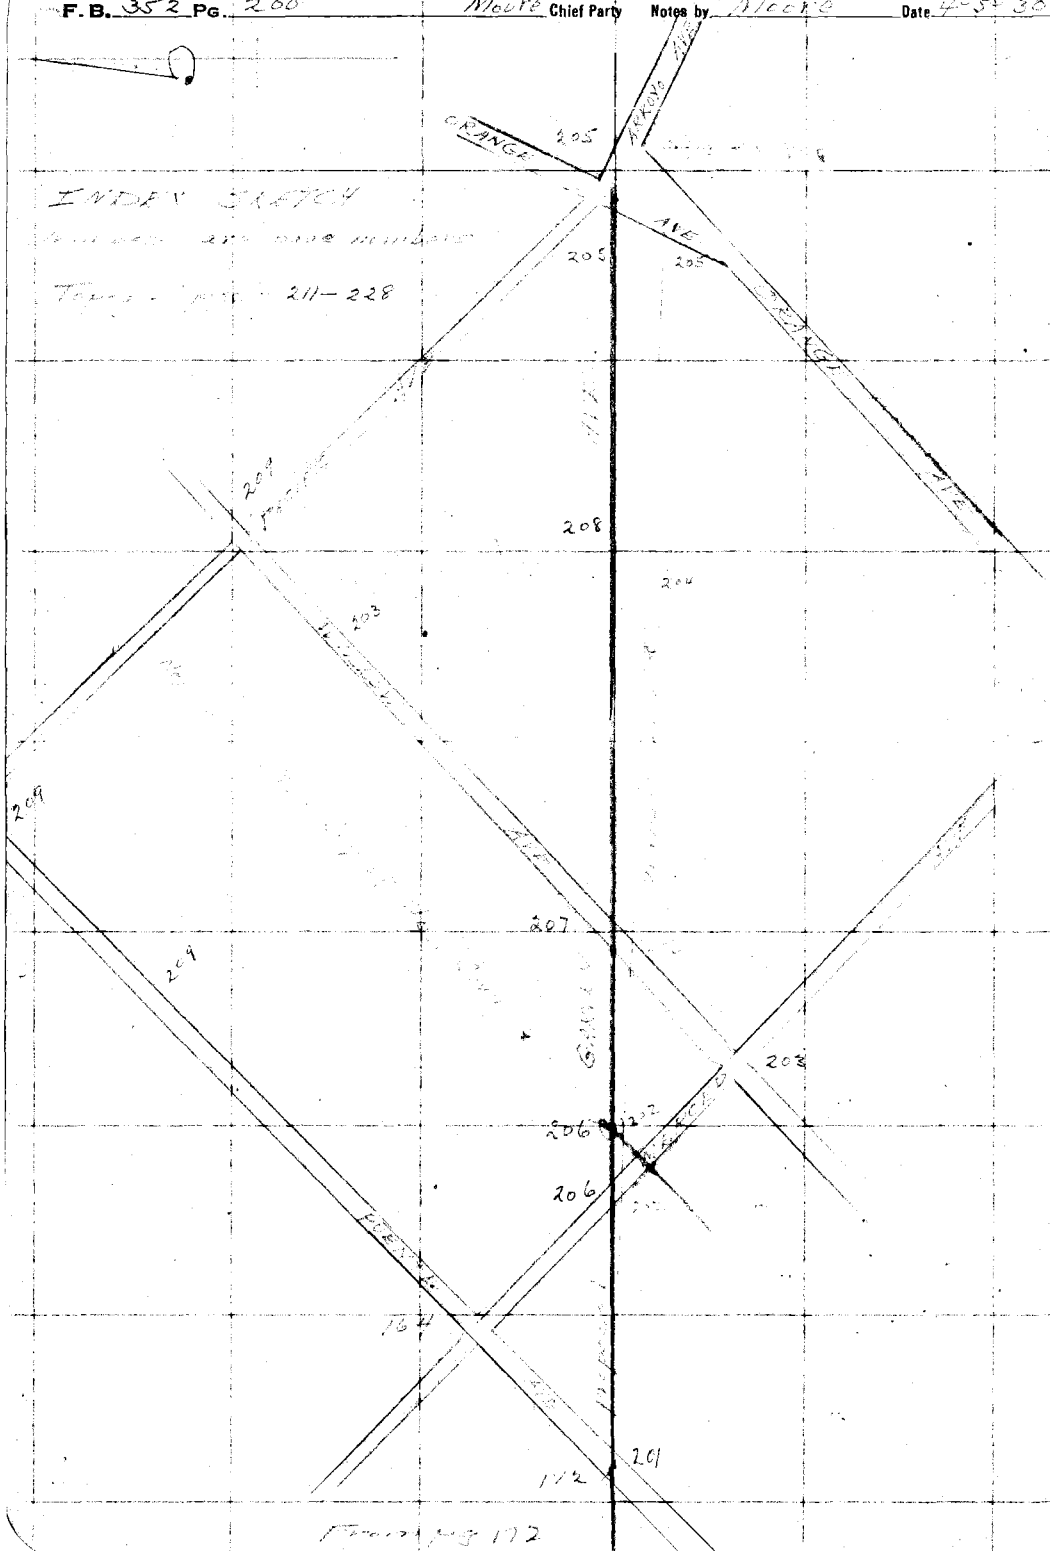

RETURN TO
LOS ANGELES COUNTY SURVEYOR

Do not extend notes this side of this line

Note: ANY ADDITIONS OR CHANGES ON THIS SHEET MUST BE MADE OR CIRCLED IN Red. WITH DATE AND NAME OF PERSON MAKING CHANGE.

Date 4-5-30 Notes by Moore Chief Party Moore F.B. 353 PG. 201

Platted by D.A.White	W. O. No. 796 D. O. No. 048
Date June, 1930.	Location
Map No. 13-519-2.	Surveyed by L.B. Moore
Platting C'k'd by H. U. M. H.	Date 4-5-30 C. Johnson
Date AUG 12 1930	Indexed

Notice: ANY ADDITIONS OR CHANGES ON THIS SHEET MUST BE MADE OR CIRCLED IN Red. WITH DATE AND NAME OF PERSON MAKING CHANGE.

Do not extend notes this side of this line

RETURN TO LOS ANGELES COUNTY SURVEYOR

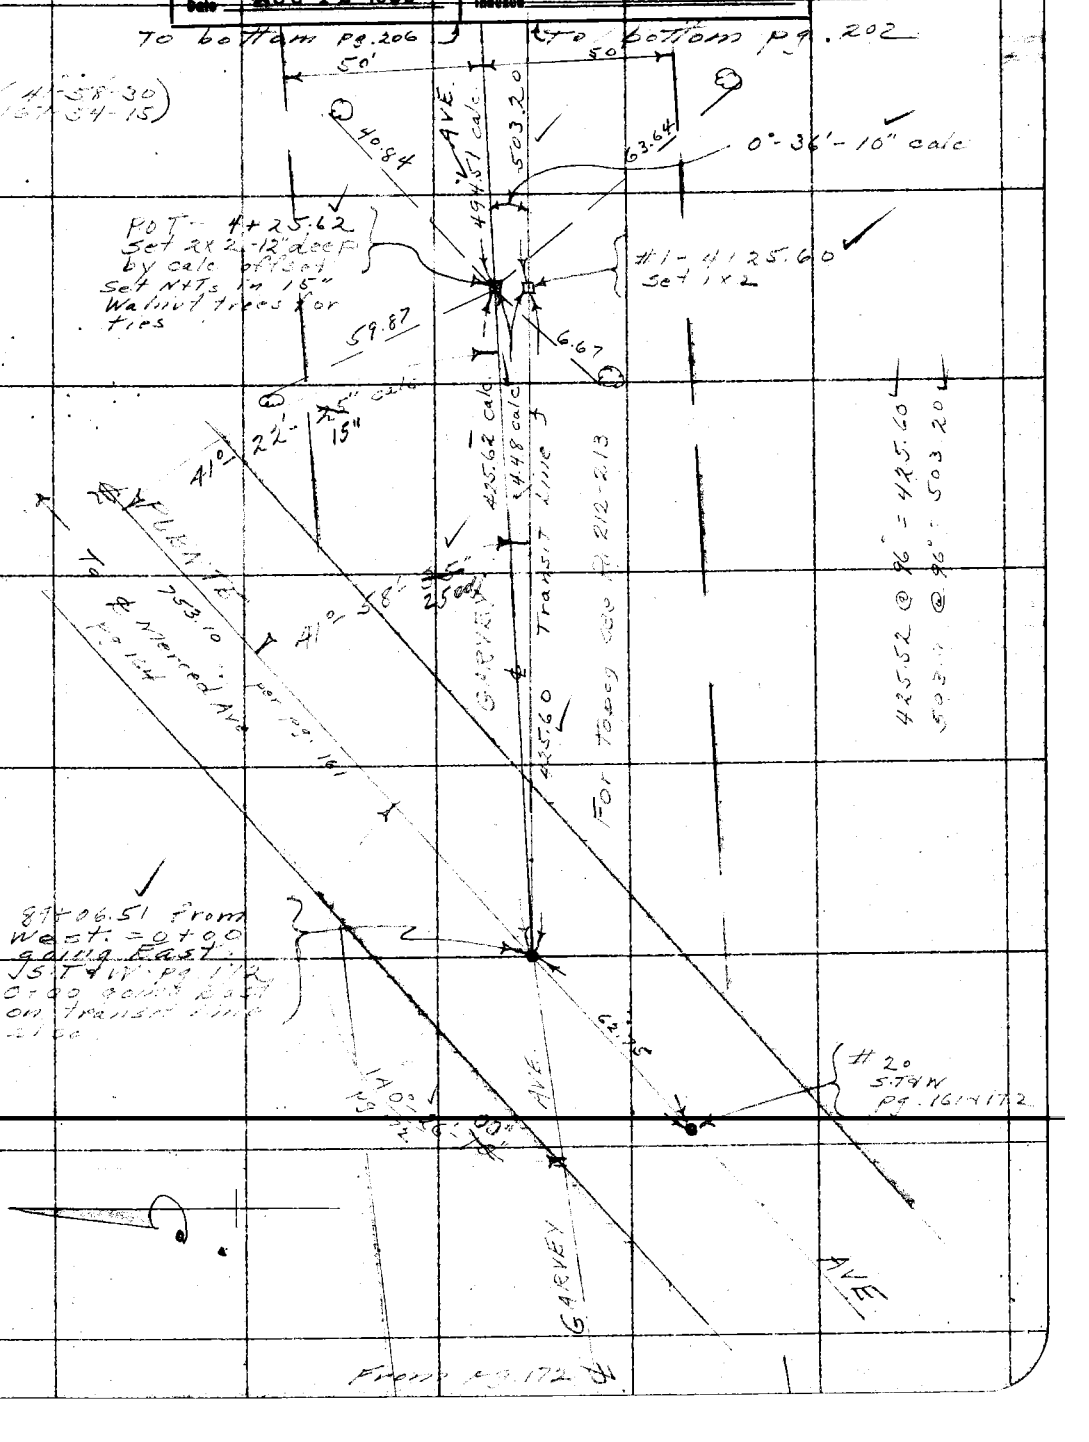

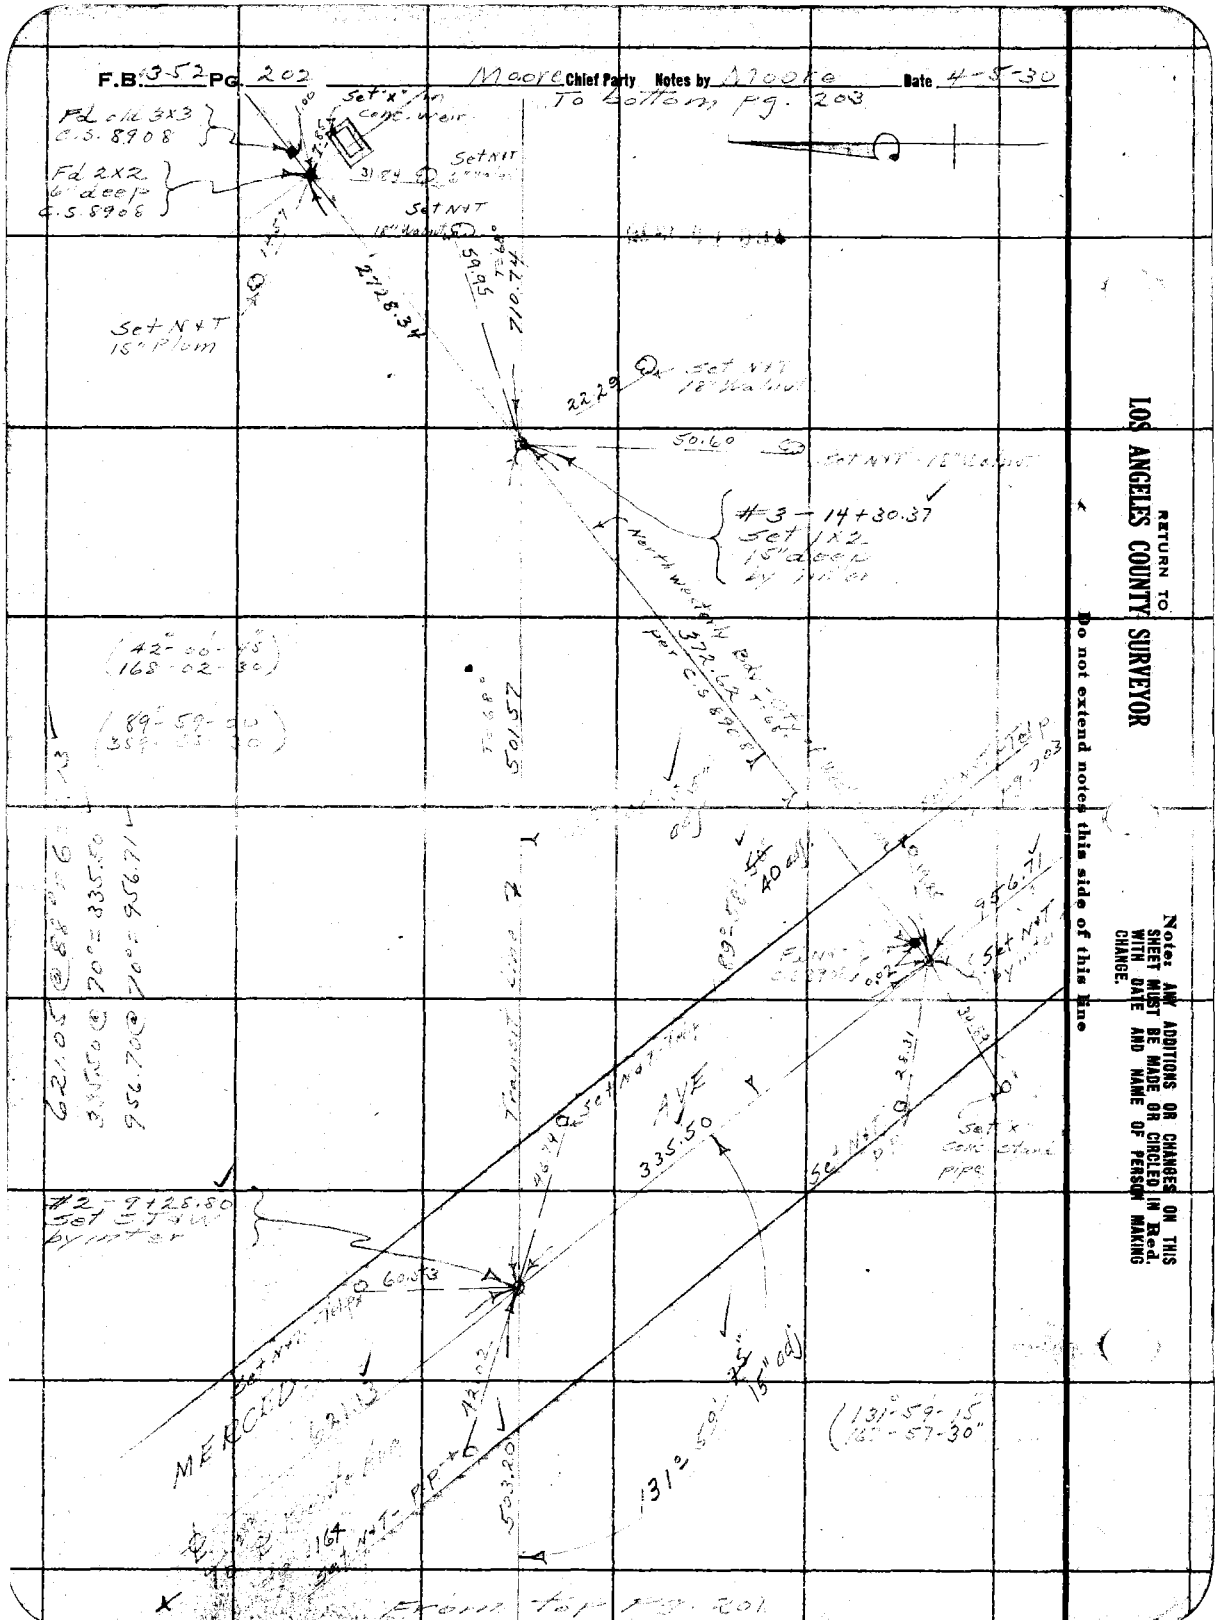
F.B. 3-52 Pg. 202
Moore Chief Party
Notes by Moore
Date 4-5-30
To Bottom pg. 203
Fd chis 3x3 c.s. 8908
Fd 2x2 6" deep c.s. 8908
Set NAT
Set NAT 15" Plum
#3 - 14+30.37
Set 1x2 15" deep
#2 - 9+25.80
Set Lead Plug
MERCED AVE
335.50
Tangent
Curve
Set NAT
Set X cons. Stone
Pipe
Set NAT
Set NAT
Set NAT

Date 4-15-30 Notes by Moore Chief Party Moore F.B. 352 PG. 203

Platted by D.A. White	W. O. No. 796 C. C. O. No. 028
Date June, 1930	Location Survey
Map No. B-519-2	Surveyed by [illegible]
Platting C'k'd by H U M H	Date 4-15-30
Date AUG 12 1930	Indexed A. C. Johnson

To bottom pg. 204

To STaW & Pacific Ave per C.S. 8965 FB 231-112 pg. 209

Fd N4T 15" Walnut

Fd 2x2 flush over 3/4" I.P. per C.S. 8965 FB 231-94

#6 - 36+01.71 Set 1x2 - 12" acep

Fd N4T 15" Walnut

Fd STaW 3" Pine

Set N4T Tel. p

#5 - 28+60.70 Set STaW by inter

Set N4T 15" Walnut

Set N4T Tel p

Set N4T 15" Walnut

#4 - 21+41.11 Set 1x2 - 12" acep

Transit Line

AVE

MERCED

(179°-59'-00" 359-56-00)

(89°-59'-45" 359-58-30)

(179°-00'-15" 179°-00'-30")

1435.30 @ 76° = 1435.37

1292.71 @ 76° = 1292.78

From top pg. 202

Note: ANY ADDITIONS OR CHANGES ON THIS SHEET MUST BE MADE OR CIRCLED IN Red. WITH DATE AND NAME OF PERSON MAKING CHANGE.

Do not extend notes this side of this line

RETURN TO LOS ANGELES COUNTY SURVEYOR

F.B. 352 Pg. 204 Moore Chief Party Notes by Moore Date 4-16-30

To bottom Pg. 205

358.97

#7 - 51+49.48
Set 1x2 - 12" deep

4.00

Set 1x2

502.51

#8 - 46+46.97
Set 1x2 - 12" deep

Transit Line

503.92 @ 76° 503.92
502.43 @ 26° 502.51
358.72 @ 88° 358.97

#7 - 41+43.02
Set 1x2 - 12" deep

541.31

From top Pg. 203

RETURN TO
LOS ANGELES COUNTY SURVEYOR

Do not extend notes this side of this line

Note: ANY ADDITIONS OR CHANGES ON THIS SHEET MUST BE MADE OR CIRCLED IN Red. WITH DATE AND NAME OF PERSON MAKING CHANGE.

Date 4-16-30 Notes by Moore Chief Party Moore F.B. 352 PG. 205

Platted by D.A. White	W. O. No. 796 C. S. G. No. 026
Date June, 1930	Location Gar[illegible]
Map No. B-519-2	Surveyed by
Platting C'k'd by H.U.M.H.	Date 4-16-30
Date AUG 12 1930	Indexed C. Johnson

Note: ANY ADDITIONS OR CHANGES ON THIS SHEET MUST BE MADE OR CIRCLED IN Red. WITH DATE AND NAME OF PERSON MAKING CHANGE.

Do not extend notes this side of this line

RETURN TO LOS ANGELES COUNTY SURVEYOR

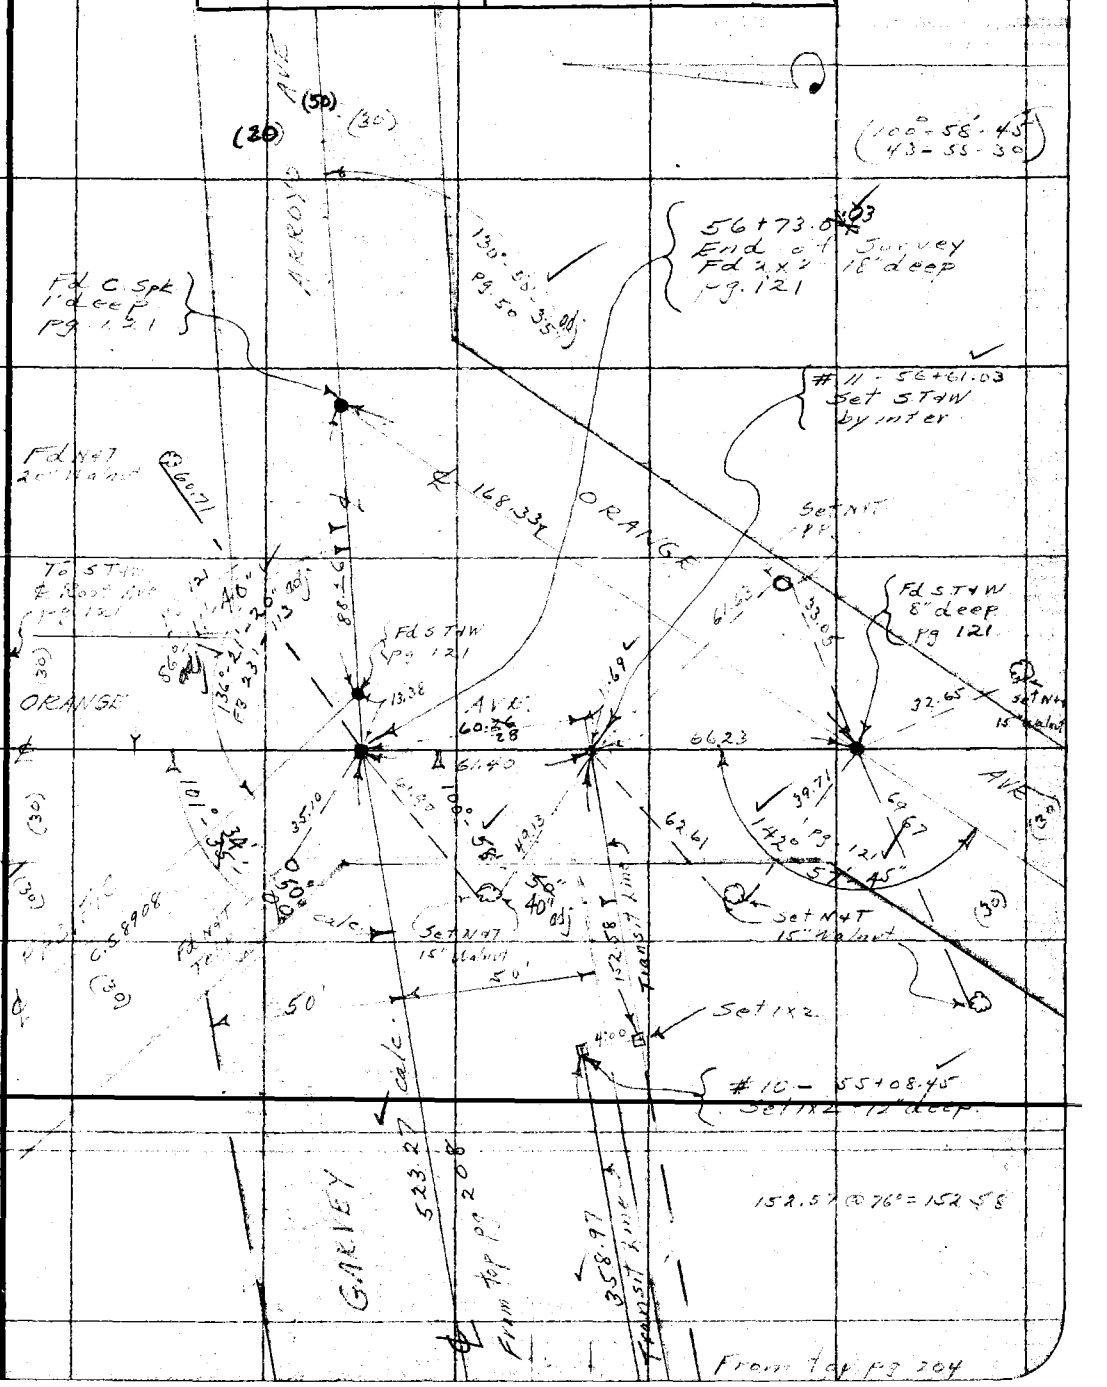

F.B. 352 PG. 206 Moore Chief Party Notes by Moore Date 4-17-30

To bottom pg. 207

POT - 14+47.38
Set 2x2-12" deep
by calc offset
set NAILS in 12" Walnut
trees for ties

#3 - 1x2
pg. 202

AVE

GARVEY

MERCED

AVE

Northwesterly Bdy. City of West Covina

50' 50'

2114-214-216

41°-24'-25"

527.25

For Topog. See

Tie Line

05 calc

13'-10"

Set NAIL & Tag

48.18

58.93

Set NAIL Tag

NAIL pg. 202

#2 - STAKE pg. 202

31.08

Set NAIL PP

POT - 9+20.13 by
Set STAKE
Calc offset

494.51 calc

13.03 Calc.

per pg. 202

From top pg. 207

RETURN TO
LOS ANGELES COUNTY SURVEYOR

Do not extend notes this side of this line

Note: ANY ADDITIONS OR CHANGES ON THIS SHEET MUST BE MADE OR CIRCLED IN Red. WITH DATE AND NAME OF PERSON MAKING CHANGE.

Date 4-17-30 Notes by Moore Chief Party Moore F.B. 352 PG. 207

Platted by D.A.White	W. O. No. 796 U. S. G. No. 028
Date June, 1930	Location Gallup Ave
Map No. B-519-2	Surveyed by Moore
Platting C'k'd by H. U. M. H.	Date 4-17-30
Date AUG 12 1930	Indexed A. C. Johnson

Notes: ANY ADDITIONS OR CHANGES ON THIS SHEET MUST BE MADE OR CIRCLED IN Red. WITH DATE AND NAME OF PERSON MAKING CHANGE.

Do not extend notes this side of this line

RETURN TO LOS ANGELES COUNTY SURVEYOR

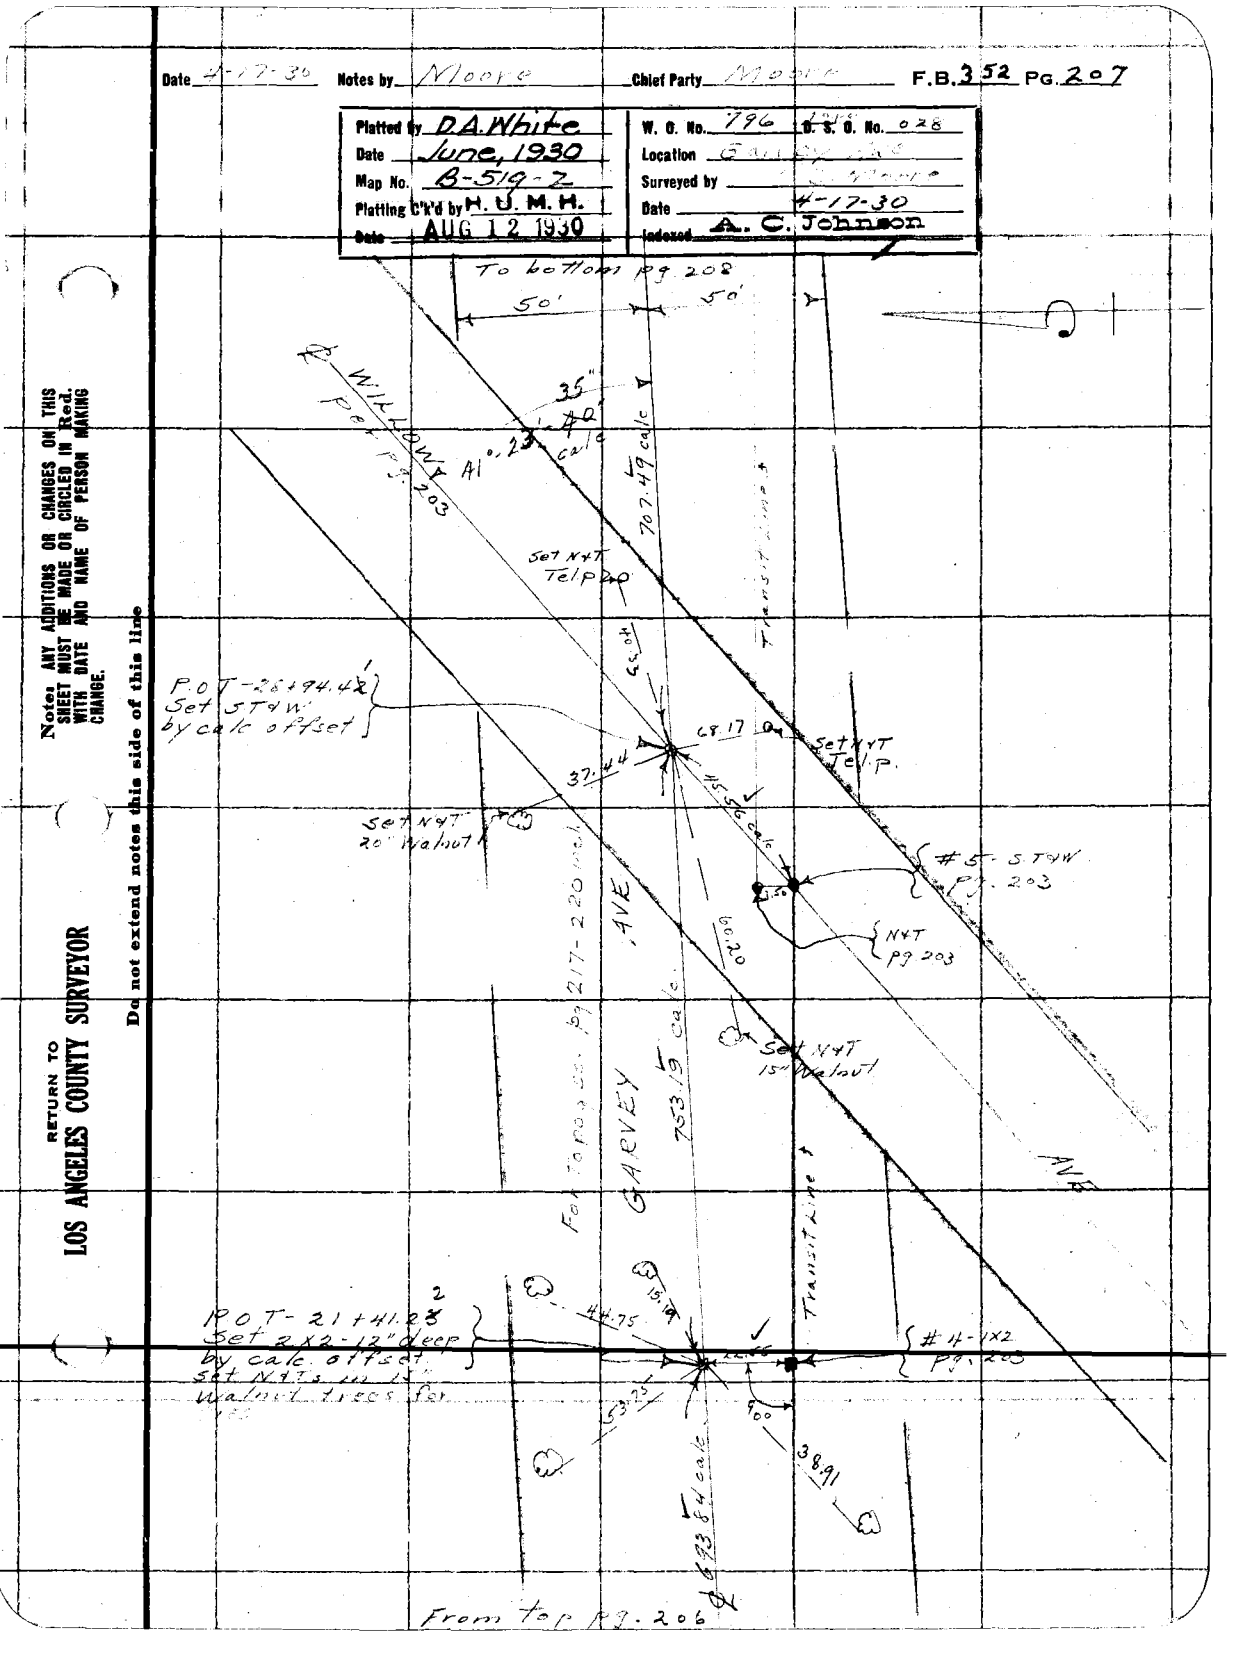

F.B. 352 PG. 208 Moore Chief Party Notes by Moore Date 4-17-30

To bottom pg 205

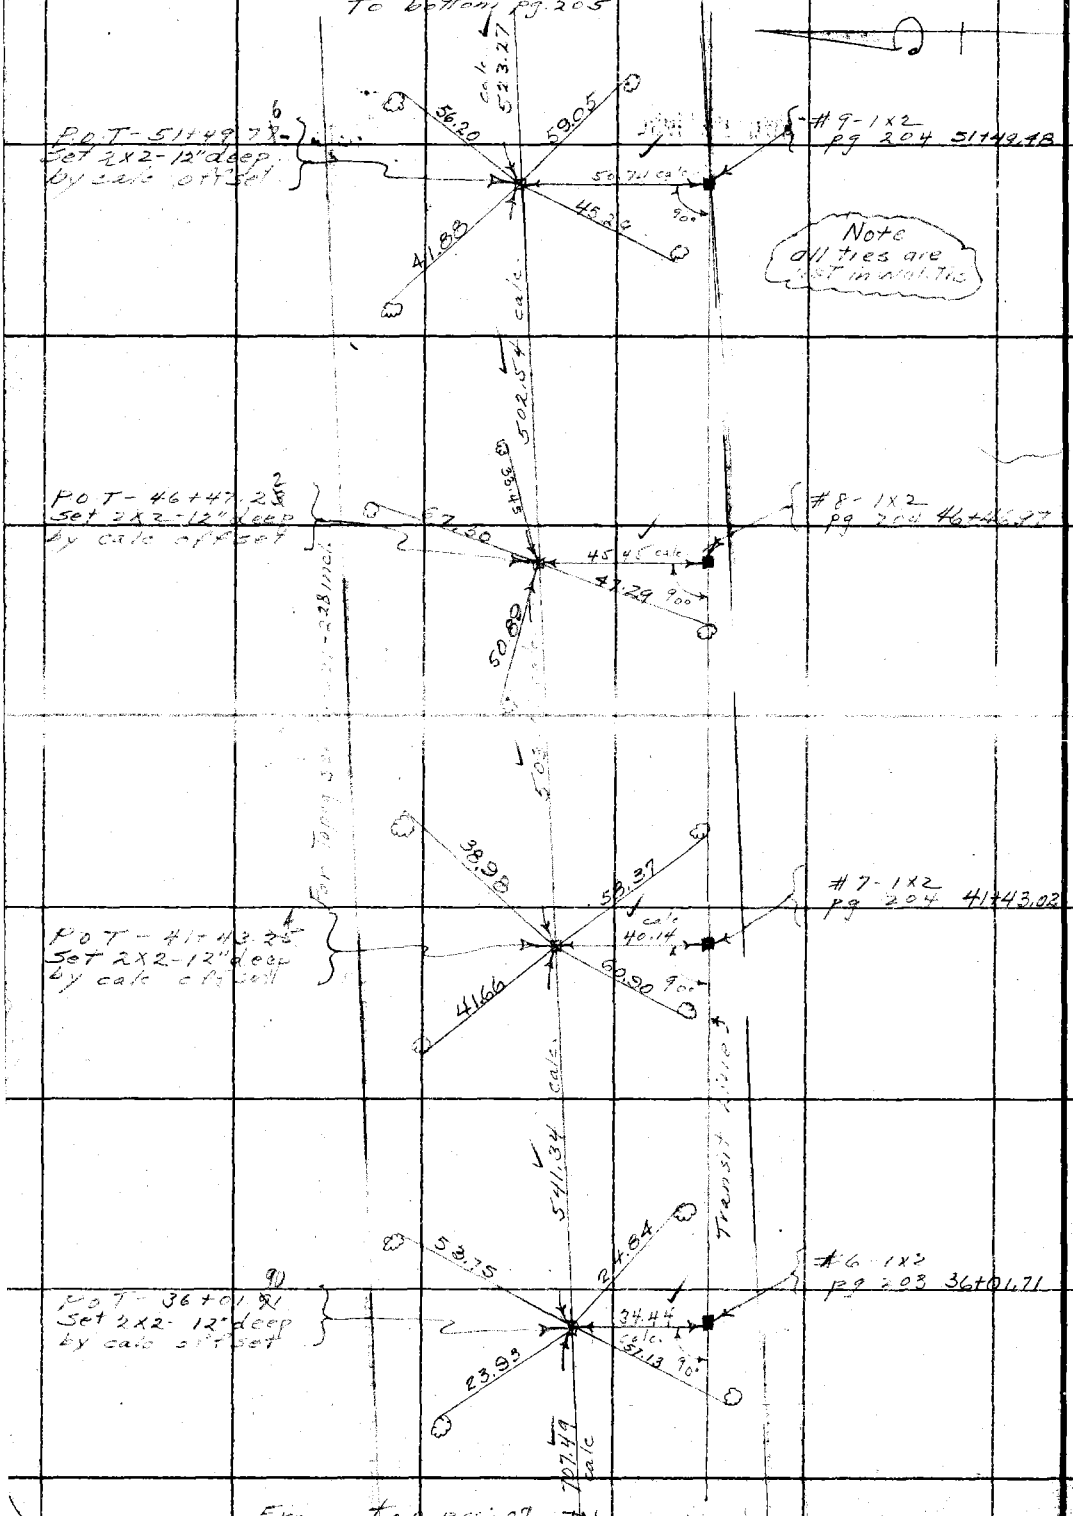

RETURN TO
LOS ANGELES COUNTY SURVEYOR

Do not extend notes this side of this line

Note: ANY ADDITIONS OR CHANGES ON THIS SHEET MUST BE MADE OR CIRCLED IN Red. WITH DATE AND NAME OF PERSON MAKING CHANGE.

Date 5-2-30 Notes by Moore Chief Party Nelson F.B. 352 PG. 209

Platted by D.A. White
Date June, 1930.
Map No. B-519-2
Platting Ch'd by H.U.M.H.
Date AUG 12 1930

W. O. No. 796 U. S. O. No. 022
Location 831' W. of E
Surveyed by
Date 4-23-30
Indexed A. C. Johnson

Note: ANY ADDITIONS OR CHANGES ON THIS SHEET MUST BE MADE OR CIRCLED IN Red. WITH DATE AND NAME OF PERSON MAKING CHANGE.

Do not extend notes this side of this line

RETURN TO LOS ANGELES COUNTY SURVEYOR

Set N&T
Fd S.T.&W.
FB 231-112
Fd N&T
PACIFIC AVE
1918 C.S.
Rel C.S. 8908
Set N&T PP
Fd S.T.&W.
FB 231-97
Rel Dept
F.C. 595-12
F.B. 311-15
adj
WILLOW ST AVE
Rel C.S. 8908
Fd N&T
Set N&T
Fd old N&T
Set Nail & Tag
Set 2x2
Fd 1½" I.P.
FB 231-92
Fd old N&T
PUENTE
From left

F.B. 352 Pg. 210 _____ Chief Party Notes by _____ Date _____

RETURN TO

LOS ANGELES COUNTY SURVEYOR

Do not extend notes this side of this line

Note: ANY ADDITIONS OR CHANGES ON THIS SHEET MUST BE MADE OR CIRCLED IN Red. WITH DATE AND NAME OF PERSON MAKING CHANGE.

Date 4-18-30 Notes by Standard Chief Party [illegible] F.B. 352 Pg. 21

Platted by D.A.White	W. O. No. 776 D. S. O. No.
Date June, 1930.	Location Garvey Ave
Map No. CSB-519-2.	Surveyed by A. D. Moore
Platting Ch'k'd by H. U. M. H.	Date 4-18-30
Date AUG 12 1930	Indexed A. C. Johnson

TOPOGRAPHY
for
RELOCATION
GARVEY AVE
from
PUENTE AVE
to
INTERSECTION
CRANE AVE and PEARL AVE

April 18-19, 1930

Party
[illegible]
Day
Off

Note: ANY ADDITIONS OR CHANGES ON THIS SHEET MUST BE MADE OR CIRCLED IN Red. WITH DATE AND NAME OF PERSON MAKING CHANGE.

Do not extend notes this side of this line

RETURN TO LOS ANGELES COUNTY SURVEYOR

F.B. 352 Pg. 212 — Chief Party — Notes by R Copeland — Date 4-18-30

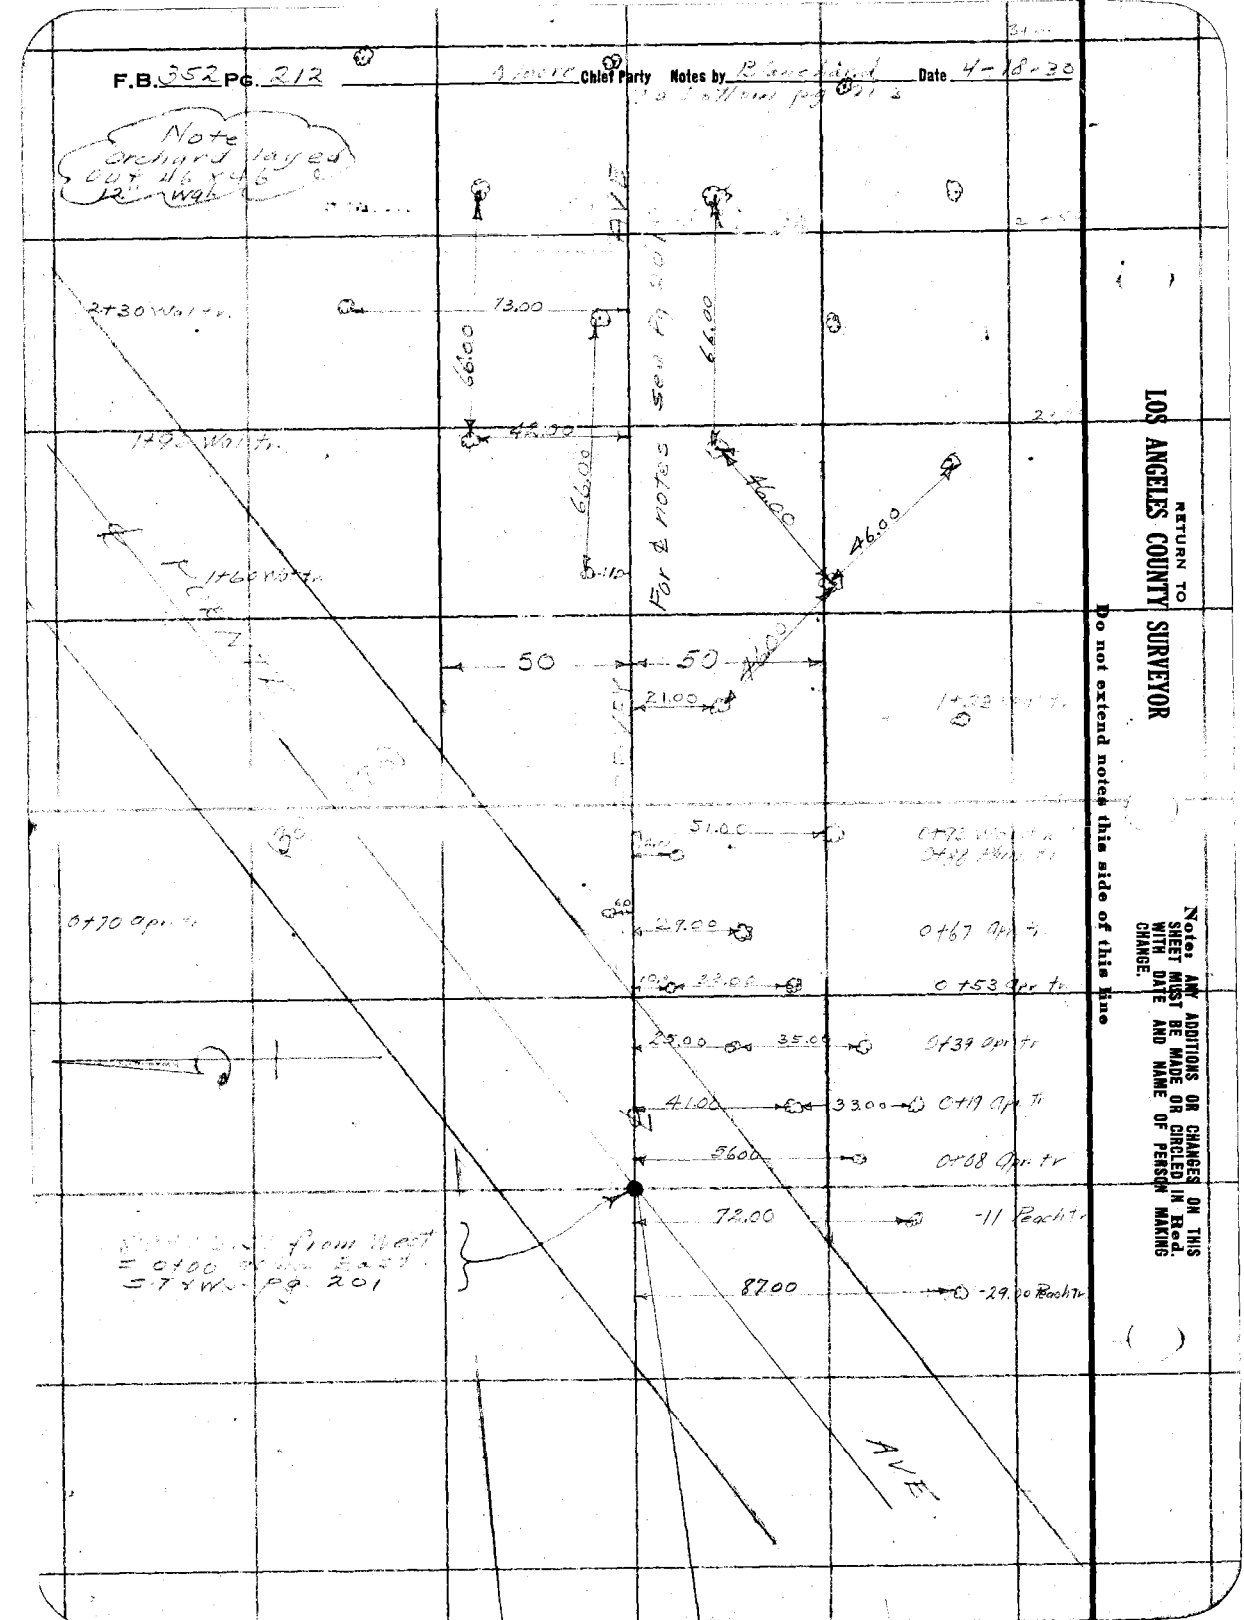

RETURN TO
LOS ANGELES COUNTY SURVEYOR

Do not extend notes this side of this line

Note: ANY ADDITIONS OR CHANGES ON THIS SHEET MUST BE MADE OR CIRCLED IN Red. WITH DATE AND NAME OF PERSON MAKING CHANGE.

Date 4/8/30 Notes by Blanchard Chief Party Moore F.B. 352 PG. 213

Platted by D.A.White	W. O. No. 796 D. S. O. No.
Date June, 1930	Location Garvey Ave
Map No. B-519-2	Surveyed by L.D.M.
Platting ck'd by H U M H	Date 4/16/30 A.C. Johnson
Date AUG 12 1930	Indexed

To Bk 9 pg 214

Note
Orchard layed
out 46 x 46
12" Val Tile

Note: ANY ADDITIONS OR CHANGES ON THIS SHEET MUST BE MADE OR CIRCLED IN Red. WITH DATE AND NAME OF PERSON MAKING CHANGE.

Do not extend notes this side of this line

RETURN TO
LOS ANGELES COUNTY SURVEYOR

50 50

POT 4+25.62
Pg-201

46.00

46.00

From Top pg 212

3100

Cont Bot Pg 215

F.B. 352 Pg. 214 — Chief Party Moore — Notes by Blanchard — Date 4/18/30

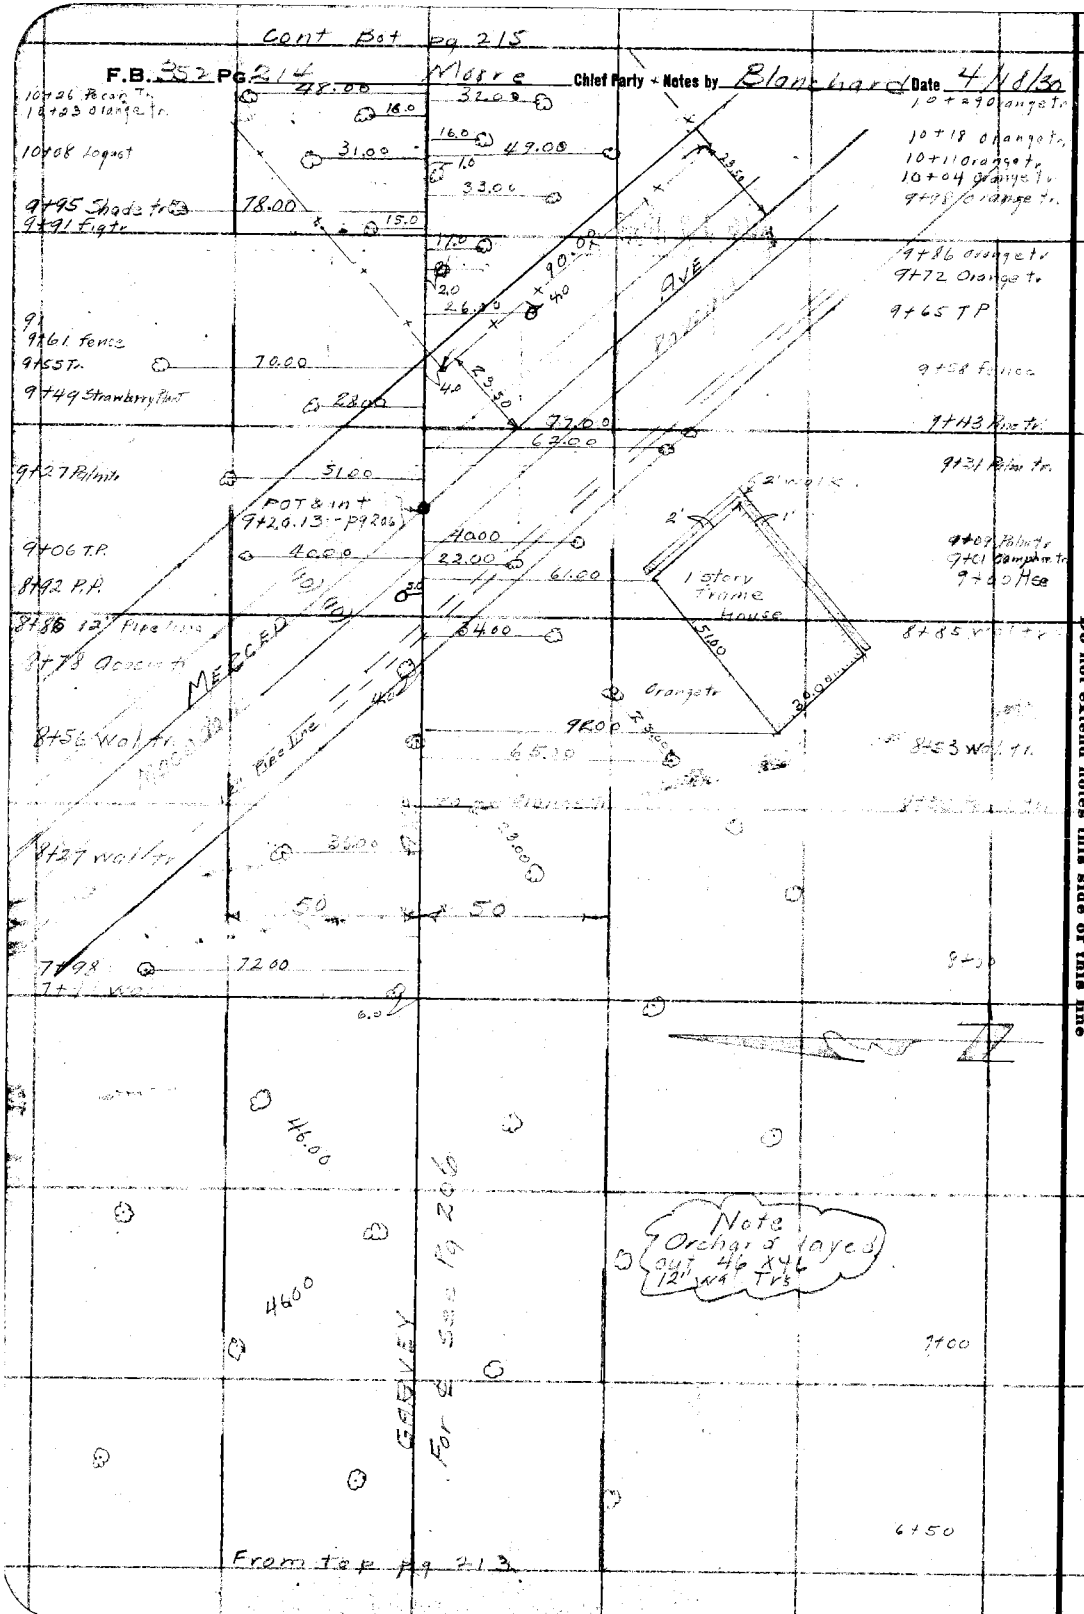

RETURN TO
LOS ANGELES COUNTY SURVEYOR

Do not extend notes this side of this line

Notes: ANY ADDITIONS OR CHANGES ON THIS SHEET MUST BE MADE OR CIRCLED IN Red. WITH DATE AND NAME OF PERSON MAKING CHANGE.

Date 4/18/30 Notes by Blanchard Chief Party Moore F.B. 352 PG. 215

Platted by D.A.White	W. O. No. 796 D. S. O. No.
Date June, 1930.	Location [illegible]
Map No. B-519-2	Surveyed by I.D. Mann
Platting C'k'd by H. U. M. H.	Date 4/18/30
Date AUG 12 1930	Indexed A. C. Johnson

Notes: ANY ADDITIONS OR CHANGES ON THIS SHEET MUST BE MADE OR CIRCLED IN Red. WITH DATE AND NAME OF PERSON MAKING CHANGE.

Do not extend notes this side of this line

RETURN TO LOS ANGELES COUNTY SURVEYOR

cont B07 pg 216

13+25 wal tr 1"

38.00

29.00

13+17 wal tr 1"

12+95 wal tr

75.00

12+88 wal tr 1"

6.09

63.00

12+20 wal tr 1"

12+35 wal tr 1"

41.00

27.00

12+47 wal tr 1"

12+29 wal tr 1"

78.00

12+17 wal tr 1"

7.70

AVE

60.00

12+08 wal tr 1"

50

50

25.00

11+80 wal tr 1"

11+50 fence

11+38 wal tr 1"

45.00

12.0

28.00

11+40 wal tr 1"

11+27 apple tr

52.00

11+04 apple tr

11+00 fence

37.00

GARVEY

10+97 Almond tr

46.00

10+85 Almond tr

15.0

10+72 wal tr

76.00

10+70 Plum tr

32.00

55.00

10+70 wal tr 1"

10+67 Plum tr

47.00

10+53 Plum tr

15.0

15.0

10+50 Plum tr

10+45 Plum tr

63.00

10+41 Plum tr

3.00

10+30 Orange tr

10+30

cont Easterly pg 214

F.B. 352 Pg. 216 Moore Chief Party Notes by Blanchard Date 4/18/30

cont fr bk 301 pg 317

Note
orchard lava 2
out 49 x 49
13" wa Trs

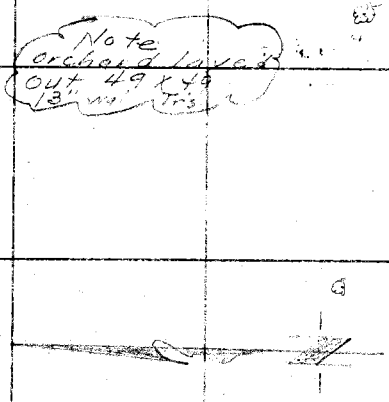

50 50

15+71 wa/tr. 13" 71.00

15+32 wa/tr 40.00

15+00 wa/tr. 70.00

14+93 wa/tr 13"

14+58 wa/tr 1" 40.00

14+32 wa/tr 1"

14+23 wa/tr 1" 70.00

13+95 wa/tr 1" 34.00

13+70 wa/tr 1" 74.00

13+56 wa/tr 1"

Northwesterly Bdy of Rancho [illegible]

49.00 Pg 206

For ℄ Sec

28.00 14+51 wa/tr 18"

POT 14+47.38
Pg 206

West

7.0 63.00 14+15 wa/tr 13"

29.00 12+ wa/tr 1"

4.0

cont fr sta 315

RETURN TO
LOS ANGELES COUNTY SURVEYOR.

Do not extend notes this side of this line

Note: ANY ADDITIONS OR CHANGES ON THIS SHEET MUST BE MADE OR CIRCLED IN Red. WITH DATE AND NAME OF PERSON MAKING CHANGE.

Date 7/11/30 Notes by [illegible] Chief Party [illegible] F.B. 352 PG. 217

Platted by D.A.White	W. O. No. 79 D. S. O. No.
Date June. 1930.	Location [illegible]
Map No. B-519-2	Surveyed by [illegible]
Platting C'k'd by H.U.M.H.	Date 4/11/30 E. C. Johnson
Date AUG 12 1930	Indexed

Cont from Bot. pg 216

20+91 wal tr. first tr. in New orchard
20+87 wal tr. last tr. in this orchard
4.0
20+15 gnval tr. last tr. in this orchard
43.00
20+81 wal tr. last tr.
79.00
50
50
Note Orchard layed out 13+91 to 13+87 Trs
GARVEY AVE
For see pg - 207
40.0
Cont from top pg 214
17.5

Notes: ANY ADDITIONS OR CHANGES ON THIS SHEET MUST BE MADE OR CIRCLED IN Red. WITH DATE AND NAME OF PERSON MAKING CHANGE.

Do not extend notes this side of this line

RETURN TO LOS ANGELES COUNTY SURVEYOR

F.B. 352 Pg. 218 Maine Chief Party Notes by Blanchard Date 4/19/38

cont from pg 219

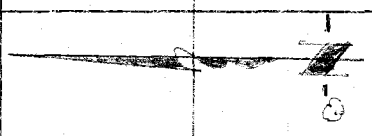

50 50

AVE

Note
Orchard layed out
50X50 13' Mid Trs.

Do not extend notes this side of this line

RETURN TO
LOS ANGELES COUNTY SURVEYOR

Note: ANY ADDITIONS OR CHANGES ON THIS SHEET MUST BE MADE 9D CIRCLED IN Red. WITH DATE AND NAME OF PERSON MAKING CHANGE.

50.00 70.00 50.00

70.00 22+25 wal tr.

FARGO

21+42 wal tr.

33.00

21+90 wal tr
New orchard

GAREY

5.0

21+56 wal tr.
New orchard

70.00

21+48 wal tr.

POT 21+41.23
Pg. 207

41.00

21+24 wal tr
New orchard

33.00

21+13 wal tr
& Pipe line

cont from top pg 217

Date 4/18/30 Notes by Blanchard Chief Party [illegible] F.B. 352 PG 219

Platted by D.A.White.	W. O. No. 796 D. S. O. No.
Date June, 1930.	Location [illegible]
Map No. B-519-2	Surveyed by [illegible]
Platting C'k'd by H.U.M.H.	Date 4/18/30
Date AUG 12 1930	Indexed C. C. Johnson

cont bat pg 220

Note: ANY ADDITIONS OR CHANGES ON THIS SHEET MUST BE MADE OR CIRCLED IN Red. WITH DATE AND NAME OF PERSON MAKING CHANGE.

Do not extend notes this side of this line

RETURN TO LOS ANGELES COUNTY SURVEYOR

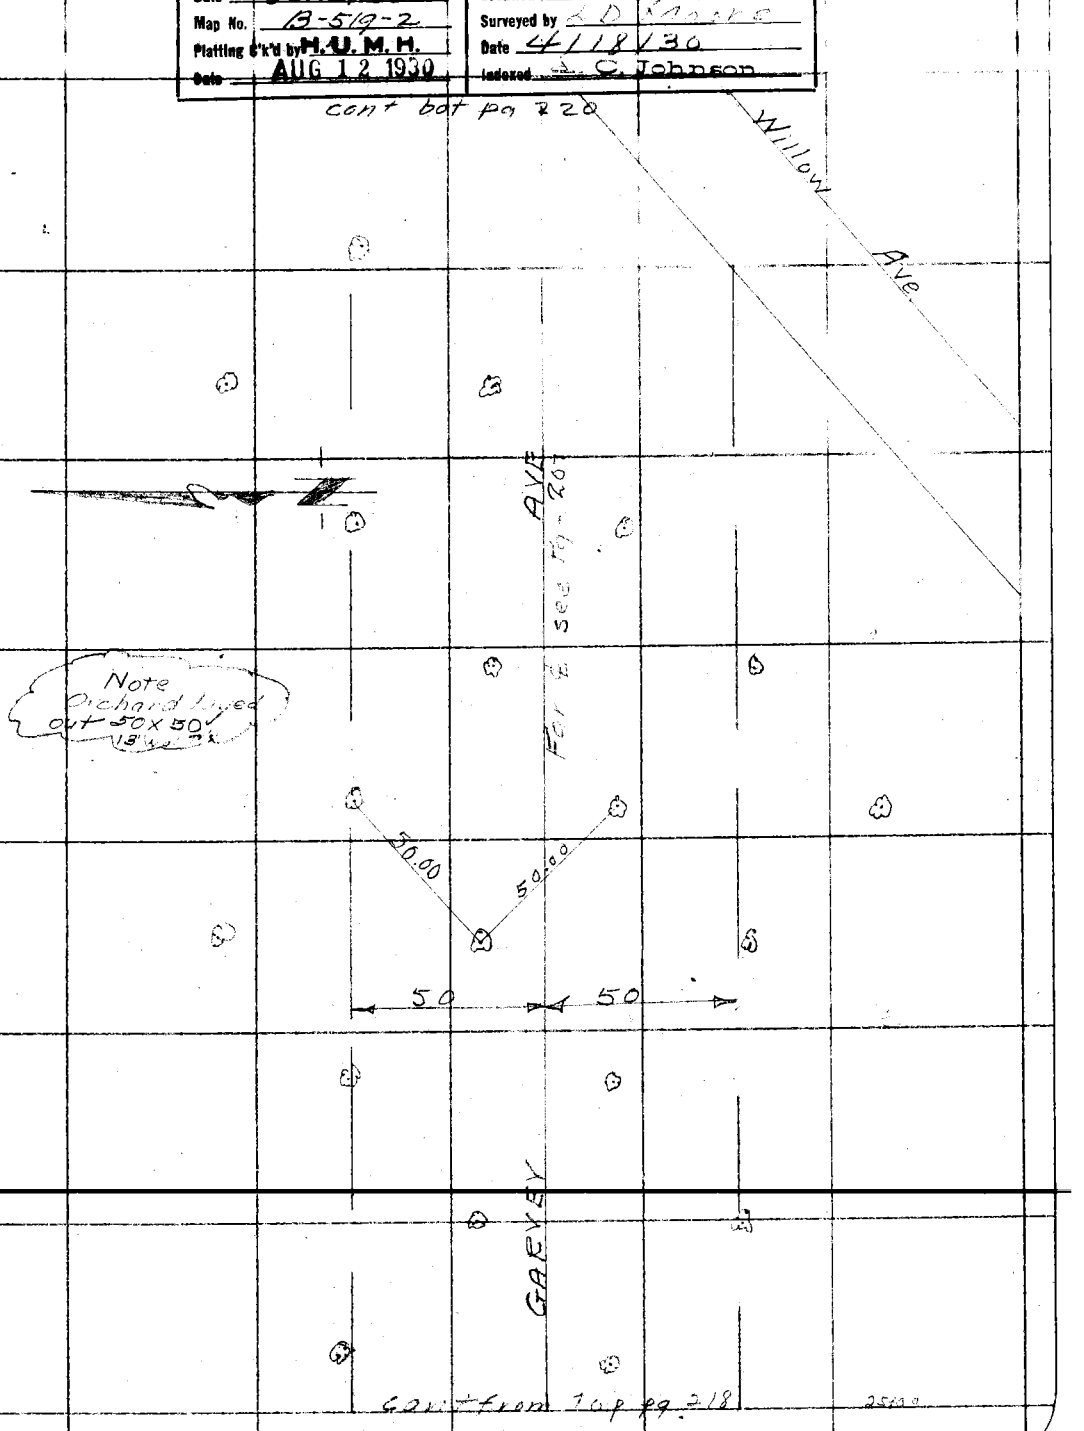

Con't from top pg. 218

25m0

F.B. 352 Pg. 220 Moore Chief Party Notes by Blanchard Date 4/19/30

cont from Pg 221

Note
Orchard layed
Out 50 x 50
13 wal trs

30+69 wal tr.

30+62 wal tr

30+28 wal tr.

30+10 T.P.

29+94 wal tr.

29+34 T.P.

29+07 wal Tr.

28+71 wal Tr.

50 50

80.00

50.00

70.00

73.00

15.0

55.00

60.00

14.0

29+86 wal tr

29+55 wal

28.00

29+47 wal

Willow

63.00

32.00

29+12 wal.

POT 28+04.42
Pg 207

83.00

28+78 wal

59.00

28+59 T.P.

28+34 wal Tr.

40

36.00

27+96 wal Tr.

70.00

cont from top pg 219 27+60 wa

Gale Ave

Pacific Ave

RETURN TO
LOS ANGELES COUNTY SURVEYOR

Do not extend notes this side of this line

Note: ANY ADDITIONS OR CHANGES ON THIS SHEET MUST BE MADE OR CIRCLED IN Red. WITH DATE AND NAME OF PERSON MAKING CHANGE.

Date 4/19/35 Notes by [illegible] Chief Party [illegible] F.B. 352 PG 221

Platted by D.A.White.	W. O. No. 796 D. S. O. No.
Date June, 1930	Location [illegible]
Map No. B-54-2	Surveyed by [illegible]
Platting Chkd by M. U. M. H.	Date 4/19/30
Date AUG 12 1930	Indexed C. Johnson

Cont bot pg 222

Note
Orchard layed
Out 50 x 50
13" wall tr's.

Note: ANY ADDITIONS OR CHANGES ON THIS SHEET MUST BE MADE OR CIRCLED IN Red. WITH DATE AND NAME OF PERSON MAKING CHANGE.

Do not extend notes this side of this line

RETURN TO
LOS ANGELES COUNTY SURVEYOR

34

50 50

33424 Pipe line

5'

12" Gate

10.0

10.0

Cont from Typ pg 220

F.B. 322 PG. 222 Moore Chief Party Notes by Blanchard Date 4/19/30

cont from pg 223

AVE

Note Orchard leaves out 50 x 50 13.1 ac

36

50 50

208

FOR ST =

POT 35+01.9

35+85 w of ℄

GARVEY

17.00

53.00

35+19 w of ℄

35+52 w of ℄

54.00

15.00

25+48 w of ℄

cont from typ pg 224

RETURN TO
LOS ANGELES COUNTY SURVEYOR

Do not extend notes this side of this line

Notes: ANY ADDITIONS OR CHANGES ON THIS SHEET MUST BE MADE OR CIRCLED IN Red. WITH DATE AND NAME OF PERSON MAKING CHANGE.

Date 4/19/30 Notes by Blanchard Chief Party Moore F.B. 352 PG. 223

Platted by D.A.White
Date June, 1930
Map No. B-579-2.
Platting Ch'd by M.U.M.H.
Date AUG 12 1930

W. O. No. 296 D. S. O. No.
Location Ga. Hoy Line
Surveyed by L.D. Kinsey
Date 4/19/30
Indexed C. Johnson

cont bot pg 224

Note
Orchard 10 ac
Cit 50 x 50
13" Walnuts

41+49 walt

56.00

Pat 41+43.25
Pg - 208

140

41+41 walt

41+10 walt

23.00

45.00

41+60 walt

50 50

For L. See Pg - 208

GAFFEY

39

cont from top pg 223

RETURN TO
LOS ANGELES COUNTY SURVEYOR

Do not extend notes this side of this line

Note: ANY ADDITIONS OR CHANGES ON THIS SHEET MUST BE MADE OR CIRCLED IN Red. WITH DATE AND NAME OF PERSON MAKING CHANGE.

F.B. 352 Pg. 224 Moore Chief Party Notes by Blanchard Date 4/19/30

Cont Def Map

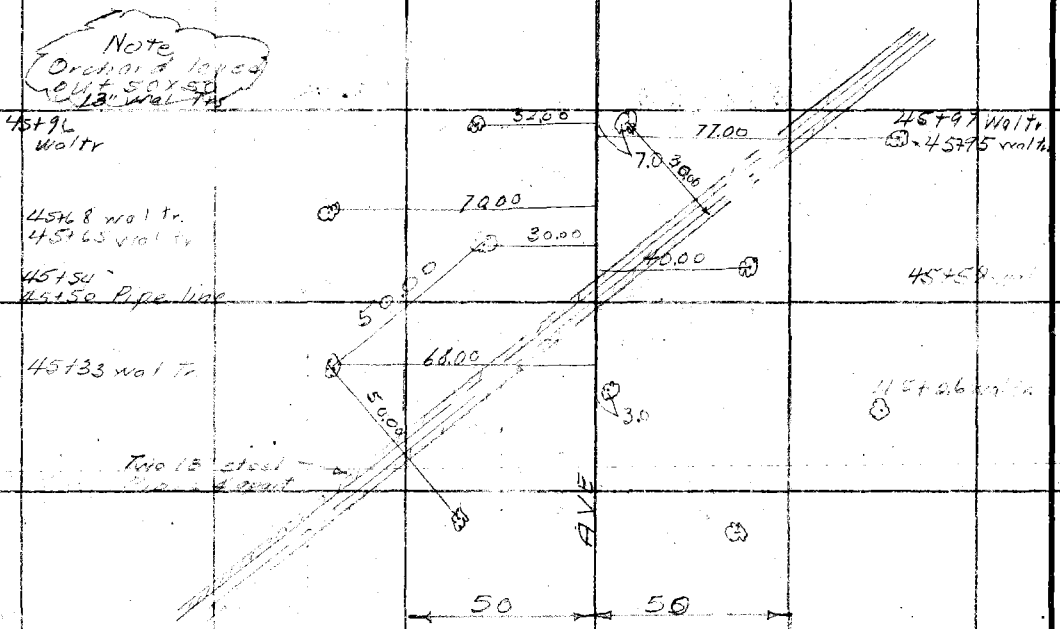

RETURN TO
LOS ANGELES COUNTY SURVEYOR.

Do not extend notes this side of this line

Notes: ANY ADDITIONS OR CHANGES ON THIS SHEET MUST BE MADE OR CIRCLED IN Red. WITH DATE AND NAME OF PERSON MAKING CHANGE.

Date 4-7-30 Notes by Blanchard Chief Party Maire F.B. 352 Pg. 225

Platted by D.A.White.	W. O. No. 796 D. S. O. No.
Date June, 1930	Location Garvey Ave
Map No. B-519-2.	Surveyed by L.S. Maire
Platting C'k'd by M.U.M.H.	Date 4/19/30 C. Johnson.
Date AUG 12 1930	Indexed

Note
Orchard layed out 50 x 50 15 walks

cont bot pg 226

61.00

49+09 wal

48+78 wal

23.00

48+47 wal tr.

14

50 50

53.00

47+69 wal tr.

For t. see Pg - 208

GARVEY AVE

26.00

46+78 wal tr.

46+69 wal tr.

28.0

42.00

46+64 wal tr.

POT 46+47.23
Pg - 208

46+36 wal tr.

67.00

6.0

45.00

46+27 wal
46+25 wal

cont from top pg 224

RETURN TO
LOS ANGELES COUNTY SURVEYOR

Notes: ANY ADDITIONS OR CHANGES ON THIS SHEET MUST BE MADE OR CIRCLED IN Red. WITH DATE AND NAME OF PERSON MAKING CHANGE.

Do not extend notes this side of this line

F.B. 352 PG. 226 Mosko Chief Party Notes by Blanchard Date 9/19/20

cont dot pg 227

52+86 orange tr

38.00

72.00

52+67 TP

Note orchard layout 50x50

13" wal tr

{POT 51+49.77 Pg-225

52+19 lemon tr.

46.00

AVE

30.00

61+98 wal tr

50 50

51+64 TP

25.00

3.0

51+60 wal tr

51+57 orange tr

60.00

36.00

51+81 apple tr.

51+30 wal tr.

35.00

51+18 wal tr

51

56+92 Pear tr.

50+89 wal tr

66.00

2.0

50+66 apricot

69.00

For 2 see Pg-204

50+21 almond

74.00

50

49+86 wal tr.

cont from top pg 225

RETURN TO
LOS ANGELES COUNTY SURVEYOR

Do not extend notes this side of this line

Notes: ANY ADDITIONS OR CHANGES ON THIS SHEET MUST BE MADE OR CIRCLED IN Red. WITH DATE AND NAME OF PERSON MAKING CHANGE.

Date 4/19/30 Notes by Blanchard Chief Party L.D. Moore F.B. 352 PG. 227

Platted by D.A. White	W. O. No. 796 D. S. O. No.
Date June 1930.	Location Gilbert Ave
Map No. B-519-2.	Surveyed by L.D. Moore
Platting C'k'd by M. U. M. H.	Date 4/19/30
Date AUG 12 1930	Indexed C. Johnson

Note: ANY ADDITIONS OR CHANGES ON THIS SHEET MUST BE MADE OR CIRCLED IN Red. WITH DATE AND NAME OF PERSON MAKING CHANGE.

Do not extend notes this side of this line

RETURN TO LOS ANGELES COUNTY SURVEYOR

cont for pg 228

56+29 Pipe line
56+37 wal Tr.

56+81 well box

56+18 wal Tr.

55+80 conc pipe line & wal Tr.
55+70 T.P.

55+78 Hse

55+34 wal Tr. 13"

55+44 wal Tr. 13"
55+39 wal Tr. 13"
55+28 fig Tr. 4"

55+12 orange Tr. 6"
55+06 6" conc wall

56+12 wal Tr.
1 story frame Gar.

54+96 Gar.

54+83 wal Tr. 13"

54+74 T.P

54+75 wal Tr.
54+68 wal Tr. 13"

54+45 wal Tr. 13"
54+34 wal Tr. 13"

54+39 wal Tr.

54+10 wal Tr. 13"

54+00 Wal

53+75 wal Tr. 13"
53+70 T.P.

53+68 wal

53+42 wal Tr. 13"

53+30 wal

53+01 wal

cont from Top pg 226

GARVEY AVE

For 4 see Pg - 205

13" Pipe line

55

F.B. 252 Pg. 228 Moore Chief Party Notes by Blanchard Date 4/19/30

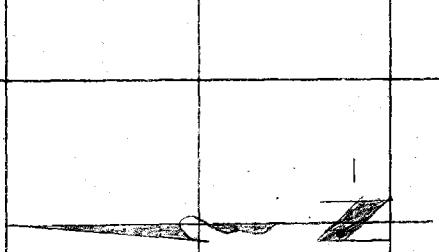

(30) (30)

AVE

Macadam Pavement

2" corrugated pipe

ORANGE

AVE

56+73. on Tr.

7.00

40.0

39.00

1.0

1.0

56+63.4 Guard rail & wing fr.
56+53 end of wall
56+50 Palm tr.
56+44 on Tr.
56+45 TP

0.00

0.00

22.00

56+42 Palm tr.

INT 56+73.04
Pg 205, End of SW curve

(30) AVE

& PACIFIC

(30)

AVE

Pg 205

50 50

GARVEY

cont from Tap #9227

RETURN TO
LOS ANGELES COUNTY SURVEYOR

Do not extend notes this side of this line

Notes: ANY ADDITIONS OR CHANGES ON THIS SHEET MUST BE MADE OR CIRCLED IN Red. WITH DATE AND NAME OF PERSON MAKING CHANGE.

Date _____ Notes by _____ Chief Party _____ F.B. 352 Pg. 229

Platted by	W. O. No. D. S. O. No.
Date	Location
Map No.	Surveyed by
Platting C'k'd by	Date
Date	Indexed

Notes: ANY ADDITIONS OR CHANGES ON THIS SHEET MUST BE MADE OR CIRCLED IN Red. WITH DATE AND NAME OF PERSON MAKING CHANGE.

Do not extend notes this side of this line

RETURN TO
LOS ANGELES COUNTY SURVEYOR

F.B.____ Pg.____ _____ Chief Party Notes by_____ Date____

352