Notes by _____ Chief Party _____ F.B. _____ Pg. _____

Platted by _____	W. O. No. _____ D. S. O. No. _____
Date _____	Location _____
Map No. _____	Surveyed by _____
Platting C'k'd by _____	Date _____
Date _____	Inclosed _____

 

F.B 399 PG. Index Chief Party Notes by Date

F.B. 399

PAGES: Index, 1 to 3 incl., , 5 to 15 incl.,
17 to 41 incl., , 42A to 77 incl., ,
79 to 83 incl., , 85 to 93 incl., ,
95 to 123 incl.,

RETURN TO LOS ANGELES COUNTY SURVEYOR

Do not extend notes this side of this line

Note: ANY ADDITIONS OR CHANGES ON THIS SHEET MUST BE MADE OR CIRCLED IN Red. WITH DATE AND NAME OF PERSON MAKING CHANGE.

Date [illegible] Notes by PWA Chief Party PWA F.B. 399 Pg 1

Platted by	W. O. No. 920 B. & S. O. No. 622
Date	Location [illegible] Ext
Map No.	Surveyed by P.W. Atkins Sup
Platting C'k'd by	Date Oct. 12, 1929.
Date	Indexed A. C. Johnson

Notes: ANY ADDITIONS OR CHANGES ON THIS SHEET MUST BE MADE OR CIRCLED IN Red. WITH DATE AND NAME OF PERSON MAKING CHANGE.

Do not extend notes this side of this line

RETURN TO LOS ANGELES COUNTY SURVEYOR

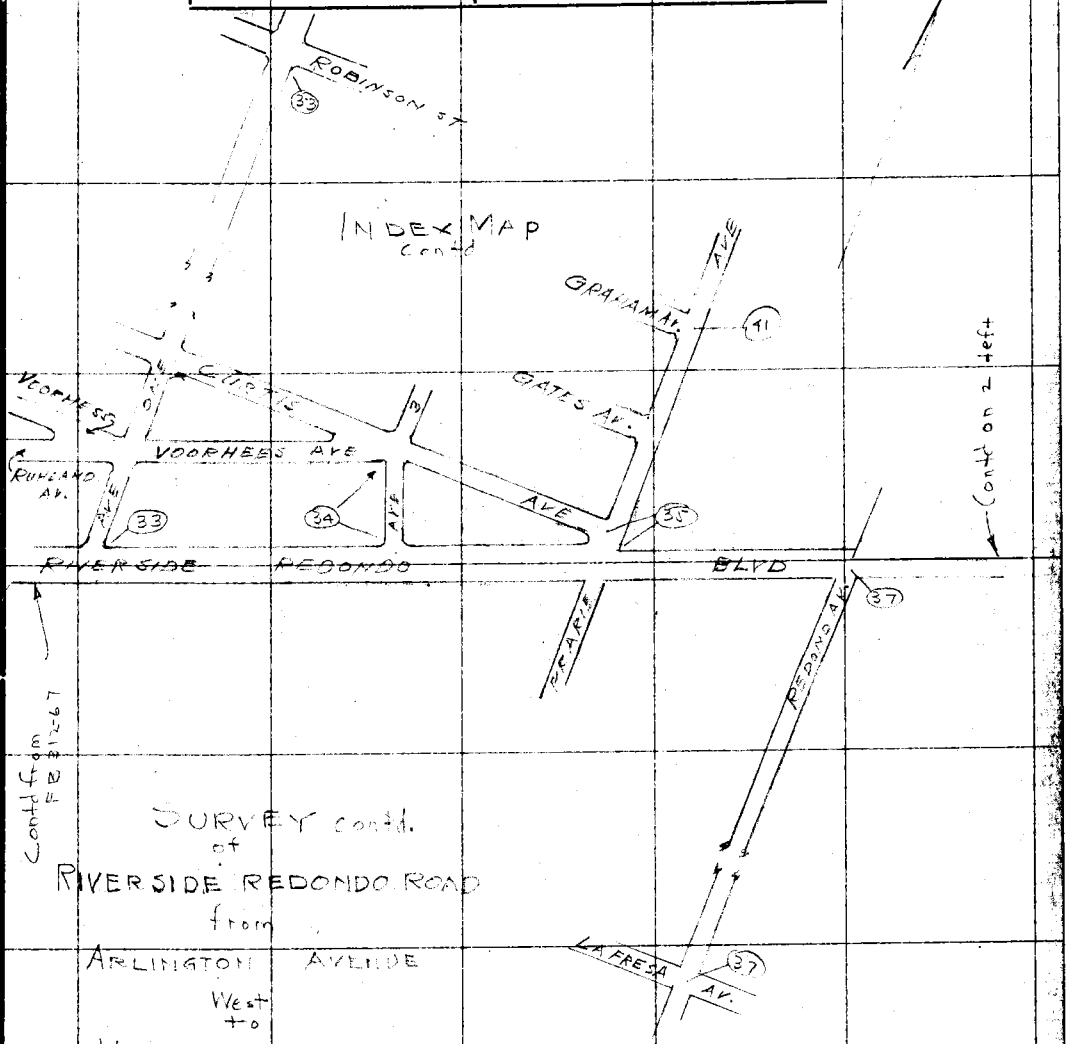

SURVEY cont'd
of
RIVERSIDE REDONDO ROAD
from
ARLINGTON AVENUE
West
to
HERMOSA AVE.

See F.B. 312-61-128
F.B. 424-1 to 39

For Adopted Center Line
See F.B. 424-44 to 108.

F. B. 399 Pg. 2 Chief Party Notes by [illegible] Date 10-22-29

INDEX MAP
Contd

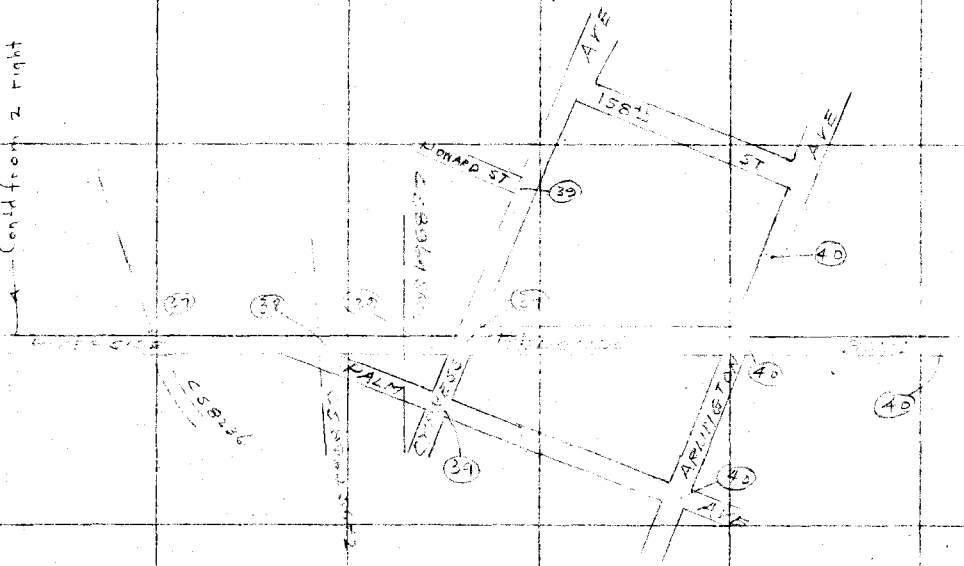

Continued from 2 right

RETURN TO
LOS ANGELES COUNTY SURVEYOR

Do not extend notes this side of this line

Note: ANY ADDITIONS OR CHANGES ON THIS SHEET MUST BE MADE OR CIRCLED IN Red. WITH DATE AND NAME OF PERSON MAKING CHANGE.

Date _____ Notes by _____ Chief Party _____ F.B. 242 PG 181

Platted by A. Svenson.	W. O. No. 920 D. O. No. 022
Date Aug. 1930	Location Nr. Redondo Road
Map No. B-442-2	Surveyed by Prel. Hinds Dept.
Platting Ck'd by D.M. Finley	Date 4-12-29
Date Nov. 1933	Indexed

64.16 @ 64° = 64.15
443.24 @ 64° = 433.17
497.22

Contd fr. 100 AB 317 (30)

(190)

(10) (10)

30.00'

Fd 2½" Standard flush + SMCo tag

Fd spk. conc. prv. RD FB 231-32 32+51.37 alg. M 102

LANE

FR

Fd 1½ x 1½ stake

Set 1½ x 1½ stake

Fd 1½ x 1½ stake

930.06

64.15

N+T tk p. E+

40.15

6.44

Cut N+T

52.29

N+T PP

(20)

10 10

497.32

433.17

8.05

50.50 Adj.

Fd 2" IP flush new subdivision

Fd Brass disc C.S.M mon. 2+tin. (FB 101-49, 2c+52.79)

N+T PP

Fd 20 lb steel rail mon. 2 ft up.

RETURN TO LOS ANGELES COUNTY SURVEYOR

Note: ANY ADDITIONS OR CHANGES ON THIS SHEET MUST BE MADE OR CIRCLED IN Red. WITH DATE AND NAME OF PERSON MAKING CHANGE.

Do not extend notes this side of this line

399 4

F. B. 312 PG. 130 Chief Party Notes by Date

RETURN TO
LOS ANGELES COUNTY SURVEYOR

Do not extend notes this side of this line

Note: ANY ADDITIONS OR CHANGES ON THIS SHEET MUST BE MADE OR CIRCLED IN Red. WITH DATE AND NAME OF PERSON MAKING CHANGE.

Date 4-13-29 Notes by [illegible] Chief Party [illegible] F.B. 342 PG. 5

Platted by A. Svenson.	W. O. No. 920 D. O. No. 229
Date Aug. 1930	Location [illegible]
Map No. B-442-2	Surveyed by [illegible]
Platting C'k'd by O. M. Finley	Date 4-13-29
Date Nov. 1933.	Indexed [illegible]

Note: ANY ADDITIONS OR CHANGES ON THIS SHEET MUST BE MADE OR CIRCLED IN Red. WITH DATE AND NAME OF PERSON MAKING CHANGE.

Do not extend notes this side of this line.

RETURN TO LOS ANGELES COUNTY SURVEYOR

11.00 Contd fr. 74 bot FB 312

(40) (20)

117.13 Fd remains of old 2"x3" stk

(20)

20.02 31.02

LANE

183.43

66.30

1: 9046
4=363.09 15
90 46 03.75

24th ST

1+83.43 Set 1"x2" stk with tk flush P.O.T

Adopted Center Line

183.43 @ 64° = 183.43
66.30 @ 64° = 66.30

Contd on 134

173.03 @ 64° = 173.04

HARPER

11.00

173.04

3+56.47 Set 1"x2" stk with tk flush by int.

205.97

247.04

11.00 to ℄ line

247.04 @ 64° = 247.04

21st ST (60)

(30) (30)

9° 00'

11.00 Contd on top pg 134

F.B. 312 Pg. 134 — Chief Party — Notes by — Date 4-13-29

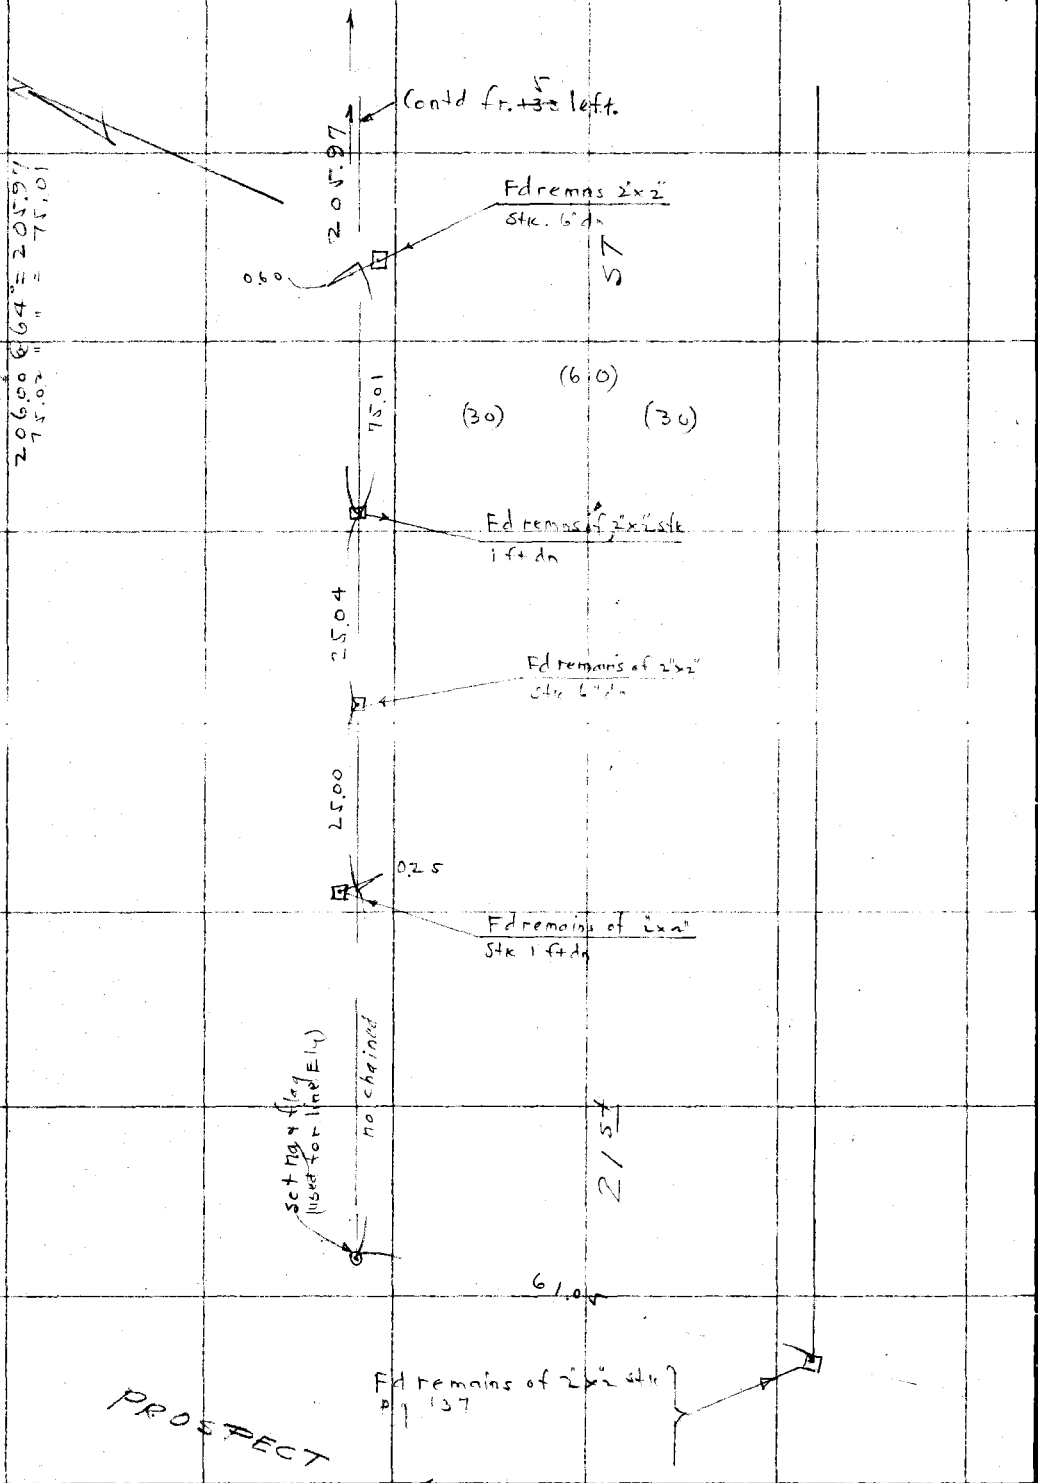

RETURN TO LOS ANGELES COUNTY SURVEYOR

Do not extend notes this side of this line

Note: ANY ADDITIONS OR CHANGES ON THIS SHEET MUST BE MADE OR CIRCLED IN Red. WITH DATE AND NAME OF PERSON MAKING CHANGE.

Date 4-13-49 Notes by Dina Chief Party Dina F.B. ~~342~~ 346 Pg 135

Platted by A. Svenson	W. O. No. 420 C. S. C. No. 029
Date Aug. 1930	Location Rec. Rancho to Pol
Map No. B-442-2	Surveyed by Dina Hollins Dan
Platting C'k'd by D. M. Finley	Date 4-13-49
Date Nov. 1933	Indexed A. C. Johnson

Contd fr ~~185~~ 186

11.00

(40)

(20) (20)

LANE

247.04

6+03.51

Set 1x2 stk with tk fl. POT

S 3.78 @ 64° = S 3.77

Adopted Center Line

53.77

20th PL. (40)

(20) (20)

40°

31.58

20.58

6+57.28

Fd Remains of 2x2 stk, 6" dn

(40)

WYLIE LANE

(20)

HARPER

261.97

262.00 @ 64° = 261.97

Contd on top pg ~~191~~ 8

11.00

RETURN TO LOS ANGELES COUNTY SURVEYOR

Notes: ANY ADDITIONS OR CHANGES OR THIS SHEET MUST BE MADE OR CANCELED IN RED. WITH DATE AND NAME OF PERSON MAKING CHANGE.

Do not extend notes this side of this line

F. B. 399 / 342 Pg. 6 / 136 — Chief Party — Notes by — Date 4-13-29

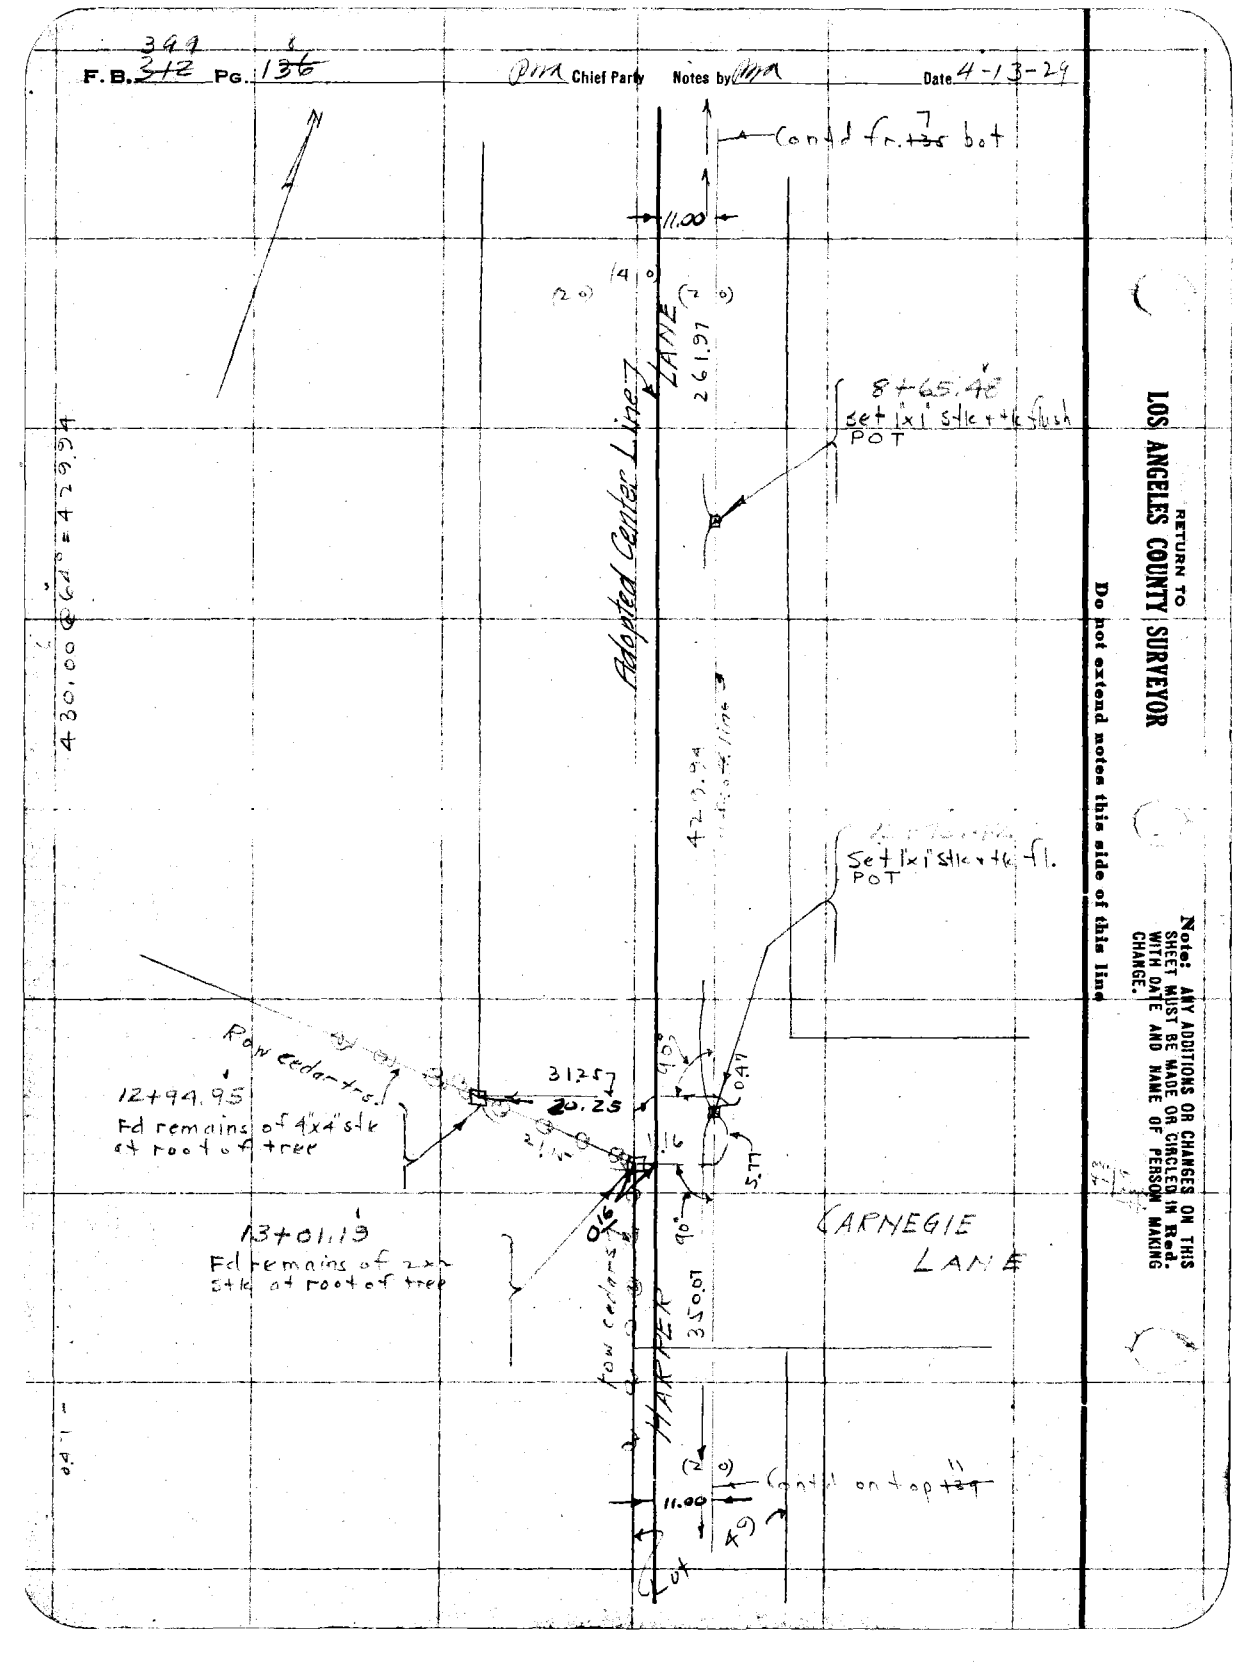

RETURN TO
LOS ANGELES COUNTY SURVEYOR

Do not extend notes this side of this line

Note: ANY ADDITIONS OR CHANGES ON THIS SHEET MUST BE MADE OR CIRCLED IN Red. WITH DATE AND NAME OF PERSON MAKING CHANGE.

399 9

Date ____ Notes by ____ Chief Party ____ F.B. 312 Pg 137

Platted by A. Svenson	W. O. No. 924 D. C. O. No.
Date Aug. 1930	Location Rio Hondo
Map No. B-442-2	Surveyed by
Platting Clk'd by D. M. Finley	Date
Date NOV. 1933	Indexed

Cont'd on bott pg 138

PORTLAND ST

21 ST. ST.

(80) AVALON BLVD

(40) (40)

PROJECT

NW lot Lot 78 MB 9-57

@ 64° 4+50.98 Fd remains 2"x2" stk line. bears N

4+50.02 fr remains 4x4 fr post in W line

WYLIE ST

20TH. PL.

@ 64° 2+06.98 fr S Fd remains 2x2 stk. on line. 6" dn

0+34.27 from S Fd old original 2x2 stk x tk flush apparently S'ly on Lot 123 MB 9-57

0.03

20TH. ST.

HARRINGTON ST

0+04.00 fr S Fd New 2"x2" stk x tk flush

0.15

0+01.97 fr N Fd 2" IP 3" dn

+ stk

0+00 Going N'ly Fd old original 2"x2" stk x tk flush well rotted = B.C. M.B. 9-57

on line

0.08

0.65

0+05.98 fr N Fd old orig. 2"x2" stk x tk well rotted + flush

Curved lot line

Note: ANY ADDITIONS OR CHANGES ON THIS SHEET MUST BE MADE OR CIRCLED IN Red. WITH DATE AND NAME OF PERSON MAKING CHANGE.

Do not extend notes this side of this line

RETURN TO LOS ANGELES COUNTY SURVEYOR

F.B. 399 372 Pg. 10 138 Chief Party Notes by [illegible] Date 1-24-49

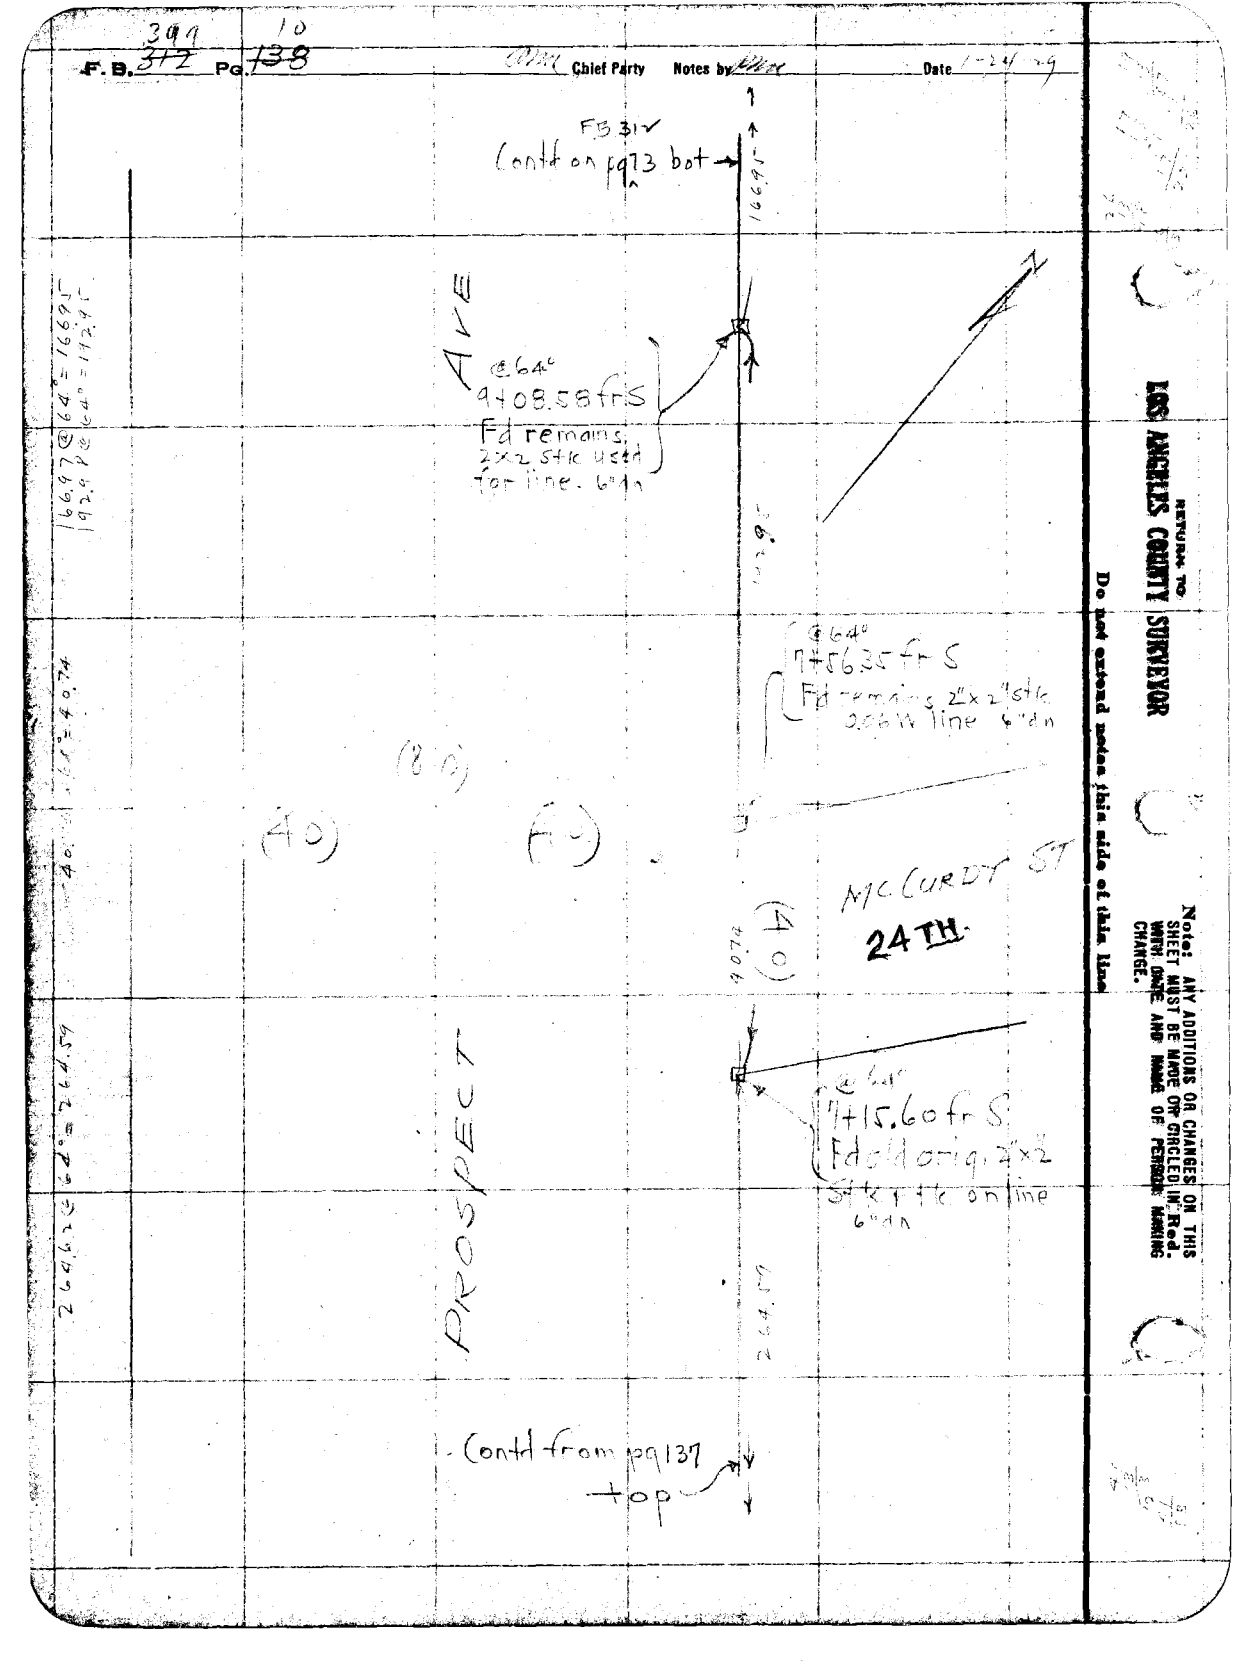

RETURN TO LOS ANGELES COUNTY SURVEYOR

Do not extend notes this side of this line

Notes: ANY ADDITIONS OR CHANGES ON THIS SHEET MUST BE MADE ON CIRCLED IN Red. WITH DATE AND NAME OF PERSON MAKING CHANGE.

Date 4-13-29 Notes by DMA Chief Party DMA F.B. 312 Pg 139

299 11

Platted by A. Svenson
Date Aug. 1930
Map No. B-442-2
Platting C'k'd by D. M. Finley
Date Nov. 1930

W. O. No. 920 U. S. O. No.
Location Riv. Redondo Rd
Surveyed by Paul Atkins Dep
Date 4-13-29
Indexed

Note: ANY ADDITIONS OR CHANGES ON THIS SHEET MUST BE MADE OR CIRCLED IN RED, WITH DATE AND NAME OF PERSON MAKING CHANGE.

Do not extend notes this side of this line

RETURN TO LOS ANGELES COUNTY SURVEYOR

20905

350.12 @ 64° = 350.07

241.00 @ 64° = 240.97

45.88 @ 64° = 45.87

29.11

12.263 @ 64° = 12.26

Contd fr 8 ~~136~~ bot

11.00

350.07

16+45.49
Set 1"x1" stk + tk flush
P.O.T.

16+45.84
Fd old 1"x2" Stk + tk
6" dn. solid

0.04

11.04

0.35

50°

16+93.94
Fd old 4"x4"
Stk + tk fl.

10.70 (20)

0.32

48.30

17+42.24
Fd old 4"x4"
Stk + tk fl.

10.92

0.08

48.40

240.97

17+90.64
Fd old 4"x4" stk
+ tk fl.

10.85

0.15

49.95

Lot 49

18+40.52
Fd 2" IP flush

10.70

0.30

45.87

11½ offset line

18+86.46
Set 1"x1" stk + tk fl.
P.O.T.

19+15.57 ft N
Fd 2"x2" Stk + tk 6" up
Prop. owner claims

11.00

29.11

9.46

209.05

Contd on top pg 140

(20)

(40)

ORMOND LANE

Contd on (20) ~~140~~ 17 top

HARPER

E. Mlly Line Redondo
Villa Tract M.B. 6 87

399 12

F.B. 312 Pg. 140 (Pva) Chief Party Notes by (Pva) Date 4-18-29

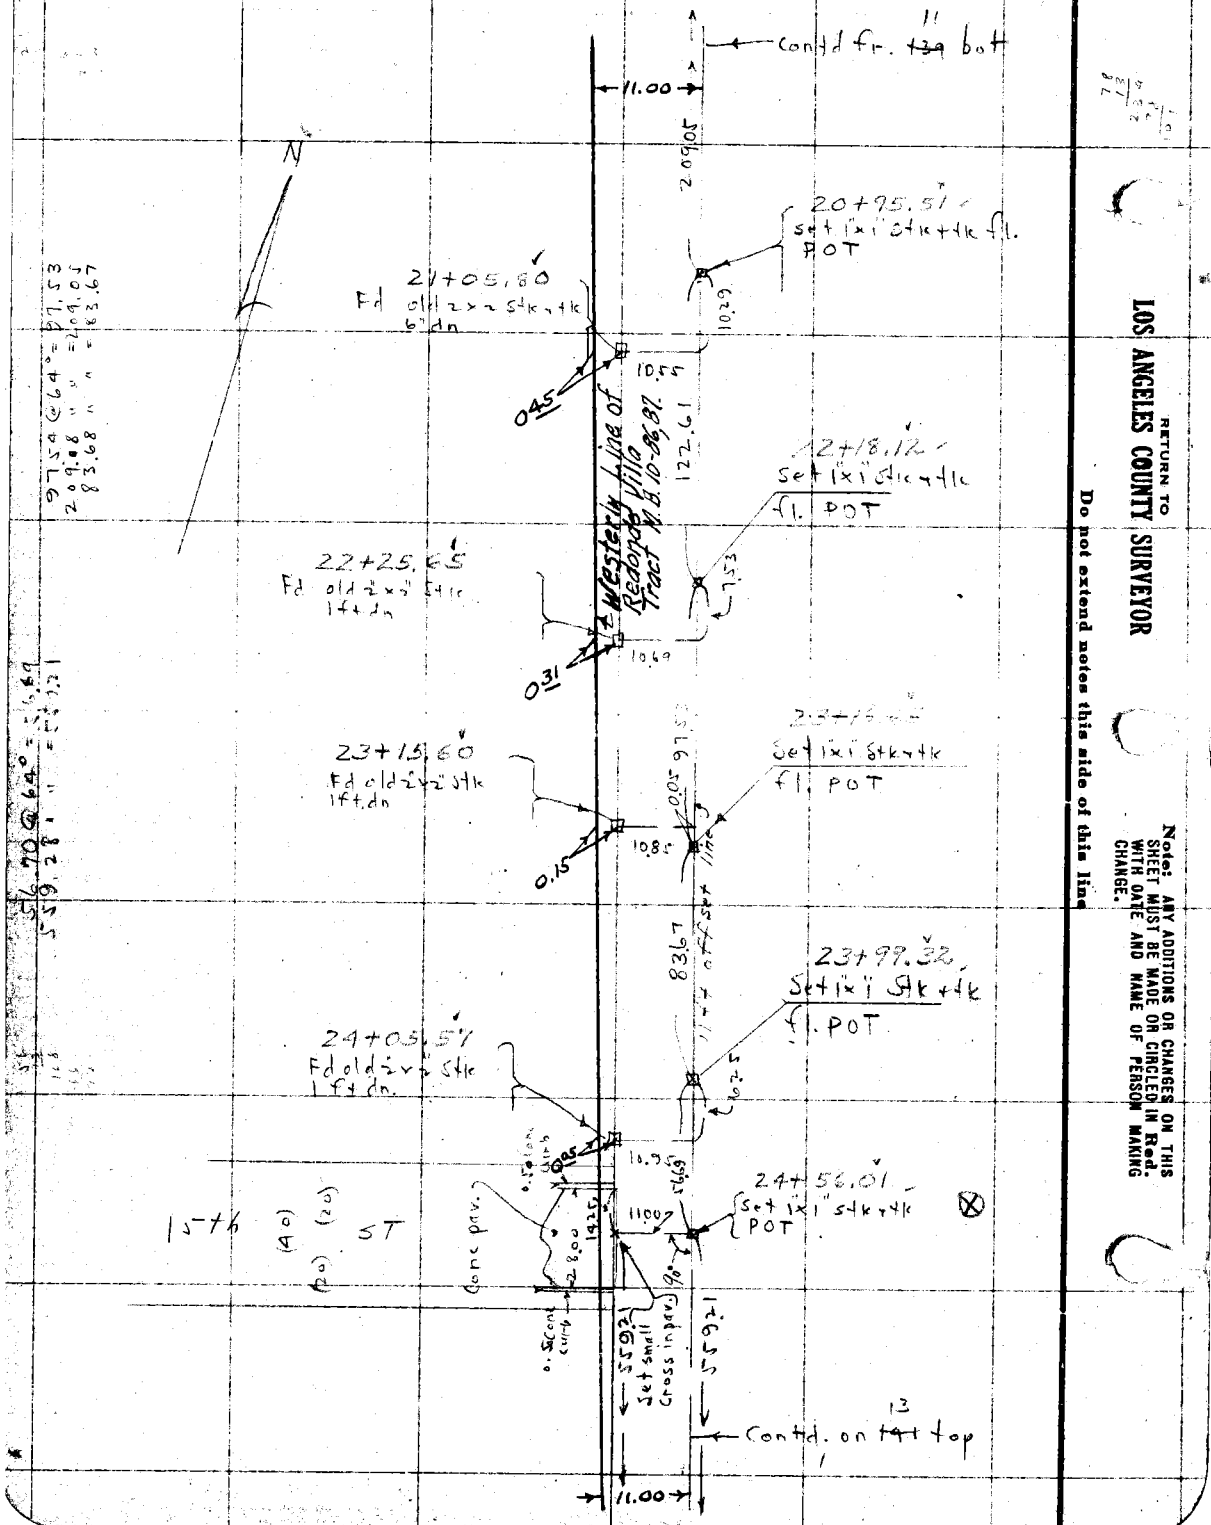

RETURN TO LOS ANGELES COUNTY SURVEYOR

Do not extend notes this side of this line

Note: ANY ADDITIONS OR CHANGES ON THIS SHEET MUST BE MADE OR CIRCLED IN Red. WITH DATE AND NAME OF PERSON MAKING CHANGE.

Date 4-13-29 Notes by RHA Chief Party RHC F.B. 312 Pg 13 (397) 41

Plotted by A. Svenson
Date Aug 1930
Map No. B-442-2
Plotting C'k'd by D. M. Finley
Date Nov. 1933

W. O. No. 920 B. S/O. No. 079
Location Riv. Redondo Rd
Surveyed by Pkm, Tilkins, Dee
Date 4-13-29
Indexed A. C. Johnson

Notes: ANY ADDITIONS OR CHANGES OF THIS SHEET MUST BE MADE OR CHANGED IN Red. WITH DATE AND NAME OF PERSON MAKING CHANGE.

Do not extend notes this side of this Ride

RETURN TO LOS ANGELES COUNTY SURVEYOR

I = 3921 45
A = 1512 25
A = 9921 41 25
Supl = 8038 15

Contd from 1+40 bot

11.00

981.31 @ 80° = 981.28
981.33 @ 80° = 981.30
981.29
(982.39)
1.06

Westline Redondo Villa Tr.

S 59.21 E

11 ft offset line

30+15.21
Fd 4" IP filled with + set in conc. Cop. tk top. 1½ ft dn
FB 101-41. RD FB 41-50.

30+40

11.00

981.29

AVE

30+15.62
Fd Spk W+T. FB 101-41
RD FB 41-50

Fd + IP Conc. Curb
0.5 Conc. Curb

46/4

11.00

set pch mk

Fd SW+T. in conc. pav.
(9+82.33 - FB 101-41)

SANTE FE

32.48

Fd 4" IP cop. tk

Fd m
20.25

S 9.27 E

A
C

AVE.

0.5 Conc Curb

Fd x in curb

(20) (A 0) (20)

HARPER

399 14

F.B. 312 Pg. 142 PMA Chief Party Notes by PMA Date 4--29

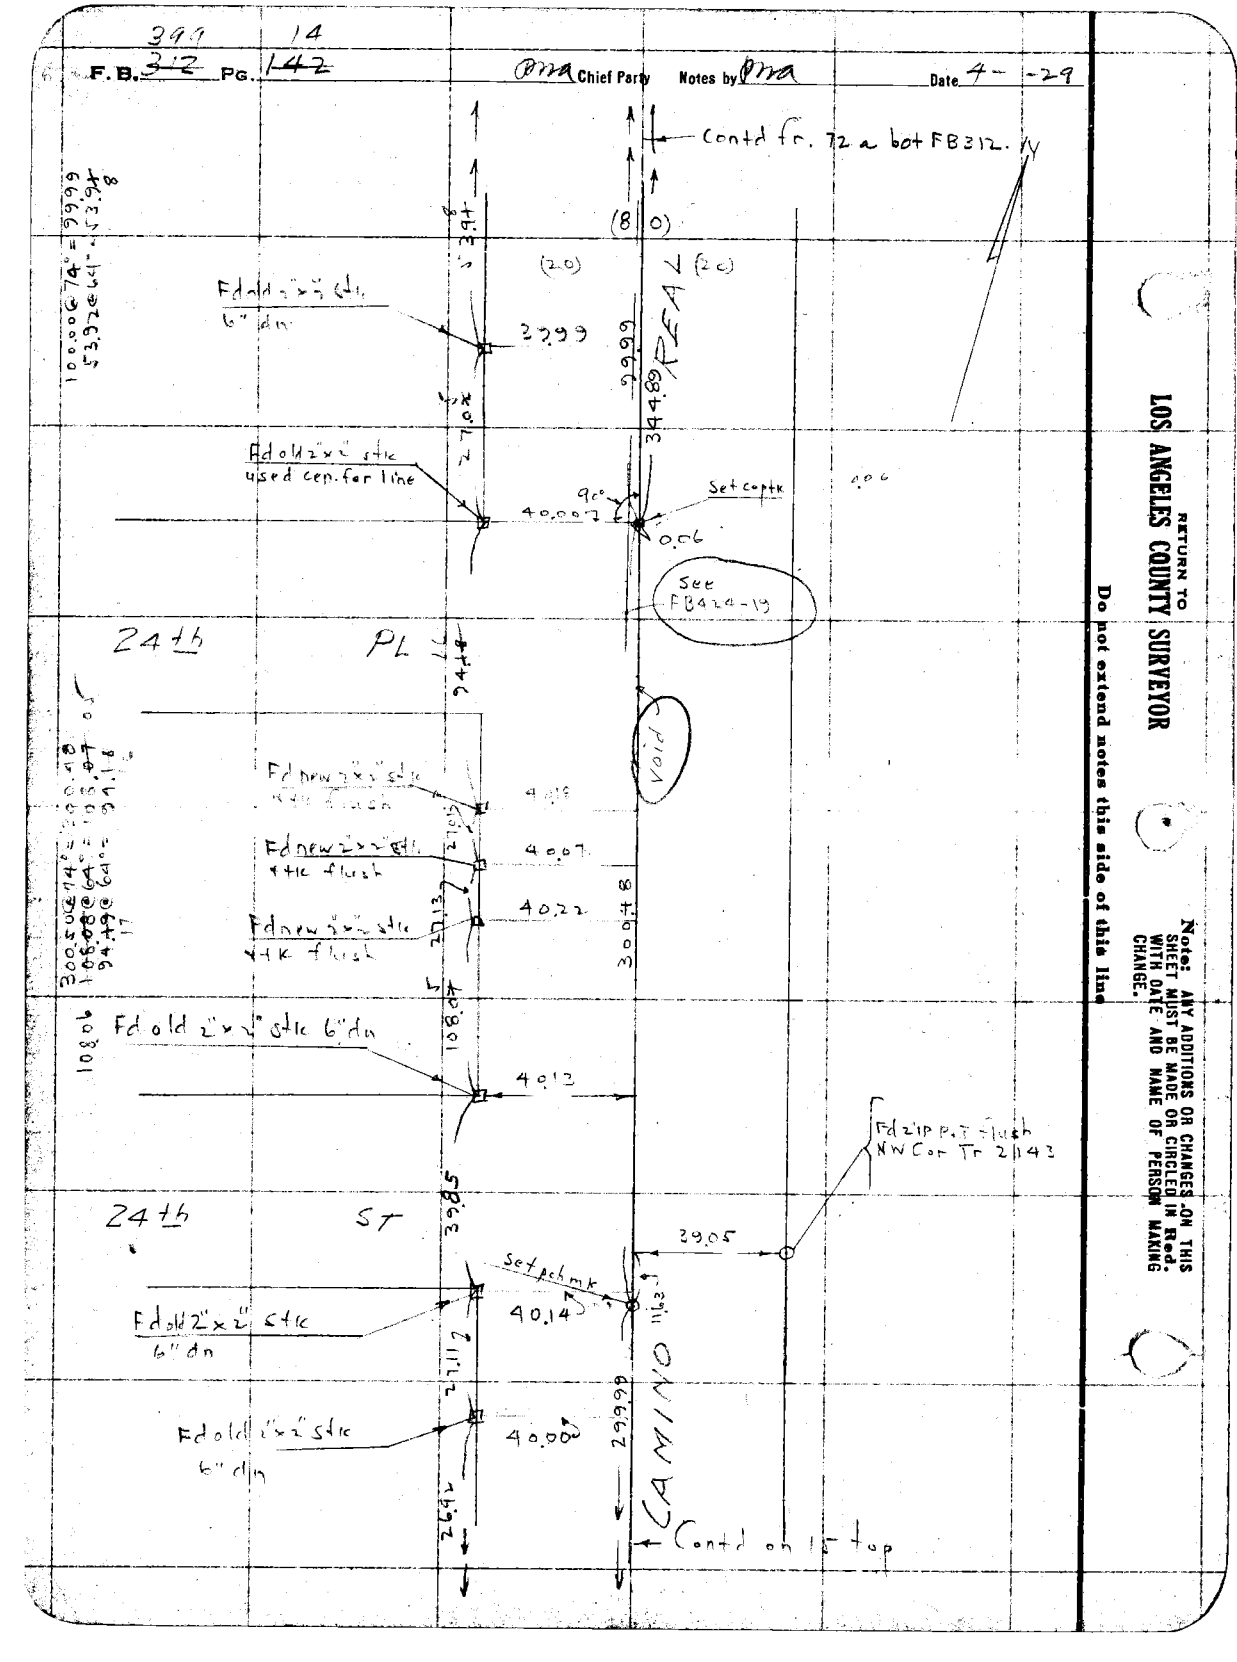

RETURN TO LOS ANGELES COUNTY SURVEYOR

Do not extend notes this side of this line

Note: ANY ADDITIONS OR CHANGES ON THIS SHEET MUST BE MADE OR CIRCLED IN Red. WITH DATE AND NAME OF PERSON MAKING CHANGE.

Date 4- -29 Notes by Pira Chief Party Pira F.B. 312 PG. 143

399 15

Platted by A. Svenson
Date Aug. 1930.
Map No. B-442-2
Platting C'k'd by D. M. Finley
Date Nov. 1933

W. O. No. 920 D. & C. No. 029
Location Riv. Redondo Rd
Surveyed by Paul Atkins Dep
Date 4- -29
Indexed A. C. Jc

Notes: ANY ADDITIONS OR CHANGES ON THIS SHEET MUST BE MADE OR CANCELED IN Red. WITH DATE AND NAME OF PERSON MAKING CHANGE.

Do not extend notes this side of this line

RETURN TO LOS ANGELES COUNTY SURVEYOR

Contd fr. 14 bot

Fd old 2x2 without tk flush

269.27

3999 (60)

(40) (40)

REAL

300.00@74°= 299.98
.23
.23

299.98

See FB 424-19

VOID

Fd 2" IP & PT flush SW Cor Tr. 2143

23
250.30

39.37

N & T set in PP

11.81

31.45

Fd old 1x2" stk used cen. for line

40.00

Set L+T curb

29.27

Set copt k in oiled surf on conc. pav

(30) (60) (60)

ST.

2154

7.86

50.00

Set L+T curb

Set L+T edge old conc pav

CAMINO

399 | 16

F. B. _____ Pg. _____ DMA Chief Party Notes by RMA Date 4- -29

RETURN TO
LOS ANGELES COUNTY SURVEYOR

Do not extend notes this side of this line

Note: ANY ADDITIONS OR CHANGES ON THIS SHEET MUST BE MADE OR CIRCLED IN Red. WITH DATE AND NAME OF PERSON MAKING CHANGE.

Date 4-16-29 Notes by D.I.R. Chief Party D.I.R. F.B. 112 Pg 44

Platted by A. Svenson
Date Aug. 1930.
Map No. B-442-2
Platting C'k'd by D. M. Finley
Date Nov 1930.

W. O. No. 920 D. S. D. No. 029
Location Riv. Rec. & Pk. Rd
Surveyed by Dept. of Parks
Date 4-16-29
Indexed

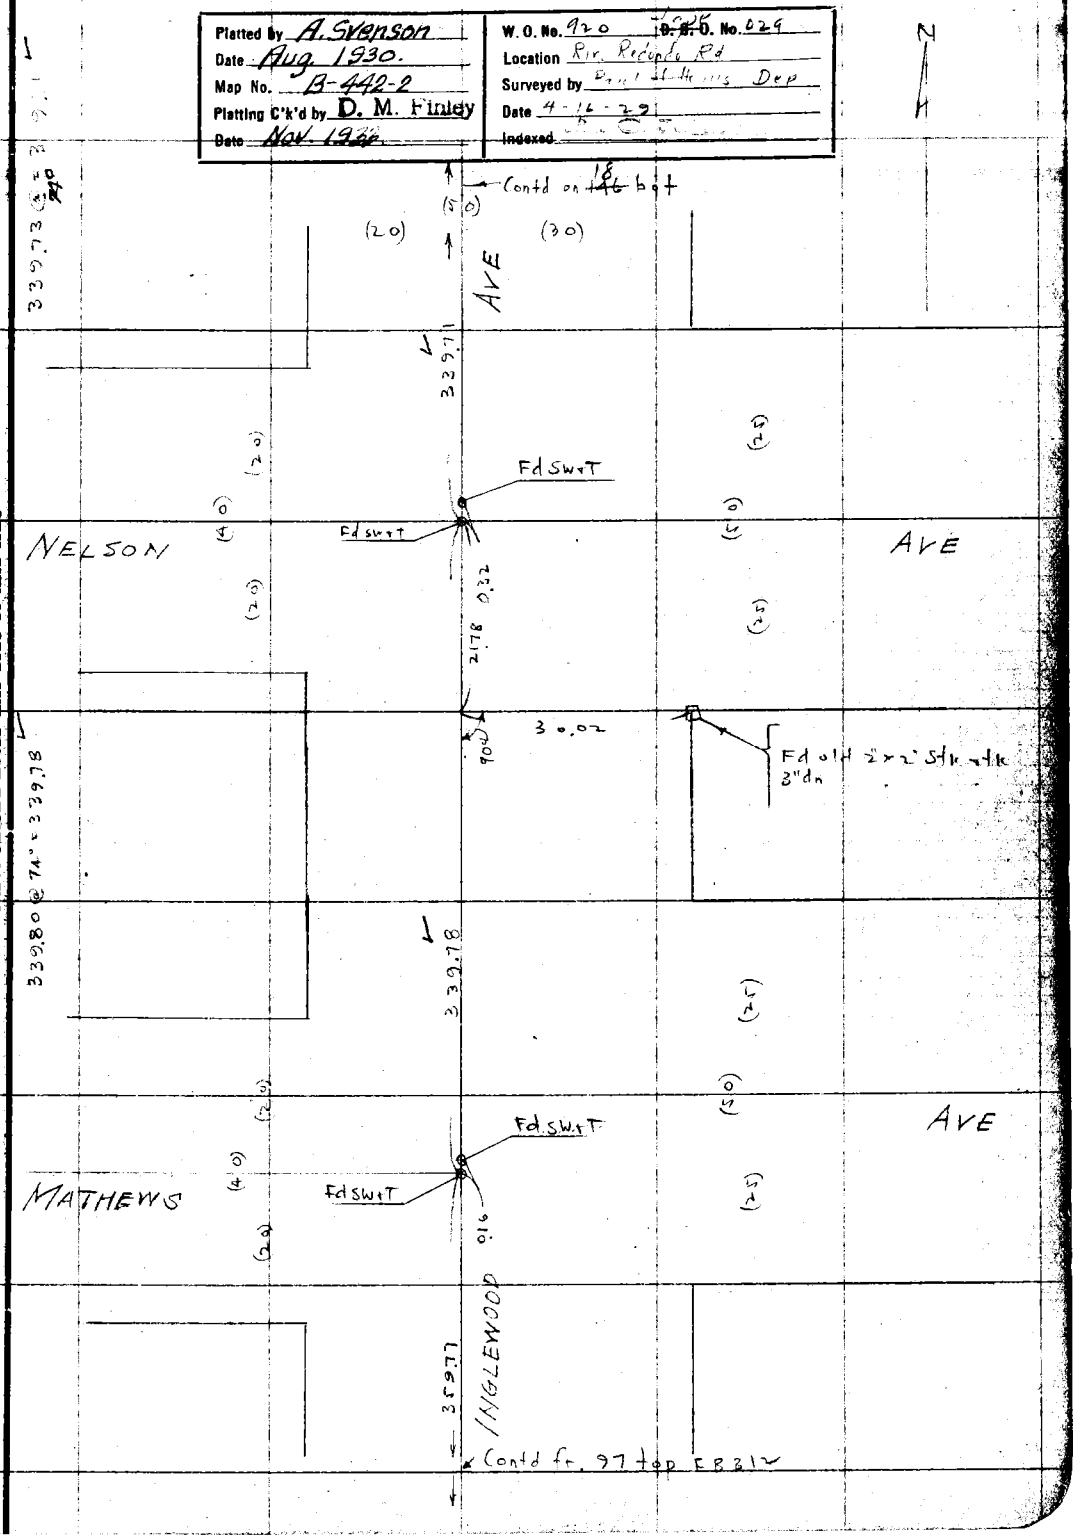

Notes: ANY ADDITIONS OR CHANGES ON THIS SHEET MUST BE MADE OR CIRCLED IN Red. WITH DATE AND NAME OF PERSON MAKING CHANGE.

Do not extend notes this side of this line

RETURN TO LOS ANGELES COUNTY SURVEYOR

399 18

F. B. ~~342~~ Pg. ~~146~~ Dma Chief Party Notes by Dma Date 4-16-29

RETURN TO
LOS ANGELES COUNTY SURVEYOR

Do not extend notes this side of this line

Note: ANY ADDITIONS OR CHANGES ON THIS SHEET MUST BE MADE OR CIRCLED IN Red. WITH DATE AND NAME OF PERSON MAKING CHANGE.

Date [illegible] Notes by JNA Chief Party [illegible] F.B. 399 Pg. 19

Platted by A. Svenson
Date Aug. 1930
Map No. B-442-2
Platting C'k'd by D. M. Finley
Date Nov. 1933

W. O. No. 920 S. B. M. No. C-4
Location Rv Redondo Rd
Surveyed by [illegible]
Date [illegible]
Indexed

Notes: ANY ADDITIONS OR CHANGES OR THIS SHEET MUST BE MADE OR CIRCLED IN Red. WITH DATE AND NAME OF PERSON MAKING CHANGE.

Do not extend notes this side of this line

RETURN TO
LOS ANGELES COUNTY SURVEYOR

N

Contd fr bat

~~639.99~~ @ 64° = 639.87
Pg 20

See F.B. 442-68.

NW 90 01 15
360 05 30
90 01 20

NE 89 58 45
359 54 45
89 58 41.25

(20) (40) (20)

89 58 45

Fd C S Mon 1 ft dn
(10+99.31 f- W F.B 101-67

Contd fr 20 left

639.90
~~639.87~~

(40)

GRANT 80

(40)

AVE

FLAGLER

F. B. 399 Pg. 20 — Chief Party — Notes by — Date 4-25-29

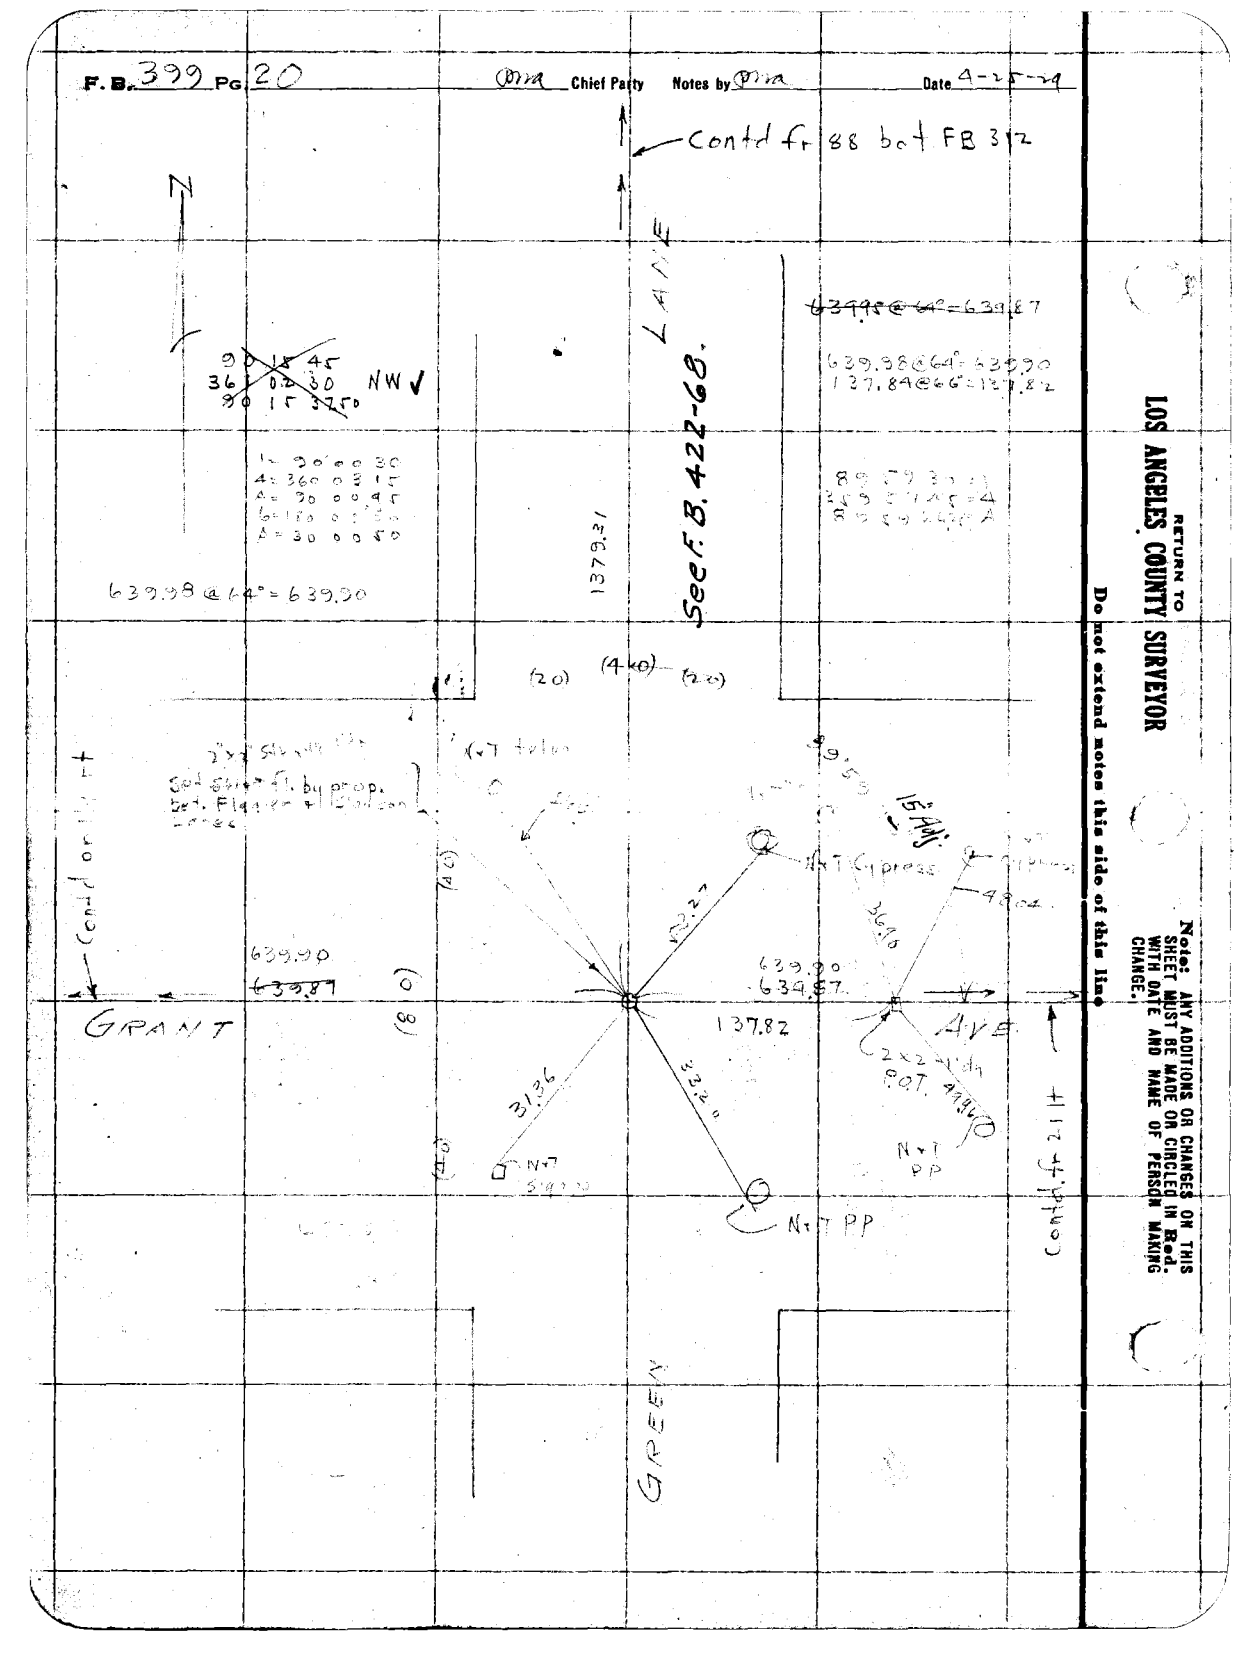

Date 9-25-29 Notes by JMA Chief Party JMA F.B. 399 Pg 21

Platted by A. Svenson	W. O. No. 220 ~~B. C. O.~~ No. 029
Date Aug. 1930	Location Riv. Rd. to Lo[illegible]
Map No. B-442-2	Surveyed by [illegible]
Platting C'k'd by D. M. Finley	Date 4-25-29
Date Nov. 1933	Indexed

Sec. B. 422-69

Contd fr 90 in FB 31

~~639.95~~ @ 64' = 639.89

639.98 @ 64' = 639.90

NE

NW

1379.52

1379.52 [illegible] @ 270° = 1379.52

Contd on 20 in

Not tel pole

Ingr. Fire Plug

Set ~~SW+T~~ ft. by prop. bet Flagler + Slauson Lanes

639.90 ~~639.87~~

639.90 ~~639.87~~ Y

Not [illegible]

BLOSSOM

Notes: ANY ADDITIONS OR CHANGES ON THIS SHEET MUST BE MADE OR CIRCLED IN Red. WITH DATE AND NAME OF PERSON MAKING CHANGE.

Do not extend notes this side of this line

RETURN TO LOS ANGELES COUNTY SURVEYOR

F. B. 399 Pg 22 — Chief Party — Notes by — Date 4-25-24

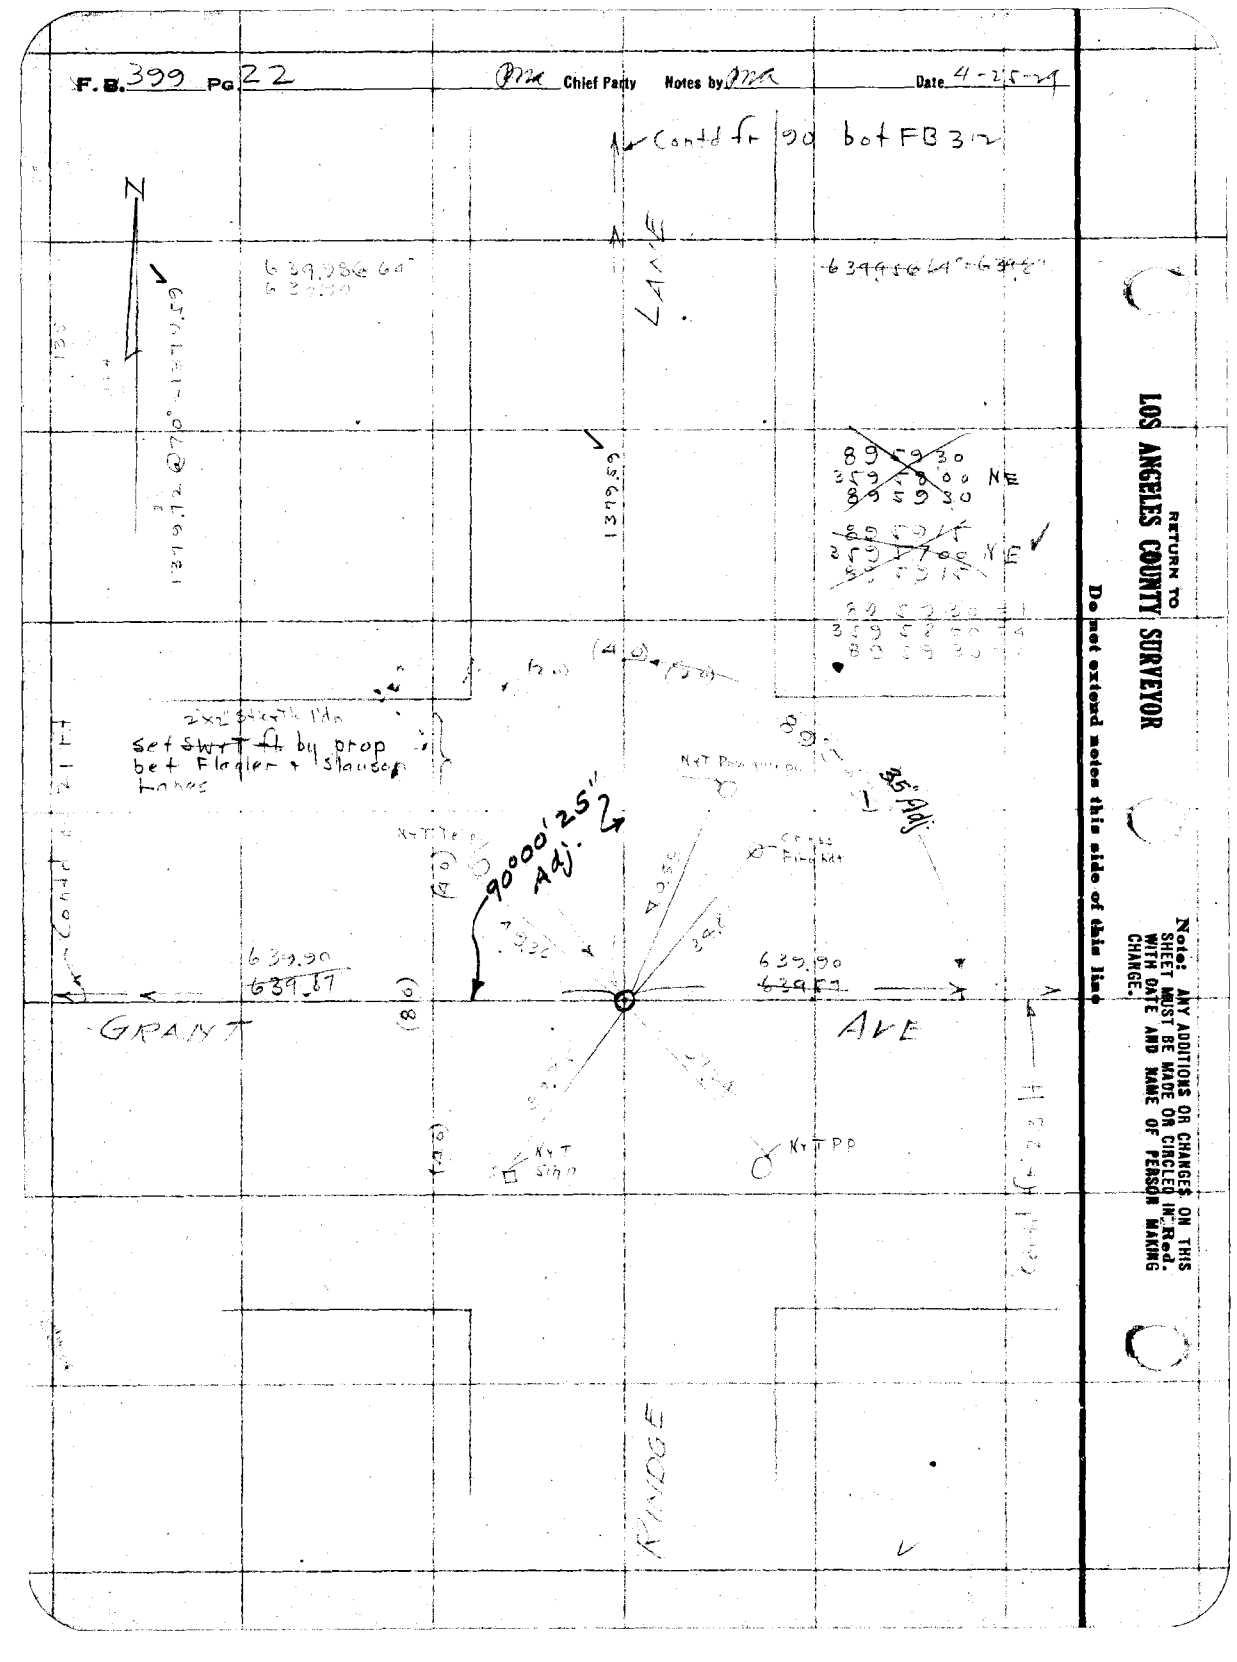

RETURN TO
LOS ANGELES COUNTY SURVEYOR
Do not extend notes this side of this line

Note: ANY ADDITIONS OR CHANGES ON THIS SHEET MUST BE MADE OR CIRCLED IN Red. WITH DATE AND NAME OF PERSON MAKING CHANGE.

Date 4-25-29 Notes by DNR Chief Party DNR F.B. 529 Pg 23

Platted by A. Svenson	W. O. No. 920 T.S.C. No. 029
Date Aug. 1930	Location Mtx. Redondo Rd
Map No. B-442-2	Surveyed by D. [illegible] Dep
Platting Ck'd by D. M. Finley	Date 4-25-29
Date Nov. 1933	Indexed A. C. Johnson

Notes: ANY ADDITIONS OR CHANGES ON THIS SHEET MUST BE MADE OR CIRCLED IN Red. WITH DATE AND NAME OF PERSON MAKING CHANGE.

Do not extend notes this side of this line

RETURN TO LOS ANGELES COUNTY SURVEYOR

Contd from 91 bot FB 312

633.83 @ 70° = 639.77
639.91 @ 64° = 639.85
639.98 @ 69° = 639.90

See F.B. 422 — 70-71

89 58 00
359 52 00 NE
89 58 00

1372.80 @ 70° = 1379.67

90 00 00
360 01 14 NW
90 00 18.75

90°00'10" Adj.

89°57'55" Adj.
89°58'05" Adj.

Fd C.S. Mon. Iftdn
(26+58.91 FB 101 +

N+T MB pp

35.03

639.90
639.87

639.85

Contd on 22 14

Contd

GRANT (8

AVE

N+T PP

SLAUSON

F. B. 399 PG 24 Chief Party Notes by Date 4-25-29

(cont'd from 93 bot.) FB 312

LAKE

1379.97 ℄ 64° = 1379.79

1379.79

639.85 ℄ 90° = 639.77

639.92 ℄ 90° = 639.85

89 58 45 NE

359 59 45

89 58 41

(cont'd on 23 bot.)

set SW & T fl. by prop. bet. Slauson & Fulton Lanes

(40) (40) (40)

89°58' 35" 35" Adj

63985 (0) (88) 63985

(40) (40)

32.51

32.85

N&T sign PO

N&TPO

MACKAY

(40)

RETURN TO LOS ANGELES COUNTY SURVEYOR

Do not extend notes this side of this line

Note: ANY ADDITIONS OR CHANGES ON THIS SHEET MUST BE MADE OR CIRCLED IN Red. WITH DATE AND NAME OF PERSON MAKING CHANGE.

Date 4-25-29 Notes by Wire Chief Party Wire F.B. Pg 25

Platted by A. Svenson
Date Aug. 1930
Map No. B-442-2
Platting C'k'd by D. M. Finley
Date Nov. 1933

W. O. No. 920 D. B. & M. No. 029
Location Rev. Rancho Ex. ...
Surveyed by Dan'l A Thing Job
Date 4-21-29
Indexed S. C. Johnson

Notes: ANY ADDITIONS OR CHANGES OF THIS SHEET MUST BE MADE OR CIRCLED IN Red. WITH DATE AND NAME OF PERSON MAKING CHANGE.

Do not extend notes this side of this line

RETURN TO LOS ANGELES COUNTY SURVEYOR

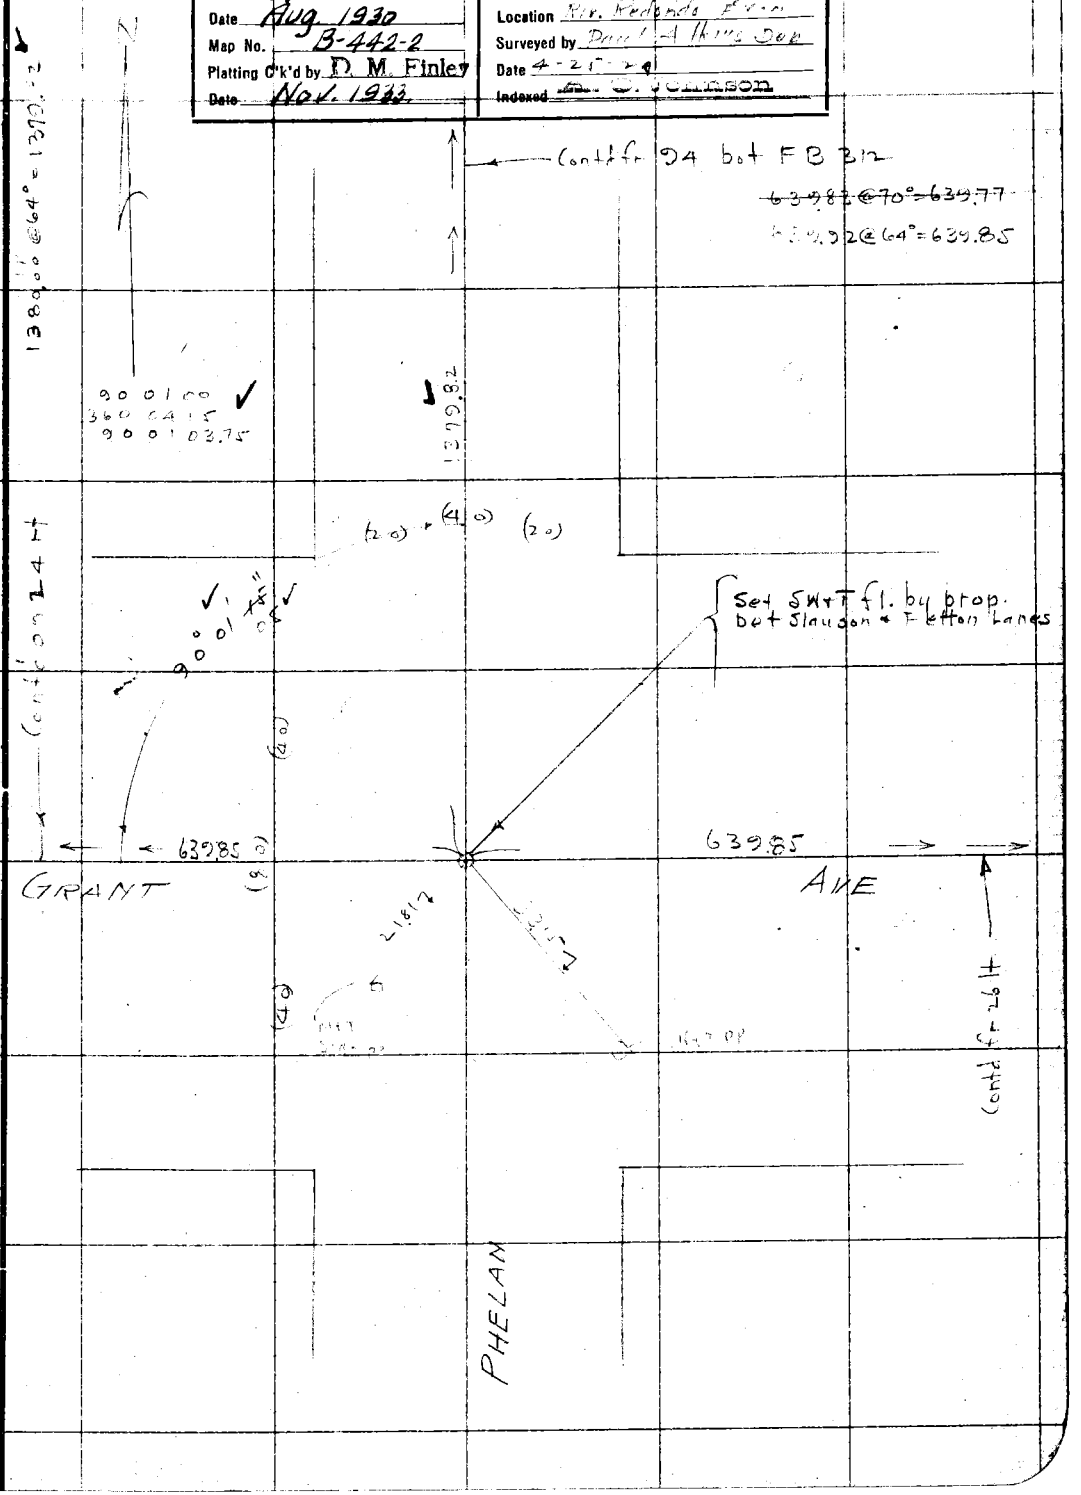

RETURN TO
LOS ANGELES COUNTY SURVEYOR

Note: ANY ADDITIONS OR CHANGES ON THIS SHEET MUST BE MADE OR CIRCLED IN Red. WITH DATE AND NAME OF PERSON MAKING CHANGE.

Do not extend notes this side of this line

F.B. 399 Pg 26 Chief Party DRM Notes by DRM Date 4-24-11

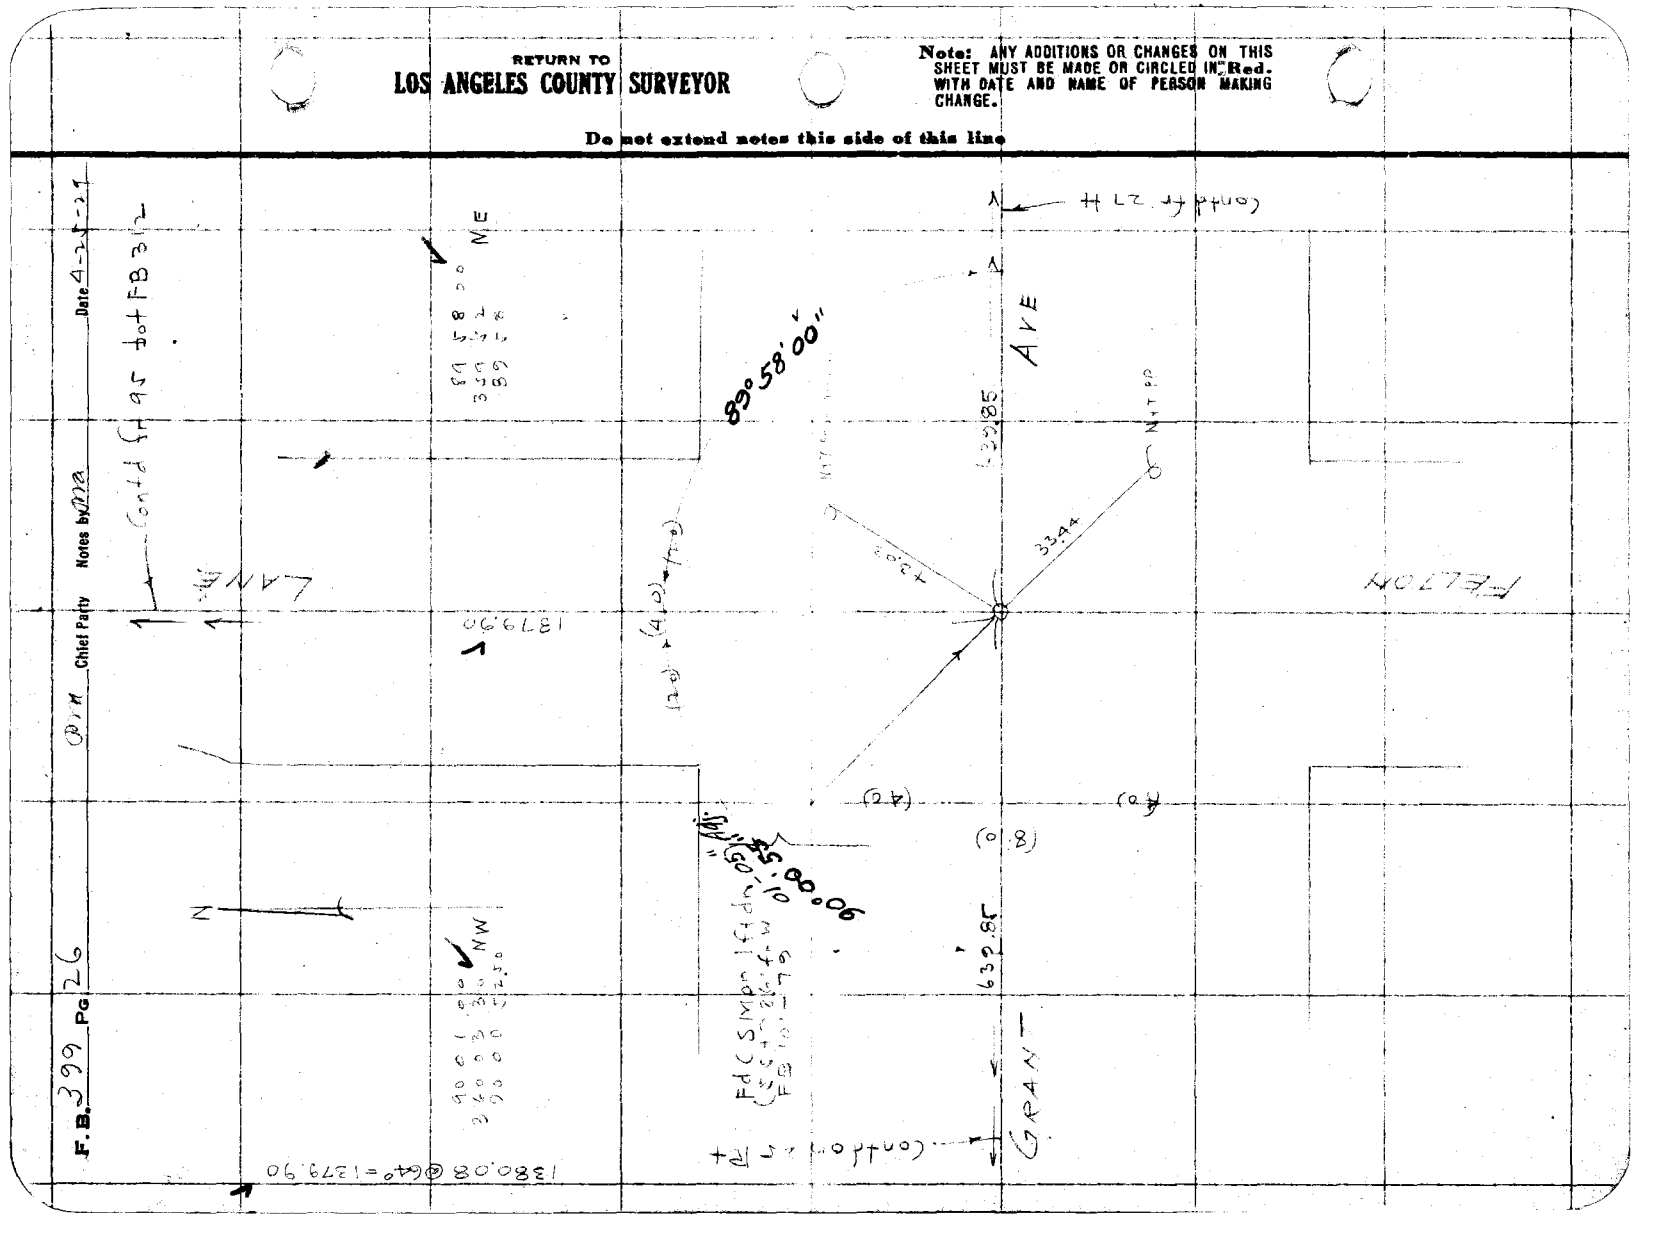

Date 4-17-29 Notes by Pina Chief Party Pina F.B. 393 Pg 27

Platted by A. Svenson	W. O. No. 420 S.S.C. No.
Date Aug. 1930	Location Nr. Redondo Dr.
Map No. B-448-2	Surveyed by Pina Alkire Dep
Platting C'k'd by D. M. Finley	Date 4-17-29
Date Nov. 1933	Indexed

Notes: ANY ADDITIONS OR CHANGES ON THIS SHEET MUST BE MADE OR CIRCLED IN Red. WITH DATE AND NAME OF PERSON MAKING CHANGE.

Do not extend notes this side of this line

RETURN TO LOS ANGELES COUNTY SURVEYOR

N

Contd from pg 96 bot. FB 314

639.85 ✓

LANE

567. ✓

(40)

(20) (20)

1279.61

Set 2"x24" stk w+t
Hd down RP
15° Adj.

90°02'

(40)

4691

2"IP P+T (LACoSCo)

4288.55

4.0ct

3832

Contd on 26+

Contd on 29+

(80) 639.85 ✓

567.55 ✓

GRANT AVE

Set Spk W+T flush by prop. lot. Rigley Alley & Fenton Lane

(40)

5694

3201

4.7 Ct

NAT PP

PERKINS

F.B. 391 Pg. 28 Chief Party Notes by Date 4-25-29

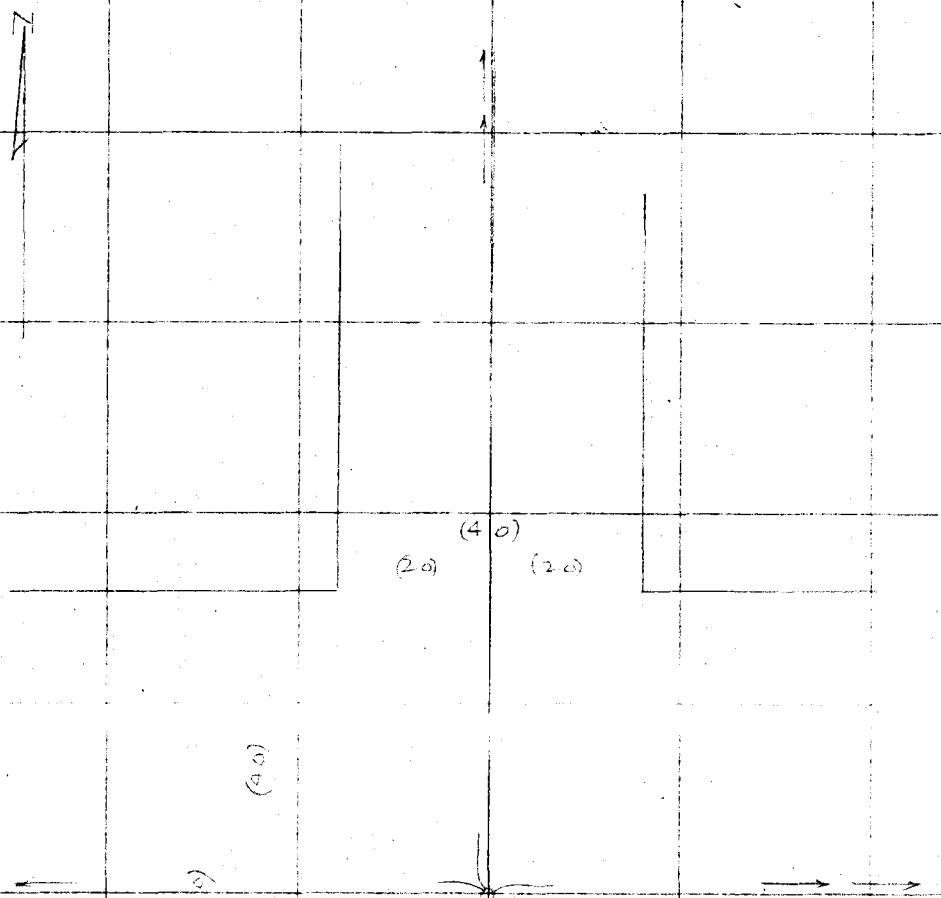

RETURN TO
LOS ANGELES COUNTY SURVEYOR

Do not extend notes this side of this line

Note: ANY ADDITIONS OR CHANGES ON THIS SHEET MUST BE MADE OR CIRCLED IN Red. WITH DATE AND NAME OF PERSON MAKING CHANGE.

Date 4-25-29 Notes by DMF Chief Party DMF F.B. 399 Pg 29

Platted by A. Svenson
Date Aug. 1930
Map No. B-442-2
Platting Ck'd by D. M. Finley
Date Nov. 1933

W. O. No. 970 D. S./C. No. 029
Location El Redondo Rd
Surveyed by D. M. Finley Jr.
Date 4-25-29
Indexed

RETURN TO
LOS ANGELES COUNTY SURVEYOR

Notes: ANY ADDITIONS OR CHANGES OR THIS SHEET MUST BE MADE OR CIRCLED IN Red. WITH DATE AND NAME OF PERSON MAKING CHANGE.

Do not extend notes this side of this line

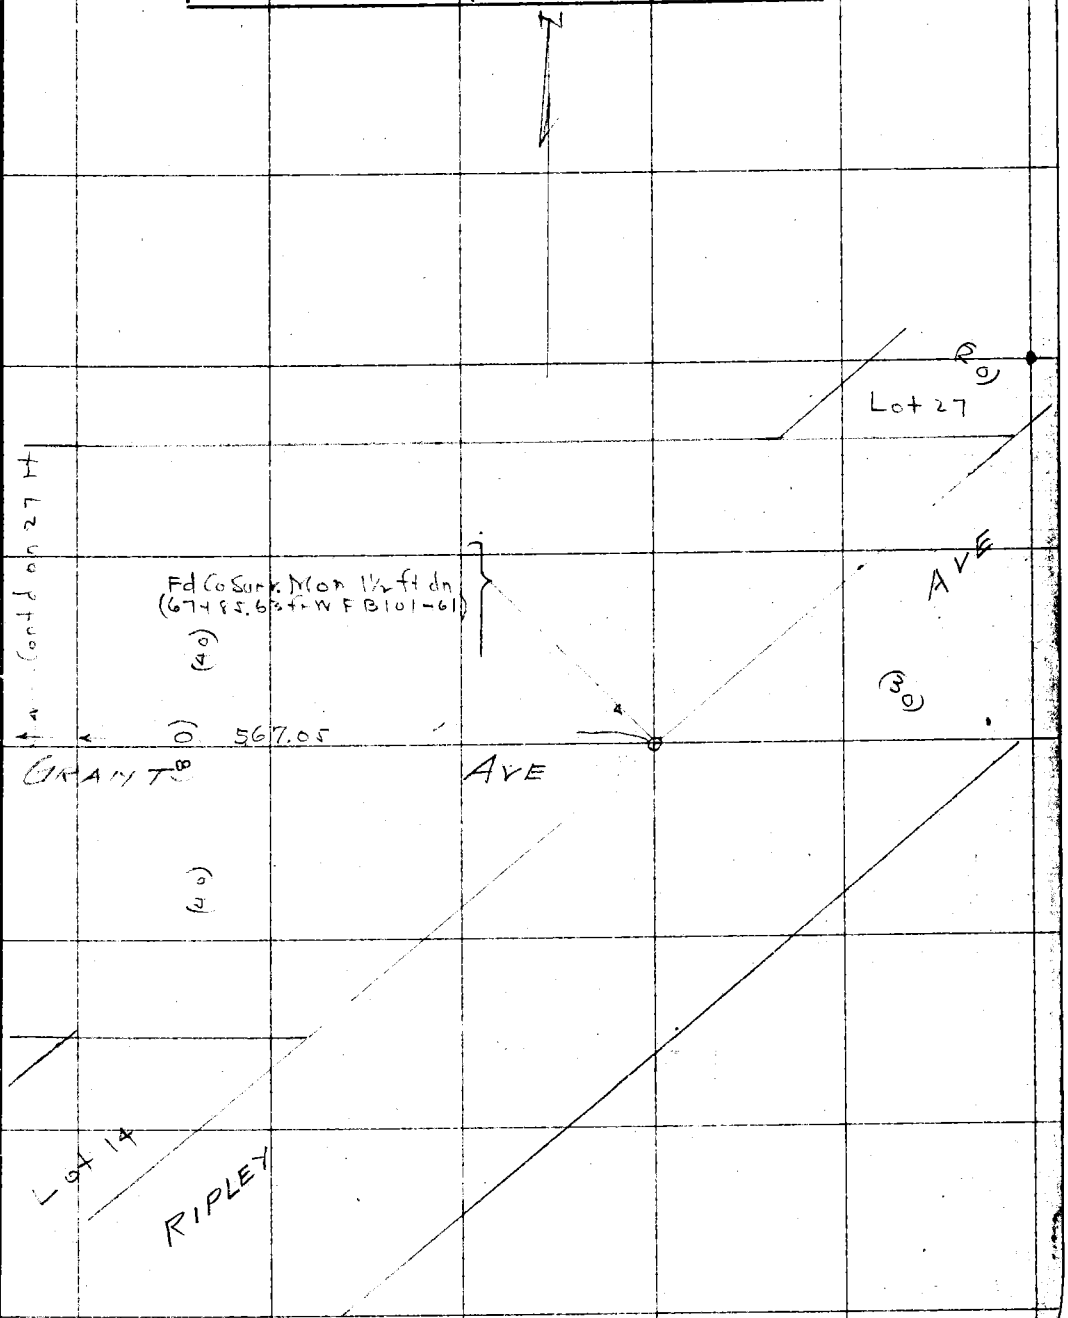

F. B. 399 Pg. 30 Chief Party Notes by Date 4- -24

55.51 @ 64° = 55.50
53.25 " " = 53.24
46.26 " " = 46.25
79.81 " " = 79.80
53.52 " " = 53.51
66.54 " " = 66.53

68° 54'
275 36
68 24

1119.98 @ 84° = 111.98
74.19 @ 11° = 74.19
186.17

Set NIT 10 ft off curb
No stakes fd

ALLEY

10.00

TR. No. 9486

(10)
(20)
(10)

6.98

Cont. on P.B. 31 14

Cont. in F.B. 312-Pg. 105

(30)
Rec. Tr 9486
74.18

112.14
112.39

(30)

RIVERSIDE REDONDO BLVD

53.47
66.53

(30)

chiseled cross
in steel vent pipe

111+37.23 ft E
Fd SW - mng. pt.
FB 312 - 104

110+63.04 ft E
Set LIT Conc. mrk.
by Rec. Tr. mng. pt
Tr. No. 9486

~~74.18~~
~~112.14~~
~~112.37~~

RETURN TO LOS ANGELES COUNTY SURVEYOR

Do not extend notes this side of this line

Note: ANY ADDITIONS OR CHANGES ON THIS SHEET MUST BE MADE OR CIRCLED IN Red. WITH DATE AND NAME OF PERSON MAKING CHANGE.

Date 5-7-29 Notes by [illegible] Chief Party [illegible] F.B. 399 Pg. 31

Platted by J.D. Price.	W.O. No. 920 ~~S.B.~~ No. 029
Date March, 1931.	Location Riv. Redondo Rd
Map No. C.S.B-442-Sht.1.	Surveyed by [illegible] Dep
Platting C'k'd by Roesser	Date 5-7-29
Date Dec. 1931	Indexed

Notes: ANY ADDITIONS OR CHANGES ON THIS SHEET MUST BE MADE OR CIRCLED IN Red. WITH DATE AND NAME OF PERSON MAKING CHANGE.

Do not extend notes this side of this line

RETURN TO LOS ANGELES COUNTY SURVEYOR

+86.17 @ 64° = +86.17
+86.18 @ 74° = +86.17
35.30 @ 64° = 32.30
155.90 @ 84° = 155.30
186.32 @ 76° = 186.32

Tr No. 9486

Sec Pg 30

Cont'd fr F.B. 312 - 105 Rt

Set L.T. conc curb

Cont'd 32 Rt

RIV. @ REDONDO BLVD

Tr No. 9306

Fd 2" IPP+T fl. Tr No. 9306 Sht 2

Fd 2" IPP+T fl. Tr No. 9306 Sht 2

Fd 2" IPP+T

Set Nail

ASHLEY

ALLEY

1 = 111 06 30
4 = 68 54 45
Δ = 111 06 26

1 = 68 54 30
2 = 137 49 30
Δ = 68 54 45

F.B. 399 Pg. 32 — Chief Party — Notes by — Date 5-7-29

150.18 @ 74° = 150.17
35.15 @ 74° = 35.15
58.90 @ 74° = 58.89
53.61 @ 74° = 53.60

556.08 @ 64° = 556.04
pg 31 → 186.13 −
369.94

111 05 30
444 22
111 05 30
68 54 30

369.74 @ 76° = 369.72

Tr. No. 9486

105+81.19 ft E
Set L+T conc. pav. ft.
by int.

Cont'd fr. 31.++

Cont'd on 31.++

Set L+tk conc curb

Fd L+T on line

RIVERSIDE & REDONDO

369.72

BLVD

(50) (50) (30 R)

3 2 1

Tr. No. 9306

(50) (36.66)

ALLEY

Fd 2" IP P+T flush
Most Wly Cor Lot 1
Tr No. 9306.

Set Na

7

ROSLIN

Fd 2" IP P+T flush
SE Cor Lot 12
Tr No. 9306

Set Na

RETURN TO
LOS ANGELES COUNTY SURVEYOR

Do not extend notes this side of this line

Note: ANY ADDITIONS OR CHANGES ON THIS SHEET MUST BE MADE OR CIRCLED IN Red. WITH DATE AND NAME OF PERSON MAKING CHANGE.

Date 2-15-29 Notes by [illegible] Chief Party [illegible] F.B. 397 Pg. 33

Platted by J.D.Price.	W.O. No. 920 ~~5.B.~~ C.S.B. No. 079
Date March, 1931.	Location Riv. Redondo Rd
Map No. C.S.B-447. Sht.1	Surveyed by Dana Alleine Dep
Platting Ck'd by Rosser	Date 4-15-29
Date Dec. 1933	Indexed

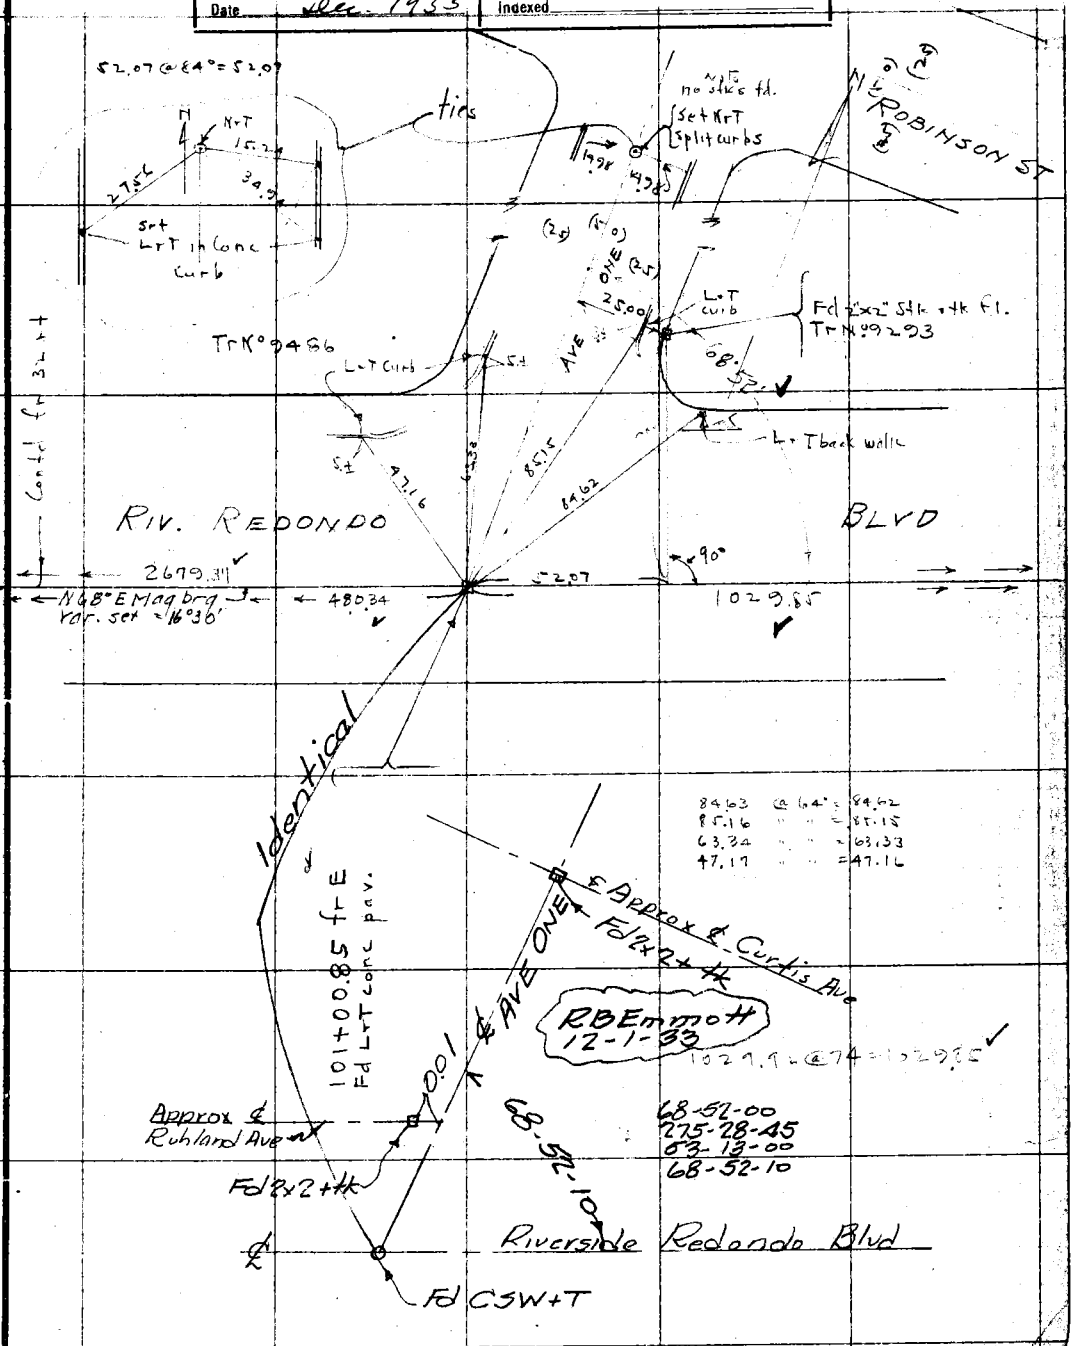

Note: ANY ADDITIONS OR CHANGES ON THIS SHEET MUST BE MADE OR CIRCLED IN Red. WITH DATE AND NAME OF PERSON MAKING CHANGE.

Do not extend notes this side of this line

RETURN TO LOS ANGELES COUNTY SURVEYOR

F. B. 399 Pg. 34 — Chief Party — Notes by — Date 4-29

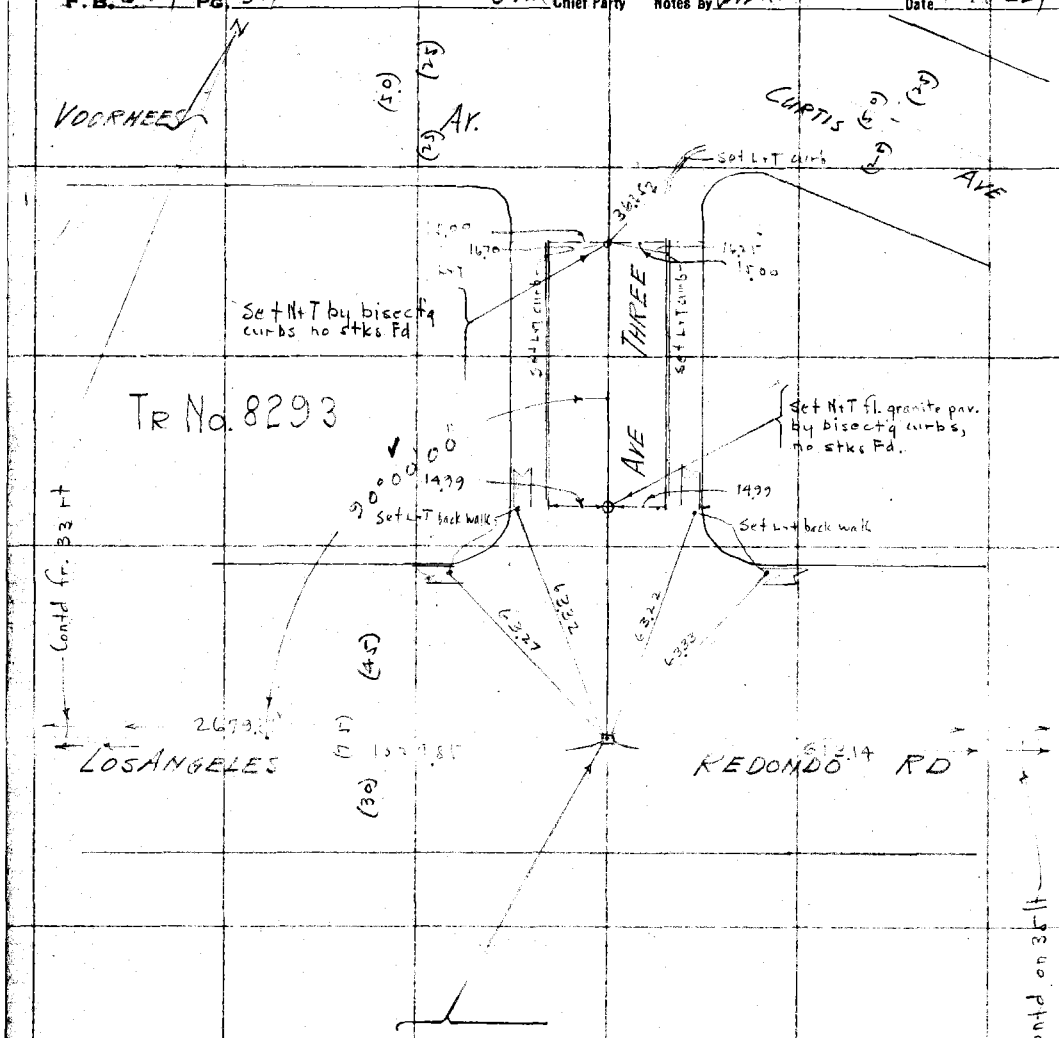

29.85
14.93

RETURN TO
LOS ANGELES COUNTY SURVEYOR
Do not extend notes this side of this line

Note: ANY ADDITIONS OR CHANGES ON THIS SHEET MUST BE MADE OR CIRCLED IN Red. WITH DATE AND NAME OF PERSON MAKING CHANGE.

90° 36'00" ✓

6334 @ 64° = 63.33
6323 " " = 63.22
6333 @ 64° = 63.32
6324 " " = 63.23

~~613.05~~ @ 87° = ~~613.06~~
613.13 @ 87° = 613.14

Date 4-30-29 Notes by [illegible] Chief Party [illegible] F.B. 211 PG. 35

Platted by J.D. Price.
Date March, 1931.
Map No. C.S. B-442 Sht. 1
Platting Ck'd by [illegible]
Date Dec. 1933

W. O. No. 920 [illegible] No. 029
Location Riv. Redondo Rd
Surveyed by [illegible]
Date 4-30-29
Indexed A. C. Johnson

Notes: ANY ADDITIONS OR CHANGES ON THIS SHEET MUST BE MADE OR CIRCLED IN Red. WITH DATE AND NAME OF PERSON MAKING CHANGE.

Do not extend notes this side of this line

RETURN TO LOS ANGELES COUNTY SURVEYOR

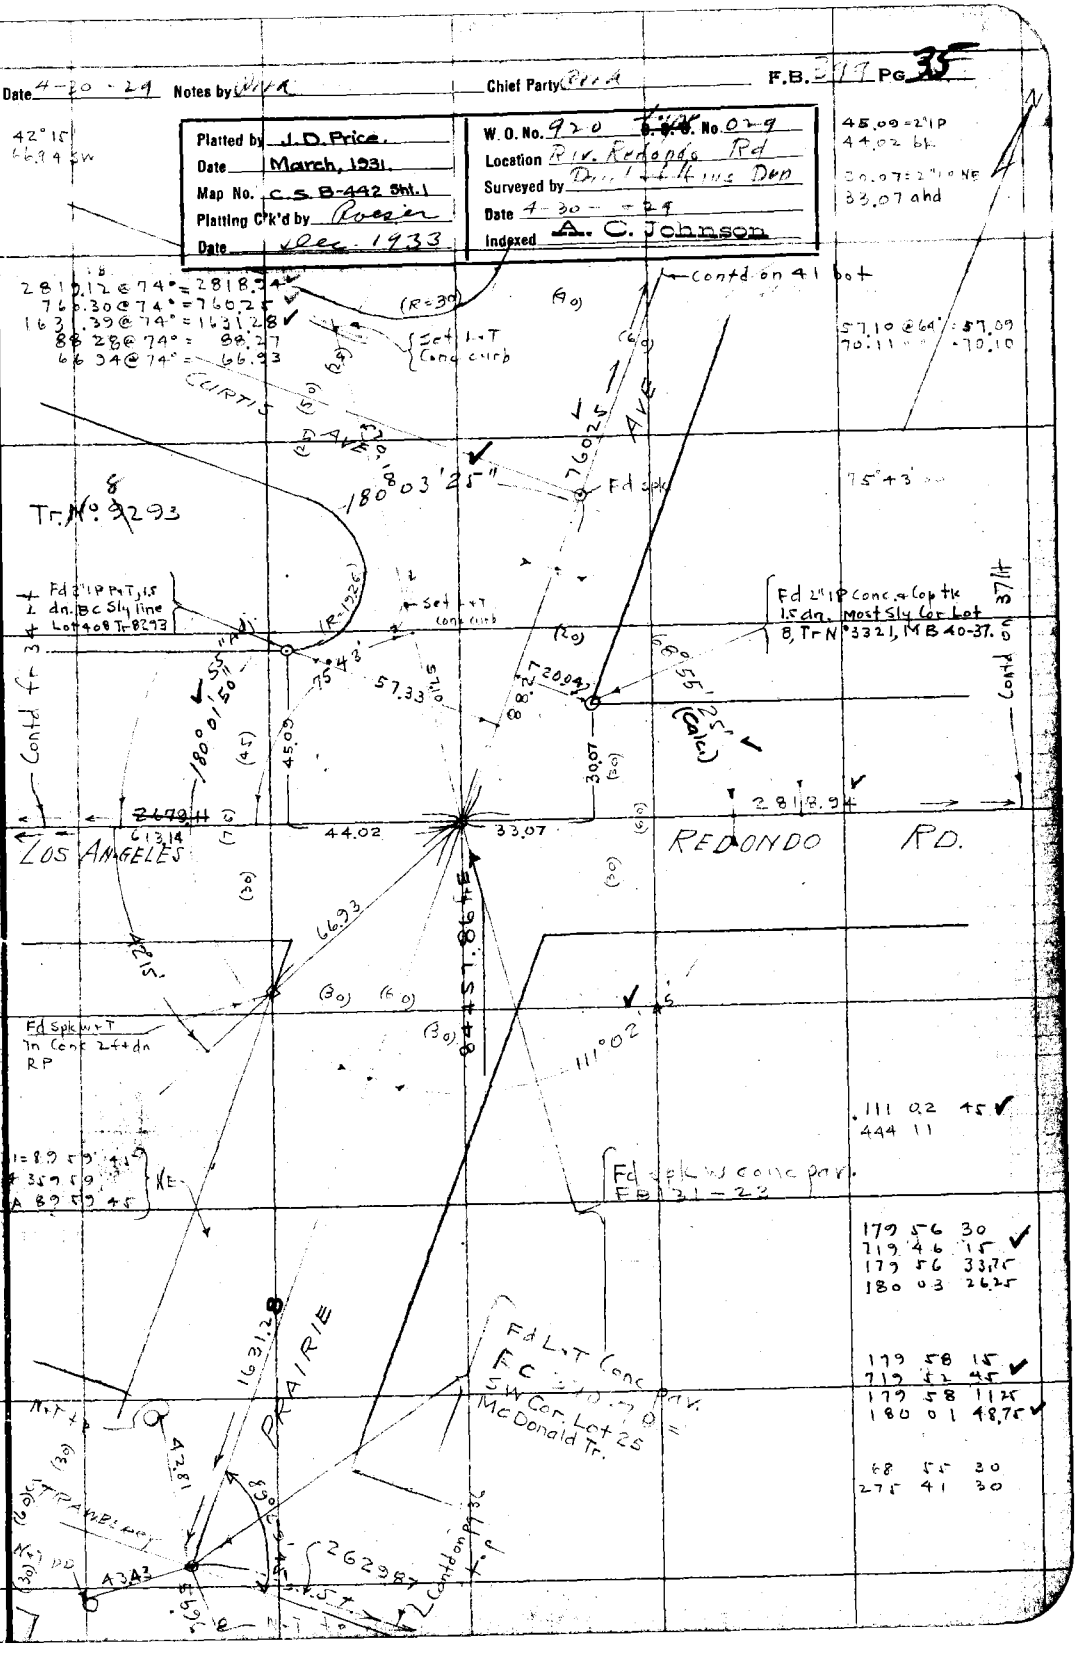

RETURN TO
LOS ANGELES COUNTY SURVEYOR

Note: ANY ADDITIONS OR CHANGES ON THIS SHEET MUST BE MADE OR CIRCLED IN Red. WITH DATE AND NAME OF PERSON MAKING CHANGE.

Do not extend notes this side of this line

F.B. 311 PG. 36 Chief Party DNA Notes by DNA Date -24-

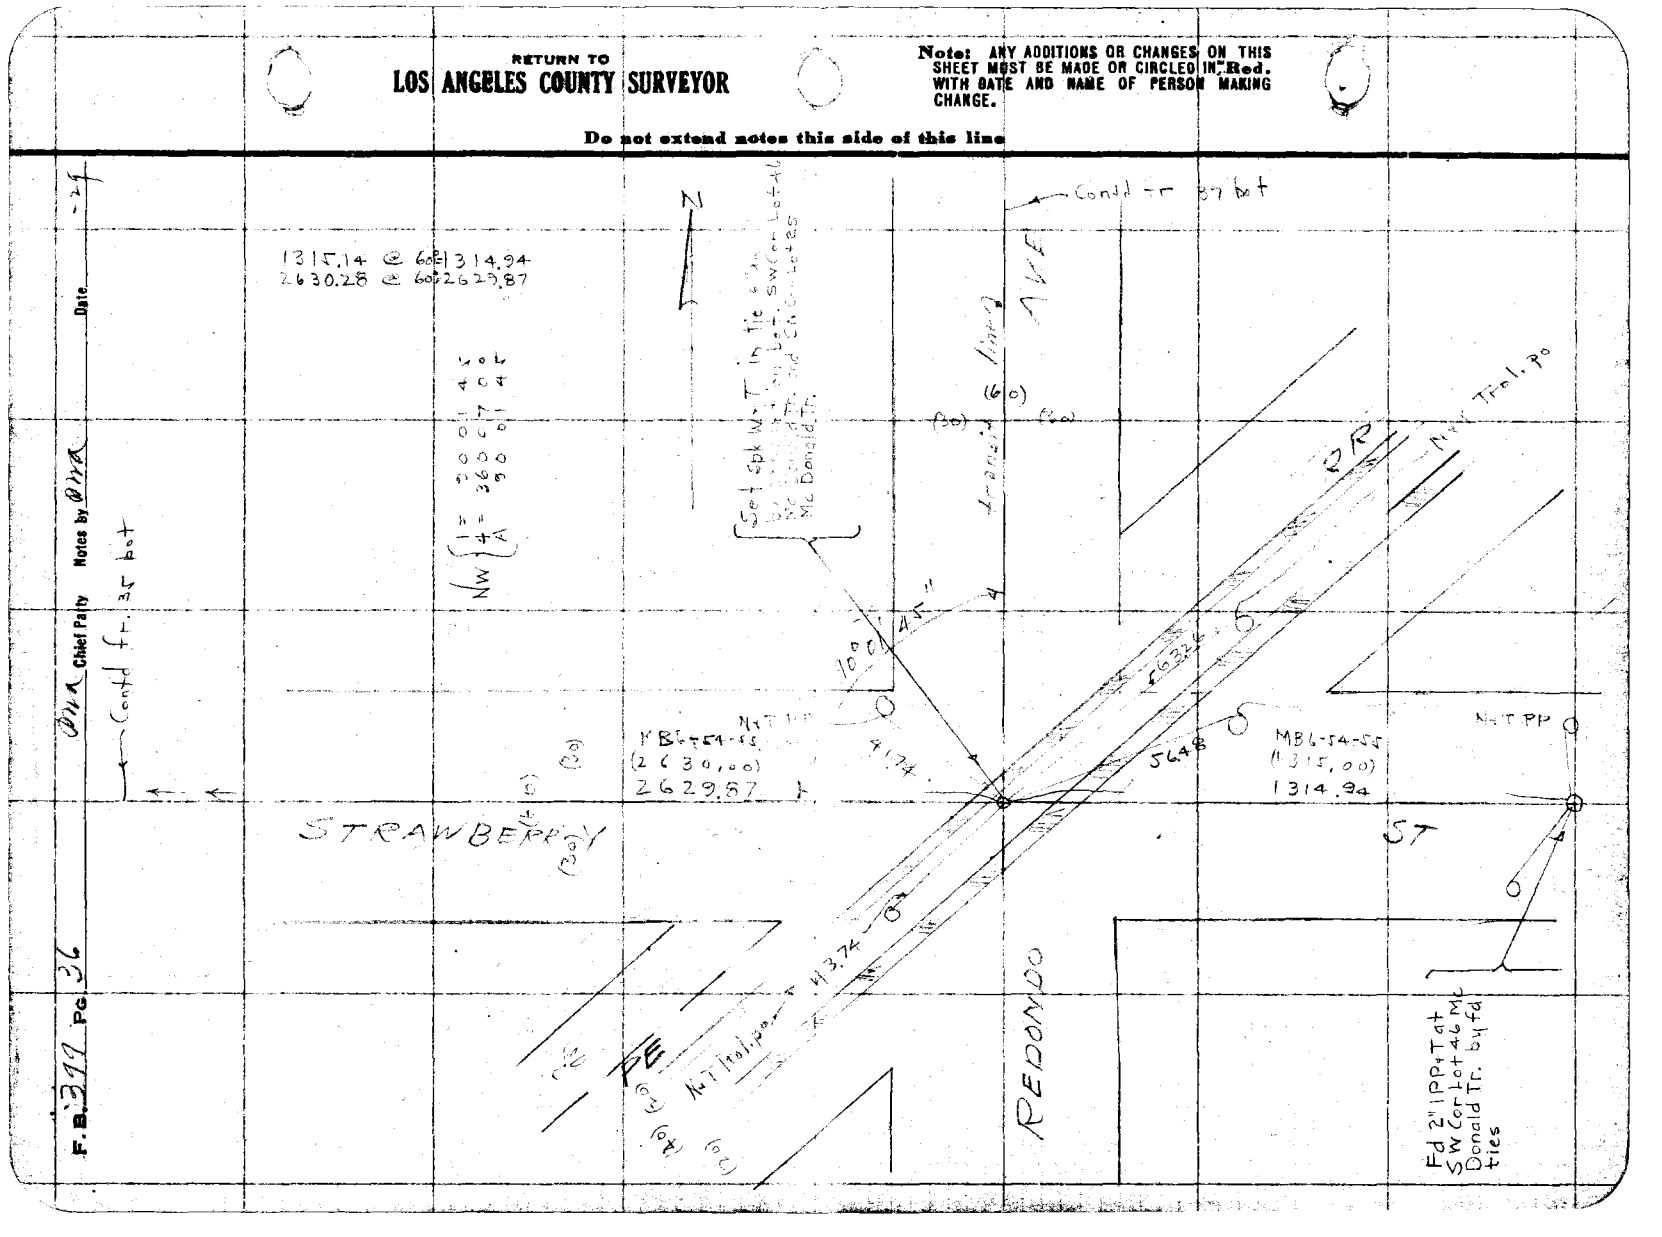


Platted by J.D. Price.
Date March, 1931.
Map No. C.S.B. 442 Sht. 1
Platting Ck'd by Roesen
Date Dec. 1933

W.O. No. 920 S.S.O. No. 029
Location Riv. Redondo RD
Surveyed by Price & Hamm Dep.
Date 5-3-29
Indexed A. C. JOHNSON

Notes: ANY ADDITIONS OR CHANGES ON THIS SHEET MUST BE MADE OR CIRCLED IN Red. WITH DATE AND NAME OF PERSON MAKING CHANGE.

Do not extend notes this side of this line

RETURN TO LOS ANGELES COUNTY SURVEYOR

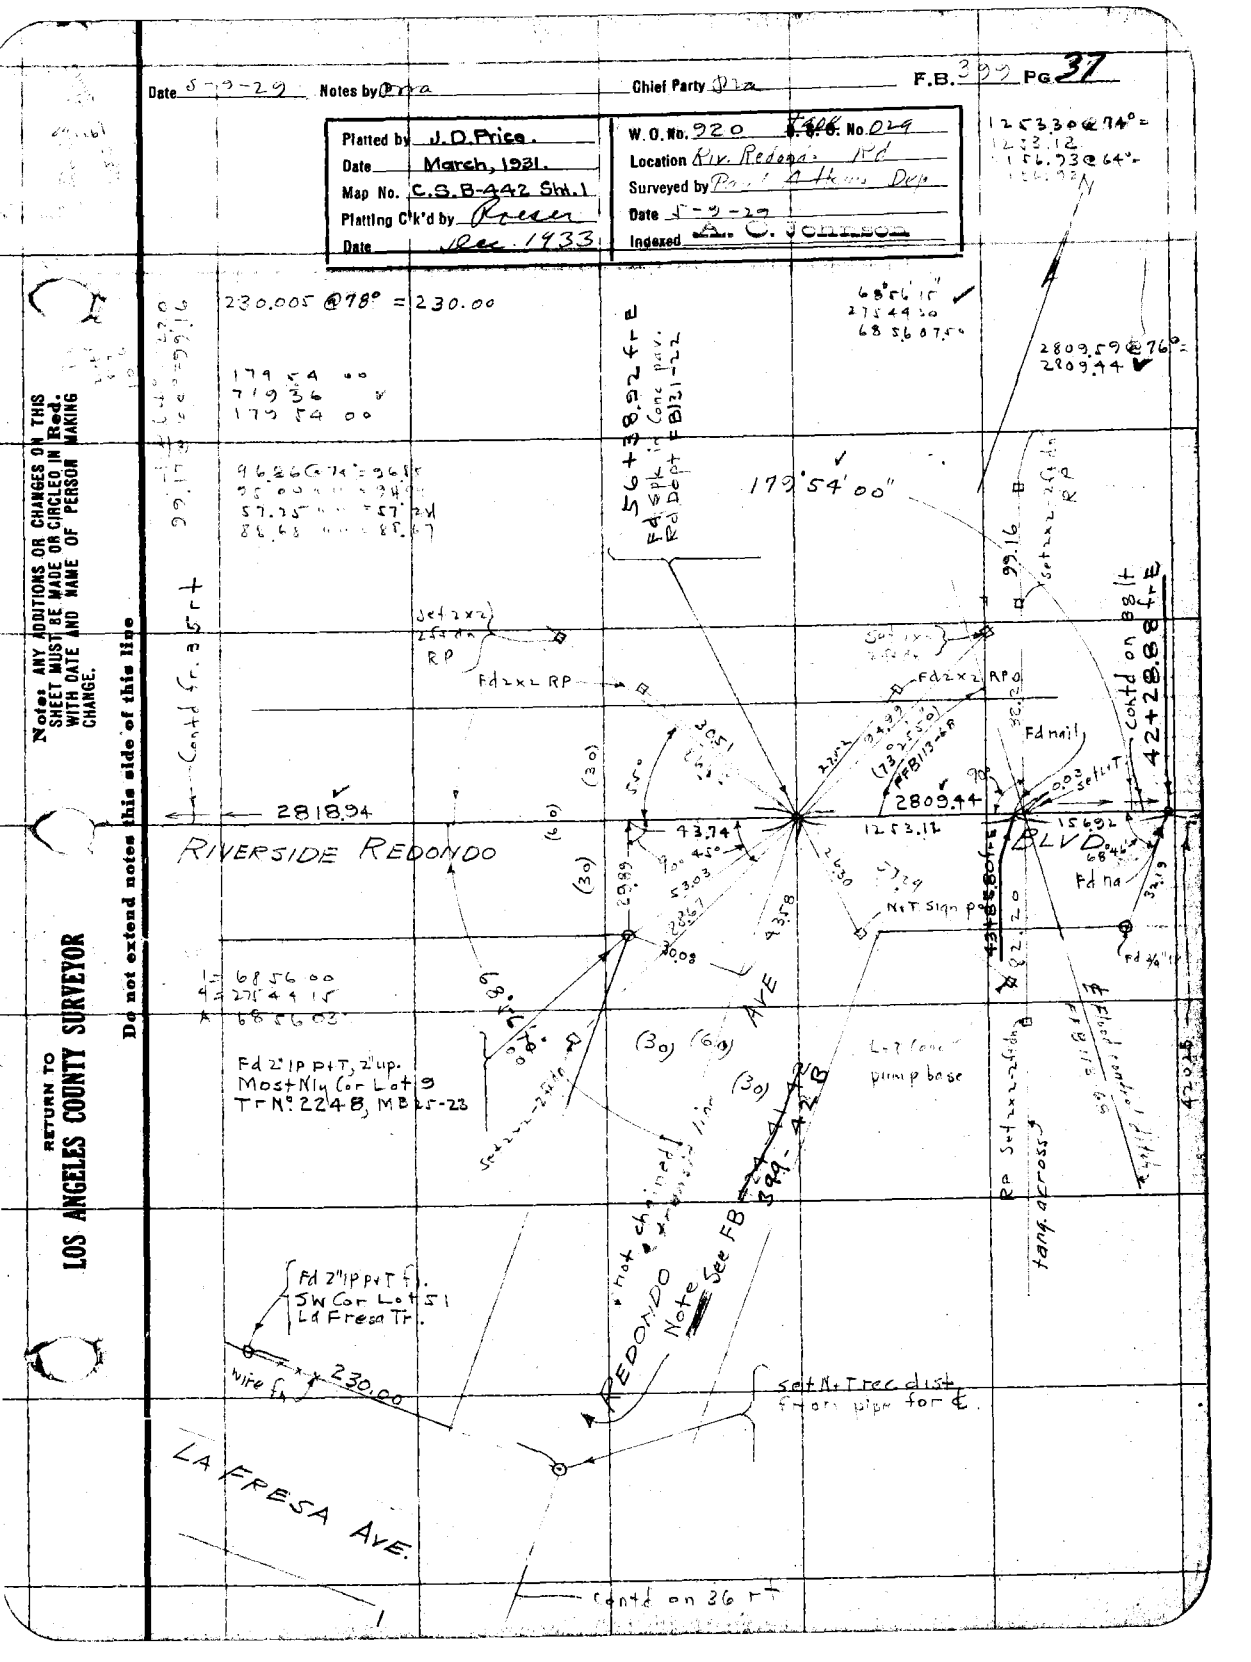

F.B. 399 Pg. 38 — Piva Chief Party — Notes by Piva — Date 5-9-29

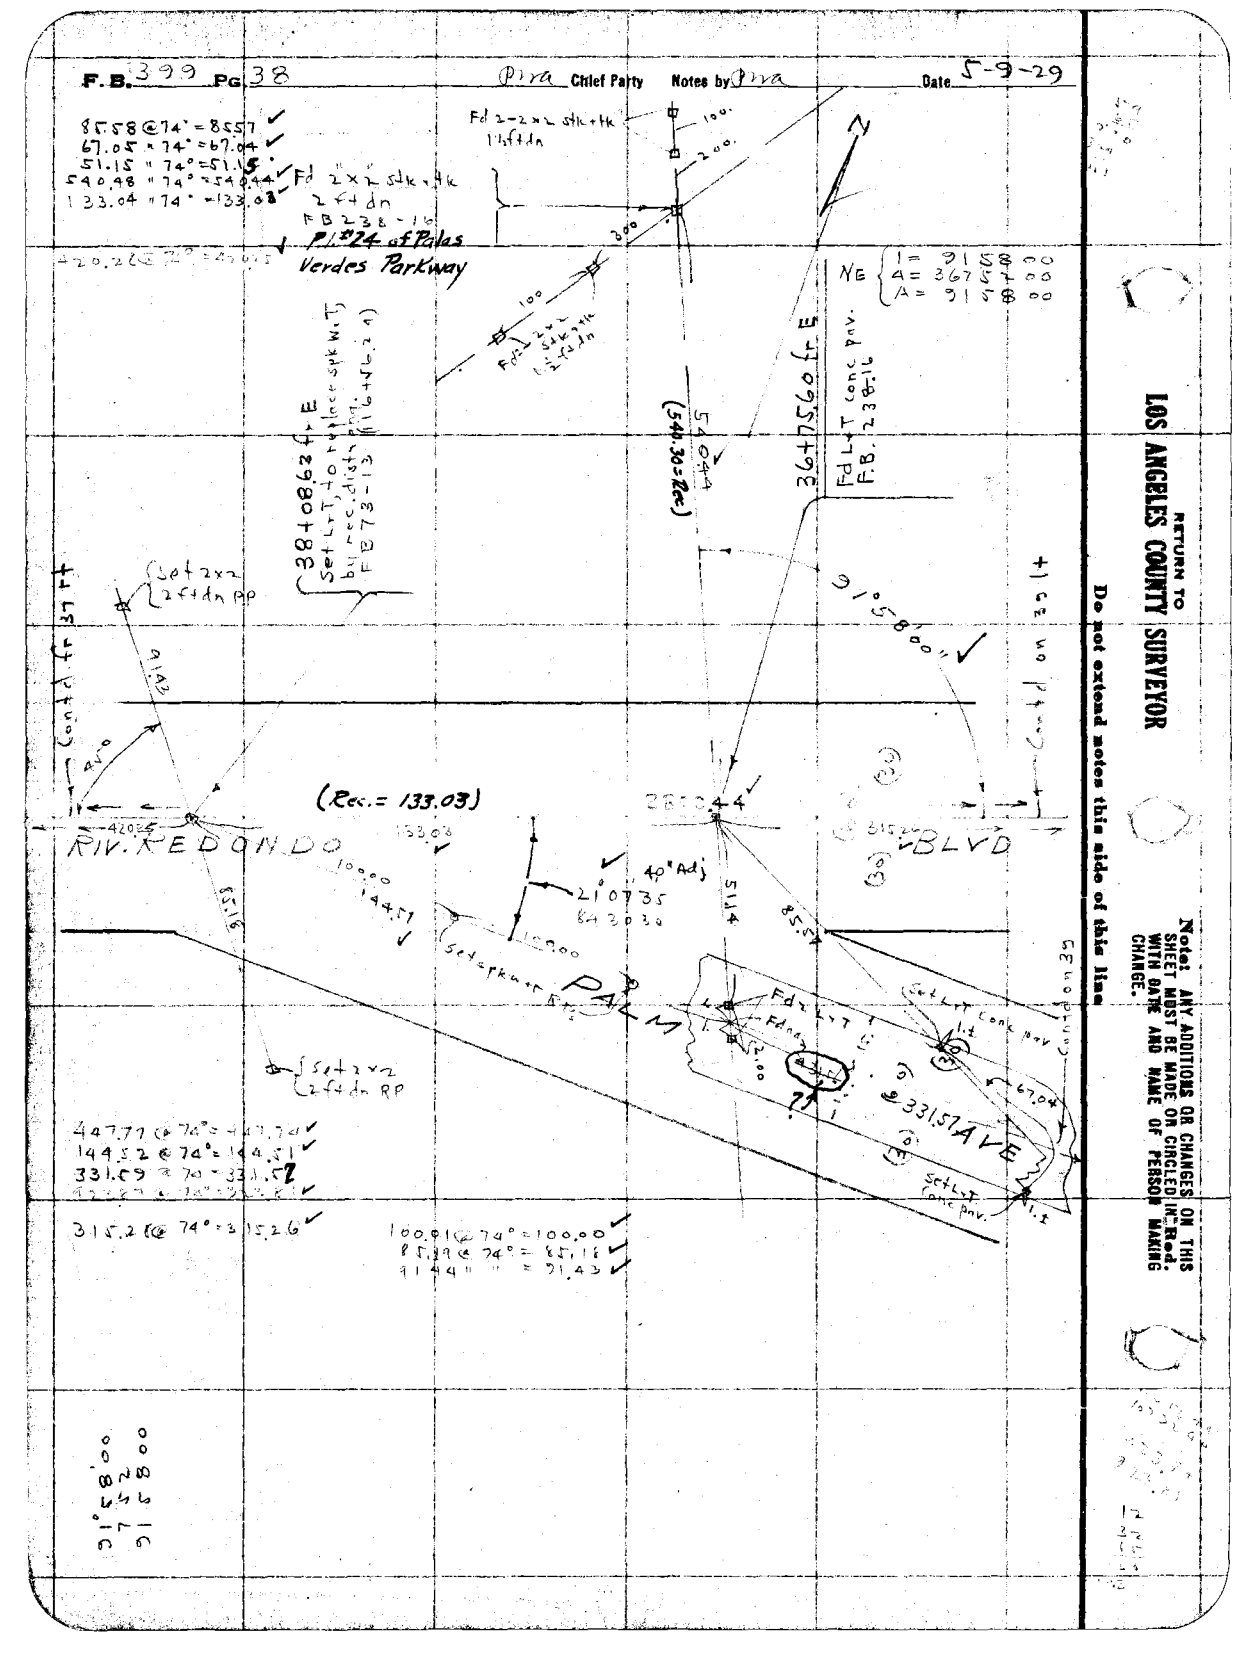
RIV. REDONDO BLVD
PALM AVE
Fd 2-2x2 stk+tk 1.5ft dn
Fd 2x2 stk+tk 2 ft dn
F.B. 238-16
P.I. #24 of Palos Verdes Parkway
Set L+T, 0.0 ft ahead of sta. W.T. by rec. dist. F.B. 273-13 (116+76.24)
Fd L+T conc mon. F.B. 238-16
Set 2x2 2 ft dn RP
Fd L+T conc mon
Set L+T conc mon
Set L+T conc mon
Set tk in conc
(Rec. = 133.03)
(540.30 = Rec.)
Cont. 47.34 ft
Cont. 420.26 ft
Cont. 420.26 ft
Cont. 420.26

Date 5-9-29 Notes by [illegible] Chief Party [illegible] F.B. [illegible] Pg 39

Platted by J.D. Price.
Date March, 1931.
Map No. C.S. B-442 Sht. 1
Plotting C'k'd by Roesen
Date Dec. 1933

W. O. No. 920 T.O.C. No. 029
Location Riv. Redondo Rd
Surveyed by P. [illegible] Hollings Dep
Date 5-9-29
Indexed [illegible]

Notes: ANY ADDITIONS OR CHANGES ON THIS SHEET MUST BE MADE OR CIRCLED IN Red, WITH DATE AND NAME OF PERSON MAKING CHANGE.

Do not extend notes this side of this line

RETURN TO LOS ANGELES COUNTY SURVEYOR

RIV. REDONDO

BLVD

PALM

AVE

ALE

Howard St

Contd fr 38 Lt

Contd on 40 Lt

28+09.44

28+29.48 Fd Spk in Conc Pav. (111+79.48 RD 131-15) Single pt

33+60.34 Fwd

28+17.61 Fwd






















F.B. 399 Pg. 40 JMA Chief Party Notes by JMA Date 5-10-29

Tape Std @ 84°

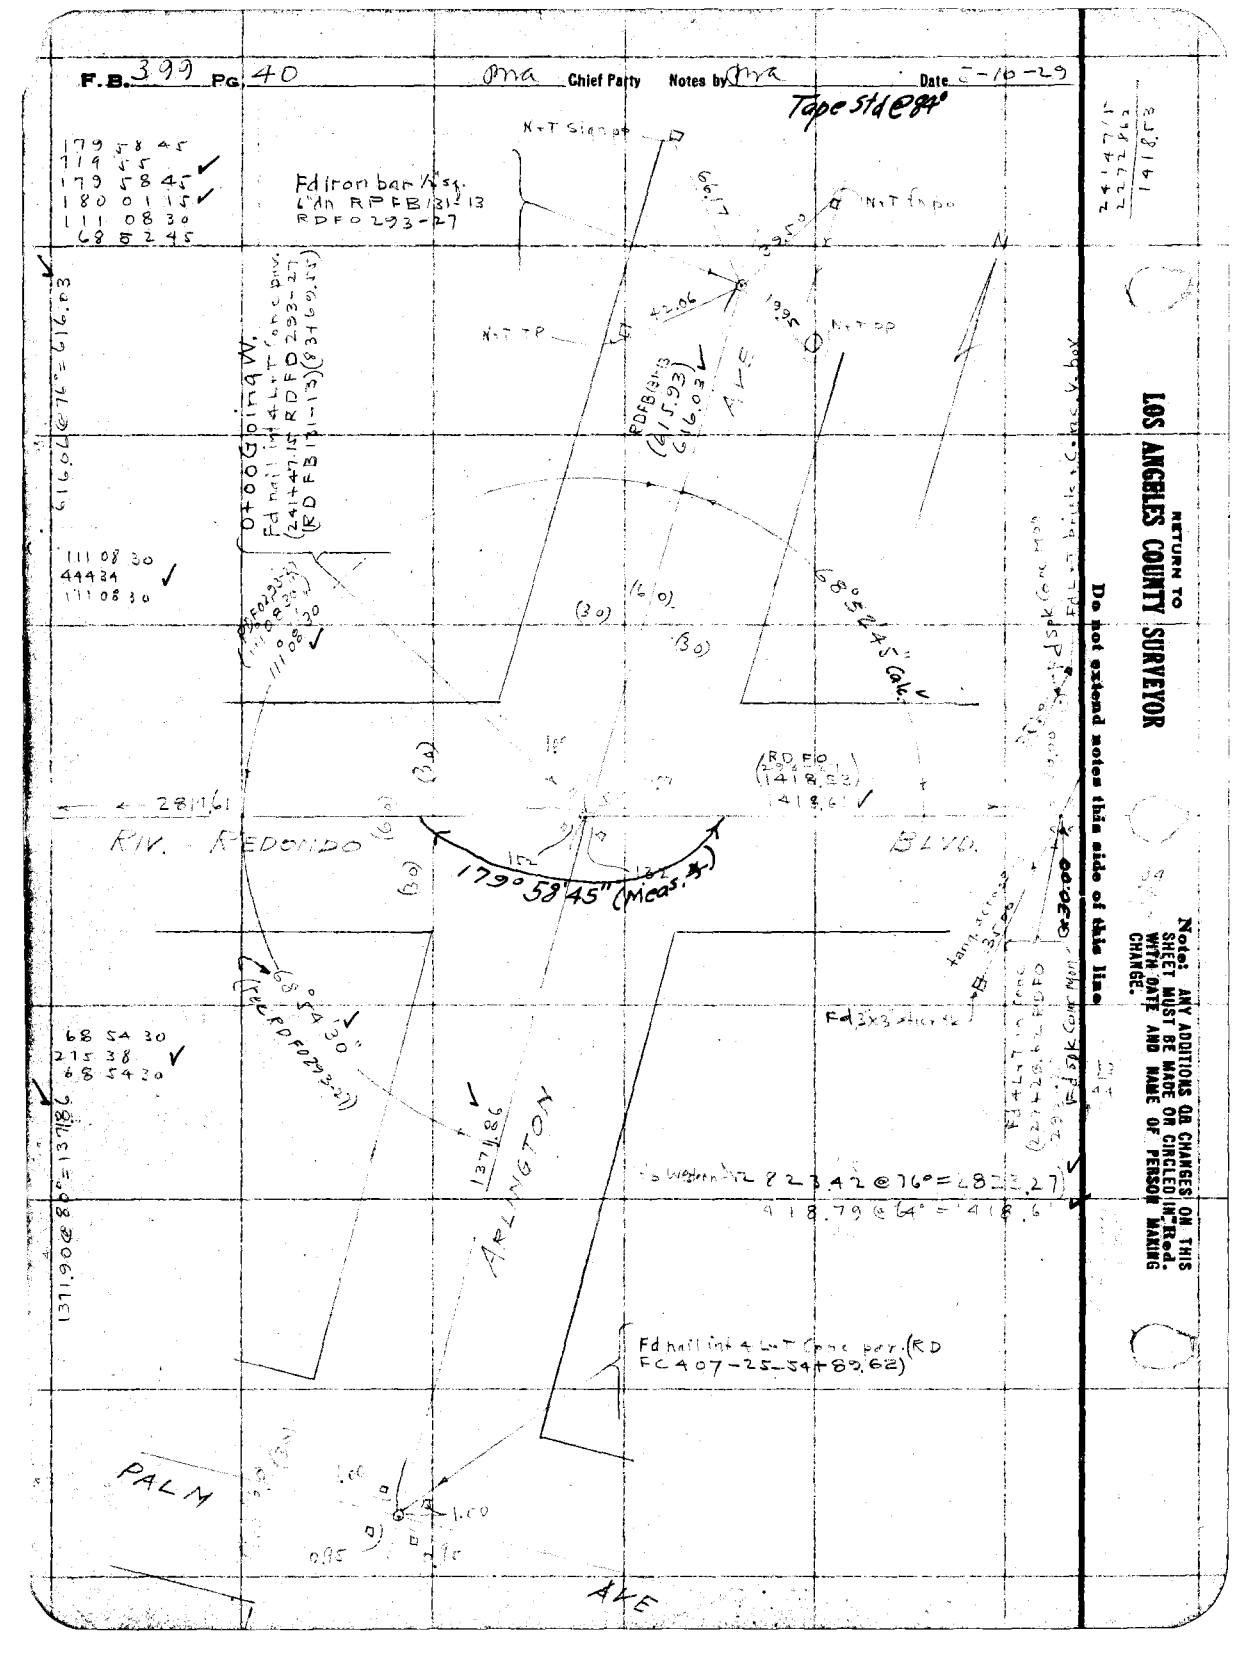

179 58 45
179 45
179 58 45
180 01 15
111 08 30
68 54 30

24+47.15
2272 Pks
1418.53

616.03 @ 76° = 616.03

111 08 30
44434
111 08 30

68 54 30
215 38
68 54 30

1371.90 @ 80° = 1351.86

RETURN TO
LOS ANGELES COUNTY SURVEYOR

Do not extend notes this side of this line

Note: ANY ADDITIONS OR CHANGES ON THIS SHEET MUST BE MADE OR CIRCLED IN Red. WITH DATE AND NAME OF PERSON MAKING CHANGE.

Date 5-25-29 Notes by PMA Chief Party PMA F.B. 299 Pg 41

Platted by J.D. Price.	W.O. No. 920 D.S.D. No. 029
Date March, 1921	Location Riv [illegible] Rd
Map No. C.S.B-442 Sht.1	Surveyed by P. [illegible]
Platting C'k'd by Rowen	Date 5-25-29
Date Dec 1933	Indexed A. C. Johnson

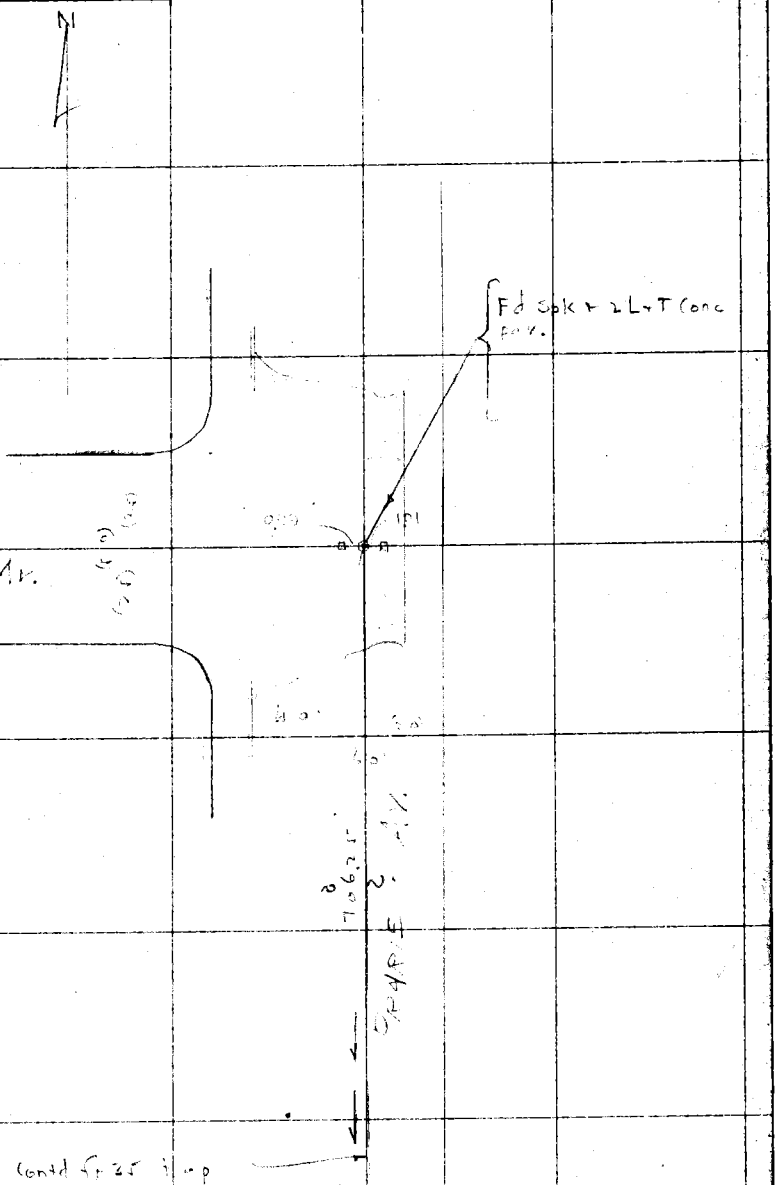

Notes: ANY ADDITIONS OR CHANGES ON THIS SHEET MUST BE MADE OR CIRCLED IN Red. WITH DATE AND NAME OF PERSON MAKING CHANGE.

Do not extend notes this side of this line

RETURN TO LOS ANGELES COUNTY SURVEYOR

RETURN TO

LOS ANGELES COUNTY SURVEYOR

Note: ANY ADDITIONS OR CHANGES ON THIS SHEET MUST BE MADE OR CIRCLED IN Red. WITH DATE AND NAME OF PERSON MAKING CHANGE.

Do not extend notes this side of this line

Date

Notes by

Chief Party

FB 1302 Pg. 1 of 2

Date 1-20-30 Notes by [illegible] Chief Party [illegible] F.B. 399 Pg. 42

Platted by J.D. Price.
Date March, 1931.
Map No. C.S.B-44 Sht. 1.
Platting C'k'd by [illegible]
Date Dec. 1933

W. O. No. 920 Sup. No. 062
Location Riverside Redondo Rd
Surveyed by [illegible] Atkins Jr.
Date Jan 20, 1930
Indexed [illegible]

Notes: ANY ADDITIONS OR CHANGES ON THIS SHEET MUST BE MADE OR CIRCLED IN Red. WITH DATE AND NAME OF PERSON MAKING CHANGE.

Do not extend notes this side of this line

RETURN TO LOS ANGELES COUNTY SURVEYOR

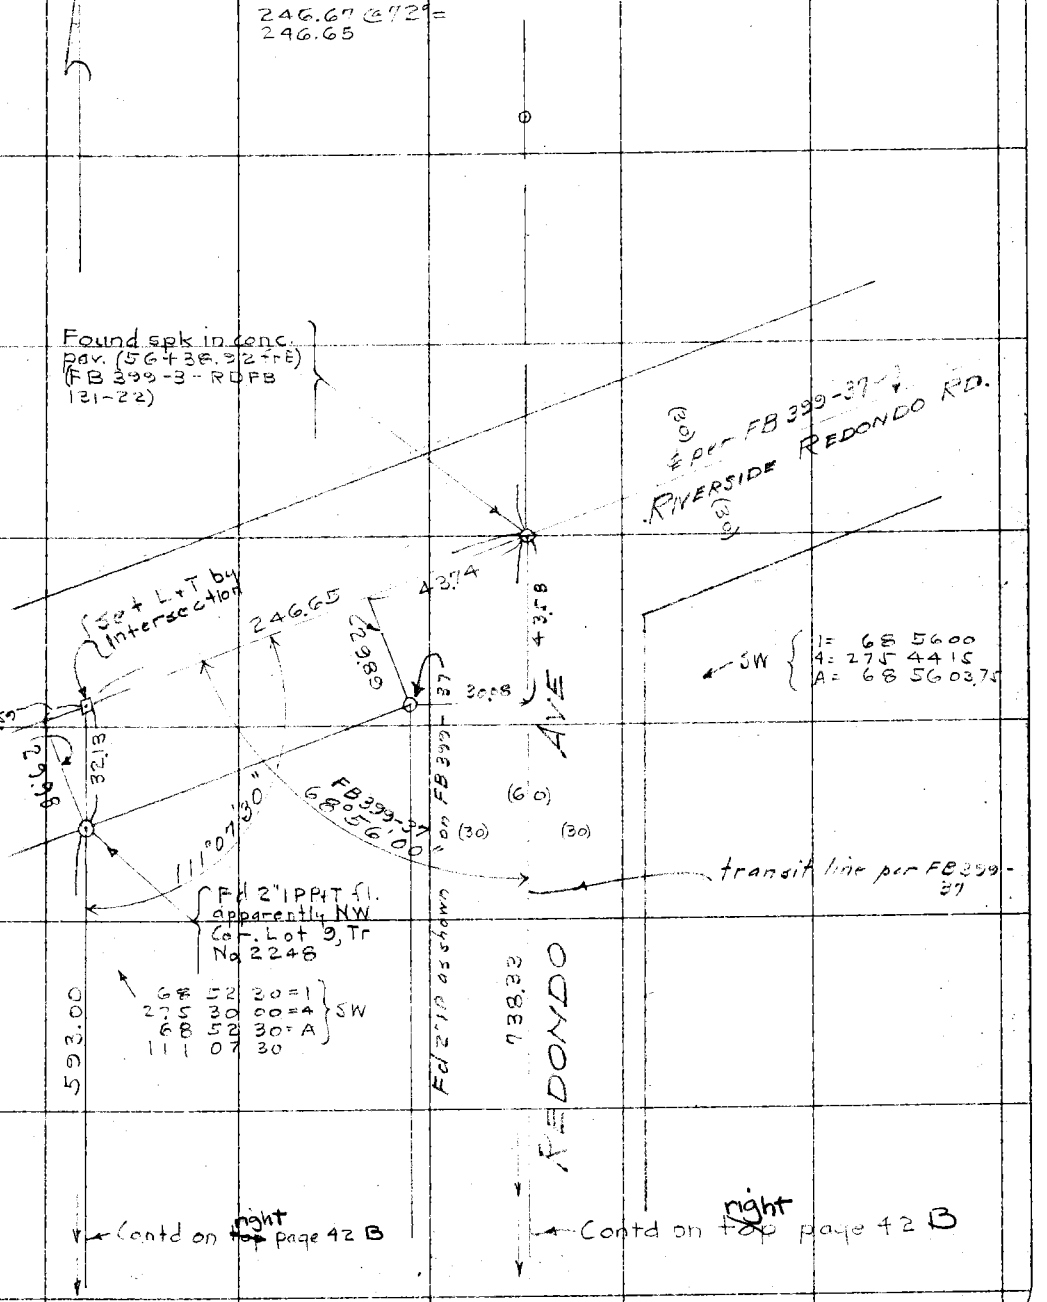

Contd on right page 42 B

Contd on right page 42 B

RETURN TO
LOS ANGELES COUNTY SURVEYOR

Note: ANY ADDITIONS OR CHANGES ON THIS SHEET MUST BE MADE OR CIRCLED IN **Red.** WITH DATE AND NAME OF PERSON MAKING CHANGE.

Do not extend notes this side of this line



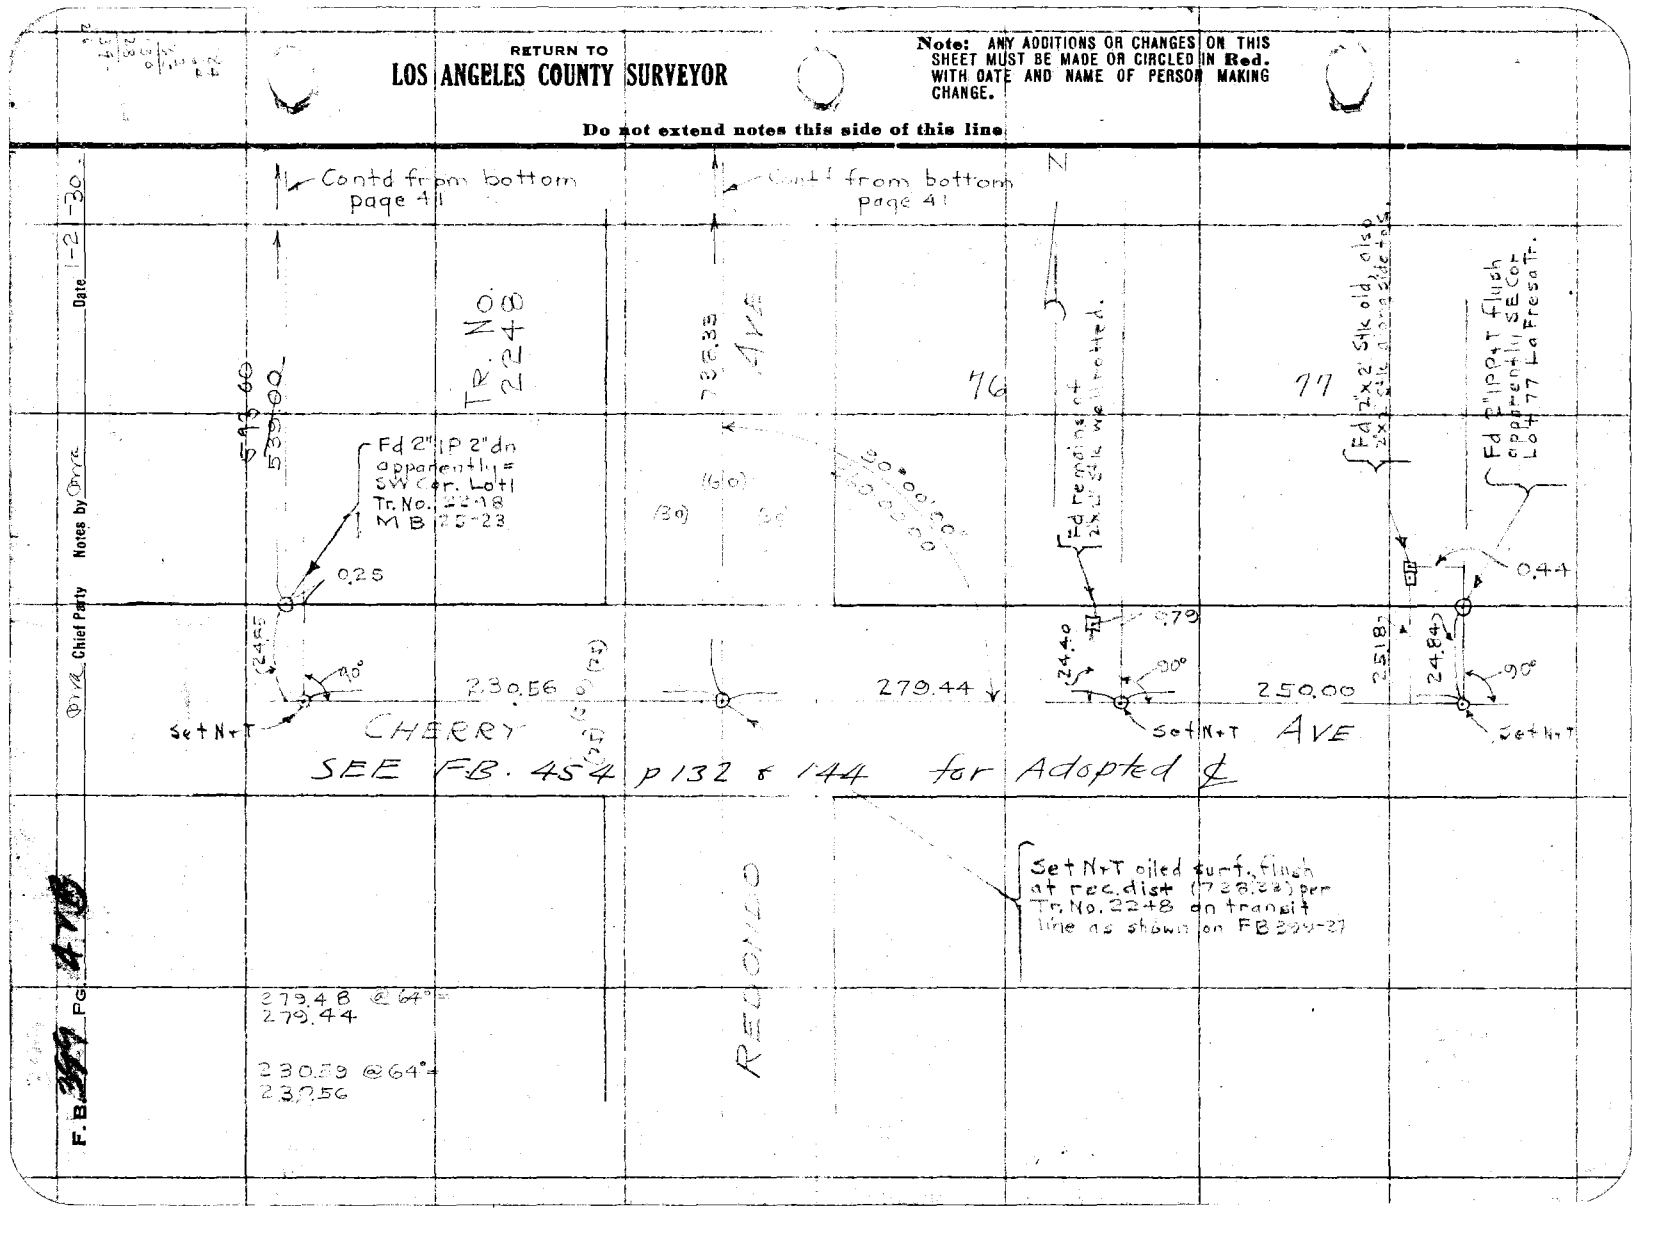

Date 5-27-29 Notes by DHA Chief Party DHA F.B. 392 Pg 43

Platted by J. D. Price	W. O. No. 970 D. S. O. No.
Date Jan., 1930.	Location Riverside Redondo Blvd
Map No. C.S. B-442-Sh. #1.	Surveyed by D
Platting C'k'd by	Date 5-27-29
Date	Indexed

Notes: ANY ADDITIONS OR CHANGES OF THIS SHEET MUST BE MADE OR CIRCLED IN Red. WITH DATE AND NAME OF PERSON MAKING CHANGE.

Do not extend notes this side of this line

RETURN TO LOS ANGELES COUNTY SURVEYOR

TOPOGRAPHY

RIVERSIDE REDONDO BLVD

from

ARLINGTON AVE

to

HAWTHORNE BLVD.

& notes: FB 289-103-105
and FB 392-39-49

Note: Conc. pav. + walks shaded thus

S 32.13
S 1300
2-85
A 9.2 C

F. B. 399 Pg. 44 Chief Party Notes by DMM Date 5-27-79

Contd pg 47 bot

BLVD

0+67.TP

0+65.65 EC

12.0

BC 0+37.20

POC 0+39.60 55.70

29.85

℄ pg 40

ARLINGTON

conc. pavement

0+09.70

Conc Gont. E4 W. pg 40

POC 0+13.00

27.90

RIVER SIDE

BC 0+57.00

15.00

RETURN TO
LOS ANGELES COUNTY SURVEYOR

Do not extend notes this side of this line

Note: ANY ADDITIONS OR CHANGES ON THIS SHEET MUST BE MADE OR CIRCLED IN Red. WITH DATE AND NAME OF PERSON MAKING CHANGE.

Date _____ Notes by _____ Chief Party _____ F.B. 392 Pg 45

Platted by J.D. Price	W.O. No. 97 C.S.B. No. 1
Date Jan., 1930	Location E. Av. Redondo Rd
Map No. C.S. B-442, Sh. #1	Surveyed by [illegible]
Platting C'k'd by Topo Svenson	Date [illegible]
Date	Indexed

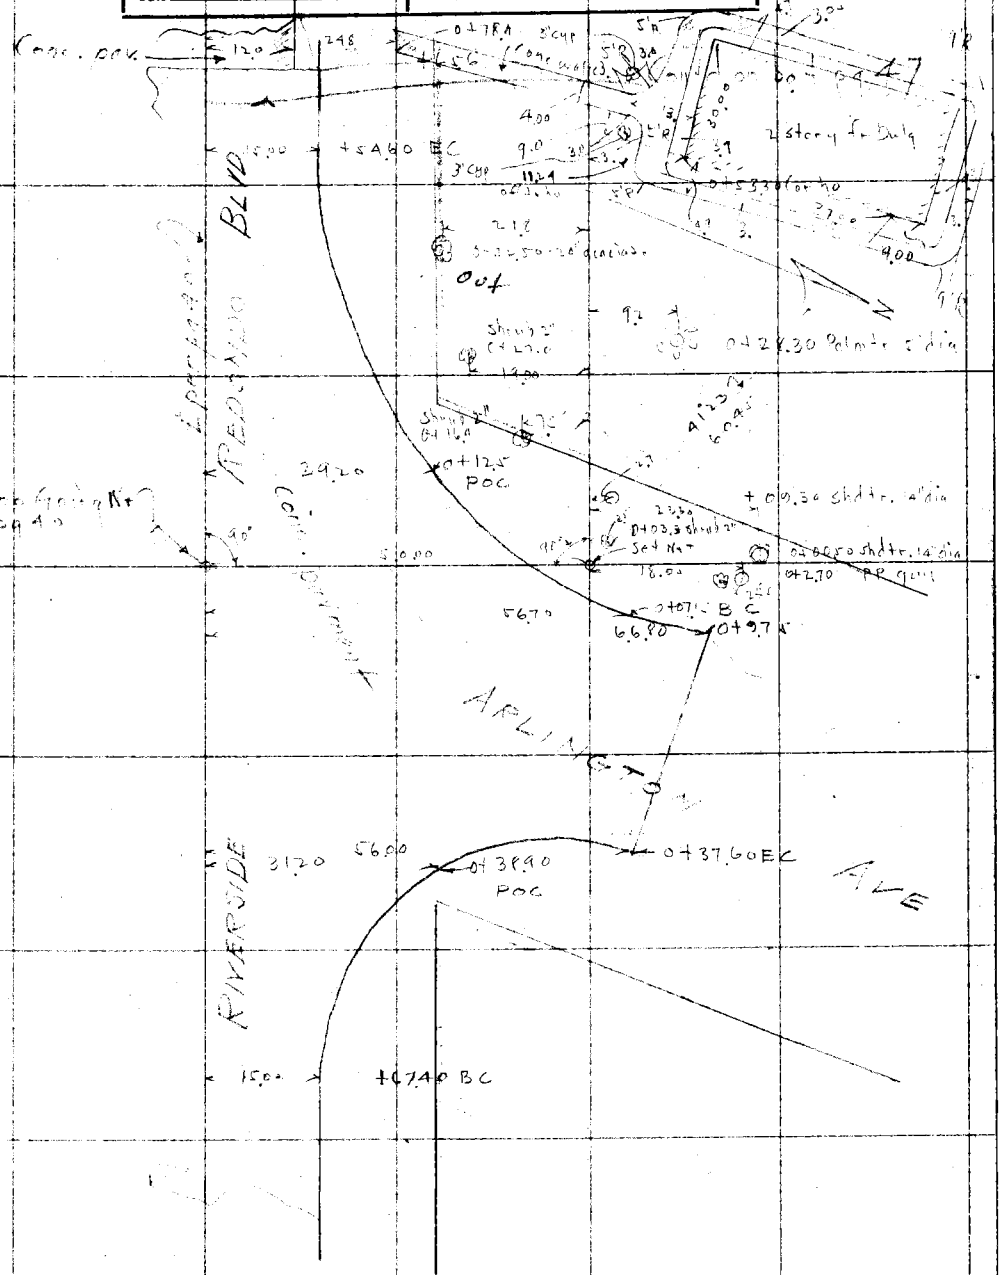

Notes: ANY ADDITIONS OR CHANGES OF THIS SHEET MUST BE MADE OR CIRCLED IN Red, WITH DATE AND NAME OF PERSON MAKING CHANGE.

Do not extend notes this side of this line

RETURN TO
LOS ANGELES COUNTY SURVEYOR

F.B. 399 PG. 46 Chief Party Notes by Date 5-27-29

RETURN TO
LOS ANGELES COUNTY SURVEYOR

Do not extend notes this side of this line

Note: ANY ADDITIONS OR CHANGES ON THIS SHEET MUST BE MADE OR CIRCLED IN Red. WITH DATE AND NAME OF PERSON MAKING CHANGE.

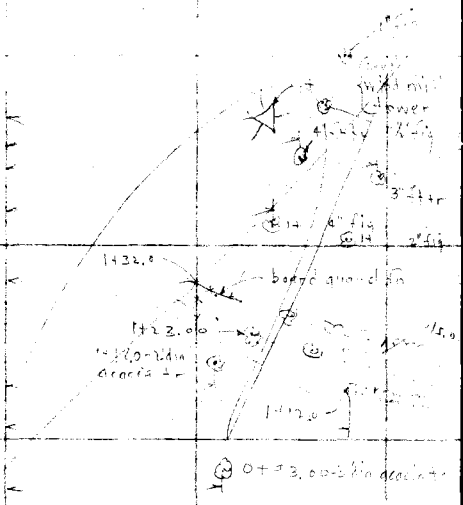

Date [illegible] Notes by [illegible] Chief Party [illegible] F.B. 399 PG 47

Platted by J.D. Price.
Date Jan, 1930
Map No. C.S. B-442 Sh #1
Platting C'k'd by Topo Svenson
Date

W.O. No. 920 S.&C.O. No. 1
Location [illegible]
Surveyed by [illegible]
Date [illegible]
Indexed [illegible]

Notes: ANY ADDITIONS OR CHANGES OR THIS SHEET MUST BE MADE OR CIRCLED IN Red. WITH DATE AND NAME OF PERSON MAKING CHANGE.

Do not extend notes this side of this line

RETURN TO LOS ANGELES COUNTY SURVEYOR

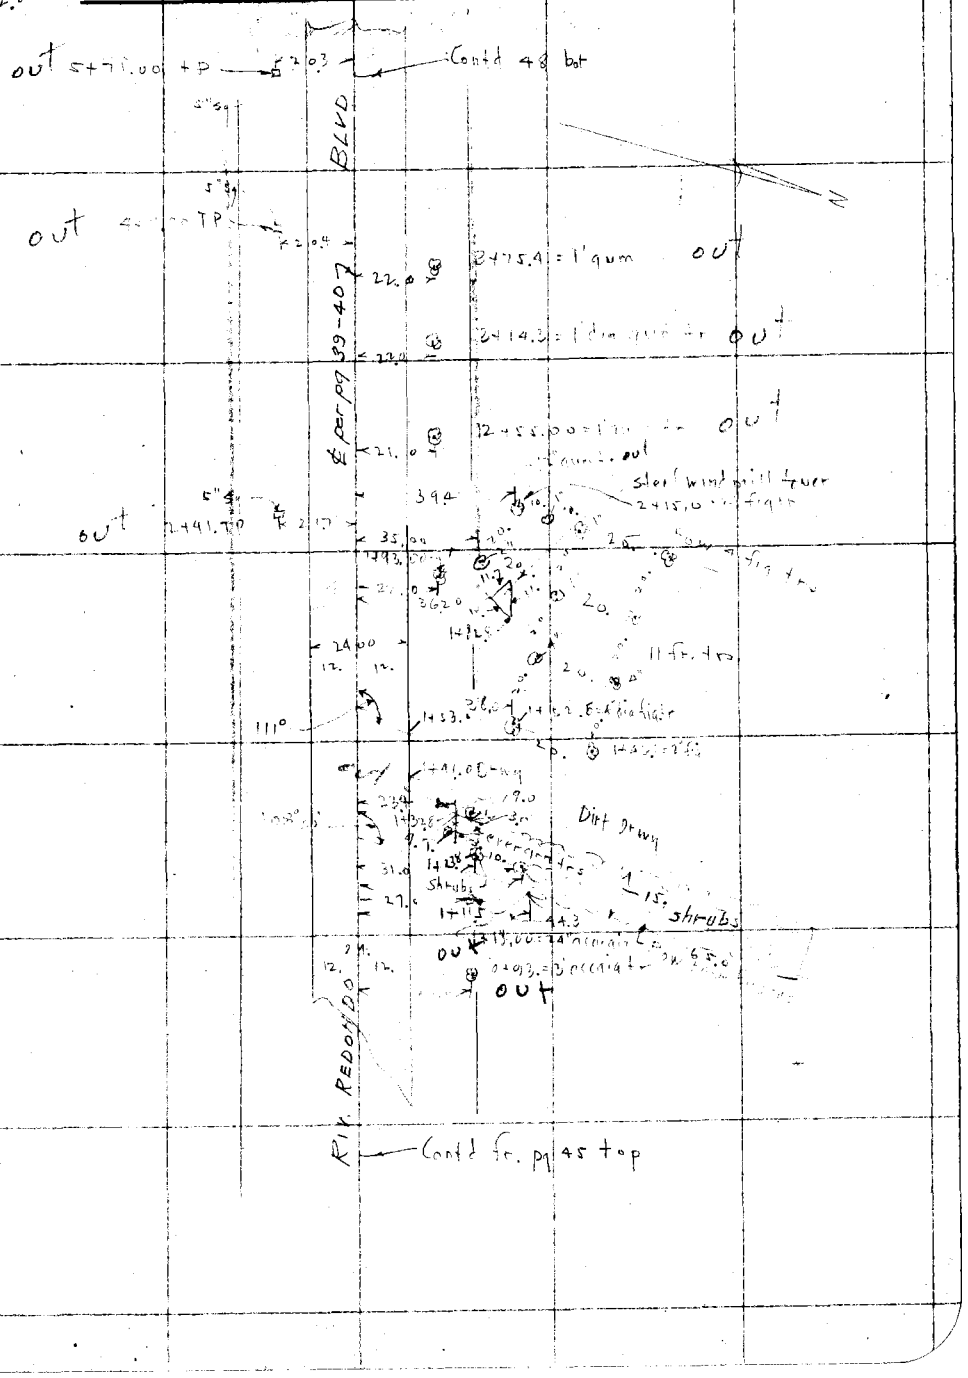

F. B. 399 Pg. 48 — Chief Party — Notes by — Date 5-28-29

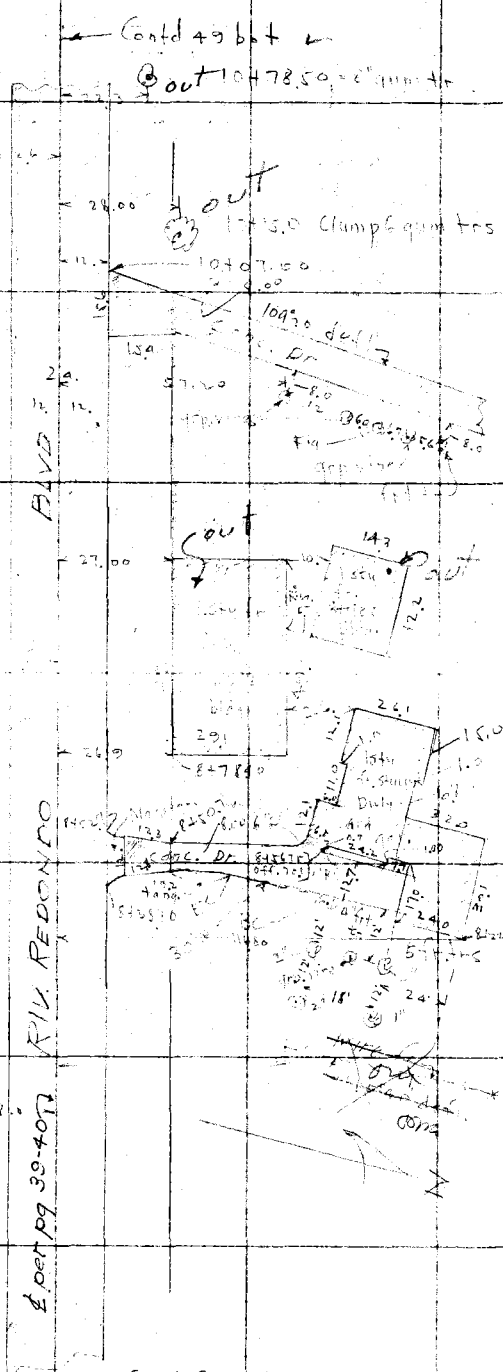

RETURN TO LOS ANGELES COUNTY SURVEYOR

Do not extend notes this side of this line

Note: ANY ADDITIONS OR CHANGES ON THIS SHEET MUST BE MADE OR CIRCLED IN Red. WITH DATE AND NAME OF PERSON MAKING CHANGE.

Date 5-31-29 Notes by [illegible] Chief Party [illegible] F.B. [illegible] Pg 49

Platted by J. D. Price.	W. O. No. [illegible] D. O. No. 1
Date Jan., 1930	Location Riv. Tributary [illegible]
Map No. C.S. B-442-Sh-1	Surveyed by [illegible]
Platting C'k'd by Topo Svenson	Date [illegible]
Date [illegible]	Indexed [illegible] Johnson

Contd so blot

16+73.0=6" gum tr

16+77.0=2" palm tr

F 35.1

22.1

@ out

16+32.0 PP

F 22.6

24

30

02

out

16+43.0

E per pg 39-407

BLVD.

RIV. REDONDO

N

out 12+41.00 PP

F 22.6

12+51.00=2" palm tr

F 35.00

22.4

@ out

13+50.00=10" gum tr out

out 13+35.0 PP

F 22.6

22.4

@ out

12+59.00=8" gum tr out

12+04.40 PP out

F 22.6

22.9

@ 11+38.00=7" gum tr out

Contd fr 48 top

Notes: ANY ADDITIONS OR CHANGES OR THIS SHEET MUST BE MADE OR CIRCLED IN Red. WITH DATE AND NAME OF PERSON MAKING CHANGE.

Do not extend notes this side of this line

RETURN TO LOS ANGELES COUNTY SURVEYOR

F. B. 399 Pg. 50 DMA Chief Party Notes by DMA Date 5-28-27

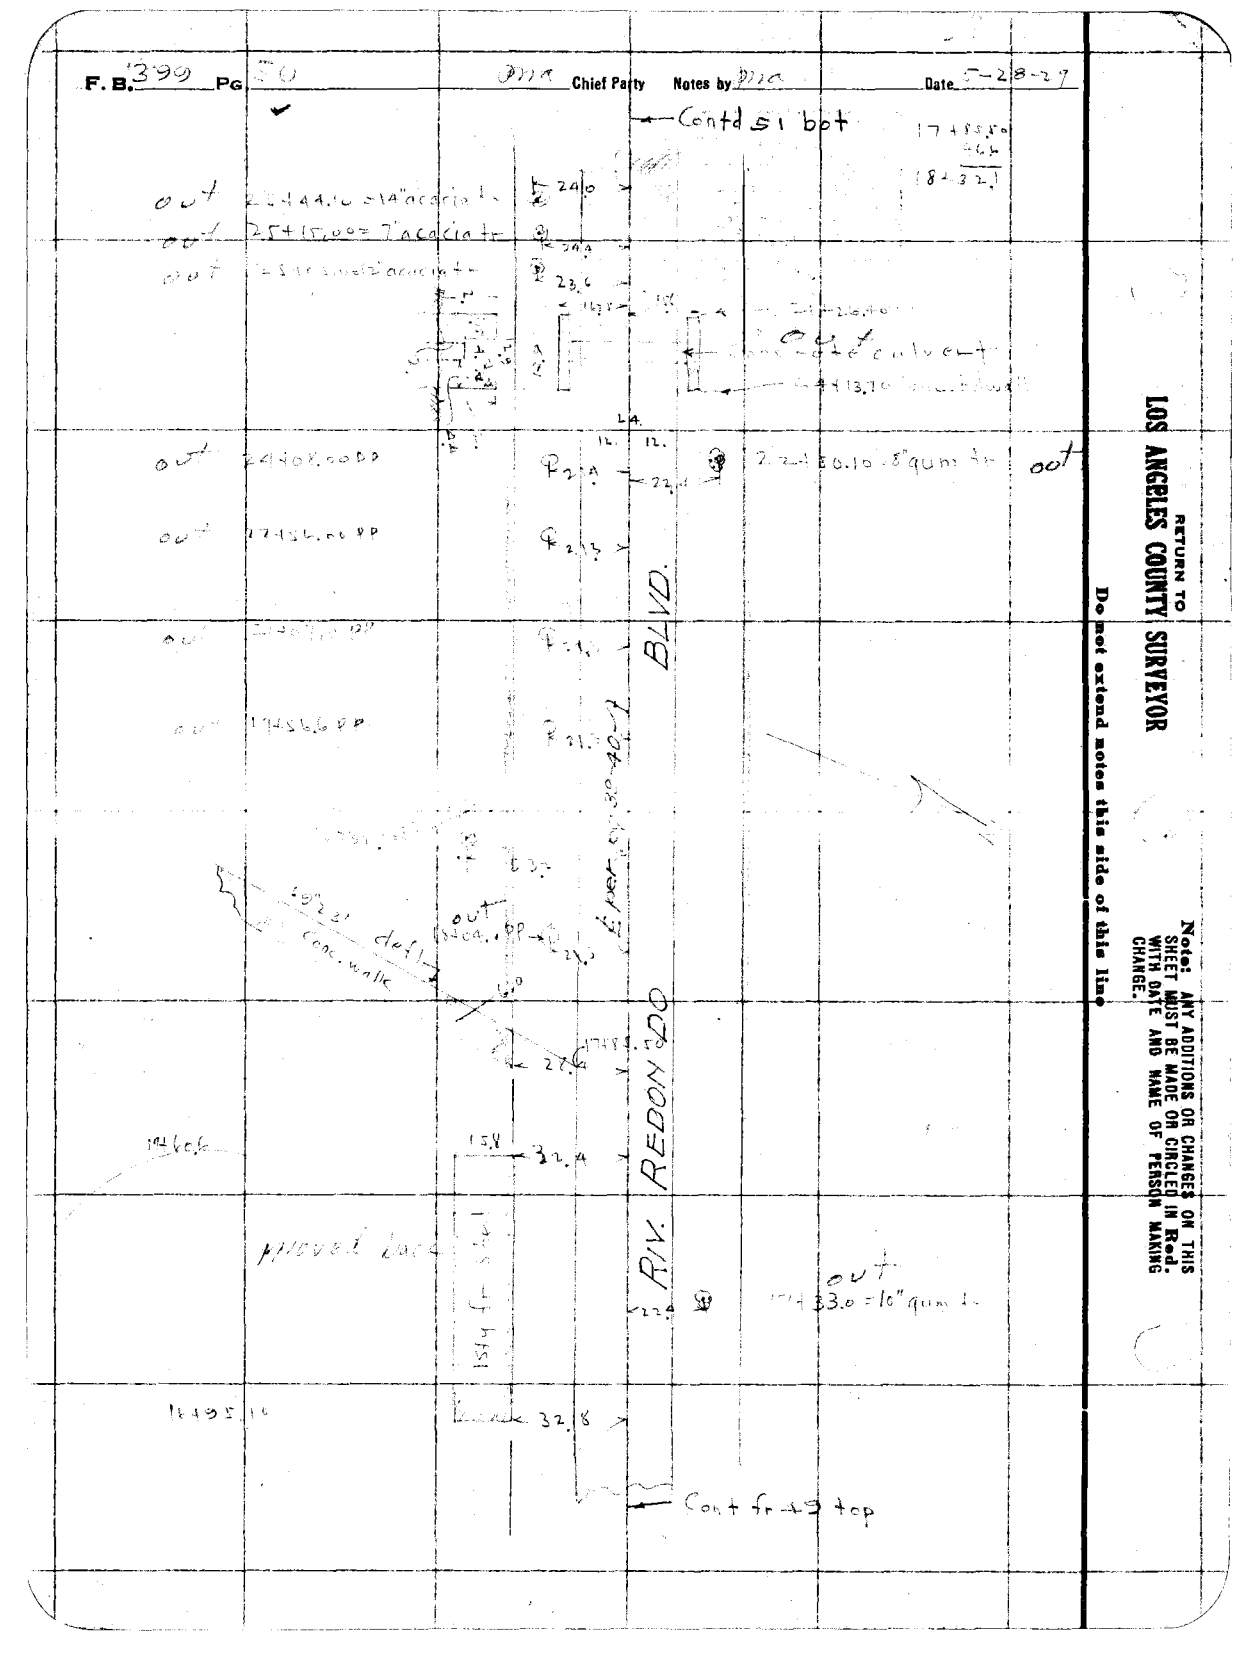

RETURN TO
LOS ANGELES COUNTY SURVEYOR
Do not extend notes this side of this line

Note: ANY ADDITIONS OR CHANGES ON THIS SHEET MUST BE MADE OR CIRCLED IN Red. WITH DATE AND NAME OF PERSON MAKING CHANGE.

Date _____ Notes by _____ Chief Party _____ F.B. _____ Pg. 51

Platted by J. D. Price	W. O. No. _____ D. S. O. No. _____
Date Jan., 1930	Location Pac. Redondo
Map No. C.S. B-942-Sh. 1	Surveyed by _____
Platting C'k'd by Topo Surveys	Date _____
Date _____	Indexed _____

Notes: ANY ADDITIONS OR CHANGES OF THIS SHEET MUST BE MADE OR CIRCLED IN RED, WITH DATE AND NAME OF PERSON MAKING CHANGE.

Do not extend notes this side of this line

RETURN TO
LOS ANGELES COUNTY SURVEYOR

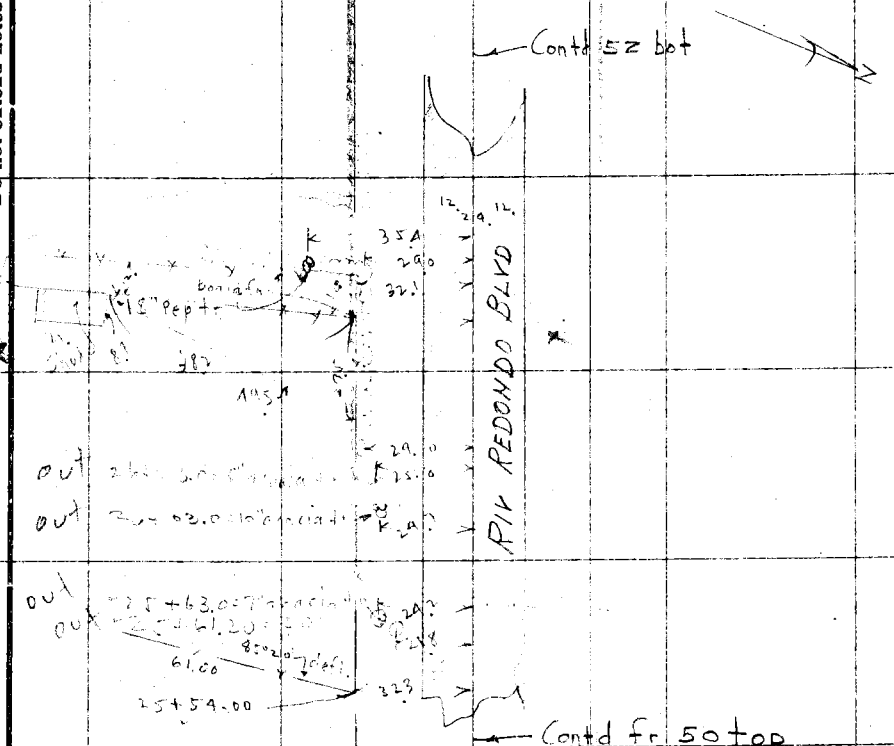

F.B. 399 Pg. 52 Chief Party Notes by [illegible] Date 5-29-29

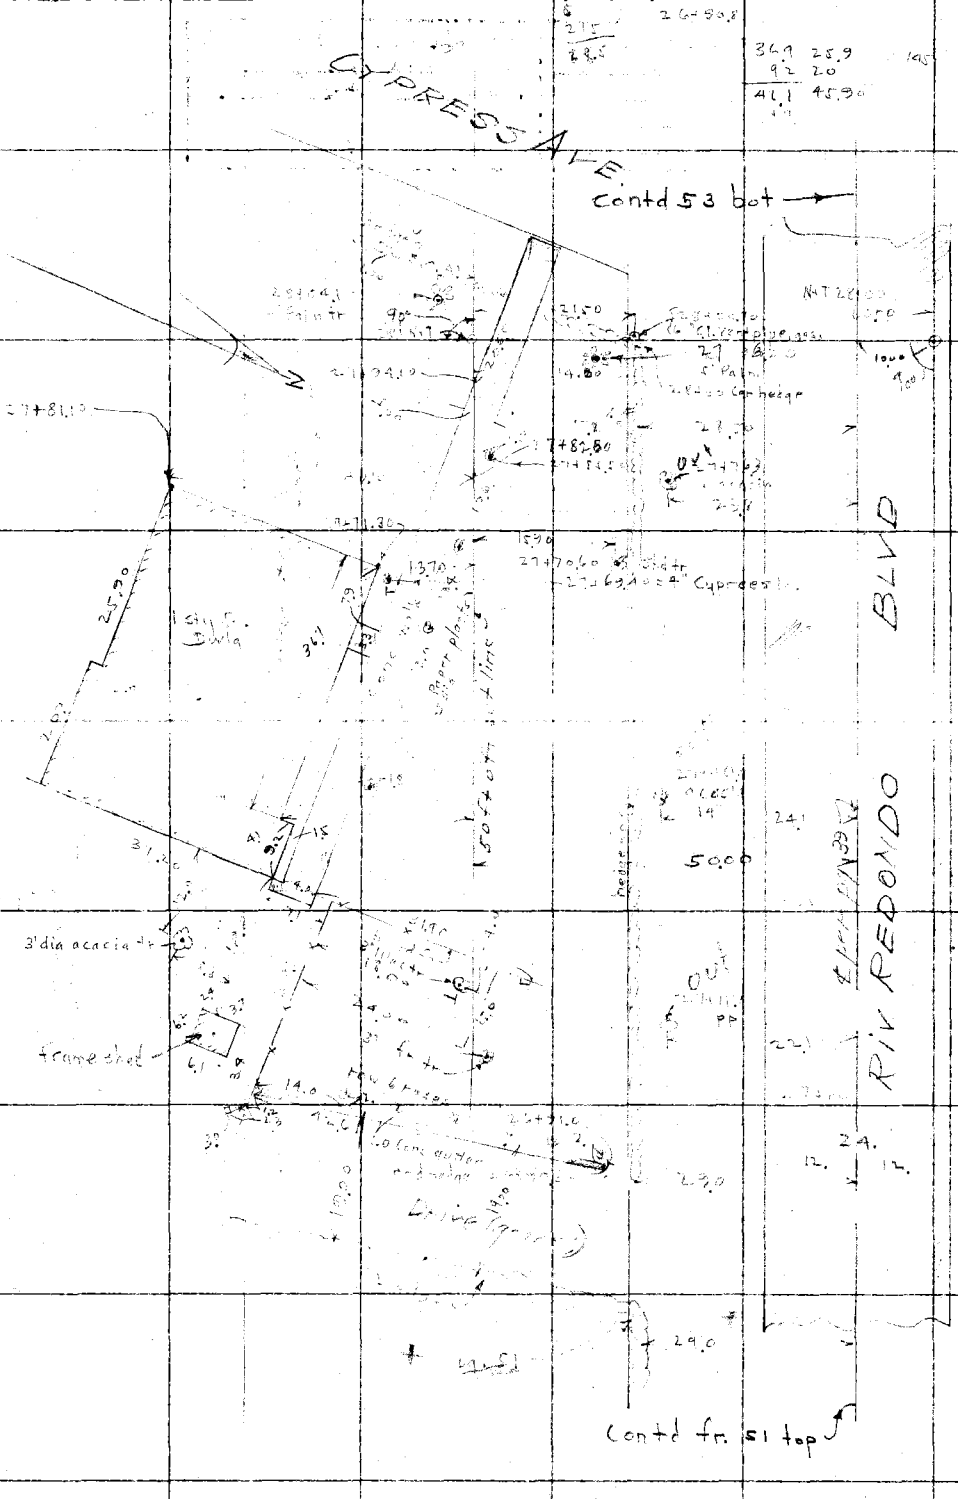

RETURN TO
LOS ANGELES COUNTY SURVEYOR

Do not extend notes this side of this line

Note: ANY ADDITIONS OR CHANGES ON THIS SHEET MUST BE MADE OR CIRCLED IN Red. WITH DATE AND NAME OF PERSON MAKING CHANGE.

Date 5-29-[illegible] Notes by [illegible] Chief Party [illegible] F.B. [illegible] Pg. 53

Platted by J. D. Price.	W. O. No. 920 ~~D. S. O. No.~~
Date Jan. 1930	Location
Map No. C. S. B-442-1	Surveyed by
Platting C'k'd by Topo Svensen	Date
~~Date~~	Indexed ~~C.~~ S. Johnson

Contd. 54, bot.

BLVD

out

out

Macadam

out

Conc. culvert

12" standpipe

out

Conc. headwall

out

Pole & guy

valve box

Conc. headwall

CYPRESS AVE


Contd fr 52 top

Notes: ANY ADDITIONS OR CHANGES OF THIS SHEET MUST BE MADE OR CIRCLED IN Red. WITH DATE AND NAME OF PERSON MAKING CHANGE.

Do not extend notes this side of this line

RETURN TO LOS ANGELES COUNTY SURVEYOR

F. B. [illegible] PG. 54 Chief Party Notes By Date 5-[illegible]-7

Cont'd 55 bot

Cont'd fr 53 top

RETURN TO
LOS ANGELES COUNTY SURVEYOR

Do not extend notes this side of this line

Note: ANY ADDITIONS OR CHANGES ON THIS SHEET MUST BE MADE OR CIRCLED IN Red. WITH DATE AND NAME OF PERSON MAKING CHANGE.

Date 5-20-29 Notes by DWK Chief Party Price F.B. 222 Pg 55

Platted by J. D. Price.	W. O. No. 420 B. S. C. No. 1
Date Jan., 1930	Location Rio Hondo
Map No. C.S. 8-442-JL/.	Surveyed by
Platting C'k'd by Topo Svensen	Date
Date	Indexed

Notes: ANY ADDITIONS OR CHANGES OR THIS SHEET MUST BE MADE OR CIRCLED IN Red. WITH DATE AND NAME OF PERSON MAKING CHANGE.

Do not extend notes this side of this line

RETURN TO LOS ANGELES COUNTY SURVEYOR

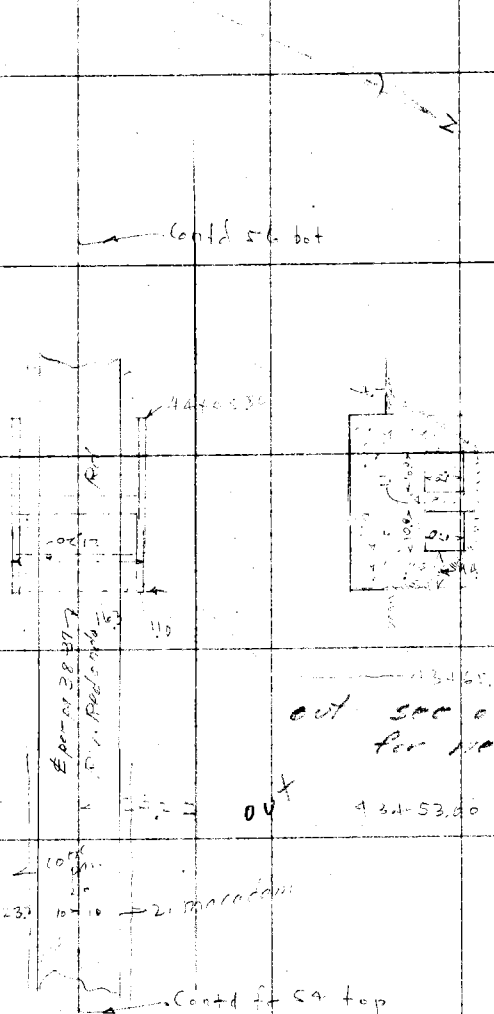

F. B. 399 Pg. 56 — Chief Party — Notes by — Date

RETURN TO
LOS ANGELES COUNTY SURVEYOR
Do not extend notes this side of this line

Note: ANY ADDITIONS OR CHANGES ON THIS SHEET MUST BE MADE OR CIRCLED IN Red. WITH DATE AND NAME OF PERSON MAKING CHANGE.

Date 5-2 Notes by Chief Party F.B. Pg. 57

Platted by J.D. Price
Date Jan., 1930
Map No. CS. B-442-Sh1.
Platting C'k'd by Topo Svenson
Date

W. O. No. 920 B. S. O. No. 1
Location Rte Redondo
Surveyed by Dep
Date 5-31-30
Indexed

Contd fr 58 bot

32.0

15½ F.

Contd to 58 top

Notes: ANY ADDITIONS OR CHANGES ON THIS SHEET MUST BE MADE OR CIRCLED IN Red. WITH DATE AND NAME OF PERSON MAKING CHANGE.

Do not extend notes this side of this line

RETURN TO LOS ANGELES COUNTY SURVEYOR

F. B. 399 Pg. 58 DMA Chief Party Notes by DMA Date 5-31-07

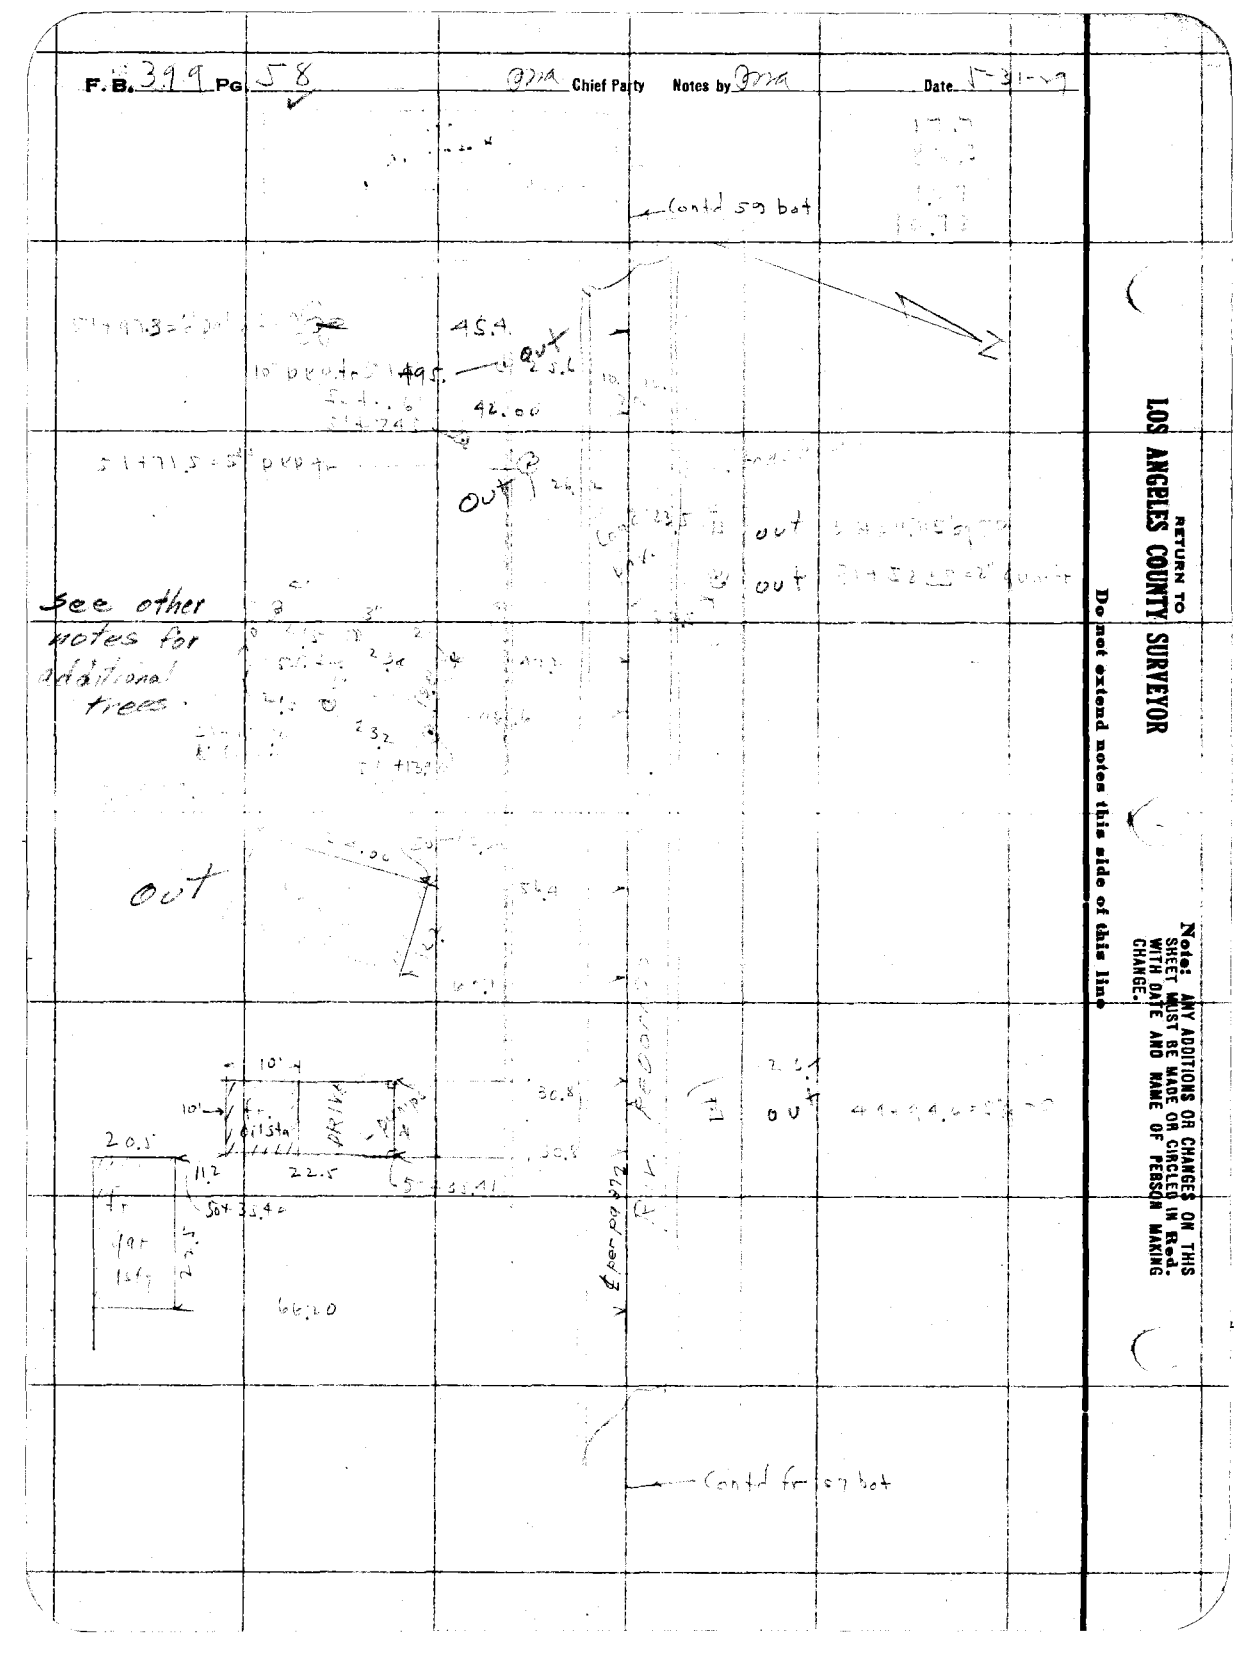

RETURN TO
LOS ANGELES COUNTY SURVEYOR

Do not extend notes this side of this line

Note: ANY ADDITIONS OR CHANGES ON THIS SHEET MUST BE MADE OR CIRCLED IN Red. WITH DATE AND NAME OF PERSON MAKING CHANGE.

Date _____ Notes by _____ Chief Party _____ F.B. _____ Pg. 59

Platted by J.D. Price.	W. O. No. [illegible] D. S. O. No. [illegible]
Date Jan., 1930.	Location [illegible]
Map No. C.S. 8-442-14.1.	Surveyed by _____
Platting C'k'd by TopoSvenson	Date [illegible]
Date _____	Indexed _____

Note: ANY ADDITIONS OR CHANGES OR THIS SHEET MUST BE MADE OR CIRCLED IN Red. WITH DATE AND NAME OF PERSON MAKING CHANGE.

Do not extend notes this side of this line

RETURN TO
LOS ANGELES COUNTY SURVEYOR

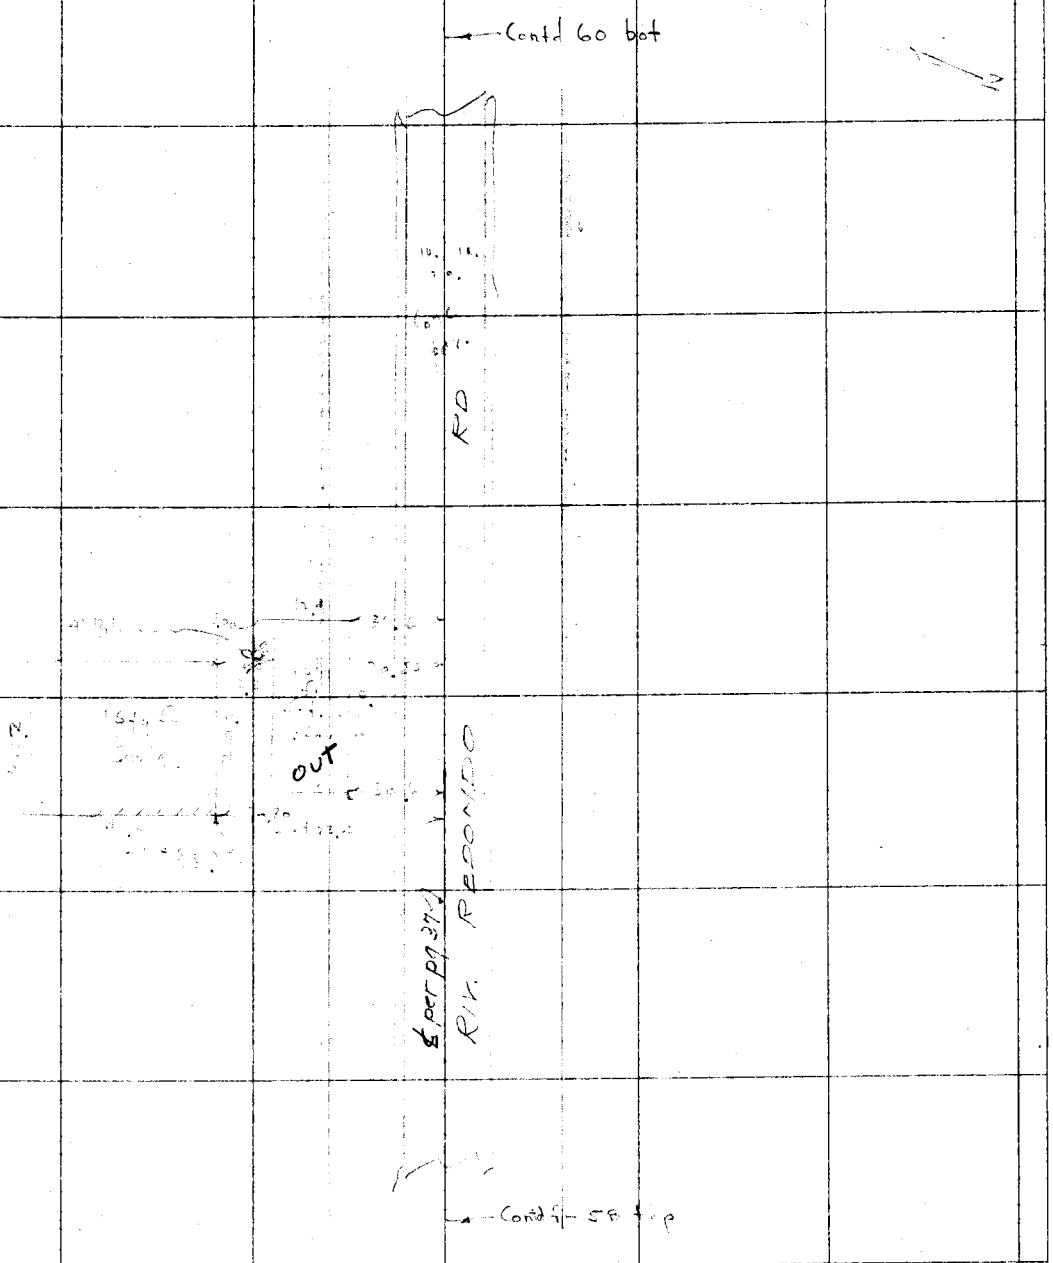

F.B. 399 Pg 60 Chief Party Notes by [illegible] Date 5-31-29

Contd 61 bot

Plot first

Fig on hand

Plot first

Contd fr 59 top

RETURN TO
LOS ANGELES COUNTY SURVEYOR
Do not extend notes this side of this line

Note: ANY ADDITIONS OR CHANGES ON THIS SHEET MUST BE MADE OR CIRCLED IN Red. WITH DATE AND NAME OF PERSON MAKING CHANGE.

Date 6-3-29 Notes by O.I.A Chief Party O.I.A F.B. 399 PG 61

Platted by J.D. Price
Date Jan., 1930.
Map No. C.S. B-492-1
Platting C'k'd by Topo Svenson
Date

W.O. No. 920 B.S.O. No. 1
Location
Surveyed by
Date 6-3-29
Indexed C. Johnson

Contd 62 bot

Note: ANY ADDITIONS OR CHANGES OF THIS SHEET MUST BE MADE OR CIRCLED IN Red. WITH DATE AND NAME OF PERSON MAKING CHANGE.

Do not extend notes this side of this line

RETURN TO
LOS ANGELES COUNTY SURVEYOR

Plot first

Contd to 60 top

F.B. 399 PG. 62 Chief Party Notes by [illegible] Date 6-3-29

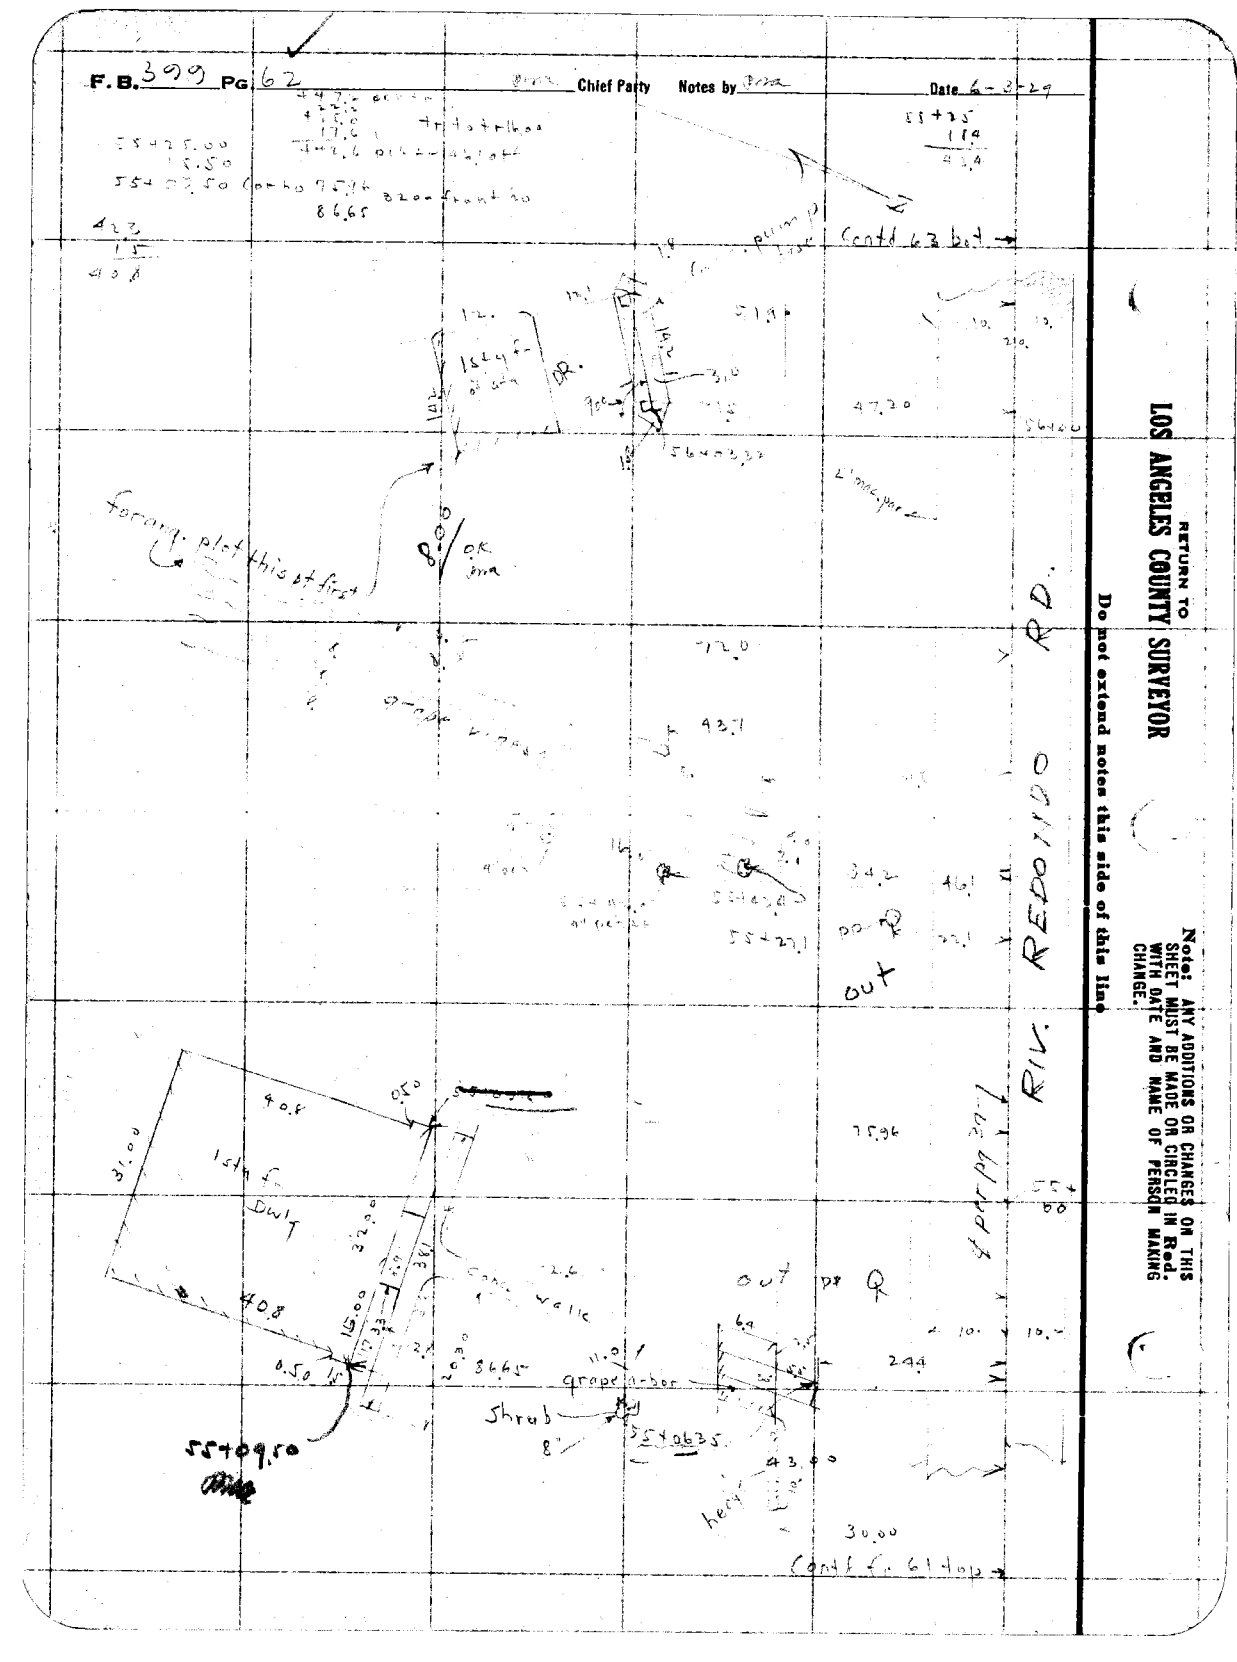

Date 6-[illegible]-39 Notes by [illegible] Chief Party [illegible] F.B. [illegible] Pg 63

Platted by J.D. Price	W.O. No. 920 ~~T.S.S.~~ No.
Date Jan., 1938	Location Tor. Redondo Rd
Map No. C.S. B-442-Sh #1	Surveyed by [illegible]
Platting C'k'd by Topo Svenson	Date 6-3-39
Date	Indexed [illegible] Johnson

Notes: ANY ADDITIONS OR CHANGES OF THIS SHEET MUST BE MADE OR CIRCLED IN Red. WITH DATE AND NAME OF PERSON MAKING CHANGE.

Do not extend notes this side of this line

RETURN TO LOS ANGELES COUNTY SURVEYOR

Gum trees have been cut down but are growing again

Cont'd 64 bot

Champ gum 63+84.00

Champ gum 63+79.2

63+79.3 PP3 out 22.6

Champ gum 63+68.4

2" gum 63+59.9

2" gum 63+57.5

Champ gum 63+47.0

Champ gum 63+46.00

Sycamore 63+37.6

R.D.

out

out 62+[illegible] 10" gum

out 62+39.3 PP O 22.6

out

out 60+[illegible].0 PP

out 59+59.40 PPQ

CIV. REDONDO

out [illegible] PP

Δ Dan-Ry 37

out [illegible] PP 22.6

Cont'd to 62+00

RETURN TO
LOS ANGELES COUNTY SURVEYOR

Note: ANY ADDITIONS OR CHANGES ON THIS SHEET MUST BE MADE OR CIRCLED IN **Red.** WITH DATE AND NAME OF PERSON MAKING CHANGE.

Do not extend notes this side of this line

F.B. 399 PG. 64

Chief Party [illegible]

Notes by [illegible]

Date 6-2-24

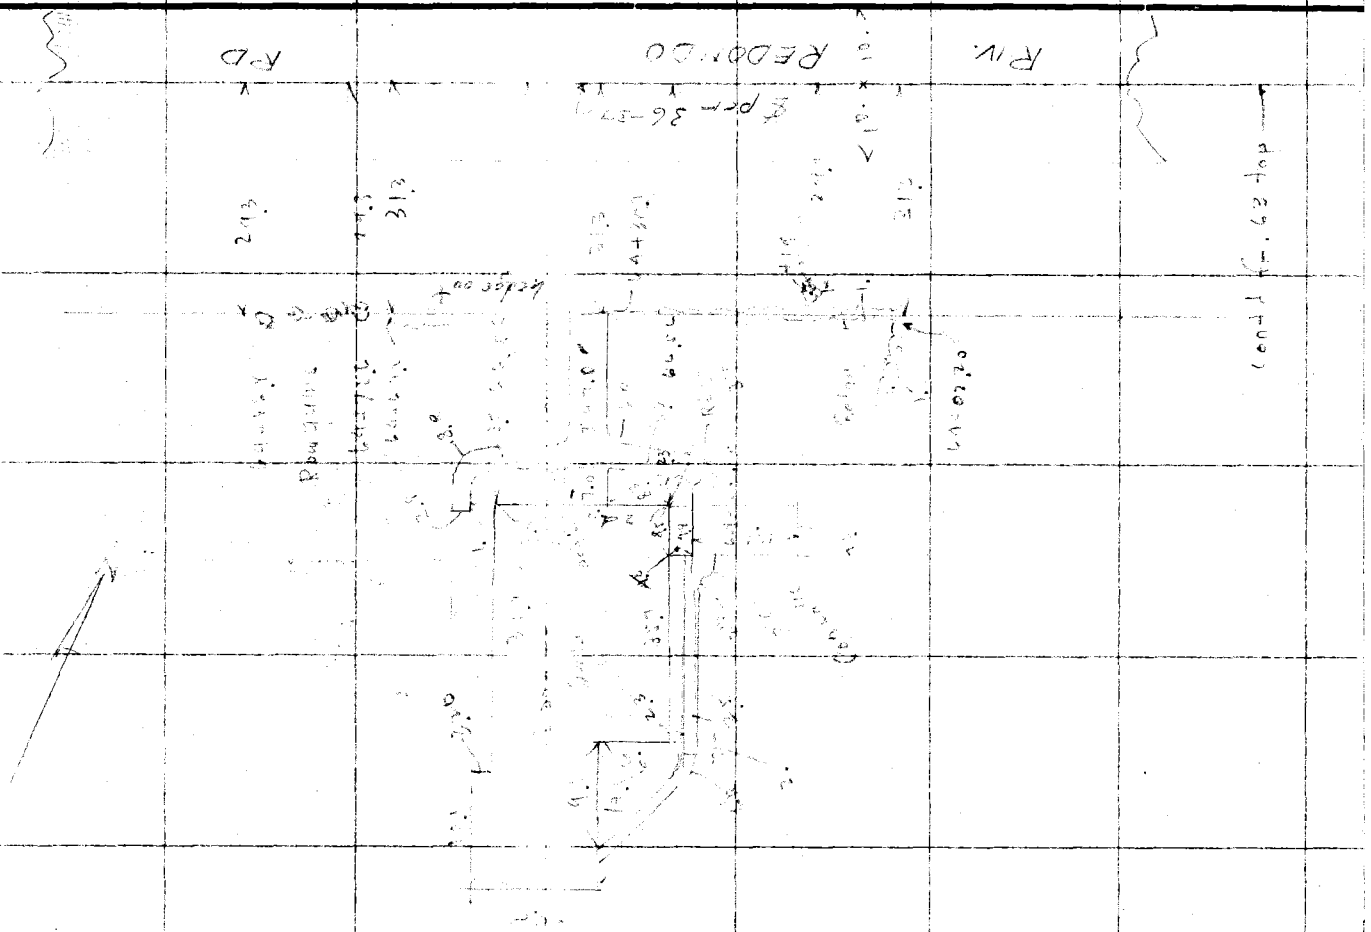
Contd to bot
Contd from bot
Rlv. to Redondo
Ex Pcl 36-37
213.
313.
Rdwy
Rdwy
Rdwy

Date 6-[illegible]-29 Notes by J.D.P. Chief Party [illegible] F.B. [illegible] Pg. 65

Platted by J. D. Price	W. O. No. [illegible] S. O. No.
Date Jan., 1930.	Location Rio Redondo [illegible]
Map No. C.S.B-442-Sh#1.	Surveyed by [illegible]
Platting C'k'd by Topo Svensen	Date 6-5-29
Date	Indexed [illegible]

Note: ANY ADDITIONS OR CHANGES ON THIS SHEET MUST BE MADE OR CIRCLED IN Red. WITH DATE AND NAME OF PERSON MAKING CHANGE.

Do not extend notes this side of this line

RETURN TO
LOS ANGELES COUNTY SURVEYOR

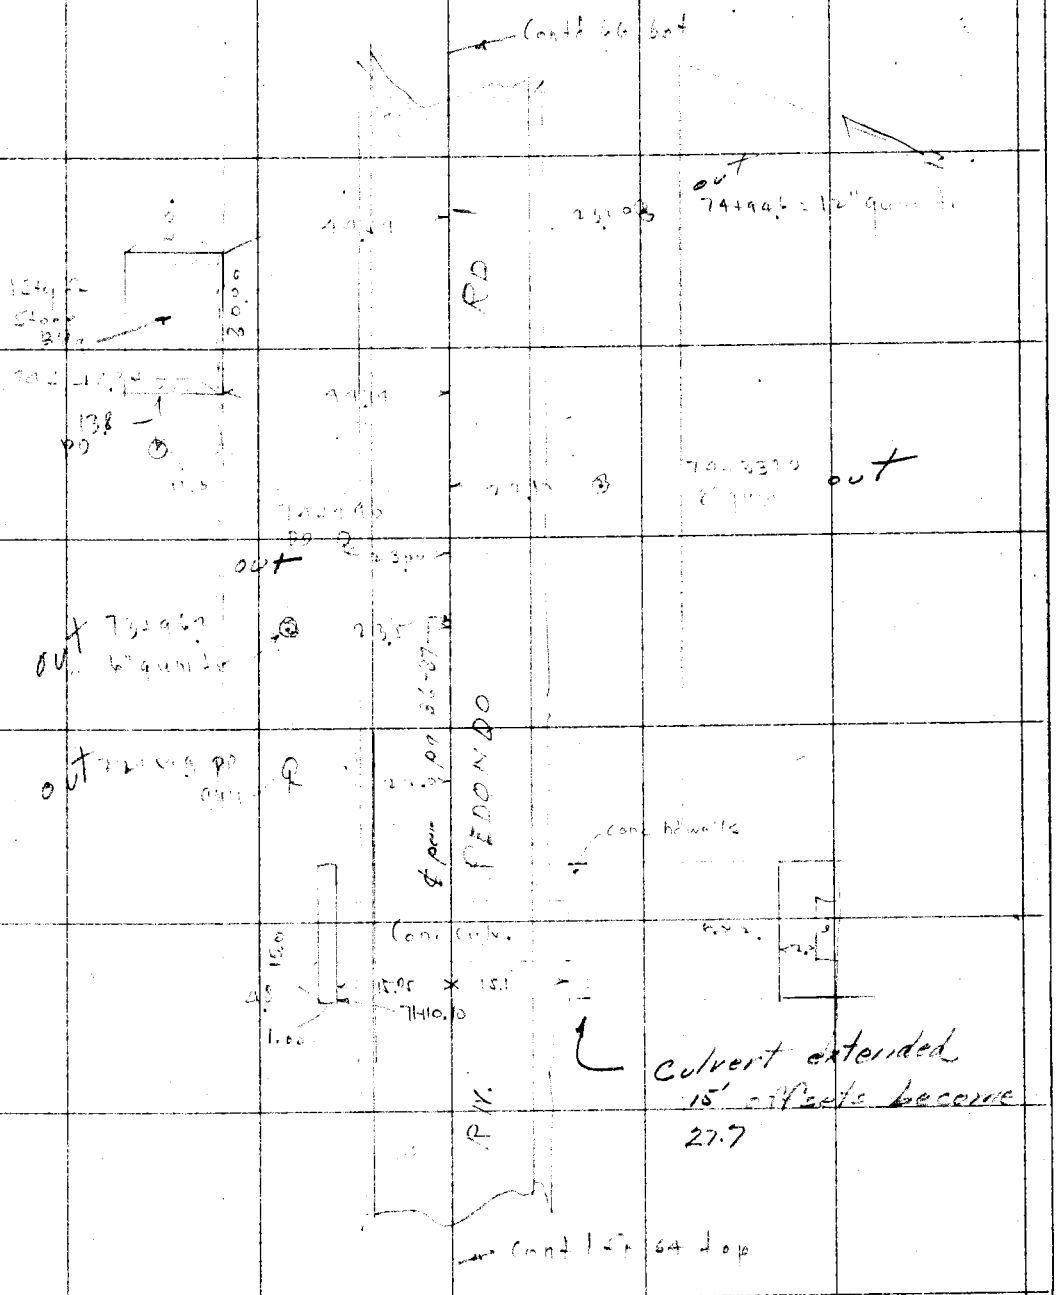

F. B. 299 PG 66 — Chief Party — Notes by — Date 6-22-79

cont'd 67 bot →

79+10.00 — 40.30

16th C. Store bldg 30.10 × 120

out

79+90.60 = PP out — 40.30 — RD — ℄ 22.5

78+23.90 = 6" qum tr out @ 23.0

78+90.30 = PP out — ℄ 22.4

76+93.80 = PP out — ℄ 22.5 — 22.0 @ out — 76+77.30 = 5" qum tr

76+43.60 = 3" qum tr out — @ 22.1 — 22.6 @ out — 76+16.40 = 8" qum tr

75+57.20 PP out — ℄ 22.0 — 22.6 @ out — 75+59.40 = 12" qum tr

75+22.20 = 10" qum tr out @ 23.5

IRR. REDONDO

cont'd from top →

RETURN TO
LOS ANGELES COUNTY SURVEYOR
Do not extend notes this side of this line

Note: ANY ADDITIONS OR CHANGES ON THIS SHEET MUST BE MADE OR CIRCLED IN Red. WITH DATE AND NAME OF PERSON MAKING CHANGE.

Date 6-3-29 Notes by J.D.P. Chief Party J.D.P. F.B. 322 Pg 67

Platted by J.D. Price.	W.O. No. 920 S.S.O. No. 1
Date Jan, 1930	Location Rix Redondo Rd
Map No. C.S.B-442-64 #1	Surveyed by
Platting C'k'd by Topo Svenson	Date 6-3-29
Date	Indexed

Note: ANY ADDITIONS OR CHANGES ON THIS SHEET MUST BE MADE OR CIRCLED IN Red. WITH DATE AND NAME OF PERSON MAKING CHANGE.

Do not extend notes this side of this line

RETURN TO
LOS ANGELES COUNTY SURVEYOR

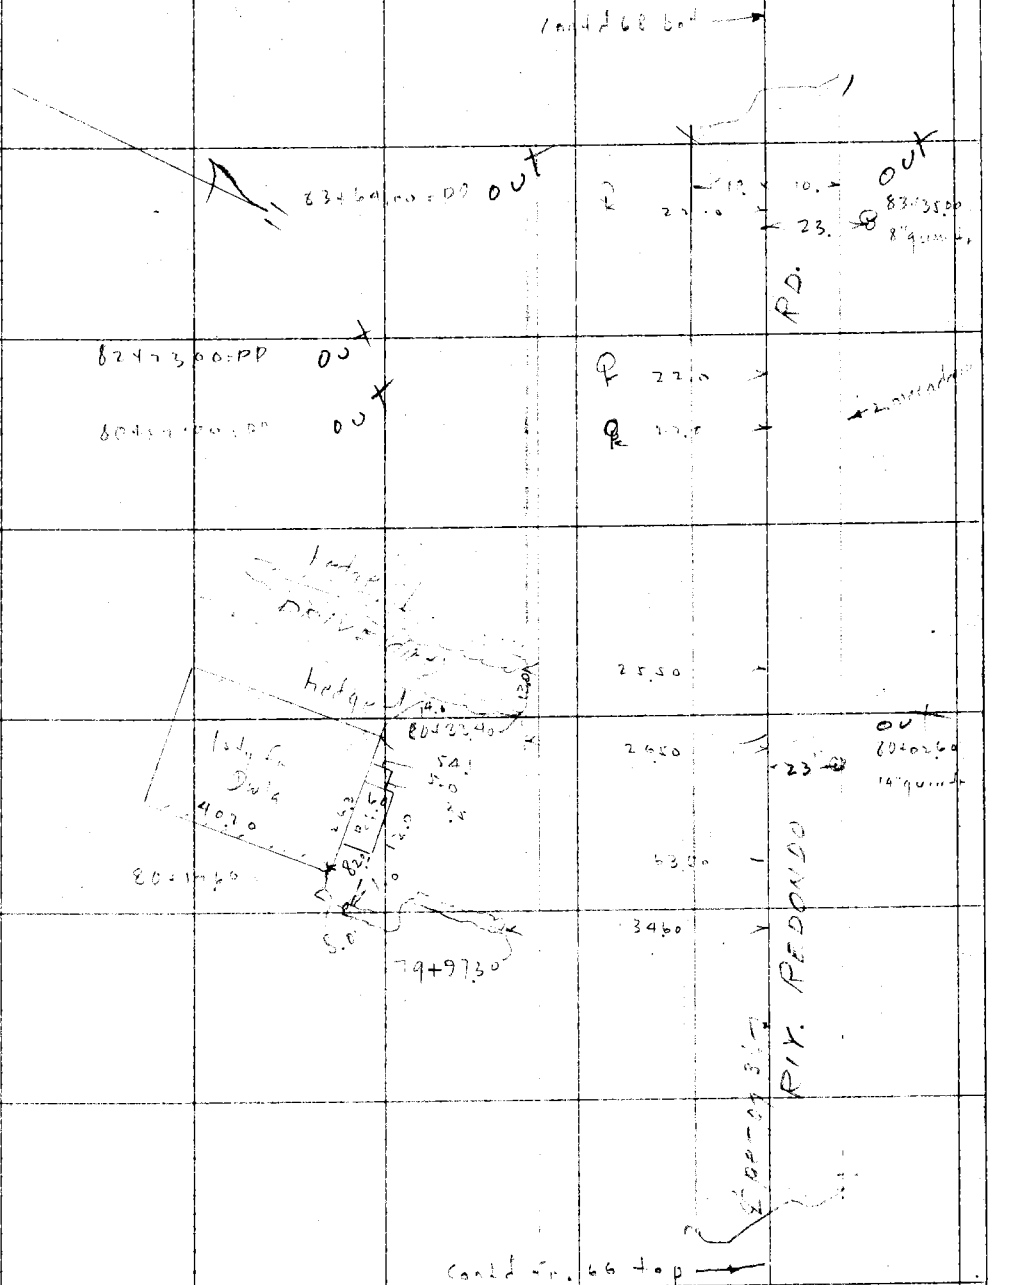

F. B. 399 PG. 68 DIM Chief Party Notes By DIM Date 6-3-29

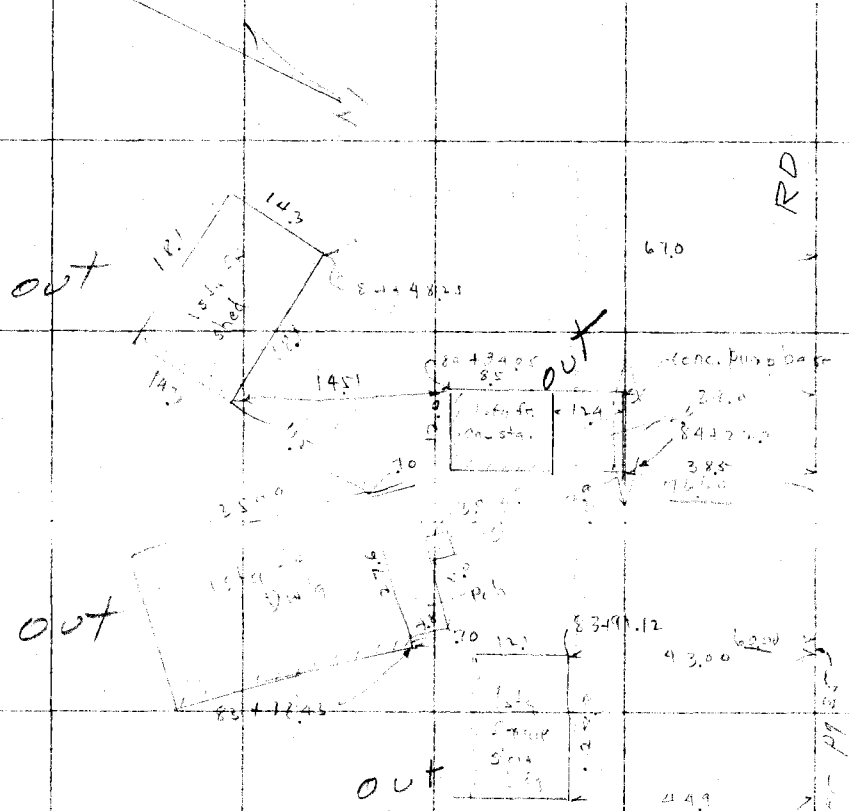

RETURN TO
LOS ANGELES COUNTY SURVEYOR

Do not extend notes this side of this line

Note: ANY ADDITIONS OR CHANGES ON THIS SHEET MUST BE MADE OR CIRCLED IN Red. WITH DATE AND NAME OF PERSON MAKING CHANGE.

Date 6-3-49 Notes by [illegible] Chief Party [illegible] F.B. 399 Pg 69

Platted by J.D. Price
Date Jan., 1930
Map No. C.S.B-442-Sh.#1
Platting C'k'd by Topo Svenson
Date

W.O. No. 920 ~~F.B.O.~~ No. 1
Location RIV. REDONDO RD
Surveyed by [illegible]
Date [illegible]
Indexed [illegible] C. JOHNSON

38.7
8441.30

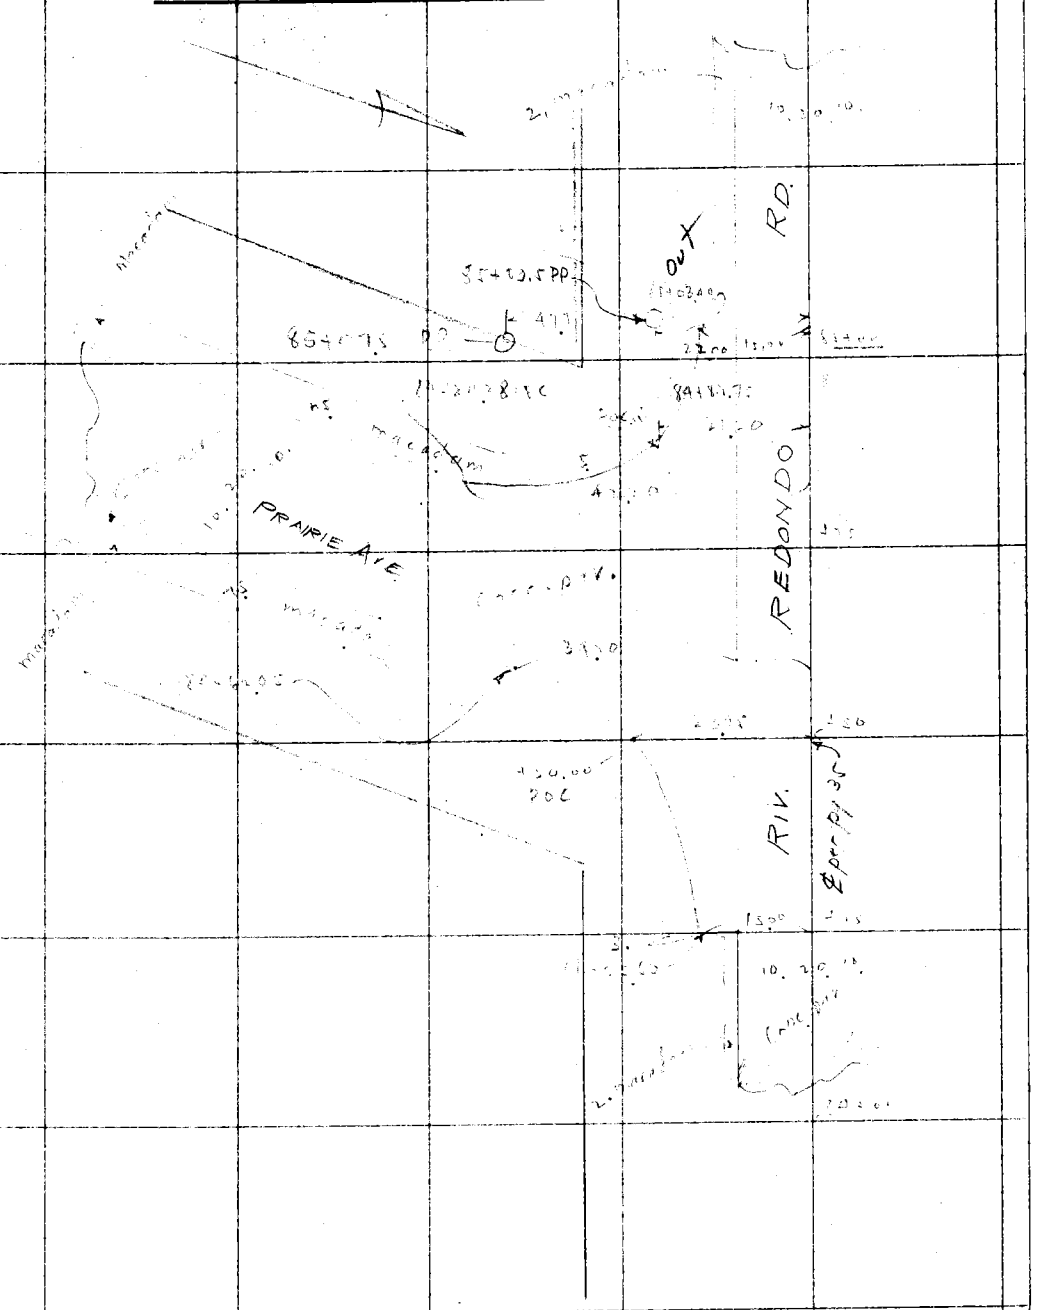

Notes: ANY ADDITIONS OR CHANGES OF THIS SHEET MUST BE MADE OR CIRCLED IN Red. WITH DATE AND NAME OF PERSON MAKING CHANGE.

Do not extend notes this side of this line

RETURN TO
LOS ANGELES COUNTY SURVEYOR

F.B. 399 Pg. 70 Chief Party Notes by Date 6-3-29

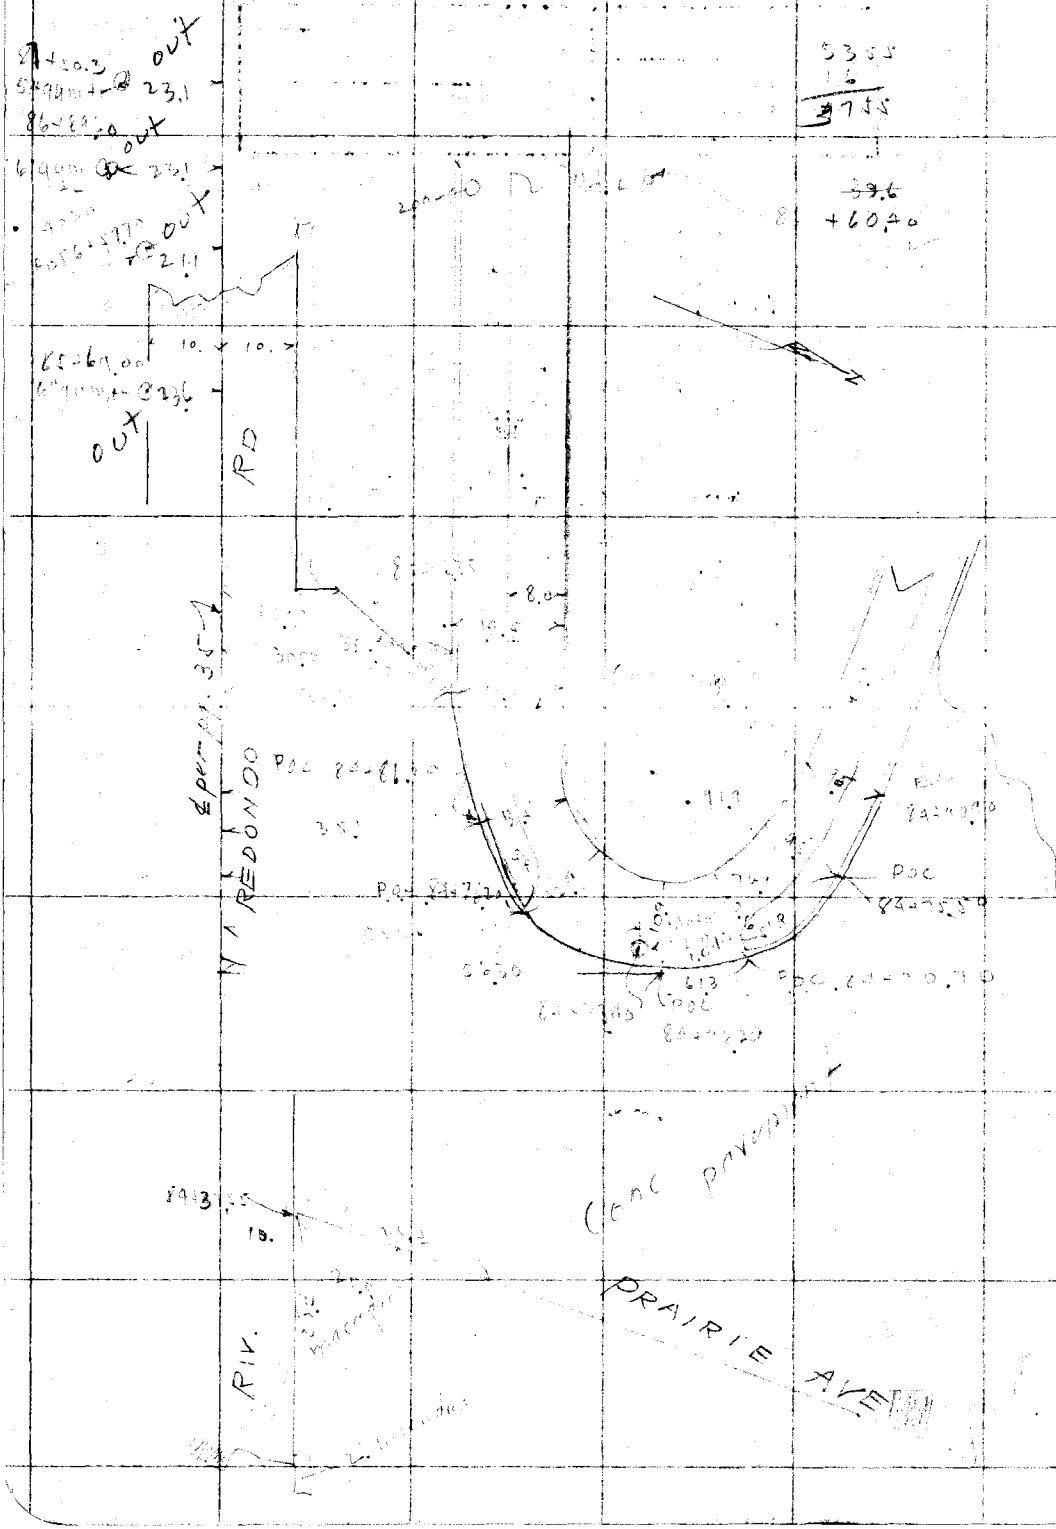

RETURN TO
LOS ANGELES COUNTY SURVEYOR
Do not extend notes this side of this line

Note: ANY ADDITIONS OR CHANGES ON THIS SHEET MUST BE MADE OR CIRCLED IN Red. WITH DATE AND NAME OF PERSON MAKING CHANGE.

Date 6-29-29 Notes by JMA Chief Party Pina F.B. 322 PG 71

Platted by J.D. Price.	W. O. No. [illegible] S.D. No. 1
Date March, 1931	Location Rix Redondo Rd
Map No. C.S. B-442 Sht. 1.	Surveyed by [illegible]
Platting C'k'd by Topo Svenson	Date 10-3-29
Date	Indexed by SVENSON

Notes: ANY ADDITIONS OR CHANGES OR THIS SHEET MUST BE MADE OR CIRCLED IN Red. WITH DATE AND NAME OF PERSON MAKING CHANGE.

Do not extend notes this side of this line

RETURN TO
LOS ANGELES COUNTY SURVEYOR

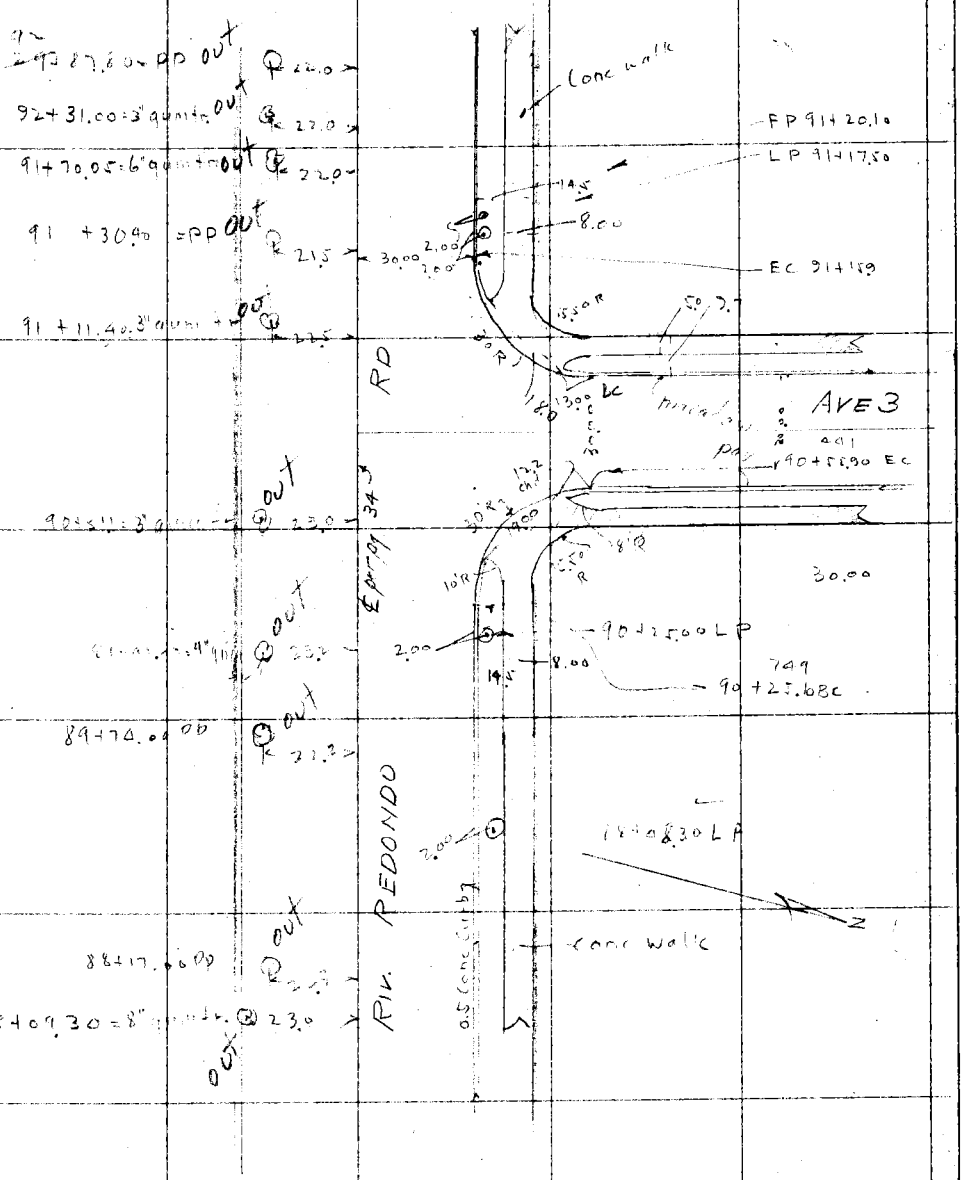

F.B. 399 PG. 72 Chief Party Notes by Date

RETURN TO
LOS ANGELES COUNTY SURVEYOR
Do not extend notes this side of this line

Note: ANY ADDITIONS OR CHANGES ON THIS SHEET MUST BE MADE OR CIRCLED IN Red WITH DATE AND NAME OF PERSON MAKING CHANGE.

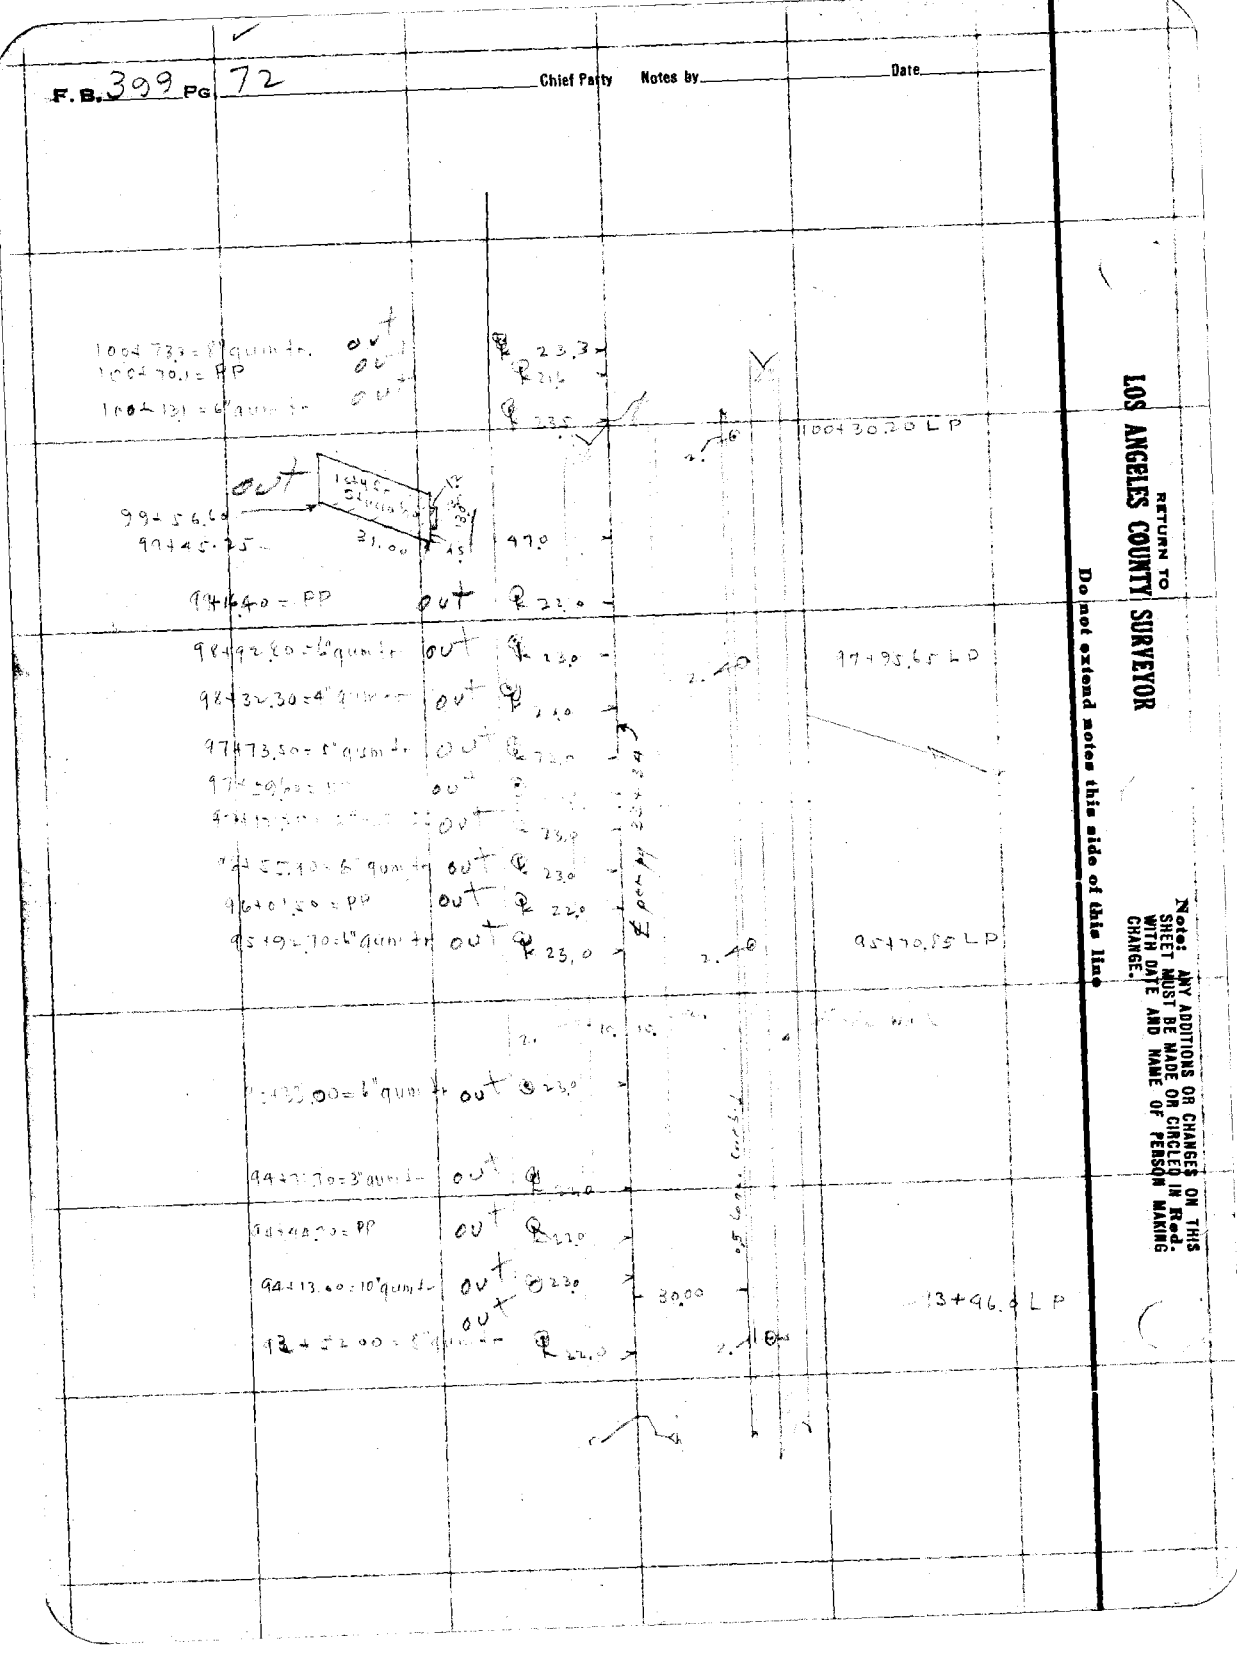
1004 73.3 = 8" quin tr.
1004 70.1 = PP
1004 13.1 = 6" quin tr.
out
out
out
23.3
23.5
1004 30.20 LP
99+56.60
99+45.25
out
1524 Cr
31.00
45°
47.0
99+40 = PP
out
22.0
98+92.60 = 6" quin tr.
98+32.30 = 4" quin tr.
97+73.50 = 5" quin tr.
out
out
out
23.0
97+95.65 LP
2.40
97+57.10 = 6" quin tr.
96+01.50 = PP
95+49.70 = 6" quin tr.
out
out
out
23.0
22.0
23.0
95+70.55 LP
2.40
Pavement
Curb & Gutter
out
23.0
94+72.70 = 3" quin tr.
out
94+48.50 = PP
out
22.0
94+13.00 = 10" quin tr.
out
23.0
30.00
13+96.8 LP
out
22.0
2.10

Date 6-[illegible]-31 Notes by D.J.S Chief Party [illegible] F.B. 299 Pg. 73

Platted by J.D. Price	W.O. No. 920 ~~B.S.B.~~ No. 1
Date March, 1931.	Location Rt. Redondo Rd
Map No. C.S.B-442 Sht. 1	Surveyed by [illegible] Dep
Platting C'k'd by Ivor Svenson	Date 6-11-31
Date	~~Indexed~~ A. C. Johnson

Notes: ANY ADDITIONS OR CHANGES ON THIS SHEET MUST BE MADE OR CIRCLED IN Red. WITH DATE AND NAME OF/. PERSON MAKING CHANGE.

Do not extend notes this side of this line

RETURN TO LOS ANGELES COUNTY SURVEYOR

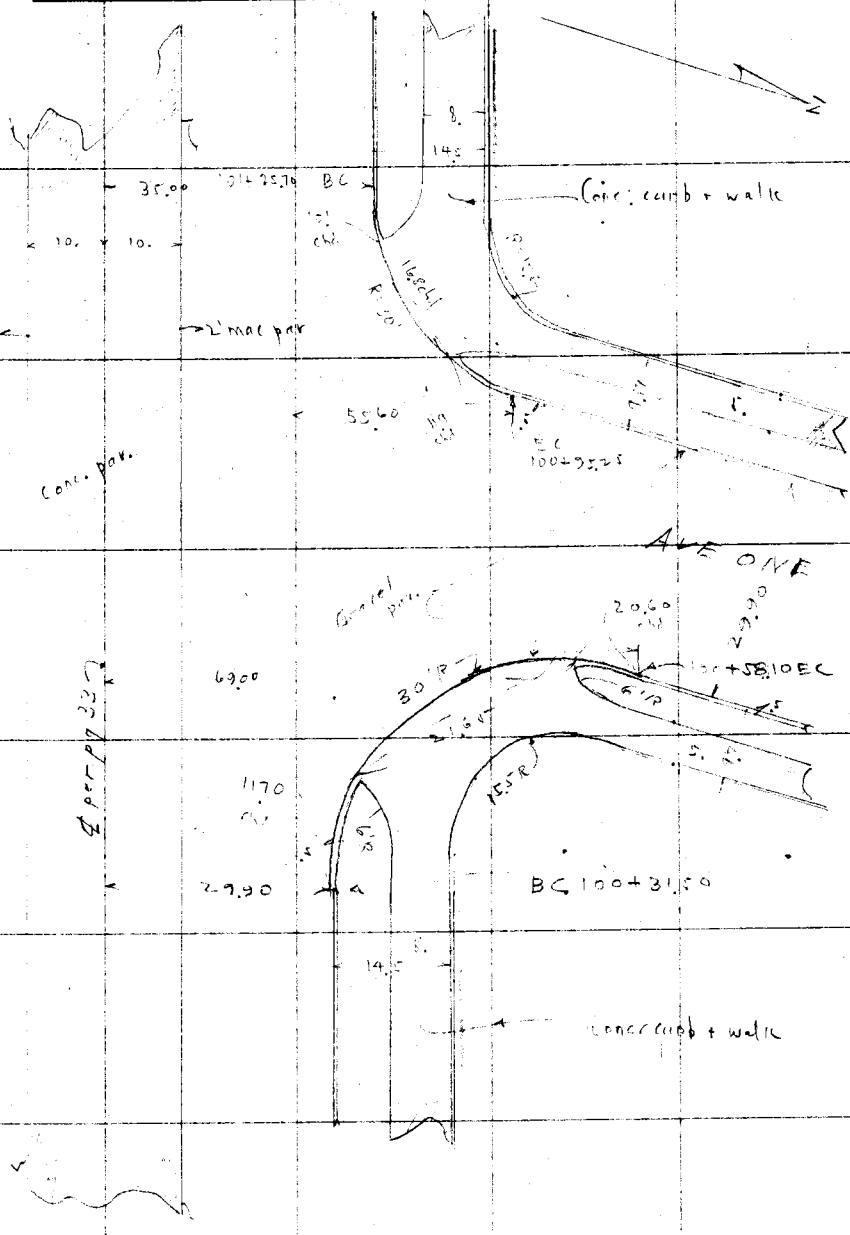

F.B. 399 Pg. 74 Chief Party Notes by Date 6-4-29

Contd 75 bot

105+40.00 = 3" P

out

104+33.90 = 1"

out

103+84.90 = PP

out

103+73.30 = 1"

Bldg out foundation left

103+30.75

Stucco Bldg

out

103+13.50 = 3"

out

102+52.70 = 6"

out

102+02.20 = PP

out

101+93.8 = 3"

out

101+64.60

Bldg

out

RIM REDONDO

Contd from 73 top

RETURN TO
LOS ANGELES COUNTY SURVEYOR
Do not extend notes this side of this line

Note: ANY ADDITIONS OR CHANGES ON THIS SHEET MUST BE MADE OR CIRCLED IN Red. WITH DATE AND NAME OF PERSON MAKING CHANGE.

Date 6-4-29 Notes by [illegible] Chief Party [illegible] F.B. 397 Pg. 75

Platted by J. D. Price.	W. O. No. 920
Date March, 1931.	Location Riv. Redondo Rd
Map No. C.S.B-442 Sht. 1	Surveyed by [illegible]
Platting C'k'd by Topo Svenson	Date 6-4-29
Date	Indexed

Notes: ANY ADDITIONS OR CHANGES ON THIS SHEET MUST BE MADE OR CIRCLED IN Red. WITH DATE AND NAME OF PERSON MAKING CHANGE.

Do not extend notes this side of this line

RETURN TO LOS ANGELES COUNTY SURVEYOR

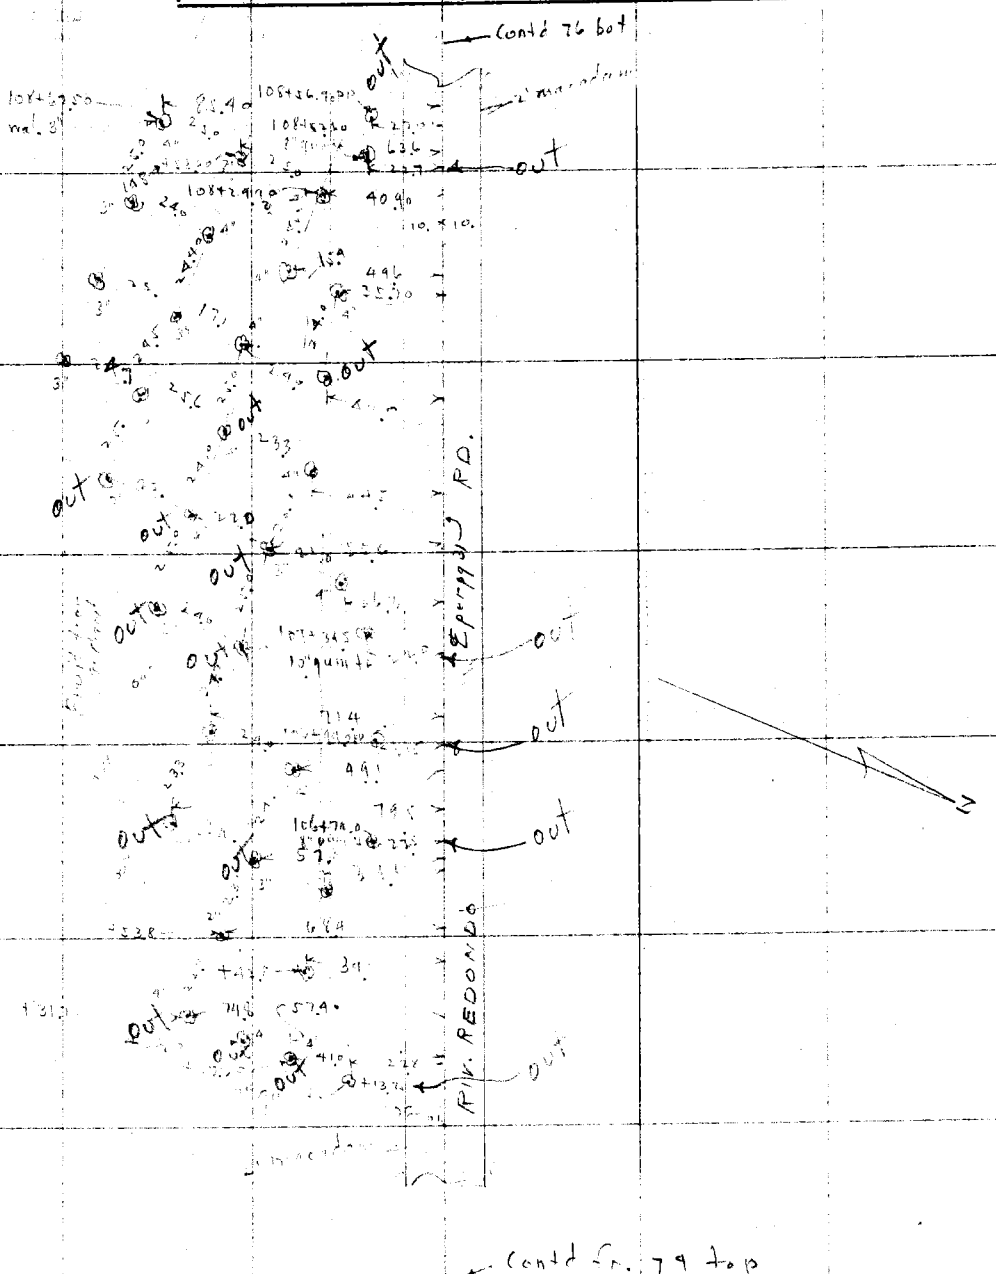

F. B. 299 Pg. 76 Chief Party Notes by Date 6-5-79

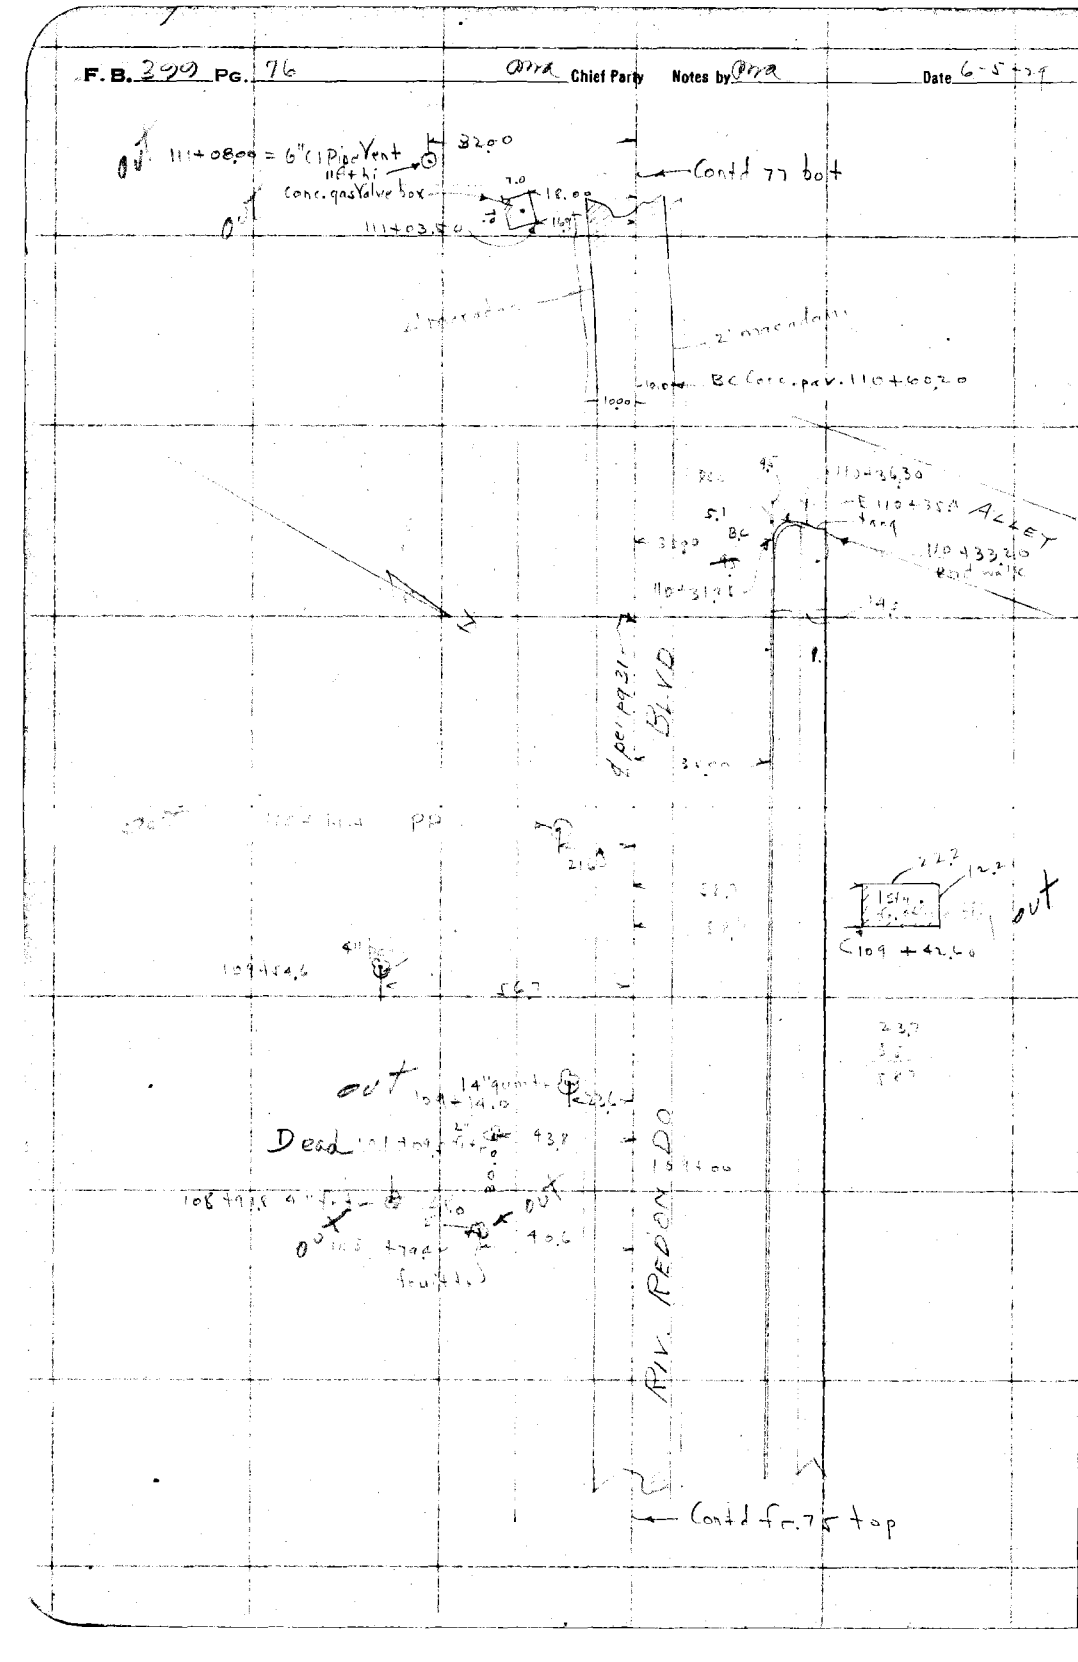

RETURN TO
LOS ANGELES COUNTY SURVEYOR

Do not extend notes this side of this line

Note: ANY ADDITIONS OR CHANGES ON THIS SHEET MUST BE MADE OR CIRCLED IN Red. WITH DATE AND NAME OF PERSON MAKING CHANGE.

Date 6-5-27 Notes by [illegible] Chief Party [illegible] F.B. 399 Pg. 77

Plotted by A Svenson
Date 8-8-30 Sht. 1.
Map No. 5442 [illegible]
Price-Isoo Svenson
Platting C'k'd by J.D. Price.
Date 4-13-31.

W.O. No. 920 Topo
B.O.D. No. 1
Location Riv. Redondo Rd
Surveyed by [illegible] Altins Dep
Date 6-5-27
Indexed

Notes: ANY ADDITIONS OR CHANGES OR THIS SHEET MUST BE MADE OR CIRCLED IN Red. WITH DATE AND NAME OF PERSON MAKING CHANGE.

Do not extend notes this side of this line

RETURN TO LOS ANGELES COUNTY SURVEYOR

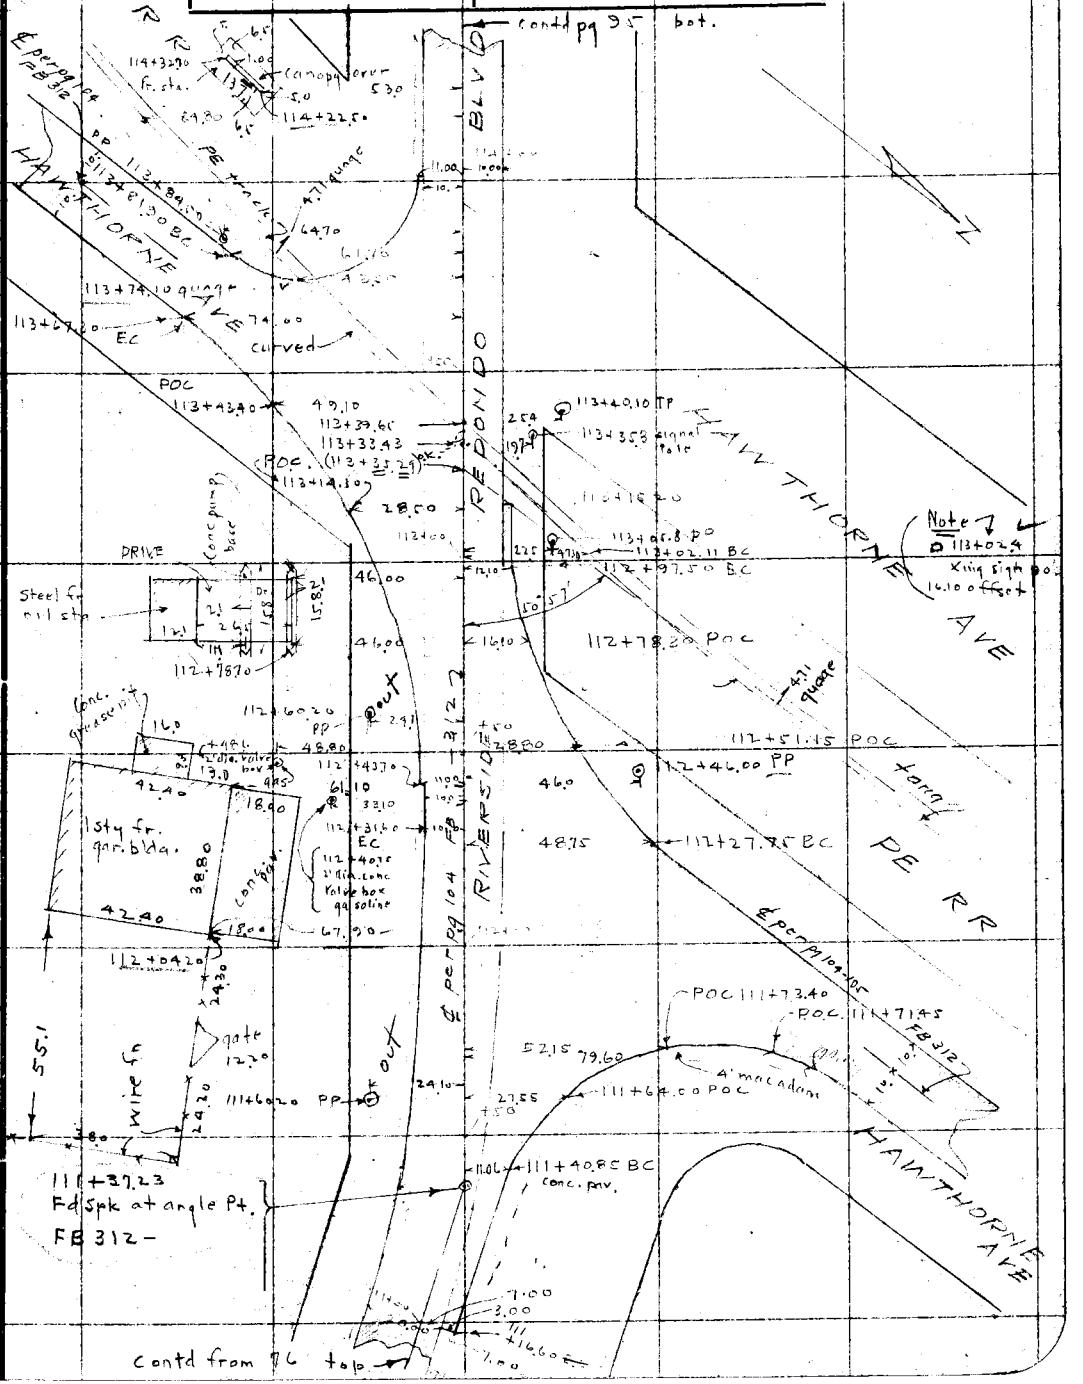

F. B. 399 PG 18 Chief Party Notes by Date

RETURN TO
LOS ANGELES COUNTY SURVEYOR

Do not extend notes this side of this line

Note: ANY ADDITIONS OR CHANGES ON THIS SHEET MUST BE MADE OR CIRCLED IN Red. WITH DATE AND NAME OF PERSON MAKING CHANGE.

Date 6-10-27 Notes by [illegible] Chief Party [illegible] F.B. 395 Pg. 79

Platted by A Svenson	W. O. No. 920 D. S. O. No.
Date 8-8-30	Location Gould Ave
Map No. B44-362	Surveyed by [illegible]
Platting Ck'd by J. D. Price	Date [illegible]
Date 4-14-31.	Indexed

TOPOGRAPHY
in
GOULD LANE
from
PROSPECT AVE
to
CAMINO REAL (+ South)

page 80 to 83

[illegible] chf
Soderblom Inst
Graham Mdch
[illegible] Engineer Rodman

Notes: ANY ADDITIONS OR CHANGES ON THIS SHEET MUST BE MADE OR CIRCLED IN Red. WITH DATE AND NAME OF PERSON MAKING CHANGE.

Do not extend notes this side of this line

RETURN TO LOS ANGELES COUNTY SURVEYOR

F.B. 399 PG 80 — Dra Chief Party — Notes by Dra — Date 6-10-29

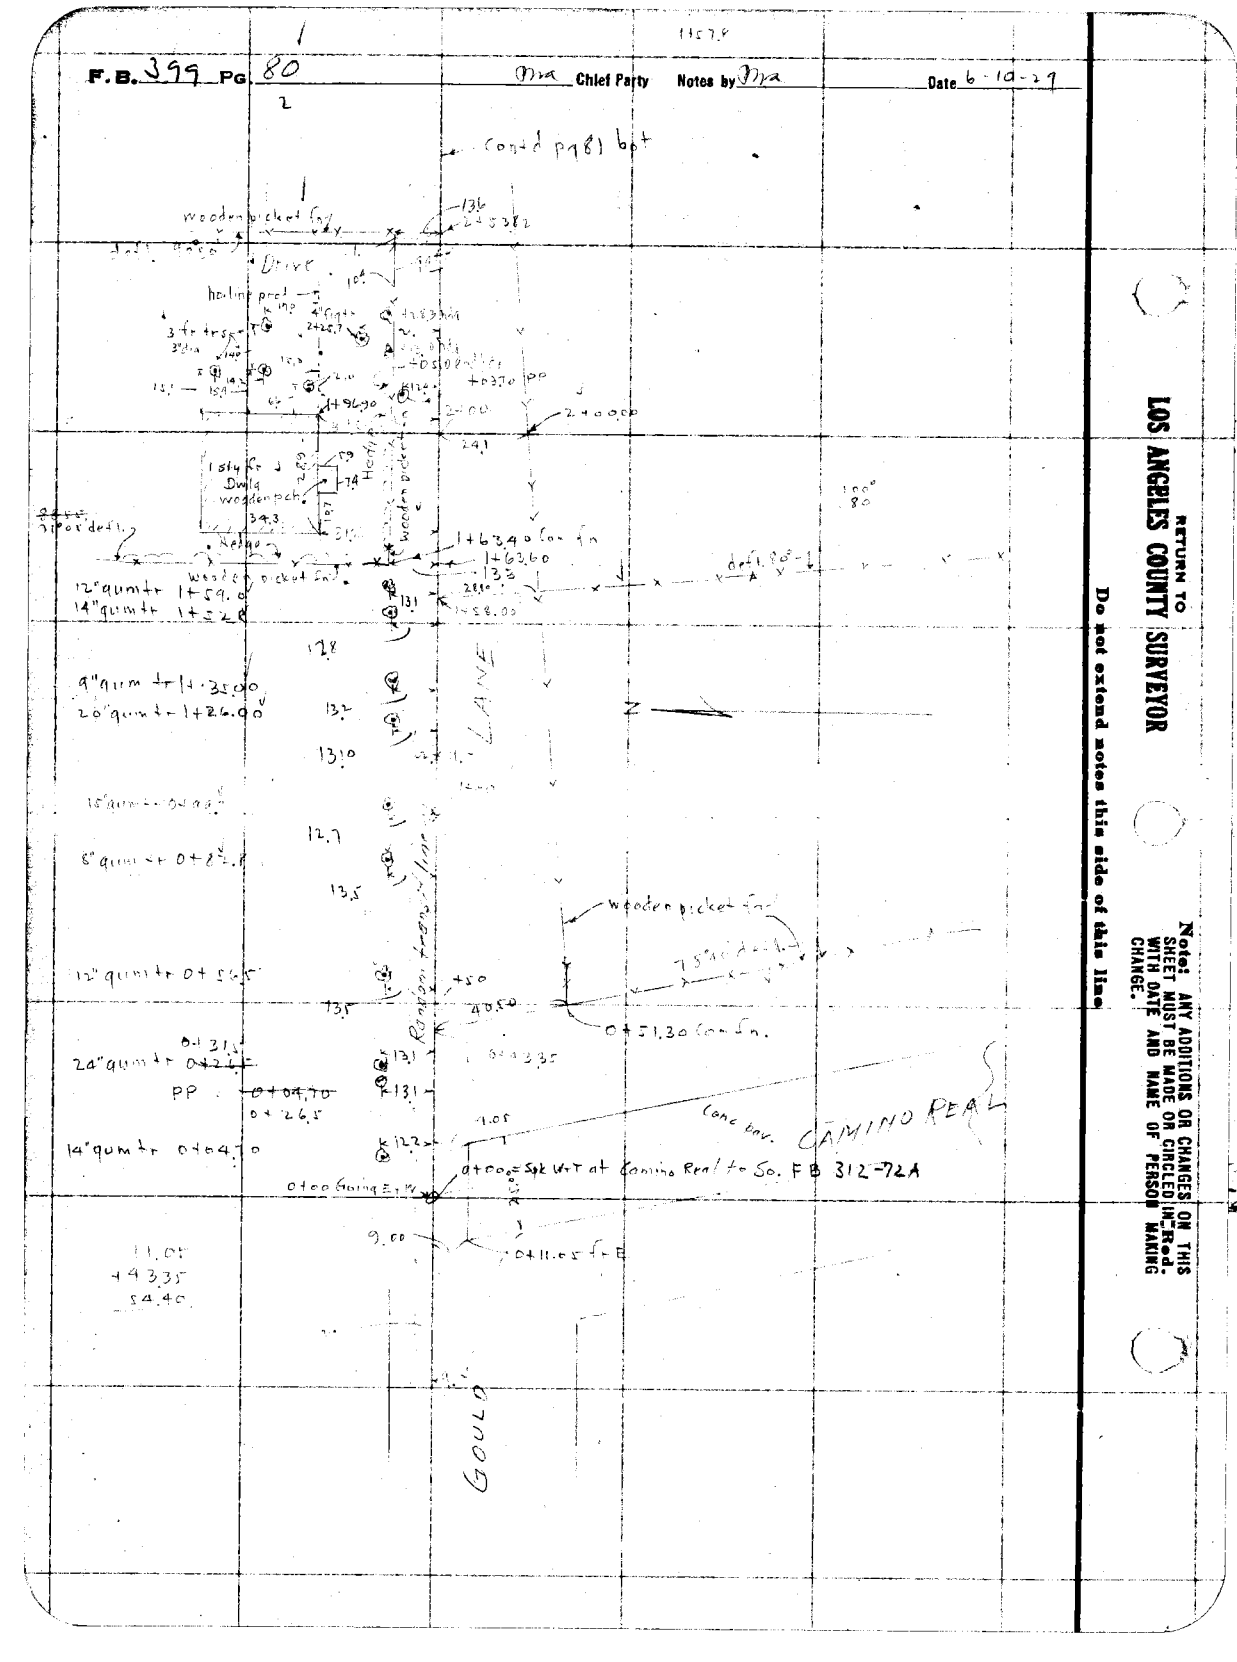

RETURN TO LOS ANGELES COUNTY SURVEYOR

Do not extend notes this side of this line

Note: ANY ADDITIONS OR CHANGES ON THIS SHEET MUST BE MADE OR CIRCLED IN Red. WITH DATE AND NAME OF PERSON MAKING CHANGE.

Date 6-11-29 Notes by [illegible] Chief Party [illegible] F.B. 299 Pg 81

Platted by A Svenson	W. O. No. 900 U. S. O. No.
Date 8-30	Location Gould Lane
Map No. B 492-Sh2	Surveyed by D. [illegible]
Platting C'k'd by J. D. Price	Date 6-11-29
Date 4-14-'31.	Indexed A. C. Johnson

Notes: ANY ADDITIONS OR CHANGES ON THIS SHEET MUST BE MADE OR CIRCLED IN Red. WITH DATE AND NAME OF PERSON MAKING CHANGE.

Do not extend notes this side of this line

RETURN TO LOS ANGELES COUNTY SURVEYOR

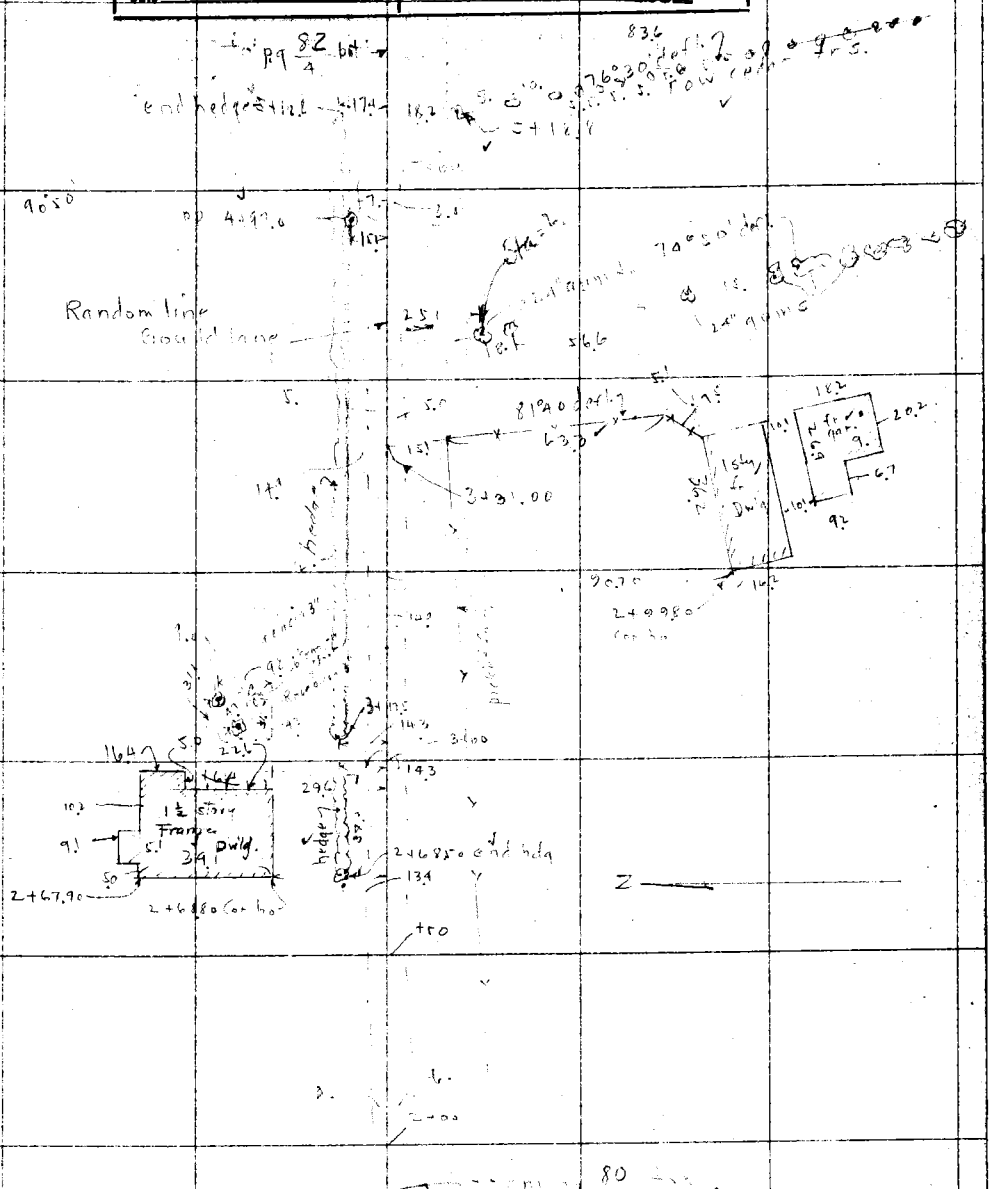

F.B. 299 PG. 82 — Orra Chief Party — Notes by Orra — Date 6-11-29

20.

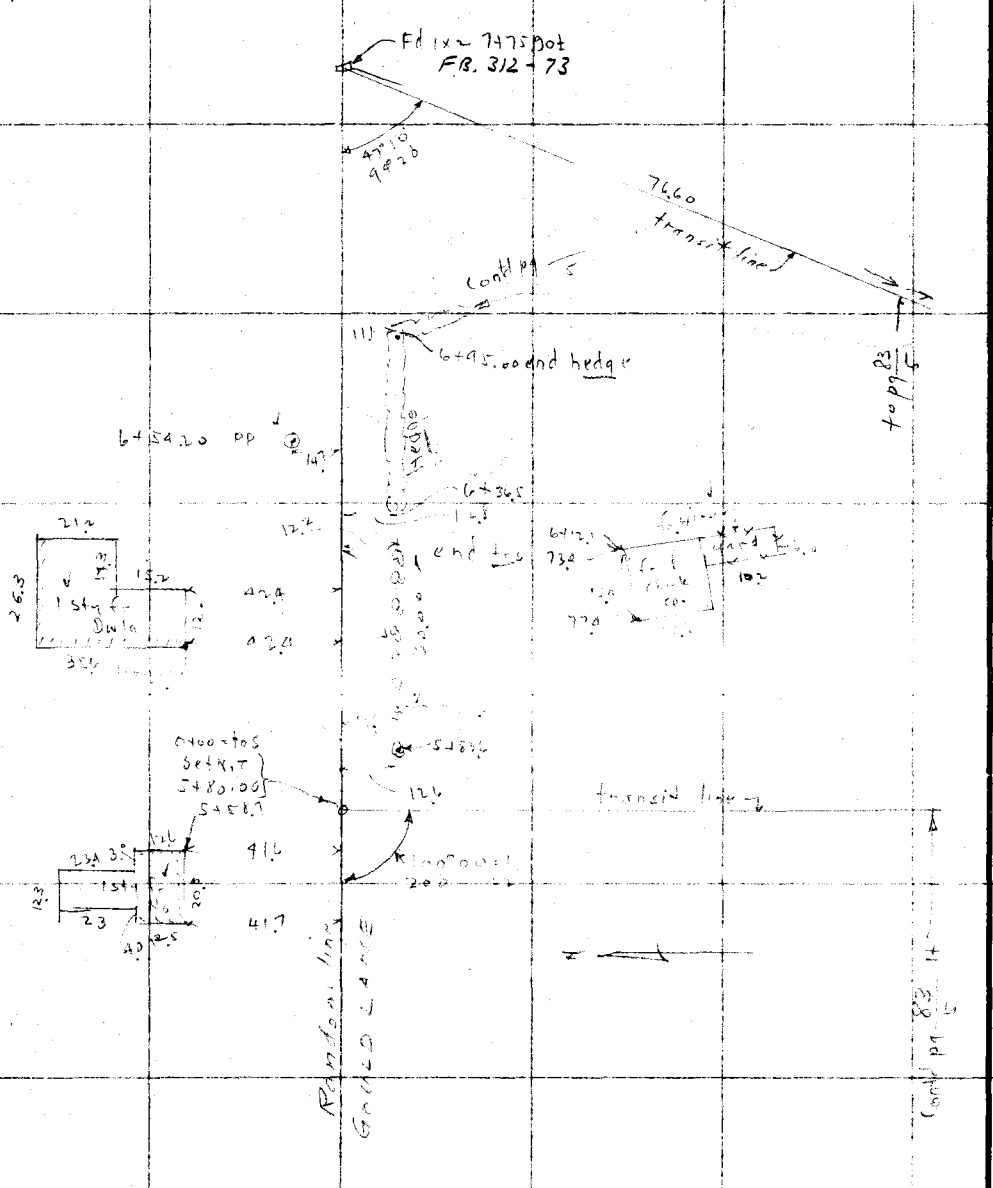

263
143
12

RETURN TO
LOS ANGELES COUNTY SURVEYOR

Do not extend notes this side of this line

Note: ANY ADDITIONS OR CHANGES ON THIS SHEET MUST BE MADE OR CIRCLED IN Red. WITH DATE AND NAME OF PERSON MAKING CHANGE.

Date 6-11-29 Notes by [illegible] Chief Party [illegible] F.B. 399 Pg. 83

Platted by A Svenson	W. O. No. 920 D. S. O. No.
Date 7-8-30	Location [illegible]
Map No. B992-Sh2	Surveyed by [illegible]
Platting C'k'd by J.D. Price.	Date 6-11-29
Date 4-14-'31.	Indexed H. C. Johnson

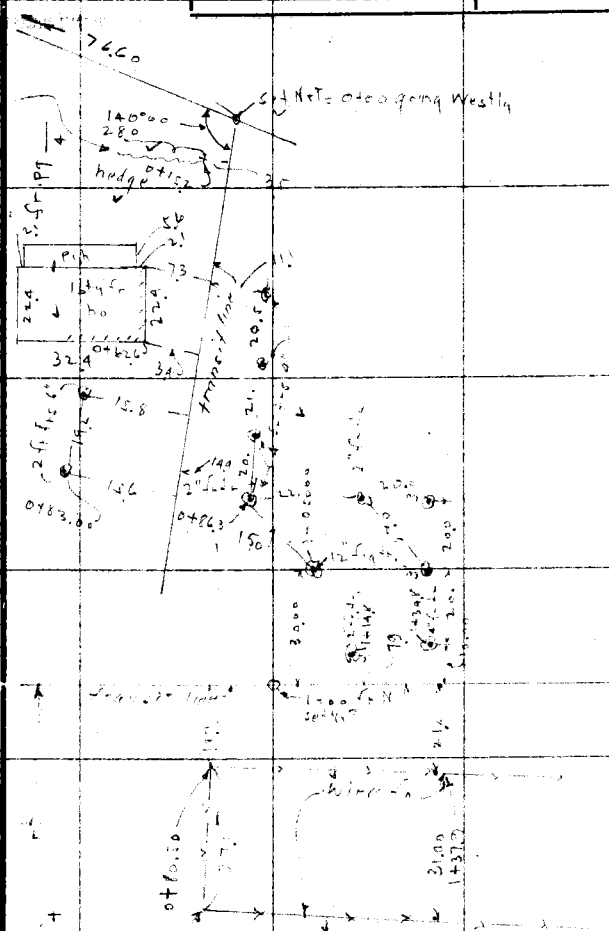

RETURN TO
LOS ANGELES COUNTY SURVEYOR

Do not extend notes this side of this line

Note: ANY ADDITIONS OR CHANGES ON THIS SHEET MUST BE MADE OR CIRCLED IN Red. WITH DATE AND NAME OF PERSON MAKING CHANGE.

F.B. 399 Pg. 84 Chief Party Notes by Date

RETURN TO
LOS ANGELES COUNTY SURVEYOR

Do not extend notes this side of this line

Note: ANY ADDITIONS OR CHANGES ON THIS SHEET MUST BE MADE OR CIRCLED IN Red. WITH DATE AND NAME OF PERSON MAKING CHANGE.

Date 6-12-29 Notes by [illegible] Chief Party [illegible] F.B. [illegible] Pg 85

Platted by A. Svenson
Date Aug. 1930
Map No. B-442-2
Platting C'k'd by D. M. Finley
Date Nov. 1933

W. O. No. 920 ~~T.80.~~ No 029
Location Riv. Redondo Rd
Surveyed by Parr & Hilkins Dep
Date 6-12-29
Indexed [illegible]

9003 15
89 56 20
179 59 34
25

Contd 86 bet

900015
360100 SW

Contd FB 312 - 96 top

Set 2x2 Stk + tk
2' dn R P

90°00'20" Adj.
90°00'15"

Set 2x2 Stk + tk
2' dn R P

Set 2"x2" Stk + tk
2' dn ; by prop.
bet. Inglewood
and Vail Aves.

PERKINS

Set 2x2 Stk + tk
2' dn R P

Set 2"x2" Stk + tk
2' dn R P

Fd Sw in mac. par.

SW
NW

ROBINSON

Nx T + 1 po

Fd sw

Fd Spk + W
at Center St

INGLEWOOD AVE

Nx T Pp
18223 E

Nx T Stop sign pu

Contd on 187 top

1605.64 @ 74° =
1605.54

Notes: ANY ADDITIONS OR CHANGES OR THIS SHEET MUST BE MADE OR CIRCLED IN Red. WITH DATE AND NAME OF PERSON MAKING CHANGE.

Do not extend notes this side of this line

RETURN TO
LOS ANGELES COUNTY SURVEYOR

F.B. 399 Pg. 86 DRA Chief Party Notes by DRA Date 6-12-29

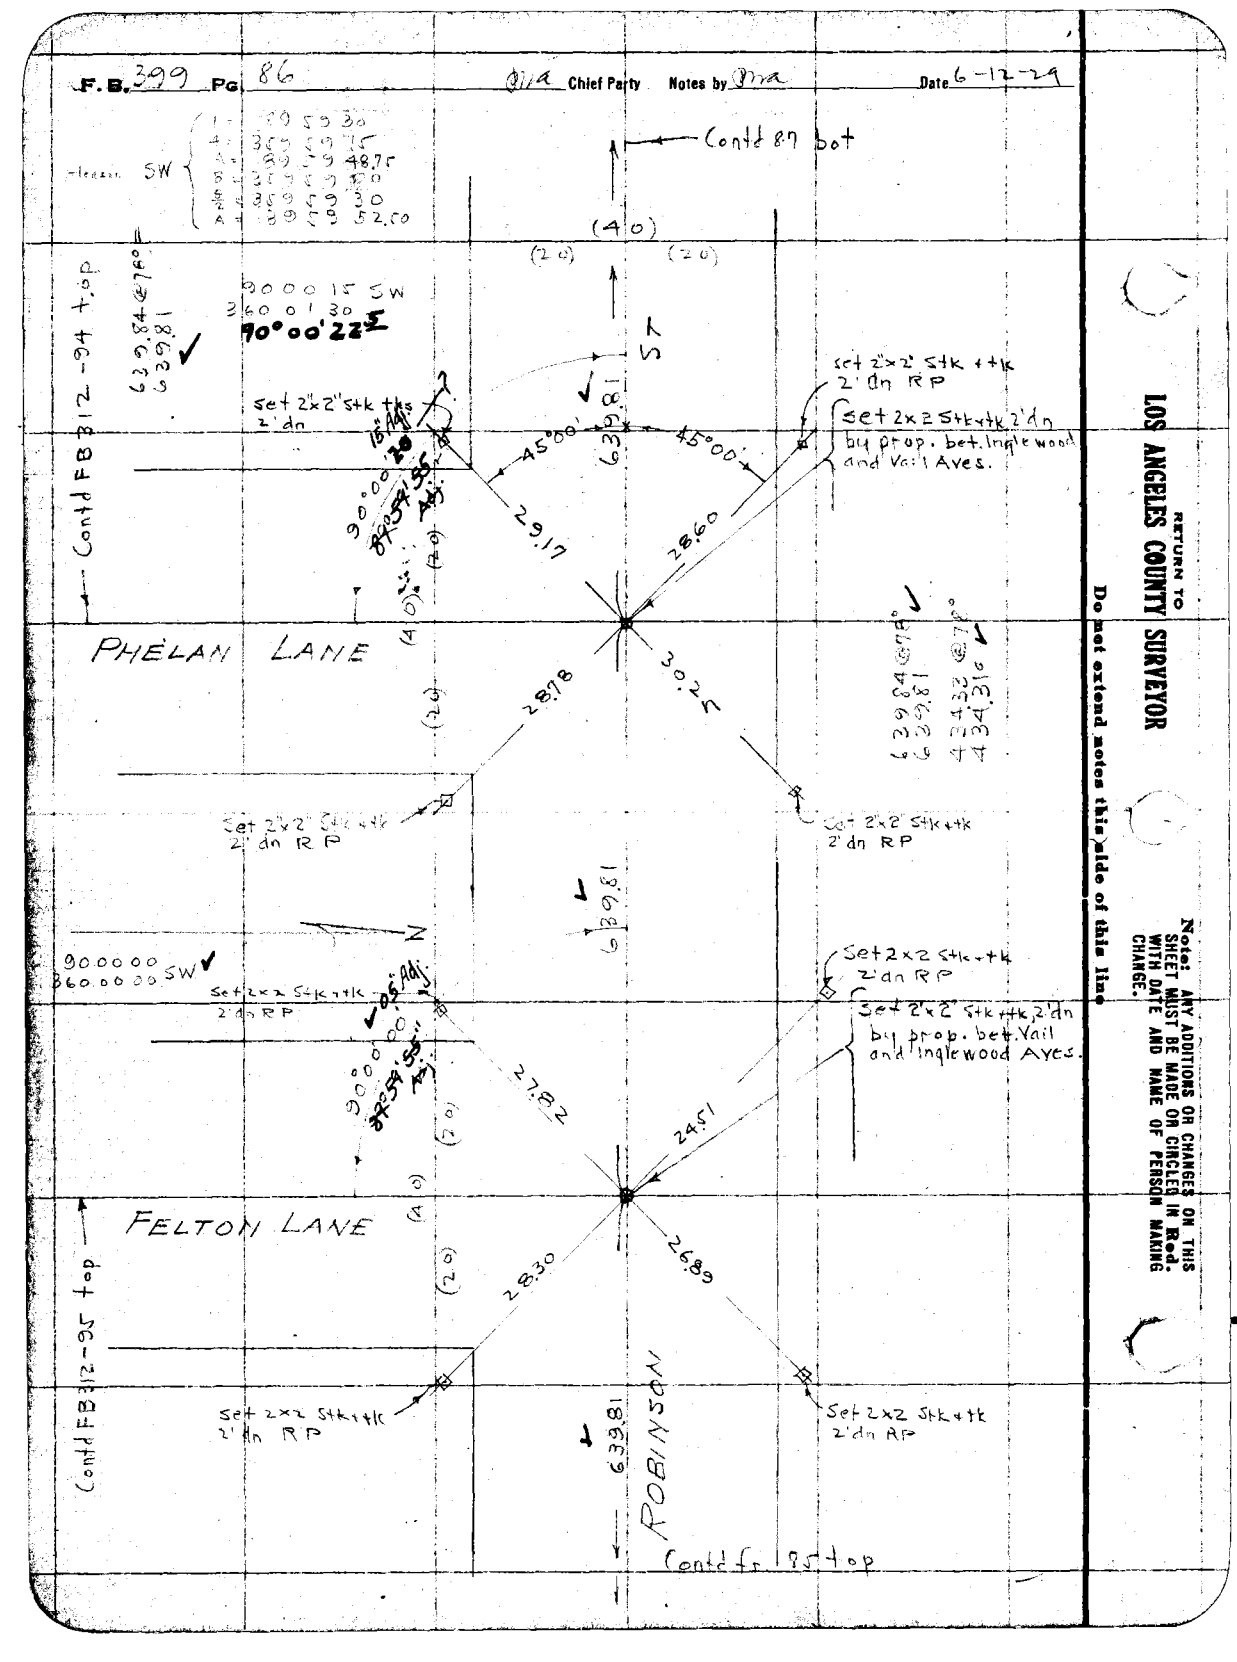

RETURN TO
LOS ANGELES COUNTY SURVEYOR
Do not extend notes this side of this line

Note: ANY ADDITIONS OR CHANGES ON THIS SHEET MUST BE MADE OR CIRCLED IN Red. WITH DATE AND NAME OF PERSON MAKING CHANGE.

Date 6-12-29 Notes by gma Chief Party gma F.B. 309 Pg 81

Plotted by A. Svenson
Date Aug. 1930
Map No. B-442-2
Platting C'k'd by D. M. Finley
Date Nov. 1933

W. O. No. 920 S.P.W. No. 024
Location Riv. Redondo Rd
Surveyed by Bureau of Highways Dept
Date 6-12-29
Indexed

264609@84°
264618 to =
20
4 6 9 1 8

180 00 30 ✓
720 01 30 North
180 00 22.50

90 02 30 ✓
90 07 22.50 SW

@84° = 432.93
@84° = 640.00

312-92 top

Set 2"x2" Stk+tk 2'dn RP

Contd F.B. 312-92 top

Vail to Mackay 432.93
Mackay to Phelan 640.00

Contd 88 bot

Fd 3/4" IP 6"dn. Solidly set; as shown on M B 11-110 & center Sec 29.

Set 2"x2" Stk+Tk 2'dn

Fd 1" IP, new, flush, SW Cor Lot 2 RF 140 0.02 W. of cent pipe in plug

VAIL

2646.10

20.00

tang. across

Set 2"x2" Stk+tk 2'dn RP

89 57 15 ✓
359 45 45
89 57 15

Set 2"x2" Stk+tk 2'dn RP

89 57 15 SE
359 45 45 ✓
89 57 15

Set 2"x2" Stk+tk 2'dn RP

Set 2"x2" Stk+tk 2'dn by prop. bet Inglewood + Vail Ave.

45°00'

45°00'

calc 89°59'55" Adj.

MACKAY LANE

Contd F.B. 312-92 top

Set 2"x2" Stk+tk 2'dn RP

90 00 15 ✓ SE
360 00 30
90 00 07.50
89 59 55 calc

639.81 ✓

ROBINSON

Contd fr. 86 top

Set 2"x2" Stk+tk 2'dn RP

639.84@78°
639.81 ✓

Notes: ANY ADDITIONS OR CHANGES OF THIS SHEET MUST BE MADE OR CIRCLED IN Red. WITH DATE AND NAME OF PERSON MAKING CHANGE.

Do not extend notes this side of this line

RETURN TO LOS ANGELES COUNTY SURVEYOR

F.B. 3910 Pg. 8F — Chief Party — Notes by — Date 6-13-29

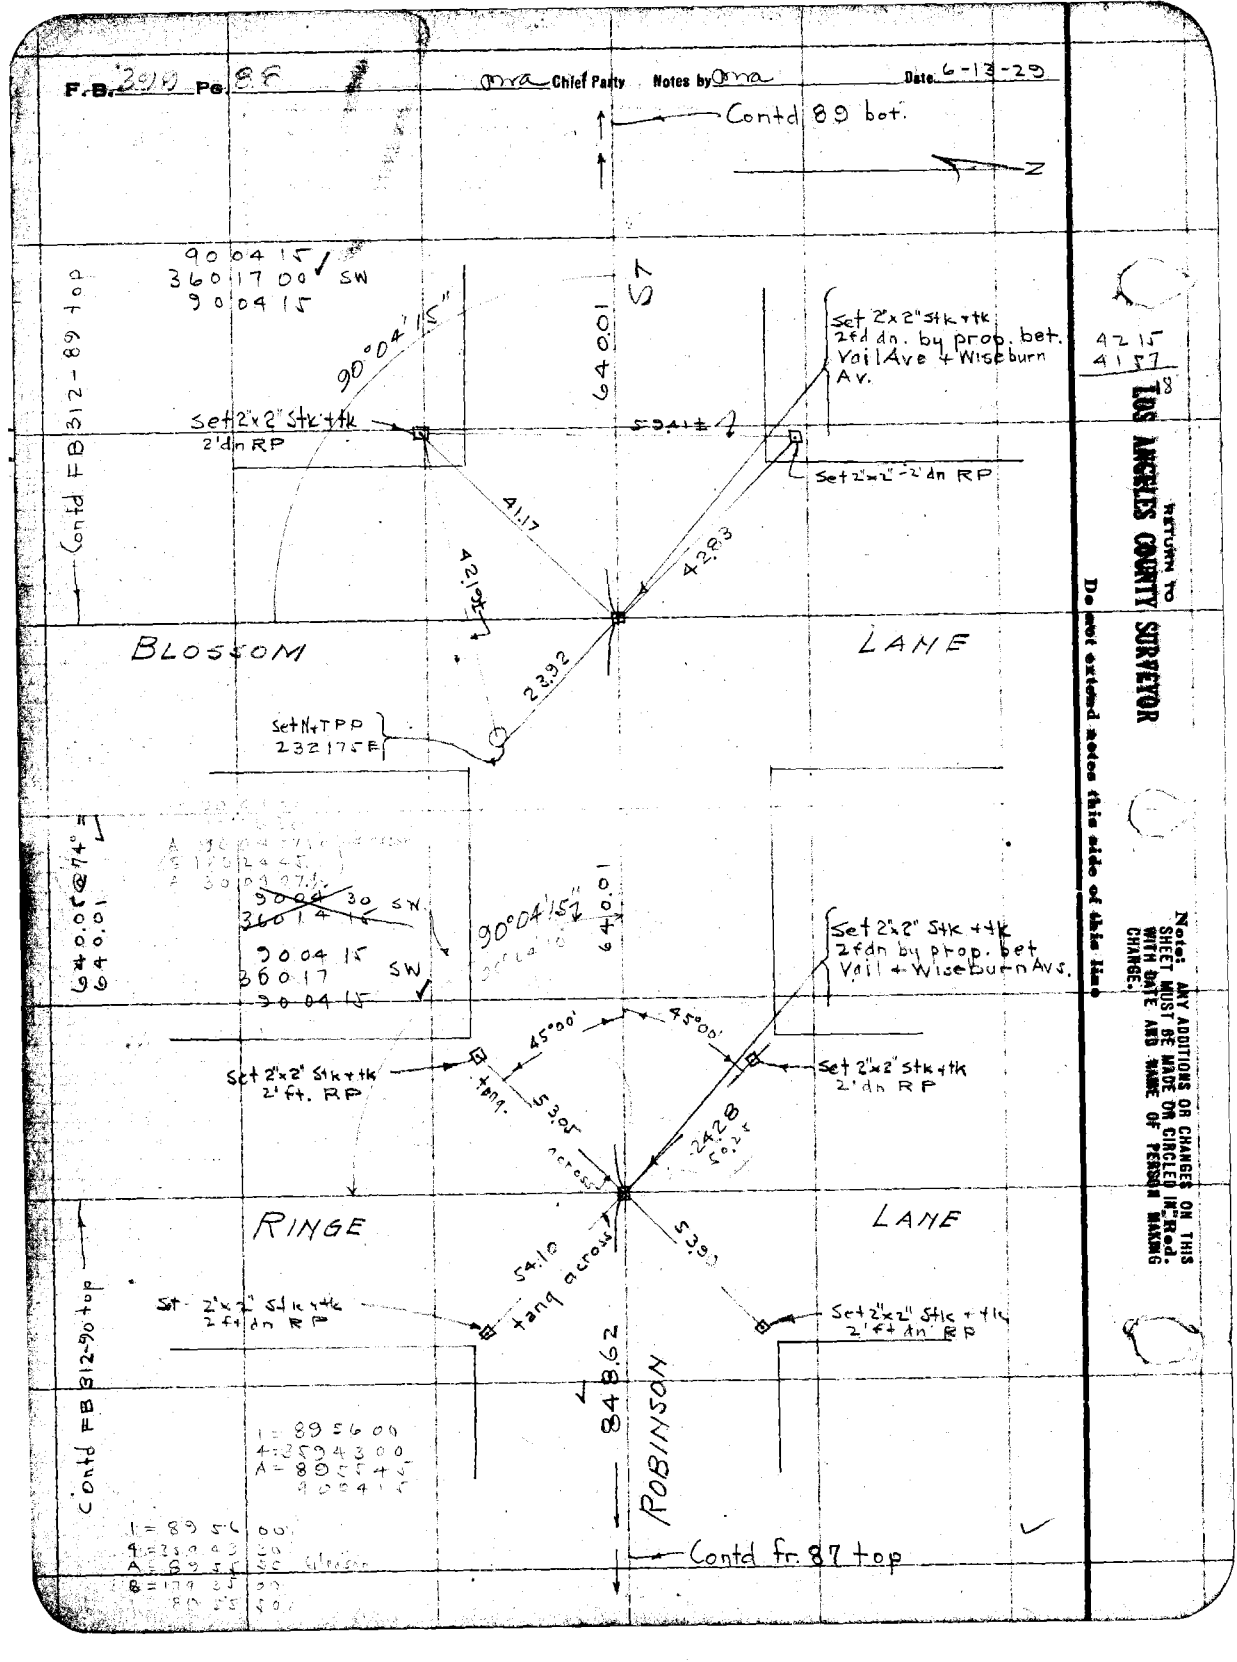

42 15
41 57

RETURN TO LOS ANGELES COUNTY SURVEYOR

Do not extend notes this side of this line

Note: ANY ADDITIONS OR CHANGES ON THIS SHEET MUST BE MADE OR CIRCLED IN RED. WITH DATE AND NAME OF PERSON MAKING CHANGE.

Date 6-13-29 Notes by [redacted] Chief Party [redacted] F.B. 299 Pg 89

Platted by A. Stenson
Date Aug. 1930
Map No. B-442-2
Platting Ck'd by D. M. Finley
Date Nov. 1930

W. O. No. 920 S.O. No. 1029
Location Riv. Redondo Rd
Surveyed by Paul A Atkins Dep
Date 6-13-29
Indexed A. C. Johnson

17942.15
55849
17942.15

00015
004045

Tie dist
120.74@84°=
120.74

17942.00
71884.55
17941.56.25

Notes: ANY ADDITIONS OR CHANGES ON THIS SHEET MUST BE MADE OR CIRCLED IN Red. WITH DATE AND NAME OF PERSON MAKING CHANGE.

Do not extend notes this side of this line

RETURN TO LOS ANGELES COUNTY SURVEYOR

Contd 90 bot

Set 2"x2" Stk + tk 6" dn FB 41-53 (RD Pt)

Fd 4" IP fill Conc. FB41-53, flush

RD

0°10'10"

89 29 00

359°35'50"

89°26'52.50

Fd SW in pav. RD FB41-53

Fd SW (78+00 FB41-53

Set pck nail in top tk Fd in pav.

Fd 4"IP filled conc. Cap tk in top RD FB41-53

Fd 4" IP filled conc. flush RD FB41-53

20.01

20.01

20.01

20.00

20.00

WISEBURN AVE

N

ST 179°42'15"

514.21

Vail to Wiseburn 2643.02

@ 74°=2642.85

514.24 @ 74°=

514.21

Set K&T Pow quy po

Set 2"x2" Stk + tk 2' dn. by prop bet. Vail Ave & Wiseburn Ave

120.74

GREEN

LANE

ROBINSON

Contd FB 312-88 top

640.05@74°=

640.01

N 89 45 20 E

89 44 13.75

25.82

5.57

68°55'

Set K&T PP 1.57 S 0.68 E

q"IP

Set K&T PP 1.57 0.50 E

640.01

Contd fr. 88 top

F.B. 399 Pg. 90

Chief Party Donna Notes by Donna Date 6-21-29

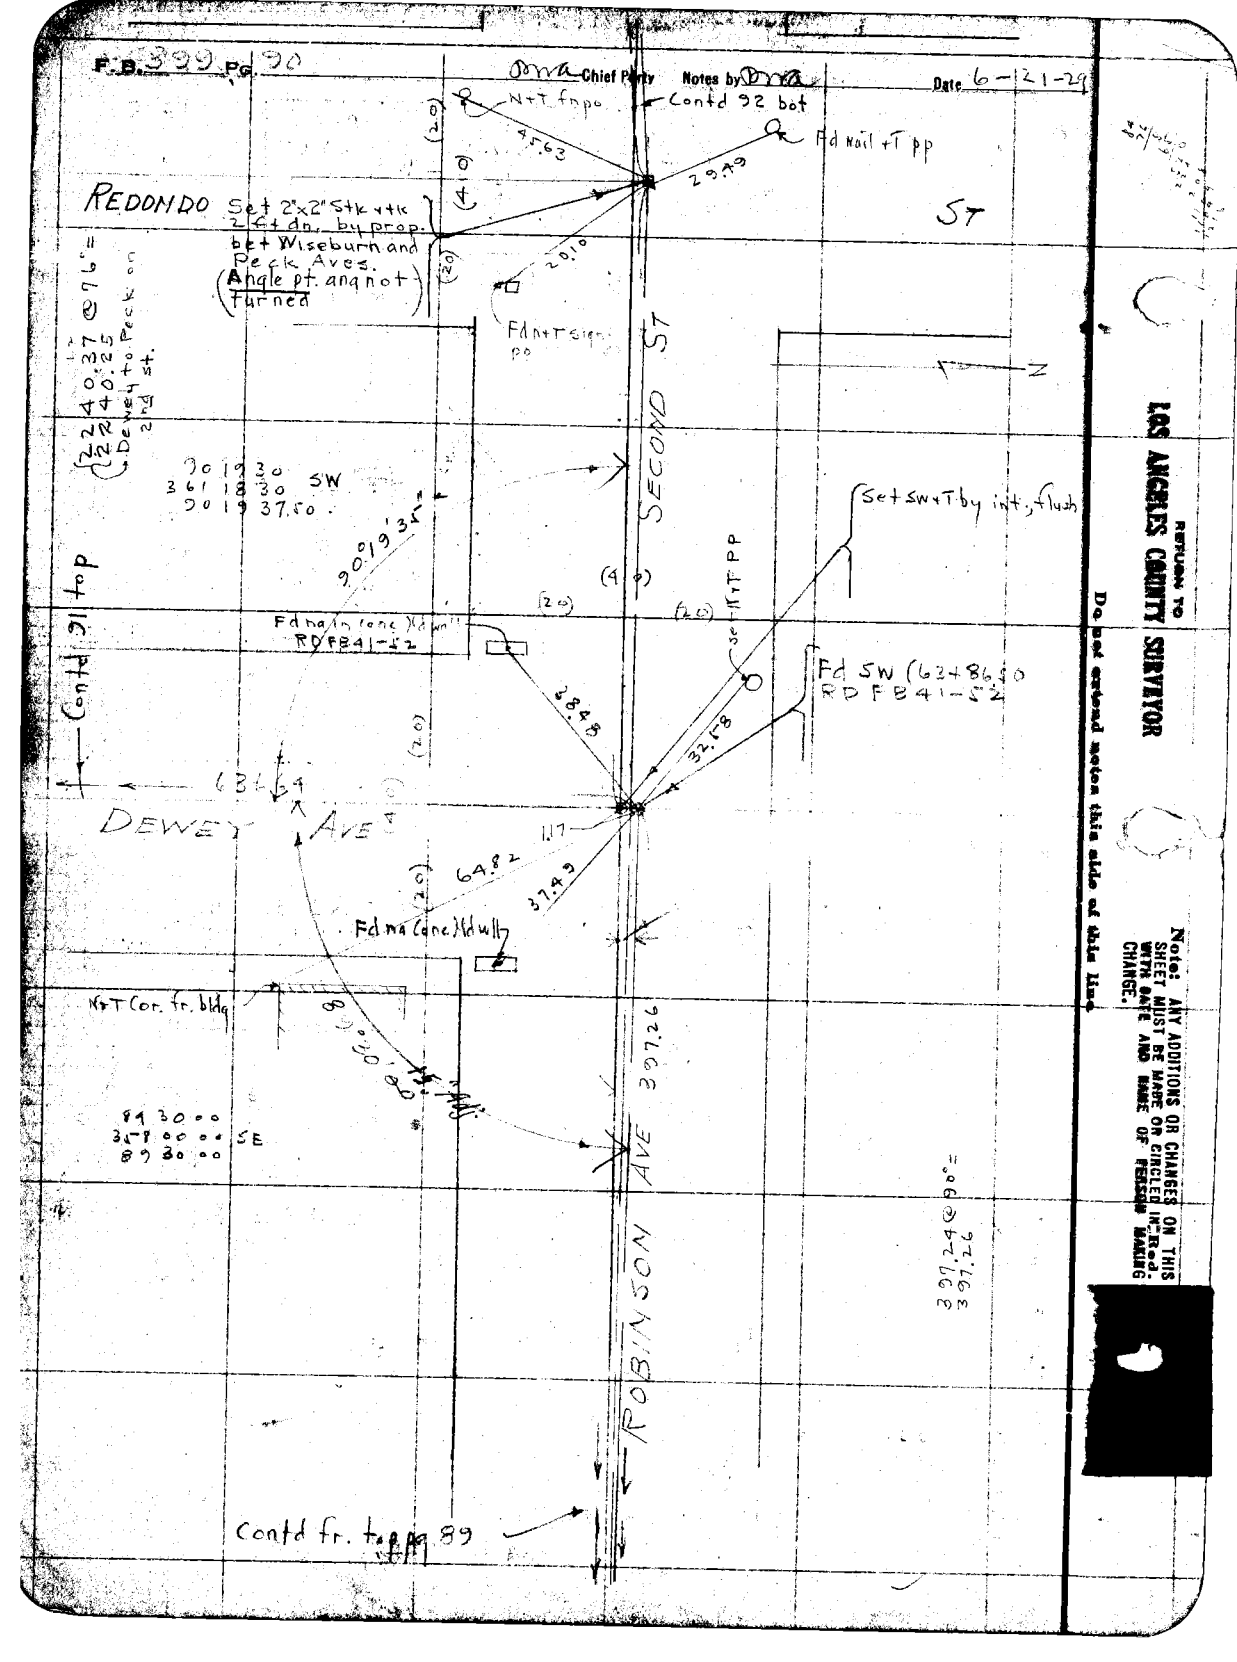

RETURN TO LOS ANGELES COUNTY SURVEYOR

Do not extend notes this side of this line

Note: ANY ADDITIONS OR CHANGES ON THIS SHEET MUST BE MADE OR CIRCLED IN Red. WITH DATE AND NAME OF PERSON MAKING CHANGE.

Date 6-13-29 Notes by Pma Chief Party Pma F.B. 599 Pg 91

Platted by A. Svenson	W. O. No. 020 +C.O. No. 029
Date Aug. 1930	Location R.v. Redondo Rd
Map No. B-442-2	Surveyed by Paul Matthews Dep
Platting C'k'd by D. M. Finley	Date 6-21-29
Date Nov. 1933	Indexed A. C. Johnson

Contd fr 90 left

(20) (0) (20)

636.64

AVE

636.64 @ 90° = 636.64

Fd SW RD FB 41-52 (57+49.88)

949.77 @ 90° = 949.77

(RD FB 41-52)

949.77

Fd SW RD FB 41-52 (48+00.07) 002 E line

DEWEY

1059.42 @ 90° = 1059.42

1059.42

Contd FB 312-86-top

Notes: ANY ADDITIONS OR CHANGES ON THIS SHEET MUST BE MADE OR CIRCLED IN Red. WITH DATE AND NAME OF PERSON MAKING CHANGE.

Do not extend notes this side of this line

RETURN TO LOS ANGELES COUNTY SURVEYOR

1586.37
636.60
949.72
1059.42

F.B. 399 Pg 92 — Chief Party — Notes by — Date 6-24-29

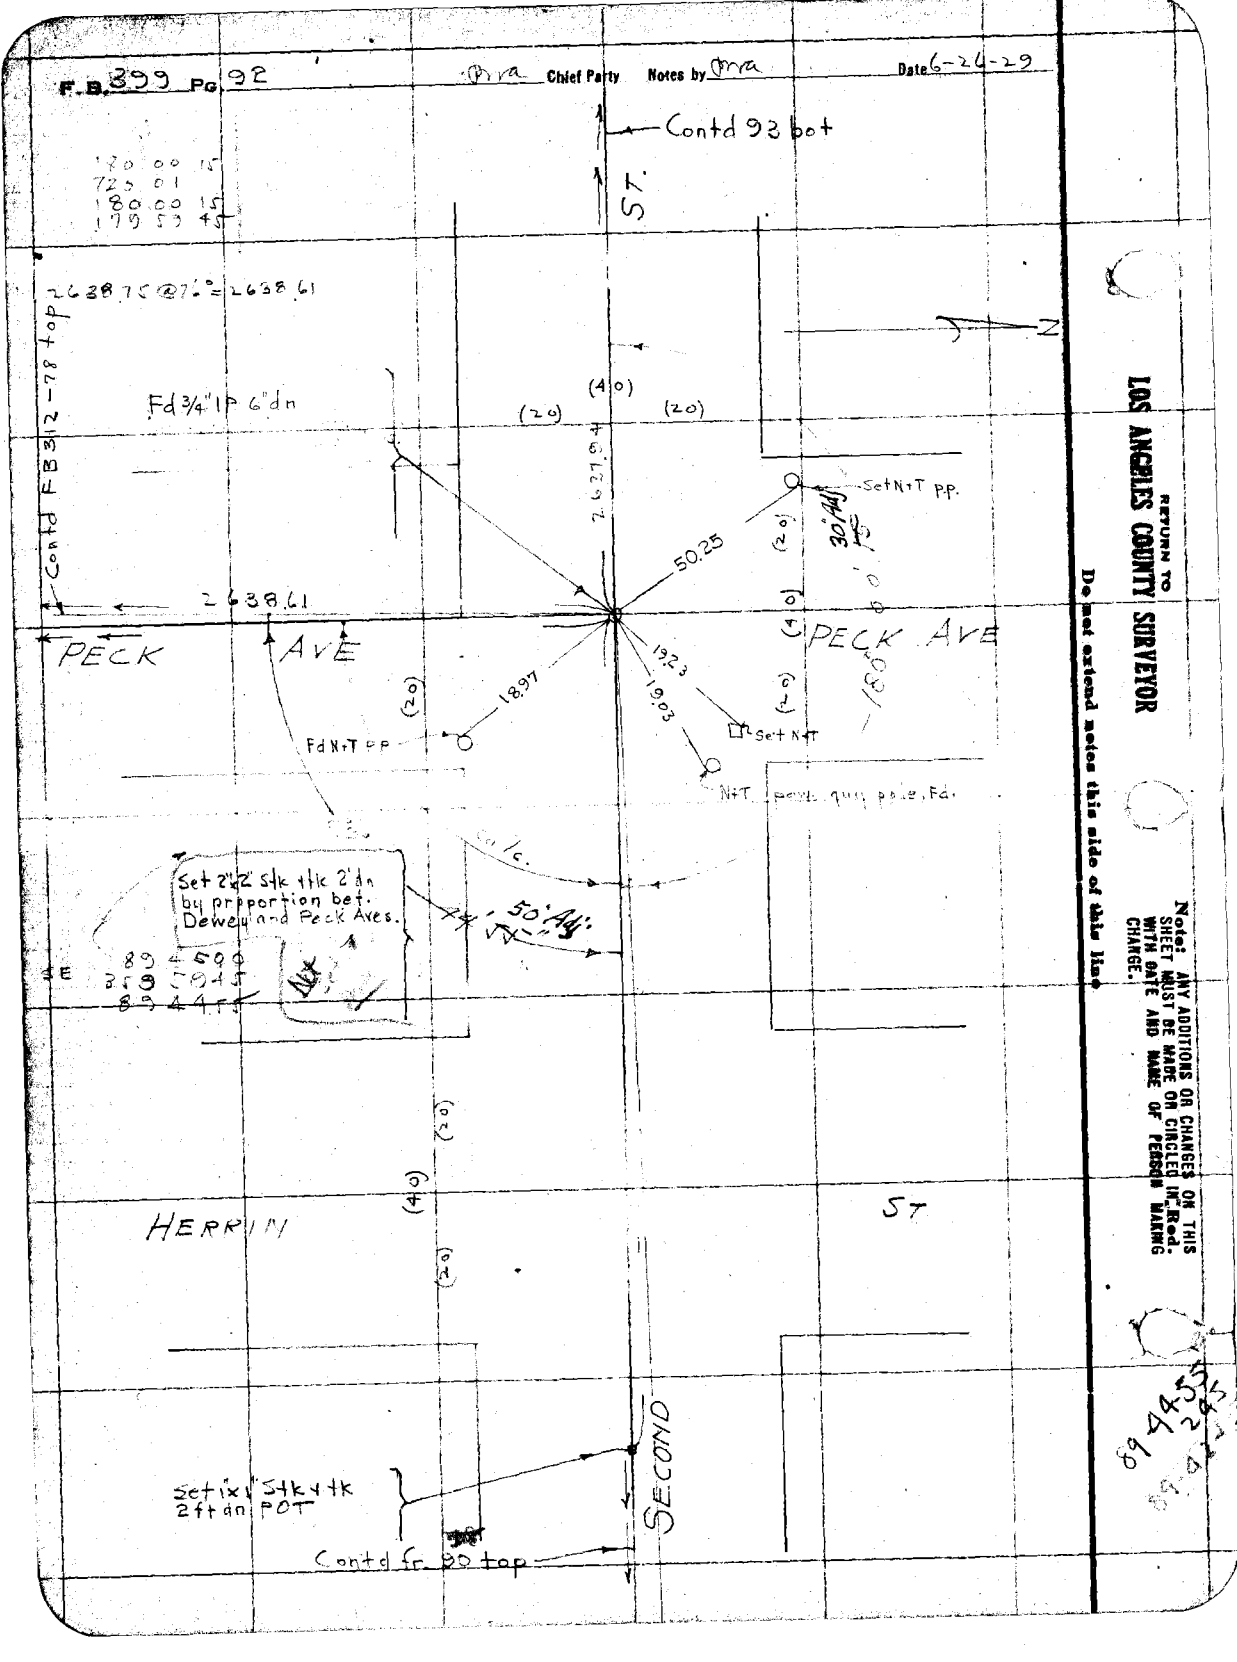

RETURN TO
LOS ANGELES COUNTY SURVEYOR

Do not extend notes this side of this line

Note: ANY ADDITIONS OR CHANGES ON THIS SHEET MUST BE MADE ON CIRCLED INK Red. WITH DATE AND NAME OF PERSON MAKING CHANGE.

Date 29 Notes by [illegible] Chief Party [illegible] F.B. 399 PG 93

Platted by A. Swanson	W. O. No. 920 S.P.C. No. 029
Date Aug. 1930	Location Riv. Redondo Rd
Map No. B-442-2	Surveyed by Paul Atkins Dep
Platting Ck'd by D. M. Finley	Date 1929
Date Nov. 1933	Indexed A. C. Johnson

Contd FB 312-125 right

(30)

ST.

2637.04

Z

(20) (40) (20)

SECOND

Contd fr. 92 top

RETURN TO
LOS ANGELES COUNTY SURVEYOR

Notes: ANY ADDITIONS OR CHANGES ON THIS SHEET MUST BE MADE OR CIRCLED IN IRed. WITH DATE AND NAME OF PERSON MAKING CHANGE.

Do not extend notes this side of this line

F.B. 329 Pg. 94 Chief Party Notes by Date

RETURN TO
LOS ANGELES COUNTY SURVEYOR

Note: ANY ADDITIONS OR CHANGES ON THIS SHEET MUST BE MADE OR CIRCLED IN Red. WITH DATE AND NAME OF PERSON MAKING CHANGE.

Do not extend notes this side of this line

Date 8-16-29 Notes by Dma Chief Party Dma F.B. 399 Pg. 95

Platted by A Svenson	W. O. No. 920 D. S. O. No.
Date 8-7-30	Location Riv. Redondo Rd
Map No. B 442. Sh 2	Surveyed by Paul A Helms
Platting C'k'd by J.D. Price.	Date Aug. 16, 1929
Date 4-11-31	Indexed A. C. JOHNSON

Notes: ANY ADDITIONS OR CHANGES ON THIS SHEET MUST BE MADE OR CIRCLED IN Red, WITH DATE AND NAME OF PERSON MAKING CHANGE.

Do not extend notes this side of this line

RETURN TO LOS ANGELES COUNTY SURVEYOR

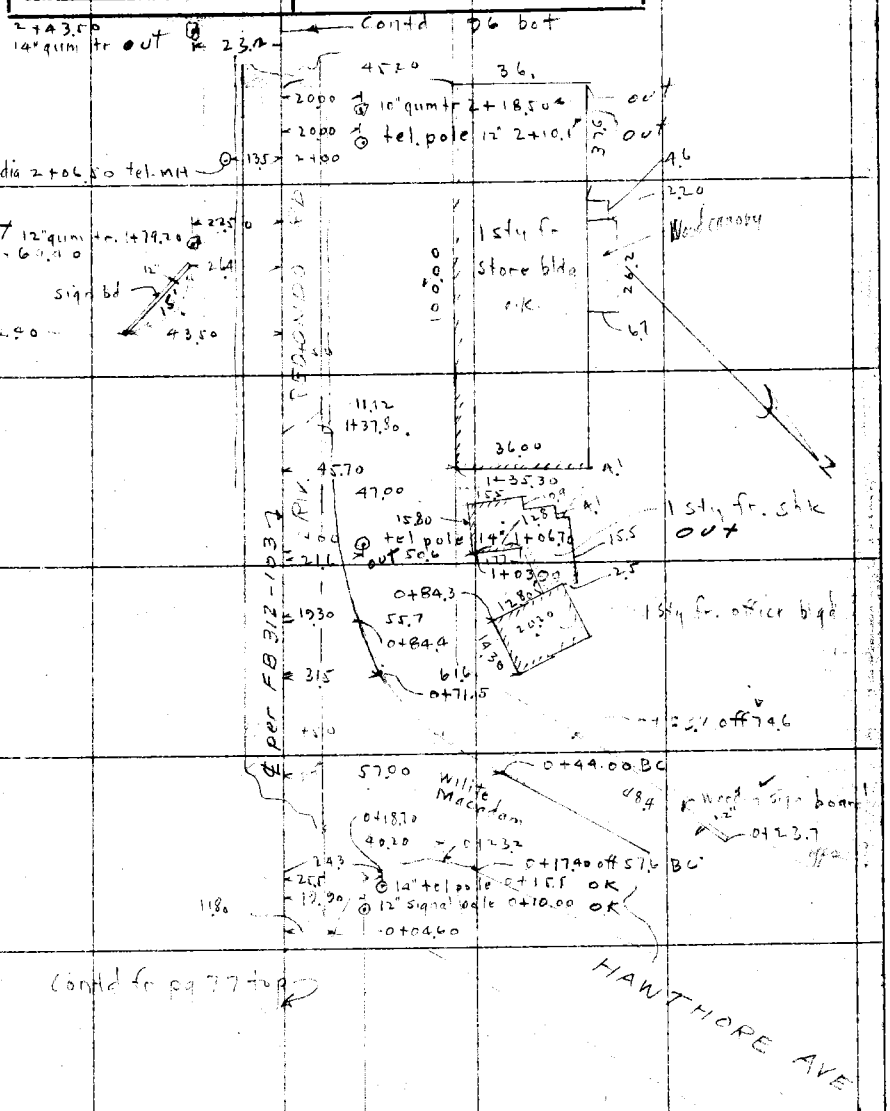

F. B. 399 PG. 96 — Chief Party — Notes by — Date 8-16-29

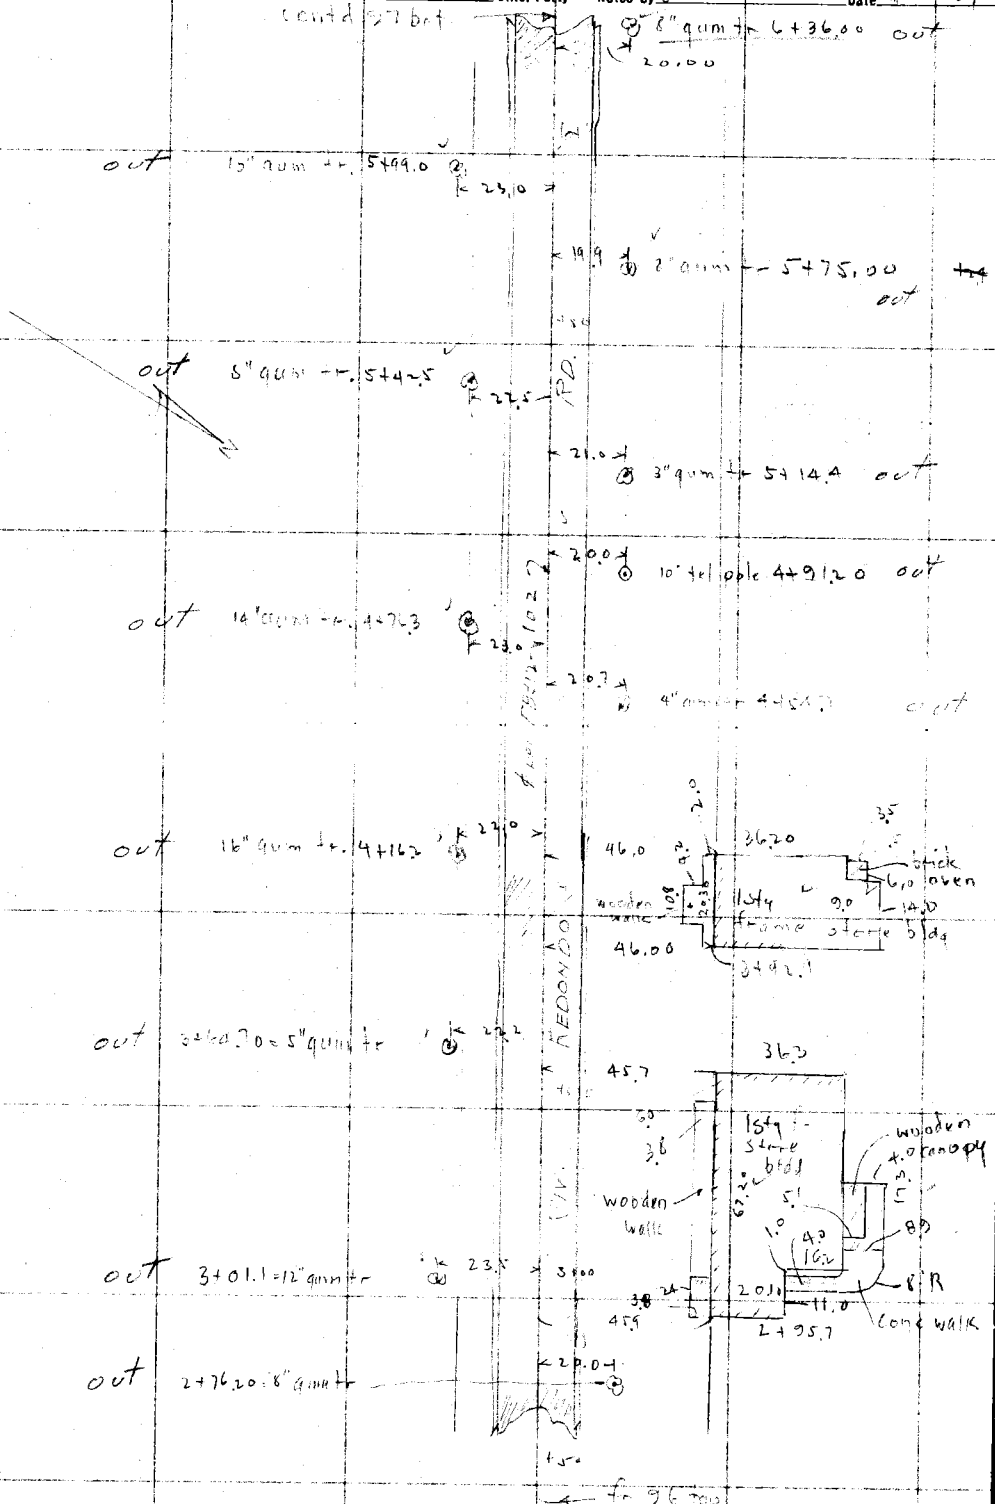
out
out
out

Date 8-16-29 Notes by [illegible] Chief Party [illegible] F.B. 399 Pg 97

Platted by A Svenson	W. O. No. 920 D. S. O. No.
Date 8-7-30	Location Riv. Redondo Rd
Map No. R 37 Sh 2	Surveyed by Dept Engineering Dep
Platting C'k'd by J.D.Price.	Date Aug 16, 1929
Date 4-11-31.	Indexed

Notes: ANY ADDITIONS OR CHANGES OF THIS SHEET MUST BE MADE OR CIRCLED IN Red. WITH DATE AND NAME OF PERSON MAKING CHANGE.

Do not extend notes this side of this line

RETURN TO LOS ANGELES COUNTY SURVEYOR

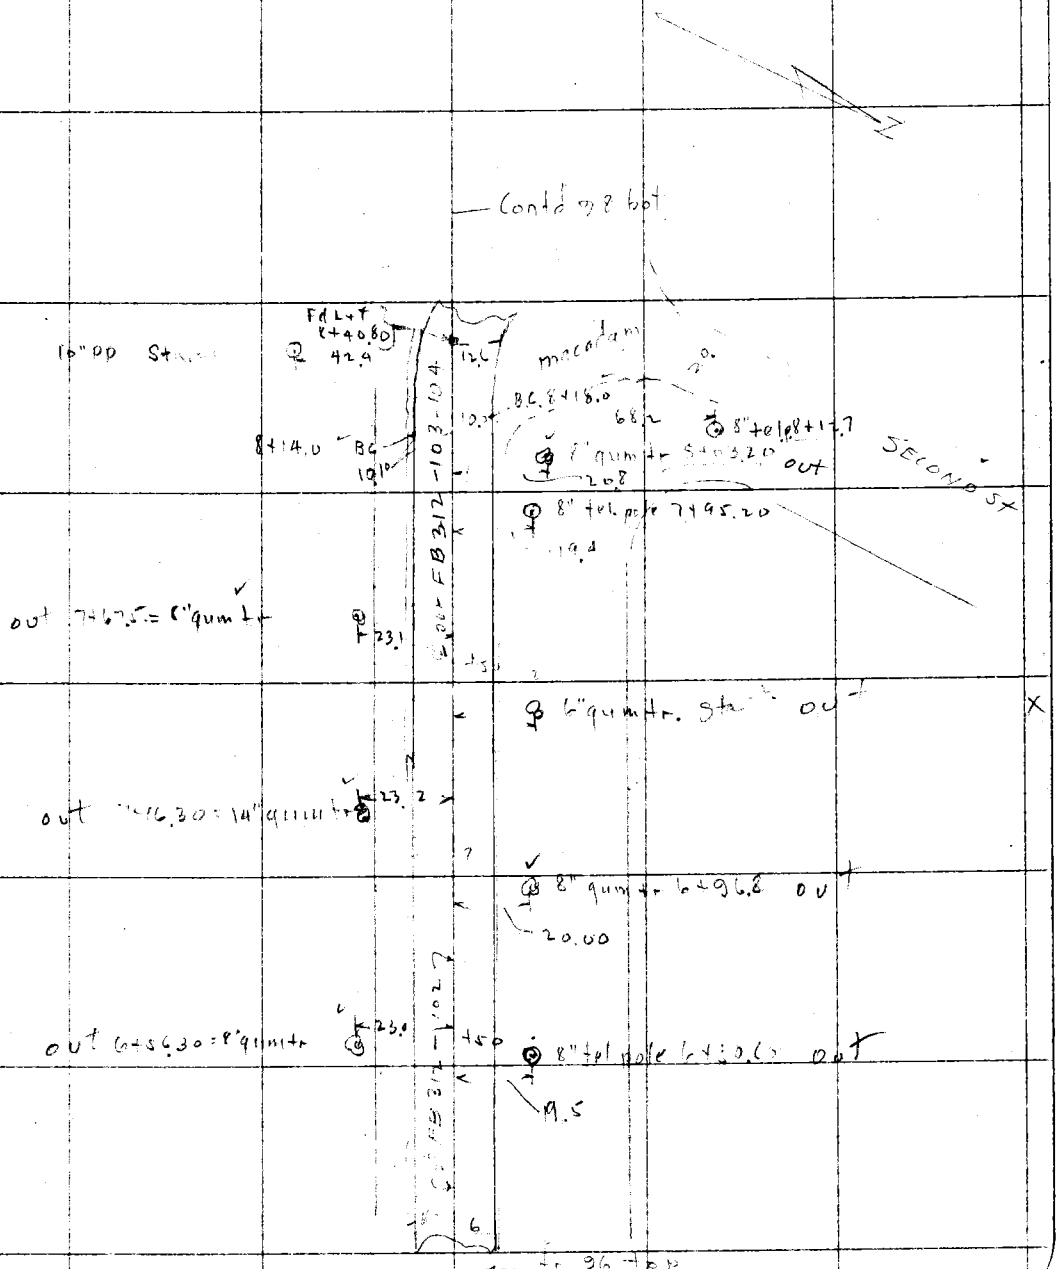

F.B. 392 PG. 98 Chief Party Notes by Date 8-12-21

Condd 99 Dist

14" gum tr 11+43.5 out

117

11+16.0 = 12" tr pp

29.0

10+86.3 = 12" gum tr out

104

10+64.4 pp 8" out

174

14" gum tr 10+27.1 out

10.1

9+92.0

22.6

12" gum tr 9+66.1 out

11.7

10" PO 9+38.0 out

14.0

11.0

9+07.40

27.0

12" Gum tr 9+08.0 out

8+49.20

8+44.8 BC

20.

8+56.90 POC

Macadam

7.97 tip

RETURN TO
LOS ANGELES COUNTY SURVEYOR

Do not extend notes this side of this line

Note: ANY ADDITIONS OR CHANGES ON THIS SHEET MUST BE MADE OR CIRCLED IN Red. WITH DATE AND NAME OF PERSON MAKING CHANGE.

Date 8-16-29 Notes by [illegible] Chief Party [illegible] F.B. 200 Pg 99

Platted by A. Svenson
Date 8-7-30
Map No. B 442-Sh2
Platting C'k'd by J.D. Price.
Date 4-11-31

W.O. No. 920 D.S.O. No.
Location [illegible]
Surveyed by [illegible]
Date Aug to 14 29
Indexed C. Johnson

Note: ANY ADDITIONS OR CHANGES ON THIS SHEET MUST BE MADE OR CIRCLED IN Red. WITH DATE AND NAME OF PERSON MAKING CHANGE.

Do not extend notes this side of this line

RETURN TO LOS ANGELES COUNTY SURVEYOR

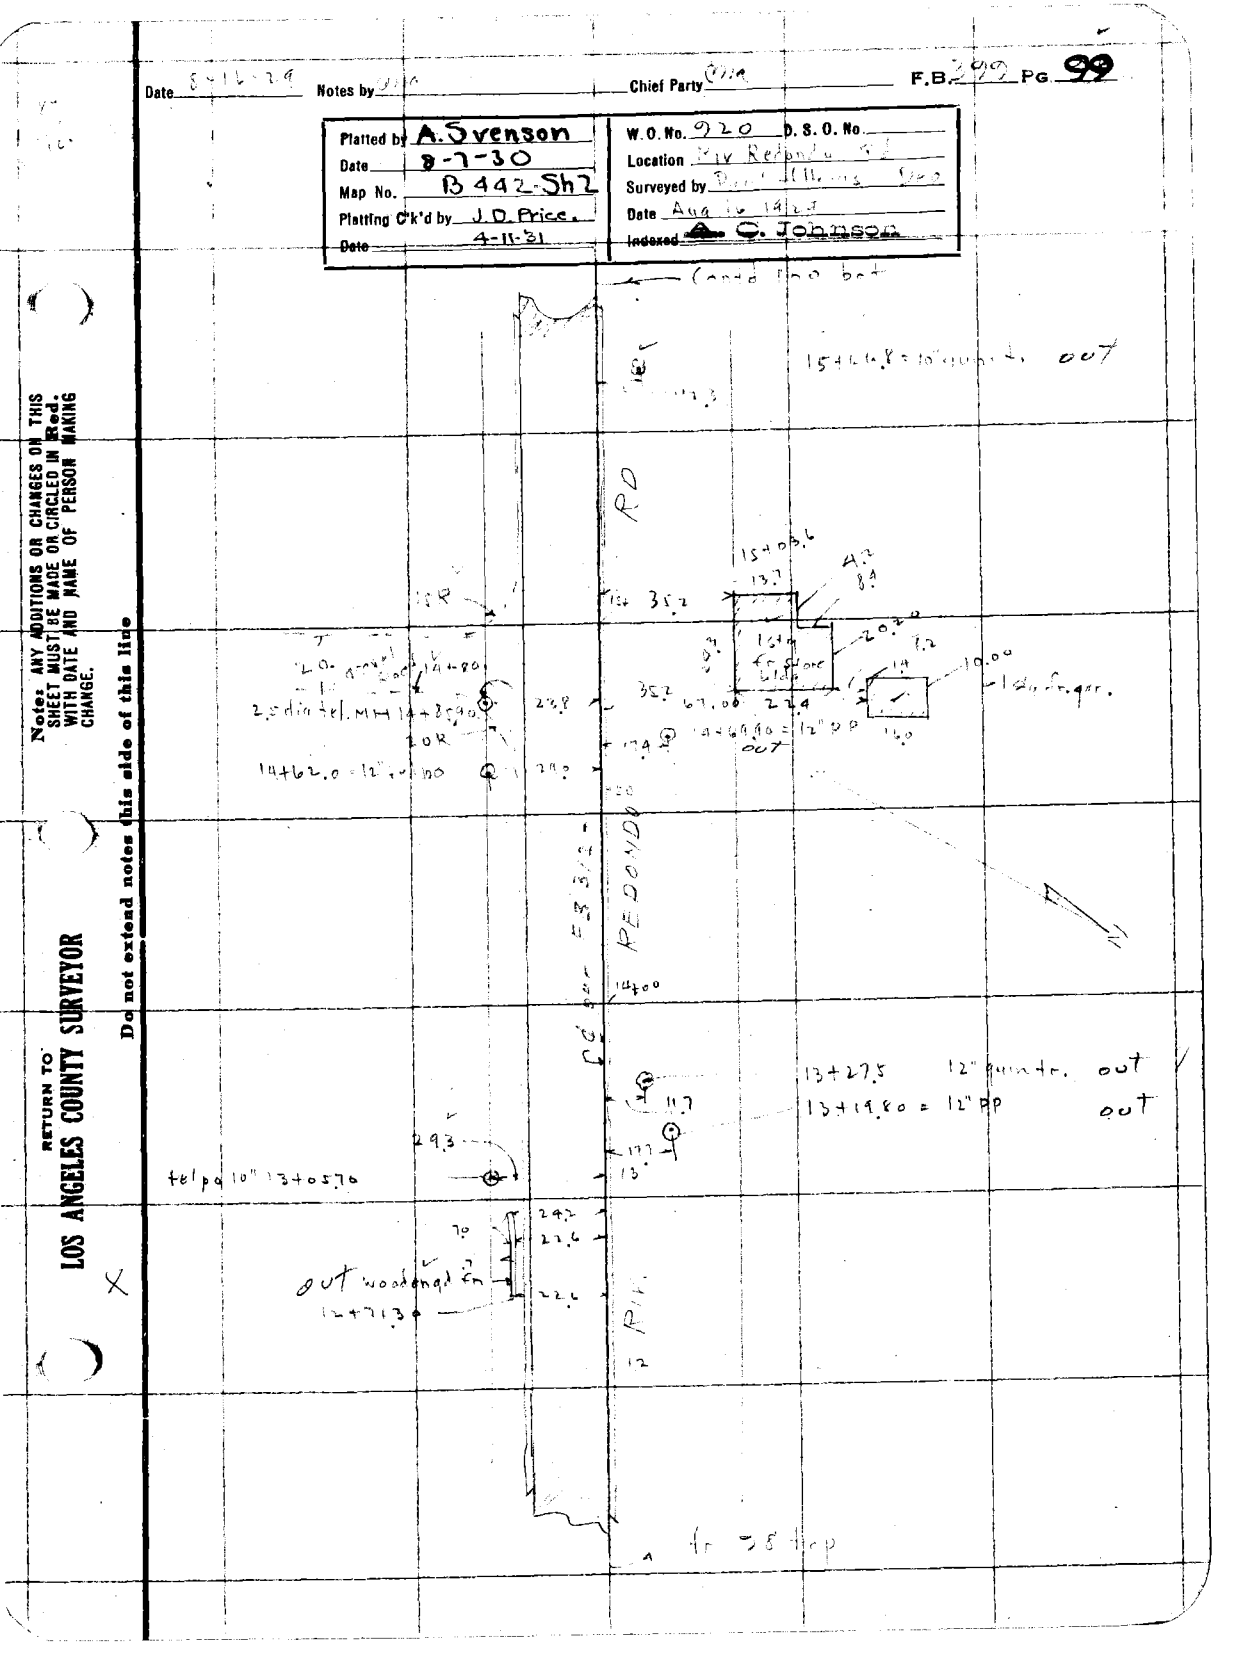
RO
REDONDO
out
out
out

F. B. 399 Pg. 100 Chief Party Notes by Date 8-16-29

← Contd 101 bot

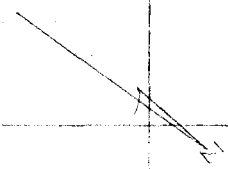

Fd 2x2" Stk with tk on R R bridge
FB 312 → 100

Pavement

20+69.50 = 14" PP

20+ 4.40 = 14" tel pole

30.00

19+30.00 = 16" tel pole

19+20.90 out

14" PP

19+71.00

17+71.00 = 14" tel pole

out 17+68.20 = 18" PP

out 17+67.40 = 12" PP

20.0 machine 5th St

33.6

17+26.0

19+00

17+63

20.2

43.2

12.4

43.2

1st fl office b'g

16+97.40

16+19.70 = tel ps. 12"

16+18.30 = 12" PP out

16+00

← ft 99 tel

Date 8-19-30 Notes by Atkins Chief Party Atkins F.B. 399 Pg. 101

Platted by A Svenson	W.O. No. 920 D.S.O. No.
Date 8-8-30	Location R/W Redondo Rd
Map No. B442-Sh2	Surveyed by Paul Atkins Dep
Platting C'k'd by J.D. Price.	Date Aug 19-29
Date Aug 31	Indexed by C. Johnson

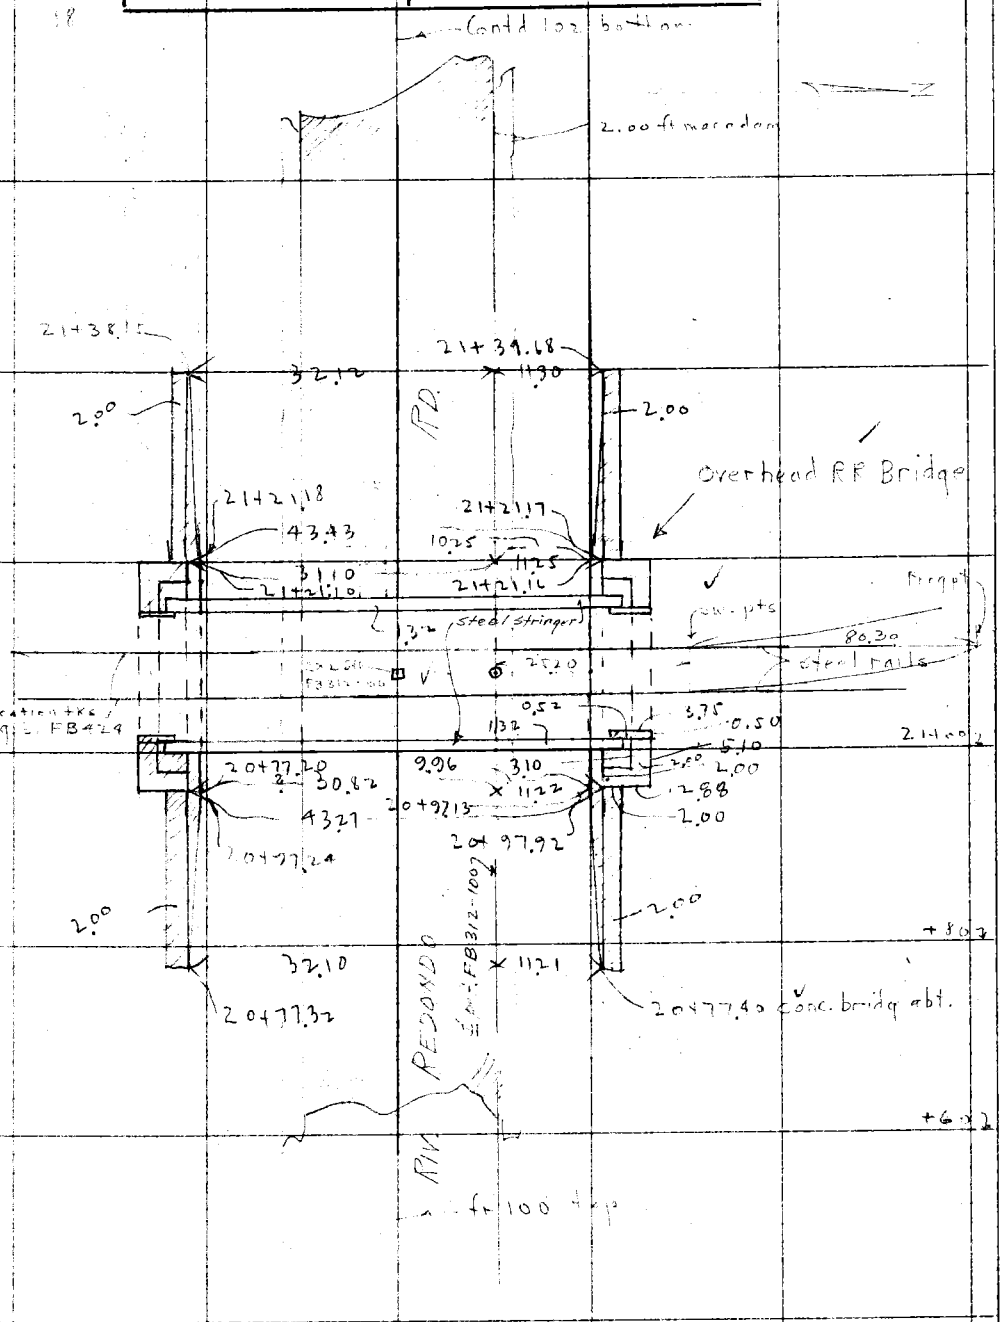

Notes: ANY ADDITIONS OR CHANGES OF THIS SHEET MUST BE MADE OR CIRCLED IN Red. WITH DATE AND NAME OF PERSON MAKING CHANGE.

Do not extend notes this side of this line

RETURN TO LOS ANGELES COUNTY SURVEYOR

F. B. 399 Pg. 102 — Chief Party. — Notes by — Date 8-17-29

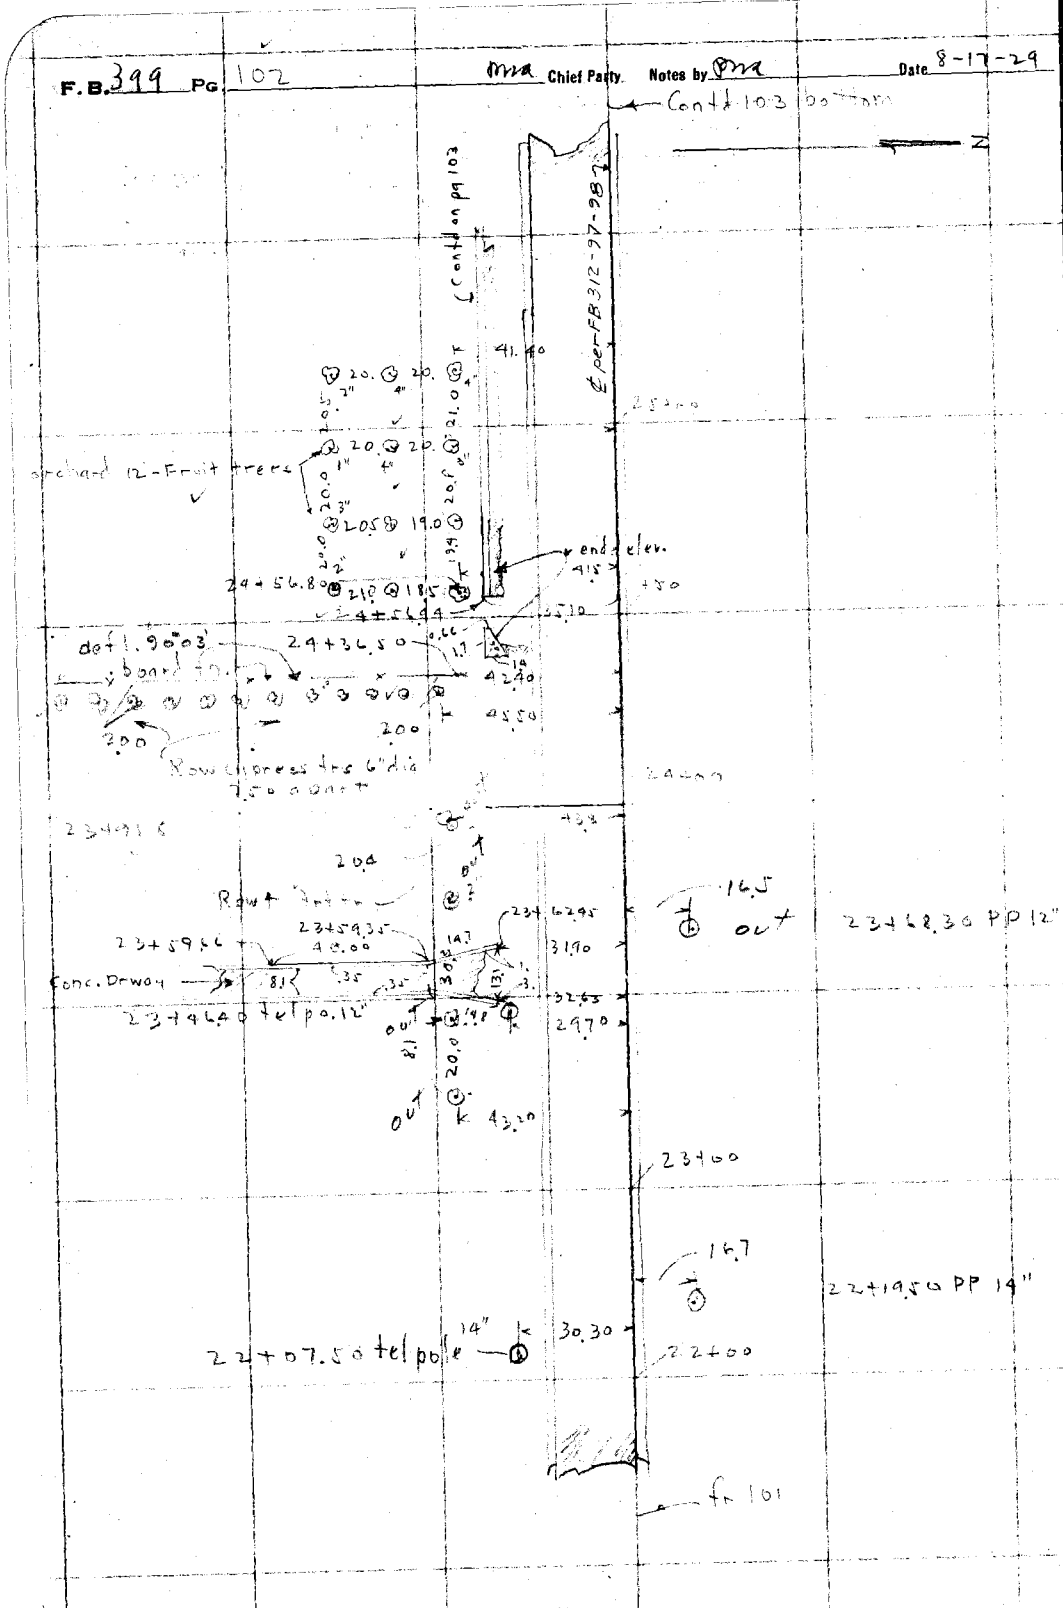

RETURN TO
LOS ANGELES COUNTY SURVEYOR
Do not extend notes this side of this line

Note: ANY ADDITIONS OR CHANGES ON THIS SHEET MUST BE MADE OR CIRCLED IN Red. WITH DATE AND NAME OF PERSON MAKING CHANGE.

Date 5-13-29 Notes by Atkins Chief Party Atkins F.B. 399 Pg 103

Plotted by ASvenson
Date 8-8-30
Map No. B442-Sh2
Platting Ck'd by J.D. Price.
Date 4-11-31.

W. O. No. 920 D. S. O. No.
Location Riv. Redondo Road
Surveyed by Paul A Heins Dep
Date Aug. 19, 1929.
Indexed by E. Johnson

Note: ANY ADDITIONS OR CHANGES OF THIS SHEET MUST BE MADE OR CIRCLED IN Red. WITH DATE AND NAME OF PERSON MAKING CHANGE.

Do not extend notes this side of this line

RETURN TO LOS ANGELES COUNTY SURVEYOR

+76.66 dep wall
+94.00 14.00 lg
+96.30 fr. N curb
+96.50 next fr N
+99.40 dia elev. 13.7
+97.10
+92.75 telpo
+92.50
+76.00 fr. in elev 17.30 off

Z
Macadam
2.0
Macadam
20.00 Conc. Pav.
Cont. on bell
offset lines
(30)
39.0 1" acacia
19.10
14.67
26+03.50
26+02.75 telpo
26+00
+94.85
14.00
+94.20
3" willow 8"
20.85
17.60
8.5
Pop. tr 5'
+99.4
+97.10 = 2" pep tr
Hemlock 5"
Calc +9.87 transit
90° 00'
25+90.00 Set nq.
3.00
+77.19
2.10
25+82.94
+77.92
17.30
9.50
4.10
Conc walk
0.5
25+76.66
2.75
3.0
10 steps
Conc. walks
R=6.1 true center
12" willow
+76.00
6.4
29.2
8.8
3.8
0.7
2.1
6" popl tr +45.50
3" pop. +48.60
8" poplar tr +51.40
47.9 Hemlock 11"
transit line
Conc. retaining wall
top of 2
(30)
2.00
ft 102
RIV. REDONDO
& Per 18 212 - 38'
+75
+50
+25
25+00

F. B. 399 PG. 104 Chief Party Notes by Date 8-19-29

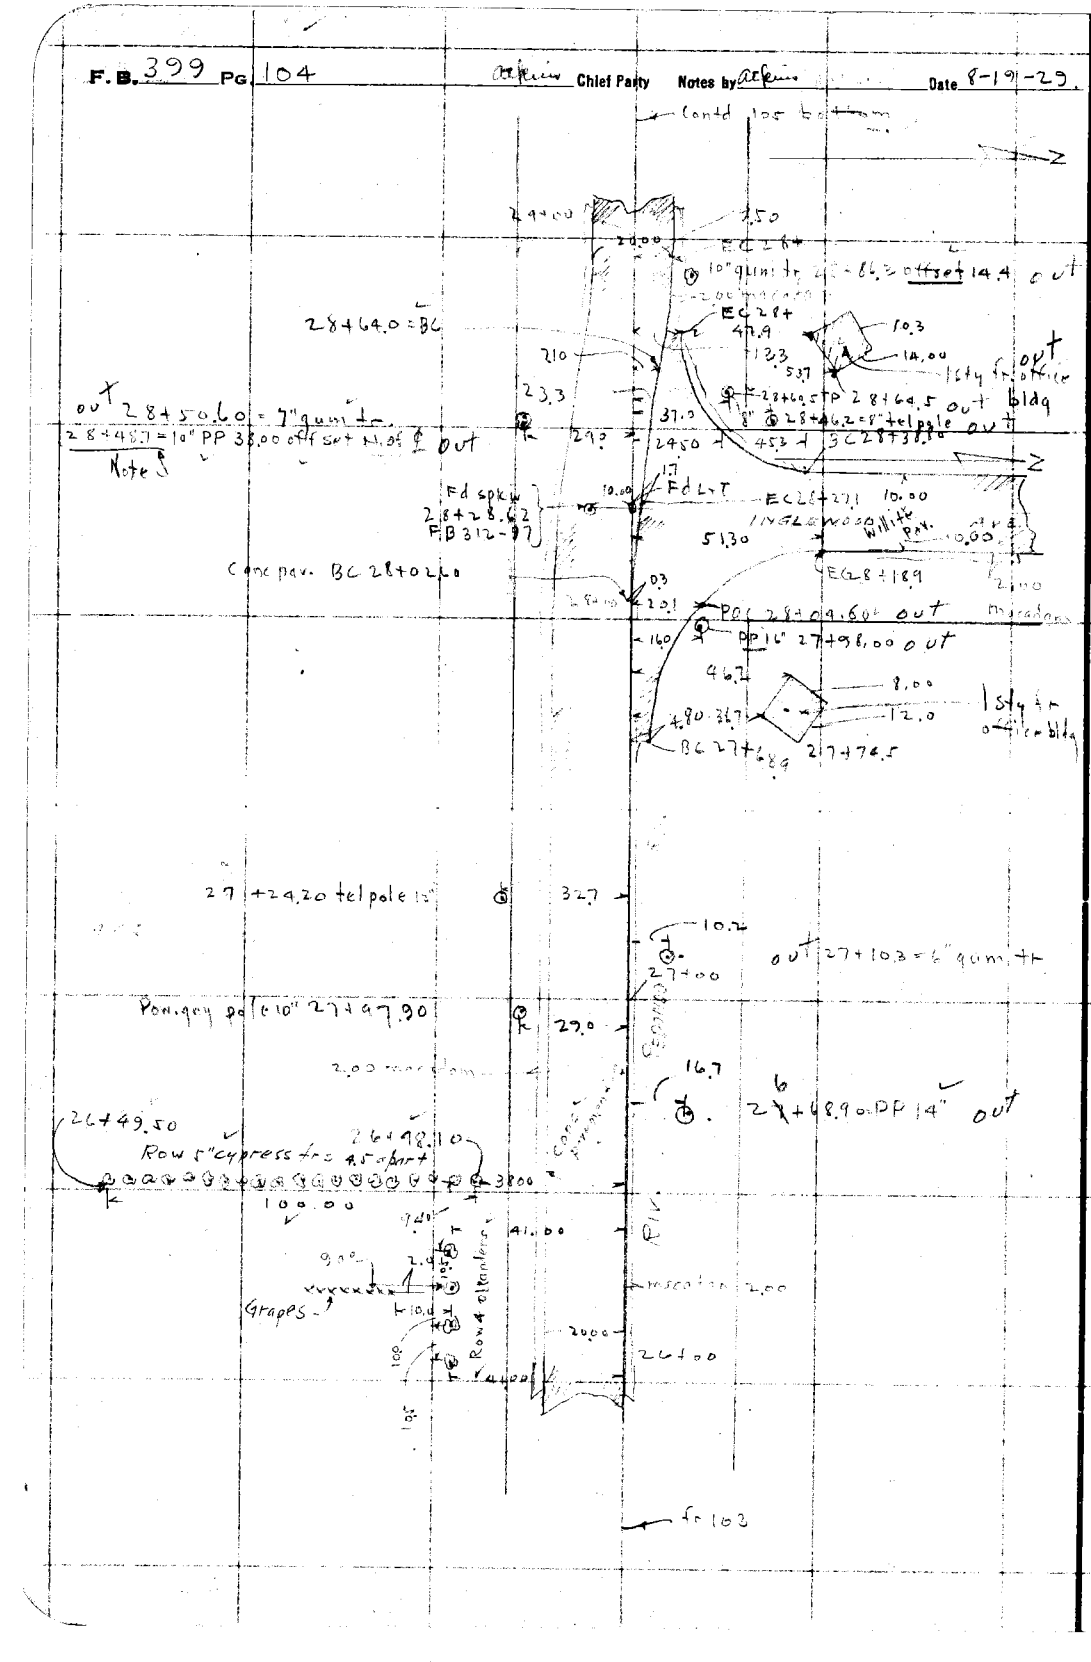

RETURN TO
LOS ANGELES COUNTY SURVEYOR

Do not extend notes this side of this line

Note: ANY ADDITIONS OR CHANGES ON THIS SHEET MUST BE MADE OR CIRCLED IN Red. WITH DATE AND NAME OF PERSON MAKING CHANGE.

Date 8-19-29 Notes by Arkema Chief Party Arkema F.B. 399 PG 105

Platted by ASvenson	W. O. No. 920 D. S. O. No.
Date 8-8-30	Location Riv. Redondo Rd
Map No. B 442-Sh2	Surveyed by Paul A Hinds Dep
Platting C'k'd by J.D. Price	Date 8-19-1929
Date 4-13-31	Indexed

Contd from bottom

32+00

Cypress Hedge 4"

31+62.8 = 9" quin tr out

31+60.00 EC

31+59.00 = end row cypress Hedge

PERKINS

oiled surf.

LANE

30+99.00 = 14" PP out

30+70.00 = 6" quin tr out

30+99.6 POC

30+67.00 BC

30+40.00 Cor bldg

1 sty fr. stucco store bldg

Conc fish pool

offset 32.80 frame oil house

board fnc

Conc. gas pump base

offset 33.00

30+25.20 fr. flower std out

30+11.00 = 8" quin tr out

REDONDO

29+80.00 = 9" quin tr out

29+76.50 = 10" PP

29+42.0 = 12" quin tr out

29+51.0 = 14" PP out

29+20.0 = 7" quin tr out

29+00

fr 104

Notes: ANY ADDITIONS OR CHANGES ON THIS SHEET MUST BE MADE OR CIRCLED IN Red. WITH DATE AND NAME OF PERSON MAKING CHANGE.

Do not extend notes this side of this line

RETURN TO LOS ANGELES COUNTY SURVEYOR

F. B. 399 Pg. 106 Atkins Chief Party Notes by Pina Date 8-19-29

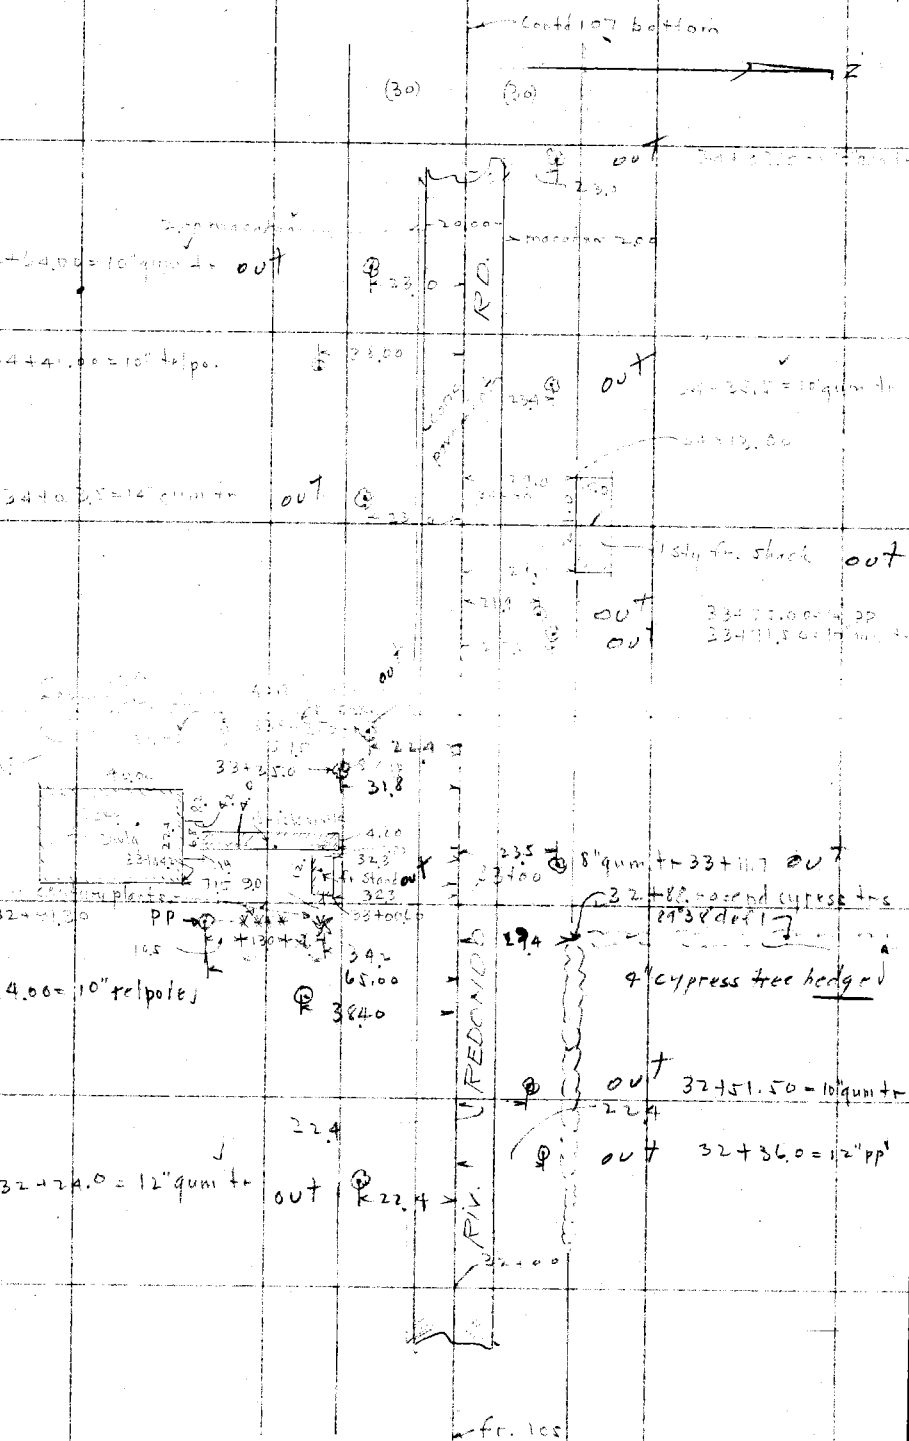
Contd 107 bottom
(30)
(30)
out
20.00
RD.
3444.00 = 10" tel pole
out
out
out

Date 5-20 Notes by Atkins Chief Party Atkins F.B. 392 Pg. 107

Platted by A Svenson	W. O. No. 920 D. S. O. No.
Date 8-8-30	Location Riv. Redondo Road
Map No. B 442-5h2	Surveyed by Dep. I.W. Atkins Dep
Platting C'k'd by J.D. Price.	Date Aug. 20'26.
Date 4-13-'31.	Indexed

Carried on 108

out

Oiled surf

20R

228

LOR

FELTON AVE

Pd L+T

37+60.09

FB 311-35

(30)

(20.00)

out

37+35.00

LANE

A.D.I.

out

out

out

F.B. 399 Pg. 128 Paul W. Chapin Chief Party Notes by [illegible] Date 8-20-29

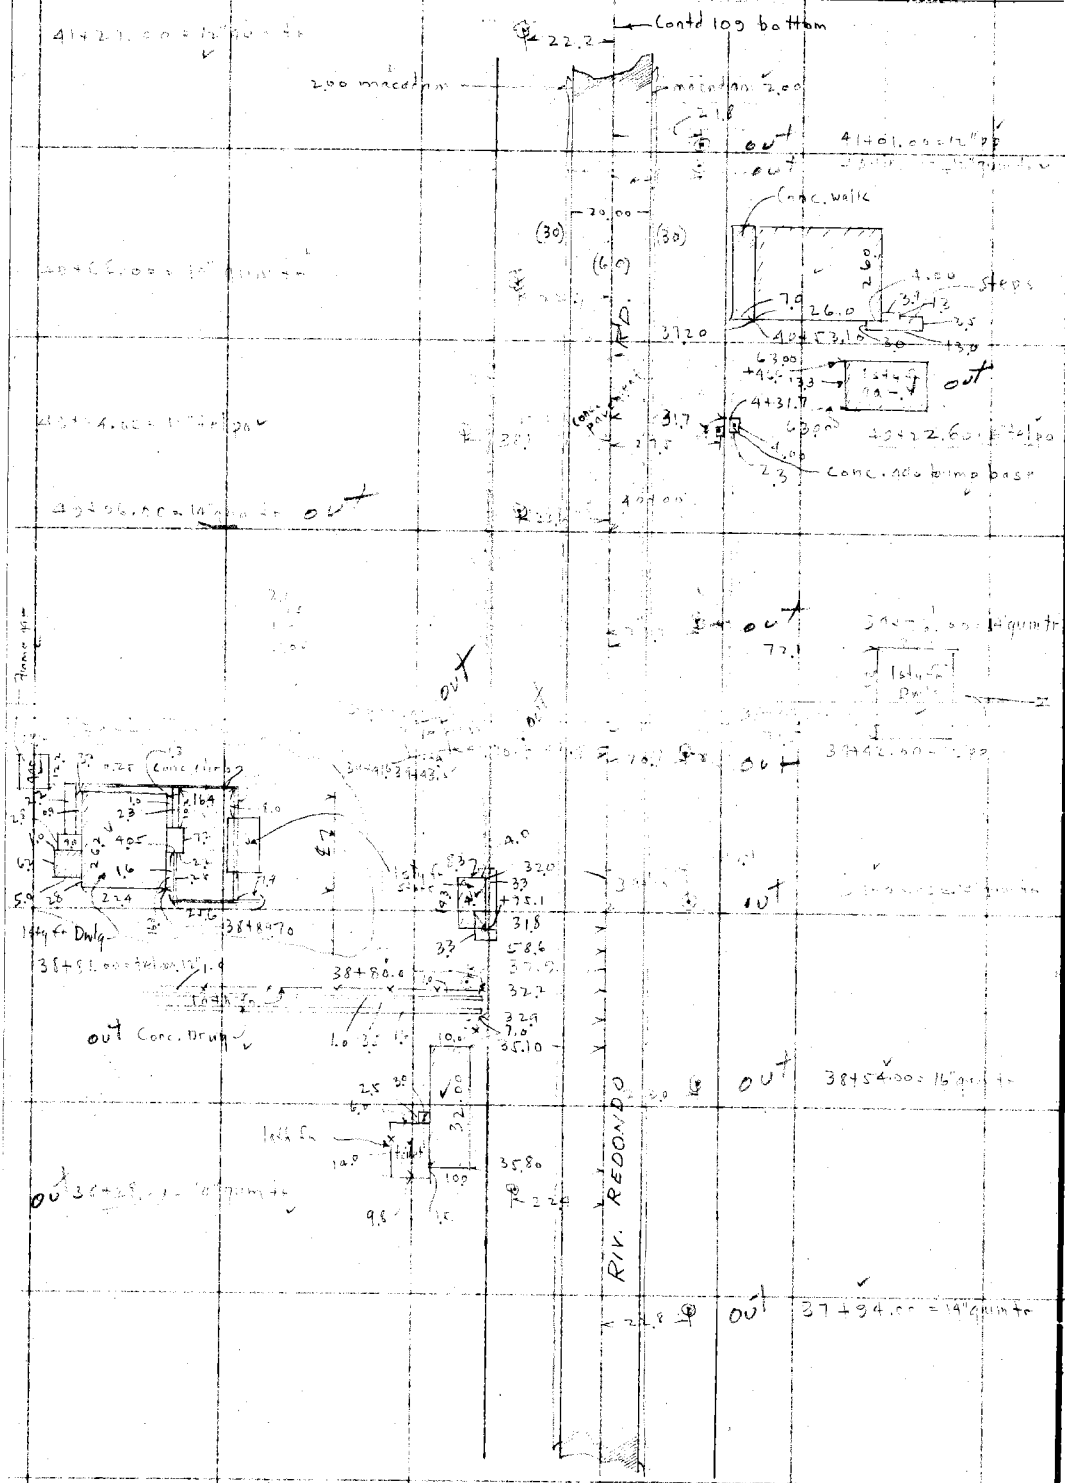

RETURN TO
LOS ANGELES COUNTY SURVEYOR
Do not extend notes this side of this line

Note: ANY ADDITIONS OR CHANGES ON THIS SHEET MUST BE MADE OR CIRCLED IN Red. WITH DATE AND NAME OF PERSON MAKING CHANGE.

Date 8-[illegible]-31 Notes by [illegible] Chief Party [illegible] F.B. [illegible] Pg 109

Platted by A Svenson	W. O. No. 920 D. S. O. No.
Date 8-8-30	Location Riv. Redonda Rd
Map No. B 442-Sh 2	Surveyed by [illegible]
Platting C'k'd by J. D. Price	Date 8-20-30
Date 4-13-31	Indexed

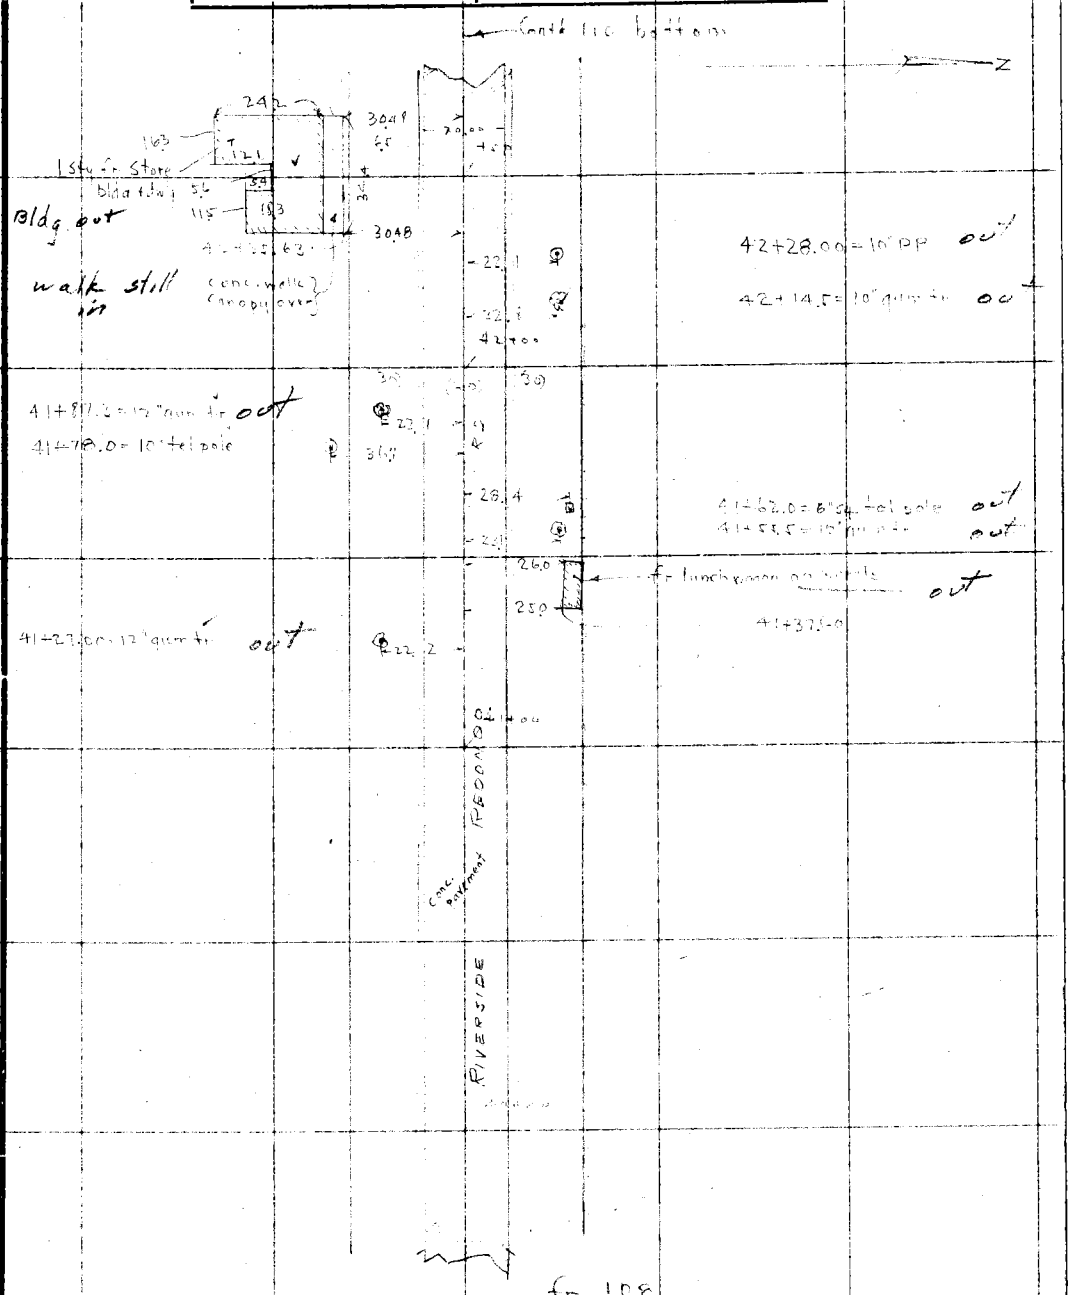

RETURN TO
LOS ANGELES COUNTY SURVEYOR

Do not extend notes this side of this line

Note: ANY ADDITIONS OR CHANGES OR THIS SHEET MUST BE MADE OR CIRCLED IN Red. WITH DATE AND NAME OF PERSON MAKING CHANGE.

F.B. 399 PG 110 Chief Party Notes by Date 8-21-29

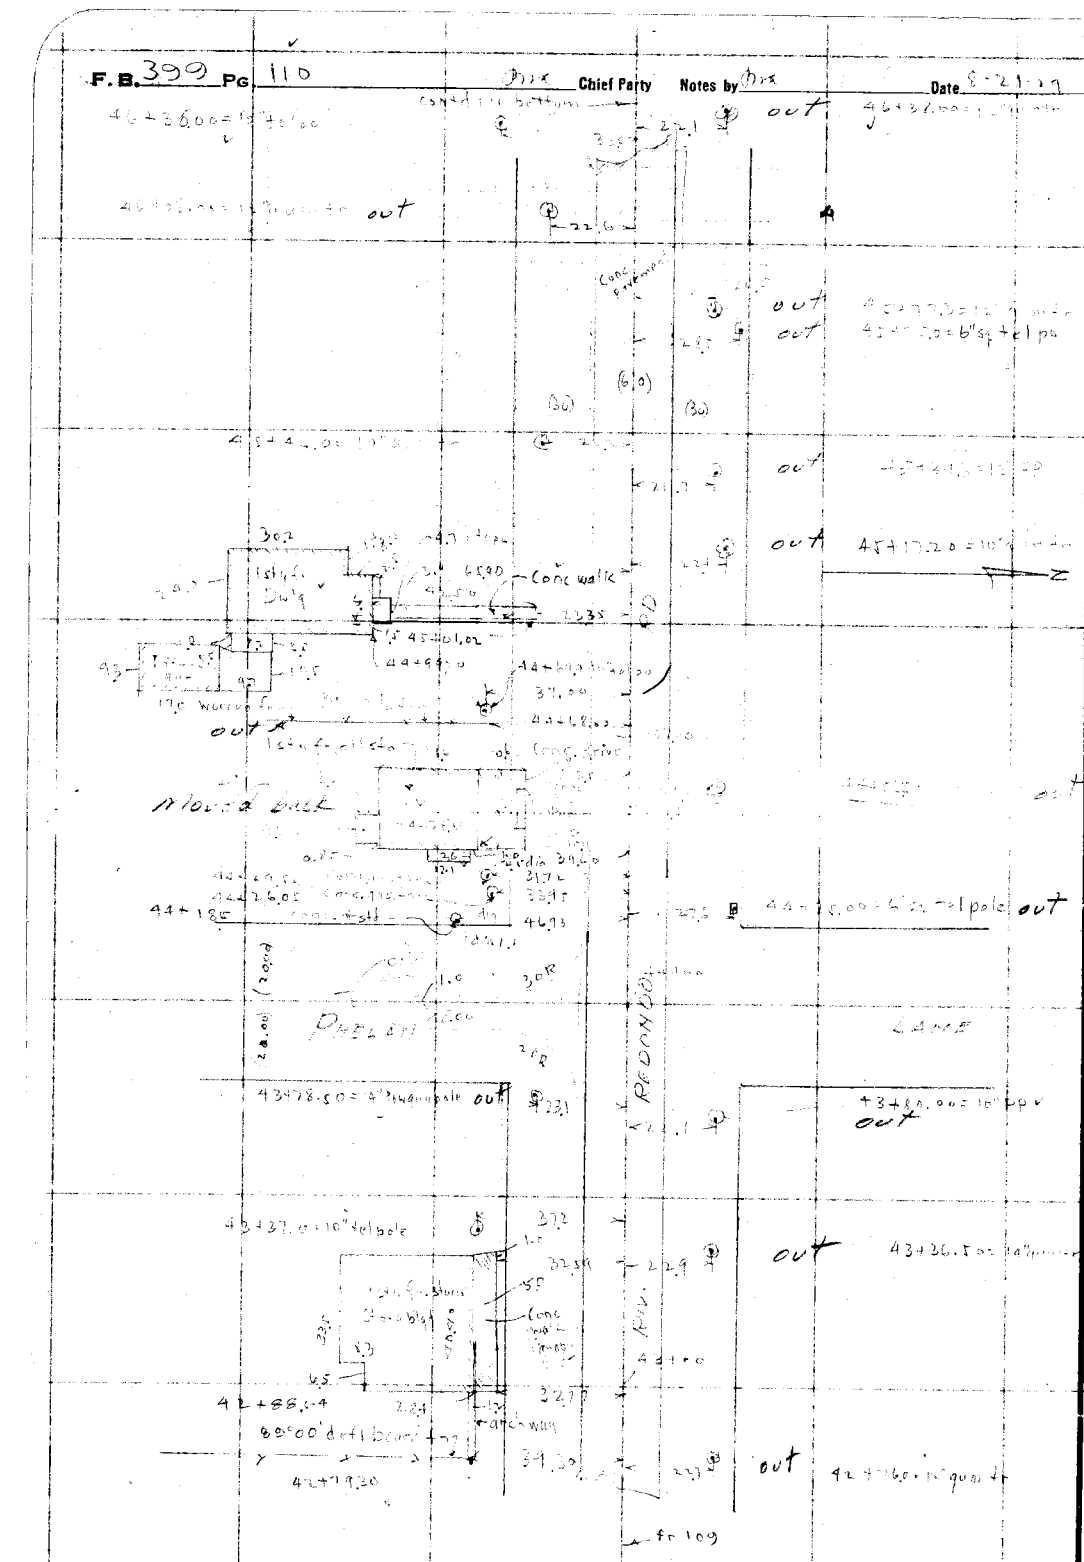

Date 8-21-30 Notes by DNK Chief Party DNK F.B. 354 Pg. 111

Plotted by A Svenson	W.O. No. 920 D.S.O. No.
Date 8-8-30	Location R/W Redondo Rd
Plotting C'k'd by J.D. Price.	Date Aug 21 1929

Contd 112 bottom

out

out

out

F.B. 399 Pg. 112 Chief Party Notes by Date 8-21-29

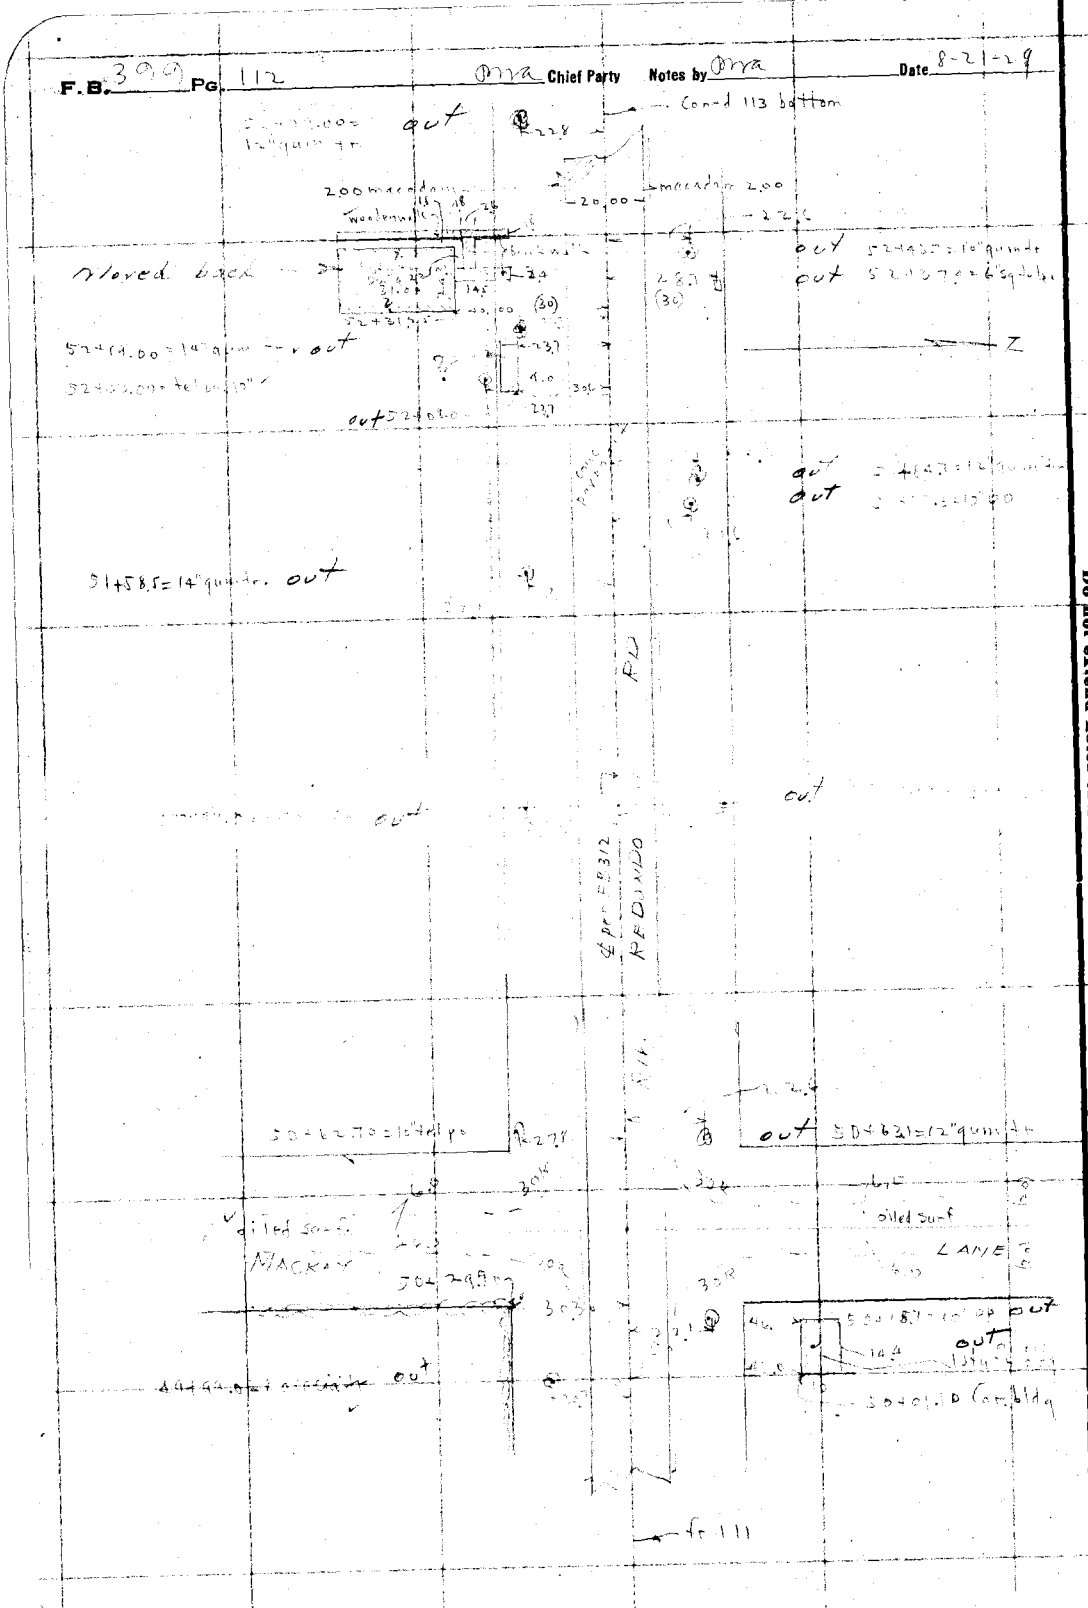
out
Cond 113 bottom
200 macadam
Weekman
moved back
out
out
out

Date 8-22-30 Notes by [illegible] Chief Party [illegible] F.B. 360 Pg. 113

Platted by A Svenson	W. O. No. 920 D. S. O. No.
Date 8-8-30	Location
Map No. B442 Sh2	Surveyed by [illegible]
Platting Ck'd by J.D. Price	Date 8-22-30
Date 4-13-'31.	Indexed

Notes. ANY ADDITIONS OR CHANGES OR THIS SHEET MUST BE MADE OR CIRCLED IN Red. WITH DATE AND NAME OF PERSON MAKING CHANGE.

Do not extend notes this side of this line

RETURN TO LOS ANGELES COUNTY SURVEYOR

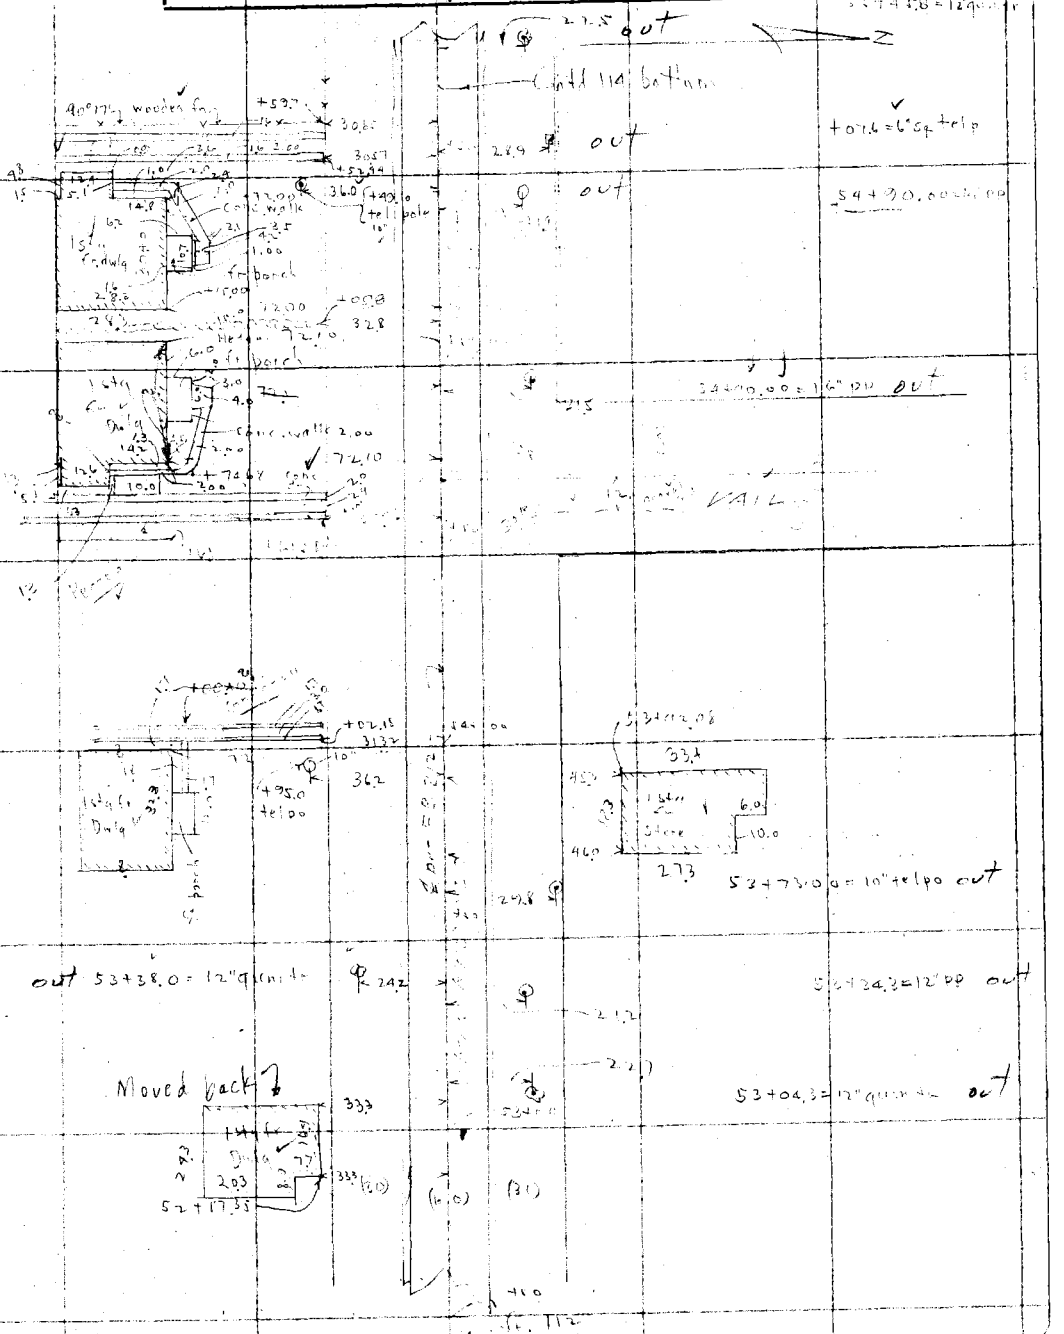

F. B. 3099 PG. 114 Chief Party Notes by DVA Date 8-22-29

RETURN TO
LOS ANGELES COUNTY SURVEYOR

Do not extend notes this side of this line

Note: ANY ADDITIONS OR CHANGES ON THIS SHEET MUST BE MADE OR CIRCLED IN Red. WITH DATE AND NAME OF PERSON MAKING CHANGE.

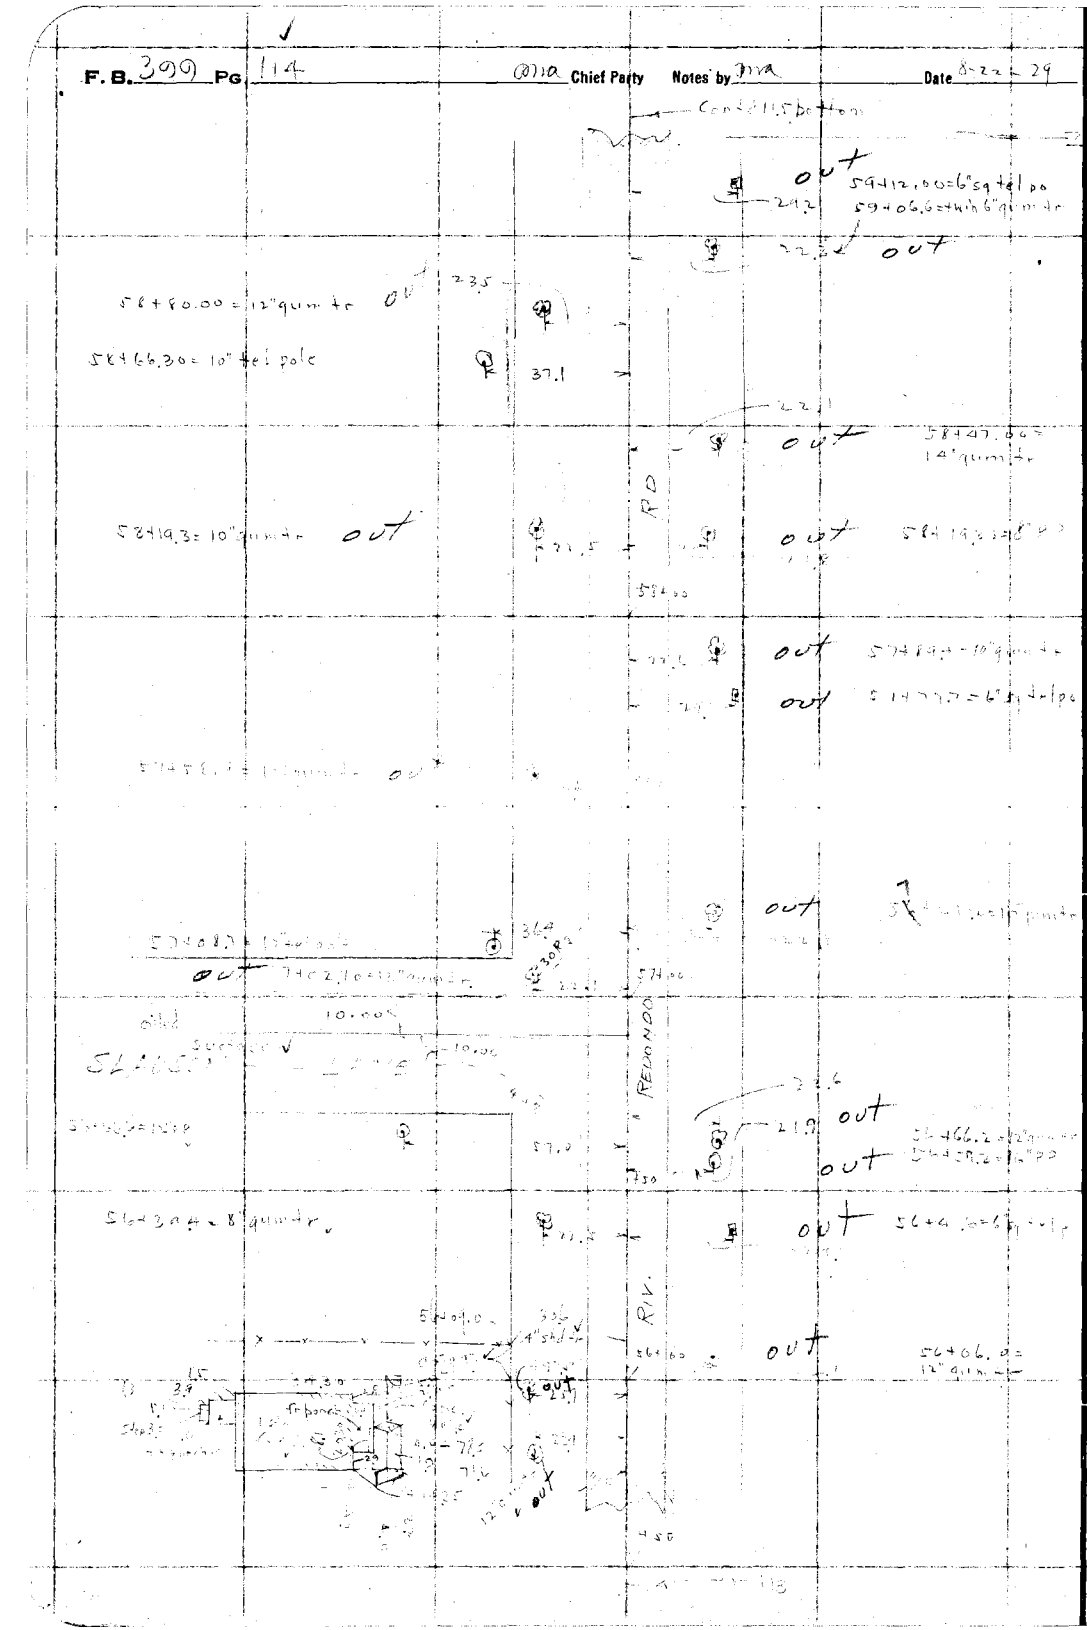
Const 11.5 bottom
out
59+12.00=6"sq tel po
59+06.6=twin 6"quin dr
out
58+80.00=12"quin dr
out
58+66.30=10" tel pole
37.1
out
58+47.00=14"quin dr
58+19.3=10"quin dr
out
out
out

Date 8-25-29 Notes by D.M.K. Chief Party D.M.K. F.B. 322 Pg 115

Platted by A Svenson	W. O. No. 3220 D. S. O. No.
Date 8-8-30	Location
Map No. B 942-Sh 2	Surveyed by
Platting C'k'd by J.D. Price	Date
Date 4-13-'31	Indexed

Contd. from bottom








Cont'd. on f. 114

Notes: ANY ADDITIONS OR CHANGES OR THIS SHEET MUST BE MADE OR CIRCLED IN Red. WITH DATE AND NAME OF PERSON MAKING CHANGE.

Do not extend notes this side of this line

RETURN TO LOS ANGELES COUNTY SURVEYOR

F.B. 399 Pg. 116 Chief Party Notes by Date 8-

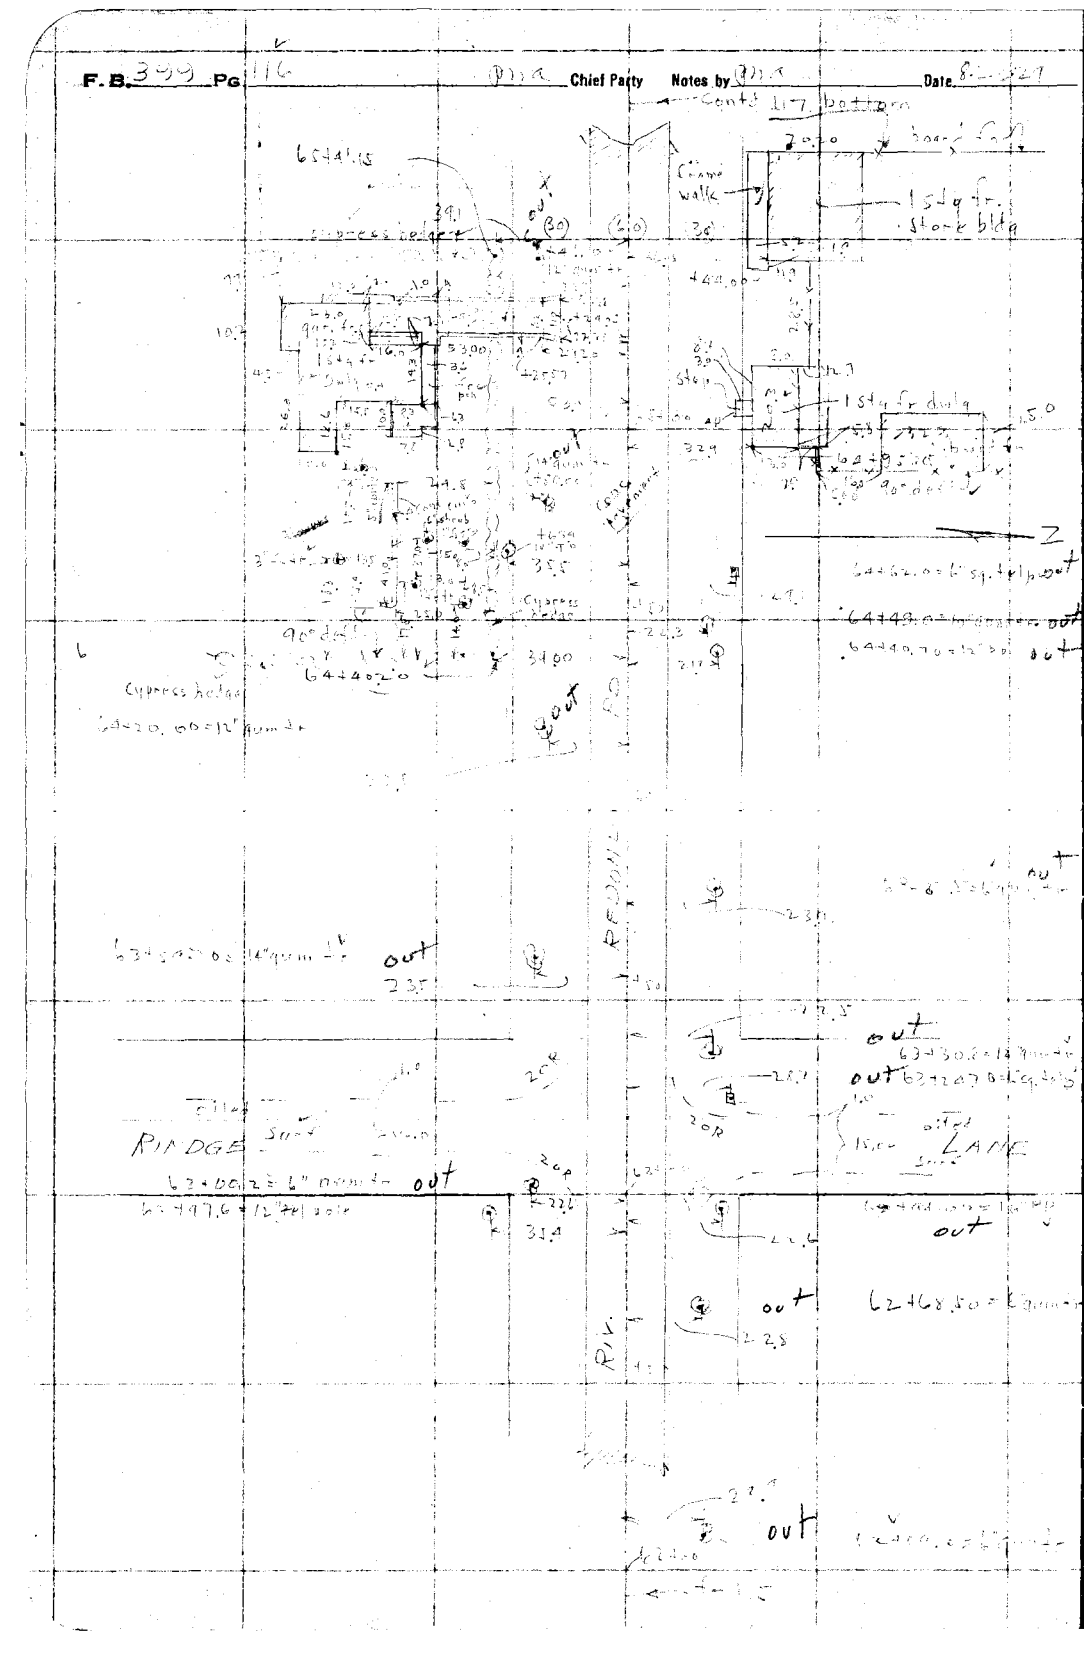

Date 6-23-29 Notes by DHA Chief Party DHA F.B. 399 Pg. 117

Platted by A Svenson
Date 8-8-30
Map No. B 442-Sh 2
Platting C'k'd by J.D. Price
Date 9-13-31.

W. O. No. 220 D. S. O. No.
Location Kir Keaney Rd
Surveyed by P. [illegible]
Date Aug 2 & 1929
Indexed A. C. Johnson

Contd 118 bottom

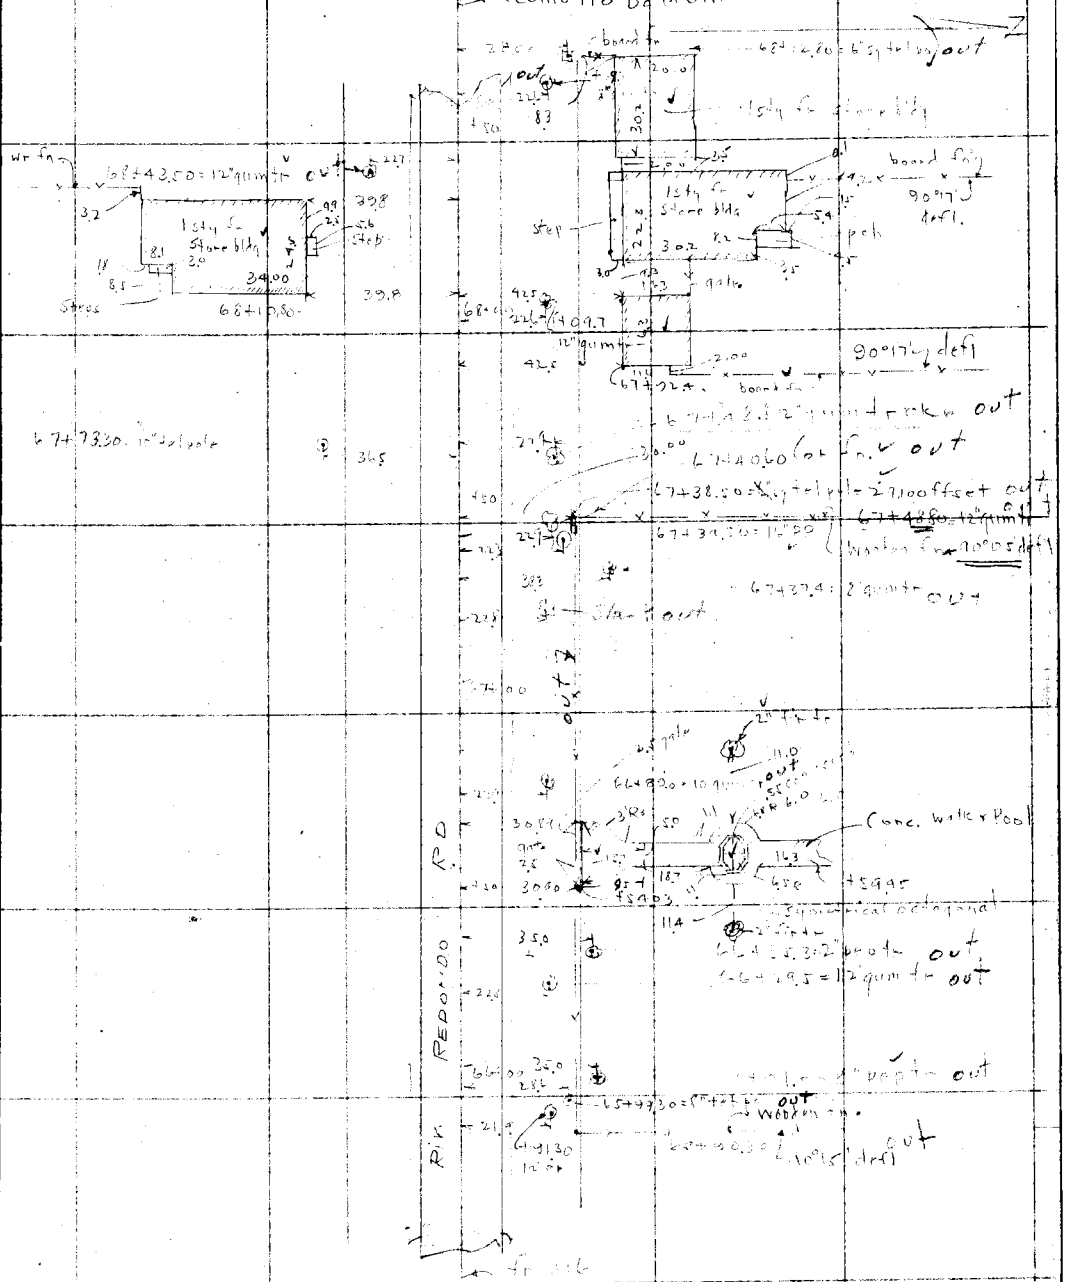

Notes: ANY ADDITIONS OR CHANGES OR THIS SHEET MUST BE MADE OR CIRCLED IN Red. WITH DATE AND NAME OF PERSON MAKING CHANGE.

Do not extend notes this side of this line

RETURN TO LOS ANGELES COUNTY SURVEYOR

F. B. 399 Pg. 118 Chief Party Notes by Date 8-26-1929

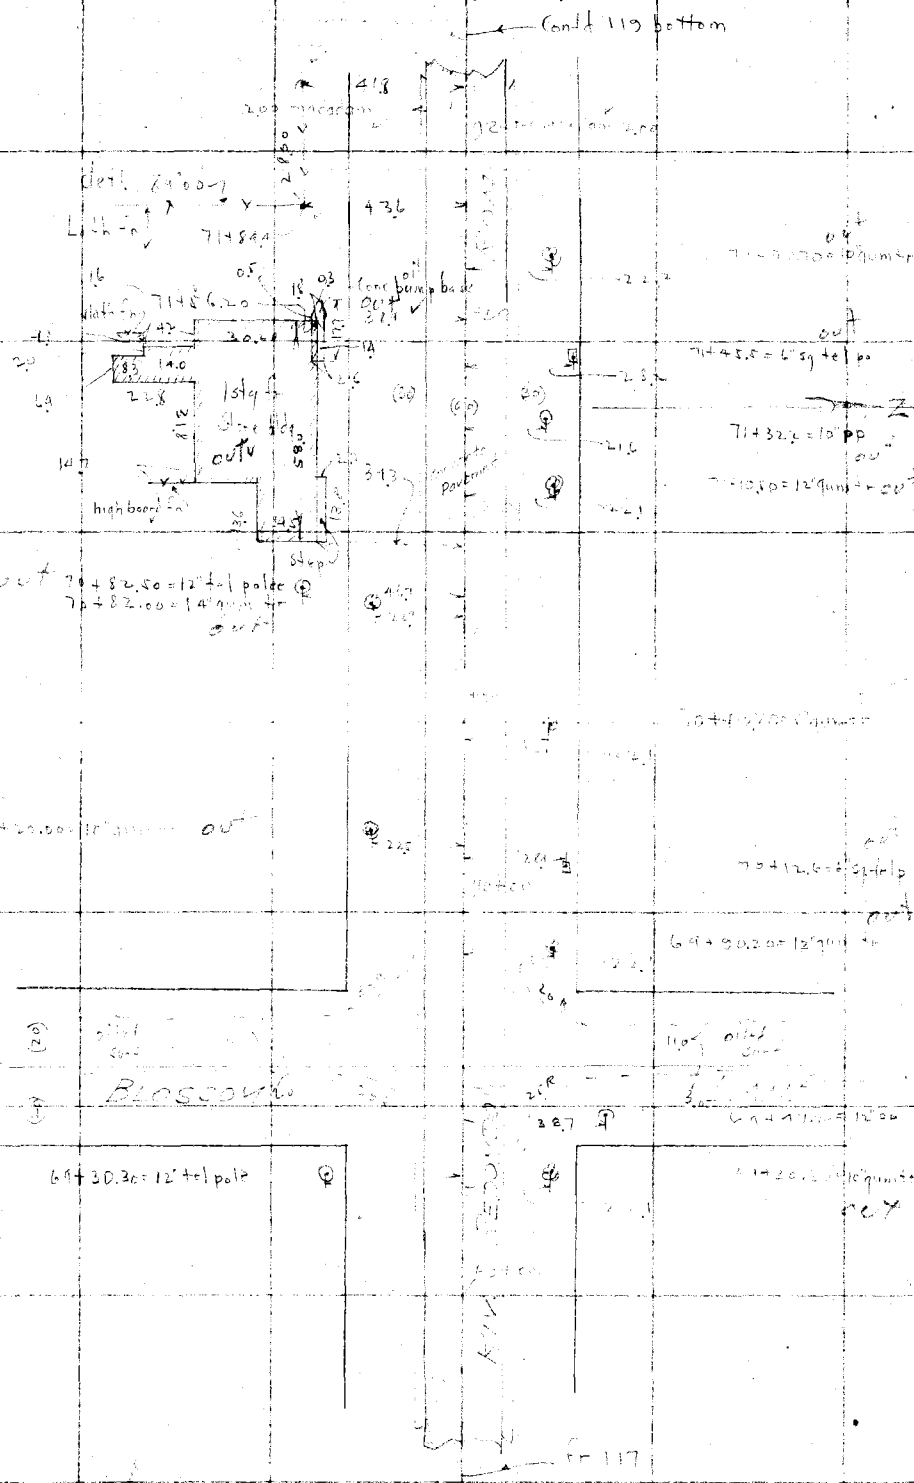

RETURN TO
LOS ANGELES COUNTY SURVEYOR

Do not extend notes this side of this line

Note: ANY ADDITIONS OR CHANGES ON THIS SHEET MUST BE MADE OR CIRCLED IN Red. WITH DATE AND NAME OF PERSON MAKING CHANGE.

Date 3-26-29 Notes by Cota Chief Party Cota F.B. 399 Pg 119

Platted by A Svenson	W. O. No. 920 D. S. O. No.
Date 8-8-30	Location Riv. Redondo Rd.
Map No. B492 Sh2	Surveyed by Paul Hilling Dan
Platting C'k'd by J.D.Price	Date Aug 26, 1929
Date 4-13-31.	Indexed A. C. Jones

Notes: ANY ADDITIONS OR CHANGES ON THIS SHEET MUST BE MADE OR CIRCLED IN Red. WITH DATE AND NAME OF PERSON MAKING CHANGE.

Do not extend notes this side of this line

RETURN TO LOS ANGELES COUNTY SURVEYOR

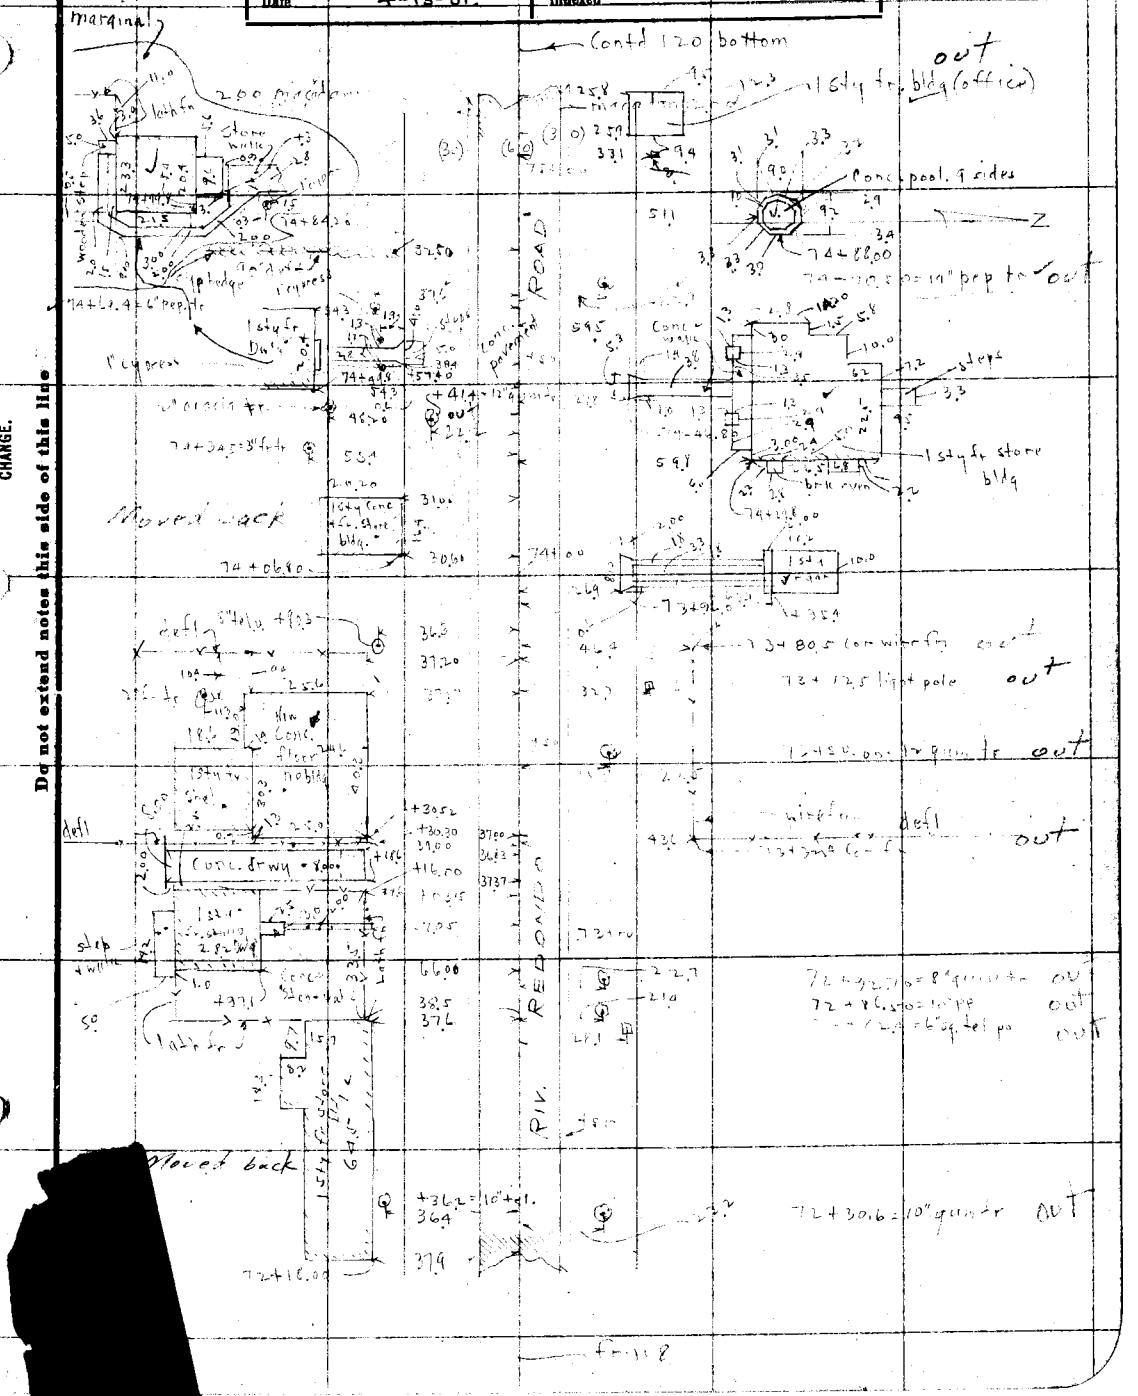

F.B. 399 PG 120 Chief Party Notes by Date 8-27-29

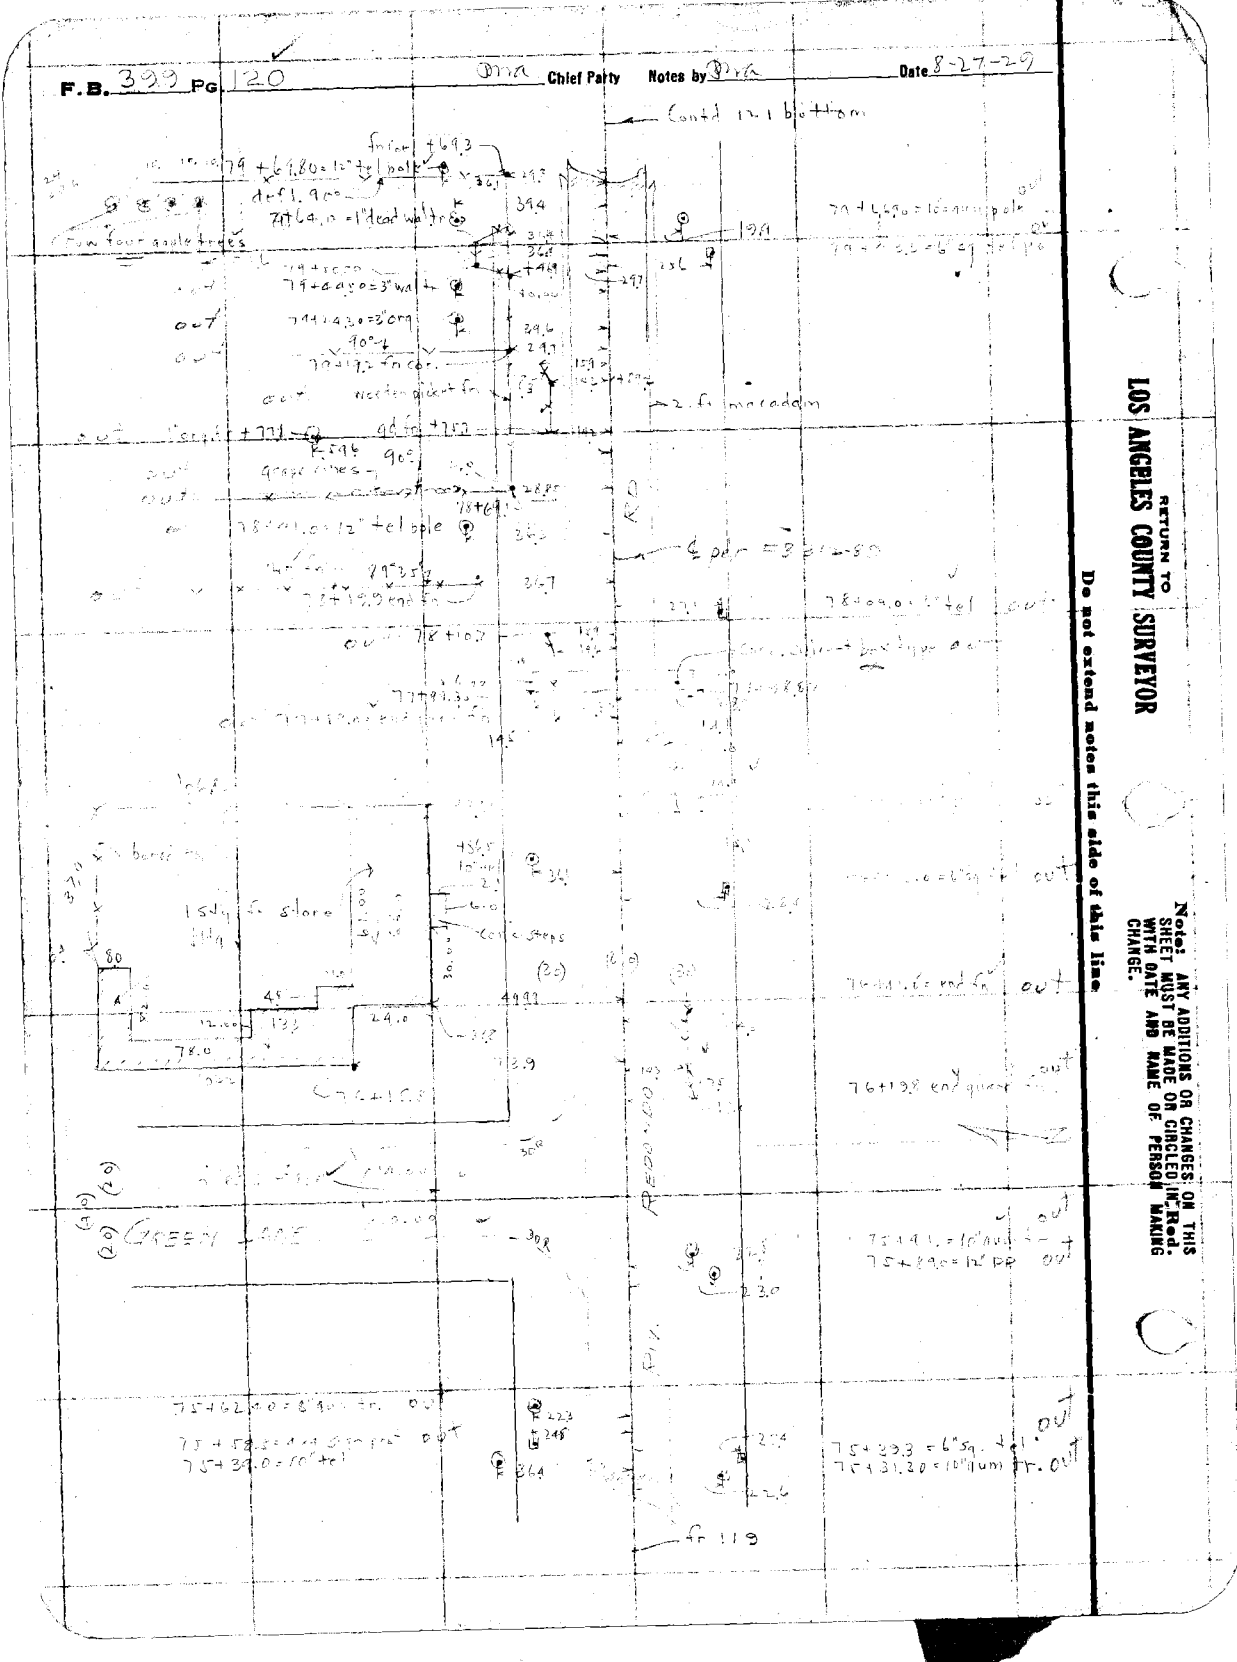

Date 8-28-49 Notes by [illegible] Chief Party [illegible] F.B. [illegible] Pg 121

Platted by A Svenson	W.O.No. [illegible] D.S.O.No.
Date 8-8-50	Location Riv. Redondo Rd
Map No. B992 Sh2	Surveyed by [illegible]
Platting C'k'd by J.D. Price	Date 8-28-49
Date 4-13-31	Indexed [illegible]

Note: ANY ADDITIONS OR CHANGES ON THIS SHEET MUST BE MADE OR CIRCLED IN Red. WITH DATE AND NAME OF PERSON MAKING CHANGE.

Do not extend notes this side of this line

RETURN TO LOS ANGELES COUNTY SURVEYOR

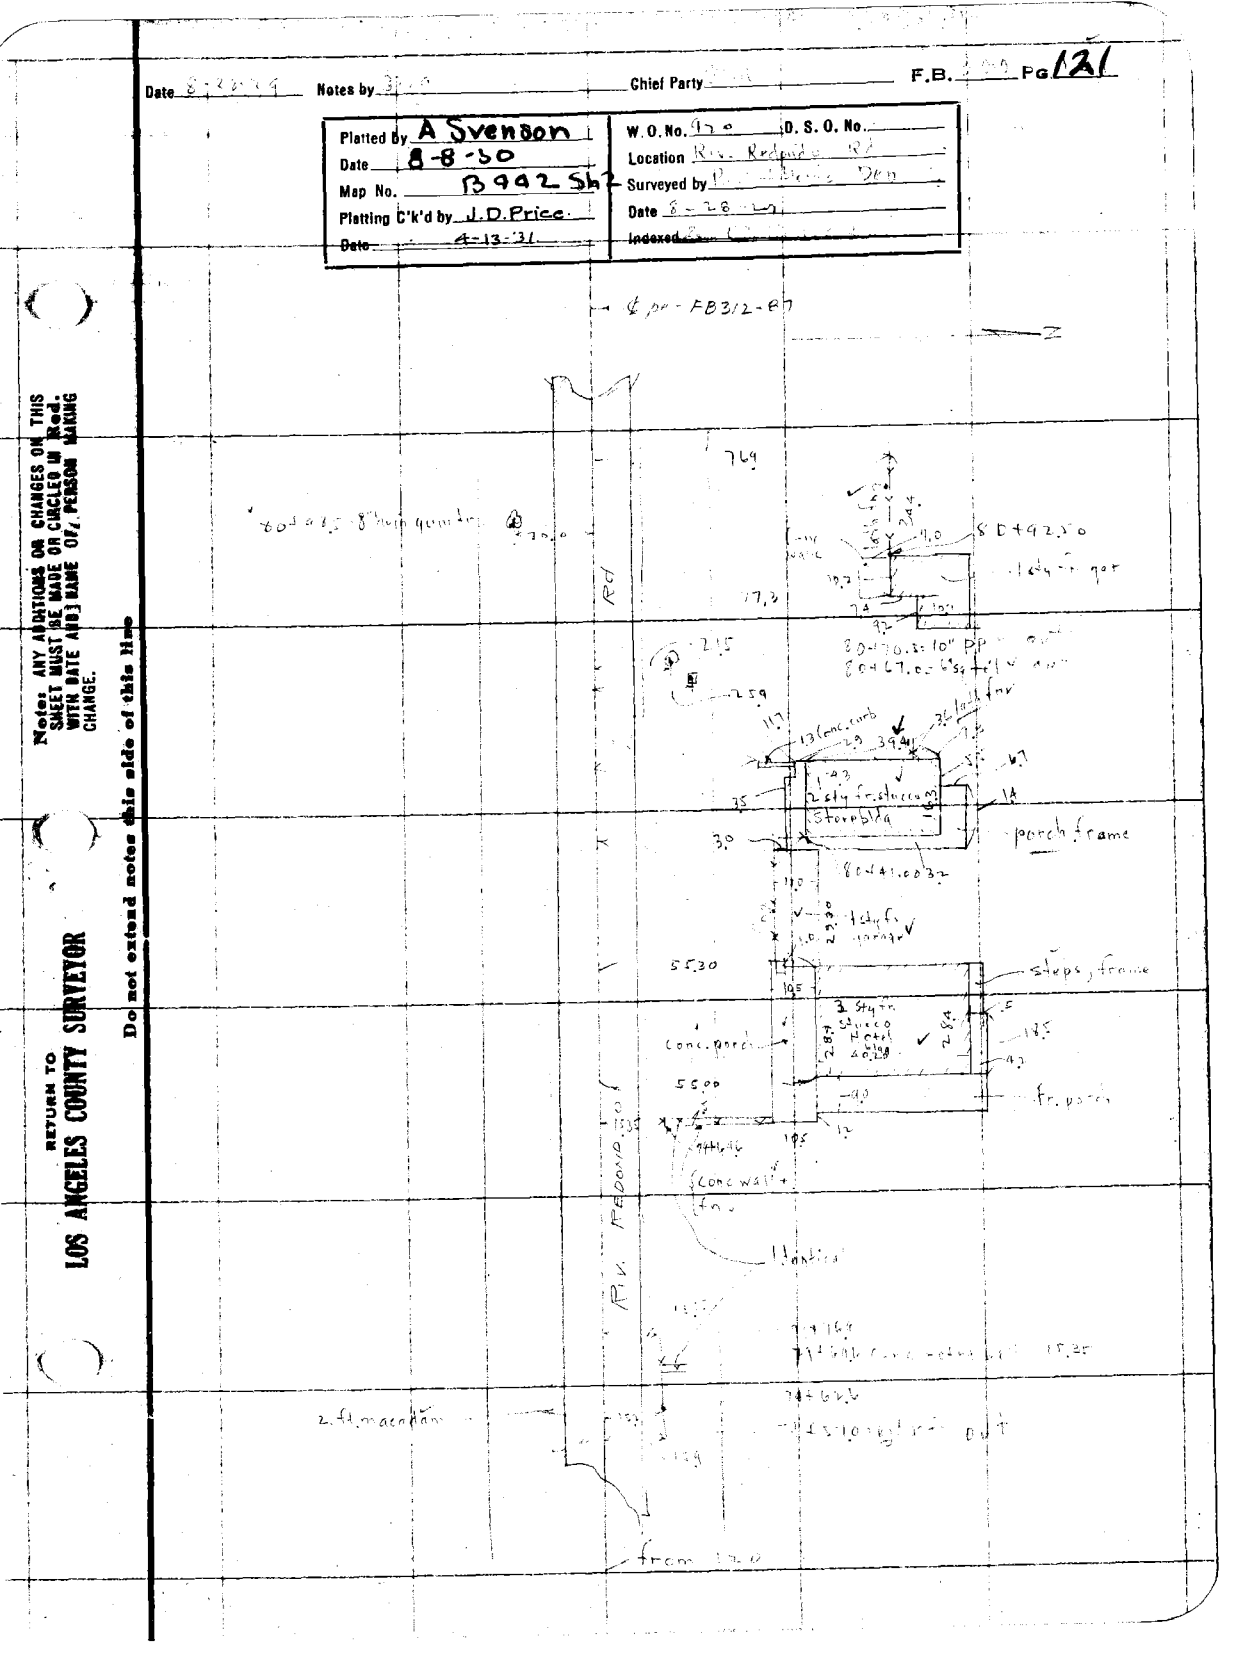

F. B. 399 Pg. 122 Chief Party Notes by Date

See Also 399 (73.04
(T5-121

424 - 40-44 4

END of
FB 399

RETURN TO
LOS ANGELES COUNTY SURVEYOR

Do not extend notes this side of this line

Note! ANY ADDITIONS OR CHANGES ON THIS SHEET MUST BE MADE OR CIRCLED IN Red. WITH DATE AND NAME OF PERSON MAKING CHANGE.

Notes Ck'd by	Survey of Redondo Beach Blvd
Map No. B - 441 - 1	W. O. 7920 Tape No. 032 St'd 84 °F.
Office Work	Surveyed by RB Emmott
Checked Rosen	Notes RBE Date 12/1/33
Date Dec. 1933	Indexed A. C. Johnson 12-3-33

F.B. 399 Pg. 123

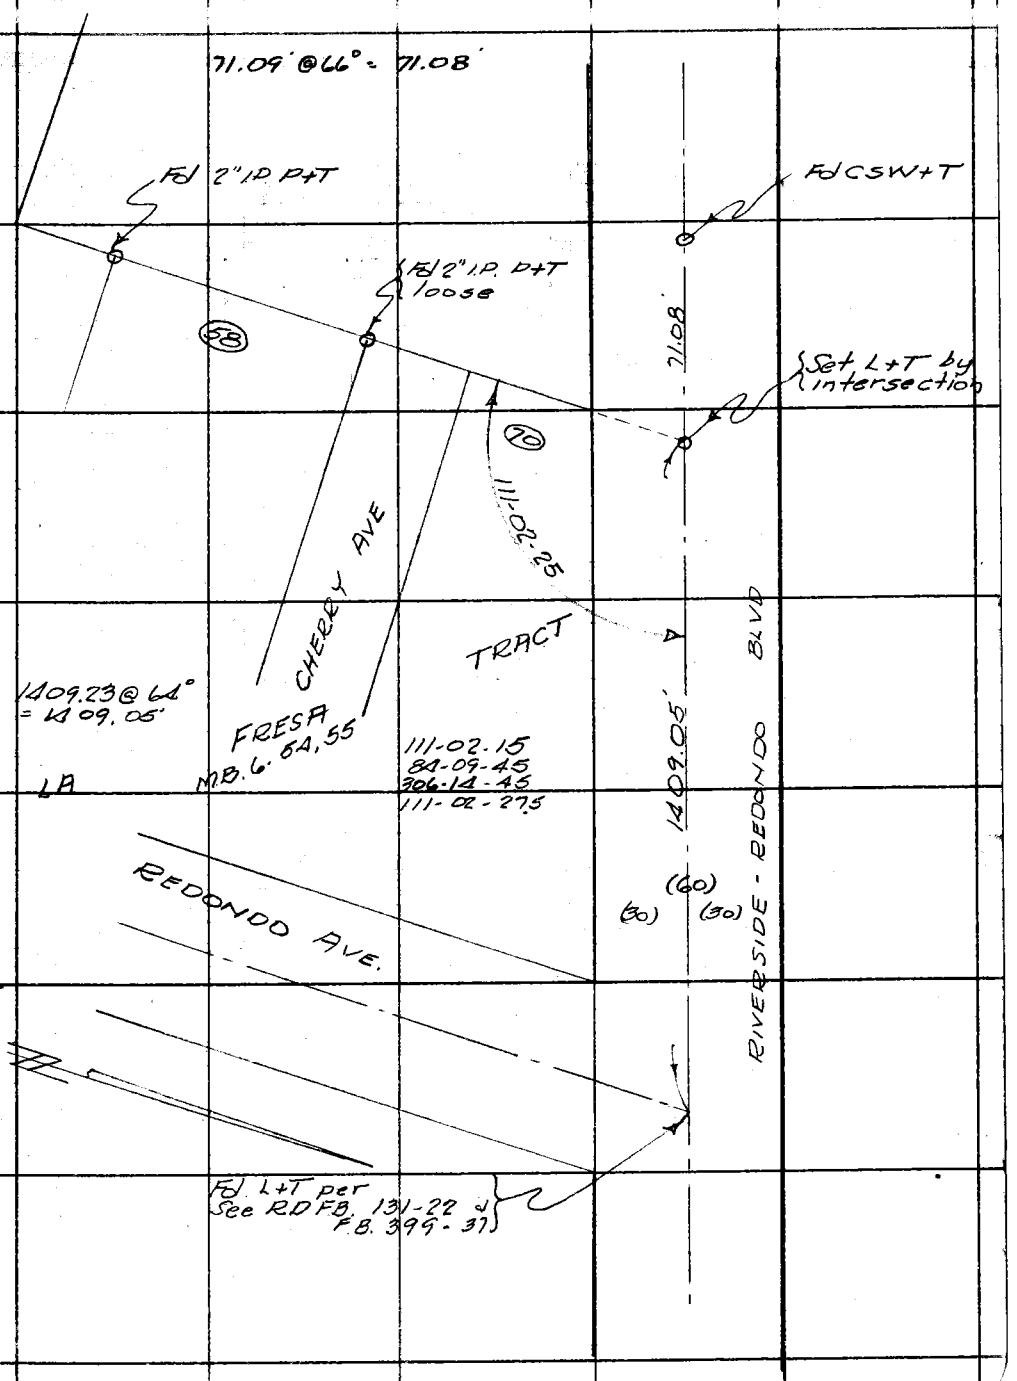

Note: ANY ADDITIONS OR CHANGES ON THIS SHEET MUST BE MADE IN OR CIRCLED IN Red Ink. WITH DATE AND NAME OF PERSON MAKING CHANGE.

Do not extend notes this side of this line

RETURN TO
LOS ANGELES COUNTY SURVEYOR
700 HALL OF RECORDS

FORM 247 10M 8-31

LOS ANGELES COUNTY SURVEYOR

700 HALL OF RECORDS

399

F.B. 399 Pg. 124