Survey of

W. O. Tape No. St'd °F.

Computed By

Checked By

Indexed

F.B. Pg.

NOTES

F.B. 420 Pg Index

F.B. 420

PAGES: Index, 1 to 6 incl., , 7 to 33 incl.,

, 35 to 39 incl.,

75 to 94 incl., 95,

RETURN TO
LOS ANGELES COUNTY SURVEYOR
700 HALL OF RECORDS
Do not extend notes this side of this line

NOTE: ANY ADDITIONS OR CHANGES ON THIS SHEET MUST BE MADE ON CHECKED IN Red Ink, WITH DATE AND NAME OF PERSON MAKING CHANGE.

Date _____ Notes by A.W.V.F. Chief Party A.W. Van Fleet F.B. 420 Pg. 1

Tape

Plotted by Wood
Date Mar. 1930
Map No. B-455
Plotting Ck'd by _____
Date _____

W. O. No. 955 C.O. No. 029
Location Inglewood-Redondo Blvd.
Surveyed by A.W. Van Fleet
Date _____
Inspected A. C. Johnson

Div. I

Notice: ANY ADDITIONS OR CHANGES OF THIS SHEET MUST BE MADE IN CIRCLED "Red" WITH DATE AND NAME OF PERSON MAKING CHANGE.

Do not detach sheets this side of this Note

RETURN TO LOS ANGELES COUNTY SURVEYOR

℄ SURVEY
INGLEWOOD-REDONDO BLVD.
DIV. I
W.O. 955

Party
Van Fleet
Forney
Kennaston
Irwin
Floyd

100' Band Tape #029 Calibrated @ T. 84° F. Surveyed Sept. 17 to Oct. 24, 1929

℄ has all been double chained.
℄ of survey shown in blue pencil.

F. B. 420 Pg. 2 A.W. Van Fleet Chief Party Notes by A.W. Van Fleet Date Sept. 1929

To bottom of page 3

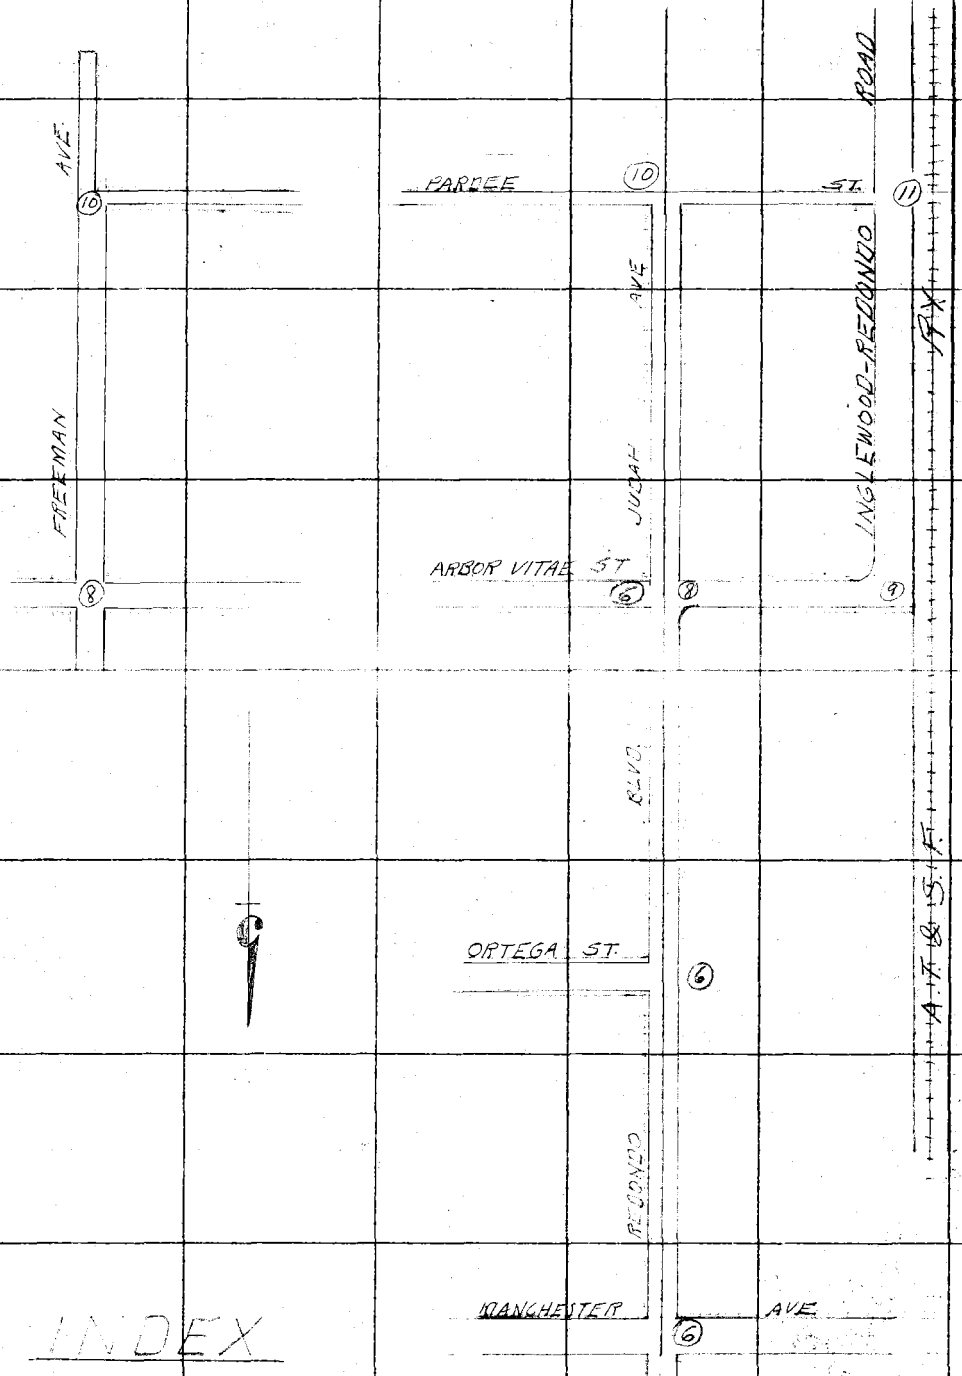

INDEX

RETURN TO
LOS ANGELES COUNTY SURVEYOR

Do not extend notes this side of this line

Note: ANY ADDITIONS OR CHANGES ON THIS SHEET MUST BE MADE OR CIRCLED IN Red. WITH DATE AND NAME OF PERSON MAKING CHANGE.

Date Sept. 1929 Notes by A.W.V.F. Chief Party A.W. VanFleet F.B. A20 Pg 3

Platted by Wood	W. O. No. 955 D. S. O. No.
Date Mar. 1930	Location Inglewood-Redondo Blvd
Map No. B-455	Surveyed by A.W. VanFleet
Platting Ck'd by	Date Sept. 1929
Date	Indexed A. C. Johnson

Div. I

To bottom of page 4

ROAD

LENNOX (16) (16) (17)

AVE.

PALM ST. (14) (14) (15)

FREEMAN

INGLEWOOD-REDONDO

A T & S F

(12) SAN ANTONIO (12) Beginning of Div. I ST. (13)

From top of page 3

Notes ANY ADDITIONS OR CHANGES ON THIS SHEET MUST BE MADE OR CIRCLED IN Red. WITH DATE AND NAME OF PERSON MAKING CHANGE.

Do not extend notes this side of this line

RETURN TO LOS ANGELES COUNTY SURVEYOR

F. B. 420 Pg. 4 A.W. Van Fleet Chief Party Notes by A.W.V.F. Date Oct. 1929

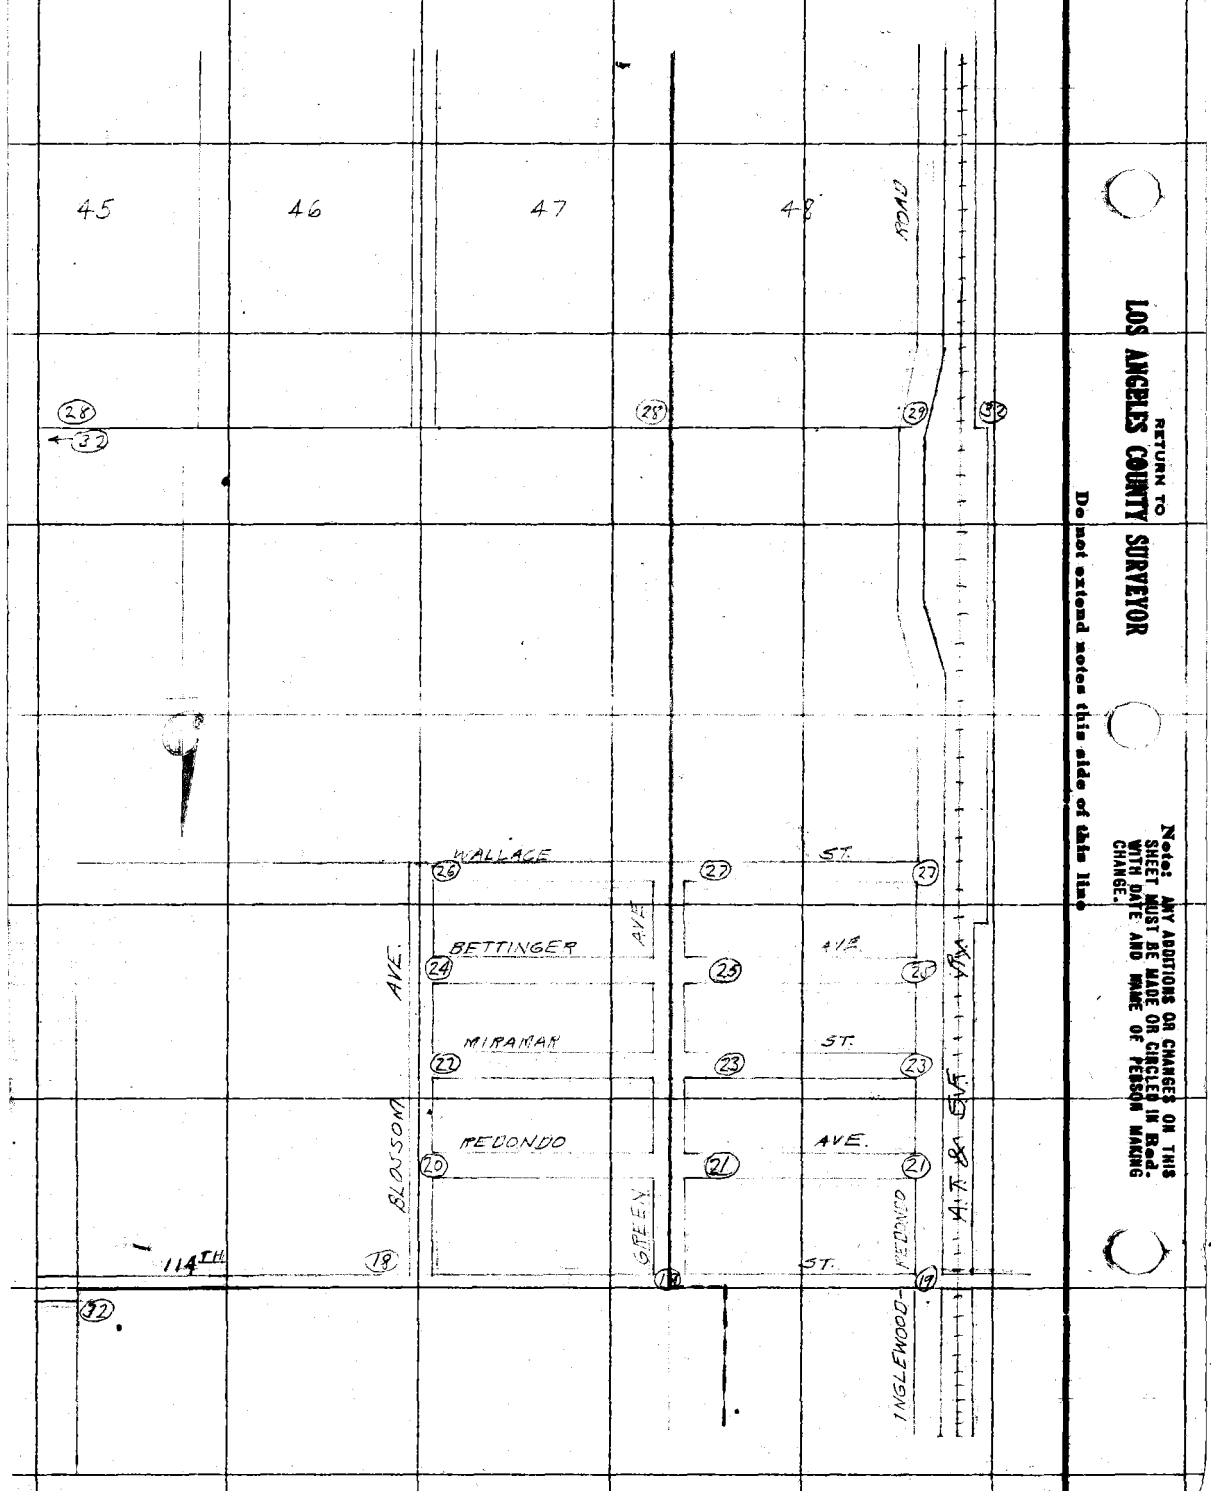

RETURN TO LOS ANGELES COUNTY SURVEYOR

Do not extend notes this side of this line

Note: ANY ADDITIONS OR CHANGES ON THIS SHEET MUST BE MADE OR CIRCLED IN Red WITH DATE AND NAME OF PERSON MAKING CHANGE.

Date Oct. 1929 Notes by A.W.V.F. Chief Party A.W. VanFleet F.B. 420 Pg. 5

Platted by Wood
Date May 1930
Map No. B-455-2
Platting C'k'd by CAR
Date

W. O. No. 955 D. S. O. No.
Location Inglewood & Redondo Blvd.
Surveyed by A.W.Van Fleet
Date Oct. 1929
Indexed A. C. Johnson

Div. I

Notes. ANY ADDITIONS OR CHANGES OR THIS SHEET MUST BE MADE OR CIRCLED IN Red. WITH DATE AND NAME OF PERSON MAKING CHANGE.

Do not extend notes this side of this line

RETURN TO LOS ANGELES COUNTY SURVEYOR

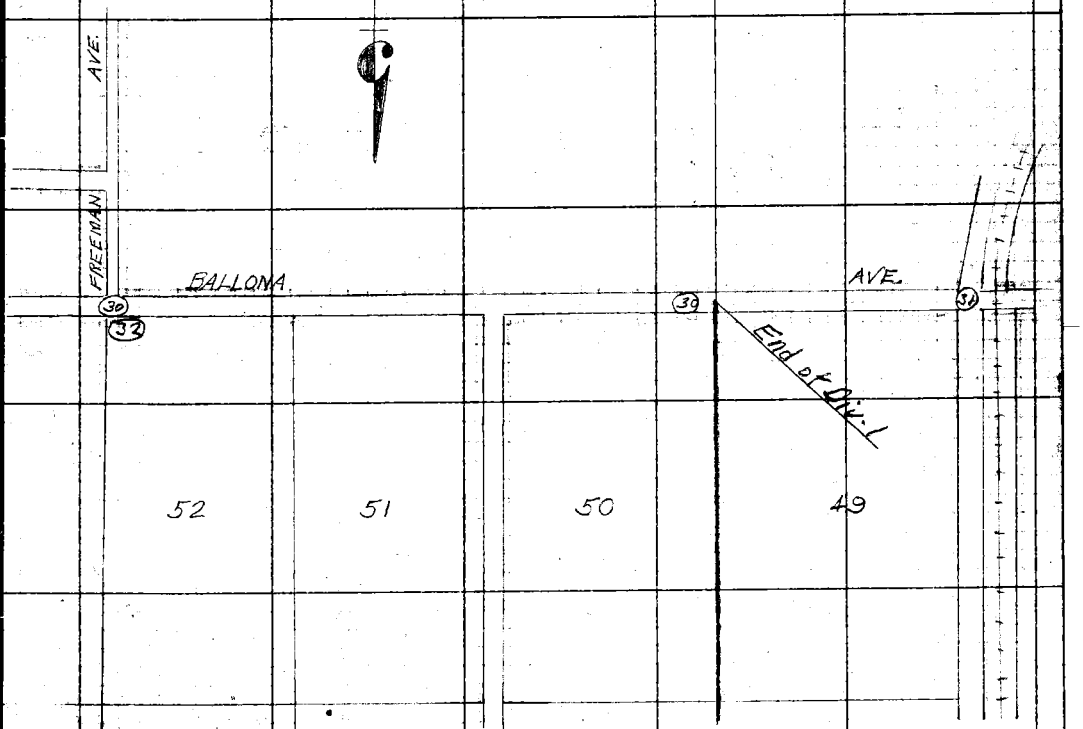

F. B. 420 Pg. 6 A.W. Van Fleet Chief Party Notes by A.W.V.F. Date 9-18-29

To bottom of page 10

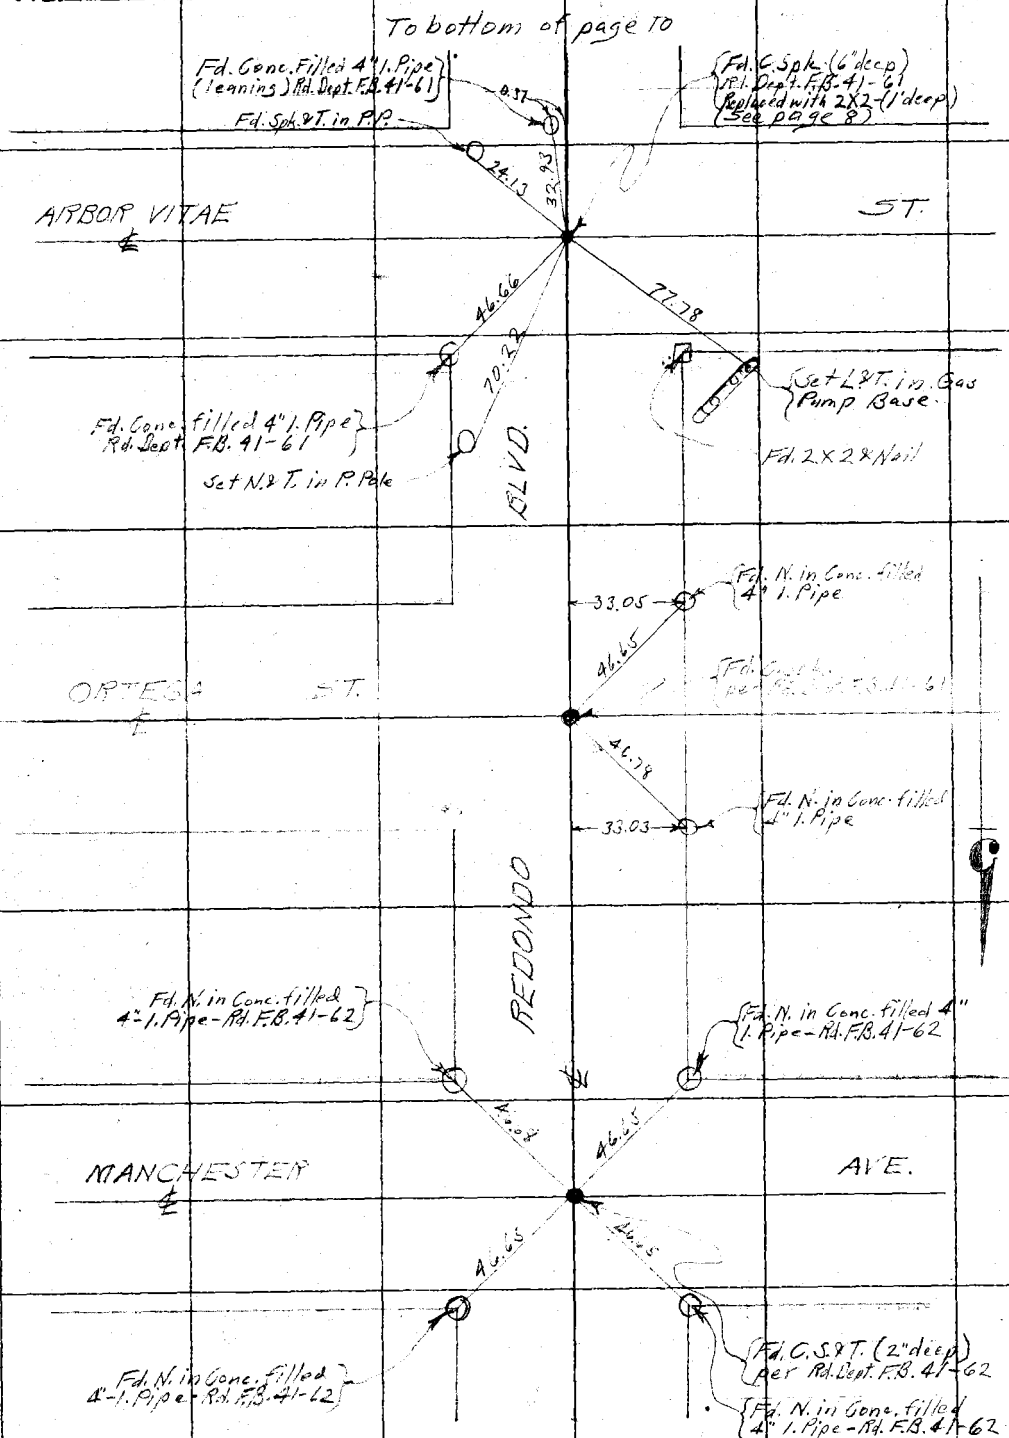

RETURN TO LOS ANGELES COUNTY SURVEYOR

Do not extend notes this side of this line

Note! ANY ADDITIONS OR CHANGES ON THIS SHEET MUST BE MADE OR CIRCLED IN Red. WITH DATE AND NAME OF PERSON MAKING CHANGE.

Date _____ Notes by _____ Chief Party _____ F.B. 420 Pg. 7

Platted by Wood
Date Mar. 1930
Map No. B-455-2
Plotting C'k'd by Cook
Date

W.O. No. 955 D.S.O. No.
Location Inglewood-Redondo Blvd
Surveyed by
Date
Indexed A. G. Johnson

DIV. I

Note: ANY ADDITIONS OR CHANGES ON THIS SHEET MUST BE MADE OR CIRCLED IN Red. WITH DATE AND NAME OF PERSON MAKING CHANGE.

Do not extend notes this side of this line

RETURN TO
LOS ANGELES COUNTY SURVEYOR

F.B. 420 Pg. 8 A.W. Von Fleet Chief Party Notes by A.W.V.F. Date 10-9-29

To bottom of page 10

To bottom of page 10

(30) (33) (33) (33)

1319.00 AVE 1319.00

89°58'30" ②
359°54'00" ②
89°58'30".

89°55'15" ①
359°41'15" ②
89°55'19"

AVE

JUDAH

TRANSIT LINE

Set P.M. on M.H. Cover by 4 chiseled marks on rim. This point is said (by Inspector) to replace Glendale Sewer Engr's ~~Monument~~ to replace Glendale City Mon. destroyed when sewer was built. L.A. Co. Metropolitan Sewer.

To bottom of page 9

89° 89°55'15" 55' 20"

12.00

ARBOR VITAE

55' I.T.

0.22

89°58' 45" 89°57'15" 30"

52.22

Set N.V.T.

179°59'

180°

179° 58' 45" 00

Fd. 2 x 2 (1' deep) per page 6 Ties on page 6

BLVD.

(33) (33)

FREEMAN

179°58'15" ③
359°53'00" ④
179°58'15".

REDWOOD

RETURN TO LOS ANGELES COUNTY SURVEYOR

Do not extend notes this side of this line

Note: ANY ADDITIONS OR CHANGES ON THIS SHEET MUST BE MADE OR CIRCLED IN Red. WHEN DATE AND NAME OF PERSON MAKING CHANGE.

Date 10-9-29 Notes by A.W.V.F Chief Party A.W. VanFleet F.B. 420 Pg. 9 1-7

Plotted by Wood
Date Mar. 1930
Map No. B-455-1
Plotting Ck'd by [illegible]
Date

W. O. No. 955 Sup. No. 029
Location Inglewood-Redondo Blvd
Surveyed by A.W. VanFleet
Date 10-9-29
Indexed A. C. Johnson

DIV. I

Notes: ANY ADDITIONS OR CHANGES OF THIS SHEET MUST BE MADE OR CANCELED IN Red. WITH DATE AND NAME OF PERSON MAKING CHANGE.

Do not extend notes this side of this line

RETURN TO LOS ANGELES COUNTY SURVEYOR

To bottom of page 11

From right of page 8

90°01'15" ①
360°05'00" ④
90°01'15".

90°08'15" ①
360°33'00" ④
90°08'15".

Set Nail by Inter.

INGLEWOOD REDONDO RD.

(25) (25) (30) (30)

Set N.&T. in 10" Euca.

131766

Fd. O&I 4X4 & Nail Accepted as ½ Sec. Cor

REDONDO BLVD.

527.72

90°08' 30"
90°04'50"
90°02'45"
90°01'

263.98 78.23 15 15

Fd. N.&T. in F.P.

0.03 19.93 38.47 56.78 50.71 33.01

Fd. N.&T. in F.P.

Set N.&T. in P.P. #339283-E
Fd. C. Spk. (Ideep)
F.B. 41-60
F.B. 73-117
This Spk. Leans to the North
Fd. Conc. Filled 4" I. Pipe & N.
Rd. Dept. F.B. 41-60

Set N.&T. in Id. P/c

527.75 T. 74° = 527.72 ✓

A. T. & S. F.

Sec. Line

9

F.B. 420 Pg. 10 A.W. Van Fleet Chief Party Notes by A.W.V.F. Date 10-10-29

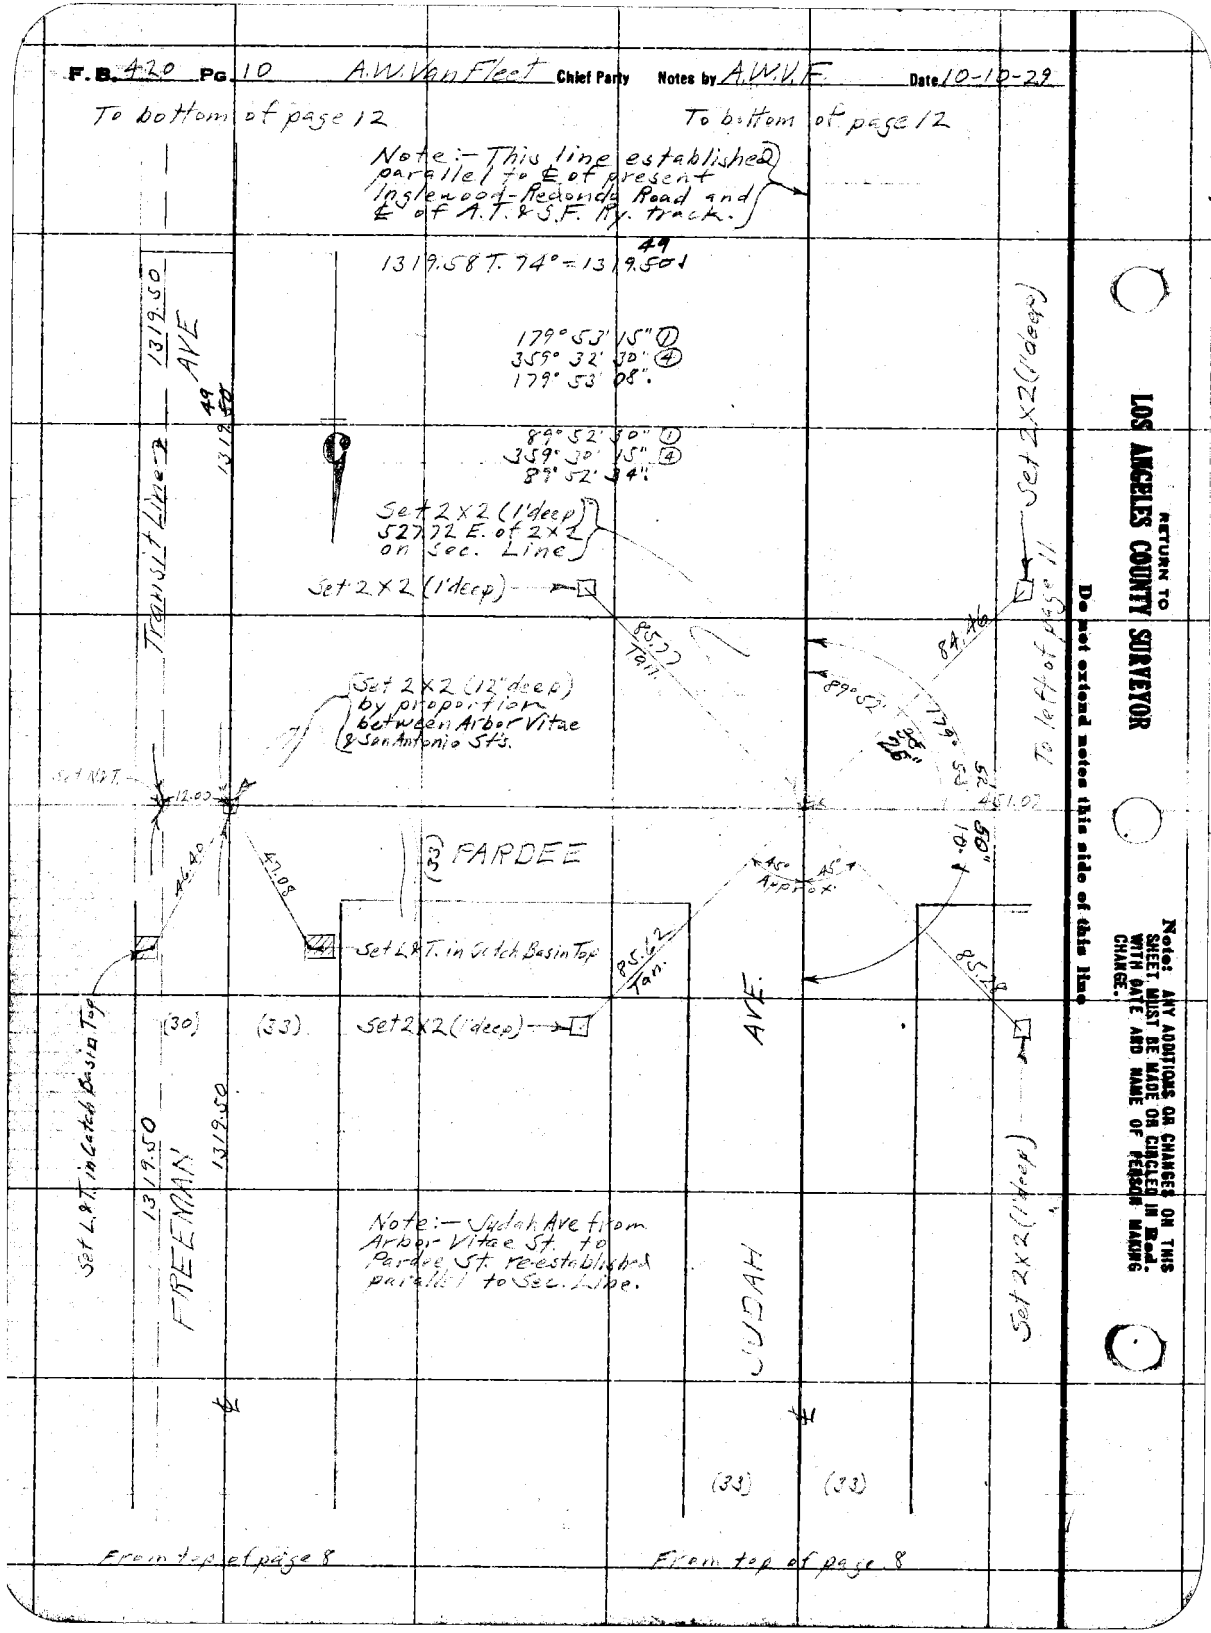

RETURN TO LOS ANGELES COUNTY SURVEYOR

Do not extend notes this side of this line

Note: ANY ADDITIONS OR CHANGES ON THIS SHEET, MUST BE MADE OR CIRCLED IN Red. WITH DATE AND NAME OF PERSON MAKING CHANGE.

Date 10-11-29 Notes by A.W.V.F. Chief Party A.W. Vanfleet F.B. 422 Pg. 11

Tape

Platted by Wood
Date May 1930
Map No. B-455-2
Platting Ck'd by Oak
Date

W. O. No. 955 Sec. No. 029
Location Inglewood-Redondo Blvd.
Surveyed by A.W.V.F.
Date 10-11-29
Ladomed A. C. Johnson

Div. I

To bottom of page 13

90° 00' 15" ①
360° 01' 00" ④
90° 00' 15".

(25) (25) (30) (30)

1317.73 T. 76° = 1317.66 ✓

451.10 T. 74° = 451.07 ✓

90° 07' 45" ①
360° 30' 30" ④
90° 07' 38".

ROAD

Set N.&T. in 8" Eucal.

RY.

1317.66

Set N.&T. in 12" Eucal.

Set 2"x2" (1 deep) by Projection between ⊙ 4"x4" ⊙ Sec. Cors. & Cent. Mon. of San Antonio

90° 07' 40" 30.74
26.32
90° 00' 25" 45.33
54.96
76.65

From right of page 10

451.07

(33)

ST.

42.58
78.14
66.44

Set C.S.W.&T. by Inter.

Set N.&T. in 10" Eucal.

N

1317.73 T. 76° = 1317.66 ✓

INGLEWOOD-REDONDO

Set N.&T. in 6" Eucal.

A. T. & S. F.

Sec. Line

1317.66

From top of page 9

RETURN TO
LOS ANGELES COUNTY SURVEYOR

Do not extend notes this side of this line

Notes: ANY ADDITIONS OR CHANGES OF THIS SHEET MUST BE MADE OR CIRCLED IN Red, WITH DATE AND NAME OF PERSON MAKING CHANGE.

F.B. 420 Pg. 12 A.W. Van Fleet Chief Party Notes by A.W.V.F Date 10-1-29

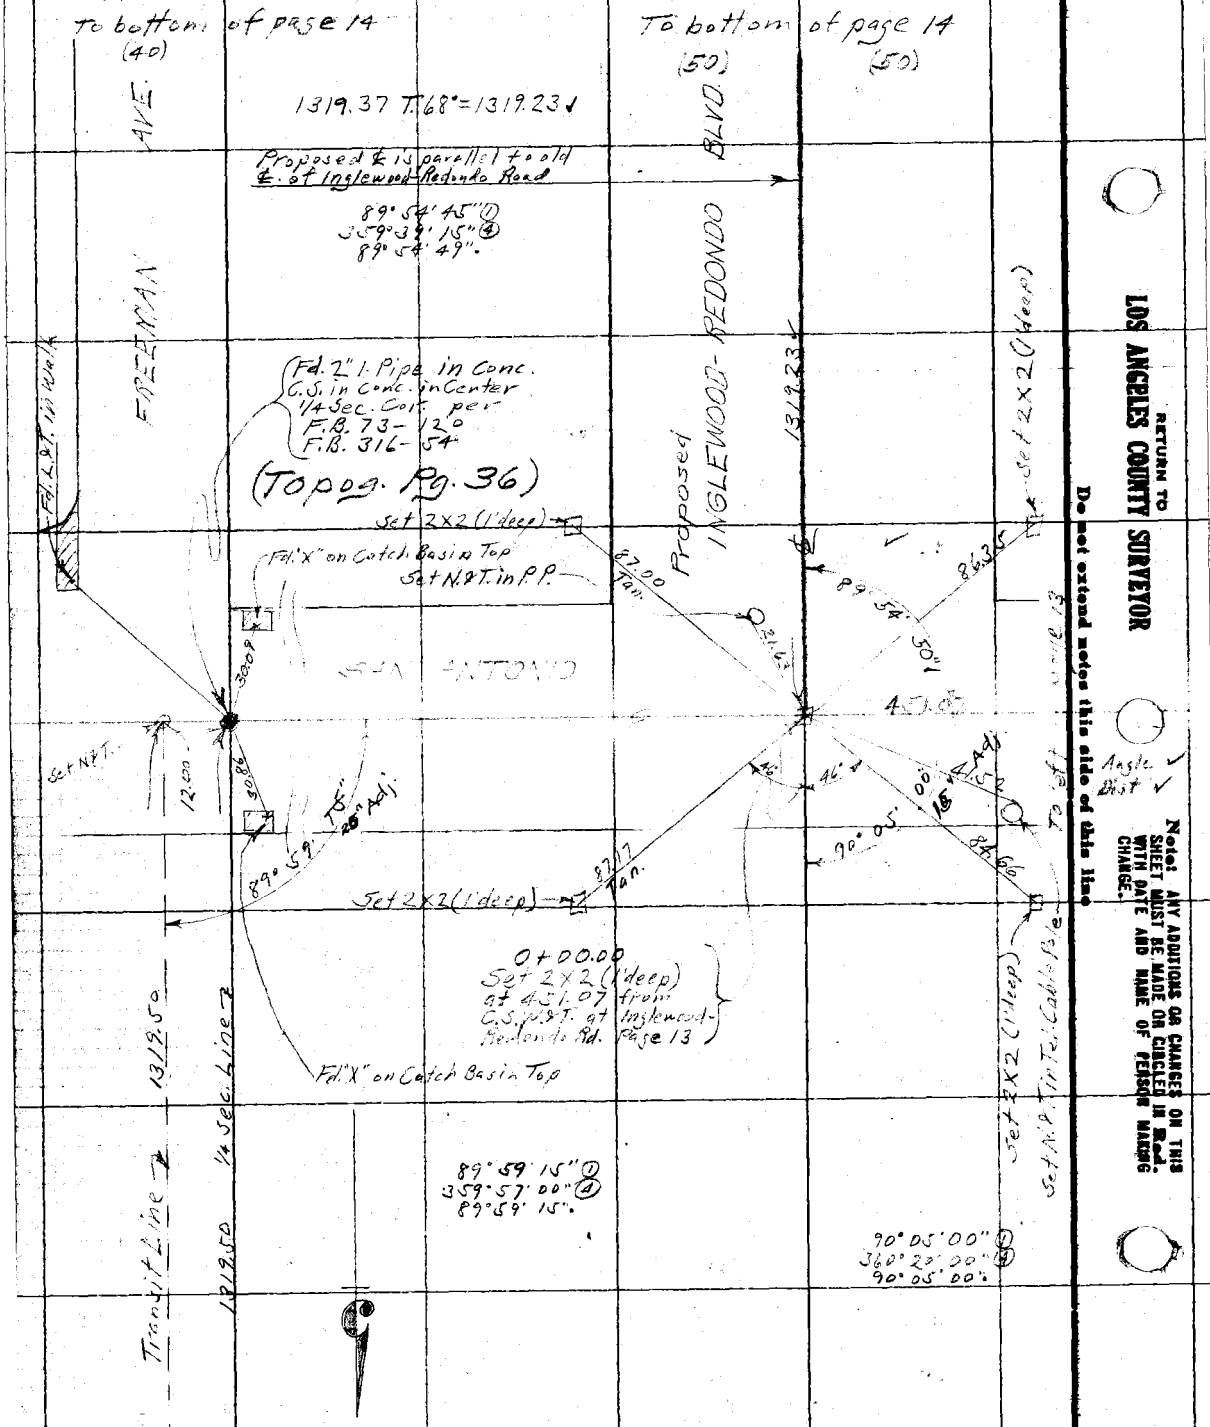

RETURN TO
LOS ANGELES COUNTY SURVEYOR
Do not extend notes this side of this line

Angle
Dist

Note: ANY ADDITIONS OR CHANGES ON THIS SHEET MUST BE MADE OR CIRCLED IN Red. WITH DATE AND NAME OF PERSON MAKING CHANGE.

Date 10-11-29 Notes by A.N.V.F. Chief Party A.N.V.F. Tape F.B. 420 Pg. 13

Plotted by Wood
Date Mar. 1930
Map No. B-455-2
Plotting Ck'd by OAR
Date

W. O. No. 955 ~~W. O. No~~ 029
Location Inglewood-Redondo Blvd
Surveyed by A.N.V.F.
Date 10-11-29
Indexed A. C. Johnson

Div. I

Notes: ANY ADDITIONS OR CHANGES ON THIS SHEET MUST BE MADE OR CIRCLED IN Red: WITH DATE AND NAME OF PERSON MAKING CHANGE.

RETURN TO LOS ANGELES COUNTY SURVEYOR

Do not extend notes this side of this line

To bottom of page 15

451.10 T. 29° = 451.07 ℄

(25) (25) (30) (30)

ROAD. P.Y. Sec. Line

Accepted as Sec. Cor. Fd. 6" Sq. Conc. Mon. with L.T. in Center (18" deep) Checks 2 ft. S per R.B. 73-119 Set 2X2 at surface

179° 59' 45" ①
359° 59' 00" ②
179° 59' 45".

Fd. N. & T. in Tel. Pole
Set N. & T. in Tel. Pole
Set N. & T. in 8" Encal.

ST.

(30) (30)

451.02

From right of page 12

3371 42.00 50.92

54.84 73.90

89° 54' 45" 90° 02' 10" 23.22

70.34 42.11 42.10

Set Punch Mark on Washer 0.05 S. of C.L. by Inter.

Fd. C.S.W. & T. R.B. 73-119

Set N. & T. in 10" Encal.

Fd. N. & T. in Cable Pole

INGLEWOOD-REDONDO

Set N. & T. in Tel. Pole

A. T. & S. F.

1317.66

89° 54' 45" ①
359° 38' 45" ②
89° 54' 41".

90° 02' 00" ①
360° 08' 30" ②
90° 02' 08".

From top of page 11

F. B. 420 Pg. 14 A.W. Van Fleet Chief Party Notes by A.W.V.F Date 10-14-29

To bottom of page 16

To bottom of page 16

Proposed ℄ is parallel to old ℄ of Inglewood-Redondo Rd.

1319.37 T. 68° = 1319.23 ✓

89°56'00" D
359°44'00" ④
89°56'00".

13+19.23 ✓
Set 2X2 (1' deep) by Inter.

(Topog. Pg. 36)

Fd. 2X2 (1' deep) 3X Tics. F.B. 73-120-B

Set 2X2 (1' deep)

Fd. N.&T. in 10" Acacia

Fd. L.&T. in Catch Basin Top

PALM ST.

20.36

20.12

0.24

(30)

(30)

(50)

(50)

BLVD.

1319.23

Set 2X2 (1' deep)

88.84

89°25'00"

86.55

To left of page 15

45° App.

45°

84.55 Tan.

84.44 Tan.

Fd. N&T. in Catch Basin Top

Set 2X2 (1' deep)

AVE.

FREEMAN

½ Sec. Line

(40)

Proposed INGLEWOOD-REDONDO

1319.23

Set 2X2 (1' deep)

Note:- ℄ of proposed Inglewood-Redondo Blvd. from San Antonio St. to 114th St. is laid parallel to ℄ of present Inglewood-Redondo Road and ℄ of A.T. & S.F. Ry.

From top of page 12

From top of page 12

RETURN TO LOS ANGELES COUNTY SURVEYOR

Do not extend notes this side of this line

Note: ANY ADDITIONS OR CHANGES ON THIS SHEET MUST BE MADE OR CIRCLED IN Red WITH DATE AND NAME OF PERSON MAKING CHANGE.

Tie to Angle Point

Date 10-14-29 Notes by A.W.V.F. Chief Party A.W.Vaughn Jr. F.B. 420 Pg. 15

Tape

Platted by Wood
Date Mar. 1930
Map No. B-455-2
Plotting Ck'd by Carr
Date

W. O. No. 955 S.C.O. No. 029
Location Inglewood-Redondo Blvd.
Surveyed by A.W.V.F.
Date 10-14-29
Indexed A. C. Johnson

Div. I

NOTE: ANY ADDITIONS OR CHANGES ON THIS SHEET MUST BE MADE OR CIRCLED IN Red. WITH DATE AND NAME OF PERSON MAKING CHANGE.

RETURN TO LOS ANGELES COUNTY SURVEYOR

Do not extend notes this side of this line

To bottom of page 17

451.14 T.68° = 451.09

(25) (25) (30) (30)

90° 04' 00" ①
360° 16' 00" ④
90° 04' 00"

R.

F.Y.

90° 04' 00"

8.82

42.52

10" Eucal.

0.04

54.88
74.22

Fd 2" I. Pipe in Conc. with C.S. in center F.B. 73-120-8 F.B. 316-53

From right of page 14

Proposed ℄ of Palm St. per C.S. 8812
451.09

Set O.M. in Washer by Inter.

Set N.T. in 10" Eucal.

Fd. N.T. in

53.22

42.29

Fd. C.S. & W. per F.B. 73-120-8 F.B. 316-53

INGLEWOOD-REDONDO

A. T. & S. F.

Sec. Line

From top of page 13

F. B. 420 Pg. 16 A.W.Vail-Fleet Chief Party Notes by A.W.V.F Date 10-15-29

To bottom of page 18

1438.28 T. 66° = 1438.11

To bottom of page 18

(50) (50)

Proposed ℄ is parallel to old ℄ of Inglewood-Redondo Rd.

26+38.46
Set 2×2 (1' deep) by Inter.

(Topog. Pg. 37)

Fd. C.S. in Center of 2" I. Pipe in Conc. F.B. 316-54

Fd. N. & T. in 15" Acacia

Fd. X" in Conc Catch Basin

Set 2×2 (1' deep)

95.34 Tan

34.65

18.34

LENNOX

30

63.35

18.22

Fd. X" in Conc Catch Basin

Fd. N. & T. in 10" Acacia

95.55 Tan

Set 2×2 (1' deep)

1/4 Sec. Line

90° 03' 45" ①
360° 15' 00" ②
90° 03' 45".

Proposed INGLEWOOD - REDONDO

1438.11

1319.23

BLVD.

84.81

431.09

35°-44'-45"

53° Approx.

90° 03'

82.01

To left of 2426.17

Set 2×2 (1' deep)

Set 2×2 (1' deep)

This Angle Dist.

RETURN TO LOS ANGELES COUNTY SURVEYOR

Do not extend notes this side of this line

Note: ANY ADDITIONS OR CHANGES ON THIS SHEET MUST BE MADE OR CIRCLED IN Red. WITH DATE AND NAME OF PERSON MAKING CHANGE.

From top of page 14

From top of page 14

Date 12-15-29 Notes by S.V.V.F. Chief Party A.W. VanFleet F.B. 420 Pg. 17

Tape

Div. I

Plotted by Wood	W. O. No. 955 Sup. No. 029
Date Mar. 1930	Location Inglewood-Redondo Blvd
Map No. B-455-2	Surveyed by A.W. VanFleet
Plotting Ck'd by Clark	Date 10-15-29
Date	Indexed A. C. Johnson

To bottom of page 19

451.15 T 68° = 451.09

(25) (25) (30) (30)

ROAD

Ft. N.E.T. in 10" Eucy.

RY.

Set Nail on Line between 114th St. & San Antonio Ave.

From right of page 16

Fd. 2" I.P. in Conc. (Flush). F.B. 733-119 Sec. Cor. F.B. 316-53

559.4

0.06

24.13

55.00

74.64

Proposed E. of Lennox Ave. per C.S. B-337

451.09

89° 56' 15" 25.14

50.19

Fd. O.S.W. PT. (Flush) per F.B. 316-53

89° 56' 15" ①
359° 45' 00" ④
89° 56' 15".

INGLEWOOD-REDONDO

A. T. & S. F.

Sec. Line

From top of page 15

Notes: ANY ADDITIONS OR CHANGES ON THIS SHEET MUST BE MADE OR CIRCLED IN Red. WITH DATE AND NAME OF PERSON MAKING CHARGE.

Do not extend notes this side of this line

RETURN TO LOS ANGELES COUNTY SURVEYOR

F.B. 420 Pg. 18 A.W. Van Fleet Chief Party Notes by A.W.V.F. Date 10-15-29

To bottom of page 20

To bottom of page 21

(30) (30) AVE. (20) (30) (30) (20)

330.01

AVE

1320.06 to Wallace St. Pg. 26

BLOSSOM

Proposed ℄ of Inglewood-Redondo Blvd.

90°00'00" ①
360°00'00" ④
90°00'00"

(Topog. Pg. 37)

330.04

GREEN

90°00'14" ①
360°01'00" ④
90°00'15"

90°00'00"

90°00'15" adj.

180°

114TH

660.19

54+94.93 E.C.

54+10.79

Δ = 23°36'40"
R = 800
T = 167.21
L = 329.67

{Set P.M. on Pavement by L.&T. ties as shown per F.C. 301-20E}

54+76.43

Set Cit. on pavement 45.27 east of 2X2 on ℄ of Inglewood-Redondo Road produced from North.

660.23 T 74° = 660.19

4) 1320.13 T. 74° = 1320.06
330.03 T. 74° = 330.015 Proportioned

330.07 T. 72° = 330.04

1200.00 T. 66° = 1199.86

90°02'00" ①
360°08'15" ④
90°02'04"

Δ = 23°38'55"
R = 800
T = 167.48
L = 330.20

49+65.26 P.S.C.

1199.86

To left of 90°02'04"

Proposed ℄ is parallel to old ℄ of Inglewood-Redondo Rd.

46+35.06 B.C.

40+76.57
Set 2X2 (1' deep)

1438.11

From top of page 16

RETURN TO LOS ANGELES COUNTY SURVEYOR

Do not extend notes this side of this line

Dist. ✓

Note: ANY ADDITIONS OR CHANGES ON THIS SHEET MUST BE MADE OR CIRCLED IN Red. WITH DATE AND NAME OF PERSON MAKING CHANGE.

Date 10-15-29 Notes by A.W.V.F. Chief Party A.W. Faulkner F.B. 420 Pg. 19

Platted by Wood	W. O. No. 955 S.P.O. No. 029
Date Mar. 1930	Location Inglewood-Redondo Blvd
Map No. B-455-2	Surveyed by
Plotting Ck'd by Chas	Date 10-15-29
Date	Indexed A. C. Johnson

Div. I

To bottom of page 21

431.11 T. 68° = 431.07

24.00

(25) (25) (50) (50)

℄

90° 01' 15" ①
360° 05' 00" ②
90° 01' 15"

Fd. C. Spk. (Hy sp.)
Rd. Dept. F.B. 41-59
F.C. 301-20 E.1
F.B. 73-118-119
See F.C. 301-18

ROAD
330.08

P.Y. Offset Line

Sec. Line

Set 2 x 2 1' deep by Inter. See ties pg 33

90° 01' 15" O.K.

ST.

431.07

20.00

75.50
55.00

(30)

24.00

89° 58' 00" Adj.

INGLEWOOD - REDONDO

S2+ NAT.

A. T. & S. F.

Set G.S. W.R.T. by R.S. Dist. From Intersection of 11th St. and E of Inglewood Redondo Rd. See F.B. 73-119

From right of page 18

(Ties on pg. 33)

89° 58' 00" ①
359° 52' 00" ②
89° 58' 00".

(25) (25) (30) (30)

From top of page 17

Notes: ANY ADDITIONS OR CHANGES ON THIS SHEET MUST BE MADE OR CANCELED IN Red. WITH DATE AND NAME OF PERSON MAKING CHANGE.

Do not extend notes this side of this line

RETURN TO LOS ANGELES COUNTY SURVEYOR

F. B. 420 Pg. 20 A.W. Van Fleet Chief Party Notes by A.W.V.F. Date 10-2-29

To bottom of page 22

(30) (30)

AVE.
330.02

Set 2 x 2 (1' deep)

Set 2 x 2 (15" deep) by proportion between 114th St. and Wallace St.

40.95 Appx.

47.68 Appx.

Set 2 x 2 (1' deep)

(30)

REDONDO

662.17 Calc.

40.08

45° Approx. 45°

47.25

(30)

Set 2 x 2 (1' deep)

Set 2 x 2 (1' deep)

To top of page 21

BLOSSOM
330.01

From top of page 18

RETURN TO
LOS ANGELES COUNTY SURVEYOR

Do not extend notes this side of this line

Note: ANY ADDITIONS OR CHANGES ON THIS SHEET MUST BE MADE OR CIRCLED IN Red. WITH DATE AND NAME OF PERSON MAKING CHANGE.

Date 10-2-29 Notes by A.W.V.F. Chief Party A.W. VanFleet F.B. 420 Pg. 21

Tape

Platted by Wood
Date Mar. 1930
Map No. B-455-2
Platting Ck'd by Oak
Date

W. O. No. 955 ~~S. O. No.~~ 029
Location Inglewood-Redondo Blvd.
Surveyed by A.W. VanFleet
Date 10-2-29
Indexed A. C. Johnson

Div. I

Notes: ANY ADDITIONS OR CHANGES OF THIS SHEET MUST BE MADE OR ENCIRCLED IN Red. WITH DATE AND NAME OF PERSON MAKING CHANGE.

RETURN TO LOS ANGELES COUNTY SURVEYOR

Do not extend notes this side of this line

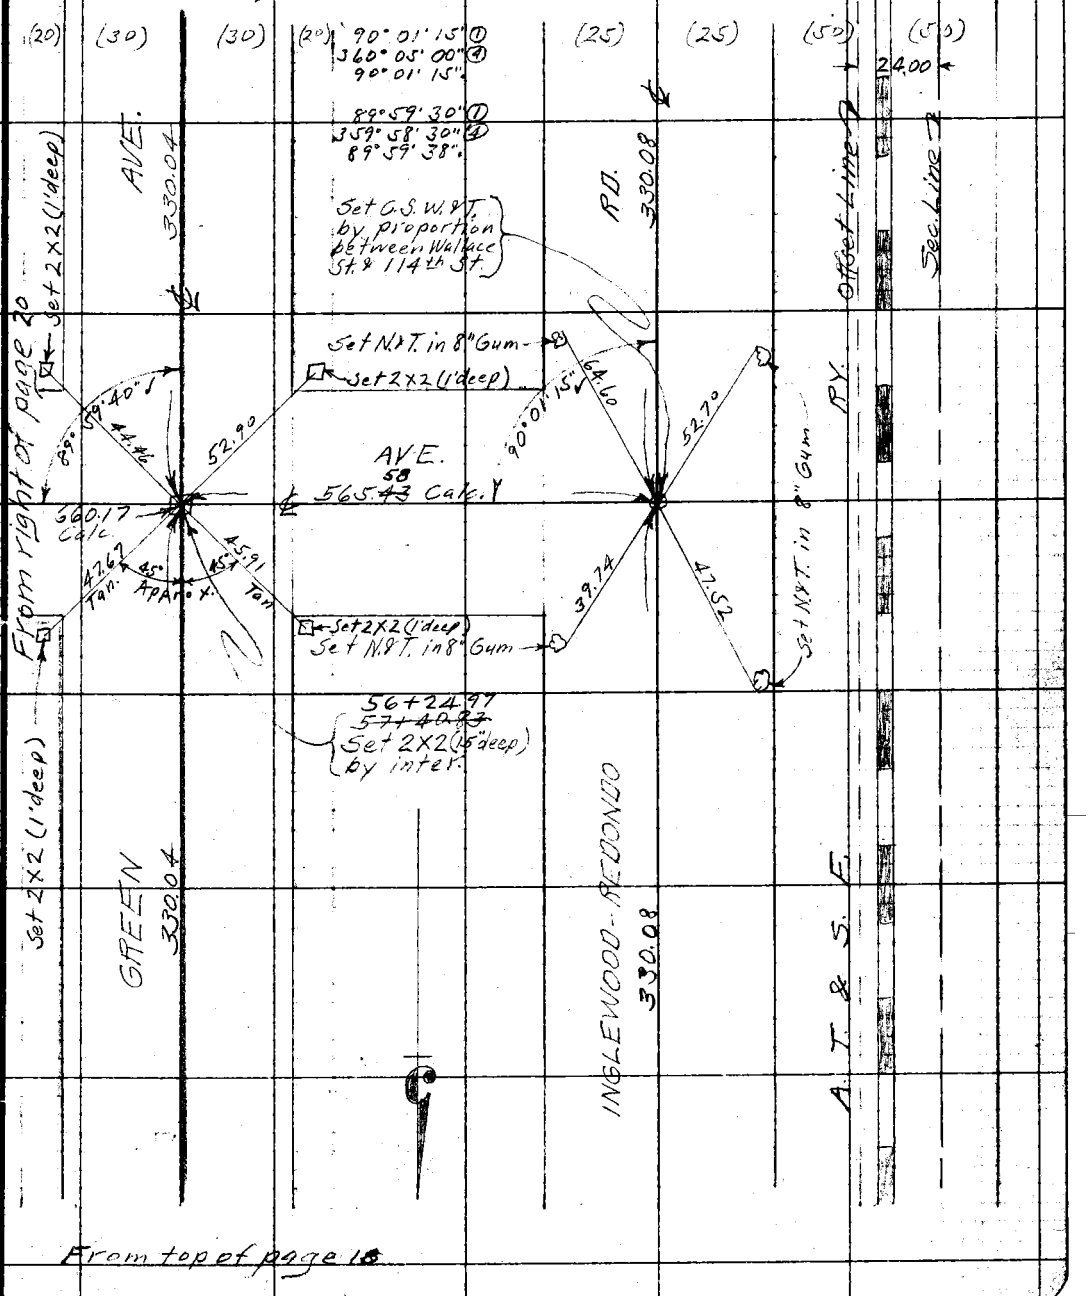

F.B. 420 Pg 22 A.W. Van Fleet Chief Party Notes by A.W.V.F. Date 10-2-29

To bottom of page 24

(30) (30)

AVE. 33001

Set N.P.T. in Cor. of 8'X12' House

Set 2X2 (15" deep) by proportion between 114th St. and Wallace St.

52.00

(30) MIRAMAR

(30)

Set N.P.T. in Cor. of House

To left of page 23

BLOSSOM 33004

From top of page 20

RETURN TO LOS ANGELES COUNTY SURVEYOR
Do not extend notes this side of this line
Note: ANY ADDITIONS OR CHANGES OR THIS SHEET MUST BE MADE OR CIRCLED IN Red. WITH DATE AND NAME OF PERSON MAKING CHANGE.

Date 10-2-29 Notes by A.W.V.F. Chief Party A.W. Von Fleet F.B. 420 Pg. 23

Tape

Div. I

Plotted by Wood	W. O. No. 955 S. S. No. 029
Date Mar. 1930	Location Inglewood-Redondo Blvd.
Map No. B-455-2	Surveyed by A.W. Von Fleet
Plotting C'k'd by AWR	Date 10-2-29
Date	Indexed A. C. Johnson

RETURN TO LOS ANGELES COUNTY SURVEYOR

Note: ANY ADDITIONS OR CHANGES ON THIS SHEET MUST BE MADE OR CIRCLED IN Red, WITH DATE AND NAME OF PERSON MAKING CHANGE.

Do not extend notes this side of this line

To bottom of page 25

To bottom of page 25

(20) (30) (30) (20) (30) (20)

24.00

90° 01' 30" ①
360° 06' 00" ②
90° 01' 30".

90° 00' 00" ①
360° 00' 00" ②
90° 00' 00".

Set N.&T. in 10" Eucal.

Set C.S.W.&T. by proportion between Wallace St. & 114th St.

Set 2X2 (1deep)

Set 2X2 (1deep)

Set N.&T. in 6" Eucal.

Offset Line 2

Sec. Line 2

AVE. 330.06

HD. 330.08

RY.

90° 00' 00"

90° 01' 30"

51.82

A 7.16

565.74 Calc.

660.16 Calc.

50.04 Tan.

53.91 Tan.

35.78

49.09

45.01

From right of page 22

Set 2X2 (1deep)

Set N.&T. in 10" Eucal.

59755.01
~~60179.87~~

Set 2X2 (5deep) by Inter.

Set 2X2 (1deep)

GREEN 330.04

INGLEWOOD-REDONDO 330.08

Set N&T in 8" Eucal.

A. T. & S. F.

From top of page 21

From top of page 21

F.B. 420 PG. 24 A.W. VanFleet Chief Party Notes by A.W.V.F. Date 10-3-29

To bottom of page 26

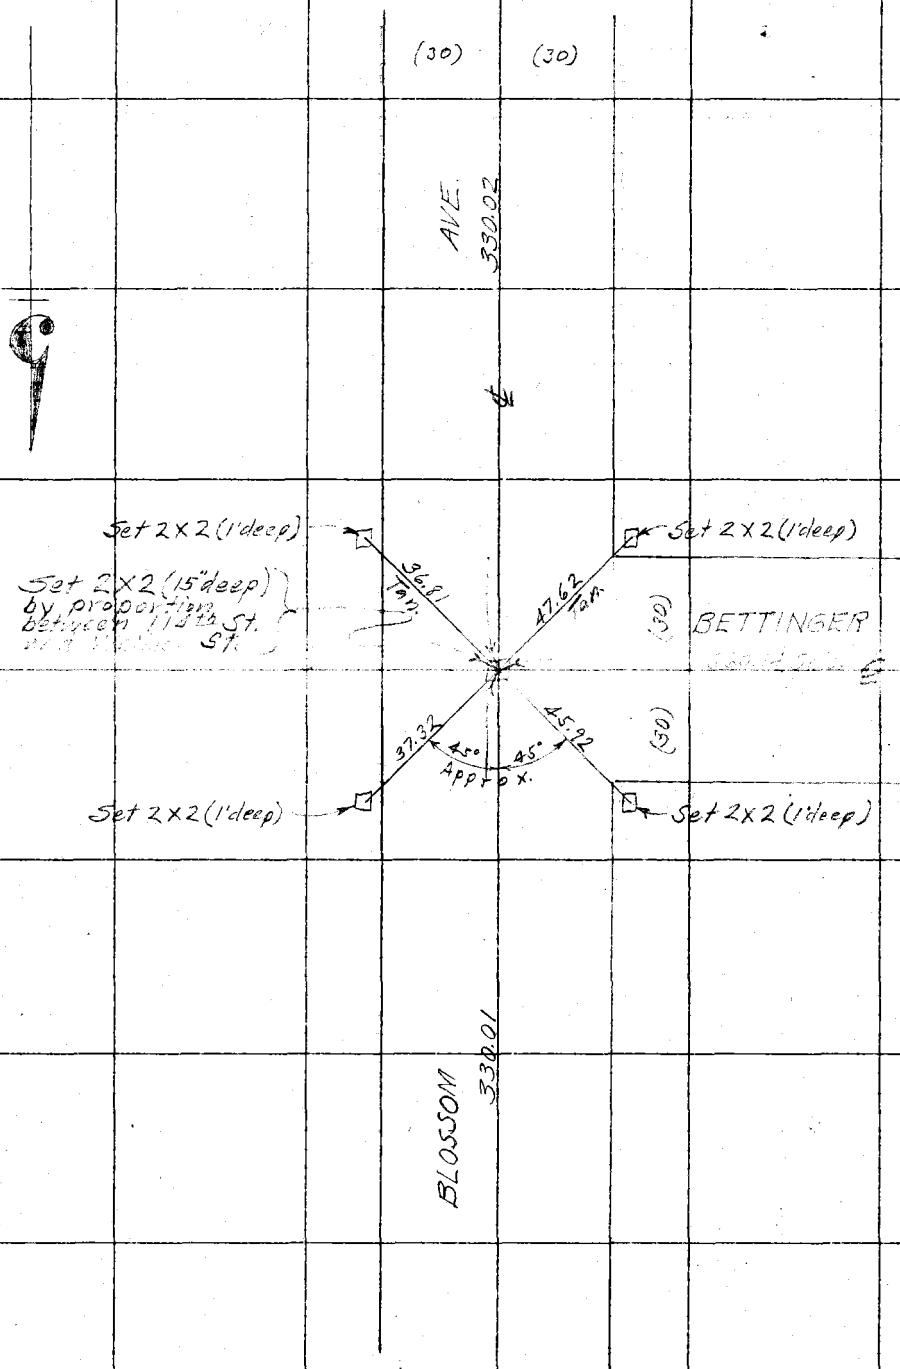

To left of page 25

From top of page 22

RETURN TO LOS ANGELES COUNTY SURVEYOR

Do not extend notes this side of this line

Note! ANY ADDITIONS OR CHANGES ON THIS SHEET MUST BE MADE OR CIRCLED IN Red. WITH DATE AND NAME OF PERSON MAKING CHANGE.

Date 10-3-29 Notes by A.W.V.F. Chief Party A.W. VanFleet F.B. 420 Pg. 25

Platted by Wood	W. O. No. 955 S. B. C. No. 229
Date Mar. 1930	Location Inglewood-Redondo Blvd.
Map No. B-455-2	Surveyed by A.W.V.F.
Platting C'k'd by CAR	Date 10-3-29
Date	Inspected A. C. Johnson

Div. I

Notes: ANY ADDITIONS OR CHANGES ON THIS SHEET MUST BE MADE OR CIRCLED IN Red, WITH DATE AND NAME OF PERSON MAKING CHANGE.

Do not extend notes this side of this line.

RETURN TO LOS ANGELES COUNTY SURVEYOR

To bottom of page 27

To bottom of page 27

From right of page 24

From top of page 23

From top of page 23

90° 01' 30" ①
360° 06' 15" ②
90° 01' 34"

90° 00' 00" ①
360° 00' 00" ②
90° 00' 00"

Set C.S.W.&T. by proportion between Wallace St. & 114th St.

Set N.&T. in 6" Encal.

Set 2X2 (1' deep)

Set N.&T. in 6" Encal.

Set 2X2 (1' deep)

Set N.&T. in 8" Encal.

Set 2X2 (1' deep)

Set 2X2 (1' deep)

Set N.&T. in 8" Encal.

Set 2X2 (1' deep)

Set 2X2 (1' deep)

62+85.67
~~64+00.93~~
Set 2X2 (1' deep) by Inter.

(20) (30) (30) (20) (25) 25 (50) (50)

24.00

AVE. 330.26

90° 00' 00"
Tan. 55.00

51.93 Tan.

AVE. 565.90 Calc.

660.14 Calc.

90° 01' 35"

41.84

29.52

Offset Lines

Sec. Lines

PV.

330.08

47.73

45° Tan. 44.09

45°

41.21

36.61

GREEN 330.26

INGLEWOOD-REDONDO 330.08

A. T. & S. F.

F.B. 420 Pg. 26 A.W. Van Fleet Chief Party Notes by A.W.V.F Date 10-1-29

1226.24 T. 78° = 1226.19 ✓
566.08 T. 78° = 566.06 ✓
660.16 T. 78° = 660.13 ✓

(Topog. Pg. 38)

FA. 2" I. Pipe, R&T. per T: N° 2663 ✓
M.B. 27-24

(30) WALLACE (30)

660.13
N 12 [illegible]

To left of page 27

O.K.

AVE.

20° 00'

90° 00' 45" ①
360° 03' 00" ④
90° 00' 45"

BLOSSOM

330.02
1320.06 from 1143 St. P.B. 14

(30) (30)

From top of page 24

RETURN TO LOS ANGELES COUNTY SURVEYOR

Do not extend notes this side of this line

Note! ANY ADDITIONS OR CHANGES ON THIS SHEET MUST BE MADE IN RED. WITH DATE AND NAME OF PERSON MAKING CHANGE.

Date 10-1-29 Notes by A.W.V.F. Chief Party A.W. Van Fleet F.B. 420 Pg. 27

Tape

Platted by Wood
Date Mar. 1930
Map No. B-455-4
Platting Ck'd by
Date

W. O. No. 955 D. S. O. No. 029
Location Inglewood-Redondo Blvd.
Surveyed by A.W. Van Fleet
Date 10-1-29
Indexed A. C. Johnson

DIVI

RETURN TO LOS ANGELES COUNTY SURVEYOR

Notice: ANY ADDITIONS OR CHANGES OF THIS SHEET MUST BE MADE OR CIRCLED IN Red. WITH DATE AND NAME OF PERSON MAKING CHARGE.

Do not extend notes this side of this Ride

To bottom of page 28

To bottom of page 29

From right of page 26

From top of page 25

(50) (50) (25) (25) (50) (100)

1323.30 T.84 / 1323.30

90°00'00" ①
360°00'30" ④
90°00'08".

Set 2X2 (1' deep)

Fd. 2" I. Pipe P.P.T. per T-No 26631 N.B. 27-24

Set N.P.T. in 8" Gum

Set N.P.T.

Set N.P.T. in 8" Encl.

Set 1X2 by Inters. P.Y.

Set 2X2 (1' deep) 9 ft. Inter. of Sec. Line & Wallace St.

24.00

1323.30

660.13

566.06

1226.19

30.00

25.00

70.81

24.00

42.72

49.95

90°00'00"

90.43

25.28

35.88

89°58'00"

Set N.P.T. in P.P.

Set 2X2 (1' deep)

67+30.99 66+15.13

Set 2X2 (1' deep) by proportion between Blossom Ave. and Inglewood-Redondo Road

Set C.S.W.P.T. by offsets.

Set N.P.T. in 6" Encl.

Set N.P.T. in 8" Encl.

92.22

Sec. Line

Offset Line

A. T. & S. F.

330.06

330.28

GREEN AVE.

INGLEWOOD-REDONDO

90°00'15" ①
360°01'15" ④
90°00'19".

89°58'00" ①
359°52'00" ④
89°58'00".

(20) (30) (30) (20)

(50) (100)

24.00

F.B. 420 Pg 28 A.W. Van Fleet Chief Party Notes by A.W.V.F. Date 10-22-29

To bottom of page 30

89+56.52
Set 2×2 (1' deep)
in North Bank
of Irrig Ditch
(Topog. Pg. 39)

1741.39

Irrig. Ditch

1982.52 T. 70° = 1982.34 ✓
902.24 T. 82° = 902.23 ✓
1741.44 T. 80° = 1741.39 ✓

LOT 47

Set 2×2 (1' deep)

85.97

202.33

Set 2×2 (1' deep)

85.00

Fd. 2" I. Pipe
P.S.T. (1950)
Center of Sec. 8
See pg. 32

Set N.&T. in
24" Encl.
(Topog. Pg. 38)

180° 00' 45"

660.78
20.04 Ch.

To left of curve 29

2639

12.00 2.00

Set N.&T.

Set N.&T.

12.00

S. 1/4 Cor. Sec. 8
T. 1 S., R. 13 W.
Fd. 2" I. Pipe
P.S.T. (1950)

79° 26' 43"

66.23

86.04
79° 11'

Fd. F.C.S. W.&T.
F.C. 371-63 ✓
See pg. 32

Set 2×2 (1' deep)
~~79+38.43~~
~~80+54.29~~
Set 2×2 (1' deep)
by proportion
between Center
of Sec. & W. 1/4 Cor.

85.73
79° 11'

90° 01' 00"

Highwood Ave.

90° 01' 00" ①
360° 04' 00" ④
90° 01' 00"

180° 00' 45" ①
360° 03' 00" ④
180° 00' 45"

1323.90

Set 2×2 (1' deep)
Set N.&T. in 15" Pepper

1/4 Sec. Line

From top of page 27

RETURN TO
LOS ANGELES COUNTY SURVEYOR
Do not extend notes this side of this line

Note! ANY ADDITIONS OR CHANGES ON THIS SHEET MUST BE MADE OR CIRCLED IN Red. WITH DATE AND NAME OF PERSON MAKING CHANGE.

Date 10-22-29 Notes by A.W.V.F. Chief Party A.W. Van Fleet F.B. 420 Pg. 29

T 9 S

Platted by	Wood
Date	Mar. 1930
Map No.	B-455-2
Plotting Ck'd by	
Date	

W. O. No. 955 Sheet No. 029
Location Inglewood-Redondo Blvd
Surveyed by A.W. Van Fleet
Date 10-22-29
Inspected C. C. Johnson

Div. I

To bottom of page 31

660.84 T. 70° = 660.78 ↑

(25) (25) (50) (50)

ROAD

179°59'45" ①
359°59'00" ②
179°59'45"

Sec. Line

Set N.&T. in Wisburn Sign Post

LOT 48

Fd. C.S. W.&T. per Rd. Dept. F.B. 41-57

Fd. 2x2 (Ident.) Accepted as 1/4 Cor. Sec. 8

Set N.&T. in 10" Eucal.

Fd. 4" Cone, filled I.P. Rd. Dept. F.B. 41-57

1/4 Sec. Line 660.78

.05 25.02 25.19 113.45 12.00

38.53 53.30 82.45

Set N.&T. in P.P.

Set 1x2

89°59'15" ①
359°57'00" ②
89°59'15"

INGLEWOOD — REDONDO

Set N.&T. in P.P.

Set N.&T. in P.P.

(25) (25) (50) (100)

24.00

From top of page 27

From right of page 28

Notes ANY ADDITIONS OR CHANGES ON THIS SHEET MUST BE MADE OR CIRCLED IN Red. WITH DATE AND NAME OF PERSON MAKING CHANGE.

Do not extend notes this side of this line

RETURN TO LOS ANGELES COUNTY SURVEYOR

F.B. 420 Pg. 30 A.W. Van Fleet Chief Party Notes by A.W.V.F Date 10-23-29

S.W. Tie 98.04 @ 2°16' = 97.94
N.W. " 70.52 @ 3°12' = 70.41

89°59' 45" (1)
359°59' 00" (4)
89°59' 45".

1983.48 T. 78° = 1983.~~39~~ 40

(Topog. Pg. 39)

105+82.05
~~106+27.91~~
Set C.S.W.F.T. by prop. between S.W. Cor. & S. 1/4 Cor. of Sec. 8 - Replaced with 2×2 (1' deep)

Fd. N & T. in P.P.

Fd. C.S.W. & T. in 20" Eucal.

Fd. Wire Sets (3" deep) Set by Boyer F.B. 422-5 S. 1/4 Cor. Sec. 8 Set 2×2 (1' deep)

54.25

(25)

50.00

BALLONA

78.00 Tan.

End of Div. I

Set 2×2 (1' deep) 14.5' Set N & T. in Eucal.

97.94

12.41

99.44 Tan.

89°58' 50" B.L.D.

To Int. of Blvd. & 3rd

(25)

To C.S.W. & T. Inglewood Ave. See Pg. 32

223.1

70.50

Set N & T. in Tel. Pole

Set 2×2 (1' deep)

Fd. N & T. in F.P.

Fd. 1" I. Pipe in Conc. (3" deep)

40

89°59' 45"

89°58' 45" (1)
359°55' 15" (2)
89°58' 49".

¼ Sec. Line

Proposed INGLEWOOD-REDONDO

LT. 139

Set 2×2 (1' deep) Set N & T. in 8" Pepper

(50) (50)

From top of page 28

RETURN TO LOS ANGELES COUNTY SURVEYOR

Do not extend notes this side of this line

Note: ANY ADDITIONS OR CHANGES OR THIS SHEET MUST BE MADE OR CIRCLED IN Red WITH DATE AND NAME OF PERSON MAKING CHANGE.

Date 10-23-29 Notes by A.W.V.F. Chief Party A.W.Van Fleet F.B. 420 Pg. 31

Tape

Div. I

Platted by Wood	W. O. No. 455 Sup. W. O. No. 029
Date Mar. 1930	Location Inglewood-Redondo Blvd.
Map No. B-455-2	Surveyed by A.W.Van Fleet
Platting Ck'd by Clark.	Date 10-23-29
Date	Indexed

Notes: ANY ADDITIONS OR CHANGES ON THIS SHEET MUST BE MADE OR CINGLED IN Red. WITH DATE AND NAME OF PERSON MAKING CHANGE.

Do not extend notes this side of this line

RETURN TO LOS ANGELES COUNTY SURVEYOR

661.16 T. 78' = 661.13

Fd. C.S.W.&T. set by Boyer on Div 2 of this project. S.W. Cor. Sec. 8 F.B. 422-4

Set P.K. on Tin

From right of page 30

AVE.

661.13

(25)

(25)

(25)

(25)

(50)

(50)

24.00

RY.

44.07

44.60

89° 58' 15"

10

89° 58' 15" ①
359° 53' 00" ④
89° 58' 15" =

INGLEWOOD-REDONDO ROAD

A. T. & S. F. Ry. Co. Main Track

Fd. N.&T. in Tel. Pole

Fd. N.&T. in P.P.

Fd. N.&T. in P.P.

Sec. Line

From top of page 29

F.B. 420 PG. 32 A.W. Van Fleet Chief Party Notes by A.W.V.F. Date 10-24-29

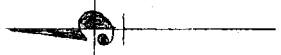

Fd. C.S.W. F.C. 371-63 W

Fd. C.S. & W. F.C. 371-64 S

Inglewood Ave.

Ave.

1146

Set Nail by Tie's F.C. 301-305

Fd. 2" I. Pipe, P & T. (flush) at Center of Sec. 8 by Inter.

89°58'45" 90°01'15"

89°55'45" ① 359°55'00" ④ 89°58'45".

90°01'15" ① 360°05'00" ④ 90°01'15".

(T.S. Mon. 50' (3" Iron Pipe) F.B. 420-30

Ave

W. Line of Sec. 8

Fd. 2x2 (Wood) F.B. 420-29

RETURN TO LOS ANGELES COUNTY SURVEYOR

Do not extend notes this side of this line

Note: ANY ADDITIONS OR CHANGES ON THIS SHEET MUST BE MADE OR CIRCLED IN Red. WITH DATE AND NAME OF PERSON MAKING CHANGE.

Date 12-29-29 Notes by A.W.V.T. Chief Party A.W. Von Fleet F.B. 420 Pg. 33

Platted by Wood
Date Mar. 1930
Map No. B-455-2
Platting Ck'd by Rar.
Date

W. O. No. 955 ~~S. C. O.~~ No. 029
Location Inglewood-Redondo Blvd
Surveyed by A.W. Von Fleet
Date 10-24-29
Indexed

Div. I

(Ties to intersections of 114th St. & Inglewood Redondo Rd.

(See page 19)

Fd. N. & T. in P.P.

Fd. N. in Conc. filled 4" I.P.

ROAD

Fd. N. in Conc. filled 4" I.P.

Fd. N. & T. in Guy Pole

54.26
39.24
75.38
56.27

39.18
35.75
30.48
23.38

114TH ST.

Fd. C. Spk. See Pg. 19

Set 2x2 1" deep by Inter. See Pg. 19

39.23
53.03

39.14
54.16

Fd. N. in Conc. filled 4" I.P.

Fd. N. in Conc. filled 4" I.P.

64.99
76.55

Fd. N. & T. in Tel. Pole

INGLEWOOD-REDONDO

Notes: ANY ADDITIONS OR CHANGES ON THIS SHEET MUST BE MADE OR CIRCLED IN Red. WITH DATE AND NAME OF PERSON MAKING CHANGE.

Do not extend notes this side of this line

RETURN TO LOS ANGELES COUNTY SURVEYOR

F.B. 420 Pg. 34 Chief Party Notes by Date

RETURN TO
LOS ANGELES COUNTY SURVEYOR

Do not extend notes this side of this line

Note: ANY ADDITIONS OR CHANGES ON THIS SHEET MUST BE MADE OR CIRCLED IN Red. WITH DATE AND NAME OF PERSON MAKING CHANGE.

Date _____ Notes by A.W.V.F. Chief Party A.W. Van Fleet F.B. 420 Pg. 35

Platted by Wood	W. O. No. 955 D. S. O. No.
Date Mar. 1930	Location Inglewood-Redondo Blvd.
Map No. B-455-2	Surveyed by A. W. Van Fleet
Platting C'k'd by A.A.R.	Date
Date	Indexed A. C. Johnson

Notes: ANY ADDITIONS OR CHANGES ON THIS SHEET MUST BE MADE OR CIRCLED IN Red. WITH DATE AND NAME OF PERSON MAKING CHANGE.

Do not extend notes this side of this line

RETURN TO LOS ANGELES COUNTY SURVEYOR

TOPOGRAPHY

INGLEWOOD-REDONDO BLVD.

DIV. I

Party
Van Fleet
Gregory
Knudsen
Nathan

Oct. 25, 1929

F.B. 420 Pg. 36 A.W. Van Fleet Chief Party Notes by A.W.V.F Date 10-25-29

To bottom of page 37

Cultivated Land (Grain)

13+45 {4" Gas Pipe Line on top of ground

Proposed ℄ PALM Unimproved Traveled Road AVE.

13+19.23
Fd. 2 X 2 (1' deep)
F.B. 420-14

Cultivated Land (Grain)

Proposed ℄ of INGLEWOOD BLVD.

24'

29'

42'

0+35 Sign Board

0+16.5 {Power Pole & 6Hx Wire

23.5 14.5

Oil & Screenings

SAN ANTONIO ST.

18'

33'

Tel. Cable Pole 0-18

0+00.00
Fd. 2 X 2 (1' deep)
F.B. 420-12

RETURN TO LOS ANGELES COUNTY SURVEYOR

Do not extend notes this side of this line

Notes: ANY ADDITIONS OR CHANGES ON THIS SHEET MUST BE MADE OR CIRCLED IN Red. WITH DATE AND NAME OF PERSON MAKING CHANGE.

Date 10-25-29 Notes by A.W.V.F. Chief Party A.W.Vaughn Fleet F.B. 420 Pg. 37

Platted by Wood	W. O. No. 955 D. S. O. No.
Date Mar. 1930	Location Inglewood-Redondo Blvd.
Map No. B-455-2	Surveyed by A.W.Vaughn Fleet
Platting C'k'd by CAR.	Date 10-25-29
Date	Indexed

To bottom of page 38

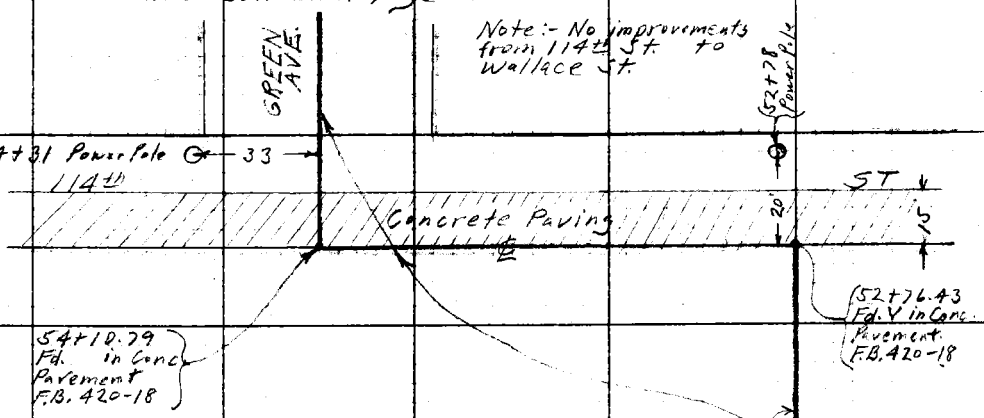

Cultivated Land - (Grain)

PROPOSED & INGLEWOOD & REDONDO BLVD.

(E Pg. 16)

Proposed & LENNOX AVE.

From top of page 36


Do not extend notes this side of this line

RETURN TO LOS ANGELES COUNTY SURVEYOR

F.B. 420 Pg. 38 A.W. VanFleet Chief Party Notes by A.W.V.F. Date 10-25-29

To bottom of page 39

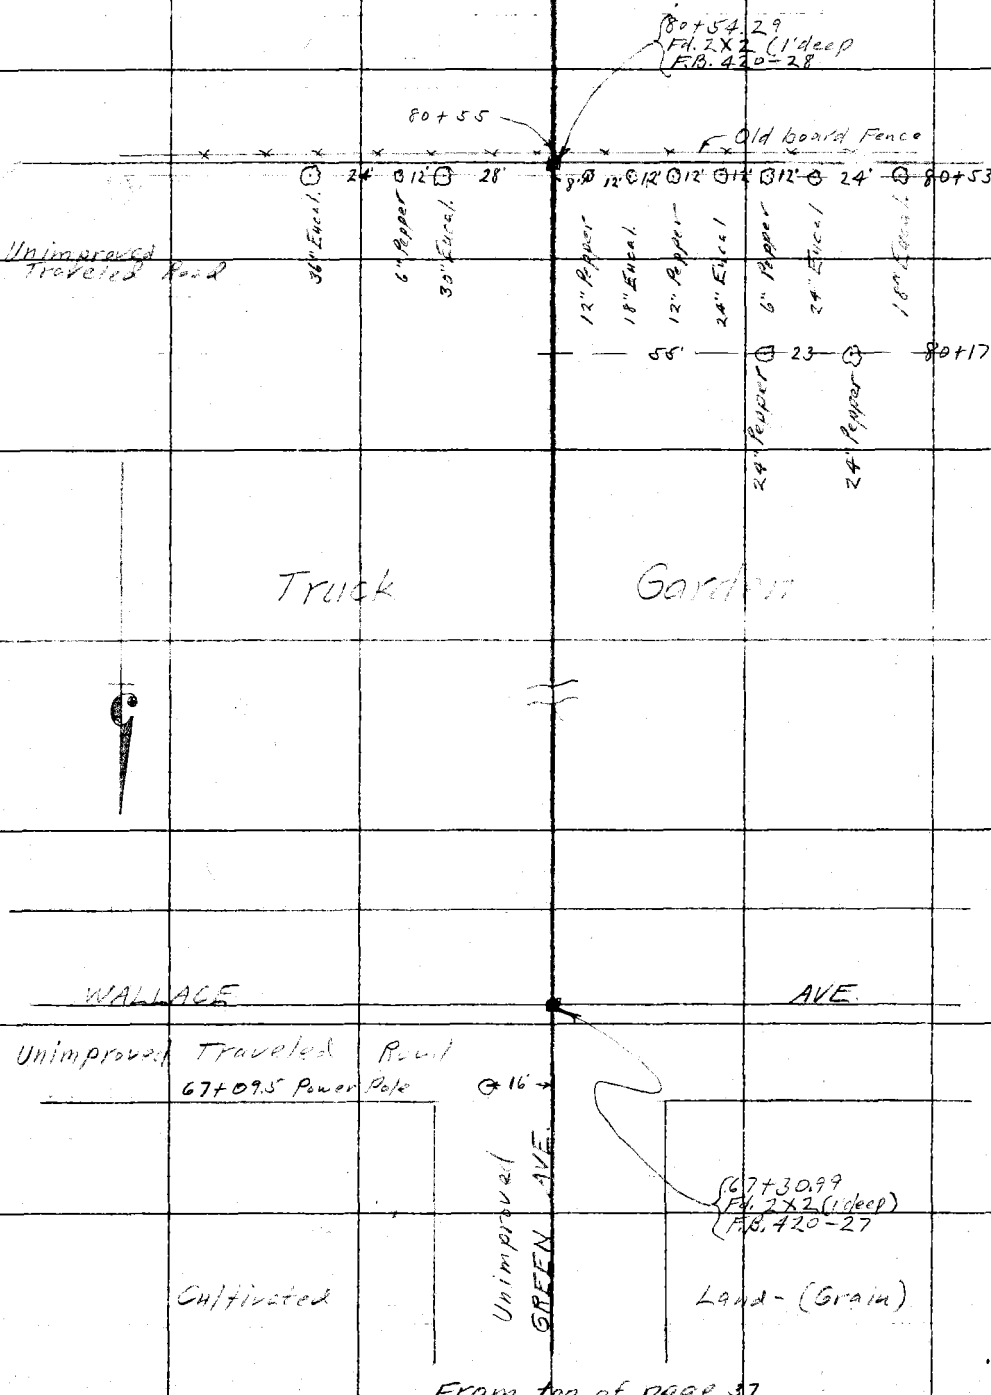

From top of page 37

RETURN TO
LOS ANGELES COUNTY SURVEYOR
Do not extend notes this side of this line

Notice: ANY ADDITIONS OR CHANGES ON THIS SHEET MUST BE MADE OR CIRCLED IN Red. WITH DATE AND NAME OF PERSON MAKING CHANGE.

Date 10-25-29 Notes by A.W. VanFleet Chief Party A.W. VanFleet F.B. 420 Pg. 39

Platted by Wood
Date Mar. 1930
Map No. B-455-2
Platting C'k'd by
Date

W. O. No. 955 D. S. O. No.
Location Inglewood-Redondo Blvd.
Surveyed by A.W. VanFleet
Date 10-25-29
Indexed A. C. Johnson

Div. I

106+97.9
Fd. 2 x 2 (1 deep)
F.B. 420-30

Oil & Screenings

BALLONA AVE.

106+74 Tel. Pole — 80.5 — 106+73 Old Fence Line - Posts only

71' — 45' — 15 — 16 — 16

8" Pepper — 3" Pepper — 8' — 106+74 — 106+66

Ploughed Ground

68.5

Old Frame Stable and Hay Barn

1" Hydrant

105+29 — 105+13

78' Corral — 16' — Frame Garage

104+91

90' — 78' — 24' — 1 Story Frame Shop

104+85 — Wooden Fence

89+51 — 4' Irrig. Ditch

From top of page 38


Do not extend notes this side of this line

RETURN TO LOS ANGELES COUNTY SURVEYOR

RETURN TO
LOS ANGELES COUNTY SURVEYOR

Note: ANY ADDITIONS OR CHANGES ON THIS SHEET MUST BE MADE OR CIRCLED IN Red. WITH DATE AND NAME OF PERSON MAKING CHANGE.

Do not extend notes this side of this line

F.B. 420 Pg. 40

Chief Party

Notes by

Date

Survey by D.M. Finley — Survey of Centinela Creek — F.B. 420 Pg.
Map No. B-102-2-1505 — W.O. 72.1 Tract No. 851 Sht 2 of
Date March 1937 — Indexed A. C. Johnson

L. SURVEY OF PROP'D. CENTINELA CREEK.

from

JEFFERSON BLVD.

to

[redacted] AVE.

Tan Pc = 0.57 normal to
PC-VVT. IND.

Pc Line & other lines

Stanford

Ashworth

Colgate

Yale Pl.

Yale Ave.

Rafael Ave.

Boyd

Grant

INDEX SHEET
CENTINELA CREEK

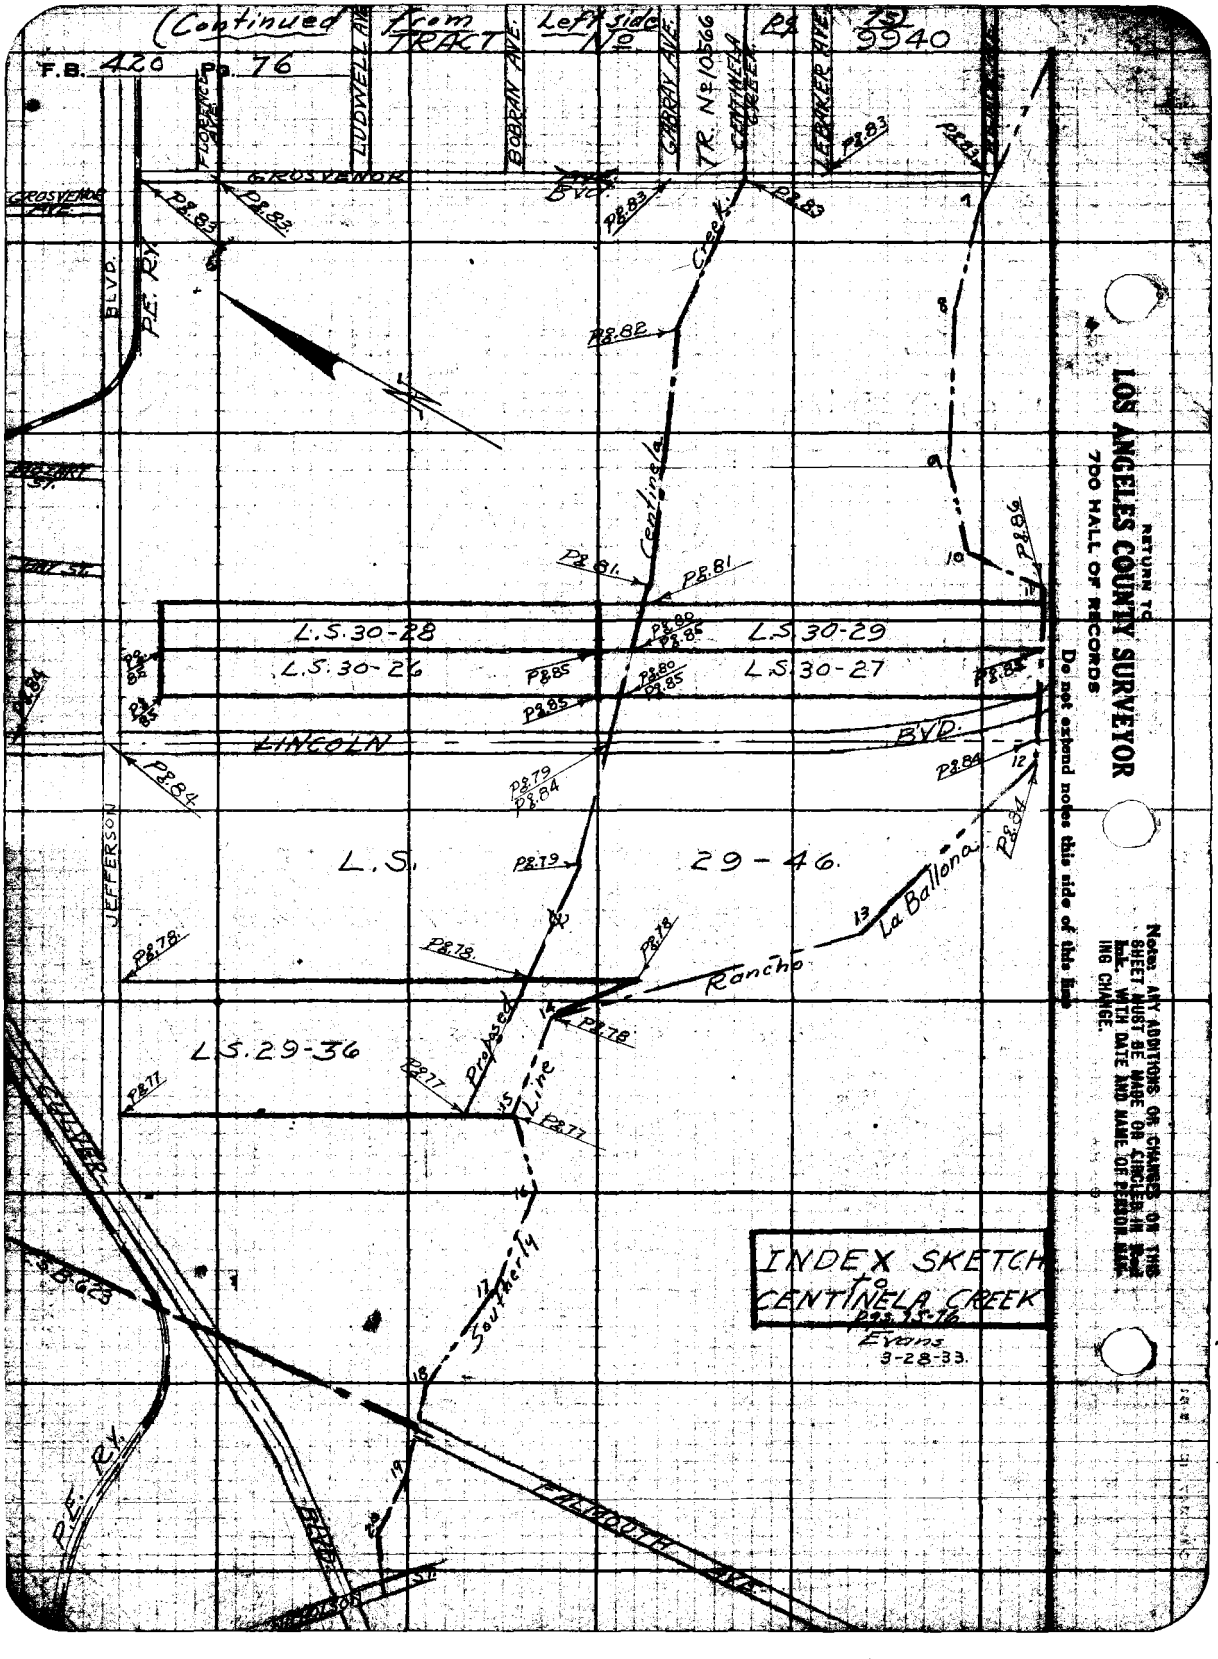
(Continued from TRACT Left side No
TR. No 10566
RS 9940
F.B. 420 PG. 76
FLORENCE AVE.
LUDWELL AVE.
EDGAR AVE.
GARRAY AVE.
CONTINENTAL CRESCENT
LEARKER AVE.
GROSVENOR BVD.
CRESTVIEW AVE.
BLVD.
P.E. RY.
Creek
Centinela
L.S. 30-28
L.S. 30-29
L.S. 30-26
L.S. 30-27
LINCOLN BVD.
JEFFERSON
L.S. 29-46.
La Ballona
Rancho
L.S. 29-36
Proposed Line
Southerly
P.E. RY.
P&8.82
P&8.83
P&8.81
P&8.80
P&8.85
P&8.84
P&8.79
P&8.78
P&8.77
P&8.86
P&8.87
INDEX SKETCH
to
CENTINELA CREEK
Pgs. 75-76
Evans
3-28-33.
RETURN TO
LOS ANGELES COUNTY SURVEYOR
700 HALL OF RECORDS
Do not extend notes this side of this line
NOTE: ANY ADDITIONS OR CHANGES OR THIS SHEET MUST BE MADE ON CIRCLED #
BOOK WITH DATE AND NAME OF PERSON MAK-
ING CHANGE.

Notes Ck'd by D. M. Finley | Survey of Centinella Creek. | F.B. 420 #1 Pg. 77
Map No. B-104-2-B.502 | W. O. 767 | Tape No. 051 | St'd 14 of.
Office Work R. M. McAllister | Surveyed by [illegible]
Field Work D. M. Finley | [illegible]
Date Mar. 1933 | Indexed A. C. Johnson

L.B. 45-18.8 conc. [illegible]

CENTINELLA (40)

P.I. Sta 12+77.12 (Meas.) compass & mon. in center

Rel. 1 1/2" "P" 2' per L.B. 371-16, 8" below surface of water. Replaced with 1 1/2" 6" above ground.

906.45 Tot. 906.5 (Meas.) 617.06

40' Half

55'

Curve Data

Rel. 2 1/2" P.I. (Meas.) L.S. 24-54

Tangent Line Sta 13+23.50 Back Line Ahd L.B. 371-56

Note. (For "P" Line 5' West See L.B. 371-101.

I. S. 29-36.

(50) JEFFERSON BLVD.

Rel. 1 1/2" conc. in permit for L.B. 371-56 See Ref. Dept. for [illegible]

LOS ANGELES COUNTY SURVEYOR
720 HALL OF RECORDS

F.B. 420 Pg. 78

(161-02-30
284°-09-45
161-02-26 ¼

Fd 2" I.P. P&T. flush, per L.S. 29-36 & L.S. 29-46

Fd 2" I.P. P&T. flush L.S. 29-36

35.63

35.20

(161°-02'-25")
(161°-08'-30" Rad.)

35.10

906.52'

617.95' At 62° = 617.86'

70°-03'-40"

113+42.20 POT Set 2XC-flush by intersection

113+42.20

(70°-03-45
280°-14-45
70°-03-41¼

L.S. 29-46.

L.S. 29-36.

Fd 2" I.P. P&T. flush per L.S. 29-36

CENTINELLA

CREEK.

JEFFERSON

BLV'D.

RETURN TO
LOS ANGELES COUNTY SURVEYOR
700 HALL OF RECORDS

Do not extend notes this side of this line

NOTE: ANY ADDITIONS OR CHANGES ON THIS SHEET MUST BE MADE OR CIRCLED IN Red Ink. WITH DATE AND NAME OF PERSON MAKING CHANGE.

Notes Ck'd by D. M. Finley | Survey of Centinella Creek. | F.B. 420 Pg. 7
Map No. B-104-2 B-565. | W. O. 769 | Tape No. 051 St'd 8' of.
Office Work R. W. McAllister | Surveyed by E. Evans
Field Work D.M. Finley | Date 2-14-33
Date Mar. 1933. | Indexed A. C. Johnson

(To C.L. pg. 80)

(40) P.T. (40)

CENTINELA CREEK.

104+50.18 Cut spk. in lead pg. 84

see pg. 84

Lincoln Blvd. & Roosevelt Hwy.

N45°-53'-E 1268.7

Δ = 62°-13'-54"

109+86.97 P.C.

R = 1200.00

Δ = 14°-07'-25"

T. = 148.83

L. = 295.77

S 76°-46'-E 1211.84

S 76°-46'-E 906.52

PI Sta. 1+22.3 P"20 per L.B. 371-S. Replaced with 2" I.P. flush, conc. & cpr. nail center.

(165+48 / 303=18) 165+48

111+70.80 E.C. (40)

(40) P.T.

From Left side pg. 76.



RETURN TO LOS ANGELES COUNTY SURVEYOR 700 HALL OF RECORDS

Form 2247 3-31

RETURN TO
LOS ANGELES COUNTY SURVEYOR
700 HALL OF RECORDS

Note: ANY ADDITIONS OR CHANGES ON THIS SHEET MUST BE MADE OR CIRCLED IN Red Ink. WITH DATE AND NAME OF PERSON MAKING CHANGE.

Do not extend notes this side of this line

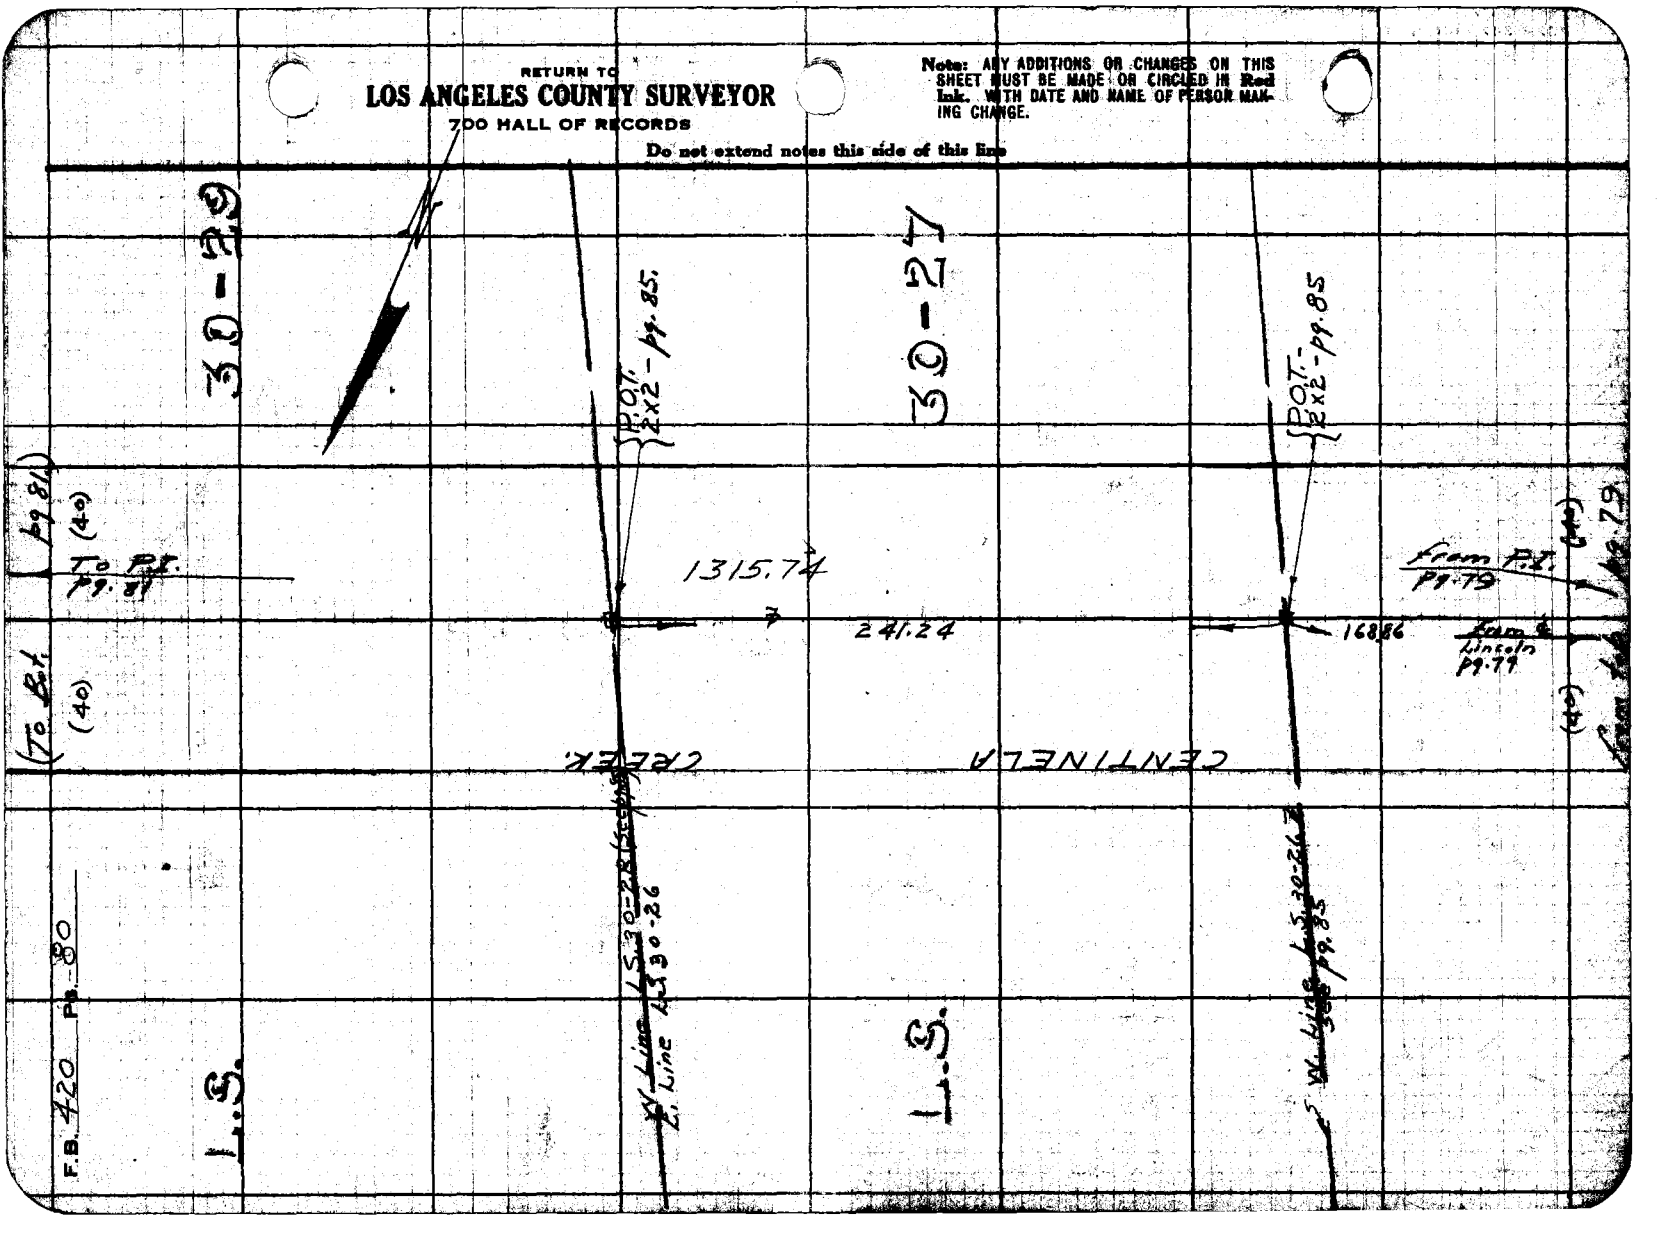

F.B. 420 Pg. 80

Notes Ck'd by D. M. Finley | Survey of Centinela Creek | F.B. 420 Pg. 84
Map No. B-104-2 B-303 | W. O. 769 | Tape No. 051 | St'd 2nd of F.
Comp. from R. H. McAllister | Surveyed by [illegible]
Checked D.M. Finley | [illegible]
Date Mar 1933 | Indexed A. C. Johnson

(To Bar. P.82)

(167°-07'-45"
308°-30'-30"
167°-07'-37½")

P.O.T. Set 2x2, flush top of dike

4123.16 P.O.T. 21+77.49

CENTINELA CREEK

96+78.09 B.C.

P.I. Set 4"x4" R/W Stub Chr. mon'd ⊙

Δ 12°52'20"
R 540.00
T 60.92
L 121.32

167°-07'-40"

Notice: ANY ADDITIONS OR CHANGES OF THIS SHEET MUST BE MADE ON CIRCLE & BE INITIALED WITH DATE AND NAME OF PERSON MAKING CHANGE.

Do not extend notes this side of this line

RETURN TO LOS ANGELES COUNTY SURVEYOR 700 HALL OF RECORDS

87+80.41 P.T.

See P.9.86 East Line L.S. 30-29

L. S. 30-29.

P.19 is 5' out

(40) (40)

P.89

FORM 247 (DM 2-31)

RETURN TO
LOS ANGELES COUNTY SURVEYOR
700 HALL OF RECORDS

Note: ANY ADDITIONS OR CHANGES ON THIS SHEET MUST BE MADE OR CIRCLED IN **Red Ink.** WITH DATE AND NAME OF PERSON MAKING CHANGE.

Do not extend notes this side of this line

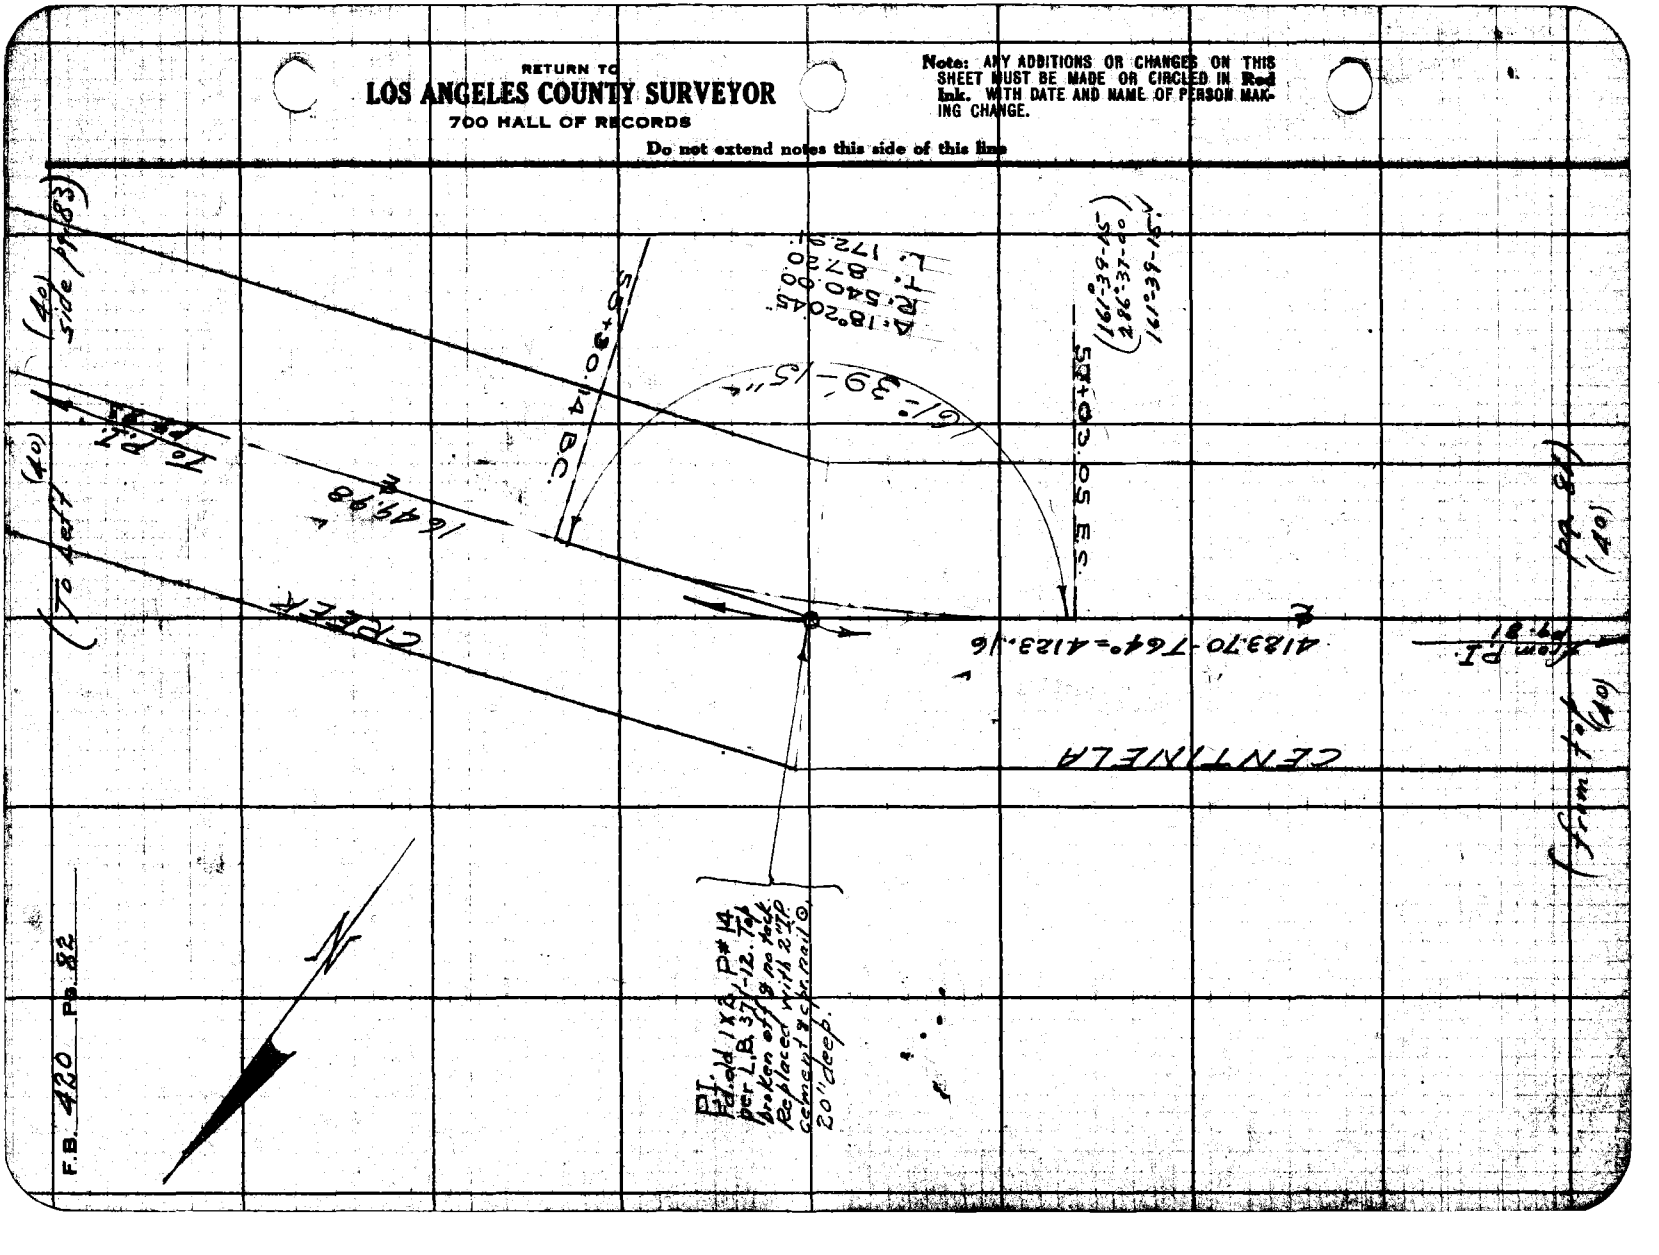

Notes Ck'd by D. M. Finley
Map No. B-104-25 963
Date Mar. 1933

Survey of Centinela Creek
W. O. 762 Tape No. 057 St'd 82 °F.
Indexed A. C. Johnson

F.B. 420 Pg. 83

JEFFERSON BLVD.

P.E. R.R.

Fd. 3/4" I. in R.R. tie per F.B. 336-60

(30)

FLORENCE AVE.

Fd. conc. mon. S.V.T. D, 18" dn. Rd. Dept. F.A. 168-38

GROSVENOR

LUDWELL AVE.

(97)

BOBRAN AVE.

(98)

50' adj. 11"

53'-55"

15' Adj'd

BVD.

GABRAY AVE.

(99)

90°-01'-33"

10°-06'-10"
540'
96.12

162.82

Fd. 2x2-12" dn. per F.B. 396-2

Fd. 2x2-12" dn. per F.B. 396-2

(40)

N 78°-51'-00" E 1660.17 T.B.M.

Proposed CENTINELA CREEK

CENTINELA CREEK

784.80 To Centerline

(169°-52-00)
319°-35-30
169°-53-62½

(90°-01-30)
360°-06-15
90°-01-33¾

(78°-52-15)
258°-22-15
78°-52-18¾

P.I. Set 2" I.P. cap & dot, mon. cent. 10' Lft. by rad. also from Engrs. Acc. to 10566

Fd. 3/4" I. 18" L. per F.B. 396-62

(30)

BLOCK AVE.

(99)

LOS ANGELES COUNTY SURVEYOR
700 HALL OF RECORDS
RETURN TO

Notice: Any alterations or changes of this map, with the use and name of person making change.

Do not extend notes past this line

FORM 247 M-W-1-31

F.B. 420 Pg. 84

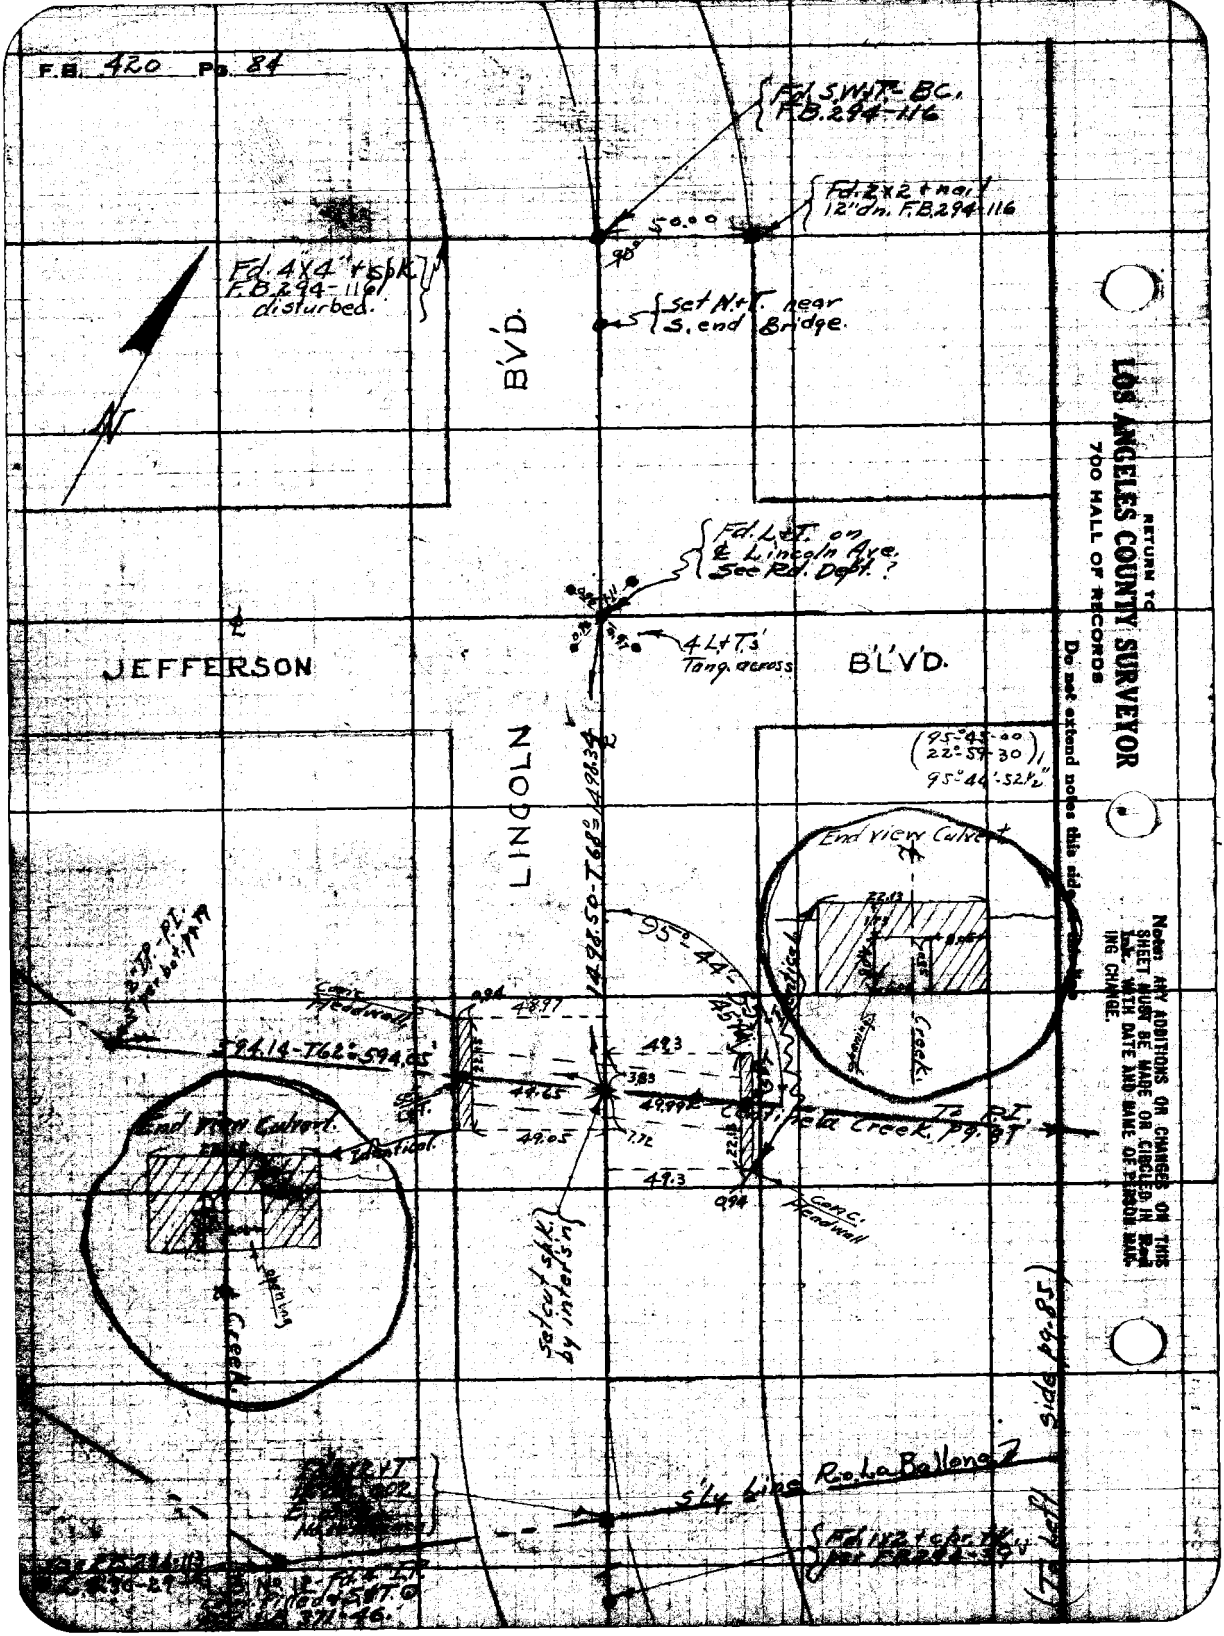
Fd. 5/8" I.P. BC. F.B. 294-116
Fd. 2x2 + nail 12" On. F.B. 294-116
50.00
90°
Fd. 4X4" r spk F.B. 294-116 disturbed.
Set N.r.T. near S. end Bridge.
BLVD.
N
Fd. L.&T. on E. Lincoln Ave. See R.S. Dept.?
4 L.+T.'s Tang. across
JEFFERSON
BLVD.
LINCOLN
(95°-45'-00" 22°-59'-30") 95°-44'-52½"
End view Culvert
Creek
95°-44'-
Conc. Headwall
22.13
3.85
49.99±
49.65
49.05
7.72
49.3
9.94
Conc. Headwall
Set cut spk. by intersn.
To P.T. Pg. 87
594.14-T62°-594.05'
End View Culvert
Creek
Set cut spk. by intersn.
S'ly line Rancho Ballona
Fd. 1½ I.P. Bent
Fd. 2 I.P. Bent

Notes Ck'd by D.M. Finley | Survey of Centinela Creek F.B. 420 Pg. 85
Map No. B-104 2 B 503 | W. O. 767 Tape No. 2251 St'd 64 °F.
Comp. Work R. W. McAllister | Surveyed by
Plotted D.M. Finley | Traced
Date Mar. 1933 | Indexed A. C. Johnson

JEFFERSON BLVD.

Rd. 2" I.P.P.W.T. Flush per L.S. 30-26

1/4 Sec.

Fd. 2" I.P.P.W.T. Flush per L.S. 30-269 L.S. 30-28

(83°-49-00) (335°-16-30) 83°-49-07½"

L. S. 30-28.

L.S. 30-29

(83°-48-45) (335°-15-15) 83°-48-46¾"

West Line L.S. 30-26

(83°-49-00) (335°-16-30) 83°-49-07½"

Fd. 2" I.P.P.W.T. Flush per L.S. 30-26

Fd. 2" I.P.P.W.T. Flush per L.S. 30-28

Fd. 2" I.P.P.W.T. Flush per L.S. 30-27

Fd. 2" I.P.P.W.T. Flush per L.S. 30-279 L.S. 30-29

Centinela Creek. Seg. P.S.

Set 2x2 Flush by intersn

POT

(97°-55-15) (391°-41-09) 97°-55-15"

Set 2x2 Flush by intersn

L. S. 30-27

Searched for I.P. per L.S. 30-27 Found nothing Set 2x2 Flush by intersn

Made diligent search for steel rod per L.S. 30-27 but found nothing

Feb. 1932

Southerly line of

West Line L.S. 30-27

Note: ANY ALTERATIONS OR CHANGES ON THIS SHEET MUST BE MADE IN THE CONTROLLER'S OFFICE WITH DATE AND NAME OF PERSON MAKING CHANGE.

Do not record within this area of Title Sheet

RETURN TO 720 HALL OF RECORDS

LOS ANGELES COUNTY SURVEYOR

RETURN TO
LOS ANGELES COUNTY SURVEYOR
700 HALL OF RECORDS

Note: ANY ADDITIONS OR CHANGES ON THIS SHEET MUST BE MADE OR ENCLED IN Red Ink. WITH DATE AND NAME OF PERSON MAKING CHANGE.

Do not extend notes this side of this line

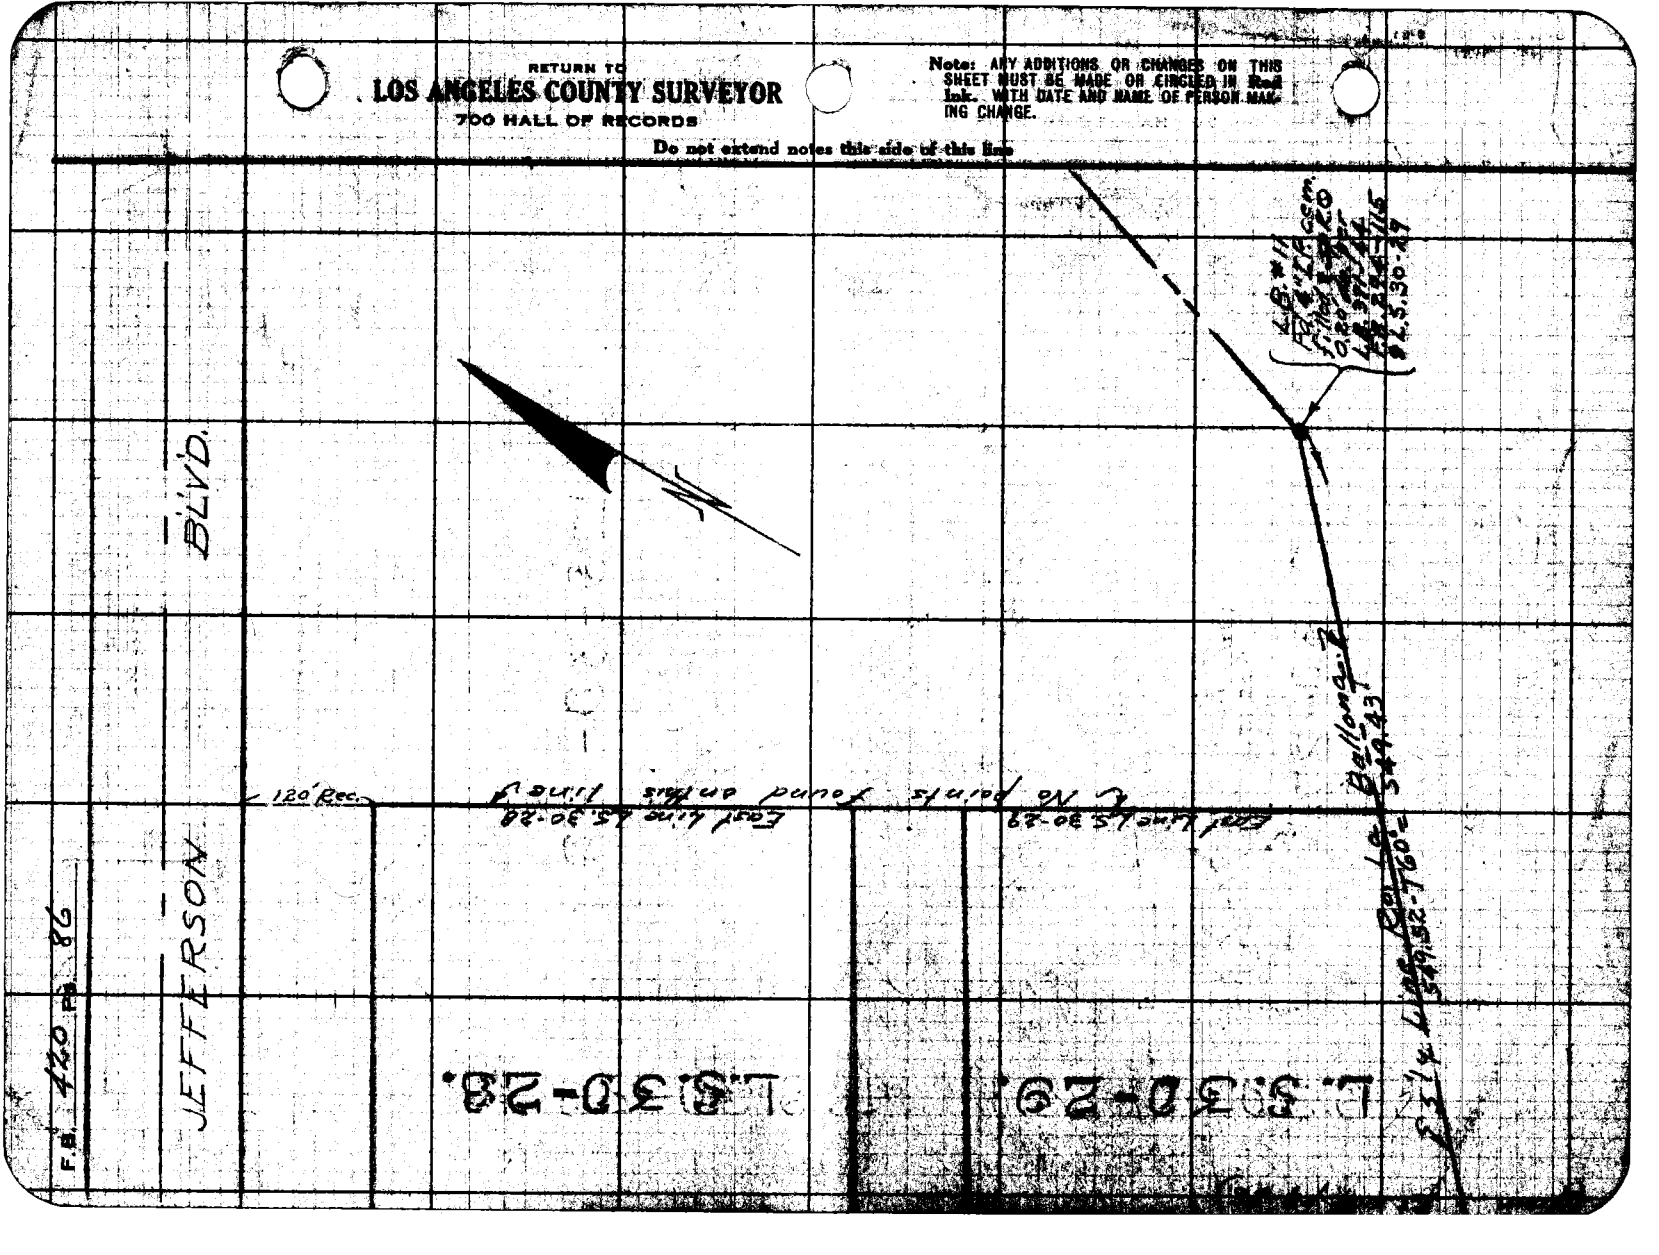

Notes Ck'd by R.M. Finley
Map No. B-303
Office Work R.W. McA.
Notes R.M. Finley
Date Apr. 1939

Survey of Centinela Creek
W. O. 762 Tape No. 051 St'd 84 OF.
Surveyed by [illegible]
[illegible] 4-3-39
Indexed A. C. Johnson

F.B. 420 Pg 87

Fd. 3"x1" in conc. mon. 14" dn. P.I. - See F.B. 396-64 & Rd. Dept. F.C. 888-3

LUDWELL AVE.

Fd. spk. in conc. mon. 14" dn. See F.B. 396-65 & Rd. Dept. F.C. 888-4 0.02 W/ of ℄

GABRAY AVE.

99-42

(102°21'-30" 49°26'-15" 102°21'-33¾")

TR. 10566.

CENTINELA CREEK

(From P.I. 784.99-T62=784.99)

306.73-T62=306.73

To ℄ Barrier

POT. Set 2x2 flush, top sand bank.

POT. Set 2x2-14" dn. by intersection.

LEBAKER AVE.

Fd. spk. in conc. mon. 14" dn. See F.B. 396-66 & Rd. Dept. F.C. 888-5 0.02 W. of ℄

CENTINELA ℄ per F.B.

(100)

BEJACK AVE.

F.B. 396-66 Fd. conc. Mon. Spk. c/c -18" dn. per Rd. Dept. F.C. 888-5

Ranch - Line Z

N.

T.R.

RETURN TO LOS ANGELES COUNTY SURVEYOR 700 HALL OF RECORDS

Notice: Any alterations or changes on this sheet must be made or checked by and with date and the name of person making the change. Do not extend notes to the date of this land

FORM 247 (5M 8-51)

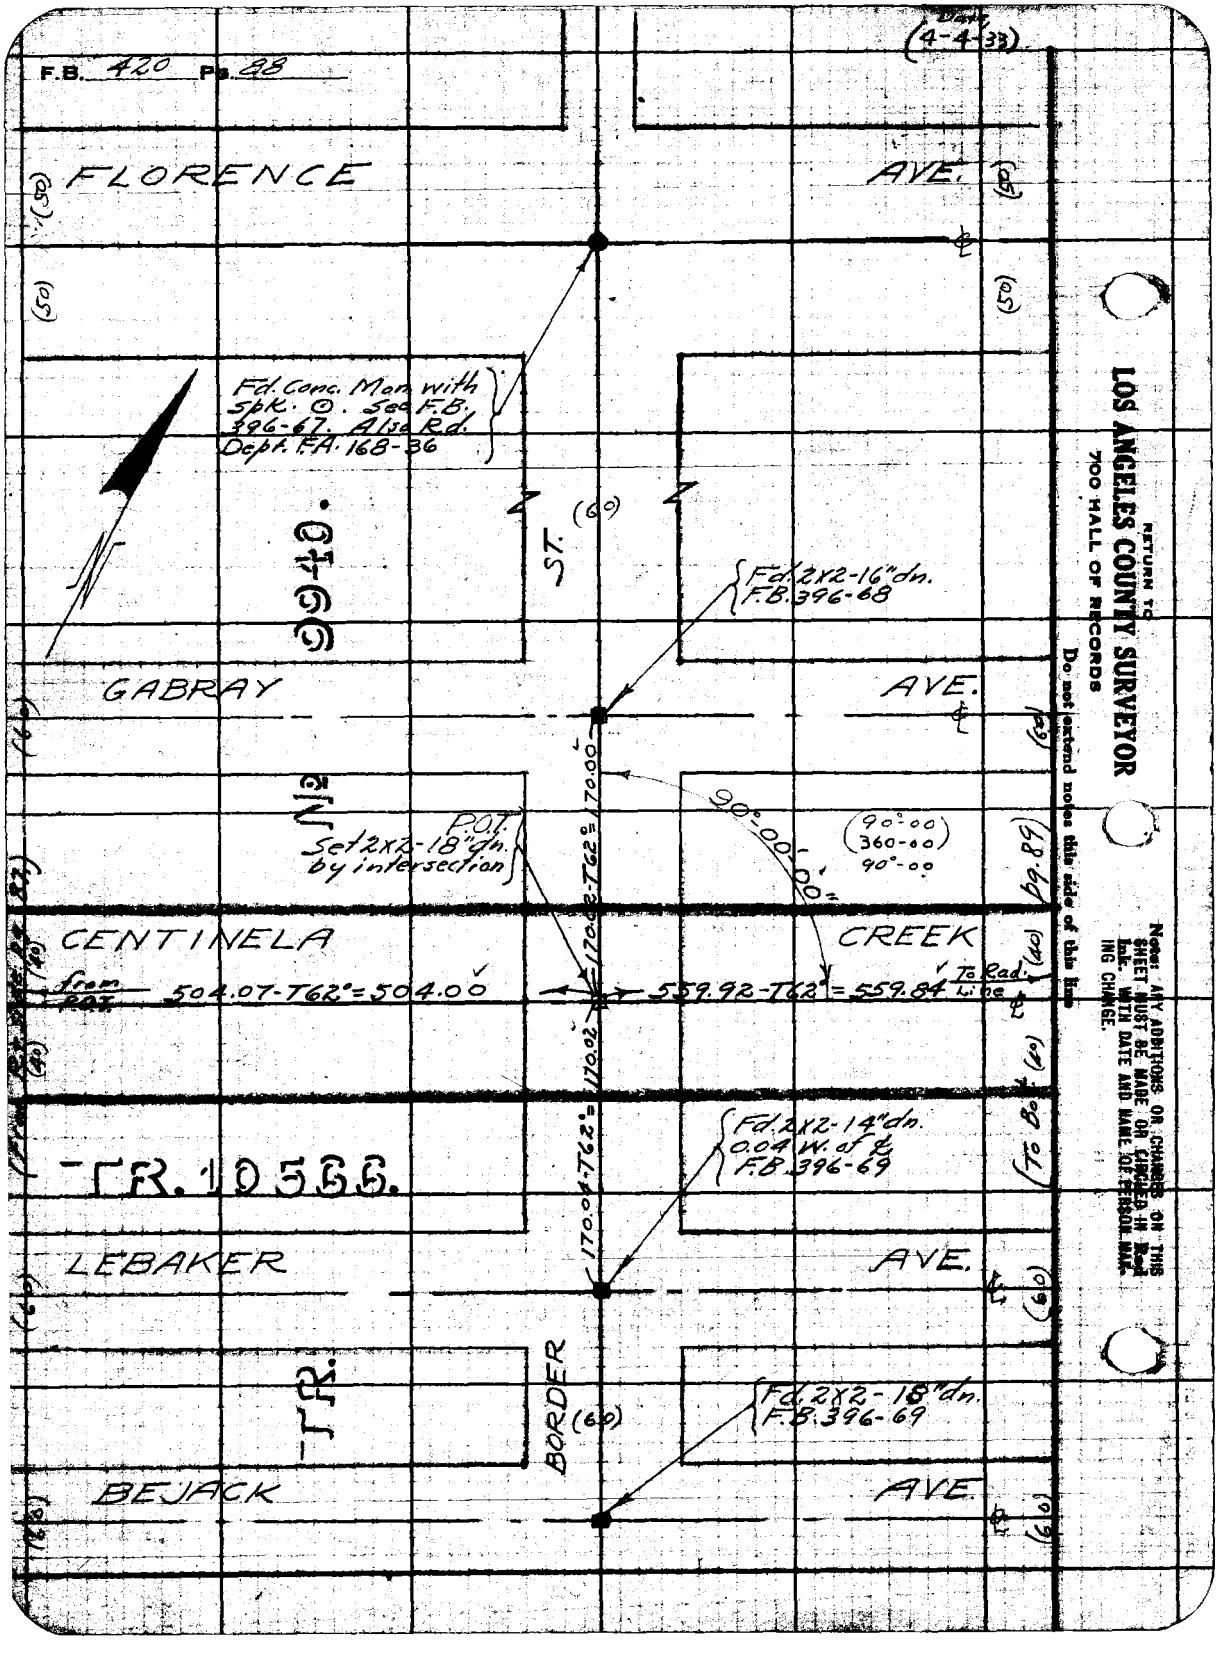
F.B. 420 Pg. 28
Date (4-4-38)
FLORENCE AVE.
(80)
(50)
Fd. Conc. Mon. with Spk. ⊙. See F.B. 396-67. Also Rd. Dept. F.A. 168-36
ST. (60)
Fd. 2x2-16" dn. F.B. 396-68
GABRAY AVE.
(60)
P.O.T. Set 2x2-18" dn. by intersection
170.00
90°-00'-00"
(90°-00 / 360-00 / 90°-00)
99.84
CENTINELA CREEK
(100)
From P.O.T. 504.07-T62°=504.00
559.92-T62°=559.84 To Rad. Line
170.02
170.04-T62°=
To 80'
TR. 10566.
Fd. 2x2-14" dn. 0.09 W. of ℄ F.B. 396-69
LEBAKER AVE.
(60)
TR.
BORDER (60)
Fd. 2x2-18" dn. F.B. 396-69
BEJACK AVE.
(60)
RETURN TO LOS ANGELES COUNTY SURVEYOR 700 HALL OF RECORDS
Do not extend notes this side of this line
NOTE: ANY ADDITIONS OR CHANGES ON THIS SHEET MUST BE MADE ON CARDEX IN Red Ink. WITH DATE AND NAME OF PERSON MAKING CHANGE.


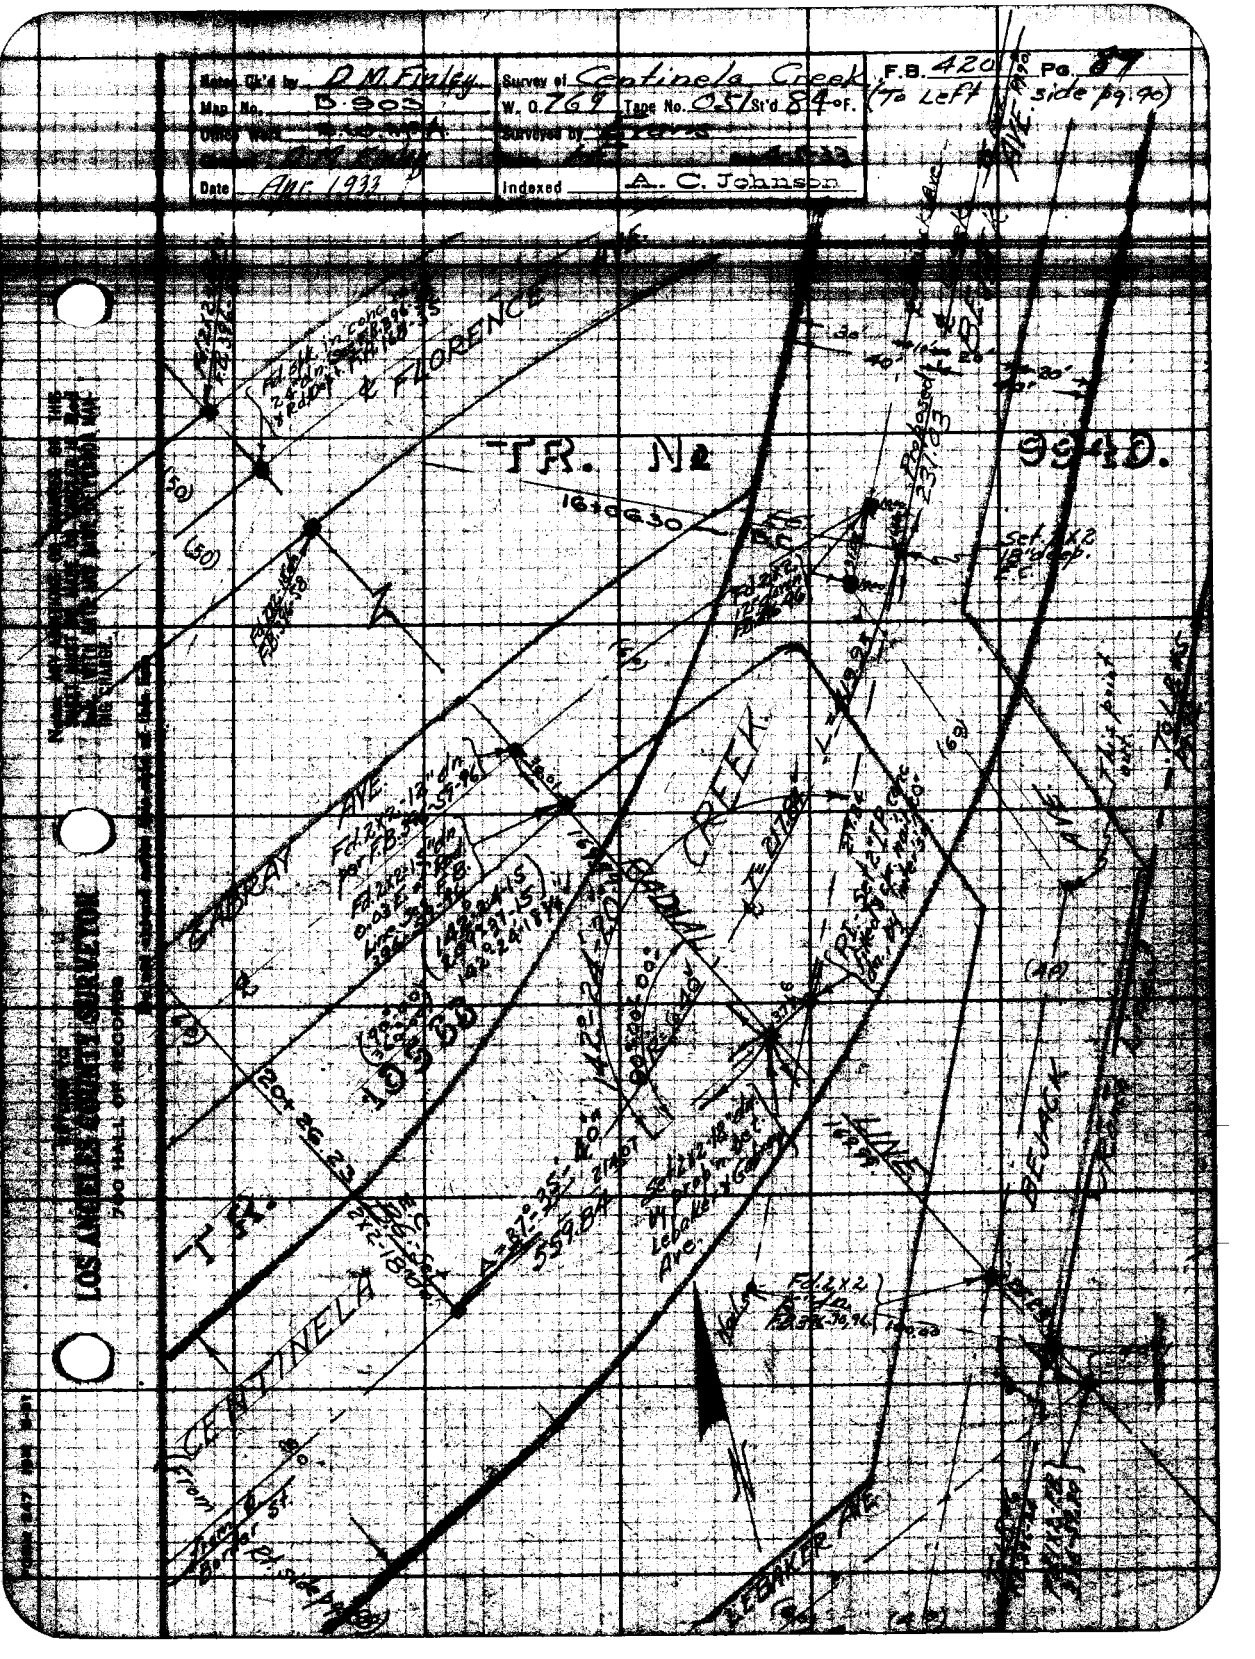
TR. No 9940.
CENTINELA CREEK
BAKER AVE.
FLORENCE
Set 2"x2" 18" in Conc.
Set 2"x2" 18" in Conc.
Set 2"x2" 18" in Conc.

RETURN TO
LOS ANGELES COUNTY SURVEYOR
700 HALL OF RECORDS

Note: ANY ADDITIONS OR CHANGES ON THIS SHEET MUST BE MADE OR CIRCLED IN Red Ink. WITH DATE AND NAME OF PERSON MAKING CHANGE.

Do not extend notes this side of this line (To L.t. side pg. 91)

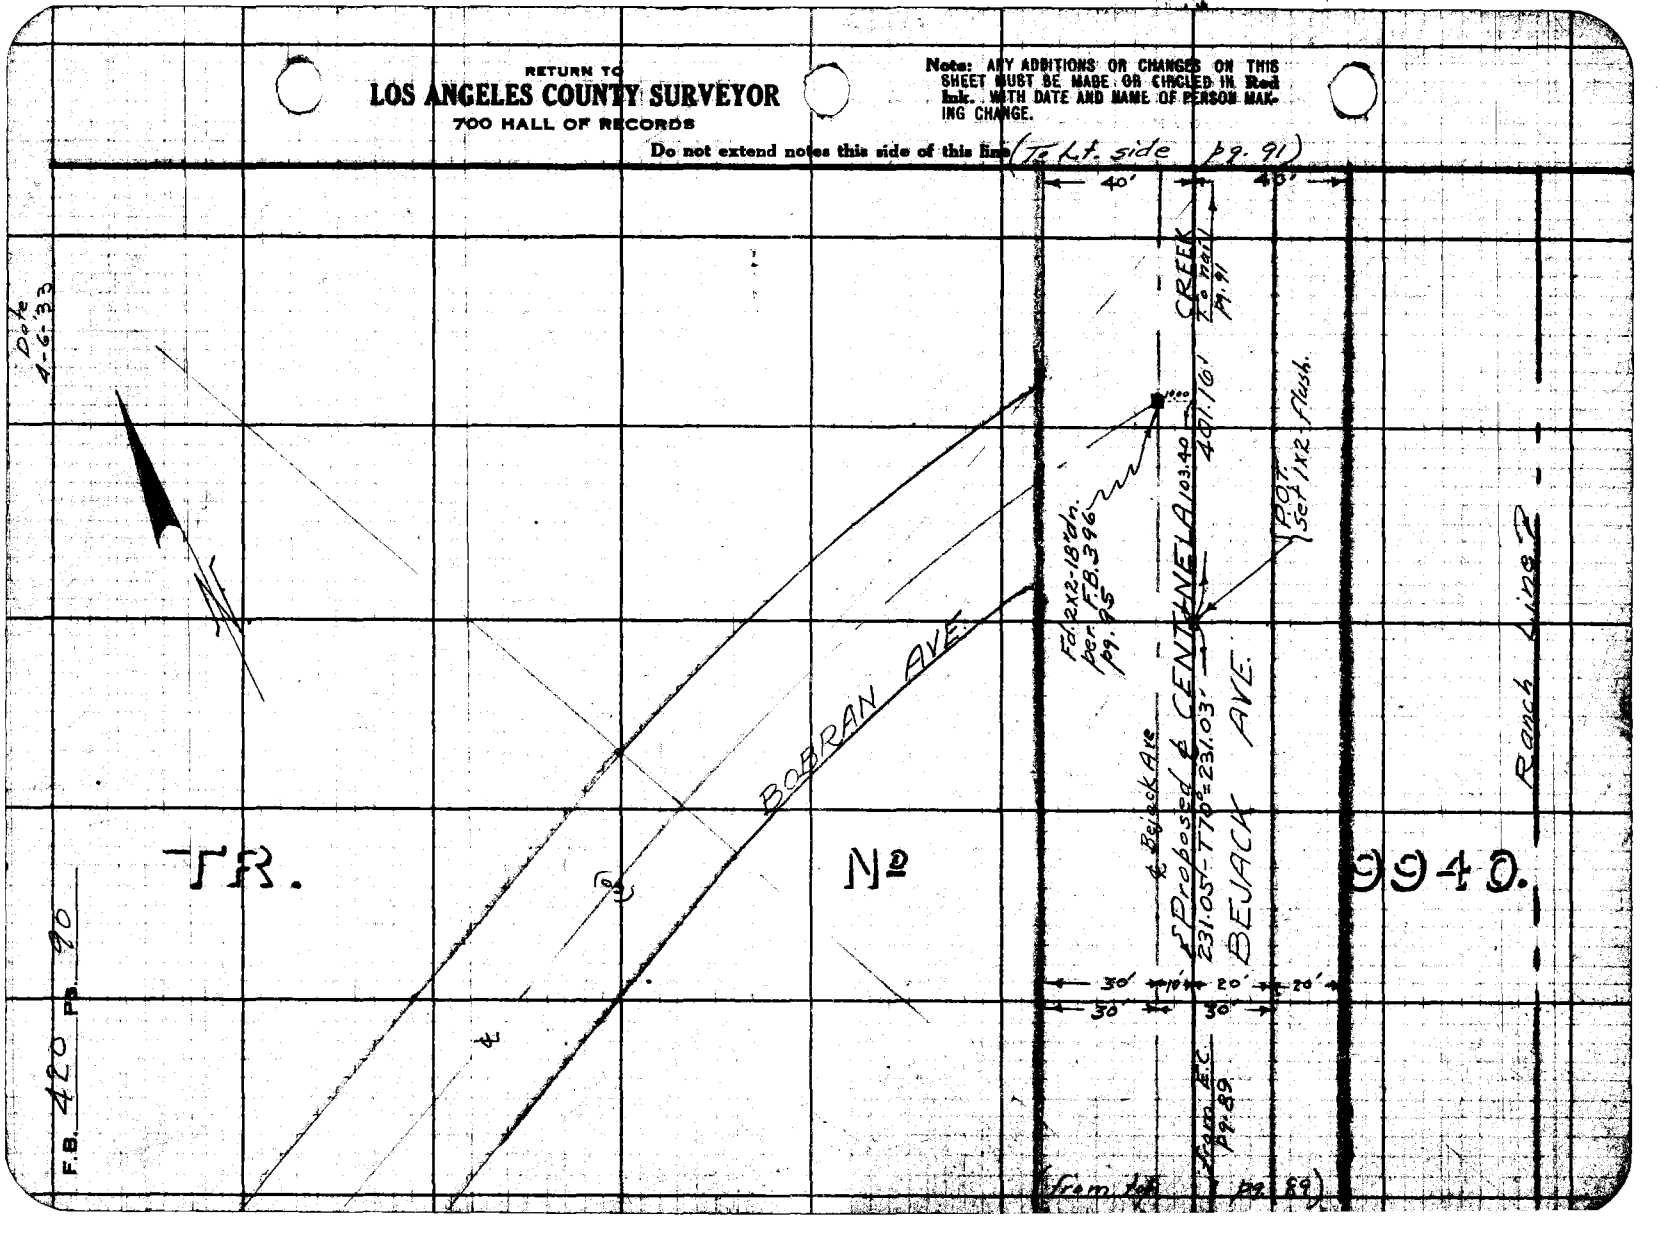

Notes Ck'd by D.M. Finley | Survey of Centinela Creek. | F.B. 420 Pg. 21
Map No. B-303 | W. O. 769 | Tape No. 051 St'd 84° °F.
Date Apr. 1933 | Indexed A. C. Johnson

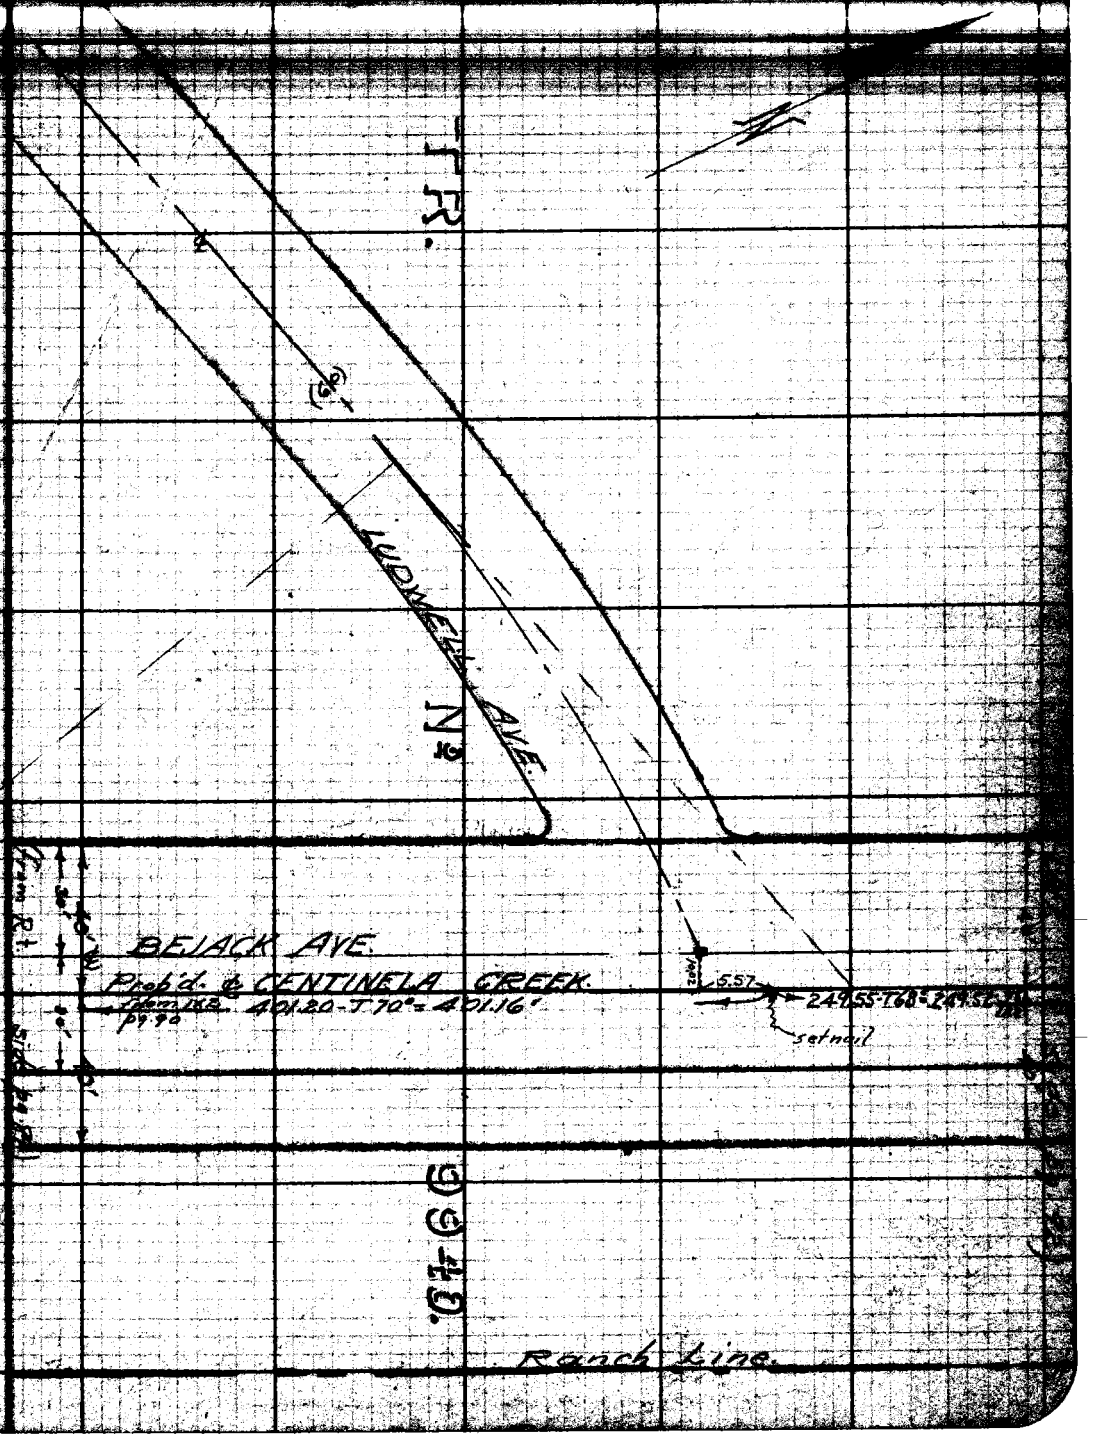

LOS ANGELES COUNTY SURVEYOR
700 HALL OF RECORDS

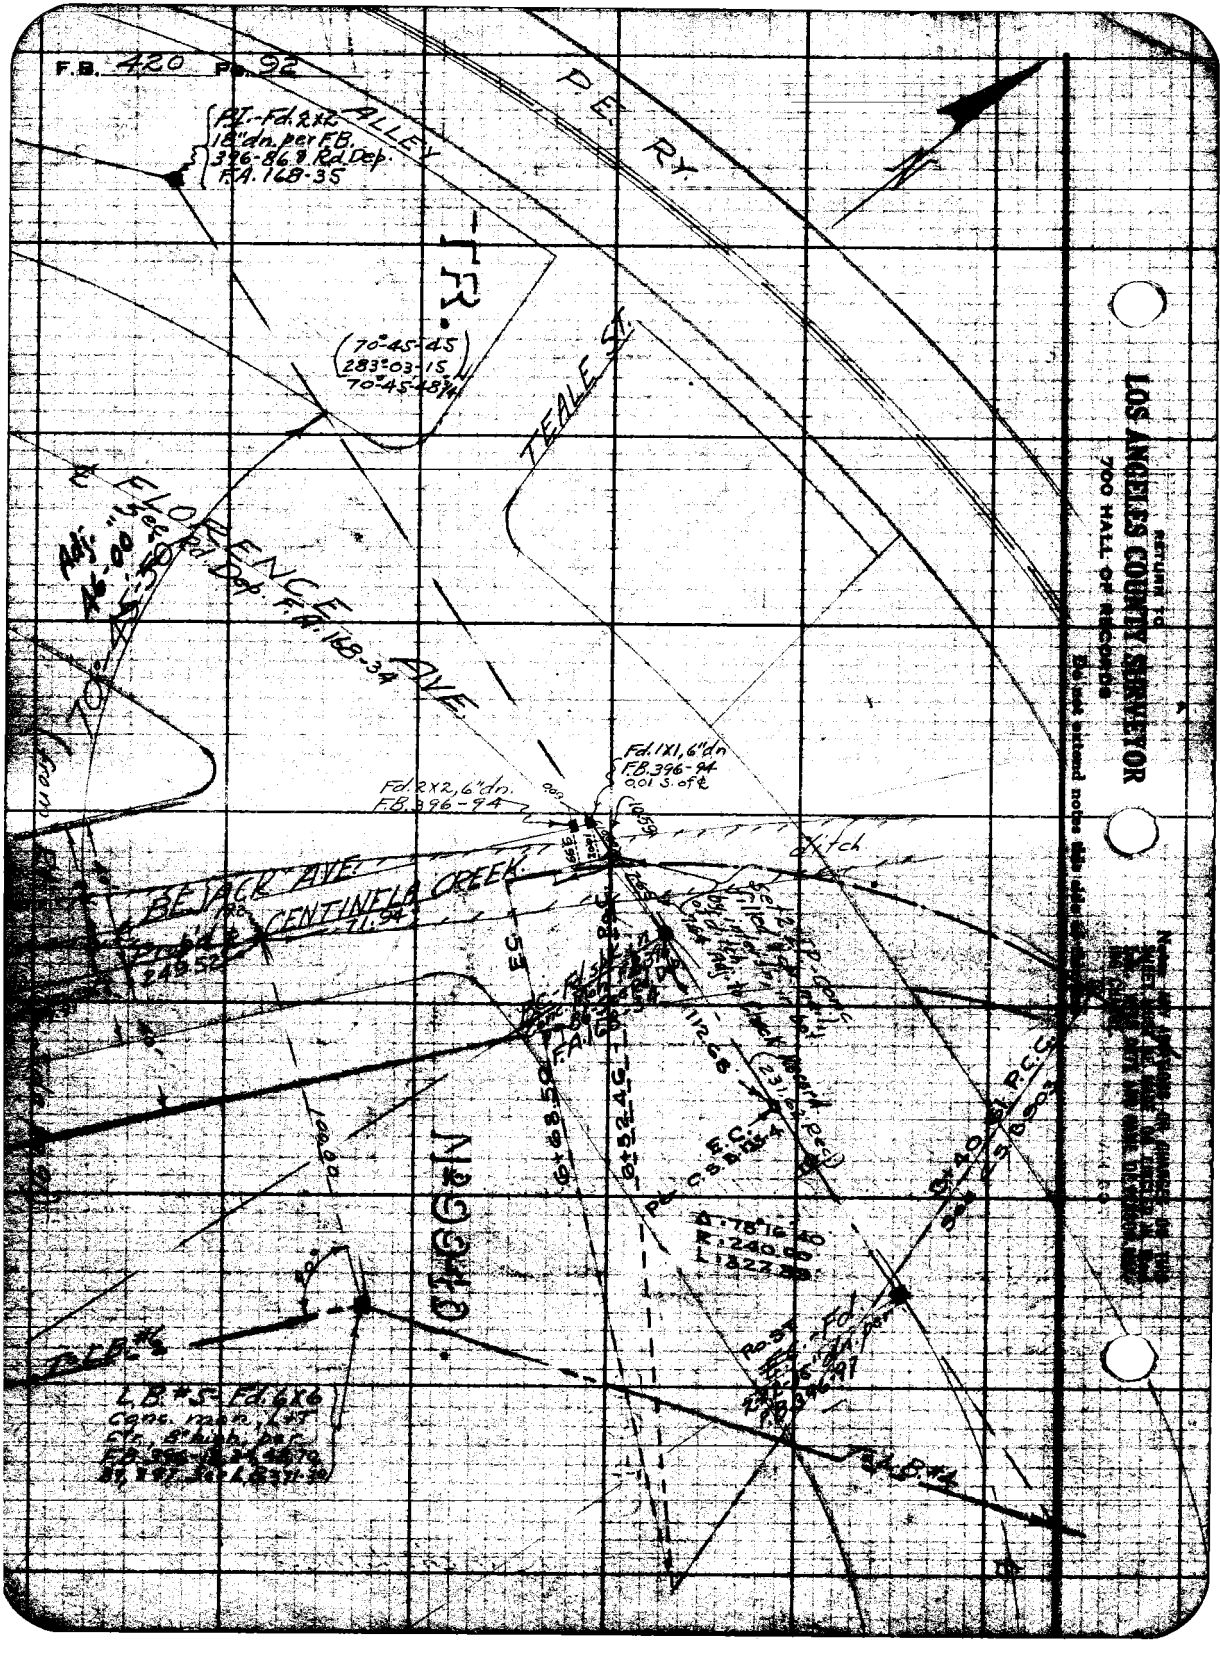
F.B. 420 Pg. 92
P.E. RY.
ALLEY
P.T. Fd. 2x2 18" dn. per F.B. 396-86 & Rd. Dep. F.A. 168-35
(70°45'45" 283°03'15" 70°45'48")
TEALE ST.
FLORENCE AVE.
Adj. 0.00 N. 0.50 W.
Fd. 2x2, 6" dn. F.B. 396-94
Fd. 1x1, 6" dn. F.B. 396-94 0.01 S. of ℄
Ditch
CENTINELA CREEK
71.94
219.52
112.46
E.C.
P.C.C.
R=240.00
L=422.33
Fd.
L.B. #5 Fd. 4x4 Conc. mon. 1.5' ↑ ctr. Stamp. Illegible
LOS ANGELES COUNTY SURVEYOR
700 HALL OF RECORDS

Book Ck'd by

Map No. B-903

Office Work R.W.M.F.A.

Checked D. M. Finley Sept 1933

Date

Survey of Centinela Ave

W. O. 7769 Twp No. 03S, Sh'd 76 ft.

Surveyed by L. D. Moore

Notes V. Moore Date 9-19-33

Inspected A. C. Johnson

F.B. 420 Pg. 93

& CHANGE

of

CENTINELA CREEK

from

Sta. 7+40±01.32 to Sta.

Job # 7769

Party

Moore

Van Fleet

Bowers

Harris

Sept 19, 20, 1933

For Profile see L.B.

See L.B. 371-93 For Profile of

Proposed Line Change.

Return to LOS ANGELES COUNTY SURVEYOR 700 HALL OF RECORDS

Do not record notes this side of this line

Notice: ANY ADDITIONS OR CHANGES ON THIS SHEET MUST BE MADE ON CIRCLED BOOK AND WITH DATE AND NAME OF PERSON MAKING THE CHANGE

FORM 547 10M 8-31

F.B. 420 Pg. 94

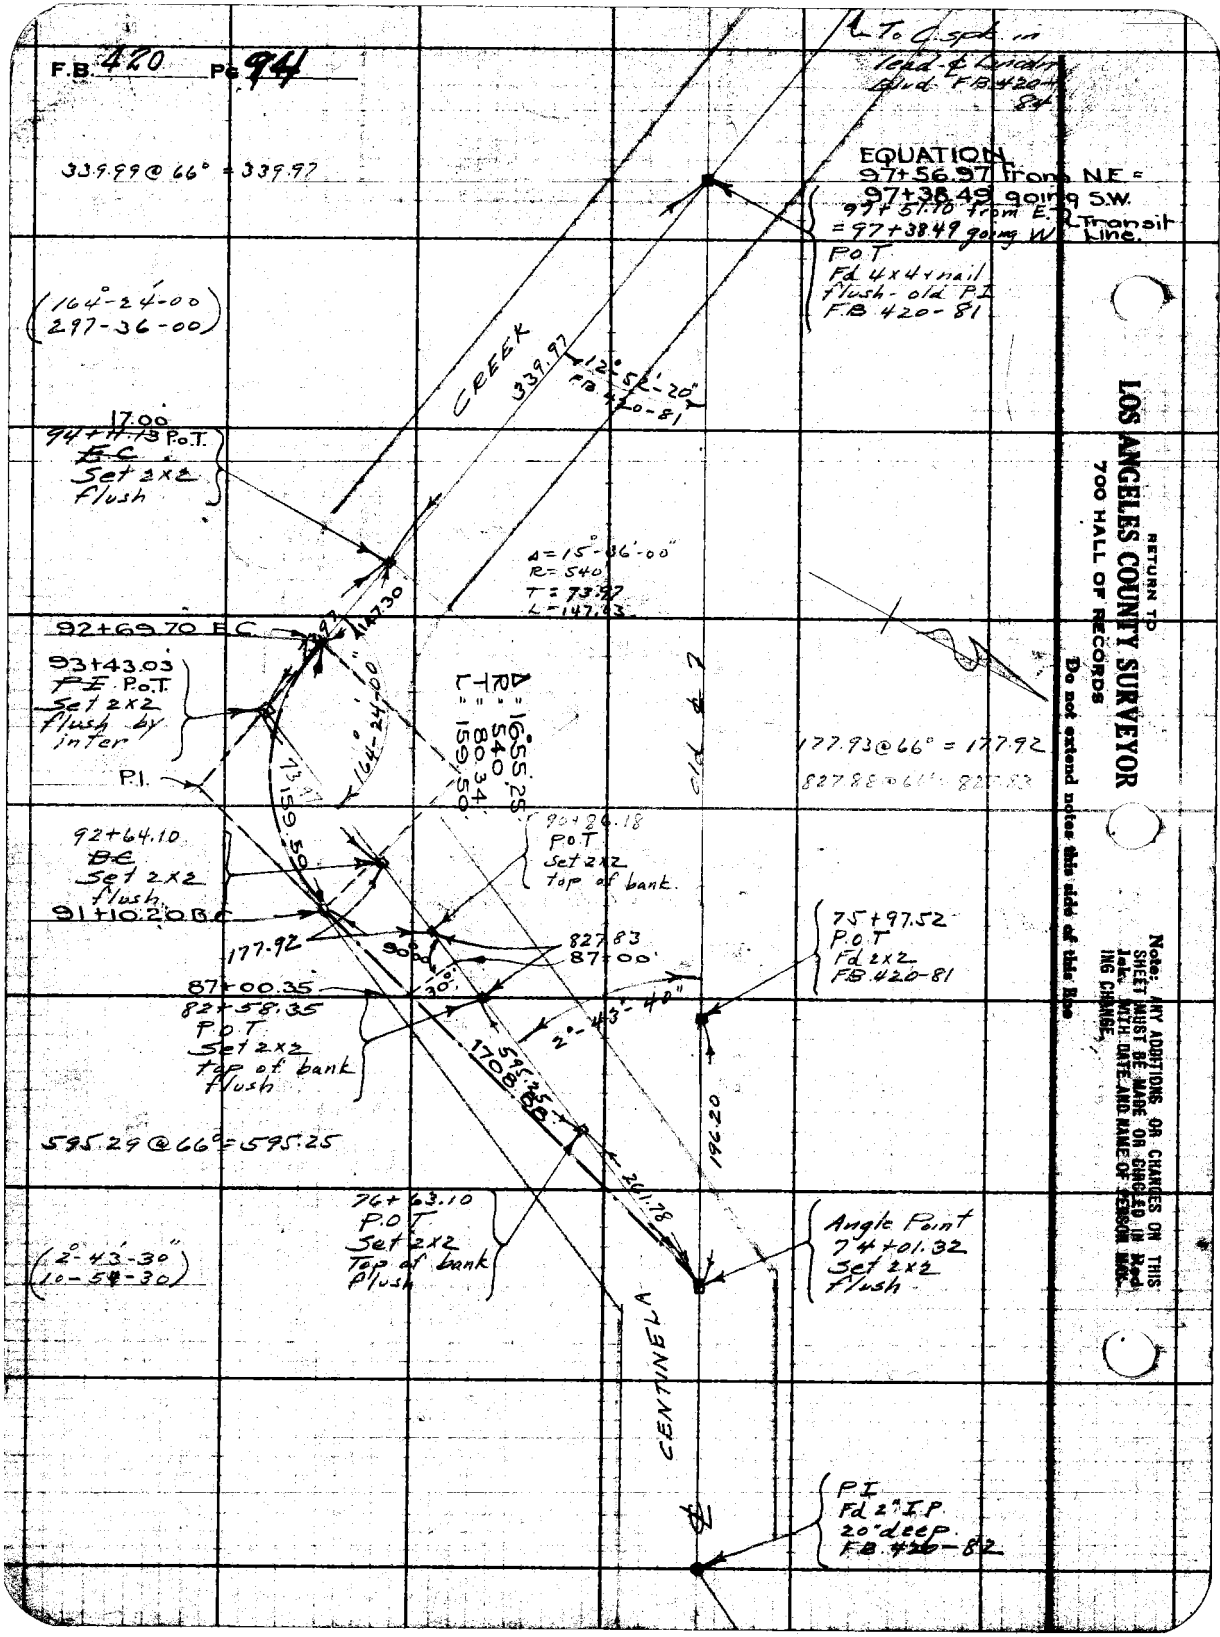

RETURN TO
LOS ANGELES COUNTY SURVEYOR
700 HALL OF RECORDS
Do not extend notes this side of this line

Note: ANY ADDITIONS OR CHANGES ON THIS SHEET MUST BE MADE ON CIRCLED IN Red Ink WITH DATE AND NAME OF PERSON MAKING CHANGE.

FORM 247 SN 2-34

RETURN TO
LOS ANGELES COUNTY SURVEYOR
700 HALL OF RECORDS

Note: ANY ADDITIONS OR CHANGES ON THIS SHEET MUST BE MADE OR CIRCLED IN Red Ink WITH DATE AND NAME OF PERSON MAKING CHANGE.

Do not extend notes this side of this line

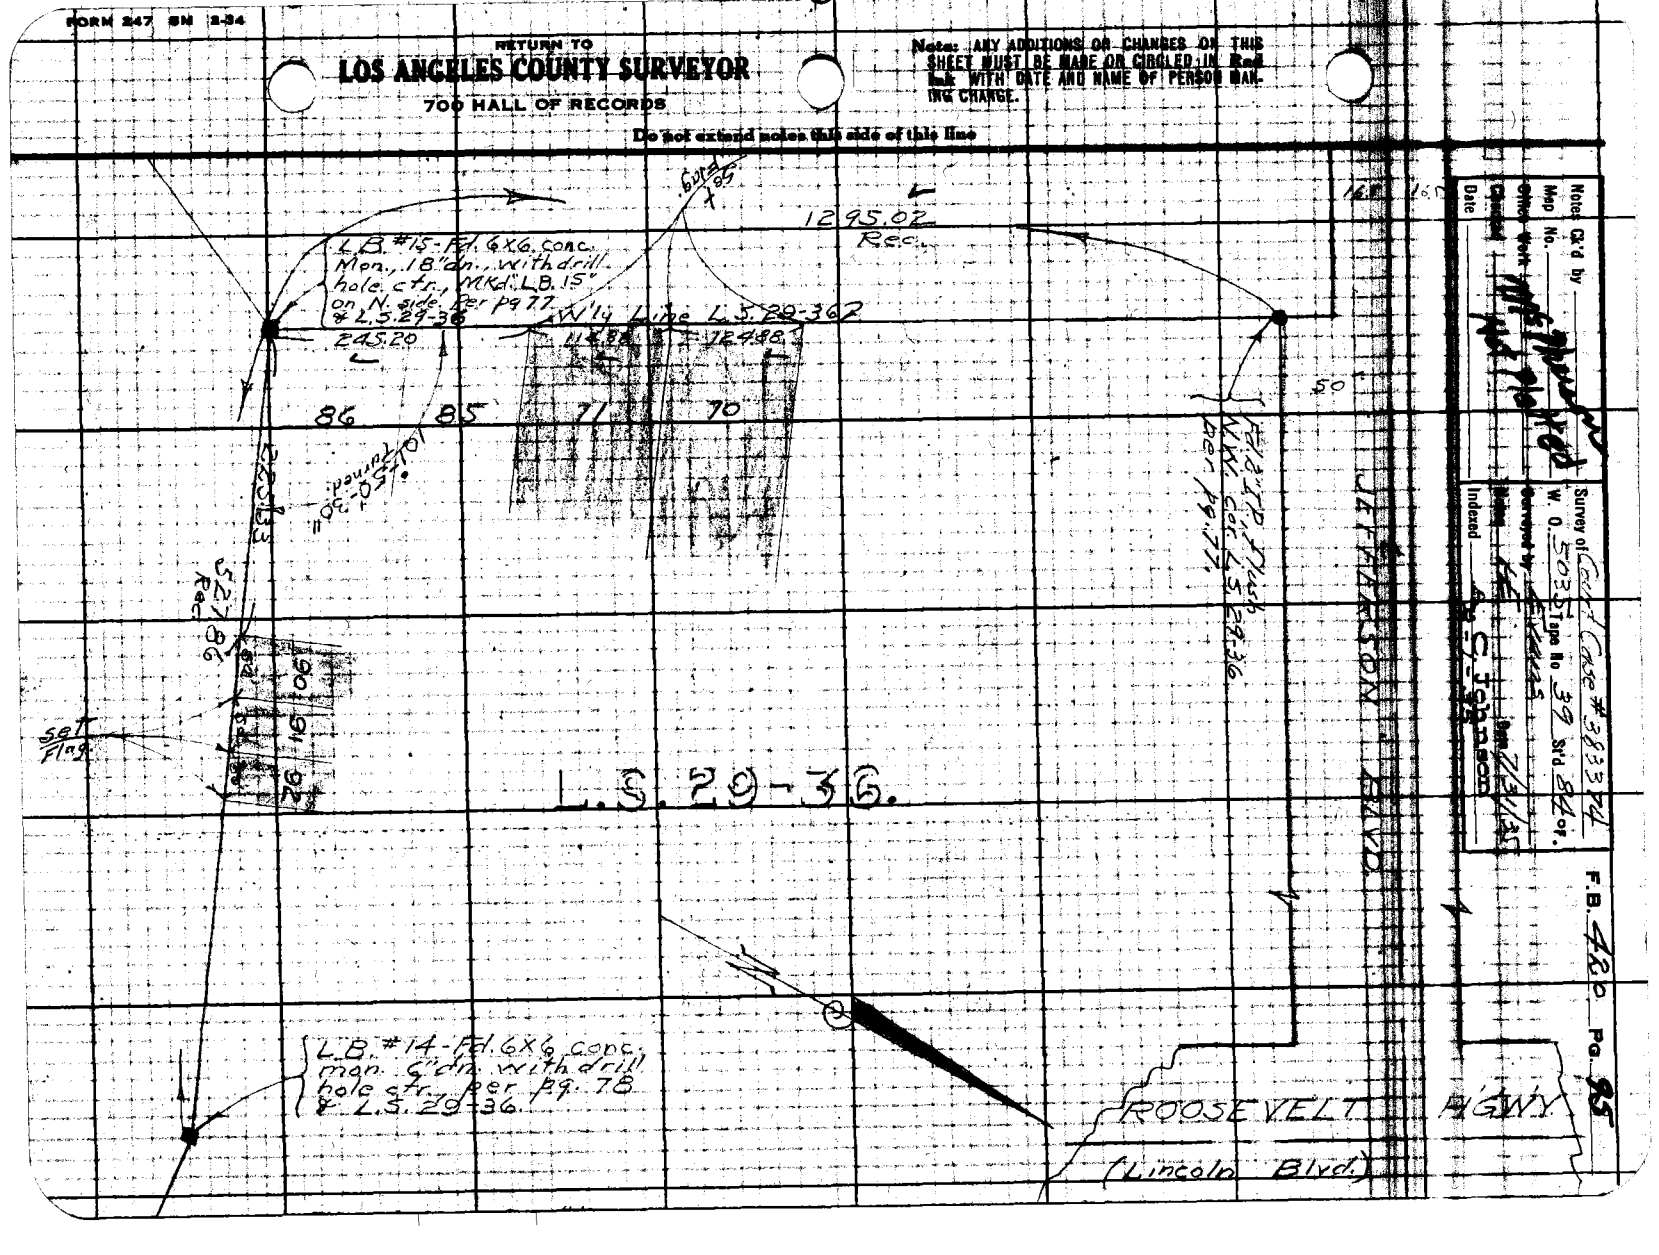

Noted Ck'd by
Map No.
Office Work Completed
Checked
Date

Survey of Court Case #3833 PZ
W. O. 5033 Type No. 39 Std. Sht. or.
Surveyed by
Drawn
Indexed
Checked

F.B. 420 Pg. 85

RETURN TO

LOS ANGELES COUNTY SURVEYOR

700 HALL OF RECORDS

Note: ANY ADDITIONS OR CHANGES ON THIS SHEET MUST BE MADE OR CIRCLED IN Red Ink WITH DATE AND NAME OF PERSON MAKING CHANGE.

Do not extend notes this side of this line

P.B.

P.G.

Notes Ck'd by Clark
Map No. B-455-C
Office Work Clark
Checked Clark
Date Feb. 1941

Survey of Eagle - Redondo Blvd
W. O. 7955 Tape No. 07 Std's 62°F
Surveyed by [illegible]
Notes [illegible]
Indexed [illegible]

F.B. 420 PG. 101

SURVEY
OF
INGLEWOOD - REDONDO BLVD.
FROM
CENTURY BLVD.
NORTH TO
LA TIJERA BLVD
W.O.# 7955

Moore
Fenner
Kaufman
Civalte

B-455-

Note: Any Additions or Changes to this Sheet Must Be Made by Owner with Date and Name of Person Making Changes

RETURN TO
LOS ANGELES COUNTY SURVEYOR
720 HALL OF RECORDS
Do not remove seal from this sheet

FORM 247 BM 10-58

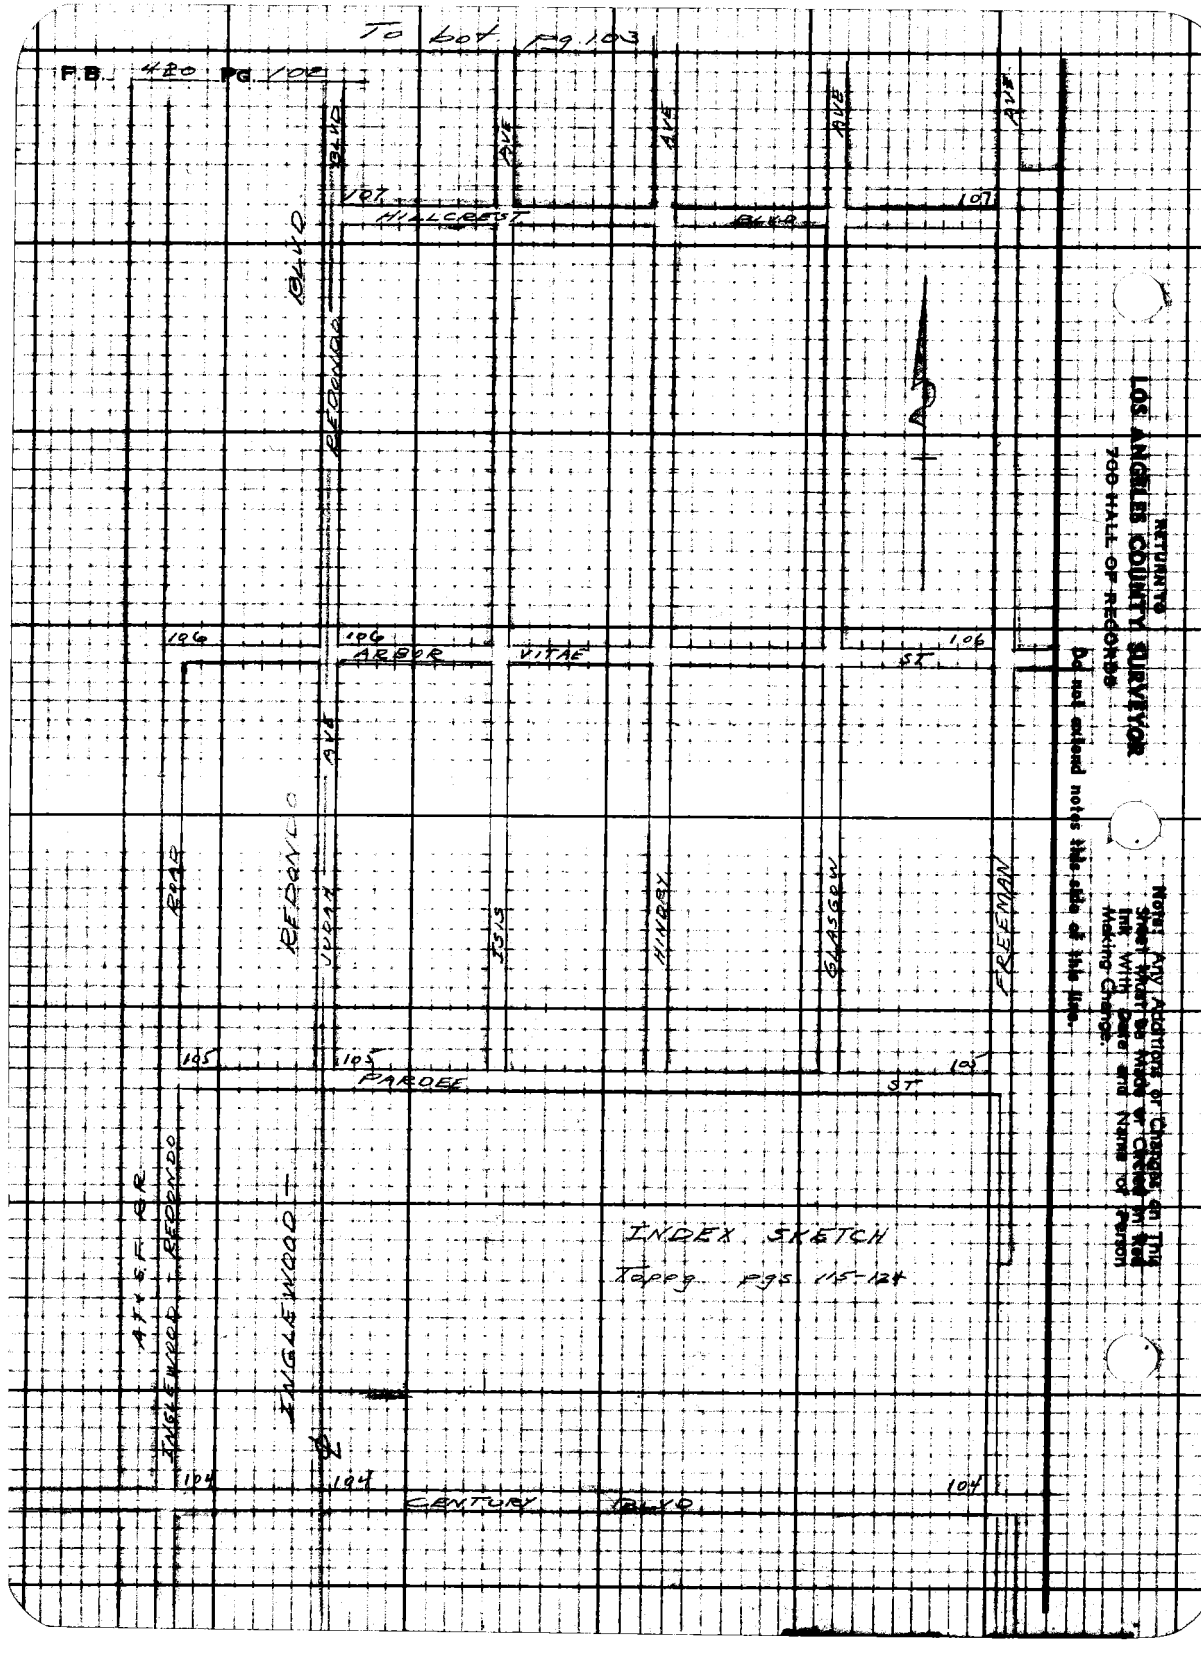
To Lot Pg. 103
HILLCREST
BLVD.
AVE
ARBOR
VITAE
ST
FREEMAN
REDONDO
JUAN
ENGLEWOOD
CENTURY
PAROEE
106
105
104
107
INDEX SKETCH
Topog. Pgs. 115-124
LOS ANGELES COUNTY SURVEYOR
RETURN TO
700 HALL OF RECORDS
Do not unbind notes this side of this line.
Note: Any Additions or Changes on this Sheet Must Be Made by Owner or Agent With Date and Name of Person Making Change.


F.B. 420 Pg. 103

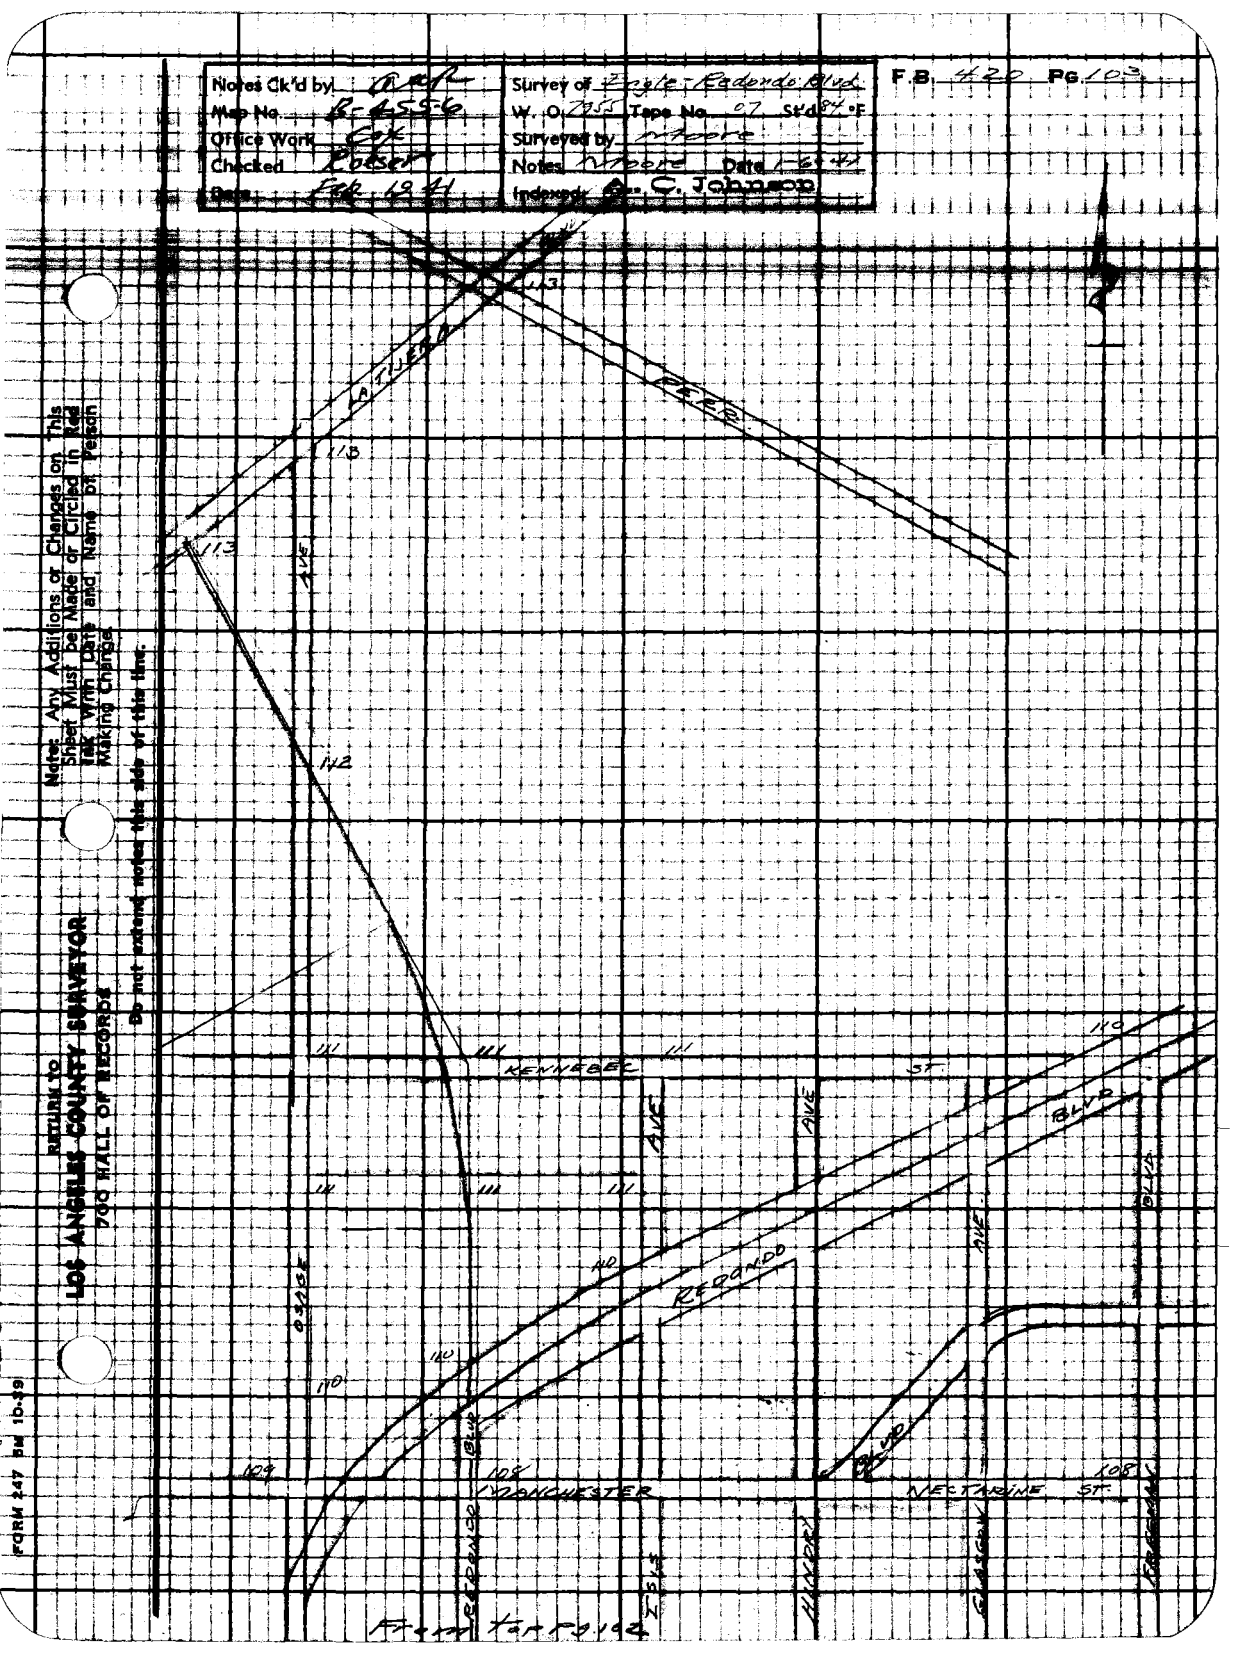

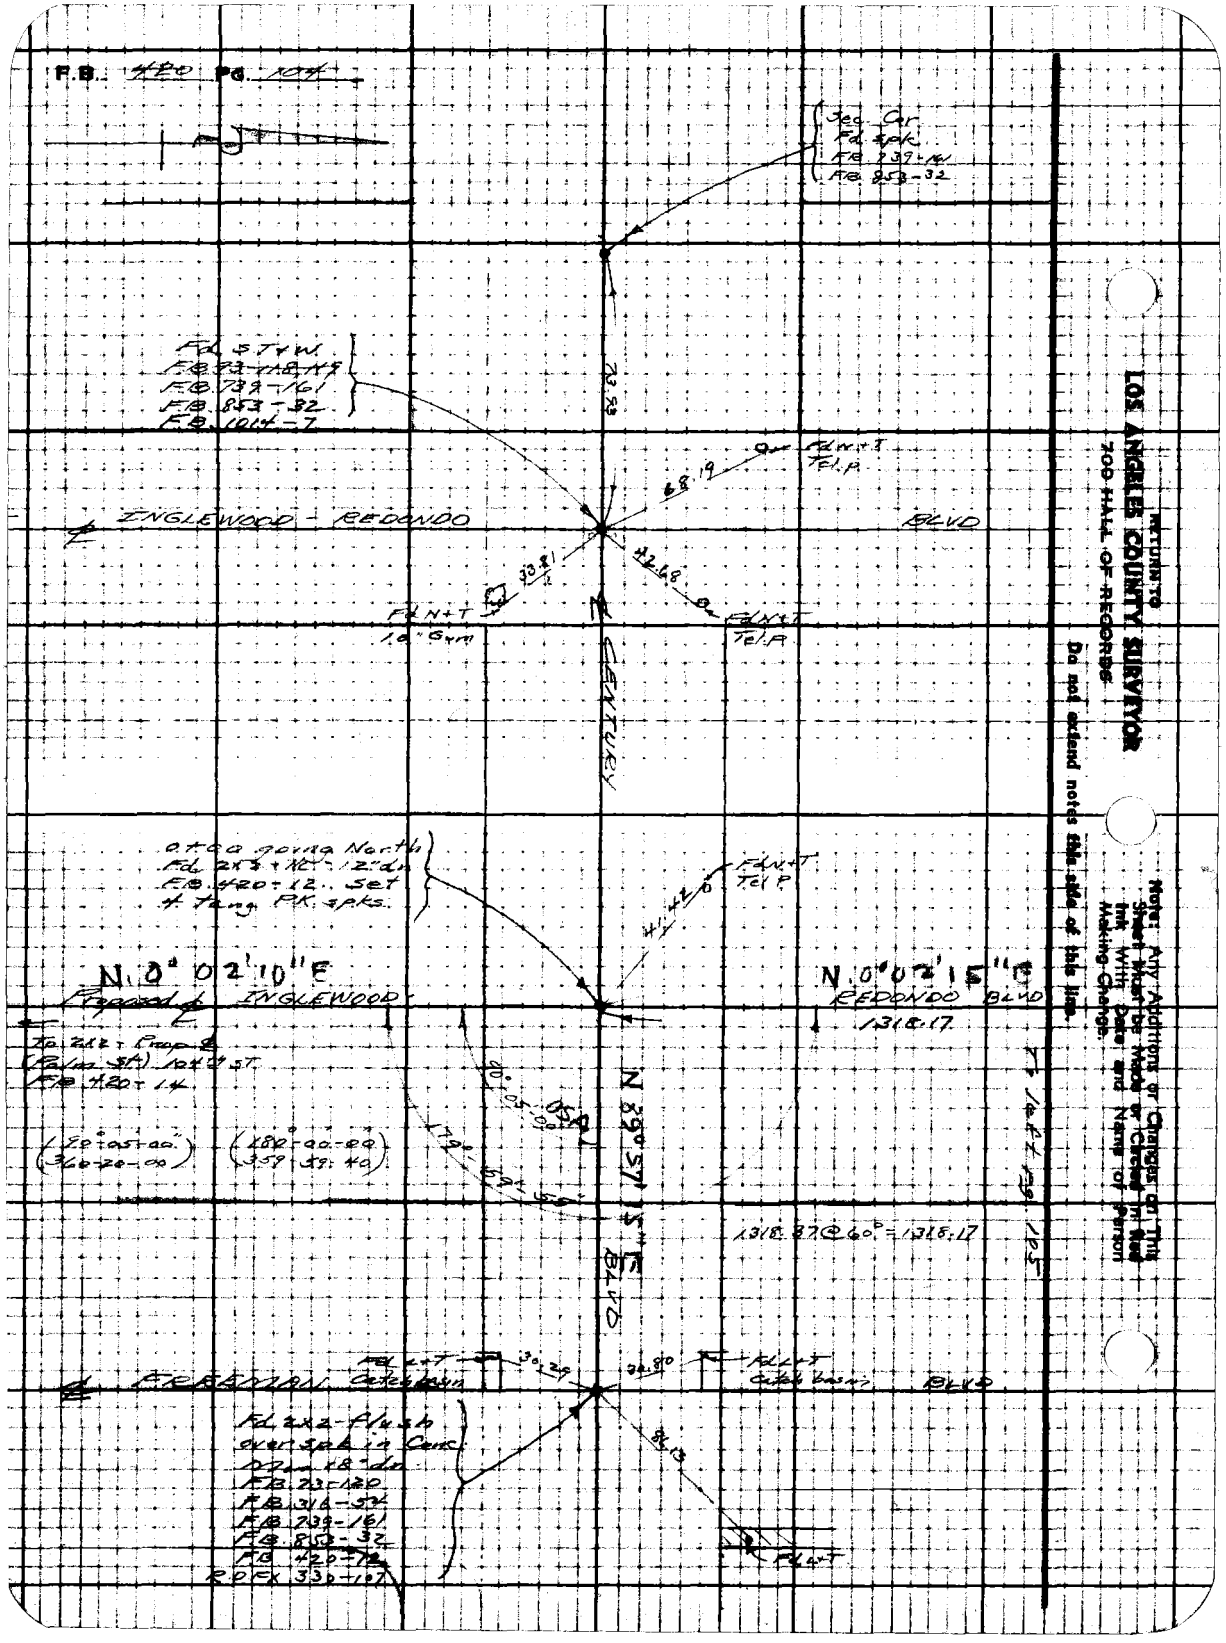

RETURN TO
LOS ANGELES COUNTY SURVEYOR
700 HALL OF RECORDS

Do not extend notes this side of this line

Note: Any Additions or Changes to This Sheet Must Be Made by Clerk in Red Ink With Date and Name of Person Making Change.

Notes Ck'd by: RAR
Map No. B-455-6
Office Work: COP
Checked: RAR
Date: Feb. 19 71

Survey of: Inglewood - Redondo Blvd
W. O. 7955 Tape No. 27 St'd 84°F
Surveyed by: Mayone
Notes: Moore Date 1-6-71
Indexed: A. C. Johnson

F.B. 4220 Pg. 105

Notes: Any Additions or Changes on This Sheet Must Be Made or Circled in Red Ink With Date and Name of Person Making Change
Do not extend notes this side of this line.

RETURN TO
LOS ANGELES COUNTY SURVEYOR
900 HALL OF RECORDS

FORM 247 SM 10-69

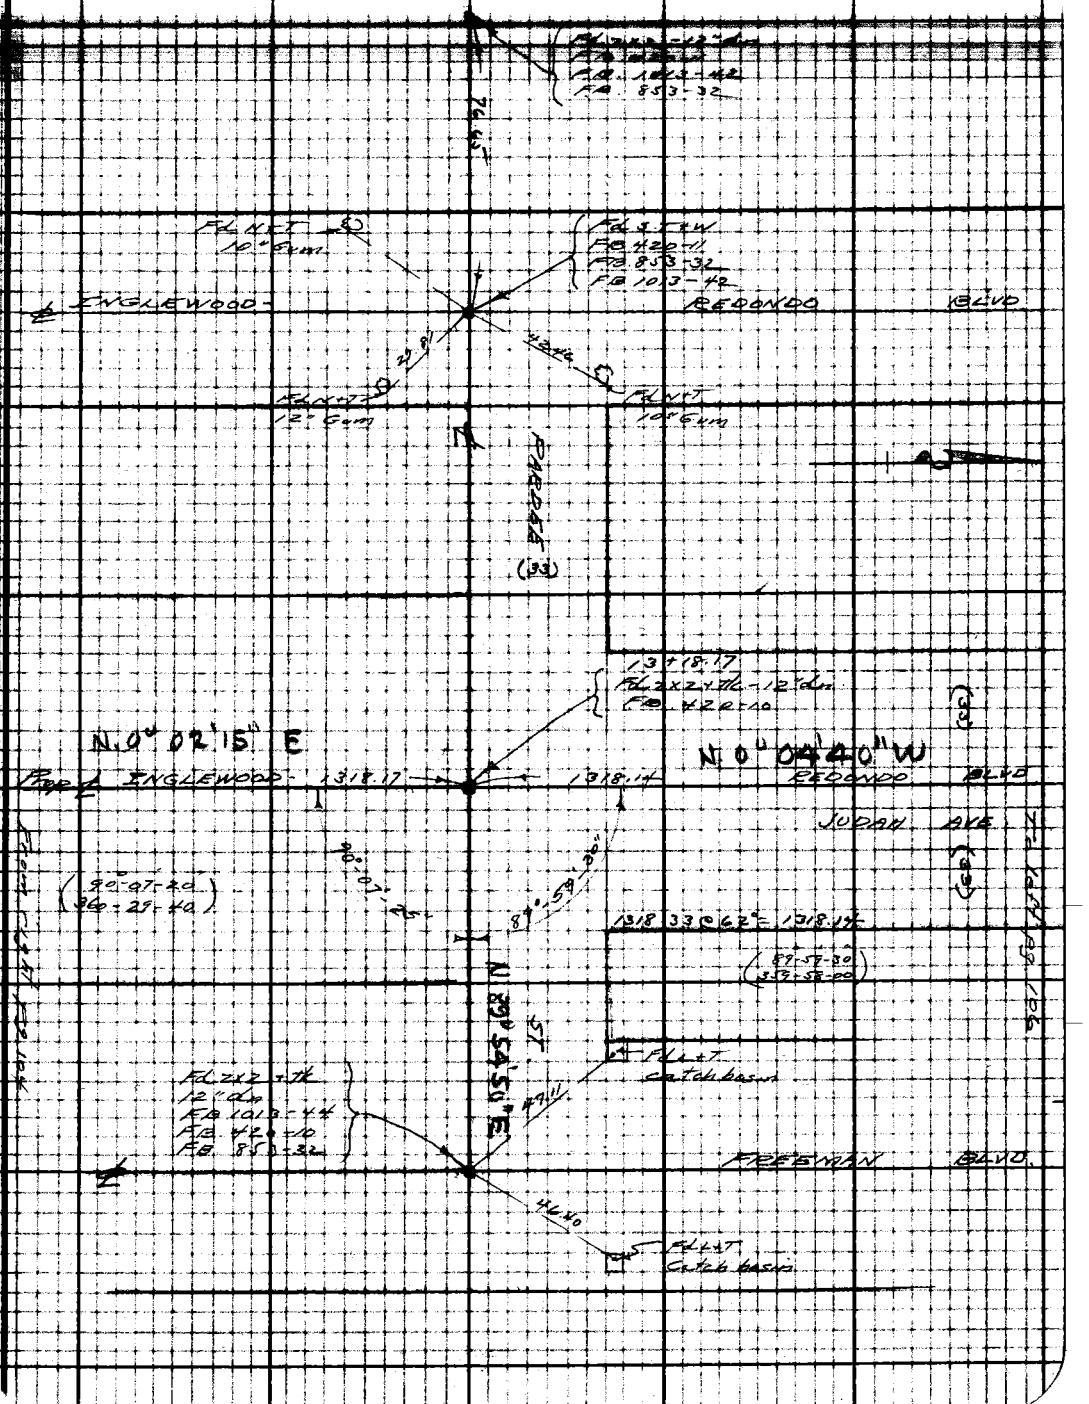

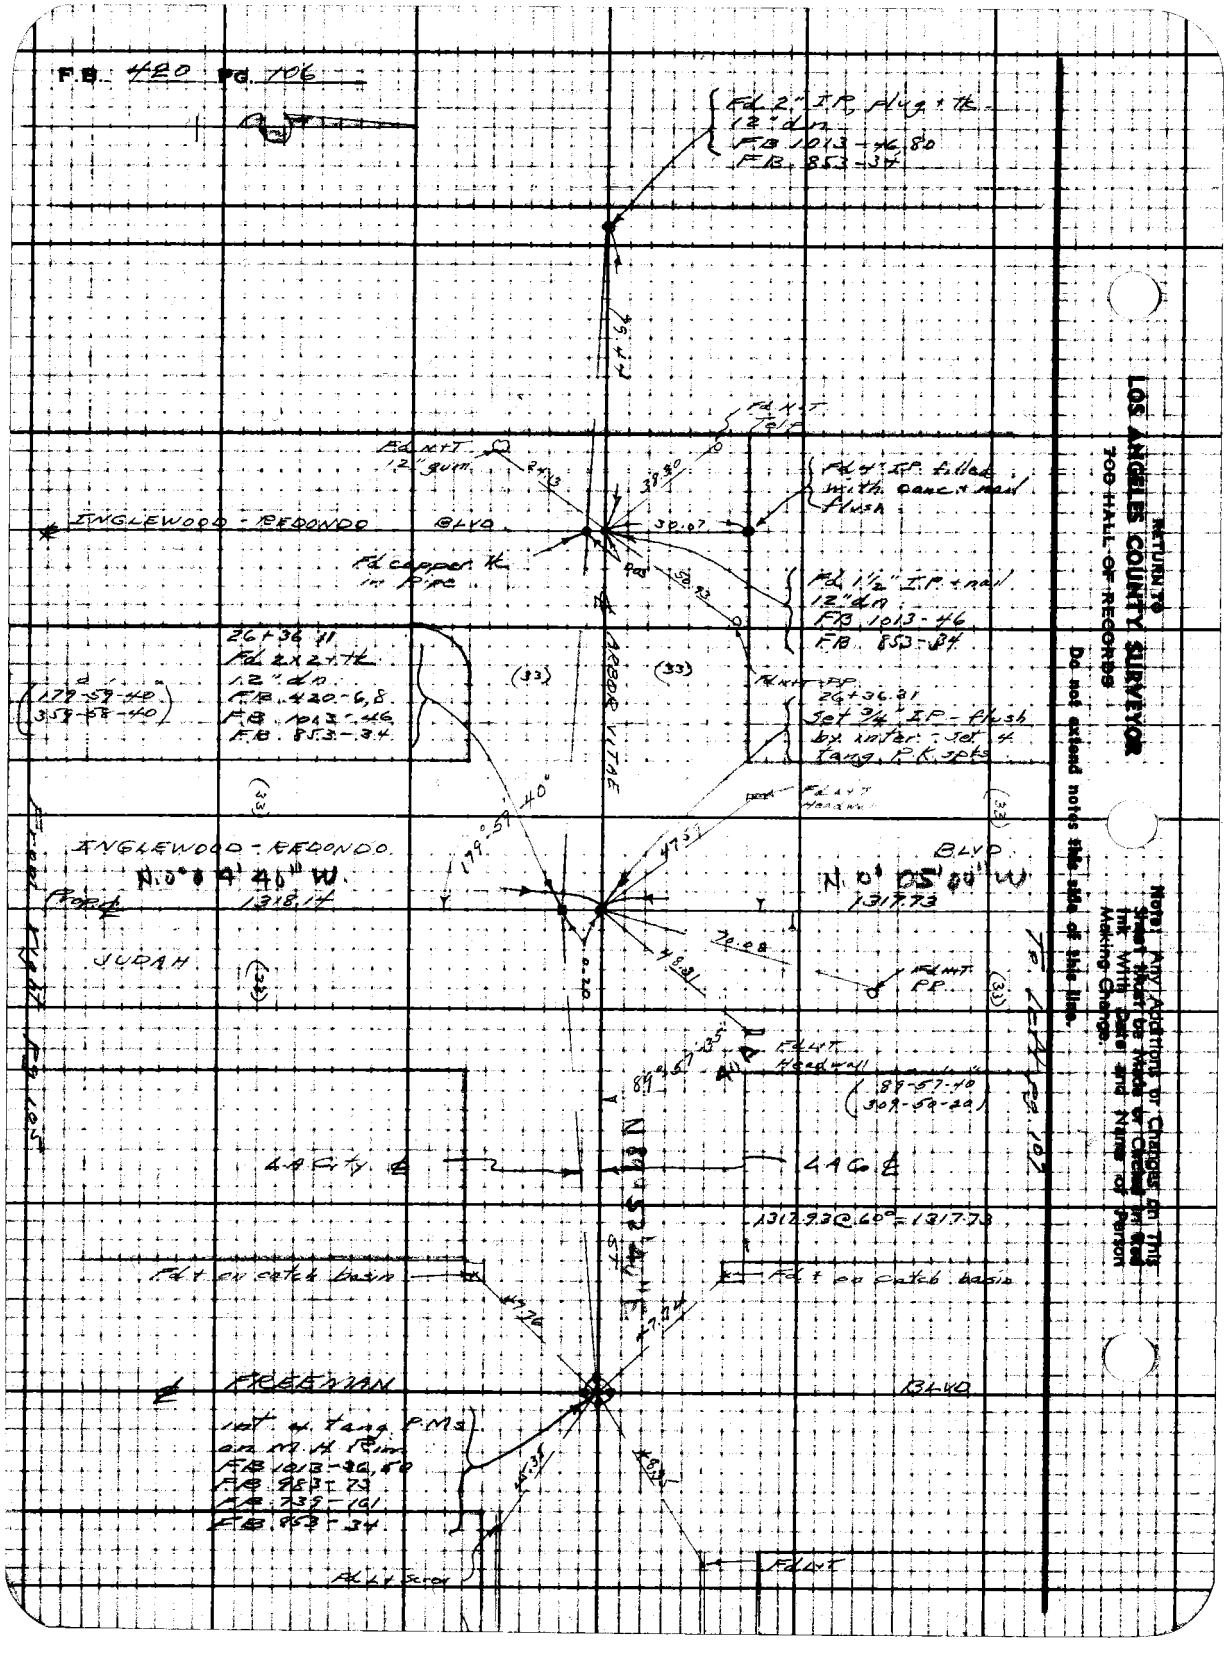
F.B. 420 Pg. 106
Fd 2" I.P. flush
12" dia
FB 1013-46, 80
FB 853-34
Fd MKT.
12" dia.
Fd 1" I.P. flush
with conc. mon.
Flush
INGLEWOOD - REDONDO BLVD.
Fd copper tk.
in Pipe
Fd 1½" I.P. + nail
12" dia
FB 1013-46
FB 853-34
26+36.41
Fd 2x2 tk
12" dia
FB 420-6,8
FB 1013-46
FB 853-34
ARBOR VITAE
Fd MKT. P.P.
26+36.31
Set ¾" I.P. flush
by water - Set ¾
Tang. P.K. Nail
ANGLEWOOD - REDONDO BLVD.
N 0° 04' 40" W
1318.14
N 0° 05' 00" W
1317.73
JUDAH
Fd MKT. P.P.
Fd MKT.
Fd MKT.
1317.73 @ 0.40 = 1317.73
Fd ½" on Calc'd Line
Fd ½" on Calc'd Basis
FREEMAN
Set MKT. Tang. P.M.S.
on MKT. 14' Line
FB 1013-46, 80
FB 853-34
FB 1013-46
FB 853-34
Fd MKT.
LOS ANGELES COUNTY SURVEYOR
RETURN TO
708 HALL OF RECORDS
Do not extend notes this side of this line.
Note: Any Additions or Changes on This Sheet Must Be Made or Checked in Red Ink With Date and Name of Person Making Change.

Notes Ck'd by: [illegible]
Map No. R-4556
Office Work: [illegible]
Checked: [illegible]
Date: Feb. 1944

Survey of: Eagle-Redondo blvd
W. O. 7955 Tape No. 07 St'd 84°F
Surveyed by: Moore
Notes: Moore Date 1-7-44
Indexed: A. C. Johnson

F.B. 420 Pg. 107

Note: Any Additions or Changes on This Sheet Must be Made or Circled in Red Ink With Date and Name of Person Making Change.

RETURN TO
LOS ANGELES COUNTY SURVEYOR
700 HALL OF RECORDS
Do not extend notes this side of this line.

FORM 247 BM 10-58

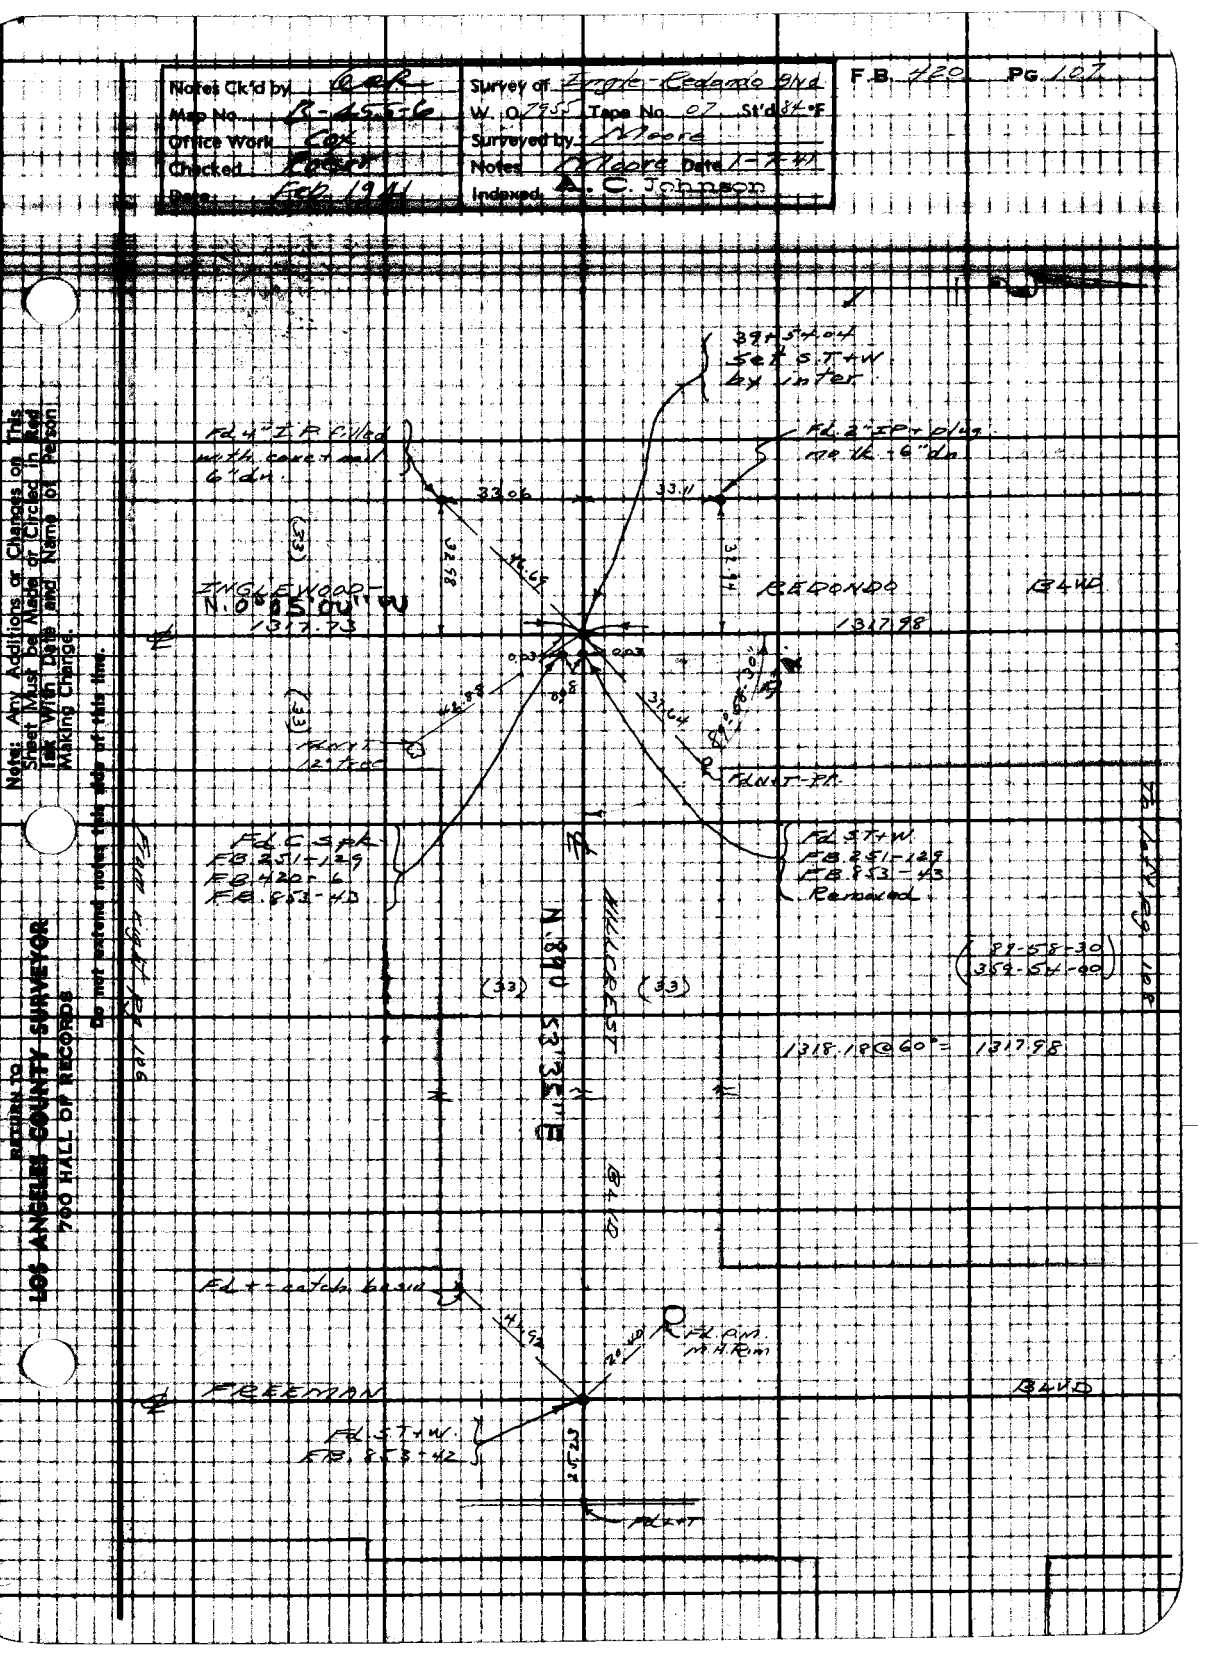

F.B. 420 Pg. 108

To East Pg 109

RETURN TO
LOS ANGELES COUNTY SURVEYOR
900 HALL OF RECORDS

Do not append notes this side of this line

Note: Any Additions or Changes to This Sheet Must be Made or Dated and Signed in Ink With Date and Name of Person Making Change.

ATSF R/W

MARCHESITE

(50)

(50)

INGLEWOOD

(38)

1317.98

(33)

N.0° 05' W

REDONDO BLVD

388.44

5.2+72.02
FD. spk
FB. 251-69
FB. 282-25
FB. 285-70
FB. 853-47
FD. FB. 50-137

FD. 1/2" IP

FD. 3/4" IP

40.08 rad.

40.08 rad.

40.08 rad.

40.08 rad.

90° 00' 00"

N. 89° 54' 50" E.

388.42 @ 44° = 388.44

29-09-20
360-24-00

FD. 1" IP
Fica Mon

0.30

McCARTHUR ST.

FREEMAN

BLVD

FD. 1" IP

FD. 1" IP

1.47' ± to sq. ts
e.o. in Fence
FB. 1913-24
FB. 285-13P
FB. 853-46

Notes Ck'd by: Clark
Map No. Redondo
Office Work: Cox
Checked: Foster
Date: Feb. 1944

Survey of: Torrance - Redondo Blvd.
W. O. 745 Tape No. 97 Std. 84°F
Surveyed by: Pollard
Notes: Pollard Date 1-7-44
Indexed: A. C. Johnson

F.B. 420 Pg. 108

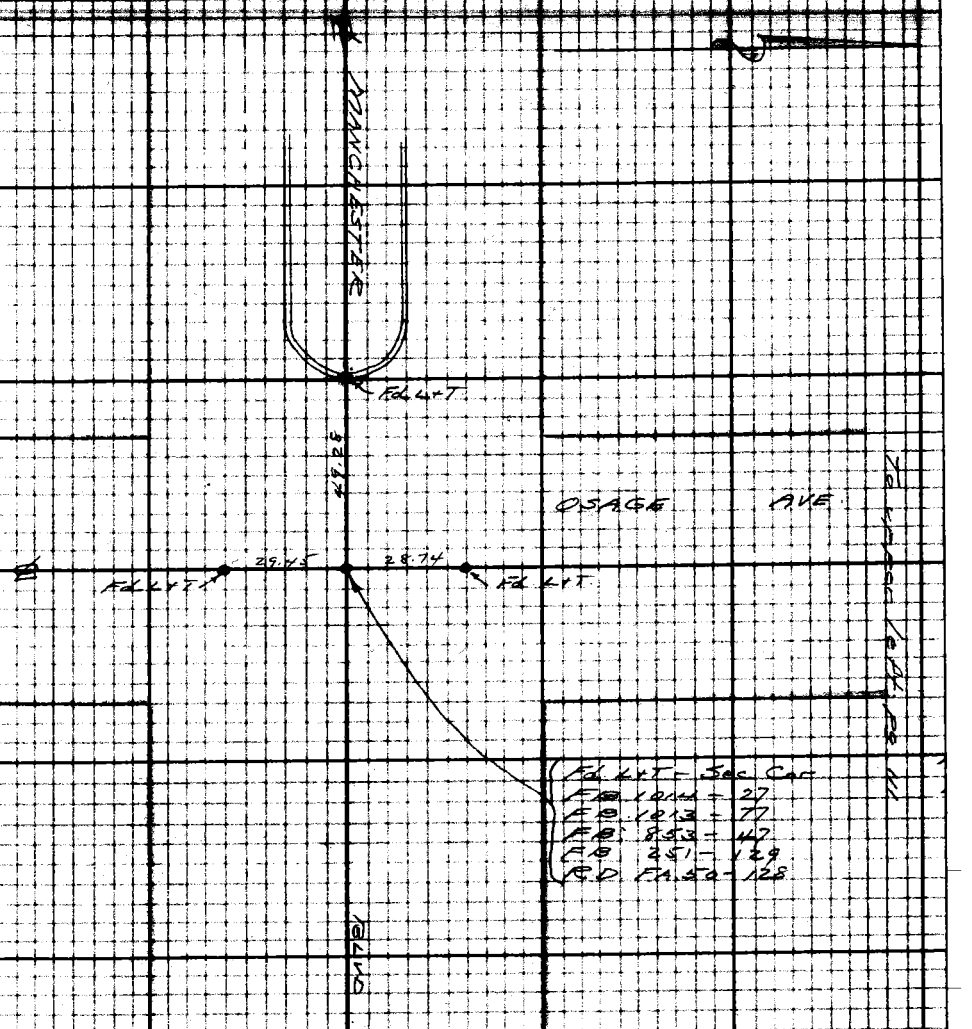

From top pg. 108

Note: Any Additions or Changes on This Sheet Must be Made or Circled in Red Ink with Date and Name of Person Making Change.

Do not extend notes this side of this line.

RETURN TO
LOS ANGELES COUNTY SURVEYOR
700 HALL OF RECORDS

FORM 247 BM 10-58

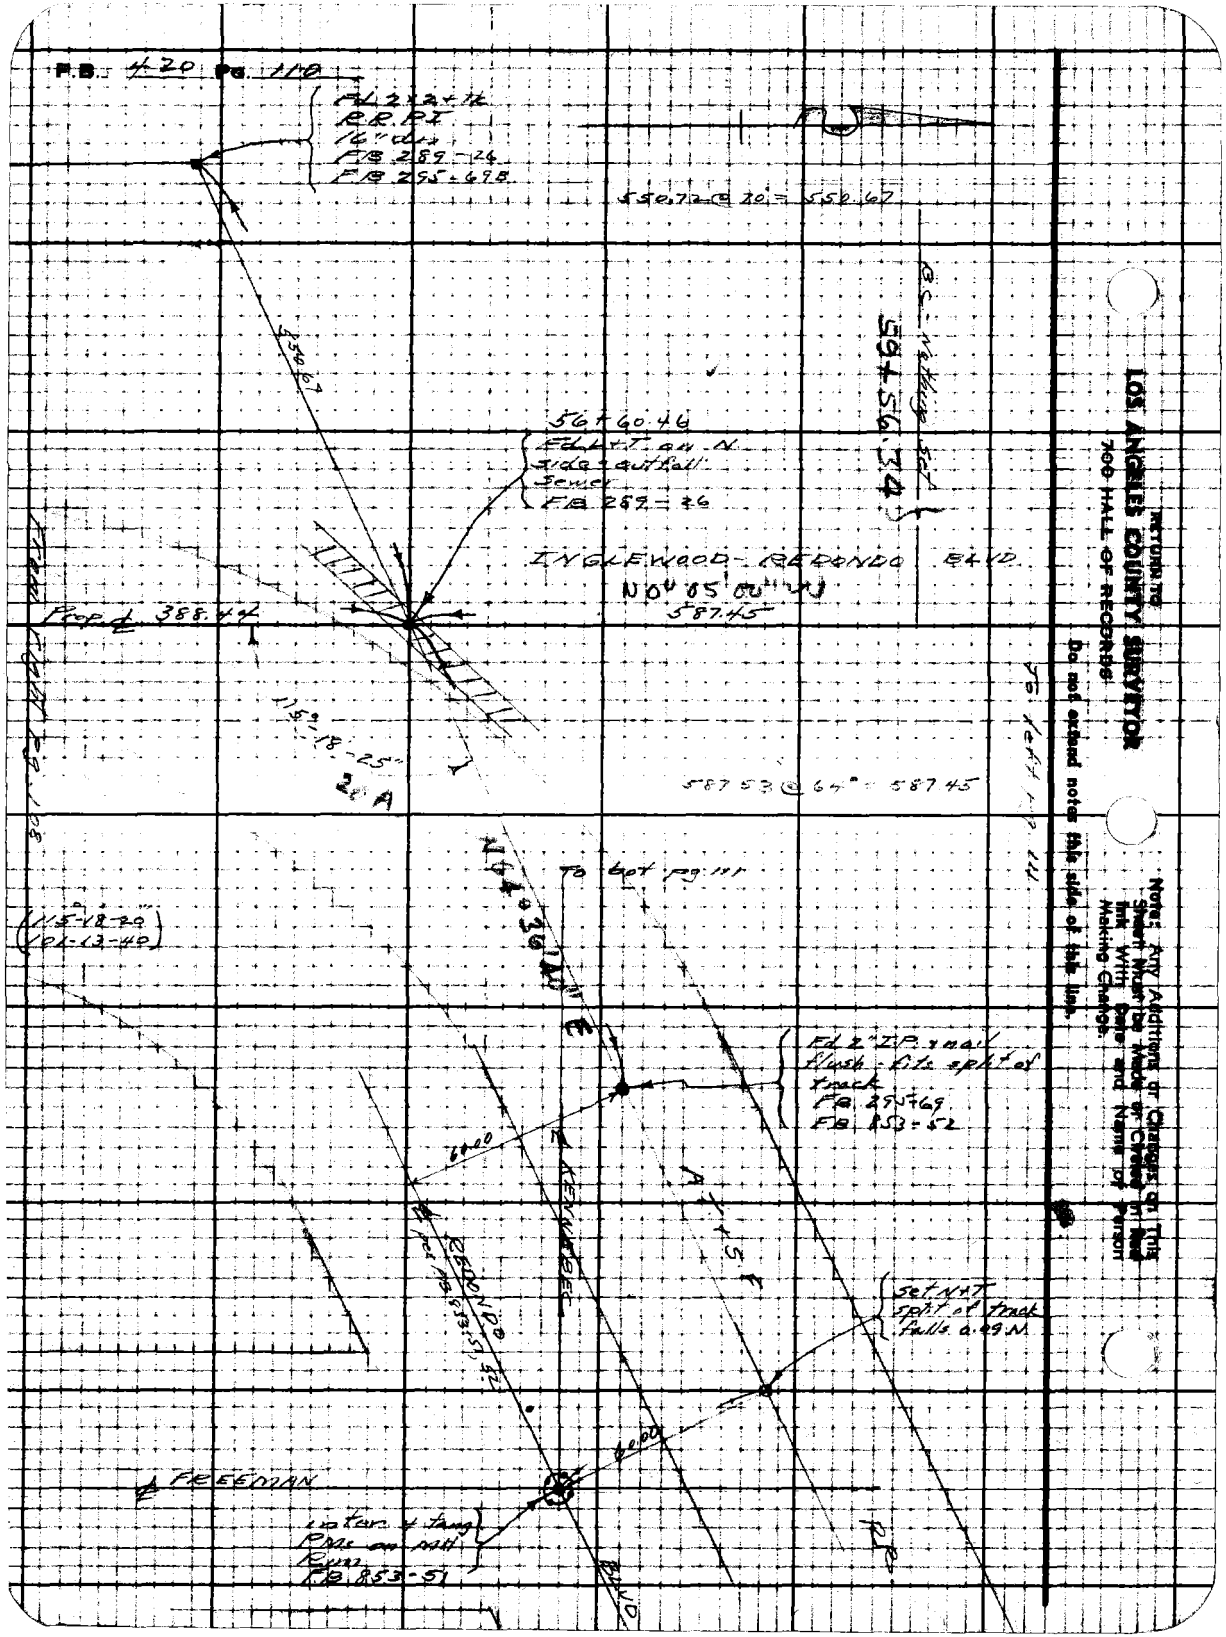
P.B. 420 Pg. 1110
Fd 2 x 2 x 14
R.R.P.K.
14" Ulm
FB 289-24
FB 295-698
550.72 @ 20° = 550.67
594.56.34
56+60.46
Fd L.T. on N. side of gutter
Sewer
FB 282-26
INGLEWOOD-REDONDO BLVD.
N0°05'00"W
587.45
Prop. ℄ 388.402
115°18'25"
587.53 @ 64° = 587.45
To Sht. Pg. 111
N44°36'00"E
Fd 2" IP. x nail flush, 0.1± east of track
FB 294-69
FB 853-52
A 115 F
Set N.T. east of track Falls 0.09 N.
REDONDO BLVD.
FREEDMAN
Fd Tack & Tag Pipe on path
FB 853-51
(115°18'29" 101-13-40)
RETURN TO
LOS ANGELES COUNTY SURVEYOR
769 HALL OF RECORDS
Do not extend notes this side of this line.
Note: Any Additions or Changes or This Sheet Must Be Made or Caused to Be Made by Writing Date and Name of Person Making Change.

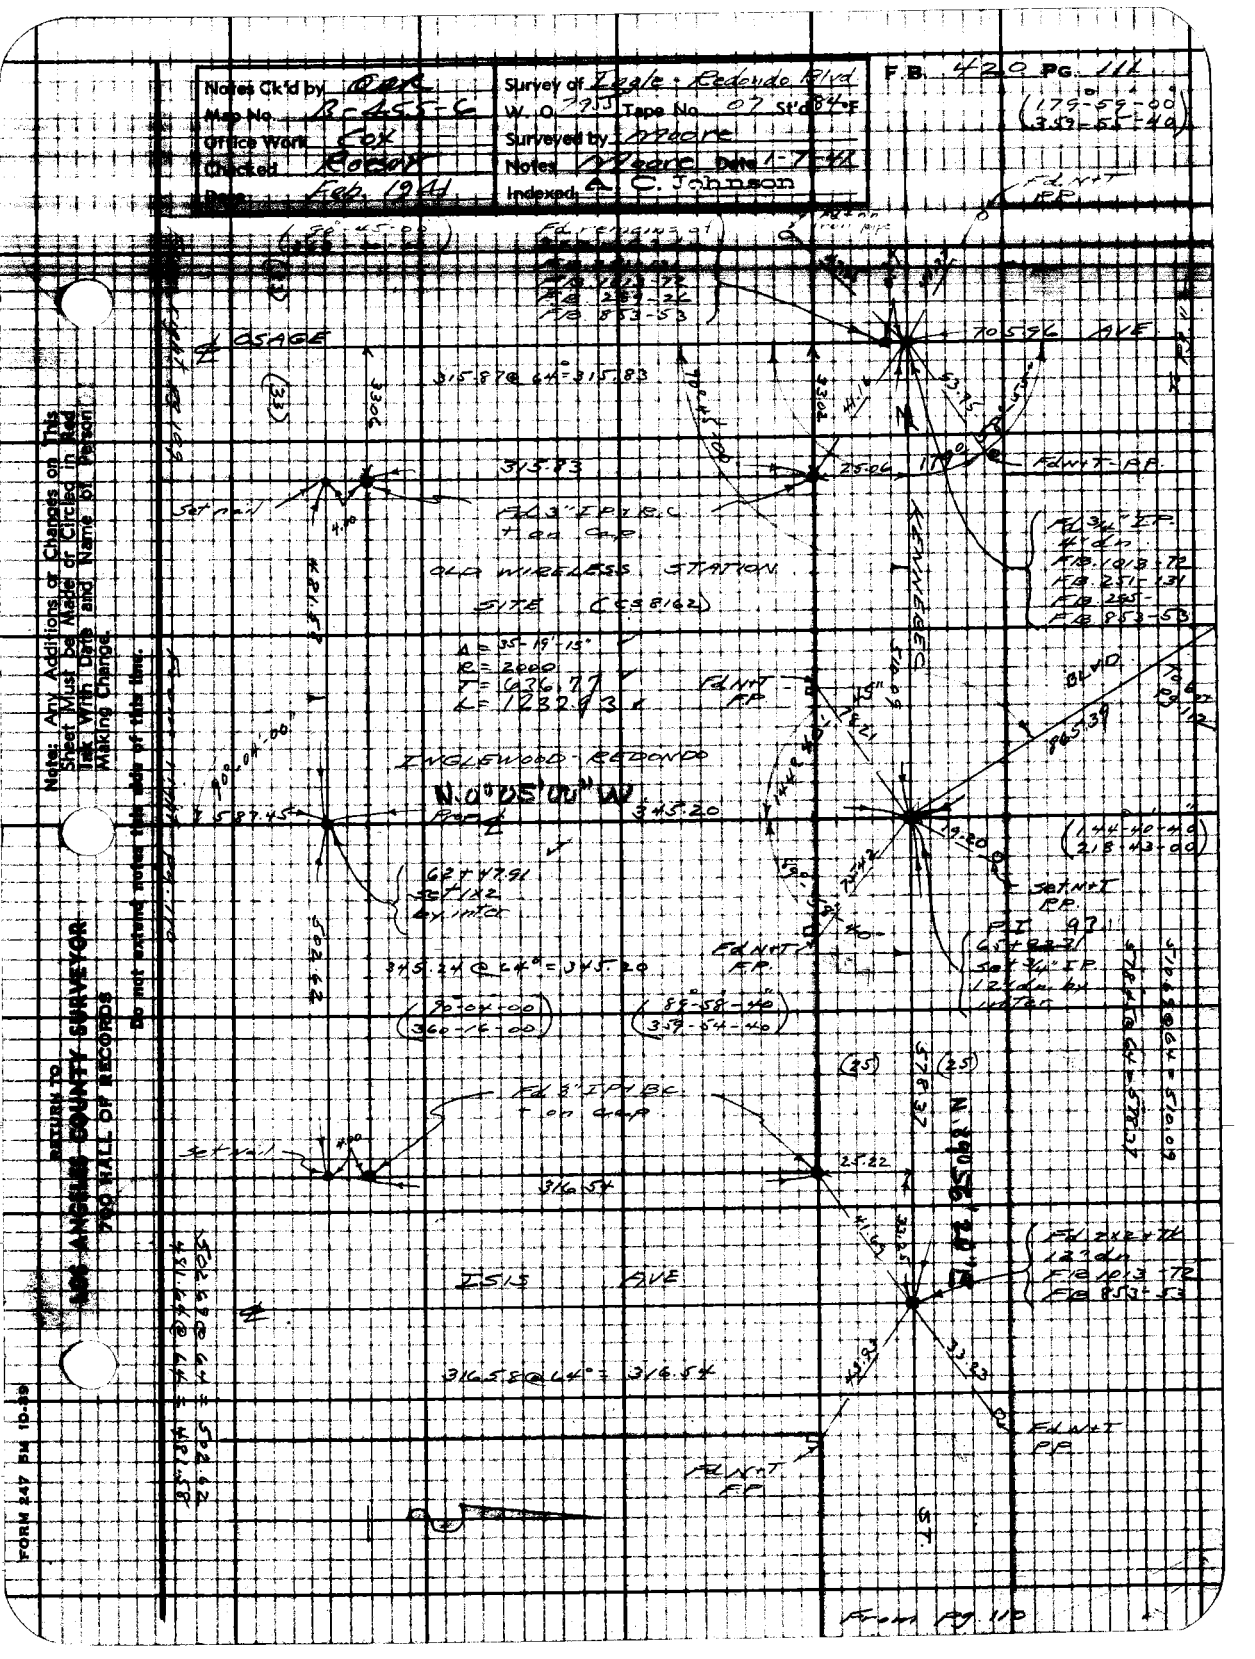
Notes Ck'd by
Map No. R-45-6
Office Work
Checked
Date Feb. 1911
Survey of Eagle - Redondo Blvd
W.O. 7255 Tape No. 07 St'd 84°F
Surveyed by Meade
Notes Meade Date 1-7-11
Indexed C. Johnson
F.B. 420 Pg. 114
Note: Any Additions or Changes on This Sheet Must be Made or Circled in Red Ink With Date and Name of Person Making Change.
Do not extend notes this side of this line.
RETURN TO
LOS ANGELES COUNTY SURVEYOR
900 HALL OF RECORDS
FORM 247 BM 10-59
N.0°05'00" W
Δ = 35°19'15"
R = 2000
T = 636.77
L = 1232.93
OLD WIRELESS STATION
SITE
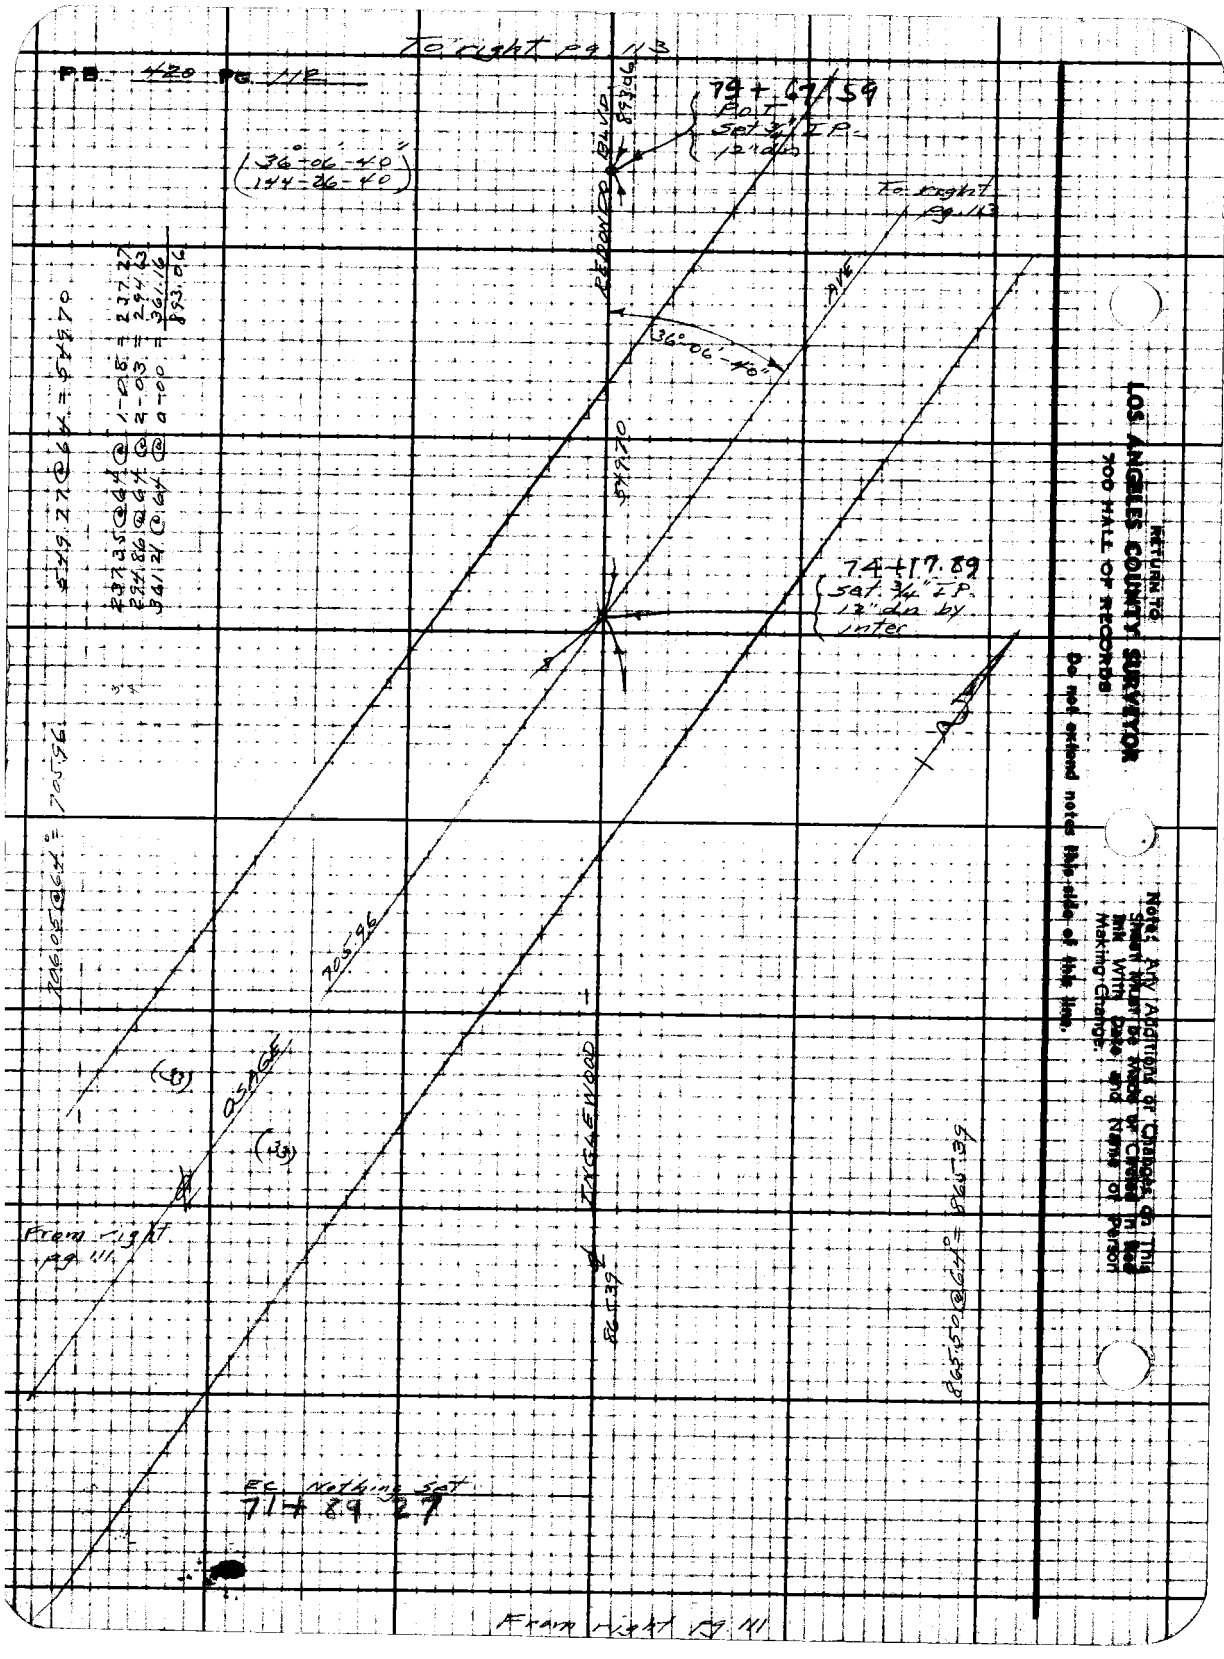
To right pg 113
P.B. 420 Pg. 11&12
79+67.59
Bolt
Set 3/4" I.P.
12" dn by
Inter
(36°-06'-40")
(144°-06'-40")
To right
pg 113
36°-06'-40"
74+17.89
Set 3/4" I.P.
12" dn by
Inter
LOS ANGELES COUNTY SURVEYOR
700 HALL OF RECORDS
RETURN TO
Do not extend notes this side of this line.
Notes, Any Additions or Changes on This Sheet Must Be Made Up Check in Red Ink With Date and Name of Person Making Change.
From right pg 111
EC Nothing Set
71+89.27
From right pg 111

Notes Ck'd by: RAK
Map No: A-455-6
Office Work: CAK
Checked: RAK
Date: Feb 1941

Survey of: Topo Cad 13/4d
W. O. 7755 Tape No. St'd 62°F
Surveyed by: Meeks
Notes: Meeks Date: 1-16-41
Indexed: [illegible]

F.B. 420 Pg. 113

Note: Any Additions or Changes on This Sheet Must be Made or Circled in Red Ink With Date and Name of Person Making Change.

RETURN TO
LOS ANGELES COUNTY SURVEYOR
700 HALL OF RECORDS
Do not detach notes this side of this line.

FORM 247 BW 10-58






























RETURN TO
LOS ANGELES COUNTY SURVEYOR
700 HALL OF RECORDS

Note: Any Additions or Changes on This Sheet Must be Made or Circled in Red Ink With Date and Name of Person Making Change.

Do not extend notes this side of this line.

F.B. 4320 Pg. 1145

Notes Ck'd by	Survey of Inglewood Blvd
Map No. R-865-6	W. O. 7855 Tape No. St'd. °F
Office Work Cpk	Surveyed by Moore
Checked Chester	Notes Moore Date 4-27-64
Date 5-18-64	Indexed A. G. Johnson

F.B. 432 Pg. 115

TOPOGRAPHY
ON
INGLEWOOD-REDONDO BLVD.
FROM
CENTURY BLVD.
NORTH TO
LA TIJERA BLVD.
JOB # 7855

RETURN TO
LOS ANGELES COUNTY SURVEYOR
700 HALL OF RECORDS

Note: Any Additions or Changes on This Sheet Must Be Made or Circled in Red Ink With Date and Name of Person Making Change.

Do not extend notes this side of this line.

FORM 247 ISM 10-63

To Bk 4 pg 117

F.B. 420 pg 116

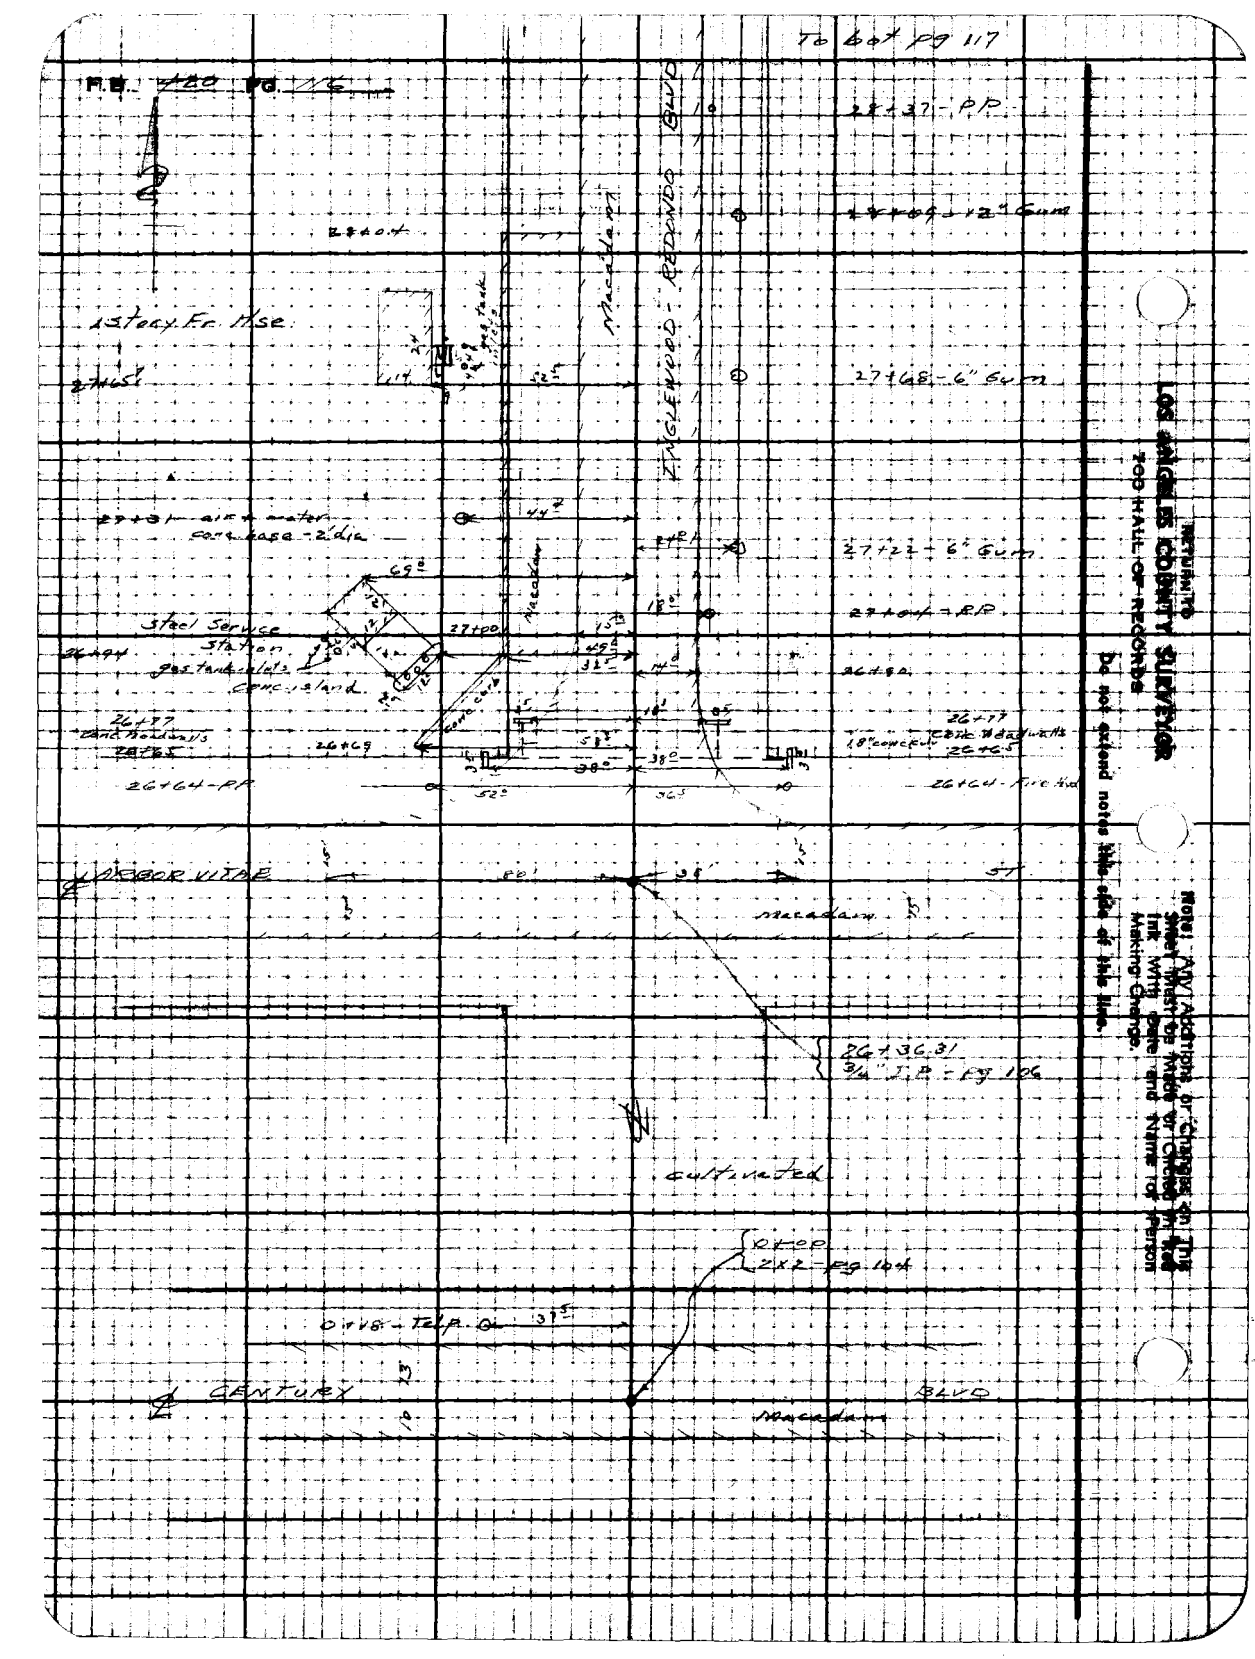

RETURN TO
LOS ANGELES COUNTY SURVEYOR
TOP HALF OF RECORDS
Do not extend notes into this area

NOTE: ANY Additions or Changes on This Sheet Must Be Made or Checked in Ink With Date and Name of Person Making Change.

Notes Ck'd by

Indexed [illegible]

F.B. 420 Pg. 117

Note: Any Additions or Changes on This Sheet Must be Made or Circled in Red Ink With Date and Name of Person Making Change

RETURN TO
LOS ANGELES COUNTY SURVEYOR
700 HALL OF RECORDS
Do not extend notes this side of this line.

FORM 247 BM 10-58

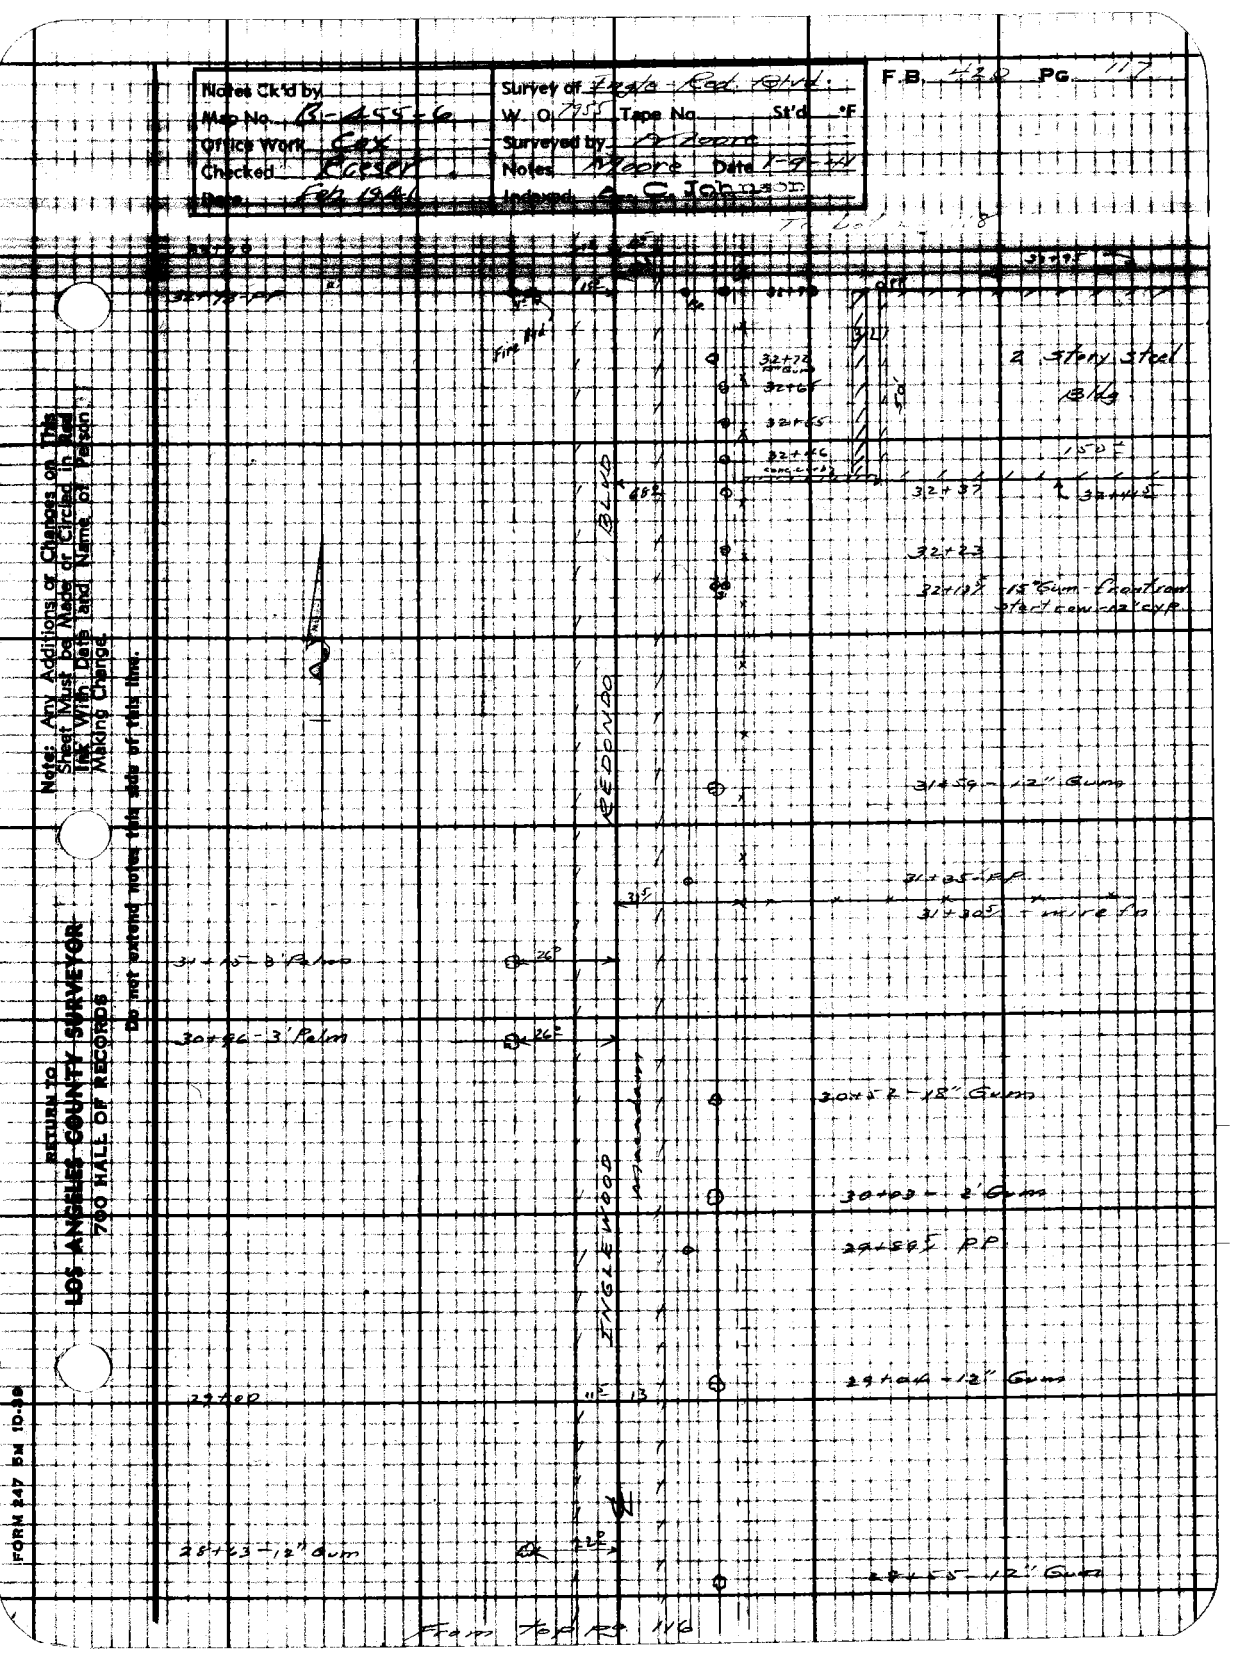

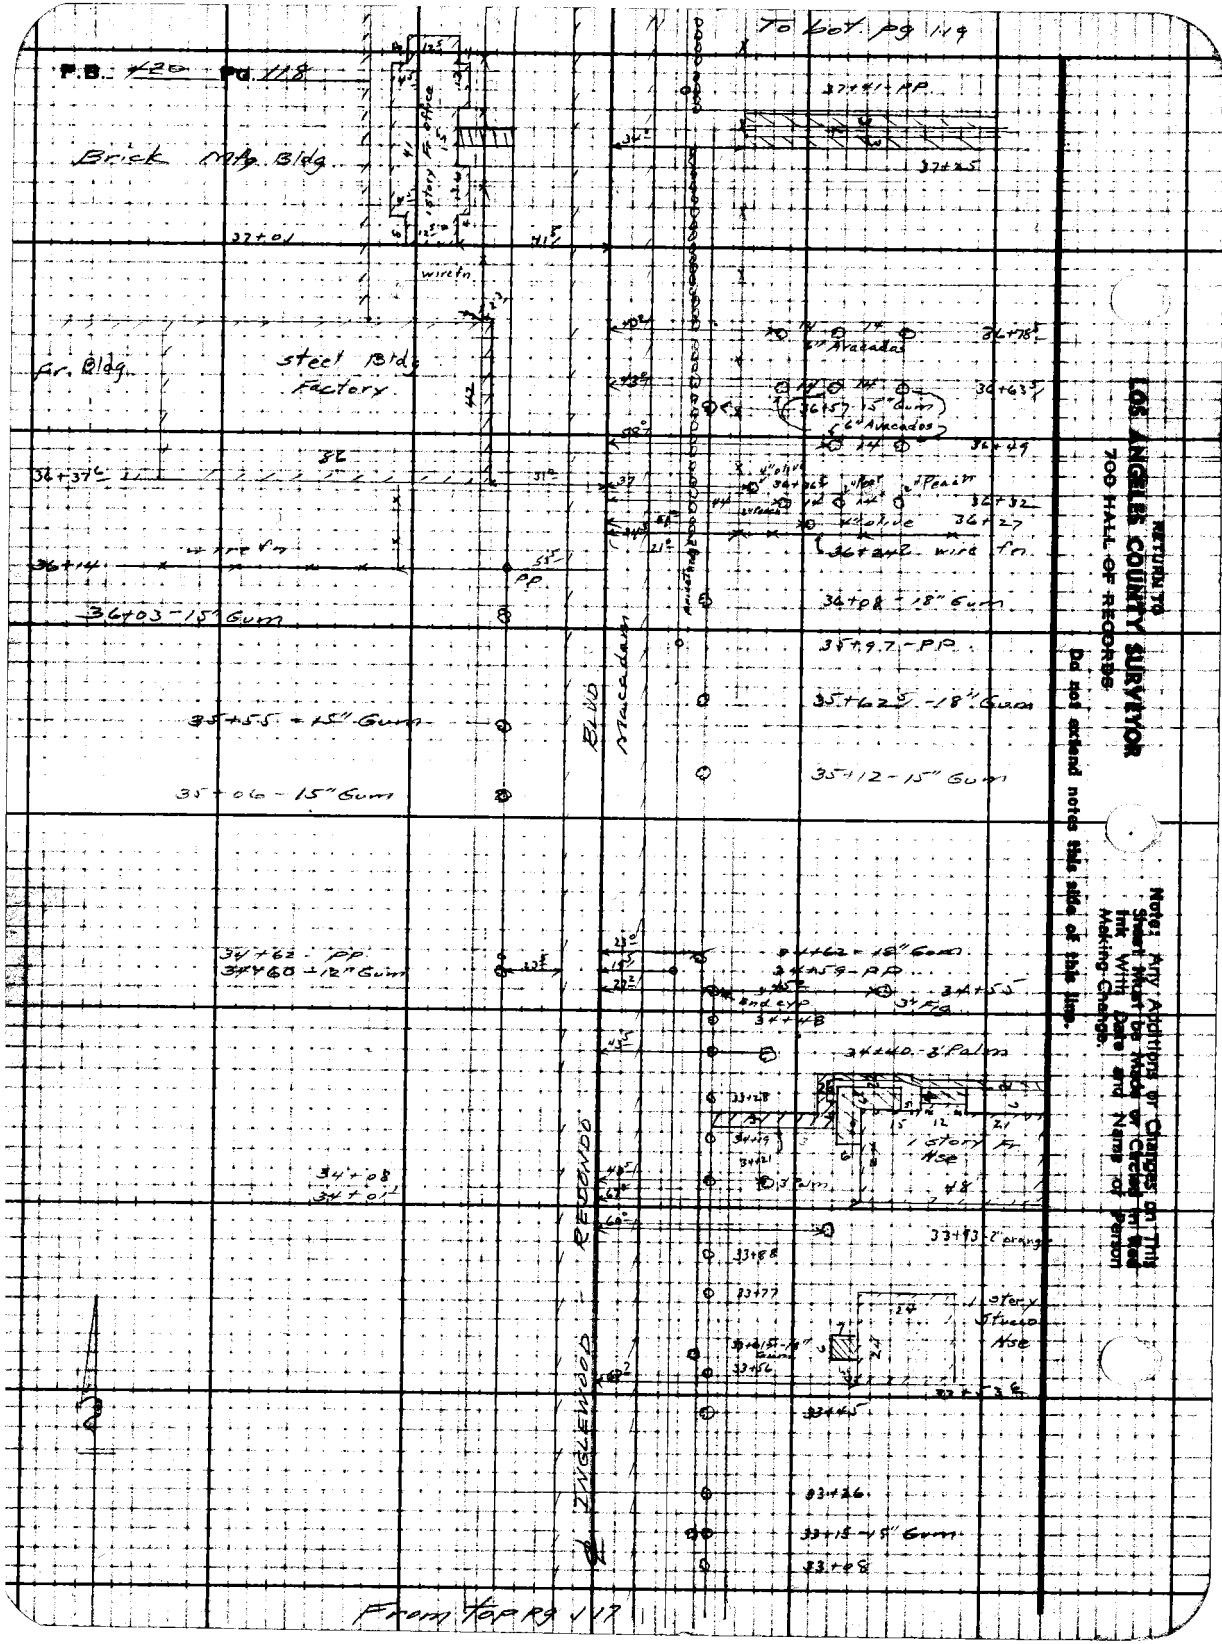
To Lot Pg 119
F.B. 420 Pg. 118
Brick Mfg. Bldg.
Gr. Bldg.
Steel Bldg. Factory
Wire fn.
Pipe fn.
Wood fn.
Redondo Blvd
Inglewood
From Map Pg 117
RETURN TO
LOS ANGELES COUNTY SURVEYOR
700 HALL OF RECORDS
Do not extend notes this side of this line.
Notes: Any Additions or Changes on This Sheet Must Be Made or Circled in Red Ink With Date and Name of Person Making Change.

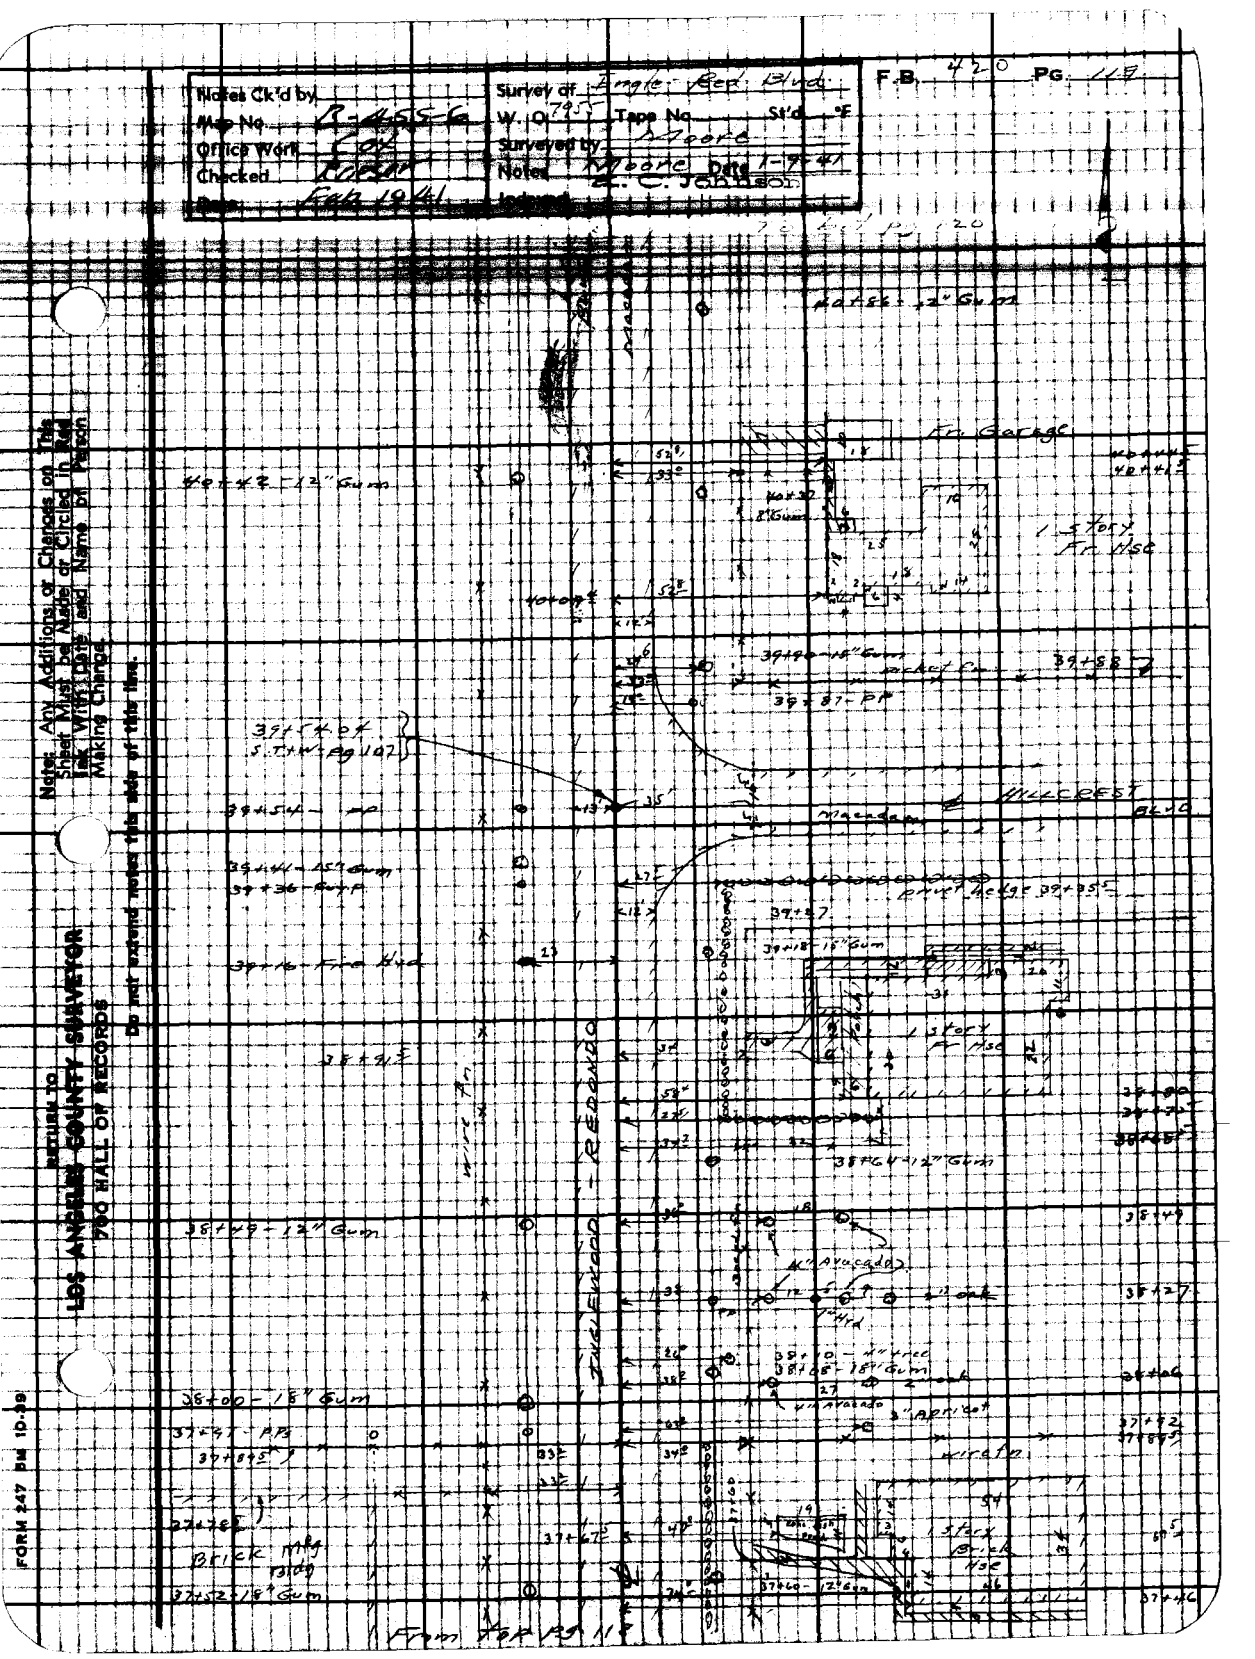
Notes Ck'd by
Map No R-4465-6a
Office Work OK
Checked Robert
Date Feb 19 41
Survey of Angeles Blvd.
W. O. 795-1 Tape No St'd °F
Surveyed by Moore
Notes Moore Date 1-7-41
L. C. Johnson
Indexed
Note: Any Additions or Changes on This Sheet Must be Made or Circled in Red Ink With Date and Name of Person Making Change.
Do not extend notes this side of this line.
RETURN TO
LOS ANGELES COUNTY SURVEYOR
700 HALL OF RECORDS
FORM 247 Rev 10-39
Fr. Garage
1-Story Fr. Misc
Macadam
Brick Bldg

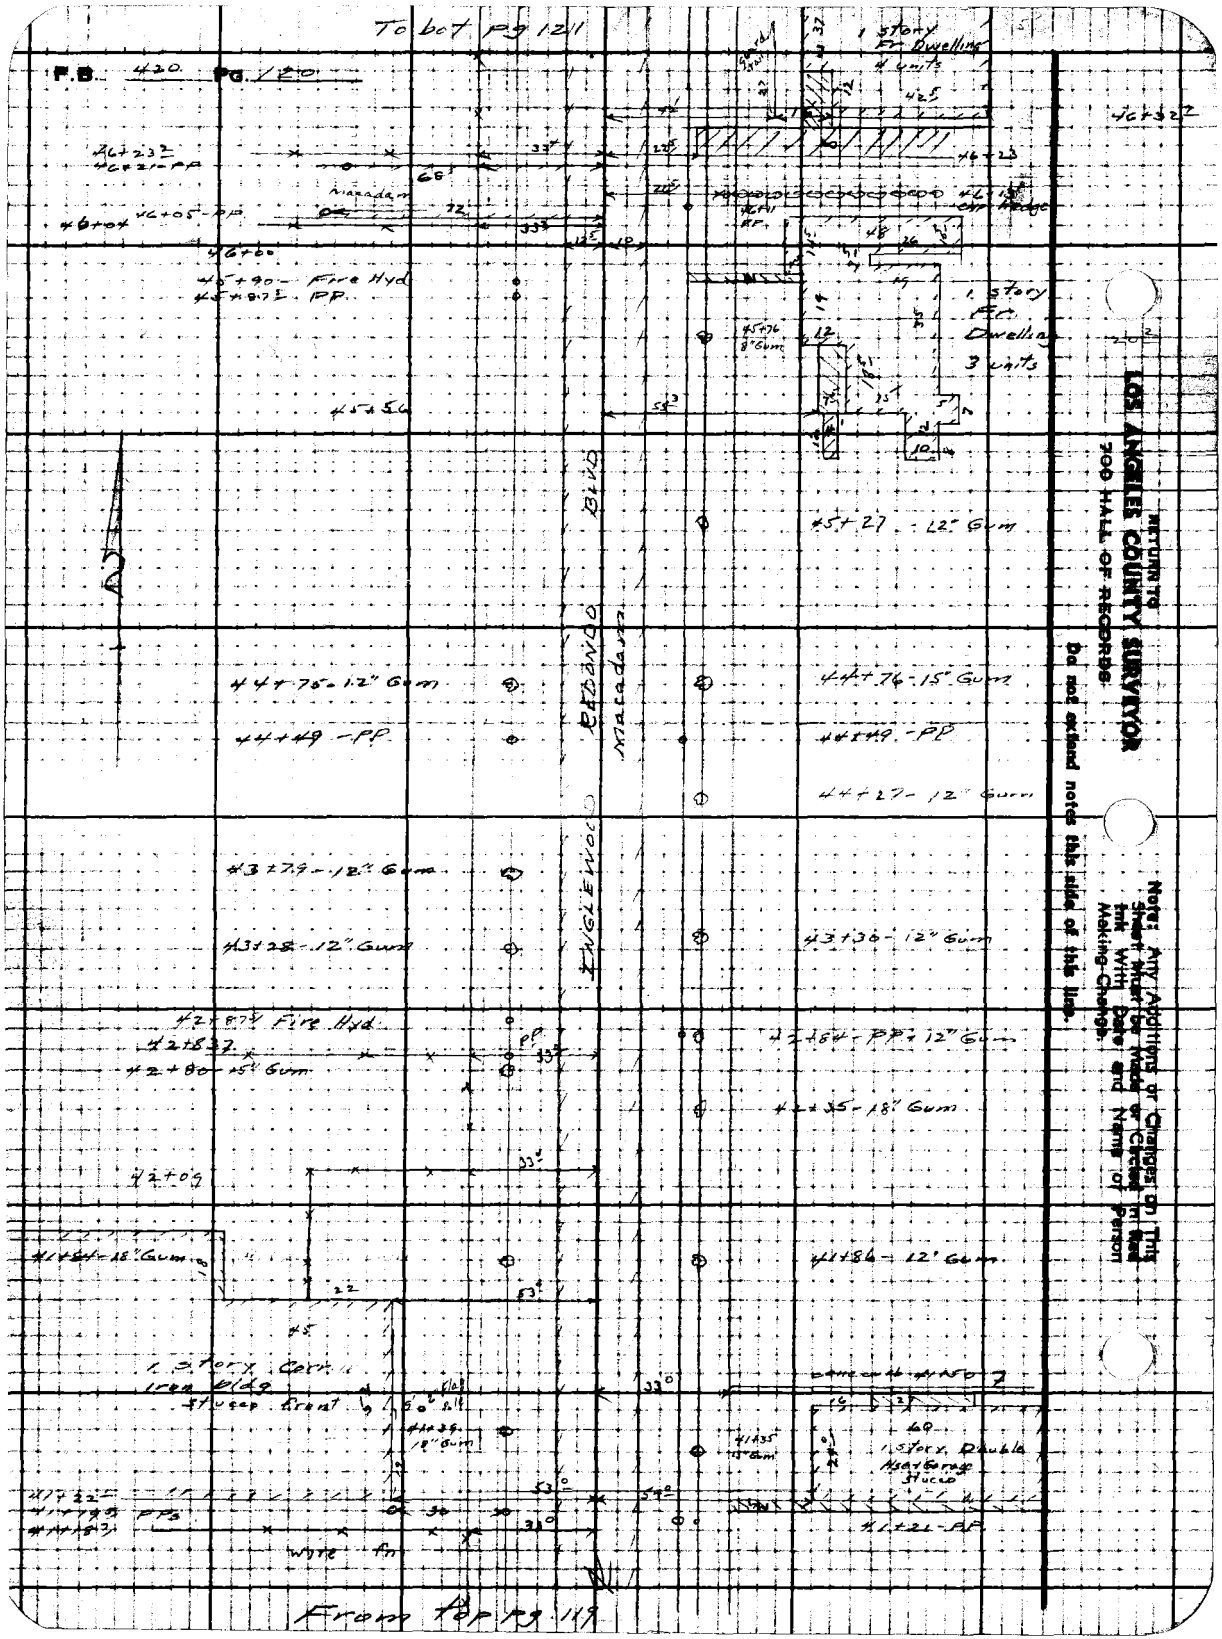
To bot pg 121
F.B. 420 Pg. 120
1 Story Ft. Dwelling 4 units
#6+32
#6+23
#6+23
#6+05 - PP
#6+00
#5+90 - Fire Hyd
#5+81 - PP
#5+56
#5+76 8" Gum
1 Story Ft. Dwelling 3 units
#5+27 - 12" Gum
#4+75 - 12" Gum
#4+49 - PP
#4+76 - 15" Gum
#4+49 - PP
#4+27 - 12" Gum
#3+79 - 12" Gum
#3+28 - 12" Gum
#3+30 - 12" Gum
#2+87½ Fire Hyd
#2+83.7
#2+80 - 5" Gum
#2+65 - PP - 12" Gum
#2+35 - 18" Gum
#2+09
#1+84 - 12" Gum
#1+84 - 18" Gum
#1+35 - 18" Gum
#1+22 - AP
#1+22 - PP
#0+83 - PP
White Fir
Macadam
Englewood
LOS ANGELES COUNTY SURVEYOR
700 HALL OF RECORDS
RETURN TO
Do not extend notes this side of this line.
Note: Any Additions or Changes on This Sheet Must be Made or Checked in Ink With Date and Name of Person Making Change.
From top pg 119



Note: Any Additions or Changes on this Sheet Must be Made or Circled in Ink With Date and Name of Person Making Change.

Do not extend notes this side of this line.

RETURN TO
LOS ANGELES COUNTY SURVEYOR
700 HALL OF RECORDS

FORM 247 5M 10-39

Eagle Rock Blvd.

1 Story Ft. Use




1 Story Ft. Dwelling






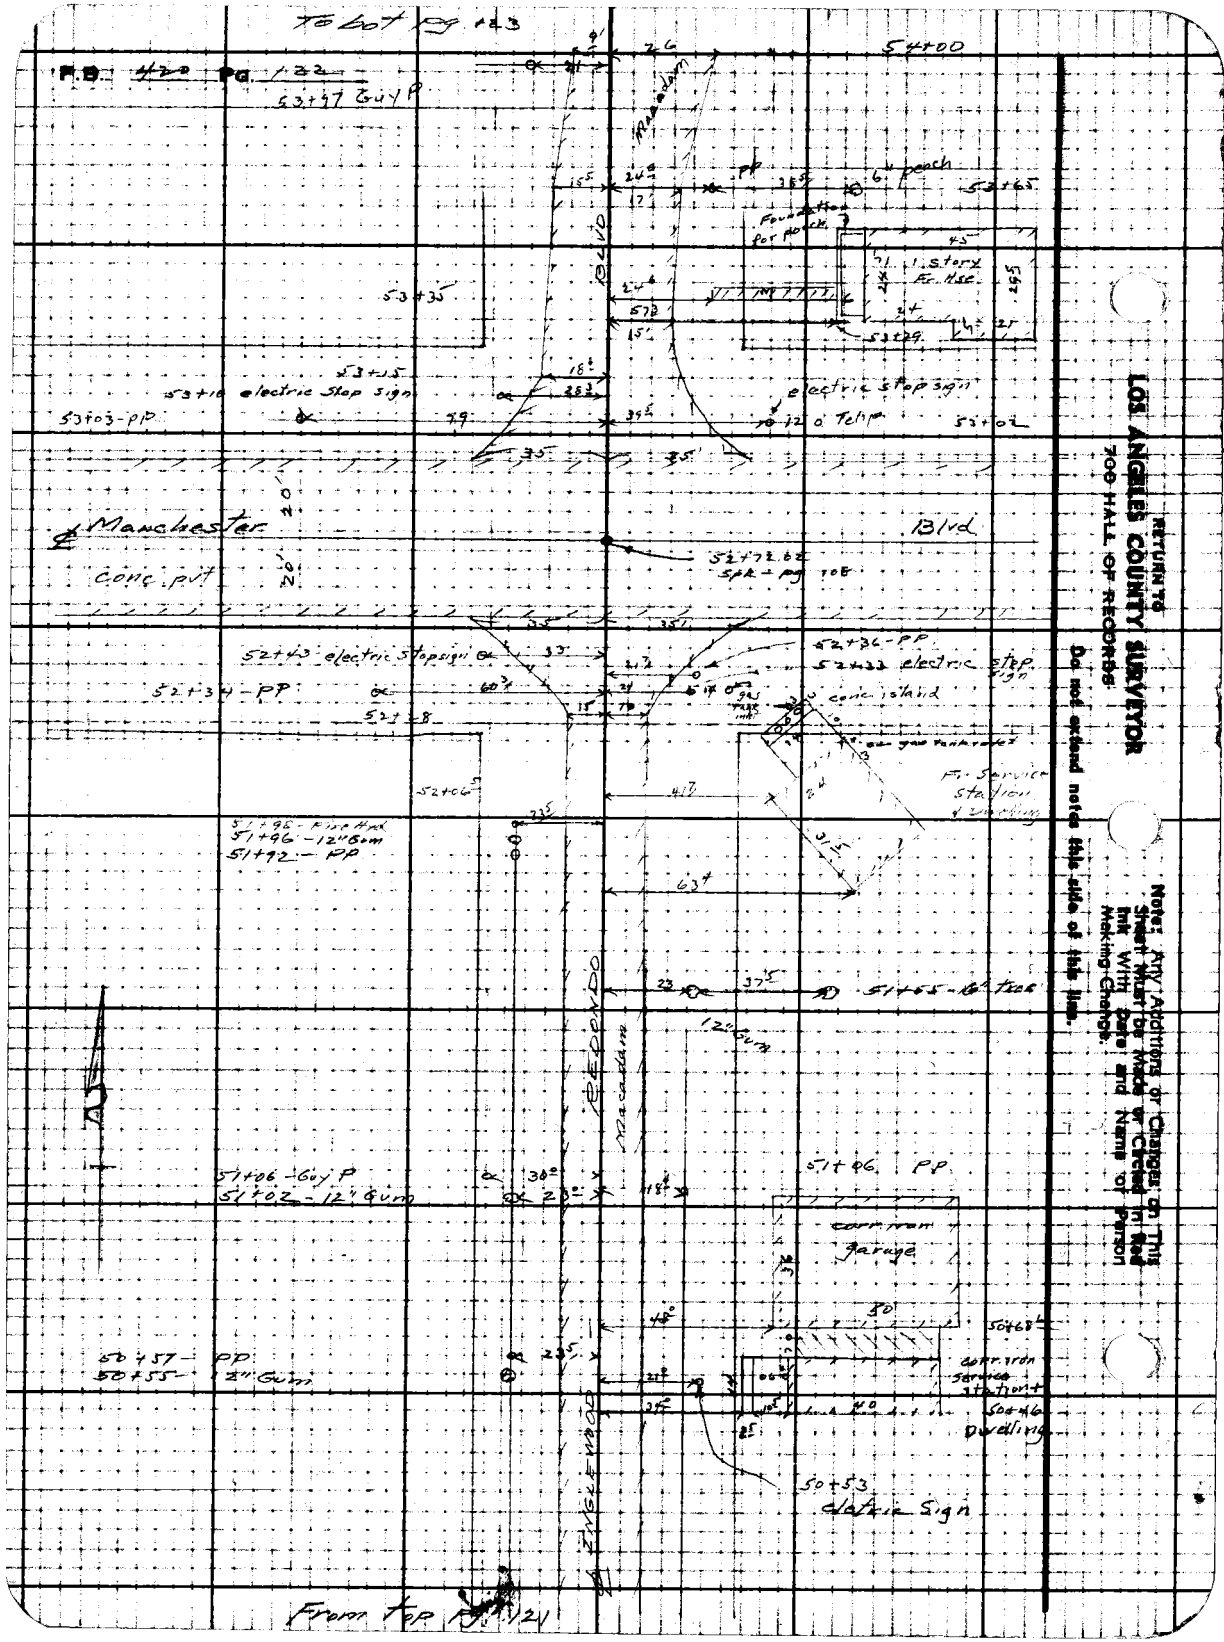

RETURN TO
LOS ANGELES COUNTY SURVEYOR
700 HALL OF RECORDS

Do not extend notes this side of this line.

Notes: Any Additions or Changes on This Sheet Must Be Made or Circled in Red Ink With Date and Name of Person Making Change.

Notes Ck'd by







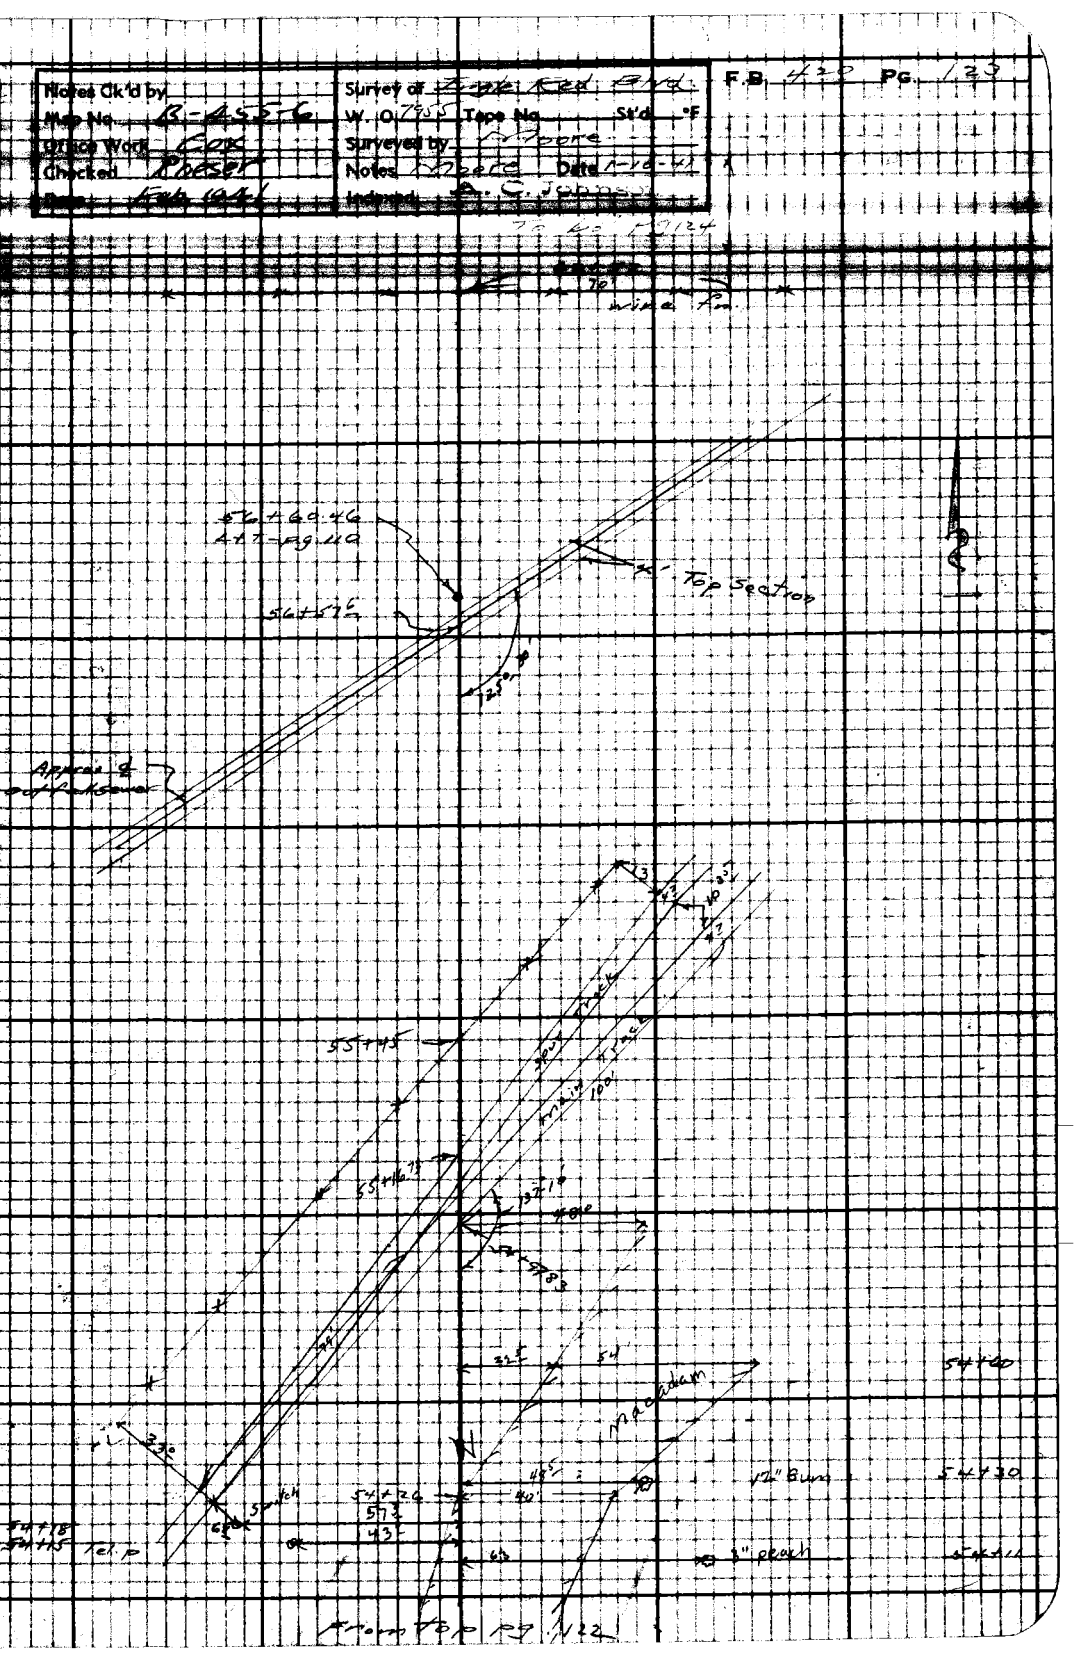

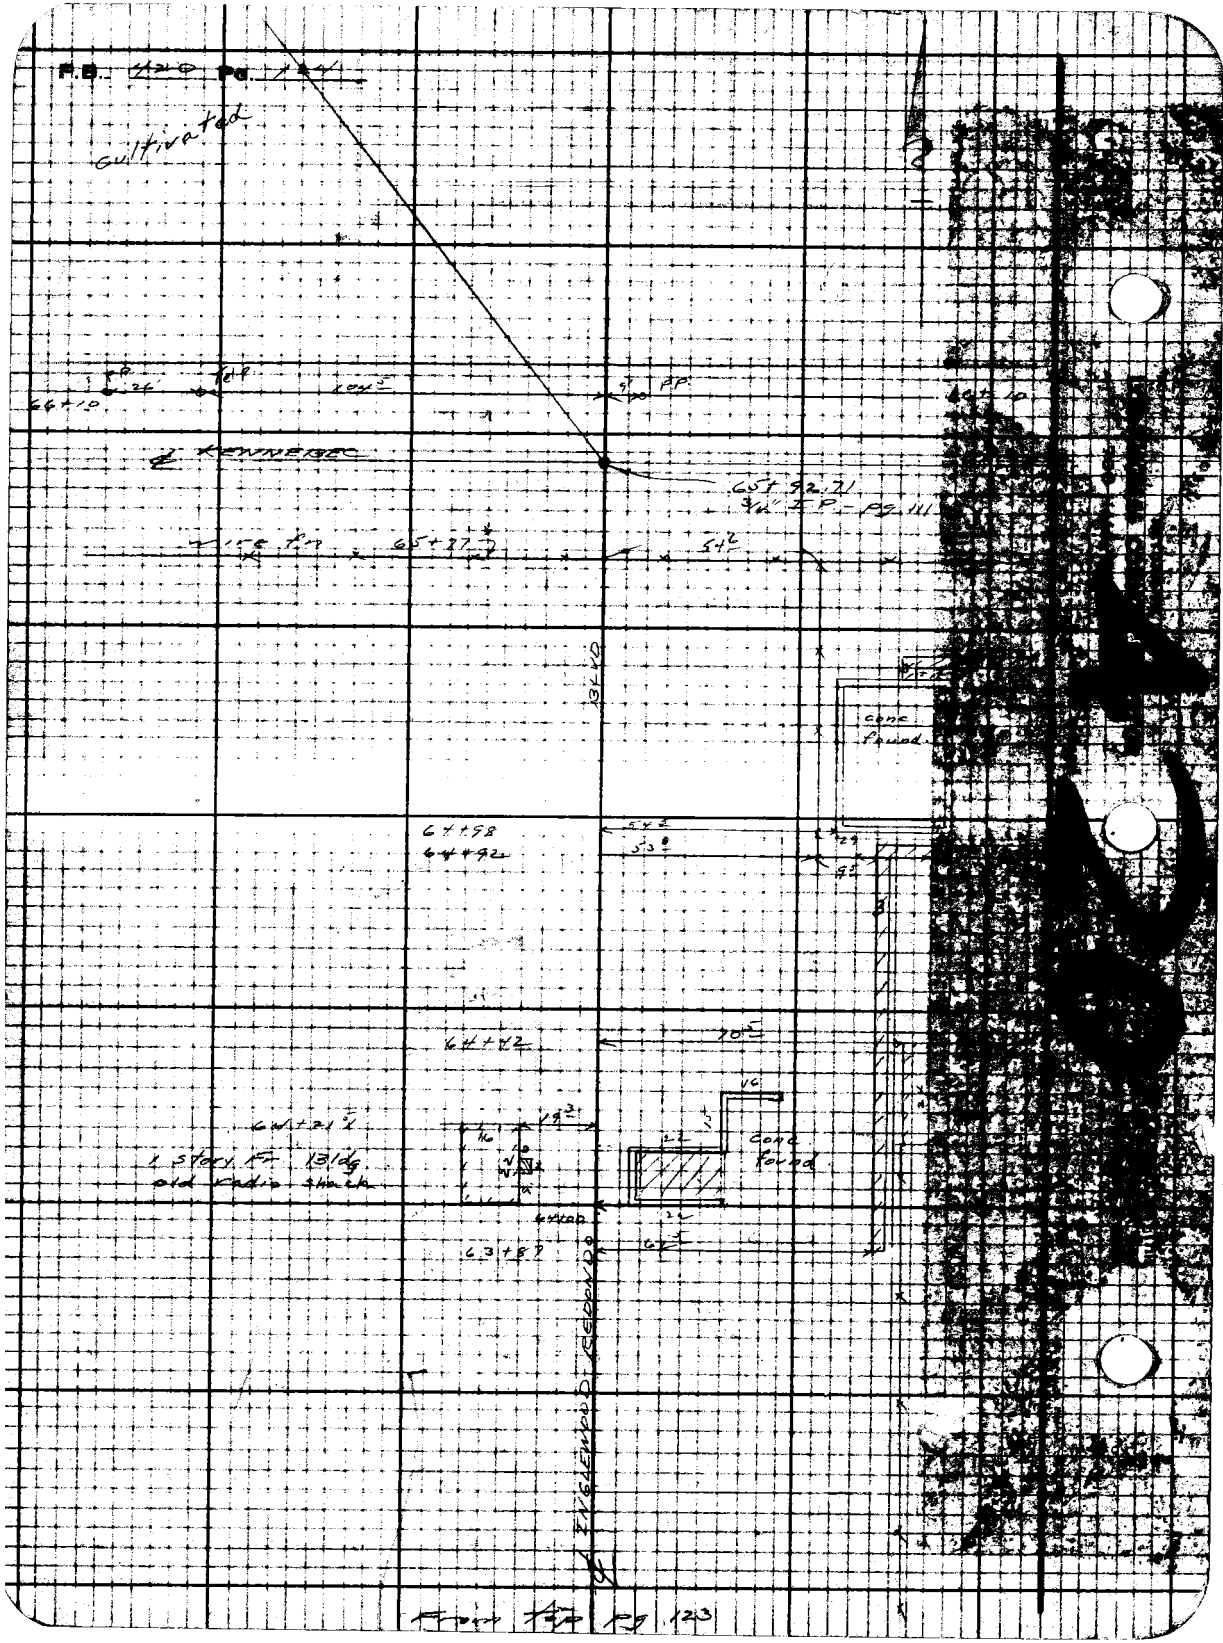
cultivated
65+92.71
3/4" I.P. Pg. 111
conc found
conc found
1 story 1=
