Notes by _____ Chief Party _____ F.B. _____ Pg. _____

Platted by _____	W. O. No. _____ D. S. O. No. _____
Date _____	Location _____
Map No. _____	Surveyed by _____
Platting C'k'd by _____	Date _____
Date _____	Indexed _____

A124

F.B. 424 Pg. Index Chief Party Notes by Date

F.B. 424

PAGES: Index, 1, 2, ,5 to 9 incl., , 11 to 16 incl., , 18 to 34 incl., , 37 to 108 incl., , 111, , 113 to 144 incl., 145 to 149 incl., , 151 to 171 incl.,

Date 10-10-29 Notes by Orra Chief Party Orra F.B. 424 Pg 1

Platted by A. Svenson	W. O. No. 920 D.S.B. No. 822
Date Aug 1930.	Location Riv. Redondo Rd
Map No. B-442-2	Surveyed by P.W. Atkins Dep
Platting C'k'd by D M Finley	Date Oct 22 1922
Date Nov. 1933.	Indexed A. C. Johnson

Notes: ANY ADDITIONS OR CHANGES ON THIS SHEET MUST BE MADE OR CIRCLED IN Red. WITH DATE AND NAME OF PERSON MAKING CHANGE.

Do not extend notes this side of this line

RETURN TO LOS ANGELES COUNTY SURVEYOR

SURVEY
of
RIVERSIDE REDONDO ROAD EXTENSION
(Continued)
from
ARLINGTON AVE
West
to
HERMOSA AVE

P.W. Atkins chief
C.C. Holliday Inst.
K.C. Fleisler Hd ch.
C.F. Withich R ch
P.T. Graham Hd ch

See F.B. 312-61 to 128
F.B. 399-1 to 122
For Final Adopted Center Line See F.B. 424-44 to 108

F.B. 424 Pg. 2 | Chief Party | Notes by | Date 10-22-29

INDEX MAP

See FB 312-62-63-64-65-66-67-
also
FB 399-1-2

RETURN TO
LOS ANGELES COUNTY SURVEYOR

Do not extend notes this side of this line

Note: ANY ADDITIONS OR CHANGES ON THIS SHEET MUST BE MADE OR CIRCLED IN Red. WITH DATE AND NAME OF PERSON MAKING CHANGE.

RETURN TO
LOS ANGELES COUNTY SURVEYOR

Note: ANY ADDITIONS OR CHANGES ON THIS SHEET MUST BE MADE OR CIRCLED IN Red. WITH DATE AND NAME OF PERSON MAKING CHANGE.

Do not extend notes this side of this line

Date _____ Notes by _____ Chief Party _____ F.B. 424 Pg 3

Plotted by _____
Date _____
Map No. _____
Platting C'k'd by _____
Date _____

W. O. No. _____ D. S. O. No. _____
Location _____
Surveyed by _____
Date _____
Issued A. C. Johnson

RETURN TO
LOS ANGELES COUNTY SURVEYOR

Note: ANY ADDITIONS OR CHANGES ON THIS SHEET MUST BE MADE OR CIRCLED IN Red. WITH DATE AND NAME OF PERSON MAKING CHANGE.

Do not extend notes this side of this line

Date

Notes by

Chief Party

F.B. 424 Pg. 4

424

F.B. 399 Pg 25

Date 9-10-29 Notes by Ona Chief Party Ona

Plotted by A. Svenson
Date Aug. 1930
Map No. B-442-2
Plotting Ck'd by Dr. M. Pinkley
Date MAY 1932

W. O. No. 920 Topo
C. S. O. No. 029
Location Riv. Redondo Rd
Surveyed by Dr Atkins Dep
Date Sept 19 1929
Inspected A. C. Johnson

89.55 26.75
99 26 03.75
80 38 15
90

(11 15 00)

Contd bottom of

I = 99 26 00"
NW Δ = 37 44 15
A = 99 26 09.75

I = 79 48 15
NE Δ = 31 9 15
A = 79 48 15

I = 99 25 30
Δ = 37 42 15
99 25 33.75

126.06@74°

Fd spk W+T fl. in macadam pav. F.B. 101-41 (0+82.35) used for Random Line in Kruttschnitt Lane going North.

MB 9-155

LANE

KRUTTSCHNITT

MB 10-86-87

(DC) 126.05

(20)

100.48

L+T Conc. pump base

(20.32)

19° 48' 15"

N+T PP

(30)

Fd spk W+T at Harper Lane FB 329-13

Fd spk W+T FB 101-41

99° 26' 00"

51.74

41° 56' 35"

(32.96)

AVE

(60)

(30)

SANTA FE

44.94

53.93

N+T PP

Fd spk W+T FB 101-41

L+T Conc pump base

99-25-33
79-48-15
179-13-50
0-46-10

Notes: ANY ADDITIONS OR CHANGES ON THIS SHEET MUST BE MADE ON CHECK'S Red. WITH DATE AND NAME OF PERSON MAKING CHANGE.

Do not detach sheets from this book

RETURN TO LOS ANGELES COUNTY SURVEYOR

424 6 contd bottom 7

F.B. 399 Pg 124 Chief Party Notes by Date 9-11-29

MB 10-86-87

(30) (50) contd bot 7 (20)

(20) 59.96

See pg 37-38 for this line 1

PALM LANE

LANE

MB 10-86-87

Set 2"x2" Stk q tk 2 ft dn = P.O.T.

600.00' Δ1° = 59.96
180.73 Δ2° = 180.72

CARVER ST

(20) (20)

WOLLACOTT ST

HERMOSA VILLA TR.
MB 9 155

MB 10-86-87

Fd remains 2"x2" Stk with tack 4 ft dn

1321 (50) 180.72

90°

41.59

KRUTT ST

Set N+T fl. by int (out)

126.05

Contd fr. top 5

RETURN TO LOS ANGELES COUNTY SURVEYOR

Do not extend notes this side of this line

Notice: ANY ADDITIONS OR CHANGES ON THIS SHEET MUST BE MADE ON ENCLOSED IN RED. WITH DATE AND NAME OF PERSON MAKING CHANGE.

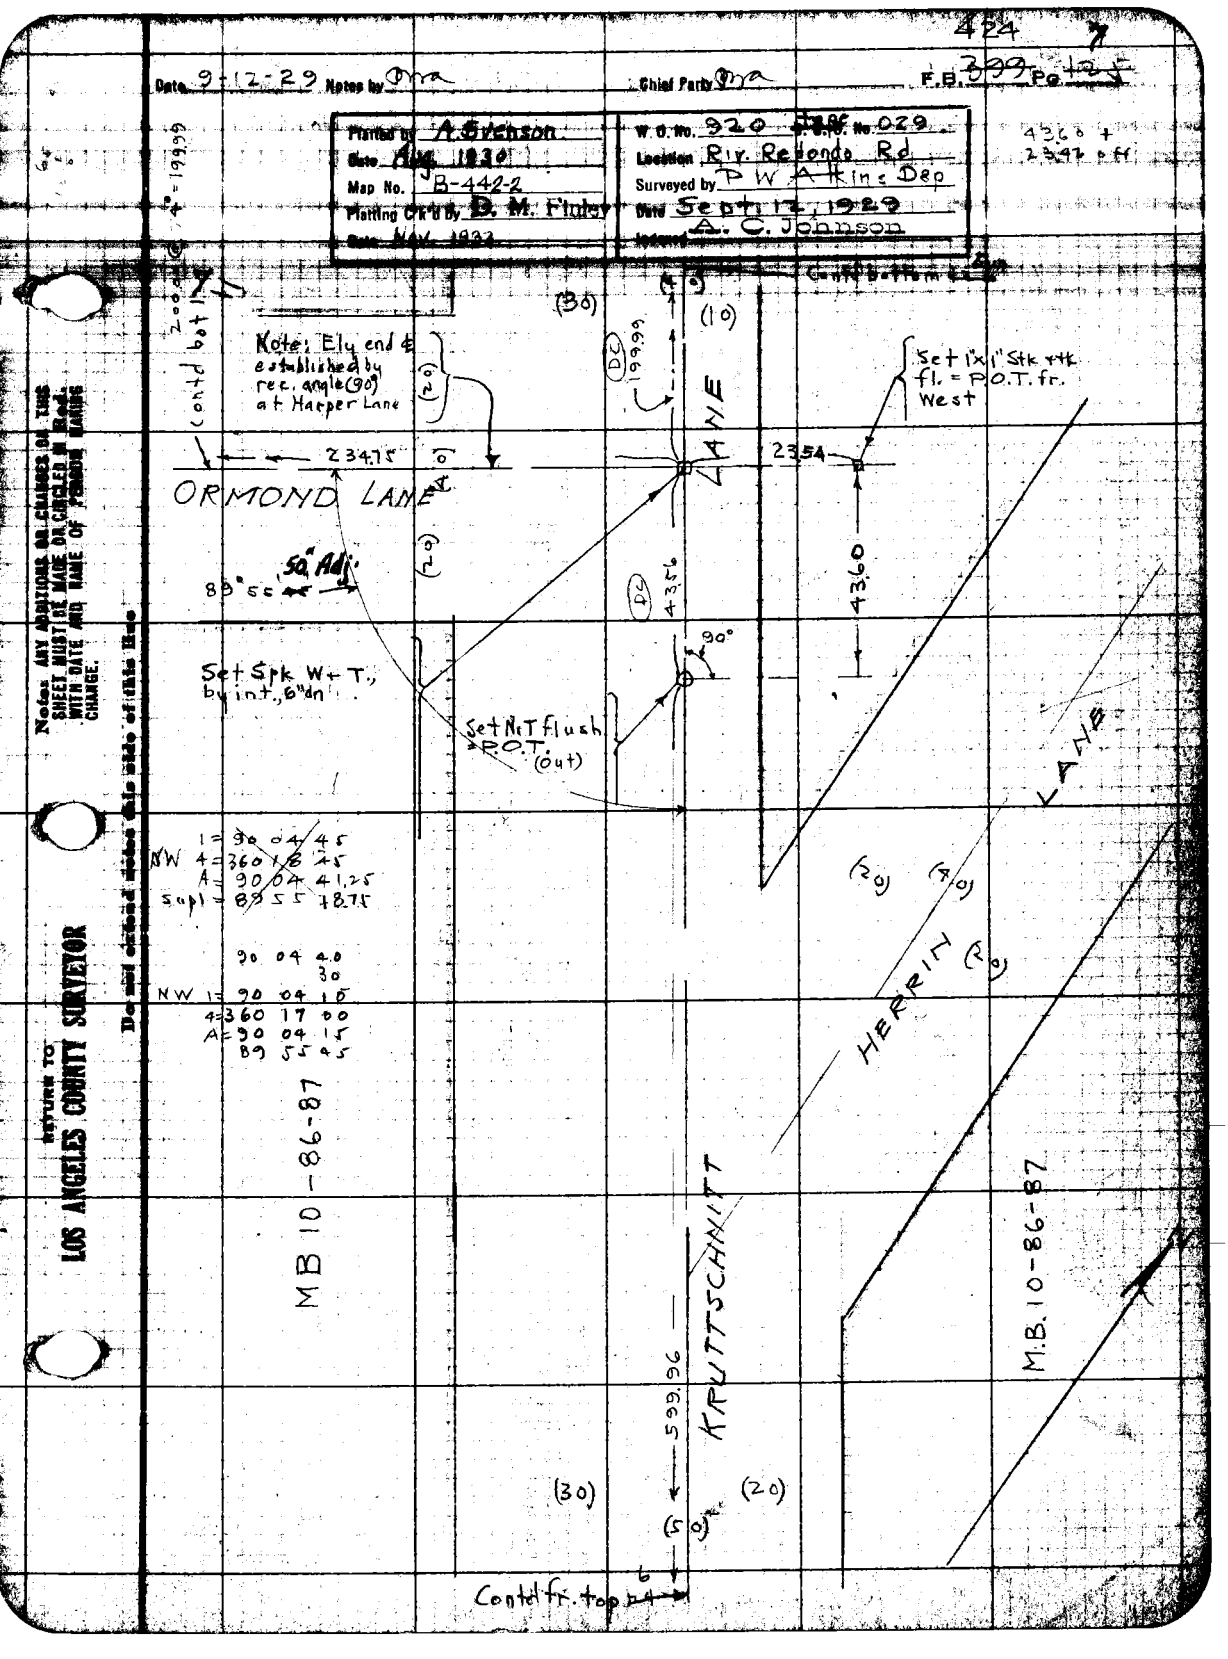
424
Date 9-12-29 Notes by Dma
Chief Party Dma
F.B. 399 Pg 125
Date Aug 1930
Map No. B-442-2
Plotting Ck'd By B. M. Finley
Date Nov. 1932
W. O. No. 920 Sub. No. 029
Location R/W. Redondo Rd
Surveyed by P W Atkins Dep
Date Sept 12, 1929
Inked A. C. Johnson
4360 +
2397 P.T.
Contd bot 1.1
Note: Ely end of established by rec. angle (90) at Harper Lane
(30)
(10)
(20)
DC 199.99
LANE
Set 1"x1" Stk x-tk fl. = P.O.T. fr. West
234.75
ORMOND LANE
2354
89° 55'
Sq. Adj.
43.54
43.60
90°
Set Spk W+T., by int., 6" dn
Set N&T flush P.O.T. (out)
LANE
1 = 90 04 45
NW 4 = 360 17 45
A = 90 04 41.25
supl = 89 55 78.75
90 04 4.0
30
NW 1 = 90 04 15
4 = 360 17 00
A = 90 04 15
89 55 45
HERRIN (20)
(20)
(20)
MB 10-86-87
599.96
KRUTTSCHNITT
(30)
(20)
(5)
M.B. 10-86-87
Contd fr. top
Return to LOS ANGELES COUNTY SURVEYOR
Notice ANY ADDITIONS OR CHANGES ON THIS SHEET MUST BE MADE IN CIRCLED # Prod. WITH DATE AND NAME OF PERSON MAKING CHANGE.
Do not extend notes this side of this line

824 8

B. 399 Pg. 126 Chief Party Notes by Date 9-12-29

Contd on bottom 127

Contd on 13 left

LANE

DIXON

KRUTTSCHNITT

Set N+T flush POT (O+)

Set N+T 1 tree

Set 2"x2" Stk+tk

Set 2"x" 24 dia RP

Fd 4x4 + nail -3' up

Set N+T in 6" cypress

tape No 022

129.24 @ 78° = 129.23
300.00 @ 3°15' = 299.51
299.52 @ 78° = 428.74

100.00 @ 74° = 96.59
200.00 @ 5°W = 199.99
199.24 @ 74°T = 192.23
32.27 @ 74°T = 31.43
100.00 @ 74°T = 96.59
431.98

A+ = 27 59 30
A- = 27 59 26.67
27 59 26
11 58 15
27 59 33.75

+6.33
16.99

2.8 0 0 0
1 1 2

Adj.

contd fr. top 128

RETURN TO LOS ANGELES COUNTY SURVEYOR
Do not extend notes this side of this line
Notes: ANY ADDITIONS OR CHANGES ON THIS SHEET MUST BE MADE OR CIRCLED IN Red. WITH DATE AND NAME OF PERSON MAKING CHANGE.

107 3015
28 F
135 3015
7845
5 6 5 F H

Date 9-13-29 Notes by [illegible] Chief Party [illegible] F.B. 424 Pg. 9 399 Pg. 51

Plotted by A. Svenson
Date Aug. 1930.
Map No. B-442-2
Platting C'k'd by D. M. Finley
Date Nov. 1933.

W. O. No. 926 B.&S.O. No. 929
Location Rte. Redondo Rd
Surveyed by P.W. Atkins Dep
Date Sept 19, 1929
Inspected A. C. Johnson

.01273
.00232
.0427

Contd on bot pg 78 FB 312

LANE

Contd on

(20) (R/W)

REED (R/W)

(DC) 774.00

100.00 @ 3°54 = 399.76
99.77 @ 74° = 99.76
200.86 @ 9°24 = 197.31
197.31 @ 74° = 197.31
100.00 @ 8°50 = 98.76
98.77 @ 74° = 378.17
378.13 @ 74° = 774.00

KRUTTSCHNITT

(20) (40) (20)

Set 2"x [illegible] Stk + tk 2 ft dn P.O.T.

CARNEGIE LANE

(20)

37.00 62.58

Set 2-1"x1" Stk + tk 2 ft dn R Ps

428.74
421.49

Contd fr top tan

RETURN TO LOS ANGELES COUNTY SURVEYOR

Notes: ANY ADDITIONS OR CHANGES OF THIS SHEET MUST BE MADE OR CIRCLED IN Red. WITH DATE AND NAME OF PERSON MAKING CHANGE.

Do not extend notes this side of this line

RETURN TO
LOS ANGELES COUNTY SURVEYOR

Note: ANY ADDITIONS OR CHANGES ON THIS SHEET MUST BE MADE OR CIRCLED IN Red. WITH DATE AND NAME OF PERSON MAKING CHANGE.

Do not extend notes this side of this line

Date

Notes by

Chief Party

F. B. 424 Pg. 10 ~~128~~

424 RR
399 129

Date 9-13-29 Notes by Pwa Chief Party Pwa F.B. Pg.

Planted by A Svenson
Date Aug. 1929
Map No. 8-441-2
Platting Ck'd by D. M Finley
Date May 1931

W. O. No. 920 3rd Sup. No 023
Surveyed by PW Atkins
Date 9-13-29
Checked by C. [illegible]

Notes: ANY ADDITIONS OR CHANGES OF THIS SHEET MUST BE MADE OR CIRCLED IN RED WITH DATE AND NAME OF PERSON MAKING CHANGE.

Do not extend notes this side of this line

RETURN TO LOS ANGELES COUNTY SURVEYOR

Contd bottom 130

Set Nr spk + T flush = P.O.T.

LANE

(40) (20) (20)

263.74

GOODMAN

AVE

(40) (20)

17.50

Set wr spk + T flush for center Goodman Lane, by proportioned dist. from Krutschnitt + Harper Lanes.

237.49 @ 74°T = 237.47

ORMOND

237.47

I = 89 55 45
4 = 359 42 15
A = 89 53 30
NE Ang. 11 12
tape No 922
718.38 @ 72° = 718.32
NW to 1x2 + tk. on hill

Set wr spk + T flush for center Lane, by proportion bet. Krutschnitt + Harper Lanes.

(20)

718.32

STEINHART

LANE

(40) (20)

15.11

Contd on 131 pt.

234.82 @ 1°10' V = 234.77
234.77 @ 74° T = 234.75

234.75

Set Wire spk + T fl. = P.O.T.

Contd ft. 125 left

424 | 12

F.B. 399 Pg 130 — Chief Party — Notes by — Date 9-13-29

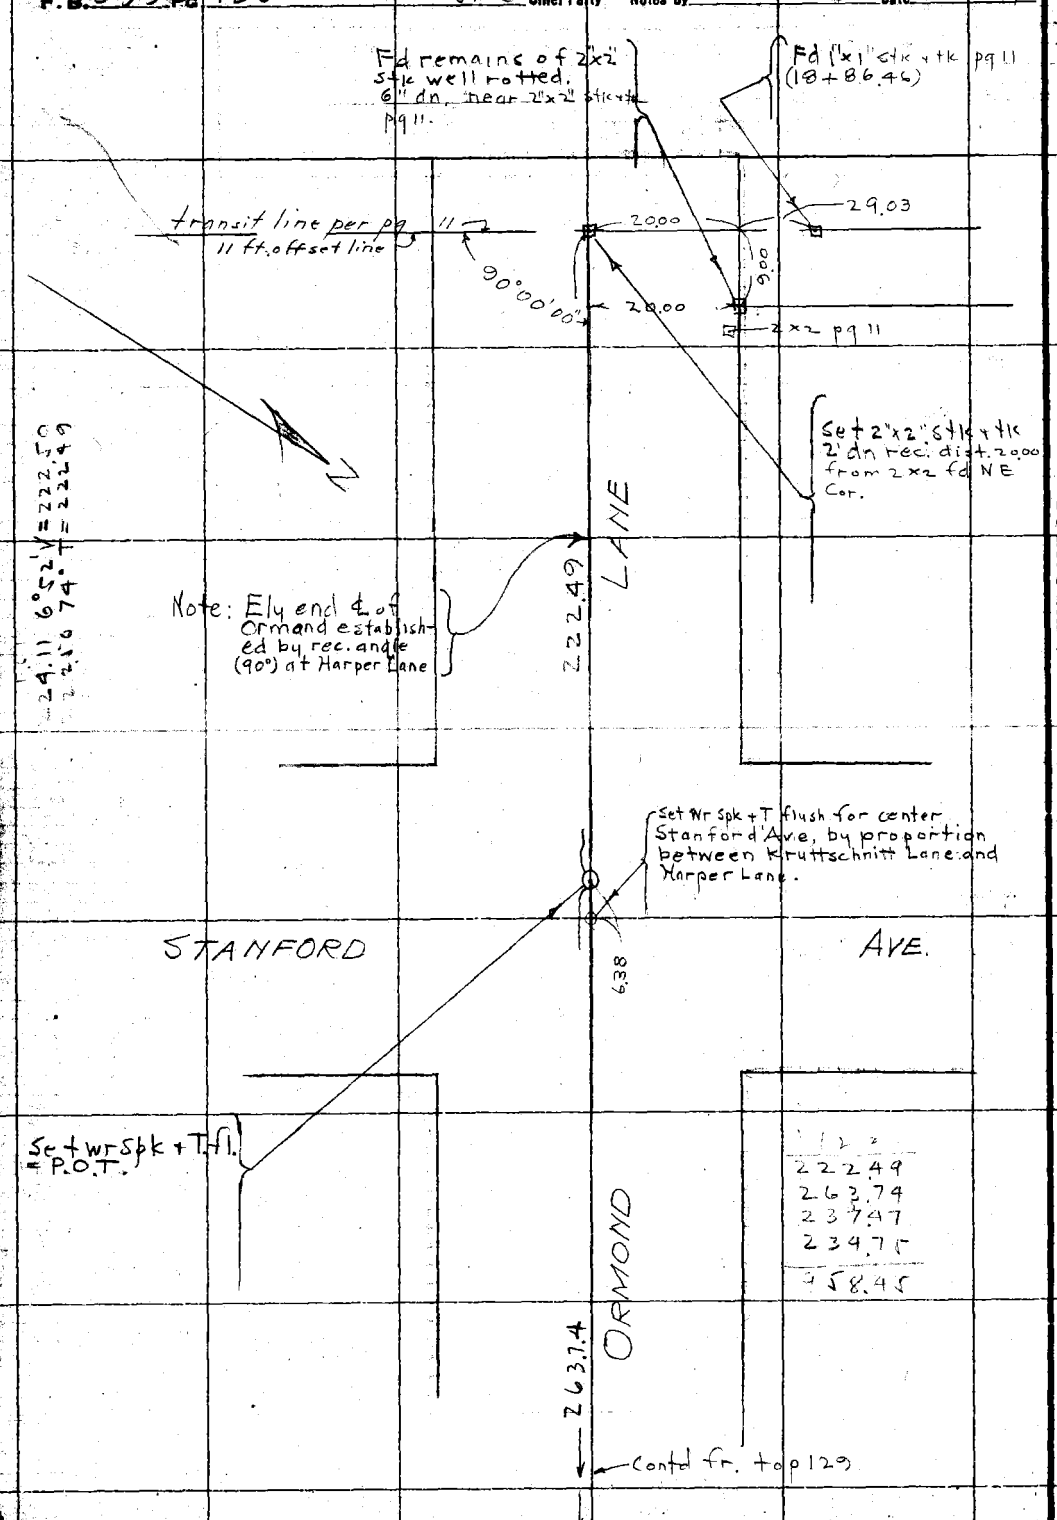

1	2	3
222.49		
263.74		
237.97		
234.75		
958.45		

24.11 6°52'1" = 222.49
2.16 74.7 T = 222.49

RETURN TO LOS ANGELES COUNTY SURVEYOR

Do not extend notes this side of this line

Notice: ANY ADDITIONS OR CHANGES ON THIS SHEET MUST BE MADE OR CIRCLED IN RED WITH DATE AND NAME OF PERSON MAKING CHANGE.

424 13

Date 10-3-29 Notes by Dma Chief Party Dma F.B. 399 Pg 31

Plotted by A. Svenson
Date Aug. 1930
Map No. B-442-2
Plotting C'k'd by D M Fin.
Date Nov. 1931

W. O. No. 320 D. S. O. No.
Location Riv. Redondo Road
Surveyed by P W Atkins Dep
Date 10-8-29
Inspected by C. Johnson

Inst C C Halliday
Hdd K C Heisler
Rear C Mattfeld
Extra G H Boyd

Contd on

LANE

Set 1½" Stk + tk flush = POT

(20) (40) (20)

WYLIE LANE

(20)

(40)

(20)

Δ 6°59'00" Y = 397.00
@ 72° T = 139.29
@ 72° T = 536.29
@ 72° T = 64.91
601.20

400.00
397.03
139.30

64.92

60.20

Transit line

Set 1½" Stk + tk flush = POT

(40)

(20)

CARNEGIE LANE

(40)

(20)

718.32

STEINHART

Contd from 12q right

Notice: ANY ADDITIONS OR CHANGES OF THIS SHEET MUST BE MADE IN CIRCLES IN Red. WITH DATE AND NAME OF PERSON MAKING CHANGE.

Do not extend notes this side of this line

RETURN TO LOS ANGELES COUNTY SURVEYOR

424 14

F.B. ~~389~~ Pg. 132

Chief Party Notes by Date 10-7-29

Contd on bot pg. 133

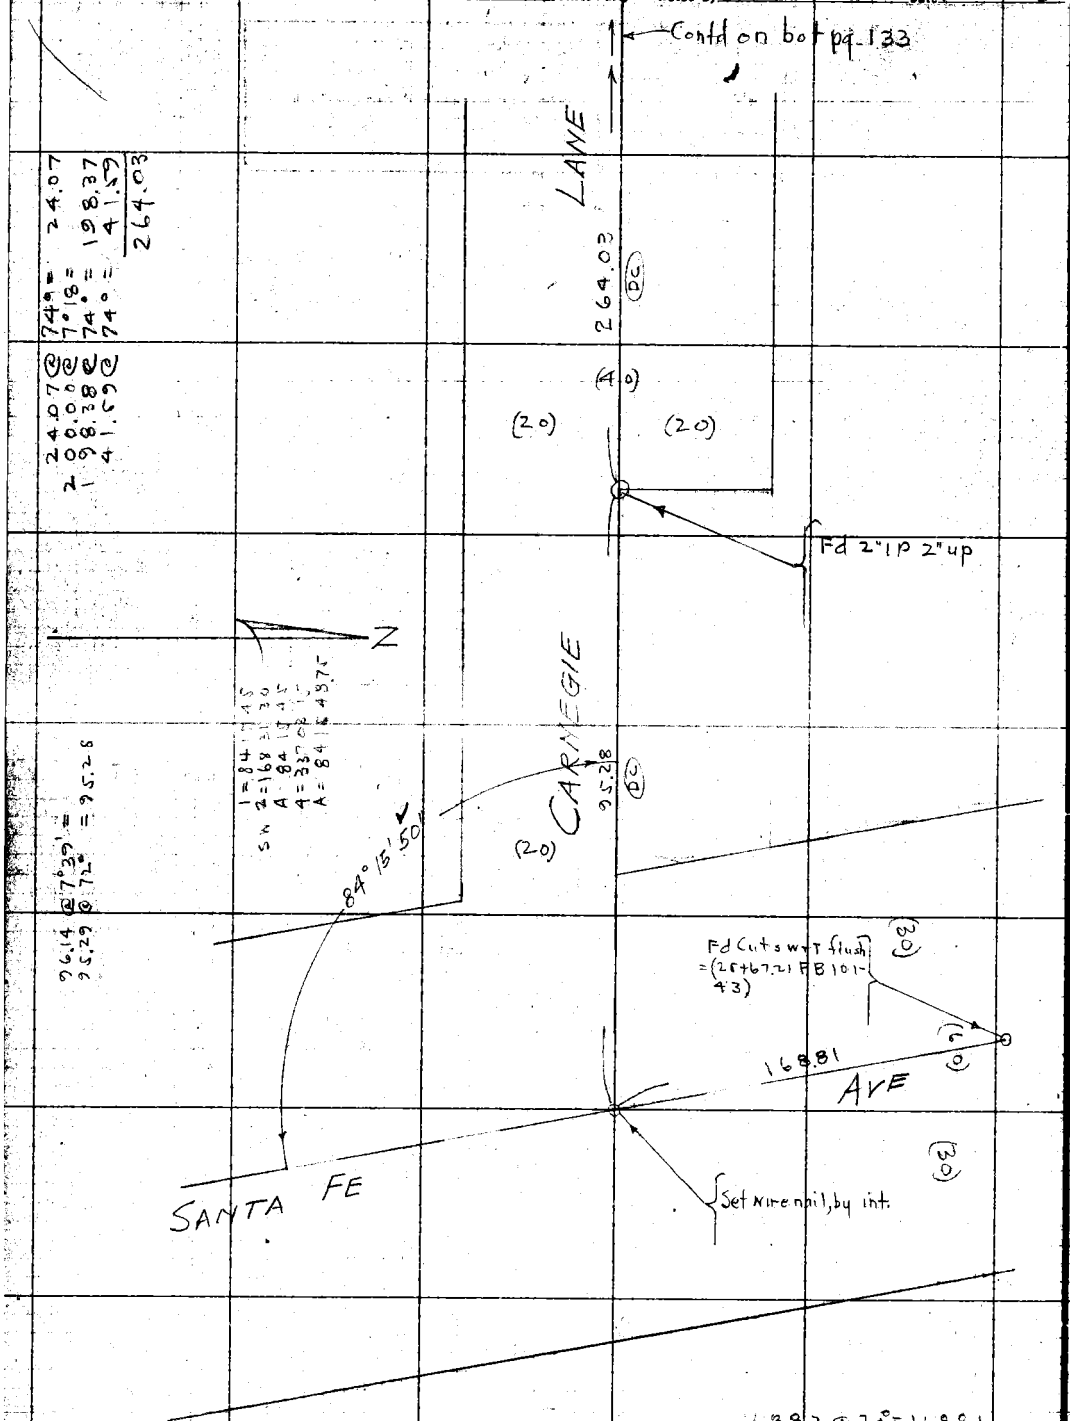

RETURN TO LOS ANGELES COUNTY SURVEYOR

Do not extend notes this side of this line

Note: ANY ADDITIONS OR CHANGES OR THIS SHEET MUST BE MADE OR CIRCLED IN RED, WITH DATE AND NAME OF PERSON MAKING CHANGE.

424 15

Date 10-7-29 Notes by DNA Chief Party DNA F.B. 399 Pg. 132

Platted by A. Svenson
Date Aug. 1930
Map No. B-442-2
Platting C'k'd by D M Pinter
Date Nov. 1933

W. O. No. 920 Sup. W. O. No. 022
Location Riv. Redond Rd
Surveyed by DNA Atkins Dep.
Date 10-7-29
Indexed by A. C. Johnson

I = 89 52 15
2779 46 30
NN A = 89 52 15
4 35 29 30 45
A = 89 52 15

Contd on bottom pg 134

Fd remains of 1"x2" stk but no tack used cent.

300.00 @ 78° = 299.99
300.00 @ 4°36" =
299.03 @ 78° = 299.02
198.94 @ 78° = 198.93
797.94

(20) (40) (20)

24+44.36

20.00

90°

LANE

Set N+T flush 20 ft off old 1x2 stk fd.)

797.94

2x2 2ft dn

199.96

2x2 2ft dn

4.88

66.00

HERRIN

(40)

(20)

55.72

47.29

4°

4°

2x2 2ft dn

ST

455.96 @ 74° =
455.93

(20)

455.93

Set N+T flush = POT transit point

(40)

(20)

WOLLACOTT

ST

(20)

264.03

CARNEGIE

Contd from top pg 132



RETURN TO LOS ANGELES COUNTY SURVEYOR

424 16

F.B. 399 PG. 134 Chief Party Notes by Date 10-7-29

.00246
.492

334
.668

100.00 @ 74° = 99.99
200.00 @ 4°91' =
199.33 @ 74° = 199.32
498.23 @ 74° = 498.20
797.51

200.00 @ 4°01' =
199.51 @ 74° = 199.50
30.38 @ 74° = 30.38
229.88

Z

Set 2"x2" Stk with tk 24 in dn, by int.

Set 2"x2" Stk with tk 24 in dn = POT

Set 2"x2" stk with tk 24 in dn

tang actual

Cont'd from pg 126 top st.

Cont'd pg 132 top st.

5.00

5.19

230.18
229.88

797.51

35.77

(20)

(20)

DIXON

ST

49.20

45°

45°

69.62

Set 2"x2" stk with tk 24 in dn

(40)

(20)

(20)

91°12'20"

NE

~~I = 91 12 30~~
~~Δ = 91 12 30~~

I = 91 12 15
Δ = 91 12 72

CARNEGIE LANE

244.96

244.96 @ 74° = 244.96
244.96

Contd from top pg 133

RETURN TO LOS ANGELES COUNTY SURVEYOR

Do not extend notes this side of this line

Note: ANY ADDITIONS OR CHANGES ON THIS SHEET MUST BE MADE OR CIRCLED IN RED WITH DATE AND NAME OF PERSON MAKING CHANGE.

Date _____ Notes by _____ Chief Party _____ F.B. 424 Pg. 17

Plotted by	W. O. No. _____ D. S. O. No. _____
Date	Location
Map No.	Surveyed by
Plotting Ck'd by	Date
Date	Indexed A. C. Johnson

Notes ANY ADDITIONS OR CHANGES ON THIS SHEET MUST BE MADE OR CANCELED IN Red. WITH DATE AND NAME OF PERSON MAKING CHANGE.

Do not extend notes this side of this line

RETURN TO
LOS ANGELES COUNTY SURVEYOR

424 | 18

F.B. Pg

Chief Party Notes by Date 10-17-29

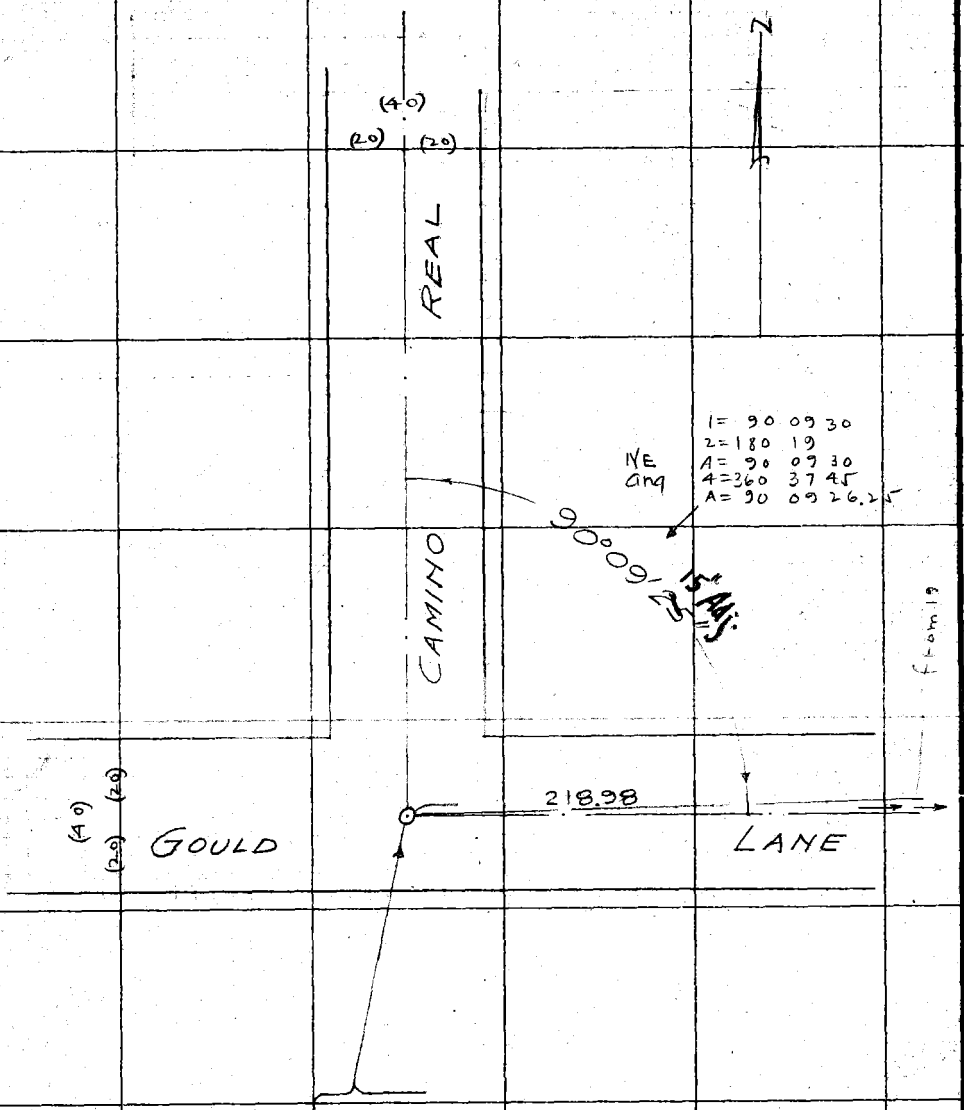

RETURN TO
LOS ANGELES COUNTY SURVEYOR

Do not extend notes this side of this line

Note: ANY ADDITIONS OR CHANGES ON THIS SHEET MUST BE MADE OR CIRCLED IN Red. WITH DATE AND NAME OF PERSON MAKING CHANGE.

Date 10-17-29 Notes by PWA Chief Party PWA F.B. 424 Pg. 19

Plotted by A. Svenson
Date Aug. 1930
Map No. B-442-2
Platting C'k'd by D M Finlay
Date Nov. 1930

W. O. No. 920 S. P. O. No. 022
Location Riv. Redondo Road
Surveyed by PW Atkins Dep
Date Oct. 19, 1929
Instrument Man C. Johnson

Notes: ANY ADDITIONS OR CHANGES OF THIS SHEET MUST BE MADE OR CIRCLED IN Red. WITH DATE AND NAME OF PERSON MAKING CHANGE.

Do not extend notes this side of this line

RETURN TO LOS ANGELES COUNTY SURVEYOR

N

NW 76.96 @ 67° = 76.95
NE 77.90 @ 67° = 77.89
SW 98.52 @ 67°01'30" = 97.30 @ 67° = 97.29
SE 92.98 @ 67° = 92.92

NE 78.11 @ 4°11' = 77.90 @ 67° = 77.89

215.77 @ 66° = 215.74 E of CR
215.79 @ 66° = 215.74

218.99 @ 67° = 218.97
219.01 @ 67° = 218.99 W of CR

Set N+T. in wooden header rec. dist (4.10) from Nrly set as shown, from ties, on line from Sec. Cor. at Camino Real to the N.

Set 2x2" stk + tk 2 ft dn RP tang across

Set L+T in Conc. pav. by int.

Set N+T from ties Hermosa City Engr FB 48-31.

Set L+T Conc walk tang across

76.95

77.89

4.10

38°52'15"

(20)

218.98

215.74

GOULD LANE

Adopted ℄

Contd to right

97.29

92.92

(40)

(80)

CAMINO REAL

Hermosa City Engr. & perFB 48-31

(40)

Set 2x2" stk + tk 2 ft dn RP tang across

45°00'

103°33'45"

Set 2x2" stk + tk 2 ft dn tang across

I = 103 33 45
Δ = 54 15 00 SW
A = 103 33 45

90°09'30"

14th St

Fd L+T Conc. Curb

Fd L+T Conc. pav. FB 39-54

(Hermosa City)

F.B. 424 Pg. 20 Chief Party Notes by Date

468.50 @ 67° = 468.45
400.00 @ 30°30' = 399.36
399.40 @ 67° = 69.07
69.08 @ 67° = 468.43
468.44

N

Set 2"x2" Stk + tk 2 ft. dn ||
P.O.T. = transit pt.

(20)

215.74

468.44
Adopted &

Contd from 1 left

Contd to right

RETURN TO
LOS ANGELES COUNTY SURVEYOR
Do not extend notes this side of this line

Note: ANY ADDITIONS OR CHANGES ON THIS SHEET MUST BE MADE OR CIRCLED IN Red. WITH DATE AND NAME OF PERSON MAKING CHANGE.

Date 10-16-29 Notes by [illegible] Chief Party [illegible] F.B. 424 Pg 21

Plotted by A. Svenson
Date Aug. 1930
Map No. B-442-2
Plotting C'k'd by D M Finley
Date Nov. 1931

W. O. No. 920 Sup. No. 932
Location Riv. Redondo Road
Surveyed by P W Atkins Dep.
Date Oct. 16, 1929
Indexed by C. Johnson

Notes ANY ADDITIONS OR CHANGES ON THIS SHEET MUST BE MADE OR CIRCLED IN Red. WITH DATE AND NAME OF PERSON MAKING CHANGE.

Do not extend notes this side of this line.

RETURN TO LOS ANGELES COUNTY SURVEYOR

20.68@68°=30.00
50.08@68°=30.00
50.05@66°=30.00
50.05@66°=30.00
586.90
414.34

Set S W+T flush in Conc pav. by proportion bet Prospect and Camino Real at Sec. Cor.

2x2 - 2 ft dn

74.66

PROSPECT AVE

Set S W+T flush in Conc pav. by int.

Set 2x2" Stk + tk 2 ft down by int.

Set 2x2" Stk + tk 2 ft dn RP

97.22

Set 2x2" Stk + tk 2 ft dn RP

N

(20) (40) (20)

75.16

45°

GOULD

(20)

38.78 90.64 10.02 41.84

Adopted E J

LANE

414.34 401.77

Contd fr. 22 left

(40) (20)

(40)

(40)

(8.0)

59.65

Contd 20 right

Set 2x2" Stk + tk 2 ft dn = POT

CROSS ROAD

45°

72°57'05"

72°57'05" PM 13 FB 3/12

2x2 - 2 ft dn

100.15

AVE

I = 72°57'
= 145 54
A = 72 57
= 291 49
A = 72 57

I = 72 57 00
2 = 145 54
A = 72 57
4 = 291 48 30
A = 72 57 07.50

Set L+T Cond Pav. RP

130

32.40

2x2 - 2 ft dn

26.57

90°

40.00

Set S W+T Conc pav for

Set L+T Conc RP Pav.

Set W+T PPN 168568E

Fd 2x2" Tk 0.03 N Line FB 399-9 0.03 E

Hawthorne St

3876
1002
4164
904
4164
1002
3876
4

F.B. 424 Pg. 22 — Chief Party — Notes by — Date 10-15-29

62.65 @ 9°11' = 61.67 @ 67° = 61.66

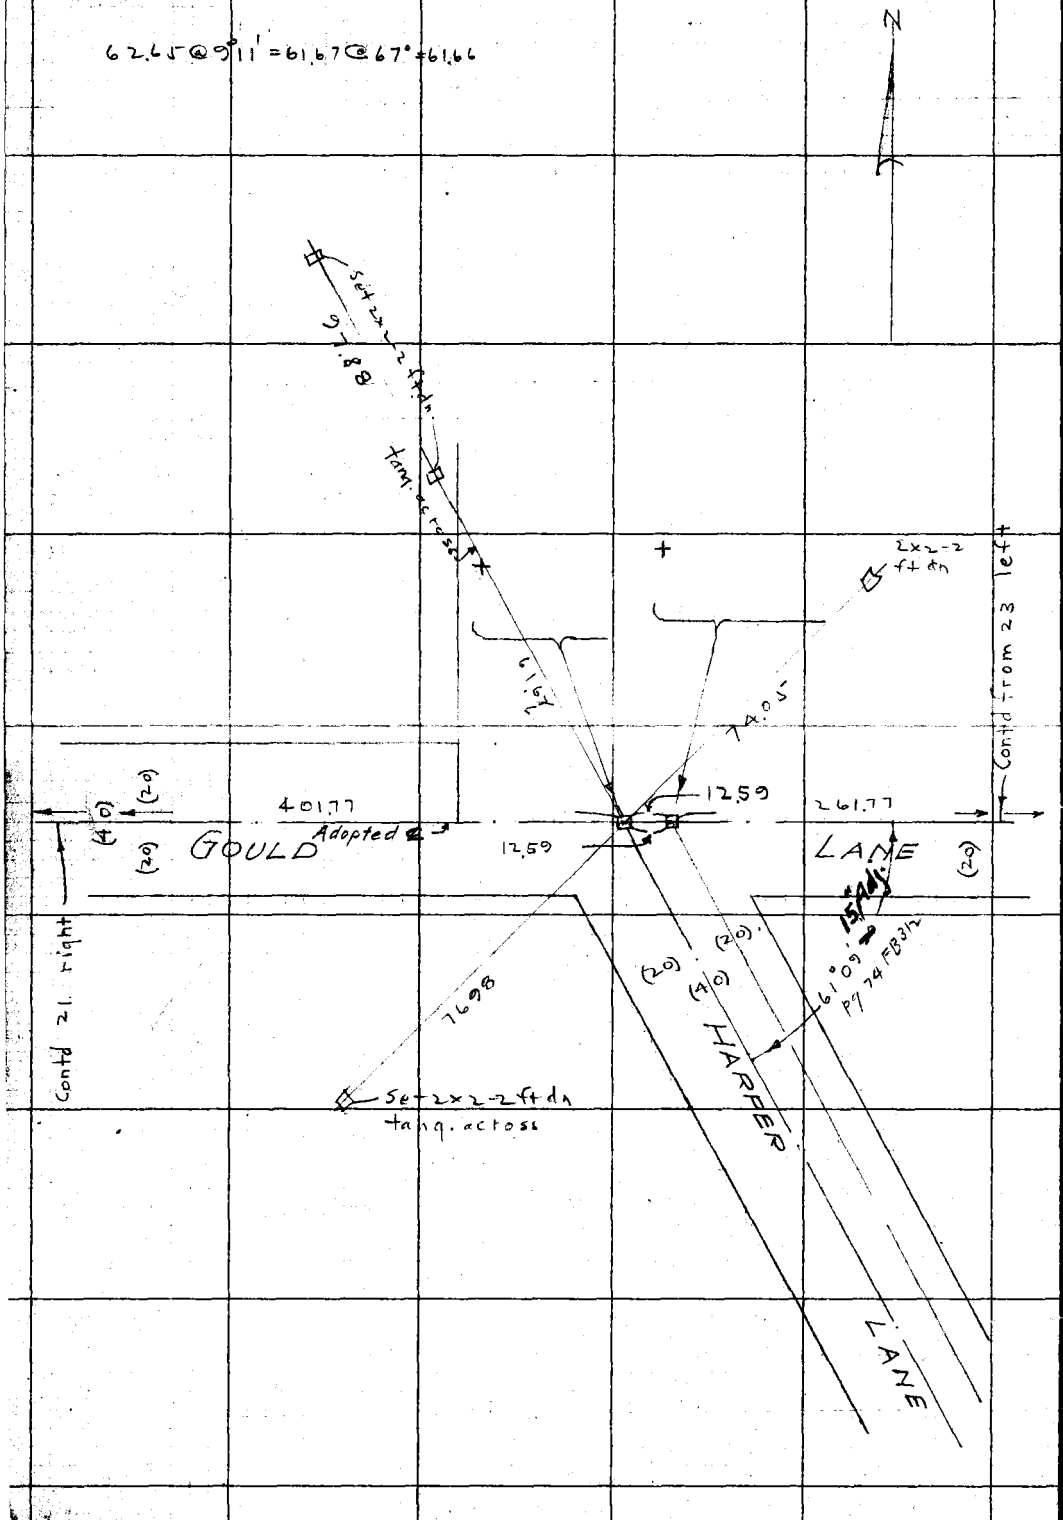

RETURN TO LOS ANGELES COUNTY SURVEYOR

Do not extend notes this side of this line

Note! ANY ADDITIONS OR CHANGES ON THIS SHEET MUST BE MADE OR CIRCLED IN Red. WITH DATE AND NAME OF PERSON MAKING CHANGE.

414.36
12.59
401.77

Date 10-15-29 Notes by Orra Chief Party Orra F.B. 424 Pg. 23

Platted by A. Svenson
Date Aug. 1930.
Map No. B-442-2.
Platting C'k'd by D. M. Finley
Date Nov. 1933

W. O. No. 920 +1PC S. C. O. No. 072
Location Riv. Redondo Rd
Surveyed by P W Atkins Dep
Date Oct. 15, 1929.
Indexed A. C. Johnson

Notes ANY ADDITIONS OR CHANGES ON THIS SHEET MUST BE MADE OR CIRCLED IN Red. WITH DATE AND NAME OF PERSON MAKING CHANGE.

Do not extend notes this side of this line

RETURN TO LOS ANGELES COUNTY SURVEYOR

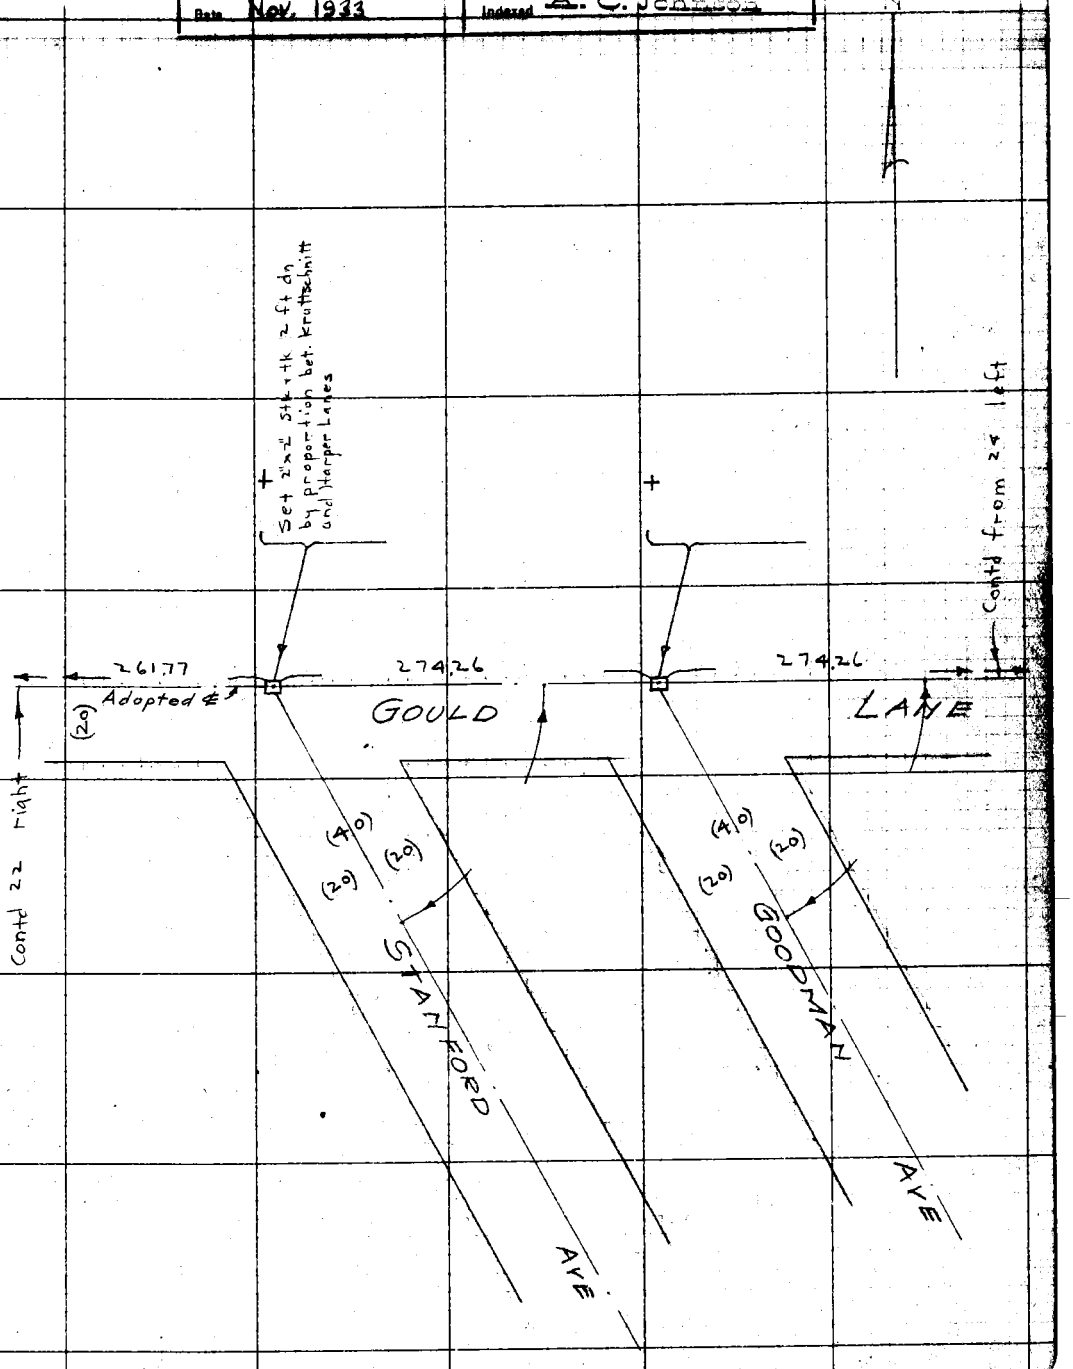

F. B. 424 PG. 24 — Chief Party — Notes by — Date

RETURN TO
LOS ANGELES COUNTY SURVEYOR
Do not extend notes this side of this line

Note: ANY ADDITIONS OR CHANGES ON THIS SHEET MUST BE MADE OR CIRCLED IN Red. WITH DATE AND NAME OF PERSON MAKING CHANGE.

N

Set + 2"x2" Stk + tk 2 ft dp by

Contd from 22 left

274.26

274.26

Adopted E

GOULD

LANE

Contd 23 right

(20)

(20)

(20)

STEINHART

LANE

Date 10-15-29 Notes by Pra Chief Party Pra F.B. 424 Pg. 25

Platted by A. Svenson	W. O. No. 920 C. of S. No. 022
Date Aug. 1930	Location Riv. Redondo Rd
Map No. B-442-2	Surveyed by D W Atkins Dep
Planimetered by D. M. Finley	Date Oct. 15, 1929.
Date Nov. 1933.	Inspected A. C. Johnson

Note: ANY ADDITIONS OR CHANGES ON THIS SHEET MUST BE MADE OR CIRCLED IN Red, WITH DATE AND NAME OF PERSON MAKING CHANGE.

Do not extend notes this side of this line

RETURN TO LOS ANGELES COUNTY SURVEYOR

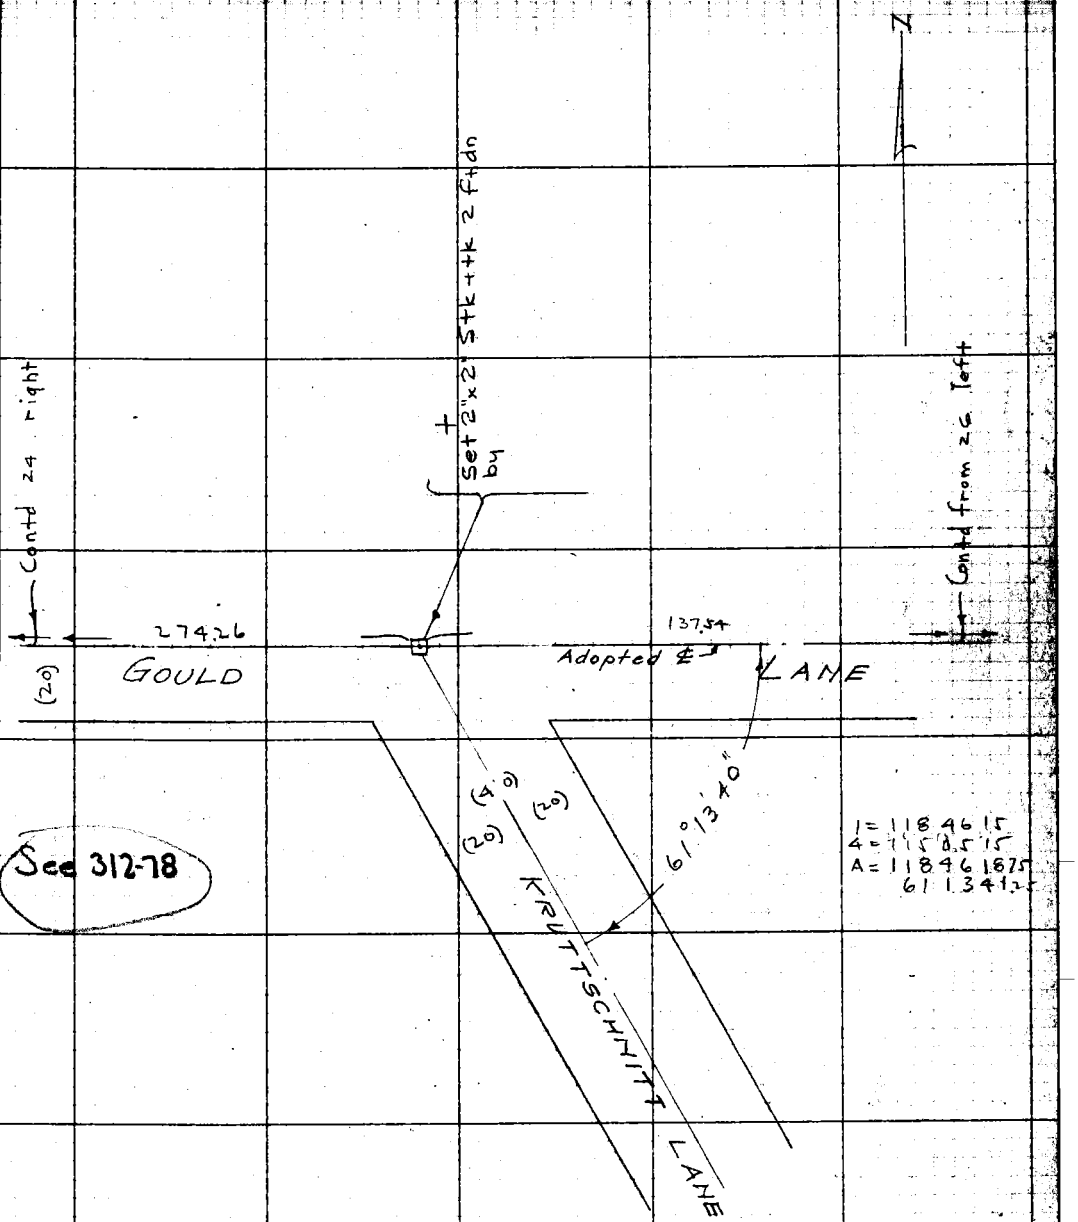

See 312-78

B.B. 424 PG. 26 Chief Party Notes by Date 10-5-29

N

AVE

PECK

(20)

(40)

(60)

(20)

LANE

137.54

Adopted ℄ GOULD

(20)

(Contd 27 right)

(Contd left)

RETURN TO
LOS ANGELES COUNTY SURVEYOR

Do not extend notes this side of this line

Note: ANY ADDITIONS OR CHANGES ON THIS SHEET MUST BE MADE OR CIRCLED IN Red. WITH DATE AND NAME OF PERSON MAKING CHARGE.

424

Date 3-8-29 Notes by DWA Chief Party DWA F.B. 312 Pg. 157

Platted by A Svenson
Date Aug. 1930
Map No. B-442-2
Platting ck'd by D. M. Finley
Date Nov. 1933

W. O. No. 920 S. C. No. 029
Location Rio Redondo Rd
Surveyed by DWA Kins Dep
Date 3-8-29
Indexed A. C. Johnson

(20) (40) (20)

Fd 2x2 stk + tk fl. — 100.2 — 200.2 — Fd 3"x2" stk + tk flush

N

RUHLAND AVE

(20) (40) (20)

200.0 Fd 2"x2" stk + tk fl.

ST

Fd 2x2 6" dn — 0.00 — Set N+T

90°

(20) (40) (20) 500.2

MATHEWS AVE.

200.3 Fd 2x2 6" dn

SECOND

← Contd from 102 top FB 312

Notes: ANY ADDITIONS OR CHANGES ON THIS SHEET MUST BE MADE OR CIRCLED IN Red. WITH DATE AND NAME OF PERSON MAKING CHANGE.

Do not extend notes this side of this line

RETURN TO LOS ANGELES COUNTY SURVEYOR

424 28

F.B. 312 Pg. 132 Chief Party Notes by Dma Date 3-11-29

610.10 @ 64° = 610.02

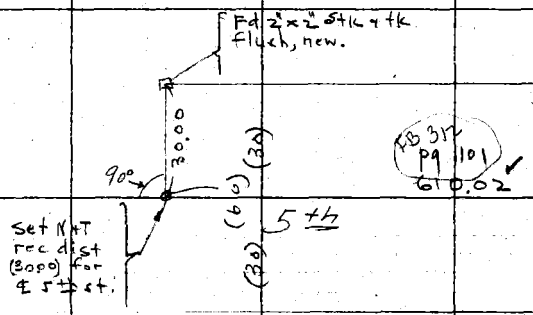

Contd from 101 bot.

FB 312

5T

This 4th not used

RETURN TO LOS ANGELES COUNTY SURVEYOR

Do not extend notes this side of this line

Note: ANY ADDITIONS OR CHANGES ON THIS SHEET MUST BE MADE OR CIRCLED IN Red. WITH DATE AND NAME OF PERSON MAKING CHANGE.

424 29

Date 3-11-29 Notes by Dira Chief Party Dira F.B. 312 PG 133

Platted by A. Svenson	W. O. No. 920 C. S. O. No. 029
Date Aug. 1930	Location Riv. Redondo Rd
Map No. B-442-2	Surveyed by Dira & Atkins Dep
Platting Ck'd by D. M. Finley	Date 3-11-29
Date Nov. 1933	Inspected A. C. Johnson

Notes ANY ADDITIONS OR CHANGES ON THIS SHEET MUST BE MADE OR CIRCLED IN Red. WITH DATE AND NAME OF PERSON MAKING CHANGE.

Do not extend notes this side of this line

RETURN TO LOS ANGELES COUNTY SURVEYOR

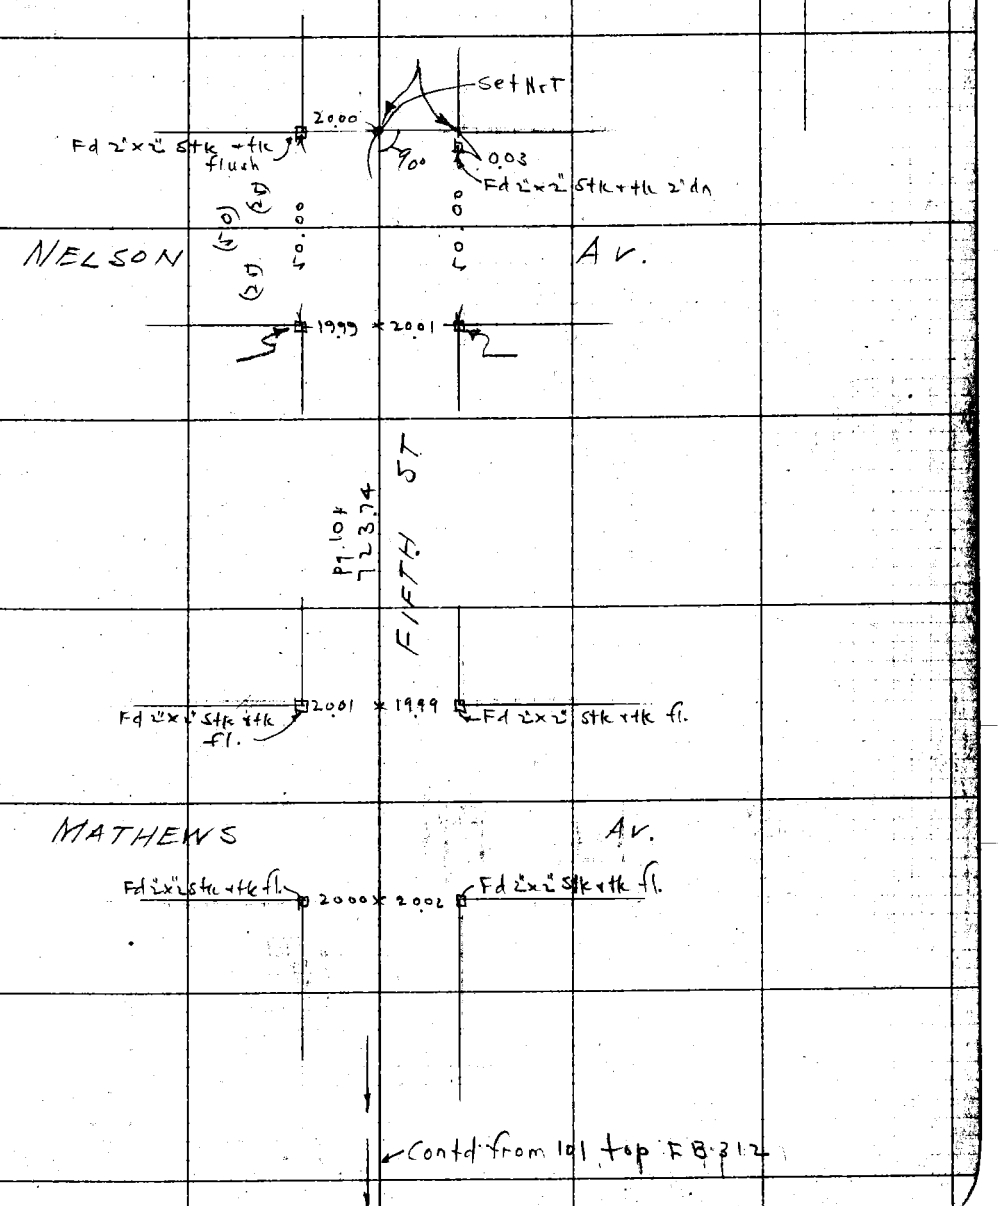

Contd from 101 top FB 312

424 30

F.B. 318 Pg. 134 Chief Party Notes by Date 3-14-29

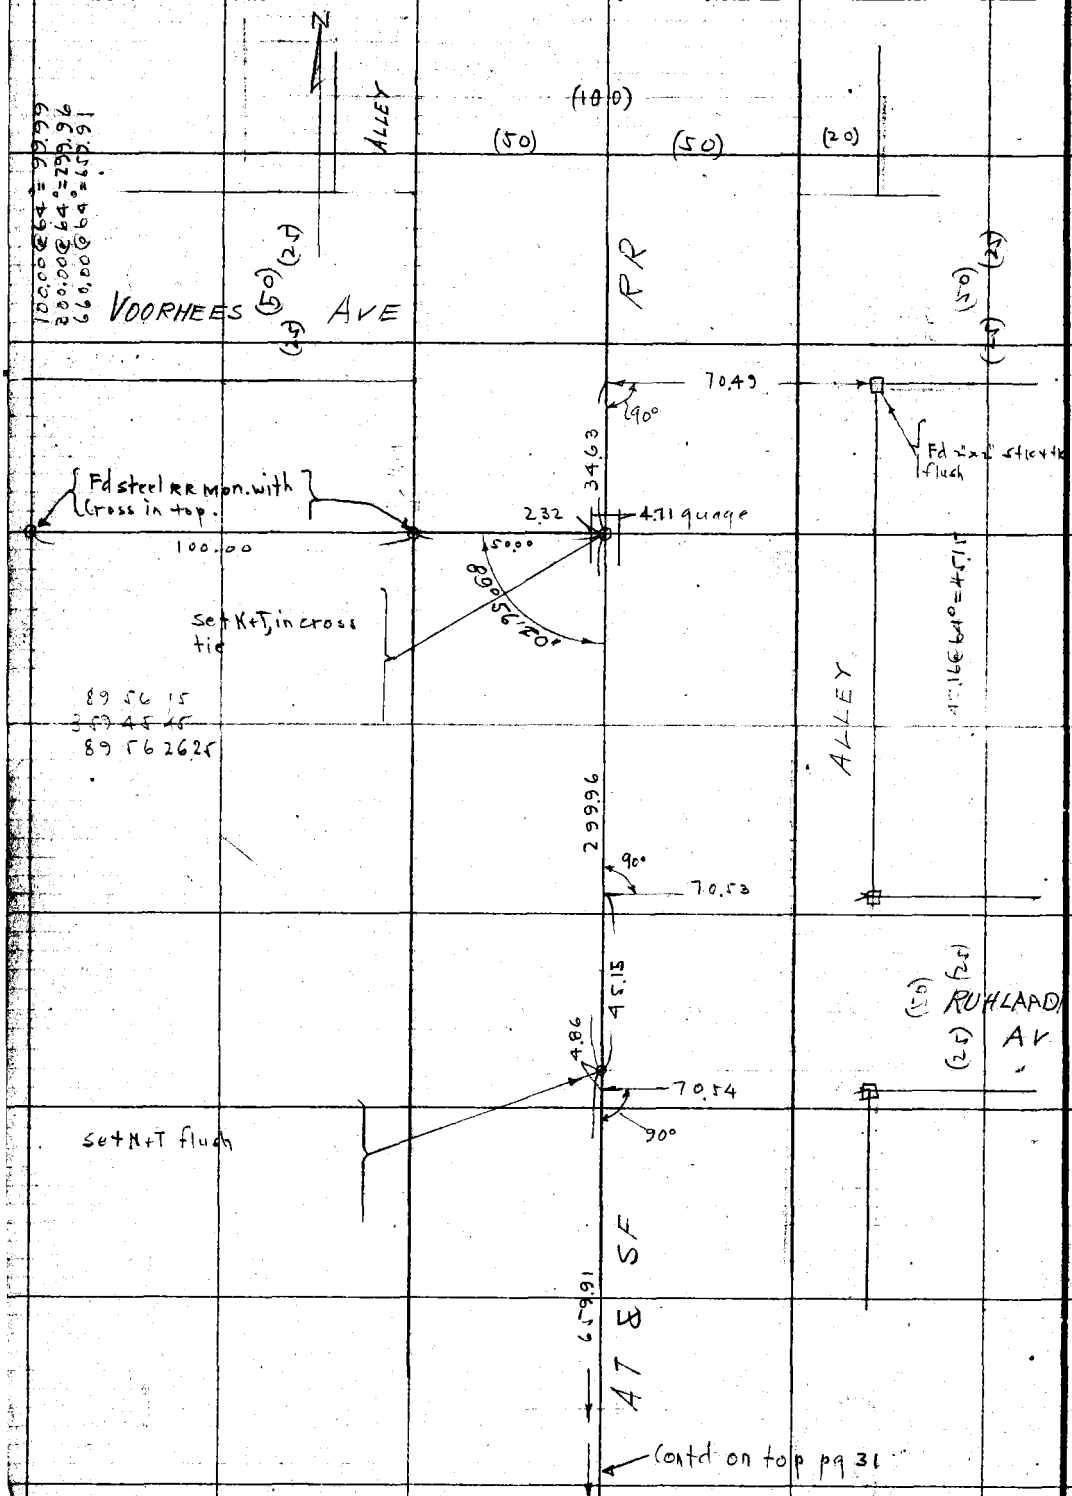

RETURN TO LOS ANGELES COUNTY SURVEYOR

Do not extend notes this side of this line

Note: ANY ADDITIONS OR CHANGES ON THIS SHEET MUST BE MADE OR CIRCLED IN Red WITH DATE AND NAME OF PERSON MAKING CHANGE.

424 31

Date 3-14-29 Notes by Mra Chief Party Mra F.B. 312 Pg 105

Plotted by A Svenson
Date Aug. 1929
Map No. B-442-2
Plotting Ck'd by D. M. Finley
Date Nov. 1929

W. O. No. 920 7[illegible] No. 029
Location Rim Redondo. Rd
Surveyed by Paul Atkins Dep.
Date 3-14-29
Interested Party C. Johnson

2513

N

Notes: ANY ADDITIONS OR CHANGES ON THIS SHEET MUST BE MADE OR CIRCLED IN Red. WITH DATE AND NAME OF PERSON MAKING CHANGE.

Do not extend notes this side of this line

RETURN TO LOS ANGELES COUNTY SURVEYOR

Contd from bottom page 5a

(50) R (50)

ALLEY

71.04 @ 64° =
71.03 @ 17°18' =

(20)

Yers 17° 8' = 8.655515
7.03 1.151442
3.21 10.506957
67.82 6911 = 3.2133
96

679.91

90°

70.68

2.13

2.47

4.71 guage tk

(50) (25)

MATHEWS AV.

70.68

90°

Set K+T in cross tie

89 55 45
359 4.3 00
89 55 45

389.54

Contd fr. 100 top FB 312

S 89° 55' 45" W

7.92 E
7.08 W

1941

90

Set Cop tk POT

Calc 67.82

1941

7.08

7.92

30.30

30.30

30.30

50.00

30

Set 1"x1" Stk + tk flush, by rec. dist from RR Mon.

990.04

996.50

RETURN TO
LOS ANGELES COUNTY SURVEYOR
Do not extend notes this side of this line
Note: ANY ADDITIONS OR CHANGES ON THIS SHEET MUST BE MADE OR CIRCLED IN Red. WITH DATE AND NAME OF PERSON MAKING CHANGE.

424 32

F.B. 312 PG 136

Chief Party Notes by

Date 3-14-28

59.32 @ 64° = 59.31
81.09 @ 64° = 81.08
60.85 @ 64° = 60.84
40.16 @ 64° = 40.15
369.93 @ 64° = 369.88

Contd from bottom page 134

0.09 E 90° off 1x2

3.03 obliq agc.

837 backsta 10

482

74.90 @ 64° = 74.89

87
13
111
37
48

N

S 69° 33' E 999.00
44
999.00

RR

996.50
990.06 Calc

LANE

129 07 90
156 31 15
129 07 48.75

129° 07' 50"

FB 101-48

5.00

6.44 Calc transit line per

74.89 5 ft offset line

Set 1"x2"stk by Cal. dist

Fd 2"x2"stk (1st + 8.59 FB 101-48

stk = 4.89

Fd ¾" IP (1st + 82.79 FB 101-48

Calc 424 433.17

3.03

gauge 4.71

Set N+T, in xtic

5981

909

90°

5.00

tie pt Set 12" steel 0.98 S. linen of track

ties

362.86

5.00

Set 1"x2" stk 0.74 off ¾" IP for set line

stk = stk flush for 5.00

Fd 1"x2" stk flush 5.00 of

See pg. 3 FB 399.

Fd Brass cap (20 ft S 2.19 ft NE FB 101-48)

RxTtelpo 40.15

E 2.0

N+T PP

5229

0.84

x in rail steelmon

8.08

N+T PP

52.30 @ 64° 5229

424 39

Date 5-13-29 Notes by PRA Chief Party PRA F.B. 312 Pg 137

Platted by A. Svenson
Date Aug. 1930
Map No. B-442-2
Plotting C'k'd by D. M Finley
Date Nov. 1931

W. O. No. 920 C.S.B. No. 029
Location Rw Redondo Road
Surveyed by Paul Atkins Dep
Date 5-13-29
Inspected A. C. Johnson

9160 @ 84° = 9160
97.02 @ 84° = 97.02
88.75 @ 84° = 88.75
85.62 @ 84° = 85.62

Set 2x2-2'dn RP

Found spk as shown on pg 101

85.62

88.75

45°

(35)

(75)

(40)

(20)

(30)

628.25 to S.R.L. 2nd St F.B. 312-101

LOS ANGELES

REDONDO BLVD.

45°

(20)

97.02

9160

120

90°00'

Set 2x2-2'dn RP

Set 2x2-2'dn RP

528.73 @ 74° = 528.70

528.70

NO NAME ST.

90 0 1.15
360 0 5.75
90 0 18.75

Contd top 34

Notes: ANY ADDITIONS OR CHANGES OF THIS SHEET MUST BE MADE ON CANCELED M Bnd. WITH DATE AND NAME OF PERSON MAKING CHANGE.

Do not extend notes this side of this line

RETURN TO LOS ANGELES COUNTY SURVEYOR

424 34

F. B. 312 Pg 138 Chief Party Notes by Dma Date 1-13-29

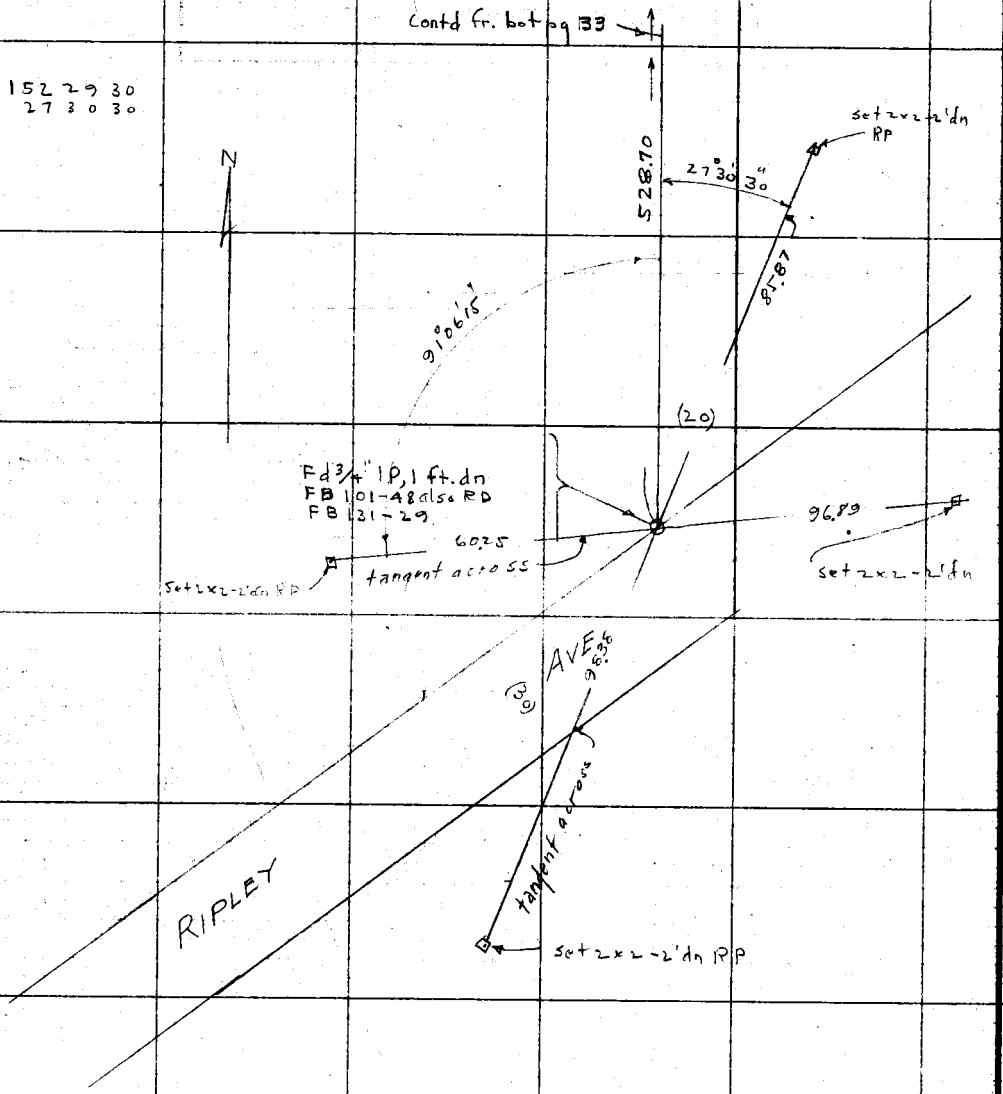

RETURN TO LOS ANGELES COUNTY SURVEYOR

Do not extend notes this side of this line

Note: ANY ADDITIONS OR CHANGES ON THIS SHEET MUST BE MADE OR CIRCLED IN Red. WITH DATE AND NAME OF PERSON MAKING CHANGE.

Date _____ Notes by _____ Chief Party _____ F.B. 424 PG. 36

Platted by _____
Date _____
Map No. _____
Platting C'k'd by _____
Date _____

W. O. No. 920 D. S. O. No. _____
Location Riverside - Redondo Rd
Surveyed by Paul Atkini - Dep
Date 5-13-29
Indexed A. C. Johnson

Note: ANY ADDITIONS OR CHANGES ON THIS SHEET MUST BE MADE OR CIRCLED IN Red WITH DATE AND NAME OF PERSON MAKING CHANGE.

Do not extend notes this side of this line

RETURN TO
LOS ANGELES COUNTY SURVEYOR

RETURN TO

LOS ANGELES COUNTY SURVEYOR

Note: ANY ADDITIONS OR CHANGES ON THIS SHEET MUST BE MADE OR CIRCLED IN **Red.** WITH DATE AND NAME OF PERSON MAKING CHANGE.

Do not extend notes this side of this line

Date

Notes by

Chief Party

F.B. 424 Pg. 36

Date 10-18-29 Notes by Orra Chief Party Orra F.B. 424 Pg 37

Platted by A. Svenson
Date Aug. 1930
Map No. B-442-2
Plotting Ck'd by D. M. Finley
Date MAY. 1933.

W. O. No. 920 C.S.D. No. 020
Location Rix. Redondo Road
Surveyed by PW-Hills Dep
Date Oct. 18, 1929
Inspected A. C. Johnson

I = 90 00 00
4 = 3 59 59 45
A = 89 59 59 25

109.83 @ 70° = 109.82

MB 10-29

Nail & tag pk 3x4"

4"x4" Nail & tag pk

MB 22-181

51.74

44.82

25+65.83

(HARPER LANE line)

transit line FB 399-12-13

= 109.82

Lot 49

1+49.07
Fd old rotted 2x2 stk 6"dn

169.07

(10) (10) (20)

9.81

87

Blk 150

90°00'00"
89°59'59"

LANE

9.95

19.93

Fd 1/2" I. stk tag illegible POT (2+56.01 FB 399-12)

155

2+19.00
Fd old rotted 2x2 stk 6"dn

(20) (20) (40)

STANFORD AVE

50.28 @ 84° = 50.28
129.61 @ 84° = 129.61
49.93 @ 84° = 49.93
169.07 @ 84° = 169.07

3+48.61 Fd old rotted 2x2 stk used cent for line

Blk 151

3+98.89
Fd old rotted 2x2 stk 6"dn

50.28

129.61

10.00

9.99

150

(20) (40)

GOODMAN AVE

229.84

PALM

Blk 152

Contd on top pg 38

Notes: ANY ADDITIONS OR CHANGES ON THIS SHEET MUST BE MADE OR CIRCLED IN Red, WITH DATE AND NAME OF PERSON MAKING CHANGE.

Do not extend notes this side of this line

RETURN TO LOS ANGELES COUNTY SURVEYOR

F.B. 424 PG. 38 b

Chief Party Notes by Date 10-18-29

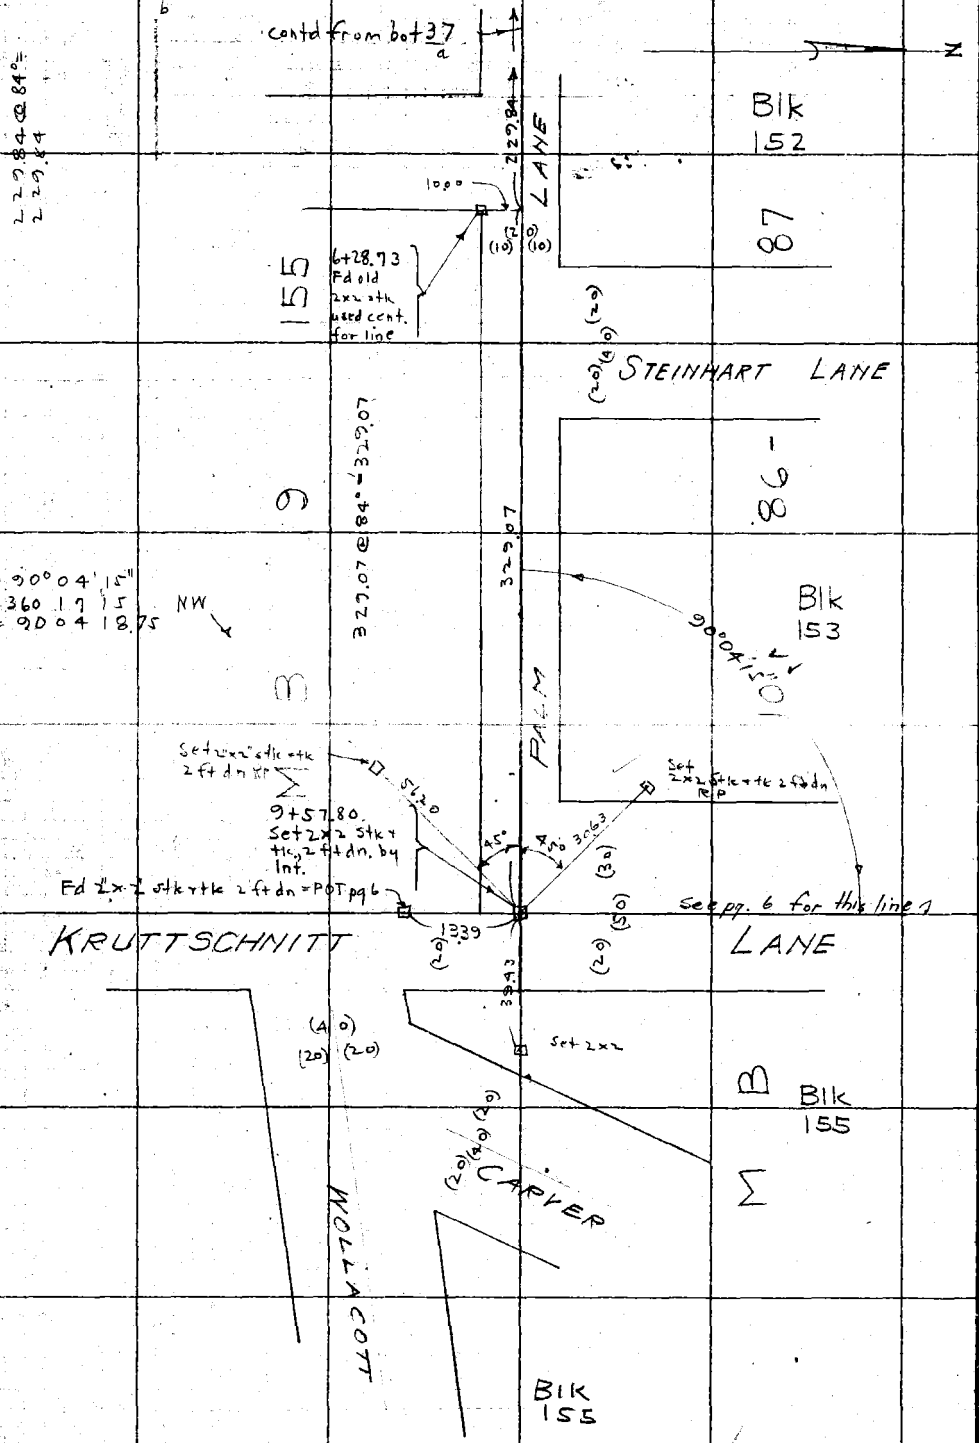

RETURN TO LOS ANGELES COUNTY SURVEYOR

Do not extend notes this side of this line

Note: ANY ADDITIONS OR CHANGES ON THIS SHEET MUST BE MADE OR CIRCLED IN Red. WITH DATE AND NAME OF PERSON MAKING CHARGE.

Date 2-27-29 Notes by Ona Chief Party Ona F.B. 424 Pg. 37

Planned by A. Svenson
Date Aug. 1933
Map No. B-442-2
Plotting C'k'd by D. M. Finley
Date NOV. 1933

W.O. No. 420 C.S.O. No. 079
Location Riv. Regnio Rd
Surveyed by Pc Atkins Dep
Date 2-27-29
Indexed by A. C. Johnson

Fd Spk 0.3' N line
F.B. 238-57

AVE

60.00 @ 84° = 60.00

55.01 @ 84° = 55.01

R.P.

AVE

L+T fd in curb

4.07 S

3.96

(30)

(60)

CENTER

6.000

4.71

5.10

55.01

4.32 S

3.96

4.06

spk in curb fd

Cross in curb fd

ST.

Fd L+T conc. pav. 0.03 S of line

L+T curb fd

(25)

(35)

(25)

(71)

(30)

(60)

(30)

Fd spk W. mac. pav.
FB 238-57

(50)

90°00'11"
36.001

Fd L+T conc pav.
FB 238-59
used for line

4798.72

4799.34 @ 64° =
4798.72

From F.B. 312-103

HAWTHORNE

PE

fr 104 top
F B 312

Contd fr. 103 top FB 312

From F.B. 312-105

HAWTHORNE

from 105 top
FB 312

RETURN TO
LOS ANGELES COUNTY SURVEYOR

Notice: ANY ADDITIONS OR CHANGES ON THIS SHEET MUST BE MADE IN CIRCLES AND WITH DATE AND NAME OF PERSON MAKING CHANGE.

Do not extend notes this side of this line

#24 ✓

F.B. 312 Pg. 40 — Chief Party — Notes by DNA — Date 2-3-30

Plotted by A Svensen 8-8-30 9442 Sh 2

Checked by J.D. Price 4-14-31

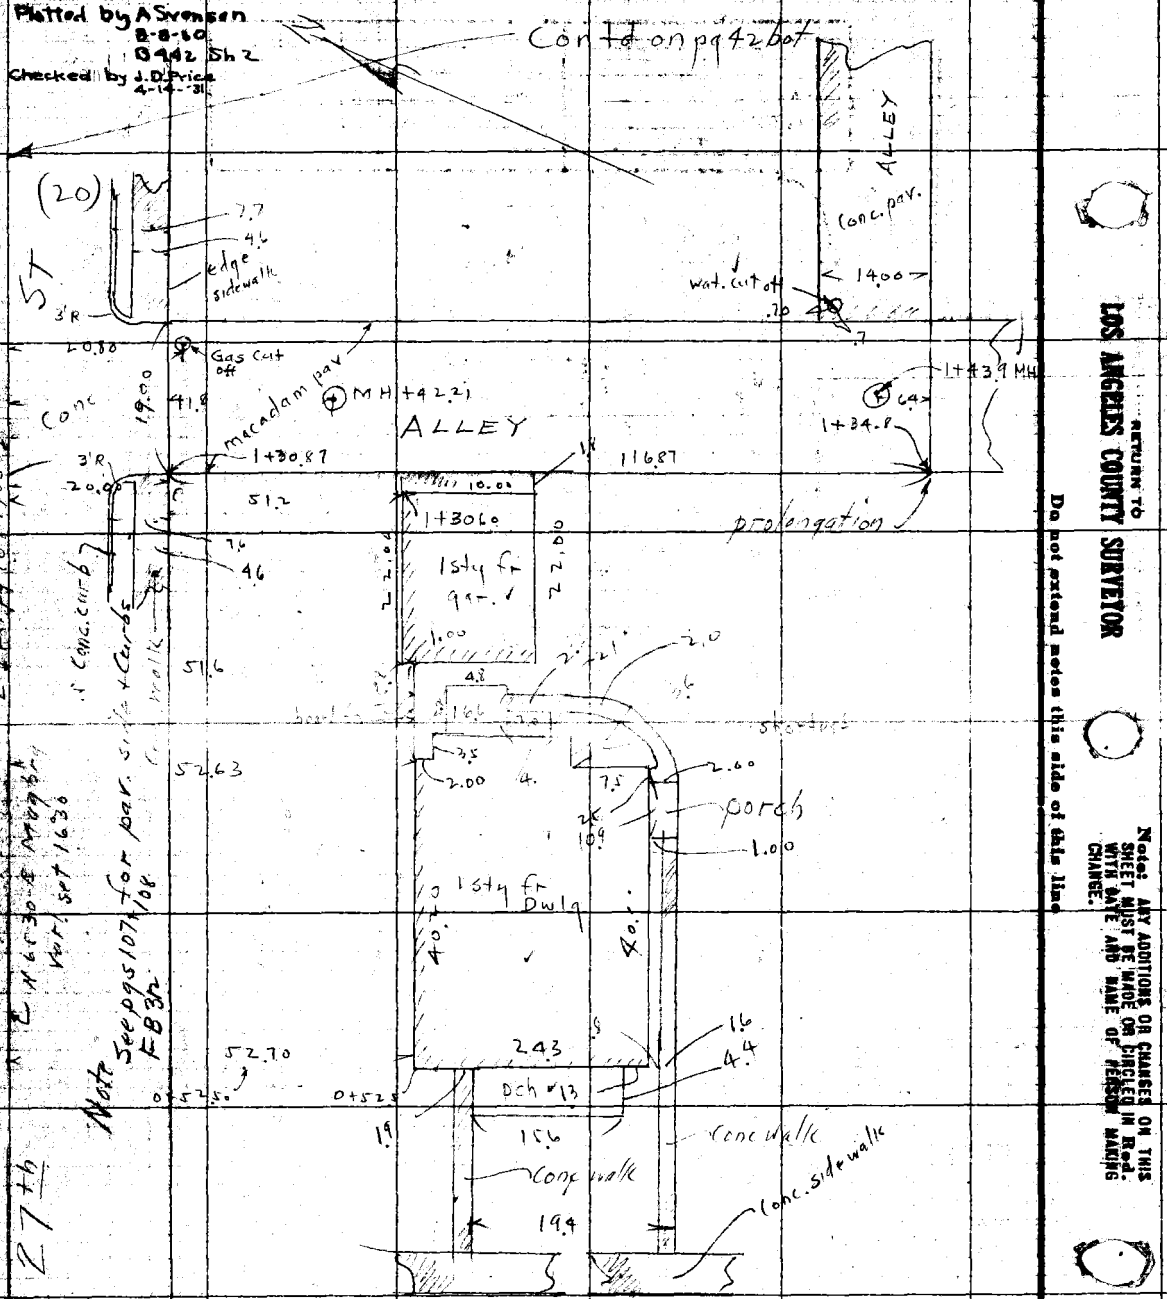

RETURN TO LOS ANGELES COUNTY SURVEYOR

Do not extend notes this side of this line

Notes: ANY ADDITIONS OR CHANGES ON THIS SHEET MUST BE MADE OR CIRCLED IN Red. WITH DATE AND NAME OF PERSON MAKING CHANGE.

22 15 40 52.5 130.5

Date 2-3-30 Notes by Price Chief Party Price F.B. 424 Pg. 41

Plotted by A Svenson
Date 2-6-30
Map No. B442-Sh2
Plotting C'k'd by J.D. Price
Date 4-14-31

W. O. No. 920 S. O. No. 062
Location River side Redondo Rd
Surveyed by Paul A Hinds Dup
Date Feb 3 1930
Inkedd A. C. Johnson

Contd on bot pg 43

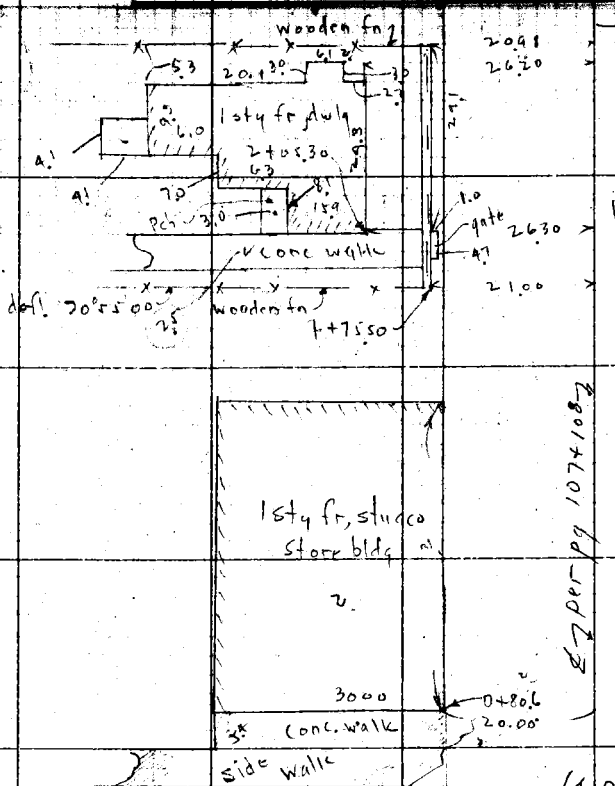

Note: pav. curb & walk FB 312-108.107

Contd fr bot pg 108 FB 312

Notice: ANY ADDITIONS OR CHANGES ON THIS SHEET MUST BE MADE OR CANCELED IN Red. WITH DATE AND NAME OF PERSON MAKING CHANGE.

Do not extend notes this side of this line

RETURN TO LOS ANGELES COUNTY SURVEYOR

F.B. 424 Pg. 42 — Chief Party — Notes by — Date 2-3-30

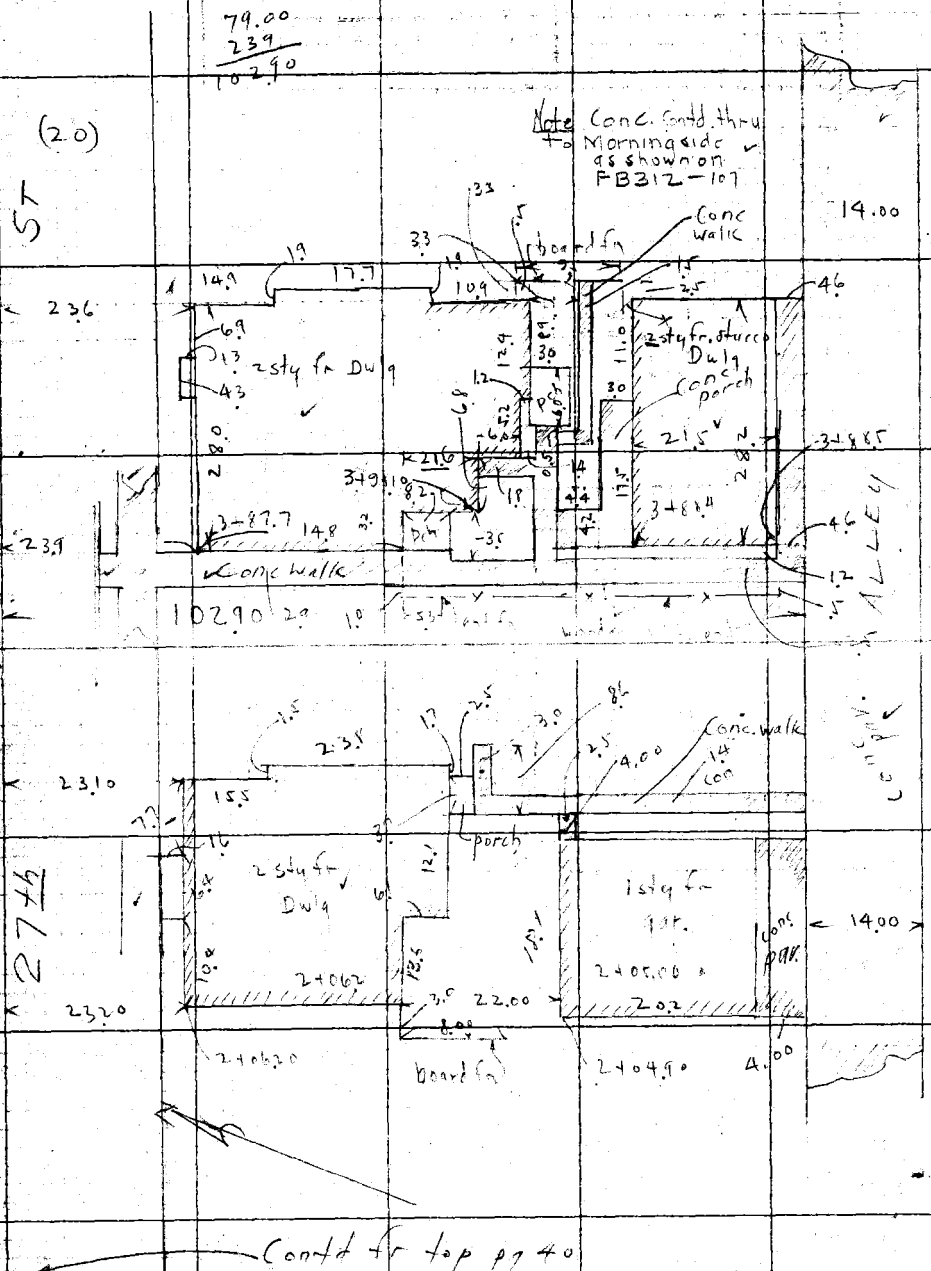

RETURN TO LOS ANGELES COUNTY SURVEYOR

Do not extend notes this side of this line

Note: ANY ADDITIONS OR CHANGES ON THIS SHEET MUST BE MADE OR ENCLOSED IN Red. WITH DATE AND NAME OF PERSON MAKING CHANGE.

Date 2-3-30 Notes by [illegible] Chief Party [illegible] F.B. 424 Pg. 43

Plotted by A Svenson
Date 2-10-30
Map No. D942-Sh2
Plotting Chkd by J.D. Price
Date 4-10-31

W. O. No. 920 S.C.E. No. 962
Location Riverside Redondo Rd
Surveyed by Paul A Hickinbotham Dep
Date Feb 3, 1930
Inspected A. C. Johnson

Note curbs + side walk (contd on the left side pg 107 FB 3)

and par.

137
5+19.00 PP

(40)
(20) ST (20)

3+85.5 PP
137

sidewalk
Conc. walk
19.5
2.5
36.0
2990
20.1
1074 108
15.5
1 sty fr stucco
10.9
conc pch
steps conc
Dwlg
24.0
2600
4.
4.00
27.50
13.00
3+57.6
1.9
3+57.7
6.9
3.5
28.0
17
5.0
6.0
60
20.20
3+59.3
4.3
wooden walk
4.
22.9
3+48.2
44.4
3+48.60
16.3
17
steps
1 sty fr
DWlg
14.0
22.00
12.0
3.3
30.30
22.75
2744
2+43.8 PP
13.9

4.00
23
1:7

877
3+2
SL S

& per 1074 108

Contd fr. top pg 41

Note: Any corrections or changes on this sheet must be made as directed by the Dept. with date and name of person making change.

Do not extend notes to this side of this line

RETURN TO LOS ANGELES COUNTY SURVEYOR

F. B. 424 PG. 44 Chief Party Notes by Date

RETURN TO
LOS ANGELES COUNTY SURVEYOR

Do not extend notes this side of this line

Note: ANY ADDITIONS OR CHANGES ON THIS SHEET MUST BE MADE BY SURVEYOR IN RED WITH DATE AND NAME OF PERSON MAKING CHANGE.

Surveyed by D. M. Finley Survey of Riverside Redondo F.B. 424 Pg.

W. O. 920 Tape No. 996 St'd 99 of F.

Corrected by Recorded

Date Nov. 1932 Indexed by C. Johnson

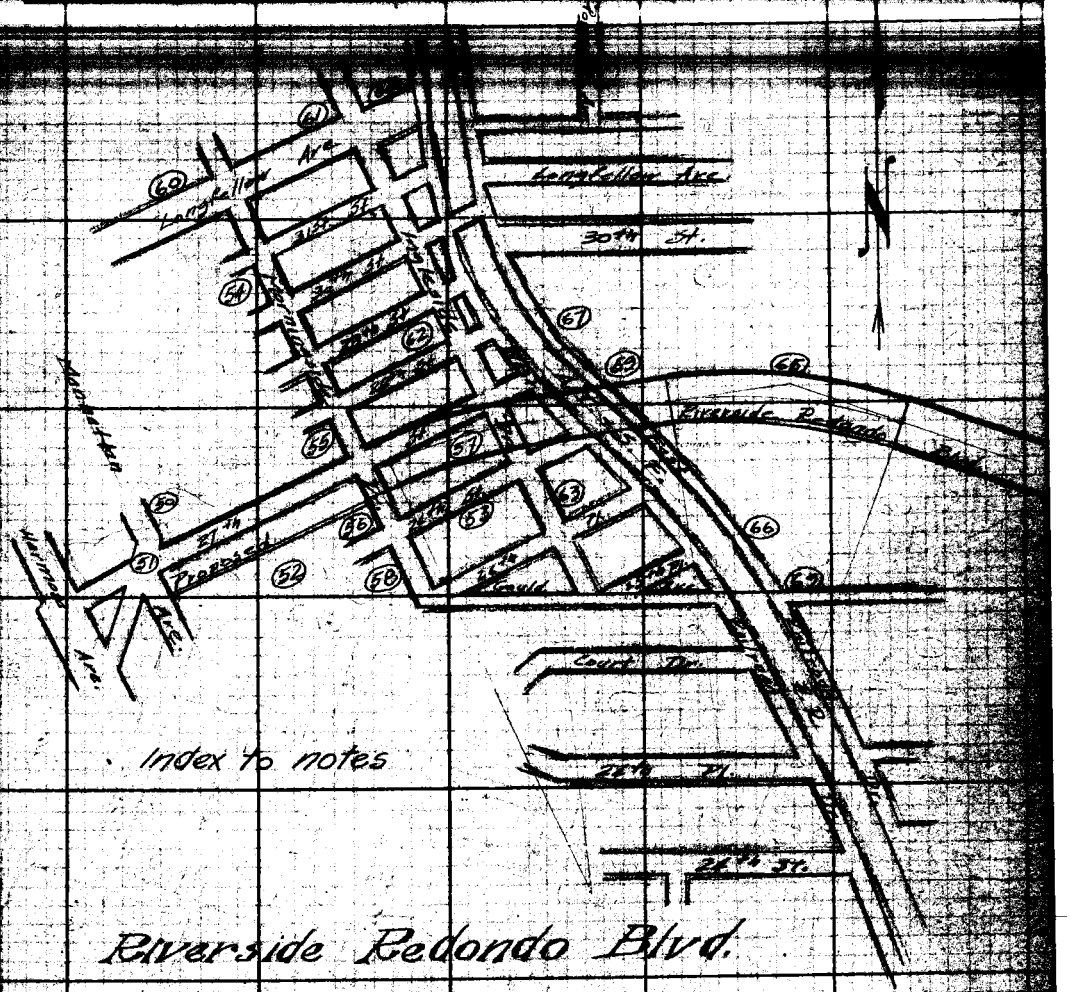

Riverside Redondo Blvd.

W.O. 920

& Monuments and additional streets.

May - July 1932.

Party.

E. A. Rosecrans
P. W. Atkins H.
F. H. Baker ch.
F. H. Blanchard ch.
W. H. Reynolds ch.

LOS ANGELES COUNTY SURVEYOR
RETURN TO
ROOM 160 HALL OF RECORDS
Do not cancel prints for changes made

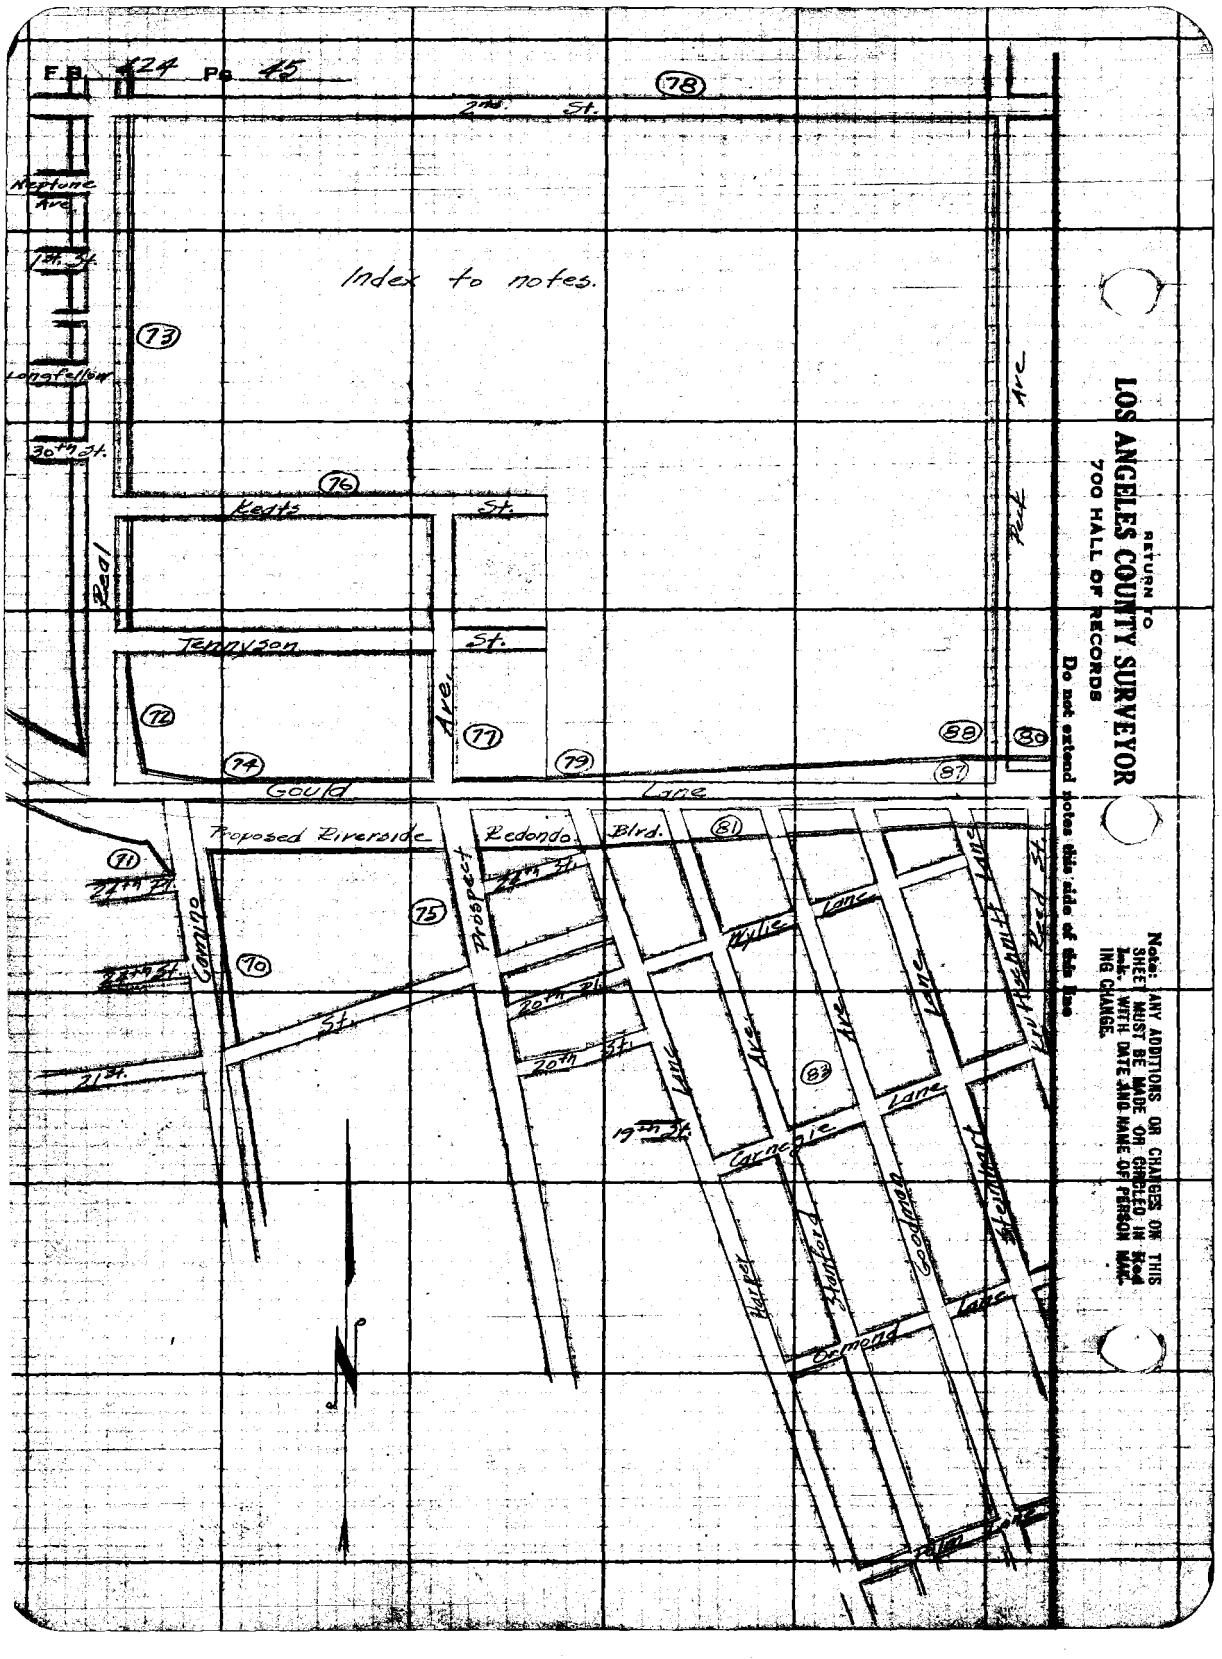
F.B. 124 Pg. 45
Index to notes.
Neptune Ave.
Longfellow
30th St.
Keats St.
Pearl
Ave.
Tennyson St.
Gould Lane
Proposed Riverside
Redondo Blvd.
Prospect
RETURN TO
LOS ANGELES COUNTY SURVEYOR
700 HALL OF RECORDS
Do not extend notes this side of this line
Note: ANY ADDITIONS OR CHANGES ON THIS SHEET MUST BE MADE OR CHECKED IN Red Ink, WITH DATE AND NAME OF PERSON MAKING CHANGE.

Notes St'd by D. M. Finley
Map No. B-442-2
Office Work J. H. Rice
Checked D. M. Finley
Date Nov. 1933

Survey of Riverside Redondo
W. O. 920 Tape No. 046 St'd 84 °F.
Surveyed by Lasserre
Notes
Date Feb 32
Indexed E. C. Johnson

F.B. 424 Pg. 46

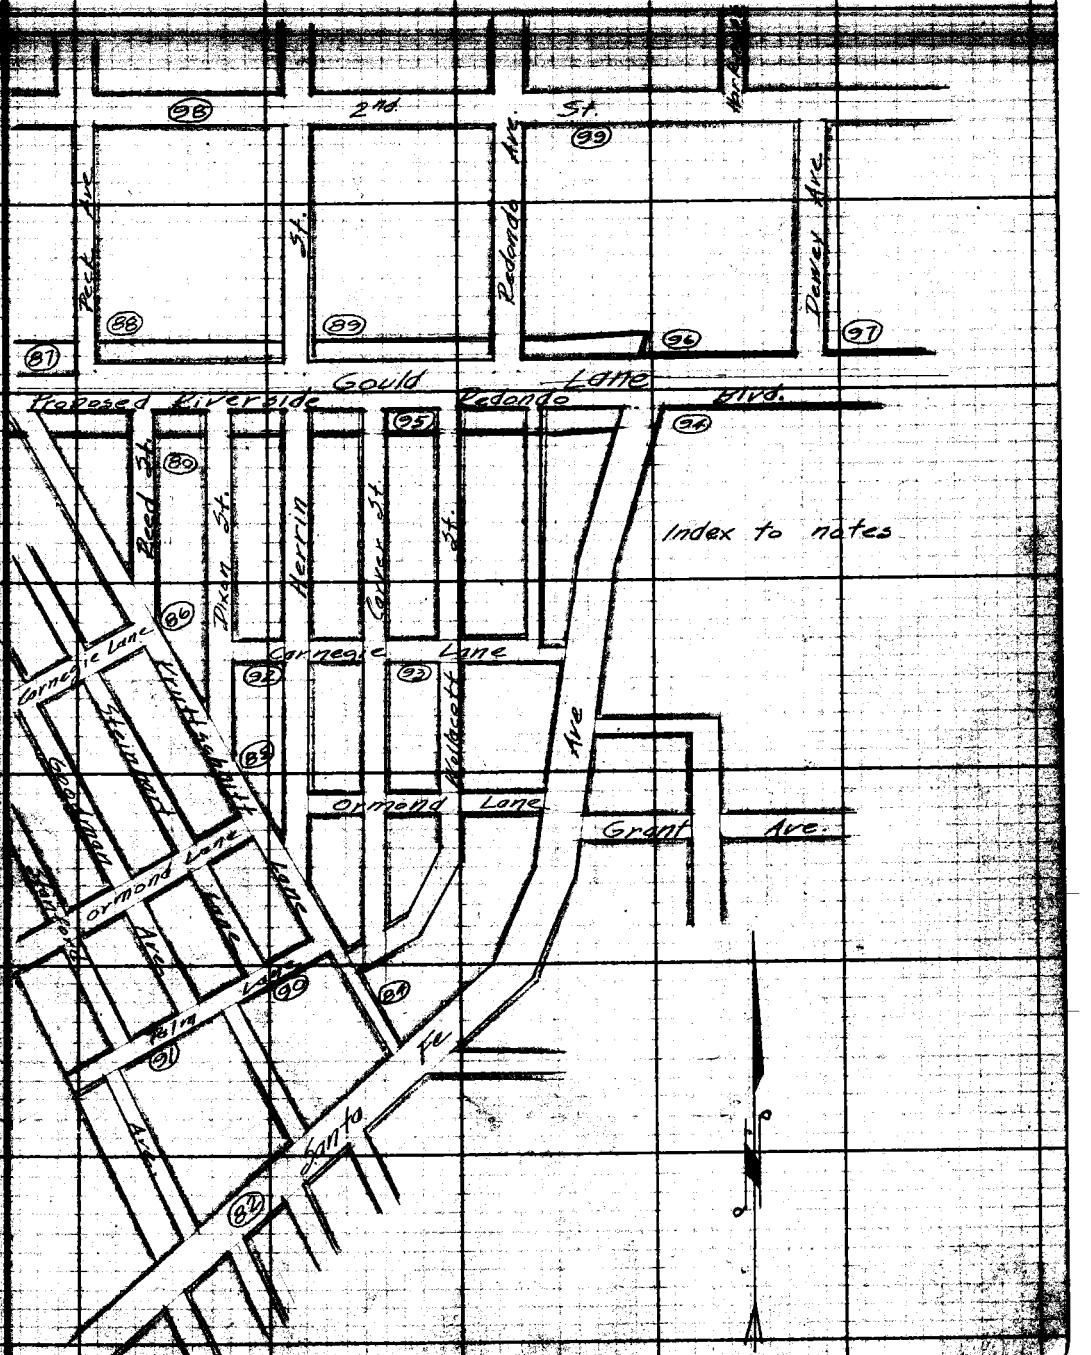

RETURN TO
LOS ANGELES COUNTY SURVEYOR
720 HALL OF RECORDS

Notice: ANY ADDITIONS OR CHANGES ON THIS SHEET MUST BE MADE OR CHECKED IN RED INK, WITH DATE AND NAME OF PERSON MAKING CHANGE.

Do not extend notes this side of this line

RETURN TO
LOS ANGELES COUNTY SURVEYOR
700 HALL OF RECORDS

Note: ANY ADDITIONS OR CHANGES ON THIS SHEET MUST BE MADE OR CIRCLED IN Red Ink. WITH DATE AND NAME OF PERSON MAKING CHANGE.

Do not extend notes this side of this line

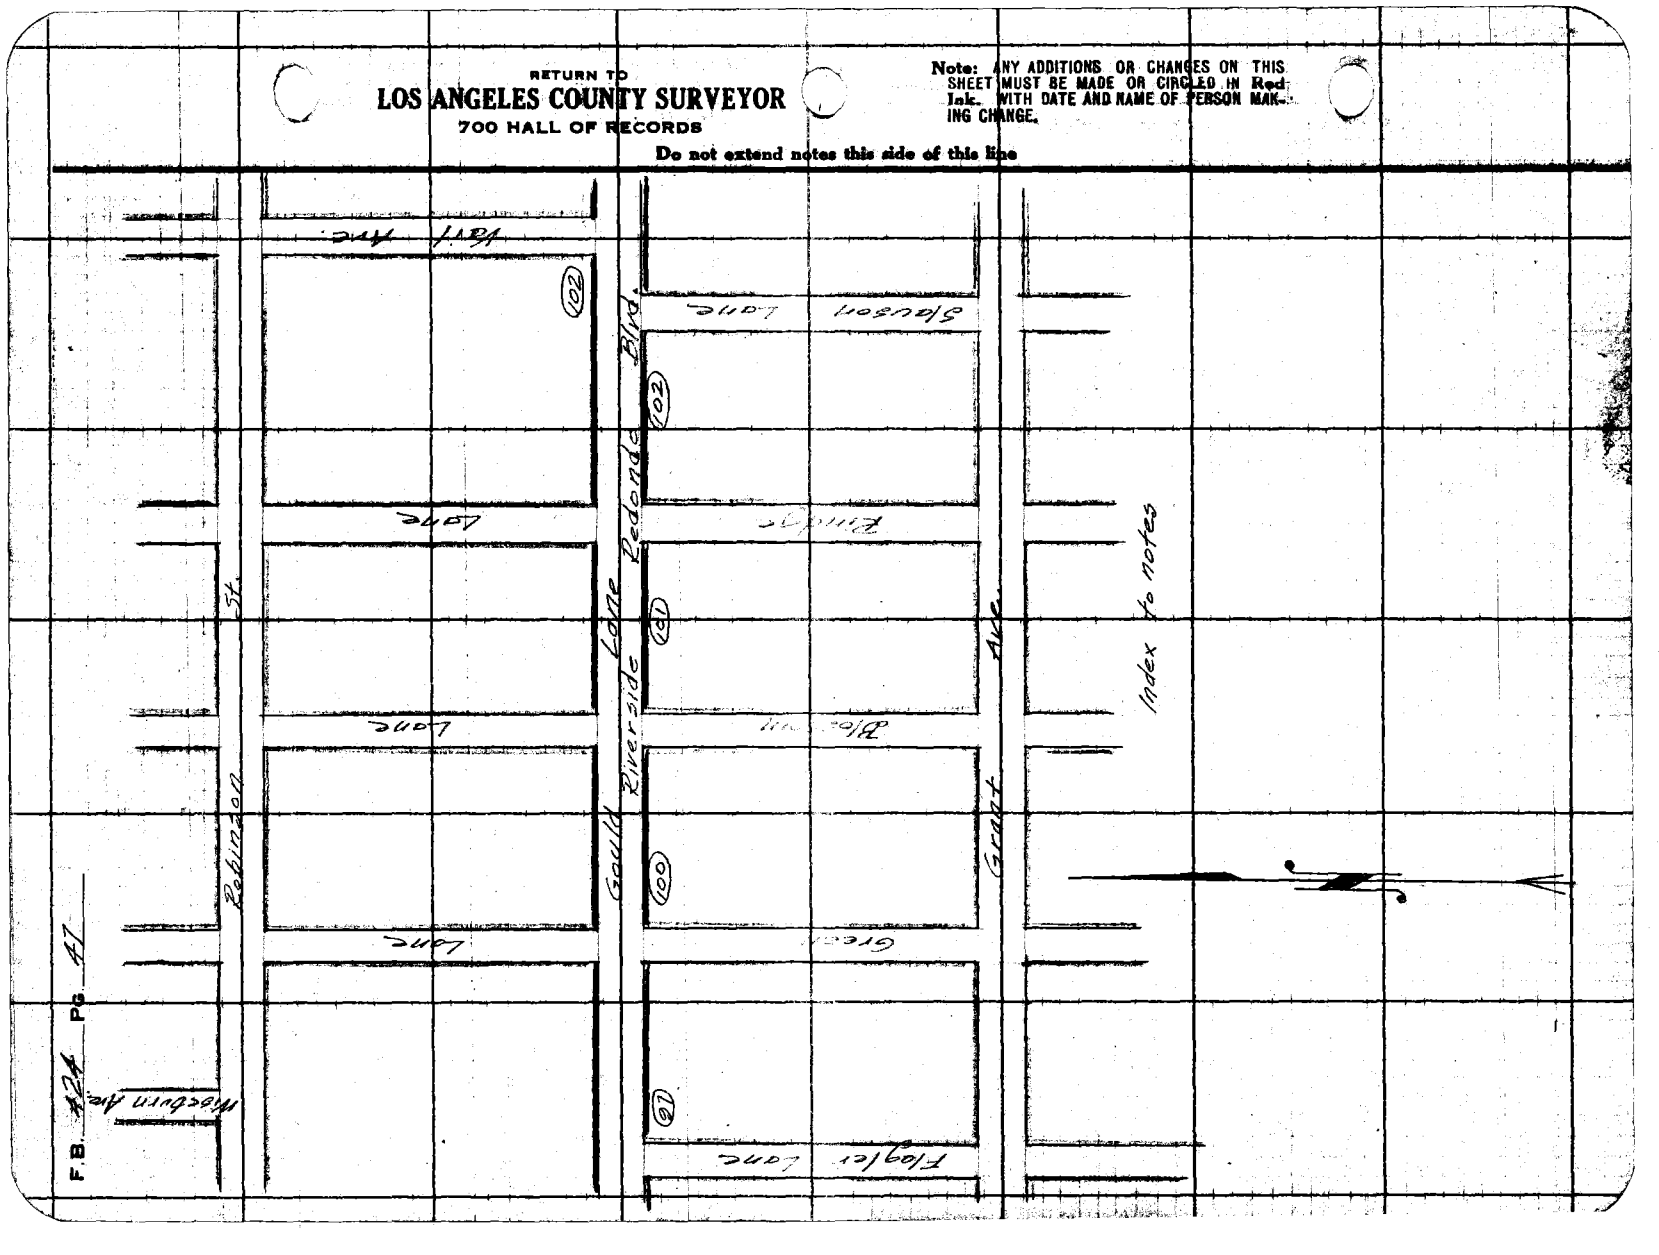

F.B. #24 PG. 47

Notes Cl'd by D. M. Finley | Survey of Riverside Redondo | F.B. 424 PG. 12

Map No. B-442-2 | W. O. 920 Tape No. 046 Sl'd 84 °F.

Office Work J. H. Rice | Surveyed by Rosecrans

Checked D. M. Finley | Notes Date July 32.

Date Nov. 1932 | Indexed A. C. Johnson

Index Map Notes

Robinson St.

Lane

Lane

Lane

Lane










Grant Ave.

Note: ANY ADDITIONS OR CHANGES ON THIS SHEET MUST BE MADE ON CIRCLED MAP Index, WITH DATE AND NAME OF PERSON MAK-ING CHANGE.

Do not extend notes this side of this line

RETURN TO

LOS ANGELES COUNTY SURVEYOR

720 HALL OF RECORDS

FORM 847 10M 8-31

RETURN TO

LOS ANGELES COUNTY SURVEYOR

700 HALL OF RECORDS

Note: ANY ADDITIONS OR CHANGES ON THIS SHEET MUST BE MADE OR CIRCLED IN Red Ink. WITH DATE AND NAME OF PERSON MAKING CHANGE.

Do not extend notes this side of this line

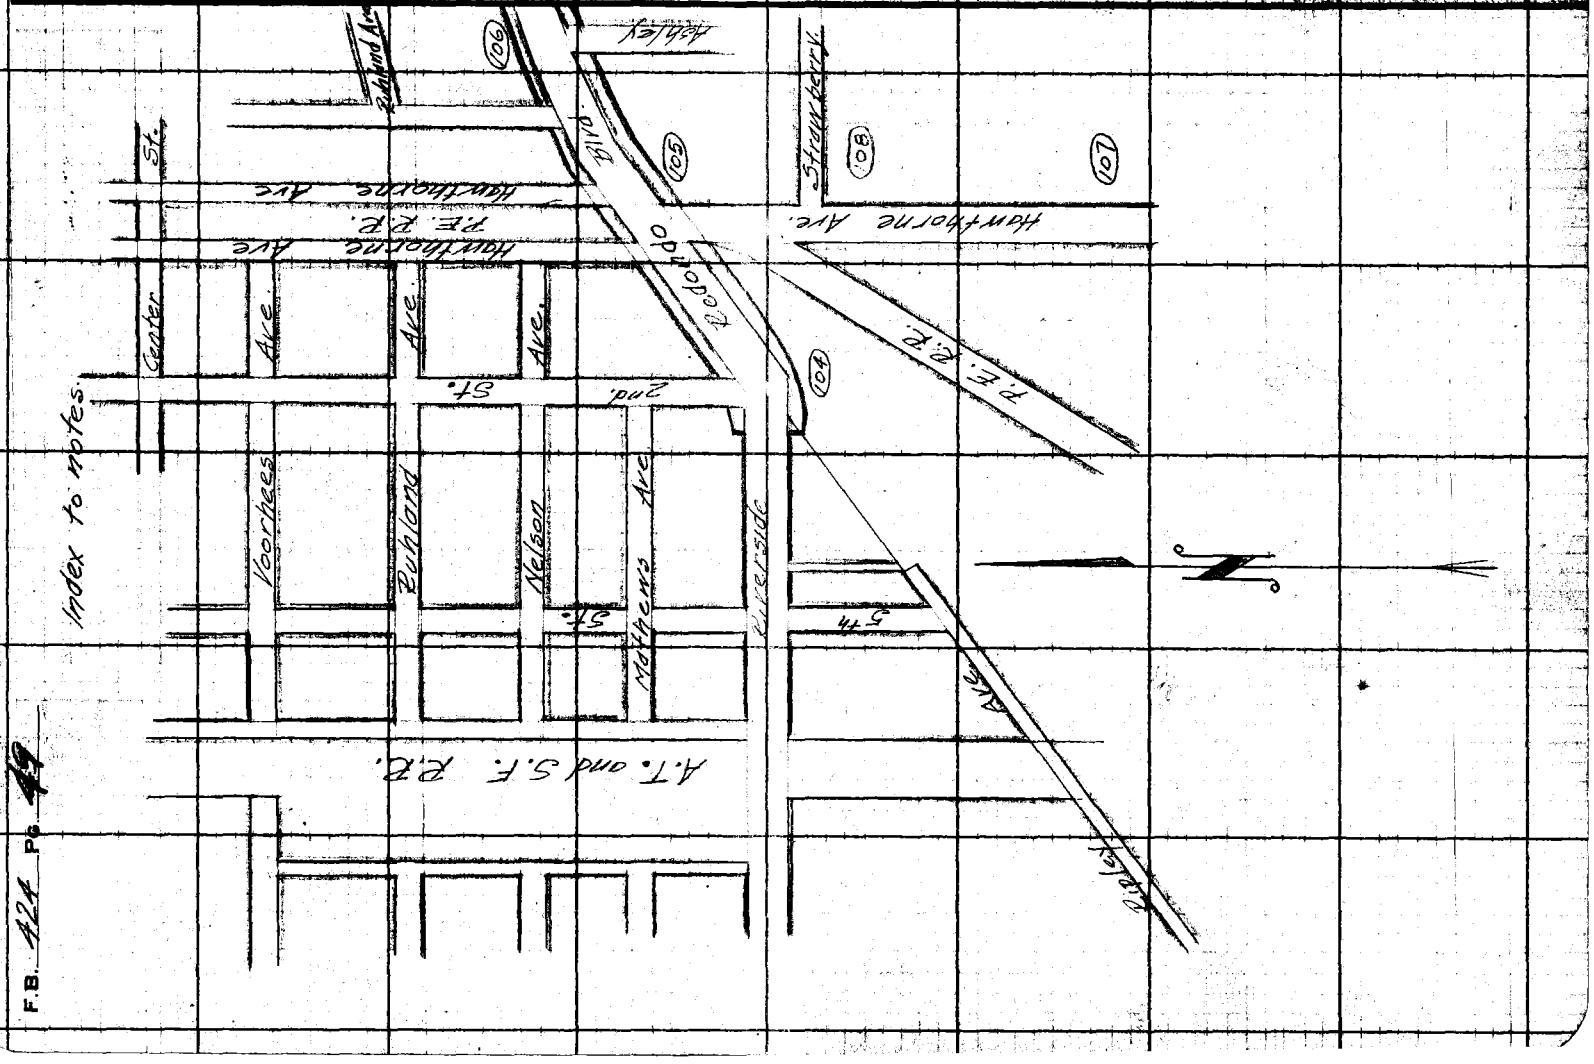

F.B. 424 Pg 49

Notes Ck'd by D.M. Finley	Survey of Riverside-Redondo Blvd.	F.B.	PG.
Map No. B-442-2	W. O. 920 Tape No. St'd °F.		
Office Work J.N. Rice	Surveyed by		
Checked D.M. Finley	Notes Date		
Date Nov. 1933	Indexed		

REASONS FOR ADJUSTING DISTANCES ALONG
ADOPTED CENTER LINE
EL CAMINO REAL BETWEEN AND INGLEWOOD AVENUE

The neccessity for adjusting some of the distances as shown in F.B. 424 between El Camino Real and the S.E. Cor. of Sec. 30 T.3S.R.14W. is because the Adopted ℄ was staked according to an office calculation which was based on the original chainage made by P.W. Atkins in Apr 1929 per F.B. 312-72-87. These adjustments enable the points set by proportion to be shown in their proper relations.

The points for street ℄s. going north from the Adopted ℄ between the S.E. Cor. of Sec. 30 T.3S. R.14W. and Vail Ave. were set by J.W. Boyer in Nov. 1929 per his chainage shown in F.B. 422-37, 38, 42 and this chainage is adopted to conform with C.S. B-455-4. The points for street ℄s. going south from the Adopted ℄ between Flagler Lane and Slauson Lane were originally set by P.W. Atkins in June 1929 per his chainage shown in F.B. 312-87-91. The distances between these points are calculated to fit Boyer's chainage shown in F.B. 422 and does not quite check the proportioning per the original chainage. The C.S. Map will show these points as replacements of P.W. Atkins original points. The adjustments of some of the distances along the Adopted ℄ as shown in F.B. 424 is due to coördinating the chainage of these two surveys.

For explanation of adjusted distances between Vail Ave. and Inglewood Ave. see F.B. 312-92.

D. M. Finley Nov. 20, 1933.

Make ANY ADDITIONS OR CHANGES ON THIS SHEET, WHERE THEY ARE NEEDED, AND INITIAL THE CHANGE.
Do not extend entries to this side of this Map
RETURN TO LOS ANGELES COUNTY SURVEYOR 700 HALL OF RECORDS
FORM 2.427 1934 5-91

RETURN TO

LOS ANGELES COUNTY SURVEYOR

700 HALL OF RECORDS

Note: ANY ADDITIONS OR CHANGES ON THIS SHEET MUST BE MADE OR CIRCLED IN **Red Ink.** WITH DATE AND NAME OF PERSON MAKING CHANGE.

Do not extend notes this side of this line

F.B. _____ PG. _____

Work Ch'd by D. M. Finley
Map No. B-442-2
Topo Work I. H. Rice
Checked D. M. Finley
Date Nov. 1942

Survey of Riverside Redondo Blvd
W. O. 220 Topo No. 046 Bk's 84 of
Surveyed by Rosecrans
Notes
Date 5-21-32
Inspected S. Johnson

F.B. 424 Pg. 50

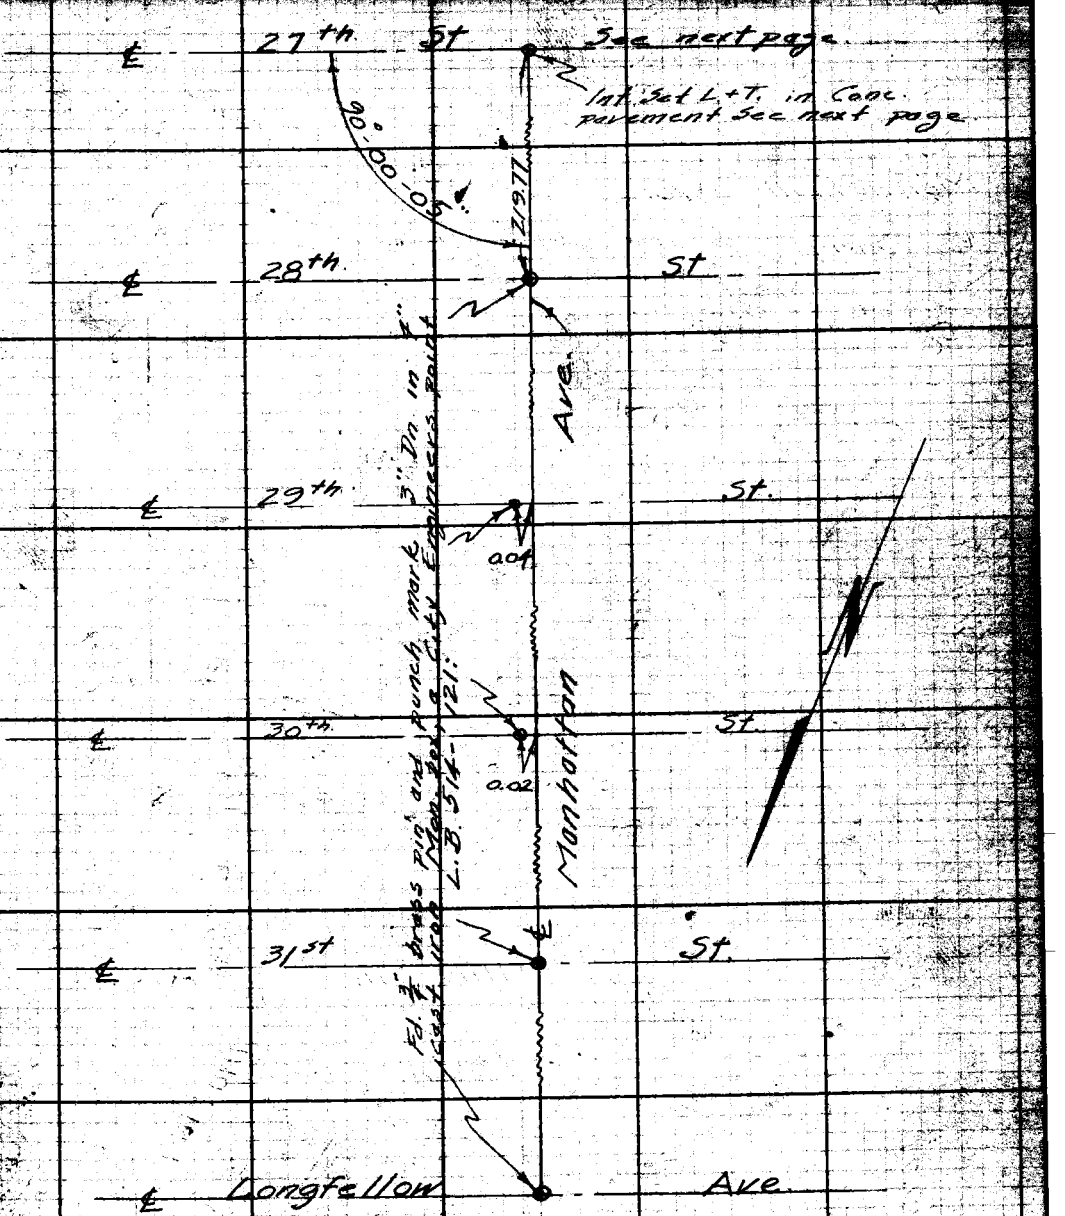

Notice! Any additions or changes on this sheet must be made or checked in red with date and name of person making change.

Do not cancel notes on this side of this line

LOS ANGELES COUNTY SURVEYOR
ROOM 370 HALL OF RECORDS

RETURN TO
LOS ANGELES COUNTY SURVEYOR
700 HALL OF RECORDS

Note: ANY ADDITIONS OR CHANGES ON THIS SHEET MUST BE MADE OR CIRCLED IN Red Ink. WITH DATE AND NAME OF PERSON MAKING CHANGE.

Do not extend notes this side of this line

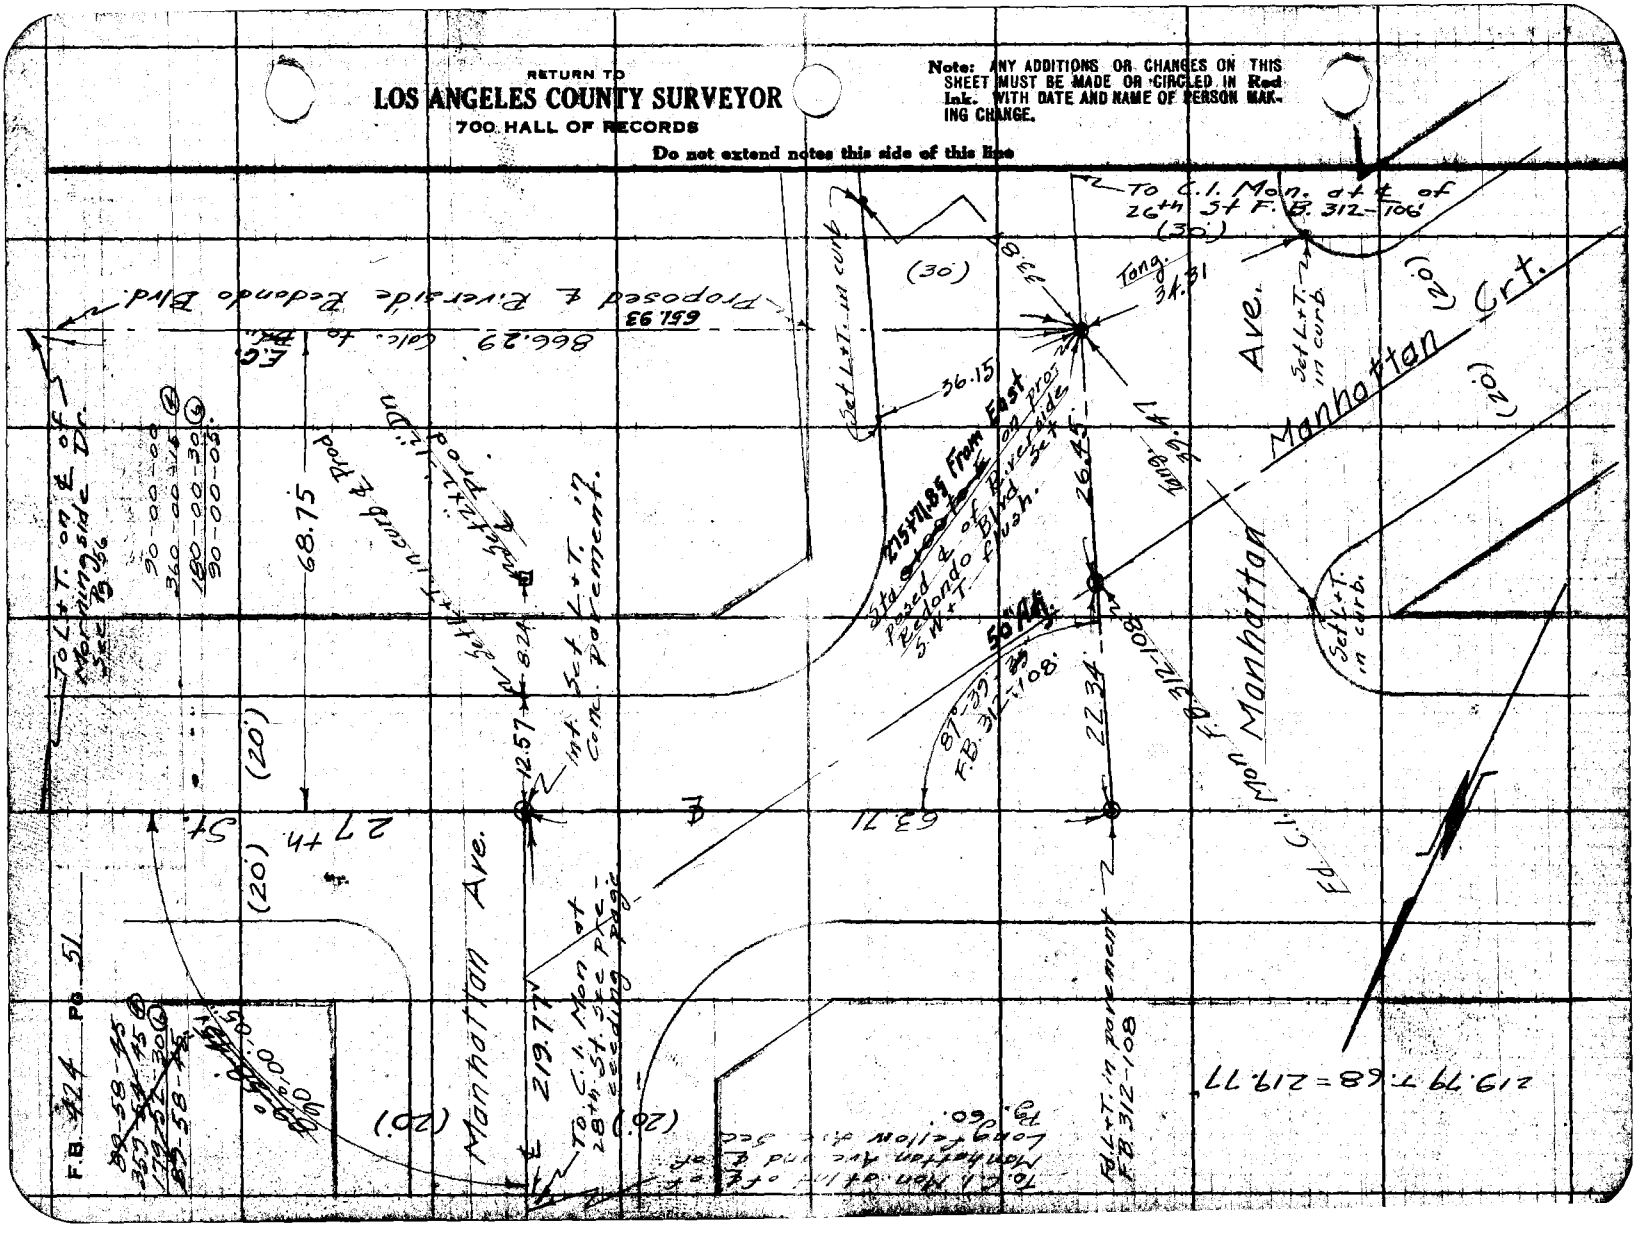

Notes Ck'd by D. M. Finley | Survey of Riverside-Redondo
Chief Div. R-440-2 | W. O. 920 Topo No. 0664 Sht. 64 of
Office Work by I. H. Rice | Prepared by Rosecrans
Checked D. M. Finley | Notes | Date 3-11-32

F.B. 424 Pg. 92

RETURN TO
LOS ANGELES COUNTY SURVEYOR
700 HALL OF RECORDS


NOTE: ANY ADDITIONS OR CHANGES ON THIS SHEET MUST BE MADE ON CIRCLED IN Red AND WITH DATE AND NAME OF PERSON MAKING CHANGE.

Ingleside Dr.

(20') (20')

19.69
293.24
99.76 @ 13-12
100.00

T. 70 = 19.69.
T. 70 = 293.21.
T. 70 = 97.11.
T. 66 = 99.99.
510.00'

St. 510.00

(20')

Morningside Dr.

(20')

Sta 6+94.86 Int. ℄
Fd L+T. in Pavement
F.B. 312-107

694.86' per F.B. 312-107

26 in.

Sta 0+00 to E. Fd. 3/4 brass
Rin. + punch mark 3' Dn. in
& East from Mon. bot. in
E.B. 312-106 & F.B. 514-126

℄ Manhattan Ave.

(30') (30')

F.B. 424 Pg 53

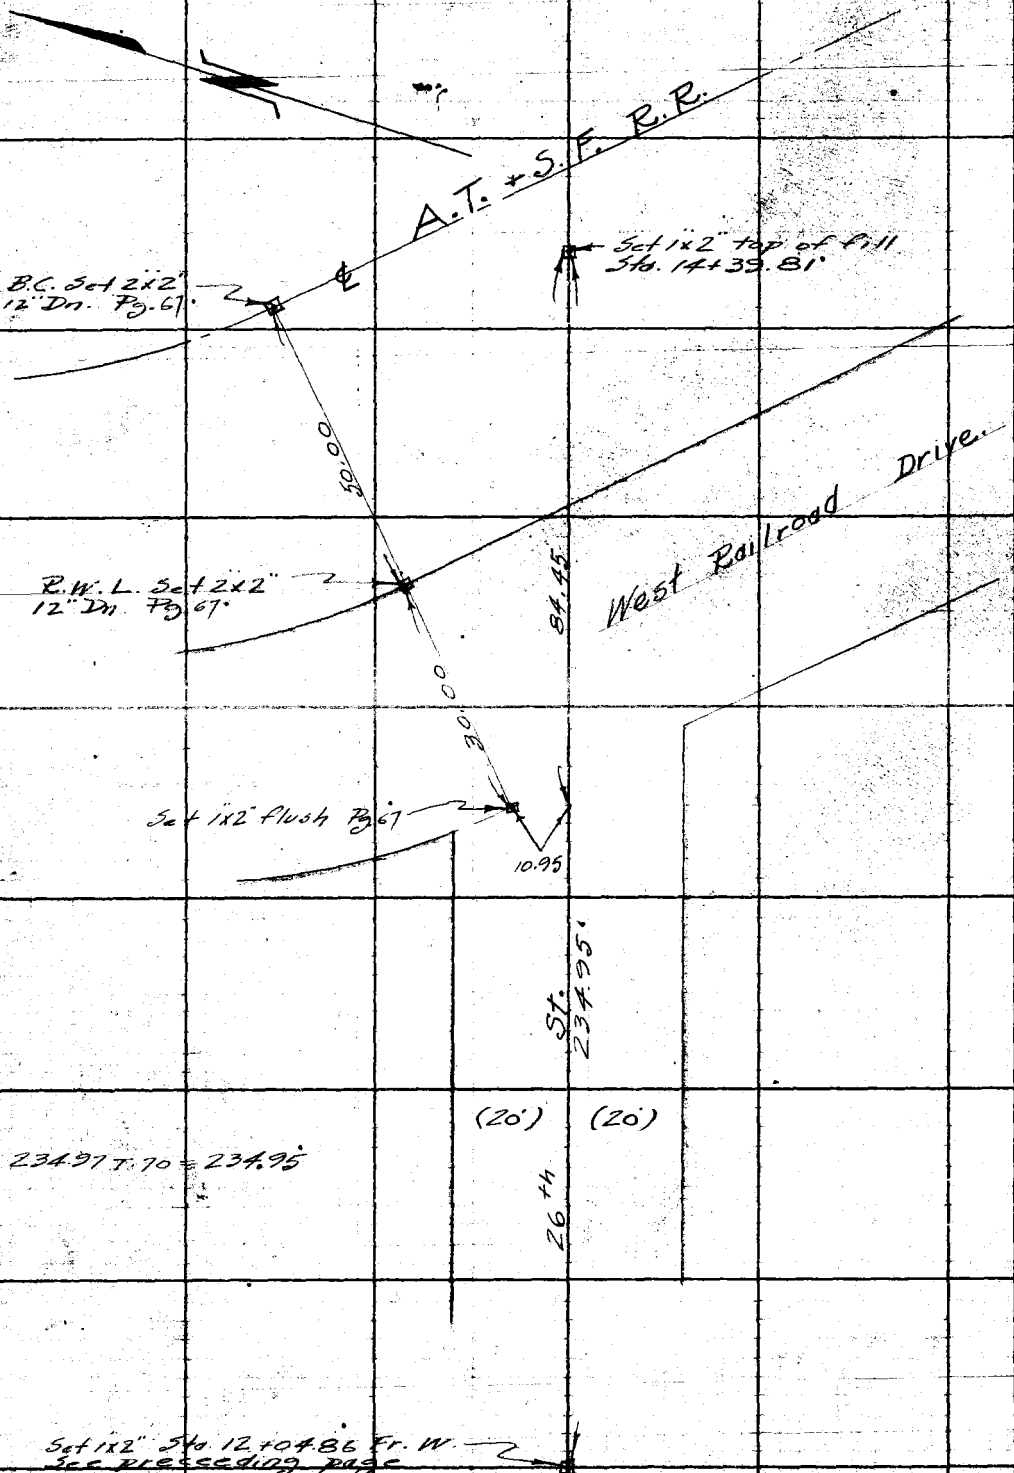

RETURN TO
LOS ANGELES COUNTY SURVEYOR
700 HALL OF RECORDS
Do not extend notes this side of this line

Note: ANY ADDITIONS OR CHANGES ON THIS SHEET MUST BE MADE OR CIRCLED IN Red Ink. WITH DATE AND NAME OF PERSON MAK-ING CHANGE.

Notes Ck'd by D. M. Finley | Survey of Riverside Redondo
Map No. B-44-2 | Vol. Cs. 220 Tape No. 046 Sht. 84 of
Office Mark L.A.C.S.Co. | Computed by Rodecap
Checked D. M. Finley | Notes | Date 5-17-32
Draftsman [illegible] | Surveyor C. J. Johnson

F.B. 424 Pg. 54

Cont. to left on next page

30th St. (20')

12.7 | 30° | 0.12 | Sta. 3+85.0 Fd nail in pavement & City Engineers point

12.6

(20')

B.R.

12.4 | 12.7

Morningside Dr.

120.0'

120.10 T. 72 = 190.09'

12.4 | 12.6

B.R.

31st St. (20')

12.5 | 90° | 0.07 | Sta. 1+94.95 Fd nail in pavement City Engineers point

12.7

(20')

B.R.

12.4 | 12.6

℄

(20') | (20')

194.95'

30-00-00
360-01-30
180-02-18
30-00-12

194.97 T. 72 = 194.95'

30°-00-12"

12.4 | 12.5

B.R. | B.R.

(25')

Int. Fd. L. & T. in pavement Sta. 0+00 to S. Sta. 6+39.95 Ft. W. See Pg. 60.

20.0

℄ Longfellow

20.0 | 20.0

Ave Pg

To C.E. Mon. at Manhattan and Longfellow Pg. 60.

20.0

(25')

B.R. | B.R.

12.7 | 12.5


RETURN TO LOS ANGELES COUNTY SURVEYOR 700 HALL OF RECORDS

Do not extend notice this side of this line

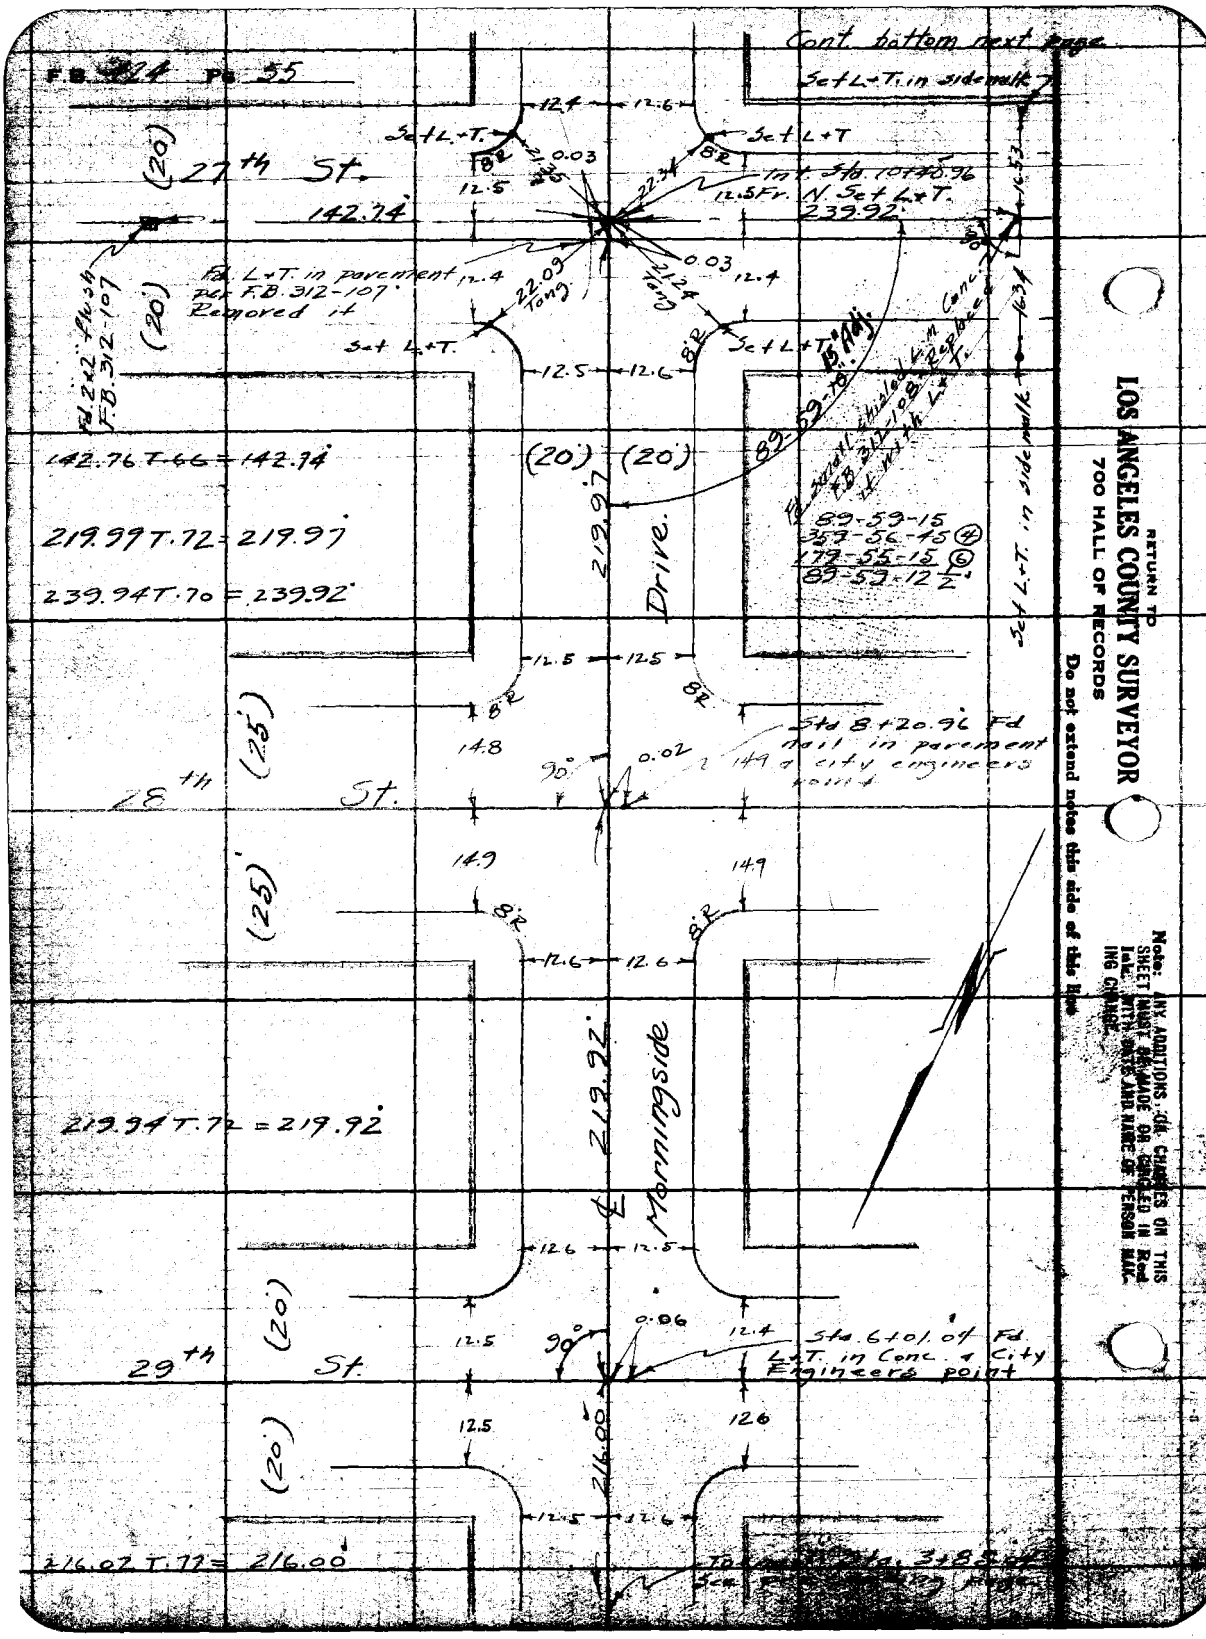
F.B. 224 Pg. 55
Cont. bottom next page
Set L.T. in sidewalk
27th St.
142.74'
(20)
Set L.T.
Ind. Sta. 10+40.96
12.5 Fr. N Set L.T.
239.92'
Fd. L.T. in pavement per F.B. 312-107. Removed it
Fd. 2x2 flush F.B. 312-107
Set L.T.
Fd. Nail
Fd. nail and shiner F.B. 312-107 L.T. 0.4' W. of the L.T.
89-59-15
357-56-45 (4)
179-55-15 (5)
89-59-12 L.
142.76 T.66 = 142.94'
219.99 T.72 = 219.97'
239.94 T.70 = 239.92'
219.97'
Drive.
Set L.T. in sidewalk
28th St.
Sta 8+20.96 Fd nail in pavement & city engineers point
14.8
14.9
219.92'
Morningside
219.94 T.72 = 219.92'
29th St.
Sta. 6+01.04 Fd. L.T. in Conc. & City Engineers point
216.00'
216.02 T.72 = 216.00'
RETURN TO
LOS ANGELES COUNTY SURVEYOR
700 HALL OF RECORDS
Do not extend notes this side of this line
Note: ANY ADDITIONS OR CHANGES ON THIS SHEET MUST BE MADE OR CAUSED IN Red Ink WITH DATE AND NAME OF PERSON MAKING CHANGE.

Notes Ck'd by D. M. Finley | Survey of Riverside Redondo Blvd | F.B. 42 Pg. 45

Checked D. M. Finley | Notes | Date 5-17-32

Rev. 1930 | Notes C. Johnson

Comp. [illegible]

12.6 12.6

26th St. Pg 52

12.4 12.5

16.1x12" Ex. W. Sta. 39+59.

90°-01'-15" 12.4 12.4

(20') (20')

Int. Sta. 14+60.82 Ft. Rt. & T. P.B. 312-107.

90-01-15 (A)

360-04-30 (B)

180-06-45 (C)

90-01-01½

Proposed

R. W. L.

171.13 T. 68 = 171.11'

68.75

171.11'

℄ Morningside

Int. Sta. 19+09.11 Ft. Rt. & T. P.B. 312-107. Sta. 19+09.92 Ex. Lt. Lt. in pavement 260 Ft. Rt.

Proposed ℄ Riverside Redondo Blvd.

50.00 50.00

269 Ft. 10.9 Ex. Lt. Lt. in pavement

R.O.T.

68.75

89°-59'-15"

(20') (20')

27th St. Sec Pg. 55

℄ Proposed

Int. Sta. 40+96 Ft. N. & T. Pro-perty Line

15.7 Ft. Rt.

89°-59'-15"

R. W. L.

Pg

RETURN TO LOS ANGELES COUNTY SURVEYOR 700 HALL OF RECORDS



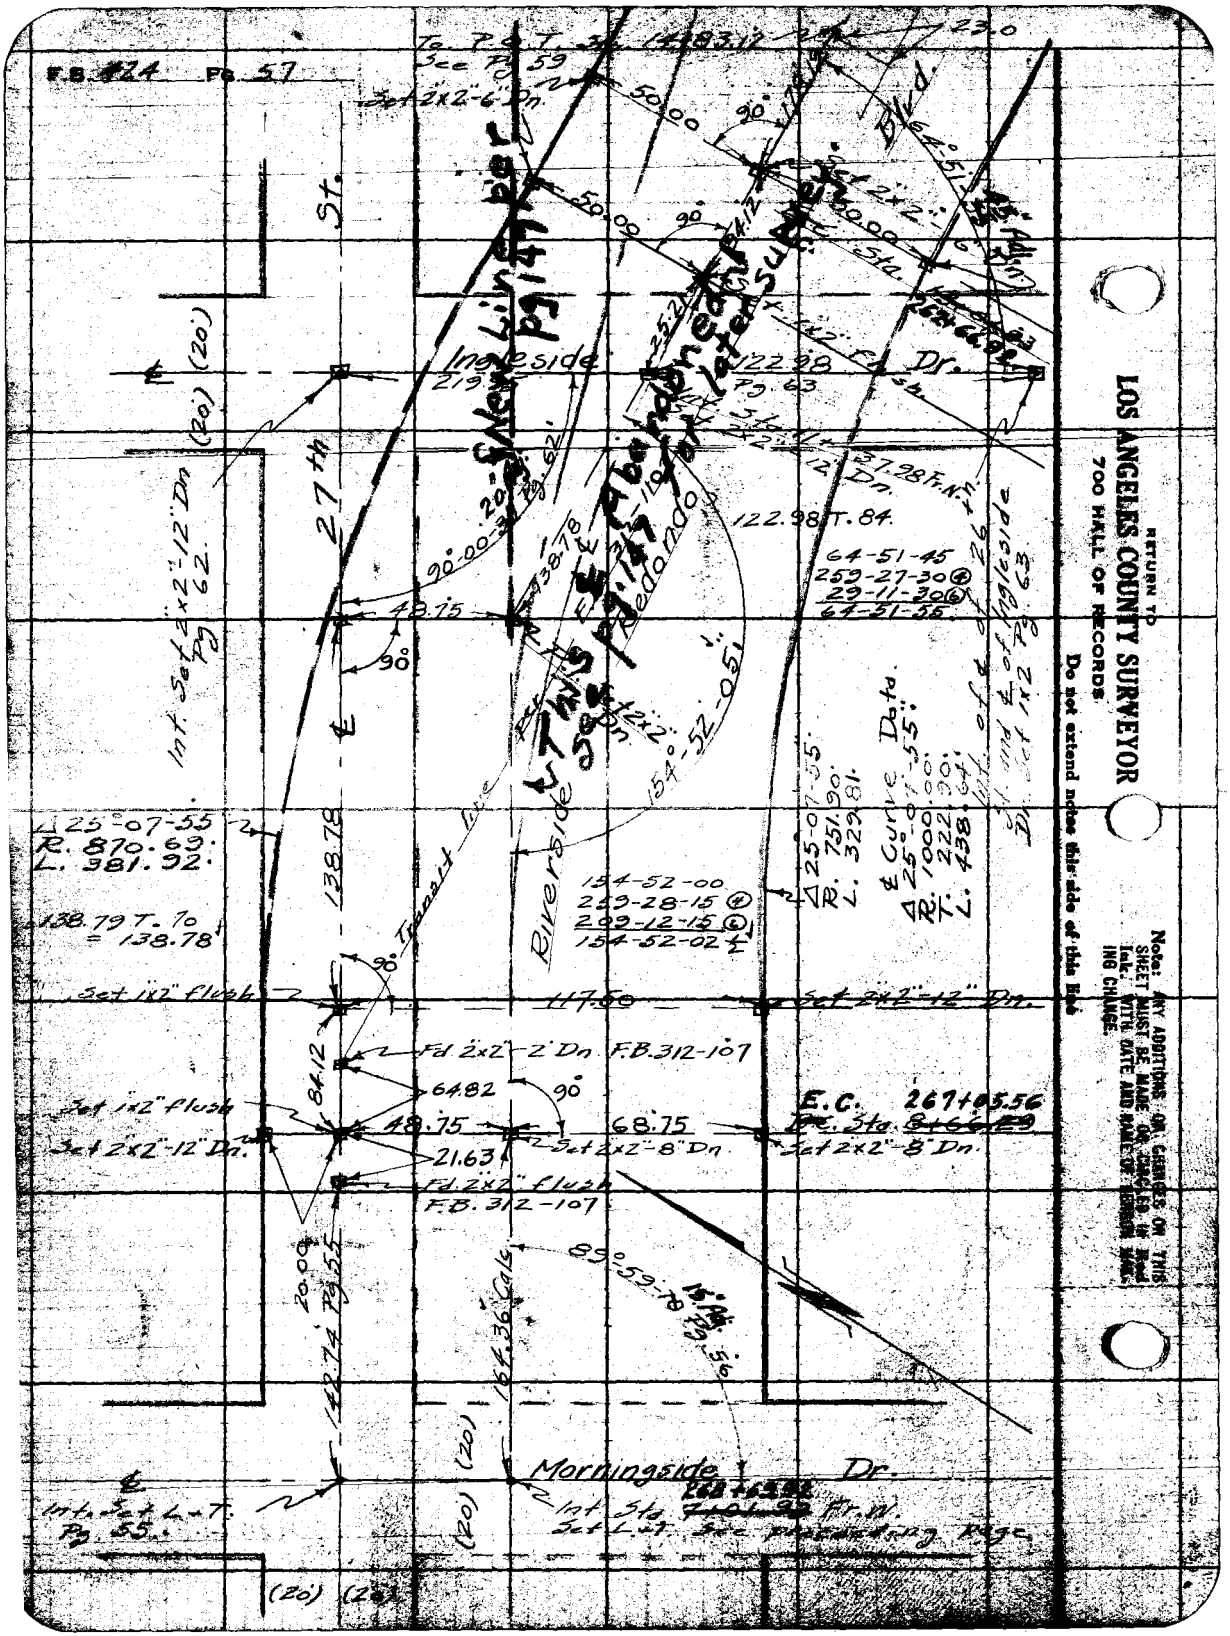
F.B. 424 Pg. 57
To P.C.T. Sta. (+)93.12
See Pg. 59
Set 2x2"-6" Dn.
50.00
90°
Blvd.
St.
Set 2x2"-12" Dn.
Ingleside
219
Pg. 62
Pg. 63
Dr.
(20')
27th
Int. Set 2x2"-12" Dn.
62.
90°-00-30
48.75
90°
Int. Set 2x2"-12" Dn.
Pg. 62
Redondo
Ave.
54°-52-00
Riverside
Set 2x2"-12" Dn.
Tangent Line
138.79
138.79 T. To
= 138.78
Set 1x2" Flush
117.50
Set 2x2"-12" Dn.
Fd 2x2"-2' Dn. F.B. 312-107
64.82
90°
48.75
68.75
Set 1x2" Flush
Set 2x2"-12" Dn.
Set 2x2"-8" Dn.
21.63
Fd. 2x2" Flush
F.B. 312-107
E.C. 267+05.56
Pc. Sta. 8+66.69
Set 2x2"-8" Dn.
20.00
Pg. 55
89°-59-30
16.36 Calc.
Morningside
Dr.
Int. Sta. 7+01.98 P.T.
Set L.T. See Preceding Page
Int. Sta. 7+42.82
Set L.T.
Pg. 55.
(20')
(20')
(20')
(20')
Int. of Ingleside & 27th
Pg. 62
Pg. 63

Notes Ck'd by D. M. Finley | Survey of Riverside Redondo Blvd. | F.B. 421
Map No. B-4427 | W. O. 220 | Title No. 0-1 | Sht. 0 of 0 Sht.
Checked D. M. Finley | Notes | Date 5-20-32
Date NOV. 1932 | Indexed

299.98 @ 00 = 299.98
99.45 @ 8-39 = 98.32
99.71 @ 18-10 = 27.09
T. 74 = 425.39
425.36

Set 2"x2"-12" Dn.
Sta 66+23.44 Fr. E
Sta 16+72.82 & Angle Side
Dn. Fr. N. Sec Pg. 63

(10') Gould Ave.

Transit
F.B. 312-68

Line 425.36

(20') 26th Place

Fd. 1"x2"-2 up.
Sta 71+18.85 Fr. E

47.20

Inf. Sta 14+40.04 Fr. N
Sta 71+66.00 Fr. E
Set 1"x2"-12" Dn.

0.04
Fd. 1"x2" Flush
Sta 71+66.04 Fr. E
F.B. 312-68

115-25-15
101-40-45 (2)
332-31-00 (3)
18-25-10

115.25 (4)

Dr.

179.22

Morningside

179.23 T. 74 = 179.22

M.L. of L of Morningside Dr. and Sta 14+40.04 Fr. N Sec Pg. 56

(20') 26th St.

(20') (20')

Ref. Cap Pg. 55

F.B. 424 Pg. 59

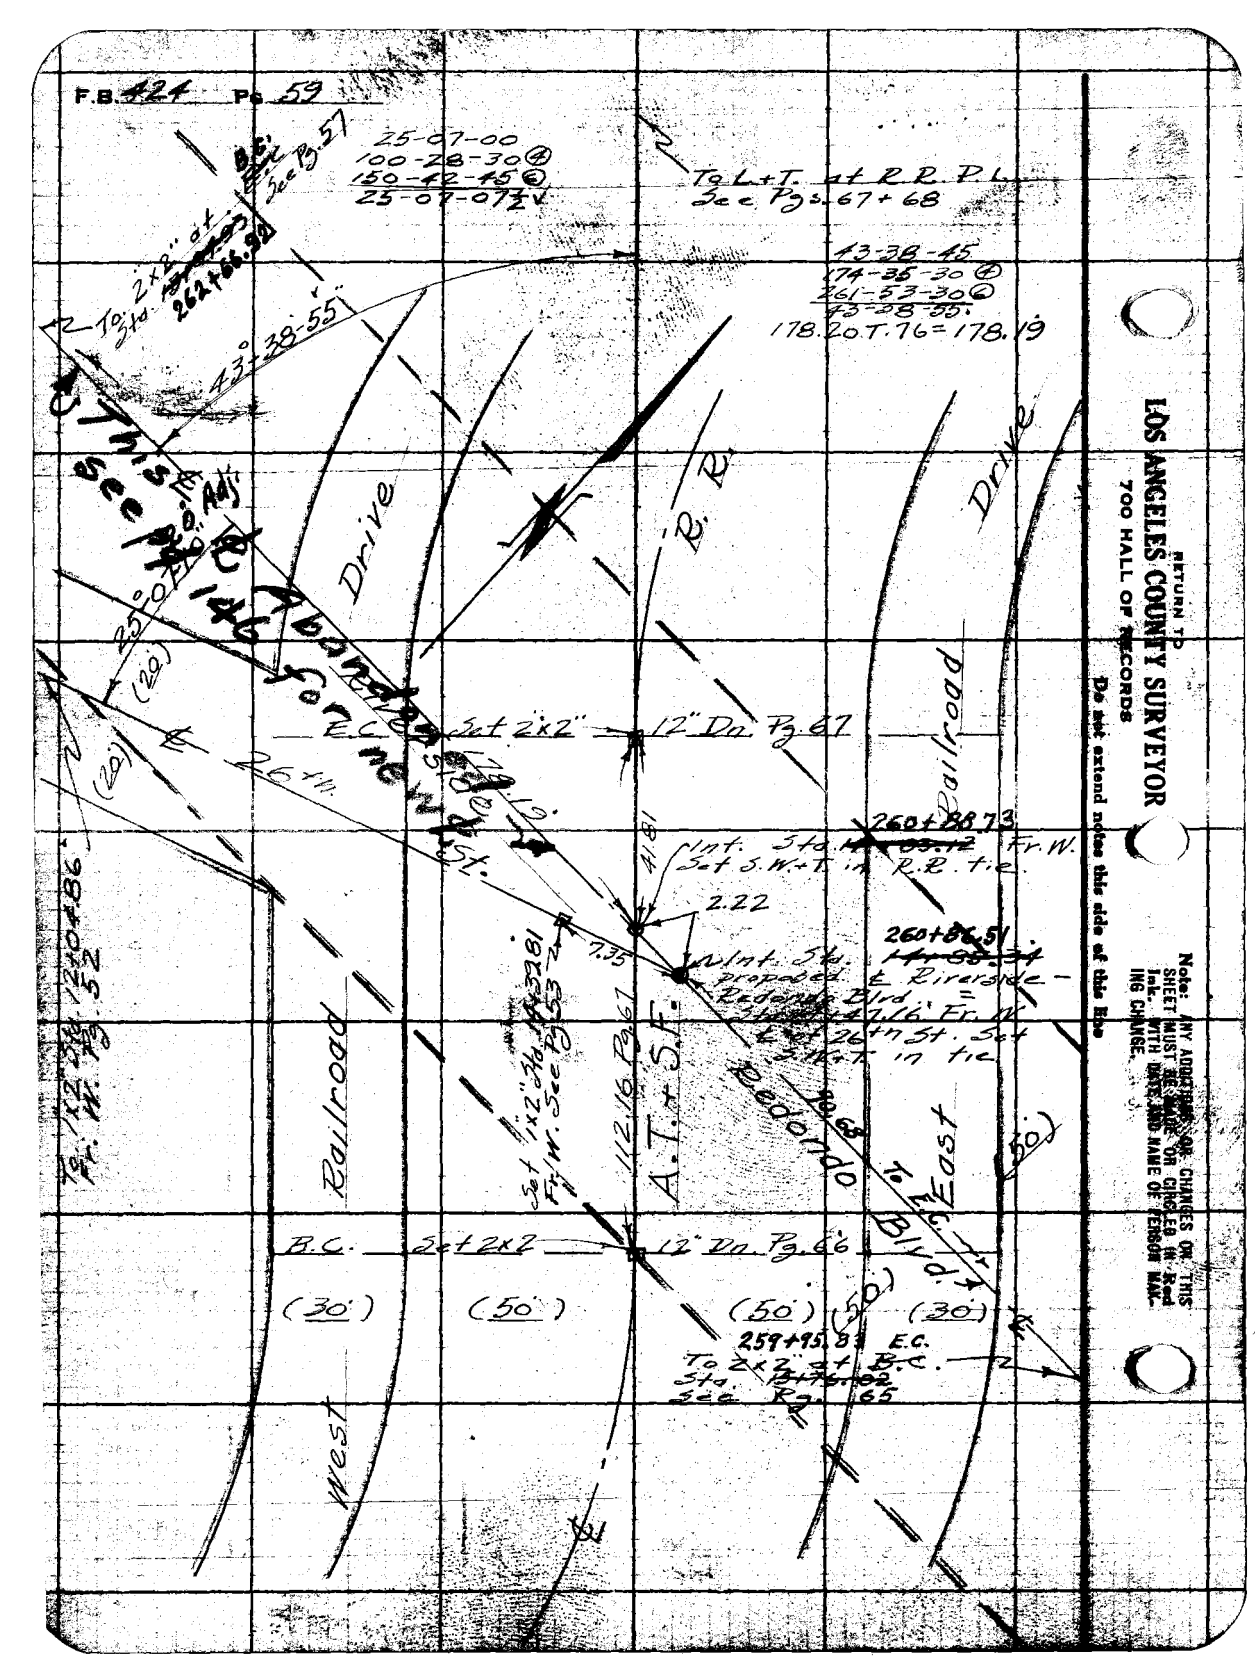

RETURN TO
LOS ANGELES COUNTY SURVEYOR
700 HALL OF RECORDS

Do not extend notes this side of this line

Note: ANY ADDITIONS OR CHANGES ON THIS SHEET MUST BE MADE OR CIRCLED IN Red Ink. WITH DATE AND NAME OF PERSON MAKING CHANGE.

Drawn by D. M. Finley | Survey of Riverside Redondo | P.B. 12 Pg. 44
Orig. No. T-242-1 | Topo No. 0-46 and 0-47
Check Date Nov. 1933 | Notes | Date 5-16-32
Traced | Cont. bottom next page.

Moraingside Drive

(20') (20')

Set L.+T. in curb

12.7 12.5 12.4 12.5

30° 29.1'

26.97 26.97

B.P. B.P.

20.0 20.0

281.68. Ave.

(25) (25)

281.71 T.70 = 281.68.

Set N.+T. in P. pole

Set nail 34d 3+58.27

B.P.

(25)

14.7

Highland Ave.

5.01 5.02

34 L.+T. 75 Fd. L.+T. in pavement

34 L.+T. 74 Fd. L.+T. in pavement

15.2

(25)

B.P.

20.0 20.0

358.27. Longview

358.32 T.64 = 358.27

Set N.+T. in P. pole

19.9 20.0

Set L.+T. in curb

(20') 14.9 28.50 32.28 15.0

Manhattan Ave.

14.9 30.5 31.82 16.0

(20')

Set L.+T. in Pavement

Fd. L.+T. in pavement

20.0 20.0

THE ENGINEERING SURVEY

FOR HALL OF RECORDS

Do not write on this sheet

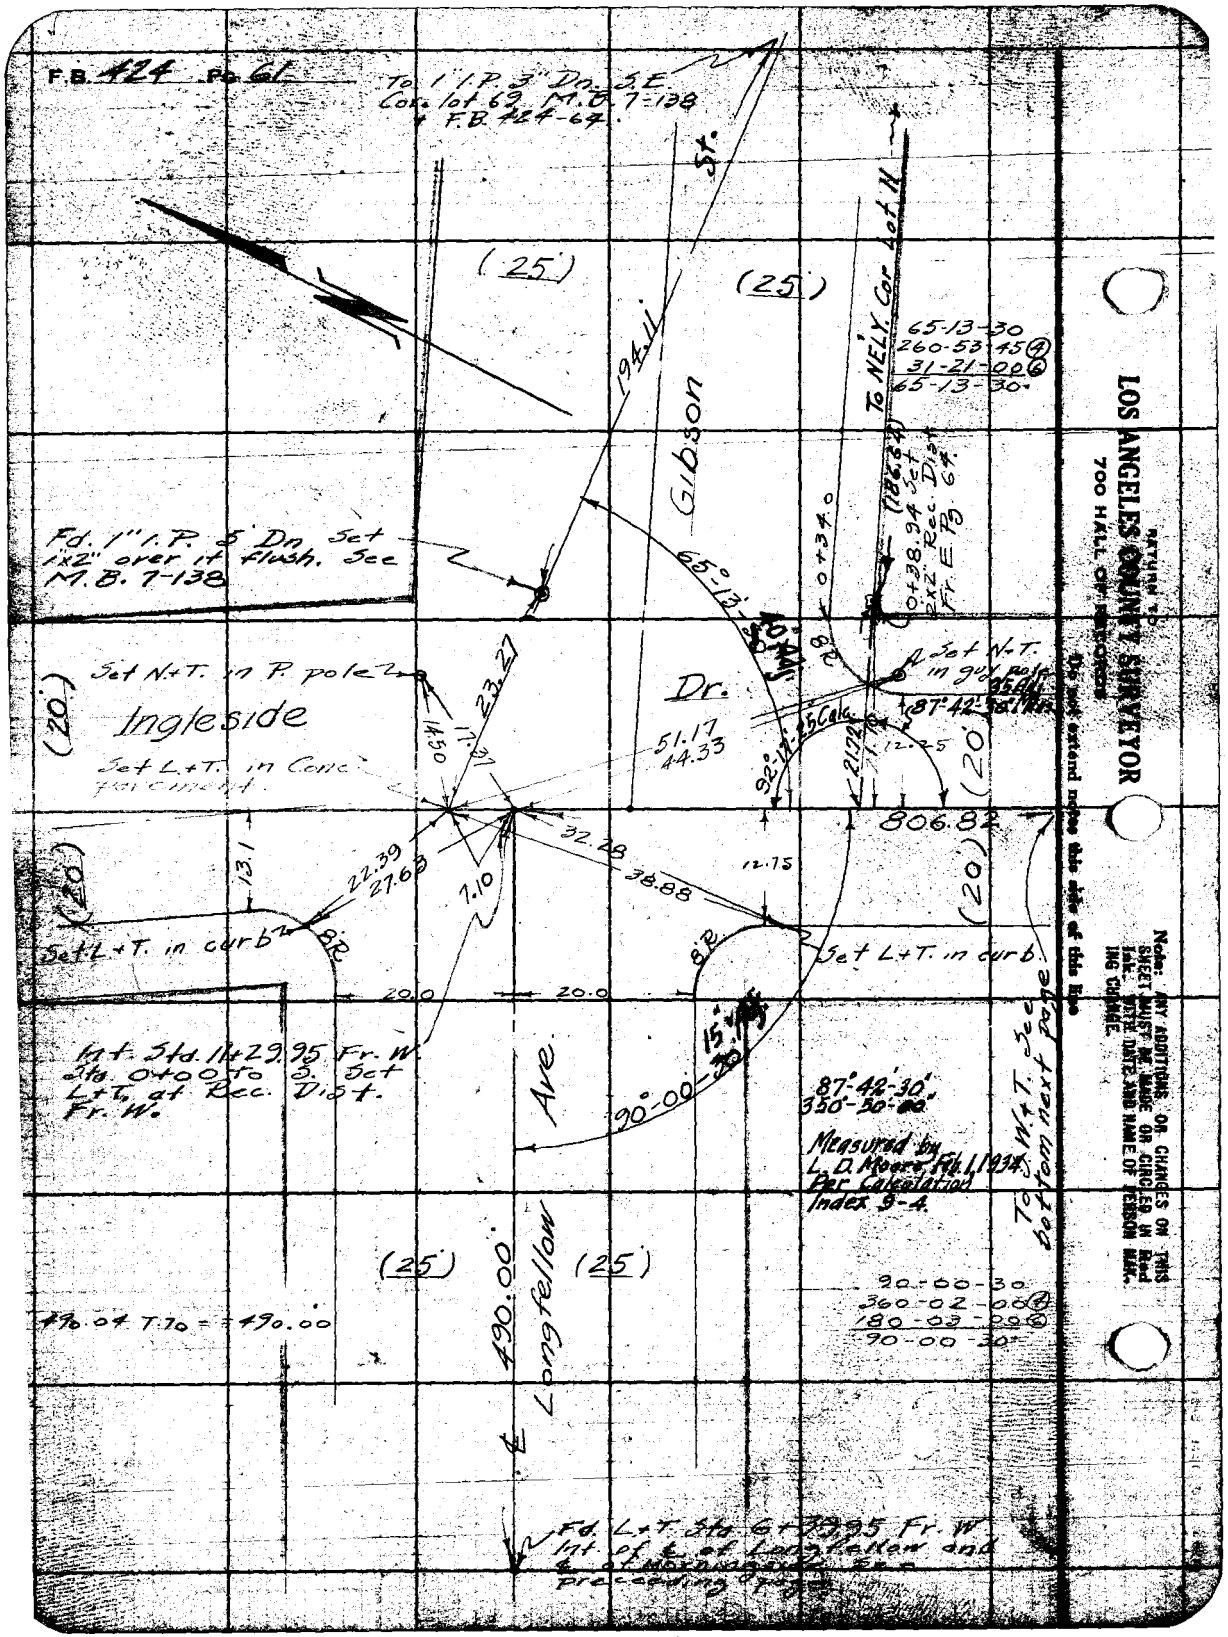
To 1" I.P. 3" Dn. S.E. Cor. Lot 69 M.B. 7-138 & F.B. 424-67.
St.
(25')
(25')
194.41'
Gibson
To N.ELY. Cor. Lot 14
65-13-30
260-53-45
31-21-00
65-13-30
(186.84') 0+38.94 Set 2"x2" Rec. Dist. Fr. E Pg. 64
0+34.0
Fd. 1" I.P. 3' Dn. Set 1"x2" over it Flush. Sec M.B. 7-138
65°-13'-30"
40' Rad.
Set N.+T. in P. pole
Ingleside
Set L.+T. in Conc. at Curb
Dr.
51.17
44.33
23.27
14.50
92°-12'-25" Calc.
21.72
12.25
Set N.+T. in 9" Pole 85.41
87°-42'-30" Set Mkr.
(20')
806.82
32.28
38.88
12.75
22.39
27.68
7.10
13.1
8R.
Set L.+T. in curb
20.0
20.0
Int. Std. 1+29.95 Fr. W. Sta. 0+00 to 3. Set L.+T. at Rec. Dist. Fr. W.
Ave.
90°-00'-00"
15' Rad.
87°-42'-30"
350-30-00
Measured by L. D. Moore Feb. 1, 1934
Per Calculation Index 9-4.
(25')
(25')
490.00
Longfellow
90-00-30
360-02-00
180-03-00
90-00-30
490.04 T.To = 490.00
To N.+T. Set at next Point
LOS ANGELES COUNTY SURVEYOR
700 HALL OF RECORDS
DATUM "D"
Do not extend notes this side of this line
Note: ANY ADDITIONS OR CHANGES ON THIS SHEET MUST BE MADE OR CIRCLED IN RED AND WITH DATE AND NAME OF PERSON MAKING CHANGE.

Notes Ch'd by D. M. Finley | Survey of Riverside-Ledondo Blvd.
Map No. B-442-2 | W. O. 720 Tape No. 046 St'd 84 °F.
Notes Work J. H. Kirk | Surveyed by Boscorane
Checked D. M. Finley | Notes [illegible]
Date Nov. 1933 | Indexed A. C. Johnson

F.B. 424 Pg. 62

Notice ANY ADDITIONS OR CHANGES ON THIS SHEET MUST BE MADE OR CIRCLED IN Red Ink, WITH DATE AND NAME OF PERSON MAKING CHANGE.

Do not extend notes this side of this line

Property of LOS ANGELES COUNTY SURVEYOR 700 HALL OF RECORDS

(20') 27th St. (20')

Set 1"x2"-Stk. 10+32.83 Pt.

228.18

102.76 387.27

89-59-25 40.00

Set 1"x2"-Stk. 12+29.57 Pt.

226.02 T.74 = 226.01

(20') Dr. (20')

Ingleside

226.01

89-59-30
353-57-
179-56-
89-59-27

(25') 28th St. (25')

0.81

Set 2.1"x T. Stk. 8+06.82 Pt.

Stk. 8+20.86 Ft. mail m. pavement, a City Engineers Point.

8+05.84 curb

8+05.77 curb

11.67 13.41

806.92 T.64 = 806.82

806.82

To 1"x T. Intersect of Long-Fellow Ave. and E. line of Ingleside Dr. See preceding page

F.B. 424 Pg 63

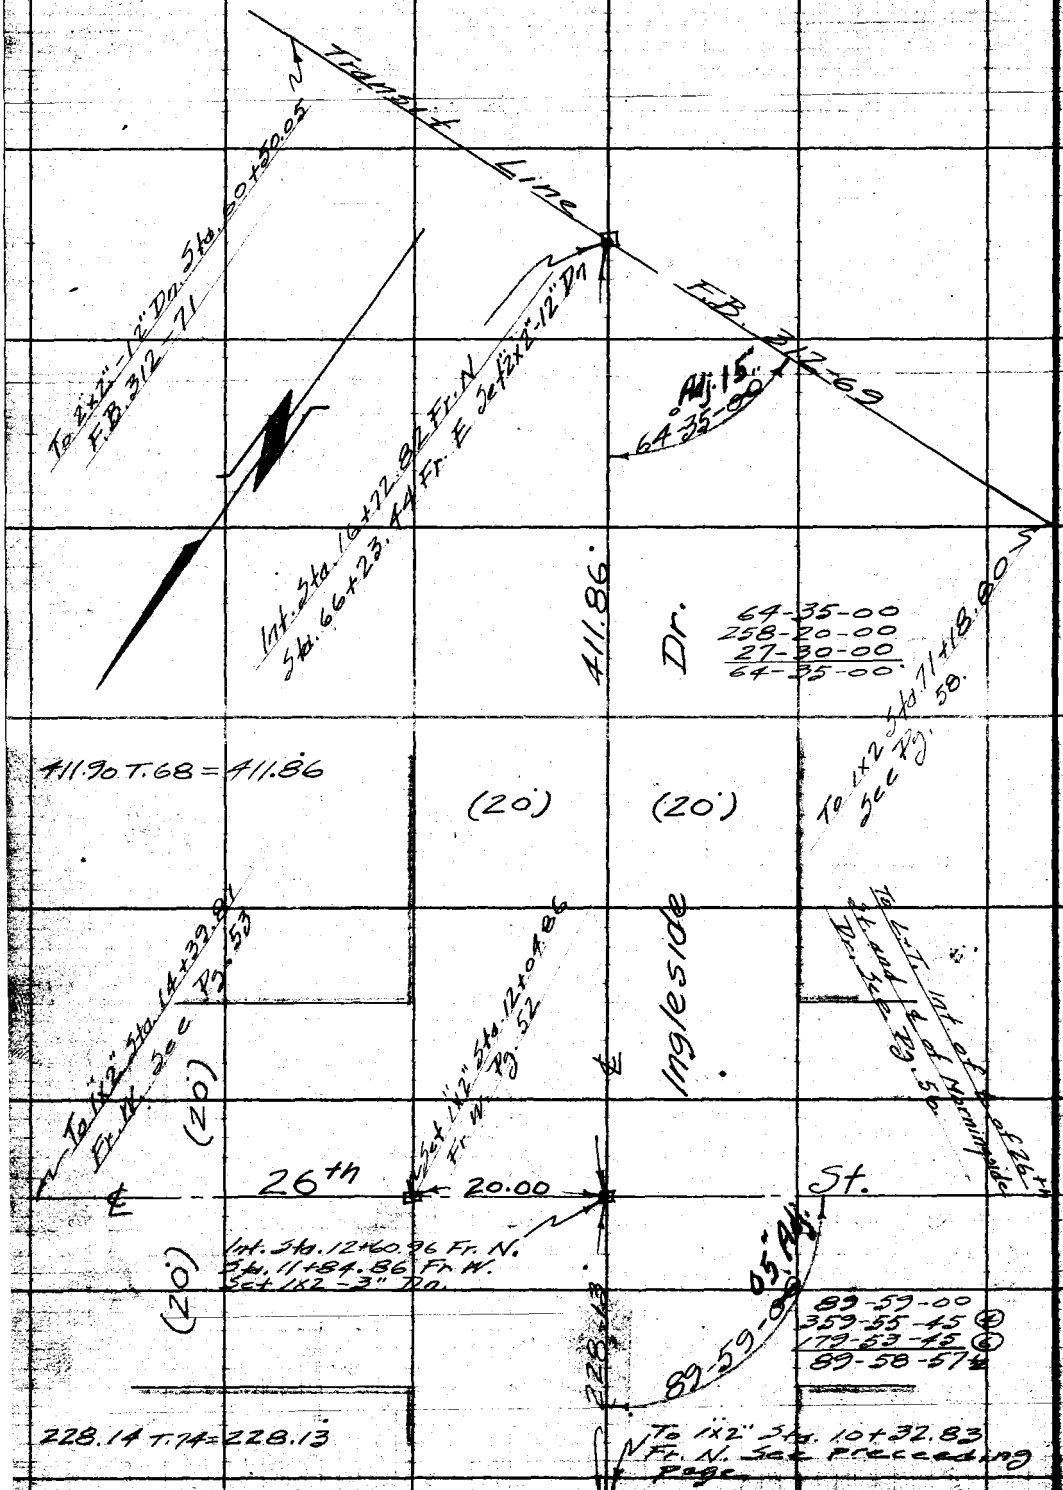

RETURN TO
LOS ANGELES COUNTY SURVEYOR
700 HALL OF RECORDS
Do not extend notes this side of this line

Note: ANY ADDITIONS OR CHANGES ON THIS SHEET MUST BE MADE OR CIRCLED IN Red Ink. WITH DATE AND NAME OF PERSON MAKING CHANGE.

Notes Ck'd by D. M. Finley
Map No. B-442-2
Office Work J. H. Rice
Checked D. M. Finley
Date Nov. 1933

Survey of Riverside Redondo Blvd.
W. O. 920 Tape No. 046 St'd. 84 °F.
Surveyed by Rosecrans
Notes
Computed
Checked

F.B. 424 Pg. 84

(50')

Fd. 2"x2" stake at split of guage F.B. 312-117

℄ A.T. & S.F. R.R.

264.38 to 2 W.I.T. of B.C. Sect Pg. 67

92.0 of ℄ 12-17 T. 14 = 90.90

(30')

90.00

30.00

98.44

(10') West Railroad Drive.

28-44-15
31-57-15
232-26-00
78-44-00

39.15

Set 2x2 8" Dn. for N.E. Cor. lot 11 Blk 140 M.B. 9-190

Fd. 1" I.P. 3" Dn. S.E. Cor. lot 69 M.B. 7-138

Log Calc. 184.44-25

184.11

30.00

98.44

VOID
28-44-15
31-57-30
26-26-30
184-44-25

186.66 T. 70 = 186.64

(26') (25') Gibson

194.13 T. 70 = 194.11

Fd. 1" I.P. 5" Dn. Set 1x2" even with flush.

Set 2x2" flush with ground at corner of lot 2 Blk 140

2.00

36.20

(20') Inglewide

Long Beach

(25')

RETURN TO
LOS ANGELES COUNTY SURVEYOR
720 HALL OF RECORDS

Notice: Any additions or changes of this sheet must be made in circled ink and initialed by the person making change.

Do not record on this sheet. Do not write on this side of this line.

Form 647 1000 9-31

Cont. bottom Pg. 64

F.B. 424 Pg. 65

Sec. Cor. Set 2x2 - 8" Dn.
to replace 4x4 Scr.
F.B. 3/2 - 72.

48.82 @ 00

32.60 @ 00	=	32.60
100.43 @ 00	=	100.43
91.85 @ 9.19	=	90.64
77.85 @ 00	=	77.85
60.10 @ 9.76	=	59.32
100.81 @ 6.10	=	100.23
100.53 @ 8.13	=	99.50
200.00 @ 00	=	200.00
760.57 T. 70	=	760.50

48.82

P.O.S.T. Set 1x2" Flush

Blvd.

760.50

S 60°-30' E

Redondo

Set 2x2"

12" Dn.

251.21 T. 74 = 251.19

R.P.P.I. Set 2x2" - 18" Dn.

251.19

100.00

Riverside

151-47-45
247-11-30 ⓒ
130-47-15 ⓒ
151-47-52½

B.C. Sta. 20+68.23

E.C. Sta. 25+09.64

Δ 28°-12'-05"
R. 1000.00'
T. 251.19'
L. 492.21'

R.P.P.I. Set 2x2"
12" Dn.

100.00

251.19

151°-47'-55"

Set Pg. 145

E.C. Sta. 15+10.02

B.C. Sta. 25+35.83

Set 2x2"

12" Dn.

(50')

(50')

341.87

341.87 T. 84

Riverside Dr. 44 St.

Redondo Blvd. and Set S.W. T.

Sta. 26+86.81

See Pg. 59

Set Pg. 145

RETURN TO
LOS ANGELES COUNTY SURVEYOR
700 HALL OF RECORDS

Do not extend notes this side of this line

Note: ANY ADDITIONS OR CHANGES ON THIS SHEET MUST BE MADE OR CINGED IN Red Ink. WITH DATE AND NAME OF PERSON MAKING CHANGE.

Engr. Ch'd by D. M. Finley
Map No. B-442-2
Comp. Work by H. Pike
Checked by E. V. Fisher
Date Nov. 1933

Survey of Riverside Redondo Blvd.
W. O. 920 Tract No. 046 Sh'd 84 of
Surveyed by Contractor
Indexed by A. C. Johnson

F.B. 424 Pg. 66

To E.C. Sec next page




B.C. Set 2"x2"-12" Dn

50.00

50.00

Set 2"x2"-12" Dn

90°

E.C. 640.47

Set N.T. in Tel. pole

640.47 T64 = 640.39

Δ 25-10-40"
R. 2867.54'
T. 640.39'
Lc. 1260.10'

Redondo Boulevard Drive

A.T. & S.F. R.R.

P.I. Set 2"x2" stake per F.B. 312-71

579.15'

West Railroad

East Railroad

Set N.T. in tie per F.B. 312-120

612.4'

635.07'

20'

50'

50'

20'

Set nail at P.I. of curve per F.B. 312-120

F.B. 424 Pg. 67

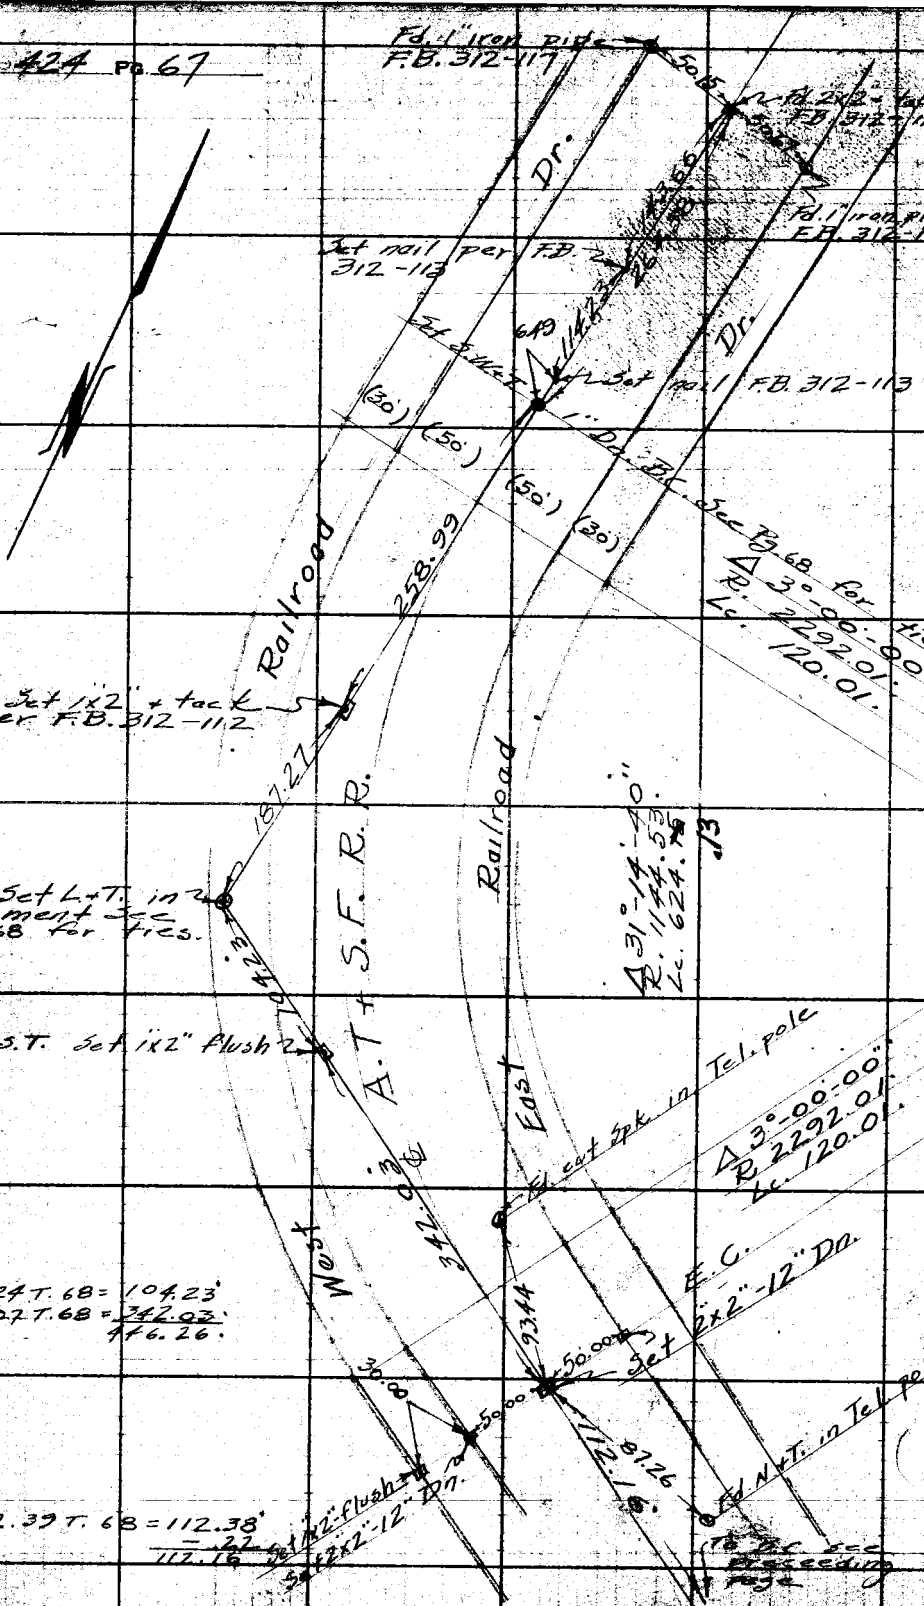

104.24 T. 68 = 104.23'
342.07 T. 68 = 342.03'
Δ 6.26'.

112.39 T. 68 = 112.38'
− .22
112.16

Set 1x2" Flush
Set 2x2"-12" Dn.

RETURN TO
LOS ANGELES COUNTY SURVEYOR
700 HALL OF RECORDS

Do not extend notes this side of this line

Note: ANY ADDITIONS OR CHANGES ON THIS SHEET MUST BE MADE OR CHECKED IN Red Ink. WITH DATE AND NAME OF PERSON MAKING CHANGE.

Maps Ch'd by D. M. Finley | Survey of Riverside-Redondo Blvd.
Map No. B-442-2 | W. O. 920 | Topo No. 046 Sh'ts 64 ea.
Office Work J.H.R.C. | Surveyed by Parr-Evans | Date 6-1933
Checked D. M. Finley | Drawn A. C. Johnson
Date Nov. 1933 | Indexed

F.B. 424 Pg. 68

Tie's to R.R. P.C. on Pg. 67

A.T. & S.F.

R.R. tracks

St.

Set L.T. in curb

P.C.

P.T.

Set L.T. in curb

B.C. Set S.W. No. T. 1' Dn. Pg. 67 in. 30

Set L.T. in curb

To E.C.

Ties: to R.R. P.I. on Pg. 67

P.O.S.T. Set L.T. in curb

To B.C.

Railroad Dr.

40.65

43.45

39.68

(30') West

R.P. Pl. Set L.T. in pavement See Pg. 67

Set L.T. in curb on Tang. Prod.

Set L.T. in curb

28th St.

(25') (25')




RETURN TO
LOS ANGELES COUNTY SURVEYOR
700 HALL OF RECORDS

Note: ANY ADDITIONS, OR CHANGES ON THIS SHEET MUST BE MADE OR CHECKED IN Red Ink. WITH DATE AND NAME OF PERSON MAKING CHANGE.

Do not extend notes this side of this line

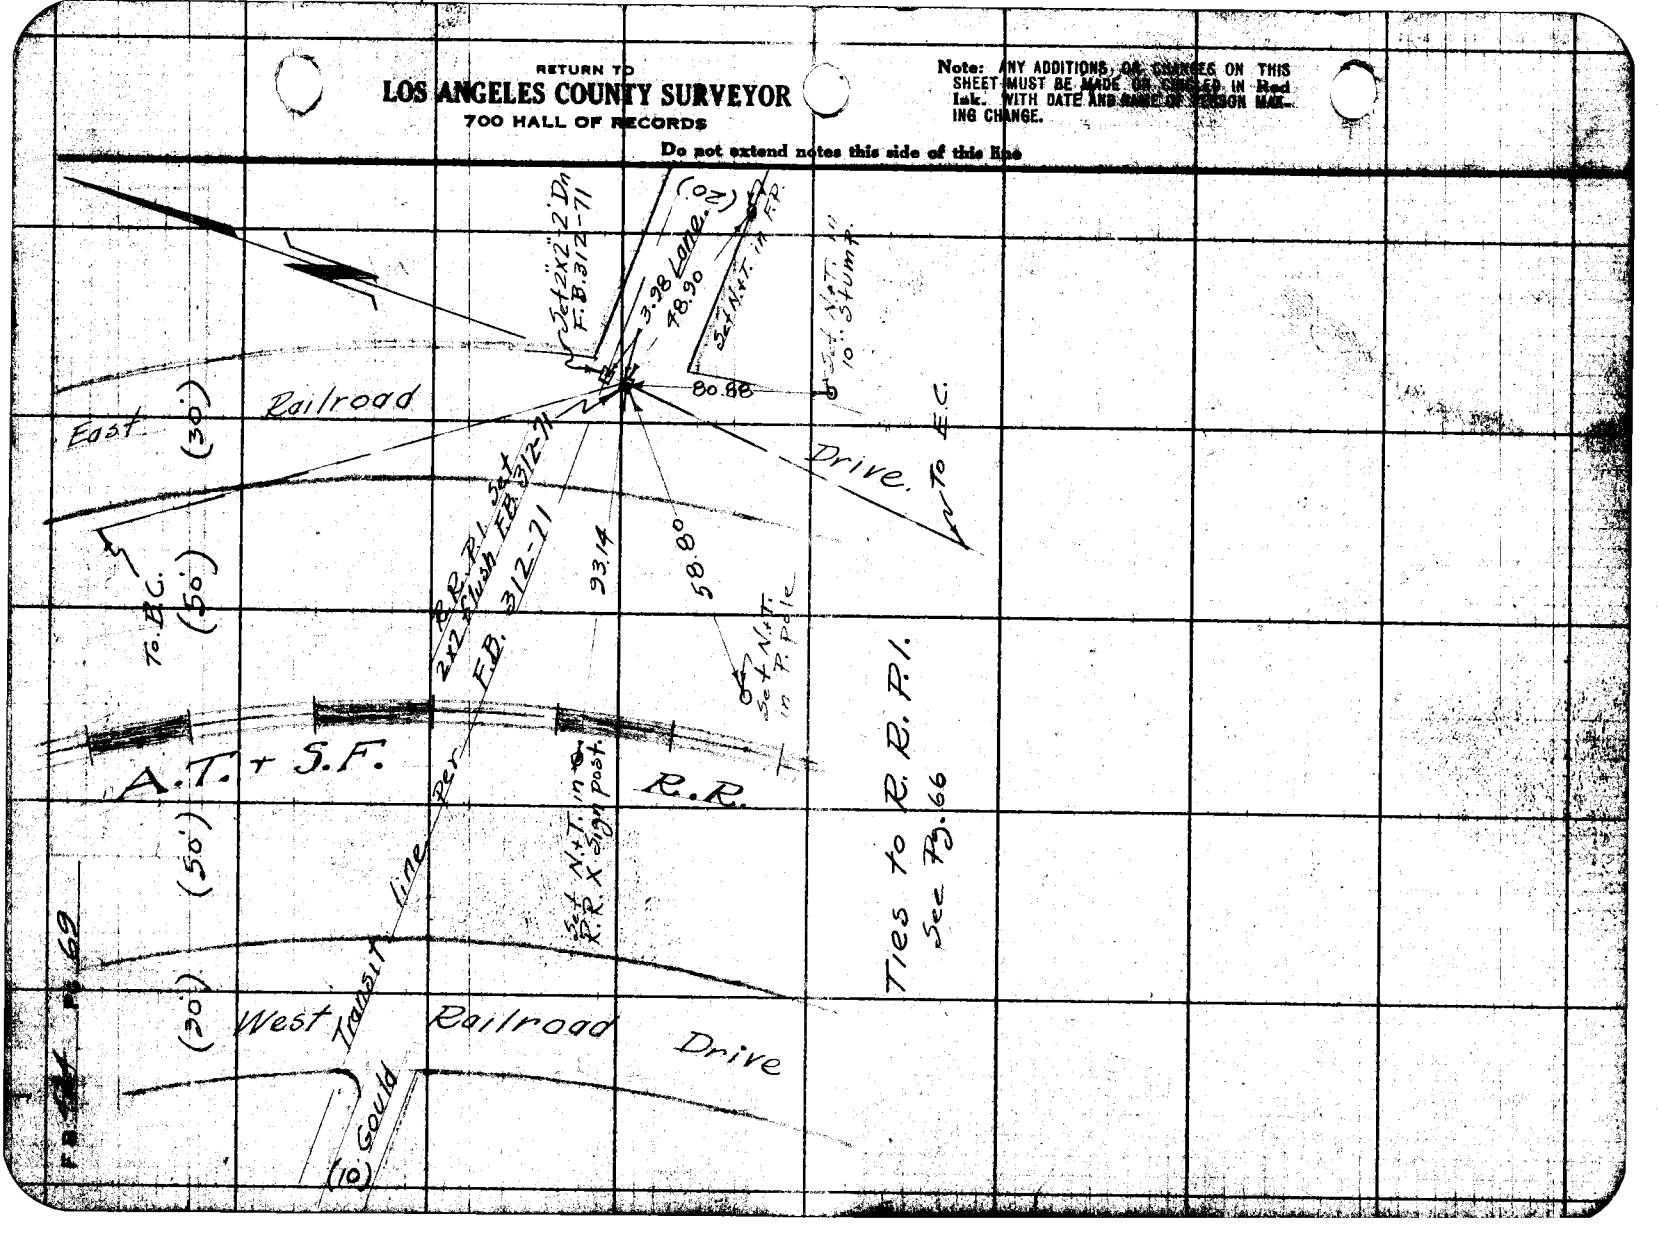

Notes Ck'd by D. M. Finley | Survey of Riverside Redondo
Map No. B-442-2 | W. O. 920 Tape No. 046 St'd 84 °F.
Plotted by J.M.Kiel | Surveyed by Rodecraft
Traced by D. M. Finley | Sheet No. 232
Date Nov. 1933. | Indexed A. C. Johnson

F.B. 424 Pg. 20

Cont. to from next page

Fd. L+T. in curb

24th. Place

(20')

Int. T.C.S.T. Fd L+T No references.

28.28

40.20 Tang.

25.60 Tang.

Fd. L+T. in curb

Fd. L+T. in curb

256.24 T.68 = 256.21

256.21

El Camino Real

Fd. L+T. in curb

11.34

40.87

Sta. 3+54.33 Fd. L+T. No references.

24th St.

(20')

28.31

40.92 Tang.

11.46 Tang.

Fd L+T. in curb

39.94

Sta. 3+34.33 Fd. 2"x2"-12" Dn F.B. 399-14

Sta. 3+07.26 Fd. 2"x2" 2' Dn F.B. 399-14

39.75

354.37 T.68 = 354.33

354.33

Fd. L+T. in curb

Fd. L+T. in curb.

Sta. 0+29.95 Fd. 2"x2" 2' Dn. F.B. 399-15

38.83

11.03

11.48

St.

Sta. 0+00.92 Fd. L+T. No references

0.93

21st.

Sta. 0+00 to N. Fd. L+T. No references.

11.03

10.59 Tang.

11.01 Tang.

Fd. L+T. in curb

(30')

RETURN TO LOS ANGELES COUNTY SURVEYOR 740 HALL OF RECORDS

Do not extend notes this side of this line

Notice: ANY ADDITIONS OR CHANGES ON THIS SHEET MUST BE MADE IN CIRCLES AND INITIALED WITH DATE AND NAME OF PERSON MAKING CHANGE

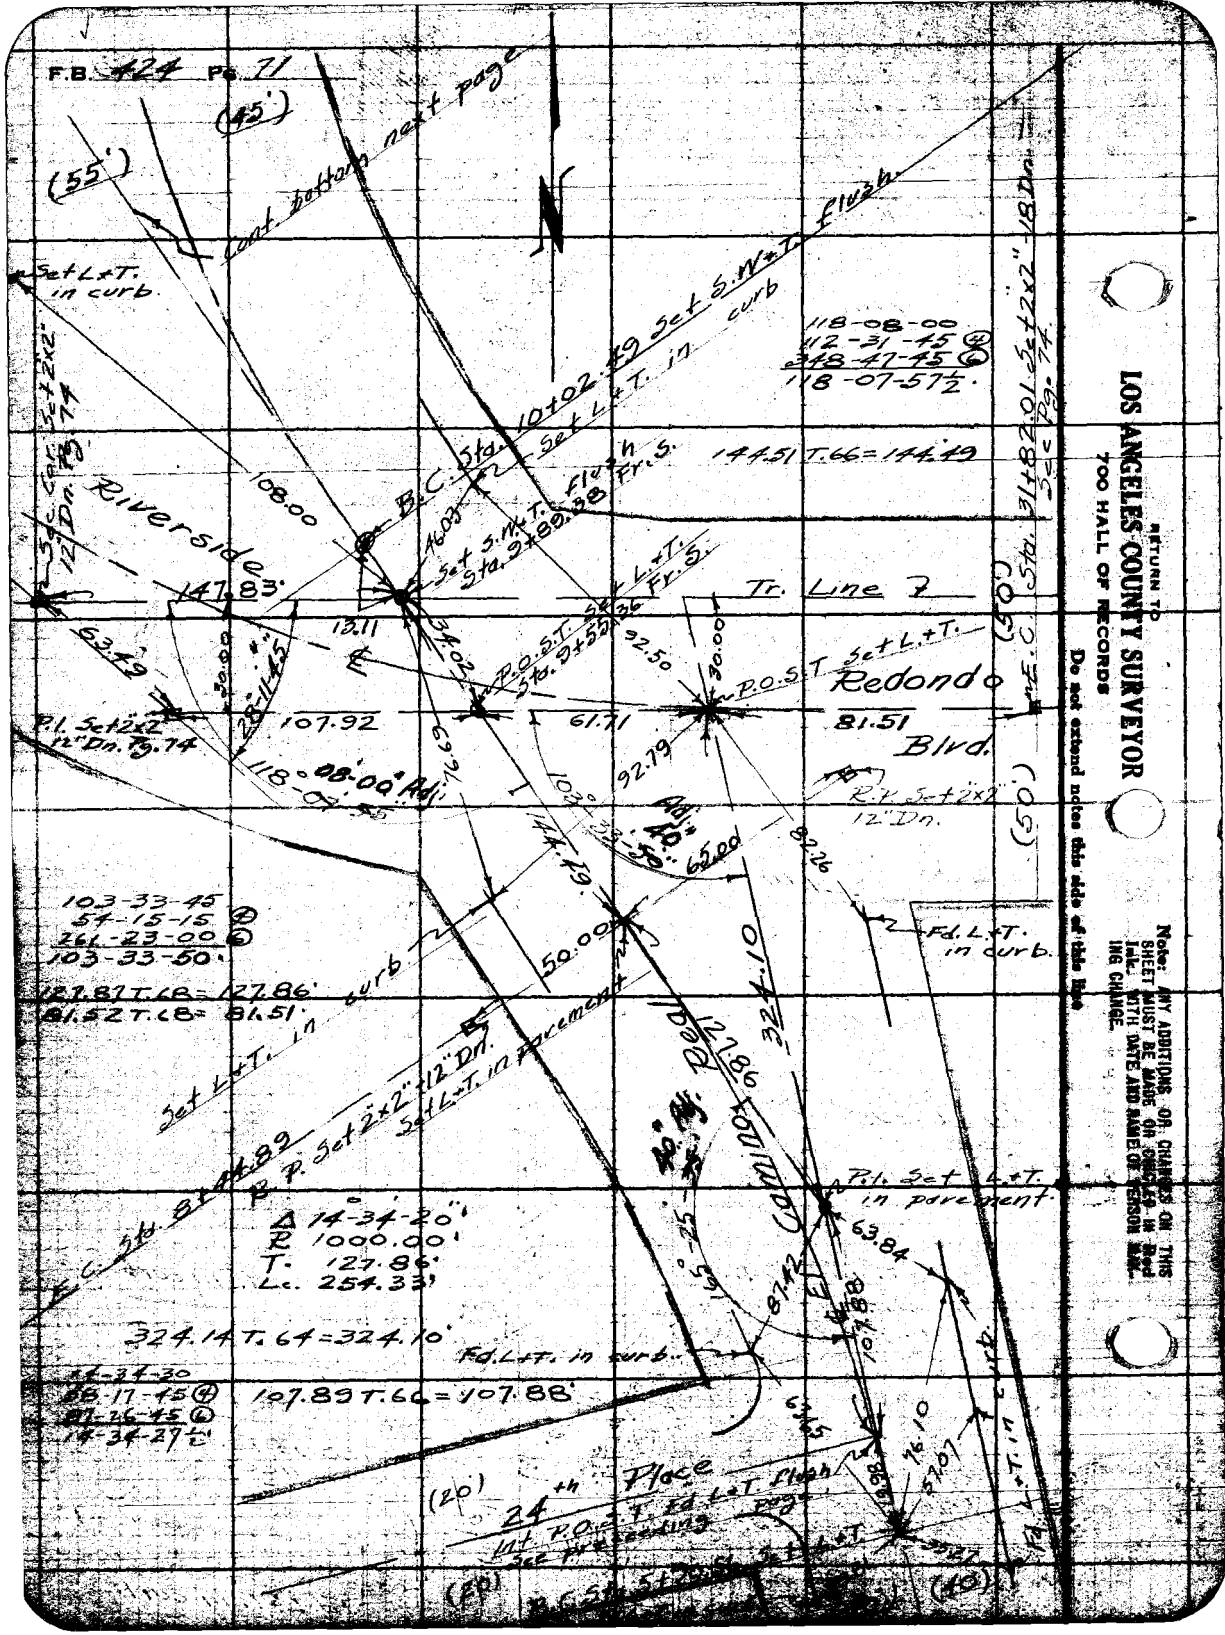

RETURN TO
LOS ANGELES COUNTY SURVEYOR
700 HALL OF RECORDS

Do not extend notes this side of this line

Note: ANY ADDITIONS OR CHANGES ON THIS SHEET MUST BE MADE ON CHECKED IN Red Ink. WITH DATE AND NAME OF PERSON MAK-ING CHANGE.

Name of Party D. M. Finley | Survey of Riverside, Redondo
Map No. B-442-2 | W. O. 920 | Tape No. 046 | St's 84 of
Office Work J.H. KLOS | Corrected by Rosecrans
Field Work D. M. Finley | Checked by
Date Nov. 1933. | Indexed A. C. Johnson

F.B. 424 Pg. 98

Cont. to Ham 11+47

248-10-30 (R)

Tennyson St.

3/4 in. I.P. Plug & Tack Flush

Set L.r.T. in curb.

248.94 T.64 = 248.91

Δ 27-57-20"
R. 1000.00'
T. 248.94
Lc. 487.92

El Camino Real

162°-02'-40"

262.05 T.66 = 262.02

Set L.r.T. in curb

118-22-30
113-29-45 (R)
250-14-30
118-22-23

Set 2x2" Flush

Set 1/2" Flush

Riverside

Redondo

107.92

Set L.r.T. in curb

Set 2x2-12" Dn

Set L.r.T. in curb

Set 3/4" I.P. Flush

Set L.r.T. in curb

Set 3/4" I.P. Flush

Set L.r.T. in curb

Set 3/4" I.P. Flush

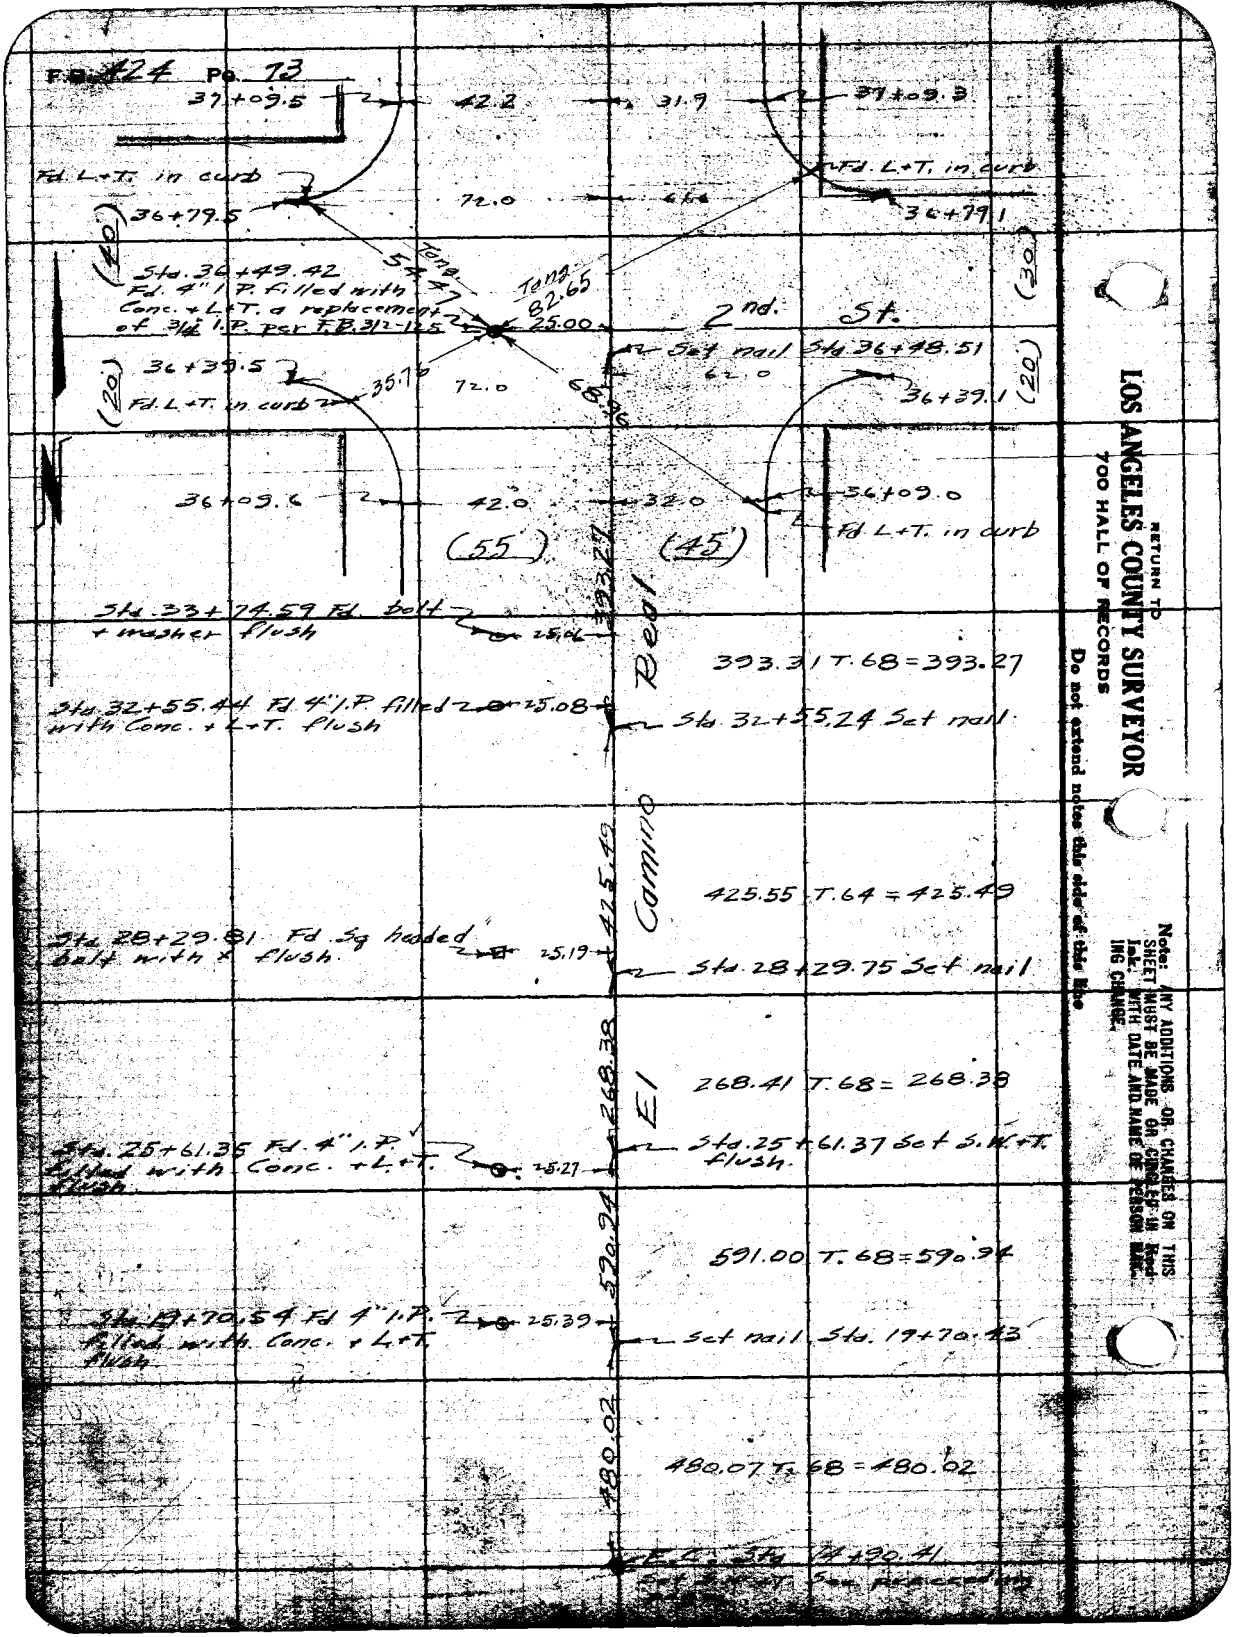
F.B. 424 Pg. 73
37+09.5
42.2
31.7
37+09.3
Fd. L+T. in curb
Fd. L+T. in curb
36+79.5
72.0
36+79.1
(40)
(30)
Sta. 36+49.42
Fd. 4" I.P. filled with
Conc. + L.T. a replacement
of 3/4" I.P. per F.B. 312-125
Tang.
S 47°
Tang.
82.65
25.00
2nd. St.
Set nail
Sta 36+48.51
62.0
36+39.5
(20)
35.7
72.0
36+39.1
(20)
Fd. L+T. in curb
36+09.6
42.0
32.0
36+09.0
(55)
(45)
Fd. L+T. in curb
393.27
Sta. 33+74.59 Fd. bolt
+ washer flush
25.06
Rec'l.
393.31 T.68 = 393.27
Sta 32+55.44 Fd 4" I.P. filled
with Conc. + L+T. flush
25.08
Sta 32+55.24 Set nail
425.49
Camino
425.55 T.64 = 425.49
Sta. 28+29.81 Fd. Sq headed
bolt with x flush.
25.19
Sta 28+29.75 Set nail
268.38
El
268.41 T.68 = 268.38
Sta. 25+61.35 Fd. 4" I.P.
filled with Conc. + L+T.
flush
25.27
Sta. 25+61.37 Set S.M+T.
flush.
590.24
591.00 T.68 = 590.94
Sta. 19+70.54 Fd 4" I.P.
filled with Conc. + L+T.
flush
25.39
Set nail Sta. 19+70.43
480.02
480.07 T.68 = 480.02
Sta. 14+90.41
Set nail
RETURN TO
LOS ANGELES COUNTY SURVEYOR
700 HALL OF RECORDS
Do not extend notes this side of this line
Note: ANY ADDITIONS OR CHANGES ON THIS SHEET MUST BE MADE BY THE SURVEYOR IN CHARGE AND WITH DATE AND NAME OF PERSON MAKING CHANGE.

Drawn and Checked by D. M. Finley Survey of Riverside-Redondo Blvd. F.B. 424 Pg.
Map No. B-442-2 W.O. 920 Topo No. CA6 Sht. 64
Date Nov. 1932 Indexed A. C. Johnson

Sta. 241+21.74 Set 1½" I.P. ... Set 1½" I.P.

Sta. 243+89.34 ... Sta. 245+81.85

Sta. 241+21.74 to T.C. = 98.20'

Set N.&T. to Pole #A18780E

B.C. Sta. 243+89.34

Δ 28°-11-45"
R. 1000.00'
T. 251.14'
L. 492.11'

Set N.&T. to Pole #51789E

151-48-15
247-12-45 (Δ)
190-23-30 (Δ)
151-48-15

Offset line Parkway

Redondo Blvd.

Set N.&T. to P.I. Sta. 245+81.85

Set N.&T. to P.I. Sta. 241+72.71

Set L.&T. to P.C. Sta. 241+70.71

Pg. 12

Pg. 11

Pg. 54

Pg. 55

Pg.

F.B. 424 Pg. 75

RETURN TO
LOS ANGELES COUNTY SURVEYOR
700 HALL OF RECORDS

Do not extend notes this side of this line

Note: ANY ADDITIONS OR CHANGES ON THIS SHEET MUST BE MADE BY OR UNDER THE INK. WITH DATE AND NAME OF PERSON MAKING CHANGE.

Prospect Ave.
Pg. 77

Set x in bolt top of fire hydrant.

Set 1x1" flush

Set 1x2" - flush

Set 2x2" - 12" Dn

Set 1x1" flush

Set N.+T. in P. pole #168575 E

Set N.+T. in guy pole #182380 E

Set L.+T. in Pavement

Set N.+T. in guy pole #168521

Set N.+T.

Proposed

Nothing set

Riverside

Redondo Blvd.

Prospect Ave.

P.O.T. Sta. 12" Dn.

Int. Sta. Set L.+T. in Pavement

P.O.T. Sta. Set 2x2-12" Dn

Tangent line Per FB 827-73

Pg. 74

Pg. 79

Pg. 77

(20) (20)

(40) (40)

(50) (50)

A6 Adj.

35' offset line

544.22

544.29 T.72 ± 544.25'

41.90

41.84

41.84

39.98

1.05

6.20

1.99

70.79

22.63

124.62

72°57'

56.55

313.36

318.78

2361+94.39

2377+36.21

2377+36.23

233+75.61

72-57-00

291-48-15

72-57-00

Set x in bolt top of fire hydrant

Notes Ch'd by D. M. Finley | Survey of Riverside Redondo | F.B. 424 Pg. 75
Map No. B-442-2 | W. O. 920 | Tape No. 046 St'd Ft.
Office Work J. H. Kier | Surveyed by Rosecrans
Field Work D. M. Finley | Notes
Date Nov. 1933 | Indexed A. C. Johnson

Sta. 134+19.14 = Sta. 132+99.14

St.

Sta. 40+98.10 Fd 2"x2" Flush F.B. 312-127

To I.P. Sta. 134+18.59 2nd Sta. See F.B. 80 Pg. 78

89°-47'-45" @ 359-10-45 @ 178-46-15 @ 89-47-45"

Int. Sta. 9+99.96 Fr. W. Set 2"x2"-12" below Sy. Prepared to

520.18

520.23 T.68 = 520.18

89°-48'-20"

(20) (20)

Prospect Ave.

Pg. 77

(20)

140.40

Set 1"x2" Flush 311.7+99.56

140.41 T.68 = 140.40

421.16

421.24 T.68 = 421.16

Sta. 2+78.40 Set 2"x2" Flush

378.40

378.44 T.68 = 378.40

90-11-15 @ 360-44-45 @ 181-03-15 @ 90-11-15"

Sta. 7+99.56 Fd 2" I.P. Dn. 0.5' F.B. 312-126

Fd. L. & T. in curb

Fd. L. & T. in curb

To I.P. Sta. 1+79.73 Sec. Cor.

20.11-10"

El Camino Real

Sec. Line

Fd. 2" I.P. Filled with lead and L.T. Flush Sta. 134+54.59 See F.B. 80 Pg. 78

Set 2"x2" Flush in curb

(30)

(10)

RETURN TO LOS ANGELES COUNTY SURVEYOR 140 HALL OF RECORDS

Number and location of each tie, side of this line

SHEET SUBJECT TO CHANGE WITH ANY AND ALL MAPS OF PERSON SIDE

RETURN TO
LOS ANGELES COUNTY SURVEYOR
700 HALL OF RECORDS
Do not extend notes this side of this line

Note: ANY ADDITIONS OR CHANGES ON THIS SHEET MUST BE MADE OR CANCELED IN Red Ink WITH DATE AND NAME OF PERSON MAKING CHANGE.

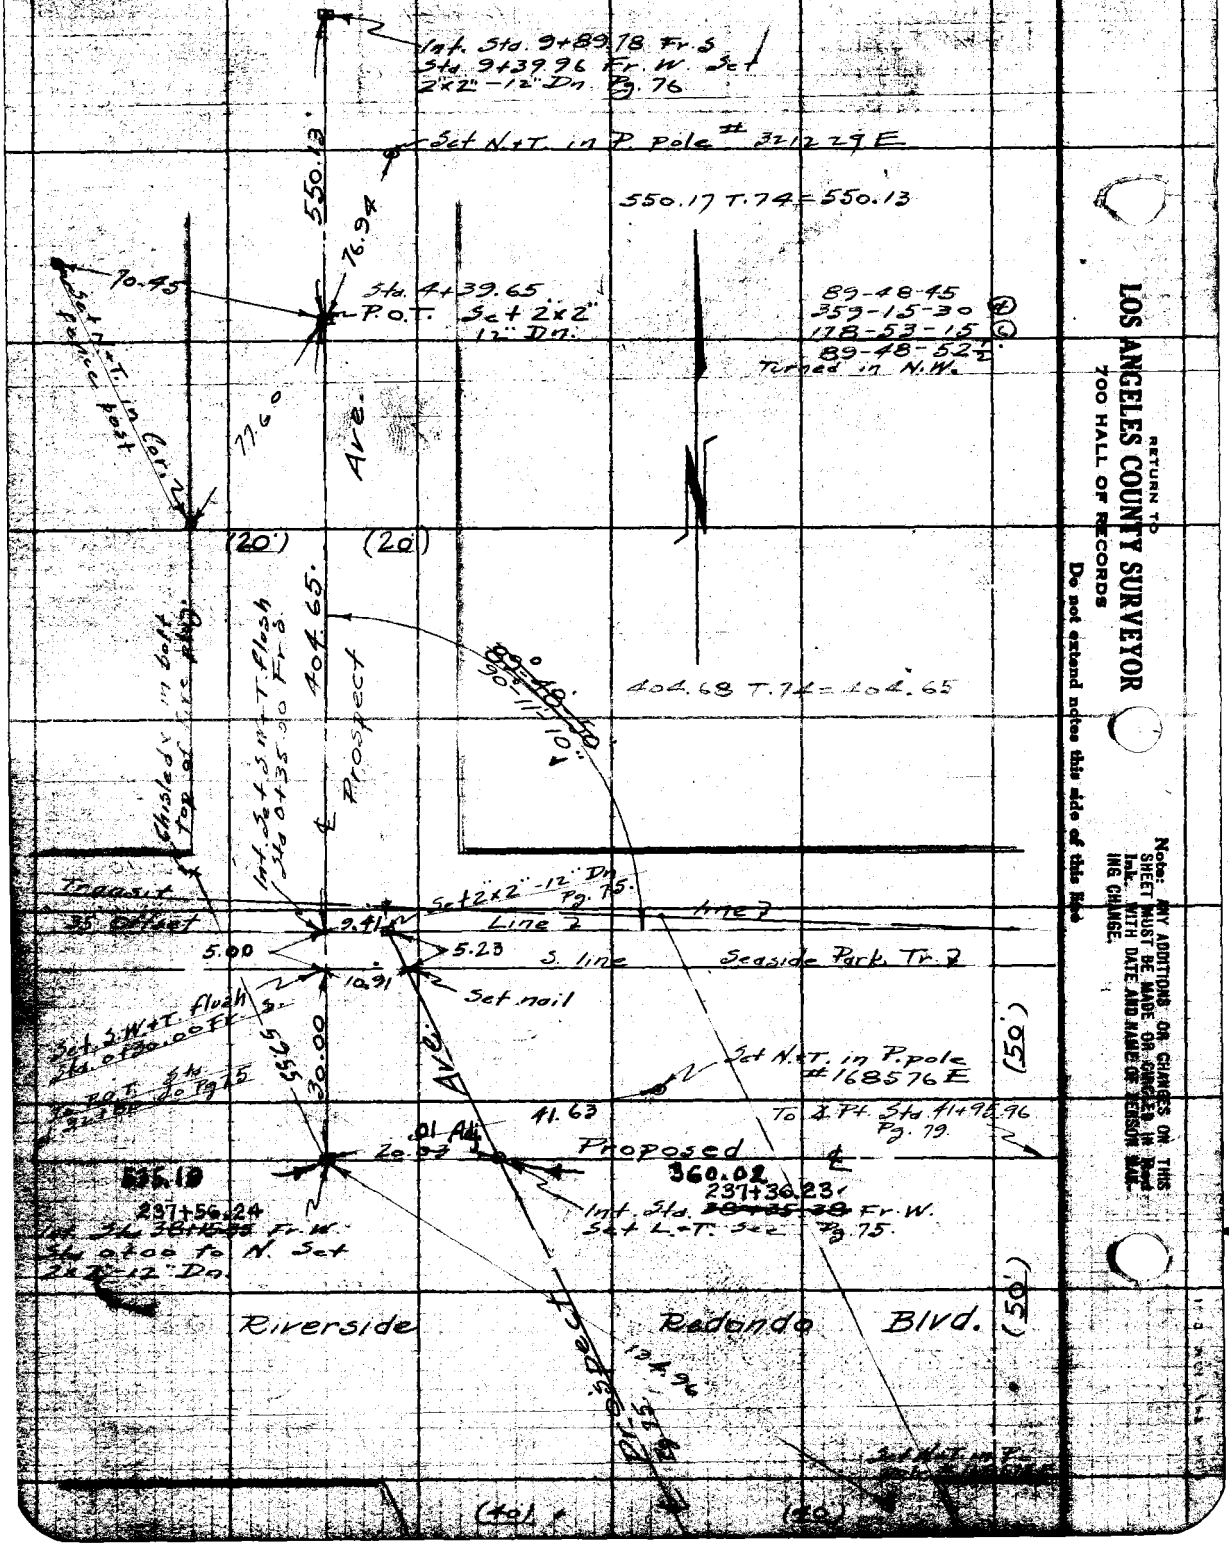

Notes Co'd by D. M. Finley | Survey of Riverside Redondo
Map No. B-448-2 | W. O. 920 Topo No. 046 Sh'd 84 °F.
Office Work J. H. Kirk | Surveyed by Reserrano
Checked D. M. Finley | Date
Date Nov. 1933 | Indexed A. C. Johnson

F.B. 424 Pg. 76

Sec Line 7

89-46-30
359-06-30 (A)
178-39-30 (B)
89-46-35

138.33 @ 00 = 138.33'
100.45 @ 3-44 = 100.23'
99.89 @ 8-39 = 98.75'
100.64 @ 7-12 = 99.84'
100.55 @ 8-04 = 99.55'
100.77 @ 4-03 = 100.51'
100.89 @ 00 = 100.89'
1338.10 T. 74 = 1338.03

89°-46'-35"

1338.03'

Sta 12+18.59 Fd 3/4" Dia.
1.P.
Fd N+T in P.P.
36.42
19.39
0.07
Fd County N+T in P. pole #21781 E.

Fd P.P. Co. N+T. in guy pole #21486 E.

Sta 13+18.58 Fd 1½" I.P. 18" Dn

Sta 12+99.64. Set 1"x1" flush

612.74

10.82 @ 00 = 10.82
100.88 @ 00 = 100.88
100.70 @ 7-12 = 99.91'
100.76 @ 7-21 = 100.47'
100.74 @ 7-56 = 99.77'
100.80 @ 3-20 = 100.63'
100.76 @ 5-29 = 100.30'
612.78 T. 74
612.74

Set 1"x1" flush Sta 6+86.87

299.43 T. 74 = 299.41'

Set N+T. in Cor. of house

58.82

299.41'

Sta 3+87.46 Set 2"x2"x12" Dn

Set N+T. in Cor. of wind break

21.54

(20) (20)

387.49 T. 74 = 387.46'

387.46'

Sta 3+32.12 E.

Sta 0+00 to Lt. Fd. Ac. 4" I.P. 12" Dn. F.B. 423-92

21.94

Peck Ave.

Fd N+T. in 4" nail

Notice: Any additions or changes on this sheet must be made on forms furnished by the Surveyor with date and name of person making.

Los Angeles County Surveyor

Do not write on back of this sheet

RETURN TO
LOS ANGELES COUNTY SURVEYOR
700 HALL OF RECORDS

Note: ANY ADDITIONS OR CHANGES ON THIS SHEET MUST BE MADE OR CHECKED IN RED Ink. WITH DATE AND NAME OF PERSON MAKING CHANGE.

Do not extend notes this side of this line

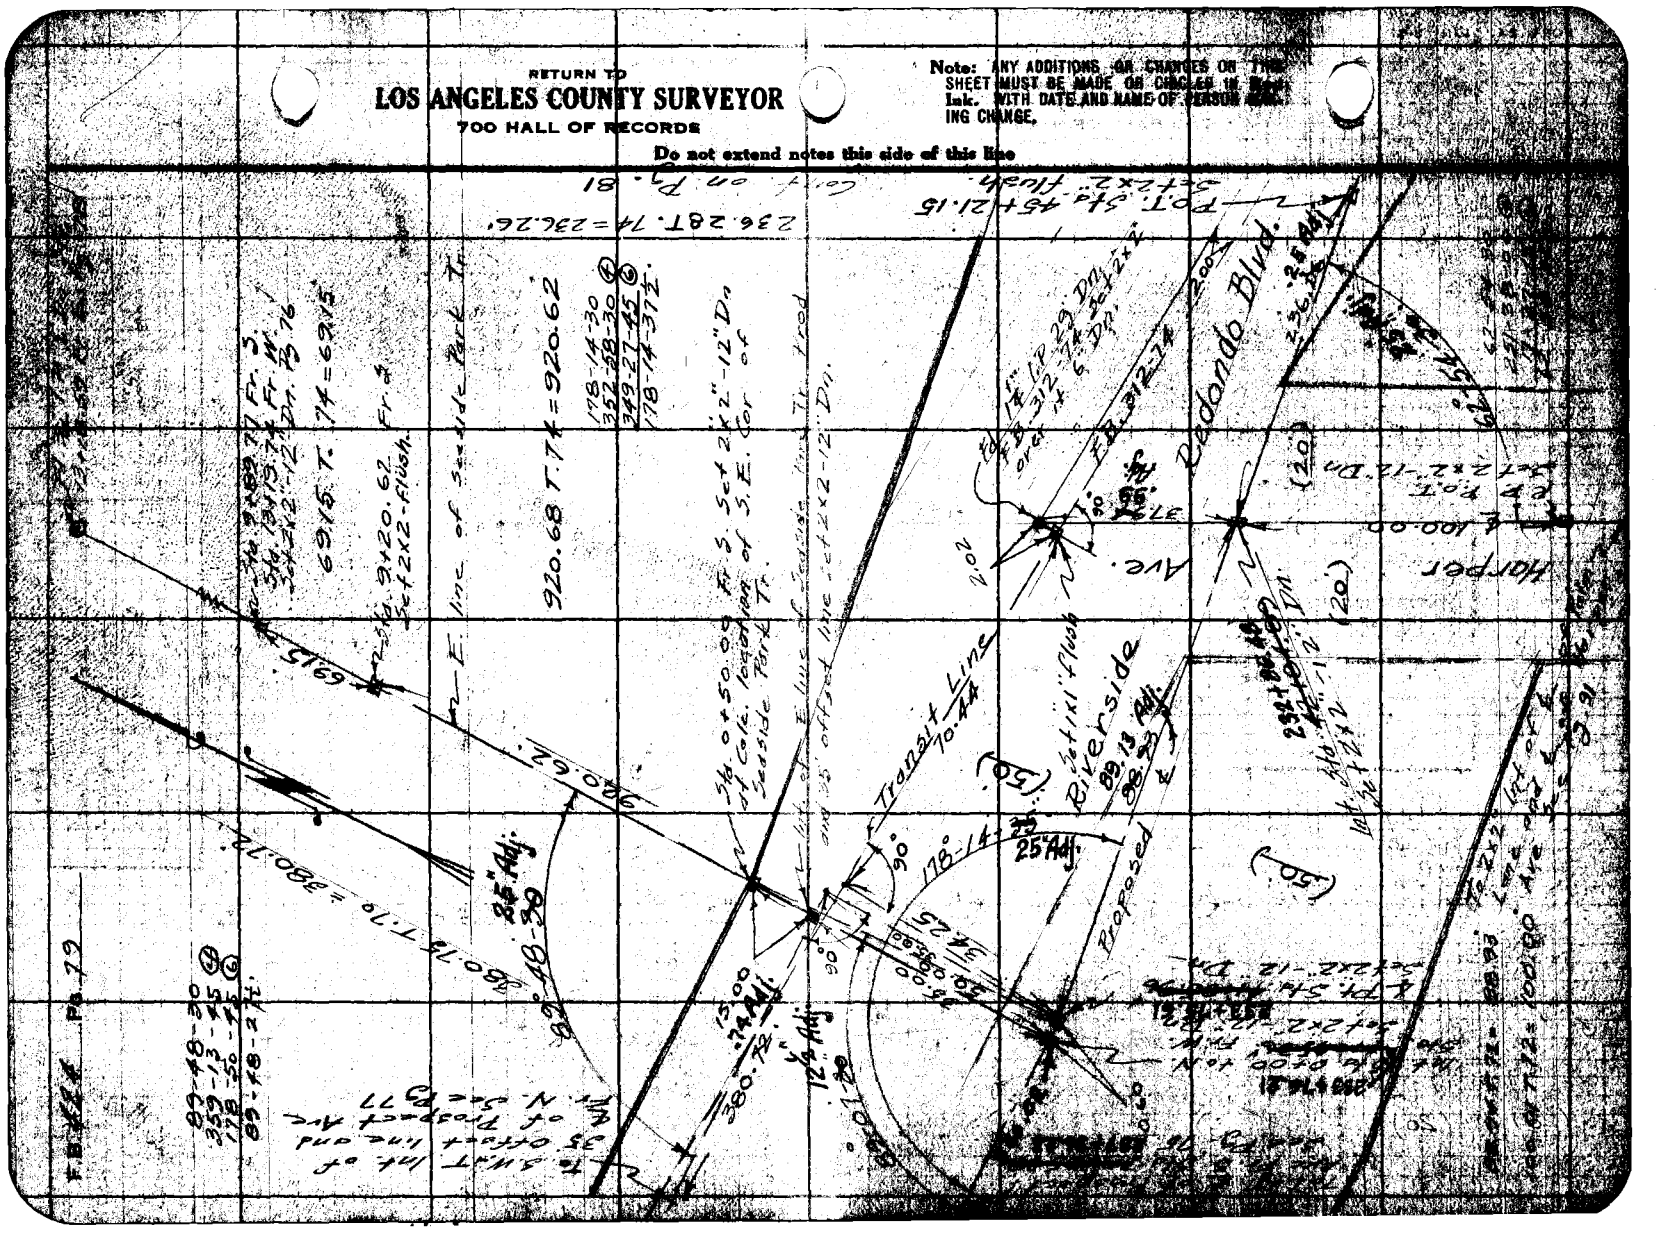

Map of D. M. Finley — Survey of Riverside Redondo
Map No. B-AA2-2 — W. O. 920 — Tape No. 046 — Sq'd 64 ch.
Date Nov. 1933 — Indexed A. C. Johnson
F.B. 422 Pg. 89

From left of Page 89

Set Spk. + T. in Top of 7" Stump

50.00

Set Spk. + T. in 24" Gum tree

216+21.99 Sta. 10+32.96 Left

Sta. 10+32.96 Left 10 Ft. 24" Gum

Set Spk. + T. in top 24" Stump

Set Spk. + T. in 12" Gum tree

Set Spk. + T. in 3" Gum tree

Set Spk. + T. in 12" Gum tree

Set Spk. + T. in 12" Gum tree

Set Spk. + T. in 12

RETURN TO

LOS ANGELES COUNTY SURVEYOR

700 HALL OF RECORDS

Note: ANY ADDITIONS OR CHANGES ON THIS SHEET MUST BE MADE OR CIRCLED IN Red Ink, WITH DATE AND NAME OF PERSON MAKING CHANGE.

Do not extend notes this side of this line

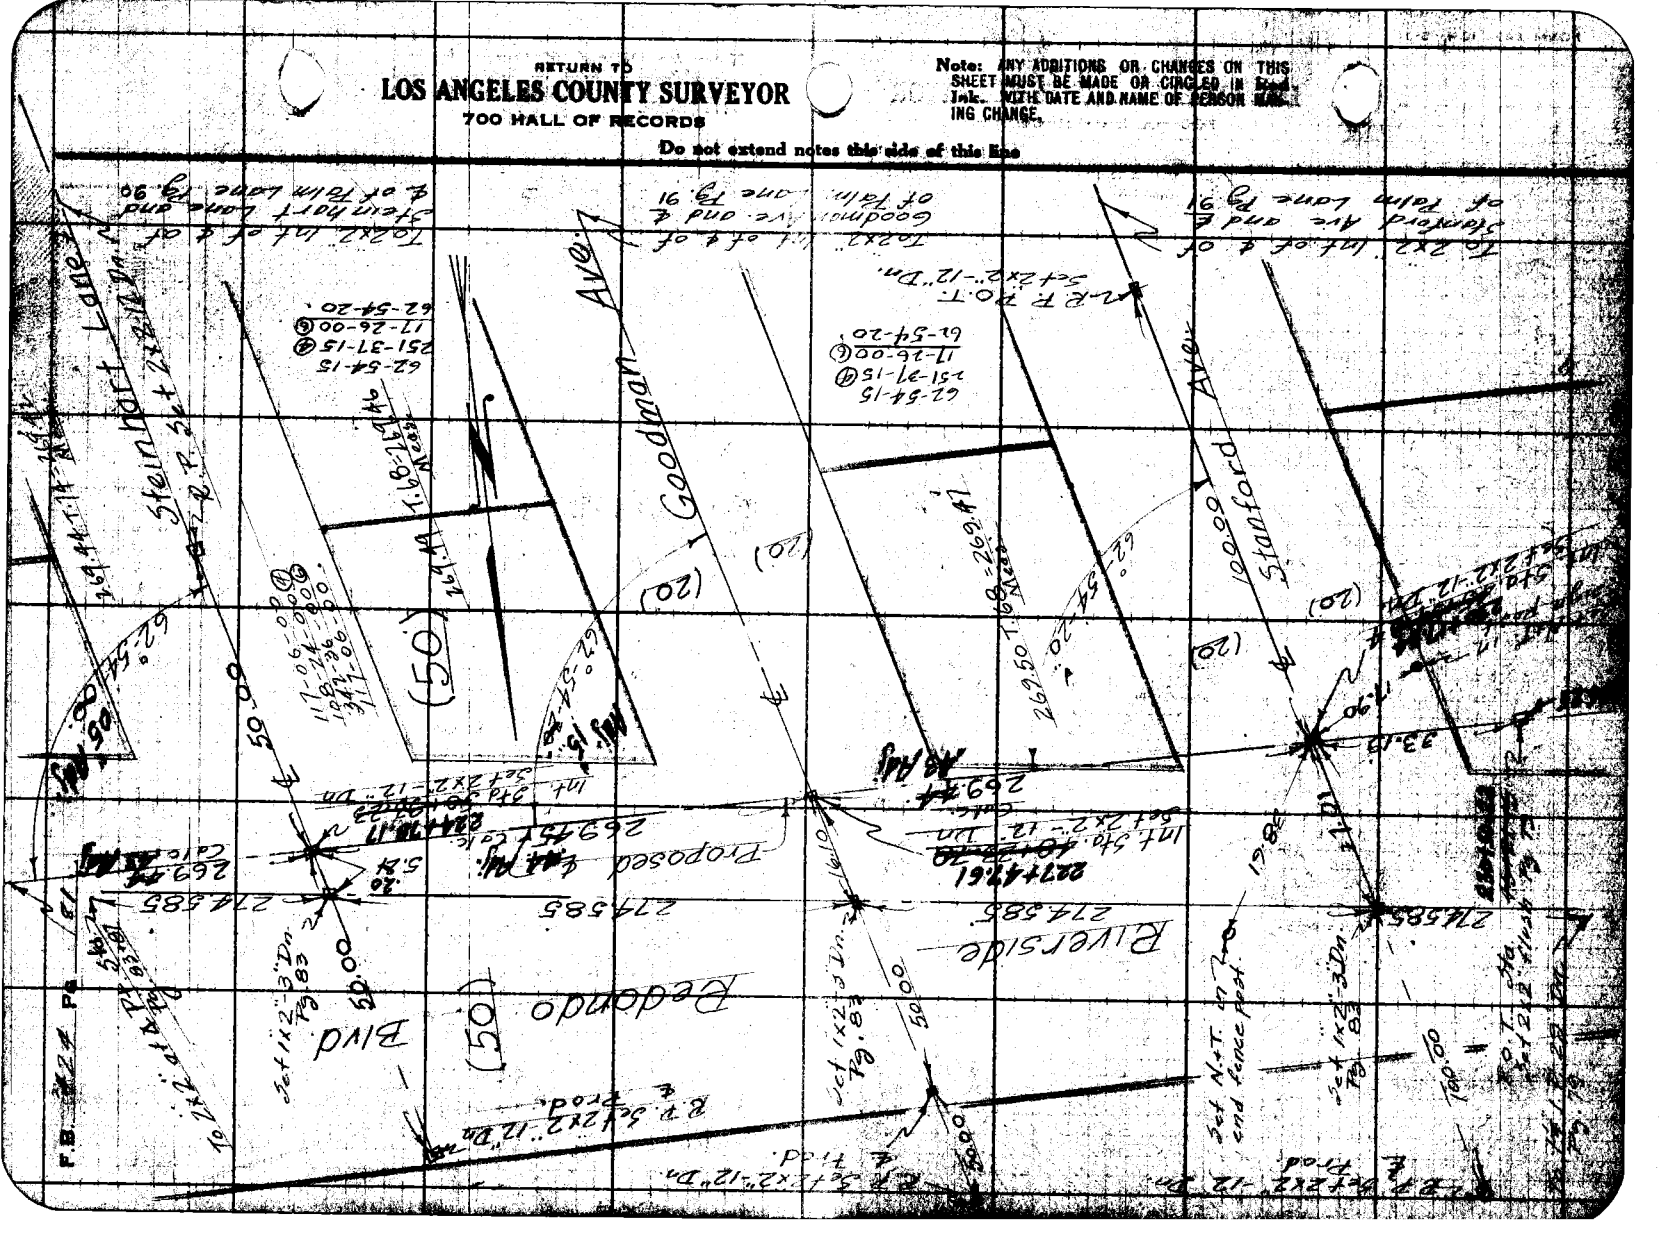
Stanford Ave.
Goodman Ave.
Riverside Blvd.
Redondo Blvd. (60)
Stewart Lane
(20)
(50)
50.00
Proposed
Set 1"x2" D.H. Tag
Set 1"x2" D.H. Tag
Set N.&T. end fence post.
Set 2"x2"-12" Dm. at end of road.
Set 2"x2"-12" Dm.
Set 3/4" pipe
Set 2"x2"-12" Dm.
Set 3/4" pipe
Set 2"x2"-12" Dm.
Set 3/4" pipe

Notes Chkd by D. M. Finley | Survey of Riverside Redondo | F.B. 424 Pg. 82
Map No. B-442-2 | W. O. 920 Tape No. 896 Sh'd 84 of
Date Nov. 1933 | Indexed A. C. Johnson

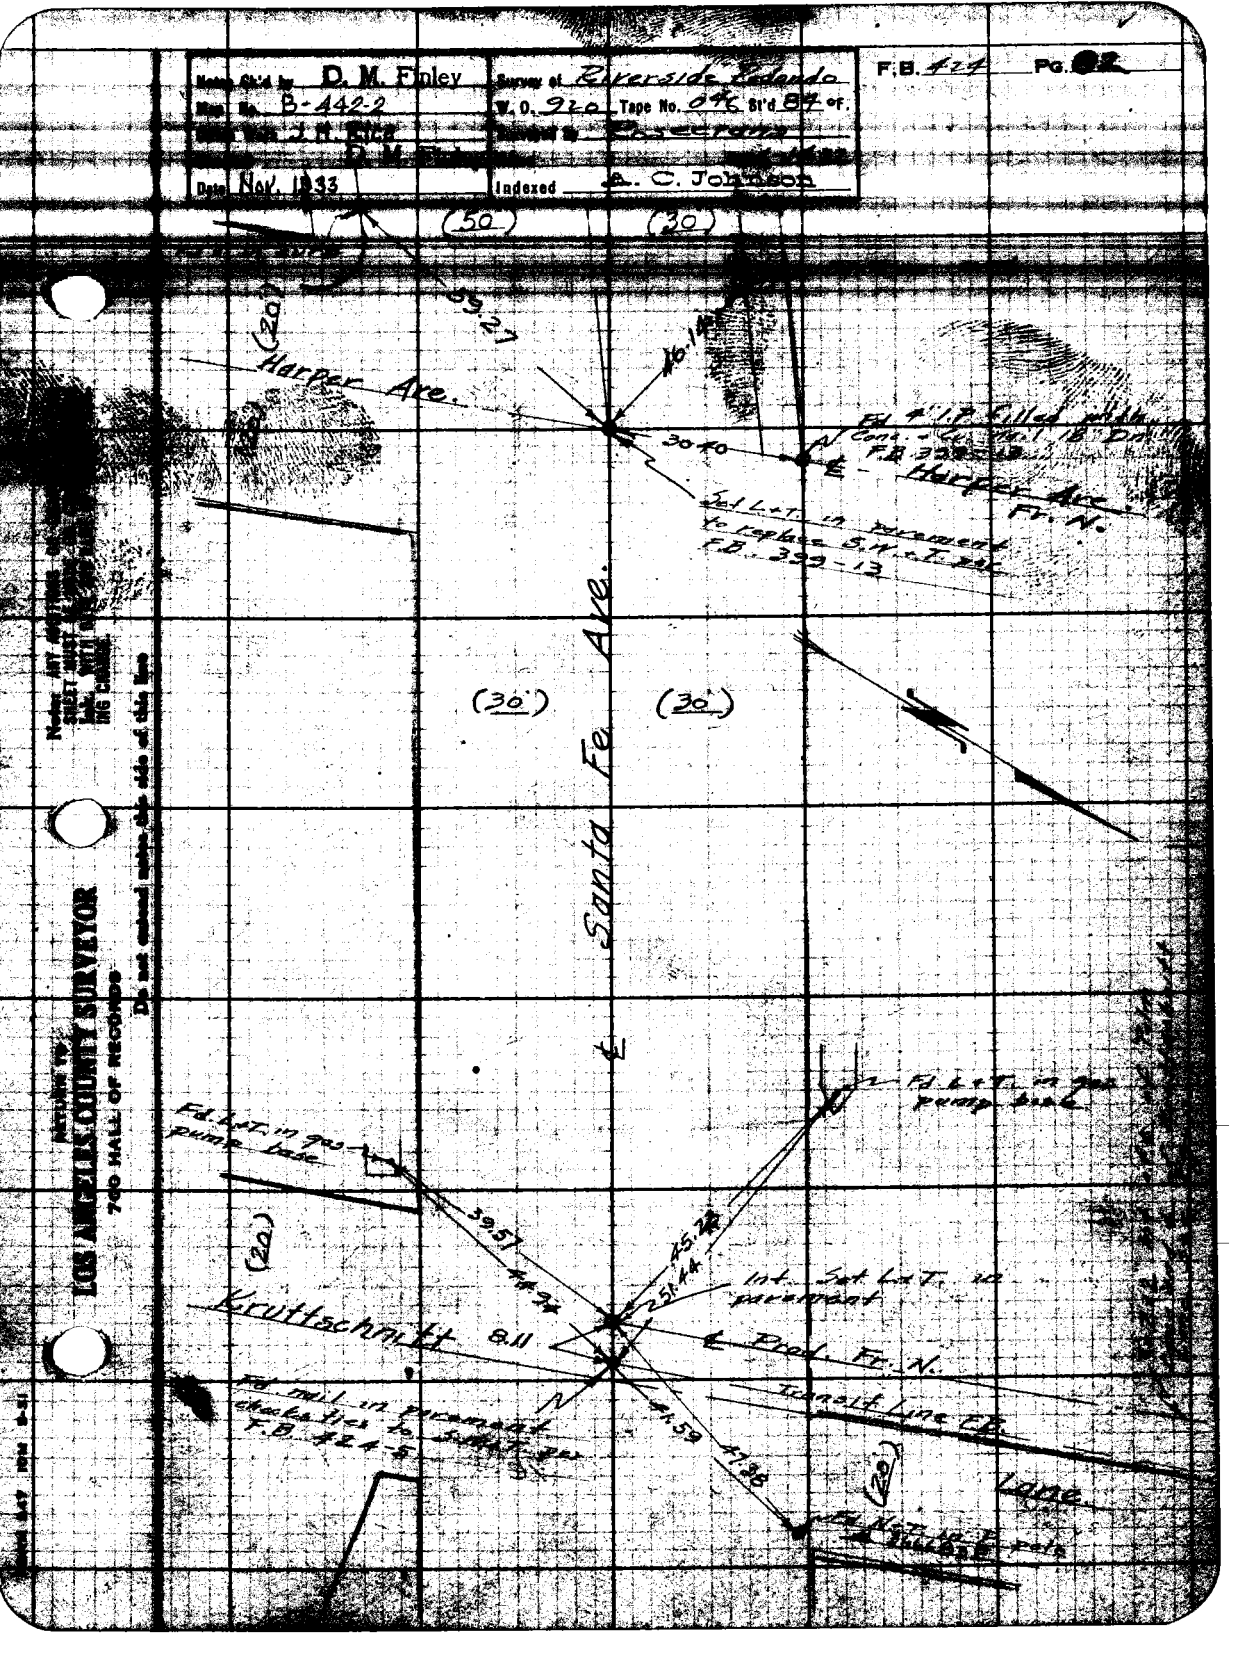

RETURN TO

LOS ANGELES COUNTY SURVEYOR

700 HALL OF RECORDS

Note: ANY ADDITIONS OR CHANGES ON THIS SHEET MUST BE MADE OR CIRCLED IN Red Ink. WITH DATE AND NAME OF PERSON MAKING CHANGE.

Do not extend notes this side of this line

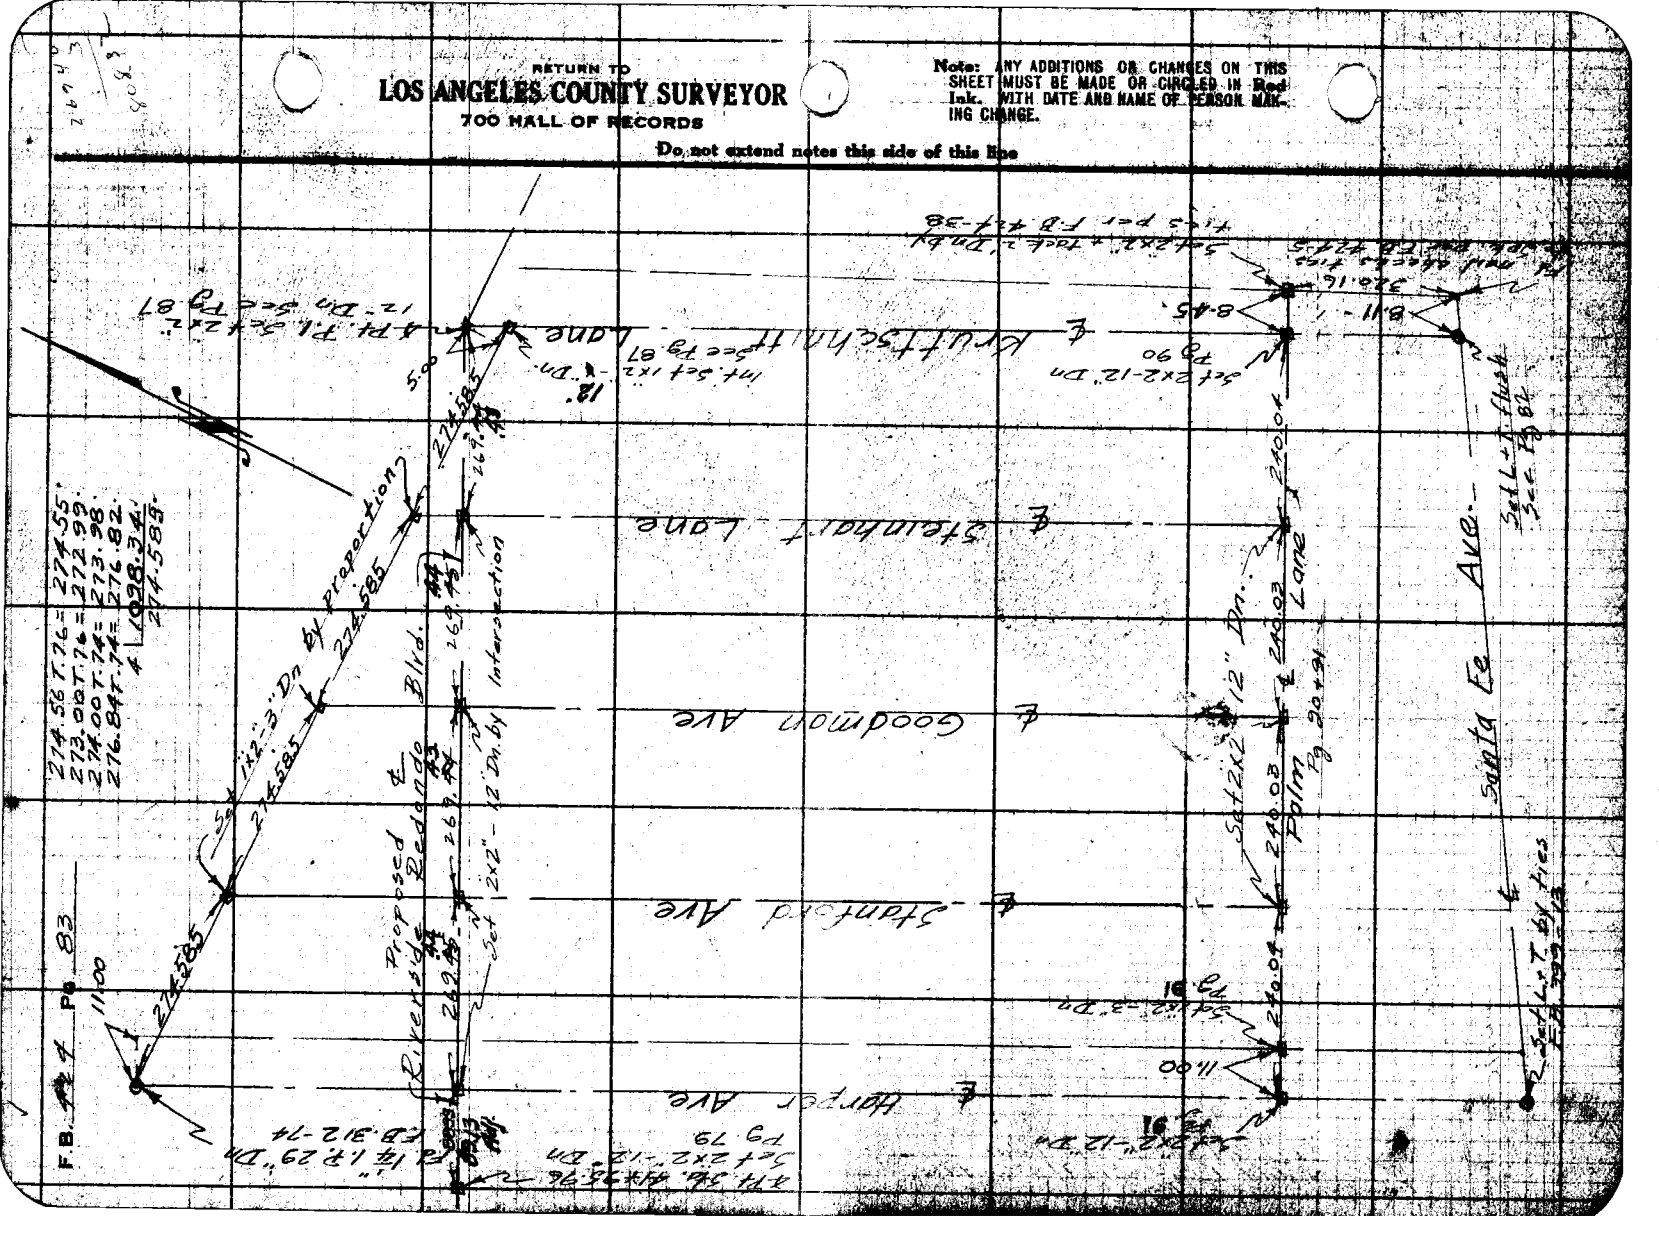
Kruithschnitt Lane
Steinbart Lane
Goodmon Ave
Stanford Ave
Harper Ave
Santa Fe Ave.
Proposed Redondo Blvd.
Intersection
Palm Lane
Set 1x2-3' Dn by preparation
Set 2x2-12" Dn.
Set 2x2-12" Dn.
Set 1x2-12" Dn.
Set 2x2-12" Dn.
Set 2x2-12" Dn.
Set 2

Notes Ch'd by D. M. Finley | Survey of Riverside Redondo | F.B. 424 Pg. 87

Map No. B-442-2 | W. O. 920 Tape No. 04 St'd 84°F.

Office Work J. H. Rice | Corrected by Closed Lines Date 6-26-33

Checked D. M. Finley | Notes

Date Nov. 1933. | Indexed A. C. Johnson

Coast Bottom Asst. Engr.

(20') (20')

℄ Palm Lane (10') (10')

Pg. 90

S 64° 22' 30" W 1210.00

Lane

(20')

℄ Wallacott St.

(20')

(20')

Krutschnitt

(30')

Ave

℄ Santa Fe

Int. Act L&T. Pg. 92

(30')

N

LOS ANGELES COUNTY SURVEYOR

RETURN TO

700 [illegible] BLDG.

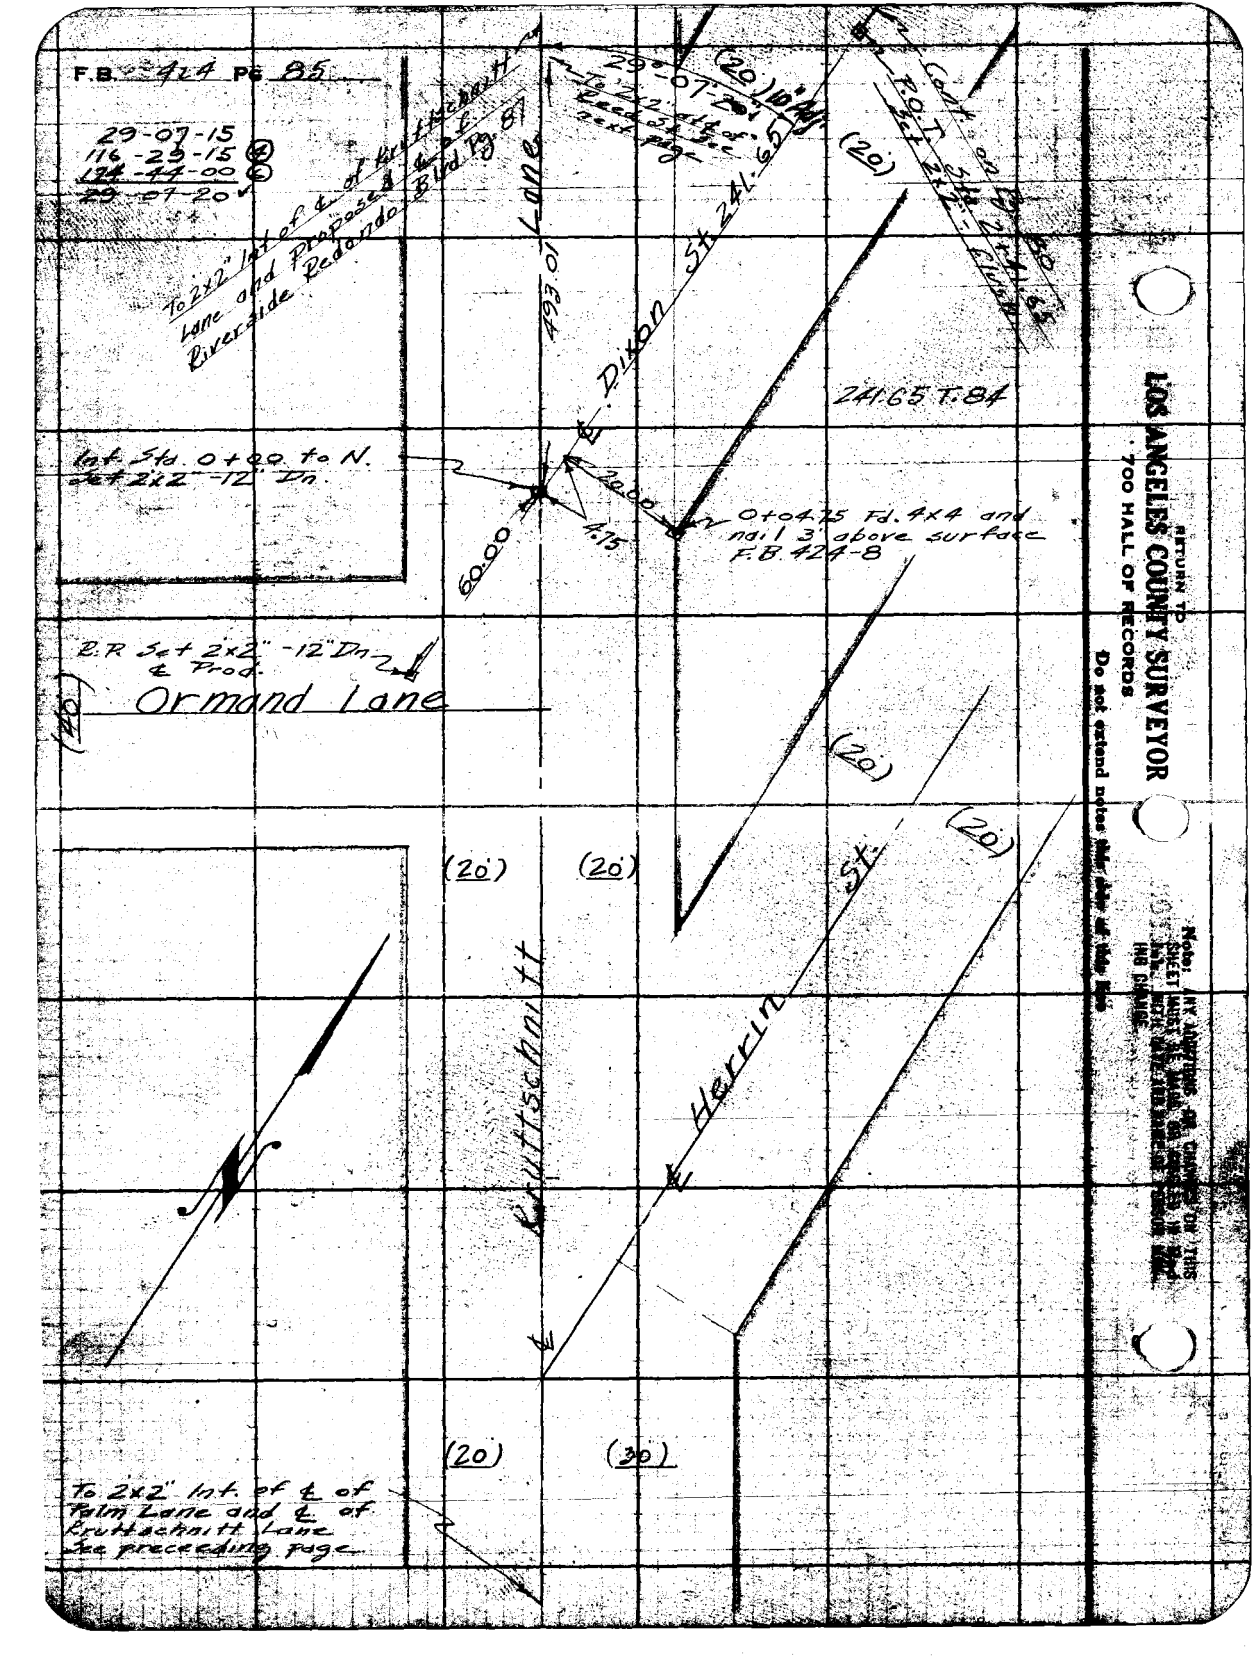
F.B. 424 Pg 85
29-07-15
116-23-15 (M)
124-44-00 (E)
29-07-20
To 2x2" lot of ℄ of Kruttschnitt Lane and Proposed ℄ of Riverside Redondo Blvd Pg 81
Kruttschnitt Lane
Dixon St 241.65
241.65 T.84
Lot Sta. 0+00 to N. 26+2x2"-12" Dn.
60.00
20.00
4.15
0+04.75 Fd. 4x4 and nail 3" above surface F.B. 424-8
B.R Sta 2+2x2"-12" Dn ℄ Prod.
Ormand Lane
(20)
(20)
(20)
(20)
(20)
(30)
Herrin St.
Kruttschnitt
To 2x2" lot. of ℄ of Palm Lane and ℄ of Kruttschnitt Lane See preceding page
RETURN TO
LOS ANGELES COUNTY SURVEYOR
700 HALL OF RECORDS
Do not extend notes

Name Ch'd by D. M. Finley | Survey of Riverside Redondo
Map No. B-442-2 | W. O. 920 | Tape No. 046 | St'd 84 °F.
Office Work ... | Surveyed by Colorado
Checked ... | Plotted ... | A. C. Jensen
Date Nov. 1938 | Indexed

F.B. 424 PG. 86

NOTICE: ANY ADDITIONS OR CHANGES ON THIS SHEET MUST BE MADE ON CIRCLED AREA AND WITH BLUE INK NAME OF PERSON MAKING CHANGE.

RETURN TO LOS ANGELES COUNTY SURVEYOR 900 HALL OF RECORDS

next page

Wylie (20') Lane

(20') Lane

Reed

(20')

712.53 T. 72 = 712.47

712.47 Kruttschnitt

(20')

29°07'-10"

1st

Reed

Int. 3 c.t 2x2"-12" Dn

60.00

493.01 82.82

493.06 T. 68 = 493.01

R.P. 3 c.t 2x2"-12" Dn. & Prod.

(20')

Carnegie Lane

(20')

82.83 T. 68 = 82.82

3 c.t 2x2" + tack flush
To R.P. W'ly & at Dixon
St. 3 c.t Macadam Mag.

F.B. 424 Pg. 87

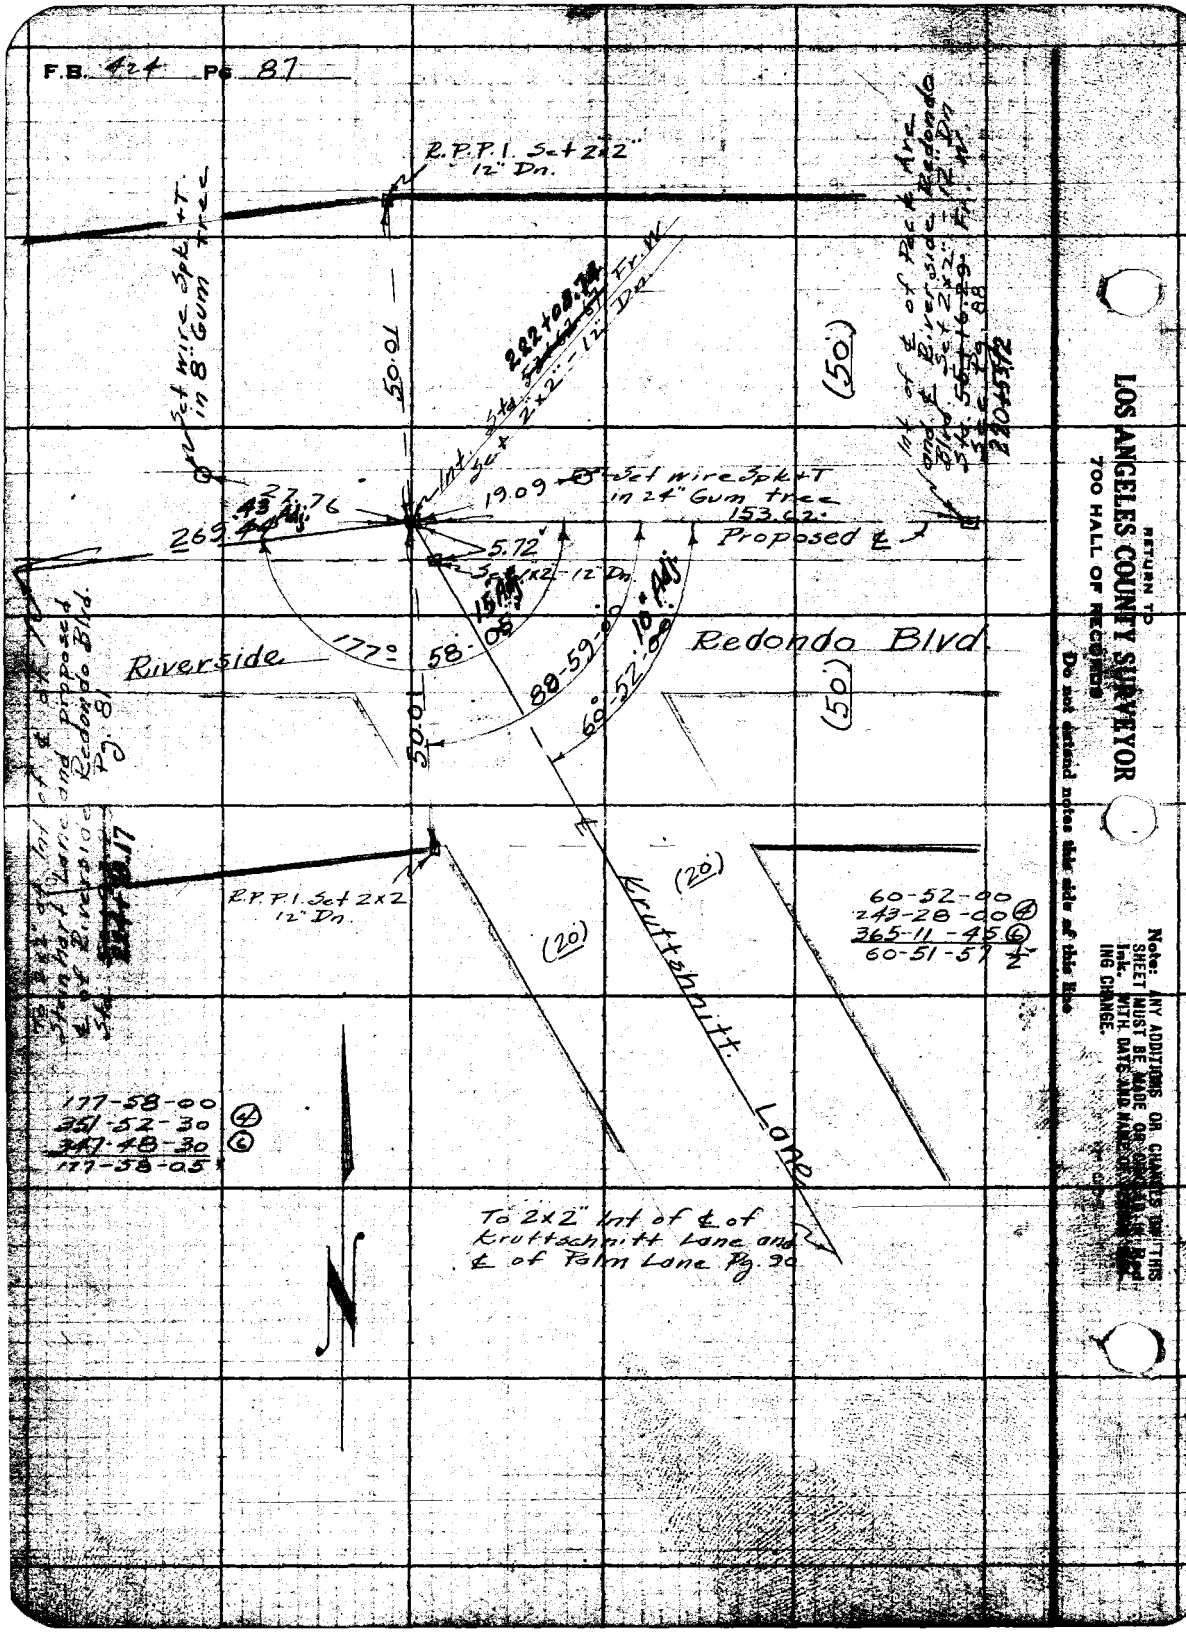

RETURN TO
LOS ANGELES COUNTY SURVEYOR
700 HALL OF RECORDS
Do not detach notes this side of this line

Note: ANY ADDITIONS OR CHANGES WITH THIS SHEET MUST BE MADE OR SIGNED BY THE Engr. WITH DATE AND MADE OR SIGNING CHANGE.

Notes Ck'd by D. M. Finley
Map No. B-442-2
Field Work J. H. Rice
Plotted by E. M. Finley
Date Nov. 1933.

Survey of Riverside Redondo
W. O. 920 Tape No. 046 St'd 64 °F.
Computed by Rosecrans 6-9-33
Indexed A. C. Johnson

F.B. 427 Pg. 88

Set 3"x4" Cor. Int. of

Ave.

Set N.&T. in 3" marker post.

Set N.&T. in P. pole #69835 E

Set 2"x2" Line Pt. 12" Dn. Top of hill.

Line Pt. Set 2"x2" - 12" Dn.
153.63 T.74 = 153.62'

Deck

(20)

89-22-00
357.65-40
176.57 Cor.
89-22-00
in N.W.
158.78 T.74 = 158.77

Set 2"x2" - 12" Dn.

Int. Sts. 220+55.12 Fr. W.
Set 2"x2" - 12" Dn.

158.77

(50)

Set wire Spk. in T. in 18" Gum tree

Set wire Spk. in T. in 5" Gum tree

Set 3" Post in 30" Gum tree

54.59

Present

Proposed

222+00.74

153.62'

Transit 4 ins 2

Pt. 3 ins.

Set 2"x2" - 12" Dn.

Pg. 87 for Ties.

5.00

5.94

F.B. 312-78

Pt. 2"x2" in Rock 2 Dn.

F.B. 312-78

F.B. 312-78

Riverside

Redondo Blvd.

(50)

(60)

59.79

Set 2"x2" - 12" Dn. in




F.B. 424 Pg. 89

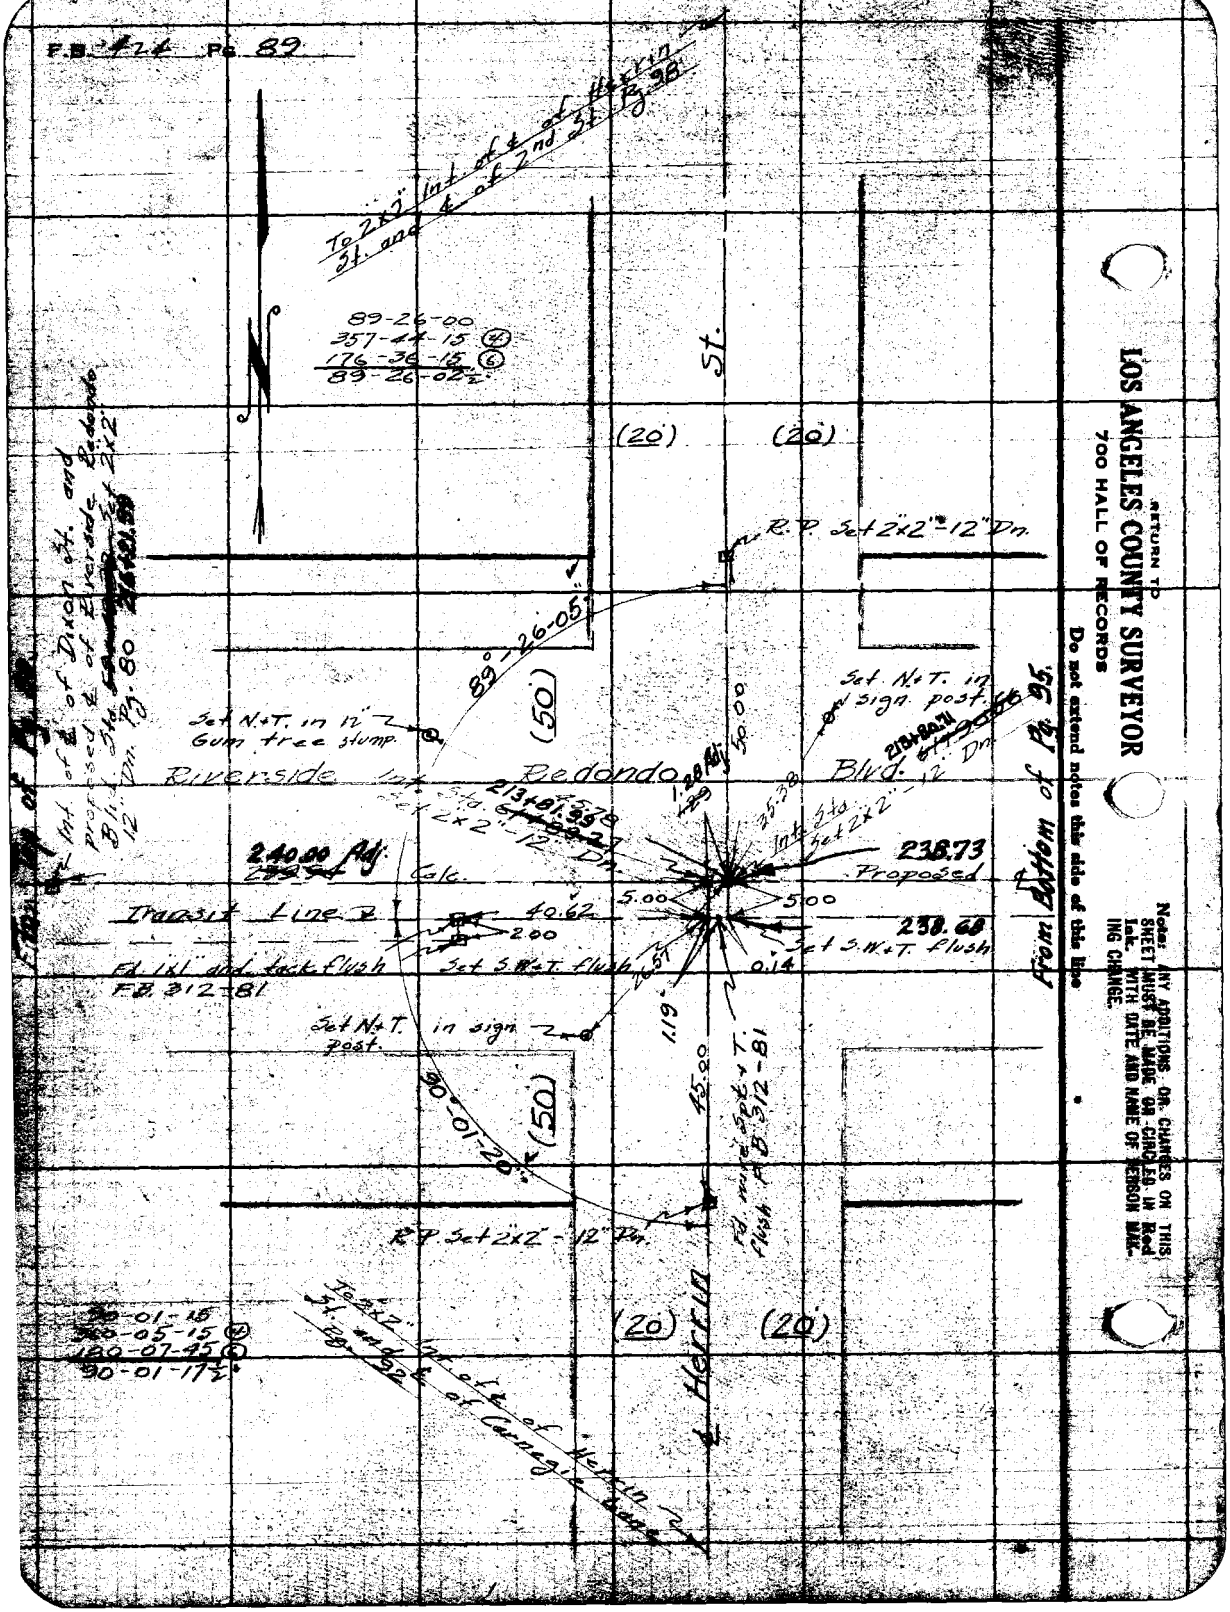

RETURN TO
LOS ANGELES COUNTY SURVEYOR
700 HALL OF RECORDS

Do not extend notes this side of this line

Notice: ANY ADDITIONS, OR CHANGES ON THIS SHEET MUST BE MADE OR CIRCLED IN Red Ink. WITH DATE AND NAME OF PERSON MAKING CHANGE.

Name Ch'd by D. M. Finley
Map No. B-44-2
Office Work
Checked
Date Nov. 1933

Survey of Riverside Redondo
W. O. 920 Tape No. 046 St'd 84 °F.
Surveyed by Eastman
Name A. C. Johnson
Indexed

F.B. 424 Pg. 30

End of Survey this side
East Goodmin Ave. See
next page

240.05 T.70 = 240.03'

89° 59' 55"

Set N.+T. in P. pole
130588 E.

240.03'

Set x in Conc. water meter

10.00

40.65

15.25

R.P. Set 2x2" -12" Dn.
& Prod.

14.30

(20)

Steinhart Lane

Set copper tack in Conc.
at house

Int. 336.24 + 40.04
from E. 2x2"
12" Dn. by proportion

(20)

Lane

240.04'

240.06 T.70 = 240.04'

Palm

Set 2x2" in top of E. & W. Redondo Blvd. and Steinhart Lane

70-00-00 E
359-59-55 E
179-59-55
89-59-55

Int. 3rd. 0.00 to W.
Set 2x2" -12" Dn.

(10) (10)

89° 59' 55"

(20)

Transit

8.45

line 7 F.B. 424-30

Kruttschnitt

Lane

Set 2x2" -12" Dn.
by tics Pg 38

66.28

Set N.+T. in
2130 post

St.

(20)

(20)

(20)

30.00

R.P. Set 2x2" -12" Dn
& Prod.

Kruttschnitt

Set N.+T.
in P. pole

Subject to changes on this sheet, must be verified with date and name of person who made the change

Subject to
LOS ANGELES COUNTY SURVEYOR
709 HALL OF RECORDS
Do not extend notes to this side of this line

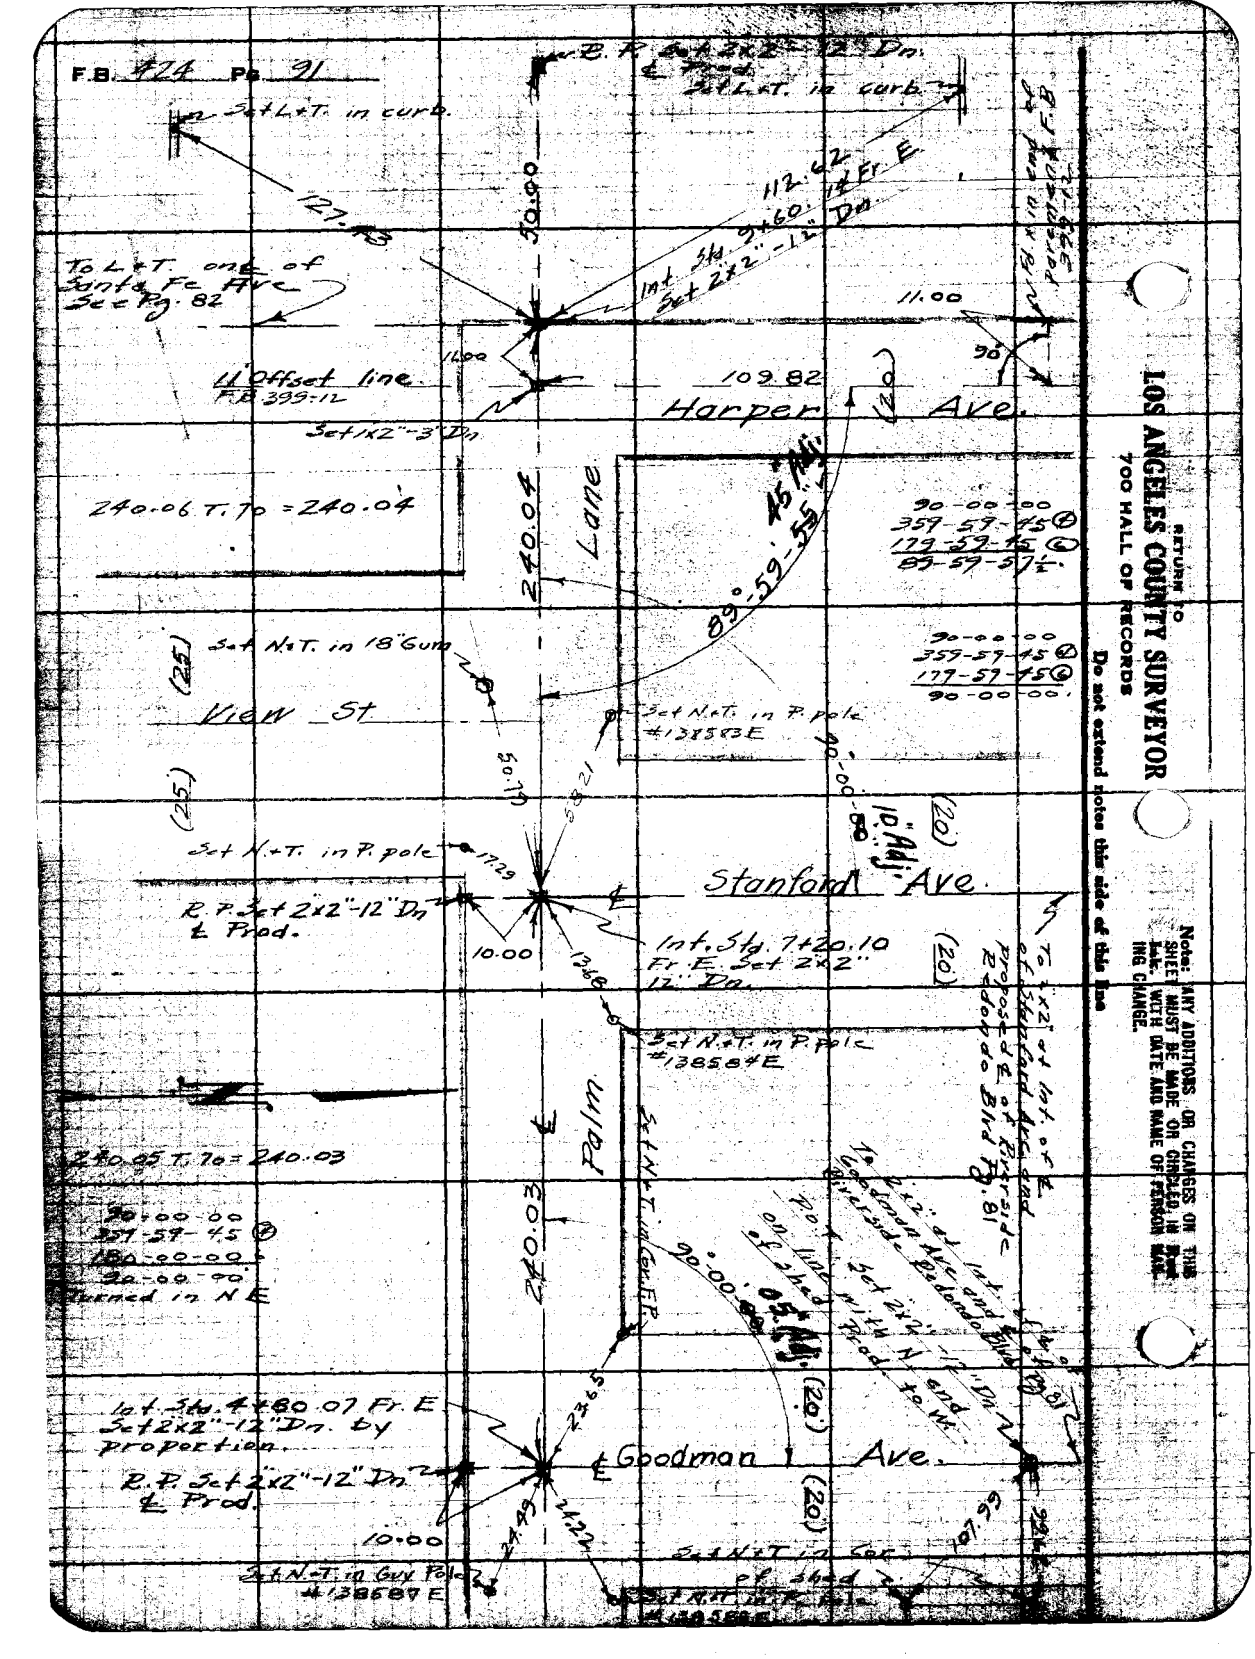
F.B. 424 Pg. 91
R. P. Set 2x2"-12" Dn. & Prod. 24 L.+T. in curb.
3 Set L.+T. in curb.
112.62
Int. Sta. 9+60.12 Fr. E Set 2x2"-12" Dn.
To L.+T. one of Santa Fe Ave See Pg. 82
11.00
11' offset line F.B. 399-12
Set 1x2"-3" Dn.
109.82
Harper Ave.
240.06 T. To = 240.04
240.04
Lane
45 (M)
89°-59'-55"
90-00-00
359-59-45 (A)
179-59-45 (C)
89-59-57½
(25)
Set N.+T. in 18" Gum
View St
Set N.+T. in P. pole #138583E
90-00-00
359-57-45 (D)
177-57-45 (B)
90-00-00
(25)
Set N.+T. in P. pole
17.29
R. P. Set 2x2"-12" Dn. & Prod.
10.00
Int. Sta. 7+20.10 Fr. E. Set 2"x2" 12" Dn.
Stanford Ave.
(20)
Set N.+T. in P. pole #138584E
240.03
Lane
240.05 T. To = 240.03
90-00-00
357-59-45 (B)
180-00-00
90-00-00
Turned in N.E.
Set N.+T. in Conc. F.P.
90°-00'-00"
05 (M)
Set 2x2" 12" Dn. N. end of Island in Int. 4 to W.
(20)
Int. Sta. 4+80.07 Fr. E Set 2x2"-12" Dn. by proportion.
R. P. Set 2x2"-12" Dn. & Prod.
10.00
Goodman Ave.
(20)
Set N.+T. in Conc. P.P. 34-d
Set N.+T. in Guy Pole #138587E
Set N.+T. in F.P. #138588E
LOS ANGELES COUNTY SURVEYOR
700 HALL OF RECORDS
RETURN TO
Do not extend notes this side of this line
Note: ANY ADDITIONS OR CHANGES ON THIS SHEET MUST BE MADE ON ORIGINAL IN Ink. WITH DATE AND NAME OF PERSON MAKING CHANGE.

Notes Cl'd by D. M. Finley | Survey of Riverside, Redondo
Map No. B-442-2 | W. O. 220 Tape No. 246 St'd 84 °F.
Field Work J.H. [illegible] | Surveyed by Rosecrans
Date Nov. 1933. | Inspected A. C. Johnson

F.B. 424 Pg. 92

Notice: Any additions or changes must be made with ink and initialed. No changes will be made in pencil.

Do not conceal notes on this side of this line

LOS ANGELES COUNTY SURVEYOR
720 HALL OF RECORDS

RETURN TO

240.12 T.74 = 240.10

(20) (20)

240.10

Lane

25 Adj.

90°-08'-15"

(20)

Herrin

50.00

St.

Int. Sta 2+40.10 Ft. W. of 12x2 - 18" Dia. by proportion

20.95 92.66

Set N+T. in sign post

Set N+T. in 18" cedar tree

Carnegie

240.10

240.12 T.74 = 240.10

90-07-45
360-30-45
180-45-15
90-07-47½

90°-07'-45"

Dixon

(20)

806.31

Int. Sta 0+00 to E'ly Sta 2+49.35 Ft. S of 2x2" - 12" Dia. by proportion

Set N+T. in 10" Gum tree

83.35 8.30

241.65

St

Set 2x2" flush Pg. 85

50.00 107.74

R.P. Set 2x2" - 12" on ℄ Road

Set N+T. in Sign post

RETURN TO
LOS ANGELES COUNTY SURVEYOR
700 HALL OF RECORDS

Note: ANY ADDITIONS OR CHANGES ON THIS SHEET MUST BE MADE OR CIRCLED IN Red Ink. WITH DATE AND NAME OF PERSON MAKING CHANGE.

Do not extend notes this side of this line

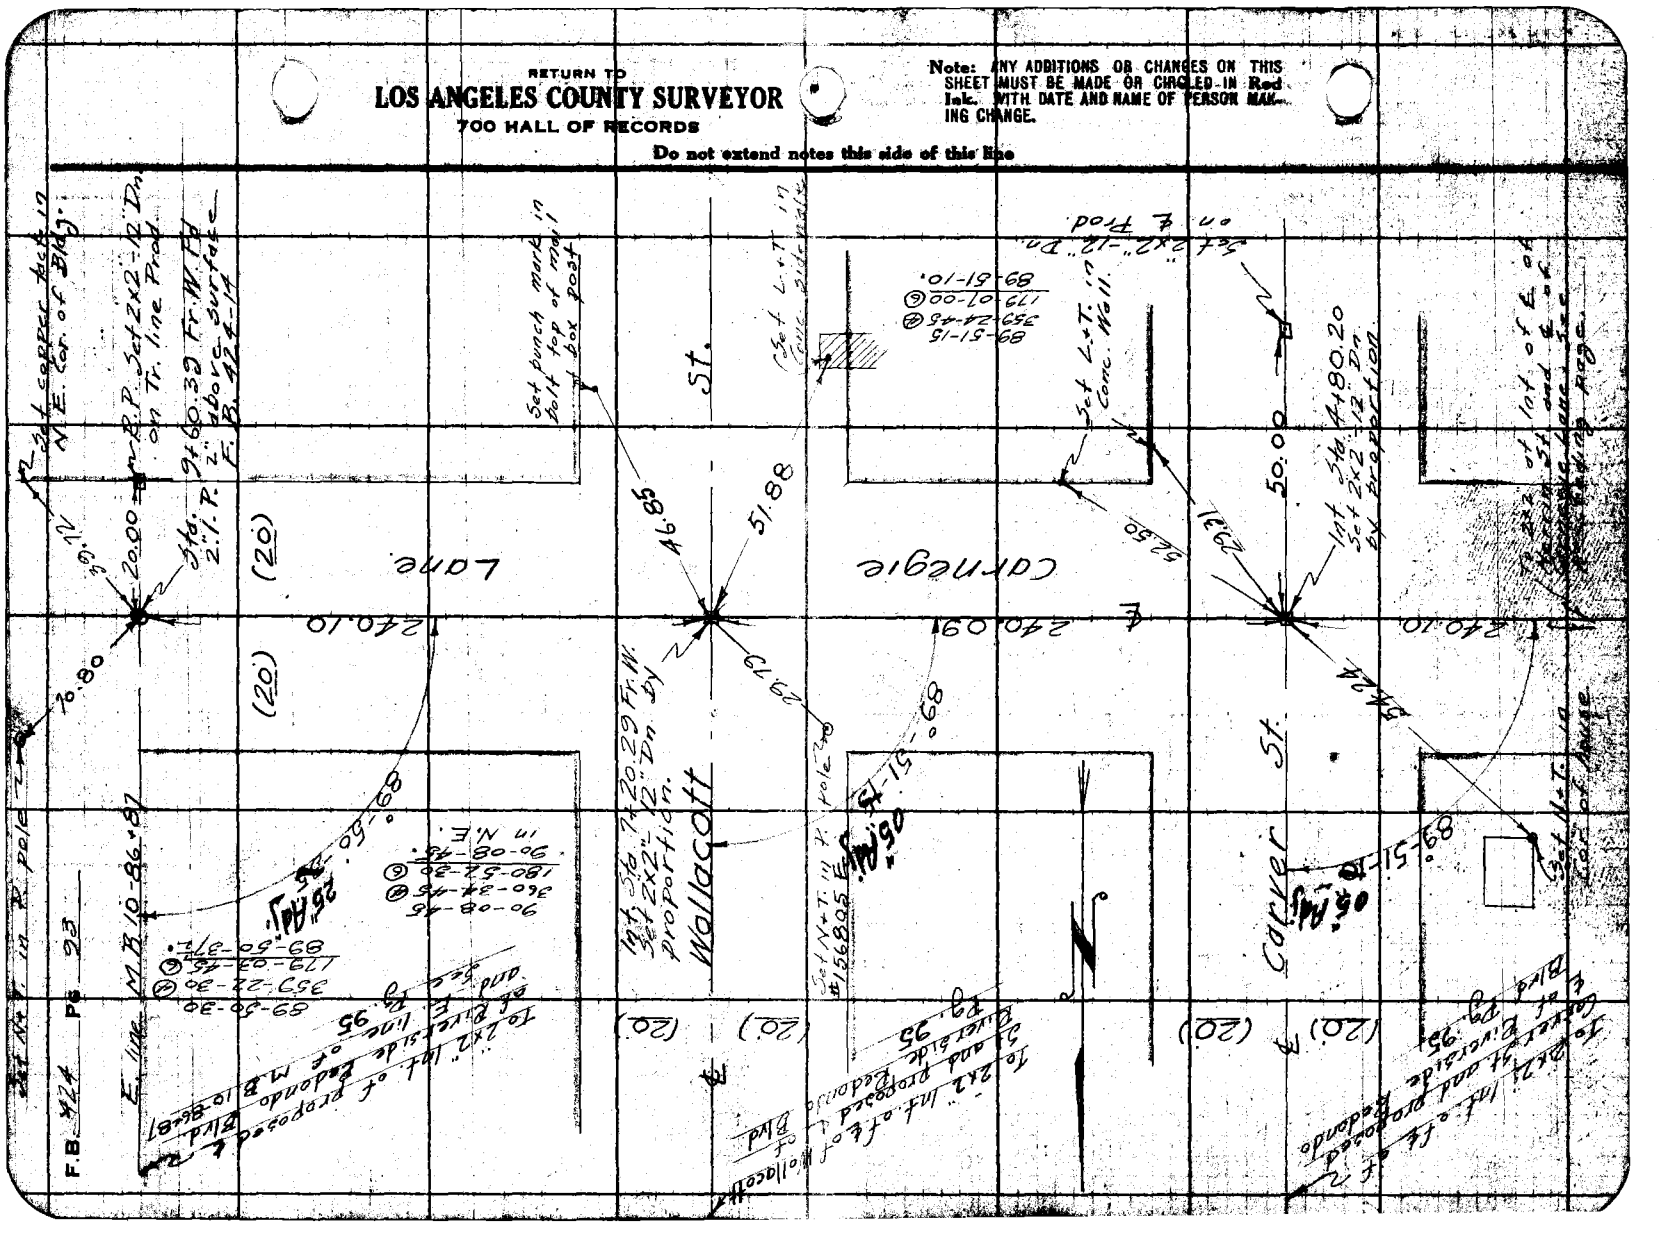
Lone St.
Carnegie St.
240.10
240.09
240.10
(20)
(20)
(20)
(20)
20.00
20.00
50.00
51.88
46.85
46.50
92.31
89-51-15
89-51-10
89-51-15
89-50-37
90-08-45
89-51-15
05 Adj.
25 Adj.
05 Adj.
Sta. 94+80.39 Fr. W. P.P. Set 2"x2" x 12" Dn. on Tr. line Prod. above surface
Set punch mark in top of mail box post
Set L.+T. in Conc. Walk
Set 2"x2"x18" Dn. on ℄ Prod.
Int. Sta. 94+80.20 Set 2"x2"x12" Dn. in ℄ Portion
Set 3/4" copper tack in N.E. Cor. of Bldg.
Set L.+T. in Conc. Walk
Set 1/2" I.P. in Conc. Walk
Int. Sta. 94+20.29 Fr. W. Set 2"x2"x12" Dn. in Portion
Set L.+T. in Conc. Walk
Set 1/2" I.P. in Conc. Walk

Notes Ck'd by D. M. Finley | Survey of Riverside Redondo
Map No. B-442-2 | W. O. 920 Type No. 046 Std 84 °F.
Office Work J. H. Kidd | Surveyed by [illegible]
Checked D. M. Finley | [illegible]
Date Nov. 1933. | Indexed A. C. Johnson


Transit line

Ave

P.I. Fd. L.+T. per Road Dept.

Fd. L.+T.

Fd. L.+T.

Fd. L.+T

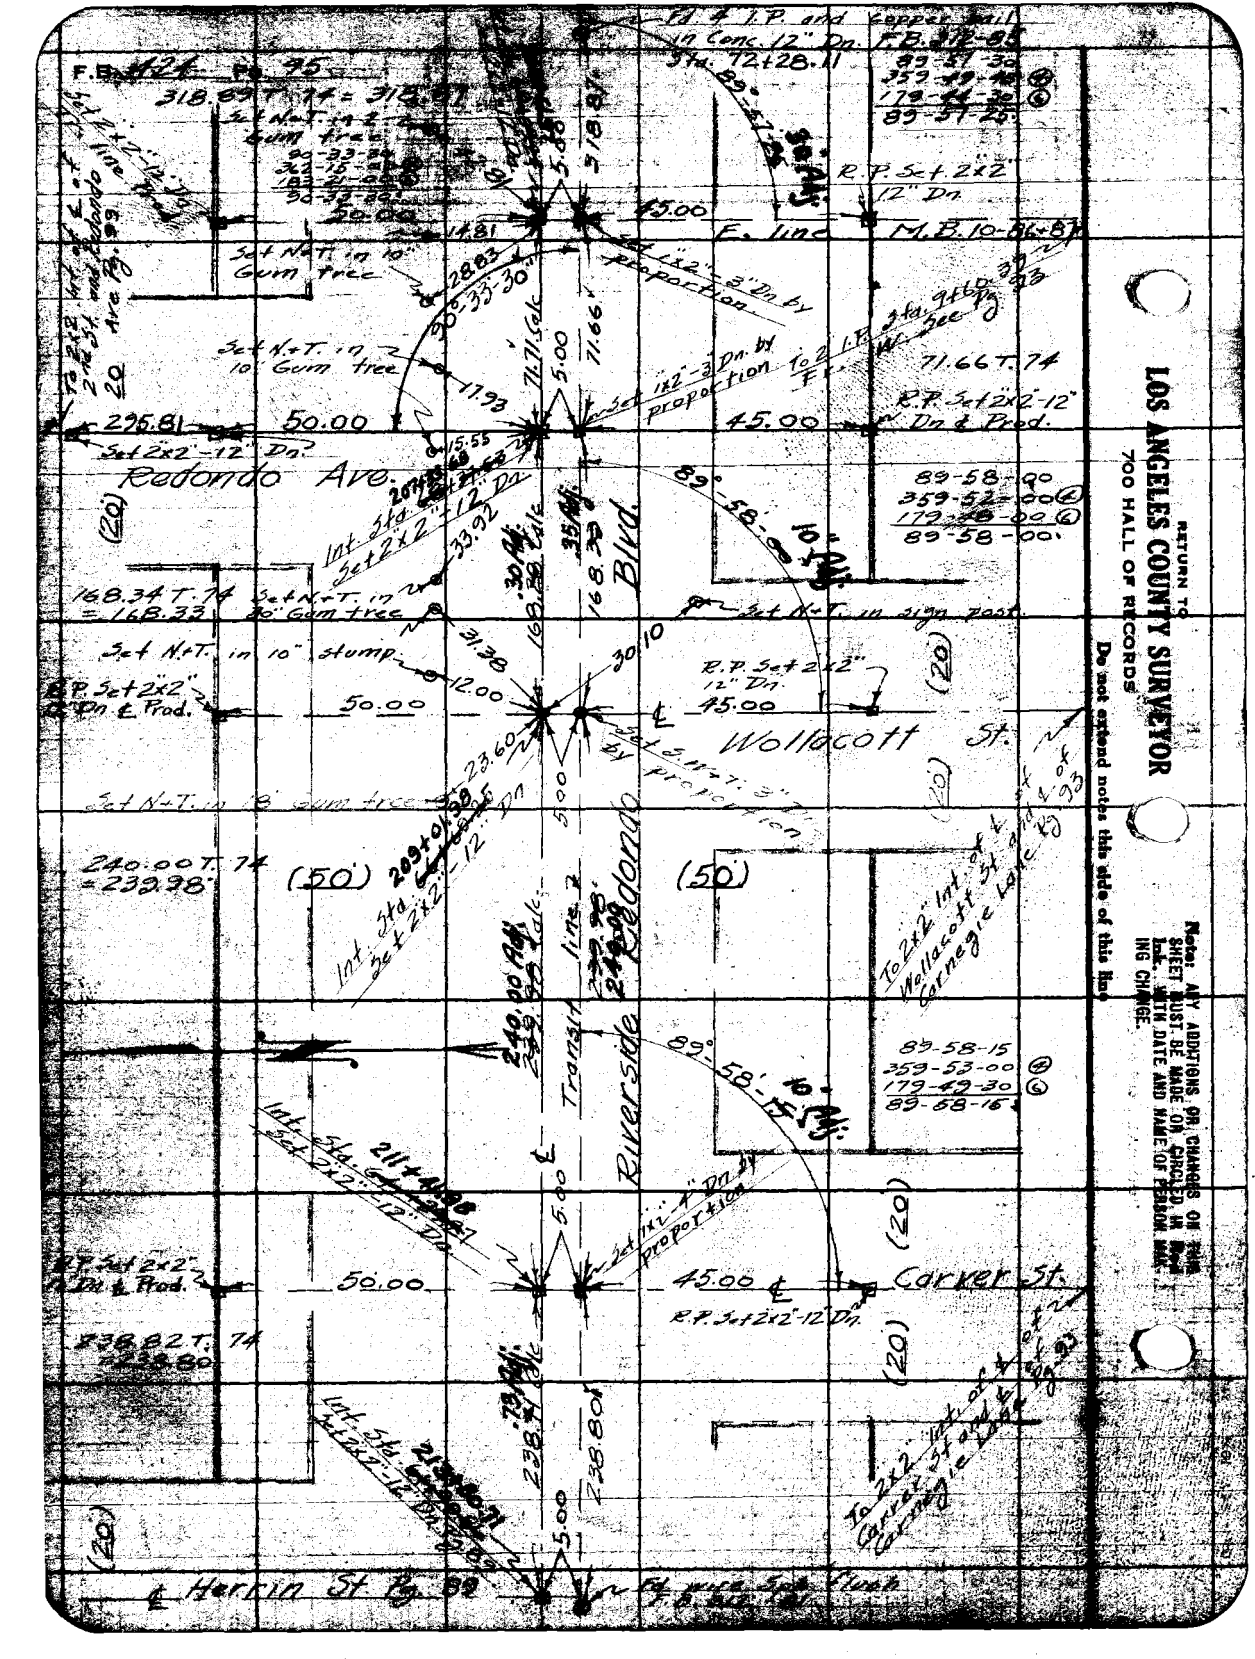
LOS ANGELES COUNTY SURVEYOR
700 HALL OF RECORDS
RETURN TO
Do not extend notes this side of this line
Redondo Ave.
Redondo Blvd.
Riverside Transit Line
E. line M.B. 10-66-87
Wollacott St.
Carver St.
Herrin St.
Set N.+T. in 10" Gum tree
Set N.+T. in 10" Stump
Set N.+T. in 8" Gum tree
Set N.+T. in sign post
R.P. Set 2x2" 12" Dn.
R.P. Set 2x2"-12" Dn & Prod.
Set 1x2"-3' Dn. by proportion
Int. Sts. Set 2x2"-12" Dn.
Int. of ℄ of Wollacott St. and ℄ of Carnegie Lane
Int. of ℄ of Carver St. and ℄ of Carnegie Lane
Set 2x2"-12" Dn.
Set 2x2" Dn & Prod.
Set 2x2" Dn & Prod.
Set 2x2"-12" Dn.
Set 2x2"-12" Dn.
Set 2x2"-12" Dn

Notes Ck'd by D.M. Finley Survey of Riverside Redondo F.B. 422 Pg.
Map No. B-442-2 W.O. 720 Tape No. 0+6 3/4 & 8+ ft.
Date Nov. 1933 Indexed

Redondo Blvd and E. of Downey Ave. See next page

Redondo Blvd

Ave.

Riverside Cal.









(50')

(50')




RETURN TO

LOS ANGELES COUNTY SURVEYOR

700 HALL OF RECORDS

Note: ANY ADDITIONS OR CHANGES ON THIS SHEET MUST BE MADE OR CIRCLED IN Red Ink. WITH DATE AND NAME OF PERSON MAKING CHANGE.

Do not extend notes this side of this line

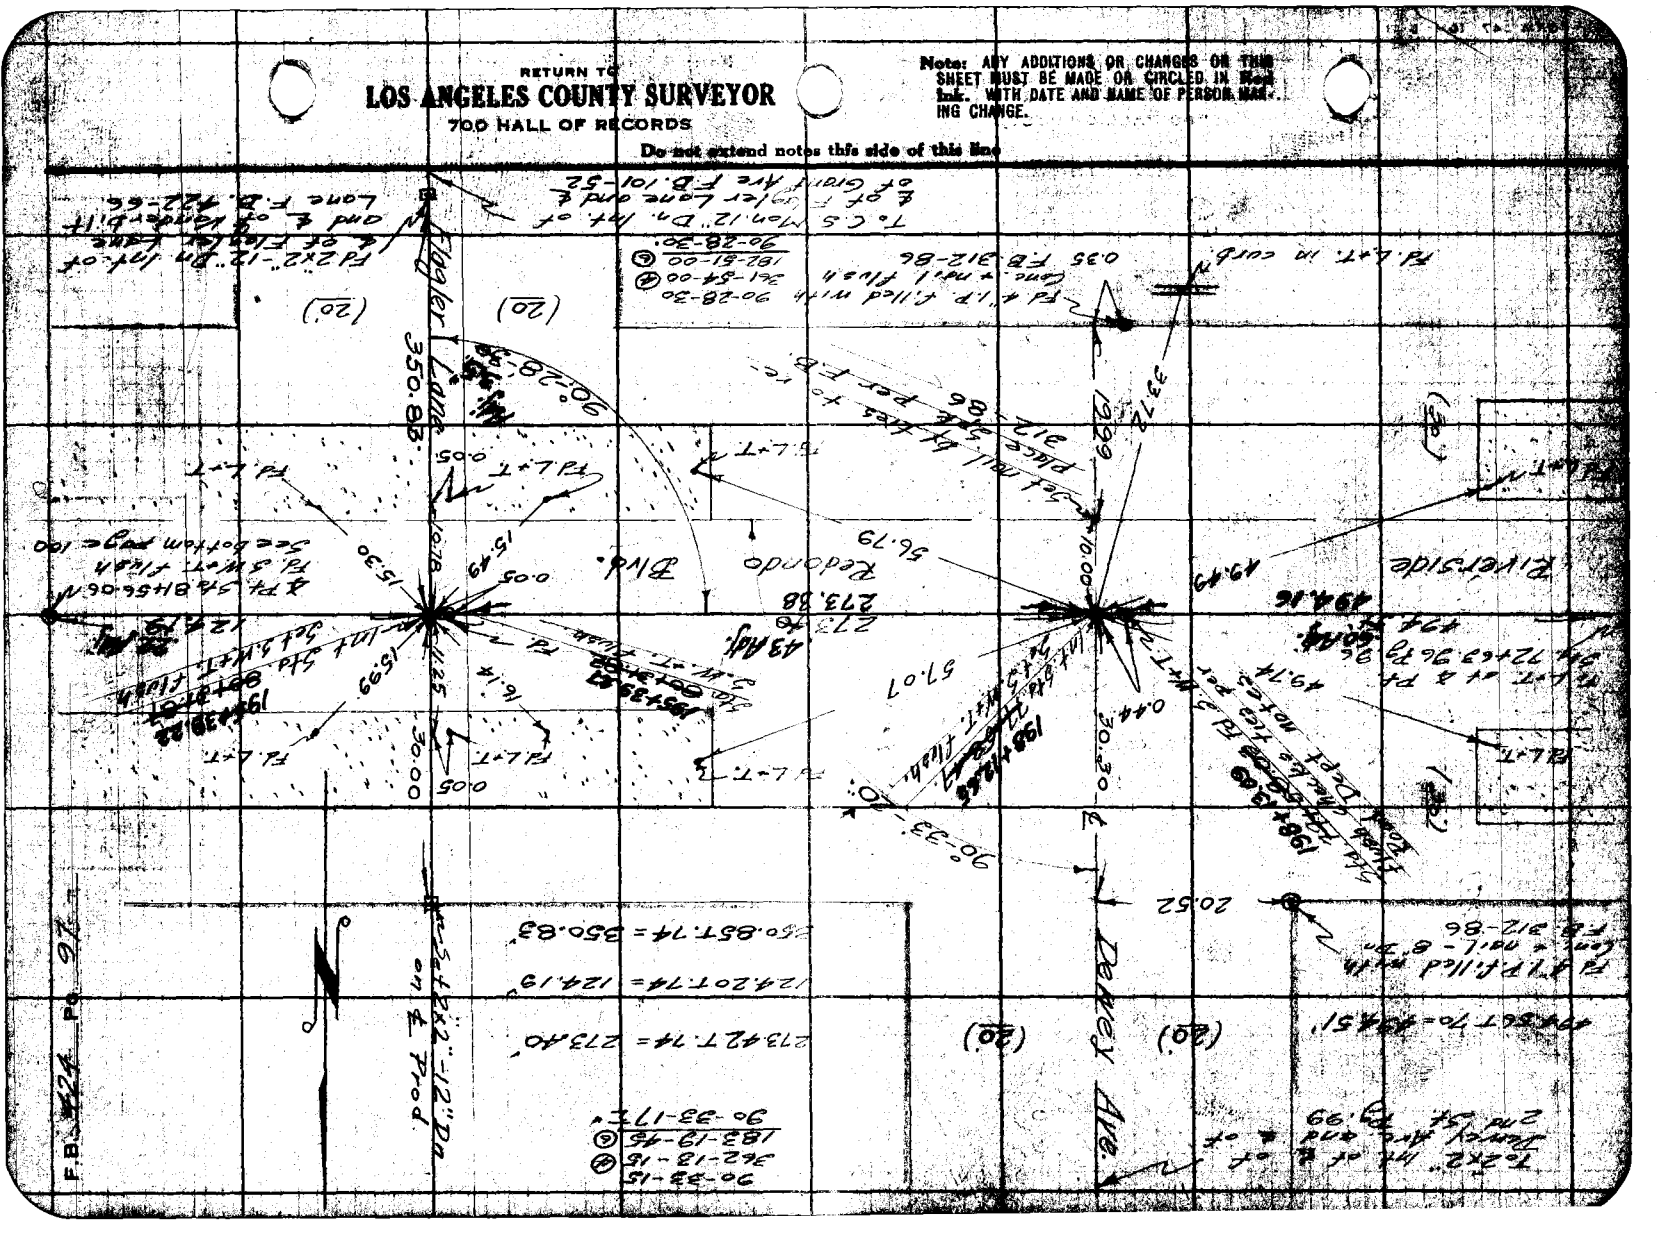

Name Co'd by D. M. Finley | Survey of Riverside, Redondo
Map No. B-442-2 | W. O. 920 Type No. C46 Sh'd Ex of
Field Work J. M. Kyle | Checked by Checked
Date Nov. 1933 | Indexed A. C. Johnson

F.B. 424 Pg. 38

To 2x2"-1st. of L of Herrin and L of Redondo Ave. See next page

C+7.21 T.76 = 647.18'

647.18' St.

Herrin Ave.

50.00 ℄ 50.00

(20') (20')

R.P. Set 2x2"-12" Dn

Int. Std. 6+71.63 Set 2x2" 12" Dn by preparation

671.66 T.76 = 671.63

(20') (20')

R.P. Set 2x2"-12" Dn

90°-20'

Second 671.63

89°-42'-30"

Peck Ave.

(20')

(20')

(20')

2637.64

90°-17'-30"

To 5/8" I.R. at R/W Corner Real Sec. 20.72

Notice: Any additions or changes on this map must be made with ink and name of person making.

Do not cancel notes on this map.

Return to LOS ANGELES COUNTY SURVEYOR 720 HALL OF RECORDS

F.B. [illegible] Pg. 99

Wisburn Ave

(20')

(20')

397.78 T. 76 = 397.76

St.

397.76

Fd. nail in Conc. culvert

Ties S.W. & T. Int. of ℄ of Inglewood Ave. and ℄ of Riverside Redondo Blvd See Pg. 97

Sta 22+40 Int. ℄ & T. flush

2 P. Set 2"x2" - 12" Dn ℄ Prod.

50.00

50.00

Int. Sta 22+39.67 Set 2"x2" 12" Dn. by proportion

1.14

0.50

37.80

37.32

29.43

Pt. Set N.+T. in sign post

℄ Dewey Ave

(20')

(20')

Fd. N.+T. in P. pole ⌀ 2676.6 E

Fd. nail in Conc. culvert

(20')

(20')

90-21-15 ⓐ
361-25-15 ⓑ
182-07-30 ⓒ
90-21-15

89-38-30
358-34-15 ⓐ
177-51-30 ⓒ
89-38-15

90°-21'-15" Ads

320.91 T. 76 = 320.86

Second

320.86

E.P. Set 2"x2" 12" Dn

180-01-00
180-00-00 ⓐ
180-01-00

45°

10.00

180°-01'-00"

Int. Sta 131+88 Set 2"x2"-12" Dn. by proportion

10.00

Pt. Set N.+T. in sign post

29.51

31.61

45°

Set 2"x2" 12" Dn

89°-38'-15" Ads

Set x "Fire plug

Orchess Ave.

Beg. at E. cor. of lot 2 Redondo Ave. and 210 Redondo Blvd.

Redondo Ave

(20')

(20')

Set N.+T. in P. pole ⌀ 2289.5 E

Set 4 post flush

Set [illegible]

RETURN TO
LOS ANGELES COUNTY SURVEYOR
700 HALL OF RECORDS

Any additions or changes on this sheet must be made on [illegible] with date and name of [illegible]

Do not extend notes this side of this line

Map No. B-442-2

Date Nov. 1931

Surveyed by D. M. Finley

Surveyed for A. C. Johnson

Bureau of Riverside Redondo

W. O. 920 Tract No. 946 Sh'ts Bk. of T.

P.B. 121 Pg.

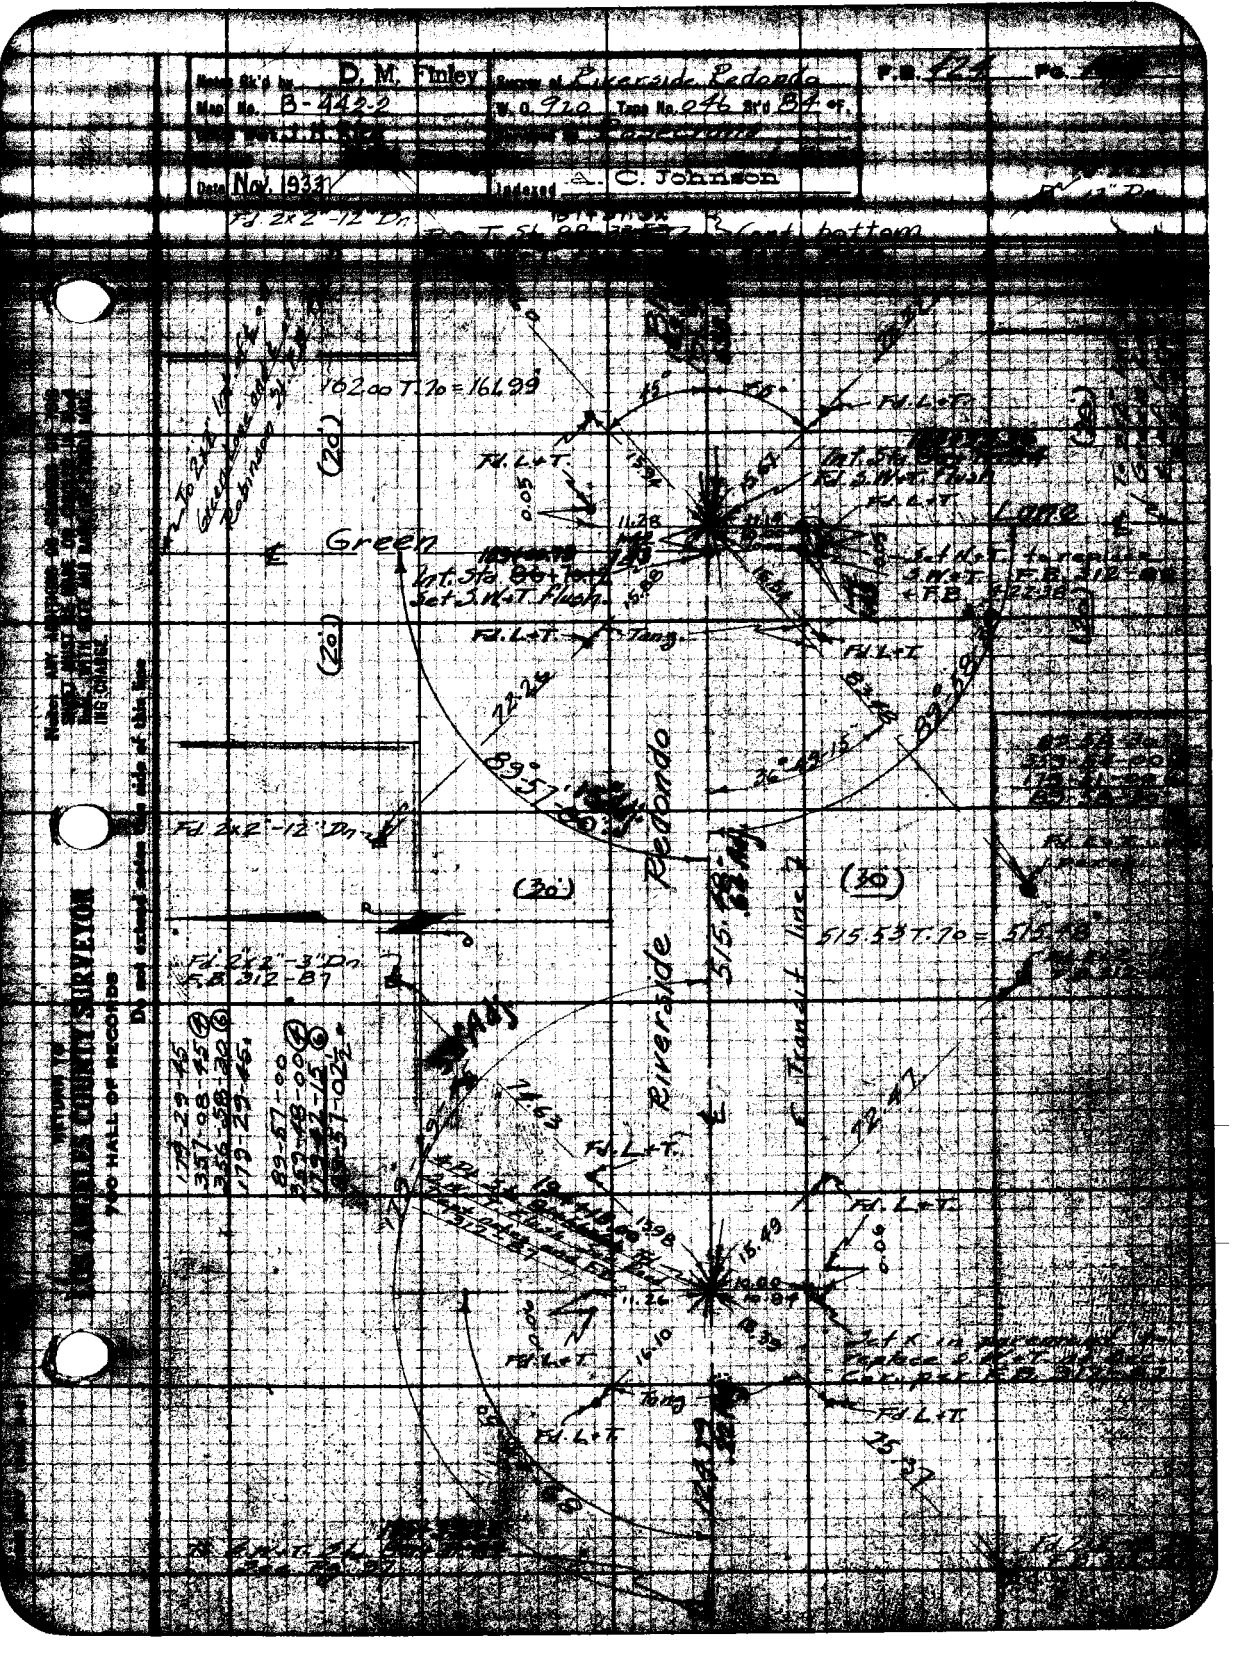
Riverside Redondo
Green
Lane
Fd. 2x2-12" D.
Fd. L+T.
Fd. 2x2-3" D.
(20')
(30')
515.53 T. To = 515.53
16200 T. To = 16199
Set 3/4" I.P. Flush
Set 3/4" I.P. Flush
Set 3/4" I.P. Flush

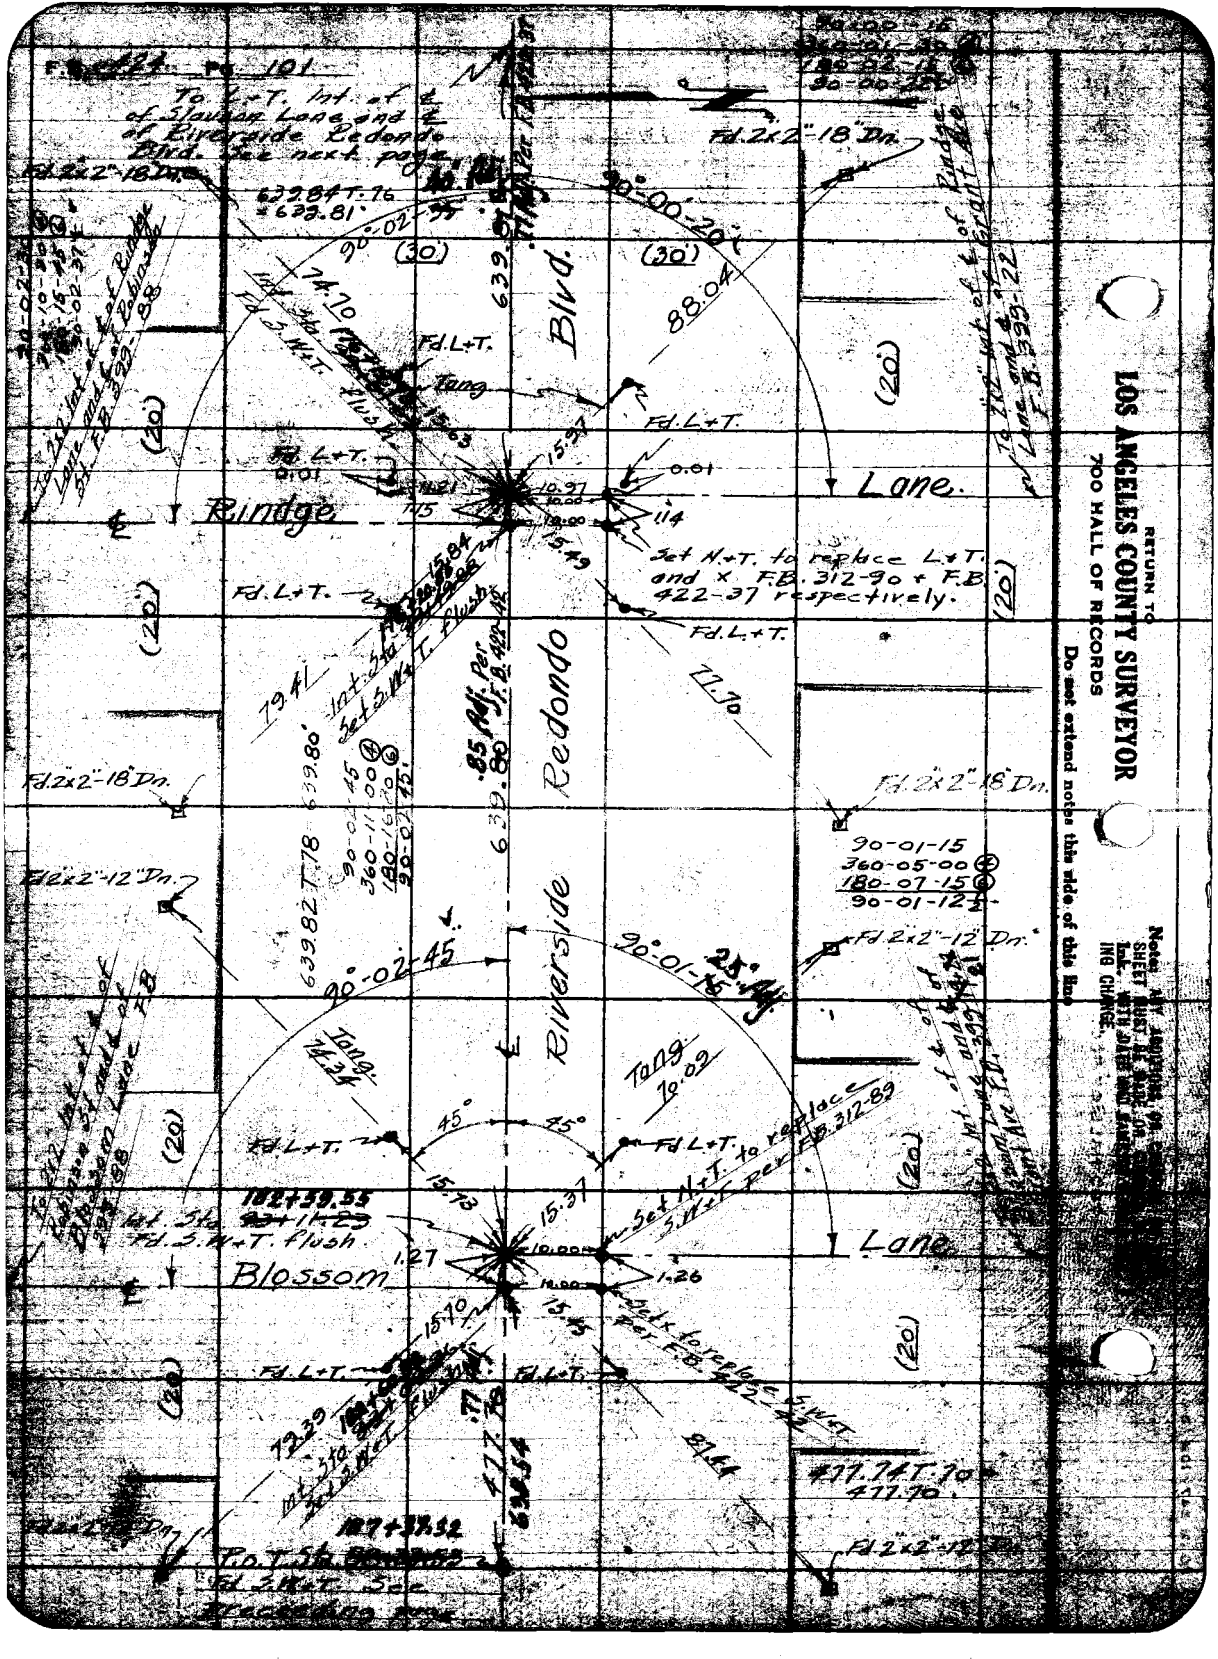
Redondo
Riverside
Ridge
Blossom
Blvd.
Lane.
Lane
Fd. 2x2"-18"Dn.
Fd. 2x2"-12"Dn.
Fd. L+T.
Set N.+T. to replace L+T. and x F.B. 312-90 + F.B. 422-37 respectively.
639.84 T. 76
639.81
639.82 T. 78
639.80
90-02-45
90-01-15
90-00-20
88.04
74.10
74.24
74.09
90-01-15
360-05-00
180-07-15
90-01-12½
Fd. 3 N.+T. flush

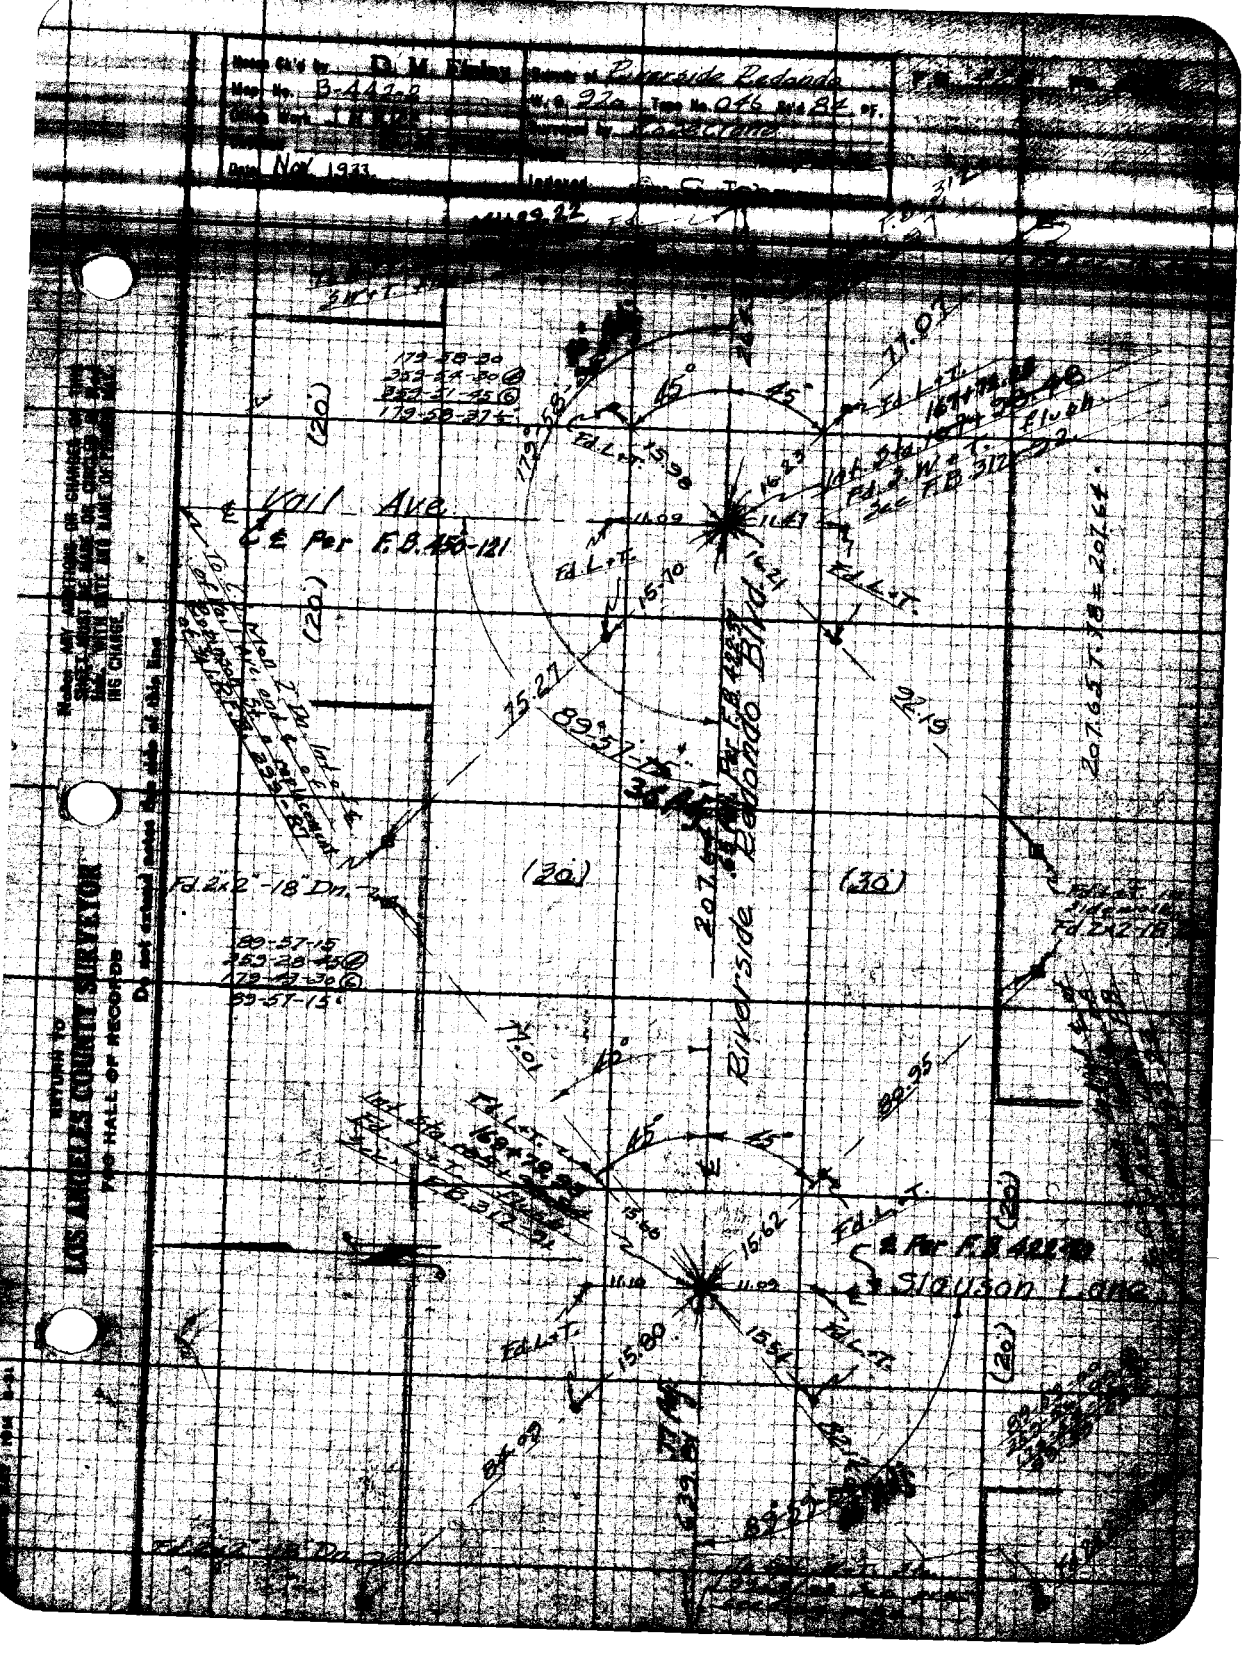
Riverside Redondo
Riverside Redondo Blvd.
C.L. Per F.B. 456-121
Slauson Lane
Per F.B. 462-18
(20)
(30)
15.27
89°57'15"
Fd. 2x2"-18" Dm.
Fd. L.+T.
Fd. 2x2"-18"
Fd. 2x2"-18" Dm.
15.62
15.80
15.54
89°57'15"
89°57'15"
89°57'15"

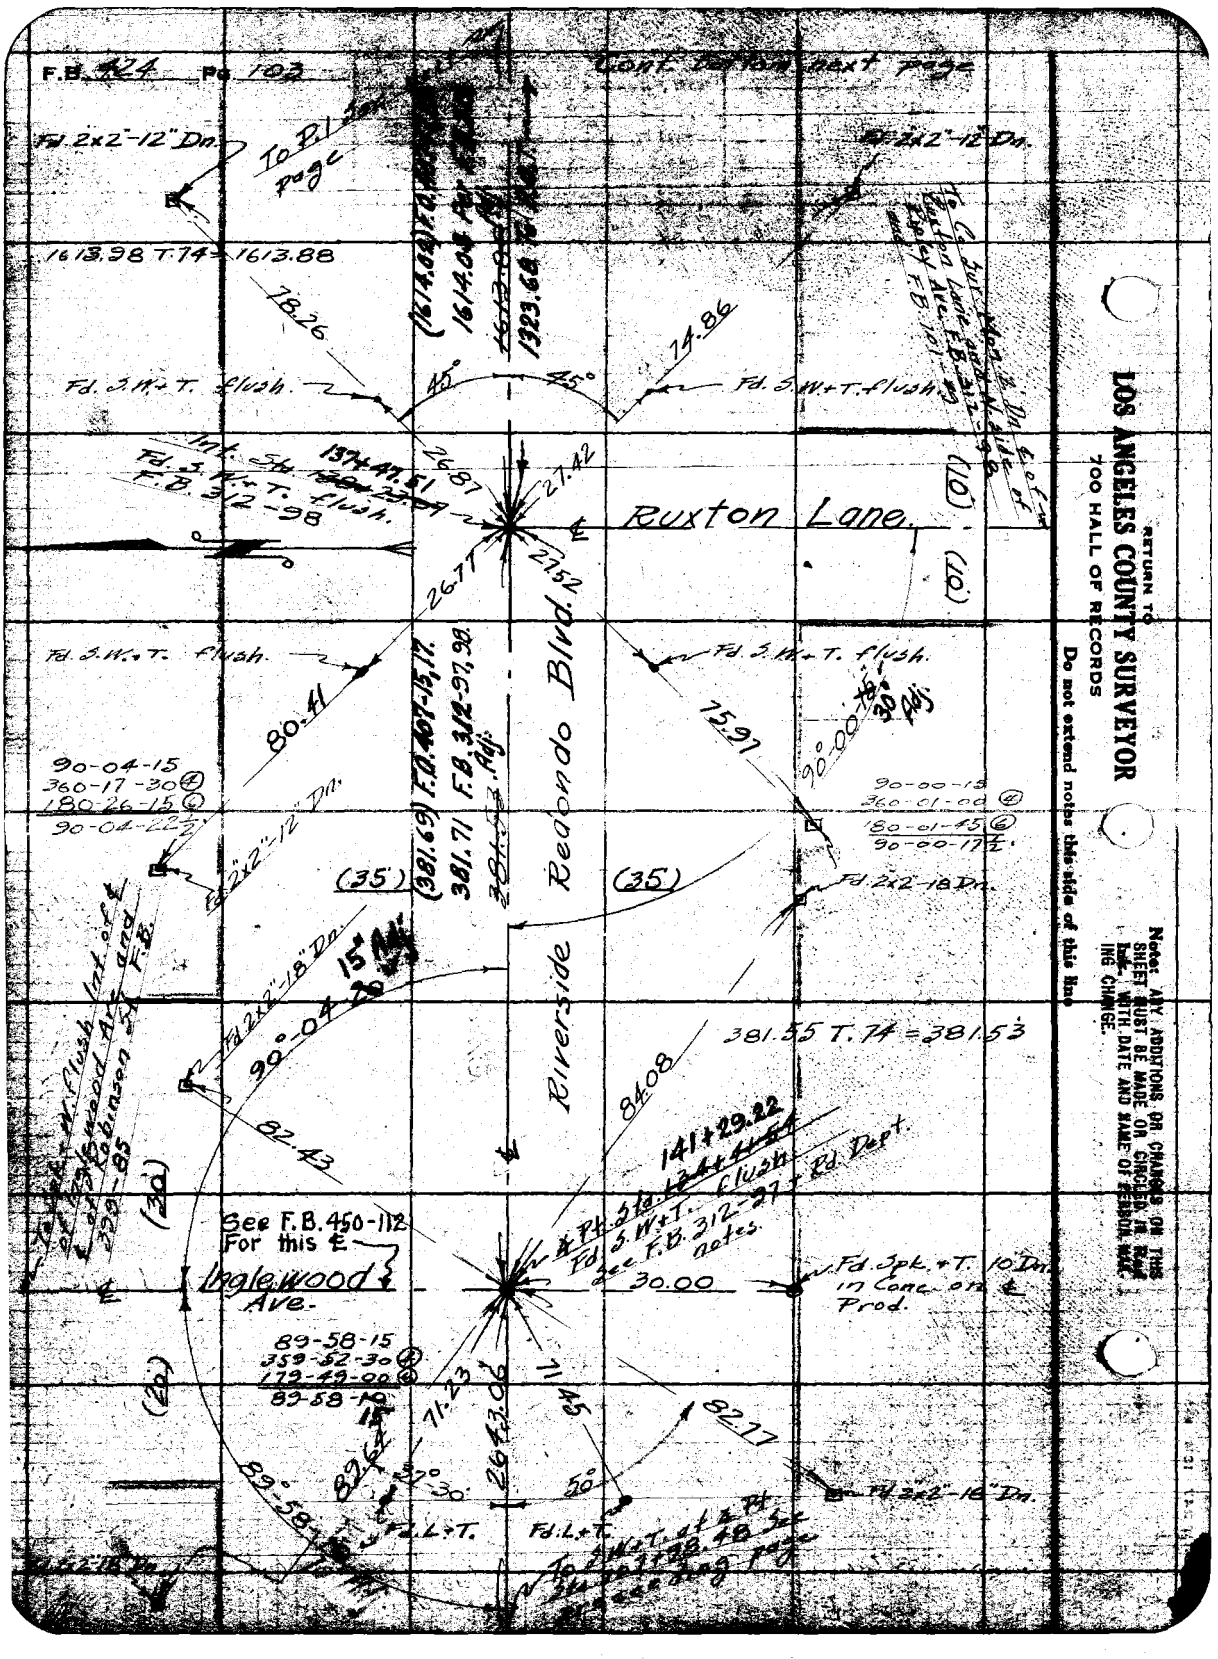

RETURN TO
LOS ANGELES COUNTY SURVEYOR
700 HALL OF RECORDS
Do not extend notes this side of this line

Notice: ANY ADDITIONS OR CHANGES ON THIS SHEET MUST BE MADE ON CIRCLED R.M. INK WITH DATE AND NAME OF PERSON MAKING CHANGE.

Notes Ck'd by	D. M. Finley	Survey of	Riverside Redondo
Map No.	B-442-2	W. O.	920 Tape No. 046 St'd 84 °F.
Office Work	J. H. Rice	Surveyed by	Pascoe & Hs
Checked	D. M. Finley	Notes	Date 7-5-32
Date	Nov. 1933.	Indexed	C. Johnson

F.B. 424 Pg. 104

Cont. bottom

Note: ANY ADDITIONS OR CHANGES ON THIS SHEET MUST BE MADE OR CIRCLED IN Red Ink. WITH DATE AND NAME OF PERSON MAKING CHANGE.

Do not extend notes this side of this line

"RETURN TO
LOS ANGELES COUNTY SURVEYOR
700 HALL OF RECORDS

290.37 T.74 = 290.35'
162.45 T.76 = 162.44'

Set S.W.+T. flush

50.00

Set 2x2"-12" Dn.

118+66.83 P.O.T.
Sta 119+04.60

Fd S.W.+T. flush

Redondo Ave.

Adj. 55.00 - 54.50

140°-54'-46" E

290.35'
162.44'

R.P. Set 2x2"-12" Dn. Tang. Prod.

Angle Point
121+56.18

R.P. Set 2x2"-12" Dn.

7.33

Fd. 2x2" - 3" Dn. a replacement
of L.+T.

F.B. 312-102

F.B. 312-102

140-54-46
203-39-15 (R)
125-29-00 (C)
140-54-50'

Δ 39°-05'-00" Calc.
R. 818.03'
T. 230.35'
L. 558.00'

This Curve Abandoned Oct. 1933.

Fd L.+T.

4334
22.10
18.14
21.87
42.62
89-03
50.00
30.32

R.P. Set 2x2" 12" Dn. Tang. Prod.

Fd L.+T.

43.31
33.32

121+98.80 P.O.T.
Post Fd. L.+T.
See F.B. 312-102

(20)

℄ 2nd St
per F.B. 424-27

39.01
0.01
Fd. L.+T.

(20)

123+32.71 P.O.T.
Post Fd. S.W.+T. flush

133.92 T.76 = 133.91

P.C. Sta 124+46.00
Set 2x2"-12" Dn.

89°-59'

50.00

Set S.W.+T. flush

50.00

Set 2x2"-12" Dn.

89-59-46
359-59-15 (R)
179-59-00 (C)
89-59-50'

To Ruxton Lane
1322.68
1614.03 Adj.

EQUATION
124+46.53 From East
124+23.83 Going West.

To Sta. 198+23.07 Lane and Redondo Blvd. See preceding page.

To Ruxton

CRM 247 10M 8-31

F.B. 424 Pg. 105

To S.W.L.T. of P.I. See next page.

136.46 T. 72 = 136.45

180.46 T. 72 = 180.45

℄ Hawthorne Ave

Fd. S.W.L.T. & I.Sh.

Fd. L.&T.

Fd. L.&T. in 90 pump base

E.C. Sta. 112+76.58 Pc

Set L.&T. see

129-04-45

156-19-15 ⓓ

54-29-00 ⓒ

129-04-30 ⓐ

℄ P.E.R.R.

Int. Sta 162+44.70

Set L.&T.

113+19.96

Sta 31+89.16 Fr. S.

113+26.73

Hawthorne Ave 180.45

P.E. Track

To Spk. on N. end of Curb at ℄ Hawthorne Ave.

129-05-00

156-19-15 ⓓ

54-29-00 ⓒ

129-04-55 ⓐ

To S.W.L.T. of Curb at ℄ and ℄ Hawthorne Ave F.B. 424-32

℄ Hawthorne Ave.

Fd. S.W.L.T. & Ch. Checks per F.B. 312-103

Orchard Ave

129-04-45

156-19-15 ⓓ

54-28-45 ⓒ

129-04-45 ⓐ

462.83 T. 78 = 462.81

50-56-00

203-44-00 ⓓ

305-35-45 ⓒ

50-55-57½ ⓐ

Rivera Ave

To S.W.L.T. of E.C. Sta. 157+04.60 See preceding page

RETURN TO

LOS ANGELES COUNTY SURVEYOR

700 HALL OF RECORDS

Do not extend notes this side of this line

Note: ANY ADDITIONS OR CHANGES ON THIS SHEET MUST BE MADE OR CIRCLED IN Red Ink. WITH DATE AND NAME OF PERSON MAKING CHANGE.

Notes Ck'd by D. M. Finley	Survey of Riverside Redondo	F.B. 424 Pg. 106	
Map No. B-442-2	W. O. 920 Tape No. 046 St'd 84 °F.		
Office Work J. H. Rice	Surveyed by Rosecrans		
Checked D. M. Finley	Notes	Date 7-X-32	
Date Nov. 1933.	Indexed A. C. Johnson		

Stationing per C.S. B-442-1

105+81.19 P.T. T.I. 1.W.T.

F.B. 399-32

369.61 T. 18 369.66
100.17 1.18
109+50.91

P.T.O.T. Sta. ~~166+19.76~~

Fd. S.W.+T. Flush F.B. 399-31

11.31 Adj. to check F.B. 399-30. B.C. 109+62.88

~~P.C. Sta. 166+31.55~~

50.00 53.62 50.00

Set S.W.+T. flush. Set 2×2"-12" Dn.

Fd. L.+T. 68°54' F.B. 399-30 Pt

Alley (20' R/W)

F.B. 399-30 79.80 46.25

Redondo Blvd. 100.17

Δ 17°58'-25" Calc.
R. 1000.00'
T. 158.15'
Lc. 313.70'

162-01-15
288-05-30 ④
252-08-15 ⑥
162-01-22½

P.O.T. Set S.W.+T. by ties F.B. 399-30

162°-01' 25 F.B. Adj.

Riverside 57.98

Fd. L.+T.

27.33

P.I. Set S.W.+T. Flush

35.24

39.50 16.20 130.45 5.00

Fd. L.+T. Fd. L.+T.

Fd. S.W.+T. Flush F.B. 312-105

P.O.T. Set S.W.+T. See preceding page

Fd. L.+T.

Hawthorne Ave. See preceding page

14.18 112+76.58 ~~162+19.76~~

Fd. L.+T. B.C. Sta. Set L.+T.

39.93 42.25

Fd. L.+T. 124°40' 50.00 Δ 55°25'

R.P. Set 2×2"-12" Dn. 33.12

Fd. L.+T. Tg. 104

Te. S.W.+T. Sta 115+14.60

RETURN TO
LOS ANGELES COUNTY SURVEYOR
700 HALL OF RECORDS.
Do not extend notes this side of this line

Note: ANY ADDITIONS OR CHANGES ON THIS SHEET MUST BE MADE OR CIRCLED IN Red Ink. WITH DATE AND NAME OF PERSON MAKING CHANGE.

FORM 247 10M 8-51

F.B. 424 PG. 107

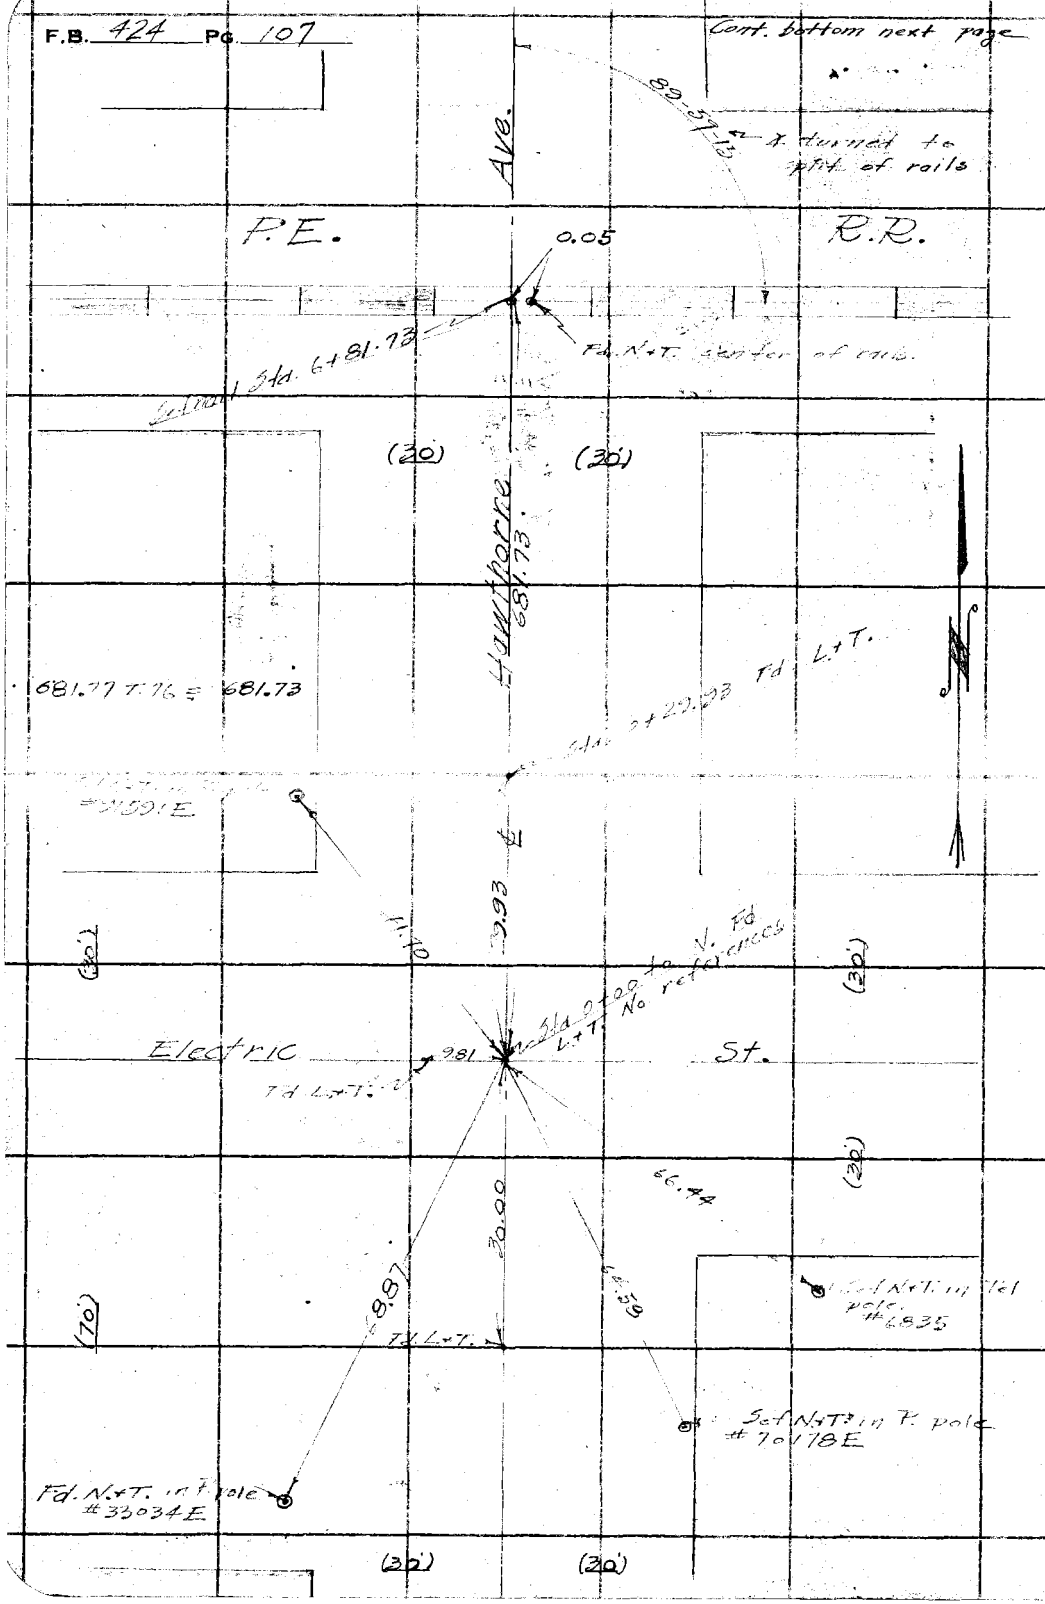

RETURN TO
LOS ANGELES COUNTY SURVEYOR
700 HALL OF RECORDS

Do not extend notes this side of this line

Note: ANY ADDITIONS OR CHANGES ON THIS SHEET MUST BE MADE OR CIRCLED IN **Red Ink.** WITH DATE AND NAME OF PERSON MAKING CHANGE.

Notes Ck'd by D. M. Finley
Map No. B-442-2
Office Work J. H. Rice
Checked
Date Nov. 1933

Survey of Riverside Redondo
W. O. 920 Tape No. 046 St'd 64 °F.
Surveyed by Rosecrans
Notes Date 7-11-32
Indexed A. C. Johnson

F.B. 424 Pg. 108

Cont on Pg. 105 Pt.

Set temporary Pt. Sta. 30+08.81

364.65 T. 76 = 364.68

Fd. L + T. Sta. 26+44.18

364.63

0.02

Ave

(30')

Strawberry St.

(30')

974.02

(30')

(30')

974.05 T. 80 = 974.02

Fd. L + T. Sta. 16+70.16

226.16 T. 74. = 226.15

226.15

Hawthorne

Sta. 14+81.60 Fd. 2" I.P. with brass cap marked as shown 12" Dn.

30.05

℄

30.01

Sta. 14+72.02 Fd. 2" I.P. with brass cap marked as shown 12" Dn.

Fd. L + T. Sta. 14+44.01

Southern California Edison Co.

121.99

SOUTHERN CALIFORNIA EDISON

STATION X

122.00 T. 74 = 121.99

30.02

Sta. 13+31.19 Fd. 2" I.P. with brass cap marked as shown Flush

30.03

O.

Sta. 13+22.02 Fd 2" I.P. with brass cap marked as shown 12" Dn.

Fd. L + T. Sta. 13+22.02

640.32 T. 76 = 640.29

640.29

Notes: ANY ADDITIONS OR CHANGES ON THIS SHEET MUST BE MADE OR CIRCLED IN Red Ink, WITH DATE AND NAME OF PERSON MAKING CHANGE.

Do not extend notes this side of this line

RETURN TO
LOS ANGELES COUNTY SURVEYOR
700 HALL OF RECORDS

FORM 247 10M 8-31

RETURN TO

LOS ANGELES COUNTY SURVEYOR

700 HALL OF RECORDS

Note: ANY ADDITIONS OR CHANGES ON THIS SHEET MUST BE MADE OR CIRCLED IN **Red Ink.** WITH DATE AND NAME OF PERSON MAKING CHANGE.

Do not extend notes this side of this line

F.B. 424 Pg. 109

Notes Ck'd by D. M. Bailey	Survey of Redondo Beach Blvd
Map No. B-442-2	W. O. 7920 Tape No. ____ St'd ____ °F.
Office Work J. H. Rice	Surveyed by L. D. Moore
Checked D. M. Bailey	Notes Moore Date 8-18-33
Date Nov. 1933	Indexed A. C. Johnson 9-18-33

F.B. 424 PG. 111

Notes: ANY ADDITIONS OR CHANGES ON THIS SHEET MUST BE MADE OR CIRCLED IN Red Ink. WITH DATE AND NAME OF PERSON MAKING CHANGE.

Do not extend notes this side of this line

RETURN TO
LOS ANGELES COUNTY SURVEYOR
700 HALL OF RECORDS

ADDITIONAL TOPOGRAPHY
ON
REDONDO BEACH BLVD
from
HERMOSA BEACH
to
ARLINGTON ST.
Job # 7920

FORM 247 10M 8-31

RETURN TO

LOS ANGELES COUNTY SURVEYOR

700 HALL OF RECORDS

Note: ANY ADDITIONS OR CHANGES ON THIS SHEET MUST BE MADE OR CIRCLED IN **Red Ink.** WITH DATE AND NAME OF PERSON MAKING CHANGE.

Do not extend notes this side of this line

F.B. 424 Pg 112

Map No. B-442-2	W. O. 7920	Tape No.	St'd °F.
Office Work J. H. Rice	Surveyed by L. D. Moore		
Checked D. M. Ridley	Notes A. Rice	Date Nov. 1933	
Date Nov. 1933.	Indexed A. C. Johnson		

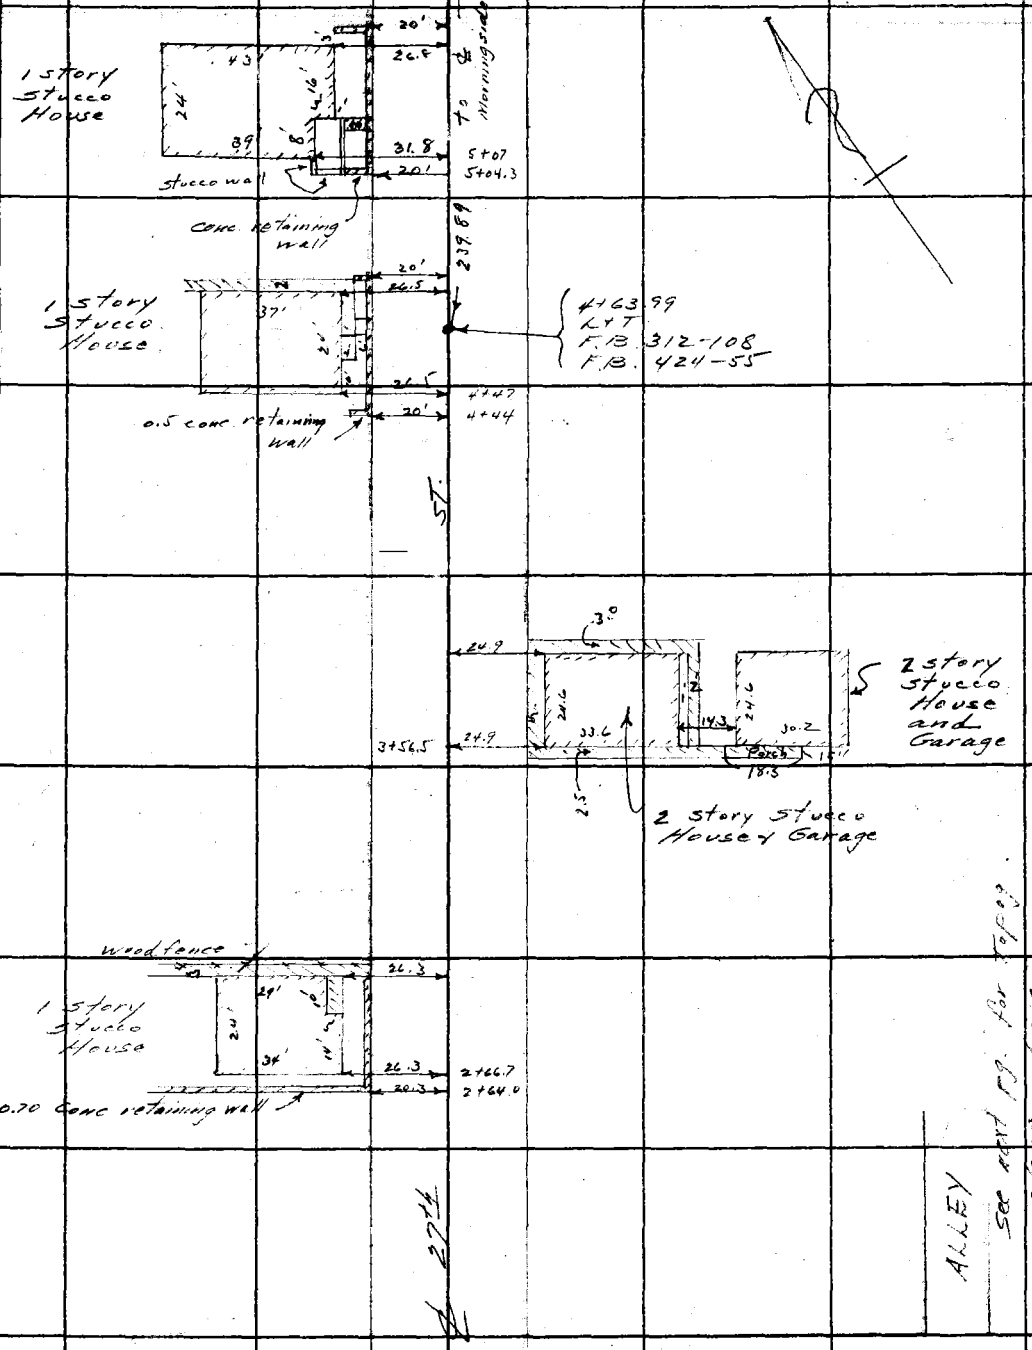

Note: ANY ADDITIONS OR CHANGES ON THIS SHEET MUST BE MADE OR CIRCLED IN Red Ink, WITH DATE AND NAME OF PERSON MAKING CHANGE.

Do not extend notes this side of this line

RETURN TO
LOS ANGELES COUNTY SURVEYOR
700 HALL OF RECORDS

FORM 247 10M 8-31

F.B. 424 PG. 114

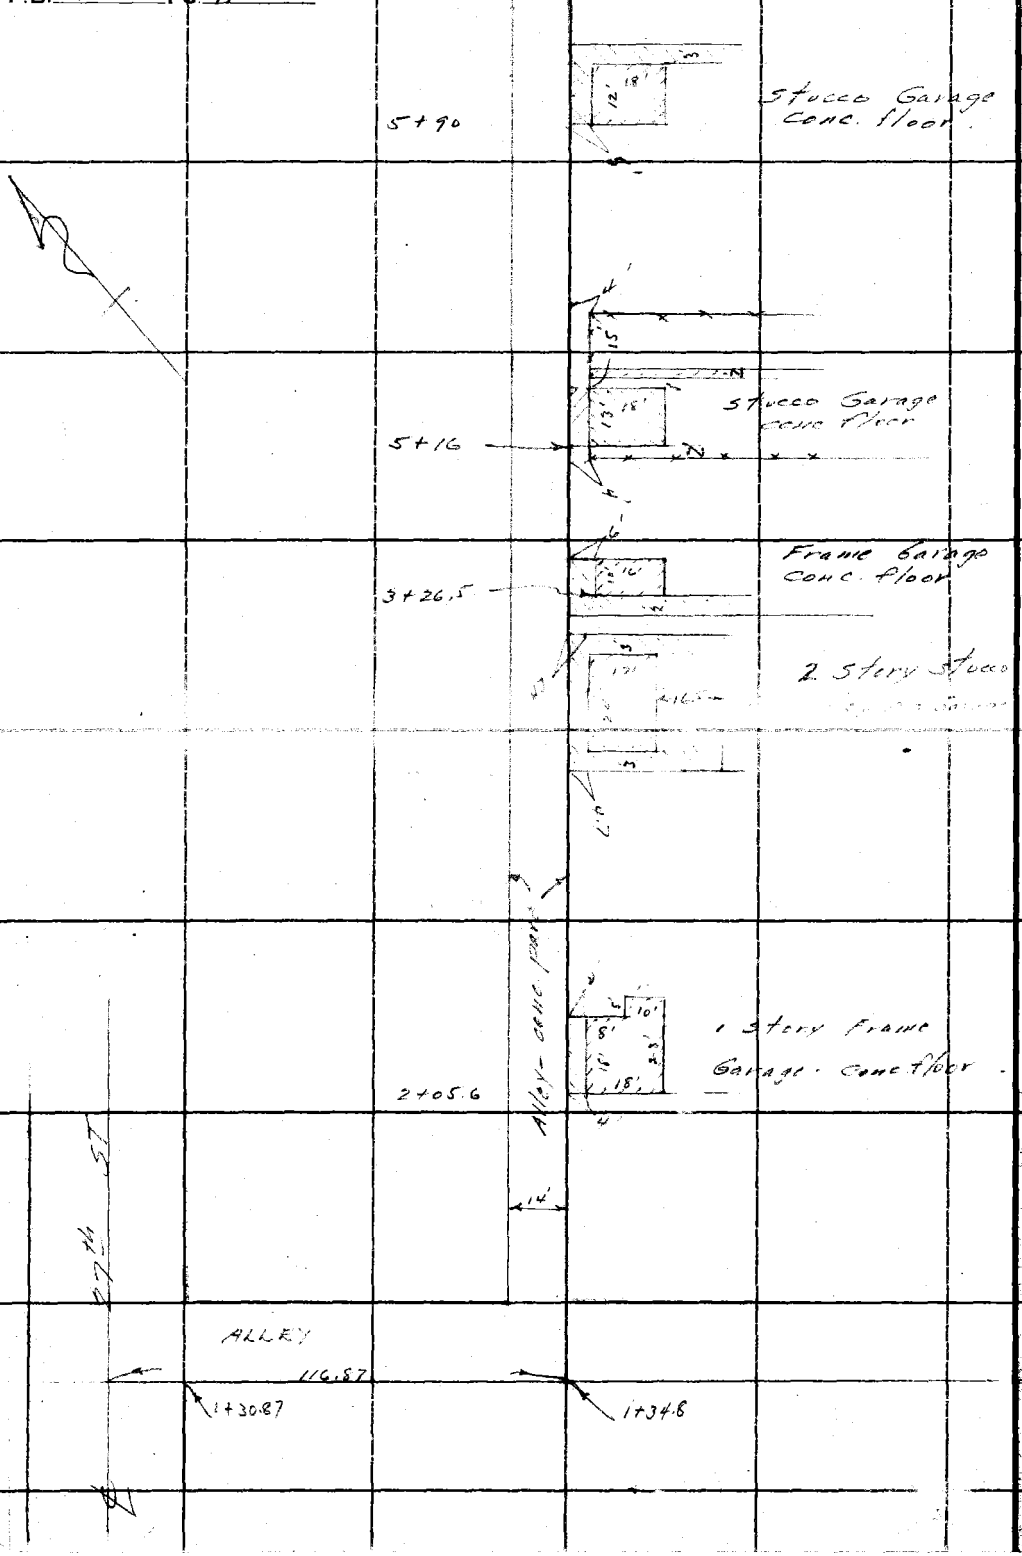

RETURN TO
LOS ANGELES COUNTY SURVEYOR
700 HALL OF RECORDS

Do not extend notes this side of this line

Note: ANY ADDITIONS OR CHANGES ON THIS SHEET MUST BE MADE OR CIRCLED IN Red Ink. WITH DATE AND NAME OF PERSON MAKING CHANGE.

Notes Ck'd by	D. M. Finley	Survey of	Redondo Beach Blvd
Map No.	B-442-2	W. O.	7920 Tape No. ____ St'd ____ °F.
Office Work	J. H. Rice	Surveyed by	L. D. Moore
Checked	D. M. Finley	Notes	Moore Date 5/11/33
Date	Nov. 1933.	Indexed	Wm. C. Johnson

F.B. 424 PG. 115

Notes: ANY ADDITIONS OR CHANGES ON THIS SHEET MUST BE MADE OR CIRCLED IN Red Ink, WITH DATE AND NAME OF PERSON MAKING CHANGE.

Do not extend notes this side of this line

RETURN TO
LOS ANGELES COUNTY SURVEYOR
700 HALL OF RECORDS

BLVD.

BEACH

REDONDO

243+59.84 B.C.
2x2 - F.B. 424 - 71, 74

35'

L4T.

52.7

28

Pave

REAL

Macadam

EL CAMINO

S.T+W.

Semi-Hwy.

FORM 247 10M 5-51

F.B. 424 Pg. 116

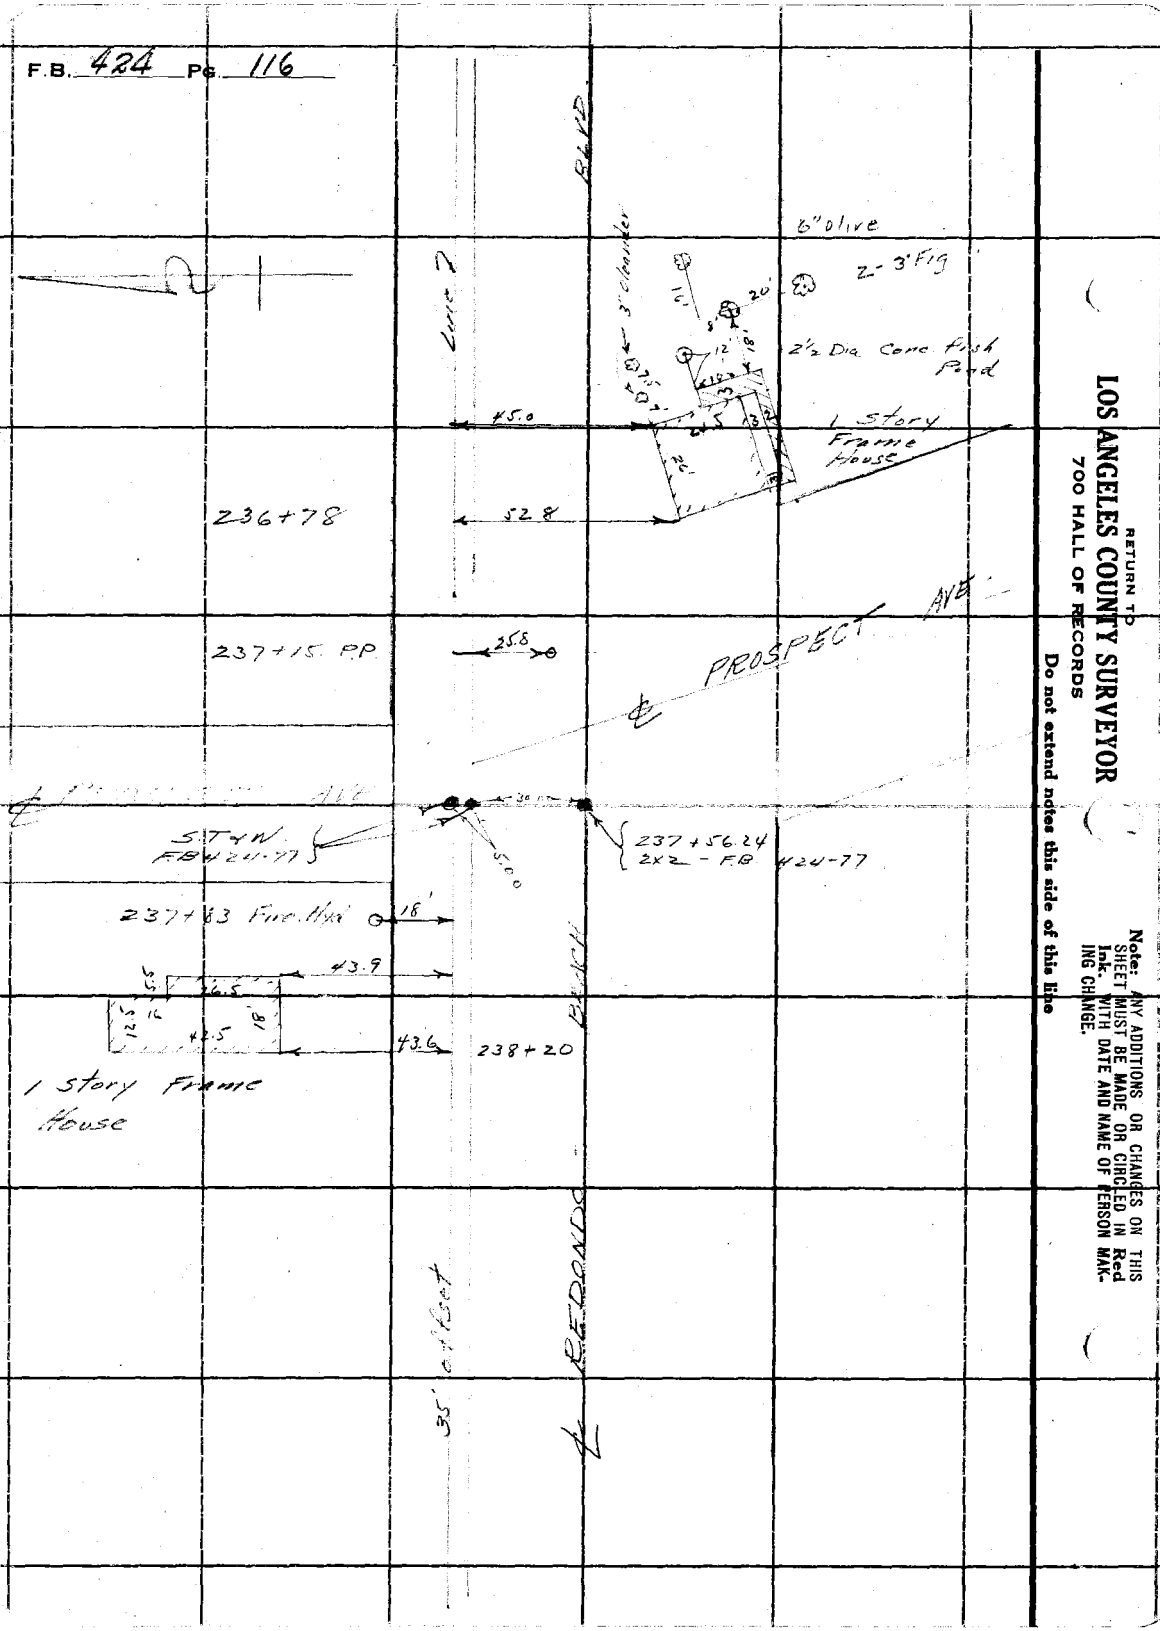

RETURN TO
LOS ANGELES COUNTY SURVEYOR
700 HALL OF RECORDS

Do not extend notes this side of this line

Note: ANY ADDITIONS OR CHANGES ON THIS SHEET MUST BE MADE OR CIRCLED IN **Red Ink.** WITH DATE AND NAME OF PERSON MAKING CHANGE.

Notes Ck'd by D. M. Finley	Survey of Redondo Beach City	F.B. 424	Pg. 119
Map No. B-442-2	W. O. 7960 Tape No.	St'd	°F.
Office Work J. H. Rice	Surveyed by [illegible]		
Checked D. M. [illegible]	Notes Moore	Date 8-18-33	
Date Nov. 1933	Indexed A. C. Johnson		

Note: ANY ADDITIONS OR CHANGES ON THIS SHEET MUST BE MADE OR CIRCLED IN Red Ink. WITH DATE AND NAME OF PERSON MAKING CHANGE.

Do not extend notes this side of this line

RETURN TO
LOS ANGELES COUNTY SURVEYOR
700 HALL OF RECORDS

6" Fig. 57.9 211+02

1 Story Frame House 28' 22' 12' 49.7

CARVER ST.

49.7

211+41

211+41.98
2X2
F.B. 424-95

20" Gum @ 12' 212+35

BLVD

213+80.71
2X2
F.B. 424-89

HERRIN ST.

HERRIN ST.

213+81.99
2X2
F.B. 424-89

BEACH

11' 215+40

KRUTTSCHNITT LANE

EL PRADO

10'

P.I.
222+08.74
2X2
F.B. 424-87

Row of 41 — Gum trees — Average size 4' at base branching into 3 or 4 — 10" trunks. Approx. equally Spaced.

13' 223+50

FORM 847 10M 5-31

F.B. 424 Pg. 118

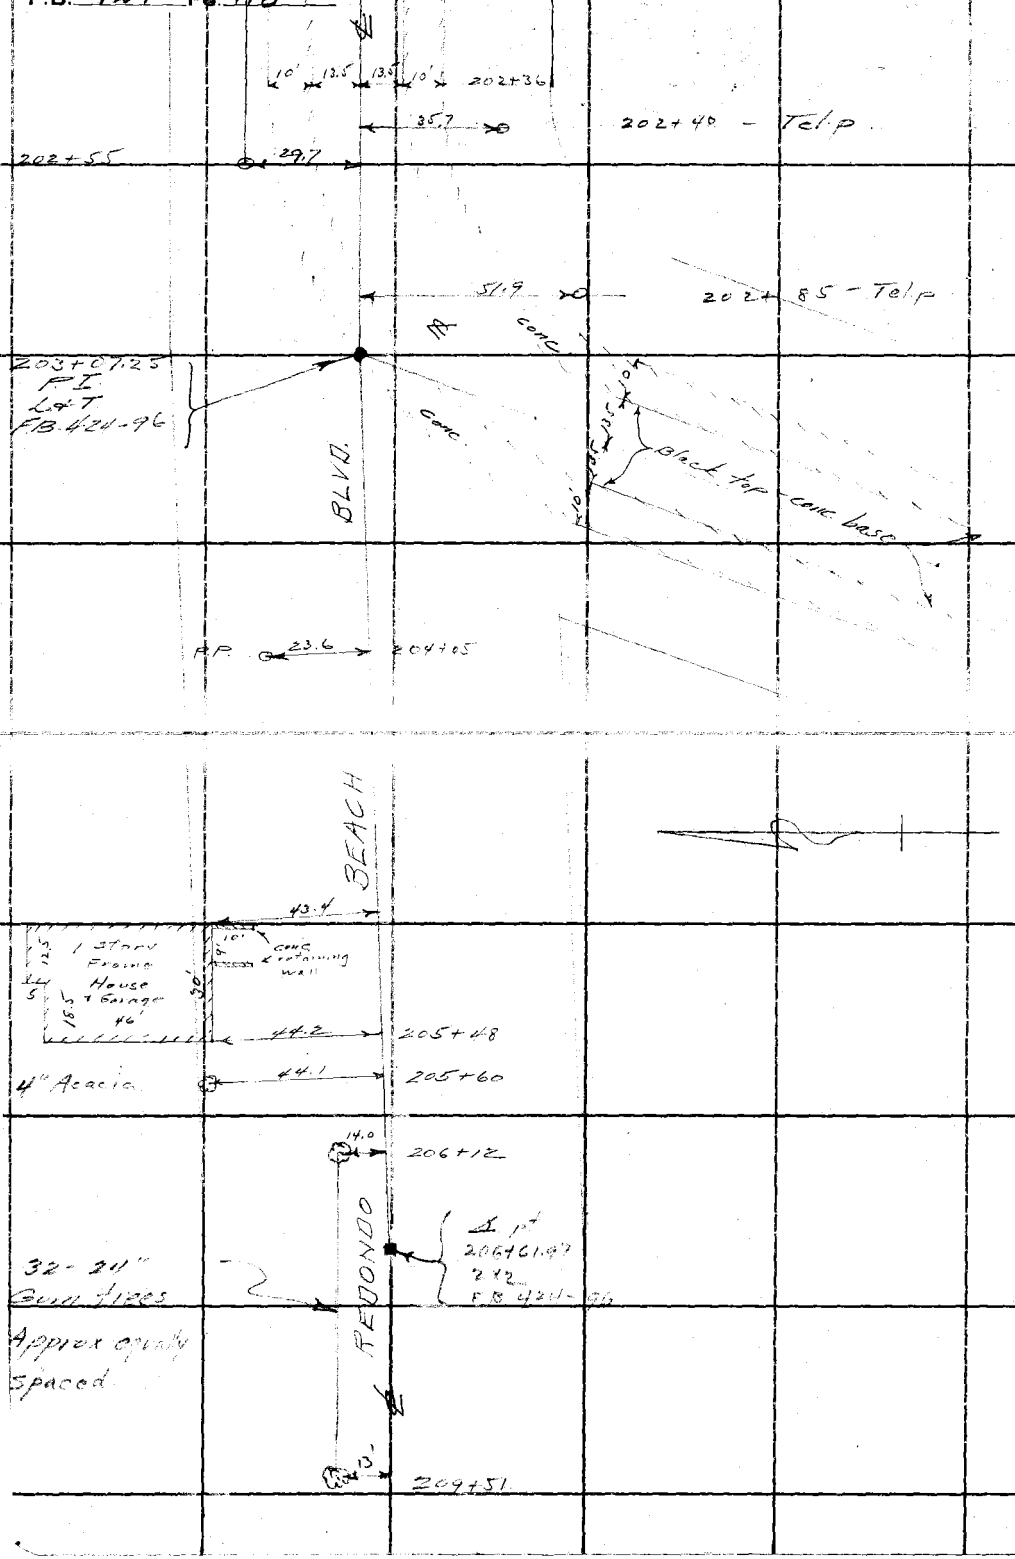

RETURN TO
LOS ANGELES COUNTY SURVEYOR
700 HALL OF RECORDS

Do not extend notes this side of this line

Note: ANY ADDITIONS OR CHANGES ON THIS SHEET MUST BE MADE OR CIRCLED IN Red Ink. WITH DATE AND NAME OF PERSON MAKING CHANGE.

Notes Ck'd by J. D. M. Finley
Map No. B-442-2
Office Work J. H. Rice
Checked D. M. Finley
Date Nov. 1933.

Survey of Redondo Beach Blvd.
W. O. 7720 Tape No. St'd °F.
Surveyed by L. D. Moore
Notes Moore Date 8-24-33
Indexed A. C. Johnson

F.B. 424 Pg. 119

Note: ANY ADDITIONS OR CHANGES ON THIS SHEET MUST BE MADE OR CIRCLED IN Red Ink. WITH DATE AND NAME OF PERSON MAKING CHANGE.

Do not extend notes this side of this line

RETURN TO
LOS ANGELES COUNTY SURVEYOR
700 HALL OF RECORDS

FORM 247 10M 8-31

Frame Garage
199+32
Frame Shed
199+40 P.P.
GRANT SCHOOL GROUNDS
199+42 - 12" Palm
199+45 - 10 - 2" Guns
BLVD.
200+04 - 12" Palm
200+32 wood electrolier - conc base
200+36.3 - Fire Hyd
Frame Shed
200+94 - P.P.
BEACH
REDONDO
201+41 - Tel P
1 Story Frame Dwelling
Conc.
202+09

F.B. 424 Pg. 120

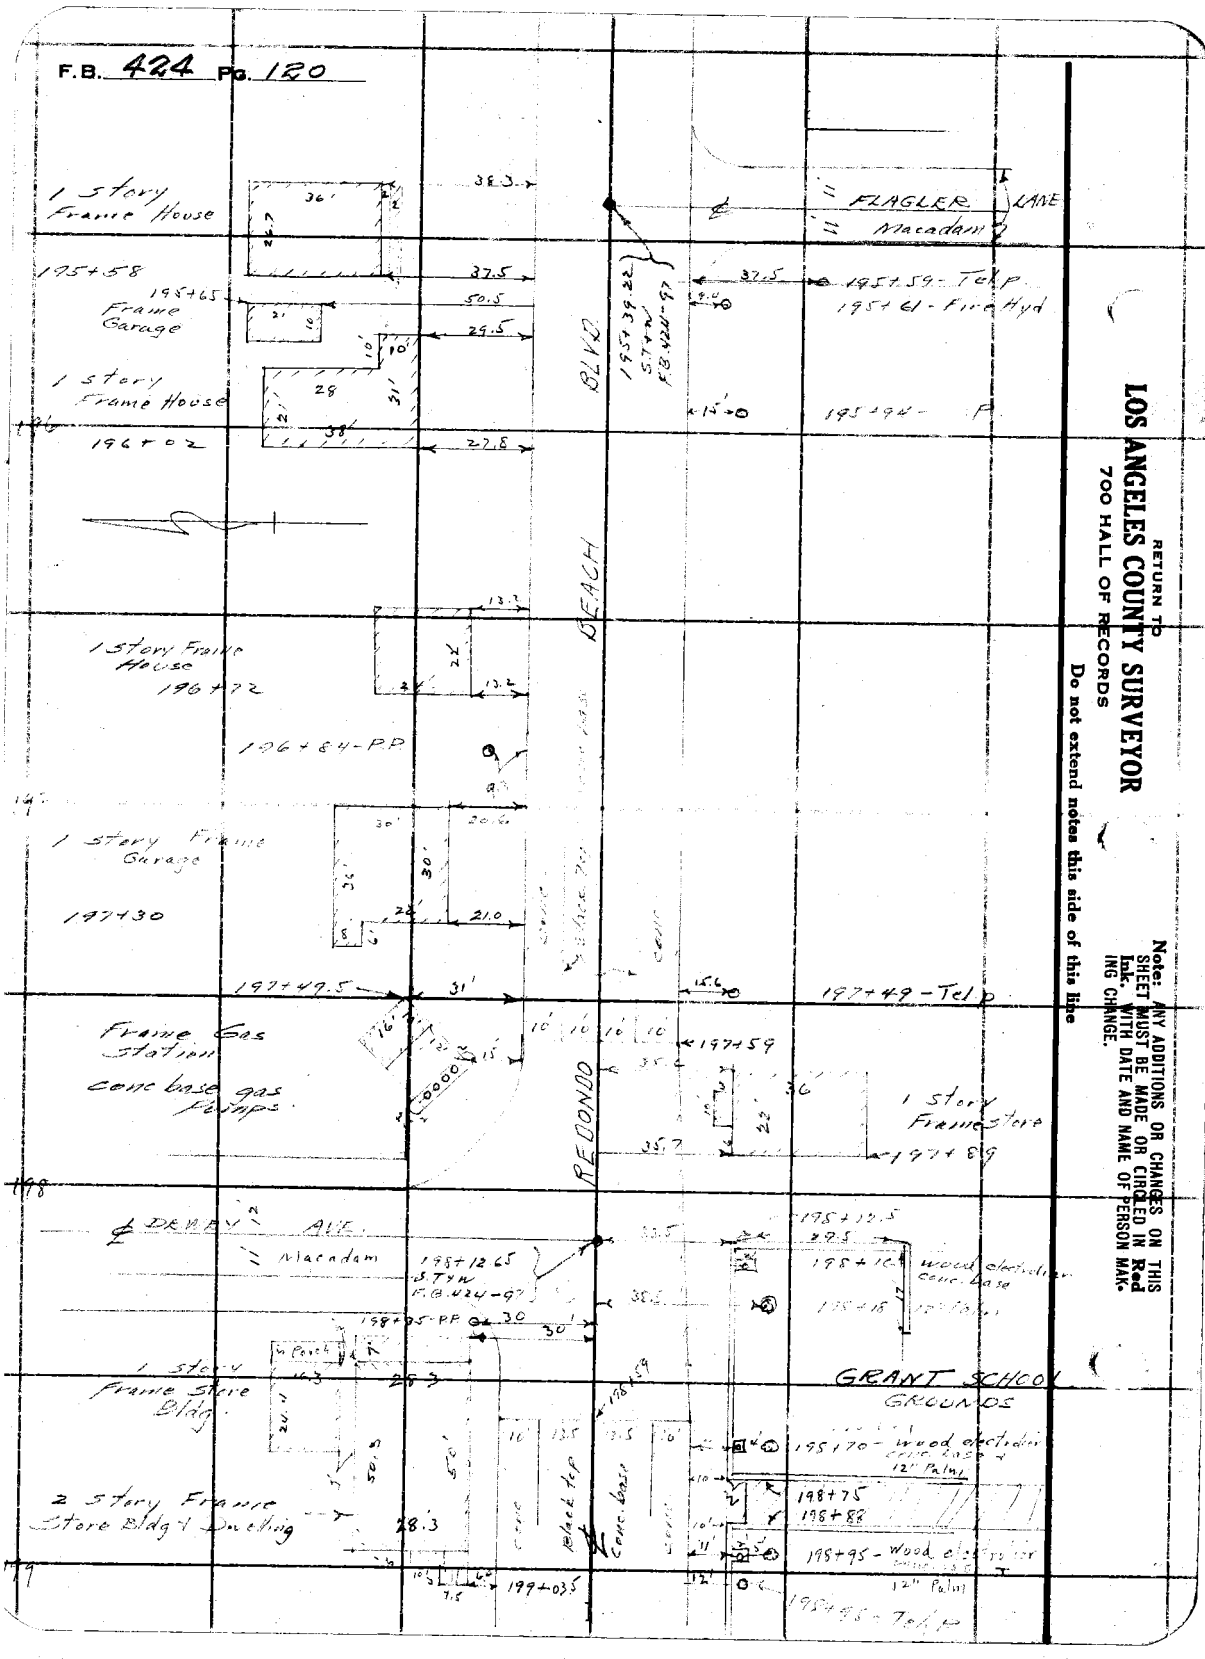

RETURN TO
LOS ANGELES COUNTY SURVEYOR
700 HALL OF RECORDS

Do not extend notes this side of this line

Note: ANY ADDITIONS OR CHANGES ON THIS SHEET MUST BE MADE OR CIRCLED IN Red Ink. WITH DATE AND NAME OF PERSON MAKING CHANGE.

Notes Ck'd by	D. M. Finley	Survey of	Redondo Beach Blvd
Map No.	B-442-2	W. O.	2220 Tape No. St'd ° F.
Office Work	J. H. Rice	Surveyed by	L. D. Moore
Checked	D. M. Finley	Notes	Moore Date 8-27-33
Date	Nov. 1933.	Indexed	A. C. Johnson

F.B. 424 Pg. 121

Note: ANY ADDITIONS OR CHANGES ON THIS SHEET MUST BE MADE OR CIRCLED IN Red Ink, WITH DATE AND NAME OF PERSON MAKING CHANGE.

Do not extend notes this side of this line

RETURN TO
LOS ANGELES COUNTY SURVEYOR
700 HALL OF RECORDS

FORM 247 10M 8-31

BLVD.

12½'
20'

192+44.5 F.COT
192+50.5 End of Fence

3 Story Stucco
Note 1 per
F.B. 399-112

192+70 P.P.

0.85

24.7

193+10

17'

Gas Pumps

1 Story Stucco
Store & Dwellings

34'
17.3

193+46

34.1

193+60

193+77 PP

57.4

Frame
Garage

193+95

REDONDO BEACH

Frame Shed
194+10

Angle Pt.
C.S.W&T.
194+15.00

53.8

1 Story
Frame
House
& Store

194+43 - Tel p

53.8

194+67

53.8

1 Story
Frame
House

54.0

195+13

195+22 - P.P.

Conc.
Black Top - Some P.C.
Conc.

10' 10' 10' 10'

F.B. 424 Pg. 122

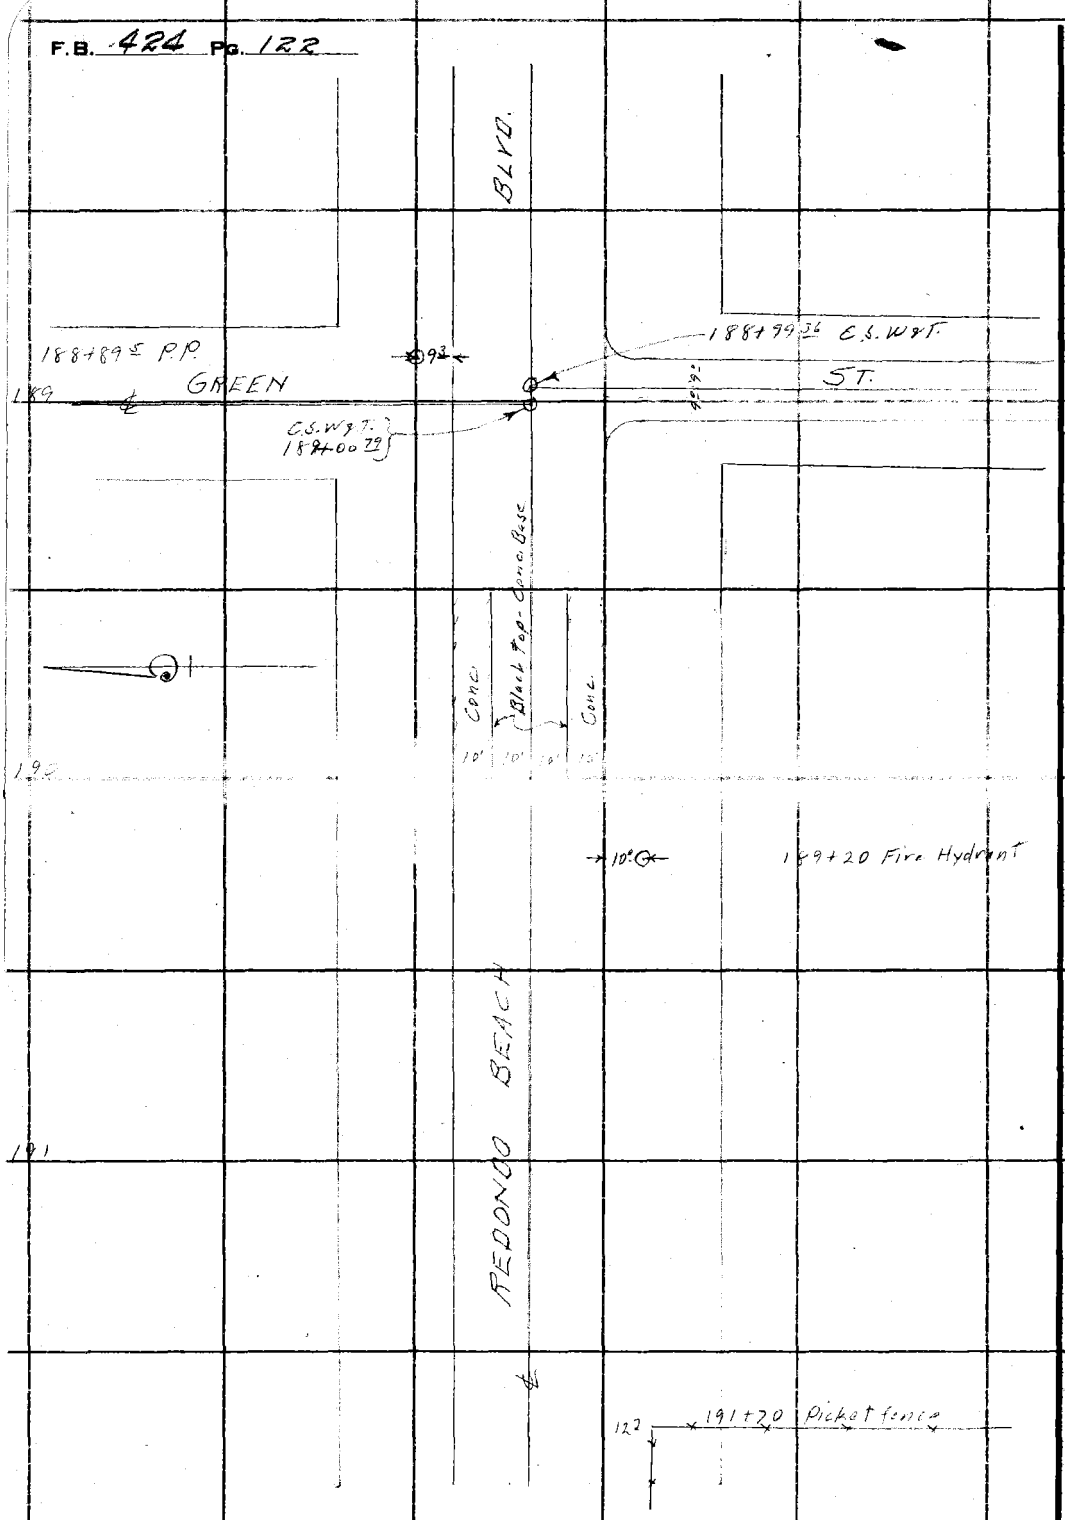

RETURN TO
LOS ANGELES COUNTY SURVEYOR
700 HALL OF RECORDS

Do not extend notes this side of this line

Note: ANY ADDITIONS OR CHANGES ON THIS SHEET MUST BE MADE OR CIRCLED IN **Red** Ink, WITH DATE AND NAME OF PERSON MAKING CHANGE.

Notes Ck'd by D. M. Finley		Survey of Redondo Beach Blvd.	
Map No. B-442-2		W. O. 1920 Tape No.	St'd OF.
Office Work J.H. Rice		Surveyed by L.D. Moore	
Checked D. M. Finley		Notes Van Fleet Date 8-28-33	
Date Nov. 1933		Indexed A. C. Johnson	

F.B. 424 PG. 123

Note: ANY ADDITIONS OR CHANGES ON THIS SHEET MUST BE MADE OR CIRCLED IN Red Ink. WITH DATE AND NAME OF PERSON MAKING CHANGE.

Do not extend notes this side of this line

RETURN TO
LOS ANGELES COUNTY SURVEYOR
700 HALL OF RECORDS

FORM 247 10M 8-31

BLVD.

22° 11.5 185

Open Front Frame Market

21.5 185+13

21.2 20±

1 Story Frame Store Bldg.

40.41

20.8 185+60

17.4

185+84 P.P.

185+84± Angle Pt. in Fence

186

9.2

Gas Pump

188+68± Conc. Found.

186+70± Curb

186+76 Ctr. of Conc. Fish Pool 9± Diam.

36±

REDONDO BEACH

45.2

17.2

1 Story Frame Garage

187

187+01±

187+38 P.P.

94

1 Story Frame Market Bldg.

187+80±

12.3

188

F.B. 424 Pg. 124

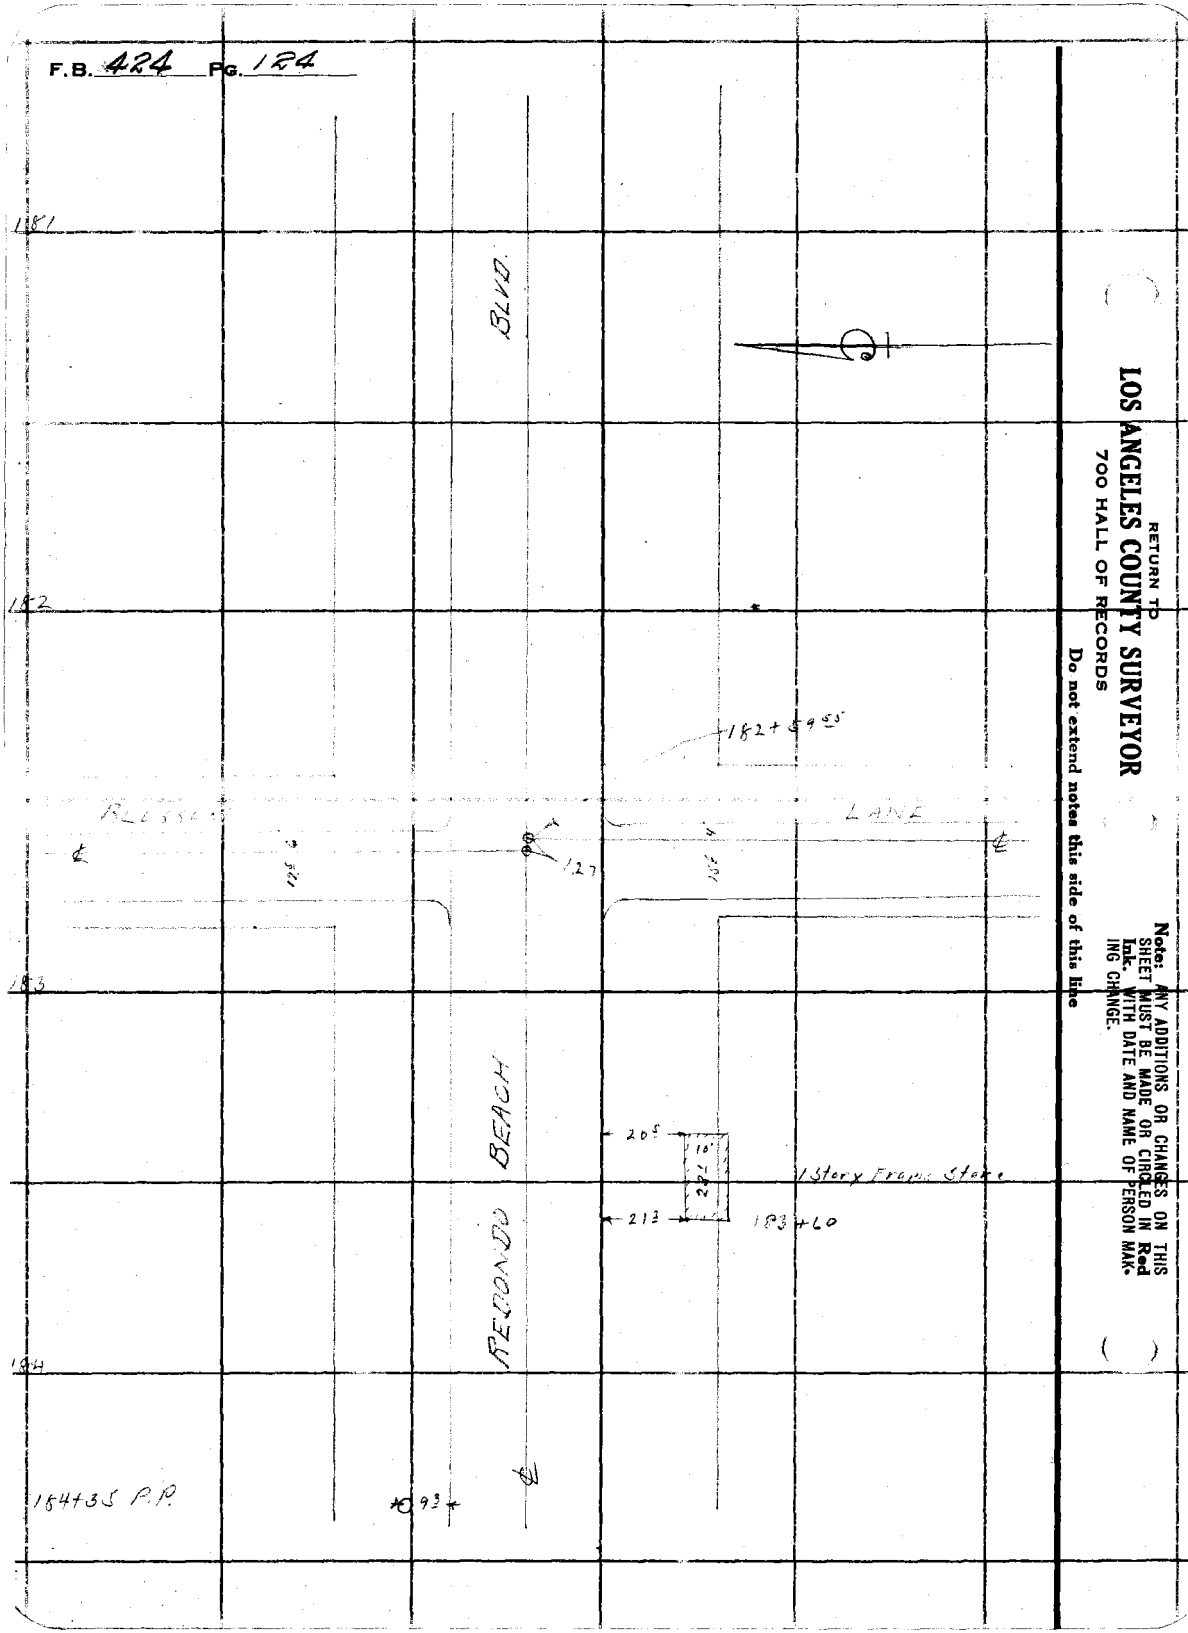

RETURN TO
LOS ANGELES COUNTY SURVEYOR
700 HALL OF RECORDS

Do not extend notes this side of this line

Note: ANY ADDITIONS OR CHANGES ON THIS SHEET MUST BE MADE OR CIRCLED IN **Red Ink** WITH DATE AND NAME OF PERSON MAKING CHANGE.

Notes Ck'd by B. M. Finley	Survey of Redondo Beach Blvd	F.B. 424	Pg. 125
Map No. B-442-2	W. O. 7920 Tape No.	St'd	°F.
Office Work J. H. Rice	Surveyed by L. D. Moore		
Checked B. M. Finley	Notes A. W. Van Fleet Date 8-28-33		
Date Nov. 1933.	Indexed A. C. Johnson		

Note: ANY ADDITIONS OR CHANGES ON THIS SHEET MUST BE MADE OR CIRCLED IN Red Ink, WITH DATE AND NAME OF PERSON MAKING CHANGE.

Do not extend notes this side of this line

RETURN TO
LOS ANGELES COUNTY SURVEYOR
700 HALL OF RECORDS

FORM 247 10M 5-31

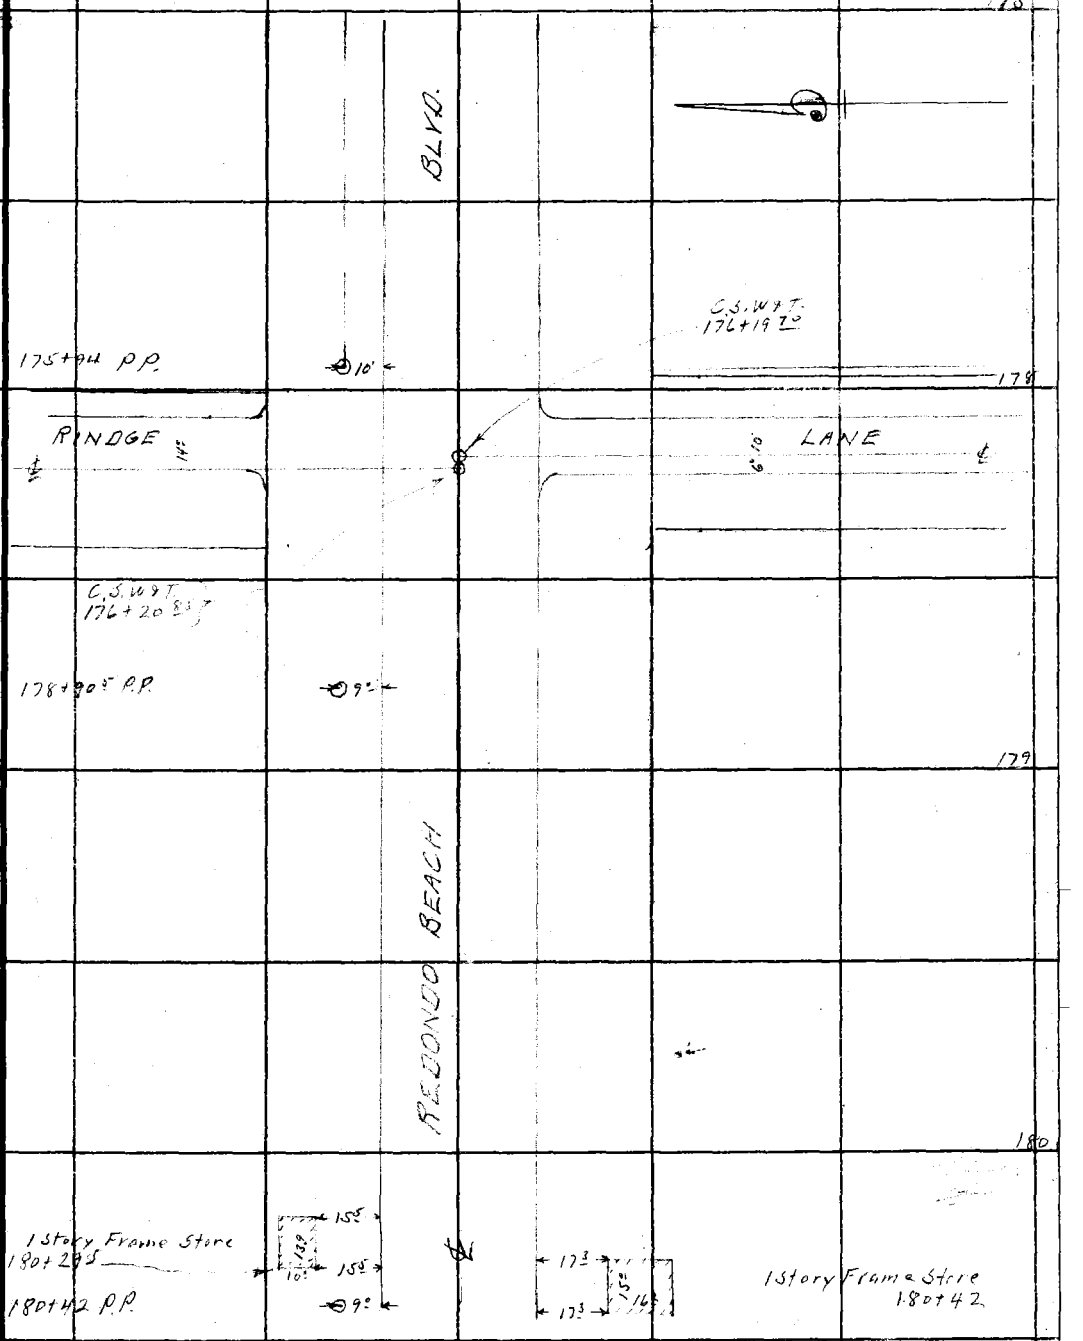

F.B. 424 Pg 126

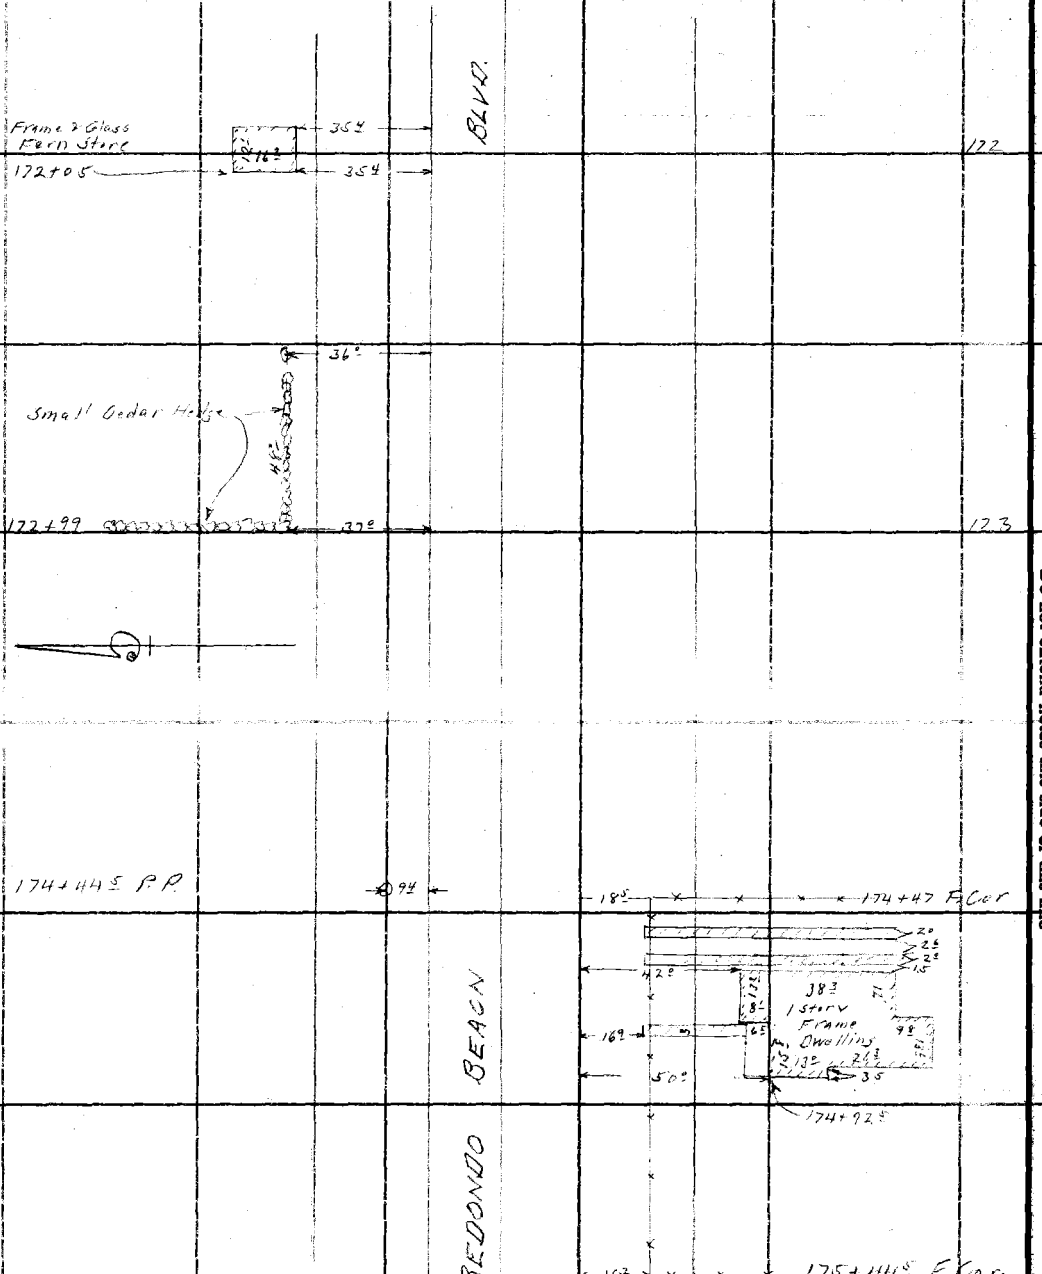

RETURN TO
LOS ANGELES COUNTY SURVEYOR
700 HALL OF RECORDS

Do not extend notes this side of this line

Note: ANY ADDITIONS OR CHANGES ON THIS SHEET MUST BE MADE OR CIRCLED IN Red Ink, WITH DATE AND NAME OF PERSON MAKING CHANGE.

Notes Ck'd by D. M. Finley	Survey of Redondo Beach Blvd	F.B. 424	PG. 127
Map No. B-442-2	W. O. 2920 Tape No.	St'd	°F.
Office Work J. H. Rice	Surveyed by L. O. Moore		
Checked D. M. F.	Notes A.W. VanFleet Date 8-28-33		
Date NOV. 1933.	Indexed A. C. Johnson		

Note: ANY ADDITIONS OR CHANGES ON THIS SHEET MUST BE MADE OR CIRCLED IN Red Ink, WITH DATE AND NAME OF PERSON MAKING CHANGE.

Do not extend notes this side of this line

RETURN TO
LOS ANGELES COUNTY SURVEYOR
700 HALL OF RECORDS

166+36 P.P.

91

BLVD.

167

1 story Frame Service Sta. 167+44

11½ 11½ 14½ 16½

C.S.W.P. 167+72 28

RAIL LANE

169

C.S.W.P. 169+79 93

169+50 P.P.

93

BEACH

SLAUSON LANE

S 20°

REDONDO

171

171+20 P.P.

92

FORM 247 10M 5-31

F.B. 484 Pg. 128

163+17½ P.P.

158+11.0± P.P.

159+97½ P.P.

161+20 P.P.

163+17½ P.P.

MACKAY

LANE

164+78' P.P.

BLVD.

BEACH

REDONDO

165

511

20' 20'

1 Story Frame Dwell.

365

165+50 - 1 Story Frame Dwelling

RETURN TO
LOS ANGELES COUNTY SURVEYOR
700 HALL OF RECORDS

Do not extend notes this side of this line

Note: ANY ADDITIONS OR CHANGES ON THIS SHEET MUST BE MADE OR CIRCLED IN Red Ink. WITH DATE AND NAME OF PERSON MAKING CHANGE.

Notes Ck'd by D. M. Finley		Survey of Redondo Beach Blvd.	
Map No. B-442-2		W. O. 7920	Tape No. St'd °F.
Office Work J. H. Rice		Surveyed by L. D. Moore	
Checked D. M. Finley		Notes A. W. Van Fleet	Date 9-5-33
Date Nov. 1933.		Indexed A. C. Johnson	

F.B. 424 Pg. 129

Note: ANY ADDITIONS OR CHANGES ON THIS SHEET MUST BE MADE OR CIRCLED IN Red Ink, WITH DATE AND NAME OF PERSON MAKING CHANGE.

Do not extend notes this side of this line

RETURN TO
LOS ANGELES COUNTY SURVEYOR
700 HALL OF RECORDS

FORM 247 10M 8-51

155+31 P.P.

156+80 P.P.

BLVD.

REDONDO BEACH

PHELAN LANE

29°

Air & Water Standard

Frame Stucco Service Station

157+53.5

157+81.8

6" Conc. Wall

157+75.5

155

20' 20'

158+21 Fence

F.B. 424 Pg. 130

148+26 P.P.

149+45 P.P.

BLVD

LANE

FELTON

150+83 P.P.

22.6
16
110.2
1 Story Frame Flower Shop
21.6
16
151+80
16'
15.2
10.0
Frame Refreshment Stand
16'
114
152+09.4

BEACH

REDONDO

152+42 P.P.

154+02 P.P.

Frame & Shingled Fruit Stand
24.5
112.9
56°
20.0
1 Story Frame Dwelling
24.8
14.3
23.2
11.9
24.5
17.3
56.2
20.3
10
154+26
154+38.5

RETURN TO
LOS ANGELES COUNTY SURVEYOR
700 HALL OF RECORDS

Do not extend notes this side of this line

Note: ANY ADDITIONS OR CHANGES ON THIS SHEET MUST BE MADE OR CIRCLED IN Red Ink. WITH DATE AND NAME OF PERSON MAKING CHANGE.

Notes Ck'd by D. M. Finley		Survey of Redondo Beach Blvd.	
Map No. B-442-2		W. O. 1920 Tape No.	St'd °F.
Office Work J. H. Rice		Surveyed by Moore	
Checked D. M. Finley		Notes Van Fleet Date 9-5-33	
Date Nov. 1933.		Indexed A. C. Johnson	

F.B. 424 Pg. 191

1404+98 P.P.

INGLEWOOD AVE.

1411+29 Fd. C.S.W.&T.

Black Top

Conc. Base

1417+97 End of Conc. strips on Each Side

1427+50 P.P.

1440+00 P.P.

10' Conc. 10' Black top 10' 10' Conc.

PERKINS

LANE

1455+36 P.P.

1467+77 P.P.

1 Story Stucco Residence

20.0 17.9 80.0 30' 30' 1477+85

Note: ANY ADDITIONS OR CHANGES ON THIS SHEET MUST BE MADE OR CIRCLED IN Red Ink, WITH DATE AND NAME OF PERSON MAKING CHANGE.

Do not extend notes this side of this line

RETURN TO LOS ANGELES COUNTY SURVEYOR 700 HALL OF RECORDS

FORM 247 10M 8-31

F.B. 424 PG. 132

135+09± ✗ in Paving Both Sides

10' 28.3

136+08 ✗ in Paving

20'

136+69± P.P.

136+69.3

20'

137+32 ✗ in Paving

1 Story Stucco Restaurant

27.2

24.8

26.3

27'

137+85.9

138+19± P.P.

139+70± P.P.

RE

RETURN TO
LOS ANGELES COUNTY SURVEYOR
700 HALL OF RECORDS

Do not extend notes this side of this line

Note: ANY ADDITIONS OR CHANGES ON THIS SHEET MUST BE MADE OR CIRCLED IN Red Ink. WITH DATE AND NAME OF PERSON MAKING CHANGE.

414

Notes Ck'd by	D. M. Finley	Survey of	Redondo Beach Blvd
Map No.	B-442-2	W. O.	7920
Office Work	J. H. Rice	Tape No.	St'd °F.
Checked	D. M. Finley	Surveyed by	Moore
Date	Nov. 1933	Notes	Van Fleet Date 9-5-33
		Indexed	A. C. Johnson

F.B. 424 Pg. 139

Note: ANY ADDITIONS OR CHANGES ON THIS SHEET MUST BE MADE OR CIRCLED IN Red Ink, WITH DATE AND NAME OF PERSON MAKING CHANGE.

Do not extend notes this side of this line

RETURN TO
LOS ANGELES COUNTY SURVEYOR
700 HALL OF RECORDS

FORM 247 10M 5-31

1 Story Frame Shop

129+20

23'

24'

129+65 P.P.

14'

23'

FIFTH ST

41½'

20'

20'

40'

24'

12'

1 Story Frame Market

130+42 ★ both sides of Paving

130+53

1 Story Frame Office

130+67

(Lumber Yard)

Wooden Fence

130+69

130+65 P.P.

26'

40'

40'

132+20 P.P.

133+59 ★ in Paving

10'

28'

F.B. 424 Pg. 134

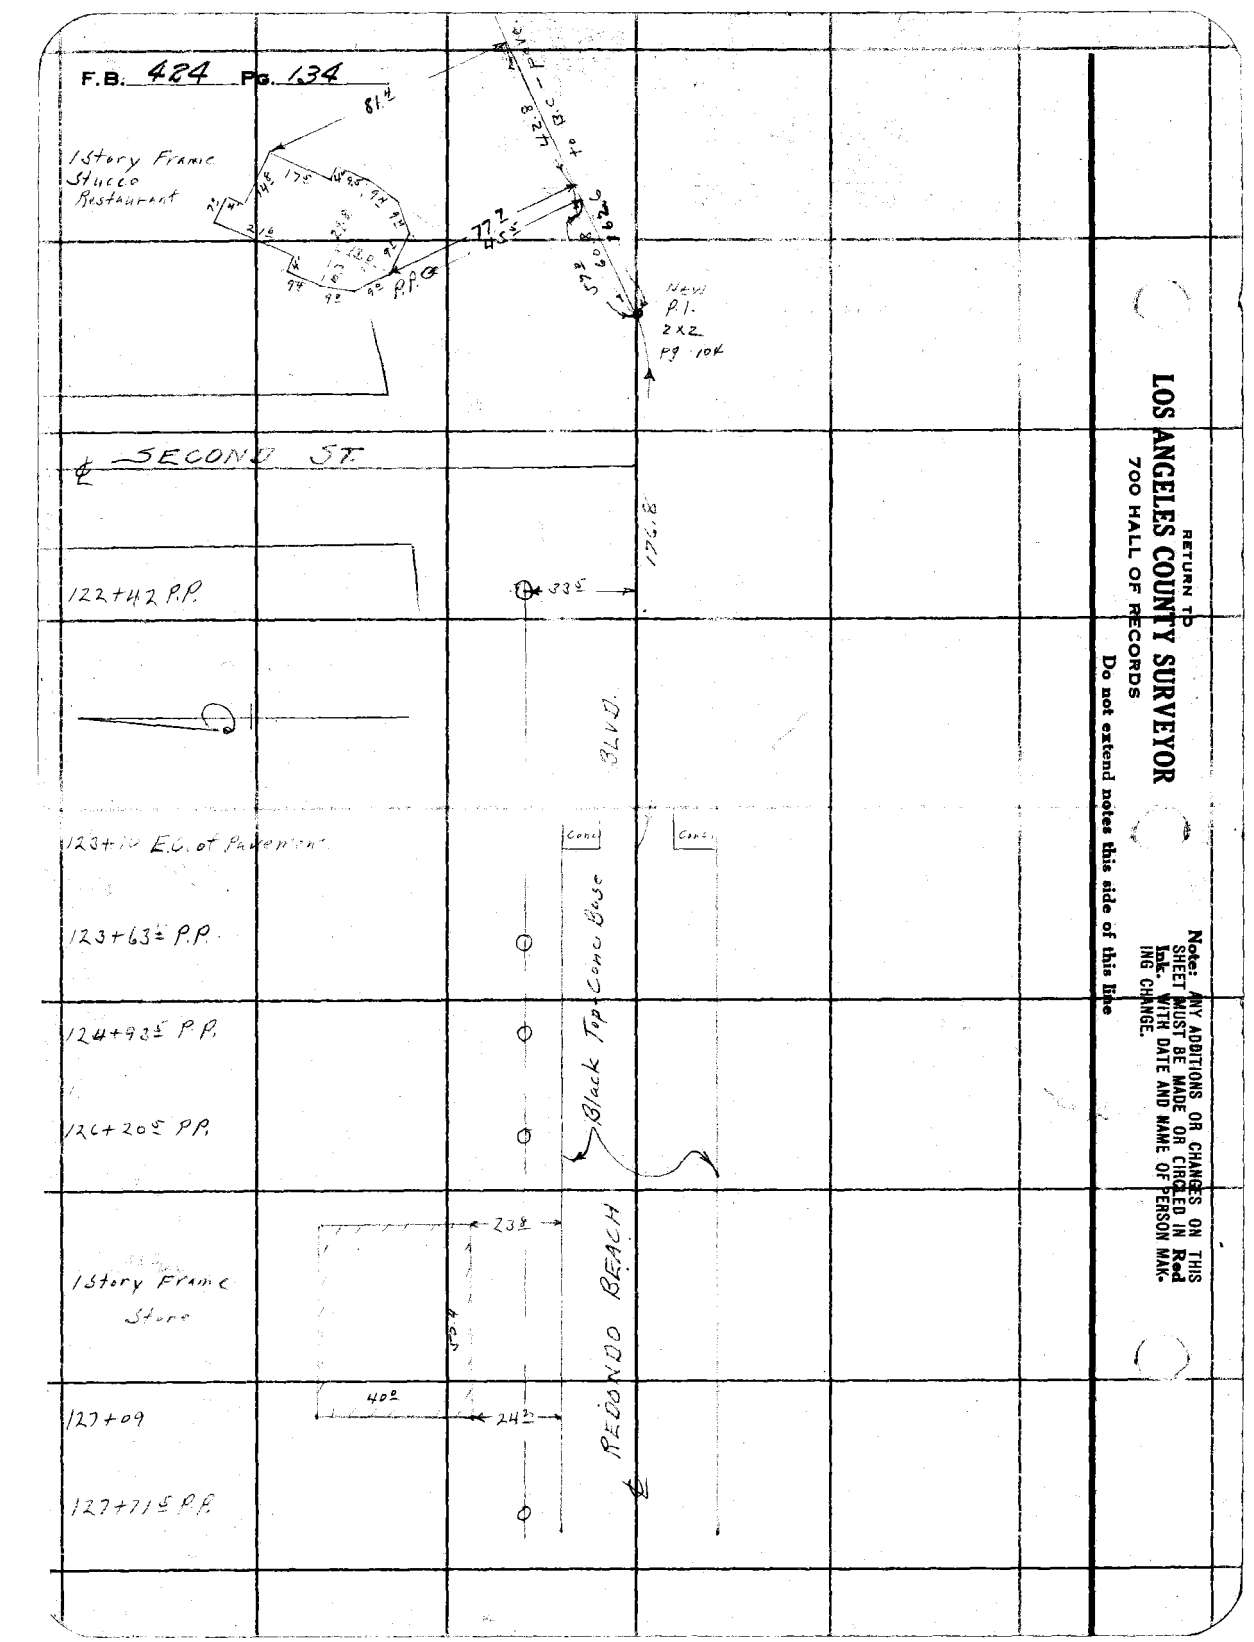

RETURN TO
LOS ANGELES COUNTY SURVEYOR
700 HALL OF RECORDS

Note: ANY ADDITIONS OR CHANGES ON THIS SHEET MUST BE MADE OR CIRCLED IN Red Ink. WITH DATE AND NAME OF PERSON MAKING CHANGE.

Do not extend notes this side of this line

Notes Ck'd by D. M. Finley
Map No. B-442-2
Office Work J.H. Rice
Checked
Date NOV. 1933

Survey of Redondo Beach Blvd.
W. O. 7920 Tape No. St'd oF.
Surveyed by Moore
Notes Van Fleet Date 9-24-33
Indexed A. C. Johnson

F.B. 424 PG. 135

Notes: ANY ADDITIONS OR CHANGES ON THIS SHEET MUST BE MADE OR CIRCLED IN Red Ink, WITH DATE AND NAME OF PERSON MAKING CHANGE.

Do not extend notes this side of this line

RETURN TO
LOS ANGELES COUNTY SURVEYOR
700 HALL OF RECORDS

BLVD.

114+56 P.P.

20°

115+87.5 P.P.

20°

117+38 P.P.

20°

1 Story Frame Realty Office

117+85

12.5
10.5

28.0

28.4

BEACH

25'

15'

118+65.83 B.C. of R/W

REDONDO

118+87 P.P.

45°

162.4 Ahead of R.I. Pavement B.C.

10 20 10

P.P. 159.4 Ahead of R.I.

45°

FORM 847 10M 8-31

F.B. 424 Pg 136

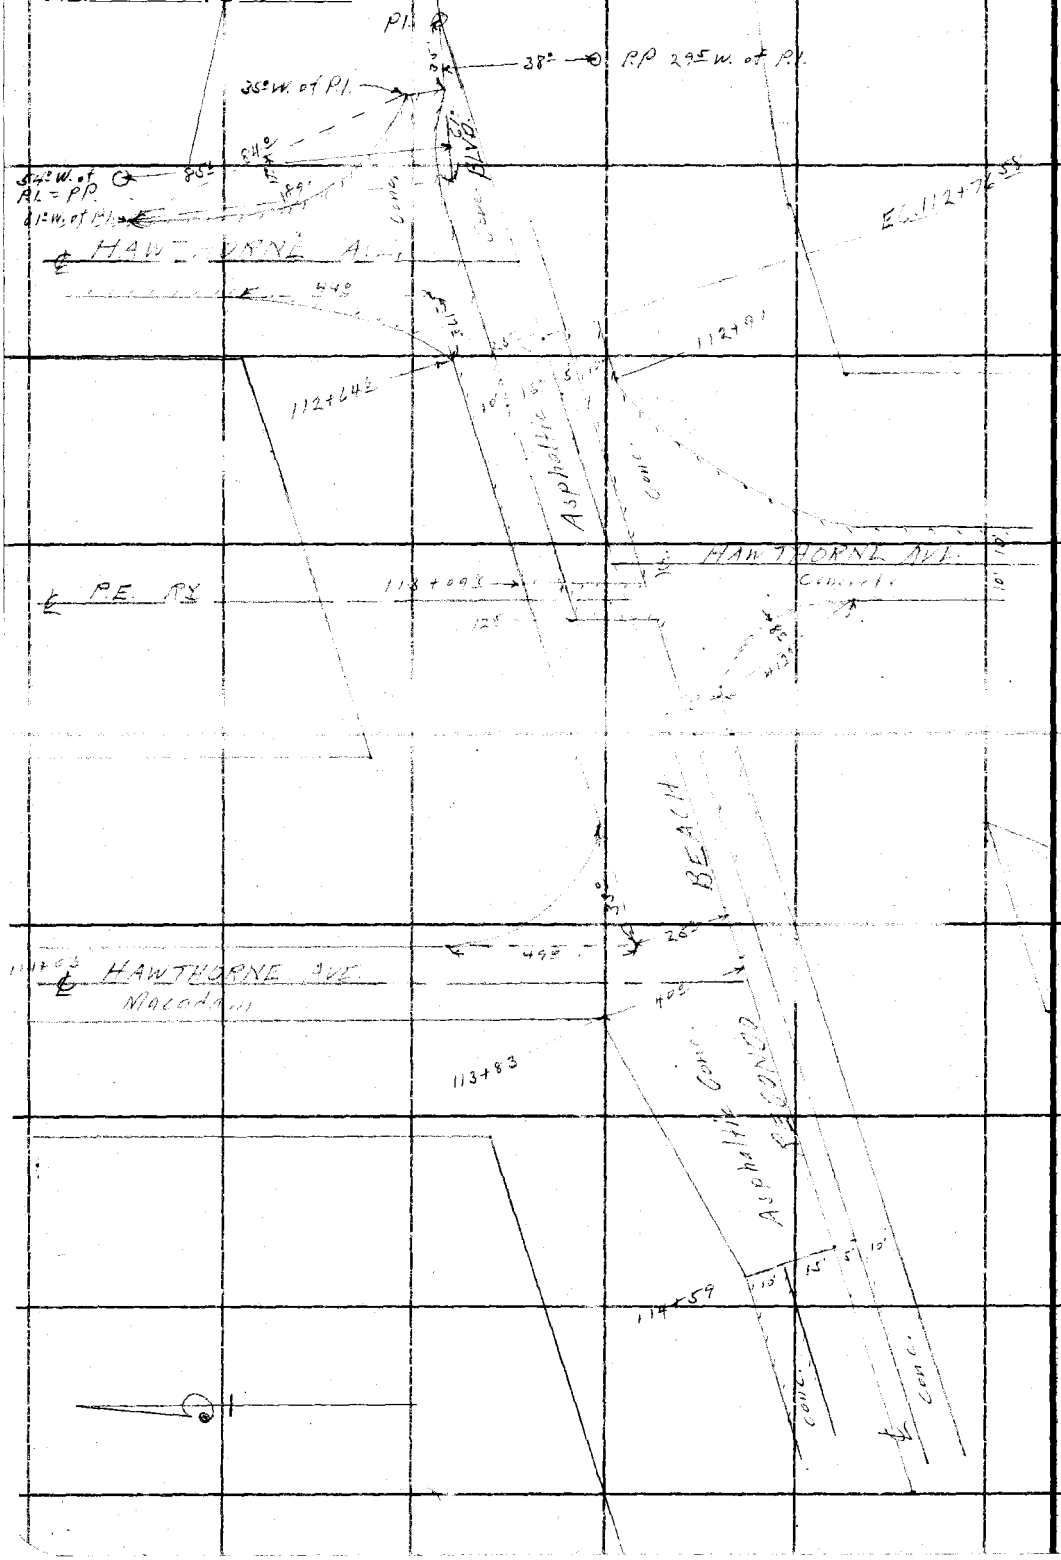

RETURN TO
LOS ANGELES COUNTY SURVEYOR
700 HALL OF RECORDS

Note: ANY ADDITIONS OR CHANGES ON THIS SHEET MUST BE MADE OR CIRCLED IN Red Ink, WITH DATE AND NAME OF PERSON MAKING CHANGE.

Do not extend notes this side of this line

Notes Ck'd by	Survey of Redondo Beach Blvd.
Map No. B-442-1	W. O. 7824 Tape No. St'd °F.
Office Work	Surveyed by Moore
Checked Roleff	Notes Van Fleet Date 9-23-33
Date Dec 1933	Indexed C. Johnson

F.B. 424 PG. 137

Note: ANY ADDITIONS OR CHANGES ON THIS SHEET MUST BE MADE OR CIRCLED IN Red Ink, WITH DATE AND NAME OF PERSON MAKING CHANGE.

Do not extend notes this side of this line

RETURN TO
LOS ANGELES COUNTY SURVEYOR
700 HALL OF RECORDS

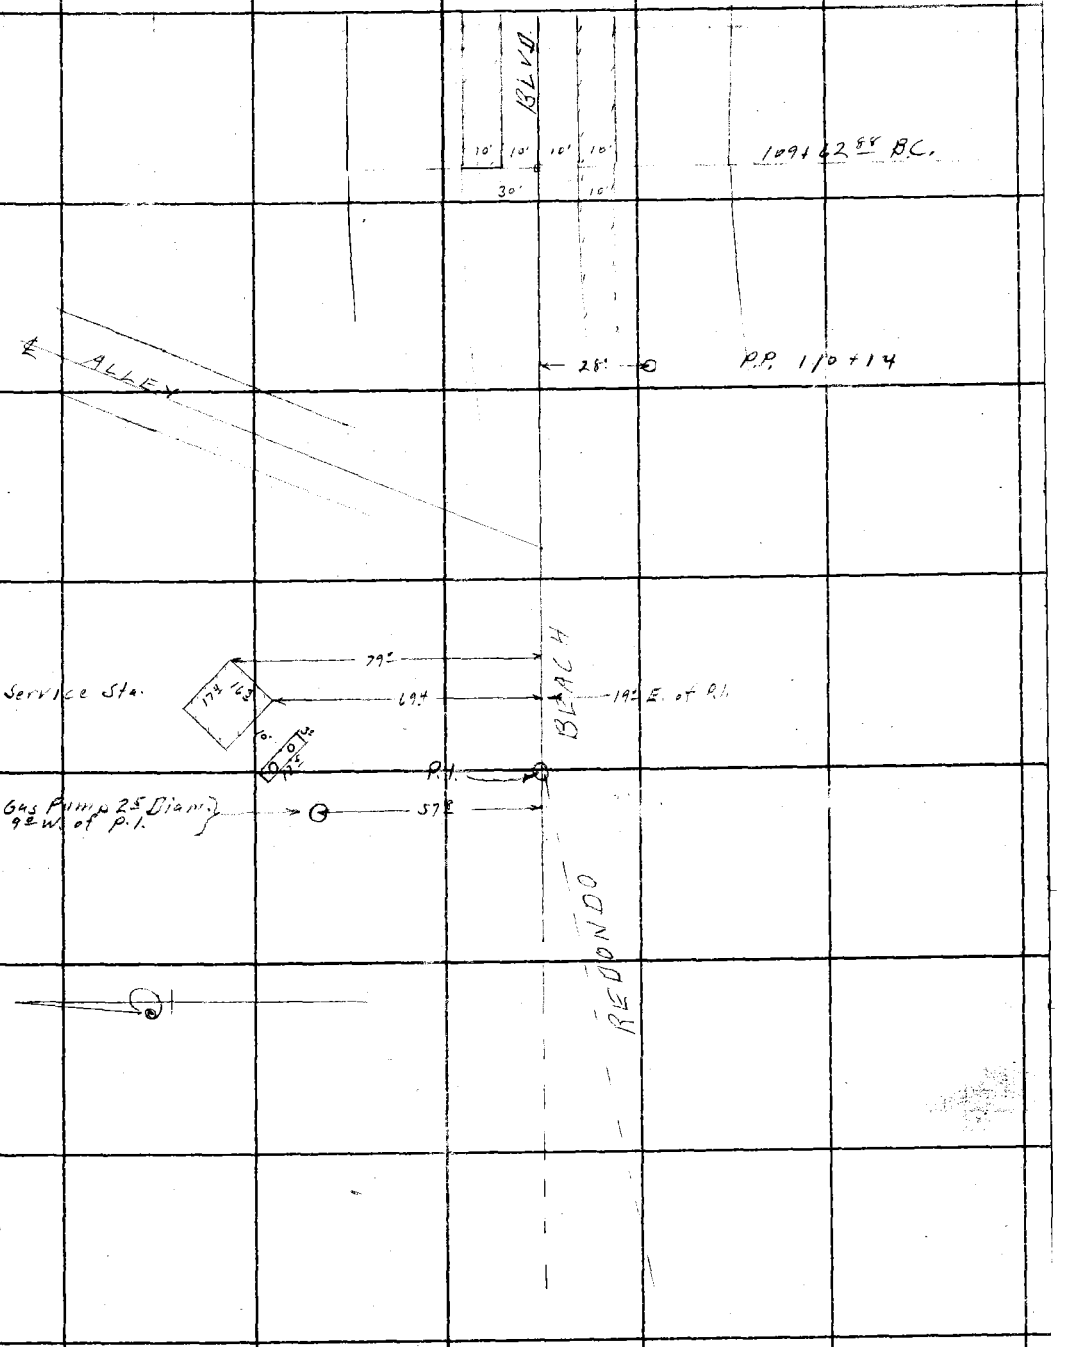

FORM 247 10M 8-31

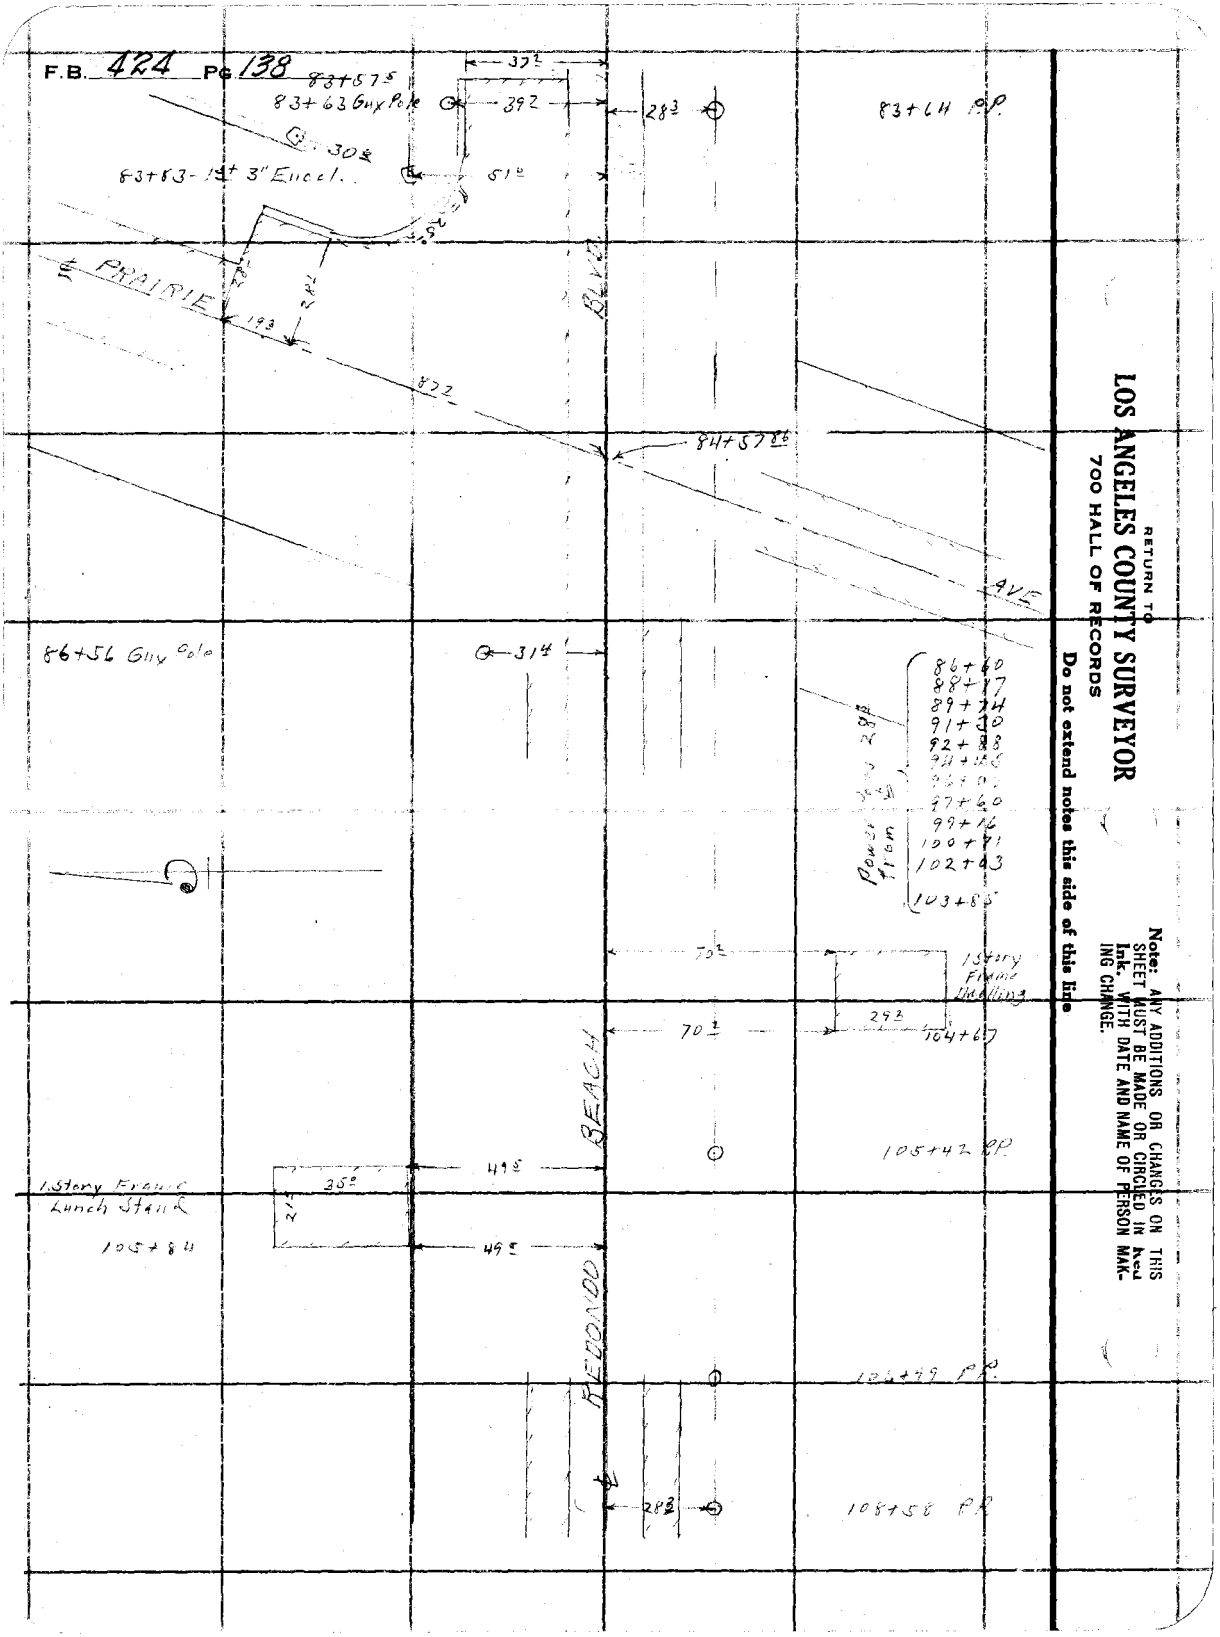

RETURN TO
LOS ANGELES COUNTY SURVEYOR
700 HALL OF RECORDS

Do not extend notes this side of this line

Note: ANY ADDITIONS OR CHANGES ON THIS SHEET MUST BE MADE OR CIRCLED IN Red Ink, WITH DATE AND NAME OF PERSON MAKING CHANGE.

Notes Ck'd by	Survey of Redondo Beach Blvd.
Map No. B-442-1	W. O. 7920 Tape No.	St'd	°F.
Office Work	Surveyed by Moure
Checked Rosen	Notes Van Fleet Date 9-22-33
Date Dec. 1933	Indexed A. C. Johnson

F.B. 424 PG. 139

Note: ANY ADDITIONS OR CHANGES ON THIS SHEET MUST BE MADE OR CIRCLED IN Red Ink. WITH DATE AND NAME OF PERSON MAKING CHANGE.

Do not extend notes this side of this line

RETURN TO
LOS ANGELES COUNTY SURVEYOR
700 HALL OF RECORDS

BLVD.

74+24 Last 3" Eucal

3" Eucal. Spaced Average of 30' apart

80+80 - 18" Eucal.

82+99 - 3" Eucal.

83+55 - 3" Eucal

49'

95'

75'

63'

30'

195'

243'

301'

195'

77+89 Guy Pole

74+30 P.P.

75+56 P.P.

76+95 P.P.

78+20 P.P.

79+41 P.P.

1 Story Frame Market Bldg.

79+91

80+88 P.P.

82+34 P.P.

REDONDO BEACH

53

FORM 847 10M 8-31

RETURN TO

LOS ANGELES COUNTY SURVEYOR

700 HALL OF RECORDS

Note: ANY ADDITIONS OR CHANGES ON THIS SHEET MUST BE MADE OR CIRCLED IN Red Ink. WITH DATE AND NAME OF PERSON MAKING CHANGE.

Do not extend notes this side of this line

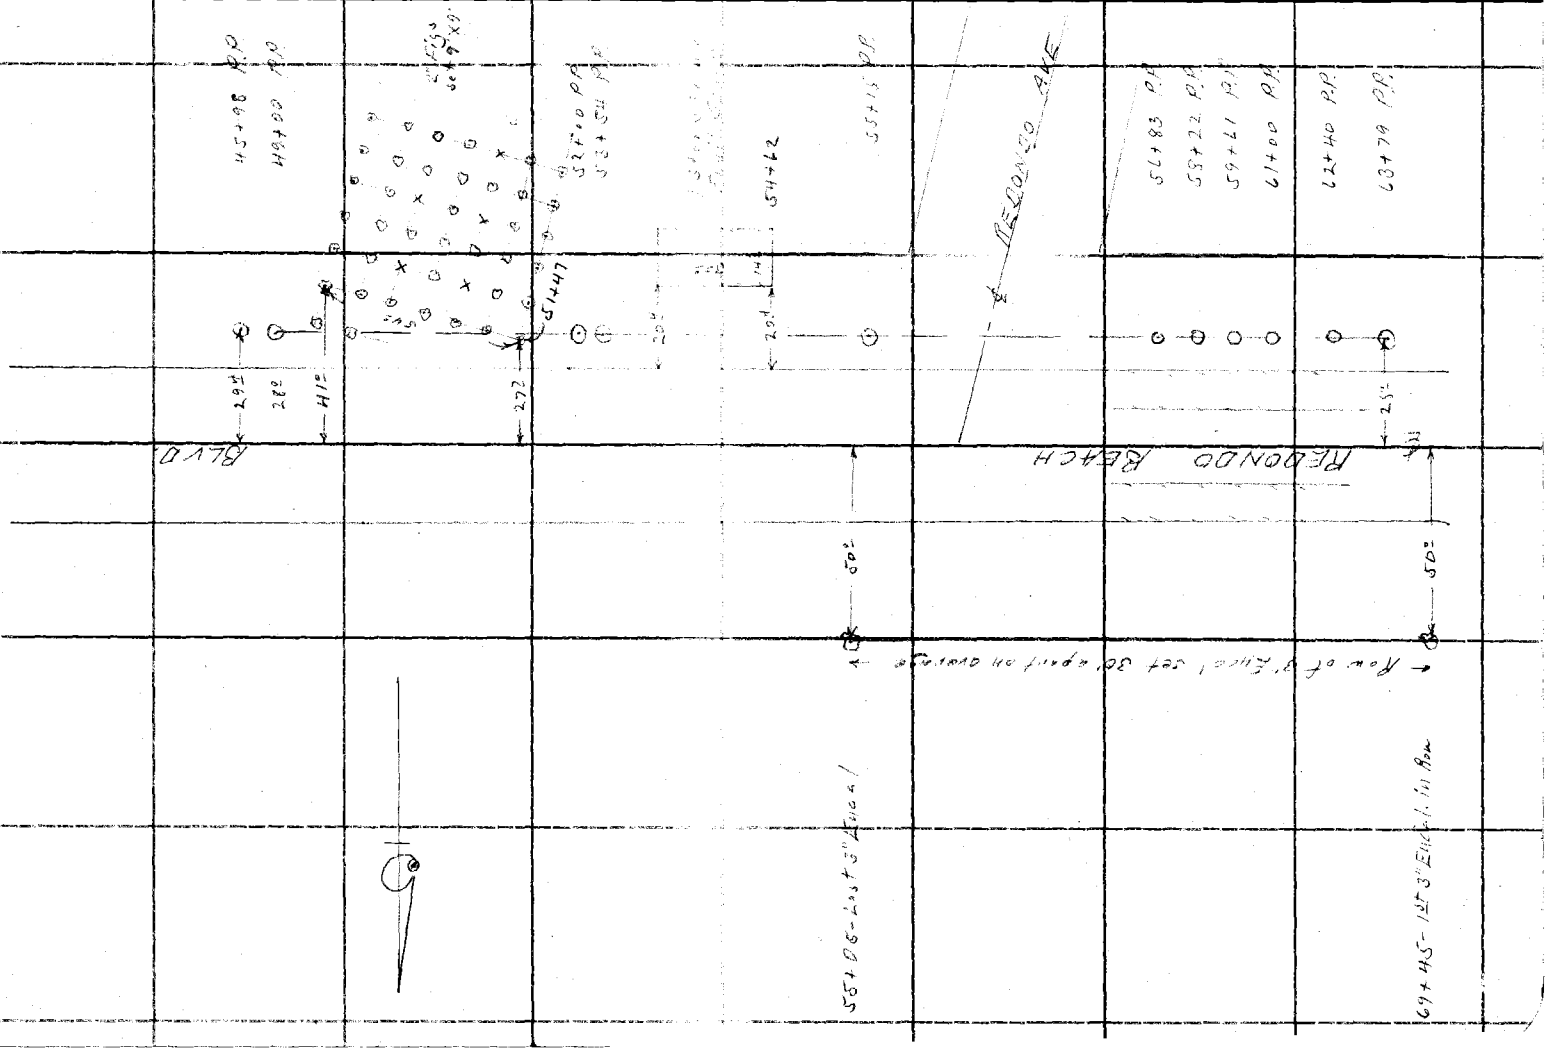

Notes Ck'd by	Survey of Redondo Beach Int.
Map No. B-442-1	W. O. 2926 Tape No. St'd °F.
Office Work	Surveyed by Moore
Checked Roesch	Notes Van Fleet Date 9-22-33
Date Dec 1933	Indexed A. C. Johnson

F.B. 424 PG. 141

Note: ANY ADDITIONS OR CHANGES OF THIS SHEET MUST BE MADE OR CIRCLED IN Red Ink, WITH DATE AND NAME OF PERSON MAKING CHANGE.

Do not extend notes this side of this line

RETURN TO
LOS ANGELES COUNTY SURVEYOR
700 HALL OF RECORDS

FORM 847 10M 5-31

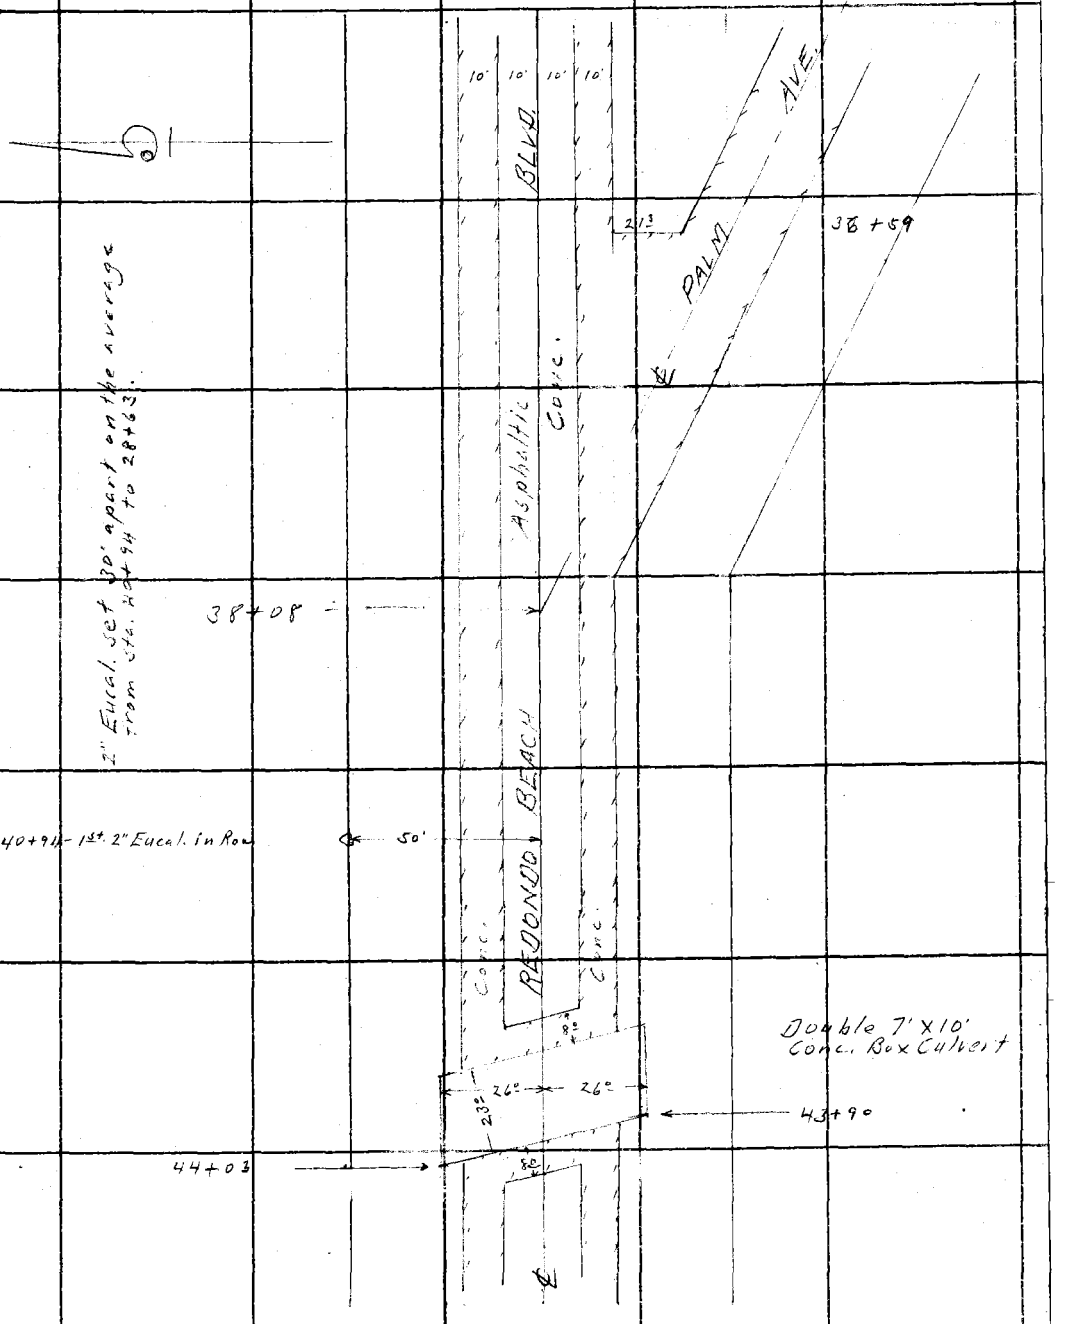

RETURN TO

LOS ANGELES COUNTY SURVEYOR

700 HALL OF RECORDS

Note: ANY ADDITIONS OR CHANGES ON THIS SHEET MUST BE MADE OR CIRCLED IN Red Ink. WITH DATE AND NAME OF PERSON MAKING CHANGE.

Do not extend notes this side of this line

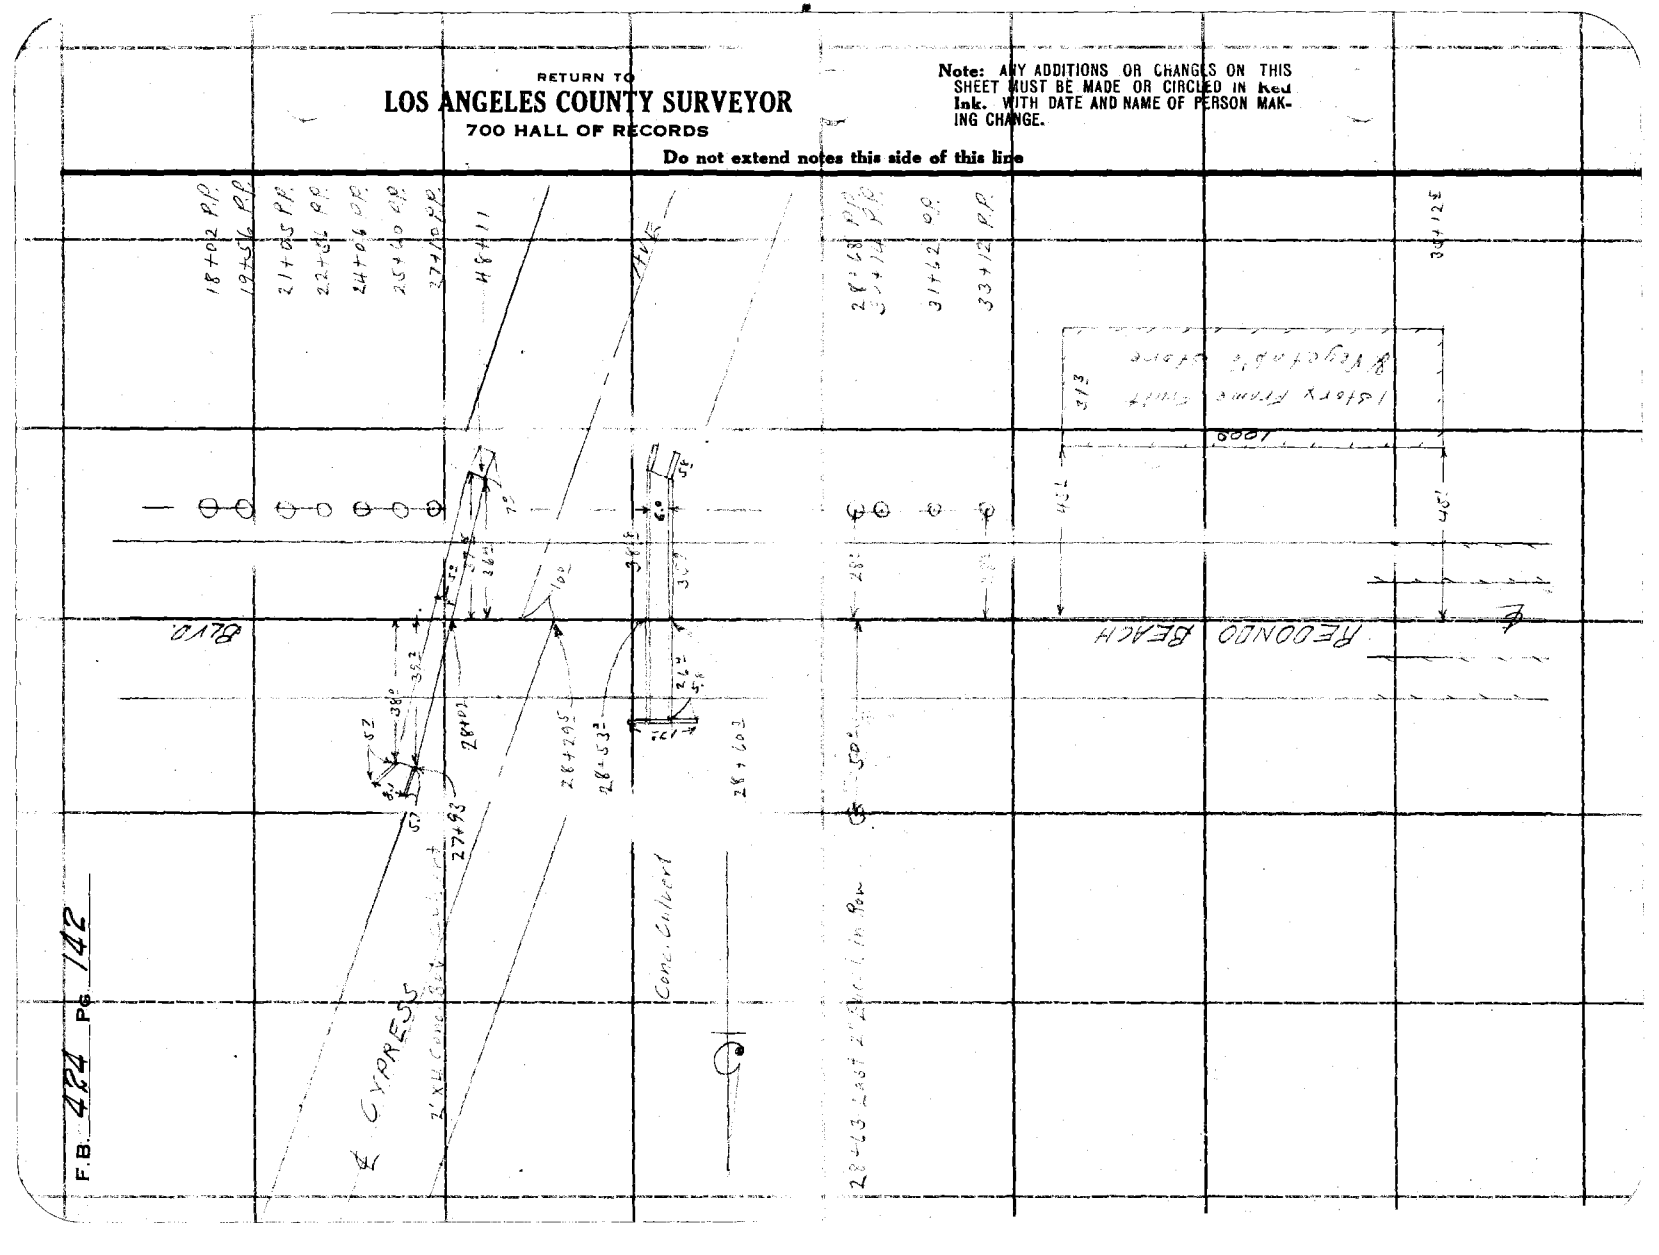

F.B. 424 Pg. 142

Notes Ck'd by		Survey of Redondo Beach Blvd.	
Map No. B-442-1		W. O. 7920	Tape No. St'd °F.
Office Work		Surveyed by Moore	
Checked Rosser		Notes 1 on 1 Tact	Date 9-29-33
Date Dec. 1933		Indexed A. C. Johnson	

F.B. 424 PG. 143

RETURN TO
LOS ANGELES COUNTY SURVEYOR
700 HALL OF RECORDS

Note: ANY ADDITIONS OR CHANGES ON THIS SHEET MUST BE MADE OR CIRCLED IN Red Ink. WITH DATE AND NAME OF PERSON MAKING CHANGE.

Do not extend notes this side of this line

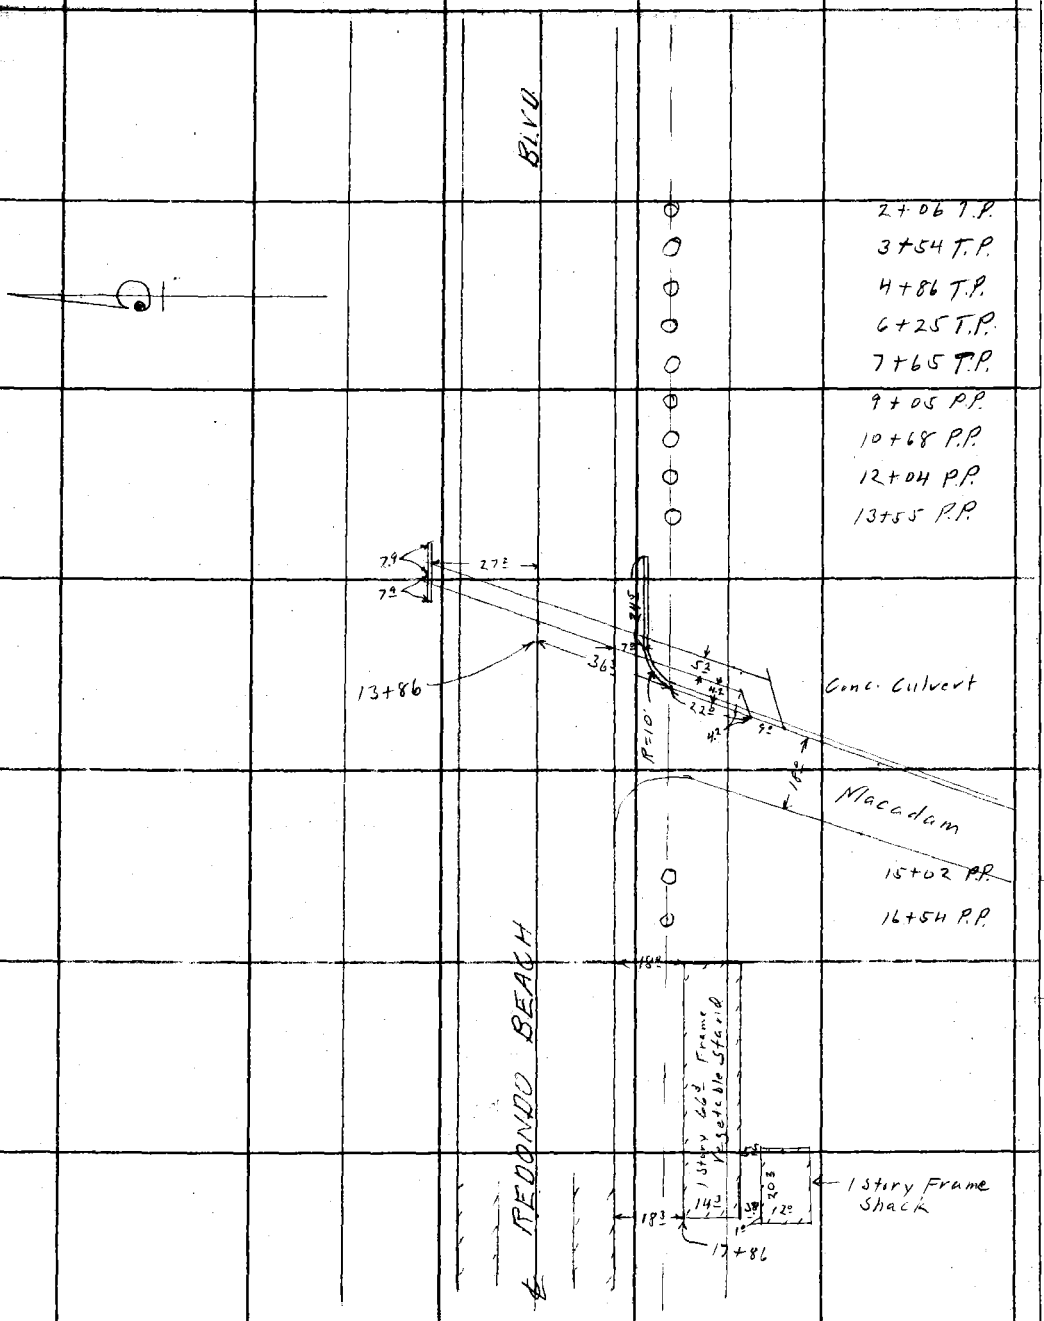

FORM 247 10M 8-31

RETURN TO
LOS ANGELES COUNTY SURVEYOR
700 HALL OF RECORDS

Note: ANY ADDITIONS OR CHANGES ON THIS SHEET MUST BE MADE OR CIRCLED IN Red Ink. WITH DATE AND NAME OF PERSON MAKING CHANGE.

Do not extend notes this side of this line

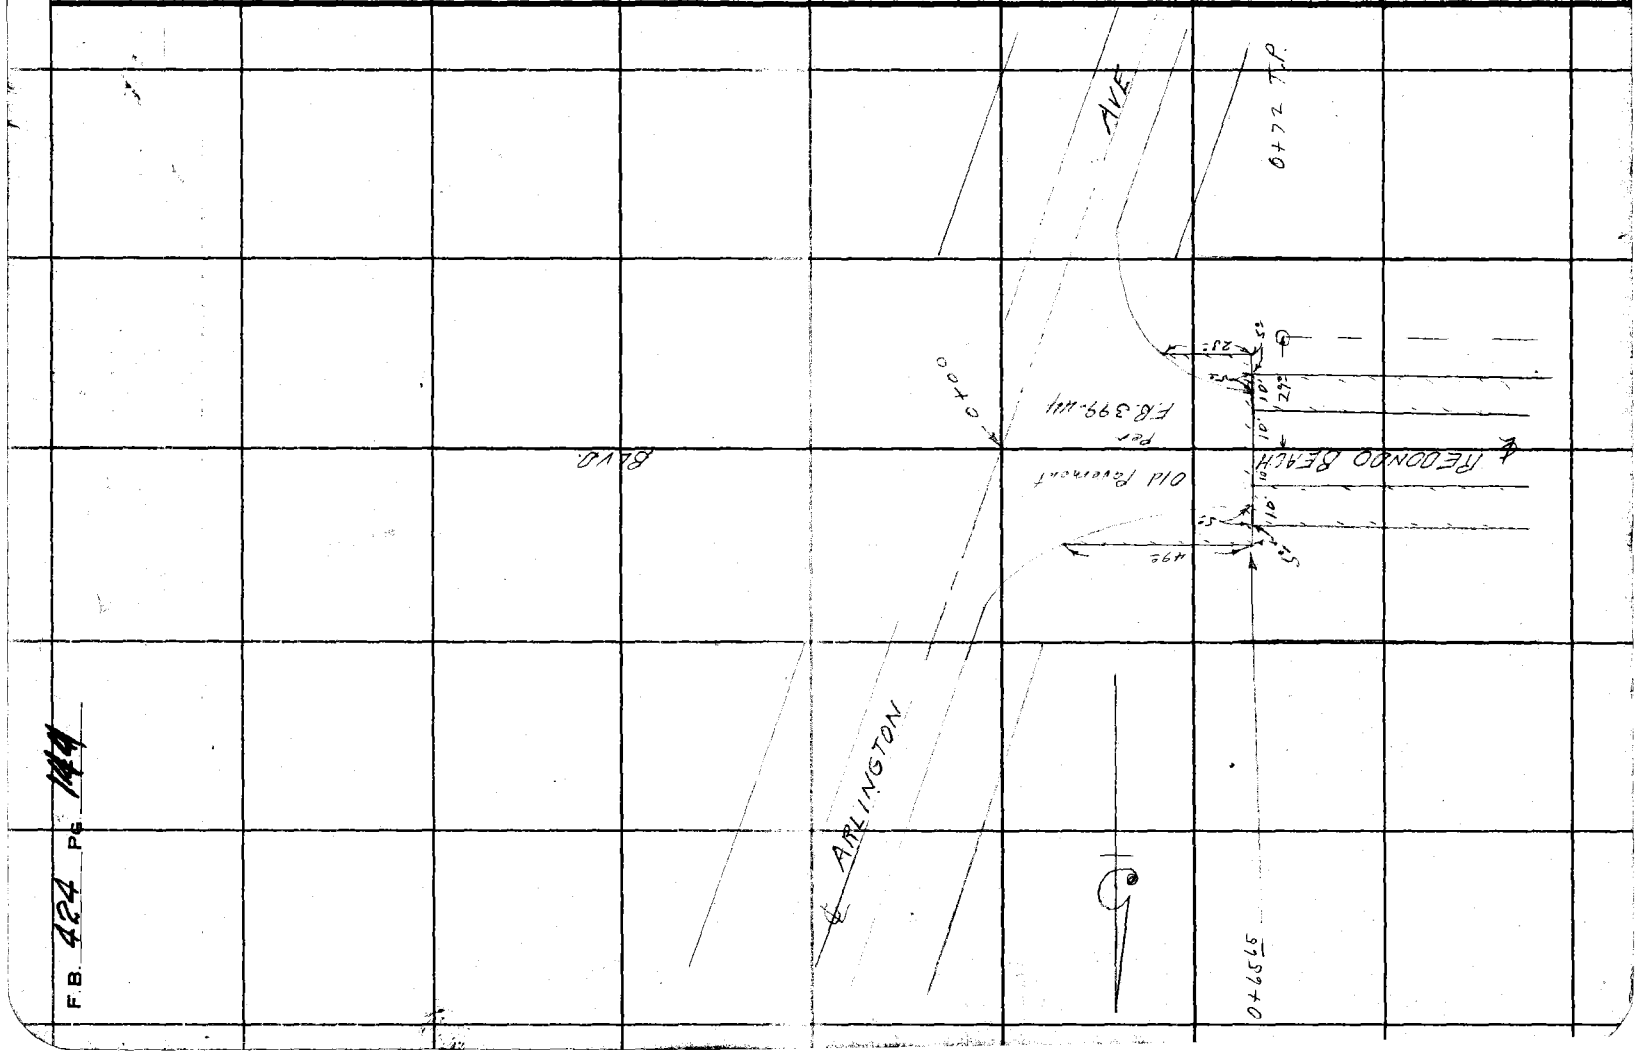

F.B. 424 Pg. 144

Notes Ck'd by	D.M. Finley	Survey of	Riverside Redondo Blvd
Map No.	B-442-2	W. O.	7920
Office Work	RW M E A.	Tape No	6 10
Checked	D.M. Finley	St'd	8 11
Date	Jan. 1936.	Surveyed by	B Vgins
		Notes	HF
		Date	12/16/35
		Indexed	A C. Johnson

F.B. 424 Pg. 145

12-30-1935

Note: ANY ADDITIONS OR CHANGES ON THIS SHEET MUST BE MADE OR CIRCLED IN Red Ink WITH DATE AND NAME OF PERSON MAKING CHANGE.

Do not extend notes this side of this line

RETURN TO
LOS ANGELES COUNTY SURVEYOR
700 HALL OF RECORDS

Old per Pg. 65

894.55' Meas.

Fd. 2x2 old P.I. per pg. 65 = P.O.T. New line.

Δ = 53°-20'-00"
R = 1000'
T = 502.32'
L = 930.84'

PROPOSED

10767

(256+47.14 Set 2x2 12" c/m. B.C.

Pg. 145-147

LINE CHANGE
From
255+03.62
To
267+37.68

RIVERSIDE

REDONDO BLVD.

1745.22' Rad.

Fd 2x2, o/c B.C. per pg. 65 = Po.T. 255+03.62 New line.

(5)

(50)

FORM 247 5M 8-34

RETURN TO
LOS ANGELES COUNTY SURVEYOR
700 HALL OF RECORDS

Note; ANY ADDITIONS OR CHANGES ON THIS SHEET MUST BE MADE OR CIRCLED IN **Red Ink** WITH DATE AND NAME OF PERSON MAKING CHANGE.

Do not extend notes this side of this line

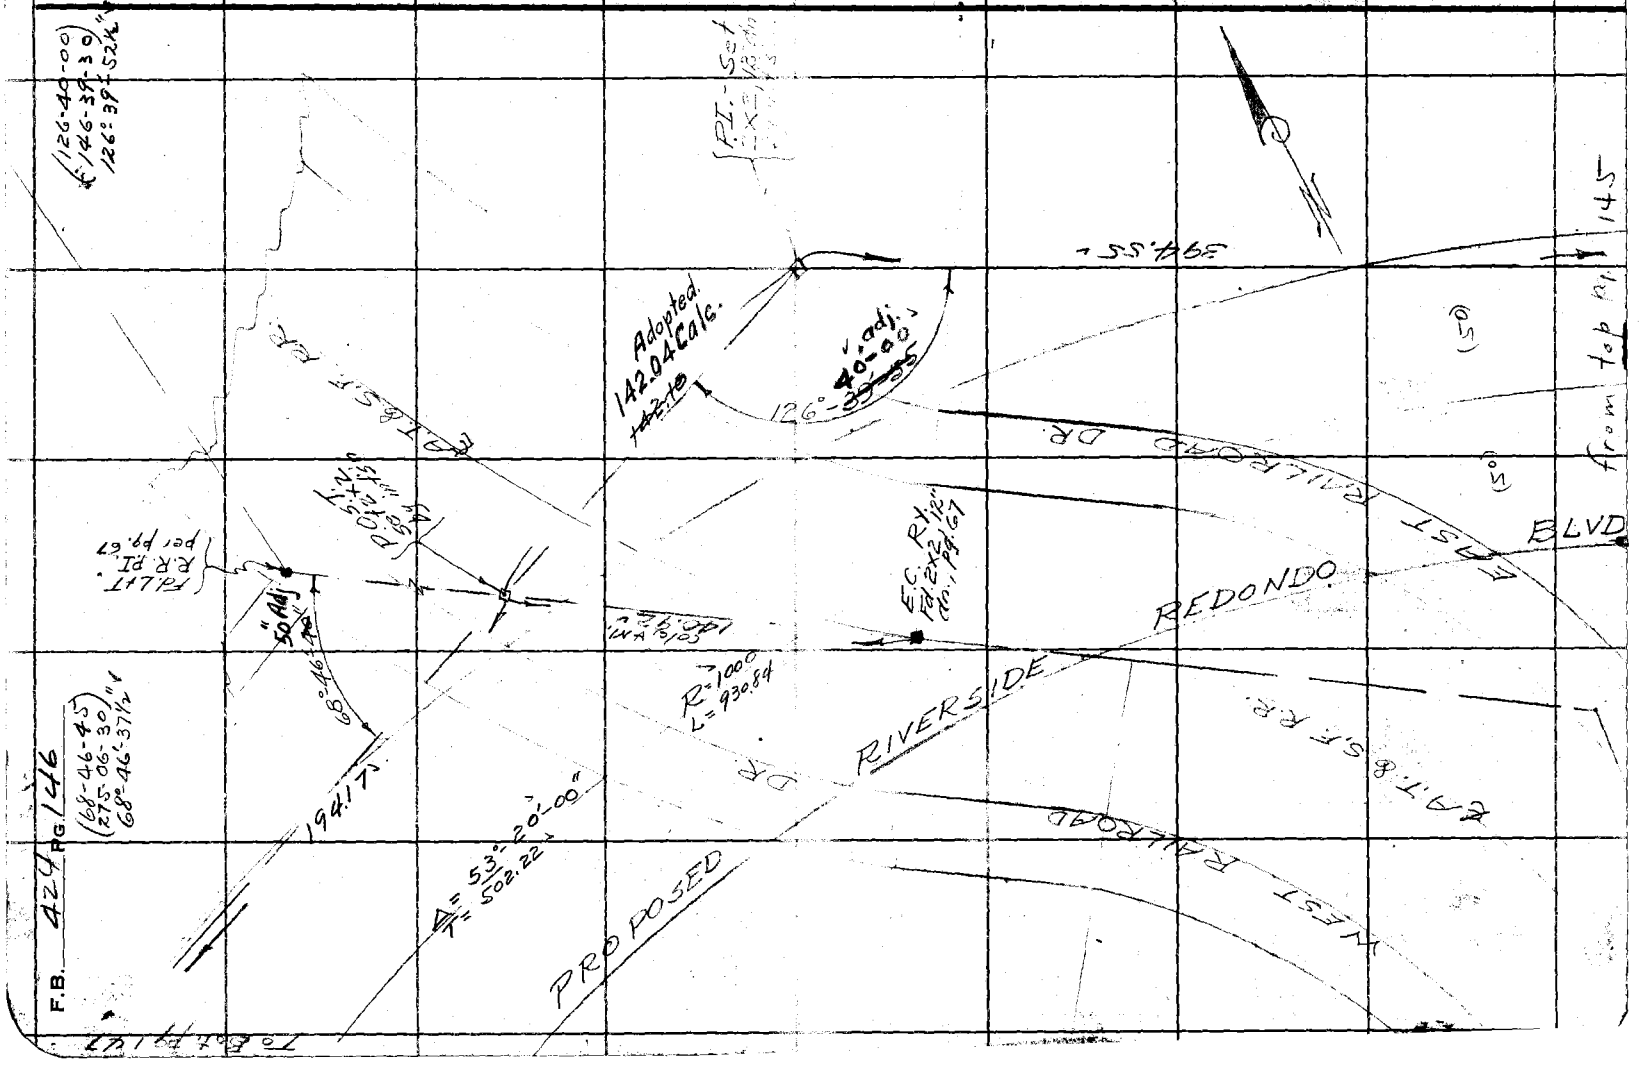

Notes Ck'd by	D.M. Finley	Survey of	Riverside Redondo Bv.
Map No.	B-442-2	W. O.	7920
Office Work	R.W.M.	Tape No	011
Checked	D.M. Finley	St'd	8 V
Date	Jan. 1936.	Surveyed by	E. Voils
		Notes	F.I.
		Date	2/16/35
		Indexed	A. C. Johnson

F.B. 424 PG. 147

Note: ANY ADDITIONS OR CHANGES ON THIS SHEET MUST BE MADE OR CIRCLED IN Red Ink WITH DATE AND NAME OF PERSON MAKING CHANGE.

Do not extend notes this side of this line

RETURN TO
LOS ANGELES COUNTY SURVEYOR
700 HALL OF RECORDS

FORM 247 5M 2-34

E. of line change.

E Q. Sta. 267+87.68 Back
P.O.T. = 267+05.56
Going S.W. on E.C.
Tan. 2 x 2 per 19.57

PROPOSED RIVERSIDE-REDONDO BV.

265+77.98 E.C.

Tan. 2 x 2 per 19.57

P.O.T. = 265+58.41

Old line per p 9.57

Old line per p 9.57

col. M. 49.23

INGLESIDE.

DR.

(From Sta. 261+46)

F.B. 424 PG. 148

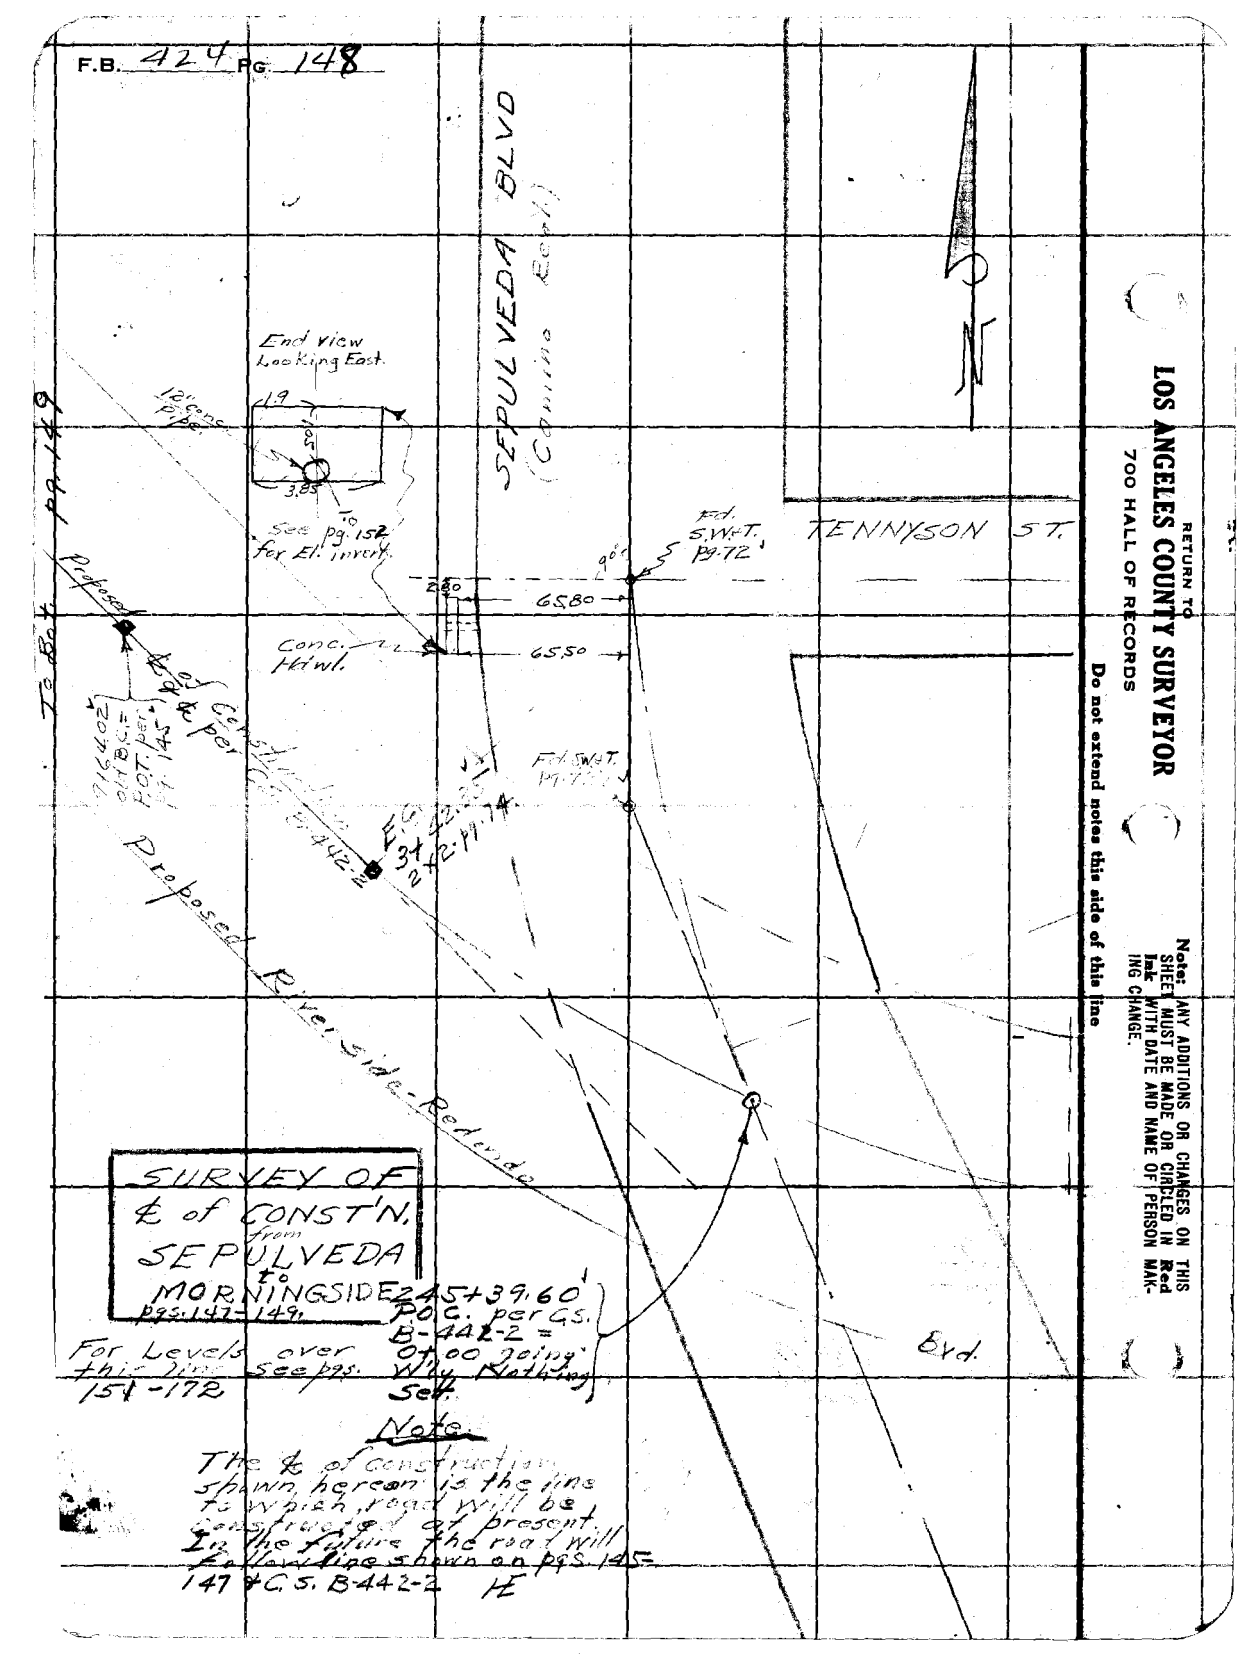

SURVEY OF
℄ of CONST'N.
from
SEPULVEDA
to
MORNINGSIDE
pgs. 147-149

245+39.60
P.O.C. per C.S.
B-442-2 =
0+00 going
Wly Radial
Sely

For Levels over this line see pgs. 151-172

Note

The ℄ of construction shown hereon is the line to which road will be constructed at present. In the future the road will follow line shown on pgs. 145-147 of C.S. B-442-2

RETURN TO
LOS ANGELES COUNTY SURVEYOR
700 HALL OF RECORDS

Note: ANY ADDITIONS OR CHANGES ON THIS SHEET MUST BE MADE OR CIRCLED IN Red Ink WITH DATE AND NAME OF PERSON MAKING CHANGE.

Do not extend notes this side of this line

Notes Ck'd by D.M.Finley		Survey of Riverside Redond. Blvd	F.B. 424 Pg 149
Map No. B-442-2		W. O. 7777 Tape No 10 St'd 84 OF.	
Office Work		Surveyed by EVANS	
Checked D.M.Finley		Notes LE	Date 12/18/35
Date Jan. 1936		Indexed A. C. Job: 12-20-1935	

Note: ANY ADDITIONS OR CHANGES ON THIS SHEET MUST BE MADE OR CIRCLED IN Red Ink WITH DATE AND NAME OF PERSON MAKING CHANGE.

Do not extend notes this side of this line

RETURN TO
LOS ANGELES COUNTY SURVEYOR
700 HALL OF RECORDS

FORM 247 5M 2-34

B+495.49, 12" Mon. Fd. 2x2, per Pg 5, 102 & 149

per Pg 155

DR

INGLESIDE

per C.S. B-442-2

Proposed 4" C.I. Const'n. Monument 356.96 Calc'd M.

WEST RAILROAD AVE

A.T.&S.F. R.R.

P.I. Fd. 2x2 Pg. 146

84.44' Calc'd M.

E.C.-15+38.53 & Const'n. P.O.C.-26^+78.13 C.S. B-442-2 Set 2x2, 12" dn.

EAST RAILROAD AVE

Calc'd M. 91.45 90°

Proposed Riverside-Redondo Blvd

R=1000' T=218.90' L=430.99'

Δ=24°41'37"

P.C.C. 11+07 Fd. 2x2 Pg. 146 Set 47¼ Perp.

(From 44/Pg. 148)

F.B. 424 PG. 150

RETURN TO
LOS ANGELES COUNTY SURVEYOR
700 HALL OF RECORDS

Note: ANY ADDITIONS OR CHANGES ON THIS SHEET MUST BE MADE OR CHARGED IN Red Ink WITH DATE AND NAME OF PERSON MAKING CHANGE.

Do not extend notes this side of this line

Profile No. _____ Notes Red. _____ Platted _____ Job No. _____ Division No. _____ L. B. 424 Pg. 151

Date _____ Date _____ Survey of _____

X-Sec. No. _____ Notes Chkd. _____ Checked D.M. Finley Survey by _____ Notes _____ Date _____

Date _____ Date Dec. 1935 Map No. _____ Indexed C. John Date 12-20-1935

NOTE: ANY ADDITIONS OR CHANGES ON THIS SHEET MUST BE MADE OR CIRCLED IN RED INK, WITH DATE AND NAME OF PERSON MAKING CHANGE

Do not extend notes this side of this line

Profile & X-Sec.
over
Proposed ℄ of Construction
from
SEPULVEDA AVE
to
MORNINGSIDE DR.

Evans
Martin
Seely
Harris

(See pgs. 148-149 for Survey notes)

STATION	B. S.	H. I.	F. S	ELEV.

PLEASE RETURN TO
LOS ANGELES COUNTY SURVEYOR
700 HALL OF RECORDS

Form 307 5M 10-34

Form 307 5M 10-34

PLEASE RETURN TO
LOS ANGELES COUNTY SURVEYOR
700 HALL OF RECORDS

NOTE: ANY ADDITIONS OR CHANGES ON THIS SHEET MUST BE MADE OR CIRCLED IN RED INK, WITH DATE AND NAME OF PERSON MAKING CHANGE

Do not extend notes this side of this line



Profile No. ____ Notes Red. ____ Platted ____ Job No. ____ Division No. ____ L. B. 424 Pg. 151

Date ____ Date ____ Survey of ____

X-Sec. No. ____ Notes Chkd. ____ Checked R.M. Finley Survey by ____ Notes ____ Date ____

Date ____ Date Dec. 1926 Map No. ____ Indexed C. Johns Date 12-20-1926

NOTE: ANY ADDITIONS OR CHANGES ON THIS SHEET MUST BE MADE OR CIRCLED IN RED INK, WITH DATE AND NAME OF PERSON MAKING CHANGE

Do not extend notes this side of this line

Profile & X-Sec.

over

Proposed ℄ of Construction

from

SEPULVEDA AVE

to

MORNINGSIDE DR.

Evans
Martin
Sedig
Harris.

(See pgs. 148-149 for survey notes)

STATION	B. S.	H. I.	F. S	ELEV.

PLEASE RETURN TO
LOS ANGELES COUNTY SURVEYOR
700 HALL OF RECORDS

Form 307 SM 10-34

Form 307 5M 10-34

PLEASE RETURN TO
LOS ANGELES COUNTY SURVEYOR
700 HALL OF RECORDS

NOTE: ANY ADDITIONS OR CHANGES ON THIS SHEET MUST BE MADE OR CIRCLED IN RED INK, WITH DATE AND NAME OF PERSON MAKING CHANGE

Do not extend notes this side of this line

L.E. 424 P.G. 52 Job No. 7920 Division No. Notes Red LE Plotted Profile No.
Survey of Riverside Redondo Blvd. Date Date X-Sec. No.
Survey by Evans Notes LE Notes Chkd. A.M.Ely Checked
Indexed Date 12/18/35 Date Dec. 1935 Date

STATION	B. S.	H. I.	F. S	ELEV.	
B.M.	1.876	186.59		184.714	Fd. R.R. spk in P.P. #38712E at N.W. for Camino Real (Sepulveda Blvd) and Gould Ave. per L.B. 174/144
T.P.	1.72	176.82	11.49	175.10	
T.P.	0.91	166.76	10.97	165.85	
T.P.	0.19	155.43	11.52	155.24	
			5.32	150.11	Invert of storm drain outlet, West side Camino Real at Tennyson Ave.
T.P.	0.40	144.17	11.66	143.77	Note (For location of invert) see Page 148
T.P.	0.41	132.86	11.72	132.45	
T.P.	1.38	122.70	11.54	121.32	
10+00 ℄			13.3	109.4	(For Hermosa Beach Datum Subtract 1.50)
40'R.			8.1	114.6	
80'R.			3.9	118.1	
80'L.			20	102.6	
10+50 ℄			15.1	107.6	
46'R.			10.2	112.5	
80'R.			5.3	117.4	
80'L.			23.3	99.4	
11+07.54 B.C.			17.8	104.9	
80R.			7.2	115.7	
42'L			21.8	100.9	
80'L.			27.6	95.1	

Form 307 5M 10-34

PLEASE RETURN TO
LOS ANGELES COUNTY SURVEYOR
700 HALL OF RECORDS

NOTE: ANY ADDITIONS OR CHANGES ON THIS SHEET MUST BE MADE OR CIRCLED IN RED INK, WITH DATE AND NAME OF PERSON MAKING CHANGE

Do not extend notes this side of this line

Profile No.____ Notes Red. LE Platted ____ Job No. 7320 Division No. ____
X-Sec. No.____ Date ____ Date ____ Survey of Riverside Avenue Blvd.
Notes Chkd. ____ Checked RAP Survey by Evans Notes LE Date 12-18-35
Date ____ Date Dec. 1935 Map No. ____ Inked C. Johnson Date ____

L. B. 424 Pg. 153

STATION	B. S.	H. I.	F. S	ELEV.
		122.70'		
T.P.	0.70	111.67'	11.73	110.97'
11+50 ℄			8.4	~~104.3~~ 103.3
45 R.			2.8	108.9'
80' R.			+2.1	114.4'
38 ℄			13.5	98.2'
80' L			17.1	94.6'
12+00			9.7	102.0'
70 R.			1.1	110.6'
80 R.			+0.5	112.2'
80' L.			19.6	92.1'
12+50 ℄			12.0	99.7'
80' R.			1.0	110.7'
80' L.			22.0	89.7'
13+00 ℄			14.5	97.2'
80' R.			3.0	108.7'
80' L			24.5	87.2'
T.P.	1.39	101.06'	12.00	99.67'
13+50 ℄			6.3	94.8'
80' R.			+5.0	106.1'
80' L.			16.21	84.9'

Form 307 5M 10-34

PLEASE RETURN TO
LOS ANGELES COUNTY SURVEYOR
700 HALL OF RECORDS

NOTE: ANY ADDITIONS OR CHANGES ON THIS SHEET MUST BE MADE OR CIRCLED IN RED INK, WITH DATE AND NAME OF PERSON MAKING CHANGE

Do not extend notes this side of this line

L.B. 424 P.G. 154 Job. No. 7320 Division No. Notes Red E Plotted Profile No.
Survey of Riverside Redondo Blvd. Date Date X-Sec. No.
Survey by Evans Notes E Notes Checked R. M. Finley Date
Indexed Date 12-18-35 Date Dec. 1935 Date

STATION	B. S.	H. I.	F. S	ELEV.	
		101.06'			
14+00 ℄			9.8	91.3'	
80' R.			42.3	103.4'	
80' L.			17.7	83.4'	
14+50 ℄			12.7	88.4'	
80' R.			0.5	100.6'	
58' L.			17.5	83.6'	T. Cut.
61' L.			18.7	82.4'	B. Cut + edge Rd.
80' L.			20.0	81.1'	℄ R.R. Ave. E.
14+92 ℄			14.8	86.3'	
15+00 L			16.5	84.6'	
7' R.			14.6	86.5'	
80' R.			5.0	96.1'	
18' L.			17.3	85.3'	T.C.
24' L.			18.2	84.1'	B.C. + edge R.R. Ave E.
56' L.			19.8	81.5'	" " " "
63' L.			19.6	81.5'	Top fill
80' L.			26.0	75.1'	B. F.
T.P.	0.70	90.17'	11.59	89.47'	
15+25 ℄			6.7	83.5'	
15+30 ℄			6.3	83.9'	edge R.R. Ave. E.

Form 307 5M 10-34

PLEASE RETURN TO
LOS ANGELES COUNTY SURVEYOR
700 HALL OF RECORDS

NOTE: ANY ADDITIONS OR CHANGES ON THIS SHEET MUST BE MADE OR CIRCLED IN RED INK, WITH DATE AND NAME OF PERSON MAKING CHANGE

Do not extend notes this side of this line

Profile No. ____ X-Sec. No. ____ Notes Red. ____ Date ____ Notes Chkd. ____ Date ____ Platted ____ Date ____ Checked D. M. Finley Date Dec. 1934 Survey of Riverside Redondo Blvd. Survey by Evans Map No. ____ Job No. 7320 Division No. ____ Notes LE Index C. Johnson Date 12-18-35 L. B. 424 Pg. 155

STATION	B. S.	H. I.	F. S	ELEV.	
		90.17			
15+46.5 ±			6.8	83.4'	Approx ℄ int. R.R. Ave E. ℄ proposed ℄ constr.
				Going N. on R.R. Ave. East.	
15+46.5 West = 0+00 going N.			6.8	83.4'	
12' R			6.1	84.1'	E. edge Tear Rd.
12' L.			7.1	83.1'	W. " " "
0+50			5.9	84.3'	
12 R.			5.2	85.0'	E. " " "
12' L			6.4	83.8'	W. " " "
1+00			4.5	85.7'	
12' R.			3.7	86.5'	E. " " "
12' L.			4.6	85.6'	W. " " "
1+50			2.2	88.0'	
12 R.			1.4	88.8'	E. " " "
12' L.			2.5	87.7'	W. " " "
2+00			+0.9	91.1'	
12' R.			+1.7	91.9'	E. " " "
12' L			+0.2	90.4'	W. " " "
		Going S. on R.R. Ave East.			
15+46.5 West = 0+00 going S.			6.8	83.4'	Approx ℄ int R.R. Ave E. ℄ Prop't. ℄ [illegible]
0+50			7.9	82.3'	

Form 307 5M 10-34

PLEASE RETURN TO
LOS ANGELES COUNTY SURVEYOR
700 HALL OF RECORDS

NOTE: ANY ADDITIONS OR CHANGES ON THIS SHEET MUST BE MADE OR CIRCLED IN RED INK, WITH DATE AND NAME OF PERSON MAKING CHANGE

Do not extend notes this side of this line

L.B. 424 P.G. 158 | Job. No. 7920 Division No. | Notes Red LE | Plotted | Date | Profile No. | X-Sec. No.
Survey of: Riverside Redondo Blvd. | Date | Checked D. M. Finley | Date Dec 1935
Survey by: Evans | Notes LE
Indexed | Date 12-18-35

STATION	B. S.	H. I.	F. S	ELEV.		
(0+50)		90.17'				
12 R.			8 3	81.9'	W. edge Trav. Rd.	
12 L.			7 2	82.0'	E. " " "	"
1+00.			8 4	81.8'		
12R.			8 7	81.5'	W. " " "	"
12'L			8 0	82.2'	E. " " "	"
1+50			9 3	80.1'		
12R.			9 6	80.6'	W. " " "	"
12'L			8 8	81.4'	E. " " "	"
2+00			10.1	80.1'		
12'R.			10 1	71.5'	W. " " "	"
12'L			9 8	80.4'	E. " " "	"
		Continuing West on Proposed ℄.				
15+63			7 0	83.2'	W. edge R.R. Ave East.	
27R.			5 8	84.4'	E. " " " "	"
31R.			5 0	85.2'		
37R.			4 7	85.5'		
40R.			5 2	85.0'		
45R			4 7	85.5'		
60'R.			0 0	90.2'		
80'R.			+2 4	92.6'		

Form 307 5[illegible] 10-34

PLEASE RETURN TO
LOS ANGELES COUNTY SURVEYOR
700 HALL OF RECORDS

NOTE: ANY ADDITIONS OR CHANGES ON THIS SHEET MUST BE MADE OR CIRCLED IN RED INK, WITH DATE AND NAME OF PERSON MAKING CHANGE

Do not extend notes this side of this line

Profile No. ____ Notes Red. HE Platted ____ Job No. 7820 Division No. ____ L. B. 424 Pg. 157
X-Sec. No. ____ Date ____ Date ____ Survey of Riverside Redondo Blvd.
Notes Chkd. ____ Checked D. M. Finley Survey by Evans Notes HE Date 12-18-35
Date Dec 1935 Map No. ____ Inked C. Johnson Date

STATION	B. S.	H. I.	F. S	ELEV.	
(15+63)		90.17			
3'L			6 4	83.8	
8'L			6 7	83.5	
25'L.			14 2	76.0	Bot. fill
34'L			15 1	75.1	
44'L			14 7	75.5	Toe fill A.T.+S.F. E. side
58'L			12 0	78.2	Top ballast E edge.
72'L.			11 9	78.3	" " W. "
80'L.			13 2	77.0	Top fill A.T.+S.F. W side
15+65 E			6 2	84.0	
15+70 E			6 4	83.8	
15+90 E			12 8	77.4	
16+00 E			13 6	76.6	
7R.			13 0	77.2	Toe fill
25R.			5 4	84.8	Top "
29R.			5 2	85.0	
30R.			6 1	84.1	
63R.			4 5	85.7	
68R.			3 2	87.0	
80R.			2 7	87.5	
13L.			14 2	76.2	B.+T.R.R. Fill

Form 307 5M 10-34

PLEASE RETURN TO
LOS ANGELES COUNTY SURVEYOR
700 HALL OF RECORDS

NOTE: ANY ADDITIONS OR CHANGES ON THIS SHEET MUST BE MADE OR CIRCLED IN RED INK, WITH DATE AND NAME OF PERSON MAKING CHANGE

Do not extend notes this side of this line

Profile No. ___ Plotted ___ Date ___
X-Sec. No. ___ Checked D. M. Finley Date Dec. 1935
Notes Red HM
Notes ___ Date 12-18-35
Job. No. 7220 Division No. ___
Survey of Riverside Redondo Blvd.
Survey by Evans Notes HE
Indexed ___ Date 12-18-35
L.B. 424 P.G. 58

STATION	B. S.	H. I.	F. S	ELEV.		
		90.17				
20 L.			12 1	78.1		
27 L.			11 4	78.5	Top Ballast E side R.R.	
41' L			11 4	78.8	" " W. " "	
53' L			12 7	77.5		
76' L.			21 9	68.8	Bot R.R. fill	
80' L.			21 4	68.8		
T.P.	3.15	85.87	7 4 5	82.72	Top of 2x2 stake P.C.C. -260+78.13 (C.S. B-442-7) = 15+38.53 E.C. const'n E.B. 424/148	
16+13			9 3	76.6	Bot R.R. fill	
16+21			7 2	78.7	Top " "	
7' R.			8 5	77.4	Bot. " "	
26 R.			6 8	77.1	" St. fill	
42' R.			0 3	85.6	Top " "	
49 R.			0 3	85.6		
50 R.			0 9	85.0	W. edge Rd.	
82' R.			1 0	84.9		
7 L			7 4	78.5		
10 L.			7 2	78.7		
28 L.			6 9	79.0		
31 L.			7.6	78.3		
39 L.			7 2	78.0		

Form 307 5M 10-34

PLEASE RETURN TO
LOS ANGELES COUNTY SURVEYOR
700 HALL OF RECORDS

NOTE: ANY ADDITIONS OR CHANGES ON THIS SHEET MUST BE MADE OR CIRCLED IN RED INK, WITH DATE AND NAME OF PERSON MAKING CHANGE

Do not extend notes this side of this line

Profile No. ____ X-Sec. ____ Notes Chkd. ____ Date ____ Notes Red. HM Date ____ Platted ____ Date ____ Checked D. M. Finlay Date Dec 1946 Job No. 7922 Division No. ____ Survey of Riverside Blvd Survey by Evans Map No. ____ Notes E. C. Johnson Date 12-19-35 L. B. 424 Pg. 159

STATION	B. S.	H. I.	F. S	ELEV.		
(16+21)		85.87				
58 L.			14.8	71.1		
68 L.			15.4	70.5		
80 L.			11.5	74.4		
16+36.5			6.34	79.53	Top of East rail	
16+44			6.03	79.84	" " West "	
16+48			6.5	79.4		
16+50			6.9	79.0		
3 R.			6.5	79.4		
27 R.			6.8	79.1		
49 R.			4.2	81.7		
68 R.			+1.0	86.9		
74 R.			+1.2	87.1		
75 R.			+0.5	86.4		
[illegible] R.			+0.7	86.6		
10 L.			7.6	78.3		
21 L.			10.6	75.3		
43 L.			12.1	73.8		
55 L.			9.0	76.9		
61 L.			8.7	77.2		
66 L.			9.8	76.1	E. edge Rd.	
80 L.			11.0	74.9	E Rd.	

Form 307 5M 10-34

PLEASE RETURN TO
LOS ANGELES COUNTY SURVEYOR
700 HALL OF RECORDS

NOTE: ANY ADDITIONS OR CHANGES ON THIS SHEET MUST BE MADE OR CIRCLED IN RED INK, WITH DATE AND NAME OF PERSON MAKING CHANGE

Do not extend notes this side of this line

L.B. 424 P.G. 160 | Job No. 7320 | Division No. | Notes Red HM | Plotted | Profile No.
Survey of Riverside Redondo Blvd | Date | Date | X-Sec. No.
Survey by Evans | Notes HE | Notes Ch. D. M. Finley | Checked
Indexed | Date 12-19-35 | Date Dec 1935 | Date

STATION	B. S.	H. I.	F. S	ELEV.		
		85.87				
16+58			7.2	78.7		
16+65			8.8	77.1		
16+76			8.5	77.4		
16+89			7.5	78.4		
16+92			6.7	79.2		
17+00			6.9	79.0		
6 R.			6.9	79.0		
27 R.			5.3	80.6		
36 R.			6.7	79.2		
45 R.			6.1	79.8		
55 R.			6.1	79.8		
64 R.			6.8	79.1		
73 R.			4.0	81.9		
90 R.			3.0	82.9	Bot cut.	
12 L.			7.4	78.5		
20 L			8.5	77.4	E. edge Rd.	
46 L			9.0	76.9	W. " "	
50 L.			8.2	77.7		
55 L.			8.5	77.4	Top fill	
63 L			11.0	74.9	Bot. "	
80 L			12.5	73.4		

Form 307 5M 10-34

PLEASE RETURN TO
LOS ANGELES COUNTY SURVEYOR
700 HALL OF RECORDS

NOTE: ANY ADDITIONS OR CHANGES ON THIS SHEET MUST BE MADE OR CIRCLED IN RED INK, WITH DATE AND NAME OF PERSON MAKING CHANGE

Do not extend notes this side of this line

Profile No. ____ Notes Red. HM Platted ____ Job No. 7320 Division No. ____ L. B. 424 Pg. 161
X-Sec. ____ Date ____ Date ____ Survey of Riverside Redondo Blvd
Notes Chkd. ____ Checked D. M. Finley Survey by Evans Notes HE Date 12-19-35
Date ____ Map No. ____ Inked C. Johnson Date

STATION	B. S.	H. I.	F. S	ELEV.	
		85.87'			
17+12			7	78.8'	
17+17			8	77.8'	E. edge Rd.
17+53.5			8.8	77.1'	Approx. ℄ intsn. of West. R.R. Ave & Cross
					North on ℄ West R.R. Ave.
17+53.5 west = 0+00 going North on ℄ R.R Ave			8.8	77.1'	
11 R.			8.3	77.6'	E. edge Rd.
11 L.			9.0	76.9'	W. " "
0+50			9.2	76.7'	going N. on ℄ R.R. Ave.
11 R.			8.7	77.2'	E. edge Rd.
11 L.			9.4	76.5'	W. " "
1+00			9.6	76.3'	℄ "
11 R.			9.1	76.8'	E. " "
11 L.			9.9	76.0'	W " "
1+50			9.6	76.1'	℄ " "
11 R.			9.5	76.4'	E. " "
11 L.			10.1	75.8'	W. " "
2+00			9.8	76.1'	℄ "
11 R.			9.4	76.5'	E. " "
11 L.			10.0	75.9'	W. " "

Form 307 5M 10-34

PLEASE RETURN TO
LOS ANGELES COUNTY SURVEYOR
700 HALL OF RECORDS

NOTE: ANY ADDITIONS OR CHANGES ON THIS SHEET MUST BE MADE OR CIRCLED IN RED INK, WITH DATE AND NAME OF PERSON MAKING CHANGE

Do not extend notes this side of this line

L.B. 424 P.G. 162 | Job. No. 1920 Division No. | Notes Red HM | Plotted | Profile
Survey of Riverside Redondo Blvd. | Date | No.
Survey by Evans | Notes HE | Checked D.M. Finley | Date | X-Sec.
Indexed | Date 12-19-35 | Date Dec 1935 | Date | No.

STATION	B. S.	H. I.	F. S	ELEV.		
		85.87 ✓				
		South	on	℄ West R.R. Ave.		
17+53.5 going W.			85	77.1	Approx. int'sn W. Railroad Ave & ℄ proposed Constn.	
=0+00 " S.			89	77.0	℄ R.R. Ave.	
0+50			89	77.0	W. edge Rd.	
11R.			85	77.4	E. " "	
11L.			96	76.3	℄ "	
1+00			101	75.8	W. " "	
11R.			93	76.6	E. " "	
11L.			133	76.6	℄ "	
1+50			137	76.2	W. " "	
11R.			127	76.2	E. " "	
11L.			164	69.5	℄ "	
2+00			168	69.1	W. " "	
11R.			161	69.7	E. " "	
11L.						
Continuing West on Proposed ℄ Constn. Riverside-Redondo Blvd.						
17+50			9	76.9	W. edge Railroad Ave.	
34R.			87	77.2	E. " " "	
41R.			64	77.5		
65R			50	80.9		
80R.			57	80.2		

Form 307 5M 10-34

PLEASE RETURN TO
LOS ANGELES COUNTY SURVEYOR
700 HALL OF RECORDS

NOTE: ANY ADDITIONS OR CHANGES ON THIS SHEET MUST BE MADE OR CIRCLED IN RED INK, WITH DATE AND NAME OF PERSON MAKING CHANGE

Do not extend notes this side of this line

Profile No.____ X-Sec. No.____ Notes Rod. LM Platted Date____ Notes Chkd. Date____ Checked D. M. Finley Date 12-15-35 Job No. 7820 Division No. L. B. 424 Pg. 163 Survey of Riverside Redondo Blvd. Survey by Evans Notes by RE Date 12-19-35 Map No.____ Inked C. Johnson

STATION	B. S.	H. I.	F. S	ELEV.	
(17+50)		85.87			
3 L.			8 1	77.8	
9 L.			8 5	77.7	
21 L.			11 1	74.2	
50' L			14 0	71.9	
80' L			17 4	68.5	
T.P.	2.95	80.72	8 0	77.77	
17+55			2.9	77.8	
17+60			3.2	77.5	
17+72			8.2	72.5	
18+00			11 6	69.1	
27 R.			8 7	72.0	Bot fill
44 R.			3.5	77.2	Top "
48 R.			3.5	77.2	
51 R.			4 6	76.1	W edge Rd.
80 R.			3 9	76.8	E " "
80' L			17 0	63.7	
T.P.	3.57	72.73	11 56	69.16	
18+50			8 5	64.2	
74 R.			1 7	71.0	Bot fill
92 R.			43 7	76.4	Top "
802.			14 2	58.5	

Form 307 5M 10-34

PLEASE RETURN TO
LOS ANGELES COUNTY SURVEYOR
700 HALL OF RECORDS

NOTE: ANY ADDITIONS OR CHANGES ON THIS SHEET MUST BE MADE OR CIRCLED IN RED INK, WITH DATE AND NAME OF PERSON MAKING CHANGE

Do not extend notes this side of this line

L.B. 424 P.G. 164 Job. No. 7920 Division No. Notes Red HM Plotted Profile No.
Survey of Riverside Redondo Blvd. Date Date X-Sec.
Survey by Evans Notes HE Notes Ch. D. M. Finley Checked No.
Indexed Date 12-19-35 Date Dec. 1935 Date

STATION	B. S.	H. I.	F. S	ELEV.		
		72.73				
18+95.49			12 8	59.9	P.I. int'sn & constn ℄ 27th St.	
19+00			13 2	59.5	℄ 27th St. (Not. constd.)	
80 R.			12 5	60.2	5' west of ℄ Ingleside Dr. (Not constd.)	
80 L.			14 3	58.4	" " " " "	" " "
T.P.	041	61.52	11 62	61.11		
19+50			5 6	56.5	℄ 27th (Not constd.)	
80 R.			4 9	56.6		
80 L.			4 4	57.1		
20+00			5 6	55.9	℄ 27th "	"
80 R.			8 0	53.5		
80 L.			3 9	57.6		
20+50			6 7	51.8	" " "	"
80 R.			9 6	51.9		
80 L.			3 9	57.6		
21+00			7 0	54.5	" " "	"
80 R.			9 6	51.9		
80 L.			5 0	56.5		
21+50			6 1	55.4	" " "	"
80 R.			7.9	53.6		
80 L.			6 1	55.4		

Form 307 5M 10-34

PLEASE RETURN TO
LOS ANGELES COUNTY SURVEYOR
700 HALL OF RECORDS

NOTE: ANY ADDITIONS OR CHANGES ON THIS SHEET MUST BE MADE OR CIRCLED IN RED INK, WITH DATE AND NAME OF PERSON MAKING CHANGE

Do not extend notes this side of this line

Profile No. ____ X-Sec. No. ____ Notes Rod. LM Platted ____ Date ____ Notes Chkd. ____ Date ____ Checked D. M. Finley Date 12-16-35 Map No. ____ Job No. 7720 Division No. ____ Survey of Riverside Redlands Blvd. Survey by Evans Notes LE Date 12-19-35 Inked C. Johnson Date ____ L. B. 424 PG. 165

STATION	B. S.	H. I.	F. S	ELEV.	
		61.52			
21+80			6 5	55.0	℄ 27th St. 14 of Const'd.
22+00			3 9	57.6	" " " " "
50 R.			7 2	54.3	
80 R.			7 0	54.5	
22 L.			5 7	55.8	
84 L.			+0 2	61.7	
T.P.	10 21	67.86	3 87	57.65	
T.P.	10 04	76 04	1 86	66 00	
22+40			8 8	67.2	" " " " "
20 R.			8 8	67.2	
80 R.			19 5	56.5	
40 L			9 8	66.2	
80 L.			12 0	64.0	
22+50			8 2	67.8	" " " " "
23+00			5 3	70.7	
80 R			4 8	71.2	
80 L			7 3	68.7	
23+50			3 9	72.1	" " " " "
80 R.			2 9	73.1	
80 L.			4 6	71.4	

Form 307 5M 10-34

PLEASE RETURN TO
LOS ANGELES COUNTY SURVEYOR
700 HALL OF RECORDS

NOTE: ANY ADDITIONS OR CHANGES ON THIS SHEET MUST BE MADE OR CIRCLED IN RED INK, WITH DATE AND NAME OF PERSON MAKING CHANGE

Do not extend notes this side of this line

L.B. 424 P.G. 166 Job No. 7920 Division No. Notes Red HM Plotted Profile No.
Survey of Riverside Redondo Blvd. Date Notes Checked Date X-Sec. No.
Survey by Evans Notes HE Notes Ch. Dal M. Finley Date 12-19-35 Date Dec. 1935 Date
Indexed

STATION	B. S.	H. I.	F. S	ELEV.		
		76.04				
23+62			4.1	71.9		
23+66			5.14	70.90	Begin Conc prmt & 27th	
23+85.52			4.50	71.54	& int'sn 27th St. & Morningside Dr. L.&T. Conc. prmt	
23+85.5 27th St.		Going North on Morningside.				
=0+00 North on Morningside			4.50	71.54		
0+21			4.46	71.58	& Morningside.	
12.5 R.			4.96	71.08	gutter	
12.5 R.			4.44	71.60	Top curb	
20' R.			4.31	71.73	Back walk.	
12.5 L.			3.97	72.07	gutter	
12.5 L.			3.96	72.08	Top curb.	
20 L.			2.97	73.07	Back walk.	
0+50			3.57	72.47	& Morningside	
12.5 R.			4.25	71.79	gutter	
12.5 R.			3.72	72.32	T. curb.	
20 R.			3.58	72.46	Back walk.	
12.5 L.			3.10	72.94	gutter	
12.5 L.			2.50	73.54	Top curb.	
20' L			2.24	73.80	Back walk.	

Form 367 5M 10-34

PLEASE RETURN TO
LOS ANGELES COUNTY SURVEYOR
700 HALL OF RECORDS

NOTE: ANY ADDITIONS OR CHANGES ON THIS SHEET MUST BE MADE OR CIRCLED IN RED INK, WITH DATE AND NAME OF PERSON MAKING CHANGE

Do not extend notes this side of this line

Profile No. ____ Notes Red. HM Platted ____ Job No. 7220 Division No. ____ L.B. 424 PG. 167
X-Sec. ____ Date ____ Date ____ Survey of Riverside Rd. Blvd.
Notes Chkd. ____ Checked M. Finley Survey by Evans Notes HE Date 12-19-35
Date Dec. 1935 Map No. ____ Inked C. Johnson Date ____

STATION	B. S.	H. I.	F. S	ELEV.	
		76.04			
0+98			2.08	73.96	℄ Morningside.
12.5 R.			2.01	73.37	gutter
12.5 R.			2.12	73.92	T. curb
20 R.			2.08	73.96	Back walk.
12.5 L.			1.53	74.51	gutter
12.5 L			0.93	75.11	T. curb.
20' L.			0.80	75.24	Back Walk.
1+50			1.27	74.77	℄ Morningside.
12.5 R.			2.00	74.04	gutter
12.5 R.			1.51	74.53	curb
20 R.			1.38	74.66	B. walk.
12.5 L			0.48	75.56	gutter
12.5 L.			+0.10	76.14	T. curb.
20' L.			+0.22	76.26	B. walk.
23+85.5 going W.	Going	South	on ℄	Morningside Dr.	
=0+00 going South on ℄ Morningside			4.50	71.54	℄ intsn.
0+21			4.49	71.55	℄ Morningside.
12.5 R			3.96	72.08	gutter
12.5 R.			3.36	72.68	T. curb.
20 R.			3.06	72.98	B. Walk.

Form 307 5M 10-34

PLEASE RETURN TO
LOS ANGELES COUNTY SURVEYOR
700 HALL OF RECORDS

NOTE: ANY ADDITIONS OR CHANGES ON THIS SHEET MUST BE MADE OR CIRCLED IN RED INK, WITH DATE AND NAME OF PERSON MAKING CHANGE

Do not extend notes this side of this line

L.B. 424 P.G. 168 | Job No. 7920 Division No. | Notes Red HM | Plotted | Profile
Survey of Riverside Redondo Blvd. | Date | No.
Survey by Evans | Notes HE | Notes Ch. D. M. Finley | Checked | X-Sec.
Indexed | Date 12-19-35 | Date Dec. 1935 | Date | No.

STATION	B. S.	H. I.	F. S	ELEV.		
(0+21)		76.04				
12.5 L.			5.06	70.98'	gutter	
12.5 L.			4.50	71.54'	T. curb.	
20' L.			4.31	71.73'	B. walk.	
0+50			4.30	71.74'	& Morningside	
12.5 R.			3.80	72.24'	gutter	
12.5 R.			3.70	72.84'	T curb.	
20 R.			3.05	72.99'	B walk.	
12.5 L.			4.83	71.21'	gutter	
12.5 L.			4.30	71.74'	T. curb	
20' L.			4.10	71.94'	B. walk.	
0+99			3.98	72.06'	& Morningside	
12.5 R.			3.43	72.61'	gutter	
12.5 R.			2.82	73.22'	T. curb.	
20 R.			2.66	73.38'	B. walk.	
12.5 L.			4.49	71.55'	gutter	
12.5 L.			4.00	72.04'	T. curb	
20 L.			4.02	72.02'	B walk.	
1+20			3.71	72.33'	& Morningside	
12.5 R.			3.05	73.01'	gutter	
12.5 R.			2.47	73.57'	curb	
20' R.			2.12	73.92'	B walk.	

Form 307 5M 10-34

PLEASE RETURN TO
LOS ANGELES COUNTY SURVEYOR
700 HALL OF RECORDS

NOTE: ANY ADDITIONS OR CHANGES ON THIS SHEET MUST BE MADE OR CIRCLED IN RED INK, WITH DATE AND NAME OF PERSON MAKING CHANGE

Do not extend notes this side of this line

Profile No. ____ X-Sec. No. ____ Notes Red. LM Platted ____ Date ____ Notes Chkd. ____ Date ____ Checked D. M. Finley Date 12-19-35 Job No. 7920 Division No. ____ Survey of Riverside Redondo Blvd. Survey by Evans Notes LE Date 12-19-35 Map No. ____ Included C. Johnson

L. B. 424 Pg. 109

STATION	B. S.	H. I.	F. S	ELEV.	
(1+20)		76 04			
12.5 L.			4 33	71.71	gutter
12.5 L.			3 81	72.23	T. curb.
20' L			3 60	72.44	B. walk.
1+50			1 94	74.10	℄ Morningside
12.5 R.			1 34	74.70	gutter
12.5 R			0 75	75.29	T. curb.
20' R.			0 51	75.53	B. walk.
12.5 L.			2 59	73.45	gutter
12.5 L.			2 06	73.98	T. curb
20' L			1 87	74.17	B. walk.
	Continuing	West on	℄ 27th St.		(Conc. pvmt.)
TP	11.93	83.47	4 50	71.54	℄ T. & inters'n Morningside Dr. & 27th St.
23+85 from E. 0+00 going W.			4 50	78.97	℄ int'n 27th & Morningside
0+70			10 80	72.57	℄ 27th St.
12.5 R.			11 10	72.37	N. gutter
12.5 R			10 56	72.91	T. N. curb.
20 R.			10 40	73.07	B. walk.
12.5 L.			11 08	72.39	S. gutter
12.5 L.			10 52	72.97	T. S. curb.
20' L.			10 35	73.12	B. walk.

Form 307 5M 10-34

PLEASE RETURN TO
LOS ANGELES COUNTY SURVEYOR
700 HALL OF RECORDS

NOTE: ANY ADDITIONS OR CHANGES ON THIS SHEET MUST BE MADE OR CIRCLED IN RED INK, WITH DATE AND NAME OF PERSON MAKING CHANGE

Do not extend notes this side of this line

L.B. 424 P.G. 170 | Job. No. 7920 Division No. | Profile No. | X-Sec. No.
Survey of Riverside Redondo Blvd. | Plotted | Checked
Survey by Evans | Date | Date
Indexed | Notes HE | Red HM | Notes Ch. D. M. Finley
Date 12-19-35 | Date | Date Dec. 1935

STATION	B. S.	H. I.	F. S	ELEV.	
		83.47			
0+50			8.42	75.05	℄ 27th
125R.			8.70	74.77	N. gutter
125R.			8.15	75.32	N. Top curb.
20R.			8.05	75.42	Back walk.
125L.			8.69	74.78	S. gutter
125L.			8.12	75.35	T. S. curb.
20'L.			7.93	75.54	
1+15			3.31	80.16	℄ 27th
125R.			3.55	79.92	N. gutter
125R.			3.01	80.46	N. curb.
20'R.			2.89	80.58	B. walk.
125L			3.56	79.91	S gutter
125L.			2.99	80.58	S curb.
20'L.			2.72	80.75	B. walk.
1+50			1.46	82.01	
125R.			1.68	81.79	N. gutter
125R.			1.12	82.35	N. curb
20R.			1.06	82.41	B. walk
125L.			1.76	81.71	S. gutter
125L.			1.28	82.19	S. curb
20'L.			1.19	82.28	B. walk.

STATION	B. S.	H. I.	F. S	ELEV.		
		83.47				
2+00			0.35	83.12	℄ 27th St.	
12.5 R.			0.61	82.86	N. gutter	
12.5 R			0.07	83.40	N. curb.	
20' R.			+0.10	83.57	B. walk.	
12.5 L.			0.63	82.84	S. gutter.	
12.5 L.			0.07	83.40	S. curb.	
20' L			+0.07	83.54	B. walk.	
T.P.	1.10	84.36	0.21	83.26		
T.P.	0.23	73.57	11.02	73.34		
T.P.	0.16	62.34	11.39	62.18		
T.P.	1.48	53.79	10.03	52.31		
B.M.			5.13	48.66	N.W. cor 27th St. & Manhattan Ave. Fd. cut. s/pk. in N. end curb return. per L.B. 174/139	

El. = 48.635 − .025 Error OK.

Profile

Notes Red. [illegible] Platted

Date Date Job No. 7920 Division No.

Sec. Survey of Manhattan Beach Blvd.

Notes Chkd. Checked Survey by Notes

Date Date 12-6-1935 Map No. Indexed Date

L. B. 424 PG. 171