Notes Ck'd by
Map No.
Office Work
Checked
Date

Survey of
W. O. Tape No St'd °F.
Surveyed by
Notes Date
Indexed

F.B. Pg.

LOS ANGELES COUNTY SURVEYOR

A36

F.B. 436 Pg. Index

F.B. 436

PAGES: Index, 3 to 7 incl., , 9 to
27 incl., 30 to 79 incl., 81 to 91 incl.,
93 to 100 incl., 101 to 107 incl.,
109 to 138 incl., , 140 to 153 incl.,

201 to 234 incl., 236 to 239 incl.,
241 to 254 incl.,

RETURN TO
LOS ANGELES COUNTY SURVEYOR
700 HALL OF RECORDS
Do not extend note this side of this line
Note: ANY ADDITIONS OR CHANGES ON THIS SHEET MUST BE MADE OR CIRCLED IN Red Ink WITH DATE AND NAME OF PERSON MAKING CHANGE.

Sheet No. ____ Sheet Total ____ F.B. ____ Pg. ____

Plotted by	W. O. No. ____ D. S. B. No. ____
Date	Location
Map No.	Surveyed by
Plotting C'k'd by	Date
Date	Indexed

LOS ANGELES S.T.

YET TO DO

Page & Cross Reference All notes
Cross Reference Topog. notes to & Notes
" " & " to Topog "
Complete Index ~~(Page numbers)~~
Complete Topog from 0+00 - 168+00
Show Proposed width of Los Angeles St.
& yet to be run from 0+00 - 168+00
Topog. yet to be taken from 0+00 to 168+00
except Along North Line Coffin Armstrong Inc.

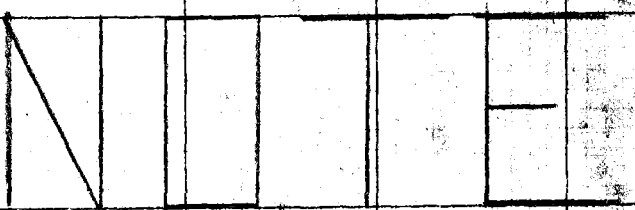

~~Pages are now numbered as follows~~
~~Index & West Side of Wash Pg - 1 - 28 inc~~
~~East Side of Wash & Pg - 1 - 20 inc~~
~~" " " " Topog Pg - 1 - 32 inc~~

~~Pages are~~ numbered as shown above only
~~None~~ of the ~~Pages~~ ~~&~~ Cross Referenced

RETURN TO LOS ANGELES COUNTY SURVEYOR

Notice: Any alteration or change on this sheet, other than those made by the County Surveyor, will render the same void.

Do not extend writing beyond the sides of this sheet.

F.B.____ Pg.____ Chief Party Notes by____ Date____

See Other Side of This P

RETURN TO
LOS ANGELES COUNTY SURVEYOR

Do not extend notes this side of this line

Note: ANY ADDITIONS OR CHANGES ON THIS SHEET MUST BE MADE OR CIRCLED IN Red. WITH DATE AND NAME OF PERSON MAKING CHANGE.

Notes Ck'd by		Survey of Los Angeles St	F.B. 436 Pg. 3
Map No.		W. O. 970 Tape No 021 Std 84 of.	
Office Work		Surveyed by F.J. NS Neal	
Checked		Notes F.J. NS Date Feb 1930	
Date		Indexed A. C. Johnson 5-5-30	

Notice: ANY ADDITIONS OR CHANGES ON THIS SHEET MUST BE MADE OR CIRCLED IN RED INK WITH DATE AND NAME OF PERSON MAKING THE CHANGE.

RETURN TO LOS ANGELES COUNTY SURVEYOR 700 HALL OF RECORDS

Do not detach notes from side of this sheet

FORM 247 BM 2-34

SURVEY OF

LOS ANGELES STREET

W. O. 970

TYLER ROAD - EL MONTE TO MAINE AVE - BALDWIN PARK

ALSO

EAST HONDO PARKWAY

PECK ROAD TO TYLER ROAD

TYLER ROAD - SECOND AVE. J.N. 7148

BRYANT ROAD TO LIVE OAK AVE

RURBAN HOMES - EL MONTE UNIT

LOWER AZUSA ROAD & PECK RD.

F.B. 436 PG. 4

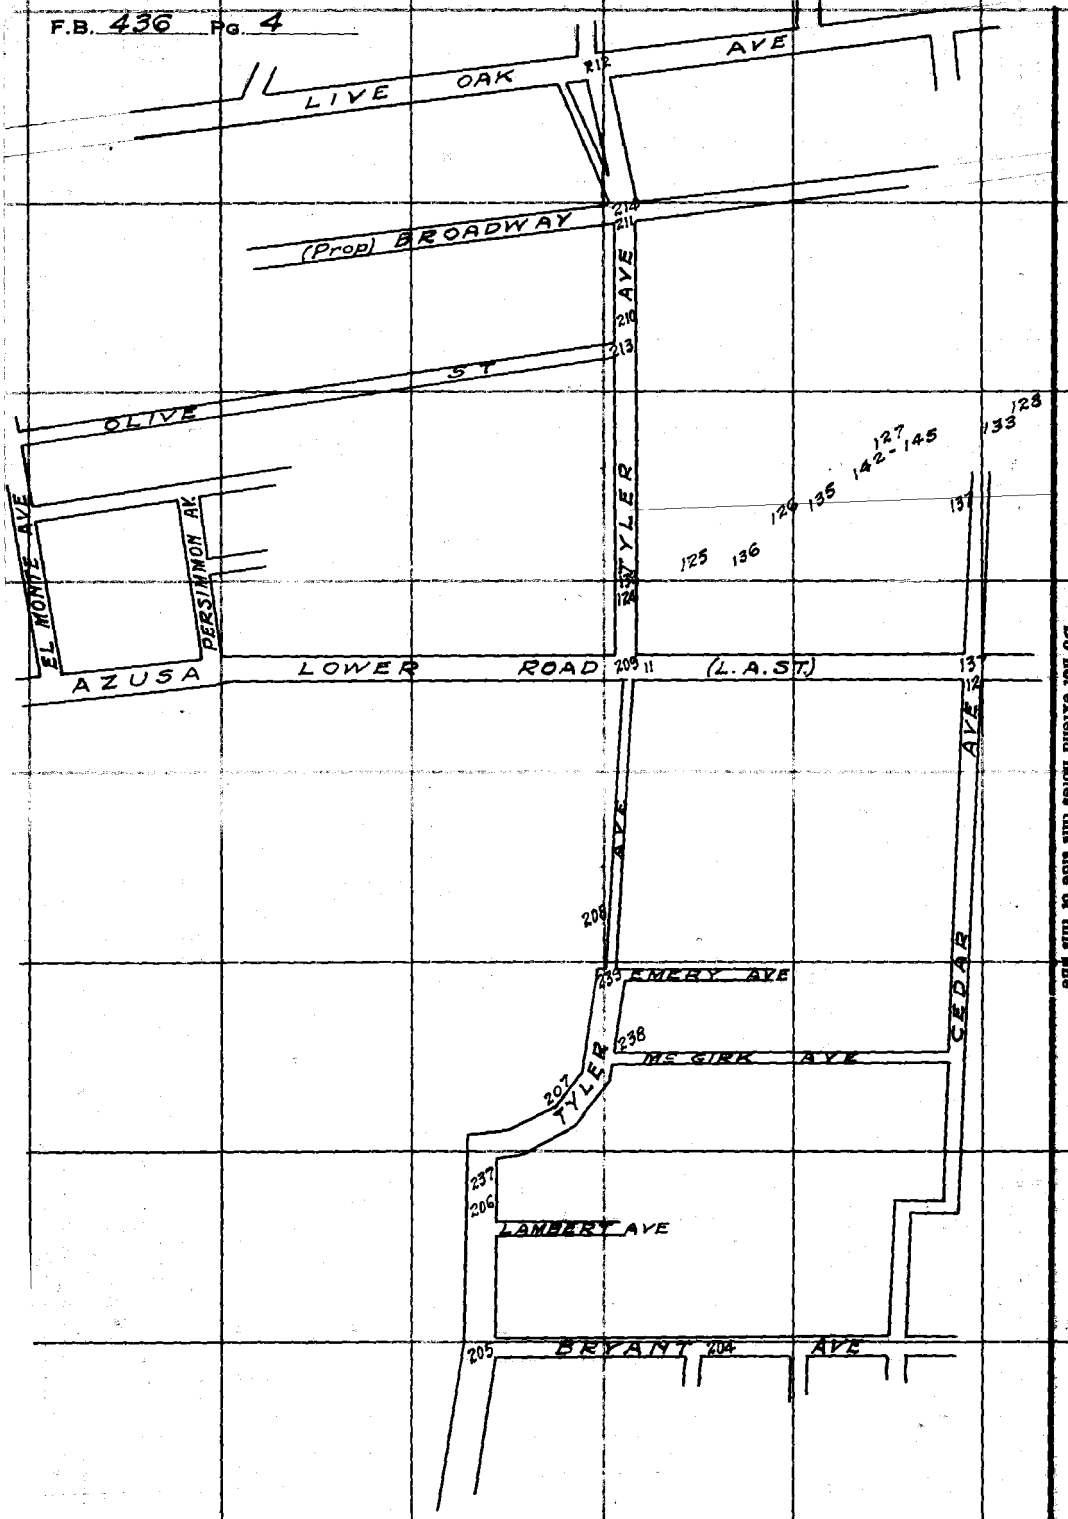

RETURN TO
LOS ANGELES COUNTY SURVEYOR
700 HALL OF RECORDS

Do not extend notes this side of this line

Notes: ANY ADDITIONS OR CHANGES ON THIS SHEET MUST BE MADE OR CIRCLED IN RED INK WITH DATE AND NAME OF PERSON MAKING CHANGE.

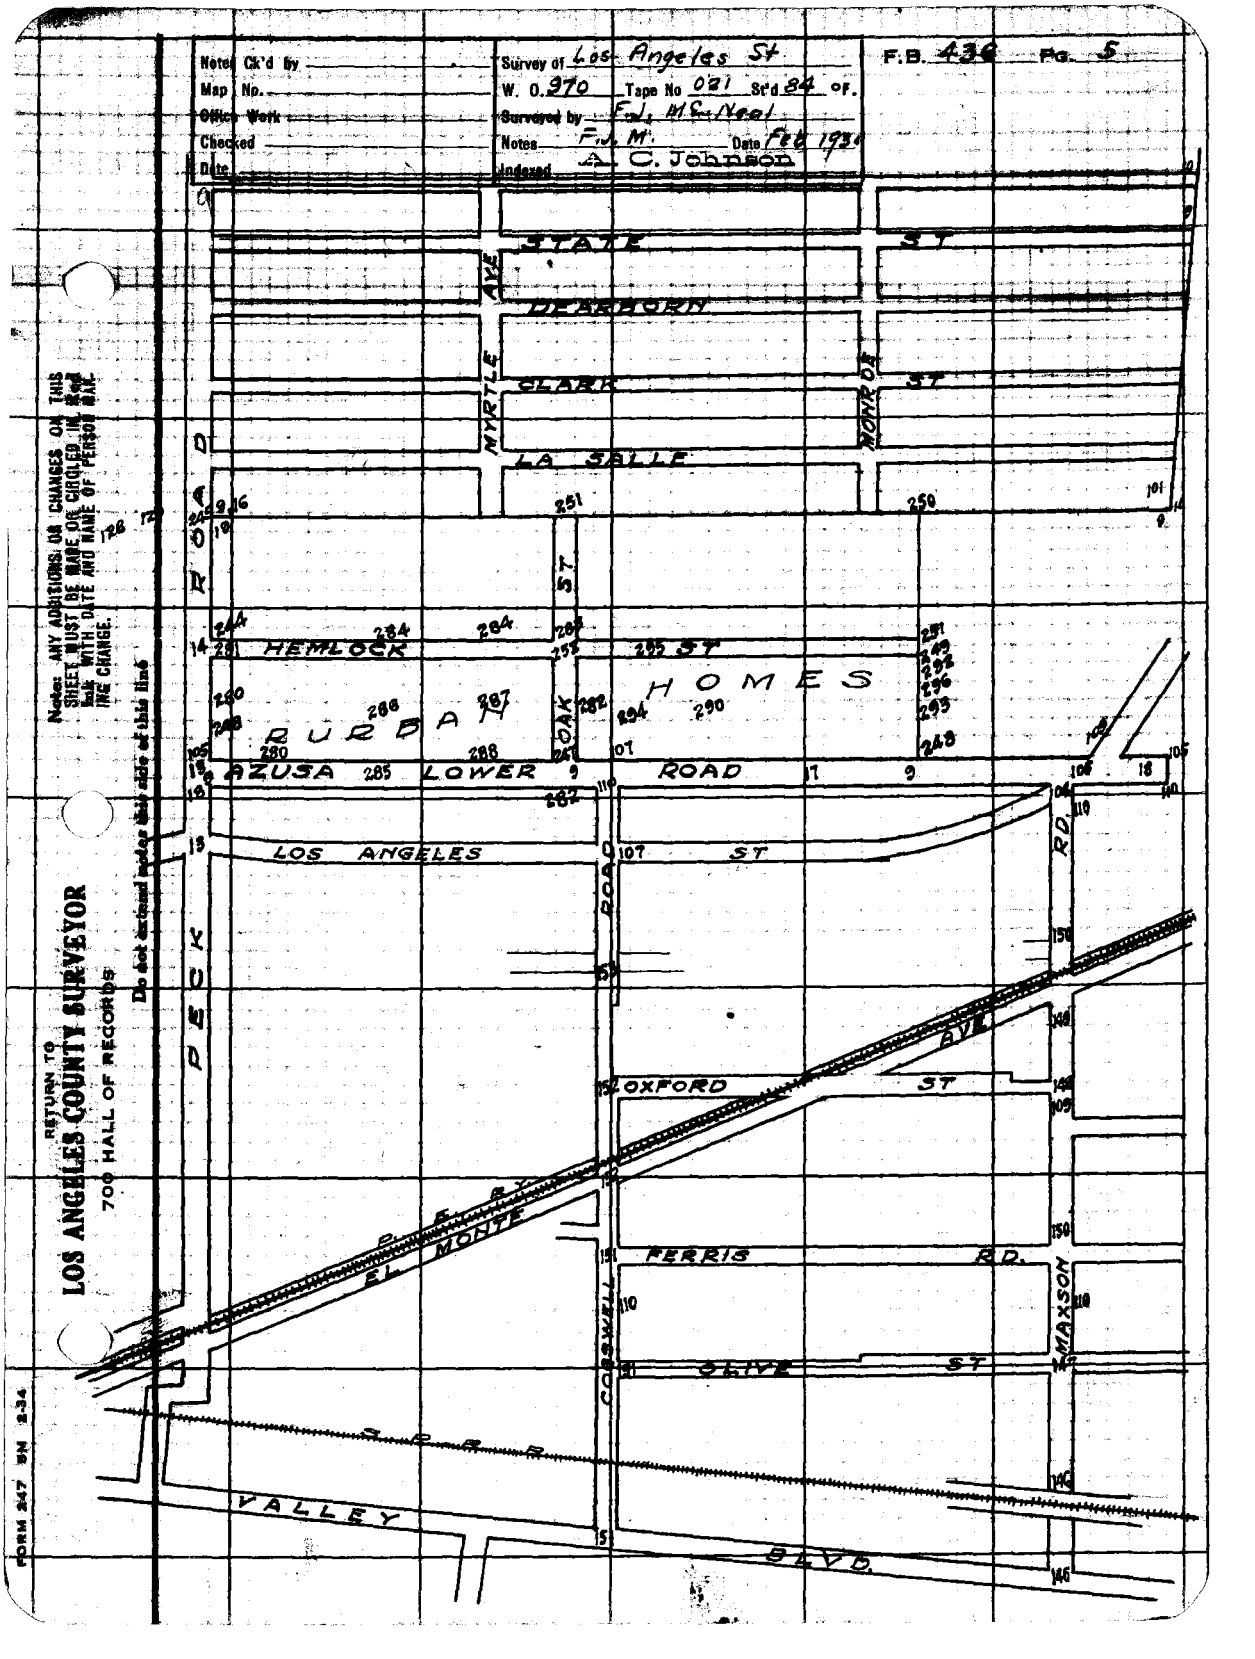
Notes Ck'd by
Map No.
Office Work
Checked
Date
Survey of Los Angeles St
W. O. 370 Tape No 021 Std 84 OF.
Surveyed by F. J. McNeal
Notes F. J. M. Date Feb 1934
Undesired A. C. Johnson
F.B. 436 Pg. 5
STATE ST
DEARBORN
MYRTLE AVE
CLARK
MONROE ST
LA SALLE
HEMLOCK
ST
HOMES
RURBAN
OAK
AZUSA
LOWER
ROAD
LOS ANGELES
ST
PECK
ROAD
OXFORD
ST
AVE
S. P. R.R.
EL MONTE
FERRIS
RD.
MAXSON
OLIVE
ST
CORNWELL
S. P. R. R.
VALLEY
BLVD.
RETURN TO
LOS ANGELES COUNTY SURVEYOR
700 HALL OF RECORDS
Do not extend notes this side of this line
Notice: ANY ADDITIONS OR CHANGES OR THIS SHEET MUST BE MADE OR CROSS IN RED INK WITH DATE AND NAME OF PERSON MAKING THE CHANGE.
FORM 247 5M 2-34

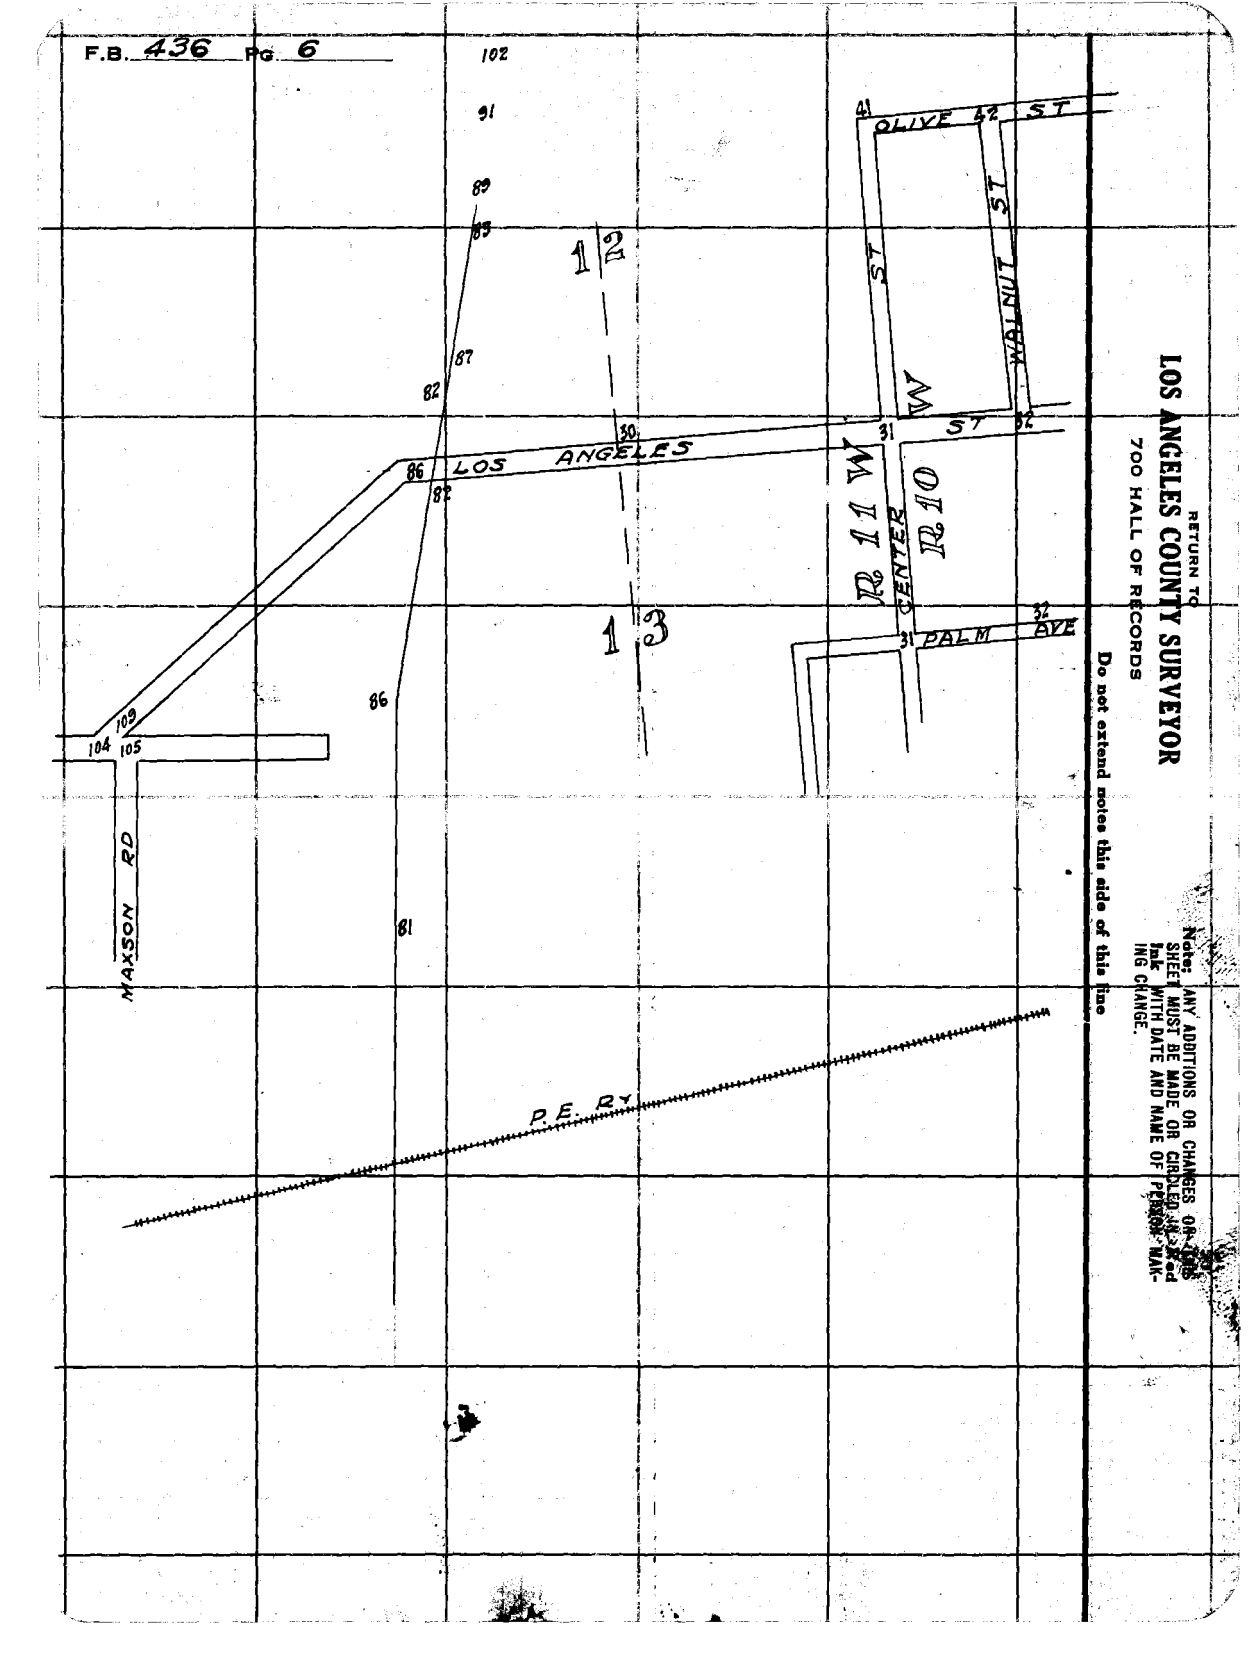
F.B. 436 PG. 6
102
91
89
85
87
82
86
LOS ANGELES
82
86
109
104
105
MAXSON RD
81
P.E. RY.
1 2
1 3
41
OLIVE
42
ST
31
PALM
AVE
32
RETURN TO
LOS ANGELES COUNTY SURVEYOR
700 HALL OF RECORDS
Do not extend notes this side of this line
Note: ANY ADDITIONS OR CHANGES OR TIES SHEET MUST BE MADE OR CIRCLED AND DATED IN Ink WITH DATE AND NAME OF PERSON MAKING CHANGE.

Notes Ck'd by	Survey of Los Angeles St
Map No.	W. O. 970 Tape No 021 St'd 84 or.
Office Work	Surveyed by F.J. McNeal
Checked	Notes F.J.M. Date Feb 1930
Date	Indexed A. C. Johnson

F.B. 436 Pg. 7

Note: ANY ADDITIONS OR CHANGES OF THIS SHEET MUST BE MADE OR CHECKED IN Red Ink WITH DATE AND NAME OF PERSON MAKING CHANGE.

Do not extend notes this side of this line

RETURN TO
LOS ANGELES COUNTY SURVEYOR
700 HALL OF RECORDS

FORM 247 BM 2-34

OLIVE ST

LOS ANGELES ST

CLARK ST

PALM AVE

ALAMEDA AVE

BRESEE AVE

STEWART AVE

MADER AVE

SIERRA AVE

LA RICA AVE

MAINE AVE

43 44 45 46 47

33 34 35 36 37 39 40 38

36 37 39 40

33 34 35

RETURN TO

LOS ANGELES COUNTY SURVEYOR

700 HALL OF RECORDS

Note: ANY ADDITIONS OR CHANGES ON THIS SHEET MUST BE MADE OR CIRCLED IN **Red Ink** WITH DATE AND NAME OF PERSON MAKING CHANGE.

Do not extend notes this side of this line

F.B. 436 Pg. 8

Date _____ Notes by M Chief Party M F.B. 436 Pg. 9

Platted by _____
Date _____
Map No. _____
Platting C'k'd by _____
Date _____

W. O. No. 970 D. S. O. No. _____
Location Los Angeles St
Surveyed by F. J. McNeal
Date Feb - 1930
Indexed A. C. Johnson

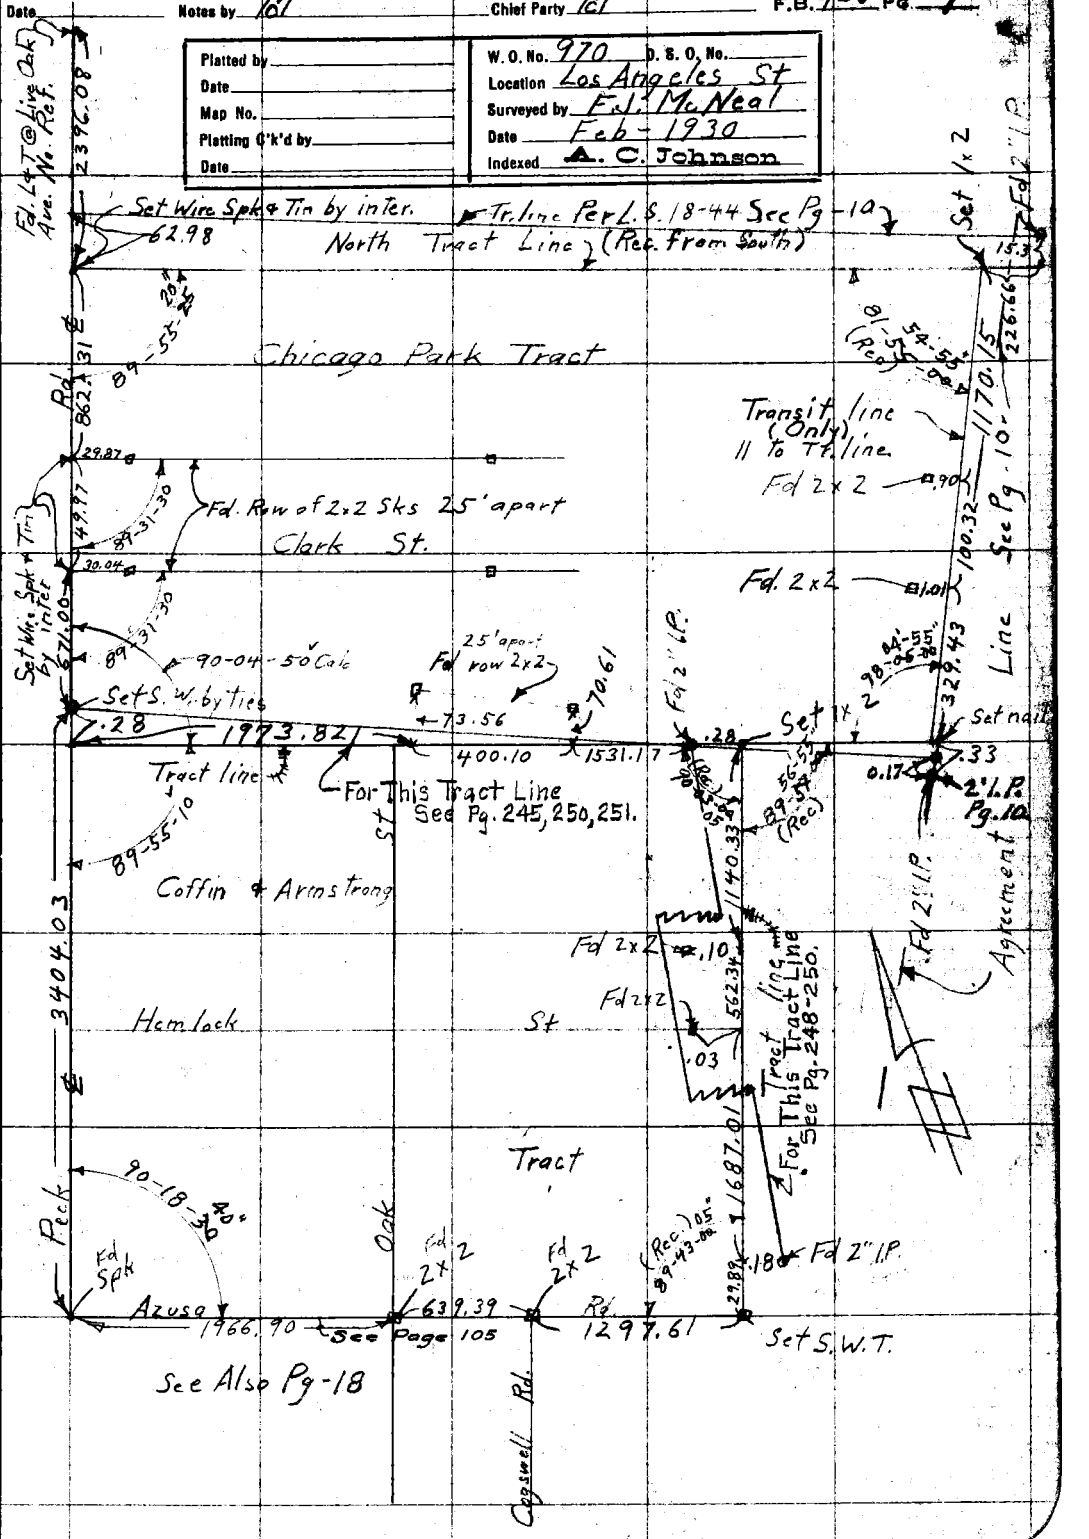

RETURN TO
LOS ANGELES COUNTY SURVEYOR

Do not extend notes this side of this line

Notes: ANY ADDITIONS OR CHANGES ON THIS SHEET MUST BE MADE OR CINCLED IN Red. WITH DATE AND NAME OF PERSON MAKING CHANGE.

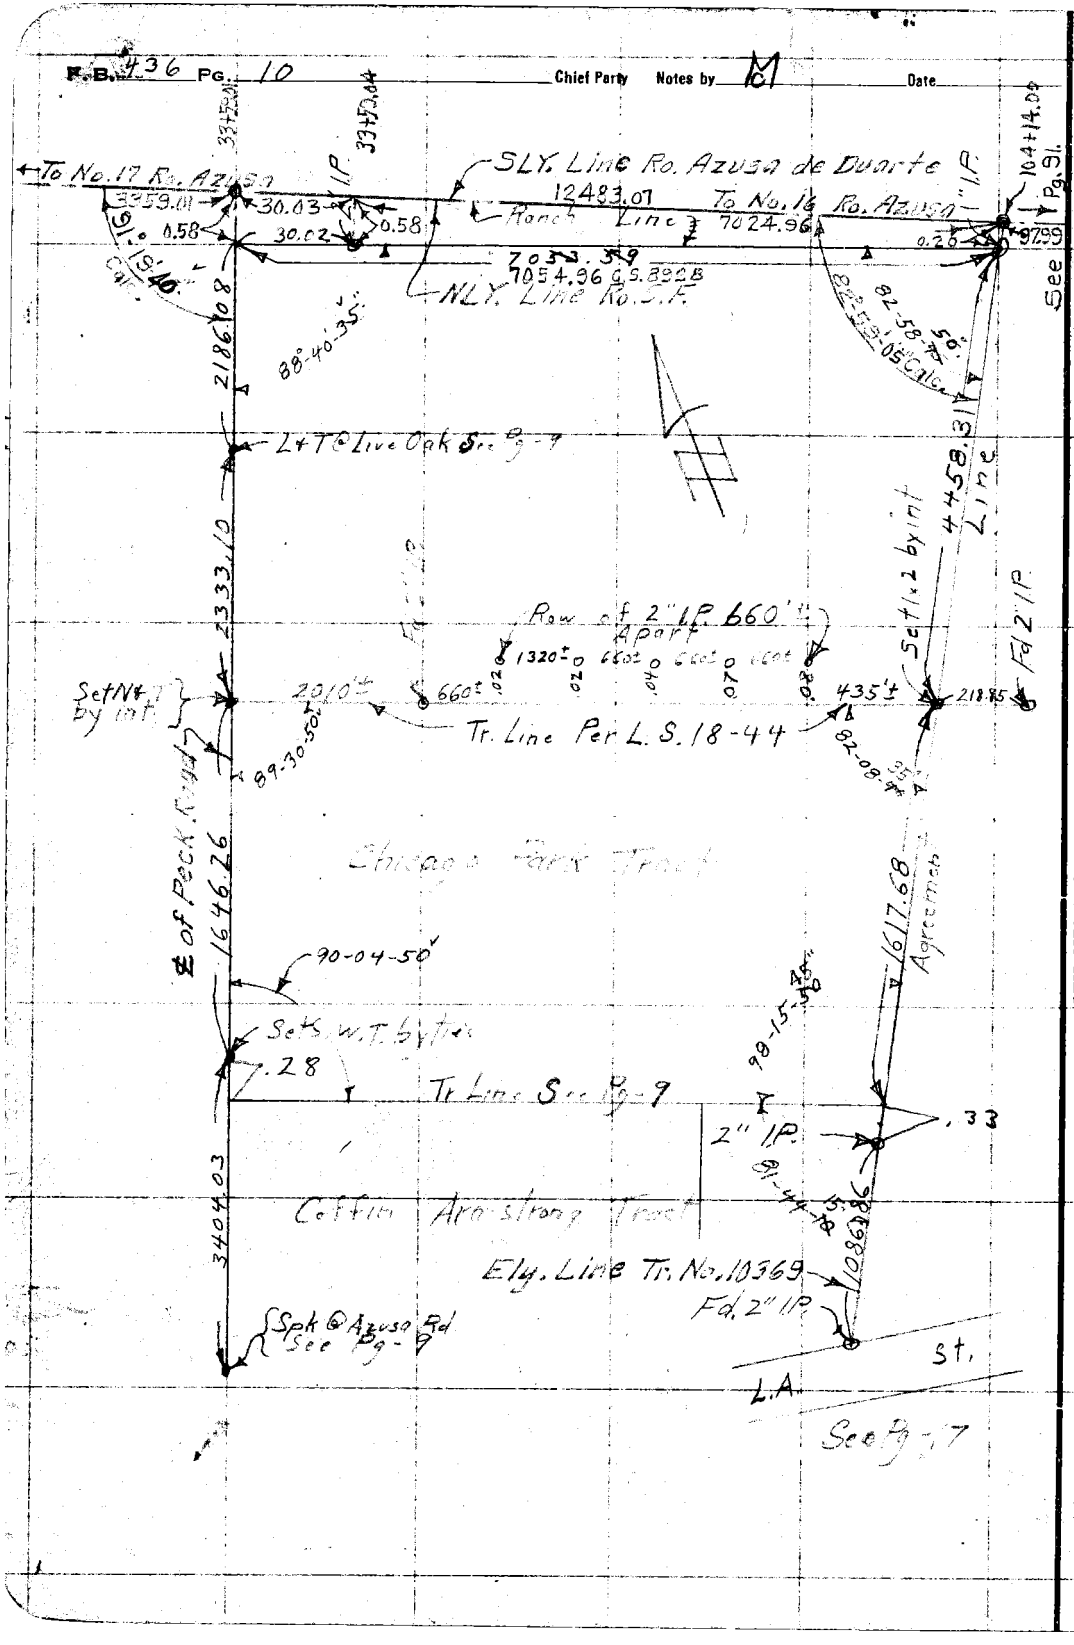
F.B. 436 Pg. 10
Chief Party
Notes by M
Date
To No. 17 Ro. Azusa
SLY. Line Ro. Azusa de Duarte
12483.07
To No. 16 Ro. Azusa
Rancho Line
7024.96
7054.96 G.S. 332.8
NLY. Line Ro. S.F.
See Pg. 91
2186.08
88-40-35"
Lt to Live Oak See Pg-7
2333.10
Row of 2" IP 660' Apart
1320'
660'
Set 1x2 by int
4458.31
Line
Fd 2" IP
Set Nail by int
2010'
660'
Tr. Line Per L.S. 18-44
435'4
218.85
89-30-50"
92-08-35"
E of Rock Road
1646.26
Chicago Park Tract
90-04-50"
Sets W.T. by tie
.28
Tr. Line See Pg-9
1617.68
Agreement
99-15-25"
2" IP
.33
81-44-10"
3404.03
Coffin Armstrong Tract
Ely. Line Tr. No. 10369
1086.6
Fd 2" IP
Spk @ Azusa Rd
See Pg-9
St.
L.A.
See Pg-7
RETURN TO
LOS ANGELES COUNTY SURVEYOR
Do not extend notes this side of this line
Note: ANY ADDITIONS OR CHANGES ON THIS SHEET MUST BE MADE OR CIRCLED IN Red. WITH DATE AND NAME OF PERSON MAKING CHANGE.

Date _____ Notes by M Chief Party M F.B. 436 Pg. 11

Platted by _____
Date _____
Map No. _____
Platting C'k'd by _____
Date _____

W. O. No. 970 T.S.C. No. 021
Location Los Angeles St
Surveyed by F.J. McNeal
Date Feb - 1930
Indexed A. C. Johnson

Tape = 84°

W.S. 46 4-4

RETURN TO LOS ANGELES COUNTY SURVEYOR

Notes: ANY ADDITIONS OR CHANGES ON THIS SHEET MUST BE MADE OR CIRCLED IN Red. WITH DATE AND NAME OF PERSON MAKING CHANGE.

Do not extend notes this side of this line

To Bot. Pg. -12

98-39-15
394-36-30
98-39-10

RD.

Fd 1/2" iron rod in Conc flush - 28+47.39 Per F.B. 25-47

26.35

1794.09@58° = 1793.79

(25) (25)

1793.79

37-32-30
150-10-45
37-32-40

To Ah. Pg. -15

Set N4T. PP.

545.65

P# A Set (x24t) 8+69.59

869.59

869.71@62° = 869.59

37-32-40

43.31

98-39

38.77

Set N4T in Walnut

Fd 3/4" I.P. 4t. in Conc 4" Dn - Per. Tr. #3293

Fd 3/4" I.P. 4t -10" Dn F.B. 25-47

26.78

Tyler 15 Rd.

15

Fd 3/4" I.P. + t 12" Down Per F.B. 25-47 P# X - 0+00

43.66

50 Calc

81-20

Fd N4T in Walnut

27.09

892.58@64° = 892.46

AZUSA

892.46

Transit Line

463.67

80-02-35

P#1 - 0+00 Set S.W.T.

Fd 4" I.P. 4t. in Conc Flush - Per. Tr. #3293

"P" line Sec 1-5

Fd L&T No Ref

LOWER

F.B. 436 Pg. 12 Chief Party Notes by Date

Tape = 84°

To Lt. Pg -13

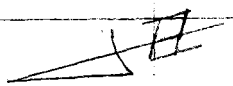

RD.

25.5 — Fd Rock - nox - flush 11+92.10 Per F.B. 25-47 ✓

1829.15@58° = 1828.84 ✓

1828.34

24.68 — Fd 1/2" Iron Rod in Conc ✓ flush - 14+58.06 Per F.B. 25-47 ✓

Fd 1/2" Iron Rod in Conc 6" Dn - 15+43.98 Per F.B. 25-47 ✓ — 23.98

(25) (25)

Set N⌖T in T.P. # A-38325-T — 47.35

P.O.T. Set S.W.T. — 18.24 — Set N⌖T in PP # 278483-E

AZUSA

1793.79

Fd 1/2" Iron Bar in Conc 6" Dn - 20+13.76 Per F.B. 25-47 ✓ — 24.76

Fd 1/2" Iron rod in Conc 2" Dn - 20+22.22 - Per F.B. 25-47 ✓ — 24.86

Road

Fd 1/4 x 1/2 Iron bar with P.M. Set in Conc - 6" On 20+25.42 - Per F.B. 25-47 ✓

LOWER

From Top Pg - 11

RETURN TO LOS ANGELES COUNTY SURVEYOR

Do not extend notes this side of this line

Note: ANY ADDITIONS OR CHANGES ON THIS SHEET MUST BE MADE OR CIRCLED IN Red. WITH DATE AND NAME OF PERSON MAKING CHANGE.

WS 46-B-4

Date _____ Notes by M Chief Party M F.B. 436 Pg. 13

Platted by _____
Date _____
Map No. _____
Platting C'k'd by _____
Date _____

W. O. No. 970 D. S. O. No. _____
Location Los Angeles St
Surveyed by F.L. McNeal
Date 8-[illegible]-25
Indexed _____

Tape = 84°

Notice: ANY ADDITIONS OR CHANGES ON THIS SHEET MUST BE MADE OR CIRCLED IN Red. WITH DATE AND NAME OF PERSON MAKING CHANGE.

Do not extend notes this side of this line

RETURN TO LOS ANGELES COUNTY SURVEYOR

To Bot. Pg - 14

RD.

1716.96

Fd. N+T Walnut

53.62

Fd. N+T T.P.

60.97

Fd. Spk No Ref.

LOWER-AZUSA RD.

55.41

Fd. N+T. T.P.

65.09

Fd. N+T-Walnut

527.60

527.59 @ 88° = 527.60
527.65 @ 78° = 527.63

(30) (30)

105-26-30
61-45-45
15-26-25.

Fd. 3/4" I. Sor. in Conc. 8" Dn Per. FC 468-13

26.25

29.99

105.23.41

32.41

Fd. L+T. N. P.P.

LOWER-AZUSA RD.

1828.84

36.03

75.43

53.88

Fd. N+T. P.P.

PECK

From Top Pg - 12

Fd. N+T P.P. T.P.

F.B. 436 PG. 14 — Chief Party — Notes by — Date

WS 46 B-3

Tape = 84°

To Bot. Pg - 16

RD.

Fd 2" IP no tag 2' W & 2' OF No Rec

29.7

1291.34

245.14

HEMLOCK

Fd. Spk. No Tag

1.03

ST.

(30) (30)

1716.96

Fd 1½" IP no tag 8" Dp
N.E. Cor. Lot 2 EC 16.8 1.5E

29.1

Fd. 1½" IP no tag
18" Dp N.E. Cor.
Lot-2 Per. E.C. 16.8 W

29.4

PECK

17/6.92 @ 88° = 17/6.96
1717.07 @ 80° = 1717.03

From Top Pg - 13

RETURN TO
LOS ANGELES COUNTY SURVEYOR
Do not extend notes this side of this line

Note: ANY ADDITIONS OR CHANGES ON THIS SHEET MUST BE MADE OR CIRCLED IN Red. WITH DATE AND NAME OF PERSON MAKING CHANGE.

Date _____ Notes by M Chief Party M F.B. 436 Pg 15

Platted by _____
Date _____
Map No. _____
Platting C'k'd by _____
Date _____

W. O. No. 970 S. O. No. _____
Location Los Angeles St
Surveyed by E. J. McNeal
Date Feb - 1930
Indexed A. C. Johnson

Tape = 84°

To Lt. Pg-16

589.25@62°
=589.17

"P" Line & "PA" Line

See Also L. B. 338-175

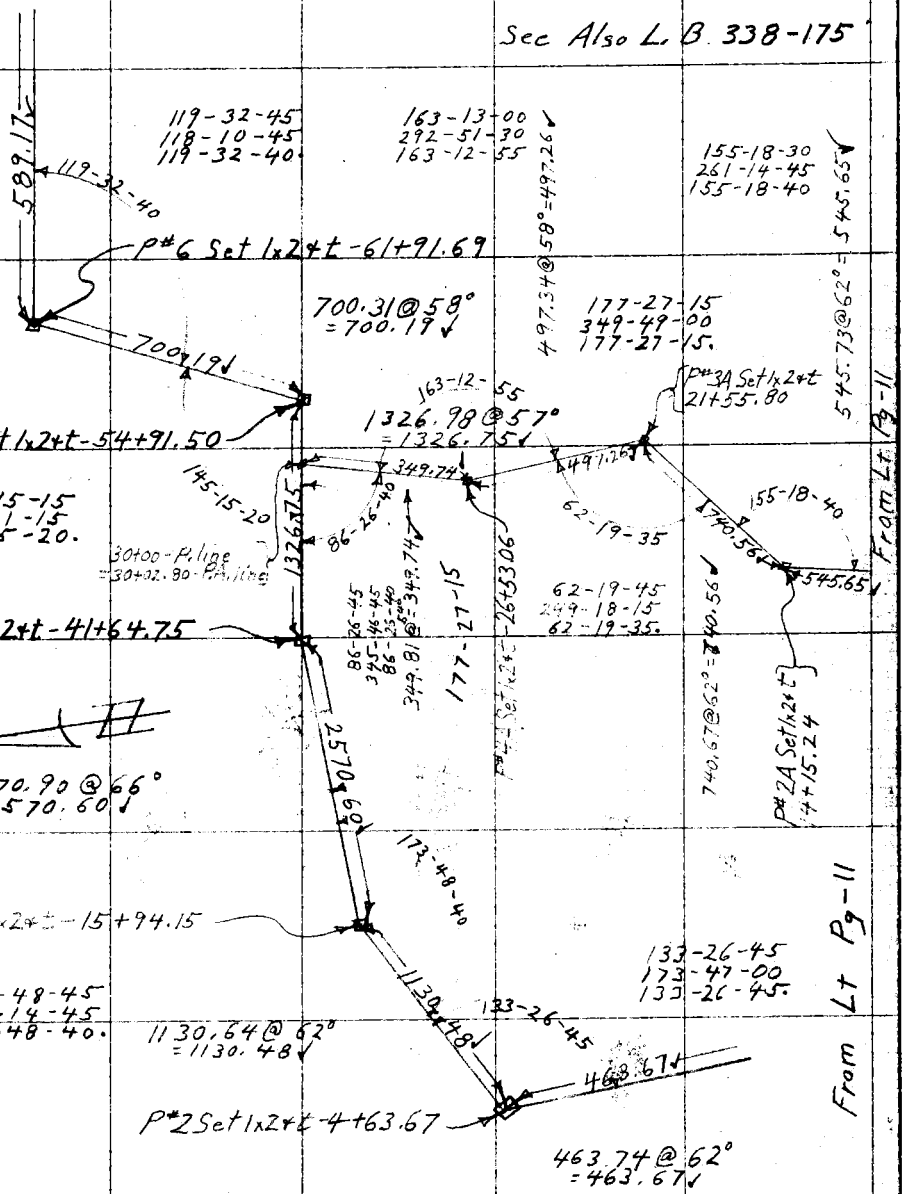

Notes: ANY ADDITIONS OR CHANGES OF THIS SHEET MUST BE MADE OR CIRCLED IN Red. WITH DATE AND NAME OF PERSON MAKING CHANGE.

Do not extend notes this side of this line

RETURN TO LOS ANGELES COUNTY SURVEYOR

F.B. 436 PG. 16 — Chief Party — Notes by — Date

WC 46 R-3

Tape = 84°

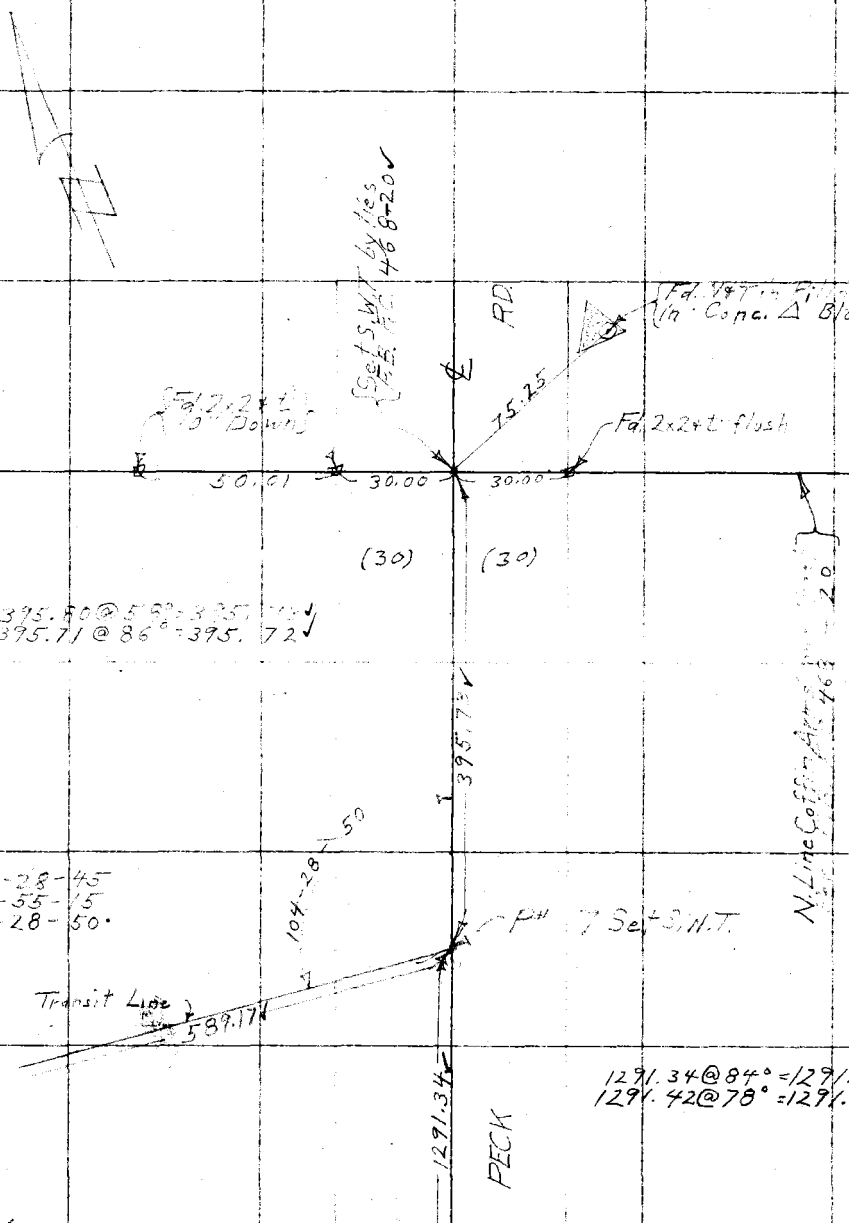

RETURN TO
LOS ANGELES COUNTY SURVEYOR

Do not extend notes this side of this line

Notes: ANY ADDITIONS OR CHANGES ON THIS SHEET MUST BE MADE OR CIRCLED IN Red. WITH DATE AND NAME OF PERSON MAKING CHANGE.

Date _____ Notes by EM Chief Party _____ F.B. 436 Pg. 17

Platted by _____
Date _____
Map No. _____
Plotting C'k'd by _____
Date _____

W. O. No. 970 D. S. O. No. _____
Location Los Angeles St.
Surveyed by F. S. McNeal
Date ARC-1930
Indexed A. C. Johnson

WS-46 C-4

Notes: ANY ADDITIONS OR CHANGES ON THIS SHEET MUST BE MADE OR CHECKED BY Rod. WITH DATE AND NAME OF PERSON MAKING CHANGE.

Do not extend notes this side of this line

RETURN TO LOS ANGELES COUNTY SURVEYOR

To 2x2 @ 1/4 1/4 Cor.

See Pg -10

Los Angeles St.

1086.86
L.E.L.Y. Line Lot 1 Tr. No. 10369
Fd 2" I.P. Per Tr. 10369

58.42
29.18'
Set 1x1 by lnt.
Fd. 2x2
.24
.07
3.44'
Fd. 2x2
.27
29.18'
Fd 2" I.P. Per Tr. 10369
121-18-55" E
50

Set 1x1 by lnt.

1685.42
L.E.L.Y. Line Lot 2 Tr. No. 10369.

See Pg -18

Los Angeles
126.78'

Ties on Pg - 86

2x2

See Pg - 18

F.B. 436 Pg. 18 Chief Party Notes by Date

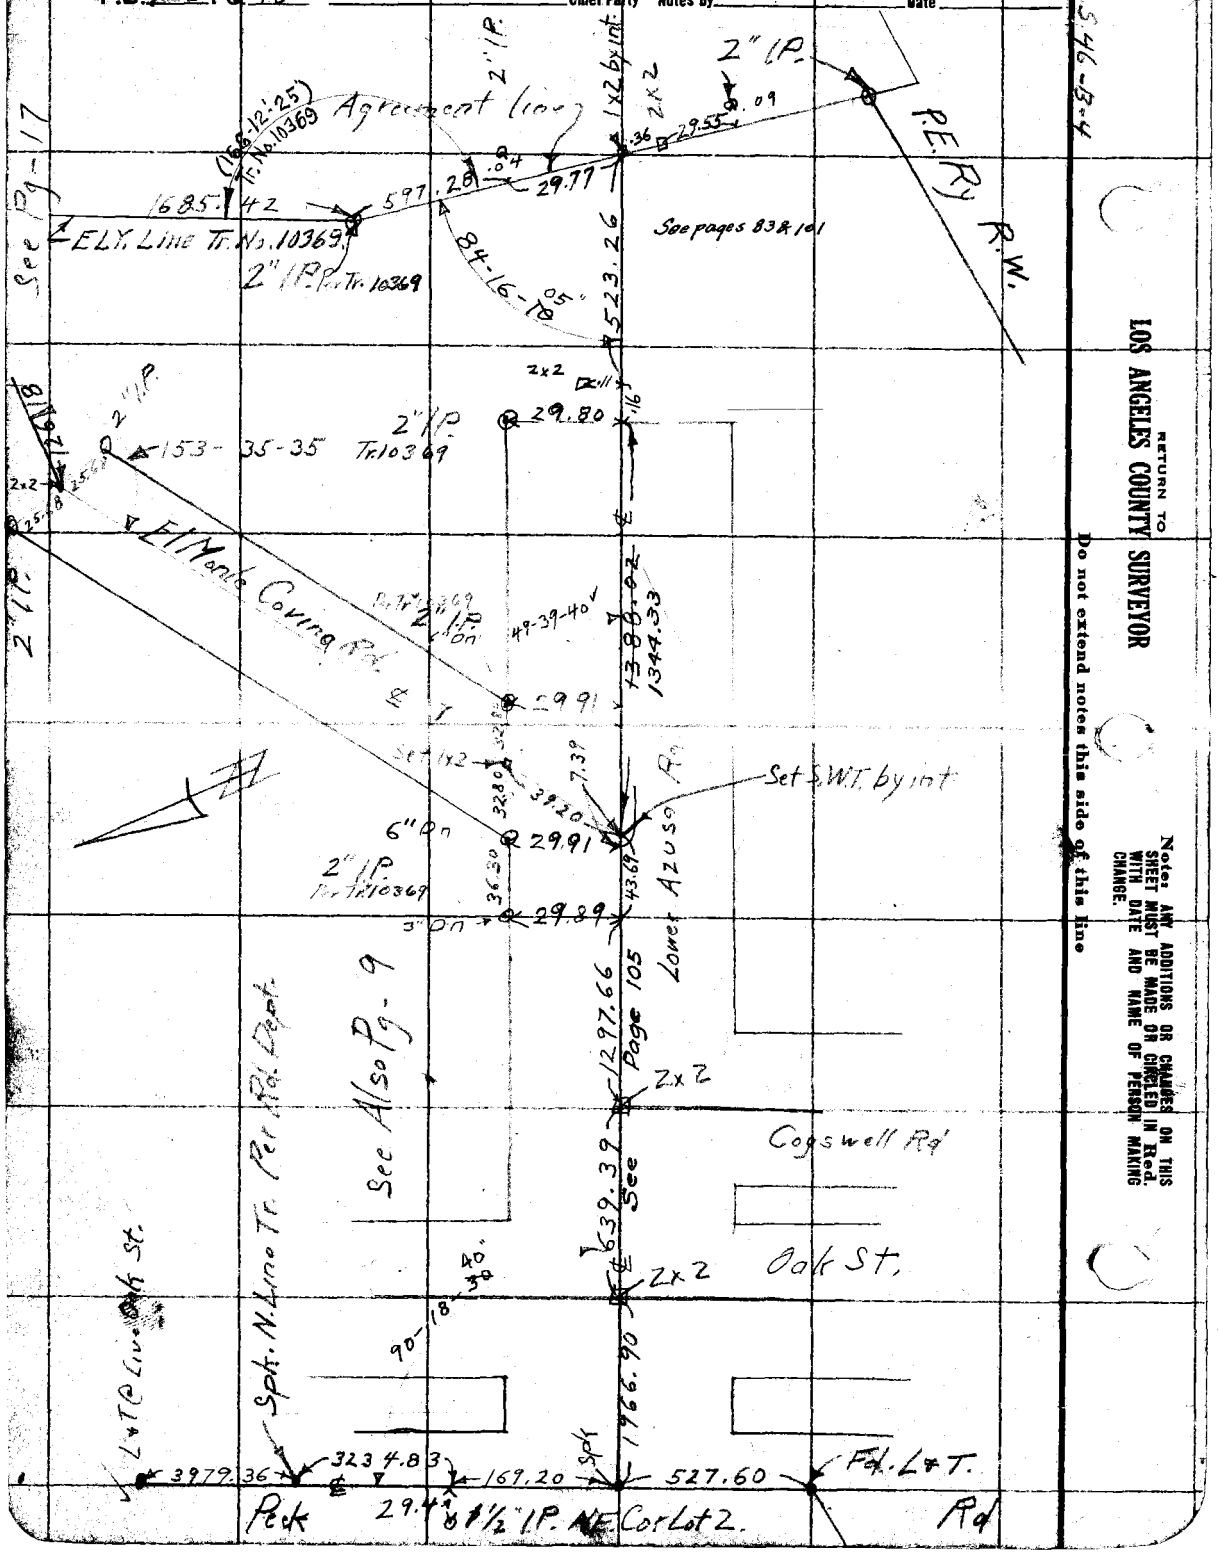

RETURN TO
LOS ANGELES COUNTY SURVEYOR

Do not extend notes this side of this line

Notes: ANY ADDITIONS OR CHANGES ON THIS SHEET MUST BE MADE OR CIRCLED IN Red. WITH DATE AND NAME OF PERSON MAKING CHANGE.

Date _____ Notes by M Chief Party _____ F.B. 436 Pg. 19

Platted by _____
Date _____
Map No. _____
Platting C'k'd by _____
Date _____

W. O. No. [illegible] S. O. No. _____
Location Los Angeles St.
Surveyed by E. J. McNeal
Date Apr. - 1930
Indexed A. C. Johnson

To Bot Pg - 20

17+13	< 51.8	⊙ 9" Walnut
17+07	< ~~2050~~ ⊙	6" Cottonwood
17+05.5	< 22.0 ⊙	3" Shade Tree
17+03	< 22.5 ⊙	4" Shade Tree
17+00	< 22.0 ⊙3' ⊙	2-6" & 10" Cottonwood
10" Walnut & 12" Valve	< 83.5	⊙15" ⊙ 16+86.5
16+78.4	< 43.0 ⊙	9" Cottonwood
16+75.0	< 41.2 ⊙	4" Cottonwood
16+61.5	< 49.1 ⊙	10" Cottonwood
16+50	< 62.1	⊙ 8" Cottonwood
16+39.5	< 82.3	⊙ 24" Walnut

← Record N. line Coffin Armstrong Tr
Sec Pg 99

0+0 S.W.T. } See Pg 9

28

PECK RD.

Note: ANY ADDITIONS OR CHANGES ON THIS SHEET MUST BE MADE OR CIRCLED IN Red, WITH DATE AND NAME OF PERSON MAKING CHANGE.

Do not extend notes this side of this line

RETURN TO LOS ANGELES COUNTY SURVEYOR

F.B. 436 Pg. 20 Chief Party Notes by M. Date

To Bat Pg -21

18" Cottonwood 28.1 18+38.0

4' Wire Fence 1.0 8" Walnut 18+36.2

Clump 6-4" Walnuts 7.0 18+28

18+23 4" Walnut 4.6 51.4 10" Walnut 18+20

6" Walnut 4.0 18+17.3

F.P. 6" Walnut 35.5 9.0 18+10.5

18+03 4" Walnut

Rec. N. line Coffin Armstrong Tr. → See Pg 9

17+94 21.0 19.0 12" Valve 40.5 - 2-12" Wa

5" Shade Tree 3.7 17+86

2-4" Walnuts 17+79

5.0 6" Walnut 17+77.7

4" Walnut 6.6 17+74

17+71.0 51.2 10" Walnut

Clump 7-4" Walnuts 5.5 17+59.5

2" Walnut 0.4 17+49.5

17+43.0 6" Walnut 5.7 21.2 18.0 12" Valve 17+43.0 43.0 2-12" Walnut

17+35.5 11.3 Clump - 4-4" Walnut

15.5 6" Walnut 17+23.5

12" Cottonwood 3.4 17+24

17+15 17.7 6" Walnut

From Top Pg -19

RETURN TO LOS ANGELES COUNTY SURVEYOR

Do not extend notes this side of this line

Note: ANY ADDITIONS OR CHANGES ON THIS SHEET MUST BE MADE OR CIRCLED IN Red. WITH DATE AND NAME OF PERSON MAKING CHANGE.

Date _____ Notes by M Chief Party _____ F.B. 436 Pg. 21

Plotted by _____
Date _____
Map No. _____
Plotting C'k'd by _____
Date _____

W. O. No. 970 D. S. O. No. _____
Location Los Angeles St
Surveyed by F.J. McNeal
Date Apr-1930
Indexed A. C. Johnson

RETURN TO LOS ANGELES COUNTY SURVEYOR

Note: ANY ADDITIONS OR CHANGES ON THIS SHEET MUST BE MADE OR CIRCLED IN RED, WITH DATE AND NAME OF PERSON MAKING CHANGE.

Do not extend notes this side of this line

To Bot. Pg - 22

19+16 F.P. 46.4 51.9 ⊙ 9" Walnut 19+16

15.2 ⊙ 8" Walnut 19+11.5

Rec. N. line Co. Affirm. & Armstrong Tr. See Pg-9

10.4 ⊙ 4-6" Walnuts 19+05.4

11.1 ⊙ 3" Walnut 19+00

11.6 ⊙ 4" Walnut 18+96

18+91.5

22.3 15.2 12" Irr. Value 4.5.0 ⊙ 6 "4/4" Walnuts

9.5 ⊙ 10" Walnut 18+89.2

9.6 ⊙ 3-4" Walnut 18+84.5

10.0 ⊙ 2-6" Walnut 18+79.8

18+67.4 F.P. 43.8 51.4 ⊙ 9" Walnut 18+68.0

11.0 ⊙ Clump 3-8" Walnuts 18+64.7

8.2 ⊙ 2" Walnut 18+60.5

6.8 ⊙ 8" Walnut 18+57.5

9.0 ⊙ 8" Walnut 18+54.5

8" Shade Tree ⊙ 27.9 18+53.8

2.0 ⊙ 2-6" Walnuts 18+48

18+41.3 22.5 16.0 12" Valve 42.6 ⊙ 2-12" Walnut

2.9 ⊙ 8" Walnut 18+41.3

4' Wire Fence

From Top Pg - 20

F.B. 436 Pg. 22 Chief Party Notes by M Date

To Bot Pg - 23

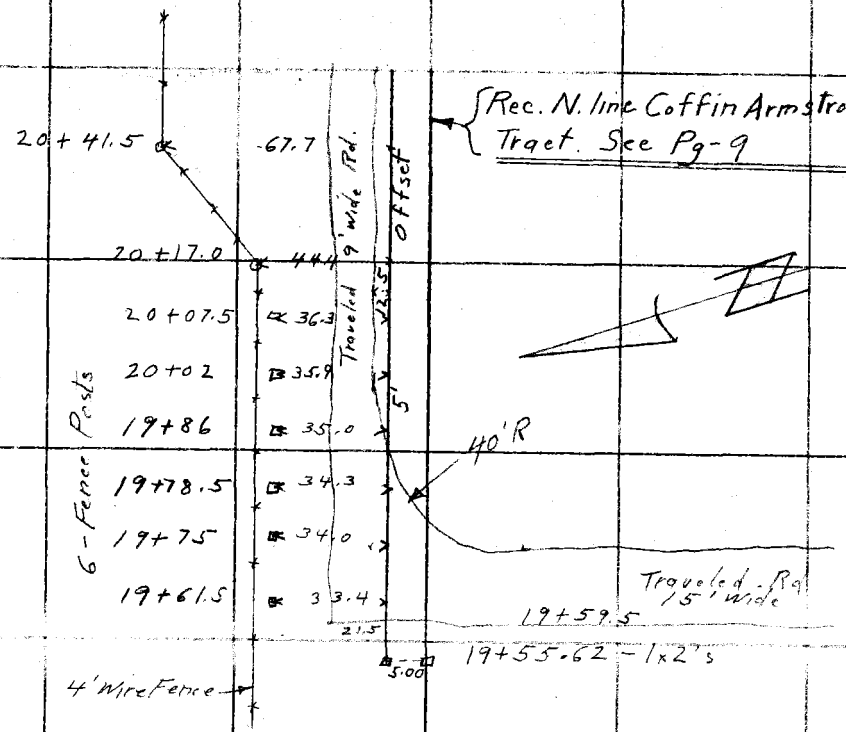

From Top Pg - 21

RETURN TO
LOS ANGELES COUNTY SURVEYOR

Do not extend notes this side of this line

Notes: ANY ADDITIONS OR CHANGES ON THIS SHEET MUST BE MADE OR CIRCLED IN Red. WITH DATE AND NAME OF PERSON MAKING CHANGE.

Date _____ Notes by _____ Chief Party _____ F.B. 436 Pg. 23

Plotted by _____
Date _____
Map No. _____
Plotting C'k'd by _____
Date _____

W. O. No. 970 B. S. O. No. _____
Location Los Angeles St
Surveyed by F.J. McNeal
Date Apr-1930
Indexed A. C. Johnson

61.9
24+35

To Bot. Pg. - 24

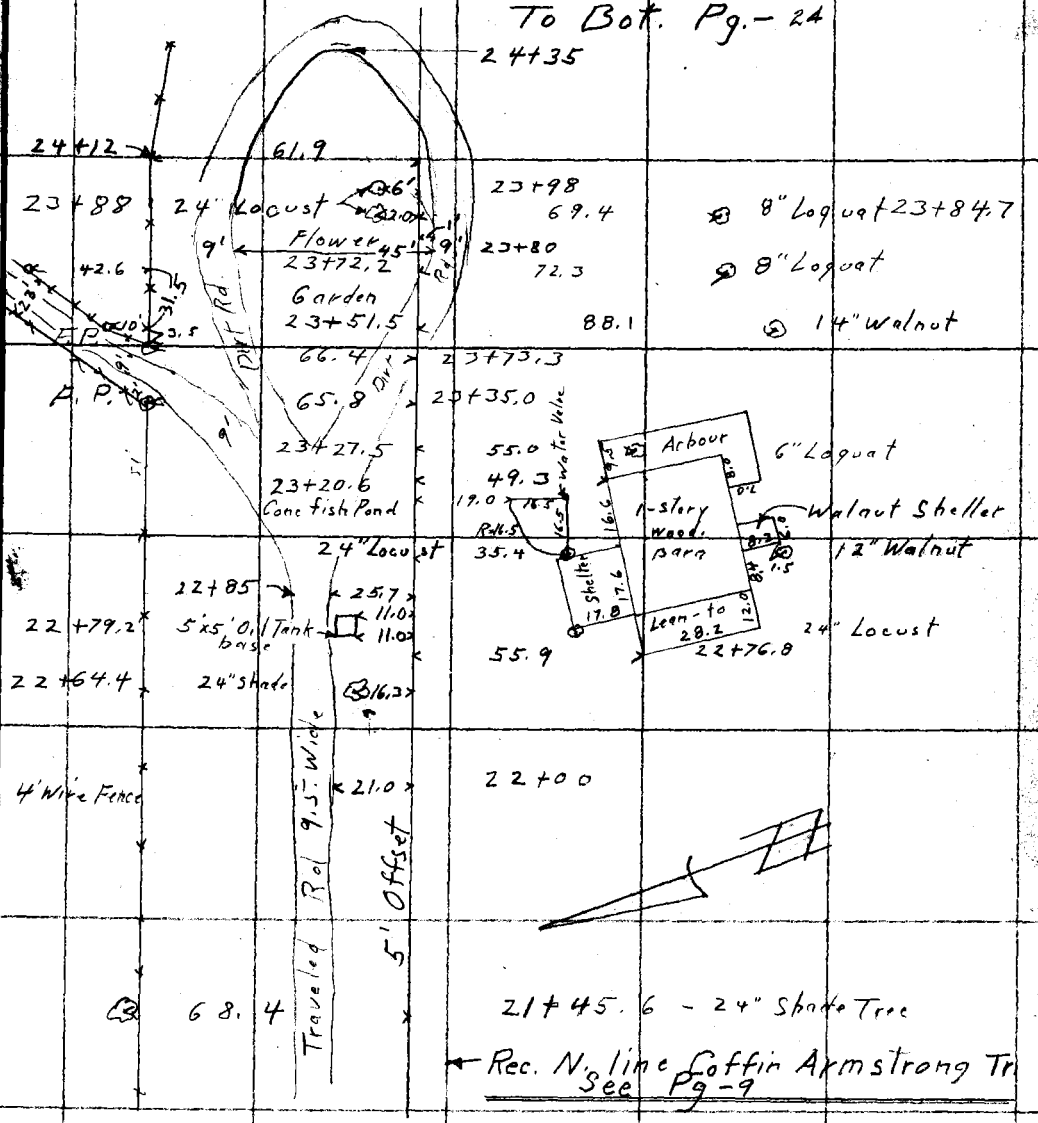

From Top Pg - 23

Note: ANY ADDITIONS OR CHANGES ON THIS SHEET MUST BE MADE OR CANCELED, AS DESIRED, WITH DATE AND NAME OF PERSON MAKING CHANGE.

Do not extend notes this side of this line

RETURN TO LOS ANGELES COUNTY SURVEYOR

F.B. 436 Pg. 24 — Chief Party — Notes by M — Date

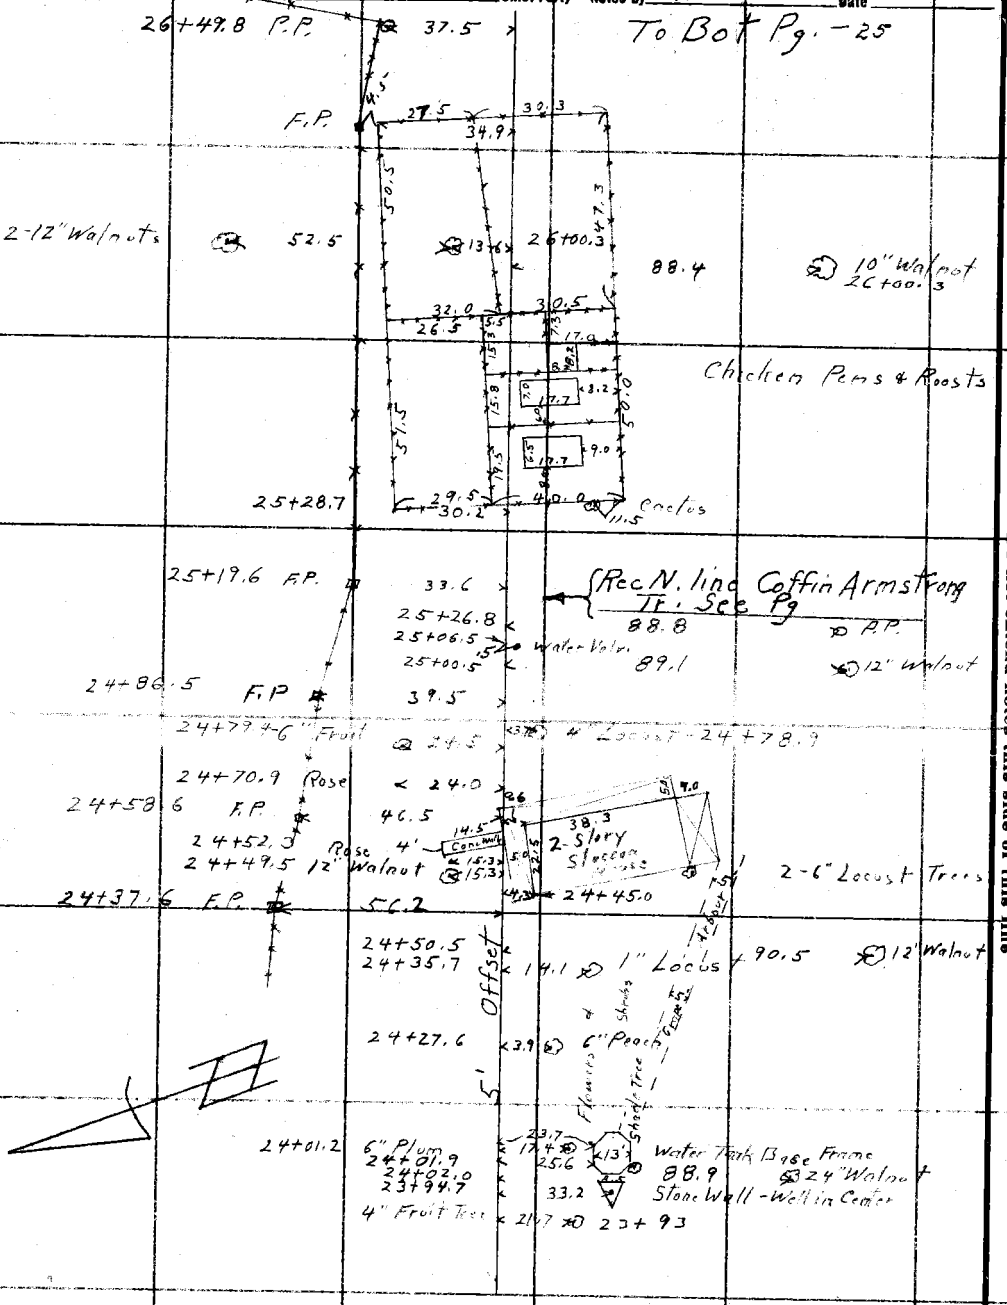

RETURN TO
LOS ANGELES COUNTY SURVEYOR
Do not extend notes this side of this line

Notes: ANY ADDITIONS OR CHANGES ON THIS SHEET MUST BE MADE OR CIRCLED IN Red. WITH DATE AND NAME OF PERSON MAKING CHANGE.

Date _____ Notes by MT Chief Party _____ F.B. 436 Pg 25

Platted by _____
Date _____
Map No. _____
Platting C'k'd by _____
Date _____

W. O. No. 970 D. S. O. No. _____
Location Los Angeles St
Surveyed by E. J. McNeal
Date Apr - 1930
Indexed A. C. Johnson

To Bot. Pg. - 26

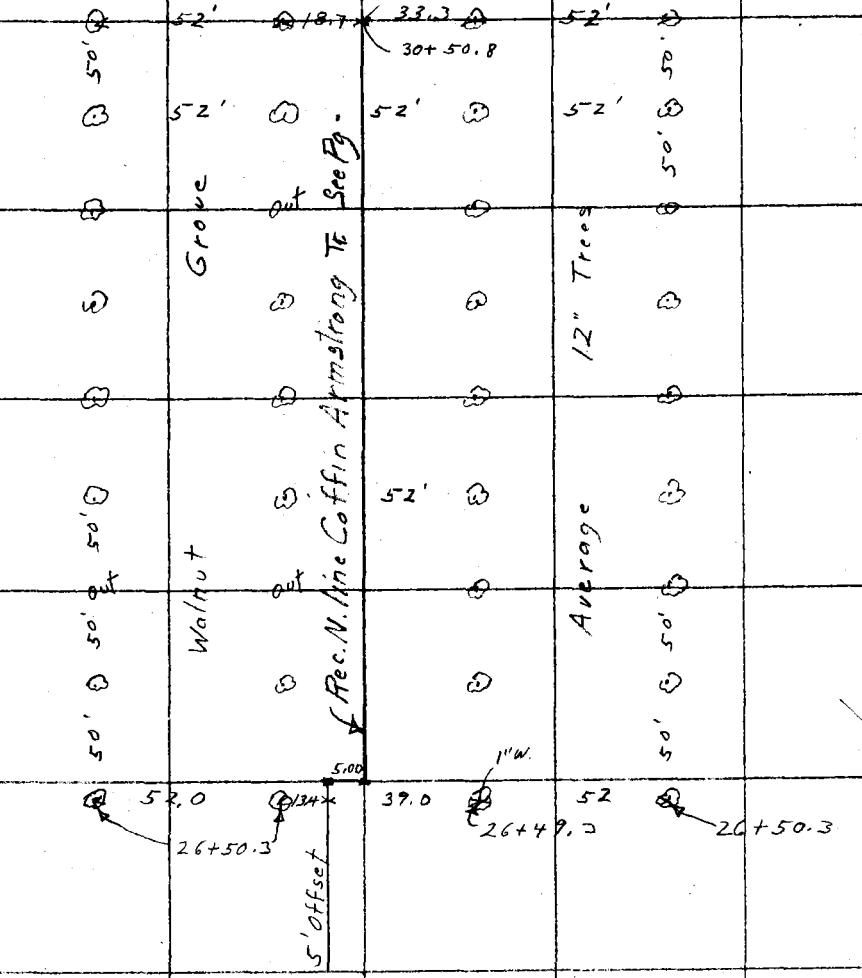

From Top Pg 25

RETURN TO
LOS ANGELES COUNTY SURVEYOR

Notes: ANY ADDITIONS OR CHANGES ON THIS SHEET MUST BE MADE OR CIRCLED IN Red. WITH DATE AND NAME OF PERSON MAKING CHANGE.

Do not extend notes this side of this line

F.B. 436 Pg. 26 Chief Party Notes by M Date

To Bot, Pg. -27

RETURN TO
LOS ANGELES COUNTY SURVEYOR
Do not extend notes this side of this line

Notes: ANY ADDITIONS OR CHANGES ON THIS SHEET MUST BE MADE OR CIRCLED IN Red. WITH DATE AND NAME OF PERSON MAKING CHANGE.

52' 15.8 36.2 52'
35+99.5

50' 50' 50' 50' 50' 50' 50' 50' 50' 50' 50' 50'

Grove

Tr. See Pg. 9

18" Trees

52' 52' 52' 52'

Walnut

Rec. N. line Coffin Arms (Ave)

Average

52 18.5 33.5 52
31+00.8

From Top Pg - 25

Date _____ Notes by M Chief Party _____ F.B. 435 Pg 27

Platted by	W. O. No. 970 D. S. O. No.
Date	Location Los Angeles St
Map No.	Surveyed by E.J. McNeal
Platting C'k'd by	Date Apr. 1930
Date	Indexed A. C. Johnson

RETURN TO LOS ANGELES COUNTY SURVEYOR

Note: ANY ADDITIONS OR CHANGES ON THIS SHEET MUST BE MADE OR CIRCLED IN Red. WITH DATE AND NAME OF PERSON MAKING CHANGE.

Do not extend notes this side of this line

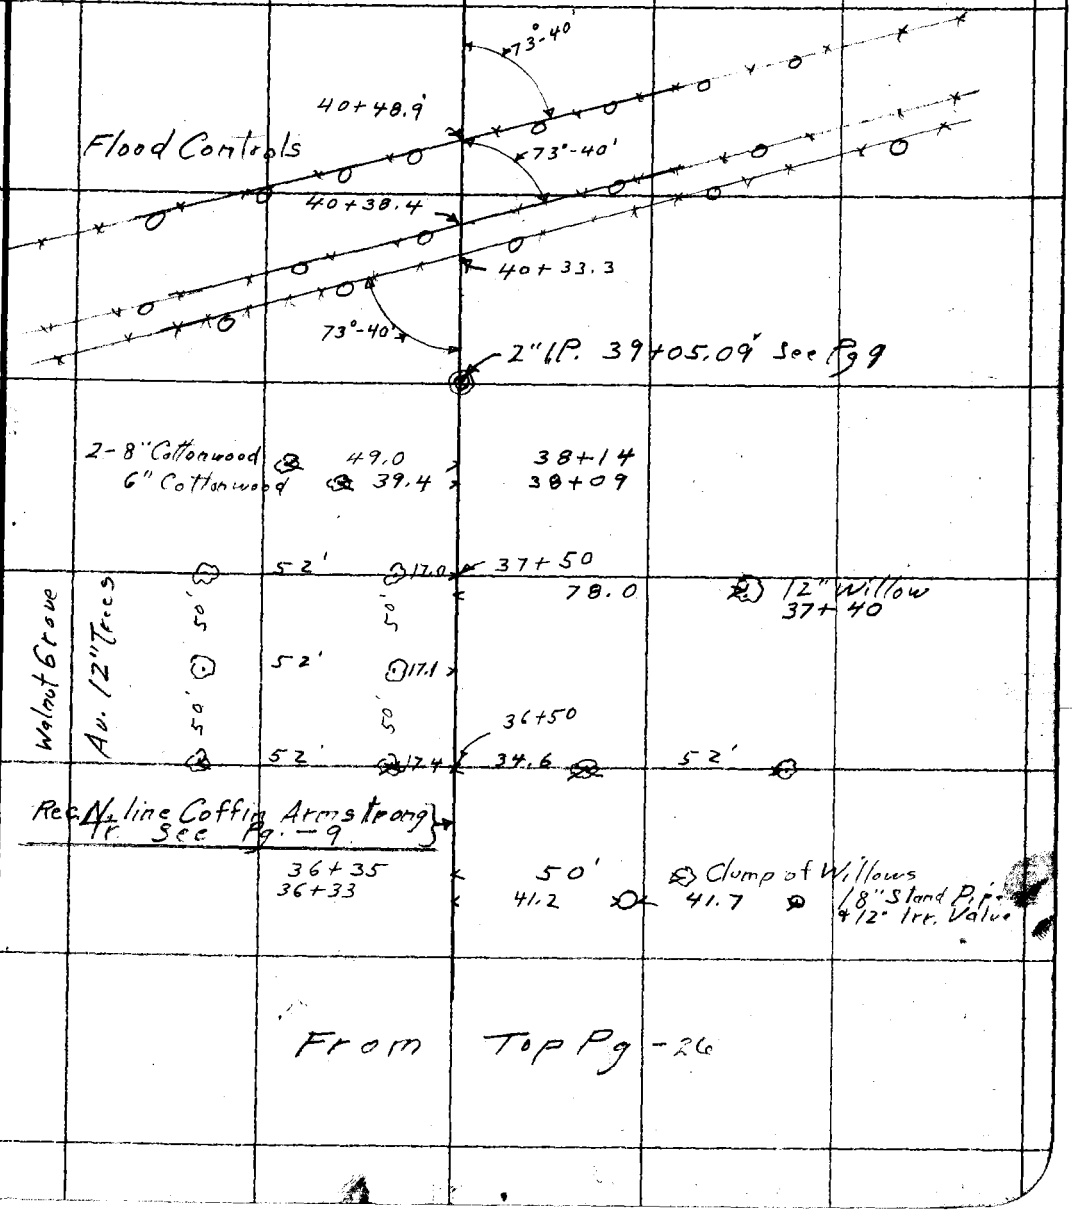

F.B. 436 PG. 28 _____ Chief Party Notes by _____ Date _____

RETURN TO
LOS ANGELES COUNTY SURVEYOR

Do not extend notes this side of this line

Note: ANY ADDITIONS OR CHANGES ON THIS SHEET MUST BE MADE OR CIRCLED IN Red. WITH DATE AND NAME OF PERSON MAKING CHANGE.

Date _____ Notes by _____ Chief Party _____ F.B. 436 PG 29

Platted by _____
Date _____
Map No. _____
Platting C'k'd by _____
Date _____

W. O. No. 970 D. S. O. No. _____
Location Los Angeles St
Surveyed by F. J. McNeil
Date _____
Indexed A. C. Johnson

Other Side Used

Note: ANY ALTERATIONS OR CHANGES ON THIS SHEET MUST BE CIRCLED IN Red. WITH NAME OF PERSON MAKING CHANGE

Do not extend notes this side of this line

RETURN TO
LOS ANGELES COUNTY SURVEYOR

F.B. 436 Pg. 30 — M Chief Party — Notes by M — Date

W.S. 46-C4

Tape 84°

1323.89 @ 62° = 1323.70 ✓
1323.84 @ 68° = 1323.70 ✓

For Topog See Pg - 50

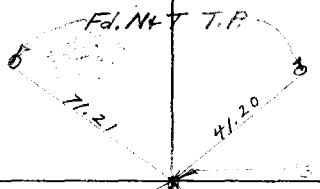

LOS ANGELES ST.

=168+00 Ahead
Fd. 2x2+t-12" Dn
Per F.B. 372-6

To 47 (9)

RETURN TO
LOS ANGELES COUNTY SURVEYOR

Do not extend notes this side of this line

Note: ANY ADDITIONS OR CHANGES ON THIS SHEET MUST BE MADE OR CIRCLED IN Red. WITH DATE AND NAME OF PERSON MAKING CHANGE.

Date _____ Notes by EM Chief Party EM F.B. 436 Pg. 31

Platted by H.U.M.H.	W.O. No. 3520 Lot No.
Date July 1941	Location Los Angeles St. R/W
Map No. CSE 1648	Surveyed by E.J. McNeal
Platting C'k'd by	Date Mar. 5 1930
Date	Indexed A. C. Johnson

W.S. 46-C-4

Tape 84°

179-58-15
359-53-15
89-58-20.

To Bot. Pg. - 41

For Topog. See Pg. - 55

R.P. Set 2x2+t 18" Dn

Fd N+T P.P.

ST.

(20) (20)

Fd N+T G.P.

R.P. Set 2x2+t 18" Dn

89-22-45
357-30-45
89-22-40

73.44

148.23

75.12

Fd 1" I.P.+t

LOS ANGELES

ST.

From Rt. Pg. -30

1323.70

669.744

To Walnut St.

181+23.70
Fd. 1" I.P.+t - 2" Dn
Per F.B. 372-4
See back of 4

38.88

Fd N+T P.P.

90°

44.94

73.94

(R.P. Set 2x2+t 18" Dn Tang

669.84 @ 62° = 669.74 ✓
669.79 @ 64° = 669.70 ✓

(25) (25)

CENTER

90-44-00
362-56-15
90-44-05

Fd. N+T P.P.

Fd. N+T S.P.

37.76

26.01

(40)

PALM

AVE

Fd N+T T.P.

Set nail by tie
F.B. 372-7

Fd N+T S.P.

To Bot. Pg. -32

RETURN TO
LOS ANGELES COUNTY SURVEYOR

Do not extend notes this side of this line

Notes: ANY ADDITIONS OR CHANGES ON THIS SHEET MUST BE MADE OR CIRCLED IN Red. WITH DATE AND/ NAME OF/ PERSON MAKING CHANGE.

F. B. 436 PG. 32 Chief Party Notes by M Date

W.S. 46-C-4

RETURN TO LOS ANGELES COUNTY SURVEYOR

Do not extend notes this side of this line

Note: ANY ADDITIONS OR CHANGES ON THIS SHEET MUST BE MADE OR CIRCLED IN Red. WITH DATE AND NAME OF PERSON MAKING CHANGE.

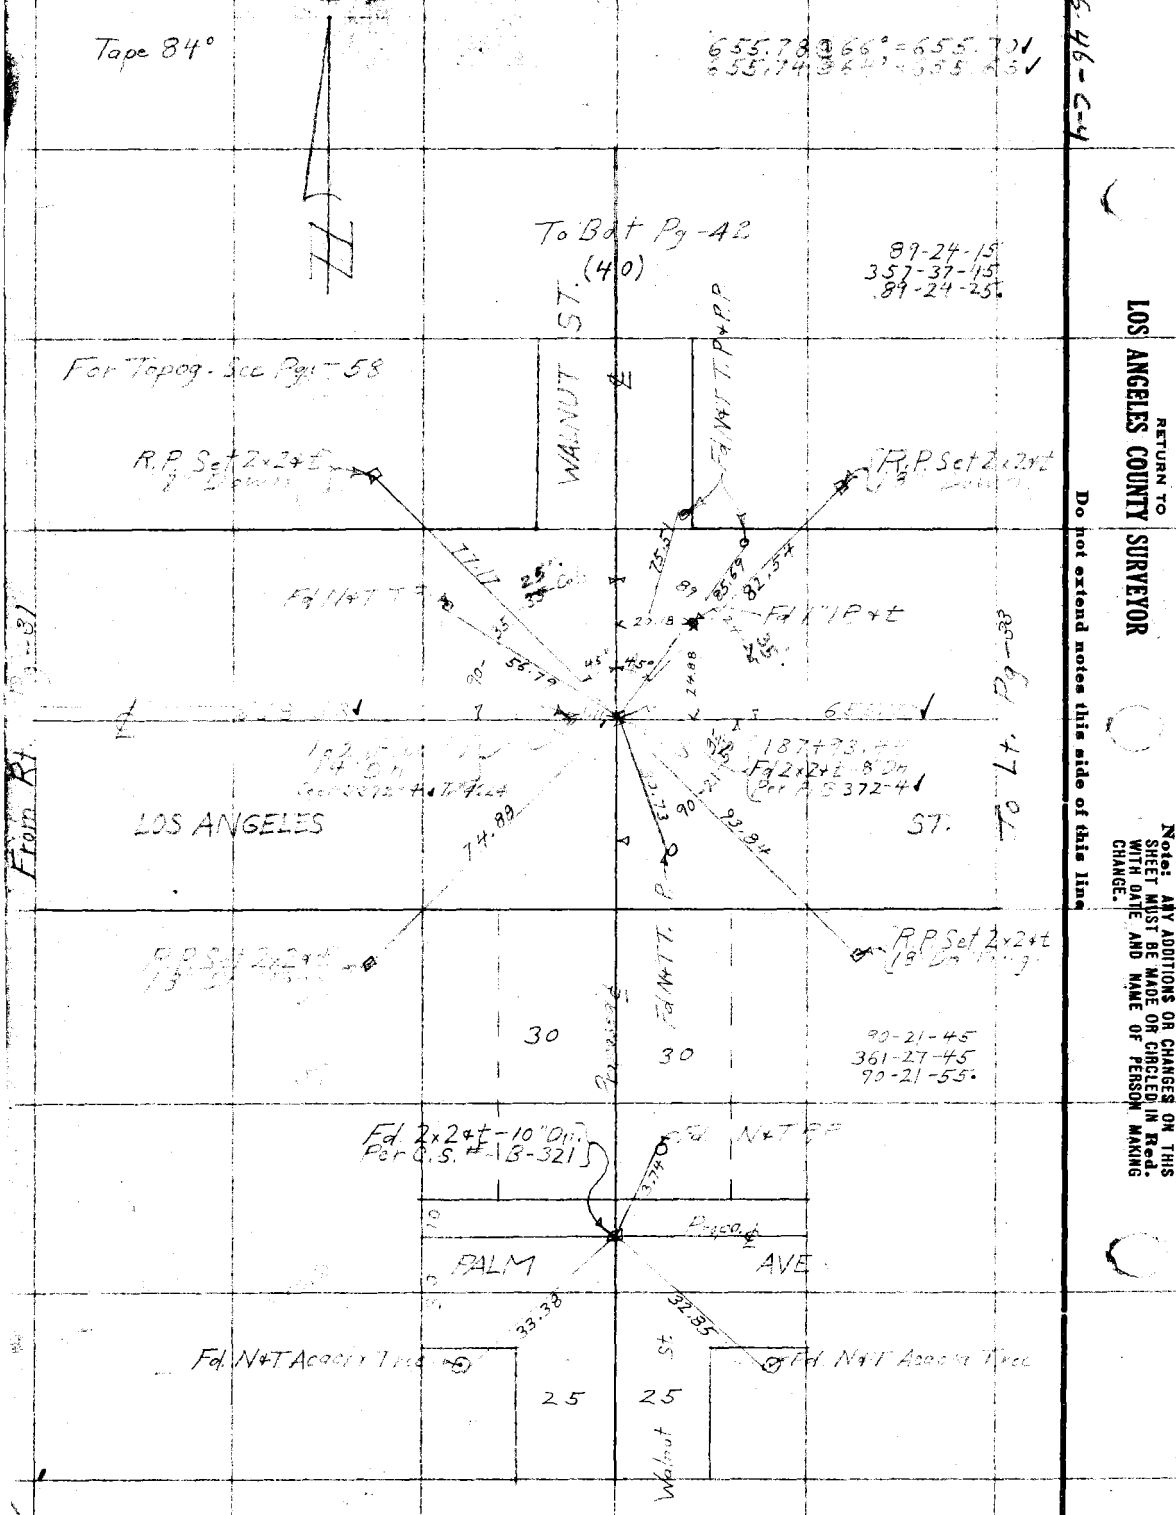

Date _____ Notes by M Chief Party M F.B. 436 Pg

Platted by H. U. M. H.	W. O. No. 970 D. S. O. No.
Date July 1941	Location Los Angeles St.
Map No. B-1648	Surveyed by F. J. McNeal
Platting C'k'd by	Date Mar - 1930
Date	Indexed A. C. Johnson

W.S. 46-30-4

Tape 84°

90-35-15
362-21-00
90-35-15

To Bot Pg 43

(40)

For Topog. See Pg. - 61

AVE

R.P. Set 2x2x t 18" On. Tag

Fd N+T 11" P.P.

Fd N+T G.P.

89-24-40

R.P. Set 2x2x t 8" On Tag

S.E. Cor. of 18

Fd N+T. T.P.

LOS ANGELES

ST.

83.88

35-20

181.1

32.28

29.82

90.08

Calc

26.57 to Fd 2x2x t

194+53.48 Set nail by int

To ℄ Breese Ave

655.70

659.92

From Rt. Pg - 32

Fd 2x2x t - 8" On - F.B. 372-3
194+49.14

Fd 2" I.P. t - 18" On - No Ref.

Fd N+T. T.P.

45°

45°

Fd. old 4x4 No Tack - Flush F.B. 372-3 117.4

75.08

35.83

R.P. Set 2x2x t - 18" On

(25)

MERCED

Proposed ℄

Fd N+T Cypress

89-56-15
359-45-30
89-56-20.

PALM AVE

Fd N+T P.P.

18.51

Fd 2x2x t - 10" On Pcd F.B. 372-117

43.87

(-)

(50)

To Lt. Pg - 54

RETURN TO
LOS ANGELES COUNTY SURVEYOR

Notes: ANY ADDITIONS OR CHANGES OR THIS SHEET MUST BE MADE OR CIRCLED IN Red. WITH DATE AND NAME OF PERSON MAKING CHANGE.

Do not extend notes this side of this line

F.B. 436 Pg. 34 — Chief Party — Notes by M — Date

WS 46 D-4

Tape 34°

For Topog. See Fd. 64

To Bot. Fd. 144

70-35-15
362-21+08
90-35-15

(40)

AVE

BRESEE

Fd. 1" IP

Fd. 2x2+t

4"up SW. Cor Lot 7

660.05 @ 70°-65°
660.33 @ 64°-65°

Lot 12

Fd 2x2+t

Lot #12

Fd 2x2

Fd 2x2+t

R.P. Set 2x2+t 8" Dn. Tang.

Fd. VAT T.P.

Set 1/2"

20.32

17.98

14.52

26.11

24.86

45°

45°

201+13.40

LOS ANGELES

ST.

Fd. VAT T.P.

16.90

79.17

21.43

16.63

R.P. Set 2x2+t 8" Dn. Tang.

R.P. Set 2x2+t 8" Dn. Tang.

89-51-30
359-26-15
89-51-35

30

30

30' Offset

Proposed ℄

Fd. 1" IP 0.04' Deep
Per F.B. 372-31

Fd. 2x2+t-12" Dn
Per F.B. 372-31

Fd. N47° Gum Tree

42.39

30.00

90°

Set 1/2x24

55.41

51.21

16.43

Proposed ℄

30

Fdx on top of Iron Valve

70.65

PALM

AVE

30

RETURN TO
LOS ANGELES COUNTY SURVEYOR

Do not extend notes this side of this line

Note: ANY ADDITIONS OR CHANGES ON THIS SHEET MUST BE MADE OR CIRCLED IN Red. WITH DATE AND NAME OF PERSON MAKING CHANGE.

W.S. 46 D-4

Date _____ Notes by M Chief Party M F.B. # 36 Pg 35

Plotted by H. U. M. H.	W. O. No. 920 O. S. O. No.
Date July 1941	Location Los Angeles Co.
Map No. B-1648	Surveyed by F. J. McNeal
Platting Ck'd by	Date Mar - 1930
Date	Indexed A. C. Johnson

Notes: ANY ADDITIONS OR CHANGES ON THIS SHEET MUST BE MADE OR CIRCLED IN Red. WITH DATE AND NAME OF PERSON MAKING CHANGE.

Do not extend notes this side of this line

RETURN TO LOS ANGELES COUNTY SURVEYOR

For Topog. See Pg. - 67

To Bot. Pg - 45 (20)

Tape 84°

90-35-15
362-20-45
90-35-10.

STEWART AVE

Fd. 2x24t-4" up Loose S.E. Cor. 1.0' ±

Fd. 2x24t-6" Dn Per F.B. 372-2

Set 8" Dn

From Rt Pg 34

To Lt. Pg - 36

Fd. Spk. in Paper

90'

31.20

77.11

45°

45°

79.91

89-27-45

24.95 R

634.99

25.00

662.43

Set N+T

89-58-30

49.49

LOS ANGELES ST.

Fd N+T. G.P.

80.79

34.37

91.51

Fd. Spk P.P.

RP Set 2x24t 8" Dn Tan.

30'

30'

RP Set 2x24t 8" Dn. Tan.

179-57-30
359-50-15
89-57-35

662.53 @ 60° - 662.43
662.51 @ 54° - 662.42

Fd. x on Conc. Wall

25.00 Proposed ℄

89-58-30
359-54-30
89-58-35.

Fd. x on Iron Band of Irrigation Valve

34.88

56.11

42.79

Fd. 2x24t-12" Dn Per F.B. 372-30

Set 1x24t

25.00

Proposed ℄

PALM AVE

33.44

49.17

Fd. x on Iron Band of Irrigation Valve

F.B. 436 Pg. 36 Chief Party Notes by Date

WS 46 D-4

Tape 84°

For Topog See Pg. -78

CRP Set 2x24 t 18" Dn. Topog.

Fd. 1/2" Iron Pipe 1.2' Dn.

+351.32 18" Dn. Topog.

LOS ANGELES ST.

Fd. Nail & Tag

77.51

57.63

Fd. Nail & Tag

From Hill Pg-35

Set 2x2 t-18" Dn.

39.72

82.76

45°

89.59

79.26

CRP

157.99

Fd. Nail & Tag

(25) (35)

LA HIGA AVE

R.P. Set 2x24 t. 18" Dn.

Fd. Nail & Tag

Fd. Nail & Tag

23.29

15.67

CLARK ST.

Set 1x1/4 t by Ties Per. F.B. 37 2-21

45.35

Fd. Nail & Tag

(55)

RETURN TO
LOS ANGELES COUNTY SURVEYOR

Do not extend notes this side of this line

Note! ANY ADDITIONS OR CHANGES ON THIS SHEET MUST BE MADE OR CIRCLED IN Red. WITH DATE AND NAME OF PERSON MAKING CHANGE.

W.S. 446 - D-4

Date _____ Notes by MM Chief Party M F.B. 436 Pg. 37

Platted by H. U. M. H.	W. O. No. 970 D. S. B. No.
Date July 1941	Location Los Angeles St
Map No. B-1648	Surveyed by F. J. McNeal
Platting C'k'd by	Date Mar 1930
Date	Indexed A. C. Johnson

Notes: ANY ADDITIONS OR CHANGES ON THIS SHEET MUST BE MADE OR CIRCLED IN Red. WITH DATE AND NAME OF PERSON MAKING CHANGE.

Do not extend notes this side of this line

RETURN TO LOS ANGELES COUNTY SURVEYOR

Tape 84°

For Topog See Pg. - 72

To Bot Pg. 46

89-26-15
357-45-45
89-26-25

690.35 @ 64° = 690.26
690.40 @ 60° = 690.29

From Rt Pg. - 36

To Lt. Pg - 39

LOS ANGELES ST.

AVE

Fd. N+T. T.P.

Fd. N+T. P.P.

SIERRA MADRE

(25) (25)

CLARK ST.

(50)

R.P. Set 2x24t 18" Dn Tang.

R.P. Set 2x24t 18" Dn

220 + 77.60
Fd. 3/4" IP+t-4" Dn
Per. F.B. 372 - 1, 25

641.78

690.26

Fd. X in Wlet

72.61

36.43

89

73.14

45°

45°

28.14

78.76

74.25

90-00-30
360-01-15
90-00-20.

Fd. L+T in Curb

Fd. L+T in Curb

45.14

34.90

20.32

Fd. 2x2+t - 12" Dn
Per F.B. 372-25 1.

Fd. L+T in Curb

F.B. 436 PG. 38 — Chief Party — Notes by M — Date

W.S. 4960-4

Tape 84°

(60)

90-33-15
362-13-15
90-33-20

To Bot. Pg - 47

For Topog. See Pg - 79

Fd. L+T Curb

AVE

Fd. L+T Curb

90-33-25

50.03

44.12

LOS ANGELES

ST.

Pg-40

234+22.45
Fd. bolt - Pt
F.B. 372-11

165.01'

From Rt.

89-58-18
89-58-50

30.00

Fd. 2" I.P. & L-2" up

43.43

50.94

30.02

Fd. 2" I.P. & L - flush

35.02

35.02

Fd. L+T Curb

Fd. L+T Curb

89-58-45
359-55-15
89-58-50.

MAINE

℄

To Top Pg - 48

(70)

RETURN TO
LOS ANGELES COUNTY SURVEYOR

Do not extend notes this side of this line

Note: ANY ADDITIONS OR CHANGES ON THIS SHEET MUST BE MADE OR CIRCLED IN Red. WITH DATE AND NAME OF PERSON MAKING CHANGE.

WS. 46-D-4

Date _____ Notes by M Chief Party M F.B. 436 Pg 9

Platted by H U M H	W. O. No. 970 D. S. O. No.
Date July-1941	Location Los Angeles St
Map No. B-1648	Surveyed by F J McNeal
Platting C'k'd by	Date Mar-1930
Date	Indexed A. C. Johnson

Note: ANY ADDITIONS OR CHANGES ON THIS SHEET MUST BE MADE OR CIRCLED IN Red. WITH DATE AND NAME OF PERSON MAKING CHANGE.

Do not extend notes this side of this line

RETURN TO LOS ANGELES COUNTY SURVEYOR

Tape 84°

Fd. N4T. T.P.

+67.86 4t-6"Dm 372-43

227 Fd. 2x2 Per F.B.

Fd. N4T Gum

LOS ANGELES ST.

70.23

55.03

Set N4T.

690.26t

0.04

489.58

49.09

90-00-45

From Pt. Pg-37

For Topog. See Pg-75

To Lt. Pg-40

Fd N4T umbrella

30

AVE.

30

5' offset

Proposed ℄

ROBIN

90-00-45
360-02-45
90-00-40

489.64@ 64° = 489.58✓
489.64@ 60° = 489.56✓

30

Set N4T

20.05

5.00

7.40

Fd. 2x24t-12"Dm Per F.B. 372-48✓

Proposed ℄

BALLENTINE

30

14.82

5.76

PLACE

Ties are N4T Fd. in orange trees

F.B. 436 Pg. 40 — Chief Party — Notes by M — Date

Tape 84°

2x24t-S.E.Cor.Lot-3-Tr#4802

For Topog See Pg-78

Fd. 2x24t. 0.72-N 78°E

Fd. 2x24t. 0.32+57.44

Fd. N+T. T.P.

Fd. N+T. G.P.

23.76

23.94

165.01

489.58

27.93

87-58-50 See Note

9.66

Fd. N+T P.P.

From Pg. 39

To Pg. 38

LOS ANGELES ST.

Note

The 2x2@ Los Angeles and the N+T@ Clark are equal distances from Maine Ave. The Alley is 11 to Maine. A Cannot be turned with less than a 100' offset.

10 10

165.03@64°=165.01

165.03@64°=165.01

Proposed Alley

Fd x in Curb

Fd. N+T P.P.

27.68

36.53

Fd N+T by ties C.B. 372 78E

CLARK ST.

Fd N+T P.P.

25.70

32.30

Fd. x on Curb

RETURN TO LOS ANGELES COUNTY SURVEYOR

Do not extend notes this side of this line

Notes: ANY ADDITIONS OR CHANGES ON THIS SHEET MUST BE MADE OR CIRCLED IN Red. WITH DATE AND NAME OF PERSON MAKING CHANGE.

M.S. 46 C-3

Date _____ Notes by M Chief Party M F.B. 436 Pg. 41

Platted by H.U.M.H.	W. O. No. 970 D. S. D. No.
Date July-1941	Location Los Angeles St.
Map No. B-1648	Surveyed by F. J. McNeal
Platting C'k'd by	Date Mar-1930
Date	Indexed A. C. Johnson

Fd 2" IP + t-3" Dn Per Tr # 4624 ✓
M68-33
Set N+T P.P.
59.44
(25) OLIVE ST
21.70
Set N+T P.P.

(20) (20)

ST.

20.15 Fd 2x2+t-S.W.Cor Lot-57

4624

20.00 Fd 2x2+t S.W.Cor Lot-53
20.01 Fd 2x2+t S.W.Cor Lot-52
20.12 Fd 2x2+t S.W.Cor Lot-51

20.11 Fd 2x2+t S.W.Cor Lot-49
19.9 Fd 3/4" IP. no tack S.W.Cor Lot-46
20.18 Fd. 2x2+t-S.W.Cor Lot-45

CENTER

20.35 Fd 2x2+t-S.W.Cor Lot-43
20.33 Fd 2x2+t-S.W.Cor Lot 41

TRACT

From Top Pg-31

Note: ANY ADDITIONS OR CHANGES ON THIS SHEET MUST BE MADE OR CIRCLED IN Red. WITH DATE AND NAME OF PERSON MAKING CHANGE.

Do not extend notes this side of this line

RETURN TO LOS ANGELES COUNTY SURVEYOR

F.B. 436 PG. 42 M Chief Party Notes by M Date

WS 46 C-3

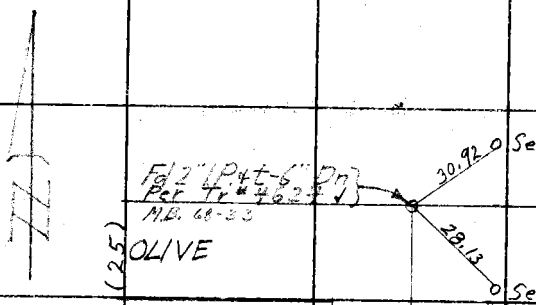

	(20) (20) ST.	
	20.59	Fd 2x2+t S.W. Cor Lot - 91
	19.92	Fd 2x2+t S.W. Cor Lot - 90
S.E. Cor Lot - 60 - Fd. 2x2+t	20.22 20.00	Fd 2x2+t S.W. Cor Lot - 89
	19.07	Fd 2x2+t S.W. Cor Lot - 88
S.E. Cor Lot - 62 - Fd 2x2+t	(20) (20) 20.00 20.00	Fd. 2x2+t S.W. Cor Lot - 87
	20.19	Fd 2x2+t S.W. Cor Lot - 86
	20.00	Fd 2x2+t S.W. Cor Lot - 85
S.E. Cor Lot - 65 - Fd 2x2+t	20.08	
S.E. Cor Lot - 66 - Fd 2x2+t	20.00	
S.E. Cor Lot - 68 - Fd 2x 2+t	20.04 19.94	Fd 2x2+t S.W. Cor. Lot - 81
S.E. Cor Lot - 69 - Fd 2x2+t	20.17 20.04	Fd 2x2+t S.W. Cor Lot - 80
S.E. Cor Lot - 70 Fd 2x 2+t	20.03 19.82	Fd 2x2+t S.W. Cor - Lot - 79
S.E. Cor Lot - 71 Fd 2x2+t	20.03 20.10	Fd 2x2+t S.W. Cor. Lot 78
	WALNUT 20.08	Fd 2x2+t S.W. Cor. Lot - 77
	From Top Pg - 32	

NO. 462.4

RETURN TO LOS ANGELES COUNTY SURVEYOR

Do not extend notes this side of this line

Notes: ANY ADDITIONS OR CHANGES ON THIS SHEET MUST BE MADE OR CIRCLED IN Red. WITH DATE AND NAME OF PERSON MAKING CHANGE.

W.S. 46 D-3

Date _____ Notes by M Chief Party M F.B. 436 Pg. 48

Platted by H U M H	W. O. No. 970 D. S. O. No.
Date July 1941	Location Los Angeles St.
Map No. B-1648	Surveyed by F.J. McNeal
Platting C'k'd by	Date Mar - 1930
Date	Indexed by C. Johnson

Note: ANY ADDITIONS OR CHANGES ON THIS SHEET MUST BE MADE OR CIRCLED IN Red. WITH DATE AND NAME OF PERSON MAKING CHANGE.

Do not extend notes this side of this line

RETURN TO LOS ANGELES COUNTY SURVEYOR

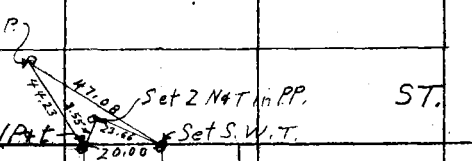

S.E.Cor.Lot-92-Fd. 3/4"IP. no tack
20.15
20.07
Fd 2x2 no tack-S.W.Cor Lot-125

TRACT

20.03
Fd. 2x2+t-S.W. Cor.Lot-124

S.E.Cor Lot-94-Fd 2x2+t
20.00

AVE

S.E.Cor Lot-95-Fd. 2x2+t
19.68

(20) (20)

S.E.Cor.Lot-97-Fd.2x2+t
19.15
19.94
Fd 2x2+t-S.W. Cor. Lot-120

S.E.Cor.Lot-99-Fd 2x2+t
19.76

S.E.Cor.Lot-100-Fd. 2x2+t
20.30
20.28
Fd 2x2 no tack-S.W.Cor Lot-117

S.E.Cor.Lot-102-Fd. 2x2 no tack
18.38

E

NO.- 4624

19.86
Fd. 2x2 no tack S.W.Cor. Lot-112

S.E.Cor. Lot-106-Fd.2x2+t
19.83
19.85
Fd rotten 2x2-S.W.Cor Lot-111

19.99
Fd 2x2+t S.W. Cor. Lot-110

S.E.Cor. Lot-108-Fd. 2x2+t
20.06
19.92
Fd 2x2+t S.W. Cor Lot-109

MERCED

From Top Pg-33

F.B. 436 PG. 44 — Chief Party — Notes by M — Date

W.S. 46-03

RETURN TO LOS ANGELES COUNTY SURVEYOR

Do not extend notes this side of this line

Notes ANY ADDITIONS OR CHANGES ON THIS SHEET MUST BE MADE OR CIRCLED IN Red. WITH DATE AND NAME OF PERSON MAKING CHANGE.

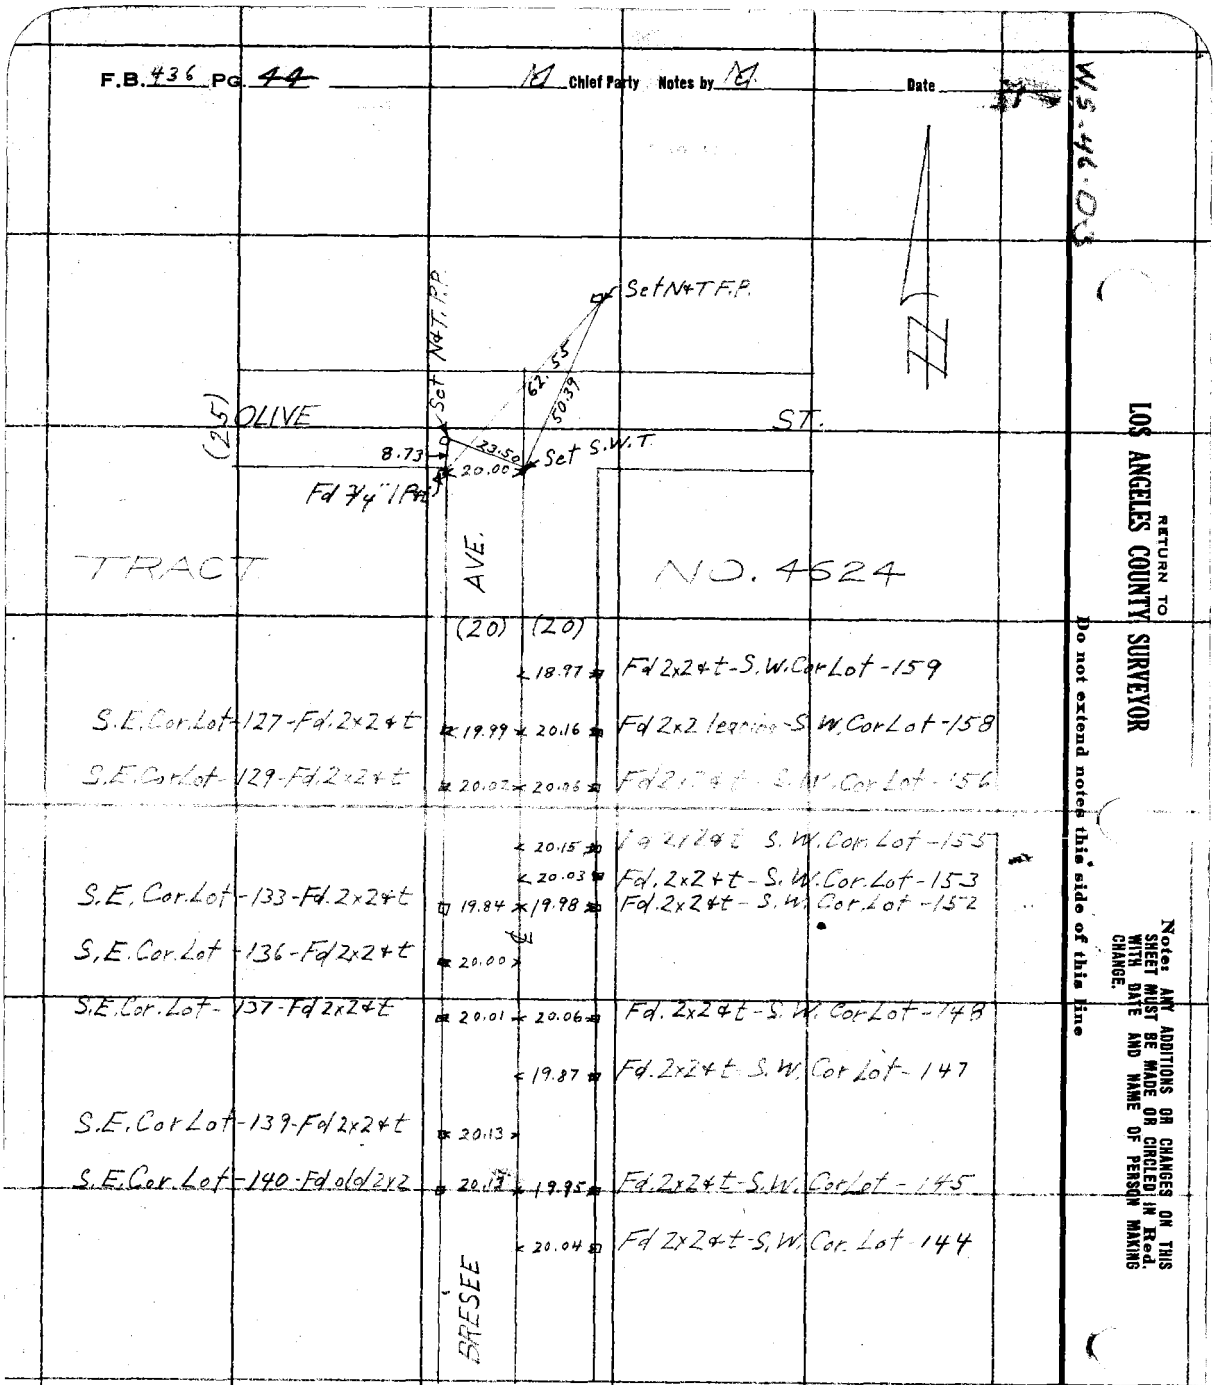

From Top Pg – 34

RETURN TO
LOS ANGELES COUNTY SURVEYOR

Note: ANY ADDITIONS OR CHANGES ON THIS SHEET MUST BE MADE OR CIRCLED IN Red. WITH DATE AND NAME OF PERSON MAKING CHANGE.

Do not extend notes this side of this line

W.S. 46-D-3

Date _____ Notes by M Chief Party M F.B. 436 Pg. 45

Platted by H.U.M.H.	W. O. No. 970 D. S. O. No.
Date July 1941	Location Los Angeles St
Map No. B-1648	Surveyed by F.J. McNeal
Platting C'k'd by	Date Mar - 1936
Date	Indexed A. C. Johnson

Set N+T P.P. — 73.49 — Fd. 1" I.P.+t Bears N 46° 24' E Per Tr. 4624 M.B. 41-33

(25) OLIVE ST.

Set N+T P.P. — 29.30 — 49.15 — Set N+T Fig Tree

Fd. 1" I.P.+t 20.04

S.E. Cor. Lot-159-Fd. 2x2+t 19.95

(20)

S.E. Cor. Lot-158-Fd. 1¼" I.P. 19.88

S.E. Cor. Lot-157-Fd. 2x2+t Fd. 1¼" I.P. 2.16 19.80

S.E. Cor. Lot-156-Fd. 2x2+t Fd. 1¼" I.P. 0.15 19.91

S.E. Cor. Lot-155 Fd. 2x2+t 19.91

S.E. Cor. Lot-152-Fd. 2x2+t 20.08

S.E. Cor. Lot-151-Fd. 2x2+t-3" Dn 20.12

S.E. Cor. Lot-150 Fd. 1" I.P.+t-3" Dn 19.97

S.E. Cor. Lot-149-Fd. 3/4" I.P. 20.28

S.E. Cor. Lot-148-Fd. 1" I. Rod 20.09

S.E. Cor. Lot-147-Fd. 2x2+t 19.98

S.E. Cor. Lot-146-Fd. 2x2+t 19.83

S.E. Cor. Lot-145-Fd. 2x2+t 20.36

S.E. Cor. Lot-143-Fd. 2x2+t 20.17

4624

TRACT

AVE

STEWART

From Top Pg - 35

F.B. 436 Pg. 42 Chief Party Notes by CM Date

W.S. 46 D-3

Fd. Conc. Mon.
< 21.63

OLIVE

Fd. 3/4" IP+t-3"Dp
Per F.B. 2-289-7.5

33.25

Set N+T G.P.

ST.

27.17

1344.62

24.46

29.28

Set Cut Lock St. Sign up. 3

Set N+T P.P.

T 1N, R 14W

AVE.

828.01@90°-828.04
494.90@89°-494.91
21.67
344.62

OHIO ST

MADI

Fd. 2"IP+t-6"up
Set in Conc.
S.E. Cor Lot 4

25.18

SIERRA

From Top Pg. 37

RETURN TO
LOS ANGELES COUNTY SURVEYOR
Do not extend notes this side of this line

Notes: ANY ADDITIONS OR CHANGES ON THIS SHEET MUST BE MADE OR CIRCLED IN Red. WITH DATE AND NAME OF PERSON MAKING CHANGE.

Date _____ Notes by M Chief Party M F.B. 436 Pg. 47

Plotted by H.U.M.H.
Date July-1941
Map No. B-1648
Plotting C'k'd by
Date

W. O. No. 970 D. S. O. No.
Location Los Angeles St
Surveyed by F. J. McNeal
Date Mar-1930
Indexed A. O. Jones

WS 46 D-3

Notes: ANY ADDITIONS OR CHANGES ON THIS SHEET MUST BE MADE OR CIRCLED IN Red. WITH DATE AND NAME OF PERSON MAKING CHANGE.

Do not extend notes this side of this line

RETURN TO LOS ANGELES COUNTY SURVEYOR

From Rt. Pg. - 46

(60)

Fd. L+T Curb

S.W.T.

.07 .03

48.14

Fd. L+T Curb

48.78

42.78

Fd. N+T T.P.

OLIVE ST.

1344.62 ℄

Fd. 2x2+2 Tacks -6" Dp.
Per F.B. 252-344-3 of S.W.T.

48.53

48.29

Fd. L+T Curb

(30)

AVE. 19

Fd. L+T Curb

Fd. N+T T.P.

Fd. 2" I.P. + t — 22+24.8 @ 34.93 ›

19+33.3 - Fd. N+T

(30)

Fd. 2" I.P. + t. -3" up 15+26.0 @ 45.04 ›

14+76.0 @ 42.65 ›

Fd. Row 2x2+2 -Av. 3" up

14+26.0 @ 45.09 ›

13+76.0 @ 45.07 ›

13+25.9 @ 45.06 ›

12+75.9 @ 45.07 ›

12+25.8 @ 45.01 ›

11+91.1 @ 45.06 ›

MAINE

From Top Pg. - 38

F.B. 436 Pg. 98 — Chief Party — Notes by — Date

From: Bk of Pg – 38

(70)

0+83.9	35.07
1+33.7	35.08
1+83.9	35.09
2+33.9	35.00
2+84.4	35.03
3+34.7	35.95
3+84.7	34.94
4+34.8	34.90
4+85.3	34.90
5+35.3	34.90
5+85.3	34.89
6+35.3	34.91

AVE.

Ft. Row of 7x7 & t – Av 1" up

Fd. 2" I.P. & t

Fd. 2" I.P. & t

44.22

43.80

Fd. 1" Pipe

Fd. 1" Pipe

43.97

103 Nail 103

44.18

Fd. 1" Pipe

(50)

CLARK

ST

MAINE

Fd. Nail in Lead Per F.B. 372-144

W.S. 46 Dwy

RETURN TO
LOS ANGELES COUNTY SURVEYOR

Do not extend notes this side of this line

Note: ANY ADDITIONS OR CHANGES ON THIS SHEET MUST BE MADE OR CIRCLED IN Red. WITH DATE AND NAME OF PERSON MAKING CHANGE.

Date _____ Notes by M Chief Party M F.B. 436 Pg. 49

Platted by H.U.M.M.	W. O. No. 970 D. S. O. No.
Date July-1941	Location Los Angeles St.
Map No. B-1648	Surveyed by F. J. McNeal
Platting C'k'd by	Date May-1930
Date	Indexed A. C. Johnson

To Bot. Pg-50

24.5 ⊙

24.5 ⊙

24.5 ⊙

Tel. Pole

Paving

ST

Pow. Pole

24.5 ⊙

24.5 ⊙

Tel. Pole

Walk

24.5 ⊙

36" Pepper ⊙

36" Pepper ⊙

3" Orange ⊙

Tel. Pole

Stationing Omitted On This Page

LOS ANGELES

Macadam

Pow. Pole

Shrub

Guy Wire

Note: ANY ADDITIONS OR CHANGES ON THIS SHEET MUST BE MADE OR CIRCLED IN Red. WITH DATE AND NAME OF PERSON MAKING CHANGE.

Do not extend notes this side of this line

RETURN TO LOS ANGELES COUNTY SURVEYOR

F.B. 436 Pg. 50 — Chief Party — Notes by M — Date

To Bot Pg -51

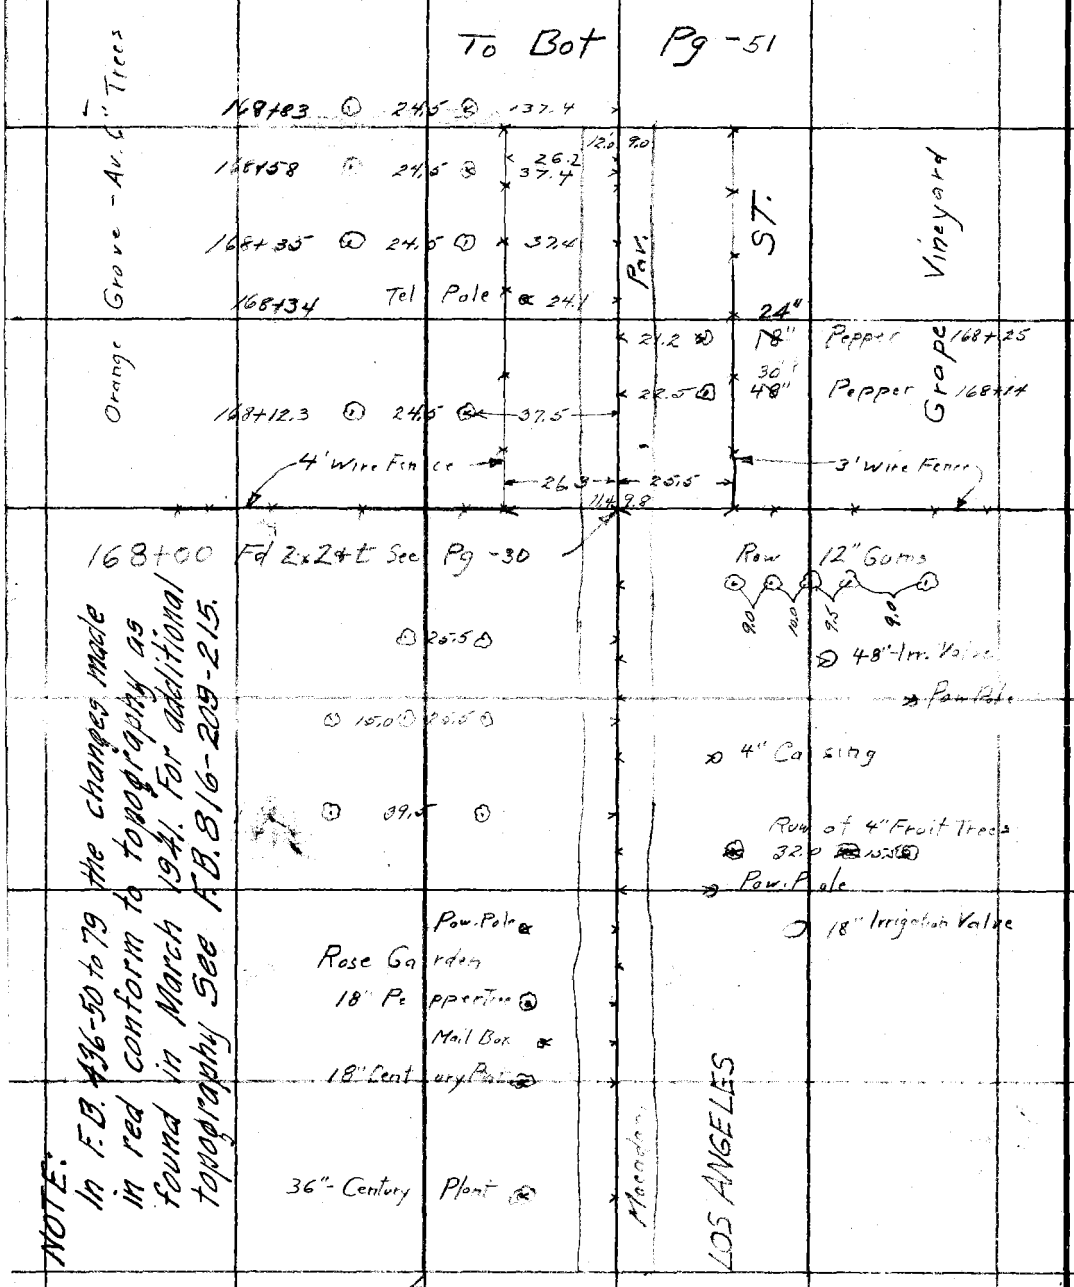

NOTE: In F.B. 436-50 to 79 the changes made in red conform to topography as found in March 1941. For additional topography See F.B. 316-209-215.

From Top Pg -49

RETURN TO LOS ANGELES COUNTY SURVEYOR

Do not extend notes this side of this line

Notes: ANY ADDITIONS OR CHANGES ON THIS SHEET MUST BE MADE OR CIRCLED IN Red. WITH DATE AND NAME OF PERSON MAKING CHANGE.

Date _____ Notes by M Chief Party M F.B. 436 Pg 51

Platted by H. U. M. H.	W. O. No. 970 O. S. O. No.
Date July-1941	Location Los Angeles St
Map No. B-1648	Surveyed by F. L. McNeal
Platting C'k'd by	Date Mar -1930
Date	Indexed by C. Johnson

RETURN TO LOS ANGELES COUNTY SURVEYOR

Notes: ANY ADDITIONS OR CHANGES ON THIS SHEET MUST BE MADE OR CIRCLED IN Red. WITH DATE AND NAME OF PERSON MAKING CHANGE.

Do not extend notes this side of this line

To Bot Pg - 52

Orange Grove Ave. - 64' Trees

ST

Pav.

LOS ANGELES

Macadam

Vineyard

Grape

			26.2	12.0	6"	out 7 Pepper	
				26.8	30"?		
			18.8		36"	Pepper	170+62
			19.4	16'	12"	Pepper	170+48.7
170+42		24.4	37.4				
170+21		24.5	37.4		24' 18"	Pepper	170+24
170+10		Tel. P.	24.2				
170+00		24.5	37.4	19.7	12"	Pepper	169+89
169+98		24.5	37.4	24.6	18"	Pepper	169+78
				24.9	30' 24"	Pepper	169+64
169+53		24.5	37.4	24.3	30"? 36"	Pepper	169+40
169+29		24.5	37.4	10.6-34			
				26.8			169+30
				26.1			169+11
				25.2		Pole	Pole 169+10
				15.0		Mail	Box 169+07
169+06		24.5	37.4				FOut. 4' Fence
				21.0	24" 18"	Pepper Tree	169+3
				20.2	18" 12"	Pepper Stump	168+91
4' Wire Fence					3'	Wire Fence	
			26.2	12.0 9.0	26.0		

From Top Pg - 50

F.B. 436 Pg. 52 — M Chief Party — Notes by M — Date

To Bot. Pg -53

173+41.3	℄ 24.5 ℄	37.6	25.7	27.5	
173+21	℄ 24.5 ℄	37.7			
173+18	Tel. Pole	℄ 23.7			
172+98	℄ 24.5 ℄	37.9			
			27.3	End 3'-Begining 4' Fence	172+84
			25.5	Pow Pole -172+83	
172+77	℄ 24.5 ℄	38.0			
172+55	℄ 24.5 ℄	38.0			
172+33	℄ 24.5 ℄	38.2			
172+26	18"-Century Plant	℄ 24.2			
172+12	℄ 24.5 ℄	38.2			
171+89	℄ 24.5 ℄	38.2			
171+79	Tel. Pole	℄ 23.7			
171+67.8	℄ 24.5 ℄	38.2			
171+46.5	℄ 24.5 ℄	38.2			
~~170+93~~	~~4' Wire Fence Out~~	~~℄ 26.2~~			
170+21	℄ 24.5 ℄	37.4			
170+94	℄ 24.5 ℄	37.4			
	4' Wire Fence		24.8	25'	Pow P & Guy Wire 170+92.5
				3'	Wire Fence
		26.2	12.0 9.0	26.8	

From Top Pg -51

Vineyard

Grape

Orange Grove Av. 6" Trees

Macadam

LOS ANGELES ST.

Paving

RETURN TO LOS ANGELES COUNTY SURVEYOR

Do not extend notes this side of this line

Note: ANY ADDITIONS OR CHANGES ON THIS SHEET MUST BE MADE OR CIRCLED IN Red. WITH DATE AND NAME OF PERSON MAKING CHANGE.

Date _____ Notes by M Chief Party M F.B. 436 Pg 54

Plotted by H U M H
Date July-1941
Map No. B-1648
Plotting C'k'd by _____
Date _____

W. O. No. 970 U. S. G. No. _____
Location Los Angeles St.
Surveyed by F. J. McNeal
Date May-1930
Indexed A. C. Johnson

Notes: ANY ADDITIONS OR CHANGES ON THIS SHEET MUST BE MADE OR CIRCLED IN RED WITH DATE AND NAME OF PERSON MAKING CHANGE.

Do not extend notes this side of this line

RETURN TO LOS ANGELES COUNTY SURVEYOR

To Bot Pg.-54

Orange Grove Av - 6" Trees

177+06 Tel. Pole ⊗ 23.4

175+74 Tel. Pole ⊗ 23.8

174+63.5 — 25.6

4' Wire Fence →

174+51 ⓓ 24" ⓟ 37.6

17443 Tel. Pole ⊗ 24.1

174+29 ⓓ 24" ⓟ 37.6

174+08 ⓓ 24" ⓟ 37.6

173+85 ⓓ 24" ⓟ 37.7

173+63.8 ⓓ 24" ⓟ 37.8

4' Wire Fence → 25.7

13' Pav'd

28.4 ST.

26.4 ⊗ Pow. Pole 174+45

25.5 ⊗ Pow. Pole 175+93

27.8 ⊗ 12" Pepper 175+01

25.3 ⊗ Pow. Pole 174+31

Macadam

LOS ANGELES

Grape

13'+8'

27.5 ← 4' Wire Fence

From Top Pg-52

F.B. 438 Pg. 54 — M Chief Party — Notes by M — Date

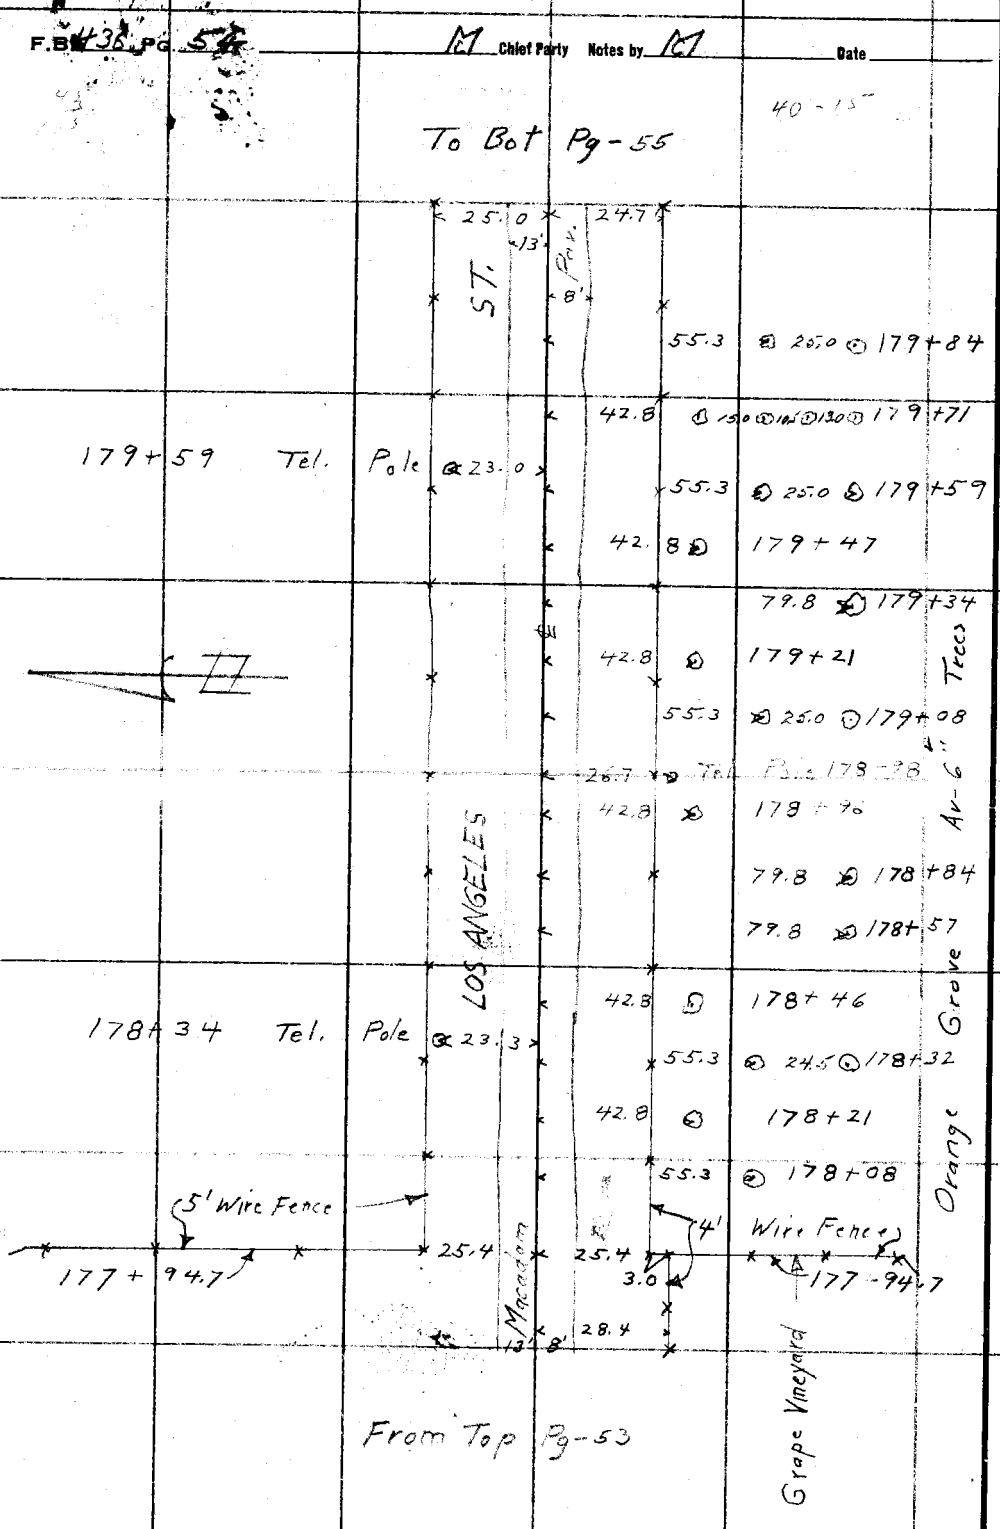

RETURN TO
LOS ANGELES COUNTY SURVEYOR

Do not extend notes this side of this line

Note: ANY ADDITIONS OR CHANGES ON THIS SHEET MUST BE MADE OR CIRCLED IN Red. WITH DATE AND NAME OF PERSON MAKING CHANGE.

Date _____ Notes by M Chief Party M F.B. 436 PG 56

Plotted by H.U.M.H.
Date July 1941
Map No. B-1648
Plotting C'k'd by _____
Date _____

W. O. No. 970 D. S. O. No. _____
Location Los Angeles St.
Surveyed by F. J. McNeal
Date Mar-1930
Indexed by C. Johnson

Note: ANY ADDITIONS OR CHANGES ON THIS SHEET MUST BE MADE OR CHECKED IN RED WITH DATE AND NAME OF PERSON MAKING CHANGE.

Do not extend notes this side of this line

RETURN TO LOS ANGELES COUNTY SURVEYOR

To Bot Pg - 56

182+20

182+21 Tel Pole 22.5

182+00

ST.

59.3

24.2 4' Sign

63.2 Shrubs

25.0 Irr Valve

26.4 Pow

1 Story Frame House 22.0 Roses 182+11.8

Pole 181+89

26.3 24" ST. Sign 181+42

Stand Pipe 181+53

CENTER ST.

181+43 2 Tel. Pol. Out

25.3 40' R 30.2

Macadam

1" I.P. Sec Pg - 31

181+09 2 Mail Boxes 37.7

181+03 St. Sign

181+00 23.2

25.0

38.0

35.3

Pow. Pole 181+07

6 Mail Boxes 181+10

180+98.1

38.1

Water Meter 180+95.3 4' Fence

24.9

27.6 Irr. Valve 180+95.5

Roses on Fence

5' Fence 23.3

18" Irr. Valves 180+84

Tel. Pole 180+87 22.6

180+71

54.6 180+78.4

42.0 4" Orange

55.3

180+65.9 Conc. Walks

1 Story Frame House

Lath Fence 2.3 3.8

½" Fig 180+34.0

180+42.7

26.0 P.P.

48.4

42.0

48.9

60.9

67.1

50.7

62.2

51.3

179+18

179+76

179+17 1" Fruit Trees

179+07

179+96.8

16.0

LOS ANGELES

Macadam

5' Fence 25.0 24.7 4' Fence

From Top Pg - 54

F.B. 436 Pg. 56 — Chief Party — Notes by — Date

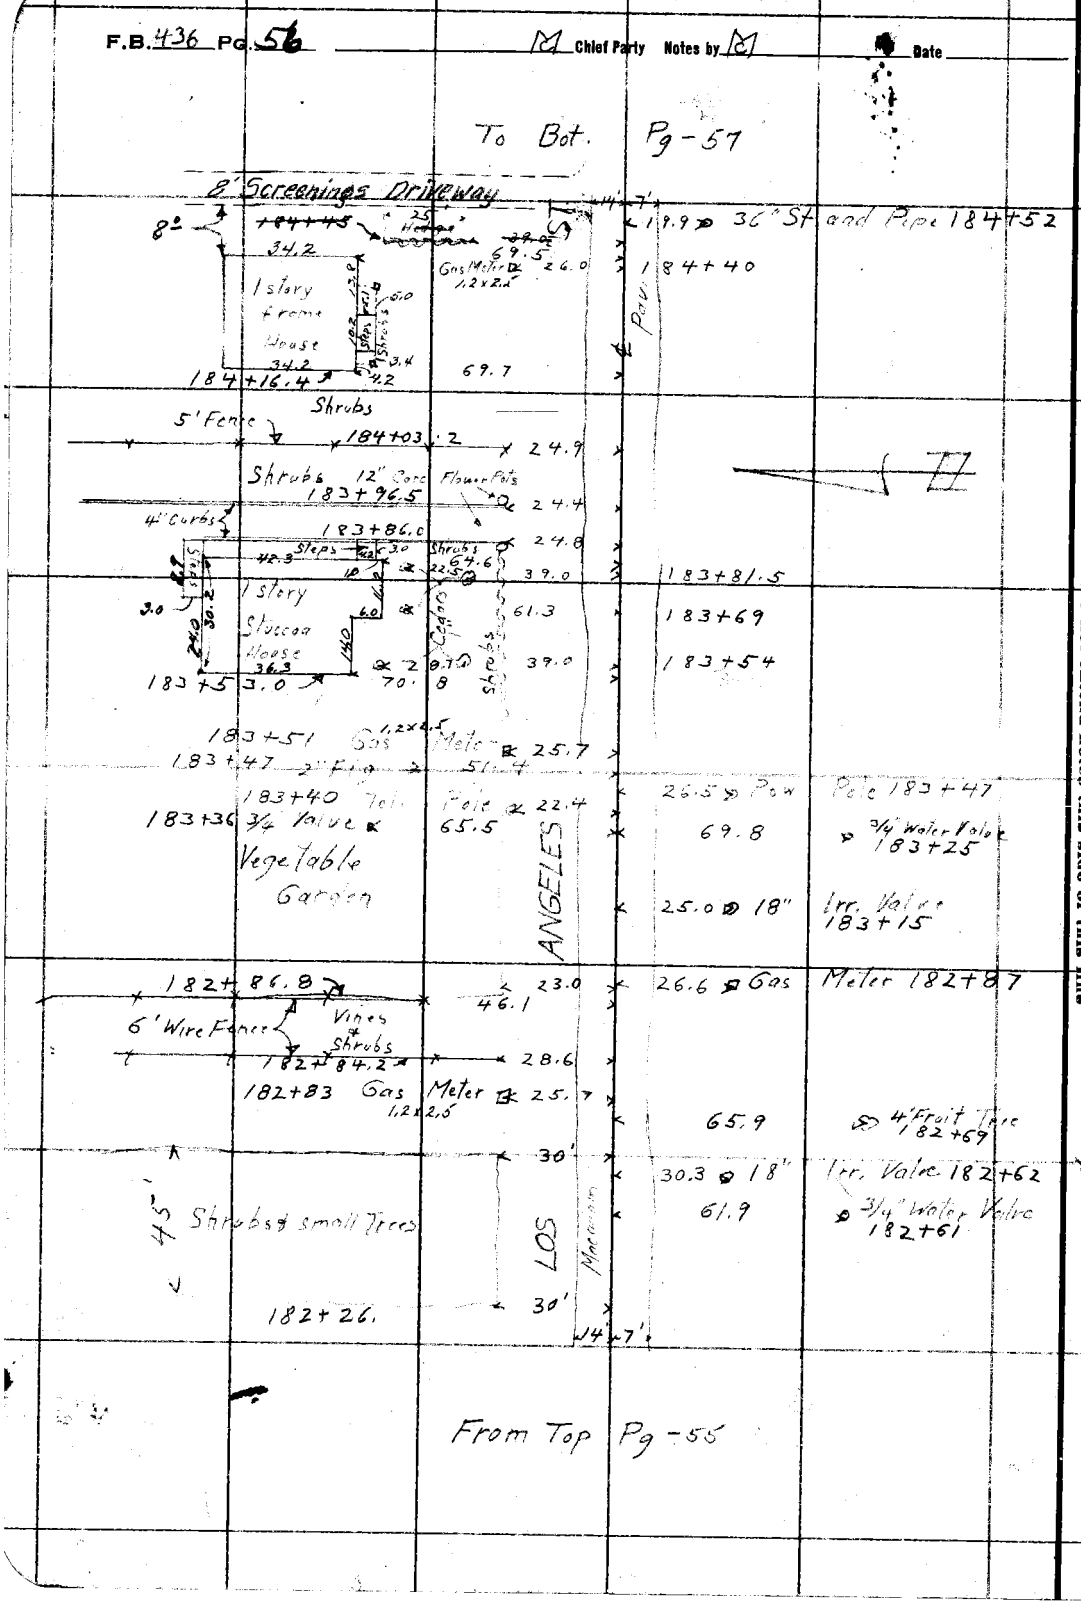

RETURN TO
LOS ANGELES COUNTY SURVEYOR

Do not extend notes this side of this line

Note: ANY ADDITIONS OR CHANGES ON THIS SHEET MUST BE MADE OR CIRCLED IN Red. WITH DATE AND NAME OF PERSON MAKING CHANGE.

Date _____ Notes by M Chief Party M F.B. 436 Pg. 57

Platted by H.U.M.H.
Date July-1941
Map No. B-1648
Platting C'k'd by
Date

W. O. No. 970 D. S. O. No.
Location Los Angeles St.
Surveyed by F.J. McNeal
Date May-1930
Indexed A.C. Jonnson

To Bot. Pg-58

ST.

187+40 Tel. Pole @ 21.6 > 14' > 7½ 20.8 2-8" 12" Peppers 187+20

187+04 clump of 5-8" shade trees 12"

35.3 35.

35.2 30" 24" Gum 186+92

25.0 Pow. Pole - 186+53

186+35 Roses 37.9

186+27 14" Pine 19.5

186+13 ½" Fruit Hedge 34.9 21.8 Pow Pole 186+08

186+00 Gas Meter 1.2x2.5 26.0

185+96 14" Pine 16.0 34.9 ½" Fruit Tree

185+81 Roses 12' Shrub 10' 28.2

185+37 1" Fig 65.0

Gas Meter 1.2x2.5 22.5 20.0

185+21

185+07 6" Walnut 65.0

LOS ANGELES

184+95 18" Palm 36.5 26.1 Pow. Pole 184+99

184+83 Tel/Pole 21.4 > 14' > 7½

184+73 3" Orange 65.6

From Top Pg-56

RETURN TO LOS ANGELES COUNTY SURVEYOR

Do not extend notes this side of this line

Notes: ANY ADDITIONS OR CHANGES ON THIS SHEET MUST BE MADE OR CIRCLED IN Red. WITH DATE AND NAME OF PERSON MAKING CHANGE.

F.B. 436 PG. 58 — M Chief Party — Notes by M — Date

To Bot Pg-59

ST.

120 8.0

189+02
189+99
~~189+98~~ Mail Boxes ℄ 20.8 ×
℄ 20.8 ×
~~℄ 20.8~~ ×
~~< 38.0~~ ~~Stake 189+80S~~
Pav. < 23.6 o Pow. Pole 189+79

189+42 Gas 1.2x2.4" Meter ℄ 26.7 ×
< 64.9
187+32 ⊙ 48" Pepper
~~< 64.0~~
~~189+01~~ ~~Guy Wire~~ ~~26.7~~ Gas 4.4x1.8 ℄ 26.7 ~~Pole~~ Stake 187+83 24.0

188+79 < 26.7 ℄ 26.7
~~188+75~~ ~~188+74~~ Guy Wire Tel Pole ℄ 24.2 ~~< 46.2~~ ~~26.2~~ 8.5 Guy Pole & Wire ~~188+78~~

~~Lamp 13~~ ~~Guy Wire 24.7~~
< 26.2 ⊙ 12" Pepper 188+34

13.0 8.0
< 24.2 o Pow. Pole 188+13
188+13 1.0 ST. Sign ℄ 26.6 < 17.6 ⊙ Fire Plug + Meter 188+06
188+88 2-Mail Boxes ~~℄ 40.6~~ 24.0 S. < 24.7 o Pow. Pole 188+05

℄ 1.0 Macadam 1.0 Pav. 187+93. 44-2x2 See Pg-32
WALNUT ST.

20.0 < 20.0 ⊙ 24" Stand Pipe 187+75
13.0 8.0
LOS ANGELES
Macadam
4.7

From Top Pg-57

RETURN TO LOS ANGELES COUNTY SURVEYOR

Do not extend notes this side of this line

Notes: ANY ADDITIONS OR CHANGES ON THIS SHEET MUST BE MADE OR CIRCLED IN Red. WITH DATE AND NAME OF PERSON MAKING CHANGE.

Date _____ Notes by M Chief Party M F.B. 436 Pg. 59

Platted by H. U. M. H.	W. O. No. 970 D. S. O. No.
Date July-1941	Location Los Angeles St
Map No. B-1648	Surveyed by F. J. McNeal
Platting C'k'd by	Date Mar-1930
Date	Indexed A. O. Johnson

To Bot. Pg-60

Notes: ANY ADDITIONS OR CHANGES ON THIS SHEET MUST BE MADE OR CIRCLED IN Red. WITH DATE AND NAME OF PERSON MAKING CHANGE.

Do not extend notes this side of this line

RETURN TO LOS ANGELES COUNTY SURVEYOR

~~1914-32.1~~

~~59.9~~ ~~Alley~~ ST. ~~Wood Fence~~ 12.0 8.0 Pow.

1917.25 Tel Pole ⊙ 22.0 ×

~~1914-20~~ ~~Ref. to Corner~~ ~~×~~ 23.0 ⊗ Pow

Pole 191+21

58.0 ×⊙ 16.0 ⊙ 191+08

191+02 58.0 ~~×~~ 16.6 ⊙ 18" Irr Valve

58.2 ⊙16.0⊙ 190+92.5

6" Apricots 6" Orange Trees

73.7 ⊙ 70

℄ 58.2 ⊙16.5⊙ 190+59.6

58.2 ⊙15.5⊙ 190+44

LOS ANGELES Macadam

190+33 24.2 ×10⊙ 2" Water Valve & 36" Stand Pipe

190+15 ~~23.1~~

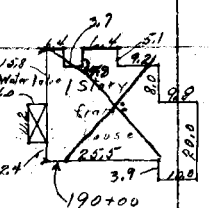

190+28.4 58.5 Shrubs

~~190+08~~ ~~Mail Box~~ ~~×~~ ~~20.9~~

190+05 Pow. Pole ⊙ 21.2 × ~~41.8~~

12.0 8.0

From Top Pg-58

F.B. 436 PG. 60 — M Chief Party — Notes by M — Date

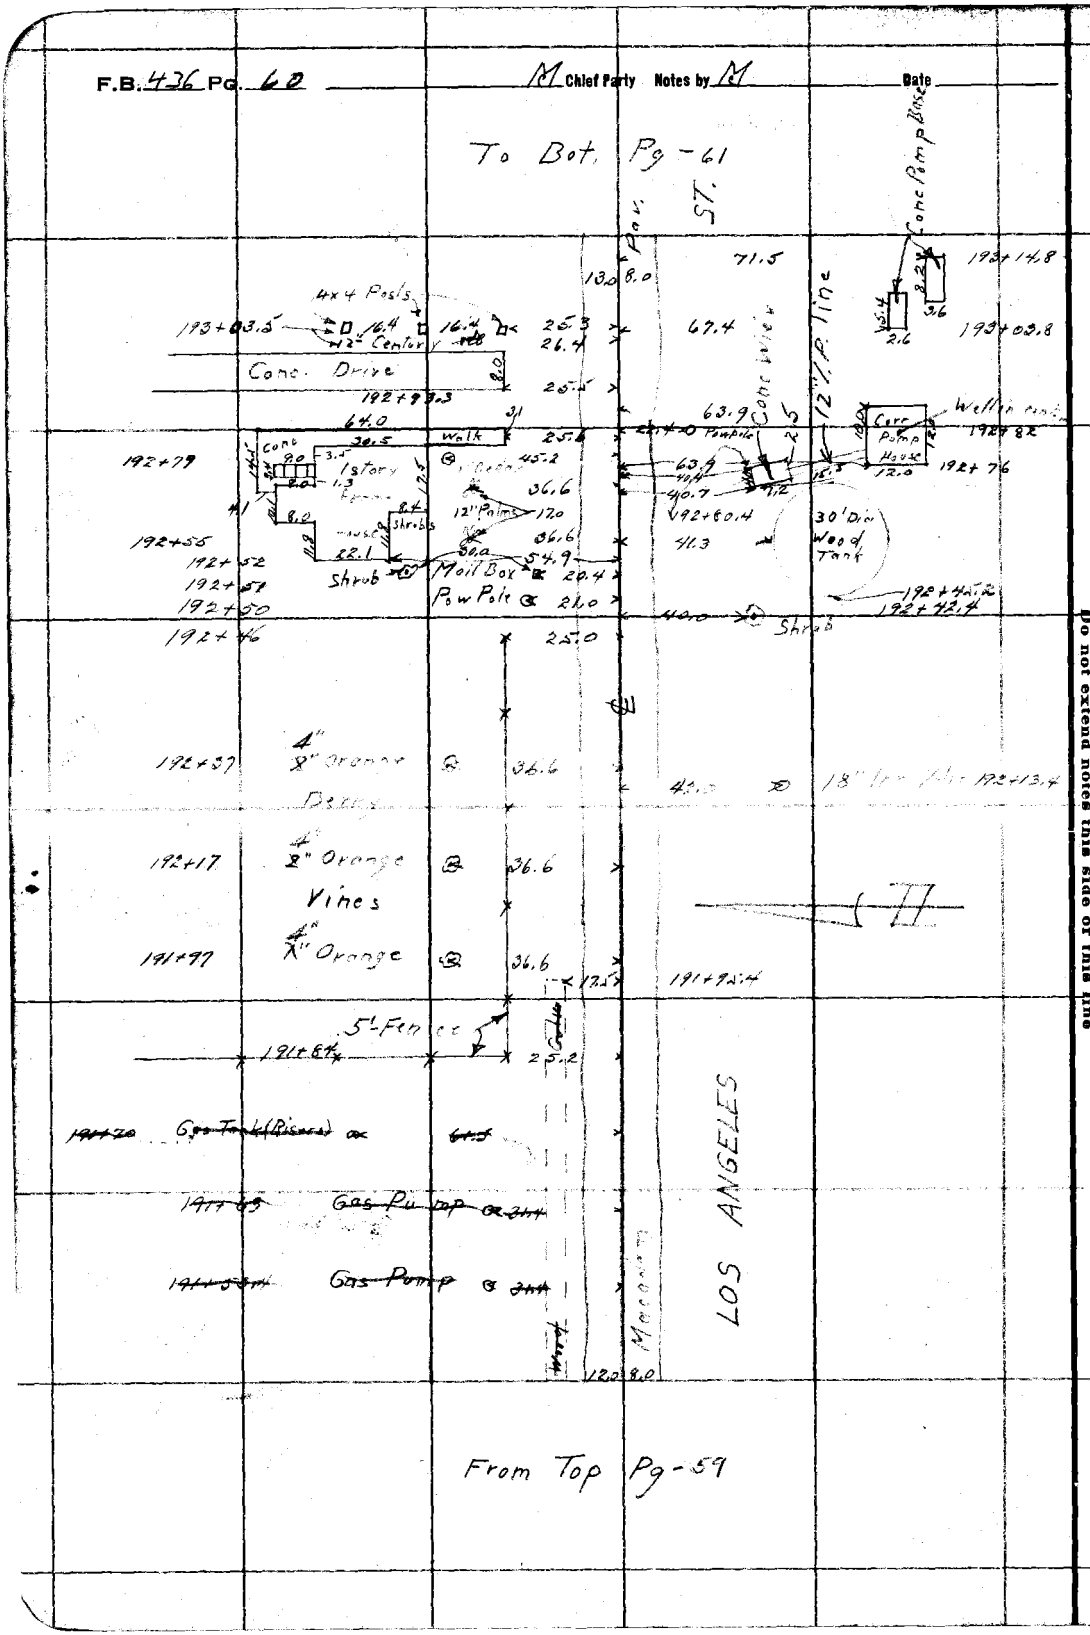

RETURN TO
LOS ANGELES COUNTY SURVEYOR

Do not extend notes this side of this line

Notes: ANY ADDITIONS OR CHANGES ON THIS SHEET MUST BE MADE OR CIRCLED IN Red. WITH DATE AND NAME OF PERSON MAKING CHANGE.

Date _____ Notes by M Chief Party M F.B. 436 Pg. 61

Platted by H. U. M. H.	W. O. No. 970 D. S. O. No.
Date July 1941	Location Los Angeles St.
Map No. B-1648	Surveyed by F. J. McNeal
Platting C'k'd by	Date Mar - 1930
Date	Indexed A. C. Johnson

RETURN TO LOS ANGELES COUNTY SURVEYOR

Do not extend notes this side of this line

Notes: ANY ADDITIONS OR CHANGES ON THIS SHEET MUST BE MADE IN CIRCLED IN Red. WITH DATE AND NAME OF PERSON MAKING CHANGE.

To Bot Pg - 62

194+88 4" Gum
194+84 6" Gum
4' Fence
194+83 Guy Wire
5-2 2-6"
4' Fence Guy
194+74
194+71 4" Gum
Guywire + Pole
Macadam
4.34 offset
Merced Ave
194+26.8
194+06
193+89 12" Gum
193+55
193+22.6 36" Gum
23.3 36.3 28.6 24.2 28.0 24.4 36.3 17.0 36.0 11.0 2x2 See Pg 33 25'R. 25.1 Tel. Pole 29.2 29.4 30.0
Pavt
ST.
194+75.5
194+69
3' Wire Fence
194+57
194+46
194+46.2
Tel Pole
Dirt Road
194+12.1
Pow. Pole
194+15
Road to South
St. Sign
Conc Wier
Los Angeles
Mercedes
28.7 Set Post Out.
6" Scrub Peppers
30.3
8" Pipe line
193+84
193+67.6
193+50
Valve
Enters Ground
193+42
193+33
29.2 Clump 6-8" Pepper
193+16.7

From Top Pg - 60

F.B. 436 PG. 62 — M Chief Party — Notes by M — Date

To Bot Pg - 63

Pow Pole 195+91

195+87.4	8" O 16.0	O 27.6	
195+83	O 16.2	O 37.0	
195+79		O 44.3	
195+77.2	Small Gum Trees & Shoots	Gas Meter	27.0
195+72	3-4" O 16.2	O 36.6	
195+67	18" Trees O 16.0	O 36.8	
195+64.2	O 16.0	12" O 16.0	O 27.9
195+59		O 36.8	
195+56		O 44.0	
195+51.6	O 31.0	8" O 36.4	
195+48	O 16.0	O 43.6	
194+43	4' Fence O 16.5	O 28.6	20.0
	2-2" Gums	3-2" Gums	
194+41		Tel Pole	20.0
194+39	3-8" Gums	O 36.6	
~~194+79~~	~~1-8" 2-3" Gums~~	~~O 36.6~~	
~~194+~~	~~2-8" Gums~~	~~O 36.6~~	
~~194+96~~	~~2-4" Gum~~	~~O 36.6~~	
194+92.4	4-8" Gums	O 28.6	
	4' Fence	25.3	

Mangam — LOS ANGELES — 3' Fence

13.0 8.0 24'

From Top Pg - 61

RETURN TO LOS ANGELES COUNTY SURVEYOR

Do not extend notes this side of this line

Notes: ANY ADDITIONS OR CHANGES ON THIS SHEET MUST BE MADE OR CIRCLED IN Red WITH DATE AND NAME OF PERSON MAKING CHANGE.

Date _____ Notes by M Chief Party M F.B. 436 Pg 43

Platted by H.H.M.H.
Date 1-14-1941
Map No. B-1648
Platting C'k'd by
Date

W. O. No. 970 D. S. O. No.
Location Los Angeles St
Surveyed by F.J. McNeal
Date Mar - 1930
Indexed A. C. Johnson

To Bot. Pg - 64

Notes: ANY ADDITIONS OR CHANGES ON THIS SHEET MUST BE MADE OR CIRCLED IN RED WITH DATE AND NAME OF PERSON MAKING CHANGE.

Do not extend notes this side of this line

RETURN TO LOS ANGELES COUNTY SURVEYOR

199+08 2-4" Gums @ 7.0 49.4
Hedge
198+46
199+05
198+99
13.0 8.0 Pow.
ST.
24.0
28.7
25.0
63.6
Water Tank Stand 199+05 to Center
12" Pepper in Center
Dia. = 7'
63.6
8" I.P.
16.0
Cone Platform with well in center
16.0
198+94.5

198+21 Tel. Pole ∝ 20.1
19.0 8.6 Pow. Pole & 18" Valve 198+88
21.7 ∅ 38" Stand Pipe 197+37
20.0 ∅ Pow. Pole 197+37

196+99 18" Pine @ 41.5

196+80 Tel Pole ∝ 20.0
16" & 6" Gums
196+73 68.4
196+60 14" Gum 36.8
1 Story Brick
30.6
30.2
196+25 22.2 54.8
12.7 ∅ Mail Box 196+31
Rock Curb
196+17 54.5
Rock Curb
196+04 20.1
Maccoia
LOS ANGELES
3'- Fence

From Top Pg - 42

F.B. 436 Pg. 64 — Chief Party M — Notes by M — Date

To Bot. Pg-65

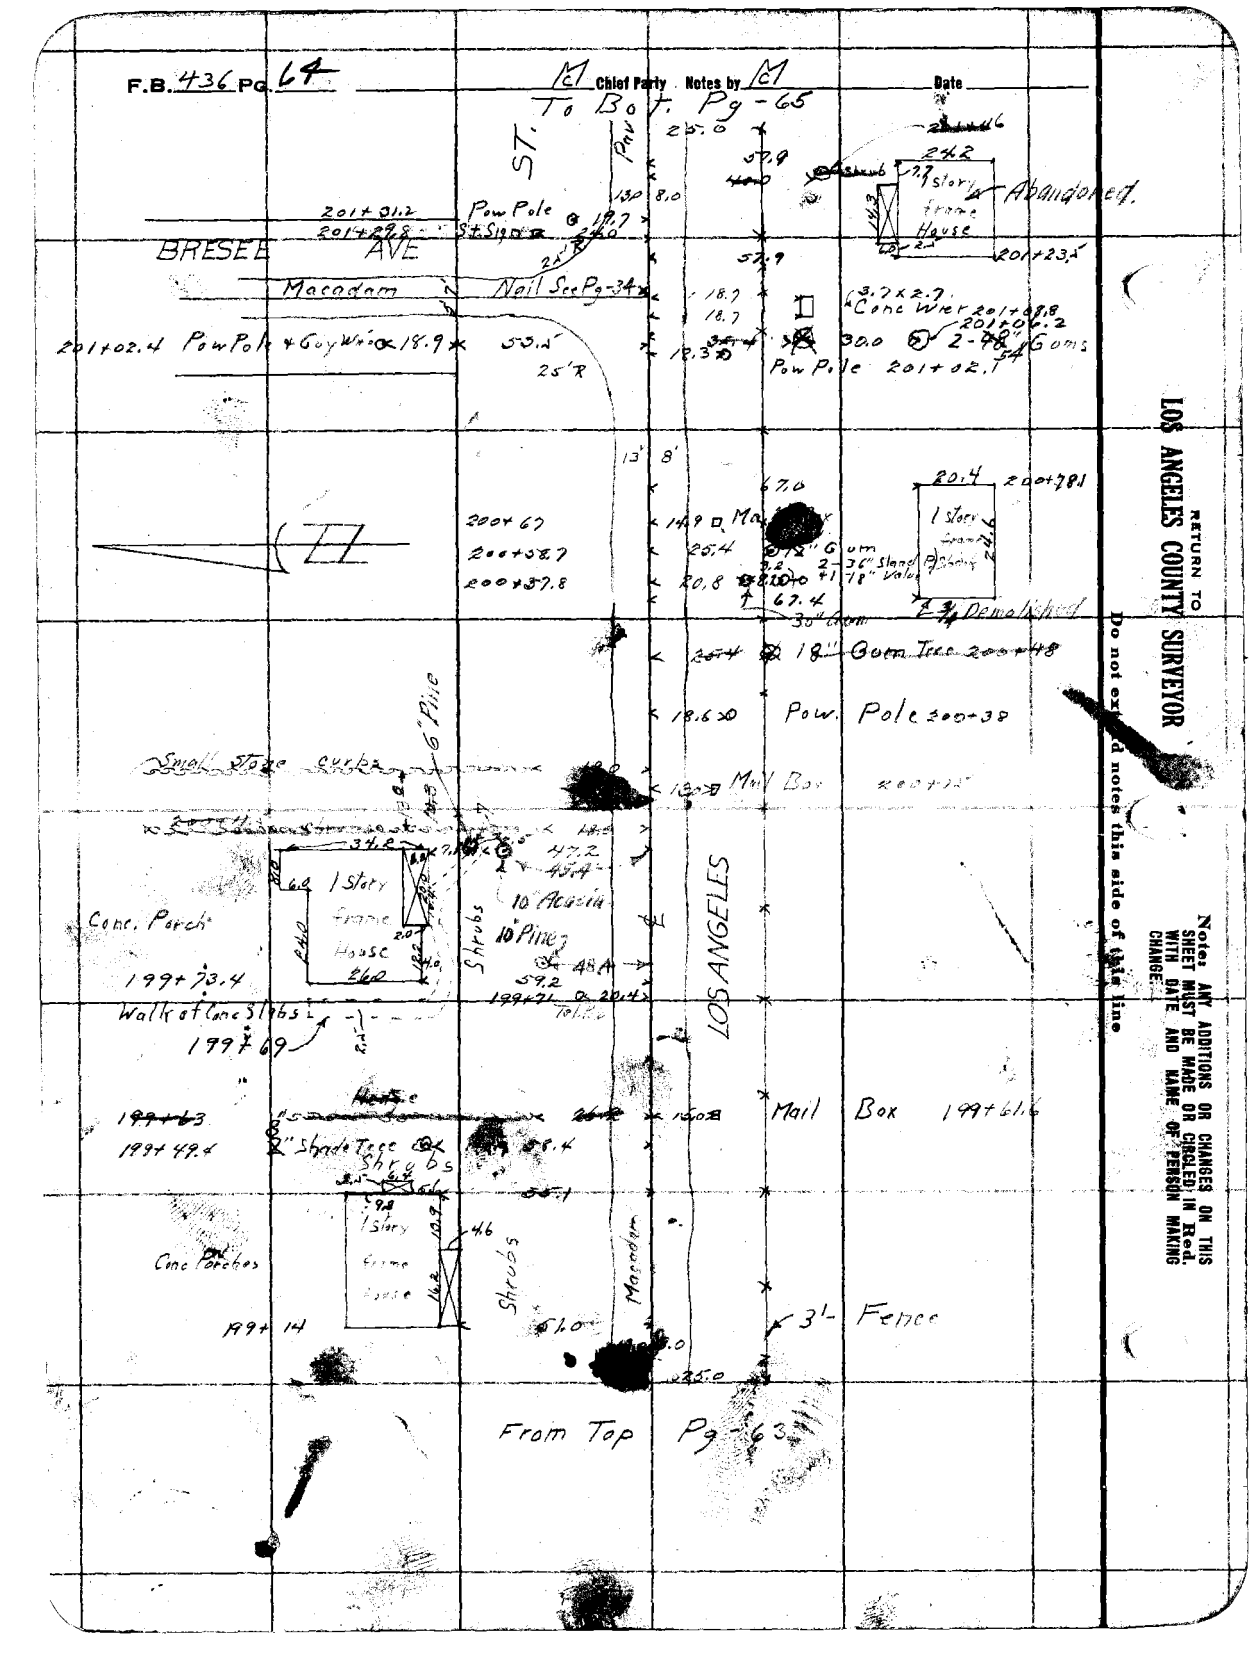

RETURN TO LOS ANGELES COUNTY SURVEYOR

Do not extend notes this side of this line

Note: ANY ADDITIONS OR CHANGES ON THIS SHEET MUST BE MADE OR CIRCLED IN Red. WITH DATE AND NAME OF PERSON MAKING CHANGE.

Date _____ Notes by M Chief Party M F.B. 436 Pg. 65

Plotted by H.U.M.H.
Date July 1941
Map No. B-1648
Plotting C'k'd by _____
Date _____

W. O. No. 970 U. S. G. No. _____
Location Los Angeles St.
Surveyed by E.J. McNeal
Date Mar-1930
Indexed A. C. Johnson

To Bot Pg - 66

Hedge 203+82.6 Mail Box
Conc. Drive + Porches
1 story frame House
Shrubs
Fruit Trees
Flowers
Hedge
203+24
203+45
203+33
Pav.
ST.
3' Fence
Pow. Pole 202+84
202+84 Tel Pole & 196
48" Pepper 202+71
Berry Vines
Pow. Pole
1 story Frame Shack
1" Water Valve 201+52
Water Meter 201+52.4
Gas Meter
LOS ANGELES
Macadam

From Top Pg - 64

RETURN TO LOS ANGELES COUNTY SURVEYOR

Notes: ANY ADDITIONS OR CHANGES ON THIS SHEET MUST BE MADE OR CIRCLED IN Red. WITH DATE AND NAME OF PERSON MAKING CHANGE.

Do not extend notes this side of this line

F.B. 436 Pg. 66 — Chief Party — Notes by M — Date

To Bot Pg-67

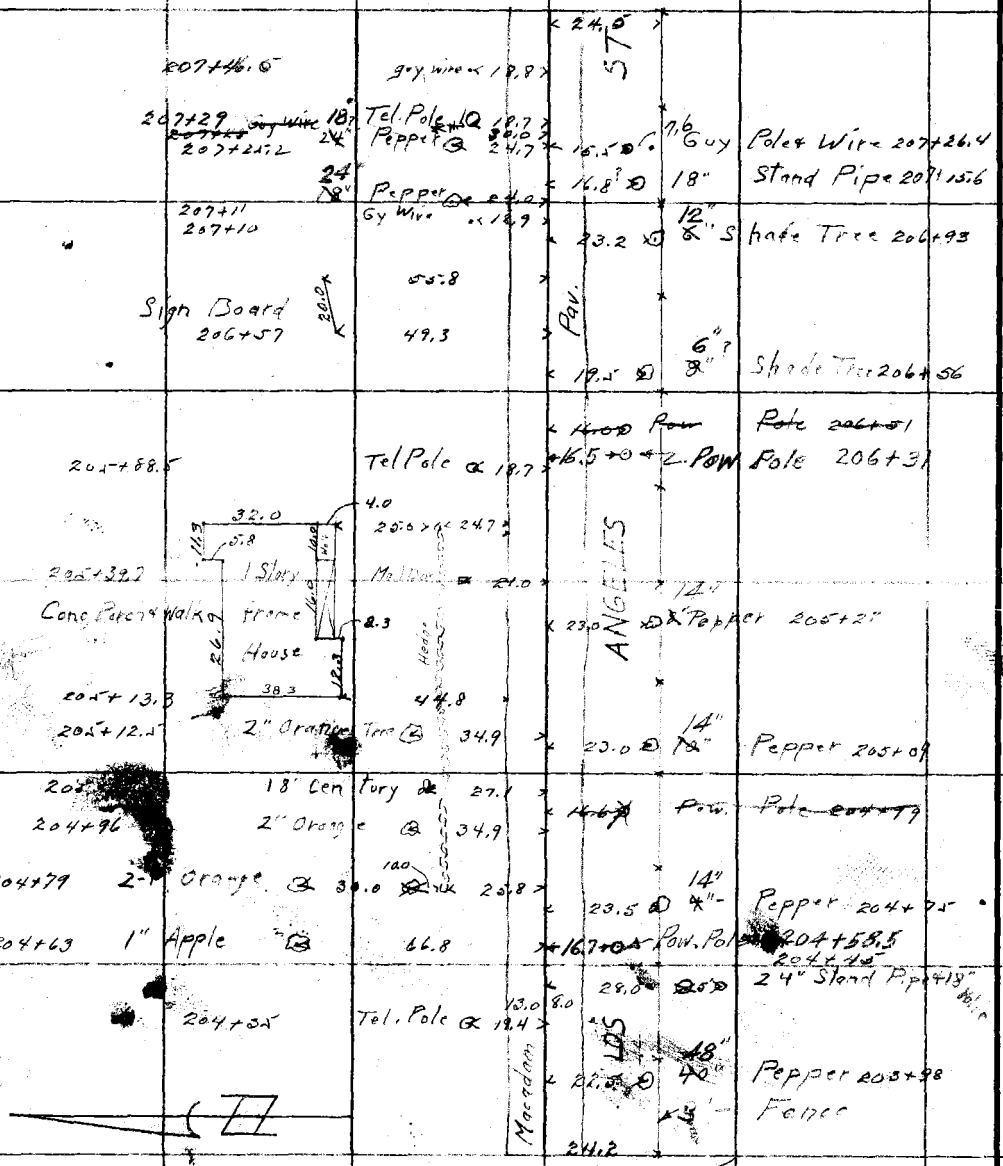

RETURN TO
LOS ANGELES COUNTY SURVEYOR

Do not extend notes this side of this line

Note: ANY ADDITIONS OR CHANGES ON THIS SHEET MUST BE MADE OR CIRCLED IN Red. WITH DATE AND NAME OF PERSON MAKING CHANGE.

Date _____ Notes by CM Chief Party CM F.B. 436 Pg. 67

Plotted by H. U. M. H.	W. O. No. 970 D. S. O. No.
Date July 1941	Location Los Angeles St
Map No. B-1648	Surveyed by F. J. McNeal
Plotted C'k'd by	Date Mar - 1930
Date	Indexed A. C. Johnson

QS 56-14

To Bot. Pg 68

208+61.7 ⊙ 18.6 ⊙ 42.8 — 13.0 8.0 Pav'd ST.

208+51.3 12" Irr. Valve ⊙ 44 ⊙ 42.8 — 28.3 ⊙ 12" Irr. Valve 208+53

208+41.2 ⊙ 18.4 ⊙ 42.8 — 21.6 ⊙ 24" 36" Gum 208+46

208+31.2 Orange Trees ⊙ 42.8 — 24.0 ⊙ 42 Gas Meter 208+20

208+22 ⊙ 18.6 ⊙ 42.8 — 1.0 10' Hedge +1' Cedar

208+12.5 12" Irr. Valve Irr. Wtr 4.4 ⊙ 42.8 — 13.8 6" Cedar Tree 208+05

208+02 Out ⊙ 18.6 ⊙ 42.8 — 14.8 Mail Box 208+01.7

207+89.8 4" Water Meter Plug ⊙ Orange ⊙ 42.8 — 15.4 Water Meter 207+90.1

207+80.5 St. Sign & Fire 2-4" Gas ⊙ 18.6 ⊙ 18.4 — 15.3 Pepper Pole 207+79.4

STEWART AVE 2x2 See Pg - 55 — 26.0 ⊙ 18.6 ⊙ 16.0 ⊙ 24" Pepper Trees 207+73.4

Dirt Rd 207+63 — 10.4 Conc - Wier 3.7x2.7 207+71.2 — 3' Fence

207+43.0 ⊙ 16.0 Tel. Pole Guy Wire — 55.0 — 207+47.5 2.0 Conc. Culvert

Pepper ⊙ 24.0 — 39.4 — 13.2 13.6 ⊙ Conc Tank — Conc Wier — Mail Box 207+41.4 12" Black Walnut

LOS ANGELES Macadam — 27.3 — 24.5 — 52.1 — 3" IP — 3' Fence

From Top Pg - 66

Do not extend notes this side of this line

NOTE: ALL ADDITIONS OR CHANGES ON THIS SHEET MUST BE MADE OR CIRCLED IN RED WITH DATE AND NAME OF PERSON MAKING CHANGE.

RETURN TO LOS ANGELES COUNTY SURVEYOR

F.B. 436 Pg. 68 — Chief Party — Notes by M — Date

To Bot Pg-69

210+63 48" Adm ⊙ 17.9 — 12.0 9.0 — Pav. — ST.

210+51 ⊙ 18.6 ⊙ 42.6

210+44 Tel. Pole ⊙ 18.0

210+23 ⊙ 18.6 ⊙ 42.6

210+12 36" Palm ✱ 20.1

210+00 ⊙ 18.6 ⊙ 42.7


209+86.4 12" Irr. Valve ⊙ 29.2

209+81.5 ⊙ 18.6 ⊙ 42.8

209+71.5 ⊙ 27.8

209+60.7 ⊙ 18.6 ⊙ 42.8

5" Drainage

209+49.6 ⊙ 18.6 ⊙ 42.8

209+32 ⊙ 18.6 ⊙ 42.8

209+18 ⊙ 18.6 ⊙ 42.8

209+05 Tel. Pole ⊙ 18.0

208+95 12" Irr Valve ⊙ 4.4

208+81.5 ⊙ 18.6 ⊙ 42.8

208+73.3 ⊙ 27.8

Out

~~21.2 ⊙ 1-24" 45 8" Gums~~ 210+38.7

~~14.3 ✱ 12" Irr. Valve 209+84~~

~~26.0 ⊙~~ Water Meter 209+79

25.9 ✱ Gas Meter 209+73

20.4 ⊙ 48" Pepper 209+67

14.8 ⊙ Pow Pole 209+49.6

20.2 ⊙ ~~36"~~ 24" Gum 209+32

20.0 ⊙ 12" Irr. Valve 209+18.

~~21.3 ✱ 36" Gum 208+91~~

19.0 ⊙ Irr. Valve 208+87

LOS ANGELES — Manhattan — 43.0 8.0

From Top Pg-67

RETURN TO LOS ANGELES COUNTY SURVEYOR

Do not extend notes this side of this line

Notes: ANY ADDITIONS OR CHANGES ON THIS SHEET MUST BE MADE OR CIRCLED IN Red. WITH DATE AND NAME OF PERSON MAKING CHANGE.

Date _____ Notes by M Chief Party M F.B. 436 Pg. 69

Platted by H. U. M. H.
Date July 1941
Map No. B-1648
Platting C'k'd by _____
Date _____

W. O. No. 970 D. S. O. No. _____
Location Los Angeles St
Surveyed by F. J. McNeal
Date Mar - 1930
Indexed A. C. Johnson

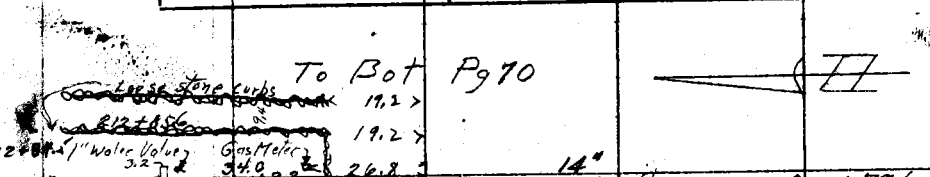

From Top Pg - 68

Note: ANY ADDITIONS OR CHANGES ON THIS SHEET MUST BE MADE OR CIRCLED IN RED WITH DATE AND NAME OF PERSON MAKING CHANGE.

Do not extend notes this side of this line

RETURN TO LOS ANGELES COUNTY SURVEYOR

F.B. 436 PG. 70 — Chief Party — Notes by — Date

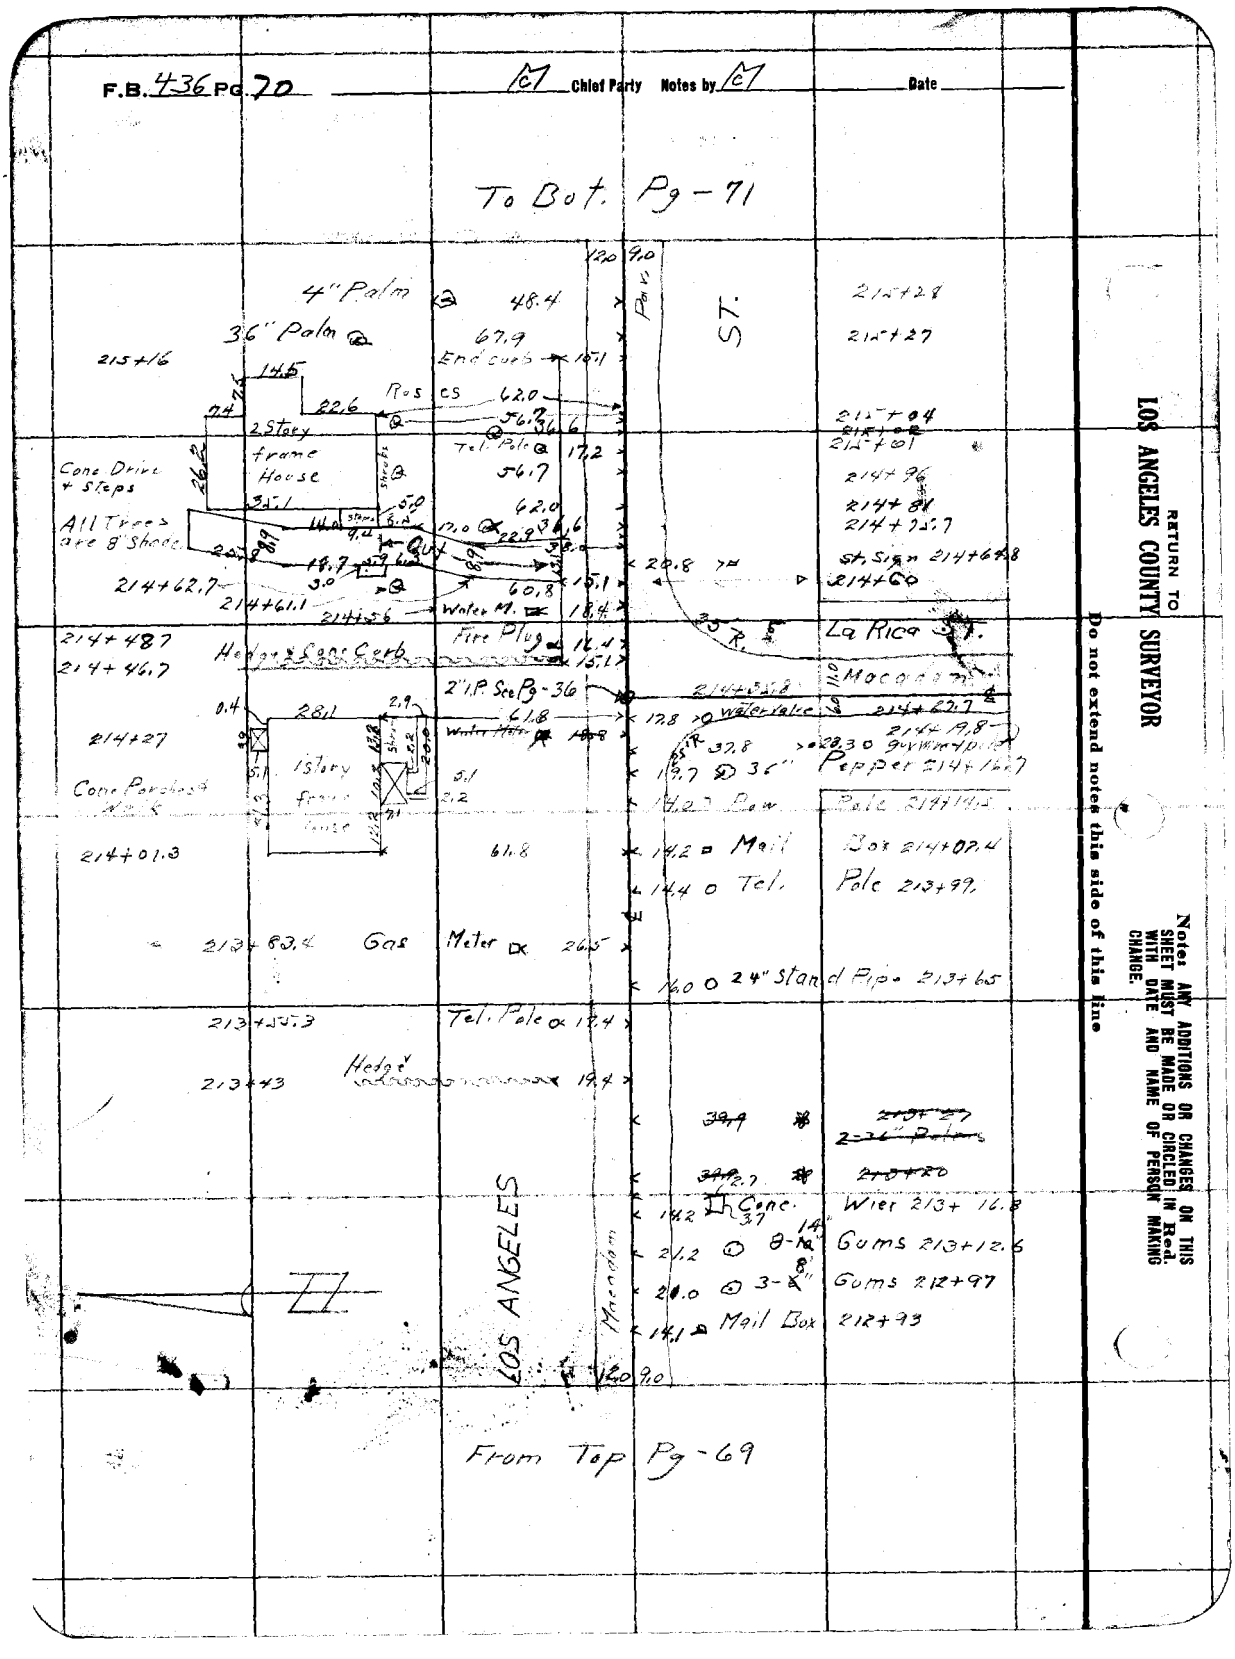

RETURN TO
LOS ANGELES COUNTY SURVEYOR

Do not extend notes this side of this line

Notes: ANY ADDITIONS OR CHANGES ON THIS SHEET MUST BE MADE OR CIRCLED IN Red. WITH DATE AND NAME OF PERSON MAKING CHANGE.

Date _____ Notes by M Chief Party M F.B. 436 PG 71

Plotted by H. U. M. H.	W. O. No. 970 D. S. D. No. _____
Date July 1941	Location Los Angeles St.
Map No. B-1648	Surveyed by F. J. McNeal
Plotting C'k'd by _____	Date May - 1930
Date _____	Indexed A. C. Johnson

Notes: ANY ADDITIONS OR CHANGES ON THIS SHEET MUST BE MADE ON CIRCLED IN RED WITH DATE AND NAME OF PERSON MAKING CHANGE.

Do not extend notes this side of this line

RETURN TO LOS ANGELES COUNTY SURVEYOR

To Bot Pg - 72

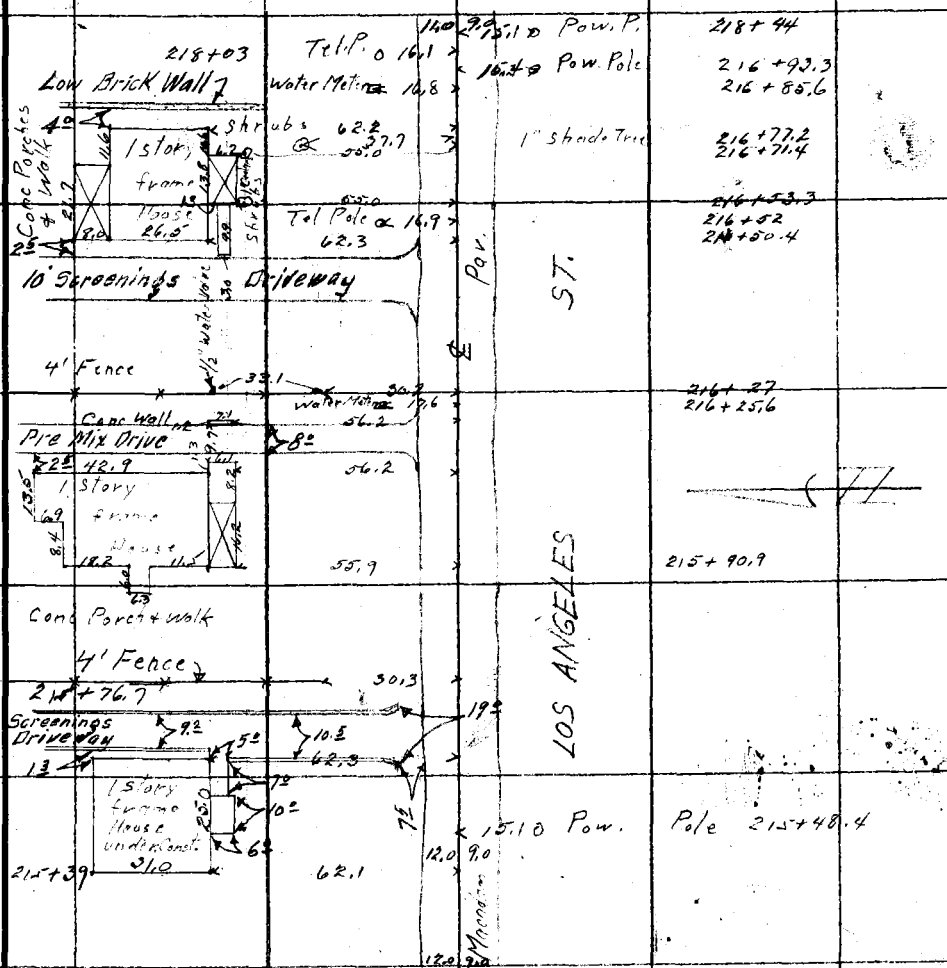

From Top Pg - 70

F.B: 436 Pg. 72 M Chief Party Notes by M Date

To Bot Pg - 73

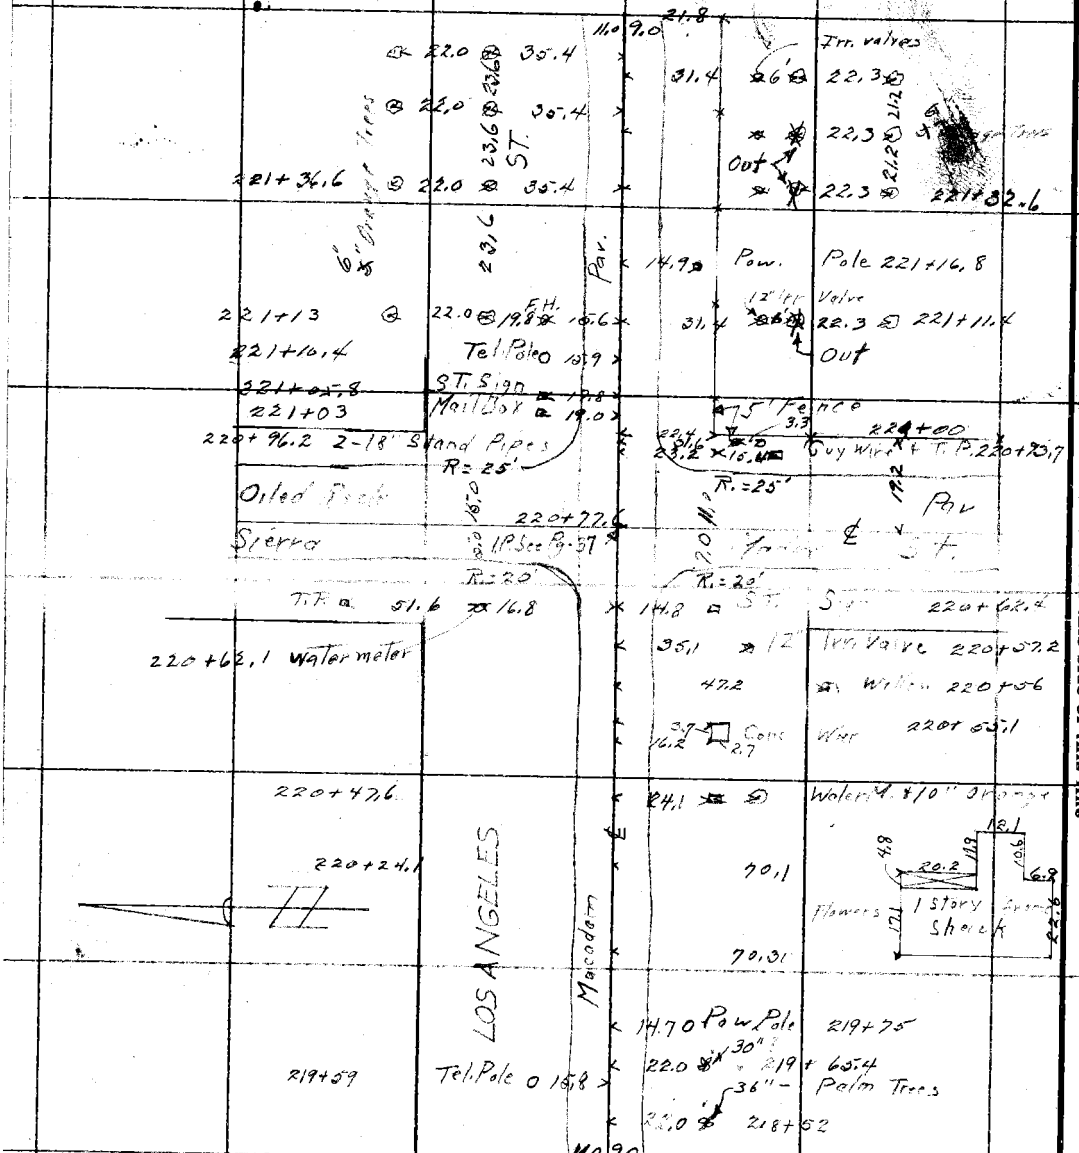

RETURN TO
LOS ANGELES COUNTY SURVEYOR

Do not extend notes this side of this line

Notes: ANY ADDITIONS OR CHANGES ON THIS SHEET MUST BE MADE OR CIRCLED IN Red. WITH DATE AND NAME OF PERSON MAKING CHANGE.

Date _____ Notes by M Chief Party M F.B. 436 PG 73

Plotted by H.U.M.H.
Date July 1941
Map No. B-1648
Plotting C'k'd by _____
Date _____

W. O. No. 970 D. S. O. No. _____
Location Los Angeles St
Surveyed by F.J. McNeal
Date May - 1930
Indexed A. C. Johnson

Note: ANY ADDITIONS OR CHANGES ON THIS SHEET MUST BE MADE OR CIRCLED IN Red. WITH DATE AND NAME OF PERSON MAKING CHANGE.

Do not extend notes this side of this line

RETURN TO LOS ANGELES COUNTY SURVEYOR

To Bot. Pg 74

4 Fence
224+00
223+98
223+94
224+02
Tel. Pole
8" Orange
Water valve
Fish Pond (conc.) 223+91.5
1 story frame house
223+62
6" Orange
223+61
41. Fence
8" Plum
223+54
5' Fence
223+56
223+44
ANGELES
Macadam
223+25.3
223+06.5 ...Wind
223+01.7
Out
Tel. Pole
222+50.3
Pow Pole
222+45.7
Out
5' Fence
LOS

From Top Pg 72

F.B. 436 Pg. 74 — M Chief Party — Notes by M — Date

To Bot. Pg - 75

225+98 3" Loquat 23.9 — 12.0 9.0 — PAV ST.

225+85 22.0 39.3 — Irr. Valves-12"

224+82 10" Tel. Pole 17.1 — 31.3 — 22.0

225+76 8" Walnut 23.1

225+62 22.0 — 22.0

10" 8" walnut 27.1

225+39 22.4

Trees 10" 8" Walnut 16.0 Pow Pole 225+26

225+16 22.3

10" 8" Walnut

224+93 6" Orang

22.3

224+81.5 Walnut 23.1

224+70

224+47 22.0 39.3 — 31.3 — 22.0 224+46.5

3' Wire Fence

224+37 224+37 3' Wire Fence

224+33 Gas Meter 36.2 18.4 24.2

31.3 12" Irr Valve 224+24

18.0 Water Meter 224+14

224+11 36" Pepper 71.2 16.4 Pow. Pole 224+12

34.8 32.2 224+04.4

Conc

4'

24.3

11.0 9.0

LOS ANGELES

From Top Pg - 73.

RETURN TO LOS ANGELES COUNTY SURVEYOR

Do not extend notes this side of this line

Note: ANY ADDITIONS OR CHANGES ON THIS SHEET MUST BE MADE OR CIRCLED IN Red. WITH DATE AND NAME OF PERSON MAKING CHANGE.

Date _____ Notes by M. Chief Party M F.B. 436 Pg 75

Platted by M. J. M. H.
Date 1-14-1941
Map No. 18-1648
Platting C'k'd by _____
Date _____

W. O. No. 970 D. S. O. No. _____
Location Los Angeles St.
Surveyed by E. L. McNeal
Date Mar-1930
Indexed A. C. Johnson

Notes: ANY ADDITIONS OR CHANGES ON THIS SHEET MUST BE MADE OR CIRCLED IN Red. WITH DATE AND NAME OF PERSON MAKING CHANGE.

Do not extend notes this side of this line

RETURN TO LOS ANGELES COUNTY SURVEYOR

To Bot. Pg - 76

227+64

4" Fruit 227+52.1 70' water Met. 18.6 54.1 2-6" Fruit Trees 16.0 3-6" Fruit Trees 12" Irr. Valves 3 22 14.0 31.7

12.0 9.0 Pav. ST. LOS ANGELES

33.3 16.2 W.M. 33.0 33.1 33.3

28.0 227+46 227+35.4 14.5 6" Orange 227+31 Water Tank Out. 227+24 windmill, well in center, gasoline pump. 227+19.5 24" Shade Tree 227+14.4 Irr. Valves-12" 227+09.4 28.0 226+87

6" Fig + Loquat 227+23 32.4 22.4

12" Irr. Valves 3-4" Fruit Trees 227+11 3.0 19.0 18.0 31.7

6" Cherry 6" Grapefr. 227+03 22.0 39.3

227+00 Tel. Pole 17.3

226+80 39.3 16.0 Pow. Pole 05' 22.0 226+87 6" Orange Trees + 12" Irr. Valves 74' 226+81

226+68 23.2 6" Orange Trees

226+56.4 39.3 226+43.8 23.2 226+31 39.3

05' 226+65.7 80' 226+43.4

Macadam

4" Orange 23.2 22.0 39.3 24" cement conc. 226+44 33.3 06' 22.0 226+04

From Top Pg - 74

F.B. 436 PG. 76 — Chief Party — Notes by M — Date Mar.

To Bot. Pg - 77

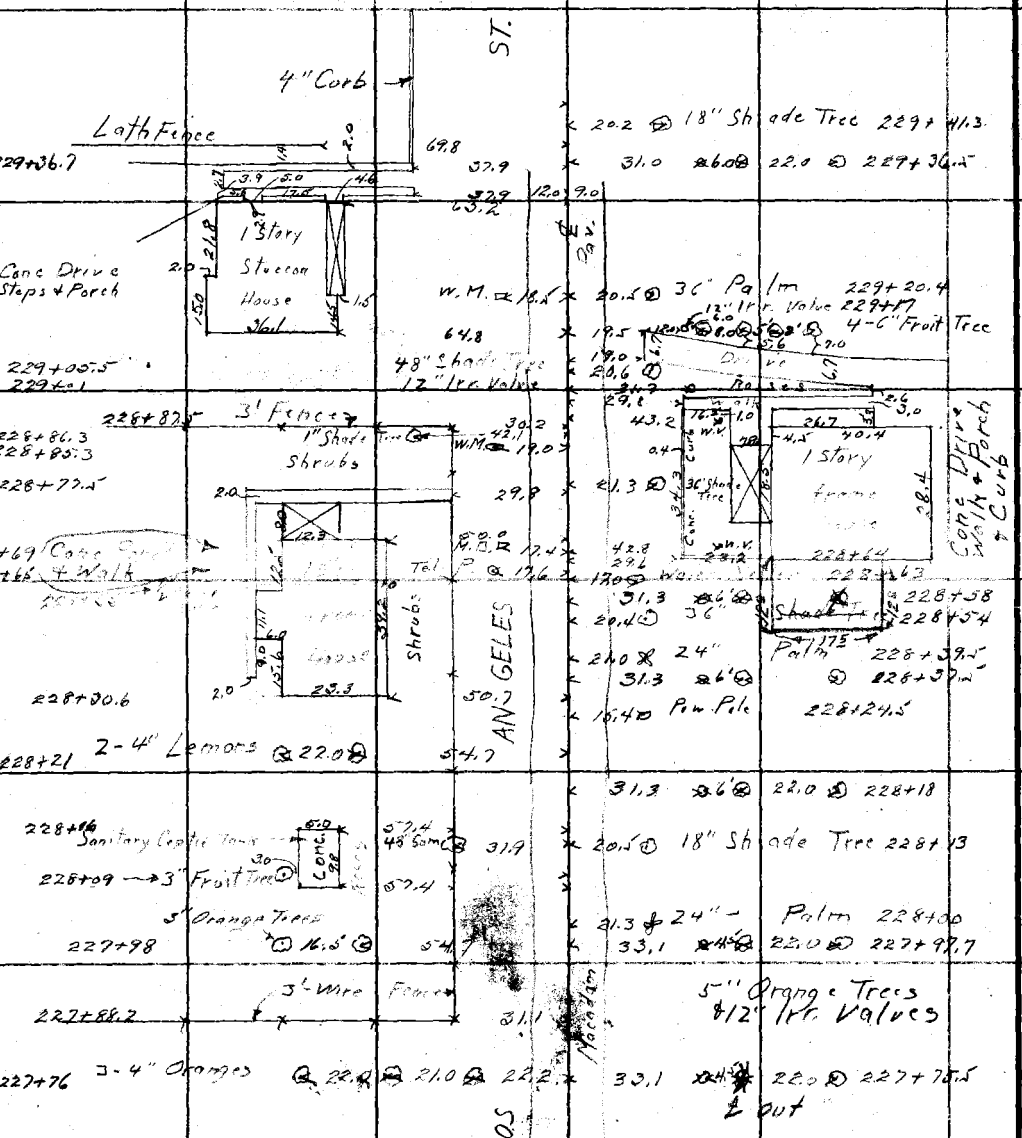

From Top Pg - 75

RETURN TO LOS ANGELES COUNTY SURVEYOR

Do not extend notes this side of this line

Notes: ANY ADDITIONS OR CHANGES ON THIS SHEET MUST BE MADE OR CIRCLED IN Red. WITH DATE AND NAME OF PERSON MAKING CHANGE.

Date _____ Notes by M Chkd' Party M F.B. 436 Pg 77

Plotted by H.U.M.H.
Date July 1941
Map No. B-1648
Platting C'k'd by _____
Date _____

W. O. No. 970 D. S. O. No. _____
Location Los Angeles St
Surveyed by E.J. McNeal
Date Mar-1930
Indexed A.C. Johnson

To Bot. Pg 78

Notes: ANY ADDITIONS OR CHANGES MUST BE MADE ON CORNER OF SHEET WITH DATE AND NAME OF PERSON MAKING CHANGE.
Do not extend notes this side of this line
RETURN TO LOS ANGELES COUNTY SURVEYOR

230+83
Irr. Valve + 8" Orange Trees
230+62
Fence out.
ST.
230+48 4' Fence
230+57.5
230+51 1½" Fruit
St. Sign
Pav.
230+44 2" Shade
Conc Walk + Porch
1 Story Frame House
Shrubs
4" Tel. Pole
3 - Mailbox
8" Fruit Tree
230+47
12" Irr. Valve + 2 - 8" Orange
230+30.4
230+26.6
230+23
Out 7
230+19
230+14.8
2" Fruit
230+00
230+13
229+93.4
W.M.
W. M.
1 Story Frame House
Conc Walk Porch + Steps
10" Shade
229+98
10' Screenings Drive 4' Fence
229+88
72' Conc. Drive
Pole 229+86.6
Pow.
10" Orange + 12" Irr. Valve
229+78
4'-Fence
3" Fruit
229+70
229+68
Stucco Wall
2" Palm
67.8
3' Hedge
LOS ANGELES
1 Story Stucco House
Conc
Wire
229+65
Palm
229+59.2
2-4" Orange 229+57
48"
229+54.3
229+50
229+42.4
229+40
Shrubs
Sprinklers
1" Pine Tree
Conc Curb-Drive Porch + Steps
229+46
229+42
Sprinklers
3" Cedars
2-12" Pines
Macadam
LOS

From Top Pg - 76

F.B. 436 Pg. 78 — Chief Party M — Notes by M — Date May 1930

To Bot Pg - 79

233+77.4 M. Hole Dig = 2.5'

Tel/Pole 24" S.P. Guy Wire 18" Iron Valve

120 9.0

233+78.8

232+76.4

233+36.7 Tel. Pole 18.0 13.0 Stop Sign 233+74.4

232+26.9 Guy Pole 22.1 14.0 Pow Pole 64.0

232+68.9

6.7 28.3 1.0 8.2

1 Story Frame House

48.1

232+22.4 W.M. 18.0

232+01

231+85.6 Tel. Pole 17.7 W.M. 21.7 64.0

231+84 Water M. 17.7 20.6 Out 5' Fence 231+76.4

6' orange 16.0 8" shade

231+77 LOS ANGELES ST. 12.9

See note on Page 50.

21.6 8" Shade 4.0

10" Palm 231+69

5.0.4 W.M. 1½" V. 31.7 10.0 21.6 8/12" Shade 41.0 50.4

6.0 2.2 Conc Steps 23.6 6.2

2-Story Frame House 21.0

10" Palm 231+40

231+33

231+55

231+46

231+41

Macadam

62.3

6" Snag & Tree

231+42.5

231+30.4

Conc Walk & Curb

231+12.3

Pow Pole 15.8 231+22.5

30.0 21.2 231+23.8

W.M. 17.0 5' Fence Out

4' 1 Story Stucco House 6.2 6.4 5.0 2.0 1.8 4.0 13.6 31.2 20.0 2.0

231+14.3 Irr. Valve & Grate

22.0

230+98 2-8" Fruit Trees

22.0

4" 230+97.7 30.0

238+78.5 Traveled Rd. 10.0

M.O. 9.0

From Top Pg - 77

RETURN TO LOS ANGELES COUNTY SURVEYOR

Do not extend notes this side of this line

Note: ANY ADDITIONS OR CHANGES ON THIS SHEET MUST BE MADE OR CIRCLED IN Red. WITH DATE AND NAME OF PERSON MAKING CHANGE.

Date _____ Notes by M Chief Party M F.B. 4 36 Pg 79

Platted by July 1944
Date H U M
Map No. B-16
Platting C'k'd by _____
Date _____

W. O. No. 970 D. S. O. No. _____
Location Los Angeles St.
Surveyed by F. J. McNeal
Date Mar-1930
Indexed A. C. Johnson

57.0

Note: ANY ADDITIONS OR CHANGES MUST BE MADE OR CANCELED IN RED. SHEET MUST BE RETURNED WITH DATE AND NAME OF PERSON MAKING CHANGE.

Do not extend notes this side of this line

RETURN TO LOS ANGELES COUNTY SURVEYOR

S 17

ST

113 11.0

Asphalt Fce

Concrete

12.1

19.7

2.5 20.6 73.0 20.5 4.2

5' Walk
3.5 Parking
6" Curb
MAINE

15' R

5' Walk
3.5 Park
6" Curb
AVE

Bolt Sec B-384

25.0

Macadam

Pav.

6" Curb
233+94.5 Fire Plug
5' Walk
233+87.4 Auto
233+82.1 St.
Sign

36.1 36.7

15' R

6" Curb
43.2 P.P. & G. Wire 233+95
5.0 Walk

233+65.5

12.0 9.0

LOS ANGELES

Pav.

Mar. 12.0 9.0

From Top Pg - 78

RETURN TO
LOS ANGELES COUNTY SURVEYOR

Note: ANY ADDITIONS OR CHANGES ON THIS SHEET MUST BE MADE OR CIRCLED IN Red. WITH DATE AND NAME OF PERSON MAKING CHANGE.

Do not extend notes this side of this line

F.B. 431 Pg. 80

Chief Party _____ Notes by _____ Date _____

RETURN TO
LOS ANGELES COUNTY SURVEYOR

Note: ANY ADDITIONS OR CHANGES ON THIS SHEET MUST BE MADE OR CIRCLED IN Red. WITH DATE AND NAME OF PERSON MAKING CHANGE.

Do not extend notes this side of this line

NS 46 B-5

Date ____ Notes by EM Chief Party ____ F.B. 436 Pg. 21

Platted by ____
Date ____
Map No. ____
Plotting C'k'd by ____
Date ____

W. O. No. 770 O. S. O. No. ____
Location Los Angeles St.
Surveyed by E. M. Neal
Date Apr. - 1931
Indexed A. C. Johnson

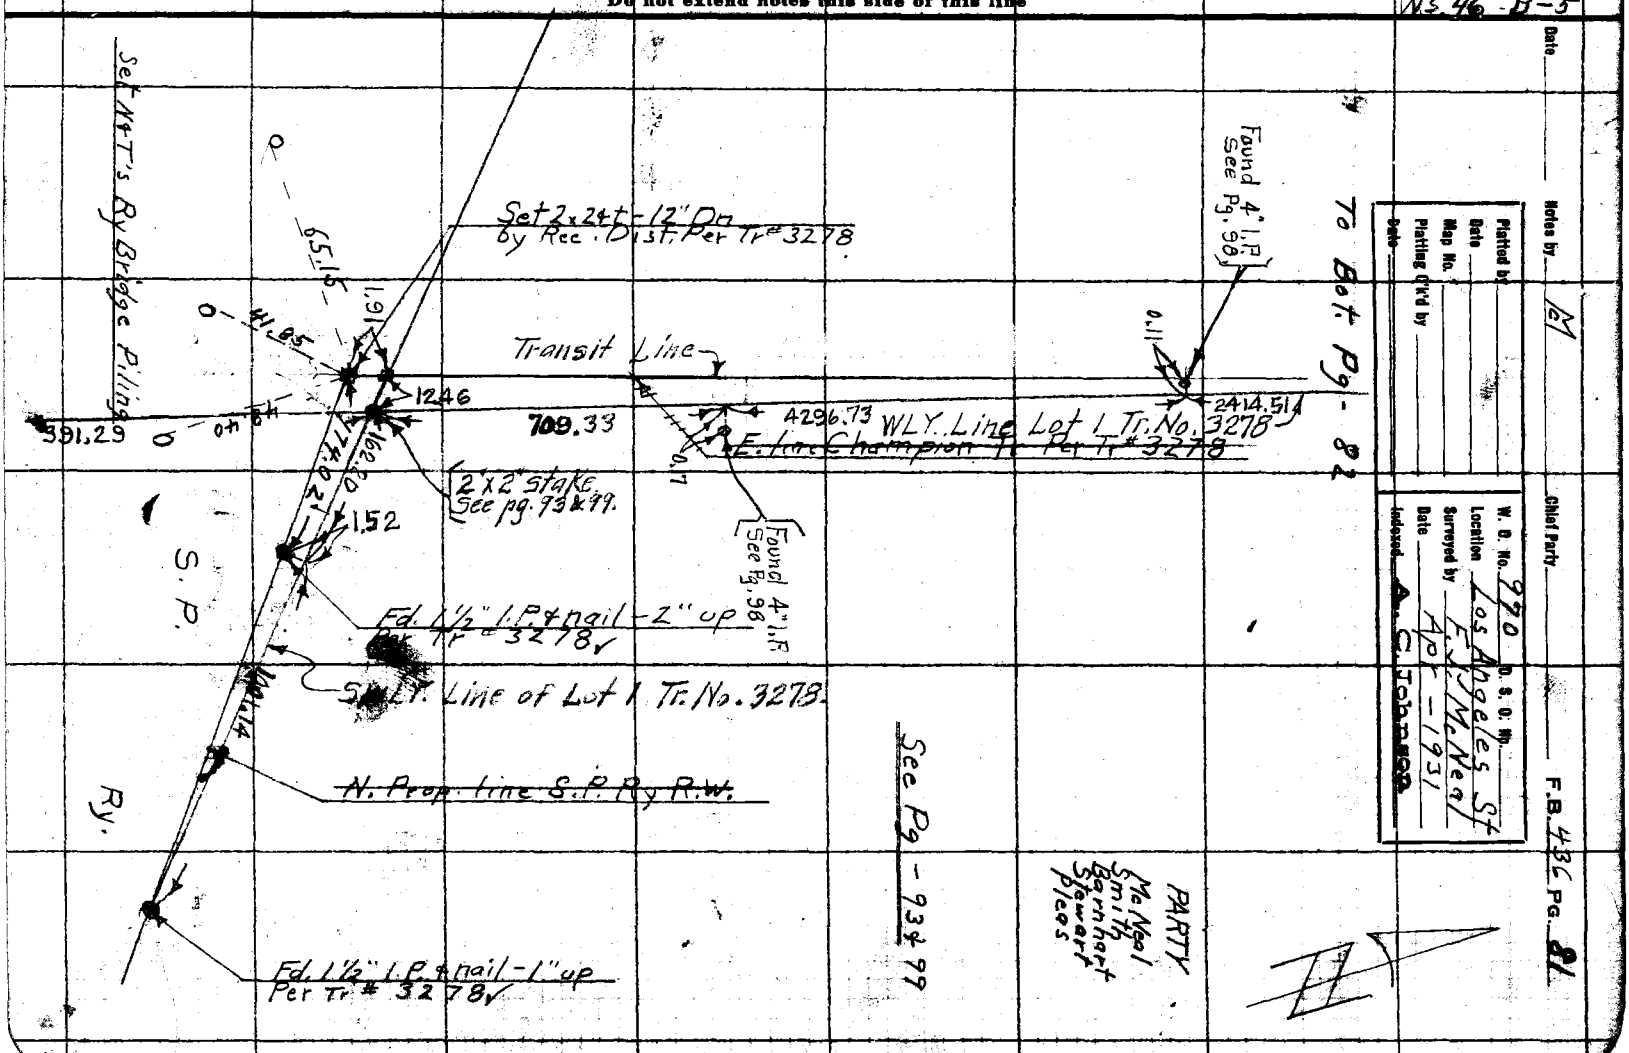

T# 036 = 84°

F.B. 436 Pg. 82 — Chief Party — Notes by KT — Date

WS 46 B-5

To Bot Pg - 23

621.78 @ 88° = 621.80 ✓

Set N+T in Tie

Set N+T in Piling

Fd 2" I.P no tack - 6" Dn Per Tr# 103691

0.21

2985.54

621.80 ✓

Set N+T Bridge Piling

130.94

27.54

29.62

Set N+T in Piling

Ry.

Fd 2x3+t - flush Per Tr# 32781

See Pg. - 100

Fd 4" I.P. conc. filled with small round head bolt 1/4 center - flush - per Tr# 32781 ✓

P. E.

ST.

E. line Champion Tr Per Tr# 3278

0.29

1492 ✓

0.52

ELMONTE

Ely. Line Rd. S.E. ✓

2414.51

Fd 2" I.P+t - flush Per F.O. 260 - 35 ✓

Fd 2" I.P+t - flush Per F.O. 260 - 35 ✓

From Top Pg - 81
" Lt " - 93

RETURN TO
LOS ANGELES COUNTY SURVEYOR

Do not extend notes this side of this line

Note: ANY ADDITIONS OR CHANGES ON THIS SHEET MUST BE MADE OR CIRCLED IN Red. WITH DATE AND NAME OF PERSON MAKING CHANGE.

T 1N 036 = 84°

Date _____ Notes by M Chief Party _____ F.B. 436 Pg. 83

Platted by _____
Date _____
Map No. _____
Platting Ck'd by _____
Date _____

W. O. No. 970 D. S. O. No. _____
Location Los Angeles St.
Surveyed by F. J. McNeal
Date Apr-1931
Indexed A. C. Johnson

To B.t Pg-84

Notes: ANY ADDITIONS OR CHANGES ON THIS SHEET MUST BE MADE OR CIRCLED IN Red. WITH DATE AND NAME OF PERSON MAKING CHANGE.

Do not extend notes this side of this line

RETURN TO LOS ANGELES COUNTY SURVEYOR

@ Lower Azusa Rd Prod
Per R.S. 432-18

Fd. 1x2 ± - flush Pct Pg-18
ELY. Line Lot 2 Tr. No. 10969.

627.05 To Angle Point →

316.44

To No. 3 Rd. S.F. →

R1.20

99.08

316.24

Transit Line.

Fd. 2x2 only - 4" up - No Ref.

Fd. 2x2 only - flush - No Ref

East Line Rancho San Francisco with

0.50

27.02

See Pg. 101

523.42

108.11

103.50

93-45-05"

4.61

Set 3x3 ± nail - flush
in mound of Rocks - by inter

93-39-45

40-00"

108 .12 @70° = 108.11

93-39-45
14-39-30
3-37-50.

Fd. S.W.T. opposite 2" I.P.
S.E. Cor. Coffin Armstrong Tr.
Per Pg-18

Agreement line - Pg-18

ELY. Line Rancho S.F.

385.54

From Top Pg. 82

T#036 = 84°

F.B. 436 Pg. 84 Chief Party Notes by M Date

To Bot Pg - 85

Sta. #2 - Set 3x3 4 nail - flush in mound of Rocks by Rec. Dist Per D-10-550 ✓

2102.88 ✓ Transit Line

See Pg. 101

168-52-00 ✓

168-52-00
315-28-00
168-52-00.

316.24 ✓ Transit Line

~~E. line Rd. San Francisquito~~

316.26 @ 76° = 316.24 ✓
316.26 @ 80° = 316.25 ✓

30.06 ✓ Calc Dist for N. Prop line
+ 286.18 ✓ Rec Per D-10-550
= 316.24 ✓

From Top Pg - 83

RETURN TO
LOS ANGELES COUNTY SURVEYOR

Do not extend notes this side of this line

Notes: ANY ADDITIONS OR CHANGES ON THIS SHEET MUST BE MADE OR CIRCLED IN Red. WITH DATE AND NAME OF PERSON MAKING CHANGE.

Date _____ Notes by M Chief Party _____ F.B. 496 Pg. 85

Platted by _____
Date _____
Map No. _____
Platting C'k'd by _____
Date _____

W. O. No. 970 D. S. O. No. _____
Location Los Angeles St
Surveyed by F.J. McNeal
Date Apr-1931
Indexed A. C. Johnson

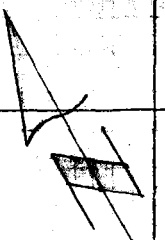

To Rt. Pg - 86

Chaining across Gravel Pit

Notes: ANY ADDITIONS OR CHANGES ON THIS SHEET MUST BE MADE OR CIRCLED IN Red. WITH DATE AND NAME OF PERSON MAKING CHANGE.

Do not extend notes this side of this line

RETURN TO LOS ANGELES COUNTY SURVEYOR

E Line Rx San Fernando Rd

2102.88 Transit Line

T=036 = 84°
102.26@93° = 102.27 - inter.
T=33 = 84°
289.51@12-12@86° = 282.97 - 1x2
T=036 = 84°
951.31@86° = 951.32 - 1x2
T=33 = 84°
205.66@5-23@84° = 204.75 - 1x2
149.14@5-50 = 148.37@78° = 148.36 - 1x2
T=036 = 84°
272.00
82.51
58.66
413.11@98° = 413.21 - 1x2
Total = 2102.88

From Top Pg - 84

RETURN TO
LOS ANGELES COUNTY SURVEYOR

Note: ANY ADDITIONS OR CHANGES ON THIS SHEET MUST BE MADE OR CIRCLED IN Red. WITH DATE AND NAME OF PERSON MAKING CHANGE.

Do not extend notes this side of this line

W.S. 46 C-4

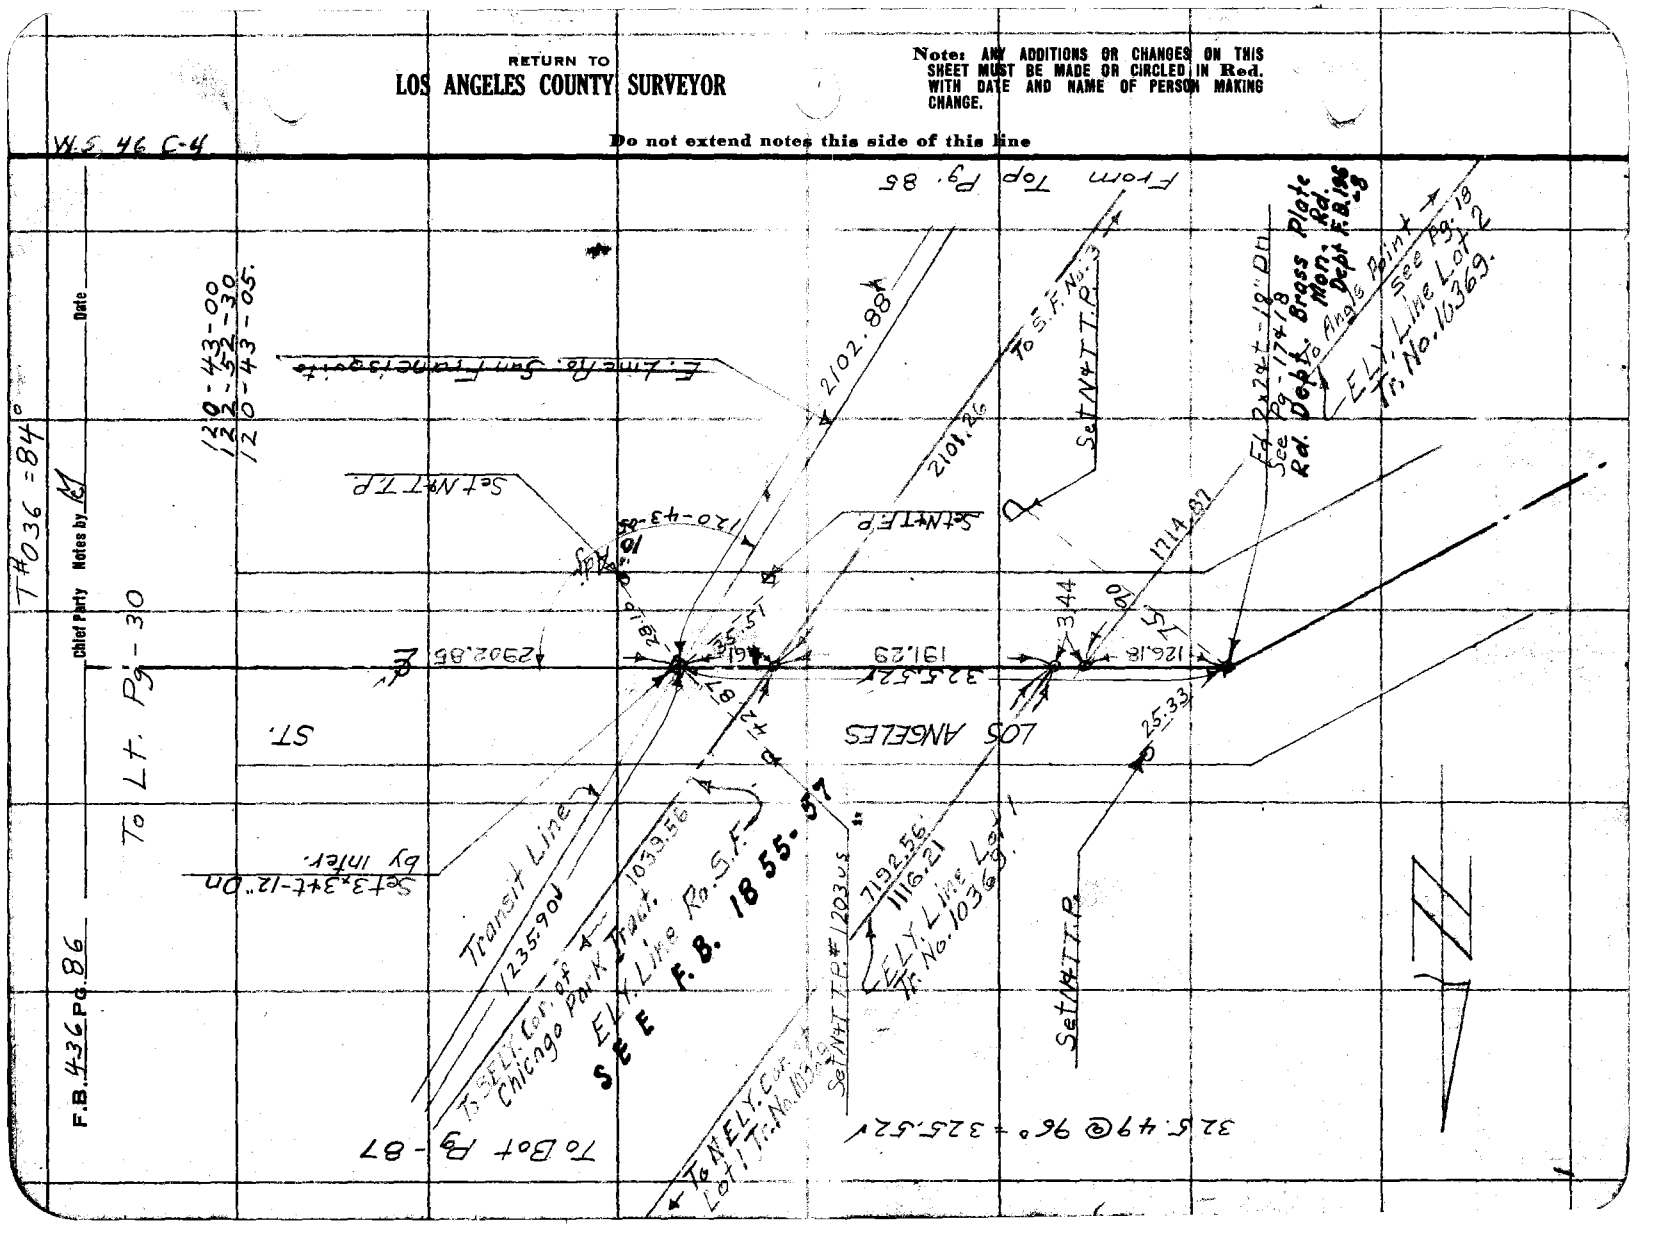

T#036 = 84°

Date _____ Notes by M Chief Party _____ F.B. 436 Pg. 87

Platted by	W. O. No. 970 D. S. O. No.
Date	Location Los Angeles St.
Map No.	Surveyed by F.J. McNeal
Platting C'k'd by	Date Apr - 1931
Date	Indexed A. C. Johnson

To Bat. Pg - 88

878.44

878.41 @ 90° = 878.44✓

Set 3x3 N - flush in mound of Rocks
P.O.T. - Edge of Dirt Road.

876.73

876.7 / @ 88° = 876.73✓

P.O.T. #1
Set 3x3 N - flush in mound of Rocks

1235.90

1235.87 @ 88° = 1235.90✓

S E F.B. 1855: 63, 65

Trans. Line

Elias Rancho San Francisquito

FOR ADDED

From Lt. Pg - 86

RETURN TO
LOS ANGELES COUNTY SURVEYOR

Notes: ANY ADDITIONS OR CHANGES ON THIS SHEET MUST BE MADE OR CIRCLED IN Red. WITH DATE AND NAME OF PERSON MAKING CHANGE.

Do not extend notes this side of this line

T# 036 = 84°

F.B. 436 Pg. 88 Chief Party Notes by CM Date

To Bot Pg - 89

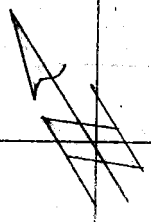

1214.46 @ 92° = 1214.52 ✓

1214.52

P.O.T. #4
Set 3x34N - flush - In mound of Rocks

0°-01'-55"
1.74

59°-12'-00"
F.E. 547-34

1248.39
Transit Line
F.E. Per 547-34

988.25 @ 90° = 988.29 ✓

988.29

Established by intersection

2.62

Set 2x2 [illegible] and tack.

80.90

62.24

2.29

P.O.T. #3
Set 3x34N - flush In mound of Rocks


S 89°-55'-00" E
F.B. 1855 - 63

878.44 ✓

509.4

Transit Line

From Top Pg - 87

RETURN TO
LOS ANGELES COUNTY SURVEYOR

Do not extend notes this side of this line

Note: ANY ADDITIONS OR CHANGES ON THIS SHEET MUST BE MADE OR CIRCLED IN Red. WITH DATE AND NAME OF PERSON MAKING CHANGE.

T#036 = 84°

Date _____ Notes by M Chief Party _____ F.B. 436 Pg. 89

Platted by _____
Date _____
Map No. _____
Platting C'k'd by _____
Date _____

W. O. No. 970 D. S. O. No. _____
Location Los Angeles St.
Surveyed by F.J. McNeal
Date Apr. -1931
Indexed A. C. Johnson

TO Pt. Pg - 91

856.05 @ 94° = 856.11
- 50.32
805.79

P.O.T. #6
Set 3x34N - flush
In mound of Rocks

805.79

SEE F.B. 1855 - 63, 65

E. line Rd. San Francisquito

1053.49

Transit Line

1053.44 @ 92° = 1053.49

ADOPTED LINE

P.O.T. #5
Set 3x34N - flush
In mound of Rocks

1214.52

FOR

From Top Pg - 88

RETURN TO
LOS ANGELES COUNTY SURVEYOR

Note: ANY ADDITIONS OR CHANGES ON THIS SHEET MUST BE MADE OR CIRCLED IN Red. WITH DATE AND NAME OF PERSON MAKING CHANGE.

Do not extend notes this side of this line

F.B. 436 Pg. 90 Chief Party Notes by Date

7102.94 Calc
7003.48 Mc

RETURN TO
LOS ANGELES COUNTY SURVEYOR

Do not extend notes this side of this line

Notes: ANY ADDITIONS OR CHANGES ON THIS SHEET MUST BE MADE OR CIRCLED IN Red. WITH DATE AND NAME OF PERSON MAKING CHANGE.

Date _____ Notes by M Chief Party _____ F.B. 436 Pg. 91

Platted by _____
Date _____
Map No. _____
Platting C'k'd by _____
Date _____

W. O. No. 970 U. S. G. No. _____
Location Los Angeles St
Surveyed by F.J. McNeal
Date Apr - 1931
Indexed A. C. Johnson

WS. 46 C-D-3

RETURN TO LOS ANGELES COUNTY SURVEYOR

Notes ANY ADDITIONS OR CHANGES ON THIS SHEET MUST BE MADE OR CIRCLED IN Red. WITH DATE AND NAME OF PERSON MAKING CHANGE.

Do not extend notes this side of this line

124+83.07
Sta. No. 16 Rd. AZUSA
Ed. 2 I.P. +t-12"DP
Per F.B. 270-54-E

Set 3x3 4N-flush in mound of rocks

50.32

HWY.

C.S. Mon. 64
F.B. 1855-64

RD. AZUSA DE DUARTE
2069.07
Per F.B. 270

1971.08

105+11.99
S.F. No. 2
Set S.W.T. by Prop. Set Sta
16817 per F.B. 270

Set 3x3 4N-flush in mound of rocks

FOR ADOPTED TRAVERSE LINE

SEE F.B. 1855-64

50.32

805.79N

92089.10

To S.F. No. 3
See Pg. 102

E.E. Line Rd. San Francisquito

104+14.00
Set S.W.T. by int.

197.99

83°31'-15"

33'-05" All 33'-32"

83-

NELY. Prolongation of ELY. Line Lot 1 Tr. No. 10369

6876.15 To NELY. Cor. Lot 1 Tr. No. 10369

Ap Pt 10
See Ap's F.B. 270-60

Sta. No. 16

026

Found 1" I.P.
See Pg. 10.

82°59'-05"

7024.96

12483.07 To Sta. No. 17
Rancho Line

ARROW

To Sta. No. 17

SAN FRANCISQUITO

83-33-00
334-11-45
83-32-55

Fd. 2x24t-6"DP
Per F.B. 270-62D

To Sta. No. 17

See Pg. 10

From Top Pg. 89

F.B. 436 Pg. 92 _____ Chief Party Notes by _____ Date _____

RETURN TO
LOS ANGELES COUNTY SURVEYOR

Do not extend notes this side of this line

Note: ANY ADDITIONS OR CHANGES ON THIS SHEET MUST BE MADE OR CIRCLED IN Red. WITH DATE AND NAME OF PERSON MAKING CHANGE.

WS 46 B-5

Date _____ Notes by MCL Chief Party _____ F.B. 436 Pg. 22

Platted by _____
Date _____
Map No. _____
Platting C'k'd by _____
Date _____

W. O. No. 970 D. S. O. No.
Location Los Angeles St.
Surveyed by F. J. McNeal
Date May - 1931
Indexed A. C. Johnson

T 1N R 11W = 84°

Random Line

Fd. 4" I.P. with Spk. in conc -3" Dn
Per Tr # 3278
La. Puente #1

40.24
.14
49.97

Split of rails

82-30-00
329-59-30
82-29-50

82° 29' 50"

See Also Pg. - 95

995.25

Fd. 1½" I.P. 4t-2" up
Per C.S. # B 457

McNeal
Smith
Bernhart
Graham
Fralic
Taylor

1" Conc. 6" up
45°
2

1001.14
- 5.89
995.25

1001.26 @ 66° = 1001.14
= 5.89
995.25

168.09
- 5.89
162.20

168.10 @ 78° = 168.09
= 5.89
162.20

Fd. C.S. Mon
Per C.S.
La Puente #

Fd. 1½" I.P. 4t-2" up
Per C.S. # B 457

N. Line S.P. Ry.

Fd. 1x24t-flush
Per C.S. # B 457

See Pg. - 99

5.89

1.528

Fd. 1½" I.P. 4t-2" up
Per C.S. # B 457

Pg - 96

391.29

To Lt.

110-46-00
83-04-00
110-46-00.

110° 51' 25"

162.20

Fd. 2x24t-12" Dn
Per C.S. # B 457

Set 2x24t-18" Dn
by Inter
of Lot 1

110° 46' 00"

12.46

389.64

To Bot Pg - 82

WLY. Line of
Tr. No. 3278

109.33

110° 46' 00"

1.91

Fd. 2x24t-18" Dn
Per Pg - 81

Random Line

Fd. 4x4 24" Dn
on E Gilman Ave
Per C.S. # B 457
Set 2x24t-6" Dn

RETURN TO
LOS ANGELES COUNTY SURVEYOR

Do not extend notes this side of this line

Notes: ANY ADDITIONS OR CHANGES ON THIS SHEET MUST BE MADE OR CIRCLED IN Red. WITH DATE AND NAME OF PERSON MAKING CHANGE.

T#036 = 84°

F.B. 436 Pg. 94 Chief Party Notes by M Date

MS 46 B-6

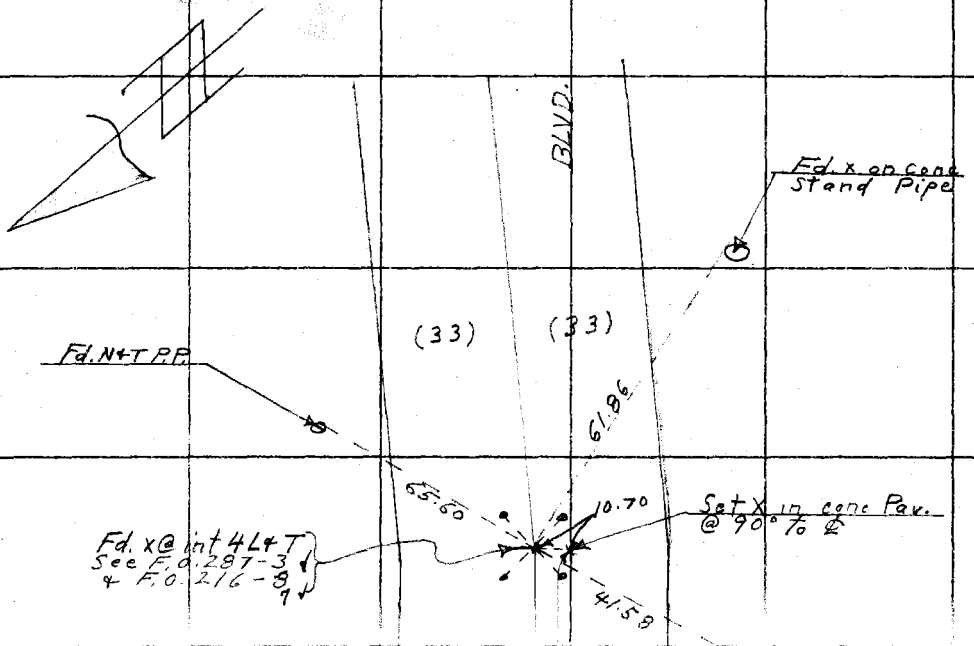

To Rt. Pg - 95

RETURN TO
LOS ANGELES COUNTY SURVEYOR
Do not extend notes this side of this line

Note: ANY ADDITIONS OR CHANGES ON THIS SHEET MUST BE MADE OR CIRCLED IN Red. WITH DATE AND NAME OF PERSON MAKING CHANGE.

T 036 = 84°

Date _____ Notes by M Chief Party _____ F.B. 436 Pg. 25

Plotted by _____
Date _____
Map No. _____
Plotting C'k'd by _____
Date _____

W. O. No. 970 D. S. O. No. _____
Location Los Angeles St.
Surveyed by F.J. McNeal
Date 5-7-31
Indexed A. C. Johnson

W.S. 46 B-5

RETURN TO LOS ANGELES COUNTY SURVEYOR

Notes: ANY ADDITIONS OR CHANGES ON THIS SHEET MUST BE MADE IN RED, CIRCLED IN RED, WITH DATE AND NAME OF PERSON MAKING CHANGE.

Do not extend notes this side of this line

To Top Pg 96

Fd. C.S. Mon. #2 La Puente See Pg-93

82-30-15
330-01-15
82-30-20.

N. Line S.P. Per Pg-93

S. Ry. Co. Wly. Line Ro. La Puente Per L.S. 8-24

Fd. 1" I.P. See Pg-93

82-30-35

Fd. 2x24 t Nail No Ref.

0.11

0.15

994.99

#1 La Puente Fd. 4" I.P. See Pg-93

40.22

171-45-00
326-59-15
171-44-50

S. R. Ry.

(100)

59.90

Fd. 1½" I.P. + t-2" up Per Tr. # 3278

0.20

221.42 @ 80°
= 221.42

From Bot Pg-94

221.42

Fd. 1½" I.P. + t-2" up Per Tr. # 3278

86-45-30
347-02-00
86-45-30.

50.29

Set S.W.T. @ Calc. Dist. from N+T

POMONA

86-45-30

1663.19

10.72

BLVD.

Bridge

Set N+T by int.

10.70 Offset

1015.83

(100)

1015.95 @ 66°
= 1015.83

RETURN TO
LOS ANGELES COUNTY SURVEYOR

Note: ANY ADDITIONS OR CHANGES ON THIS SHEET MUST BE MADE OR CIRCLED IN Red. WITH DATE AND NAME OF PERSON MAKING CHANGE.

Do not extend notes this side of this line

WS 46-0-5

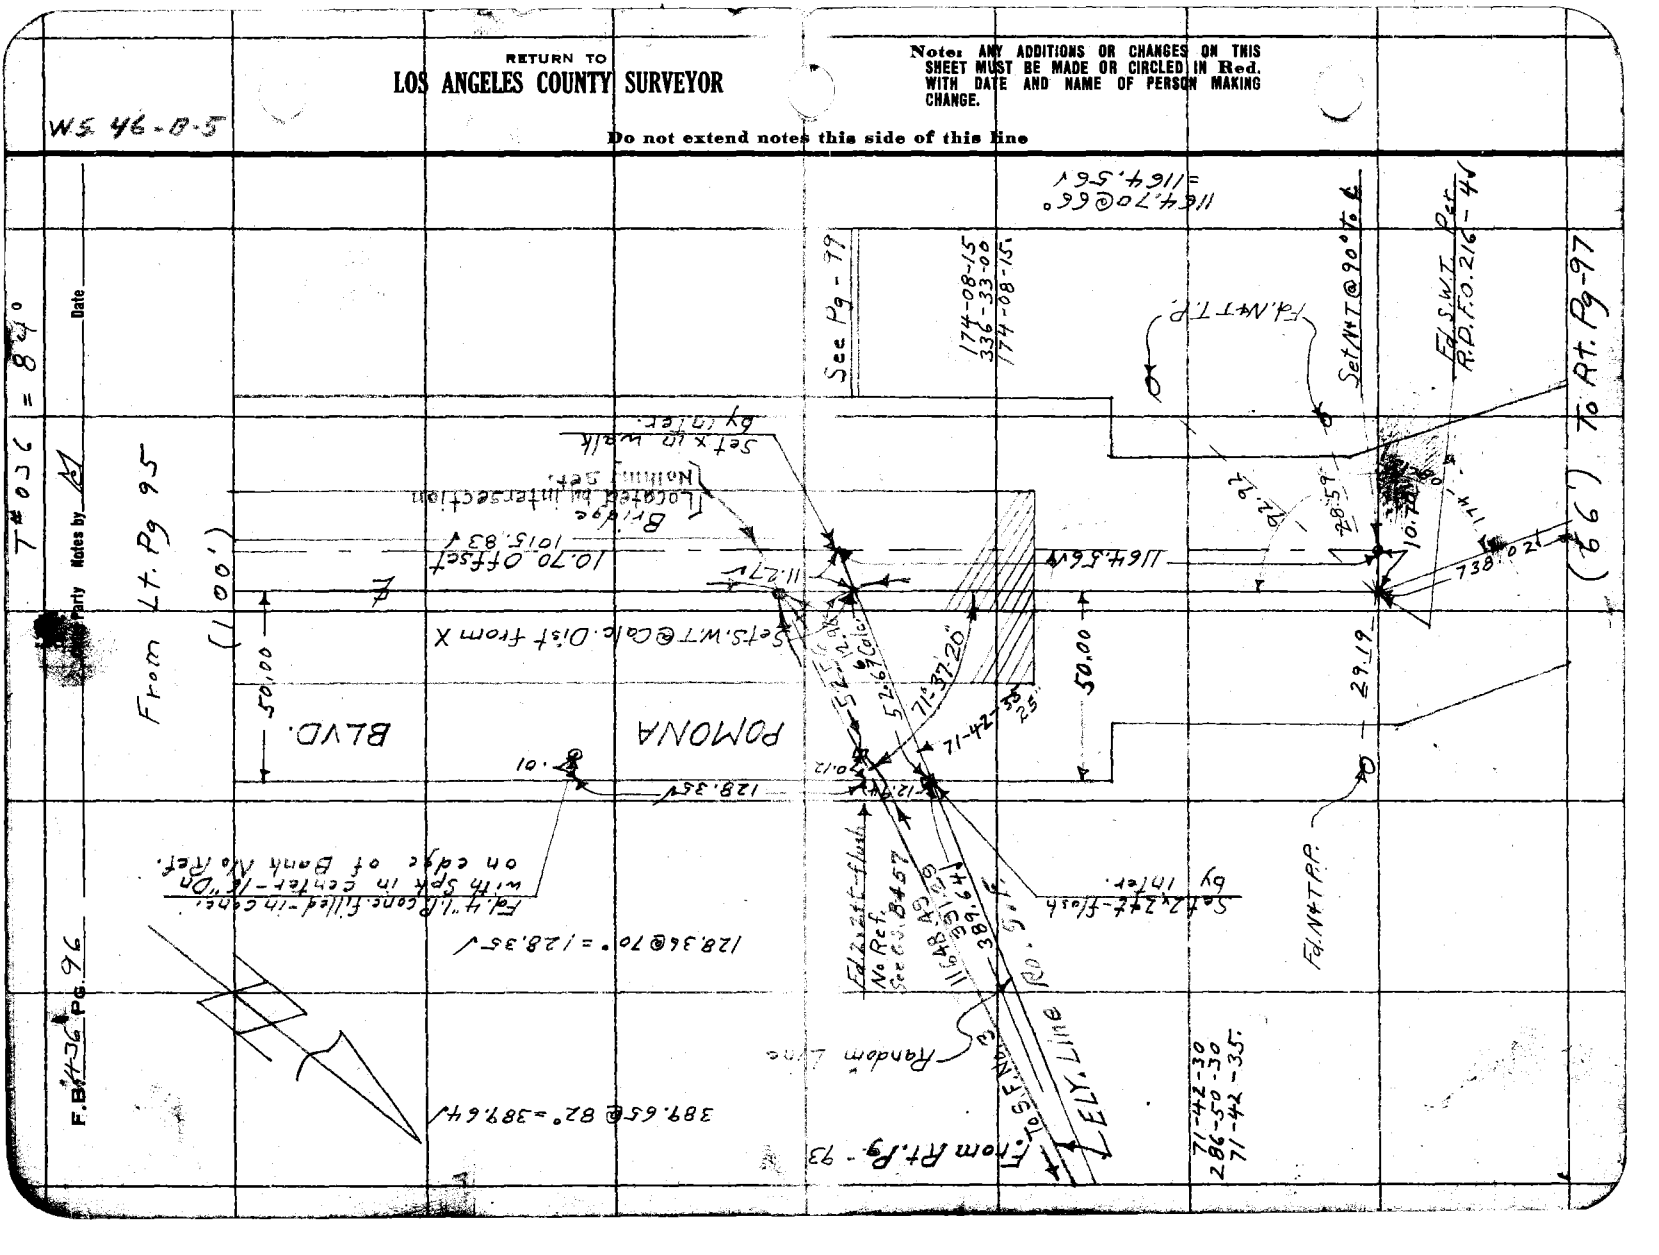

T#036 = 84°

Date _____ Notes by M Chief Party _____ F.B. 436 Pg 27

Platted by	W. O. No. 970 B. S. O. No.
Date	Location Los Angeles St
Map No.	Surveyed by F. J. McNeal
Platting C'k'd by	Date May - 1931
Date	Indexed A. C. Johnson

W.S 46-8-5

Note: ANY ADDITIONS OR CHANGES ON THIS SHEET MUST BE MADE OR CIRCLED IN Red. WITH DATE AND NAME OF PERSON MAKING CHANGE.

Do not extend notes this side of this line

RETURN TO LOS ANGELES COUNTY SURVEYOR

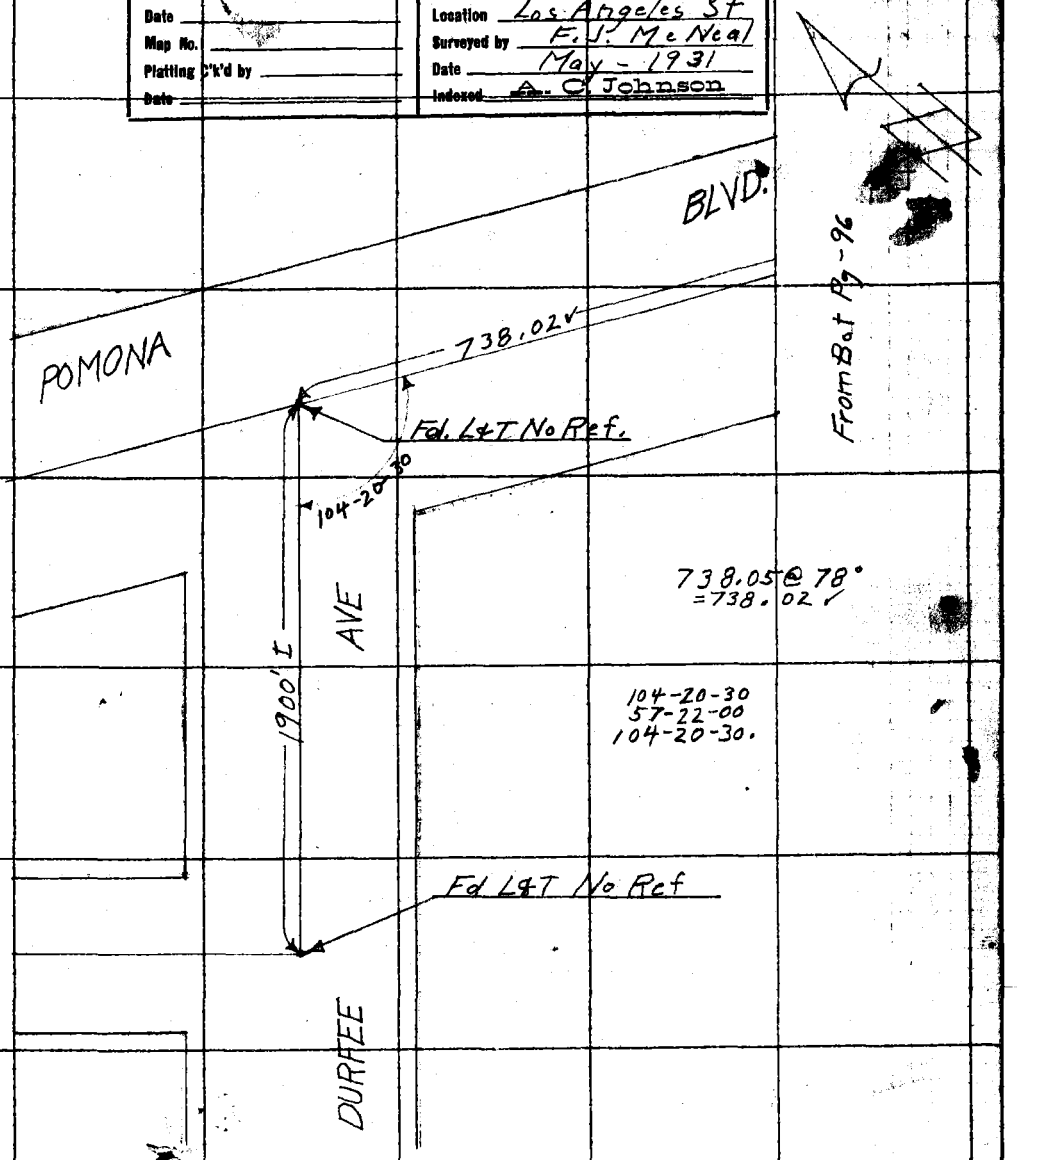

T#036 = 840°

F.B. 436 Pg. 98 Chief Party Notes by M Date

W.S 45-B-5

To Bot. Pg -100

2414.67 @ 74° = 2414.51

Fd 4" I.P & nail -18" up I.P. is Conc. filled and was set in Conc. but now has a Conc. collar due to wash out - No Ref.

2414.51

E. Line Champion Tr Per C.S. B-45

0.11

4297.01 @ 74° = 4296.73

4296.73

0.11

Fd 4" I.P & nail -12" up I.P. is Conc. filled No Ref.

709.38 @ 74° = 709.33

709.33

From Top Pg - 99

RETURN TO LOS ANGELES COUNTY SURVEYOR

Do not extend notes this side of this line

Notes: ANY ADDITIONS OR CHANGES ON THIS SHEET MUST BE MADE OR CIRCLED IN Red. WITH DATE AND NAME OF PERSON MAKING CHANGE.

T 036 = 84

W.S. 4K-8-5

Date _____ Notes by M Chief Party _____ F.B. 436 Pg. 77

Platted by _____
Date _____
Map No. _____
Platting C'k'd by _____
Date _____

W. O. No. 970 D. S. O. No. _____
Location Los Angeles St
Surveyed by F. J. McNeal
Date May - 1931
Indexed A. C. Johnson

To B.o.t Pg - 98

110-51-00
83-23-45
110-50-55.

McNeal
Smith
Wilson
Barnhart
Fiatte

709.33

Fd 2 x 24 t 12" Dn
Per Pg - 93 + C.S. B 45 ✓

110-51-00
83-23-45
194-14-45

N. Line Per Pg - 93 ✓

S.P.

162.20
1.52

1½" I.P.

Ry. R.W.

18-35
67-24-45

E line Champion Tr
Per C.S. B 45 ✓

391.32 @ 74° - 391.29 ✓

391.29

Fd 2 x 24 t - flush
Per Pg - 96 - See C.S. B 45 ✓

POMONA

52.29
59.86

BLVD.

Set X on Bridge Piers.

Notes: ANY ADDITIONS OR CHANGES ON THIS SHEET MUST BE MADE OR CIRCLED IN Red. WITH DATE AND NAME OF PERSON MAKING CHANGE.

Do not extend notes this side of this line

RETURN TO
LOS ANGELES COUNTY SURVEYOR

T#036 - 84°

F.B. 436 Pg. 100 Chief Party Notes by M Date

WS 76-B-4

To Bot Pg - 101

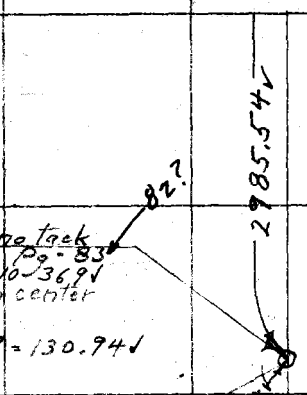

Fd 2" I.P. no tack
6" Dn Per Pg - 83
Per Tr. # 10369
Set nail in center

130.95 @ 76° = 130.94

130.94

Fd 2x3 t - flush Per Pg - 82
Per Tr # 3278

Ry.

204.44 @ 76° = 204.43

P.E.

204.43

E. line Champion Tr.
Per C.S. B 4571

ST.

Fd 2" I.P. t - flush
Per Pg - 82
" E.O. 260-35
" Tr # 10369

146.92

Fd 2" I.P. t - 3" Dn
Per Pg - 82
" E.O. 260-35
" Tr # 10369

EL MONTE

From Top Pg - 98

77.55 @ 8-34 @ 70.77
27.55 @ 0-00 @ 27.55
44.77 @ 11-47 @ 44.77
144.99

Notes: ANY ADDITIONS OR CHANGES ON THIS SHEET MUST BE MADE OR CIRCLED IN Red. WITH DATE AND NAME OF PERSON MAKING CHANGE.

RETURN TO LOS ANGELES COUNTY SURVEYOR

Do not extend notes this side of this line

T 7 S R 36 E 38 F

Date _____ Notes by M Sheet Party _____ F.B. 436 Pg. 100

Platted by _____
Date _____
Map No. _____
Platting C'k'd by _____
Date _____

T. B. No. 970 U. S. G. No. _____
Location Los Angeles St.
Surveyed by F. J. McNeal
Date May-1931
Indexed A. C. Johnson

Note: ANY ADDITIONS OR CHANGES ON THIS SHEET MUST BE MADE OR CIRCLED IN Red. WITH DATE AND NAME OF PERSON MAKING CHANGE.

Do not extend notes this side of this line

RETURN TO LOS ANGELES COUNTY SURVEYOR

See Pg - 102

324.04 @ 74° = 324.02 ✓

S.F. No. 3 See Pg. 102.

Set 1x24"

Rd. Line

320.10

S.P. #2 Per Pg. 82
Fd. 3x3 4 nail & tag in mound of Rocks Per Pg - 82

0.27

5.06

H.M.S. C-23-31

Fd n+t in T pole

Fd n+t in T pole

4.93

Fd n+t in T pole

0.11

Fd n+t in T pole

Fd S.W.T. opposite 2" I.P. S.E. Cor. of Rancho Adams from Tr. Per Pg - 18 & 83

@ Lower Azus & Rd. Prod. Per Pg 18 & 83

Ties

324.02

315.97

Set Red Wood 4x4 - 5' long 74" up with tack Spk & Fender washer in center, by interv.

Fd 3x3 4 n - tag in mound of Rocks Set Per Pg - 83 ✓

626.92

4.61

93-45-15
15-01-00
3-45-15

E. line Champion Tr.

E'ly. Line Rd. S.F. 2785.54

From Top Pg - 100

2985.70 @ 76° = 2985.54 ✓

F.B. 436 Pg. 102 Chief Party Notes by M Date 6-3-31

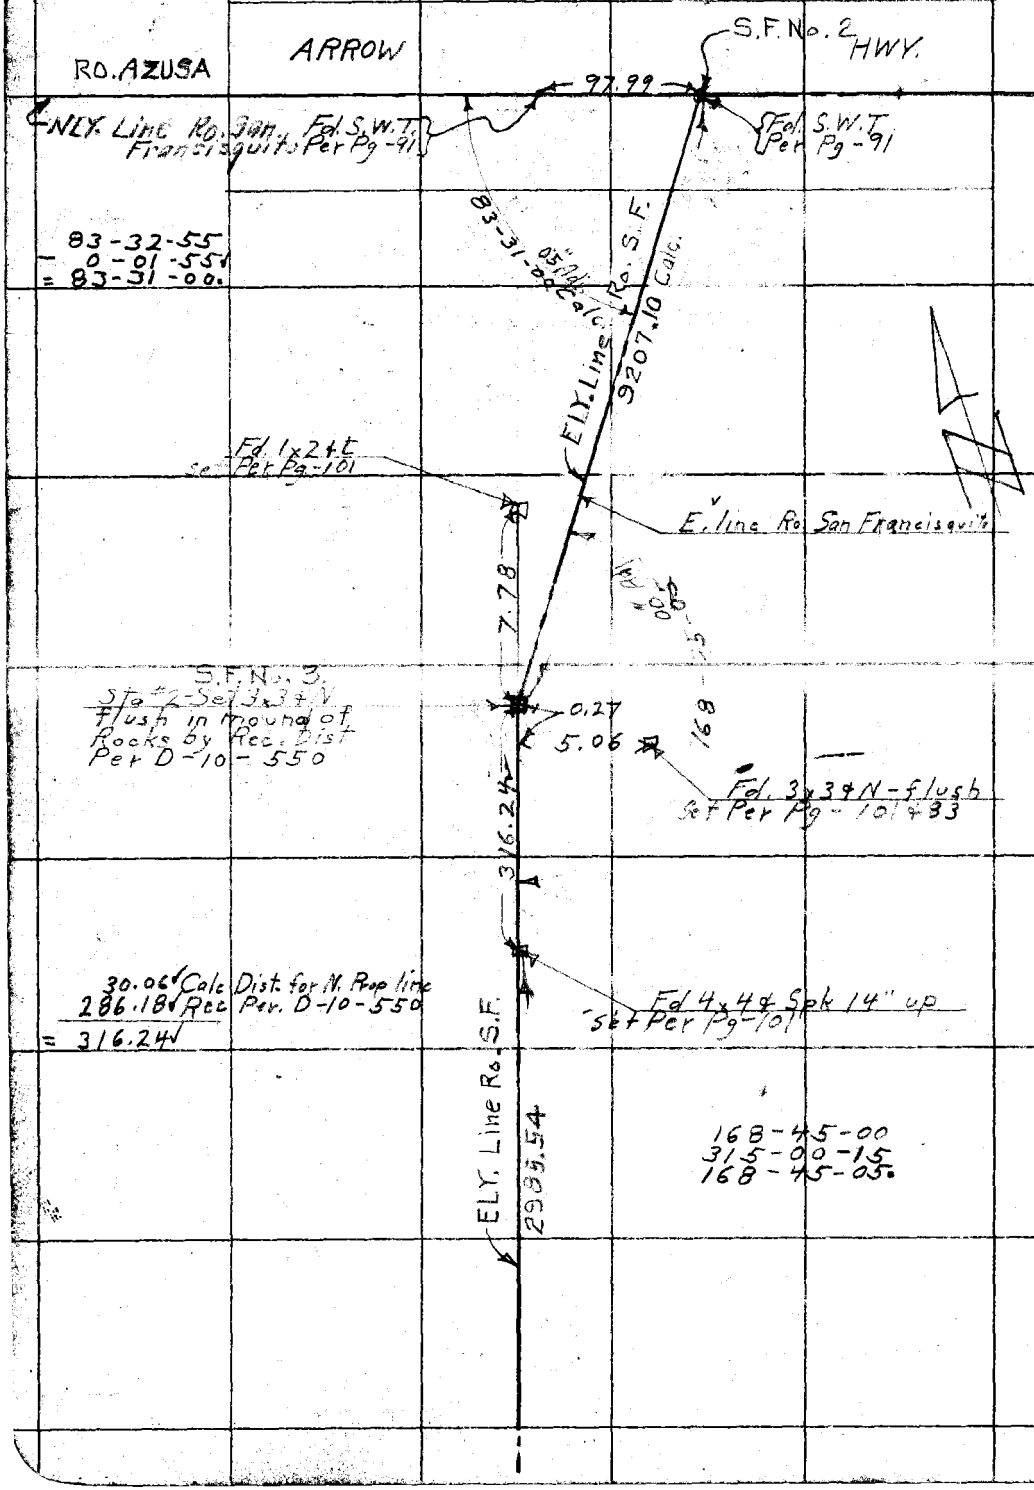

RETURN TO
LOS ANGELES COUNTY SURVEYOR

Do not extend notes this side of this line

Note: ANY ADDITIONS OR CHANGES ON THIS SHEET MUST BE MADE OR CIRCLED IN Red. WITH DATE AND NAME OF PERSON MAKING CHANGE.

Notes Ck'd by McPherson	Survey of Los Angeles St
Map No.	W. O. 970 Tape No. 042 Ck'd 64 °F.
Office Work	Surveyed by Rosecrans
Checked	Notes Date 3-23-33
Date	Indexed A. C. Johnson 4-20-33

F.B. 436 Pg. 102

Notice: ANY ADDITIONS OR CHANGES ONLY THIS SHEET MUST BE MADE ON CIRCLED IN Red Ink. WITH DATE AND NAME OF PERSON MAKING CHANGE.

RETURN TO
LOS ANGELES COUNTY SURVEYOR
700 HALL OF RECORDS

Do not extend notes this side of this line

LOS ANGELES ST.

Between E line of Tr. 9360 M.B. 182-20 and Int. of Lower Azusa, and El Monte and Corina Rds.

W.O 970

Transit # 16858
Tape # 042

Party E.A. Rosecrans
P.W. Atkins
F.H. Blanchard
H.H. Reynolds

To be C.S.B-902

FORM 247 10M 8-31

F.B. 436 PG. 104

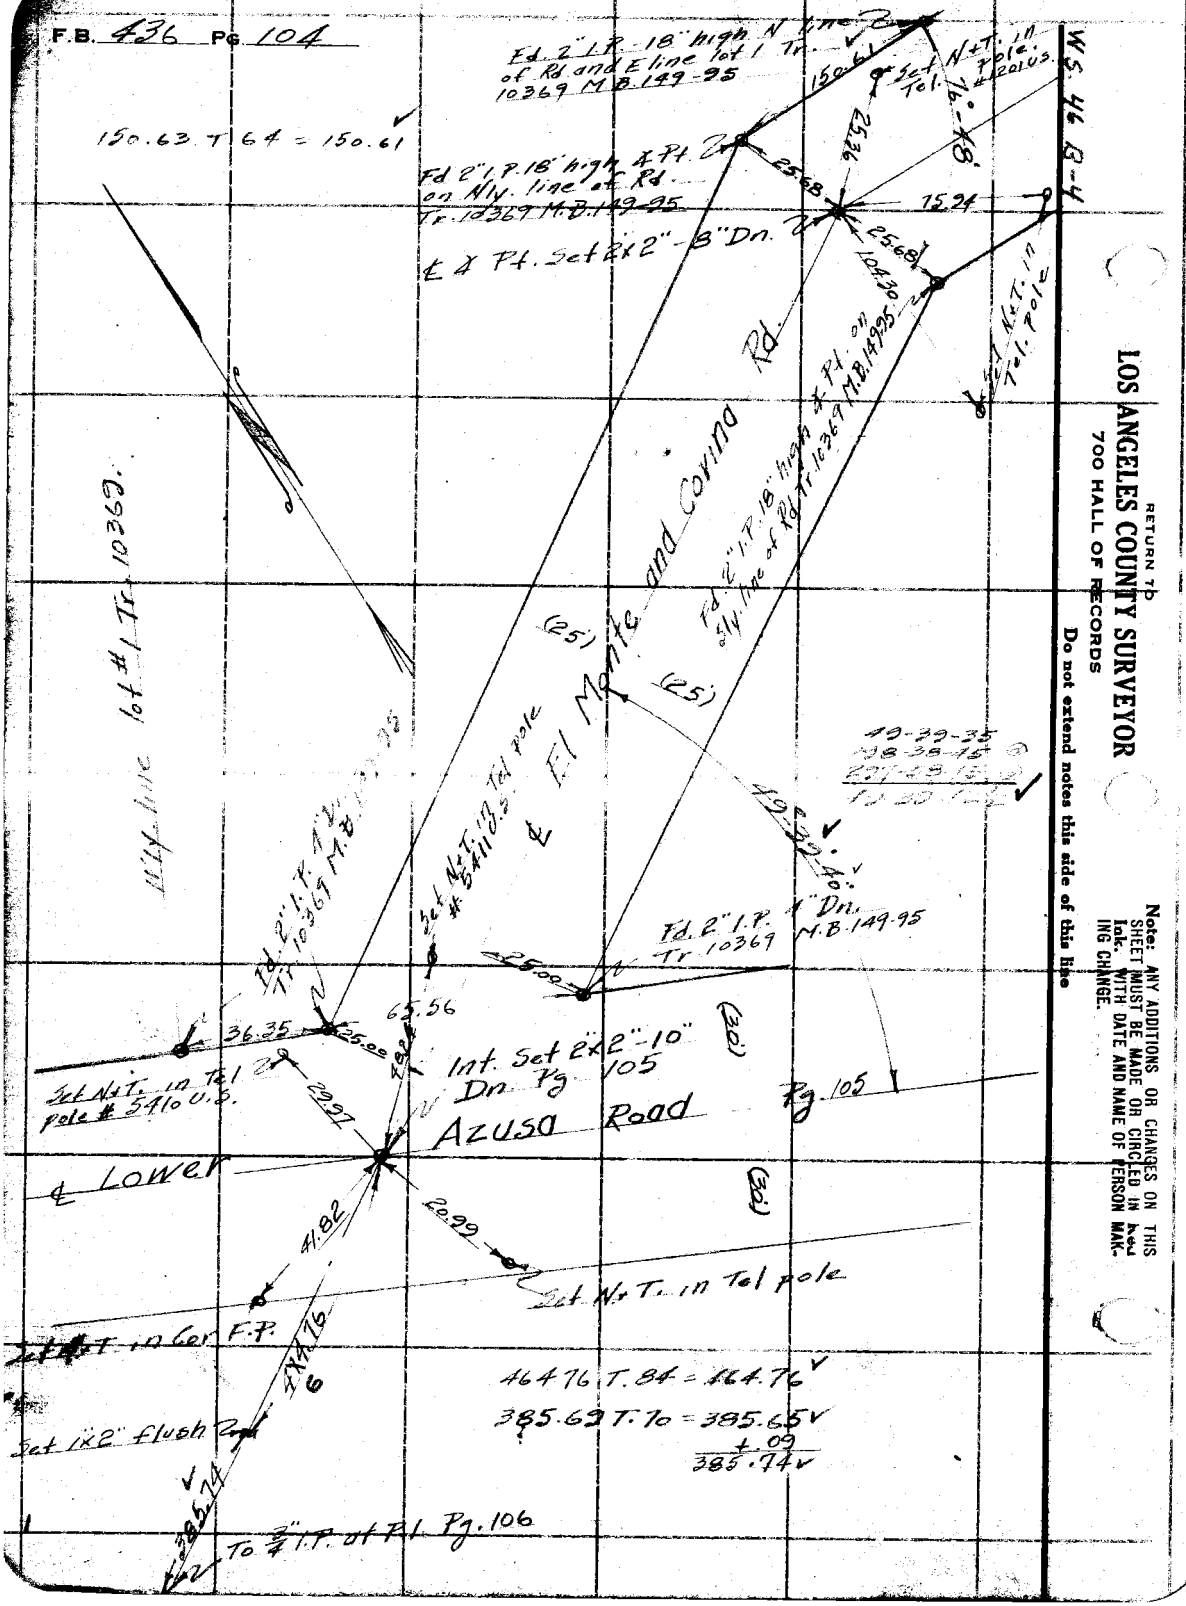

RETURN TO
LOS ANGELES COUNTY SURVEYOR
700 HALL OF RECORDS

Do not extend notes this side of this line

Note: ANY ADDITIONS OR CHANGES ON THIS SHEET MUST BE MADE OR CIRCLED IN red Ink. WITH DATE AND NAME OF PERSON MAKING CHANGE.

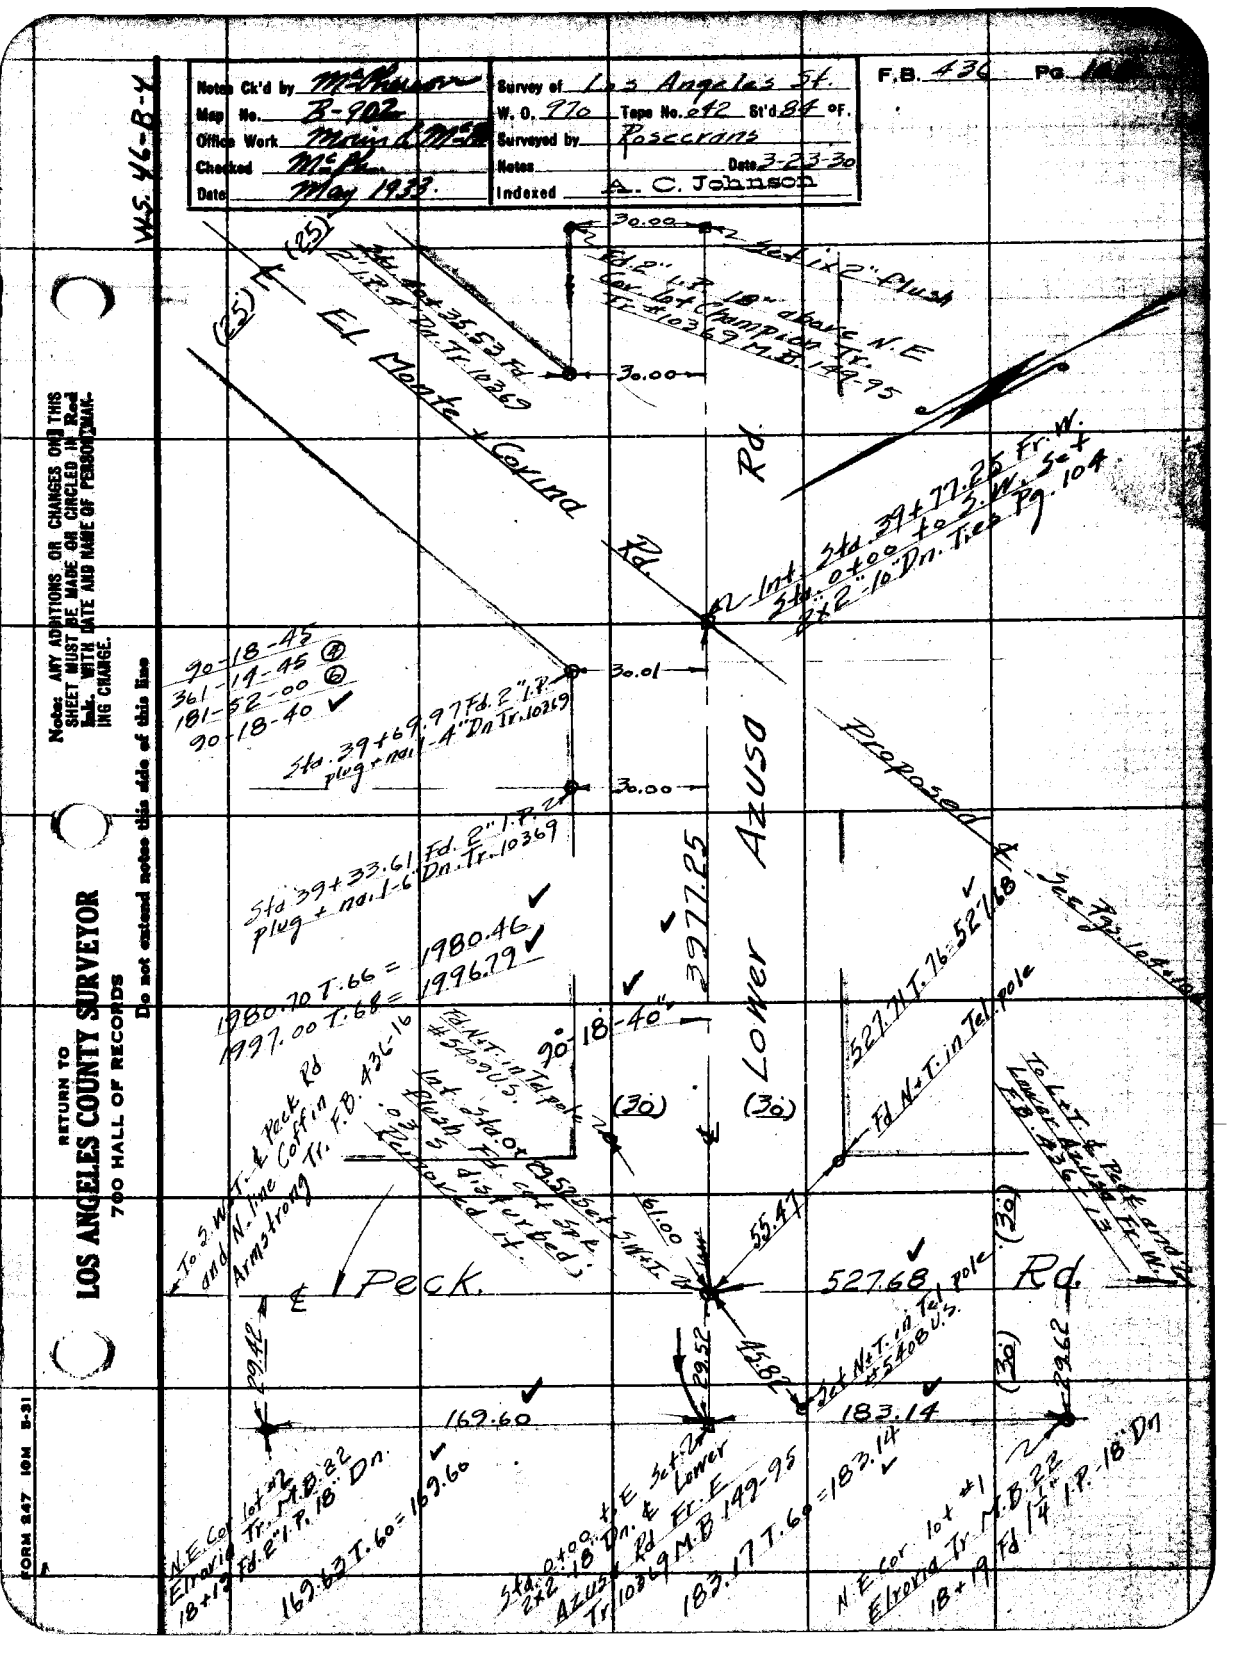
Notes Ck'd by McPherson
Map No. B-902
Office Work Maps & Misc
Checked McPh
Date May 1933.
Survey of Los Angeles St.
W. O. 970 Tape No. 242 St'd 84 °F.
Surveyed by Poscerans
Notes Date 3-23-30
Indexed A. C. Johnson
F.B. 436 Pg.
W.S. 46-B-4
Notes ANY ADDITIONS OR CHANGES ON THIS SHEET MUST BE MADE ON CIRCLED IN Red Ink, WITH DATE AND NAME OF PERSON MAKING CHANGE.
Do not extend notes this side of this line
RETURN TO
LOS ANGELES COUNTY SURVEYOR
700 HALL OF RECORDS
FORM 247 10M 8-31
(25)
E.L. Monte & Covina Rd.
Sta. 39+35.53 Fd. 2" I.P. Dn. Tr. 10369
30.09
2 Fd. 2" I.P. 18" above N.E. Cor. lot Champion Tr. M.B. 19-95
Tr. 10369
30.00
Sta. 39+77.26 Fr. W. Sta. 0+00 to S.W. Sta. 2+2.10 Dn. T.C.E. Pg. 104
90-18-45
361-14-45 ④
181-52-00 ⑤
90-18-40 ✓
Sta. 39+69.97 Fd. 2" I.P. plug + nail "A" Dn. Tr. 10369
30.01
30.00
Sta. 39+33.61 Fd. 2" I.P. plug + nail 1.6 Dn. Tr. 10369
1980.70 T.66 = 1980.46 ✓
1997.00 T.66 = 1996.79 ✓
3977.25
Lower Azusa
Proposed
Sta. 39+10.00
527.71 N. 76-52'68" W.
Fd. N. & T. in Tel. pole
90° 18-40"
(30)
(30)
Fd. N. & T. in Tel. pole #5540 U.S.
1st Sta. 0+00 Fd. cut Sta. (surveyed)
To 2nd T. & Peck Rd and N. line Coffin Armstrong Tr. F.B. 436-16
To 1st T. & Peck and Lower Azusa F.B. 436-13
61.00
55.47
527.68
Peck.
Rd.
29.52
45.82
2nd N. & T. in Tel. pole #5540 U.S.
183.14
169.60
N.E. cor lot #2 Elnora Tr. M.B. 22 18+12 Fd. 2" I.P. 18" Dn.
169.62 T.60 = 169.60
Sta. 0+00 ± E. 2+2.18 Dn. ± Lower Azusa Rd. Tr. 10369 M.B. 149-95
183.17 T.60 = 183.14
N.E. cor lot #1 Elnora Tr. M.B. 22 18+19 Fd. 1/4" I.P. 18" Dn.

RETURN TO
LOS ANGELES COUNTY SURVEYOR
700 HALL OF RECORDS

Note: ANY ADDITIONS OR CHANGES ON THIS SHEET MUST BE MADE OR CIRCLED IN Red Ink. WITH DATE AND NAME OF PERSON MAKING CHANGE.

WS 46-B-4

Do not extend notes this side of this line

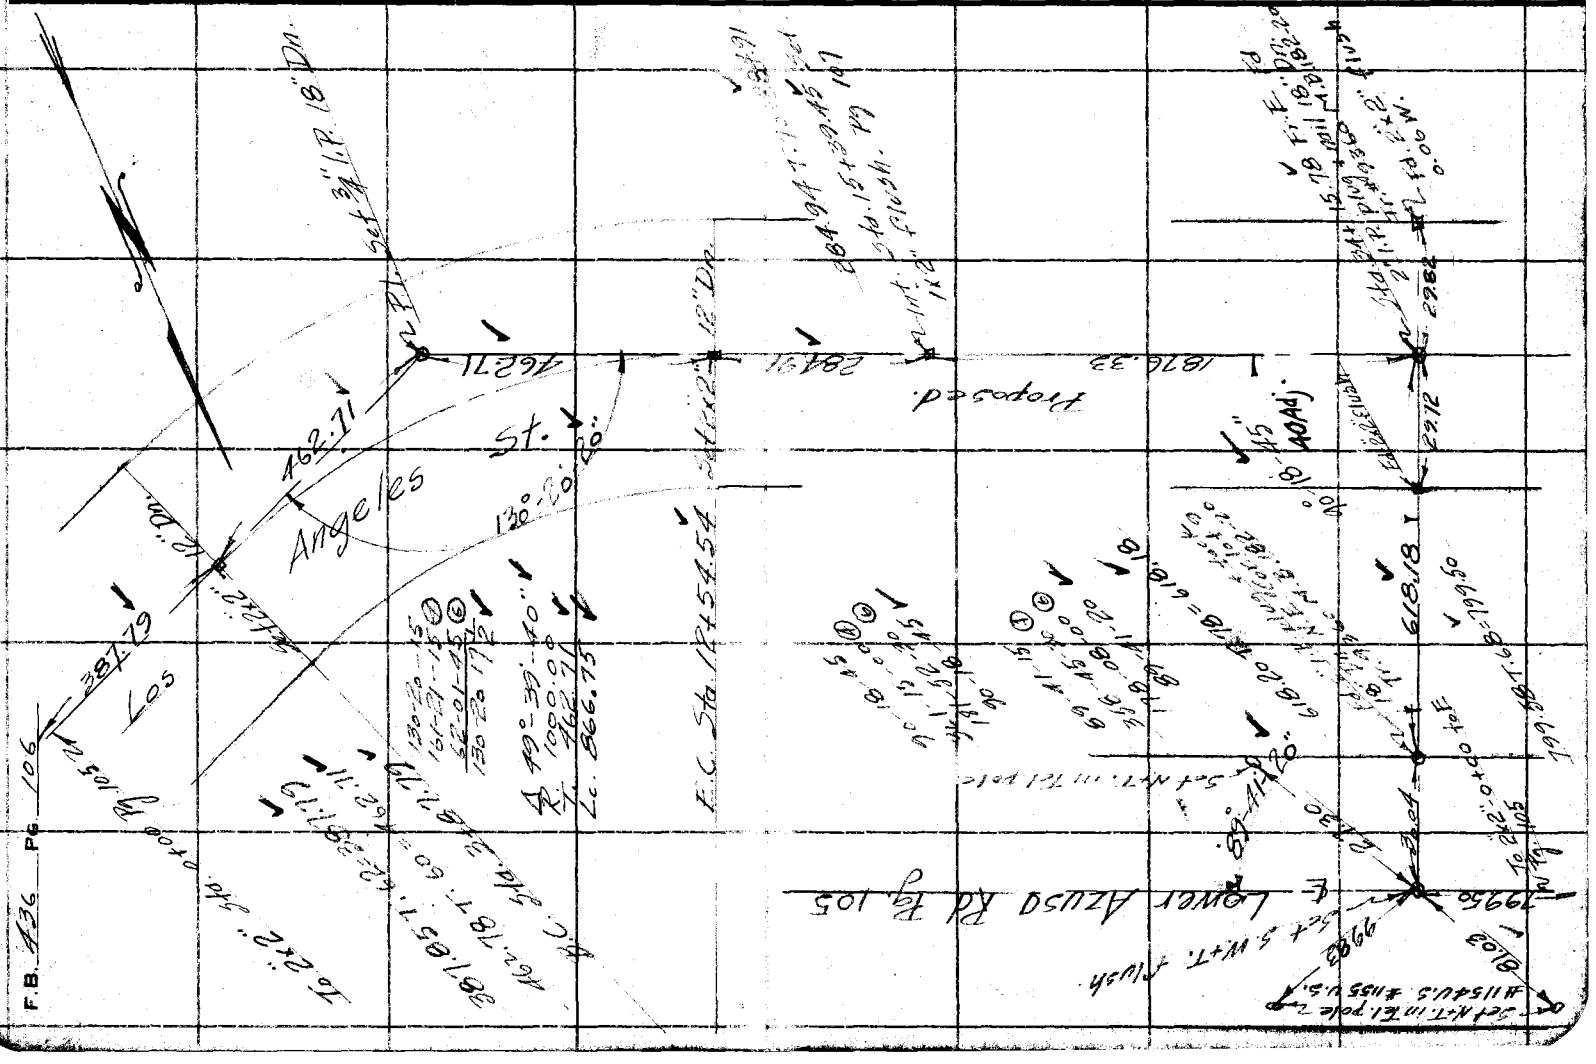

Notes Ck'd by McPherson
Map No. B-302
Office Work Marion C. McP.
Checked McPh.
Date May 1933

Survey of Los Angeles St.
W. O. 710 Tape No. 42 St'd 66 °F.
Surveyed by Rosecrans
Notes Date 3-16-33
Indexed A. C. Johnson

F.B. 136 Pg 107

WS 46 B-4

Notes: ANY ADDITIONS OR CHANGES ON THIS SHEET MUST BE MADE OR CIRCLED IN Red Ink. WITH DATE AND NAME OF PERSON MAKING CHANGE.

Do not extend notes this side of this line

RETURN TO
LOS ANGELES COUNTY SURVEYOR
700 HALL OF RECORDS

FORM 347 10M 5-31

Lower Azusa Rd Pg

Cogswell Rd

Los Angeles St. Pg

Proposed

See Pg 110

RETURN TO

LOS ANGELES COUNTY SURVEYOR

700 HALL OF RECORDS

Note: ANY ADDITIONS OR CHANGES ON THIS SHEET MUST BE MADE OR CIRCLED IN **Red Ink.** WITH DATE AND NAME OF PERSON MAKING CHANGE.

Do not extend notes this side of this line

F.B. 436 PG 108

W.S. 46 R-4

Notes Ck'd by McPherson	Survey of Los Angeles St.
Map No. B-997	W. O. 220 Tape No. 042 St'd Bk of
Office Work K.C.Fle	Surveyed by Rosecrans
Checked McPherson	Notes Date 4-3-33
Date May 1933	Indexed A. C. Johnson

F.B. 434 Pg. 1

Notes: ANY ADDITIONS OR CHANGES ON THIS SHEET MUST BE MADE OR CIRCLED IN Red Ink. WITH DATE AND NAME OF PERSON MAK. ING CHANGE.

RETURN TO
LOS ANGELES COUNTY SURVEYOR
700 HALL OF RECORDS
Do not extend notes this side of this line

FORM 847 10M 8-31

Set N+T. in Tel. pole #5411 U.S.

Lower Azusa Road (30')

1300.50 ℄ 35.76 ℄ El Monte & Covina Road Pg. 104

1431

69.40

Set N+T. in Tel pole

89°47'00" Pg. 110

Int. Set 2"x2"-12" Dn. Pg. 104.

Set N+T. in Tel pole 2.98 Dn.

Int. Set 2"x2"-12" Dn.

(25') (25')

Maxson Rd.

2618.87

2619.11 T. 70 = 2618.87

Ran this ℄ Per D. 58-89 O.R. 6076: 359 and Adams and Ells subdivision. This ℄ does not fit improvements.

Set N+T. in Tel. pole #A38077 T.

Lot line

Set 2"x2"-12" Dn. Pg. 110

See Pg. 110 2

Set N+T. in P. pole #74336 E

Set N+T. in Tel. pole #A36015 T.

89°43'30"

89-43-30
358-54-15 @
178-21-15 @
89-43-322

Fd. 1½" I.P. and T+T 2.107-69 T.L. plugged 1½" with 4" Dn.

Set N+T. in 18" W. nut tree

C.S. Mon. 3.150

Set N+T. in 18" W. nut tree

Fd x in 3" Con. standpipe

RETURN TO
LOS ANGELES COUNTY SURVEYOR
700 HALL OF RECORDS

Note: ANY ADDITIONS OR CHANGES ON THIS SHEET MUST BE MADE OR CIRCLED IN Red Ink. WITH DATE AND NAME OF PERSON MAKING CHANGE.

Do not extend notes this side of this line

WS 46 B-4

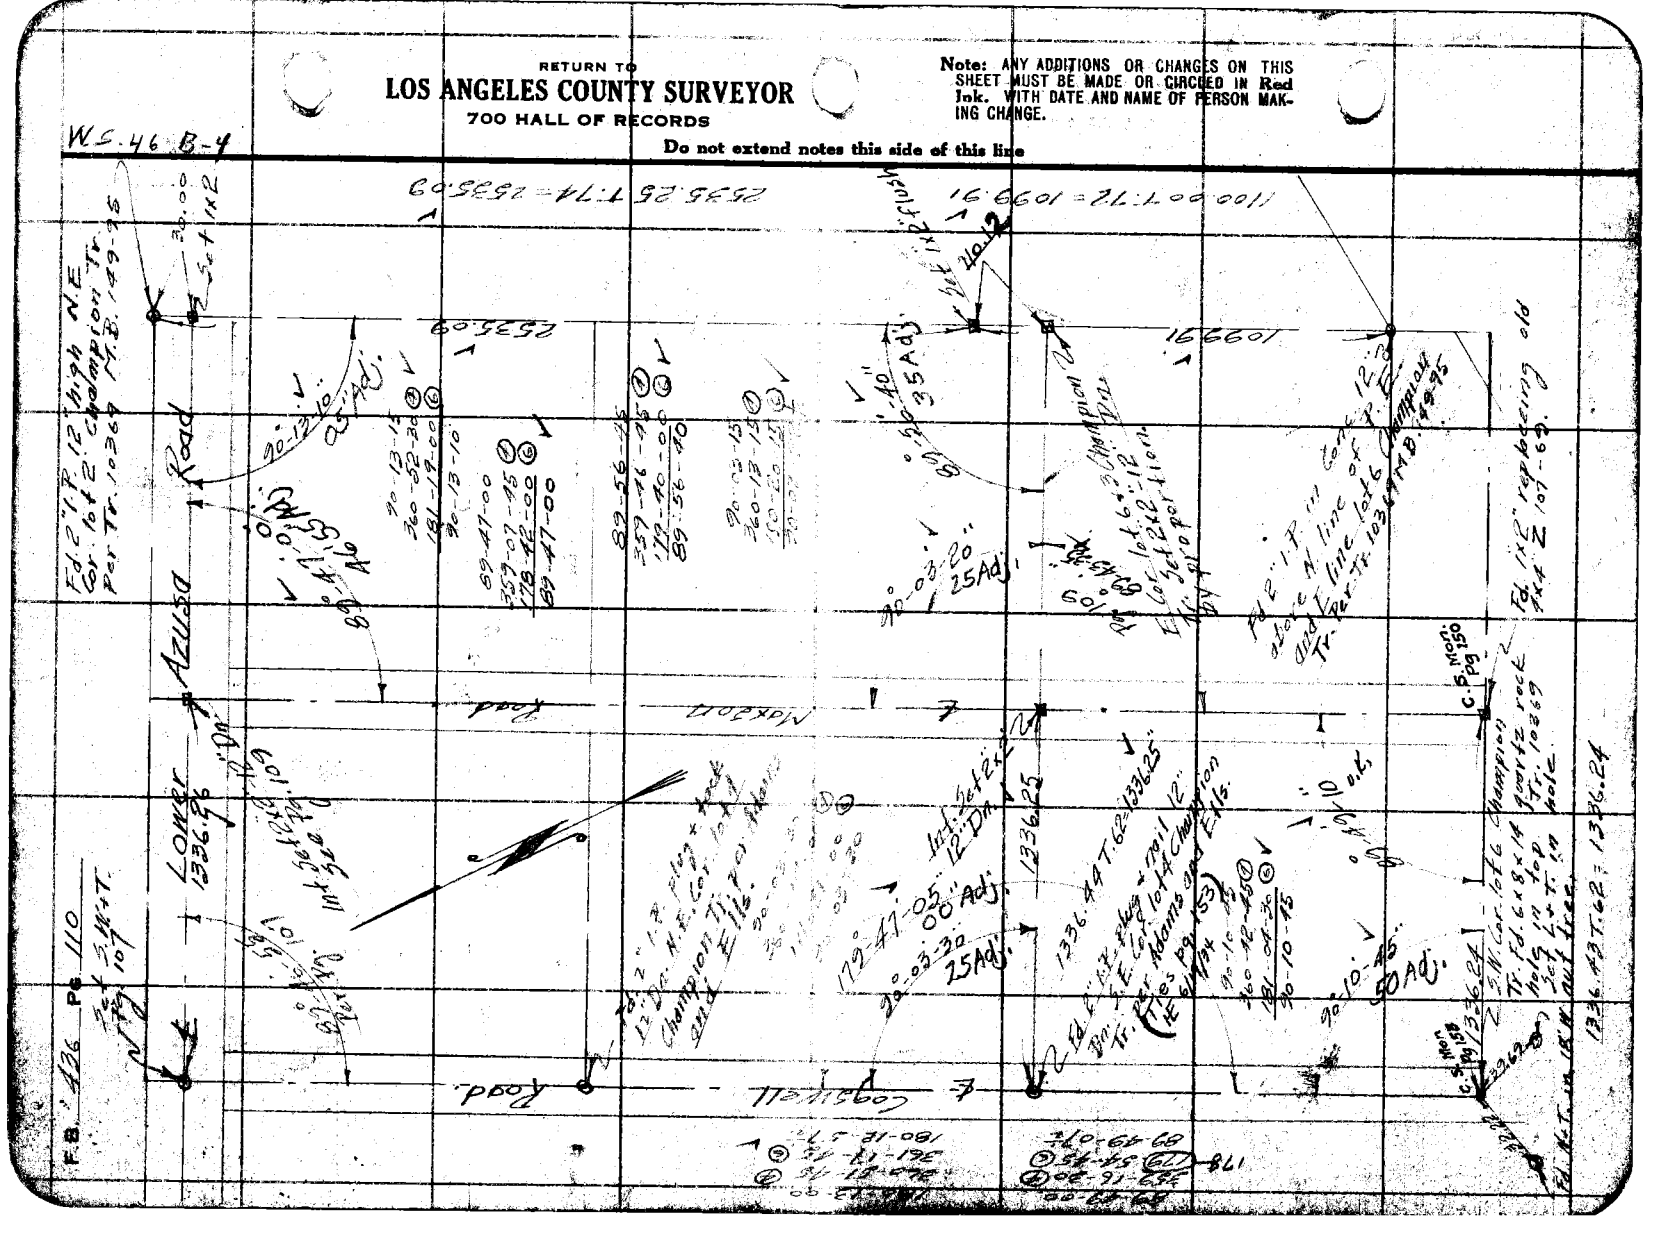
Azusa Road
Lower
1336.96
Road
Cogswell
Road

Notes Ck'd by	Survey of Los Angeles St.
Map No. B-902	W. O. 970 Tape No. 12 St'd 66° F.
Office Work Fiella	Surveyed by Rosecrans
Checked McNamara	Notes Date 3-28-33
Date May 1933	Indexed A. C. Johnson 3-30-33

F.B. 436 Pg. 111

Cont bottom next page

Note: ANY ADDITIONS OR CHANGES ON THIS SHEET MUST BE MADE OR CIRCLED IN Red Ink, WITH DATE AND NAME OF PERSON MAKING CHANGE.

RETURN TO
LOS ANGELES COUNTY SURVEYOR
700 HALL OF RECORDS

Do not extend notes this side of this line

FORM 847 10M 5-31

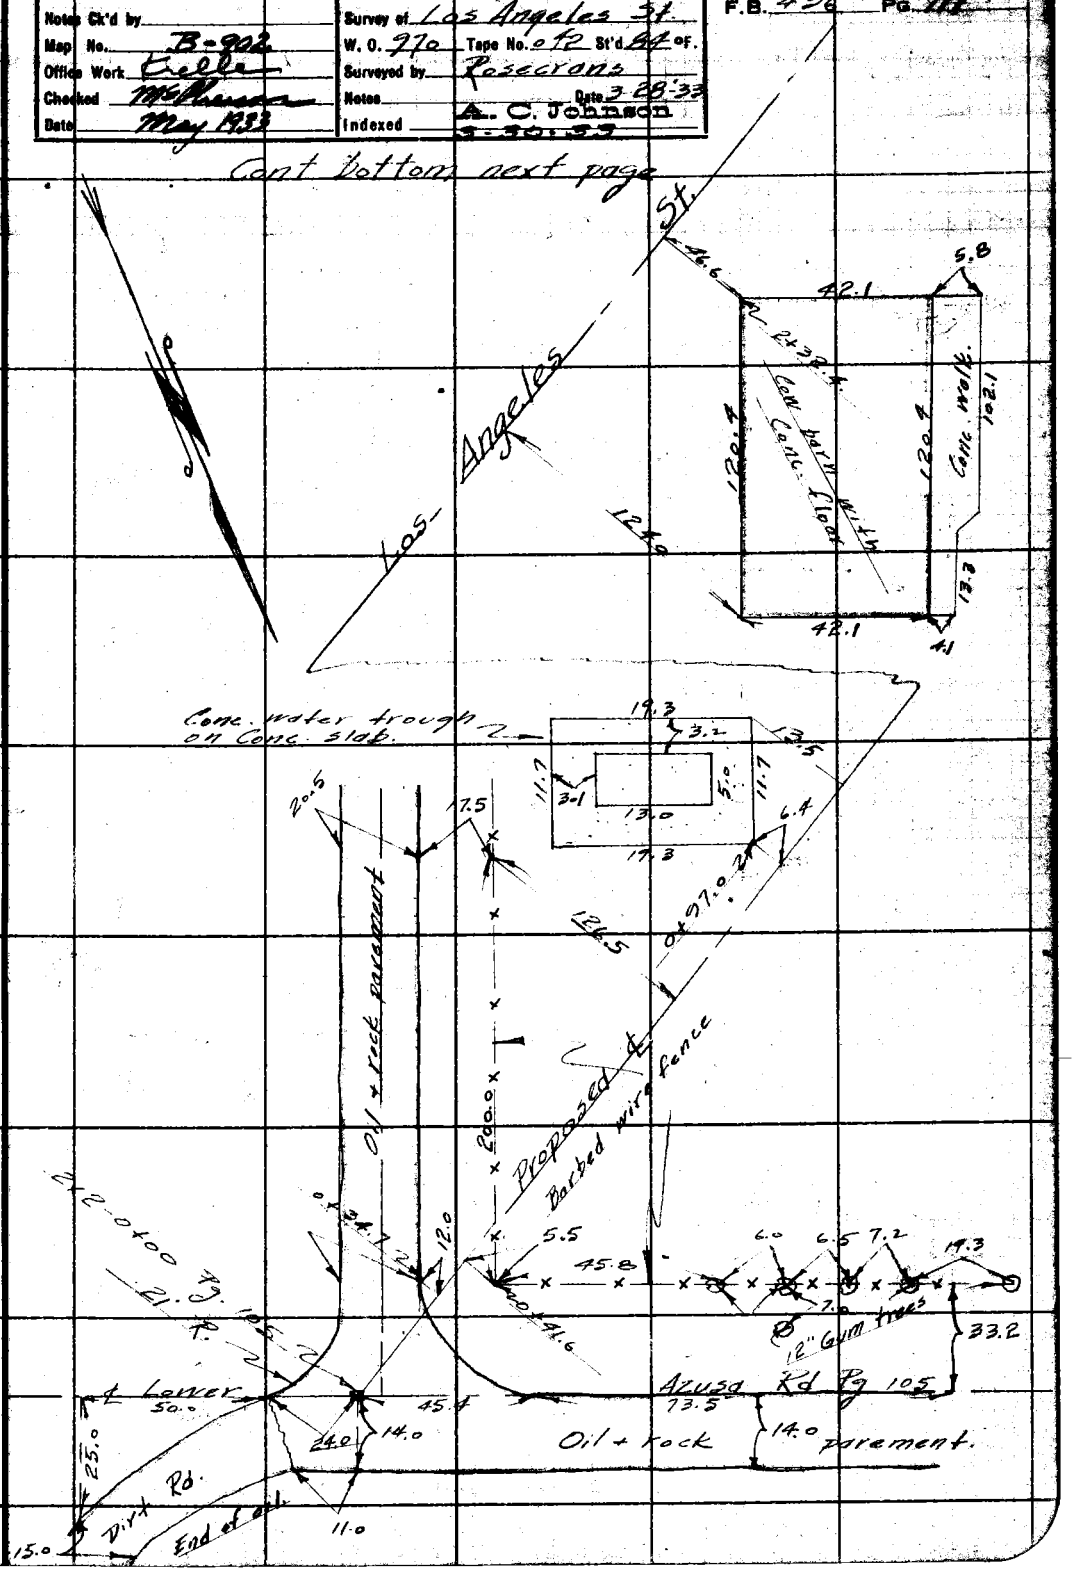

RETURN TO

LOS ANGELES COUNTY SURVEYOR

700 HALL OF RECORDS

Note: ANY ADDITIONS OR CHANGES ON THIS SHEET MUST BE MADE OR CIRCLED IN Red Ink. WITH DATE AND NAME OF PERSON MAKING CHANGE.

Do not extend notes this side of this line

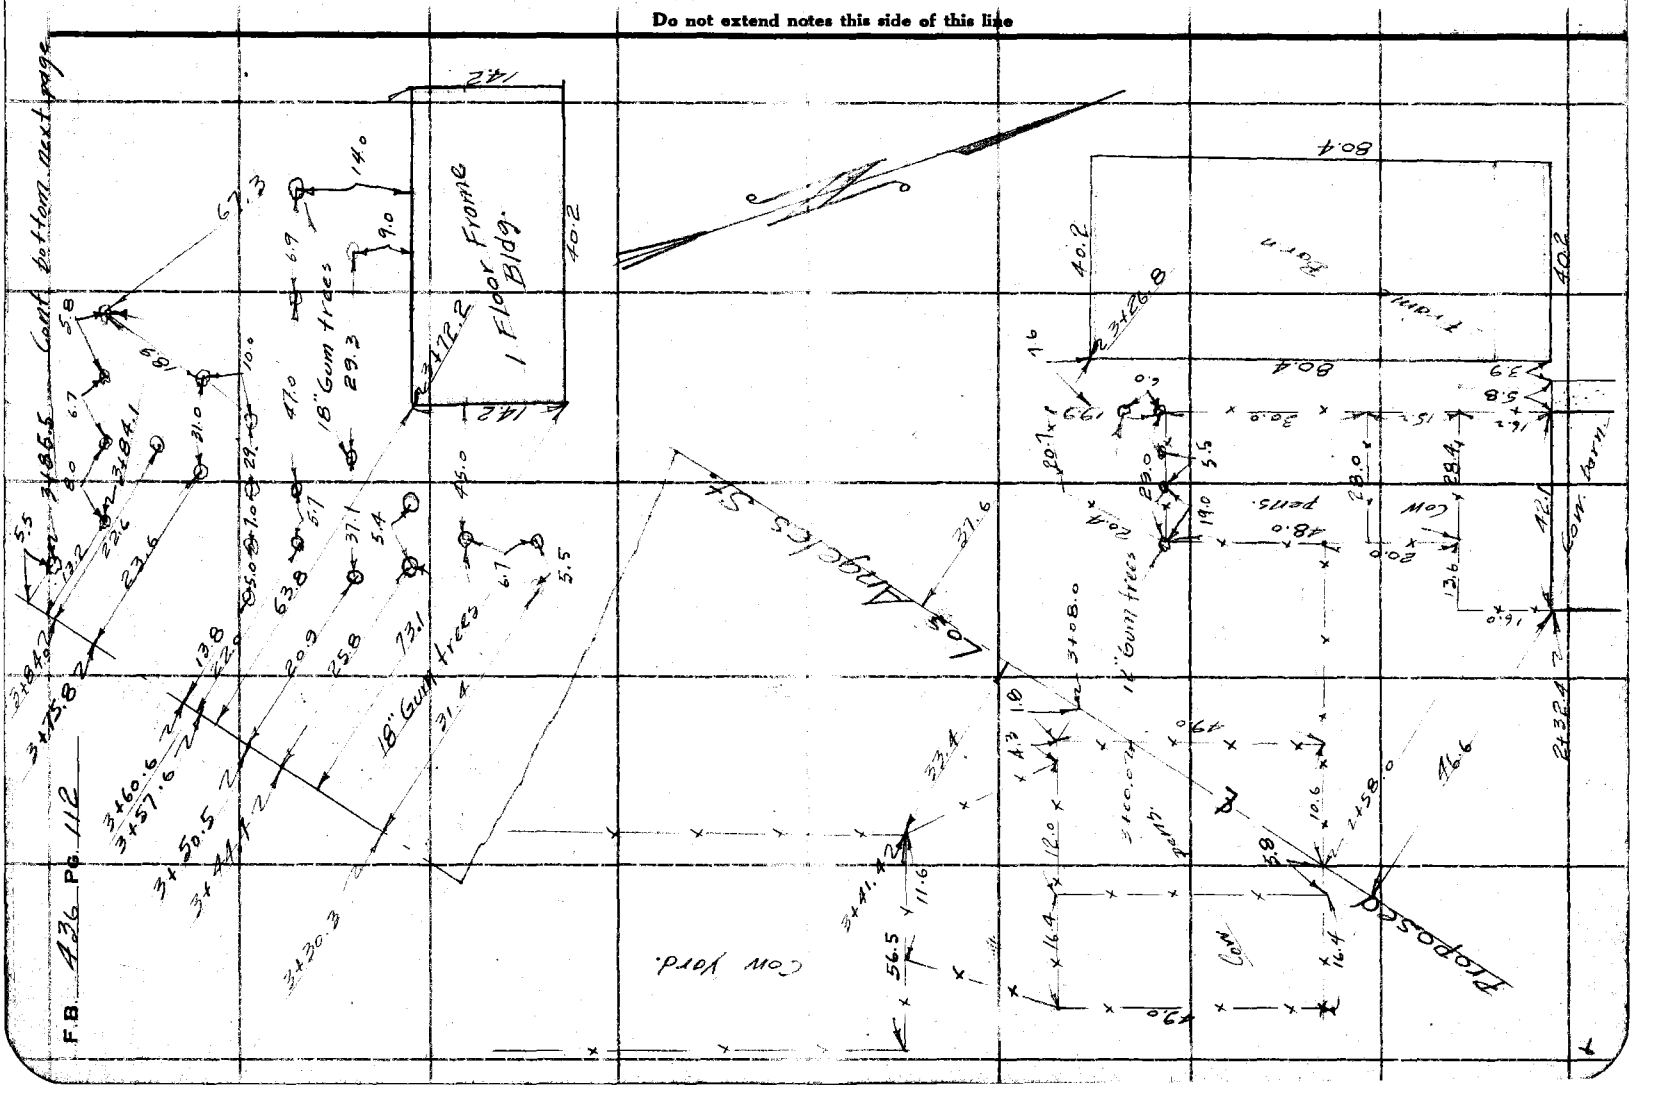

Notes Ck'd by		Survey of Los Angeles St.	F.B. 436 Pg. 113
Map No. Br. 902		W. O. 270 Tape No. 42 St'd. 99.9 °F.	Cont. next bottom page.
Office Work Kyle		Surveyed by Pescrons	
Checked McJohnson		Notes Date 3-22-33	
Date May 1933		Indexed A. C. Johnson	

RETURN TO
LOS ANGELES COUNTY SURVEYOR
700 HALL OF RECORDS
Do not extend notes this side of this line

Notes: ANY ADDITIONS OR CHANGES ON THIS SHEET MUST BE MADE IN Red Ink, WITH DATE AND NAME OF PERSON MAKING CHANGE.

FORM 847 10M 5-31

18" W nut trees
18" Conc. water valve
18" Gum trees
6°12'30"
1439.5
24"
12" water pipe line on surface
B.C. Sta. 3+87.79
Set 2"x2"-12" Dri. Pg. 106
Sta. 0+00 S. W'ly. for Topog.

RETURN TO
LOS ANGELES COUNTY SURVEYOR
700 HALL OF RECORDS

Note: ANY ADDITIONS OR CHANGES ON THIS SHEET MUST BE MADE OR CIRCLED IN **Red Ink.** WITH DATE AND NAME OF PERSON MAKING CHANGE.

Do not extend notes this side of this line

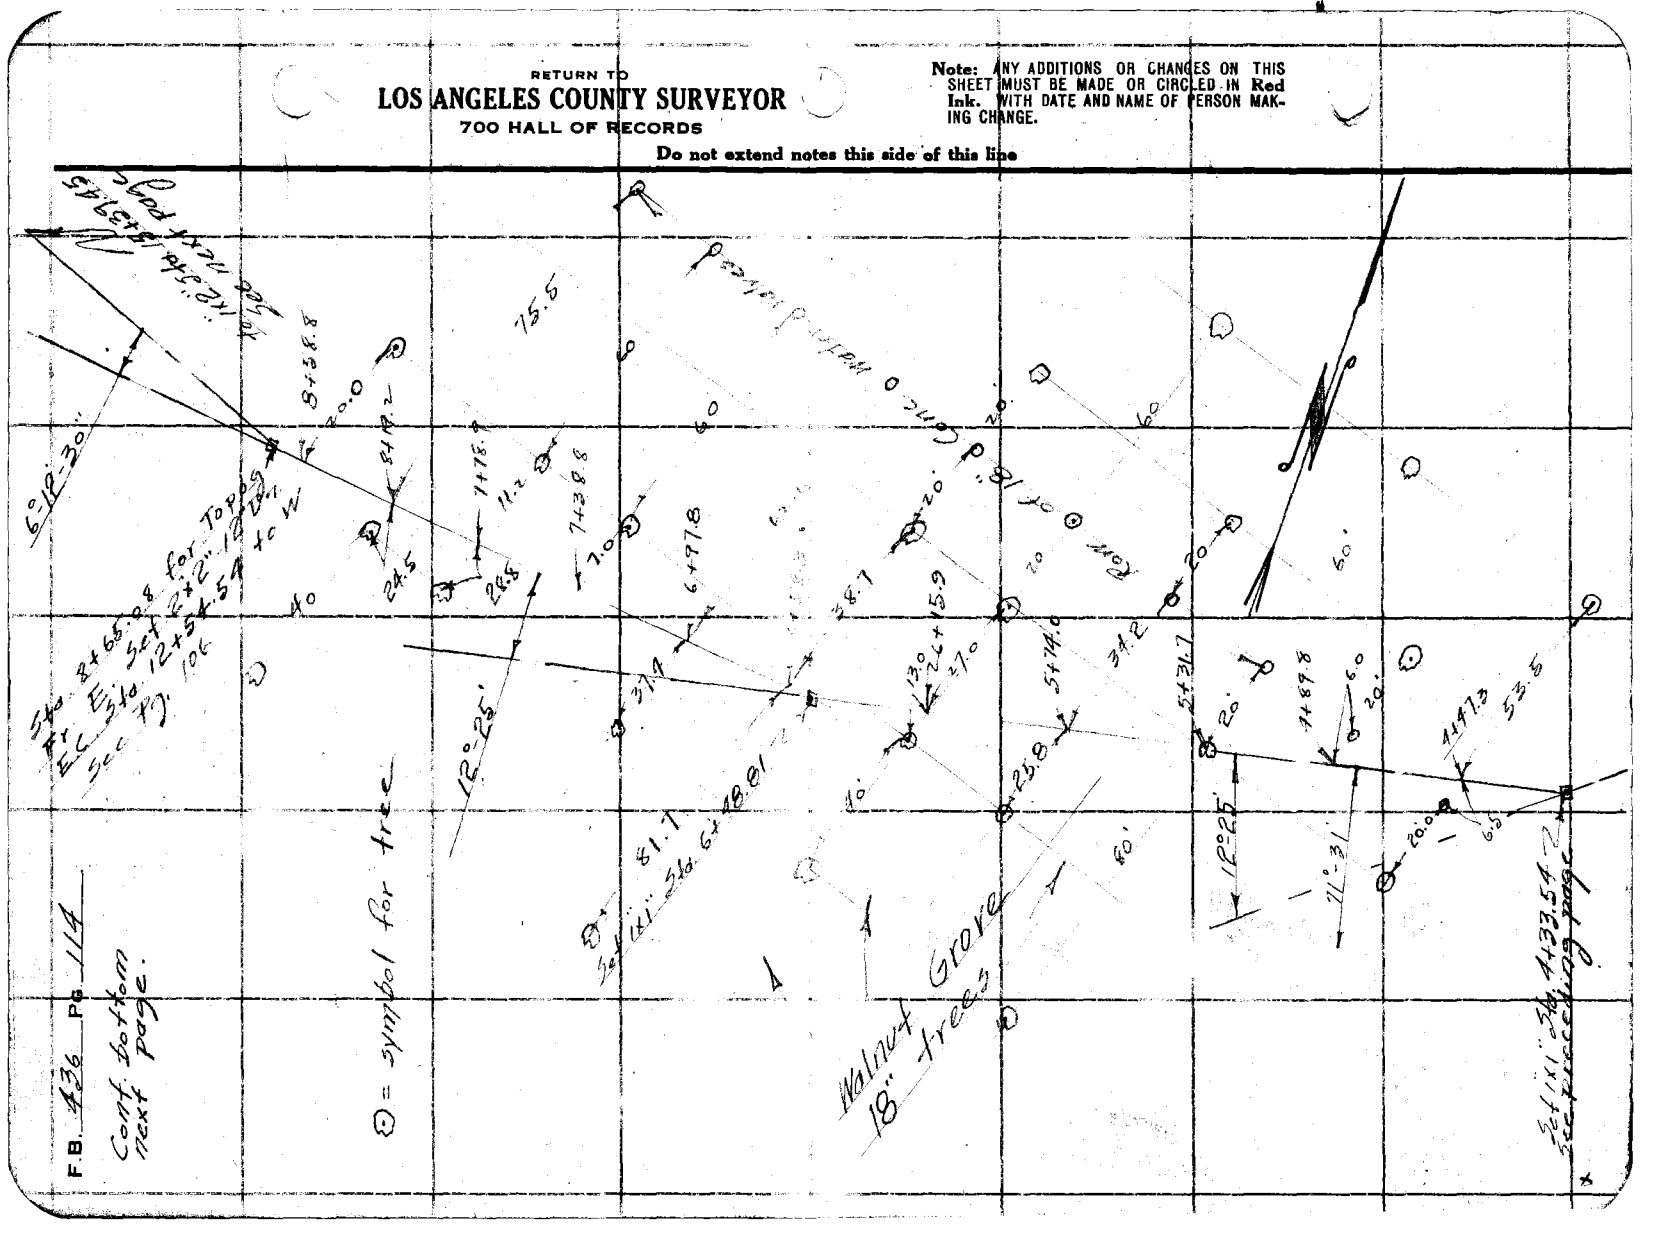

Notes Ck'd by		Survey of Los Angeles St.	F.B. 436 Pg. 115
Map No. B-902		W. O. 270 Tape No. 42 St'd 64 °F.	
Office Work Good		Surveyed by Rosecrans	
Checked M.S. Hansen		Notes Date 3-20-33	
Date May 1933.		Indexed A. C. Johnson	

Cont. bottom next page. 1x2 Sta 15+39.95
Pg. 107

60.3 — 20' — 61.0
15+29.8

St.

40 — 20 — 20' — 60 — 20
14+89.0

Los Angeles

20 — 20' — 60. — 18" Conc. water valve
11+99.5

Grove St.

20' — 60 — 20
14+09.0

Walnut
18" tree

60 — 20 — 60
13+68.5

Row of

Proposed ℄

20' — 60 — 20
13+28.2

60 — 20' — 60.0
12+88.6

E.C. Sta. 12+54.54
1x2x2 Pg 106

Note: ANY ADDITIONS OR CHANGES ON THIS SHEET MUST BE MADE OR CIRCLED IN Red Ink. WITH DATE AND NAME OF PERSON MAKING CHANGE.

Do not extend notes this side of this line

RETURN TO
LOS ANGELES COUNTY SURVEYOR
700 HALL OF RECORDS

FORM 247 10M 8-31

F.B. 436 Pg. 116

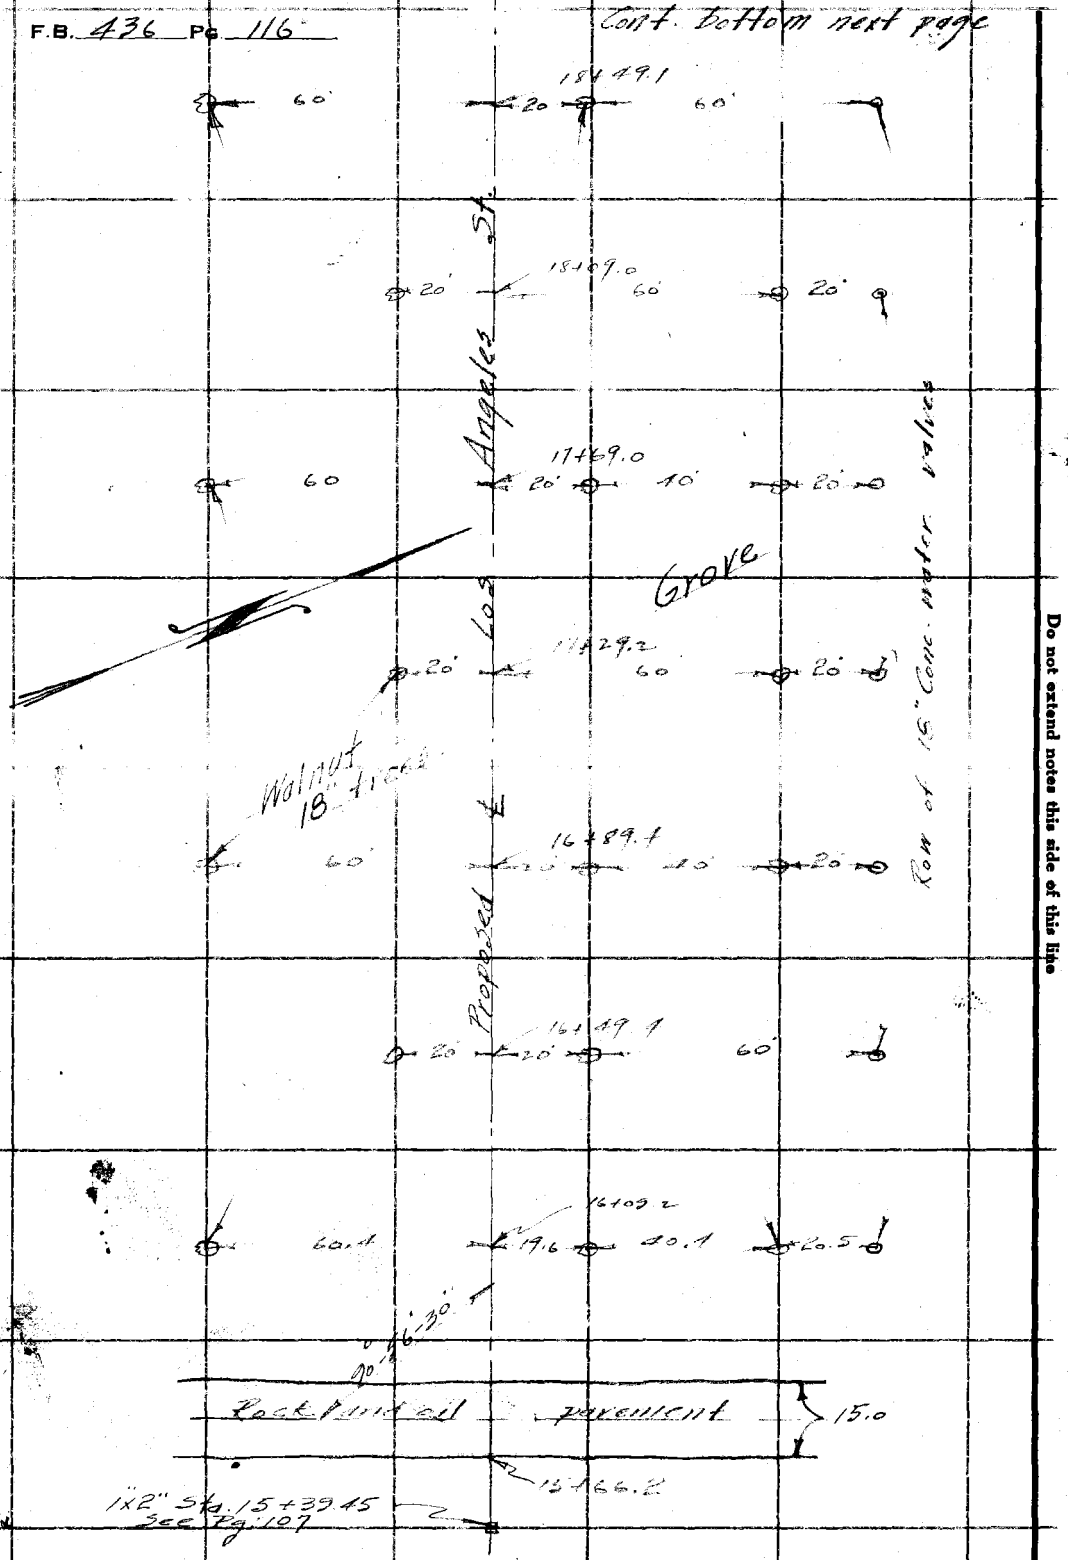

RETURN TO
LOS ANGELES COUNTY SURVEYOR
700 HALL OF RECORDS

Do not extend notes this side of this line

Note: ANY ADDITIONS OR CHANGES ON THIS SHEET MUST BE MADE OR CIRCLED IN Red Ink. WITH DATE AND NAME OF PERSON MAKING CHANGE.

Notes Ck'd by B-902
Map No.
Office Work Krelle
Checked McPherson
Date May, 1933.

Survey of Los Angeles St.
W. O. 970 Tape No. 042 St'd 84 °F.
Surveyed by Rosecrans
Notes
Date 2-20-33
Indexed A. C. Johnson

F.B. 426 PG. 119

Cont bottom next page

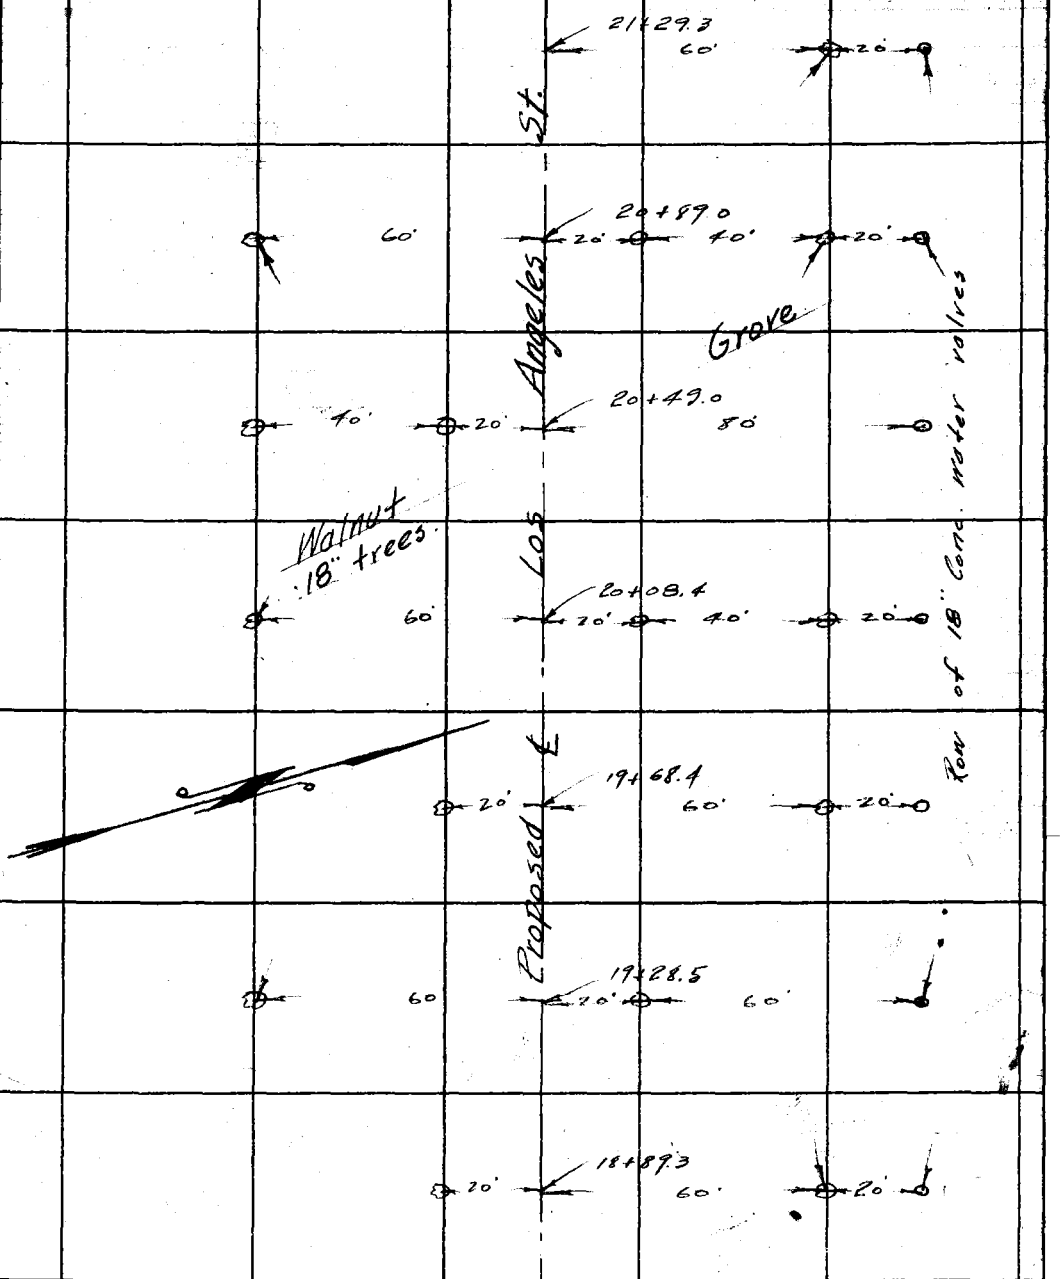

Note: ANY ADDITIONS OR CHANGES ON THIS SHEET MUST BE MADE OR CIRCLED IN Red Ink. WITH DATE AND NAME OF PERSON MAKING CHANGE.

Do not extend notes this side of this line

RETURN TO
LOS ANGELES COUNTY SURVEYOR
700 HALL OF RECORDS

FORM 847 10M 8-31

F.B. 436 Pg. 118

Cont. bottom next page

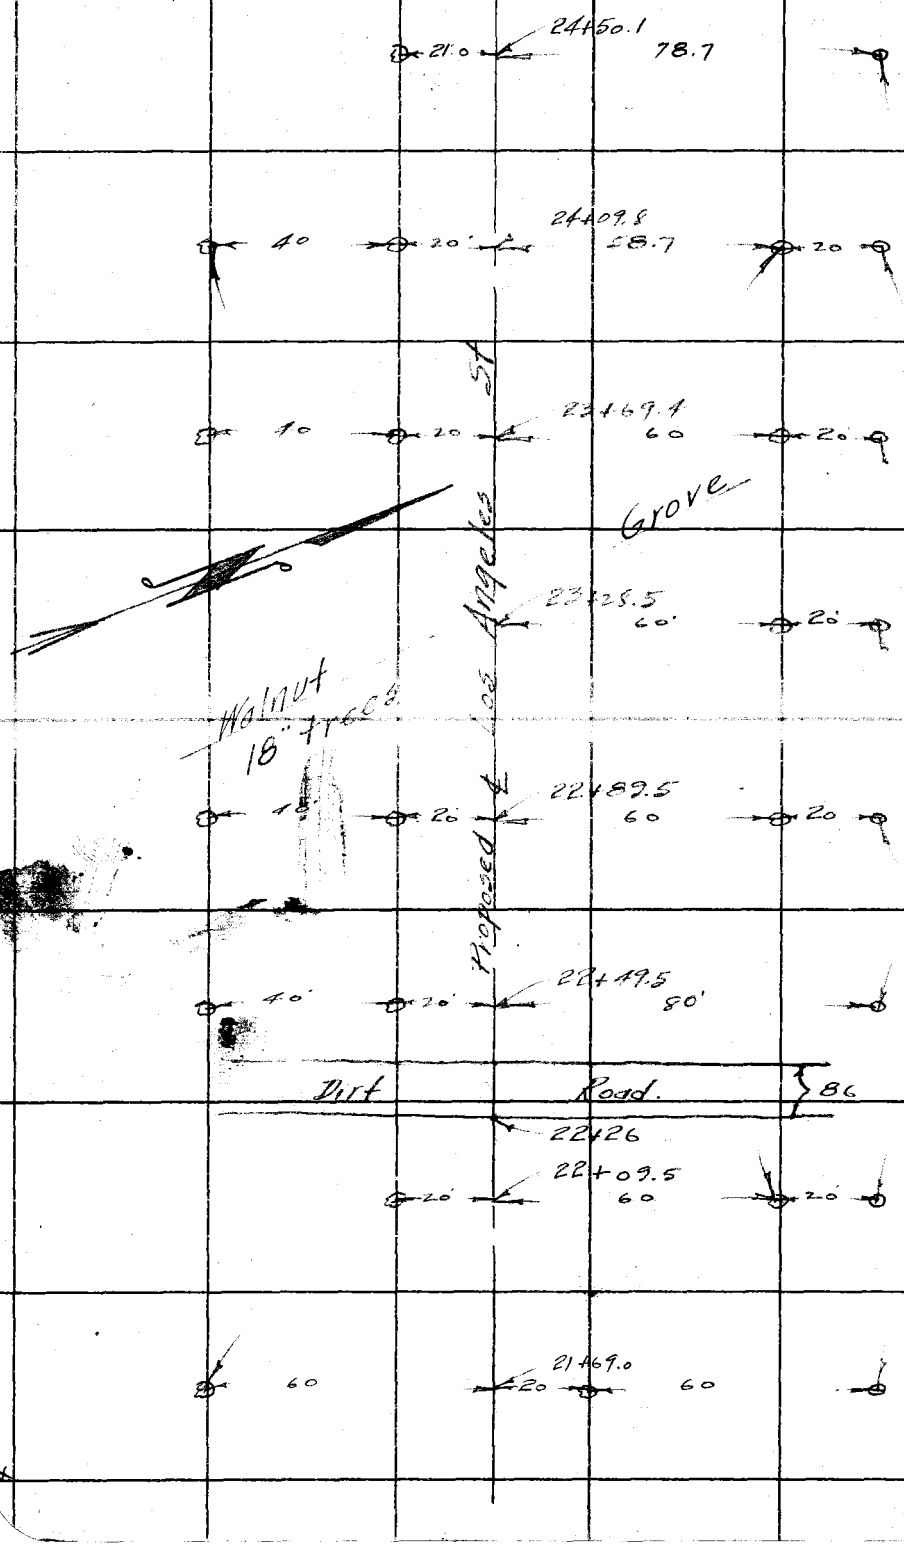

RETURN TO
LOS ANGELES COUNTY SURVEYOR
700 HALL OF RECORDS

Do not extend notes this side of this line

Note: ANY ADDITIONS OR CHANGES ON THIS SHEET MUST BE MADE OR CIRCLED IN Red Ink. WITH DATE AND NAME OF PERSON MAKING CHANGE.

Notes Ck'd by B-902	Survey of Los Angeles St.	F.B. 436	Pg. 119
Map No.	W. O. 270	Tape No. 042	St'd 84 °F.
Office Work Krafft	Surveyed by Rosecrans		
Checked McPherson	Notes	Date 3-30-33	
Date May 1933.	Indexed	A. C. Johnson	

Cont. bottom next page

28+34.8
57.0

60' 33' 28+06.4 26. 40'

27+85.5
65.5

3½" Conc. stand pipe 5½ high.

Grove

60' 33' 27+46.2 26.0 40'

Walnut 18" trees.

27+15.6
57.0

Los Angeles St.

60 32' 26+87.1 26'

26+51.4
57.0

62.3

60' 32' 26+27.7 26.3 39.8

18" Conc. water valves

25+98.5
57.0

62.3

32' 25+68.8 66.0

Proposed

25+39.2
57.0

32.1 25+09.4 66.3

24+79.7
56.8

62.0

Row of

Note: ANY ADDITIONS OR CHANGES ON THIS SHEET MUST BE MADE OR CIRCLED IN Red Ink., WITH DATE AND NAME OF PERSON MAKING CHANGE.

RETURN TO
LOS ANGELES COUNTY SURVEYOR
700 HALL OF RECORDS
Do not extend notes this side of this line

FORM 847 10M 5-31

F.B. 136 PG 120

Cont. bottom next page

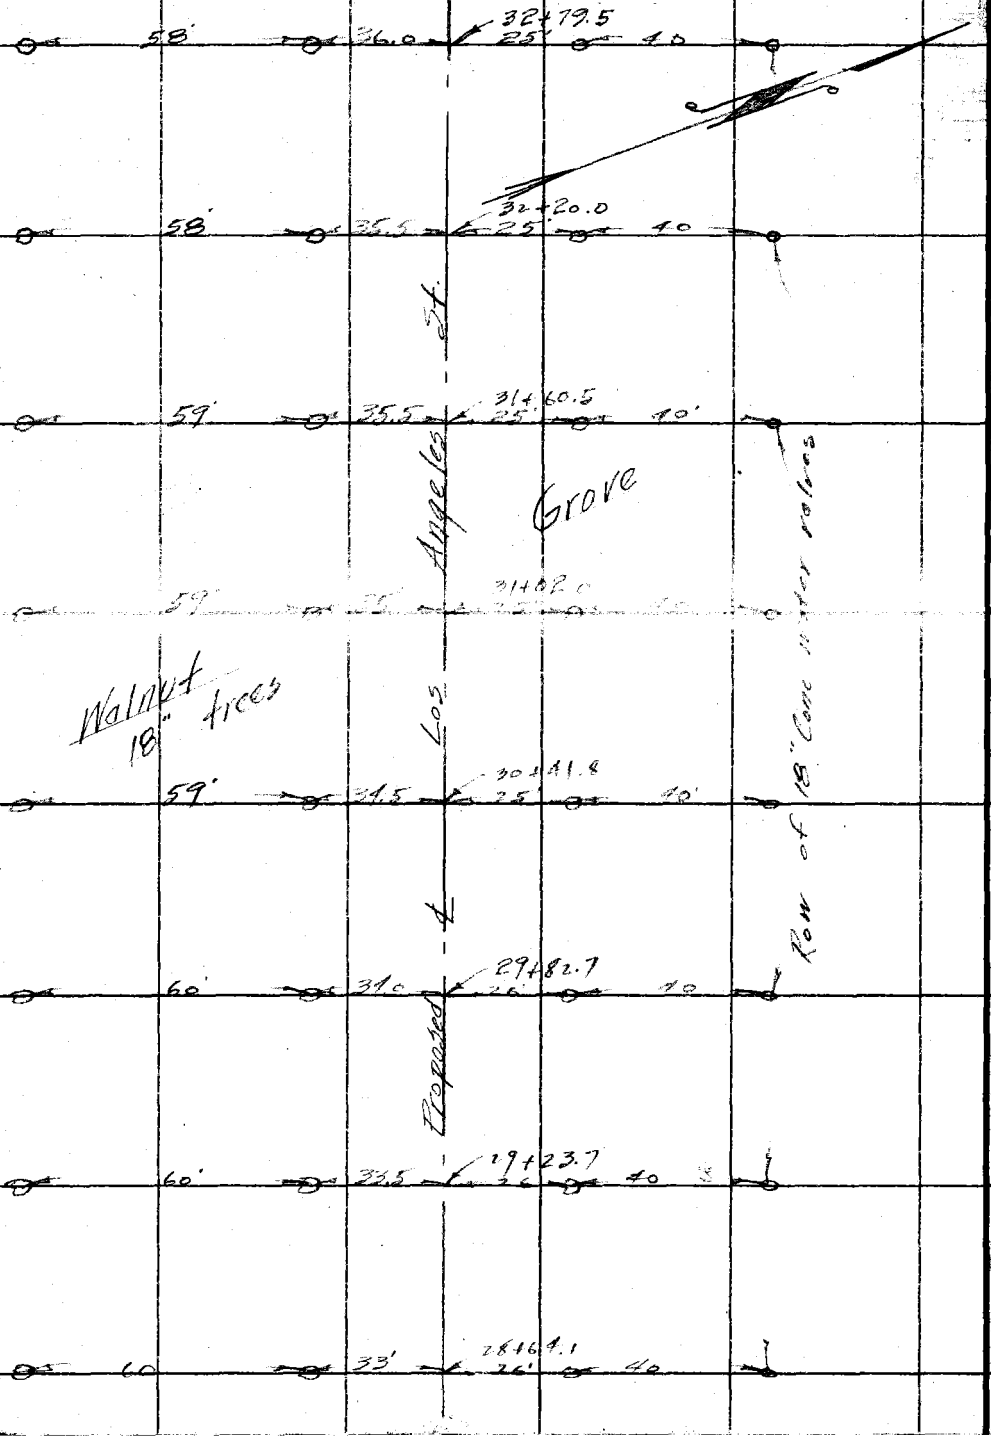

RETURN TO
LOS ANGELES COUNTY SURVEYOR
700 HALL OF RECORDS

Do not extend notes this side of this Line

Note: ANY ADDITIONS OR CHANGES ON THIS SHEET MUST BE MADE OR CIRCLED IN Red Ink. WITH DATE AND NAME OF PERSON MAKING CHANGE.

Notes Ck'd by		Survey of Los Angeles St.	F.B. 436 PG. 121
Map No. B-902		W. O. 970 Tape No. 242 St'd 24 °F.	
Office Work Riggle		Surveyed by Rosecrans	
Checked McKenna		Notes Date 3-30-33	
Date May 1933		Indexed A. C. Johnson	

Notes: ANY ADDITIONS OR CHANGES ON THIS SHEET MUST BE MADE OR CIRCLED IN Red Ink. WITH DATE AND NAME OF PERSON MAKING CHANGE.

RETURN TO
LOS ANGELES COUNTY SURVEYOR
7DO HALL OF RECORDS

Do not extend notes this side of this line

FORM 247 10M 8-31

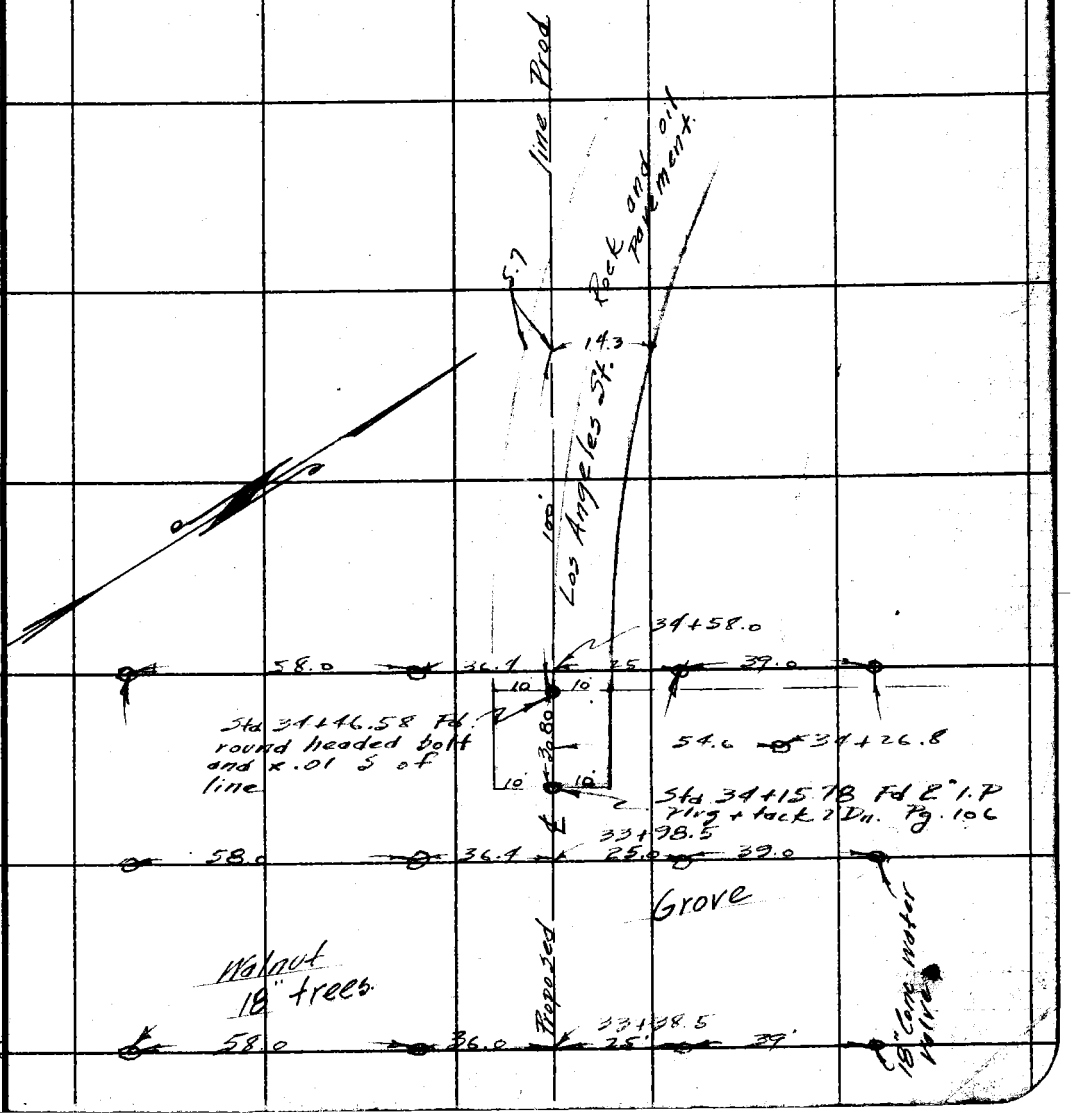

RETURN TO

LOS ANGELES COUNTY SURVEYOR

700 HALL OF RECORDS

Note: ANY ADDITIONS OR CHANGES ON THIS SHEET MUST BE MADE OR CIRCLED IN **Red Ink.** WITH DATE AND NAME OF PERSON MAKING CHANGE.

Do not extend notes this side of this line

F.B. 436 PG 122

Notes Ck'd by	Survey of Los Angeles St.
Map No.	W. O. 970 Tape No. 042 St'd 84 °F.
Office Work	Surveyed by Rosecrans
Checked	Notes Date 4-24-33
Date	Indexed A. C. Johnson 4-28-33

F.B. 436 Pg. 128

Note: ANY ADDITIONS OR CHANGES ON THIS SHEET MUST BE MADE OR CIRCLED IN Red Ink, WITH DATE AND NAME OF PERSON MAKING CHANGE.

RETURN TO
LOS ANGELES COUNTY SURVEYOR
700 HALL OF RECORDS
Do not extend notes this side of this line

FORM 247 10M 8-31

(LOS ANGELES STREET)

SURVEY

EAST HONDO PARKWAY

From Peck Rd. to Tyler Rd. north of Lower Azusa Road.

Mar. and Apr. 1933
W.O. 970

Transit # 16858.
Tape # 042

Party E.A. Rosecrans
P.W. Atkins
F.H. Blanchard
H.H. Reynolds

RETURN TO
LOS ANGELES COUNTY SURVEYOR
700 HALL OF RECORDS

Note: ANY ADDITIONS OR CHANGES ON THIS SHEET MUST BE MADE OR CIRCLED IN **Red Ink.** WITH DATE AND NAME OF PERSON MAKING CHANGE.

Do not extend notes this side of this line

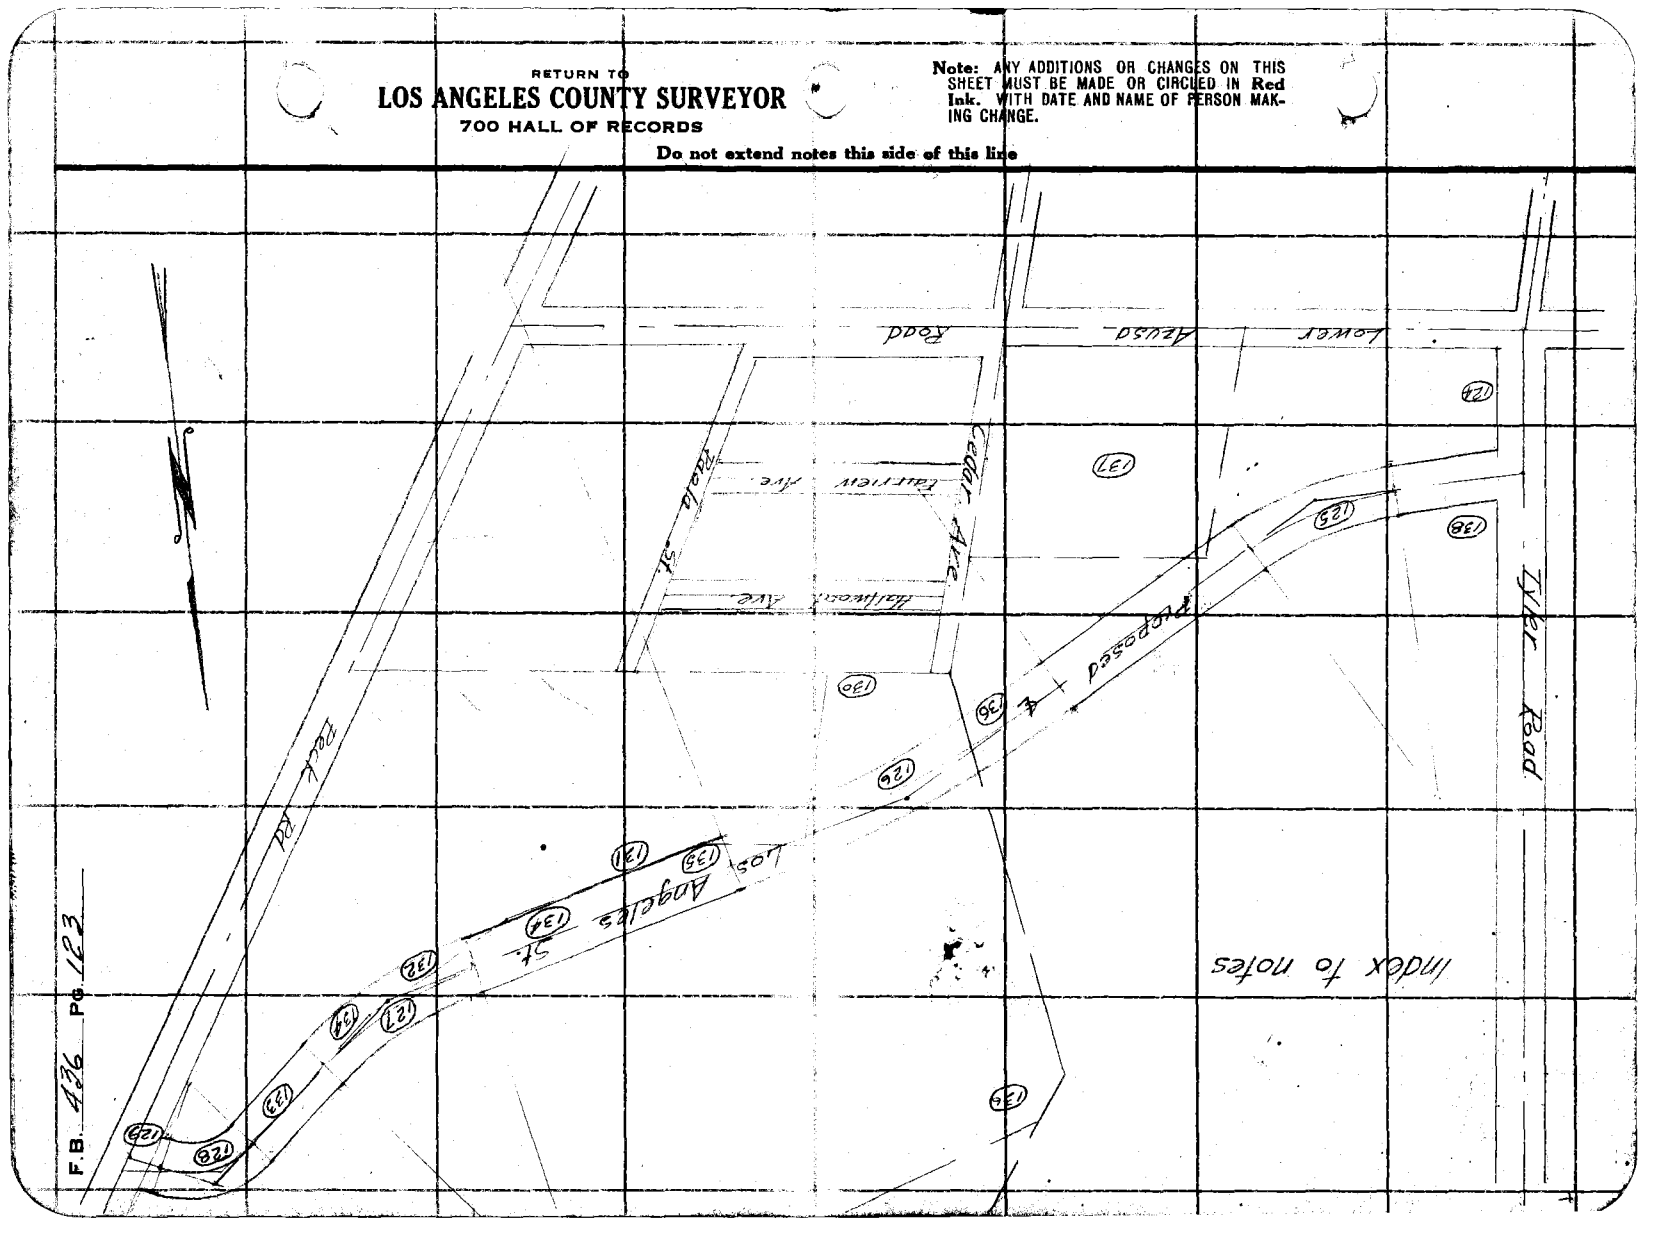

F.B. 436 Pg 129

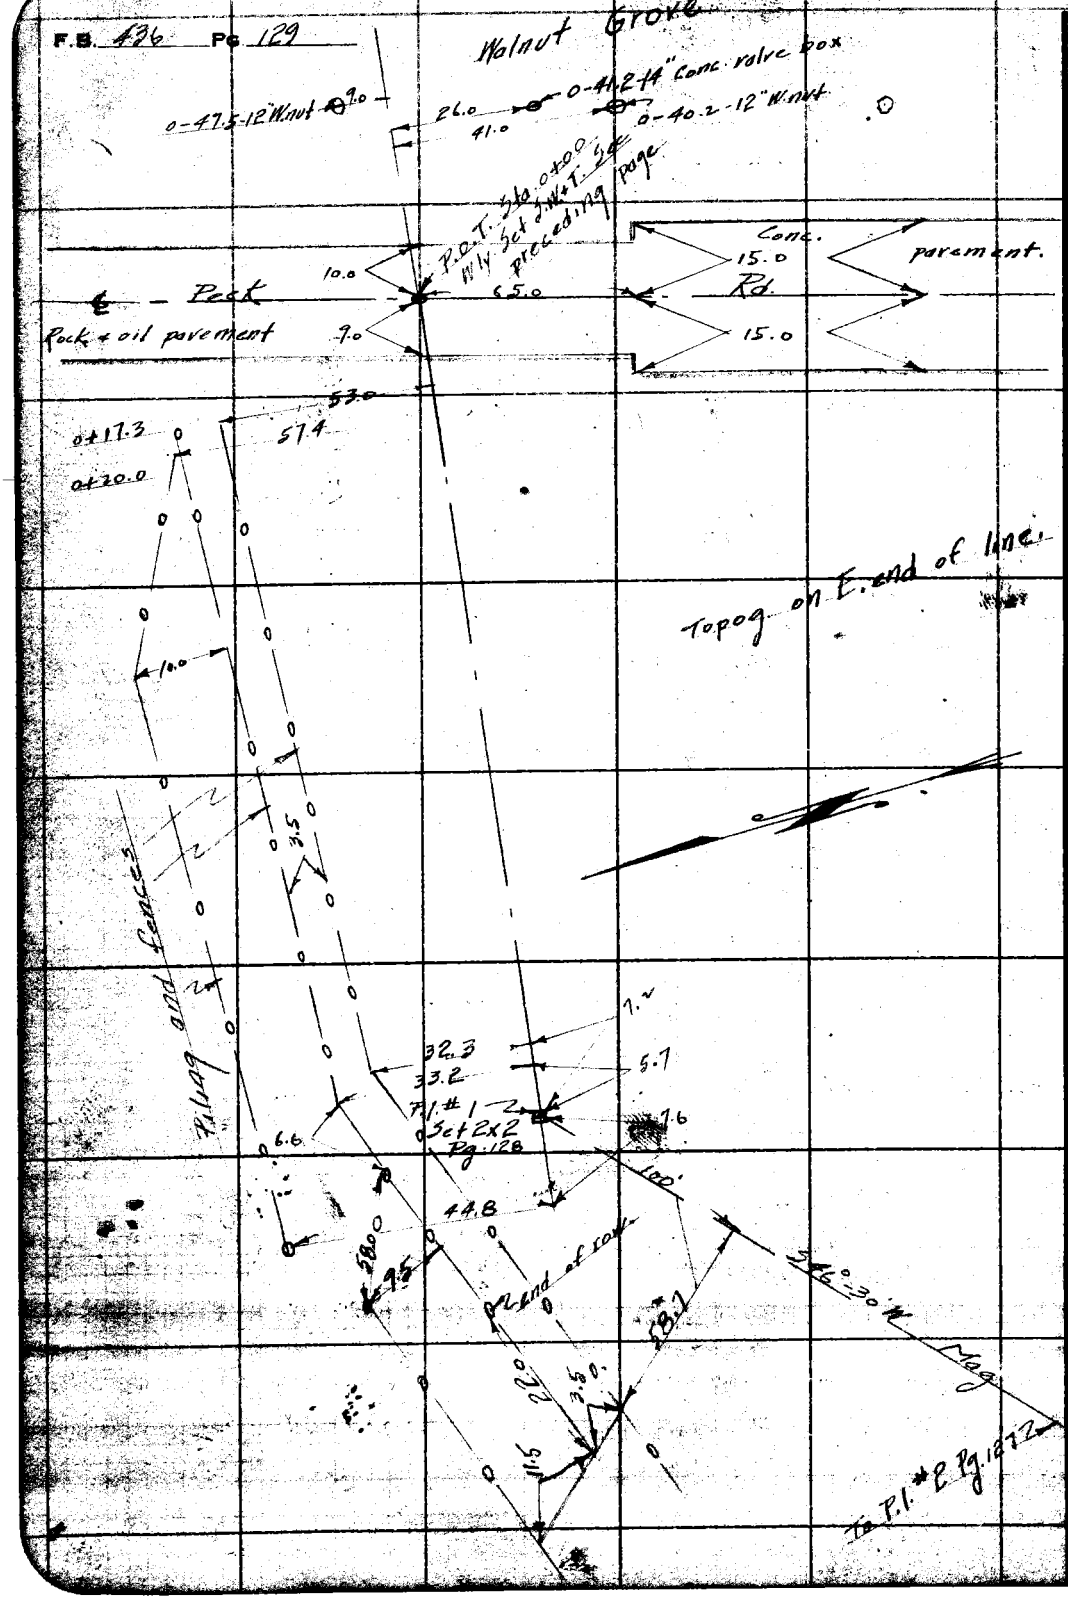

RETURN TO
LOS ANGELES COUNTY SURVEYOR
700 HALL OF RECORDS

Do not extend notes this side of this line

Note: ANY ADDITIONS OR CHANGES ON THIS SHEET MUST BE MADE OR CIRCLED IN Red Ink WITH DATE AND NAME OF PERSON MAKING CHANGE.

RETURN TO

LOS ANGELES COUNTY SURVEYOR

700 HALL OF RECORDS

Do not extend notes this side of this line

Note: ANY ADDITIONS OR CHANGES ON THIS SHEET MUST BE MADE OR CIRCLED IN Red Ink. WITH DATE AND NAME OF PERSON MAKING CHANGE.

FORM 647 - JOM 5-91

Notes Ck'd by M.E.Ph.com	Survey of Los Angeles St
Map No. 3-912	W. O. 710 Tape No. 042 Sh'd 84 of
Office Work Alvarin & M.E.Ph.	Surveyed by Rosecrans
Checked M.E.Ph.	Notes
Date May 1933	Indexed A. C. Johnson

F.B. 436 Pg. 128

SW S.46 R-3

RETURN TO
LOS ANGELES COUNTY SURVEYOR
700 HALL OF RECORDS

Do not extend notes this side of this line

Note: ANY ADDITIONS OR CHANGES ON THIS SHEET MUST BE MADE OR CIRCLED IN Red INK, WITH DATE AND NAME OF PERSON MAKING CHANGE.

W.S. 46-B-3

Los Angeles St.

Proposed

S.A.E. Bdy.

186.37

186.37

186.37

RETURN TO
LOS ANGELES COUNTY SURVEYOR
700 HALL OF RECORDS

Do not extend notes this side of this line

Note: ANY ADDITIONS OR CHANGES ON THIS SHEET MUST BE MADE OR CIRCLED IN Red Ink. WITH DATE AND NAME OF PERSON MAKING CHANGE.

FORM 247 10M 5-91

W.S 46 B-3

Noted Ck'd by M.Sheridan	Survey of Los Angeles St.
Map No. B-912	W. O. 910 Tape No. 42 Std 84 of.
Office Work Marina MSph	Surveyed by Rosecrans Date 3-21-33
Checked MSph.	Notes
Date May 1923	Indexed C. Johnson

F.B. 436 Pg. 126

Cont'd Pg. next page.

To 2½" o.d. I.P. Sta. 12+22.11
Proj. 3+Ac. in 10 Cahuenga Wood

Set Exp. 18 Dn. 14.09

B.C. Sta. 22+93.54
Chisled x in E. 90° post.

58.14

Chisled 2+W in 2 elm.

Iron Post Tangent

62.11

3.40

1.14

Los Angeles St.

Proposed

8000

918.14

169°-30'-30"

Δ 10°-39-30"
R. 10000.00
T. 918.14
L. 831.14

169-30-30
219-03-00 ②
388-01-45 ①
169-30-30

o.k.

918.12 T. 88 = 918.14

Set #3 Set ¾ I.P. 2
Proj. 1.6± ft. 18 Dn.

370 17T:92 = 370.81
100 00T:88 = 100.92
1070.89

1070.83

To 2½" o.d. Sta. 45+99.92
See preceding Page.

2 Sta. 42+72.18

(40) (40)

Sta. 41+84.68 L.C.

2 Pro. T. Set ½" Plush.

163.29

809.08 T. 14 = 809.03
109.11 T. 81 = 109.11
918.14

RETURN TO
LOS ANGELES COUNTY SURVEYOR
700 HALL OF RECORDS

Do not extend notes this side of this line

Note: ANY ADDITIONS OR CHANGES ON THIS SHEET MUST BE MADE OR CIRCLED IN Red Ink. WITH DATE AND NAME OF PERSON MAKING CHANGE.

W.S.M. 76 A-3

F.B. 436 Pg 125

Sta 41+24.68

To P.R.B. at E.C. See next page

South bottom next page.

N 51° E. Mag.

Los Angeles St.

475.24

475.24 T. 84

2" I.P. Plug + tack 18" Dn.

941

141.00

141.00 T 84

R.O.T.

See Sta 45+99.92 Sta 42+18 Dn.

46°01'54" B.C.

Proposed

171.86

191

170.25

Proposed Curb Line per Map 1950

Prolong. Common to Lots 3 & 4

Now P.L.

36.44

60.30

Sta 5M+T. in 2" Willow

Sta 5M+T. in 2" Willow

1100

Mon. L.T. #4 set 3/4" 18" Dn.

(40)

(40)

(40)

This Alignment Abandoned May 1950.

410.83

410.857.78 = 410.83

Sta 4M+28.18 Dn.

Sta 4M+28.18 Dn.

Sta 4M+28.18 Dn.

RETURN TO
LOS ANGELES COUNTY SURVEYOR
700 HALL OF RECORDS

Do not extend notes this side of this line

Note: ANY ADDITIONS OR CHANGES OF THIS SHEET MUST BE MADE OR CIRCLED IN Red Ink. WITH DATE AND NAME OF PERSON MAKING CHANGE.

FORM 247 10M 9-51

W.S. 46-D 43

Notes Ck'd by	Mitchell
Map No.	B-912
Office Work	Mann + Mann
Checked	Mann
Date	May, 1923

Survey of Los Angeles St
W. O. 910 Tape No. 042 Std 84 of
Surveyed by Assessments
Notes
Indexed A. C. Johnson
Date 4-18-23

F.B. 426 Pg. 184

Los Angeles St.

Road

(Second Ave.)

Proposed

Transit Line

Tyler

Taylor

Note: For this area see W.S. 46-D 43

Ref. to Ft. & Lower Arcade Rd. and to L.B. 338-18

Chain link fence

Stairway

Pl. flush.

#5 set N.T.M.P.

#4 set N.T.M.P.

#3 set N.T.M.P.

#2 set N.T.M.P.

#1 set N.T.M.P.

#7 set N.T.M.P.

#6 set N.T.M.P.

#8 set N.T.M.P.

#9 set N.T.M.P.

Notes Ck'd by	M.S. Thomson	Survey of	Los Angeles St.
Map No.	2-912	W. O.	970 Topo No. 242 St'd 84 °F.
Office Work	Marine M.S.H.	Surveyed by	Rosecrans
Checked	M.S.H.	Notes	Date 4-18-33
Date	May 1933.	Indexed	A. C. Johnson 4-18-33

F.B. 436 Pg. 130

Cont. bottom next page.

To base line Next page

Δ Pk. #3 Tack in Pk. 1.5' plug + tack 12" Dia. at Pole Car 3.2' E. Ellison survey

228.32

131.8

105-22-15
61-29-15 (A)
272-14-15 (B) ✓
105-22-22½

105-22-15
61-28-30 (A)
272-12-45 (B) ✓
105-22-07½

105-22-20 94

686.81

686.90 T. 64 = 686.81 ✓

Wire iron post fence

105-22-10
15 Adj.

Δ Pk. #1. Pk. 2' plug + tack Fd. 2' I.P. plug + tack 6" Dia. Ty. 1 ft. B 538 M.B. 170-49

668.20

127.92

97-27-30
30 Adj.

Δ Pk. #2 Pk. 1.5' plug + tack Fd. 1" I.P. 12" Dia. Tr. Dn. Sec Ellison survey

Fd. 1" I.P. 12" Dia. B 538 - M.B. 170-49 and M.B. 28-18

97-27-30
29-50-30 (A)
224-18-45 (B) ✓
97-27-37½

668.32 T. 56 = 668.20

127.94 T. 56 = 127.92

To Iron Pin in Conc. Mon. W. Line Tr. B 538 and N line Lower Azusa Rd. M.B. 170-49

Notes ANY ADDITIONS OR CHANGES ON THIS SHEET MUST BE MADE ON CIRCLED # Red Ink, WITH DATE AND NAME OF PERSON MAKING CHANGE.

RETURN TO
LOS ANGELES COUNTY SURVEYOR
720 HALL OF RECORDS
Do not extend notes this side of this line

FORM 847 10M 5-31

F.B. 436 Pg. 131

To 2" I.P. at Pt. See ↗ next page

2776

Pt. #5. 3/4 L.+T. in Conc. base at fence Post. Record Ex. N. See next Pg.

24.15

Set 1x2" Flush.

168-01-45
312-07-15 ④
288-10-45 ⑤
168-01-47½

168°-01'-50" Adj.

638.45 T.50 = 638.38

638.38

Note; L.+T.s should be adjusted for true lot Cor.

144°-47'-25" Adj.

500

144-47-30
219-09-45 ⑥
148-44-15 ⑦
144-47-27½

11" Iron post

Set 1x2" Flush.

867

Pt. #4 Pk. nail & tag in top of fence post 2x2

Cor. in Conc. Record F.B.

Fd. 2x2" C.P. Ellison F.B. 714-211

See L.B. 714-211

228.36

228.36 T.60 = 228.32

Pt. #3. Fd. 12" I.P. 12" Dia. of fence Cor. See preceding page

RETURN TO
LOS ANGELES COUNTY SURVEYOR
700 HALL OF RECORDS

Do not extend notes this side of this line

Note: ANY ADDITIONS OR CHANGES ON THIS SHEET MUST BE MADE OR CIRCLED IN Red Ink. WITH DATE AND NAME OF PERSON MAKING CHANGE.

Notes Ck'd by McPherson	Survey of Los Angeles St.
Map No. R-912	W. O. 770 Tape No. 442 St'd 66 OF.
Office Work Marint McPh	Surveyed by Rosecrans
Checked McPh.	Notes
Date May 1933	Indexed A. C. Johnson

F. B. 436 Pg. 97

To Apt. #8 Sec 20 next page

157-51-45 ✓
40 Adj.

#7 Apt. in Prop. line Sd 2" I.P. 18 Dn. on E. side of F.P. Sec Ellison Survey

157-51-45
271-26-45 ④
227-10-30 ⑤ ✓
157-51-45

320.59 T. 68 = 320.56 ✓

320.56 ✓

9.0

#6 Apt. in Prop. line Sd at a fence Post. 2" I.P. 18" Sec Ellison Survey.

166-57-00
307-48-15 ④
281-42-15 ⑤ ✓
166-57-02

166° 57' 02"

217.66 ✓

217.68 T. 68 = 217.66 ✓

#5 Apt. in Prop. line Sd at L.+T. in Conc base of 4 F.P. using record Dist and 4 Fr. N.

Note: ANY ADDITIONS OR CHANGES OR THIS SHEET MUST BE MADE OR CIRCLED IN Red Ink, WITH DATE AND NAME OF PERSON MAKING CHANGE.

Do not extend notes this side of this line

RETURN TO
LOS ANGELES COUNTY SURVEYOR
700 HALL OF RECORDS

FORM 847

F.B. 436 Pg. 133

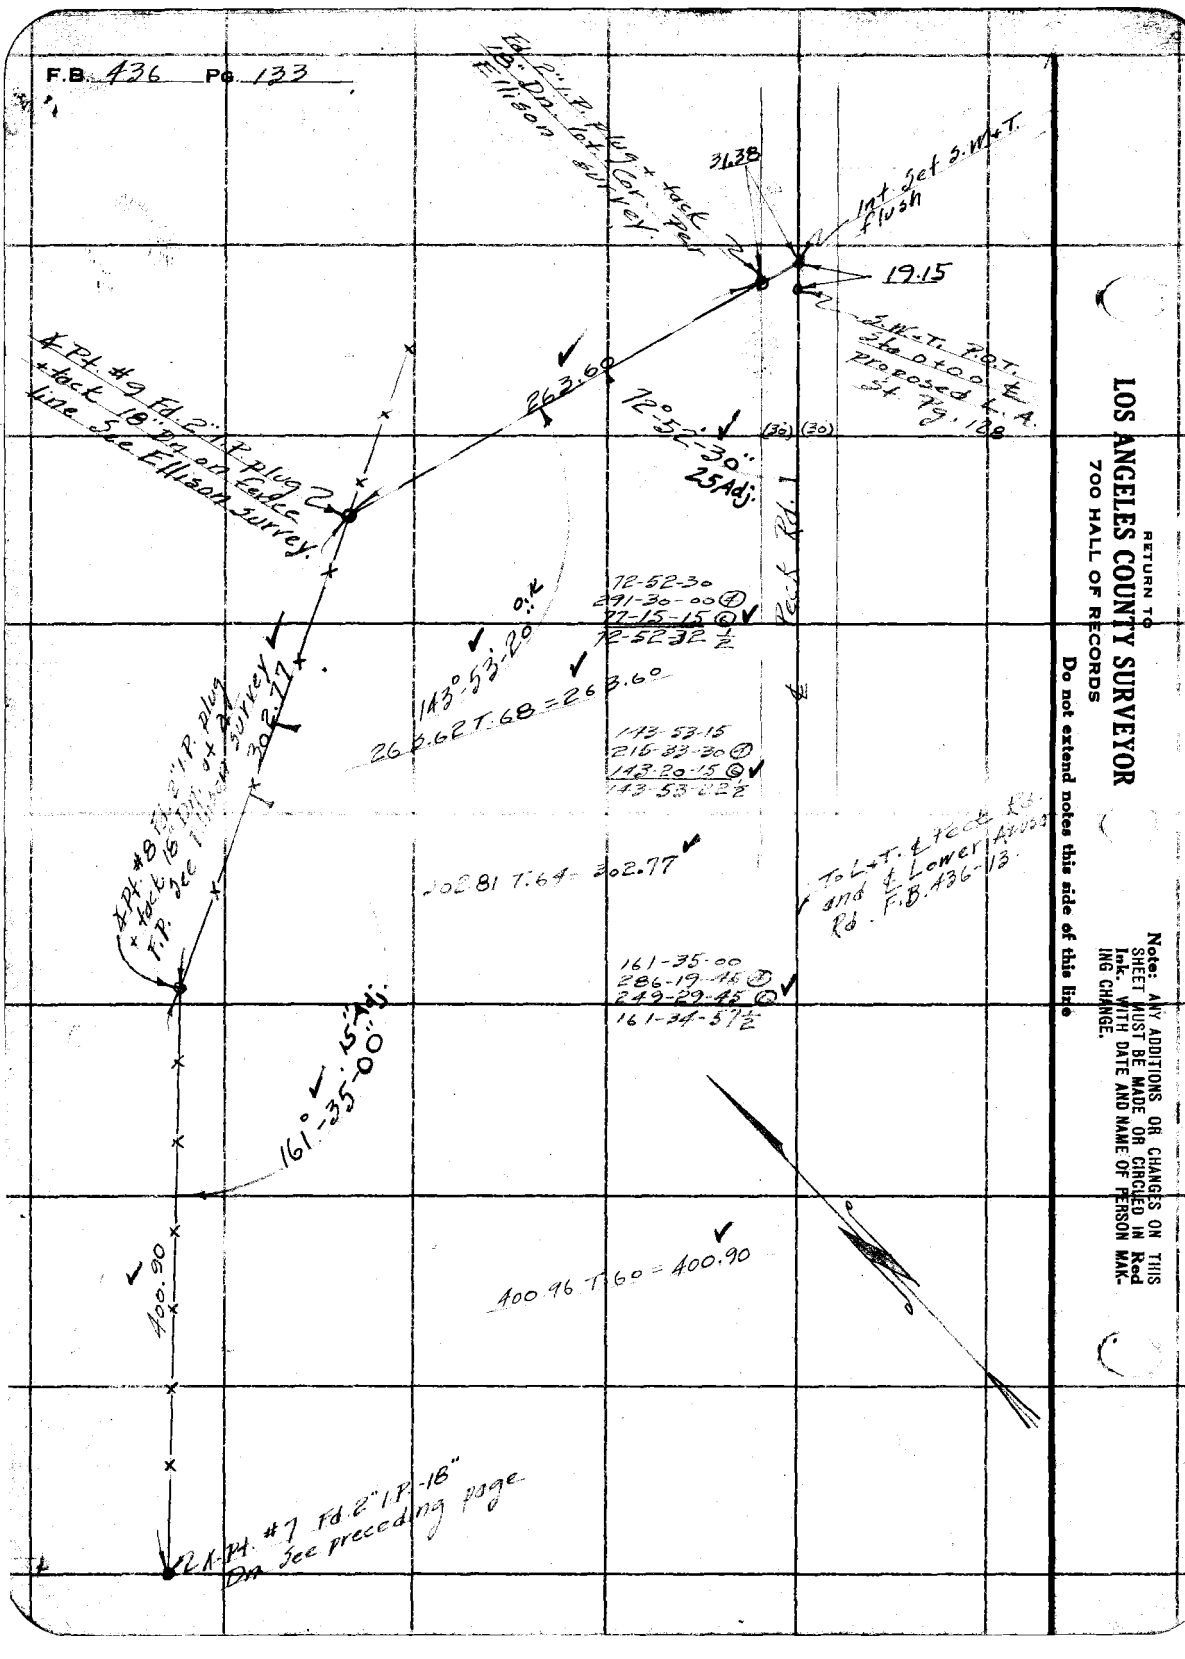

RETURN TO
LOS ANGELES COUNTY SURVEYOR
700 HALL OF RECORDS

Note: ANY ADDITIONS OR CHANGES ON THIS SHEET MUST BE MADE OR CIRCLED IN **Red** Ink. WITH DATE AND NAME OF PERSON MAKING CHANGE.

Do not extend notes this side of this line

Notes Ck'd by McPherson	Survey of Los Angeles St
Map No. B-912	W. O. 276 Tape No. 242 St'd 84 °F.
Office Work Morin-McPh	Surveyed by Rasecrans
Checked McPh	Notes Date Feb-33
Date May 1933.	Indexed A. C. Johnson

F.B. 436 PG. 128

Notes: ANY ADDITIONS OR CHANGES OF THIS SHEET MUST BE MADE IN Red Ink WITH DATE AND NAME OF PERSON MAKING CHANGE.

Do not extend notes this side of this line

RETURN TO
LOS ANGELES COUNTY SURVEYOR
720 HALL OF RECORDS

FORM 847 10M 8-31

Lot lines intersections.

B.C. Sta. 8+54.88 Set 2x2-12" Dn. Pg. 127

28.91 T.68

Int. Set 2x2-12" Dn.

251.85 T.60 = 251.81

A.P.I. #8 Fd 2" I.P. Pg. 133

103.95 T.68 = 103.94

28.21

251.81

270.15

103.94

Int. Set 2x2-12" Dn.

81.12

O.K. 5°-21'-10" Pg. 135

To A.P.I. #7 Fd 2" I.P. See Pg. 132

E.C. Sta. 5+54.54 Set 2x2

See Pg. 128

N 3°03'35" E

198.83

192.83

13°-03'-35"

A.P.I. #9 Fd 2" I.P. Pg. 133

P.I. #1 Set 2x2 Pg. 128

Proposed Lot Line

199.91

8°15'55"

Set 2x2-12" down

13-03-30
52-14-15 (R)
78-21-30 (L)
13-03-35

8-16-00
33-03-15 (R)
49-35-15 (L)
8-15-55

100.32 T.68 = 100.32

14.05 T.68 = 14.04

14.04

100.32

8°-15'-55" Pg. 128

B.C. Sta. 4+53.32 Fd 2x2-12" Dn.

Fd 3" I.P. 10" Dn. See Pg. 132

F.B. 436 PG 135

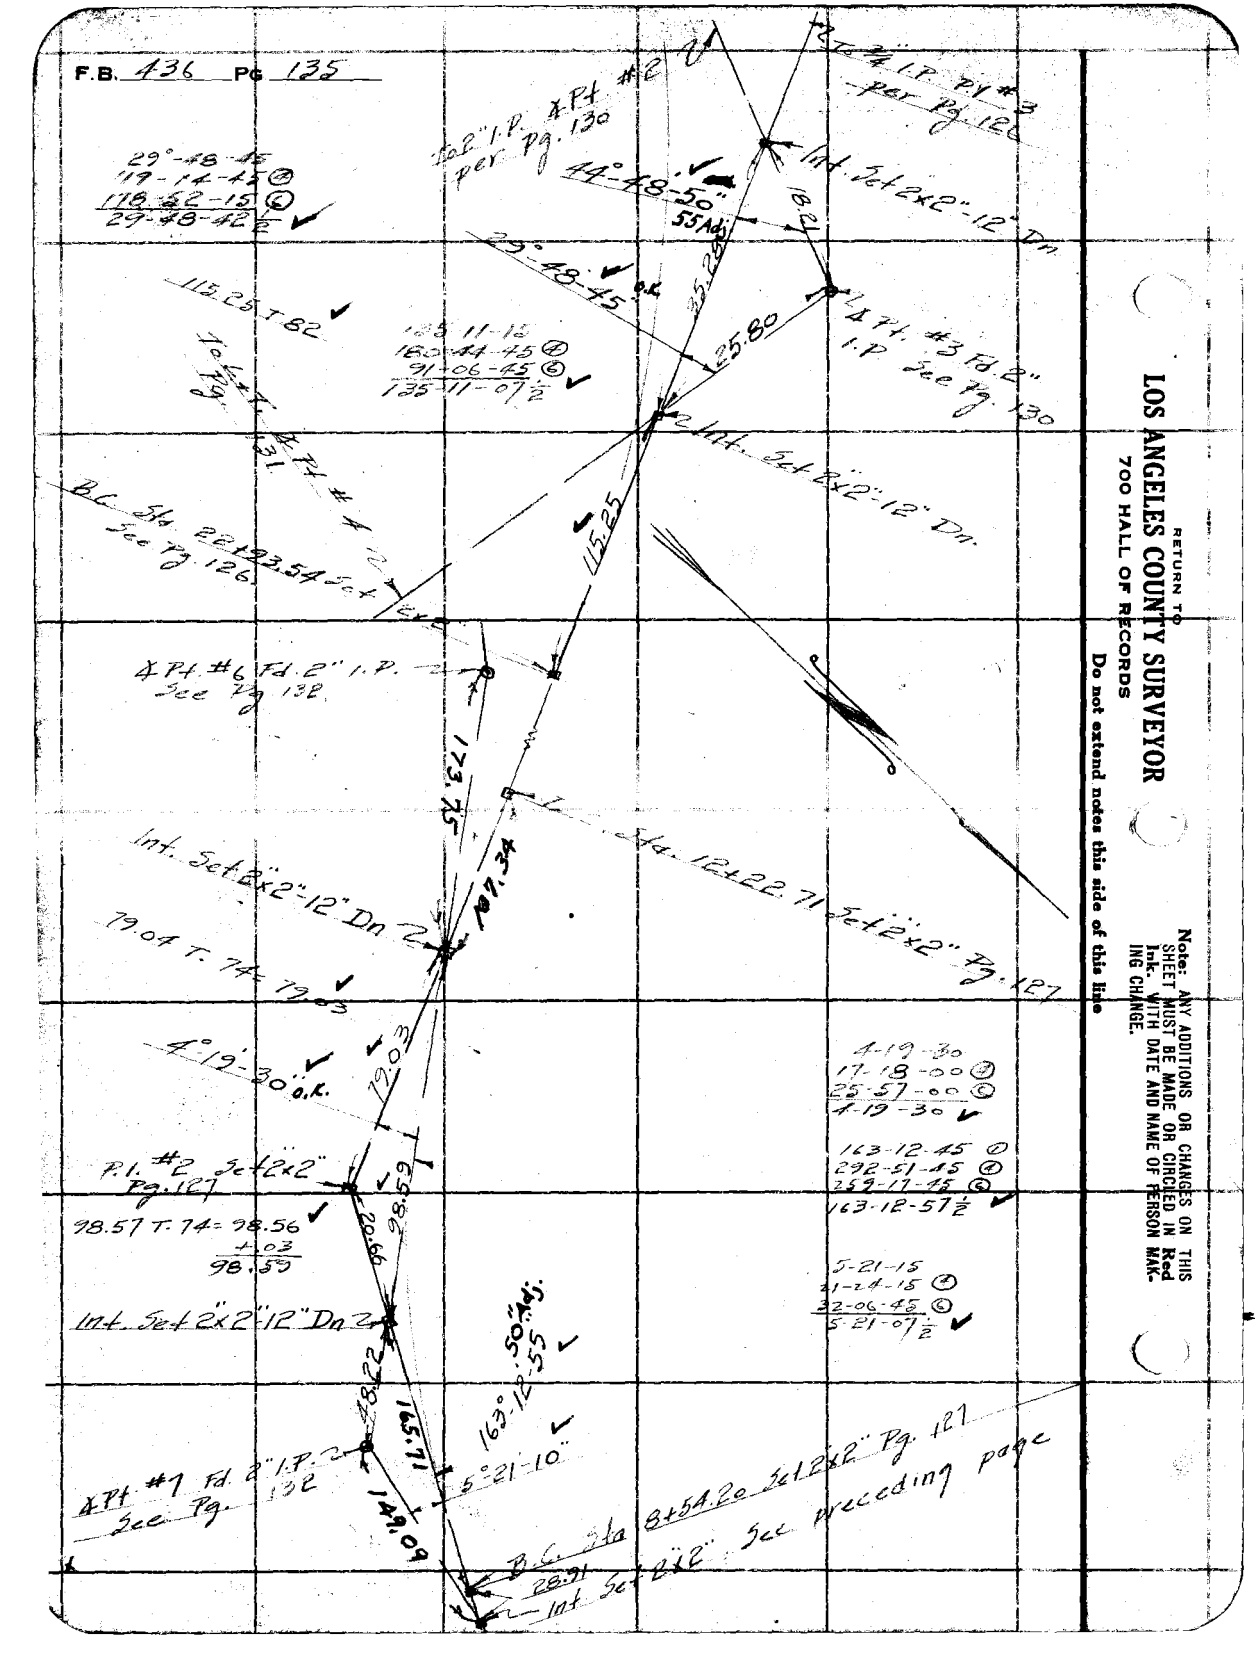
Int. Set 2x2"-12" Dn.
Int. Set 2x2"-12" Dn.
Int. Set 2x2"-12" Dn.

Notes Ck'd by	McPherson	Survey of	Los Angeles St.
Map No.	B-912.	W. O.	770 Tape No. 242 St'd 66 OF.
Office Work	Maring McP.	Surveyed by	Rosecrans
Checked	McP.	Notes	Date 4-25-33
Date	May 1933	Indexed	A. C. Johnson

F.B. 436 PG. 126

W.S. 46-03

Note: ANY ADDITIONS OR CHANGES OR THIS SHEET MUST BE MADE ON CIRCLED PRINT Init. WITH DATE AND NAME OF PERSON MAKING CHANGE.

Do not extend notes this side of this line

RETURN TO
LOS ANGELES COUNTY SURVEYOR
700 HALL OF RECORDS

695.22

Ed. N&T. in top of piling per Ellison survey.

Set S+W. in piling

695.28 T. 70 = 695.22

25.71

Ed. N&T. in top of piling per Ellison survey.

13°-33'-50"

XH and Prop. Cor. Set 3/4" I.P. 4 Dn 2x2" over it 6" Dn. Rec. ∠ and Dist. Fr. N&T. in piling per Ellison Survey. Point falls in River bed. See F.B. 644-86

1406.56

1406.74 T. 64 = 1406.56

114.41 T. 66 = 114.40

119-35-00
118-19-45 (A)
357-29-45 (B)
119-34-57½

119°-34'-55" O.K.

P.I. #3 Set 3/4" I.P. See Pg. 126

114.40

Los Angeles St. Pg. 126

P.O.S.T. Set 2x2-18" Dn.

192.45 T. 66 = 192.43

To 3/4" I.P. P.I. #4 See Pg. 125

Proposed ℄

192.43

161°-49'-05" O.K.

Fd. 2" I.P. plug + tack & Pt #1 per Pg. 130.

161-49-00
287-16-15 (A)
250-54-15 (B)
161-49-02½

To iron pin in Conc. Mon. W. line Tr. 8538 + N. line Lower Azusa Rd. M.B. 170-49

FORM 847 10M 8-31

F.B. 436 Pg. 137

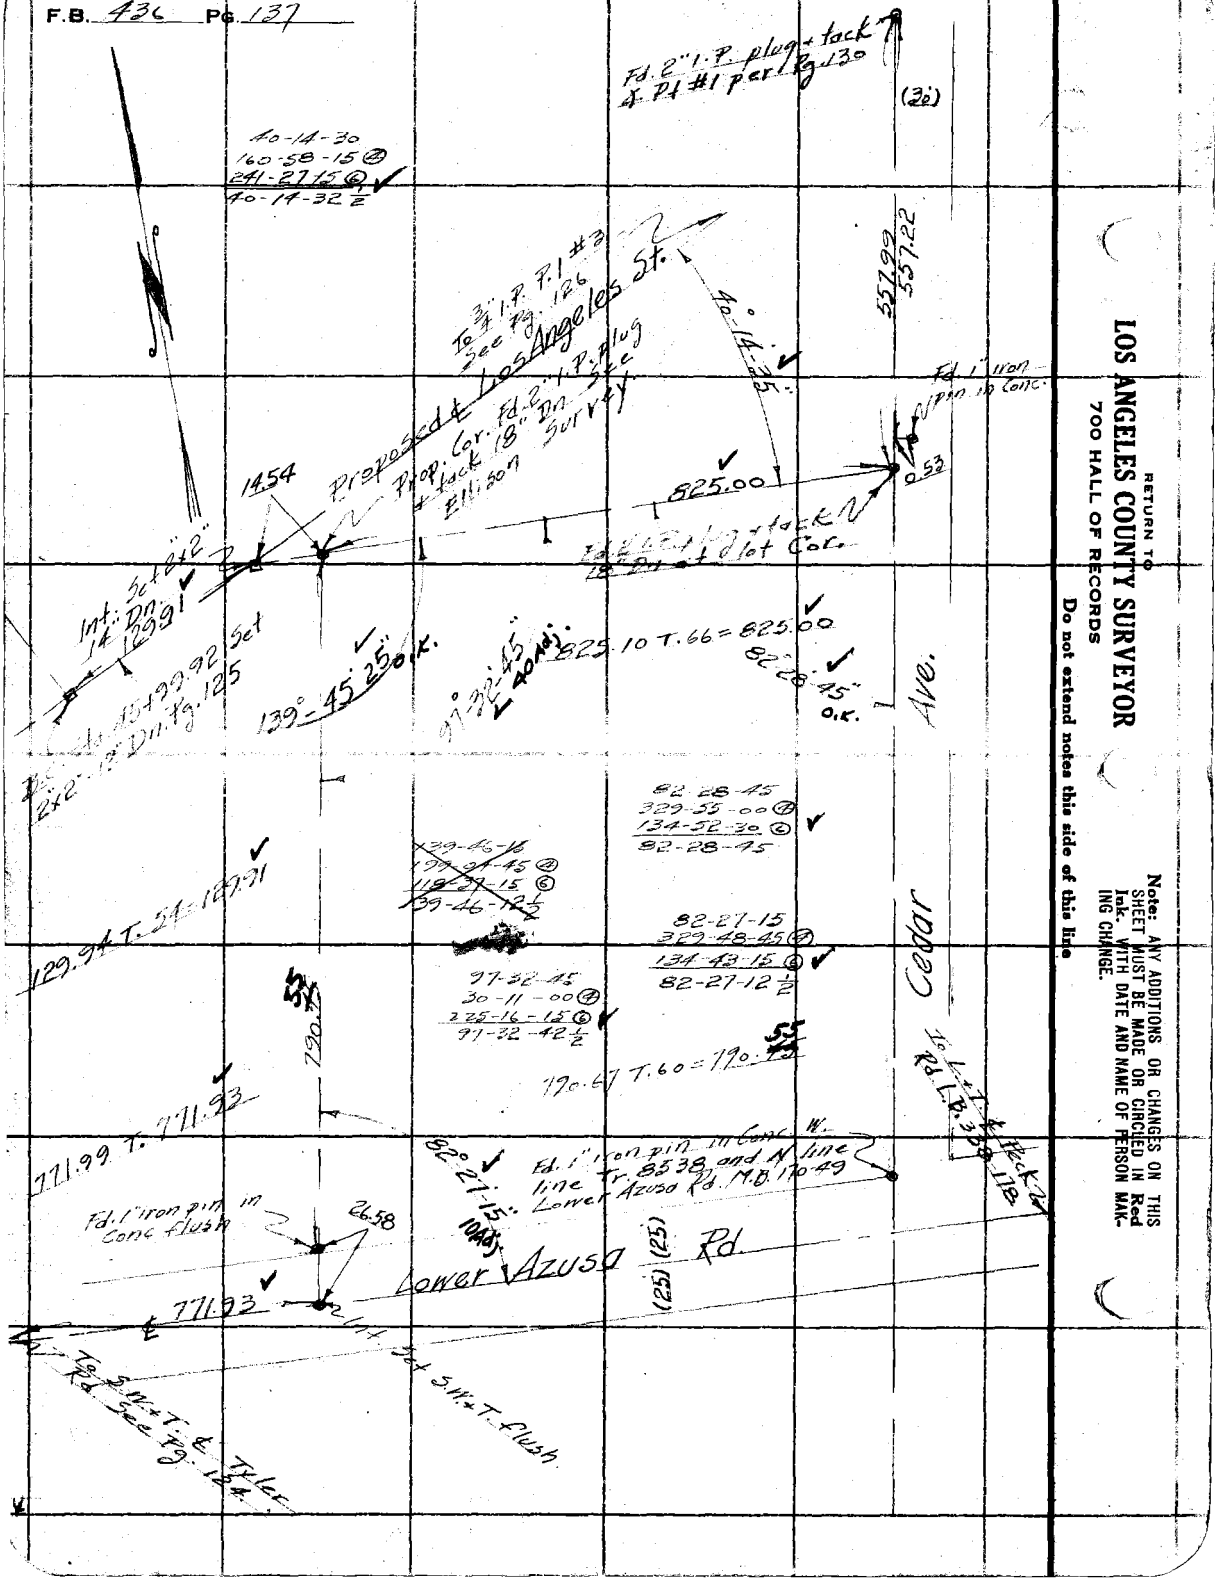

RETURN TO
LOS ANGELES COUNTY SURVEYOR
700 HALL OF RECORDS

Do not extend notes this side of this line

Note: ANY ADDITIONS OR CHANGES ON THIS SHEET MUST BE MADE OR CIRCLED IN Red Ink. WITH DATE AND NAME OF PERSON MAKING CHANGE.

FORM 247 TDM 5-51

RETURN TO
LOS ANGELES COUNTY SURVEYOR
700 HALL OF RECORDS

Note: ANY ADDITIONS OR CHANGES ON THIS SHEET MUST BE MADE OR CIRCLED IN Red Ink. WITH DATE AND NAME OF PERSON MAKING CHANGE.

Do not extend notes this side of this line

Notes Ck'd by
Map No. B-912



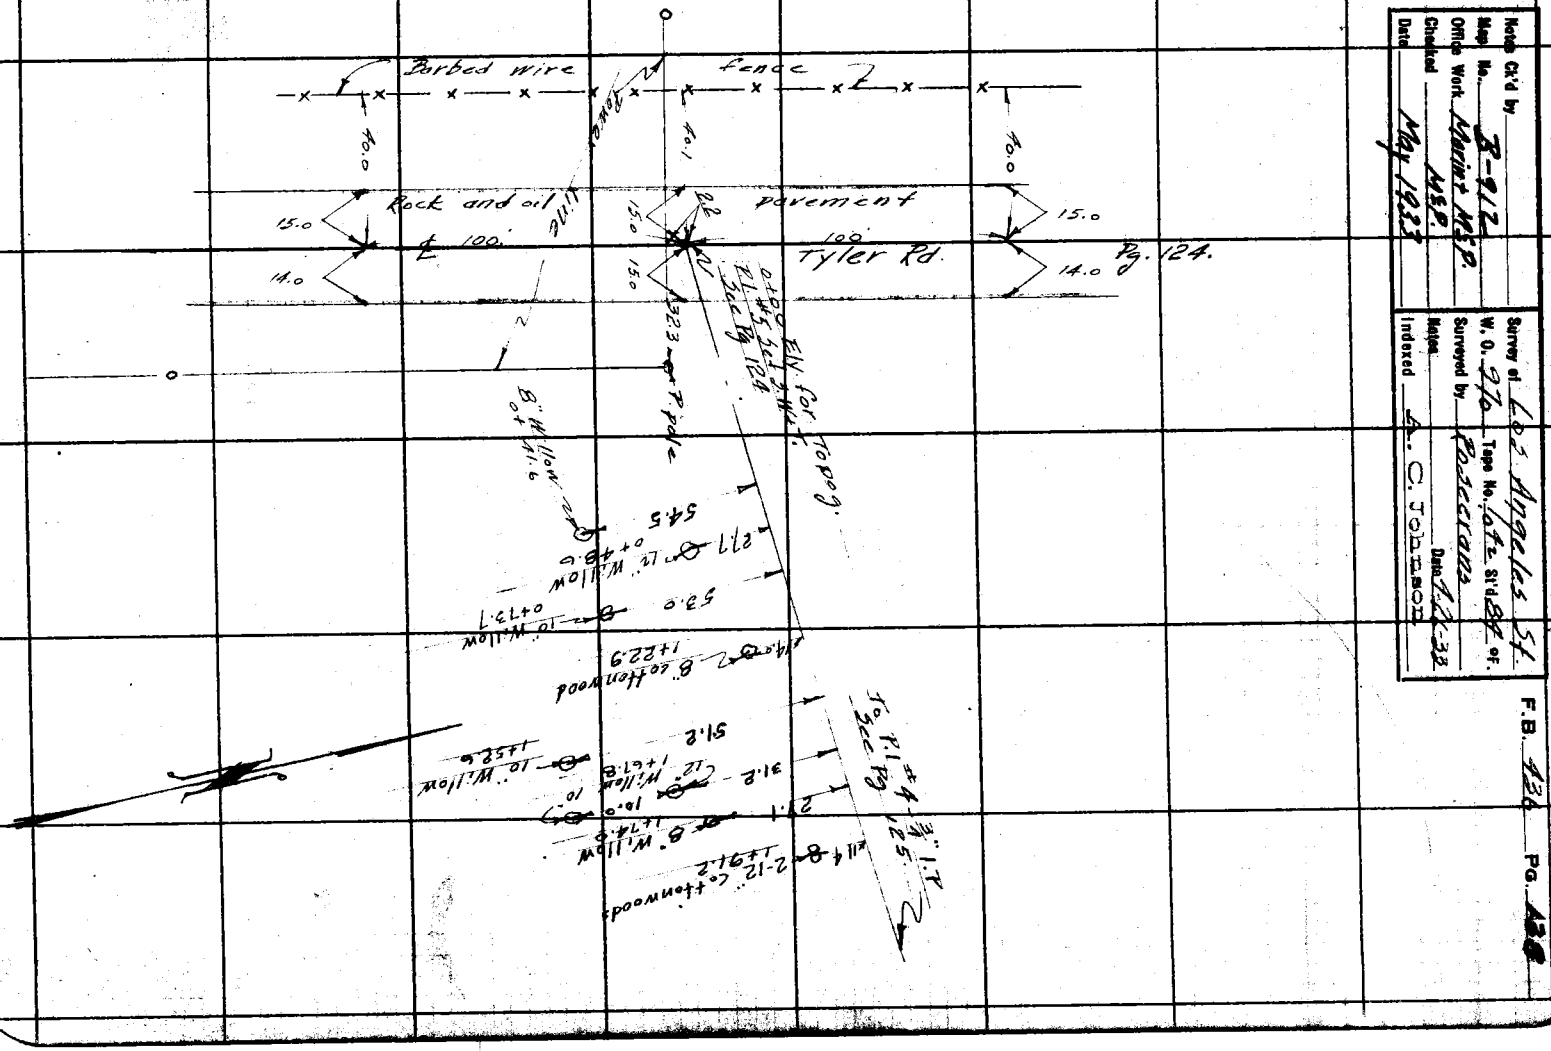

RETURN TO

LOS ANGELES COUNTY SURVEYOR

700 HALL OF RECORDS

Note: ANY ADDITIONS OR CHANGES ON THIS SHEET MUST BE MADE OR CIRCLED IN Red Ink. WITH DATE AND NAME OF PERSON MAKING CHANGE.

Do not extend notes this side of this line

F.B. 436 Pg. 139

Notes Ck'd by	Survey of Los Angeles St.
Map No. B-912	W.O. 7970 Tape No. 035 St'd 76 °F.
Office Work K.V.MORIN	Surveyed by L.D. Moores party
Checked	Notes A.W. Van Fleet Date
Date	Indexed A. C. Johnson 8-10-33

F.B. 436 Pg. 146

NOTE: ANY ADDITIONS OR CHANGES ON THIS SHEET MUST BE MADE OR CHECKED IN Red Ink, WITH DATE AND NAME OF PERSON MAKING CHANGE.

RETURN TO
LOS ANGELES COUNTY SURVEYOR
700 HALL OF RECORDS

Do not extend notes this side of this line

FLAGGING
("A" Line)
PROPOSED CHANGE OF LINE

LOS ANGELES STREET

BETWEEN PECK RD. AND TYLER RD.

AUGUST, 1933

Party

A.W. Van Fleet
L.H. Fenner
W.F. Harris
L.C. Cole

Note:- Yellow flags are set on this [redacted] marked "℄ of L.A. St. "A" Line".

FORM 847 10M 8-31

RETURN TO

LOS ANGELES COUNTY SURVEYOR

700 HALL OF RECORDS

Note: ANY ADDITIONS OR CHANGES ON THIS SHEET MUST BE MADE OR CIRCLED IN Red Ink. WITH DATE AND NAME OF PERSON MAKING CHANGE.

Do not extend notes this side of this line

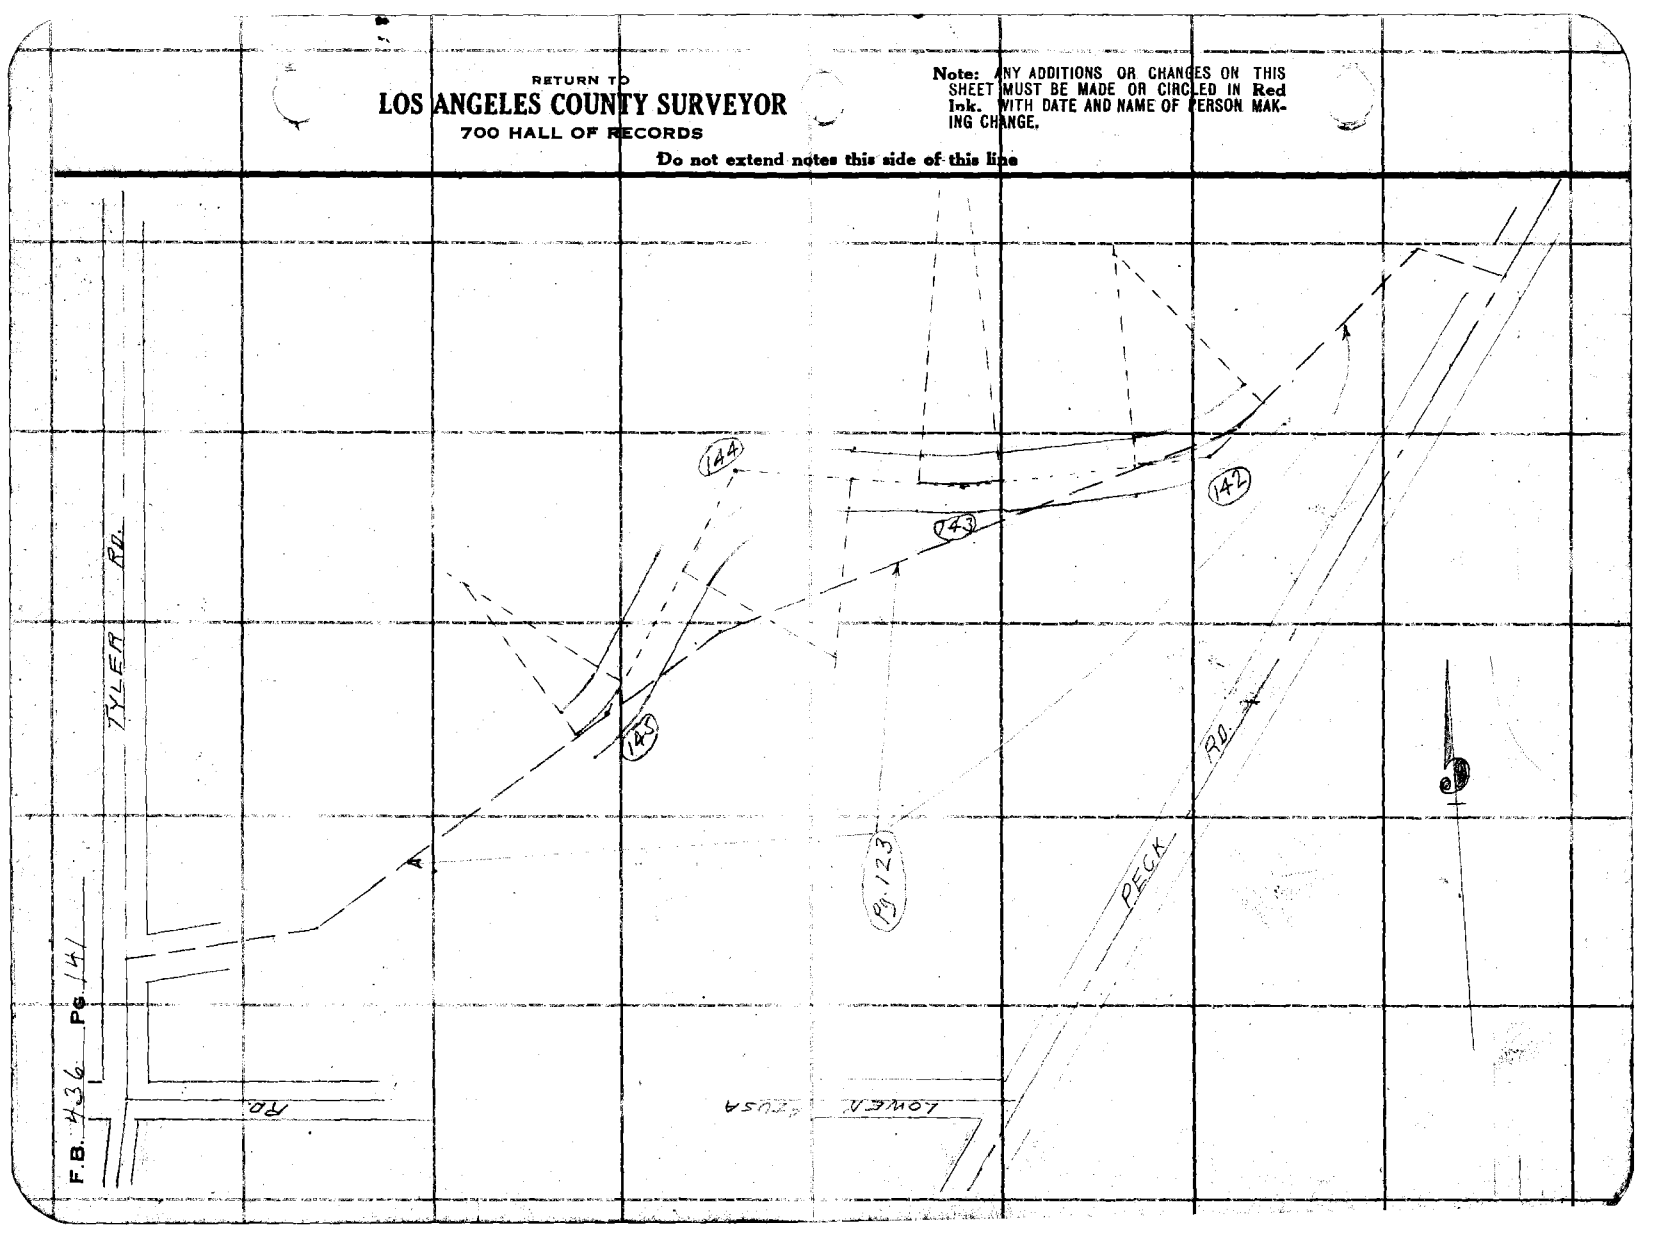

Notes Ck'd by	Drawn
Map No.	B-912
Office Work	K.V.McERLIN
Checked	Drawn
Date	Sept. 1933

Survey of	Los Angeles St.
W.O.	7970 Topo No. 035 Sh'd. 76 of
Surveyed by	L. D. Moorhead party
Notes	A.W. Van Fleet Date 8-7-33
Indexed	A. C. Johnson

F.B. 436 Pg. 142

W.O. 46 R-3

To bottom of page 143

(40') (40')

19" Line
701.23'
T=76°

St.

12+77.6 3 E.C.
Set 2x2 - 12" deep

T=76°
213.35

Set N.&T. in 6" Willow Limb - 10' above ground.

155° 54'-45" ①
263° 39' 15" ⑧
155° 54' 49" ✓

15
Δ = 24° 05' 30"
R = 1000'
T = 213.35'
L = 420.44'
Ex = 22.50

P.I. #2-A
Set 2X2-18" deep
per Office Sketch

352.2

155° 54' 45" Rad

Angle

P.O.S.T.
Fd. 2X2-18" deep
P.I. # 2 per F.B. 436-127

Beginning of "A" Line

B.C.

Set N.&T. in Cor. Fence Post

8+59.27 2 B.C.
Set 2x2 - 12" deep

183.36 @ 64° = 183.35

3.07

8+54.20 15 P.O.T.
Fd 2x2 - 12" deep
F.B. 436-127

Prop. Ang.

Note: ANY ADDITIONS OR CHANGES ON THIS SHEET MUST BE MADE OR CIRCLED IN Red Ink, WITH DATE AND NAME OF PERSON MAKING CHANGE.

Do not extend notes this side of this line

RETURN TO
LOS ANGELES COUNTY SURVEYOR
700 HALL OF RECORDS

FORM 247 .10M 5-31

F.B. 436 Pg. 143

To bottom of page 141

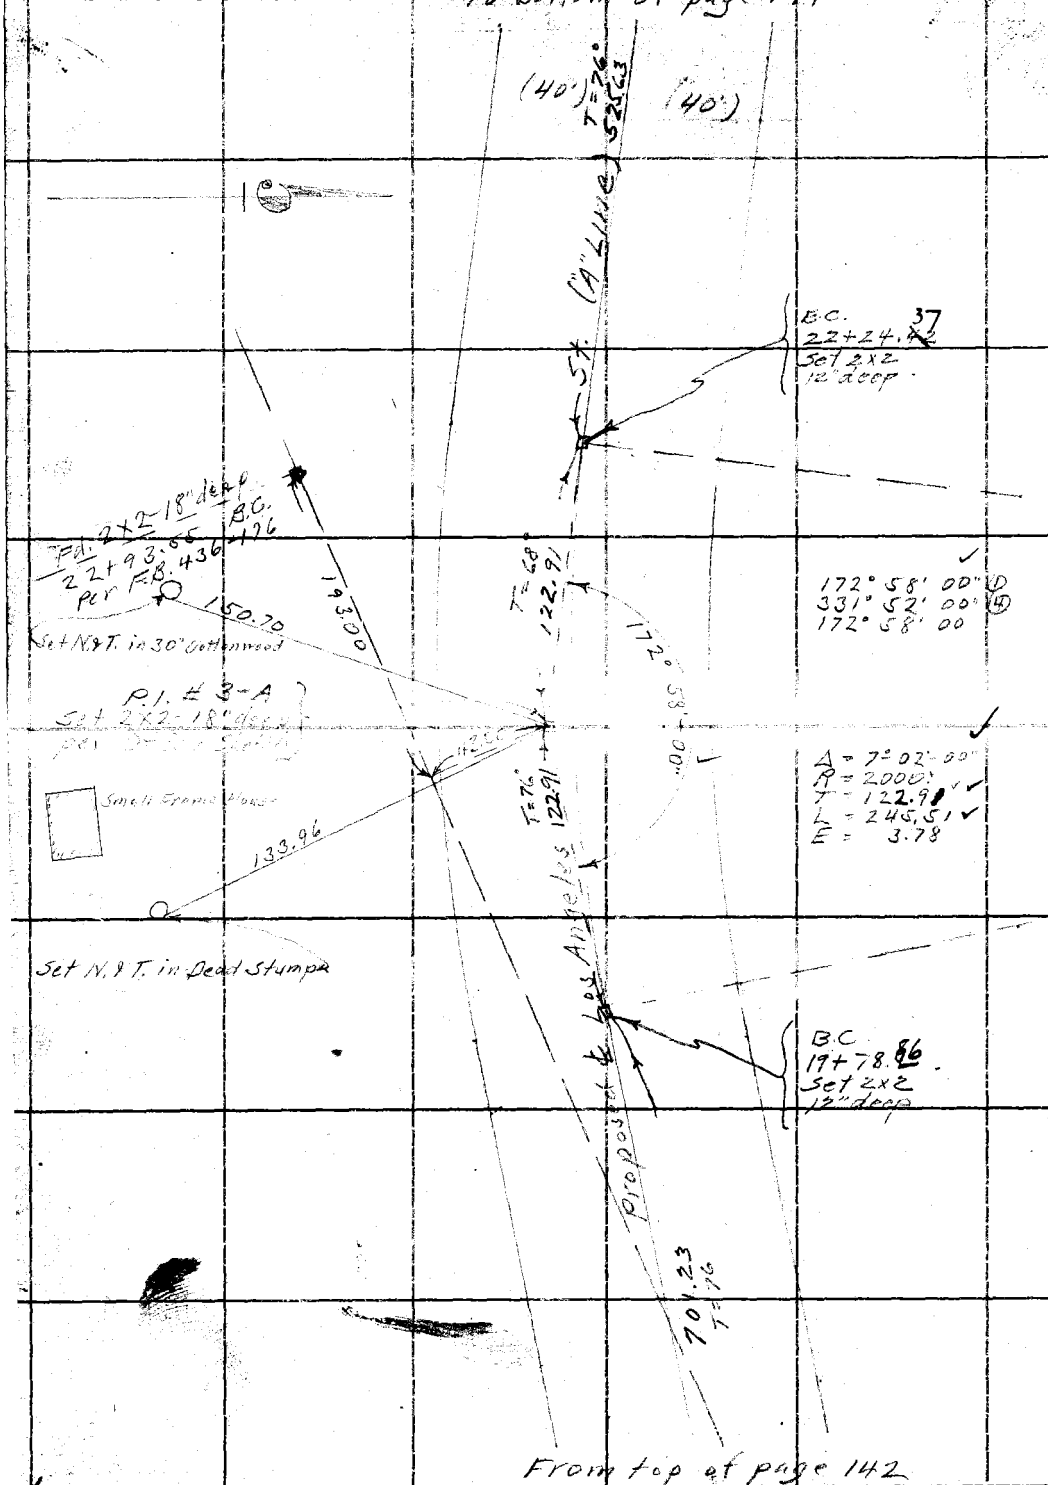

RETURN TO
LOS ANGELES COUNTY SURVEYOR
700 HALL OF RECORDS

Do not extend notes this side of this line

Note: ANY ADDITIONS OR CHANGES ON THIS SHEET MUST BE MADE OR CIRCLED IN Red Ink. WITH DATE AND NAME OF PERSON MAKING CHANGE.

W.S. 44 A 33

Notes Ck'd by	Drew	Survey of	Los Angeles St.
Map No.	B-912	W.O.	7970 Topo No. 035 Sht's 74
Office Work	K.V. Morin	Surveyed by	L.D. Moore, party
Checked	Drew	Notes	A.W. Van Fleet Date 8-8-33
Date	Sept. 1933	Indexed	A. C. Johnson

F.B. 436 Pg. 144

To bottom of page 145

EC 344+17.66
Set 2x2
12" deep

("A" line
115.56
T=76°
(40')

(40')

St.

42100

346.81
T=76°

Fd. 2x2-18" deep
P.I. #3
per F.B. 436-126

141° 44' 45" ⓓ
206° 58' 45" ⓔ
141° 44' 41

13100

21600

Set N.&T. in Piling

51.01

24.35

P.I. #4-A
Set 2x2-18" deep
per Office sketch

33.55

Δ = 38° 15' 20"
R = 1000.
T = 346.81'
L = 667.68'
E = 58.43

45°

100.00' "A" line

160.77
T=76°

P.O.S.T
Set 1x2
flush

Los Angeles St.

216.04
T=76°

BC
274+50.00
Set 2x2
12" deep

Prop. St. 76°

From top of page 143

RETURN TO
LOS ANGELES COUNTY SURVEYOR
700 HALL OF RECORDS
Do not extend notes this side of this line

Notice: ANY ADDITIONS OR CHANGES ON THIS SHEET MUST BE MADE OR CIRCLED IN Red INK, WITH DATE AND NAME OF PERSON MAKING CHANGE.

FORM 547 10M 8-31

RETURN TO
LOS ANGELES COUNTY SURVEYOR
700 HALL OF RECORDS

Note: ANY ADDITIONS OR CHANGES ON THIS SHEET MUST BE MADE OR CIRCLED IN Red Ink. WITH DATE AND NAME OF PERSON MAKING CHANGE.

M.S. 46

Do not extend notes this side of this line

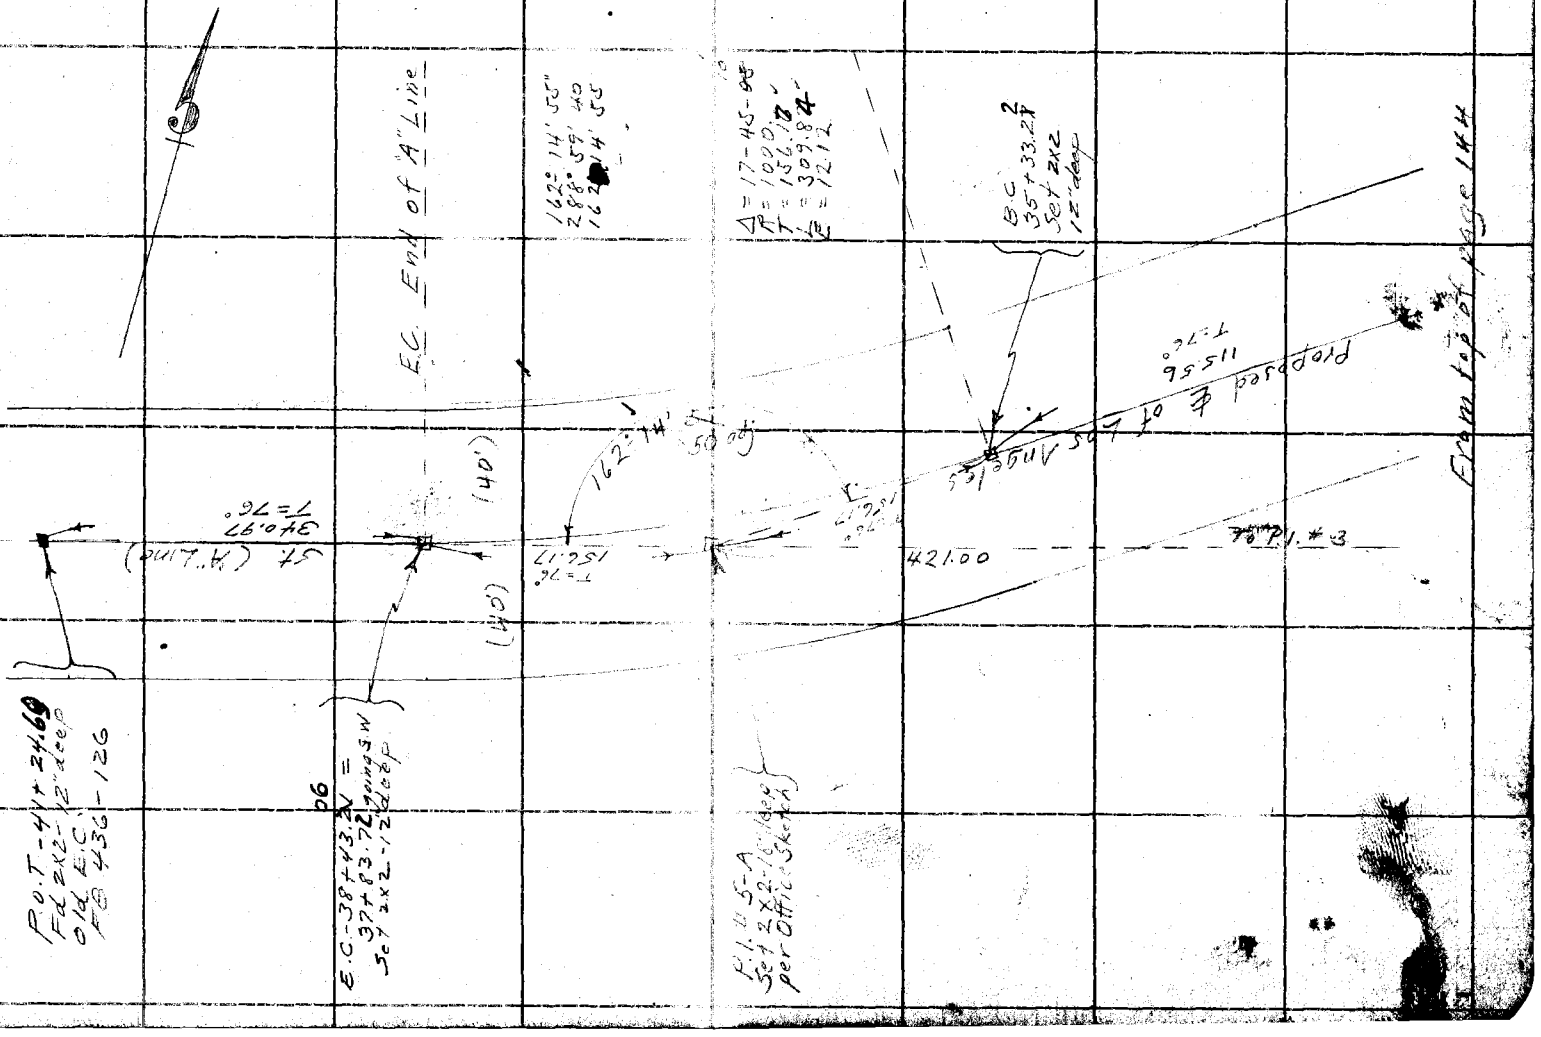

F.B. 436 Pg. 145

Notes Ck'd by MS Hanson
Map No. Sew. Dist. 6-71
Office Work MS Hanson
Checked
Date 10-6&9-33.

Survey of Checking Tr. 10745
W. O. 5066 Page No. 243 Sh'd 84 Pcs.
Surveyed by Evans
Notes
Indexed
Date 9/29/33
A. C. Johnson
10-3-33

F. B. 436 Pg. 186

W.S. 46-8

(Cont'd Bot. Next Pg.) Center Line of Maxson Rd. Adopted by the Co. Surveyor is a straight line from P.C. (P.C. P.M.C.) 75 on 2½" iron pipe (Pt. B, B 142). SUB

MAXSON RD.

Transit Line

Fd. 6X6 conc. State Hwy. mon. 6" high. 30.00 N. of ℄

29.88

Fd. 59 head bolt & W. on ℄

Blvd.

Fd. SWT. Fd. F.B. 352/134 Head been Knocked W. of ℄

Fd. N. in old 4X4 Rotten, 16" in. F.B. 352/13 Cor. Lots 7 & 8, Blk B; 16th 1st 2, Blk. F, M.R. 31/50 0.05 W. of ℄

Fd. 5/8 head bolt & washer. On ℄

Proposed Survey

Fd. 1½ I.P. with tack in Mon. Well 30.00 W. of ℄

Fd. 10"x10" Sq. Conc. mon. 12" high. Top Knocked off & leaning slightly Dist. taken to ctr. 0.26 E. of ℄

378.75 Rec. per F.B. 352/13

L.A. R.R.

Fd. SWT. F.B. 352/133 1.89 W. of ℄

1.89

Fd. No. 2 I.P. P.T. flush 30.00 W. of ℄

MAXSON

Fd. 2X2, 4' in., which replaces old 4X4 per F.B. 352/13. See same for ties 0.68 E. of ℄

3.

(F.B. 352/13 (622.13 Rec.)) 1/4 adopted ℄

Fd. 1½ I.P. P.T. flush 0.68 E. of ℄

1.

P.M.C. Lead & Tack at Int. of Adopted ℄ of Maxson Road with ℄ of Pomona Blvd

POMONA

Fd. L & T. per F.B. 216-5 & F.B. 352-5

Fd. L & T. F.B. 352-13

BLVD.

Note: ANY ADDITIONS OR CHANGES OF THIS SHEET MUST BE MADE IN RED INK WITH DATE AND NAME OF PERSON MAKING CHANGE.

Do not extend notes this side of this line

RETURN TO
LOS ANGELES COUNTY SURVEYOR
700 HALL OF RECORDS

FORM 247 10M 5-31

F.B. 436 Pg. 147

To Bot. Next pg.)

TR. 10745.

7

S. Line Tr. 10745

2921

Fd. 2" I.P. P&T Flush. S.E. Cor. Tr. 10745 29.61 W. of ℄

2941

Fon & dist.

set sewer spk. & T. flush.

set sewer spk. & T in Bk.

2

1

3.

(89°-59'-15" 359°-57'-00" 89°-59'-15")

(See F.B. 352/849

89°-59'-15" 20 Adj

Fd. N&T 18" Wal.

36.00

31.66

0.64

Fd. old 4x4 & Nail 24" dn. F.B. 352/9, 13.

0.30 E. of ℄

To ℄ Cogswell Rd.

1322.76 - T 84°

0.84

Set wire spk. & T. by inf'sn.

Fd. 2x2-12" dn. F.B. 352/9 on ℄

FERRIS RD.

Fd. N&T 12" Wal.

30.54

31.21

Fd. N&T 18" Wal.

Replaced 2x2 with 2" I.P. & B.C. in conc. 18" dn. & set 2x2 flush above mon. I.E. 10/17/33

MAXSONS SUB.

5.

4.

Center Line of Maxson Road is a straight Line from L+T. (Pt. C, B. 146) to Old 2"x4" Stake (Pt. B, B. 146)

Marked

COUNTY SURVEYOR'S MONUMENT 62 I.E.

MAXSON RD.

Transit Line

Adopted

Replaced with 2" I.P. & B.C. in conc. 18" dn. & set 2x2 flush above mon. I.E. 10/17/33

COUNTY SURVEYOR'S MONUMENT 59 I.E.

Marked.

6.

3

Fd. 1½" I.P. P. & T. 12" dn. F.B. 352/8, 13, & 134 on ℄

Fd. N&T 18" Wal.

31.35

Fd. N&T P.P.

Set sewer spk. & T.

29.18

OLIVE ST

Fd. old R'wd. 4x4 20" dn. 10/17/33 I.E.

0.20

0.10

52.53

52.53

0.15

Set N&T Tel. P.

cut X in 24" std. pipe

7.

2.

From Tot. Next pg.)

W 546 B-5

RETURN TO

LOS ANGELES COUNTY SURVEYOR

700 HALL OF RECORDS

Do not extend notes this side of this line

Note: ANY ADDITIONS OR CHANGES ON THIS SHEET MUST BE MADE OR CIRCLED IN Red Ink WITH DATE AND NAME OF PERSON MAKING CHANGE.

Notes Ck'd by	McPherson	Survey of	Tr. 10745
Map No.	Sur. Div. 15-71	W. D.	5966 Page No. 073 Bk'd & Pg.
Office Work	McPherson	Surveyed by	Evans
Checked		Notes	HE Date 9/28/33
Date	10-6-33.	Indexed	C. Johnson

F.B. 436 Pg.

W.S. 46 B-4

(To Bk. Notes Pg.)

Notes: ANY ADDITIONS OR CHANGES ON THIS SHEET MUST BE MADE ON CIRCLED IN Red Ink. WITH DATE AND NAME OF PERSON MAKING CHANGE.

Do not extend notes this side of this line

RETURN TO LOS ANGELES COUNTY SURVEYOR 700 HALL OF RECORDS

FORM 247 10M 5-31

1

Fd. old 4X4 & nail 1.5 Conn. See Tr. 10799, Tr. 10369, L.S. 29-45 & R.B. 352/8. - S.E. Cor. BLK D. Cogswell TPact. 0.17 W. of E

0.17

NISSOURI ST.

2

A6

Set sewer S/K & Tin Flush.

TBM 66.32

Line

0.81

1

Fd. old 3X3, 12" in. No Kg. N.E. Cor. Lot 6, Maxsons Sub. Per Tr. 10745 0.81 E. of E

Set Sewer S/K. F.T. by int. Sn.

1.30

N. line Maxson Sub.

Fd. nail & small tin.

2.86

To E Cogswell Road 1322.09 - 1.90 = 1322.06

8 ft. offset line

Set P.M.

1.40

(89°35'45" 358.23.30 89°35'52.6)

3

0.56

Fd. Nail & small tin.

N. Line Tr. 10745

89°35'52" 29.00

1pk

Center Line of Maxson Road is a straight line from L. & T. (Pt. S.B. No. 1) To old 2"x4" Stake (Pt. B, Pg. 140)

MAXSONS SUB.

MAXSON ROAD

7

Fd. 2" I.P.P.T. Flush. Tr. 10745 29.48 W. of E

2

Adopted

29.51 W. of E

29.06

0.96

0.51

DEANA ST.

Fd. Nail & small tin 0.51 E. of E

29.12

Fd. 2" I.P.P.T. Flush. Tr. 10745 29.56 W. of E

Δ = 0°00'25"

Tan. = .000109

(From Tab preceding pg.)

F.B. 436 Pg. 149

(To Bk. 7 Next Pg.) 9/29/33

W.S. 46 B-4.

RETURN TO
LOS ANGELES COUNTY SURVEYOR
700 HALL OF RECORDS

Do not extend notes this side of this line

Note: ANY ADDITIONS OR CHANGES ON THIS SHEET MUST BE MADE OR CIRCLED IN Red Ink. WITH DATE AND NAME OF PERSON MAKING CHANGE.

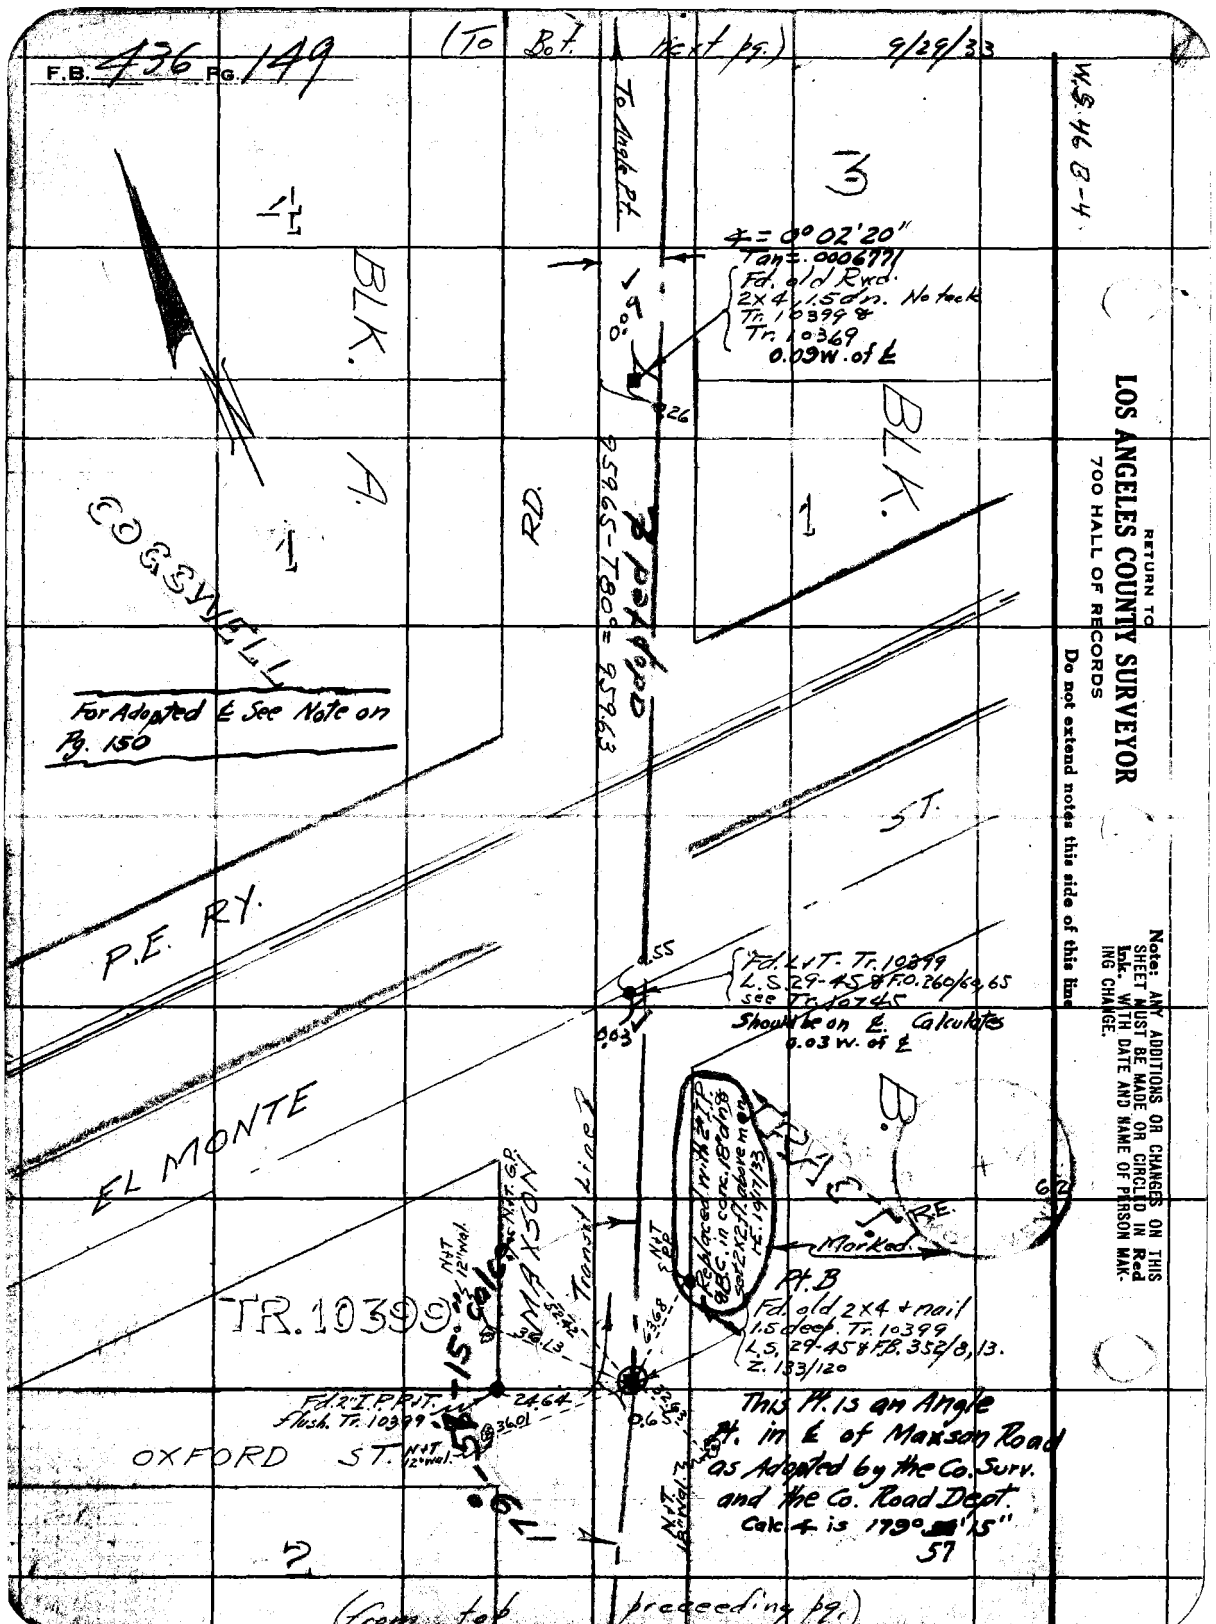

Notes Ck'd by: McMasson	Survey of: T.C. 10745
Map No.: Sur Div. 5571	W. O.: 5966 Tape No.: 023 St'd: 84 °F.
Office Work: McMasson	Surveyed by: Evans.
Checked:	Notes: Date: 9/29/33
Date: 10-6 to 9-1933.	Indexed: A. C. Johnson

F.B. 436 Pg. 108

W.S. 46 B-4

(Sta.)

LOT 3 TRACT

R.D.

Fd 2"x2"-12"d/n. per F.B. 436/109, 110. Ties same book.

COUNTY SURVEYOR'S RE. MONUMENT

Marked.

CHAMPION

LOT

40 = Calc.

Elder F.B. 436/105 a.k.a. Maxson

6.

Replaced with 2" I.P. + B.C. in conc. 18"d/n. 1917/33. (Set EX 2 Fd. same mon.)

Pt. A

Fd 3/4" I.P.P.T., 4" down replacing 4x4 per F.B. 436/109, 110. See L:107/69

This Pt. is on E Maxson.

(179°-11-15
356-45-30
179°-11-22½")

13'

179°-11-22½"

31.99

37.09

32.68

Set Nail & Tin 12" Wal.

Fd. I.P.P. 0.45' Fd. 1" Pipe

Fd. Nail & Tin 12" Wal.

COGSWELL

TRACT 3.

E of Maxson is a straight Line from Pt. A, this Page to Pt. B, Pg. 107.

Adopted

(from top of preceding pg.)

NOTE: ANY ADDITIONS OR CHANGES ON THIS SHEET MUST BE MADE OR CIRCLED IN Red Ink, WITH DATE AND NAME OF PERSON MAKING CHANGE.

RETURN TO LOS ANGELES COUNTY SURVEYOR 700 HALL OF RECORDS

Do not extend notes this side of this line

FORM 247 10M 8-31

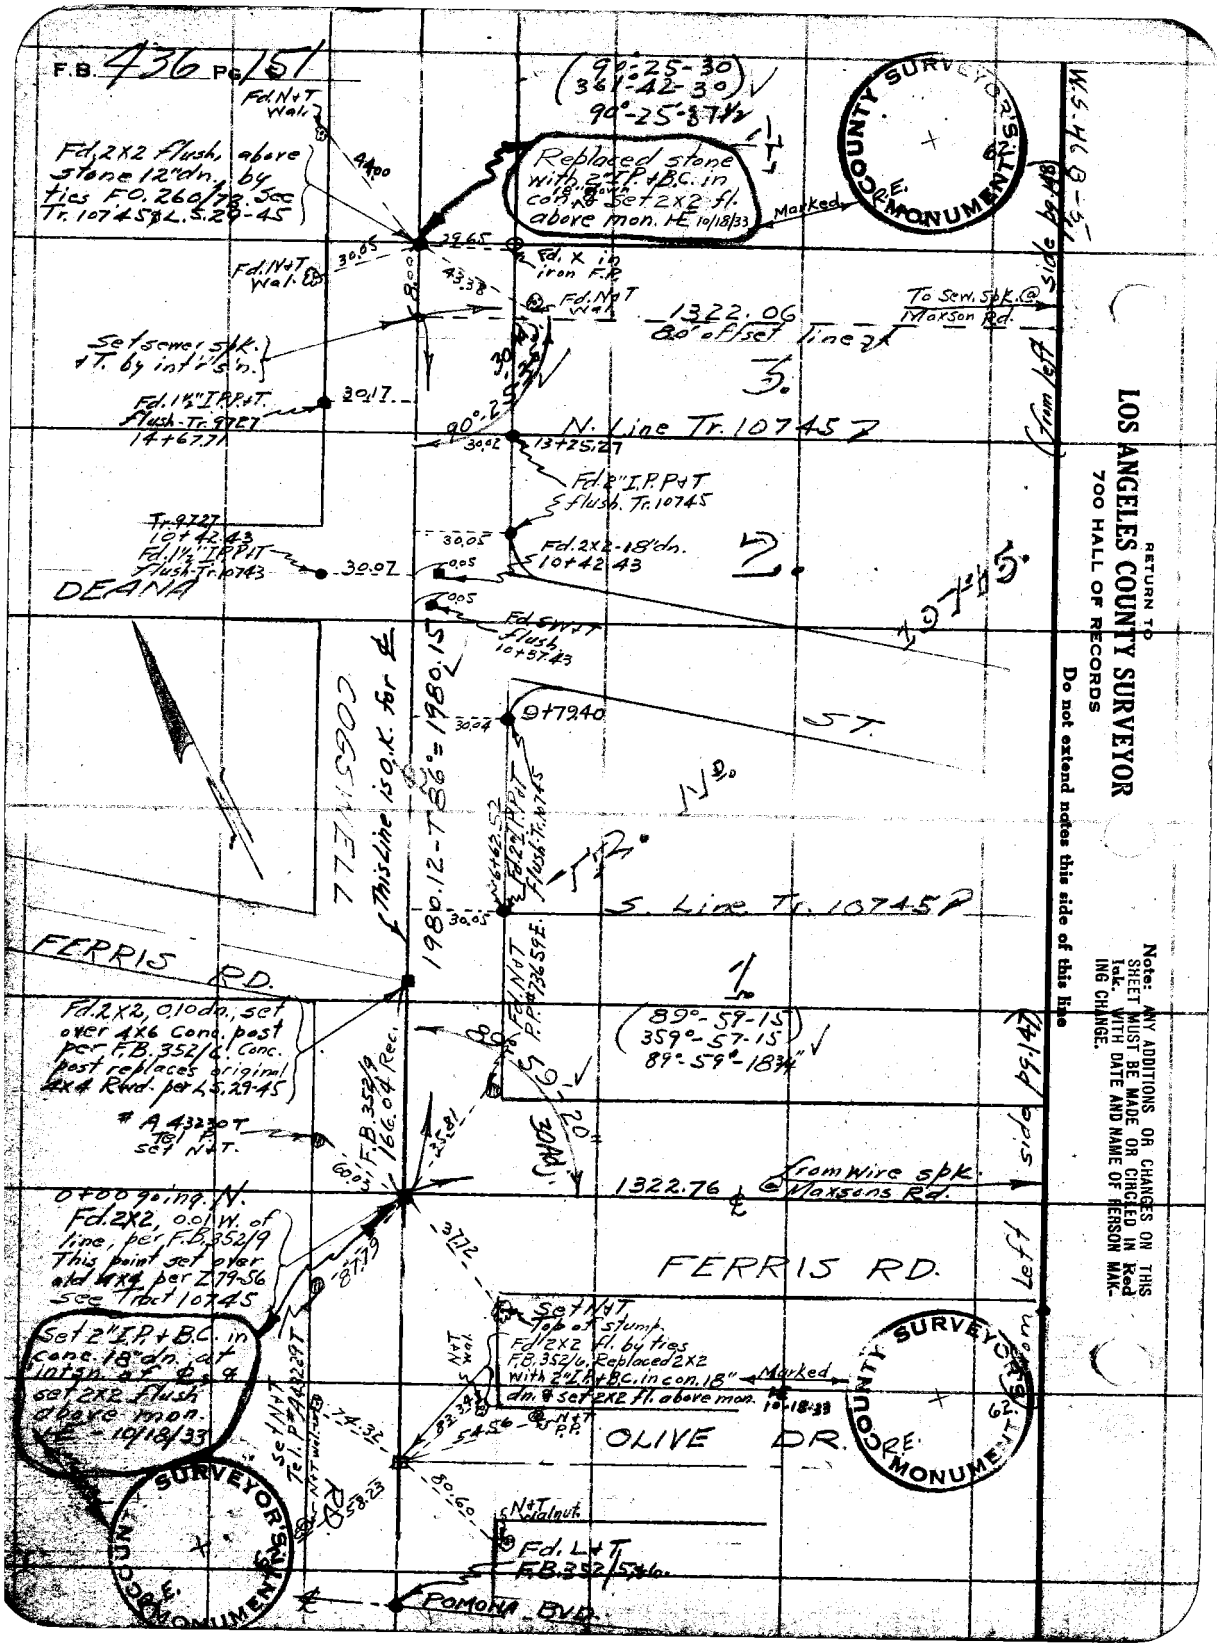
F.B. 436 Pg 151
Fd. N&T Wall
Fd. 2X2 flush, above stone 12"dn., by ties FD. 260/78. Sec Tr. 10745 & L.S. 20-45
(90°-25-30)
(361-42-30)
90°-25-30"
Replaced stone with 2" I.P. & B.C. in con. & Set 2X2 fl. above mon. HE 10/18/33
Marked
COUNTY SURVEYOR'S MONUMENT
W.S. 46 Q-S-W
Fd. X in iron F.P.
Fd. N&T Wall
1322.06
80' offset line
To Sew. Spk. @ Marson Rd.
Set sewer spk. & T. by int'l's'n.
Fd. 1½" I.P.P&T. Flush-Tr. 9727 14+67.71
N. Line Tr. 10745
Fd. 2" I.P.P&T Flush. Tr. 10745
Tr. 9727 10+42.43
Fd. 1½" I.P.P&T Flush-Tr. 10743
DEANA
Fd. 2X2-18"dn. 10+42.43
Fd. Sp. N&T flush 10+57.43
COSTNER
This line is O.K. for E
1980.12-T 89°=1980.15
9+79.40
S. Line Tr. 10745
FERRIS RD.
Fd. 2X2, 0.1 dp., set over 4X6 Conc. post per F.B. 352/6 (Conc. post replaces original 4X4 Rwd. per L.S. 29-45
A 43230 T
Tel. P.
set N&T.
(89°-59-15)
359°-57-15"
89°-59°-18¾"
Fd. N&T P.P. 336.59 E.
0+00 going N. Fd. 2X2, 0.1 W. of line, per F.B. 352/9 This point set over old 4X4 per L 79-56 see Tract 10745
Set 2" I.P. & B.C. in conc. 18" dn. at int'sn. of ℄'s & set 2X2 flush above mon. HE - 10/18/33
Set N&T Tel. P. #A 43229 T
Set N&T Tab. & stump.
Fd. 2X2 fl. by ties F.B. 352/6. Replaced 2X2 with 2" I.P. & B.C. in con. 18" dn. & set 2X2 fl. above mon.
Marked
10-18-33
OLIVE DR.
N&T Walnut
Fd. L&T F.B. 352/5 & 6.
POMONA BLVD.
1322.76 ℄ from Wire spk. @ Marsons Rd.
RETURN TO
LOS ANGELES COUNTY SURVEYOR
700 HALL OF RECORDS
Do not extend notes this side of this line
Note: ANY ADDITIONS OR CHANGES ON THIS SHEET MUST BE MADE OR CIRCLED IN Red Ink. WITH DATE AND NAME OF PERSON MAKING CHANGE.

Notes Ck'd by McPherson
Map No. Sur. Div. 5-71
Office Work McPherson
Checked
Date 10-6 to 9-1933.

Survey of T.E. 10745
W. O. 5064 Topo No. 023 St'd 84 ef.
Surveyed by Evans
Notes
Indexed A. C. Johnson
Date 10/9/33

F.B. 436 Pg. 102

(To Bot. pg. 153)

WS 46 B-4

Not the ℄.

(90°-53'-30")
(363°-34'-00")
90°-53'-30" ✓

N'ly Prolongation Mkd. Line S.E. COUNTY SURVEYOR'S MONUMENTATION Cor. Mkd. Wit.

Set Nail & Tin. Wal.

Reduced I.P. with 2" I.P. B.C. in conc. 18" dp. & set 2x2 flush. M.E. 10/18/33

1" in iron Fac. A

Fd. 2" I.P. Pd T 6" dp. L.S. 29-45

179°06'-45" Calc.

Stone with X in top L.S. 29-45

OXFORD ST.

To old 2x4 bet. pp. 149

Fd. S.W.T. in Top rwd 4x4, 8" dp. per L.S. 29-45

Meksons Sub

L.V.T. wier box

(90°-21-15)
(361°-25-30)
90°-21'-22½" ✓

Cogswell Rd.

Set 2x4 in Fac. post.

Set N.T. Wal.

Set N.T. wal.

Oxford St.

Set M.T. in tile per above

Set L.T. wier box.

COGSWELL RD.

This Line is O.K. for E of Cogswell

P.E. RY.

Fd. ¼" Iron Pin 0.1 dp. per L.S. 29-45

Fd. L.T.

EL MONTE ST.

RETURN TO
LOS ANGELES COUNTY SURVEYOR
700 HALL OF RECORDS

Note: ANY ADDITIONS OR CHANGES ON THIS SHEET MUST BE MADE FOR CIRCLED IN Red Ink. WITH DATE AND NAME OF PERSON MAKING CHANGE.

Do not extend notes

FORM 847 10M 8-31

RETURN TO

LOS ANGELES COUNTY SURVEYOR

700 HALL OF RECORDS

Note: ANY ADDITIONS OR CHANGES ON THIS SHEET MUST BE MADE OR CIRCLED IN Red Ink. WITH DATE AND NAME OF PERSON MAKING CHANGE.

W.S. 46 B-4

Do not extend notes this side of this line

Evans found this monument to be 0.57' West of a straight line from A to B. Center-line of Cogswell Road is a direct line from A to B per Deeds 58-39; 58-51; 58-75 & 60-184.

SURVEYOR'S MONUMENT No. 19 COUNTY

Replaced rock w/ T.B.M. 2" I.P. P.P.B.C. in con. 18" dia. & 8" sq. x 2" thick concrete mon. Elev. 1011.933

Fd. quartz rock 1.1' in top, Brass Tag NM, on Lot 3 Blk. A Cogswell Tr. (L.S. E9-45. Ties F.B. 436/11)

AVE.

Fd. Nail & T 12" Wal.

Mon. Lead

NAIL & TAG

NAIL & TAG

NAIL & TAG

Notes Ck'd by D. M. Finley
Map No. B-912
Office Work R. W. Mc Allister
Checked D. M. Finley
Date June 1950

Survey of E. Hondo Parkway
W. O. 7970 Tape No. 681 Std. 68 °F
Surveyed by G. G. PORTER
Notes Foster Date 8-1-47
Indexed C. C. JOHNSON 8-8-47

F.B. 436 Pg. 155

East Hondo Parkway

Line Change

Relocation Lower Azusa Rd to Tyler Ave

8-1-47

Foster
Snyder
Stock
Exchange
Banks

to Po 9
Pg-159-164

Platted on H.C. 48-11

Traced on C.S.B-912 in June 1950

Note: Any Additions or Changes on This Sheet Must Be Made or Circled in Red Ink With Date and Name of Person Making Change.

Do not extend notes this side of this line.

RETURN TO
LOS ANGELES COUNTY SURVEYOR
700 HALL OF RECORDS

FORM 247 5M 5.48

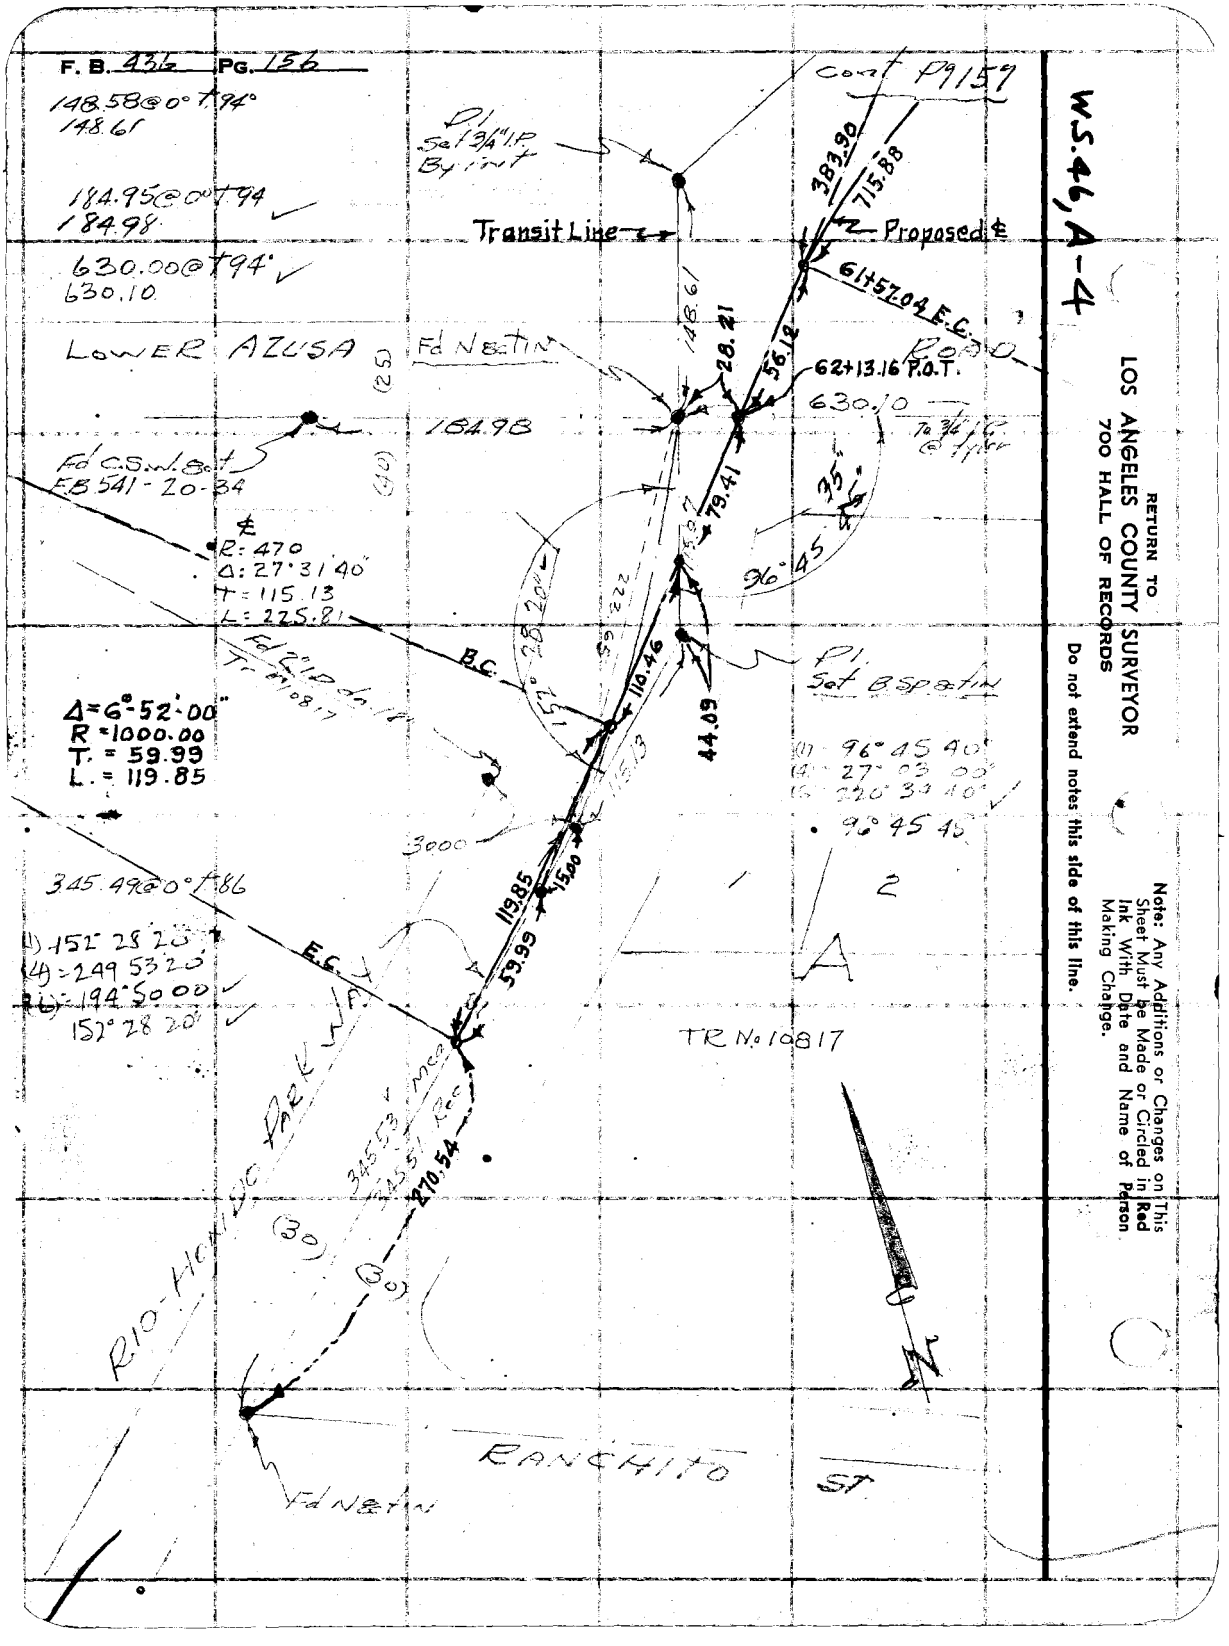
F. B. 436 PG. 156
148.58@0°T94°
148.61
184.95@0°T94
184.98
630.00@T94°
630.10
LOWER AZUSA
Fd NAIL & TIN
Fd C.S.W.L.S. 1"
F.B. 541 - 20 - 34
(25)
(40)
184.98
℄
R: 470
Δ: 27°31'40"
T: 115.13
L: 225.81
Fd 2" I.P. ds
T.T. 10817
B.C.
Δ=6°52'00"
R=1000.00
T.=59.99
L.=119.85
345.49@0°T86
(1) 152° 28 20
(4) 249 53 20
(R) 194 50 00
152° 28 20
3000
119.85
59.99
1500
E.C.
345.53' Rec
345.51' Rec
270.54
(30)
(30)
RIO HONDO PARKWAY
RANCHITO ST
Fd Nail
Cont P9159
383.90
715.88
Transit Line
Proposed ℄
61+57.04 E.C.
62+13.16 P.O.T.
630.10
To ¾" I.P. @ 1.00' Under
148.61
28.21
56.12
79.41
35°
96°45
110.46
44.09
Pl Set ¾" I.P. By Inf
Pl Set BSpoint
(1) 96° 45 40"
(4) 27° 03 00"
(R) 320° 39 40"
96° 45 45"
TR No. 10817
A
1
2
N
W.S. 46, A-4
RETURN TO
LOS ANGELES COUNTY SURVEYOR
700 HALL OF RECORDS
Do not extend notes this side of this line.
Note: Any Additions or Changes on This Sheet Must be Made or Circled in Red Ink With Date and Name of Person Making Change.

FORM 247 5M 5-46

RETURN TO
LOS ANGELES COUNTY SURVEYOR
700 HALL OF RECORDS

Note: Any Additions or Changes on This Sheet Must be Made or Circled in Red Ink With Date and Name of Person Making Change.

Do not extend notes this side of this line.

W.S. 44, A-4

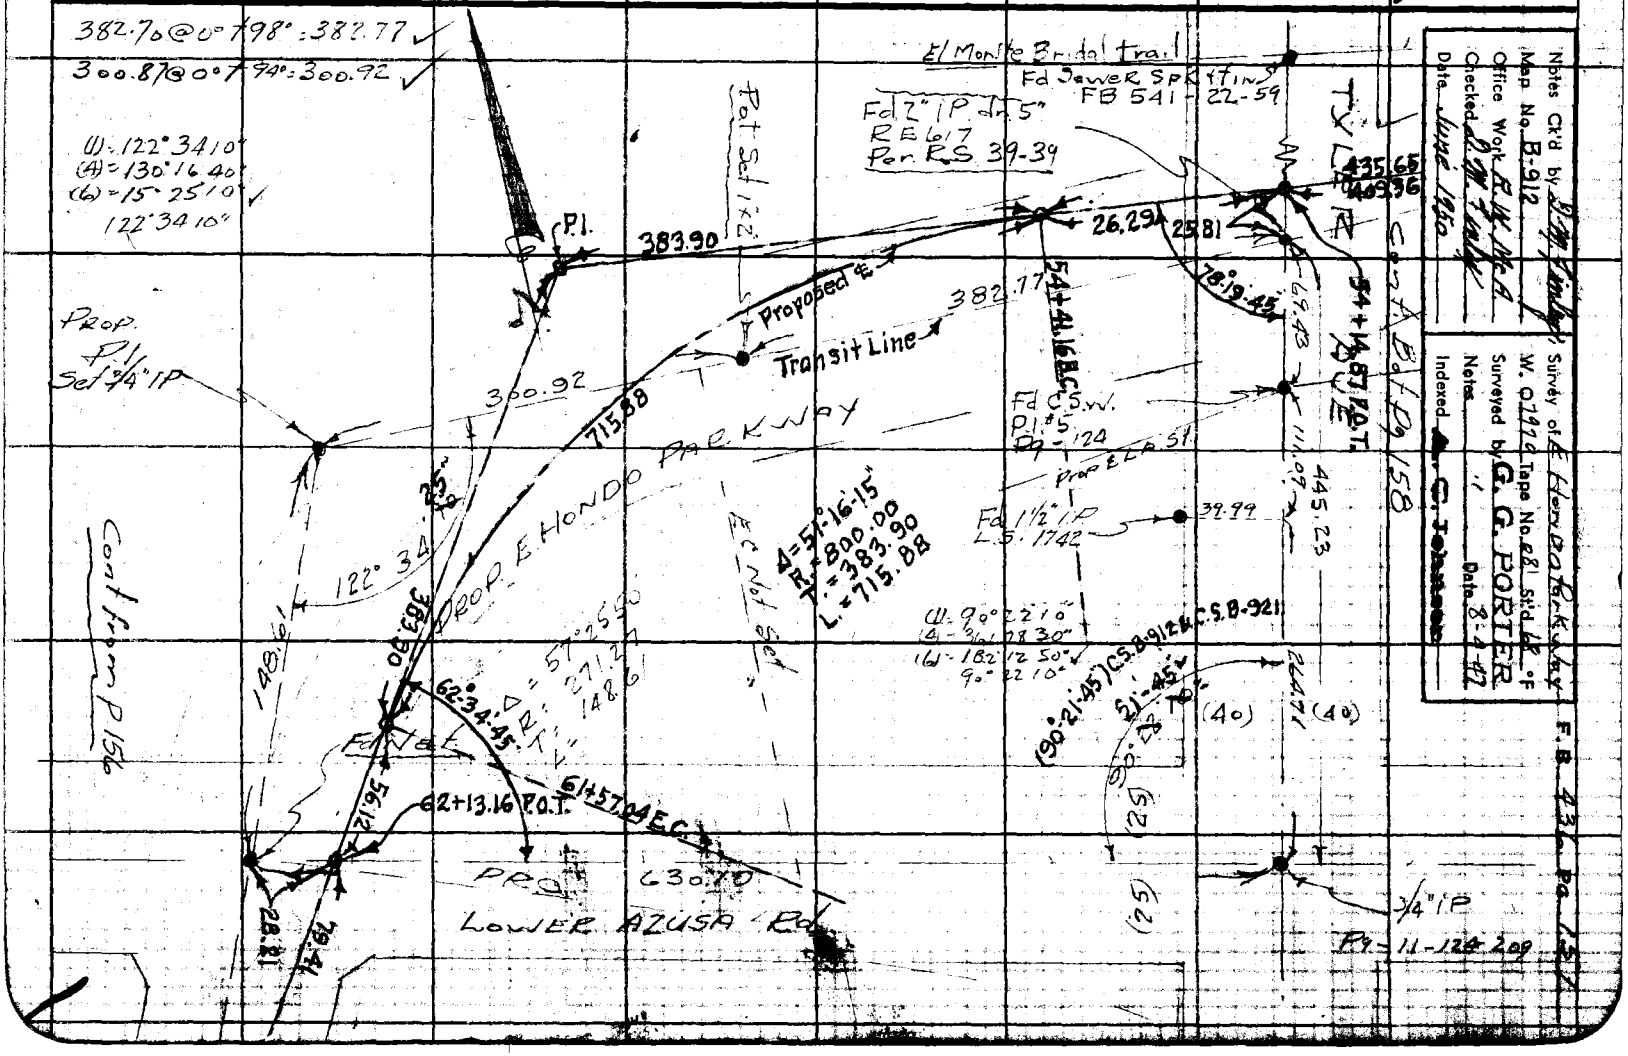

Notes Ck'd by [illegible]
Map No. B.912
Office Work [illegible]
Checked [illegible]
Date June 1960

Survey of E. Hondo Parkway
W. O. 1717 Tape No. 81 Sht. 12 of [illegible]
Surveyed by G. G. PORTER
Notes [illegible] Date 8-4-42
Indexed A. G. Johnson

F.B. 431 Pg. 15

RETURN TO
LOS ANGELES COUNTY SURVEYOR
700 HALL OF RECORDS

Note: Any Additions or Changes on This Sheet Must be Made or Circled in Red Ink With Date and Name of Person Making Change.

W.S. 46, A-3

Do not extend notes this side of this line.

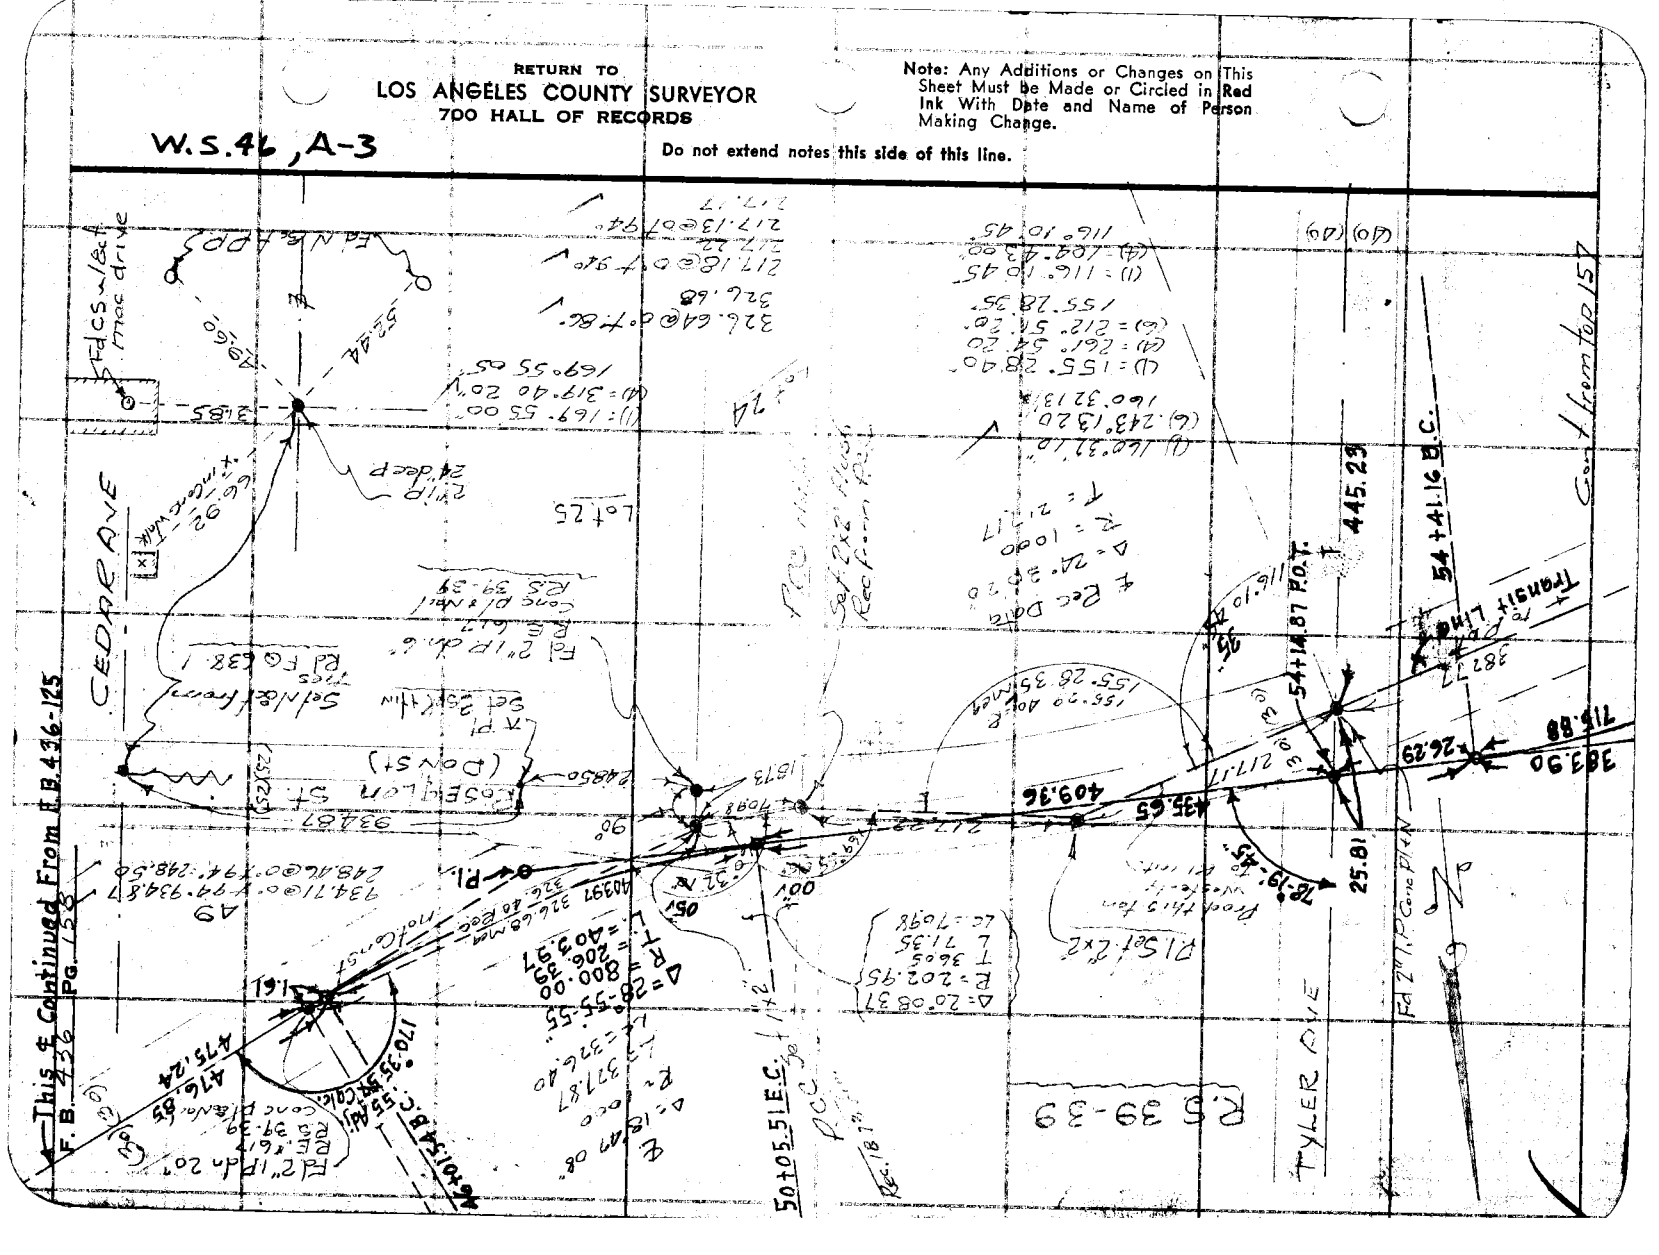
CEDAR AVE
TYLER AVE
R.S. 39-39
Set 2"x2" Hub
Rec. 18 7th
Rec. 50+05.51 E.C.
54+41.16 P.C.C.
445.23
409.36
435.65
217.17
26.29
715.88
383.90
25.81

Notes Ck'd by R.M. Finley	Survey of E. Hondo Parkway	F.B. 436	Pg. 159
Map No. B-912	W. 07970 Tape No. 08 Std. °F		
Office Work RW MSA	Surveyed by Porter		
Checked R.M. Finley	Notes Snyder Date 8-4-47		
Date June 1950	Indexed A. C. Johnson		

Location Improvements

East Hondo Parkway Lower Azusa Rd.

to Tyler Ave

8-4-47

Note: Any Additions or Changes on This Sheet Must be Made or Circled in Red Ink With Date and Name of Person Making Change.

Do not extend notes this side of this line.

RETURN TO
LOS ANGELES COUNTY SURVEYOR
700 HALL OF RECORDS

FORM 247 5M 5-46

F. B. 436 Pg. 160

(End.) See Pg. 161

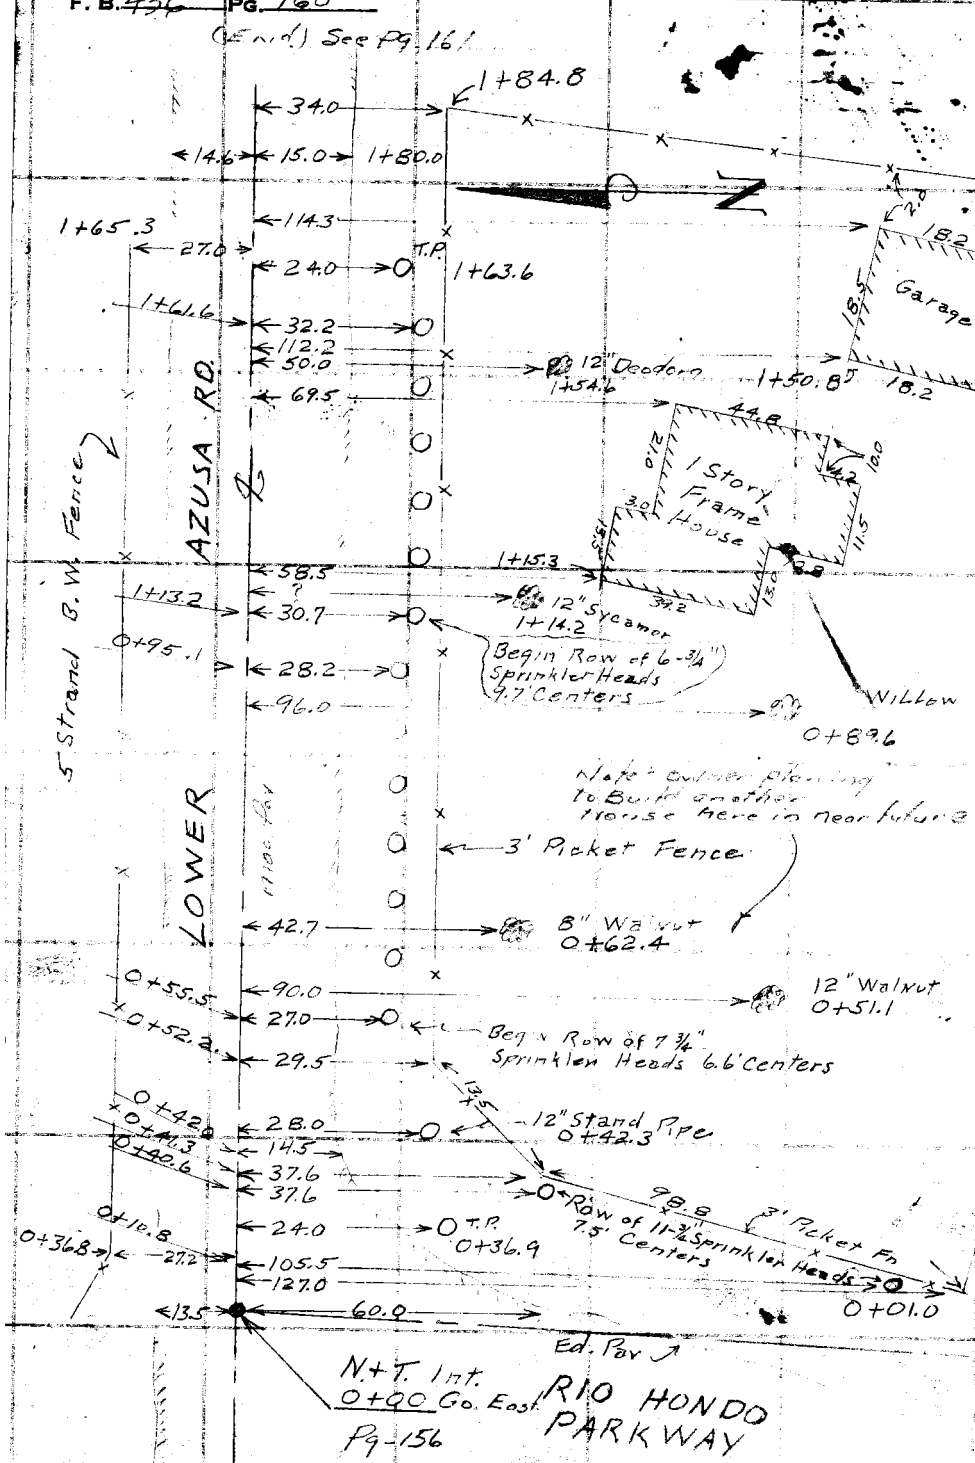

RETURN TO
LOS ANGELES COUNTY SURVEYOR
700 HALL OF RECORDS

Do not extend notes this side of this line.

Note: Any Additions or Changes on This Sheet Must be Made or Circled in Red Ink With Date and Name of Person Making Change.

Notes Ck'd by D. M. Finley
Map No. B-912
Office Work R.W.M. & A.
Checked D. M. Finley
Date June 1950

Survey of E. Hondo Parkway
W. O. 7970 Tape No. St'd °F
Surveyed by Porter.
Notes Snyder Date 8-4-47
Indexed A. C. Johnson

F. B. 436 Pg. 161

Note: Any Additions or Changes on This Sheet Must be Made or Circled in Red Ink With Date and Name of Person Making Change.

Do not extend notes this side of this line.

RETURN TO
LOS ANGELES COUNTY SURVEYOR
700 HALL OF RECORDS

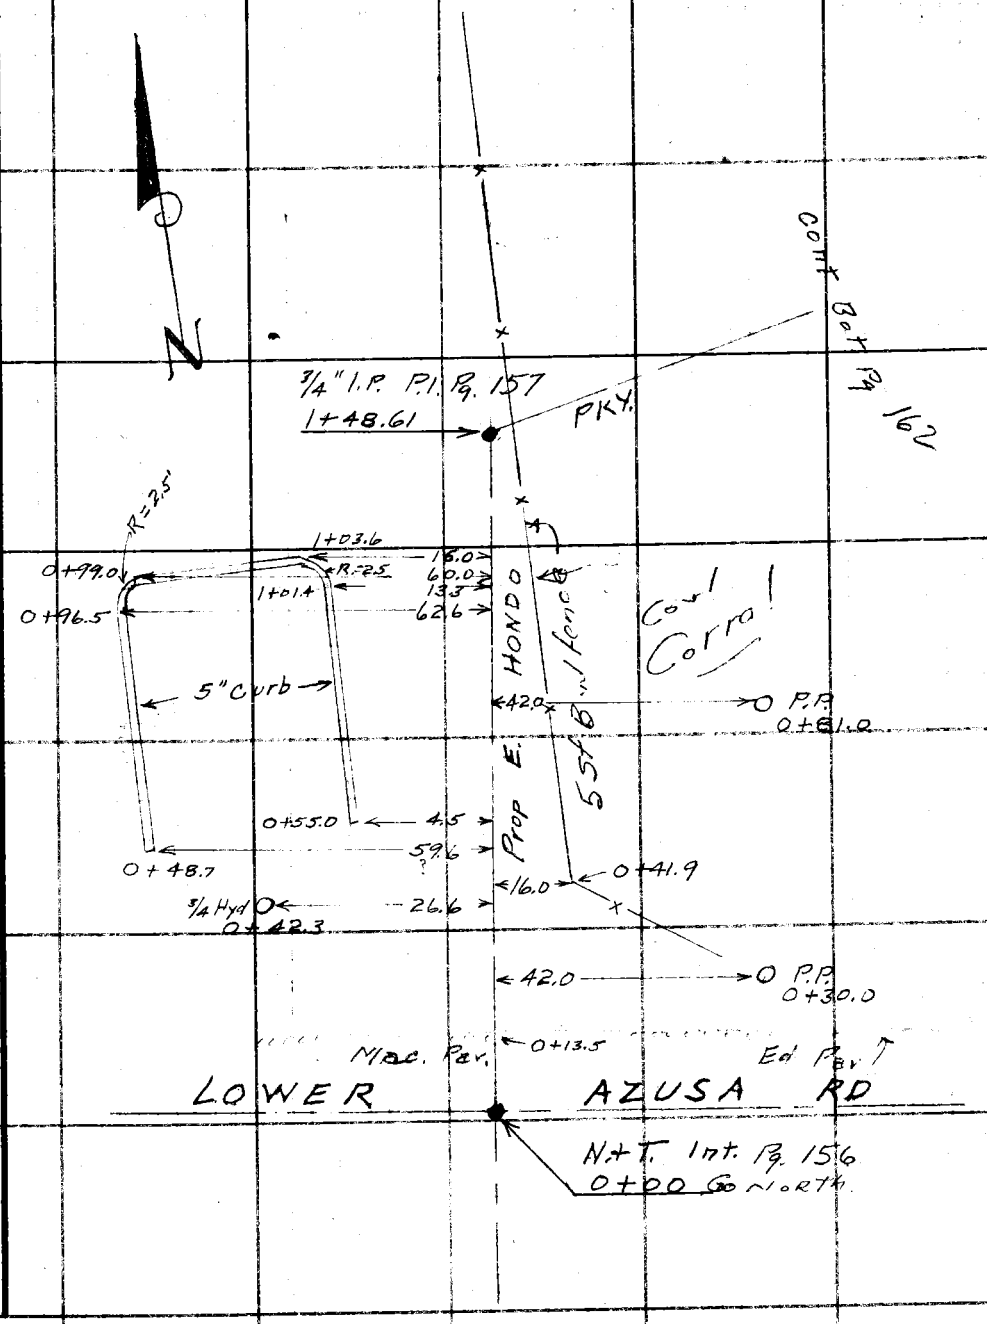

FORM 247 5M 5-46

F. B. 436 Pg. 162 Cont. Bot. Pg. 163

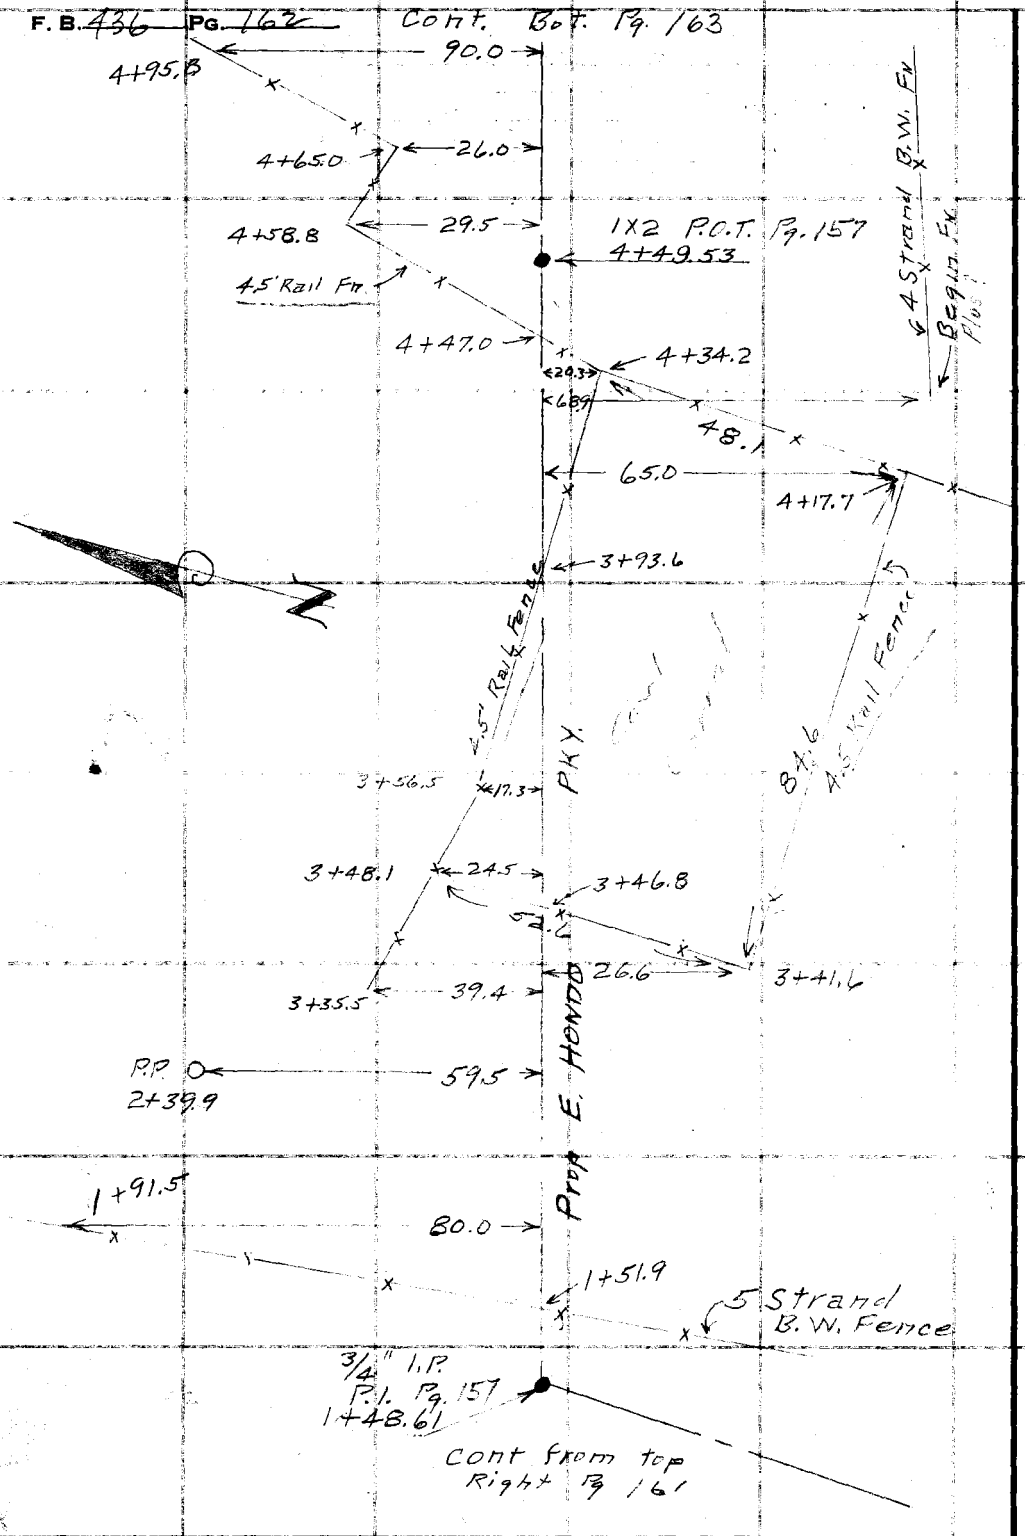

RETURN TO
LOS ANGELES COUNTY SURVEYOR
700 HALL OF RECORDS

Do not extend notes this side of this line.

Note: Any Additions or Changes on This Sheet Must be Made or Circled in Red Ink With Date and Name of Person Making Change.

Notes Ck'd by D.M. Finley
Map No. B-912
Office Work R.W.M.S.A.
Checked D.M. Finley
Date June 1950

Survey of E. Hondo Parkway
W. O. 1970 Tape No. St'd °F
Surveyed by Porter
Notes Snyder Date 8-4-47
Indexed A. C. Johnson

F.B. 436 Pg. 163

Note: Any Additions or Changes on this Sheet Must be Made or Circled in Red Ink With Date and Name of Person Making Change.

Do not extend notes this side of this line.

RETURN TO
LOS ANGELES COUNTY SURVEYOR
700 HALL OF RECORDS

FORM 247 5M 5-46

Cont. Bet. B. 164

← 35.5 → 2-10" Locust 32.0 → 6+76.1

← 88.0 → 14" Locust 6+63.0

Clump of 5-10" Locust

← 105.0 → 6+40.7

← 37.6 → 8" Locust 35.0 → 8" Locust 6+29.3

6+29.3 2-10" Locust

← 35.9 → 26.5 → 16" Locust

6+22.8

← 80.5 → 12" Locust 6+00

Prop E. HONDO PKY

← 24.2 → 8" Locust 38.4 → 12" Loc 8.5 → 18" Locust

5+97.8 2-8" Locust

← 26.7 → 29.0 →

5+76.0

10" Locust Clump of 6-6" Locust

← 28.9 → 19.5 →

5+67.0

3-10" Locust

← 17.2 → 28.0 → 20.8 →

5+58.2

4 Strand B.W. Fence

10"

← 7.3 → 5+45.1

12" Loc

← 28.0 → 31.0

5+39.5

10" Locust

← 8.0 → 10.8

5+33.8

← 14.8 → 14" Locust 5+30.0

Cont. from top pg. 162

F. B. 436 PG. 164

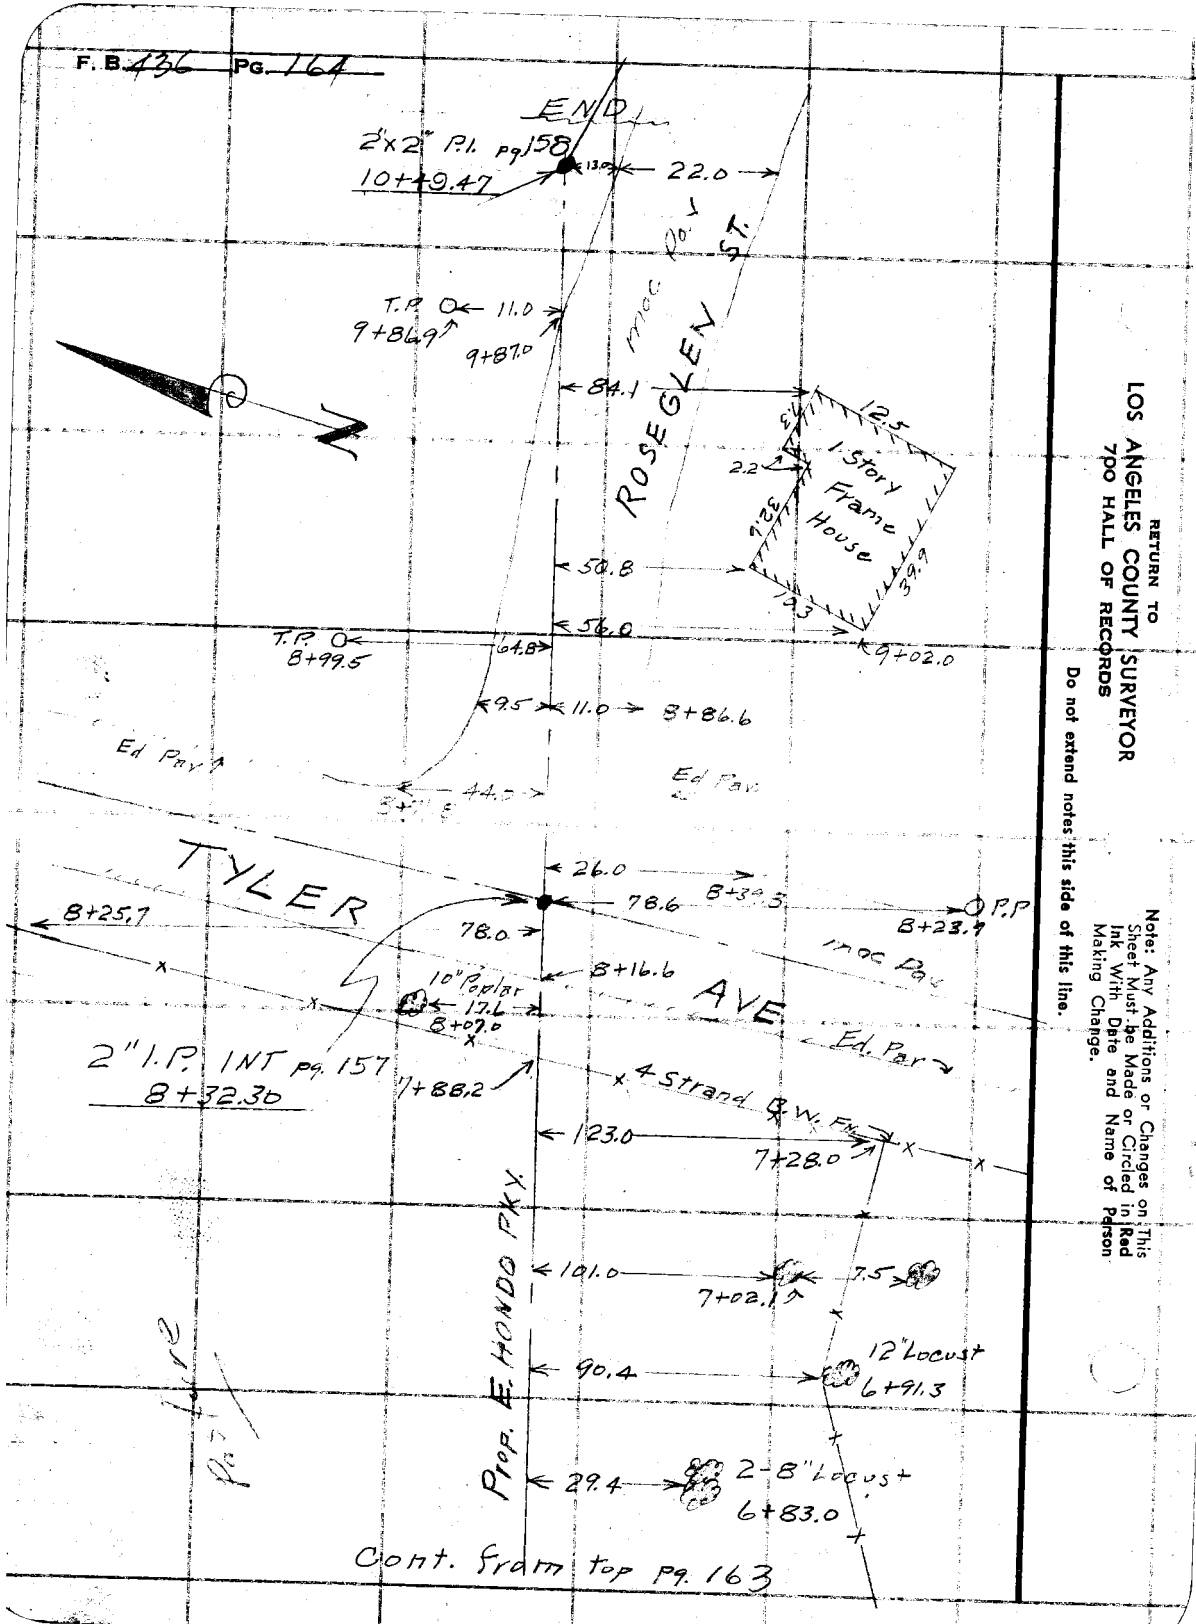

RETURN TO
LOS ANGELES COUNTY SURVEYOR
7DO HALL OF RECORDS

Do not extend notes this side of this line.

Note: Any Additions or Changes on This Sheet Must be Made or Circled in Red Ink With Date and Name of Person Making Change.

Notes Ck'd by		Survey of TYLER AVE	F.B. 436 Pg. 198
Map No. C.S. B-921		W. O. 4433 Tape No. 081 St'd 68 °F	
Office Work RWH CA 5/11/50		Surveyed by Porter	
Checked		Notes Porter Date 6-28-46	
Date		Indexed A. C. Johnson 7-2-46	

LOCATION IMPROVEMENTS
on
Lot #1. R.S. 39-26

North West Corner of TYLER AVE
AND EMERY ST

J.N. 4433

Ref C.S. Map # B-921
F.B. 436 - 215 - 226 - 239

Porter
Holmes
Nand
Cohsner

Note: Any Additions or Changes on This Sheet Must be Made or Circled in Red Ink With Date and Name of Person Making Change.

Do not extend notes this side of this line.

RETURN TO
LOS ANGELES COUNTY SURVEYOR
700 HALL OF RECORDS

FORM 247 SM 11-41

F.B. 436 PG. 199

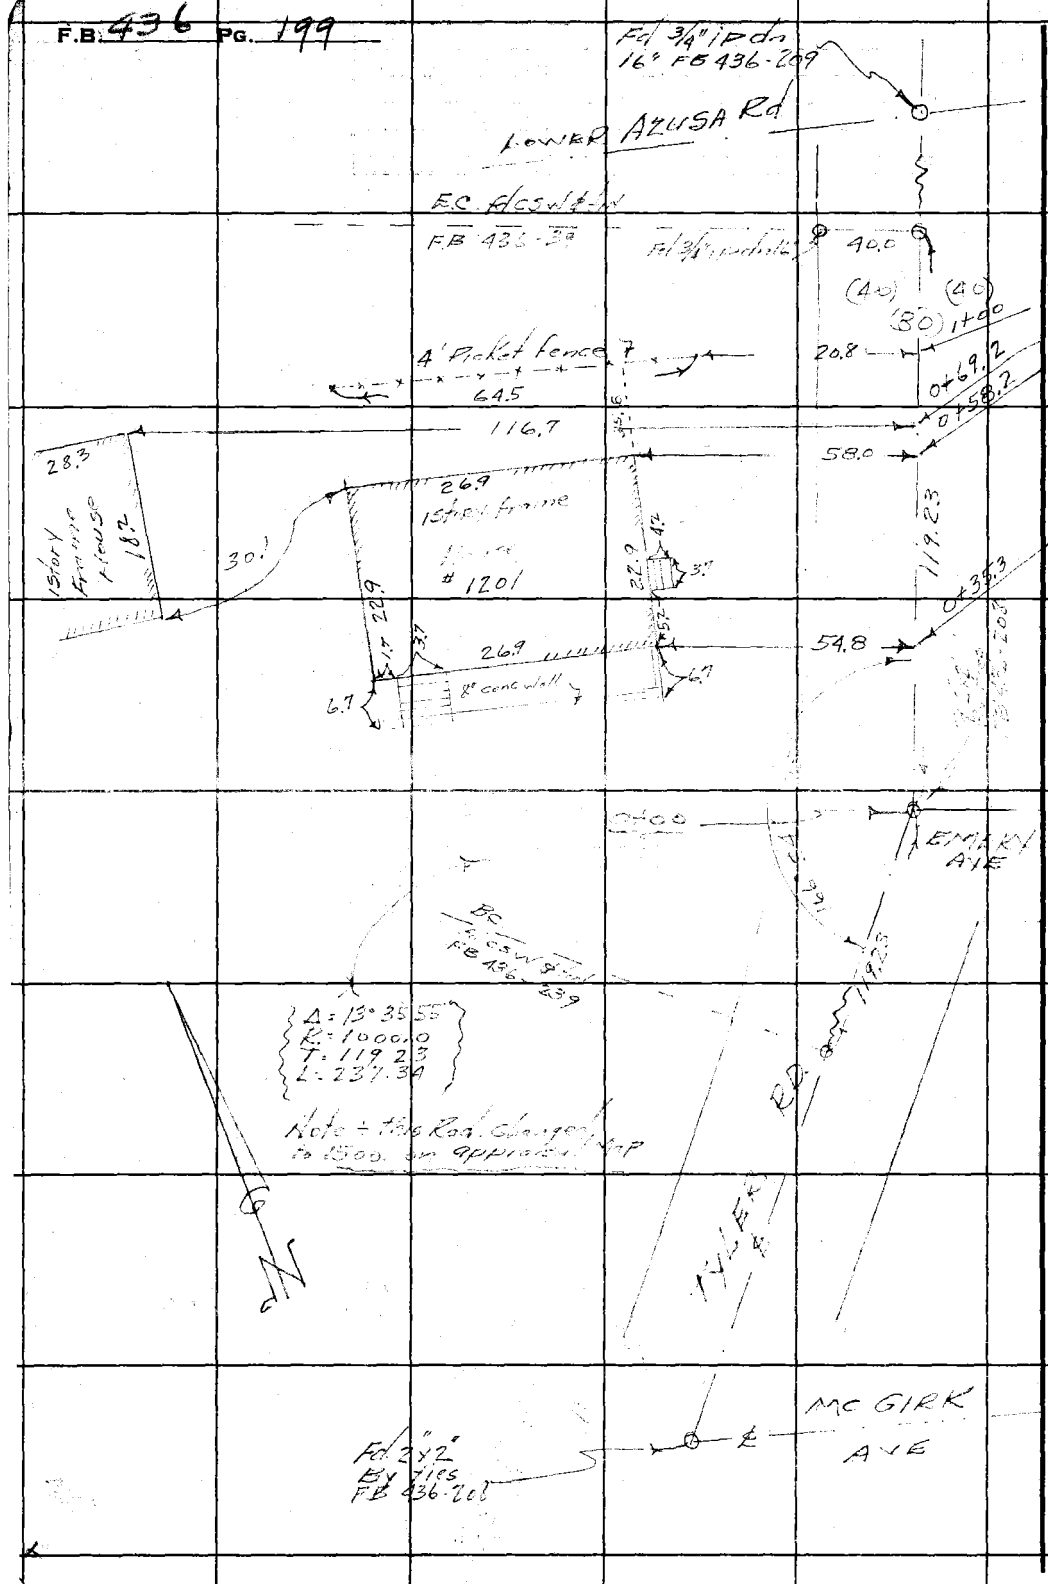

RETURN TO
LOS ANGELES COUNTY SURVEYOR
700 HALL OF RECORDS

Do not extend notes this side of this line.

Note: Any Additions or Changes on This Sheet Must be Made or Circled in Red Ink With Date and Name of Person Making Change.

Notes by	K Johnson	Survey of	Tyler Road
Map No.	A-927	W. O.	1148 Topo No. 41 Sht's 84 ef.
Scale	1in. = 10ft	Surveyed by	Rosecrans
Checked	Dr. Ed	Notes	Date 5-11-33
Date	June 1933	Indexed	A. C. Johnson 5-17-33

F.B. Lib. No.

TYLER ROAD SURVEY

TYLER ROAD - SECOND AVE.

W.O. 1148

April and May 1933

North of El Monte from Center of Road to Live Oak Ave. & and topography. Proposed width = 80 ft.

Transit # 16858
Tape # 041
Topography Pg 215 to Pg. 234.

Party E.A. Rosecrans
E.H. Ellis
F.H. Blanchard
H.H. Reynolds

FOR HALL OF RECORDS

F.B. 436 PG. 201

Cont bottom next page.

Index to notes.

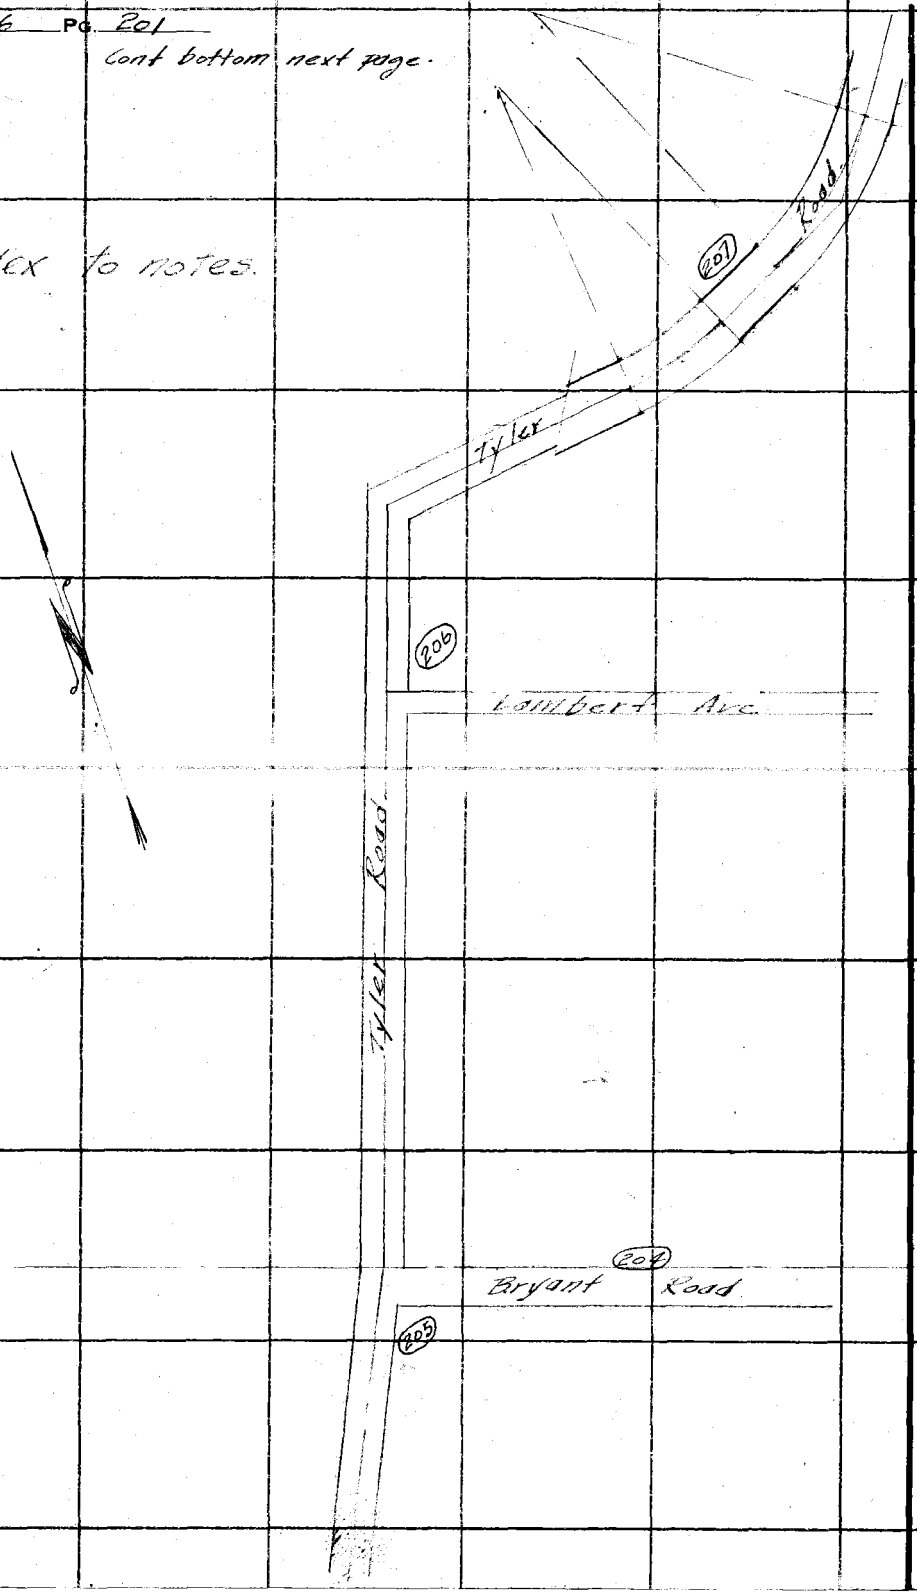

RETURN TO
LOS ANGELES COUNTY SURVEYOR
700 HALL OF RECORDS

Do not extend notes this side of this line

Note: ANY ADDITIONS OR CHANGES ON THIS SHEET MUST BE MADE OR CIRCLED IN Red Ink. WITH DATE AND NAME OF PERSON MAKING CHANGE.

Notes Ck'd by	McPherson	Survey of	Tyler Road
Map No.	B-921	W. O.	7148
Office Work	Rice-Taylor	Tape No.	041
Checked	Drew	Surveyed by	Rosecrans
Date	June-1934	Notes	
		Date	5-11-33
		Indexed	A. C. Johnson


Cont. bottom next page.

index to notes.

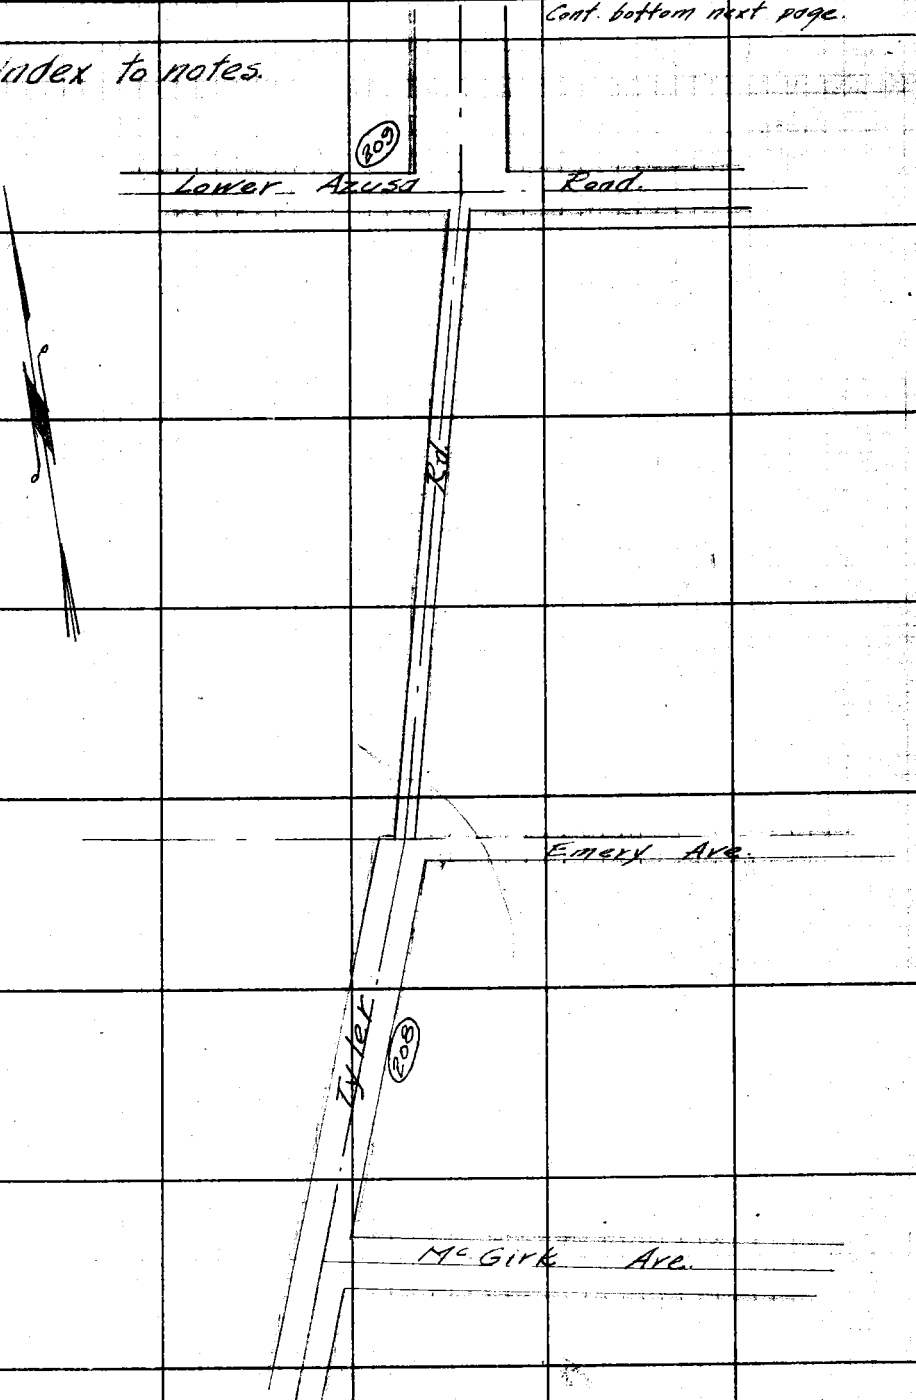

RETURN TO
LOS ANGELES COUNTY SURVEYOR
700 HALL OF RECORDS

Do not extend notes this side of this line

Note: ANY ADDITIONS OR CHANGES ON THIS SHEET MUST BE MADE IN OR CIRCLED IN Red Ink. WITH DATE AND NAME OF PERSON MAKING CHANGE.

FORM 247 10M 8-31

F.B. 436 PG. 203

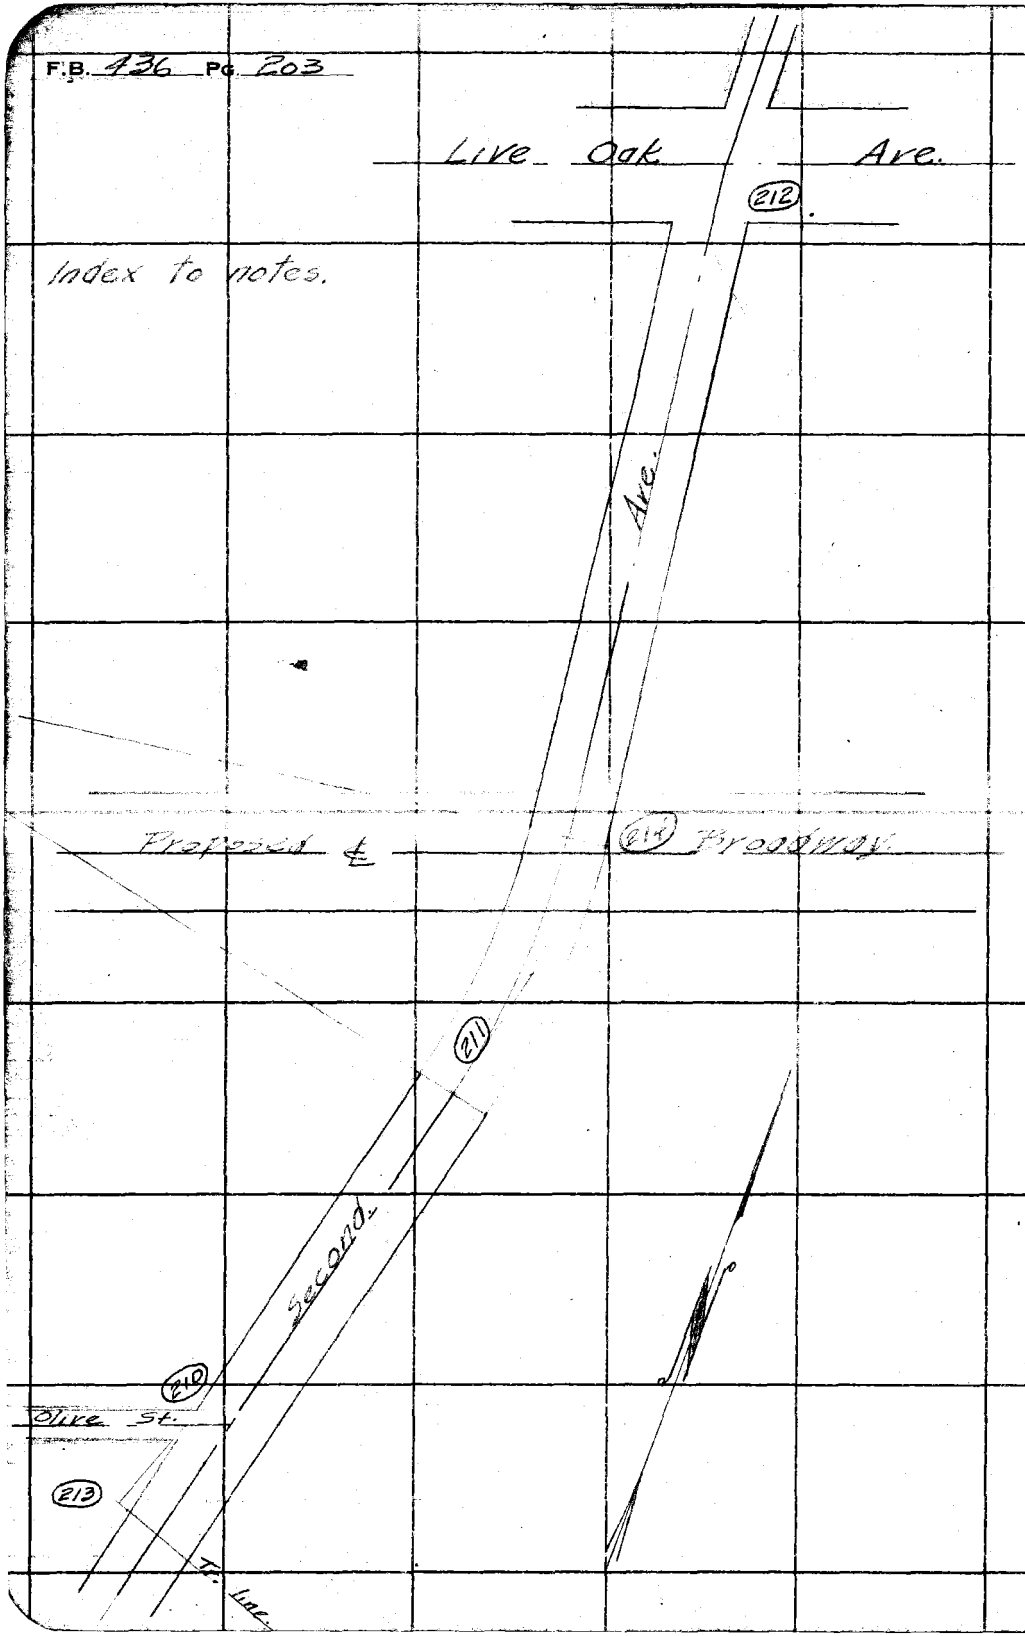

RETURN TO
LOS ANGELES COUNTY SURVEYOR
700 HALL OF RECORDS

Do not extend notes this side of this line

Note: ANY ADDITIONS OR CHANGES ON THIS SHEET MUST BE MADE OR CIRCLED IN **Red Ink.** WITH DATE AND NAME OF PERSON MAKING CHANGE.

Notes Ck'd by	McPherson	Survey of	Tyler Ave
Map No.	B-921	W. O.	7448
Office Work	Rice-Taylor	Tape No.	042
Checked	Drew	Surveyed by	Rosecrans
Date	June-1934	Notes	
		Date	4-27-33
		Indexed	A. C. Johnson

F.B. 436 Pg. 2446

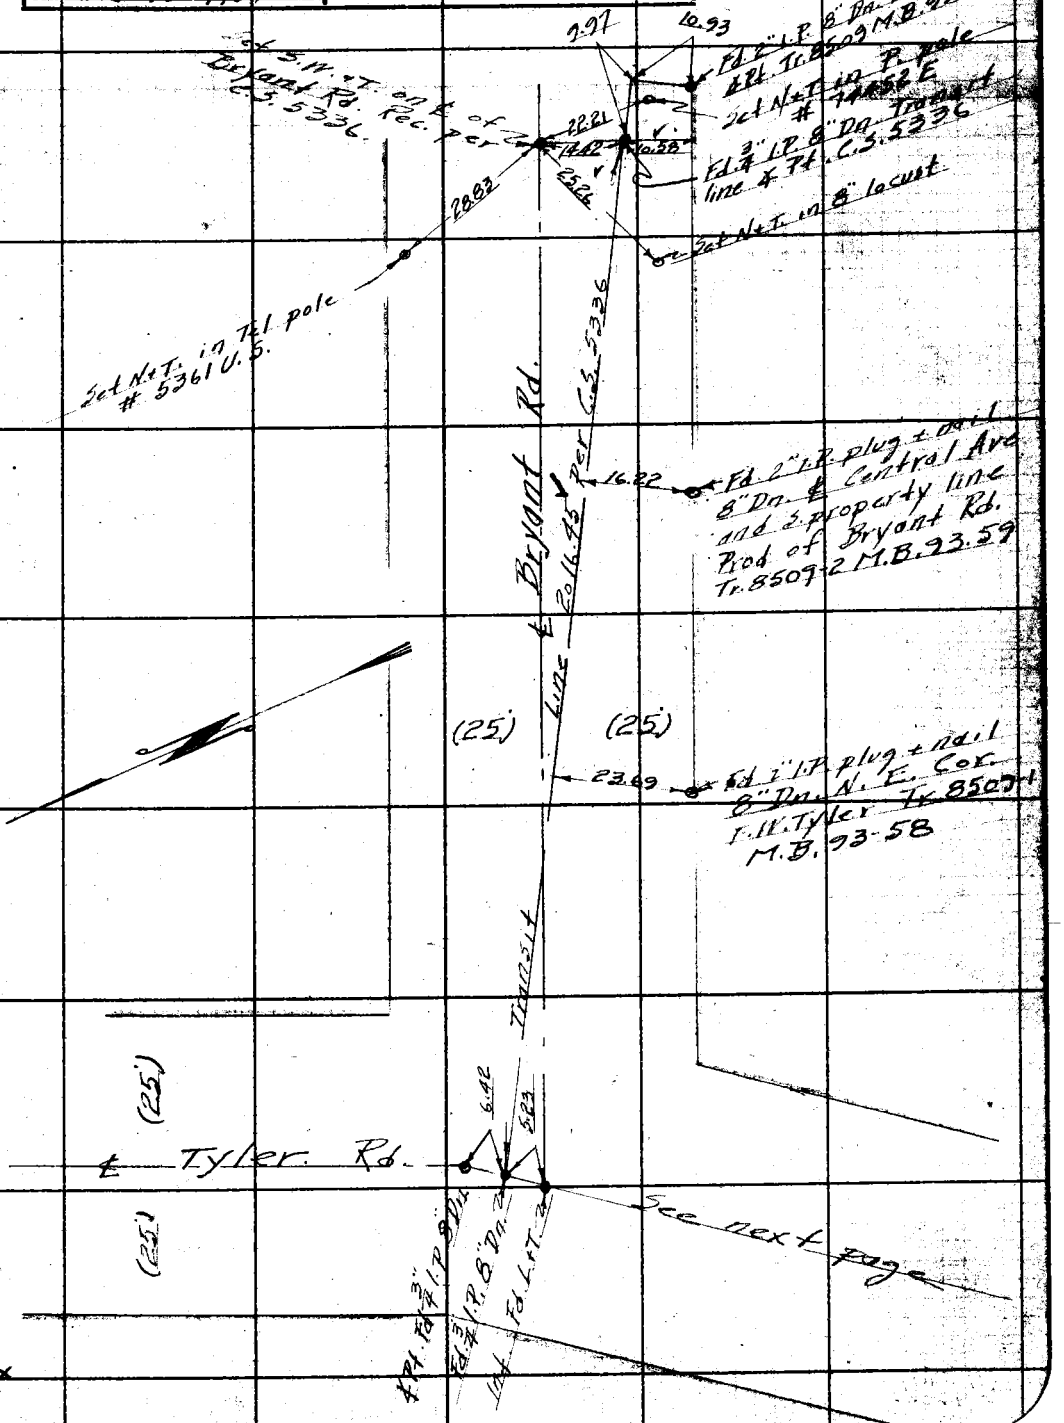

RETURN TO
LOS ANGELES COUNTY SURVEYOR
720 HALL OF RECORDS

Notes: ANY ADDITIONS OR CHANGES OF THIS SHEET MUST BE MADE OR CIRCLED IN Red Ink. WITH DATE AND NAME OF PERSON MAKING CHANGE.

Do not extend notes this side of this line

FORM 247 10M 8-31

RETURN TO

LOS ANGELES COUNTY SURVEYOR

700 HALL OF RECORDS

Note: ANY ADDITIONS OR CHANGES ON THIS SHEET MUST BE MADE OR CIRCLED IN **Red** Ink. WITH DATE AND NAME OF PERSON MAKING CHANGE.

WS-46A-4

Do not extend notes this side of this line

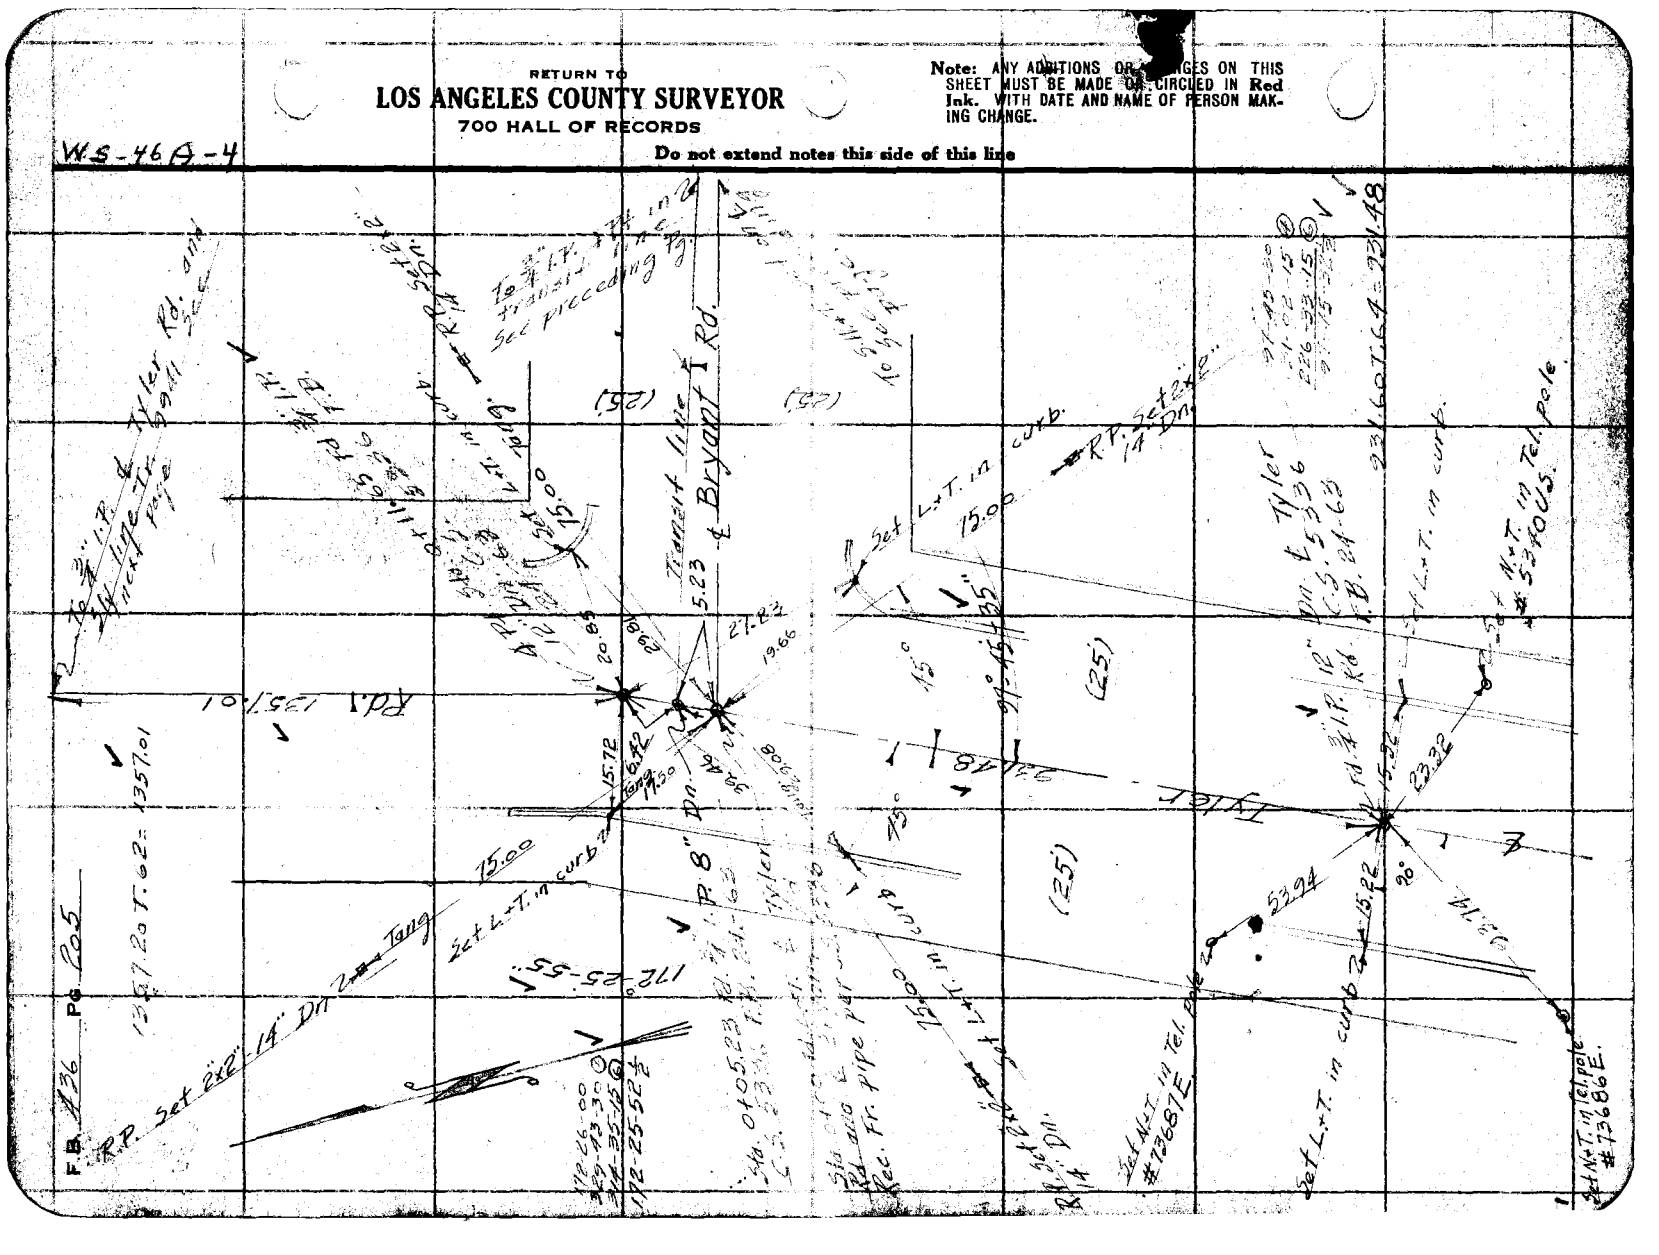

Maps Ch'd by McPherson | Survey of Tyler Road | F.B. 436 Pg. 206
Map No. B-921 | W. O. 2146 Tape No. 241 St'd. 66° F.
Office Work Rec. Taylor | Surveyed by Rosecrans
Checked Drew | Notes | Date 4-28-33
Date June - 1934 | Indexed | A. C. Johnson

WS-116 A-4

Ed. 4" I.P. plug + tack above surface. R.P. Set 2x2"-18" Dn. & Prod.

Road

(25')

24.44

20.00

408.03

25.67

Ft. Pt. Sta. 15+56.33 Fd. 3" I.P. & C.S. 5336 Dn. 0.25-43. F.B. 25-43.

28.90

R.P. Set 2x2"-14" Dn. on & Prod.

Tyler

120-06-20
120-25-30 ②
260-38-15 ⑥
120-06-22½

120-06-25

408.09 T. 62 = 408.03

(25')

(25')

187.69 T. 64 = 187.67

187.67

Set N&T. in St. marker R.P. Set 2x2" 1.2' Dn.

Set N&T. in Tel. pole

Set N&T. in Tel. pole #A3140 G.T.

Set N&T. in Tel. pole

75.00

Lambert Ave

To 4" I.P. filled with lead 12" above S.E. Cor. Lot Tr. 3293 M.B. 36-41

(80')

25.44

36.61

66.07

24.96

42.07

Set N&T. in St. Marker

Fd. 4" I.P. filled with lead Cor. and in Mon. Dn. Tr. #3293 R.B. 36-41

75.00 Tang

45°

VES 7.01

90°-39-25

90-39-30
362-37-45 ②
183-56-30 ⑥
90-39-25

To ¾" I.P. at 4 Pt. Sta. 0+11.65 See Pg. 205

R.P. Set 2x2" 14" Dn.

Notes: ANY ADDITIONS OR CHANGES OF THIS SHEET MUST BE MADE OR CHECKED IN Red Ink, WITH DATE AND NAME OF PERSON MAKING CHANGE.

Do not extend notes beyond this line

RETURN TO
LOS ANGELES COUNTY SURVEYOR
700 HALL OF RECORDS

FORM 247 10M 8-31

RETURN TO
LOS ANGELES COUNTY SURVEYOR
700 HALL OF RECORDS

Note: ANY ADDITIONS OR CHANGES ON THIS SHEET MUST BE MADE OR CIRCLED IN **Red Ink.** WITH DATE AND NAME OF PERSON MAKING CHANGE.

Do not extend notes this side of this line

W.S.A.-4

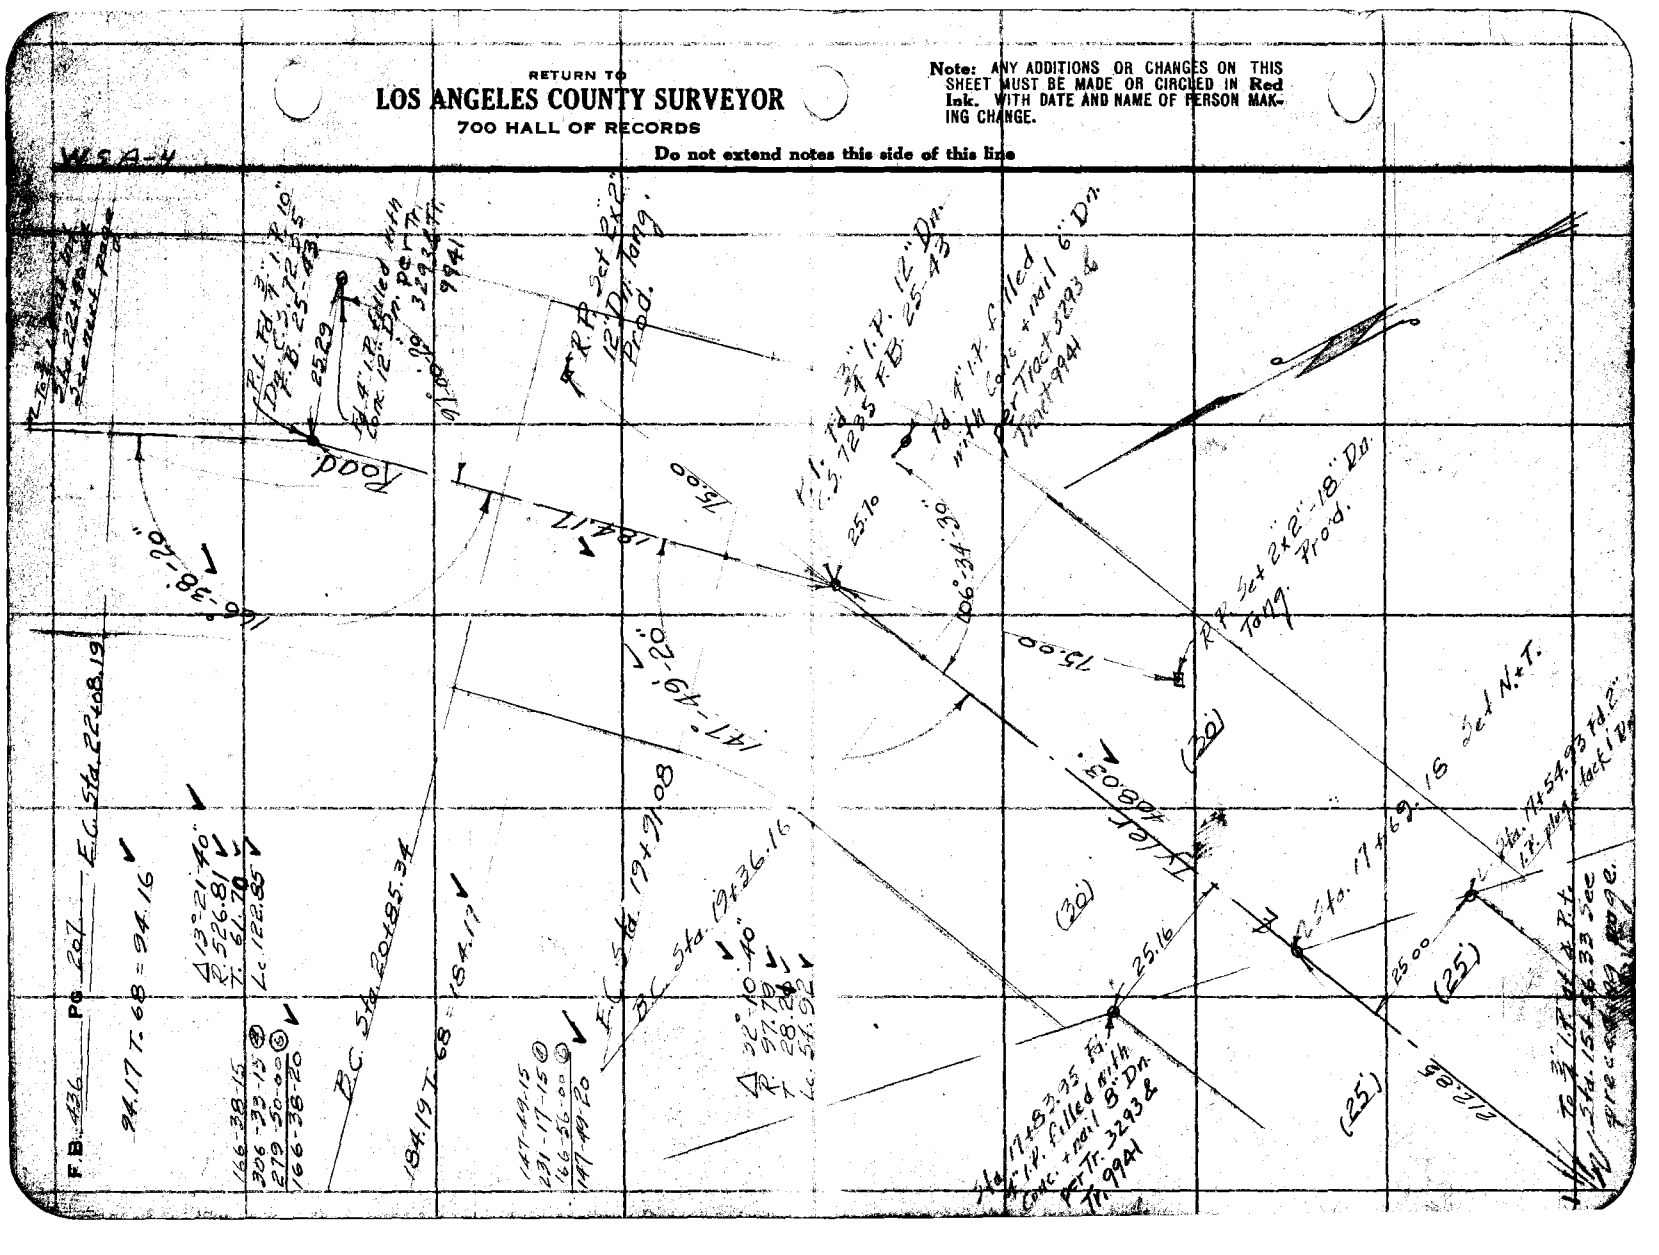
Road
Road
F.C. Sta. 19+91.08
B.C. Sta. 19+36.16
P.C. Sta. 20+85.34
P.T. Sta. 17+68.39
Sta. 14+54.93 Rd. 2° Is. pt. on tract 9941
Is Set N.&T.
Is Sta. 17+68.9
Is Sta. 15+46.33 Rec.
Is Sta. 17+45.35 Fd. 4" I.P. filled with Conc. + nail & Dr. Pt. Tr. 3293 & Tr. 9941
Fd. 4" I.P. filled with Conc. + nail & Dr. Pt. Tr. 3293 & Tract 9941
Fd. 3" I.P. 12" Dr. FB 25-43
R.P. Set 2x2" 12" Dr. Tang. Prod.
R.P. Set 2x2" 18" Dr. Tang. Prod.

Notes Ck'd by [illegible]
Map No. T-961
Office Work Rice - Taylor
Checked Rice
Date June - 1934

Survey of Tyler Road
M. D. 1148 Town No. 4N St'd Bk. of
Surveyed by Rosecrans
Notes
Date 5-1-33
Indexed A. C. Johnson

F.B. 436 Pg. 248

W.S. 4 A-41

To 3 N.&T. & Lower W. Azusa Rd. and E. of Tyler Rd. See next page.

Fd. 1" I.P. filled with conc. and mkd. Flush M.E. Cor. 0.04 E. and 0.04 S. of Cor. Fd. 1" I.P. filled with conc. and mkd. Flush M.E. Cor. 0.04 E. and 0.04 S. of Cor.

Fd. 1" I.P. filled with conc. and mkd. Flush M.E. Cor. 0.04 E. and 0.04 S. of Cor. Lot 1, T.R. 3092 Fd. 36-41

81-20-15
81-20-20
81-20-22½

Fd. 3/4" I.P. filled with conc. and mkd. 1/8 Dia. 2 E. Cor. Lot 1, T.R. 3092 Fd. 36-41

Fd. 3/4" I.P. 0.08 E. of Cor. J.B. Palen T.R. 3092

R.P. 5x6 2x12" Dia. 18"

100.00

2708 2678

43.71

0.08

100.00

Emery Ave.

R.P. 5x6 2x12" Dia. 18"

Fd. 1" I.P. filled with conc. and mkd. 1/8 Dia. 2 E. Cor. NW Cor. Lot 6, T.R. 3092 Fd. 36-41

24.61

1.66

112-15-35

112-15-30
89-02-30
202-30-40
112-15-37½

Fd. N.-T. in R. pole 4.23 E.

Punch mark top of Fire Plug

686.51

Δ 71° 54' 23.15 Fd. I.P. 12" Dia. C.S. 12.35 F.B. 25-41

686.57 T. to = 686.51

(20)

(30)

71-21-30
285-25-30
68-08-45
71-21-27½

Tyler Road

Punch mark top Fire Plug

71-21-25

(30)

Mc Girk Ave.

Fd. 3/4" I.P. filled with conc. and mkd. 1/8 Dia. 2 E. Cor. 6 Tr. 3092 M.B. 36-41

24.73

50.22

Int. 3/4" I.P. 2.24 E. and 2.12 Dia. Tr. 3092 M.B. 36-41

66.42

Fd. 2" I.P. Plug & tack Flush E. Prod Fr. E.

66.63

25.00

24.03

Fd. 3/4" I.P. filled with conc. and mkd. 1/8 Dia. 2 E. Cor. Lot 1, T.R. 3092 M.B. 36-41

Fd. 1" I.P. 18" Dia. & Cedar Post Headed E. & W. McGirk Ave. 2.12 E. and 2.12 N. of Int. of Tyler Rd. & McGirk Ave. T.R. 3092 M.B. 36-41

24.16

To 3/4" I.P. at Pt. See preceding Page.

Fd. 3/4" I.P. 4.36 E. of Cor.

Fd. 3/4" I.P. 2.24 E. and 2.28 N. of Cor. and mkd. 1/8 Dia. 2 E. Cor. Lot 1, T.R. 3092 M.B. 36-41

Fd. 3/4" I.P. 4.72 E. of Cor.

Fd. 3/4" I.P. 2.69 Fd. 1" I.P. Filled with conc. and mkd. 1/8 Dia. 2 E. Cor. and mkd. 1/8 Dia. 2 E. Cor. Lot 1, T.R. 3092 M.B. 36-41

Fd. 3/4" I.P. 4.72 E. of Cor.

RETURN TO
LOS ANGELES COUNTY SURVEYOR
700 HALL OF RECORDS

Do not extend notes this side of this line

NOTE: ANY ADDITIONS OR CHANGES OF THIS SHEET MUST BE MADE OR COMPILED IN RED INK, WITH INITIALS AND NAME OF PERSON MAKING CHANGE

FORM 247 10M 8-31

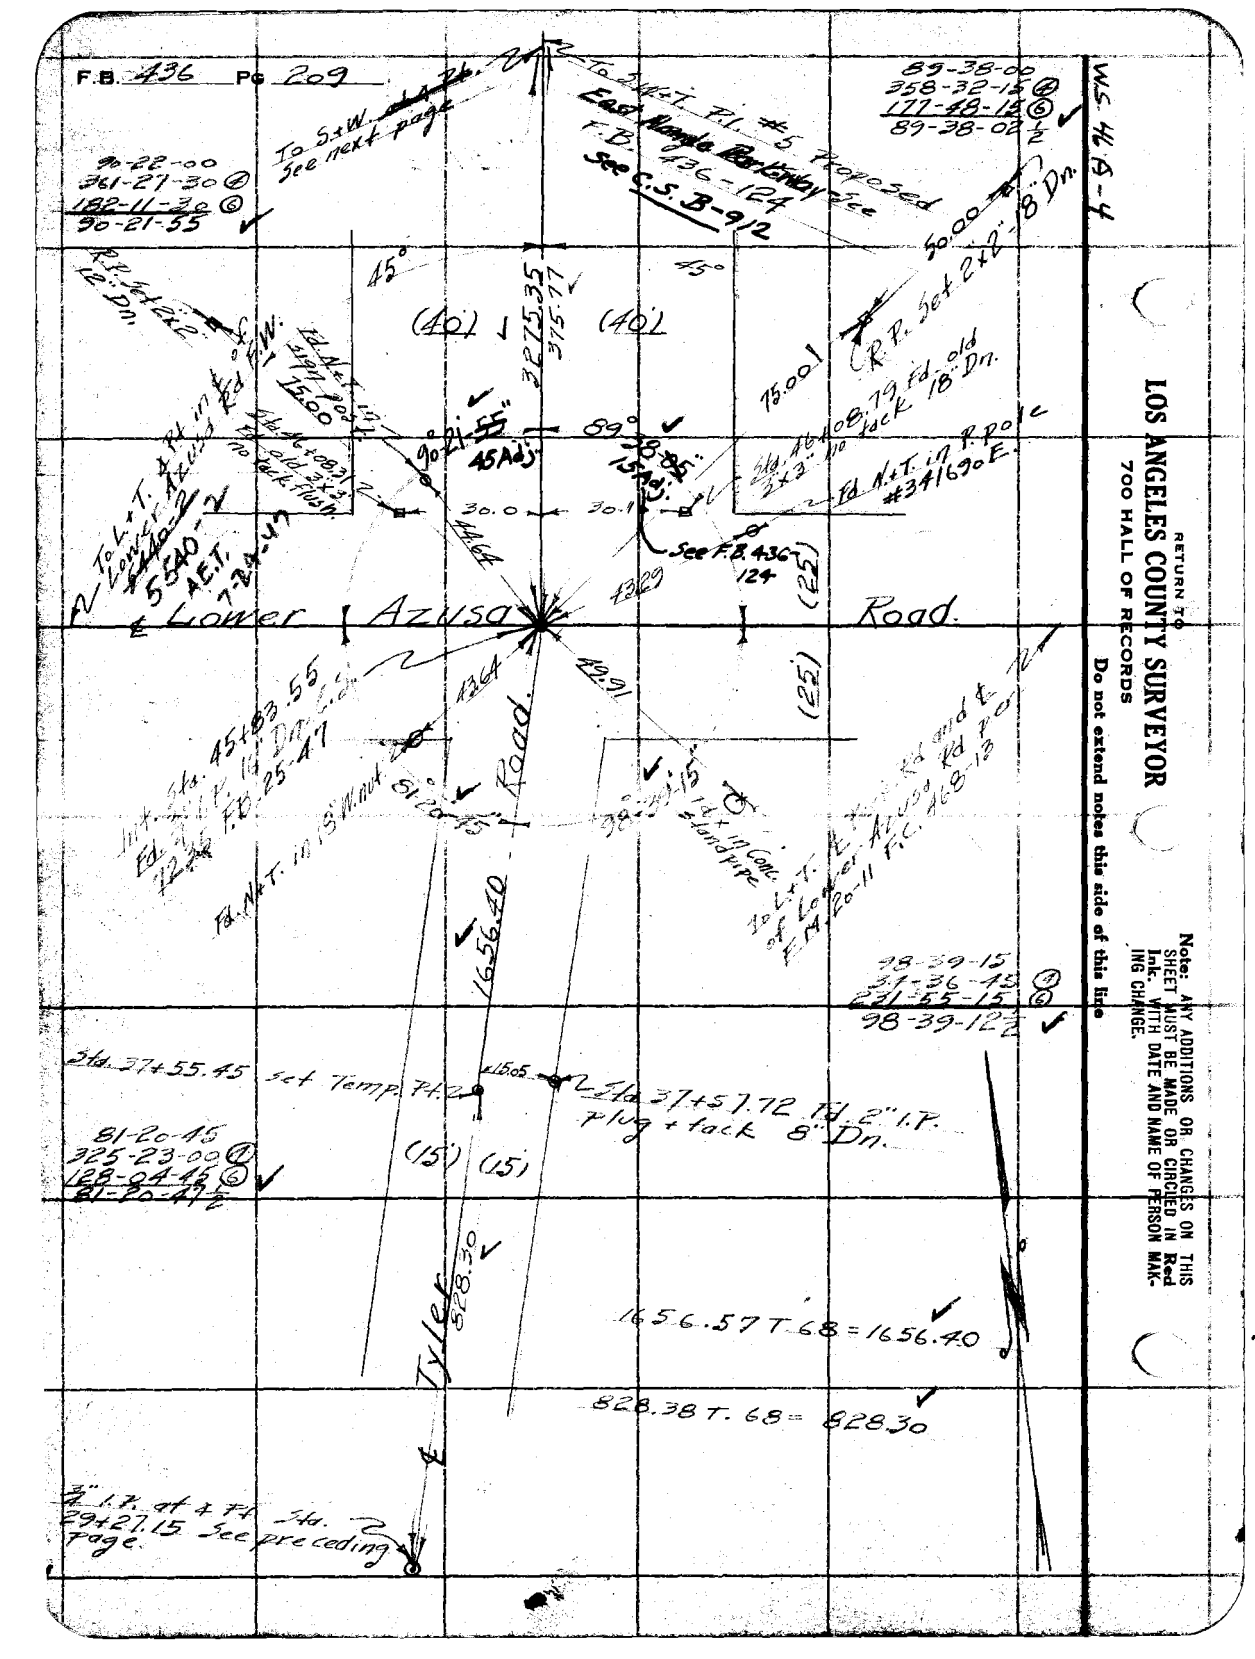

RETURN TO
LOS ANGELES COUNTY SURVEYOR
700 HALL OF RECORDS

Do not extend notes this side of this line

Note: ANY ADDITIONS OR CHANGES ON THIS SHEET MUST BE MADE OR CIRCLED IN Red Ink. WITH DATE AND NAME OF PERSON MAKING CHANGE.

Notes Ck'd by McAuley
Map No. B-921
Office Work Rice-Taylor
Checked Drew
Date June-1934

Survey of Tyler Road
W. O. 748 Tape No. 941 Std. 66 of F.
Surveyed by Roscrans
Notes Date 5-7-33
Indexed A. C. Johnson

F.B. 436 Pg. 210

M.S. 44-3

RETURN TO
LOS ANGELES COUNTY SURVEYOR
700 HALL OF RECORDS
Do not extend notes beyond this line

Notice: ANY ADDITIONS OR CHANGES ON THIS SHEET MUST BE SIGNED OR INITIALED. WITH DATE AND NAME OF PERSON MAKING CHANGE.

FORM 247 10M 8-31

1175.40 T.76 = 1175.34 ✓

To S.&W. at P.I. See next page.

(40') (40')

Ave 1175.34

182-37-45
10-30-45 ④
15-16-00 ⑥ ✓
182-37-10

Fd. L.&T. in curb.

P.C. Sta. 78+71.79 Fd
S.&W. Flush. F.M. 20-35

Int. Sta. 78+58.9 Fd.
S.&W. Flush. F.M. 20-35

30.68
41.52
1.89
Tang. 78.34
49.50
Tang.
75.00
32.32
23.68

Fd. L.&T. in curb.

Fd. L.&T. in curb.

St. St.

Second

54.27
44.24

Freer
Olive
(20)
(20)

Fd. L.&T. in curb

177-22-20 ✓

3275.35

(Tyler Ave.)

To S.&W. at L.&T. & Olive St. & Double Dr. F.M.
54.40-30

73-20-30 ✓

3275.61 T.72
= 3275.35 ✓

73-20-30
293-21-45 ⑦ ✓
80-03-00 ⑥
73-20-30

To ℄ I.R. & Tyler Rd. and ℄ Lower Azusa Rd. See preceding page

F.B. 436 Pg 211

W.S. 46 A-3

To S.+W. lot & of Second Ave. and & Live Oak Ave.
See next page.

1441.53 T. 82 = 1491.51

Fd. S.W.+T.

E.C. Sta. 91+53.90
flush F.M. 20-34.

167-43-00
310-52-15 (R)
286-18-00 (L)
167-43-00

Fd L+T. in curb

167.6 X T. 80 = 107.61

16°-13'-00"

Ave. (Taylor)

125.00

Fd. L+T. in curb

Δ 12-17-00
R. 1000.00
T. 107.60
Lc. 214.38

Fd. L+T. in curb

Fd. L+T. in curb

Second

125.00

(40')

(40')

B.C. Sta. 89+39.52 Fd. S.W.+T.
flush F.M. 20-34

To S.+W. cor. & R.P. Sta. 78+71.79
See preceding page

RETURN TO
LOS ANGELES COUNTY SURVEYOR
700 HALL OF RECORDS
Do not extend notes this side of this line

Note: ANY ADDITIONS OR CHANGES ON THIS SHEET MUST BE MADE OR CIRCLED IN Red Ink. WITH DATE AND NAME OF PERSON MAKING CHANGE.

W.S. 46 A-3

Notes Ck'd by	McPherson	Survey of	Tyler Road
Map No.	B-921	W. O.	7128
Office Work	Rice-Taylor	Surveyed by	Pasterans
Checked	Dres	Notes	
Date	June-1934	Indexed	A. C. Johnson

Tape No. 041 St'd 24 °F.

Date 5-4-33

F.B. 436 Pg. 218

RETURN TO
LOS ANGELES COUNTY SURVEYOR
700 HALL OF RECORDS

Note: ANY ADDITIONS OR CHANGES ON THIS SHEET MUST BE MADE ON CIRCLED # Red Ink. WITH DATE AND NAME OF PERSON MAKING CHANGE.

Do not extend notes this side of this line

98-55-30
35-42-15 ④
233-23-15 ⑤
98-55-32 Σ

R.P. Set 3/4" I.P. 18" Dn.

Live Oak Ave. (50')

N. To S.+W. & Live Oak Ave. and Double Dr. F.W. 5440-26

Set L.+T. in curb.

50.00

98-55-30

45°

19.92

Tang.

81-04-30

Int. Sta. 104+87.80 Fd. S.+W. Flush No. Ties.

Live Oak Ave.

(Las Tunas Dr.) (50')

50.14

82-47-20

52.95

53.14

Tang.

50.29

Set L.+T. in curb.

97-12-40

50.18

50.19

Second St. (Tyler Ave.) (40')

Sta. 104+82.16 Fd. Conc. R.P. Filled with Mk. and Set L.+T. in curb. 2' Dn.

Sta. 104+82.20 Fd. 2"x2" x Hook 1' Dn.

To S.+W. Flush & Live Oak Ave. Chas. 27 Ave. and ℄ @ 40 L.T. F.A. 44-136

82-47-15
331-09-15 ④
136-44-00 ⑤
82-47-20

97-12-45
28-50-45 ④
222-16-15 ⑤
97-12-42

To 1" Iron Pipe in ℄ Flush & Walnut Ave. and Second Ave. F.B. 229-39

81-04-30
324-18-00 ④
126-27-00 ⑤
81-04-30

R.P. Set 3/4" I.P. 18" Dn.

50.00

Set L.+T. in curb.

Tang.

To S.+W. at P.I. Sec. 2 preceding page

FORM 247 10M 5-31

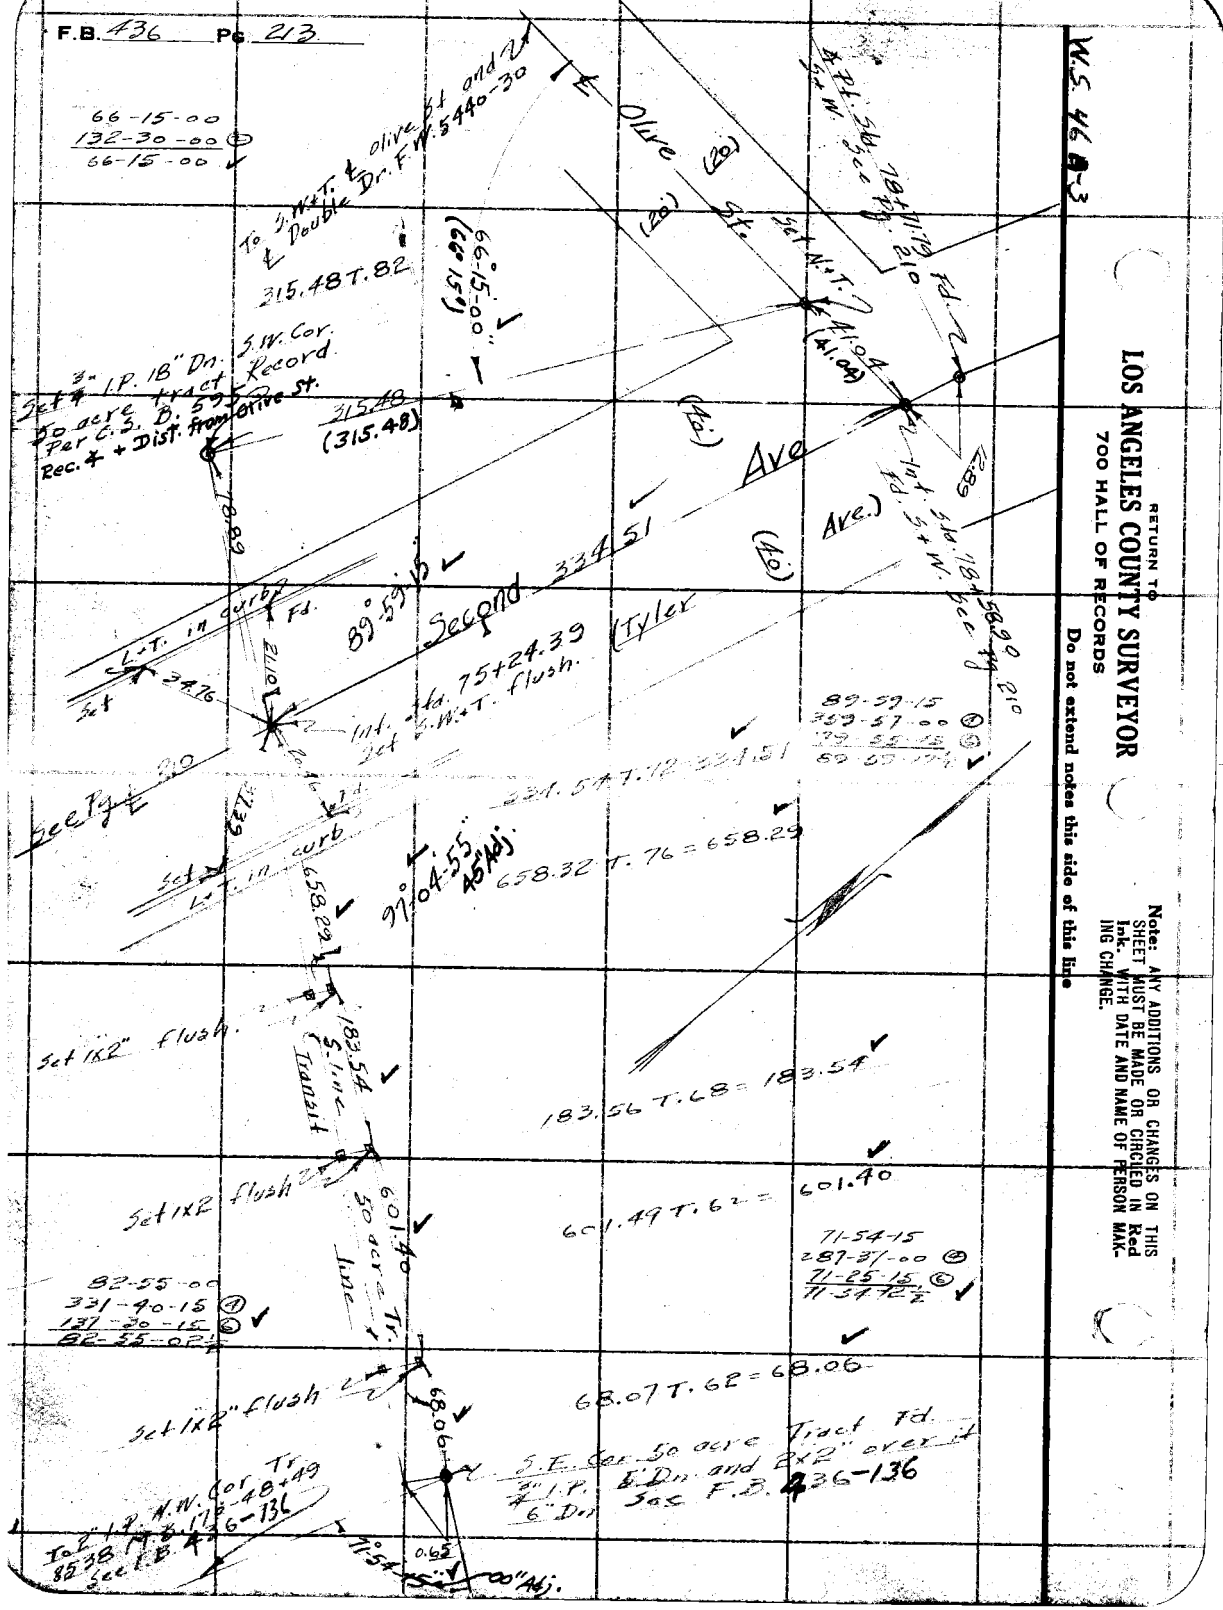
F.B. 436 Pg. 213
W.S. 46 A-3
RETURN TO
LOS ANGELES COUNTY SURVEYOR
700 HALL OF RECORDS
Do not extend notes this side of this line
Note: ANY ADDITIONS OR CHANGES ON THIS SHEET MUST BE MADE OR CIRCLED IN Red Ink. WITH DATE AND NAME OF PERSON MAKING CHANGE.
66-15-00
132-30-00
66-15-00
To S.W.T. & Olive St. and Double Dr. F.W. 5440-30
315.48 T. 82
66-15-00 (660.15')
Set 3- I.P. 18" Dn. S.W. Cor. 20 acre tract of Record Per C.S. Bk. 57 Pg. 5 Rec. & + Dist. from Olive St.
315.48 (315.48)
18.89
L.T. in curb
Fd.
Set
2.476
Ellio
Int. Sta. 75+24.39 Set S.W.T. flush.
89°59'15" 331.54
Second
(Tyler
(40)
Ave
(40)
Ave.)
Fd. 3/4 in. pipe
89-59-15
359-57-00
89-55-15
89-57-45
See Page 210
Set L.T. in curb
658.29
97°04'55" 45 Adj.
658.32 T. 76 = 658.29
Set 1X2" flush.
183.54
S. line Transit
183.56 T. 68 = 183.54
Set 1X2" flush
601.40
50 acre Tr. line
601.49 T. 62 = 601.40
71-54-15
287-37-00
71-25-15
71-34-42½
82-55-00
331-40-15
131-20-15
82-55-02½
Set 1X2" flush
68.06
68.07 T. 62 = 68.06
S.E. Cor. 50 acre Tract Fd. 3/4" I.P. & Dn. and 2X2" over it 6" Dn. See F.B. 436-136
N.W. Cor. Tr. 48+49
To 2" I.P. 1.78 N. & 1.36 W. 436-136
88.38 See F.B. 436-136
11°54'
0.65
00" Adj.

W.S. 46 A-3

Notes Ck'd by MS Hanson		Survey of Tyler Road	F.B. 536 Pg. 212
Map No. 3-92		W. O. 7448	Tape No. 041 St'd 64 °F.
Office Work Rice-Taylor		Surveyed by Rosecrans	
Checked Draw		Notes	Date 5-8-33
Date June- 1934		Indexed A. C. Johnson 5-17-34	

97-15-30
23-02-30 ⓐ
223-33-45 ⓒ
97-15-37½ ✓

To S+W int. ℄ Live Oak Ave and ℄ Tyler Ave Sta. 104+87.80 Pg. 212

932.13 T.68 = 932.03 ✓

97°15'35" ✓

Ave.] Pg. 211

(Tyler Ave.)

Ed. 2"x2" iron tack & tag Proposed ℄ Broadway C.S. 62-4 F.B. 271 103+109.

S.C. Sta. 914+53.20 Ed. S. W.+T. 3<-Pg. 211. (50')

Ed. L.+T. in curb.

28.69

20.31 ✓

Ed. L.+T. in curb.

Sc+L.+T. in curb.

18.69

20.68

20.24

Broadway 332.03 ✓

Sc+L.+T. in curb.

Proposed ℄

Broadway P.O.T. Sta. 512+50.03 Second Ave P.O.T. Sc+3.W.+T. flush.

(50')

W.P. L.+T. & El Monte Rd and proposed ℄ Broadway C.S. 62-4 F.B. 271-106.

Second

P.I. Ed. S.+W. Pg. 211

(40')

(40')

P.C. Sta. 892+39.5< See Pg. 211

Ed. S.W.+T.

RETURN TO
LOS ANGELES COUNTY SURVEYOR
700 HALL OF RECORDS
Do not extend notes this side of this line

Notice: ANY ATTENTIONS OR CHANGES ON THIS SHEET MUST BE MADE OR CANCELLED IN INK, WITH DATE AND NAME OF PERSON MAKING CHANGE

FORM 247 10M 5-31

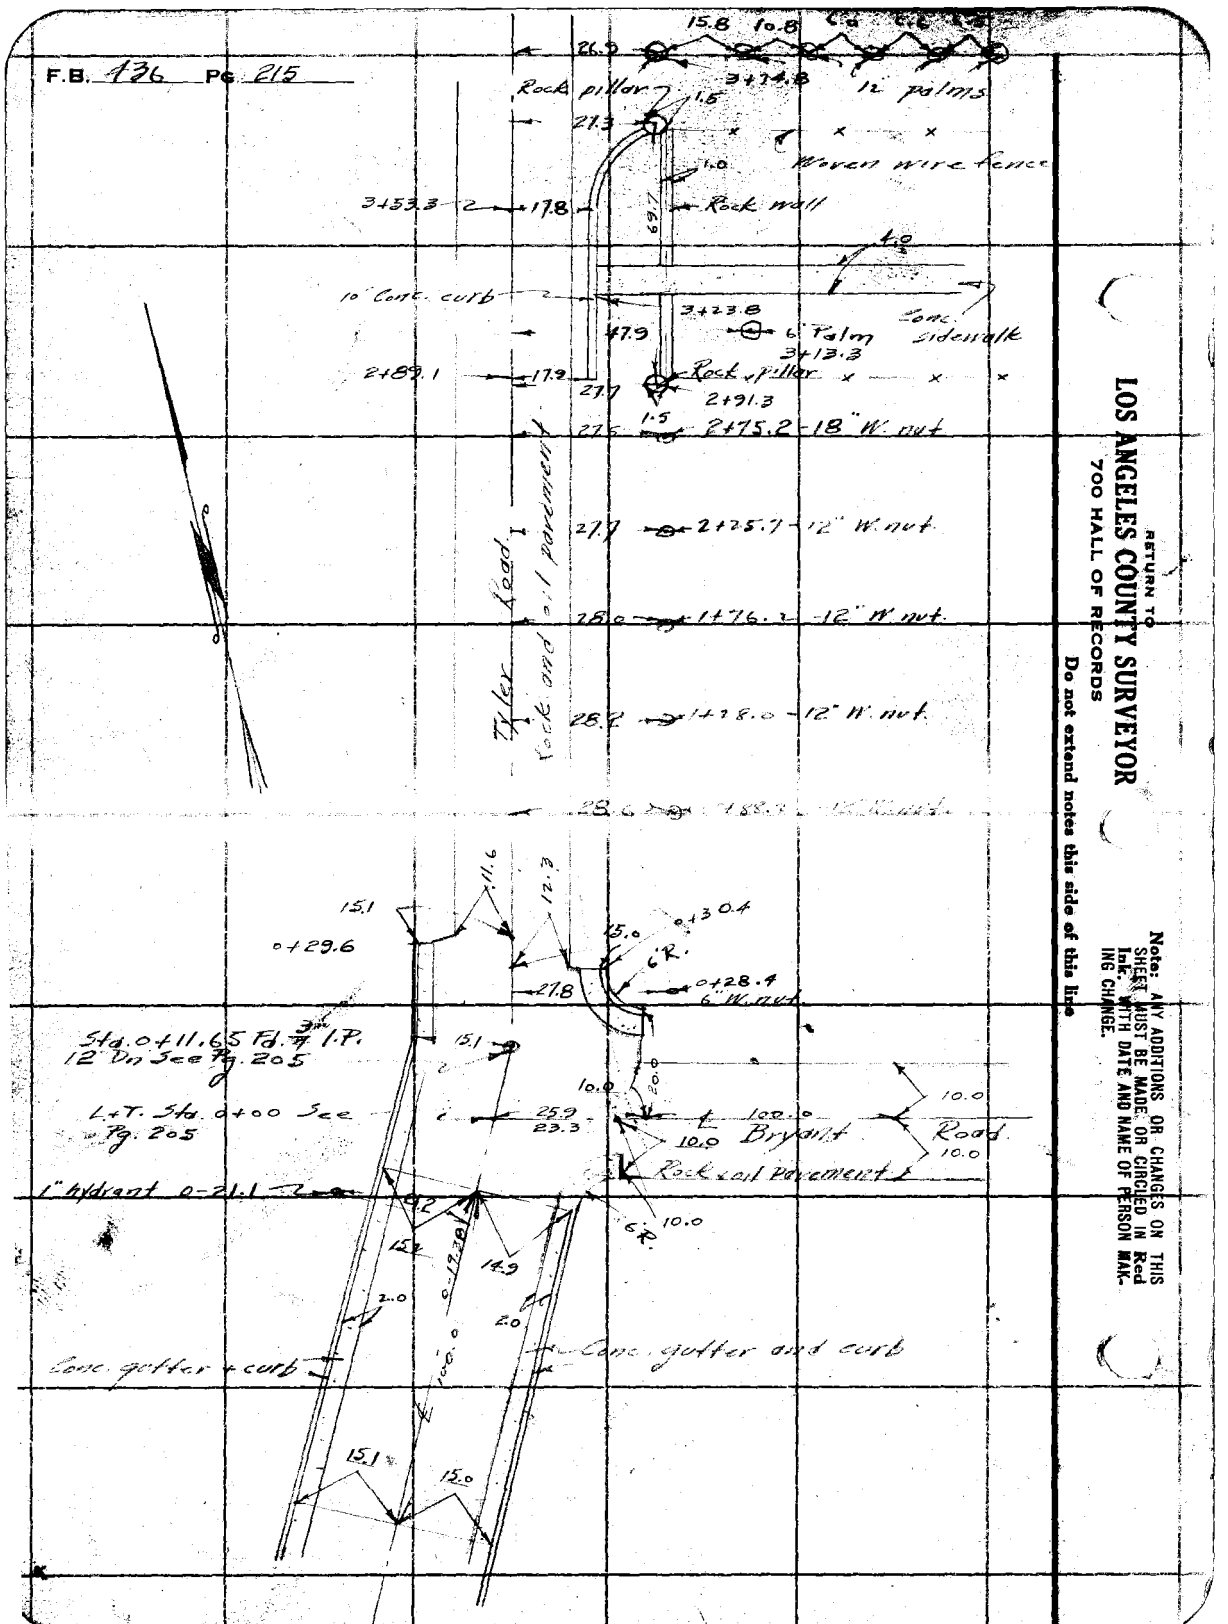

RETURN TO
LOS ANGELES COUNTY SURVEYOR
700 HALL OF RECORDS

Do not extend notes this side of this line

Note: ANY ADDITIONS OR CHANGES ON THIS SHEET MUST BE MADE OR CIRCLED IN Red Ink WITH DATE AND NAME OF PERSON MAKING CHANGE.

Notes Ck'd by	McPherson	Survey of	Tyler Road.
Map No.	B-921	W. O.	7148
Office Work	Rice-Taylor	Tape No.	941
Checked	Drew	Surveyed by	Rosecrans
Date	June-1934	Date	5-8-33
		Indexed	A. C. Johnson

F.B. 436 Pg. 216

Cont. bottom next page

Woven wire fence

13+68.7

25.7

9.1

14+00

19.0

15.1 Rock + oil pavement

15.8

100.0

Tract line Pg. 206

13+68.66

19.0

13+47.1

Fd. 3" I.P. Sta 13+68.66 See Pg. 206

Rock + oil pavement

7A97.5-6" Fig. Tr.

46.8

9.5

13.6

27.5

6A67.5-18" W. nut

Road

27.2

6+18.5 18" W. nut

Tyler

27.0

5+70.8-18" W. nut

26.8

5+19.6-18" W. nut

4+71.2

26.6

19.6

18" W. nut.

18" W. nut

4+22.2

26.9

24.5

25.5

12" W. nut

8" Fruit

12" W. nut

4+09.0

29.1

26.4

12.0

8" Fruit tree 12"

Sta 4+00 Set N+T.

20

13.8

3+85.2

29.4

18.5

18.5

6 peach 8" loquat 12" peach

Note: ANY ADDITIONS OR CHANGES MUST BE MADE ON THIS SHEET AND INITIALED IN INK. WITH DATE AND NAME OF PERSON MAKING CHANGE.

RETURN TO
LOS ANGELES COUNTY SURVEYOR
700 HALL OF RECORDS
Do not extend notes this side of this line

FORM 847 10M 8-31

RETURN TO
LOS ANGELES COUNTY SURVEYOR
700 HALL OF RECORDS

Note: ANY ADDITIONS OR CHANGES ON THIS SHEET MUST BE MADE OR CIRCLED IN **Red Ink.** WITH DATE AND NAME OF PERSON MAKING CHANGE.

Do not extend notes this side of this line

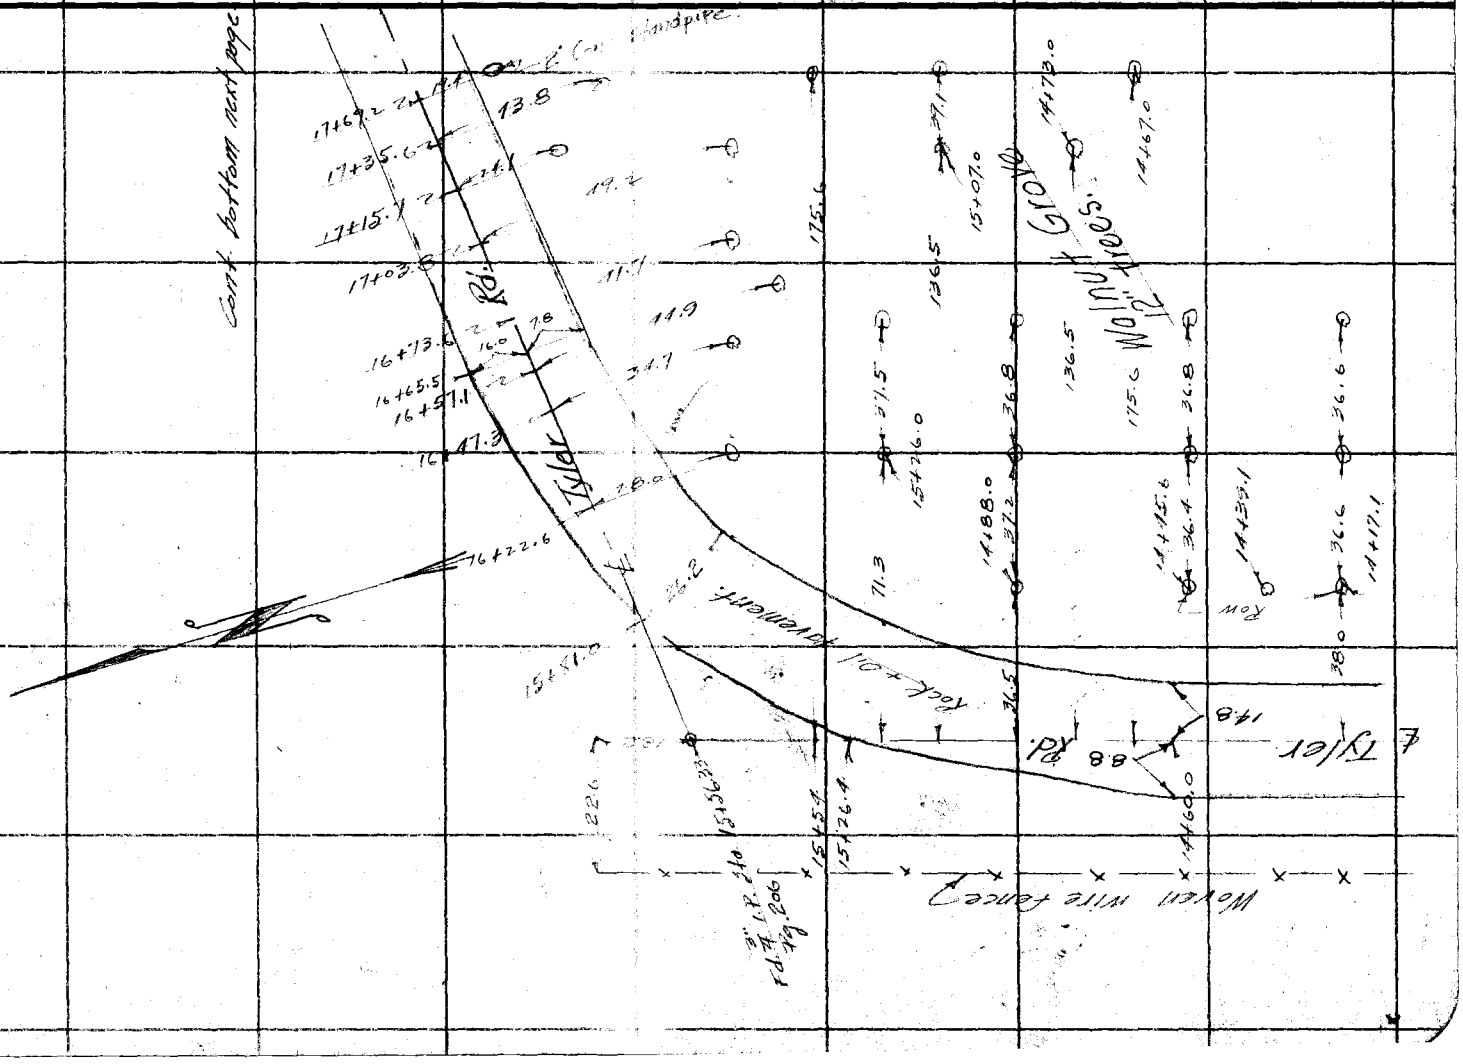

F.B. 1126 Pg. 21

Notes Ck'd by Drew	Survey of Tyler Road
Map No. B-921	W. O. 7148 Tape No. 041 Bk'd 84 of F.
Office Work Rice-Taylor	Surveyed by Rosecrans
Checked Drew	Notes Date 5-9-33
Date June-1934	Indexed A. C. Johnson

F.B. 136 Pg. 81

Cont. bottom next page.

Notes: ANY ADDITIONS OR CHANGES OF THIS SHEET MUST BE MADE IN RED AND WITH INK AUTHORITY OF PERSON MAKING CHANGE

RETURN TO
LOS ANGELES COUNTY SURVEYOR
720 HALL OF RECORDS

Do not extend notes this side of this line

FORM 847 10M 8-31

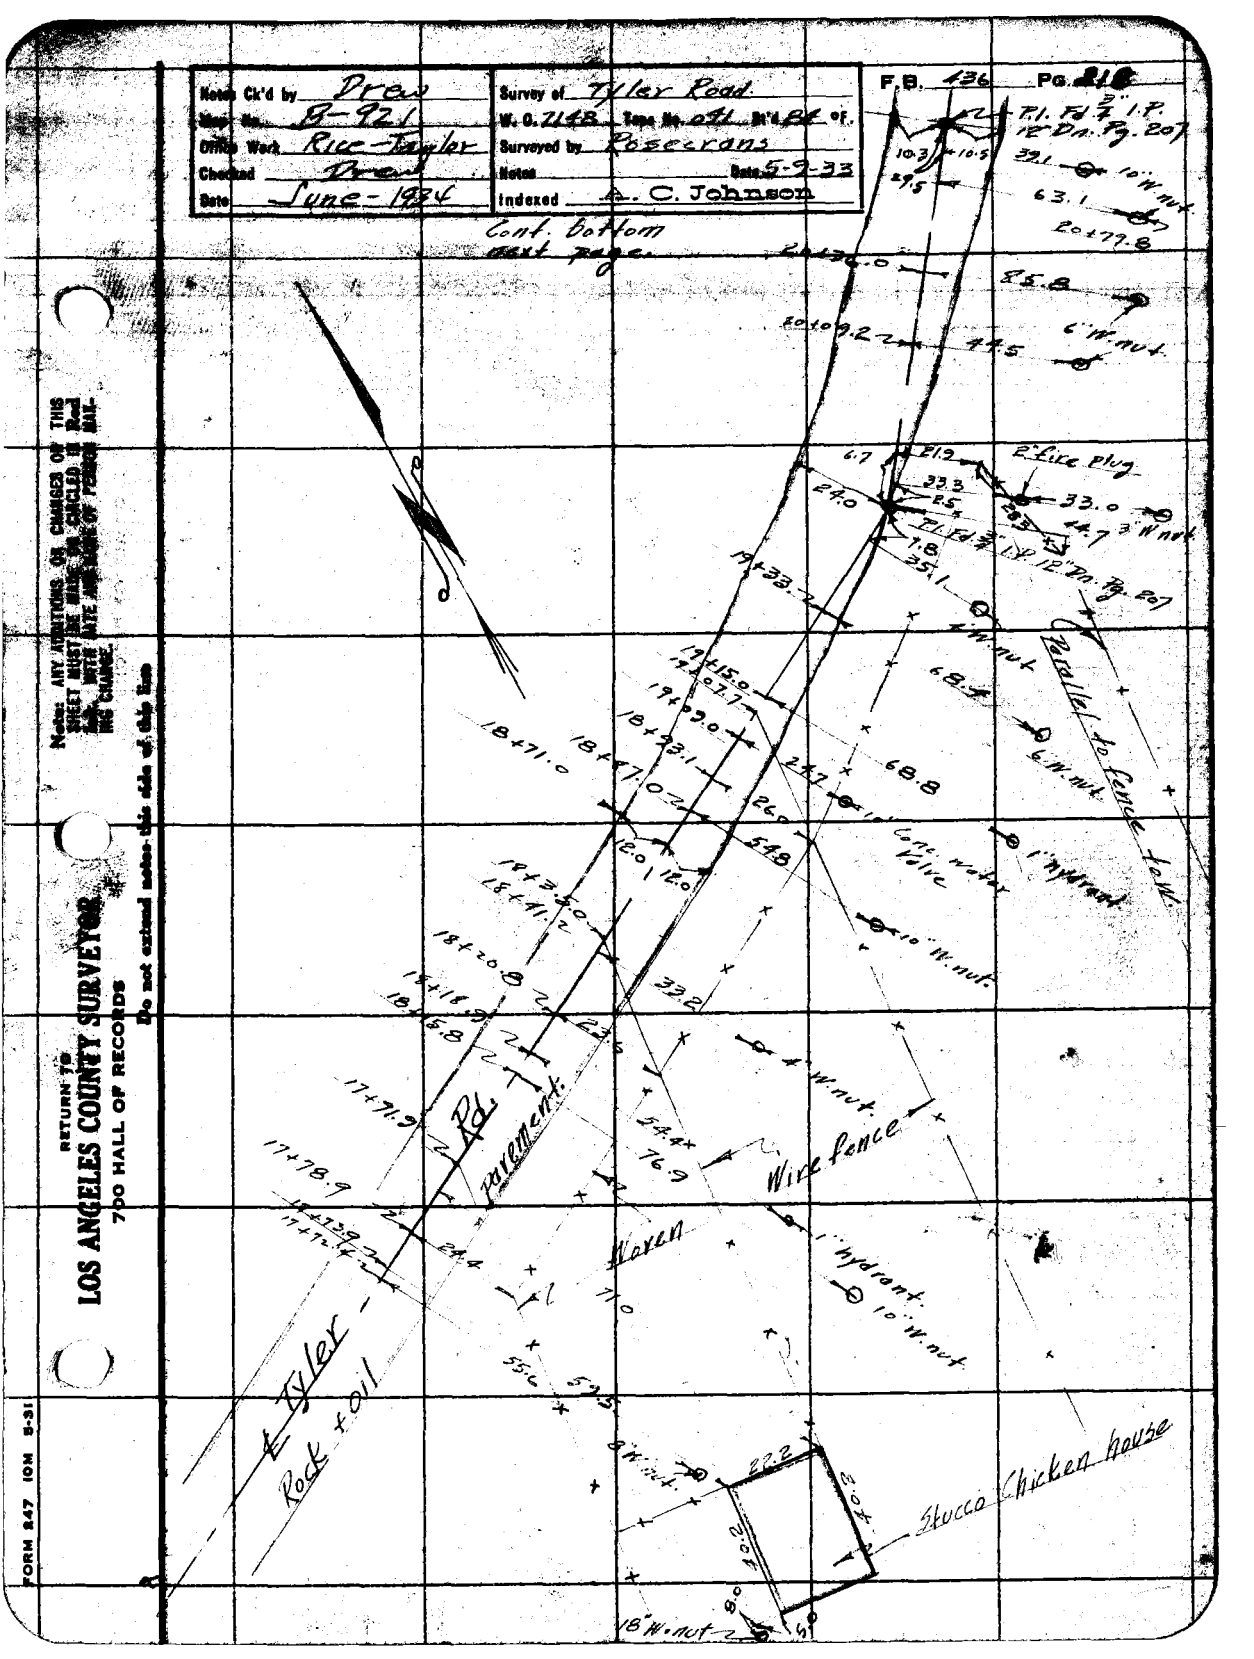

F.B. 436 Pg. 219

cont. bottom next page.

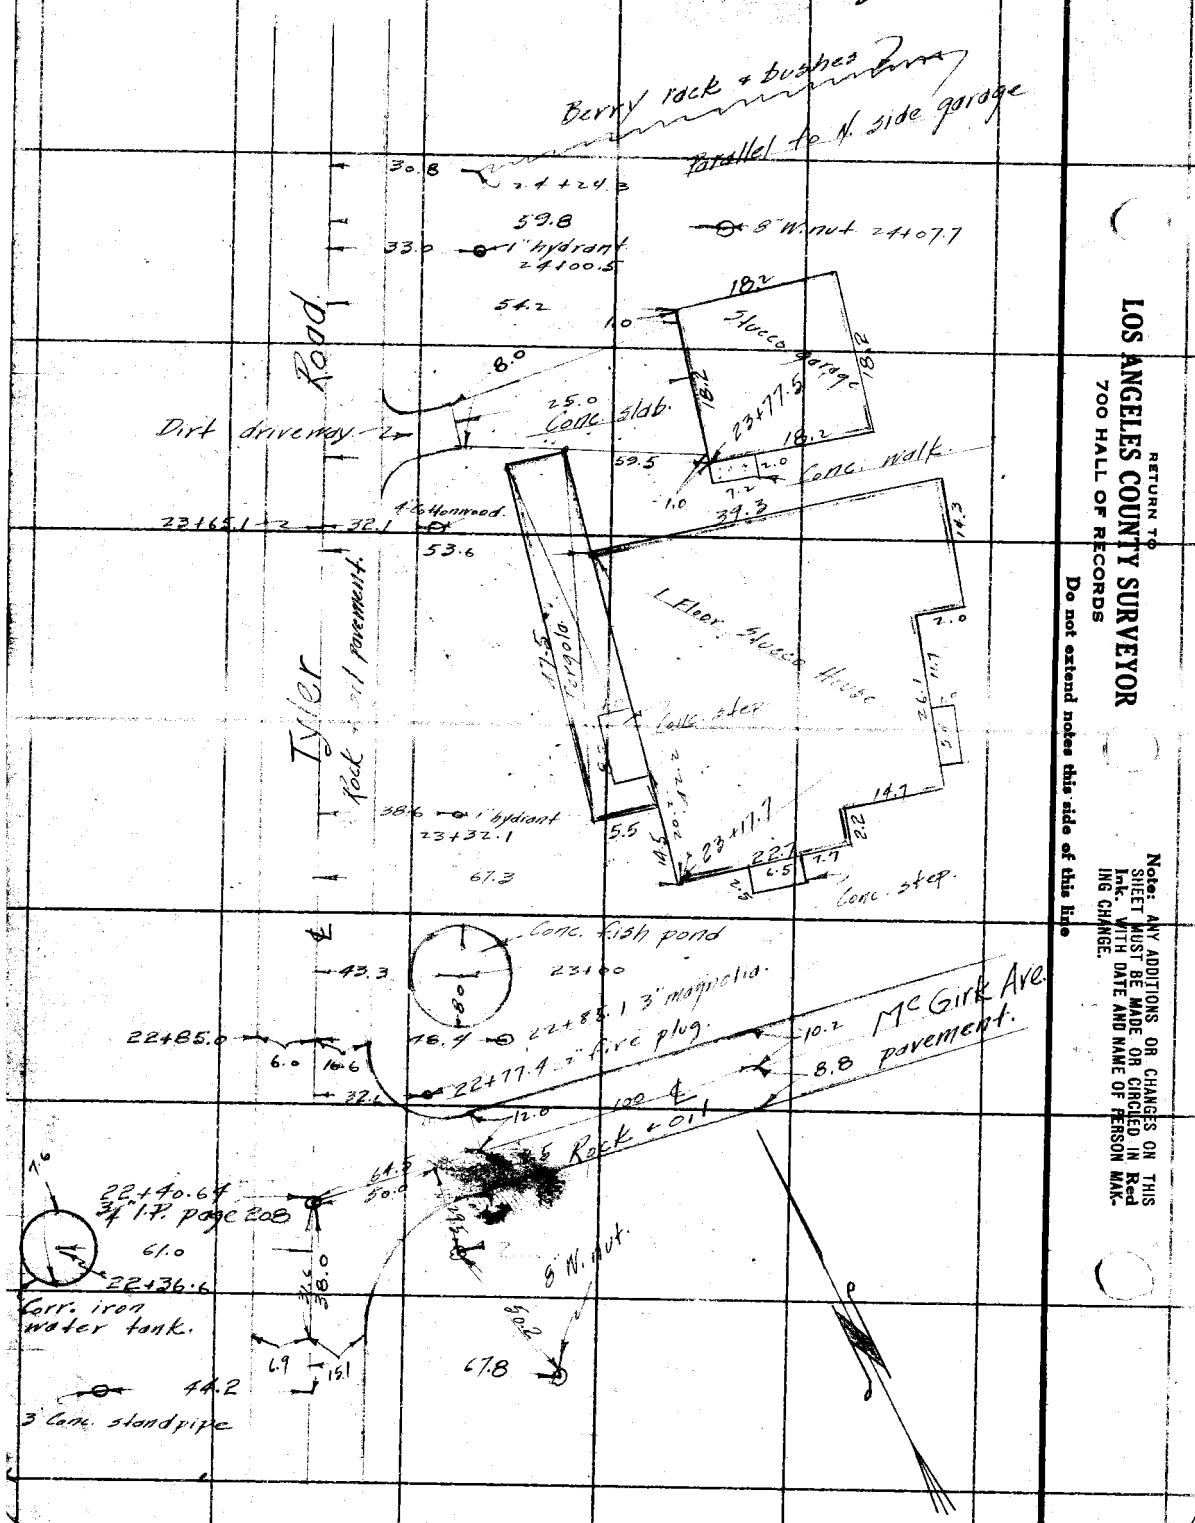

RETURN TO
LOS ANGELES COUNTY SURVEYOR
700 HALL OF RECORDS

Do not extend notes this side of this line

Note: ANY ADDITIONS OR CHANGES ON THIS SHEET MUST BE MADE OR CIRCLED IN Red Ink. WITH DATE AND NAME OF PERSON MAKING CHANGE.

Notes Ck'd by Drew
Map No. 3-921
Office Work Rice-Taylor
Checked Drew
Date June-1934

Survey of Tyler Road.
W. O. 7148 Tape No. 241 St'd 64 ft.
Surveyed by Rosecrans
Notes Date 5-9-33
Indexed A. C. Johnson

F.B. 436 Pg. 220

Cont. bottom Pg. 223.

40.7 — 28+76.0 - 8" W. nut.

54.0 — 28+26.0 - 10" W. nut.

27+78.5 6" W. nut.

66.3

27+12.3 6" W. nut.

31.4

26+95.0

10.0

Dirt driveway

26+85.0

10°

43.6 — 26+65 8" W. nut.

26+62

33.5 — 26+55.0 1" hydrant

57.0 — 26+15.4 8" W. nut

6.4 15.2

26+00

71.4 — 25+73.0 1" hydrant.

70.1 — 25+69.5 6" W. nut.

45.0 — 25+61.5 3" peach.

Tyler Road

34.2 — 6" W. nut 25+03.7

52.0

34.1

Rock + oil pavement

1 Floor Stucco House

14.1

28.1

3.0

13.2

44.1

33.7

1.0 5 4.0 — Conc. step

61.3

46.9 — 6" W. nut. 24+55.8

Notes: ANY ADDITIONS OR CHANGES ON THIS SHEET MUST BE MADE OR CIRCLED IN Red Ink. WITH DATE AND NAME OF PERSON MAKING CHANGE.

RETURN TO
LOS ANGELES COUNTY SURVEYOR
700 HALL OF RECORDS
Do not extend notes this side of this line

FORM 247 10M 8-31

F.B. 436 PG. 221

Cont. bottom next page

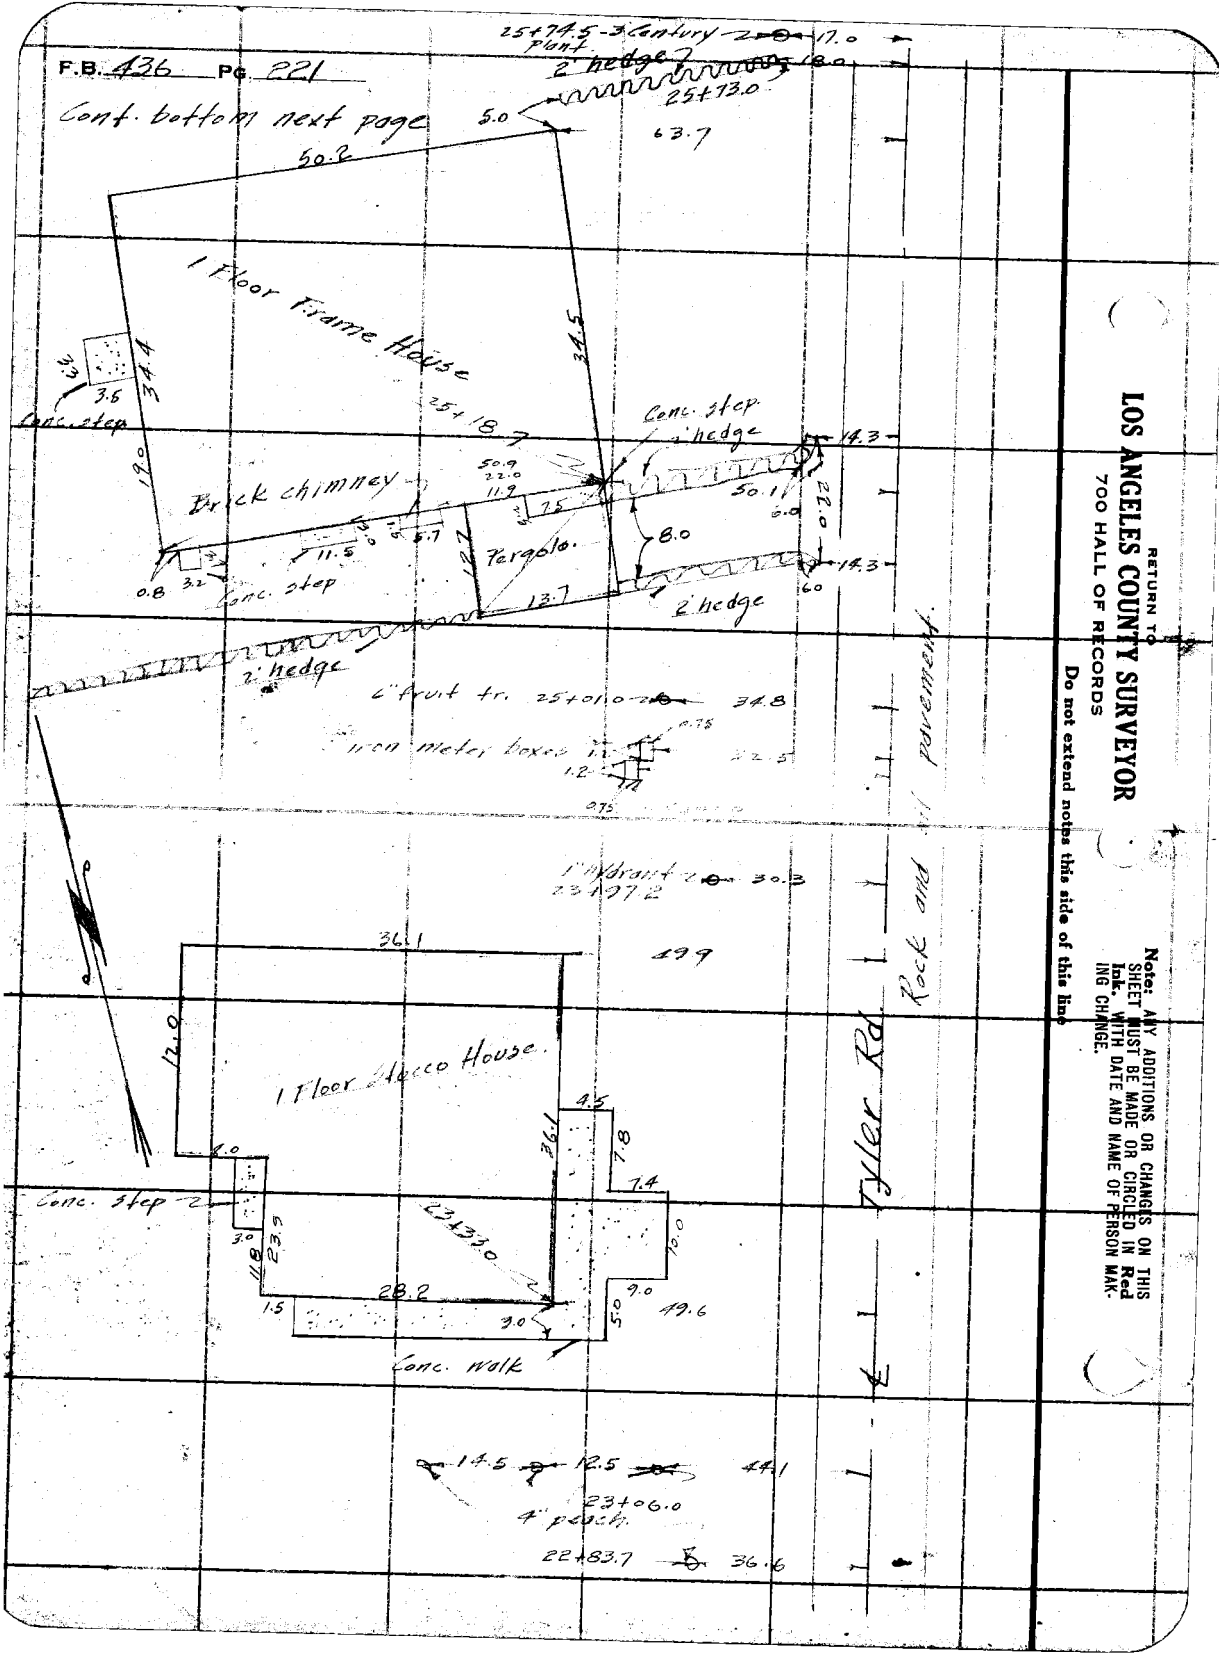

RETURN TO
LOS ANGELES COUNTY SURVEYOR
700 HALL OF RECORDS

Do not extend notes this side of this line

Note: ANY ADDITIONS OR CHANGES ON THIS SHEET MUST BE MADE OR CIRCLED IN Red Ink, WITH DATE AND NAME OF PERSON MAKING CHANGE.

Notes Ck'd by Drew
Map No. B-921
Office Work Rice - Taylor
Checked Drew
Date June-1934

Survey of Tyler Road.
W. O. 1148 Tape No 041 St'd 24 °F.
Surveyed by Rosecrans
Notes Date 5-9-32
Indexed A. C. Johnson

F.B. 436 Pg. 282

Cont bottom next page.

562

31.0

34.2

48.7

2' Hedge

18.5

Conc step

Stucco House

1 Floor

28.1

12.0

3.5

28.1

4.7

Conc step

28+26.1

8.2

34.2

49.5

9.6

12.8

28+00

27+97.7

17.5

Conc step

3" Walnut 27+78.7

23.5

4" plum 27+67.9

44.8

4" locust 27+59.4

69.9

37.5

4" Shade tree 27+43.8

40.6

Conc. fish pond

4.0

27+40.3

35.0

54.5

26.1

0.2

4.0

Pergola

Floor Frame House

2.8

11.1

5.8

Conc. step

28.1

27+00

44.2

26.1

Conc step

3.4

5.0

Tyler Rd

Rock + oil pavement.

Notes: ANY ADDITIONS OR CHANGES OF THIS SHEET MUST BE MADE OR CIRCLED IN Red Ink WITH DATE AND NAME OF PERSON MAKING CHANGE.

RETURN TO
LOS ANGELES COUNTY SURVEYOR
700 HALL OF RECORDS
Do not extend notes this side of this line

FORM 247 10M 8-31

F.B. 436 Pg. 223

Cont. bottom next page

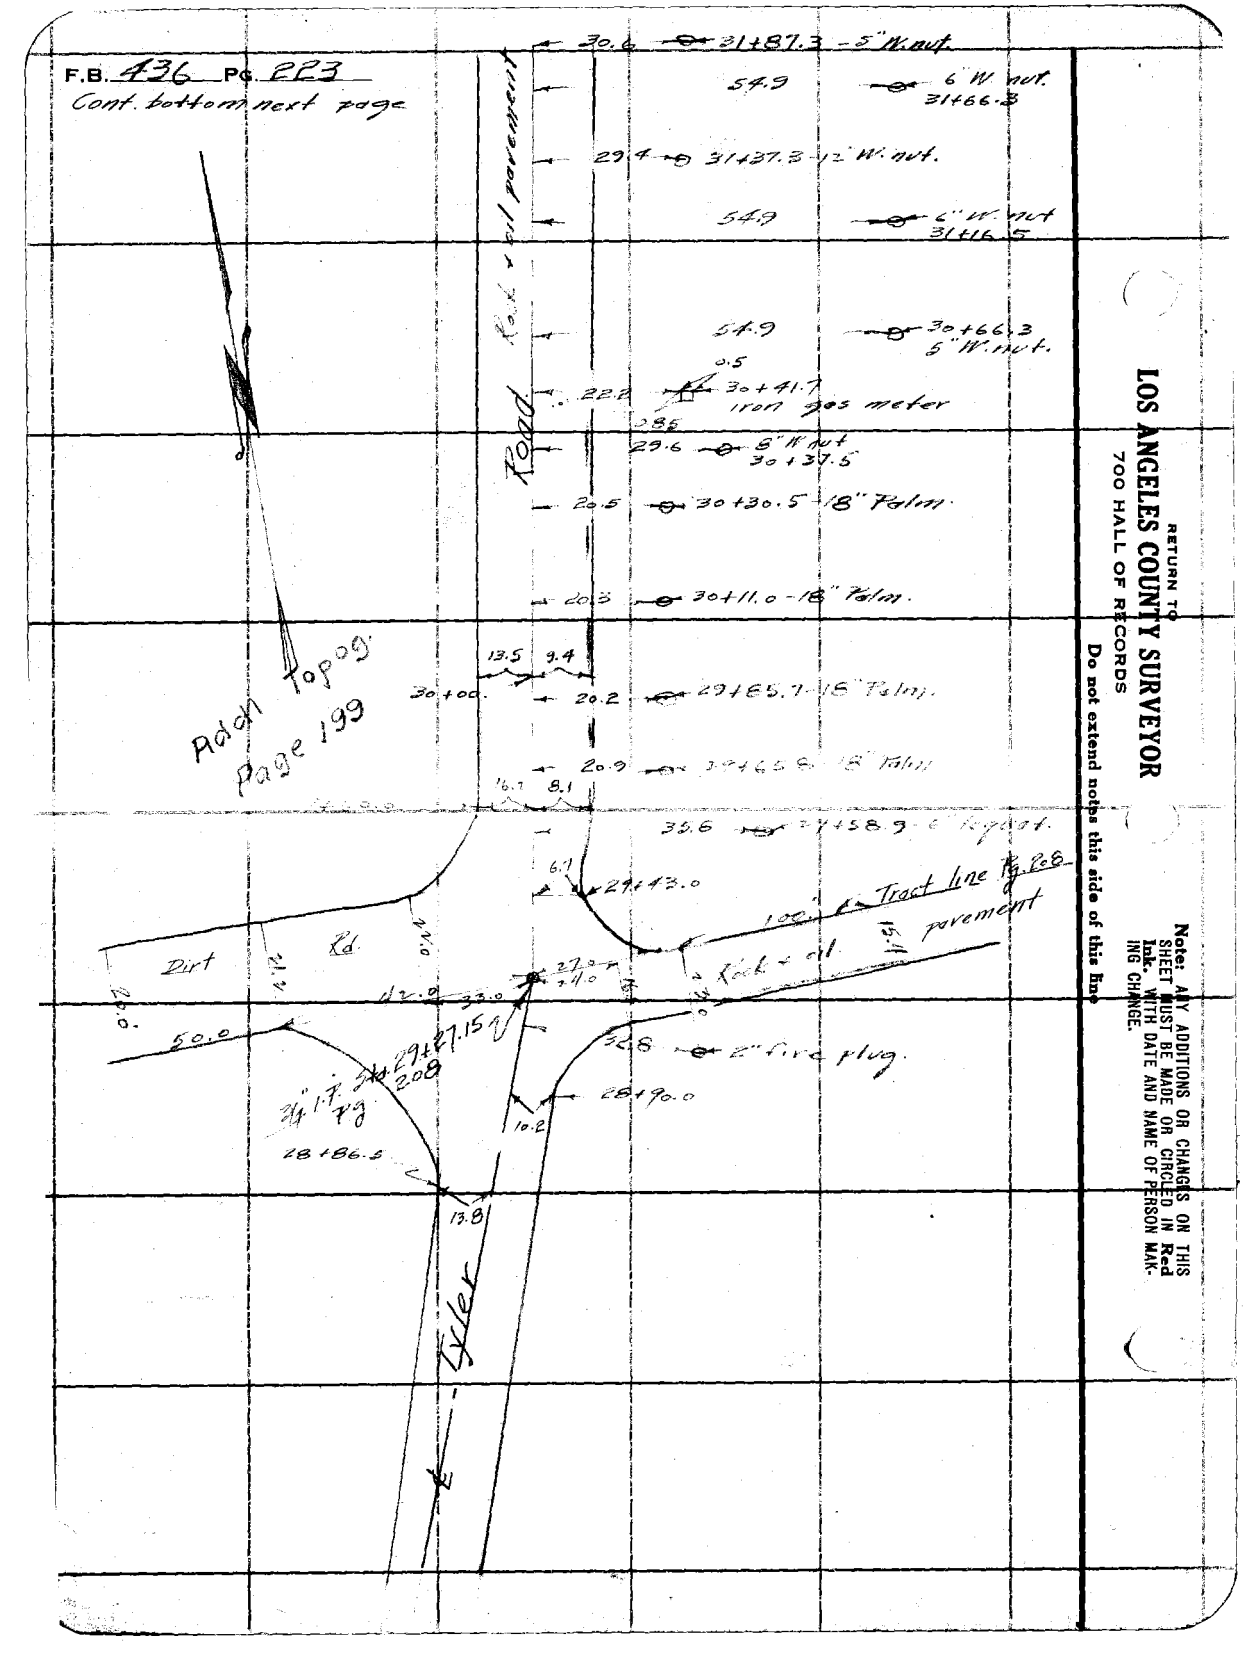

RETURN TO
LOS ANGELES COUNTY SURVEYOR
700 HALL OF RECORDS

Do not extend notes this side of this line

Note: ANY ADDITIONS OR CHANGES ON THIS SHEET MUST BE MADE OR CIRCLED IN **Red Ink** WITH DATE AND NAME OF PERSON MAKING CHANGE.

Notes Ck'd by Drew	Survey of Tyler Road
Map No. B-921	W. O. 1462 Tape No. 241 St'd 24 of.
Office Work Rice-Taylor	Surveyed by Rasecrans
Checked Drew	Notes Date 5-10-33
Date June-1934	Indexed A. C. Johnson

F. B. 436 Pg. 224

Cont. bottom next page.

37+35.5 - end of row.

37+15.6

56.5

63.9

1" hydrant 37+00

36+85.8

36+66.0

36+26.2

35+86.2

35+36.7

35+16.0

53.7

34+85.0

35+01.0 1" hydrant

31+65.9

34+36.4

33+67.9

33+65.6

33+31.5

33+15.8

32+87.6

32+66.0

31.0

32+37.2

50.0

32+15.6

32+02.5

30.5

10.3 10.0

Row of 18" W. nut trees

Row of 6" W. nut trees

Tyler Road

R & G oil pavement.

Notes: ANY ADDITIONS OR CHANGES ON THIS SHEET MUST BE MADE OR CIRCLED IN Red Ink. WITH DATE AND NAME OF PERSON MAKING CHANGE.

Do not extend notes this side of this line

RETURN TO
LOS ANGELES COUNTY SURVEYOR
700 HALL OF RECORDS

FORM 847 10M 8-31

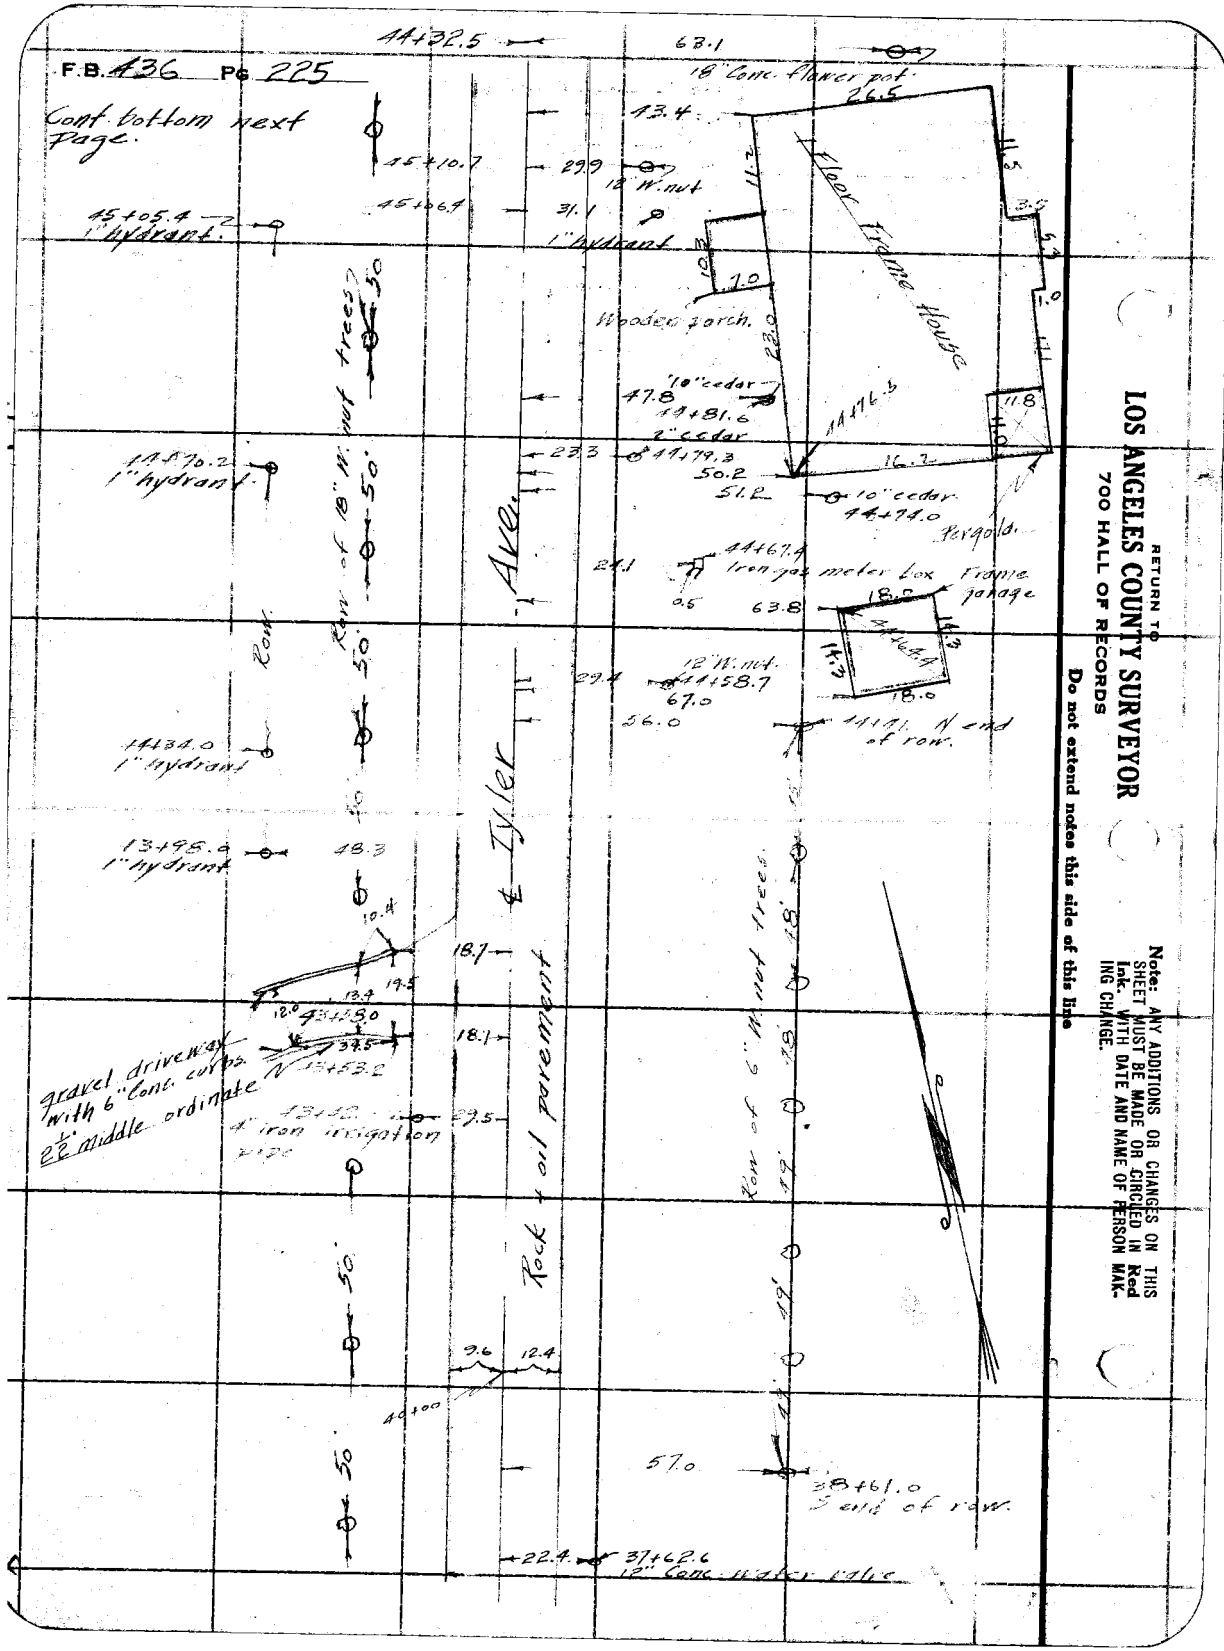
F.B. 436 PG 225
Cont. bottom next Page.
11+32.5
68.1
18" Conc. flower pot.
26.5
13.4
29.9
12" W. nut
31.1
1" hydrant
45+10.7
45+05.4
1" hydrant
45+69.4
Floor frame House
Wooden porch.
10" cedar
47.8
11+81.6
2" cedar
11+76.3
11+70.2
1" hydrant
Row of 18" W. nut trees
50.
50.2
51.2
10" cedar
46+74.0
Pergola.
11+67.4
Iron gas meter box
Frame garage
63.8
12" W. nut
11+58.7
67.0
56.0
11+21 N end of row.
11+34.0
1" hydrant
13+95.4
1" hydrant
48.3
Tyler Ave.
Rock & oil pavement
Row of 6" W. nut trees
gravel driveway with 6" Conc. curbs
22' Middle ordinate
N 13+53.2
4" iron irrigation pipe
13+42.
23.5
3.6
12.4
49+00
57.0
38+61.0
End of row.
22.4
37+62.6
12" Conc. water valve
RETURN TO
LOS ANGELES COUNTY SURVEYOR
700 HALL OF RECORDS
Do not extend notes this side of this line
Note: ANY ADDITIONS OR CHANGES ON THIS SHEET MUST BE MADE OR CIRCLED IN Red Ink. WITH DATE AND NAME OF PERSON MAK-ING CHANGE.

Notes Ck'd by Drew	Survey of Tyler Road.
Map No. 8-921	W. O. 748 Tape No. 011 St'd 84 PF.
Office Work Rice-Taylor	Surveyed by Rosecrans
Checked Drew	Notes Date 5-10-33
Date June - 1934	Indexed A. C. Johnson

F.B. 436 PG. 286

Cont. on bottom next page.

Note: ANY ADDITIONS OR CHANGES OF THIS SHEET MUST BE MADE OR CIRCLED IN Red Ink. WITH DATE AND NAME OF PERSON MAKING CHANGE.

RETURN TO LOS ANGELES COUNTY SURVEYOR 700 HALL OF RECORDS

Do not extend notes this side of this line

FORM 247 10M 5-31

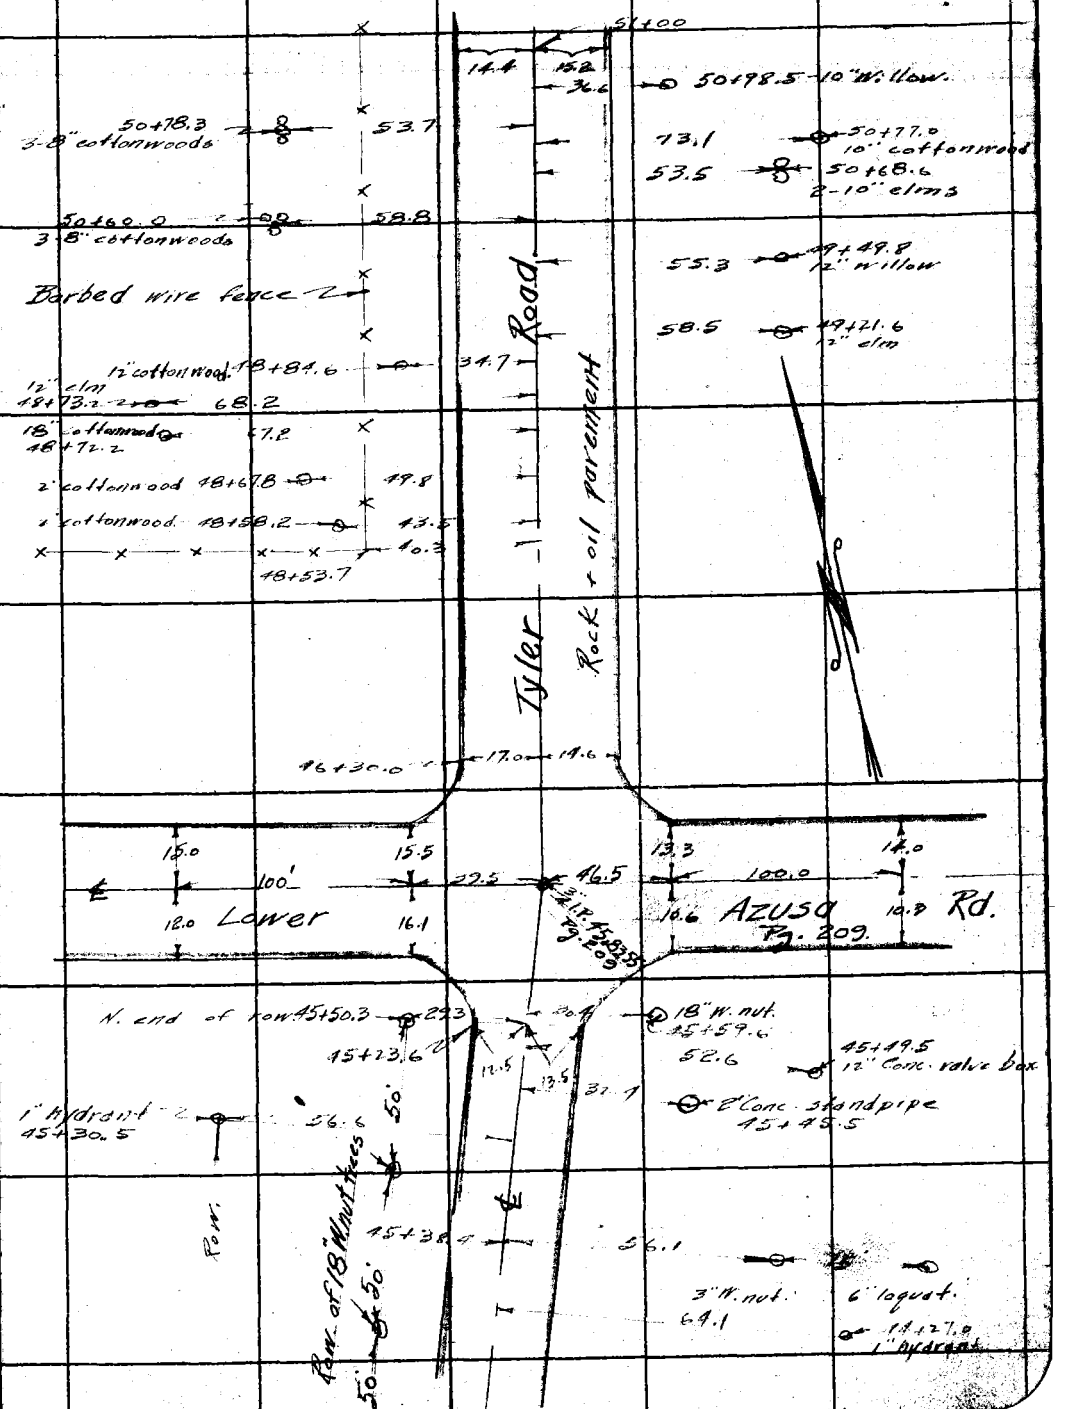

F.B. 136 Pg 227

Cont. bottom next page.

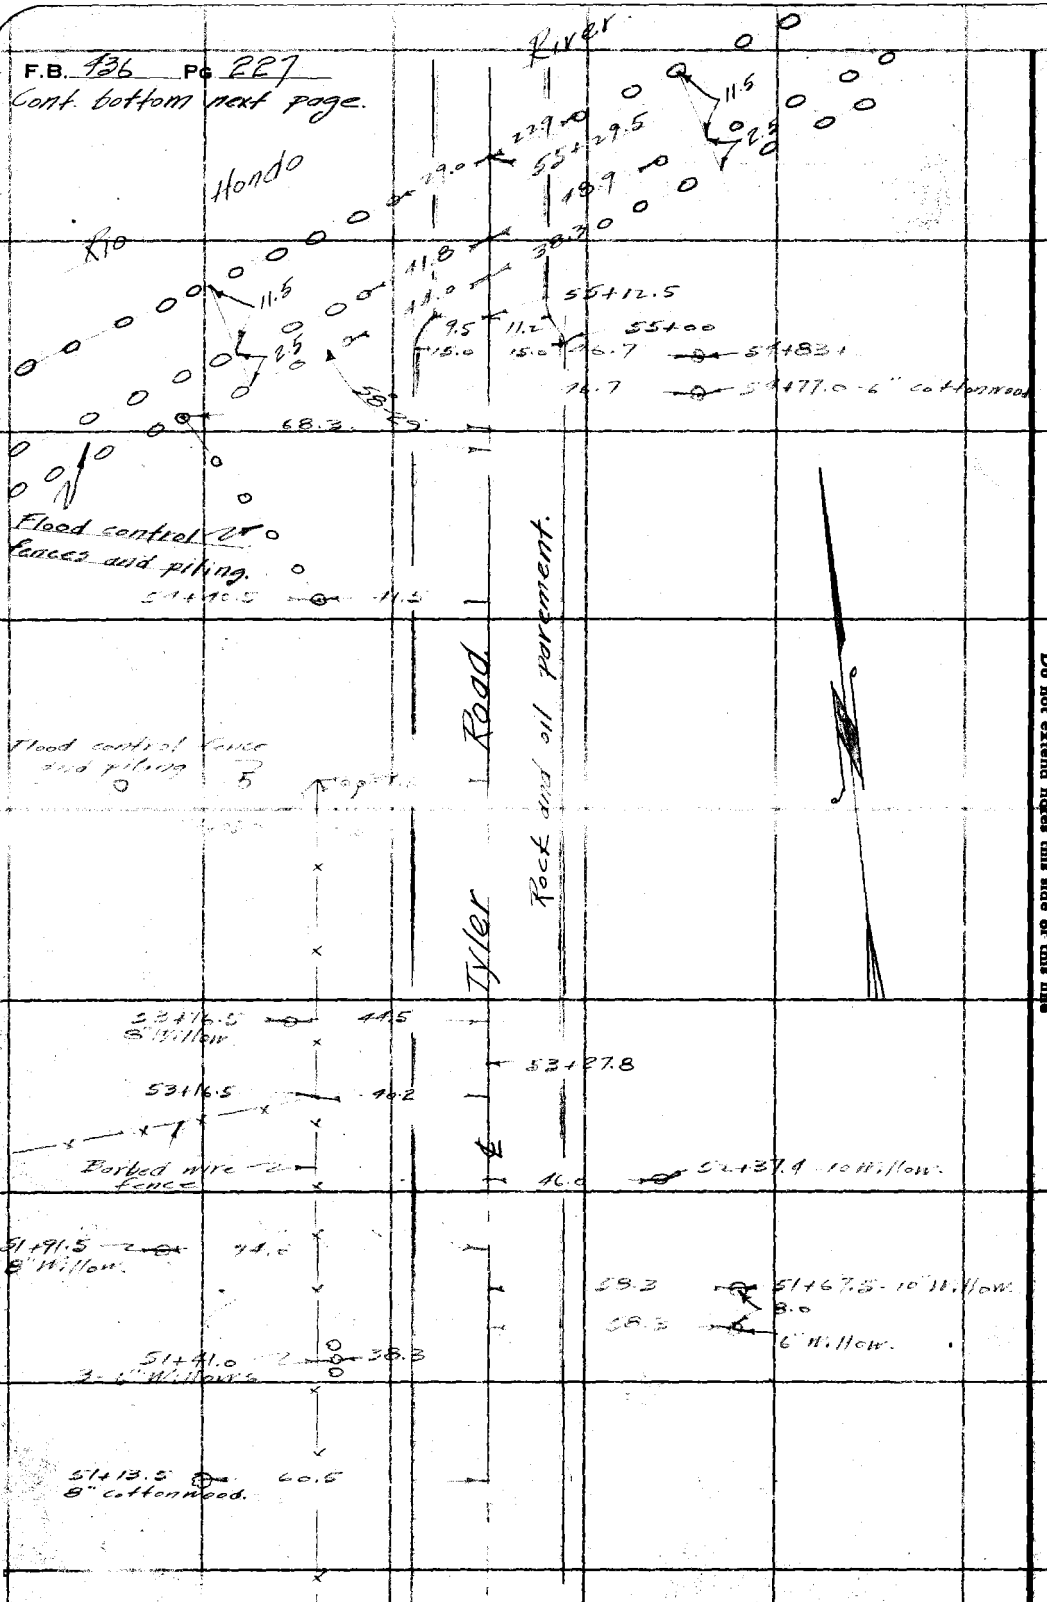

RETURN TO
LOS ANGELES COUNTY SURVEYOR
700 HALL OF RECORDS

Note: ANY ADDITIONS OR CHANGES ON THIS SHEET MUST BE MADE OR CIRCLED IN Red Ink. WITH DATE AND NAME OF PERSON MAKING CHANGE.

Do not extend notes this side of this line

Notes Ck'd by Drew	Survey of Tyler Road.
Map No. B-921	W. O. 748 Tape No. 041 St'd 84 of F.
Office Work Rio Taylor	Surveyed by Rozecrans
Checked Drew	Notes Date 5-10-32
Date June-1934	Indexed C. Johnson

F.B. 436 Pg. 428

Cont. bottom next page.

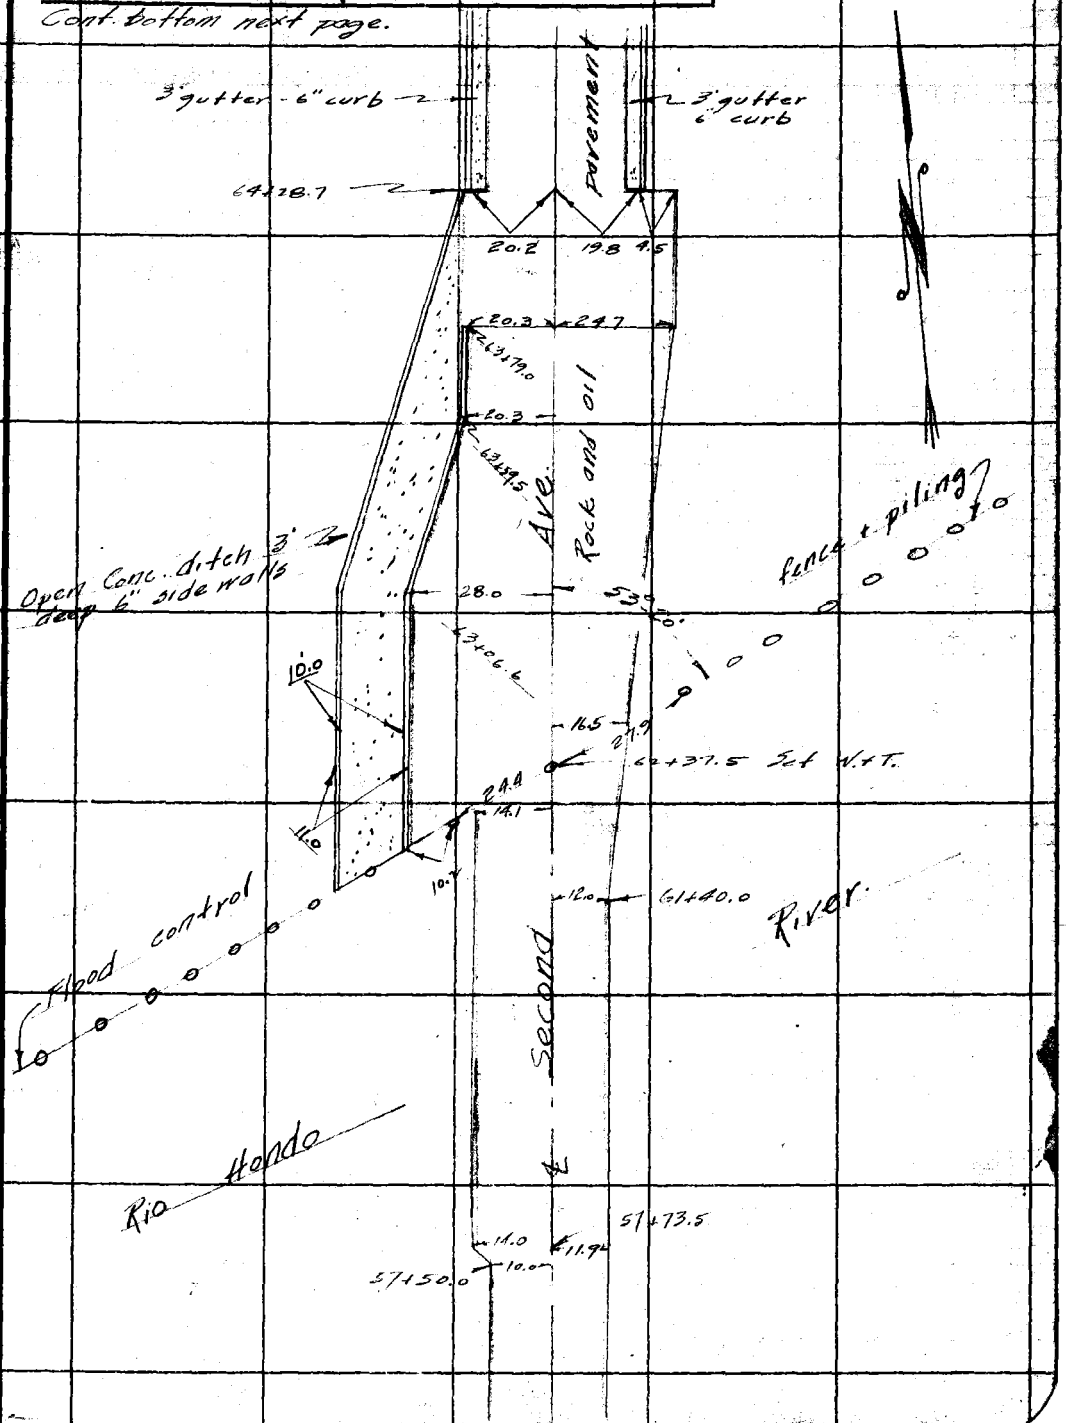

Note: ANY ADDITIONS OR CHANGES OF THIS SHEET MUST BE MADE IN Red Ink. WITH DATE AND NAME OF PERSON MAKING CHANGE.

Do not extend notes this side of this line

RETURN TO
LOS ANGELES COUNTY SURVEYOR
700 HALL OF RECORDS

FORM 247 10M 8-31

F.B. 436 PG. 229

Cont. bottom next page.

65.0

10" W nut. 76+54.6

44.4

6" W nut. 75+85.6

Second Ave.

Rock and oil pavement

Conc. approach

7.3 12.0 18.3

7.3 12.0 18.2

75+12.1

20.1 19.9 21.7

Sidewalk

Sidewalk

12.0 18.0 18.0 74+27.7 12.0

Wooden shed.

12" iron water valve in Conc. Box.

3.0 3.0

50.4 74+24.2

Sidewalk

7.2 12.0 18.2

7.8 12.0 18.8

Conc. approach

Conc. approach

20.0 20.0

69+62.0

69+62.6

RETURN TO
LOS ANGELES COUNTY SURVEYOR
700 HALL OF RECORDS

Do not extend notes this side of this End

Note: ANY ADDITIONS OR CHANGES ON THIS SHEET MUST BE MADE OR CIRCLED IN Red Ink. WITH DATE AND NAME OF PERSON MAKING CHANGE.

Notes Ck'd by Drew	Survey of Tyler Road.
Map No. B-921	W. O. 7168 Tape No. 41 St'd 84 oF.
Office Work Rice-Taylor	Surveyed by Rosecrans
Checked Drew	Notes Date 5-11-33
Date June-1934	Indexed A. C. Johnson

F.B. 436 Pg. 2-12

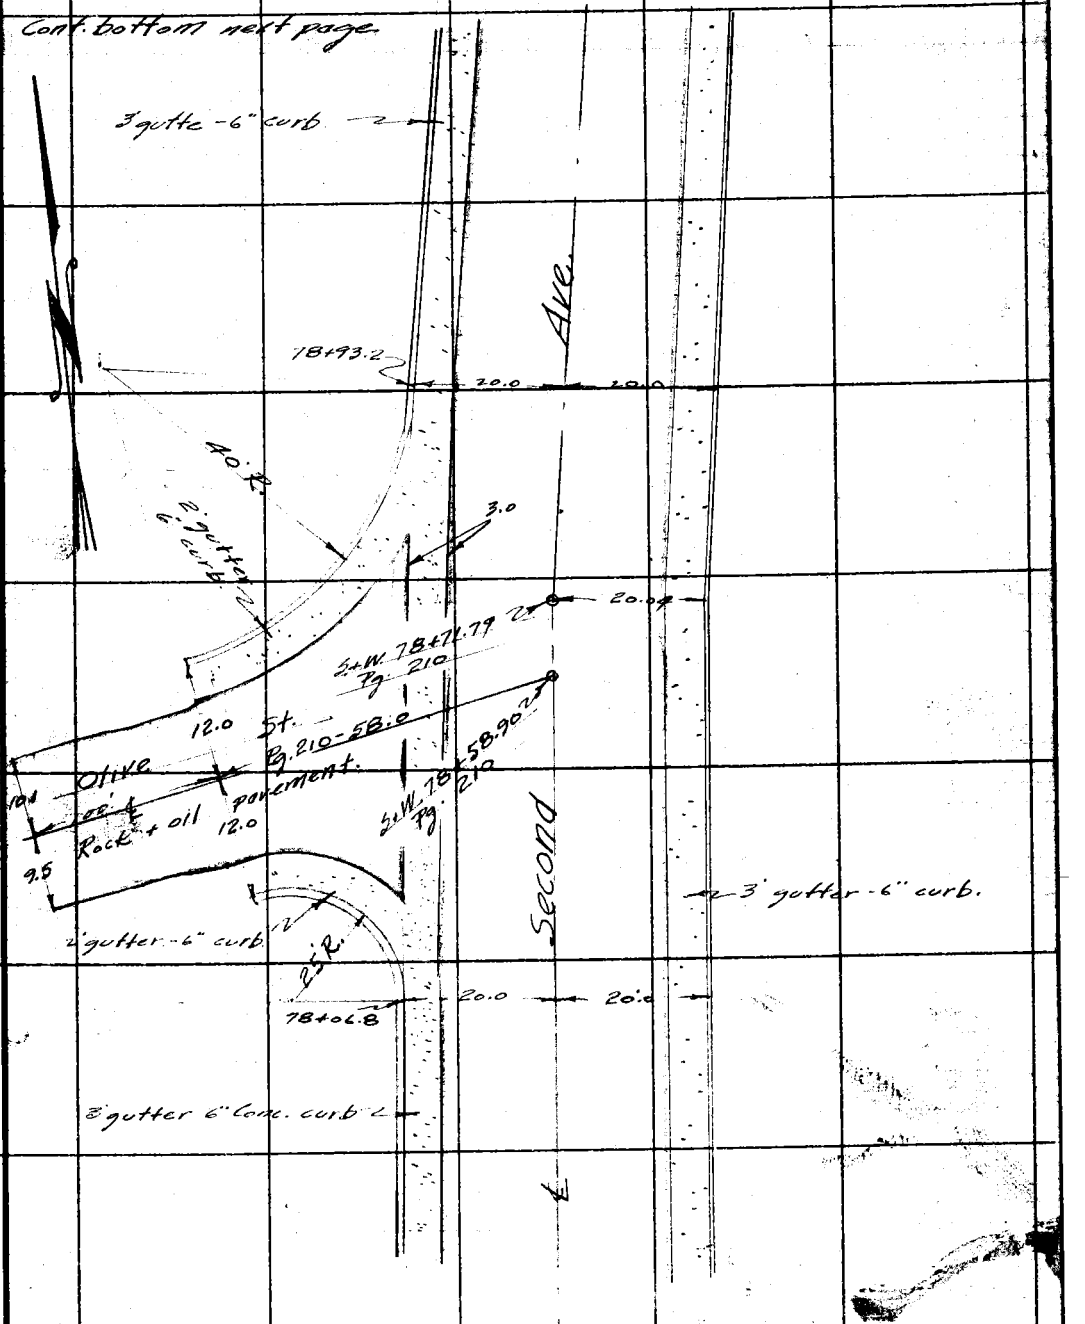

Note: ANY ADDITIONS OR CHANGES OF THIS SHEET MUST BE MADE IOR CIRCLED IN Red Ink., WITH DATE AND NAME OF PERSON MAKING CHANGE.

RETURN TO
LOS ANGELES COUNTY SURVEYOR
700 HALL OF RECORDS

Do not extend notes this side of this line

FORM 247 10M 8-31

RETURN TO
LOS ANGELES COUNTY SURVEYOR
700 HALL OF RECORDS

Note: ANY ADDITIONS OR CHANGES ON THIS SHEET MUST BE MADE OR CIRCLED IN **Red Ink.** WITH DATE AND NAME OF PERSON MAKING CHANGE.

Do not extend notes this side of this line

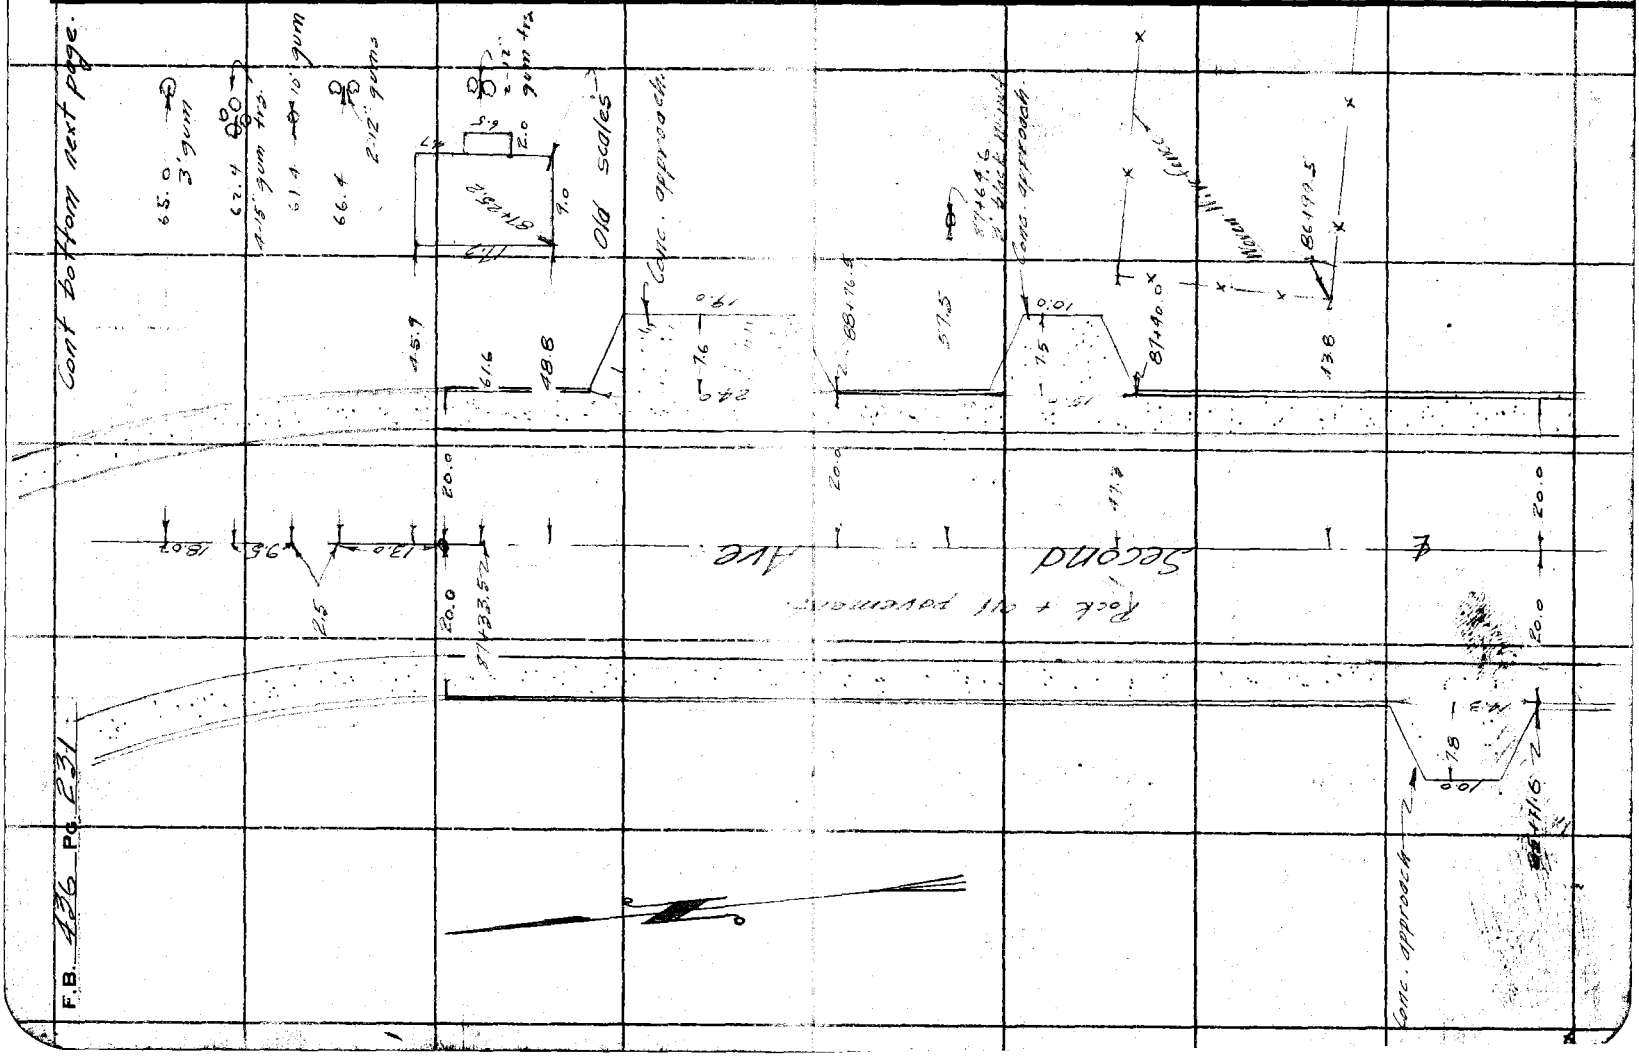

Notes Ck'd by Drew
Map No. B-921
Office Work Rice-Taylor
Checked Drew
Date June-1934

Survey of Tyler Road
W.O. 7148 Tape No. 41 St'd 84 °F.
Surveyed by Roscrans.
Notes Date 5-11-33
Indexed A. C. Johnson

F.B. 436 Pg. 282

Cont. bottom next page

42.0
84.5
92+ I W B
Wooden Barn
120.3
E.C. 91+53.20 V
Pg. 211
20.1
20.0
17.0
24.0
16.0
7.5
56.2
Conc. approach
AVE.
15.2
49.5
55.5
3' gutter 6" curb
5.4
14.3
25.8
T.L. 2+W Pg. 211 V
Wooden Barn
40.0
Second
Rock and oil pavement.
47.9
55.5
3' gutter 6" curb
B.C. 89+39.52
20.0
20.0
2 W + T. Pg. 211 V
℄

RETURN TO
LOS ANGELES COUNTY SURVEYOR
700 HALL OF RECORDS

Notes: ANY ADDITIONS OR CHANGES ON THIS SHEET MUST BE MADE IN RED INK. WITH DATE AND NAME OF PERSON MAKING CHANGE.

Do not extend notes this side of this line

FORM 247 10M 8-51

F.B. 436 PG. 233

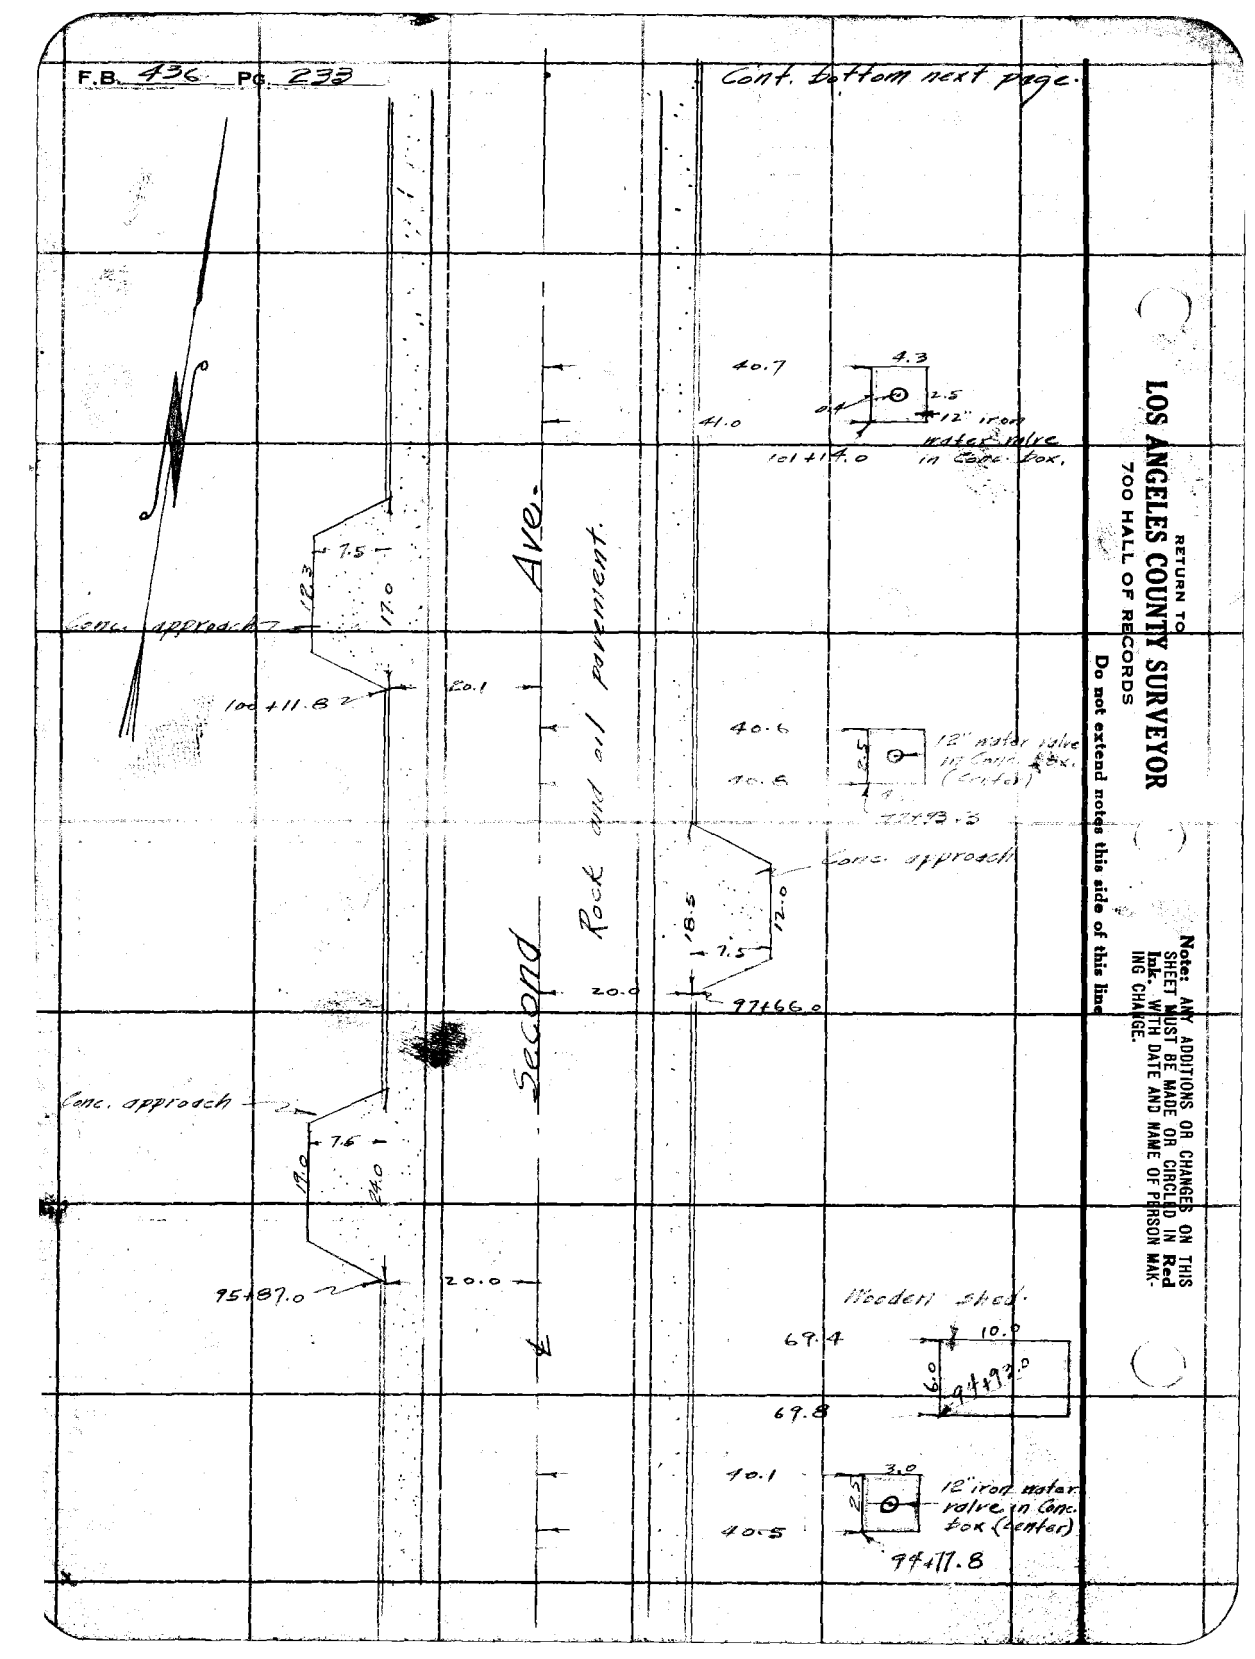

RETURN TO
LOS ANGELES COUNTY SURVEYOR
700 HALL OF RECORDS

Do not extend notes this side of this line

Note: ANY ADDITIONS OR CHANGES ON THIS SHEET MUST BE MADE OR CIRCLED IN Red Ink. WITH DATE AND NAME OF PERSON MAKING CHANGE.

Notes Ck'd by Drew
Map No. B-921
Office Work Rice-Taylor
Checked Drew
Date June-1934

Survey of Tyler Road
W. O. 7140 Tape No. 042 St'd 64 °F.
Surveyed by Rosecrans
Notes
Date 5-11-33
Indexed A. C. Johnson

F.B. 436 Pg. 284

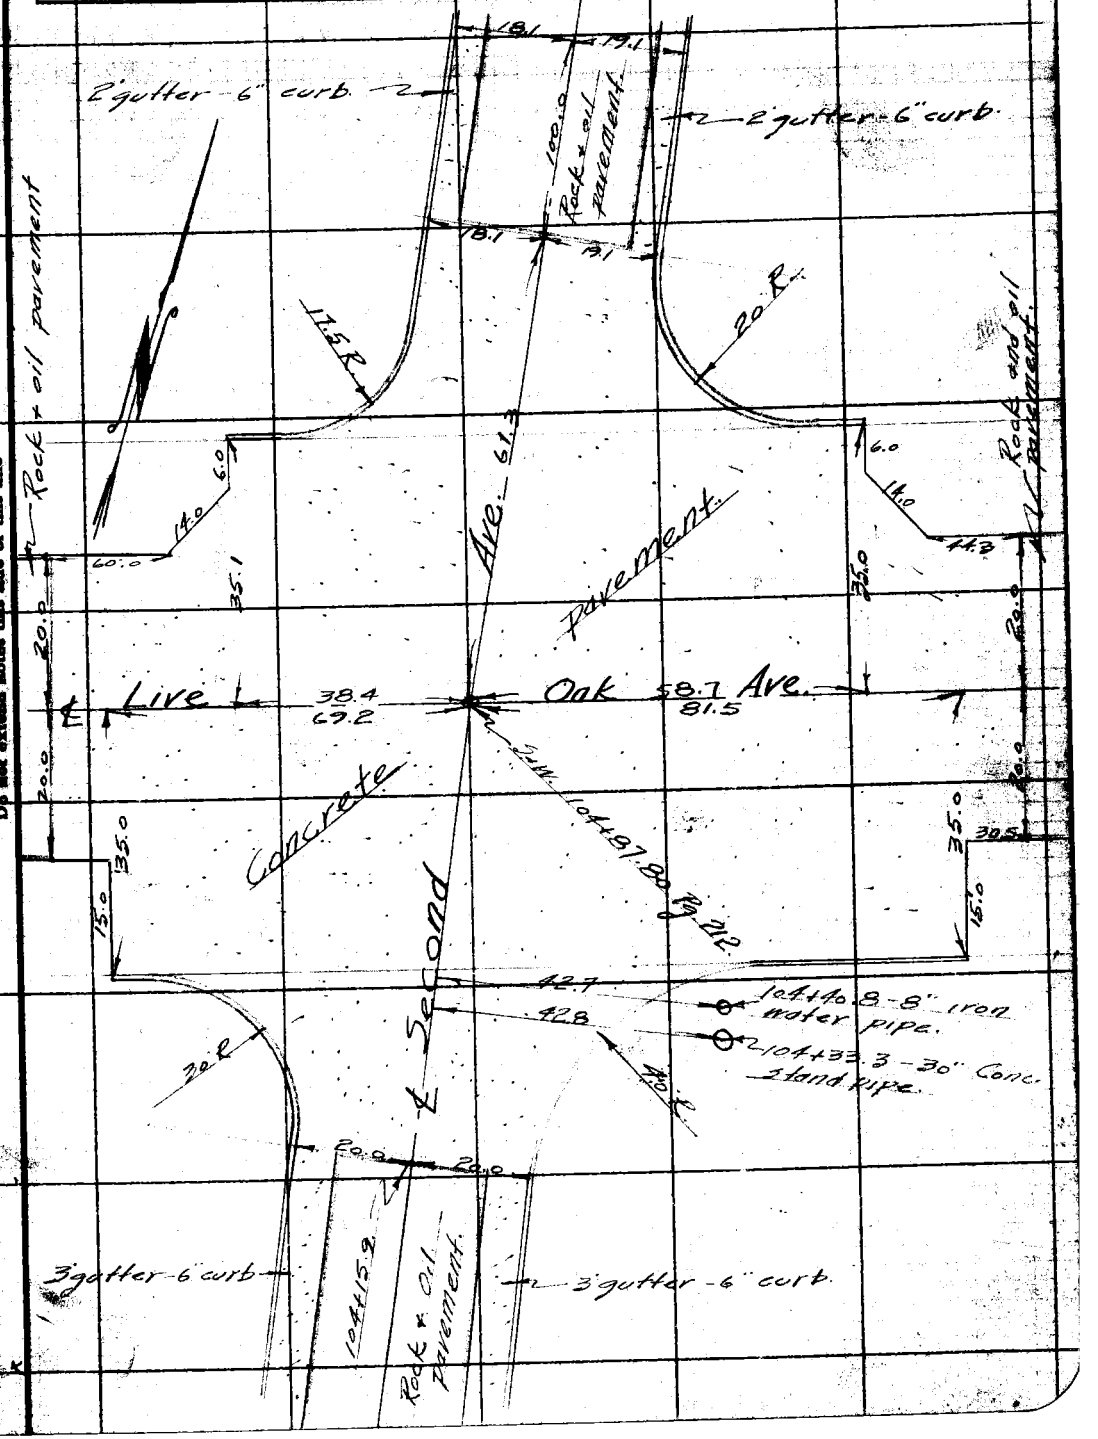

Notes: ANY ADDITIONS OR CHANGES OF THIS SHEET MUST BE MADE ON OR CIRCLED IN Red Ink. WITH DATE AND NAME OF PERSON MAKING CHANGE.

Do not extend notes this side of this line

RETURN TO
LOS ANGELES COUNTY SURVEYOR
700 HALL OF RECORDS

FORM 847 10M 8-31

RETURN TO

LOS ANGELES COUNTY SURVEYOR

700 HALL OF RECORDS

Note: ANY ADDITIONS OR CHANGES ON THIS SHEET MUST BE MADE OR CIRCLED IN **Red Ink.** WITH DATE AND NAME OF PERSON MAKING CHANGE.

Do not extend notes this side of this line

F.B. 436 Pg. 235

Notes Ck'd by	Drew	Survey of	Tyler Ave.
Map No.	B-921	No. of Tract	Tape No. 075 Sht'd 84 ft.
Office Work	Ric-Taylor	Surveyed by	Rosecrans
Checked	D-R-L	Notes	Date 5-8-34
Date	June-1934	Indexed	C. Johnson 5-21-34

F.B. 436 Pg. 826

Final &

TYLER AVE.

Thru. Tract # 9941 North of El Monte.

Job # 7148

Party E.A. Rosecrans
H.S. Johnson.
R.C. Bowers
J.A. Willess.

RETURN TO
LOS ANGELES COUNTY SURVEYOR
700 HALL OF RECORDS

Do not extend notes this side of this line

Note: ANY ADDITIONS OR CHANGES ON THIS SHEET MUST BE MADE OR CANCELED IN RED INK, WITH DATE AND NAME OF PERSON MAKING THE CHANGE.

FORM 247 10M 5-31

RETURN TO
LOS ANGELES COUNTY SURVEYOR
700 HALL OF RECORDS

Note: ANY ADDITIONS OR CHANGES ON THIS SHEET MUST BE MADE OR CIRCLED IN **Red Ink.** WITH DATE AND NAME OF PERSON MAKING CHANGE.

WS 46 A-4

Do not extend notes this side of this line

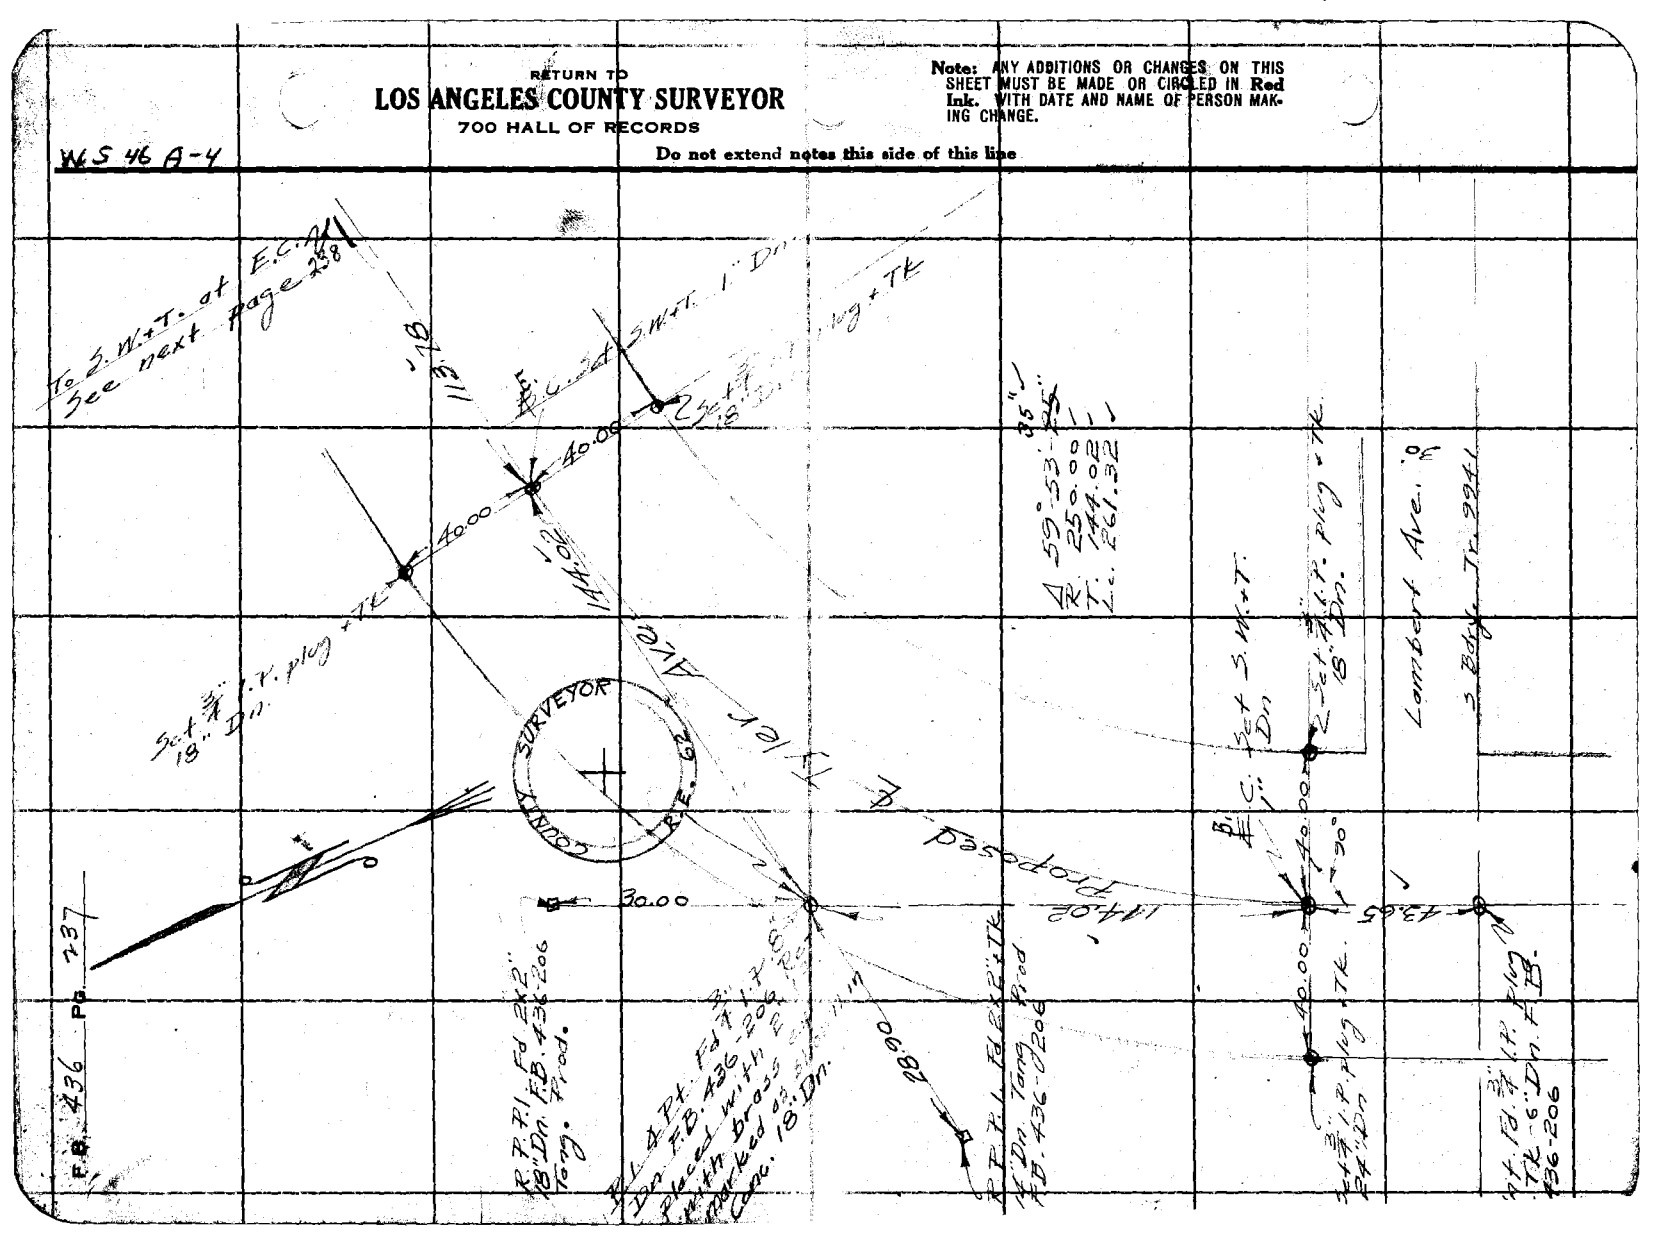
To S.W.T. at E.C.A. See next Page 238
Set ¾" I.P. plug + TK 18" Dn.
40.00
144.02
Set ¾" I.P. plug + TK
Set ¾" I.P. plug + TK
Set ¾" I.P. plug + TK

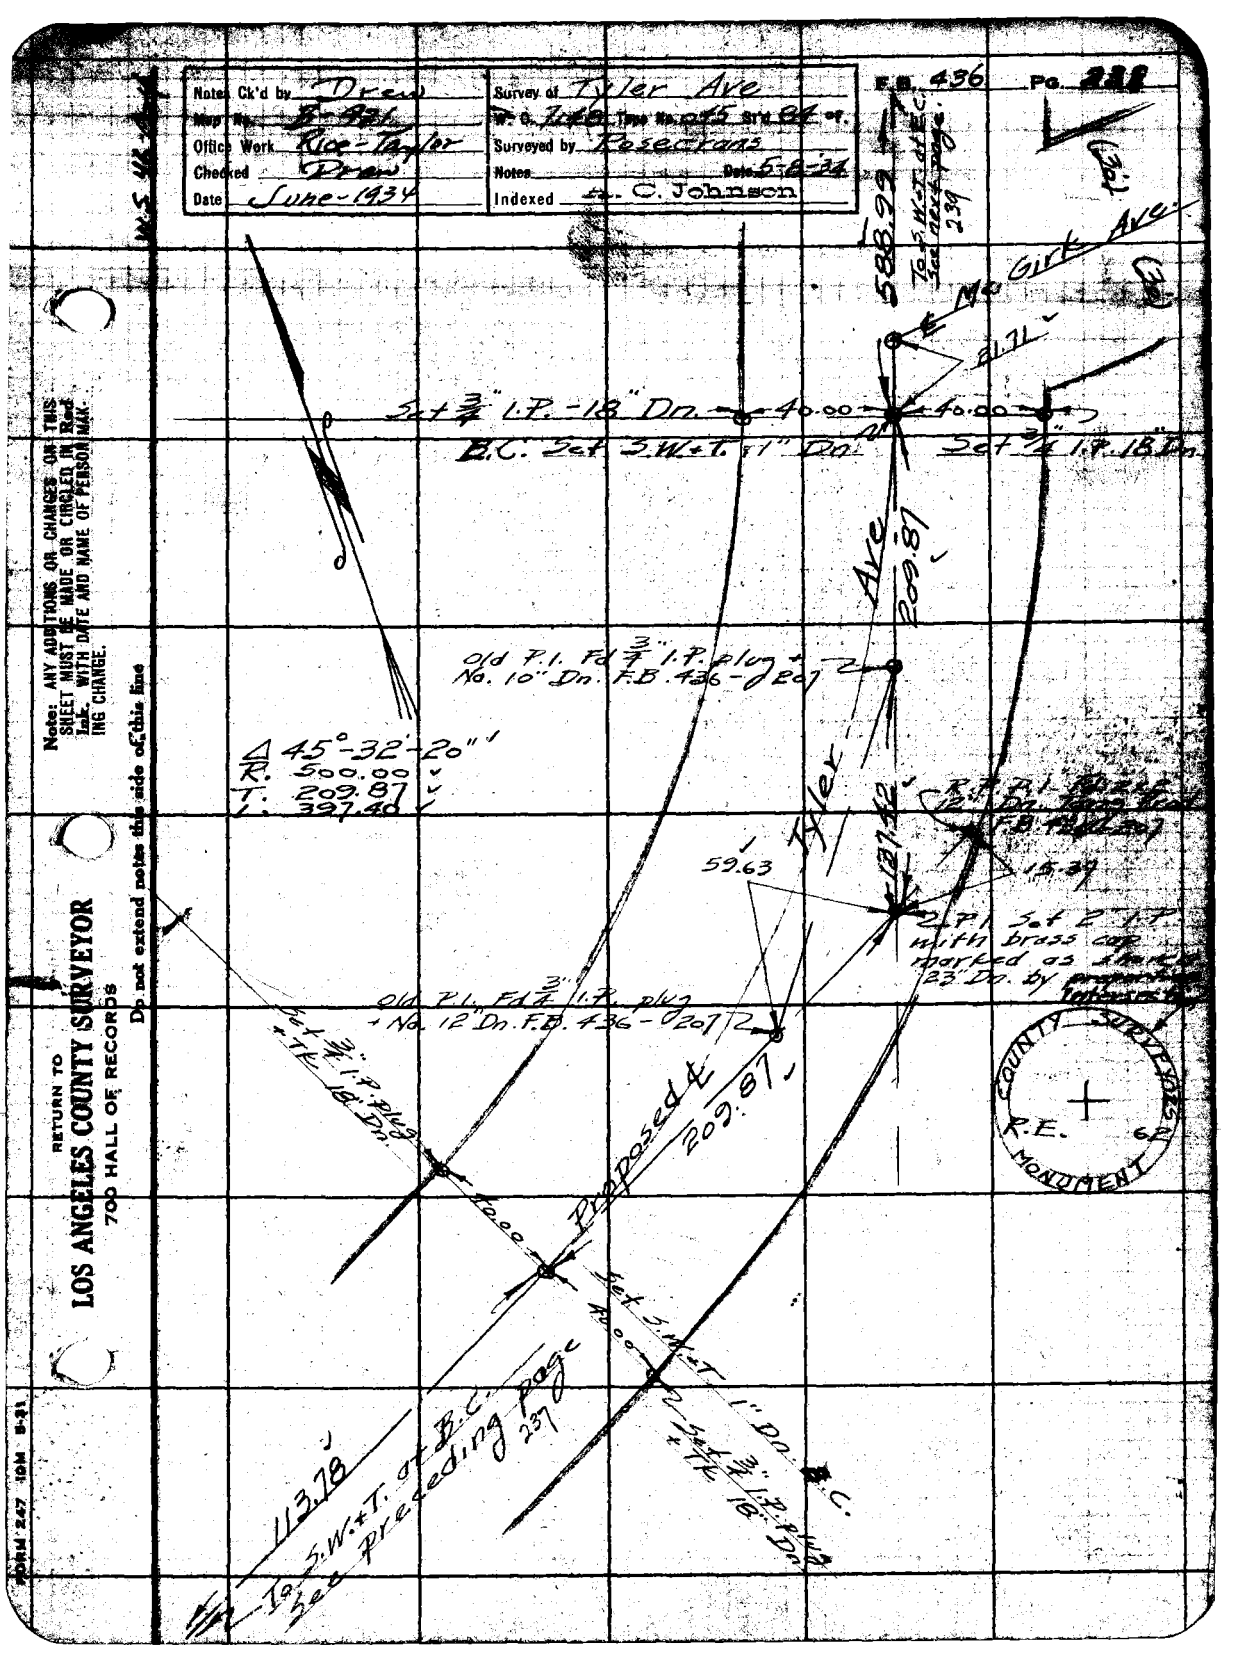
Notes Ck'd by Drew
Map No. B-831
Office Work Rice-Taylor
Checked Drew
Date June-1934
Survey of Tyler Ave
Surveyed by Pesecrans
Notes
Date 5-2-34
Indexed C. Johnson
F.B. 436 Pg. 228
Mc Girk Ave.
Set 3/4" I.P. -18" Dn.
P.C. Set 3.W.T. 1" Dn.
Set 3/4" I.P. 18" Dn.
Old P.I. Fd 3/4" I.P. plug + No. 10" Dn. F.B. 436-207
Tyler Ave
Δ 45°-32'-20"
R. 500.00
T. 209.87
L. 397.40
59.63
Set 3/4" I.P. plug + Tk. 18" Dn.
Proposed ℄
Set 3.W.T. 1" Dn.
P.C.
Set 3/4" I.P. plug + Tk. 18" Dn.
113.78
To S.W.T. of P.C. See preceding page
237
Note: ANY ADDITIONS OR CHANGES OR THIS SHEET MUST BE MADE OR CIRCLED IN Red Ink WITH DATE AND NAME OF PERSON MAKING CHANGE.
Do not extend notes this side of this line
RETURN TO
LOS ANGELES COUNTY SURVEYOR
700 HALL OF RECORDS
COUNTY SURVEYOR
R.E. 6P
MONUMENT

RETURN TO
LOS ANGELES COUNTY SURVEYOR
700 HALL OF RECORDS

Note: ANY ADDITIONS OR CHANGES ON THIS SHEET MUST BE MADE OR CIRCLED IN Red Ink. WITH DATE AND NAME OF PERSON MAKING CHANGE.

Do not extend notes this side of this line

WS 46-A-4

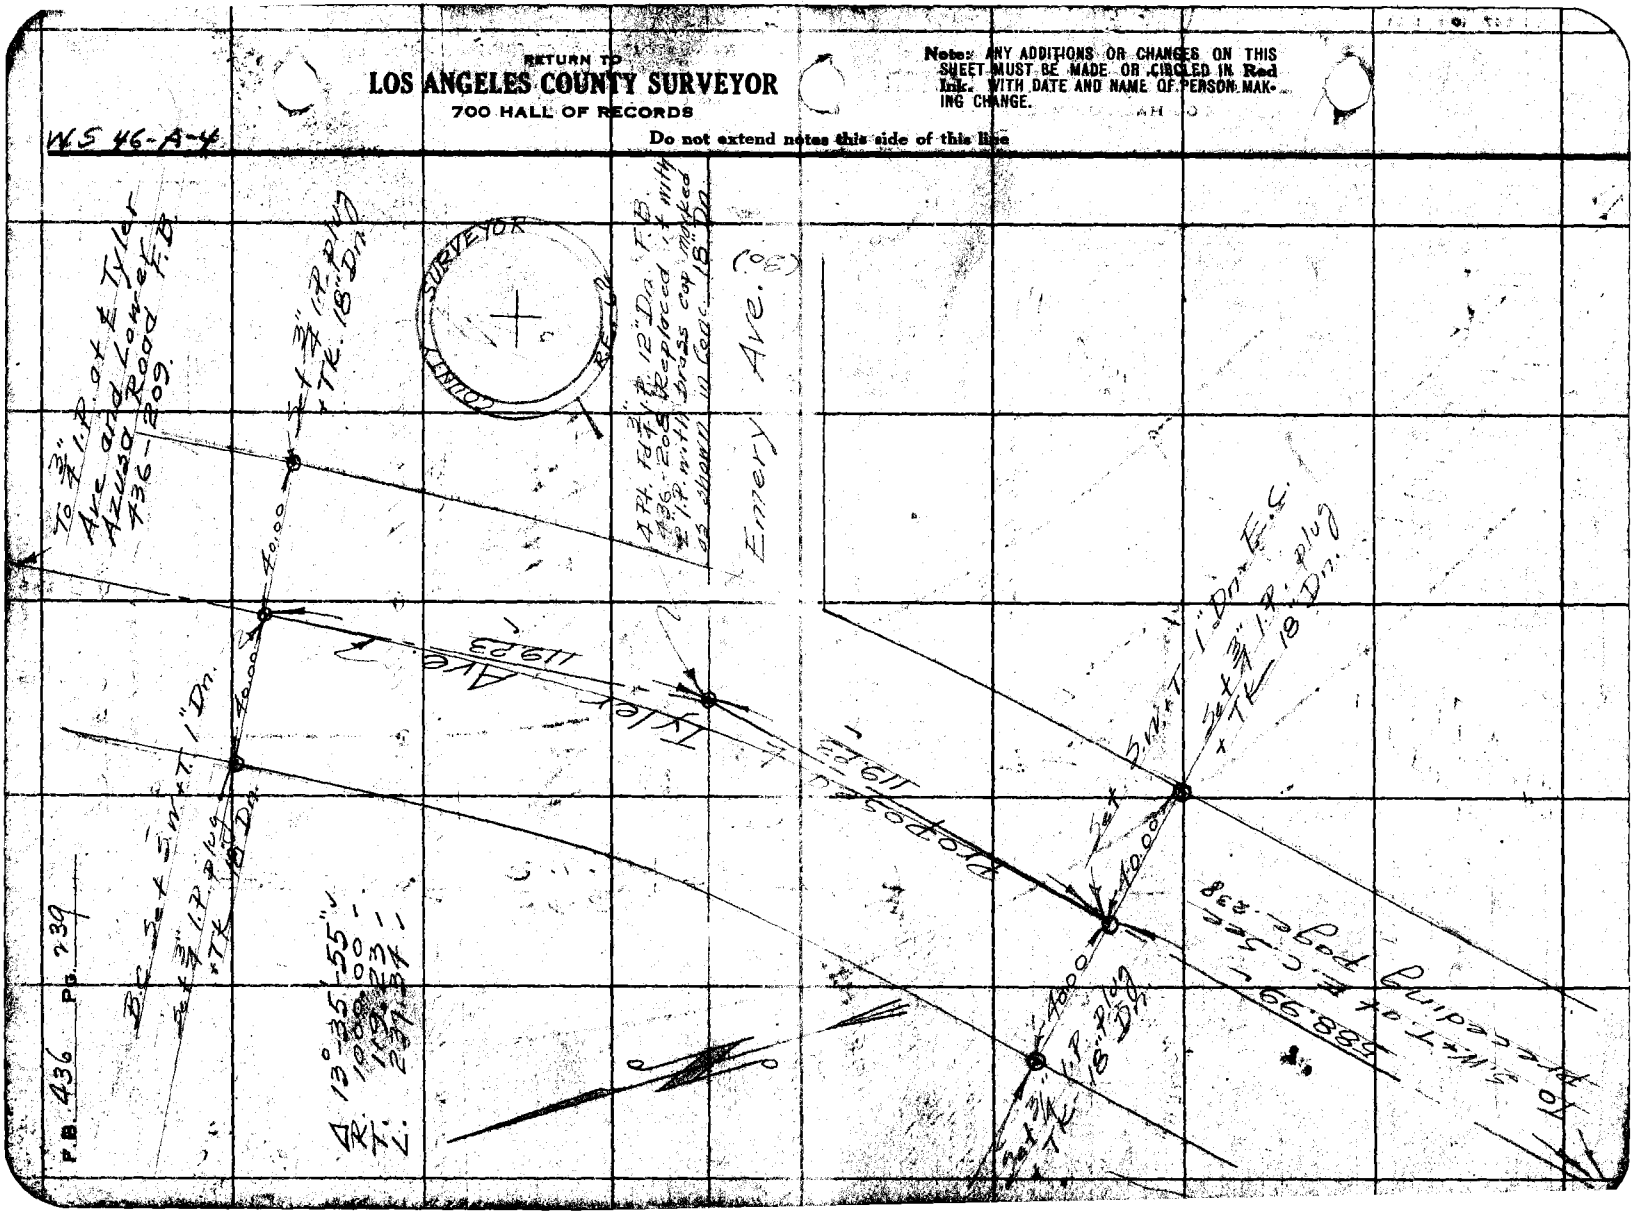

Indexed

SURVEY OF
RURBAN HOMES PROP
CONSISTING OF
LOTS 5, 6, 10, & 11
IN
COFFIN & ARMSTRONG

PARTY

H. F. Evans - Dep.
A. F. Von Fleet - R.C.
E. F. Brock - R.C.
D. S. Sedig - R.C.

TRIPOD 237
Number 224

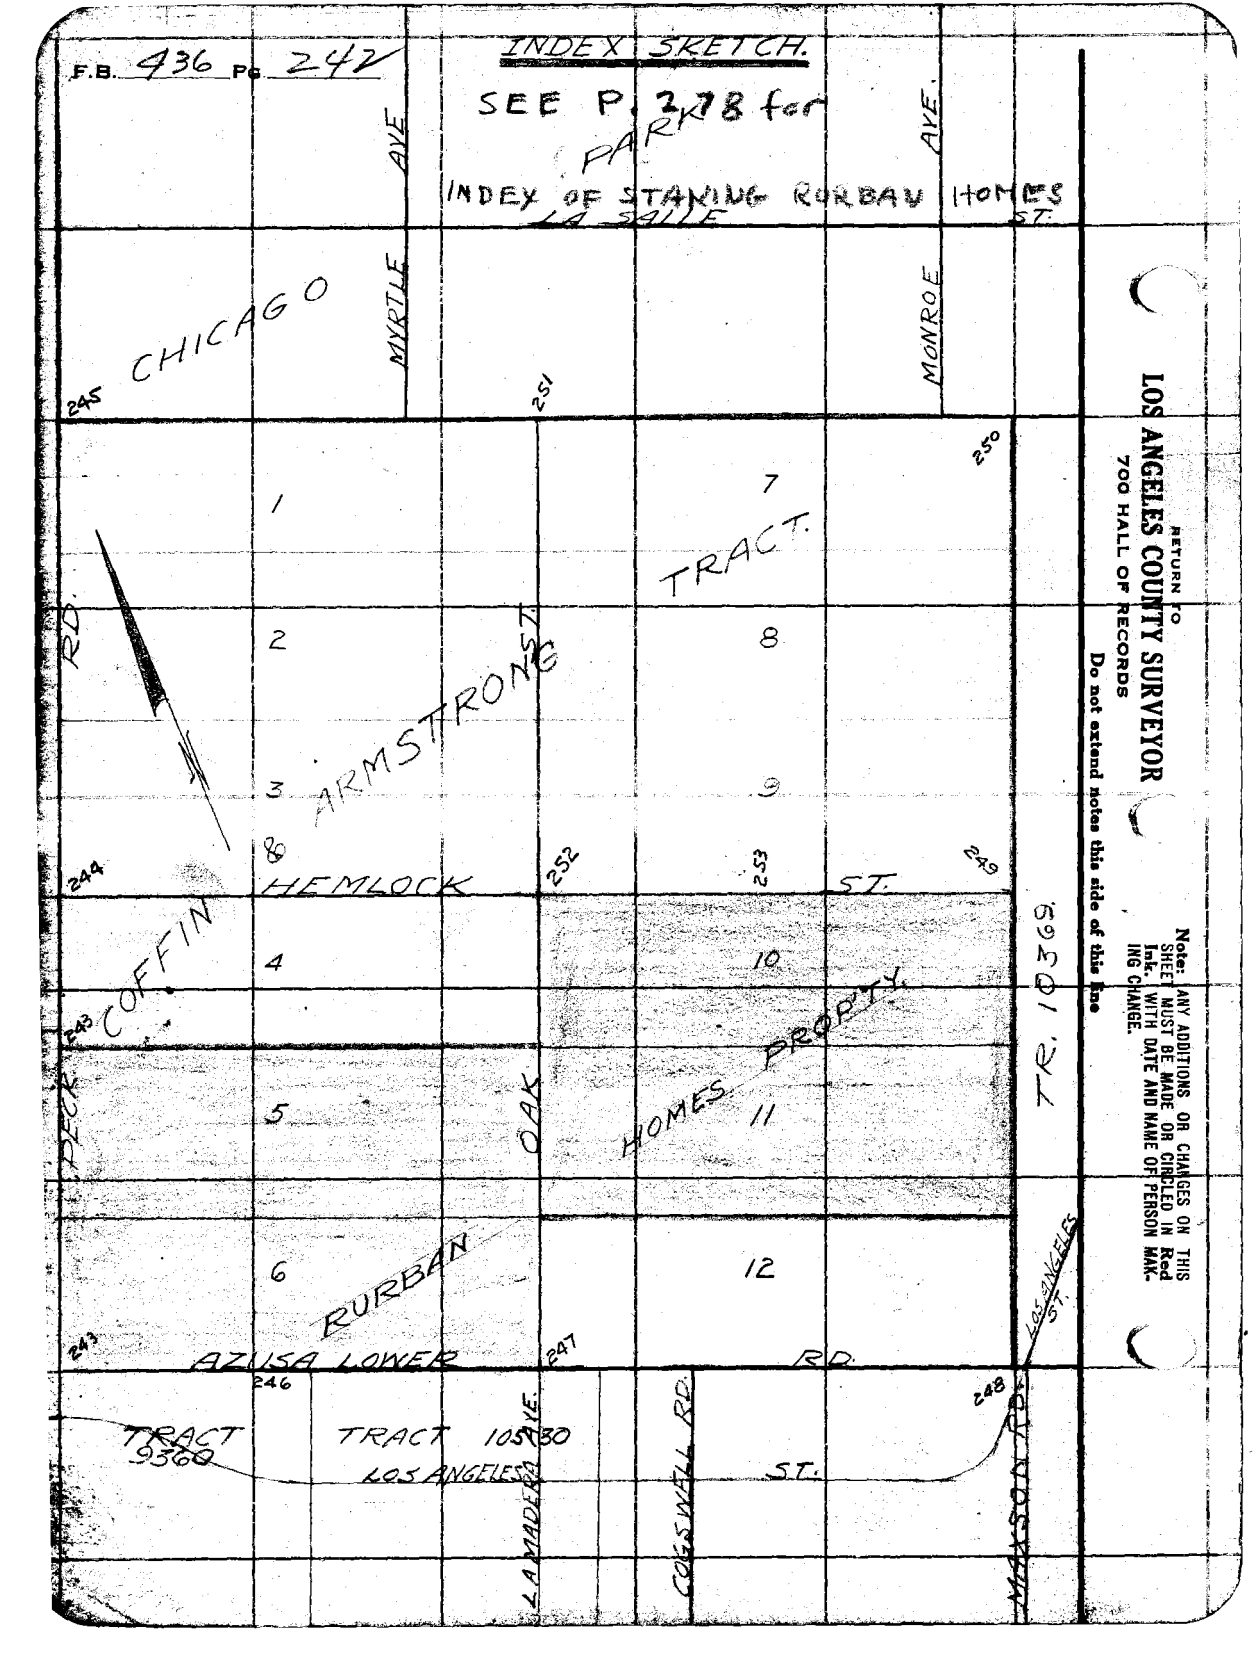
F.B. 436 Pg 242
INDEX SKETCH.
SEE P. 278 for INDEX OF STAKING
PARK
LA SALLE AVE.
RURBAN HOMES
ST.
CHICAGO
MYRTLE
MONROE
AVE.
245
251
250
1
2
3
8
7
8
9
TRACT
RD.
ARMSTRONG
244
HEMLOCK
252
253
ST.
249
COFFIN
4
10
243
PECK
5
11
OAK
HOMES PROPTY.
6
12
RURBAN
AZUSA LOWER
247
RD.
LOS ANGELES ST.
246
248
TRACT 9360
TRACT 10530
LOS ANGELES
LA MADERA AVE.
COGSWELL RD
ST.
MAXSON RD.
RETURN TO
LOS ANGELES COUNTY SURVEYOR
700 HALL OF RECORDS
Do not extend notes this side of this line
Note: ANY ADDITIONS OR CHANGES ON THIS SHEET MUST BE MADE OR CIRCLED IN Red Ink, WITH DATE AND NAME OF PERSON MAKING CHANGE.

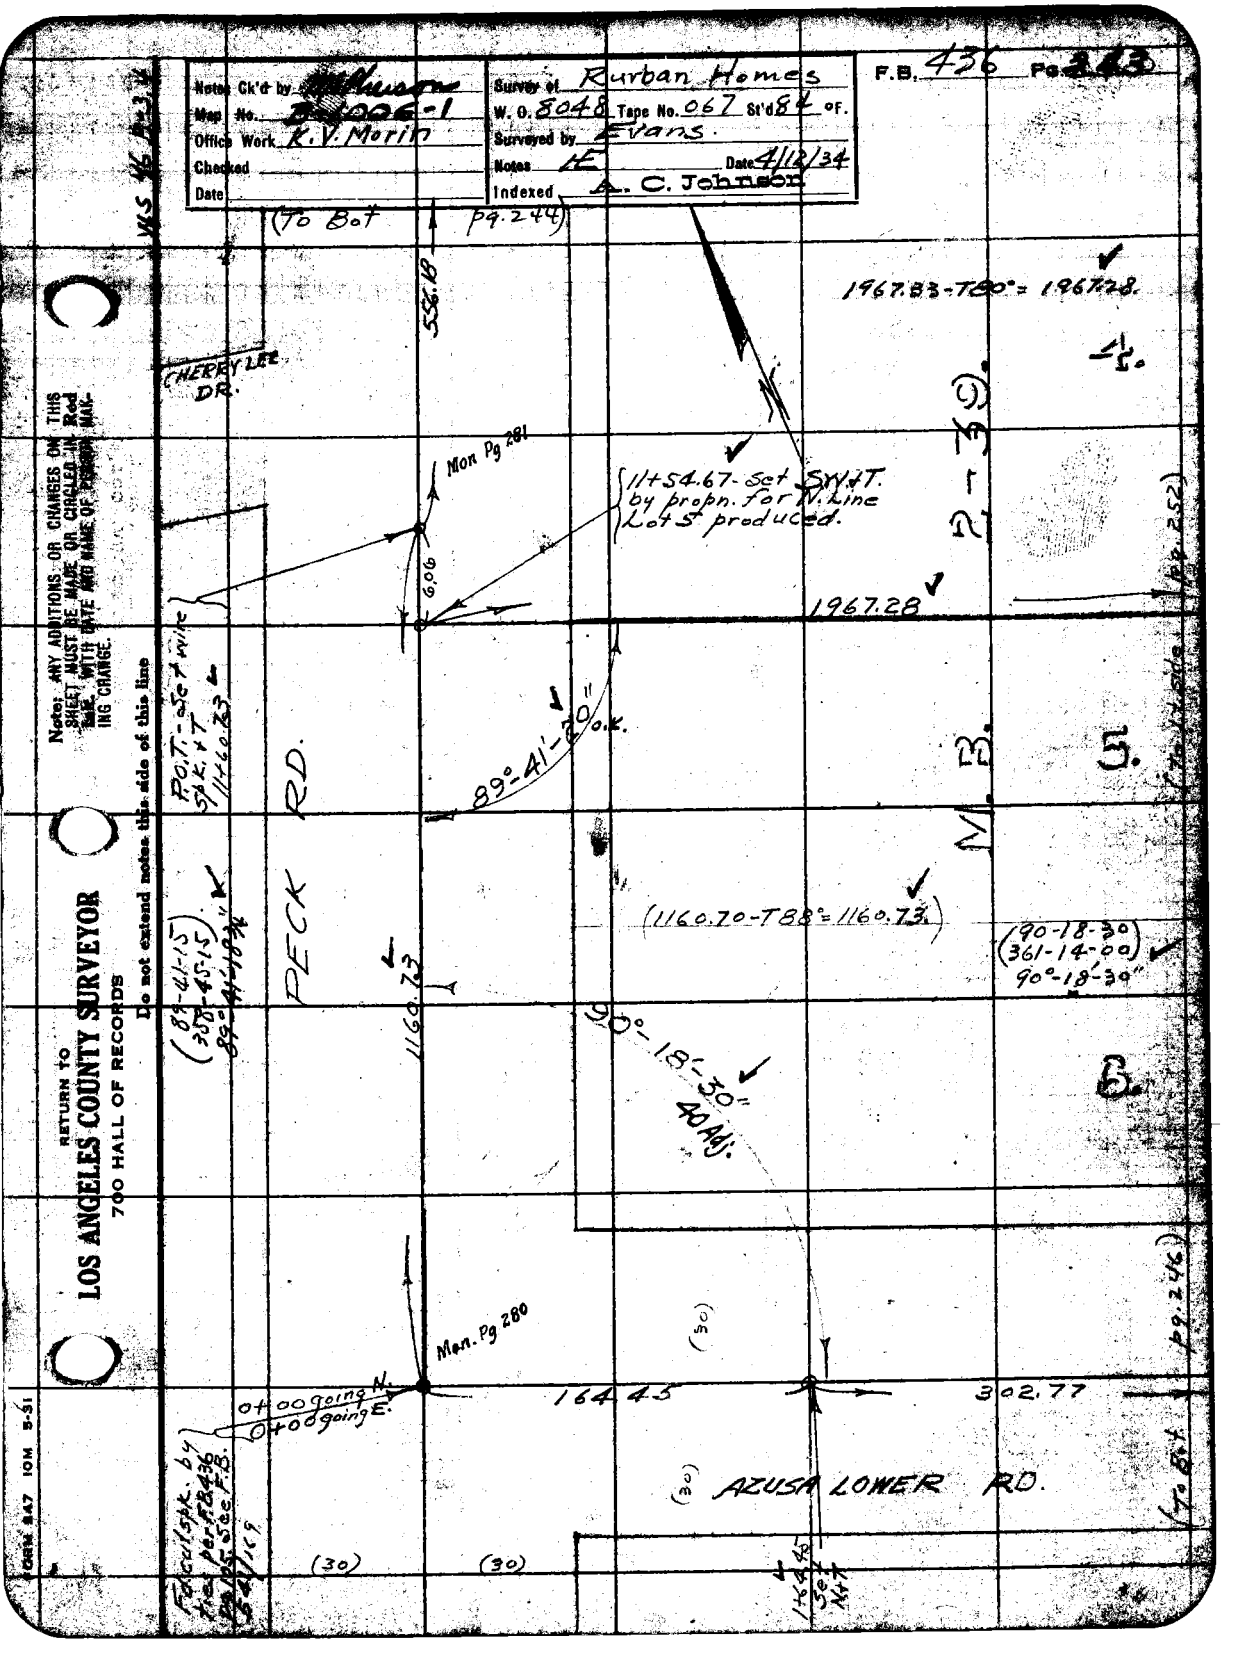
Notes Ck'd by
Map No. 2006-1
Office Work R.V. Morin
Checked
Date
Survey of Rurban Homes
W. O. 8048 Tape No. 067 St'd 84 of.
Surveyed by Evans.
Notes E
Date 4/12/34
Indexed A. C. Johnson
F.B. 436 Pg. 243
(To Bot pg. 244)
558.18
CHERRY LEE DR.
1967.83-T90°=1967.28.
1/2 C.
Mon Pg 281
11+54.67-Set SW.J.T. by propn. for N. Line Lot 5 produced.
6.06
1967.28
(To Bot pg. 252)
P.O.T.-Set 2" pipe
S 41° 45' E
11+60.33
89°-41'-10" o.k.
PECK RD.
B. 5.
(89-41-15)
(358-45-15)
89°-41'-10"
1160.73
(1160.70-T88°=1160.73)
(90-18-30)
(361-14-00)
90°-18'-30"
90°-18'-30"
40 Adj.
5.
RETURN TO
LOS ANGELES COUNTY SURVEYOR
700 HALL OF RECORDS
Do not extend notes this side of this line
Notes: ANY ADDITIONS OR CHANGES ON THIS SHEET MUST BE MADE OR CHECKED IN Red Ink WITH DATE AND NAME OF PERSON MAKING CHANGE.
W.S. 46 P.33
Mon Pg 280
0+00 going N.
0+00 going E.
1644.5
302.77
(To Bot pg. 246)
Fd. Cr. Sht. by trail Per F.B. 436 Pg. 168 Sec. F.B. 541 pg. 168
(30)
(30)
(30)
AZUSA LOWER RD.
1644.5 Set N+T
FORM 847 10M 8-51

F.B. 436 Pg 244

To Bot. pg. 245

4/12/34

W.S. 46 B-3

PECK RD.

1134.27

(90-18-45
361-15-00
90-18-45)

from South 17+17.00 - Set L&T by prop'n. N. & S. for E. Hemlock St. 39+04.78 from E.

90° 18' 45"

HEMLOCK ST.

0.K

(20)

1967.39

(282.44 Meas.)

174.91 - Fd cut Spk. per F.B. 436/14 Removed.

0.03

0.09

(20)

T 84° 55' 18"

(30) (30)

(from top pg. 243)

RETURN TO
LOS ANGELES COUNTY SURVEYOR
700 HALL OF RECORDS

Do not extend notes this side of this line

Note: ANY ADDITIONS OR CHANGES ON THIS SHEET MUST BE MADE OR CIRCLED IN Red Ink. WITH DATE AND NAME OF PERSON MAKING CHANGE.

W.S. 46-B-3

Notes Ck'd by McPherson
Map No. B-1006.-1
Office Work K.V. Morin
Checked
Date

Survey of Rurban Homes
W. O. 8048 Tract No. 067 St'd 84 of F.
Surveyed by Evans
Notes HE Date 4/12/24
Indexed A. C. Johnson

F.B. 436 Pg. 246

M.R. 30-100-101

Note: ANY ADDITIONS OR CHANGES ON THIS SHEET MUST BE MADE OR CIRCLED IN Red Ink. WITH DATE AND NAME OF PERSON MAKING CHANGE.

Do not extend notes this side of this line

RETURN TO
LOS ANGELES COUNTY SURVEYOR
700 HALL OF RECORDS

FORM 247 10M 5-31

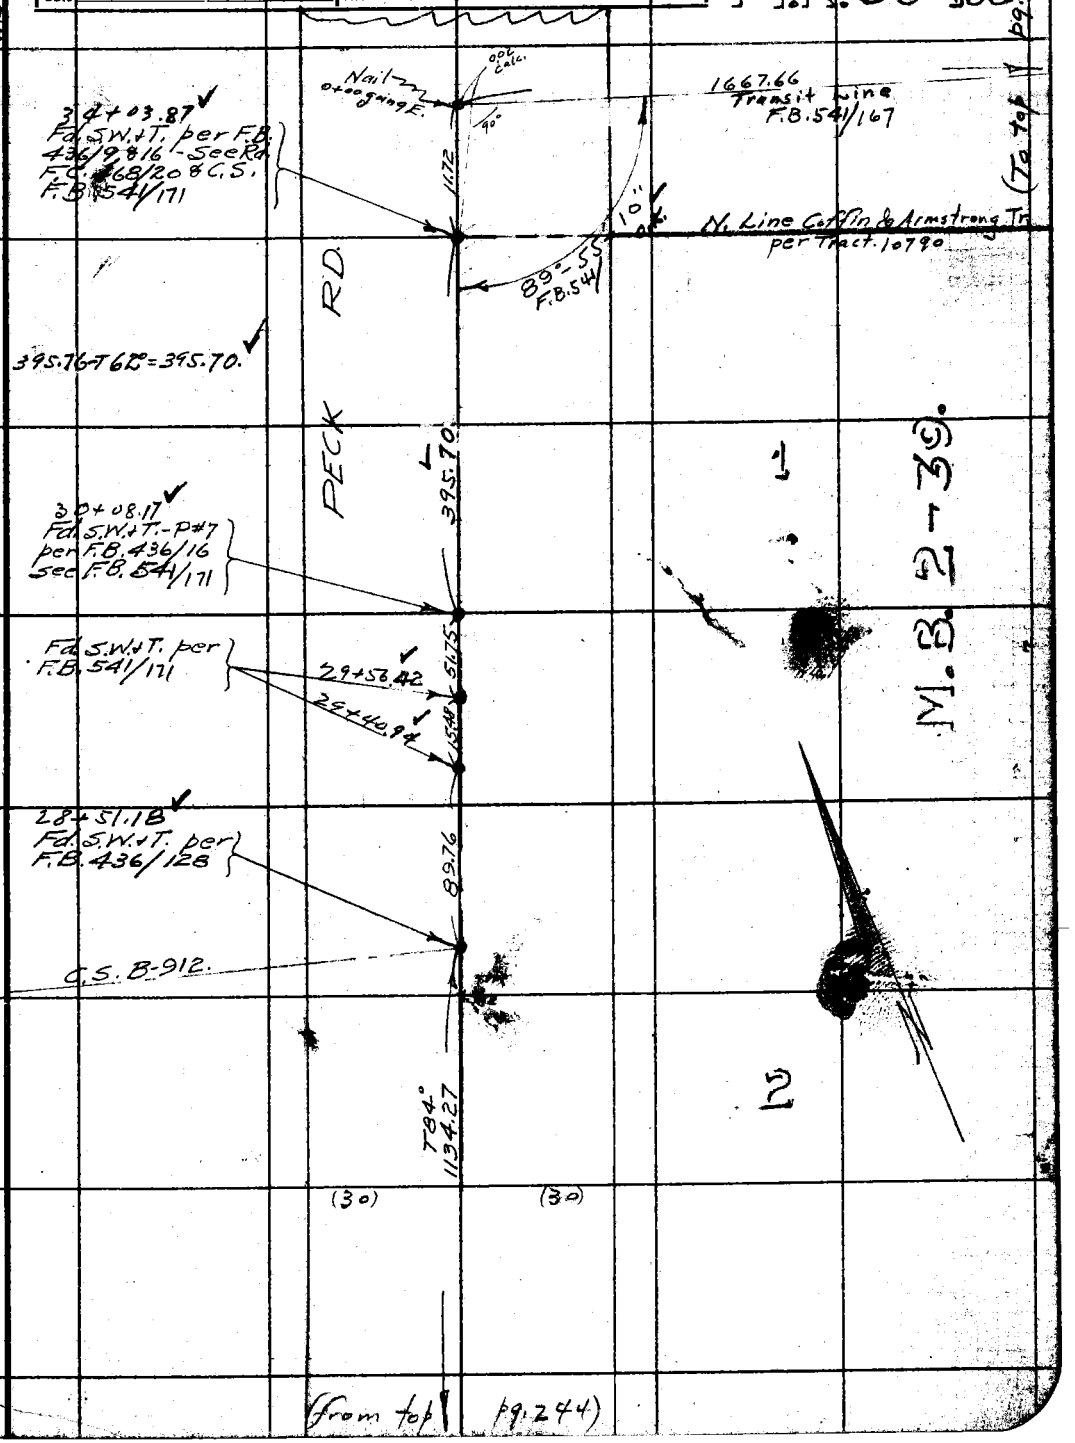

(From top pg. 244)

F.B. 436 Pg. 246

(To Bot. pg. 247) 4/12/34

RETURN TO
LOS ANGELES COUNTY SURVEYOR
700 HALL OF RECORDS

Do not extend notes this side of this line

Note: ANY ADDITIONS OR CHANGES ON THIS SHEET MUST BE MADE OR CIRCLED IN Red Ink. WITH DATE AND NAME OF PERSON MAKING CHANGE.

COFFIN & ARMSTRONG

-TR. 9560 -

-TR. 10530.

-TR. 27360.

301.98

Set Nail 13+64.52

301.14

Set Nail 10+63.42

(30) 292.54 (30)

60°

Fd. SW'LT 7+69.88

RD.

AZUSA TOWER

308.66

4+67.22 Set Nail

308.77

(from Rt. Side pg. 243)

Notes Ck'd by McPherson
Map No. B-1006-1
Office Work K.Y. Morin
Checked
Date

Survey of Rurban Homes
W. O. 8048 Tape No. 067 St'd 67 of.
Surveyed by Evans
Notes HE Date 4/13/34
Indexed A. C. Johnson

F.B. 436 Pg. 247

#5.46.8-4

(To Bot. pg. 248)

1444.67-T74°=1444.58

1444.58

(90°-18'-00")
(361-12-00)
90°-18'-00" ✓

Set N.J.T.
22+37.79 ✓

LOWER RD.

10530.

Note: ANY ADDITIONS OR CHANGES ON THIS SHEET MUST BE MADE OR CIRCLED IN Red Ink. WITH DATE AND NAME OF PERSON MAKING CHANGE.

Do not extend notes this side of this line

90°-18'-00" O.K. ✓

2692.21-T84°=2692.21

19+68.58 ✓
Fd. 5" redhead.
1.72 S
Mon Pg 282

LA MADERA AVE.

OAK ST

(20)
Mon Pg. 285

302.57 ✓

0+00 going N.

19+66.86 - Fd. old 2x2, 0.15 N. of ℄ Set ¾" I.P. cem. filled & nail ⊙ on ℄ 12'dn.; by proportion between Peck Rd. & SE. cor. Lot 12 Coffin & Arms Terra Tract per Tract (Prop. ?)

RETURN TO
LOS ANGELES COUNTY SURVEYOR
700 HALL OF RECORDS

(To Bot. Pg. (20))

302.04

302.57-T74°=302.57 ✓

(30)

(30)

301.98

AZUSA

TRACT

(from top pg. 246.)

FORM 247 10M 5-31

RETURN TO
LOS ANGELES COUNTY SURVEYOR
700 HALL OF RECORDS

Note: ANY ADDITIONS OR CHANGES ON THIS SHEET MUST BE MADE OR CIRCLED IN **Red Ink**, WITH DATE AND NAME OF PERSON MAKING CHANGE.

Do not extend notes this side of this line

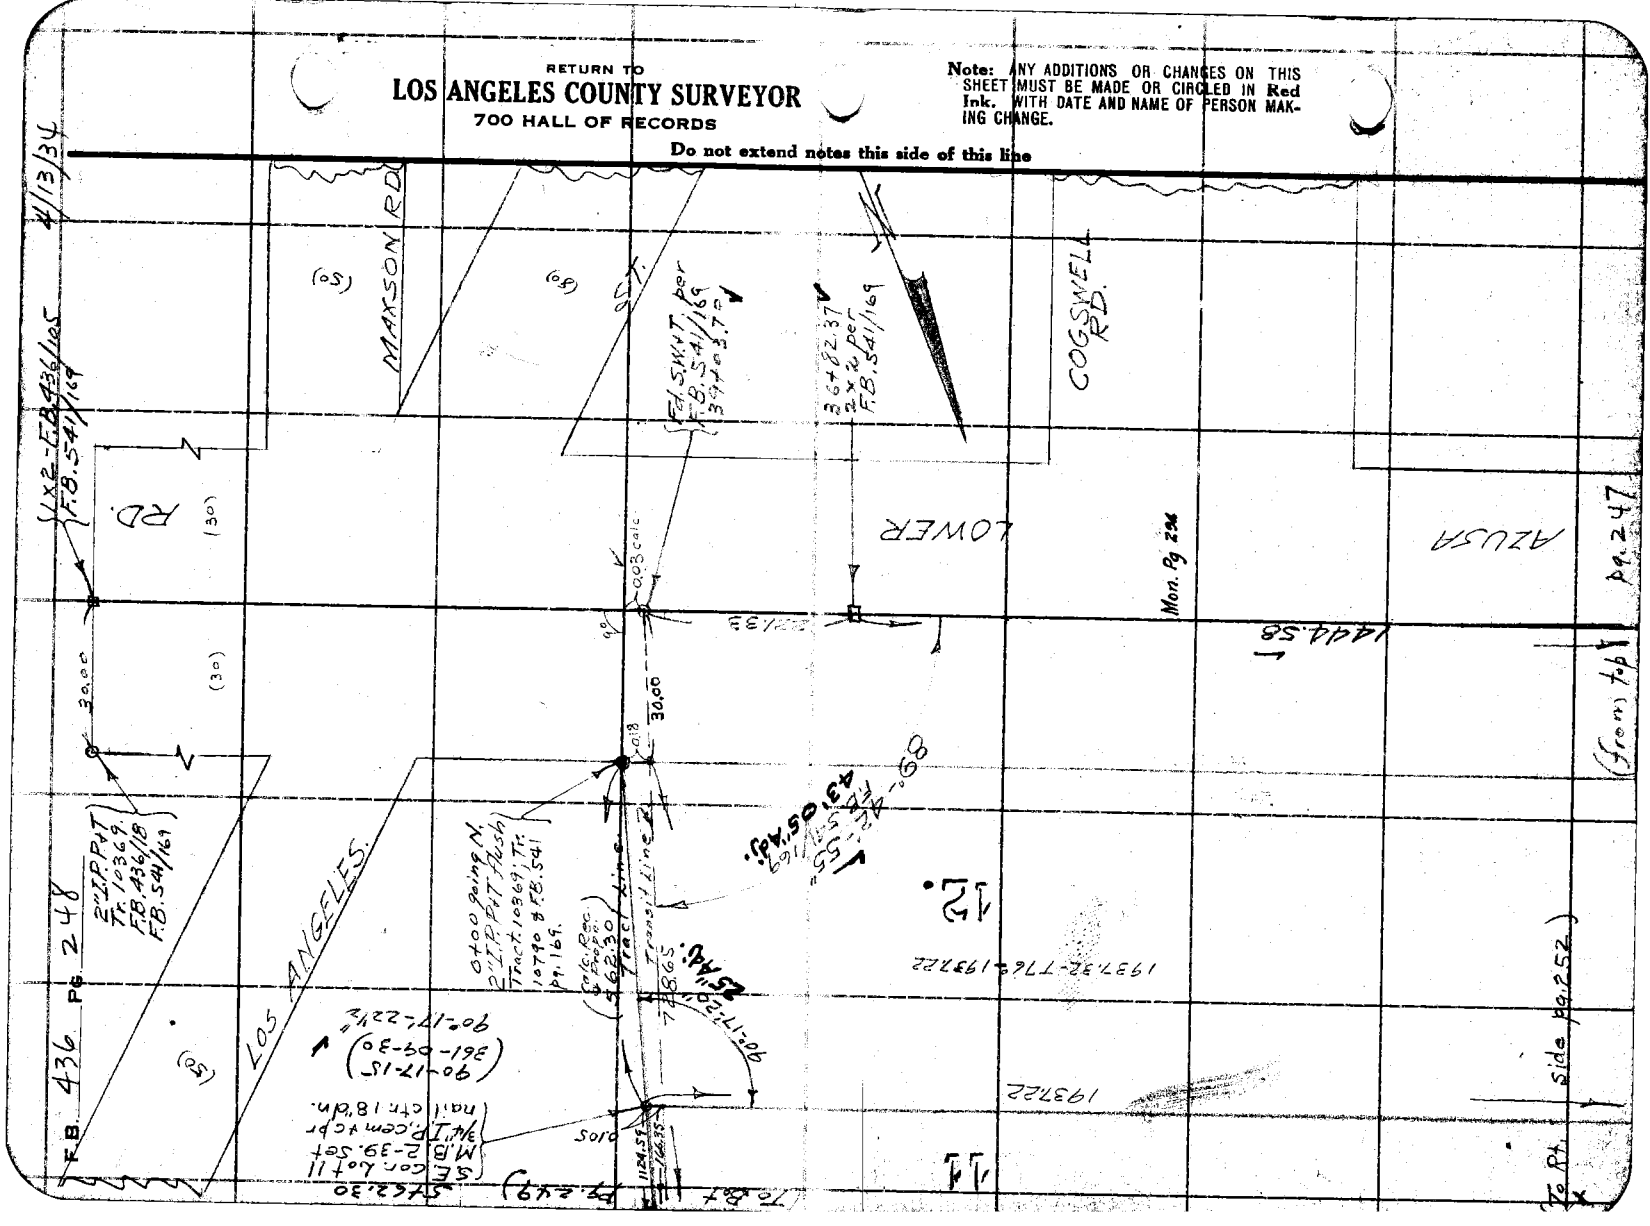

Notes Ck'd by McPherson
Map No. B-1006-1
Office Work K.Y. Morin
Checked
Date

Survey of Rurban Homes
W. O. 8048 Tape No. 067 St'd. 84 °F.
Surveyed by Evans
Notes KE Date 4/4/34
Indexed A. C. Johnson

F.B. 436 Pg. 249

W.S. 46 B. 4

(To Lt. side pg. 250)

513.33-T86°=513.34

9.

Asph. To. 10780 N.E.
Con. Curb
1760.69
1714.61
Trans. Line F.B. 436/249

HEMLOCK ST.

(20) pg. 253

0 tpo going West. Set 3/4" I.P. cem'd in pr. mail on by prop'n North & South. 12" dn. 16780.89 from South.

0.05

513.34

0.08

Trans. Line

Fd. 2X2 flush F.B. 436/9 and F.B. 541/168. Removed.

(To Lt.)

(20)

90°-17'-30"

(90-17-30)
361-10-00
90°-17'-30"

M.B. 2-39.

Trans. Line

1124.59

958.32

.10

T.R. 1039.

7+28.65 Set 2X2 on True Line.

1X2 F.B. 541/169

166.35
728.65

(From Lt. side pg. 248)

RETURN TO
LOS ANGELES COUNTY SURVEYOR
700 HALL OF RECORDS
Do not extend images this side of this line

Note: ANY ADDITIONS OR CHANGES ON THIS SHEET MUST BE MADE OR CIRCLED IN Red Ink. WITH DATE AND NAME OF PERSON MAKING CHANGE.

FORM 247 10M 8-31

RETURN TO
LOS ANGELES COUNTY SURVEYOR
700 HALL OF RECORDS

Note: ANY ADDITIONS OR CHANGES ON THIS SHEET MUST BE MADE OR CIRCLED IN Red Ink. WITH DATE AND NAME OF PERSON MAKING CHANGE.

Do not extend notes this side of this line

W.S. 46 C-3

4/13/36

CHICAGO PARK.

(To Bdy. 4 251)

797.64
Transit Line per F.B.

27+72.88
1x2
S. F.B. 54 1/167

813.1

1132.47
54 1/168

3940.535
Nail
F.B. 54 1/168

0.27

1x2
F.B. 54 1/168

1.80

Tract Line per Tr. 10790.

12.20

0.28

1714.61

3348.58 from South.
For 2" I.P. Ptr. in conc. 13" high as per Tract No. 10369 & 10790 see F.B. 436/6 & 54 1/168 N.E. Cor. Lot 7 Coffin & Armstrong Tr. per Tr. 10369

1702.69

Transit Line

S. Tract Line

Tr. 10369.

F.B. 436 Pg. 250

7

COFFIN & ARMSTRONG TRACT.

(from Bdy. 249.240)

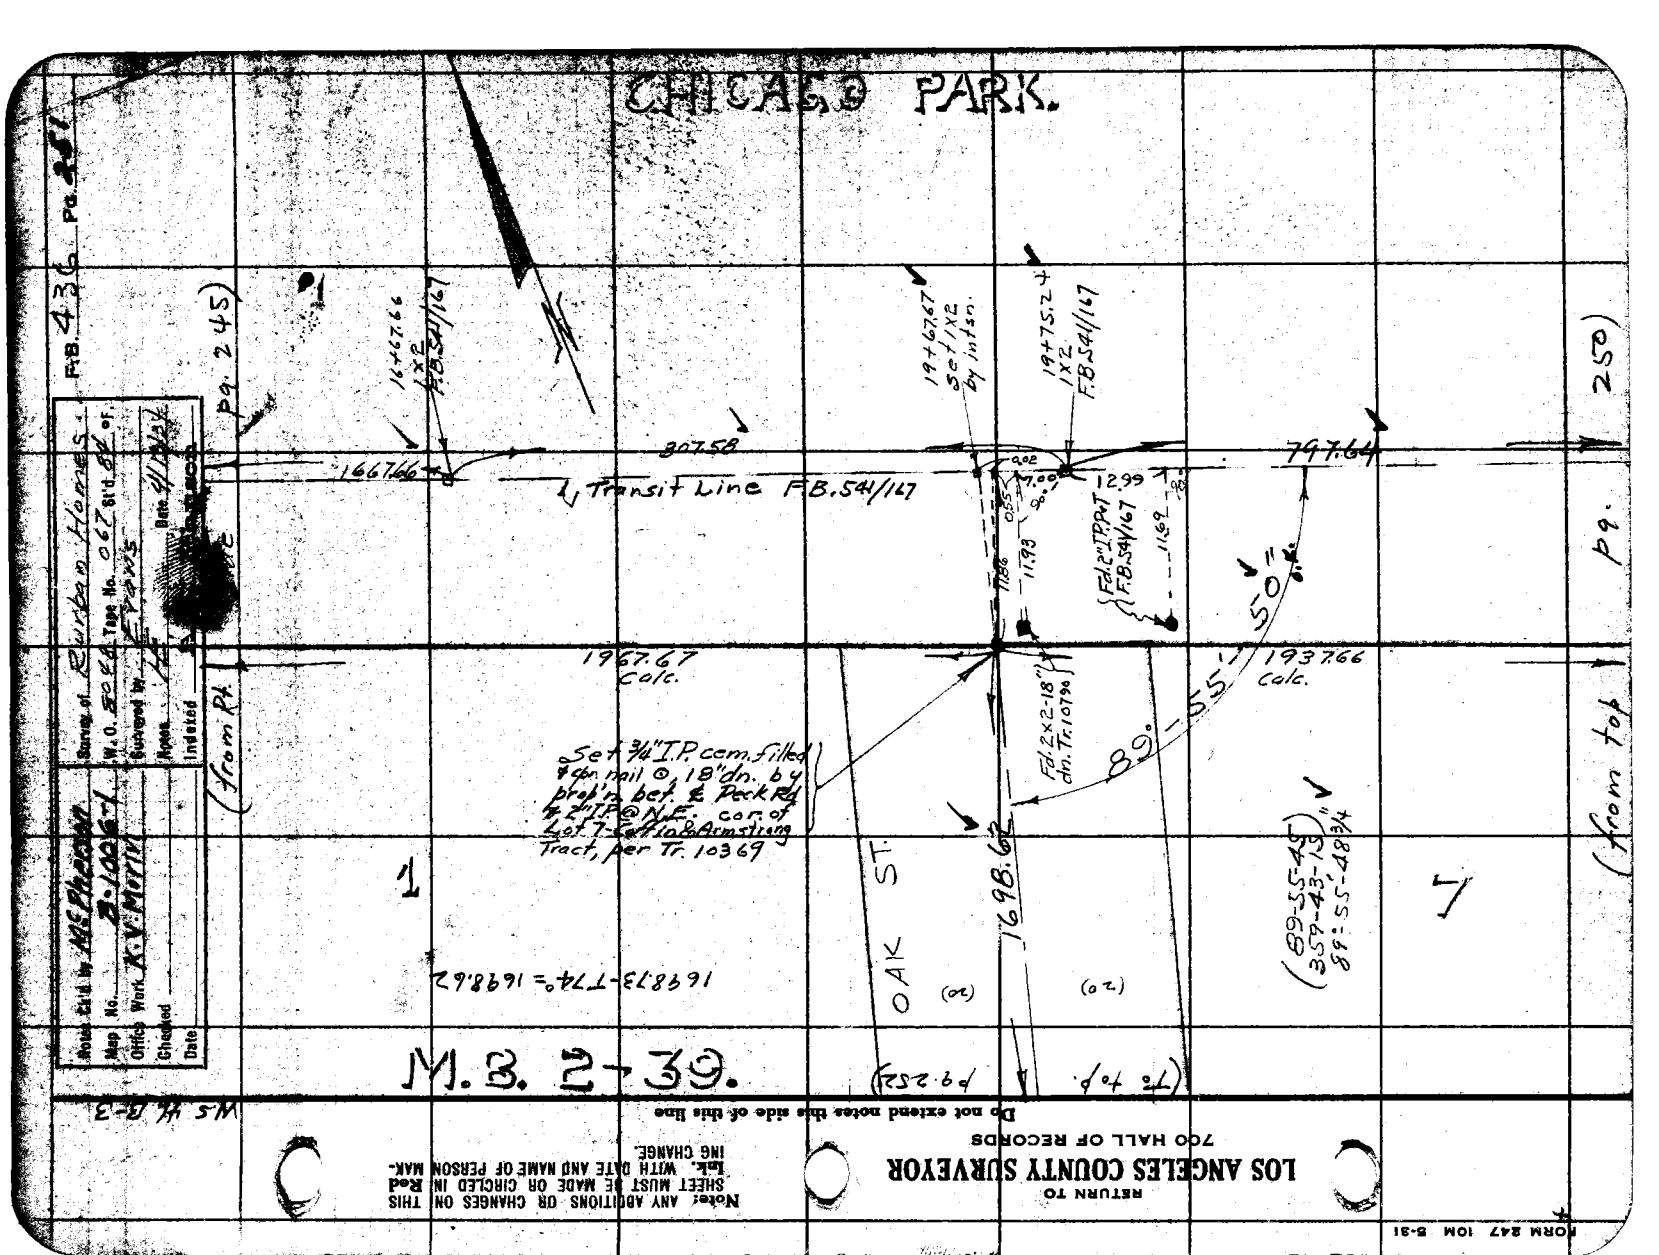
CHICAGO PARK.
(from Pt. 1 Pg. 245)
Checked
Date
Indexed
16+67.66 1X2 F.B.541/167
19+67.67 Set 1/2" by Intsn.
19+75.24 1X2. F.B.541/167
207.58
166.66
℄ Transit Line F.B.541/167
799.64
(from top Pg. 250)
F&L 2" I.P. at F.B.541/167
1.92
2.99
1.86
0.85
11.93
90°
1967.67 Calc.
1937.66 Calc.
89°-55'-50"
Set 3/4" I.P. com. filled w/ 4d nail @ 18" dn. by prof'n. bet. & Peck Rd. & I.P. @ N.E. cor. of Lot 7 Catlin & Armstrong Tract, per Tr. 10369
F&L 2"x2-18" dn. Tr. 10790
1698.62
OAK ST.
(20)
(20)
(89-55-45) (359-43-13) 89°-55'-48 3/4"
7
1
1
16+81.73-7.74 = 1698.62
M. B. 2-39.
(To top Pg. 252)
W.S. # 2-3
Do not extend notes this side of this line
RETURN TO
LOS ANGELES COUNTY SURVEYOR
700 HALL OF RECORDS
Note: ANY ADDITIONS OR CHANGES ON THIS SHEET MUST BE MADE OR CIRCLED IN Red Ink, WITH DATE AND NAME OF PERSON MAKING CHANGE.
FORM 847 10M 5-31

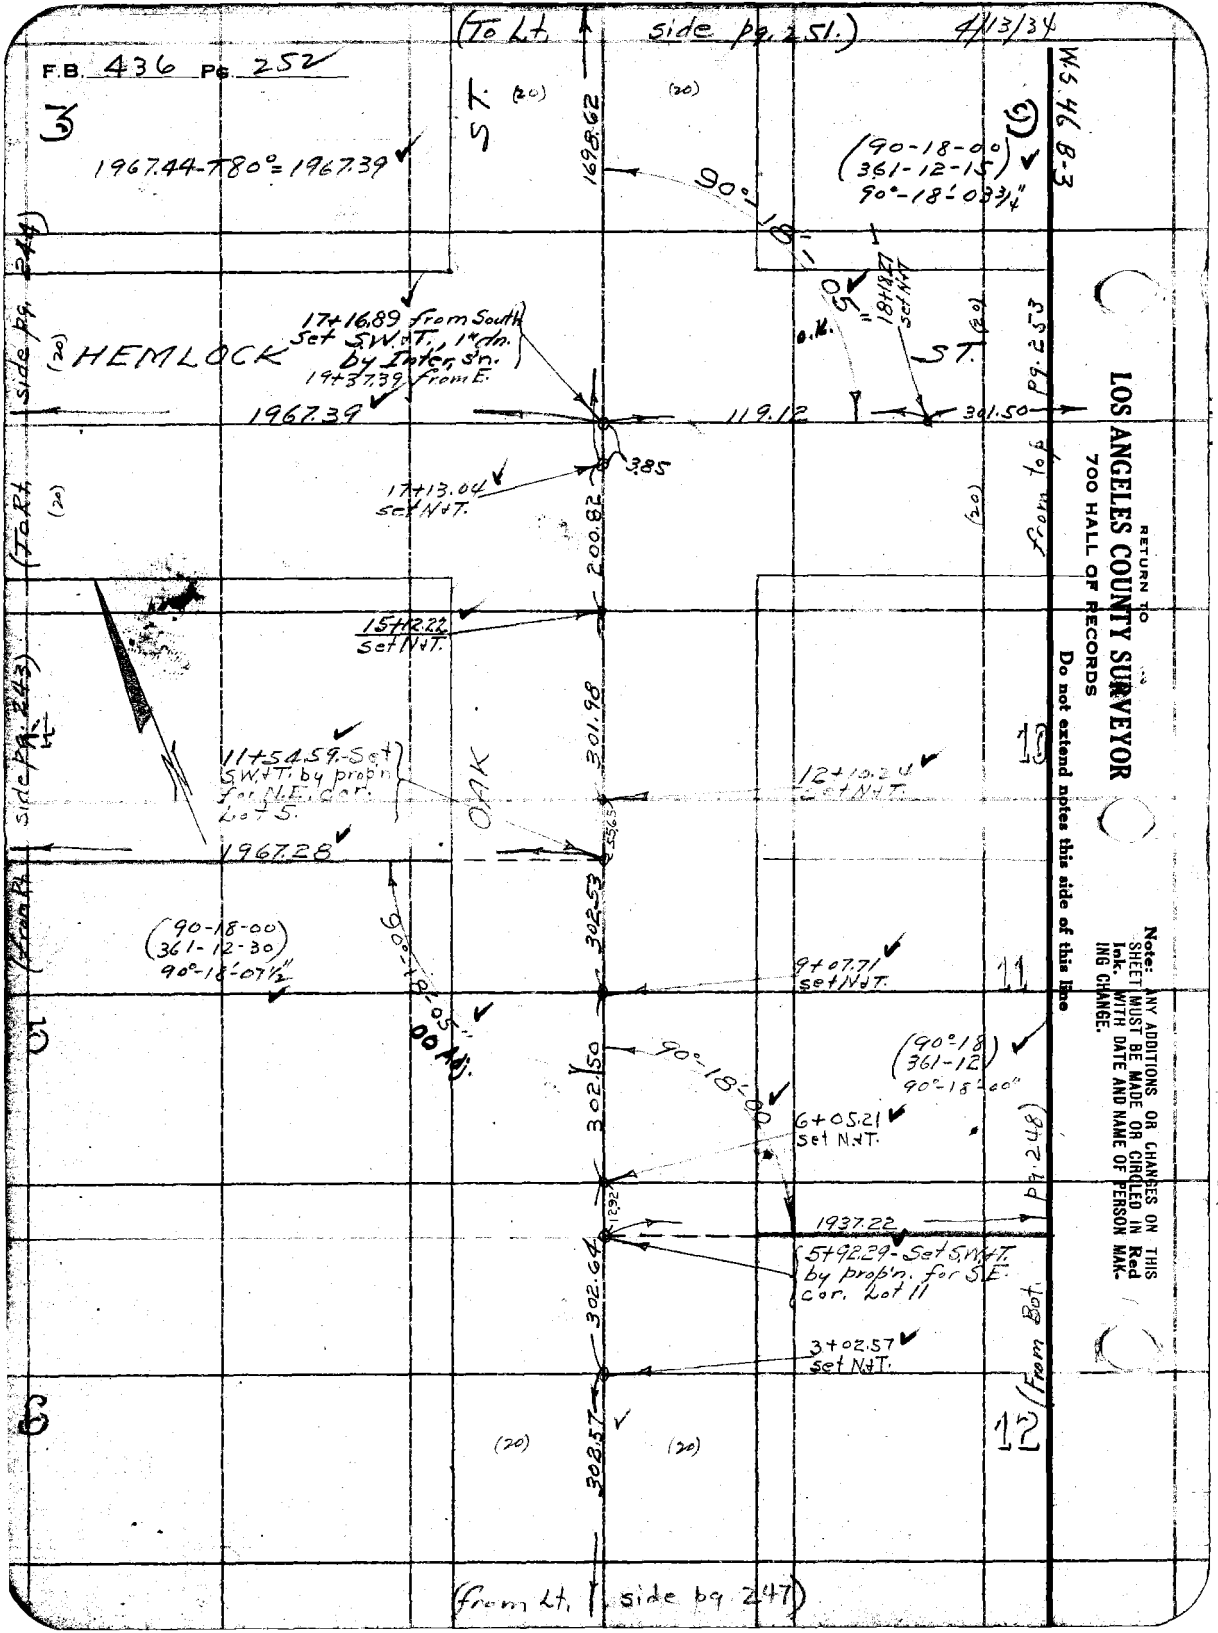
(To Lt. side pg. 251.)
4/13/34
F.B. 436 Pg. 252
ST. (30)
1692.62
90°-18'-
(90-18-00)
361-12-15
90°-18'-03¾"
WS 46 B-3
1967.44-T80°=1967.39
17+16.89 from South
Set S.W.T., 1st sh.
By Prop'n. sh.
19+37.39 from E.
HEMLOCK
1967.39
119.12
301.50
Pg. 253
385
17+13.04
Set N.T.
200.82
15+12.22
Set N.T.
301.98
11+54.59-Set
S.W.T. by prop'n
for N.E. cor.
Lot 5.
1967.28
12+19.24
Set N.T.
OAK
302.53
9+07.71
Set N.T.
(90-18-00)
361-12-30
90°-18'-07½"
90°-18'-05"
90°-18'-00"
302.50
(90°18
361-12
90°-18'-00"
6+05.21
Set N.T.
1392
1937.22
Pg. 248
5+92.29-Set S.W.T.
by prop'n. for S.E.
cor. Lot 11
302.64
3+02.57
Set N.T.
308.57
(20)
(from Lt. side pg. 247)
RETURN TO
LOS ANGELES COUNTY SURVEYOR
700 HALL OF RECORDS
Do not extend notes this side of this line
Note: ANY ADDITIONS OR CHANGES ON THIS SHEET MUST BE MADE OR CIRCLED IN Red Ink. WITH DATE AND NAME OF PERSON MAKING CHANGE.

Notes Ck'd by MS Merson
Map No. B-1006 sh 1
Office Work K.V. Marin
Checked
Date

Survey of Rurban Homes
W. O. 8048 Type No. 067 St'd 84' or.
Surveyed by Evans
Notes H. Date 4/16/34
Indexed C. Johnson

F.B. 436 Pg. 253

To Rt. side pg. 252

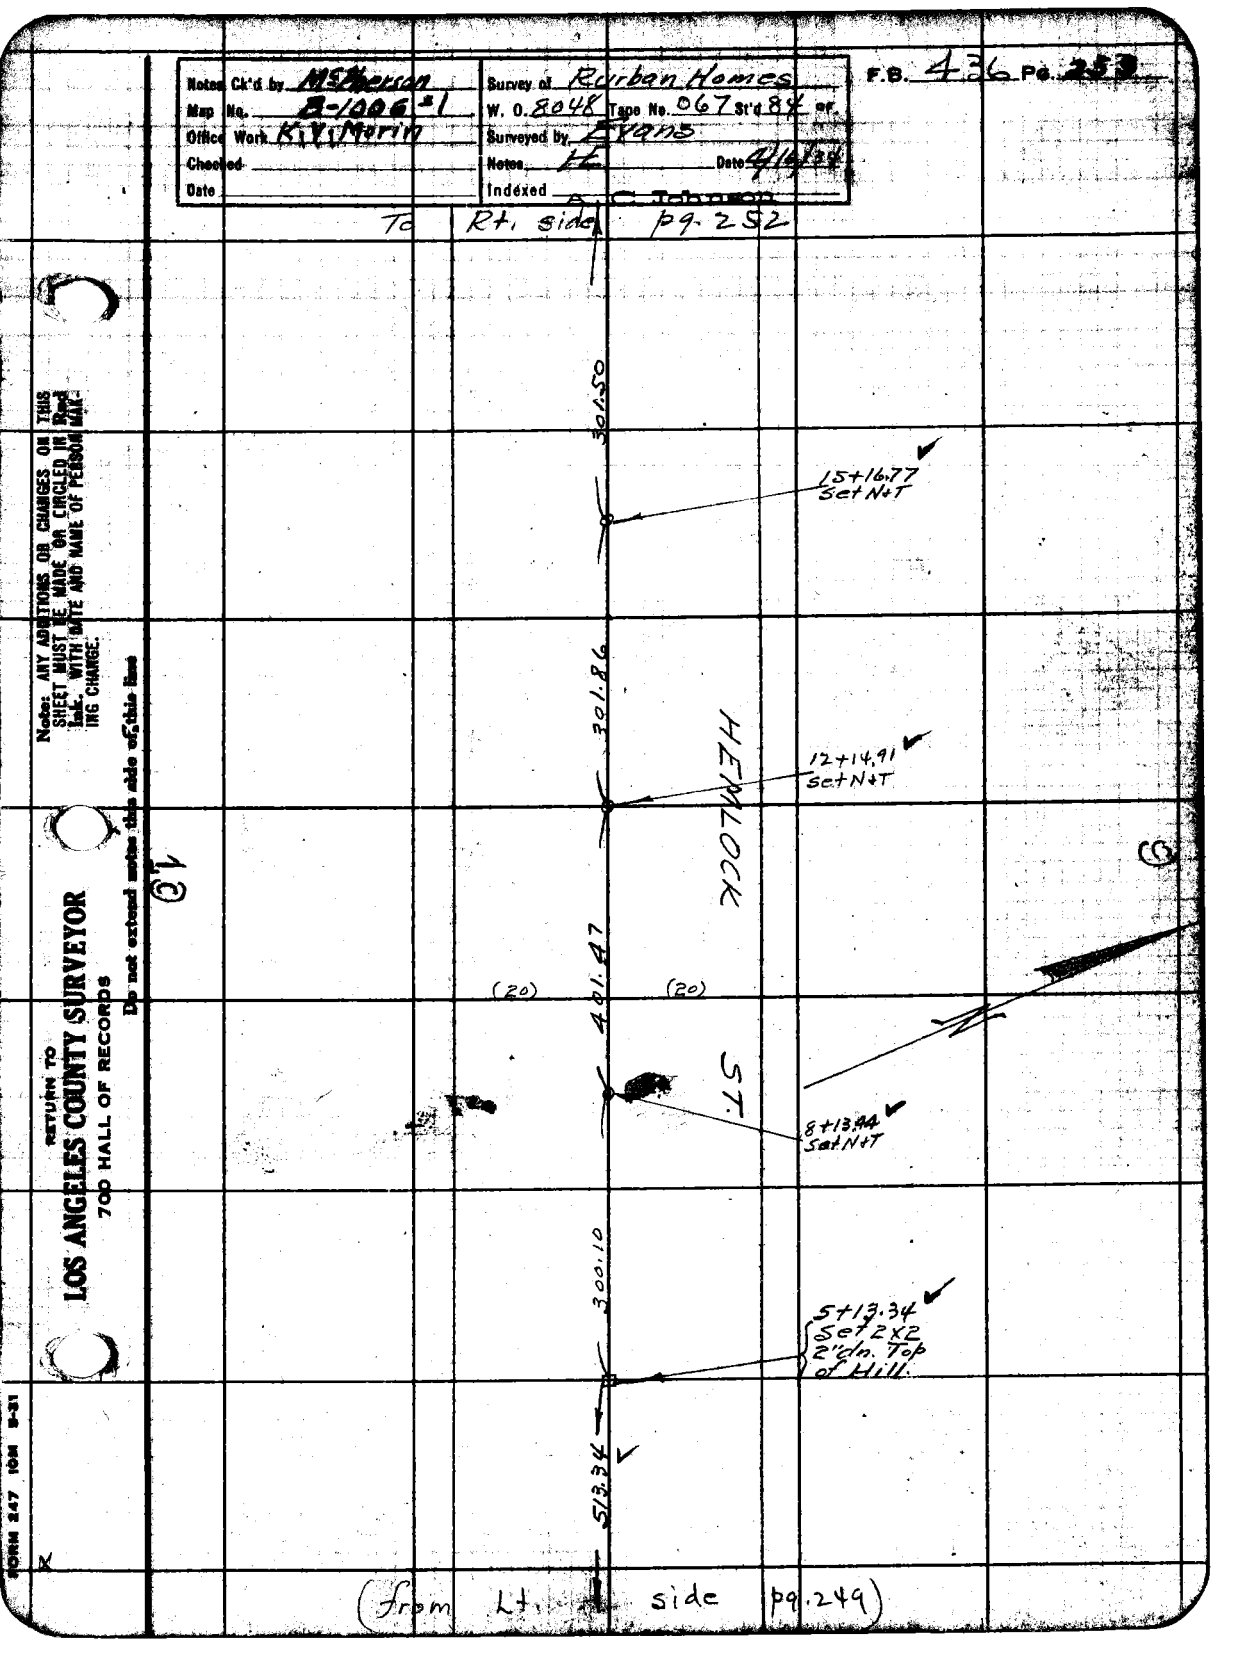

(from Lt. side pg. 249)

RETURN TO
LOS ANGELES COUNTY SURVEYOR
700 HALL OF RECORDS

Do not extend notes this side of this line

Note: ANY ADDITIONS OR CHANGES ON THIS SHEET MUST BE MADE OR CIRCLED IN Red Ink, WITH DATE AND NAME OF PERSON MAKING CHANGE.

FORM 247 10M 8-31

RETURN TO

LOS ANGELES COUNTY SURVEYOR

700 HALL OF RECORDS

Note: ANY ADDITIONS OR CHANGES ON THIS SHEET MUST BE MADE OR CIRCLED IN **Red Ink.** WITH DATE AND NAME OF PERSON MAKING CHANGE.

Do not extend notes this side of this line

F.B. 436 PG. 254

Notes Ck'd by		Survey of Ruben Homes	F.B. 436 Pg 255
Map No. B-1006-2		W. O. 8048 Tape No. 067 St'd 8# oF.	
Office Work Wood		Surveyed by Evans	
Checked		Notes HE Date 4/28/34	
Date		Indexed A. C. Johnson 4-25-34	

RETURN TO
LOS ANGELES COUNTY SURVEYOR
700 HALL OF RECORDS
Do not extend notes this side of this line

Note: ANY ADDITIONS OR CHANGES ON THIS SHEET MUST BE MADE OR CIRCLED IN Red Ink WITH DATE AND NAME OF PERSON MAKING CHANGE.

FORM 247 10M 8-31

Sta 19+37.39 from E. Sw't-pg. 252
17+16.89 from S.
℄ Hemlock St.

Sta 13.34 2 x 2 per pg. 253

OAK ST.

200'

R.H. 0+00 going E.

Line "A" ℞

LOT 10

Red Head 0+00 going East.

Line "B." ℞

2 1/2'

R.H. 0+00 going E.

Line "C" ℞

LOT 11

R.H. 0+00 going E.

Line "D" ℞

R.H. 0+00 going E.

Line "E" ℞

See pg. 252 Sw't-Sta 92.29 from S. 0+00 going E.

N Line Lot 12 ℞

LOT 12

Transit Lines for Location of trees.

(See pgs. 257-272 for plus ± offset from these lines to trees.)

F.B. 436 Pg. 286

Location of trees in Lots 5 and 6

(See pgs. 243 to 252 for Survey)

LOT 4

{For tabulation of missing trees see pg. 276.}

11+54.67 from S. S.W.&T. per pg. 243.

11+94.59 from S. S.W.&T. pg. 252

See pg. 276 for pump house & pressure.

N. Line Lot 52

1967.28

LOT 5

WALNUT GROVE

18" trees - 50' @ 50 intervals

See pg. 276 for tabulation of trees which are missing

LOT 6

0+00 going N. 5 K.K. pg. 243 0+00 going E.

0+00 going N. 3/4 I.P. pg. 243 1966.8 from E. 20'

AZUSA LOWER RD.

RETURN TO
LOS ANGELES COUNTY SURVEYOR
700 HALL OF RECORDS

Note: ANY ADDITIONS OR CHANGES ON THIS SHEET MUST BE MADE OR CIRCLED IN Red Ink. WITH DATE AND NAME OF PERSON MAKING CHANGE.

Do not extend notes this side of this line

Notes Ck'd by
Map No. B-1006-2
Office Work Wood
Checked
Date

Survey of Rurban Homes F.B. Pg. 257
W. O. 8048 Tape No. 067 St'd 84 °F.
Surveyed by Evans
Notes Date 4/19/34
Indexed A. C. Johnson

Location of Walnut trees along Hemlock St.
See pgs 252-253 for &

Station	Offset Rt. (or north)	Lt. (or south)	Remarks
4+50.5		71.3	10" Wal.
4+50.8		19.8	5" wal.
5+02		71.4	14" wal.
5+02.7		20.1	18" wal.
5+12.7		25.0	20" water valve
5+52.3		71.6	14" wal.
5+53.2		20.6	18" wal.
6+02.7		20.3	18" Wal.
6+02.5		71.4	18" wal.
6+52.8		20.5	18" Wal.
7+03.2		21.1	16" wal
7+52.5		21.8	" "
7+76		28.4	20" water valve
8+03.1		20.6	16" wal
8+02.6		72.2	18" Wal
7+52.2		71.7	14" wal
7+02.3		71.9	14" wal.
6+52.5		71.2	10" wal.
8+52.6		21.2	18" Wal.
9+02.1		20.9	16" wal.
9+52.7		21.8	16" wal.
10+02.6		21.6	16" wal.
8+52.5		72.2	18" Wal.
9+02		72.4	16" wal.
9+52.0		72.2	14" Wal.
10+02.4		72.3	10" wal.
10+52.3		21.3	16" Wal
11+02.7		21.6	14" Wal
11+52.3		21.5	14" Wal.
10+51.8		72.7	18" Wal.
11+02.2		72.3	12" Wal
11+52.3		72.5	16" Wal

(cont'd top pg. 258)

RETURN TO
LOS ANGELES COUNTY SURVEYOR
700 HALL OF RECORDS
Do not extend water this side of this line
Note: ANY ADDITIONS OR CHANGES ON THIS SHEET MUST BE MADE ON CIRCLED IN Red INK, WITH DATE AND NAME OF PERSON MAK-ING CHANGE.
FORM 247 10M 8-31

Contd. from Bot. pg. 257

F.B. 436 Pg. 258

Station	Offset (south or) Rt.	Offset (south or) Lt.		Remarks.
12+02.3		22.1		18" Wal.
12+52.2		21.9		14" Wal.
13+02.7		21.6		16" Wal.
13+52.1		21.7		12" Wal.
13+76.4		27.4		30" con. standpipe 6' high.
12+01.5		72.4		16" Wal.
12+52.3		73.1		12" Wal.
13+02		73.1		16" Wal.
13+52		73.0		18" Wal.
14+02.1		22.1		14" Wal.
14+53.5		21.5		8" Wal.
15+52.6		22.1		18" Wal. (one tree cut in 1st Row.)
14+02.6		73.1		8" Wal.
14+52.1		73.3		16" Wal.
15+02.2		73.8		12" Wal.
15+51.8		73.2		16" Wal
16+01.9		73.4		16" Wal.
16+52.7		22.2		12" Wal.
17+02.5		23.8		14" Wal.
17+52.4		23.5		18" Wal.
16+02.6		74.3		14" Wal.
16+41.7		59.2		6" water well - center of 6'x6' windmill, parallel to ℄
16+51.4		74.3		14" Wal.
17+01.2		74.5		16" Wal.
17+51.6		74.5		16" Wal.
18+02		23.9		14" Wal.
18+52.5		23.2		18" Wal.
19+01.6		23.7		18" Wal. (end of row.)
18+02.3		74.4		16" Wal.
18+51.7		75.1		10" Wal.
19+01.7		74.9		14" Wal. (end of row.

(End.)

RETURN TO
LOS ANGELES COUNTY SURVEYOR
700 HALL OF RECORDS
Do not extend notes this side of this line

Note: ANY ADDITIONS OR CHANGES ON THIS SHEET MUST BE MADE OR CIRCLED IN Red Ink. WITH DATE AND NAME OF PERSON MAKING CHANGE.

Notes Ck'd by
Map No. B-1006-2
Office Work Wood
Checked
Date

Survey of Rurban Homes
W. O. 8084 Tape No. 067 St'd 84 oF.
Surveyed by Evans
Notes HE Date 4/19/34
Indexed A. C. Johnson

F.B. 436 Pg. 259

Location of Trees along "Line A" - see pg. 255 for survey.

Station	Offset Rt. (or South)	Offset Lt. (or North)	Remarks.
0+34.9		23.4	14" Wal.
0+34.3		74.2	18" Wal.
0+85.2		74.9	16" Wal.
0+84.9		23.4	16" Wal.
0+35.2	28.2		14" Wal
0+35.6	79.2		14" Wal.
0+85.8	78.7		14" Wal.
0+85.2	27.4		12" Wal.
1+34.6		28.4	14" Wal
1+34.4		74.7	14" Wal
1+85.1		74.5	16" Wal
1+85.4		23.6	16" Wal
2+34.2		23.9	10" Wal.
2+34.4		75.2	20" Wal.
2+85.1		74.8	14" Wal.
2+85.4		23.6	18" Wal.
1+35	27.7		16" Wal.
1+85.7	27.1		18" Wal
2+35	27.6		14" Wal
2+85.8	27.2		16" Wal.
1+35.8	78.5		16" Wal.
1+85.3	78.6		16" Wal
2+35.1	79.4		10" Wal.
2+86	78.8		16" Wal.
3+35.4		23.7	14" Wal
3+85.3		23.7	16" Wal
4+34.3		23.7	16" Wal
4+84.6		24.3	14" Wal.
3+35.1		74.8	16" Wal.
3+85		75.2	10" stump.
4+34.1		75.5	16" Wal
4+84		75.2	14" Wal.
3+35.4	27.9		16" Wal.

(cont'd top p9.260)

Note: ANY ADDITIONS OR CHANGES ON THIS SHEET MUST BE MADE OR CIRCLED IN Red Ink, WITH DATE AND NAME OF PERSON MAKING CHANGE.

RETURN TO LOS ANGELES COUNTY SURVEYOR 700 HALL OF RECORDS

Do not extend notes this side of this line

FORM 247 10M 8-31

F.B. 436 PG. 260

Cont'd. from Bot. pg. 259

Station	offset Rt. (or South)	offset Lt. (or North)	Remarks
3+85.8	27.4		16" Wal.
4+34.3	26.9		14" Wal.
4+85.1	27.0		14" Wal.
3+35.2	78.7		16" Wal
3+86.1	78.7		18" Wal.
4+34.6	78.7		16" Wal.
4+85.3	77.5		10" Wal.
5+34.3		24.3	14" Wal.
5+85		24.6	12" Wal
6+34.9		24.2	18" Wal.
6+85.0		24.2	18" Wal.
5+34.1		76.0	16" Wal.
5+84.5		75.9	16" Wal.
6+34.5		75.9	14" Wal.
6+84.4		76.1	14" Wal.
5+35.0	26.7		12" Wal
5+85.2	27.2		14" Wal.
6+35.2	27.2		16" Wal.
6+85.2	26.6		14" Wal.
5+34.5	78.1		18" Wal.
5+85.3	78.0		16" Wal.
6+35.4	78.0		16" Wal.
6+85.6	78.0		16" Wal.
7+35.1		25.2	16" Wal.
7+84.8		24.8	14" Wal.
8+34.6		24.7	18" Wal.
8+85.1		25.3	16" Wal.
7+34.8		76.3	18" Wal
7+84.2		76.6	12" Wal.
8+34.5		76.4	16" Wal.
8+84.8		76.6	16" Wal.
7+35.4	26.2		16" Wal.
7+85.1	26.4		16" Wal.
8+34.9	26.6		14" Wal.
8+85.1	26.0		18" Wal.
7+35.5	77.5		18" Wal.
7+85.4	77.3		16" Wal.
8+35.4	77.3		18" Wal.
8+85.4	77.6		14" Wal.

(Cont'd top pg. 261.)

RETURN TO
LOS ANGELES COUNTY SURVEYOR
700 HALL OF RECORDS

Do not extend notes this side of this line

Note: ANY ADDITIONS OR CHANGES ON THIS SHEET MUST BE MADE OR CIRCLED IN Red Ink. WITH DATE AND NAME OF PERSON MAK-ING CHANGE.

(Contd from Bk. 59, Pg. 260)

Notes Ck'd by
Map No. B-1006-2
Office Work Wood
Checked
Date

Survey of Rurban Homes
W. O. 8048 Tape No. 067 St'd 84 oF.
Surveyed by Evans
Notes K Date 4/19/34
Indexed A. C. Johnson

F.B. 430 Pg. 261

Station	Offset Rt.	Offset Lt.	Remarks
9+34.3		25.4	18" Wal.
9+84.1		25.5	18" Wal.
10+35		25.7	18" Wal.
10+84.6		25.9	18" Wal.
9+34.2		77.5	20" Wal.
9+83.9		76.7	18" Wal.
10+34.5		77.2	20" Wal.
10+84.5		76.8	16" Wal.
9+35.3	25.6		18" Wal
9+84.2	25.2		18" Wal.
10+34.8	25.5		16" "
10+84.2	25.2		18" "
9+35.5	76.7		14" "
9+85	77.1		16" "
10+35.1	76.5		16" "
10+85.2	76.6		16" "
11+33.8		26.4	10" "
11+84.5		26.0	18" "
12+35.5		25.7	20" "
12+84.5		26.5	22" "
11+34.3		77.3	18" "
11+83.5		77.1	16" "
12+34.6		77.5	18" "
12+83.7		77.5	12" "
11+34.5	25.1		16" "
11+83.2	25.1		16" "
12+34.8	24.6		12" "
12+84.9	24.2		14" "
11+34.3	76.4		16" "
11+82.8	76.5		16" "
12+35.3	77.2		18" "
12+85	76.0		18" "

Note: ANY ADDITIONS OR CHANGES ON THIS SHEET MUST BE MADE OR CIRCLED IN Red Ink. WITH DATE AND NAME OF PERSON MAKING CHANGE.

RETURN TO
LOS ANGELES COUNTY SURVEYOR
700 HALL OF RECORDS
Do not extend notes this side of this line

FORM 247 10M 8-31

F.B. 436 Pg 262

(From Bot pg 261)

Station.	Offset. Rt. (or South)	Offset. Lt. (or North)	Remarks.
13+34 E		25.6	4" walnut.
13+85 E		26.7	16" "
14+34 E		26.4	10" "
14+85 E		26.8	12" "
13+34 E		77.5	10" "
13+84 E		77.4	12" "
14+35.1		78.2	18" "
14+86.1		78.1	12" "
13+34 E	24.3		12" "
13+84 E	25.1		8" "
14+36 E	24.2		10" "
14+85 E	24.2		12" "
13+35	75.5		18" "
13+85 E	75.3		10" "
14+36.2 E	75.2		8" "
14+85.1	75.2		6" "
15+34 E		26.6	10" "
15+33.8 E		77.8	6" " End trees
15+35.8 E	74.2		12" "
15+36.1	75.8		14" "

Location of walnut trees along "LINE B"
(See pg. 255 for survey) 4/20/34

0+35.4		18.3	18" walnut.
0+85.6		19.2	18" "
0+84.7		69.6	20" "
0+34.9		70.2	18" "
0+35 E	32.2		18" "
0+85 E	32.2		16" "
0+86.1	83.3		18" "
0+35.6	83.2		10" "
1+34 E		19.1	16" "
1+85.4		19.4	16" "
2+34 E		19.2	14" "
2+85.3		19.3	18" "
1+34.1		70.8	20" "
1+85		70.3	14" "
2+34.4 E		69.6	18" "
2+84 E		70.1	20" "

(To top pg 263)

RETURN TO
LOS ANGELES COUNTY SURVEYOR
700 HALL OF RECORDS
Do not extend notes this side of this line
Note: ANY ADDITIONS OR CHANGES ON THIS SHEET MUST BE MADE OR CIRCLED IN Red Ink. WITH DATE AND NAME OF PERSON MAKING CHANGE.

(from Bot pg. 262)

Notes Ck'd by
Map No. B-1006-2
Office Work Wood
Checked
Date

Survey of Burban Homes
W. O. 8048 Tags No. 067 St'd 84 °F.
Surveyed by Evans
Notes AE Date 4/20/34
Indexed A. C. Johnson

F.B. 436 Pg. 263

Station	Offset Rt.	Offset Lt.	Remarks
1+35 4	32.6		16" Walnut.
1+85 1	32.7		16" "
2+34 9	32.8		8" "
2+84 1	32.7		12" "
1+35 5	83.2		18" "
1+85 4	83.3		16" "
2+34 1	84.2		16" "
2+86	83.3		16" "
3+35 3		18.5	16" "
3+85		18.7	18" "
4+35		19.3	18" "
4+85 2		19.2	16" "
3+34 1		70.2	16" "
3+85 1		69.2	20" "
4+34 3		70.3	12" "
4+84 1		70.5	18" "
3+35 5	32.7		16" "
3+86 4	31.9		18" "
4+36	32.3		10" "
4+85 2	31.1		16" "
3+34 9	83.9		18" "
3+85 6	85.1		16" "
4+34 9	83.4		20" "
4+85 1	82.9		18" "
5+35		20.2	18" "
5+84 8		19.9	16" "
6+35 2		19.8	14" "
6+85 1		19.6	16" "
5+33 9		71.3	18" "
5+83 9		70.5	8" "
6+34 6		71.5	16" "
6+84 4		71.5	16" "
5+34 7	31.1		18" "
5+85 9	31.4		18" "
6+35 1	31.2		16" "
6+85 5	31.5		16" "
	(To	To	pg. 264)

Note: ANY ADDITIONS OR CHANGES ON THIS SHEET MUST BE MADE OR CIRCLED IN Red Ink, WITH DATE AND NAME OF PERSON MAKING CHANGE.

RETURN TO
LOS ANGELES COUNTY SURVEYOR
700 HALL OF RECORDS
Do not extend notes this side of this line

FORM 247 10M 8-31

F.B. 436 PG. 264

(from Bot. pg. 263)

Station	Offset. Rt. (or South)	Offset. Lt. (or North)	Remarks.
5+35.2	83.1		12" Walnut.
5+85.1	82.7		16" "
6+36.2	82.7		16" "
6+85.3	82.9		16" "
7+35		20.5	16" "
7+85.2		20.4	16" "
8+35.1		20.8	16" "
8+84.9		20.4	18" "
7+34.7		71.8	20" "
7+84.9		71.3	16" "
8+34		71.4	14" "
8+84.1		71.6	18" "
7+35	30.9		14" "
7+85.4	30.5		18" "
8+35.1	30.9		18" "
8+85.5	30.5		18" "
7+35.2	82.5		16" "
7+85.9	82.3		16" "
8+35.6	82.3		12" "
8+85.5	81.5		16" "
9+34.7		20.7	16" "
9+84.8		20.8	16" "
10+34.9		20.9	14" "
10+85.2		21.2	16" "
9+34.3		72.2	16" "
9+84.6		72.0	18" "
10+34.5		72.0	18" "
10+84.2		71.6	20" "
9+35.0	30.1		18" "
9+85.2	30.2		12" "
10+35.8	30.0		16" "
10+85.1	30.4		20" "
9+34.8	82.0		18" "
9+85	81.7		18" "
10+35.6	81.9		18" "
10+85.8	81.6		18" "
11+34		20.9	18" "
11+83.4		21.1	18" "

(To top pg. 265)

RETURN TO
LOS ANGELES COUNTY SURVEYOR
700 HALL OF RECORDS
Do not extend notes this side of this line

Note: ANY ADDITIONS OR CHANGES ON THIS SHEET MUST BE MADE OR CIRCLED IN Red Ink. WITH DATE AND NAME OF PERSON MAKING CHANGE.

(From Bot. Pg. 264)

Work Ck'd by
Map No. B-1006-2
Office Work Wood
Checked
Date

Survey of Burban Homes
W. O. 8048 Type No. 067 Str'd 84 of.
Surveyed by Evans
Notes HE Date 4/20/34
Indexed A. C. Johnson

F.B. 436 Pg. 265

Station	offset Rt.	offset Lt.		Remarks.
12+34		21	6"	walnut.
12+85		22	8"	"
11+33		72	18"	"
11+83		72	16"	"
12+33		72	8"	"
12+84		70	6"	"
11+34	29		12"	"
11+84	30		10"	"
12+34	30		6"	"
12+85	30		12"	"
11+35	81.8		18"	"
11+85	81		18"	"
12+34	81		10"	"
12+84	81.1		18"	"
13+34		21	20"	"
13+85		22	12"	"
14+35		21	16"	"
14+85		22	14"	"
13+33		72	10"	"
13+85		71	4"	"
14+35		71	4"	"
14+84		72	5"	"
13+34	30		16"	" (300)
13+86	30		14"	"
14+35	30		12"	"
14+85	30		14"	"
13+34	80		16"	"
13+86	81		10"	"
14+35	81		16"	"
14+85	81.1		20"	"
15+33		20	10"	"
15+84		20.1	16"	" (end tree)
15+33		72	3"	" " "
15+34	29		10"	"
15+85	30.1		10"	"
16+35	31.2		4"	" " "

(To top Pg. 266)

Note: ANY ADDITIONS OR CHANGES ON THIS SHEET MUST BE MADE OR CIRCLED IN Red Ink. WITH DATE AND NAME OF PERSON MAKING CHANGE.

Do not extend notes this side of this line

RETURN TO
LOS ANGELES COUNTY SURVEYOR
700 HALL OF RECORDS

FORM 247 10M 8-31

(from Bot pg. 265)

F.B. 436 Pg. 266

Station	Offset Rt. (or South)	Offset Lt. (or North)	Remarks
15+35	81 S		14" Walnut.
15+85	80.9 S		16" "
16+35	81.2 S		18" "
16+86.1	80.6 S		12" " (end tree)
			END.
Location of Walnut trees along LINE C. (See pg. 255 for Survey.)			
0+35		26.4 E	20" Walnut.
0+85		26.3 E	15" "
0+34.9		77.4 E	12" "
0+85.1		77.8 E	16" "
0+35.5	24.6 S		16" "
0+85.2	25.2 S		18" "
0+35.7	75.8 S		18" "
0+35.2	50.5 S		16" Plum
0+85.1	75.9 S		18" Walnut
1+35		27.2 E	18" "
1+85.3		27.3 E	20" "
2+35		26.9 E	18" "
2+85.1		26.7 E	20" "
1+34.4		78.4 E	22" "
1+84.8		78.2 E	18" "
2+33.9		78.8 E	20" "
2+85.4		78.4 E	14" "
1+34.9	24.2 S		18" "
1+84.8	25.6 S		18" "
2+34.6	25.6 S		4" "
2+85.3	24.6 S		16" "
1+35.2	75.5 S		20" "
1+86	75.7 S		16" "
2+35.5	76.0 S		18" "
2+85.6	75.4 S		18" "
3+34.3		26.0 E	20" "
3+84.7		26.2 E	18" "
4+35		26.3 E	16" "
4+84.7		26.1 E	18" "

(To Top pg. 267)

RETURN TO
LOS ANGELES COUNTY SURVEYOR
700 HALL OF RECORDS
Do not extend notes this side of this line
Note: ANY ADDITIONS OR CHANGES ON THIS SHEET MUST BE MADE OR CIRCLED IN Red Ink. WITH DATE AND NAME OF PERSON MAKING CHANGE.

(From Bk. pg. 266)

Notes Ck'd by
Map No. B-1006-2
Office Work Wood
Checked
Date

Survey of Rurban Homes
W. O. 8048 Tape No. 067 Std 84 °F.
Surveyed by Evans
Notes HE Date 4/20/34
Indexed A. C. Johnson

F.B. 436 Pg. 267

Station	Offset Rt.	Offset Lt.	Remarks.
3+34		77	16" walnut
3+85		77.6	18" "
4+34		77.1	14" "
4+85		77.1	16" "
3+34	24		17" "
3+84	24		15" "
4+35	25		18" "
4+84	24		20" "
3+35	75		17" "
3+85	75		16" "
4+35	75		14" "
4+85	76		14" "
5+34		26	17" "
5+84		26	13" "
6+34		26	17" "
6+83		27	19" "
5+34		77.8	18" "
5+84		78	18" "
6+34		79	14" "
6+83		78.7	11" "
5+34	24		17" "
5+84	24		20" "
6+34	24		17" "
6+84	24		22" "
5+35	75		10" "
5+84.8	75		19" "
6+35	76		14" "
6+85	74		15" "
7+34		26	20" "
7+84		26	15" "
8+34		26	16" "
8+84		26	15" "
7+34		78	14" "
7+84		78	20" "
8+34		78	18" "
8+83		79	14" "

(To top pg 270)

Note: ANY ADDITIONS OR CHANGES ON THIS SHEET MUST BE MADE OR CIRCLED IN Red Ink, WITH DATE AND NAME OF PERSON MAKING CHANGE.

RETURN TO
LOS ANGELES COUNTY SURVEYOR
700 HALL OF RECORDS
Do not extend notes this side of this line

FORM 247 10M 8-31

(from Bk pg. 267)

F.B. 436 PG. 268

Station	offset Rt. (or South)	offset Lt. (or North)	Remarks
7+34	25		17" Walnut
7+84	25		18" "
8+34	24		10" Stump
8+84	25		15" Walnut
7+34	75		18" "
7+84	75		15" "
8+34	75		13" "
8+84	75		19" "
9+33		26	10" "
9+83		26	14" "
10+34		26	10" "
10+84		28	20" "
10+84		79	18" "
10+34		79	22" "
9+84		79	18" "
9+34		79	17" "
9+34	25		19" "
9+84	25		16" "
10+34	24		23" "
10+84	24		18" "
9+34	75		16" "
9+84	75		20" "
10+35	76		19" "
10+84	75		18" "
11+34		26	18" Leaning
11+83		26	3" "
12+34		26	17" "
12+84		27	14" "
11+34		79	17" "
11+83		78	6" "
12+34		79	16" "
12+84		79	19" "
11+34	23		14" "
11+84	24		20" "
12+35	23		20" "
12+84	24		22" "

(To top next column)

(from Bot Left column)

Station	offset Rt. (or South)	offset Lt. (or North)	Remarks
11+34	74		19" Walnut
11+84	74		18" "
12+35	74		20" "
12+85	75		16" "
13+34		27	17" "
13+85		27	13" "
14+34		28	14" "
14+84		28	26" "
13+34		81	10" "
13+84		80	18" "
14+34		79	18" "
14+85		79	24" "
13+35	23		8" "
13+84	23		16" "
14+34	23		20" "
14+84	23		19" "
13+34	74		17" "
13+84	74		20" "
14+35	74		20" "
14+84.8	74		17" "
15+34		28	22" "
15+84		28	18" "
16+34		28	24" "
16+84		28	17" "
15+34		79	12" "
15+84		80	13" "
16+34		80	4" "
16+84		80	12" "
15+33	22		16" "
15+84	22		13" "
16+34	22		24" "
16+84	22		16" "
15+34	74		18" "
15+85	73		22" "
16+35	73		16" "
16+85	74		24" "

To top Left pg. 269

RETURN TO
LOS ANGELES COUNTY SURVEYOR
700 HALL OF RECORDS

Note: ANY ADDITIONS OR CHANGES ON THIS SHEET MUST BE MADE OR CIRCLED IN Red Ink. WITH DATE AND NAME OF PERSON MAK-ING CHANGE.

Do not extend notes this side of this line

(From Bot Rt pg 268)

(From Bot Left column)

Notes Ck'd by
Map No. B-1006-2
Office Work Wood
Checked
Date

Survey of Forban Homes
W. O. 80[illegible] Page No 967 Sht'd 84 of
Surveyed by [illegible] rans
Notes
Date 4/25/84
Indexed
A. C. Johnson

F.B. 436 Pg. 269

Station	Offset Rt.	Offset Lt.	Remarks
17+34.8		28.9	18" Walnut
17+82.3		28.4	(End Tree) 4" "
17+35.3		81.3	16" "
17+82.6		80.8	(End Tree) 3" "
17+35.1	22.6		(End Tree) 19" "
17+35.1	73.1		20" "
17+84.4	75.5		(End Tree) 4" "
END OF LINE C.			
Location of trees along LINE D			
See (See pg. 275 for Buildings.)	pg. 255 for Survey.		
0+35.2		21.8	18" Walnut
0+85		21.6	16" "
1+34.8		21.8	16" "
1+84.7		21.8	18" "
0+34.6		73.1	16"
0+84.5		72.8	16"
0+84.6		47.7	12" Apricot
1+34.2		73.1	16" walnut
1+84		77.6	18" "
0+35.5	29.3		14" "
0+85	29.3		18" "
1+35.1 (one tree out here)	29.6		18" "
0+35.9	80.7		20" "
0+85.5	80.0		18" "
1+17.9	60.3		8" orange
1+34.6	78.8		12" walnut
1+84.2	78.2		18" "
2+35.4		22.0	16" "
2+85.1		22.1	18" "
3+35.2		21.9	18" "
3+[illegible].2		22.3	20" "
2+35		73.6	16" "
2+84.5		73.5	18" "
3+34.6		73.4	16" "
3+84.6		73.2	18" "

Station	Offset Rt.	Offset Lt.	Remarks
2+35.1	28.9		16" walnut
2+84.2	28.9		20" "
3+35.1	29.6		14" "
3+85.5	29.0		20" "
2+35.4	80.4		18" "
2+85.9	80.2		16" "
3+35.2	80.4		16" "
3+85.5	80.0		18" "
4+35.4		22.1	18" "
4+84.2		21.5	14" "
4+34.9		72.8	18" "
4+83.2		73.4	16" "
4+35.4	29.8		20" "
4+85.2	29.9		18" "
4+35.9	81.2		20" "
4+84.9	80.1		20" "
5+34.4		22.2	18" "
5+84.5		21.5	20" "
6+34.5		21.8	16" "
6+84.9		21.7	16" "
5+34		72.9	21" "
5+84.3		73.4	20" "
6+34.6		73.3	21" "
6+84.2		73.0	17" "
5+34.2	29.2		20" "
5+84.2	29.5		16" "
6+34.6	29.4		15" "
6+84.8	28.7		18" "
5+34.9	80.2		21" "
5+85.1	80.7		20" "
6+34.8	80.9		24" "
6+85.2	80.0		19" "
7+33.9		21.8	16" "
7+82.6		21.6	14" "
8+34.6		22.6	16" "
8+83.4		22.2	17" "

Notes: ANY ADDITIONS OR CHANGES ON THIS SHEET MUST BE MADE OR CIRCLED IN Red Ink WITH DATE AND NAME OF PERSON MAKING CHANGE.

Do not extend notes this side of this line

RETURN TO
LOS ANGELES COUNTY SURVEYOR
700 HALL OF RECORDS

FORM 247 10M 8-81

(To top next column)

(To top Left pg 270)

(From Bot Rt. pg. 269)

F.B. 436 PG. 270

(From Bot. Left. column)

Station	Offset Rt. (or South)	Offset Lt. (or North)	Remarks
7+33		73	14" walnut
7+83		73	23" "
8+33		73	16" "
8+83		73	14" "
7+34	28		20" "
7+84	28		19" "
8+34	29		18" "
	(One tree out here)		
7+34	80		21" "
7+84	80		18" "
8+34	80		16" "
8+84	79		18" "
9+33		216	12" "
9+84		22	20" "
10+34		22	16" "
10+84		22	18" "
9+33		73	18" "
9+83		73	20" "
10+34		73	15" "
10+84		74	10" "
9+34	29		16" "
9+84	28		16" "
10+34	30		5" "
10+84	28		16" "
9+35	80		18" "
9+83	80		18" "
10+34	79		20" "
10+84	79		20" "
11+34		22	20" "
11+84		22	16" "
12+34		22	25" "
12+84		22	18" "
11+34		74	24" "
11+84		74	18" "
12+34		74	18" "
12+84		74	10" "
11+34	27		20" "
11+84	28		18" "

Station	Offset Rt. (or South)	Offset Lt. (or North)	Remarks
12+34	28		16" walnut.
12+84	27		18" "
11+34	79		17" "
11+84	80		16" "
12+34	79		10" "
12+84	79		20" "
13+34		23	18" "
13+84		23	15" "
14+34		23	13" "
14+84		23	18" "
13+33		74	14" "
13+84		74	20" "
14+34		75	14" "
14+84		74	17" "
13+33	27		14" "
13+83	27		15" "
14+34	27		18" "
14+84	27		18" "
13+33	79		18" "
13+84	79		15" "
14+34	78		16" "
14+84	78		17" "
15+34		24	20" "
15+84		24	18" "
16+34		23	20" "
16+84		24	16" "
15+34		75	18" "
15+83		75	20" "
16+33		75	19" "
16+84		75	16" "
15+35	26		21" "
15+84	27		20" "
16+34	27		15" "
16+84	27		20" "
15+35	78		16" "
15+85	78		18" "
16+34	77		16" "
16+85	77		17" "

(To top next column)

(To top Left pg. 271)

RETURN TO
LOS ANGELES COUNTY SURVEYOR
700 HALL OF RECORDS

Do not extend notes this side of this line

Note: ANY ADDITIONS OR CHANGES ON THIS SHEET MUST BE MADE OR CIRCLED IN Red Ink WITH DATE AND NAME OF PERSON MAKING CHANGE.

(From Bot Rt. pg. 270)

(From Bot Left column)

Notes Ck'd by
Map No. B-1006-2
Office Work Wood
Checked
Date

Survey of Rurban Homes
W. O. E048 Tape No. 067 St'd 84 °F.
Surveyed by Evans
Notes Date 4/23/34
Indexed A. O Johnson

F.B. 436 Pg. 271

Station	Offset Rt.	Offset Lt.	Remarks
17+34		24	24" Walnut
17+84		24	14" Stump. (End of row)
17+34		75	18" "
17+83		75	8" " (End Tree)
17+34	27		18" "
17+84	26		18" " (End Tree)
17+34	77		18" "
17+84	78		14" stump (End row)
END OF LINE D.			
Location of trees along LINE "E" See pg. 255 for survey.			
0+35		23	18" Walnut
0+85		22	16" "
0+35		74	14" "
0+84		74	16" "
0+34	28		18" "
0+84	28		16" "
0+35	79		21" "
0+85	79		20" "
1+34		23	20" "
1+84		23	18" "
2+34		23	18" "
2+84		22	18" "
1+34		74	" "
1+84		74	24" "
2+34		74	21" "
2+84		74	18" "
1+34	28		17" "
1+84	27		18" "
2+35	27		18" "
2+84	27		20" "
1+34	79		25" "
1+84	79		20" "
2+35	79		22" "
2+85	79		20" "
(To top Next column)			

Station	Offset Rt.	Offset Lt.	Remarks
3+34		23	18" Walnut
3+84		23	17" "
4+34		23	14" "
4+84		23	20" "
3+33		75	25" "
3+84		74	16" "
4+33		73	20" "
4+84		74	20" "
3+34	28		20" "
3+84	28		17" "
4+34	27		18" "
4+83	26		10" "
3+34	78		20" "
3+84	79		19" "
4+35	79		18" "
4+84	79		18" "
5+34		22	20" "
5+34		23	15" "
6+33		23	16" "
6+84		23	18" "
5+83		74	17" "
5+83		74	18" "
6+34		74	21" "
6+84		74	16" "
5+34	28		31" "
5+84	28		18" "
6+34	27		17" "
6+84	27		18" "
5+34	79		20" "
5+84	79		28" "
6+34	79		16" "
6+84	78		19" "
7+33		24	5" "
7+83		23	20" "
8+33		23	16" "
8+84		23	18" "
(To top Lt. pg. 272)			

Notes: ANY ADDITIONS OR CHANGES ON THIS SHEET MUST BE MADE OR CIRCLED IN Red Ink, WITH DATE AND NAME OF PERSON MAKING CHANGE.

Do not extend notes this side of this line

RETURN TO LOS ANGELES COUNTY SURVEYOR 700 HALL OF RECORDS

FORM 247 10M 8-31

(from Bot. Rt. pg. 271)

F.B. 436 PG. 272

Station	Offset Rt. (or South)	Offset Lt. (or North)	Remarks
7+34		74.4	18" walnut.
7+83.1		74.1	20" "
8+33.7		74.6	18" "
8+83.5		74.8	18" "
7+34.9	27.1		17" "
7+83.9	28.3		20" "
8+34.5	27.5		21" "
8+84.4	27.6		18" "
7+35	79.1		20" "
7+85	76.4		19" "
8+34.6	79.0		16" "
8+84.6	80.0		6" "
9+34.3		23.5	18" "
9+82.5		24.1	14" "
10+33.7		24.3	20" "
10+83.5		24.4	18" "
[illegible]		25.1	18" "
9+82.2		74.2	8" "
10+33.5		74.8	16" "
10+83.9		75.4	16" "
9+35.1	27.2		18" "
9+84.5	26.9		16" "
10+34.4	27.0		18" "
10+83.1	27.1		20" "
9+34.4	28.3		18" "
9+84.4	28.2		18" "
10+34.4	28.6		18" "
10+83.8	28.1		18" "
11+34.3		23.8	22" "
11+84.5		24.2	14" "
12+34.7		24.5	14" "
12+83.6		24.0	18" "
—		—	tree 84+
11+84.0		75.1	16" "
12+33.5		76.0	10" "
12+83.1		75.2	18" "

(To top Next column)

(from Bot. Left column)

Station	Offset Rt. (or South)	Offset Lt (or North)	Remarks
11+34.4	26.9		16" Walnut
11+84.8	26.8		18" "
12+34.0	27.0		18" "
12+84.3	26.3		20" "
11+34.2	78.5		16" "
11+84.8	78.4		14" "
12+34.6	77.5		16" "
12+84.3	77.7		14" "
13+33.9		24.3	16" "
13+83.7		24.1	20" "
14+33.2		25.5	14" "
14+84.3		25.3	18" "
13+33.5		75.6	16" "
13+84.0		75.1	18" "
14+33.7		75.8	20" "
14+83.8		76.2	16" "
13+34.0	26.6		16"
13+83.1	26.5		18" "
14+34.2	26.6		20" "
14+84.6	26.0		24" "
13+34.5	78.1		14" "
13+84.3	77.9		18" "
14+34.5	77.4		18" "
14+84.7	77.4		20" "
15+33.8		24.8	18" "
15+84.6		25.8	16" "
16+33.8		25.3	18" "
16+84.1		25.5	18" "
15+33.6		76.5	18" "
15+85		76.3	20" "
16+34		76.7	20" "
16+84		76.4	24" "
15+34.3	26.1		18" "
15+84.5	25.6		16" "
16+33.9	25.9		20" "
16+84	25.2		16" "

(To top Left pg. 273)

RETURN TO
LOS ANGELES COUNTY SURVEYOR
700 HALL OF RECORDS
Do not extend notes this side of this line

Note: ANY ADDITIONS OR CHANGES ON THIS SHEET MUST BE MADE OR CIRCLED IN Red Ink WITH DATE AND NAME OF PERSON MAKING CHANGE.

(From Bot. Rt. pg 272)

(From Bot. Lt. column)

Notes Ck'd by
Map No. B-1006-2
Office Work Wood
Checked
Date

Survey of Ruhlan Homes
W. O. Boyle Tape No. 67 St'd 84 °F.
Surveyed by Evans
Notes LE Date 4/24/34
Indexed A. C. Johnson

F.B. 436 Pg. 273

Station	Offset Rt.	Offset Lt.	Remarks	Station	Offset Rt.	Offset Lt.	Remarks
15+32.9	77½		18" walnut				
15+84.6	77½		14" "				
16+34.5	76¼		20" "				
16+84.8	77¼		24" "				
17+33.7		25¼	16" "				
17+84.1		25½	18" "				
18+34		26½	18" " (end tree)				
17+34.2		76½	18 "				
17+83.6		77½	18" " (end Tree)				
17+34.4	25½		18" "				
17+84	25⅝		20" "				
18+34	25¼		16" stump				
18+85.5	25½		6" Walnut (end Tree)				
17+34.4	76¼		20" "				
18+34.3	76½		18" stump				
18+86	76⅜		8" Wal. (end tree)				

Note: ANY ADDITIONS OR CHANGES ON THIS SHEET MUST BE MADE OR CIRCLED IN Red Ink. WITH DATE AND NAME OF PERSON MAKING CHANGE.

Do not extend notes this side of this line

RETURN TO
LOS ANGELES COUNTY SURVEYOR
700 HALL OF RECORDS

FORM 247 10M 8-31

(To top Next column)

(To Top Left pg. 274)

(from Bot Rt. pg. 273)

F.B. 436 Pg. 274

Station	Offset Rt. (or South)	Offset Lt. (or North)	Remarks

(from Bot. Left column)

Station	Offset Rt. (or South)	Offset Lt. (or North)	Remarks

(To top Next column.)

(To top Left pg. 275)

RETURN TO
LOS ANGELES COUNTY SURVEYOR
700 HALL OF RECORDS

Do not extend notes this side of this line

Note: ANY ADDITIONS OR CHANGES ON THIS SHEET MUST BE MADE OR CIRCLED IN Red Ink. WITH DATE AND NAME OF PERSON MAKING CHANGE.

Notes Ck'd by	Survey of Rurban Homes
Map No. B-1006-2	W. O. 8048 Tape No. 067 St'd 84 °F.
Office Work Wood	Surveyed by Evans
Checked	Notes HE Date 4/28/34
Date	Indexed A. C. Johnson

F.B. 436 Pg. 275

Location of Bldg's etc. in Lot 11

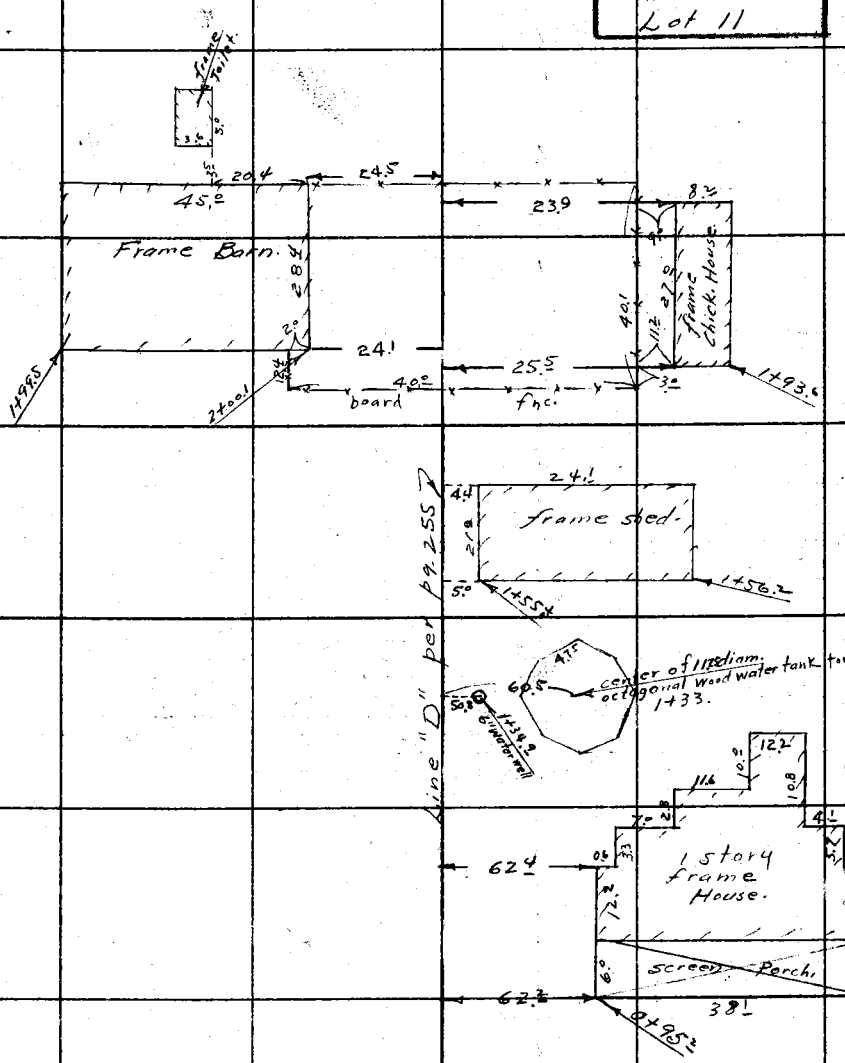

Note: ANY ADDITIONS OR CHANGES ON THIS SHEET MUST BE MADE OR CIRCLED IN Red Ink. WITH DATE AND NAME OF PERSON MAKING CHANGE.

RETURN TO
LOS ANGELES COUNTY SURVEYOR
700 HALL OF RECORDS
Do not extend notes this side of this line

FORM 247 10M 8-31

F.B. 436 PG. 276

Tabulation of missing trees in Lots 5 & 6
Rows numbered from South to North
Trees " " East to West.

In Row #1, the following trees are out. - #4, #6, #21, #23

" " #2 " " " " " - #5, #11, #15, #20, #25, #28

" " #3 " " " " " - #9, #12, #14, #18, #19, #22, #23, #26, #29, #31, #35, #37

" " #4 " " " " " - #4, #6, #8, #15, #20, #25, #33, #36

" " #5 " " " " " #34

" " #6 " " " " " - #5, #6, #14 stump, #23, #28, #31

" " #7 " " " " " #4, #7, #16, #26

" " #8 " " " " " #4, #6, #8, #14, #17, #19, #22, #25

" " #9 " " " " " - #2, #8, #24, #26, #29

" " #10 " " " " " #7, #14, #31, #34, #35, #36

" " #11 " " " " " #8, #18, #21, #24, #25, #29, #35

" " #12 " " " " " #7, #16, #26

" " #13 " " " " " #14,

" " #14 " " " " " #15, #19, #33

" " #15 " " " " " No trees out.

" " #16 " " " " " #4, #18

" " #17 " " " " " [illegible]

" " #18 " " " " " #14, #21

" " #19 " " " " " #17

" " #20 " " " " " #24

" " #21 " " " " " #36

" " #22 " " " " " #2

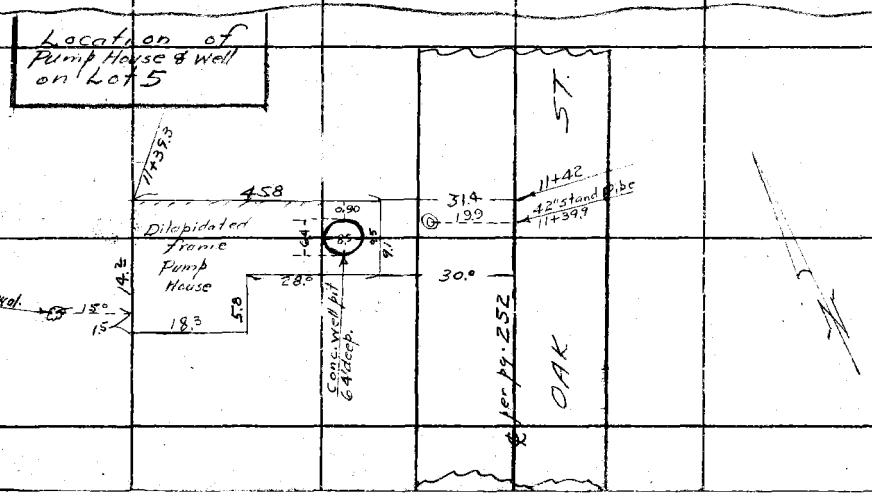

RETURN TO
LOS ANGELES COUNTY SURVEYOR
700 HALL OF RECORDS

Do not extend notes this side of this line

Note: ANY ADDITIONS OR CHANGES ON THIS SHEET MUST BE MADE OR CIRCLED IN Red Ink. WITH DATE AND NAME OF PERSON MAKING CHANGE.

Notes Ck'd by	Survey of Rurban Homes
Map. No. B-1006-2	W. O. 8048 Tape. No 045 St'd 84 of F.
Office Work Agood	Surveyed by Roscerans
Checked	Notes Date 6-15-34
Date	Indexed A. C. Johns 8-20-34

F.B. 436 Pg. 277

RURBAN HOMES

El Monte Unit

Lots 5, 6, 10 + 11

Coffin and Armstrong Tract

M.B. 2-39

Job 8048

Party Roscerans
Johnson
Wallace
Baker

Note: ANY ADDITIONS OR CHANGES ON THIS SHEET MUST BE MADE OR CIRCLED IN Red Ink WITH DATE AND NAME OF PERSON MAKING CHANGE.

Do not extend notes this side of this line

RETURN TO
LOS ANGELES COUNTY SURVEYOR
700 HALL OF RECORDS

FORM 247 3M 2-34

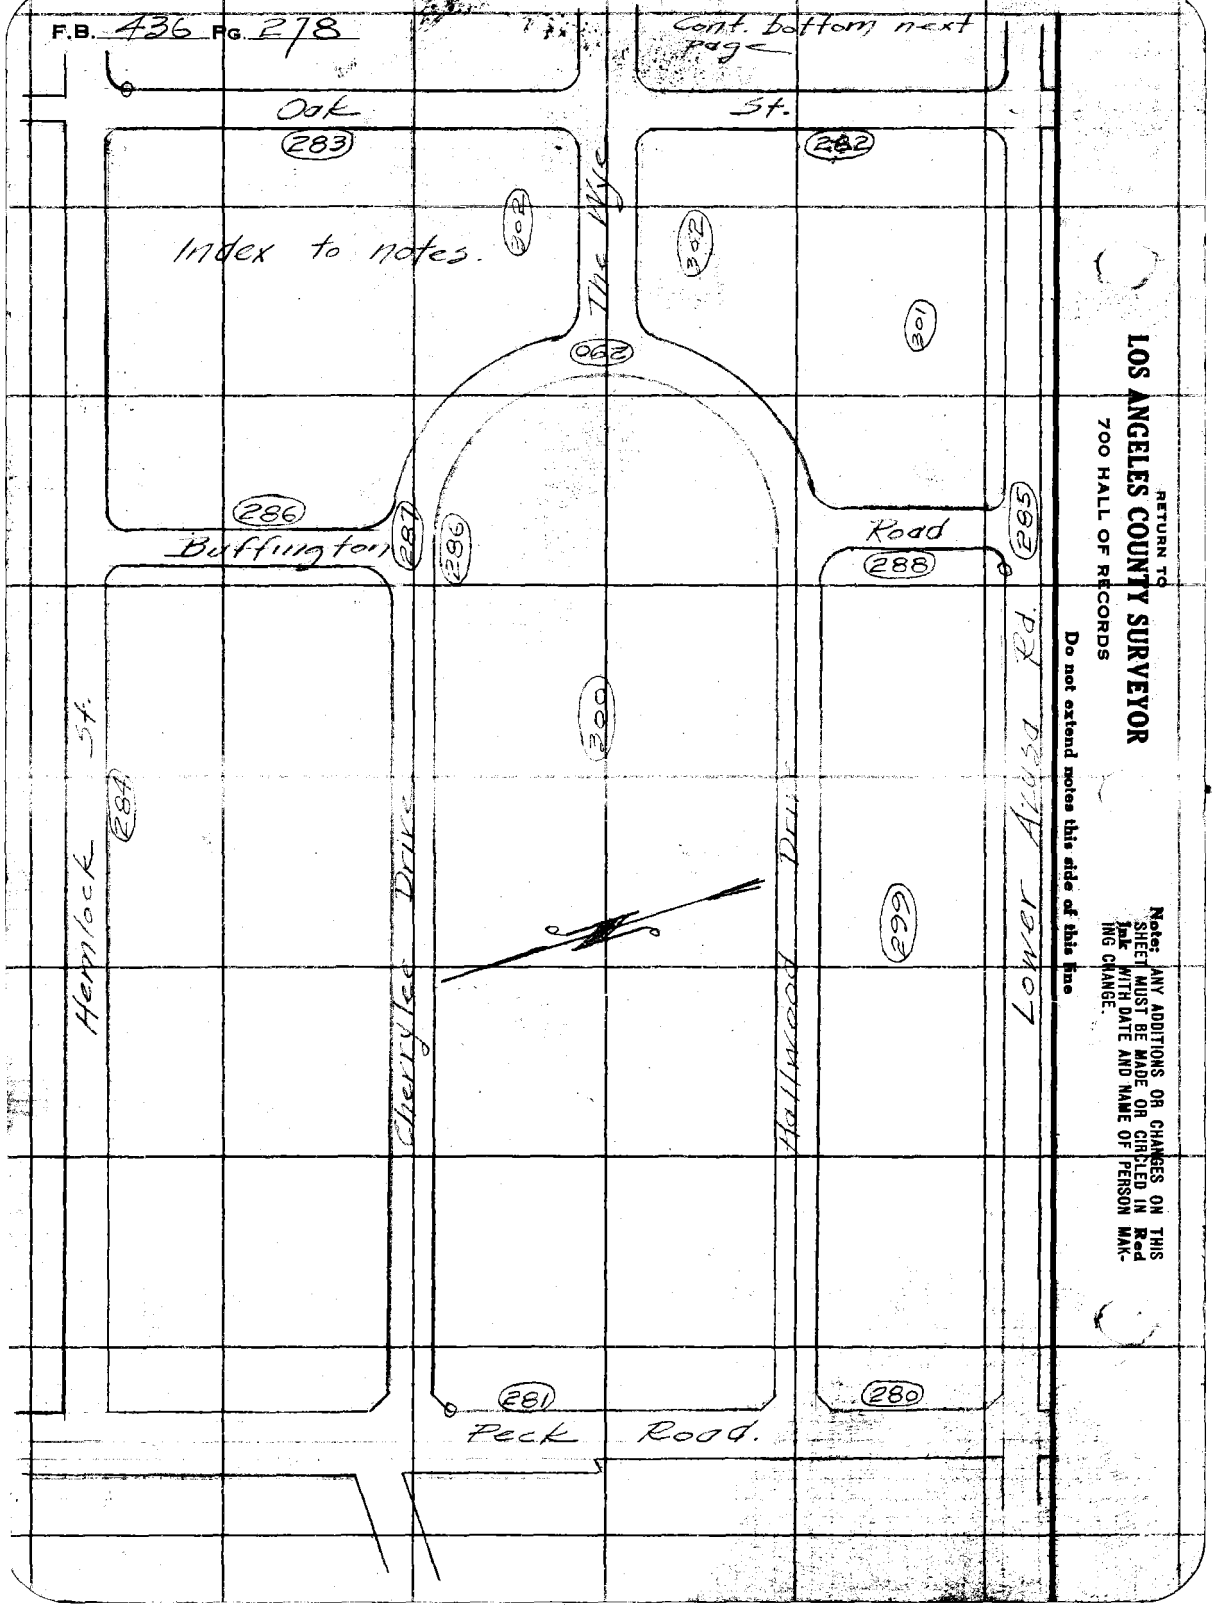

RETURN TO
LOS ANGELES COUNTY SURVEYOR
700 HALL OF RECORDS

Note: ANY ADDITIONS OR CHANGES ON THIS SHEET MUST BE MADE OR CIRCLED IN Red Ink WITH DATE AND NAME OF PERSON MAKING CHANGE.

Do not extend notes this side of this line

FORM 247 5M 2-34

RETURN TO
LOS ANGELES COUNTY SURVEYOR
700 HALL OF RECORDS

Note: ANY ADDITIONS OR CHANGES ON THIS SHEET MUST BE MADE OR CIRCLED IN Red Ink WITH DATE AND NAME OF PERSON MAKING CHANGE.

Do not extend notes this side of this line

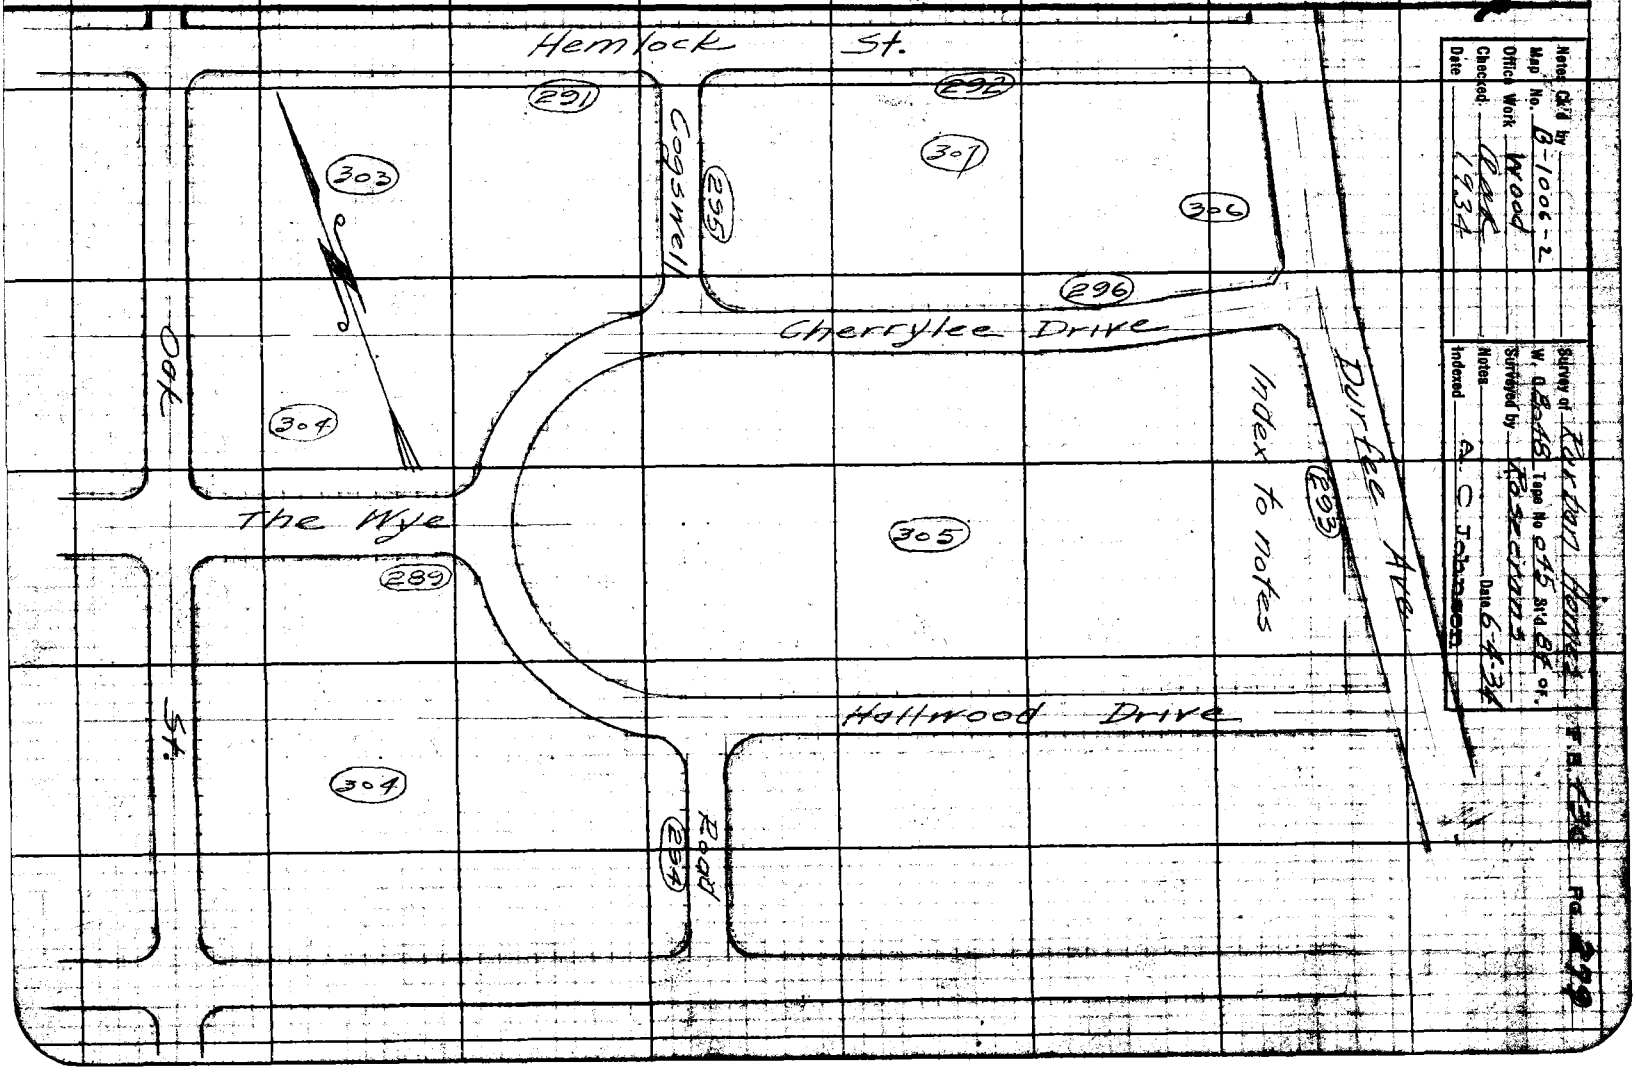

Notes Ckd by
Map No. B-1006-2
Office Work Wood
Checked: Park
Date 1934

Notes
Indexed A. C. Johansen Date 6-4-34


RETURN TO
LOS ANGELES COUNTY SURVEYOR
700 HALL OF RECORDS

Note: ANY ADDITIONS OR CHANGES ON THIS SHEET MUST BE MADE OR CIRCLED IN Red Ink WITH DATE AND NAME OF PERSON MAKING CHANGE.

WS 462-3

Do not extend notes this side of this line

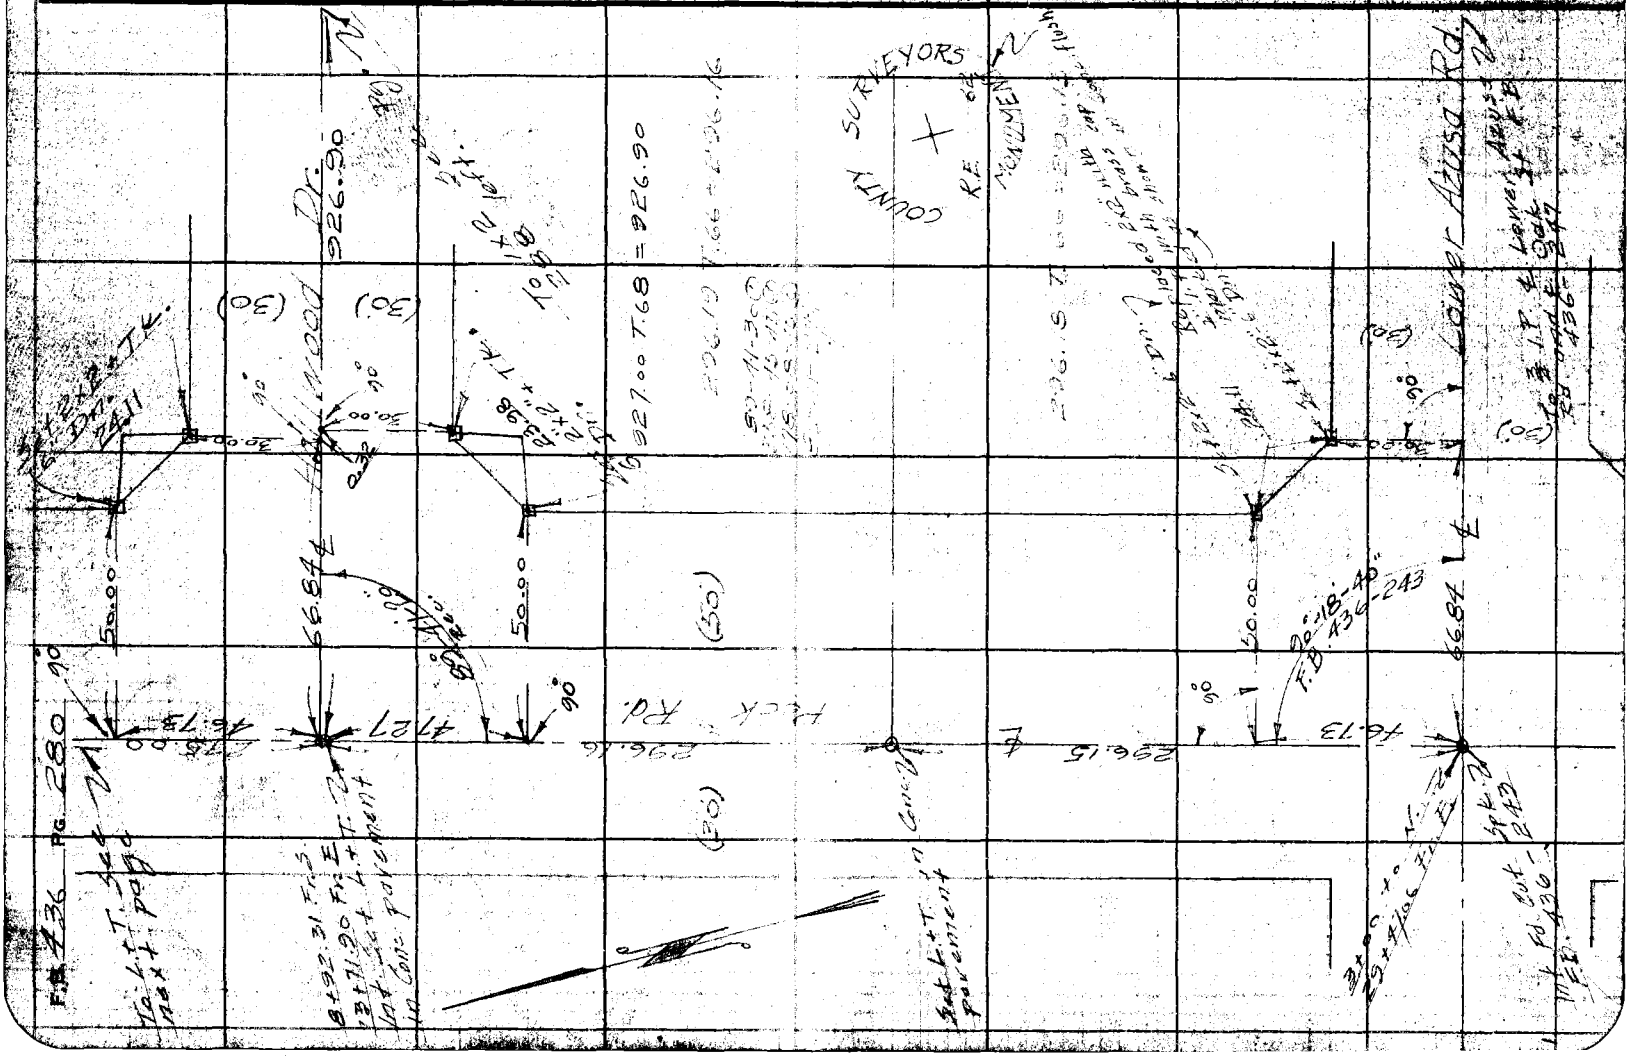
COUNTY SURVEYORS
Lower Azusa Rd
Peck Rd

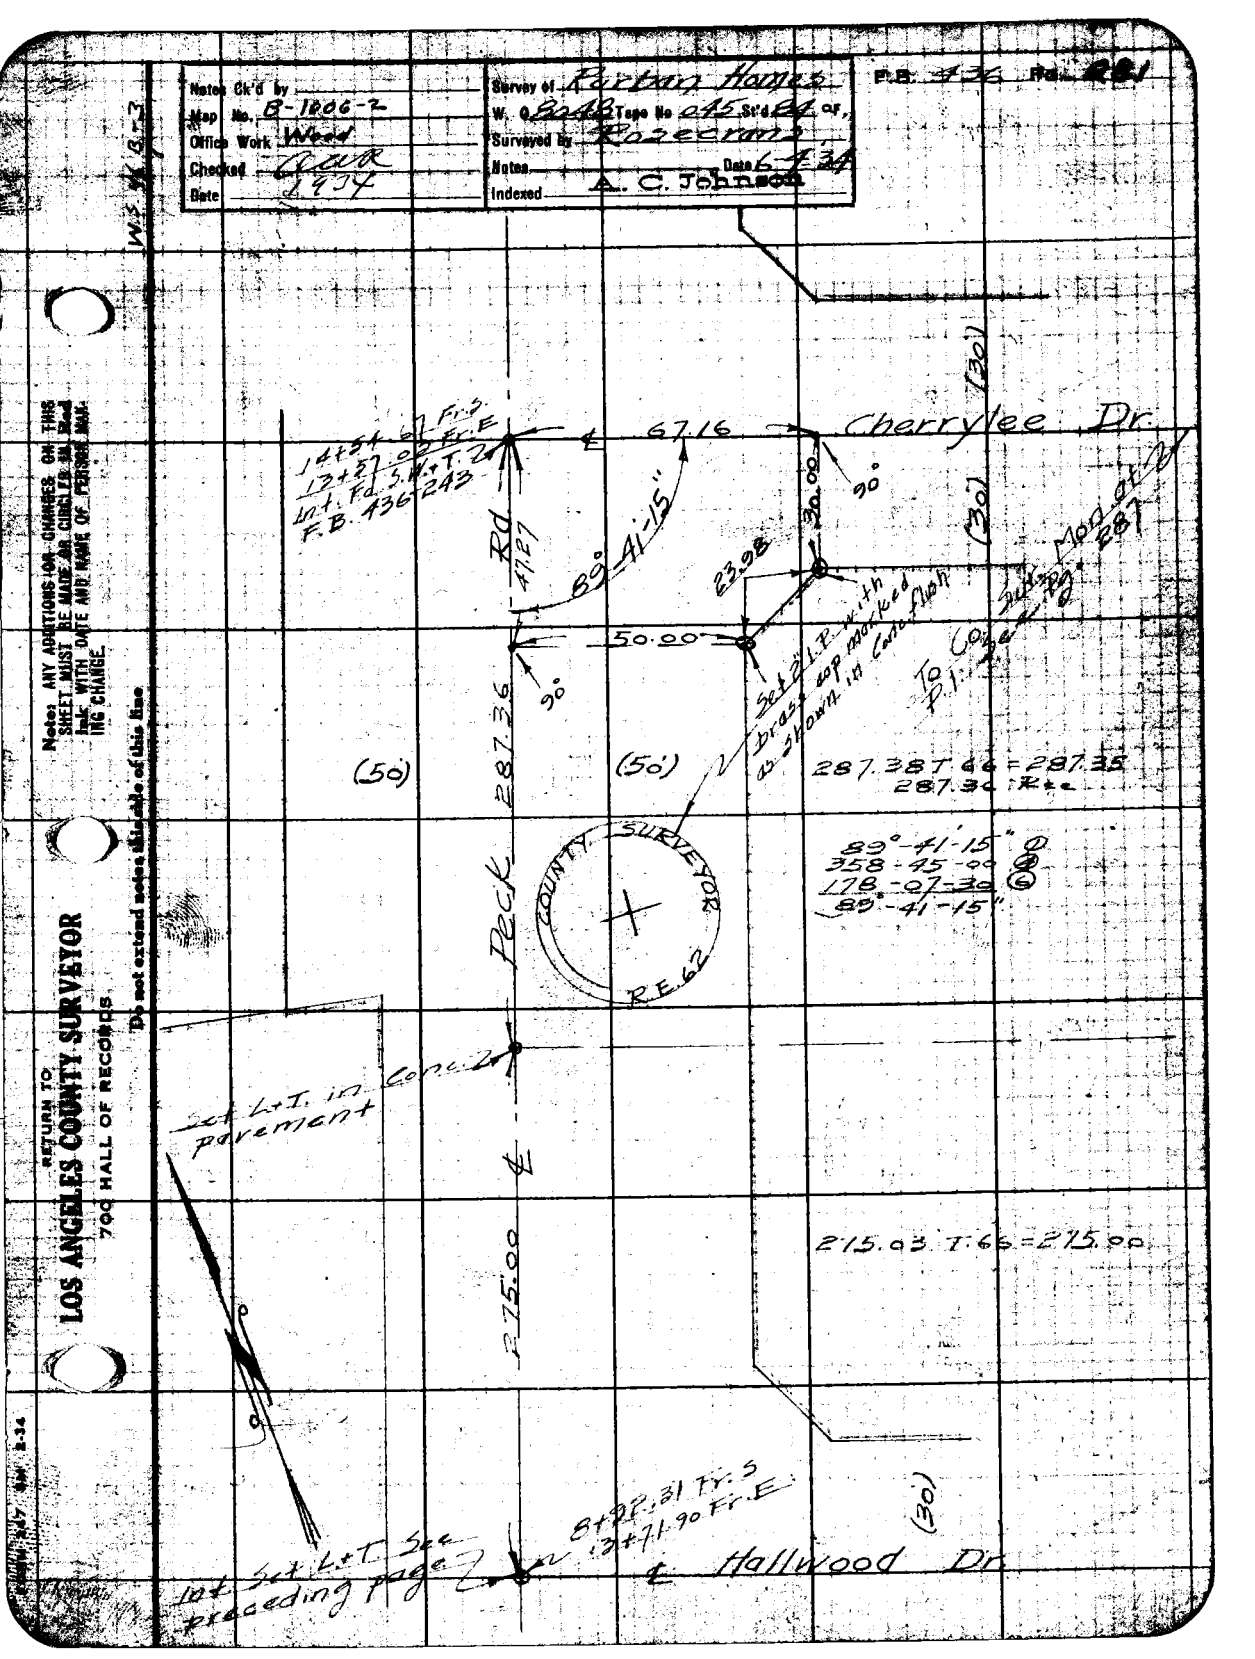
Notes Ck'd by
Map No. B-1806-2
Office Work Wood
Checked Gaw
Date 1934
Survey of Parkin Homes
W. O. 2248 Tape No 245 Std Eq. of,
Surveyed by Rosecrans
Notes
Date 6-5-34
Indexed A. C. Johnson
P.B. 436 Pg. 22
W.S. 34-13
Note: ANY ADDITIONS OR CHANGES ON THIS SHEET MUST BE MADE IN CIRCLE AS Red Ink WITH DATE AND NAME OF PERSON MAK. ING CHANGE
Do not extend notes outside of this line
RETURN TO
LOS ANGELES COUNTY SURVEYOR
700 HALL OF RECORDS
14+54.67 Fr. S
12+27.08 Fr. E
Int. Pd. S. W. L. T. 2
F.B. 436-243
67.16
Cherrylee Dr.
(30)
89°-41'-15"
R=47.27
30.00
90°
23.98
50.00
Set L.T. w. in
brass cap marked
as shown in Concrete
To P.I. 1+00.00
287.38 T. 66 = 287.35
287.36 R+c
(50)
287.36
(50)
Peck Rd
COUNTY SURVEYOR
RE 62
89°-41'-15" Ø
358-45-00 Ø
178-07-30 Ø
89°-41'-15"
Set L.T. in Conc. Pavement
215.03 T. 66 = 215.00
215.00
8+98.31 Fr. S
13+71.90 Fr. E
(30)
Hallwood Dr
Set L.T. See preceding page

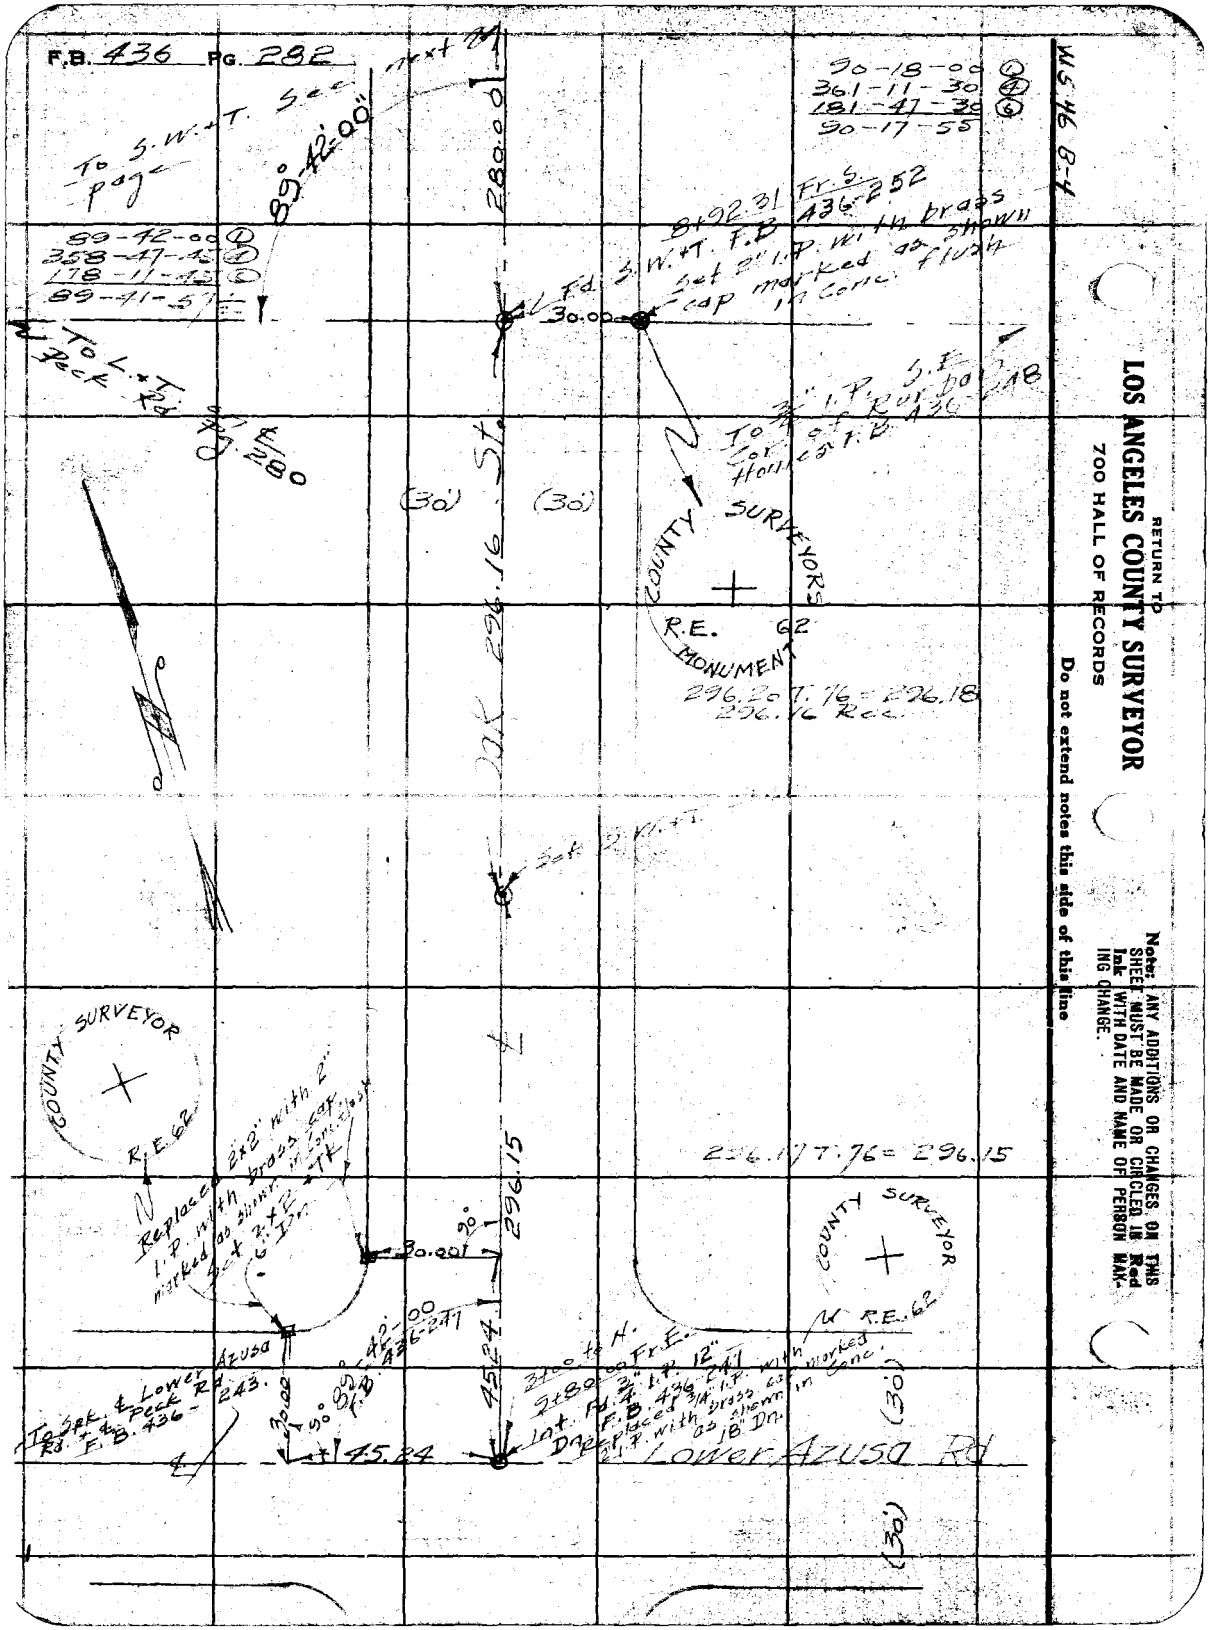
F.B. 436 Pg. 282
WS 46 B-4
RETURN TO
LOS ANGELES COUNTY SURVEYOR
700 HALL OF RECORDS
Do not extend notes this side of this line
Note: ANY ADDITIONS OR CHANGES ON THIS SHEET MUST BE MADE OR CIRCLED IN Red Ink WITH DATE AND NAME OF PERSON MAKING CHANGE.
90-18-00
361-11-30
181-47-30
90-17-55
99-42-00
358-47-15
178-11-15
99-41-57
To S.W. T. Sec
Page
N 89° 42' 00" E
280.00
8+92.31 Fr S.
436-252
S.W. T.B.
Set 3/4" I.P. with tin brass cap marked as shown in conc.
Fd. 3/4" I.P. 0.18 E of T.B.
30.00
To L. & T. Rd. Back
To Set Hollow at T.B.
COUNTY SURVEYORS
R.E. 62
MONUMENT
296.20 T. 76 = 296.18
296.16 Rec.
(30')
(30')
296.16
St.
Set 2" I.P.
COUNTY SURVEYOR
R.E. 62
296.15
296.17 T. 76 = 296.15
Replace I.P. with 2" brass cap marked as shown Set 3"x3" Conc. Mon.
30.00
30.00
296.15
COUNTY SURVEYOR
R.E. 62
Azusa
To Sak & Lower Peck Rds. F.B. 436-243.
30.00
45.24
+45.24
Set 3/4" I.P. with tin brass cap marked as shown in conc.
Lower AZUSA Rd
(30')

Notes Ck'd by
Map No. B-1006-2
Office Work Wood
Checked Oak
Date 1934

Survey of Parsons Homes
W. O. 8048 Tape No. 245 St'd 84 of.
Surveyed by Rossetti
Date 6-4-34
Indexed M. C. Johnson

F.B. 436 Pg. 283

(25') (25')

Hemlock St. (25)

Fd. P. Conc. Water Pipe Line 18' Dn.

2c+16.94 Fr. S.
19+03.29 Fr. E. F.D.
Ind. Fd. 2. W+T.
436 - 2.5 -
Replaced 2. W+T.
with 2x2" + Tk
6" Dp.

Not set on account of pipe line

COUNTY SURVEYOR R.E. 6

562.36 T. 76 = 562.33
562.32 Rec.

(30') (30') (30')

562.32

14+54.62 Ft. S.
F.B.
Fd. 2. W+T.
436 - 2.5 -

282.33 T. 76 = 282.32
282.31 Rec.

Set 2x2" + Tk Flush

90° 90° 90°

Oak

30.00 30.00

0.48

282.31

Set 2x2 + Tk flush

COUNTY SURVEYOR

19.24

F.B.

Fd. 2. W+T.
436 - 2.5 -

40.00

90° 90°

35.42

Int. Set 2x2 + Tk Flush

40.00

(40')

The

5.00 offset line

44.71 44.71

5.00

0.58 0.58

90° 90°

Wye

Int. Set 2x2 + Tk Flush

40.00

90° 18' 00"

54.76

40.00

(40')

280.03 T 76 = 280.02
280.00 Rec.

90-18-00 ©
361-12-00 ⓐ
181-18-15 ⓑ
90-18-02 ℄

Set 2x2" + Tk Flush

30.00

0.48

30.00

Set 2x2 + Tk Flush

90° 90°

To ℄ W+T. See page

Reference to LOS ANGELES COUNTY SURVEYOR 700 HALL OF RECORDS

Do not extend notes this side of this line

Note: ANY ADDITIONS OR CHANGES ON THIS SHEET MUST BE MADE OR CIRCLED IN Red Ink WITH DATE AND NAME OF PERSON MAKING CHANGE

FORM 247 BM 2-34

F.B. 436 PG. 284

W.S. 46 B-3

20+16.44 Fr. ?
19+99.29 Fr. E

℄ Oak St

Int. Fd. S.W.-T. 252'
F.B. 436-

660.03 T⅛=660.00

660.00

(30) (30)

SURVEYOR

℄ St

25+99.29 Fr. E
21+21.32 Fr. S

Set 2" I.P. Leg Level
Elev. with 2" I.P.
S.W.-T. with brass cap marked
with brass cap marked
as shown in Conc. 18" Dia.

767.30 K=

1307.44 T. ⅛=1307.37

1307.39

40' Block

℄ Peck Rd

Int. Fd. L.-T. F.B. 436-244
pavement

(30)

(30)

RETURN TO
LOS ANGELES COUNTY SURVEYOR
700 HALL OF RECORDS

Do not extend notes this side of this line

Note: ANY ADDITIONS OR CHANGES ON THIS SHEET MUST BE MADE OR CANCELED IN Red Ink WITH DATE AND NAME OF PERSON MAKING CHANGE.

Notes Ck'd by
Map No. B-1006-2
Office Work Wood
Checked Clark
Date 1934

Survey of Burbon Homes
W. O. 6048 Tape No 042 St'd 84 of F.
Surveyed by Rascrans
Notes
Date 6-6-34
Indexed A. C. Johnson

F.B. 436 Pg. 285

W.S. 46 B-4

RETURN TO
LOS ANGELES COUNTY SURVEYOR
700 HALL OF RECORDS

Note: ANY ADDITIONS OR CHANGES ON THIS SHEET MUST BE MADE OR CIRCLED IN Red Ink WITH DATE AND NAME OF PERSON MAKING CHANGE

Do not extend notes this side of this line

See Pg 288

(30') Rd. (30')

Buffington

1322.03 T. To = 1321.91
1322.06 Rec

602 34 T. To = 602 32
42 68
645 00

SURVEYED
COUNTY
R.E.

(30')

To S. W. & Post & Ends
Lower Azusa F.B. 436-243
1321.9 ± E

(30')

Lot Set S.W.+T. Replaced S.W.T. Flush. Drilled hole in Conc. with 2" I.P. with brass cap marked as shown 18" Dn.

Lower

Azusa 645.00 Rd

To N & P & Lower Azusa Rd. 04 F.B. 436-247

FORM 247 5-34

F.B. 436 PG. 286

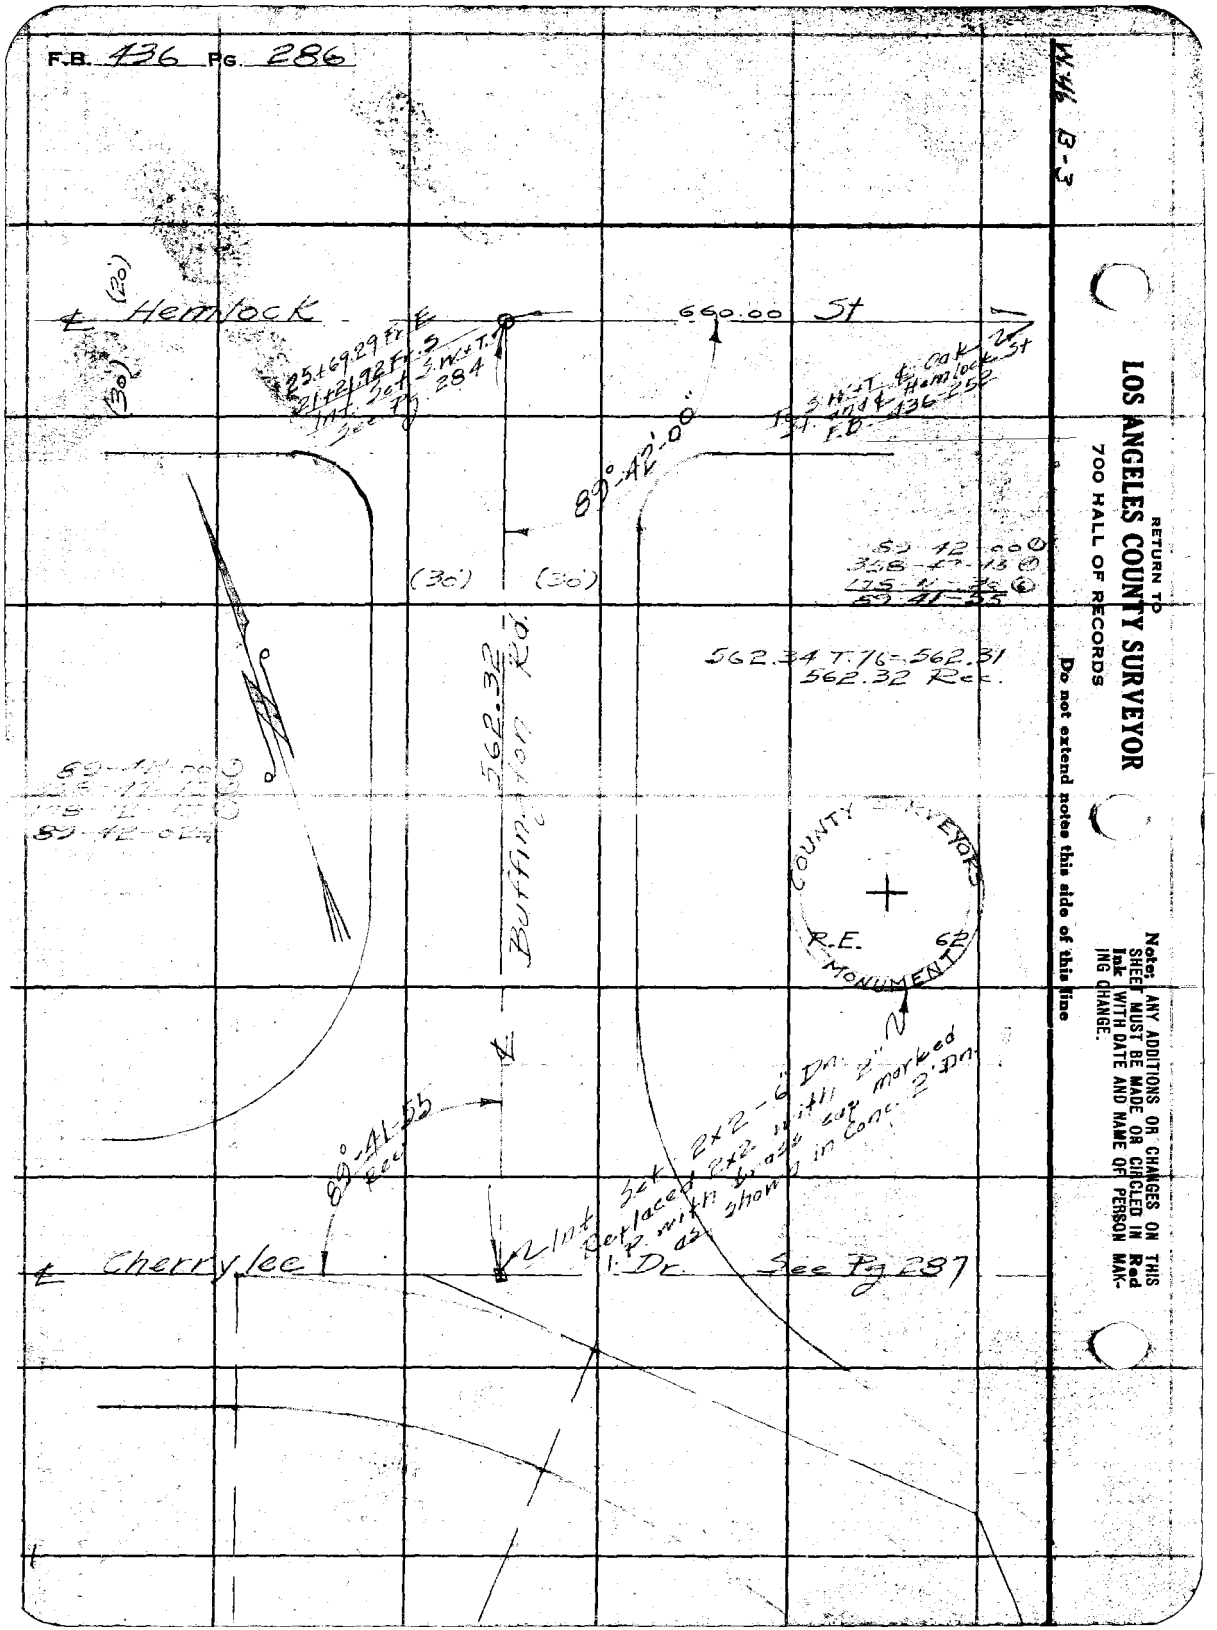

RETURN TO
LOS ANGELES COUNTY SURVEYOR
700 HALL OF RECORDS

Do not extend notes this side of this line

Note: ANY ADDITIONS OR CHANGES ON THIS SHEET MUST BE MADE OR CIRCLED IN Red Ink WITH DATE AND NAME OF PERSON MAKING CHANGE.

Rotes Ck'd by
Map Mk. B-1906-2
Office Work Wood
Checked Clark
Date 1934

Survey of Kurban Homes
W. O. 2048 Tape No 476 Bild BK
Surveyed by Pascapins
Notes
Indexed A. C. Johnson
Date 6-4-34

Bk 436 Pg 287

Mus 46 B-8

To S. Mkt & Cherry Lee Dr. and E. Peck Rd
See fg 281

B.C. Set 1x2" flush
30.00

Δ 33°-51-07"
R. 130.00
T. 39.56
L. 76.81

146-09-00 ⓓ
224-35-45 ⓟ
146-08-56

178.22 T.To = 178.24

1589

Replaced B.C. with 2" I.P. with brass cap flush marked as shown in Conc.

P.I. Set 2x2 6" Dn.

Set 2x2 +

Fd. 2.86

130.28 T.Bo = 130.28

130.28

Dn.

COUNTY SURVEYOR'S MONUMENT

R.E. + 62

S 89-42-55 E

℄ Buffington Rd.

Pg. ℄ 286

39.56

43.95

178.24

N.W. Cor. Lot 52

Set 2x2 - 6" Dn.

Replaced 2x2 with 2" I.P. with brass cap marked as shown in Conc. flush

659.99 = 662.27

660.00 Rec.

89-42-00 ⓓ
358-47-45 ⓟ
178-11-45 ⓓ
89-41-55 Rec

662.00

P.I. Set 2x2 6" Dn. Replaced 2"x2" with 2" I.P. with brass cap marked as shown in Conc. 2 Dn.

Replaced 2x2 with 2" I.P. with brass cap flush marked as shown in Conc.

Set 2x2 + 6" Dn.

30.00

89° 41' 55"

562.32

℄ Oak St

Fd. 3. W.+T. flush
436-252
P.B.

To 3. W.+T. ℄ Oak + Herm-Peck
436-252
P.B.

NOTE: ANY ADDITIONS OR CHANGES MUST BE MADE ON CIRCLED SHEET, MUST BE MADE ON CIRCLED SHEET, INITIALED WITH DATE AND NAME OF PERSON MAKING CHANGE.

Do not extend notes this side of this line

RETURN TO
LOS ANGELES COUNTY SURVEYOR
700 HALL OF RECORDS

FORM 247 RM 2-34

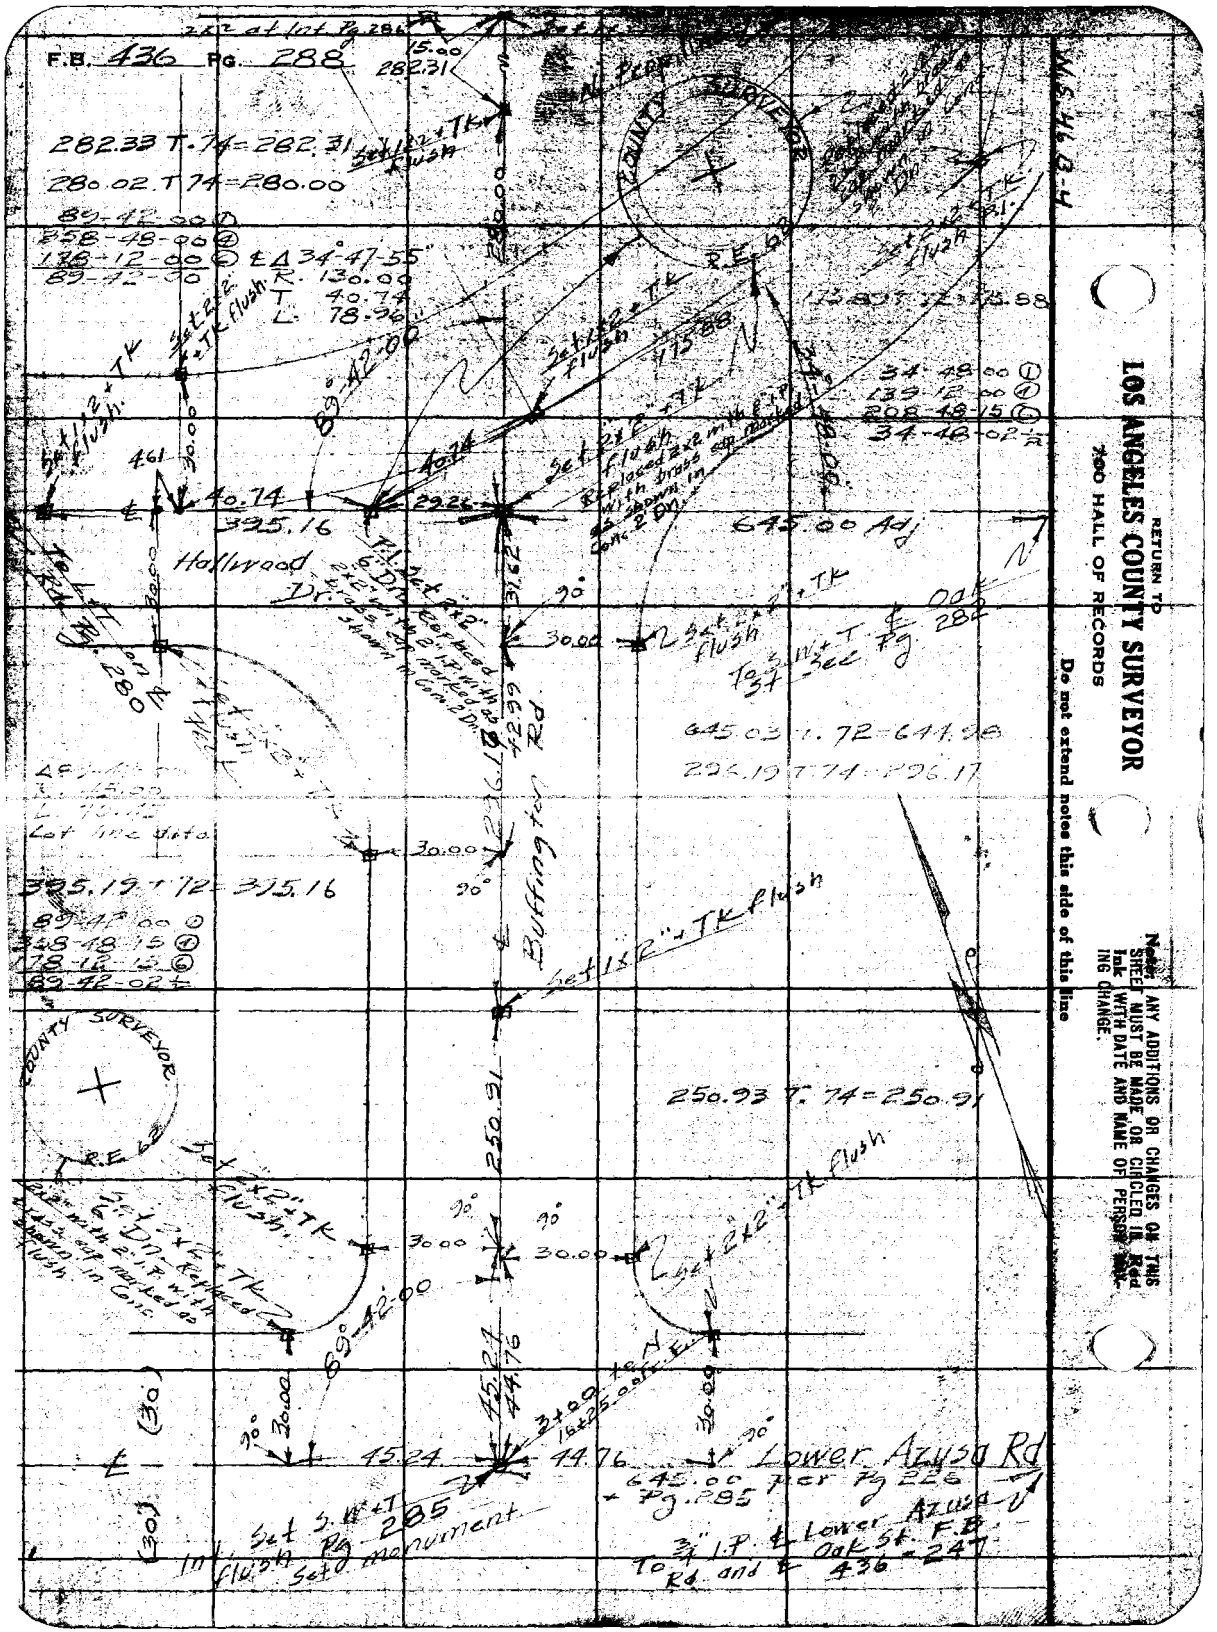
F.B. 436 PG. 288
282.33 T. 74 = 282.31
280.02 T 74 = 280.00
89-42-00 ①
258-48-00 ②
136-12-00 ③
89-12-00
Δ 34°47'55"
R 130.00
T 40.74
L 78.36
34-48-00 ①
133-12-00 ③
208-48-15 ⑤
34-48-02 ±
Hollywood Dr.
Buffington Rd
Lower Azusa Rd
COUNTY SURVEYOR
RETURN TO
LOS ANGELES COUNTY SURVEYOR
900 HALL OF RECORDS
Do not extend notes this side of this line
Note: ANY ADDITIONS OR CHANGES ON THIS SHEET MUST BE MADE OR CIRCLED IN Red Ink WITH DATE AND NAME OF PERSON MAKING CHANGE.

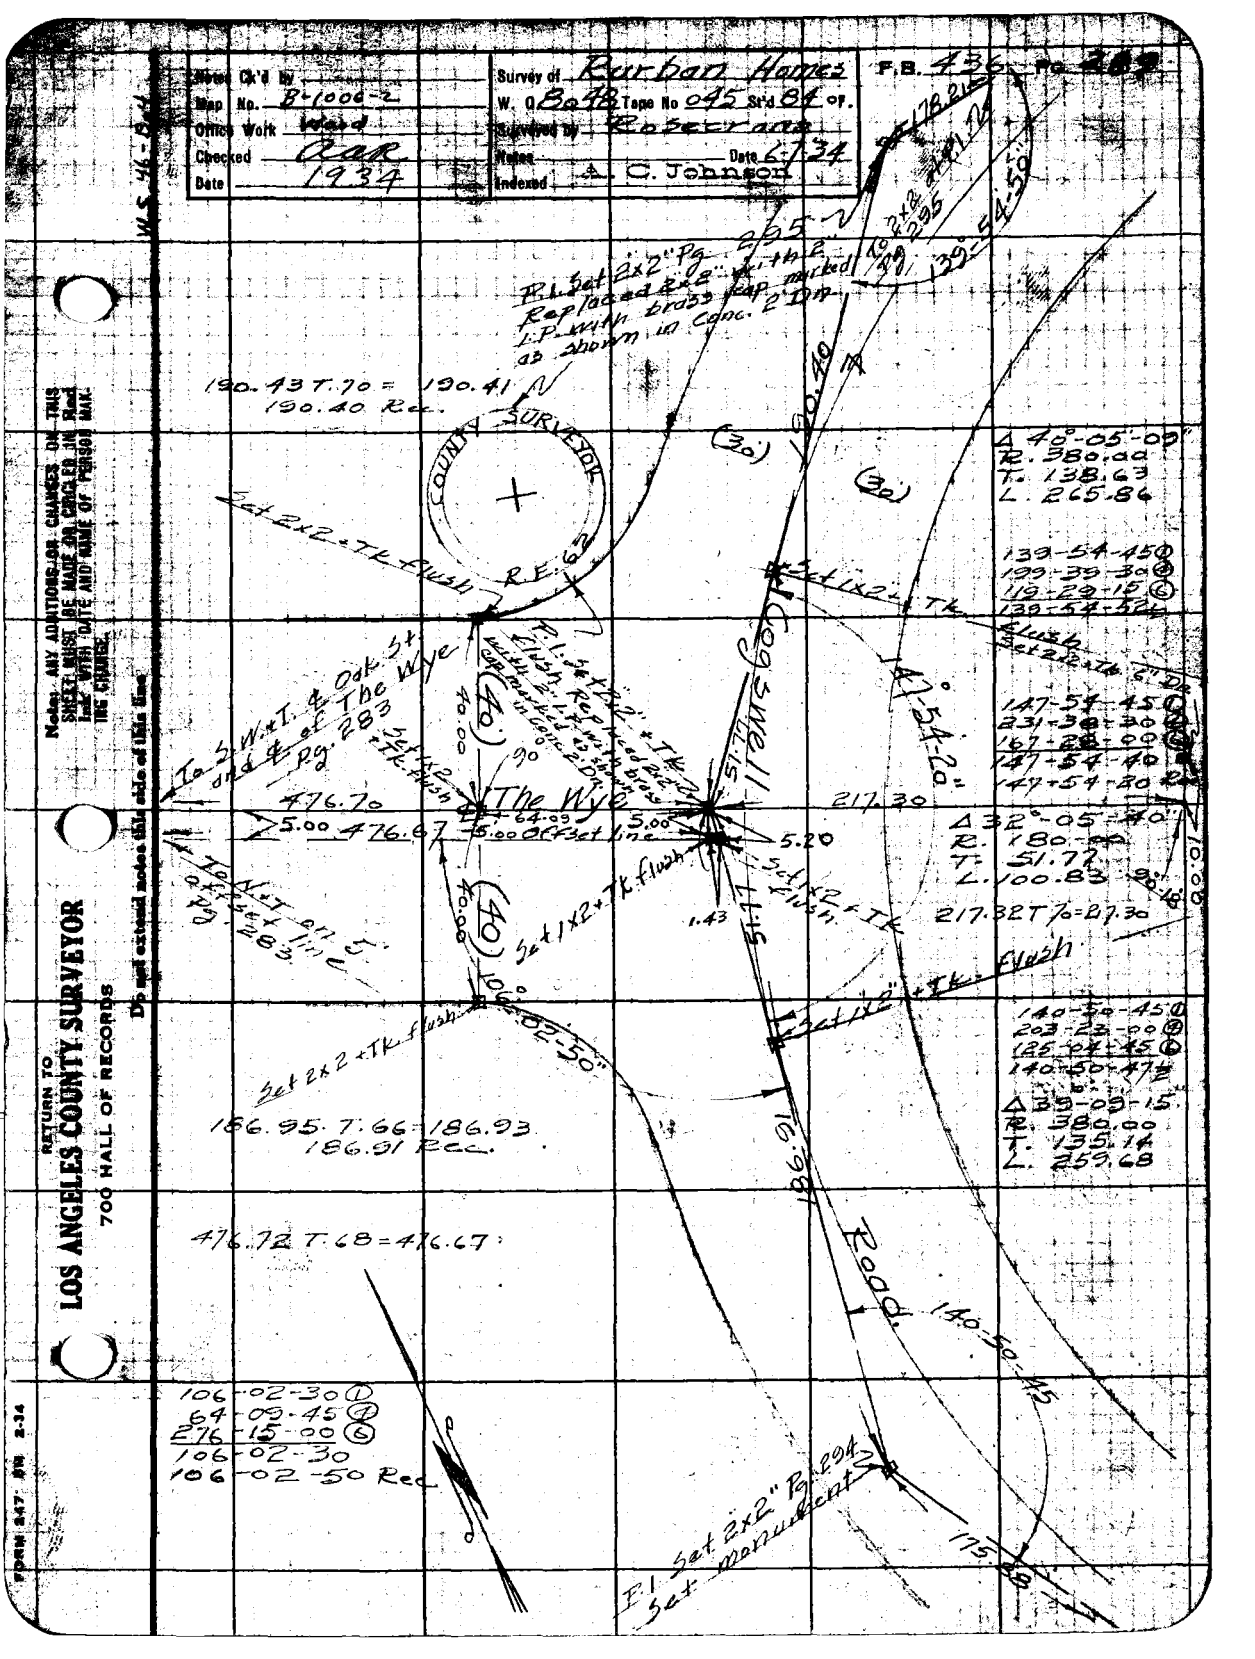
Surveyed Ck'd by
Map No. B-1000-2
Office Work Indexed
Checked Oak
Date 1934
Survey of Burbank Homes
W. O. Bo48 Tape No 045 Std 84 of.
Surveyed by Roberrans
Notes
Date 6-7-34
Indexed C. Johnson
F.B. 436 Pg. 289
Set 2x2 Pg. 295
Replaced 2x2 w. th. 2. L.P. with brass cap marked as shown in Conc. 2' Dp.
190.43 T.70 = 190.41
190.40 Rec.
COUNTY SURVEYOR
R.E. 62
Set 2x2 + Tk. flush
(30) 190.40
(32)
Δ 40°-05'-00"
R. 380.00
T. 138.63
L. 265.84
139-54-45 ①
199-35-30 ③
119-29-15 ⑤
139-54-52½
Set 1x2 + Tk.
Set 2x2 + Tk flush
147-54-45 ②
231-39-30 ④
167-28-00 ⑥
147-54-40
147-54-30 Rec.
Set 2x2 + Tk flush
To S.W.T. & Oak 5" and 4" of The Wye
Pg. 283
476.70
476.67
5.00
5.00
Offset line
The Wye
(40)
Set 1x2 + Tk flush
R.I. Set 2x2" Pg. 294 Replaced 2x2 w. th. 2. L.P. with brass cap marked as shown in Conc. 2' Dp.
Set 1x2 + Tk flush
Set 1x2 + Tk flush
1454-20"
217.30
5.20
1.43
Δ 32°-05'-40"
R. 180.00
T. 51.72
L. 100.83
217.32 T.70=217.30
Set 1x2 + Tk flush
Set 1x2 + Tk flush
Set 2x2 + Tk flush
186.95 T.66=186.93
186.91 Rec.
140-30-45 ①
203-23-00 ③
125-27-45 ⑤
140-30-47½
Δ 39-09-15"
R. 380.00
T. 135.14
L. 259.68
476.72 T.68=476.67
106-02-30 ①
64-09-45 ②
276-15-00 ⑥
106-02-30
106-02-50 Rec.
Road.
140-30-45
F.I. Set 2x2" Pg. 294
Set monument
RETURN TO
LOS ANGELES COUNTY SURVEYOR
700 HALL OF RECORDS
Note: ANY ADDITIONS OR CHANGES ON THIS SHEET MUST BE MADE AND CERTIFIED TO BY THE SURVEYOR WITH DATE AND NAME OF PERSON MAKING THE CHANGE.
Do not extend notes this side of this line
W.S. 46-Bar
Form 247 JW 2-34

RETURN TO
LOS ANGELES COUNTY SURVEYOR
700 HALL OF RECORDS

Note: ANY ADDITIONS OR CHANGES ON THIS SHEET MUST BE MADE OR CIRCLED IN **Red Ink** WITH DATE AND NAME OF PERSON MAKING CHANGE.

W.S 46 B-3

Do not extend notes this side of this line

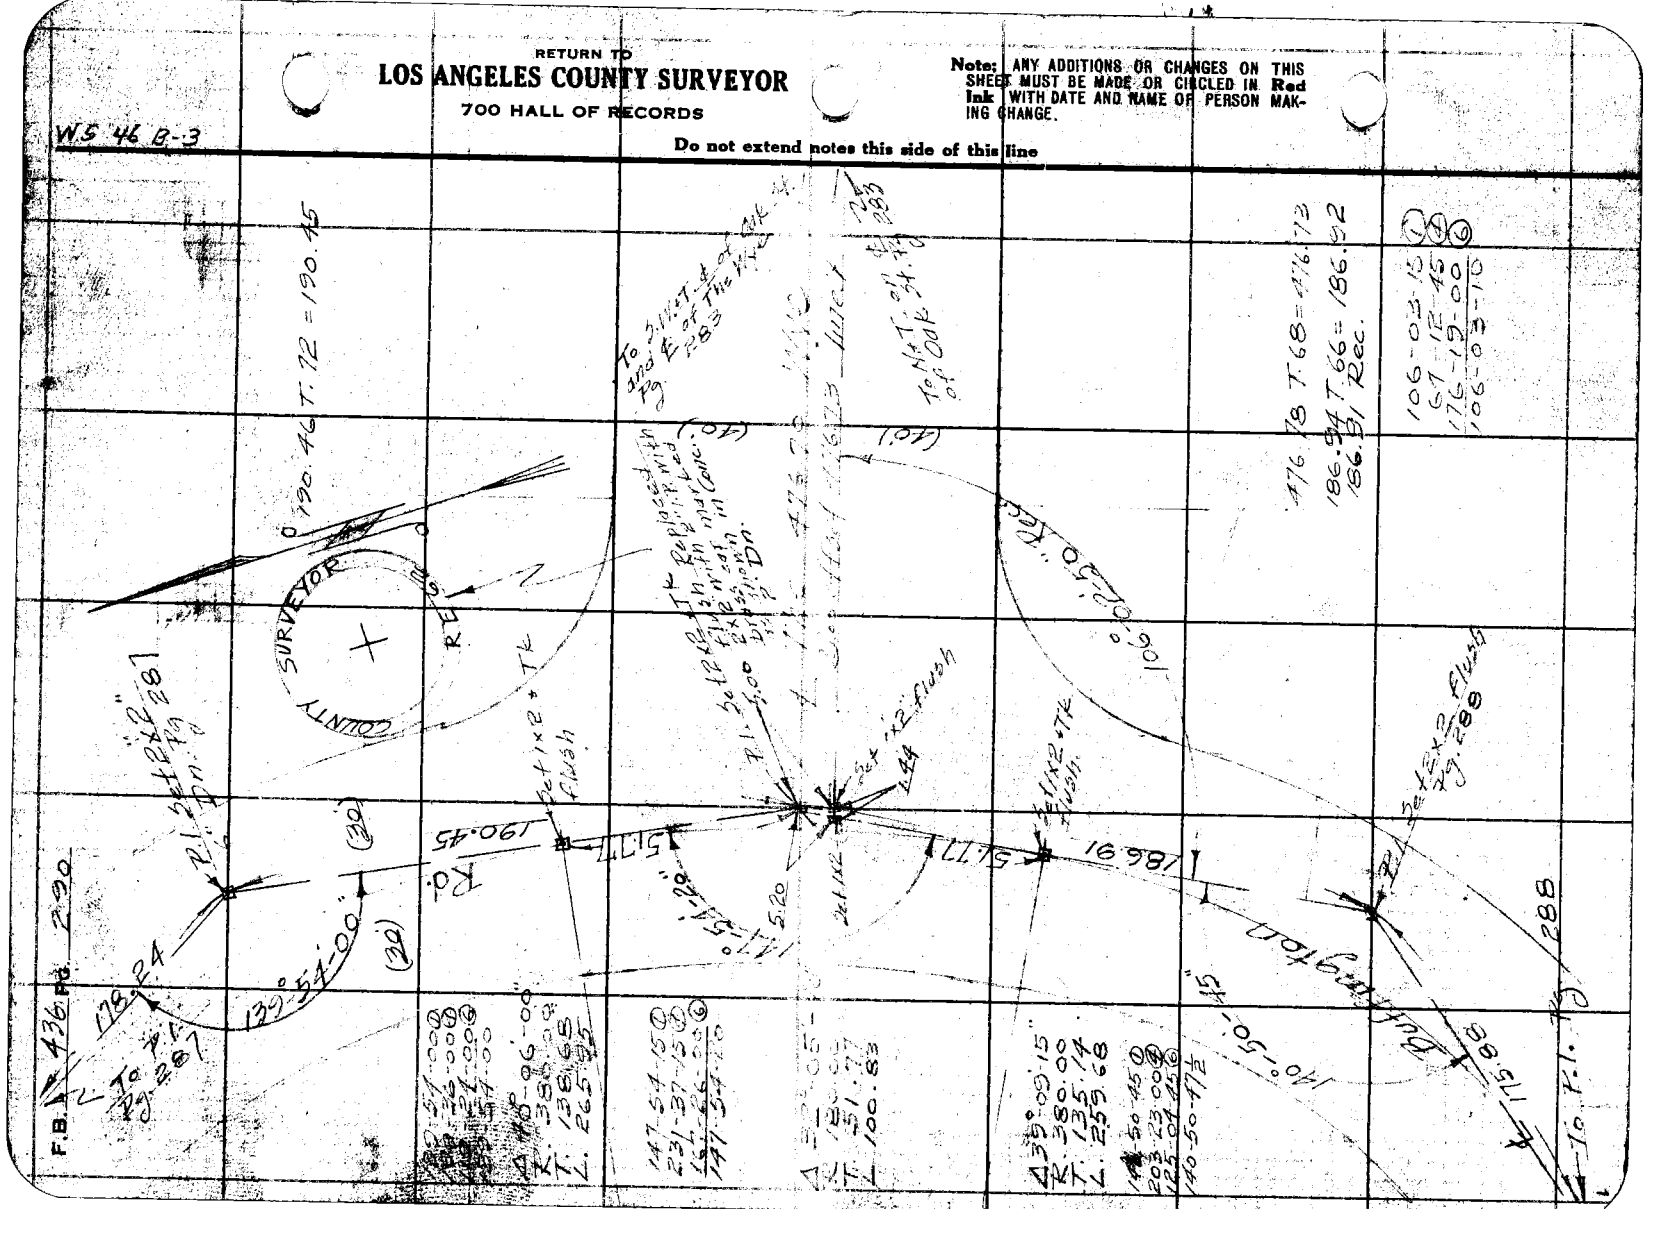

Plotted Ck'd by
Map No. 8-1006-2
Office Work Wood
Checked Oak
Date 1934

Survey of Rurban Homes
W. O. 8048 Tape No 045 St'd 84 Cr.
Surveyed by Rowland
Notes Date 6-5-34
Indexed A. C. Johnson

F.B. 436 Pg. 291

Note: ANY ADDITIONS OR CHANGES ON THIS SHEET MUST BE MADE OR CIRCLED IN Red Ink WITH DATE AND NAME OF PERSON MAK-ING CHANGE.

Do not extend notes this side of this line

RETURN TO
LOS ANGELES COUNTY SURVEYOR
700 HALL OF RECORDS

FORM 247 5M 8-34

1724
30.00
90°
Set 2"x2"x12" T.K.
Pd. N.+T. 12+14.9 Per Pg. 843
SURVEYOR
R.E.
L.A.C.O.
St.
45.24
(30')
℄ Cogswell Rd
Set S.W.+T. Flush
Replaced S.W.+T. with 2" I.P. with brass cap marked as shown in Conc. 18" Dia.
21+38.98 Fr. S.
12+49.29 Fr. E.
44.76
Hemlock
30.00
90°
(30')
Set 2"x2"x12" T.K. Dr.
(20')
(30')
660.00
660.03 T 70 = 659.97
660.00 Rec.
Set S.W.+T. Flush
℄
89-41-15 ④
358-47-15 ⑥
178-11-15 ⑥
89-41-52 ±
330.00
90°
30.00
Set 2"x2"x12" T.K. Dr. Replaced with 2" I.P. with brass cap marked as shown in Conc. flush.
89°-41'
45.24
30.00
90°
℄ (20') Oak St.
(20')
Pk.N. 2 Hole
16.94 Fr. S.
0.20 Fr. E.
Pg. 283

F.B. 436 PG. 292

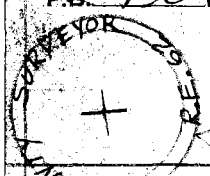

Fd. 3/4" I.P. - 12" Dn.
F.B. 436-249 Replaced
3/4" I.P. with 2" I.P. with
brass cap marked as shown in
Conc. 2' Dn.

W.S. 46 B.H.

(40')

Durfee Ave.

To 2x2" at P.I.
See Fg. 293

(40')

45.56

℄

90°

Init. Set 2"x2"
6' Dn. Replaced
2"x2" with 2" I.P. with
brass cap marked as
shown in Conc. 2 Dn.
14+42.56 Fr. ℄
0+00 +0 W.

92°-05-25"

40.00

S 1°-54' W

30.00

90°

Set 2"x2"
Dn.

Hemlock Ave.

RETURN TO
LOS ANGELES COUNTY SURVEYOR
700 HALL OF RECORDS

Do not extend notes this side of this line

Note: ANY ADDITIONS OR CHANGES ON THIS SHEET MUST BE MADE OR CANCELED IN Red Ink WITH DATE AND NAME OF PERSON MAKING CHANGE.

92-05-20
368-22-15
192-33-20
92-05-35

431.28 T. To = 431.24
431.25 Rec.

Set 2"x2" Dn. N. Cor.
lot 2 + 10 Dn. Replaced 2"x2"
with 3/4" I.P. with brass cap
marked as shown in Conc. flush

30.00

98°

Set nail

76.09

(20')

(30')

SURVEYOR

R.E.

764.07

Fd. 2"x2" 2' Dn. Top 2"
of hill Fg. 293

+ 7.07 T. To = 764.00
761.00 Rec.

764.07

To ℄ Hemlock
St & Cogswell Rd.
See preceding page

Notes OK'd by
Map No. B-1006-2
Office Work Wood
Checked Auer
Date 1934

Survey of Durban Homes
W. O. 8016 Topo No. 042 Std'd 8 Cor.
Surveyed by Rexcerans
Notes
Date 6-7-34
Indexed A. C. Johnson

F.B. 436 Pg. 293

Replaced with Co. Sur. Mon. Pg 292

Int. Set 2x2" - 6" Dn. F.B. 436-249

℄ Hemlock St. Pg 292

(20')

Fd. 3/4" I.P. 12" Dn. F.B. 436-249

(30')

14+42.56 Tr. to ℄ 0+00 to W.

534.12 T. to = 534.07
534.12 Rec.

Durfee Ave.

Note: adjusted points proportionally on this line.

168-06-30 ⓐ
312-26-15 ⓑ
288-38-00 ⓒ
168-06-30

℄ 534.12

(40')

(40')

Δ 11°-53'-25"
R. 540.00
T. 56.23
L. 112.06

168°-06'-35" 534.12'

90°

1133

Set 2x2 Tk Flush

18.84

8.39

Set 1x2 Flush

Set 2x2 Tk Flush

P.O.S.T. Set 2x2 Tk Flush

Set Co. Sur. Monuments Sur. Pg. 296

P.O.S.T. Set 2x2 Tk Flush

Set 2x2 Flush

℄ 9+52 Po

76-01-00 ⓐ
Set 04-15 ⓑ
96-06-15 ⓒ
76-01-00

169.04 T. 168-06-30

552.22 T. 168-06-21
552.20 Rec.

89-42-30
358-49-30 ⓐ
178-14-12 ⓑ
89-42-22 ⓒ
89-42-35 Rec

245.00 T. 76 = 244.98

SURVEYOR'S MONUMENT R.E.

Set 2x2 Flush

341.98

89°-42'-35"

552.20

Replaced 2x2 with 2" I.P. with brass cap marked as shown in Conc. Flush + Tk

Set 2x2 Tk 6" Dn.

30.00

Fd. 3/4" I.P. 12" Dn. F.B. 436-248

N. 0°-17'-25" W. Rec.

℄ Tos W. + T. of Pg. 292

℄ Oak St. Hallwood

(30')

Dr.

132.66 T. 82

132.66

Replaced 3/4" I.P. with brass cap marked as shown in Conc. 2" Dn.

Set 2x2 Tk 12" Dn.

1 Tk + 3+00 0+00 to W.

Fnc.

RETURN TO
LOS ANGELES COUNTY SURVEYOR
700 HALL OF RECORDS

Notes: ANY ADDITIONS OR CHANGES ON THIS SHEET MUST BE MADE ON CIRCLED JOB No. AND WITH DATE AND NAME OF PERSON MAKING THE CHANGE.

Do not extend notes this side of this line

FORM 247 BM 2-36

RETURN TO

LOS ANGELES COUNTY SURVEYOR

700 HALL OF RECORDS

Note: ANY ADDITIONS OR CHANGES ON THIS SHEET MUST BE MADE OR CIRCLED IN Red Ink WITH DATE AND NAME OF PERSON MAKING CHANGE.

W.S. 46 B-4

Do not extend notes this side of this line

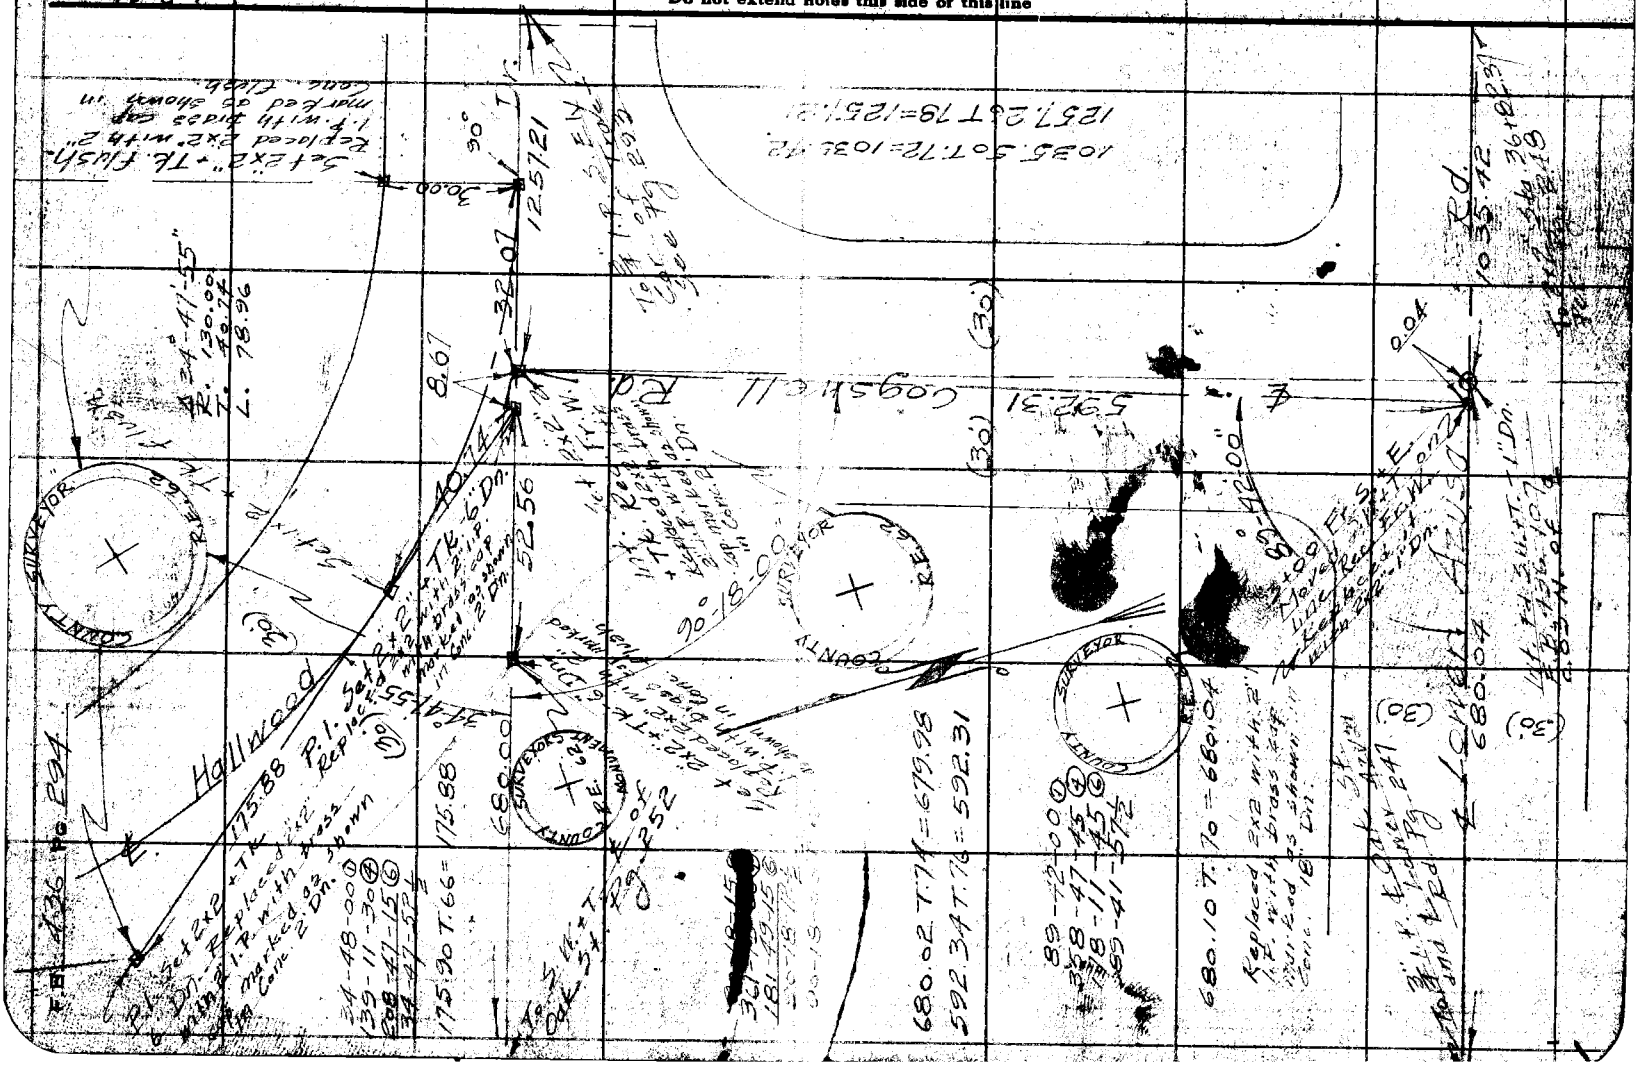
Rd.
Set 2x2" + TK. flush. Replaced 2x2" with 2" I.P. with tack and tag as shown in Cook. Chas

Was Yk Co. M.

Noted: Ck'd by	Survey of Kirban Homes F.B. 436 Pg. 24
Map No. 8-1006-2	W. O. 8048 Tape No. 045 St'd 84 of.
Office Work Wood	Surveyed by Rosecrans
Checked Aar	Notes Date 6-12-34
Date 1934	Indexed A. C. Johnson

Notice! ANY ADDITIONS OR CHANGES ON THIS SHEET MUST BE MADE OR CIRCLED IN Red INK WITH DATE AND NAME OF PERSON MAK. THE CHANGE.

Do not extend notes this side of this line

RETURN TO
LOS ANGELES COUNTY SURVEYOR
700 HALL OF RECORDS

(20) ℄ Hemlock

21.+38.96 Fr. S
12.+49.29 +k. E.

Int Sct S.W.+T. Sec. Pg. 291

44.76 45.24

St.

90° 90° 90°

30.00 30.00 30.00 30.00

90°-18-05

44.76 45.24

Set 2x2" + Tk flush

Set 2x2" + Tk flush

(30) (30) (30)

℄ Cogswell Rd

562.32

90-18-00 ①
361-12-30 ④
181-49-00 ⑥
90-18-10
90-18-05 Rec.

659.95 T. 76 = 659.92
+.06
659.98

562.33 T. 76 = 562.28
562.32 Rec.

90-18-00 ①
361-12-15 ④
181-48-15 ⑥
90-18-02 ★

1272.87 T. 72
1272.81

Set 2x2" + Tk flush

30.00

Set 1x2" + Tk Flush

Δ 89°-41'-55"
R. 75.00
T. 74.61
L. 117.42

Set 2x2" + Tk. flush

30.00

32.85

41.76

90°-18-05

178.23 T. 08 = 178.21

33-52-00 ①
136-28-30 ④
209-12-30 ⑥
33-52-05
660.0

18.79

39.58

122.87 Calc.

90°

16.24

30.00

Set 1x2" + Tk flush

Set 2x2" + Tk flush

Dr.

39.58

Set 1x2" + Tk flush

178.21

Δ 33°52'-05"
R. 130.00
T. 39.58
L. 76.84

P.I. Set 2x2" flush
Co. Surv. Mon.
Pg. 289

(20) (30)

℄ Cherrylee

Set 2x2" + Tk flush

Set 2x2" with 2½" O.D. Brass cap 4" below surface

Found 2x2" with 2½" O.D. Brass cap 4" below surface

Set 2x2" + Tk flush

℄ Dr. Redwood

Found 2x2" with 2½" O.D. Brass cap 4" below surface

Found 2x2" with 2½" O.D. Brass cap 4" below surface

Found 2x2" with 2½" O.D. Brass cap 4" below surface

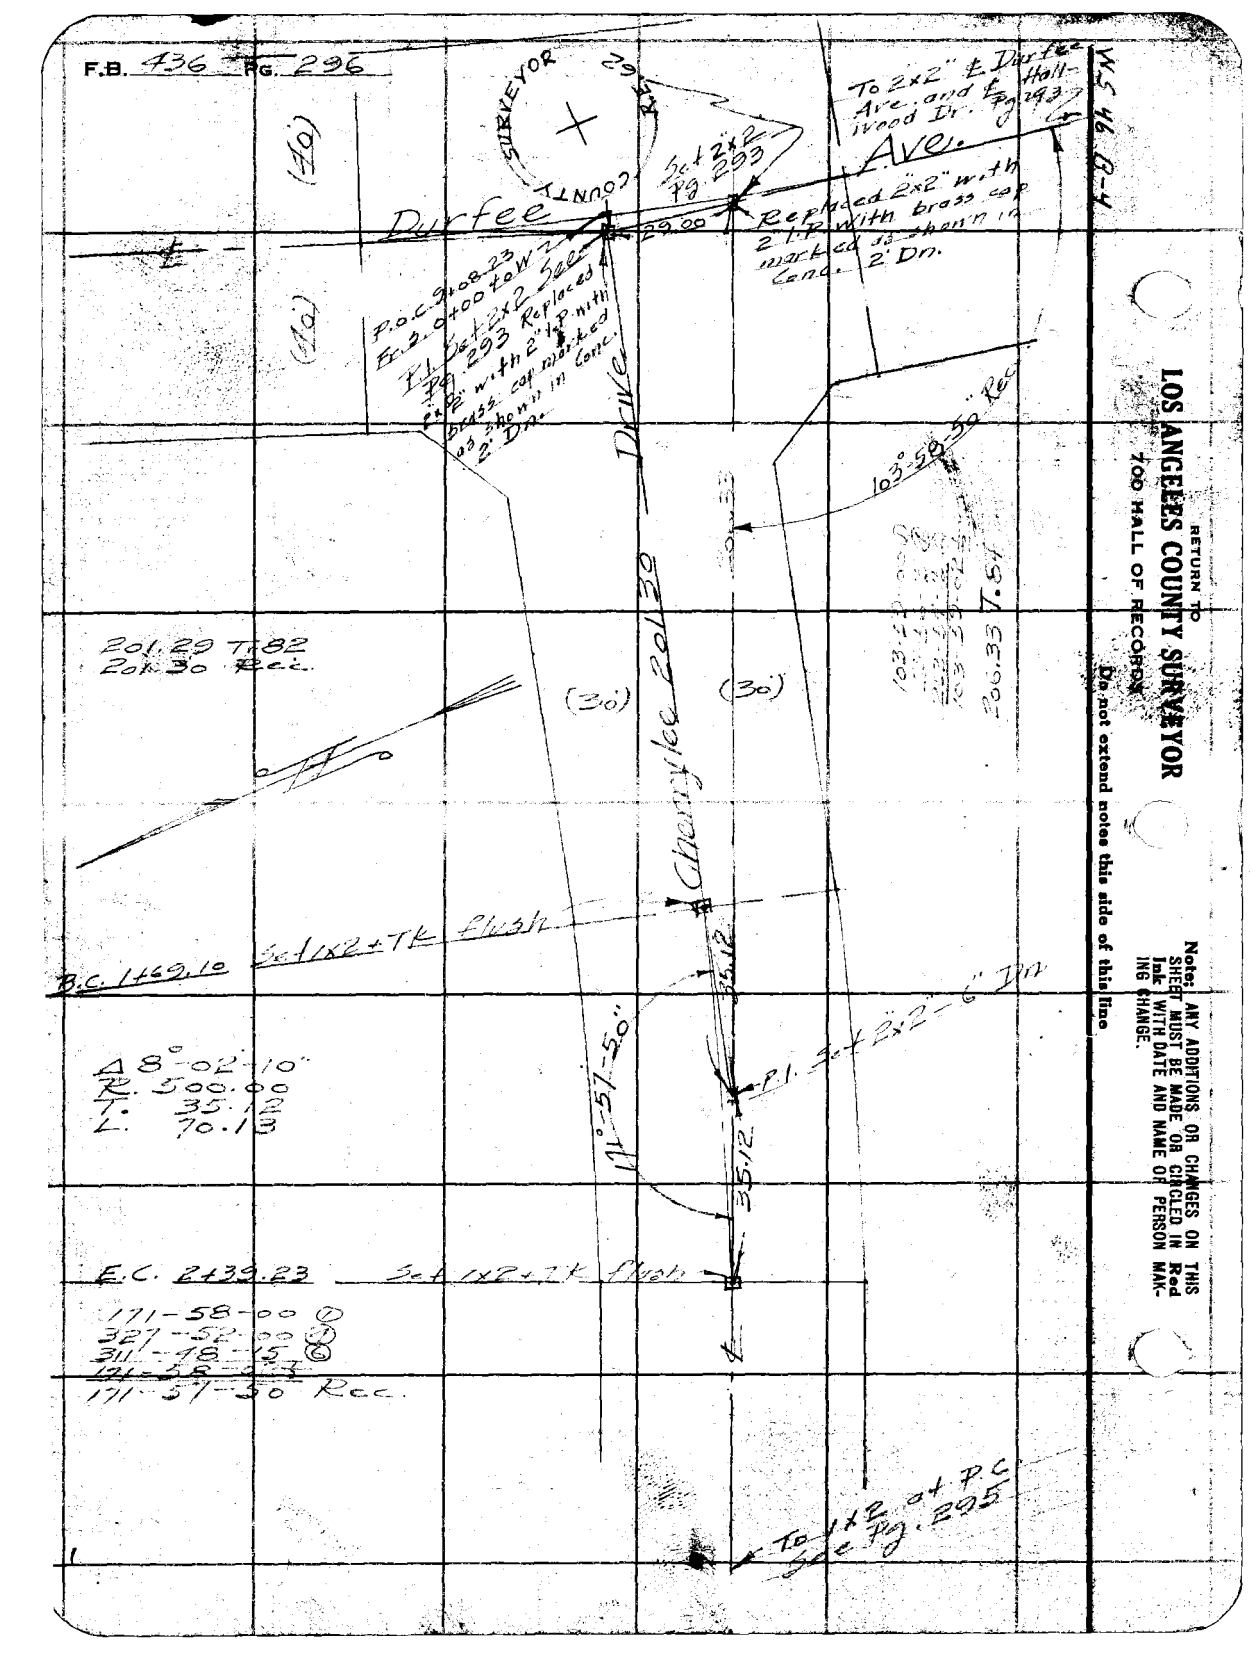
F.B. 436 PG. 296
SURVEYOR
COUNTY
Durfee
Ave.
To 2x2" E. Durfee Ave. and E. Hallwood Dr. Pg. 293
Sec. 2x2 Pg. 293
Replaced 2x2" with 2 I.P. with brass cap marked as shown in Conc. 2' Dn.
29.00
P.O.C. Sta 0+08.23 Ex. 2.0+00 40W
I.I. Set 2x2 See Pg. 293 Replaced 2x2" P. with 2" I.P. with brass cap marked as shown in Conc. 2' Dn.
(40')
(40')
(30')
(30')
103°-50' Rad
103°-50'-45" Rad
30.83
201.29 T.82
201.30 Rec.
B.C. 1469.10
Set 1x2 + Tk Flush
Δ 8°-02'-10"
R. 500.00
T. 35.12
L. 70.13
11°-57'-50"
35.12
P.I. Sta 3+B.2 - 6" Dn
E.C. 2439.23
Set 1x2 + Tk Flush
171-58-00 ①
327-52-00 ②
311-48-15 ③
171-57-30 Rec.
To 1x2 at P.C. Sec Pg. 295
W.S. 46 B-4
RETURN TO
LOS ANGELES COUNTY SURVEYOR
700 HALL OF RECORDS
Do not extend notes this side of this line
Notes: ANY ADDITIONS OR CHANGES ON THIS SHEET MUST BE MADE OR CIRCLED IN Red Ink WITH DATE AND NAME OF PERSON MAKING CHANGE.

Notes Ck'd by	Survey of Burban Homes
Map No. B-1006-2	W. O. 8048 Tape No 045 St'd 84 of.
Office Work Wood	Surveyed by Rosecrans
Checked AAR	Notes Date 6-20-34
Date 1934	Indexed A. C. Johnson

F.B. 436 Pg. 297

W.S. 46 B-4

℄ Peck Rd. Pg. 280

Int. Set L.+T. in Conc. ℄ Pg. 280 pavement +

℄ Hollywood Dr.

927.00 T. 68 = 926.90

926.90 927.01 Rec.

(30') (30')

Set 1x2 +Tk flush See Pg. 288

0.03 90° 30.00

Set 2" I.P. with brass cap marked as shown in conc. flush

COUNTY SURVEYOR

R.E. 62

Mon. 288



Set ½ Dn. Co. Sur. Pg.

℄ Buffington Rd. Pg. 288

Note: ANY ADDITIONS OR CHANGES ON THIS SHEET MUST BE MADE OR CIRCLED IN Red Ink WITH DATE AND NAME OF PERSON MAKING CHANGE.

Do not extend notes this side of this line

RETURN TO LOS ANGELES COUNTY SURVEYOR 700 HALL OF RECORDS

FORM 247 SM 2-34

F.B. 436 PG. 298

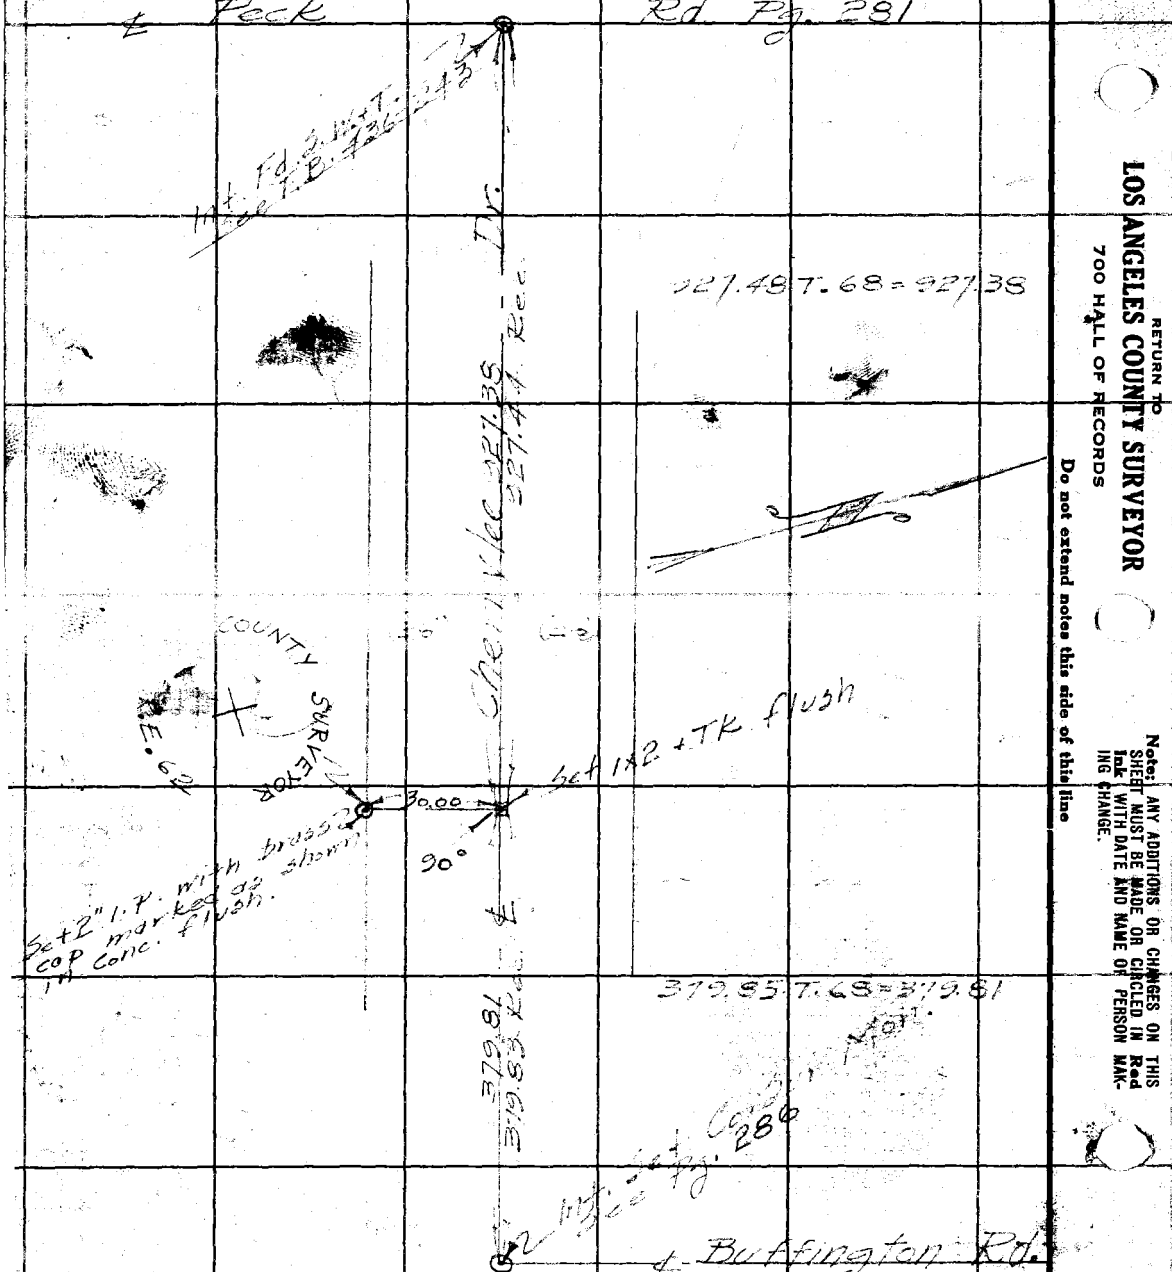

RETURN TO
LOS ANGELES COUNTY SURVEYOR
700 HALL OF RECORDS

Do not extend notes this side of this line

Note: ANY ADDITIONS OR CHANGES ON THIS SHEET MUST BE MADE OR CIRCLED IN Red Ink WITH DATE AND NAME OF PERSON MAKING CHANGE.

FORM 7 BM 2-34

RETURN TO
LOS ANGELES COUNTY SURVEYOR
700 HALL OF RECORDS

Note: ANY ADDITIONS OR CHANGES ON THIS SHEET MUST BE MADE OR CIRCLED IN RED Ink WITH DATE AND NAME OF PERSON MAKING CHANGE.

Do not extend notes this side of this line

Note: Set 3x3" redwood stakes, tops painted white and lot numbers painted on respective sides, 6" above surface at all points marked ■

Set 3"x3" redwood stake 6" above surface

Set 3x3" redwood stake 6" above surface

Set 3x3" redwood stake 6" above surface

Set 3

RETURN TO
LOS ANGELES COUNTY SURVEYOR
700 HALL OF RECORDS

Note; ANY ADDITIONS OR CHANGES ON THIS SHEET MUST BE MADE OR CIRCLED IN Red Ink WITH DATE AND NAME OF PERSON MAKING CHANGE.

Do not extend notes this side of this line

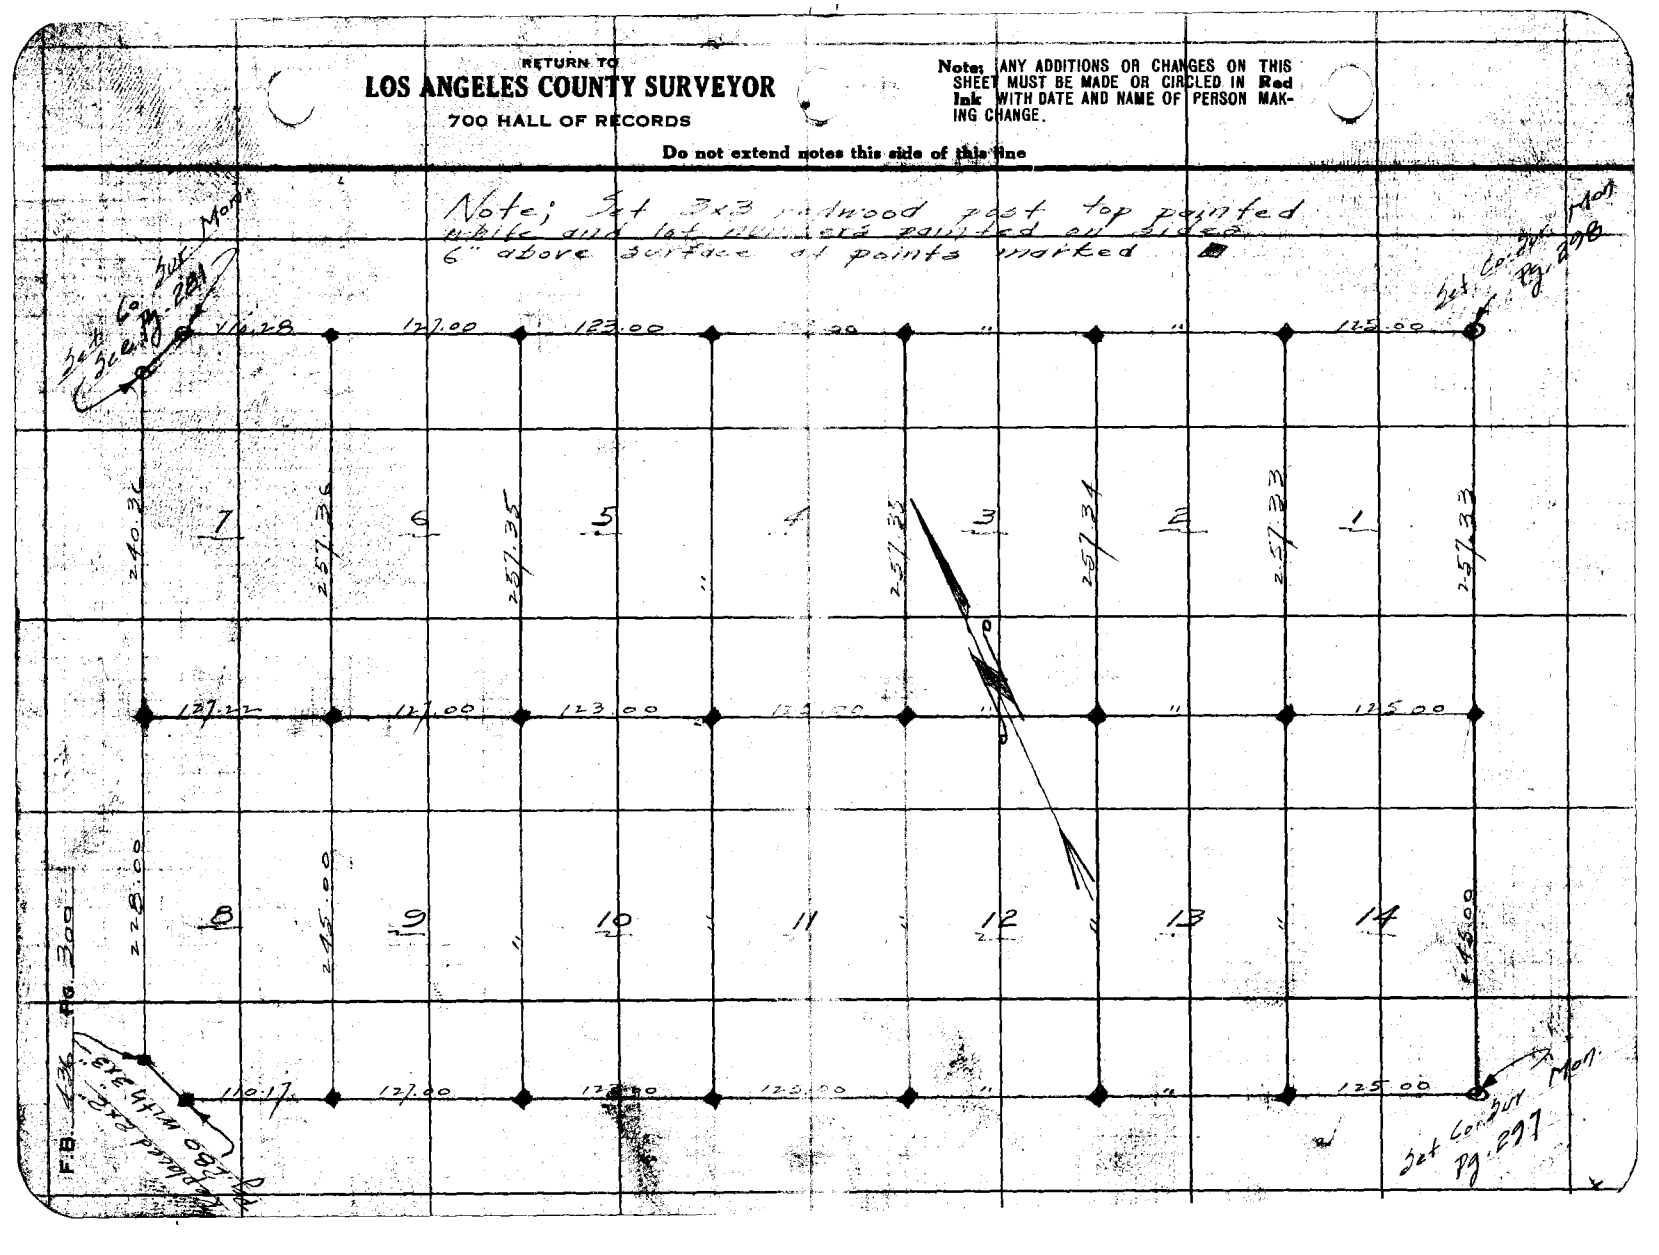

Set 3"x3" redwood stake top painted white and lot numbers painted on sides 6" above surface at points marked ●

To 3"x3" at P.C.C. line lot 40 Pg. 302

Pg. 297

W. 20

Pg. 302

N. 22° 30' W. 1.41

N. 22° 30' W. 1.41

Pg. 296

285.00

300.00

118.00

118.00

118.00

41

40

117.00

51.00

66.00

117.00

117.00

117.00

35

36

37

38

39

25.23

26.15

26.15

25.07

Set 3"x3" redwood stake top painted white and lot numbers painted on sides 6" above surface at points marked ●

Set 3"x3" redwood stake top painted white and lot numbers painted on sides 6" above surface at points marked ●

Pg. 288

162.08

117.00

117.00

117.00

101.92

Set Concr. Mon. See Pg. 282












RETURN TO
LOS ANGELES COUNTY SURVEYOR
700 HALL OF RECORDS

Note: ANY ADDITIONS OR CHANGES ON THIS SHEET MUST BE MADE OR CIRCLED IN **Red Ink** WITH DATE AND NAME OF PERSON MAKING CHANGE.

Do not extend notes this side of this line

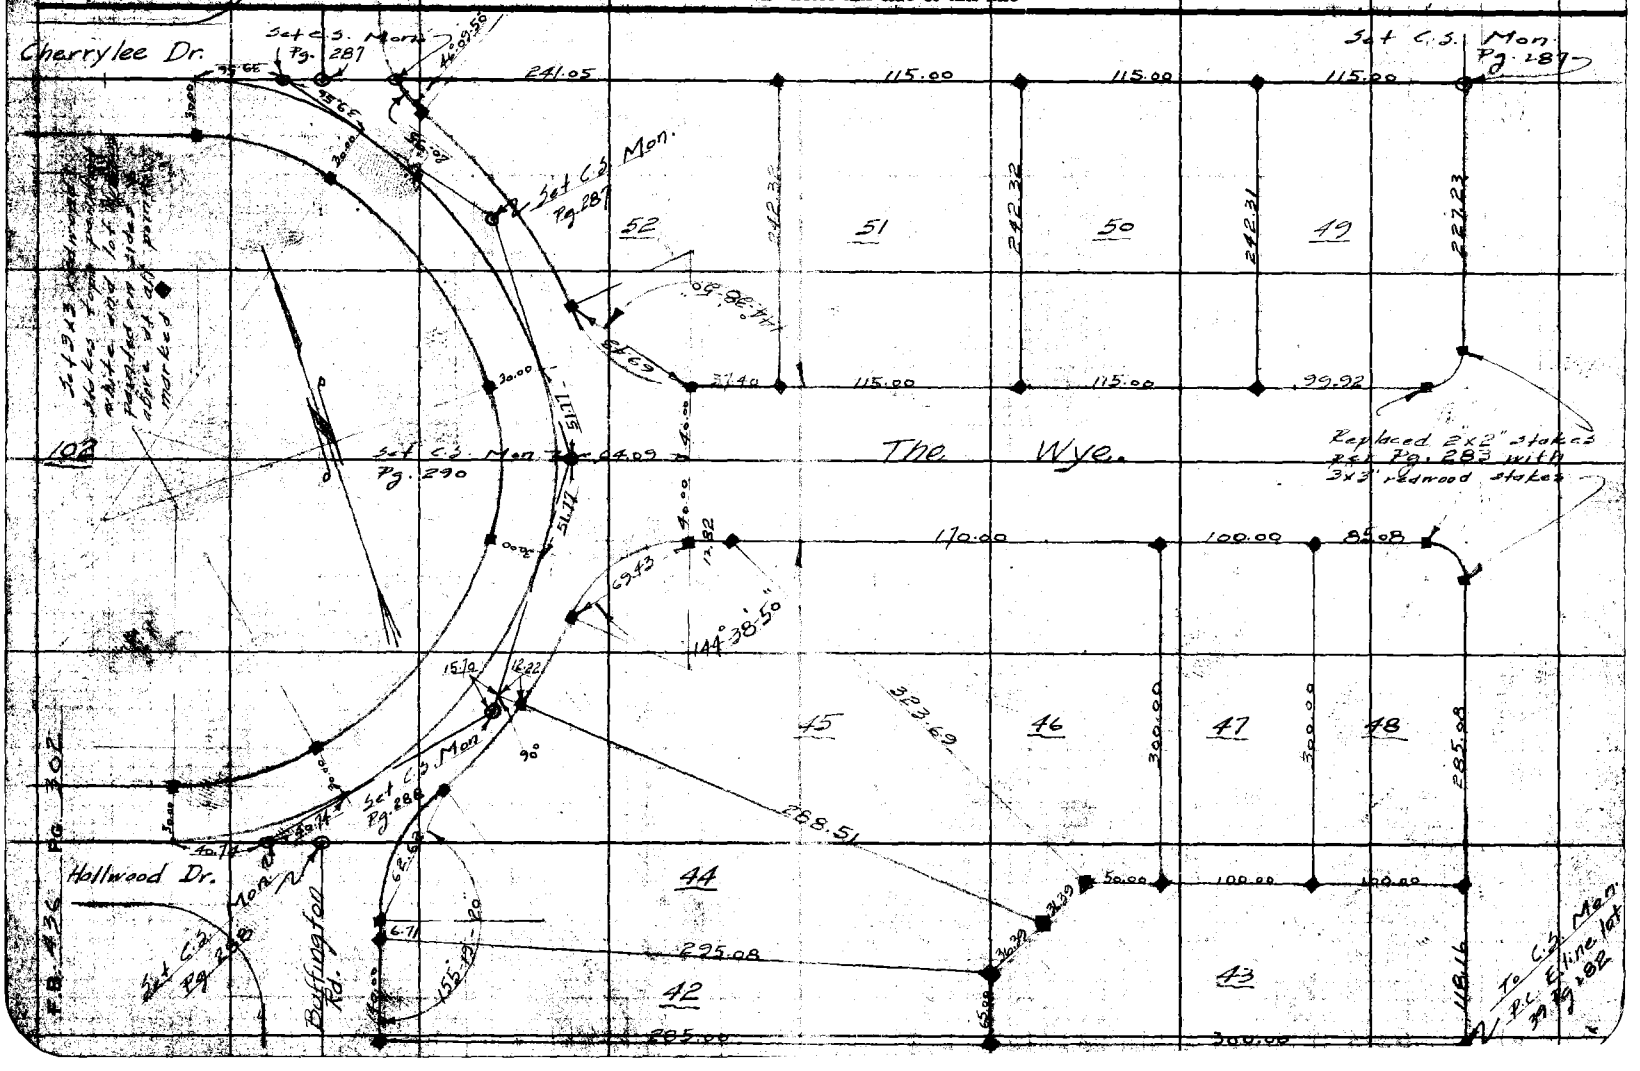

Notes Ck'd by		Survey of Burbank Homes	F.B. 436 Pg. 203
Map No. B-1006-12		W. O. 6048 Tape No. 017 St'd 7c °F.	
Office Work		Surveyed by Roseclear & Co	
Checked	1934	Notes	Date 10-5-34
Date		Indexed A. C. Johnson	

Note: ANY ADDITIONS OR CHANGES ON THIS SHEET MUST BE MADE OR CIRCLED AND INK WITH DATE AND NAME OF PERSON MAKING CHANGE.

Do not extend notes this side of this line

RETURN TO
LOS ANGELES COUNTY SURVEYOR
700 HALL OF RECORDS

FORM 247 5M 2-34

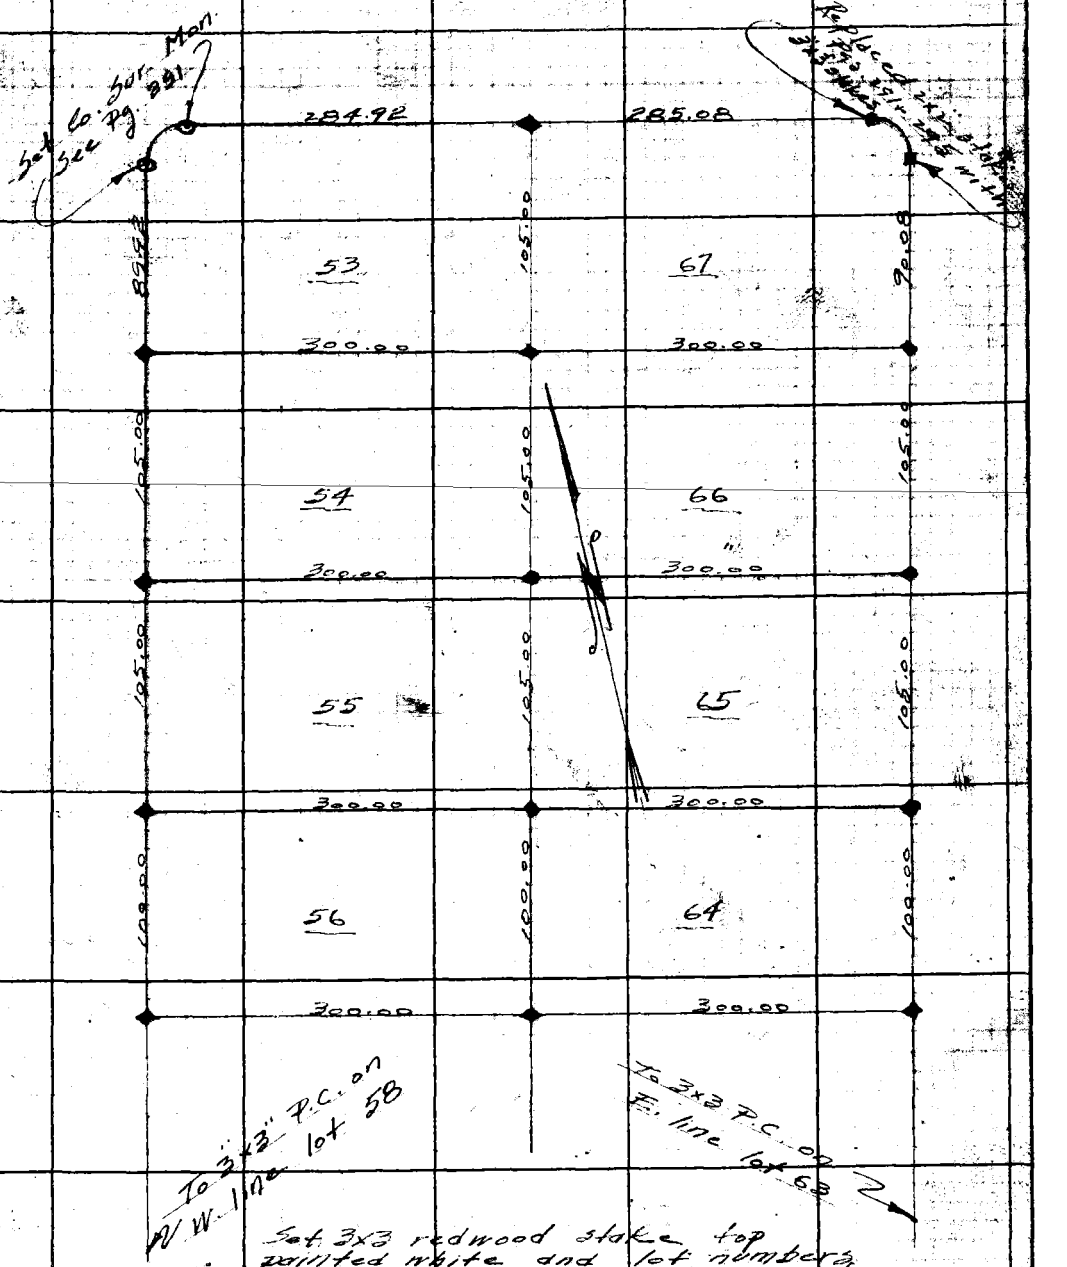

RETURN TO
LOS ANGELES COUNTY SURVEYOR
7OQ HALL OF RECORDS

Note: ANY ADDITIONS OR CHANGES ON THIS SHEET MUST BE MADE OR CIRCLED IN Red Ink WITH DATE AND NAME OF PERSON MAKING CHANGE.

Do not extend notes this side of this line

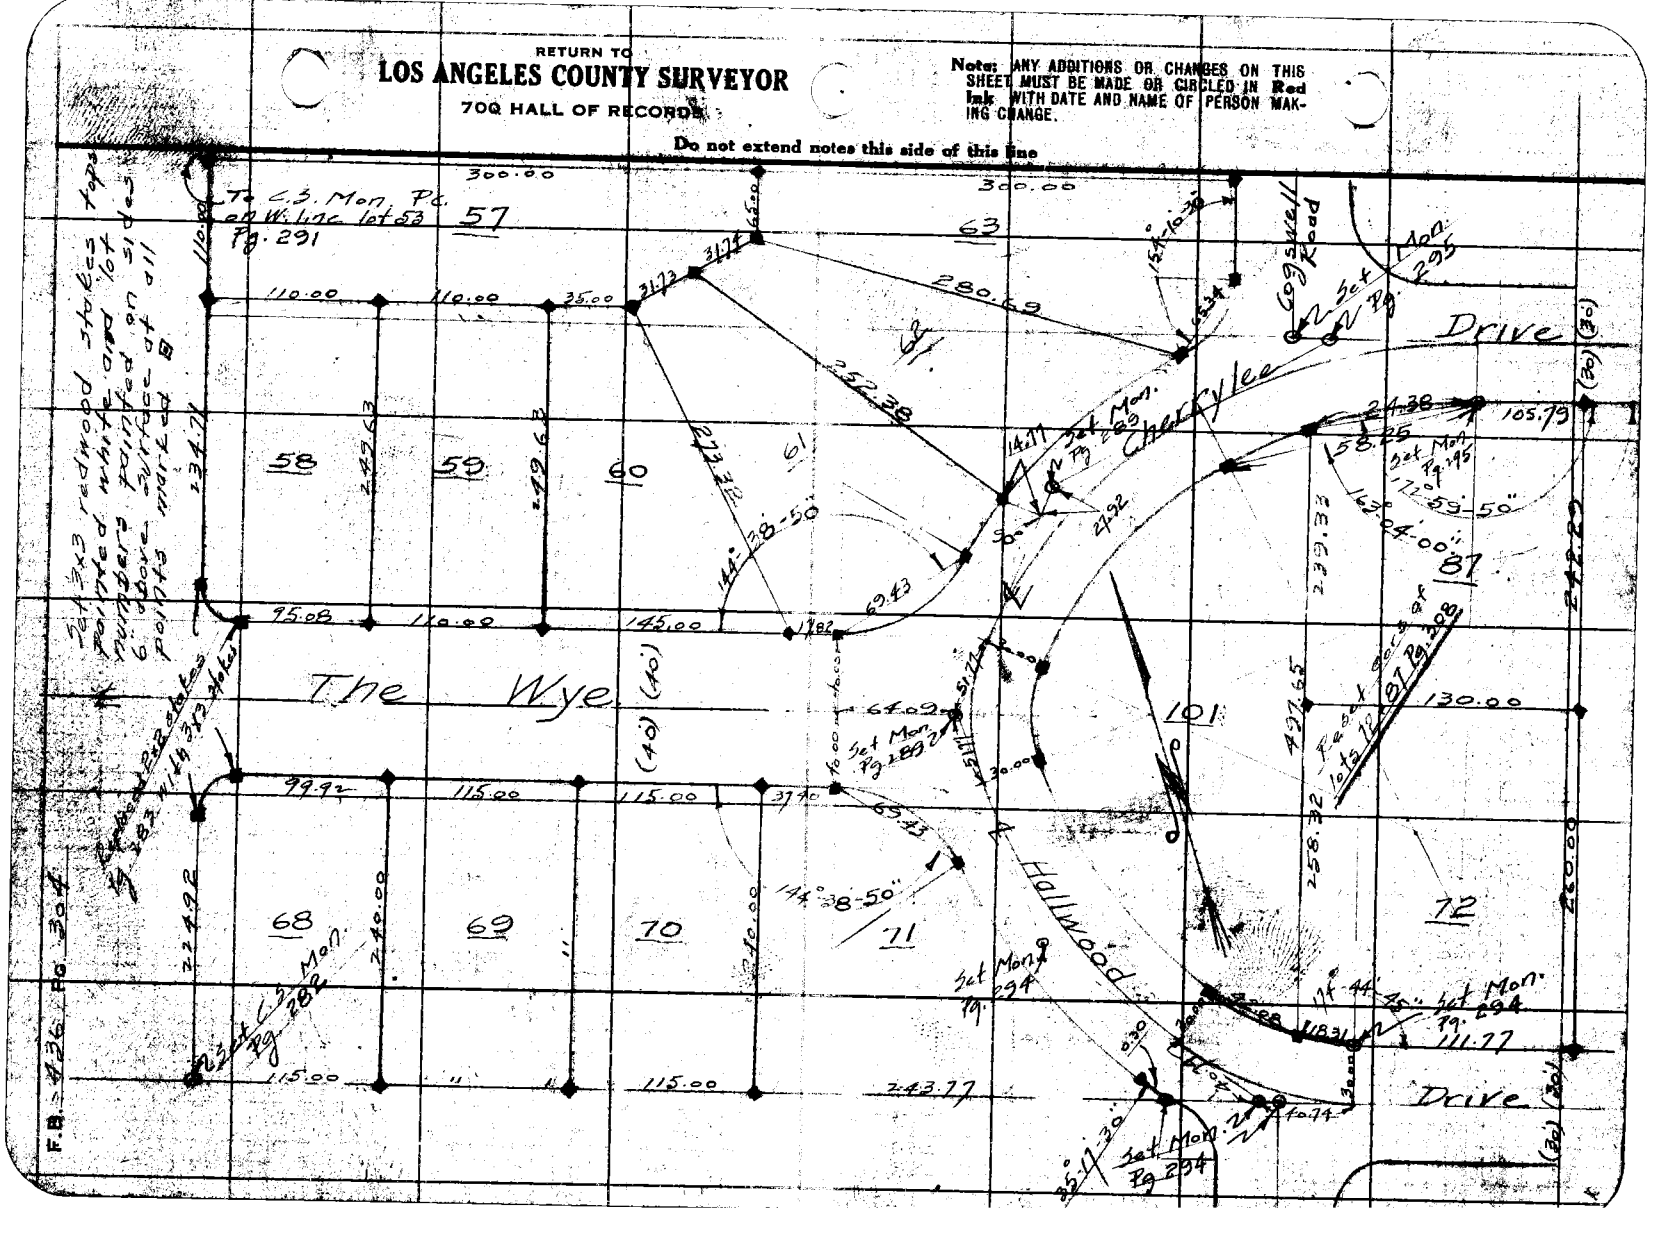

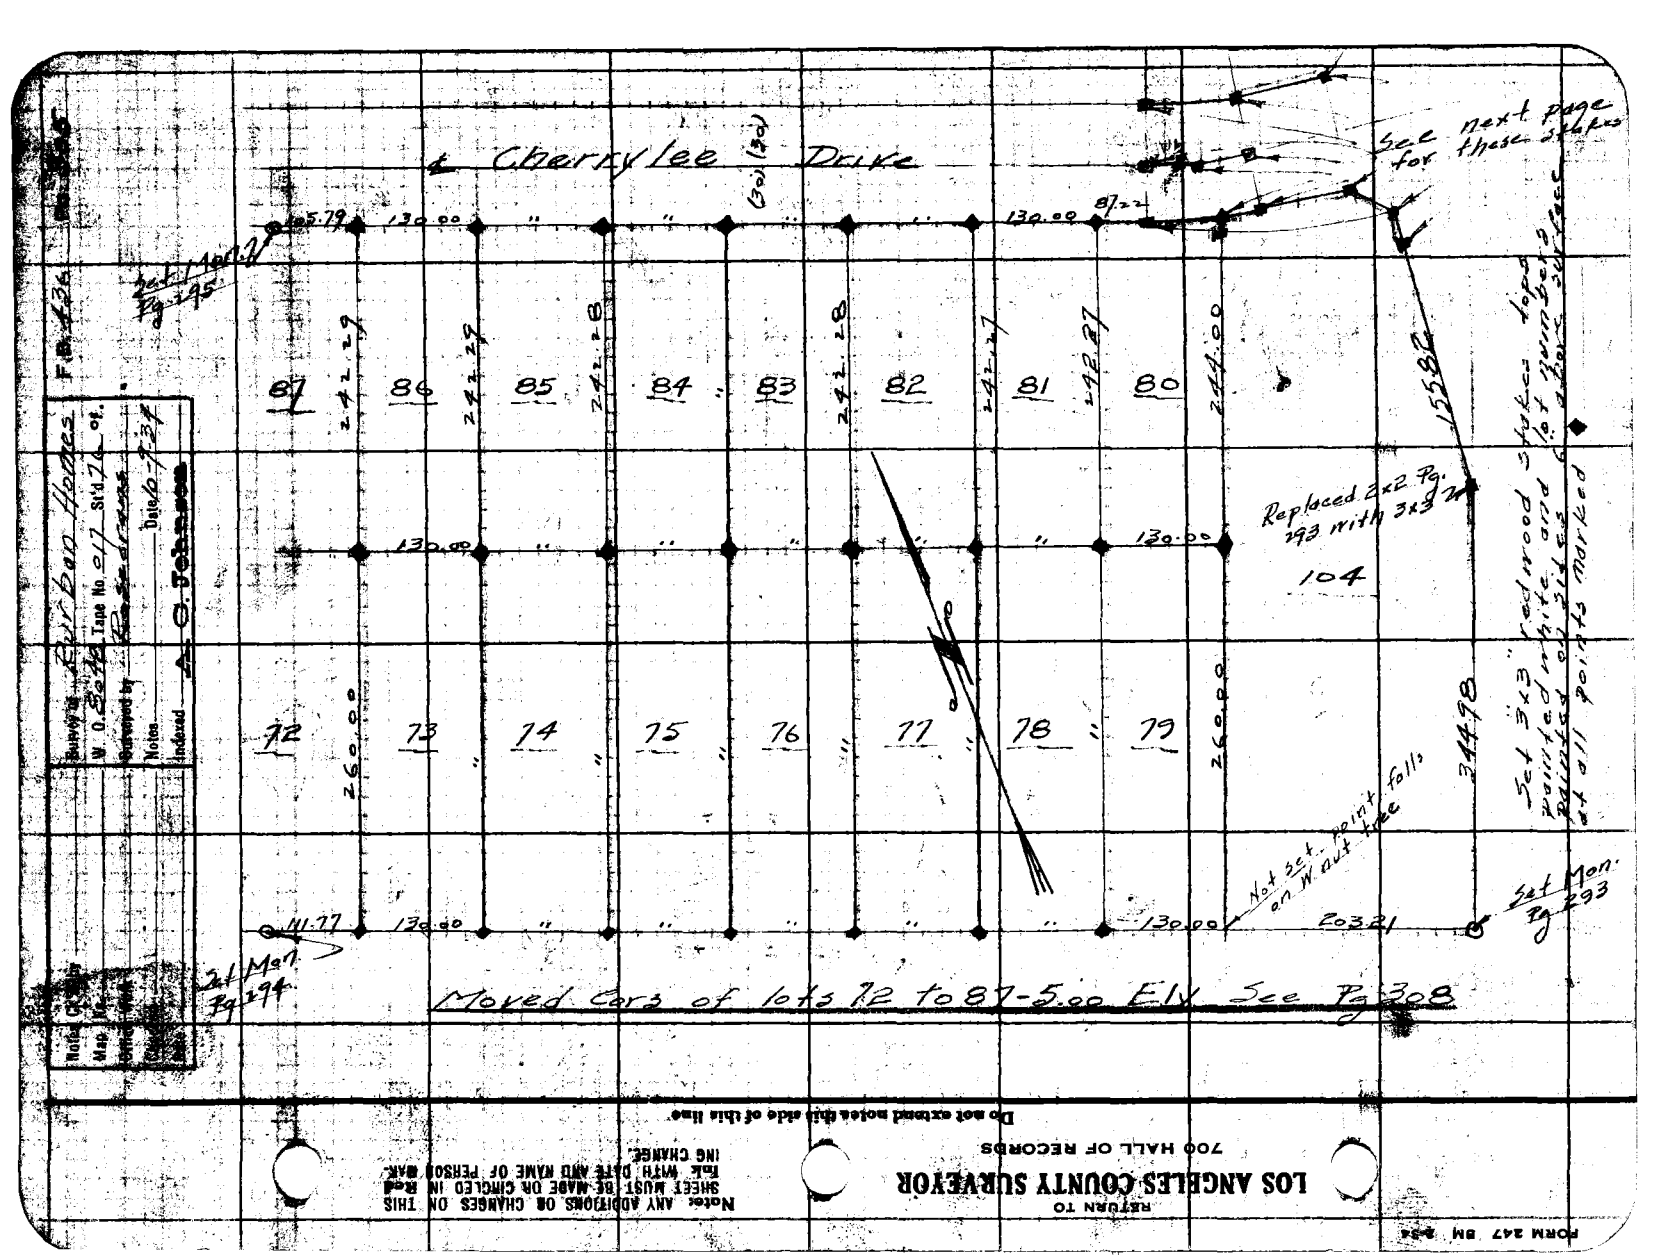
E. Cherrylee Drive
(30)
See next page for these stakes
Set next monument Pg 295
87
86
85
84
83
82
81
80
242.27
242.28
242.27
242.28
242.27
242.28
242.27
249.00
130.00
130.00
130.00
130.00
130.00
130.00
130.00
130.00
87.22
155.82
Replaced 2x2 Pg. 293 with 3x3 M
104
Set 3x3" redwood stakes tops painted white and 1'0" above surface at all points marked
72
73
74
75
76
77
78
79
260.00
260.00
Not set, point fell on W out tree
34498
Set Mon. Pg 293
111.77
130.00
E0321
Set Mon. Pg 294
Moved Cors of lots 72 to 87 - 5.00 E'ly See Pg 308
Notes
Indexed A. O. Johnson
Note Corner
Map Ref.
Index Mark
Remarks
FB 43a
Do not extend notes this side of this line
RETURN TO
LOS ANGELES COUNTY SURVEYOR
700 HALL OF RECORDS
Notice ANY ADDITIONS OR CHANGES ON THIS SHEET MUST BE MADE ON CIRCLED IN Red INK WITH DATE AND NAME OF PERSON MAK-ING CHANGE.
FORM 247 BM 2-54

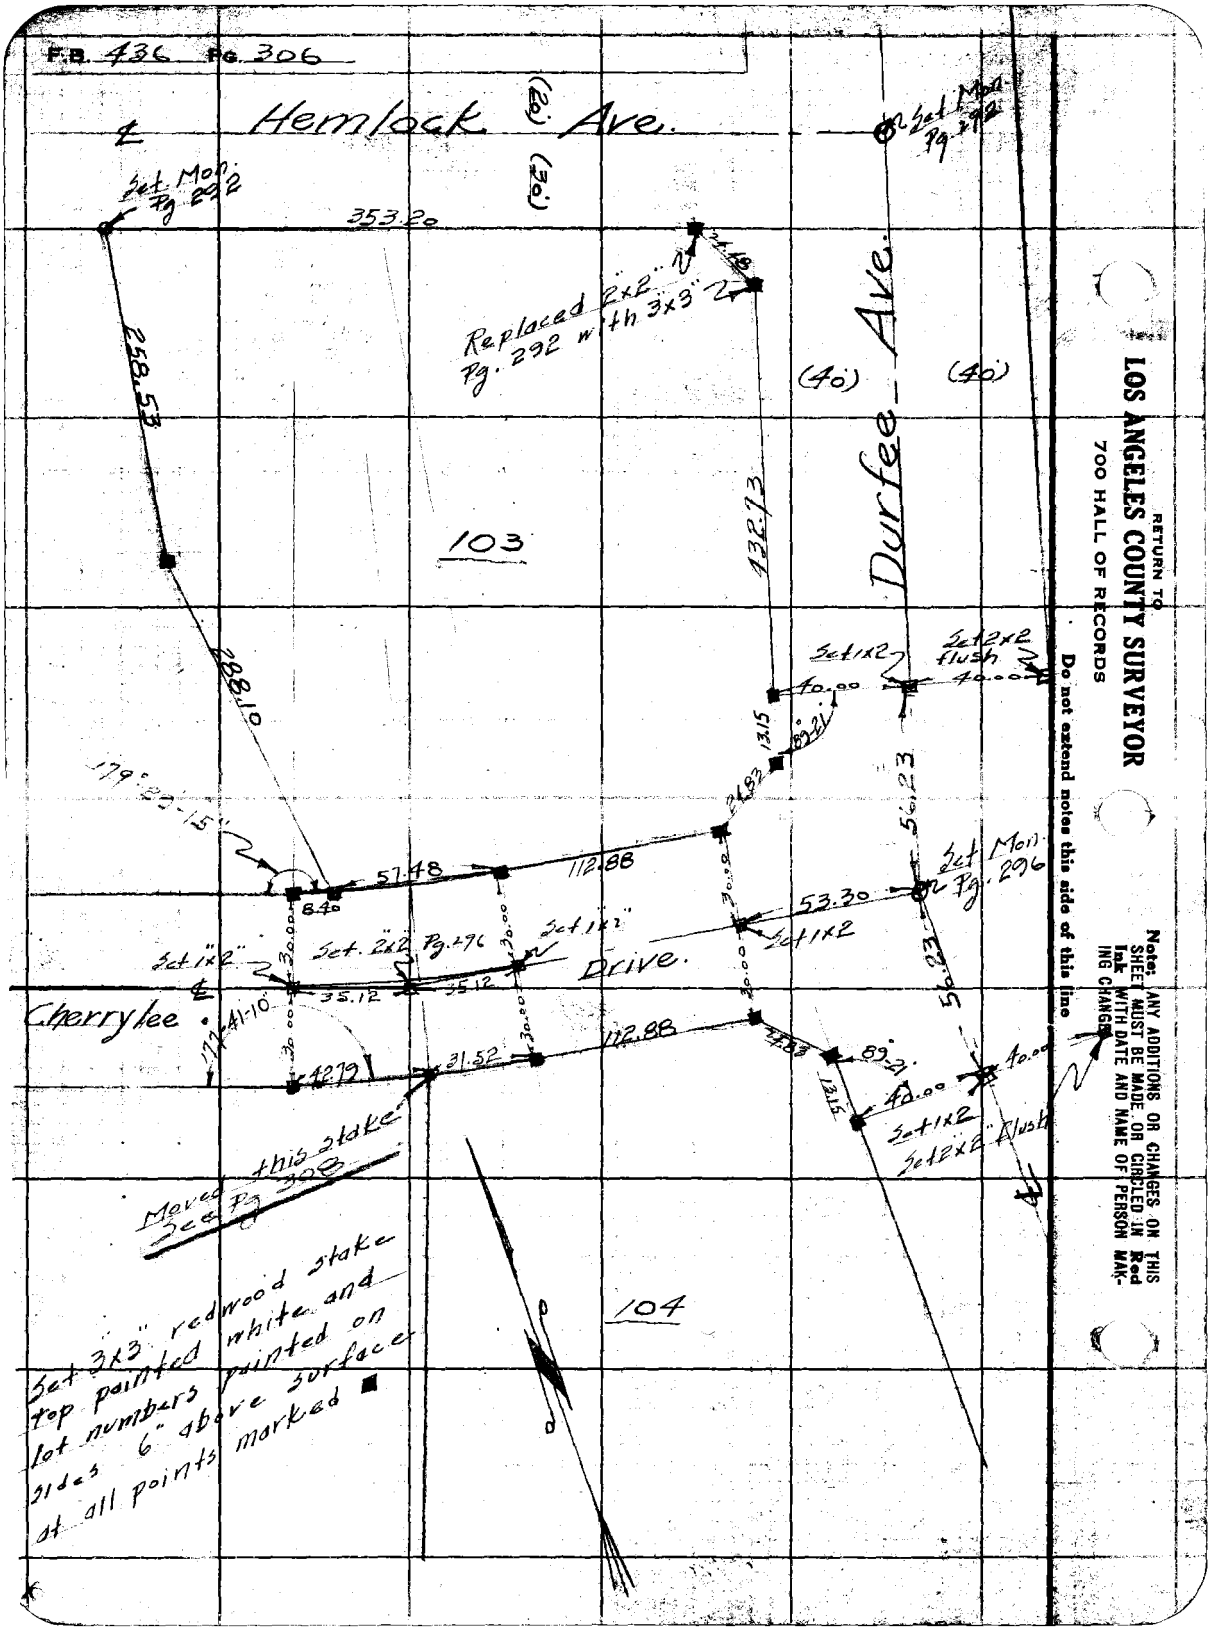
F.B. 436 Pg. 306
℄ Hemlock Ave.
(20)
(30)
Set Mon. Pg. 292
353.20
Set Mon. Pg. 292
Replaced 2"x2" Pg. 292 with 3x3"
258.53
288.10
179° 20' 15"
103
132.73
Durfee Ave.
(40)
(40)
Set 1x2"
Set 2x2" flush
40.00
40.00
313.15
89° 21'
249.53
54° 23'
57.48
112.88
8.40
Set Mon. Pg. 296
53.30
Set 1x2"
Set 1x2"
Set. 2x2 Pg. 296
Set 1x2"
30.00
35.12
35.12
Drive.
Cherrylee
177° 41' 10"
42.79
31.52
112.88
89° 21'
313.15
40.00
Set 1x2"
Set 2x2" flush
Moved this stake See Pg. 308
Set 3x3" redwood stake top painted white and lot numbers painted on sides 6" above surface at all points marked ■
104
RETURN TO
LOS ANGELES COUNTY SURVEYOR
700 HALL OF RECORDS
Do not extend notes this side of this line
Note: ANY ADDITIONS OR CHANGES ON THIS SHEET MUST BE MADE OR CIRCLED IN Red Ink WITH DATE AND NAME OF PERSON MAKING CHANGE




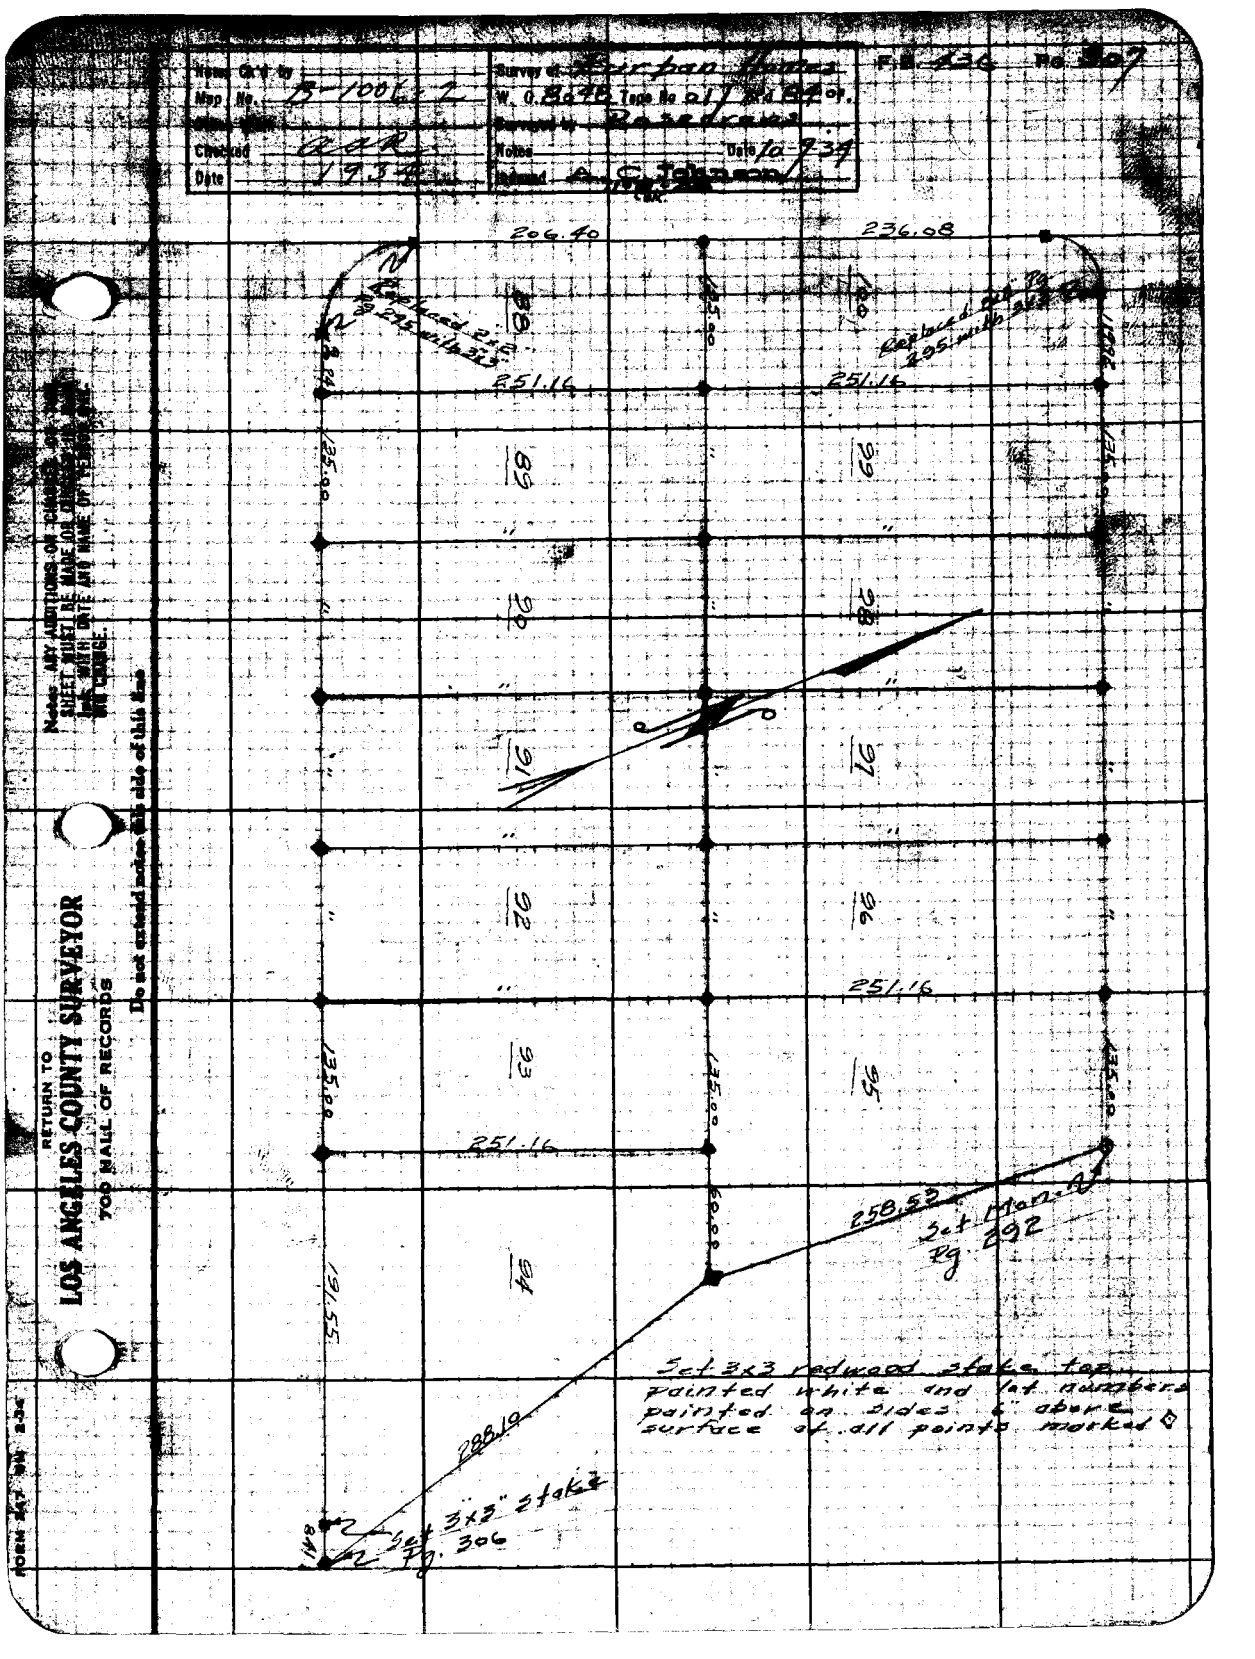

RETURN TO
LOS ANGELES COUNTY SURVEYOR
700 HALL OF RECORDS

Notes: ANY ADDITIONS OR CHANGES OF ANY KIND SHALL BE MADE ON THIS SHEET MUST BE MADE OR DRAWN, AND SIGNED BY THE PERSON MAKING THE SAME. ANY REVISED SHEET SHALL BE ACCOMPANIED BY A NEW DATE AND NAME OF PERSON MAKING THE CHANGE.

Do not extend notes this side of this line

FORM 347 (Rev. 2-34)

RETURN TO
LOS ANGELES COUNTY SURVEYOR
700 HALL OF RECORDS

Note: ANY ADDITIONS OR CHANGES ON THIS SHEET MUST BE MADE OR CIRCLED IN Red Ink WITH DATE AND NAME OF PERSON MAKING CHANGE.

Do not extend notes this side of this line

New locations of Cors. lots 72 to 87.

Set 3x3 Redwood stake top painted white and lot numbers painted on sides 6" above surface at points marked ◆

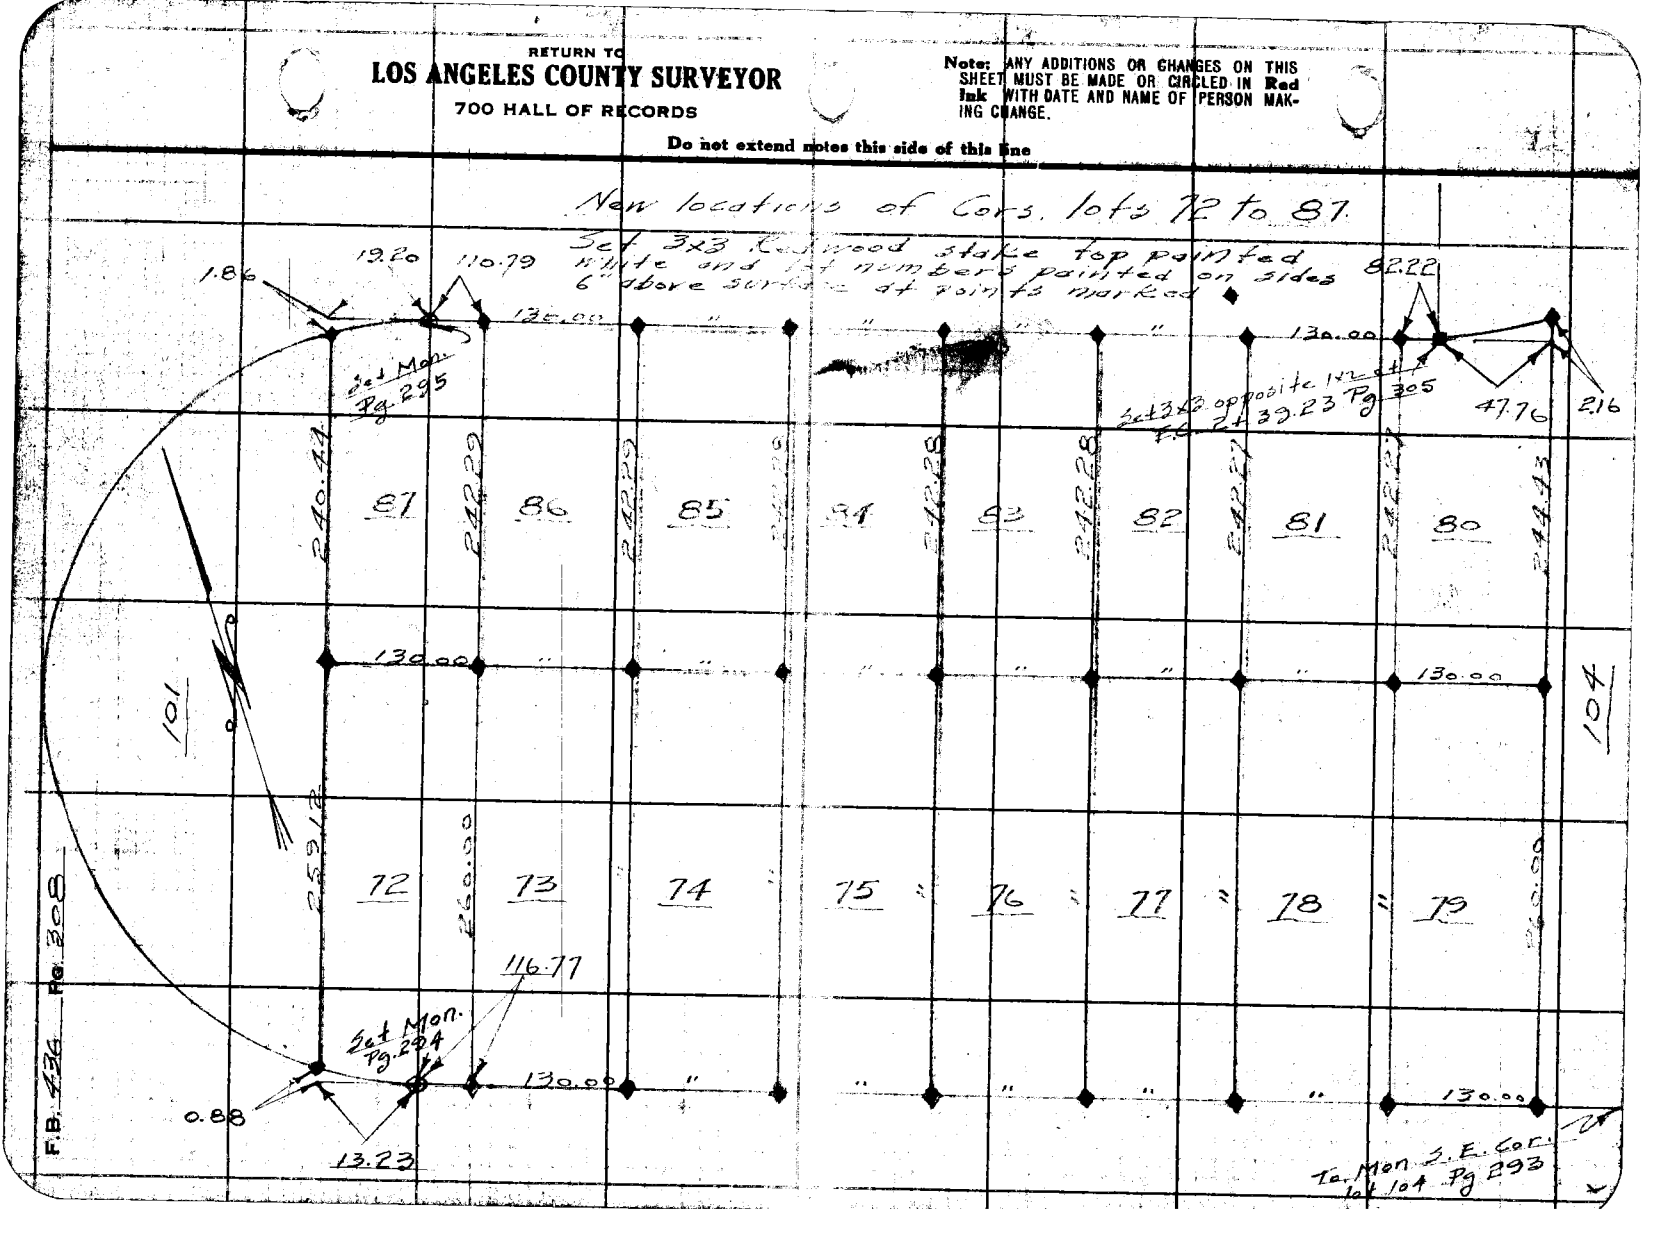

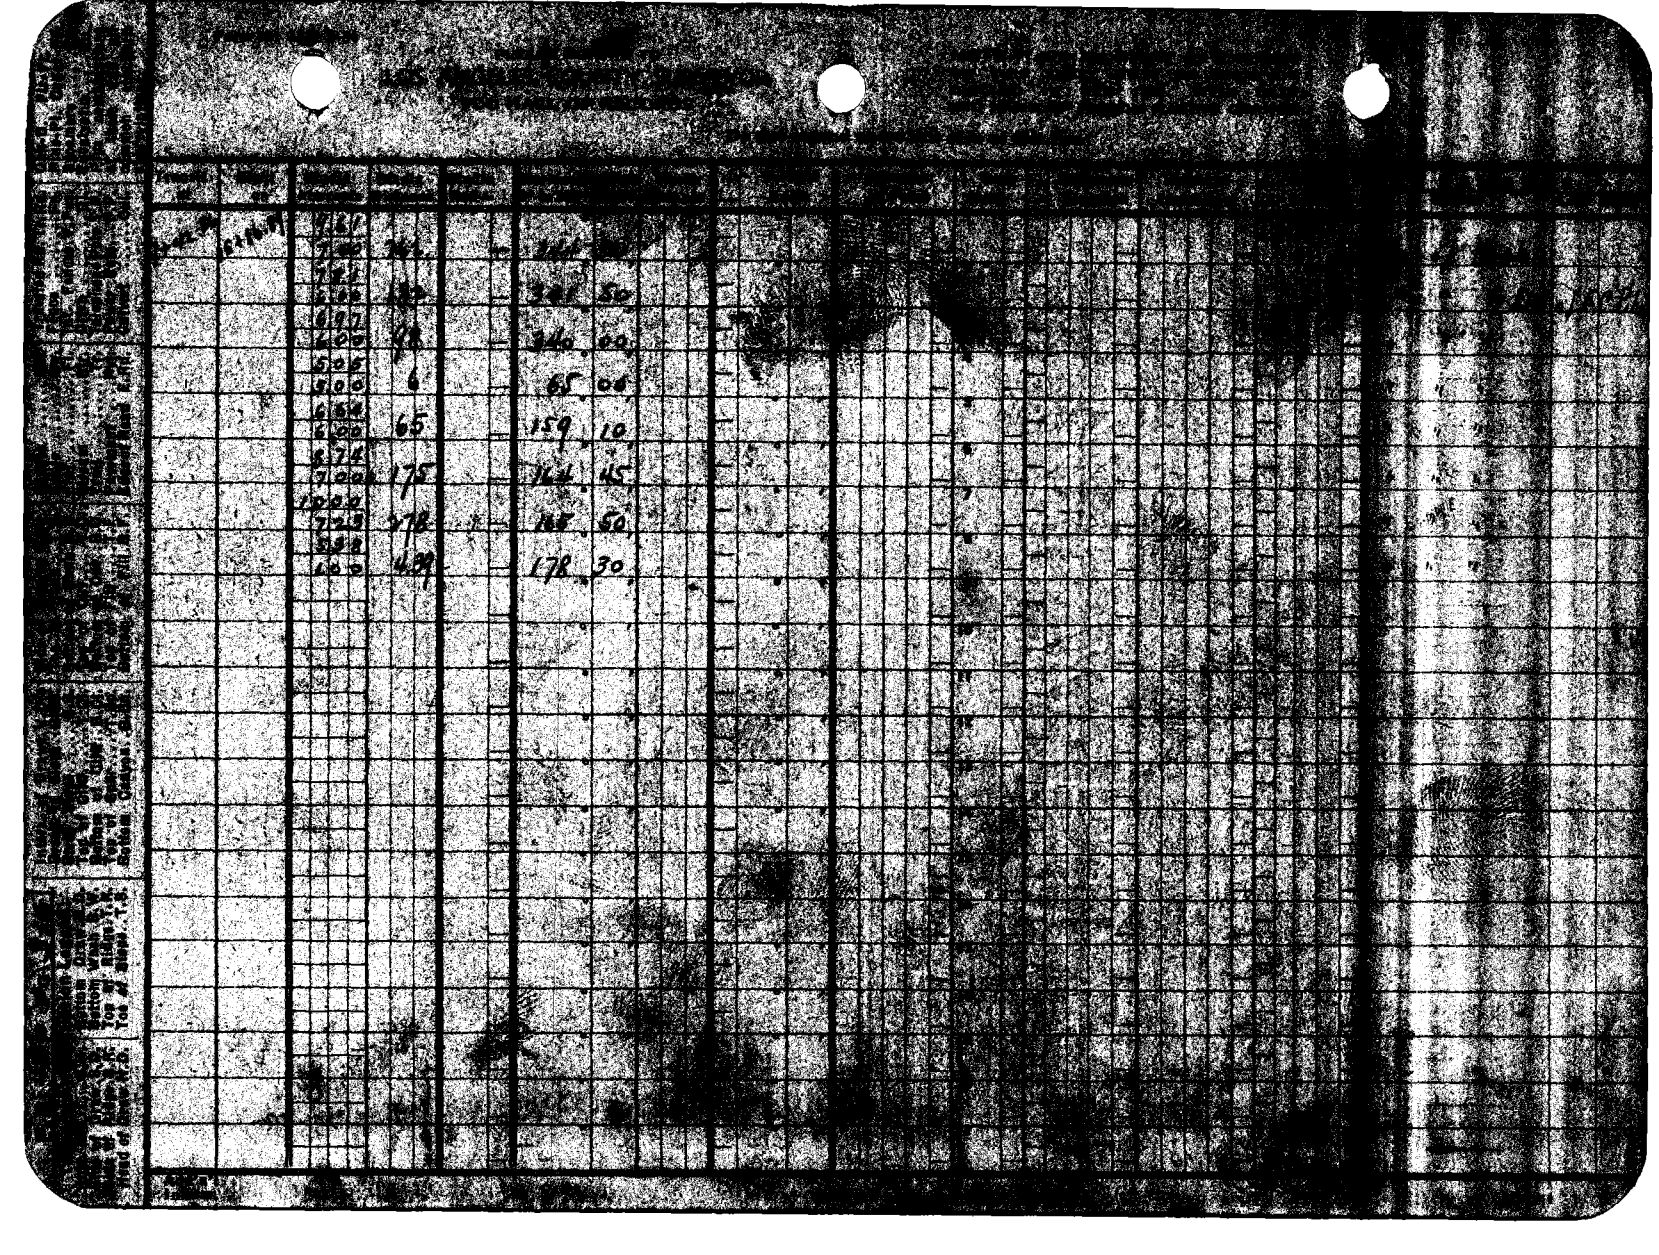

Form 301 10M 3-34

PLEASE RETURN TO
LOS ANGELES COUNTY SURVEYOR
700 HALL OF RECORDS

NOTE: ANY ADDITIONS OR CHANGES ON THIS SHEET MUST BE MADE OR CIRCLED IN RED INK, WITH DATE AND NAME OF PERSON MAKING CHANGE

Do not extend notes this side of this line

Transit at	Sight on	Stadia Intercepts	Stadia Distance	Stadia Rod—	Horizontal Angle 0° to 360° Right	Horiz. Distance	+ Vertical Angle —	Elevation of Point	+ Back Sight	+ Difference Elevation —	Height of Instrument	+ Vertical Distance —	REMARKS Station	Left	Right
5+13.34	0+00				° '		° '		1				& Hemlock Ave - 5+13.34 = 2x2		
					° '		° '		2				per F.B. 436-253. 0+00 = 3/4" I.P.		
					° '		° '		3				-Int. Hemlock Ave & Tract Line		
		5.80											per F.B. 436-249		
		5.00	81		0 00				4				Top of Bank		
		6.93											" " "		
		6.00	94		7 05				5				" " "		
		6.95											" " "		
		6.00	96		11 05				6				" " "		
		3.82											" " "		
		2.50	133		10 15				7				" " "		
		6.57											" " "		
		5.00	158		26 55				8				" " "		
		5.57											" " "		
		4.00	158		39 00				9				" " "		
		5.71											" " "		
		4.00	172		33 10				10				" " "		
		6.34											" " "		
		4.00	235		42 15				11				" " "		
		6.34											" " "		
		4.00	235		49 35				12				" " "		
		6.59											" " "		
		4.00	260		45 00				13				" " "		
		6.03											" " "		
		3.00	304		43 30				14				" " "		
		7.45											" " "		
		4.00	346		46 00				15				" " "		
		7.87											" " "		
		4.00	388		50 35				16				" " "		
		7.97											" " "		
		4.00	398		50 00				17				" " "		
					° '		° '								
7+42.36 Tract Line	16+86.89 Tract Line	11.10							18				16+86.89 - 3/4" I.P. Int. Hemlock		
		6.00	511		347 00				19				Ave & Tract Line per F.B. 436-249		
		11.43											7+42.36 - 2x2 on E. Line Coffin		
		7.00	444		349 30				20				& Armstrong Tr. per F.B. 436-249		
		10.81											Top of Bank		
		7.00	382		354 05				21				" " "		
		10.17													
		7.00	318		349 00										

Add'l Inform.

STADIA LOCATION OF TOP OF RIVER BANK THRU LOTS 10 + 11 - COFFIN & ARMSTRONG TRACT

Notes Rod. _____ Plotted Mar'34 Job No. 8048 Division No. _____ F.B. 436 Pg. 369

Date _____ Date Apr 1934 Survey of Rurban Homes Date 4-18-34

Notes Chkd. _____ Checked _____ Survey by Evans Notes Sedig

Date _____ Map No. B1006-1 Indexed A. C. Johnson Date

Date _____ Notes by _____ Chief Party _____ F.B. _____ Pg. _____

Platted by	W. O. No. _____ D. S. O. No. _____
Date	Location
Map No.	Surveyed by
Platting C'k'd by	Date
Date	Indexed

Note: ANY ADDITIONS OR CHANGES ON THIS SHEET MUST BE MADE IN CIRCLED IN Red. WITH DATE AND NAME OF PERSON MAKING CHANGE.

Do not extend notes this side of this line

RETURN TO
LOS ANGELES COUNTY SURVEYOR

F.B. _____ Pg. _____ Chief Party _____ Notes by _____ Date _____

10 S
4.7

Main — Bolt - Z 34+22.45 — Ave

90-33-20 | 89-58-50

232+57.4 Alley

222+62.9 Robin

Sierra — Madra

220+77.60 - 3/4" I.P.

89-59-40

214+35.82 — 2" I.P. — La Rice

88-27-15 | 90-00-35

Ste. 9th — 2 x 2 - 207+73.39

90-35-10

89-24-45

Bresee — 100 — 2" I.P. - 201+13.40

89-24-45 | 1.07

Merced — 2" I.P. - 194+53.48

194+49.14 - 2 x 2

89-24-25 | 89-56-20

Walnut — 2 x 2 - 187+93.44

89-22-40 | 90-04-05

Center — 1.58 | 2.0 | 1.11 — 1" I.P. 181+23.70

160+00

RETURN TO
LOS ANGELES COUNTY SURVEYOR

Do not extend notes this side of this line

Notes: ANY ADDITIONS OR CHANGES ON THIS SHEET MUST BE MADE OR CIRCLED IN RED, WITH DATE AND NAME OF PERSON MAKING CHANGE.

Date _____ Notes by McNeal Chief Party _____ F.B. 436 Pg. 158

Plotted by	W. O. No. 970 D. S. O. No.
Date	Location Los Angeles St
Map No.	Surveyed by
Plotting C'k'd by	Date Mar - 1930
Date	Indexed

Yellow = existing line
Red = Record line

N. 6.

SCALE - 10' = 1"

OLIVE ST

AVE

Paving

Rock

OHIO ST

2" I.P.

2" I.P.

Crushed

SCALE - 600' = 1"

MADRA

LOS ANGELES ST

3/4" I.P.

SIERRA

CLARK ST

2x2

Notes: ANY ADDITIONS OR CHANGES ON THIS SHEET MUST BE MADE OR CIRCLED IN Red. WITH DATE AND NAME OF PERSON MAKING CHANGE.

Do not extend notes this side of this line

RETURN TO LOS ANGELES COUNTY SURVEYOR

RETURN TO

LOS ANGELES COUNTY SURVEYOR

Note: ANY ADDITIONS OR CHANGES ON THIS SHEET MUST BE MADE OR CIRCLED IN Red. WITH DATE AND NAME OF PERSON MAKING CHANGE.

Do not extend notes this side of this line

F.B.____ Pg.____ Chief Party____ Notes by____ Date____

FORM 203 5M 10-32 L. B. PG. 1

PLATTED BY Morin	W. O. NO. 5048 D. S. O. NO.
DATE April 1934	LOCATION Rurban Homes
MAP NO. B-1006-1	SURVEYED BY Evans
PLATTING C'KD BY	DATE 4/16/34
DATE	INDEXED

B. S.	H. I.	F. S.	ELEV.	STA.	LT.	RT.	REMARKS

NOTE: ANY ADDITIONS OR CHANGES ON THIS SHEET MUST BE MADE OR CIRCLED IN RED, WITH DATE AND NAME OF PERSON MAKING CHANGE.

DO NOT EXTEND NOTES THIS SIDE OF LINE

RETURN TO Los Angeles County Surveyor

Stadia Location
of
Top of River Bank
thru
Lots 10 and 11
of
Coffin & Armstrong Tract.

Copied in FB 436-309
by A. C. Johnson

L. B. _____ PG. 7 EVANS CHIEF PARTY NOTES BY Sedig

DATE 4/18/34

ALL Angles are Turned to the Right

INST. AT	SIGHT ON	STADIA	HOR. ANGLE	VERT. ANGLE	HOR. DIST.	VERT. DIST.	ROD
1			See remarks for description				
5+13.3	0+00						
2							
3							
4		5.80					
5		5.00	16°21'		81		
		6.93					
6		6.95	7°05'		94		
		6.96					
7		3.82	11°35'		96		
		2.50					
8		6.57	10°13'		133		
		5.00					
9		5.57	26°55'		158		
		4.00					
10		5.71	37°00'		158		
		4.00					
11		6.34	33°10		172		
		4.00					
12		6.31	42°15'		235		
		4.00					
13		6.59	47°30'		235		
		4.00					
14		6.03	45°00'		260		
		3.00					
15		7.45	43°30		304		
		4.00					
16		7.87	46°00'		346		
		4.00					
17		7.97	50°35'		388		
		4.00					
18			50°00		398		
7+42.36 Tract Line	16+86.59 Tract Line		See remarks for description				
20		11.10					
		6.00	347°00		511		
21		11.43					
		7.00	349°30'		444		
22		10.81					
		7.00	354°05'		382		
23		10.17					
		7.00	349°12		318		

RETURN TO
Los Angeles County Surveyor

DO NOT EXTEND NOTES THIS SIDE OF LINE

NOTE: ANY ADDITIONS OR CHANGES ON THIS SHEET MUST BE MADE OR CIRCLED IN RED. WITH DATE AND NAME OF PERSON MAKING CHANGE.

FORM 203 5M 10-32 L. B. _____ PG. 3

PLATTED BY Morin
DATE Apr. 1934
MAP NO. B-1006-1
PLATTING C'KD BY _____
DATE _____

W. O. NO. 8048 S. O. NO. _____
LOCATION Rurban Homes
SURVEYED BY Evans
DATE 4/18/34
INDEXED _____

B. S.	H. I.	F. S.	ELEV.	STA.	LT.	RT.	REMARKS
							E Hemlock Ave - 5+13.34 = 2 x 2 per F.B. 436/253
							0+00 = 3/4" I.P. in Hemlock Ave & Tract Line per F.B. 436/249
							Top of Bank & Hemlock
							Top of Bank
							" " "
							" " "
							" " "
							" " "
							" " "
							" " "
							" " "
							" " "
							" " "
							" " "
							" " "
							16+86.89 - 3/4" I.P. Intersn Hemlock Ave & Tract Line Per F.B. 436/249
							7+42.36 - 2 x 2 on E Line Cost Intersn + ARMSTRONG Tract Per F.B. 436/249
							Top of Bank
							" " "
							" " "

Copied in F.B. 436-309

NOTE: ANY ADDITIONS OR CHANGES ON THIS SHEET MUST BE MADE OR CIRCLED IN RED WITH DATE AND NAME OF PERSON MAKING CHANGE.

DO NOT EXTEND NOTES THIS SIDE OF LINE

RETURN TO Los Angeles County Surveyor

L. B. 4PG EVANS CHIEF PARTY NOTES BY Sedig

DATE 4-15-34

P.I. Engles are turned to the Right

INST. AT	SIGHT ON	STADIA	HOR. ANGLE	VERT. ANGLE	HOR. DIST.	VERT. DIST.	ROD
744236	6486.59	7.61					
2		7.00	341°30'		262		
		7.51					
3		6.00	341°50		182		
		6.97					
4		6.60	340°00		98		
		5.05					
5		5.00	65°00		6		
		6.64					
6		6.00	159°10'		65		
		5.74					
7		7.00	164°45'		175		
		10.00					
8		7.23	165°50'		278		
		5.38					
9		1.00	178°30'		439		
10							
11							
RETURN TO
Los Angeles County Surveyor

NOTE: ANY ADDITIONS OR CHANGES ON THIS SHEET MUST BE MADE OR CIRCLED IN RED. WITH DATE AND NAME OF PERSON MAKING CHANGE.

DO NOT EXTEND NOTES THIS SIDE OF LINE

FORM 203 5M 10-32 L. B. _____ PG. 5

PLATTED BY Morin	W. O. NO. 8048 D. S. O. NO.
DATE Apr. 1934	LOCATION Rurban Homes
MAP NO. B-1006-1	SURVEYED BY Evans
PLATTING C'KD BY	DATE 4/18/34
DATE	INDEXED

B. S.	H. I.	F. S.	ELEV.	STA.	LT.	RT.	REMARKS
				Top of Bank			
				& END of T.C. Piling			

Copied in FB #36-310

NOTE: ANY ADDITIONS OR CHANGES ON THIS SHEET MUST BE MADE OR CANCELLED IN RED, WITH DATE, AND NAME OF PERSON MAKING CHANGE.

DO NOT EXTEND NOTES THIS SIDE OF LINE

RETURN TO Los Angeles County Surveyor

L. B. _____ PG _____ CHIEF PARTY _____ NOTES BY _____

DATE _____

INST. AT	SIGHT ON	STADIA	HOR. ANGLE	VERT. ANGLE	HOR. DIST.	VERT. DIST.	ELEV.
1							
2							
Los Angeles County Surveyor

RETURN TO: ANY ADDITIONS OR CHANGES CAN BE MADE ONLY BY THE SURVEYOR. CORRECT MUST BE MADE BY RULING OUT INCORRECT ENTRY AND REWRITING WITH DATE OF CHANGE. NAME OF PERSON MAKING CHANGE.

DO NOT WRITE NOTES THIS SIDE OF LINE