A 247 10M 5-31

RETURN TO
LOS ANGELES COUNTY SURVEYOR
700 HALL OF RECORDS

Note: ANY ADDITIONS OR CHANGES ON THIS SHEET MUST BE MADE OR CIRCLED IN **Red Ink.** WITH DATE AND NAME OF PERSON MAKING CHANGE.

Do not extend notes this side of this line

444

Notes Ck'd by
Map No.
Office Work
Checked
Date

Survey of
W. O. Tape No. St'd of.
Surveyed by
Notes
Indexed Date

F.B. PG.

F.B. 444 PG Index

F.B. 444

PAGES: Index,1 to 35 incl.,35A,35B,35C,
36 to 122 incl.,122 to 145 incl., ,
147, ,149, ,151,152,153,

RETURN TO
LOS ANGELES COUNTY SURVEYOR
700 HALL OF RECORDS
Do not extend notes this side of this line
Note: ANY ADDITIONS OR CHANGES ON THIS SHEET MUST BE MADE OR CIRCLED IN Red Ink- WITH DATE AND NAME OF PERSON MAKING CHANGE.

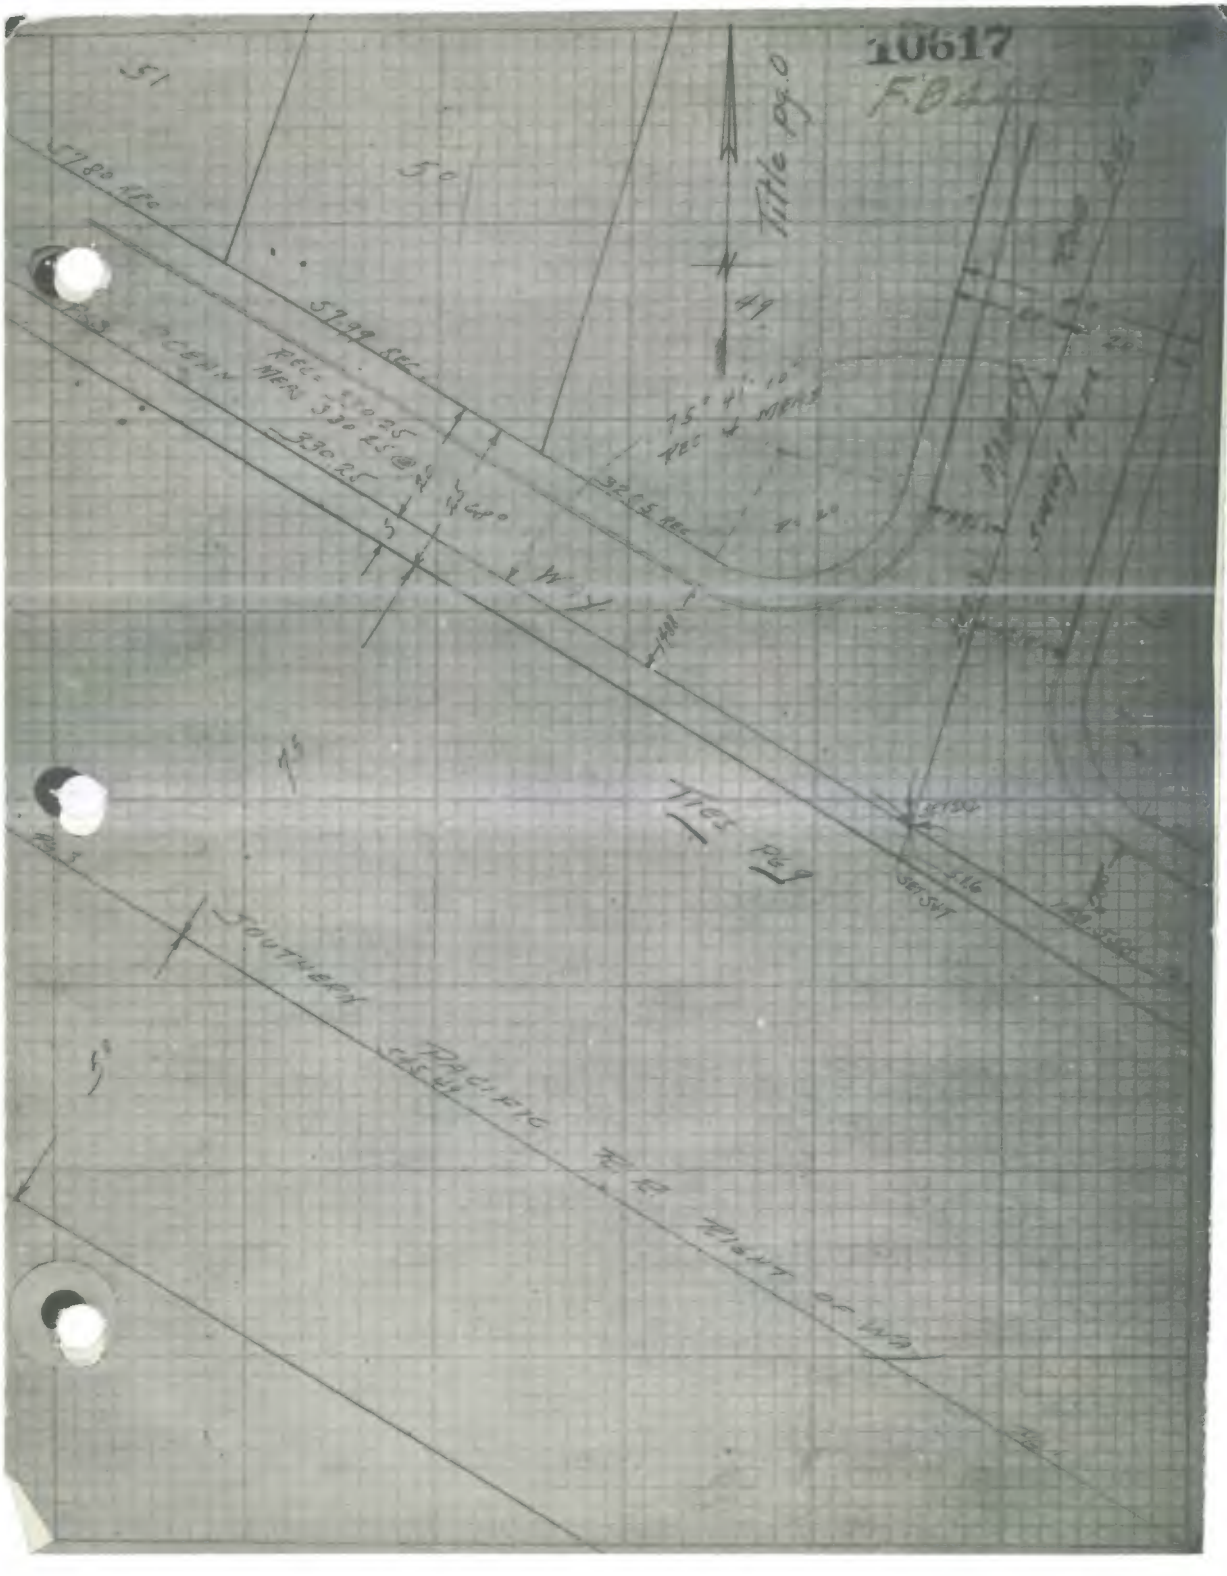
10617
Title pg. 0
51
50
49
57.80 REC
57.99 REC
OCEAN
330.25
32.05 REC
75° 41' 10"
REC 4 MEAS
WAY
TIES PG 9
SET SHT
SOUTHERN PACIFIC R.R. RIGHT OF WAY

10617 3

FB AAA-1

L.A City F.B. 20617

F.B. 444-1

INDEXED 2/1 1928

SOUTHERN PACIFIC R.R. RIGHT OF WAY ALONG MALIBU TRAIL
WESTERLY BOUNDARY SANTA MONICA CITY LIMITS AT OCEAN WAY
to
100 53' WEST OF TERRACE DRIVE

A.W.
GE 46401 ℄ SURVEY NOV 1926

BEHNING
KEITH ANDRE
LEWIS SUTCLIFFE
KRELL FERGUSON

REF TRACT MAP 1719

& TRC pg. 5, 9, 10, 11, 39
PLAT PG 1-6

(NOTE: R.R. R/W DATA AS PER TRACT MAP 1719)
LOT FRONTAGES NOT MEAS.

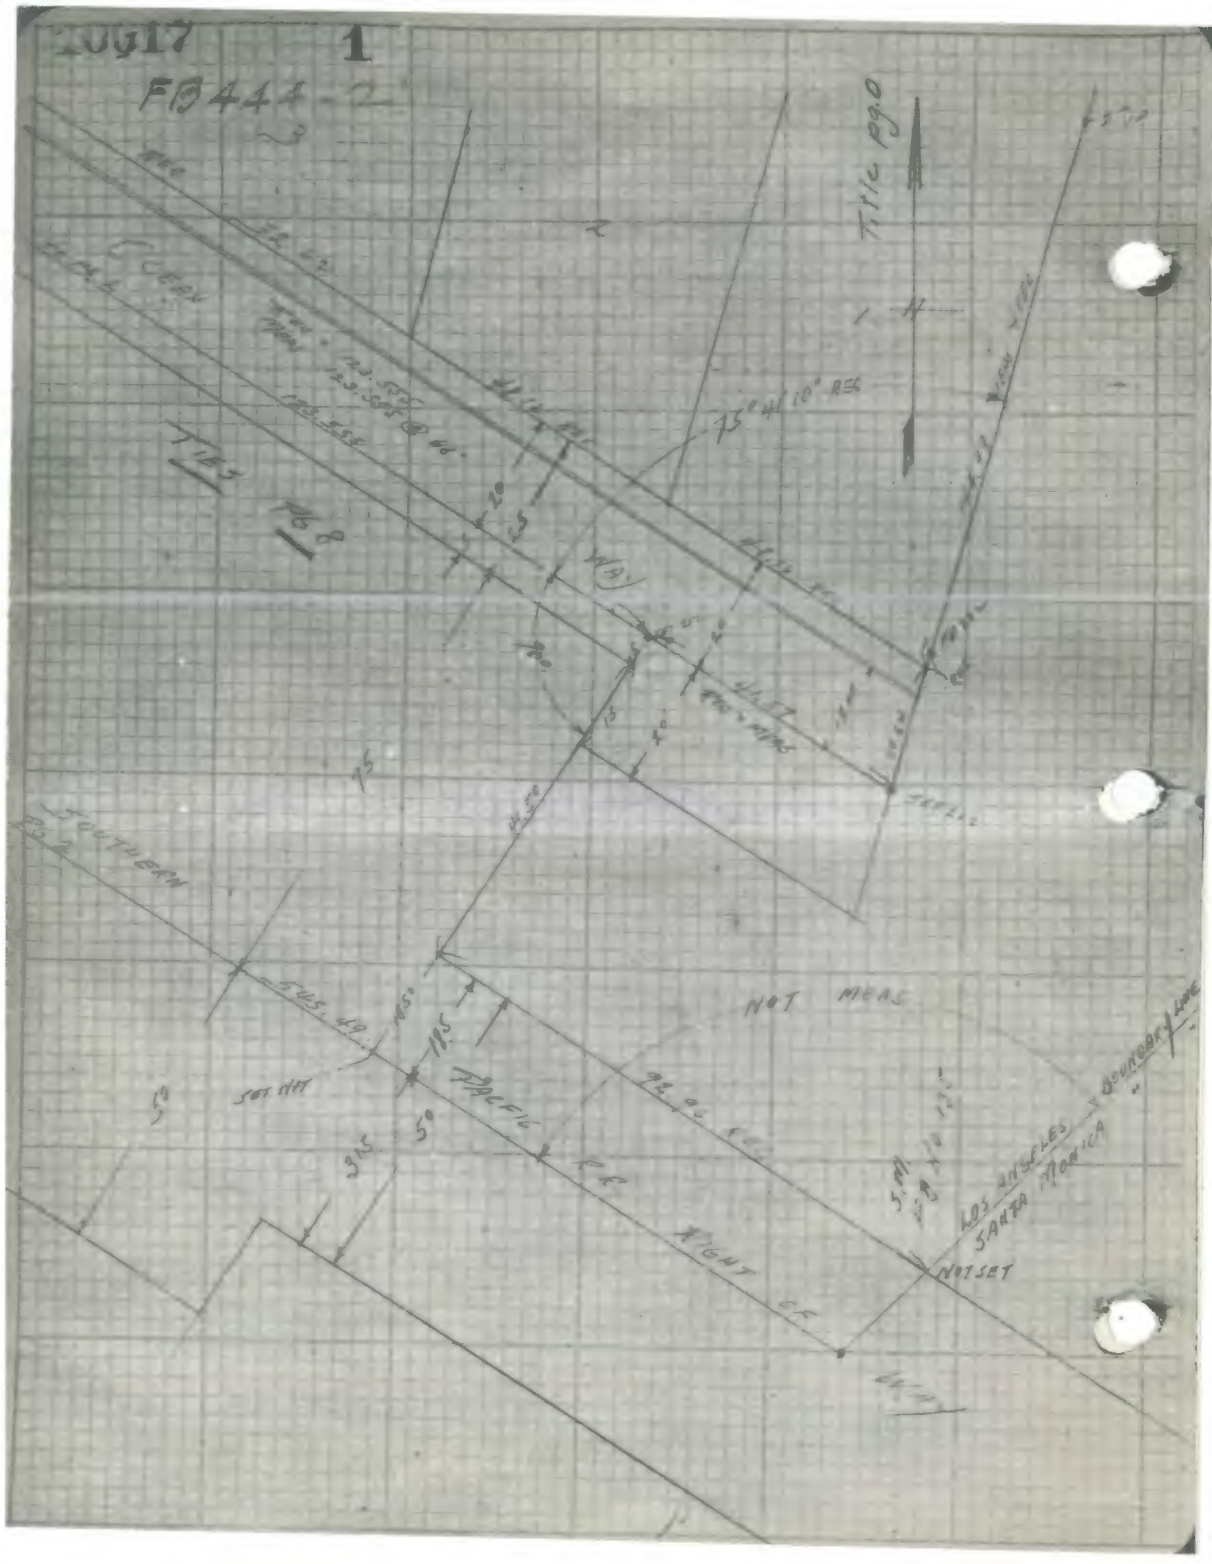

10617
1
FB444-2
Title pg.0
75° 41' 10" REC
TIES
PG 8
SOUTHERN
NOT MEAS
SET NAT
PACIFIC
RR
RIGHT OF
WAY
LOS ANGELES
SANTA MONICA
BOUNDARY LINE
NOT SET

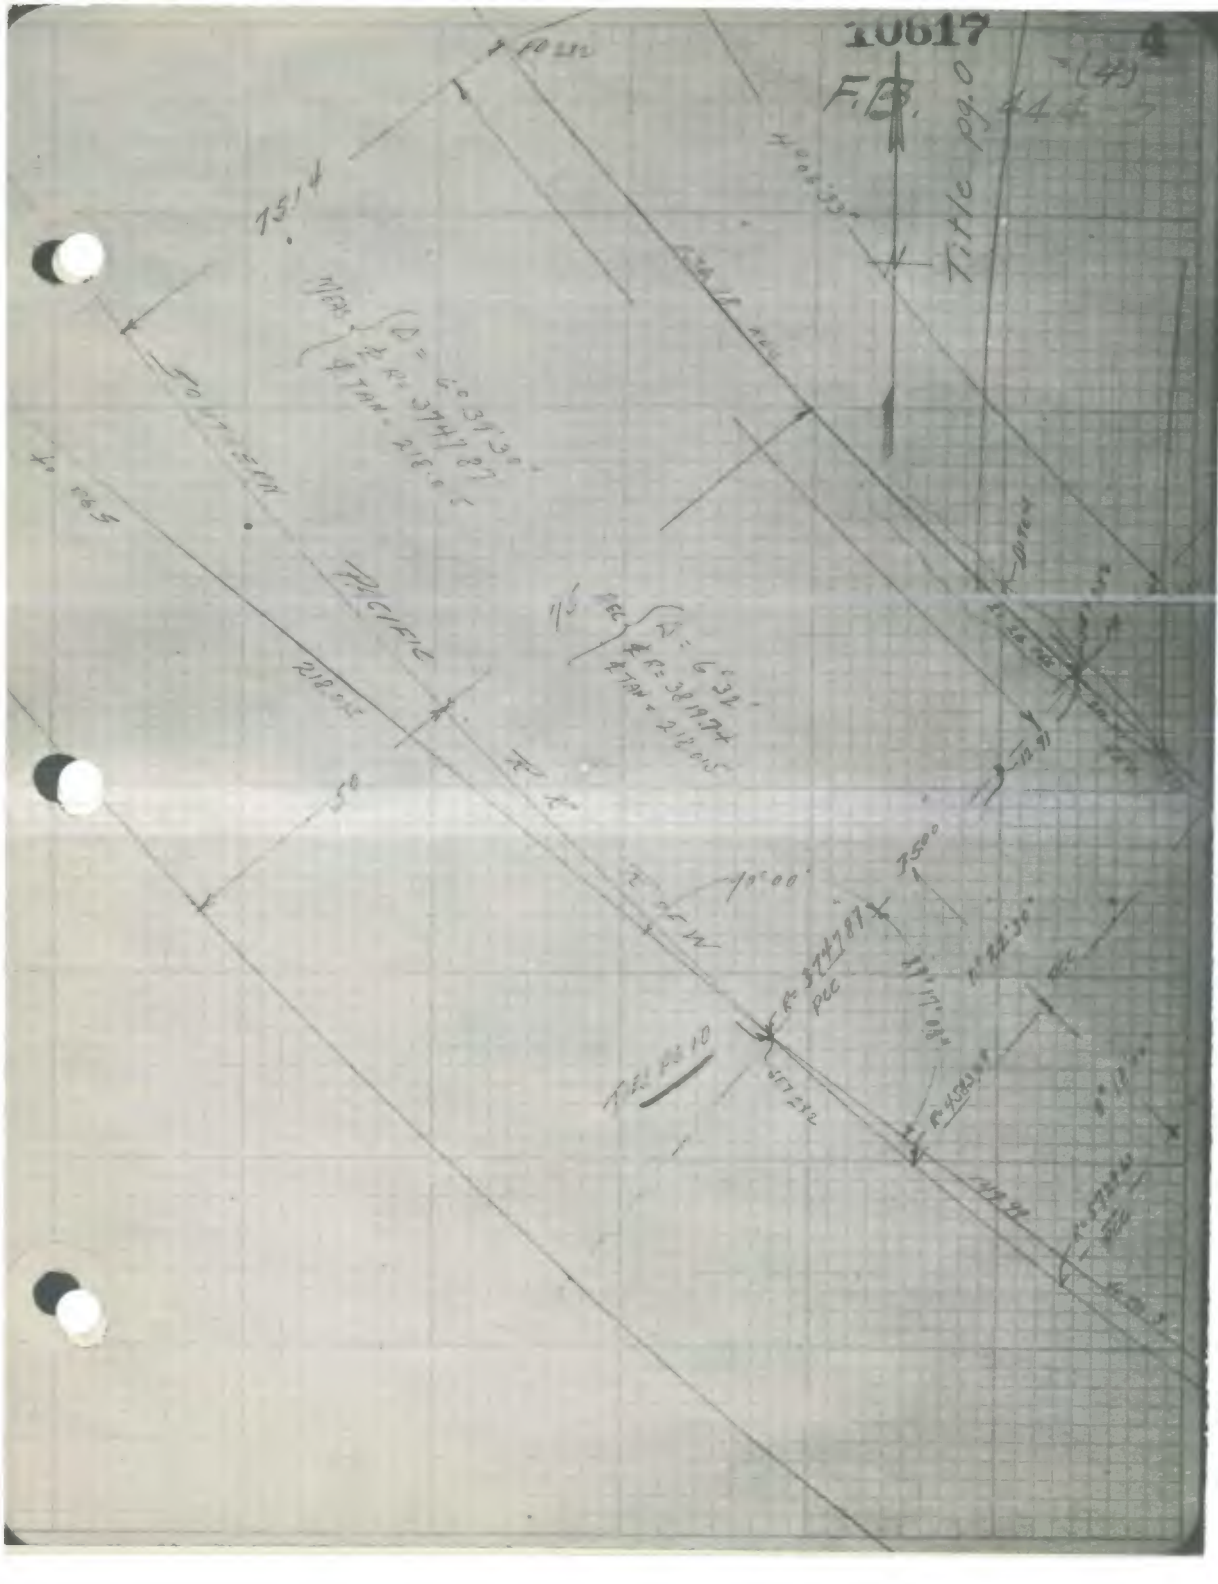
10617
4
F.B.
Title pg. 0
PACIFIC
218.015
10°00'
35.00
TIE PG 10

10617

5

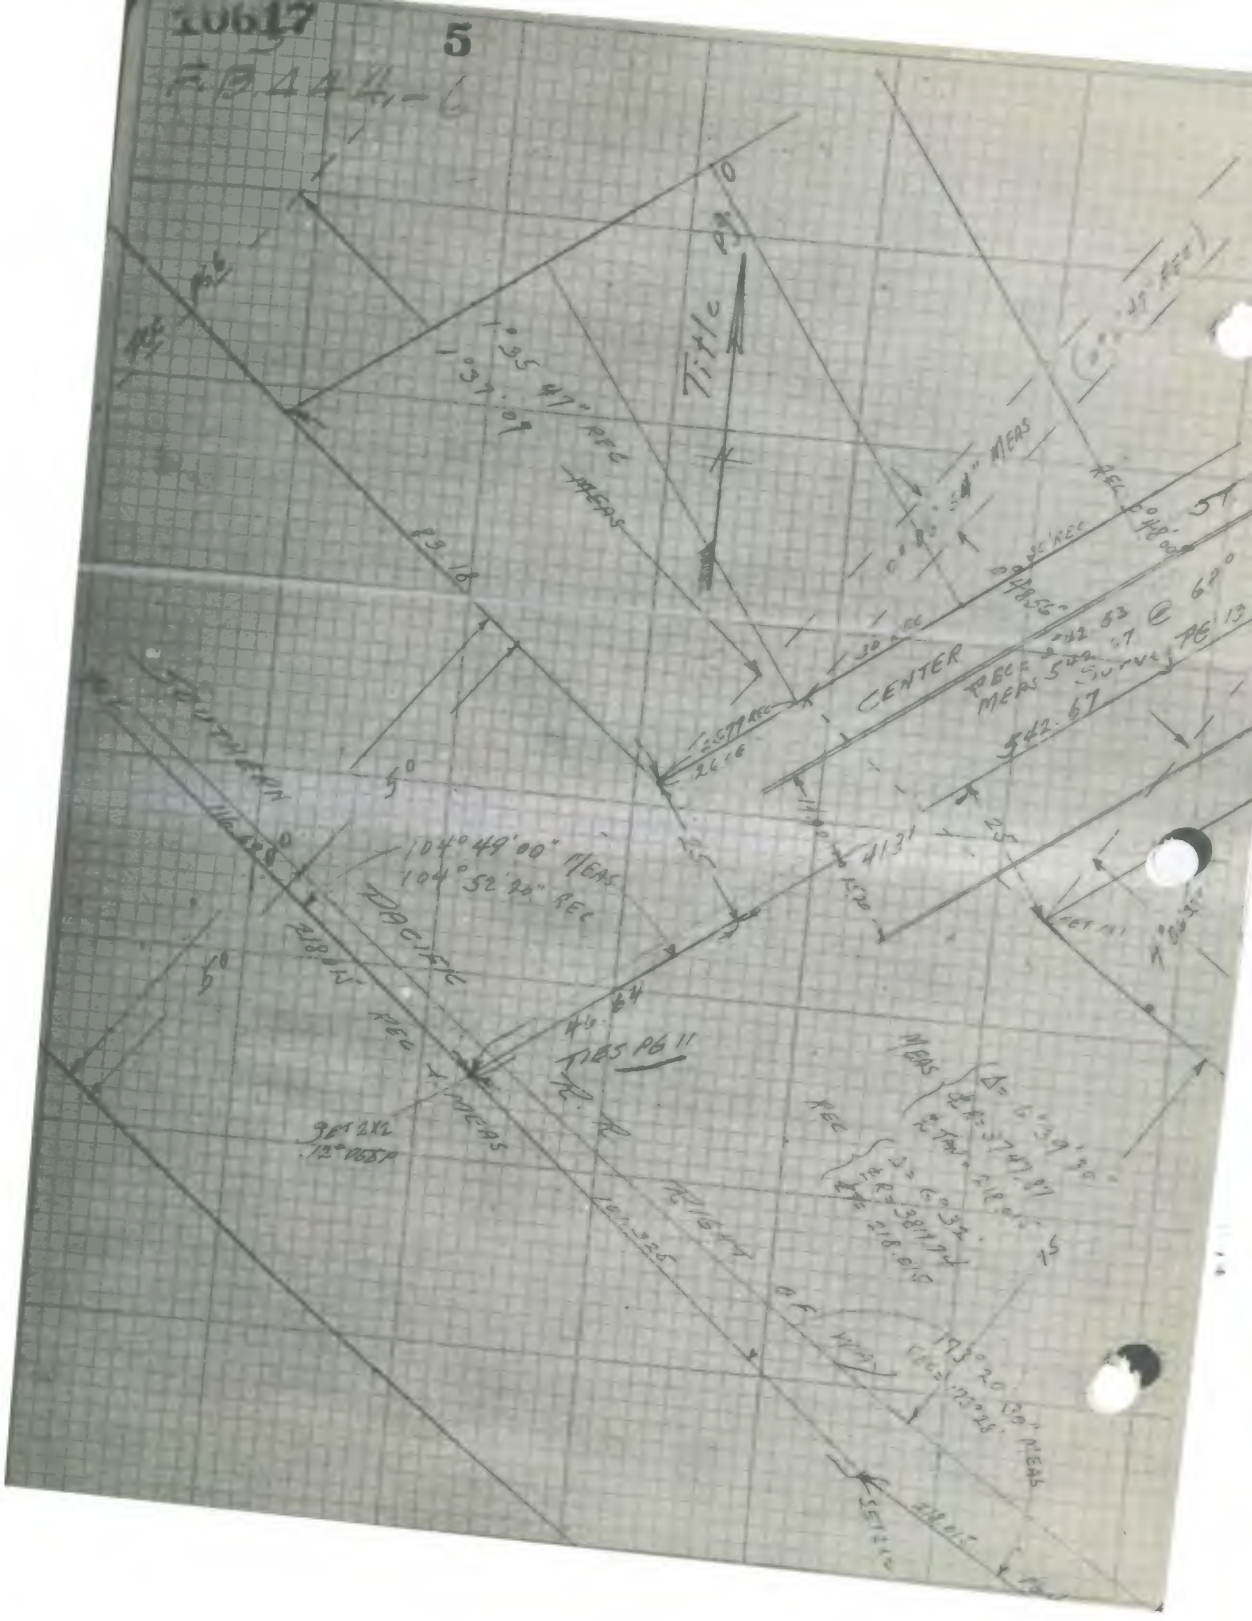

10617
INDEXED 2/1 1928
F.B 447
TERRACE DRIVE
SOUTHERN
B.C.
PACIFIC
R=761.945
R=572.61
R=4583.69
R=3749.87
89°17'00"
TIES PG 11
RIGHT OF WAY

10617
7 FB444-8 7

INDEXED 2/1 1928

SOUTHER PACIFIC RR RIGHT OF WAY ALONG MALIBU ROAD
WESTERLY BOUNDARY SANTA MONICA CITY LIMITS AT OCEAN W
to
CHANNEL ROAD
& ANGELES TIES & DISTANCES

A.4.
GE 46901

Nov 1927

BEHNING
ANDRE
SUTCLIFFE
FERGUSON

SURVEY PG 1

PLAT PG 8-9-10-11-39

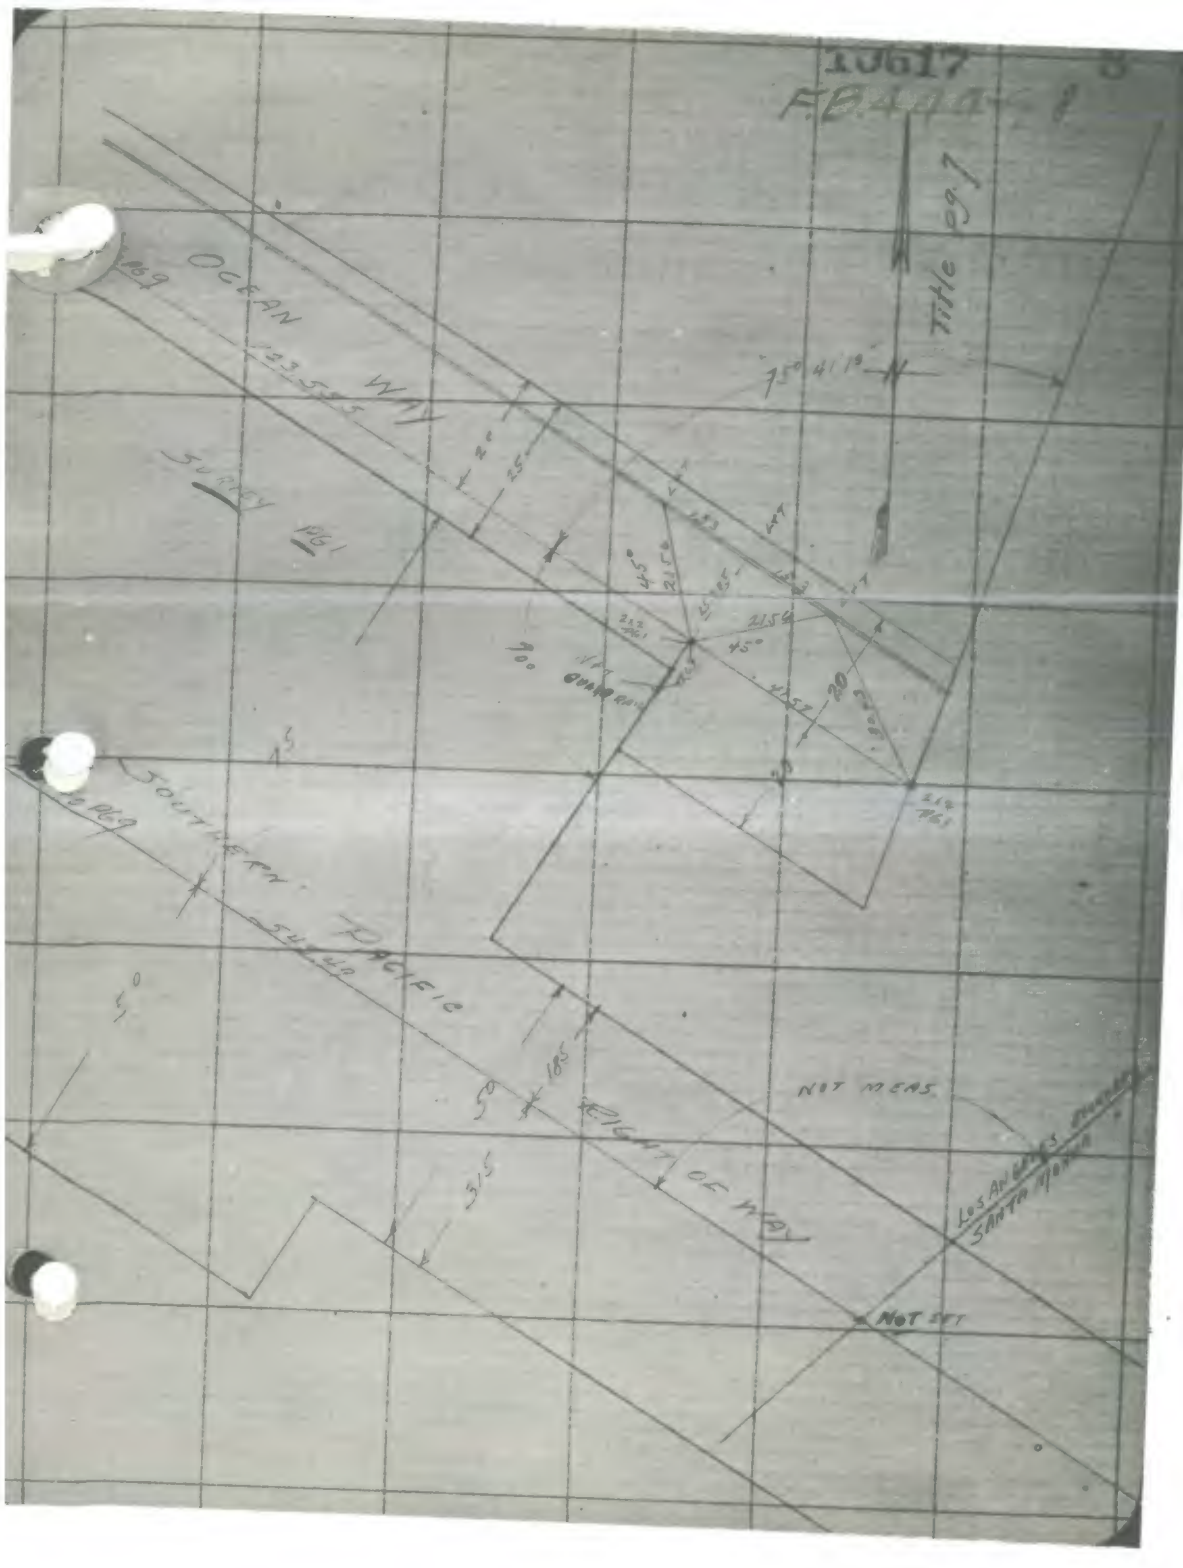
10617
F.B.444-1
Title pg. 7
OCEAN WAY
SURVEY PG1
SOUTHERN PACIFIC
RIGHT OF WAY
NOT MEAS.
NOT SET
75° 41' 19"
45°
90°
185
315
20
25

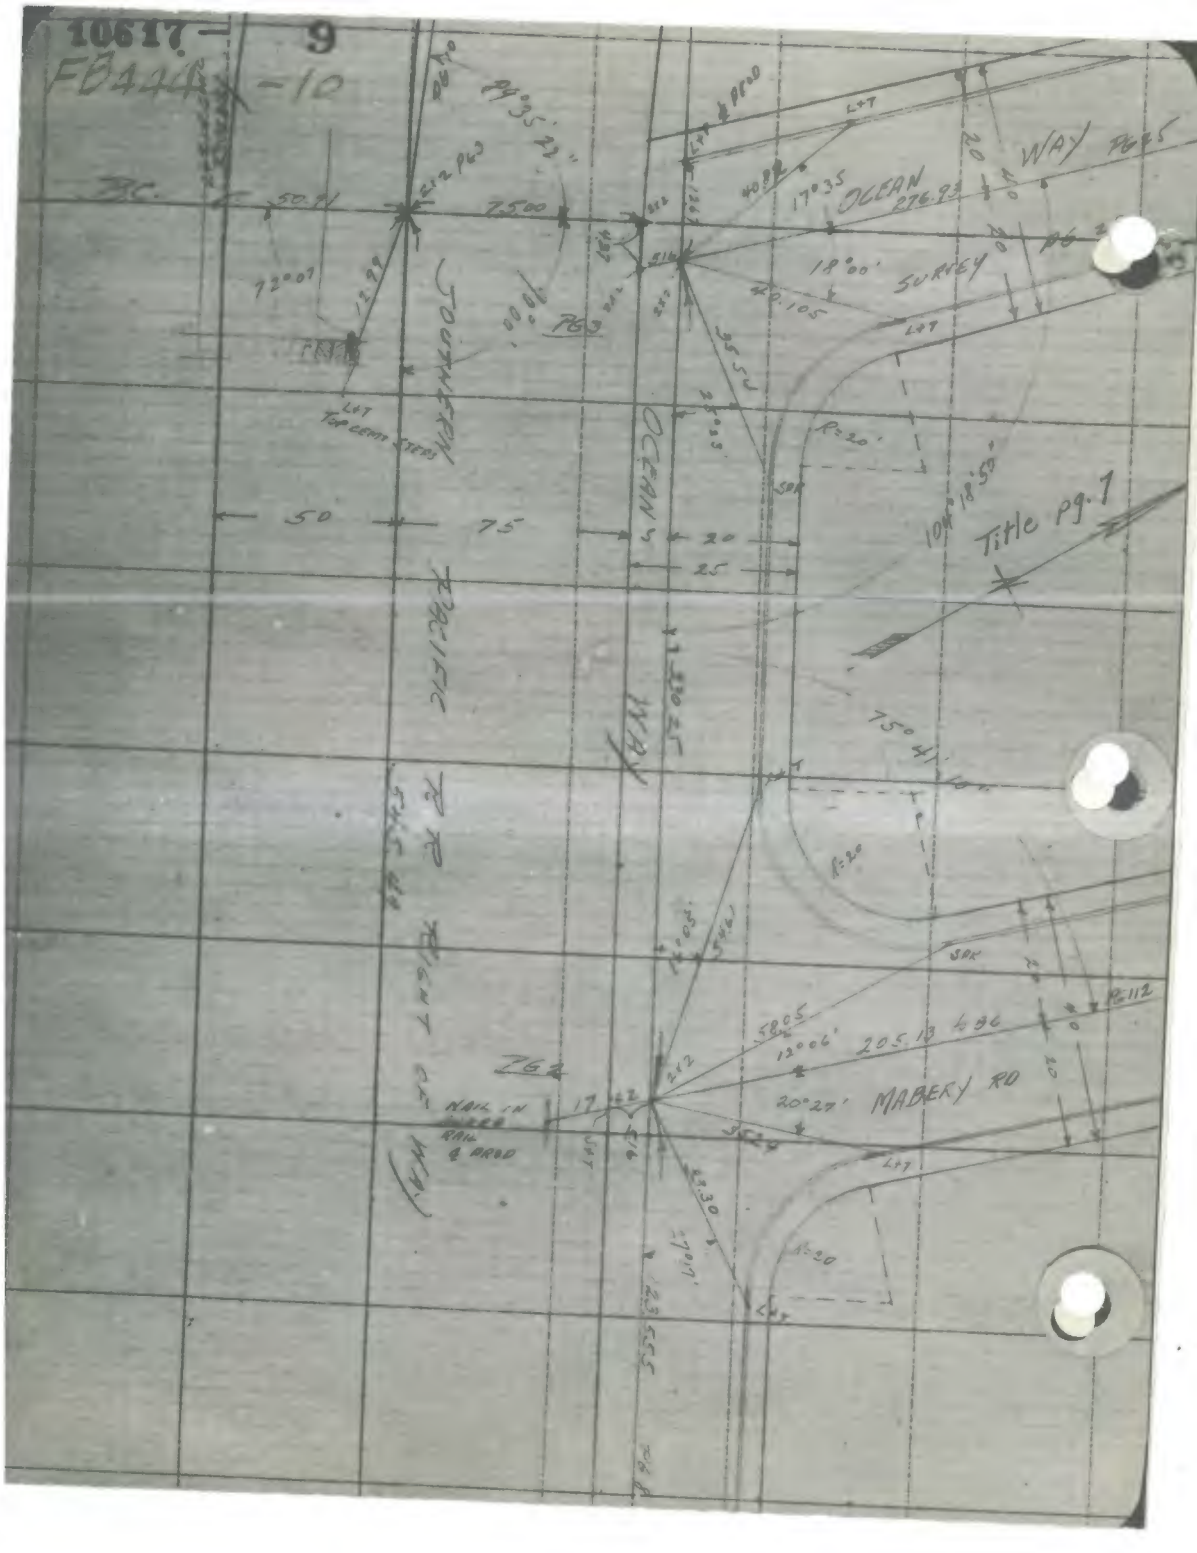
10617 — 9
FB444 -10
OCEAN WAY
SURVEY
JOUTHERN PACIFIC RR RIGHT OF WAY
OCEAN WAY
MABERY RD
Title pg. 7
PG 2
PG 3
PG 25
PG 112
L+T
TOP CENT STEPS
NAIL IN SHORE RAIL & PROD
50
75
20
25
R=20'
R=20
R=20
17°35
18°00'
20°27'
12°06'
205.13
104°18'50"
75°41'10"
72°07
50.91
7.500
40.105
35.54
23.30
23.555
27°17'
16°05'
54.61
54.5

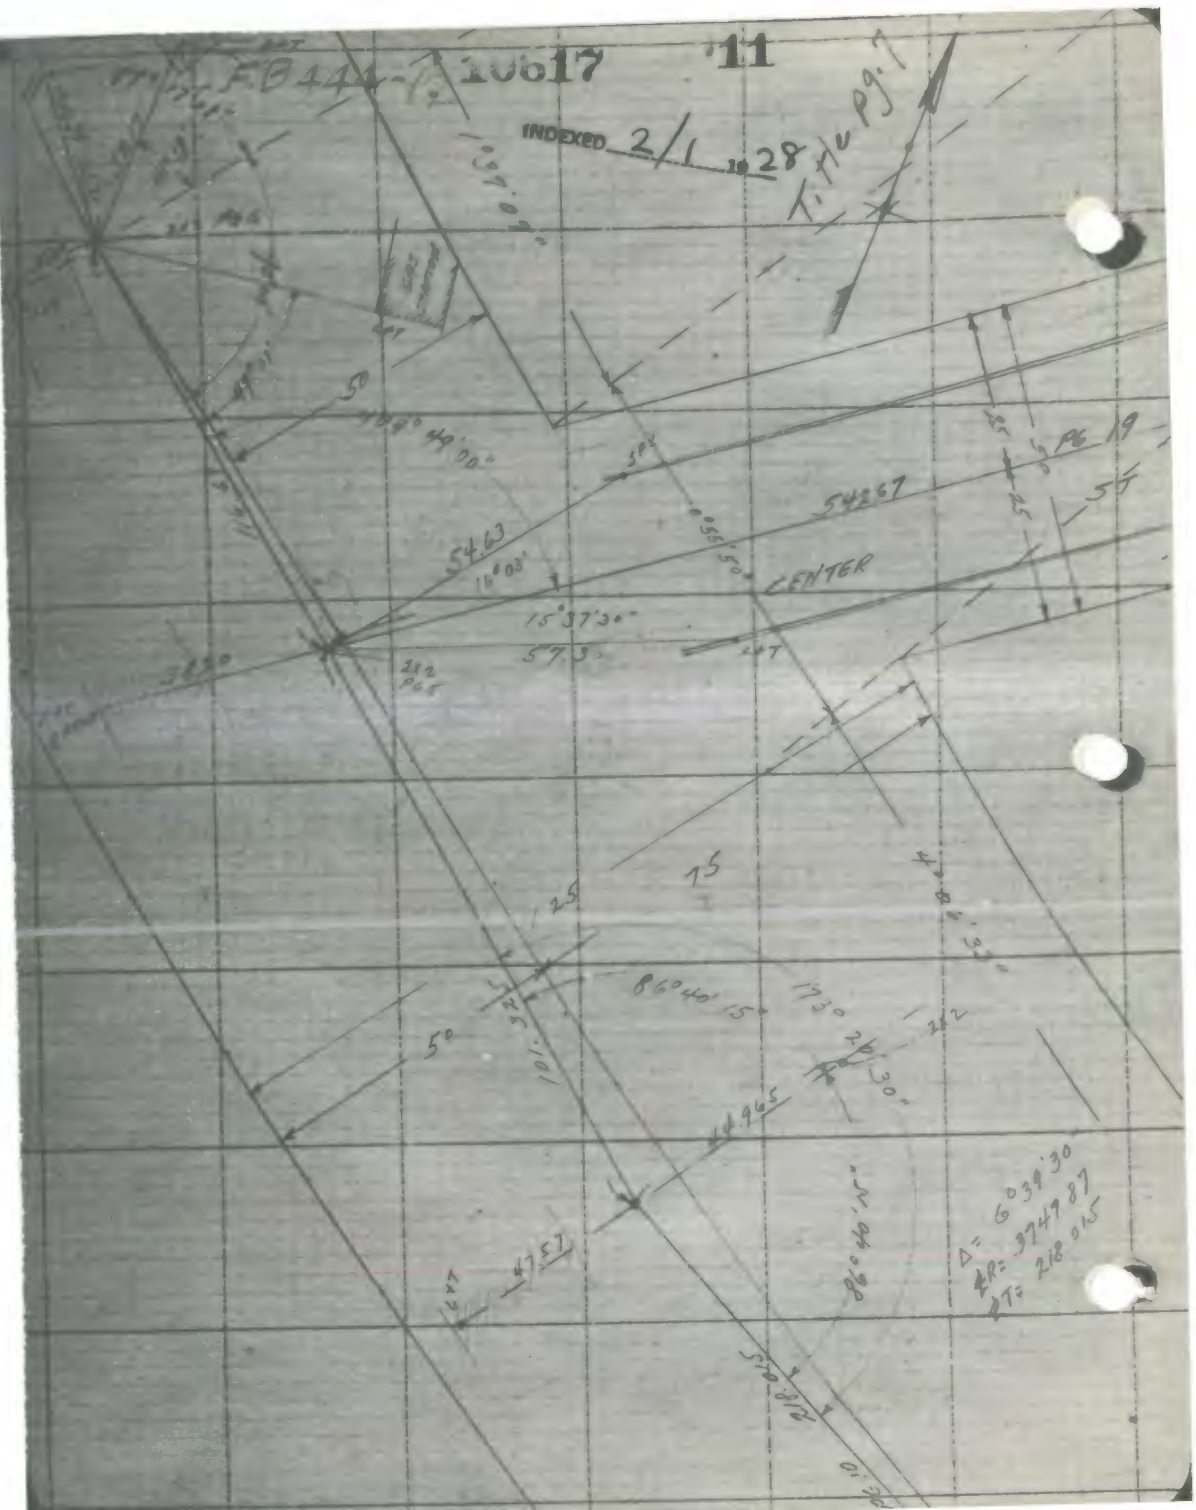

F.B 444-1
10617
'11
INDEXED 2/1 1928
Title pg. 7
1°37'09"
50
109° 49' 00"
54.63
16°03'
54267
CENTER
15°37'30"
57.3
PG 19
75
25
86°40' 15"
173° 20' 30"
5°
44.965
47.57
86°40'15"
Δ = 6°39'30
ΔR = 3749.87
ΔT = 218.015

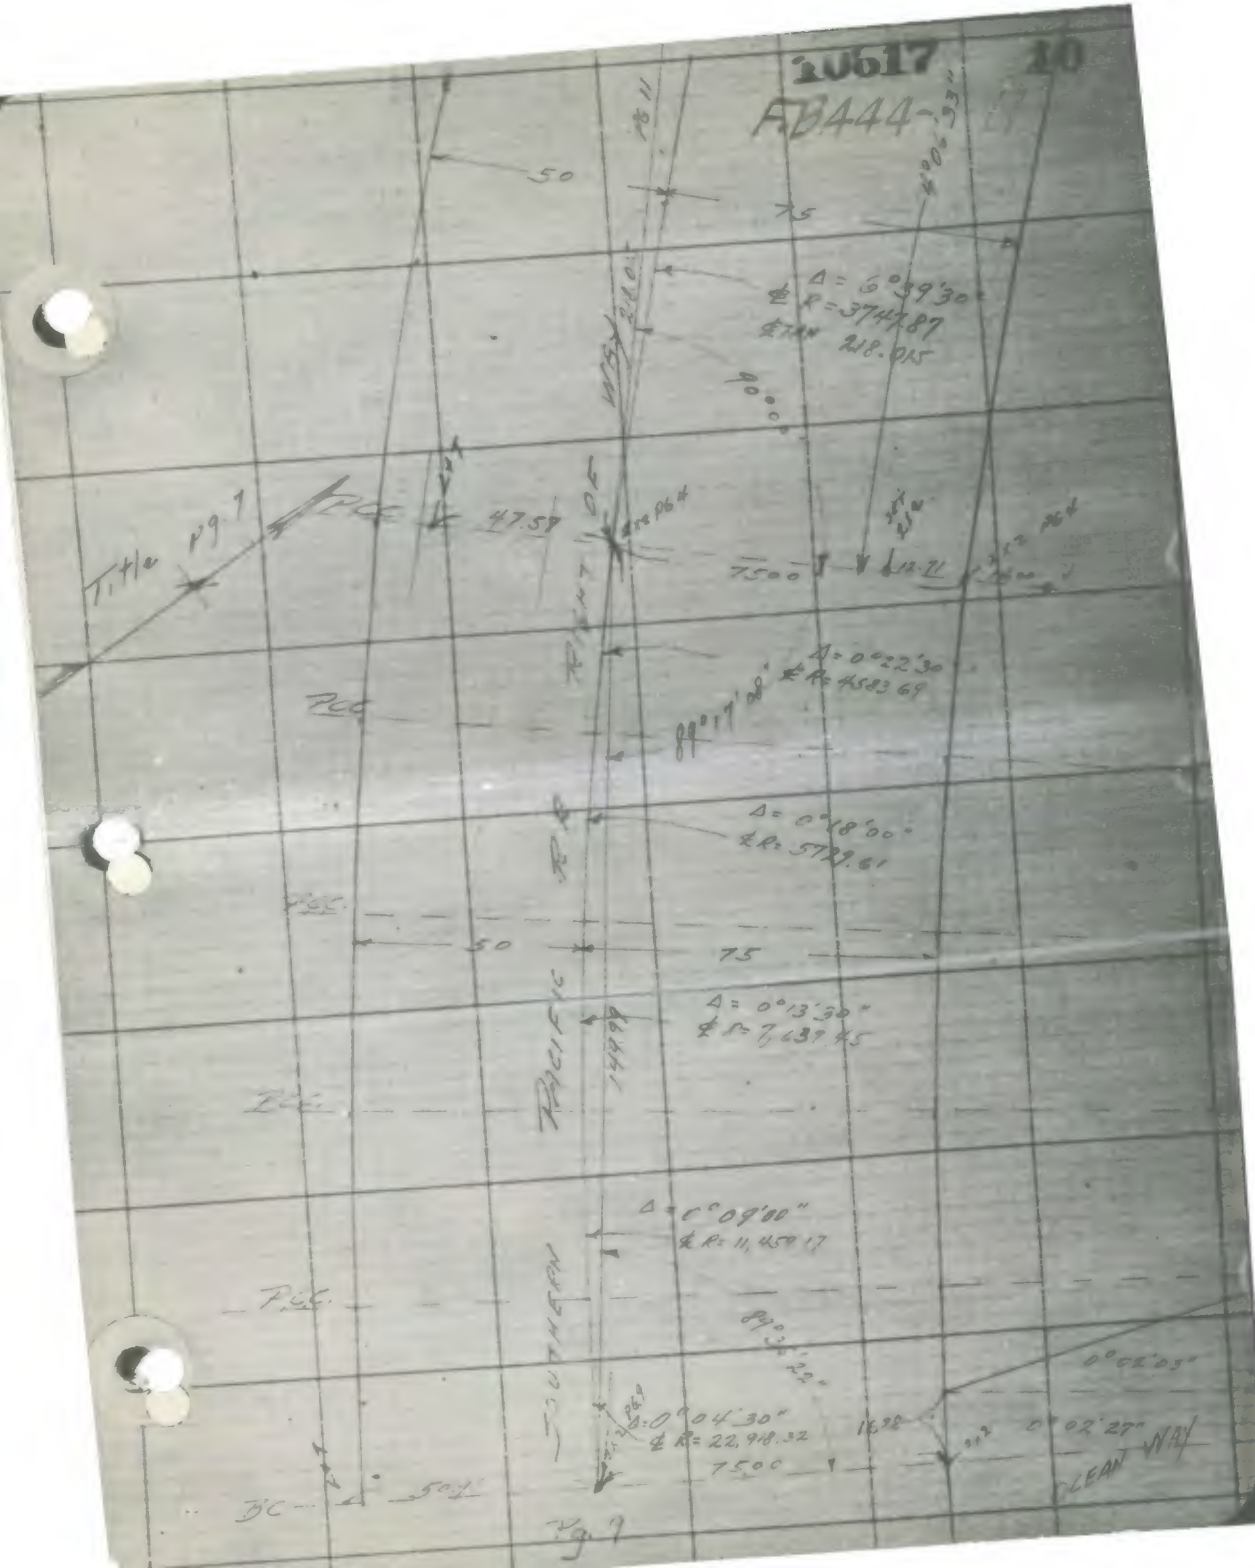
10617
10
FB444-
50
75
Δ = 6°39'30"
℄ R = 3747.87
℄ TAN 218.015
90°00'
Title pg 7
PCC
47.59
7500
12.71
Δ = 0°22'30"
℄ R = 4583.69
89°17'08"
Δ = 0°18'00"
℄ R = 5729.61
50
75
Δ = 0°13'30"
℄ R = 7,639.45
Δ = 0°09'00"
℄ R = 11,459.17
Δ = 0°04'30"
℄ R = 22,918.32
7500
0°02'03"
0°02'27"
CLEAN WAY
BC
Pg. 7

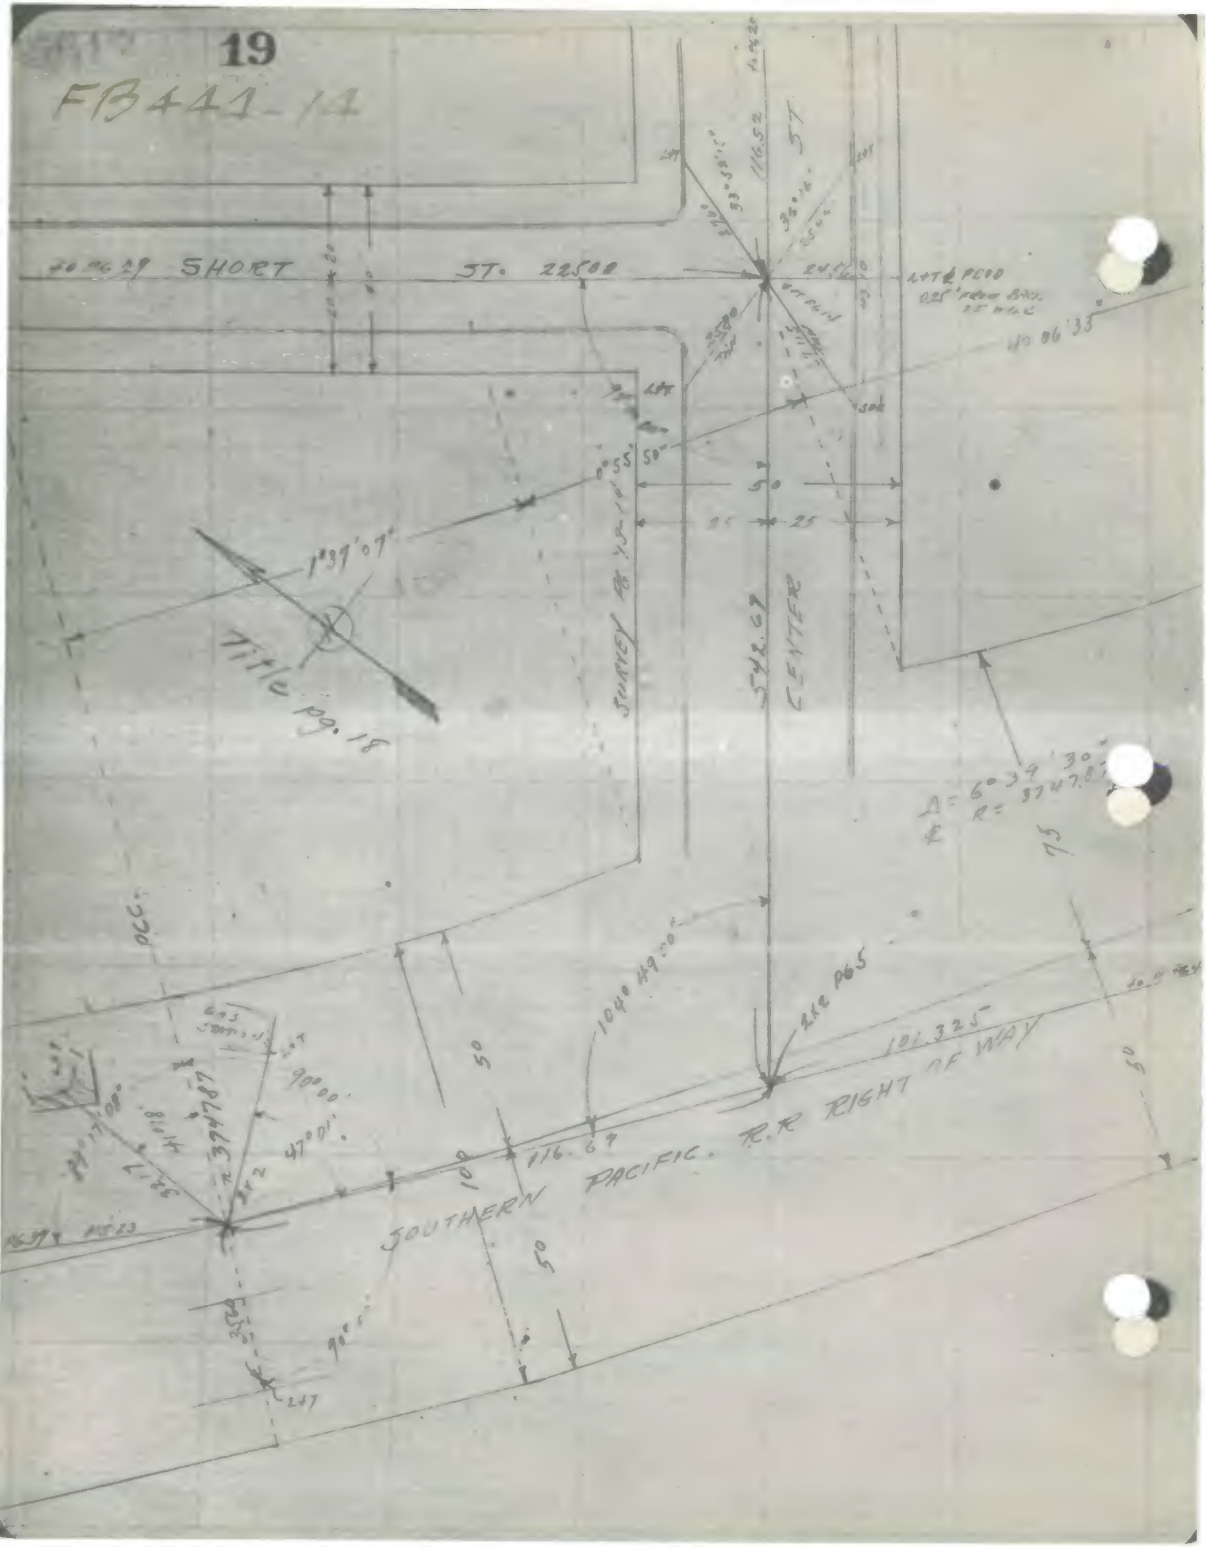
19
FB441-14
SHORT ST. 22500
ST
CENTER
542.69
SURVEY
Title pg. 18
1°37'07"
0°55'50"
50
25
25
40°06'33"
1040 49'00"
2x2 PGS
101.325
116.69
SOUTHERN PACIFIC. R.R RIGHT OF WAY
90°00'
47°01'
374787
100
50
75

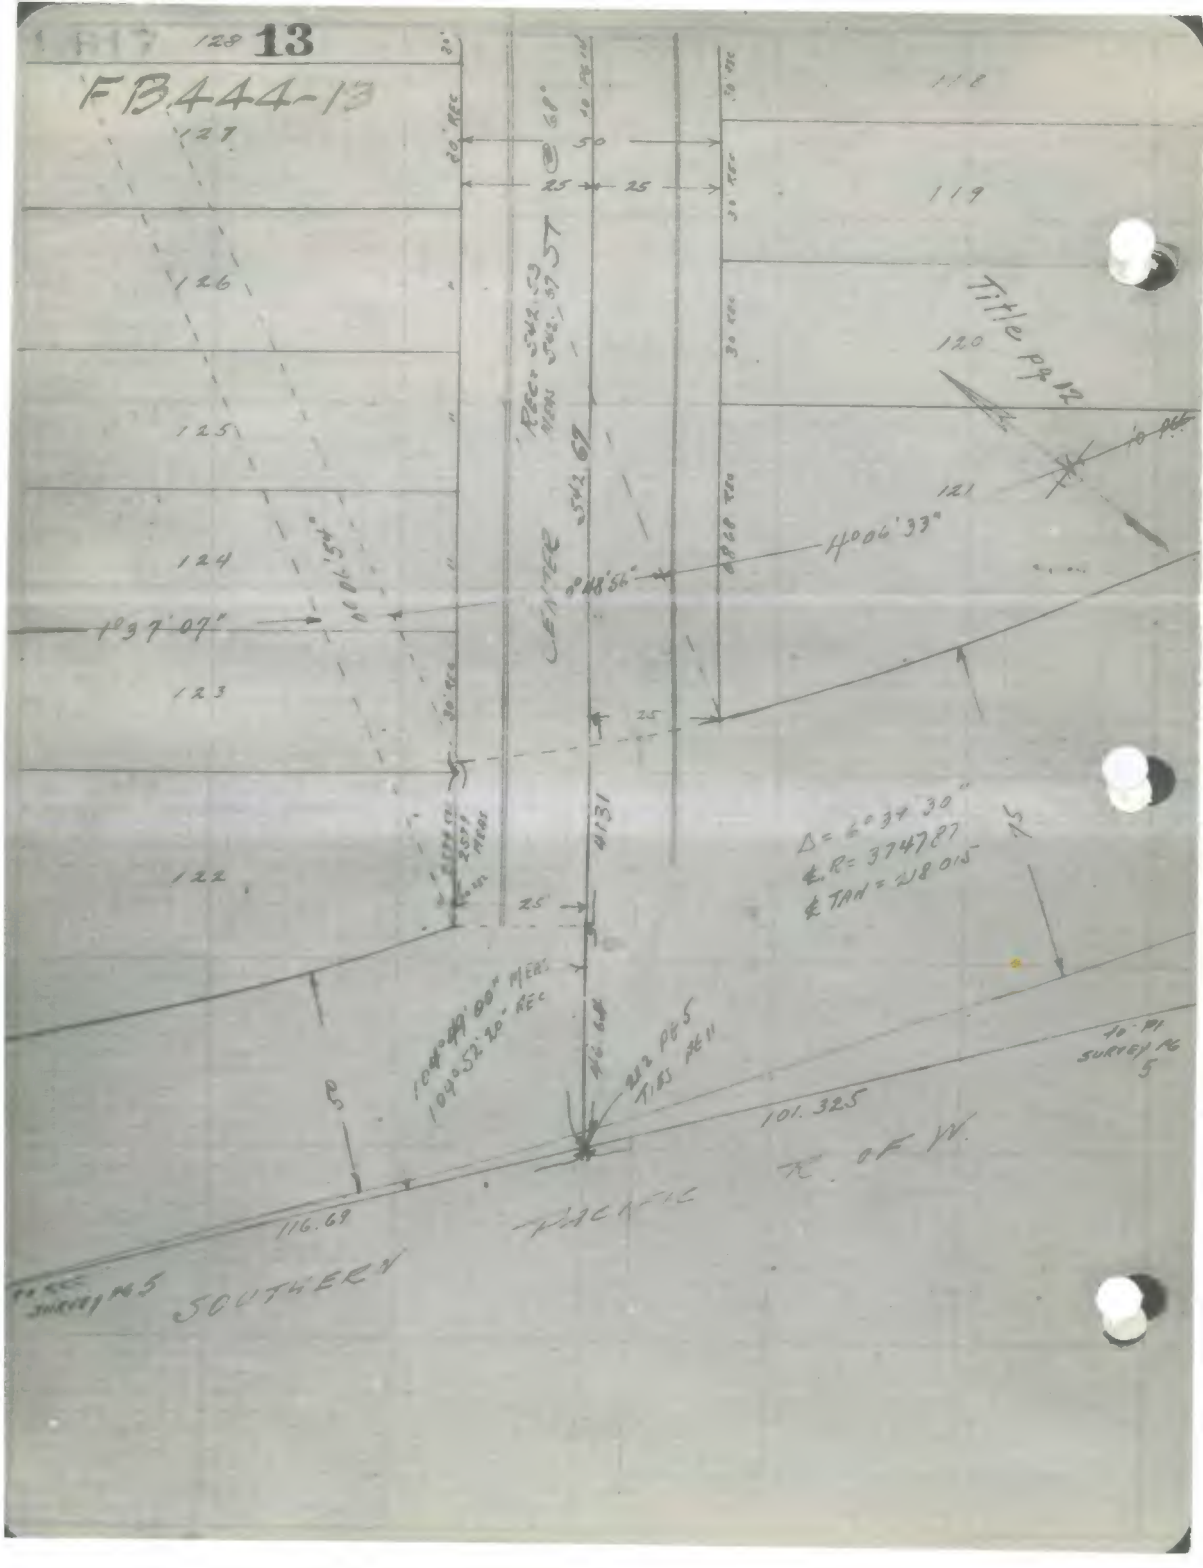

13
FB444-13
128
127
126
125
124
123
122
118
119
120
121
Title pg 12
CENTER
542.67
4°06'33"
1°37'07"
Δ = 6°34'30"
℄ R = 374787
℄ TAN = 218.015
101.325
116.69
PACIFIC
R. OF W.
SOUTHERN

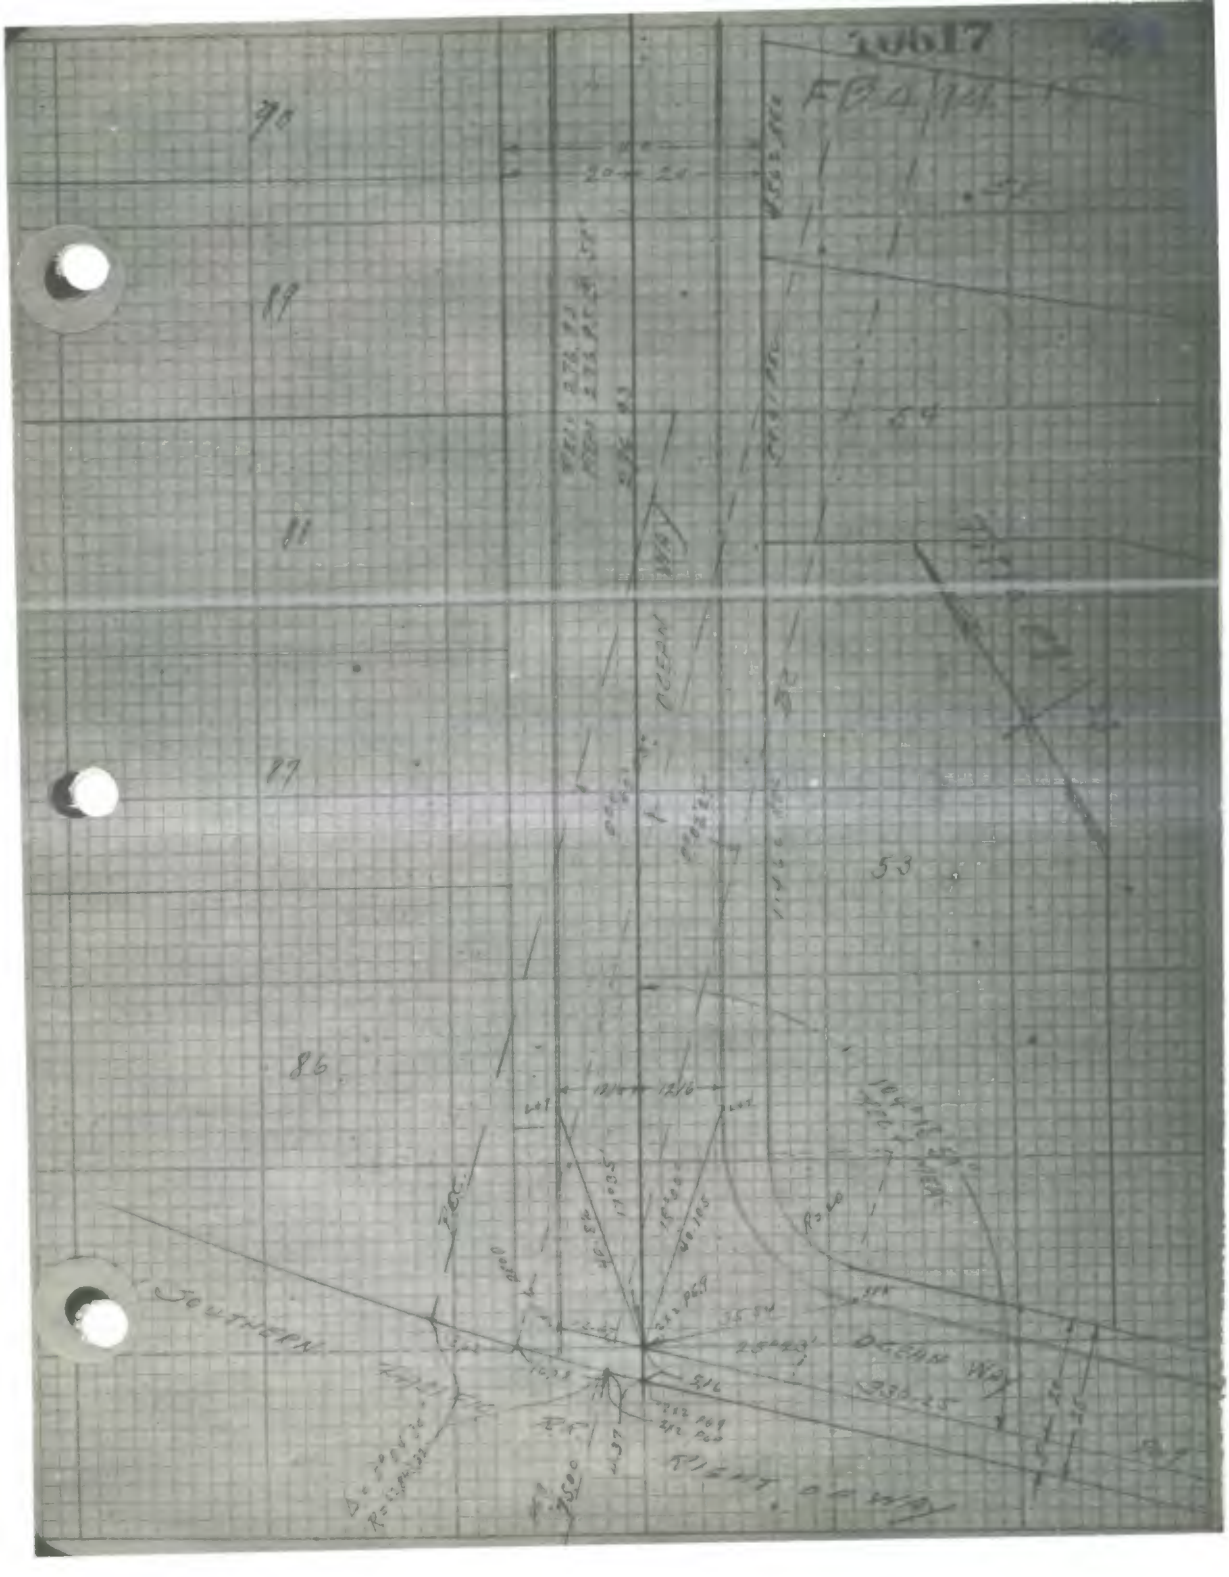
10617
FB 4/14
90
89
88
87
86
54
53
OCEAN WAY
SOUTHERN
PACIFIC
RIGHT OF WAY
OCEAN WAY
330.25
R=40

FB444-16

Title pg 26
TERRACE DR
CHAMBER ROAD
SOUTHERN PACIFIC
R.R. RIGHT OF WAY
S+T PG 6
L+T PG 6
TIES PG 39
30.0
30.775
166
165
162
161
160
159
50

F.B. 444

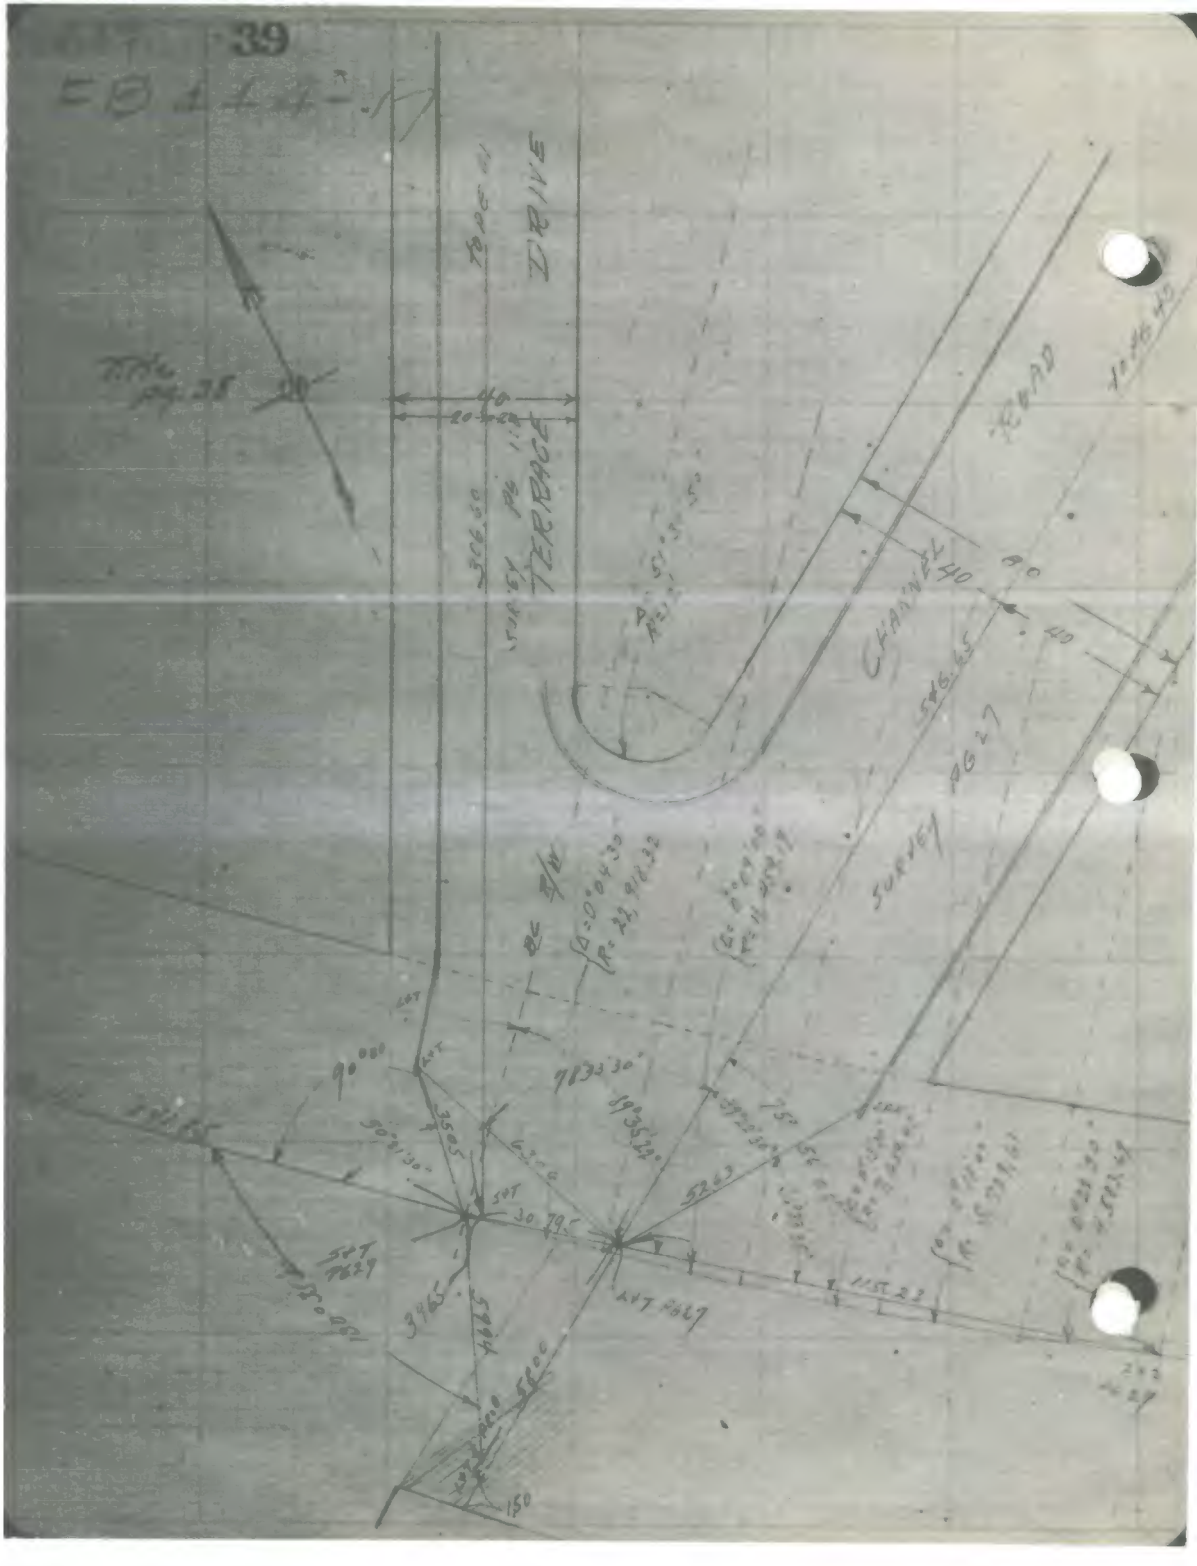
DRIVE
TERRACE
ROAD
CHANNEL
SURVEY PG 27
40
20
306.60
7833.30
5263
3965
5800
150

INDEXED 3/8 1928

FB.444-1

10617-112

10617-712

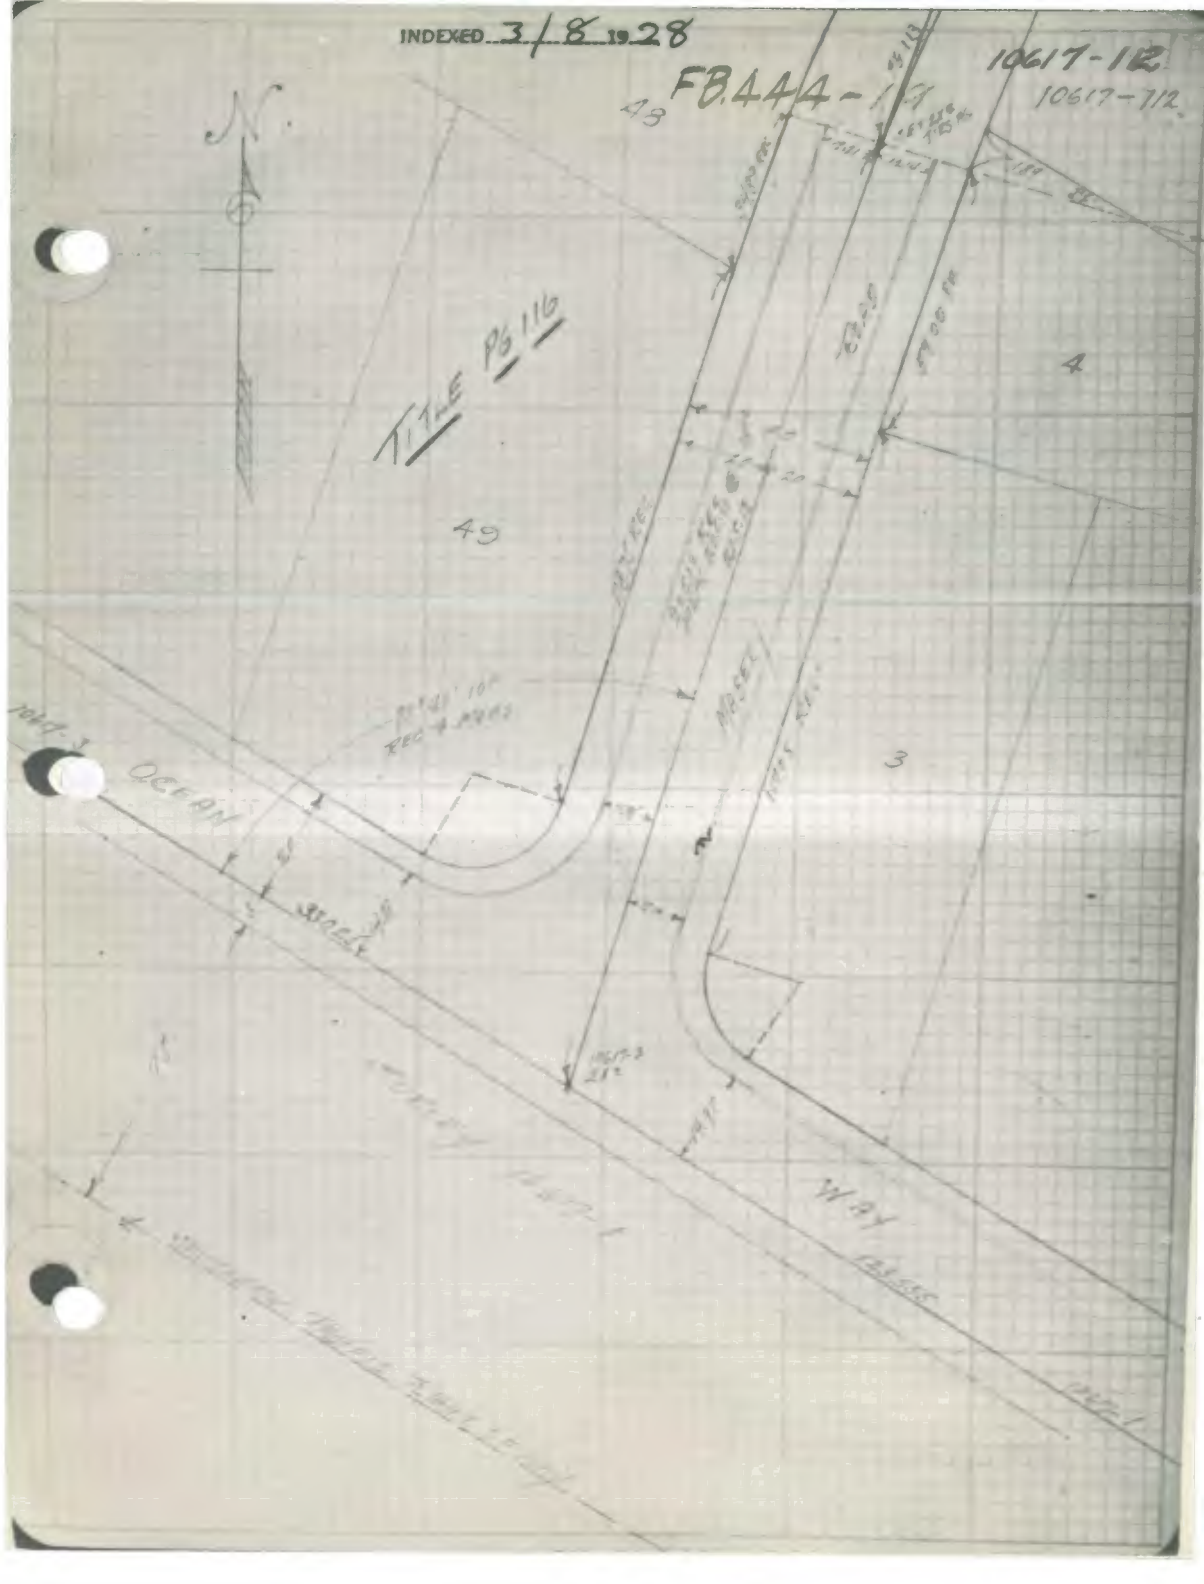

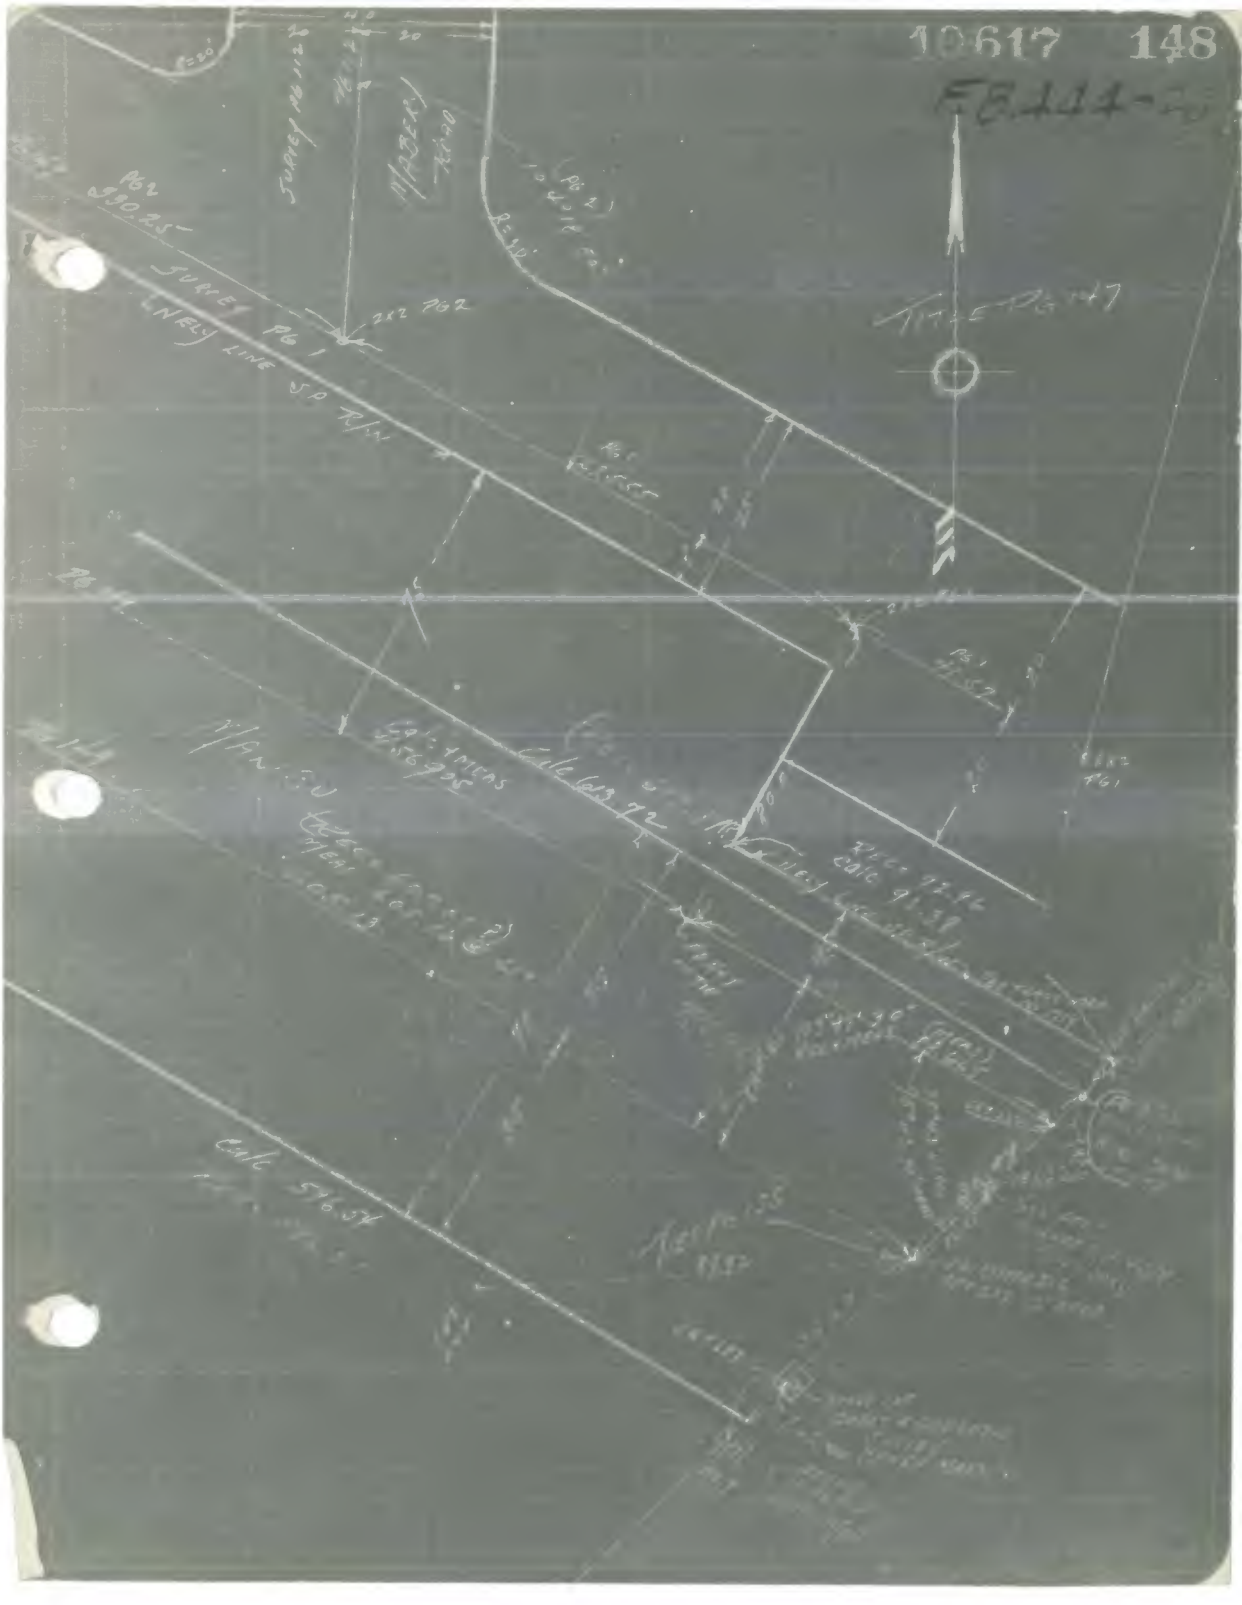
SURVEY PG 1
NELY LINE SP R/W
2x2 PG2
PG2
990.25
Calc 596.54

10617 149
OCEAN
MALIBU
ROAD

F.B. 444-22

MALIBU
VARIES
(Calc
L=588.06 calc
(L= 588.11 Rec)
Road
291.915
Rec = 291.94
Mea 291.915 @ 68°

F.B.444-73

N ELY LINE N.P.R.R. R/W
(Δ = 8°46'30"
RAD = 3805
TAN = 291.94
(Δ = 8°47'55"
3794.88
TAN = 291.915
Calc 154.79
(30.835 calc)
(57.44 calc)
(Calc 370.41)
(Calc 588.06 ARC
Rec = 588.11 ARC)
TES PG 158
MEAS
ROAD
N/ALLEY
CENTER
PG 152
PG 150

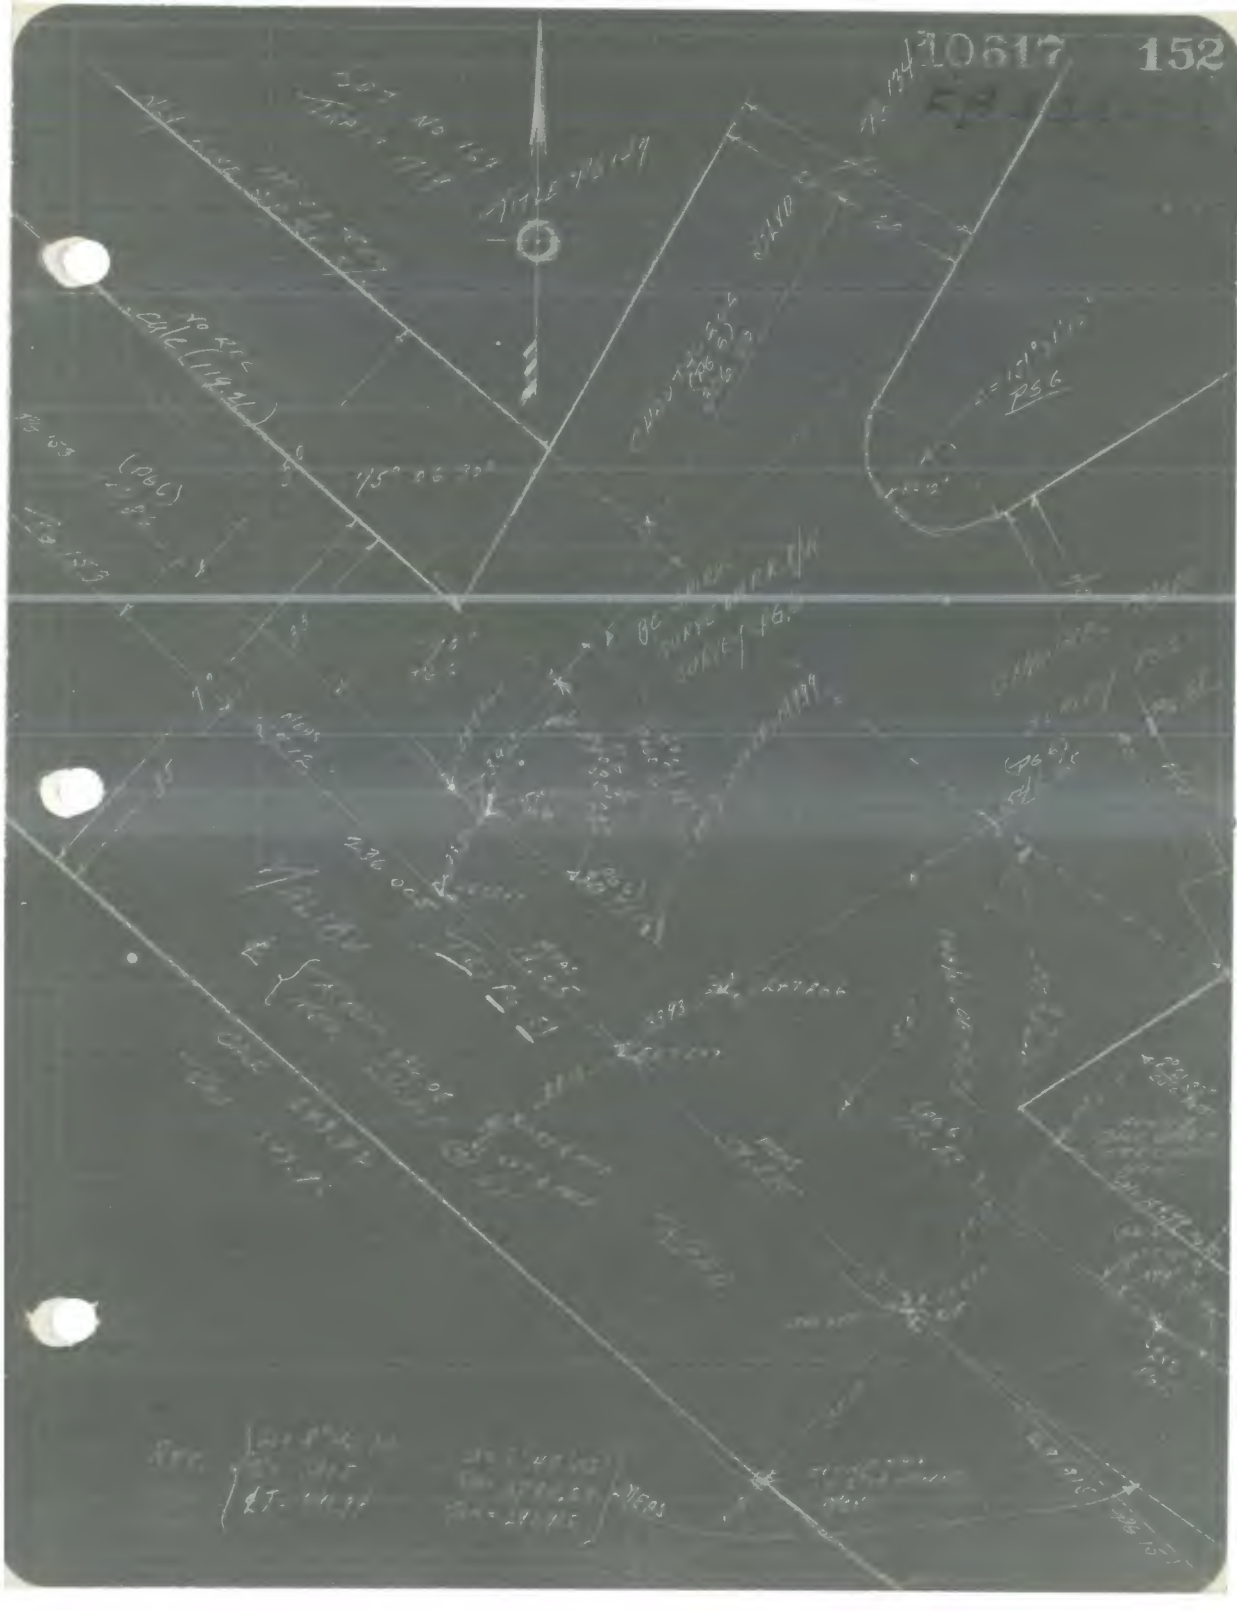

617 153
F.B 444 - 2.5

F.B. 444-26

[illegible]

MALIBU ROAD

[illegible] CENTER ST TO ALLEY N OF CHAUTAUQUA BLVD

[illegible]

[illegible]

[illegible] JAN 1929

[illegible]

[illegible]

[illegible]

[illegible]

[illegible]

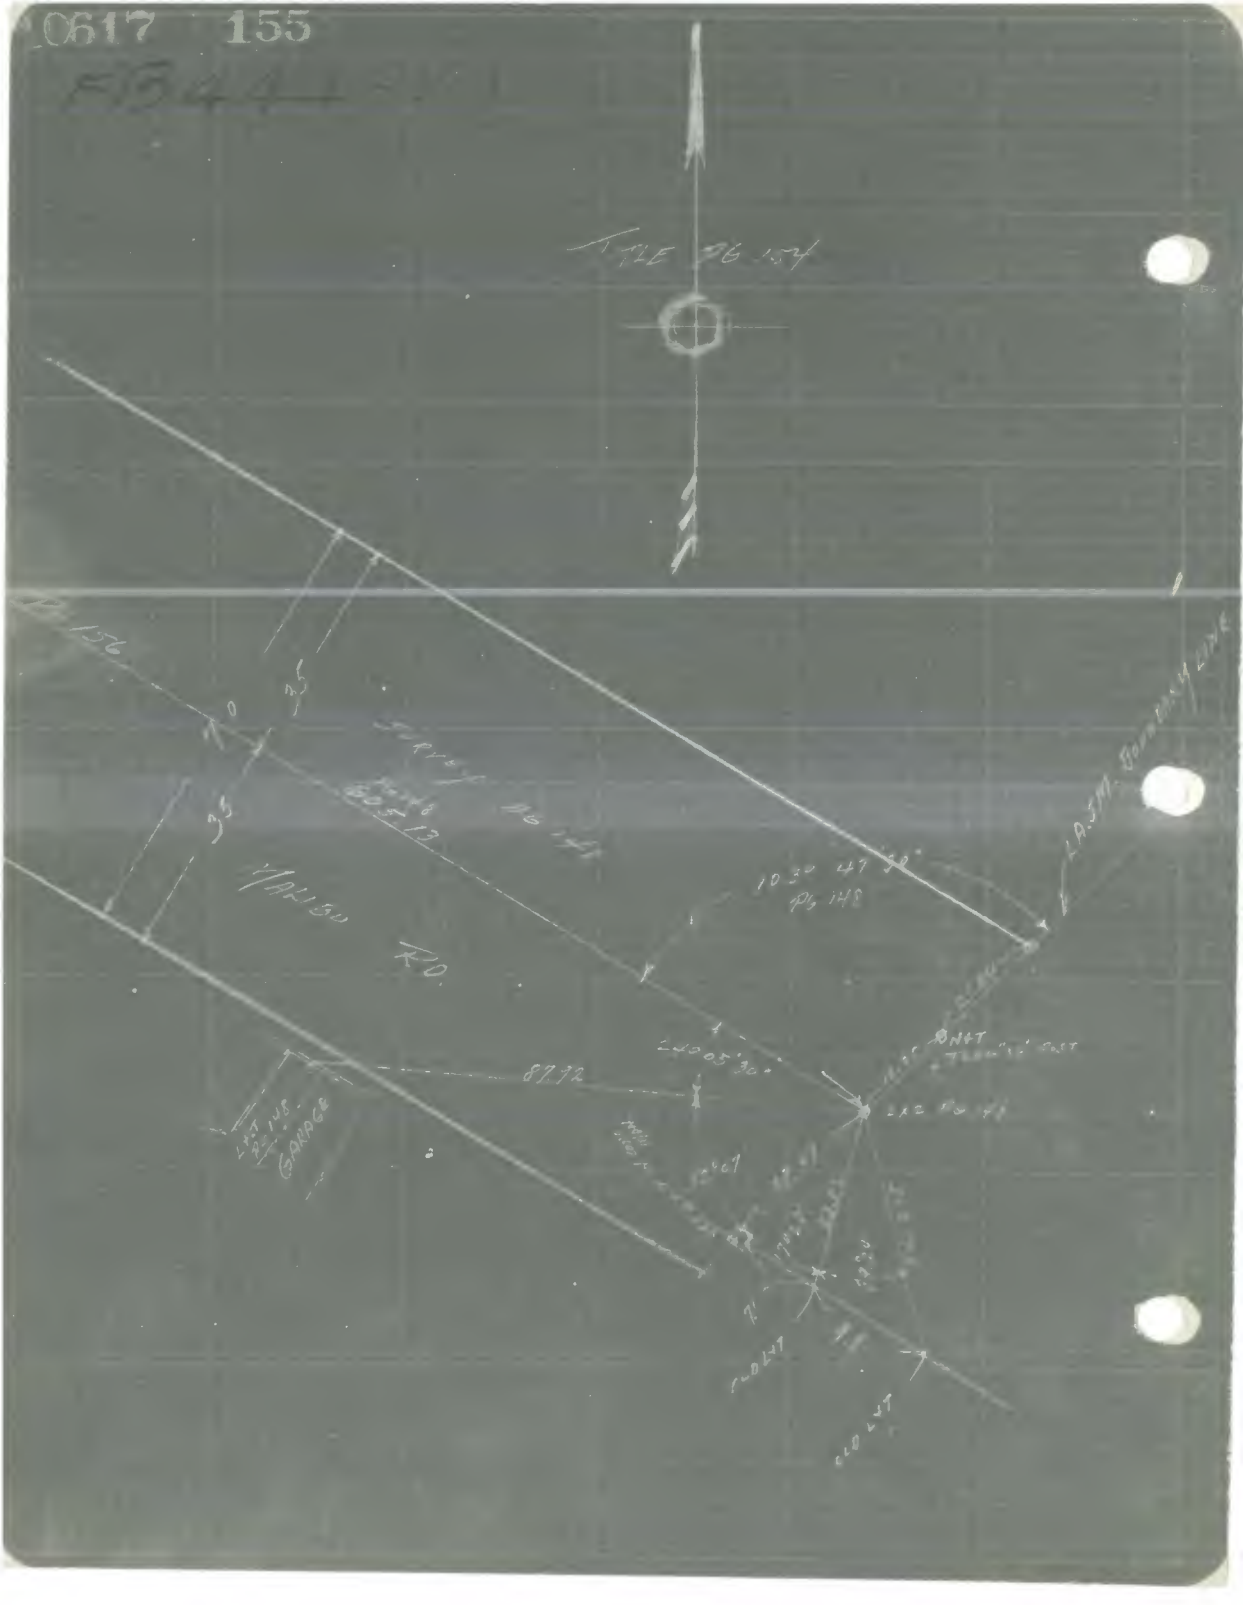
TYLE PG 154
PG 156
35
35
MALIBU RD.
87.92
GARAGE
PG 148
LA.J.M. BOUNDARY LINE
OLD LYT
OLD LYT

10617 157

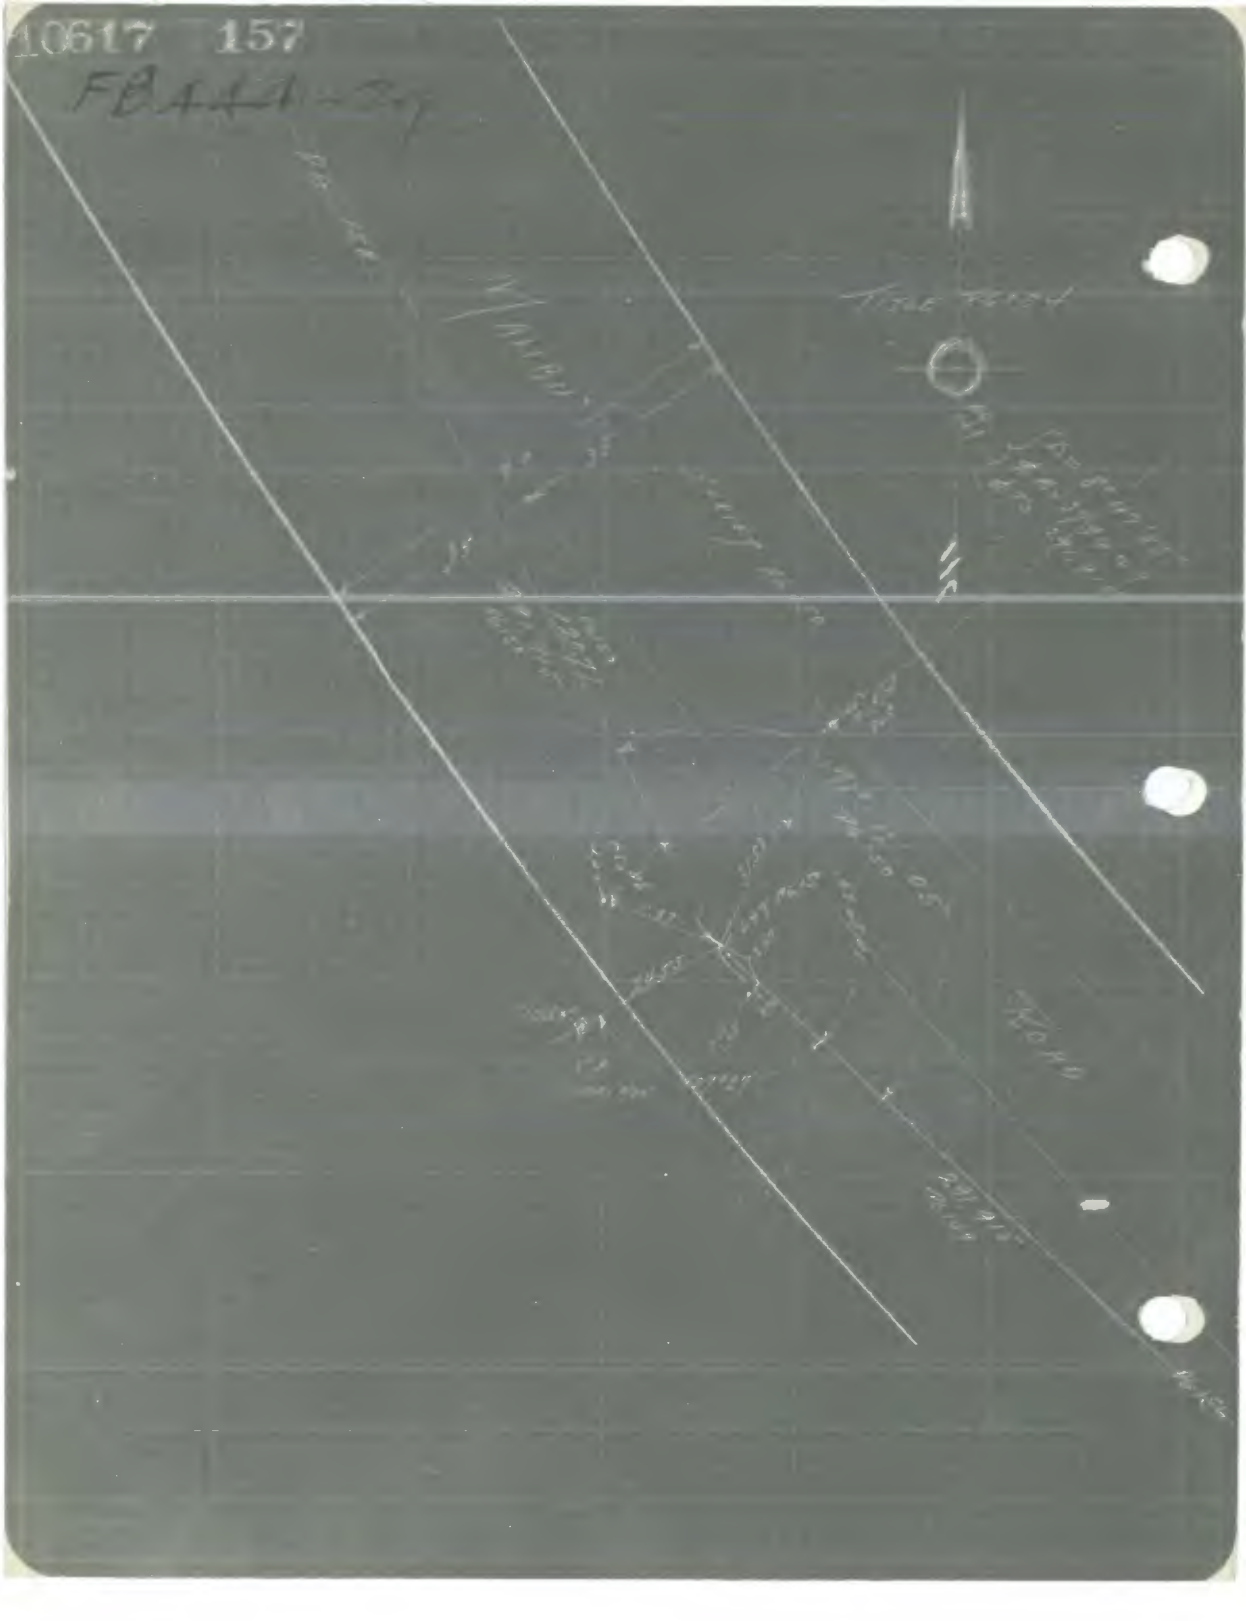

FB 444-36

0617 159

F.B. 444-5

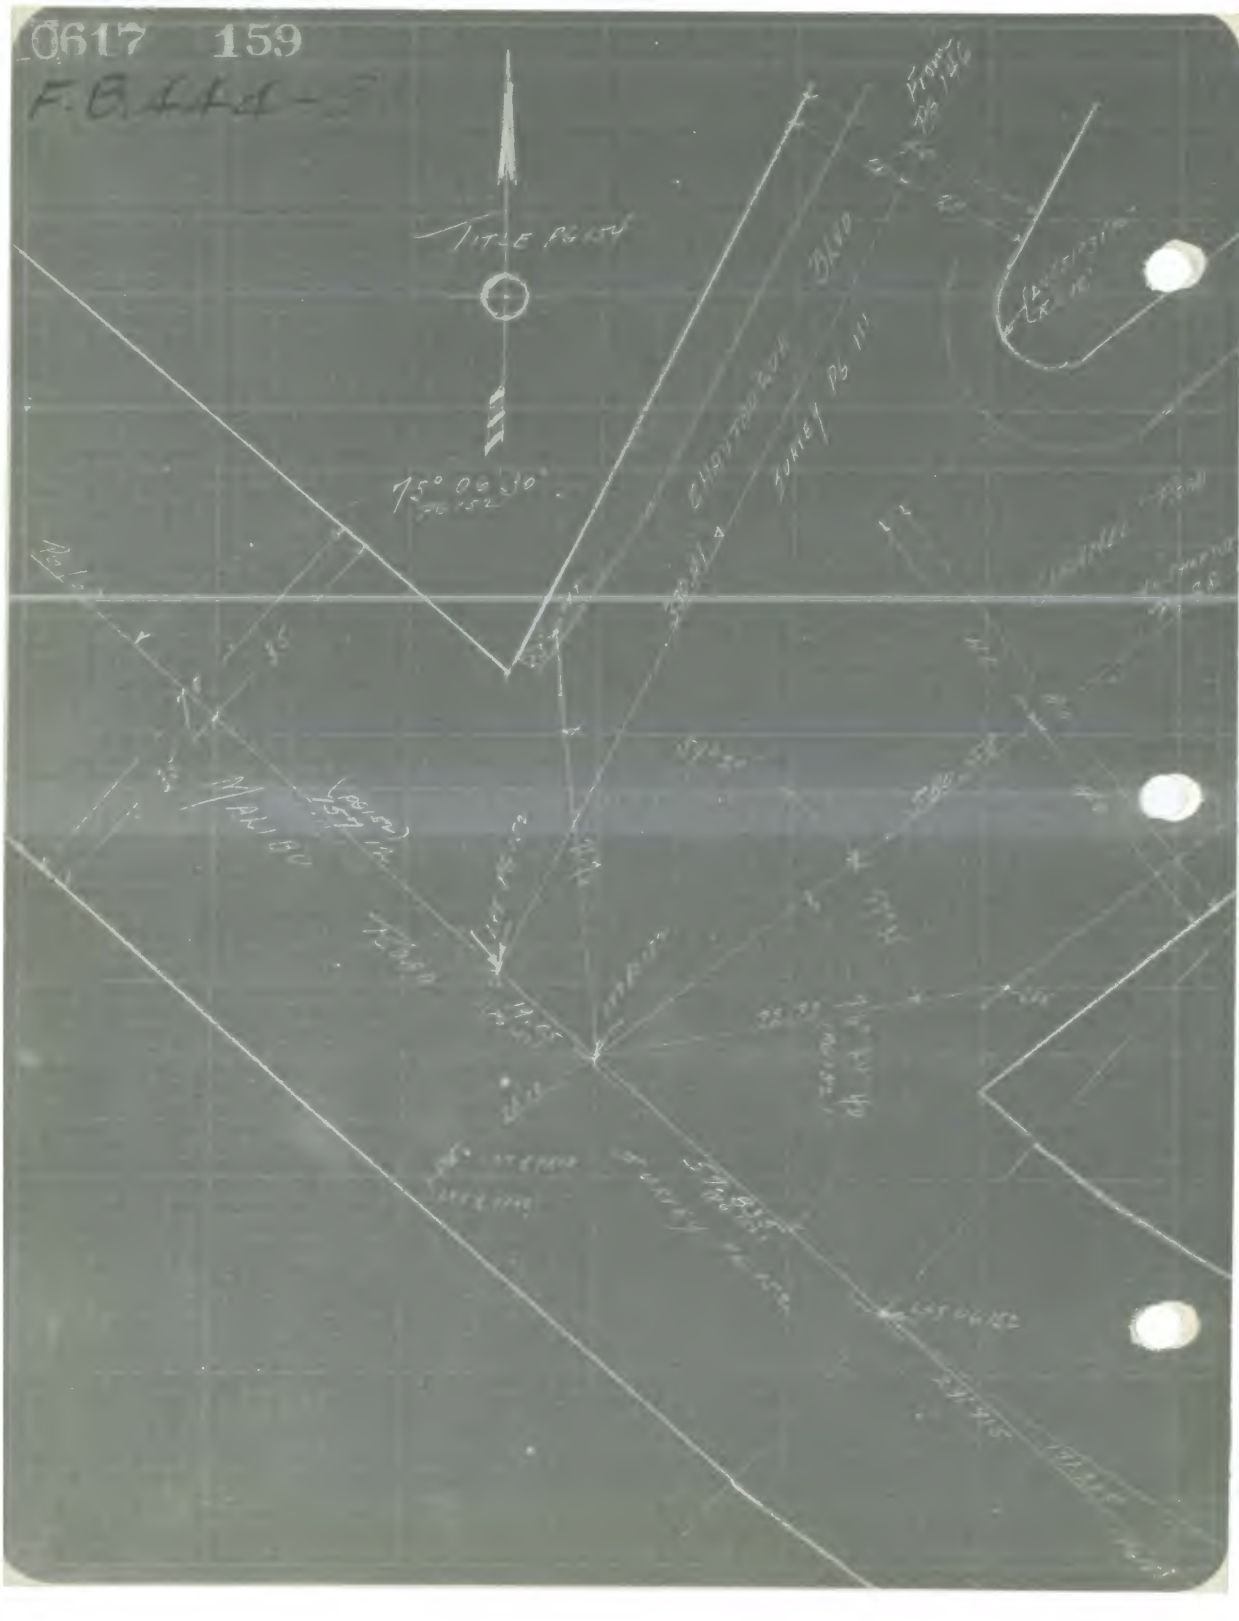

Date _____ Notes by _____ Chief Party _____ F.B. 444 Pg 39

Platted by Bert Mc Atee	W. O. No. 125 O. S. O. No _____
Date Feb 1930	Location Hawthorne Blvd + Center ST.
Map No. _____	Surveyed by Ed McNeal
Platting C'k'd by D.M. Finley	Date Jan. 30, 1930
Date Feb. 1930	Indexed A. C. Johnson · 1-30-30

HAWTHORNE BLVD.
CENTER ST.

Survey of Topography in connection with Mr. L.S. Hammonds automobile accident.

Notes: ANY ADDITIONS OR CHANGES ON THIS SHEET MUST BE MADE OR CIRCLED IN Red. WITH DATE AND NAME OF PERSON MAKING CHANGE.

Do not extend notes this side of this line

RETURN TO
LOS ANGELES COUNTY SURVEYOR

F.B. 444 Pg. 3/4 Chief Party Notes by McNeal Date 1/30/20

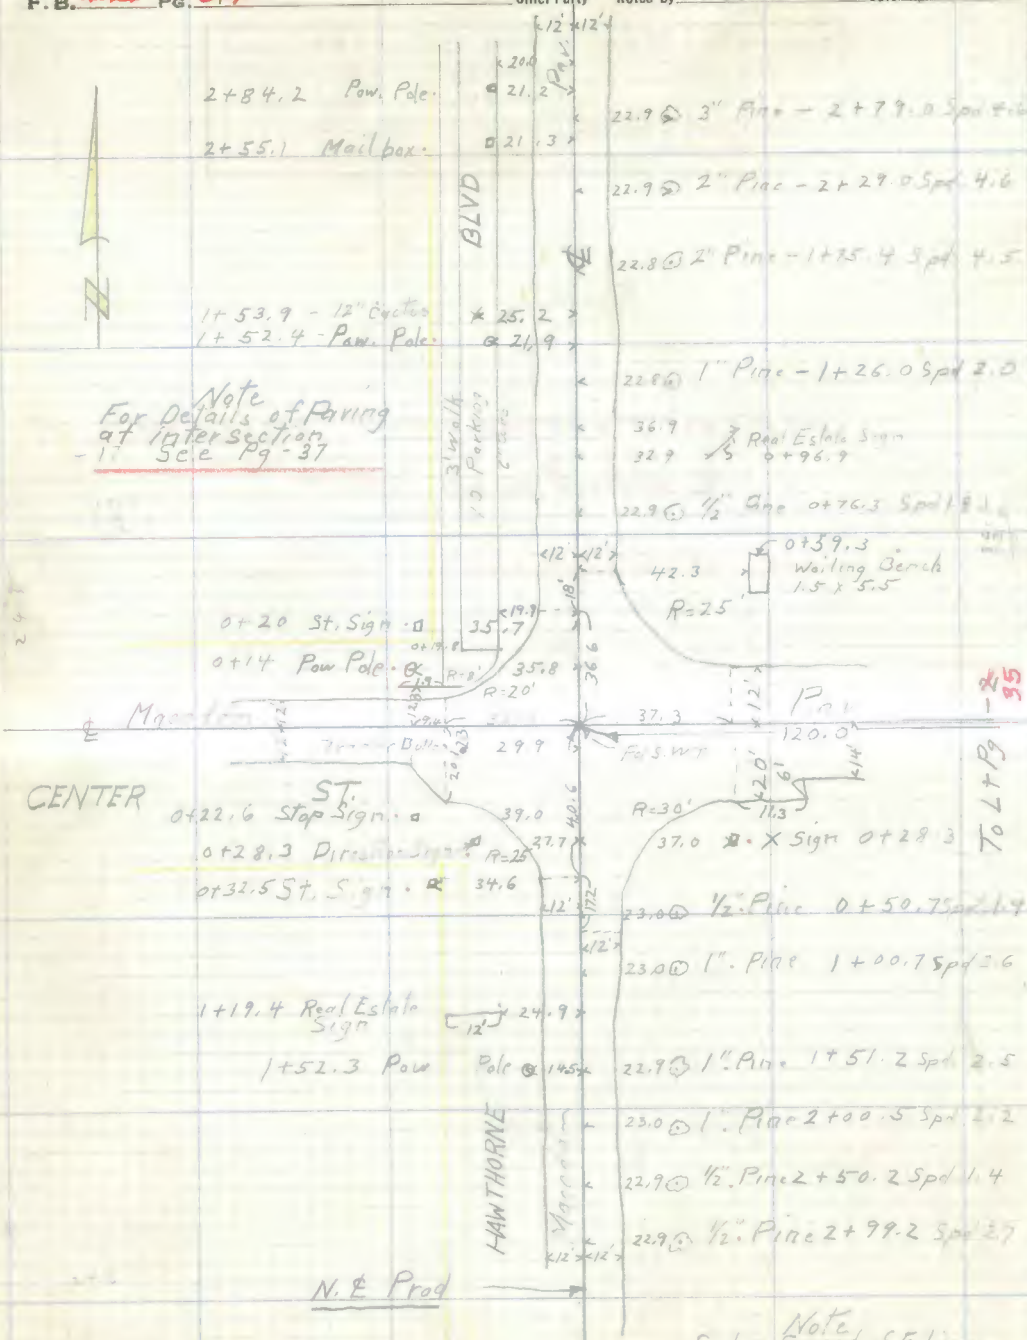

RETURN TO LOS ANGELES COUNTY SURVEYOR

Do not extend notes this side of this line

Note: ANY ADDITIONS OR CHANGES ON THIS SHEET MUST BE MADE OR CIRCLED IN Red. WITH DATE AND NAME OF PERSON MAKING CHANGE.

Date ________ Notes by Mc ________ Chief Party ________ F.B. 444 PG 35

Side Spread of Foliage on Trees

Platted by Bert McAtee	W. O. No. 125 D. S. O. No.
Date Feb. 1930	Location Hawthorne Blvd + Center St
Map No.	Surveyed by F. J. McNeal
Platting C'k'd by O. M. Finley	Date Jan - 30 - 1930
Date Feb. 1930	Indexed A. C. Johnson - 1-30-30

Note: ANY ADDITIONS OR CHANGES ON THIS SHEET MUST BE MADE OR CIRCLED IN **Red.** WITH DATE AND NAME OF PERSON MAKING CHANGE.

Do not extend notes this side of this line

RETURN TO LOS ANGELES COUNTY SURVEYOR

F.B. 444 Pg. 35A M Chief Party Notes by McNeal Date 2/10/[illegible]

Edge of Paving at Hawthorne Blvd.
and Center St See Pg - 35
East Side of R.R.

Approx. Scale 25' = 1"

RETURN TO
LOS ANGELES COUNTY SURVEYOR

Do not extend notes this side of this line

Note: ANY ADDITIONS OR CHANGES ON THIS SHEET MUST BE MADE OR CIRCLED IN Red. WITH DATE AND NAME OF PERSON MAKING CHANGE.

Date _____ Notes by M. Chief Party M F.B. 944 Pg 35B

Platted by Bert McAfee	W. O. No. _____ D. S. O. No. _____
Date Feb 1930	Location Hawthorne Blvd + Center St
Map No. _____	Surveyed by F.J. Mc Neal
Platting C'k'd by O.M. Finley	Date Feb - 1930
Date Feb. 1930	Indexed _____

Edge of Paving at Hawthorne Blvd. and Center St. West Side of R.R. See Pg - 34

Blvd

11.9 11.4
12.0 11.3
12.0 11.7
12.4 12.6
13.0 15.0
15.0 18.5
18.3 23.5
23.3

Center St.

12.1 12.0 12.4 15.4 20.0 20.3 23.4 28.5 23.1 22.6 20.4 20.1 20.3 20.2
5' 5' 5' 5' 5' 5' 5' 10' 10' 5' 5' 5' 5' 5' 5' 5'
19 12.3 13.0 12.9 13.5 17.0 25.9 10.0 15.4 13.7 12.4 12.3
S.W.T.
32.7 26.3

231
18.9 22.2
15.0 19.2
12.7 16.2
12.1 14.0
11.9 12.7

From Lt. Pg - 36

Approx Scale 25' = 1"

Hawthorne

RETURN TO
LOS ANGELES COUNTY SURVEYOR

Notes: ANY ADDITIONS OR CHANGES ON THIS SHEET MUST BE MADE OR CIRCLED IN Red. WITH DATE AND NAME OF PERSON MAKING CHANGE.

Do not extend notes this side of this line

F. B. 444 Pg 35C Chief Party Notes by Date

Details of Service sta. shown on Pg - 35

Center St.

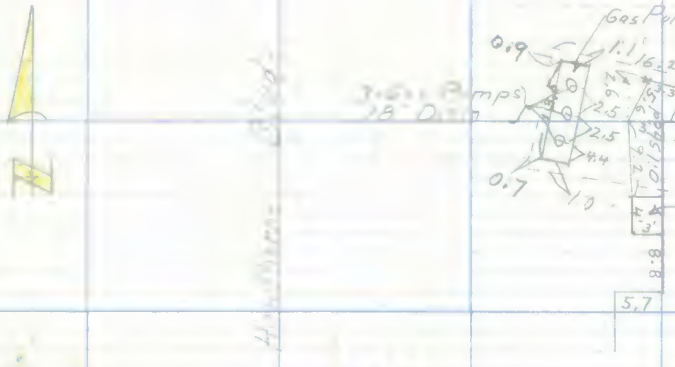

Additional Topog for Pg - 35

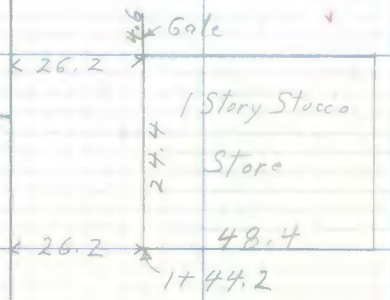

Hawthorne Blvd.

RETURN TO
LOS ANGELES COUNTY SURVEYOR

Do not extend notes this side of this line

Note: ANY ADDITIONS OR CHANGES ON THIS SHEET MUST BE MADE OR CIRCLED IN Red. WITH DATE AND NAME OF PERSON MAKING CHANGE.

F.B. 444-

F.B. 444-36

F.B. 444-37

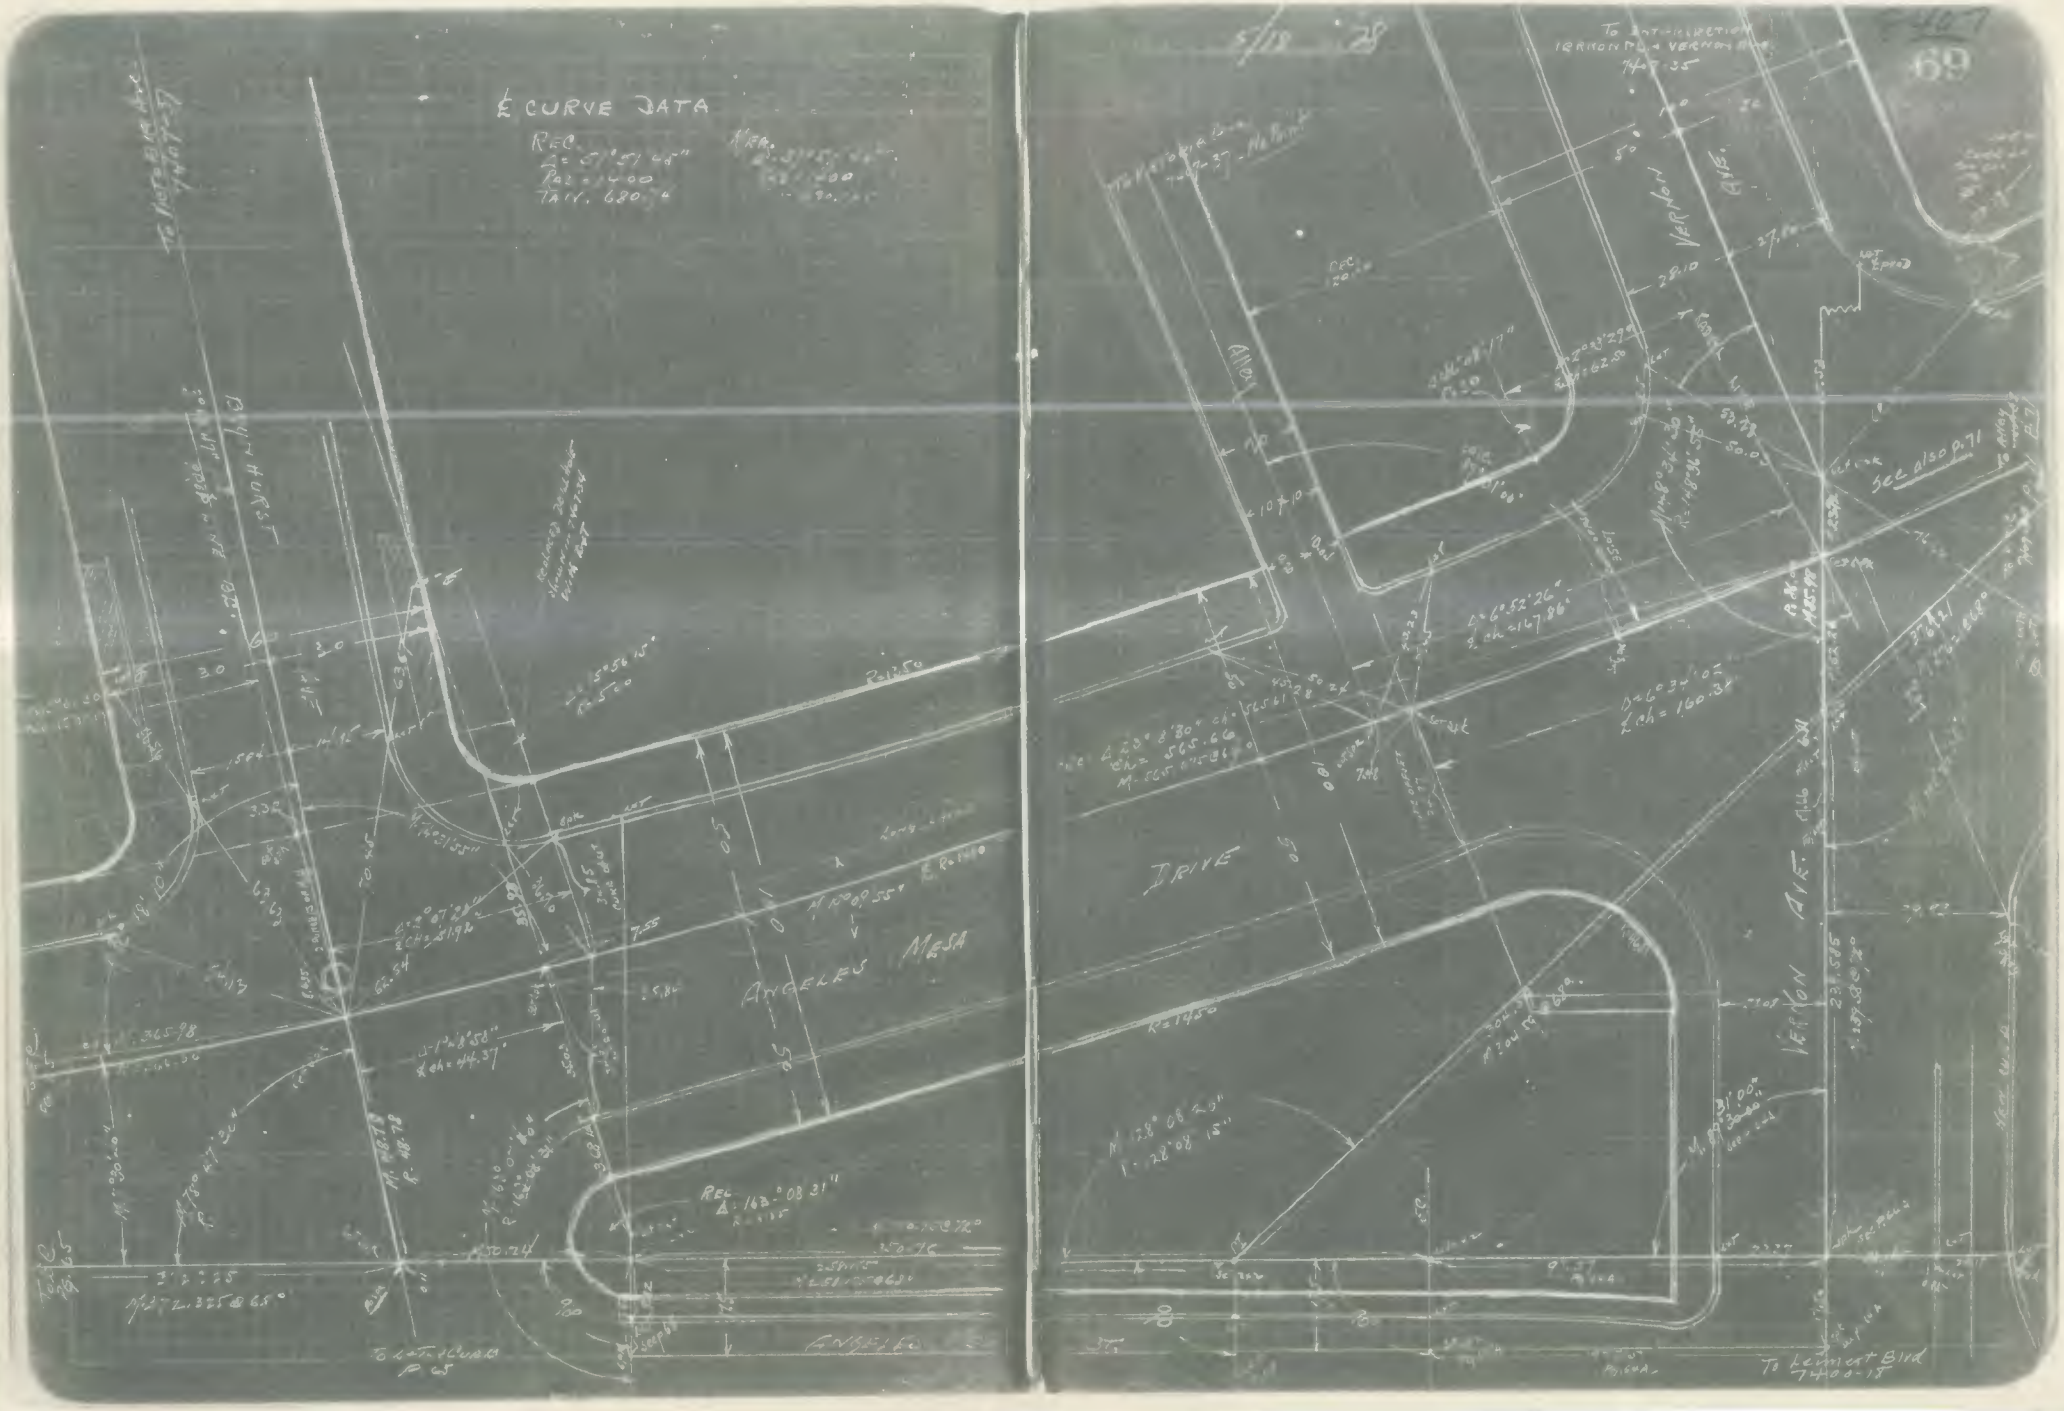

F. B. 444-40

L.A.City 17701

F. B. 444-41

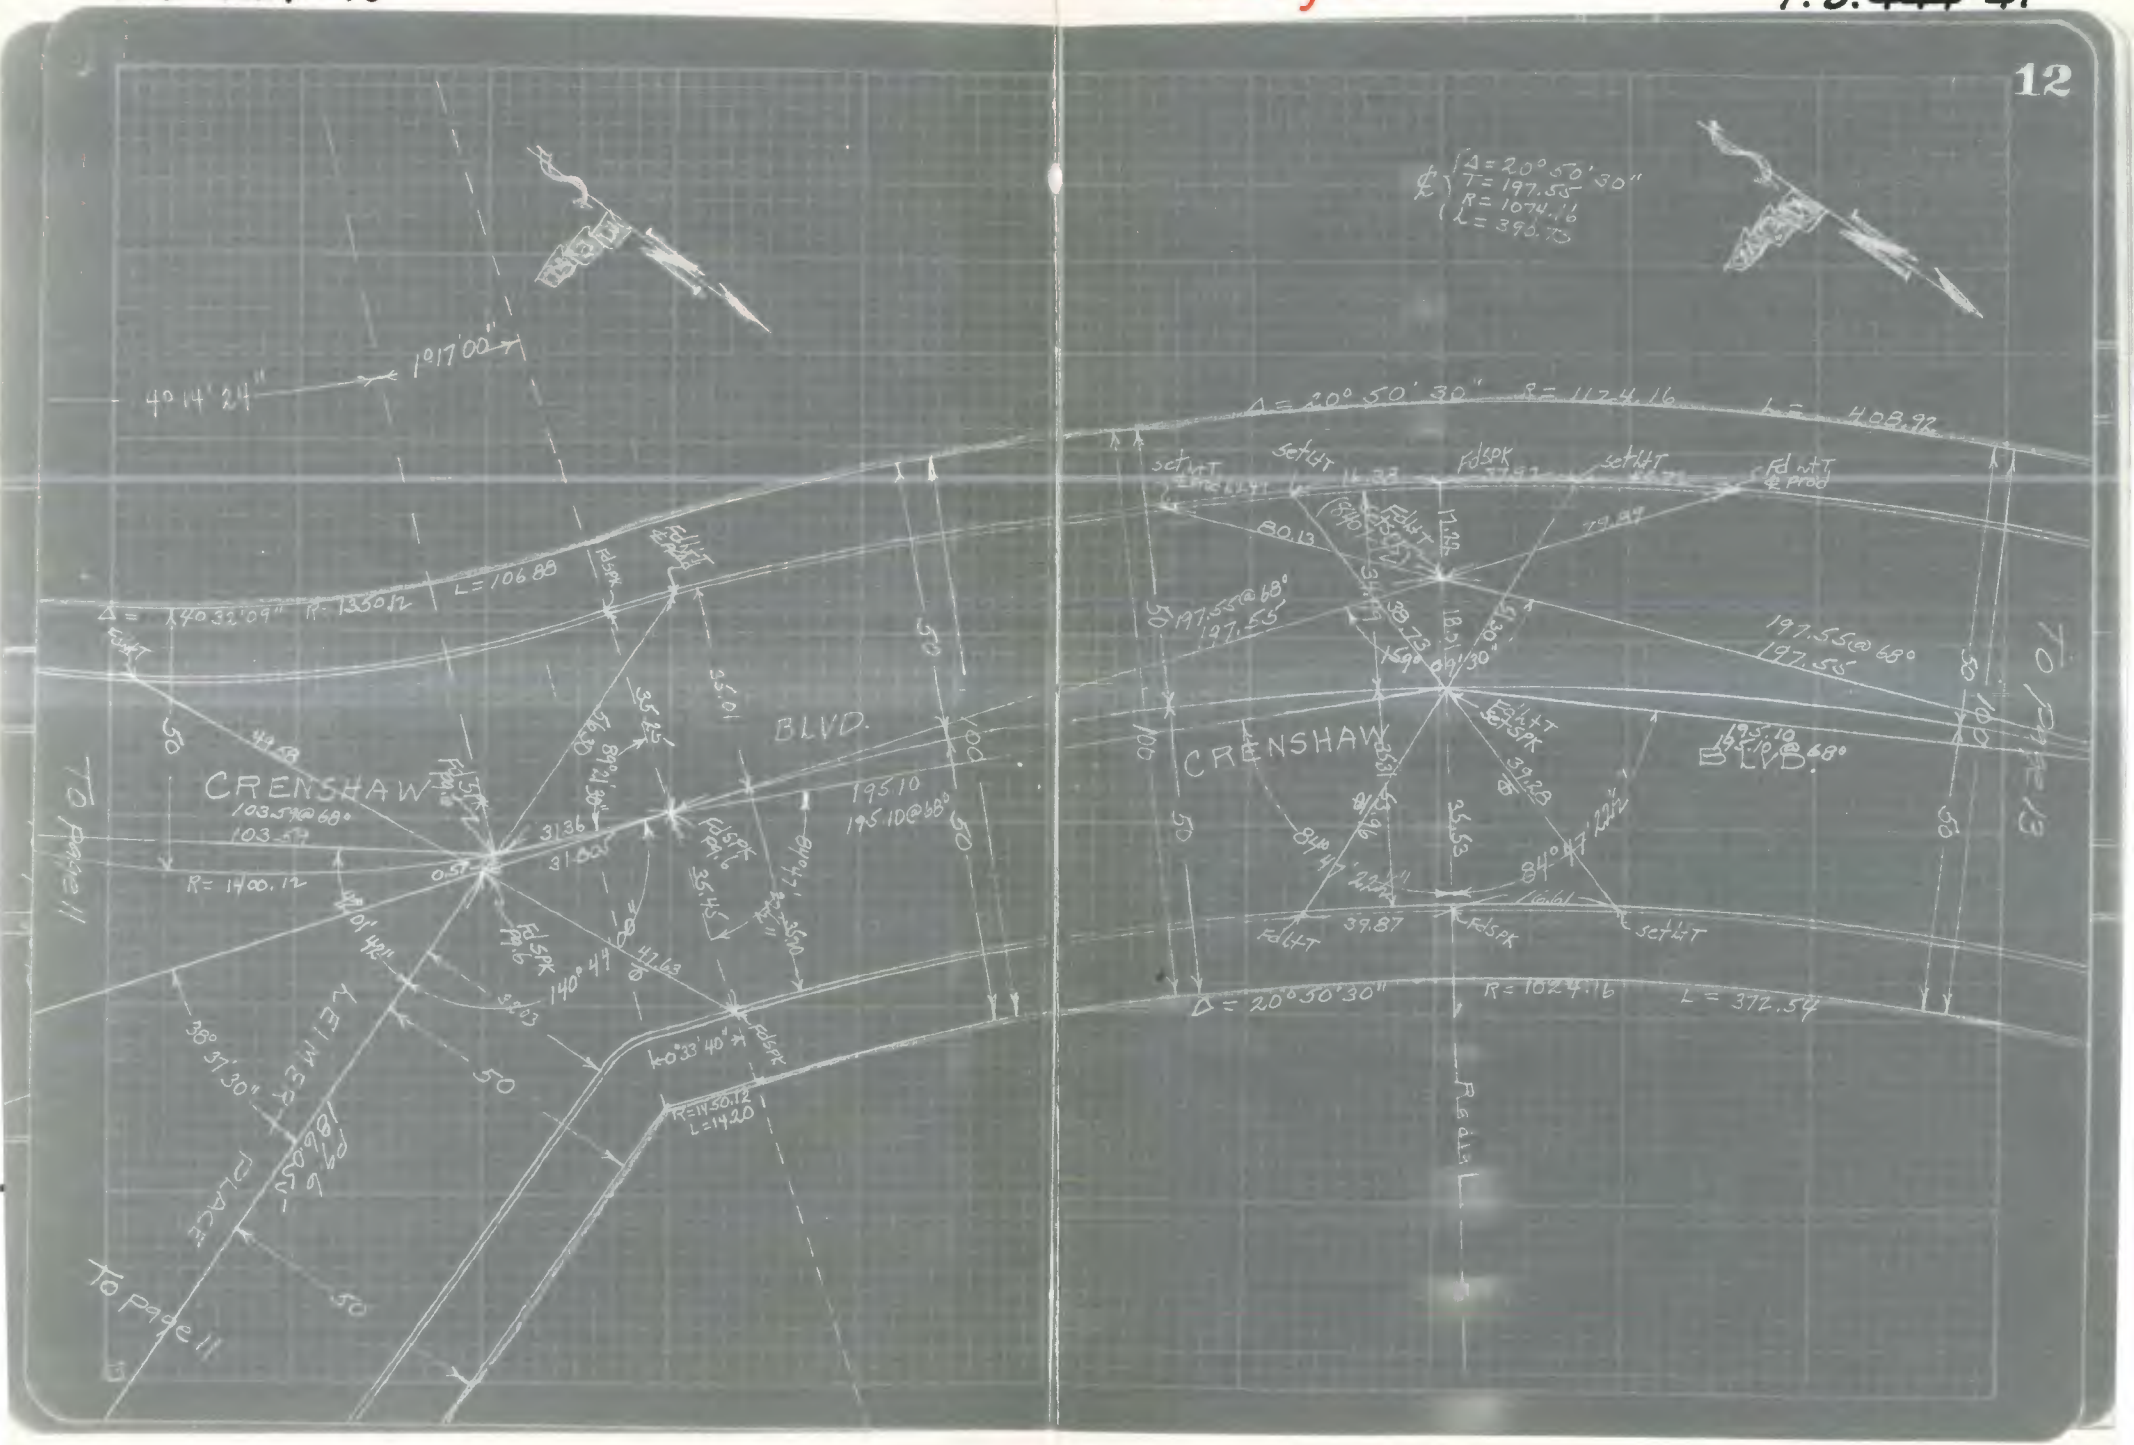

F.B. 444-42

L.A. City 17701

F.B. 444-42

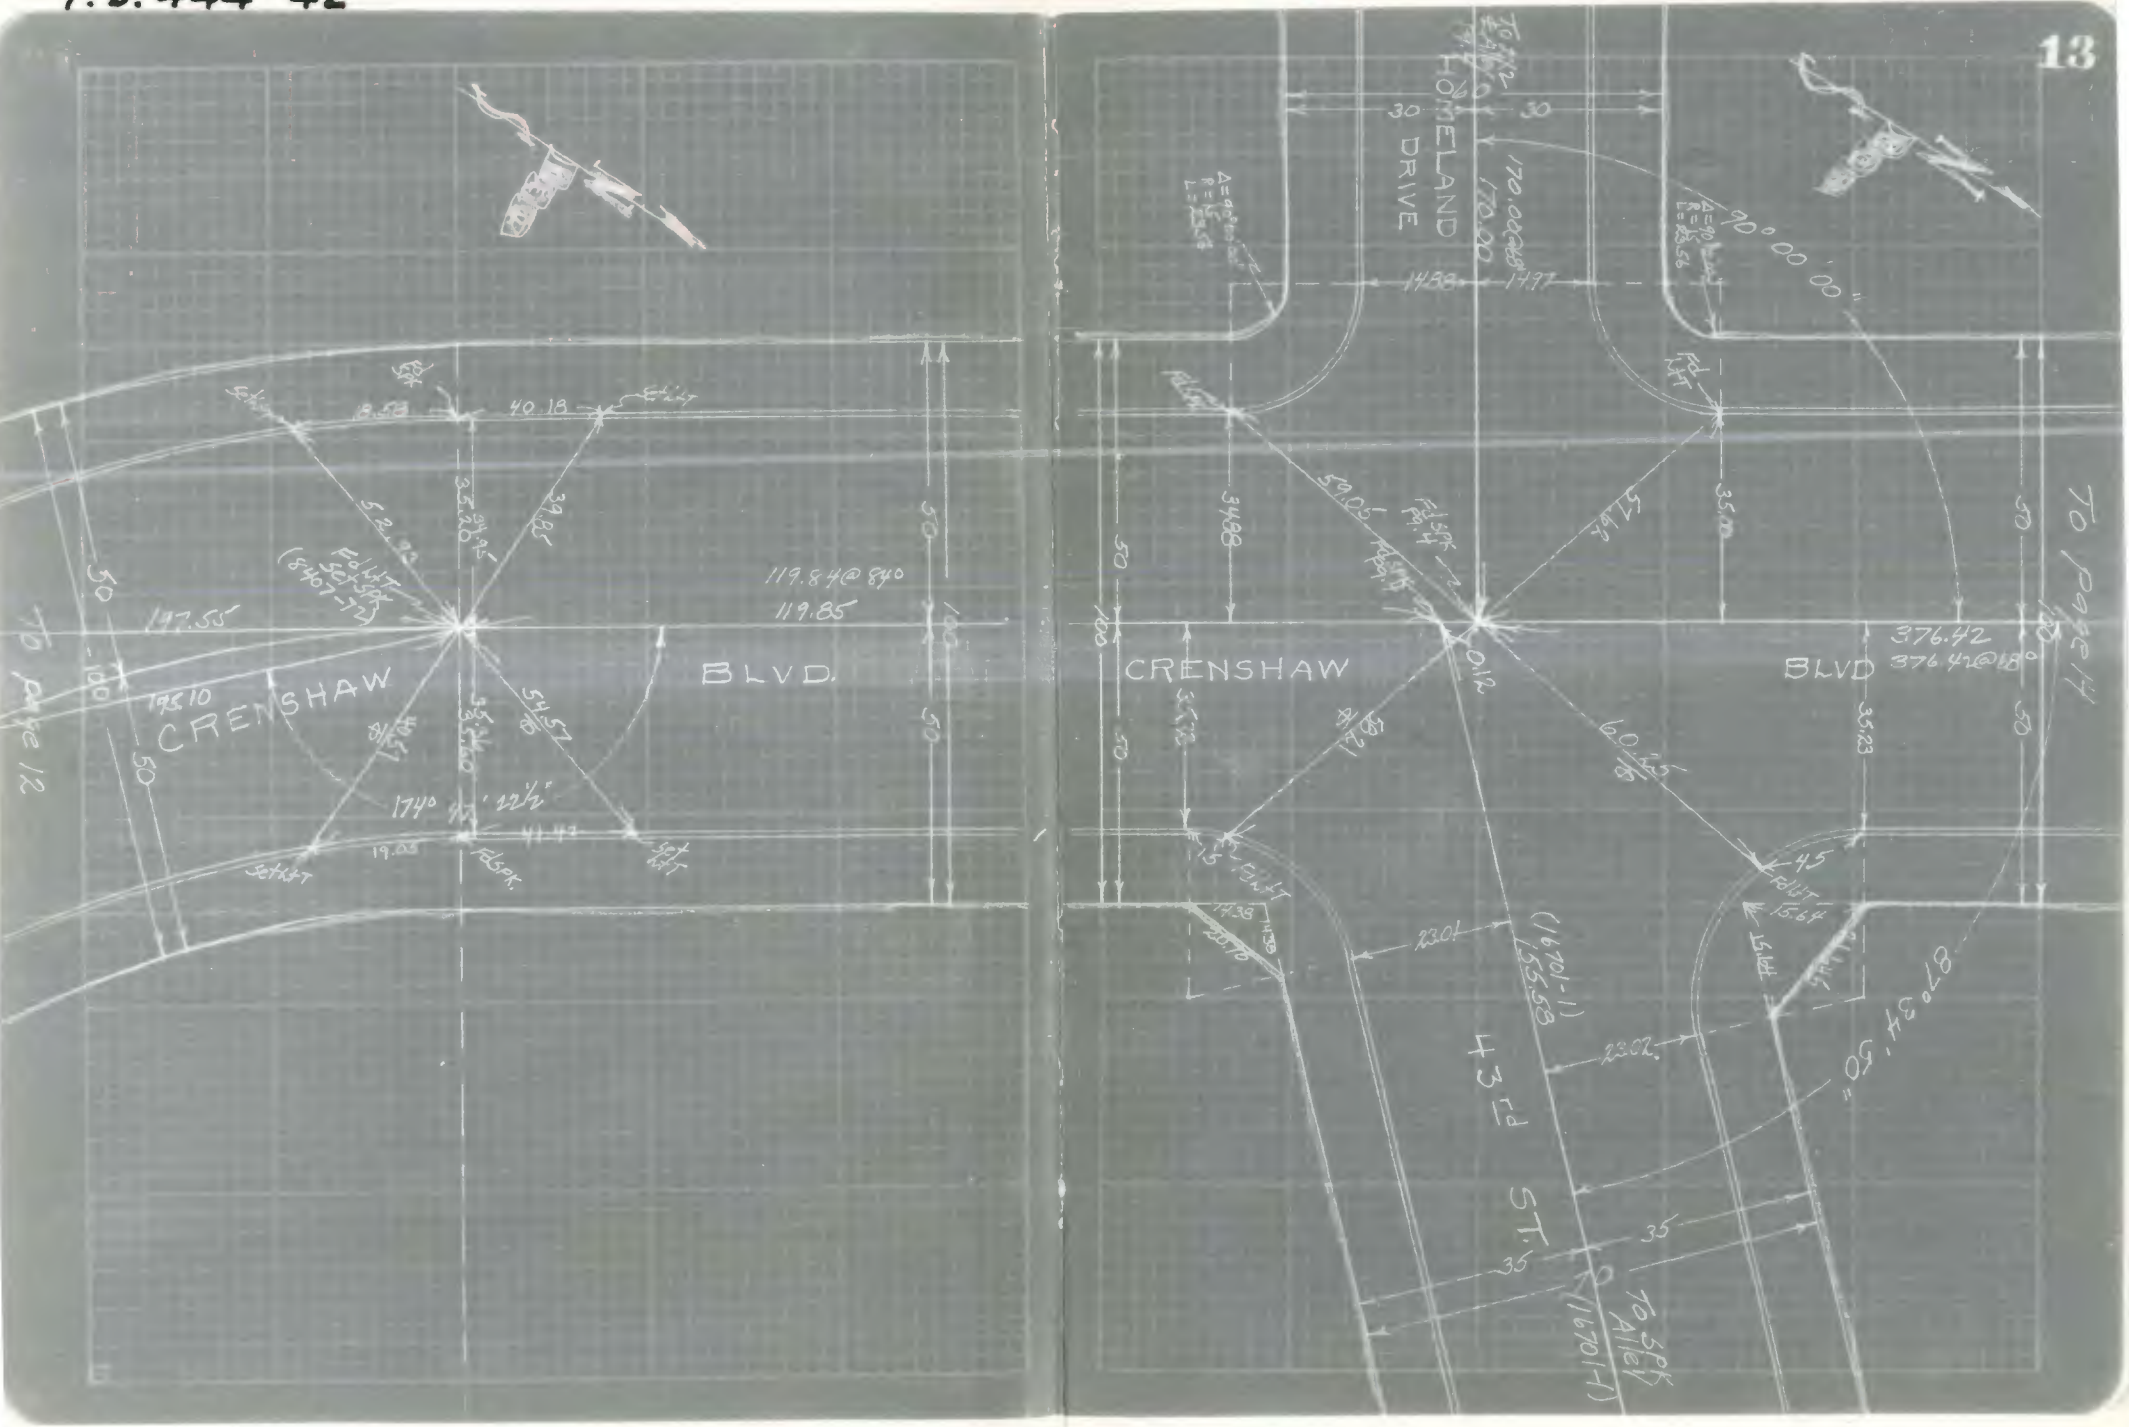

F.B. 444-43

L.A. City 17701

F.B. 444-43

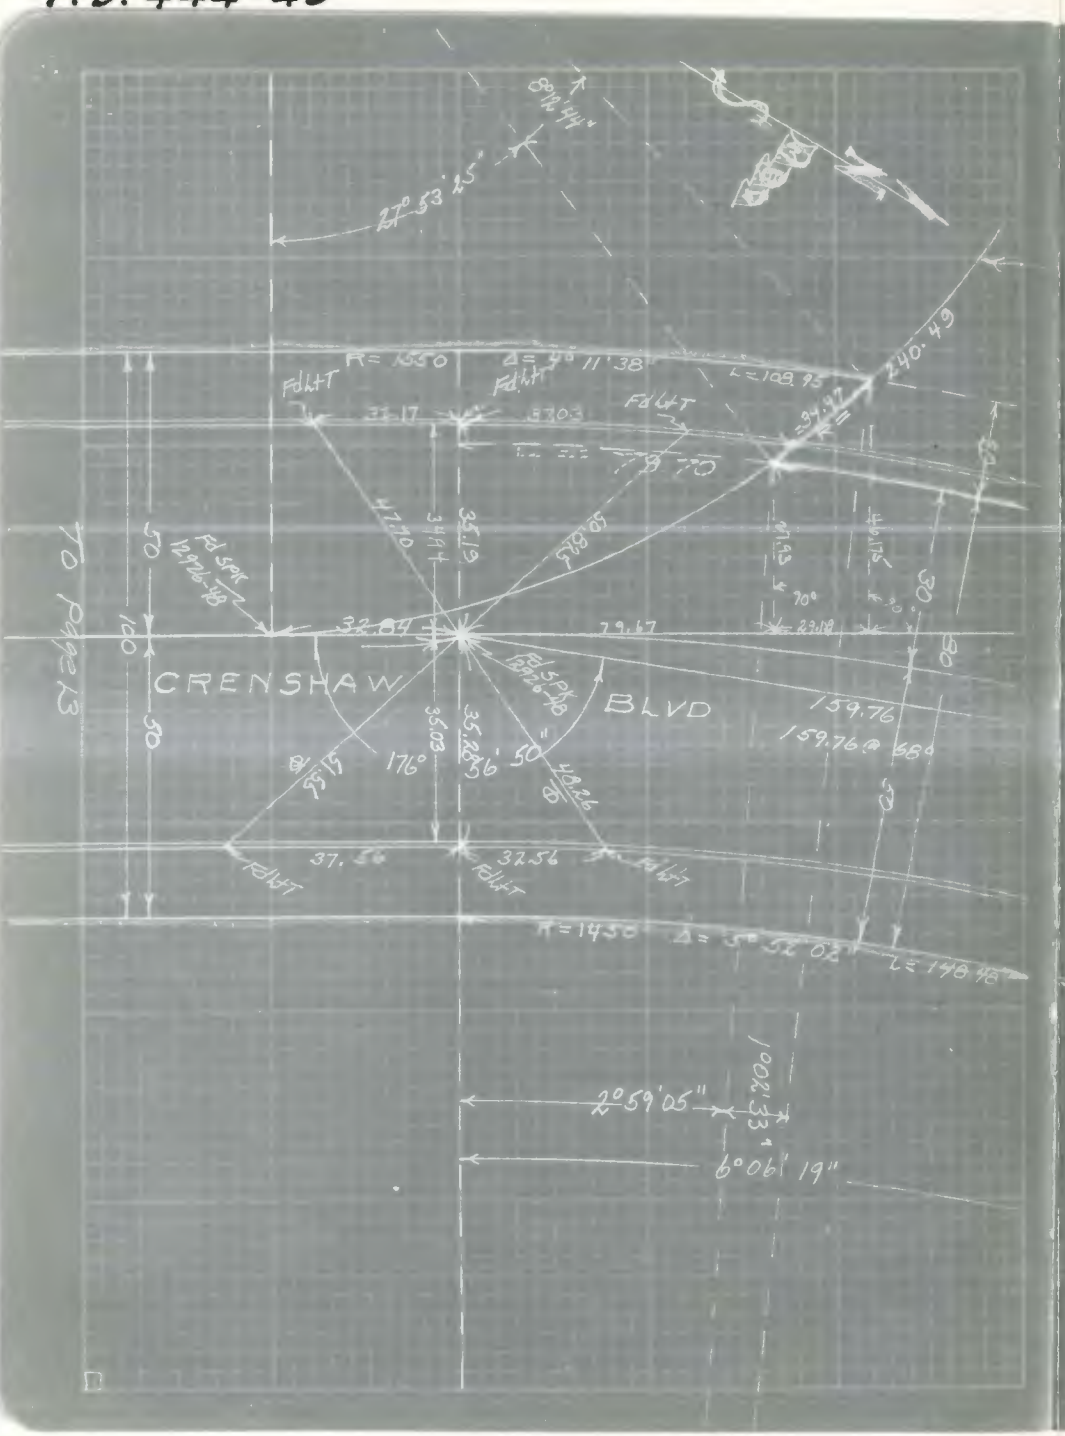

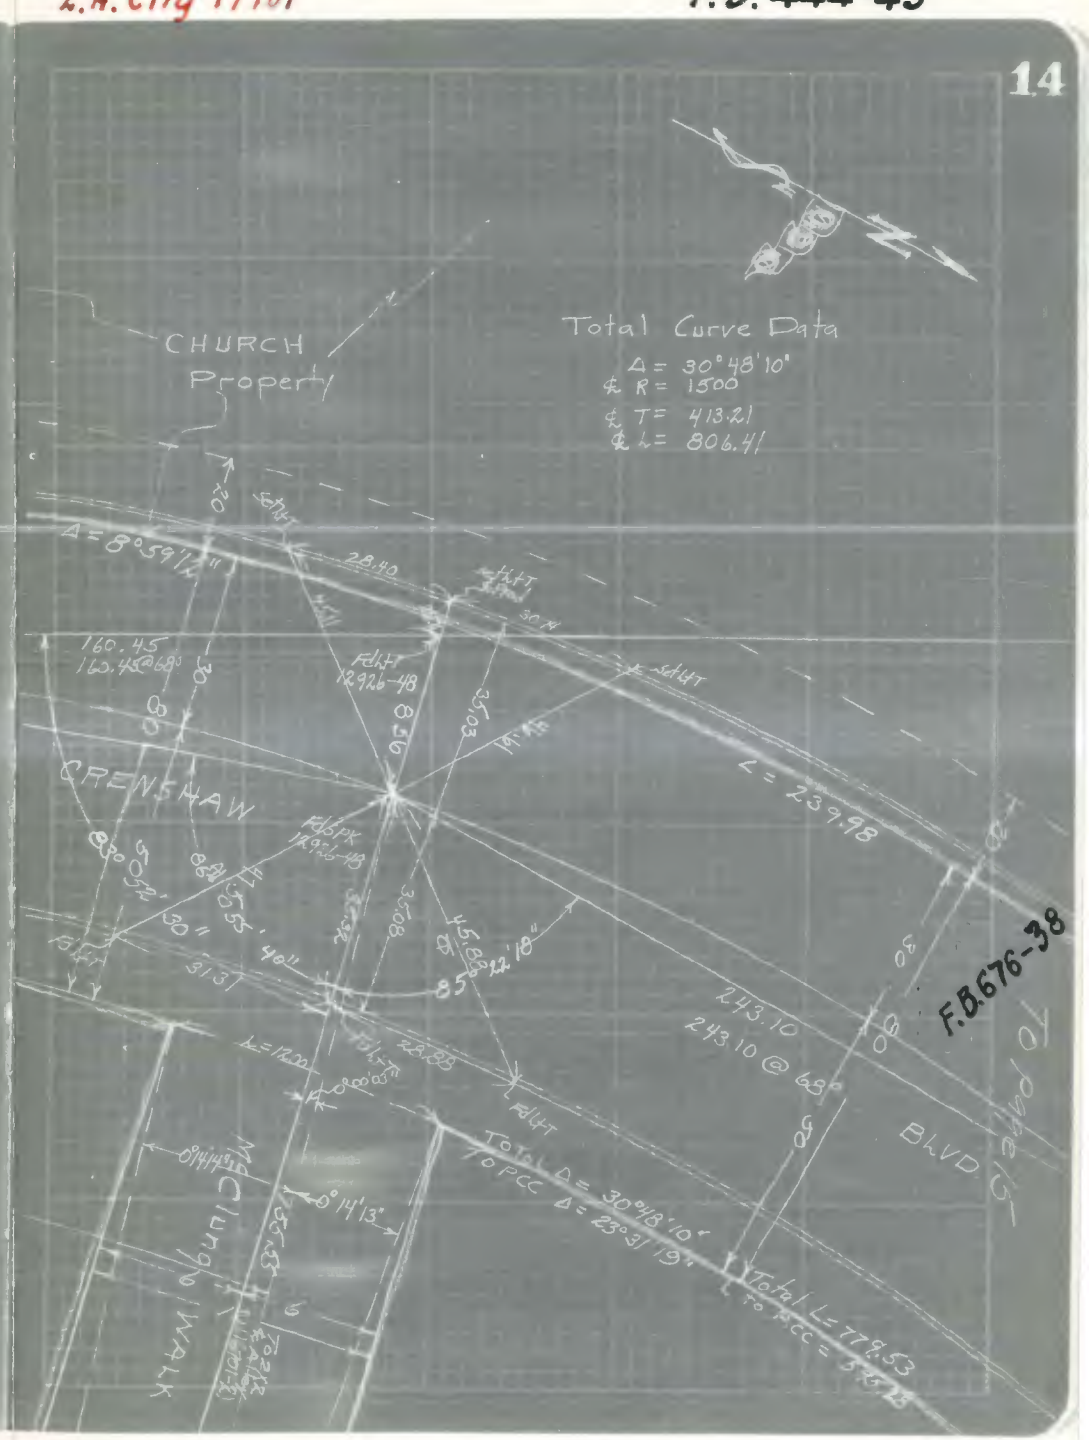

F.B. 444-44

F.B. 444-45

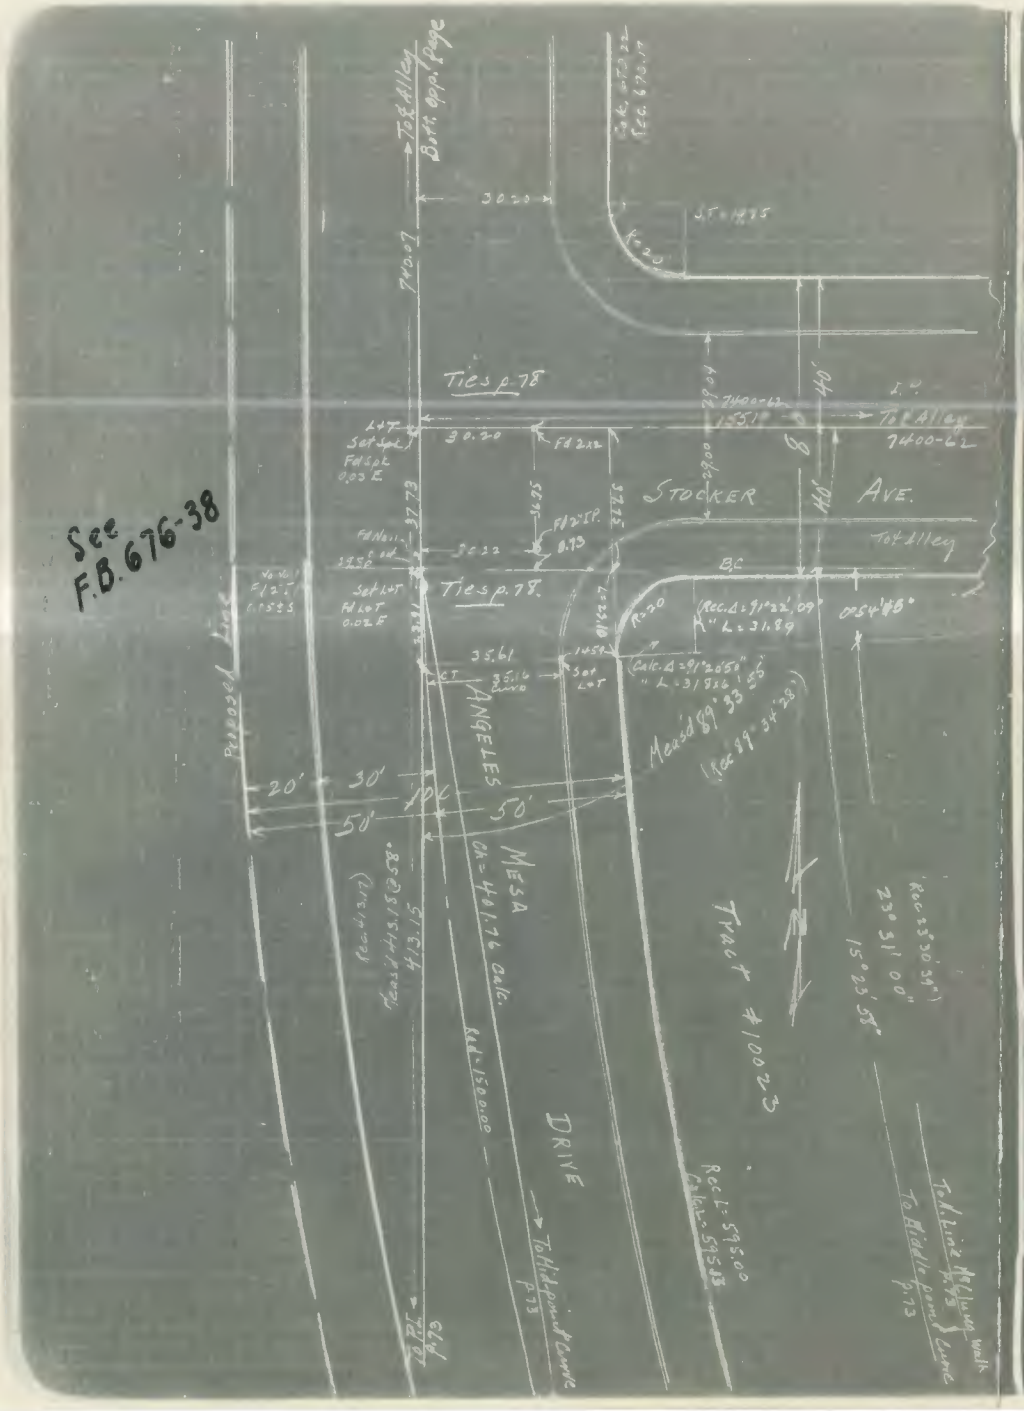

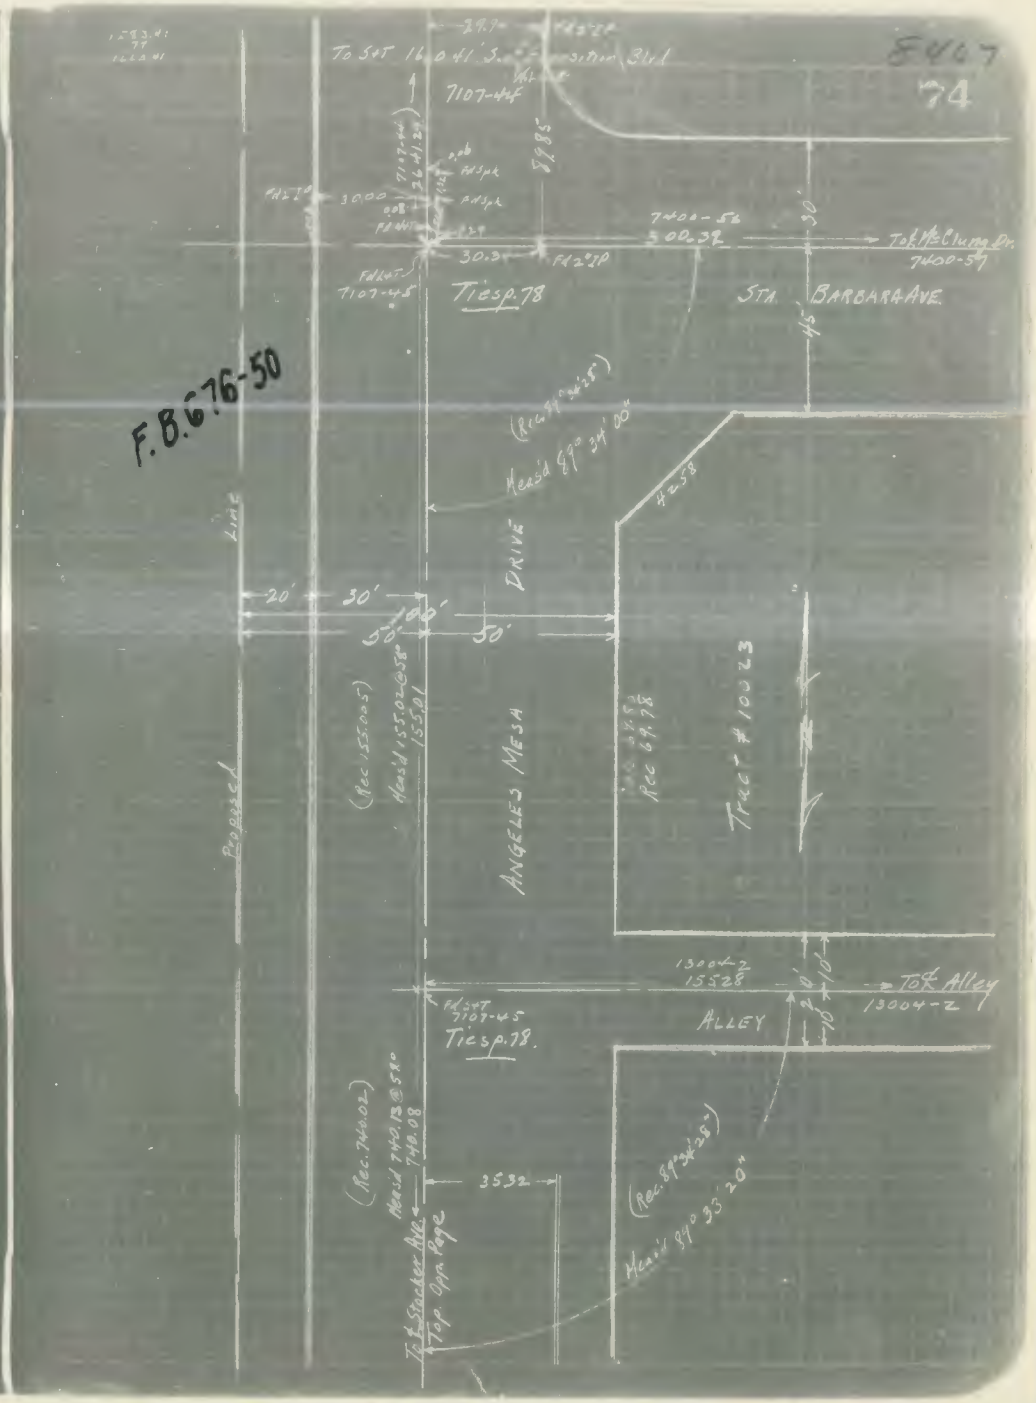

F.B. 444-46

F.B. 444-47

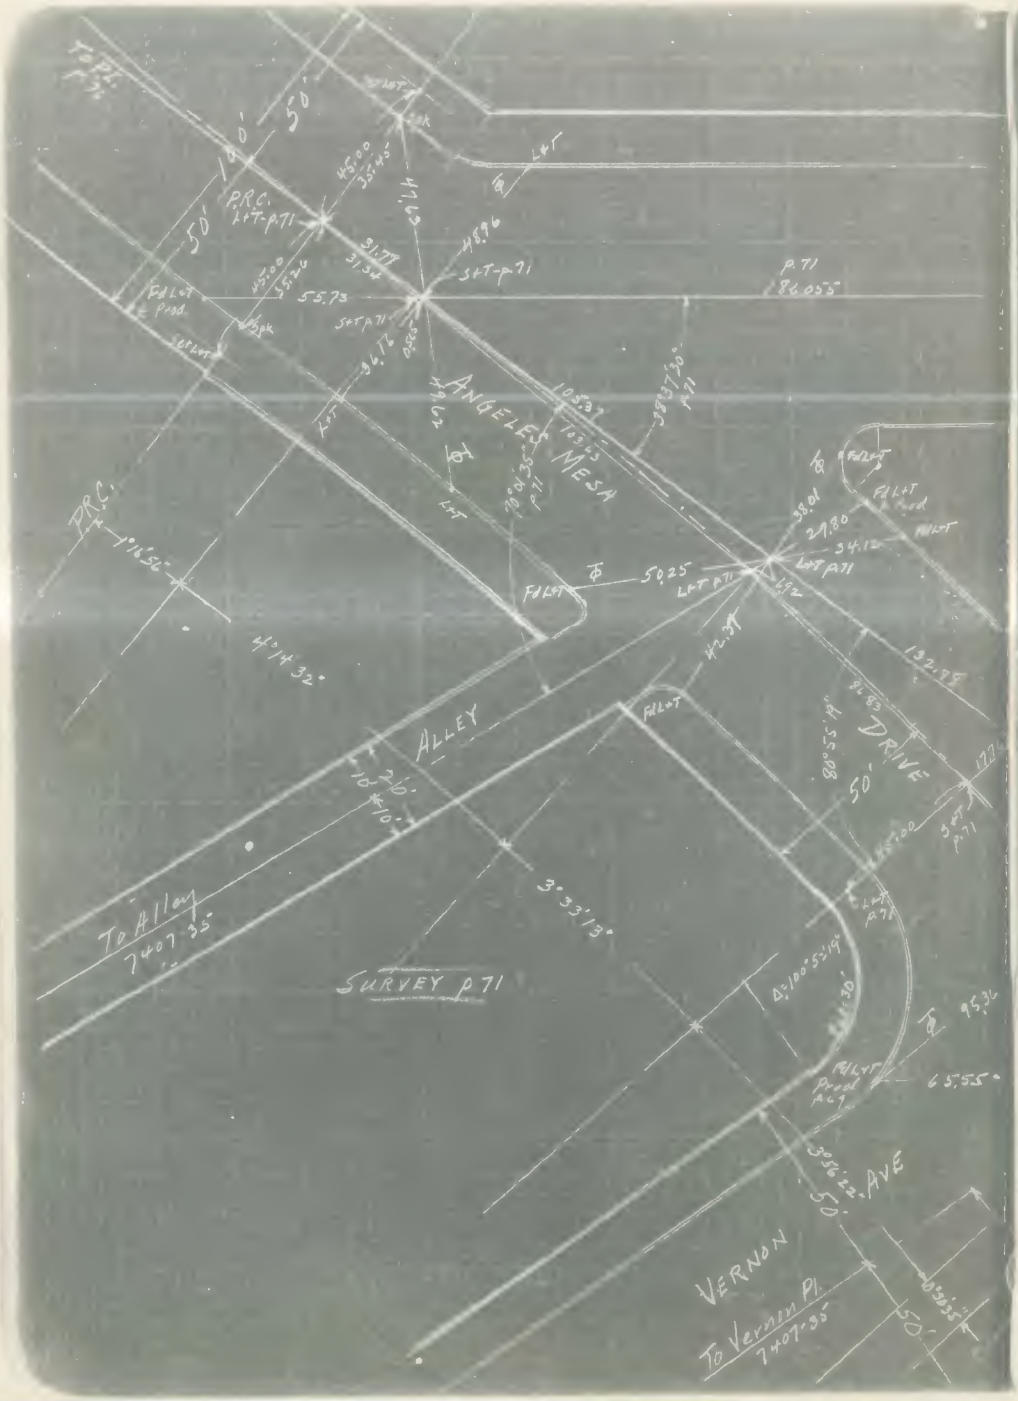

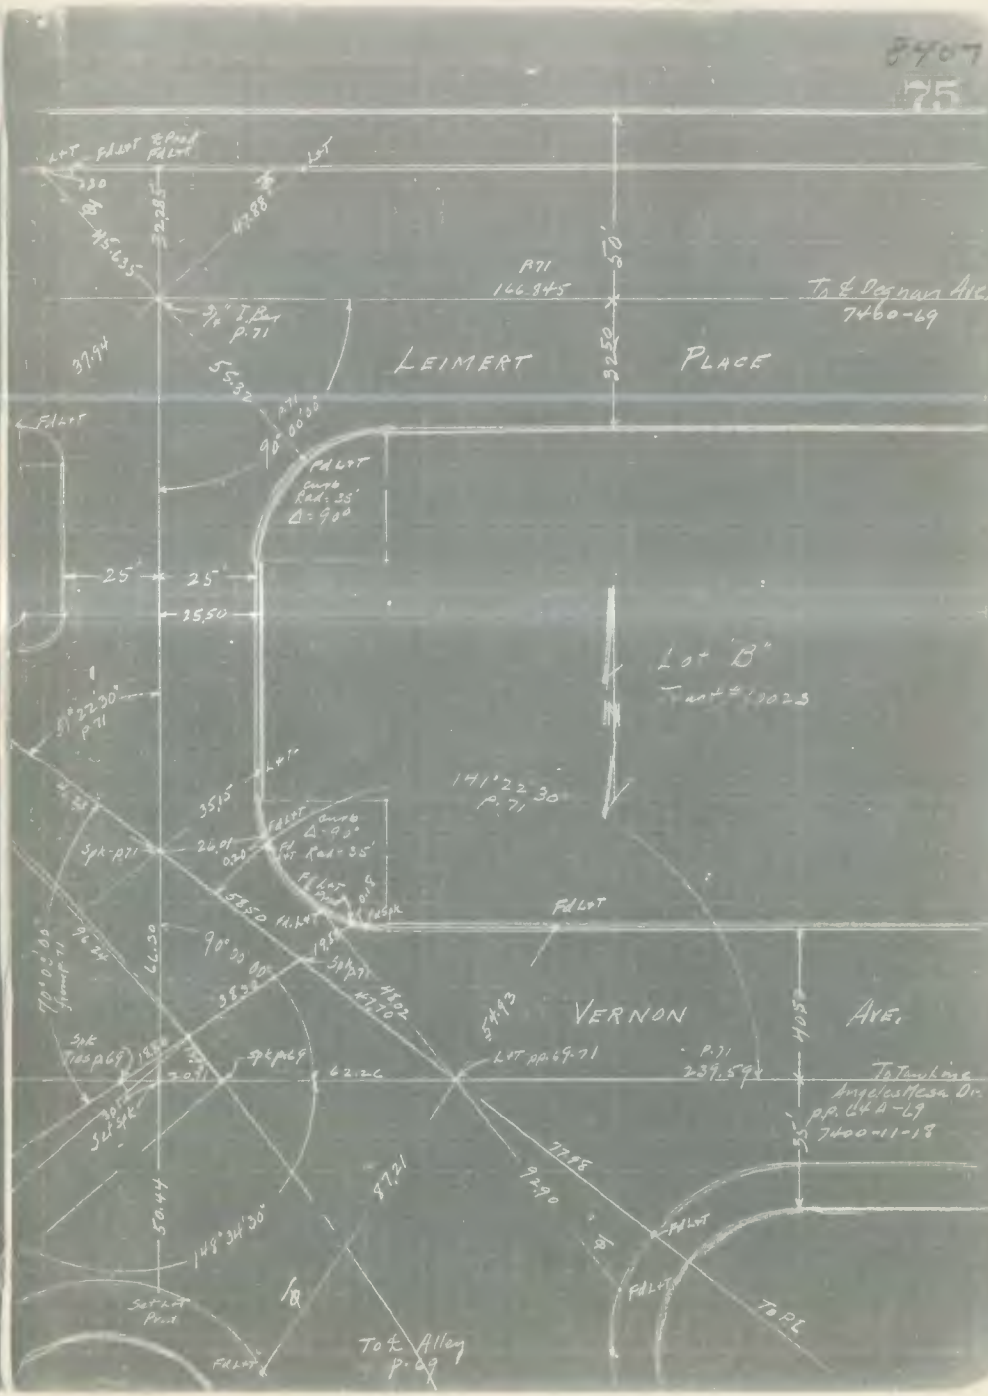

F.B. 444-48

F.B. 444-49

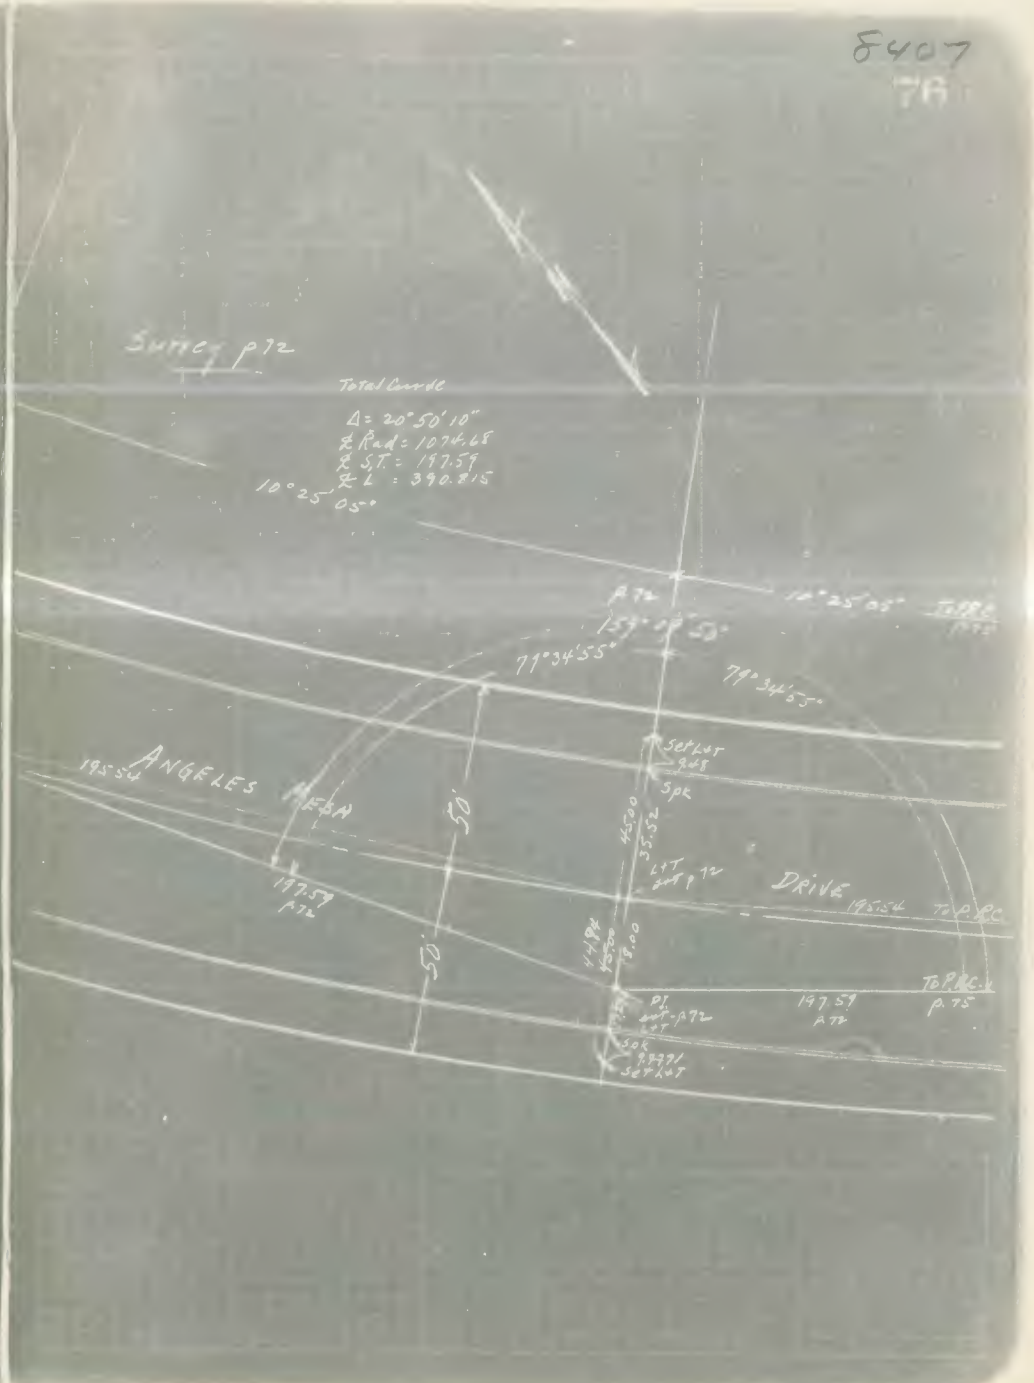

F.B. 444-50

F.B. 444-51

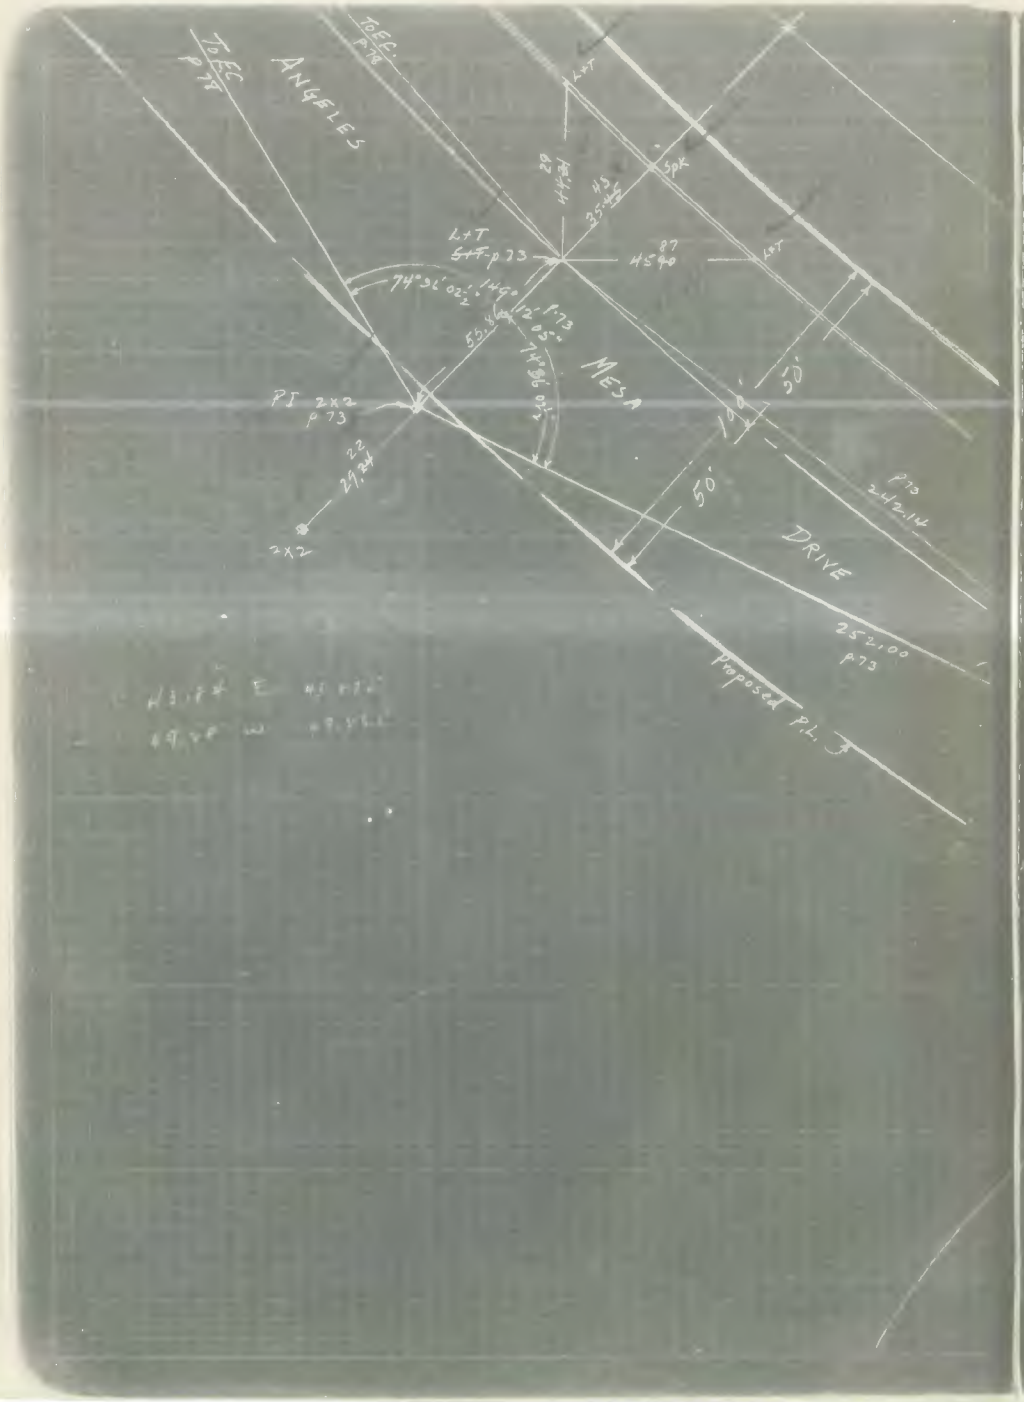

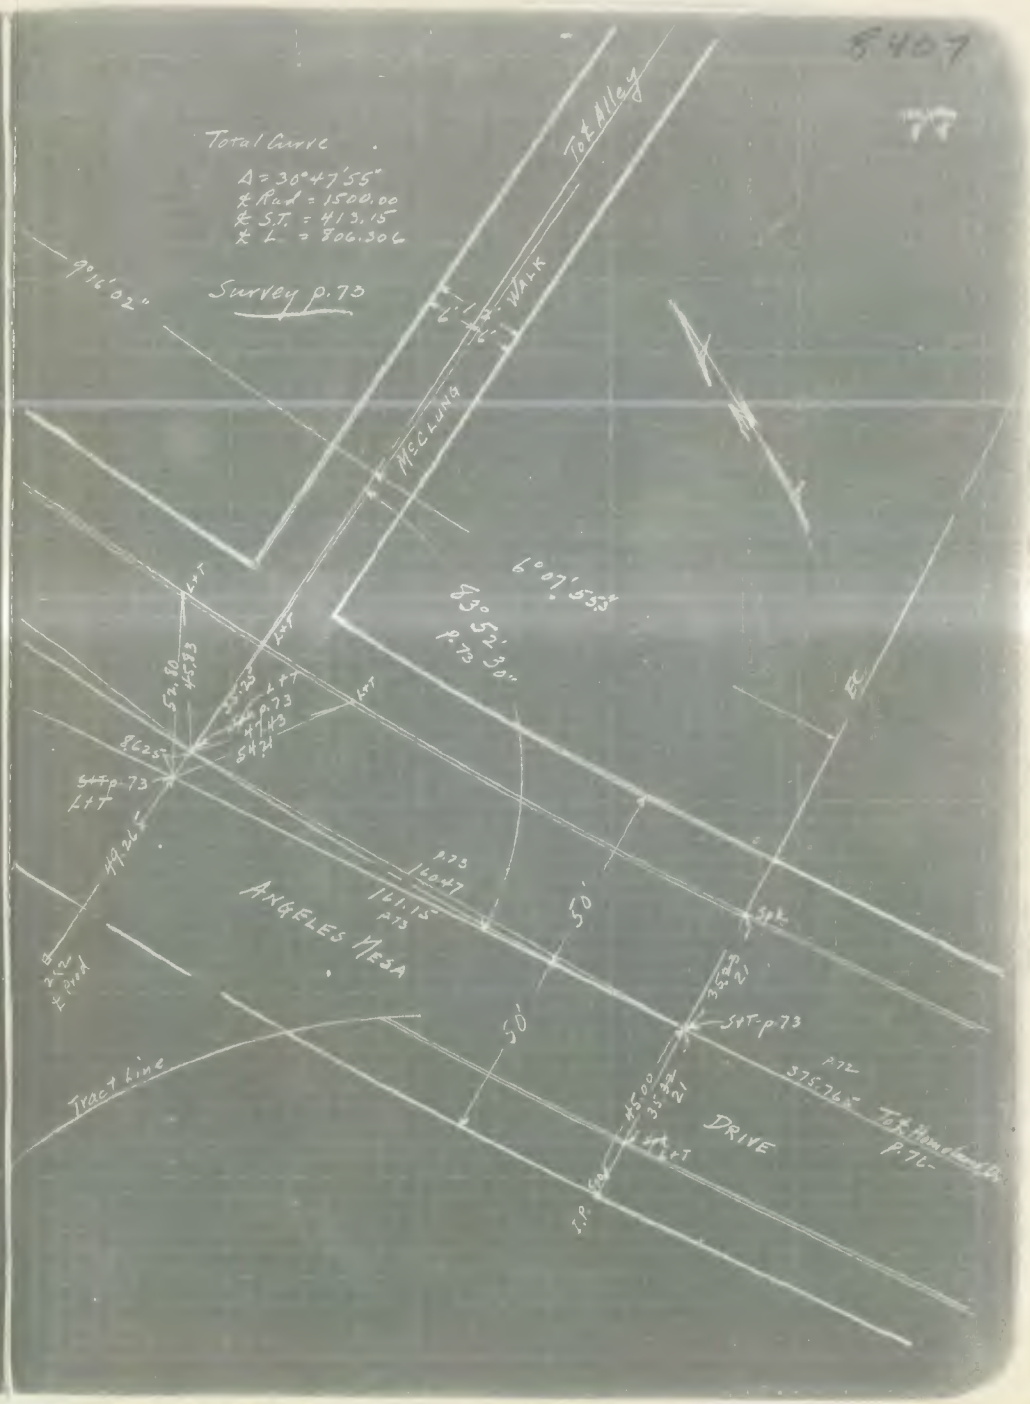

F.B. 444-52

F.B. 444-53

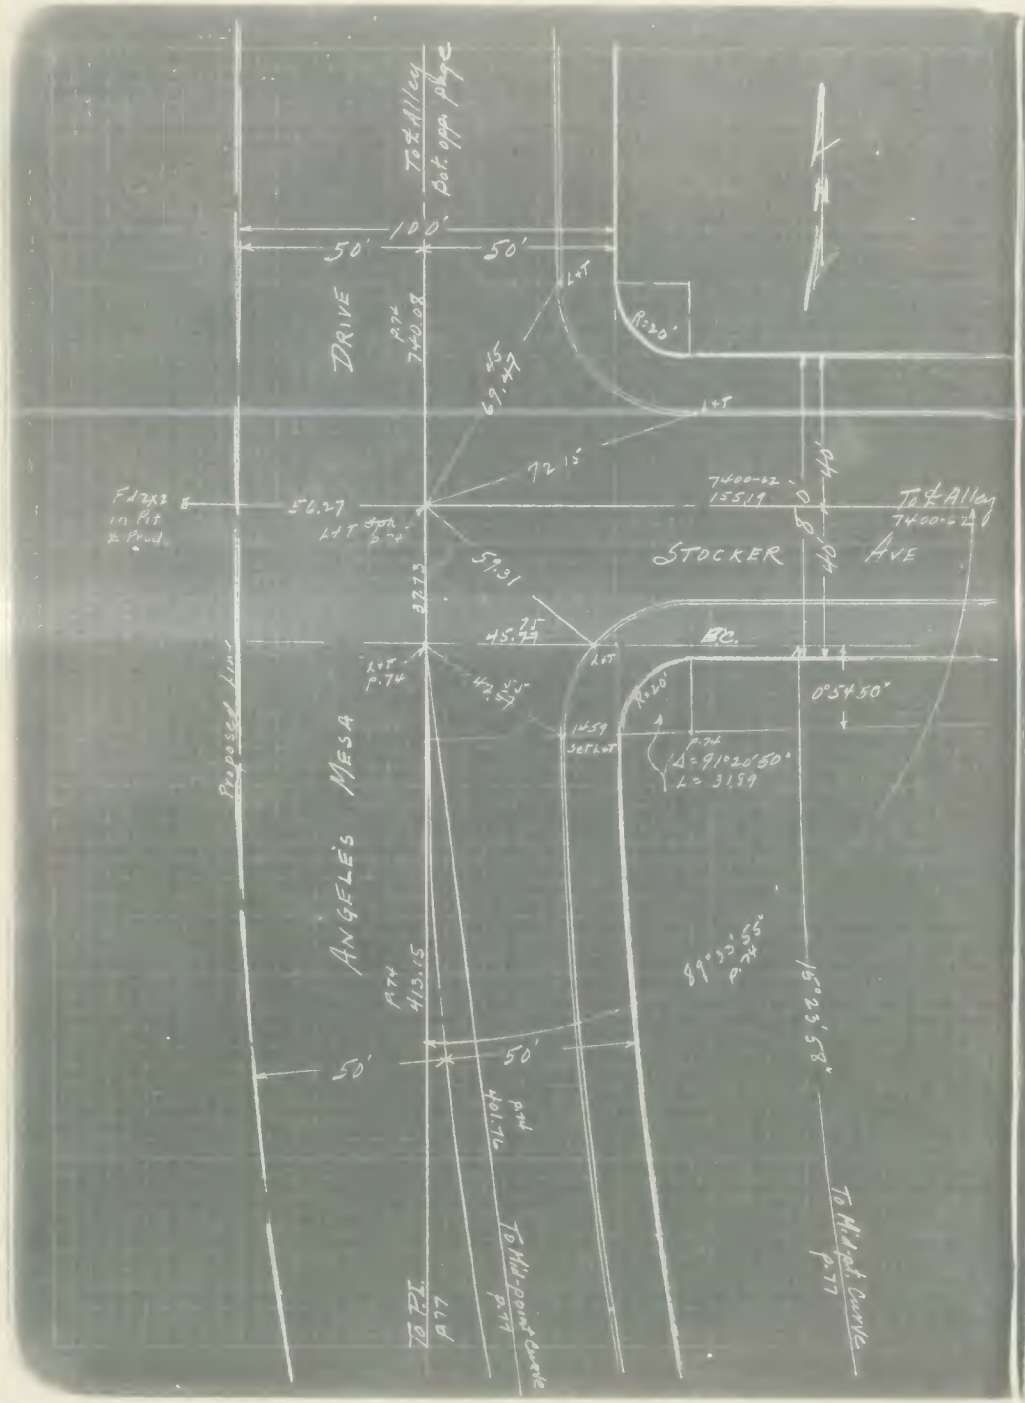

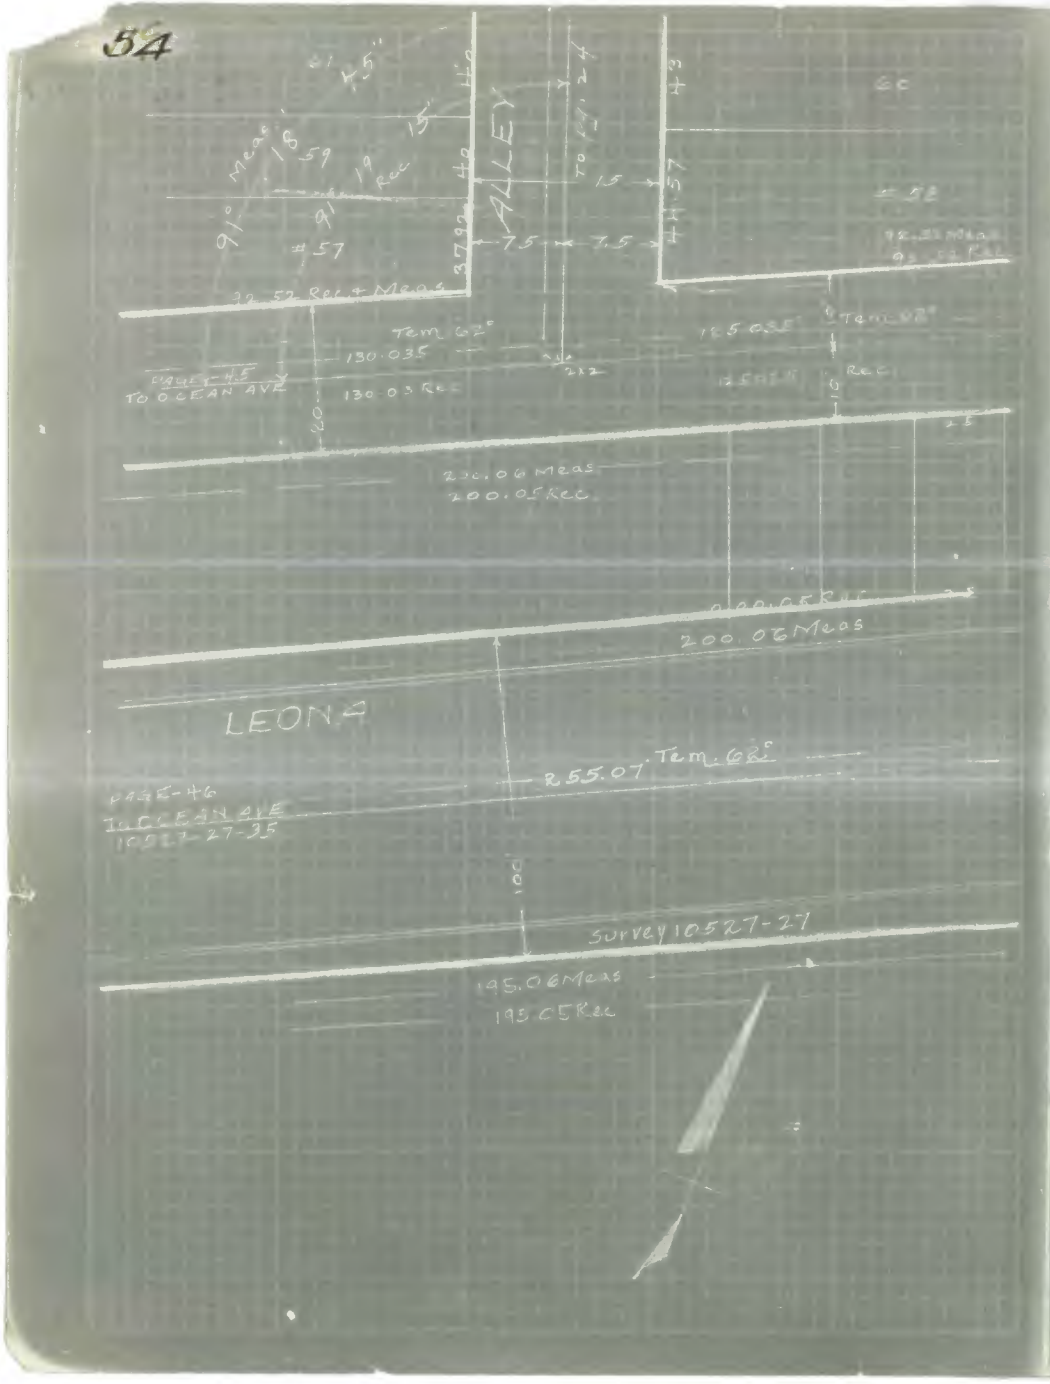
ALLEY
LEONA
PAGE-46
TO OCEAN AVE
10527-27-35
Survey 10527-27
200.06 Meas
200.05 Rec
255.07 Tem. 62°
195.06 Meas
195.05 Rec
130.035
130.03 Rec
Tem. 62°
92.52 Rec & Meas
#57
#58

FB444-54

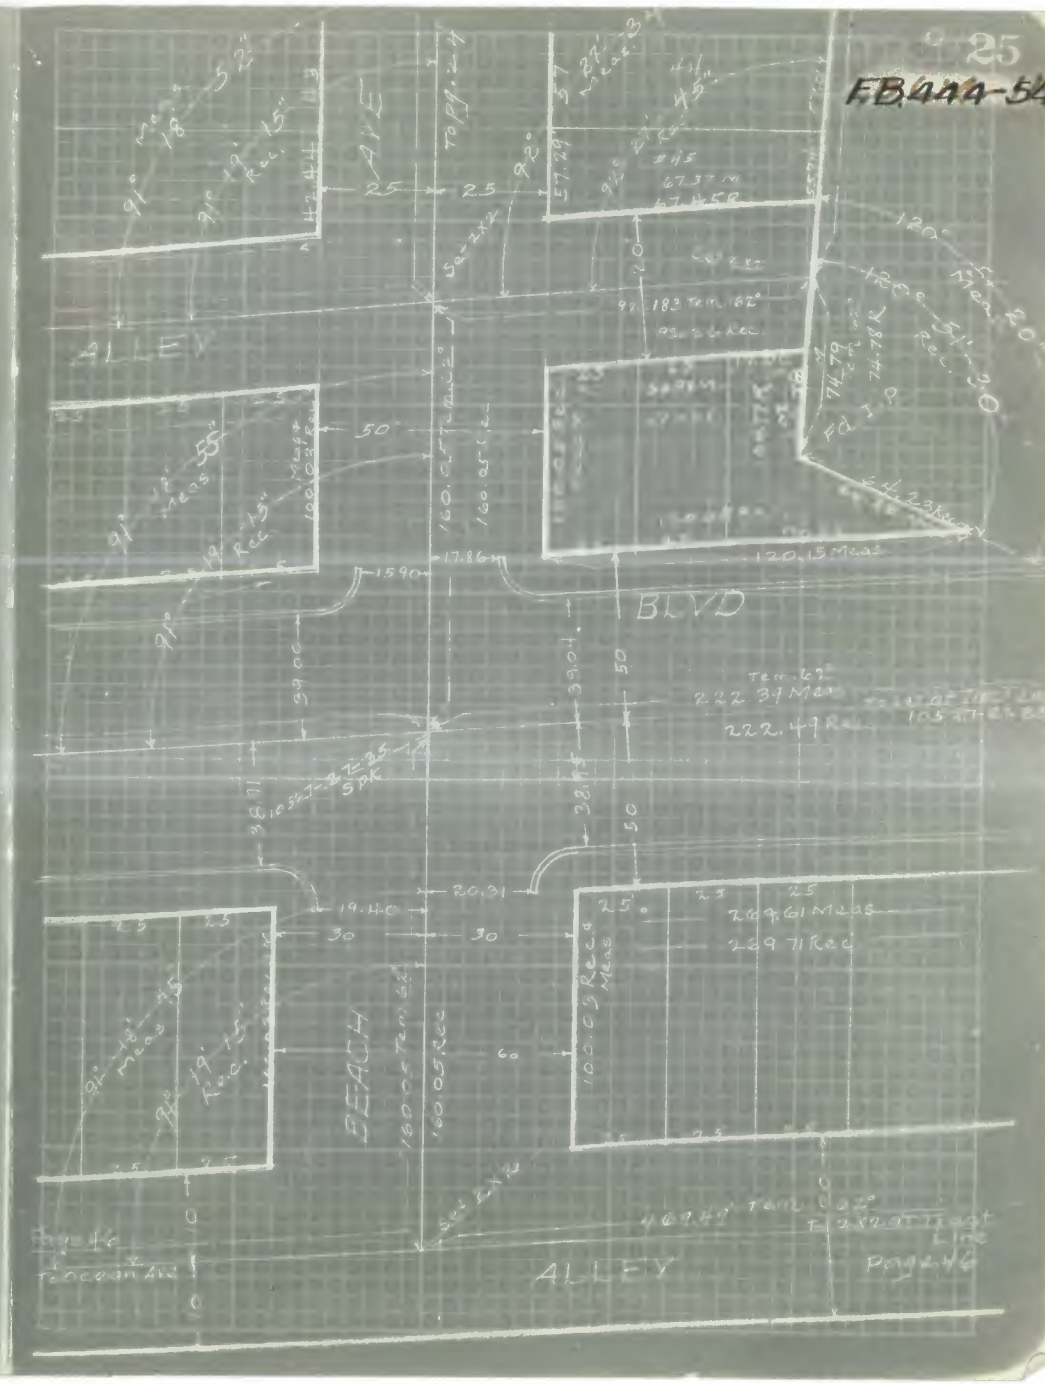
ALLEY
AVE
BLVD
BEACH
ALLEY
To Pg. 24
To Ocean Ave
Page 46
Page 46
Tem. 62°
222.39 Meas
222.49 Rec
269.61 Meas
269.71 Rec
120.15 Meas
100.03 Rec & Meas
160.05 Rec
160.05 Tem. 62°
Set 2x2
Fd. I.P.

AVE
160.05 Tem 62°
160.05 Rec.
50
255.06 M.
10527-27-35
Tie
255.07' Tem 62°
LEONA
11601-32
Ties
100
Street 10527-27
25 25 25 25
195.06 Meas
195.05 Rec
30
30
160.05
OCEAN
91° 18' Meas
91° 19' 45" Rec
195.06 Meas
195.05 R
10527-27-35
SPK.
222.49 Rec
10527-27-35
Lat
50
To HARBOR ST
10527-26-34
BLVD.
11601-32
269.71 Rec.
269.61 Meas
25 25 25 25 25 25 25 25 25
BEACH Survey Page 25
33°
52"
33°
424.14 Rec.
424.04 Meas
19° 15' Rec
38°
15"
469.490' Tem 62°
469.59 Rec
20
ALLEY
Old City Boundary Line
Produced.
11601-32
Ties
11694-6

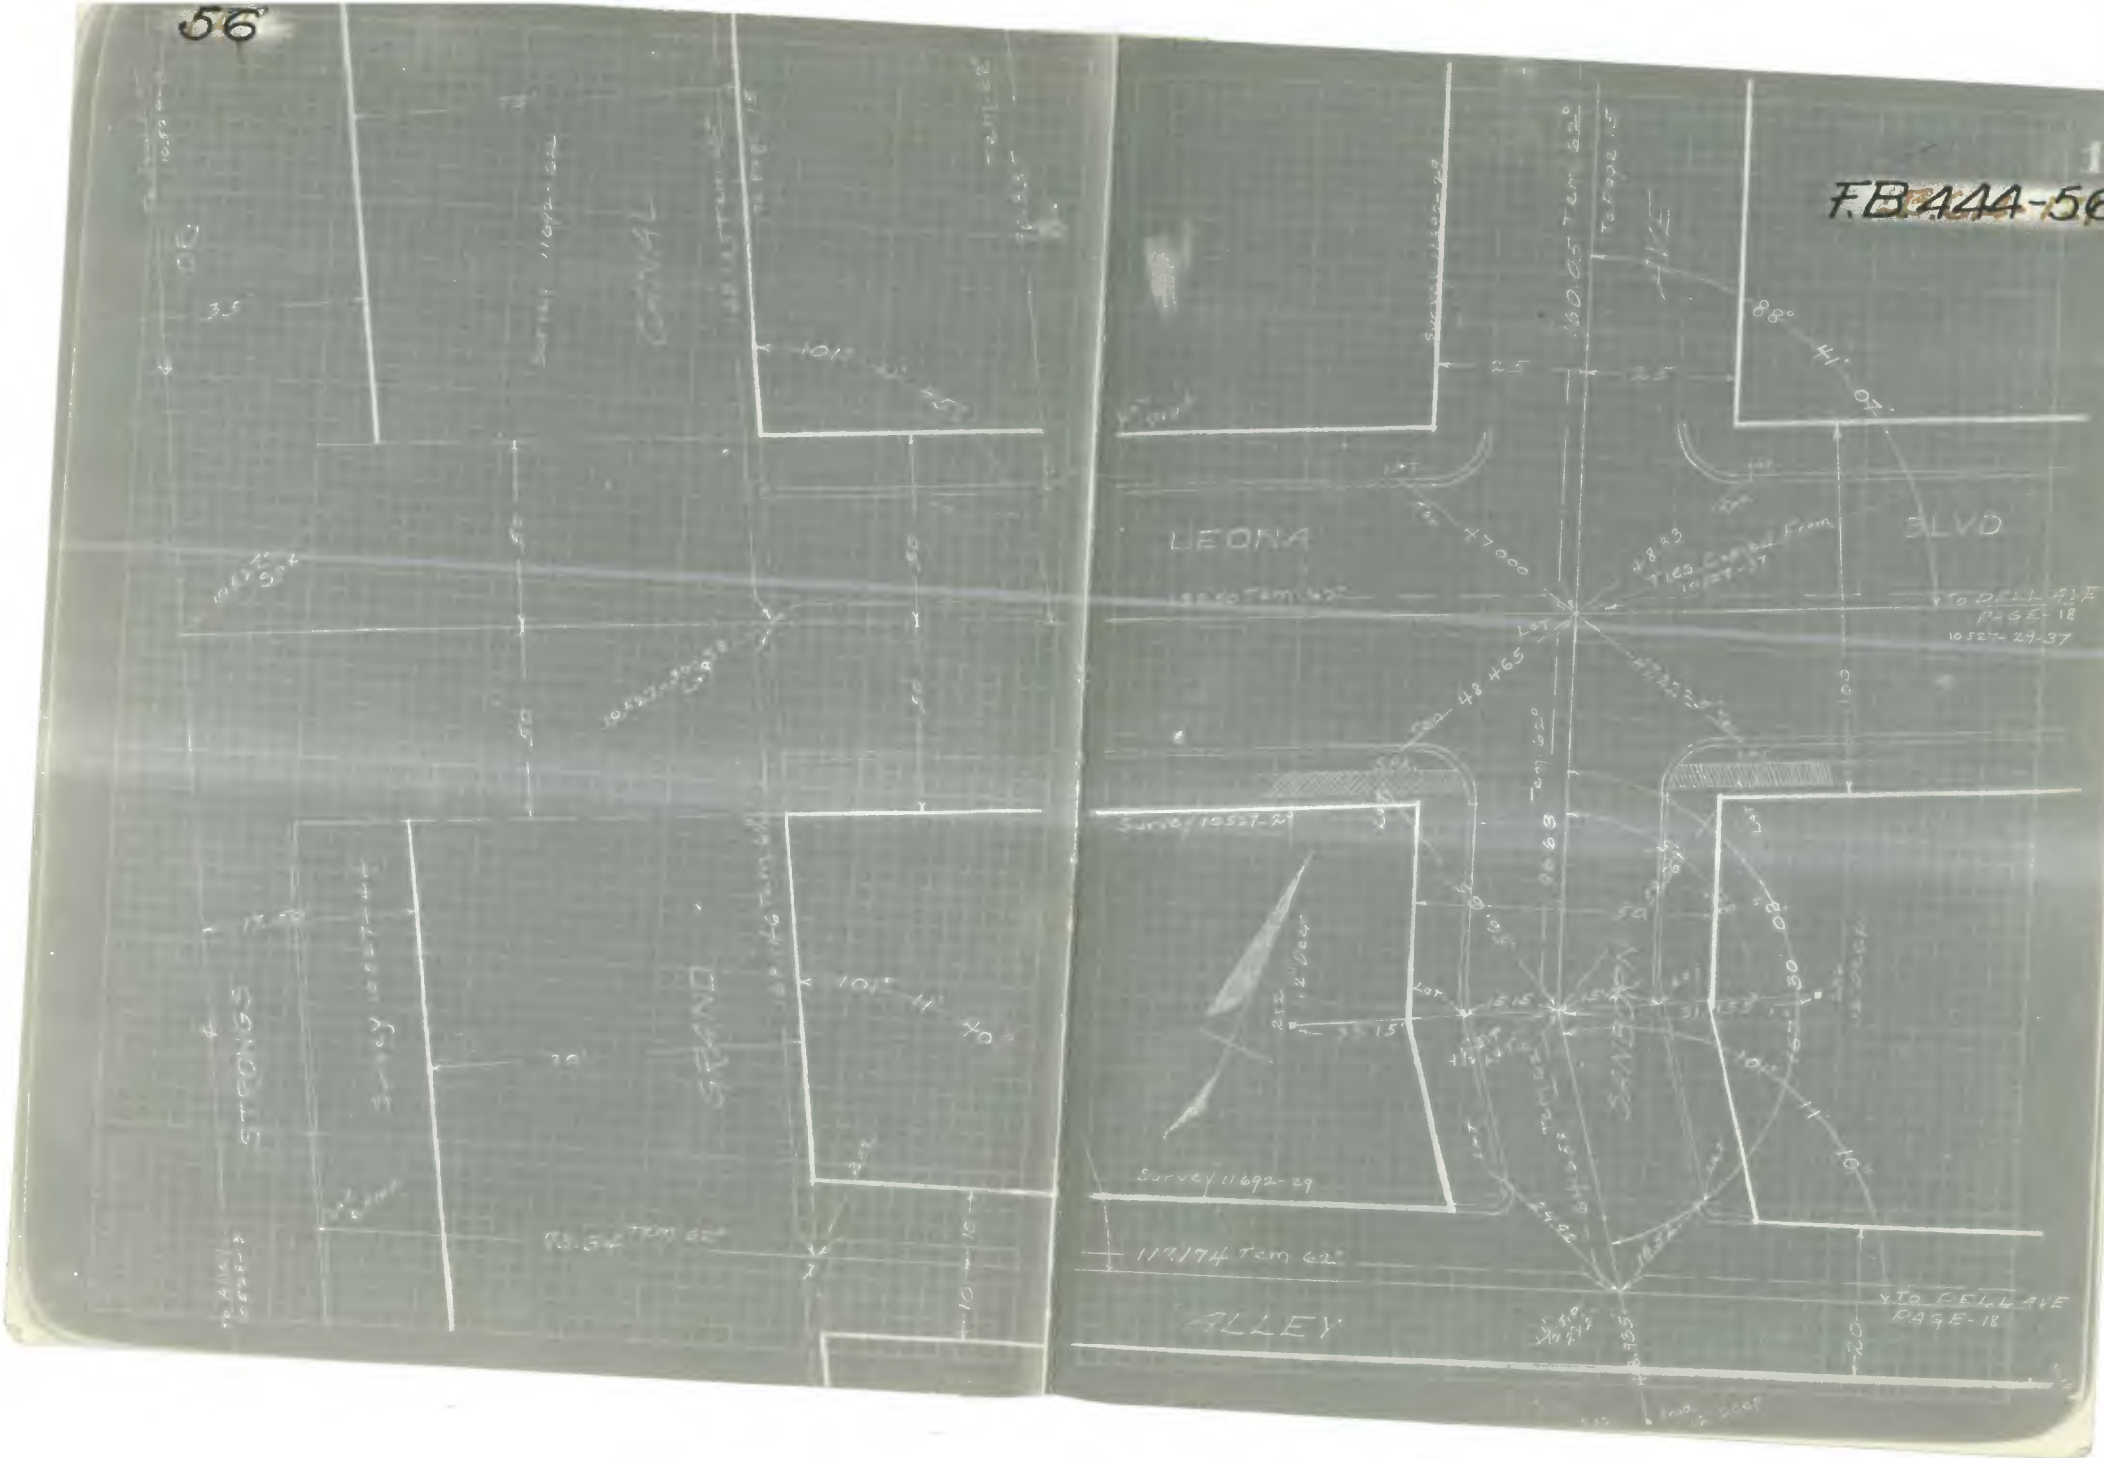
FB 444-56
CANAL
LEONA
BLVD
STRONGS
GRAND
SANBORN
ALLEY
Survey 10527-29
Survey 11692-29
117.174 Tem 62°
TO DELL AVE PAGE-18
10527-29-37
Ties Copied From
47000
48465
88° 41' 07"
101° 11' 40"
73.54 Tem 62°
160.05 Tem 62°

AVE
LEONA
BLVD
CLUNE
ALLEY
Tem. 62°
306.794
306.80'
22.18
2x2
Survey 11692-35

10527-28-36
TO CLUNE AVE
PAGE-21
306.80 Tem 62°
Survey 10527-28

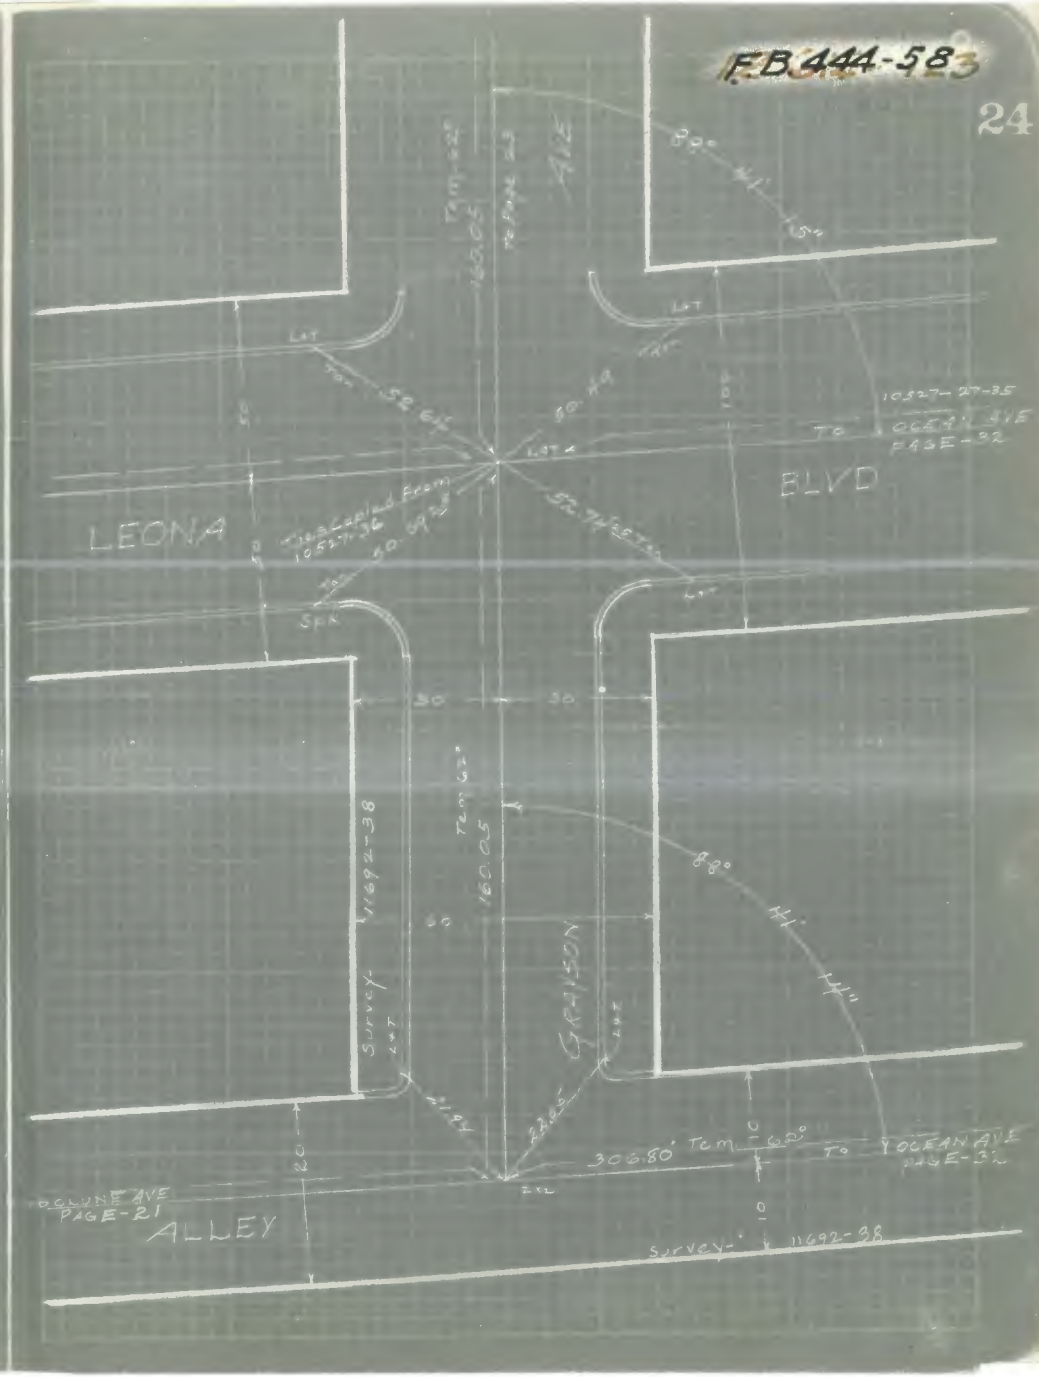
AVE
LEONA
BLVD
GRAYSON
ALLEY
10527-27-35
TO OCEAN AVE
PAGE-32
Tie Copied From
10527-36
Tem 62°
160.05
11692-38
Survey
306.80 Tem 62°
TO CLUNE AVE
PAGE-21
TO OCEAN AVE
PAGE-32
Survey 11692-38

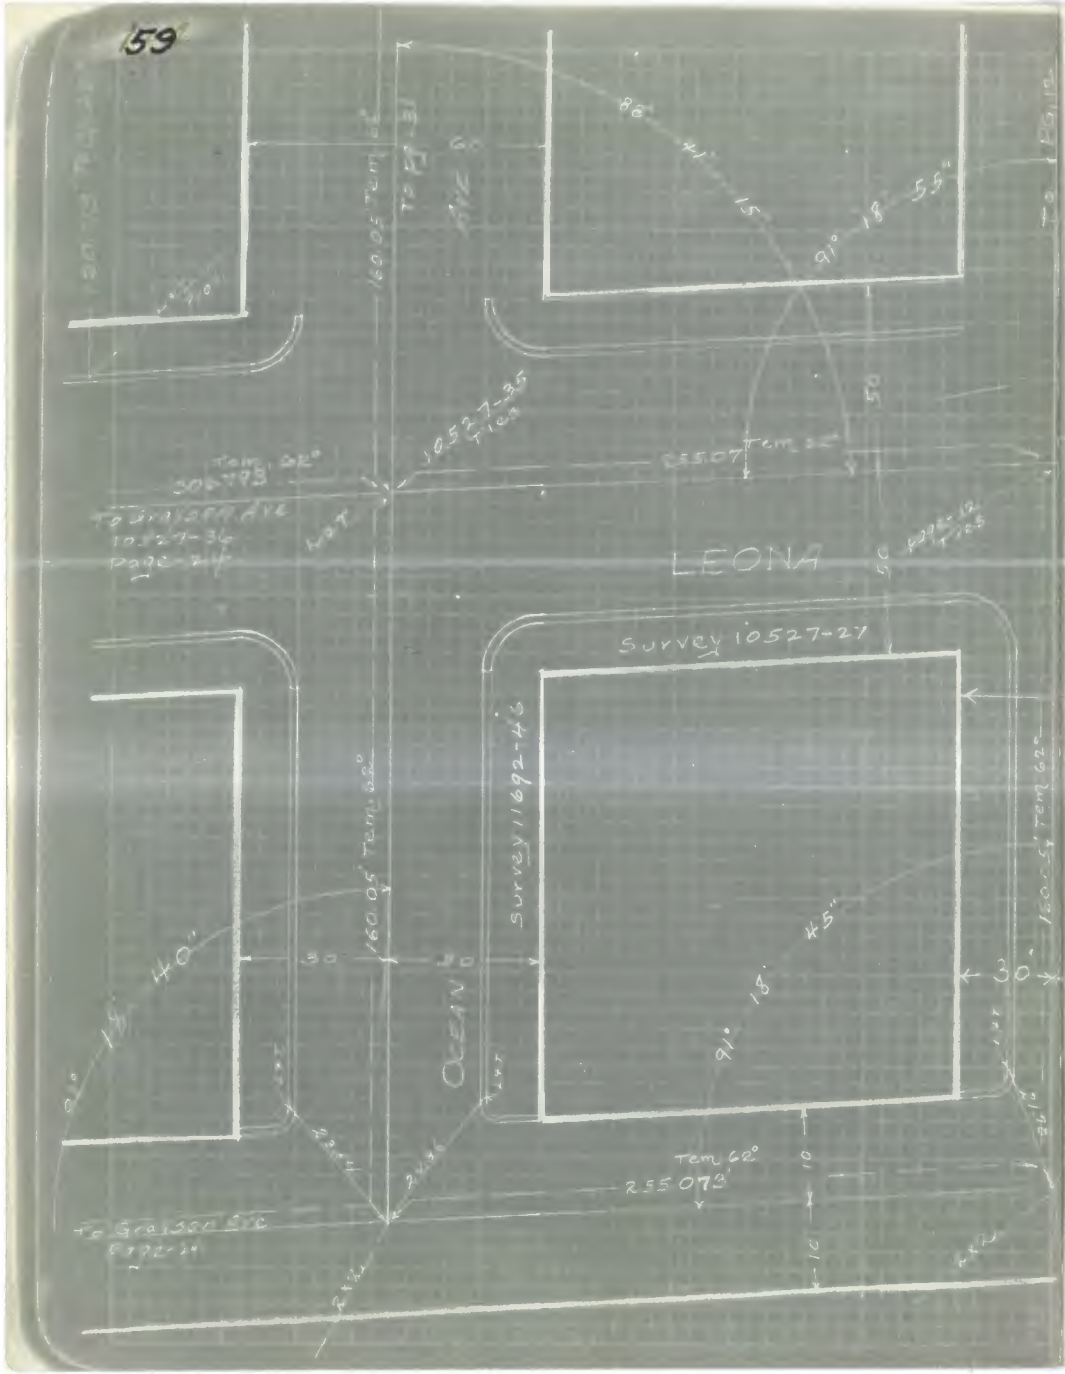
LEONA
Survey 10527-27
Survey 11692-46
OCEAN
To Grayson Ave
10527-36
Page-24
10527-35
Ties
255.07 Tem 62°
255.073 Tem 62°
160.05 Tem 62°
91° 18' 55"
91° 18' 45"
40"
30
30
30
30
Tem 62°
To Grayson Ave
Page-24

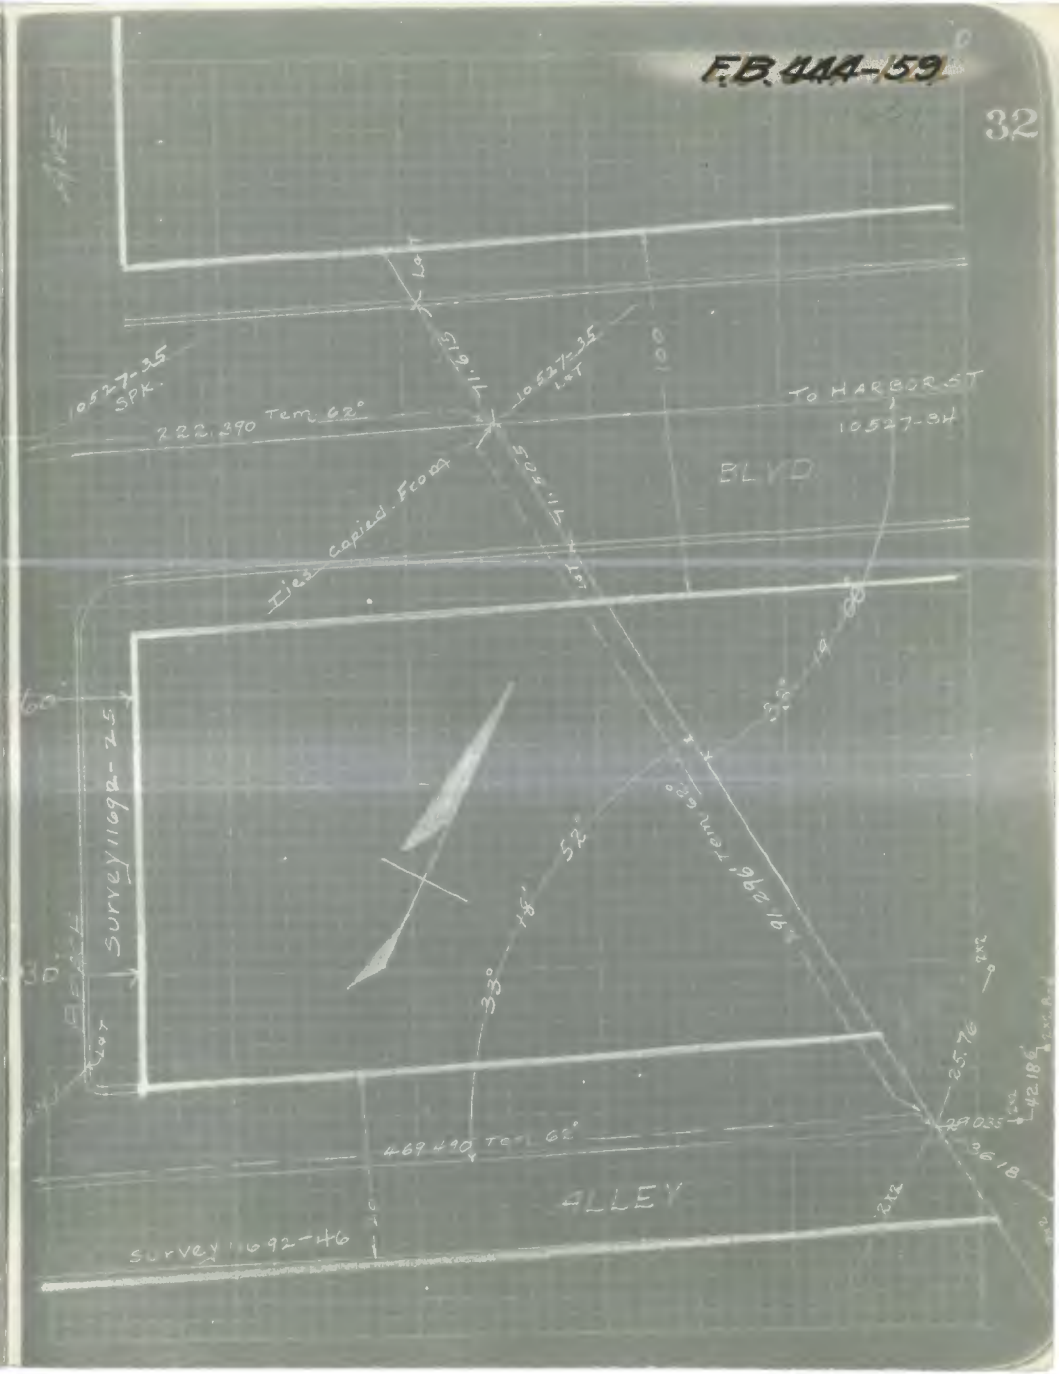
10527-35
SPK.
222.390 Tem 62°
10527-35
LOT
To HARBOR ST
10527-34
BLVD
Ties copied From
Survey 11692-25
91.296 Tem 62°
33° 18' 52"
469.490 Tem 62°
ALLEY
Survey 11692-46
25.76
42.186
29.035
36.18

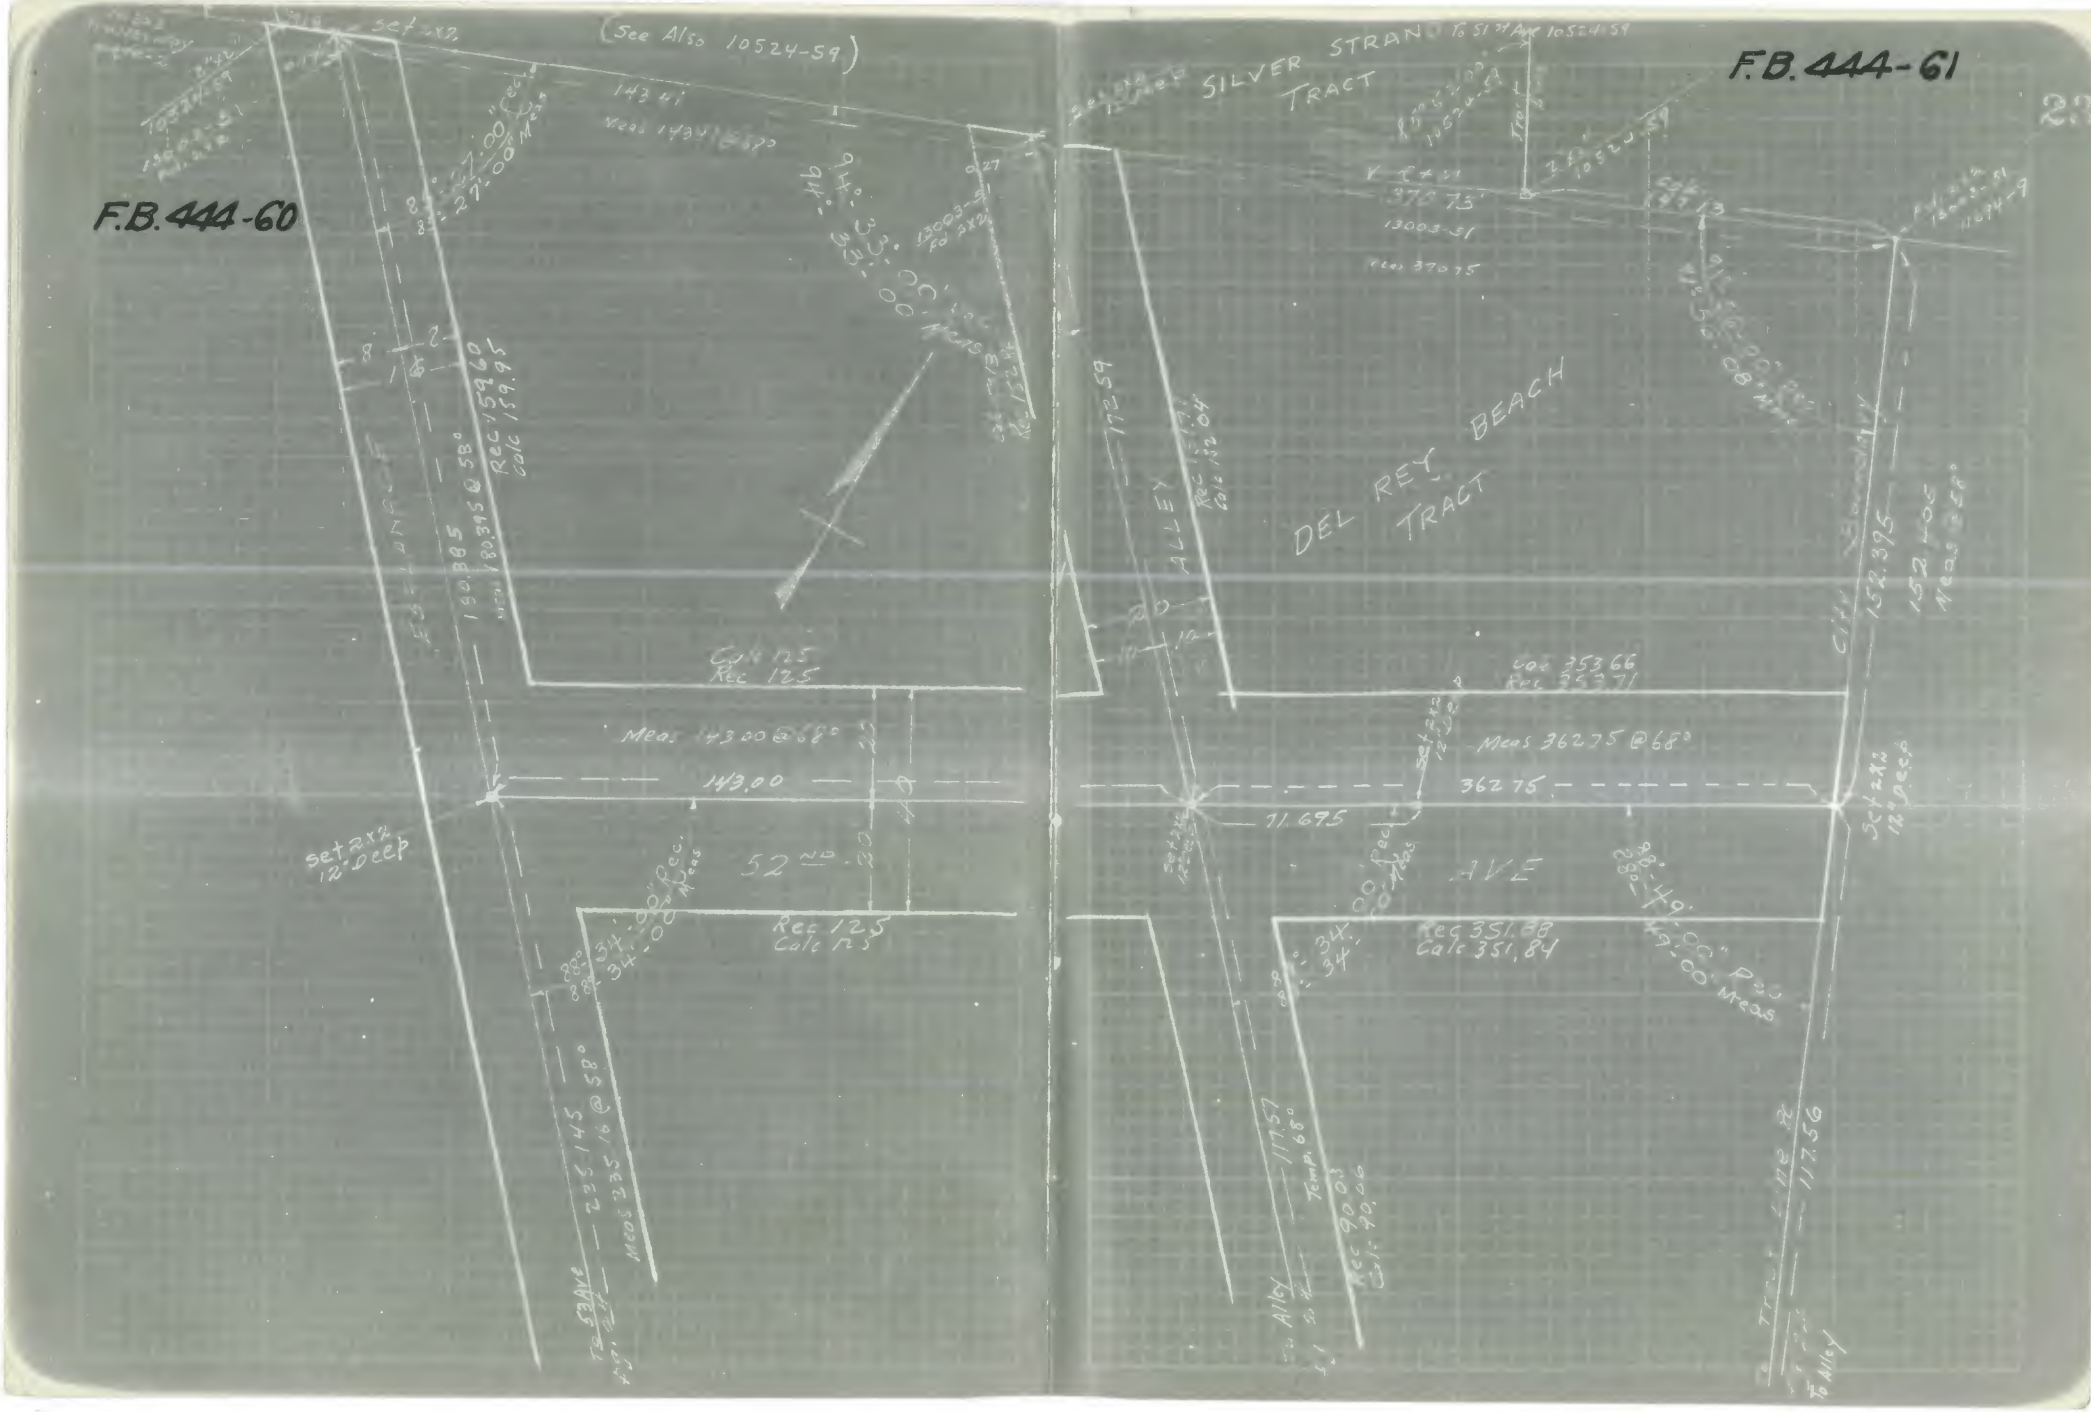
F.B. 444-60
F.B. 444-61
(See Also 10524-59)
SILVER STRAND TRACT
DEL REY BEACH TRACT
ALLEY
AVE
52ND
Rec 125
Calc 125
Meas 143.00 @ 68°
143.00
Rec 353.66
Meas 362.75 @ 68°
362.75
71.695
Rec 351.88
Calc 351.84
Set 2x2 12" Deep
Set 2x2 12" Deep
Set 2x2 12" Deep
Rec 159.60
Calc 159.95
Meas 180.395 @ 58°
Meas 235.16 @ 58°
Meas 235.145
Rec 152.04
Calc 152.04
Meas 370.75
13003-51
152.395
117.56
117.57
Temp. 68°
Rec 90.03
Calc 90.06
To Alley
To Alley

F.B. 444-62

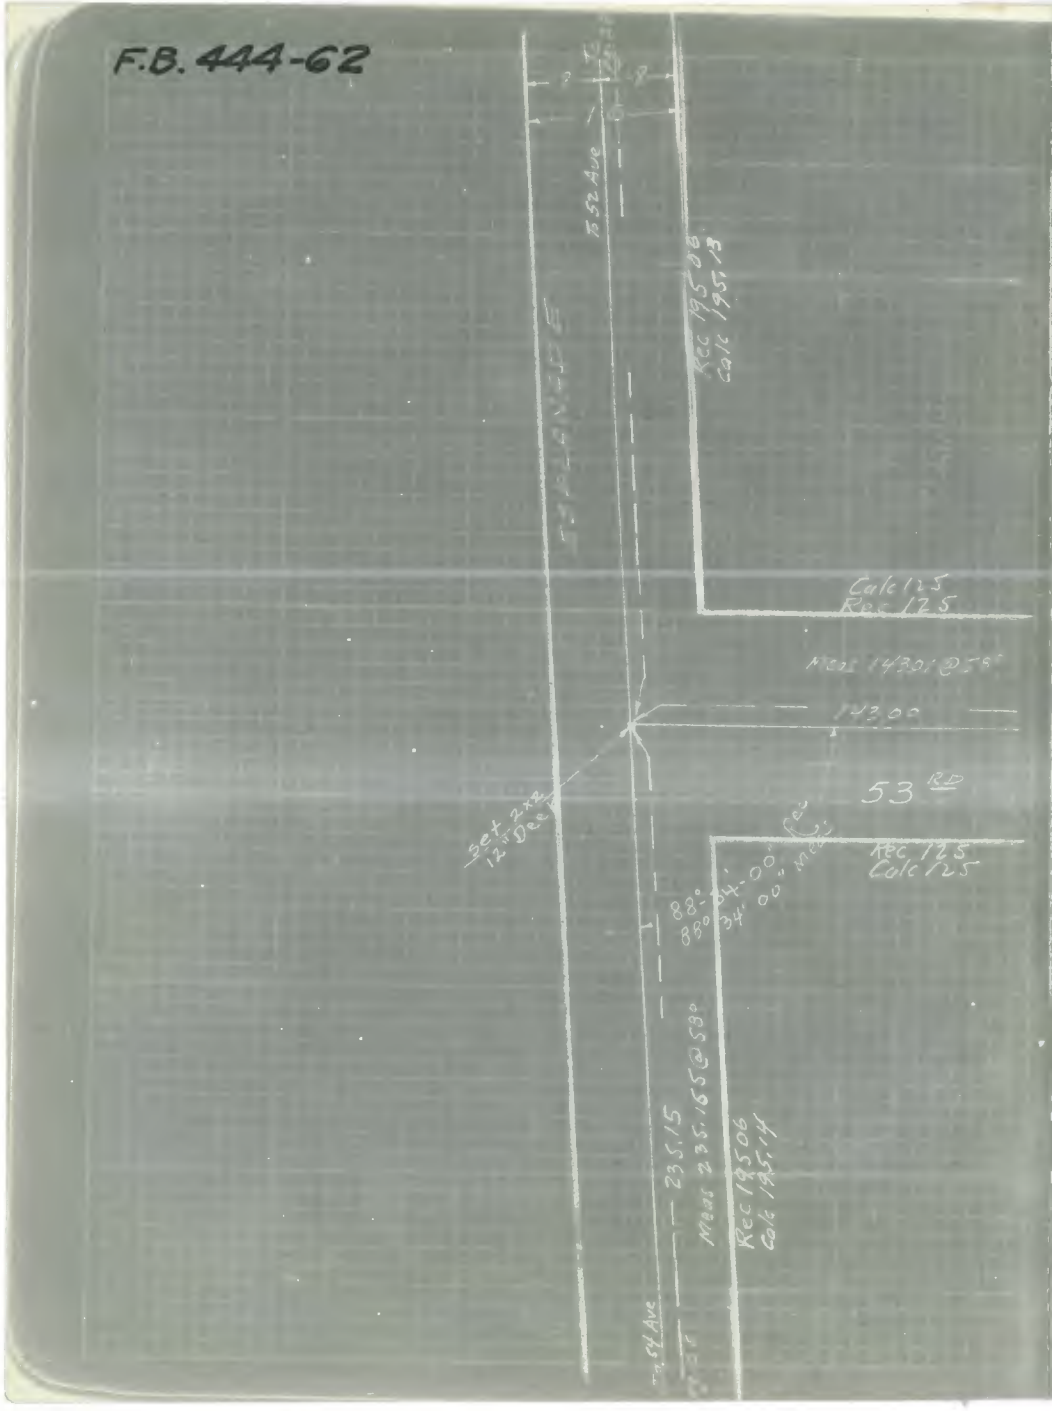

F.B. 444-63

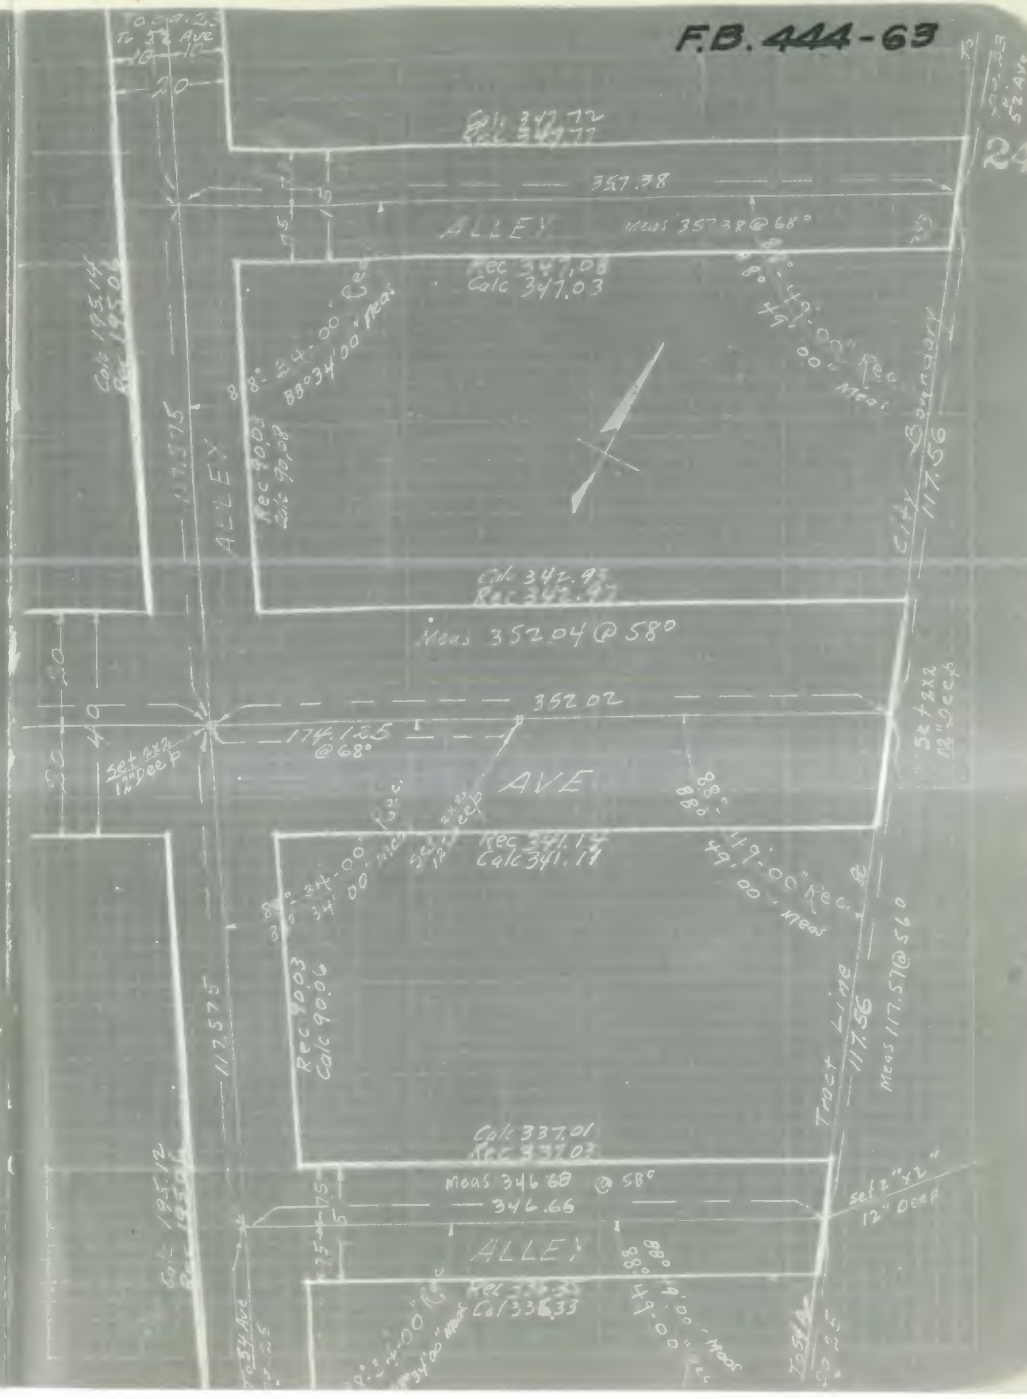

F.B. 444-64

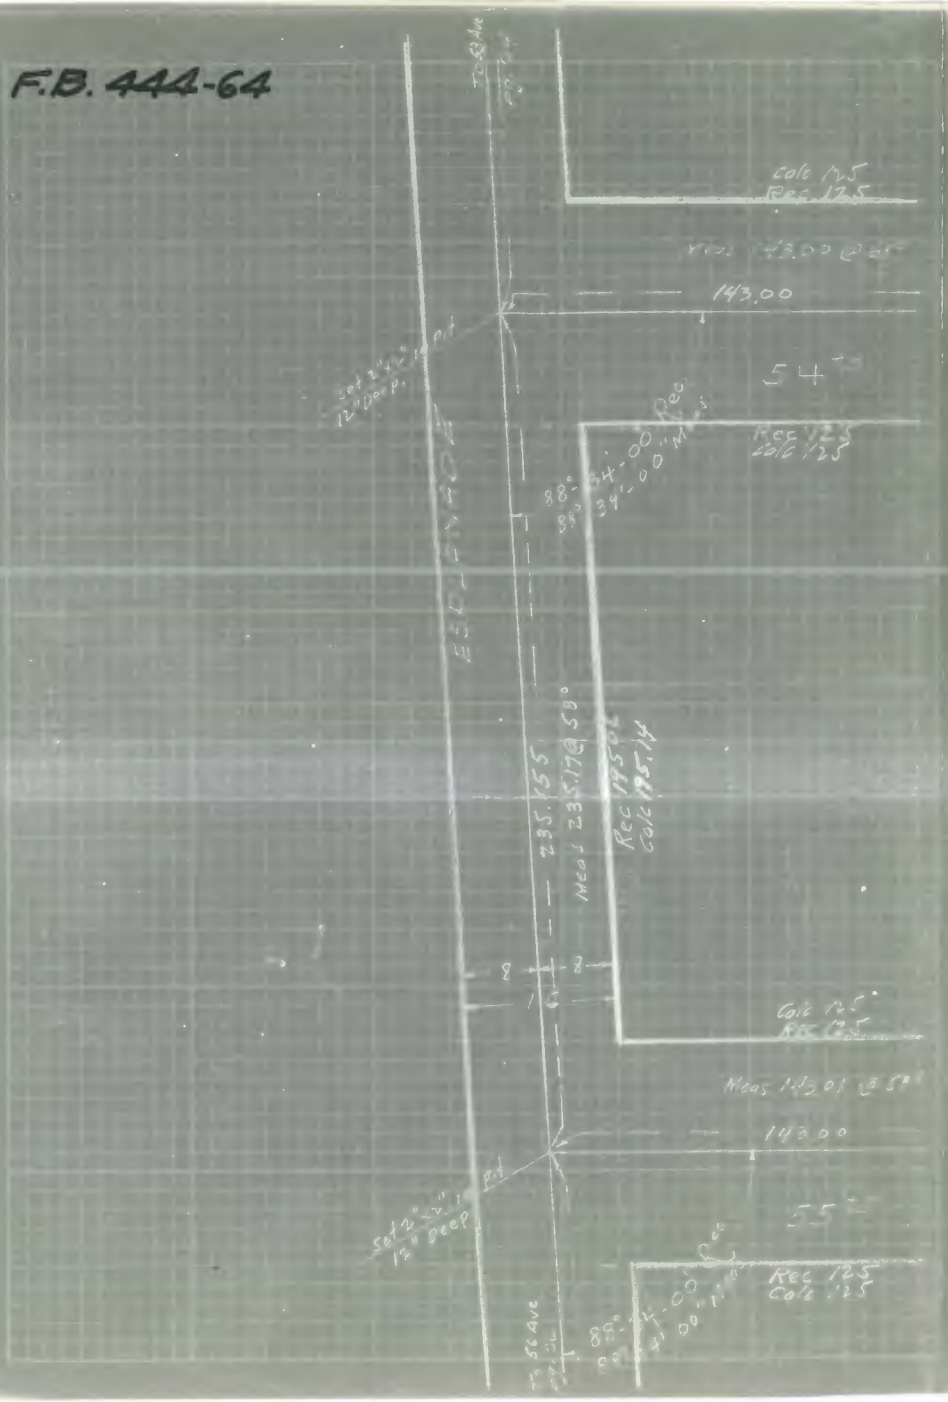

F.B. 444-65

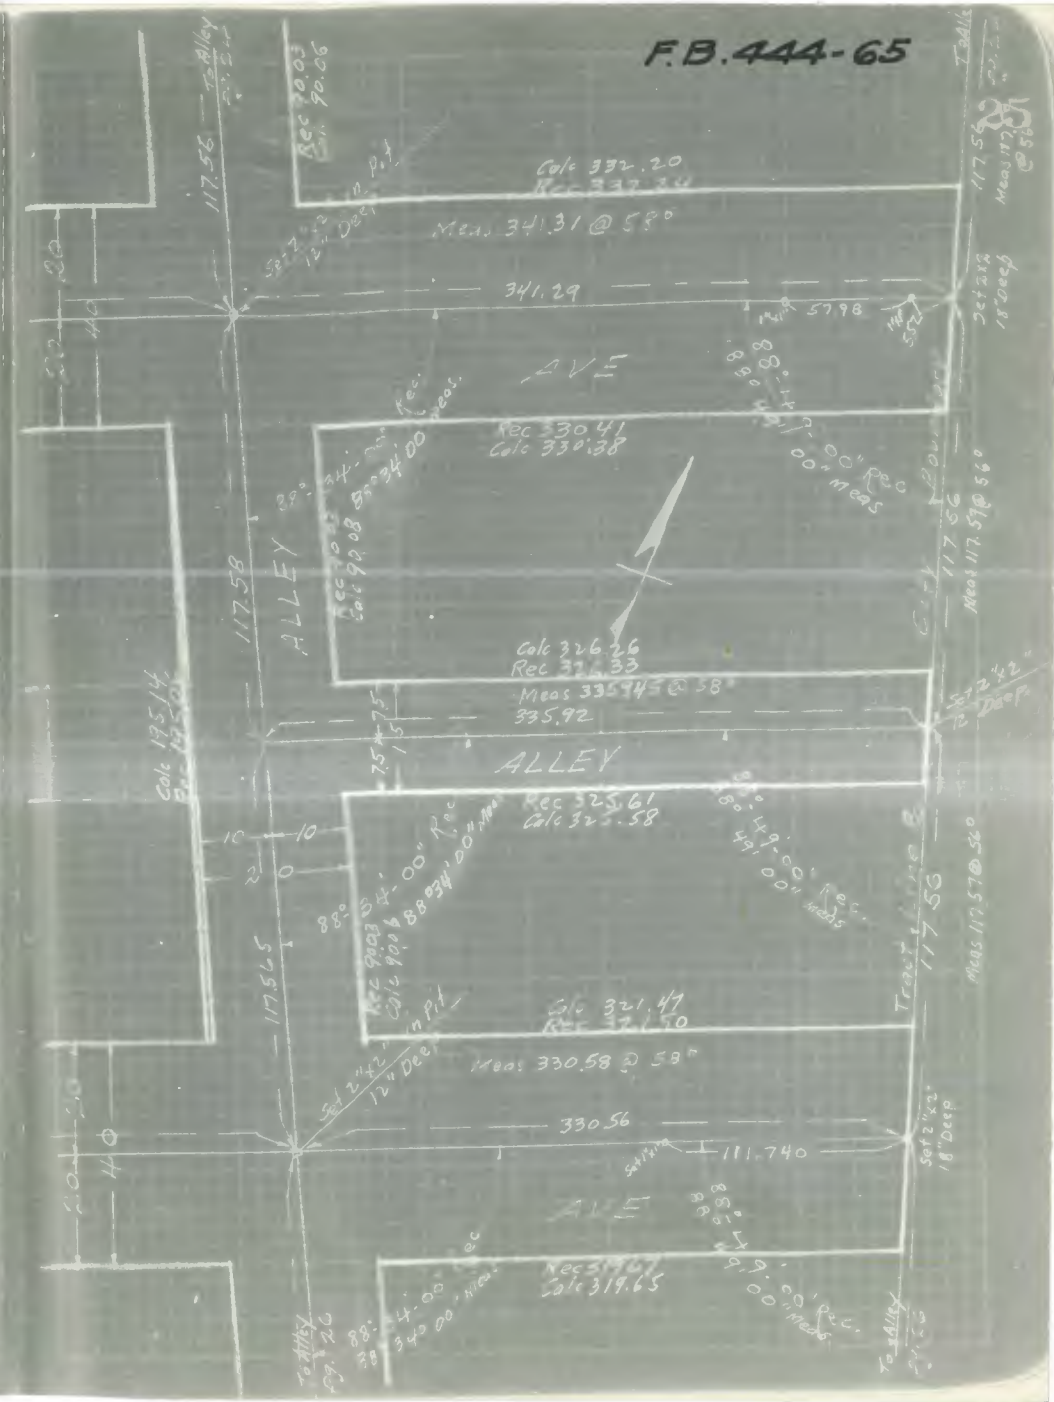

F.B. 444-66

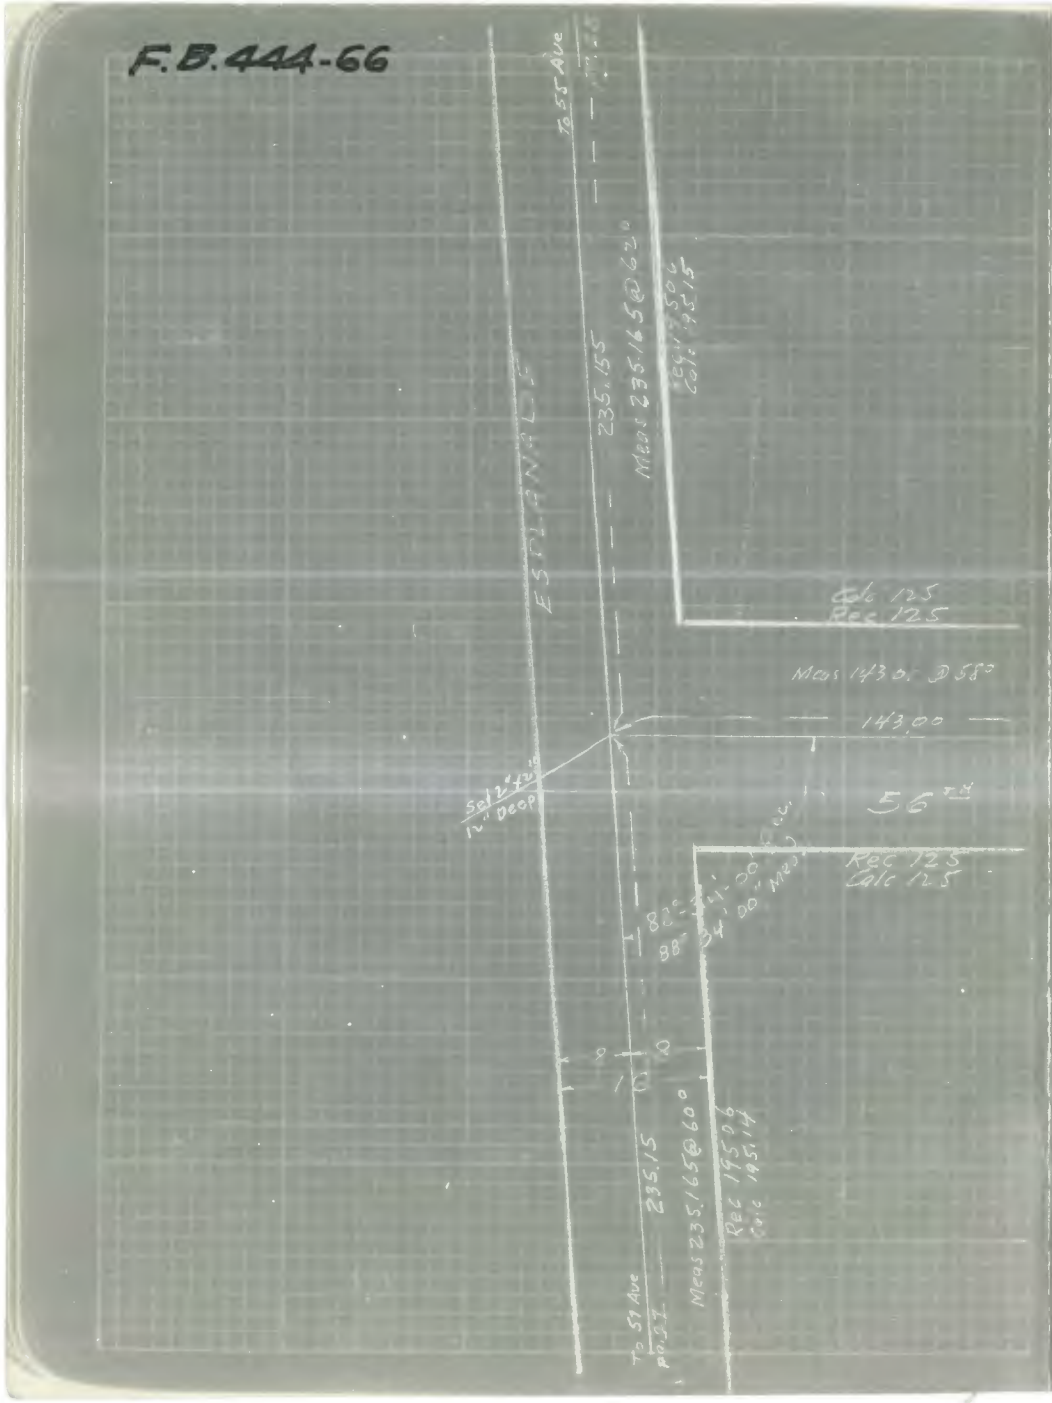

F.B. 444-67

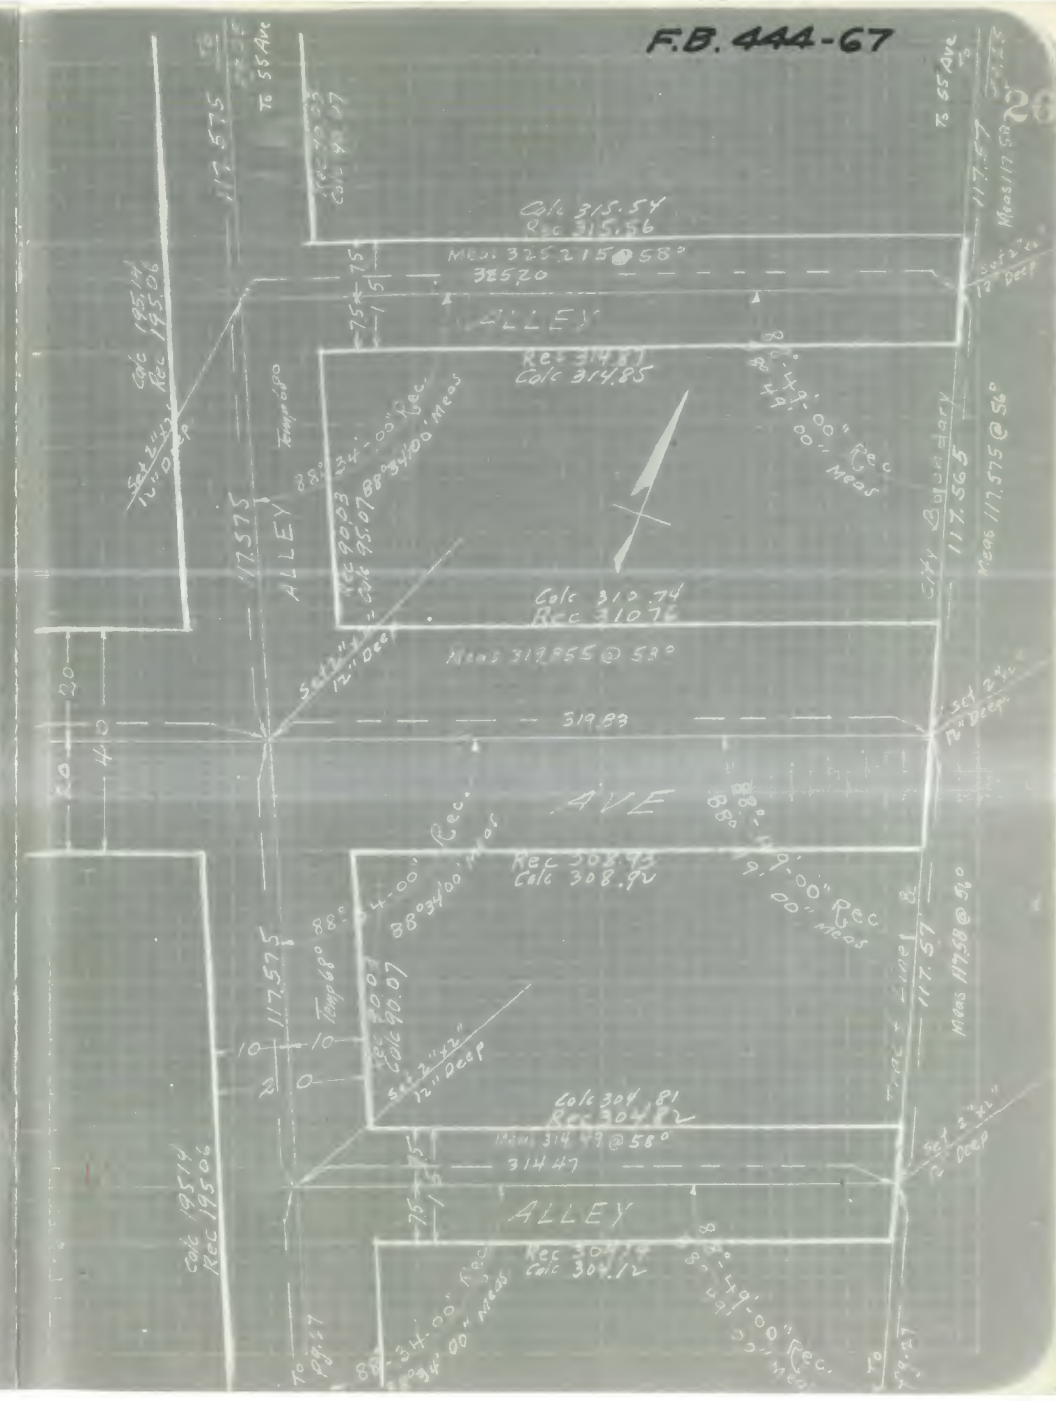

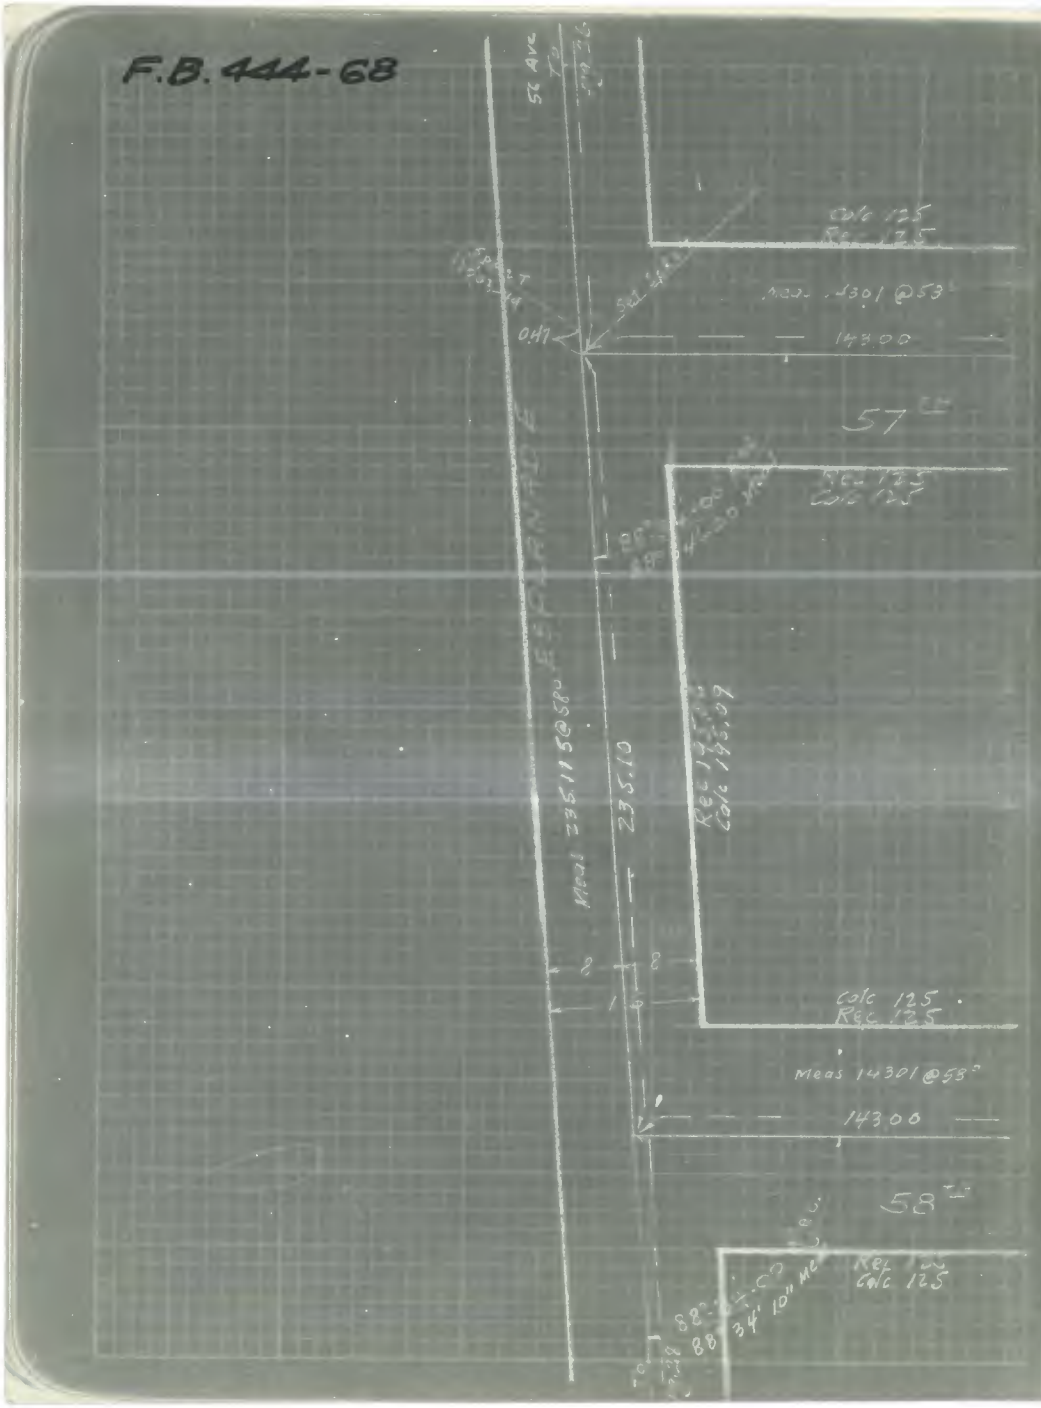
F.B. 444-68
Calc 125
Rec 125
Meas 14301 @ 53°
14300
57th
Rec 125
Calc 125
Meas 235.115 @ 58°
235.10
Calc 125
Rec 125
Meas 14301 @ 53°
14300
58th
Calc 125

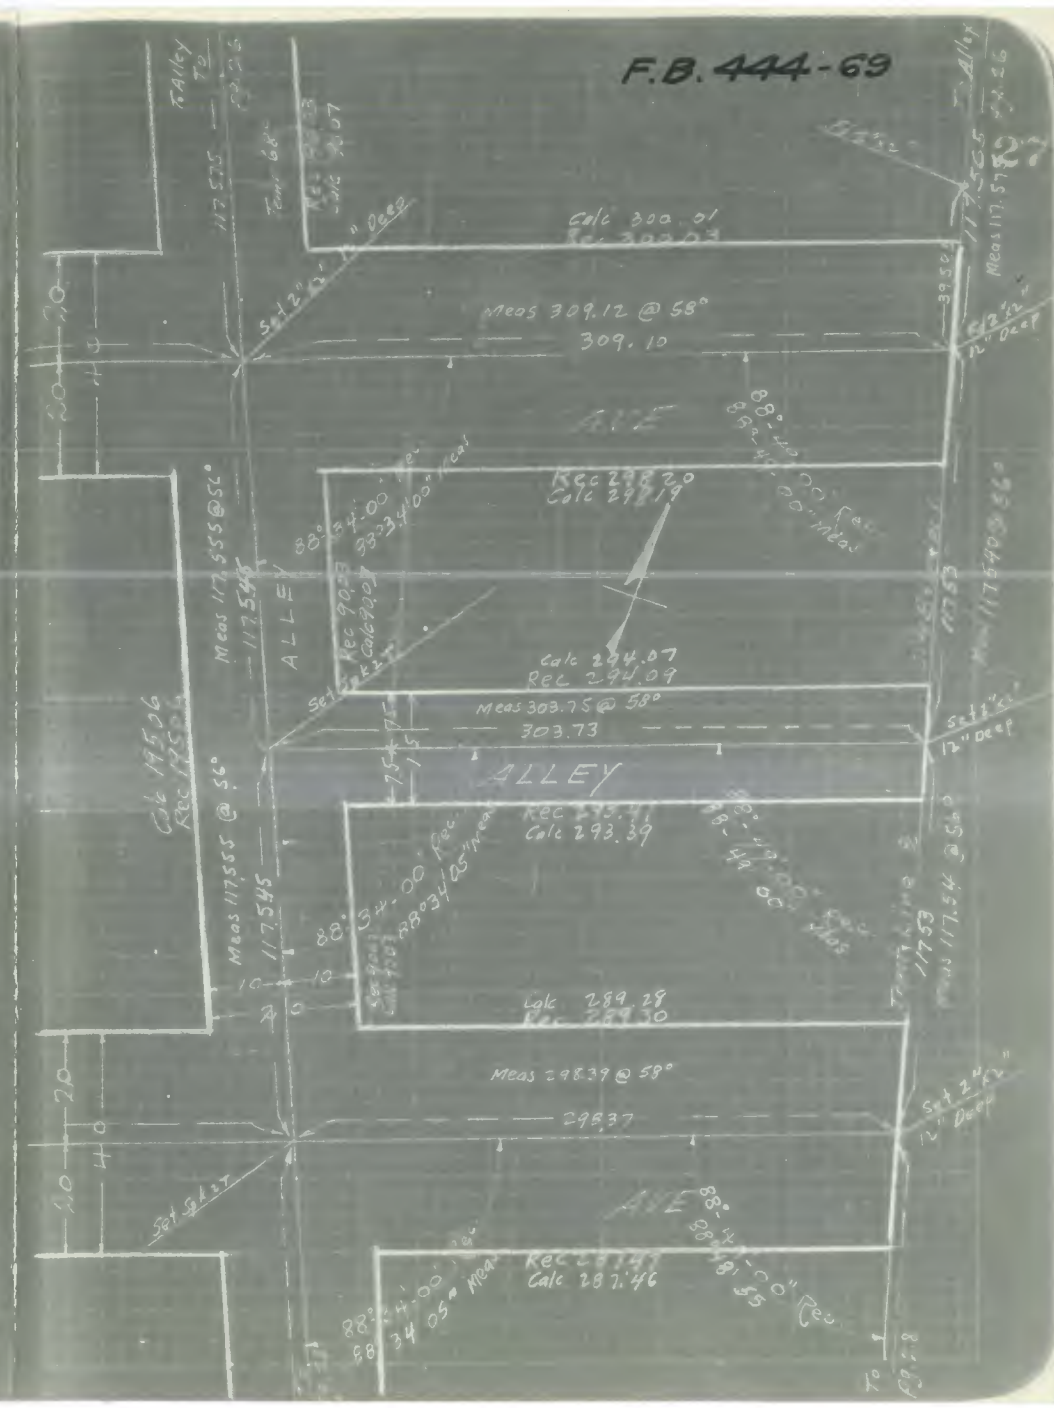
F.B. 444-69
Calc 300.01
Meas 309.12 @ 58°
309.10
AVE
Rec 298.20
Calc 298.19
Meas 117.555 @ 56°
ALLEY
Calc 294.07
Rec 294.09
Meas 303.75 @ 58°
303.73
ALLEY
Calc 293.39
Calc 289.28
Meas 298.39 @ 58°
298.37
AVE
Calc 287.46

F.B. 444-70

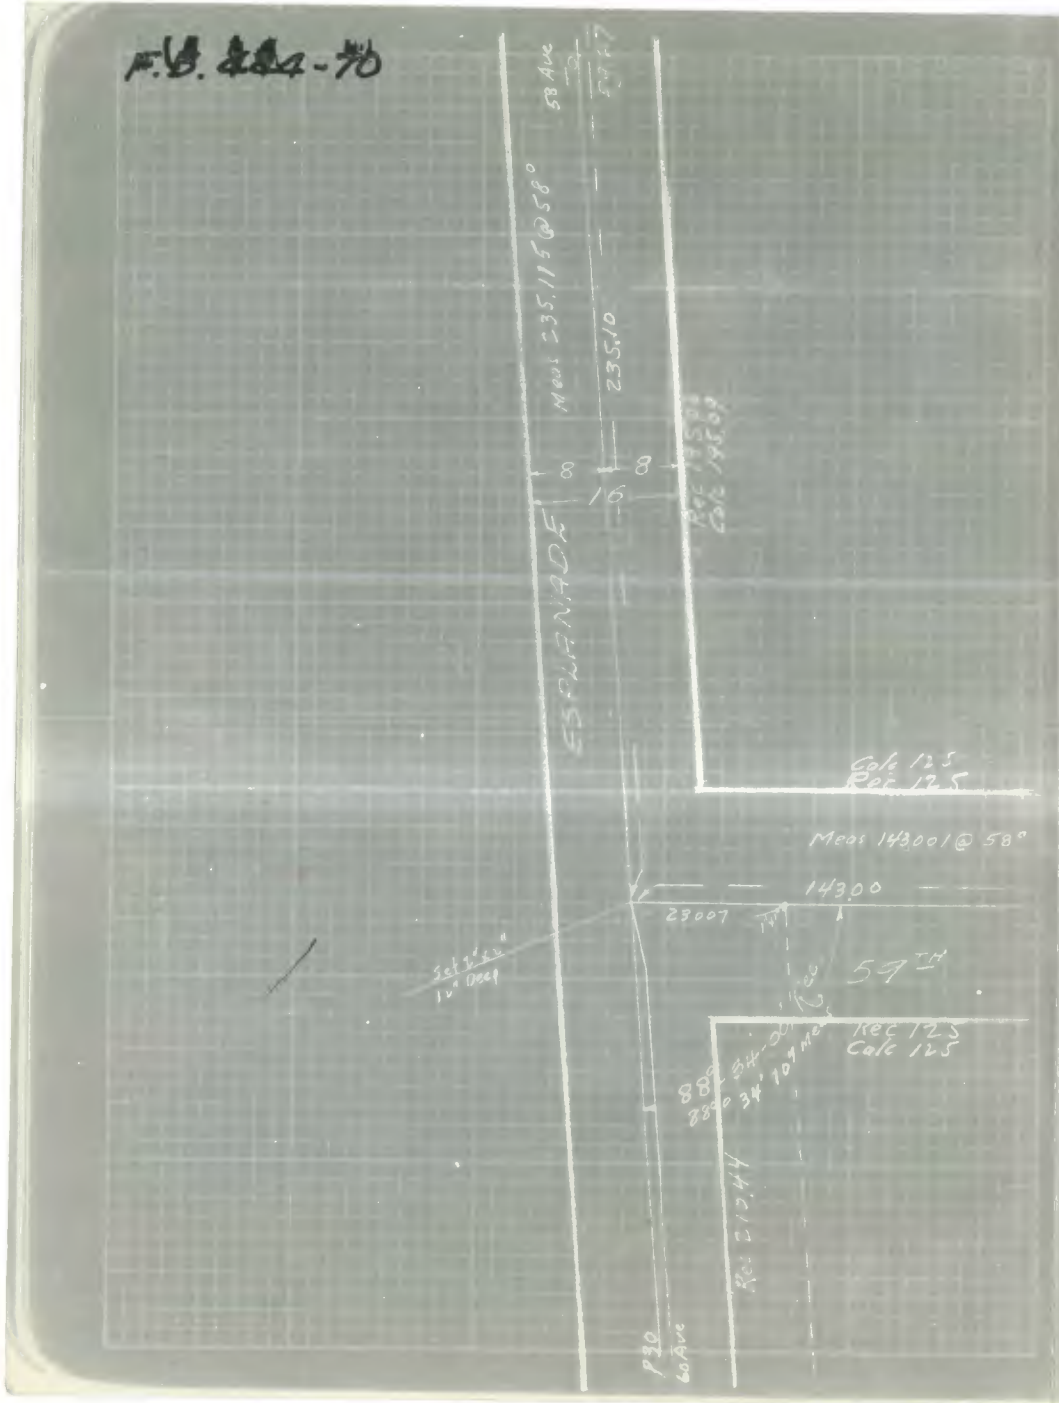

F.B. 444-71

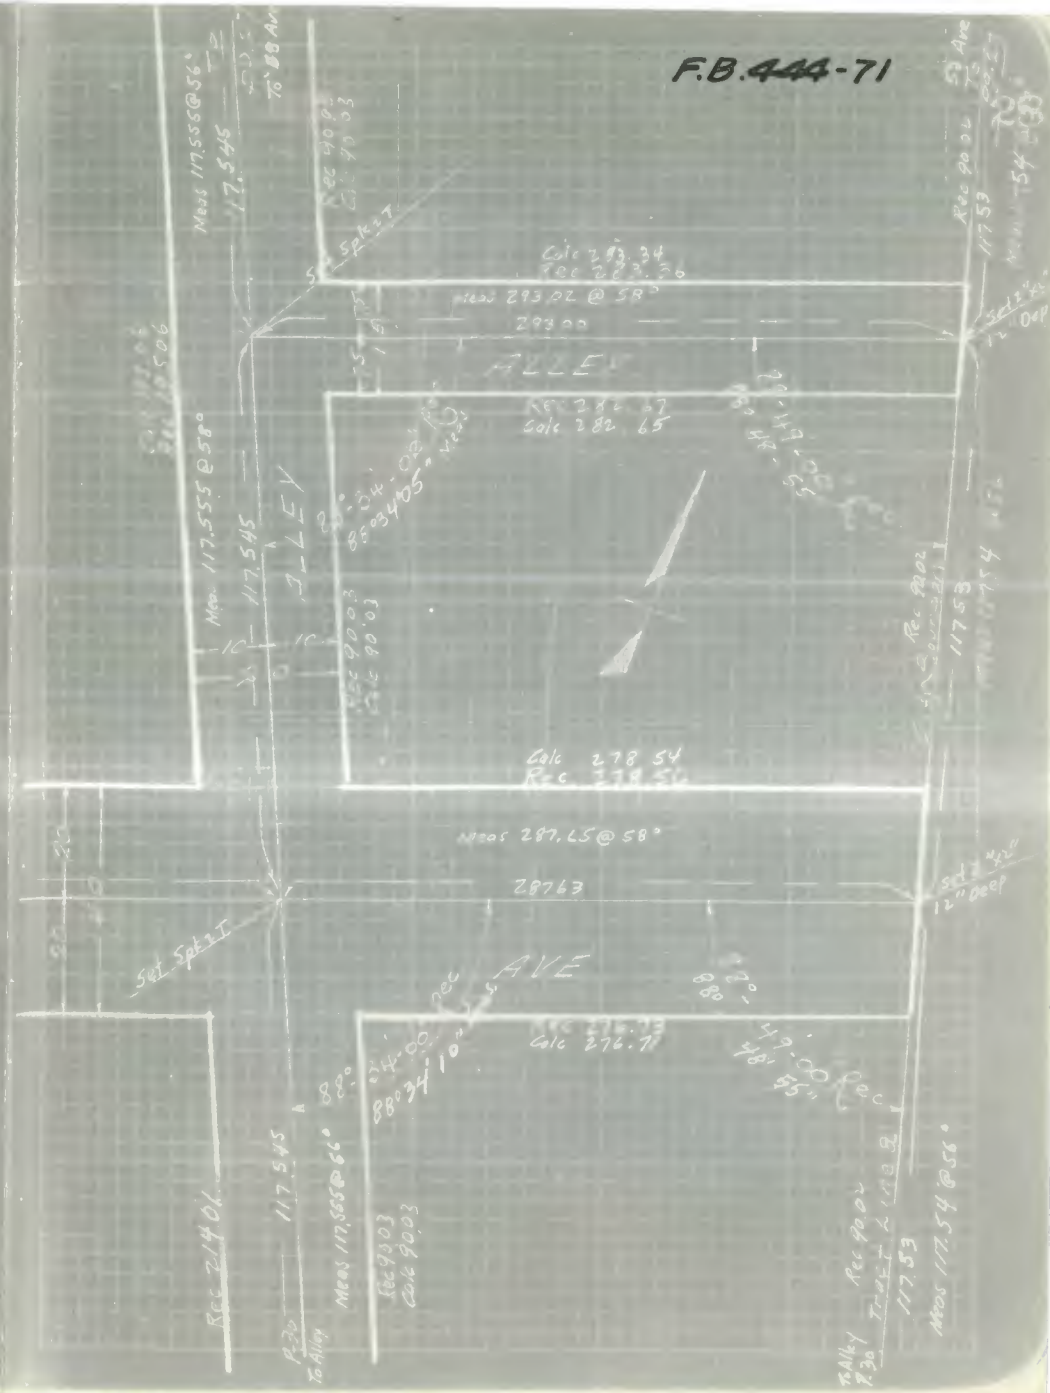

F.B. 444-72
F.B. 444-73
ESPLANADE
ALLEY
ALLEY
60th AVE
VISTA DEL MAR
To 59 Ave
To 59 Ave
Rec 91°26'00"
Meas 91°25'50"
Rec 93°04'00"
Meas 93°04'00"
Rec 93°04'00"
Meas 93°04'00"
Calc 214.02
Calc 250.265
Rec 210.47
Calc 210.47
Meas 250.935 @ 58°
250.92
Transit Line
Set Spk 27
Meas 136.81 @ 56°
136.80
Rec 109.55
Calc 109.56
Calc 125.14
143.160
120.135
120.00
43°35'00"
23.030
23.00
Set 24
Calc 126.71
46°43'51"
02°36'22"
Meas 282.285 @ 58°
282.265
Calc 271.93
Calc 266.87
Rec 266.87
Meas 91°11'10"
Rec 91°11'00"
89°33'00" Rec
89°33'00" Meas
Rec 117.5
144.670
Set 2"x2"
12" Deep
164.52
164.475
111.45
2"x2"
11601-9
Fd 2"x2"
11601-9
Temp 68°
Calc 125.21
Calc 87.11
91°10'00"
91°10'00" Rec
103.86
25
25
50
R31
R31
R31
20
20
20
10

F.B.444-74
ESPLANADE
Transit Line
135° 00' 00" Meas
72.285
Rad 258.20
Δ 90°00'
Rec 417.83
Calc 417.145
Δ 86°25'00"
Calc 377.365
Rec 377.25
Temp 68°
180.01
Meas 94°14'00"
Rec 94°14'00"
Meas 94°14'00"
22°30'00"
Calc 125.34
120.00
Calc 6.29
32.47
Spk2T
30.775
Wooden Bridge
10526-22
94.38
10526-22
94.38

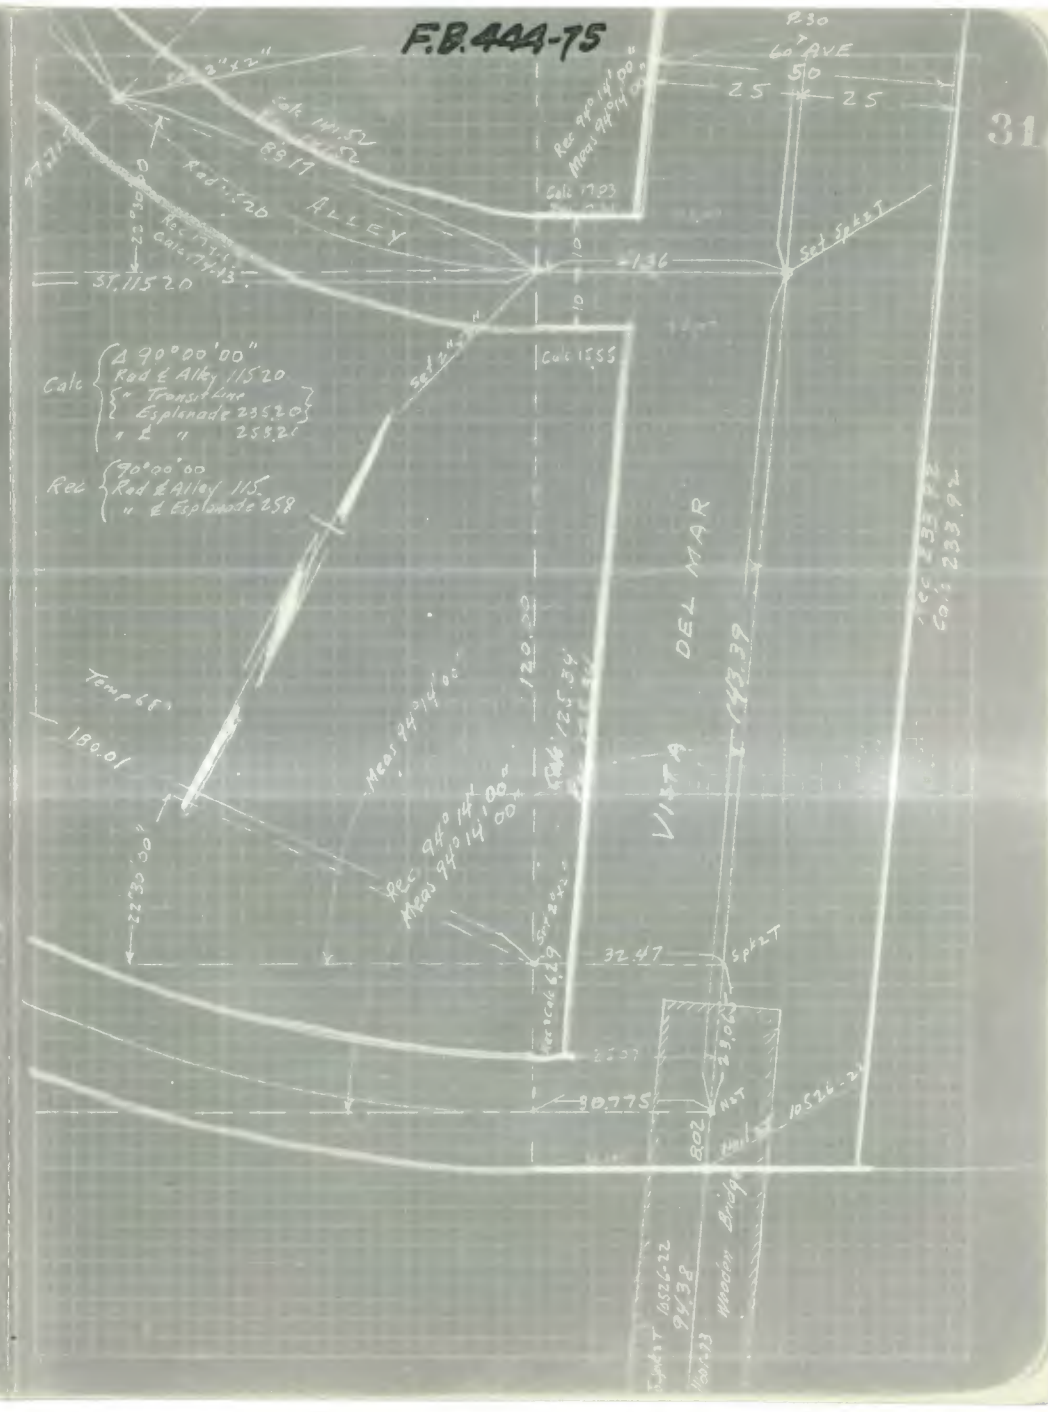
F.B.444-75
60' AVE
50
25
25
Rec 94°14'00"
Meas 94°14'00"
Calc 141.52
88.17
Rad 1520
ALLEY
Rec 174.1
Calc 174.13
ST. 115.20
Calc 17.03
Set Spk2T
Calc 15.55
Calc { Δ 90°00'00"
Rad ℄ Alley 115.20
" Transit Line
Esplanade 235.20
" ℄ " 258.21
Rec { 90°00'00
Rad ℄ Alley 115.
" ℄ Esplanade 258
VISTA DEL MAR
143.39
Calc 233.92
Rec 233.92
Spk2T
10526-22

F.B. 444-76

F.B. 444-77

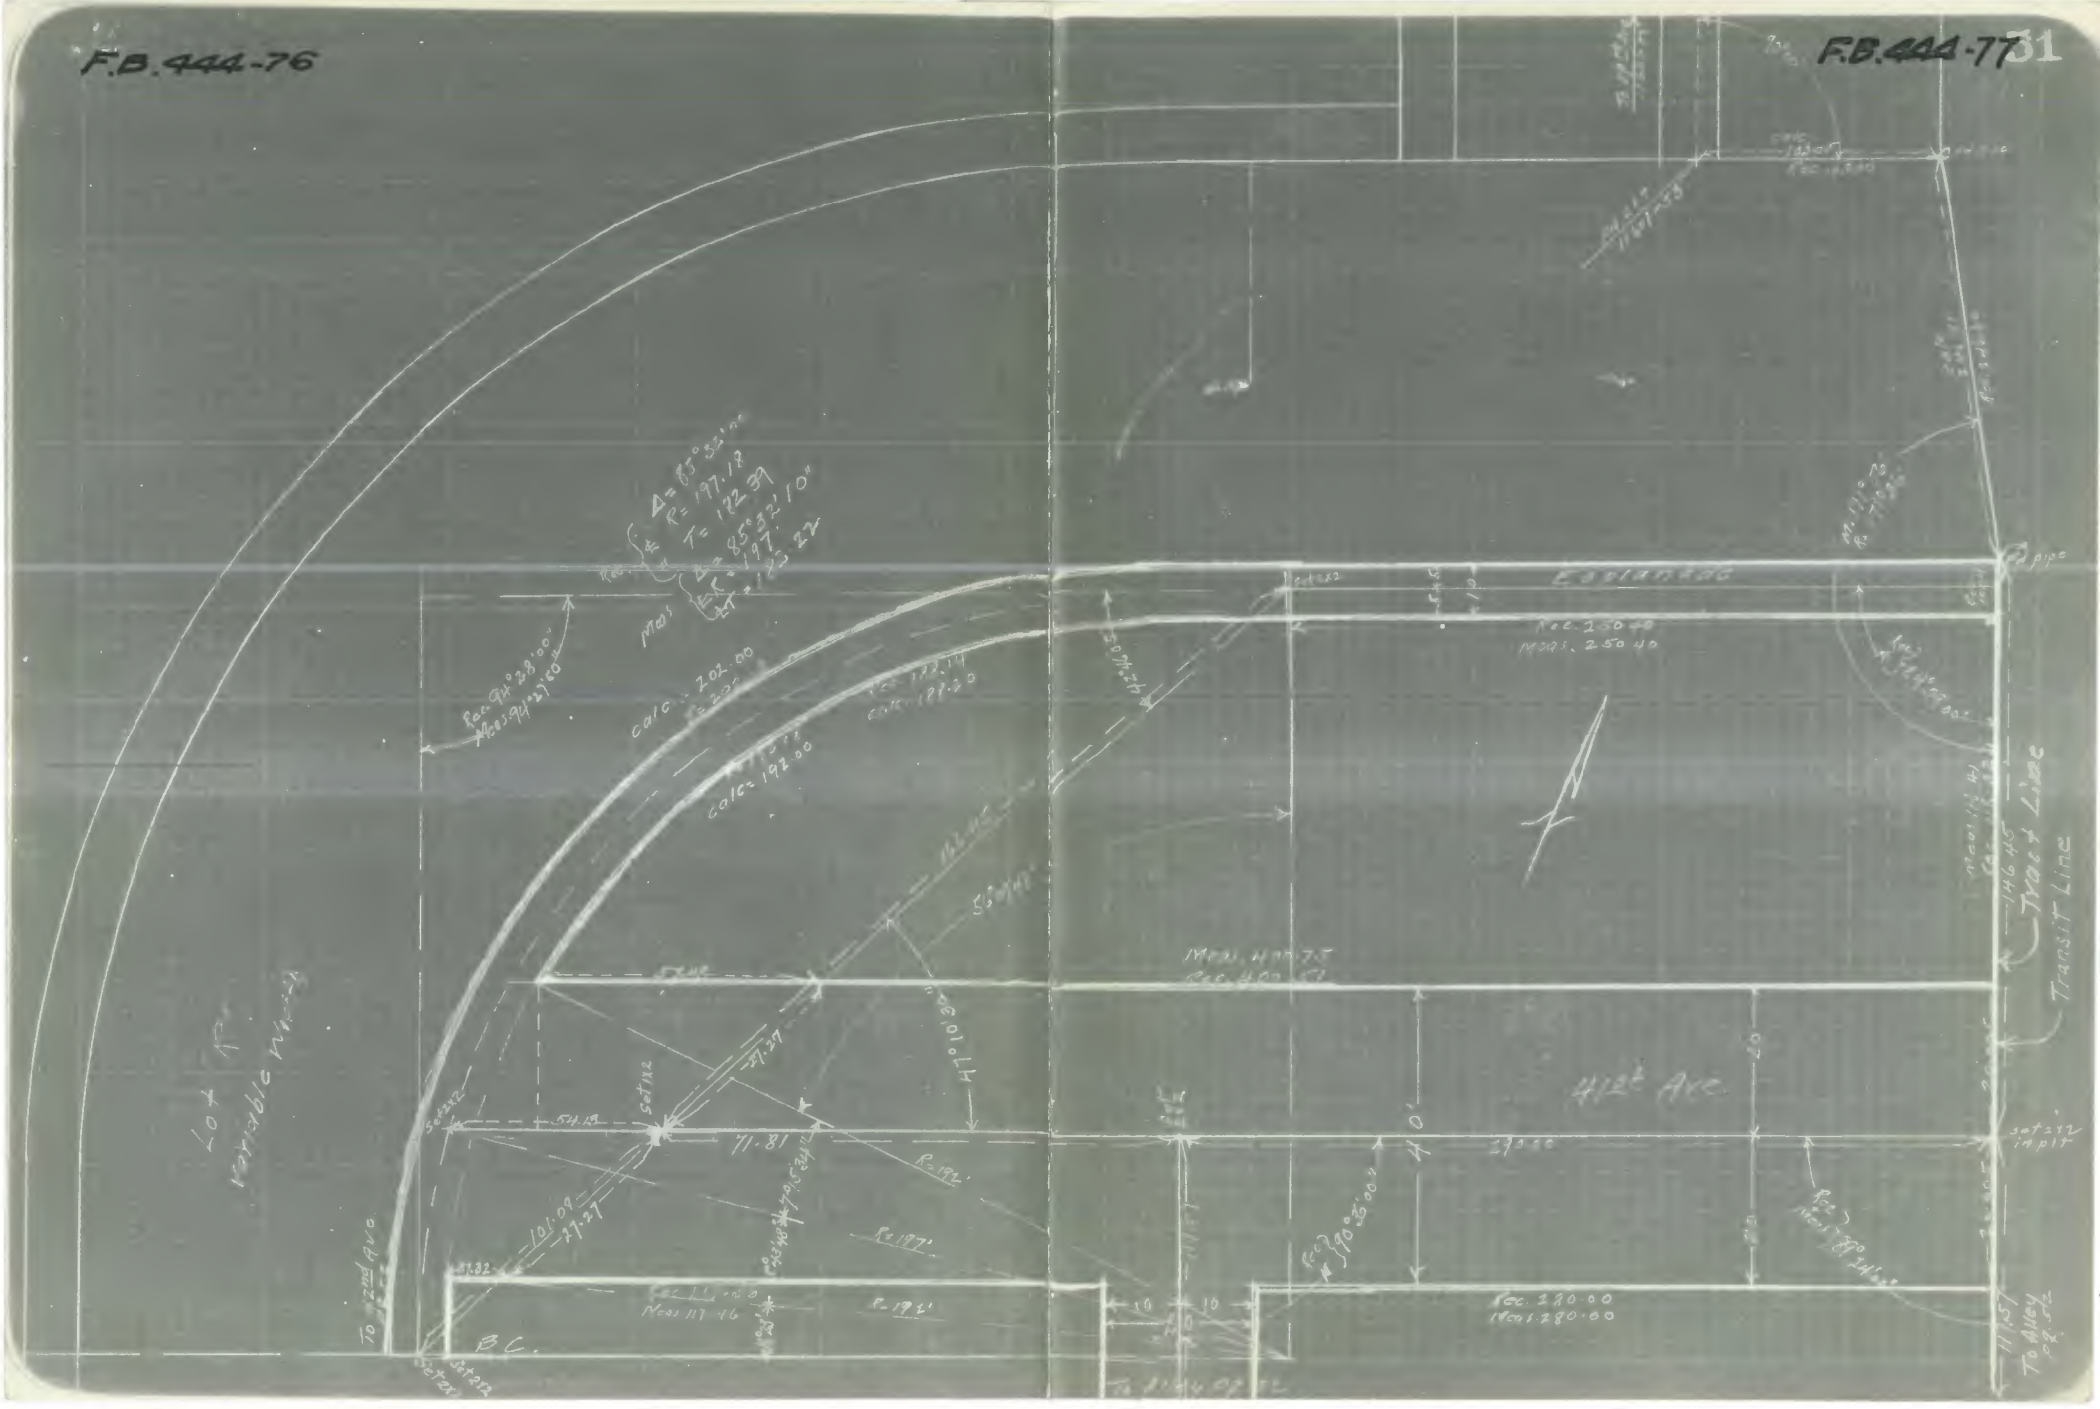

F.B. 444-78

42nd Ave.

423.36' E. of Esplanade to Esplanade

1st Alley So of 41st Ave

1st Alley So of 42nd Ave

280' E of 1st Alley E of Esplanade to 1st Alley E of Esplanade

Survey to Establish Center Line
and
Center Line Ties, Angles and Distances.

Marsh
Hoxie
Leonhardt
Kolb.

Center Line Ref. FB 10523, 10524
Tract Map " Silver Strand Tract

Tape No L-119 Tension supported 11 lbs.
calibrated 3/16-28 " suspended 21.5 "
@ 68°

F.B. 444-79

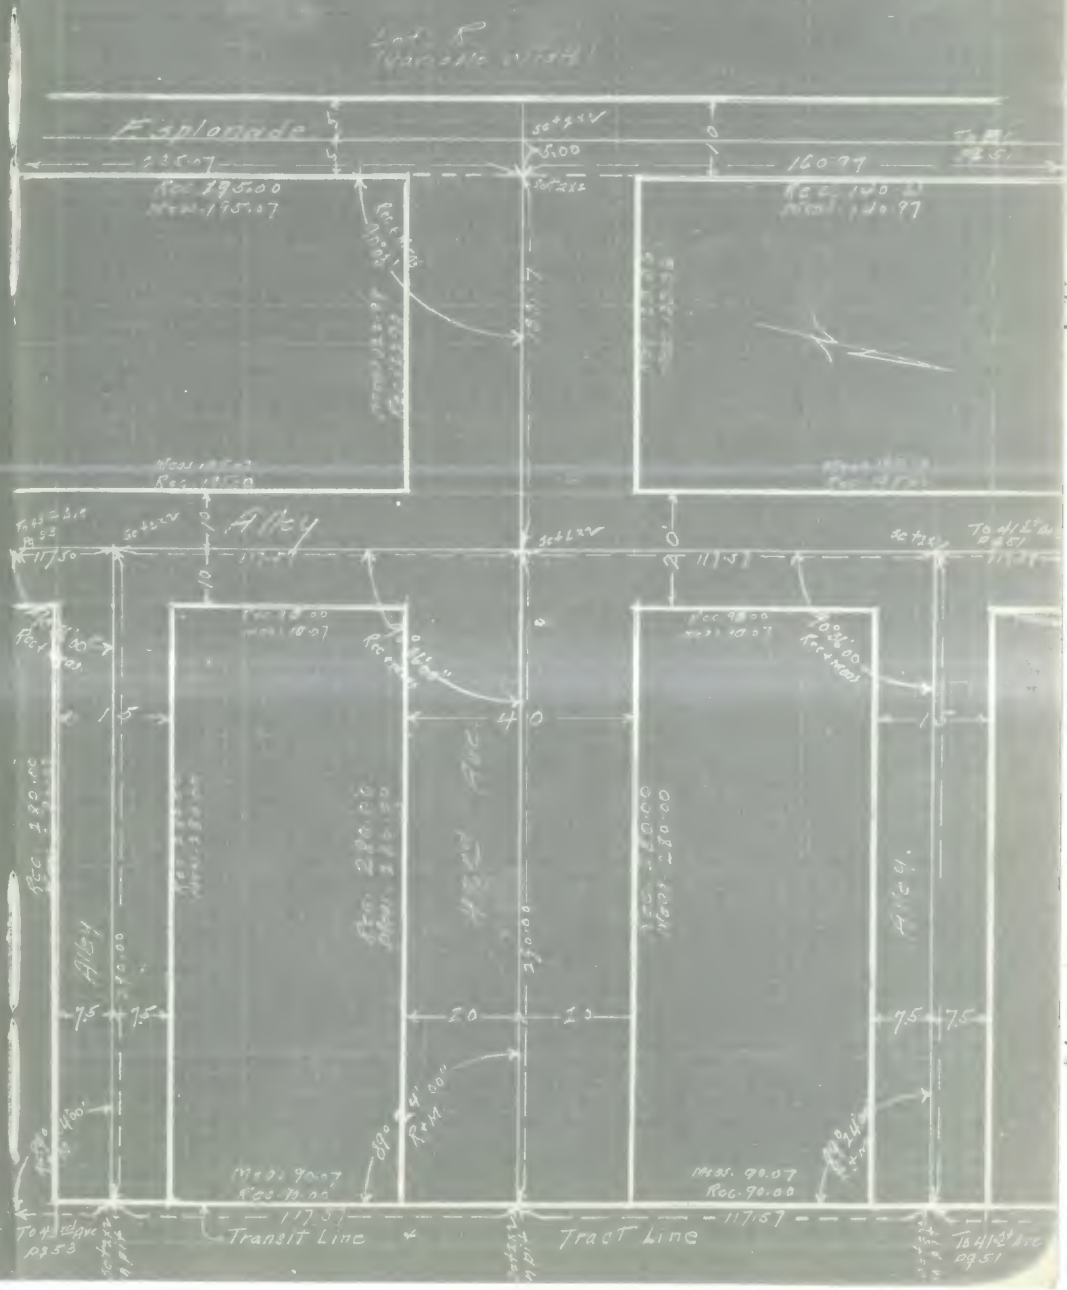

F.B. 444-80

43rd Ave.

421.11' E of Esplanade to Esplanade

Alley So of 43rd Ave.

280' E of 1st Alley E of Esplanade to 1st Alley E of Esplanade

44th Ave.

418.47' E of Esplanade to Esplanade

Survey to Establish Center Line

and

Center Line Ties, Angles, Any Distances.

March
Horn
Leonhardt
Kolb.

Center Line Ref F.B. 10523 10524

Tract " Silver Strand Tract

Tape No. L 119 Tension Supported 4 lbs.

Calibrated 3/16-28 " Suspended 21.5 "

F.B. 444-81

53

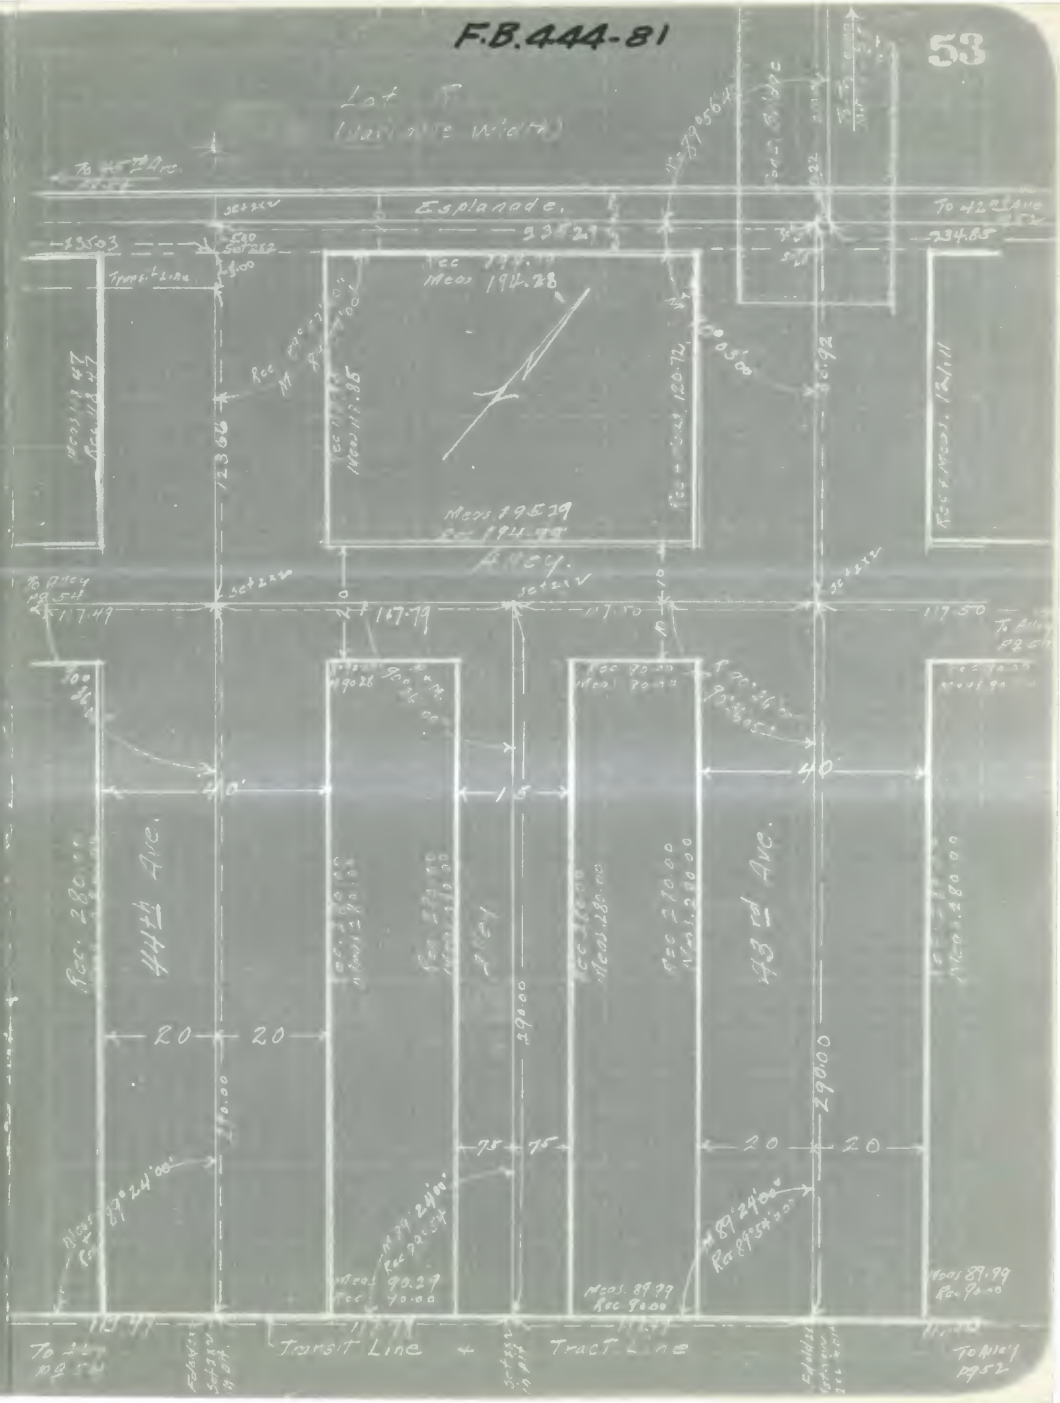

45th Ave.

416.21' E of Esplanade to Esplanade

Alley So of 44th Ave

Alley So of 45th Ave.

280' E of 1st Alley E of Esplanade to 1st Alley E of Esplanade.

Survey to Establish Center Line
and
Center Line, Ties, Angles and Distances.

Marsh
Horn
Leonhardt
Kolb.

Center Line Ref. F.B.'s 10523 10524

Tract "

Tape No. L-119 Tension Supported 21 lbs

Calibrated 3/16-28 " Supported 21.5 lbs

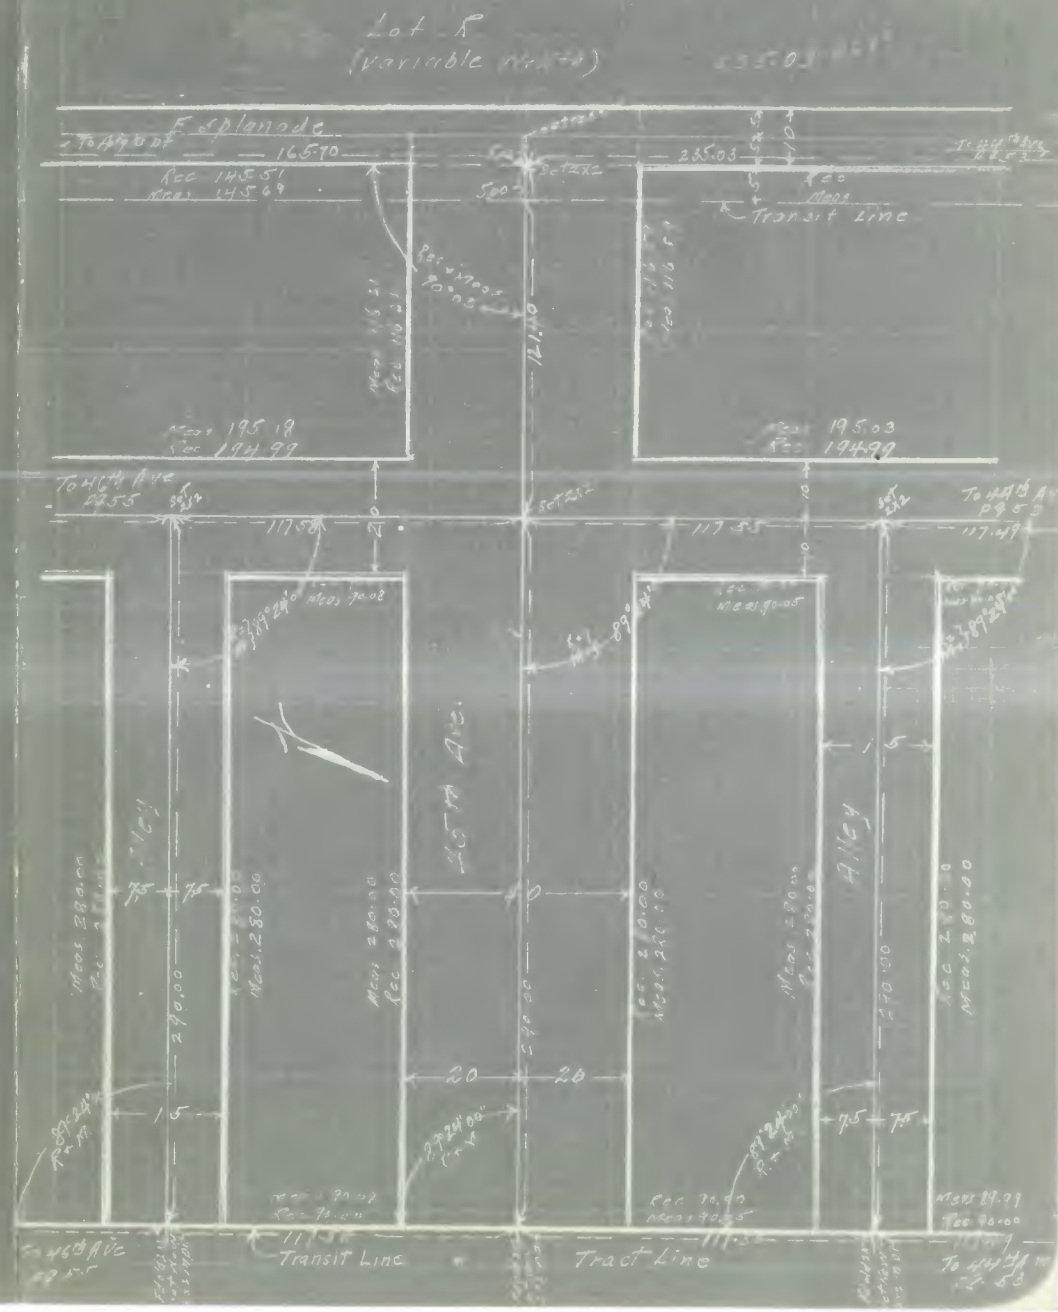

46th Ave.

418.60' E of Esplanade to Esplanade

47th Ave.

428.46' E of Esplanade to Esplanade

1st Alley So of 46th Ave.

280' E of 1st Alley E of Esplanade to 1st Alley E of Esplanade

Survey to Establish Center Line

with

Center Line Ties, Angles, & Distances

Marsh

Horn

Leonhardt

Kolb.

Center Line Ref. F.B. 10523 10524

Tract Map " Silver Strand Tract

Tape No. L-119 Tension Supported 11 lbs

Calibrated 3/16-29 " Suspended 21.5 "

@ 68°

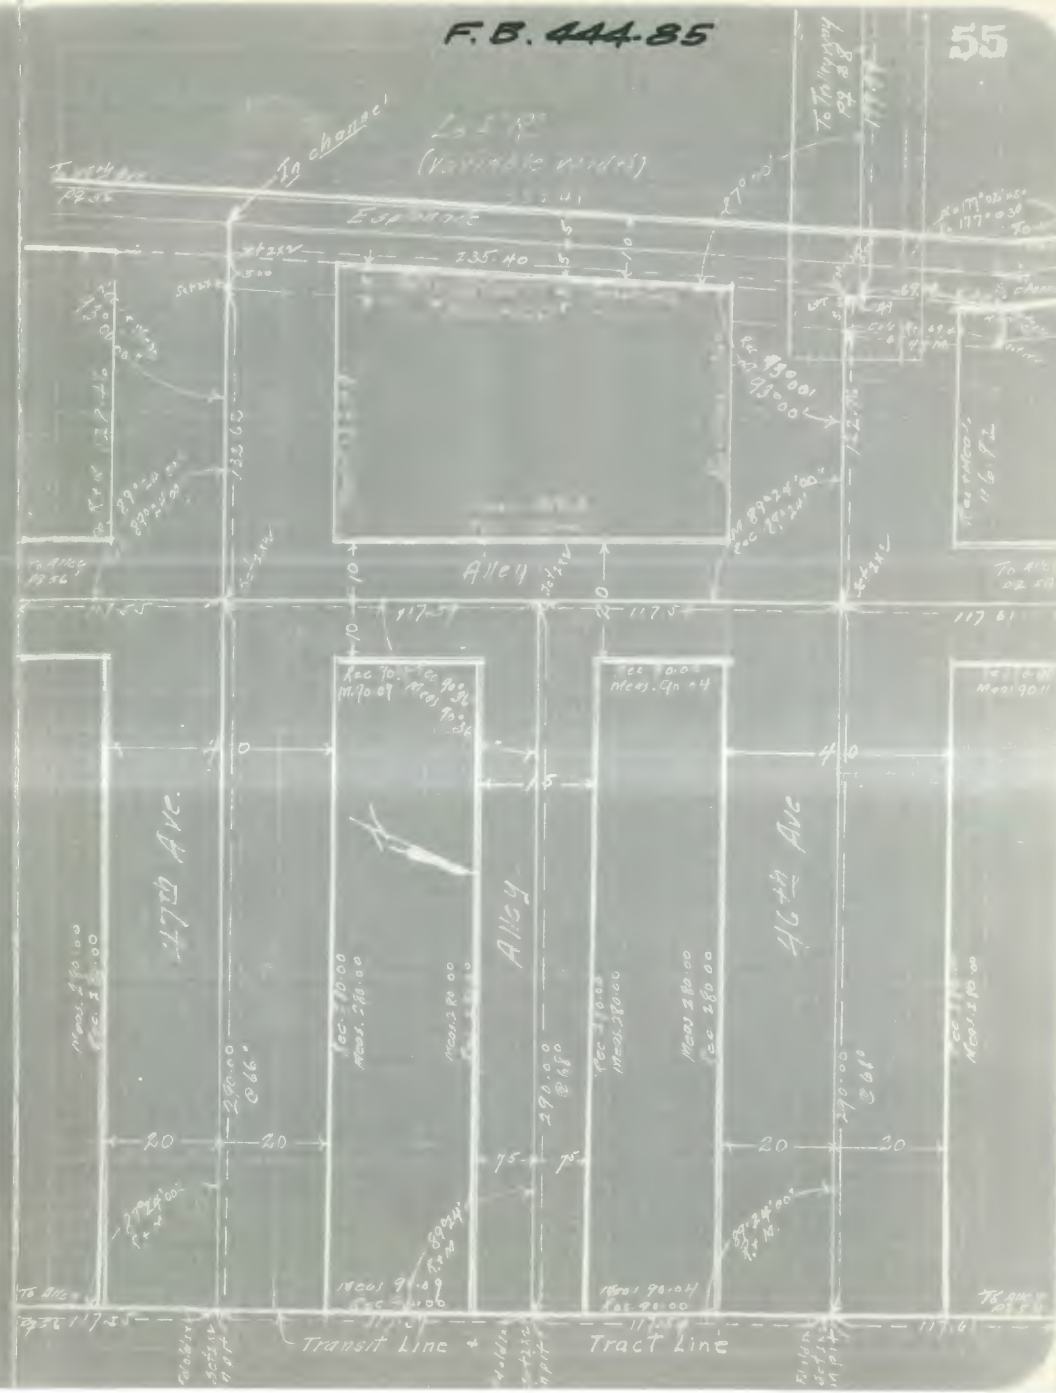

48th Ave.

438.31' E of Esplanade to Esplanade

1st Alley So of 47th Ave.

1st Alley So of 48th Ave

280' E of 1st Alley E of Esplanade to 1st Alley E of Esplanade

Survey to Establish center Line
and
Center Line Ties Angles & Distances.

Marsh
Horn
Leonhardt
Kolb.

Center Line R of 10522 10524
Tract Map " Silver Striped Tracts

Tape No L-119 Tension Supported [illegible]
Calibrated 9/16-28 " Suspended [illegible]
E68°

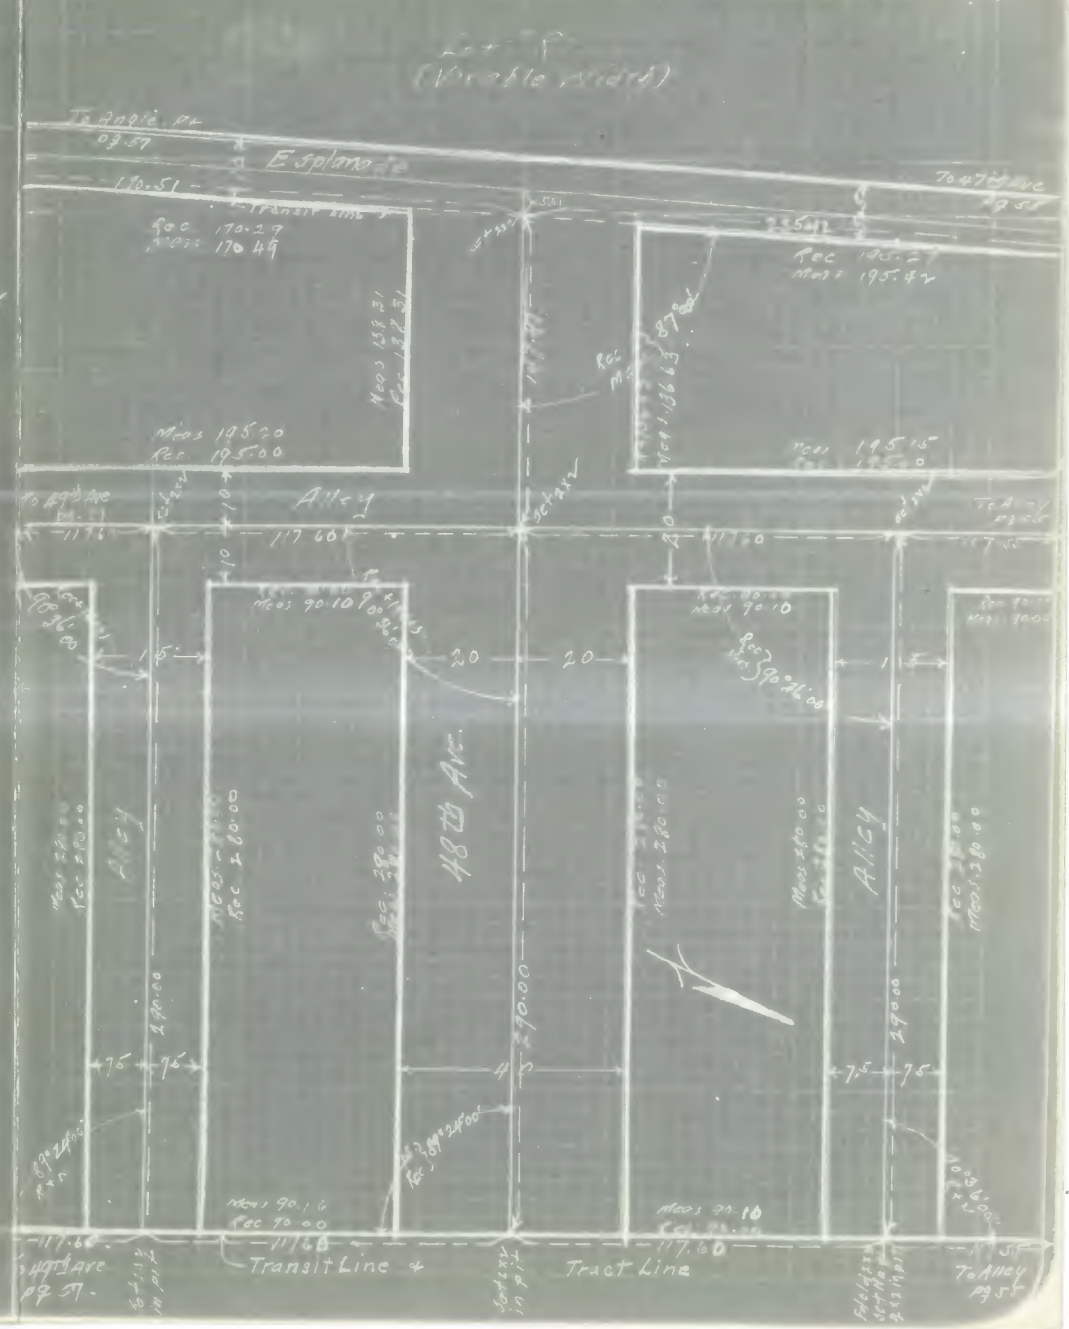

F.B. 444-88

49th Ave

442.36'E of Esplanade to Esplanade

1st Alley So of 49th Ave.

280'E of 1st Alley E of Esplanade to 1st Alley E of Esplanade

Survey to Establish center Line
and
Center Line Ties, Angles, & Distances

Marsh
Horn
Leonhardt
Kolb.

Center Line Ref FBs 10523 10524
Map " Silver Strand Tract

Tape No 2-119 Tension Supported 11 lbs
Calibrated 3/16-28 " Suspended 21.5
@ 62°

F.B. 444-89 57

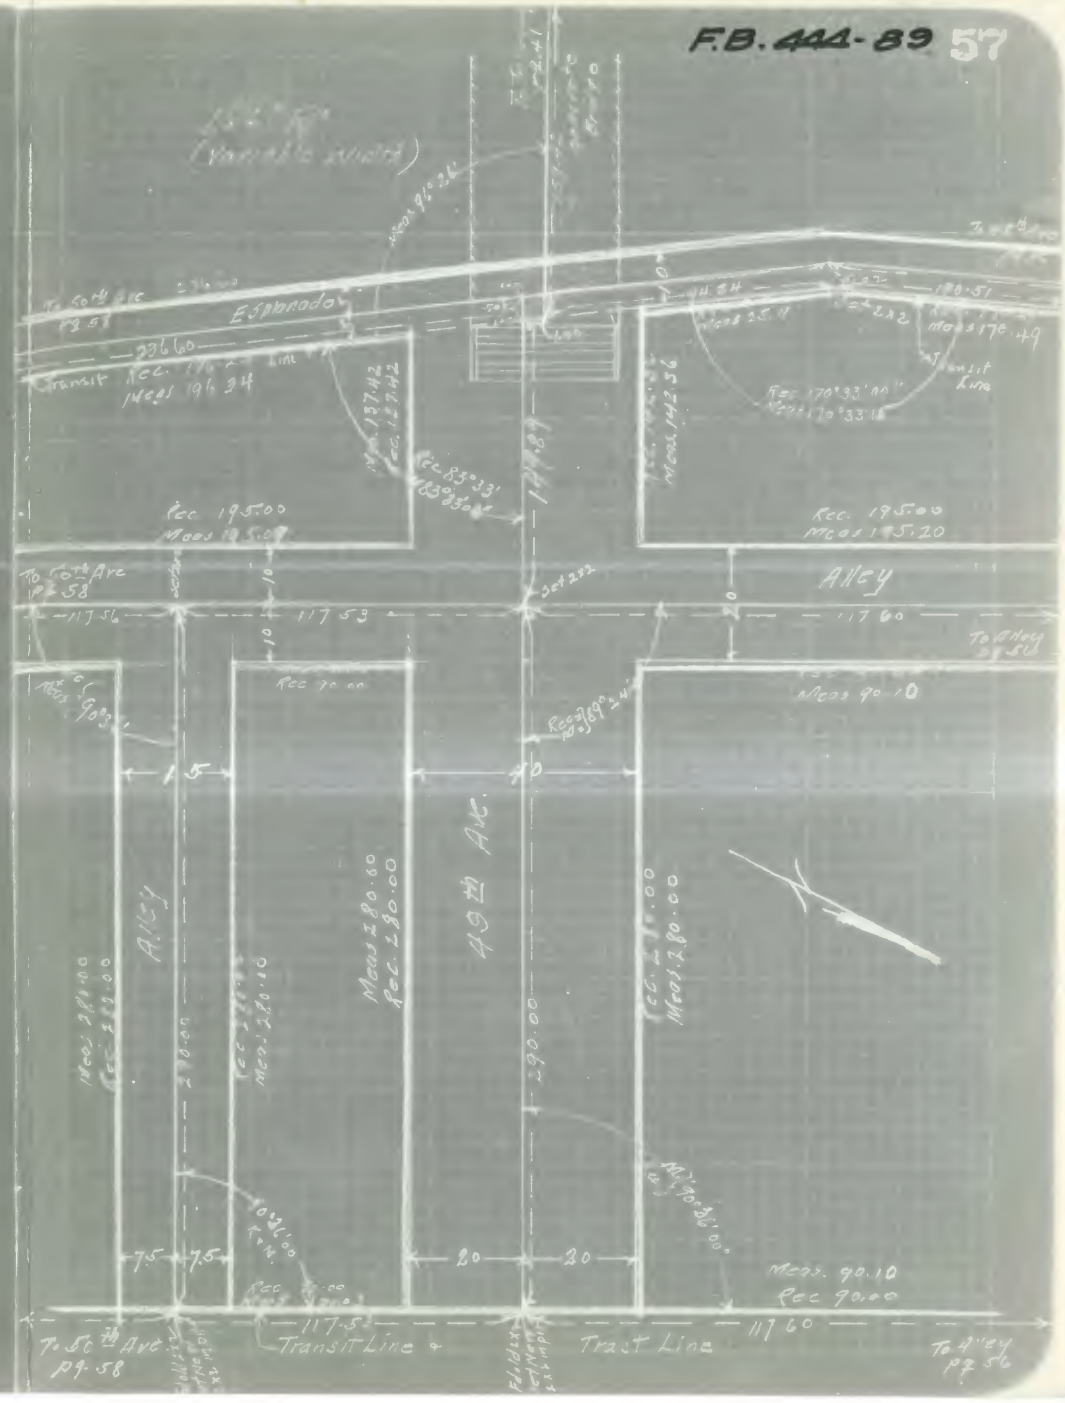

F.B. 444-90

50th Ave

413 33' E. of Esplanade to Esplanade

1st Alley So. of 50th Ave.

280 E. of 1st Alley E. of Esplanade to 1st Alley E. of Esplanade

Survey to Establish Center Line.

Marsh
Horn
Leonhardt
Kolb.

Tract Map Ref Silver Strand Tract

Tape No. L 119 Tension Supported 11 lbs.

Calibrated 3/16-28 " Suspended 21.5 "

@ 66°

F.B. 444-91 58

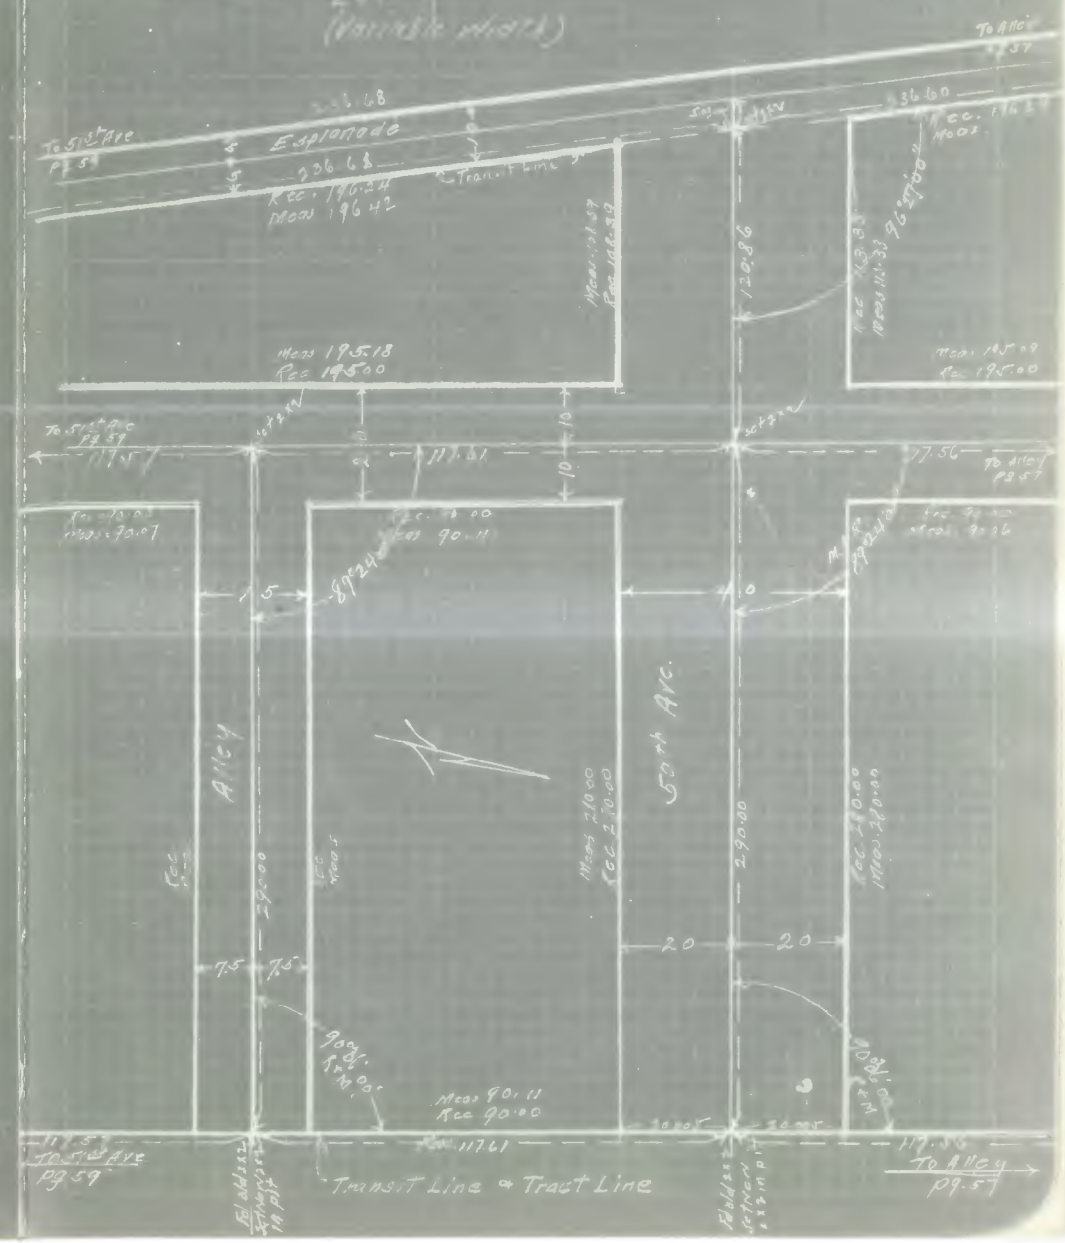

F.B. 444-92

51st Ave.

384.30' E. of Esplanade to Esplanade

1st Alley So of 50th Ave

280' E. of 1st Alley E. of Esplanade to 1st Alley E. of Esplanade

Survey to establish center line

Marsh
Horn
Lombardt
Kolb

Tract Map Ref Silver Strand Tract

Tape No L-119 Tension Supported 11 lbs

Calibrated 9/16-28 " Suspended 51.5 "

@ 68°

F.B. 444-93

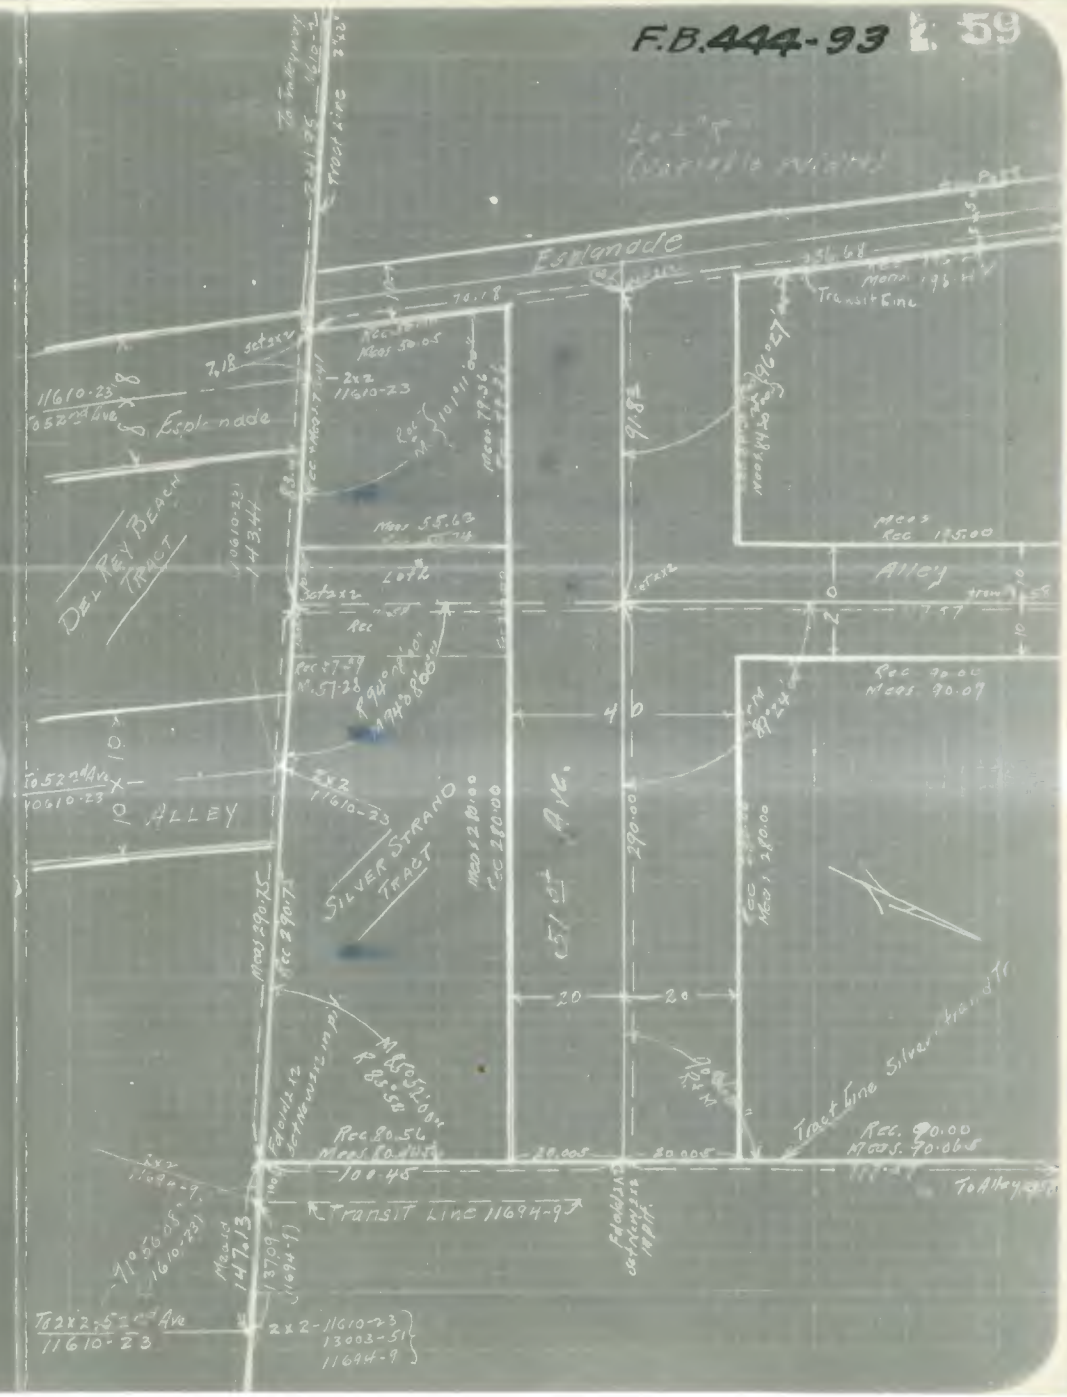

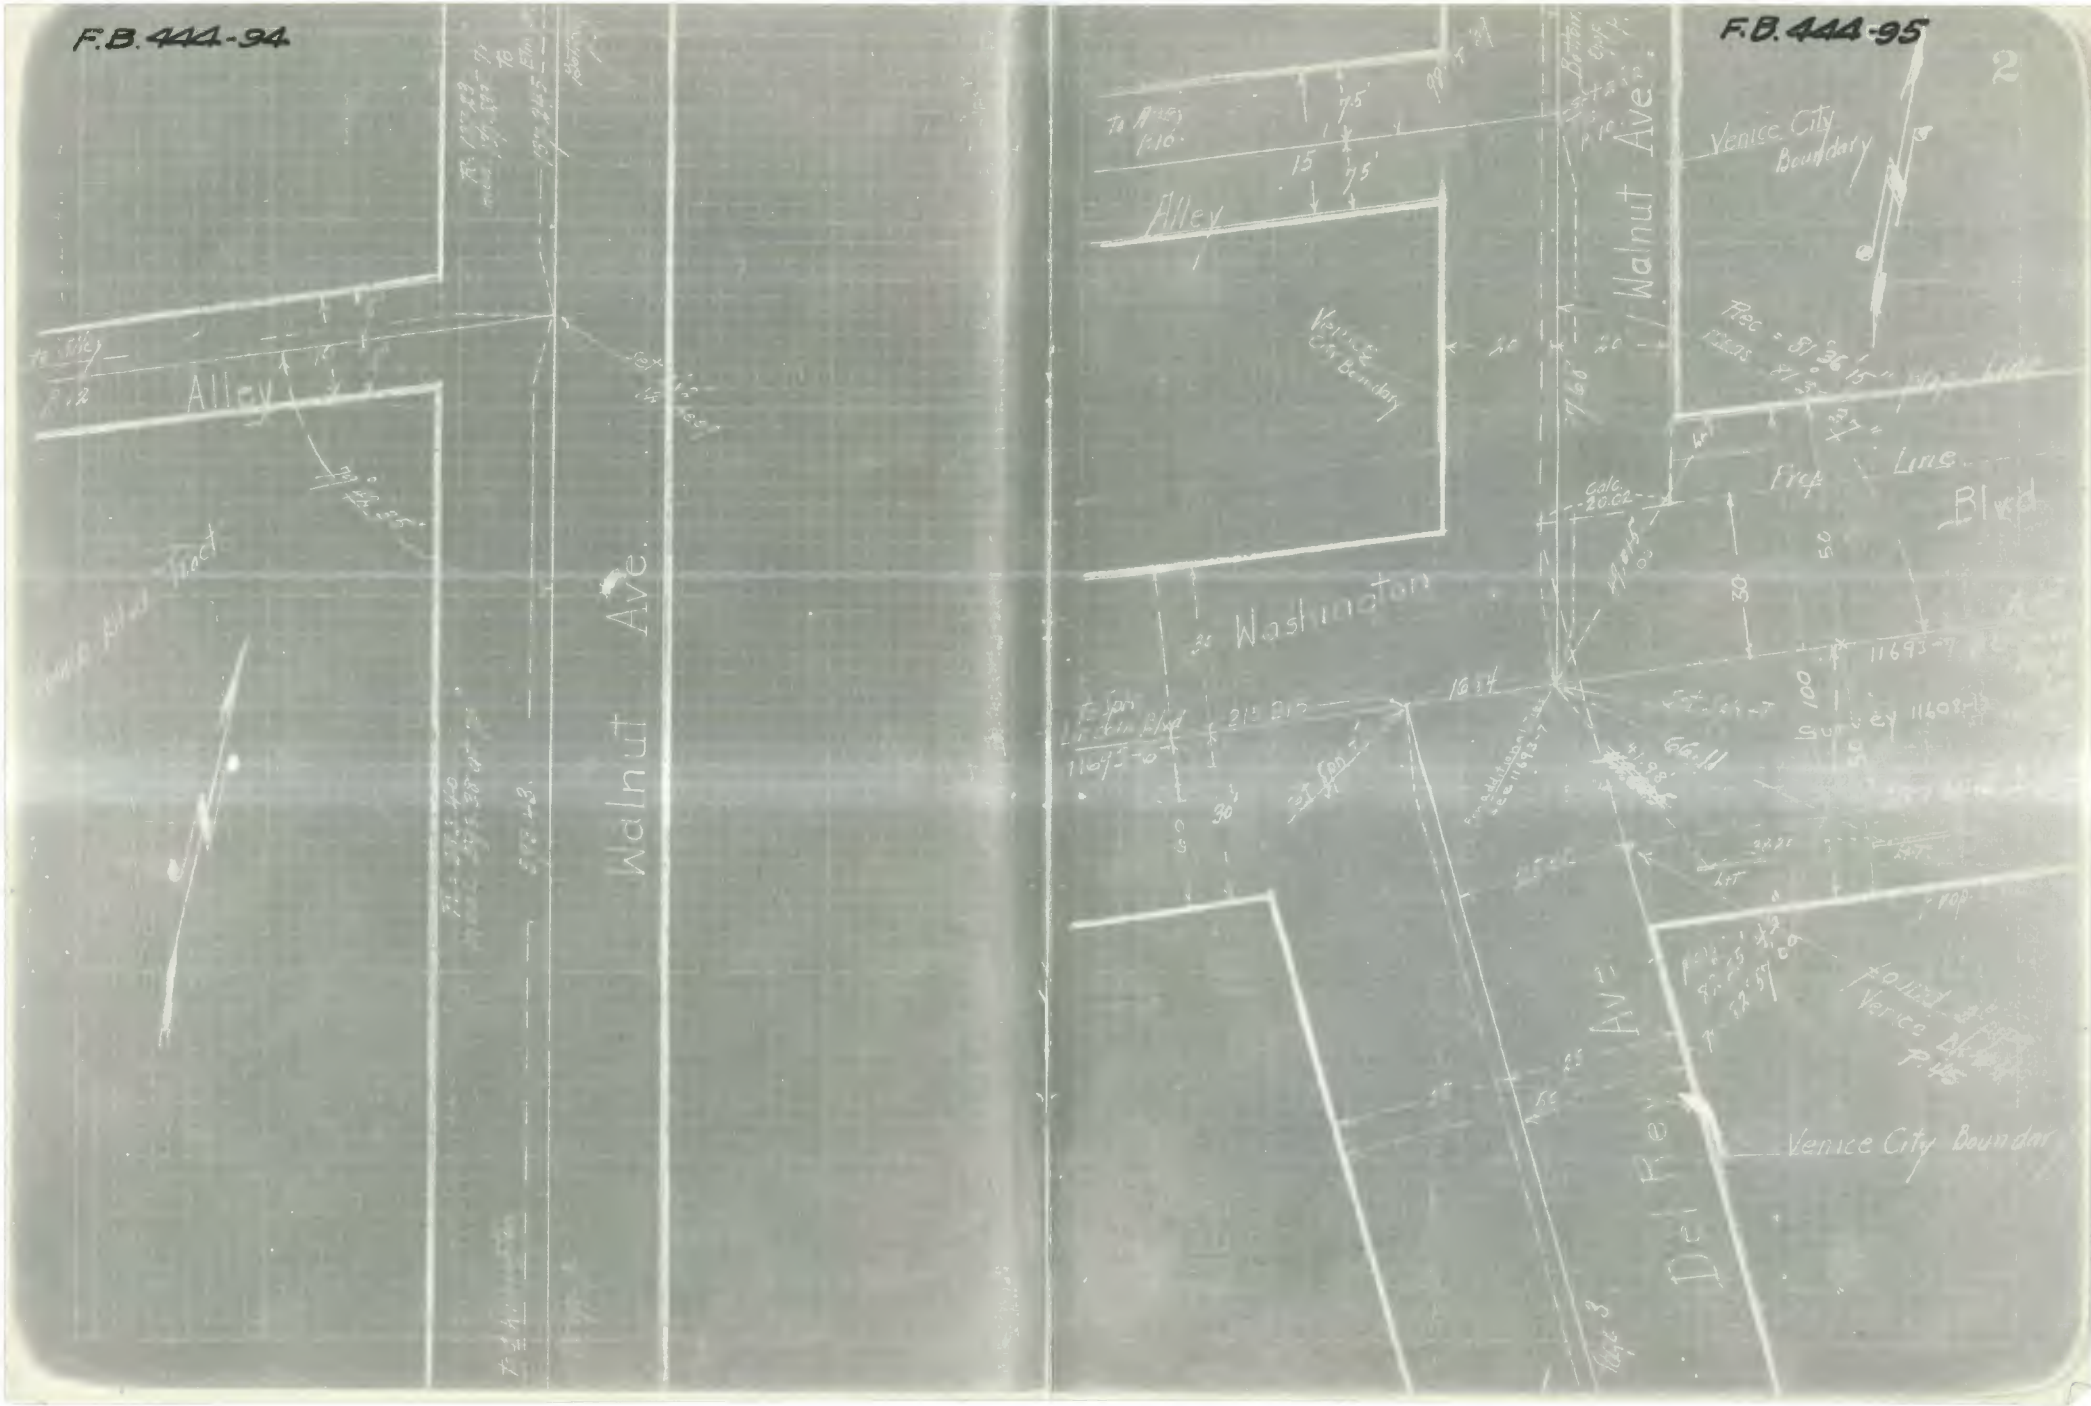
F.B. 444-94
F.B. 444-95
2
Alley
Walnut Ave.
Venice City Boundary
Washington
Alley
Walnut Ave.
Venice City Boundary
Fire Line
Del Rey Ave.
Venice City Boundary

F.B. 444-96

F.B. 444-97

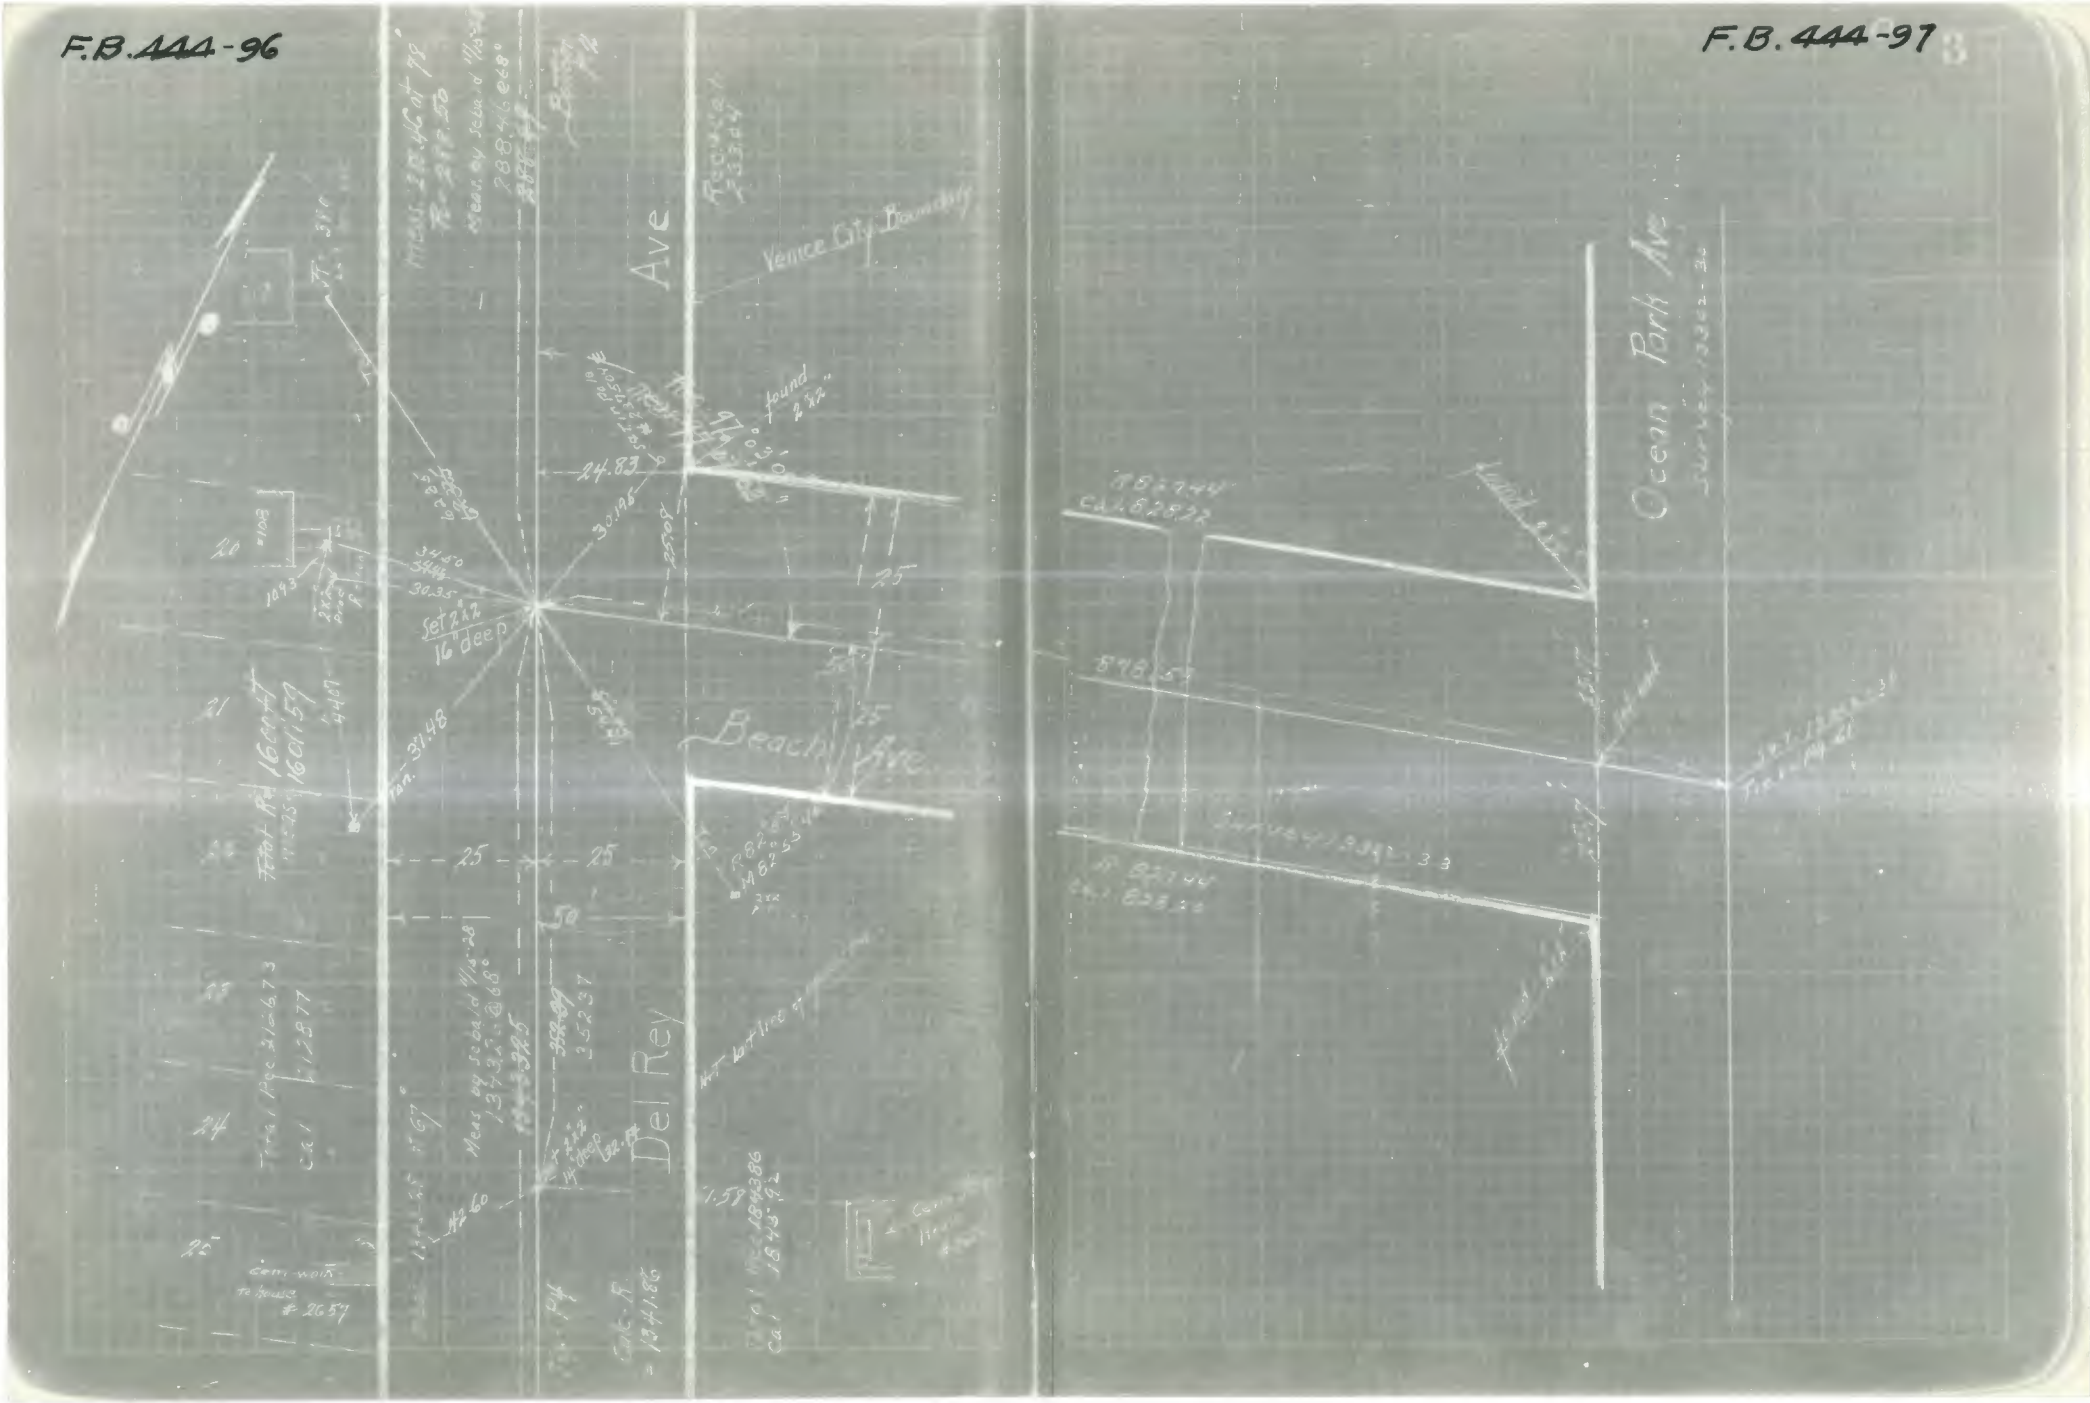

F.B. 444-98

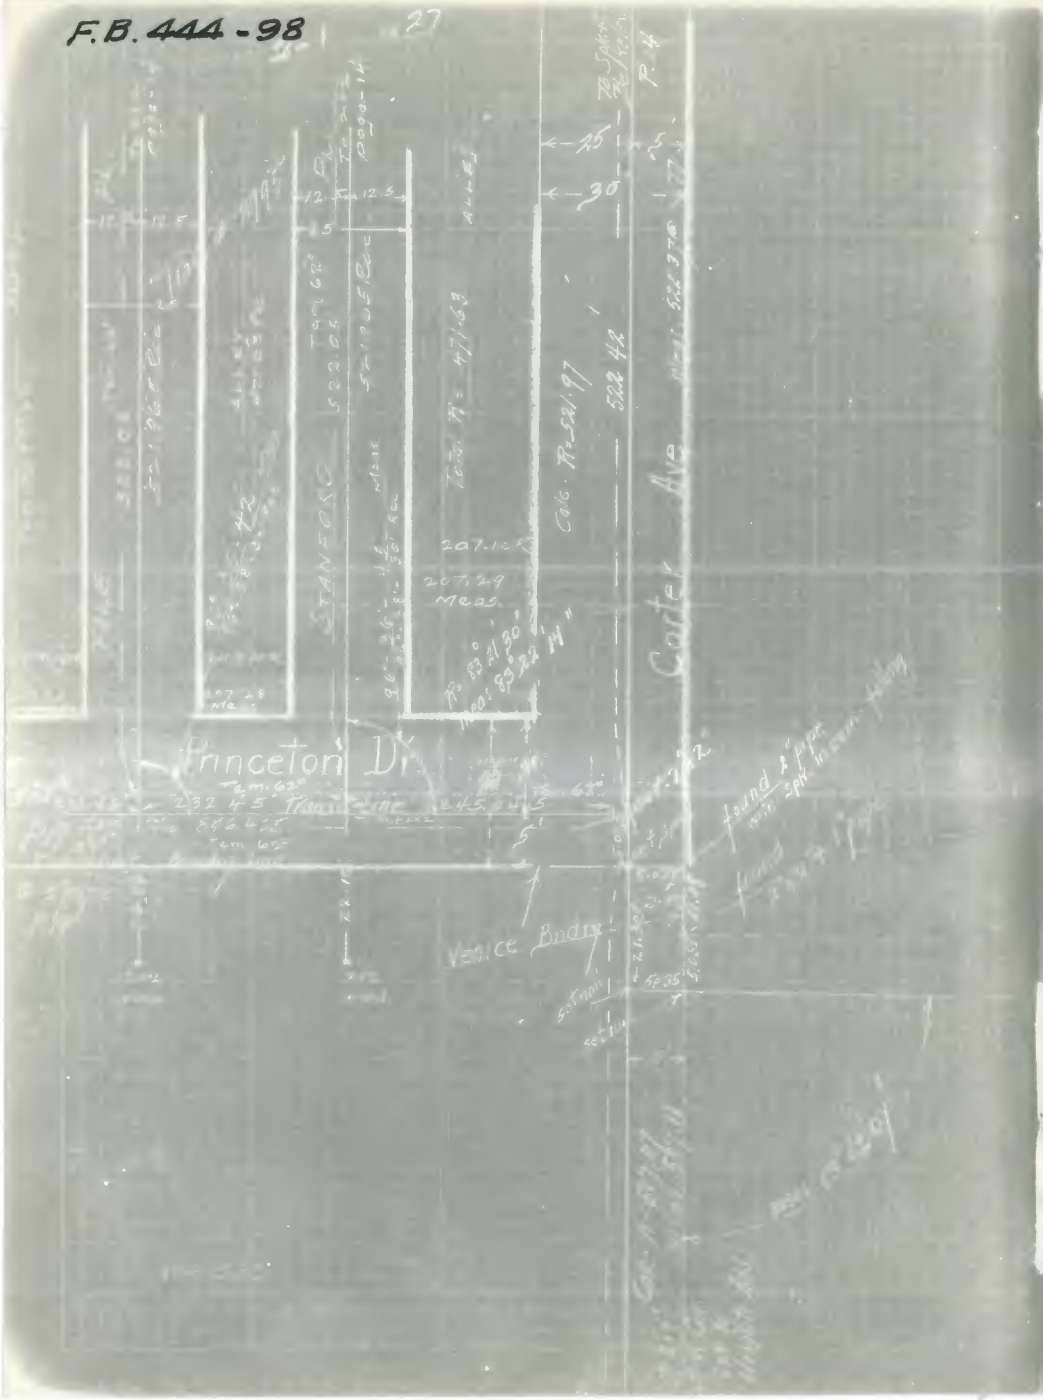

F.B. 444-99

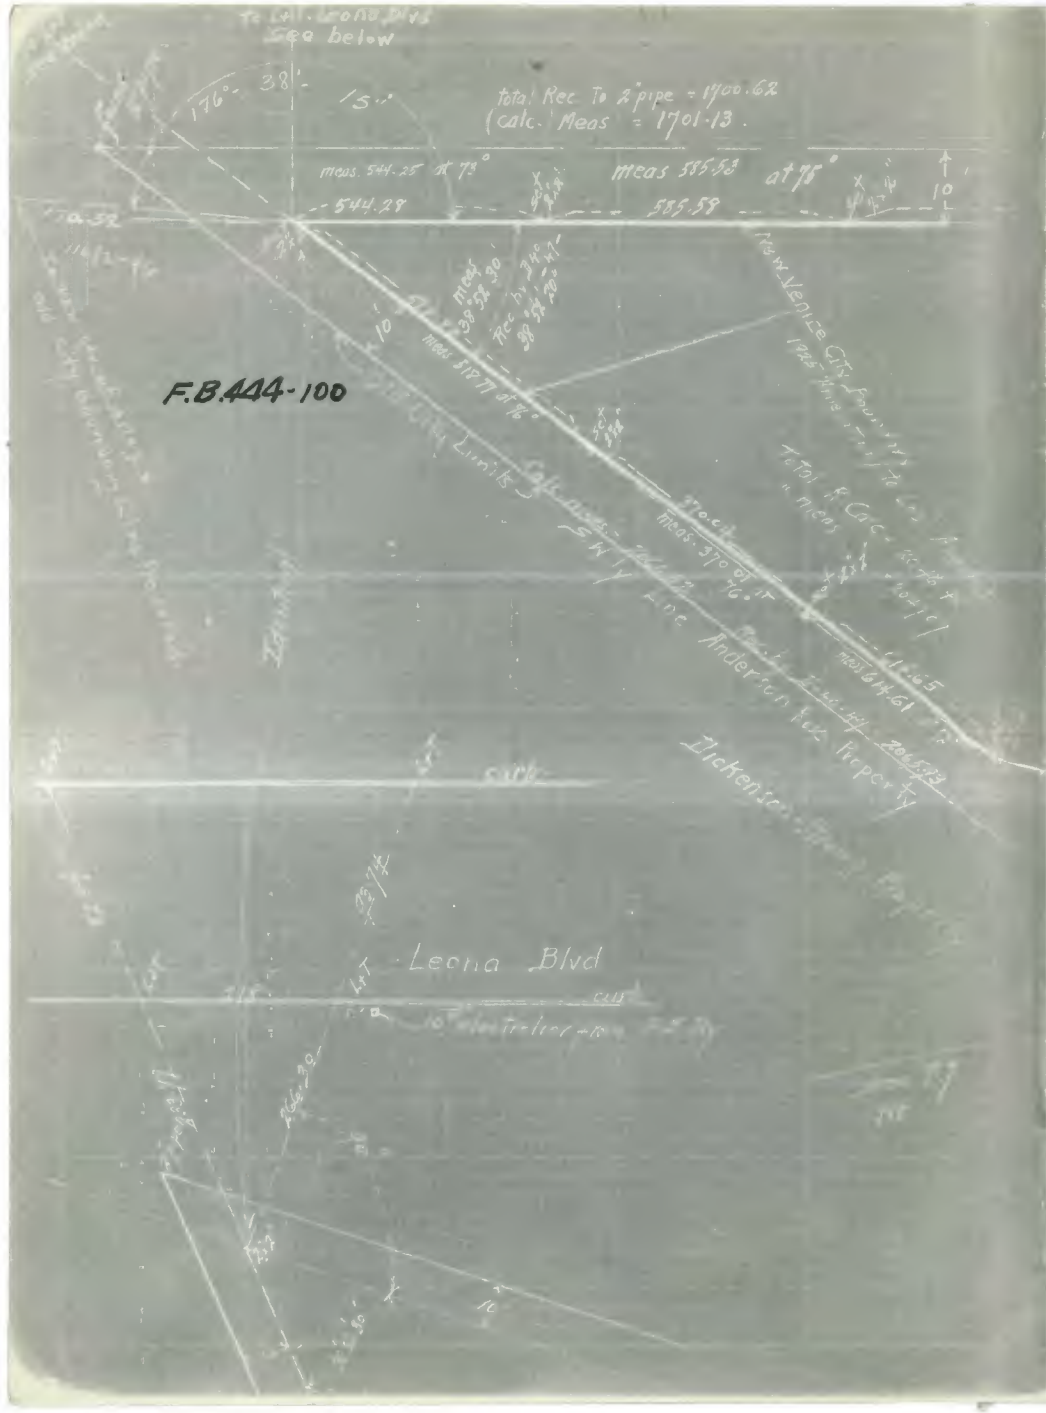
F.B.444-100
See below
total Rec To 2" pipe = 1700.62
(calc. Meas = 1701.13.
meas. 544.25 at 73°
544.28
meas 585.53 at 75°
585.58
New Venice City Boundary
Anderson Rose Property
Dickenson Property
Leona Blvd
Total R. Calc
meas 370.01 at 76°
meas 614.61
Total Rec. to 2" pipe = 1838.30
meas 542.19 at 73°
542.22
meas 424.37 at 80°
meas 94°04'20"
New Venice City Bndry
8-1-26
Venice City Boundary
13.38

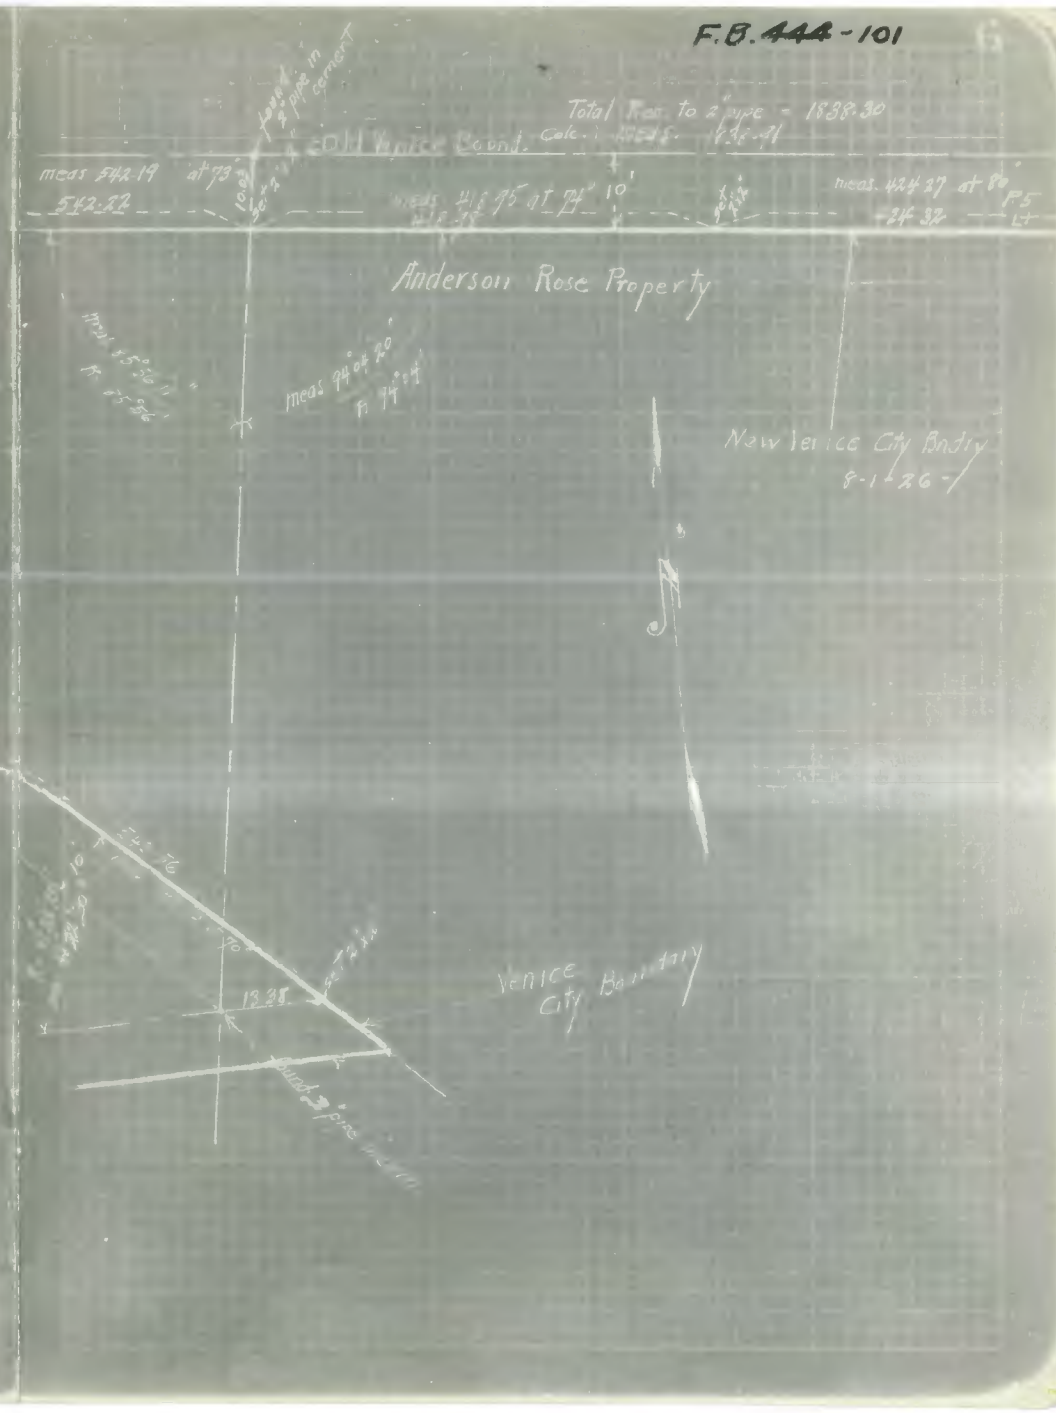
F.B.444-101
Anderson Rose Property
New Venice City Bndry
8-1-26
Venice City Boundary

F.B. 444-102

F.B. 444-103

Triangulation

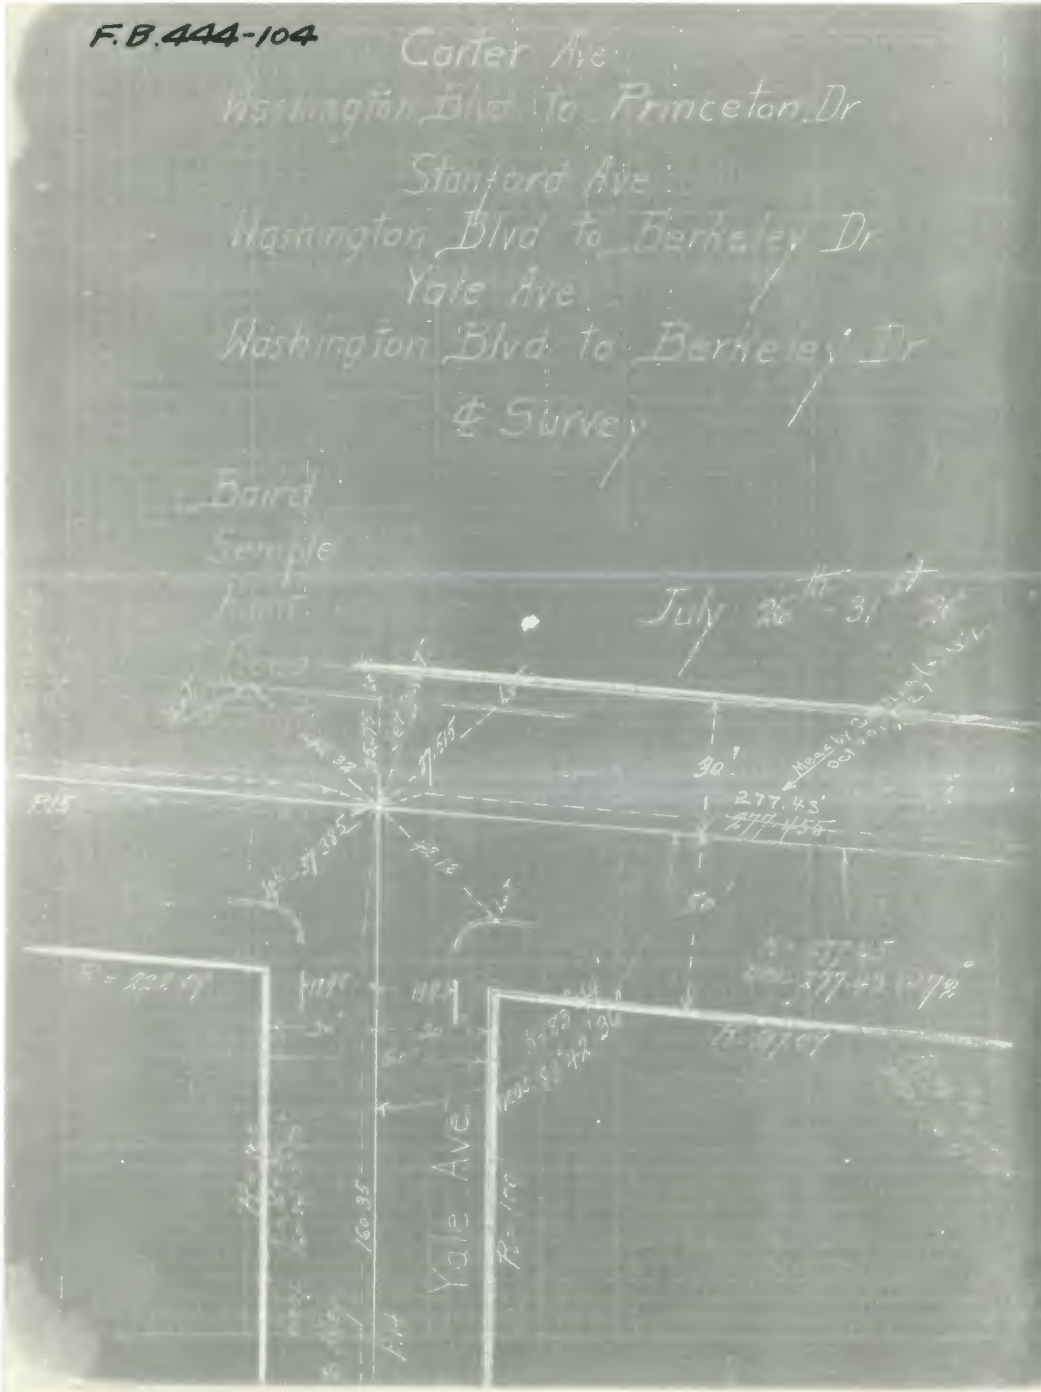
F.B. 444-104
Carter Ave
Washington Blvd to Princeton Dr
Stanford Ave
Washington Blvd to Berkeley Dr
Yale Ave
Washington Blvd to Berkeley Dr
℄ Survey
Baird
Semple
July 26th - 31st
30'
277.43'
Yale Ave
160.35

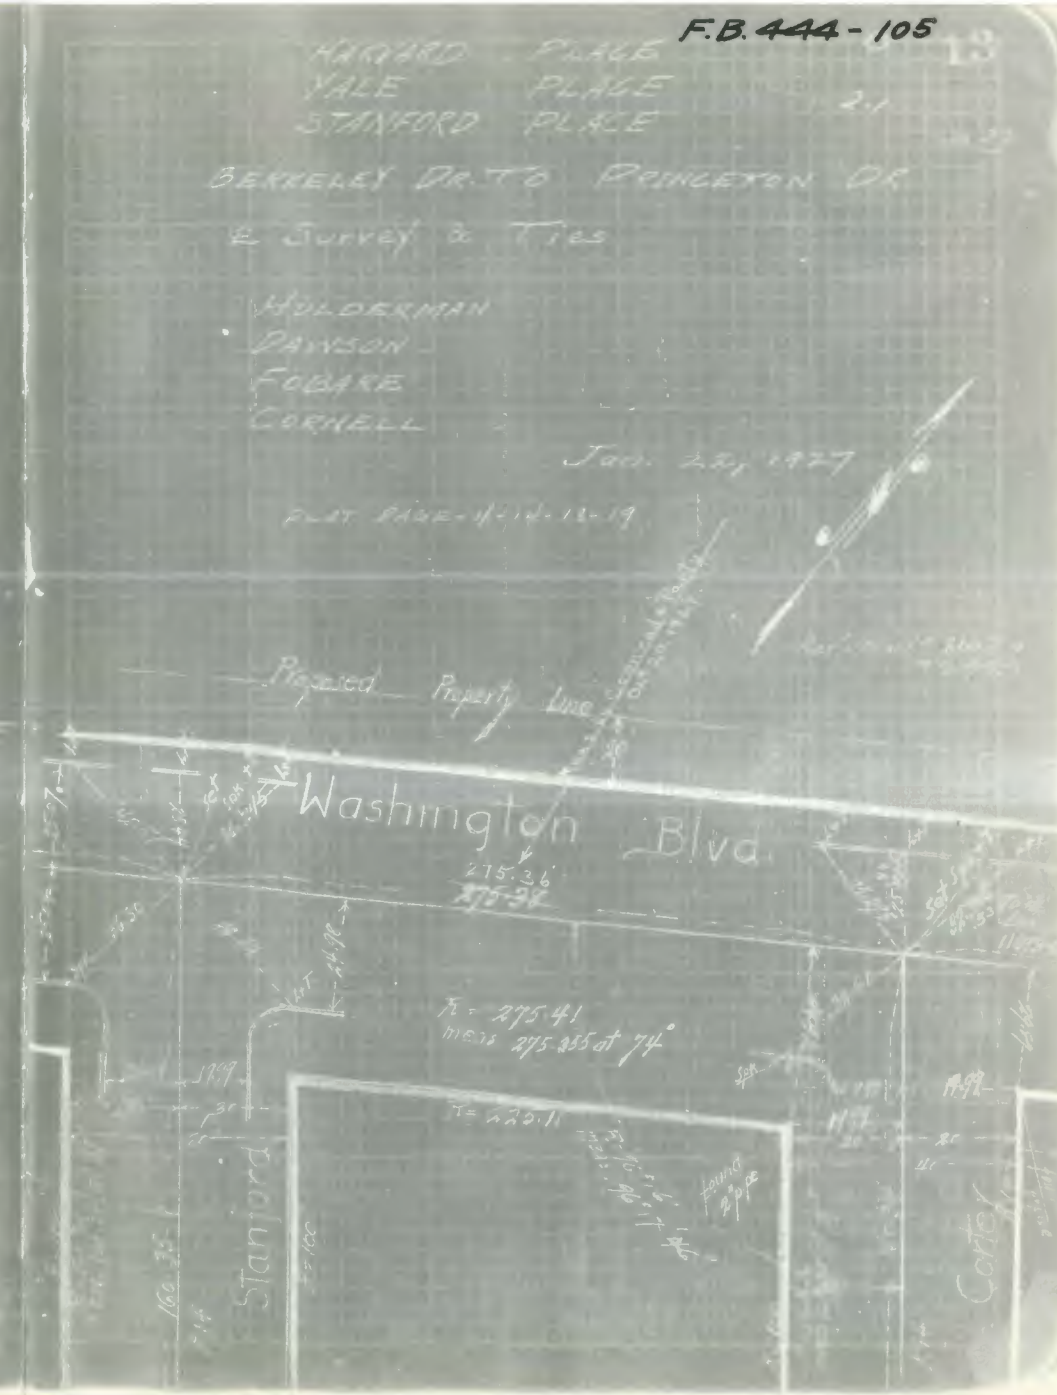
F.B. 444-105
HARVARD PLACE
YALE PLACE
STANFORD PLACE
BERKELEY DR. TO PRINCETON DR
℄ Survey & Ties
HOLDERMAN
DAWSON
FOBARE
CORNELL
Jan. 22, 1927
Proposed Property Line
Washington Blvd
275.36'
R = 275.41
meas 275.355 at 74°
Stanford
Carter

F.B. 444-106

F.B. 444-107

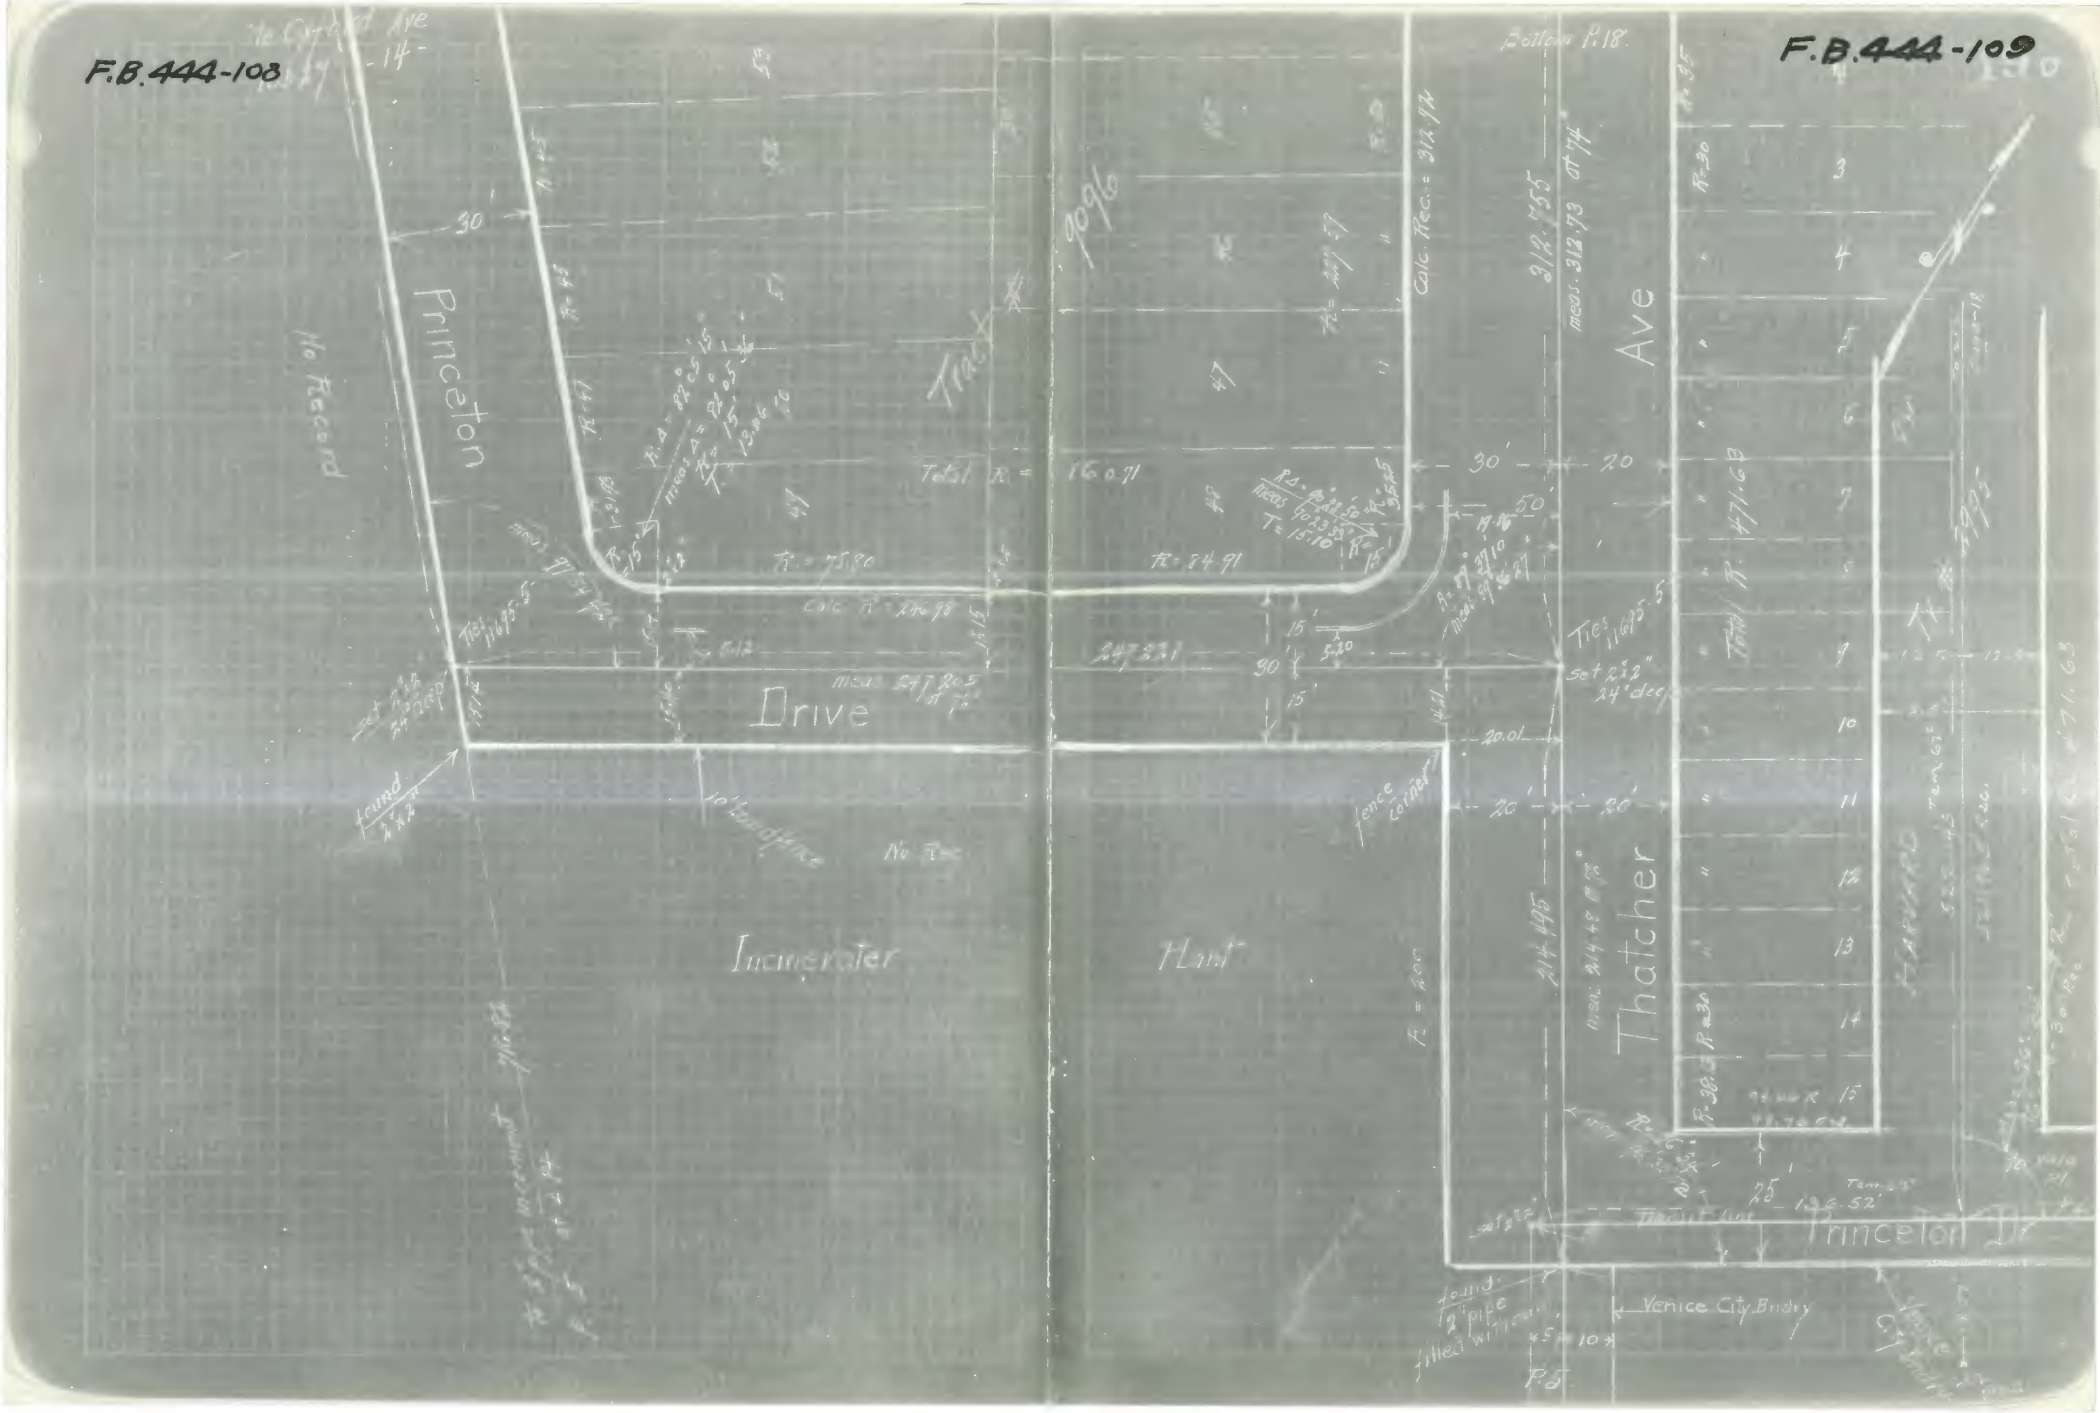
F.B.444-108
F.B.444-109
Princeton
Drive
Thatcher
Ave
Incinerator
Plant
Princeton Dr
Venice City Bndry
No Record
No Rec
Bottom P.18
Tract
Total R = 160.71
Calc. R = 246.98
Calc. Rec. = 312.92
meas. 312.73
Ties 11695.5
Set 2"x2" 24" deep
fence corner
found 2"x2"
found 2" pipe filled with cement
Total R. 471.63
Tract line
Tem. 62°
P.5

F.B. 444 - 110

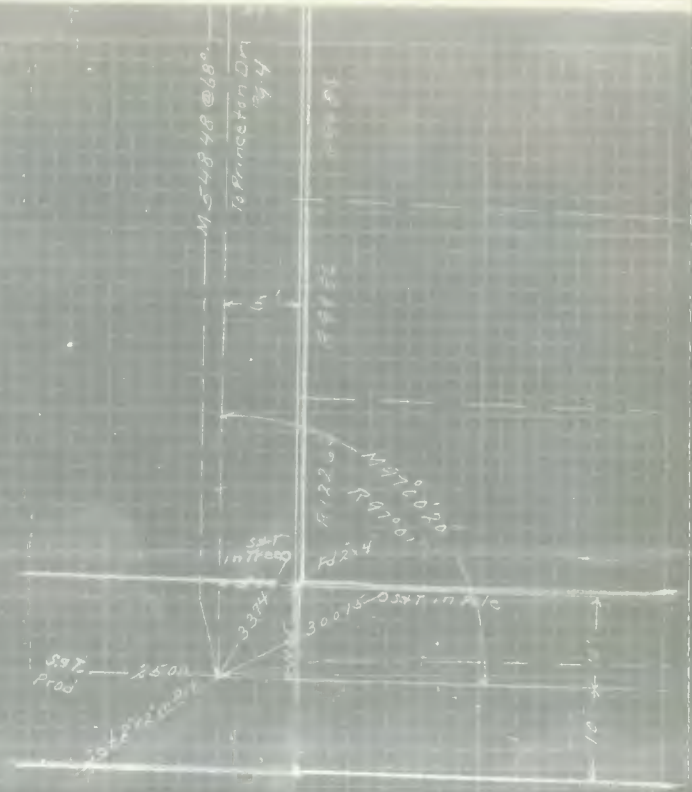

F.B. 444 - 111

FB 444 PG Index

F.B. 444

PAGES: Index,

153 to , 155 to 176 , 178 to 219

444

444

444

RETURN TO
LOS ANGELES COUNTY SURVEYOR
700 HALL OF RECORDS

Do not extend notes this side of this line

Note: ANY ADDITIONS OR CHANGES ON THIS SHEET MUST BE MADE OR CIRCLED IN Red Ink. WITH DATE AND NAME OF PERSON MAKING CHANGE.

Notes Ck'd by	Survey of
Map No.	W. O. Tape No. St'd °F.
Office Work	Surveyed by
Checked	Notes Date
Date	Indexed

F.B. PG

Note: ANY ADDITIONS OR CHANGES ON THIS SHEET MUST BE MADE OR CIRCLED IN **Red Ink**, WITH DATE AND NAME OF PERSON MAKING CHANGE.

Do not extend notes this side of this line

RETURN TO
LOS ANGELES COUNTY SURVEYOR
700 HALL OF RECORDS

FORM 247 10M 5-31

Tract 7817
M-157.54
15.15

F.B. 444-113

Storm Drain
Alley
Proposed Widening
Central Ave

F.B.444-114

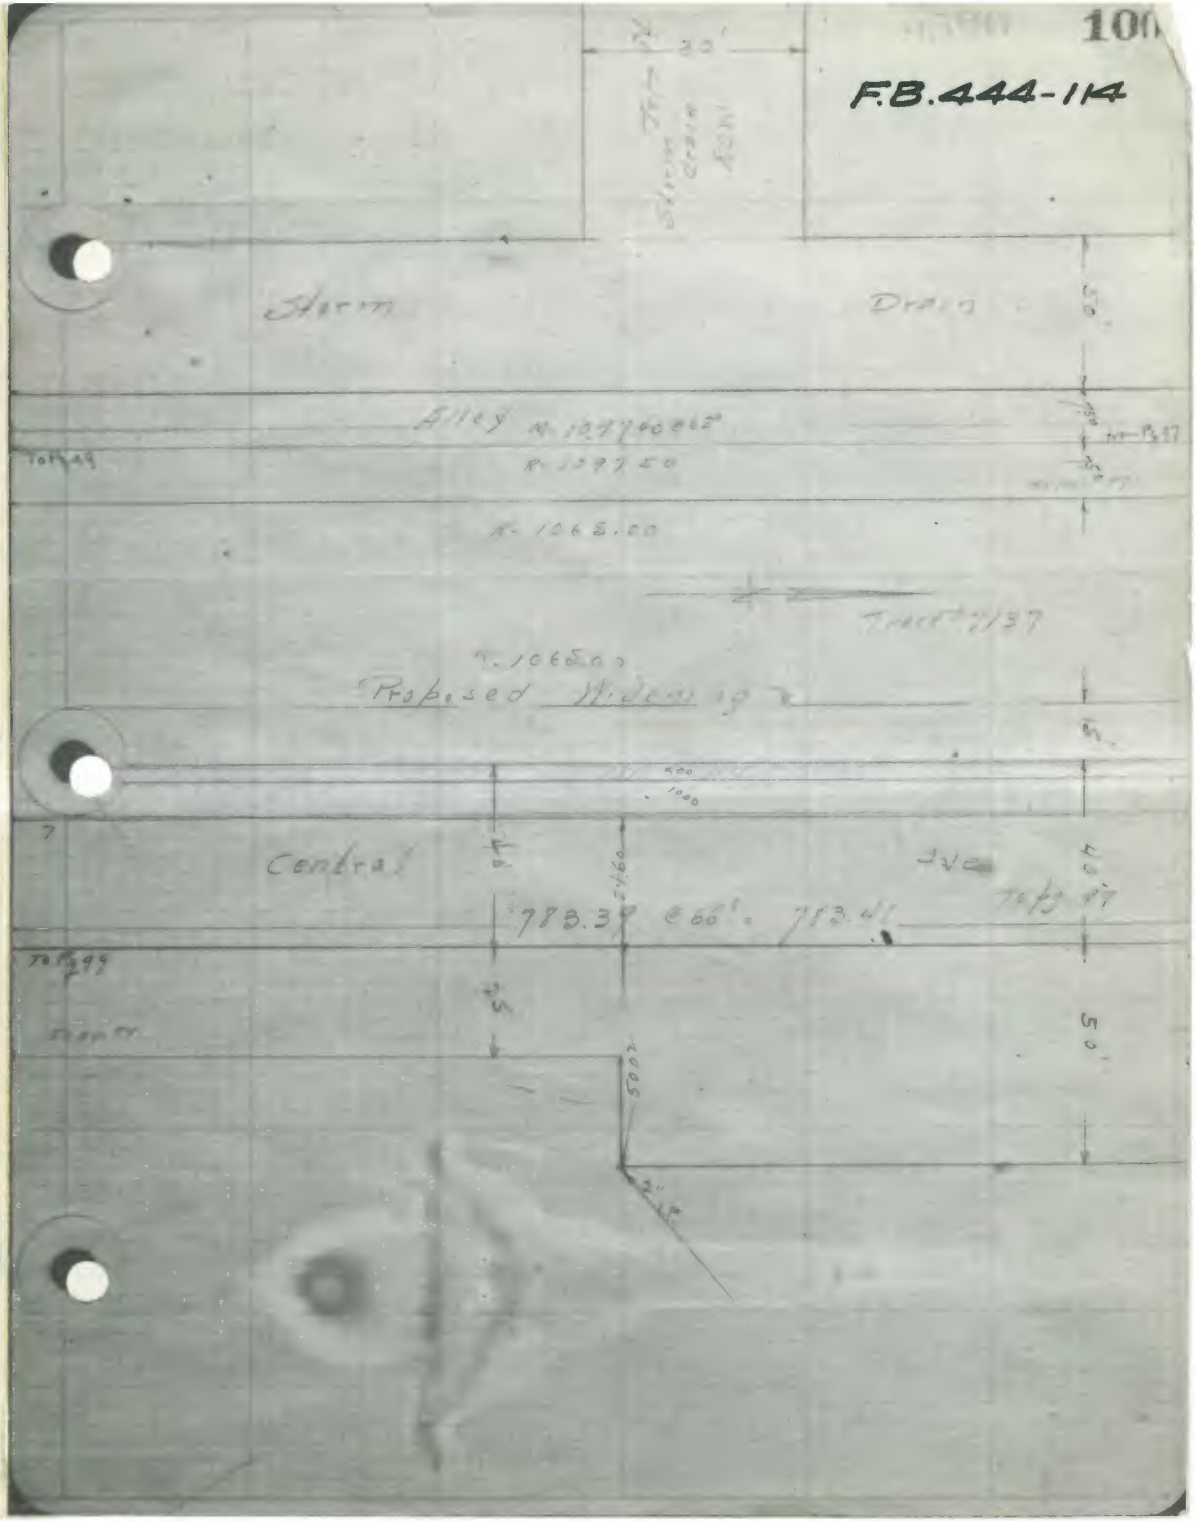

Fd 2x2 buried
Set 2x2
To Pg 104
Central Ave
No Tack

Fd 2" I.P.
Fd 2x2 buried
Lot in Cem-Irrigation Box
To Pg 101
Alley
No Alley (Not dedicated)
No Street (Not dedicated)
Angle point in alley
Not chained
Tract 7517
Drain
St. Pole
Central Ave.

F.B. 444-117

9543-159

F.B. 414-118

444

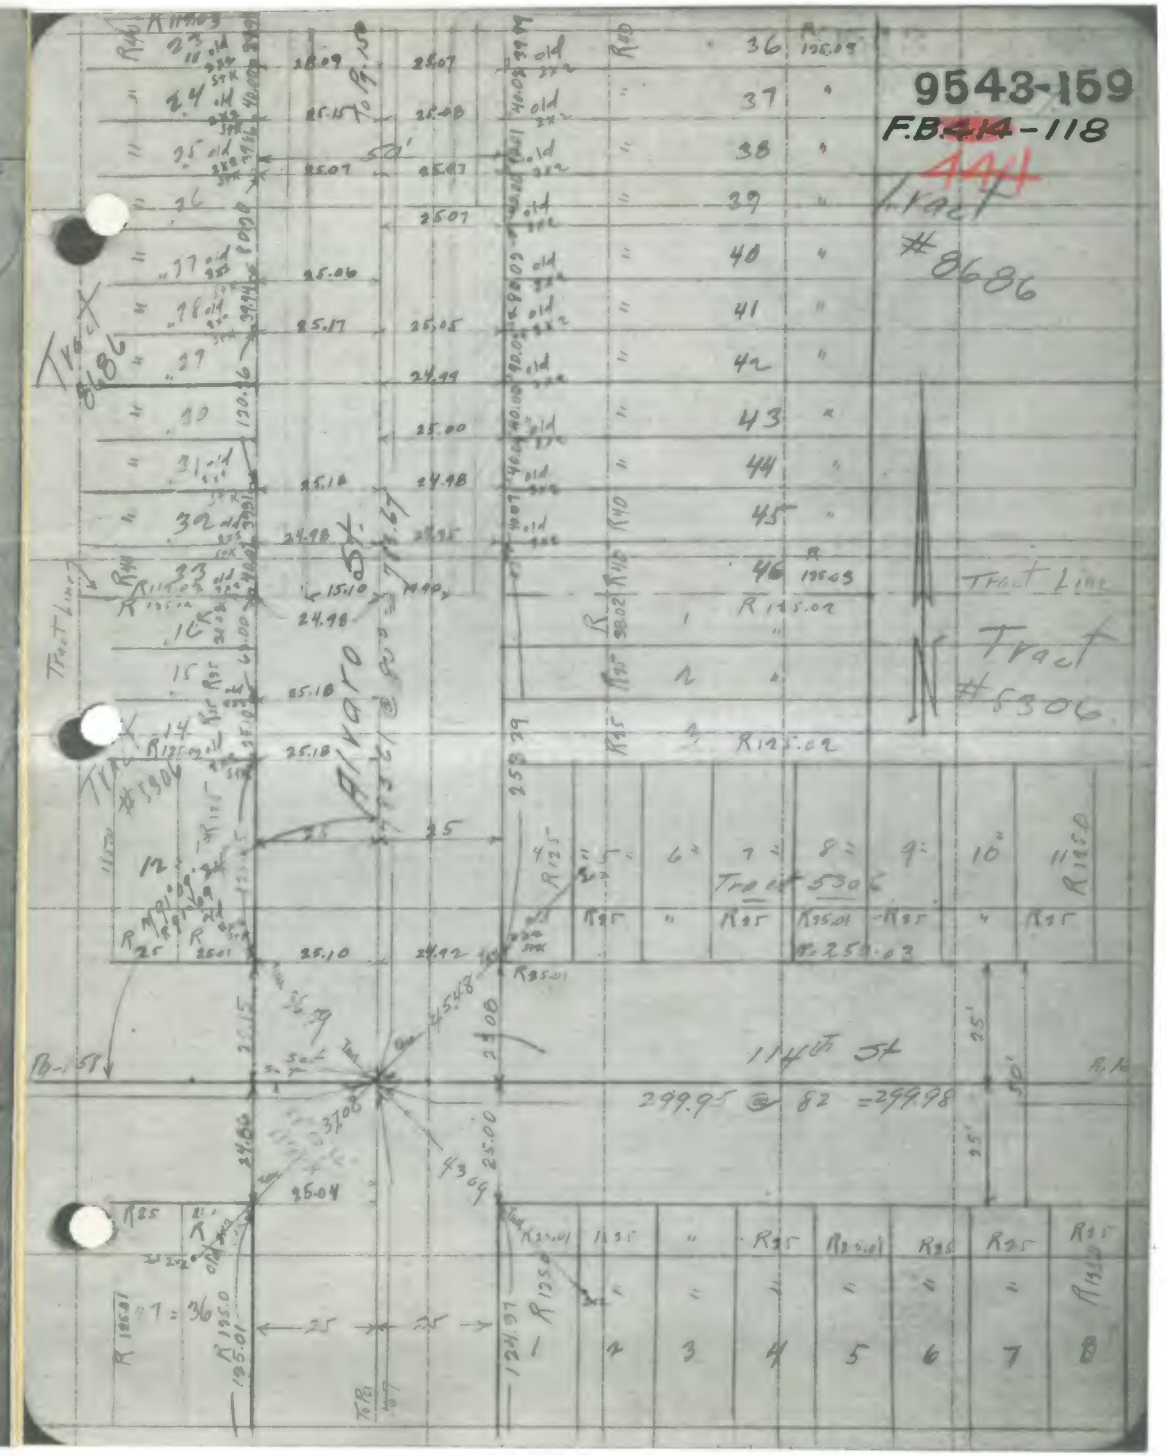

F.B. ~~414~~ 444 - 119

9543-180

Tract #6605

Tract #5306

Tract Line

11th St.

299.87 @ 78 = 299.89

9543-181

F.B. ~~414~~ 444 - 180

Tract #6603

Tract #5306

Tract Line

Zomore

11th St.

299.98 @ 78 = 300.06

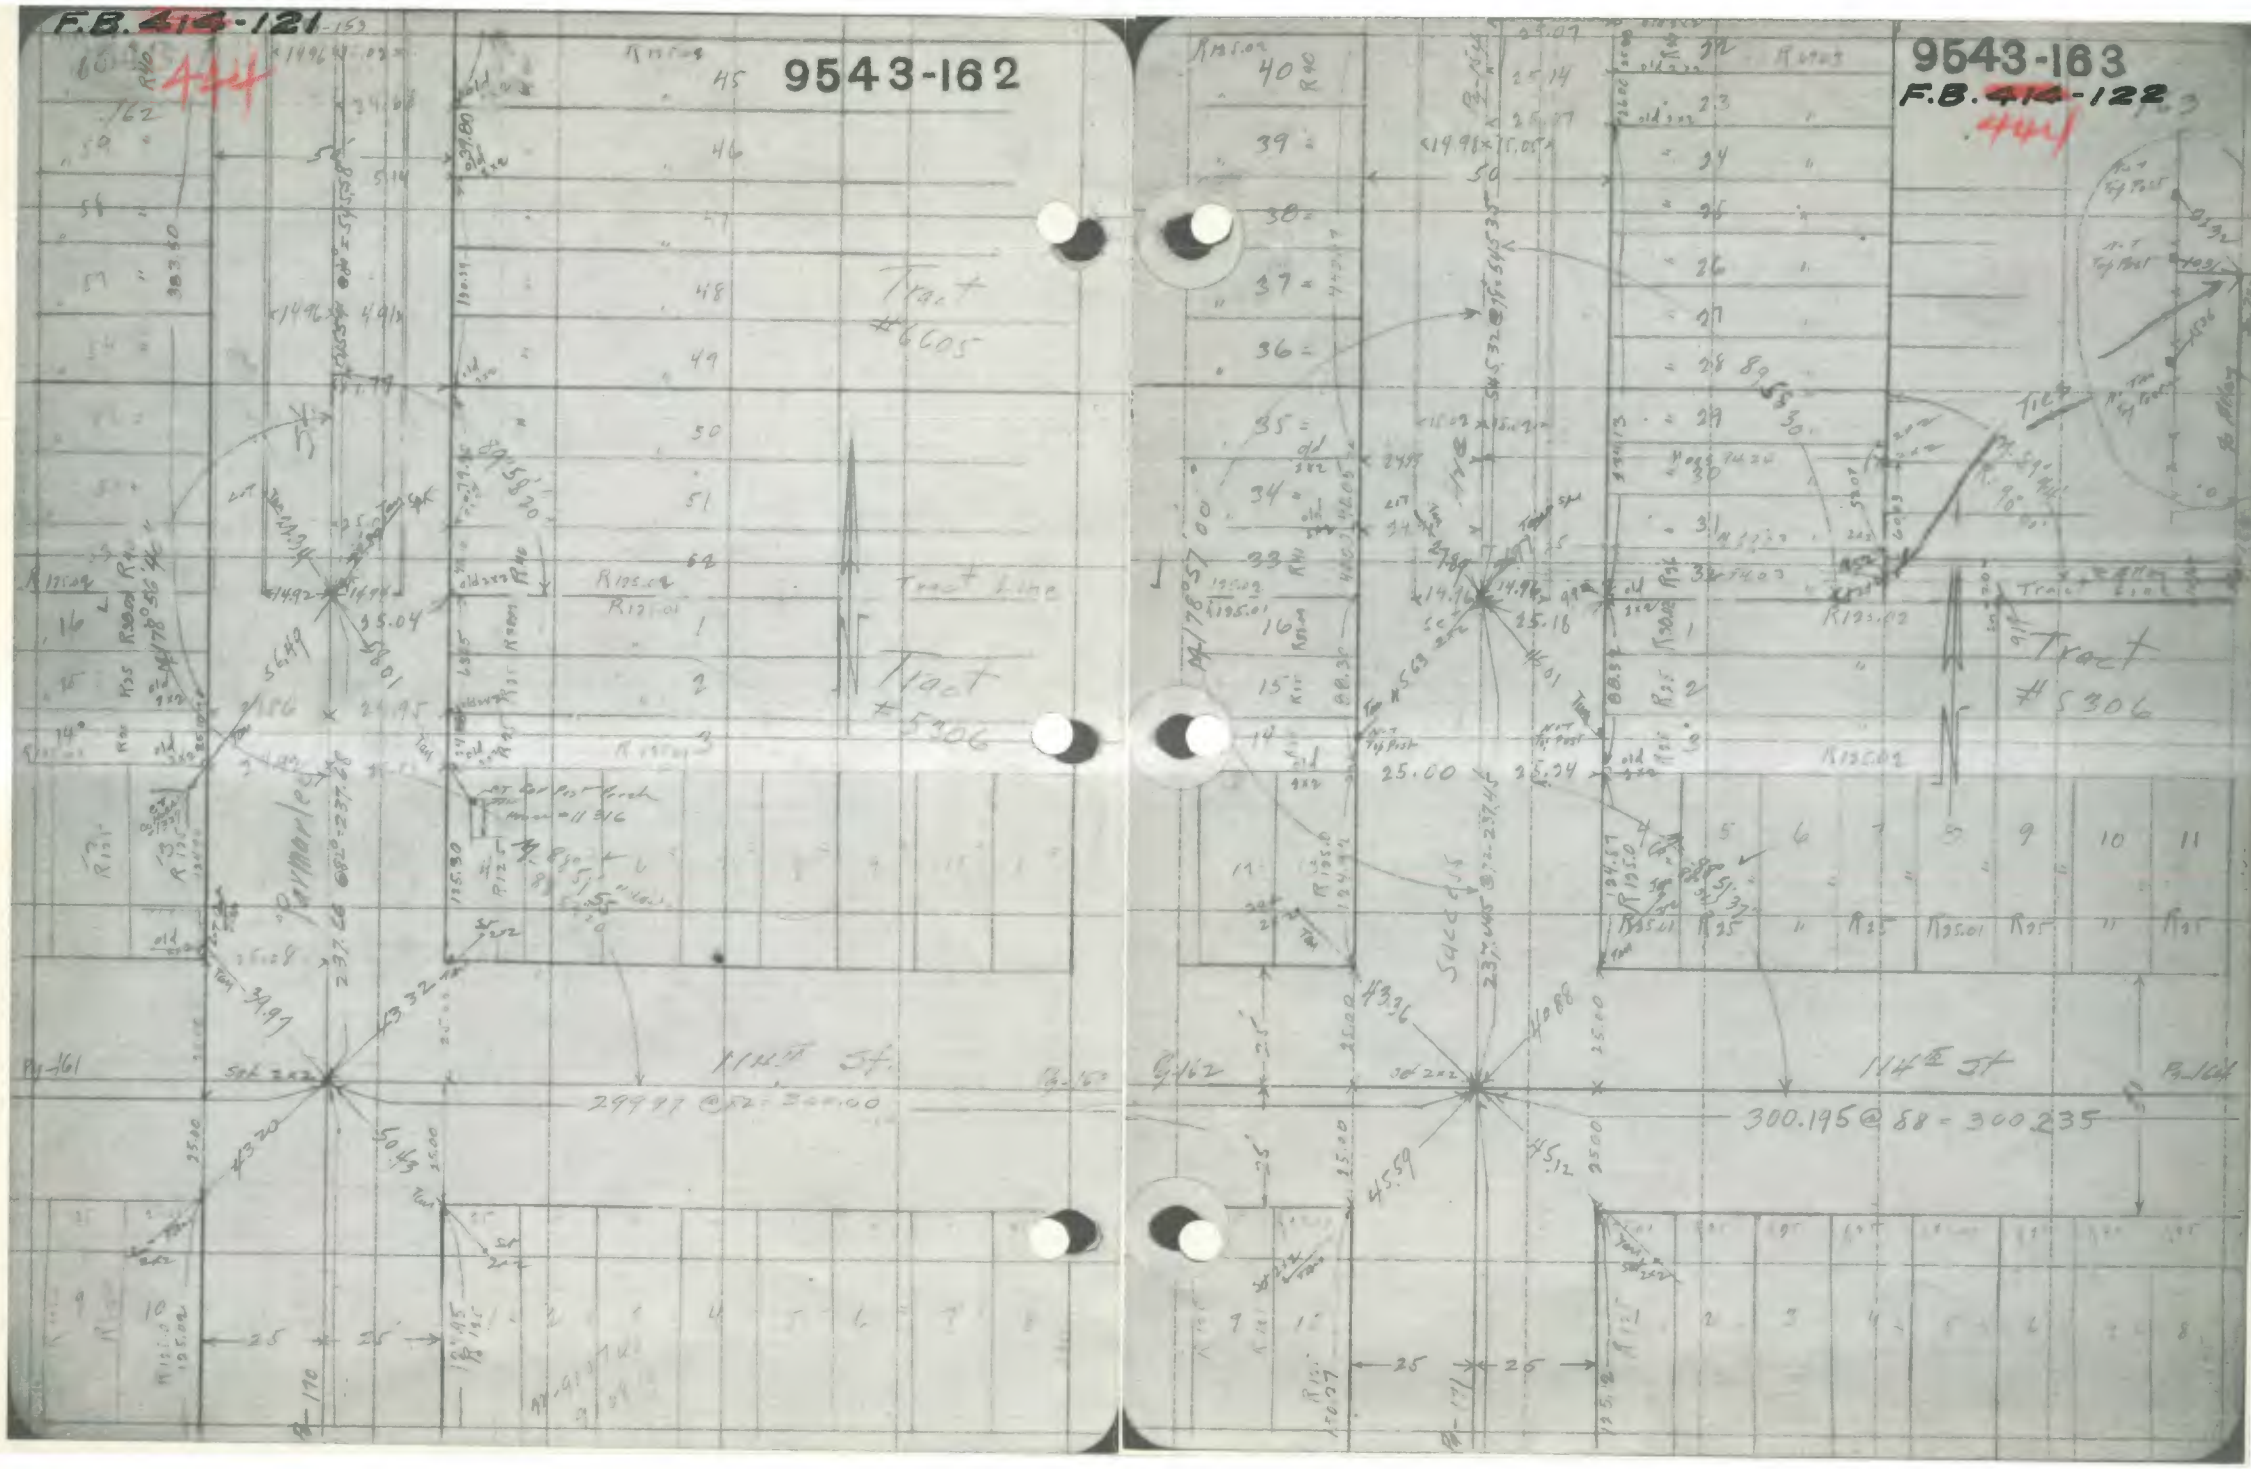
F.B. 414-121
444
9543-162
Tract #6605
Tract Line
Tract #5306
Parmarlee
114th St.
299.97 @ 82 = 300.00
9543-163
F.B. 414-122
444
Tract #5306
Success
114th St
300.195 @ 88 = 300.235

9543-164

F.B. 444-122

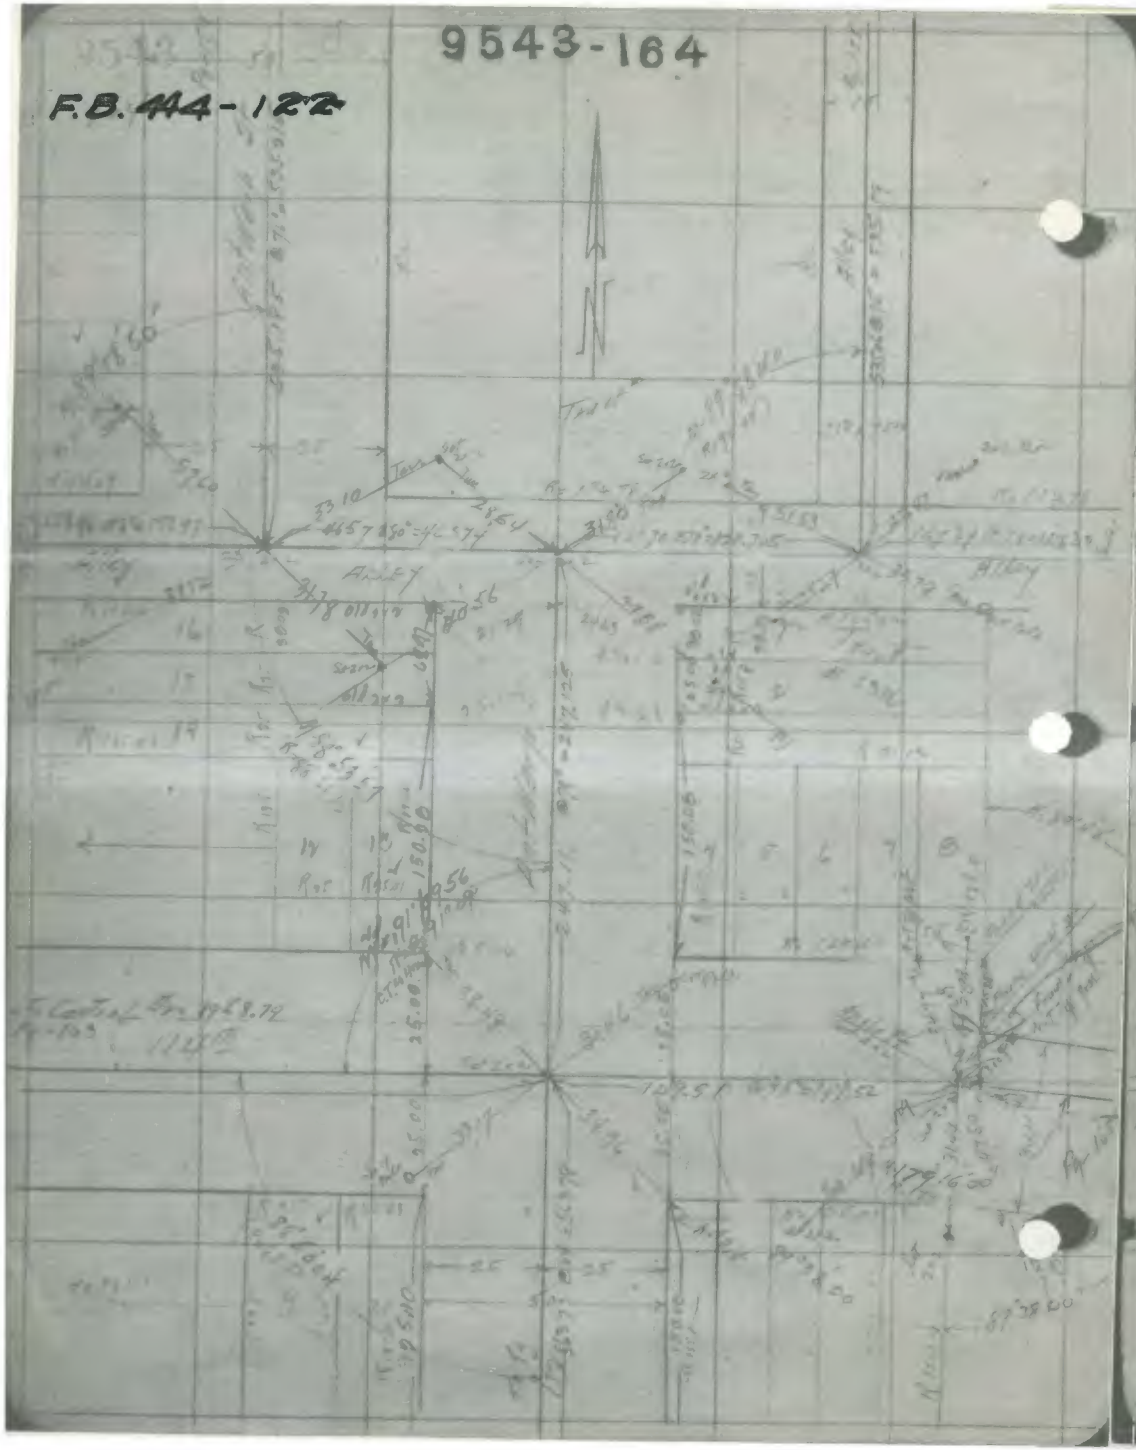

9543-165

F.B. 444-123

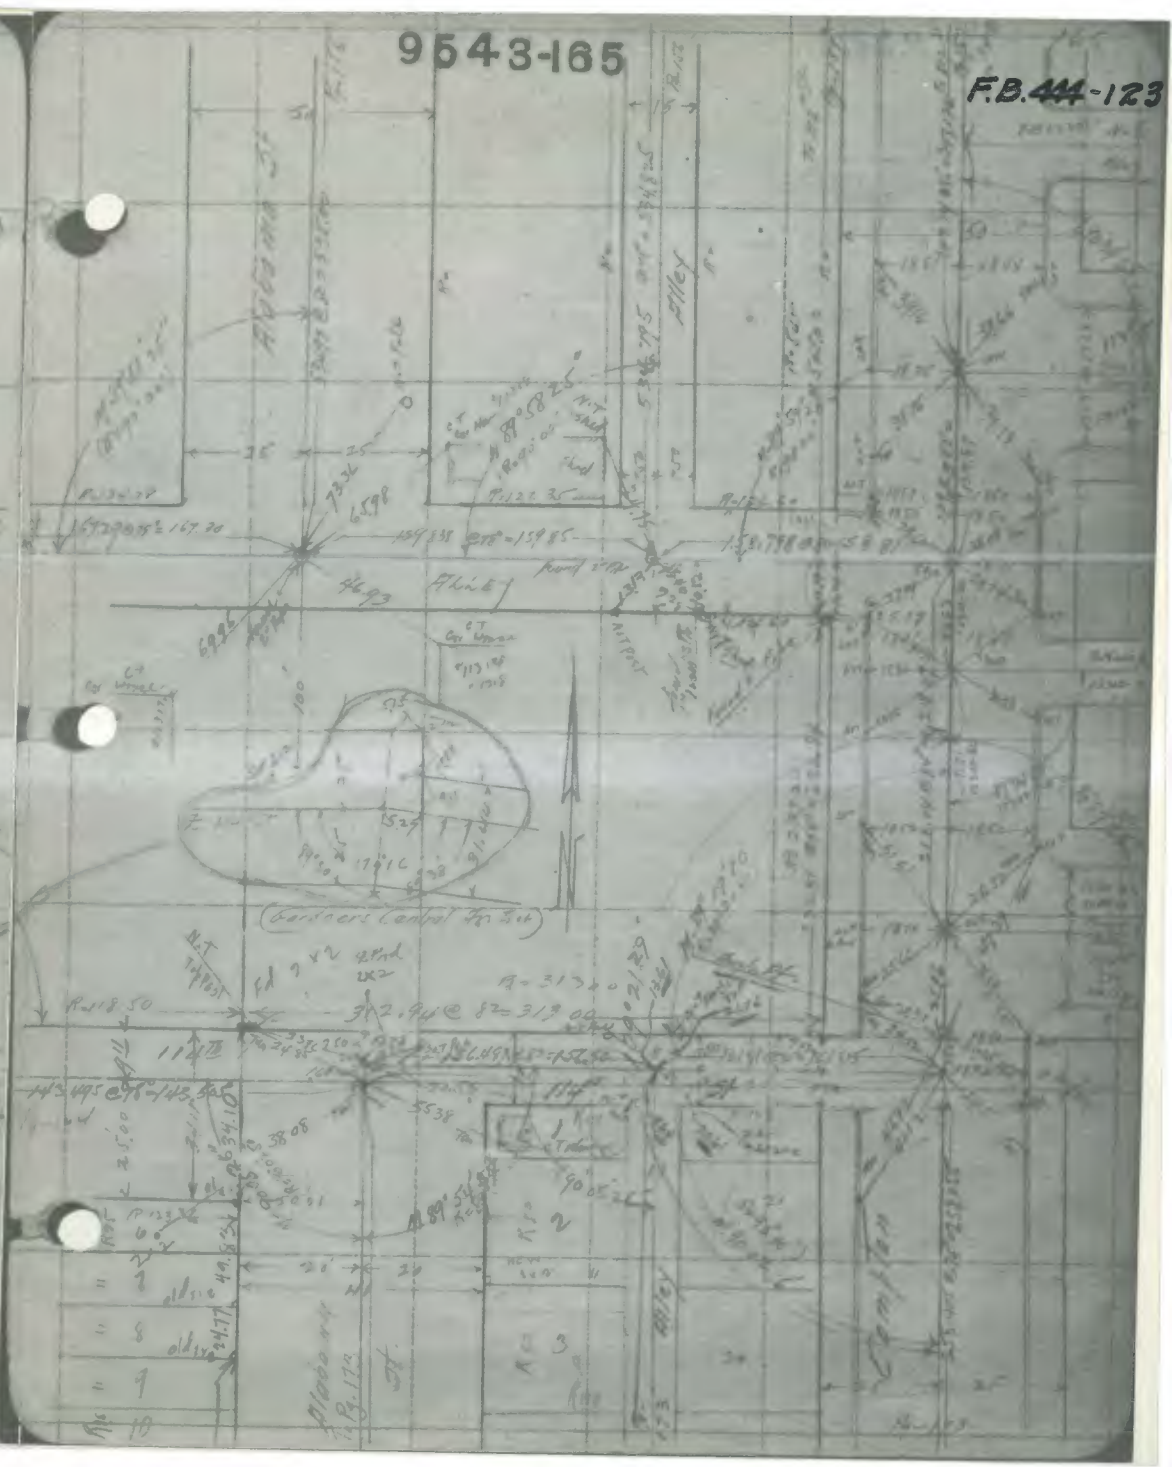

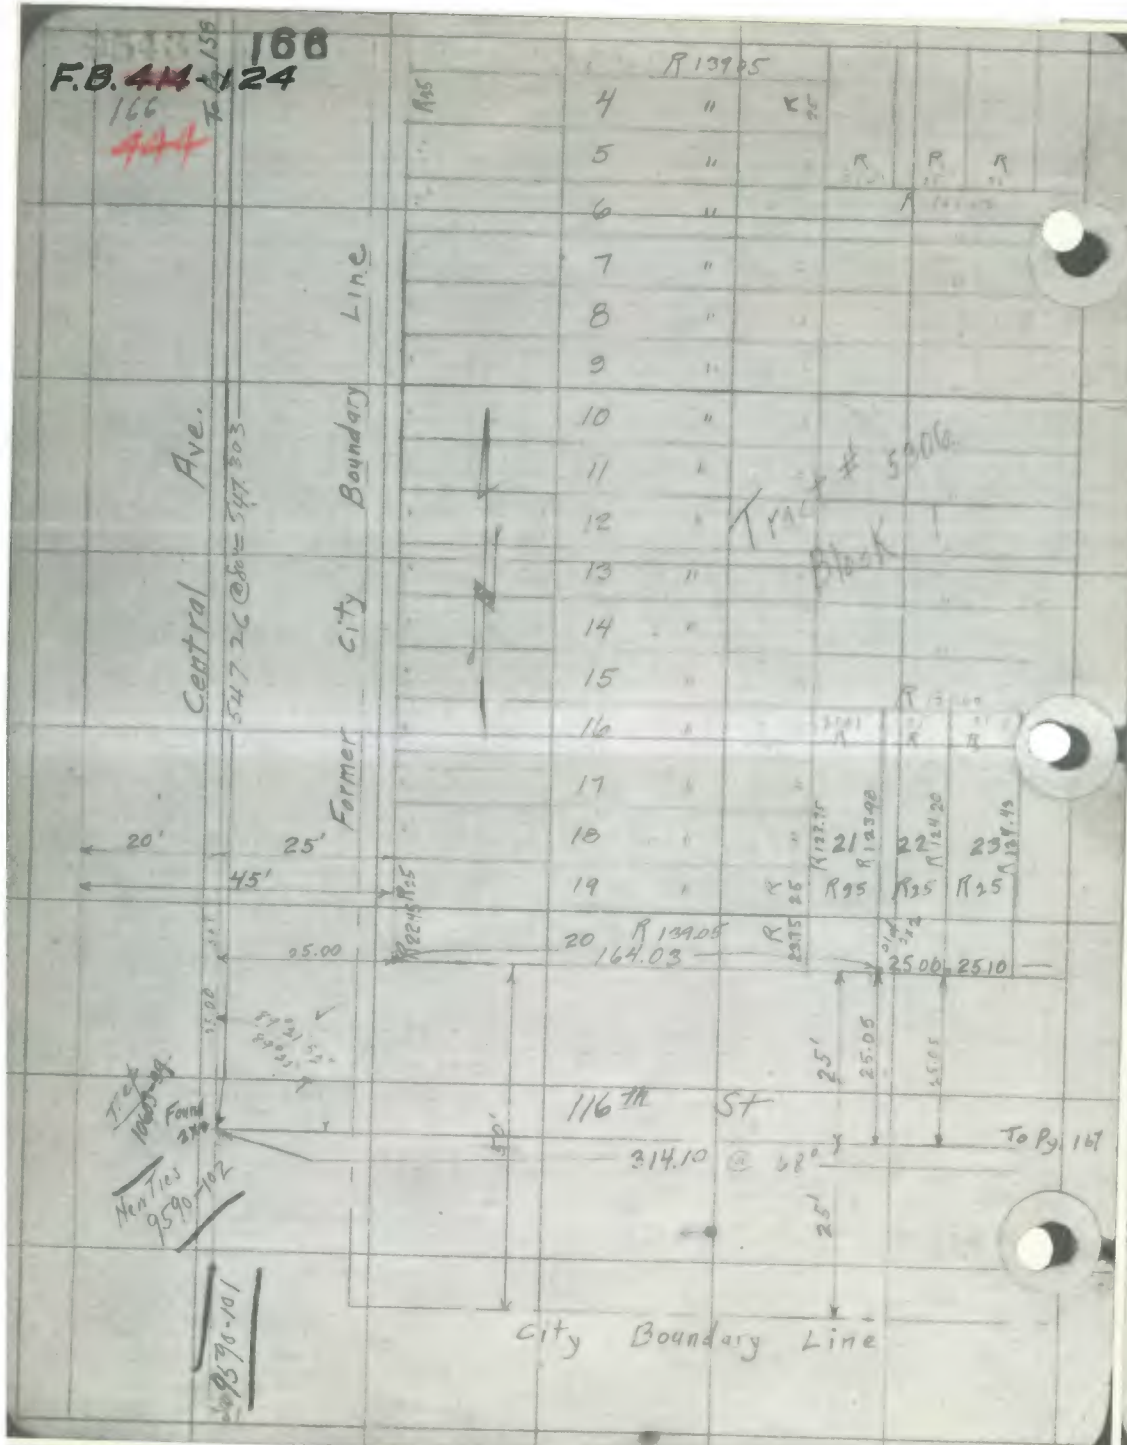
166
F.B. 444-124
Central Ave.
Former City Boundary Line
Tract # 5306
Block 1
116th St
To Pg. 167
City Boundary Line
New Ties 9590-102
9590-101

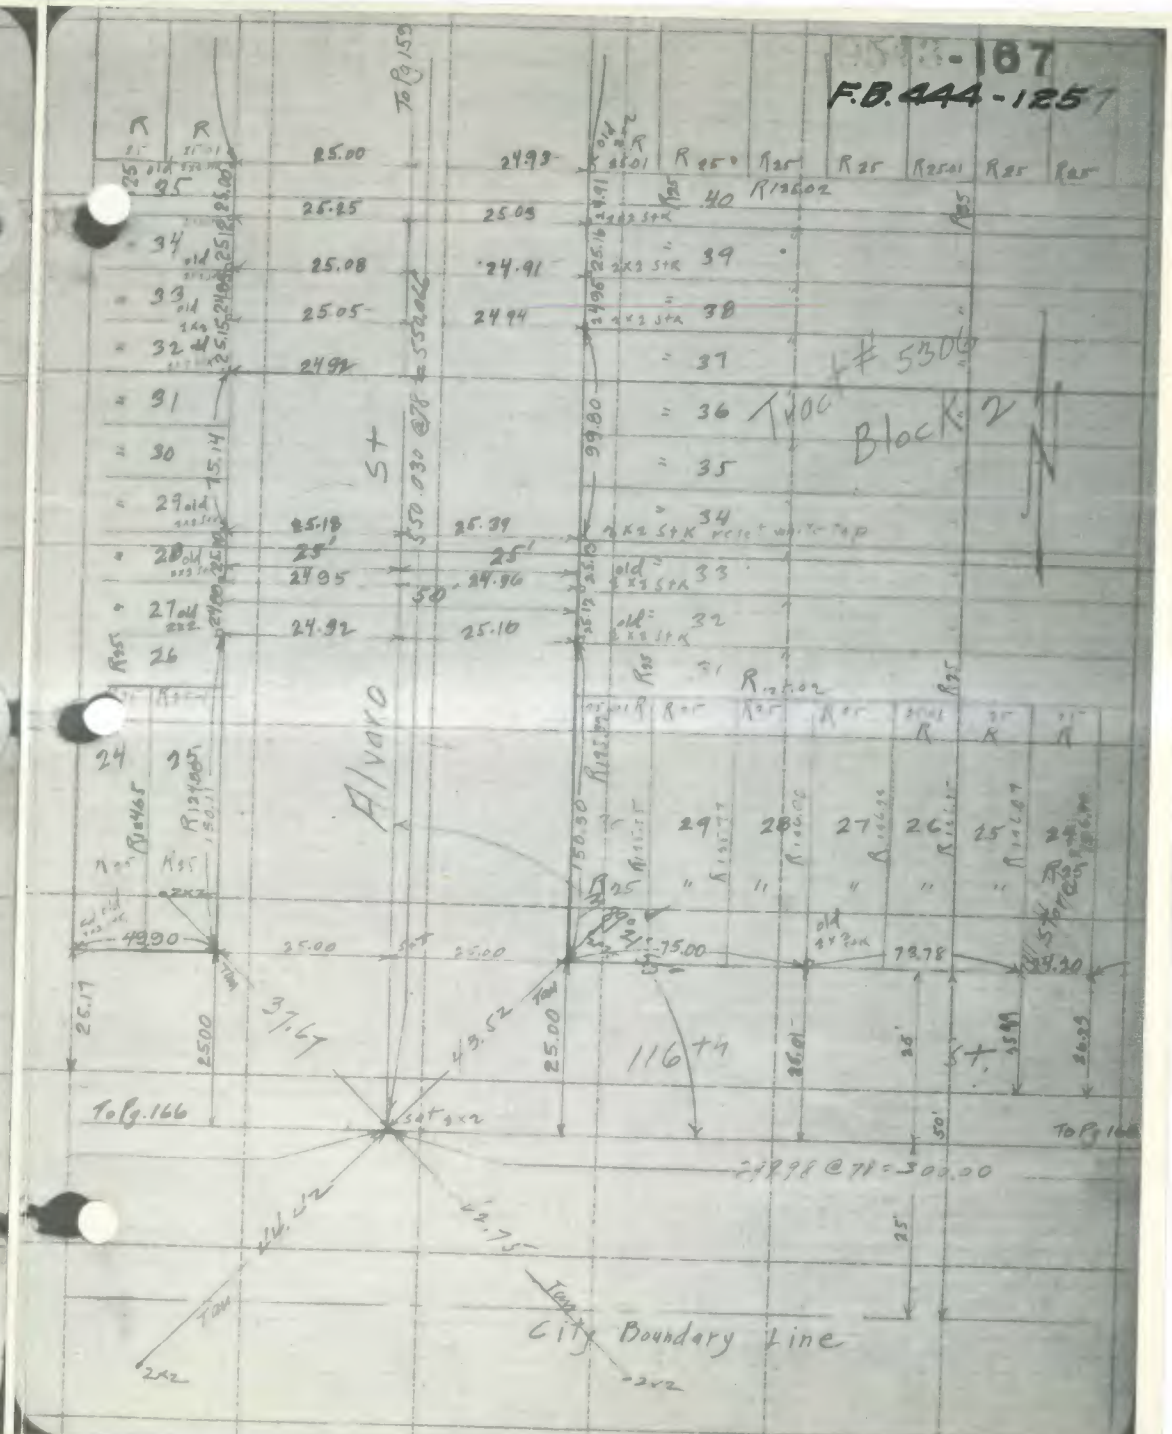
167
F.B. 444-125
Alvaro St
Tract # 5306
Block 2
116th St.
To Pg. 166
City Boundary Line

F.B. 444-126

9543-168

9543-169

F.B. 444-127

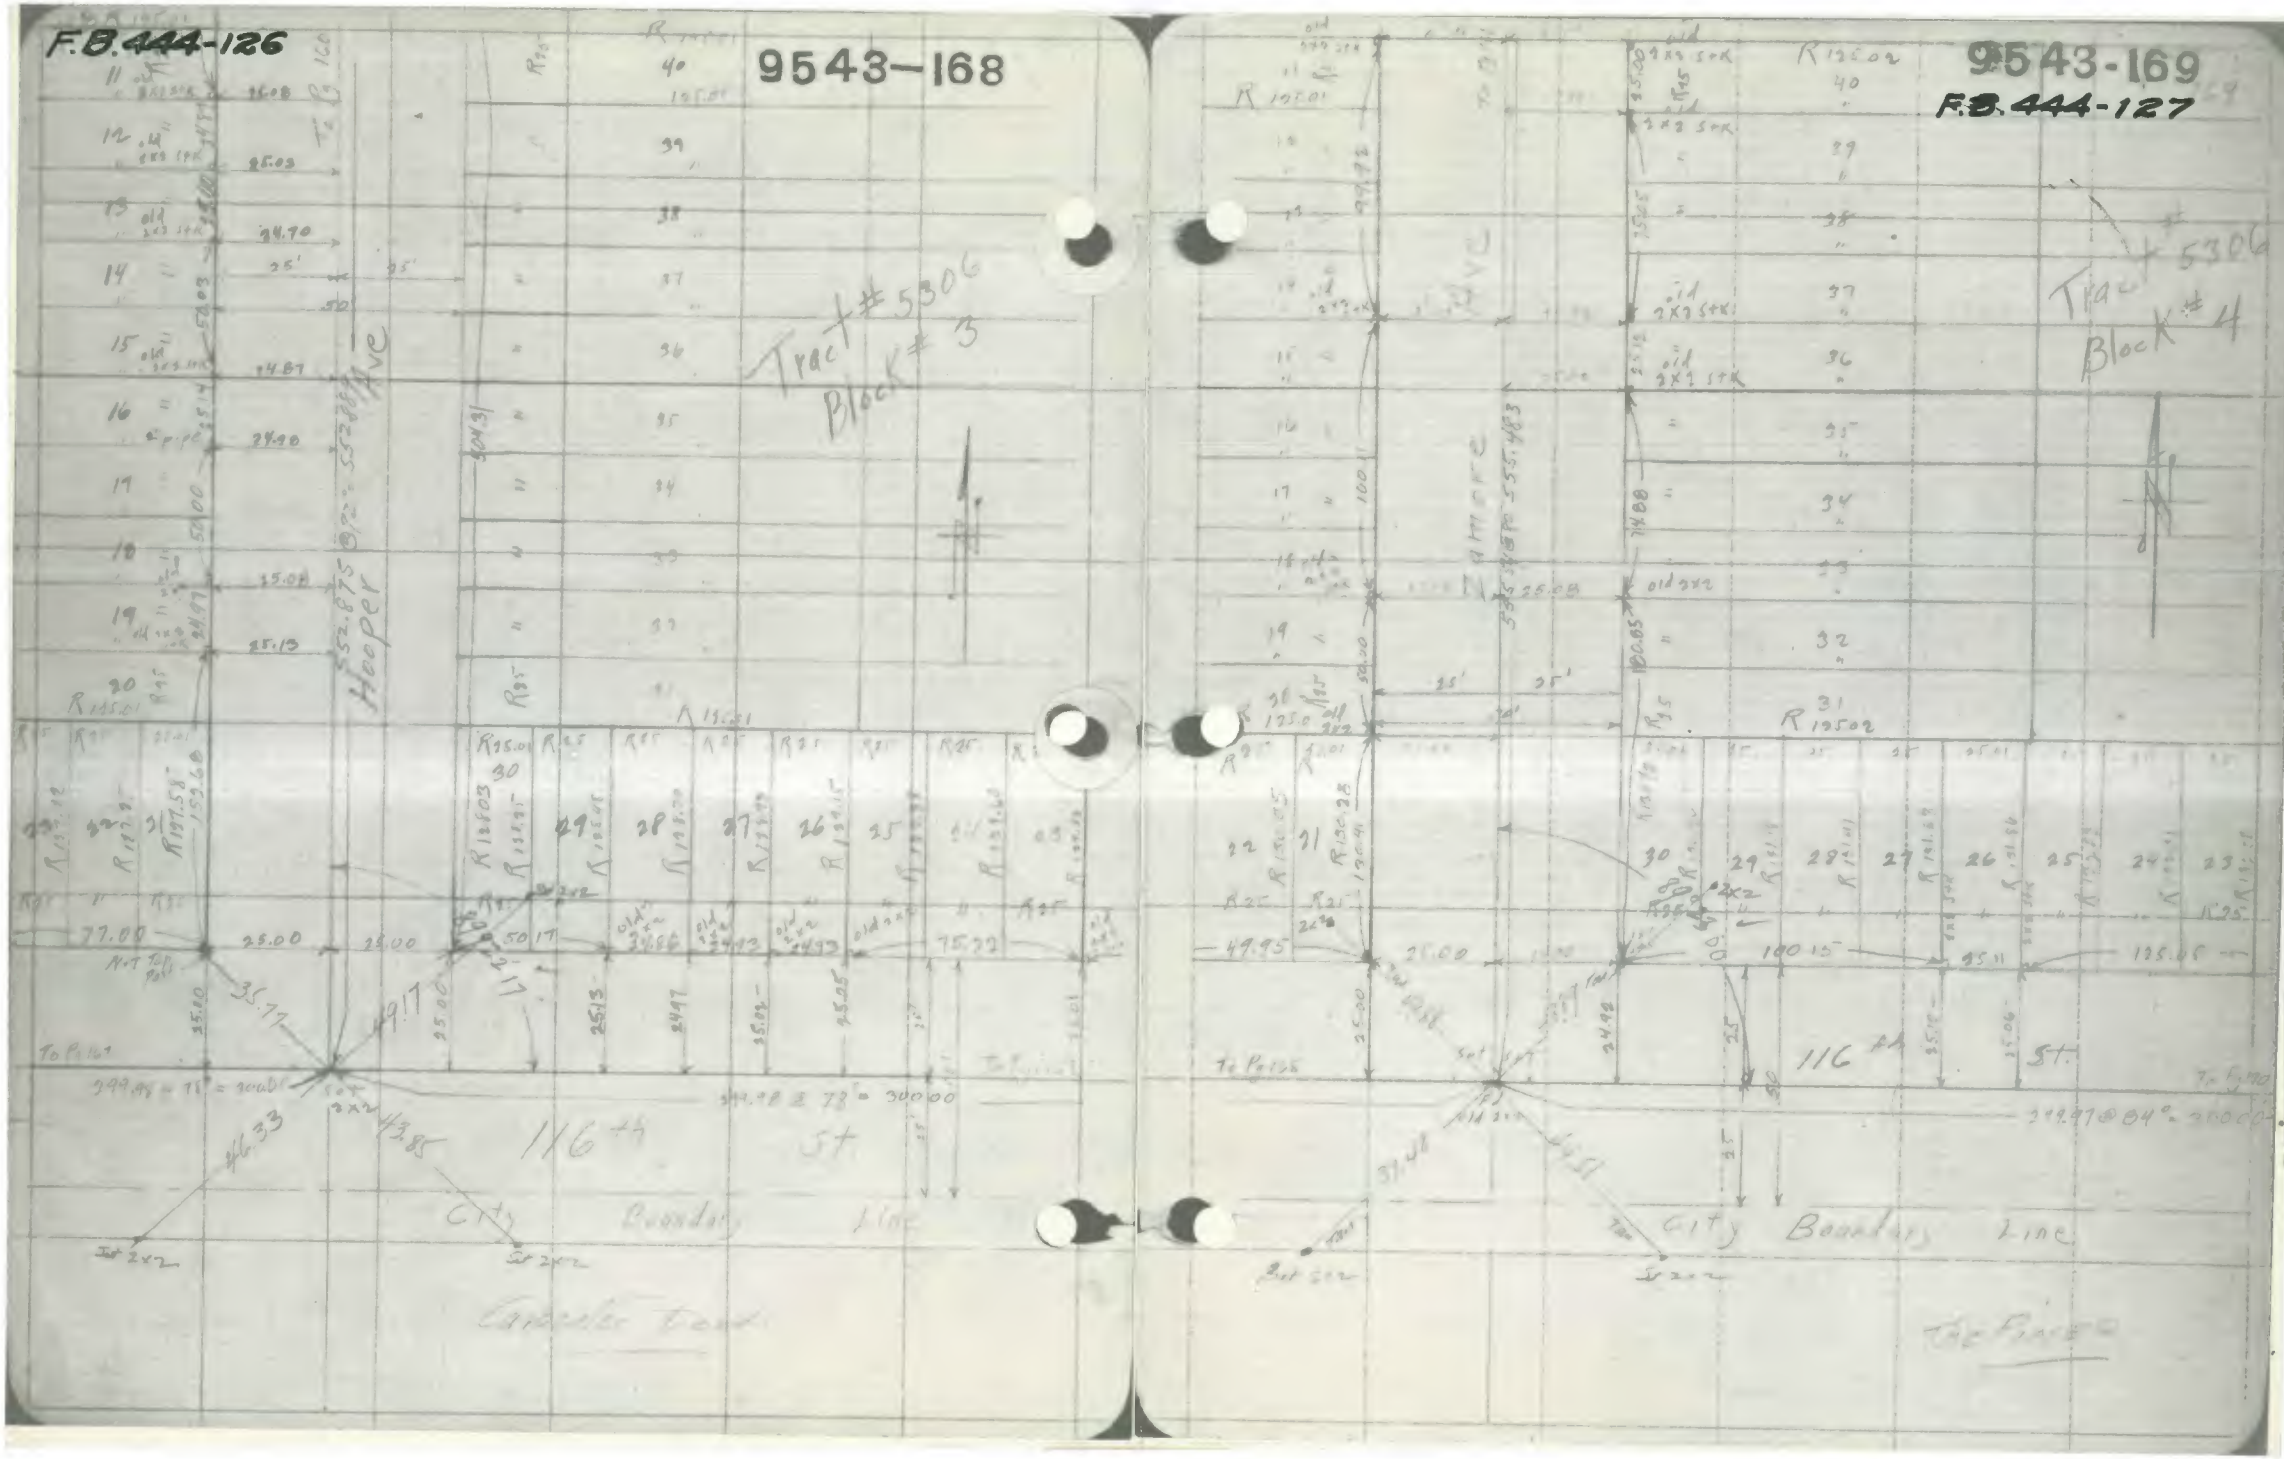

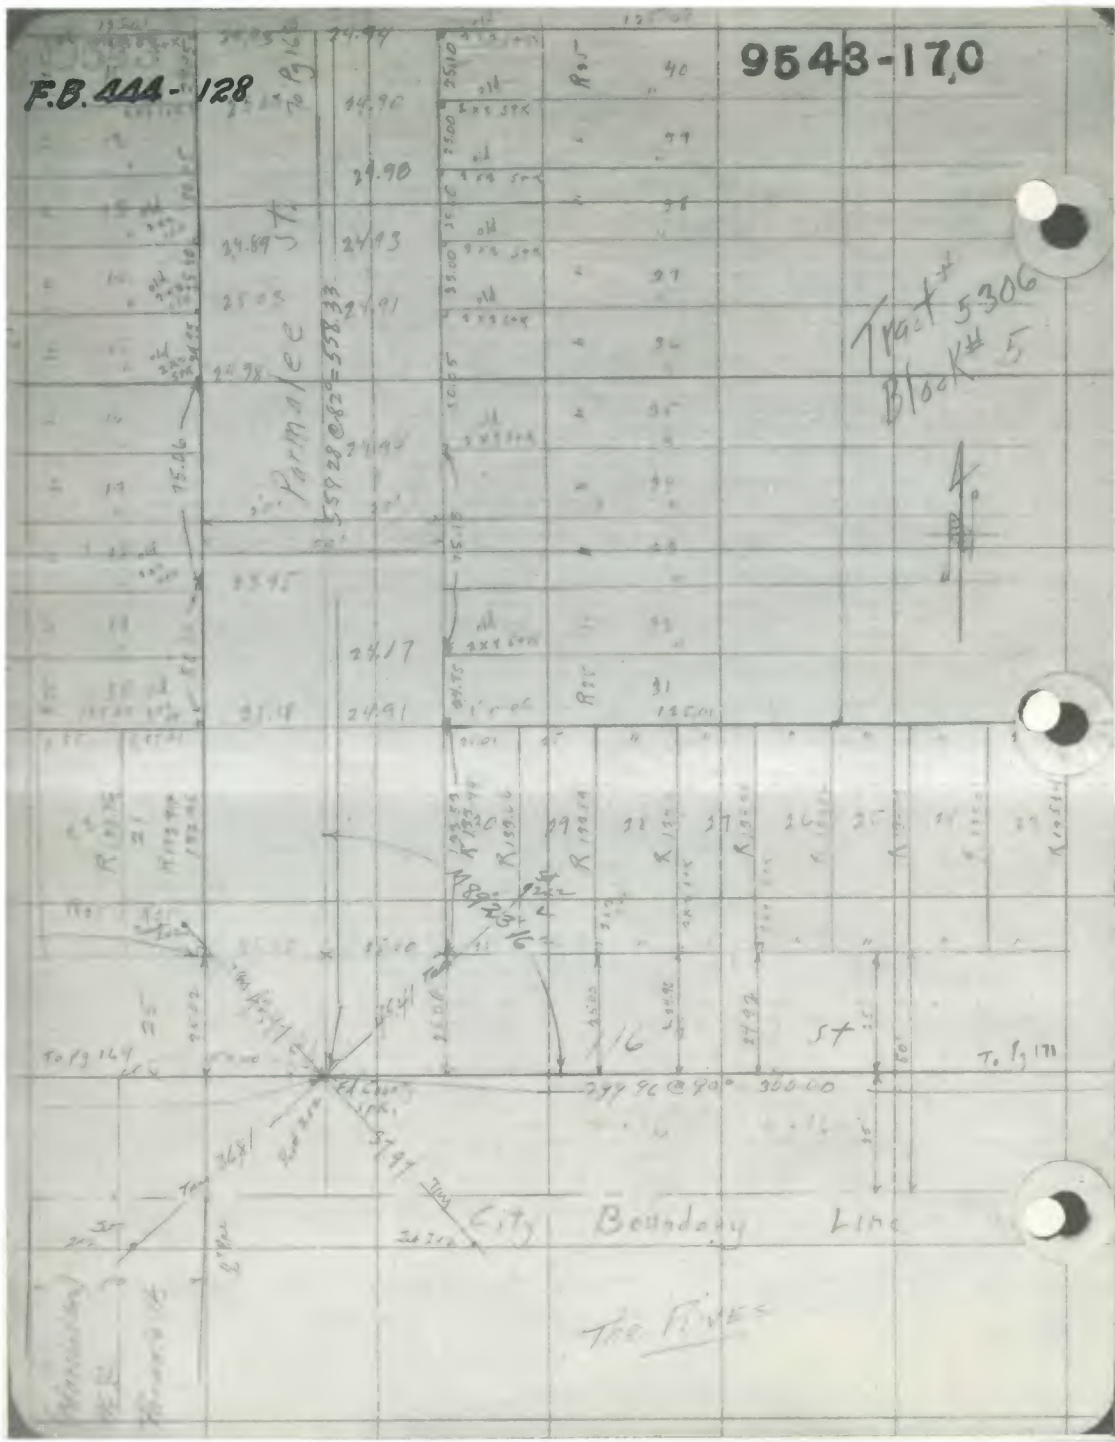
F.B. 444-128
9543-170
Tract # 5306
Block # 5
Parmalee St.
116 St
City Boundary Line
The Pines

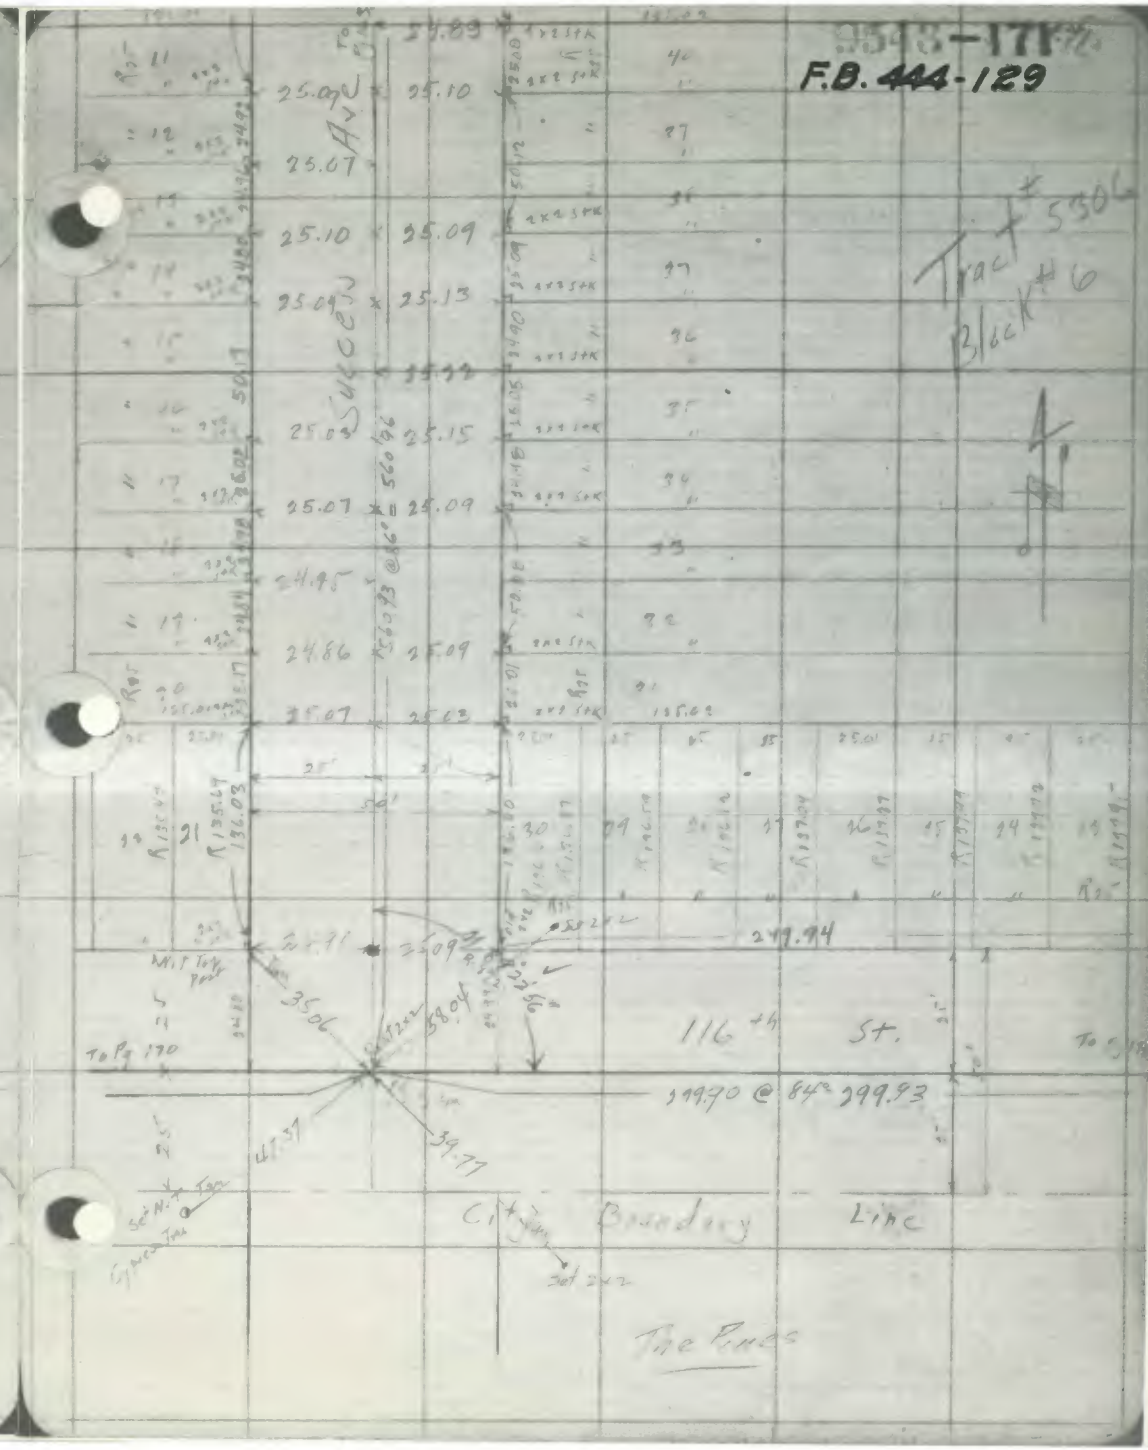
F.B. 444-129
Tract # 5306
Block # 6
Succeed Ave
116th St.
City Boundary Line
The Pines

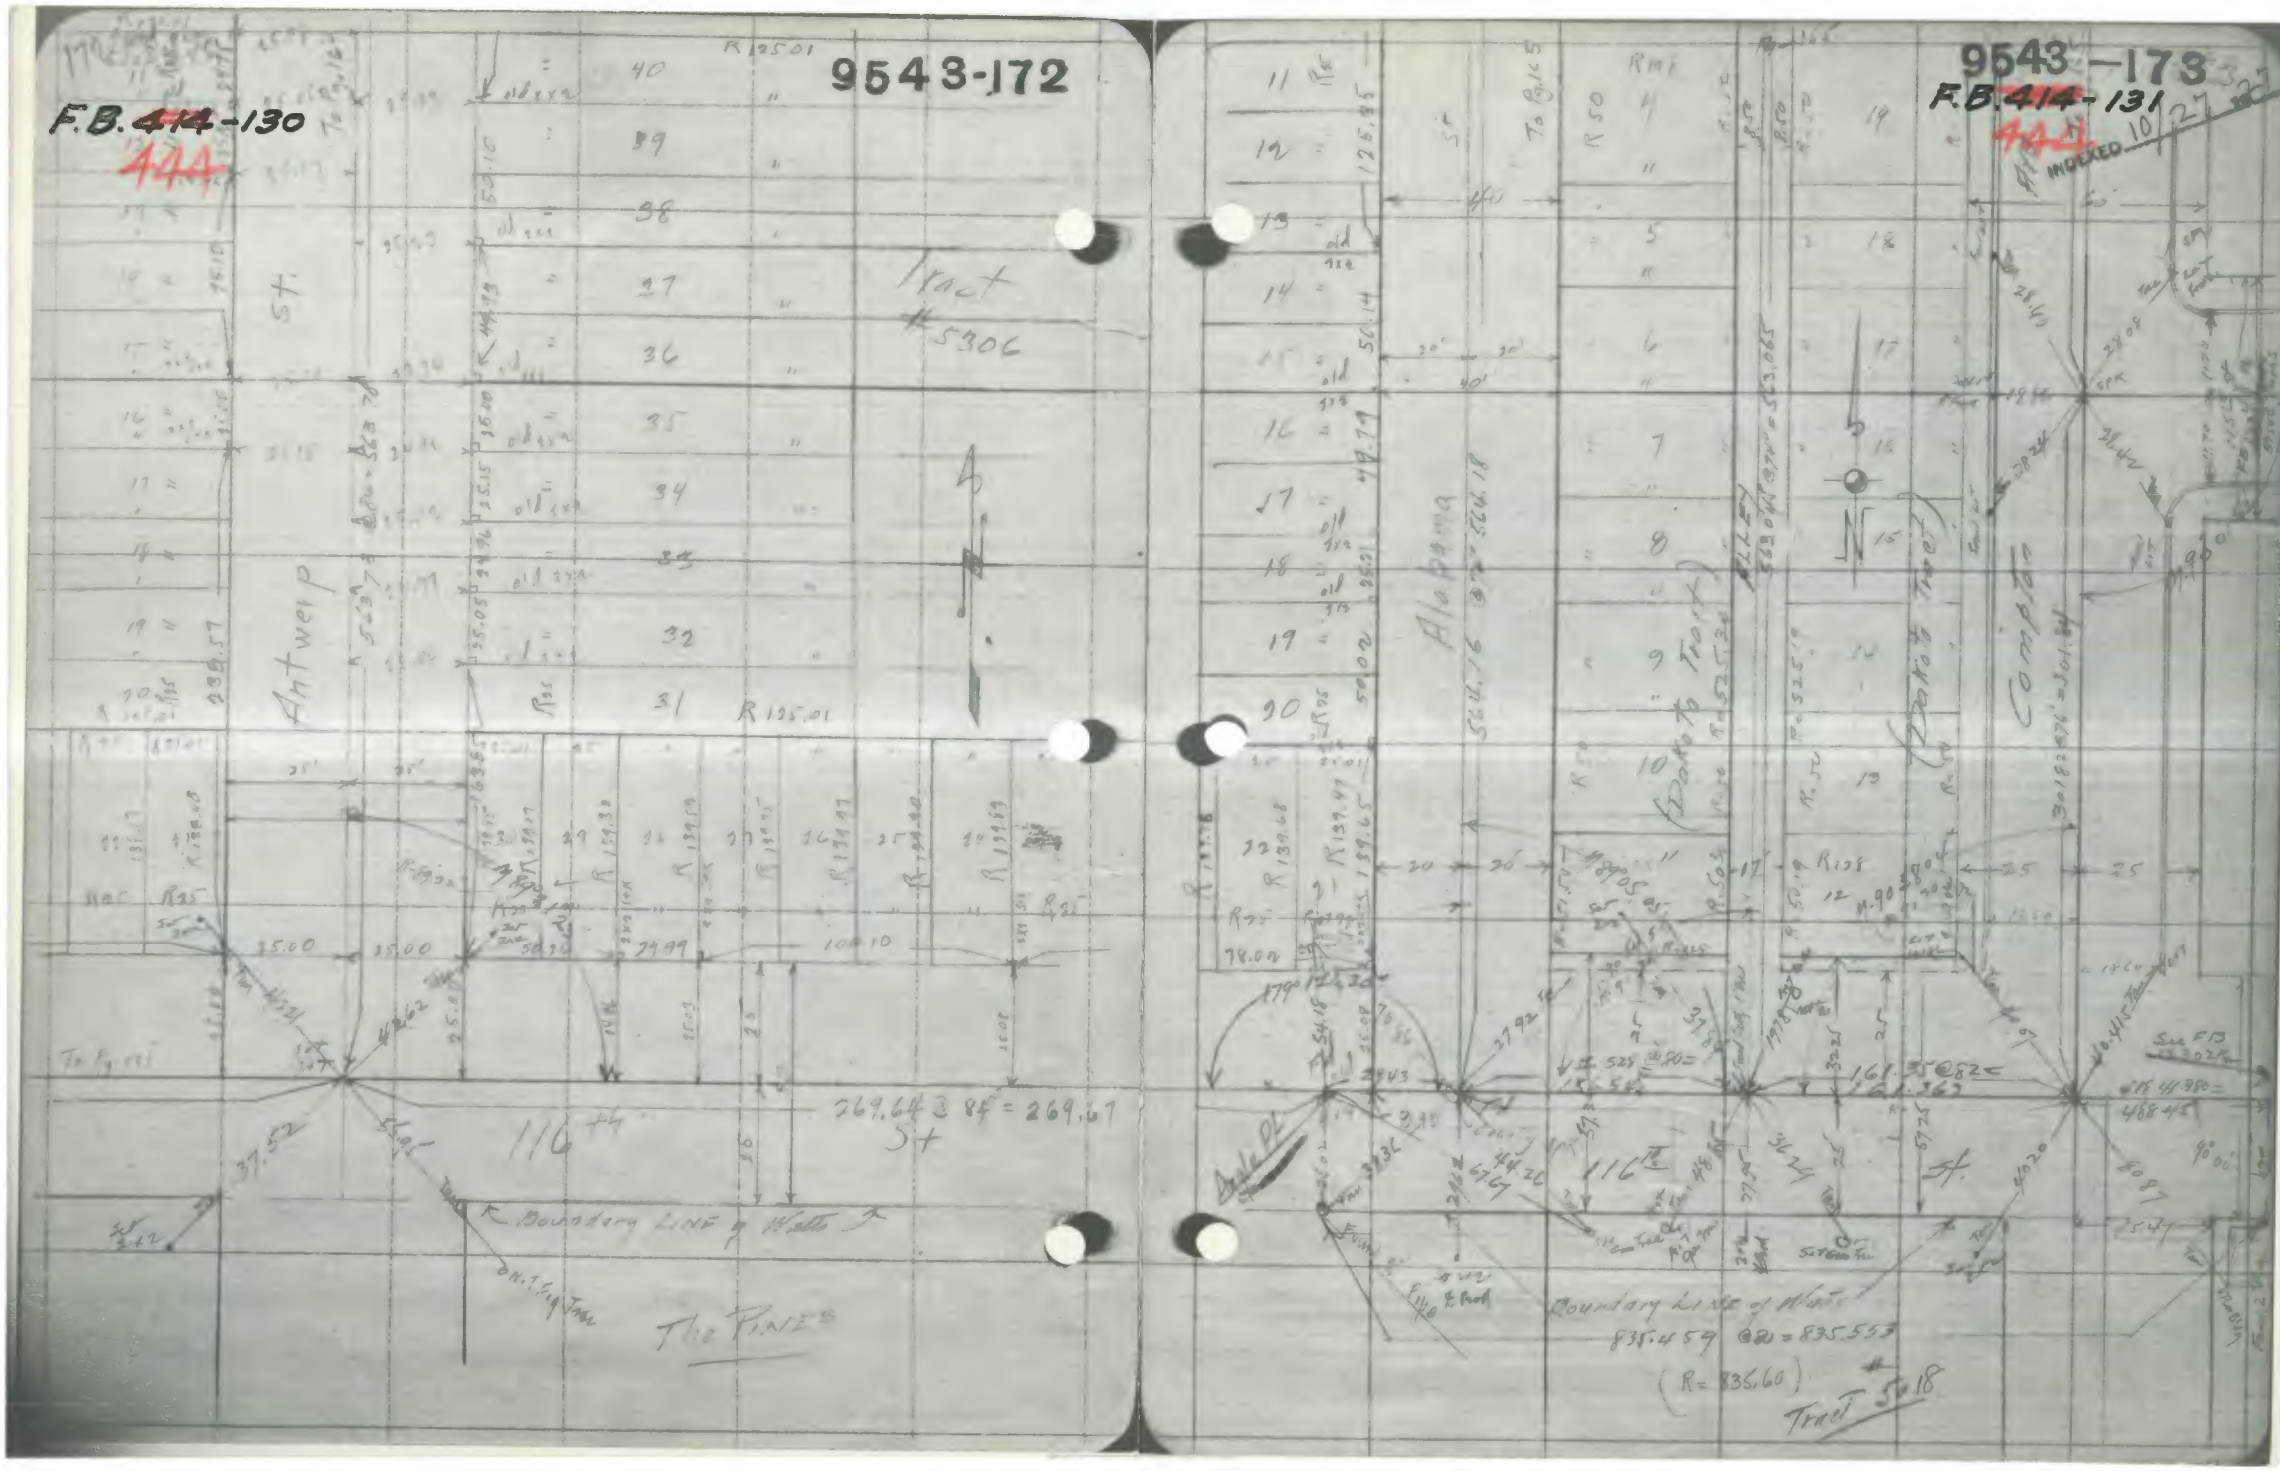
9543-172
F.B. 414-130
444
Antwerp St.
Tract #5306
116th St
269.64 @ 84 = 269.67
Boundary Line of Watts
The Pines
9543-173
F.B. 414-131
444
INDEXED 10/27
Alabama
Dakota Tract
Compton
Boundary Line of Watts
835.459 @ 80 = 835.553
(R = 835.60)
Tract 5018

79
80
F.B.444-133
Avalon Blvd
Stanford Ave
Tract 3754
Tract 3754
Avalon Blvd
Stanford Ave
M 339.66
10603-62
348.65
25'
25'

F.B.444-134

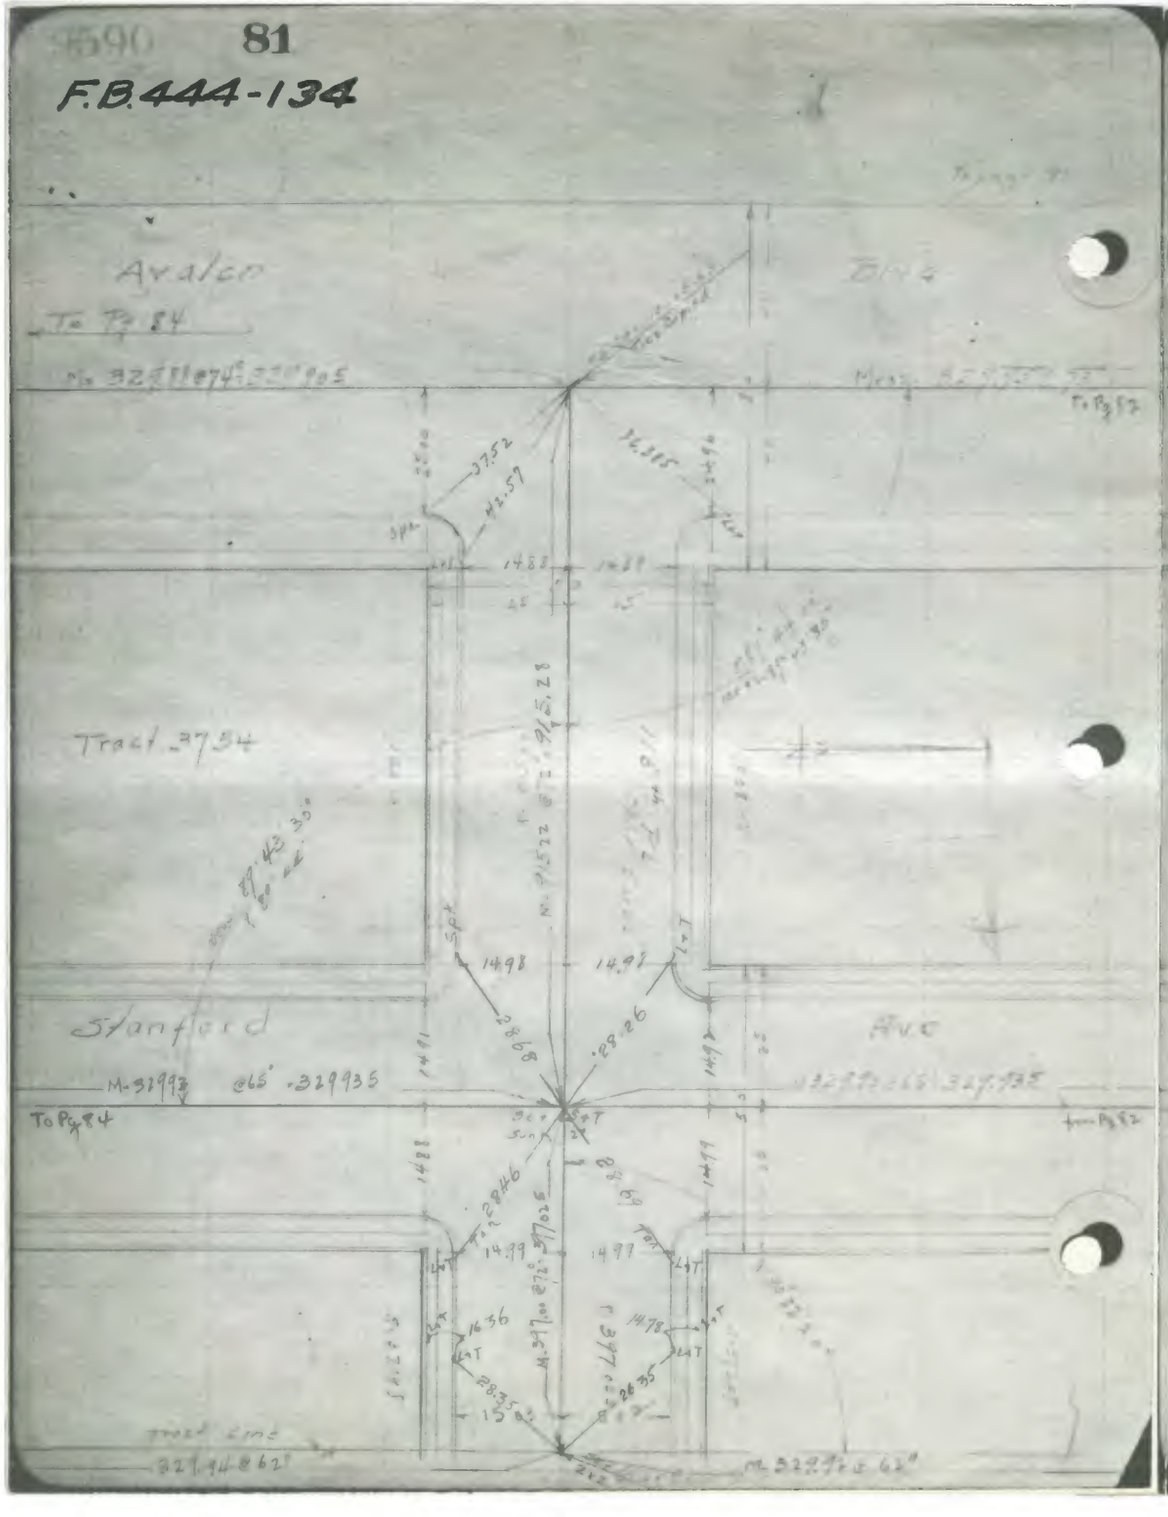

F.B.444-135

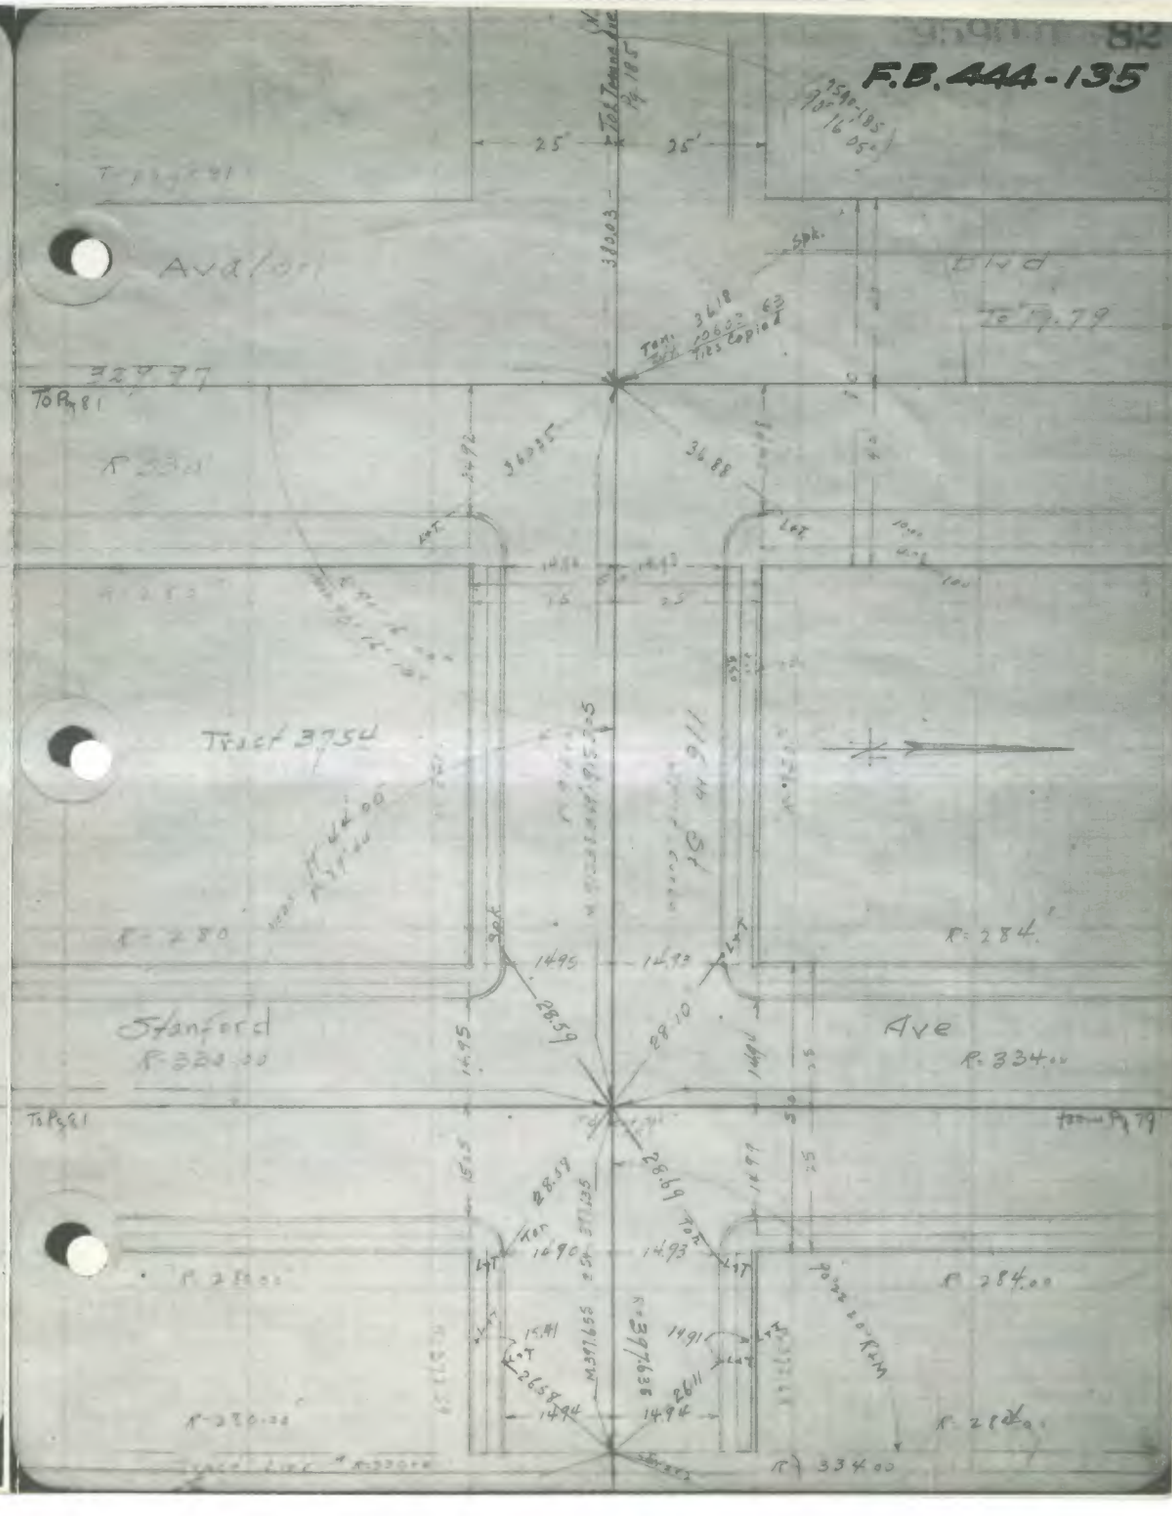

83

F.B. 444-136

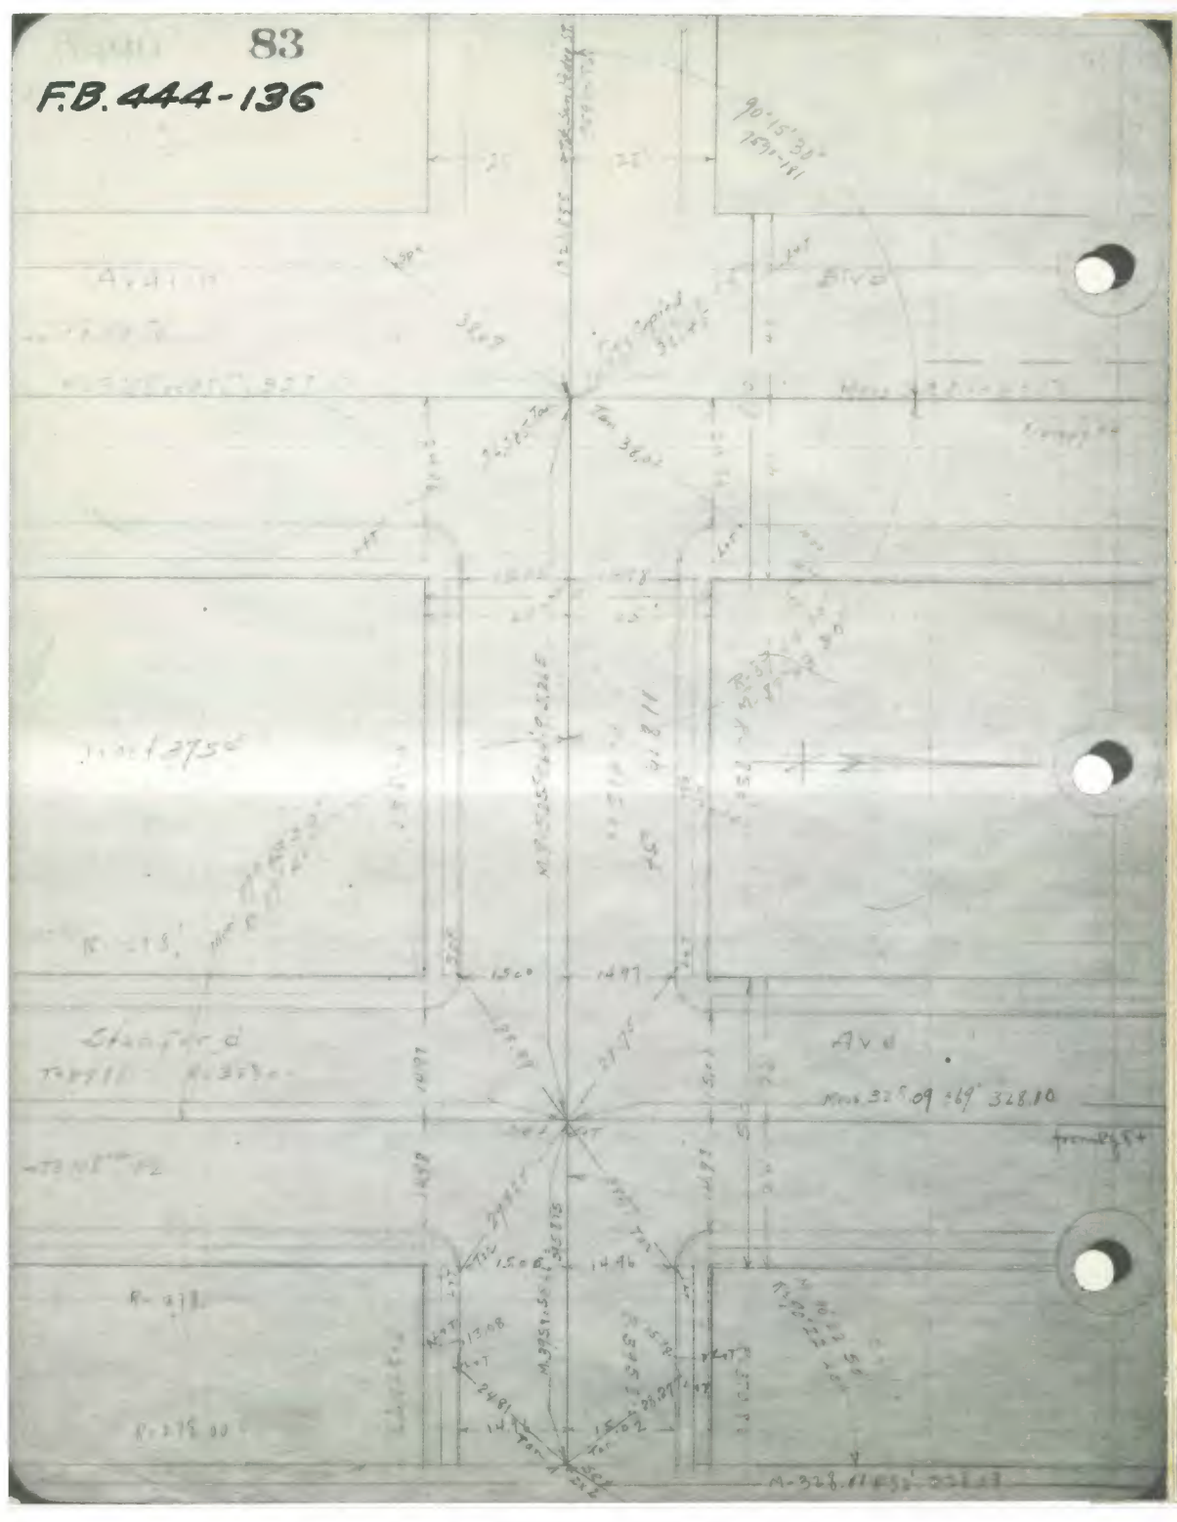

F.B. 444-137

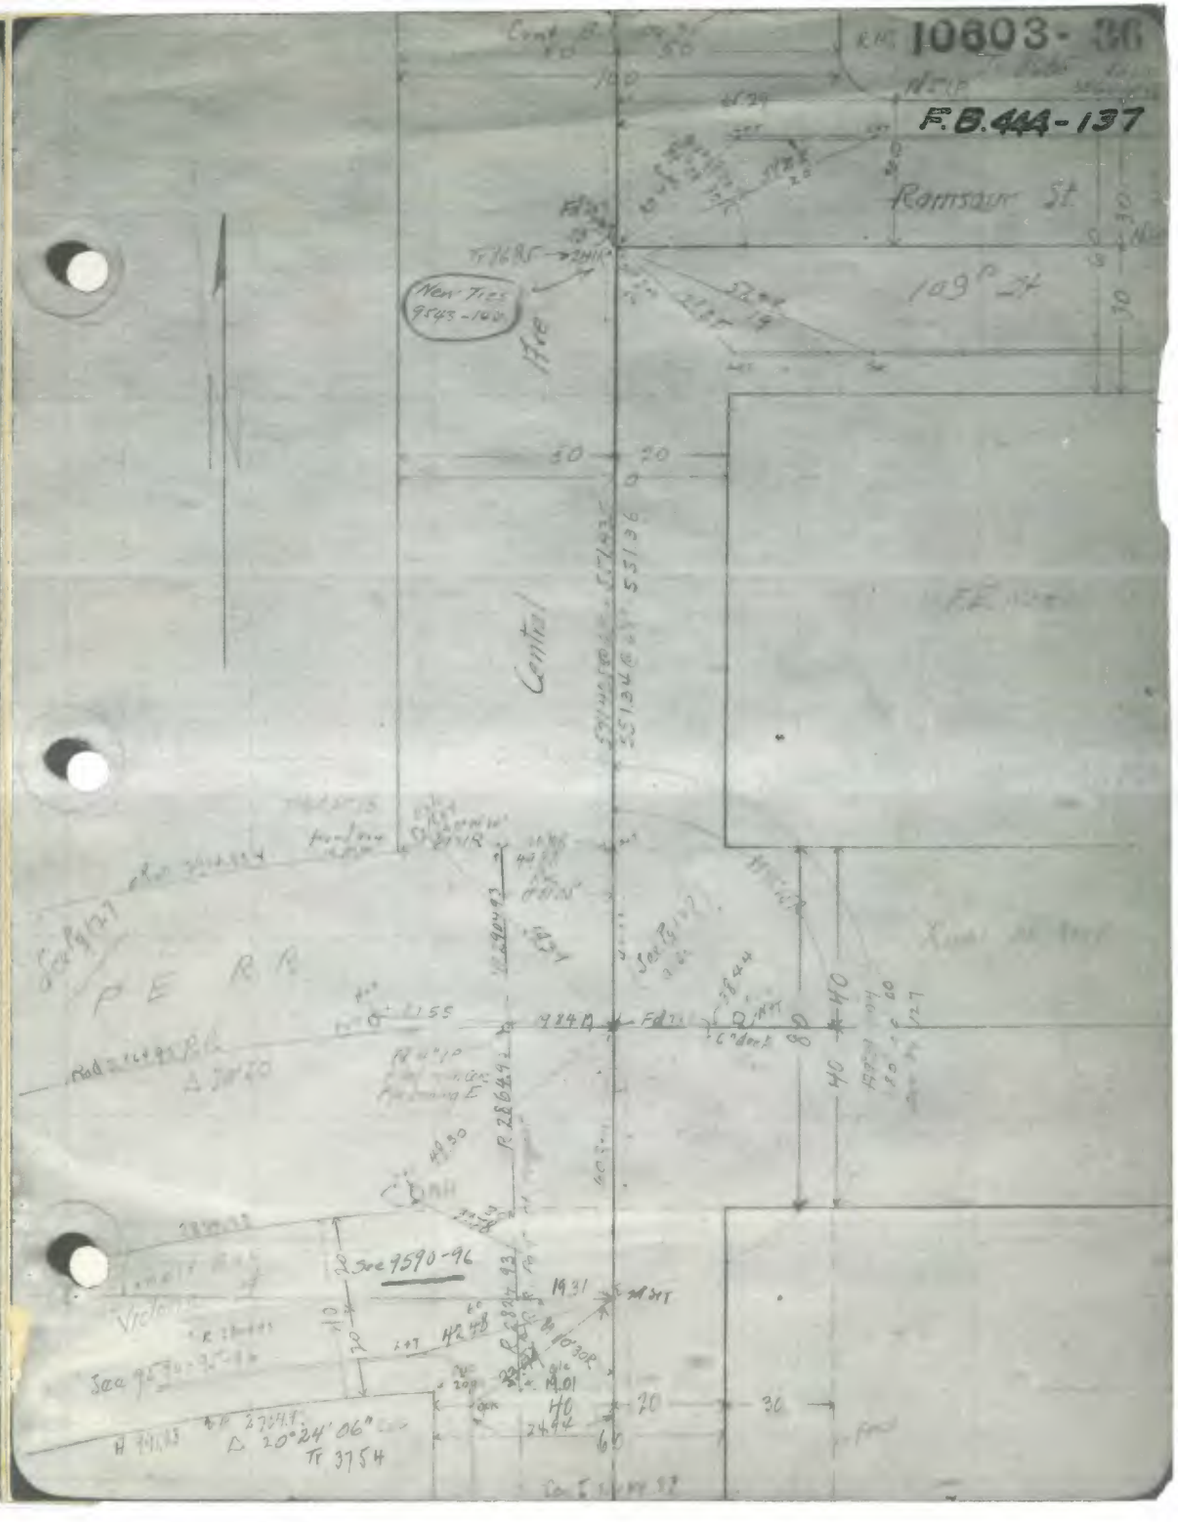

10603-37
F.B. 444-138

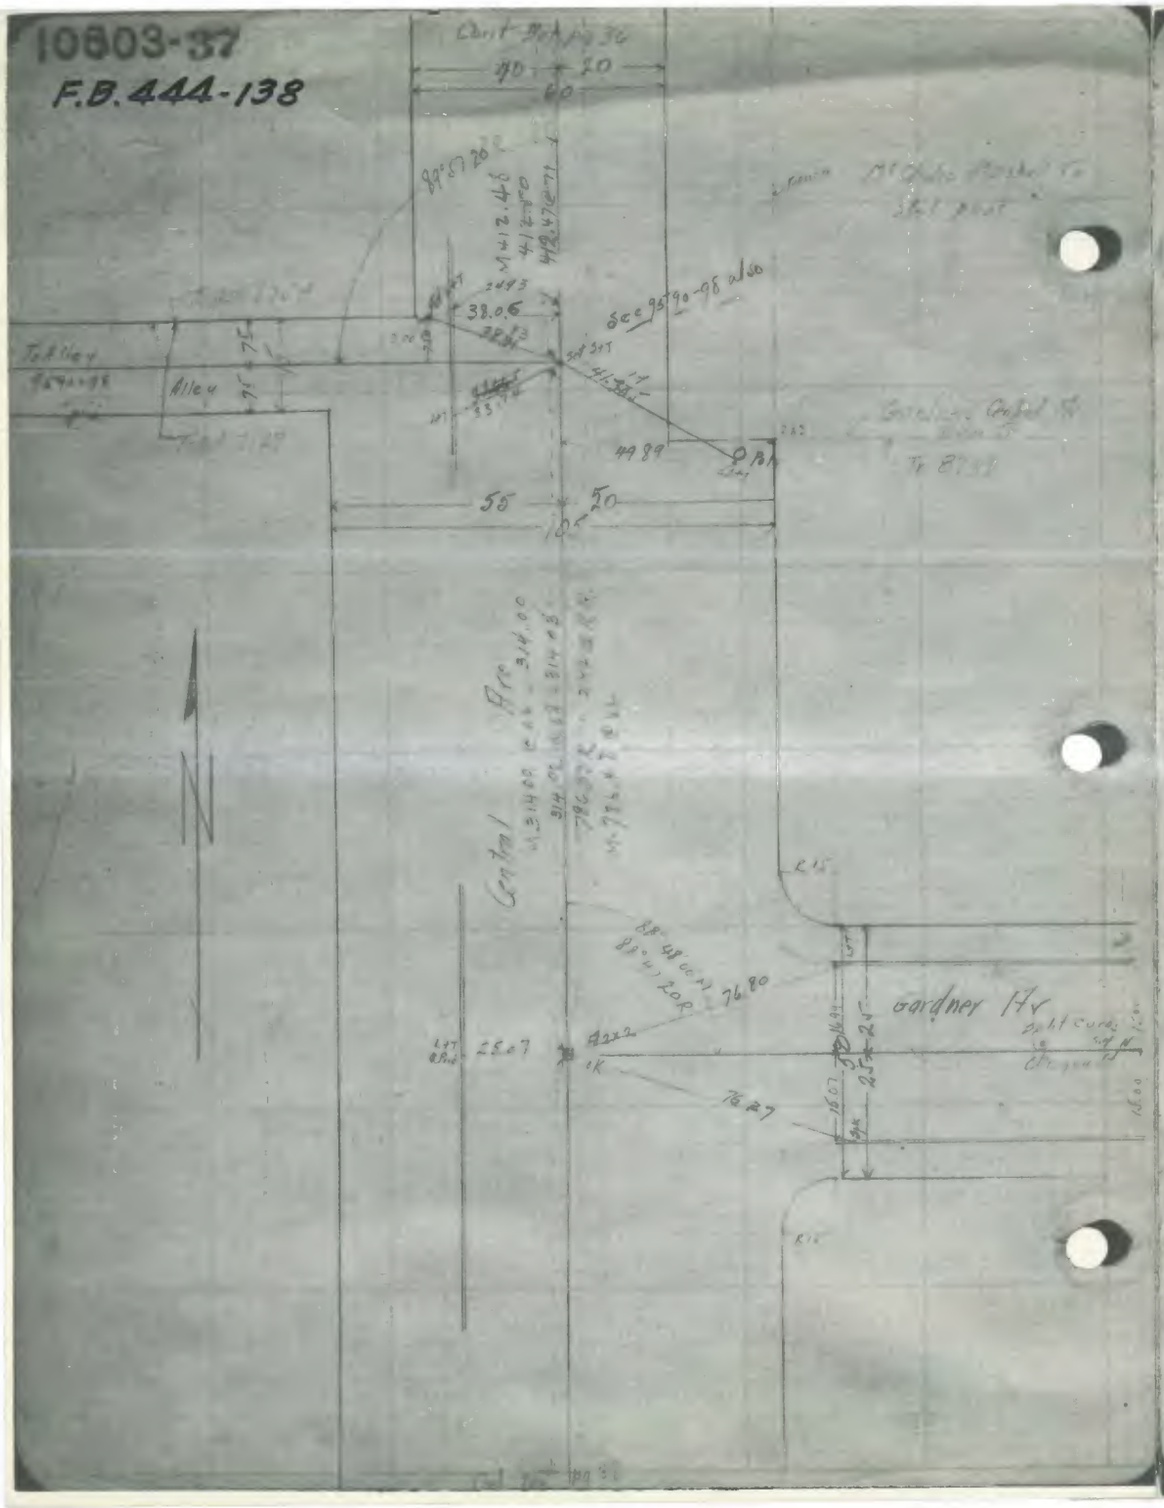

10603-38
F.B. 444-139

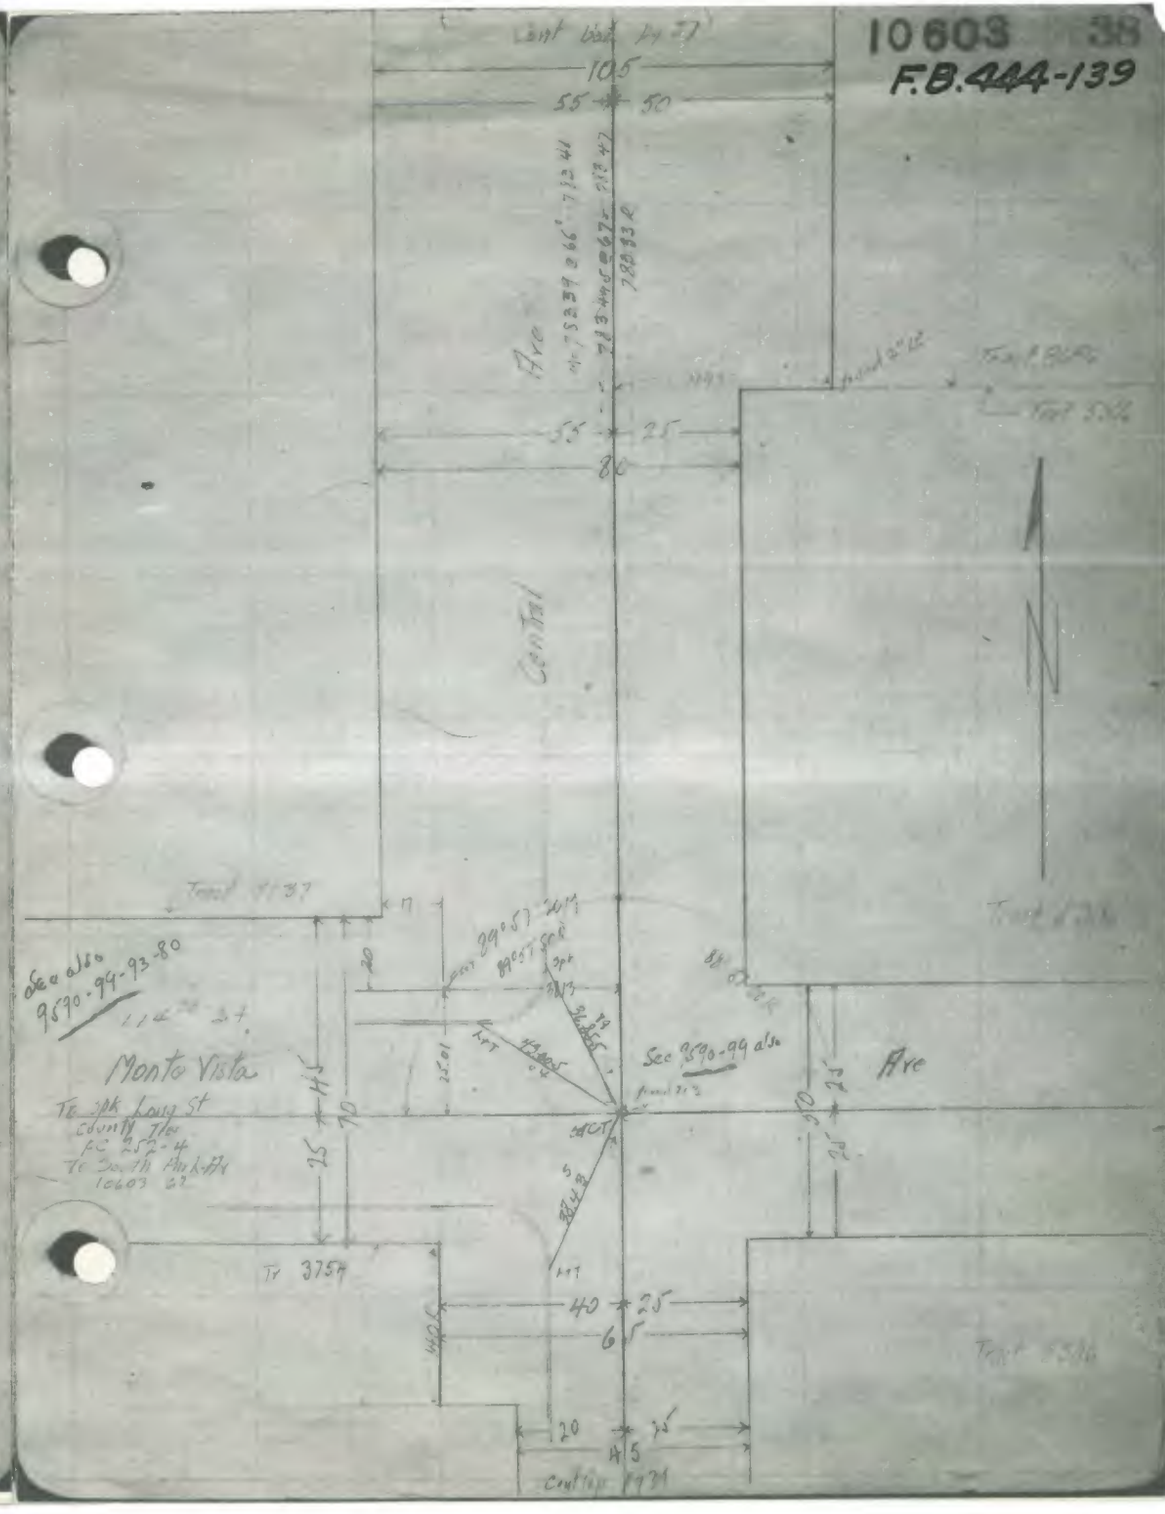

10603-39
F.B. 444-140

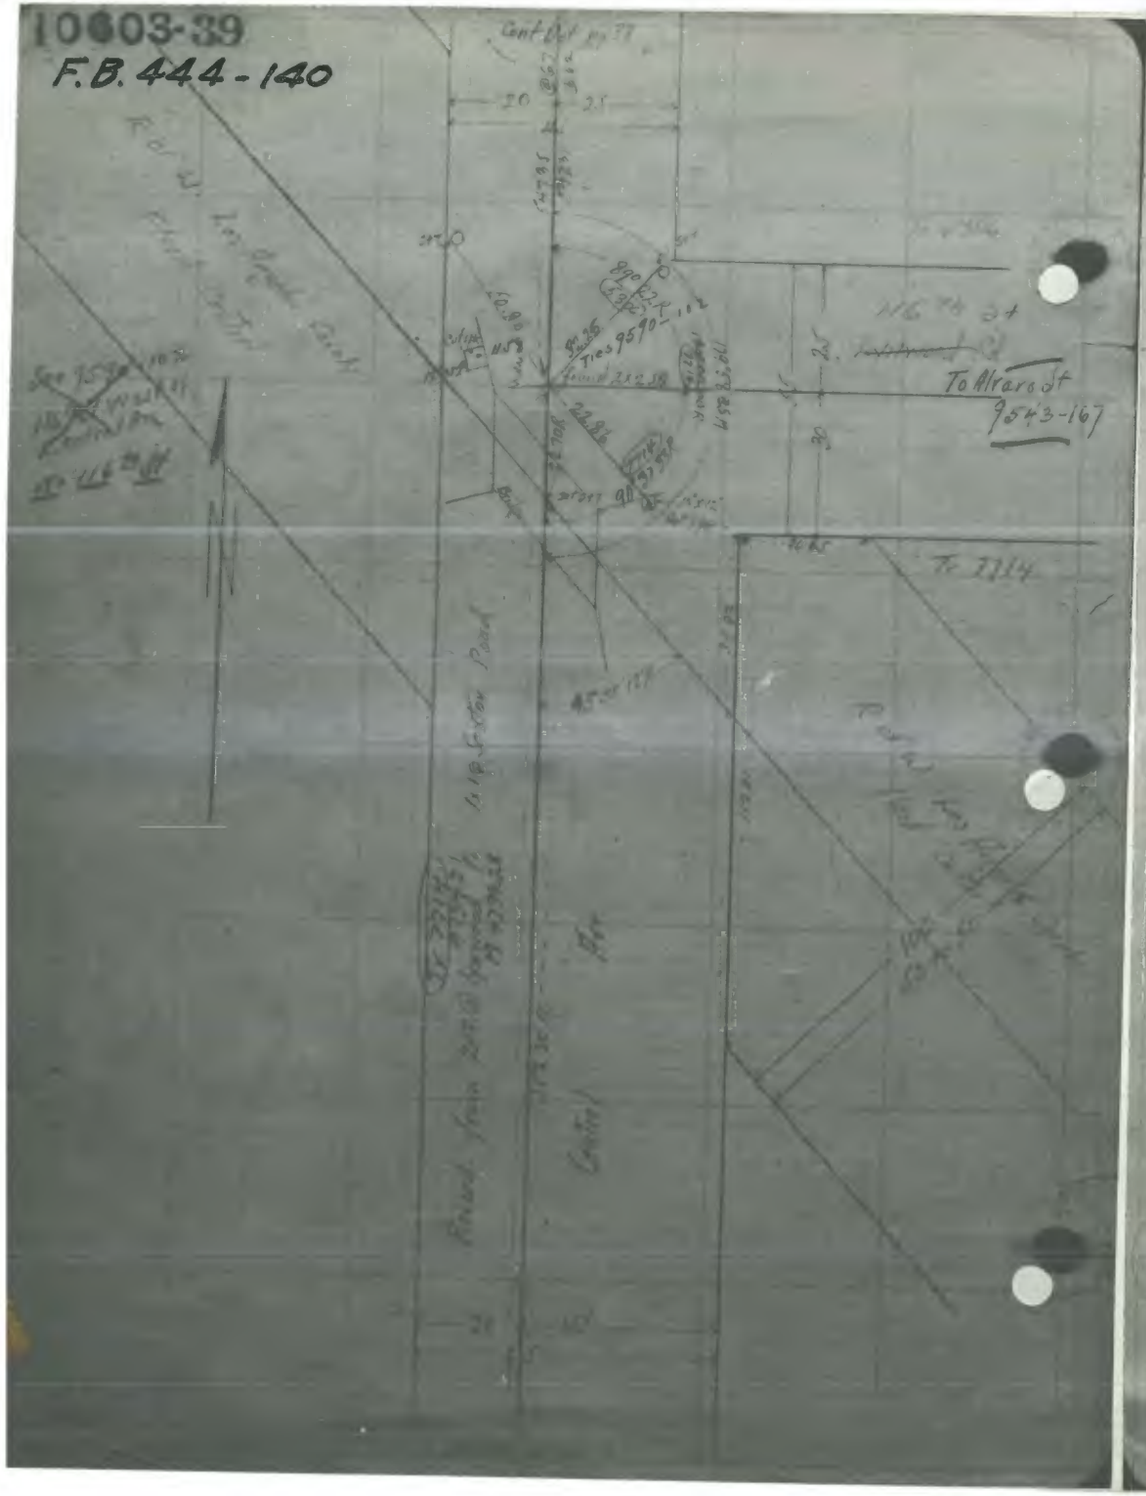

10603 40
F.B. 444-141

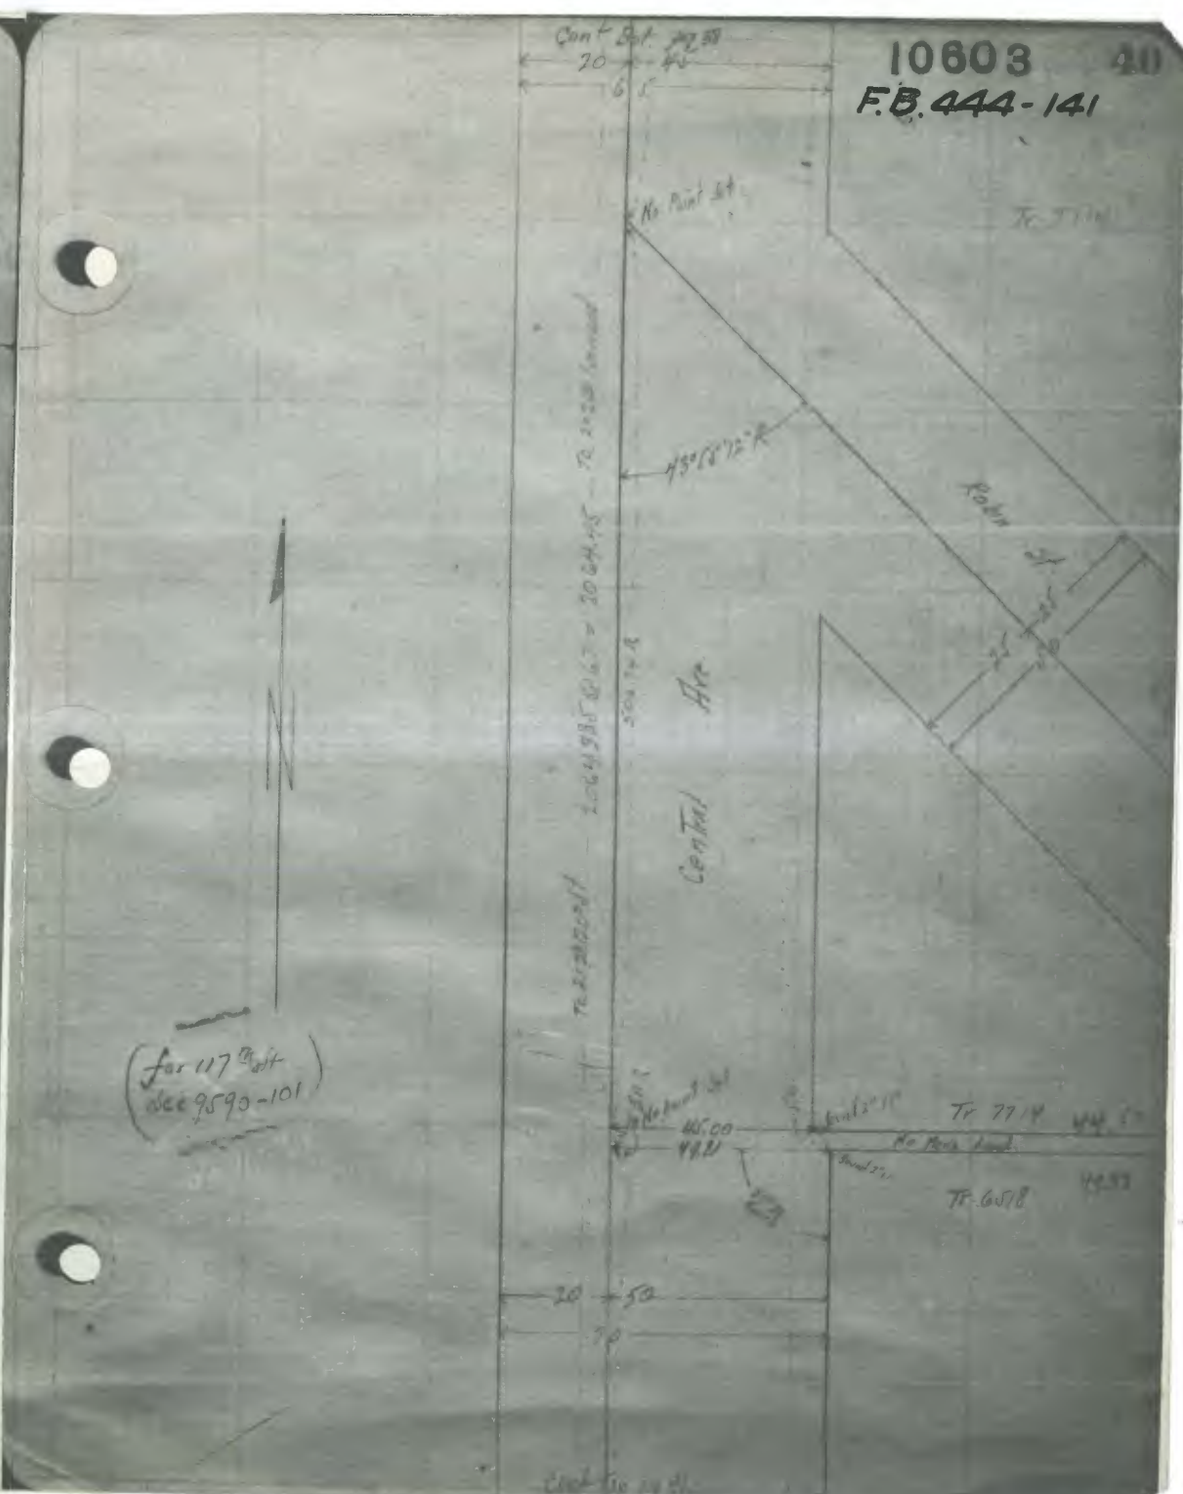

10803-41
F.B. 444-142

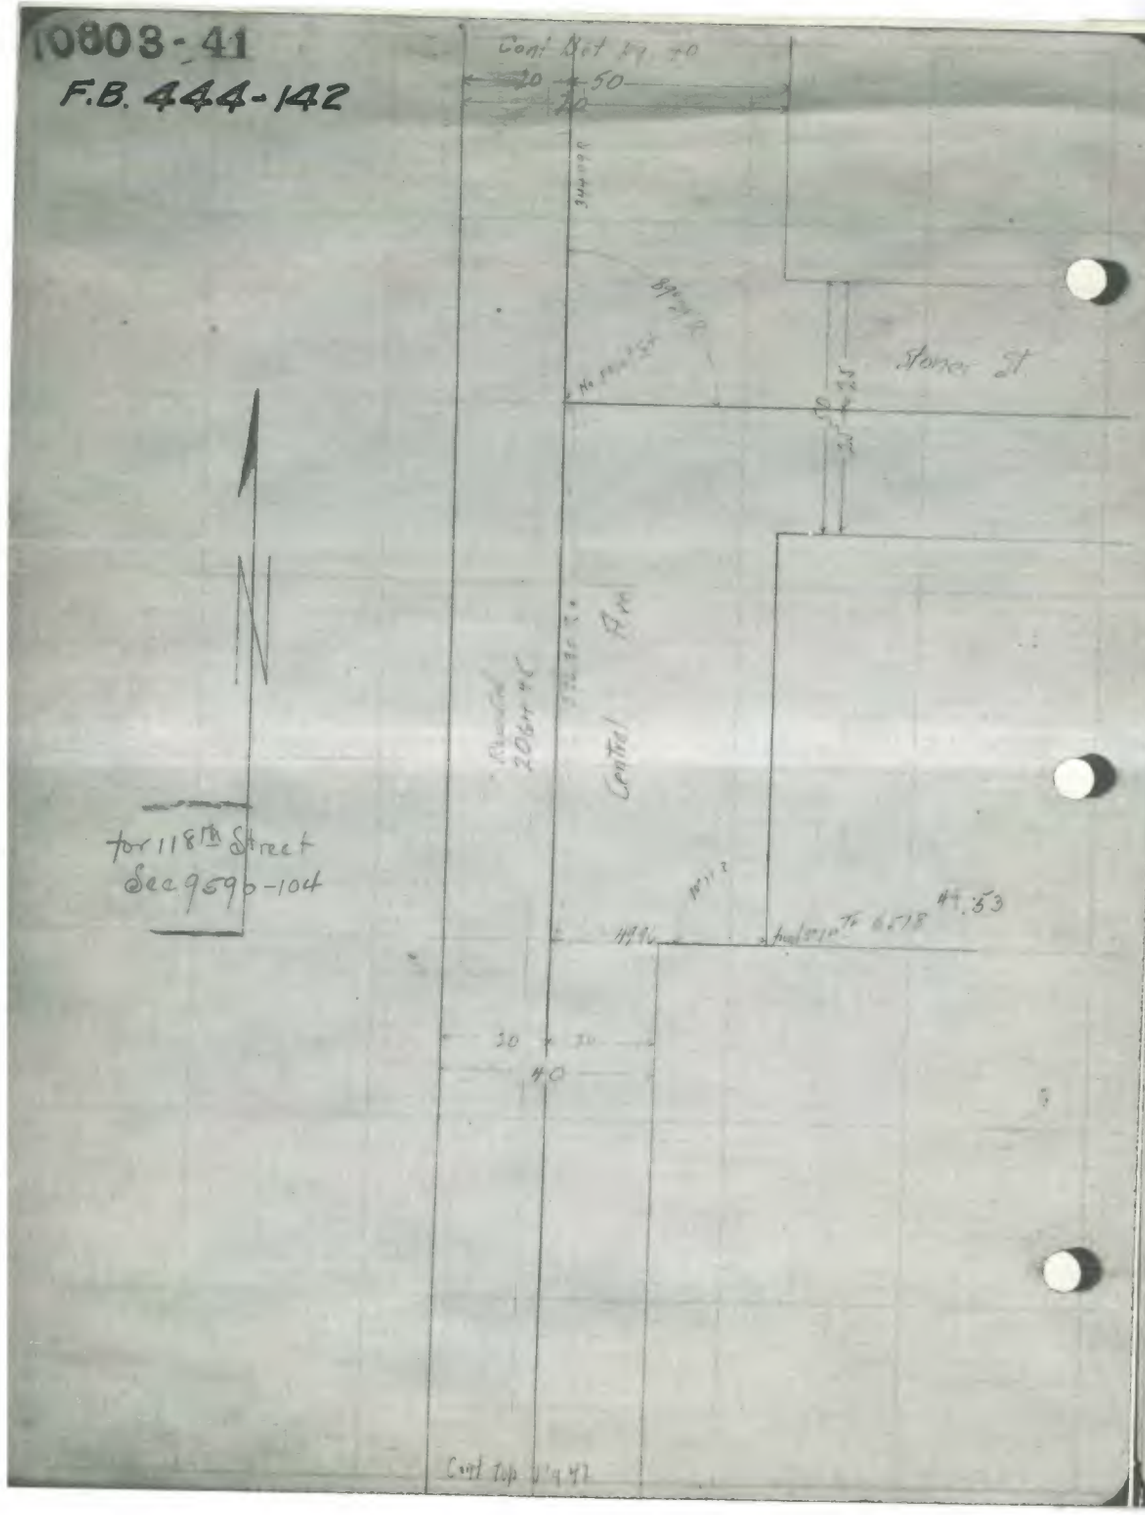

10803 42
F.B. 444-143
INDEXED 11/6 1926

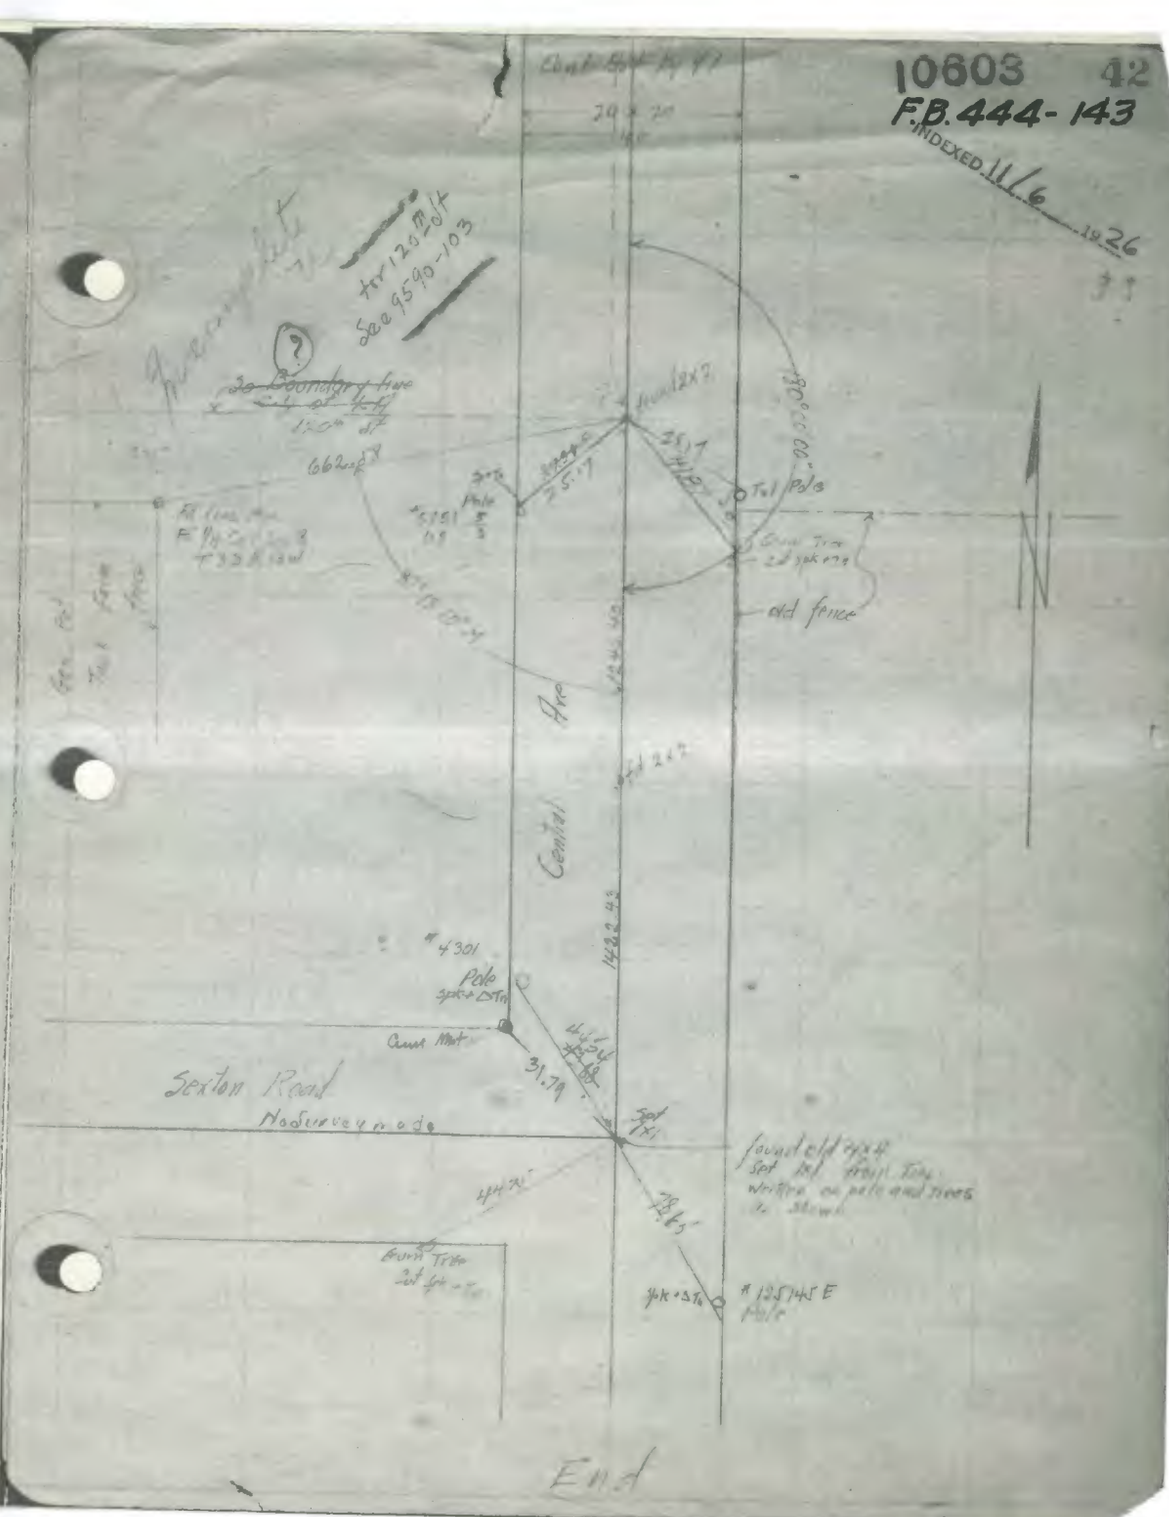

Date _____ Notes by _____ Chief Party _____ F.B. 444 PG 145

Platted by	W. O. No. 4164 D. S. O. No.
Date	Location Paving Blvd
Map No.	Surveyed by A. C. Johnson
Platting C'k'd by	Date 4-14-1930
Date	Indexed A. C. Johnson

Copied From L.A.C.ty Engrs F.B. 9590-99 By A.C. Johnson 4-14-1930

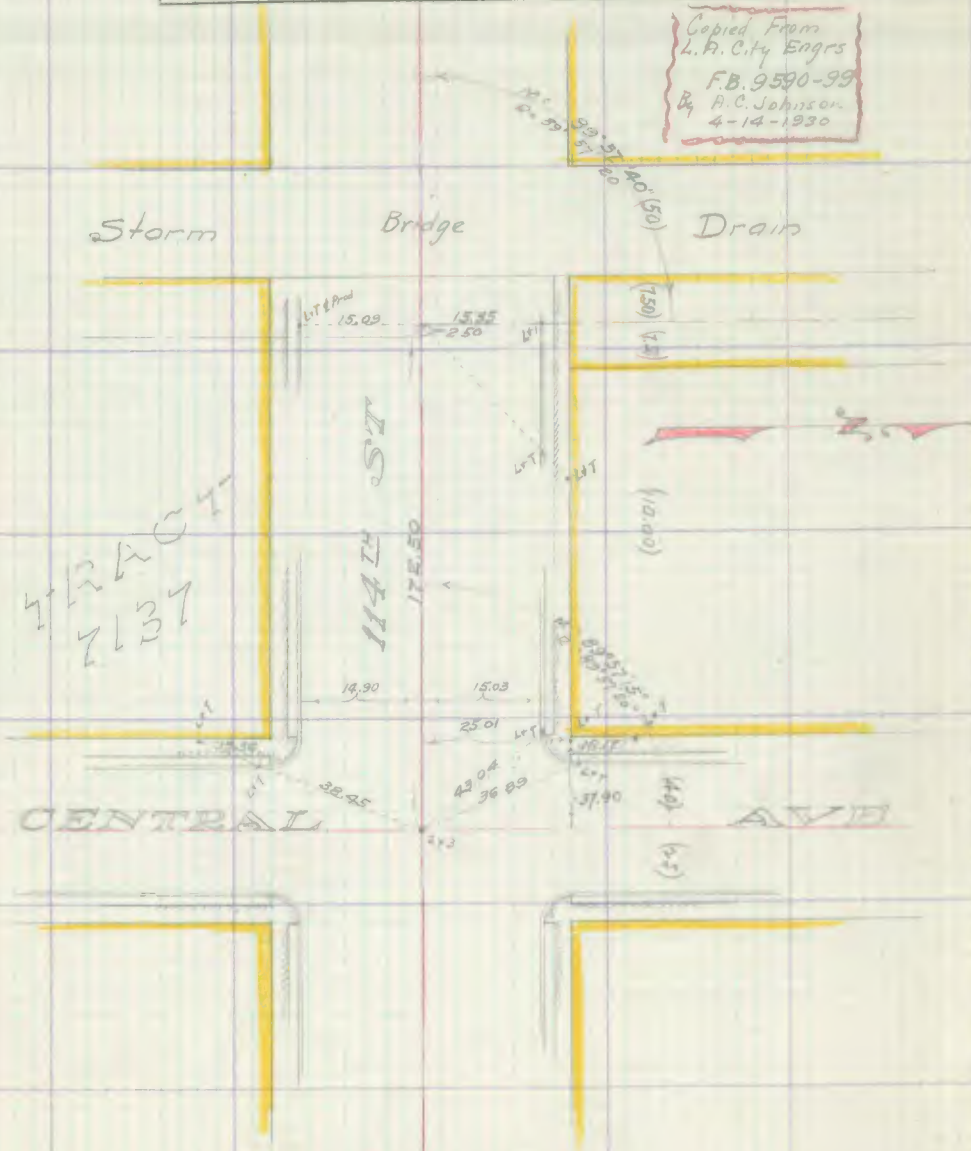

Notes: ANY ADDITIONS OR CHANGES ON THIS SHEET MUST BE MADE OR CIRCLED IN Red. WITH DATE AND NAME OF PERSON MAKING CHANGE.

Do not extend notes this side of this line

RETURN TO LOS ANGELES COUNTY SURVEYOR

F.B. 444 Pg. 156 _____ Chief Party Notes by _____ Date _____

RETURN TO
LOS ANGELES COUNTY SURVEYOR

Note: ANY ADDITIONS OR CHANGES ON THIS SHEET MUST BE MADE OR CIRCLED IN Red WITH DATE AND NAME OF PERSON MAKING CHANGE.

Do not extend notes this side of this line

Date _____ Notes by Svenson Chief Party _____ F.B. 444 Pg 147

Platted by Svenson	W. O. No. Misc. D. S. O. No. _____
Date 4-14-30	Location Hall Rec. Tunnel Std base line.
Map No. B-997	Surveyed by A Roesch
Platting C'k'd by Price	Date 3-18-30
Date 4-23-30	Indexed C. O. Johnson

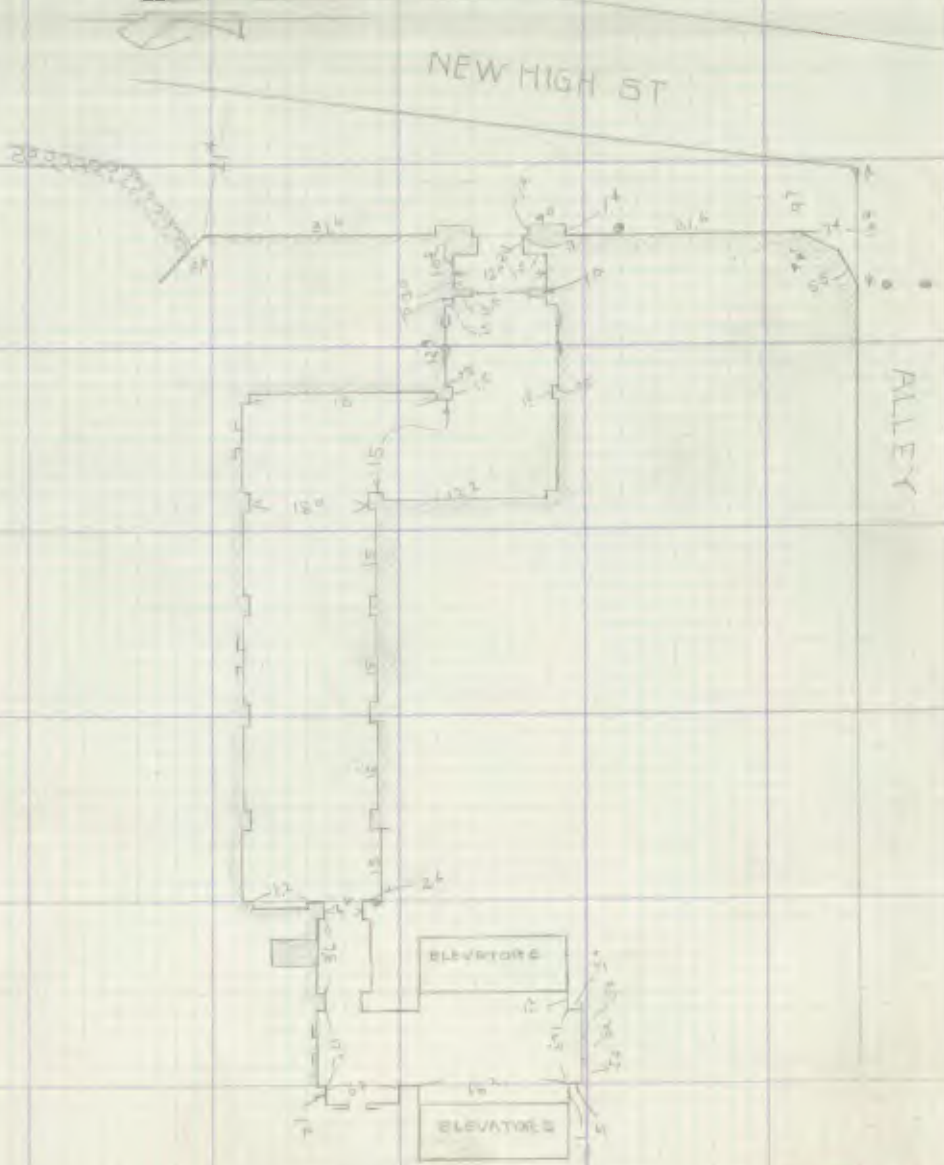

#845

Data on Tunnel from Mech Dept Map ~~A845~~ Sheet 1 #2
dated Nov. 1923.

Notes: ANY ADDITIONS OR CHANGES ON THIS SHEET MUST BE MADE OR CIRCLED IN Red. WITH DATE AND NAME OF PERSON MAKING CHANGE.

Do not extend notes this side of this line

RETURN TO
LOS ANGELES COUNTY SURVEYOR

F.B. 444 PG. 148 _____ Chief Party Notes by _____ Date _____

RETURN TO
LOS ANGELES COUNTY SURVEYOR

Do not extend notes this side of this line

Note: ANY ADDITIONS OR CHANGES ON THIS SHEET MUST BE MADE OR CIRCLED IN Red. WITH DATE AND NAME OF PERSON MAKING CHANGE.

Date _____ Notes by _____ Chief Party _____ F.B. 444 PG. 199

Platted by Svenson	W. O. No. Misc D. S. O. No.
Date 4-14-30	Location Std Base Line
Map No. B-507	Surveyed by ABaeser
Platting C'k'd by Price	Date 3-18-30
Date 4-21-30	Indexed A. C. Johnson

Notes: ANY ADDITIONS OR CHANGES ON THIS SHEET MUST BE MADE OR CIRCLED IN Red. WITH DATE AND NAME OF PERSON MAKING CHANGE.

Do not extend notes this side of this line

RETURN TO
LOS ANGELES COUNTY SURVEYOR

F.B. 444 Pg. 150 _____ Chief Party Notes by _____ Date _____

RETURN TO
LOS ANGELES COUNTY SURVEYOR

Do not extend notes this side of this line

Note: ANY ADDITIONS OR CHANGES ON THIS SHEET MUST BE MADE OR CIRCLED IN Red. WITH DATE AND NAME OF PERSON MAKING CHANGE.

Date _____ Notes by Svenson Chief Party _____ F.B. 449 Pg. 151

Platted by Svenson	W. O. No. _____ D. S. O. No. _____
Date 9-14-30	Location Tunnel-Hall Rec Std Base line
Map No. B-507	Surveyed by Roeser Svenson
Platting C'k'd by Price	Date 3-18-30
Date 4-23-30	Indexed A. O. Johnson

Note: ANY ADDITIONS OR CHANGES ON THIS SHEET MUST BE MADE OR CIRCLED IN Red. WITH DATE AND NAME OF PERSON MAKING CHANGE.

Do not extend notes this side of this line

RETURN TO LOS ANGELES COUNTY SURVEYOR

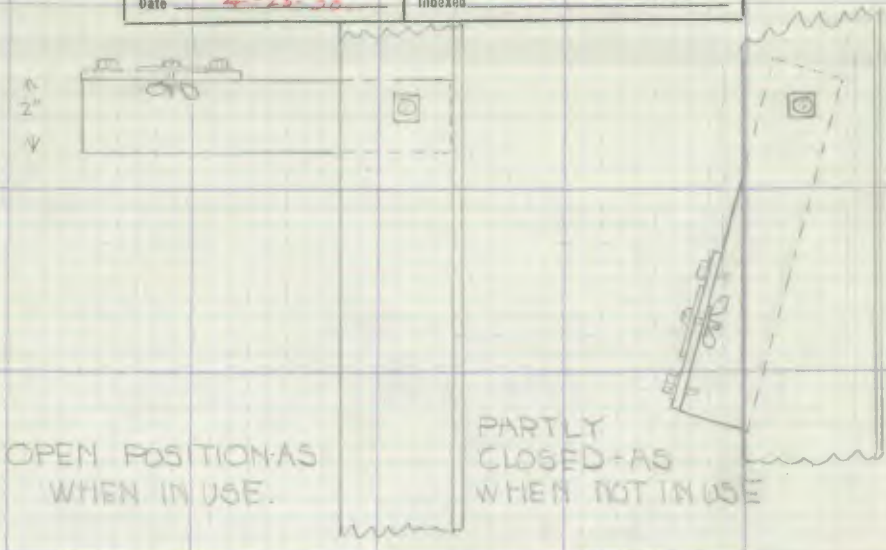

SIDE ELEVATION NORTH END.

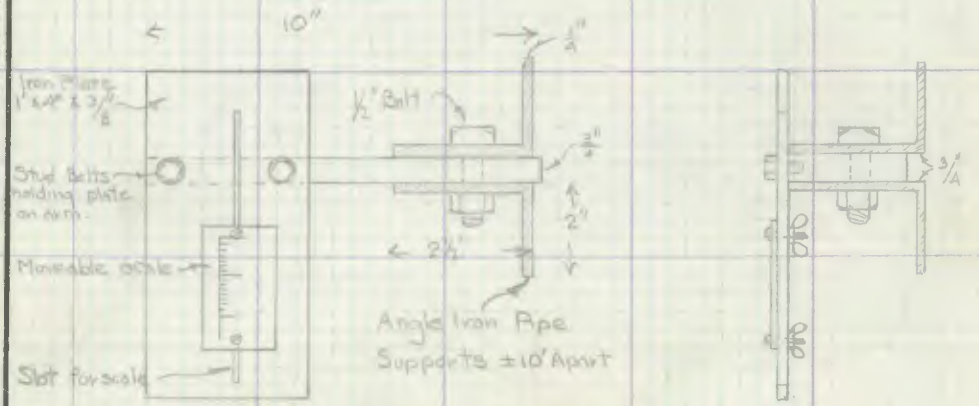

OPEN POSITION-AS WHEN IN USE CLOSED-AS WHEN NOT IN USE

PLAN - NORTH END

Over

F.B. 444 PG. 152 Chief Party Notes by Svenson Date

SIDE ELEVATION

SOUTH END

OPEN - FOR USE

CLOSED - NOT IN USE

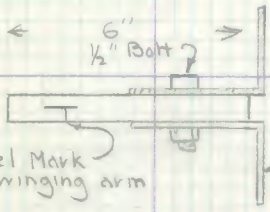

PLAN - SOUTH END

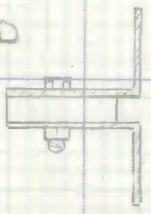

OPEN - FOR USE

CLOSED - OUT OF USE

Arm is 45' above floor and angleirons are 6' from E wall.

RETURN TO
LOS ANGELES COUNTY SURVEYOR

Do not extend notes this side of this line

Notes: ANY ADDITIONS OR CHANGES ON THIS SHEET MUST BE MADE OR CIRCLED IN Red. WITH DATE AND NAME OF PERSON MAKING CHANGE.

Date _____ Notes by _____ Chief Party _____ F.B. 444 PG. 153

Platted by _____	W. O. No. 4086 D. S. O. No. _____
Date _____	Location Garfield Ave
Map No. _____	Surveyed by _____
Platting C'k'd by _____	Date _____
Date _____	Indexed A. C. Johnson

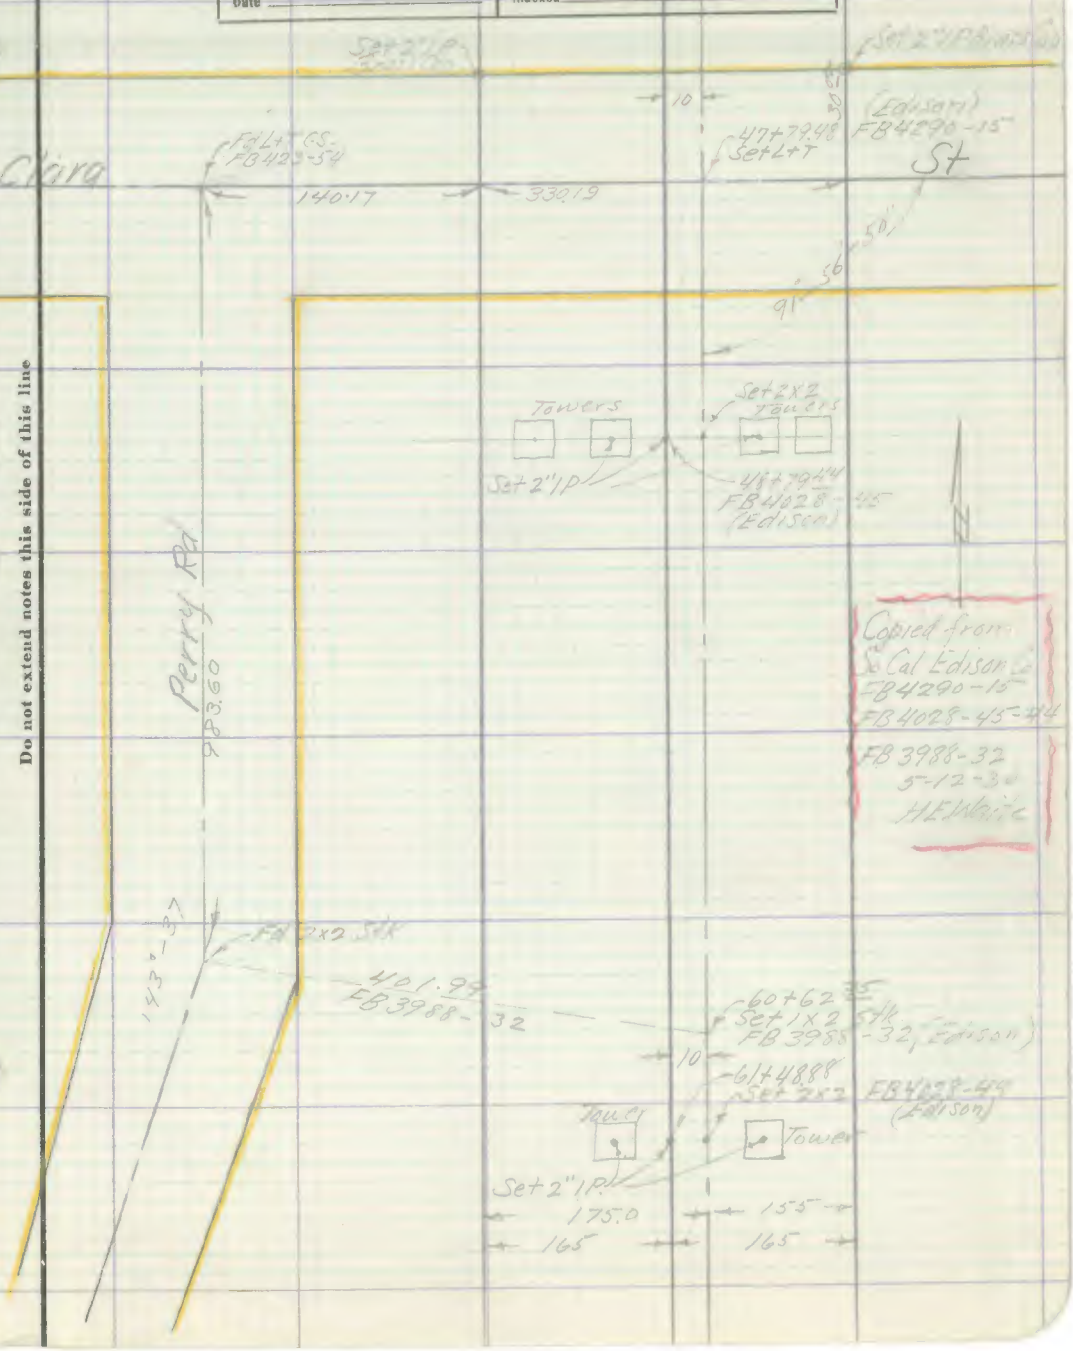

Note: ANY ADDITIONS OR CHANGES ON THIS SHEET MUST BE MADE OR CIRCLED IN Red. WITH DATE AND NAME OF PERSON MAKING CHANGE.

Do not extend notes this side of this line

RETURN TO
LOS ANGELES COUNTY SURVEYOR

F.B. _____ PG. _____ _____ Chief Party Notes by _____ Date _____

RETURN TO
LOS ANGELES COUNTY SURVEYOR

Note: ANY ADDITIONS OR CHANGES ON THIS SHEET MUST BE MADE OR CIRCLED IN Red WITH DATE AND NAME OF PERSON MAKING CHANGE.

Do not extend notes this side of this line

FB 544 A-155

FB 444-155

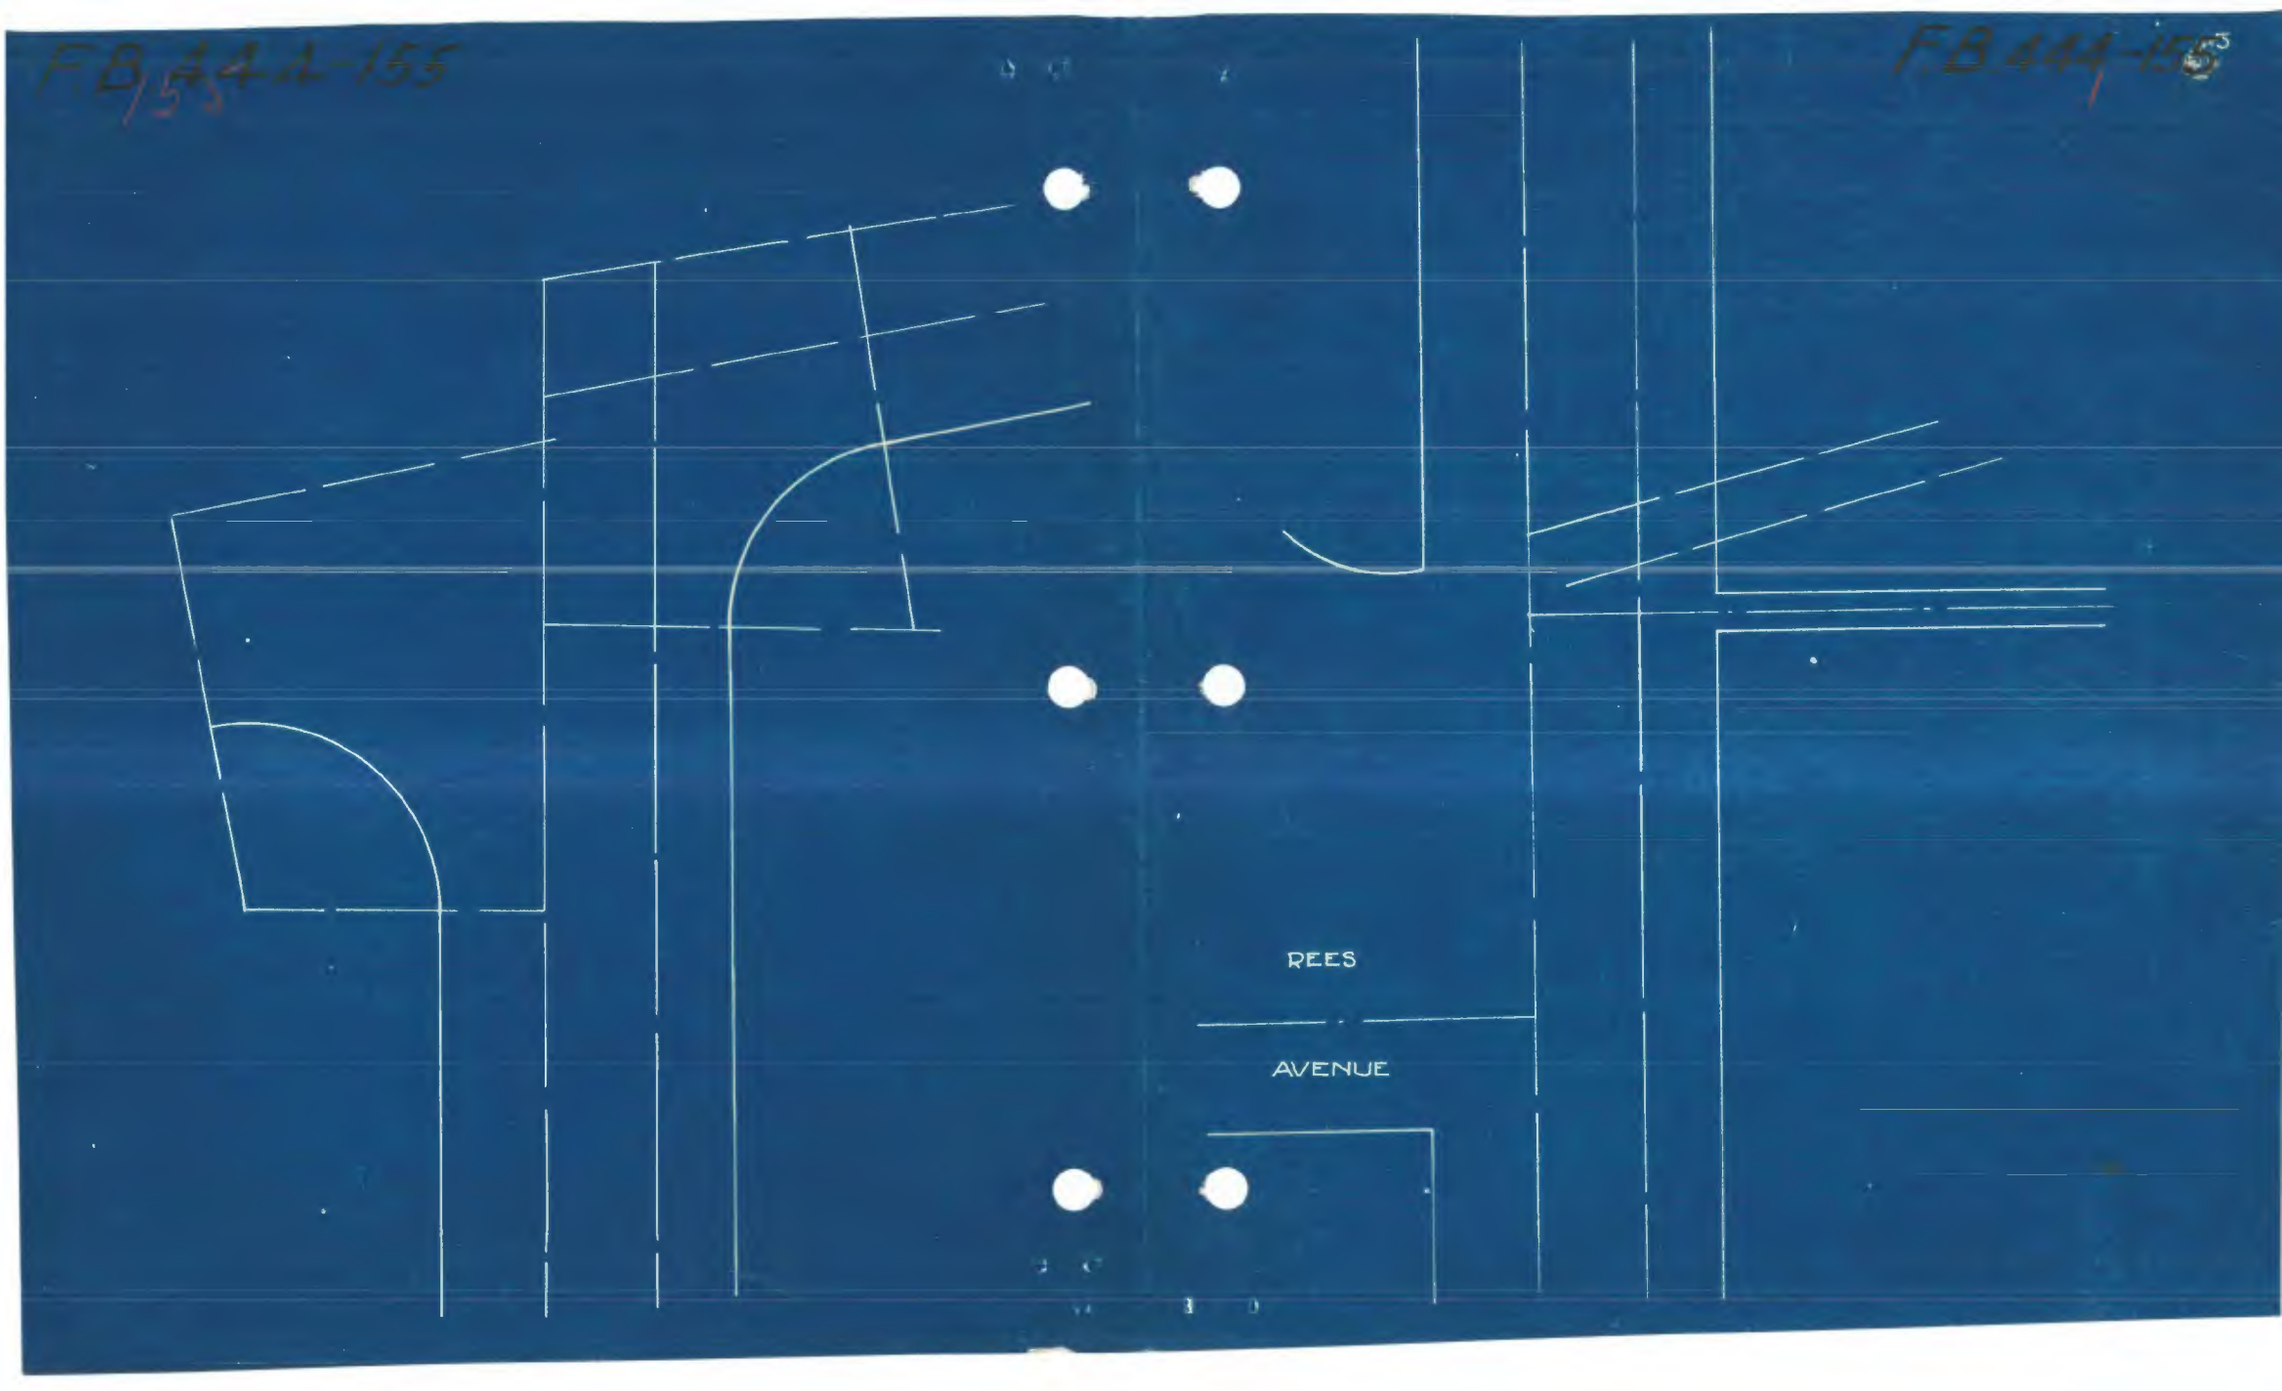

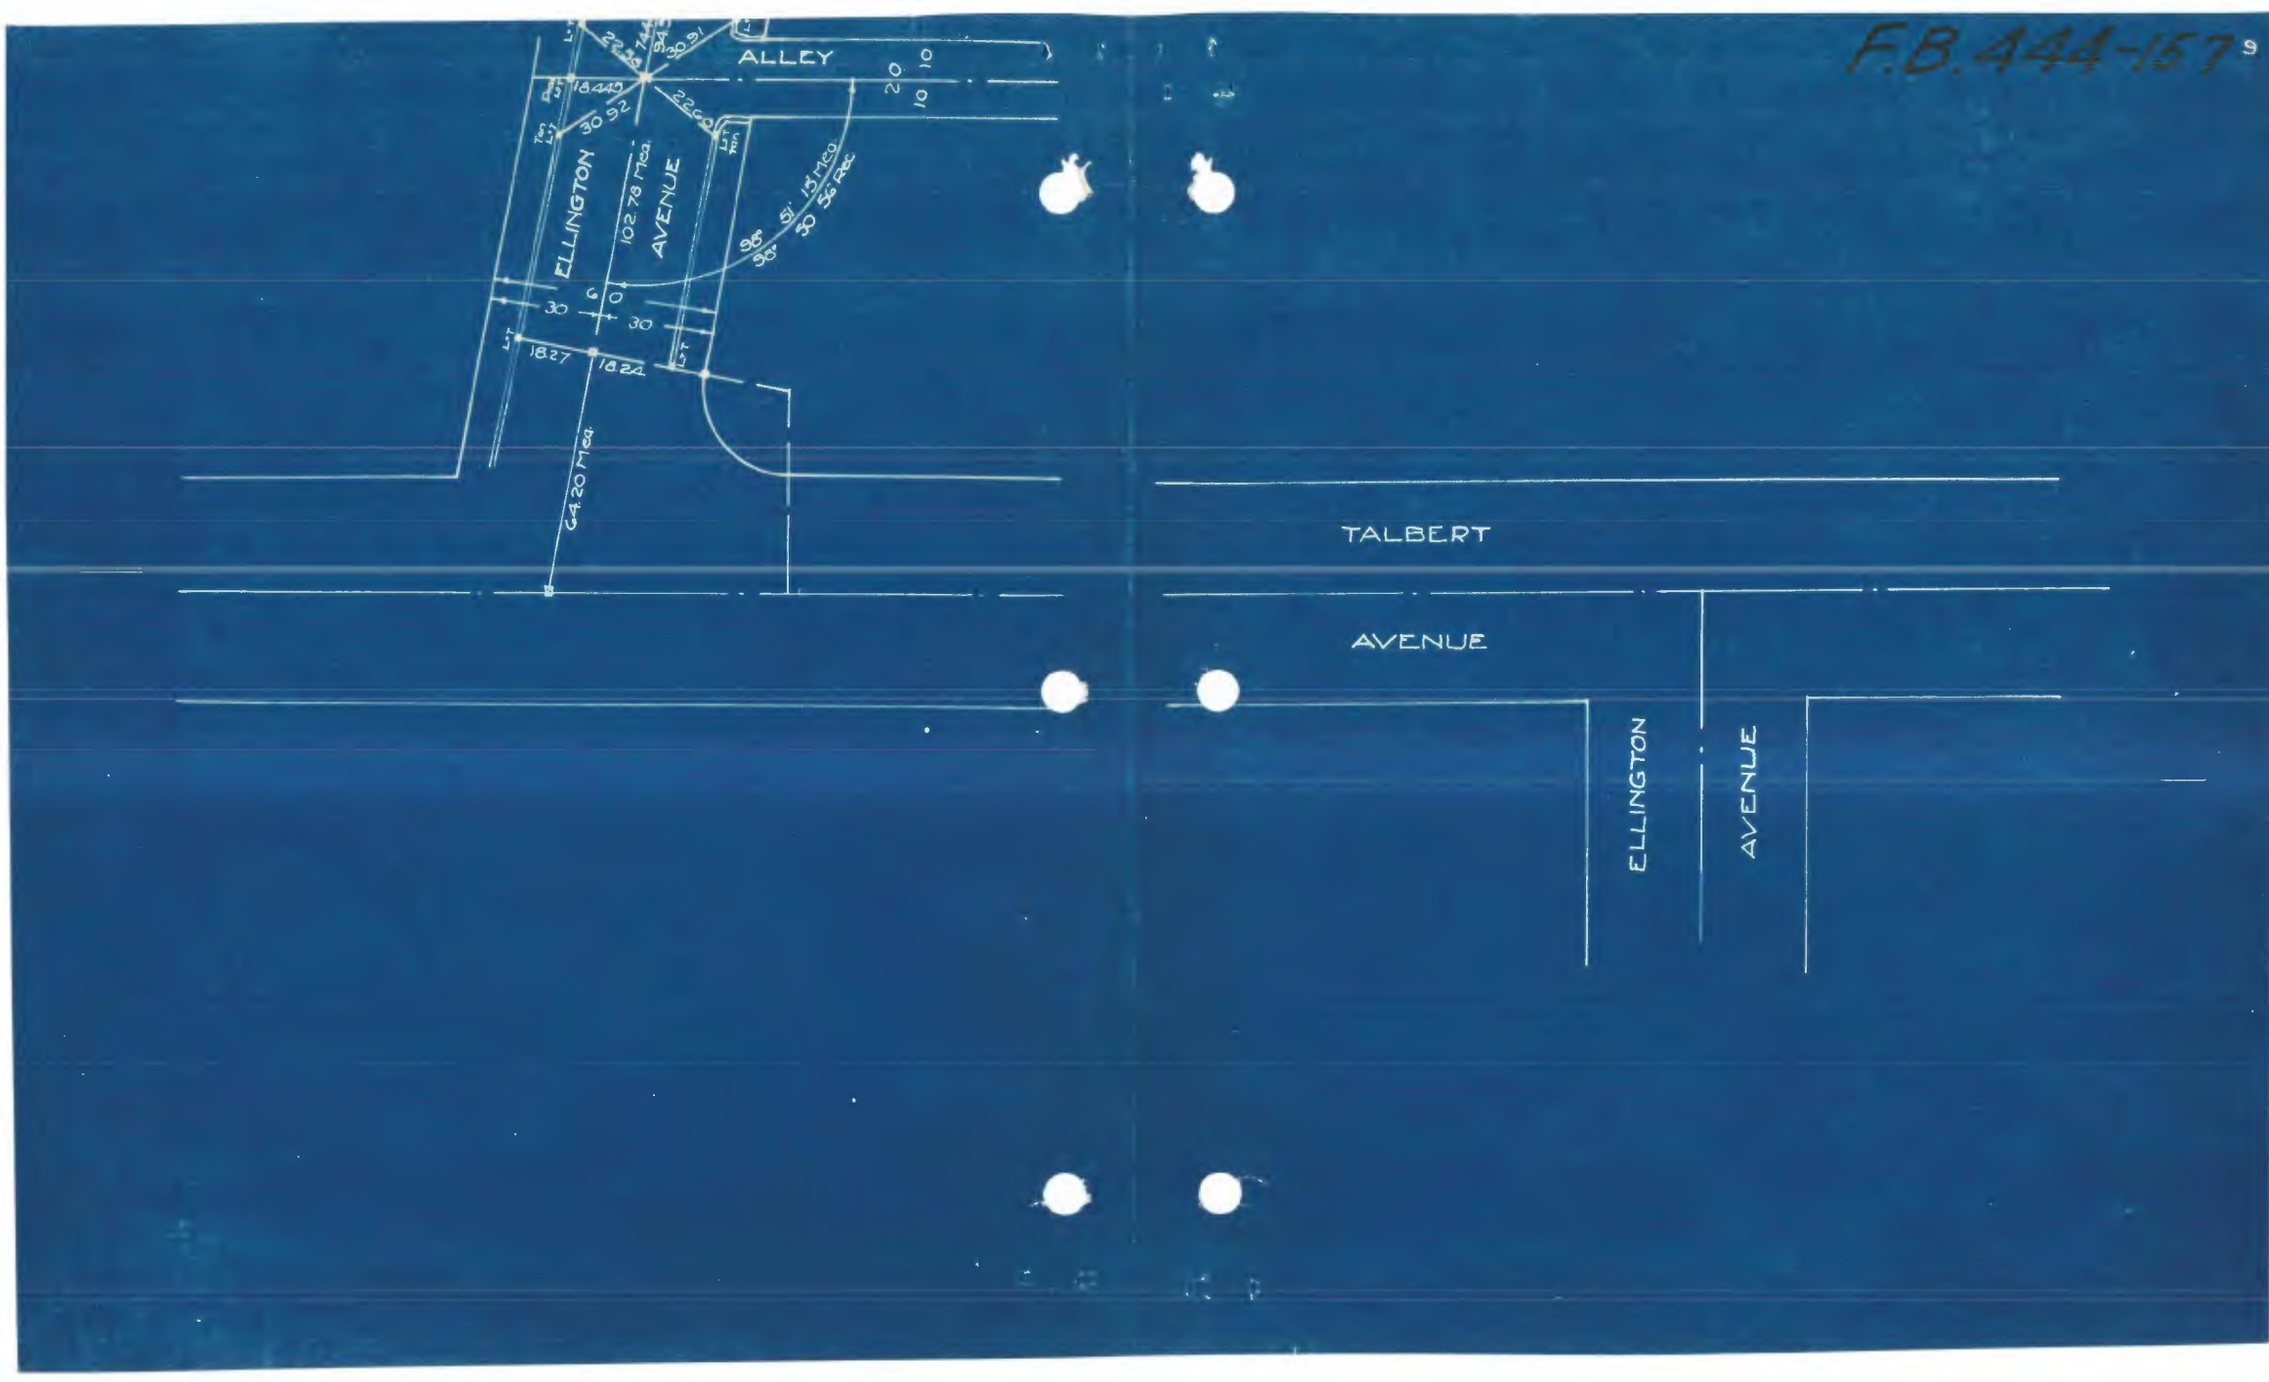
F.B. 444-157
ALLEY
ELLINGTON
AVENUE
102.78 Meas.
64.20 Meas.
TALBERT
AVENUE
ELLINGTON
AVENUE

F.B. 444-156

156

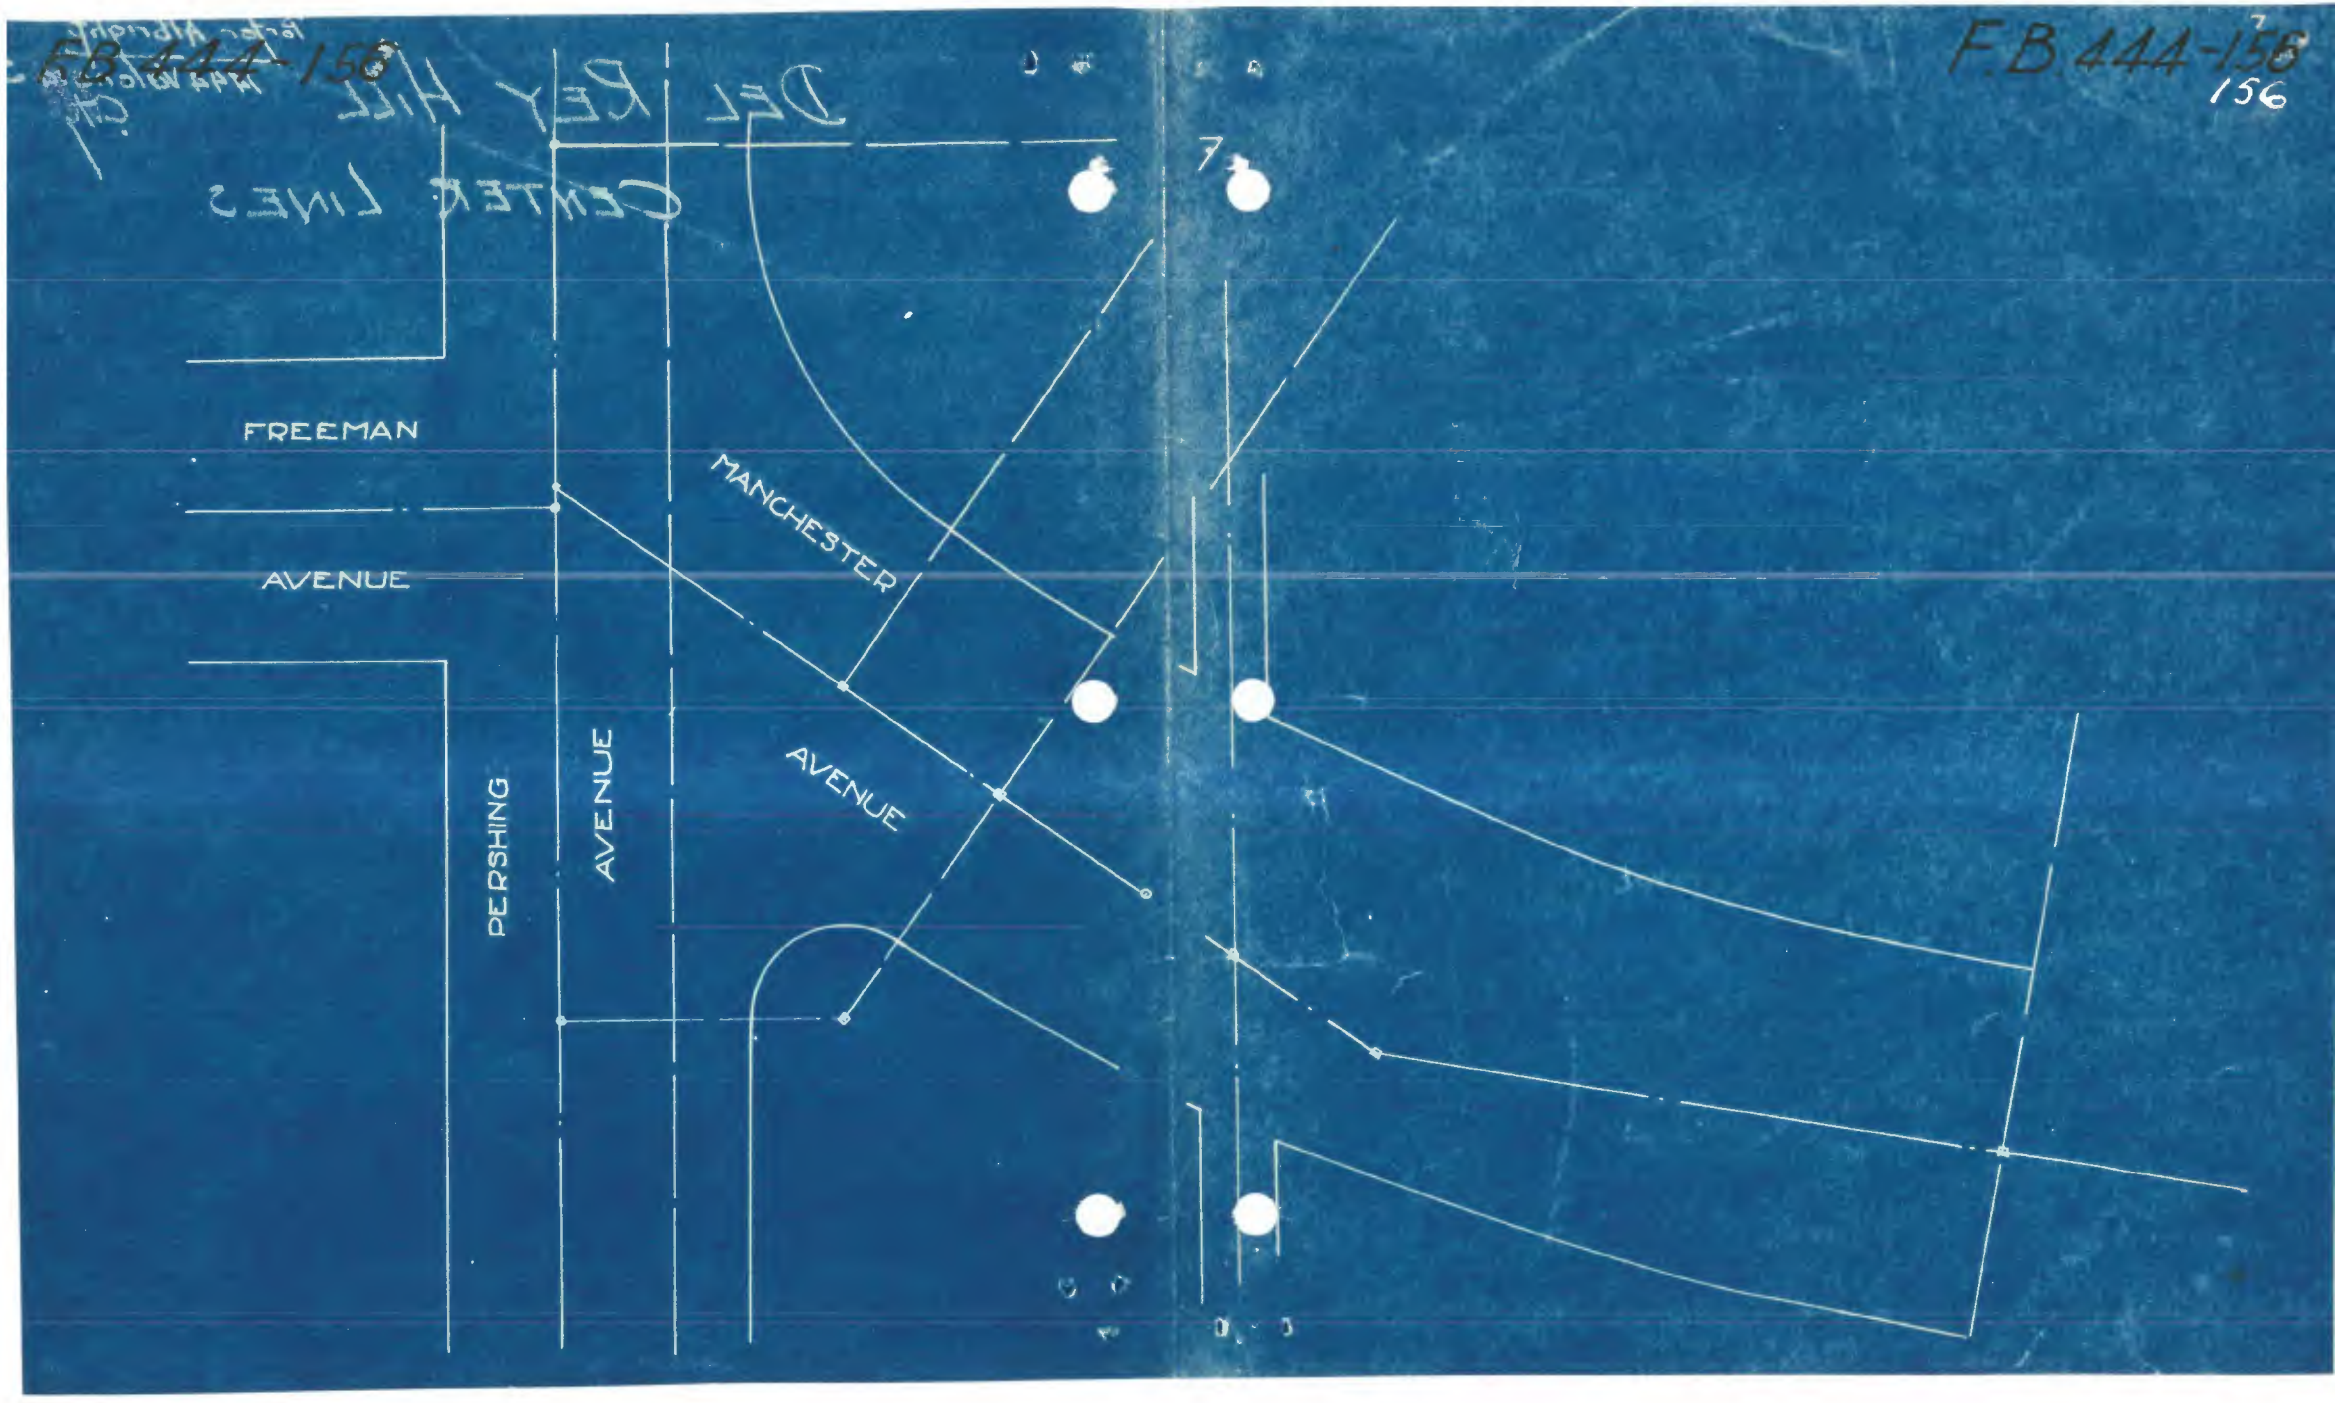

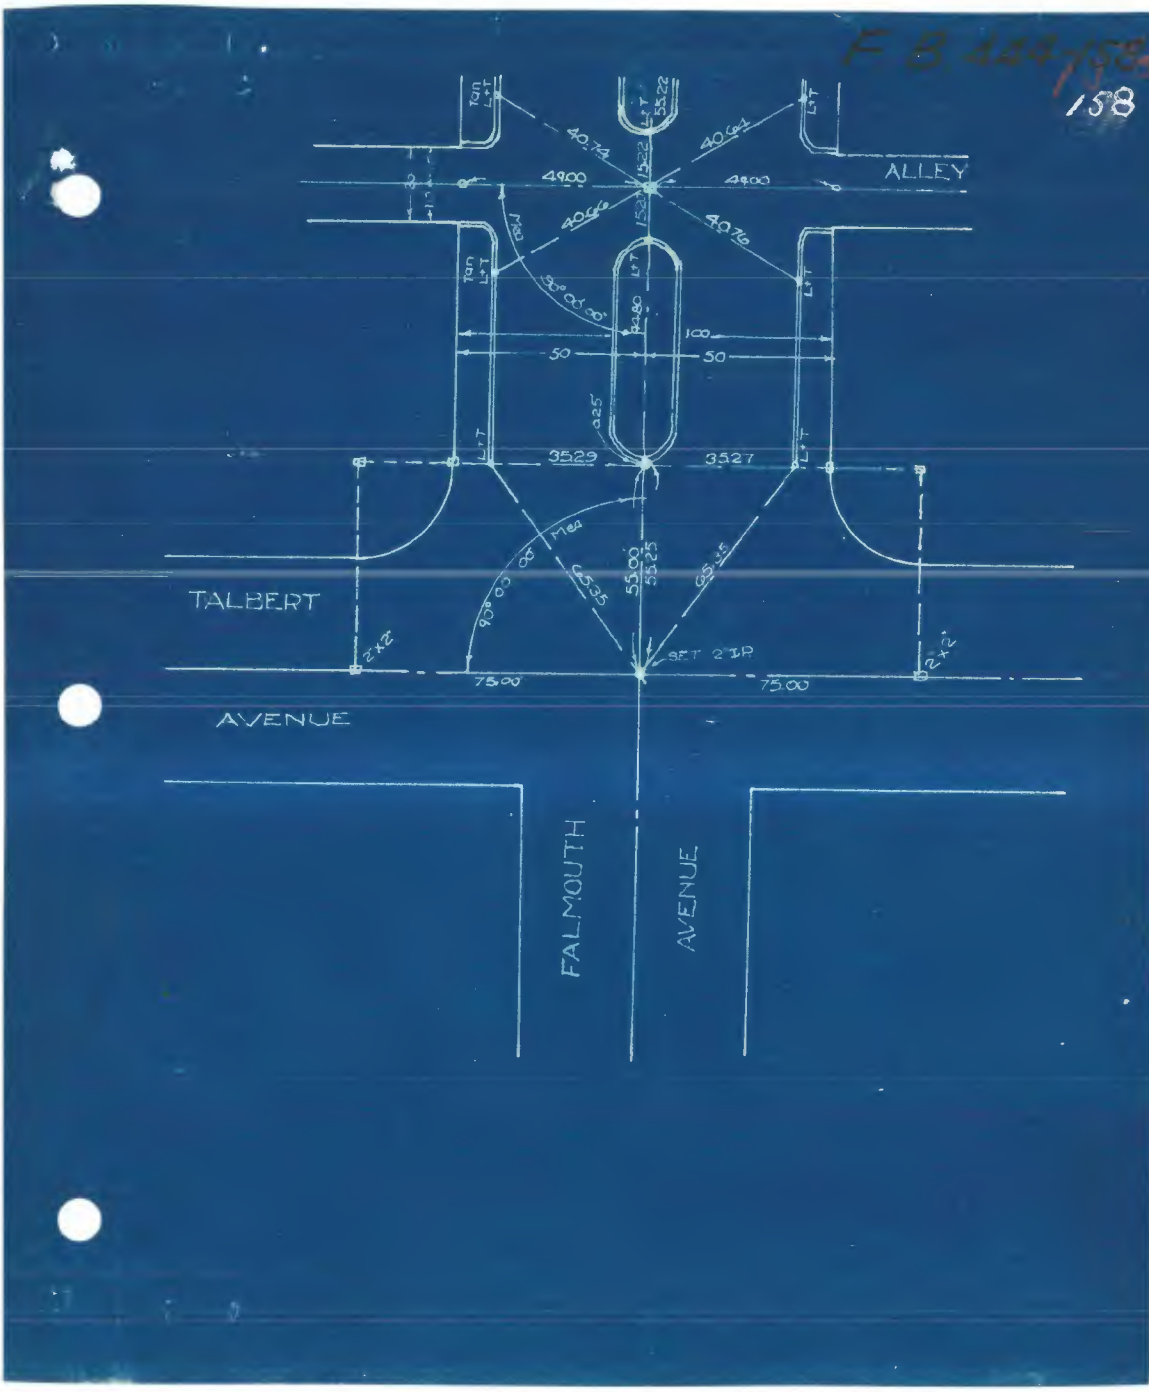

F B 444 / 58
158
ALLEY
TALBERT
AVENUE
FALMOUTH
AVENUE
Tan L+T
L+T
55.22
40.74
40.64
49.00
49.00
40.66
40.76
90°00'00"
100
50
50
35.29
35.27
55.00
55.25
65.35
65.35
90°00'00"
SET 2" IP
75.00
75.00
2"x2"
2"x2"

FB 444-159

159

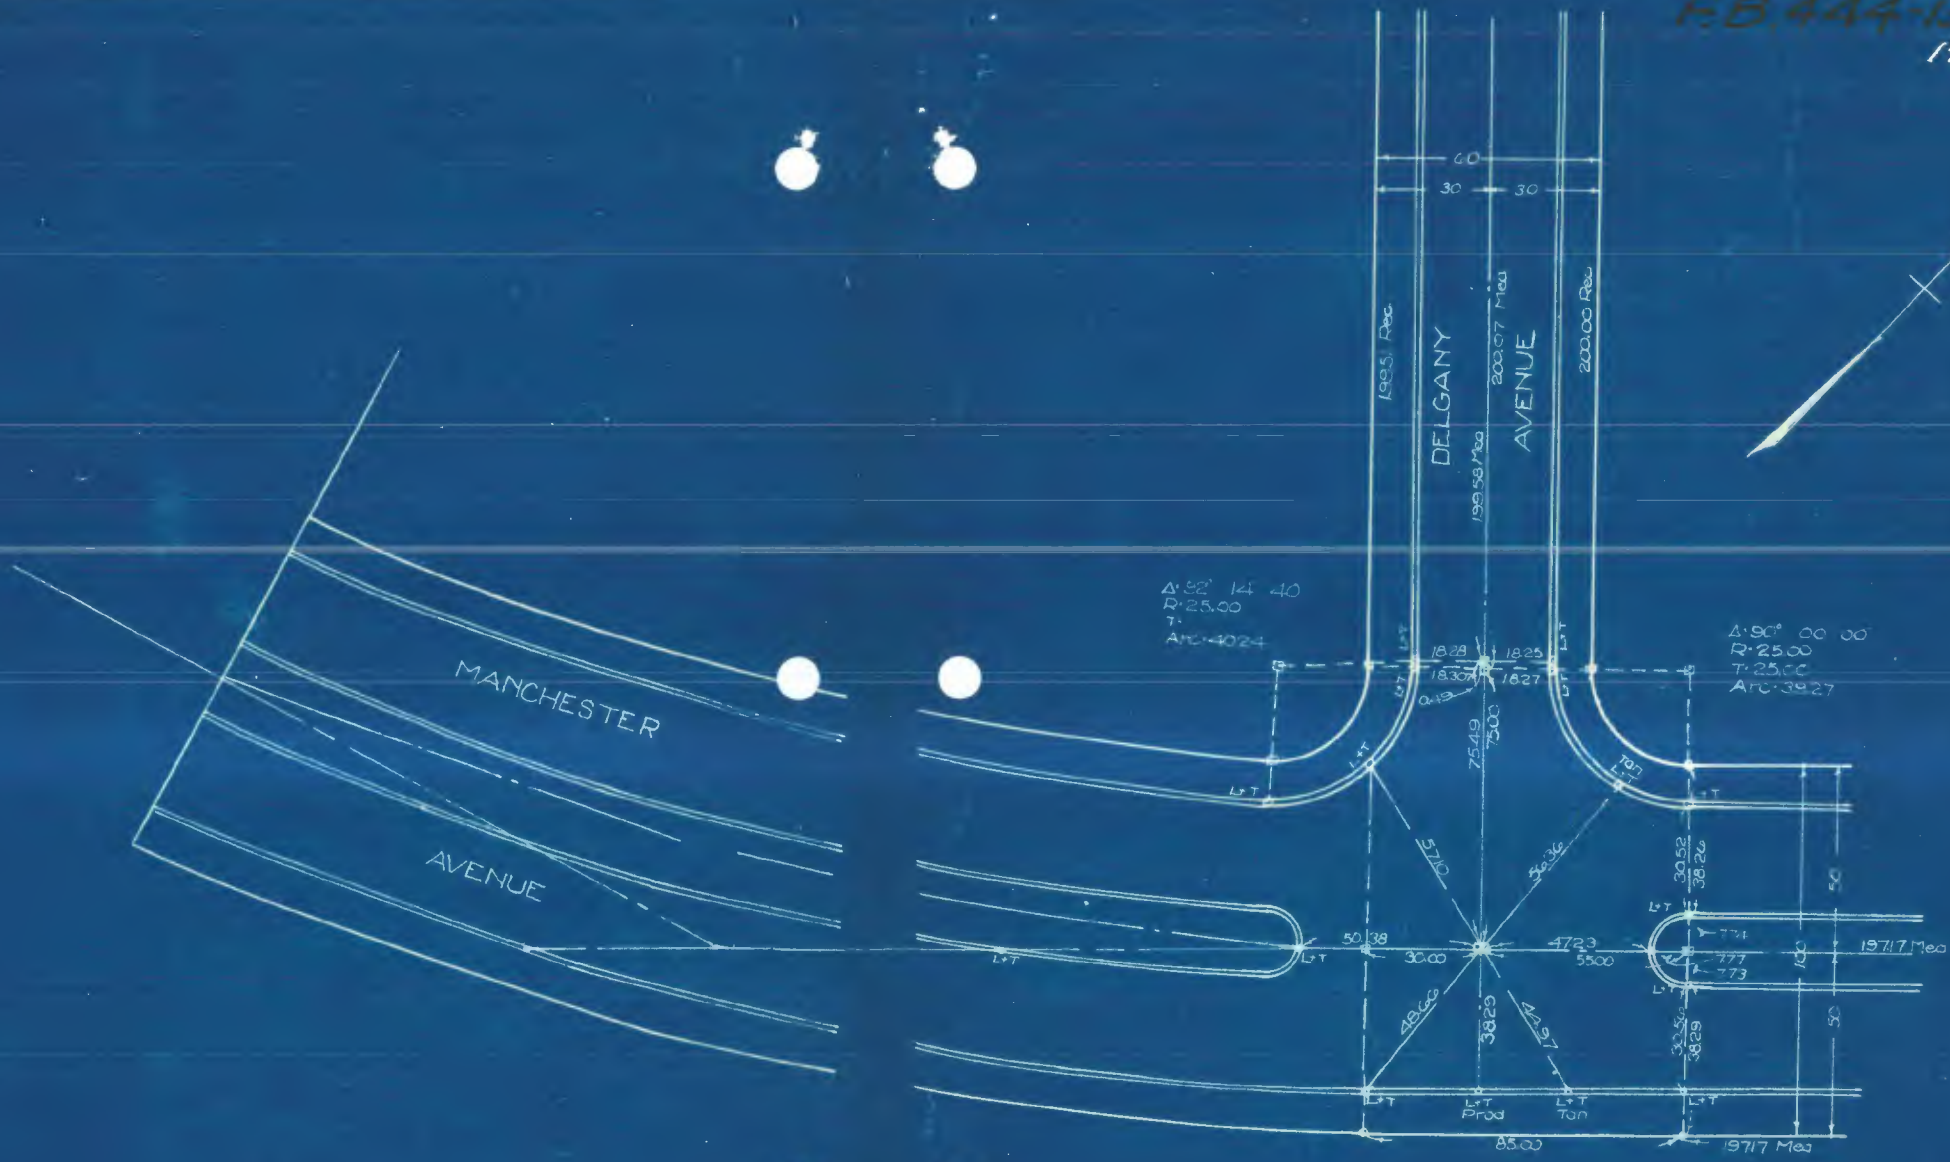

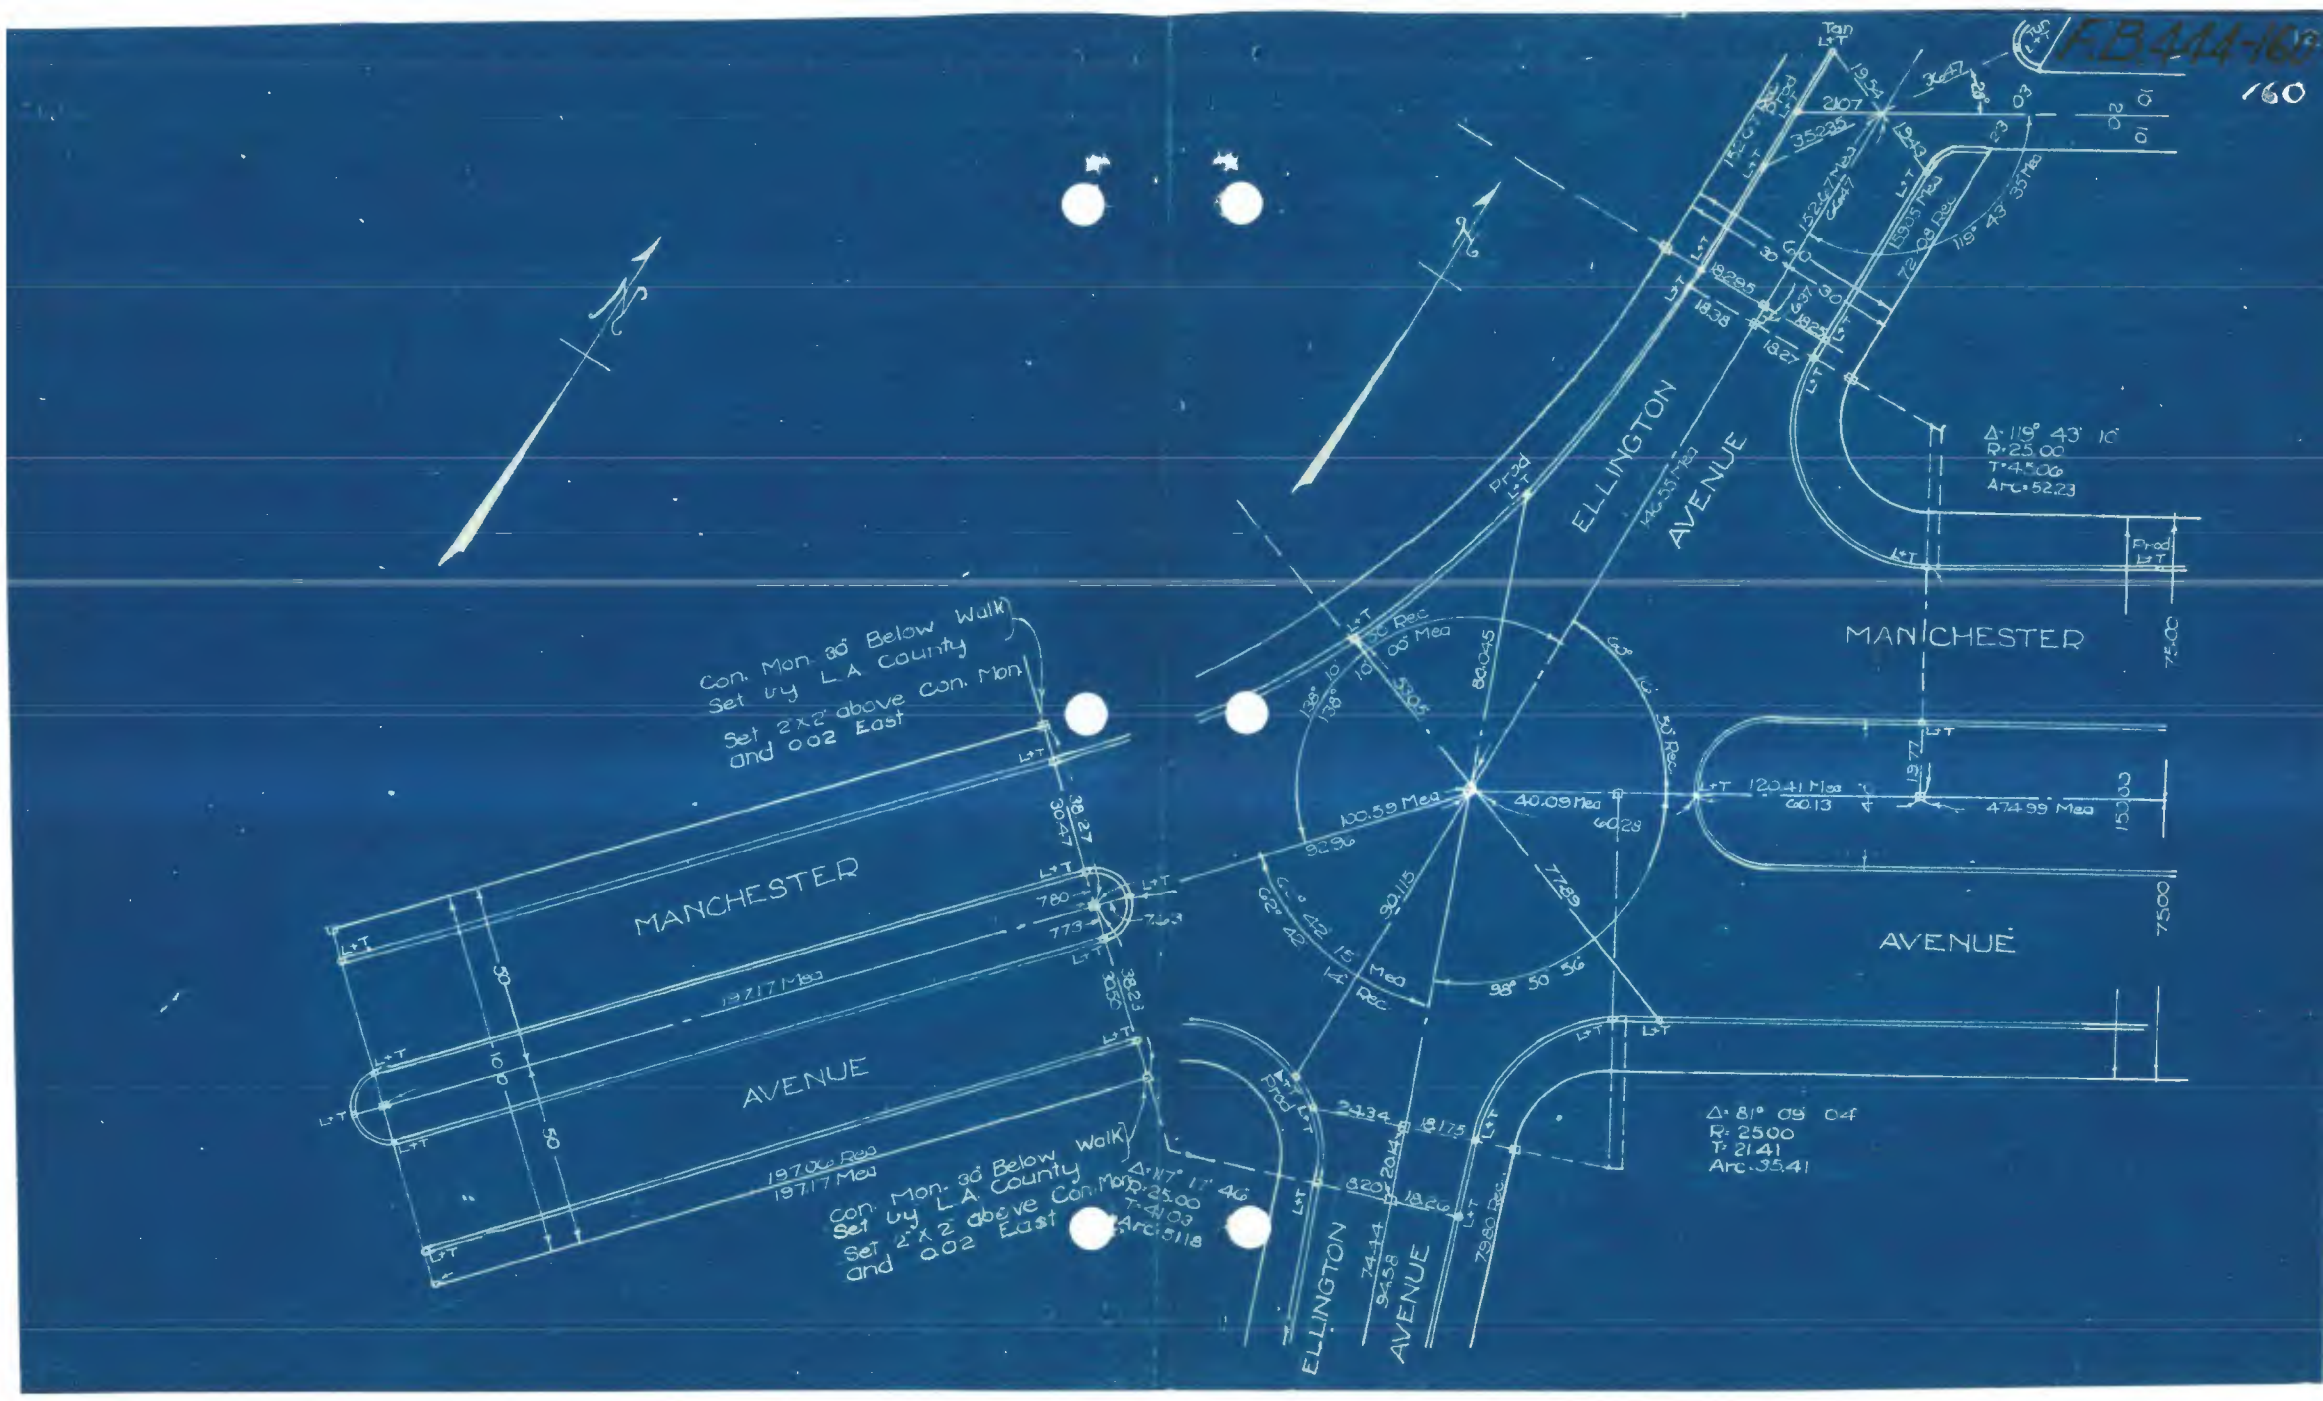

FB 444-160
160
MANCHESTER
AVENUE
ELLINGTON
AVENUE
Con. Mon. 30' Below Walk
Set by L.A. County
Set 2'x2' above Con. Mon.
and 0.02 East
Con. Mon. 30' Below Walk
Set by L.A. County
Set 2'x2' above Con. Mon.
and 0.02 East
Δ=119° 43' 10"
R=25.00
T=45.06
Arc=52.23
Δ=81° 09' 04"
R=25.00
T=21.41
Arc=35.41
Δ=117° 17' 46"
R=25.00
T=41.03
Arc=51.18

F.B. 444-161
13
161

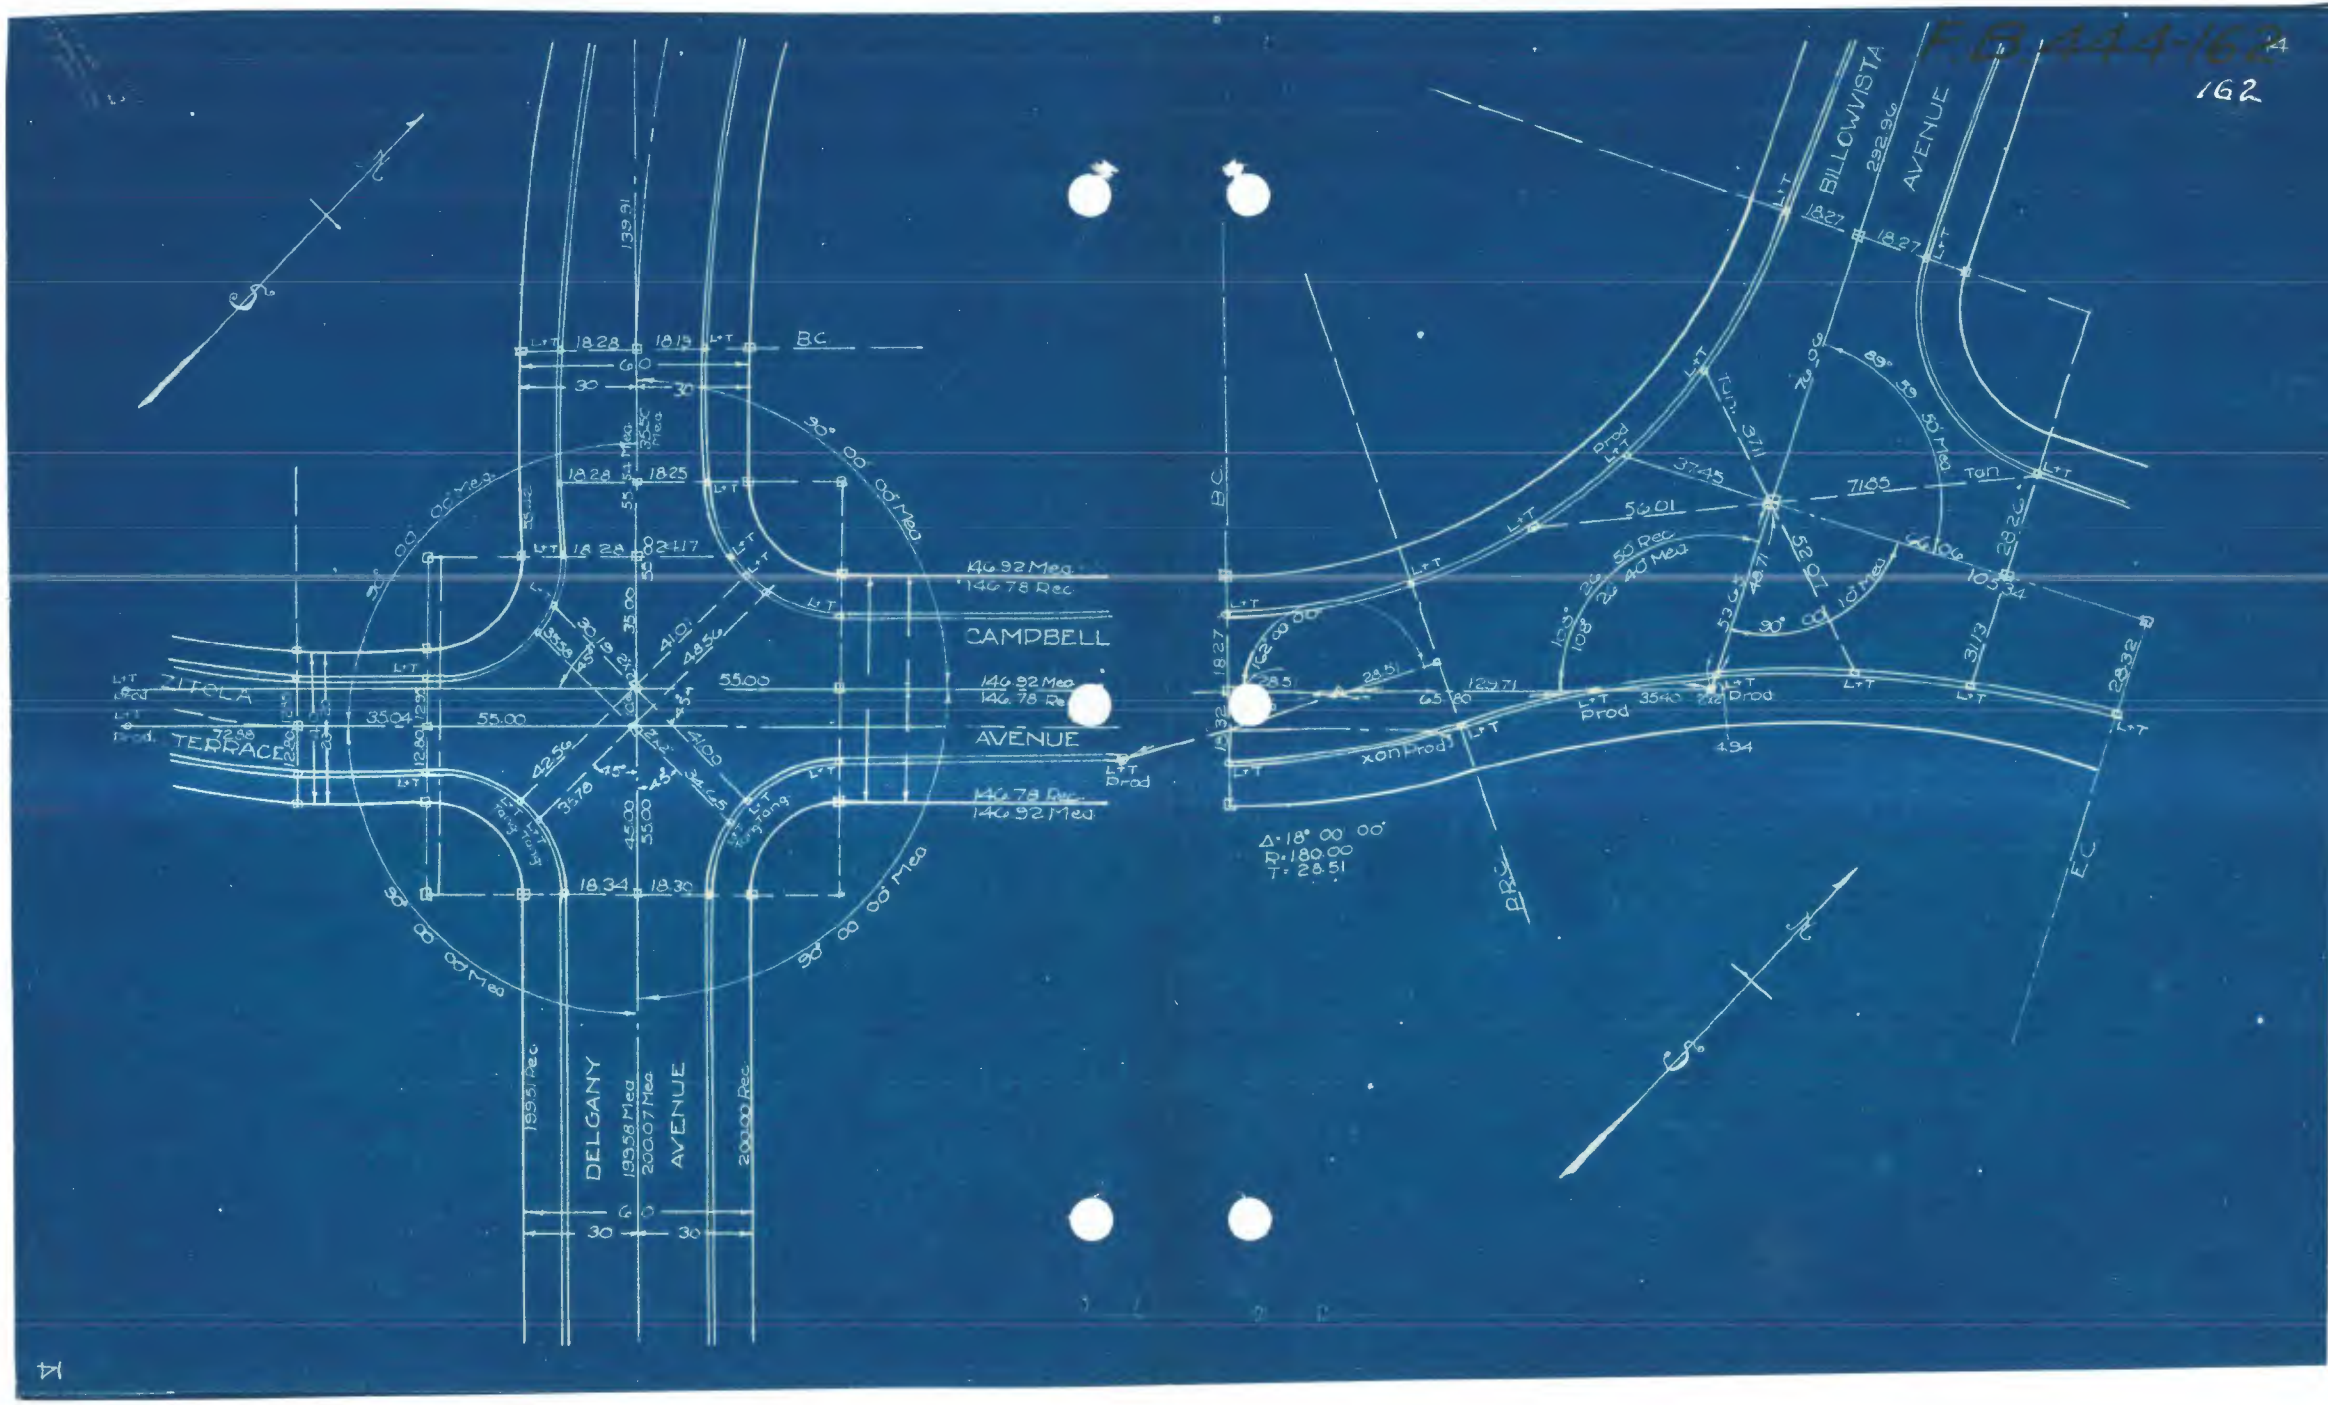

F.B. 444-162
162
BILLOWVISTA
AVENUE
CAMPBELL
AVENUE
ZITOLA
TERRACE
DELGANY
AVENUE
B.C.
B.R.C.
E.C.
Δ=18° 00' 00"
R=180.00
T=28.51
146.92 Meas
146.78 Rec
199.51 Rec
199.58 Meas
200.07 Meas
200.00 Rec
90° 00' 00" Meas

FB 444-163

163

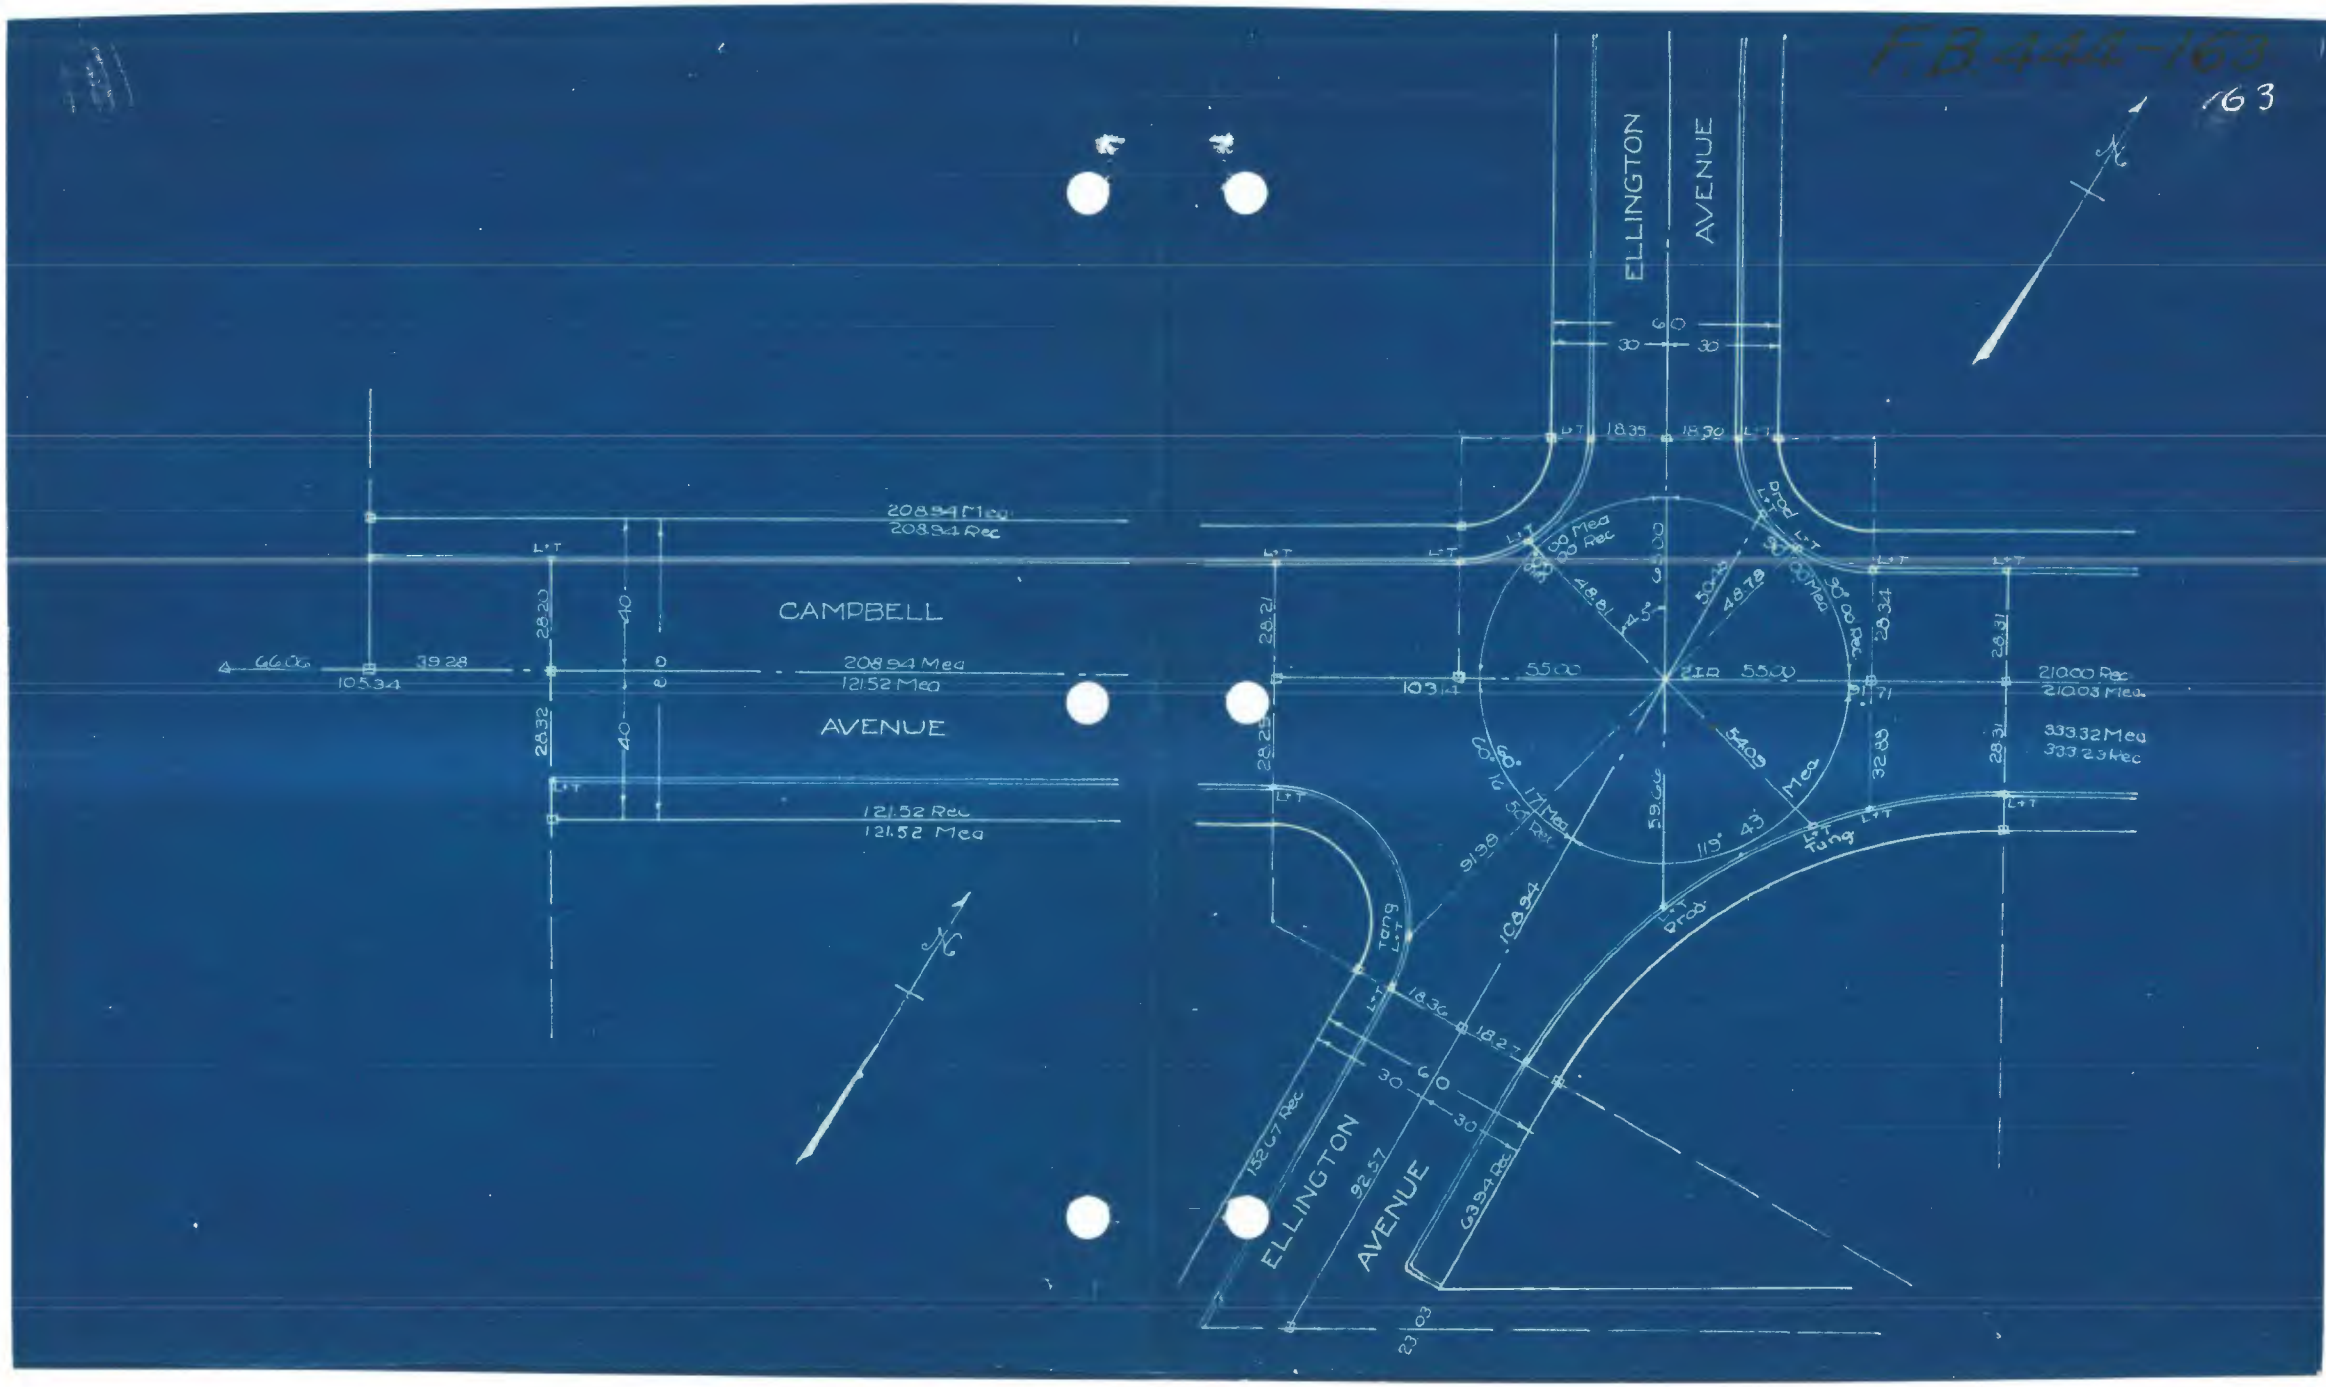

F.B. 444-164
167

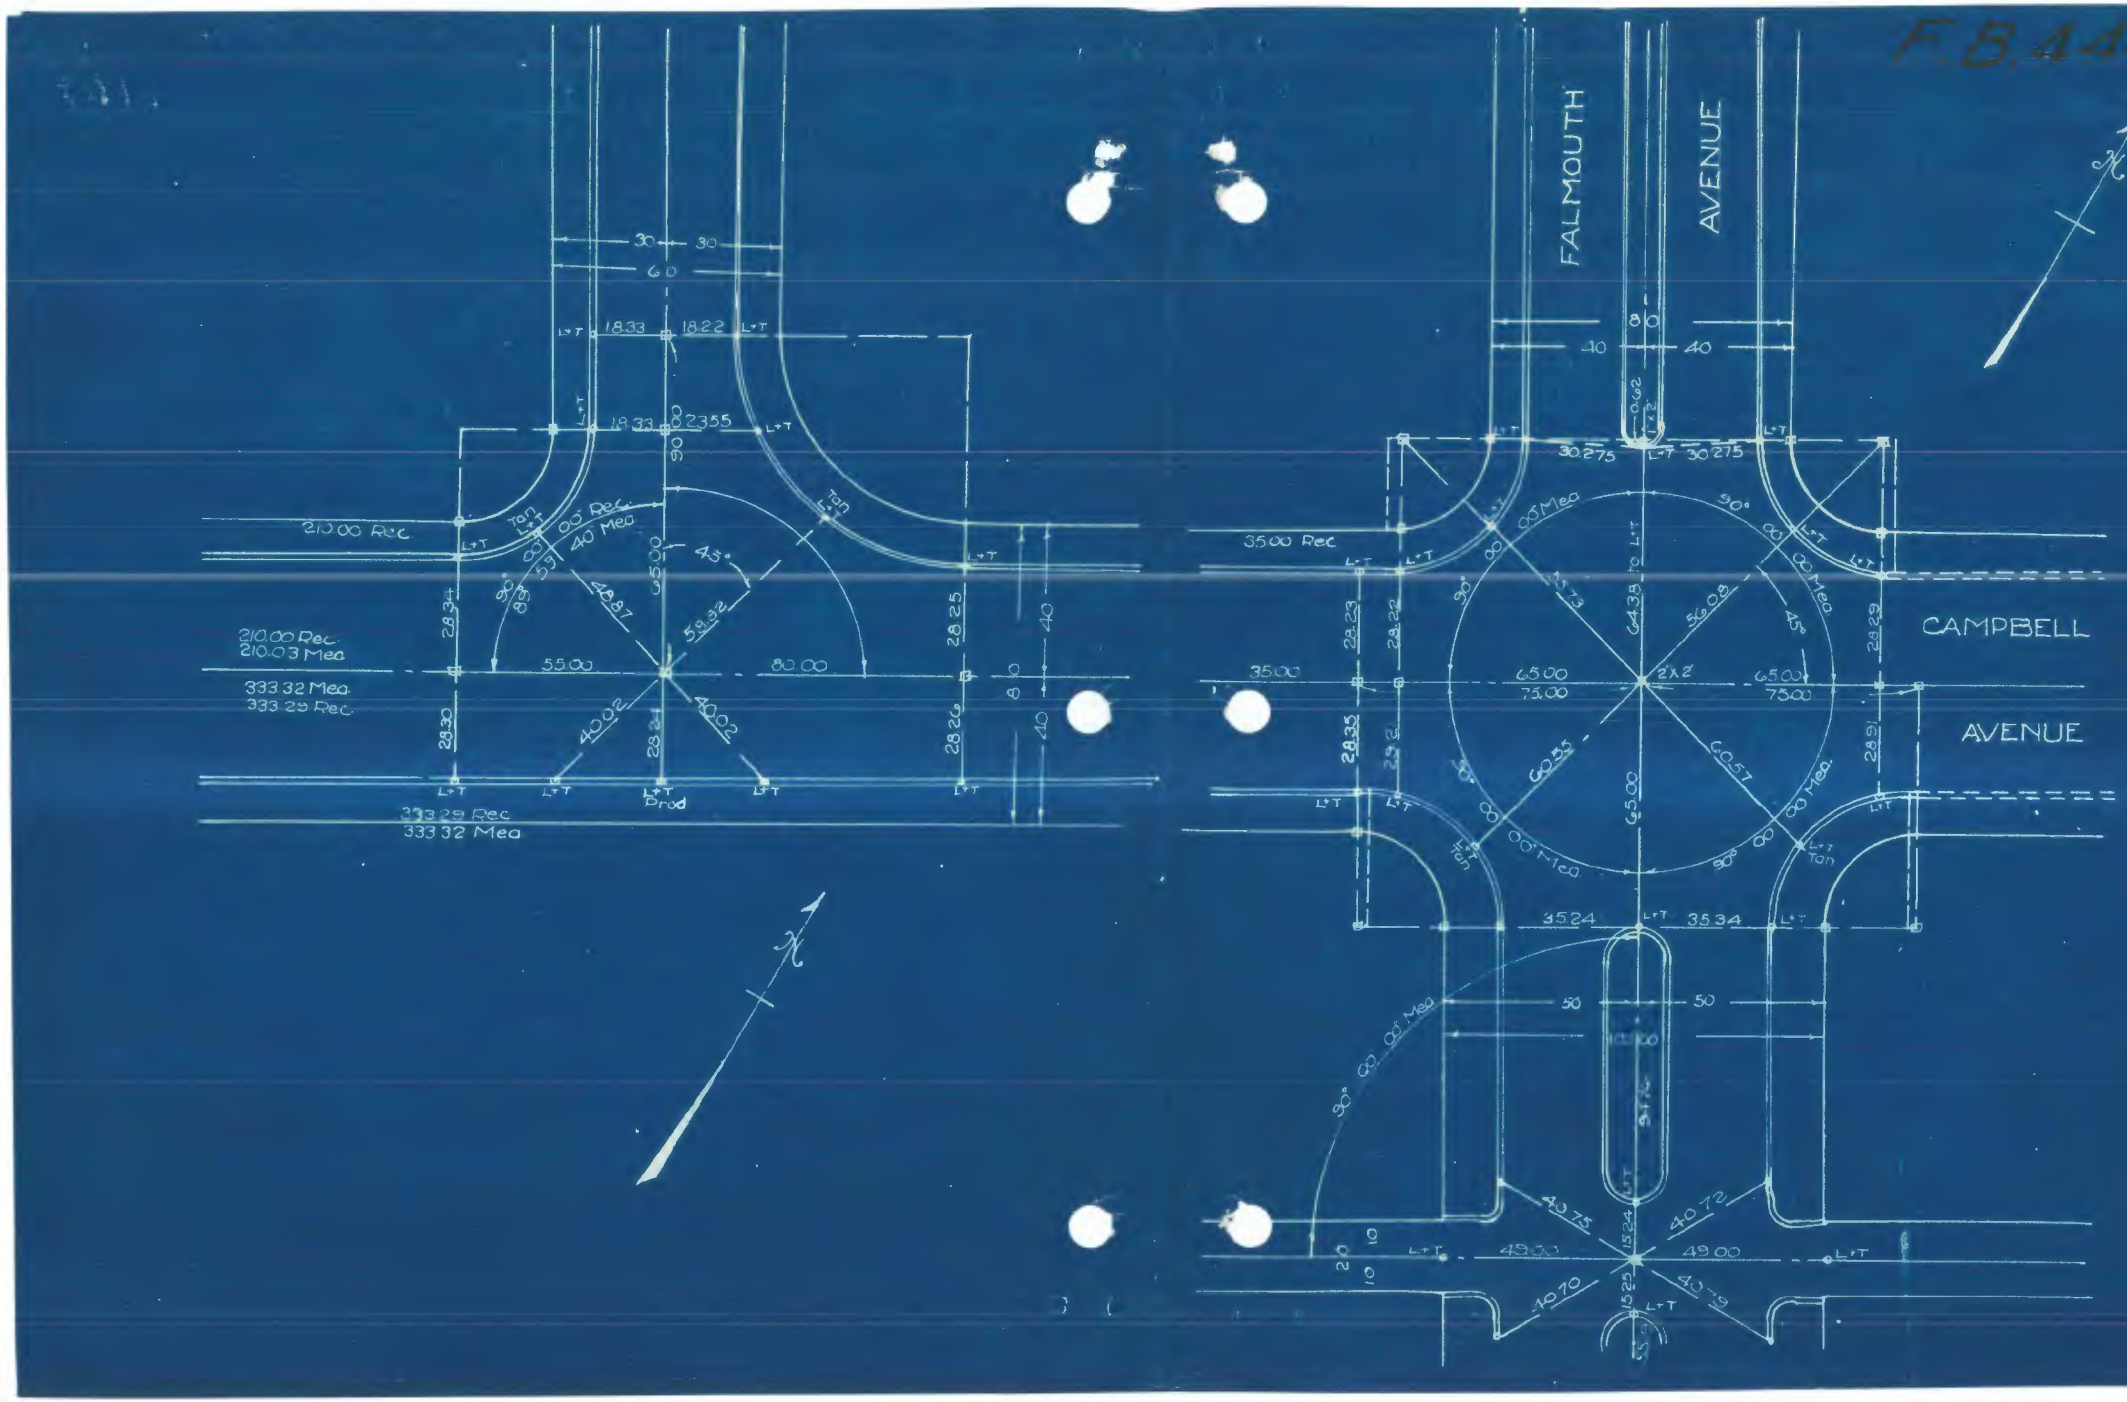

F.B. 444-166

166

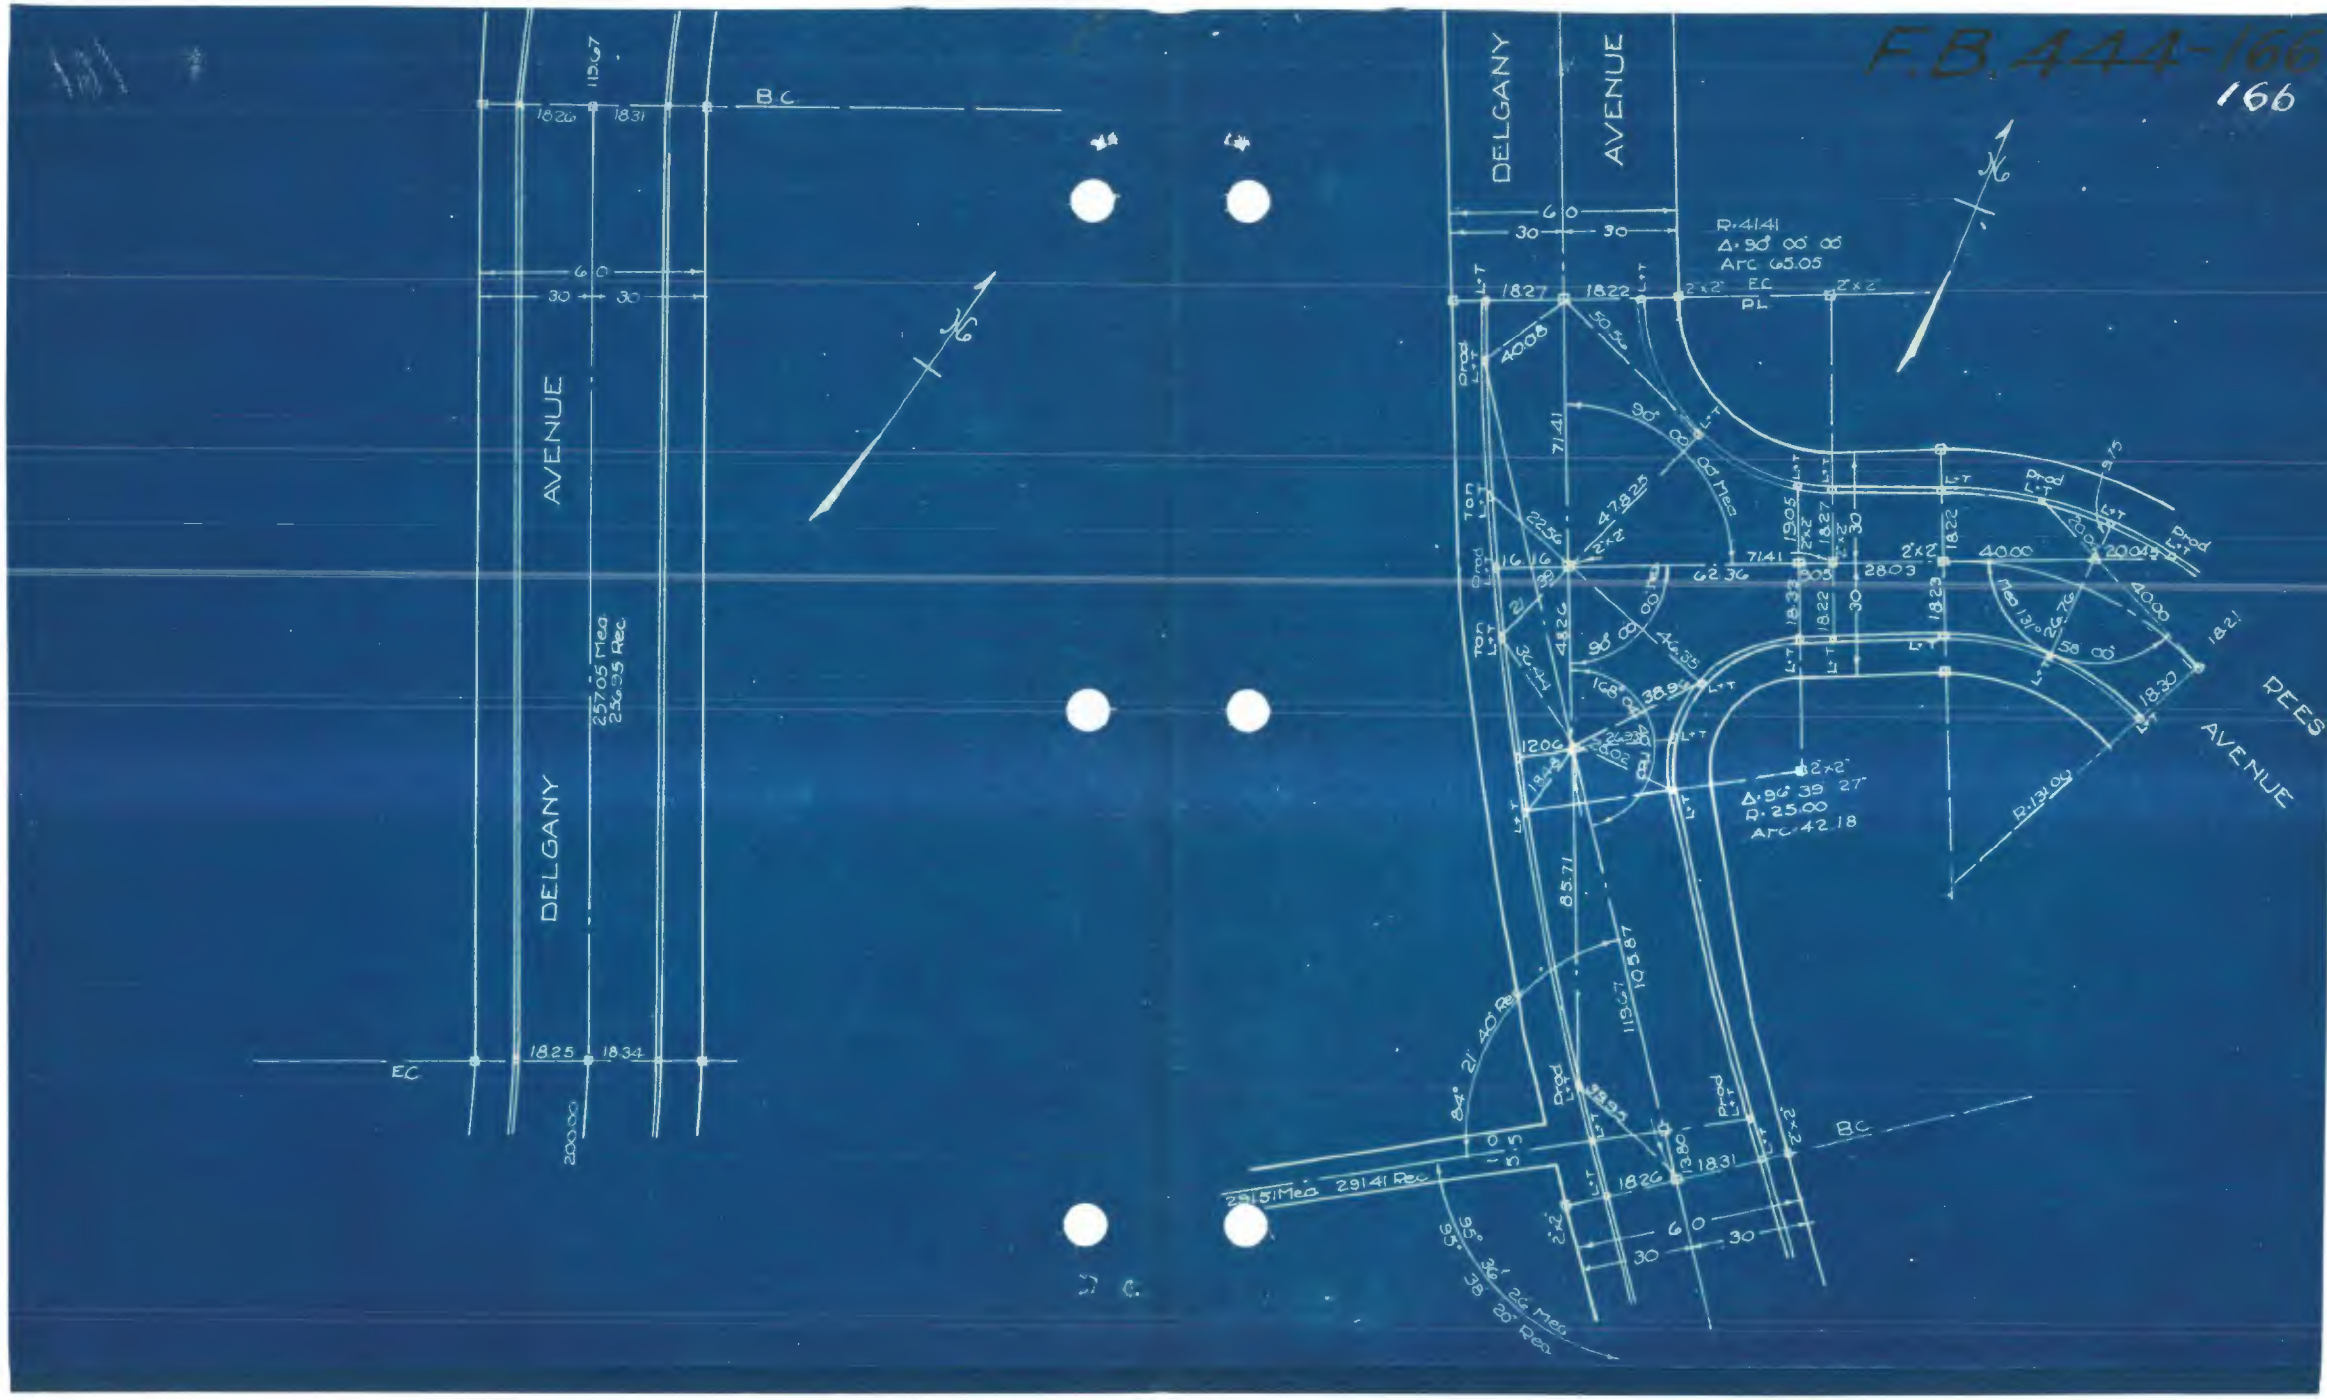
DELGANY AVENUE
DELGANY AVENUE
REES AVENUE
BC
EC
PC
PL
R=41.41
Δ=90° 00' 00"
Arc 65.05
R=25.00
Δ=96° 39' 27"
Arc 42.18
R=131.04
95° 39' 26" Mea
95° 38' 28" Rec
1826
1827
1822
1831
1825
1834
1823
1830
1821
1820
-1
-2
F.B. 444-165

165

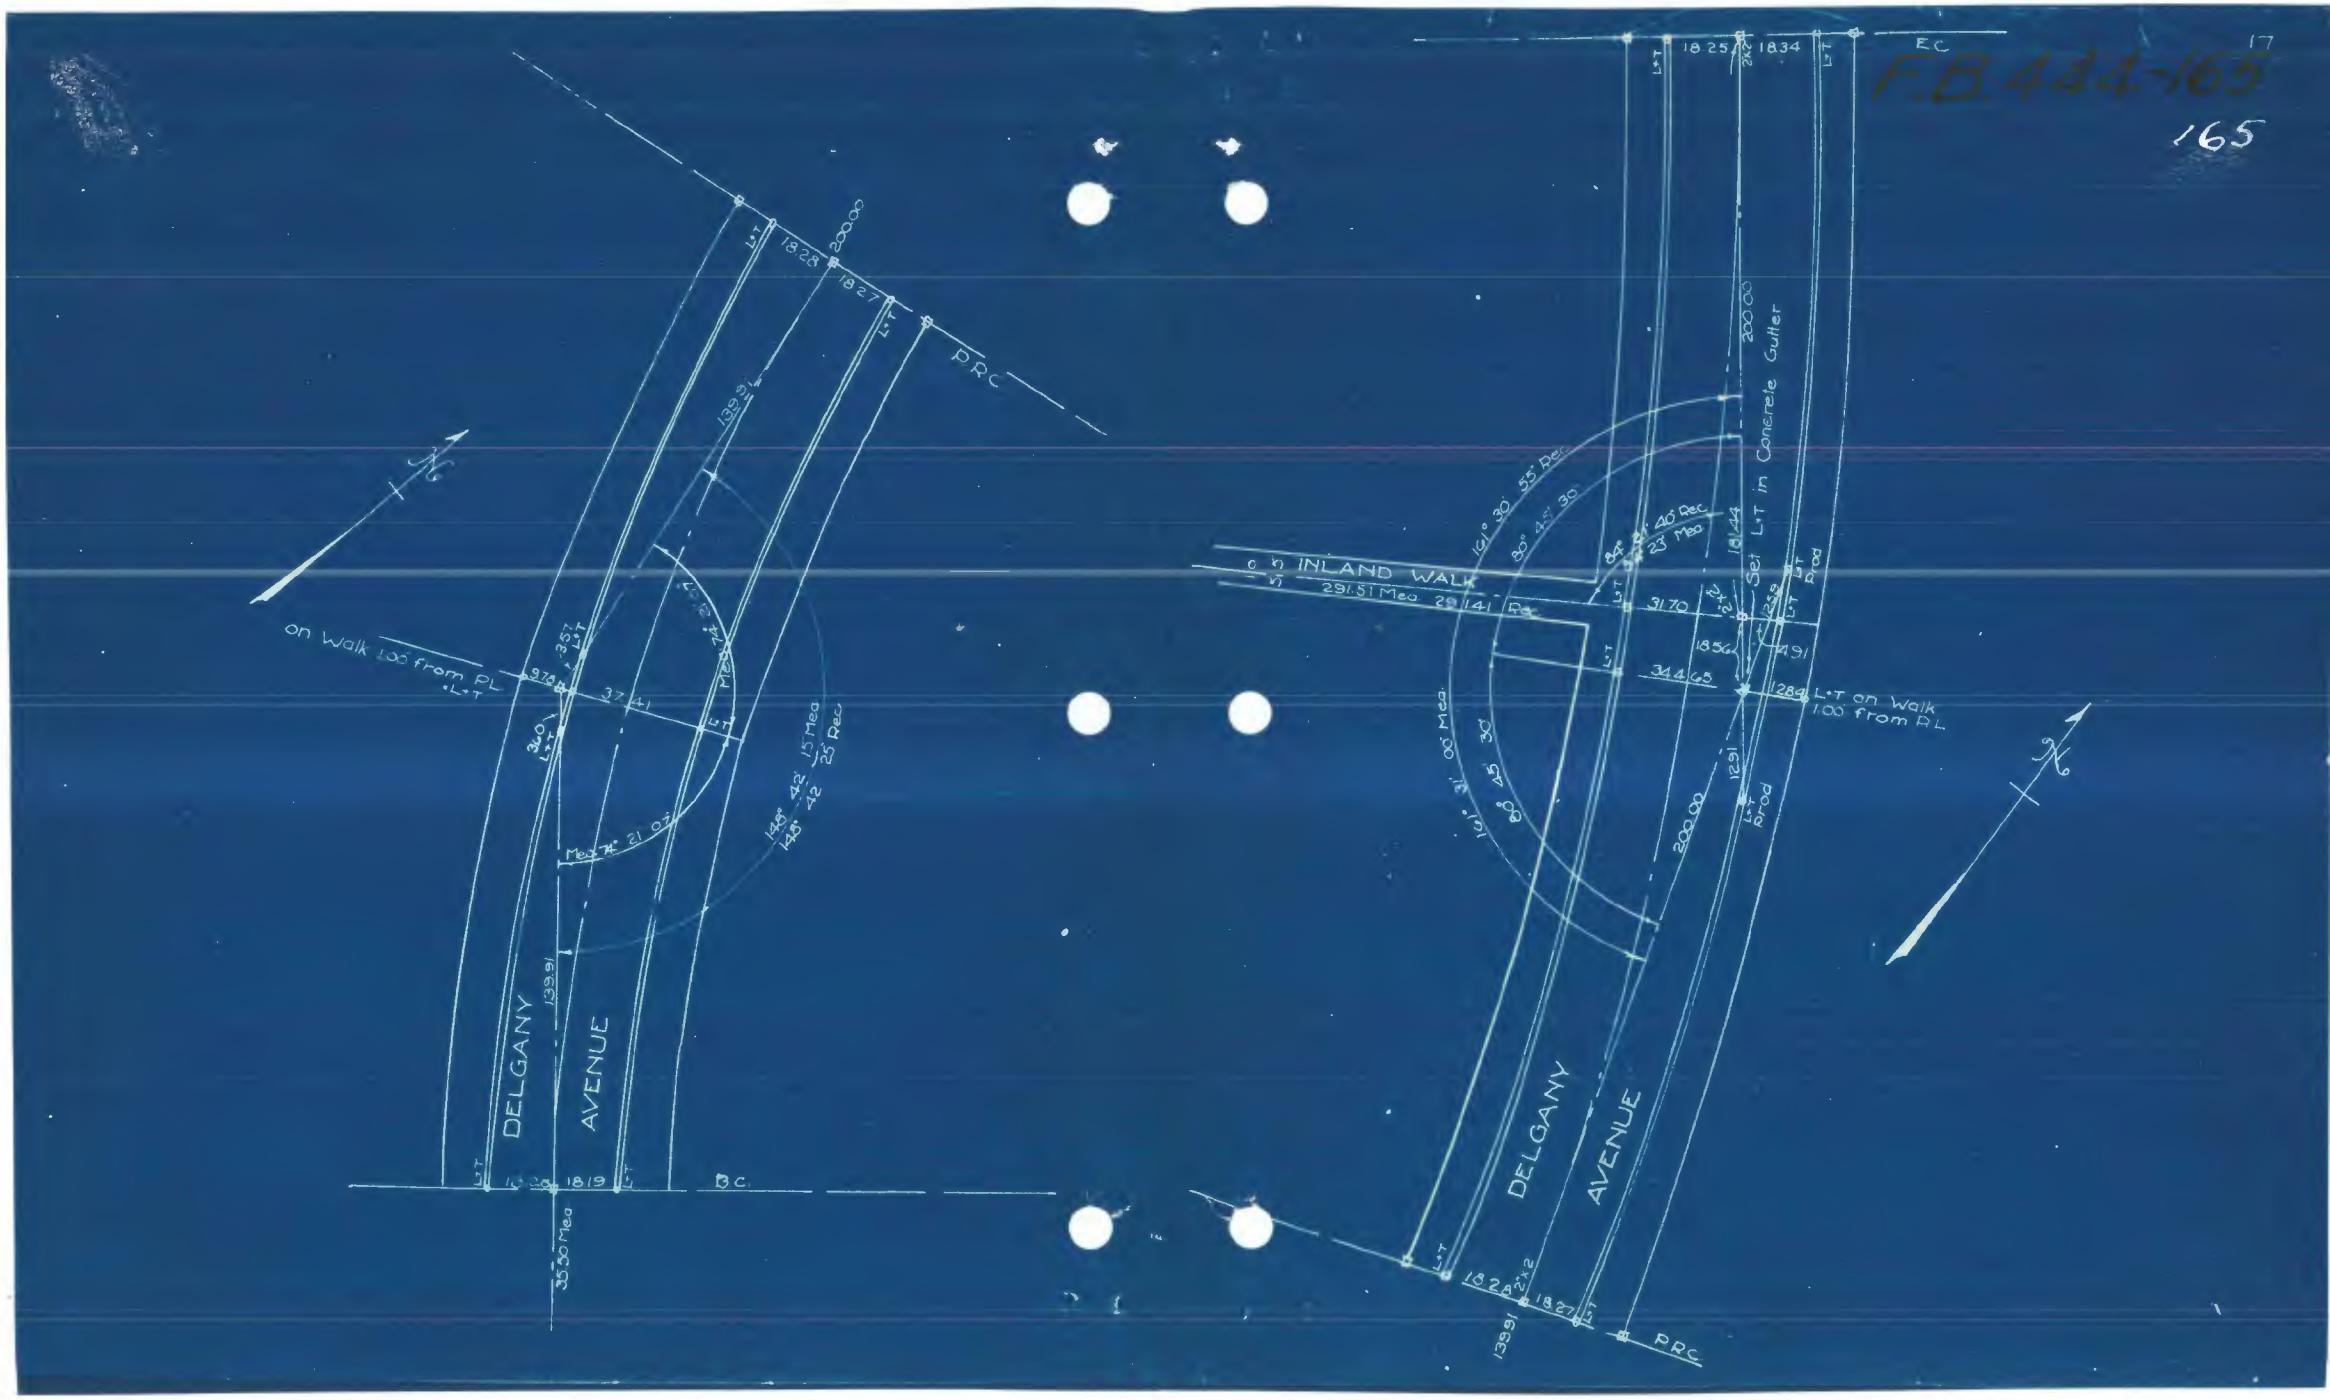

F.B. 444-167

167

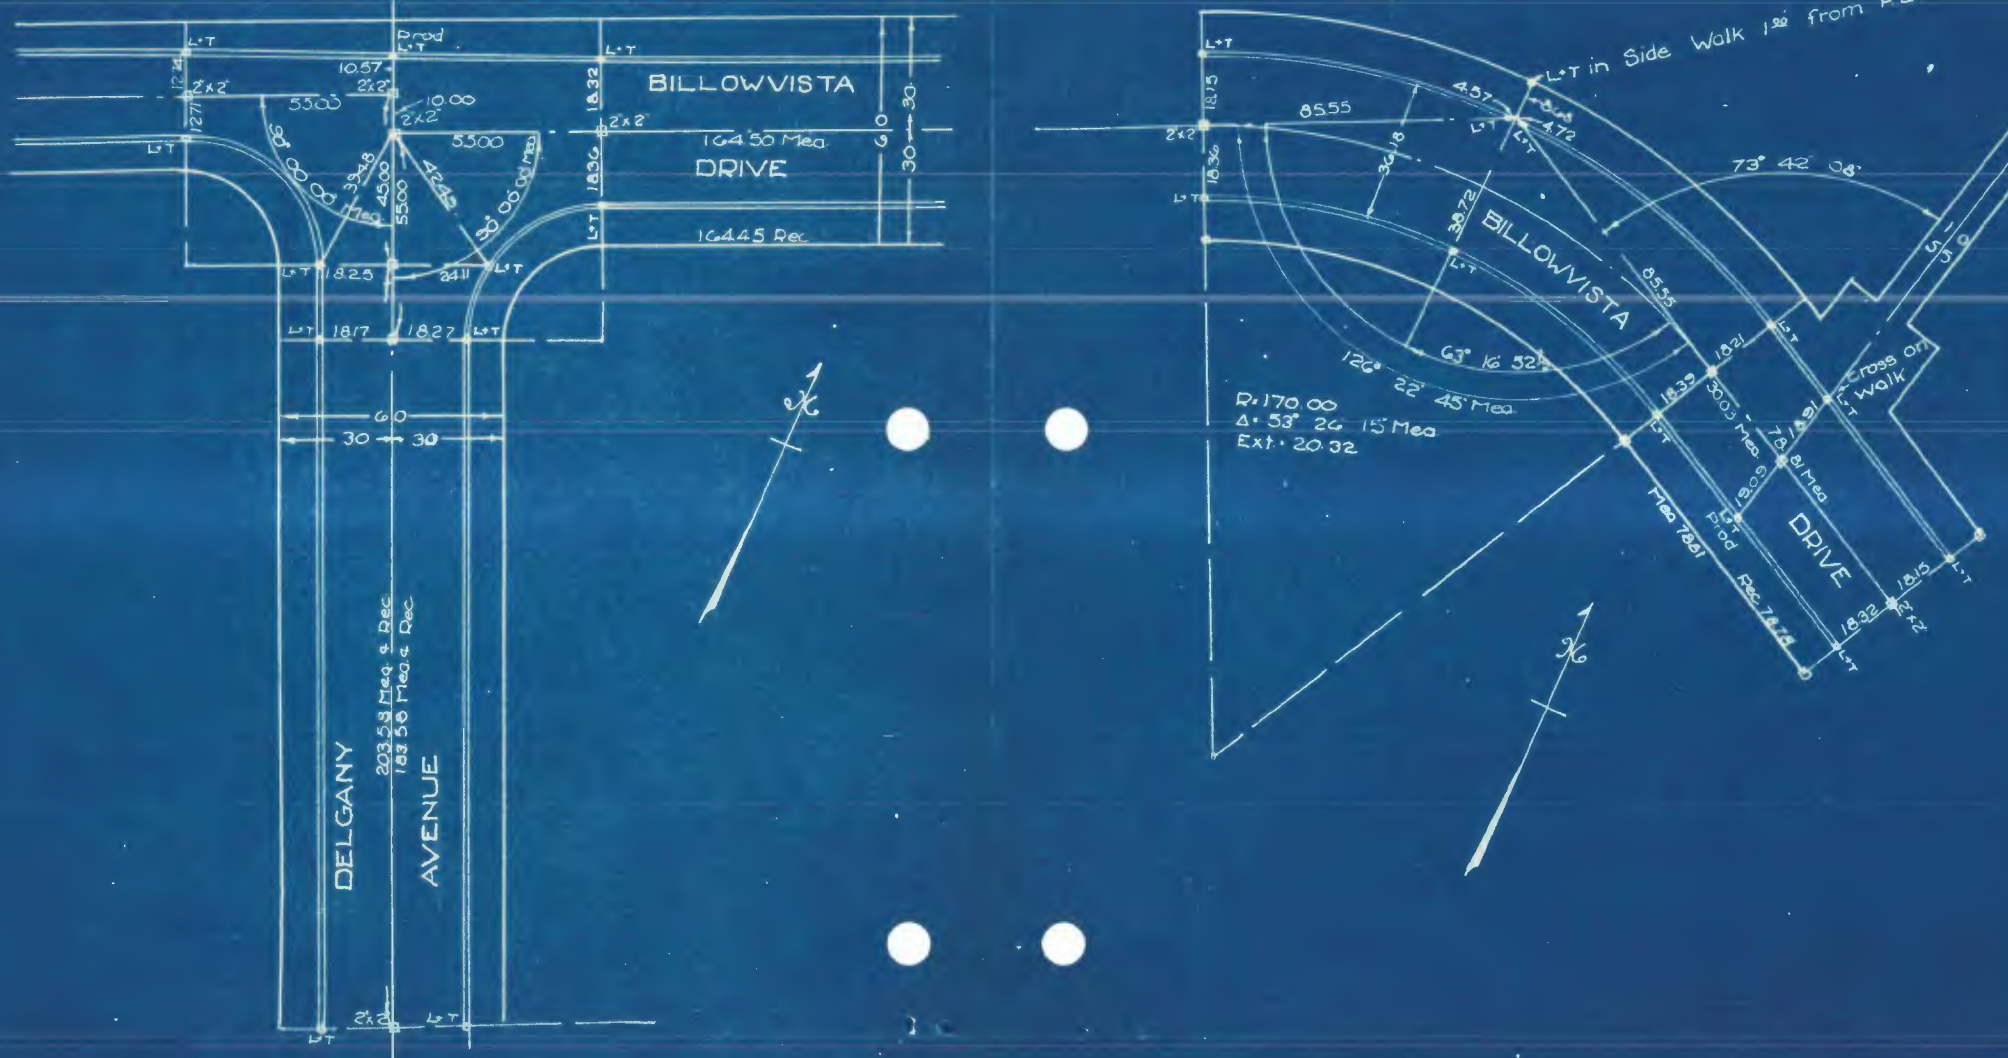

F.B. 444-168
20
168
BILLOWVISTA
DRIVE
208.51 Rec
208.48 Mea
221.68 Mea
221.71 Rec
60
30
30
REES
AVENUE
77.46 Mea
77.41 Rec
60.00
65.00
65.00
75.00
84° 48' 20" Rec
84° 48' 30" Mea
159° 51' 30" Mea
159° 51' 20" Rec
111° 20' 40" Rec
111° 20' 45" Mea
91° 00' 02" Rec
91° 00' 00" Mea
88° 48' 00" Rec
88° 48' 15" Mea
165° 53' 55" Rec
165° 53' 45" Mea
18.15
18.32
18.26
18.37
13.28
23.21
74.71
80.00
Iron Rod

FB 444-169 21

169

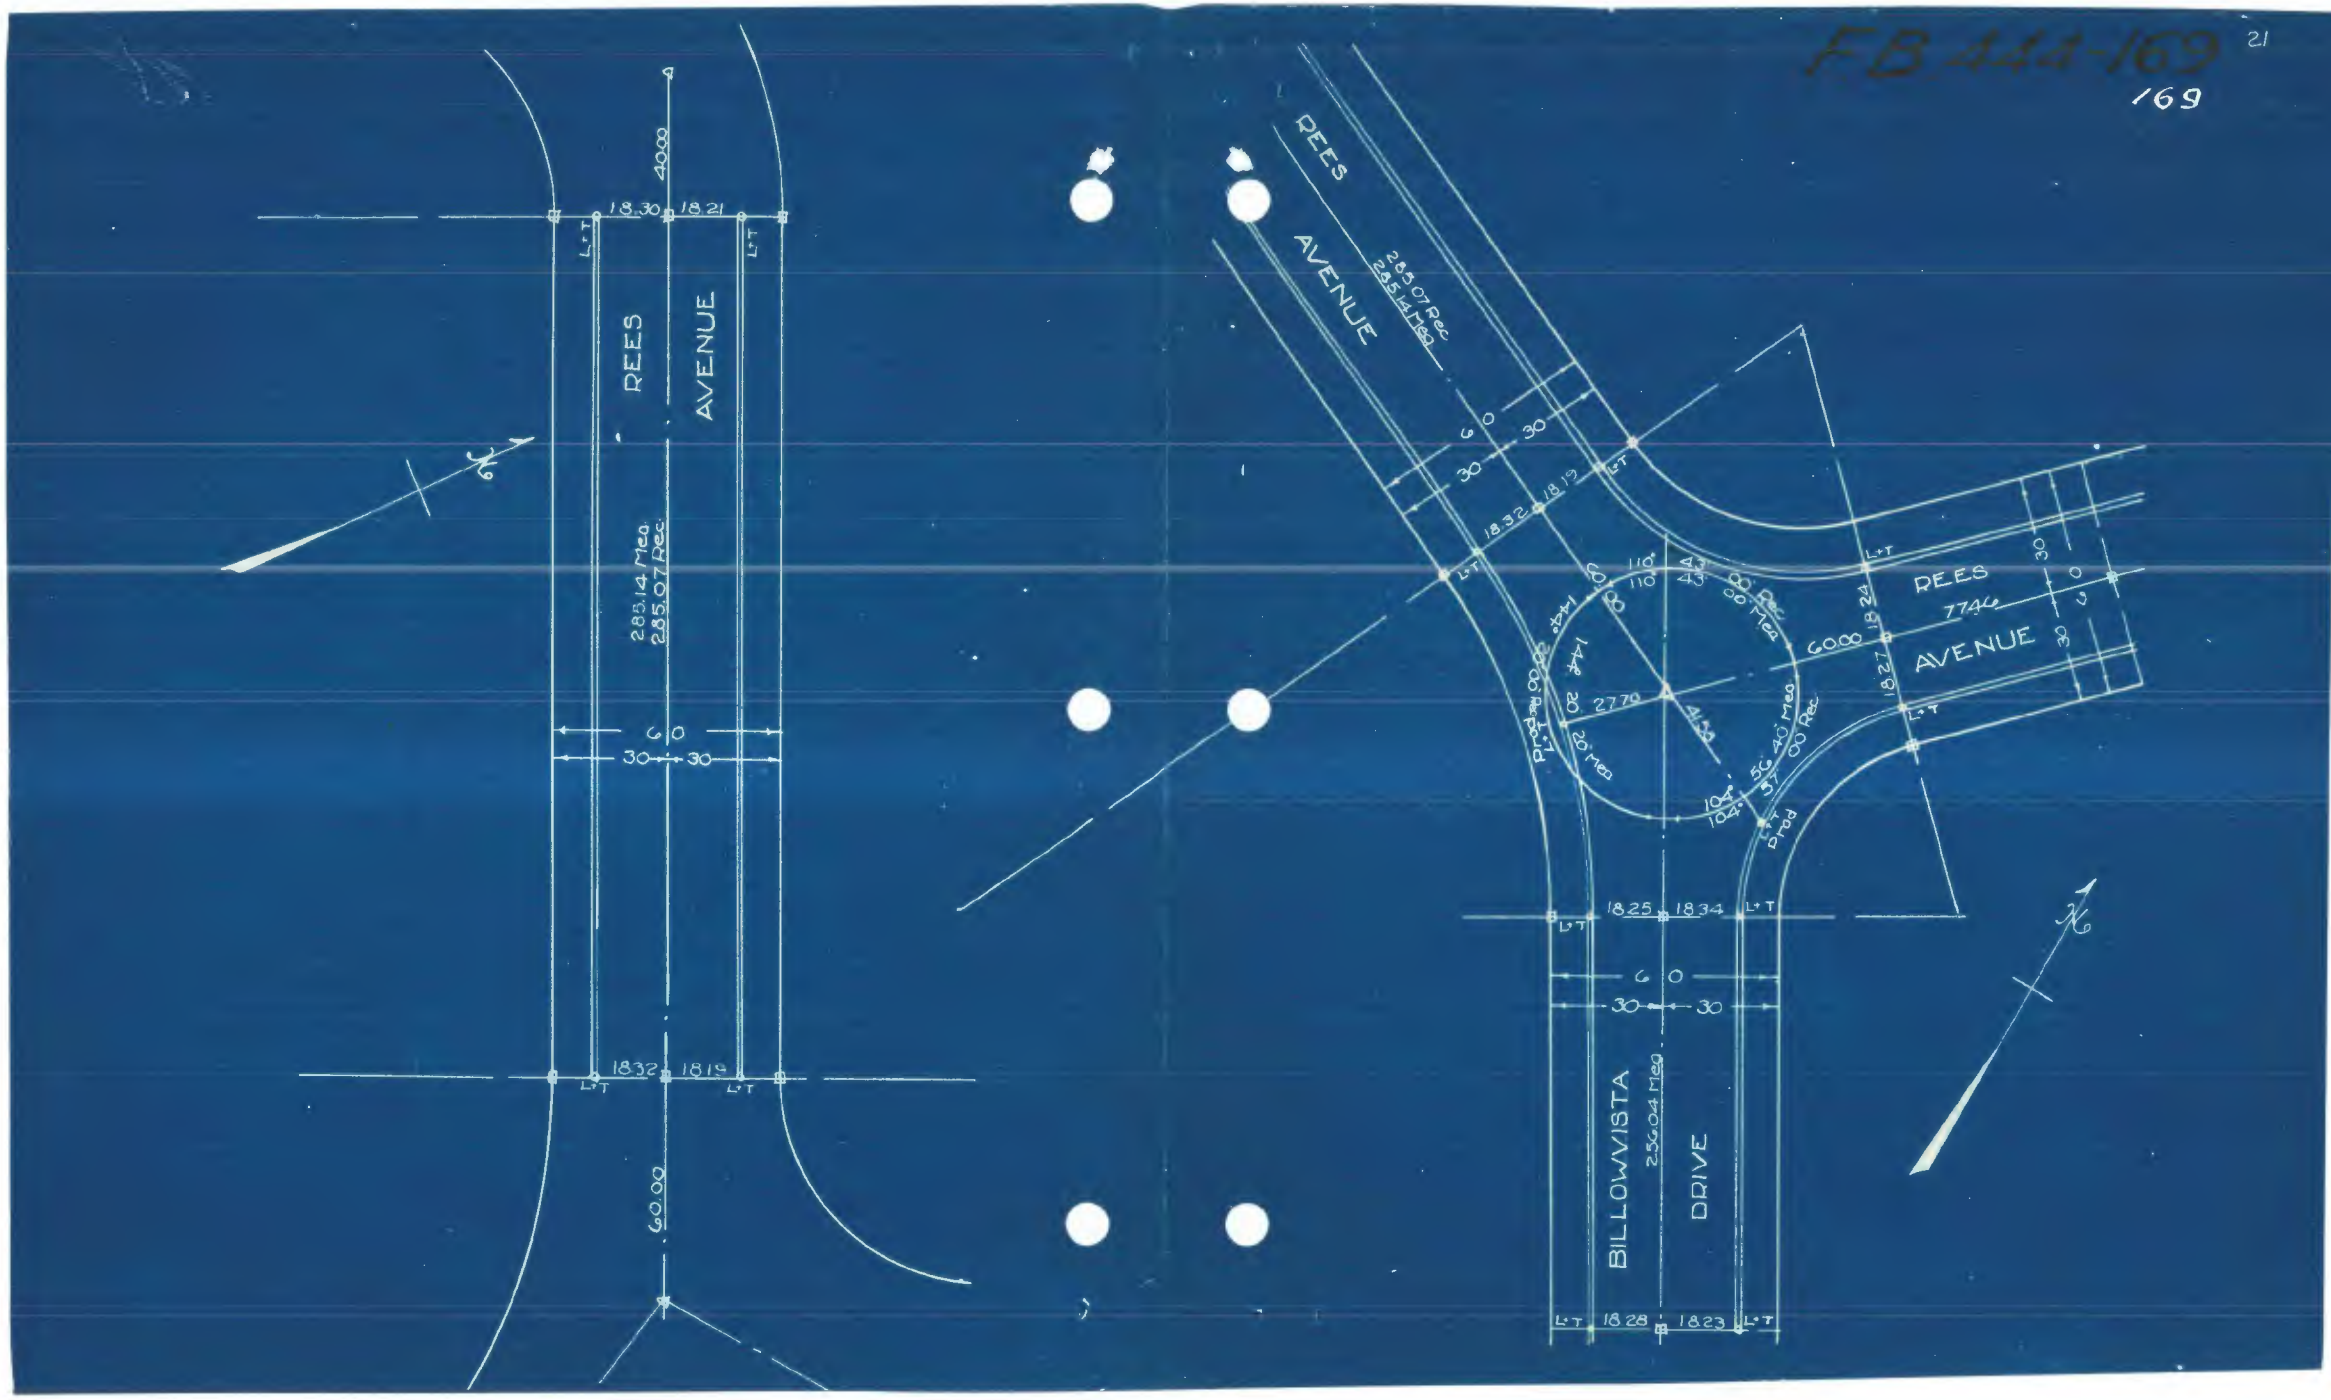

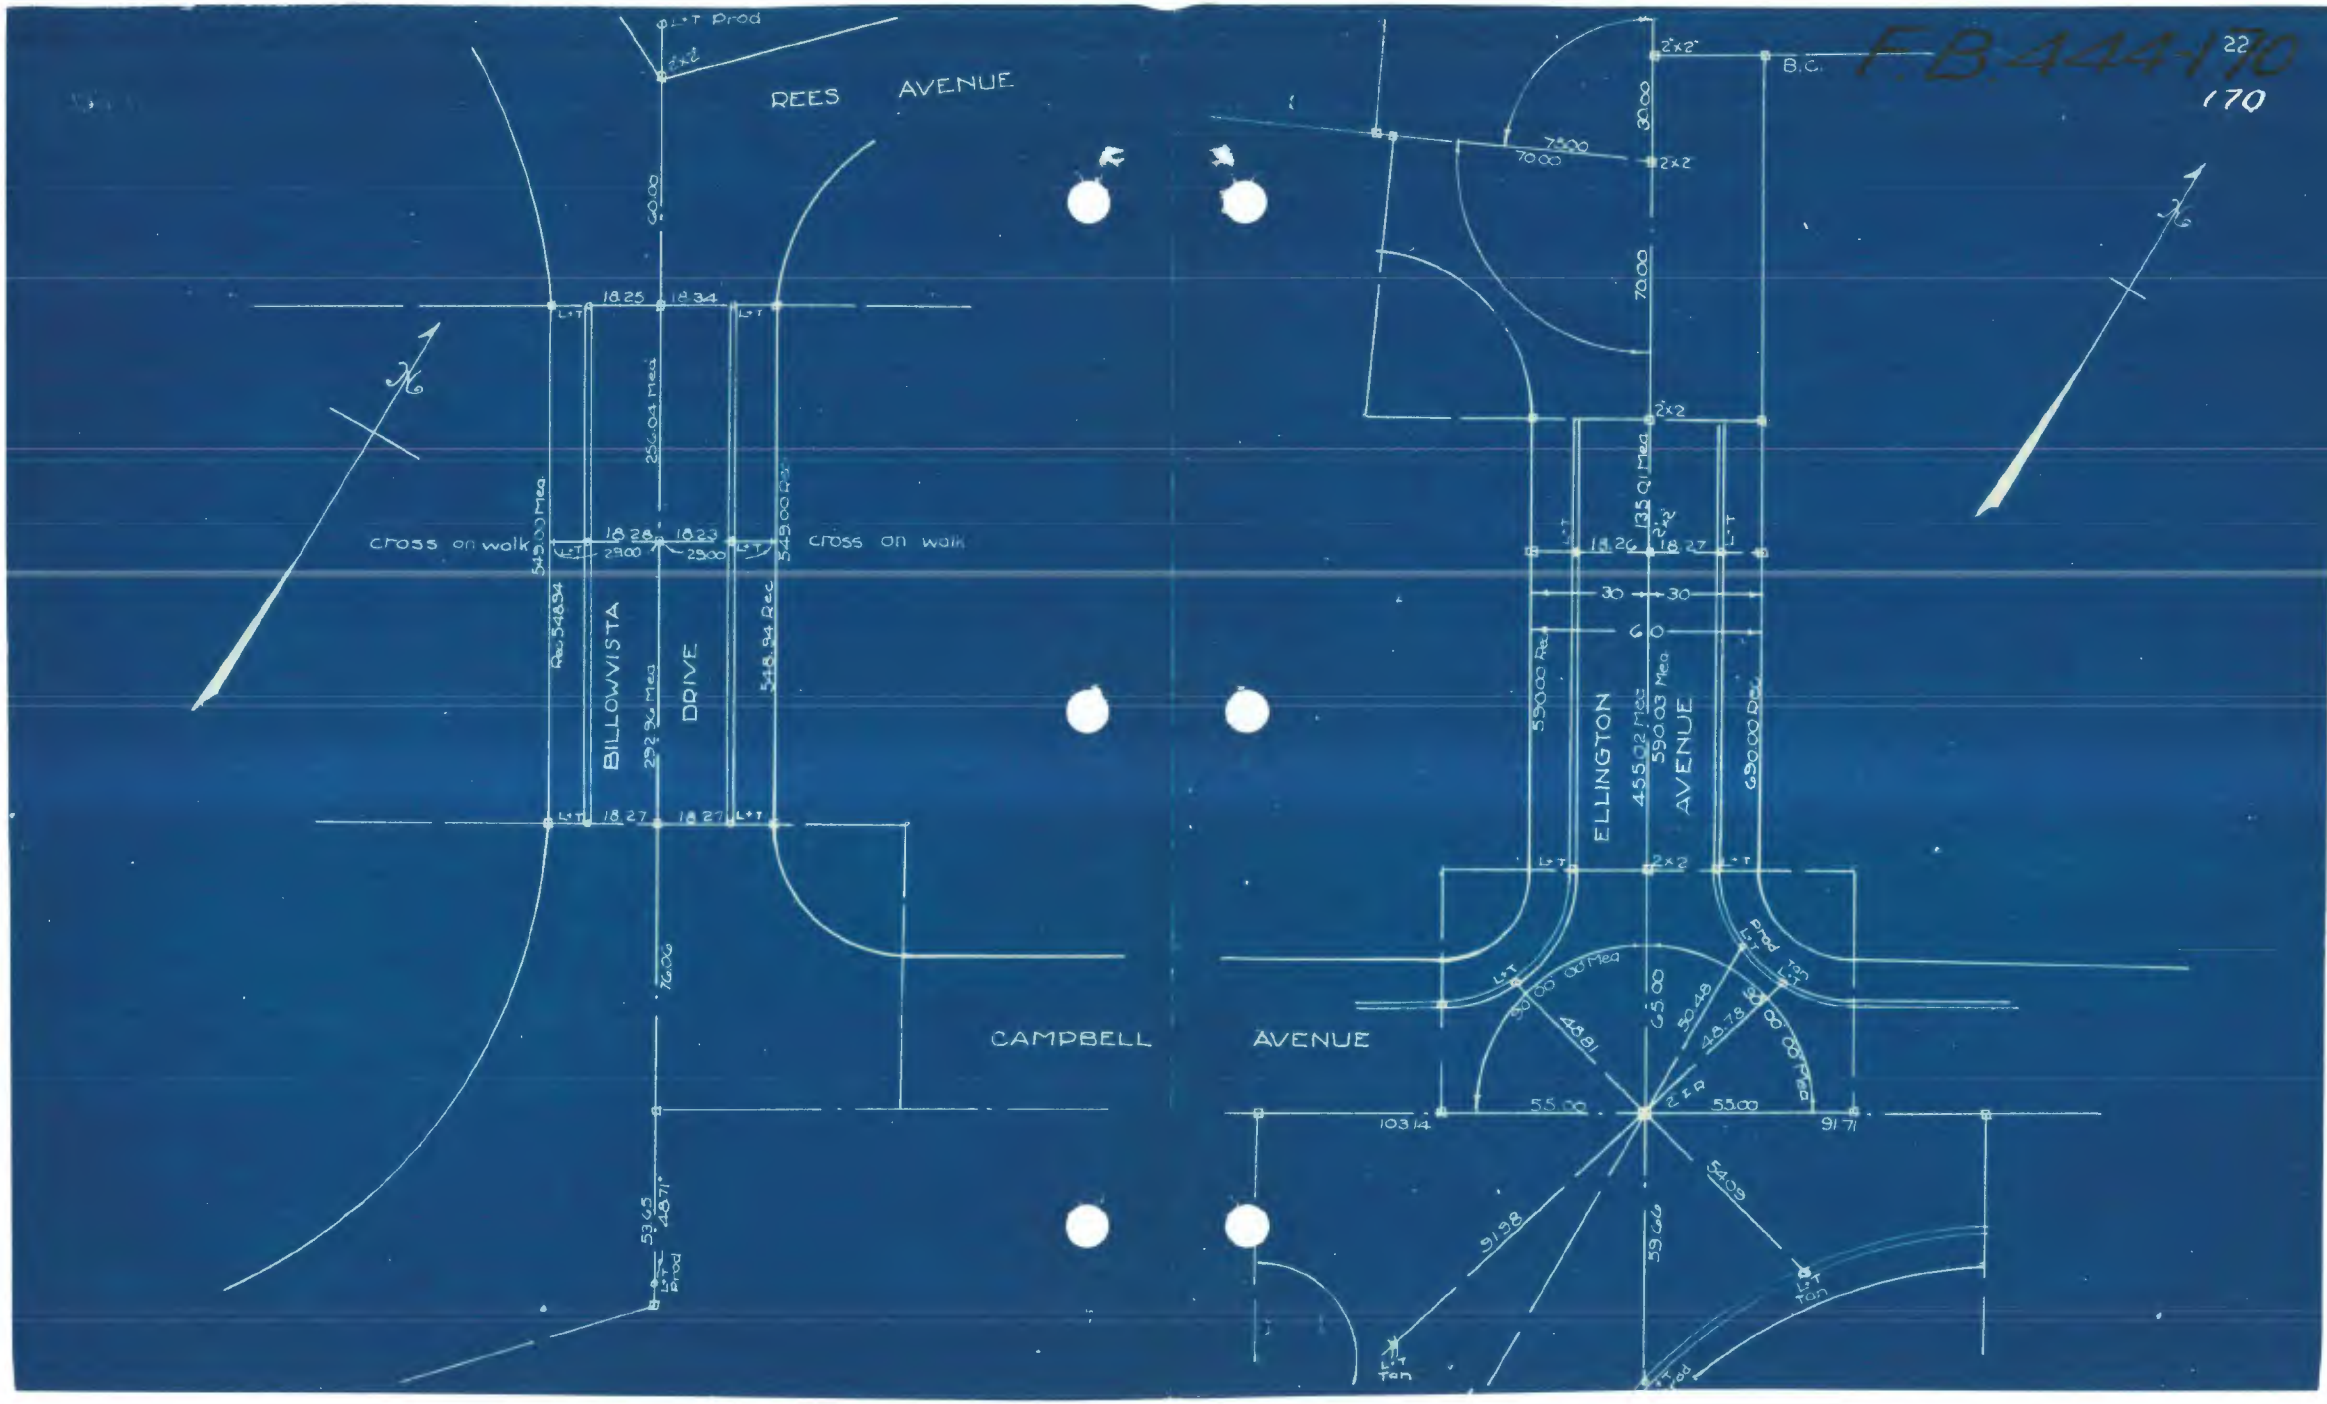
F.B. 444-170
22
170
REES AVENUE
BILLOWVISTA DRIVE
CAMPBELL AVENUE
ELLINGTON AVENUE
cross on walk
cross on walk
B.C.
L+T Prod
L+T Tan
2x2
18.25
18.34
18.28
18.23
18.27
18.27
18.26
18.27
256.04 Mea
292.96 Mea
549.00 Mea
548.94 Rec
590.00 Rec
690.00 Rec
135.01 Mea
455.02 Mea
590.03 Mea
30.00
70.00
75.00
60.00
76.06
53.65
48.71
65.00
55.00
55.00
103.14
91.71
59.66
54.09
91.98
48.81
50.48
48.78
90.00.00 Mea
90.00.00 Mea
2 FR

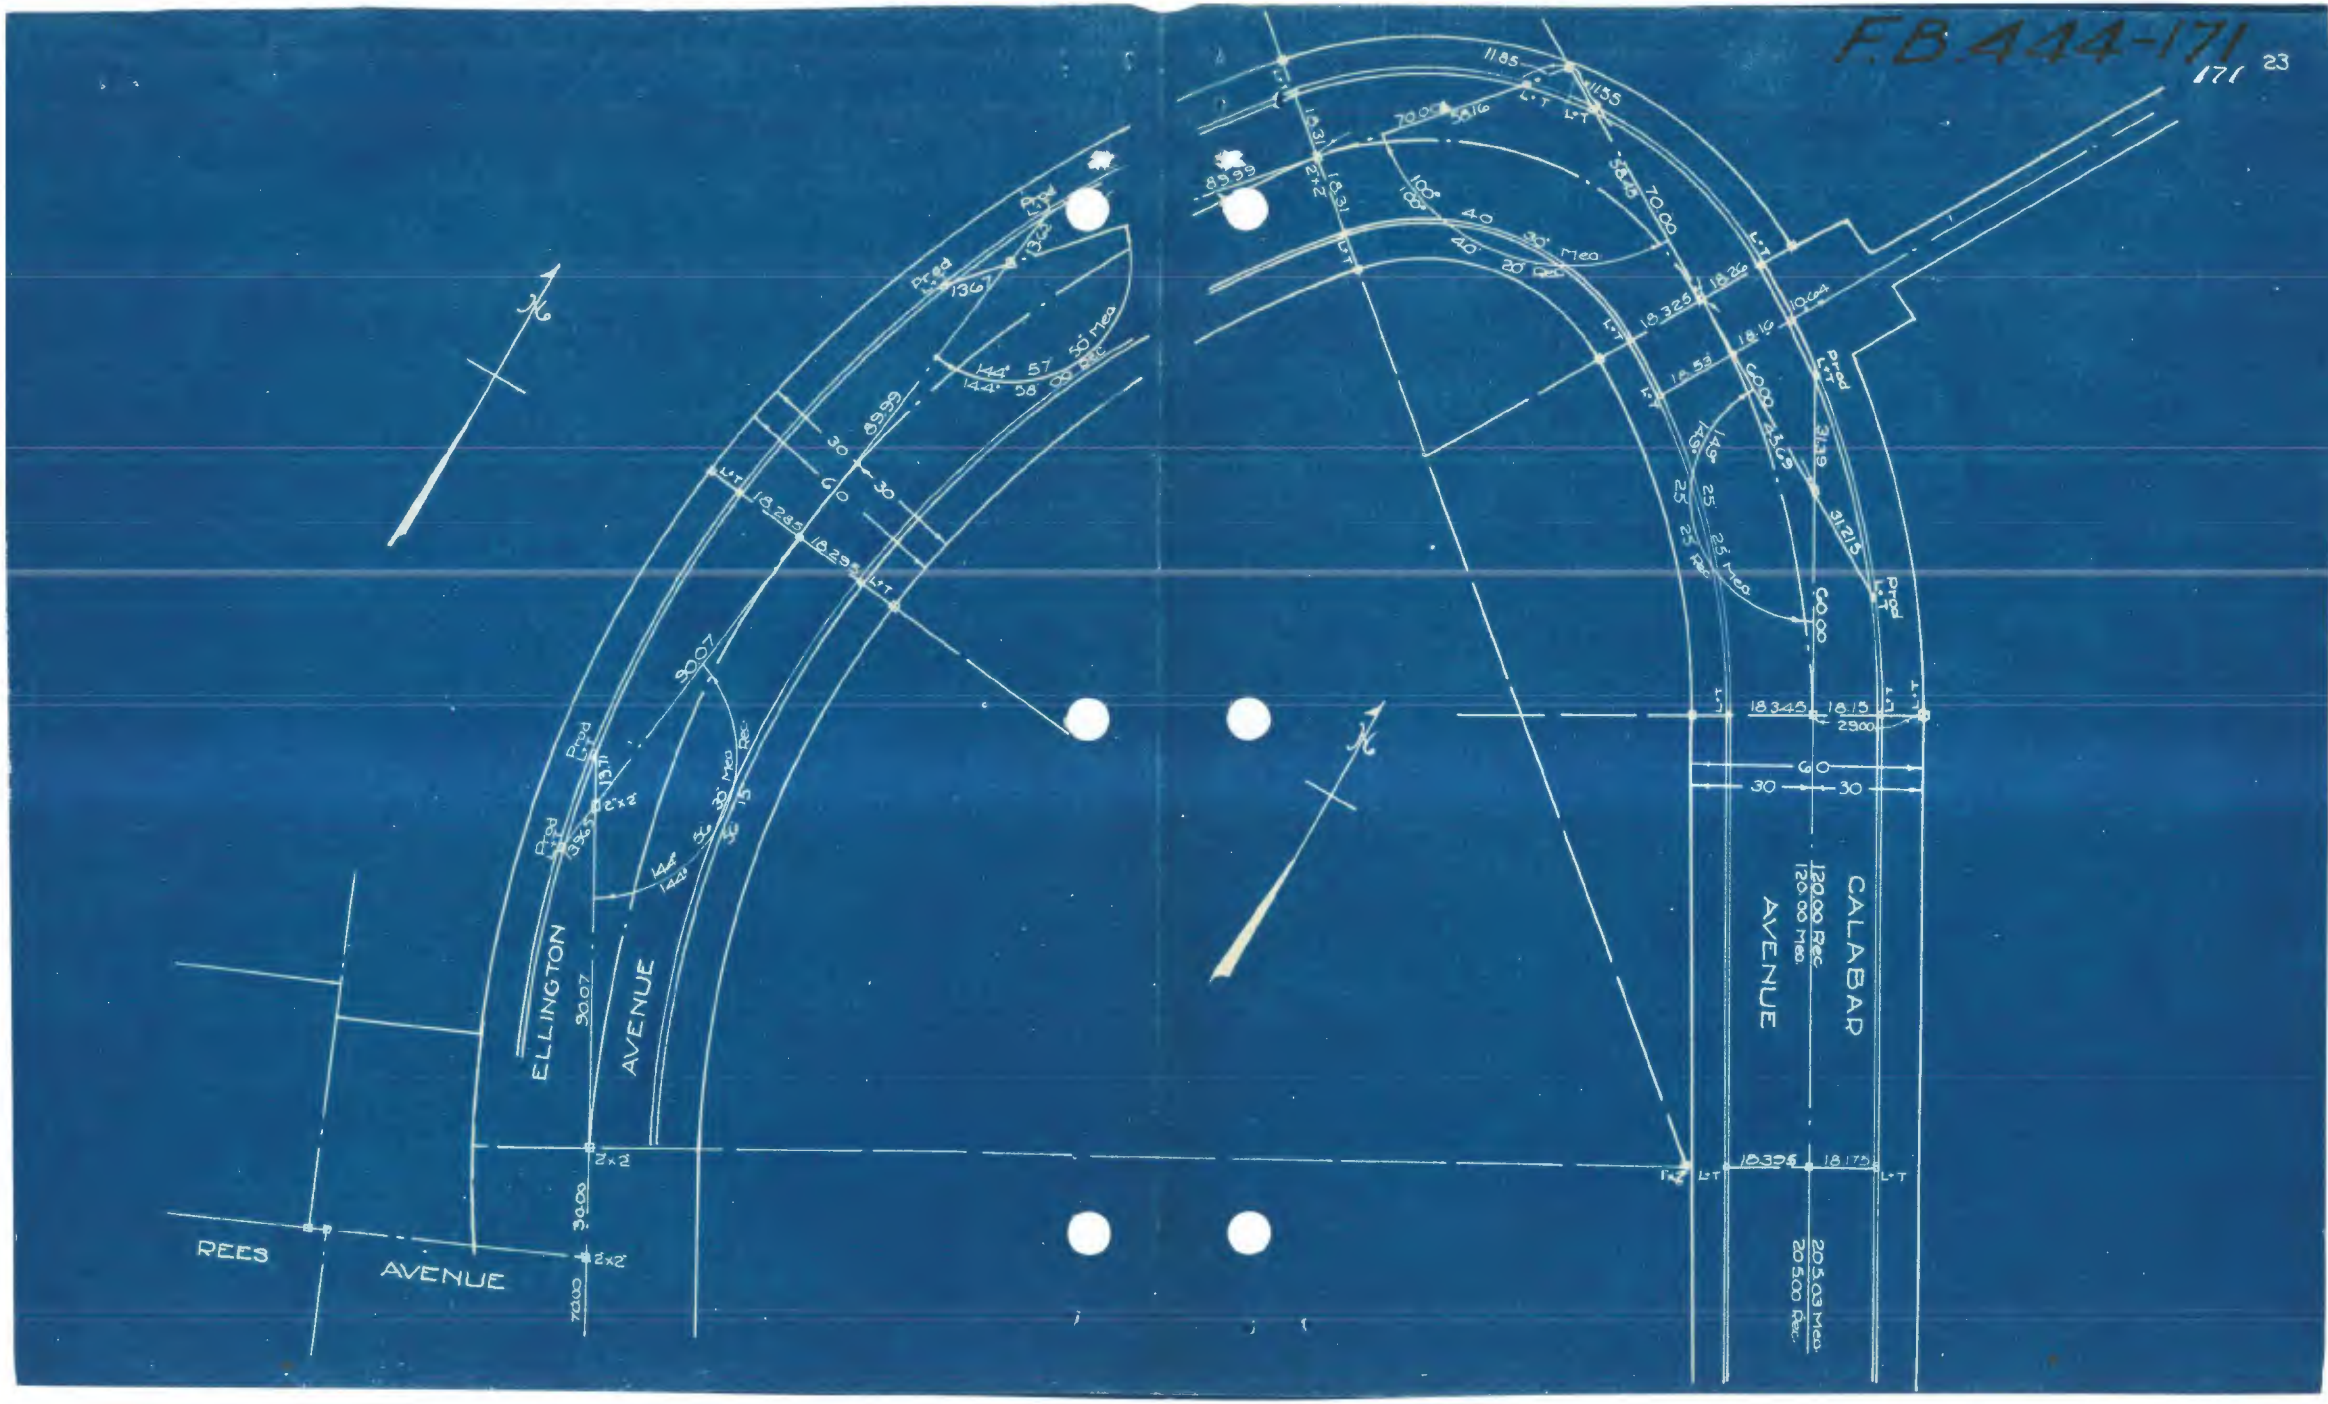
F.B. 444-171
171
23
ELLINGTON
AVENUE
REES
AVENUE
CALABAR
AVENUE
120.00 Rec.
120.00 Mea.
205.03 Mea.
205.00 Rec.
30' Mea
20' Rec
25' Mea
25' Rec
Prod
L+T
2x2
60
30
30

F.B. 444-172 24

172

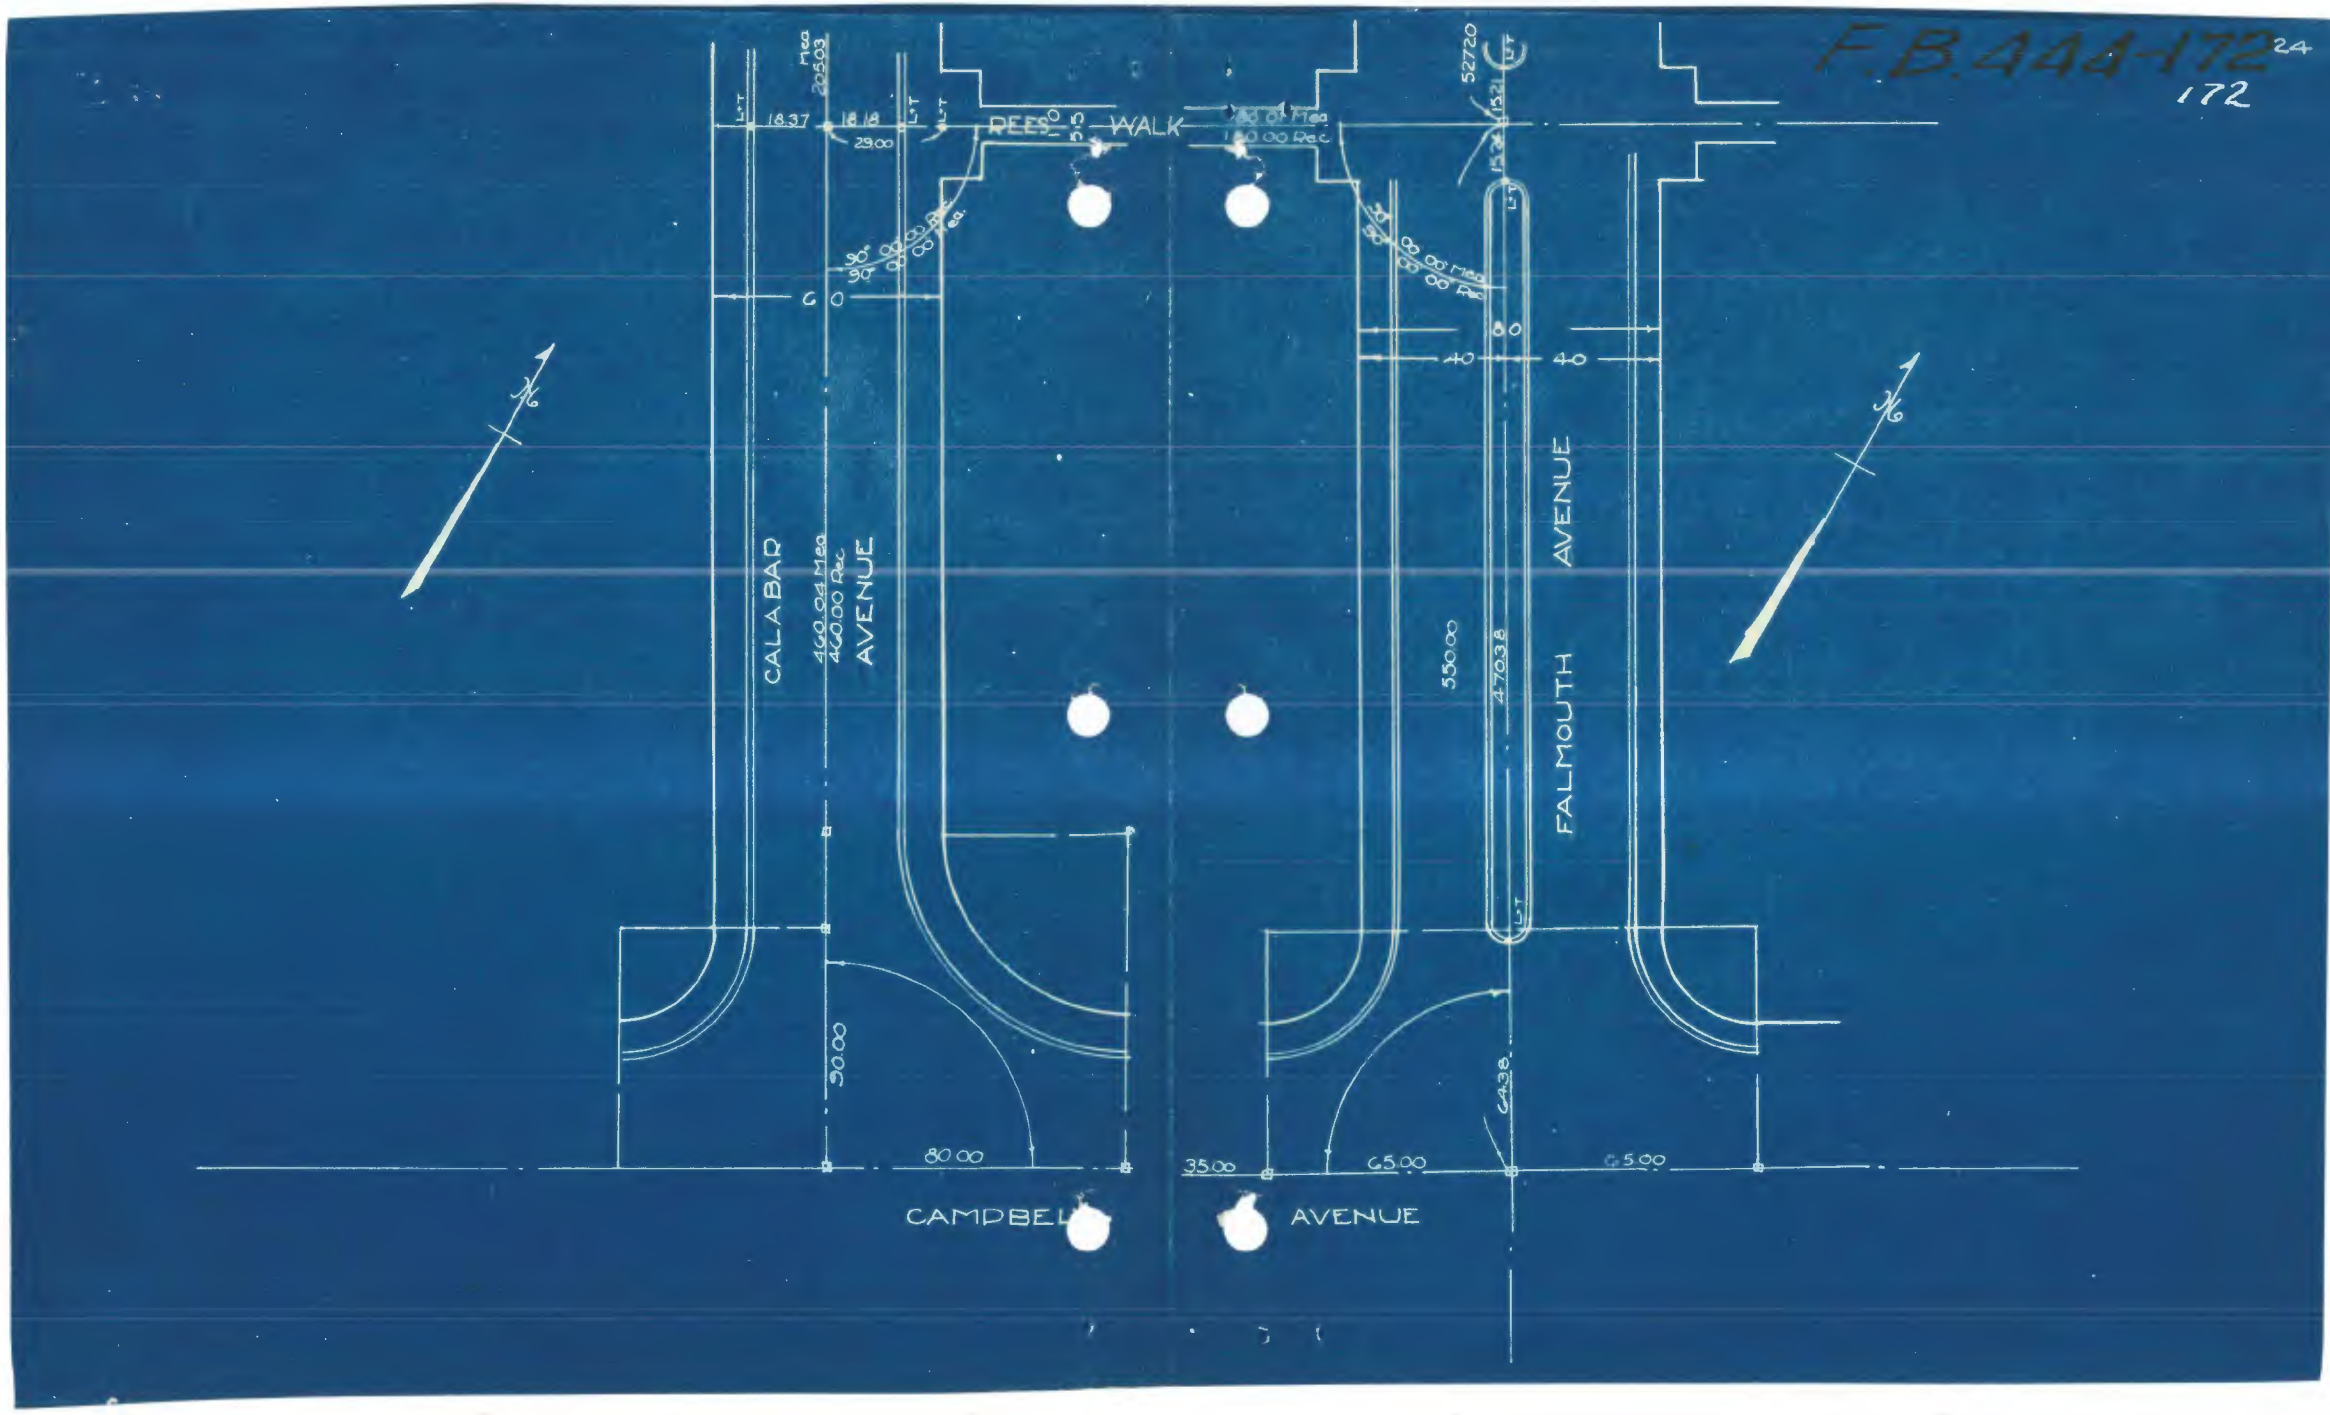

F.B. 444-173
173

F.B. 44-174 26
174

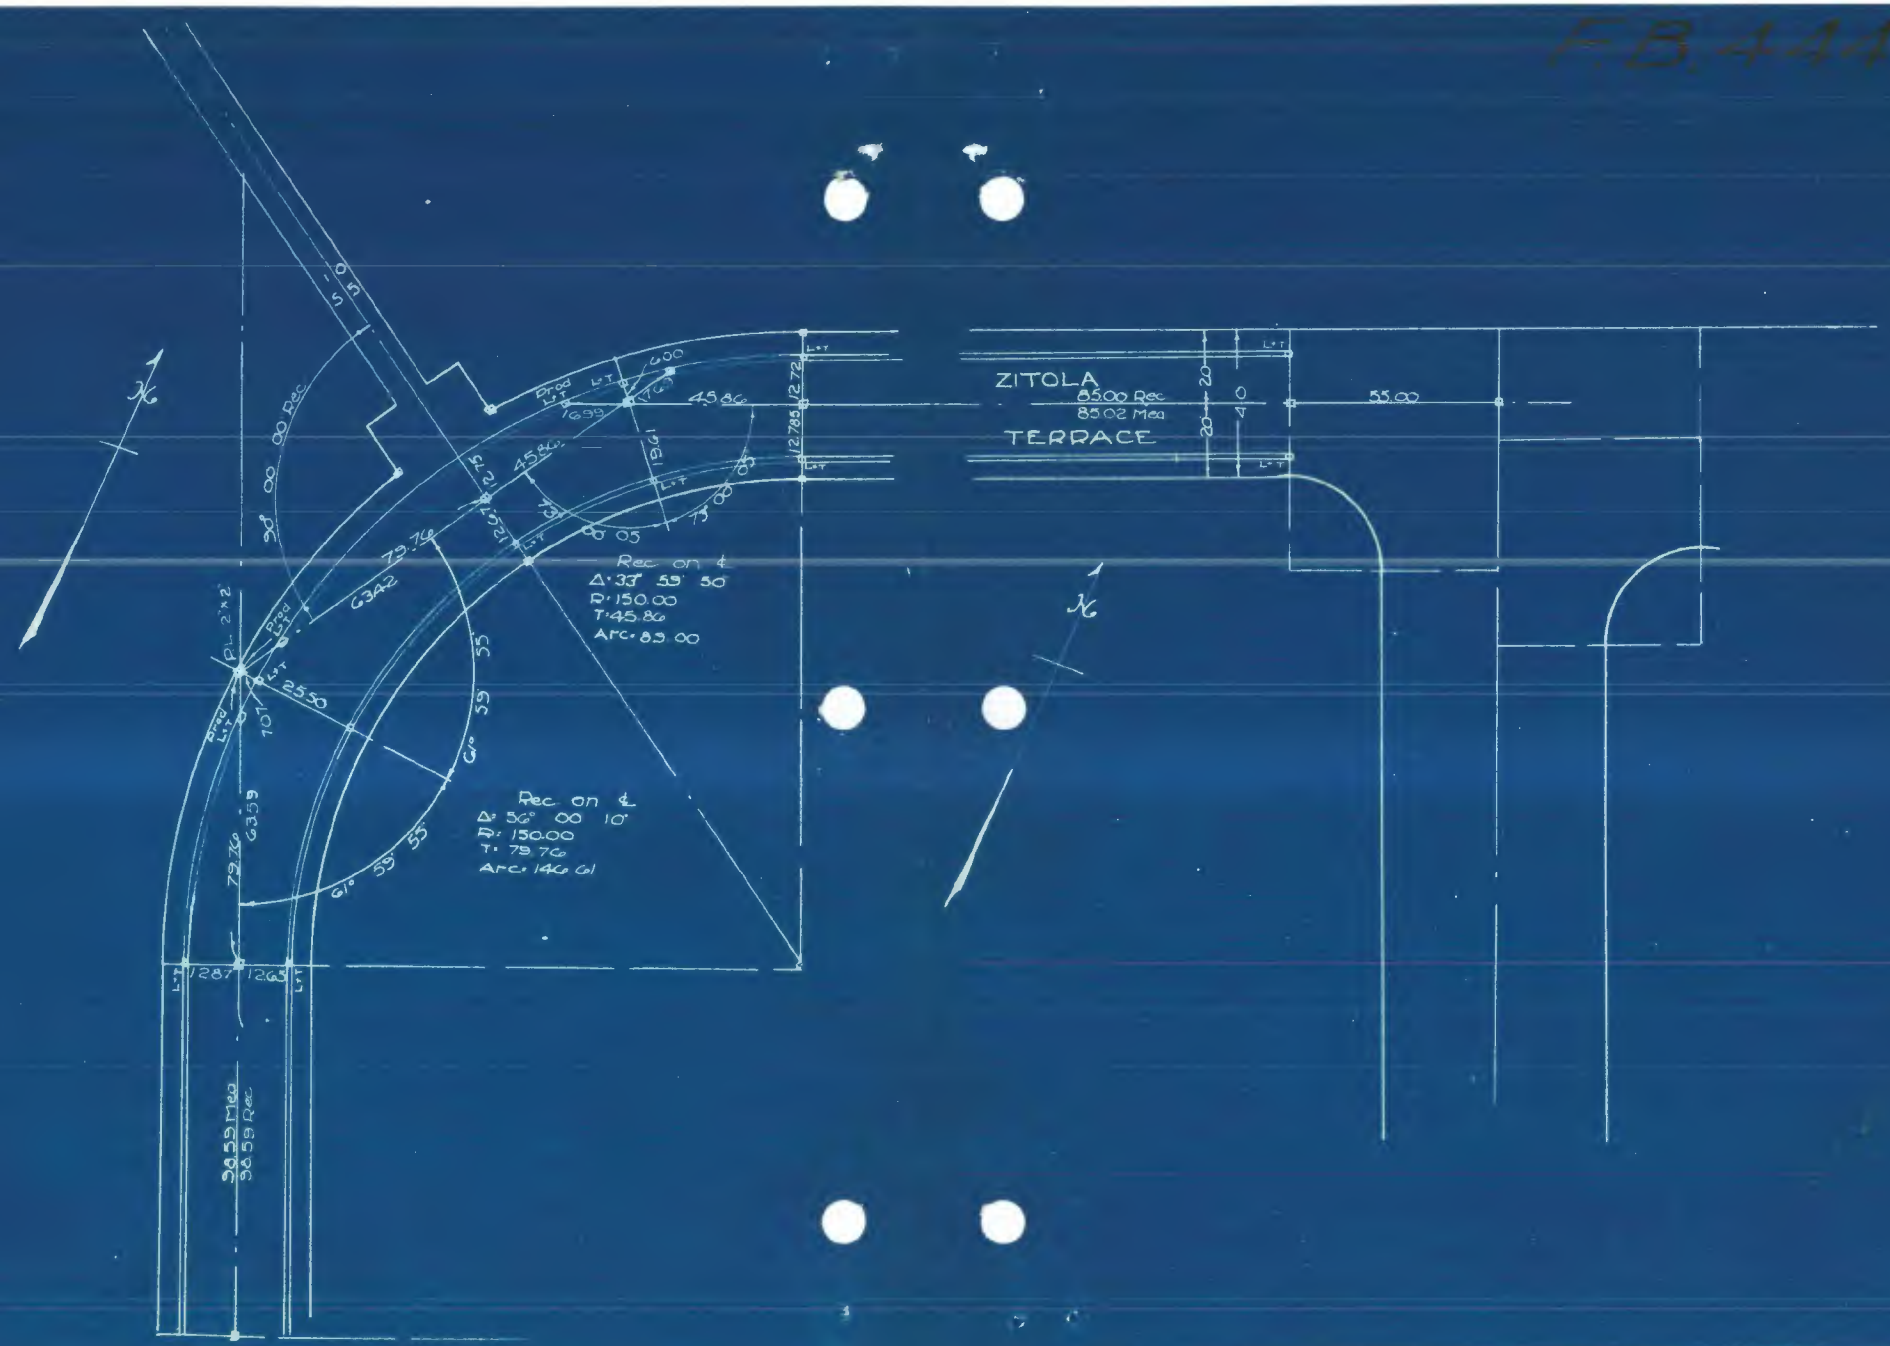

F.B. 444-175 27
175

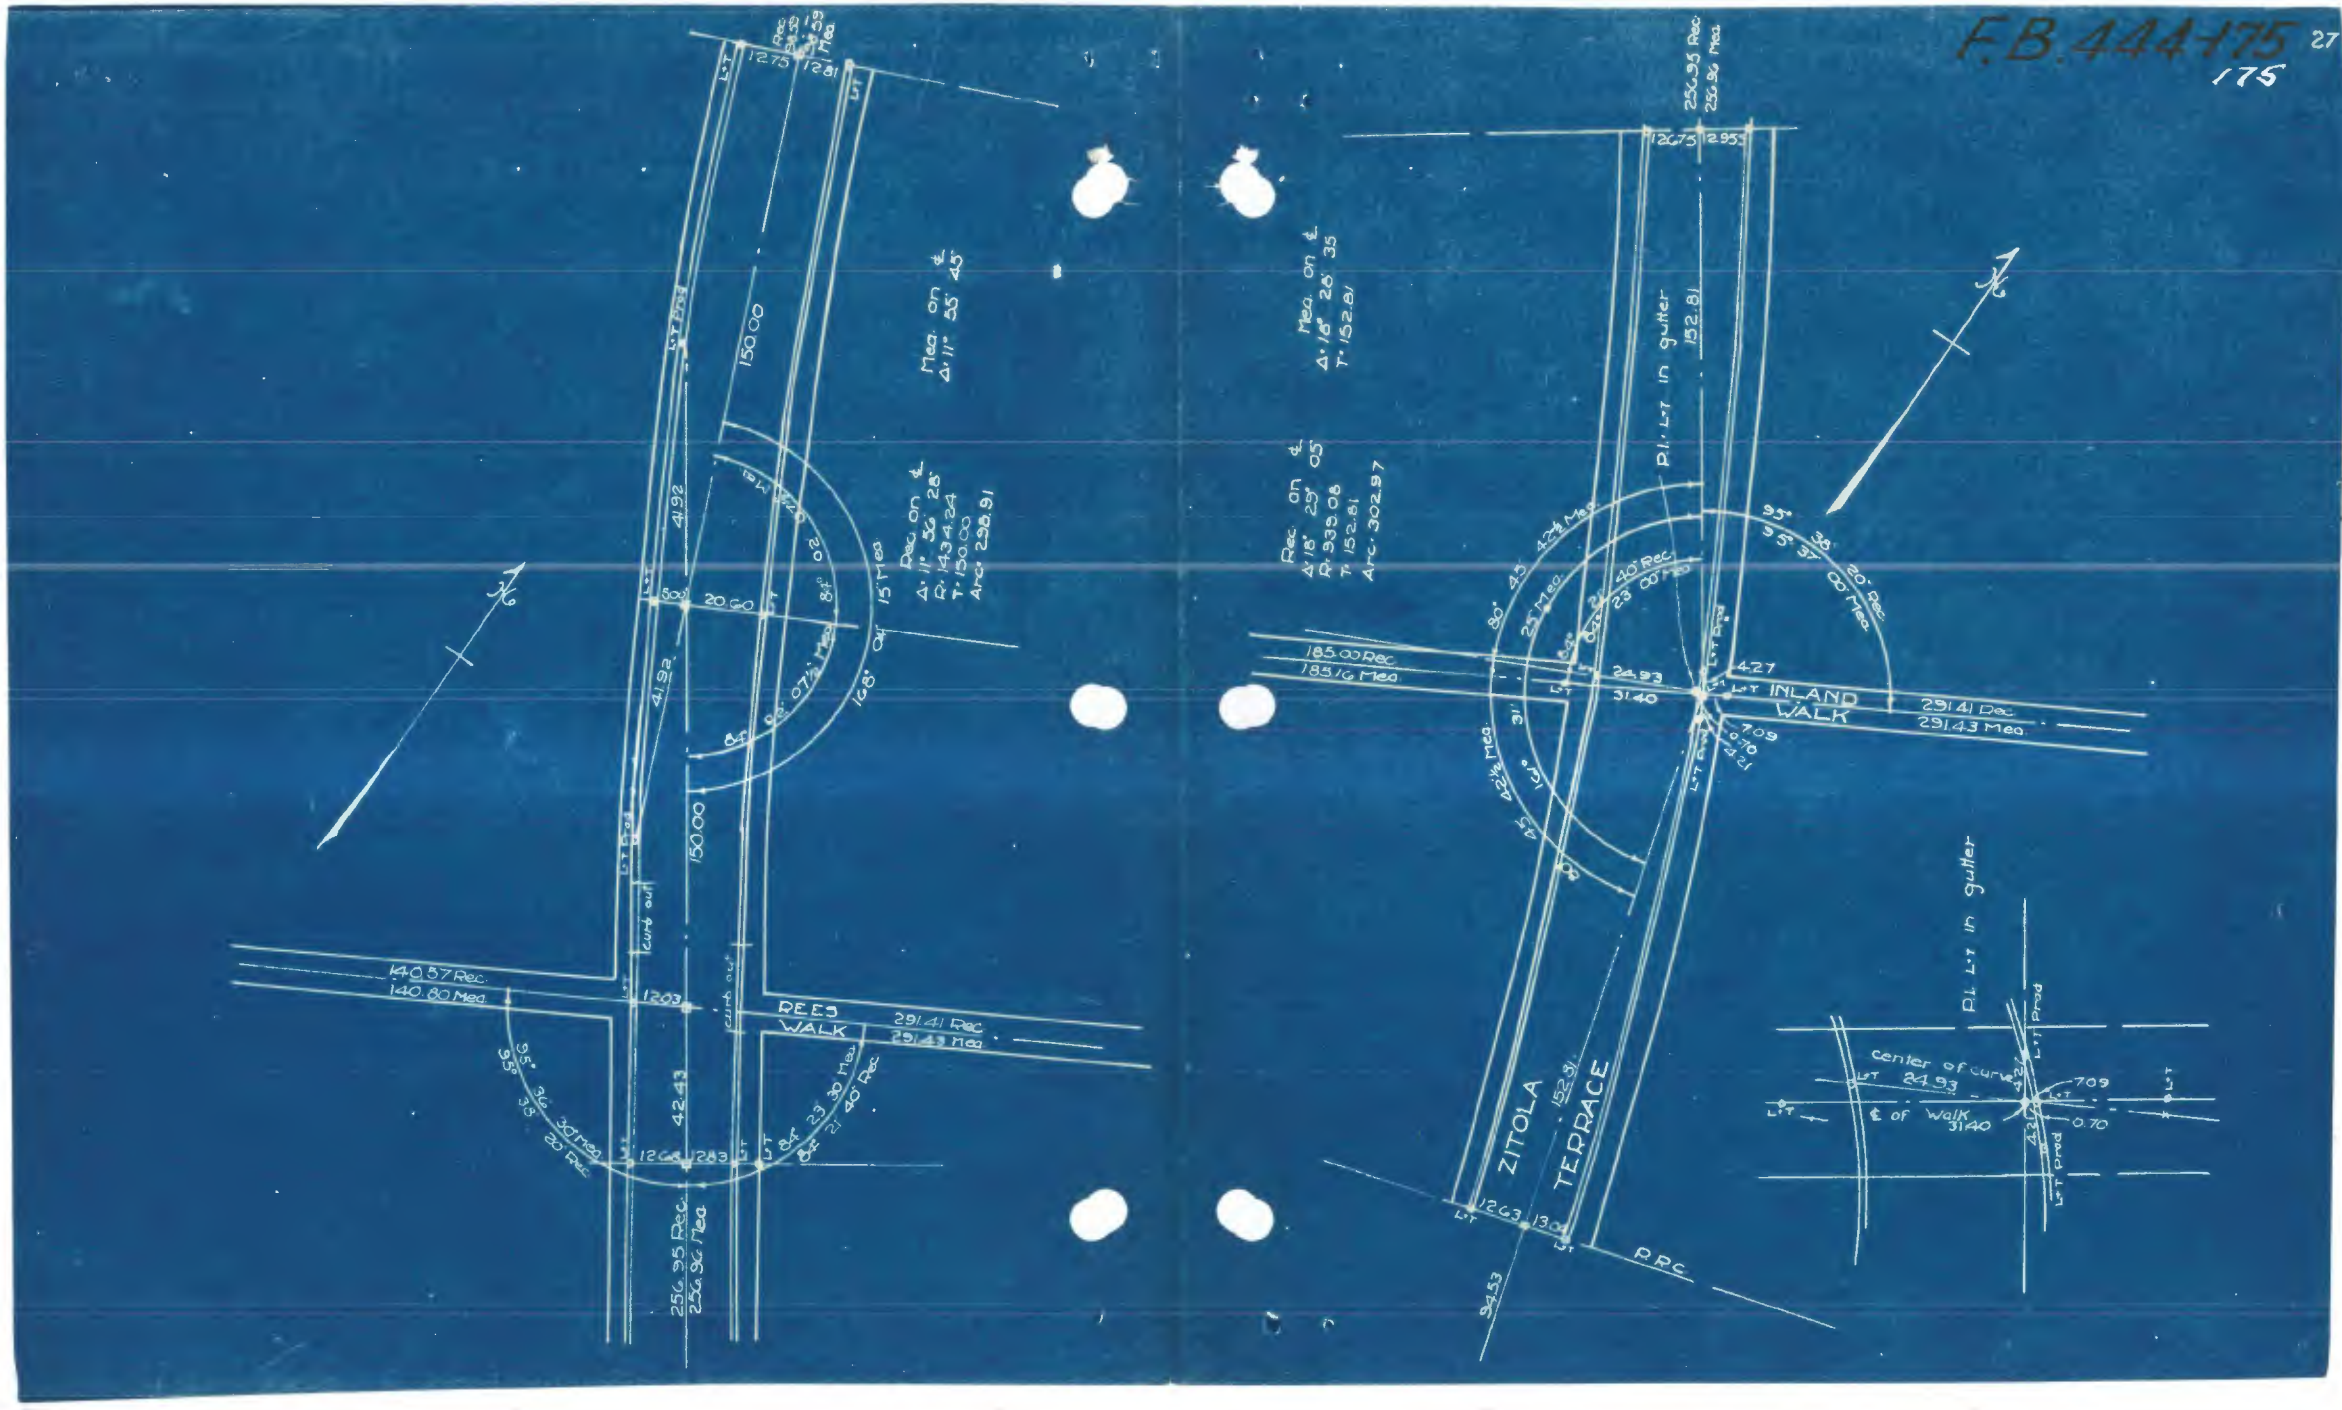

FB 444-176

176

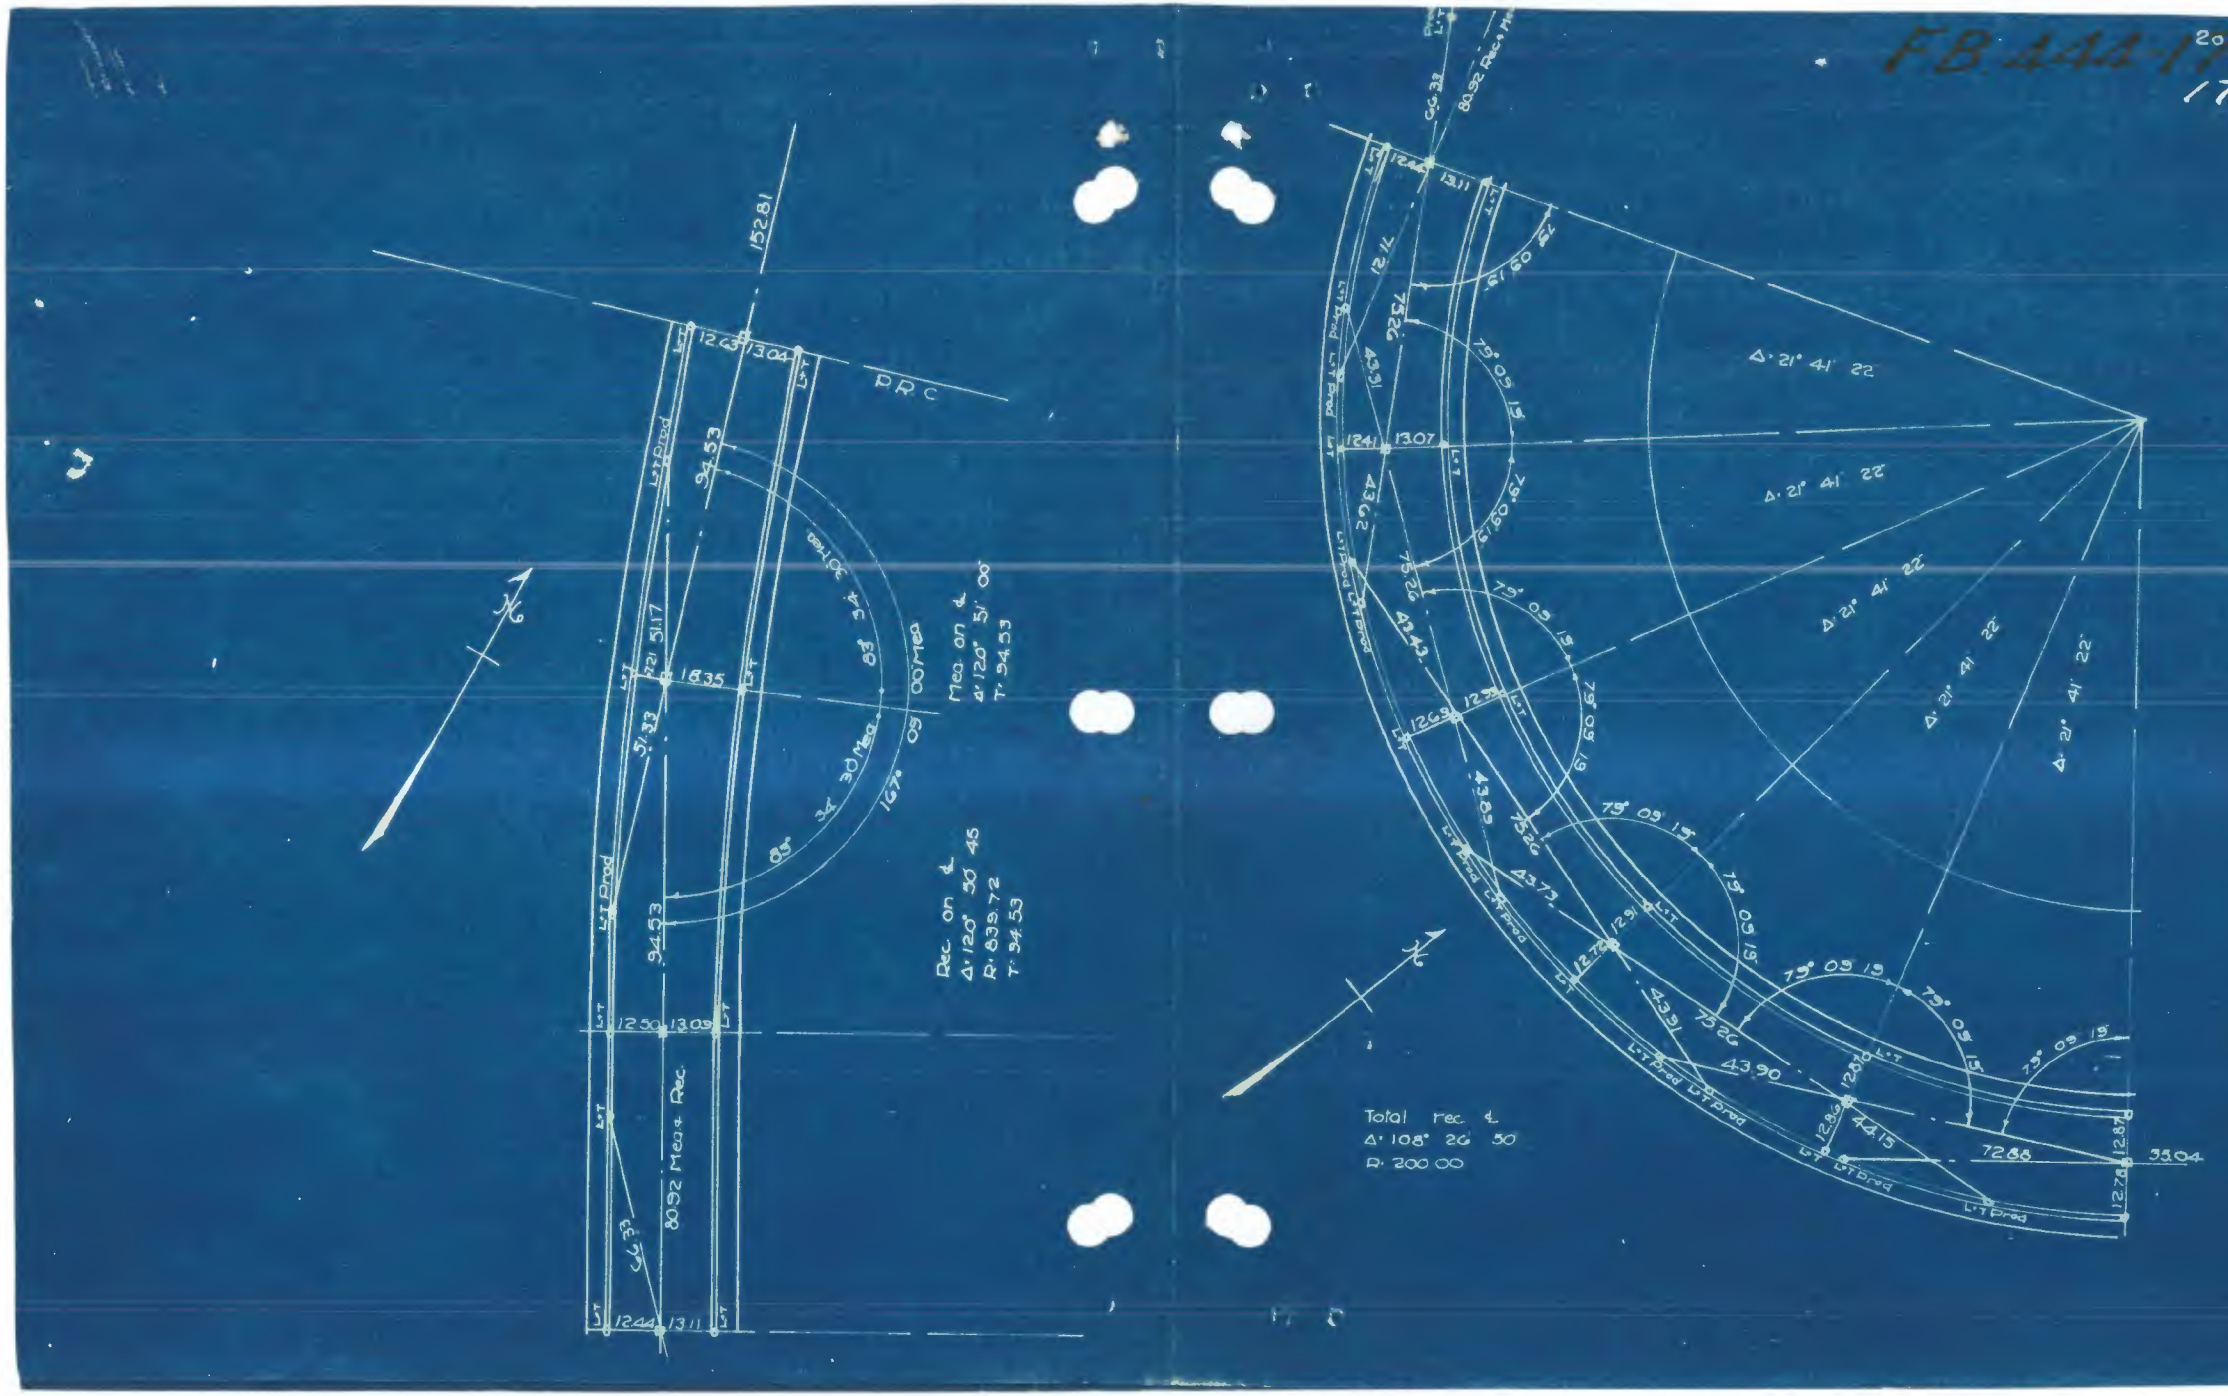

444-178

444-179

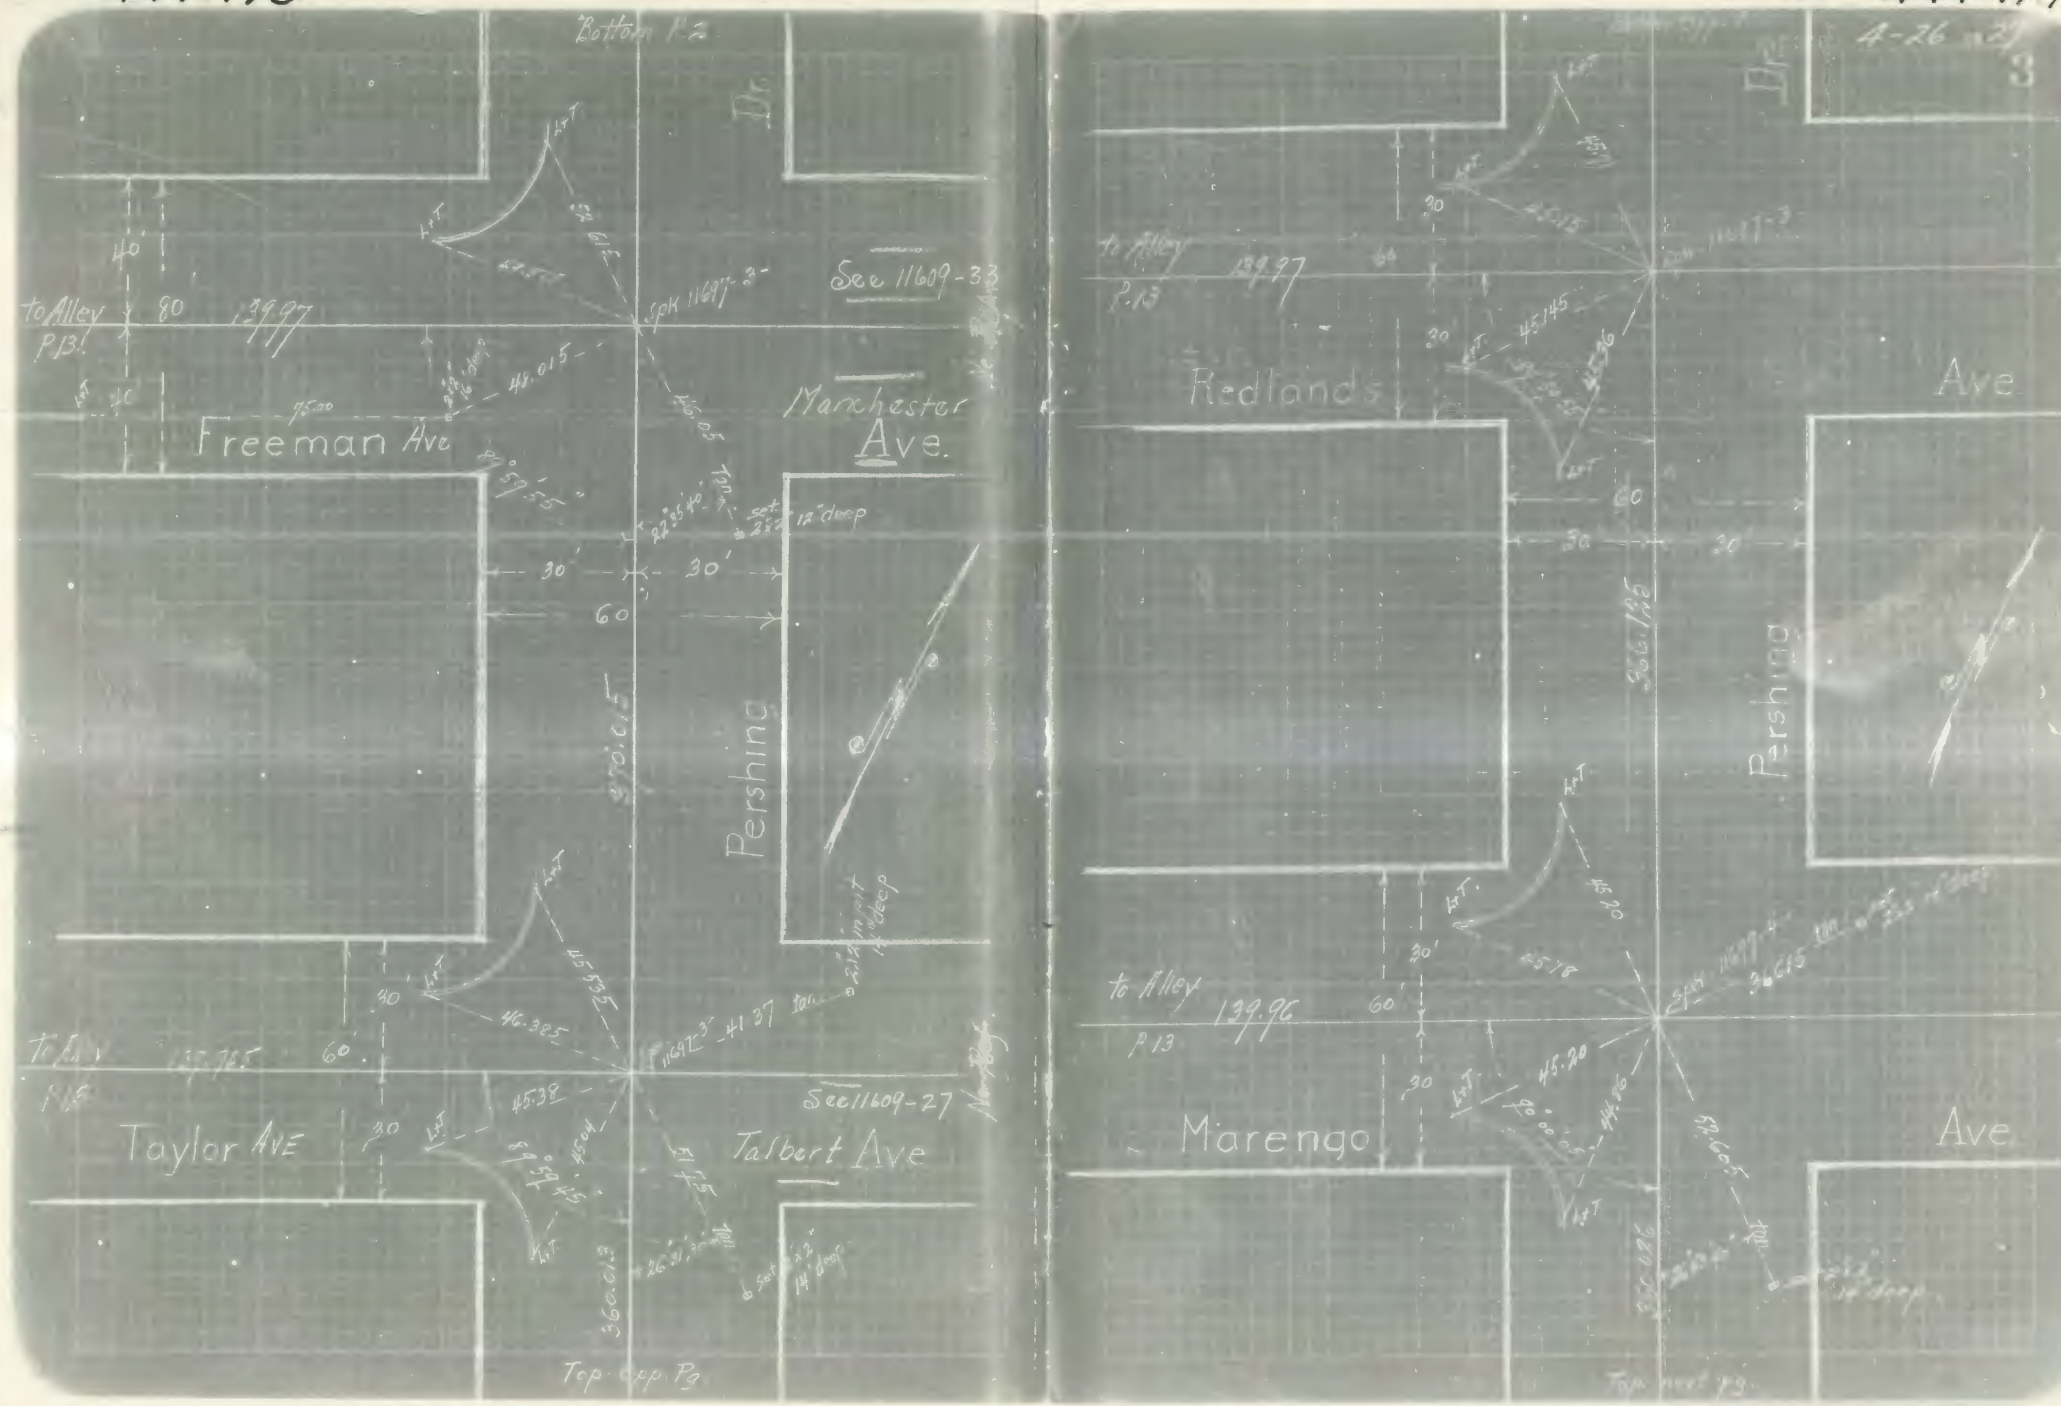

L.A 11700

444-180

444-181

37

37

Falmouth Ave

196.44 ft N of Cabora Dr to Talbert Ave

℄ Survey

G.E. #9981

Board

Thompson

Burch

Hilton

Mar 18th 30

Ref Pgs 1-3-

10529 - 10-13-24-25

Tract # 9809

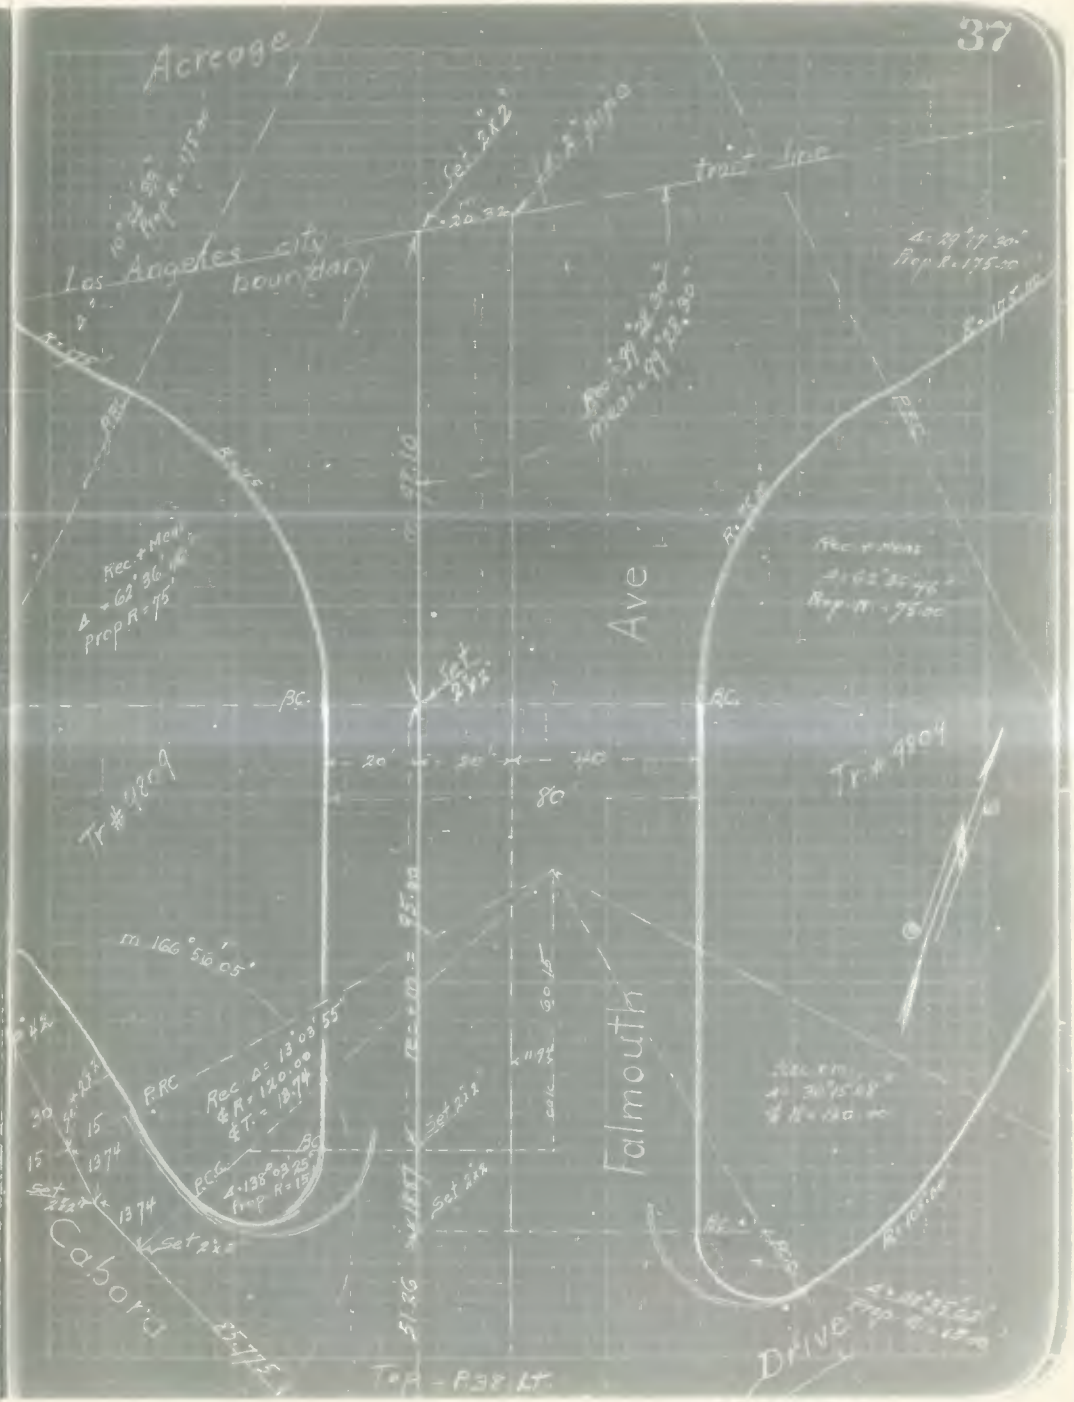

444-182

444-183

444-184

444-185

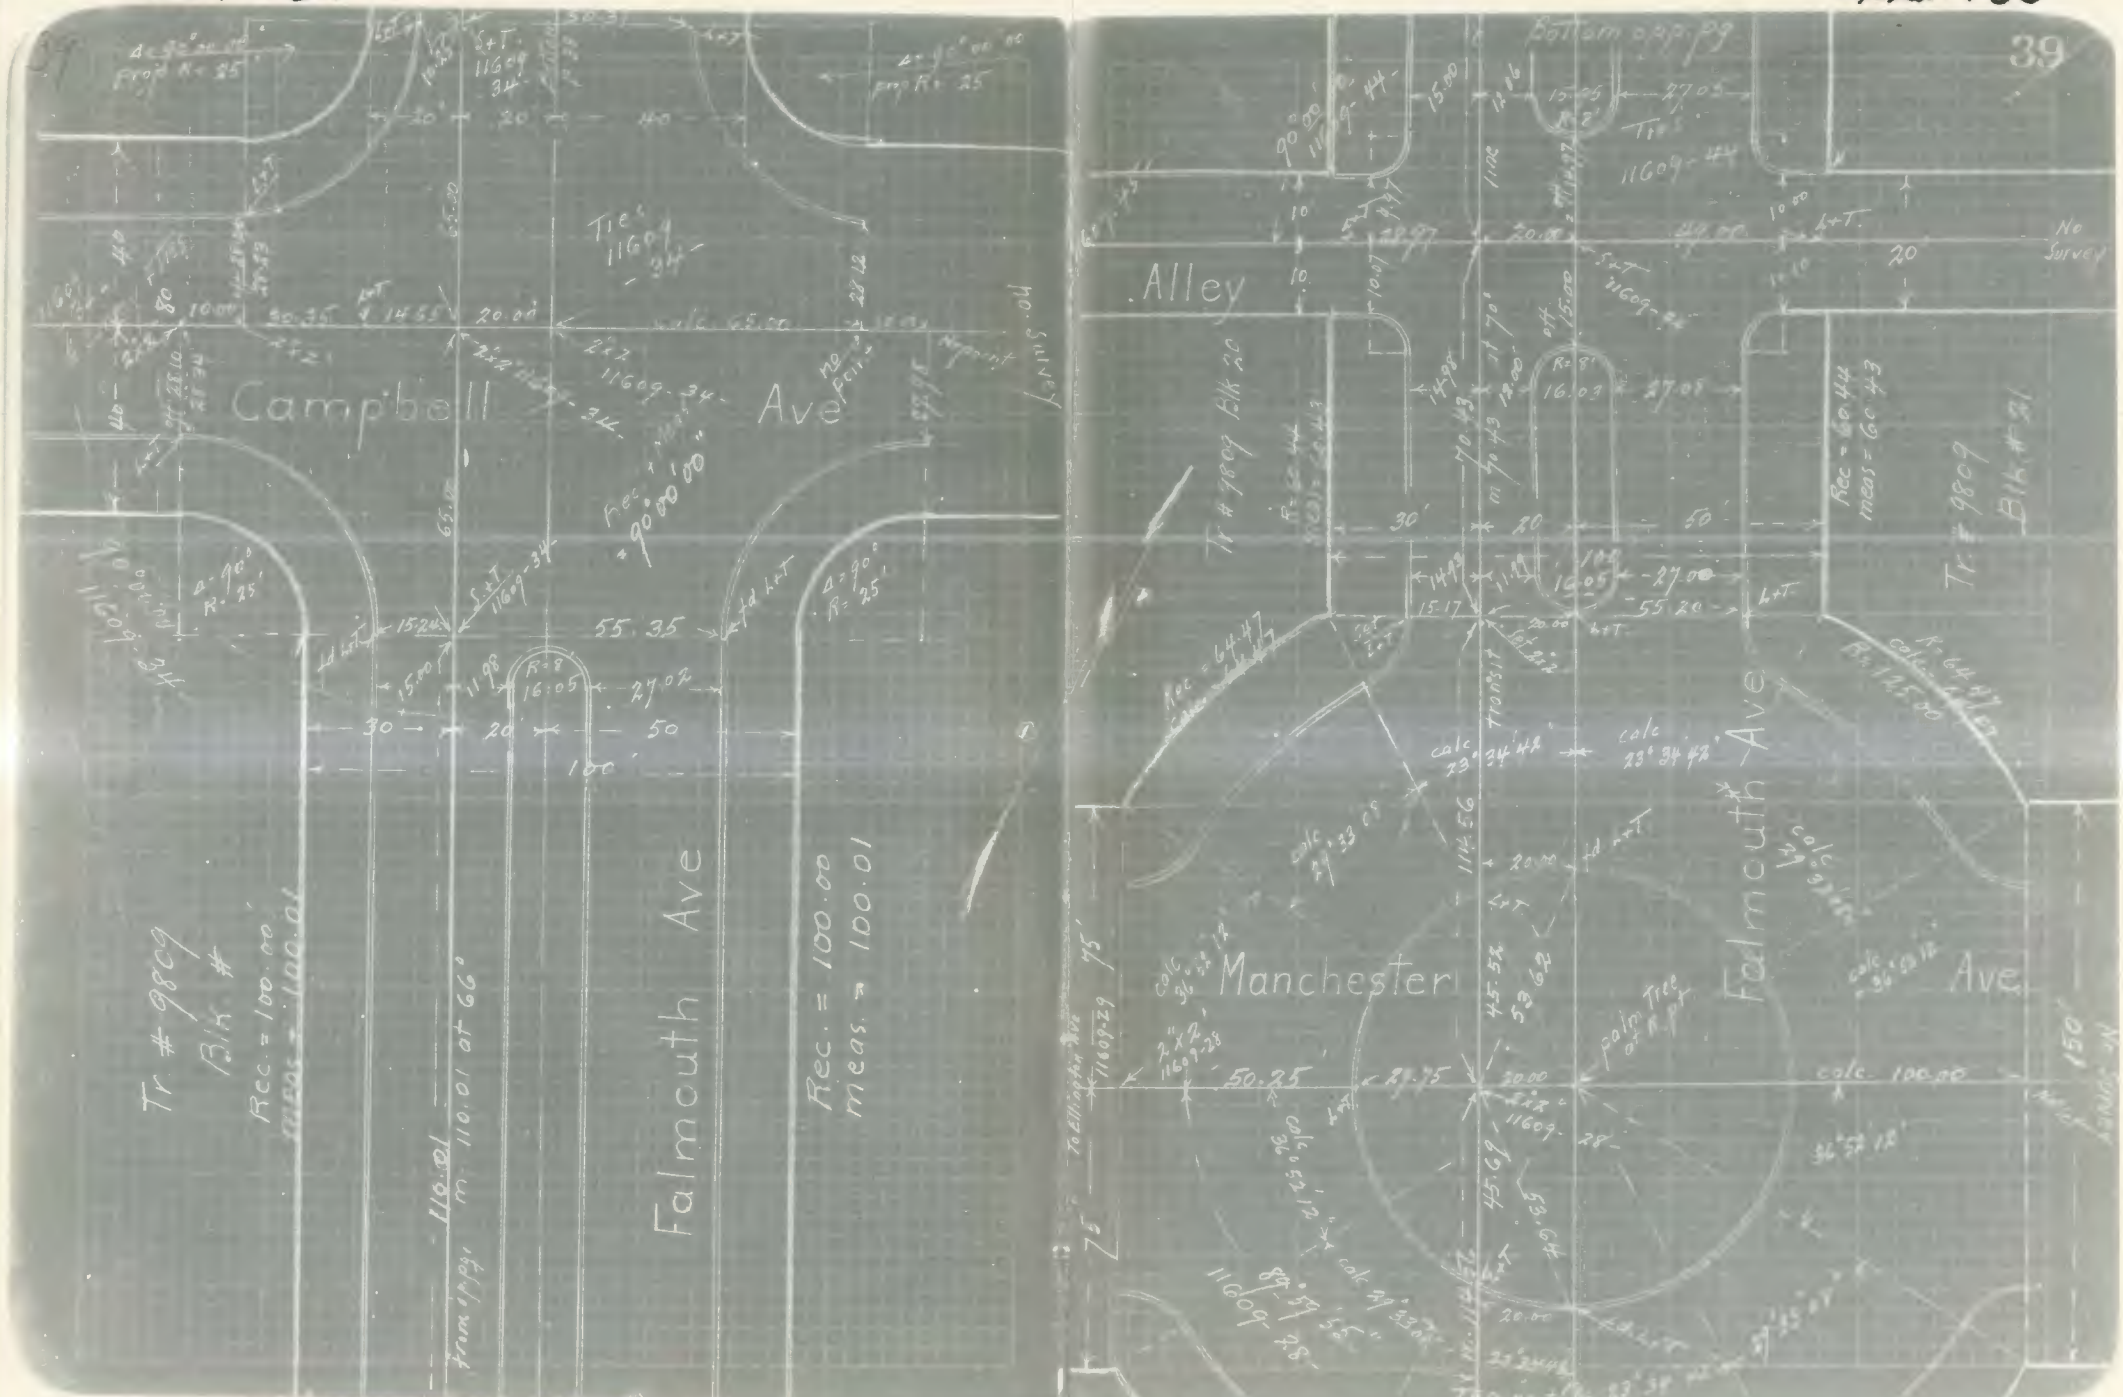

444-186

444-187

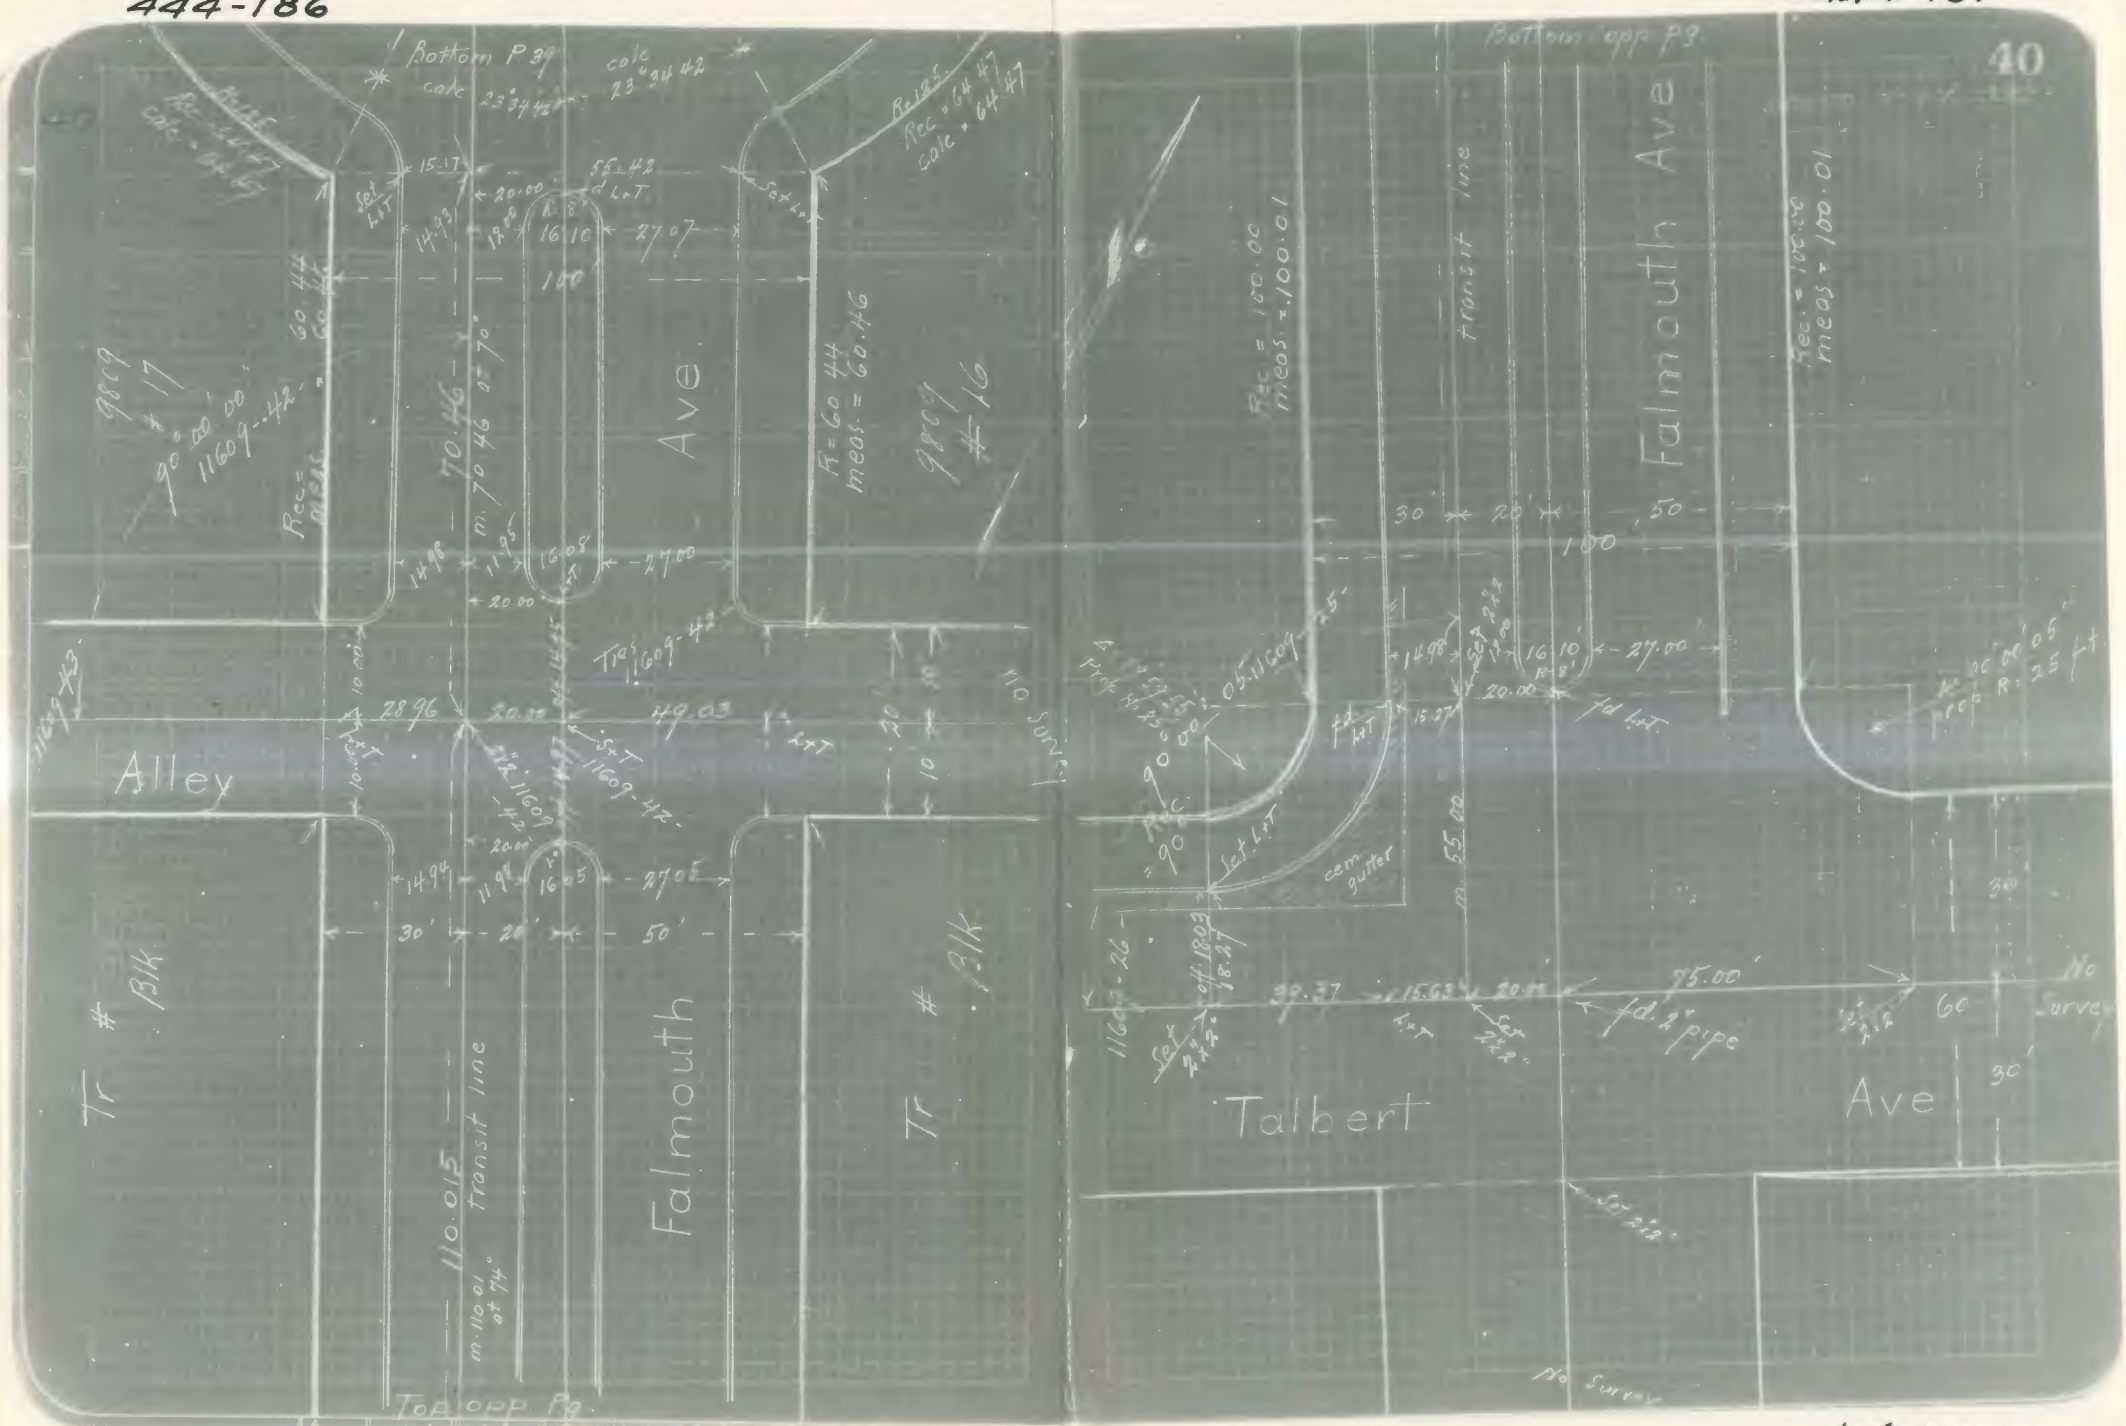

L.A. 11700

(Page 189 omitted.)

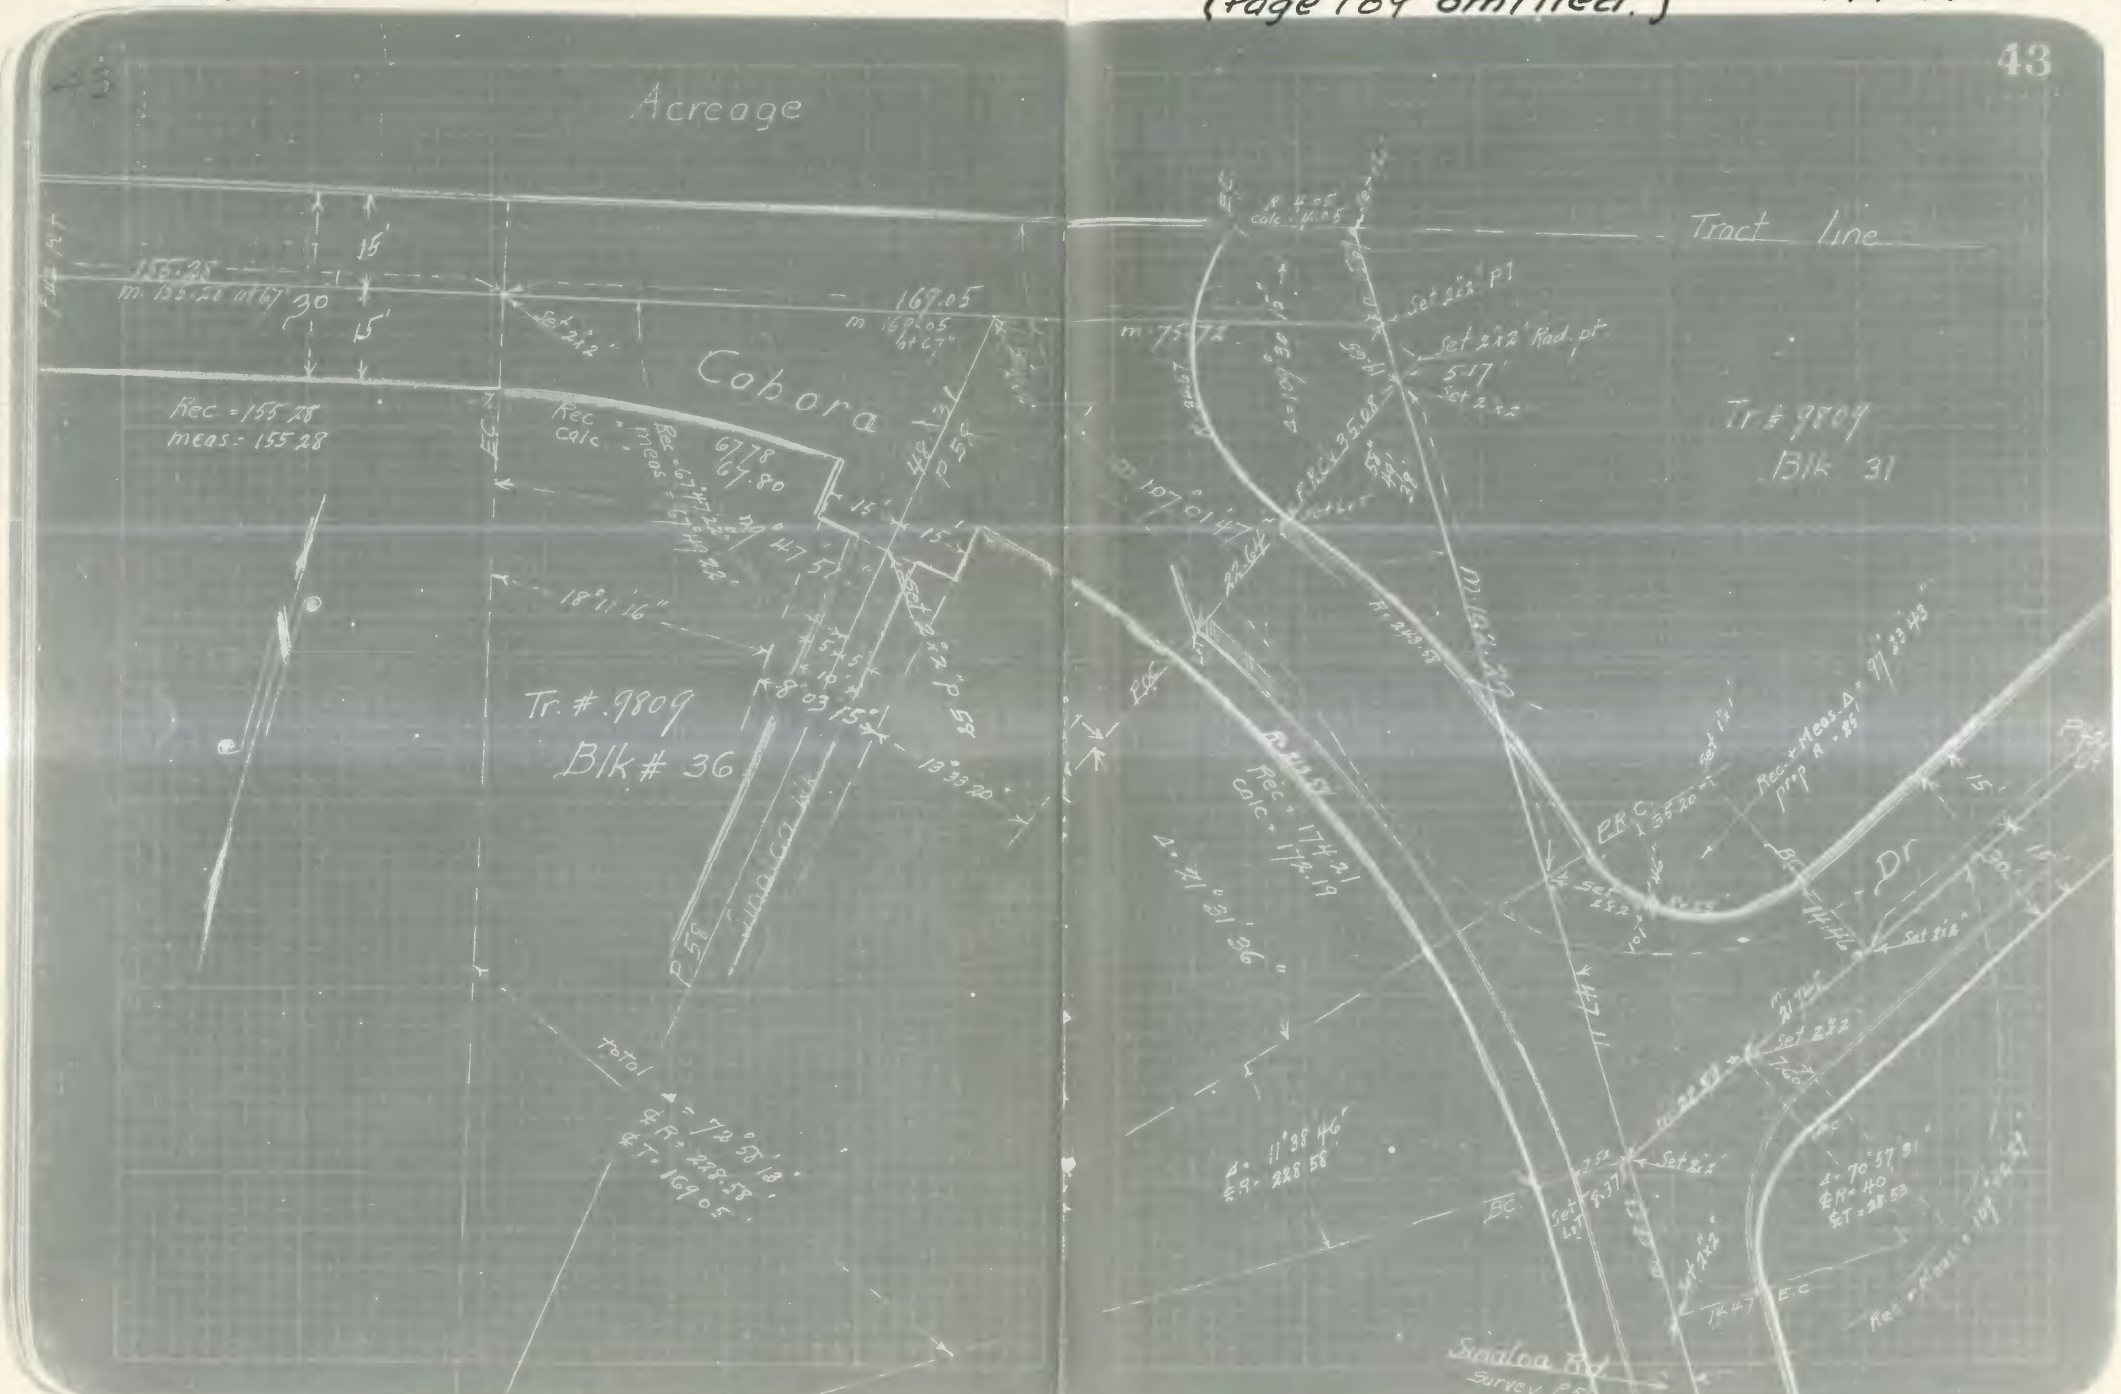

L.A. 11700

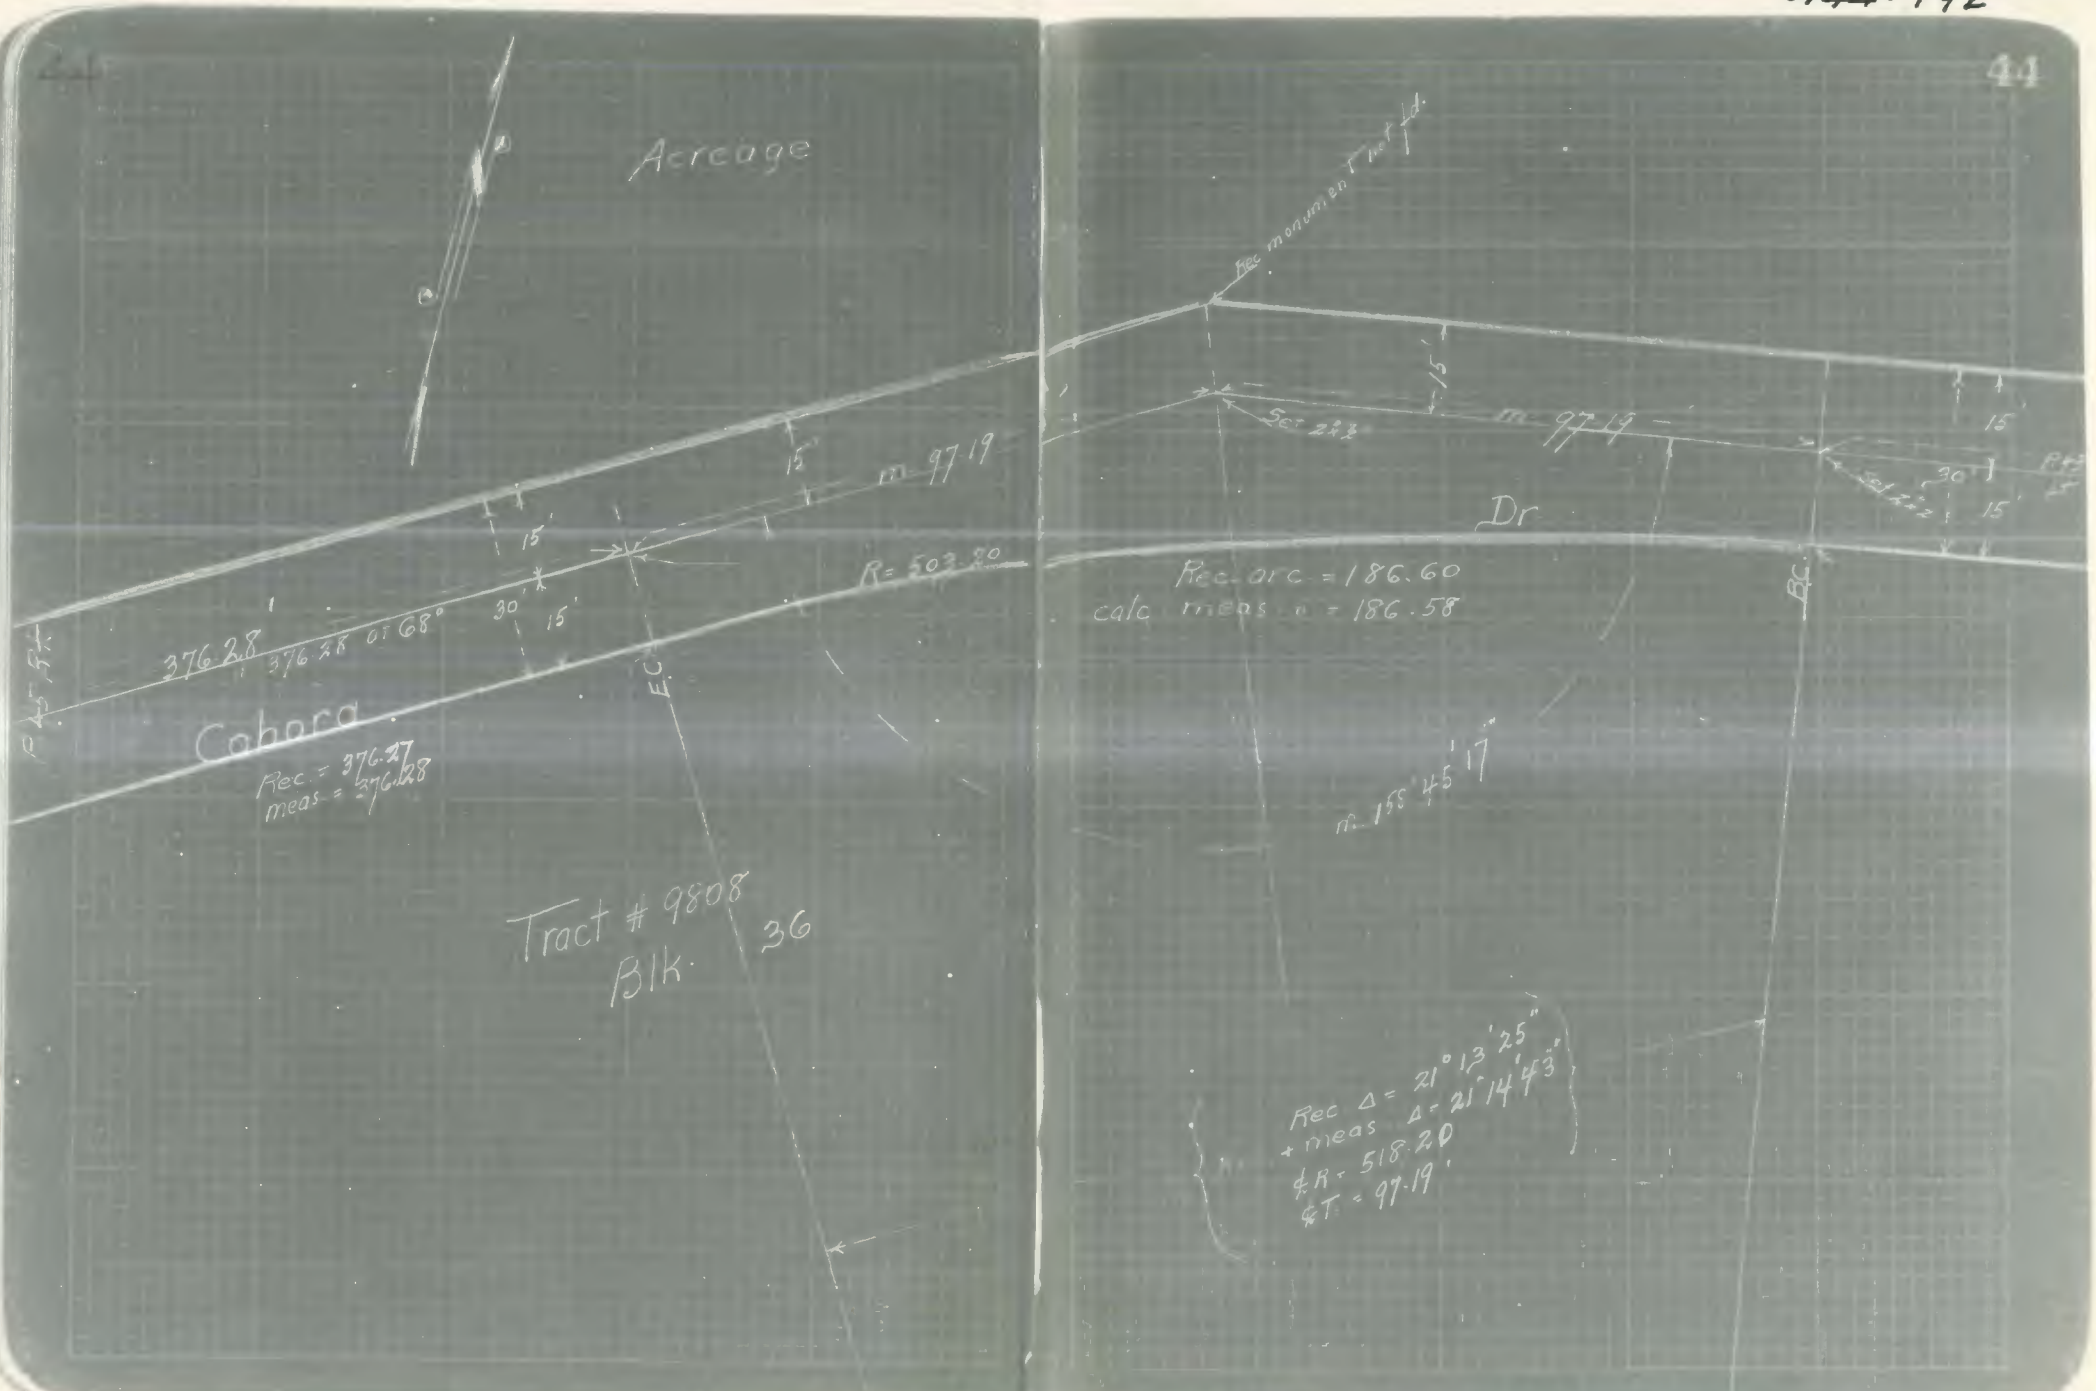
44
Acreage
Rec monument not fd.
15'
m 97.19
Set 2½
Dr
Rec. arc = 186.60
calc meas " = 186.58
R = 503.20
376.28
376.28 at 68°
30'
15'
Cabora
Rec. = 376.27
meas = 376.28
E.C.
B.C.
m 158°45'17"
Tract # 9808
Blk. 36
Rec Δ = 21°13'25"
+ meas Δ = 21°14'43"
℄R = 518.20
℄T = 97.19'

444-193

444-194

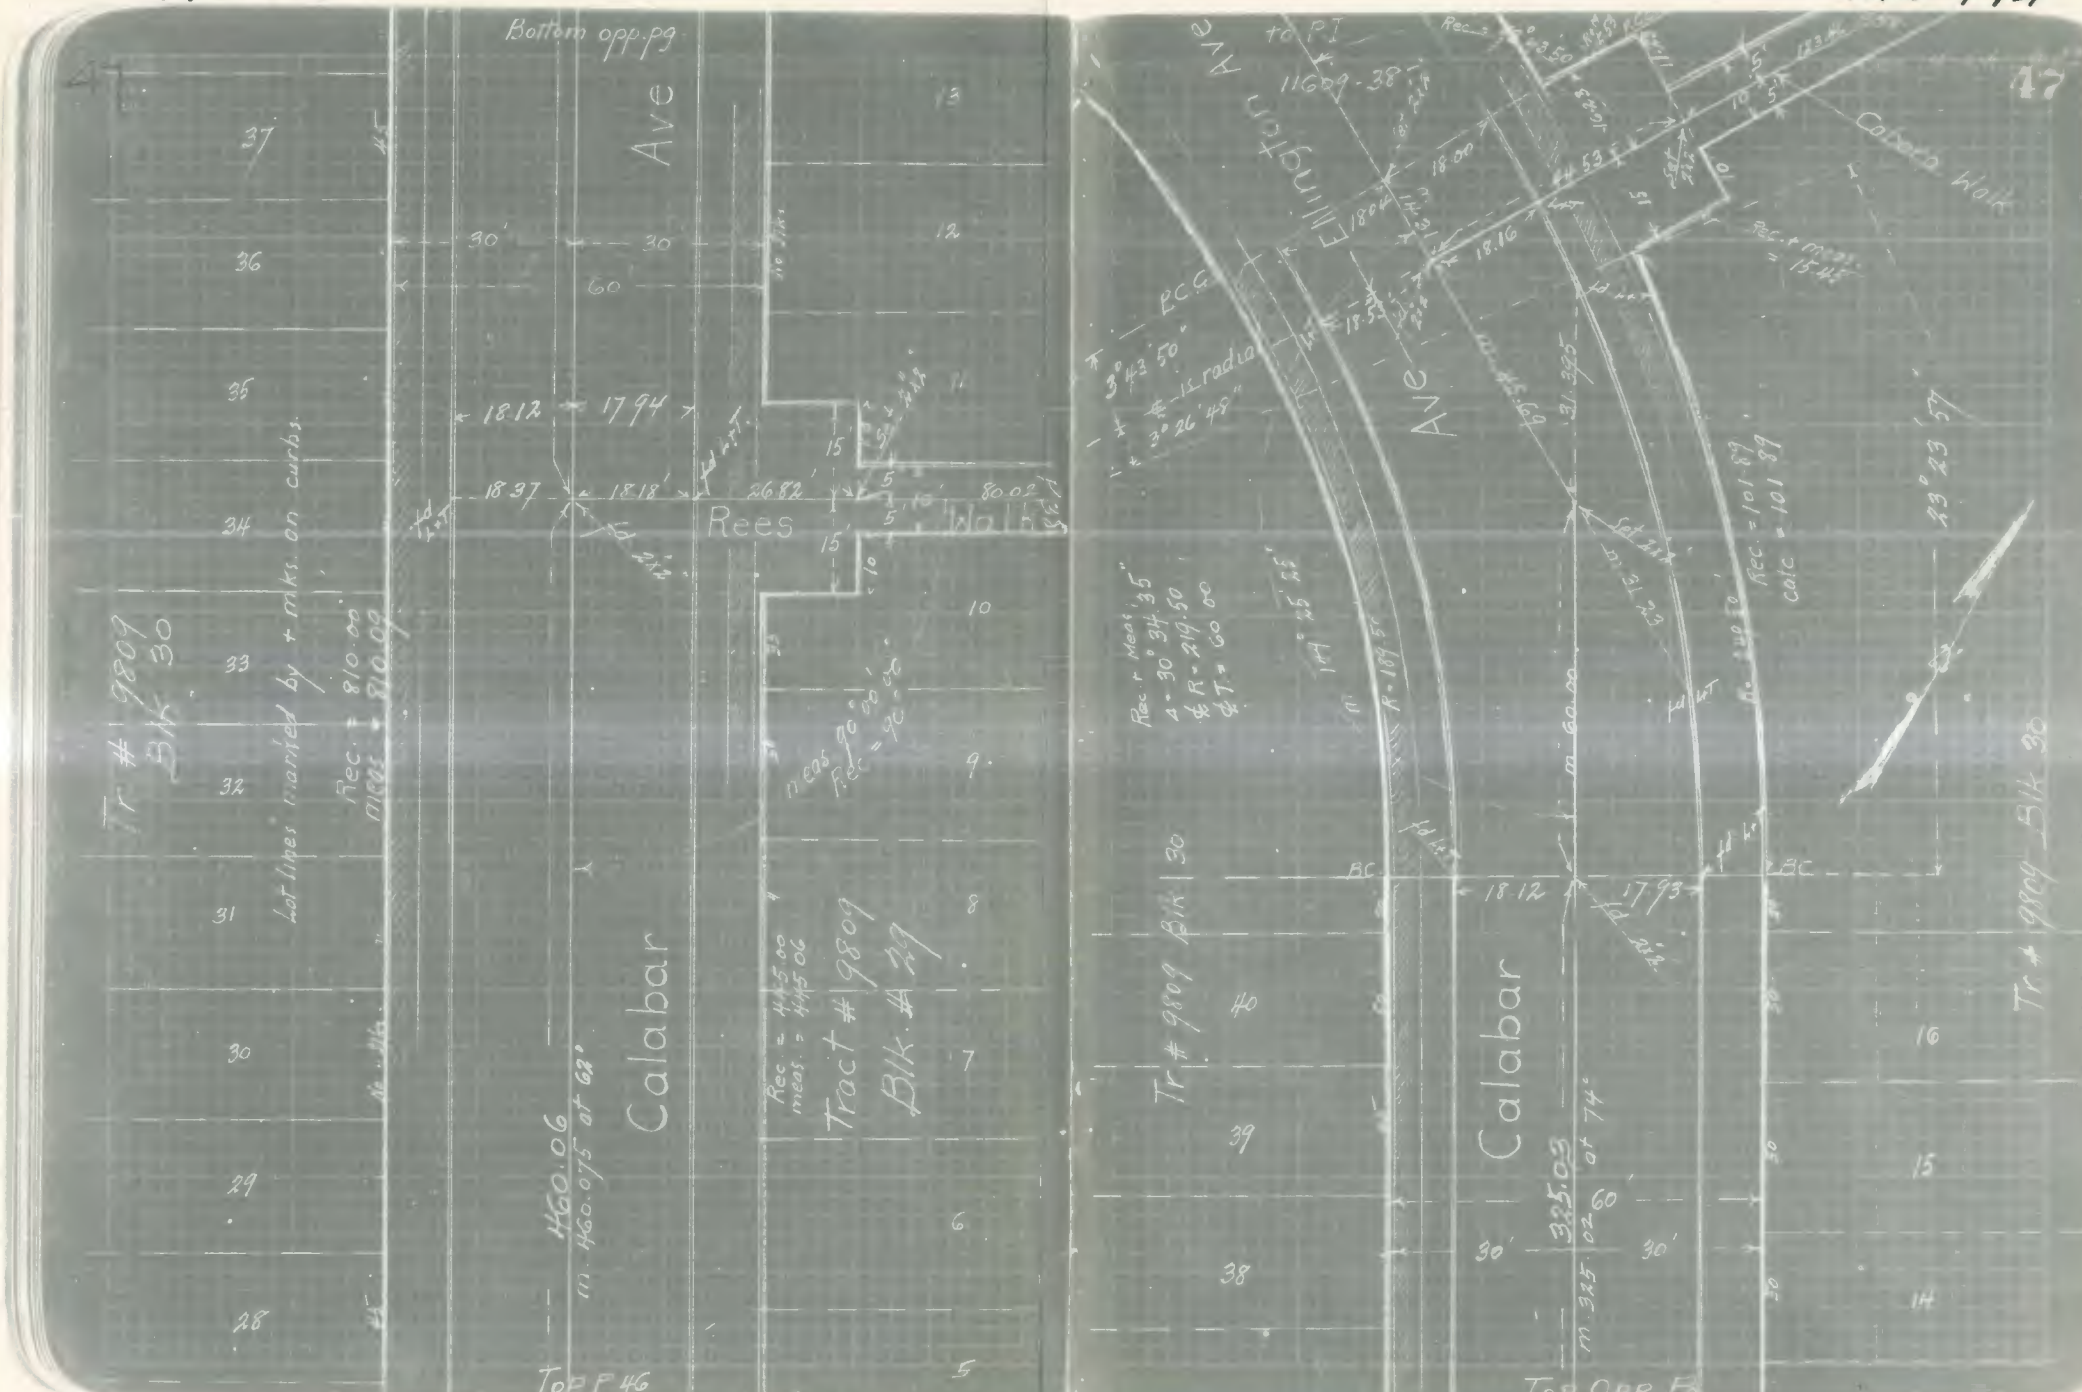

L.A. 11700

444-195

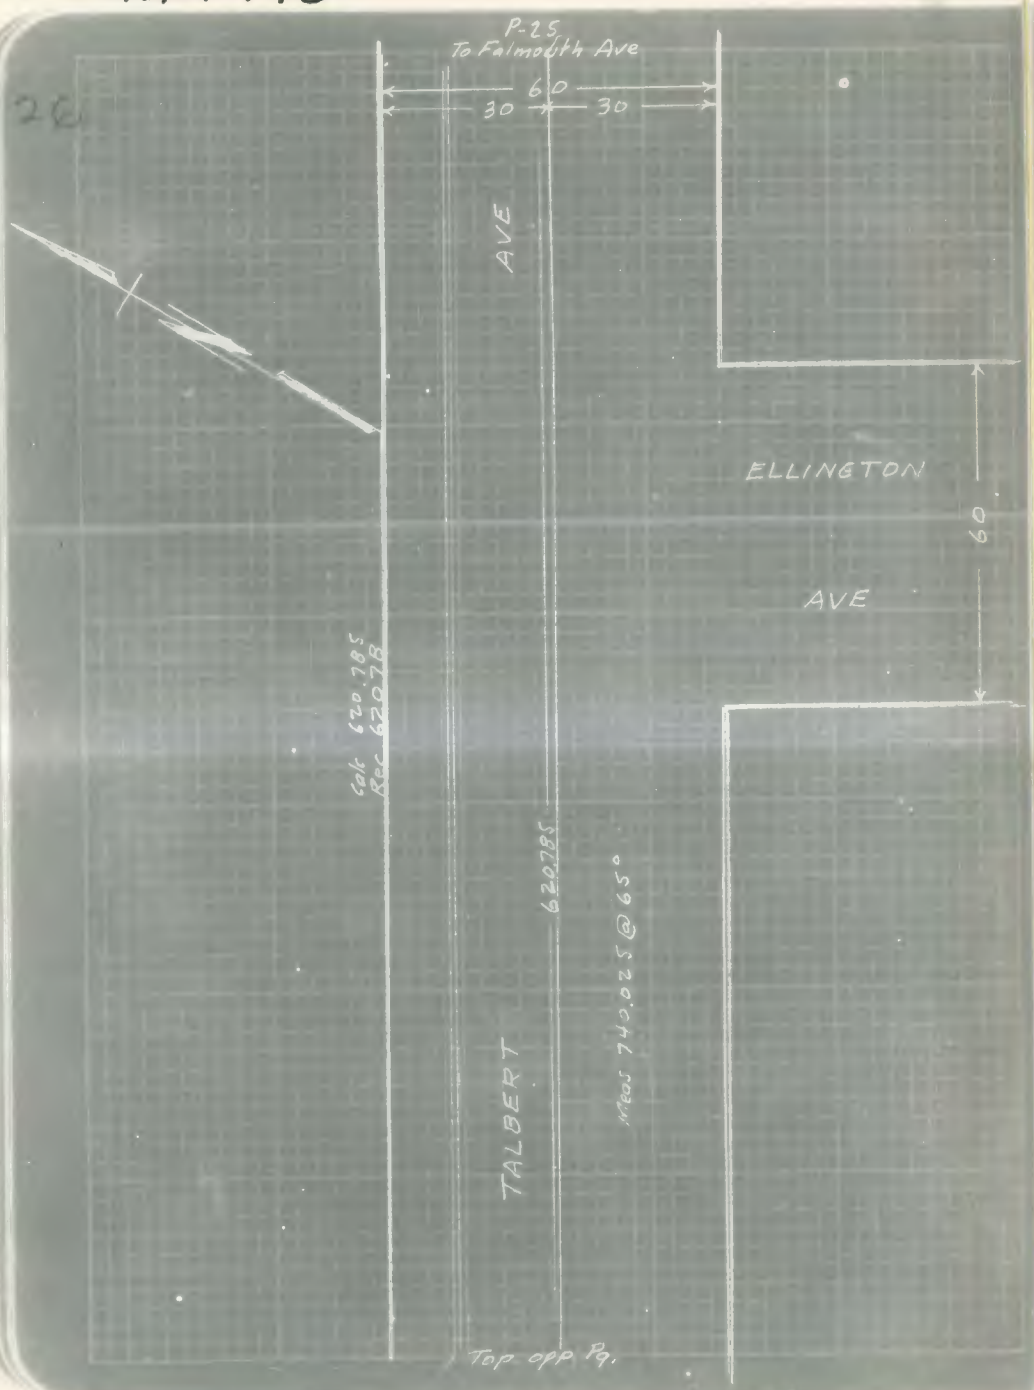

444-196

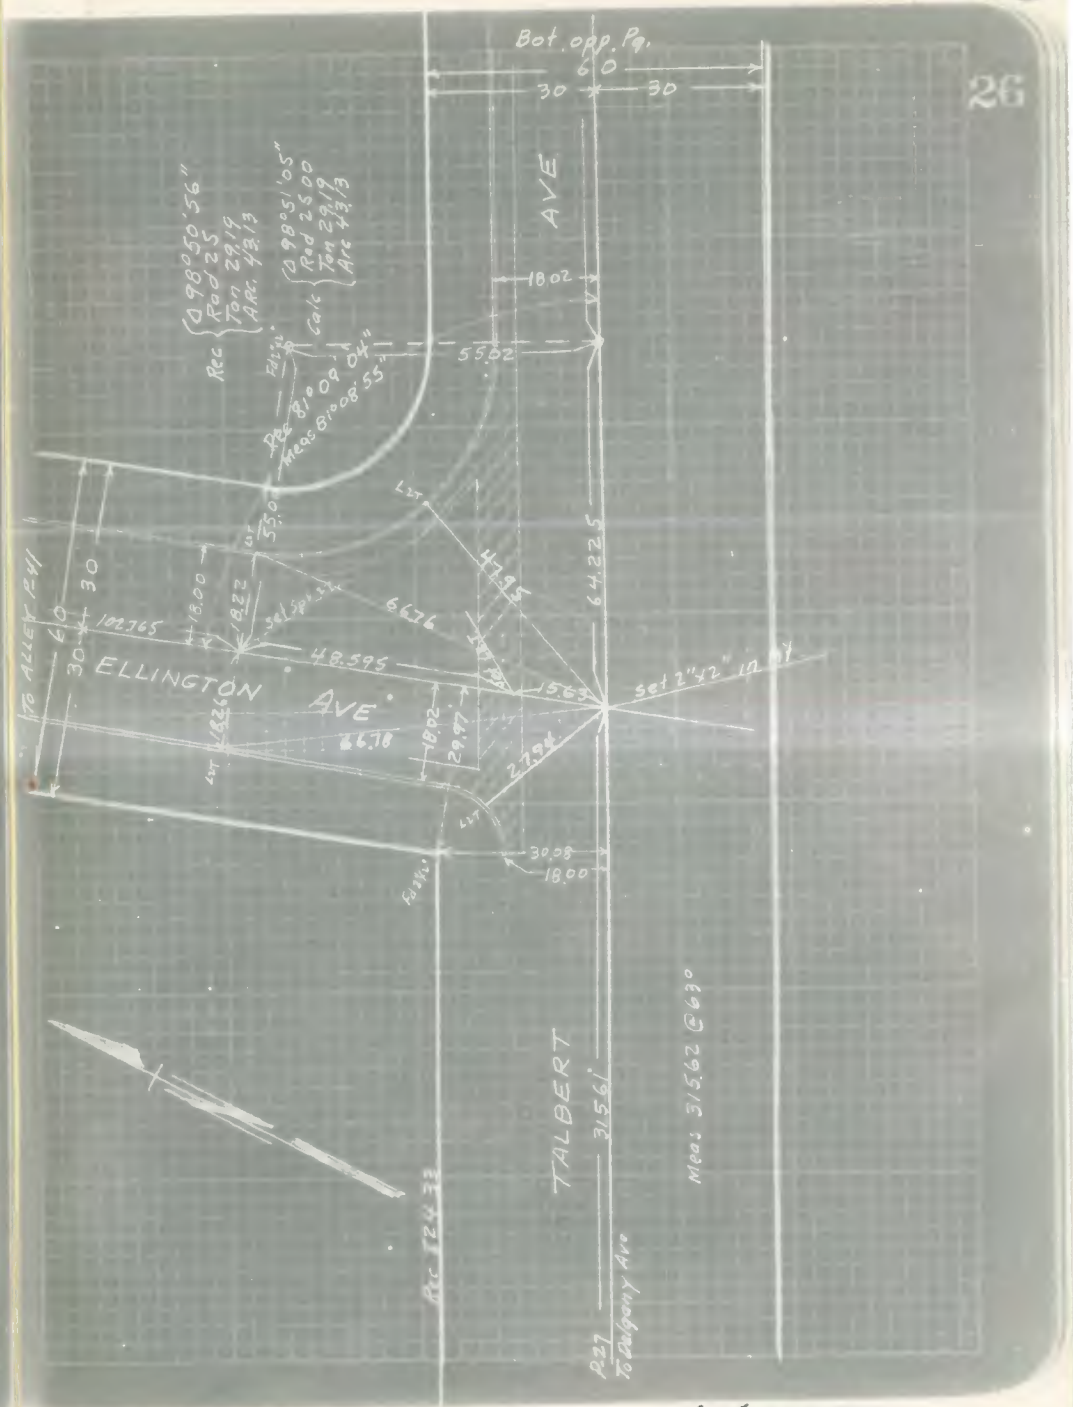

L.A. 11069

444-197

28

MANCHESTER AVE
FALMOUTH AVE to PERSHING DRIVE

& SURVEY- Ties, Angles and Measurements

Apr. 1930

C.W. Clark
H.R. Eastman
H.A. Leonhardt
J.G. Kolb

Tract # 9809
Private Engrs Ties 10529-11,12,13

WIDTH ST.
150 Falmouth Ave to Ellington Ave
100 Ellington Ave to Pershing Drive

Tape L-129 19½/16 Pull Susp. @ 68° = 100.000

444-198

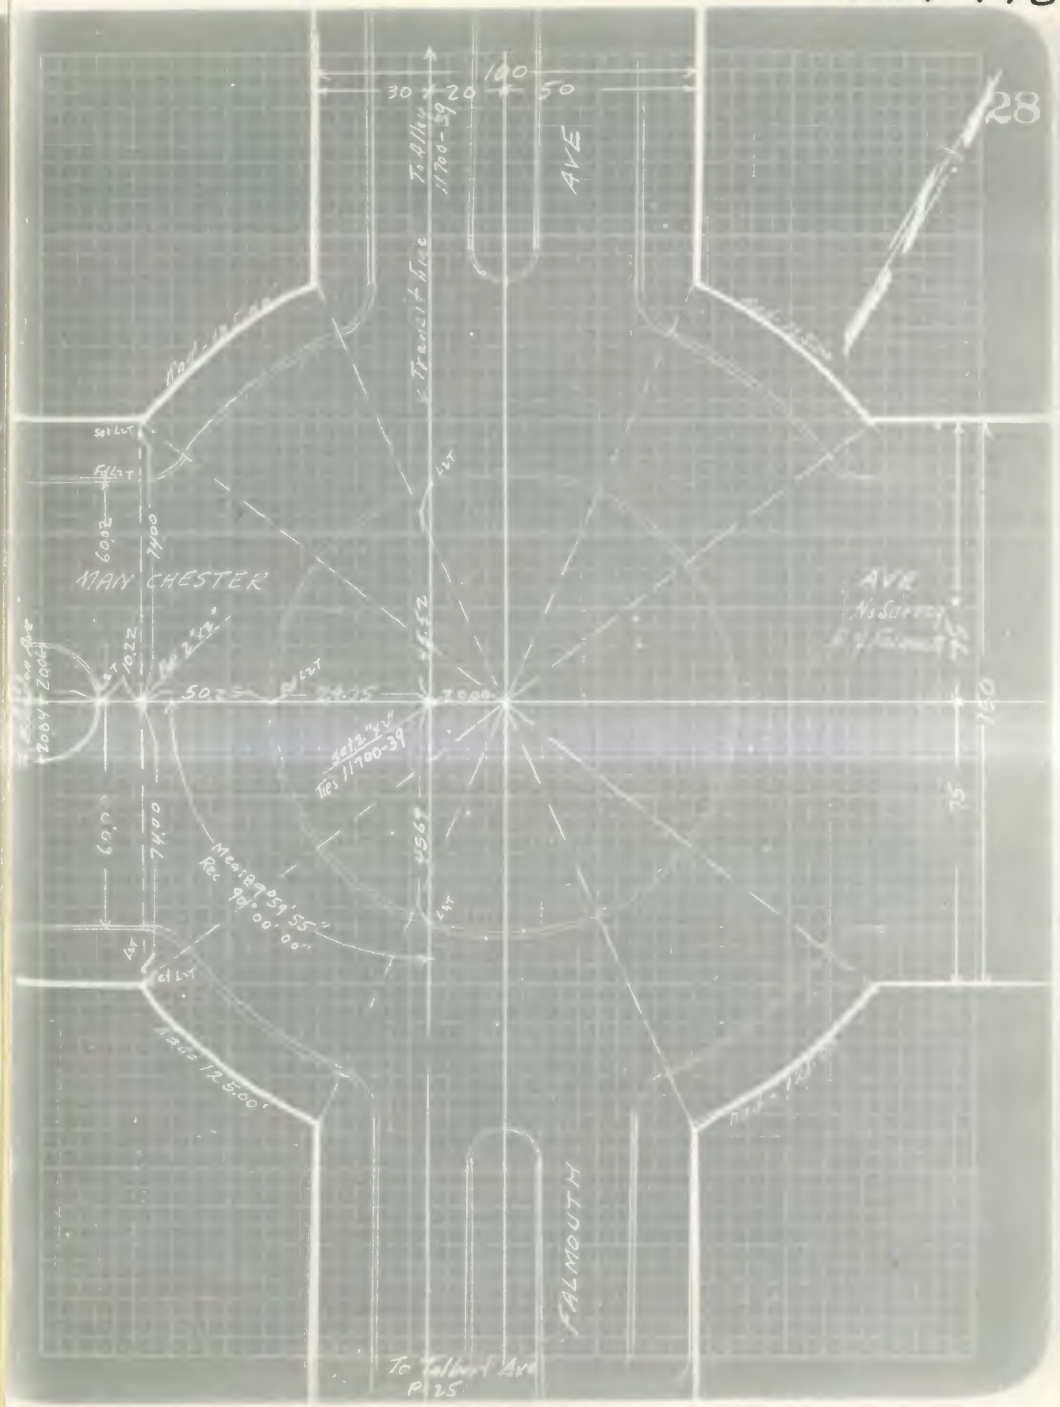

L.A. 11069

444-199

444-200

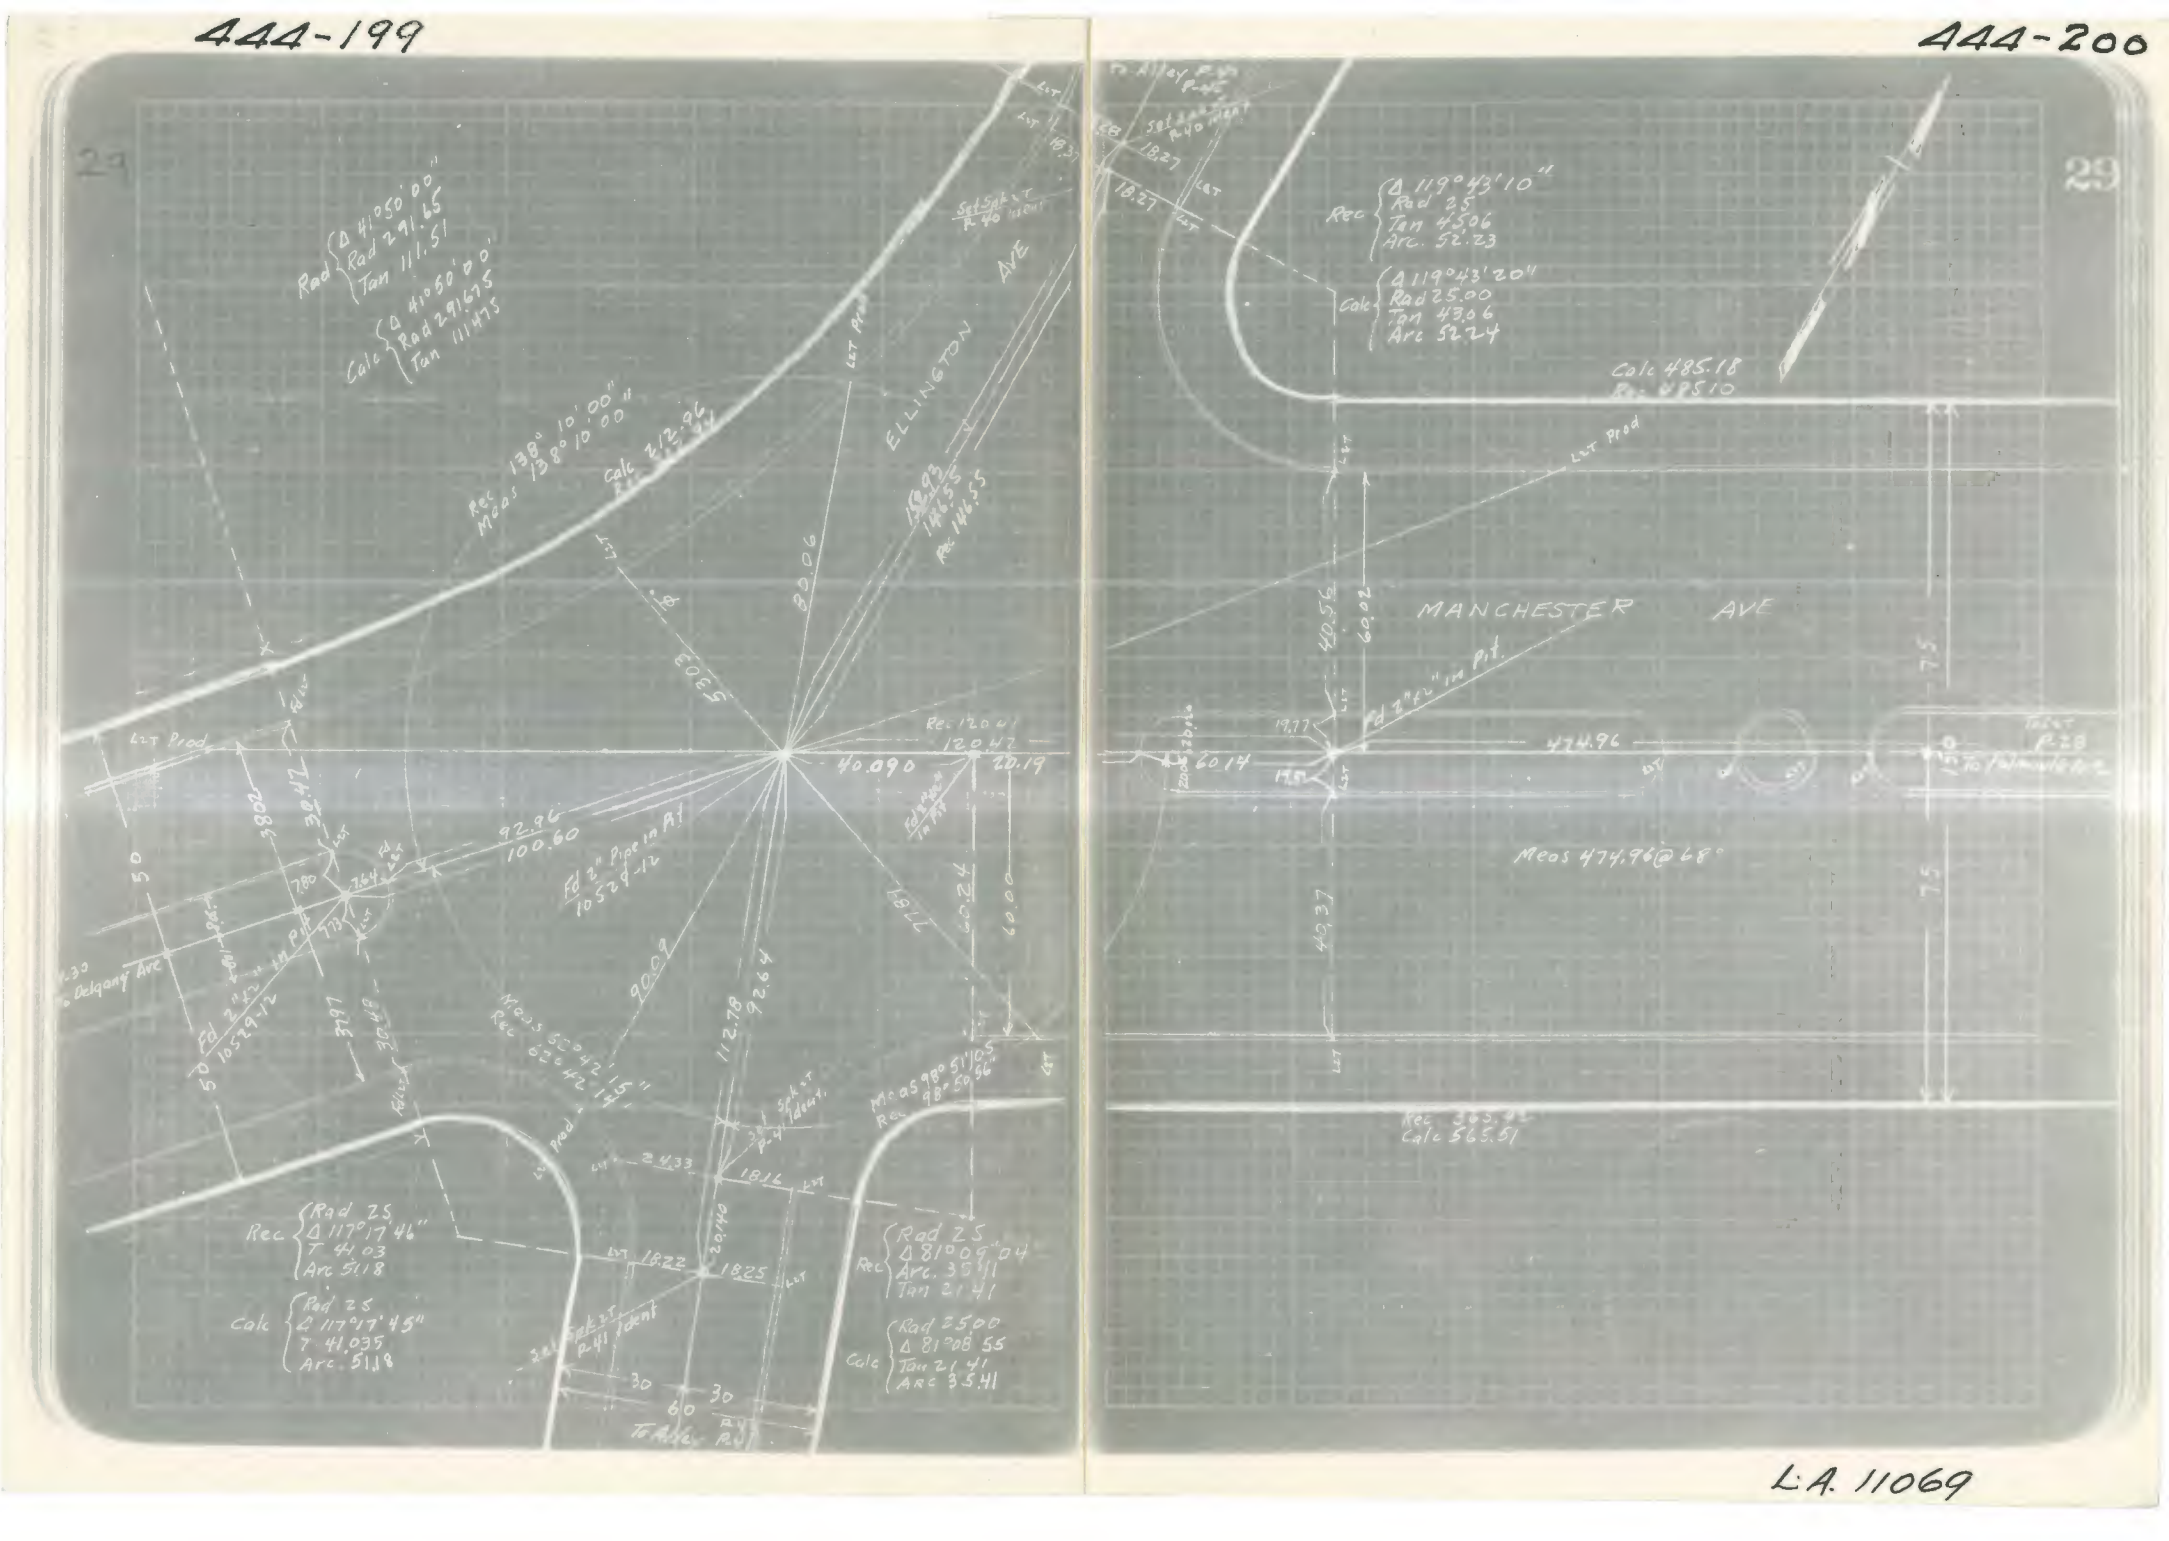

L.A. 11069

444-201

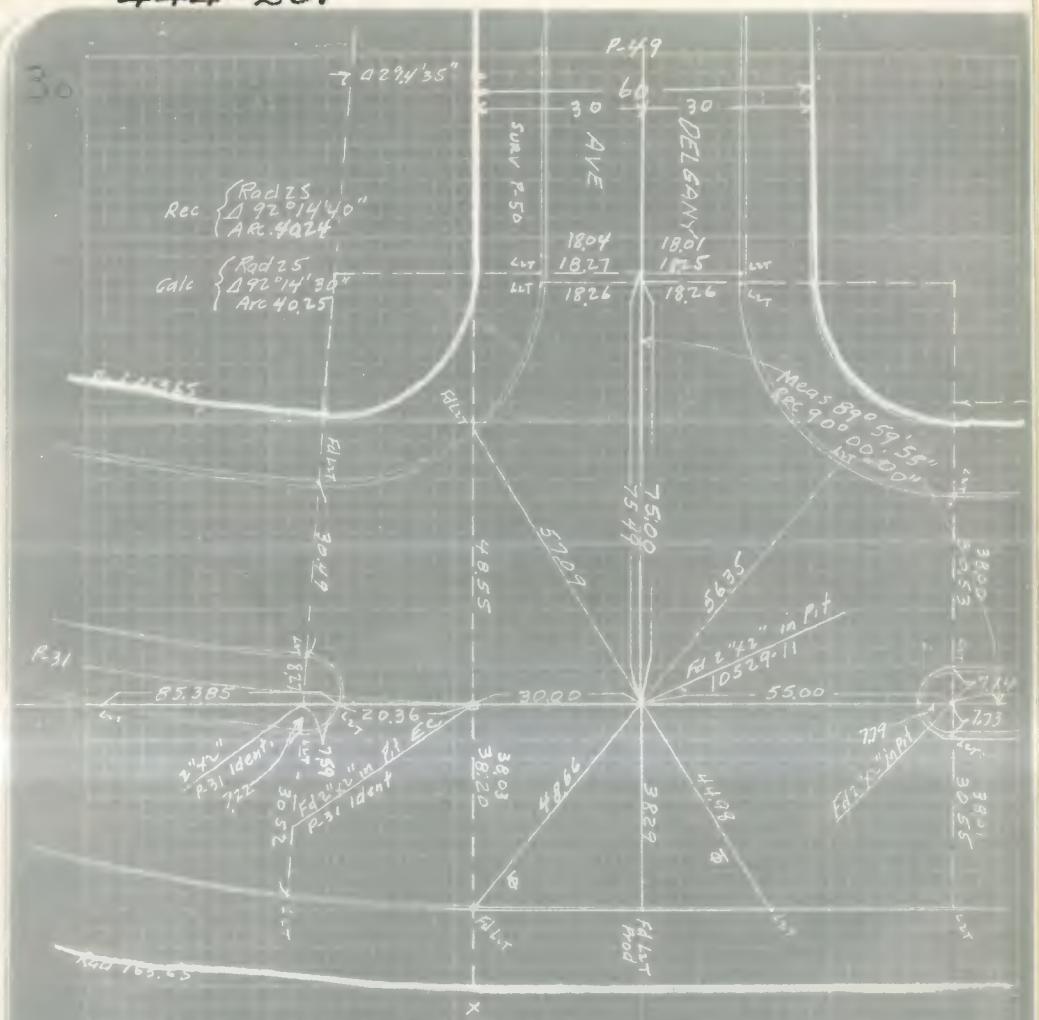

444-202

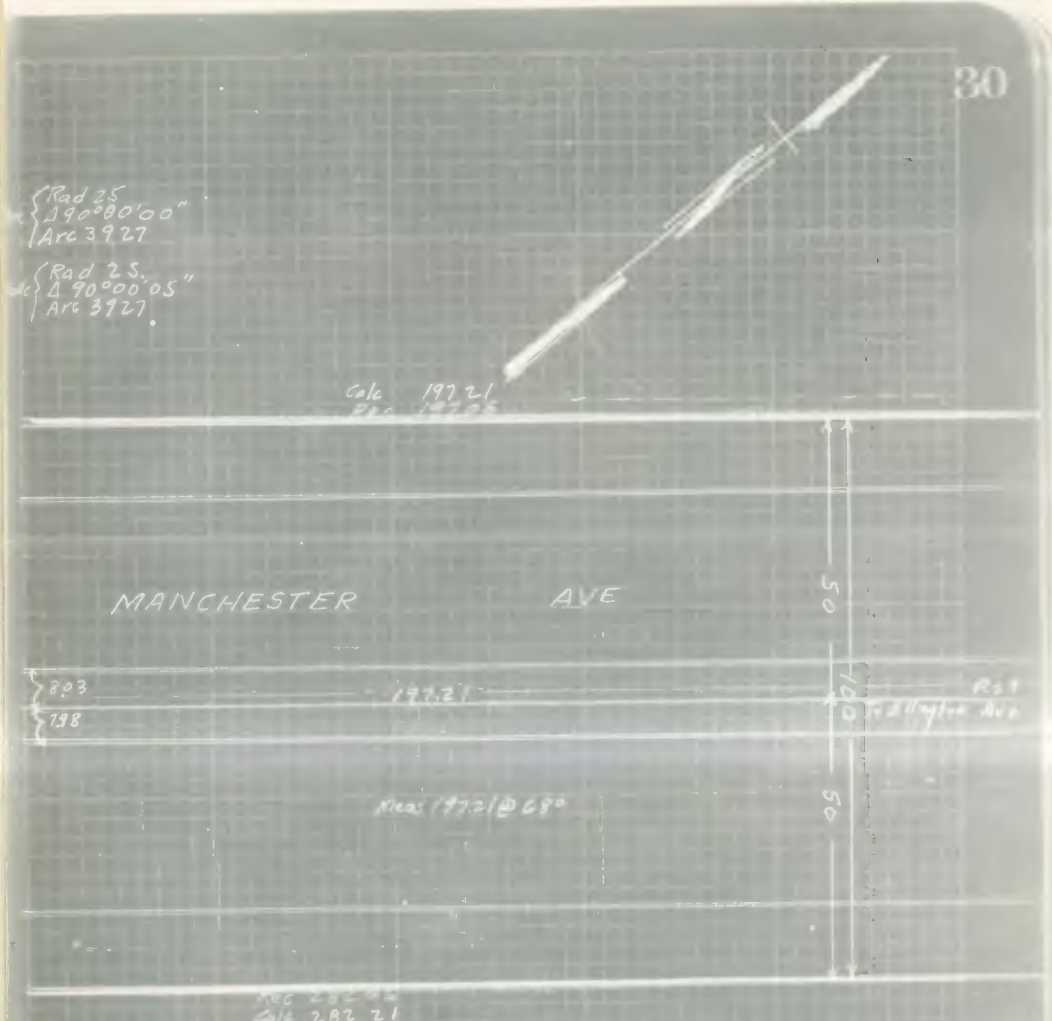

L-A.11069

444-203

444-204

34

CAMPBELL AVE

FALMOUTH AVE to DELGANY AVE

& SURVEY, Ties, Angles and Measurements

Apr. 1930

C. W. Clark

H. R. Eastman

H. A. Leonhardt

J. G. Kolb

Tract # 9809

Private Engr. Ties 10529-14, 15, 16

WIDTH ST

80 Ft Falmouth Ave to Billowvista Drive

60 Ft Billowvista Drive to Delgany Ave

Tape L-129 19½ 16 Ft Susp. @ 68° = 100.000

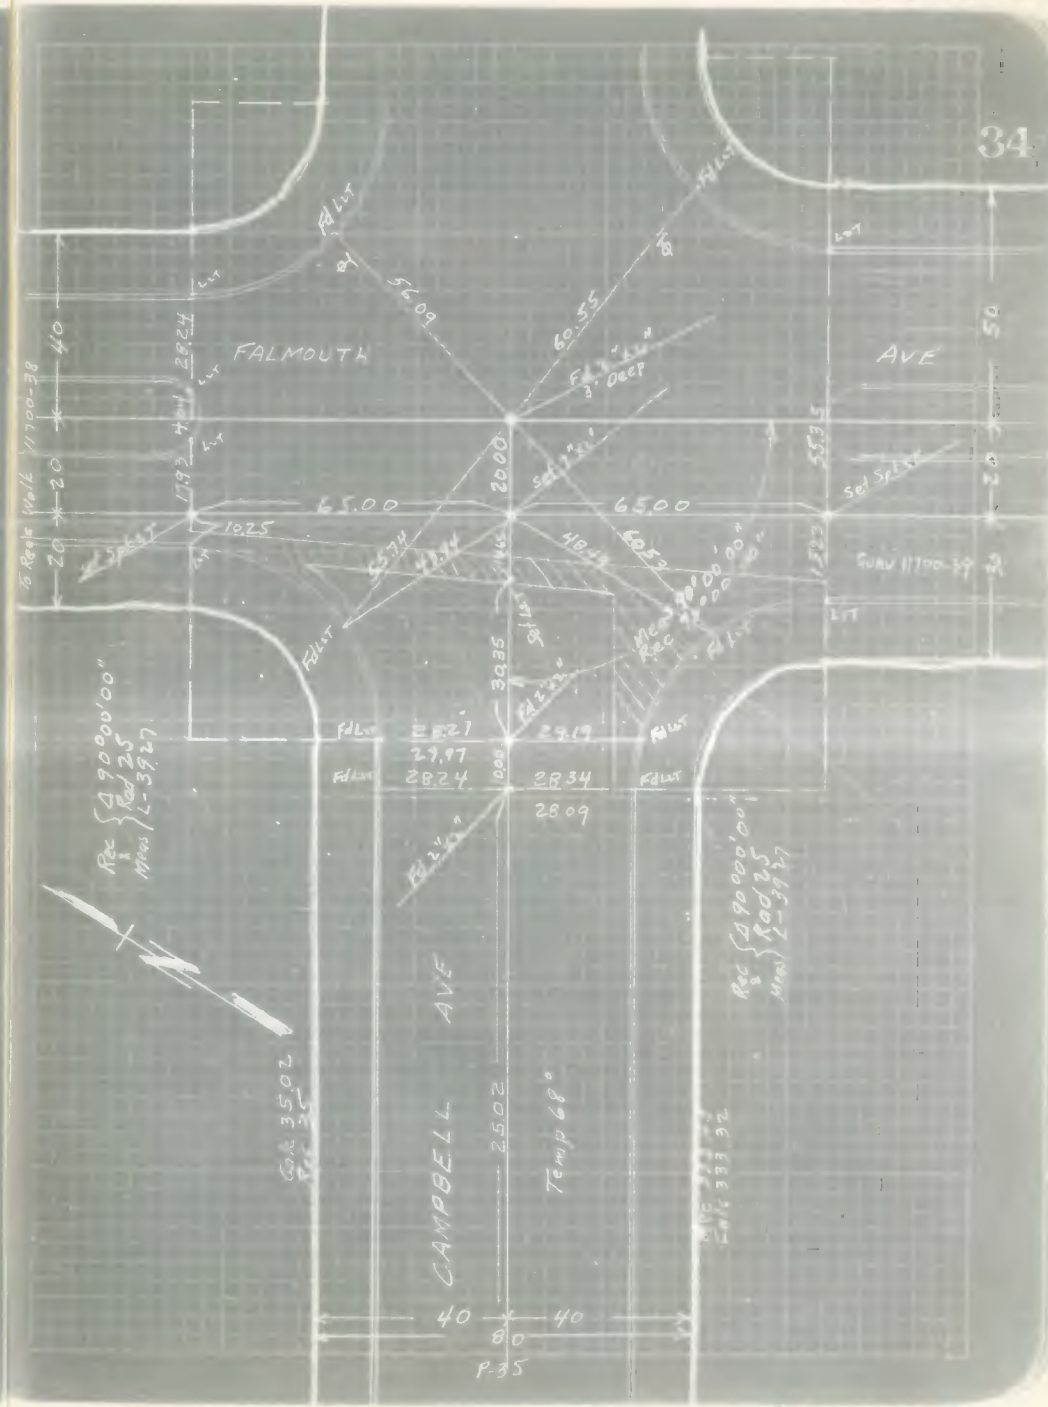

444-205

444-206

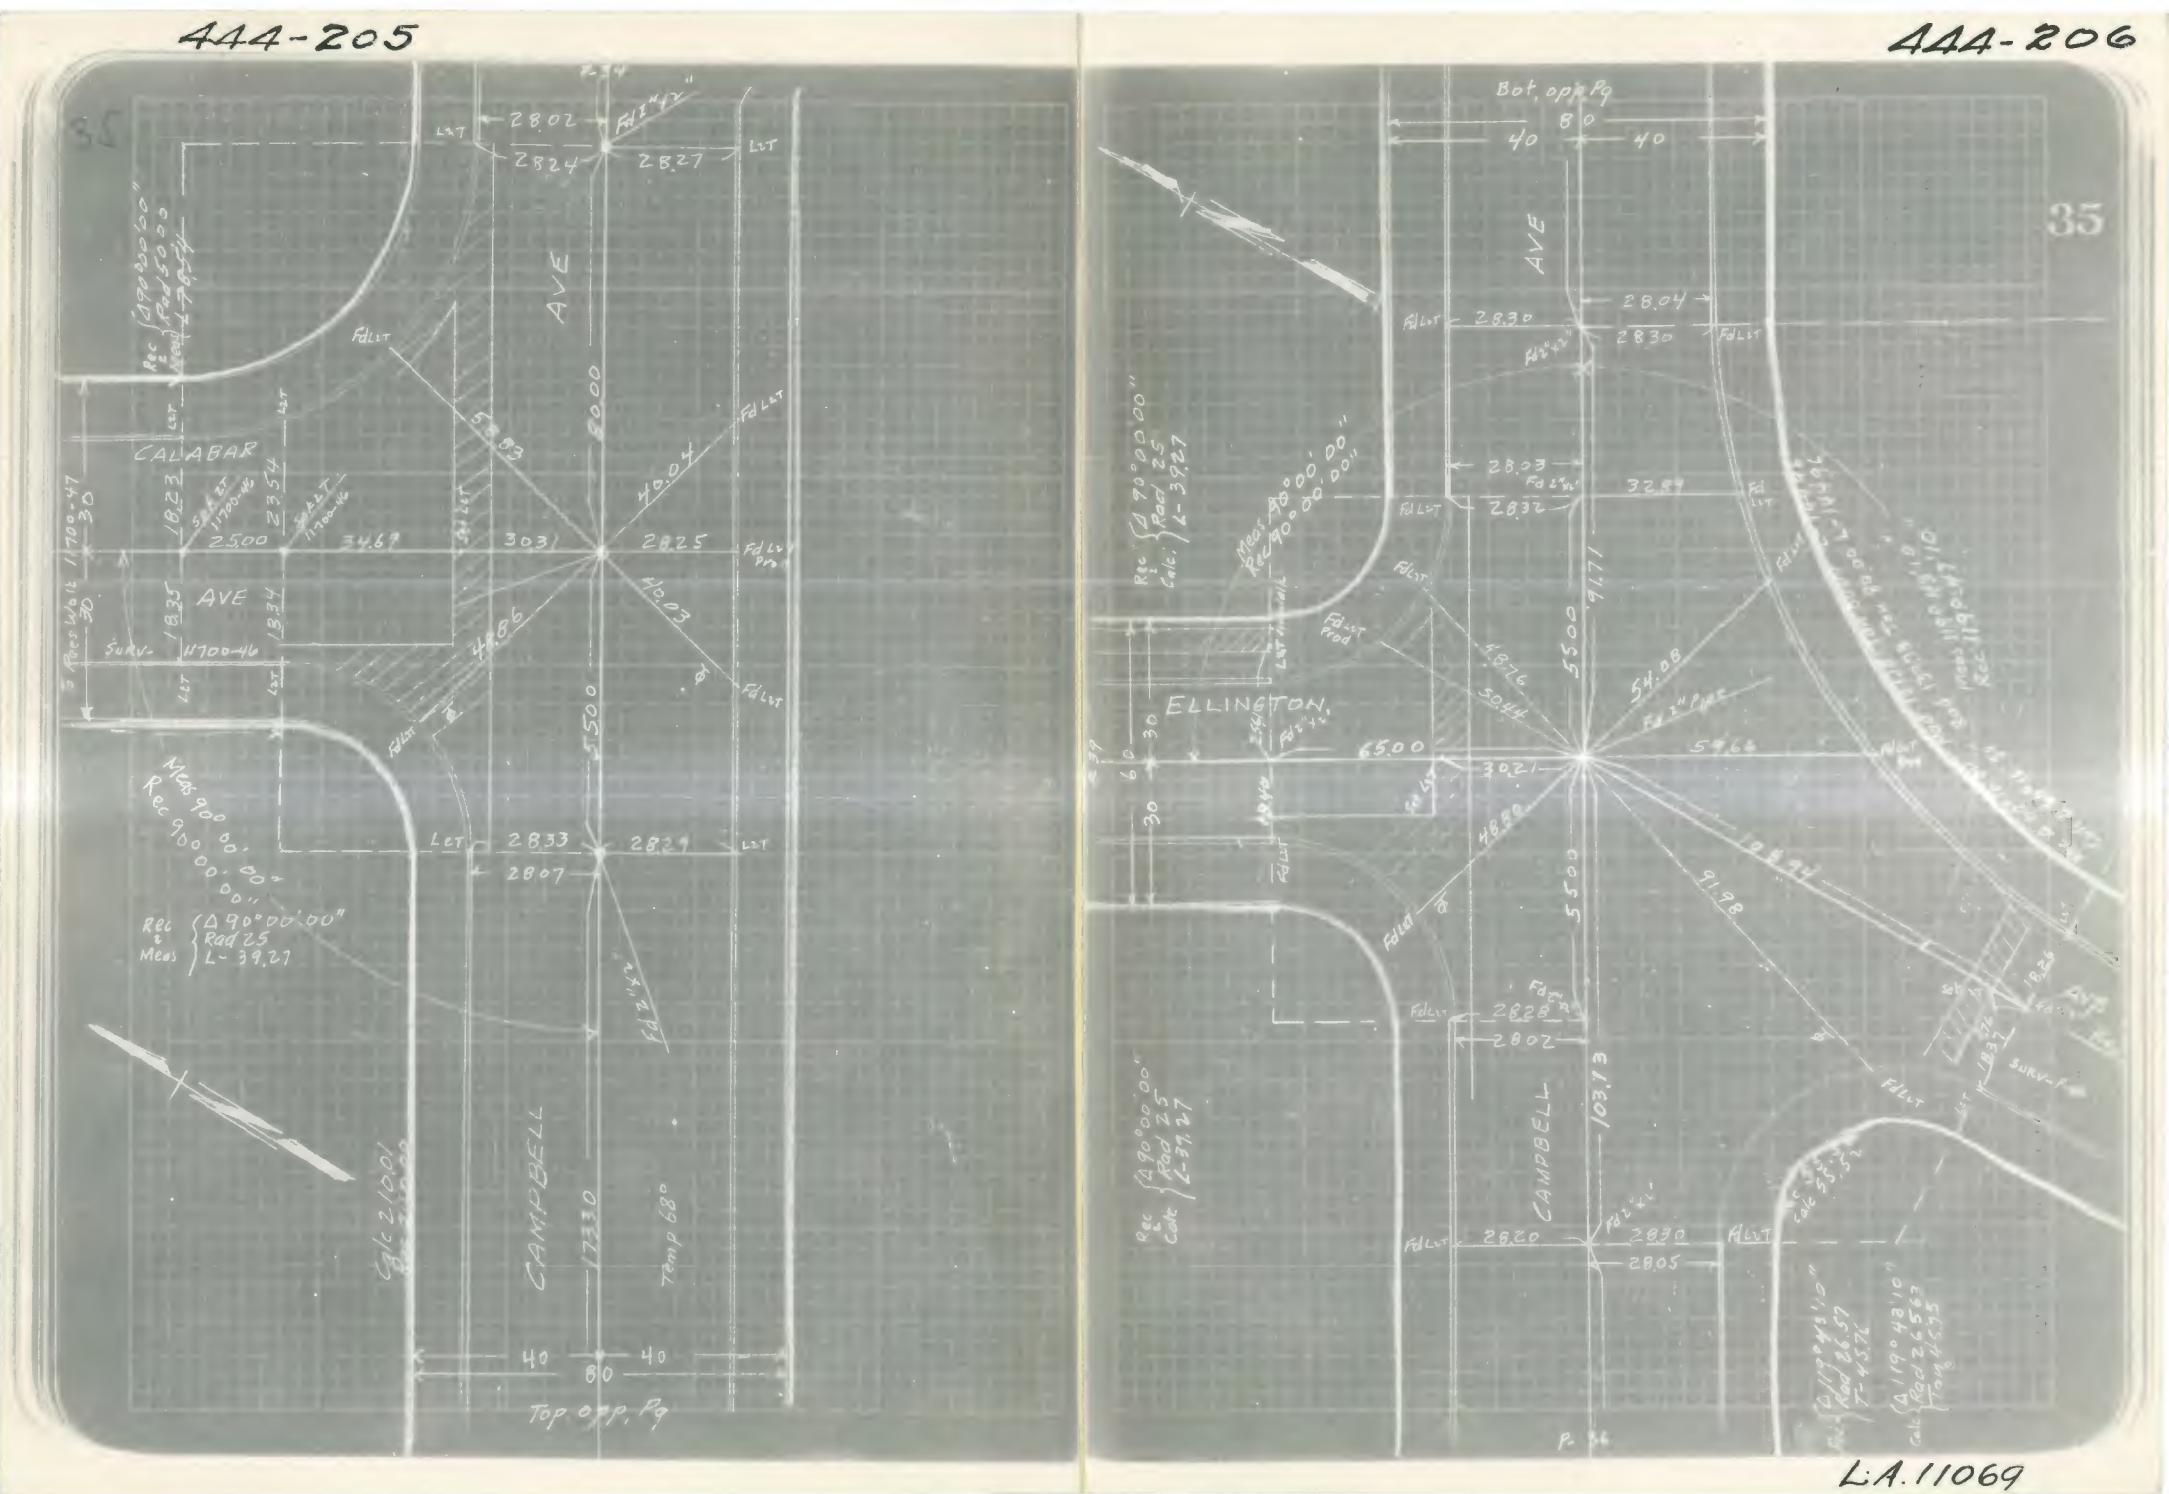

L.A. 11069

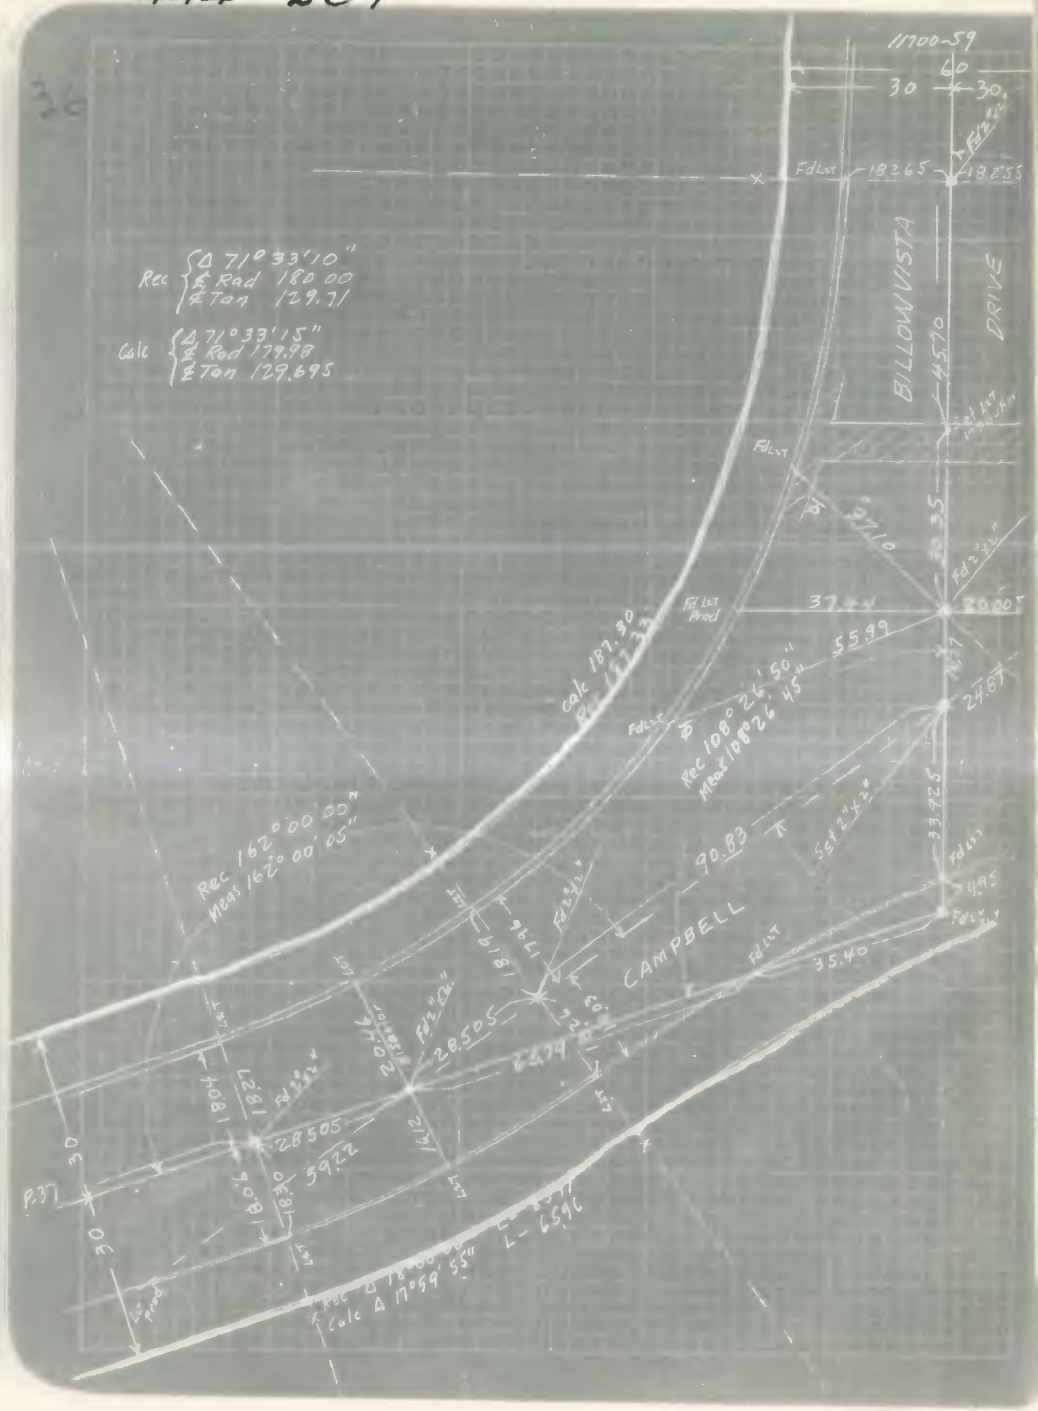
36
11700-59
60
30
30
Rec Δ 71°33'10"
℄ Rad 180.00
℄ Tan 129.71
Calc Δ 71°33'15"
℄ Rad 179.98
℄ Tan 129.695
BILLOWVISTA
DRIVE
Calc 187.30
Rec 162°00'00"
Meas 162°00'05"
Rec 108°26'50"
Meas 108°26'45"
CAMPBELL
90.83
35.40
28.505
59.22
Calc Δ 17°59'55"
L-65.96

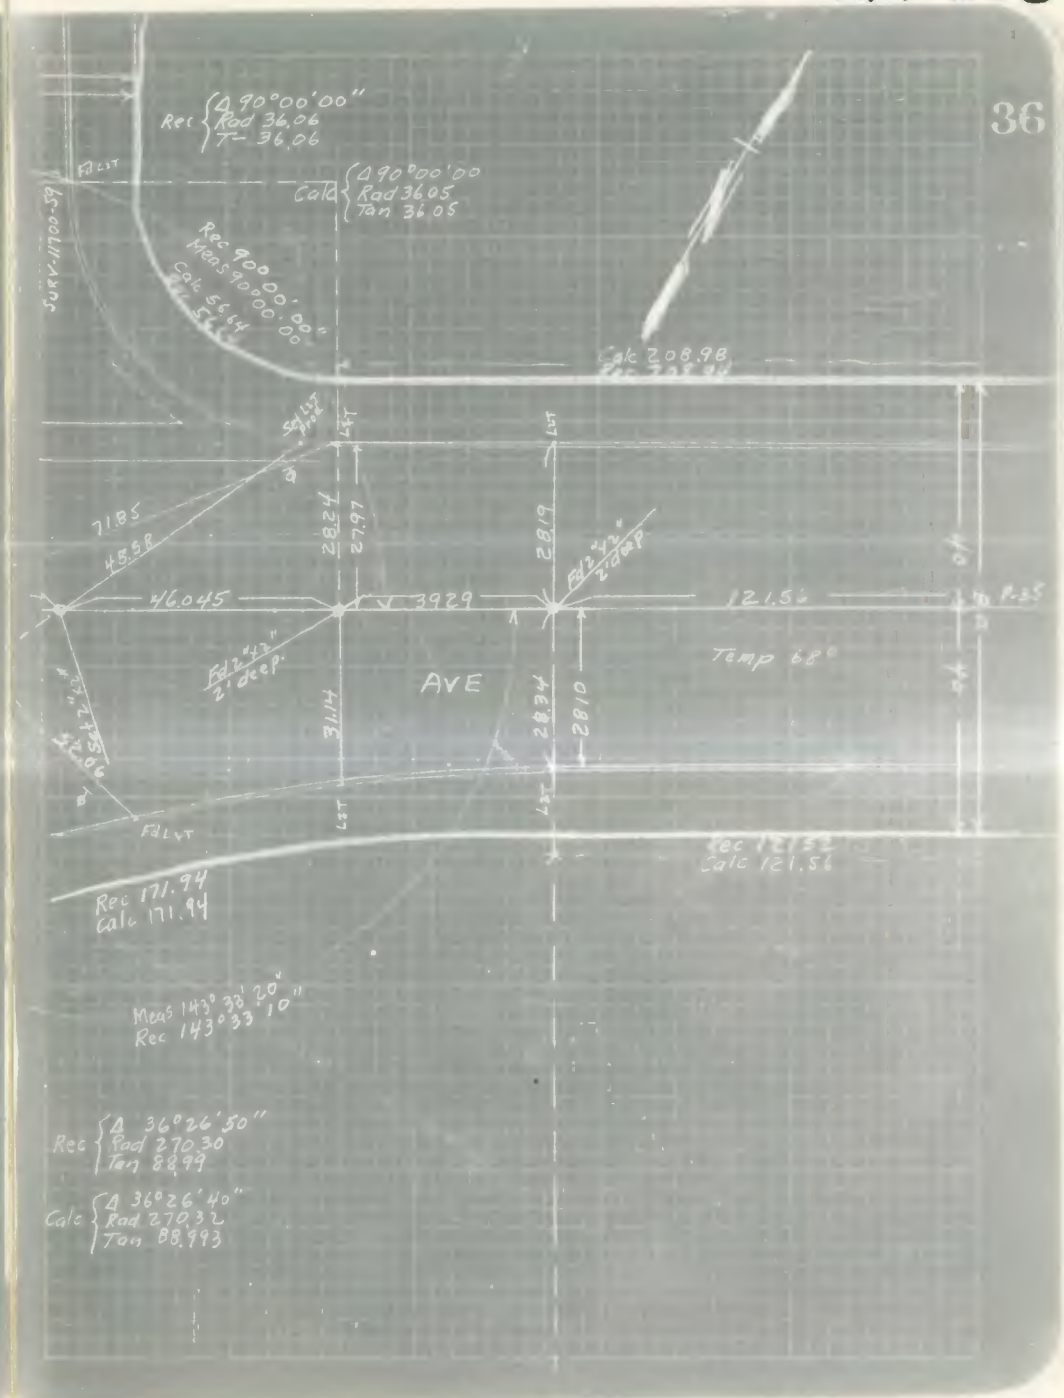
36
Rec Δ 90°00'00"
Rad 36.06
T- 36.06
Calc Δ 90°00'00
Rad 36.05
Tan 36.05
Rec 90°00'00"
Meas 90°00'00"
Calc 56.64
Calc 208.98
SURV-11700-59
71.85
48.58
46.045
39.29
121.56
Temp 68°
AVE
Rec 171.94
Calc 171.94
Rec 121.52
Calc 121.56
Meas 143°33'20"
Rec 143°33'10"
Rec Δ 36°26'50"
Rad 270.30
Tan 88.99
Calc Δ 36°26'40"
Rad 270.32
Tan 88.993

L.A. 11069

444-209

444-210

1st. ALLEY So of Manchester Ave
FALMOUTH AVE to ELLINGTON AVE

& SURVEY – Ties, Angles and Measurements

Apr. 1930

C.W.Clark
H.R.Eastman
H.A.Leonhardt
J.G.Kolb

Tract # 9809

Private Engr's Ties 10529-9,10

WIDTH Alley 20 Ft

Tape L-129 19½.'0 Pull Susp. @68° = 100.00

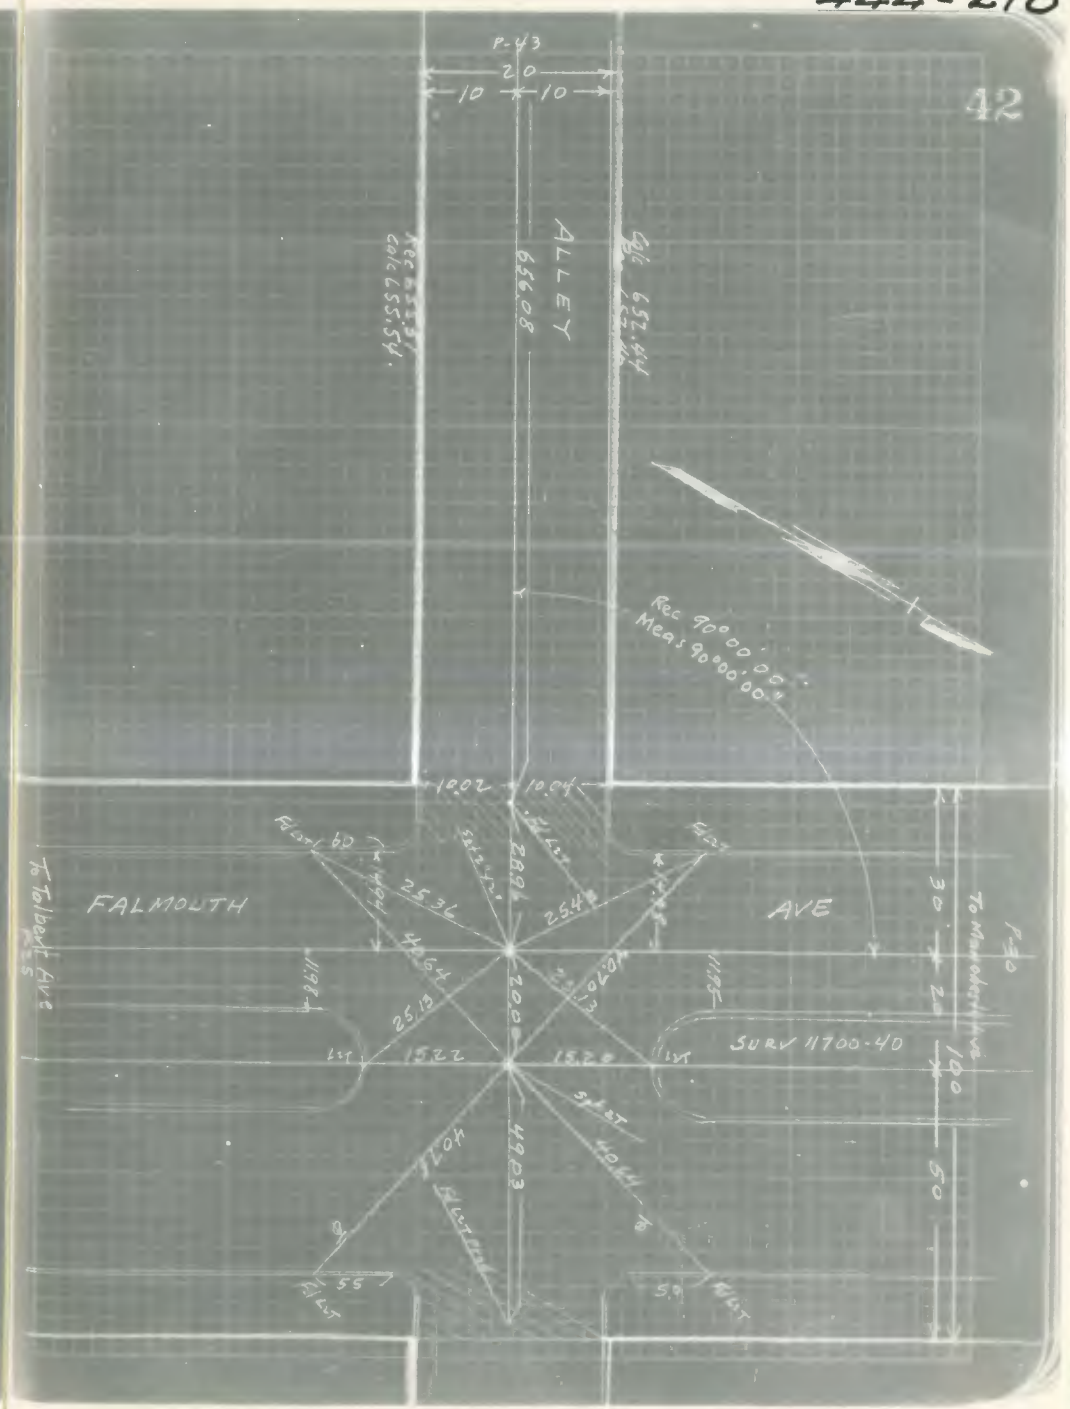

L.A. 11069

444-211

444-212

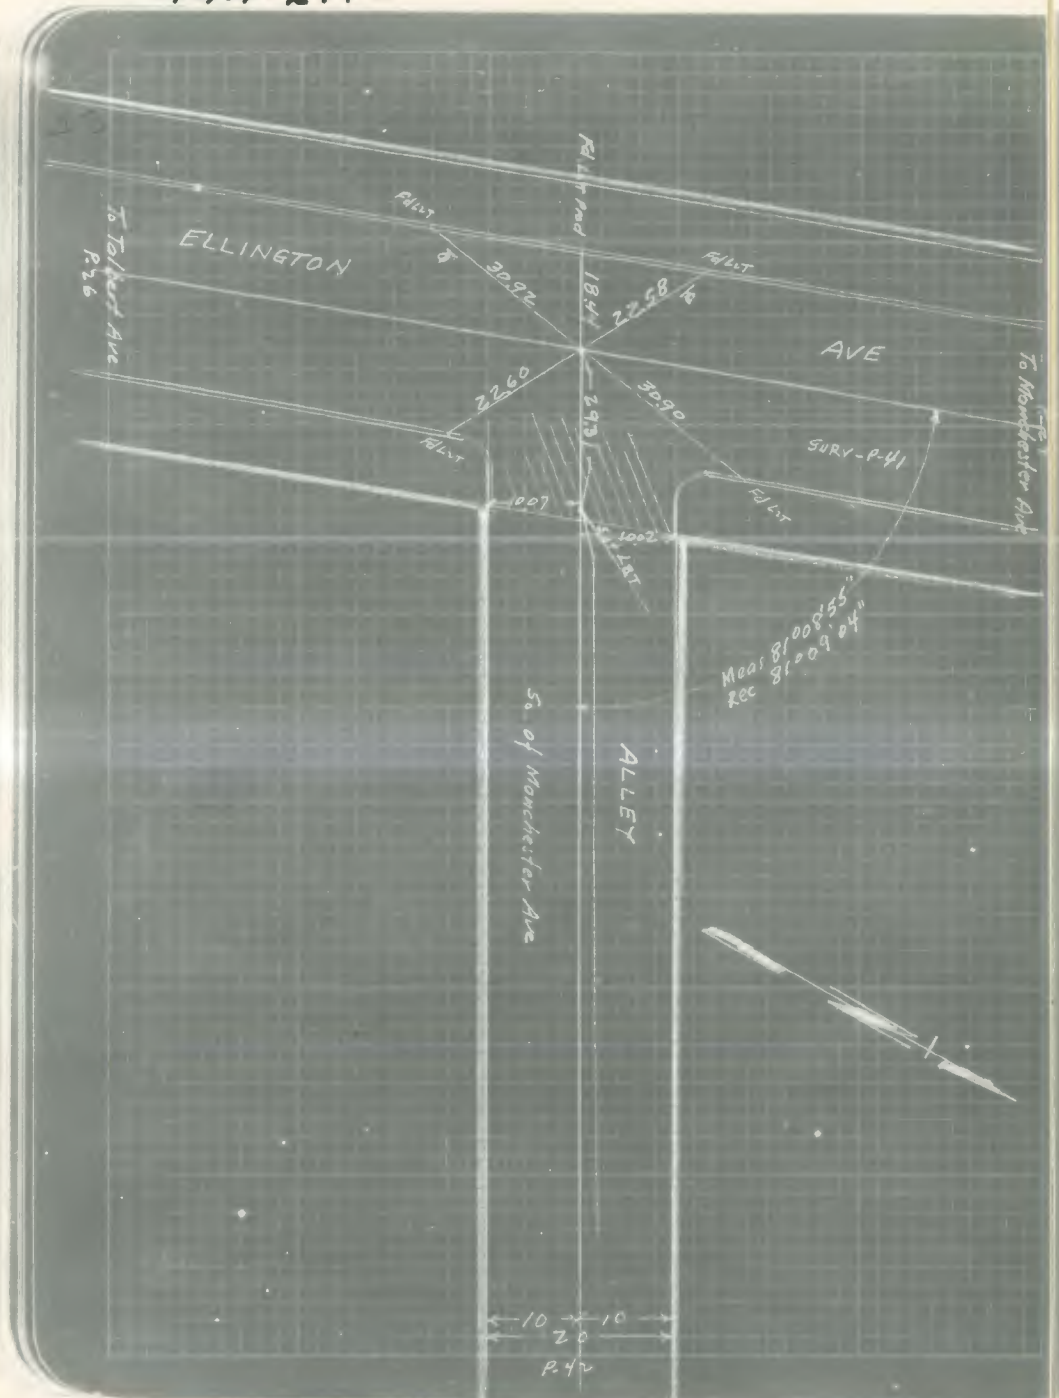

43

L.A. 11069

1st. ALLEY So. of Campbell Ave
FALMOUTH AVE to ELLINGTON AVE

℄ SURVEY - Ties, Angles, and Measurements.

Apr. 1930

C.W. Clark
H.R. Eastman
H.A. Leonhardt
J.G. Kolb.

TRACT # 9809

Private Engrs Ties 10529 - 12, 16

WIDTH Alley 20 Ft

Tape L-129 19½ lb Pull @ 680 = 100,000

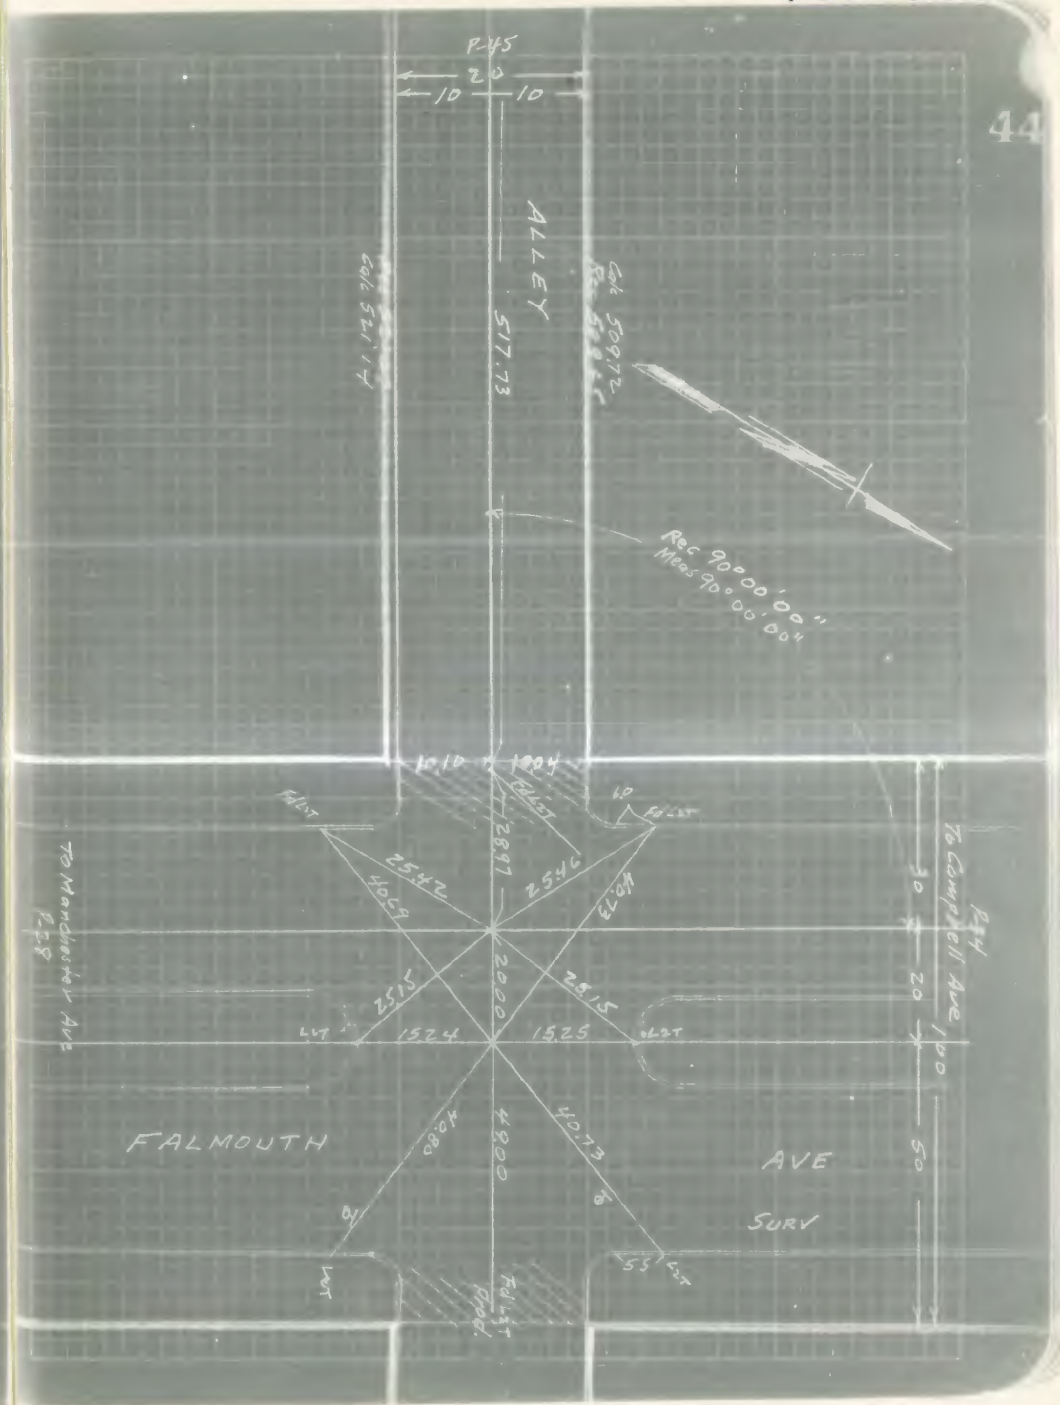

L.A. 11069

444-215

444-216

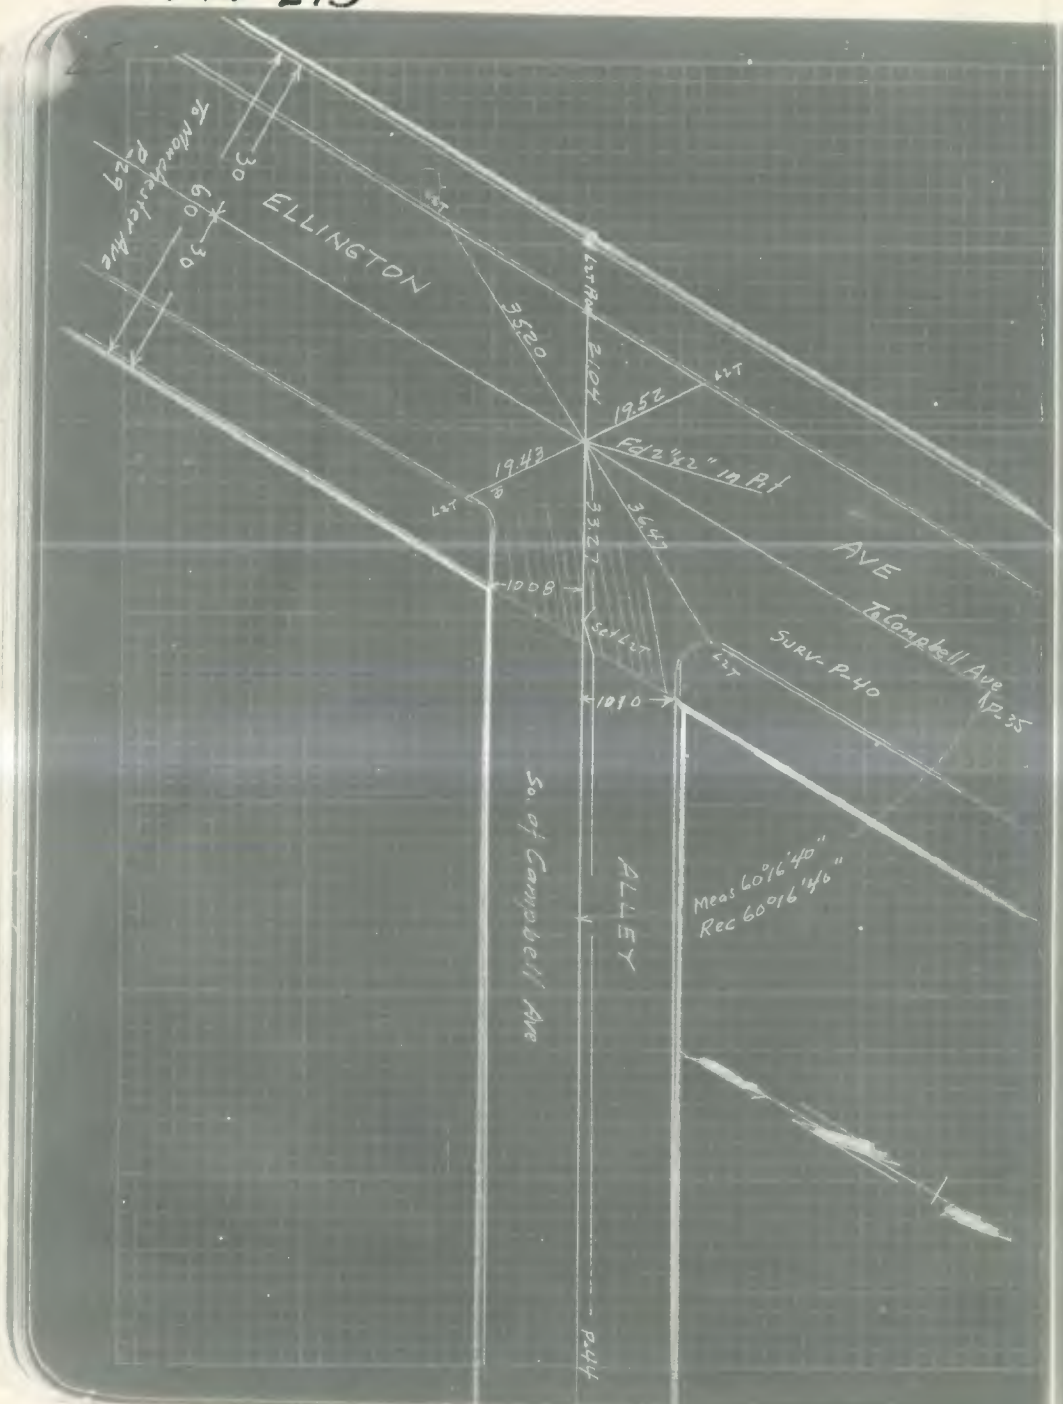

L.A. 11069

FB.
444 - 217

Copy
L.A. Co Bridge Dept
Notes

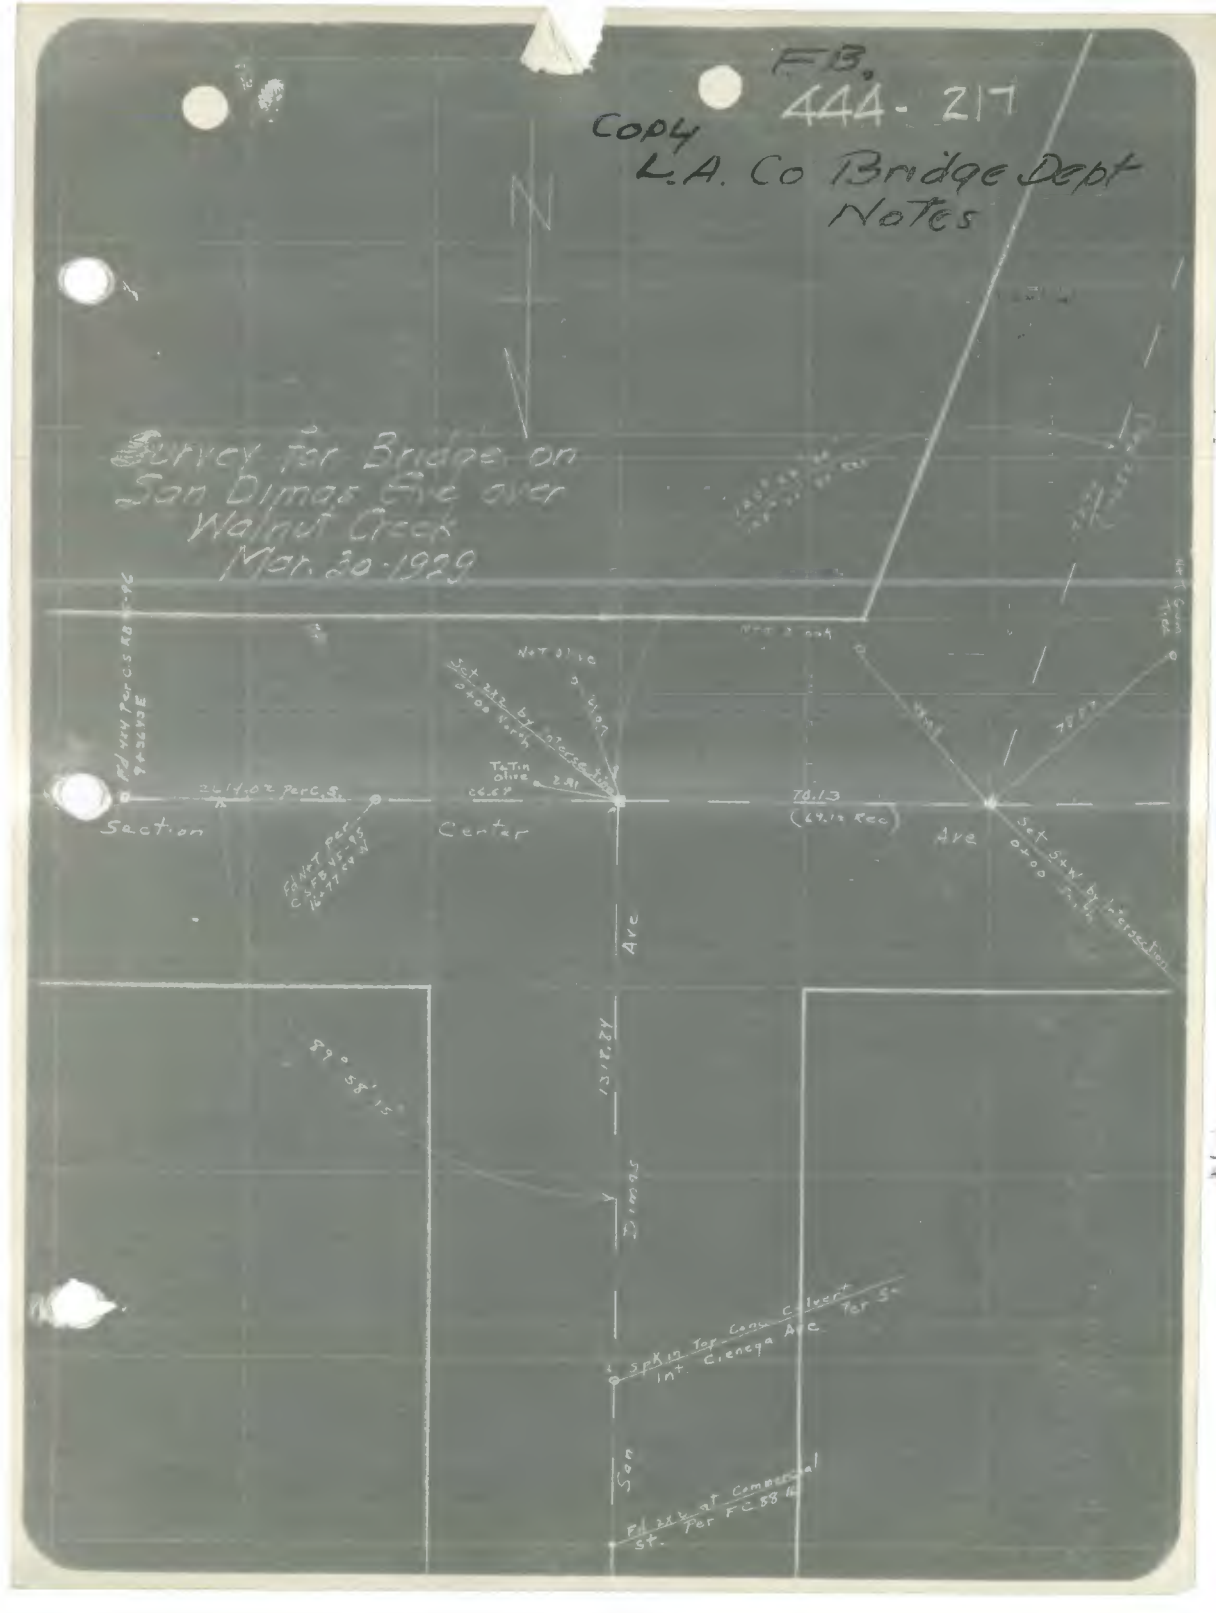

444-218

FB 444-218

F.B.
444-219

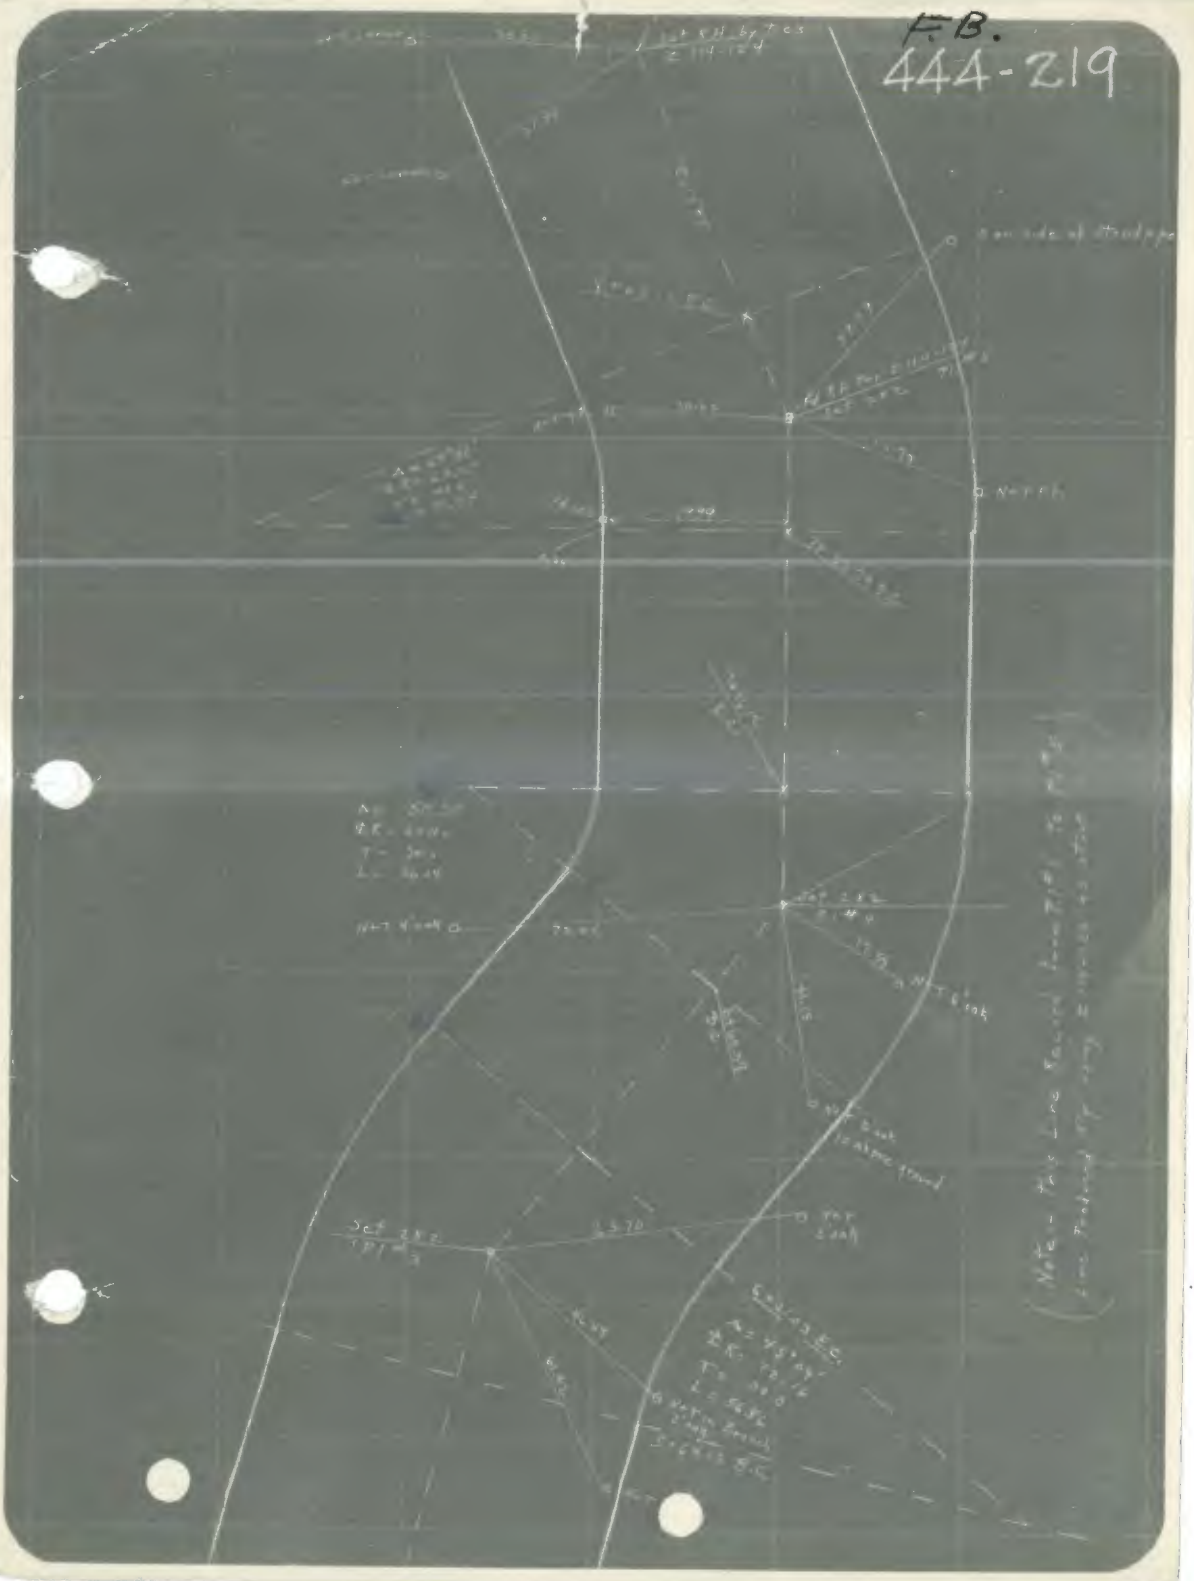

444