Survey of
W. O. Tape No. St'd °F.
Surveyed by
Notes Date
Indexed

Office Work
Checked
Date

F.B. PG.

4360

RETURN TO
LOS ANGELES COUNTY
7100 HALL OF REC

F.B. 460 Pg. Index

F.B. 460

Pages: Index, 1 to 53 incl., ,55 to 75 incl., ,77 to 107 incl., , 109 to 116 incl., 131 to 161 incl., ,163, , 165 to 182 incl.,

RETURN TO
LOS ANGELES COUNTY SURVEYOR
700 HALL OF RECORDS
Do not extend notes this side of this line
Notice: ANY ADDITIONS OR CHANGES ON THIS SHEET MUST BE MADE OR CIRCLED IN Red Ink WITH DATE AND NAME OF PERSON MAK. ING CHANGE.

Date _____ Notes by _____ Chief Party Miller F.B. 160 PG. 1

Plotted by K.V. Marin
Date Dec. 1931
Map No. B-643-1
Plotting C'k'd by D. M. Finley
Date Apr. 1933

W. O. No. 7016 S. S. P. No.
Location CYPRESS AVE
Surveyed by W.A. Miller
Date Jan. Feb Mar 1931
Indexed A. C. Johnson

0-130-1

CYPRESS AVE. SURVEY
WILMINGTON-REDONDO ROAD TO 190TH ST
W.O. 7016 Jan 29 to Mar 20 1931

Miller Chf
Gregory Inst
Boyd H.C.
Wilson R ch
Friend Extra

RETURN TO LOS ANGELES COUNTY ENGINEER
Do not unfold unless this side of this flap
Notice: Any alterations or changes on this map, made by any person other than the County Engineer, may be dangerous to life and property.

F.B. 460 PG. 2 — Miller Chief Party — Notes by — Date

Con at bottom page 3

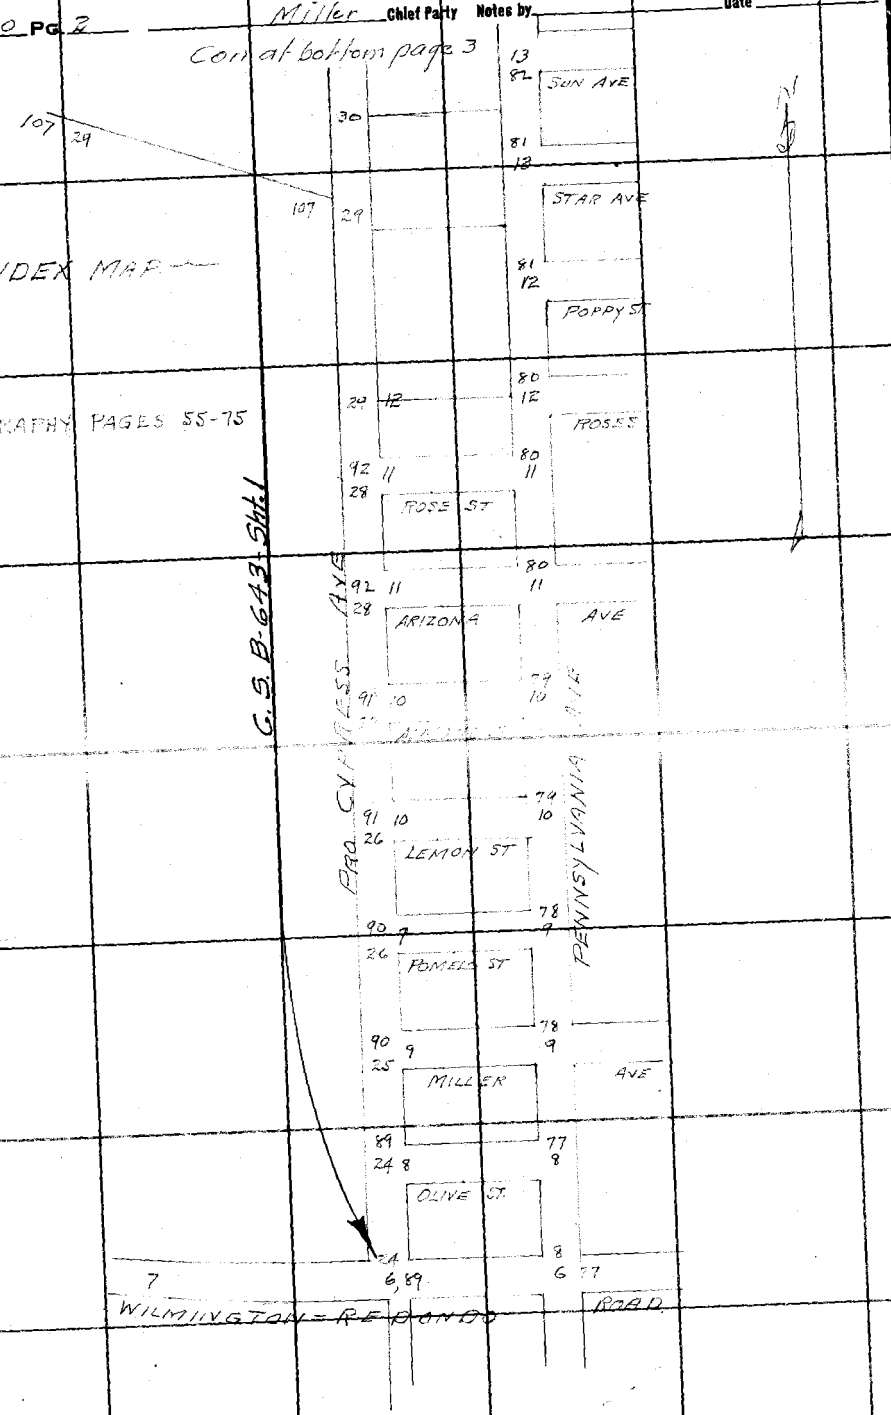

RETURN TO
LOS ANGELES COUNTY SURVEYOR

Do not extend notes this side of this line

Notes: ANY ADDITIONS OR CHANGES ON THIS SHEET MUST BE MADE OR CIRCLED IN Red. WITH DATE AND NAME OF PERSON MAKING CHANGE.

Date _____ Notes by _____ Chief Party Miller F.B. 460 Pg. 5

Platted by K. V. M.
Date Dec 1931
Map No. B-643-1
Platting C'k'd by D. M. Finley
Date Apr 1933

W. O. No. 7016 D. S. O. No. _____
Location CYPRESS AVE
Surveyed by W.A. Miller
Date Jan-Feb-Mar 1931
Indexed by C. Johnson

Con at bottom page 4

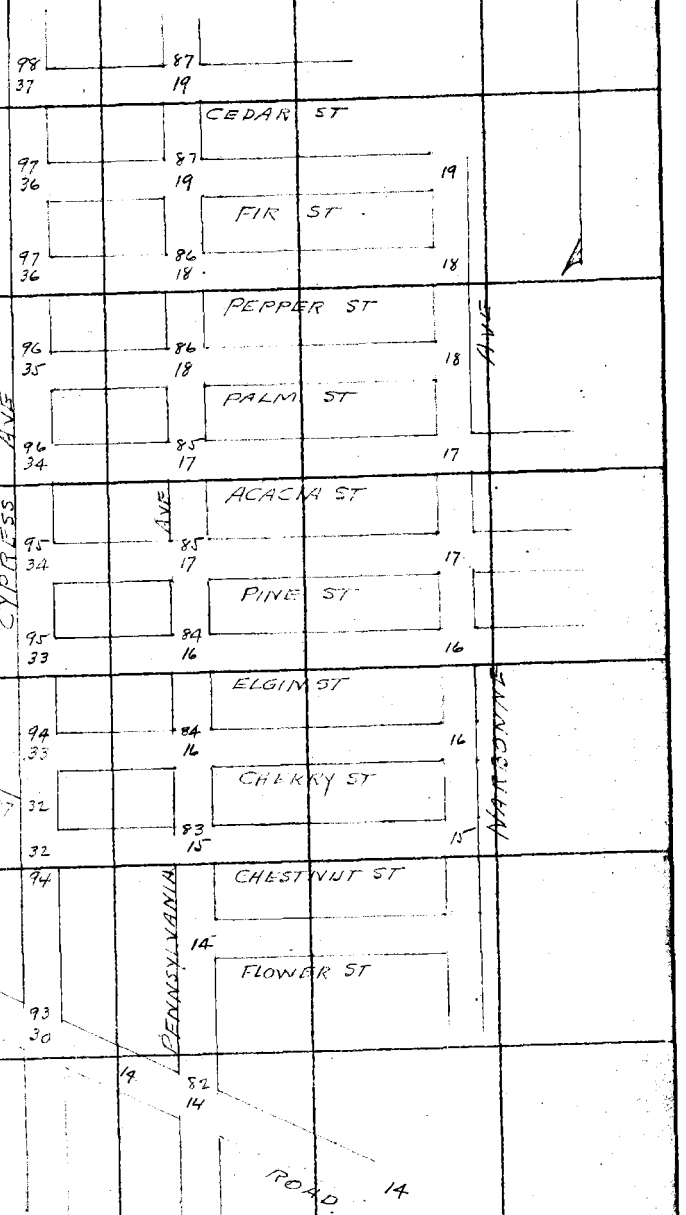

Con from Asp page 2

C.S. B-643-Sht 1

Notes: ANY ADDITIONS OR CHANGES ON THIS SHEET MUST BE MADE OR CIRCLED IN Red. WITH DATE AND NAME OF PERSON MAKING CHANGE.

Do not extend notes this side of this line

RETURN TO LOS ANGELES COUNTY SURVEYOR

F.B. 460 Pg. 4 Miller Chief Party Notes by Miller Date

Con at Bottom page 5

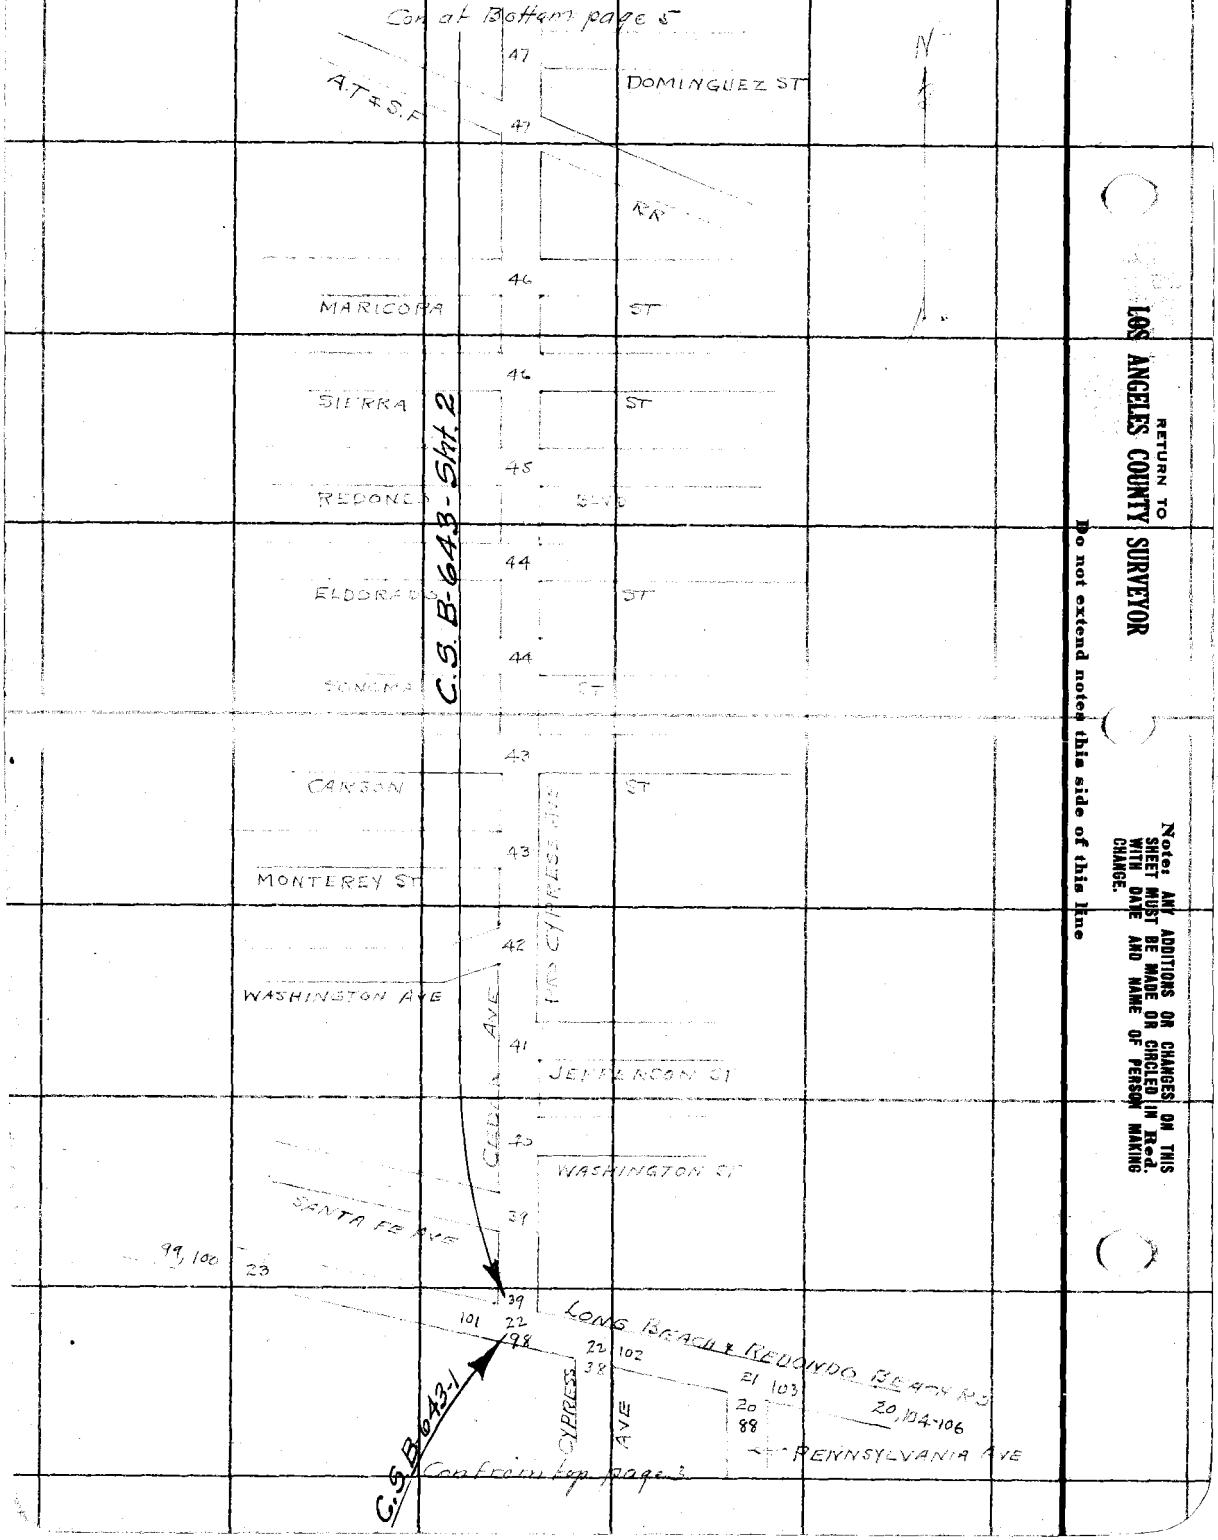

Confroin top page 5

RETURN TO
LOS ANGELES COUNTY SURVEYOR
Do not extend notes this side of this line

Note: ANY ADDITIONS OR CHANGES ON THIS SHEET MUST BE MADE OR CIRCLED IN Red. WITH DATE AND NAME OF PERSON MAKING CHANGE.

Date _____ Notes by _____ Chief Party _____ F.B. 460 Pg. 5

Platted by K. V. M.	W. O. No. 7016 D. S. D. No.
Date 12-23-31	Location CYPRESS AVE
Map No. B-643-12	Surveyed by W.A.Miller
Platting C'k'd by D. M. Finley	Date Jan.-Feb. Mar 1931
Date Apr. 1933	Indexed

TOPORAPHY PAGES 58-75

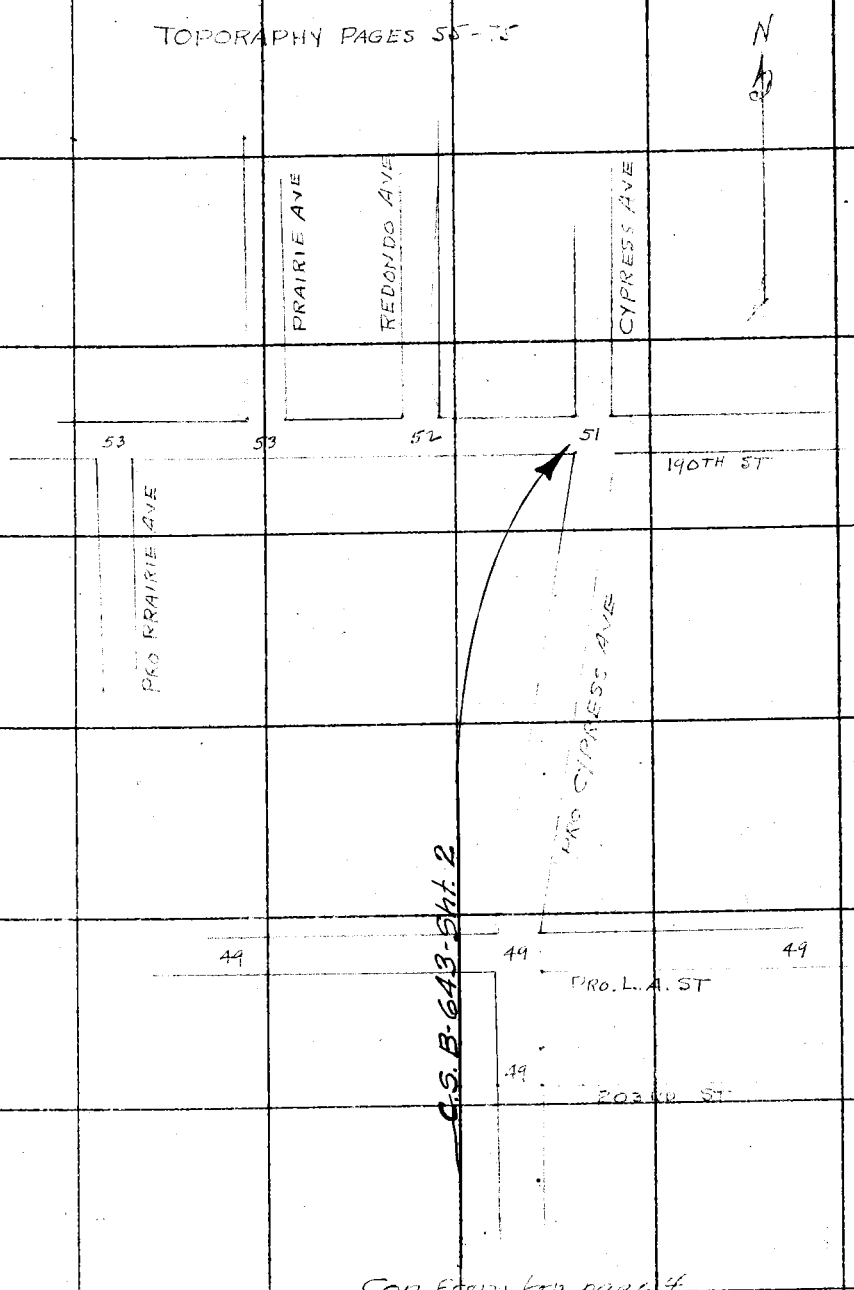

Con From top page 4

Note: ANY ADDITIONS OR CHANGES ON THIS SHEET MUST BE MADE OR CIRCLED IN Red. WITH DATE AND NAME OF PERSON MAKING CHANGE.

Do not extend notes this side of this line

RETURN TO LOS ANGELES COUNTY SURVEYOR

F.B. 460 Pg. 6 — Miller — Chief Party — Notes by Miller — Date 1-29-31

Tape "D.L." 84°F 25#

Con at bottom page 7

6+76.82
34.53
7+11.35
1+14.99
8+26.34
19.37
8+45.71
26.66
8+72.37

429.22 @ 0-00T82 = 429.21.

(50) (100) (50)

Tr # 9755

19 Adj.

429.21

Ed L.T.
Per F.A. 245-33
8+72.37.

Ed Con Mon - 12" Deep
Per F.A. 245-33
0.02 W. of 90° Off L.T

50.00 → 64 → 26.66 → 34 → 19.37

50.00

Ed Con Mon - 12" Deep
Per F.A. 245-33
0.02 W of 90° Off L.T

P.C.

HILLWORTH AVE

(30) (40) (30)

Adj.

0.55

Ed L.T.
Per F.A. 245-33
8+45.71.

For Adopted & See Pg. 89

See Page 24

Ed L.T.
No Ref.
8+26.34.
115.00 @ 0-00T76 = 114.99.

114.99

Ed L.T.
No Ref.
7+11.35.

34.53

Ed L.T.
No Ref.
6+76.82.

WILMINGTON

TRACT

.87 Adj.

676.82

676.86 @ 0-00T76 = 676.82.

REDONDO

PENNSYLVANIA

AVE

For Adopted & See Pgs. 77 to 88

Ed Spk - 6" Deep
F.B. 230-3
F.B. 304-23

(50) (100) (50)

RETURN TO
LOS ANGELES COUNTY SURVEYOR

Do not extend notes this side of this line

Notes: ANY ADDITIONS OR CHANGES ON THIS SHEET MUST BE MADE OR CIRCLED IN Red. WITH DATE AND NAME OF PERSON MAKING CHANGE.

Date 1-29-31 Notes by Miller Chief Party Miller F.B. 460 Pg. 1

8+72.87
A+29.31
13+01.58

Plotted by K. V. M.	W. O. No. 7016 D. S. O. No.
Date 12-23-31	Location CYPRESS AVE
Map No. C.S. B-643-1,2	Surveyed by W.A. Miller
Plotting C'k'd by D. M. Finley	Date Jan. 1931
Date Apr. 1933	Indexed A. C. Johnson

Tape #044
84°F 20#

Note: ANY ADDITIONS OR CHANGES ON THIS SHEET MUST BE MADE IN CIRCLES IN Red. WITH DATE AND NAME OF PERSON MAKING CHANGE.

Do not extend notes this side of this line

RETURN TO LOS ANGELES COUNTY SURVEYOR

Ed L.o.T
Per F.A. 245-33

To P.I. F.B. 455-44

Fd. Conc. Mon. 18" Deep
Per F.A. 245-33

50.00 49.99 EC

(50) (100) (50)

Δ = 41-03-15
R = 1146.28'
T = 429.19'
L = 821.34'
Per F.A. 245-33

429.19 @ 0.00 T86 = 429.20.

429.19 Adj.

WILMINGTON ROAD

TRACT No 9765

Fd. Conc. Mon. 18" Deep
Per F.A. 245-33 P.I. #9
13+01.58

Fd 2" I.P. P/L #9 T.K. - Flush

2.08

138-56-45
138-56-45
138-56-45

138-56-45
195-47-00
138-56-45

138-56-45
195-47-15
138-56-45¾
6-11-1931

429.51 Adj.

REDONDO

(50) (100) (50)

Con. from top page 6

F.B. 460 Pg. 8 — Miller Chief Party — Notes by Miller — Date 1-29-31

Tape #044
84°F 20#

Con at bottom page 9

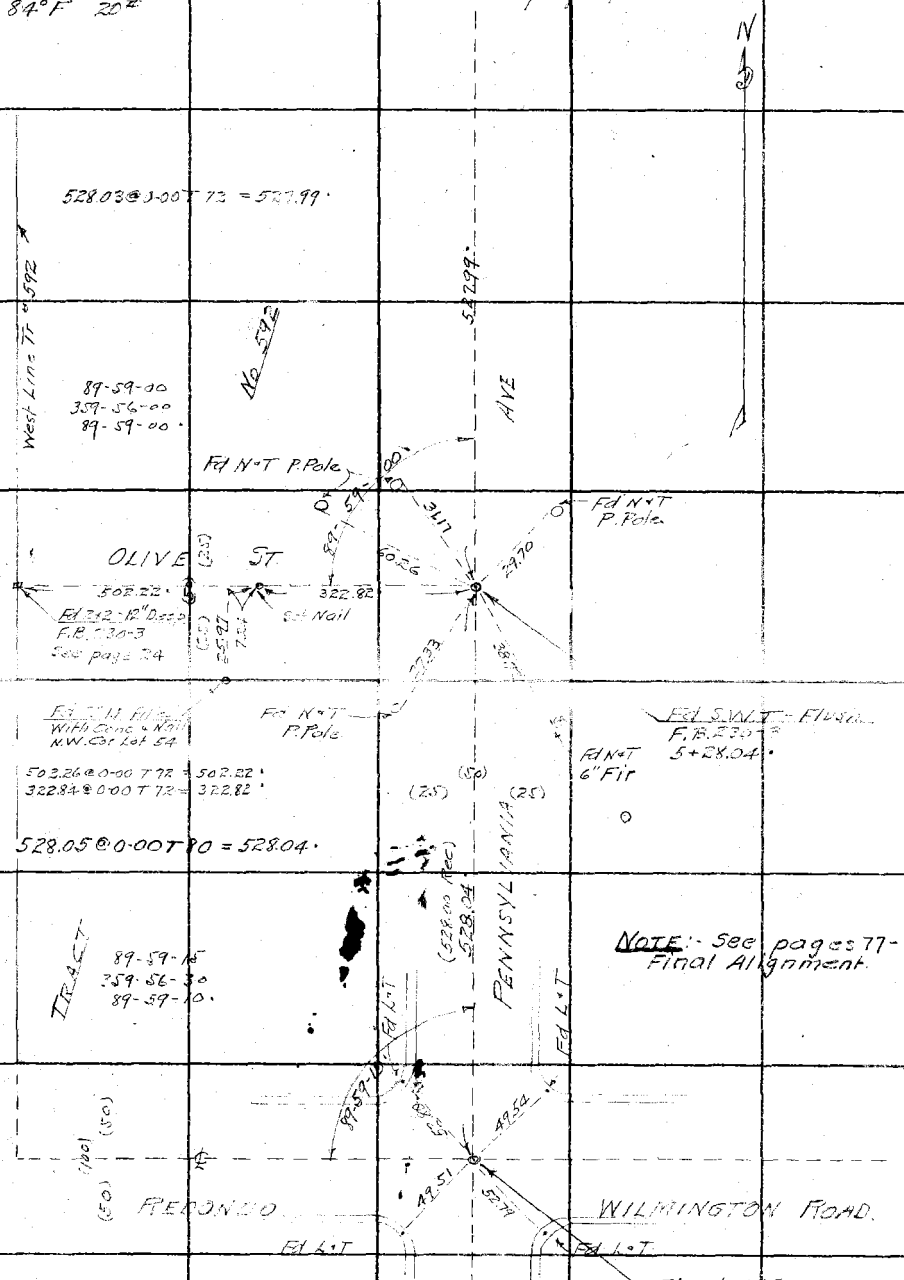

Note: See pages 77-88 For Final Alignment.

RETURN TO LOS ANGELES COUNTY SURVEYOR

Do not extend notes this side of this line

Note: ANY ADDITIONS OR CHANGES ON THIS SHEET MUST BE MADE OR CIRCLED IN Red. WITH DATE AND NAME OF PERSON MAKING CHANGE.

Date 1-30-31 Notes by Miller Chief Party Miller F.B. 490 Pg. 9

5+28.04
5+27.99
10+56.03
5+28.00
15+84.03

Platted by K. V. M.
Date 12-23-31
Map No. B-643-1, 2
Platting C'k'd by D. M. Finley
Date Apr. 1933

W. O. No. 7016 D. S. O. No.
Location CYPRESS AVE
Surveyed by W.A. Miller
Date Jan 1931
Indexed A. C. Johnson

70 pts #044
84°F 20°

Con at bottom page 10

528.06 @ 0-00 T 62 = 527.98'

89-58-30
359-53-30
89-58-22½"

Fd 2x2 - 12" Deep
F.B. 230-4
See page 26

Fd N°T P. Pole

89-58-25

527.98'

POMELO ST

825.07

170.13 · 329.98 · 324.99 ·

Set N°T

Fd N°T P. Pole

Fd S.W.T
F.B. 230-4
15+84.03.

Fd 2x2
F.B. 230-4

Fd 2x2
F.B. 230-4

Fd N°T
4" Peach

170.14 @ 0-00 T 70 = 170.13'
330.01 @ 0-00 T 70 = 329.98'
324.99 @ 0-00 T 70 = 324.96'
825.14 @ 0-00 T 70 = 825.07'

528.05 @ 0-00 T 68 = 528.00'

West Line Tr. 592

89-58-45
359-54-45
89-58-41½"

PENNSYLVANIA

528.00'

Fd N°T P. Pole

Fd 2x2 R.P. 18" Deep
F.B. 230-4

TRACT

Fd N°T
P. Pole

89°58'40"

1.34

MILLER ST

825.06'

0.95

Fd 2x2 No Tk. F.B. 304-23
Replaced with 2x2-8" Deep
5-19-31

Fd N°T P. Pole

Fd 2x2 - 12" Deep
F.B. 230-4
See pages 25

Fd N°T
P. Pole

Fd S.W.T
Per F.B. 230-4
15+56.03.

825.15 @ 0-00 T 68 = 825.06'

527.99

Con from top page 8

Note: ANY ADDITIONS OR CHANGES ON THIS SHEET MUST BE MADE OR CIRCLED IN Red. WITH DATE AND NAME OF PERSON MAKING CHANGE.

Do not extend notes this side of this line

RETURN TO LOS ANGELES COUNTY SURVEYOR

F.B. 460 Pg. 10 — Miller — Chief Party — Notes by Miller — Date 2-2-31

Tape "044
84°F 20mph

Con at bottom page 11

15+84.03
5+27.98
21+12.01
5+27.97
26+39.98

528.07 @ 0-00T 76 = 528.04.

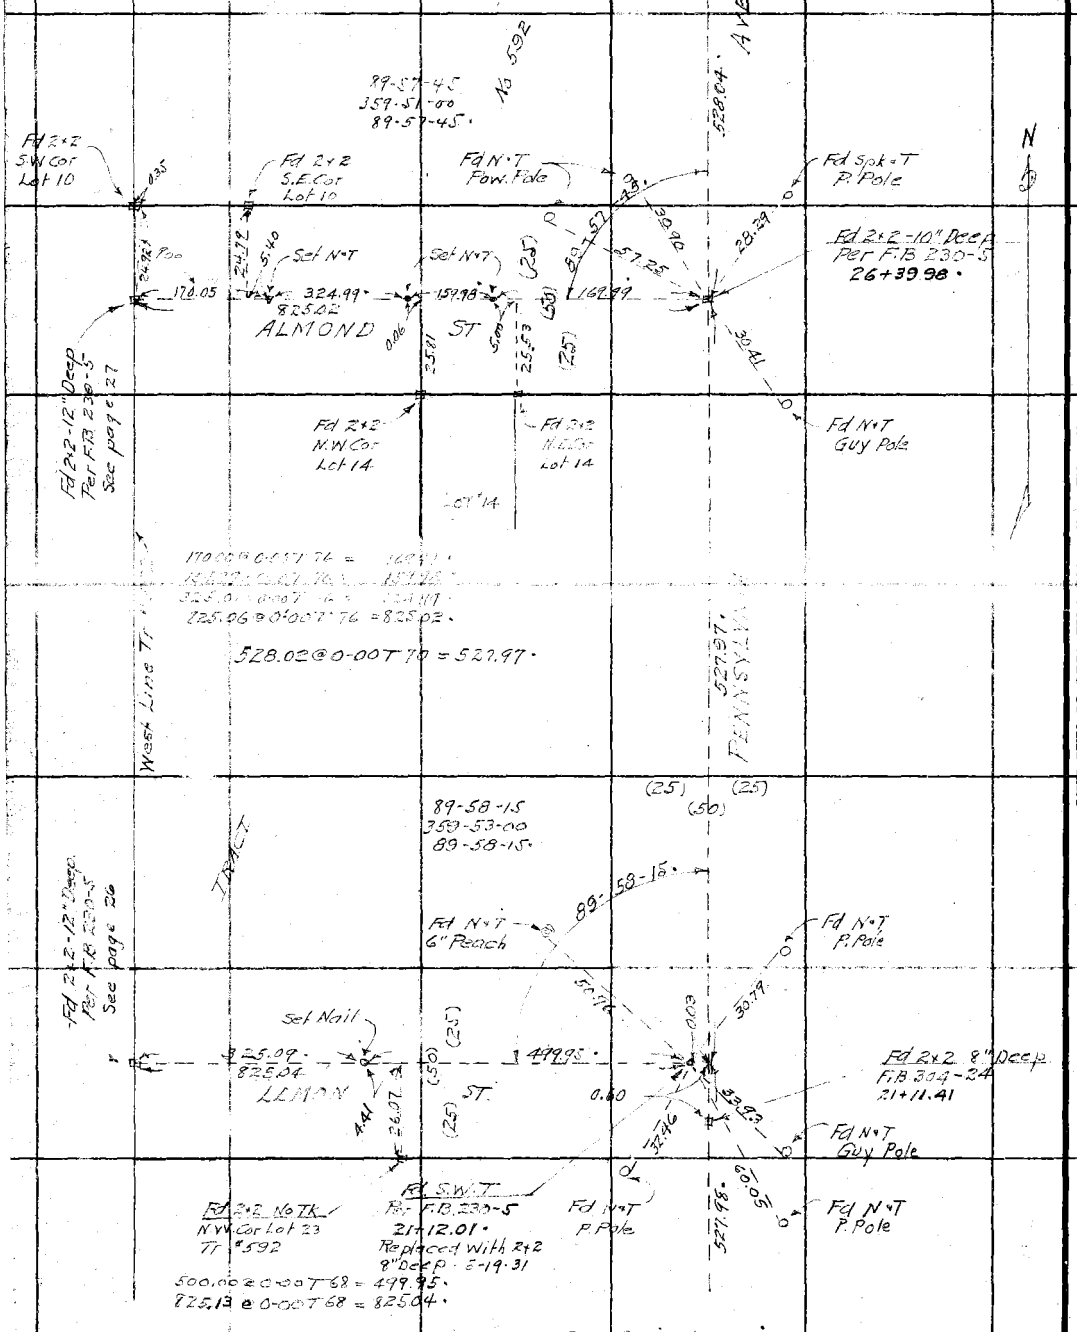

Con from top page 7

RETURN TO LOS ANGELES COUNTY SURVEYOR

Do not extend notes this side of this line

Notes: ANY ADDITIONS OR CHANGES ON THIS SHEET MUST BE MADE OR CIRCLED IN Red. WITH DATE AND NAME OF PERSON MAKING CHANGE.

Date 2-2-31 Notes by Miller Chkd Party Miller F.B. 460 Pg. 11

Platted by K. V. M.
Date 12-23-31
Map No. B-643-1, 2
Platting C'k'd by D. M. Finley
Date Apr 1933

W. O. No. 7016 D. S. O. No.
Location CYPRESS AVE
Surveyed by W.A Miller
Date Feb 1931
Indexed A. C. Johnson

TODG "944 84°F 35"

26+39.98
5+28.04
31+48.02
2+64.00
34+32.02
8.99
35+18.01

N

Con at bottom 12

178.52 @ 0-00 T 64 = 178.50 ·

89-57-45
359-51-00
89-57-45

Fd N&T P. Pole

89-57-45

178.50 AVE

Fd N&T Guy Pole

Fd 2×2 12" Deep F.B. 230-6 See Page 28

Fd 2×2 Flush

25.15 30.15 35.08 31.40

825.12 ·

ROSE ST

Fd 2×2 Flush

29.81 0.08 24.85 25.25 20.01

Fd N&T 6" Fir

Fd 2×2 - 12" Deep Per F.B. 230-6 35+18.01

Fd N&T 6" Fir

825.22 @ 0-00 T 66 = 825.12 ·

No 5959

86.00 @ 0-00 T 66 = 85.99 ·

85.99

West Line TT #5959

PENNSYLVANIA

TRACT

Set N&T 34+32.02 ·

89-57-45
359-51-15
89-57-48 3/4

264.03 @ 0-00 T 66 = 264.00 ·

264.00

825.08 @ 0-00 T 76 = 825.04 ·

Fd "X" in Walk

Fd N&T Guy Pole

179-57-45
359-58-30
179-58-37 1/2

Fd Conc. Mon With Spk-Tin 18" Deep

25.00 25.01

Fd Conc. Mon With Spk-Tin 18" Deep

Fd 2×2 12" Deep F.B. 230-6 See Page 28

89-57-50

0.12 24.11 24.11 33.46 51.23

Fd N&T 8" Fir

825.04 ·

(25) (25) (50)

ARIZONA ST.

0.28

Fd Old 2×2-12" Deep Per F.B. 230-6 804.24'

179-59-40

25.30 25.23 31.31 39.78

25.07 25.03

31+67.74

Fd N&T P. Pole

Fd 2×2-12" Deep Per F.B. 230-6 31+68.02 ·

TR. 592

Fd Conc. Mon With Spk-Tin 18" Deep

529.04

Fd N&T P. Pole

Fd Conc. Mon With Spk-Tin 18" Deep

Con from lop page 10

Note: ANY ADDITIONS OR CHANGES ON THIS SHEET MUST BE MADE OR CIRCLED IN Red. WITH DATE AND NAME OF PERSON MAKING CHANGE.

Do not extend notes this side of this line

RETURN TO LOS ANGELES COUNTY SURVEYOR

F.B. 460 Pg. 12 — Miller, Chief Party — Notes by Miller — Date 2-3-31

Tape #044
84°F 20 mi

Con'd bottom of page 13 N

35+18.01
1+78.50
36+96.51
3+51.75
40+48.26

352.24 @ 0-00 T 64 = 352.19.

352.19

Fd L.T

POPPY ST.

3768

115.23

Fd L.T & Prod.

37.11

Set S.W.T Per F.B. FB 308-90 ✓
40+48.26.

351.86 @ 0-00 T 64 = 351.75.

351.75

89-59-30
3-59-58-30
87-59-30

Fd 1/2 I.P. Flush Per F.B 230-7

800.23 @ 0-00 T 60 = 800.10.

800.10
N Line Tr. "5959"

Fd L.T Curb

89-59-30

Fd L.T Curb

ROSE ST

Fd L.T Curb

Fd 1/2 I.P. Flush Per F.B 230-7 ✓

Fd N.T. P. Pole

Fd S.W.T Per F.B. 330-7
36+96.51.

TRACT No 5959

Con from top page 11

RETURN TO
LOS ANGELES COUNTY SURVEYOR

Do not extend notes this side of this line

Notes: ANY ADDITIONS OR CHANGES ON THIS SHEET MUST BE MADE OR CIRCLED IN Red. WITH DATE AND NAME OF PERSON MAKING CHANGE.

Date 2-5-31 Notes by Miller Chief Party Miller F.B. 460 Pg. 18

Tape #044
84°F 20#

40+48.26
3+52.19
44+00.45
3+57.17
47+52.62

Platted by K. V. M.
Date 12-23-31
Map No. B-643, 1, 2
Platting C'k'd by D. M. Finley
Date Apr. 1932

W. O. No. 7016 D. S. O. No.
Location CYPRESS AVE
Surveyed by W. A. Miller
Date 2-6 1931
Indexed A. C. Johnson

Con. at bottom page 14

762.37 30-00
T 64 = 762.27.

762.37.

Fd L.T

3804

1511

Fd L.T
± Prod.

SUN AVE

Set S.W.T
Per Ties F.R. 308-96
47+52.62.

Fd L.T

352.22 @ 0-00
T 64 = 352.17.

352.17.

PENNSYLVANIA AVE

CYPRESS ST

Fd L.T

Set P.K. in M.H. Cover
Per Ties F.R. 308-98
44+00.45.

Fd L.T
± Prod

3711

1534

3384

STAIR AVE

352.19.

Fd L.T

Con from top page 12

NOTE: ANY ADDITIONS OR CHANGES ON THIS SHEET MUST BE MADE OR CIRCLED IN Red. WITH DATE AND NAME OF PERSON MAKING CHANGE.

Do not extend notes this side of this line

RETURN TO LOS ANGELES COUNTY SURVEYOR

F.B. 460 Pg. 14 — Miller — Chief Party — Notes by Miller — Date 2-7-31

Tape * o.d. 84°F 20#

Con. to bottom page 15

47+52.62
+ 63.27
5514.89
- 28.15
5543.04
- 26.50
58+09.54
20
58+09.74
+ 63.14
60+72.88

N

N 0°-23' E

FLOWER ST

Set N°T 60+72.88. Removed 5-21-31

Fd base 2½" 2½" 18" Deep 60-49.98

Fd N°T No Tag 58+09.54.

Set N°T 58+09.74. 5-20-31

TRACT

KEN

Cont. Pg. 30

Fd N°T P. Pole

Fd N°T in double 8" Gum

Fd 2½ - 2" Deep Per F.A. 216-6

Set N°T in 20" Gum

Fd S.W.T Per F.A. 216-6

Fd base 2½" 2½" 18" Deep No Tag

Replaced with New 2½ by 1/2-12 Deep

55+14.89

179-59-30
359-58-00
179-59-30

Fd C.S. Cont. No. MHA 9.5 Gum F.A. 216-6

COUNTY SURVEY WILMINGTON TWP. ROAD MONUMENT

Fd N°T Ph. Pole

Fd Old 2½ 16 Tag 6" Deep

Fd L°T

Fd N°T P. Pole

Fd S.W.T Per F.A. 216-6 F.R. 308-68

877.99 @ 0-00 T 68 = 877.90

ROAD

Fd "X" in Outlet Fire Plug

Fd N°T P. Pole

Fd S.W.T Per F.R. 308-12 Also F.B. 304-26

Set N°T 22h. Fd "X" in Fire Plug

Fd N°T P. Pole

PENNSYLVANIA

CYPRESS ST

TRACT No 12

Con. to top page 13

RETURN TO LOS ANGELES COUNTY SURVEYOR

Do not extend notes this side of this line

Note: ANY ADDITIONS OR CHANGES ON THIS SHEET MUST BE MADE OR CIRCLED IN Red. WITH DATE AND NAME OF PERSON MAKING CHANGE.

Date 2-7-31 Notes by Miller Chief Party Miller F.B. 460 Pg. 15

Platted by K. V. M.
Date 12-22-31
Map No. B-643-12
Platting C'k'd by D. M. Finley
Date Apr. 1932

W. O. No. 7016 D. S. O. No.
Location CYPRESS AVE
Surveyed by W. A. Miller
Date Feb 1931
Indexed C. Johnson

Tape "044
84° F 20°

60+72.88
3+03.99
63+76.87
2+43.43
66+02.30
2+64.60
68+66.30

Con. at bottom page 16

No LS

#847

IR

527.89

AVE

527.95 @ 0-00 T 66 = 527.89.

TRACT

#19

TR

Set N&T
68+66.30.

89-59-30
359-58-15
89-59-33 1/4.

264.08 @ 0-00 T 66 = 264.00.

840.36 @ 0-00 T 72 = 840.29.

(25) (25)

264.00

N&T

Fd S&T at Narbonne Ave

Fd N&T Guy Pole

.16 E of Line

89-59-35

Fd N&T P. Pole

28.29

2.07

CHESTNUT ST

See page 32

840.29.

Fd N&T Cypress Stake

28.47

23.53

30.69

24.53

Fd N&T P. Pole

(24) (24)

30.59

Fd 3/4" Iron Tube Set Flush

Fd 1" I.P. No Tag 66+02.30.

225.43 @ 0-00 T 68 = 225.43.

225.43

Fd N&T 6" Fir

Set N&T 10" Gum

Set N&T 6" Fir

Set L&T in Walk

25.04

.07 E of Line

Set 2x2-8" Cypress 63+76.87 Removed 5-27-31

TRACT

Set N&T P. Pole

PENNSYLVANIA AVE

TR

#15

TR

#163

Con. to on top page 14

Notes: ANY ADDITIONS OR CHANGES ON THIS SHEET MUST BE MADE OR CIRCLED IN Red. WITH DATE AND NAME OF PERSON MAKING CHANGE.

Do not extend notes this side of this line

RETURN TO LOS ANGELES COUNTY SURVEYOR

F.B. 460 Pg. 16 — Miller Chief Party — Notes by Miller — Date 2-7-31

Tape 1044
84°F 20#

Con at bottom page 17

68+66.30
5+27.89
73+94.19
5+28.49
79+22.68

N

527.89 @ 0-00 T 64 = 527.82.

TR

AVE

527.82

90-01-00
360-03-45
90-00-56¼

No 588

Fd S W T at E Harbor Ave

90-00-55

Fd N·T in Post

Fd N·T in Pole

30.29

31.51

ELGIN ST

Fd N T P Pole

See page 33 — 830.25

Fd 1" I.P. Plug + Nail - 2" Deep
79+22.68.

31.56

36

Fd X on Fire Hyd.

830.31 @ 0-00 T 72 = 830.25.

Fd N·T Guy Pole

No 847

Fd. N.T Guy Pole

N 1/4 E

528.49

528.55 @ 0-00 T 66 = 528.49.

PENNSYLVANIA AVE

TRACT

840.30 @ 0-00 T 72 = 840.23.

(25) (25)

90-00-00
359-59-45
89-59-56¼

89-59-55

.25 E of Line

Fd 60d wire Spk at E Narbonne Ave

Fd N.T Guy Pole

Set N·T Guy Pole.

CHERRY ST

See page 33 — 840.23'

30.09

31.08

29.82

(25) (SP)

Set N·T Tap Stump

Fd X in Fire Hyd.

Fd 1" I.P Plug Nail 8" Deep
73+94.19.

Set N.T Tack

527.89

Fd L.T. in Headwall

Con from top page 15

RETURN TO
LOS ANGELES COUNTY SURVEYOR

Do not extend notes this side of this line

Note: ANY ADDITIONS OR CHANGES ON THIS SHEET MUST BE MADE OR CIRCLED IN Red. WITH DATE AND NAME OF PERSON MAKING CHANGE.

Date 2-9-31 Notes by Miller Chief Party Miller F.B. 460 Pg. 17

Platted by K. V. M.
Date 12-23-31
Map No. 13-643-1,2
Platting C'k'd by D. M. Finley
Date Apr 1933

W. O. No. 7016 D. S. O. No.
Location CYPRESS AVE
Surveyed by W. A. Miller
Date Feb 1931
Indexed

Tape #044
84" F 20°

7.9 + 22.48
5 + 27.82
89 + 50.50
5 + 27.76
89 + 78.24
9.31
89 89.57

Con at bottom page 18

TRACT No 639

518.80 @ 0-00 T 68 = 518.75'

AVE

518.75'

No 588

90-00-00
359-59-30
89-59-52½

89-59

Fd 3" I.P. Cop - 6" up (Set by Oil Co)
89+68.33
90+03.46

Fd Spk. T Guy Pole

Fd S.W.T. at ℄ Narbonne Ave

Set N.T.
89+87.57'

See page 34 840.20'

ACACIA

Fd 1" I.P. Plug. N. - 0.2 Dep
89+78.26'

Fd N.T. P Pole

Fd N.T. P Pole

Fd N.T. P. Pole.

Fd "X" in top 8" Casing 4' high.

840.27 @ 0-00 T 72 = 840.20'

(25) (50) (25)

527.81 @ 0-00 T 68 = 527.76'

PENNSYLVANIA

527.76'

Fd S.W.T. at ℄ Narbonne Ave

Fd N.T. P. Pole

91-00-30
360-00-00
90-00-30'

Fd N.T. Guy Pole.

Fd N.T. 6" Acacia

840.24 @ 0-00 T 80 = 840.22'

Fd 1" I.P. Plug. T. Flush
84+50.50'

See page 34 840.22'

PINE

ST

Fd N.T. P Pole

Fd N.T. P Pole

Fd N.T. P. Pole

527.82'

Fd N.T. in Con. Fc Post

Con from top page 16

Notes: ANY ADDITIONS OR CHANGES ON THIS SHEET MUST BE MADE OR CIRCLED IN Red. WITH DATE AND NAME OF PERSON MAKING CHANGE.

Do not extend notes this side of this line

RETURN TO LOS ANGELES COUNTY SURVEYOR

F.B. 460 Pg. 18 — Miller Chief Party — Notes by Miller — Date 2-9-31

Tape "044
84° F. 20#

Con at bottom page 19

89+87.57
5+18.75
95+06.32
8.90
95+15.22
5+18.94
100+34.16
9.31
100+43.47

N

518.72 @ 0-00 T 68 = 518.72

840.19 @ 0-00 T 74 = 840.14

Fd N.T. P. Pole

AVE

518.72

Fd N.T in Standard Oil Valve Box

Fd N.T Guy Pole

10-31.27

39.28

Set N.T 100+43.47

9.31

0.0

(25) (50)

See page 36 840.14

PEPPER

ST

Fd N.T P Pole

Fd L"I.P. Plug N.
0.3 Deep
100+34.16

90-00'

Fd N.T Guy Pole

90-00-15
360-01-00
90-00-15

(25) (50) 25

518.99 @ 0-00 T 68 = 518.94

PENNSYLVANIA

518.94

Fd Spk at & Narbonne Ave

Fd N.T Guy Pole

90-00-00
360-00-00
90-00-00

TRACT

40.28

Fd "X" in Top Fire Plug

90-00-00

Fd N.T Guy Pole

Fd Spk at & Narbonne Ave

Set N.T Guy Pole

Set N.T 95+15.22

33.84

31.93

0.0T

8.90

PALM ST.

See page 35 840.25

Fd L"I.P. Plug N.
0.2 Deep
95+06.32

46.76

Set N.T → CV P Pole

Set N.T Guy Pole

Fd N.T Ph Pole.

Fd N.T P. Pole

518.25

840.30 @ 0-00 T 74 = 840.25

Con from top page 17

RETURN TO
LOS ANGELES COUNTY SURVEYOR

Do not extend notes this side of this line

Note: ANY ADDITIONS OR CHANGES ON THIS SHEET MUST BE MADE OR CIRCLED IN Red. WITH DATE AND NAME OF PERSON MAKING CHANGE.

Date 2-9-31 Notes by Miller Chief Party Miller F.B. 462 Pg. 19

Platted by K. V. M.
Date 12-23-31
Map No. 0-643-1,2
Platting C'k'd by D. M. Finley
Date Apr 1933

W. O. No. 7816 U. S. G. No.
Location CYPRESS AVE
Surveyed by W.A.Miller
Date Feb 1931
Indexed A. C. Johnson

Tape "044
84°F 20#

100+43.47
5+18.72
105+62.19
9.20
105+71.39
2+44.40
108+15.79
2+74.27
110+90.06
9.77
110+99.83

Con at bottom page 20

435.06 @ 0-00 T 70 = 435.02'

89-58-30
359-54-30
89-58-30

Fd N.T P. Pole

30' AVE

435.02'

Fd N.T Ph Pole

Fd N.T Ph Pole

42.72

32.40

29.96

56.83

Set N.T Ph Pole.

Set N.T 110+99.83'

9.77

.05

(25) (50)

See page 37 840.17'

Fd 1" I.P. Plug N 6" Deep 110+90.06'

CEDAR ST

(25) (50)

Notes: ANY ADDITIONS OR CHANGES ON THIS SHEET MUST BE MADE OR CIRCLED IN RED WITH DATE AND NAME OF PERSON MAKING CHANGE.

Do not extend notes this side of this line

RETURN TO LOS ANGELES COUNTY SURVEYOR

840.22 @ 0-00 T 74 = 840.17'

274.30 @ 0-00 T 70 = 274.27'

274.27'

No 639

PENNSYLVANIA

Set N.T P. Pole.

12.38

31.61

Set N.T Valve Box

Set S.W.T 108+15.79'

4.17

TRACT

(50) (25) (25)

Set N.T Ph Pole

244.43 @ 0-00 T 68 = 244.40'

244.40'

Fd N.T in Valve box.

Fd N.T Guy Pole

Fd God Wire Spk at ℄ Narbonne Ave

Fd Spk

Set N.T Guy Pole

43.06

9.12

31.53

Set N.T 105+71.39'

9.20

0.34

0.82

See page 36 840.25

FIR ST

(25) (50)

0.56

Fd 1" I.P. Plug N 0.3 Deep 105+62.19'

32.24

59.14

P.M. stem of Fire Hydt.

Fd N.T Ph Pole

Fd N.T P. Pole.

89-59-25"

518.72'

89-59-30
359-59-30
89-59-22½"

Fd God Wire Spk

Fd N.T Guy Pole

840.36 @ 0-00 T 64 = 840.25'

Con from top page 18

F.B. 460 Pg. 20 — Miller Chief Party — Notes by Miller — Date 2-9-31

Tape # 044
84° F 20#

110+99.83
4+35.02
115+34.85

RETURN TO
LOS ANGELES COUNTY SURVEYOR
Do not extend notes this side of this line

Notes: ANY ADDITIONS OR CHANGES ON THIS SHEET MUST BE MADE OR CIRCLED IN Red. WITH DATE AND NAME OF PERSON MAKING CHANGE.

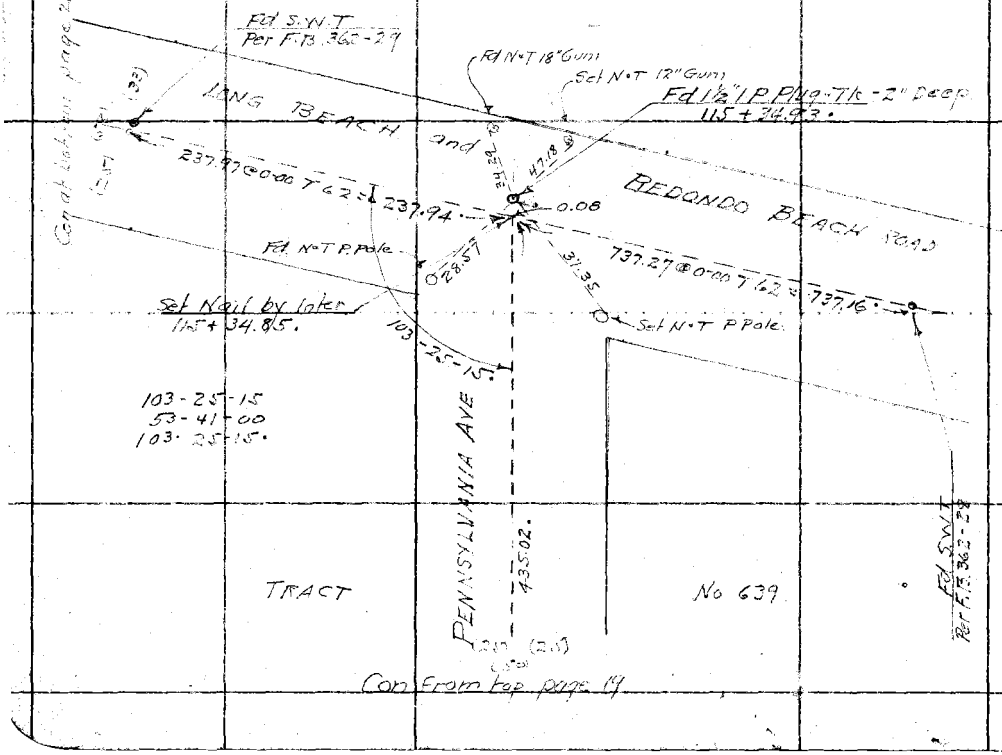

Date 2-13-31 (Friday) Notes by Miller Chief Party Miller F.B. 460 Pg. 21

Platted by K. V. M.	W. O. No. 7016 D. S. O. No.
Date 12-23-31	Location CYPRESS AVE
Map No. B-643 sh 2	Surveyed by W A Miller
Platting C'k'd by D. M. Finley	Date Feb 1931
Date Apr 1933	Indexed by C. Scanlon

Tape #044
84° F 20#

Cor at bottom page 22

(29) (S8) (27)

170.53.

170.54 @ 0-00 T 72 = 170.53.

Fd 2" I.P. Plug Tk - Flush
Cor Tr "A" 185

7.84 32.66

Set N-T

LONG BEACH and REDONDO BEACH ROAD.

439.97 @ 0-00 T 68 = 439.92.

439.92.

PLUM AVE

NOTE: See Pages 99-106 for New ℄ alignment of Long Beach & Redondo Beach Rd.

Fd 2" I.P. Plug Tk Flush

5.38 32.77

Fd S.V.T.
Rec. F.B. 345 29
See page 20
See page 102

0.07

330.24.

0.08

Fd 1½" I.P. Plug Tk - 2" Deep.
See page 30

439.92 page 29

PENNSYLVANIA AVE.

7.76

Set Nail by Inlet
See page 20

Con from left side page 20

Notes: ANY ADDITIONS OR CHANGES ON THIS SHEET MUST BE MADE OR CIRCLED IN Red. WITH DATE AND NAME OF PERSON MAKING CHANGE.

Do not extend notes this side of this line

RETURN TO LOS ANGELES COUNTY SURVEYOR

F.B. 460 Pg. 22 — Miller — Chief Party — Notes by Miller — (Friday) Date 2-13-31

Tape #on L
84°F 20#

Cont'd bottom page 23

524.84 @ 0-00 T 62 = 524.76'

524.76'

See page 39 for angle ties

See page 101 For change in angle

CEDAR AVE

Fd S.W.T

LONG BEACH AND REDONDO BEACH RD.

75.28'

NOTE:- See pages 99-105 For New & Alignment of Long Beach & Redondo Beach Rd.

Fd S.W.T
Rep. F.B. 362-30
See page 102

64.61 @ 0-00 T 72 = 64.60'

64.60'

(25) (38)

Transit Line
See page 38

5.95

25.10

Fd N.T.
Replaced with 2x2-6"Occp

Fd 4" I.P. + Cap
Mkd as Shown

PAR.

170.53'

M.H.

Cen. Line of Long Beach Rd.

RETURN TO
LOS ANGELES COUNTY SURVEYOR

Do not extend notes this side of this line

Note: ANY ADDITIONS OR CHANGES ON THIS SHEET MUST BE MADE OR CIRCLED IN Red. WITH DATE AND NAME OF PERSON MAKING CHANGE.

Date 2-17-31 Notes by Miller Chief Party Miller F.B. 460 Pg. 23

Tape #044
84°F 20#

Platted by K. V. M.
Date 12-23-31
Map No. B-643-1 to
Platting C'k'd by D. M. Finley
Date Apr. 1933

W. O. No. 7016 D. S. O. No.
Location CYPRESS AVE
Surveyed by W.A. Miller
Date Feb 1931
Indexed by C. Johnson

Notes: ANY ADDITIONS OR CHANGES ON THIS SHEET MUST BE MADE OR CANCELED IN Red. WITH DATE AND NAME OF PERSON MAKING CHANGE.

Do not extend notes this side of this line

RETURN TO LOS ANGELES COUNTY SURVEYOR

259.76 @ 0-00 7.62 = 259.72.

REDONDO BEACH ROAD

259.72.

Fd S.W.I
Per F.B. 363-30
See Page 101

2507.62

Fd 2" I.P. Flush
Plug No TR
TR = 2500, Cor Lots 22 & 23

Set N.T.

340.40 @ 0-00 7.62 = 340.35.

and

LONG BEACH

340.35.

NOTE!- See pages 99-106 For New & alignment of Long Beach & Redondo Beach Road.

0.03

Fd S.W.I
Per F.B. 363-30
See page 101

524.72.

Con from top page 22

F.B. 460 Pg. 24 — Miller Chief Party — Notes by Miller — Date 2-18-31

Tape #044
84° F 20#

Cont. of bottom page 25

0+40.00
2+23.93
2+63.93
2+61.80
5+25.43

N

266.00 @ 0-00 T 74 = 265.98.

90-00-30
0-02-00
90-00-30

265.98

90-00-30

No 592

Set 2×2 by Inter. 12" Deep
5+28.05

Fd 2×2 - 12" Deep
Page 8
5+01.22

1624

2.62

Set N.T.
Fh Pole

OLIVE ST

(25) (50)

Set 1×2
5+25.43

No 9765

Set Copper Tk

Fd 2" I.P. Cond. Filled + TK
5+01.76

Ho

AVE

261.53 @ 0-00 T 70 = 261.53.

Tract 2600 Map 7

Set 1×2
2+63.93

Fd 2" I.P. Cond. P.K. Mk. - Flush
N.W. Cor. 22 & 60 Tr. "592
2+63.93

Lakeyard & Pg 88 Cypress

223.95 @ 0-00 T 70 = 223.93.

223.93

150'

90-00-15
360-01-00
90-00-15

TRACT

Set 1×2
0+40.00

Fd 3" I.P. Plug Tk - 24" Deep
Per Tk "9765"
0+40.00

Fd L.T.

Fd 2" I.P. Plug + Tk - 18" Deep
Per Tk "9765"
0+39.98

Fd "X" in Pav
Per Fb 230-3

1.11492 See page 6

REDONDO - WILMINGTON BLVD

TRACT

Fd L.T.
See page 6

Adj. 1.64
26.00

Fd L.T. No. Tac

Fd L.T.

Fd L.T.
See page 6

HILLWORTH AVE

Set "X" in Pav. by Inter.
0+00

Note: See pages 89-98 for final alignment.

RETURN TO
LOS ANGELES COUNTY SURVEYOR
Do not extend notes this side of this line

Notes: ANY ADDITIONS OR CHANGES ON THIS SHEET MUST BE MADE OR CIRCLED IN Red. WITH DATE AND NAME OF PERSON MAKING CHANGE.

(Friday)
Date 2-13-31 Notes by Miller Chief Party Miller F.B. 460 Pg. 25

5+25.43
2+65.98
7+91.41
3+61.94
10+53.35
2+58.29
13+11.64

Plotted by K. V. M.
Date 12-23-31
Map No. B-643-1/2
Plotting C'k'd by D. M. Finley
Date Apr. 1933

W. O. No. 7016 D. S. O. No.
Location CYPRESS AVE
Surveyed by W. A. Miller
Date Feb 1931
Indexed L. C. Johnson

TAPE 100 84°F 20#

N

Con at bottom page 26

Note: ANY ADDITIONS OR CHANGES ON THIS SHEET MUST BE MADE OR CIRCLED IN Red. WITH DATE AND NAME OF PERSON MAKING CHANGE.

Do not extend notes this side of this line

RETURN TO LOS ANGELES COUNTY SURVEYOR

269.96 @ 0-00 T 72 = 269.94.

269.94 AVE

16.69

Fd 2x2 (New) - Flush.
N.W. Cor Lot 40 Tr. "592
13+18.65.

No 9765

9.01

8.65

Set 1x2
13+11.64.

No 592

Fd 2" I.P. Plug N6TK : 6" Deep
Per Tr "9765
13+02.99.

1520

258.31 @ 0-00 T 72 = 258.29.

258.29 Transit Line

CYPRESS

90-00-45
0-03-00
90-00-45.

Fd. base of Old 2x2 - 8" deep.
10+79.63.

16.20

0-00

26.28

16.13

Set 2x2 by liter
12" Deep
10+56.07.

Fd 2x2 - 12" Deep
See page 9

TRACT

825.06

2.72

MILLER ST

(25) (25) 50

Set 1x2
10+53.35.

9.95

24.95

Set x in storm
of Fire Hyd.

Set Nail PK Pole

261.96 @ 0-00 T 72 = 261.94.

261.94

PRO.

TRACT

16.22

Set 1x2
7+91.41.

9.59

Fd 1" Iron Rod - Flush.
N.W. Cor Lot 50 Tr "592
7+90.82.

262.28

Con from top page 24.

F.B. 460 PG. 26 — M. Miller Chief Party — Notes by Miller — Date 2-1-34

Temp 4°+H
84°F. 20#

Corr a: bottom page 27

13+11.64
2+69.94
15+81.58
2+65.96
17+27.54
2+61.97
21+09.51

194.59 @ 0-00
T62 = 194.59'

Set N.T. Ph Pole

Set 2x2 by Inter. 12" Deep. 21+12.18'

Fd 2x2-12" Deep See page 10

825.04

LEMON ST

(25) (25) 50

Set 1x2 21+09.51'

Set x in Stem Fire Hyd

No 9766

262.30 @ 0-00
T130 = 261.97'

Set 1x2 18+47.54'

CYPRESS

TRACT

90-01-00
0-04-00
90-01-00

265.98 @ 0-00
T70 = 265.96'

Fd N.T. B. Plc

Set 2x2 by Inter. 12" Deep 15+84.12'

Fd 2x2-12" Deep See page 9

51.79

170.13

2.54

POMELO ST

(25) (25) 50

Set 1x2 15+81.50'

Set x in Stem Fire Hyd

Set N&T Ph Pole

Fd 1" I.P. No Tk 15+57.42'

Con from bk page 25

N

RETURN TO
LOS ANGELES COUNTY SURVEYOR
Do not extend notes this side of this line

Notes: ANY ADDITIONS OR CHANGES ON THIS SHEET MUST BE MADE OR CIRCLED IN Red. WITH DATE AND NAME OF PERSON MAKING CHANGE.

Date 2-19-31 Notes by Miller Chief Party Miller F.B. 460 PG. 27

Tape #044
84° F 20

Platted by K. V. M.
Date 12-23-31
Map No. B-643.1.2
Platting C'k'd by D. M. Finley
Date Apr. 1933

W. O. No. 7016 D. S. O. No.
Location CYPRESS AVE
Surveyed by W. A. Miller
Date Feb 1931
Indexed

21+09.51
1+91.59
23+04.10
3+32.95
26+38.05
2+65.46
29+03.51

Con at bottom page 28

261.99 @ 0-00
TG2 = 261.95.

No 976

Set 1x2
29+03.51.

AVE

No 592

90-01-30
0-06-00
90-01-30.

265.49 @ 0-00
TG4 = 265.46.

Set N.T. Ph Pole.
Ed 2x2 - 6" Deep
SW Cor Lot 10 Tr #592
26+65.13

Set 2x2 by Inter
12" Deep
26+40.32.

Ed 2x2 - 12" Deep
See page 10

ALMOND ST

Set 1x2
2+34.05.

Set x in Steel
Fire Hyd.

333.79 @ 0-00
TG4 = 333.95.

CYPRESS

TRACT

PRO.

TRACT

Set 1x2
23+04.10.

Ed 2" I.P. Flush
Pc - Tr #9165
23+03.57.

Con from top page 26

RETURN TO LOS ANGELES COUNTY SURVEYOR

Note: ANY ADDITIONS OR CHANGES ON THIS SHEET MUST BE MADE OR CIRCLED IN RED, WITH DATE AND NAME OF PERSON MAKING CHANGE.

Do not extend notes this side of this line

F.B. 460 Pg. 28 — Miller Chief Party — Notes by Miller — Date 2-19-31

Tape #044
84°F 20#

Con at bottom page 29

29+03.57
2461.75
31+65.46
1+38.74
33+04.20
2+12.67
35+16.87

N

179.62 @ 0-00
T66 = 179.60

179.60

AVE

90-01-45
360-07-00
90-01-45

Fd broken 2x2 No TK - Flush
35+43.42

15.39

90-01-45

Set 2x2 by Inter
12" Deep
35+18.47

Fd 2x2 - 12" Deep
See page 11

15.58

825.12 page 11

1.60

ROSE ST

(30) (25)

Set 1x2
35+16.87

Set X in Stem
Fire Hyd.

Set Nail Pk Pole

Fd 2x2 + TK - Flush
34+13.43

15.41

CYPRESS

TRACT No 5959

Set 1x2
33+04.20

Fd 2" IP Plug + TK Flush
Ref. T.R. # 9965
33+04.12

90-01-45
0-07-00
90-01-45

138.76 @ 0-00
T66 = 138.74

138.74

PTJ.

Fd 1" I.P. & Spk
31+93.00
90.00

90-01-45

Set Nail
Pk Pole

Set 2x2 by Inter
12" Deep
31+68.43

Fd 3/2 - 12" Deep
F.B. 233-6. See page 11

825.04 See page 11

ARIZONA ST

(25) (30)

Set 1x2
31+65.46

Set X in Stem
Fire Hyd.

Fd 1" I.P. No TK
31+41.59

TRACT No 5792

Con from top page 29

RETURN TO
LOS ANGELES COUNTY SURVEYOR

Do not extend notes this side of this line

Notes: ANY ADDITIONS OR CHANGES ON THIS SHEET MUST BE MADE OR CIRCLED IN Red. WITH DATE AND NAME OF PERSON MAKING CHANGE.

Date 2-19-31 Notes by Miller Chief Party Miller F.B. 460 Pg. 29

35+16.87
1+79.60
36+96.47
5+28.13
42+24.60
73.08
42+97.68

Platted by K. V. M.
Date 12-23-31
Map No. B 643-1,2
Platting C'k'd by D. M. Finley
Date Apr. 1933

W. O. No. 7016 D. S. O. No.
Location CYPRESS AVE
Surveyed by W.A. Miller
Date Feb 1931
Indexed

Tape "044
84° F 20m.

N

62-46-45
251-07-00
62-46-45

Con't at bottom page 30

455.96 @ 0-00
T64 = 454.90.

454.90

AVE

Fd 2" I.P. & Cap of Cor. of Union Oil Co. Prop. Stamped "P.A.P. Co."

High Wire Fe

62-46-45

Set 2x2 by Inter - 12" Deep
43+02.40.
Removed 6-5-31

4.51
15.32

No 15

Fd 2" I.P. Cap + P.M. - Flush
Per TR #9765
43+04.72.

Set 1x2
42+97.68.
Removed 6-5-31

7.04
4.72
3.63
15.32
0.41

NOTE: See Page 107 for Navy Angle to TR Line at this point.

Fd 2" I.P. Plug + Tk - Flush - Leaning Sth.
Per TR #9765
42+94.65.

CYPRESS

73.09 @ 0-00
T64 = 73.08.

73.08

No 9765

15.58
0.15

Set 1x2
42+24.60.

Fd 2" I.P. Plug + Tk - 6" Deep
N.W. Cor. Lot 9 TR #15
42+24.45.

528.13 @ 0-00
T66 = 528.13.

528.13' Tangent Line

PRO.

89-59-45
359-59-00
89-59-45.

TRACT

89-59-45

15.55

TRACT

Set 2x2 by Inter.
12" Deep
36+96.47.

Fd 2" I.P. Plug & Tk - Flush
N.W. Cor TT #5959
36+96.47

TR #5959

172.60.

Con from top page 28

RETURN TO LOS ANGELES COUNTY SURVEYOR

Do not extend notes this side of this line

Note: ANY ADDITIONS OR CHANGES ON THIS SHEET MUST BE MADE OR CIRCLED IN Red. WITH DATE AND NAME OF PERSON MAKING CHANGE.

F.B. 460 Pg. 30 — Miller Chief Party — Notes by Miller — Date 2-19-31

Tape "0.99
84°F 20"

Con at bottom page 32

42+97.68
4+54.90
47+52.58
5+99.93
53+52.51
5+92.06
59+44.57
2.72
59+47.29

398.98 @ 0-00 T 62 = 398.92'

Fd 2+2 - TK
60+39.55

4.72

62-47-00
251-08-00
62-47-00

WESTON AVE

398.92'

15.42

Con to road 40.00

Fd 2" I.P. Cap + P.Mrk
59+61.76'

Set S.W.T by Inter
59+47.29'

62° 47' 00"

Set N°T P. Pole

645.40 @ 0-00 T 62 = 645.31

Set N°T
59+44.57'

2.72

7.19

0.66

Fd S.W.T No Ref

17.49

645.31

Set X in Cr
Fe Post

Fd N°T
P Pole

Fd 2" I.P. Cap + P.Mrk
59+27.08'

Fd 2" I.P. Cap + P.Mrk.
59+16.71'

ROAD

Fd Old 3/4" Sq Pipe -8" Deep

592.14 @ 0-00 T 64 = 592.06'

592.06'

PRO. CYPRESS

Set 1x2
53+52.51'

599.99 @ 0-00 T 69 = 599.93'

599.93'

Fd old 3x3 @ TK - 6" Deep
N.W. Co. Lot 72 TR "15
47+53.44'

0.86

Set 1x2
47+52.58'
Removed 6-5-31

454.90'

New 1x2

8.21

Old 3x3

9.05

Old 1x2

0.40

15.24

Con from top page 29

N

RETURN TO
LOS ANGELES COUNTY SURVEYOR
Do not extend notes this side of this line

Note: ANY ADDITIONS OR CHANGES ON THIS SHEET MUST BE MADE OR CIRCLED IN Red. WITH DATE AND NAME OF PERSON MAKING CHANGE.

Date 3-10-31 Notes by Miller Chief Party Miller F.B. 460 Pg. 31

Tape "0.41
84° F 25#

Platted by K. V. M.	W. O. No. 7016 D. S. O. No.
Date 12-23-31	Location CYPRESS AVE
Map No. B-643-12	Surveyed by W.A. Miller
Platting C'k'd by D. M. Finley	Date Feb 1931
Date Apr. 1933	Indexed A. C. Johnson

7349.71
954.53
6394.26
645.99
5748.29

Notes: ANY ADDITIONS OR CHANGES ON THIS SHEET MUST BE MADE OR CIRCLED IN Red. WITH DATE AND NAME OF PERSON MAKING CHANGE.

Do not extend notes this side of this line

RETURN TO LOS ANGELES COUNTY SURVEYOR

954.53 F.B. 455-58

F.B. 455-58 10' offset Line #

AVE

PRO. PRAIRIE

Fd 2x2 - 12" Decp. F.B. 455-58

ROAD

(20) (20) (40)

WESTON

749.55 @ 0-00 T 70 =	749.48.
1000.02 @ 0-00 T 70 =	999.93.
1000.00 @ 0-00 T 72 =	999.92.
999.99 @ 0-00 T 72 =	999.91.
1000.00 @ 0-00 T 70 =	999.91.
999.96 @ 0-00 T 68 =	999.86.
	5749.01

AVE

Set S.W.T. by Inter - Page 30
59+47.29 From Sth.

Transit Line page 30

PRO. CYPRESS

Con. from Left Side. page 30.

F.B. 460 Pg. 32 — Miller Chief Party — Notes by Miller — Date 2-20-31

Tape #044
84' F .20'

Con at bottom page 33

209.12 @ 0-00 T 66 = 209.10'

59+47.29
3+98.92
63+46.21
2+55.00
66+31.21
2+56.96
68+58.17

N

TR #2200

209.10'

AVE

TR #15

Set 2x2-12" Deep by Inter
68 + 61.03'

117-13-00
108-52-00
117-13-00'

2.86
17.30
17.40

Set 1x2
68+58.17'

Fd 2" I.P. Cap "P.M.R."
68+40.87'

Fd 2" I.P. Plug "T/C"
Per TR "9765
68+53.08

Set N.T. 36" Gum
90-00-00

10.39?

256.99 @ 0-00 T 66 = 256.96'

Set 1x2 by Inter
In Pipe Line Wall
66+03.20'

840.29' See page 15

0.99

CHESTNUT ST

(24) (48)

Set 1x2
66+01.21'

Set Nail in End
Board Post

UNION OIL CO

255.03 @ 0-00 T 66 = 255.00'

Transit Line

PACIFIC

TRACT

Set 1x2
63+46.21'

398.72'

TR #15

See from page 33

RETURN TO
LOS ANGELES COUNTY SURVEYOR

Do not extend notes this side of this line

Note: ANY ADDITIONS OR CHANGES ON THIS SHEET MUST BE MADE OR CIRCLED IN Red. WITH DATE AND NAME OF PERSON MAKING CHANGE.

Date 2-20-31 Notes by Miller Chief Party Miller F.B. 460 Pg. 88

Platted by K. V. M.
Date 12-23-31
Map No. B-643-12
Platting C'k'd by D. M. Finley
Date Apr. 1933

W. O. No. 7016 D. S. O. No.
Location CYPRESS AVE
Surveyed by W.A. Miller
Date Feb 19 31
Indexed A. C. Johnson

Tape #044
84°F 20#

68+58.17
2+09.10
70+67.27
3 24.25
73+91.52
5+28.29
79+19.81

Con at bottom page 34

TR # 588

275.03 @ 0-00
T68 = 275.00.

275.00'

90-00-45
360-03-30
90-00-52½

90-00-52½

Set N+T Ph. Pole

Set 2½ Flush

No 2200

Set part R.W. Fence Post by lot 12" Deep in Quick Sand
79+22.71'

2.90

Set 1x2
79+19.81.

See page 16

830.25'

ELGIN ST

(25) (50)

(25)

Note: ANY ADDITIONS OR CHANGES ON THIS SHEET MUST BE MADE OR CIRCLED IN Red. WITH DATE AND NAME OF PERSON MAKING CHANGE.

Do not extend notes this side of this line

RETURN TO LOS ANGELES COUNTY SURVEYOR

AVE

Set N+T Ph. Pole

528.29'

89-59-45

359-59-00
89-59-45.

No 15

528.34 @ 0-00
T70 = 528.29.

Set 2x2 - 12" Deep - by Inter
73+93.98'

2.46

840.23'

See page 16

CHERRY ST

(25) (50)

Set 1x2
73+91.52.

324.25'

Transit Line

PRO CYPRESS

324.28 @ 0-00
T70 = 324.25'

TRACT

TRACT

Set 1x2
70+67.27.

209.10'

Con from top page 32

F.B. 460 Pg. 34 — Miller — Chief Party — Notes by Miller — Date 2-20-31

Tape #344
84° F 20#

Con at bottom page 35

79+19.81
2+75.00
81+94.81
2+45.96
84+47.77
5+82.92
89+2.69

N

270.00 @ 0-00 7"GR = 269.96'

269.96'

89-59-45
359-59-00
89-59-45

15.82

Fd 2"I.P. Cap (Set by Oil Co.)
90+03.36'

Set N.T.P. Pole

Set 2x2 - 12" Deep - by Int.
89+78.14

20.13
30.67
56.23
5.45
25.00

Set N.T.P. Pole

(25) (50) 840.20' See page 17

ACACIA ST

No 2200

Set 1x2
89+72.69'

Set N.T. Ph Pole

524.77 @ 0-00 7"GR = 524.92'

AVE

90-00-30
360-02-00
90-00-30

885.

Set 2x2 by inscr.
12" deep
84+50.40'

Set N.T. Ph Pole

18.75
2.63
76.28

840.28' See page 17

(25) (50)

PINE ST

Set 1x2
84+47.77'

90°00'

Set N.T.
Open Garage

252.94 @ 0-00 7"GR = 252.76'

TRACT

Transit Line

PRO CYPRESS

TRACT

Set 1x2
81+94.81'

275.00'

Con from top page 33

RETURN TO
LOS ANGELES COUNTY SURVEYOR
Do not extend notes this side of this line

Notes: ANY ADDITIONS OR CHANGES ON THIS SHEET MUST BE MADE OR CIRCLED IN Red. WITH DATE AND NAME OF PERSON MAKING CHANGE.

Date 2-21-31 Notes by Miller Chief Party Miller F.B. 460 Pg. 35

Platted by K V M.
Date 12-23-31
Map No. B-643-1,2
Platting C'k'd by D. M. Finley
Date Apr. 1933

W. O. No. 7016 D. S. O. No.
Location CYPRESS AVE
Surveyed by W.A. Miller
Date FEB 1931
Indexed

Tape #044
84°F 20#

89+72.69
2 69.96
92+42.65
2 61.96
95+04.61
2 48.26
97+52.87
1 91.98
99+44.85

Con. at bottom page 36

85.05 @ 0-00
T 66 = 85.04.

N

Notes ANY ADDITIONS OR CHANGES ON THIS SHEET MUST BE MADE OR CIRCLED IN Red. WITH DATE AND NAME OF PERSON MAKING CHANGE.

Do not extend notes this side of this line

RETURN TO LOS ANGELES COUNTY SURVEYOR

85.04± AVE

Lot Line

Fd 4" I.P. + Cap. P.M.L.A.
99+50.84.

5.99

Set 1x2
99+44.85.

No 2200

15.18

192.00 @ 0-00
T 66 = 191.98.

191.98± Line

CYPRESS

No 639

Set 1x2
97+52.87.

248.30 @ 0-00
T 62 = 248.26.

248.26± Transit

90-00-00
360-00-00
90-00-00

90-00-00

Set N+T Ph Pole

Set 2x2-12" Deep by Inf
95+06.15.

50.03

(25)

(50)

840.25. See page 18

TRACT

1.54

20.96

23.46

PALM ST

Set x in 3" Pipe Line upright Portion

Set 1x2
95+04.61.

Set N+T P. Pole

Fd 2" I.P. + Cap. Set by S.I.(Co.)
94 +81.15.

262.00 @ 0-00
T 62 = 261.96.

261.96±

15.60

PRO

TRACT

Set 1x2
92+42.65.

Tr # 588

Con from top page 34

F.B. 460 Pg. 36 — Miller Chief Party — Notes by Miller — Date 2-21-31

Tape #044
84° F 20#

Con at bottom page 37

99+44.85
95.14
100+29.89
2+55.20
102+86.09
2+71.86
105+56.95

N

264.43 @ 0-00 7 68 = 264.40'

264.43'

AVE

90-00-30
360-02-00
90-00-30

90-00-30

Ed 1/2 I.P. Leaning (Plus offset to base)
105+91.30'

Set N&T Tank Base

No 2200

Set 2x2-12" Deep-by Inter
105+62.11'

15.26

34.35

50.53

5.16

3.06

840.25 See page 19

(50) (25) (25)

FIR ST

Set 1x2
105+56.95'

Set N&T Fe Post

271.89 @ 0-00 7 22 = 271.86'

271.86'

Transit Line

CYPRESS

No 639

Ed 2" I.P. Cap (Set by Oil Co)
102+97.91'

15.49

12.82

Set 1x2
102+85.09'

PRO

TRACT

255.23 @ 0-00 7 66 = 255.20'

255.20'

16.39

Ed 2" I.P. Cap (Set by Oil Co)
100+58.91'

Set 2x2-12" Deep-by Inter
100+33.95'

TRACT

24.02

840.14'

(50) (25)

See page 18

4.06

PEPPER ST

Set N&T 8" Cedar

Set 1x2
100+29.89'

90-00-30

840.14'

90-00-30
360-02-00
90-00-30

Con From Left page 35

RETURN TO LOS ANGELES COUNTY SURVEYOR

Do not extend notes this side of this line

Notes: ANY ADDITIONS OR CHANGES ON THIS SHEET MUST BE MADE OR CIRCLED IN Red. WITH DATE AND NAME OF PERSON MAKING CHANGE.

Date 2-21-31 Notes by Miller Chief Party Miller F.B. 460 Pg. 37

Platted by K. V. M.
Date 12-23-31
Map No. B-643-17
Platting C'k'd by D. M. Finley
Date Apr. 1933

W. O. No. 7016 D. S. O. No.
Location CYPRESS AVE
Surveyed by W. A. Miller
Date Feb 1931
Indexed by C. Johnson

Tape #044
84° F 20#

105+58.95
2+64.40
108+22.35
2+66.97
110+88.32
1+75.07
112+63.39

Con at bottom page 38

85.49 @ 0-00
T 68 = 85.48.

85.48.

No 2200

14.98

3.73

Fd 2" I.P. Plug & Nail - 6" Deep
Per TR "2200
112+67.12.

Set 1x2
112+63.39.

90-01-30
360-06-15
90-01-33¾"

No 639

175.09 @ 0-00
T 68 = 175.07.

175.07.

90-01-33¾"

Set N&T P. Pole

Set 2x2-18" Deep - by Inkr
110+90.39.

3.99

840.17. See page 19

2.01

CEDAR ST

(50) (25)

(25)

Set 1x2
110+88.32.

Set N&T 18" Gum

RETURN TO
LOS ANGELES COUNTY SURVEYOR

Do not extend notes this side of this line

Notes: ANY ADDITIONS OR CHANGES ON THIS SHEET MUST BE MADE OR CIRCLED IN Red. WITH DATE AND NAME OF PERSON MAKING CHANGE.

266.97.

Transit Line

PAS CYPRESS

267.00 @ 0+00
T 66 = 266.97.

Fd 3/4" I.P - 12" Deep
108+20.46.

15.13

0.08

5.03

Fd Old 2½" Tk 12" Deep
108+26.38.

TRACT

TRACT

Set 1x2
108+21.35.

264.40.

Con from top page 36

F.B. 460 Pg. 38 — Miller — Chief Party — Notes by Miller — Date 2-21-31

Tape "OK"
84° F 29th

112+63.39
85.48
113+48.87
3+54.96
117+05.83
29.39
117+35.22

N

RETURN TO
LOS ANGELES COUNTY SURVEYOR
Do not extend notes this side of this line

Notes: ANY ADDITIONS OR CHANGES ON THIS SHEET MUST BE MADE OR CIRCLED IN Red. WITH DATE AND NAME OF PERSON MAKING CHANGE.

LONG BEACH

Set N&T 8" Cedar.

Set N&T 6" Cedar.

Set 2x2 Replacing N&T
See page 22
117+31.63.

REDONDO

170.53. page 22

Set ⅝" W.T. Lu Later
117+35.22.

Set N&T

103-25 30
53.45
103-25-33¾.

Set 1x2
117+05.83.

Fd 4" I.P. + Cap
See page 22
117+05.83.

357.00@0-00 T 68 = 356.96.

No 2200

No 639

Fd Nail 2x2 x 18 - 6" Deep
113+54.20.

Fd Old 2x2 x 18 6" Deep
113+54.20.

Set 1x2
113+48.87.

TRACT

TRACT

85.48.

Con top of page 37

Date 2-25-31 Notes by Miller Chief Party Miller F.B. 460 PG. 39

Plotted by K V M
Date 12-23-31
Map No. B-643-1,2
Plotting C'k'd by D. M. Finley
Date Apr 1933

W. O. No. 7016 D. S. O. No.
Location CYPRESS AVE
Surveyed by W.A. Miller
Date Feb 1931
Indexed C. Tobiason

Tape "C44 84°F 20#

0+16.70
0+17.07
0+33.77
6+16.95
6+50.72
32.33
37.04
80.25
7+63.19

Con at bottom page 40

SANTA FE AVE

323.35 @ 0-00 T 66 = 323.31

Fd 2" I.P. Plug + TK TR "8019 7+75.97

Set N+T 7+63.19

80.26 @ 0-00 T 70 = 80.25

Fd 2" I.P. Plug + TK TR "10185 7+65.17

Fd 2" I.P. Plug + TK TR "10185" TR "8019 7+51.46

Fd 2" I.P. Plug + TK TR "10185 7+05.20

Fd 2" I.P. Plug + TK TR "10185 6+94.88

A.T. & S.Fe. Tract across AVE. only

Set S.W.T on Split of Rails. 6+82.94

To City Min. Carson St. Pg. 43

Set N+T 6+50.72

Fd 2" I.P. Plug + TK TR "10185 6+50.57

TRACT No 8019

617.01 @ 0-00 T 70 = 616.95

75-50-15
363-20-30
75-50-07½

CEDAR AVE

Adopted ℄ PCH CYPRESS AVE

Transit Line

Fd 2" I.P. Plug + TK TR "8019 TR "10185 0+43.85

Set N+T 6" Cedar

Fd God Wire Spk "Tin No Ref. 0+33.77

Set N+T 6" Cedar

Fd 2" I.P. Plug + TK TR "8019 TR "10185 0+23.77

LONG BEACH and

Fd 1½" I.P. 12" Deep No Ref. 0+16.70

Set N+T P. Pole

REDONDO BEACH RD

Fd S.W.T See page 22 0+00

Fd N+T P. Pole

Adopted ℄ Per Pg. 101.

See Pg. 169 To E.C. 79.91

117+29.49 Set S.W.T. See Pg. 101.

TRACT

N

No 10185

Notes ANY ADDITIONS OR CHANGES ON THIS SHEET MUST BE MADE OR CIRCLED IN Red. WITH DATE AND NAME OF PERSON MAKING CHANGE.

Do not extend notes this side of this line

RETURN TO LOS ANGELES COUNTY SURVEYOR

F.B. 460 Pg. 40 — Miller Chief Party — Notes by Miller — Date 2-25-31

Tape *C44
84.6 F 20m

Con at bottom page 41

7+63.19
3+23.31
10+96.50
2+51.94
13+38.44

N

226.11 @ 0-00 T 64 = 226.07✓

Fd 2" I.P. Plug + Tk
TR " 10185
13+67.98.

226.07

39.75

Set N4T
13+38.44✓

39.54

30.46

WASHINGTON ST (60) 30

39.74

Fd 2" I.P. Plug + Tk
TR " 10185
13+07.98

AVE

351.97 @ 0-00 T 64 = 351.94✓

CEDAR

351.94

Transit Line

LAO CYPRE

Fd 2" I.P. Plug + Tk
TR " 10185
11+08.09.

39.74

A.T. & S.Fe Track
across Ave. only

27.97

31.39

39.79

Set SWT on Spike
5-Rods
10+86.50✓

Fd 2" I.P. Plug + Tk
TR " 10185
10+65.11

(40) (80) (40)

323.31

TRACT

SANTA FE AVE

40.20

Fd 2" I.P. Plug + Tk
No Ref.
8+38.56.

TR " 8019

Con from top page 39

RETURN TO
LOS ANGELES COUNTY SURVEYOR

Do not extend notes this side of this line

Notes: ANY ADDITIONS OR CHANGES ON THIS SHEET MUST BE MADE OR CIRCLED IN Red. WITH DATE AND NAME OF PERSON MAKING CHANGE.

Date 2-26-31 Notes by Miller Chief Party Miller F.B. 460 Pg. 41

13+38.44
2+26.07
15+64.51
1+48.35
17+12.86
3+73.55
20+86.41

Platted by K. V. M.
Date 12-23-31
Map No. B-643-12
Platting C'k'd by D. M. Finley
Date Apr. 1933

W. O. No. 7016 D. S. O. No.
Location CYPRESS AVE
Surveyed by W.A. Miller
Date Feb. 1931
Indexed A. C. Johnson

Tape #044
84°F 20#

N

Con at bottom page 42

Fd 2" I.P. Plug-TK
TR #10185
21+17.89

136.77@0-00T62 = 136.75✓

136.75

39.51

31.48

Set N-T
20+86.41✓

28.52

JEFFERSON ST

39.53

Fd 2" I.P. Plug-TK
TR #10185
20+51.85

(40) (40)
(80)
CEDAR AVE

373.61@0-00T60 = 373.55✓

373.55
Transit Line
PINE CYPRESS AVE

Fd 2" I.P. Plug-TK
TR #10185
17+47.91

39.58

Set S.W.T. on Split of Rails
17+12.86✓

35.05

A.T.&S.F. Track

34.95

39.58

Fd 2" I.P. Plug-TK
TR #10185
16+77.91

148.33@0-00T58 = 148.35✓

148.35

Set N-T
14" Gum

Set N-T
15" Gum

47.01

Set N-T
15+64.51✓

54.35

Set N-T
10" Gum

Set N-T
14" Gum

Con From top page 40

Notes: ANY ADDITIONS OR CHANGES ON THIS SHEET MUST BE MADE OR CIRCLED IN Red. WITH DATE AND NAME OF PERSON MAKING CHANGE.

Do not extend notes this side of this line

RETURN TO LOS ANGELES COUNTY SURVEYOR

F.B. 460 Pg. 42 — Miller Chief Party — Notes by Miller — Date 2-26-31

Tape #044
84° F 20#

Con at bottom page 43

20+86.41
1+36.75
22+23.16
1+95.69
24+18.85

N

342.44 @ 0-00 T 64 = 342.40 ✓

342.40

Fd 2" I.P. Plug + TK
TR # 10185
24+40.34.

39.43

Set N+T
24+18.85 ✓

21.49

0.03

39.38

A.T. & S.Fe Track

Fd 2x2" TK End of Track
No Ref.
24+18.82.

39.42

Fd 2" I.P. Plug + TK
TR # 10185
23+97.84.

Tract No 2695

195.72 @ 0-00 T 64 = 195.69 ✓

CEDAR AVE

(40) (40) (80)

Fd 4x4" Nail - Flush
TR # 10185
22+43.61.

40.66

20.49

Set N+T
22+23.16 ✓

15.15

39.44

Fd 2" I.P. Plug + TK
TR # 10185
22+08.01.

136.25

WASHINGTON AVE

Con from top page 41

RETURN TO
LOS ANGELES COUNTY SURVEYOR
Do not extend notes this side of this line

Notes: ANY ADDITIONS OR CHANGES ON THIS SHEET MUST BE MADE OR CIRCLED IN Red. WITH DATE AND NAME OF PERSON MAKING CHANGE.

Date 2-26-31 Notes by Miller Chief Party Miller F.B. 460 Pg. 43

24+18.85
3+42.40
27+61.25
6+25.36
33+86.61

Platted by K. V. M.
Date 12-23-31
Map No. B-643-1,2
Platting C'k'd by D. M. Finley
Date Apr. 1933

W. O. No. D. S. O. No.
Location
Surveyed by
Date
Indexed A. C. Johnson

Tape #444
84° F 20"

N

Con at bottom page 44

Notes: ANY ADDITIONS OR CHANGES ON THIS SHEET MUST BE MADE OR CIRCLED IN Red. WITH DATE AND NAME OF PERSON MAKING CHANGE.

Do not extend notes this side of this line

RETURN TO LOS ANGELES COUNTY SURVEYOR

580.46 @ 0-00T 70 = 580.41

TORRANCE TRACT

No 2675

580.41

AVE

(40) (40) (80)

Fd City Mon.
34 + 33.80
30.26

0.77

40' CARSON ST

TRACT No 2761

(40) (40) (80)

40.78 49.65 39.21
3.64 3.52

Fd 2" I.P. Plug + TK
TR 2761 TR #10185
33+90.25

Fd 2" I.P. Plug + TK
TR #10185
33+90.13

Set N+T
33+86.61

625.43 @ 0-00T 68 = 625.36

TRACT

Adopted ℄ PACIFIC ELECTRIC RY.

70 S.W.L.T. Ry. 39.101 Trans. Line

625.36

CEDAR

Fd 2" I.P. Plug No TK
TR #10185
27+90.21

40.72

Set N+T
27+61.25

28.96

(60) 30'

33 MONTEREY ST

31.09

40.79

342.40

Fd 2" I.P. Plug + TK
TR 2761 TR #10185
27+30.16

TR #2675

TRACT No 10185

Con from top page 42

F.B. 460 Pg. 44 — Miller Chief Party — Notes by Miller — Date 2-26-31

Tape #044
84° F 20"

Con at bottom page 45

33+86.61
5+80.41
39+67.02
5-85.90
45+52.92

352.97 @ 0-00 T 62 = 352.92

Fd 2" I.P. Plug-TK
45+90.32'

352.92

Fd 2" I.P. Plug-TK
45+90.36'

Fd City Mon.-1½" I.P. Plug in 6" Pipe with Cap.
45+60.28'

40.72 | 39.30
37.40 | 0.83 | 37.38
7.36
22.70
39.13

Fd 2" I.P. No Plug, no TK 18" Deep
45+30.22'

Set X in Pav
45+52.92

(60) (30) (30)
ELDORADO ST

TR # 4970 No 4970

AVE

585.96 @ 0-00 T 66 = 585.90

585.90

CEDAR — Fresno Electric — Pine Cypress — TORRANCE

Fd base of 3x3
40+30.38.

Fd 2" I.P. Plug-TK
40+30.31'

40.84 | 39.32
0.81

Fd City Mon. 40d Wire Spk-6" Deep-in 6" Iron Pipe with Cover.
40+00.29'

(30) (30)
SONOMA ST

63.36 | 33.27 | 63.29

Set X in CR

30.01 | 29.41

Set X in CR

34.32 | 32.55

Set L&T in Curb

Set X in Pav
39+67.02

Set L&T in Curb

580.41

TR # 2761

Con from top page 43

RETURN TO LOS ANGELES COUNTY SURVEYOR

Do not extend notes this side of this line

Notes: ANY ADDITIONS OR CHANGES ON THIS SHEET MUST BE MADE OR CIRCLED IN Red. WITH DATE AND NAME OF PERSON MAKING CHANGE.

Date 2-26-31 Notes by Miller Chief Party Miller F.B. 460 Pg. 46

45+52.92
3+52.92
49+05.84
3+49.63
52+55.47

Platted by K. V. M.
Date 12-23-31
Map No. B-643-1 2
Platting C'k'd by D. M. Finley
Date Apr. 1933

W. O. No. 7016 D. S. O. No.
Location CYPRESS AVE
Surveyed by W. A. Miller
Date Feb 1931
Indexed

Tape "044
84° F 20#

N

Con at bottom page 46

296.32 30-00T 68 = 296.69✓

Fd 2" I.P. Plug ~ TK 12" Deep
TR " 4570
53+18.20'

Fd 2" I.P. Plug ~ TK-18" Deep
TR " 7877 3
53+10.30'

Fd 2" I.P. Plug ~ TK-24" Deep
53+18.48'

TR " 7877 3

296.69✓

40.81 39.30
7.96
40.79

Fd 1½" I.P. - Small Nail
8" Deep No Ref
52+64.37'

REDONDO BOULEVARD

Fd 2 E.P. ~ TK - 4" Deep
Per F.B. 238-8
52+60.30'

(140) (50) (50) (140) (52)

0.77 45.93 54.03

4.07
4.83
9.07
0.78

Set N°T
52+55.47✓

Fd City Mon. - Nail 6" Deep
In 6" I.P. With Cap
52+46.40'

0.77

24.98

39.14

Fd 2" I.P. Plug ~ TK
52+10.49'

(40) (80) (40)

349.68 @ 0-00T 62 = 349.63✓

CYPRESS AVE

349.63✓ Transit Point

CEDAR AVE

Set N°T
18" Gum

Set N°T
24" Gum

57.64 18 56.91 18

Set "X" in Pav
49+05.84✓

TRACT NO 4070

TORRANCE TRACT

60.15 52.69

352.92✓

Set N°T
18" Gum

Set N°T
18" Gum

Con From top page 44

Notes: ANY ADDITIONS OR CHANGES ON THIS SHEET MUST BE MADE OR CIRCLED IN Red. WITH DATE AND NAME OF PERSON MAKING CHANGE.

Do not extend notes this side of this line

RETURN TO LOS ANGELES COUNTY SURVEYOR

F.B. 460 Pg. 46 Miller Chief Party Notes by Miller Date 2-27-31

Tape "044 84°F 20"

Con at bottom page 47

227.72 @ 0-00766 = 227.69

52+55.47
2+96.69
55+52.16
2+64.02
58+16.18
5+30.43
63+46.61

N

Fd City Mon. - 1" I.P. Plug in 8" Deep in 8" pipe with Cap
63+93.61

0.11
7.00
227.69
MARICOPA ST
30' (60)

Set "X" in Pav.
63+43.61

(40) (20) (40)

AVE
530.43

530.49 @ 0-00766 = 530.43

TRACT

No 7873

Fd City Mon - 2x2 - 7K
6" Deep in 6" Pipe with Cap

1.23
7.30
SIERRA ST
30' (60)

Set "X" in Pav.
55+16.18

TRACT

264.05 @ 0-00768 = 264.02

CEDAR
Found Nail & Tag
PINO CANYON AVE
TOYHANCE

Set "X" in Pav.
55+52.16

246.69

Con. from top page 45

RETURN TO
LOS ANGELES COUNTY SURVEYOR

Do not extend notes this side of this line

Notes: ANY ADDITIONS OR CHANGES ON THIS SHEET MUST BE MADE OR CIRCLED IN Red. WITH DATE AND NAME OF PERSON MAKING CHANGE.

Date 2-27-31 Notes by Miller Chief Party Miller F.B. 460 Pg. 47

Tape #044 84°F 20#

Platted by K. V. M.
Date 12-23-31
Map No. P. 643-1,2
Platting C'k'd by D. M. Finley
Date Apr. 1933.

W. O. No. 7016 D. S. O. No.
Location CYPRESS AVE
Surveyed by W. A. Miller
Date Feb. 1931
Indexed A. C. Johnson

63+46.61
2+27.69
65+74.30
1+86.52
67+60.82
1+45.01
69+05.83

Fd R.R. Rail - 24" Up
69+99.27.
F.B. 238-9A

Con at bottom page 48

40.59

599.91

599.98 @ 0-00 T 66 = 599.91

75.52

Fd R.R. Rail 24" Up
69+23.75 F.B. 238-9A

Fd S.V.T
69+23.73.

40.62

17.92
0.63
7.93
17.90
118.21

Fd L.T in face of Curb
Rev F.B. 238-9B
69+13.76

DOMINGUEZ ST

Fd 2x2 in Ditch & Pt
Hollywood-Palos Verdes
Parkway F.B. 238-9.
69+07.76

78.13

14.08
20.61
40.84

Set N.T
69+05.83

Fd 1/2" I.P. Filled with
Con. & Tk. To agree with F.B. 238-9A
68+91.75 J.C.H.

39.38

Fd R.R. Rail 24" Up
68+64.99.

145.03 @ 0-00 T 68 = 145.01

145.06

ATSF R.R.

Fd R.R. Rail - 24" Up
67+80.33.

Fd. C.S.V.&T F.B. 441-39: 67+76.31

0.68

39.39

TR = 4984

40.64

15.49

Fd 1½" I.P. Plug - Tk - 12" Deep
67+72.34.
F.B. 238-9

11.52

Set N-T
67+60.82

6.19

39.37

ALLEY

(80) (80) (80)

Fd R.R. Rail
66+98.86.
F.B. 238-9

TRACT No 7873

186.54 @ 0-00 T 66 = 186.52

186.52

Transit Line

CEDAR AVE

39.37

Fd R.R. Rail 24" Up
65+83.53.

9.23

Set "X" in Pav.
65+74.30

227.69

PAC. ELECTRIC R.R.

TORRANCE TRACT

Con. from Fol. page 46

Note: ANY ADDITIONS OR CHANGES ON THIS SHEET MUST BE MADE OR CIRCLED IN Red. WITH DATE AND NAME OF PERSON MAKING CHANGE.

Do not extend notes this side of this line

RETURN TO LOS ANGELES COUNTY SURVEYOR

F.B. 460 PG. 48 — Miller — Chief Party — Notes by Miller — Date 2-27-31

Tape "OK" 84°F 20#

Con at bottom page 49

TR # 9901

69+05.83
5+99.91
75+05.74
5+99.95
81+05.69
7+13.36
88+19.05

N

224.65

39.86

Fd 2" I.P. Plug "TK"
89+26.09
F.B. 238-10
TRACT #1427

224.66 @ 0-00 T 74 = 224.65 ✓

1000.00

100.01 @ 0-00 T 74 = 100.00

39.84
7.04

Fd 3" I.P. Filled with Conc. "Wall"
89+26.09
F.B. 238-10

Set N&T
88+19.05 ✓

713.36

713.45 @ 0-00 T 64.1 = 713.36 ✓

PROP. C/L 7TH AVE

TRACT NO 7073

Set N&T
81+05.69 ✓

(42) (40) (8P)

CEDAR

600.02 @ 0-00 T 65 = 599.95 ✓

599.95

Set N&T
75+05.74 ✓

599.91

California Topo Line 17

RETURN TO
LOS ANGELES COUNTY SURVEYOR

Do not extend notes this side of this line

Note: ANY ADDITIONS OR CHANGES ON THIS SHEET MUST BE MADE OR CIRCLED IN Red. WITH DATE AND NAME OF PERSON MAKING CHANGE.

Date 3-2-31 Notes by Miller Chief Party Miller F.B. 460 Pg. 49

Platted by K. V. M.
Date 12-23-31
Map No. B-643-1/2
Platting C'k'd by D. M. Finley
Date Apr. 1933

W. O. No. 7016 B. S. O. No.
Location CYPRESS AVE
Surveyed by W.A. Miller
Date Mar. 1931
Indexed by C. Johnson

Tape #044
84°F 20m

88+19.05
2-24.65
90+43.70
1-32.99
91+76.69
49.98
92+26.67

Con at bottom page 50

683.19 @ 0-00 T 76 = 683.15

99-55-45
39-42-30
99-58-37½

Notes: ANY ADDITIONS OR CHANGES ON THIS SHEET MUST BE MADE OR CIRCLED IN Red. WITH DATE AND NAME OF PERSON MAKING CHANGE.

Do not extend notes this side of this line

RETURN TO LOS ANGELES COUNTY SURVEYOR

Tan's Line 683.15

99-55-40

Fd 2x2 18" Deep FB 441-36

Fd S.W.T Per F.B. 441-40 92+26.67

704.32 F.B. 441-44-36

0.03

Fd 2" I.P. Pkg Tk

Fd 2x2-18" Dp. F.B. 441-44

0.04 601.39' FB 441-44 40'

74.22 39.94 & Prod L.A. ST

PRO. LOS ANGELES ST

Fd 2x2-24" Deep F.B. 238-156 + F.B. 441-40

Fd S.W.T 18" Gum

46.45 83.30 49.98 50.19

Fd S.W.T 18" Gum

90-33-45
362-15-00
90-33-45

Fd S.W.T Per F.B. 441-40 91+76.69

90-33-45 0.02 35.65 169-30-40

Fd S.W.T 18" Gum

Fd S.W.T 12" Gum

169-30-45
318-02-30
169-30-37½

Fd S.W.T 18" Gum

(40) (84) (40)

133.00 @ 0-00 T 74 = 132.99

CYPRESS AVE

Tan's Line 132.99

CEDAR AVE

No 9901

Fd S.W.T Per F.B. 441-40 90+51.54

0.06

7.84

203 FD ST

(25' (SP (23'

Set I/N.T 90+43.70

TRACT No 7873

PRO 22.65

TRACT

Con from top page 48

F.B. 460 Pg. 50 Miller Chief Party Notes by Miller Date 3-2-31

Tape #044
84° F 20#

Con at bottom page 51

93+26.67
6+83.15
99+09.82
5+99.77
105+09.59
7+66.30
112+75.89

599.44 @ 0-00 7 0 = 599.44 ✓

Set N.T.P. Pole 113+36.5

70.5

Private Road
D.G. Sur.

113+05 @

Set N.T.P. Pole

92.82

18'

67.5 73.18 73.00

Set N.T. Ph. Pole 113+16 @

112+67.2

Set N.T. Ph. Pole

83.27

50.23
49.6

Set 1x2
112+75.89 ✓

766.34 @ 0-00 7 72 = 766.30 ✓

766.20 BLM

Set 1x2
105+09.59 ✓

599.80 @ 0-00 7 76 = 599.77 ✓

599.65

Set 1x2
99+09.82 ✓

577.89

Con From Fap page 49

RETURN TO
LOS ANGELES COUNTY SURVEYOR

Do not extend notes this side of this line

Notes: ANY ADDITIONS OR CHANGES ON THIS SHEET MUST BE MADE OR CIRCLED IN Red. WITH DATE AND NAME OF PERSON MAKING CHANGE.

Date 3-3-31 Notes by Miller Chief Party Miller F.B. 460 PG. 51

Platted by K. V. M.
Date 12-23-31
Map No. B. 643-1, 2
Platting C'k'd by D. M. Finley
Date Apr. 1933

W. O. No. 7016 D. S. O. No.
Location CYPRESS AVE
Surveyed by W.A. Miller
Date Mar 1931
Indexed A. C. Johnson

Tape "044
84°F 20#

112+75.89
5+99.42
118+75.31
5+99.52
124+74.83
8+52.38
133+27.21

0+82.51
1.69
0+84.20

90-00-45
360-03-00
90-00-45.

0.25
Fd 1½" I.P. & Nail 0.25 E of Line
Per F.B. 125-36

189-59-00
39-56-00
189-59-00.

Fd Conc Mon - S.W.T - 18" Deep
Per F.B. 238-155

CYPRESS AVE

1320.77 @ 0-00 T 86 =

189-59-00

ST

Fd Conc Mon - S.W.T - 18" Deep
Per F.B. 238-155

Fd L.T. 0.02 S. of Line
Per F.B. 238-157
0+84.20

90-00-45

42.46

42.46

Fd X in Conc Pav.
Per F.B. 238-157

30.00

1.69

82.51

DOMINGUEZ

2543.86

Fd L.T. 0.02 S. of Line
Per F.B. 238-157
0+82.51

42.50

30.18

Fd L.T. in Conc Pav.
Per F.B. 238-157
133+27.21

Fd Conc Mon - S.W.T - 18" Deep
Per F.B. 238-155

Fd Conc Mon - S.W.T - 18" Deep
Per F.B. 238-155

72.68

80-00-20

Fd 2" I.P. - Cap - Flush
Mtks as Shown

GEN'L PET CORP'N OF CAL'A
LAND DEPT

80-00-15
320-01-15
80-00-18¾

852.38 @ 0-00 T 82 = 852.38

852.38

Set 1×2
124+74.83

599.54 @ 0-00 T 80 = 599.54

599.52

Set 1×2
118+75.31

599.42

Con from top page 52

Con from top page 60

Notes: ANY ADDITIONS OR CHANGES ON THIS SHEET MUST BE MADE OR CIRCLED IN Red. WITH DATE AND NAME OF PERSON MAKING CHANGE.

Do not extend notes this side of this line

RETURN TO LOS ANGELES COUNTY SURVEYOR

F.B. 460 Pg. 52 — Miller — Chief Party — Notes by Miller — Date 3-3-31

Tape #044
8A¹F 20"

Tape #04-1
8A¹F 22

Con at bottom page 53

0+84.20
25+43.86
26+28.06
11+13.67
37+41.73

Tape #041
1515.25@0-00766 = 1515.07✓

1515.07✓

ST.

N

Set X in Pav
37+41.73✓

DOMINGUEZ

Tape #044
1113.73@0-00776 = 1113.67✓

1113.67✓

Fd L°Tin Pav.
Per F.B. 238-155
26+28.06✓

REDONDO AVE

2543.93@0-00780 = 2543.86✓

2543.86✓

Con from left side page 51

RETURN TO
LOS ANGELES COUNTY SURVEYOR
Do not extend notes this side of this line

Note: ANY ADDITIONS OR CHANGES ON THIS SHEET MUST BE MADE OR CIRCLED IN Red. WITH DATE AND NAME OF PERSON MAKING CHANGE.

Date 3-4-31 Notes by Miller Chief Party Miller F.B. 460 PG. 53

Tape #041
84°F 22

Platted by K. V. M.	W. O. No. 7016 D. S. D. No.
Date 12-23-31	Location CYPRESS AVE
Map No. B-643-1,2	Surveyed by W.A. Miller
Platting C'k'd by D. M. Finley	Date Mar 1931
Date Apr. 1932	Indexed C. Johnson

37+41.73
15+15.07
52+56.80
3+29.59
55+86.39

Fd L.T of BC
F.B. 455-39

89-52-45
359-31-15
89-52-48¾

ST

PRO. PRAIRIE AVE

89-52-50

30' offset Line F.B. 455-39

Fd N.Z-St a 100+58.55
Per F.B. 455-38

Fd L.T in Pav.
Per F.B. 455-39
55+86.39

329.63 @ 0-00 TG6 = 329.59

329.59

DOMINGUEZ

179-59-45
359-59-00
179-59-45

179-59-45

Fd L.T in Pav
Per F.B. 455-39
52+56.80

PRAIRIE AVE

1515.02N

Con from top page 52

Note: ANY ADDITIONS OR CHANGES ON THIS SHEET MUST BE MADE OR CIRCLED IN Red. WITH DATE AND NAME OF PERSON MAKING CHANGE.

Do not extend notes this side of this line

RETURN TO LOS ANGELES COUNTY SURVEYOR

F.B. 460 Pg. 54 Chief Party Notes by Date

RETURN TO

LOS ANGELES COUNTY SURVEYOR

Do not extend notes this side of this line

Note: ANY ADDITIONS OR CHANGES ON THIS SHEET MUST BE MADE OR CIRCLED IN Red. WITH DATE AND NAME OF PERSON MAKING CHANGE.

Date _____ Notes by _____ Chief Party _____ F.B. 460 PG. 55

Platted by J.C. Hoyt	W. O. No. 7016 D. S. O. No. _____
Date May 1931	Location CYPRESS AVE
Map No. B-643-1,2	Surveyed by W.A. Miller
Platting C'k'd by D. M. Finley	Date Mar 1931
Date Apr 1933	Indexed A. C. Johnson 2-8-31

Note: ANY ADDITIONS OR CHANGES ON THIS SHEET MUST BE MADE OR CIRCLED IN Red. WITH DATE AND NAME OF PERSON MAKING CHANGE.

Do not extend notes this side of this line

RETURN TO LOS ANGELES COUNTY SURVEYOR

TOPOGRAPHY

CYPRESS AVE. W.O. 7016

Pages 55 to.

F.B. 460 PG. 56 — Miller Chief Party — Notes by Miller & Gregory — Date 3-10-31

Con at bottom page 57

N

36.20 4" Fig 3+93.00

17.40 6.80 55.90

Chicken Yard
Woven Wire Fe

20.0 Ft. Hor. No. 5 Wire

39.0

17.20

3+69.80

13.0 Stan. Oil Co. Ph Pole 3+57.86

35.90

4" Fig 4" Apricot 4" Plums
3+51.7

4" Plum 4" Peach

20.0 20.0

4" Fig 4" Peach

35.80 20.0 20.0 20.0

4" Plums
2+73.4

14.8 Stan. Oil Co Ph Pole 1+94.11

14.80 Fence Post End
1+78.50

CULVER AVE

PACIFIC ELECTRIC R.R.

Old Barbed Wire Fe

15.0 Fence Post Bay Fe
0+83.20

5' Conc. Walk

0+40.90 Guy Pole

0+38.00 47.00 10" Gums 0+36.60

14.1 0+44.54

14.90 4" Conc. Gutter 0+37.04 Curb 0+24.94

REDONDO-WILMINGTON BLVD

15.00 10' 10' Conc Pav.

Fd 4" in Pav.
Page 24
0+00

Fd L.T in Pav.
Page 24

10.9 8" Gum Tree 0+43.7

U.P. Pole 0+34.92

32.54 15.00 30.98 32.18

4" Conc. Gutter 0+39.80 Curb 0+29.56

5' Conc. Walk

HILLWORTH AVE

RETURN TO
LOS ANGELES COUNTY SURVEYOR

Do not extend notes this side of this line

Note: ANY ADDITIONS OR CHANGES ON THIS SHEET MUST BE MADE OR CIRCLED IN Red. WITH DATE AND NAME OF PERSON MAKING CHANGE.

Date 3-10-31 Notes by Miller + Gregory Chief Party Miller + Gregory F.B. 460 PG. 57

Plotted by J.C. Hoyt	W. O. No. 7016 D. S. O. No.
Date May 1931	Location CYPRESS AVE
Map No. B-643-1, 2	Surveyed by W.A. Miller
Plotting C'k'd by D. M. Finley	Date May 1931
Date Apr. 1931	Indexed A. C. Johns

Note: ANY ADDITIONS OR CHANGES ON THIS SHEET MUST BE MADE OR CIRCLED IN Red. WITH DATE AND NAME OF PERSON MAKING CHANGE.

Do not extend notes this side of this line

RETURN TO LOS ANGELES COUNTY SURVEYOR

N

Con at bottom page 58

CYPRESS AVE

Transit Line

Base Row of Evergreens 15' High

3"to 6" diam

49.80 → 20.00 — 80.00

6"Peach. 5"Peach. 6"Apricot

2"orange 6"Peach 3"Lemon 6"Peach

2"Orange. 6"Peach. 8"Peach

Stan Oil Co. Ph Pole 8"Apricot

8+59.6 ←13.0→ 3"Orange 6"Peach

3"Lemon 6"Peach ✓

2"Cherry

6"Walnut. 8"Apricot. 6"Apple.

3"Pear. 8"Peach. 6"Plum.

3"Peak. 6"Figs 6"Apple.

3"Pear.

8+02.5 ←29.5→ 20.0 20.0 20.0

6"Fig 2"Pear. 3"Quince 6"Walnut.

7+90 ←18.00→ 80.00

6' Woven Wire Fe

6+90.5 ←12.5→ Stan Oil Co Ph Pole

Cultivated

P.R.O.

Fd 1&2 - Page 24

5+25.43

OLIVE ST

32.20

Oil + Screening Sur. 15' Wide

5+21 ←12.5→ Stan. Oil Co Ph Pole

61.10

21.30

21.20

4+55.40

24.00

1 Sty Fr. Ho

32.10

Picket Fe

45.30

45.00

1929

1 Sty Fr. Garage

4+07.20

Con From top page 56

F.B. 460 Pg. 58 — Miller — Chief Party — Notes by Miller & Gregory — Date 3-11-31

Con at bottom page 59

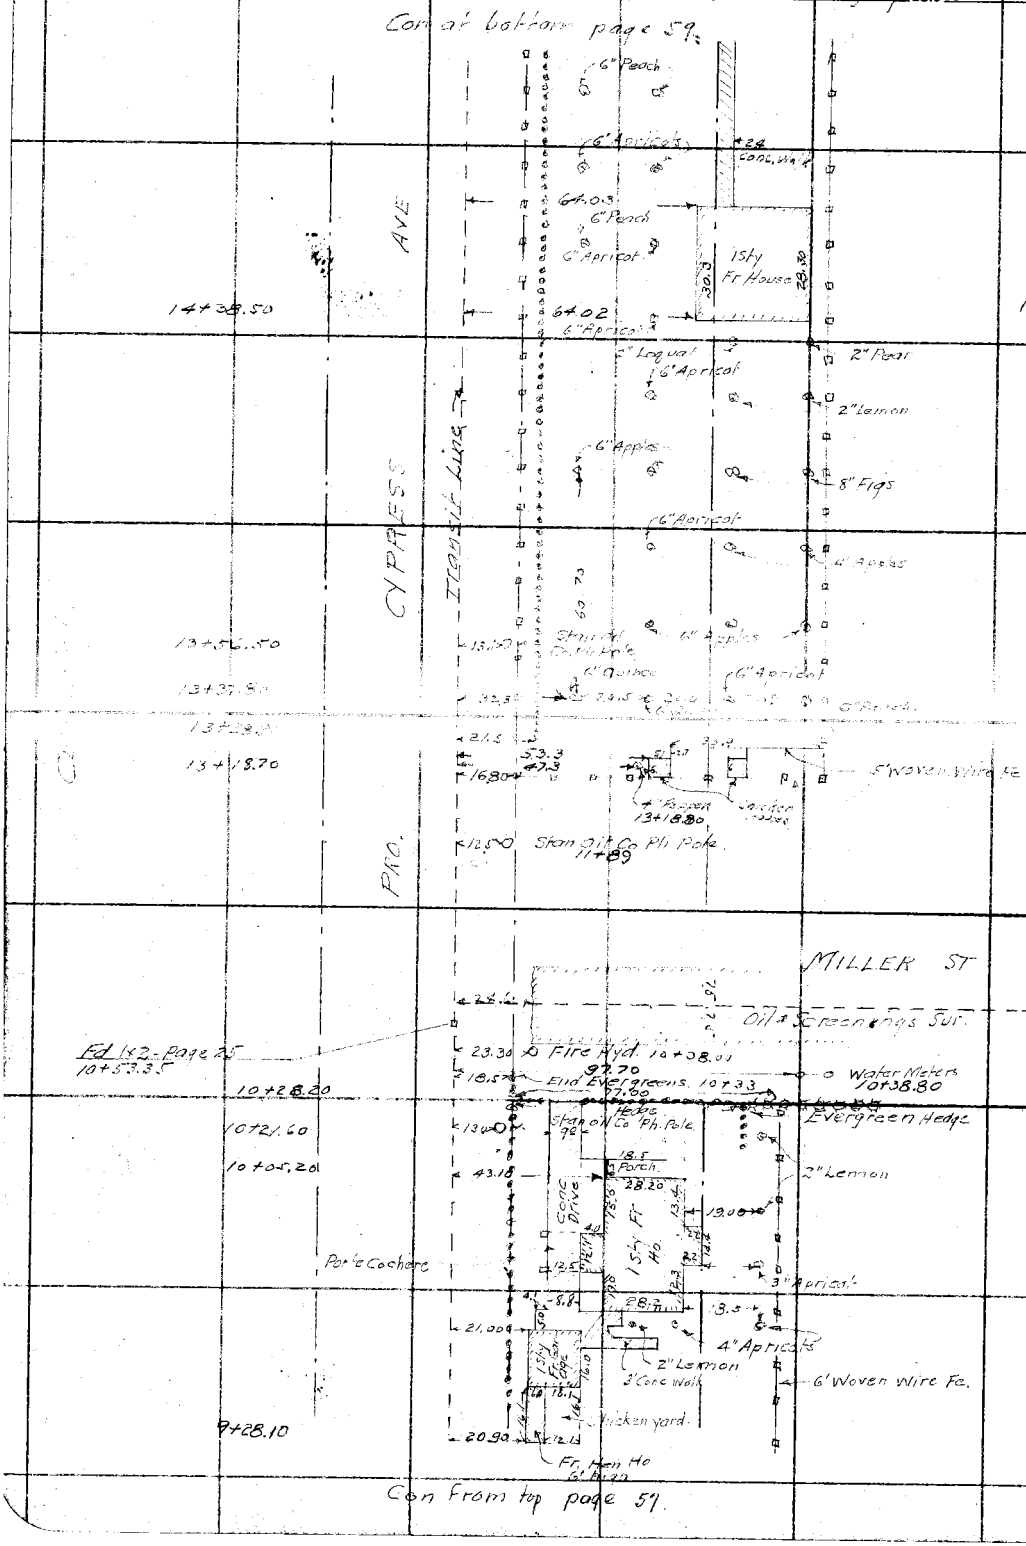

Con from top page 57

RETURN TO LOS ANGELES COUNTY SURVEYOR

Do not extend notes this side of this line

Note: ANY ADDITIONS OR CHANGES ON THIS SHEET MUST BE MADE OR CIRCLED IN Red. WITH DATE AND NAME OF PERSON MAKING CHANGE.

Date 3-11-31 Notes by Miller & Gregory Chief Party Miller F.B. 460 PG. 29

Platted by J.C. Hoyt
Date May 1931
Map No. B.643-1,2
Platting C'k'd by D. M. Finley
Date Apr. 1933

W. O. No. 7016 D. S. O. No.
Location CYPRESS AVE
Surveyed by W.A. Miller
Date Mar 1931
Indexed

Con at bottom page 60

23+56.00 — 12.7+O Stan Oil Co Ph Pole

21+87.40 — 12.5+O Stan. Oil Co Ph Pole.

21+33.20 — 25.0+O Water Meter

LEMON ST
Nat. Surface.

Fd 1x2 - Page 26
21+09.5

30.5+O Fire Hyd. 20+94.30

20+22.5 — 13.0+O Stan Oil Co Ph. Pole.

CYPRESS AVE

Transit Line

Cultivated

18+55 — 12.7+O Stan Oil Co Ph Pole.

16+89.6 — 12.7+O Stan Oil Co Ph Pole.

Water Main 16+00

PROJ.

15+99.00 — 22.5+O Phone Pole

POMELO ST.

Oil & Sprinkling Sys.

25.1 — 49.5 — 25.0 — 50.5 — 47.4 — Fire Hyd. 15+66.30

Water Meters 15+61.50

Fd 1x2 - Page 26
15+81.58

15+55.40

15+31.5

15+22.70

15+20.5

18.4 — 29.00 — 28.60

1 Sty Fr. Gar. Apt.

6' Orange 15+40

5' Woven Wire Fe

18.5 — 16.7 — 13.4 — 3' Hedge

Stan Oil Co Ph Pole

33.2 — 20.00 6' Peach

2' Cross Walk

Con From top page 58

Notes: ANY ADDITIONS OR CHANGES ON THIS SHEET MUST BE MADE OR CIRCLED IN Red. WITH DATE AND NAME OF PERSON MAKING CHANGE.

Do not extend notes this side of this line

RETURN TO LOS ANGELES COUNTY SURVEYOR

6

F.B. 460 PG. 60 Miller Chief Party Notes by Miller & Gregory Date 3-11-31

Con at bottom page 61

RETURN TO
LOS ANGELES COUNTY SURVEYOR
Do not extend notes this side of this line

Note: ANY ADDITIONS OR CHANGES ON THIS SHEET MUST BE MADE OR CIRCLED IN Red. WITH DATE AND NAME OF PERSON MAKING CHANGE.

Date 3-11-31 Notes by Miller & Gregory Chief Party Miller F.B. 460 PG. 41

Platted by J.C. Hoyt
Date May 1931
Map No. B-643-1,2
Platting C'k'd by D. M. Finley
Date Apr 1933.

W. O. No. 7016 D. S. O. No.
Location CYPRESS AVE
Surveyed by W.A. Miller
Date Mar 1931
Indexed A. O. Johnson

N

Con. at bottom page 62

CYPRESS AVE

33+52.6 Stan. Oil Co Ph. Pole.

31+30.6 Beg. old barbed wire Fe.

31+8.7 Stan Oil Co Ph Pole

ARIZONA ST

Oil & Screenings Surf

Fd 1x2 - Page 28
31+65.42

Water Valve 31+50.16 Water Meter 31+51.16
Fire Hyd. 31+49.76

81.30

Ent. Evergreens 31+38.

Fe Cor. 31+42.16

31+26

AG.50 → 6" Pepper

4' Woven wire Fe

End Evergreens 30+93

50.00

1 Sty Fr. Garage & shed

1 Sty House

4" Aprics

30+63.80

10 Pepper

3" Apricots

Fr. Chicken Shed

30+44.90
30+43

Lind Fence

86.70

Stucco Bird Ho 4.4 high

30+40.80

30+20 Stan Oil Co Ph. Pole.

Fish Pond 30+33.20

30+3.50 1 Sty Fr. Brooder

30+0.1

1 Sty Fr. Brooder

36" Woven Wire Fe.

3" Peach

50.00

1 Sty stucco Hen Ho.

29+68.4

Woven Wire Fe

6" Fig.

29+01.

4' Woven Wire Fe

Con. from top page 60

Old Barbed Wire Fe

5-Strand Barbed wire Fence

Gulf Lease

Note: ANY ADDITIONS OR CHANGES ON THIS SHEET MUST BE MADE OR CIRCLED IN Red. WITH DATE AND NAME OF PERSON MAKING CHANGE.

Do not extend notes this side of this line

RETURN TO
LOS ANGELES COUNTY SURVEYOR

F.B. 460 Pg. 62 — Miller — Chief Party — Notes by Miller & Gregory — Date 3-12-31

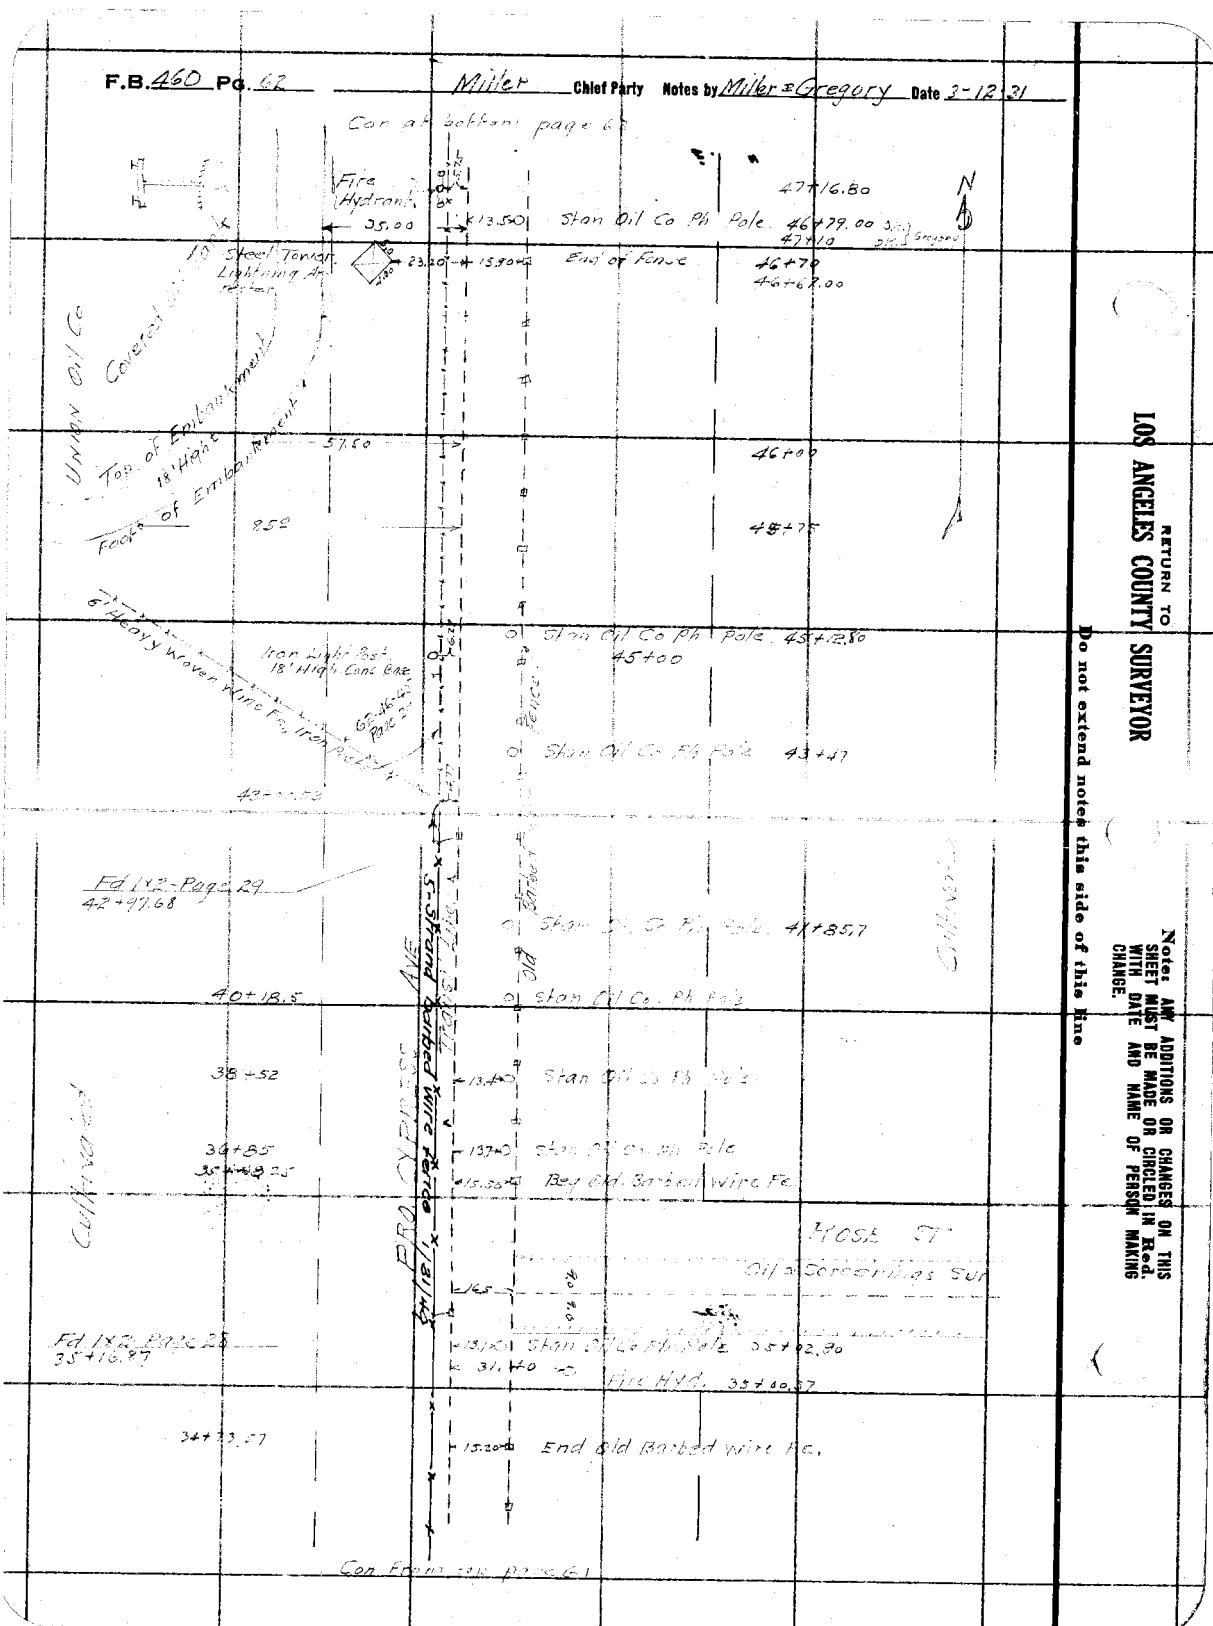

RETURN TO
LOS ANGELES COUNTY SURVEYOR
Do not extend notes this side of this line

Notes: ANY ADDITIONS OR CHANGES ON THIS SHEET MUST BE MADE OR CIRCLED IN Red. WITH DATE AND NAME OF PERSON MAKING CHANGE.

Date 3-12-31 Notes by Miller + Gregory Chief Party Miller F.B. 460 PG. 63

Platted by J.C. Hoyt	W. O. No. 7016 D. S. O. No.
Date May 1931	Location CYPRESS AVE
Map No. B-643-1, 2	Surveyed by W.A. Miller
Platting C'k'd by D. M. Finley	Date Mar 1931
Date Apr 1933.	Indexed A. C. Johnson

Con of bottom page

Stan Oil Co Ph Pole. 56+79.20

+13.50

Fire Hydrant 580 56+60.5

Stan Oil Co. Ph. Pole. 55+14.20

Steel Tower Lightning Arrester 40 23.96 54+77.50

Fire Hydrant 525 51+62.80

Stan Oil Co. Ph. Pole. 53+43.60

add 1/31/40 53+14.50

~~Iron Light Pole~~ ~~15' Iron Conc base~~

Fire Hydrant 525 52+19.7

Stan Oil Co Ph Pole. 51+78

Fire Hydrant 525 51+08.40

Steel Tower Lightning Arrester 40 23.80 50+72.5

Stan Oil Co. Ph Pole. 50+12

Fire Hydrant 577 49+74.20

Emb. 18' High

add 1/31/40 ~~Iron Light Post 15' Iron Conc base~~ 49+06

+13.40 Stan Oil Co Ph Pole. 48+45.20

Fire Hydrant 577 48+24.50

Fd 1x2" Pgs 30
47+52.58

Con from Erp page 62

CYPRESS AVE

PRO

Wire Fence

Wire Fence

Top of Embankment

Toe of Embankment

Stan Oil Co Ph Tank

Culvert

Notes: ANY ADDITIONS OR CHANGES ON THIS SHEET MUST BE MADE OR CIRCLED IN Red. WITH DATE AND NAME OF PERSON MAKING CHANGE.

Do not extend notes this side of this line

RETURN TO LOS ANGELES COUNTY SURVEYOR

F.B. 460 Pg. 64 — Miller Chief Party — Notes by Miller & Gregory — Date 3-12-31

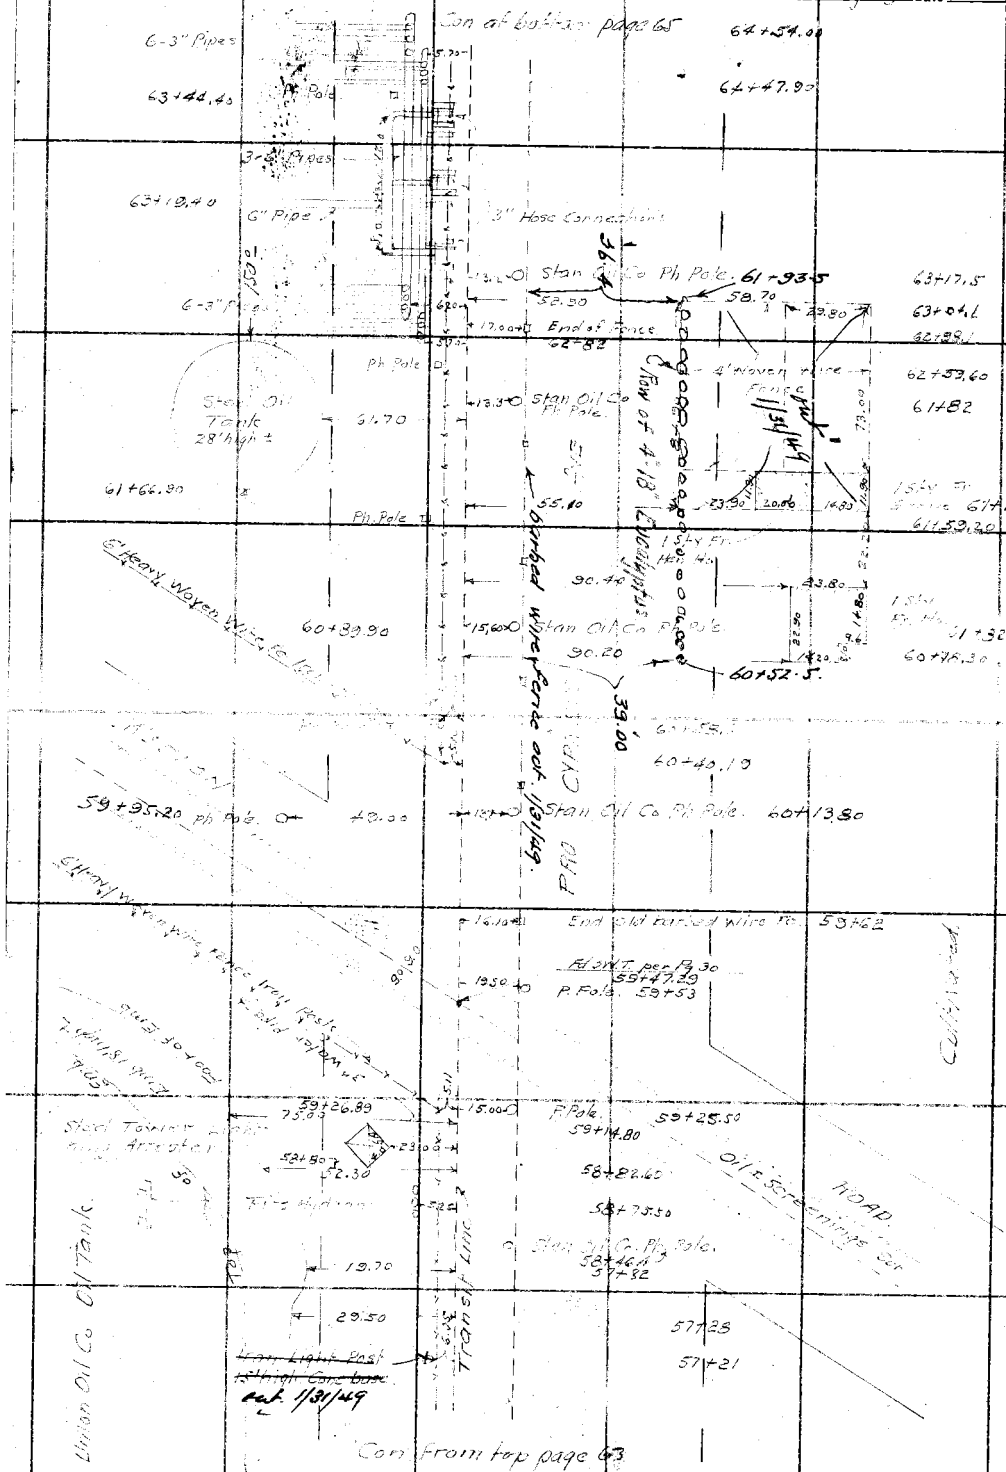
Con at bottom page 65
64+54.00
64+47.90
6-3" Pipes
63+44.40
3" Pipes
63+19.40
6" Pipe
3" Hose Connections
Stan Oil Co Ph Pole
61+93.5
63+17.5
63+04.4
62+89.
52.90
58.70
43.80
End of Fence
62+82
Ph Pole
4' woven wire fence
62+53.60
61+82
61.70
13.30
Stan Oil Co Ph Pole
61+66.90
Ph Pole
55.10
15+y Fence
61+23.40
61+59.20
Ch Heavy Woven Wire Fence
90.40
43.80
60+39.90
15,600
Stan Oil Co Ph Pole
90.20
60+52.5
39.00
Barbed wire fence ext. 11/31/49.
60+40.10
59+95.20 Ph Pole
40.00
Stan Oil Co Ph Pole
60+13.80
Old Road
Woven Wire Fence Iron Posts
Steel Post
Steel Post
Steel Tower
Ang. Angle
Ang. Angle
Ang. Angle

Date 3-12-31 Notes by Miller & Gregory Chief Party Miller F.B. 460 Pg. 65

Platted by L.C. Hoyt
Date May 1931
Map No. B-623-1, 2
Platting C'k'd by D. M. Finley
Date Apr. 1933

W. O. No. 7016 D. S. O. No.
Location CYPRESS AVE.
Surveyed by W.A. Miller
Date Mar 1931
Indexed by C. Johnson

N

Con at bottom page 66

Row of 6x6 Posts 66+21
Ed 2+2 - Flush - Page 32
66+02.20

12-Hose outlets

148.00

66+17.70 CHESTNUT ST

6-3" Pipe

Oil & Screenings Sur.

66+03.30

65+91.40

2-6" Pipe

Open Valve Well, Stan Oil Co Pipe Lines

Valve Box 2'x4'

End Cedar

65+78.00

65+80

65+76.90

65+78.00 ℄

1" Fig 1" Plum 1" Peach 1" Plum 65+77 65+76

End Old Wire Fe

1" Peach 3" Peach 2" Persimmon 65+71

Steel Oil Tank - 28' high ℄

℄ Ph Pole 65+60

62.20

2" Peach 1" Apricot

1" Peach 3" Peach 1" Pear

4" Peach 3" Peach

Stan Oil Co Ph. Pole 64+88

3" Plum 3" Peach 1" Apricot

64+52 Ph. Pole

4" Apricot 1" Peach

These 4 trees out of line

1" Plum 6" Fig 6" Apricot

2" Peach 1" Peach

2" Quince 2" Quince 3" Apricot

2" Peach 2" Apple

32.20 Peach

1" Peach

64+47.70

24.00

1" Peach 18.4 3" Peach

93.00

3" Peach 32.00 Pigeon Coop 6.00

64+42.7

150.00

UNION OIL CO.

PINE

CYPRESS AVE

6" Heavy Wire Fence from Posts

Old barbed wire Fence from Posts

Pepper Row Cedars & Pine

17.00

17.50

Beg Cedars.

63+58

63+37

Con from top page 64

Note: ANY ADDITIONS OR CHANGES ON THIS SHEET MUST BE MADE OR CIRCLED IN Red. WITH DATE AND NAME OF PERSON MAKING CHANGE.

Do not extend notes this side of this line

RETURN TO LOS ANGELES COUNTY SURVEYOR

F.B. 460 Pg. 66 — Miller Chief Party Notes by Miller & Gregory Date 3-12-31

Con at bottom page 67

ELGIN ST.

138 Ph Pole P.A.P.Co — 78+52

Ph Pole P.A.P.Co — 77+52

Ph Pole P.A.P.Co — 76+52

Ph. Pole P.A.P.Co — 75+50.5

139 Ph Pole P.A.P.Co — 74+52

15.30

CHERRY ST. (Not opened)

Fd 2×2 12" Dec ft-Lg 33 73+93.98

Ph Pole P.A.P.Co — 73+52

19.5 End Cedars — 72+76.5

Ph Pole P.A.P.Co — 72+52

Ph Pole P.A.P.Co — 71+50

These tks. dead. Highway

Ph Pole P.A.P.Co. — 71+52

Ph Pole P.A.P.Co — 69+52

Beg. old barbed wire Fence — 69+08

6 Heavy Woven Wire Fe

Fd 1×2 Pole 68+58.17

Beg Cedars. — 68+82

14.2 22.1 20.1 Ph Pole P.A.P.Co 68+69 Fe 68+66.3

End of Gums — 68+61.3

Stan Oil Co Ph Pole

68+40 Tank 68+43 } ok Gregory

Steel Oil Tank 28' high ±

11.6 Stan Oil Co Ph Pole — 68+22

End old Fence — 68+16

Beg old barbed wire Fe — 67+64

67+63

Ph Pole

66+59

11.8 Stan Oil Co Ph Pole — 66+56

24.6 Beg of Gums — 66+21

Con from top page 65

RETURN TO LOS ANGELES COUNTY SURVEYOR

Do not extend notes this side of this line

Note: ANY ADDITIONS OR CHANGES ON THIS SHEET MUST BE MADE OR CIRCLED IN Red. WITH DATE AND NAME OF PERSON MAKING CHANGE.

Date 3-13-31 Notes by Millard Gregory Chief Party Miller F.B. 460 PG. 67

Platted by J.C. Hoyt	W. O. No. 7016 D. S. O. No.
Date May 1931	Location CYPRESS Ave
Map No. B-643-1,2	Surveyed by W.A. Miller
Platting C'k'd by D. M. Finley	Date Mar 1931
Date Apr 1933	Indexed A. C. Johnson

Note: ANY ADDITIONS OR CHANGES ON THIS SHEET MUST BE MADE OR CIRCLED IN Red. WITH DATE AND NAME OF PERSON MAKING CHANGE.

Do not extend notes this side of this line

RETURN TO LOS ANGELES COUNTY SURVEYOR

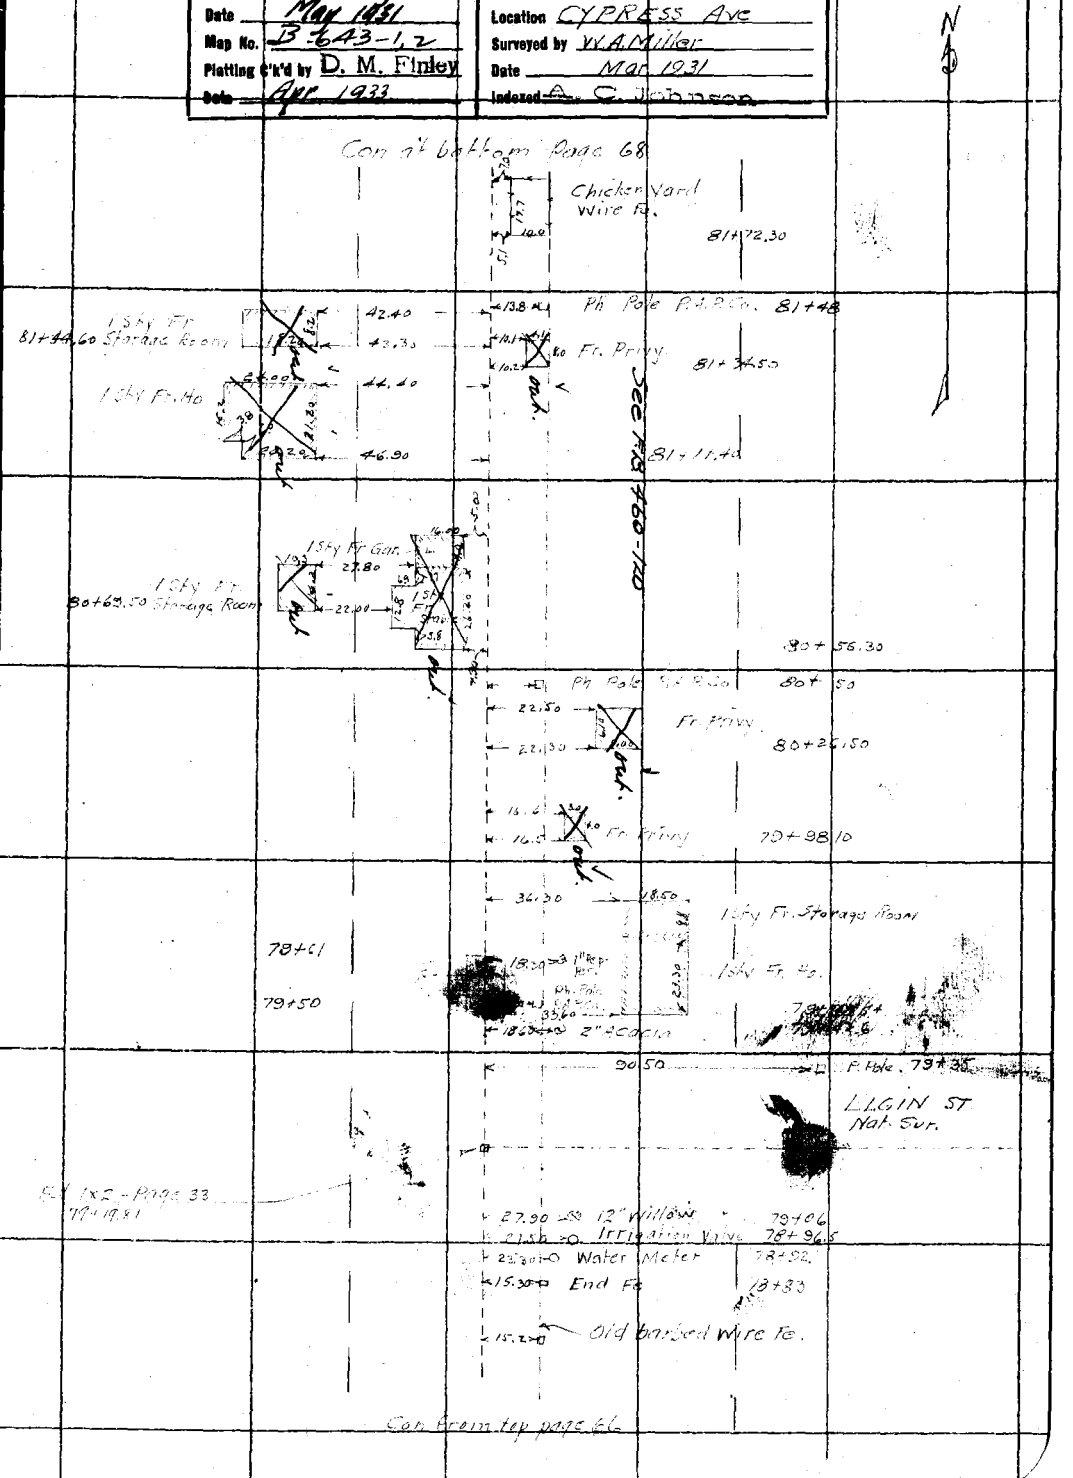

F.B. 460 Pg. 68 Miller Chief Party Notes by Miller & Gregory Date 3-13-31

Con at bottom page 69

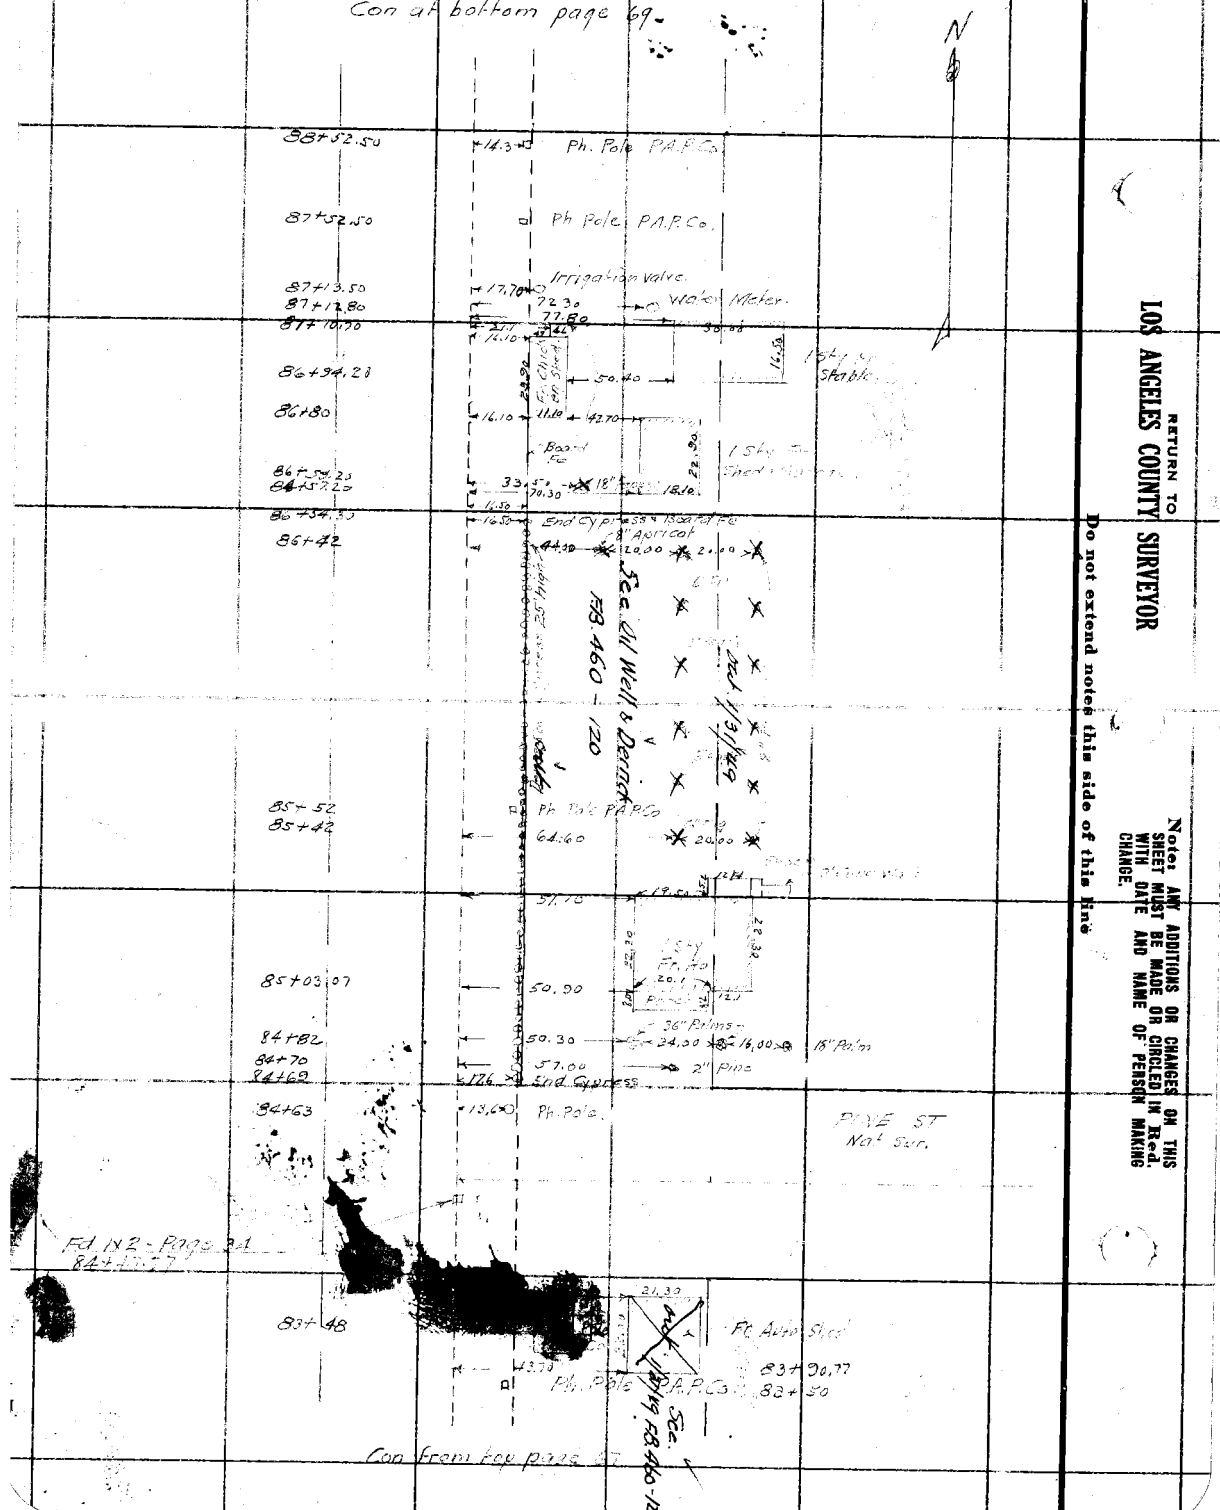

Con from top page 69

RETURN TO
LOS ANGELES COUNTY SURVEYOR

Do not extend notes this side of this line

Note: ANY ADDITIONS OR CHANGES ON THIS SHEET MUST BE MADE OR CIRCLED IN Red. WITH DATE AND NAME OF PERSON MAKING CHANGE.

Date 3-13-31 Notes by Miller & Gregory Chief Party Miller F.B. 460 Pg. 69

Platted by J.C. Hoyt	W. O. No. 7016 D. S. O. No.
Date May 1931	Location CYPRESS AVE
Map No. B-643-1,2	Surveyed by W.A. Miller
Platting C'k'd by D. M. Finley	Date Mar 1931
Date Apr 1933	Indexed A. C. Johnson

Con at bottom page 70

N

Private Road Way Oil & Gravel Surf.

14.2 Ph Pole P.A.P.Co. 95+52.5 PALM ST.

Oil & Gravel Surf.

95+10

33.50 → P. Pole. 94+78

14.30 Ph Pole P.A.P.Co. 94+57.5

Ph Pole P.A.P.Co. 93+52

4" Pipe Line

421.19 Ph. Pole P.A.P.Co 92+96 92+53

Ph. Pole P.A.P.Co 91+53.5

Ph. Pole P.A.P.Co 90+53

89+97 P. Pole. 7.40

89+76 56.30 → P. Pole ACACIA ST Nat Surf.

Ed I.X.2 - Page 34
89+72.69

14.4 Ph. Pole P.A.P.Co 89+50

Con from top page 68

Note: ANY ADDITIONS OR CHANGES ON THIS SHEET MUST BE MADE OR CIRCLED IN Red. WITH DATE AND NAME OF PERSON MAKING CHANGE.

Do not extend notes this side of this line

RETURN TO LOS ANGELES COUNTY SURVEYOR

F.B. 460 Pg. 70 — Miller — Chief Party — Notes by Miller + Gregory — Date 3-13-31

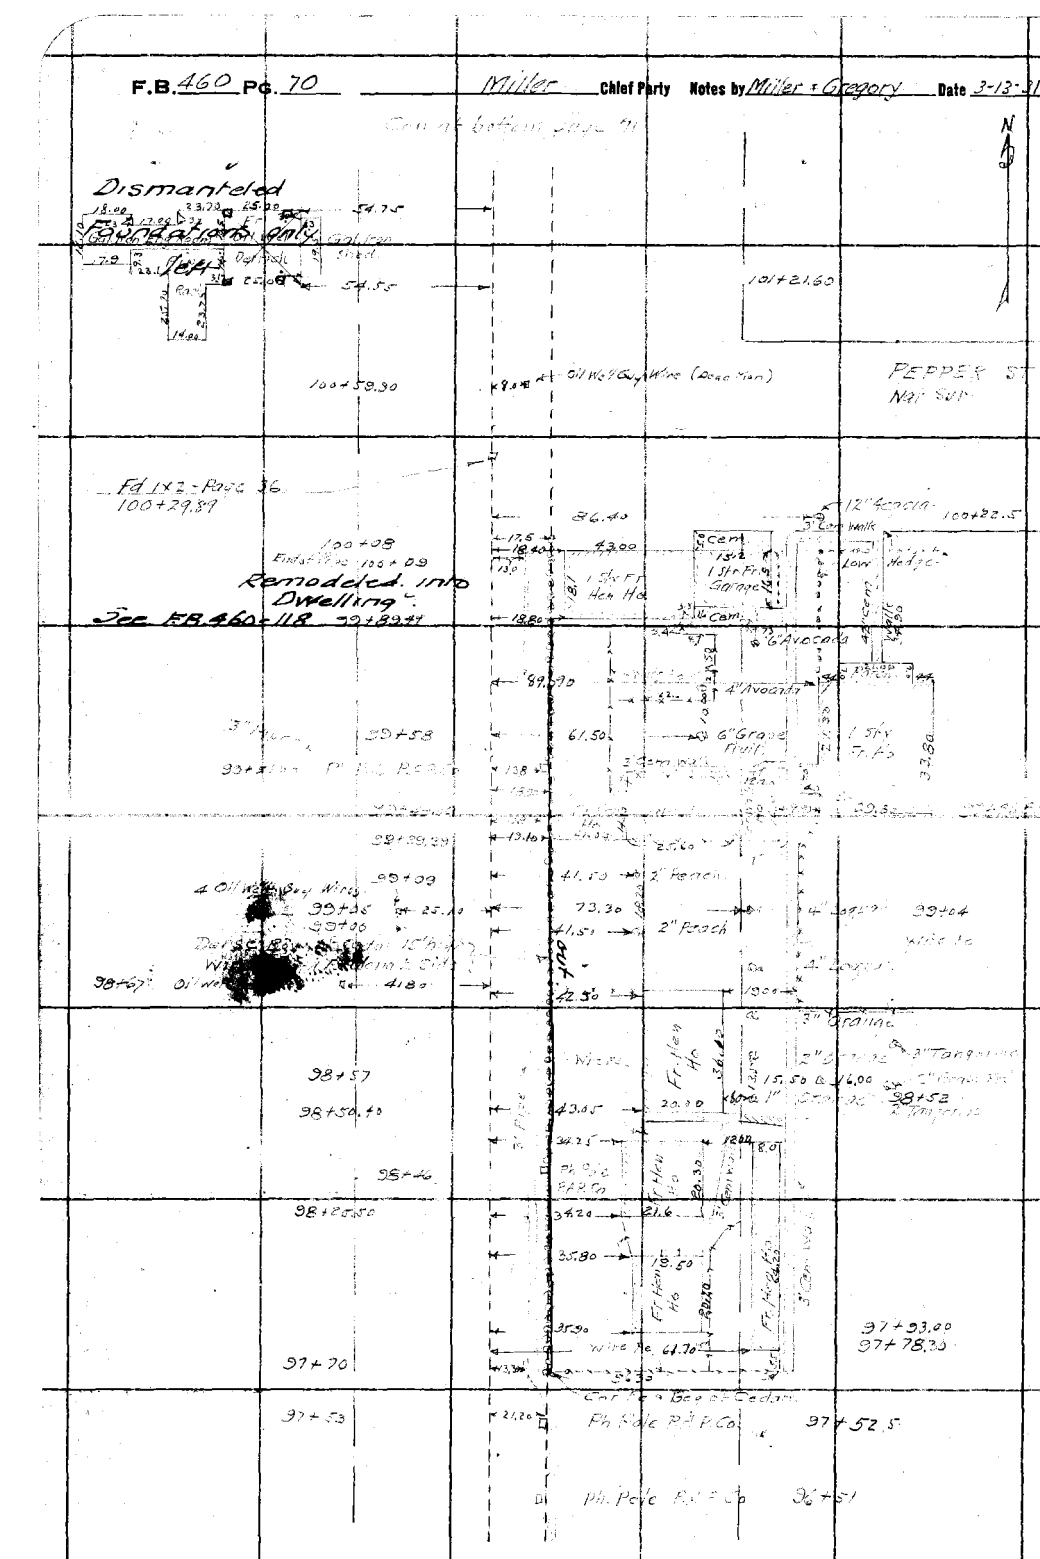

RETURN TO
LOS ANGELES COUNTY SURVEYOR
Do not extend notes this side of this line

Notes ANY ADDITIONS OR CHANGES ON THIS SHEET MUST BE MADE OR CIRCLED IN Red. WITH DATE AND NAME OF PERSON MAKING CHANGE.

Date 3-16-31 Notes by Miller-Gregory Chief Party Miller B.B. 460 Pg. 71

Platted by J.C. Hoyt
Date May 1934
Map No. B-643-1,2
Platting C'k'd by D. M. Finley
Date Apr. 1933

W. O. No. 7016 D. S. O. No.
Location CYPRESS AVE
Surveyed by W.A. Miller
Date Mar 1931
Indexed A. C. Johnson

Con at bottom page 72

Fir ST
Nat Sur

Fd 1x2 - Page 36
105+56.95

105+45.5

105+38

18" Acacia

15" Acacia

57.50

18.2

16.5

Dense Row of Cedars
6' to 12" diam

78.09

105+04

6" Apricots

Deadman

58.40

104+91

104+87

57.5

41.00

Cedars dead 1/1/42

Blackberries
& Dewberries

Dense Row of Cedars
6' to 12" diam.

16.4

Reg. Cedars

102+98

102+89.90

Steel Tank
16' high

20.40

102+65.00

35.0

102+37.00

70.0 ±

55.10

16.80

Steel Tank
11' High

Gal Iron Sheet

22.20

22.00

19.40

Pipe Rack

24.00

6.0

3.86

Frame Oil Well Derrick

25.00

102+37.60

Abandoned Cellar

101+80

101+86
101+84

25.00

101+74.2

Con from top page 70

+11.5

Road Man

102+09

63.40

81.50

67.90

81.30

91.10

6 Dead Man

101+94

F. Pole

15.00

Old Boiler Set in Brick.

Gal Iron Tank
6' high.

Tank

Note: ANY ADDITIONS OR CHANGES ON THIS SHEET MUST BE MADE OR CIRCLED IN Red. WITH DATE AND NAME OF PERSON MAKING CHANGE.

Do not extend notes this side of this line

RETURN TO
LOS ANGELES COUNTY SURVEYOR

F.B. 460 Pg. 72 Miller Chief Party Notes by Miller + Gregory Date 3-16-31

Con cit bottom page 73

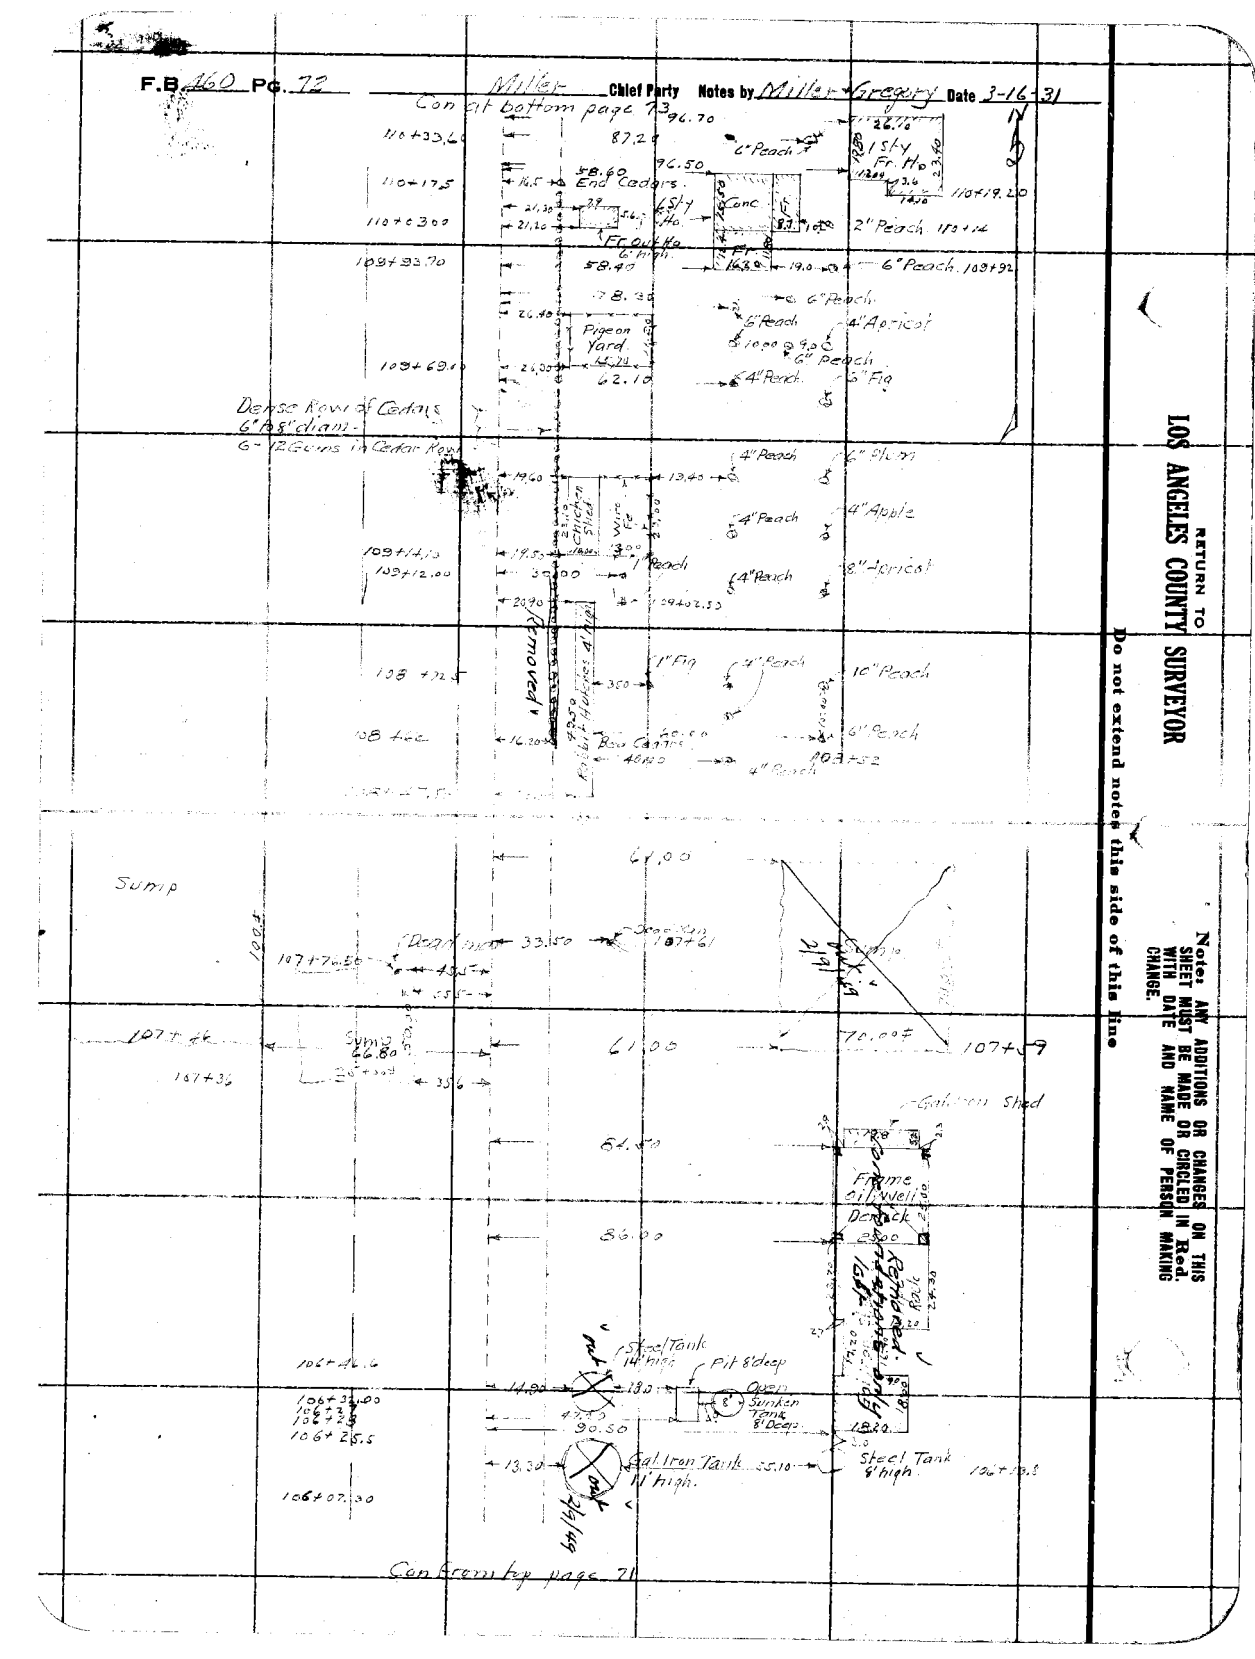

RETURN TO
LOS ANGELES COUNTY SURVEYOR

Do not extend notes this side of this line

Note: ANY ADDITIONS OR CHANGES ON THIS SHEET MUST BE MADE OR CIRCLED IN Red. WITH DATE AND NAME OF PERSON MAKING CHANGE.

Date 3-17-31 Notes by Miller Chief Party Miller & Gregory F.B. 460 Pg. 13

Plotted by J.C. Hoyt
Date May 1931
Map No. B-643-1, 2
Plotting C'k'd by D. M. Finley
Date Apr. 1933

W. O. No. 7016 D. S. O. No.
Location CYPRESS AVE
Surveyed by W.A. Miller
Date Mar 1931
Indexed A. C. Jobson

Notes: ANY ADDITIONS OR CHANGES ON THIS SHEET MUST BE MADE OR CIRCLED IN Red. WITH DATE AND NAME OF PERSON MAKING CHANGE.

Do not extend notes this side of this line

RETURN TO LOS ANGELES COUNTY SURVEYOR

Steel Tank 7' high 9' dia.

Con at bottom page 74

Platform Frame Oil Well Derrick Gal Iron Shed

Pipe Rack Removed. 2/9/49

115+68

P. Pole. 116+02

Sump

115+07

Pipe Rack Removed.

Deadman 115+25

P. Pole

Gal. Iron Shed

115+00

Deadman 114+85

Frame Oil Well Derrick (Well on production)

Pipe Rack

Sump

Gal Iron Shed

114+16

Deadman

P. Pole. 15'dia Gal. Iron Tank 5' high

114+00

Boiler Setting Brick

113+44

113+56.30

Gal Iron Pump Shed 113+57.40

Deadman 112+98

113+47

72.90

Gal Iron Tanks 10' high on 3' Platform 13' diam.

Sump

112+87

112+79

Deadman

111+36 Deadman

68.70

111+63

111+06

25.00 P. Pole.

CEDAR ST Not Sur.

Fd 1½ - Page 37 110+88.32

18" Gum

Old Ft. Carriage Removed 2/9/49.

110+46.00

110+39.00

8" Gum

Con from top 99° 12

F.B. 460 Pg. 74 Miller Chief Party Notes by Miller-Gregory Date 3-17-31

RETURN TO
LOS ANGELES COUNTY SURVEYOR

Do not extend notes this side of this line

Note: ANY ADDITIONS OR CHANGES ON THIS SHEET MUST BE MADE OR CIRCLED IN Red. WITH DATE AND NAME OF PERSON MAKING CHANGE.

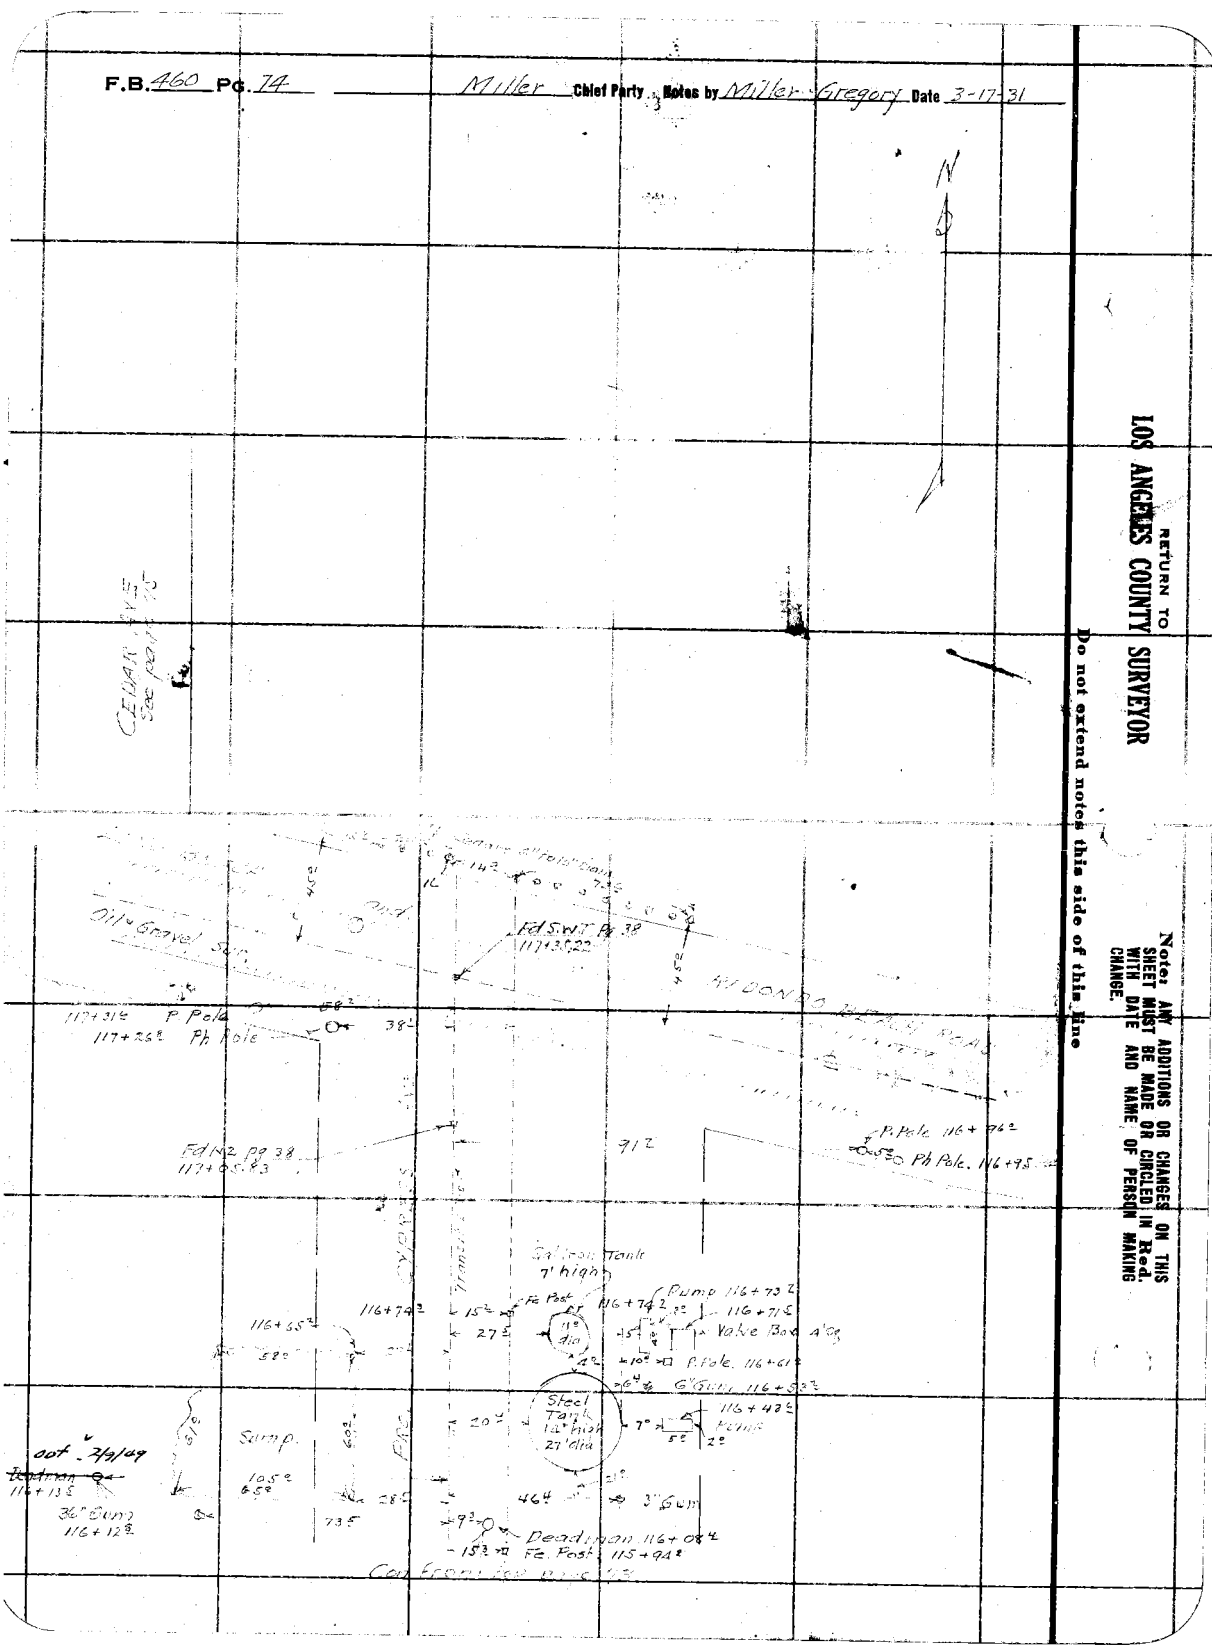

Date 3-17-31 Notes by Miller & Gregory Chief Party Miller F.B. 480 Pg. 76

Platted by J.C. Hoyt
Date May 1931
Map No. B-643-12
Platting C'k'd by D. M. Finley
Date Apr. 1933

W. O. No. 7016 D. S. O. No.
Location CYPRESS AVE
Surveyed by W.A. Miller
Date MAY 1931
Indexed C. Johnson

N

Note: ANY ADDITIONS OR CHANGES ON THIS SHEET MUST BE MADE OR CIRCLED IN Red. WITH DATE AND NAME OF PERSON MAKING CHANGE.

Do not extend notes this side of this line

RETURN TO LOS ANGELES COUNTY SURVEYOR

2+26.2
2+22.2
37.4
27.4
12+04.7
5.7
8" Cedar
Deadman 2+29.5
12" Gum 2+09.5
2+04
18.6
Frame Oil Well Derrick (On Prod.)
Pipe Rack 40.2
Ft. Shed
8" Gum
8" Cedar 1+75.2
Deadman 1+54.2
Row of Cedar Trees 6" to 10" dia., 16 in dist Shown
Row of Gum Trees 8" to 16" dia., 16 in dist Shown.
CEDAR AVE FKA CYPRESS AVE Oil & Gravel Sur.
Transit Line
Row of Gum Trees 8" to 16" dia. Total 14 to Derrick
Row of Cedar Trees 6" to 10" dia Total 13 to Derrick
0+76.2
0+72.2
15" Gum.
10" Cedar
9°±9°
0+56.2
0+49.2
0+33.2
Beg of Row of Cedars.
Beg of Row of Gum Trees.
Valve Box
Valve 0+30.2
LONG BEACH (To be removed Soon.)
Oil & Gravel Sur.
Ed S.W.T. Page 39
0+00
REDONDO BEACH RD.
Valve Box 3x3
Valve 15 x 3x3
Gal Iron Shed
4" Pipe on Surface 6" ± above Sur Water Ground at each End

Con from page 74

RETURN TO

LOS ANGELES COUNTY SURVEYOR

Note: ANY ADDITIONS OR CHANGES ON THIS SHEET MUST BE MADE OR CIRCLED IN Red. WITH DATE AND NAME OF PERSON MAKING CHANGE.

Do not extend notes this side of this line

F.B.____ Pg.____ Chief Party____ Notes by____ Date____

Date 5-25-31 Notes by Miller Chief Party Miller F.B. 460 Pg. 79

Platted by K. V. M.	W. O. No. 7016 D. S. O. No.
Date 12-23-31	Location CYPRESS AVE
Map No. B-643-1 2-	Surveyed by W.A. Miller
Platting C'k'd by D. M. Finley	Date May 1931
Date Apr. 1933	Indexed A. C. Johnson 8-16-31

Notes ANY ADDITIONS OR CHANGES ON THIS SHEET MUST BE MADE OR CIRCLED IN Red. WITH DATE AND NAME OF PERSON MAKING CHANGE.

Do not extend notes this side of this line

RETURN TO LOS ANGELES COUNTY SURVEYOR

Con at bottom page 78

N

527.64 by P.C. AVE.

Fd N&T P. Pole

Fd S.W.T. - Page 8 Removed 5-25-31

Fd N&T P. Pole

31.53 60.43 30.13 0.50

Page 89 (50) (25) 825.76 (25) (50)

OLIVE ST.

Set C.S. Brass Cap Mon. 12" Deep - Mkd as shown

26.96 38.36

Fd N&T P. Pole

(25) (50) (25)

Fd N&T 6" Fir

COUNTY SURVEYOR'S OLIVE + PENN. MONUMENT

527.64 by P.C. PENNSYLVANIA

Fd Spk - 6" Deep See Page 8

.84 Adj.

Page 89 (50) (50) 825.79 (50) (100)

WILMINGTON - REDONDO RD

ADOPTED ALIGNMENT OF PENNSYLVANIA AVE.

F.B. 460 Pg. 78 Miller Chief Party Notes by Miller Date 5-26-31

Con at bottom page 79

528.17 by Prd

AVE

Fd N.T P. Pole

Fd S.W.T - Page 9 Removed 5-26-31

Fd N.T P Pole

30.69

52.10

20.00

0.79

Page 90

(50) (25)

825.7'

POMELO ST.

Set C.S Brass Cap Mon. 12" Deep Mkd as shown.

53.57

91.13

Fd N.T P. Pole

Fd N.T 4" Apricot

COUNTY SURVEYOR'S POMELO + PENN. MONUMENT

528.16 by Prd

PENNSYLVANIA

Set N.T P Pole

Fd N.T P Pole

(50) (25) (25) 0

Fd S.W.T - Page 9 Removed 5-25-31

Found Sulf. E. Norborne Ave. per C.S.B. 137-1

83.34

24.56

46.57

0.95

Page 90 825.7'

MILLER ST

(25) (25) (adj.)

31.40

31.60

Fd N.T P. Pole.

Fd 2x2 - Page 1 Replaced with C.S Brass Cap Mon. - 12" Deep - Mkd as shown.

527.54 By Prd.

Fd N.T P Pole

COUNTY SURVEYOR'S MILLER + PENN. MONUMENT

Con from top page 77

RETURN TO
LOS ANGELES COUNTY SURVEYOR

Do not extend notes this side of this line

Note: ANY ADDITIONS OR CHANGES ON THIS SHEET MUST BE MADE OR CIRCLED IN Red. WITH DATE AND NAME OF PERSON MAKING CHANGE.

Date 5-26-31 Notes by Miller Chief Party Miller F.B. 460 Pg. 79

Platted by K. V. M.
Date 12-23-31
Map No. B-643-1,2
Platting C'k'd by D. M. Finley
Date Apr. 1933.

W. O. No. 7016 D. S. O. No.
Location CYPRESS AVE
Surveyed by W. A. Miller
Date May 1931
Indexed A. C. Johnson

N

Con at bottom page 80

528.17 By Pro

CYPRESS AVE

Fd N·T P Pole

Fd 2×2 - Page 10 Removed 5-26-31

Fd Spk·T P Pole.

31.24

28.52

57.41

0.41

Page 9L

(50) 825.48 ℄

(25) (25)

ALMOND ST

30.10

Set C.S. Brass Cap Mon 12" Deep - Mkd as shown

Fd N·T Guy Pole

COUNTY SURVEYOR'S ALMOND + PENN. MONUMENT

528.16 By Pro ℄

PENNSYLVANIA

(25) (25) (50)

Fd S.W.T - Page 10 Removed 5-26-31

Fd N·T P Pole

31.38

0.60

Page 1L

(50) 825.64 ℄

(25) (25)

LEMON ST.

31.99

33.38

59.45

Set C.S. Brass Cap Mon 12" Deep - Mkd as shown

Fd N·T Guy Pole.

Fd N·T P Pole

Fd N·T P Pole

528.17 By Pro

COUNTY SURVEYOR'S LEMON + PENN. MONUMENT

Con from top page 78

Notes: ANY ADDITIONS OR CHANGES ON THIS SHEET MUST BE MADE OR CIRCLED IN Red. WITH DATE AND NAME OF PERSON MAKING CHANGE.

Do not extend notes this side of this line

RETURN TO LOS ANGELES COUNTY SURVEYOR

F.B. 460 Pg. 80 Miller Chief Party Notes by Miller Date 3-24-31

Con at bottom page 81

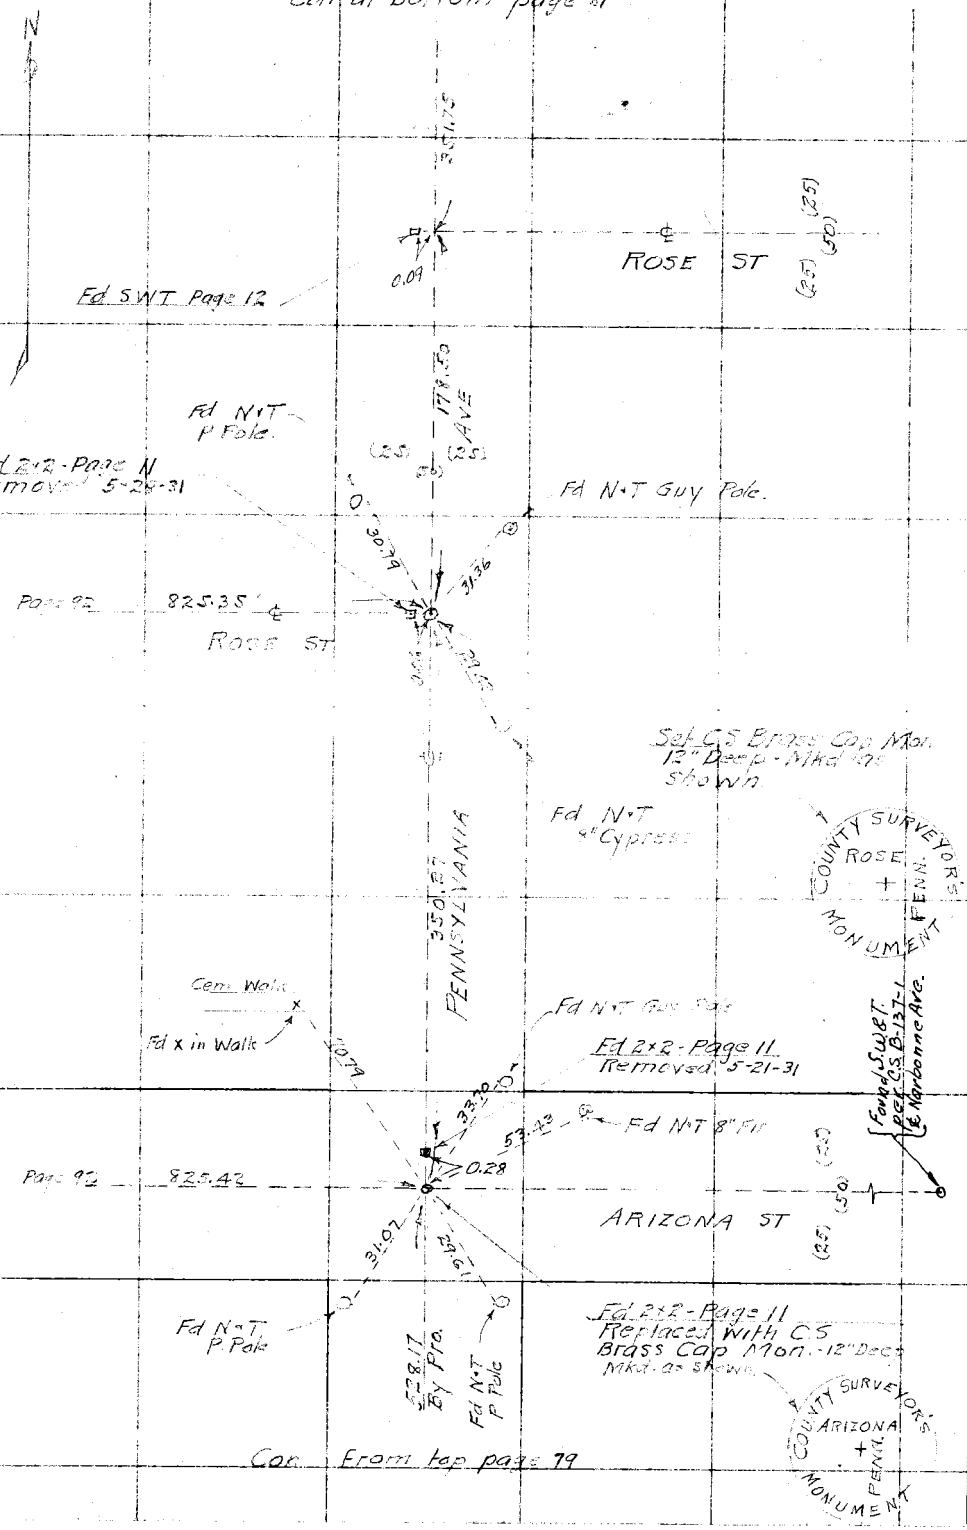

Con From top page 79

RETURN TO LOS ANGELES COUNTY SURVEYOR

Do not extend notes this side of this line

Notes: ANY ADDITIONS OR CHANGES ON THIS SHEET MUST BE MADE OR CIRCLED IN Red. WITH DATE AND NAME OF PERSON MAKING CHANGE.

Date 5-27-31 Notes by Miller Chief Party Miller F.B. 460 Pg 81

Platted by K. V. M.	W. O. No. 7016 D. S. O. No.
Date 12-23-31	Location CYPRESS AVE
Map No. B-643-1, 2	Surveyed by W.A Miller
Platting C'k'd by D. M. Finley	Date May 1931
Date Apr. 1933.	Indexed A. C. Johnson

N

Con of bottom page 82

AVE.

352.17

Fd. PM in M.H. Rim
Page 13

0.06

STAR AVE

(25) (25) (50)

(25) (25) (50)

PENNSYLVANIA

352.19

Fd. S.W.T. - Page 12

0.12

POPPY ST

(25) (25) (50)

351.72

Con. from top page 80

Notes: ANY ADDITIONS OR CHANGES ON THIS SHEET MUST BE MADE OR CIRCLED IN Red. WITH DATE AND NAME OF PERSON MAKING CHANGE.

Do not extend notes this side of this line

RETURN TO LOS ANGELES COUNTY SURVEYOR

F. B. 460 PG. 82 Miller Chief Party Notes by M. [illegible] Date 5-21-31

Con. of bottom page 83.

℄ Produced from Sec. 1

1067.40

AVE.

Page 83

WEST

762.75

Fd N.&T. 20" Gum

Fd 2"x2"- Page 14 Removed 5-21-31

Fd 2x2 - Page 14 Removed 5-21-31

Set C.S.B. Monu. Cap. Mon. 2" Deep in A.C. as Shown

117-13-30

40 Ac.

29.79

0.03

0.57

0.08

3.3 N.

Fd N.&T.

Fd L.&T. in Curb

Fd N.&T. P. Pole

56.73

ROAD

Fd X in outline of Fire Plug

117-13-30
118-54-30
117-13-30

31

762.75

PENNSYLVANIA

(25) (25)

(50)

0.08

℄ SUN ST.

Fd S.W.T. Page 13

35.17

Con. from top page 81

RETURN TO
LOS ANGELES COUNTY SURVEYOR

Do not extend notes this side of this line

Note: ANY ADDITIONS OR CHANGES ON THIS SHEET MUST BE MADE OR CIRCLED IN Red. WITH DATE AND NAME OF PERSON MAKING CHANGE.

Date 5-27-31 Notes by _____ Chief Party _____ F.B. 466 Pg. 85

Platted by K. V. M.
Date 12-23-31
Map No. B-643-1, 2
Platting C'k'd by D. N. Finley
Date Apr. 1933

W. O. No. 7016 D. S. O. No. _____
Location CYPRESS AVE
Surveyed by W. A. Miller
Date May 1931
Indexed A. C. Johnson

N

Con at bottom page 84

(25) (50) (25)

791.82 ℄ AVE

Fd N.T. P. Pole

Tak N.T. 10" Cypress

Page 94

825.00

(24) (48) (24)

℄ CHESTNUT ST.

Fd 1" I.P. Nail - Page 15 Replaced with C.S. Brass Cap Mon. 12" Deep - Mkd. as Shown.

Fd N.T. Guy Pole

Fd N.T. Cypress Snag

E. Projection from Sheet No. 2

1087.43

PENNSYLVANIA

COUNTY SURVEYOR'S CHESTNUT + PENN. MONUMENT

FLOWER ST.

(24) (48) (24)

Con from top page 82

Notes: ANY ADDITIONS OR CHANGES ON THIS SHEET MUST BE MADE OR CIRCLED IN Red. WITH DATE AND NAME OF PERSON MAKING CHANGE.

Do not extend notes this side of this line

RETURN TO LOS ANGELES COUNTY SURVEYOR

F.B. 460 Pg. 84 Miller Chief Party Notes by Miller 5-27-31

Con at bottom page 84

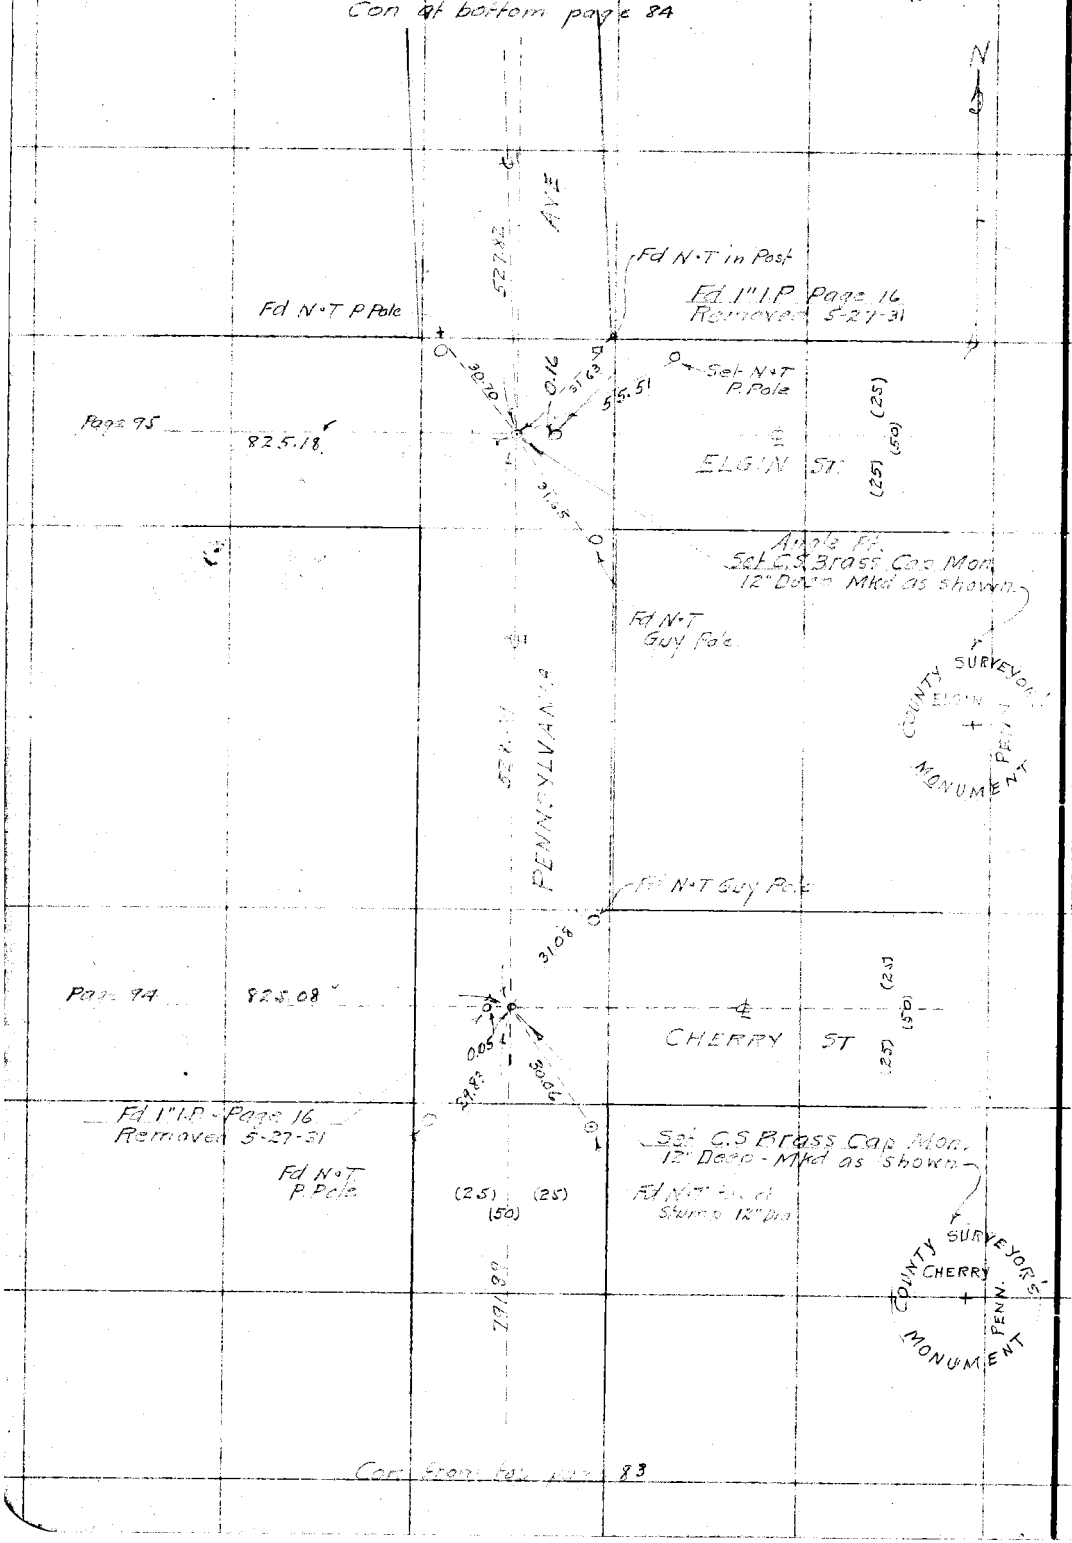

Corr from Fol. [illegible] 83

RETURN TO
LOS ANGELES COUNTY SURVEYOR

Do not extend notes this side of this line

Note: ANY ADDITIONS OR CHANGES ON THIS SHEET MUST BE MADE OR CIRCLED IN Red. WITH DATE AND NAME OF PERSON MAKING CHANGE.

Date 6-4-31 : Notes by Miller : Field Party Miller : F. B. 460 Pg. 85

Plotted by K. V. M.
Date 12-23-31
Map No. B. 643-1, 2
Plotting C'k'd by D. M. Finley
Date Apr. 1933

W. O. No. 2016 C. S. O. No.
Location CYPRESS AVE
Surveyed by W. A. Miller
Date June 1931
Indexed A. C. Johnson

Con at bottom page 86

528.06

AVE

Fd 2" I.P. & Cap.

Fd 1" I.P - Page 17 Removed 6-4-31

Fd Spike & T Guy Pole

Fd 1" I.P. No Ref. Removed 6-4-31

35.25

0.37

31.65

0.16

(25) (50)

Page 96 — 20' Adj. 825.12 — ℄ ACACIA ST

28.34

21.67

Set C.S. Brass Cap Mon. 12" Deep - Mkd. as shown

Fd N & T P. Pole

Fd X in Top 8" Casing 4' High

COUNTY SURVEYORS MONUMENT ACACIA + PENN

PENNSYLVANIA

522.76

(25) (50)

Set N & T Guy Pole

Set N & T 6" [illegible]

0.20

31.33

35.40

Page 95 — .19 Adj. 825.14 — ℄ PINE ST

(25) (50)

Set X in Fire Plug

44.62

0.30

29.58

Set N & T P. Pole

Set C.S. Brass Cap Mon. 12" Deep - Mkd. as shown.

Set N & T P. Pole

Fd 1" I.P. - Page 17 Removed 6-4-31

Fd 3/4" I.P. 0.02 W. of Line Removed 6-4-31

527.62

0.08

℄ Produced from SH

COUNTY SURVEYORS MONUMENT PINE + PENN.

Con From top page 84

Notice: ANY ADDITIONS OR CHANGES ON THIS SHEET MUST BE MADE ON CIRCLES IN RED, WITH INITIALS AND NAME OF PERSON MAKING CHANGE.

RETURN TO LOS ANGELES COUNTY SURVEYOR

Do not extend notes this side of this line

F.B. 460 Pg. 86 Miller Chief Party Notes by Miller Date 6-4-31

Con at bottom page 87

N

528.03 Pg. 18

AVE

Fd N&T P Pole

Fd N&T in Standard Oil valve Box

Fd 1" I.P. - Page 18 Removed 6-4-31

Page 97 825.09 .23 Adj.

PEPPER ST

(25) (50) (25)

31.24 0.04 39.33 31.45

Set C.S. Brass Cap Mon. 12" Deep - Mkd as shown

Fd N&T Guy Pole

COUNTY SURVEYOR'S MONUMENT PEPPER + PENN.

PENNSYLVANIA

527.84

(25) (50) (25)

Fd N&T Guy Pole

Fd X in Fire Plug

Page 96 825.17 .22 Adj.

33.85 31.94 0.20 46.75

PALM ST

Fd N&T PH Pole

29.16

Fd 1" I.P. Plug & N - Page 18 Replaced with C.S. Brass Cap Mon 12" Deep. - Mkd as shown

Fd part of old 3x3 - 12" Deep Removed 6-4-31

528.06

Fd N&T P Pole

COUNTY SURVEYOR'S MONUMENT PALM + PENN.

Con from top page 85

RETURN TO LOS ANGELES COUNTY SURVEYOR

Do not extend notes this side of this line

Notes: ANY ADDITIONS OR CHANGES ON THIS SHEET MUST BE MADE OR CIRCLED IN Red. WITH DATE AND NAME OF PERSON MAKING CHANGE.

Date

Notes by Miller Chief Party Miller F.B. 460 Pg. 87

Plotted by K.V.M.
Date 12-23-31
Map No. B-643-1,2
Plotting C'k'd by D.M. Finley
Date Apr. 1933

W. O. No. 7016 D. S. O. No.
Location CYPRESS AVE
Surveyed by W.A. Miller
Date June 1931
Indexed C. Johnson

Con at bottom page 88

444.79
AVE

Fd 2x2 - No Ref
Removed 6-5-31

Fd N&T Ph Pole

Fd N&T Ph Pole

Fd N&T Ph Pole

32.06 0.06 0.07 0.05 47.67 30.00

25' Adj.

Page 98 825.11

CEDAR ST

(25) (30) (25)

Fd 1" I.P. - Page 19
Removed 6-5-31

Set C.S. Brass Cap Mon.
12" Deep - Mkd as shown.

SURVEYOR
COUNTY
CEDAR
PENN.
ST
MONUMENT

(25) (50) (25)

PENNSYLVANIA

522.87

Fd 1" I.P. Page 19
Removed 6-4-31

Fd N&T Valve Box

43.00 31.58 0.07

Fd N&T Guy Pole

Page 97 925.24

FIR ST

(25) (50) (25)

32.58 50.16

Fd N&T Ph Pole

Set C.S. Brass Cap Mon.
12" Deep - Mkd as Shown

Fd N&T P. Pole

SURVEYOR
COUNTY
FIR
PENN.
MONUMENT

Con from top page 86

Note: ANY ADDITIONS OR CHANGES ON THIS SHEET MUST BE MADE OR CHECKED IN Red. WITH DATE AND NAME OF PERSON MAKING CHANGE.

Do not extend notes this side of this line

RETURN TO LOS ANGELES COUNTY SURVEYOR

F.B. 460 Pg. 88 Miller Chief Party Notes by Miller Date 6-3-31

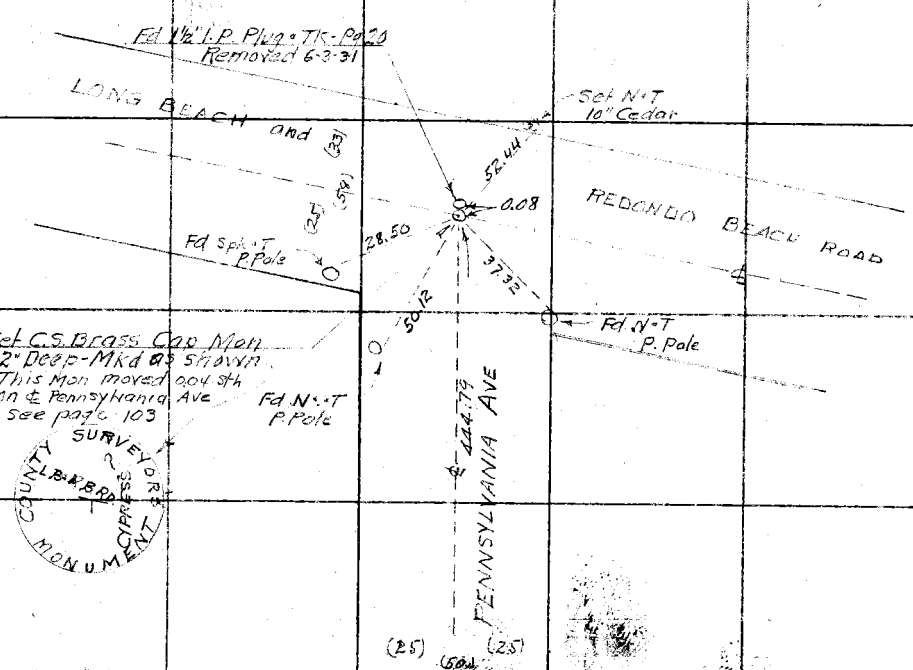

Can from Top page 87

RETURN TO
LOS ANGELES COUNTY SURVEYOR

Do not extend notes this side of this line

Note: ANY ADDITIONS OR CHANGES ON THIS SHEET MUST BE MADE OR CIRCLED IN Red. WITH DATE AND NAME OF PERSON MAKING CHANGE.

Date 5-18-31 Notes by Miller Chief Party Miller F.B. 460 Pg. 89

Plotted by K. V. M.	W. O. No. 7016 U. S. O. No.
Date 12-23-31	Location CYPRESS AVE
Map No. B-643-12	Surveyed by W.A Miller
Plotting C'k'd by D. M. Finley	Date May 1931
Date Apr 1933	Indexed A. C. Johnson

Notes: ANY ADDITIONS OR CHANGES ON THIS SHEET MUST BE MADE OR CIRCLED IN Red. WITH DATE AND NAME OF PERSON MAKING CHANGE.

Do not extend notes this side of this line

RETURN TO LOS ANGELES COUNTY SURVEYOR

Con at bottom page 90

N

527.45 by Plo

AVE

Fd 2x2 - Page 24 Removed 5-27-31

Fd 2x2 - Page 24 Removed 5-27-31

0.72

0.60

0.52

1.500

0.25?

825.76

OLIVE ST.

(25) (50) (25)

Page 77

49.12

34.13

18.67

48.40

Set N.T Fc Post

5+27.45

Set C.S. Brass Cap Man. 12" Deep - Mkd as Shown

Set N.T Pl. Pole

Set Copper TK Cor House

Fd Copper TK Cor House

COUNTY SURVEYOR'S MONUMENT OLIVE CYPRESS 5.00

12' Offset

527.45 by Plo

CYPRESS

90-00-15

360-01-15

90-00-18 1/4

90.00

50

50

100

Adj

Fd L.T page 24

WILMINGTON

Fd L.T page 24

Fd L.T page 24

.64 1.34

26.66 19.39

3.00

3.00

3.00

0.55

Set L.T

Set L.T

Set L.T

Set L.T in Conc Pav.

0+00

Set X in Pav.

TEDONDO RD.

825.74

.84 Adj

Page 77

(50) (100)

ADOPTED ALIGNMENT OF CYPRESS AVE.

F.B. 460 Pg. 90 Miller Chief Party Notes by Miller Date 5-28-31

Con at bottom page 91

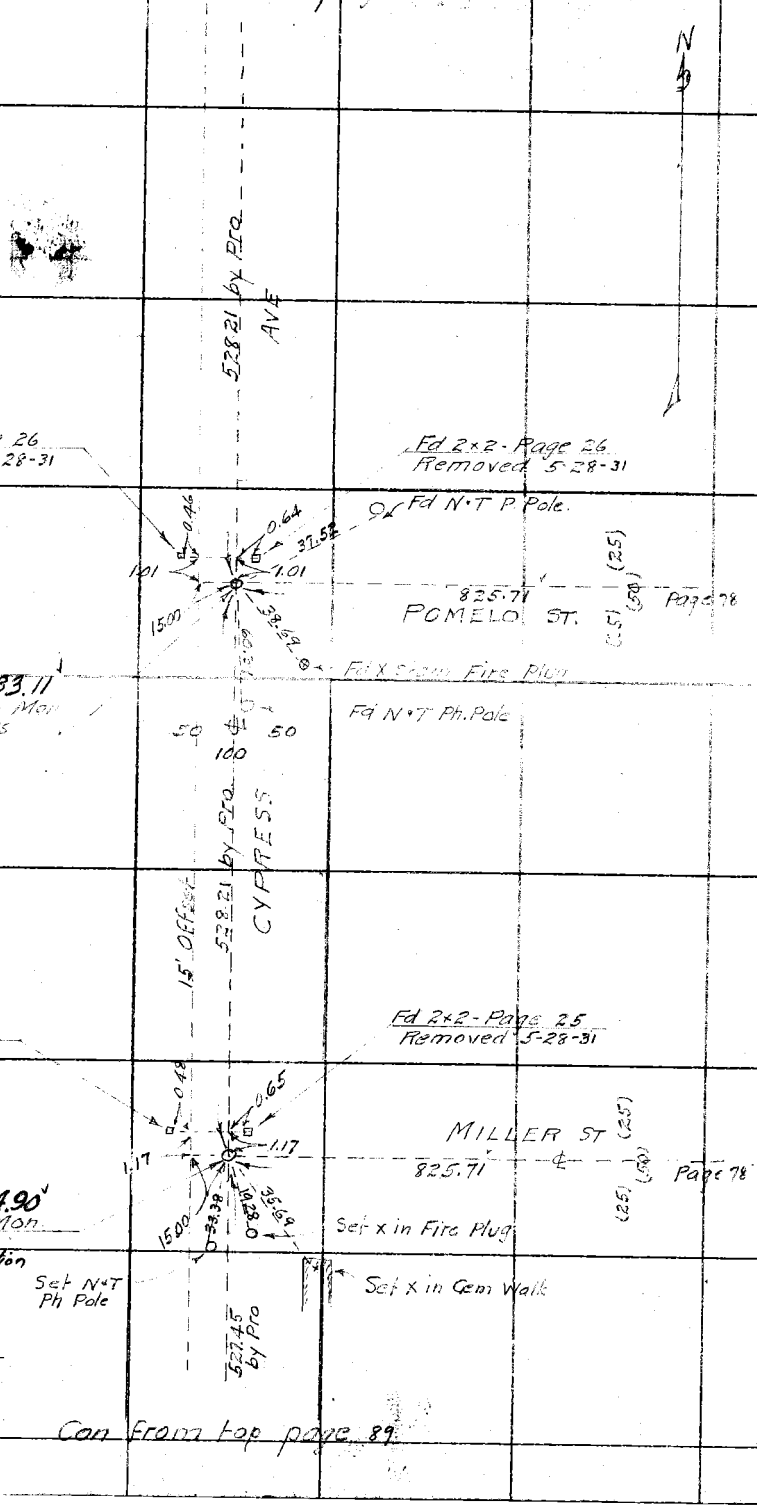

RETURN TO
LOS ANGELES COUNTY SURVEYOR

Do not extend notes this side of this line

Note: ANY ADDITIONS OR CHANGES ON THIS SHEET MUST BE MADE OR CIRCLED IN Red. WITH DATE AND NAME OF PERSON MAKING CHANGE.

Date 5-28-31 Notes by Miller Chief Party Miller F.B. 460 PG. 91

Platted by K V. M.	W. O. No. 7016 D. S. O. No.
Date 12-23-31	Location CYPRESS AVE
Map No. B-643-1,2	Surveyed by W A Miller
Platting C'k'd by D. M. Finley	Date
Date Apr. 1933	Indexed A. C. Johnson

Con at bottom page 92

528.21 by Prd

AVE

Set N°T Cypress stump

Fd 2x2 - Page 27 Removed 5-29-31

Fd 2x2 - Page 27 Removed 5-29-31

x - Fd Spk in walk

0.41 0.46 47.28 0.80 0.80

825.48

ALMOND ST.

(25) (25) (30) Page 71

1500 18.27 22.18

Fd x in Stem Fire Plug

26+39.52

Set C.S. Brass Cap Mon. 12" Deep - Mkd as shown

Fd Spk 8" Cypress

50 100 50

COUNTY SURVEYOR'S ALMOND CYPRESS MONUMENT

15' Offset

528.20 by Prd

CYPRESS

Fd N°T Ph Pole

Fd 2x2 - Page 26 Removed 5-28-31

Fd 2x2 - Page 26 Removed 5-28-31

0.42 93.71 0.54

Set P.M. in Bolt of Water Meter

23.51 0.86 0.86

825.61

LEMON ST.

(25) (25) (30) Page 79

15.00 22.19

Fd. X in Stem Fire Plug.

21+11.32

Set C.S. Brass Cap Mon. 12" Deep - Mkd as Shown.

COUNTY SURVEYOR'S LEMON CYPRESS MONUMENT

528.21 by Prd

Con from top page 90

Notes: ANY ADDITIONS OR CHANGES ON THIS SHEET MUST BE MADE OR CIRCLED IN Red. WITH DATE AND NAME OF PERSON MAKING CHANGE.

Do not extend notes this side of this line

RETURN TO LOS ANGELES COUNTY SURVEYOR

F.B. 460 Pg. 92 — Miller Chief Party — Notes by Miller — Date 5-29-31

Con at bottom page 93

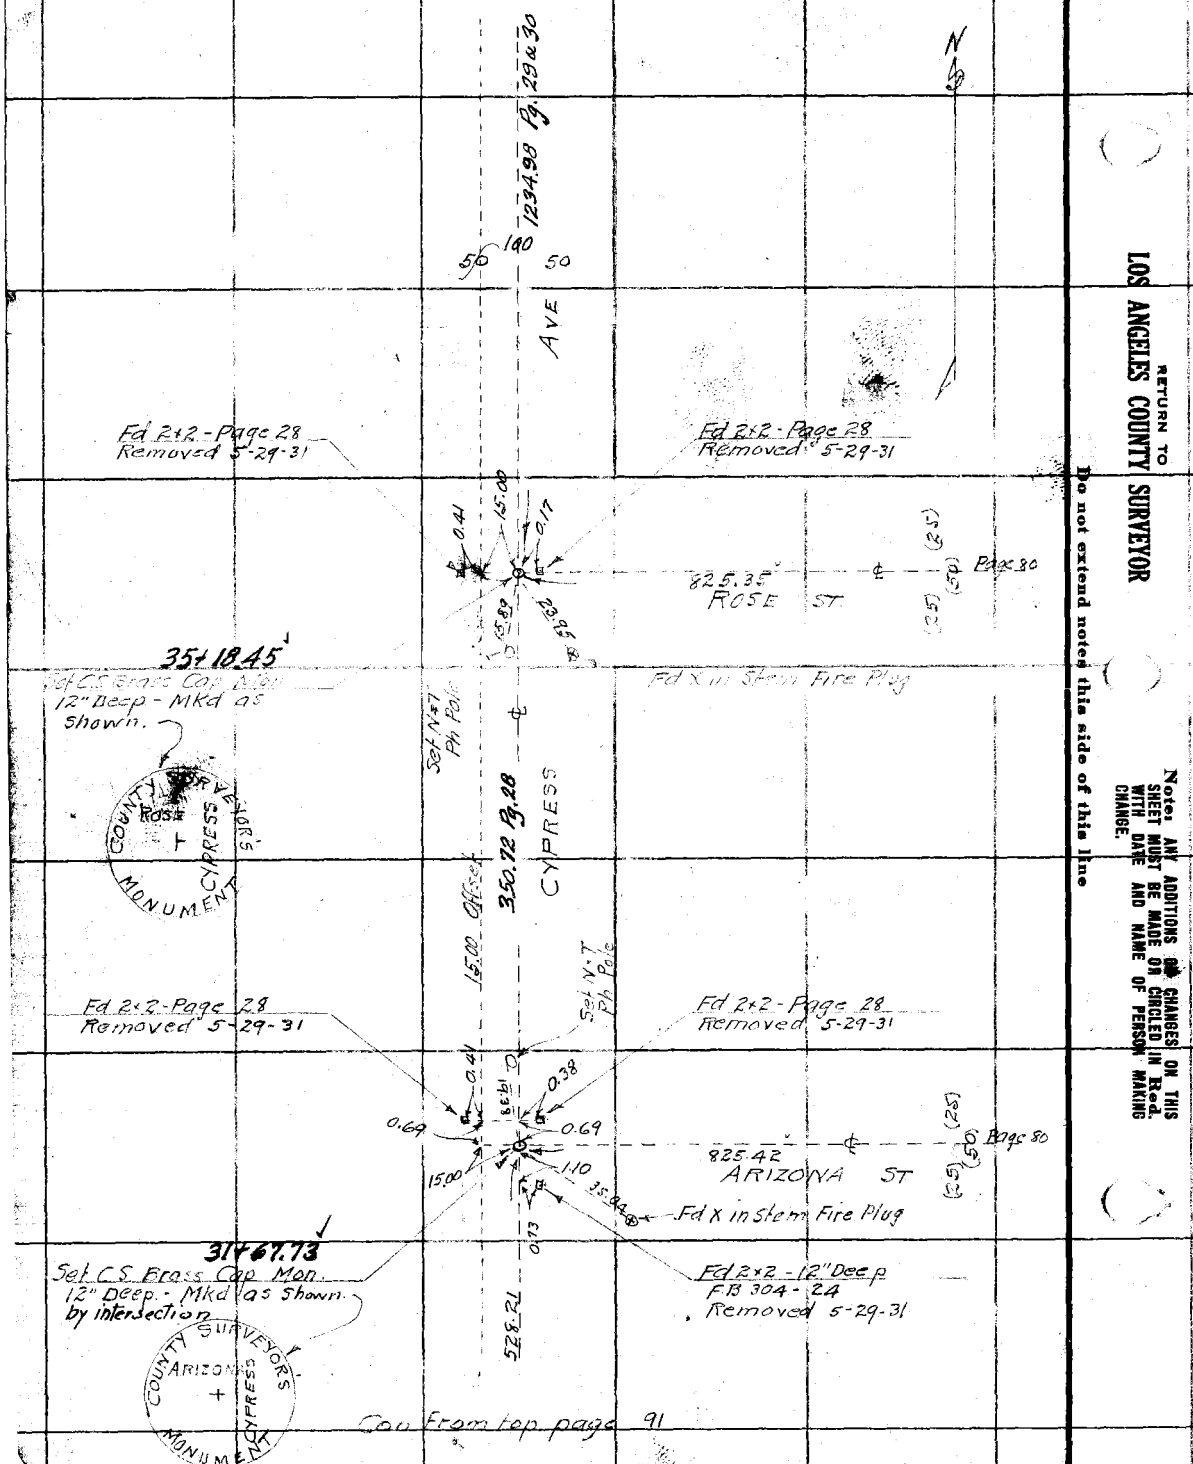

Con From top page 91

RETURN TO
LOS ANGELES COUNTY SURVEYOR

Do not extend notes this side of this line

Note: ANY ADDITIONS OR CHANGES ON THIS SHEET MUST BE MADE OR CIRCLED IN Red. WITH DATE AND NAME OF PERSON MAKING CHANGE.

Date 5-29-31 Notes by Miller Chief Party Miller F.B. 460 Pg. 93

Plotted by	K. V. M.
Date	12-23-31
Map No.	B-643-1, 2
Plotting C'k'd by	D. M. Finley
Date	Apr. 1933.

W. O. No.	7016 D. S. O. No.
Location	CYPRESS AVE
Surveyed by	W. A. Miller
Date	May 1931
Indexed	C. Johnson

Notes: ANY ADDITIONS OR CHANGES ON THIS SHEET MUST BE MADE OR CIRCLED IN Red. WITH DATE AND NAME OF PERSON MAKING CHANGE.

Do not extend notes this side of this line

RETURN TO LOS ANGELES COUNTY SURVEYOR

Con at bottom page 94

LOMITA (WESTON) ST (40) (2nd RD)

Fd 2" I.P. Cap + R.M. Page 30

Fd 3/4" I.P. Plug + TK Removed 6-1-31

Removed 6-1-31

Fd S.W. Ts - Page 30

59+39.35

Set C.S. Brass Cap Mon. 12" Deep - Mkd as shown.

BLVD (80)

937.78

Fd old 3/4" Sq Spk - Page 30 Removed 6-1-31 Page 83

COUNTY SURVEYOR'S MONUMENT Lomita + Cypress

Fd 2" I.P. Cap + R.M. Page 30.

Set N°7 P. Pole

LOMITA AVE (80)

CYPRESS AVE (80)

Wire Fence

Fd X in Cor Post

Fd N°T P+Ph. Pole

62-47-00
251-07-45
62-46-56"14

117.73

15' Offset Line

CYPRESS AVE

High Wire Fe

47+61.62

Set C.S. Brass Cap Mon. 18" Deep - Mkd as shown.

Set 'X's in Iron Fe Posts

COUNTY SURVEYOR'S MONUMENT LINE ONLY Cypress

Fd 3x3 - Page 30 47+53.44

1234.99 @ 294.30

Con from top page 92

F.B. 460 Pg. 94 — Miller Chief Party — Notes by Miller — Date 6-1-31

Con at bottom page 95

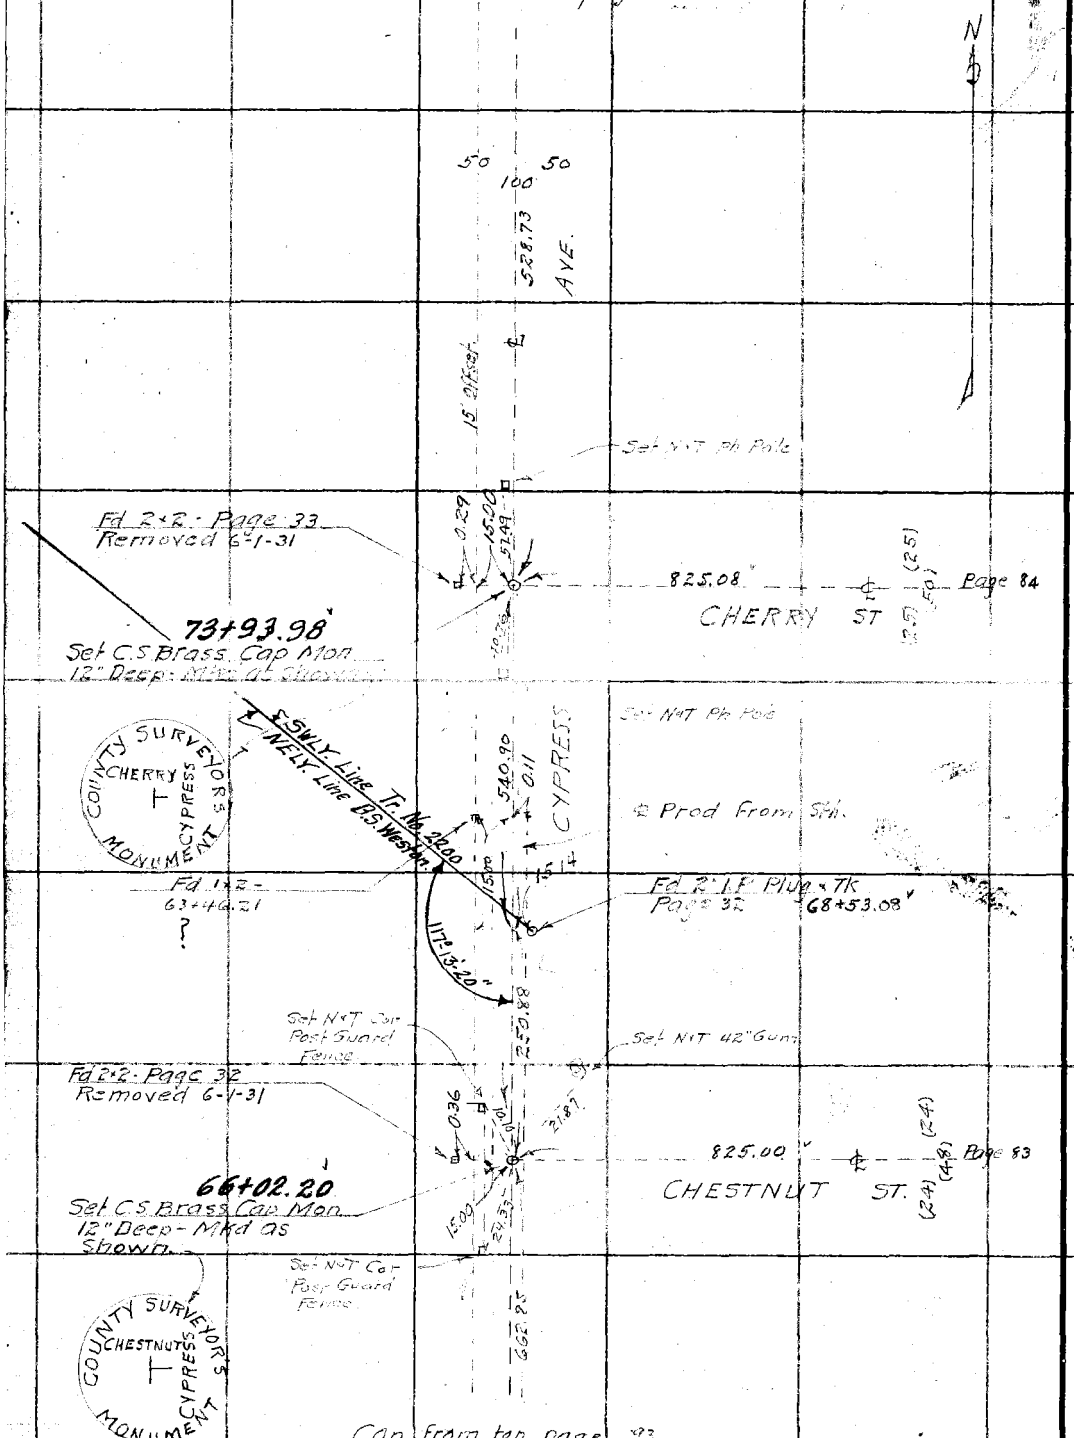

RETURN TO
LOS ANGELES COUNTY SURVEYOR

Do not extend notes this side of this line

Notes: ANY ADDITIONS OR CHANGES ON THIS SHEET MUST BE MADE OR CIRCLED IN Red. WITH DATE AND NAME OF PERSON MAKING CHANGE.

Date 6-1-31 Notes by Miller Chief Party Miller F.B. 460 Pg. 95

Platted by K. V. M.
Date 12-23-31
Map No. B-643-12
Platting C'k'd by D. M. Finley
Date Apr. 1933.

W. O. No. 7016 D. S. O. No.
Location CYPRESS AVE
Surveyed by W.A. Miller
Date June 1931
Indexed A. C. Johnson

Notes: ANY ADDITIONS OR CHANGES ON THIS SHEET MUST BE MADE OR CIRCLED IN Red. WITH DATE AND NAME OF PERSON MAKING CHANGE.

Do not extend notes this side of this line

RETURN TO LOS ANGELES COUNTY SURVEYOR

Con at bottom page 96

(80) (50) (100)

CYPRESS AVE

S22.24

Fd 2x2 - Page 34 Removed 6-2-31

0.24 1.36

Set N.T 8" Cypress

.19 Adj.

825.14 ℄ PINE ST. (25) (50) (25) (25) Page 85

84+50.40

Set C.S. Brass Cap Mon 12" Deep - Mkd as Shown

COUNTY SURVEYOR'S MONUMENT PINE T CYPRESS

Set x in Fire Plug

Set N.T's in Cors open Garage

15' DE Sewer

S22.69

CYPRESS

Fd N.T Ph Pole

Set Copper Cor Ft Ho

Fd Part of R.W. Fence Post - Page 33 Removed 6-1-31

0.27 15.00 30.74 45.72

825.18 ℄ ELGIN ST. (25) (50) (25) Page 84

79+22.71

Set C.S. Brass Cap Mon. 12" Deep. Mkd as Shown

Set N.T 12" Willow

S28.73

COUNTY SURVEYOR'S MONUMENT ELGIN T CYPRESS

Con from top page 94

F.B. 460 Pg. 96 — Miller Chief Party — Notes by Miller — Date 6-2-31

Con at bottom page 97

N

83.11

Lot Line

0.08 at 90°

99+50.84
Fd 4" I.P. + Cap
Page 35

AVE

50 444.39 50
100

Set N.T
Ph Pole

Fd 2x2 - Page 35
Removed 6-2-31

0.15
15.00
41.74
22 Adj
825.18
(25)
(50)
Page 84
PALM ST
(25)

5.79 Fd x Vel. post 4" Pipe

95+06.15

Set C.S. Brass Cap, Mon.
12" Deep, Mkd as Shown
Set x in 2" Hor. Pipe over Mon.

Fd N.T P. Pole

COUNTY SURVEYORS MONUMENT
PALM T CYPRESS

Fd 2" I.P.
Cap
Page 35

15' Offset

528 ST
CYPRESS

Set N.T
Ph. Pole

Fd 2x2 - Page 34
Removed 6-2-31

29.51
0.23
15.00
41.09
Fd N.T Ph Pole
.20 Adj
825.18
(25)
(50)
Page 85
ACACIA ST.
(25)

89+78.14

Set C.S. Brass Cap, Mon.
36" Deep - Mkd as Shown

Set N.T
Ph Pole

COUNTY SURVEYORS MONUMENT
ACACIA T CYPRESS

527.74

Con from top page 95

RETURN TO
LOS ANGELES COUNTY SURVEYOR

Do not extend notes this side of this line

Notes: ANY ADDITIONS OR CHANGES ON THIS SHEET MUST BE MADE OR CIRCLED IN Red. WITH DATE AND NAME OF PERSON MAKING CHANGE.

Date 6-7-31 Notes by Miller Chief Party Miller F.B. 460 Pg. 97

Platted by K. V. M.	W. O. No. 7016 D. S. O. No.
Date 12-23-31	Location CYPRESS AVE
Map No. B-643-1,2	Surveyed by W.A. Miller
Platting C'k'd by D. M. Finley	Date June 1931
Date Apr. 1933.	Indexed A. C. Johnson

Note: ANY ADDITIONS OR CHANGES ON THIS SHEET MUST BE MADE OR CIRCLED IN Red. WITH DATE AND NAME OF PERSON MAKING CHANGE.

Do not extend notes this side of this line

RETURN TO LOS ANGELES COUNTY SURVEYOR

Con at bottom page 98

CYPRESS AVE

50 528.12 50

100

Fd N·T Tank Base

Fd 2×2 Page 36
Removed 6-3-31

.006 1500 4682

825.24

FIR ST.

(25) (25) (50) Page 87

Set N·T 12" Acacia

105+62.11

Set C.S. Brass Cap Mon. 12" Deep - Mkd as shown

Fd N·T Fe. Post

COUNTY SURVEYORS MONUMENT FIR CYPRESS

15' Offset

528.16

CYPRESS

Fd 2" I.P. & Cap - Page 36

Fd 2×2 - Page 36
Removed 6-3-31

.011 15.00 2497

.23 Adj.

825.09

PEPPER ST.

(25) (25) (50) Page 86

2638

53.48

Set X

100+33.95

Set C.S. Brass Cap Mon. 12" Deep - Mkd as shown

Concrete

Garage

Fd N·T 8" Cedar.

831.1

COUNTY SURVEYORS MONUMENT PEPPER CYPRESS

Con from top page 96

F. B. 460 Pg. 98 Miller Chief Party Notes by Miller Date 6-3-31

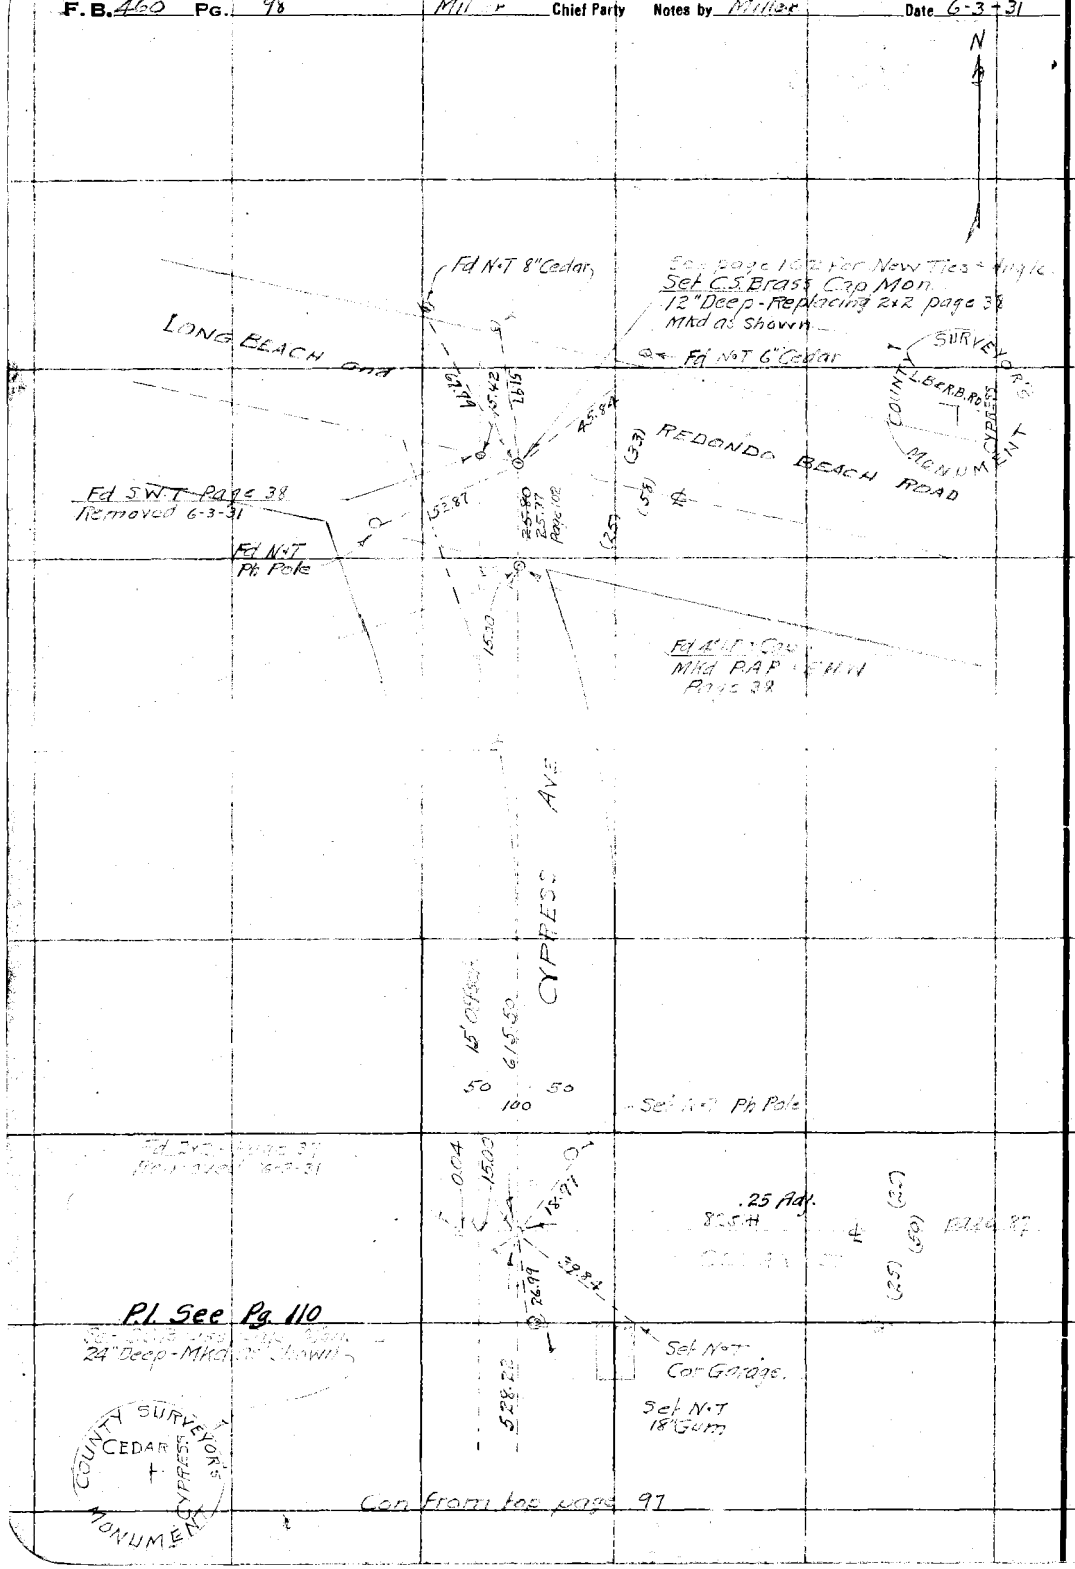

RETURN TO
LOS ANGELES COUNTY SURVEYOR

Do not extend notes this side of this line

Note: ANY ADDITIONS OR CHANGES ON THIS SHEET MUST BE MADE OR CIRCLED IN Red. WITH DATE AND NAME OF PERSON MAKING CHANGE.

Notes Ck'd by D. M. Finley		Survey of CYPRESS AVE	
Map No. B-643-1/4		W. O. 7016 Tape No.	St'd °F.
Office Work K. V. M.		Surveyed by W. A. Miller	
Checked D. M. Finley		Notes Miller	Date 6-12-31
Date Apr. 1933	by	Indexed A. C. Johnson	

F.B. 460 Pg. 97

Con at bottom page 100

N 0

Fd S.W.T F.B. 362-32
Removed 6-12-31

F.B. 362
699.94

Set S.W.T

0.03

MAPLE AVE

1153.95' F.B. 362

REDONDO BEACH ROAD

Angle Point Fd 6x6 Conc
Mon w Copper Tk
18" Deep. - F.B. 362-33 & 35

171- 59-00
327- 56-15
171- 59-03 1/4

171° 59' 05"

LONG BEACH and

Fd S.W.T F.B. 455-33

30' offset Line F.B. 455-33

MADRONE AVE

(33)

(58)

(25)

RETURN TO
LOS ANGELES COUNTY SURVEYOR
700 HALL OF RECORDS
Do not extend notes this side of this line

Note: ANY ADDITIONS OR CHANGES ON THIS SHEET MUST BE MADE OR CIRCLED IN Red Ink. WITH DATE AND NAME OF PERSON MAKING CHANGE.

FORM 247 10M 8-31

F.B. 460 Pg. 100 B.7

Con at bottom page 101

FERN AVE

Fd S.W.T - F.B. 362-31
Removed 6-12-31

Set S.W.T

599.95 F.B. 362

N

0.03

F.B. 362

ROAD

Fd S.W.T F.B. 362-31
Removed 6-12-31

Set S.W.T

499.95

0.03

F.B. 362

BEACH

REDONDO

Fd. S.W.T - F.B. 362-31-32
Removed 6-12-31

Set S.W.T

599.95

0.02

F.B. 362

AND

JUNIPER AVE

BEACH

699.94 F.B. 362

LONG

Con From top page 99

LOS ANGELES COUNTY SURVEYOR
700 HALL OF RECORDS

RETURN TO

Do not extend notes this side of this line

Note: ANY ADDITIONS OR CHANGES ON THIS SHEET MUST BE MADE OR CIRCLED IN Red INK, WITH DATE AND NAME OF PERSON MAKING CHANGE.

Notes Ck'd by D. M. Finley | Survey of | F.B. 460 Pg 101
Map No. B-643-1, 2 | W. O. | Tape No. | St'd | °F.
Office Work K. V. M. | Surveyed by
Checked D. M. Finley | Notes | Date
Date Apr. 1933 | Indexed A. C. Johnson

Con at bottom page 102

S.W.&T. Pg. 22.

75.27 Page 22

Fd N.T P. Pole

Fd N.T 6" Cedar

61.40

Set S.W.&T.

CEDAR AVE

76.96

REDONDO BEACH ROAD

Fd N.T Pb. Pole

Fd N.T 8" Cedar

75-60

524.79 F.B. 362

524.76 Page 22

75-50-30
303-21-30
75-50-22½

Fd S.W.T. F.B. 362-30
Removed 6-12-31

Set S.W.T

AND

DATE AVE

600.02 See Page 23
599.95 F.B. 362

LONG BEACH

Fd S.W.T. - F.B. 362-30
Removed 6-12-31

Set S.W.T.

599.95 F.B. 362

(331) (25)
(581)

Con Com top page 100

Note: ANY ADDITIONS OR CHANGES ON THIS SHEET MUST BE MADE OR CIRCLED IN Red Ink WITH DATE AND NAME OF PERSON MAKING CHANGE.

Do not extend notes this side of this line

RETURN TO
LOS ANGELES COUNTY SURVEYOR
700 HALL OF RECORDS

FORM 247 10M 8-31

F.B. 460 Pg 102

170.53
A39°42'45"
C 1.043

Con at bottom page 103

Page 20
237.94
ROAD

N

Fd S.W.T - F.B. 362-29
F.B. 460 - 21
Removed 6-13-31

Set S.W.T

0.12

PLUM AVE

61.45 page 22

REDONDO BEACH

PCC CYPRESS AVE

Mon - 12" Deep - by Inker
See page 98

25.77

51.98

Fd N.T
8" Cedar

Fd N.T
Pp Pole

Fd 4" I.P. w Cap
Mkd R.A.P. & E.H.W.
Page 38 & 98

103-25-30
53-42-30
103-25-30½

64.60 page 22

BEACH

Fd S.W.T - F.B. 362-30
Removed 6-13-31
See page 22

Set S.W.T

0.05

LOTS

75.27 page 22

(33.25)
(58)

Con From top page 101

RETURN TO
LOS ANGELES COUNTY SURVEYOR
700 HALL OF RECORDS

Do not extend notes this side of this line

Note: ANY ADDITIONS OR CHANGES ON THIS SHEET MUST BE MADE OR CIRCLED IN Red Ink. WITH DATE AND NAME OF PERSON MAKING CHANGE.

Notes Ck'd by	D. M. Finley	Survey of	CYPRESS AVE
Map No.	B-643-1, 2	W. O.	7016
Office Work	K. V. M.	Tape No.	St'd °F.
Checked	D. M. Finley	Surveyed by	W. A. Miller
Date	Apr. 1933	Notes	Miller Date 6-13-31
		Indexed	A. C. Johnson

F.B. 460 Pg. 103

Con at bottom page 104

(33) (1-18) (23)

ROAD

REDONDO BEACH

7996 F.B. 362

CYPRESS ST

Fd S.W.T F.B. 362-28
F.B. 460-20
Removed 6-13-31

Set S.W.T

90°

YINE AVE

LONG BEACH and

7996 Page 20

Fd N.&T. P. Pole

PENNSYLVANIA AVE

Fd N.&T. 10" Cedar

2.45

37.31

50.19

28.47

Set C.S. Brass Cap Mon. 12" Deep - Mkd as shown. on page 88.

Fd N.&T. P. Pole

103-25

231.94 Page 28

103-25-30
53-42-15
103-25-33¾

Con from top page 103.

RETURN TO
LOS ANGELES COUNTY SURVEYOR
700 HALL OF RECORDS

Note: ANY ADDITIONS OR CHANGES ON THIS SHEET MUST BE MADE OR CIRCLED IN Red Ink, WITH DATE AND NAME OF PERSON MAKING CHANGE.

Do not extend notes this side of this line

FORM 247 10M 5-31

F.B. 460 Pg. 104

Con at bottom page 105

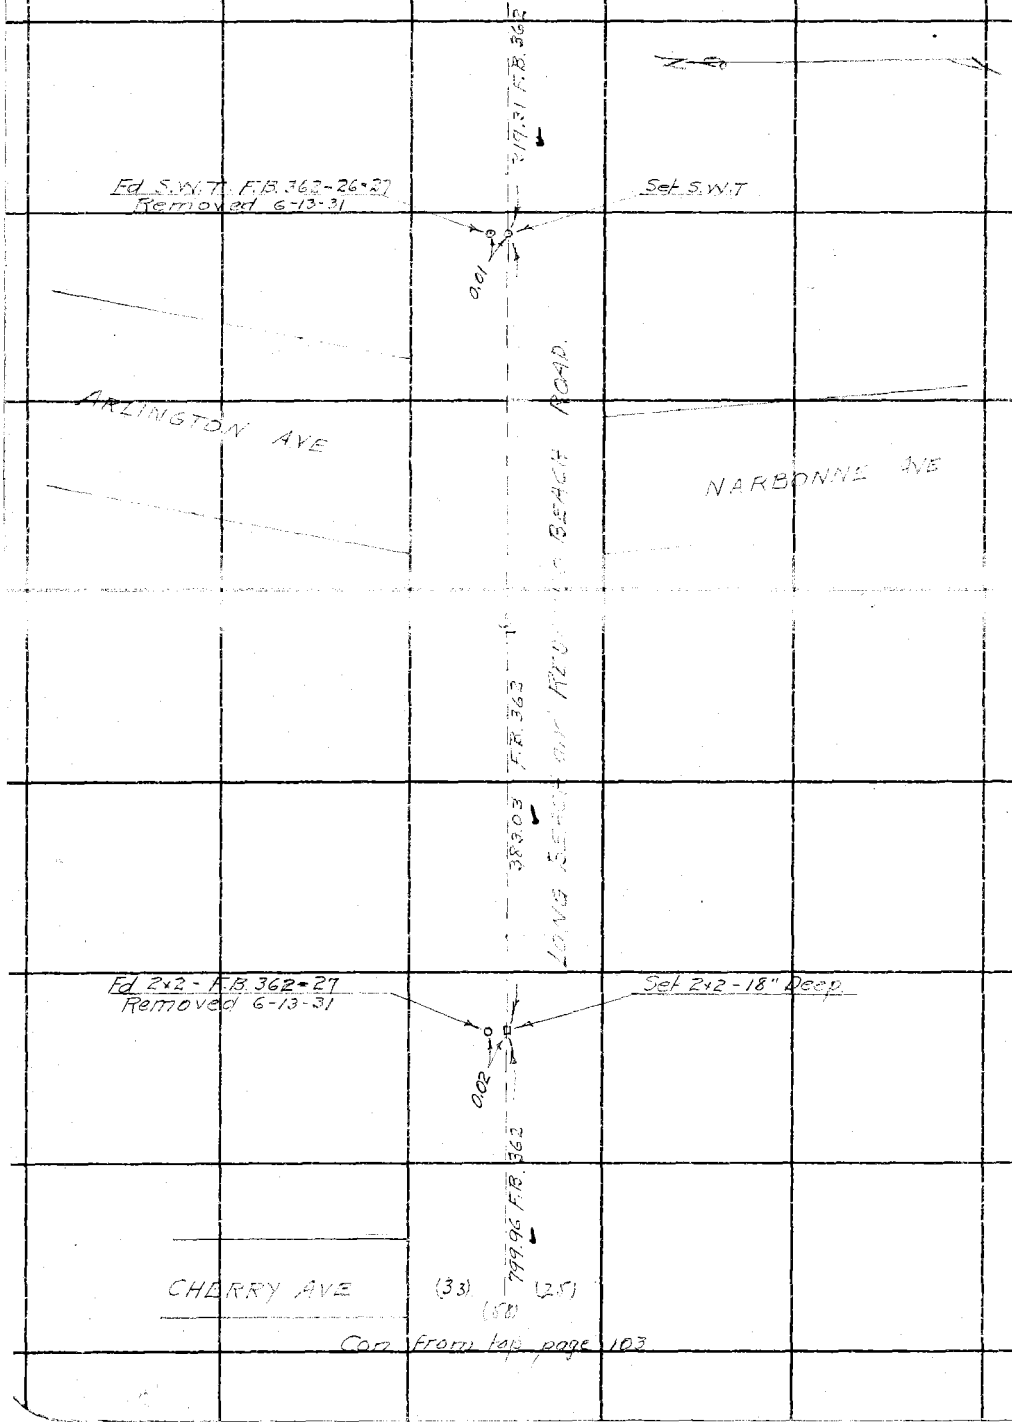

RETURN TO
LOS ANGELES COUNTY SURVEYOR
700 HALL OF RECORDS

Do not extend notes this side of this line

Note: ANY ADDITIONS OR CHANGES ON THIS SHEET MUST BE MADE OR CIRCLED IN Red Ink, WITH DATE AND NAME OF PERSON MAKING CHANGE.

Notes Ck'd by D. M. Finley	Survey of CYPRESS AVE	F.B. 460	Pg. 105
Map No. B. 643-1, 2	W. O. 7016 Tape No.	St'd °F.	
Office Work K. V. M.	Surveyed by W. A. Miller		
Checked D. M. Finley	Notes Miller Date 6-13-31		
Date Apr. 1933	Indexed A. C. Johnson		

Con at bottom page 106

N

376.99 F.B. 362

ROAD.

Missing

ANDREO AVE

REDONDO BEACH and LONG BEACH

F.B. 362

354.23

Fd. S.W.T. - F.B. 362 - 25.36
Removed 6-13-31

Set S.W.T.

GRAMERCY AVE

0.02

319.31 F.B. 362

(33) (25)
6 8 1

Con From top page 104

Note: ANY ADDITIONS OR CHANGES ON THIS SHEET MUST BE MADE OR CIRCLED IN Red Ink, WITH DATE AND NAME OF PERSON MAKING CHANGE.

Do not extend notes this side of this line

RETURN TO
LOS ANGELES COUNTY SURVEYOR
700 HALL OF RECORDS

FORM 247 10M 8-31

RETURN TO
LOS ANGELES COUNTY SURVEYOR
700 HALL OF RECORDS

Note: ANY ADDITIONS OR CHANGES ON THIS SHEET MUST BE MADE OR CIRCLED IN **Red Ink.** WITH DATE AND NAME OF PERSON MAKING CHANGE.

Do not extend notes this side of this line

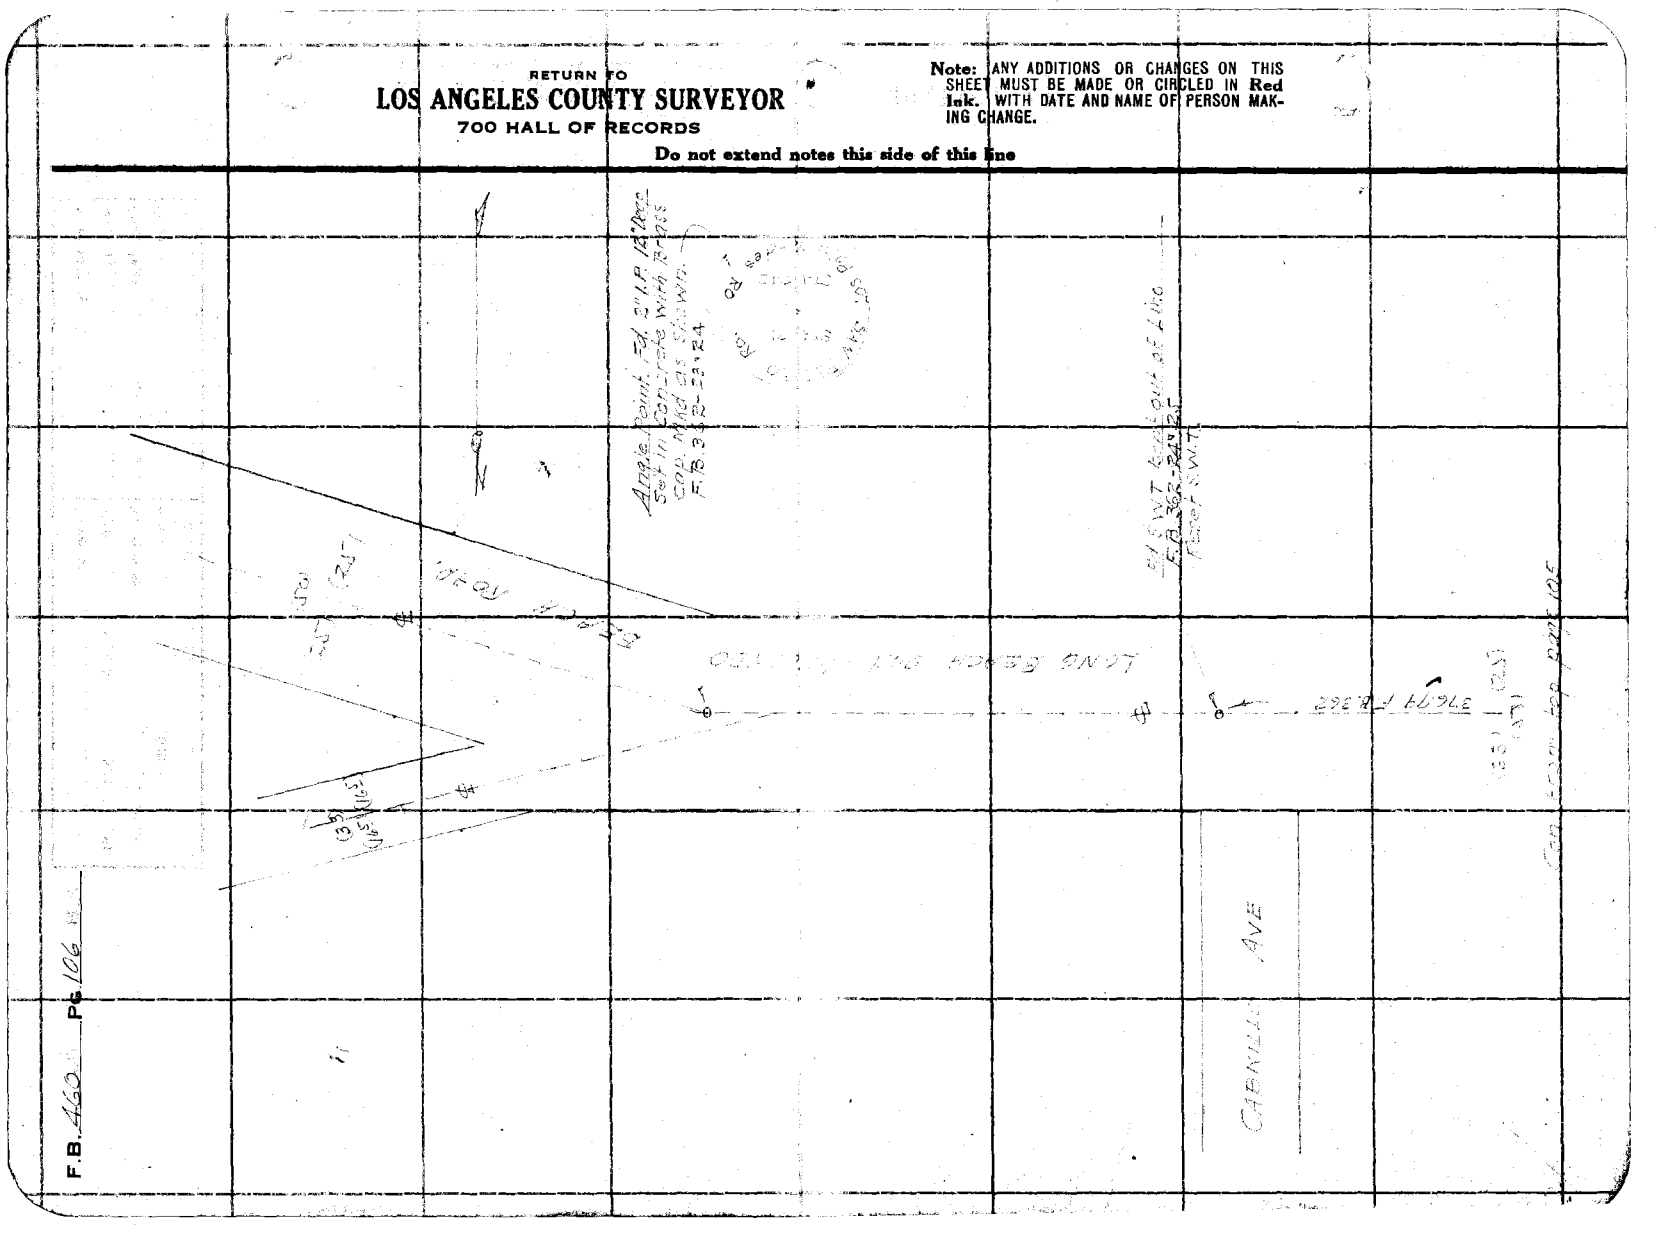
Angle Point, Ft 3/4" I.P. Flush
Set in Concrete With Brass
Cap and Punch Stamped
F.B. 362-23, P.24
CENTRAL AVE
ANGLE
(S51°-21'-E)
(S51°-21'-E)
(S51°-21'-E)

Notes Ck'd by D. M. Finley	Survey of CYPRESS AVE
Map No. B-643-1, 2	W. O. 7016 Tape No. St'd °F.
Office Work K. V. M.	Surveyed by W. A. Miller
Checked D. M. Finley	Notes Miller Date 6-15-31
Date Apr. 1933	Indexed A. C. Johnson

F.B. 460 Pg. 107

Note: ANY ADDITIONS OR CHANGES ON THIS SHEET MUST BE MADE OR CIRCLED IN Red Ink. WITH DATE AND NAME OF PERSON MAKING CHANGE.

Do not extend notes this side of this line

RETURN TO
LOS ANGELES COUNTY SURVEYOR
700 HALL OF RECORDS

42+88.82
Fd 2" I.P. Plug - TK
See page 29
42+94.05

42+83.60
Set 2x2
by Inter

55+10.45
Fd C.S. Brass Cap Mon
See page 92

ROSE AVE

47+61.62
Fd C.S. Brass Cap Mon.
See page 93

PRO. CYPRESS AVE

0.12
at 90°

5.22

Wire Fence

Fd 2" I.P. Cap - R.M.
See page 29

Set 1x2

.500

62°-46'-50" S

UNION OIL CO.

62-46-45 ✓
251-07-00
62-46-45

WIRE FENCE

.500

TRACT No 9765

Wire Fence

Fd 2" I.P. - Page 29
Stamped "P.A.F. Co"

WESTON RR

117-10-00
108-39-45
117-09-56 ✓

117-09'-56" 485'

.500 Office Line

.500

5.98

Set 1x2

0.72

0.81

Fd C.S. Brass Cap
Mon. - F.B. 455-52

Fd 6x6 Conc. Mon.
w Copper Nail - Flush
F.B. 455-56

FORM 247 10M 5-31

RETURN TO

LOS ANGELES COUNTY SURVEYOR

700 HALL OF RECORDS

Note: ANY ADDITIONS OR CHANGES ON THIS SHEET MUST BE MADE OR CIRCLED IN **Red Ink.** WITH DATE AND NAME OF PERSON MAKING CHANGE.

Do not extend notes this side of this line

F.B. 462 Pg. 108

Notes Ck'd by D.M. Finley		Survey of Cypress Ave	F.B. 460 Pg. 109
Map No. B-643-1, 2		W. O. 7016 Tape No. 036 St'd 64°F.	
Office Work K. V. M.		Surveyed by Graber	
Checked D. M. Finley		Notes N.F.G. Date 8-28-31	
Date Apr. 1933		Indexed A. C. Johnson 9-1-31	

Note: ANY ADDITIONS OR CHANGES ON THIS SHEET MUST BE MADE OR CIRCLED IN Red Ink, WITH DATE AND NAME OF PERSON MAKING CHANGE.

Do not extend notes this side of this line

RETURN TO
LOS ANGELES COUNTY SURVEYOR
700 HALL OF RECORDS

Set N&T. | 12° | Cypress Ave | Fd. N&T. (154.64 S!) per F.B. 460-41 Ties Check

12° Offset Line

See M.B. 39 for Adopted ℄ Cypress

90°

117+79.48
Fd. Cor. N&T. at Int. per F.B. 460-101

Set N&T. | 12° | CAMINO REAL

79.20

215.01 level @ 78° = 215.00'
215.01 " @ 78°

0.02

1 - 90°-00'-00"
4 - 90°-00'-00"

0.31

1 - 164°-32'-00"
4 - 298-08-15
6 - 267-12-30
164°-32'-05"

E.C.
Set 2x2 dr. 12"
16+99.97 E.C.
Not Set.

Set N&T. Cor. of Engine Room

135.80 level @ 80° = 135.80'

Δ = 15°-27'-5.5"
R = 1000 Ft.
T = 135.80'
L = 269.92'

Δ = 15°-27'-05" Calc.
R = 1000
T = 135.66
L = 269.68

Cut ⅛" Cone in Exhaust Chamber

Set N&T. Side of Car East of Pipe Rail

90°-00'-00"

215.05'

135.80'

45.50'

12°

Set 1x2

Set 2x2 ½ dr. 18" for P.I.

0.18

Not Set

R=1000'

E.C.
Set 2x2 dr. 12"

14+30.29 B.C.
Not Set

17.83' level @ 84° = 17.83'

0.04

Conta. Top pg.

FORM 247 10M 5-31

F.B. 460 PG 110

Cont bottom page —

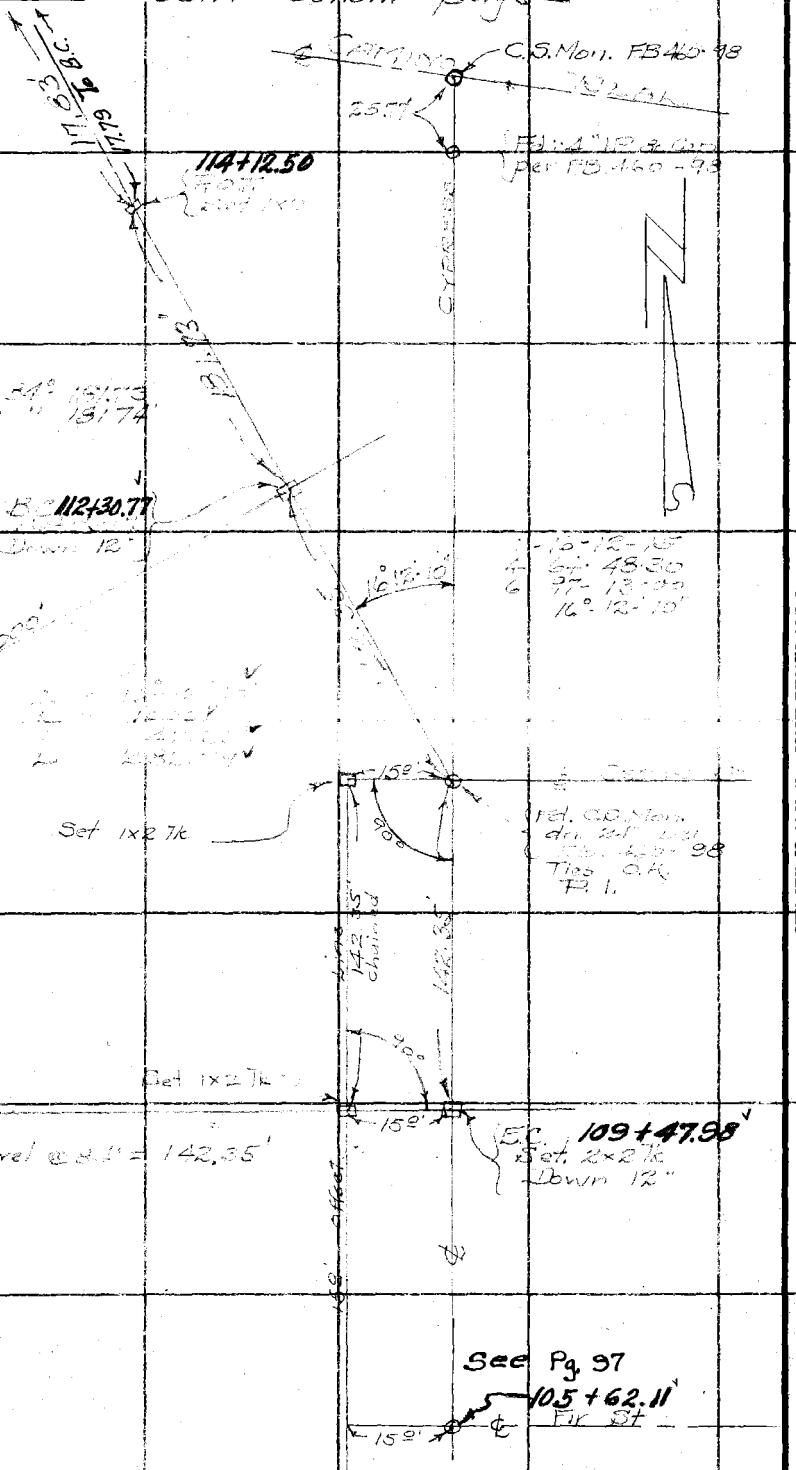

RETURN TO
LOS ANGELES COUNTY SURVEYOR
700 HALL OF RECORDS

Do not extend notes this side of this line

Note: ANY ADDITIONS OR CHANGES ON THIS SHEET MUST BE MADE OR CIRCLED IN Red Ink. WITH DATE AND NAME OF PERSON MAKING CHANGE.

Notes Ck'd by	D. M. Finley	Survey of	CYPRESS AVE
Map No.	B-643-1, 2	W. O.	7016
Office Work	K. V. M.	Tape No.	024
Checked	D. M. Finley	St'd	84 °F.
Date	Apr. 1933	Surveyed by	W. A. Miller
		Notes	Miller
		Date	Dec '31
		Indexed	

F.B. 460 Pg. 111

Note: ANY ADDITIONS OR CHANGES ON THIS SHEET MUST BE MADE OR CIRCLED IN Red Ink. WITH DATE AND NAME OF PERSON MAKING CHANGE.

Do not extend notes this side of this line

RETURN TO
LOS ANGELES COUNTY SURVEYOR
700 HALL OF RECORDS

RECHAIN
OF
HOLLYWOOD PALOS VERDES PARKWAY
FROM
L.A. STREET TO DOMINGUEZ ST.
W.O 7016.

Miller
Crumley
Gregory
Kraghess
Bridden

FORM 247 10M 8-31

F.B. 460 Pg. 112

Con't at bottom page 113

Set 2x2 by Inter. 18" Dp. using P.I. "18 and A.T. at ℄ Dominguez St. for line.

600.36 @ 0-00 T 54 = 600.24
600.37 @ 0-00 T 54 = 600.25
600.24

407.44 @ 0-00 T 68 = 407.40
407.45 @ 0-00 T 68 = 407.41
Av = 407.40.

10-20-15
41-21-00 +
62-01-30 +
10-20-15 +.

Fd 2x2 - 12" Deep
F.B. 238 - 156

Fd 2x2 - 24" Deep
F.B. 238 - 156
0.05 S. Line

Fd 2x2 - 24" Deep
F.B. 239 - 156
0.03 S. Line

PRO LOS ANGELES

ST

P.I. = 18
Ed Rotten 3x3
24" Deep F.B. 238 - 156
Replaced with new 3x3

Fd S.W.T. in Pav.
F.B. 460 - 49

PALOS VERDES PARKWAY

Adopted ℄ CEDAR
80' Wide

Fd X in Top R.R. Rail
Prop. Cor.

P.I. = 17½
Ed 2x2 in ditch
F.B. 238 - 9

Set S.W.T. on Split of Angle.

Fd L.O.T. in Curb.

Fd N.O.T. in Pav.
F.B. 460 - 49

DOMINGUEZ ST.

Fd X in Top R.R. Rail
Prop. Cor.

Set N.O.T. in Gum

HOLLYWOOD

179.39
F.B. 238 - 9

RETURN TO
LOS ANGELES COUNTY SURVEYOR
700 HALL OF RECORDS

Do not extend notes this side of this line

Note: ANY ADDITIONS OR CHANGES ON THIS SHEET MUST BE MADE OR CIRCLED IN Red Ink. WITH DATE AND NAME OF PERSON MAKING CHANGE.

Notes Ck'd by D. M. Finley	Survey of CYPRESS AVE	F.B. 460	Pg. 163
Map No. B-643-1, 2	W. O. 7016	Tape No. 024	St'd 84 °F.
Office Work K. V. M.	Surveyed by W.A.Miller		
Checked D. M. Finley	Notes Miller	Date 12-15-31	
Date Apr. 1933	Indexed		

Con at bottom page 112

600.32 @ 0-00 T 57 = 600.21
600.30 @ 0-00 T 57 = 600.19
Av = 600.20'

225'
112.50 112.50

PARKWAY
600.20
(600.00)

N

0.07 112.48 112.52

Fd 3x3 - Flush
F.B. 238-156
Not Checked for 90° off ℄

Fd 3x3 - Flush
F.B. 238-156
Not checked for 90° off ℄
Fd 2x2 - Flush
F.B. 238-156
Replaced with 2x2 - 18" Deep

133.885 @ 0-00 T 56 = 133.86
133.89 @ 0-00 T 56 = 133.87
Av = 133.86.

133.86'
(133.83)

PALOS VERDES

Fd 2x2 - 4" up
F.B. 238-156
Replaced with 2x2 - 18" Deep

℄

612.56 @ 0-00 T 56 = 612.45
612.57 @ 0-00 T 56 = 612.46
Av = 612.45.

612.45'
(612.43)

HOLLYWOOD

112.465 112.465

Fd 2x2 - Flush
F.B. 238-156
Not Checked for 90° off ℄

Fd 2x2 - Flush
F.B. 238-156
Not Checked for 90° off ℄
Set 2x2 - 6" Deep
F.B. 238-156

186.80 @ 0-00 T 68 = 186.78
186.80 @ 0-00 T 68 = 186.78
Av = 186.78.

186.78'
600.24
(599.97)

Con from top page 114

Note: ANY ADDITIONS OR CHANGES ON THIS SHEET MUST BE MADE OR CIRCLED IN Red Ink. WITH DATE AND NAME OF PERSON MAKING CHANGE.

Do not extend notes this side of this line

RETURN TO
LOS ANGELES COUNTY SURVEYOR
720 HALL OF RECORDS

FORM 247 10M 8-31

F.B. 460 Pg. 114

Con at bottom page 115

225.00
112.50 112.50

600.21 @ 0-00 T 58 = 600.16
600.27 @ 0-00 T 58 = 600.17
AV = 600.16.

PARKWAY

600.16
(600.00)

112.42 112.47

Fd 2x2 - Flush.
F.B 238-157
Not checked for 90° OFF ±

Fd 2x2 - Flush
F.B. 238-157
Not Checked for 90° off ±

Fd 1x2 - Flush.
F.B 238-157
Replaced with 2x2 - 18" Deep

600.56 @ 0-00 T 58 = 600.46
600.56 @ 0-00 T 58 = 600.46
AV = 600.46.

PALOS VERDES

600.46
(600.30)

℄

112.44 112.55

Fd 2x2 - Flush
F.B 238-157
Not checked for 90° off ±

Fd 2x2 - Flush
F.B. 238-157
Not Checked for 90° off ±

Fd 1x2 - Flush
F.B 238-157
Replaced with 2x2 - 18" Deep

600.39 @ 0-00 T 58 = 600.29
600.39 @ 0-00 T 58 = 600.29
AV = 600.29.

HOLLYWOOD

600.29
(600.00)

51
112.54

Fd 2x2 - Flush
F.B. 238-156
Not Checked for 90° off ±

Fd 1x2 - Flush
F.B 238-156
Replaced with 2x2 - 18" Deep

600.20
(600.00)

Con from top page 113

RETURN TO
LOS ANGELES COUNTY SURVEYOR
700 HALL OF RECORDS

Do not extend notes this side of this line

Note: ANY ADDITIONS OR CHANGES ON THIS SHEET MUST BE MADE OR CIRCLED IN Red Ink. WITH DATE AND NAME OF PERSON MAKING CHANGE.

Notes Ck'd by D. M. Finley	Survey of CYPRESS AVE	F.B. 460 Pg. 116
Map No. B-643-1,2	W. O. 7016 Tape No. 024 St'd 84 °F.	
Office Work K. V. M.	Surveyed by W. A. Miller	
Checked D. M. Finley	Notes Miller Date 12-15-31	
Date Apr. 1933.	Indexed	

Con at bottom page 116

N

500.82 @ 0-00 T 64 = 500.75
500.83 @ 0-00 T 64 = 500.76
Av = 500.75
18.10
482.65.

496.21 @ 0-00 T 64 = 496.15
496.23 @ 0-00 T 64 = 496.17
Av. = 496.16
10.88
485.28.

PARKWAY

℄ Produced

482.65

485.28.

P.I. 7+19
Fd L.T in Pav
F.B. 238-157

Fd L.T in Pav.
F.B. 460-51

9.85

1.68

82.50

5T

℄

(30.00)

DOMINGUEZ

Fd L.T in Pav
F.B. 238-157

Fd L.T in Pav
F.B. 238-157

351.28 @ 0-00 T 58 = 351.22
351.31 @ 0-00 T 58 = 351.25
Av = 351.23.

112.50

351.23.
(351.32)

112.50

PALOS VERDES

℄

225.00

Fd 2x2 Flush.
F.B. 238-157
Not checked For 90° off ℄

67

118.78

46

112.43

Fd 2x2 Flush
F.B. 238-157
Not checked for 90° off ℄

Fd 1x2 - Flush.
F.B. 238-157
Replaced with 2x2
18" Deep.

HOLLYWOOD

600.16
(600.00)

Con from top page 114

Note: ANY ADDITIONS OR CHANGES ON THIS SHEET MUST BE MADE OR CIRCLED IN Red Ink. WITH DATE AND NAME OF PERSON MAKING CHANGE.

Do not extend notes this side of this line

RETURN TO
LOS ANGELES COUNTY SURVEYOR
700 HALL OF RECORDS

FORM 247 10M 8-31

RETURN TO
LOS ANGELES COUNTY SURVEYOR
700 HALL OF RECORDS

Note: ANY ADDITIONS OR CHANGES ON THIS SHEET MUST BE MADE OR CIRCLED IN **Red Ink.** WITH DATE AND NAME OF PERSON MAKING CHANGE.

Do not extend notes this side of this line

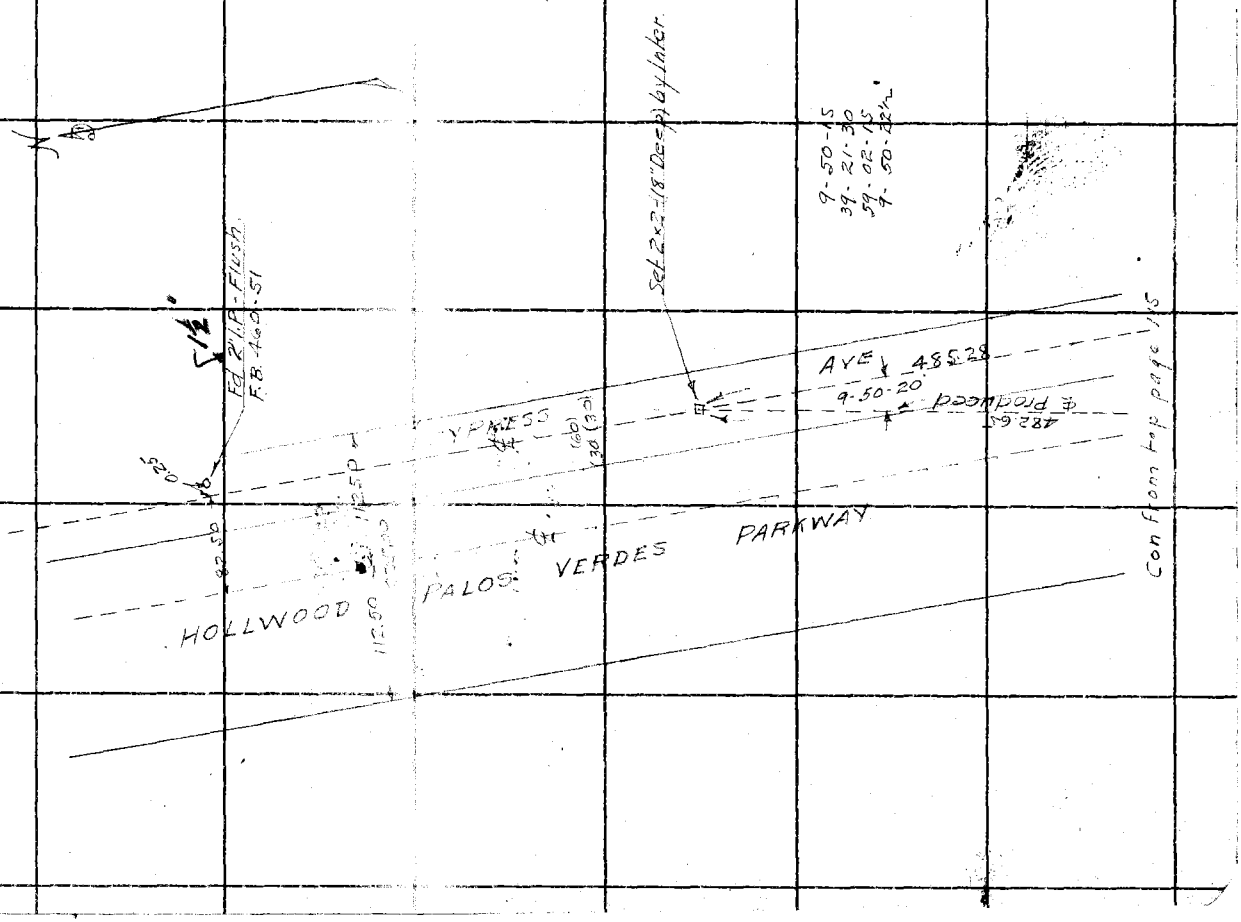

F.B. 460 Pg. 116

Notes Ck'd by D. M. Finley		Survey of	
Map No. B-643-1		W. O.	Tape No. St'd °F
Office Work R.D.M.H.		Surveyed by	
Checked D. M. Finley		Notes	Date 1-28-49
Date Feb. 1949		Indexed A. C. Johnson 2-4-49	

F. B. 460 Pg. 117

J.N. 7016
CYPRESS AVE.
(C.S.B. 643-1
F.B. 460-)

ADDITIONAL TOPOGRAPHY
TO SHOW CHANGES SINCE
ORIGINAL NOTES WERE TAKEN
IN 1931-

FEBRUARY 1-3-1949

C.V. CRUMLEY.
A. CARRASCO.
H.E. CULP.
D.D. SPARKS, JR.

Note: Any Additions or Changes on This Sheet Must be Made or Circled in Red Ink With Date and Name of Person Making Change.

Do not extend notes this side of this line.

RETURN TO
LOS ANGELES COUNTY SURVEYOR
700 HALL OF RECORDS

FORM 247 5M 5-46

F. B. 460 PG. 118

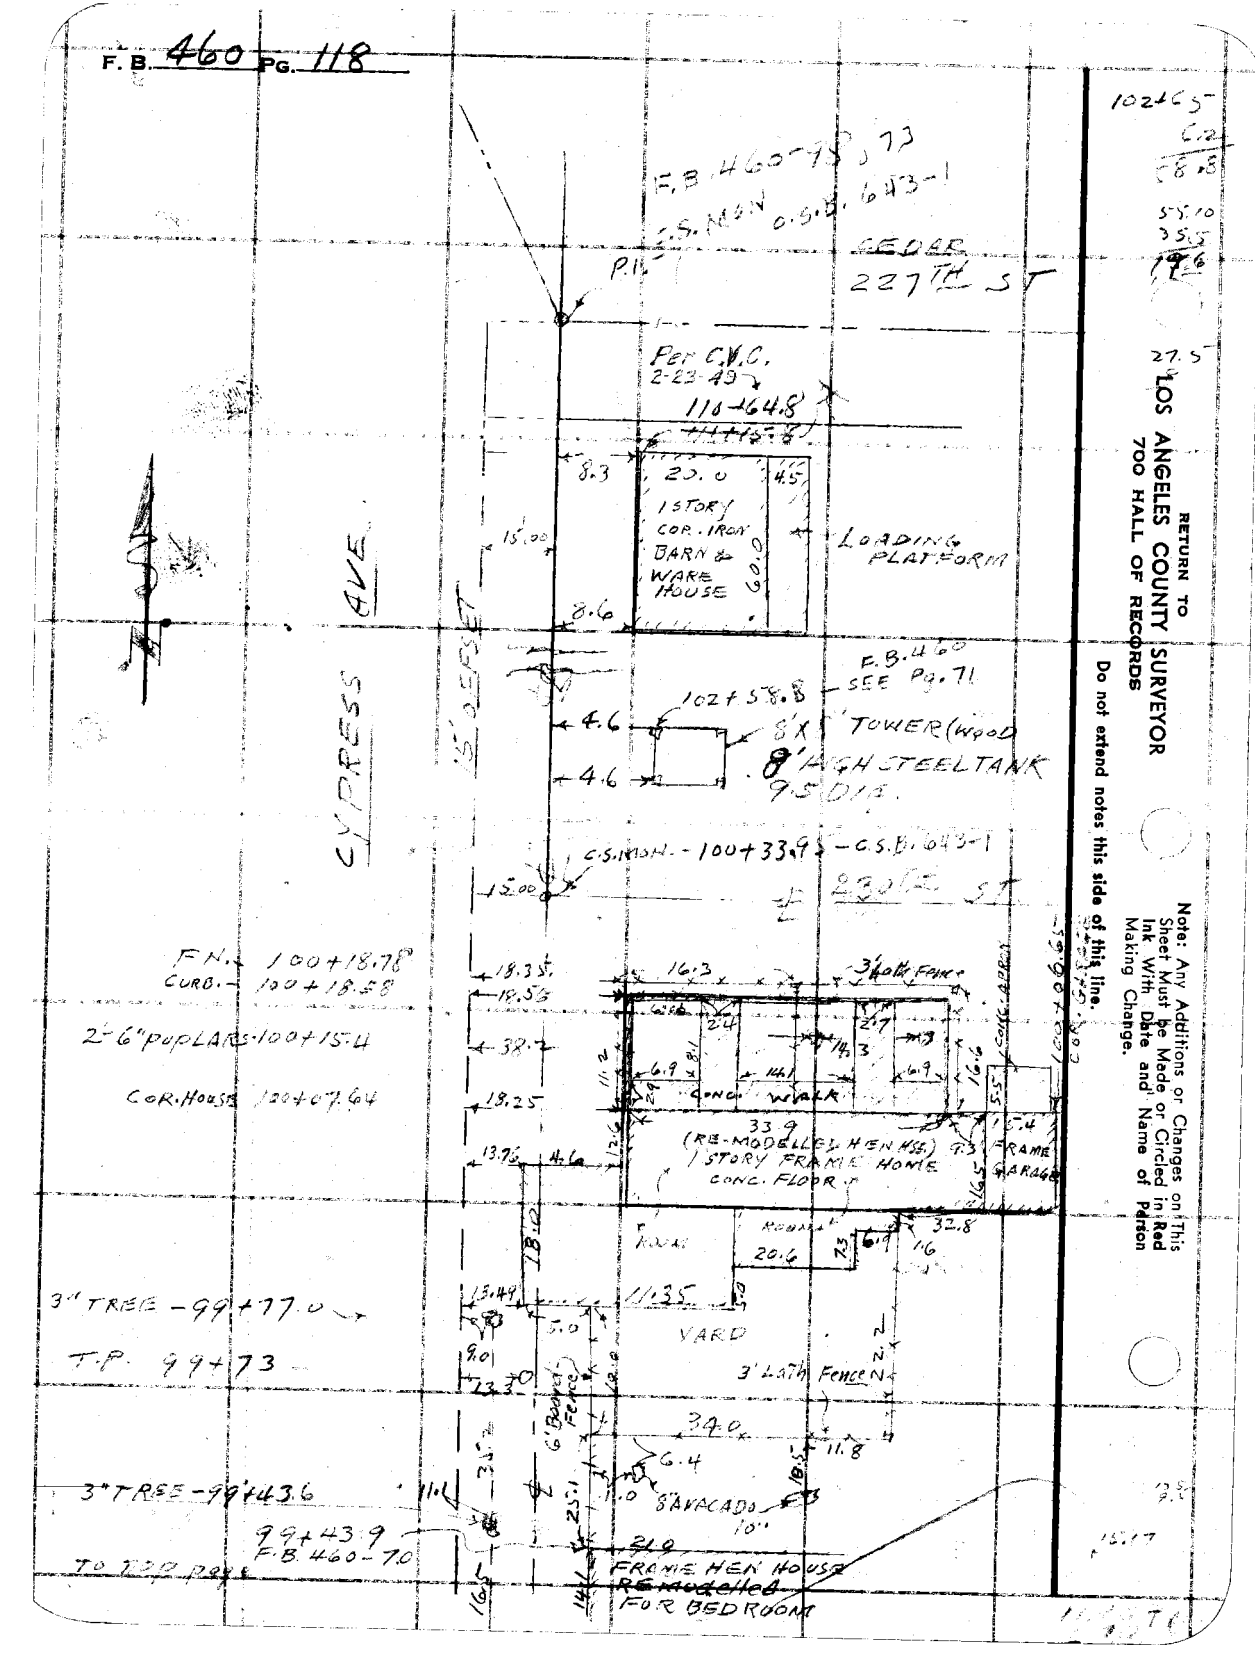

RETURN TO
LOS ANGELES COUNTY SURVEYOR
700 HALL OF RECORDS

Do not extend notes this side of this line.

Note: Any Additions or Changes on This Sheet Must be Made or Circled in Red Ink With Date and Name of Person Making Change.

F. B. 460 Pg. 119

Notes Ck'd by D. M. Finley
Map No. B-643-1
Office Work H.L.M.H.
Checked D. M. Finley.
Date Feb. 1949

Survey of CYPRESS AVE.
W. O. Z016 Tape No. St'd °F
Surveyed by C.V. CRUMLEY
Notes C.V.C. Date 3-31-49
Indexed C. Johnson

CONT'D FROM BOTTOM PAGE

99+29.39
F.B. 460-70
19.1
3" TREE
1 STORY FRAME HOUSE
21.0
1.6
7.2
1 STORY FRAME BED ROOM
11.0
2.0
10" AVACADO
AVE
12.5

3" APRICOT 99+12.3
3" TREE
10" Peach 99+00
6" APRICOT 98+89.6
16.7
47
3" APRICOT
39.0
21.5
10.4
6" AVACADO 99+04
F.B. 460-70
6" APRICOT

98+86.50
F.B. 460-70
11.7
16.5
4' Board FENCE
20.0
3" TREE 98+74.8
END
HEN HOUSE
F.B. 460-70

34.25
98+45.80
F.B. 460-70
15.0
Hen House
15' OFFSET LINE
CYPRESS

TO TOP PAGE

Note: Any Additions or Changes on This Sheet Must Be Made or Circled in Red Ink With Date and Name of Person Making Change.

Do not extend notes this side of this line.

RETURN TO
LOS ANGELES COUNTY SURVEYOR
700 HALL OF RECORDS

FORM 247 5M 5-46

F. B. 460 PG. 120

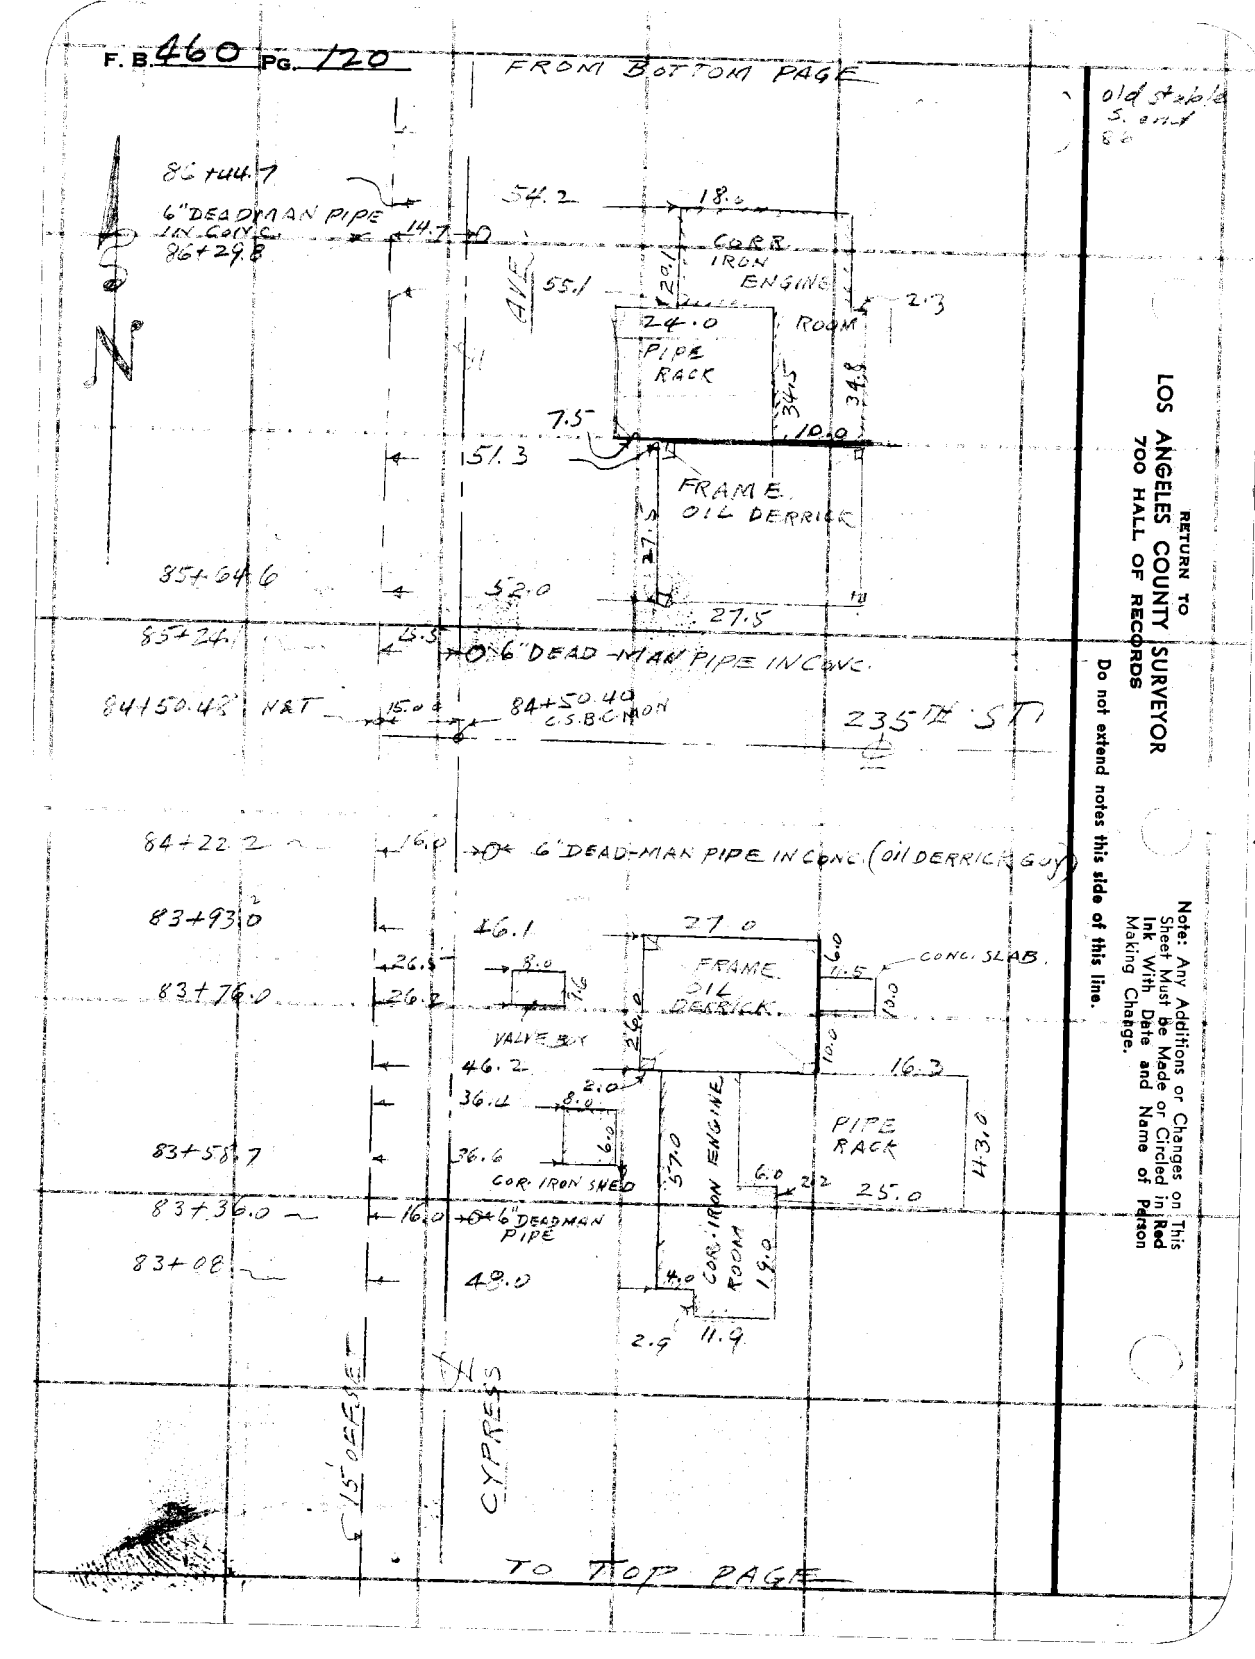

RETURN TO
LOS ANGELES COUNTY SURVEYOR
700 HALL OF RECORDS

Do not extend notes this side of this line.

Note: Any Additions or Changes on This Sheet Must be Made or Circled in Red Ink With Date and Name of Person Making Change.

76.5
57.5
26.5
685

Notes Ck'd by D. M. Finley
Map No. 9-643-1
Office Work H.U.M.H.
Checked D. M. Finley
Date Feb. 1949

Survey of CYPRESS AVE.
W. O. 7016 Tape No. St'd °F
Surveyed by C.V. CRUMLEY
Notes C.V.C. Date 2-1-49
Indexed

C. Johnson

F. B. 460 Pg. 121

FROM BOTTOM PAGE

Note: Any Additions or Changes on This Sheet Must be Made or Circled in Red Ink With Date and Name of Person Making Change.

Do not extend notes this side of this line.

RETURN TO LOS ANGELES COUNTY SURVEYOR 700 HALL OF RECORDS

FORM 247 5M 5-46

15.00

81+83.4

21.2

AVE

5½' WOVEN WIRE FENCE

81+59.8

26.5

48.0

18.2

27.6 STEEL OIL WELL DERRICK

FRAME OILWELL DERRICK

OIL RINGING & PIPE STORAGE YARD

48.0

18.5

81+30.7

1.4

PIPE RACK

41.5

42.8

CYPRESS 15' OFFSET?

80+76.5

50.5

57.0 COR. IRON ENGINE ROOM

6.5

8.7

2.5

7.7

19.0

18.6

STORAGE YARD

80+40.9

24.5

16 COR. IRON OPEN FRONT SHOP.

17.0

24.5

25.0

35

30.0 COR. IRON OPEN FRONT GARAGE

79+94.0

25.5

79+93.7

33.5

25.0

79+83.6

25.0

COR. IRON STORE ROOM

10.0

12.0

33.7

5'X4' TOILET

79+77.0

31.9

14.2

1 STORY FRAME HOUSE

24" PEPPER 79+63.5

18.8

24.2

32.3

25.0 R

35.7

79+47.0 4" TREE

21.5

14.0

4" TREE

5½' Woven Wire Fence

21.9

79+45.1

15.00

79+22.71 C.S. MON.

C.S.B. 643-1

230th ST

5.8

TO TOP PAGE

F. B. 460 PG. 122

FROM BOTTOM PAGE

5' STRAND BARB FENCE

CYPRESS AVE.

33+42.2
N. END 10" CONC. CURB

0.12

32+70.2

3.9

1 STORY FRAME GARAGE

15.9

16.7

32+74.4

4.0

23.2

32+59.9

1 STORY FRAME RESIDENCE

16.2

7.2

1.8

7.1

4.6

14.3

14.4

32+38.3

21.7

31+93.6
S. END 10" CONC. CURB

0.09

31+67.73
23+57.77

C.S. BRASS TOP MON.
C.S. F.B. 460-28 & 92
C.S.B. 643-1

20.0

25+74 S.

26.0

31+37
30 FT. WIDTH AVE.

S. EDGE GARAGE
30+63.8 - F.B. 460-61
+64.6

GARAGE
old Notes -

3.80

HOUSE F.B. 460-61

FRAME SHED

7.0

4.5

3.0

13.5

3.80

30+54.6

4.5

0.3

30+54.6

4" Lemon 30+48

10.7

33.5

18.5

9.6

9.5

34.0

30+30.5

2' CONC. WALK

9.0

1 STORY STUCCO ADD'T HOUSE

16.0

7.3

4.7

30+46.3

GRAPE ARBOR VINE

FISH POND

4" Lemon

8" WALNUT - 30+33.8

4" ORANGE - 30+19.2

5' CONC. IRON FENCE

CONT'D ON TOP PAGE

59.9
38.3
21.6
43.4
9.5
30.0

67.3

RETURN TO
LOS ANGELES COUNTY SURVEYOR
700 HALL OF RECORDS

Do not extend notes this side of this line.

Note: Any Additions or Changes on This Sheet Must Be Made or Circled in Red Ink With Date and Name of Person Making Change.

F.B. 460 Pg. 123

Notes Ck'd by D. M. Finley
Map No. B-643-1
Office Work H.U.M.H.
Checked D. M. Finley
Date Feb. 1949.

Survey of CYPRESS AVE
W. O. 7016 Tape No. St'd °F
Surveyed by C.V. CRUMLEY
Notes C.V. CRUMLEY Date 8-3-49
Indexed E. C. Johnson

FROM BOTTOM OF P.

9.0

30+12.4

BROODER HSE PG. 61

18.0

10.8 FRAME SHED 12.0

10.0

3.5

29+96.7 END ARBOR

60.5

17.5

49.6

2 CONC. WALK

2.5

ARBOR

29+96.7

29+93.4

29+94

TWIN CORAL TREE (12" DIA.)

37.1

10.3.0

10.2

27

6.7

0.3

5' CORRUGATED IRON FENCE

CYPRESS AVE

STUCCO HEN HOUSE F.B. 460-61

16.0

5.6

29+68.4

F.B. 460-61

PENS

6' WOVEN WIRE FENCE

29+61.8

23.1

OPEN SHED

12.5

0.6

SHED 10.7

LEAN TOO SHED 10.2

10.1

29+96.

28+82.1

18.2

18.1

21.5

PENS

FRAME HEN HSE

FRAME HEN HOUSE

62.4

5.8

16.4

35.6

2.6

11.5 DIA FISH POND -27+95.5

27+80.3

27+79.0 - AVOCADO OUT 37.6

0.5

7.7

1.8

6.0

27

FRAME BROODER HOUSE -

14.2

32.2

STORAGE SHED

25.9

13.6

12.3

27+76.6

2-6" AVOCADO TREES OUT 37.4

3.0

27+24.5

2-20" PEPPERS

(GARAGE & HOUSE HERE F.B. 460-60)

2" TREE

4.3

26+98.

26+77.0

20.0

2.8

6" TREE

TO TOP PAGE

6.3W

RETURN TO LOS ANGELES COUNTY SURVEYOR 700 HALL OF RECORDS

Note: Any Additions or Changes on This Sheet Must be Made or Circled in Red Ink With Date and Name of Person Making Change.

Do not extend notes this side of this line.

FORM 247 5M 5-46

16.9
12.3
7.7
0.5
37.4

F. B. 460 PG. 124

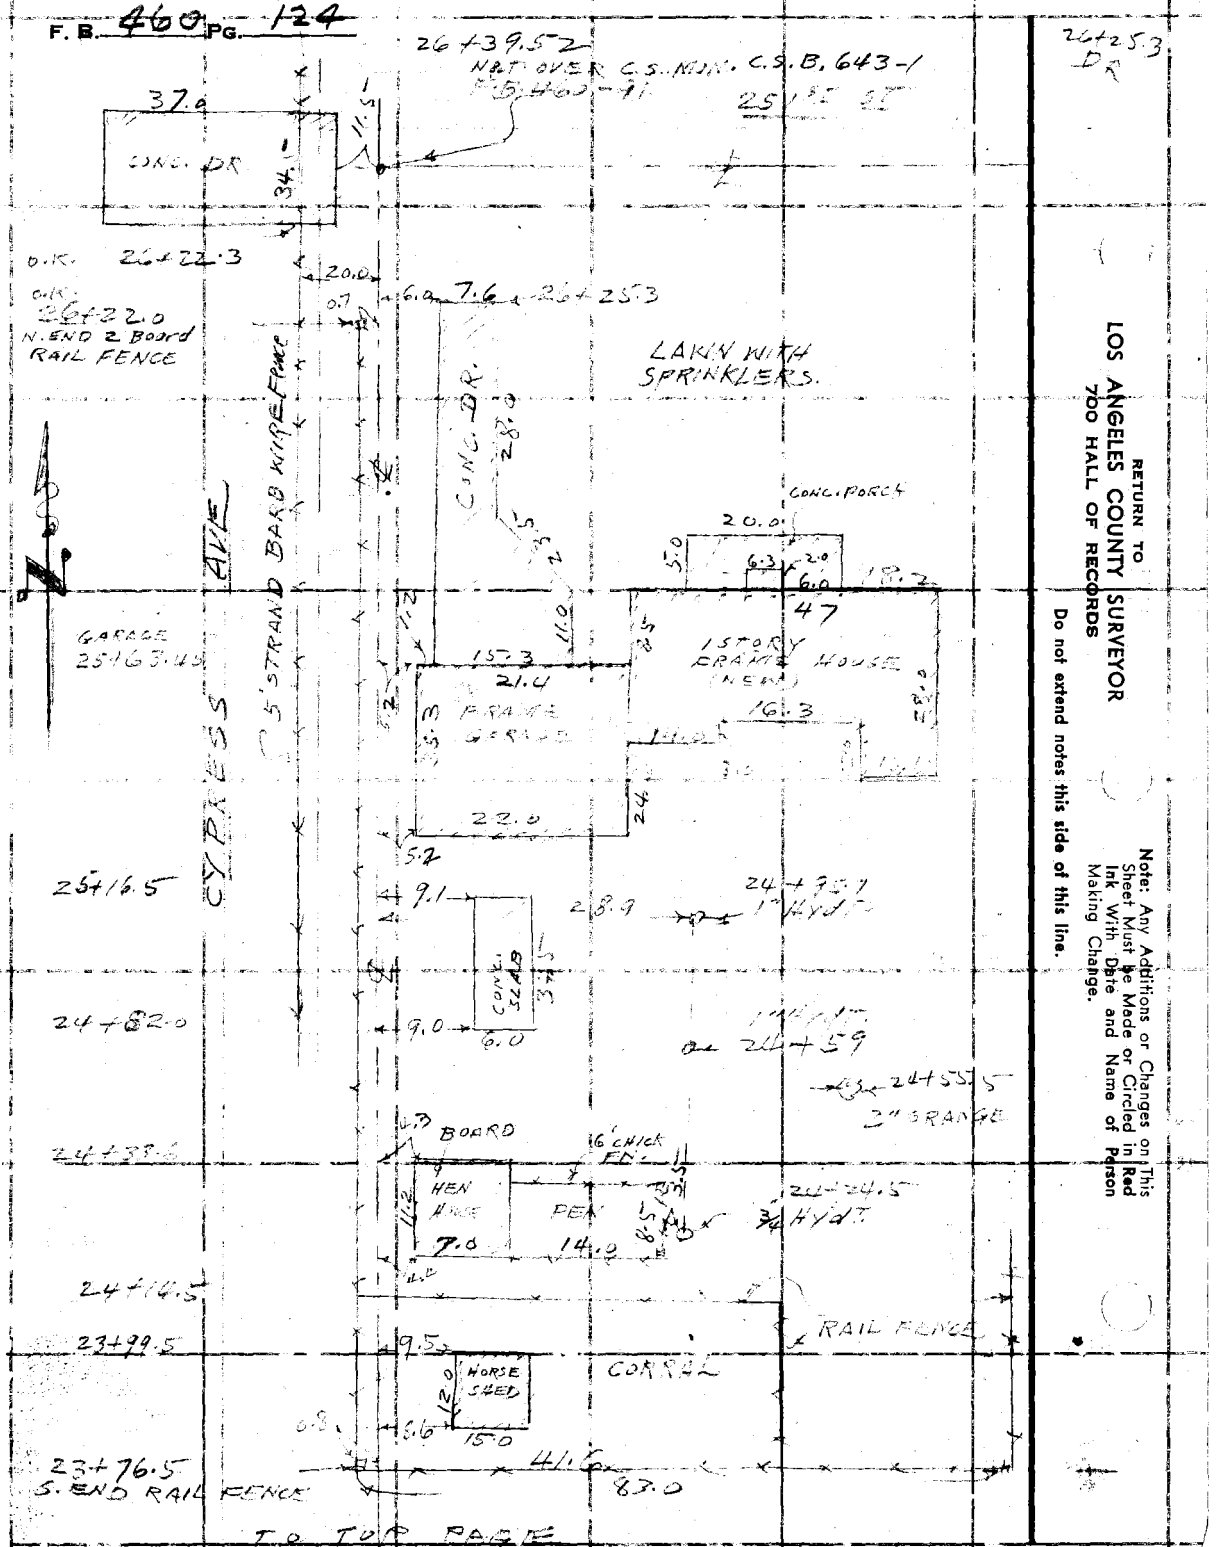

RETURN TO
LOS ANGELES COUNTY SURVEYOR
700 HALL OF RECORDS

Do not extend notes this side of this line.

Note: Any Additions or Changes on This Sheet Must Be Made or Circled in Red Ink With Date and Name of Person Making Change.

Notes Ck'd by D.M.F.
Map No. C-643-1.
Office Work HUM.H.
Checked D.M.F.
Date Feb. 1949.

Survey of CYPRESS AVE.
W. O. 7016 Tape No. St'd °F
Surveyed by C.Y. CRUMLEY
Notes C.Y.C. Date 2-3-49
Indexed E. C. Johnson

F.B. 460 Pg. 125

61 48 09

FROM BOTTOM PAGE

Note: Any Additions or Changes on This Sheet Must be Made or Circled in Red Ink With Date and Name of Person Making Change.

Do not extend notes this side of this line.

RETURN TO
LOS ANGELES COUNTY SURVEYOR
700 HALL OF RECORDS

23+61.0 —
23+48.0-H
23+26.7-H —
20.0
23+06.5-H
22+90.3
22+85.5-H.
22+75.2 FN.
2" AVACADO - 22+71.6
N. END HEDGE - 22+57.6
22+63.8 - TRELLIS
22+49.5-H
FN. COR.
END HEDGE - 22+24.5
S. END TRELLIS - 22+20.0
21+83.7
40.0
21+61.0
21+36.4
C.S. NON, C.S.B. 643-1
F.B. 460-91
-27
21+13.0

5 STRAND BARB FN
AVE
CYPRESS

2.7 17.8 13.0 14.8
16.6 3/4" HYDT
18.5
YOUNG MIXED ORCHARD TREES 12" - 2" DIA.
3/4" HYDT.
21.0 17.0
3/4" HYDT
1.9 13.4 OUT 14.0 14.6
14.6 3/4" HYDT.
6.7
1.7
4' MESH WIRE FENCE - I.P. POSTS
9.6
3/4" HYDT. 22+63.8
0.8
GRAPE TRELLIS
40.7
6.6 29.5
7.8 10.6 2" GUM TREE
1.0 10.2
22+09.0
26.4
25.0
QUONSET
DWELLING
6.0
0.3
6" C.B.
19.5
23.9
CONC. PATH
8.0
20.0
10.2
12.4
0.7
26.4
38.2
27.2
MIX DRIVE
27.0
28.4
25 3RD ST.
P.L. F.B. 1227-29
C.S.B. 195-3

FORM 247 5M 5-46

RETURN TO
LOS ANGELES COUNTY SURVEYOR
700 HALL OF RECORDS

Note: Any Additions or Changes on This Sheet Must be Made or Circled in Red Ink With Date and Name of Person Making Change.

Do not extend notes this side of this line.

F. B. 460 PG. 196

Notes Ck'd by	D. M. Finley	Survey of	LORENA ST.
Map No.	B-737	W. O.	7066 Tape No. 042 St'd 84° F.
Office Work	R. W. Stewart	Surveyed by	S. E. BUTLER
Checked	D. M. Finley	Notes	" Date 11/31.
Date	March 1932	Indexed	A. C. Johnson

F.B. 460 Pg. 131

Note: ANY ADDITIONS OR CHANGES ON THIS SHEET MUST BE MADE OR CIRCLED IN Red Ink. WITH DATE AND NAME OF PERSON MAKING CHANGE.

Do not extend notes this side of this line

RETURN TO
LOS ANGELES COUNTY SURVEYOR
700 HALL OF RECORDS

FORM 247 10M 8-31

W.O. 7066

LORENA ST.

FROM INT. BISSELL ST. & RANDOLPH ST.
(HUNTINGTON PARK)

TO INT. DOWNEY RD. & PROP. WASHINGTON ST.
(VERNON)

NOTE: The ℄ of LORENA ST as run is the ℄ of an existing 100' R/W as acquired by the City of Los ANGELES for tower line purposes as per F.B. 500 & Bureau of POWER & LIGHT R/W Maps L 180 & L 188
This survey is a retracement of their survey as per F.B. 500 and an effort was made to re-establish the tangents as they were laid out originally. Additional ties are made to cross-lines where the orig. field work did not shown them accurately and other cross ties are accepted in view of fact that R/W is of record and also impossibility of reconstructing the lines due to shifting of & destruction of points.

C.L. Berger ⌀ #16657
100' Tape #042 Std @ 84°

NOTE: TOPOG - PG. 161

BUTLER
⌀ KERNBERGER
⌀ VAN FLEET
Willess
Taylor

RETURN TO

LOS ANGELES COUNTY SURVEYOR

700 HALL OF RECORDS

Note: ANY ADDITIONS OR CHANGES ON THIS SHEET MUST BE MADE OR CIRCLED IN **Red Ink.** WITH DATE AND NAME OF PERSON MAKING CHANGE.

Do not extend notes this side of this line

F.B. 460 PG. 132 NEXT

CONT. BOT PG.

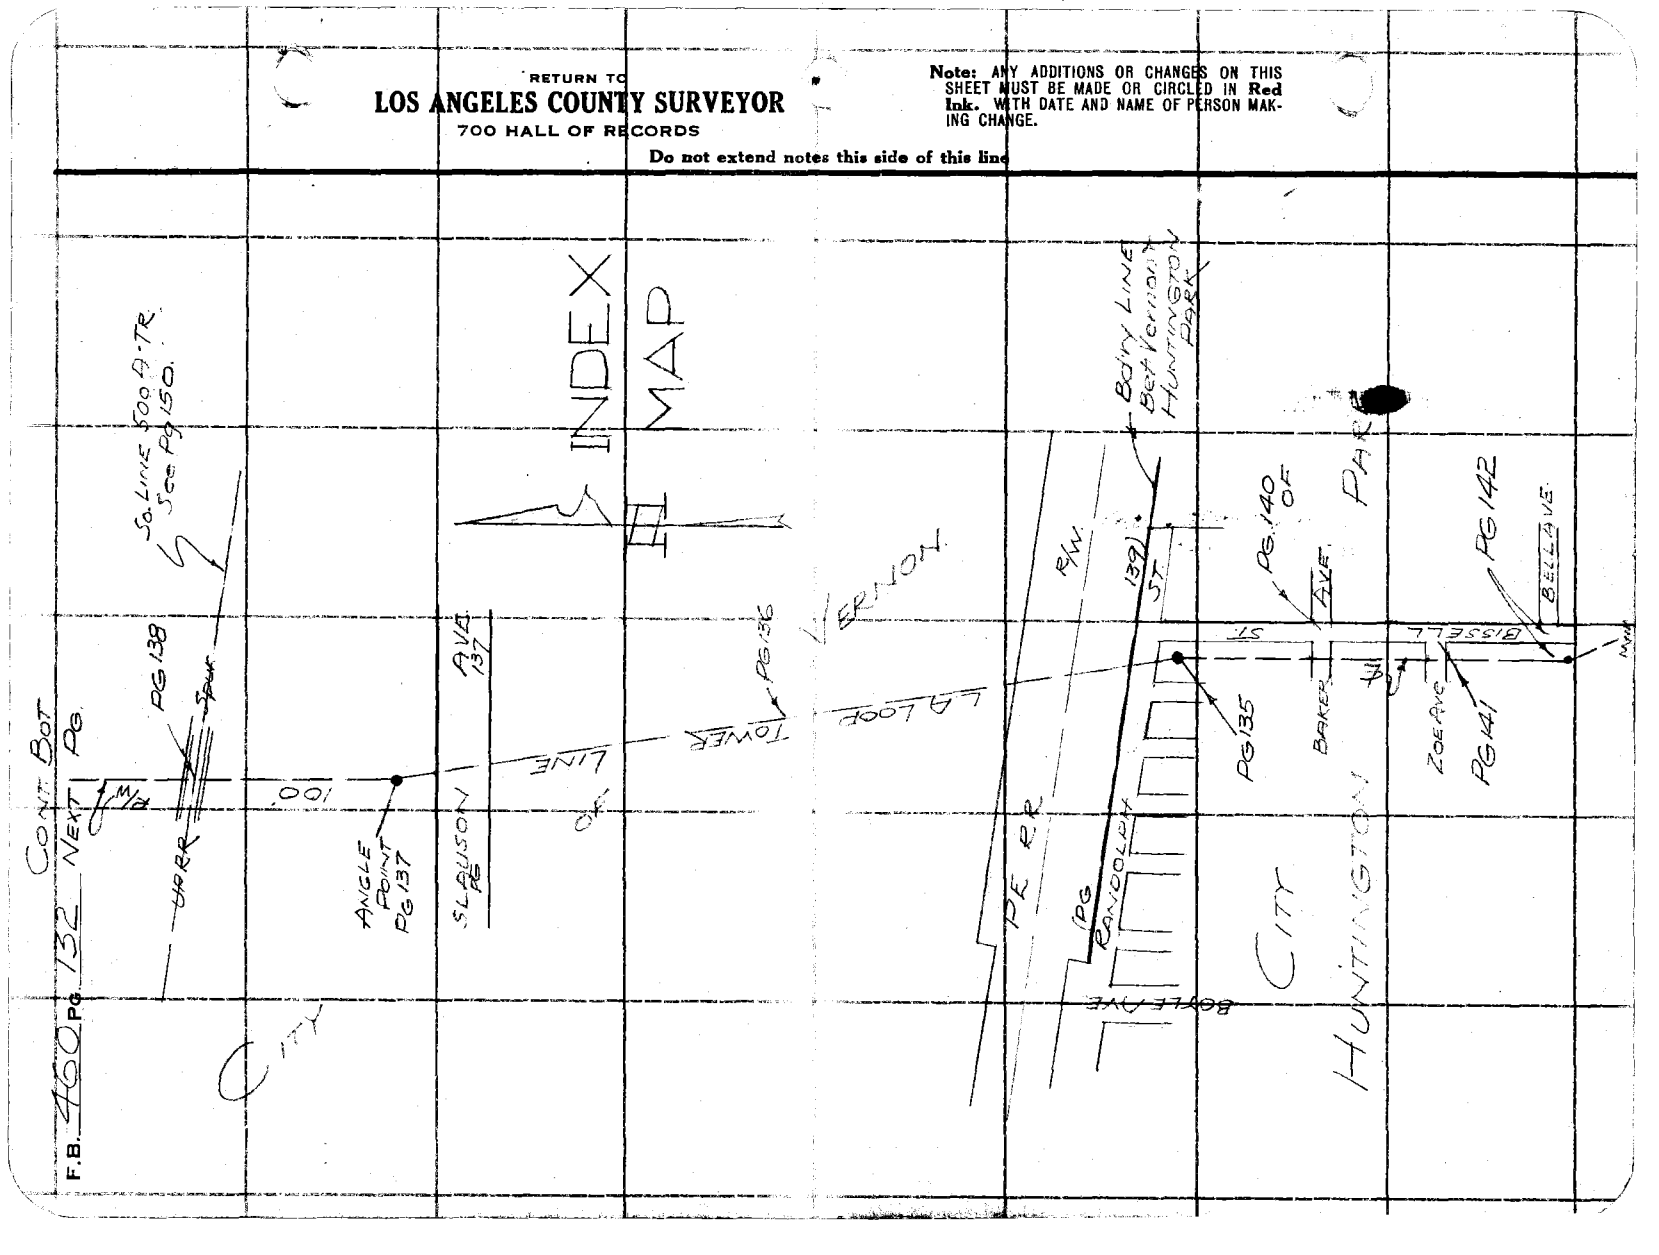

Notes Ck'd by	D. M. Finley	Survey of	LORENA ST
Map No.	B-737	W. O.	7066 Tape No. 042 St'd 84 °F.
Office Work	R. W. Stewart	Surveyed by	BUTLER
Checked	D. M. Finley	Notes	" Date 11/31
Date	Mar 1932	Indexed	A. C. Johnson

F.B. 460 Pg. 153

CONT. BOT. NEXT PG.

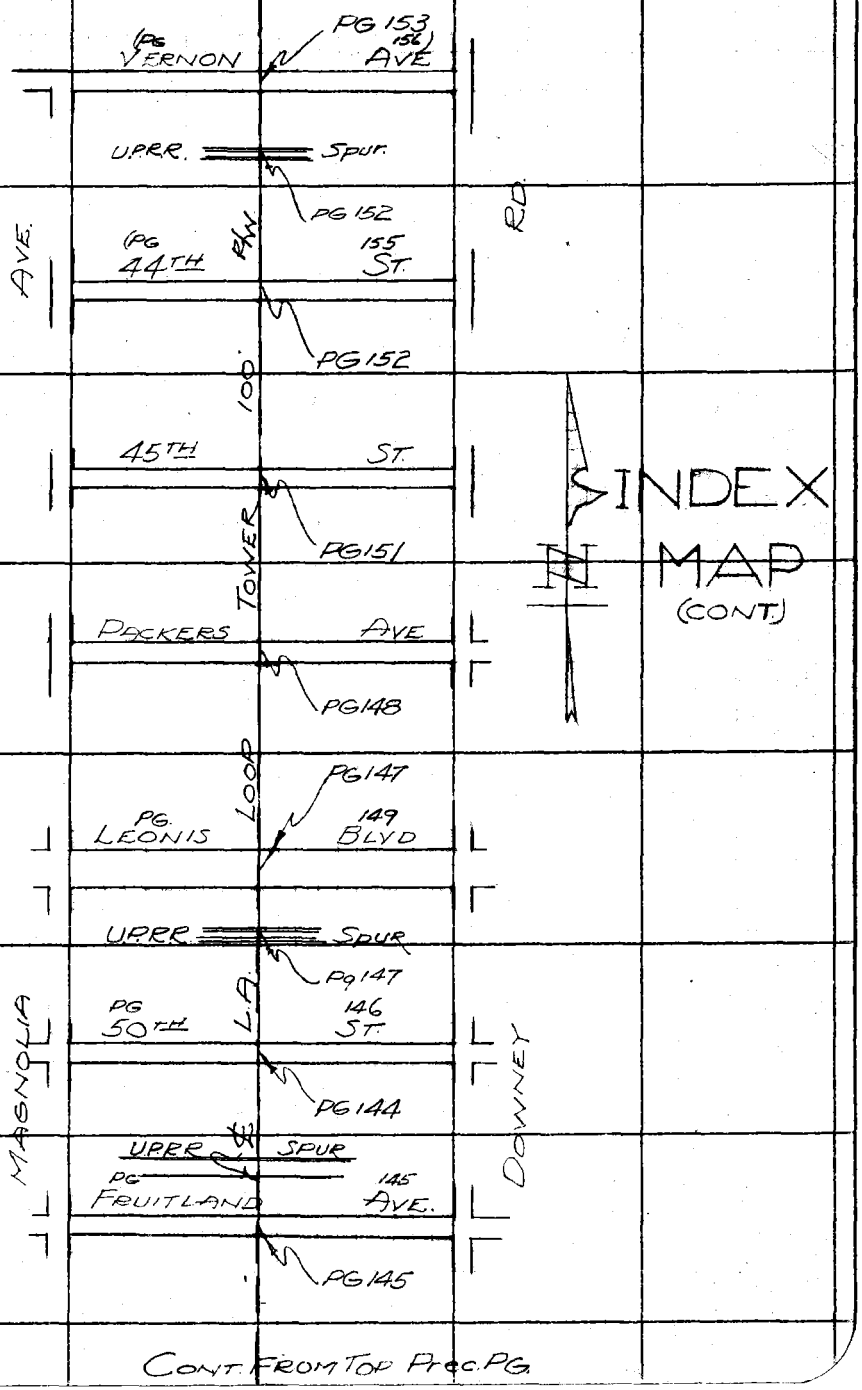

CONT. FROM TOP PREC. PG.

Note: ANY ADDITIONS OR CHANGES ON THIS SHEET MUST BE MADE OR CIRCLED IN Red Ink, WITH DATE AND NAME OF PERSON MAKING CHANGE.

Do not extend notes this side of this line

RETURN TO
LOS ANGELES COUNTY SURVEYOR
700 HALL OF RECORDS

FORM 247 10M 8-31

RETURN TO
LOS ANGELES COUNTY SURVEYOR
700 HALL OF RECORDS

Note: ANY ADDITIONS OR CHANGES ON THIS SHEET MUST BE MADE OR CIRCLED IN **Red Ink.** WITH DATE AND NAME OF PERSON MAKING CHANGE.

Do not extend notes this side of this line

F.B. 460 Pg 134

INDEX MAP (CONT.)

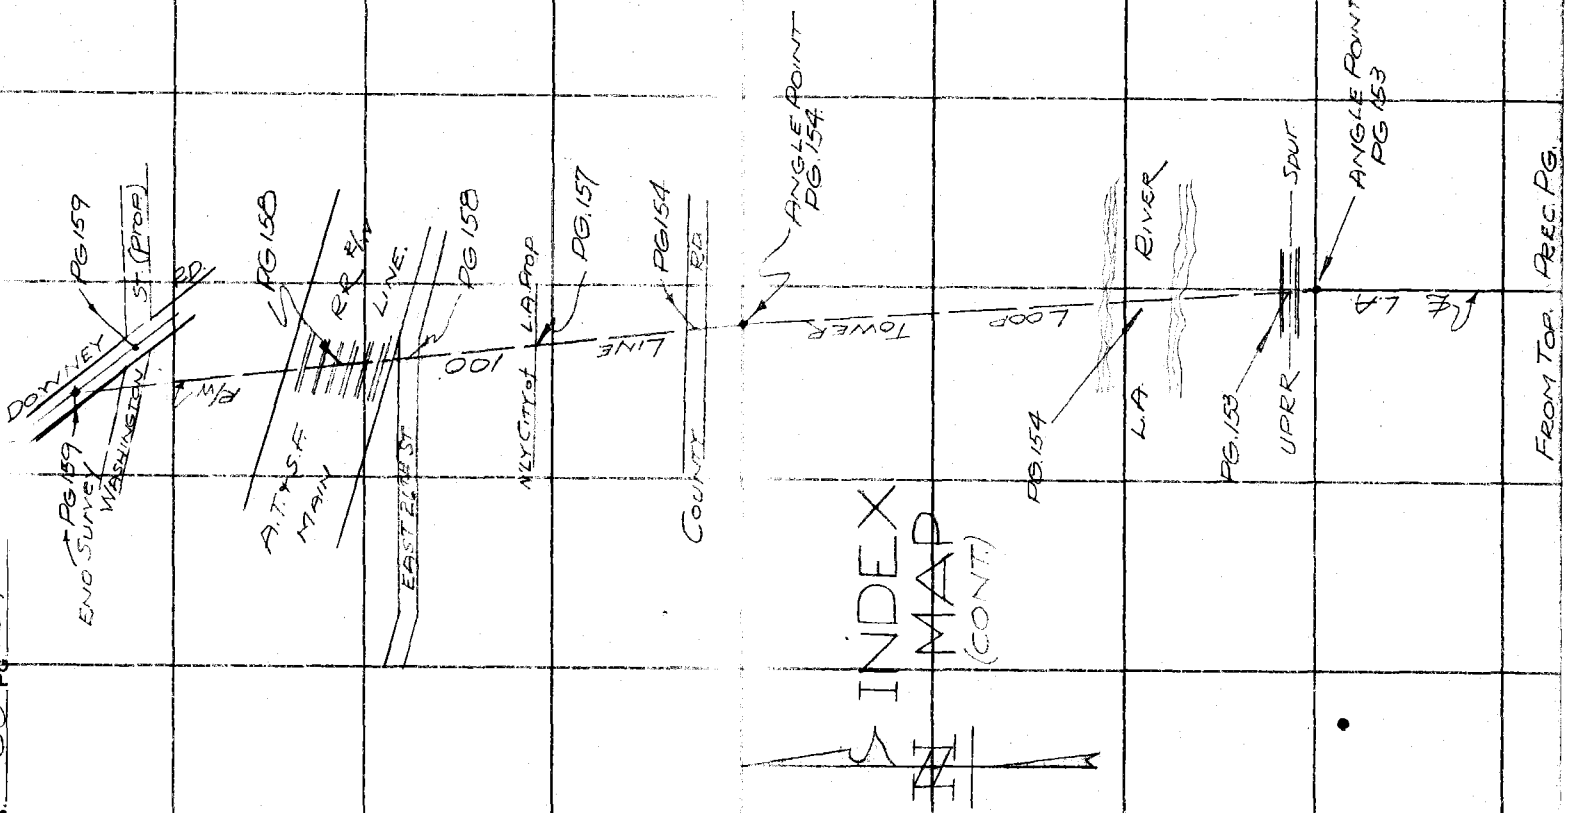

Notes Ck'd by	D. M. Finley	Survey of	LORENA ST.
Map No.	B-737	W. O.	7066 Tape No. 042 St'd 84 °F.
Office Work	R. W. Stewart	Surveyed by	BUTLER
Checked	D. M. Finley	Notes	Date 11/31
Date	Mar. 1932	Indexed	A. C. Johnson

F.B. 460 Pg. 135

RETURN TO
LOS ANGELES COUNTY SURVEYOR
700 HALL OF RECORDS
Do not extend notes this side of this line

Note: ANY ADDITIONS OR CHANGES ON THIS SHEET MUST BE MADE OR CIRCLED IN Red Ink, WITH DATE AND NAME OF PERSON MAKING CHANGE.

FORM 247 10M 8-31

CONT. BOT. NEXT. PG.

P.O.T. Set 1x2+k app. ctr. tracks.

Δ 3-19-15
Δ 13-17-00
Δ V 3-19-15.

619.28

3019.15' from Sta. 24

LOOP TOWER LINE R/W per 50 ft.

5.05 5.13 4.72

5.05 5.13 4.72

P.E.

Δ 78-26-00
Δ 13-25-00
Δ V 78-26-15.

78°26'15"

116.61

116.61

C2 @ 74°
C2 @ 74°

7600

60'

R R

60'

120'

R/W

POT. Set 2x2+k 1'DN by INT.

Set N+T

P.P. #3797.43 E. 1'UP

SLY BDRY CITY OF HUNTINGTON PARK

NLY BDRY CITY OF VERNON

No end of 2" I.P. N 6.10 E 0.50 ft.

CONT. PG 139

40'

15'

Set L+T

E line produced from Sta. 0

150

Set N+T

42.83

Set 2x2+k 18'DN by INT.

36.85

LINE

RANDOLPH

98°13'33"

LINE

36.27

ST. (40')

14.92

Fd L+T No ref.

0.02

15.51

Set L+T

15.51

90°

Δ 98-13-30
Δ 32-54-15

47.95

328

R=15

24.76

25.12

Set L+T Curb

14.91 Ch off 3

Set N+T

ST.

Set L+T MCR

R=25'

R=15

330

Fd 2x2+k leaning E.

331

332

333

334

N

39.99

327

30.18

14.98

14.98

50'

Fd 1½" I.P. P+T 2'DN = ANGLE POINT IN S. TRANSMISSION LINE = STA 341+26.7 per FB 500/214, 208, 205. Accepted.

326

325

29.99

324

Fd 2x2+k Flush.

323

BISSELL

CONT. TOP. PG 140

RETURN TO
LOS ANGELES COUNTY SURVEYOR
700 HALL OF RECORDS

Note: ANY ADDITIONS OR CHANGES ON THIS SHEET MUST BE MADE OR CIRCLED IN **Red Ink.** WITH DATE AND NAME OF PERSON MAKING CHANGE.

Do not extend notes this side of this line

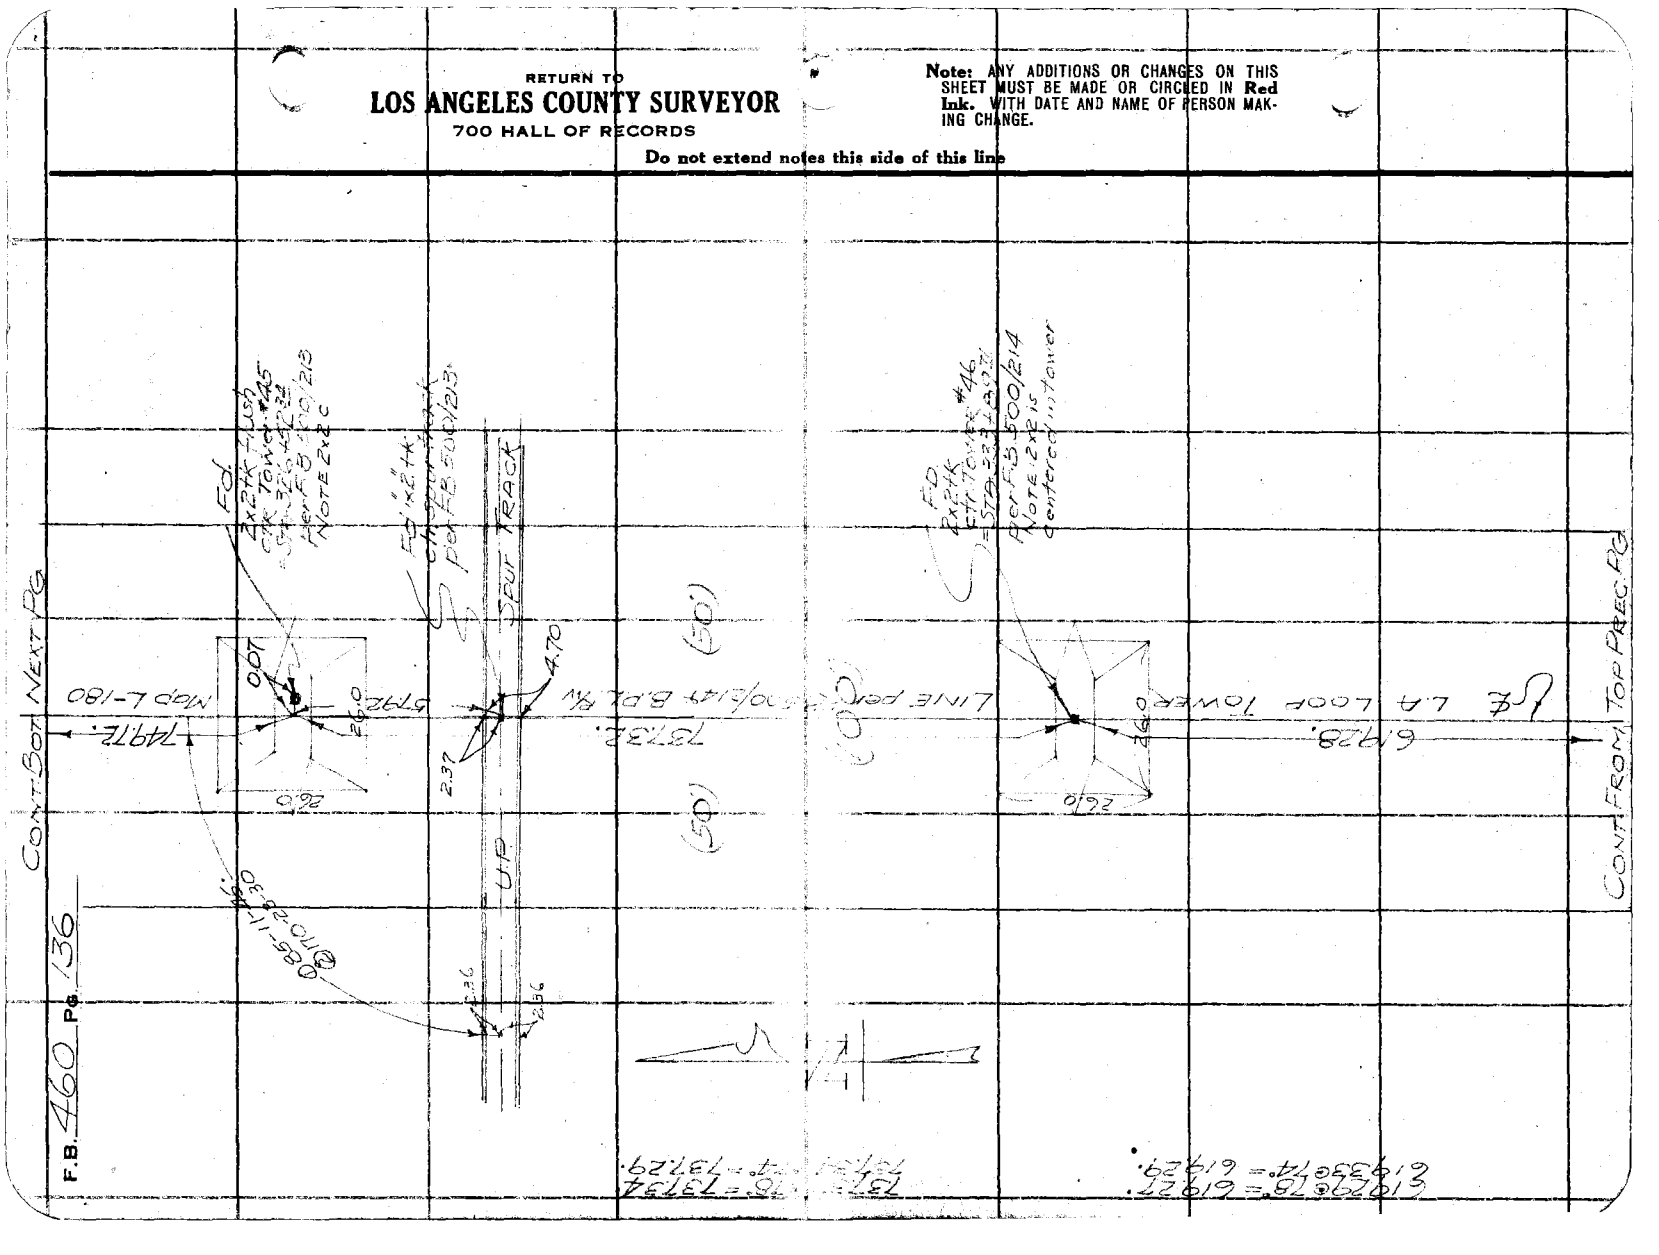

Notes Ck'd by D. M. Finley	Survey of LORENA ST.
Map No. B-737	W. O. 7066 Tape No. 042 St'd 84 °F.
Office Work R. W. Stewart.	Surveyed by BUTLER
Checked D. M. Finley	Notes Date 11/31
Date Mar. 1932	Indexed A. C. Johnson

F.B. 460 Pg. 137

Note: ANY ADDITIONS OR CHANGES ON THIS SHEET MUST BE MADE OR CIRCLED IN Red Ink, WITH DATE AND NAME OF PERSON MAKING CHANGE.

RETURN TO LOS ANGELES COUNTY SURVEYOR 700 HALL OF RECORDS

Do not extend notes this side of this line

FORM 247 10M 8-31

CONT BOT NEXT PG

℄ L.A. LOOP TOWER LINE R/W as per FB 500/214-174 & B of P&L R/W MAP #L-180.

763.55 @ 72° = 763.49
763.55 @ 72

(50') (50')

763.49

① 3-30-30
② 14-03-00

3°30'45"

Fd (per FB 500/~~213~~ 174) 1½"x1½" stake 4" DN OK for line.

(100')

① 88-50-00
② 355-17-00
AV. 88-49-45.

88°49'45"

8700

Fd 2" I.P DP&T 6" DN = C.T.R. Tower #44 = Sta 318+87.34 per FB 500/213 OK for line

Fd L&T's in Cone bases

19.40 30.03 19.40 13.00 13.01 2.34

Fd 1½" I.P DP&T 8" DN OK for line = Sta 319+00 per FB 500/198

50.0

Ties per FB 500/193 - destroyed

Fd 1½" I.P filled with conc & tk 10" DN & ref FB 500/198

5.00 96.39 (Rec) 96.86 40.0

FD 1½" I.P DP&T 15" DN = ANGLE POINT = Sta 319+02.34 per FB 500/213 Accepted

Set Nail 50' E of 1½" I.P 4 pt and 90° to forward tang. to fix So. end tangent. Norm fixed from L&T ctr. Tower #36 PB 153

Reset 8x2 tk 1' DN

208.16 FB 500/198

See LINE

25 30

Fd RR Spike without Tint Boyle Ave per FB 43/18 City of Vernon

Fd NT in PP #504374 per FB 500/194

4492 4220 8547

edge pave.

SLAUSON AVE.

30 30

0.01

749.72 749.72

749.76 @ 78° = 749.72
749.76 @ 76° =

Fd L&T No Ref & Prod.

Fd L&T No Ref

749.72

(50') (50')

CONT FROM TOP Prec. PG.

CONT BOT PG 143

F.B. 460 PG. 138

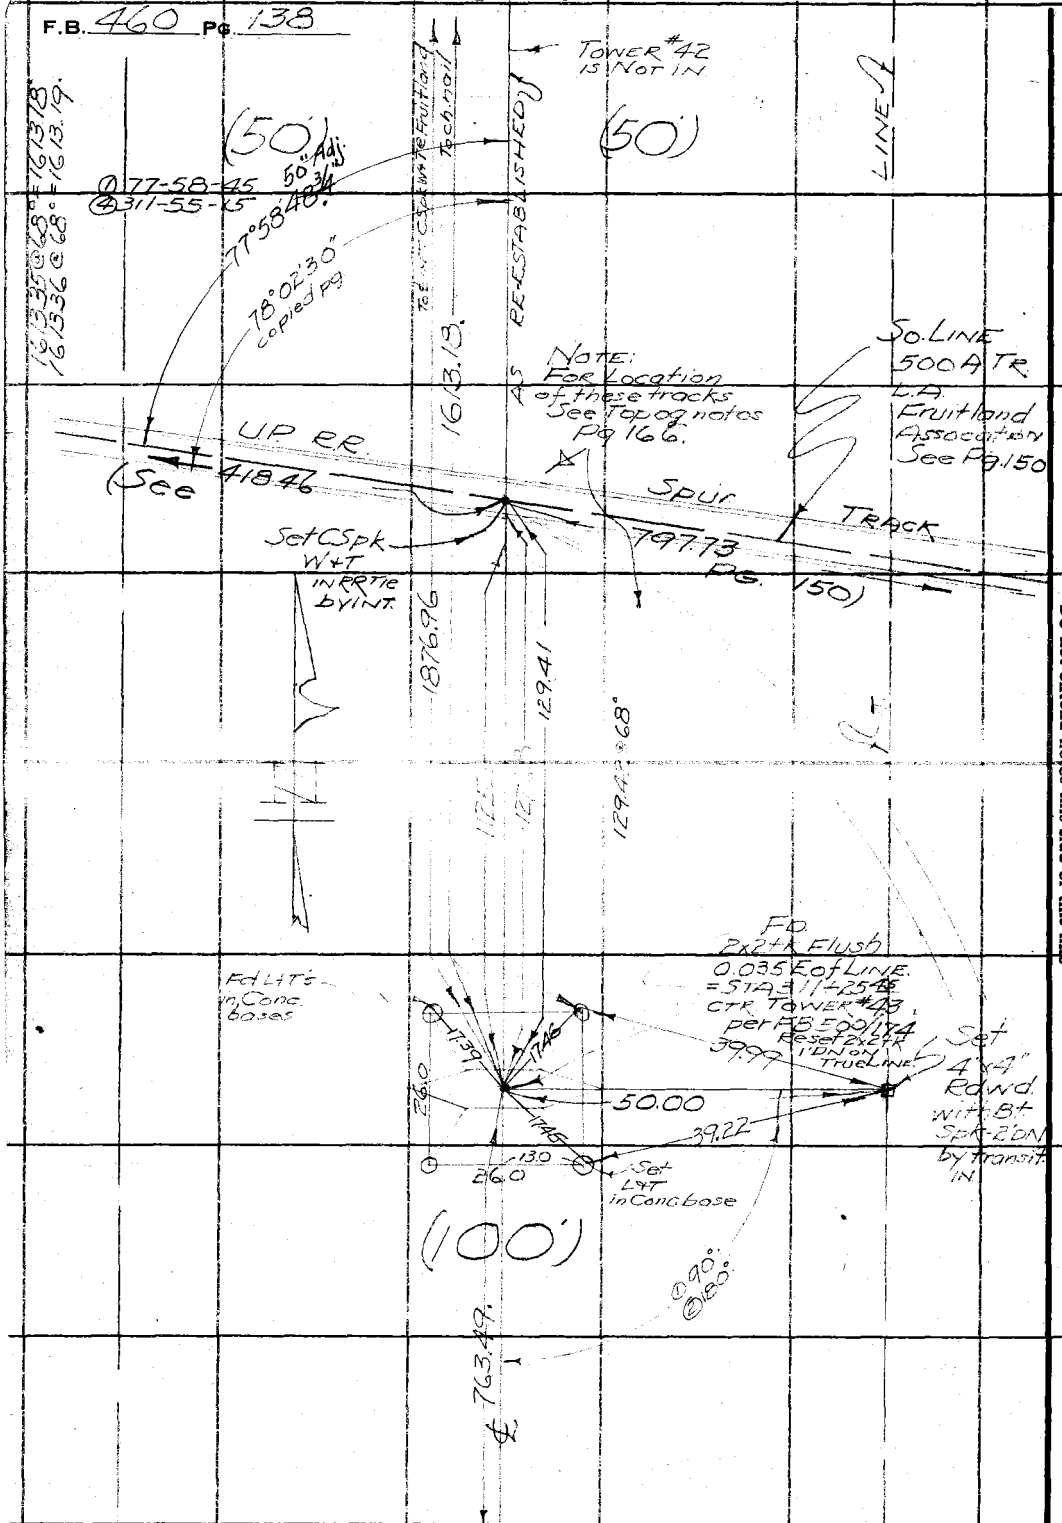

RETURN TO
LOS ANGELES COUNTY SURVEYOR
700 HALL OF RECORDS

Do not extend notes this side of this line

Note: ANY ADDITIONS OR CHANGES ON THIS SHEET MUST BE MADE OR CIRCLED IN Red Ink- WITH DATE AND NAME OF PERSON MAKING CHANGE.

FORM 247 10M 5-31

RETURN TO
LOS ANGELES COUNTY SURVEYOR
700 HALL OF RECORDS

Note: ANY ADDITIONS OR CHANGES ON THIS SHEET MUST BE MADE OR CIRCLED IN **Red Ink.** WITH DATE AND NAME OF PERSON MAKING CHANGE.

Do not extend notes this side of this line

Notes Ck'd by D. M. Finley
Map No. B-737
Office Work R. W. Stewart
Checked D. M. Finley
Date Mar. 1932

Survey of LORENA ST.
W. O. 7066 Tape No. 042 St'd 84 ft.
Surveyed by BUTLER " Date 11/31
Notes
Indexed A. C. Johnson

F. B. 490 Pg. 137

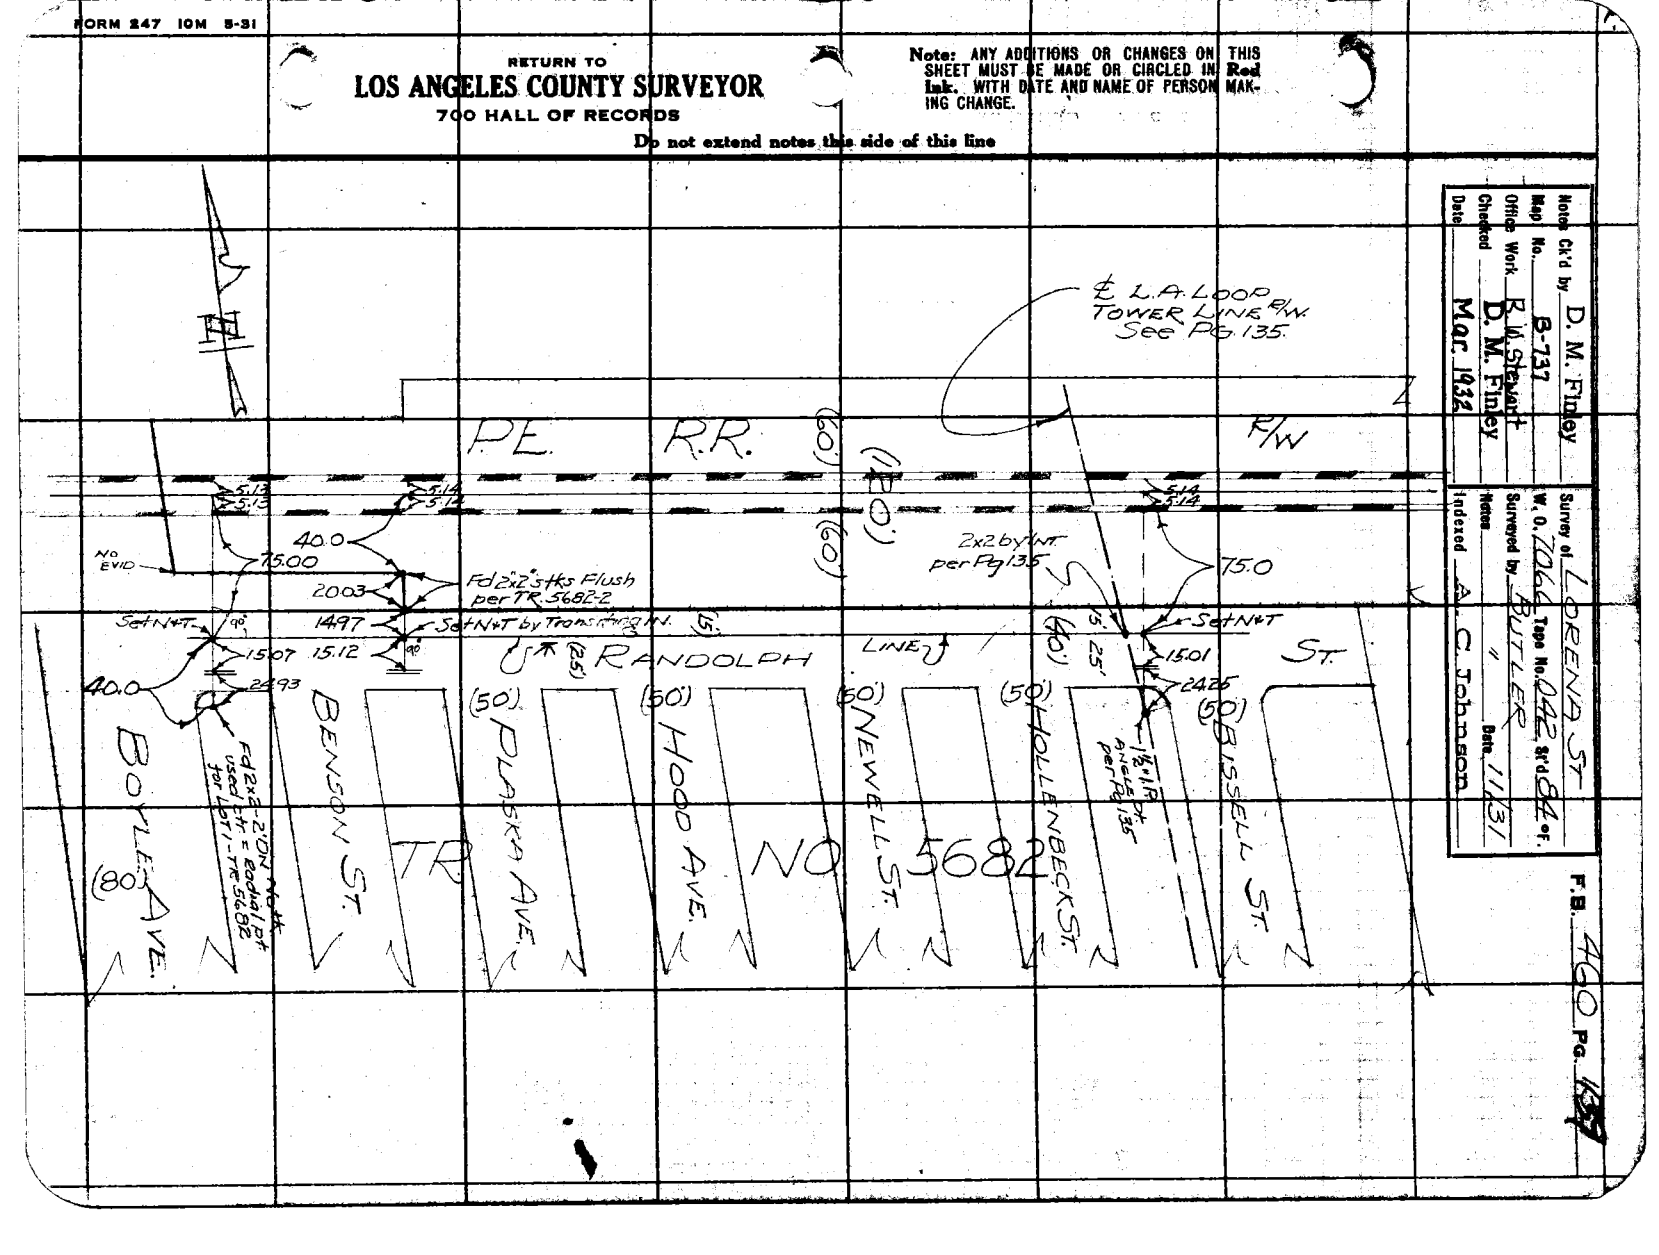

CONT. FROM BOT PG 135

F.B. 460 PG. 140

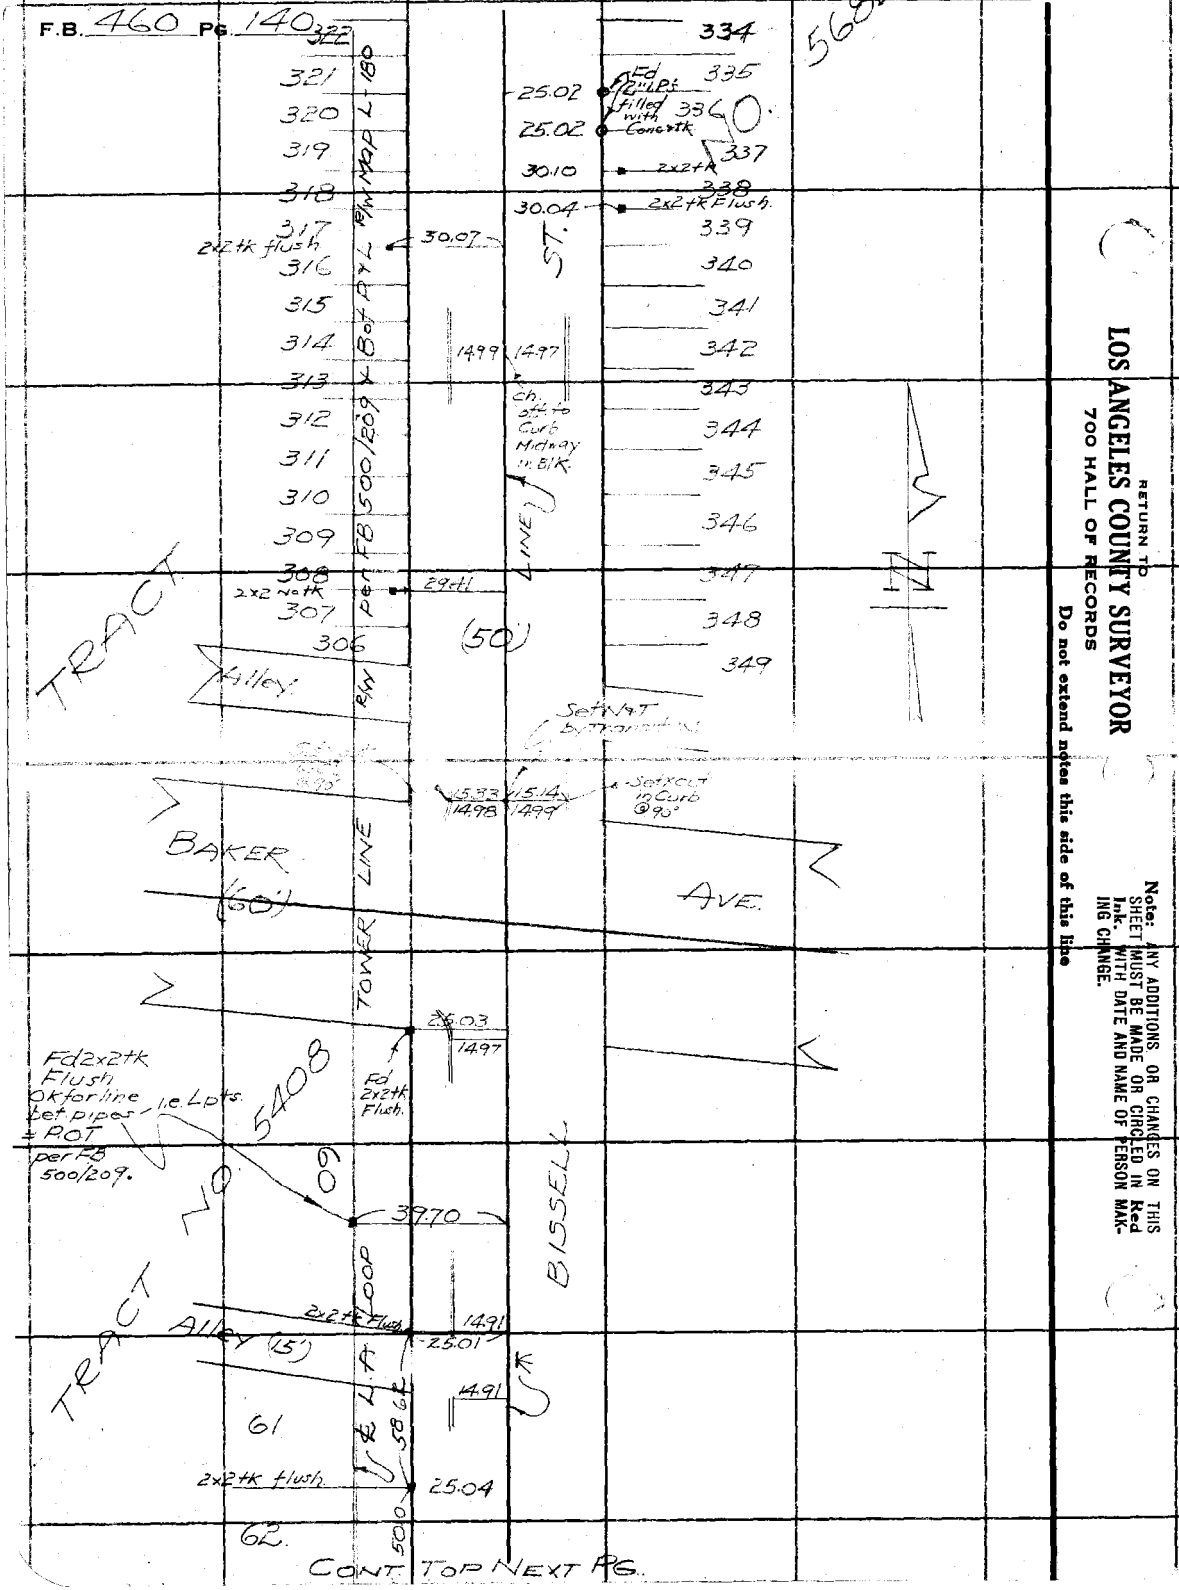

CONT. TOP NEXT PG.

RETURN TO
LOS ANGELES COUNTY SURVEYOR
700 HALL OF RECORDS
Do not extend notes this side of this line

Note: ANY ADDITIONS OR CHANGES ON THIS SHEET MUST BE MADE OR CIRCLED IN Red Ink. WITH DATE AND NAME OF PERSON MAKING CHANGE.

Notes Ck'd by D. M. Finley
Map No. B-737
Office Work R. W. Stewart
Checked D. M. Finley
Date Mar. 1932

Survey of LORENA ST.
W. O. 7066 Tape No. 042 St'd 84 °F.
Surveyed by BUTLER
Notes " Date 11/31
Indexed A. C. Johnson

F.B. 460 Pg. 174

CONT. FROM BOT. PREC. PG.

62

2x2 tk flush — 25.01

63 — 25.02

64 — 25.02

65 — 25.02

66 — 25.00

67

2x2 tk flush — 24.95

ZOE AVE (50')

Fd 1"x2" tk per F.B. 500/209' Ties N.E.

68

2x2 tk flush — 25.24

69

70 — 25.00

71

72

2x2 tk flush — 25.00

73

74 — 25.00

75

76

77 — 24.97

CONT. TOP NEXT PG.

5408

TRACT NO

L.A. LOOP TOWER LINE R/W per 10903 (50')

BISSELL ST.

L.A. G.E. 13503 45' R

P.O.T. Set Nail approx. 1.0 W

FB 500/209 48 of PWL R/W Map L 1800 ft

5003 5002 49.96 50.04 50.00

1492 1492 49.50

0.07

100 14

Note: ANY ADDITIONS OR CHANGES ON THIS SHEET MUST BE MADE OR CIRCLED IN Red Ink. WITH DATE AND NAME OF PERSON MAKING CHANGE.

Do not extend notes this side of this line

RETURN TO
LOS ANGELES COUNTY SURVEYOR
700 HALL OF RECORDS

FORM 247 10M 5-31

CONT. FROM BOT. PREC. PG

F.B. 460 PG. 142

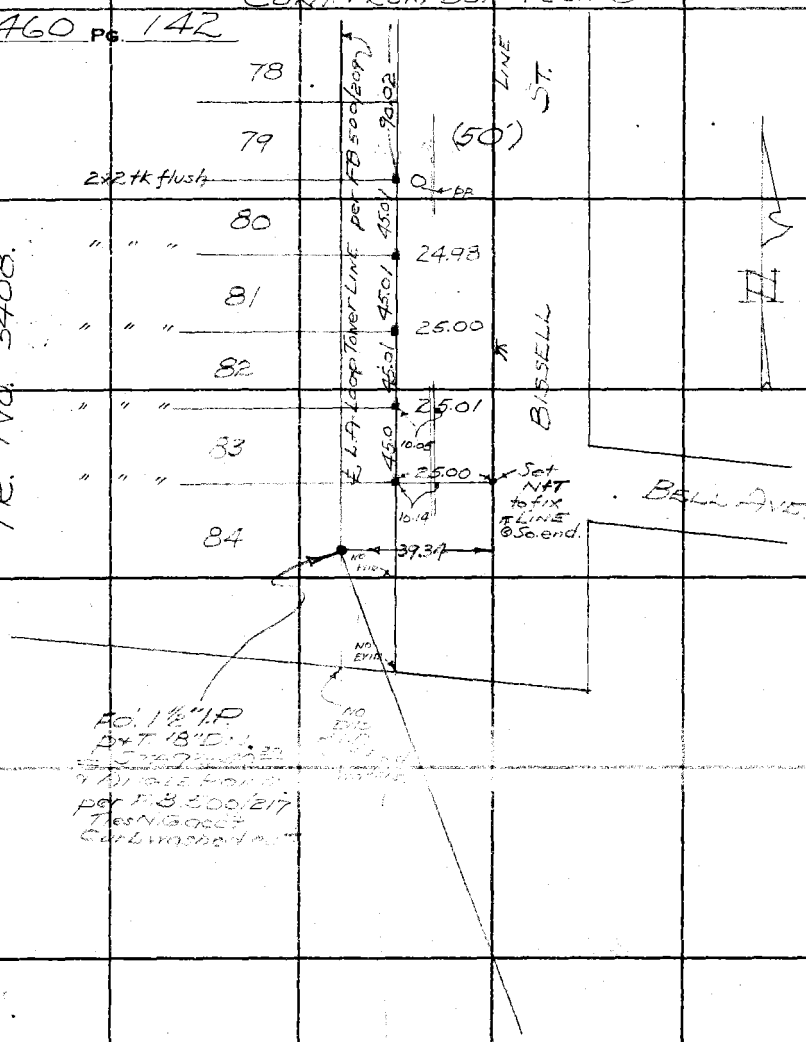

RETURN TO
LOS ANGELES COUNTY SURVEYOR
700 HALL OF RECORDS

Do not extend notes this side of this line

Note: ANY ADDITIONS OR CHANGES ON THIS SHEET MUST BE MADE OR CIRCLED IN Red Ink. WITH DATE AND NAME OF PERSON MAKING CHANGE.

Notes Ck'd by	D. M. Finley	Survey of	LORENA ST.
Map No.	B-737	W. O.	7066 Tape No. 042 St'd 84 °F.
Office Work	R. W. Stewart	Surveyed by	BUTLER
Checked	D. M. Finley	Notes	" Date 11/31.
Date	Mar. 1932	Indexed	A. C. Johnson

F.B. 460 PG. 143

RETURN TO
LOS ANGELES COUNTY SURVEYOR
700 HALL OF RECORDS
Do not extend notes this side of this line

Note: ANY ADDITIONS OR CHANGES ON THIS SHEET MUST BE MADE OR CIRCLED IN Red Ink. WITH DATE AND NAME OF PERSON MAKING CHANGE.

CONT BOT NEXT PG.

TOWER LINE R/W
& B of PAL R/W Map #L-180

56.59 56.59 56.59
56.58 56.58 56.58
56.58 56.58 56.58
56.58 56.58 56.58

RETURN TO
LOS ANGELES COUNTY SURVEYOR
700 HALL OF RECORDS

Note: ANY ADDITIONS OR CHANGES ON THIS SHEET MUST BE MADE OR CIRCLED IN Red Ink. WITH DATE AND NAME OF PERSON MAKING CHANGE.

Do not extend notes this side of this line

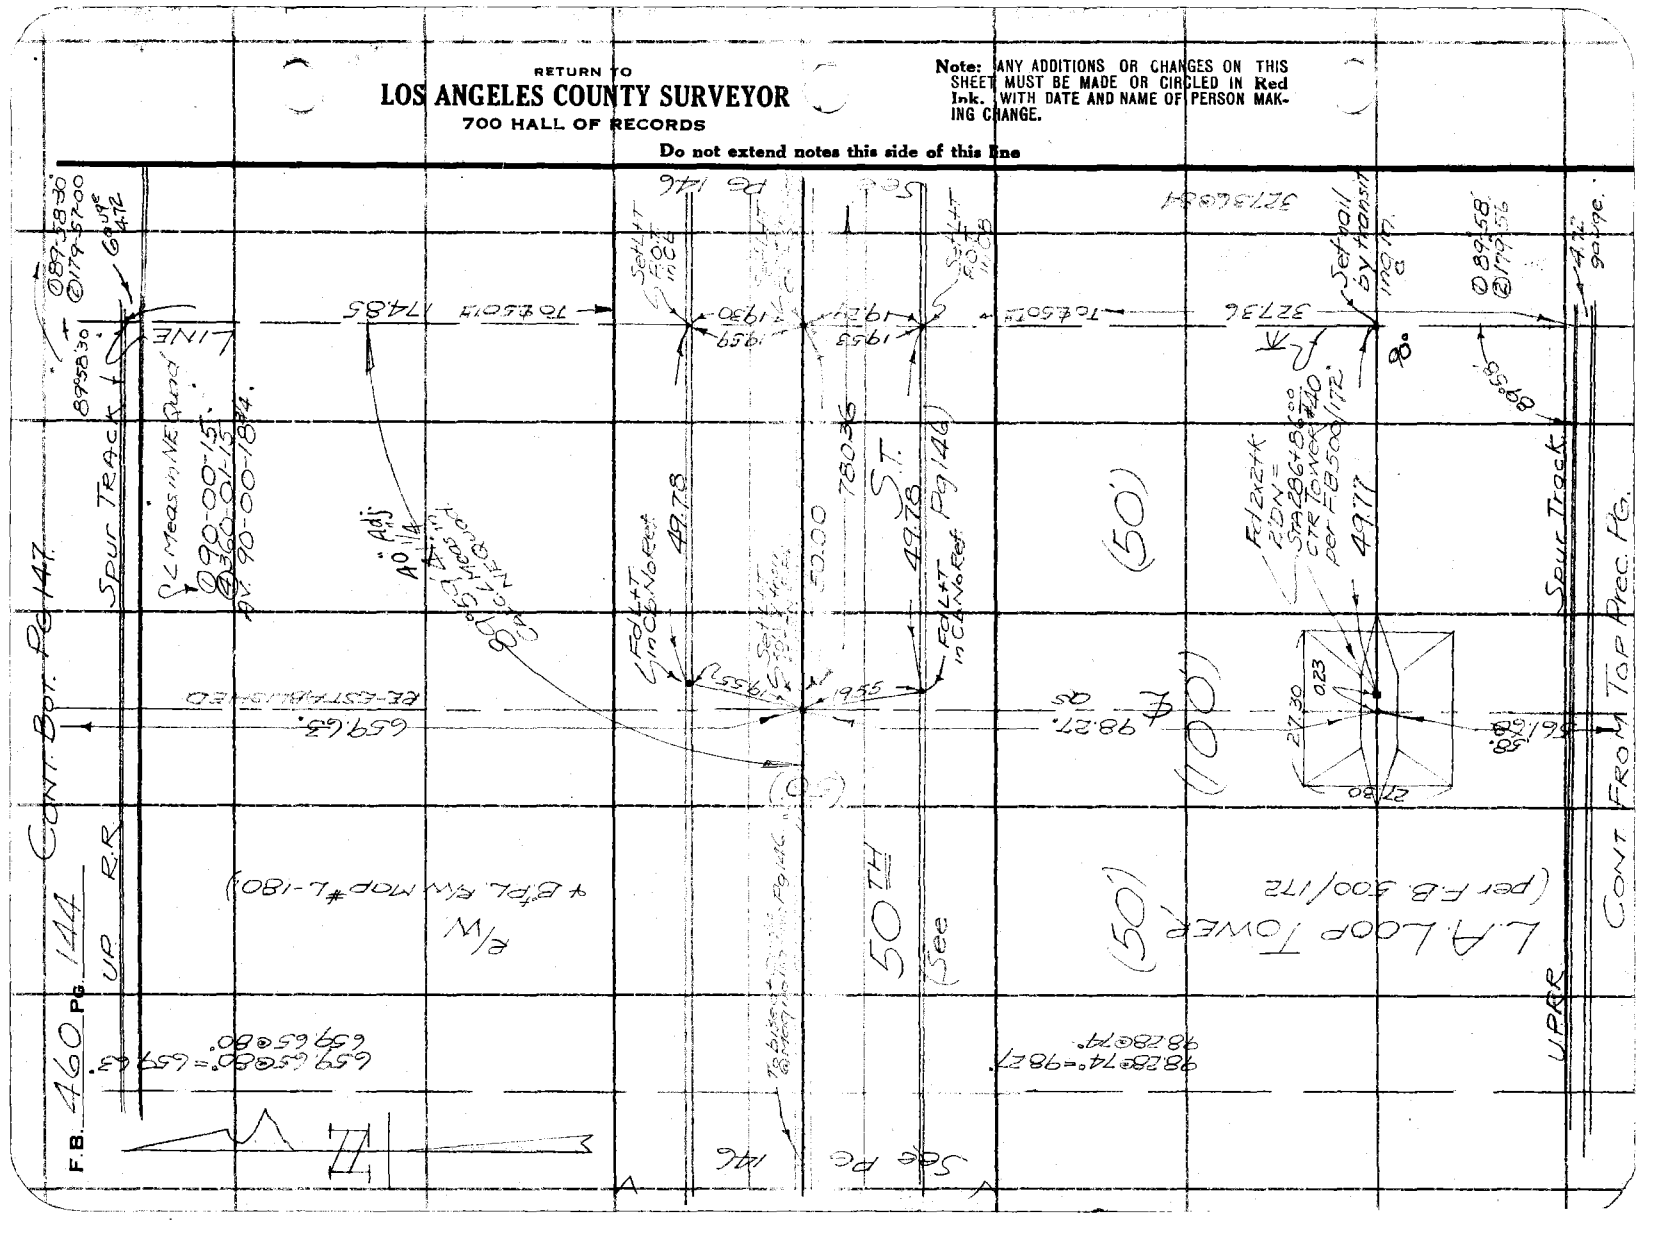

FORM 247 10M 5-31

RETURN TO
LOS ANGELES COUNTY SURVEYOR
700 HALL OF RECORDS

Note: ANY ADDITIONS OR CHANGES ON THIS SHEET MUST BE MADE OR CIRCLED IN **Red Ink.** WITH DATE AND NAME OF PERSON MAKING CHANGE.

Do not extend notes this side of this line

412.16 @ 68° = 412.12'

780.35 @ 70° = 780.28'

Notes Ck'd by D. M. Finley
Map No. B-737
Office Work R. W. Stewart
Checked D. M. Finley
Date Mar. 1932

Survey of LORENA ST.
W. O. 7064 Tape No. 042 Sht. 84 of
Surveyed by BUTLER
Notes "
Indexed A. C. Johnson Date 11/31

F.B. 460 Pg. 115

(25') (25') MALONE AVE. (50')

Fd top of fire hydrant per FB 28/58 City of Vernon

Set 4 punches in light ring to mk. end of curb lines on E. curb line

Fd N+T pp per FB 28/58 City of Vernon

Set N+T PP

50' R/W LINE (See PB 143)

50' Rad. 89°58'52" Scaled pg 143

(20') 412.12'

Fd top fire hydrant per FB 20/22 City of Vernon

Fd N+T pp as per FB 20/22 City of Vernon

(40') (40') (80')

Fd N+T PP 11775 per FB 20/22 City of Vernon

Fd old C&SPK. No Top No Ref.

C&S PK W+T & INT per pg 143

780.28'

℄ as established from data City of Vernon ℄

(20') FRUITLAND AVE.

DOWNEY RD.

MANHATTAN PLACE

LORENA ST.

Set Tack in pave. on N+T Cover by INT. of 3 ties as per FB 28/58 City of Vernon.

48.714

Set punch on N+T RIM & P.O.T.

Fd cut Lower hinge bolt wrapg as per FB 20/22 City of Vernon

Fd N+T PP per FB 28/58 City of Vernon

LA 4000 Tower (See PB 184 pg 36)

(100')

(50') (50') (20') (20') (40')

13.62 32.86 34.16 72.84 45.48 31.83 59.34 12.74 39.84 2.36 2.36 59.78 4.72

RETURN TO
LOS ANGELES COUNTY SURVEYOR
700 HALL OF RECORDS

Note: ANY ADDITIONS OR CHANGES ON THIS SHEET MUST BE MADE OR CIRCLED IN **Red Ink.** WITH DATE AND NAME OF PERSON MAKING CHANGE.

Do not extend notes this side of this line

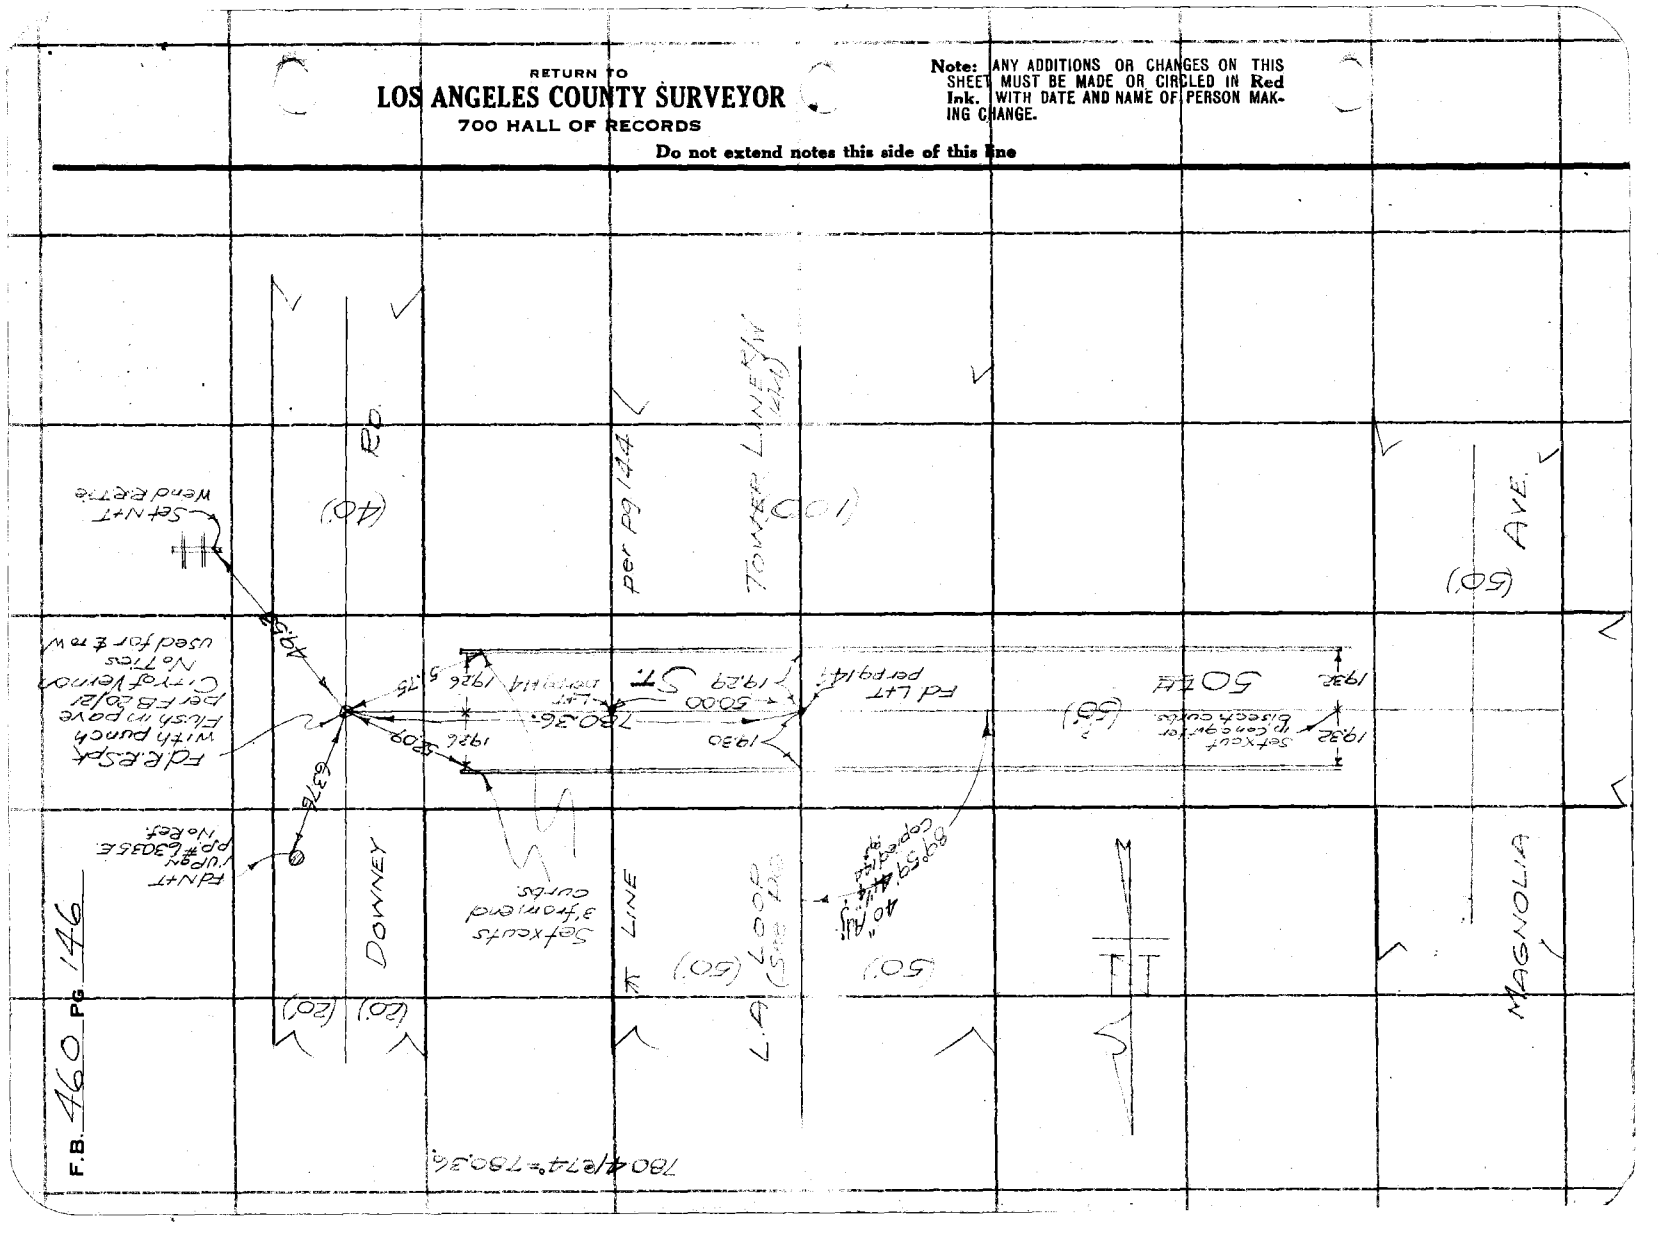

Notes Ck'd by	D. M. Finley	Survey of	LORENA ST.
Map No.	B-737	W. O.	7066 Tape No. 042 St'd 84 °F.
Office Work	R. W. Stewart	Surveyed by	BUTLER Date 11/31
Checked	D. M. Finley	Notes	
Date	Mar. 1932	Indexed	A. C. Johnson

F.B. 460 Pg. 147

Note: ANY ADDITIONS OR CHANGES ON THIS SHEET MUST BE MADE OR CIRCLED IN Red Ink. WITH DATE AND NAME OF PERSON MAKING CHANGE.

Do not extend notes this side of this line

RETURN TO
LOS ANGELES COUNTY SURVEYOR
700 HALL OF RECORDS

FORM 247 10M 8-31

CL Meas in NE Quad.

CONT BOT NEXT PG.

① 89-59-30'
④ 359-58-00

787.08@80° = 78706'
787.08@80°

(50')

P/W

TOWER LINE

& Bal P/L PM Map #L-180

90°00'30" CALC MEAS N.E. QUAD.

78706'

re-established

(50')

LINE

36.80

No Evid. of Pt. C/R TOWER #39

26.00

26.00

36.85

5.05

5.05

NOTE Back edge walk is P.L.

12'

6" Curb

1' Conc gutter

40'

Fd L+T No Ref

4974

P.O.T. Set L+T in Cb

L.A. RAILWAY

L.A. RAILWAY

Set C Spk W+T flush in pave

27.99

28.24

28.16

27.98

P.O.T. Set C Spk W+T flush in pave. by INT.

3.50

3.80

3.79

3.37

50.00 80'

73038

LEONIS BLVD.

(See PG. 149)

40'

1' Conc gutter

6" Conc Curb

27.99

28.29

28.25

27.98

49.75

Fd L+T No Ref.

P.O.T. Set L+T in Cb.

See PG. 149

12'

L.A. Loop

Bal FB 500/171

65963

(100')

90°01'30" copied from top of pg. Pg. 170.

187.64 to Leonis

472 gauge.

UPRR Spur Track

FROM TOP PG 144.

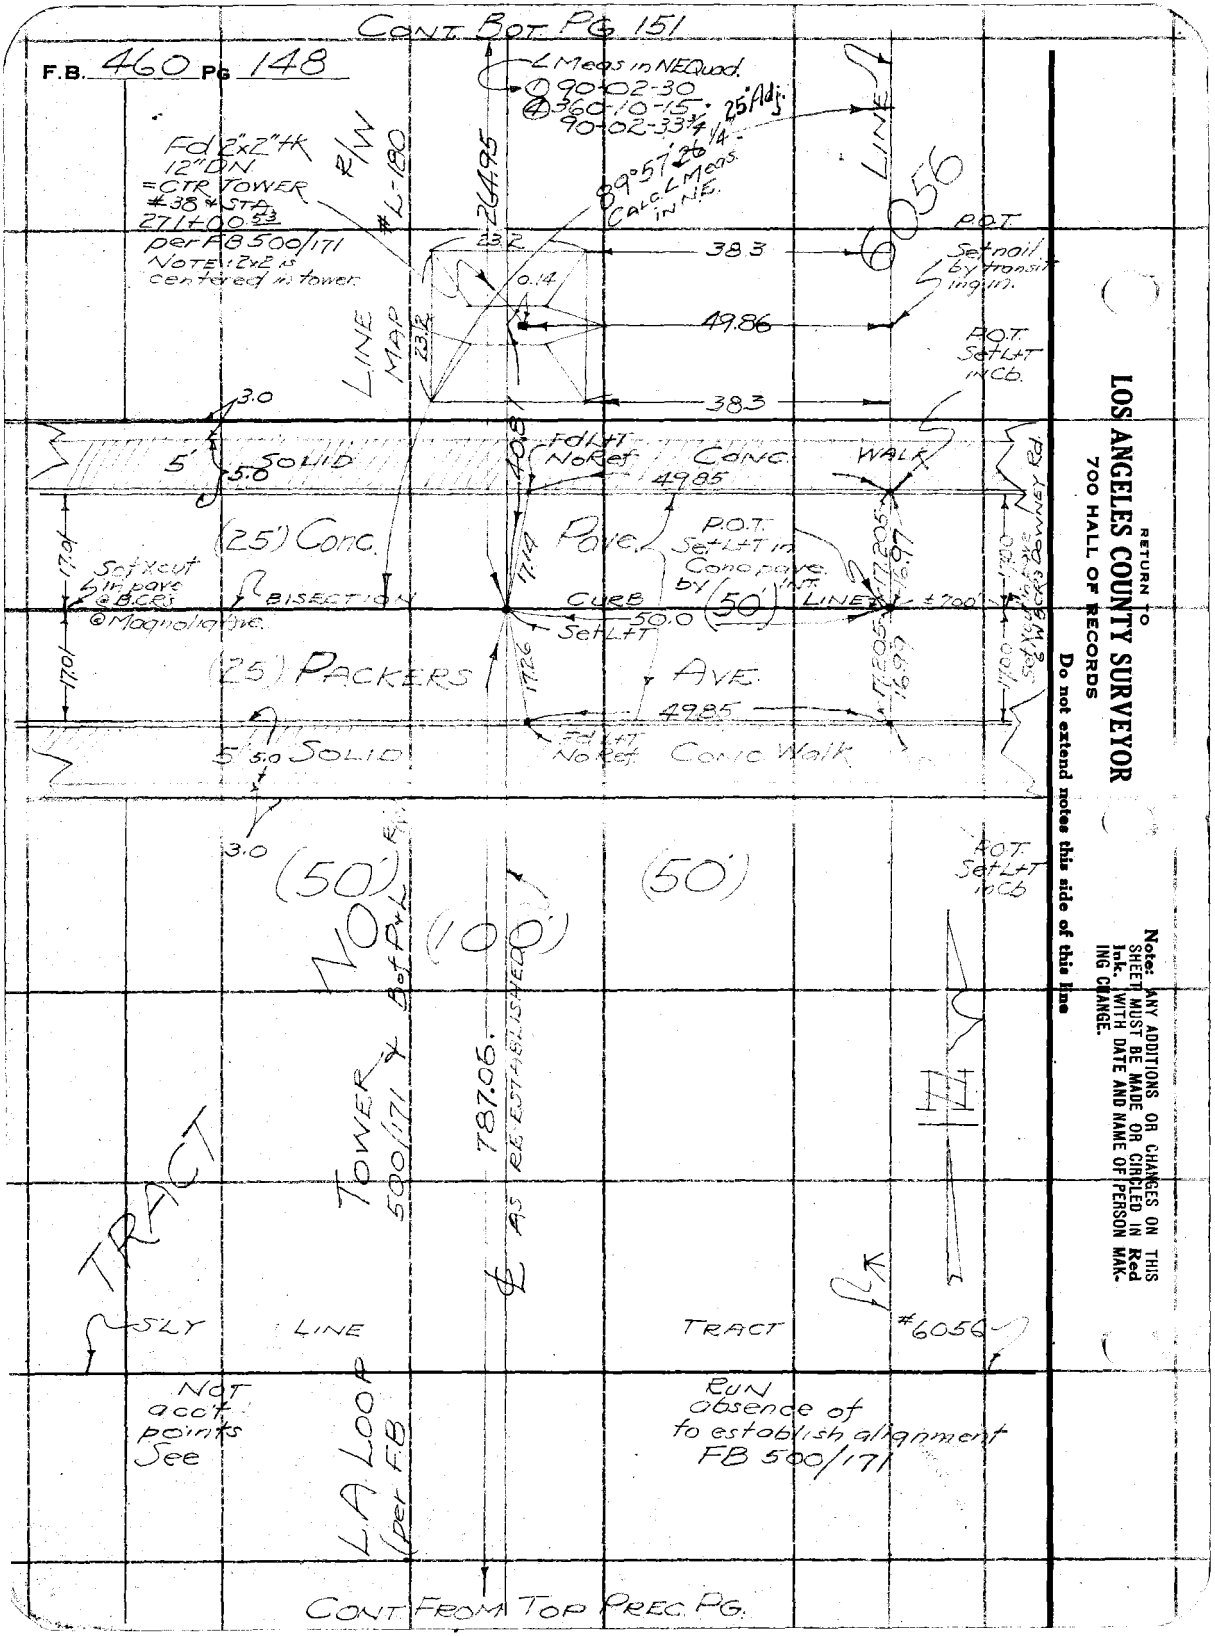
CONT. FROM PG 151
F.B. 460 PG 148
L Meas in NE Quad.
90-02-30
360-10-15
90-02-33¾
¼ - 25 Adj's
89°57'26" Calc L Meas in NE.
Fd 2"x2" Tk 12" DN = CTR TOWER #38 STA 271+00.53 per FB 500/171 NOTE: 1"x2" is centered in tower
R/W
#L-180
LINE
MAP 23/12
26.495
0.14
38.3
49.86
38.3
POT Set nail by transit in q in.
POT Set L&T in CO.
6056
3.0
5' SOLID
5.0
Fd L&T No Ref
CONC. WALK
49.85
(25') Conc.
Pave.
POT Set L&T in Conc. pave. in LINE by (50')
CURB
50.0
Set L&T
Set cut Sin pave @ BCRS @ Magnolia Inc.
BISECTION
(25') PACKERS
AVE.
49.85
Fd L&T No Ref
Conc Walk
5' SOLID
5.0
3.0
(50')
100'
(50')
(100')
TOWER # 38 500/171
787.06'
℄ AS RE ESTABLISHED
TRACT
SLY LINE
TRACT
#6056
NOT acct points See
LA LOOP (per FB
Run absence of to establish alignment FB 500/171
CONT FROM TOP PREC. PG.
RETURN TO
LOS ANGELES COUNTY SURVEYOR
700 HALL OF RECORDS
Do not extend notes this side of this line
Note: ANY ADDITIONS OR CHANGES ON THIS SHEET MUST BE MADE OR CIRCLED IN Red Ink. WITH DATE AND NAME OF PERSON MAKING CHANGE.

FORM 247 10M 5-31

RETURN TO
LOS ANGELES COUNTY SURVEYOR
700 HALL OF RECORDS

Note: ANY ADDITIONS OR CHANGES ON THIS SHEET MUST BE MADE OR CIRCLED IN **Red Ink.** WITH DATE AND NAME OF PERSON MAKING CHANGE.

Do not extend notes this side of this line

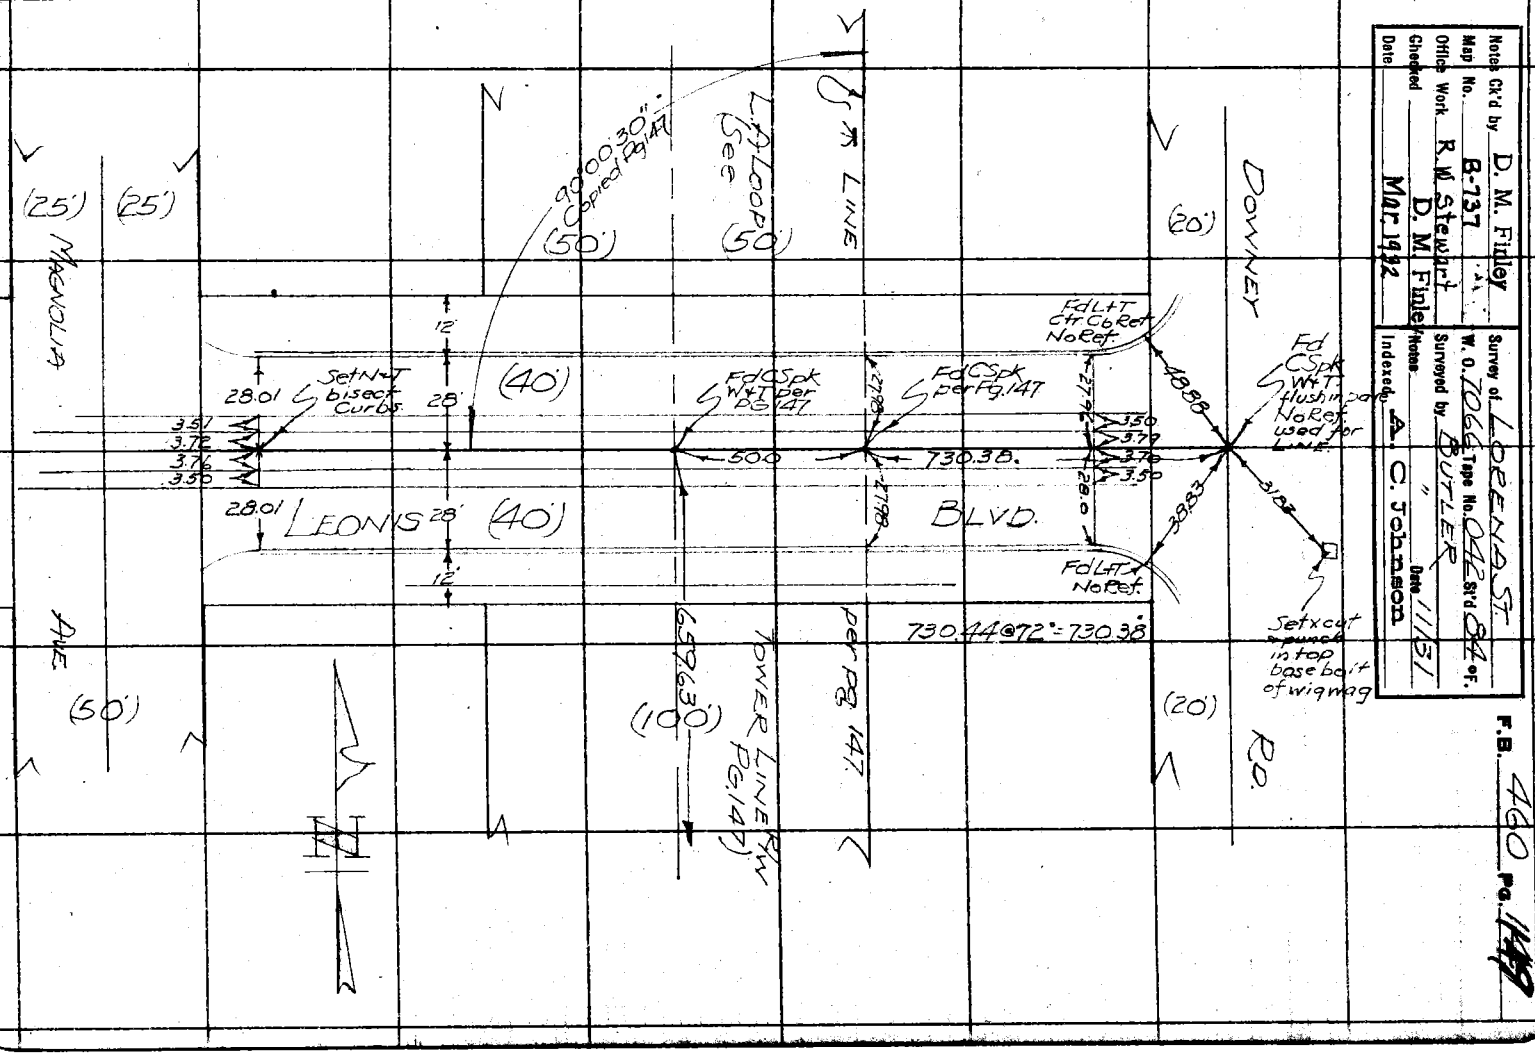



RETURN TO

LOS ANGELES COUNTY SURVEYOR

700 HALL OF RECORDS

Note: ANY ADDITIONS OR CHANGES ON THIS SHEET MUST BE MADE OR CIRCLED IN **Red Ink.** WITH DATE AND NAME OF PERSON MAKING CHANGE.

Do not extend notes this side of this line

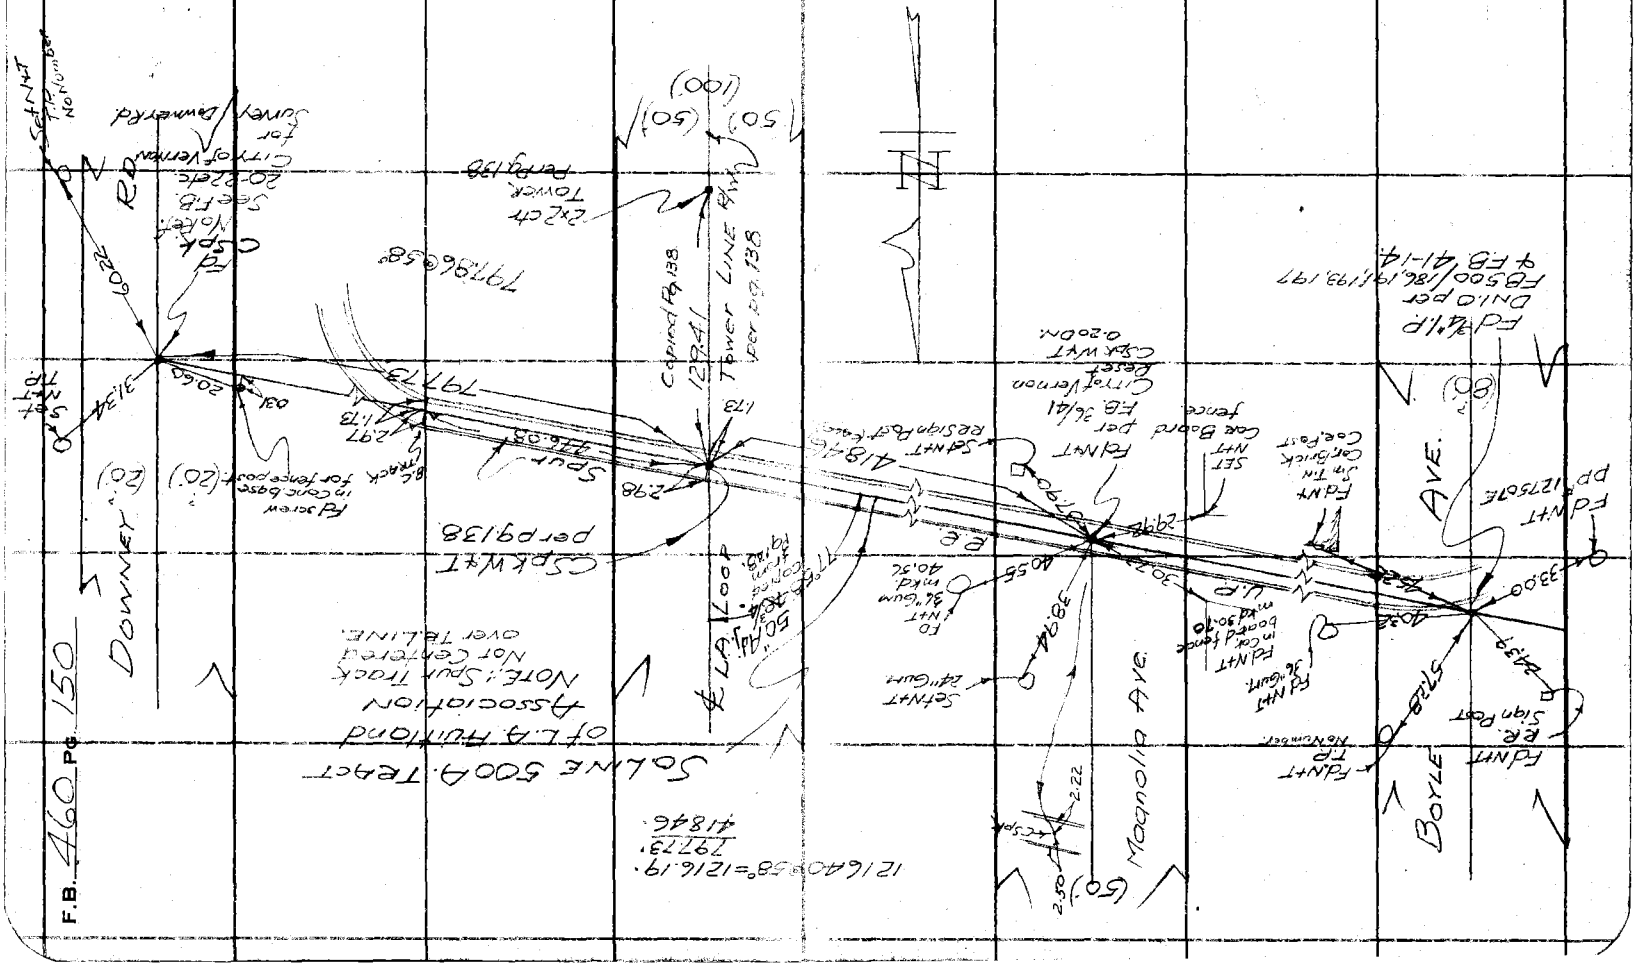
DOWNEY
BOYLE AVE.
MAGNOLIA AVE.
Set Nail & Tag
Fd Spk Nail
Fd Nail & Tag

Notes Ck'd by D. M. Finley
Map No. B-737
Office Work R. W. Stewart
Checked D. M. Finley
Date Mar. 1932

Survey of LORENA ST.
W. O. 7066 Tape No. 042 St'd 84 °F.
Surveyed by BUTLER
Notes " Date 11/31
Indexed A. C. Johnson

F.B. 460 Pg. 187

CONT BOT NEXT PG.

6056

90-02-15
360-09-15

27.176(80) = 271.75.
27.176@80

RW LINE P/W MAP #L-180

LINE

(50') (50')

(100')

90°02.15"

20.00

POL+T in Conc. pave = STA 268+75.82 per FB 500/171

P.O.T. Set L+T in Cb

3.0

SOLID 150 CONC

WALK

AVE.

(conc pave) (25')

0.08

49.92

(50') ST.

Set 100# imperial brass tacks & W of CR @ Downey Rd.

conc pave

45TH (25')

SOLID 150 CONC

WALK

3.0

P.O.T. Set L+T in Cb

TRACT NO.

L.A. LOOP TOWER per FB 500/171

B of P+L

26495. as re-established

L.T.

264.95(80) = 264.94. Magnetic
264.97@80 = 264.96.

CONT FROM TOP PG. 148

RETURN TO
LOS ANGELES COUNTY SURVEYOR
700 HALL OF RECORDS

Do not extend notes this side of this line

Note: ANY ADDITIONS OR CHANGES ON THIS SHEET MUST BE MADE OR CIRCLED IN Red Ink, WITH DATE AND NAME OF PERSON MAKING CHANGE.

FORM 247 10M 8-31

RETURN TO
LOS ANGELES COUNTY SURVEYOR
700 HALL OF RECORDS

Note: ANY ADDITIONS OR CHANGES ON THIS SHEET MUST BE MADE OR CIRCLED IN **Red Ink.** WITH DATE AND NAME OF PERSON MAKING CHANGE.

Do not extend notes this side of this line

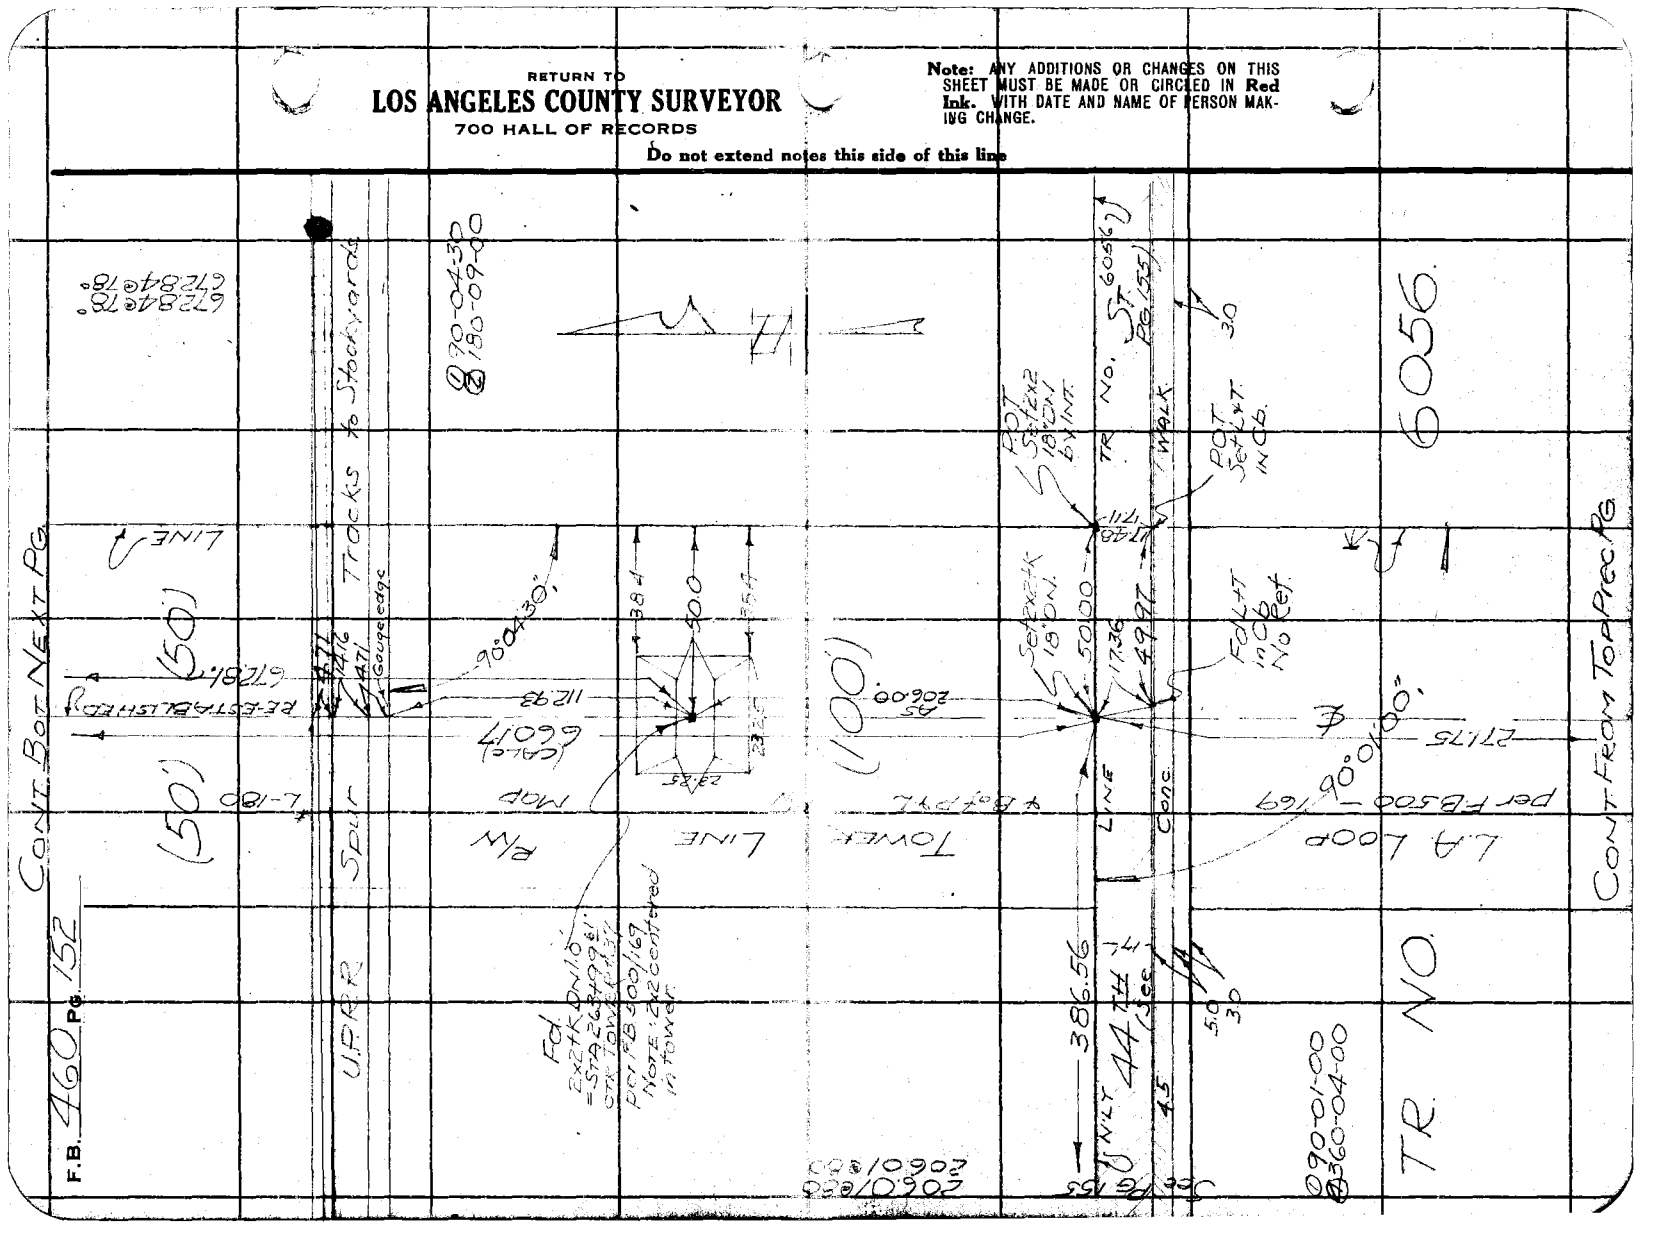

Notes Ck'd by	D. M. Finley	Survey of	LORENA ST.
Map No.	B-737	W. O. 7066	Tape No. 042 St'd 84 °F.
Office Work	R. W. Stewart	Surveyed by	BUTLER
Checked	D. M. Finley	Notes	" Date 11/31
Date	Mar. 1932	Indexed	A. C. Johnson

F.B. 460 Pg. 1253

RETURN TO
LOS ANGELES COUNTY SURVEYOR
700 HALL OF RECORDS

Do not extend notes this side of this line

Note: ANY ADDITIONS OR CHANGES ON THIS SHEET MUST BE MADE OR CIRCLED IN Red Ink. WITH DATE AND NAME OF PERSON MAKING CHANGE.

FORM 247 10M 5-31

CONT BOT NEXT PG

(0°20'33"(CALC)
0°20'36"(R)
Variance due to 0.06 offset on I.P. acct pg

Top Roadbed fill
Tracks irregular
Top roadbed fill
Bot. " " "

(50') (50')
2.36 12' Set C Spk & Wire RR Tie
U.P.R.R. SPUR
20.92
8'
20.92 @ 0°0'0" @ 68'

ANGLE PT. Set 3x3 T K Flush
90°07'
Set x cut top re-in. bar
Set nail N end M LINE
0 90-07
@ 180-14

P.O.T. Fd L+T in Conc. Cross-Brace Ctr. Tower #36 STA 256+98.62 per F.B. 500/220' L+T centered in Tower. This pt used to fix No. end Tang bet. Vernon & Slauson Aves. See Pg 157 for Sa. end.

R/W
20.75
Rectangles 29.0'
(L+T)
Set x cut top re-in. bar
2.43
28.8
90°
30.0

TR. M.B.
(50') (50')
LINE
AS RE-ESTABLISHED
218.64'
#4621
108-99-100

218.66 @ 0°0'0" @ 68'
218.66 @ 0°0'0" @ 68'

Set NAT PP #358874

Fd 2" I.P. P+T flush - S.E. Cor. TR 4621 - Lot 4 M.B. 108-99+100
9.17

See Pg 156
(30') (20')
VERNON AVE (See Pg 156)
TONLT 383.99
2" 72.11
2.75
Set NAT PP #344695E
66.0
Tower M.H.
50.0
111' Set C Spk W+T flush
21' Macadam.
50.36
20.03
Set NAT PP #358874
(20') (30')
See Pg 156
50.56 R.O.T. Set 2x4 14' DN by INT.
Set NAT PP 344696E
Rechained 1/1/32
90°02'30"
0 90-02-30
@ 360-10-00

TOWER (100')
67.28'
L.A. Loop per F.B. 500/ (CALC) 66.0'

CONT. FROM TOP PREC. PG.

CONT. BK. Pg 157

F.B. 460 Pg. 154

Remeasure

① 179-50-30
② 359-22-00
Py 179-50-30
N'LY.

① 179-50-45
② 359-23-00
Py 179-50-45

R/W MAP (50') ABLISHED (50')

514.67+

587(R) 5.87 4413(R) 44.14

Fd N+T in fence post per RB 222+227 ALL OTHER TIES ARE OUT

Fd 2" I.P p+T 6" above S.E. Cor. C.ITY of L.A. LOT per F.B. 500-222

TAYLORS Vernon Ave Villa Lots

BO'RY John R. For THIS P.O.T.

LINE SEE PG. 160A

10' OFFSET 161 LINE See Pg 160A 161

Fd 1" I.P p+T 6" ON per F.B. 500/222+228

Fd 2" I.P. + Tk. Flush in Side-walk per F.B. 500/222+228 used for LINE 227

COUNTY See PG

ROAD 160 161

64.96 RE-EST 11.54 57.00 6.517

64.96 S0°00'E 78.8'

ANGLE PT. Re-Set 3"x3" Tk. Flush. No Evid of 2" I.P. L.P.T. per F.B. 509/228 as it is under 12 Fill

30" 179°50'30"

LINE 9.95 R/W

5.28 8.00

Set 1"x2"Tk Flush by prod. from back tangent from So.

Set nail

90° to N'LY Tangent

TIES

Set L+T

12.925 13.41 Set L+T 4.33 L+T

9.95 L+T 2.6

26.0

Fd. L+T in Conc Cross Brace 1.1 TOWER 0.03 E of LINE No Tag on L+T This [illegible] @ L.P.T. but shifted 10' Sou. per F.B. 500/222 227

783.26'

783.3 783.2

TOWER

158

(CALC.) 882.56

Line Produced N'LY thru L.P.T. from back tang.

L.A. RIVER

90'

Present channel

LOOP I-5

500/222+228 & B of P&L

10'

Set nail ch. pt.

(50') (50')

℄ 86.38

L.A. per

47'

B.O.T. of ℄ Rip Rap Levee

Top Roadbed Fill as per prec. pg.

90.00 S16°17'00"E = 86.38

CONT. FROM Top Prec. PG

RETURN TO
LOS ANGELES COUNTY SURVEYOR
700 HALL OF RECORDS
Do not extend notes this side of this line

Note: ANY ADDITIONS OR CHANGES ON THIS SHEET MUST BE MADE OR CIRCLED IN Red Ink. WITH DATE AND NAME OF PERSON MAKING CHANGE.

FORM 247 10M 5-31

RETURN TO
LOS ANGELES COUNTY SURVEYOR
700 HALL OF RECORDS

Note: ANY ADDITIONS OR CHANGES ON THIS SHEET MUST BE MADE OR CIRCLED IN **Red Ink.** WITH DATE AND NAME OF PERSON MAKING CHANGE.

Do not extend notes this side of this line

Notes Ck'd by D. M. Finley
Map No. B-737
Office Work R. W. Stewart
Checked D. M. Finley
Date Mar. 1932

Survey of Lorena St.
W. O. 2064 Tape No. 042 Std. 64 ft.
Surveyed by Butler
Notes "
Date 11/31
Indexed A. C. Johnson

F.B. 460 Pg. 155

386.42@60°=386.56'

Fd 4" Conc. Cyl. Mon. with bolt in Ctr. (6" ON) NW Cor TR 6056

386.56

(50')

Monroville

(See

(50')

LA LOOP

(50')

2x2 tk per pg 152

50.00

LINE

2x2 tk per pg. 152

TR 6056

Set NHT No Eyd 2" I.P.

St. 17.00 Conc pave.

(20')

(20')

Downey

Rd.

(40')

44 TH S'LY

25.02

79'

FD 2" I. Ppt 6" ON NW Cor 5' Lot 108 TR 6056

(50')

(55')

Ave.

90°01'00" Copied Pg 152

TR LINE

Pg

TOWER

(100')

LINE

LINE

152)

RW

RETURN TO
LOS ANGELES COUNTY SURVEYOR
700 HALL OF RECORDS

Note: ANY ADDITIONS OR CHANGES ON THIS SHEET MUST BE MADE OR CIRCLED IN **Red** Ink. WITH DATE AND NAME OF PERSON MAKING CHANGE.

Do not extend notes this side of this line

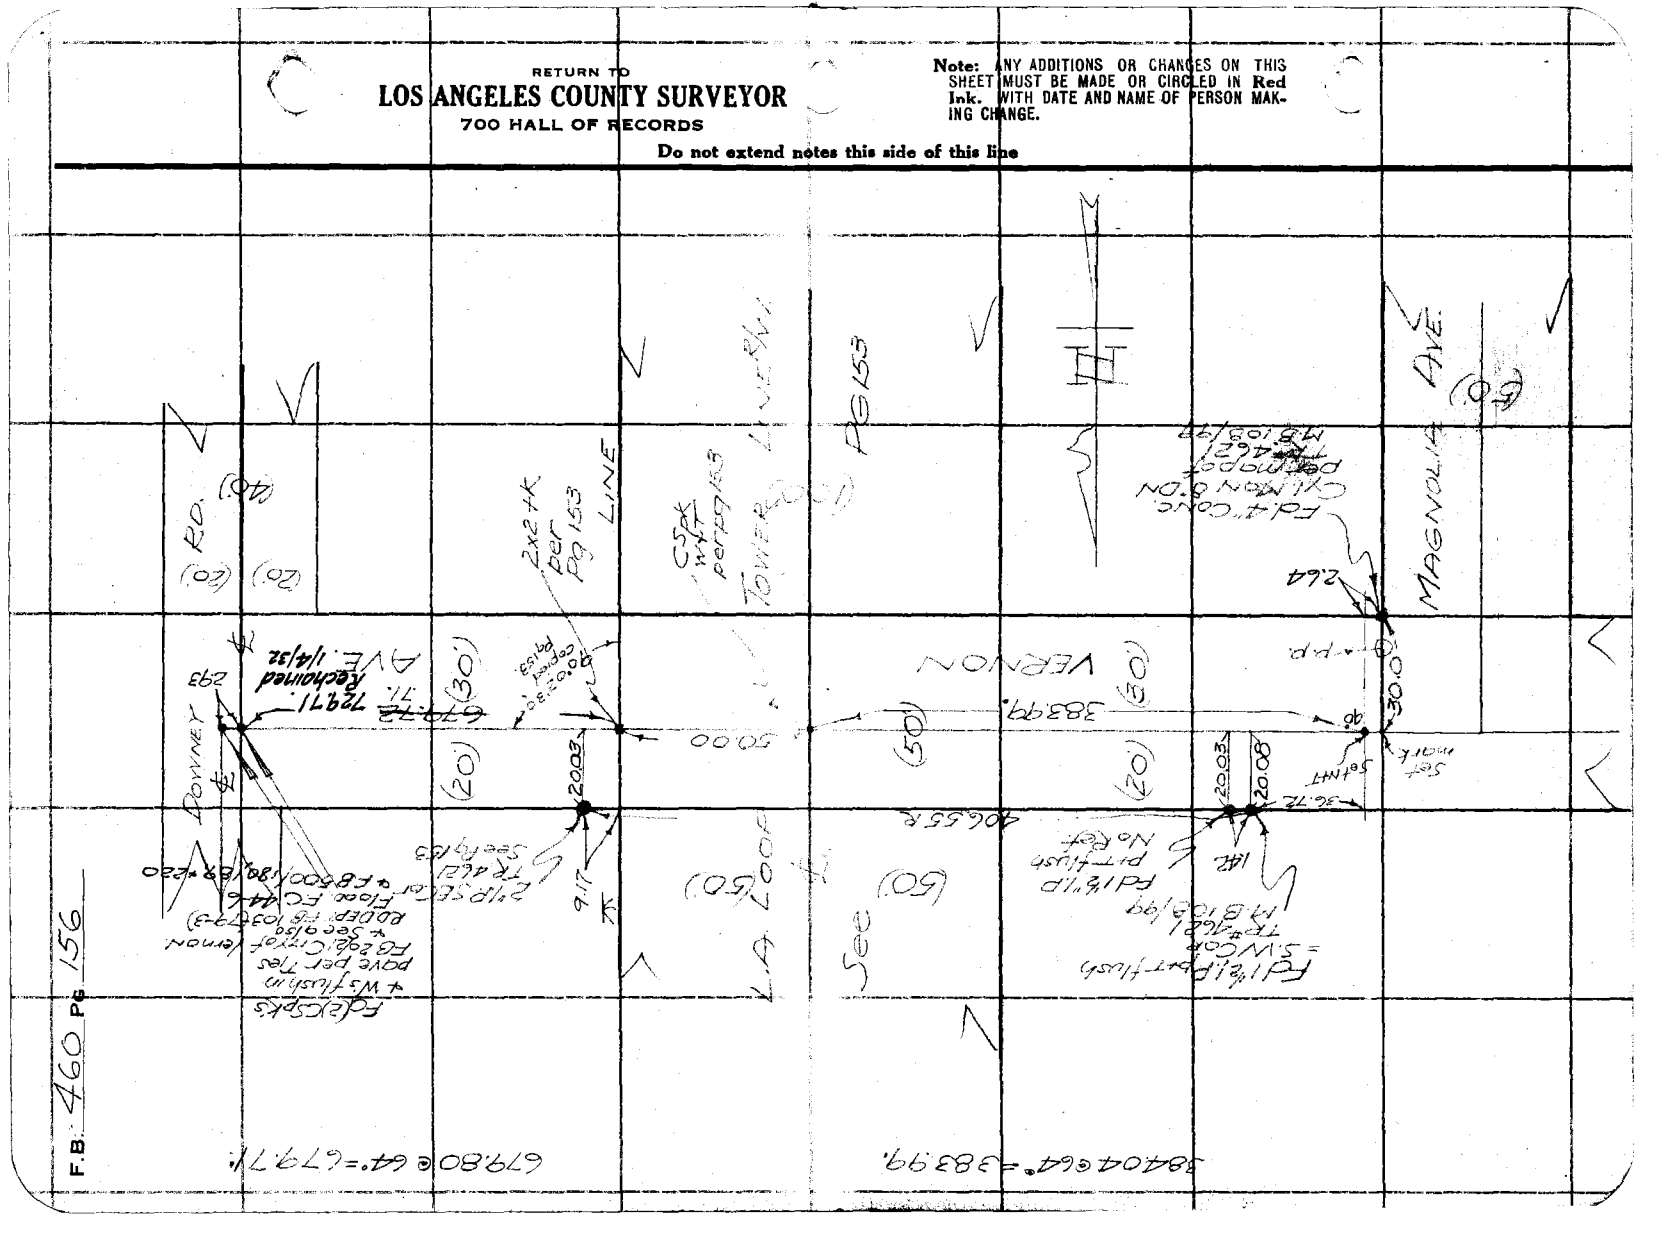
MAGNOLIA AVE.
VERNON
TOWER
LINE
Rd.
Fd 1" IP
Pt in Conc
Pedestal
Fd 4" Conc
Pedestal
Fd Excess
W's flush in
pole per Tres
Sec 9 pg 150
Floor FC 44-6
BOOFP PG 103 (79-3)
Sec 9 pg 150

Notes Ck'd by	D. M. Finley	Survey of	LORENA ST.
Map No.	B-737	W. O.	7066 Tape No. 042 St'd 84 of F.
Office Work	R. W. Stewart	Surveyed by	BUTLER
Checked	D. M. Finley	Notes	" Date 11/31
Date	Mar. 1932.	Indexed	A. C. Johnson

F.B. 460 Pg. 159

CONT. BOT. NEXT PG.

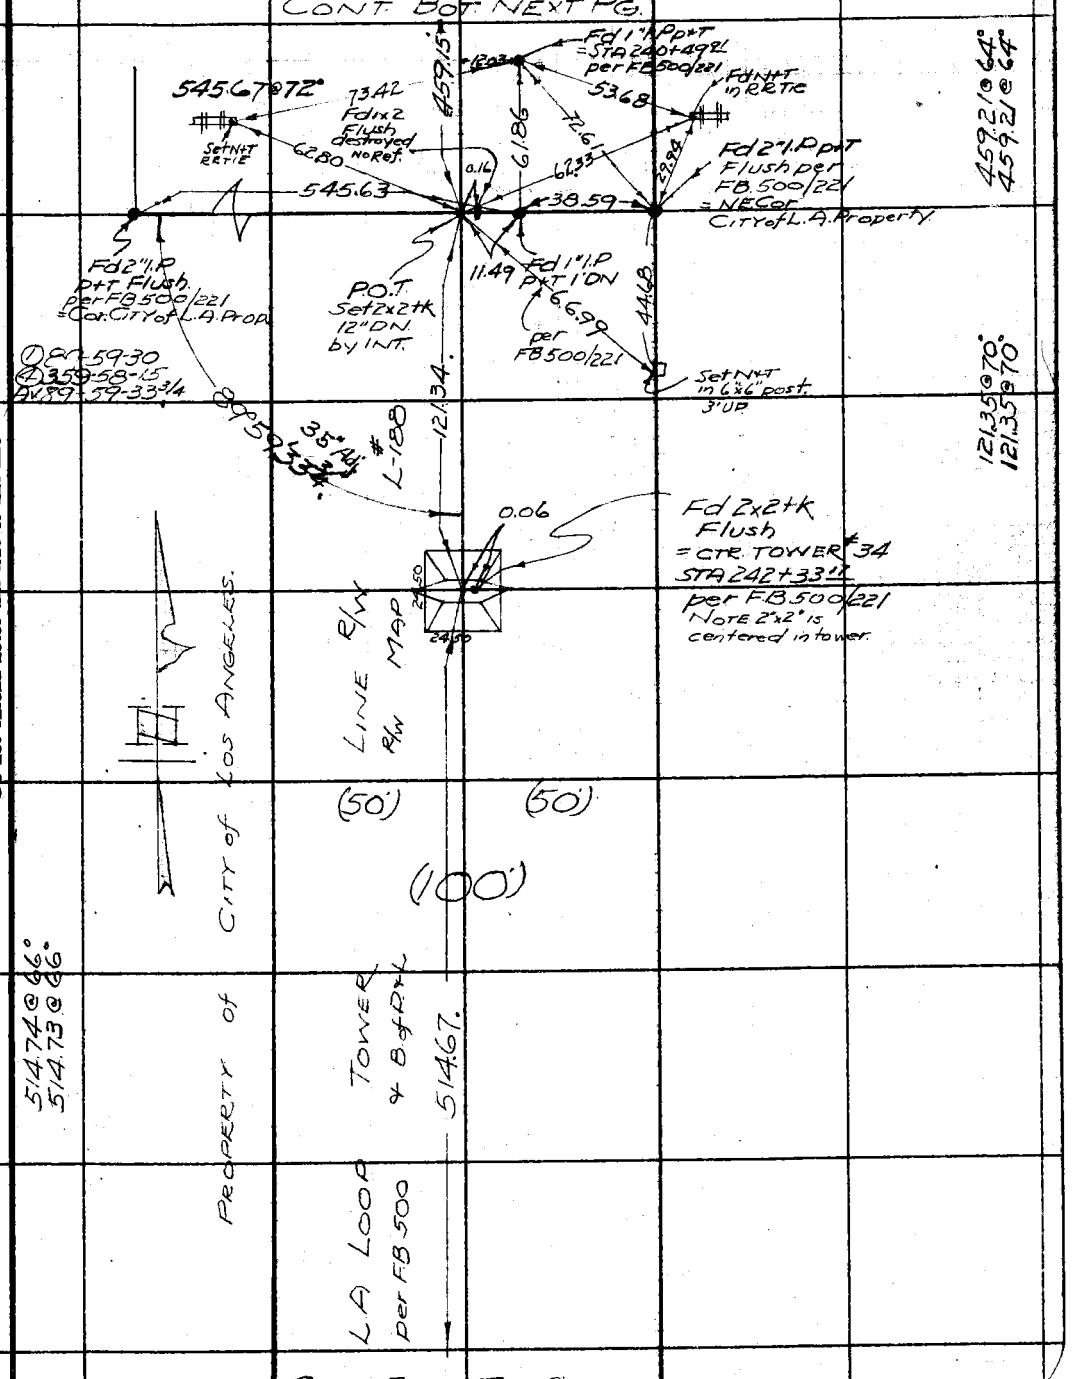

CONT FROM TOP PG 154

RETURN TO
LOS ANGELES COUNTY SURVEYOR
700 HALL OF RECORDS
Do not extend notes this side of this line

Note: ANY ADDITIONS OR CHANGES ON THIS SHEET MUST BE MADE OR CIRCLED IN Red Ink, WITH DATE AND NAME OF PERSON MAKING CHANGE.

FORM 247 10M 5-31

RETURN TO

LOS ANGELES COUNTY SURVEYOR

700 HALL OF RECORDS

Note: ANY ADDITIONS OR CHANGES ON THIS SHEET MUST BE MADE OR CIRCLED IN **Red** Ink. WITH DATE AND NAME OF PERSON MAKING CHANGE.

Do not extend notes this side of this line

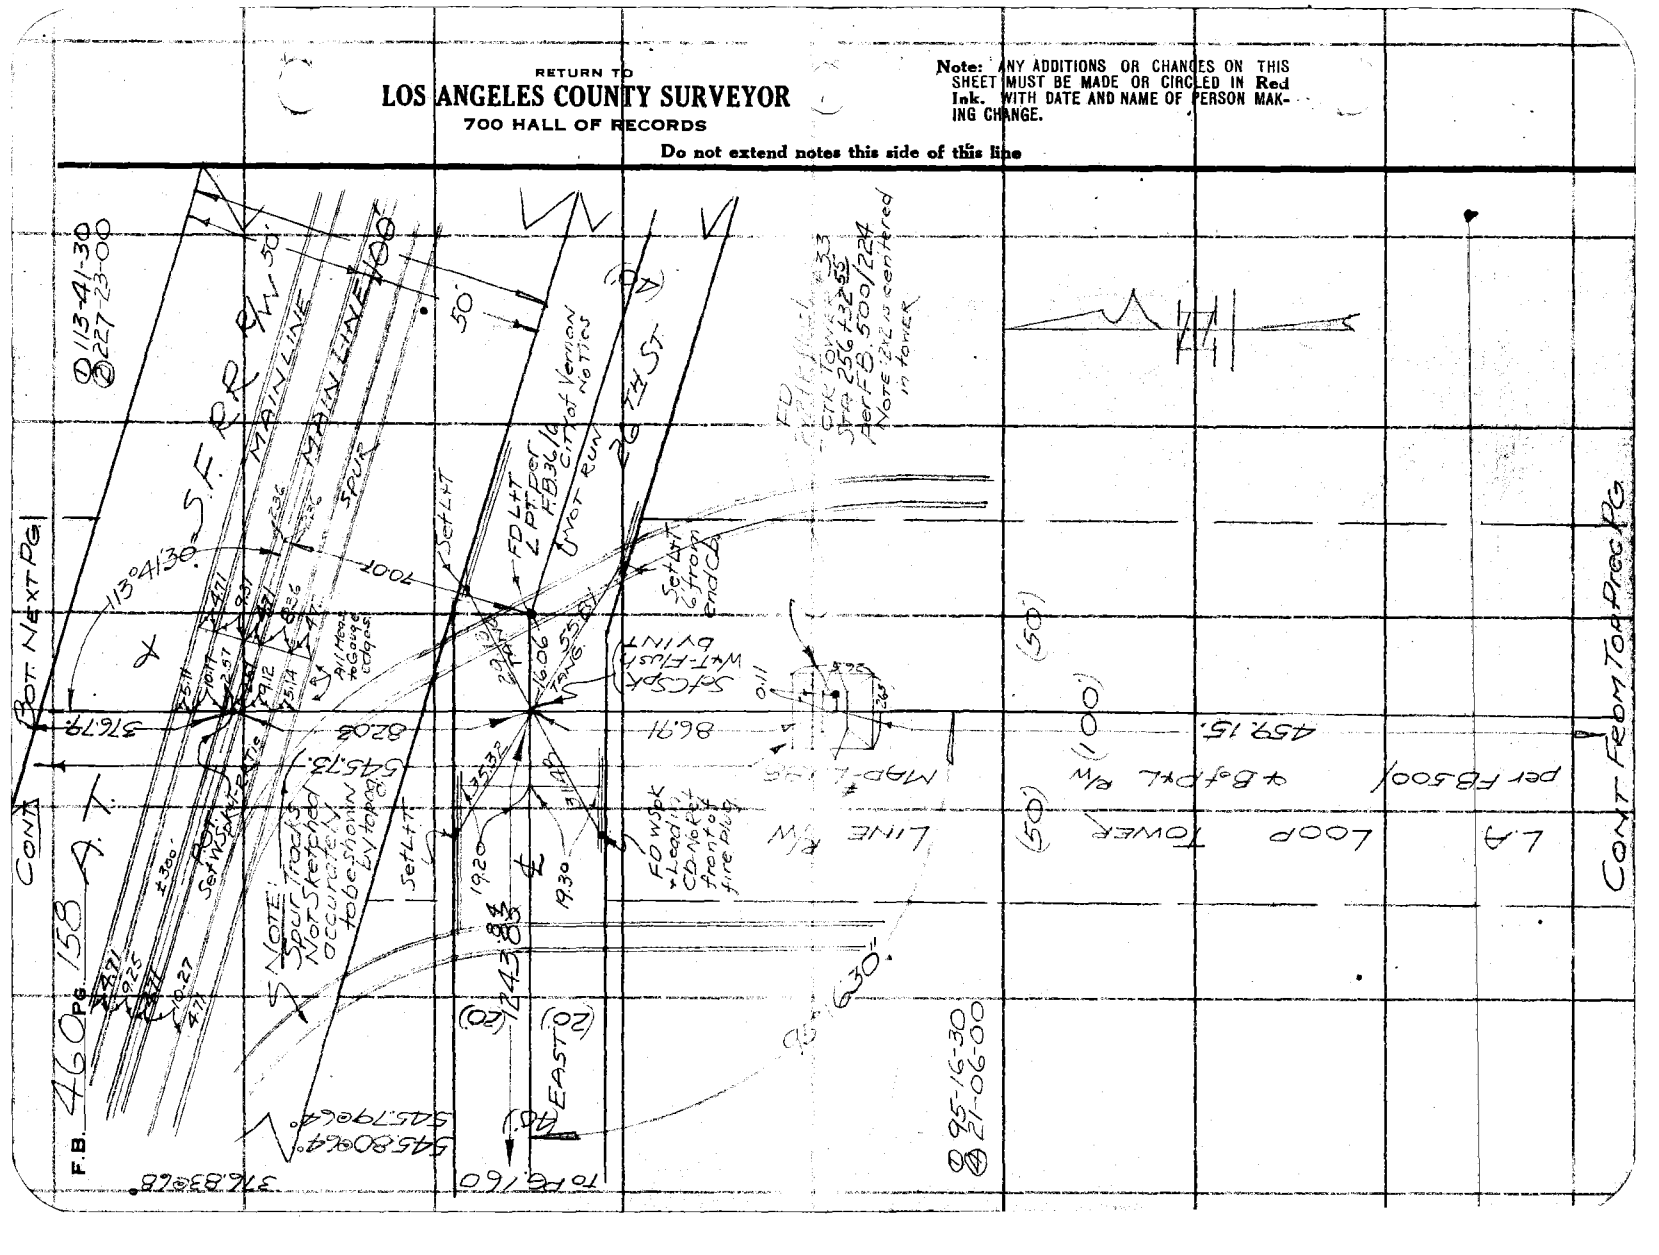

Notes Ck'd by	D. M. Finley	Survey of	LORENA ST.
Map No.	B-737	W. O.	7066 Tape No. 042 St'd 84 °F.
Office Work	R. W. Stewart	Surveyed by	BUTLER
Checked	D. M. Finley	Notes	Date 11/31
Date	Mar. 1932	Indexed	A. C. Johnson

F.B. 460 Pg. 139

Notes: ANY ADDITIONS OR CHANGES ON THIS SHEET MUST BE MADE OR CIRCLED IN Red Ink, WITH DATE AND NAME OF PERSON MAKING CHANGE.

Do not extend notes this side of this line

RETURN TO
LOS ANGELES COUNTY SURVEYOR
700 HALL OF RECORDS

FORM 247 10M 5-31

Fd L+T in C6 & Prod. per F.B. 500/236

Set L+T in C6 & Prod.

Fd 2x2 H.K. 6 D.N. = Sta 133+46.22 per R.D. F.A. 5-7

Fd. W. Spk. + Tin ±2.5' W. of St.

Set C Spk W+T flush by INT.

This pt. is L pt. & Downey per F.B. 500/236

Fd L+T R.D.F.A. 5-8

Fd. C Spk W+T flush per T/as R.D. Dept. F.A. 5-8. = L pt. in Washington = Sta 127+88.29

(PROPOSED) WASHINGTON See R.D.F.A. 5-(7-9)

Set C Spk W+T Flush by INT.

Fd L+T R.D.F.A. 5-8

DOWNEY

NOTE ALL P.I.'S ON DOWNEY R.D.

Fd C Spk W+T Flush No Ret.

ANGLE POINT Fd 2" I.P. pit DN. 1.0 per F.B. 500/223

Ed L+T on Tower

Fd L+T on Tow.

This line 90° to E.

Fd 2" I.P. pit DN. 0.6

P.O.T. Fd 2" I.P. pit FLUSH.

Fd 2" x 2" H.K. flush

L Runups

"A"
① 41-56-00
② 167-44-00
Av. 41-56-00.

"B"
① 114-45-00
② 99-00-00
Av. 114-45-00.

"C"
① 156-41-15
② 206-45-00
Av. 156-41-15.

L.A. LOOP TOWER

R.D. 35' on Long. line

CONT. FROM TOP PREC. PG.

RETURN TO
LOS ANGELES COUNTY SURVEYOR
700 HALL OF RECORDS

Note: ANY ADDITIONS OR CHANGES ON THIS SHEET MUST BE MADE OR CIRCLED IN **Red** Ink. WITH DATE AND NAME OF PERSON MAKING CHANGE.

Do not extend notes this side of this line

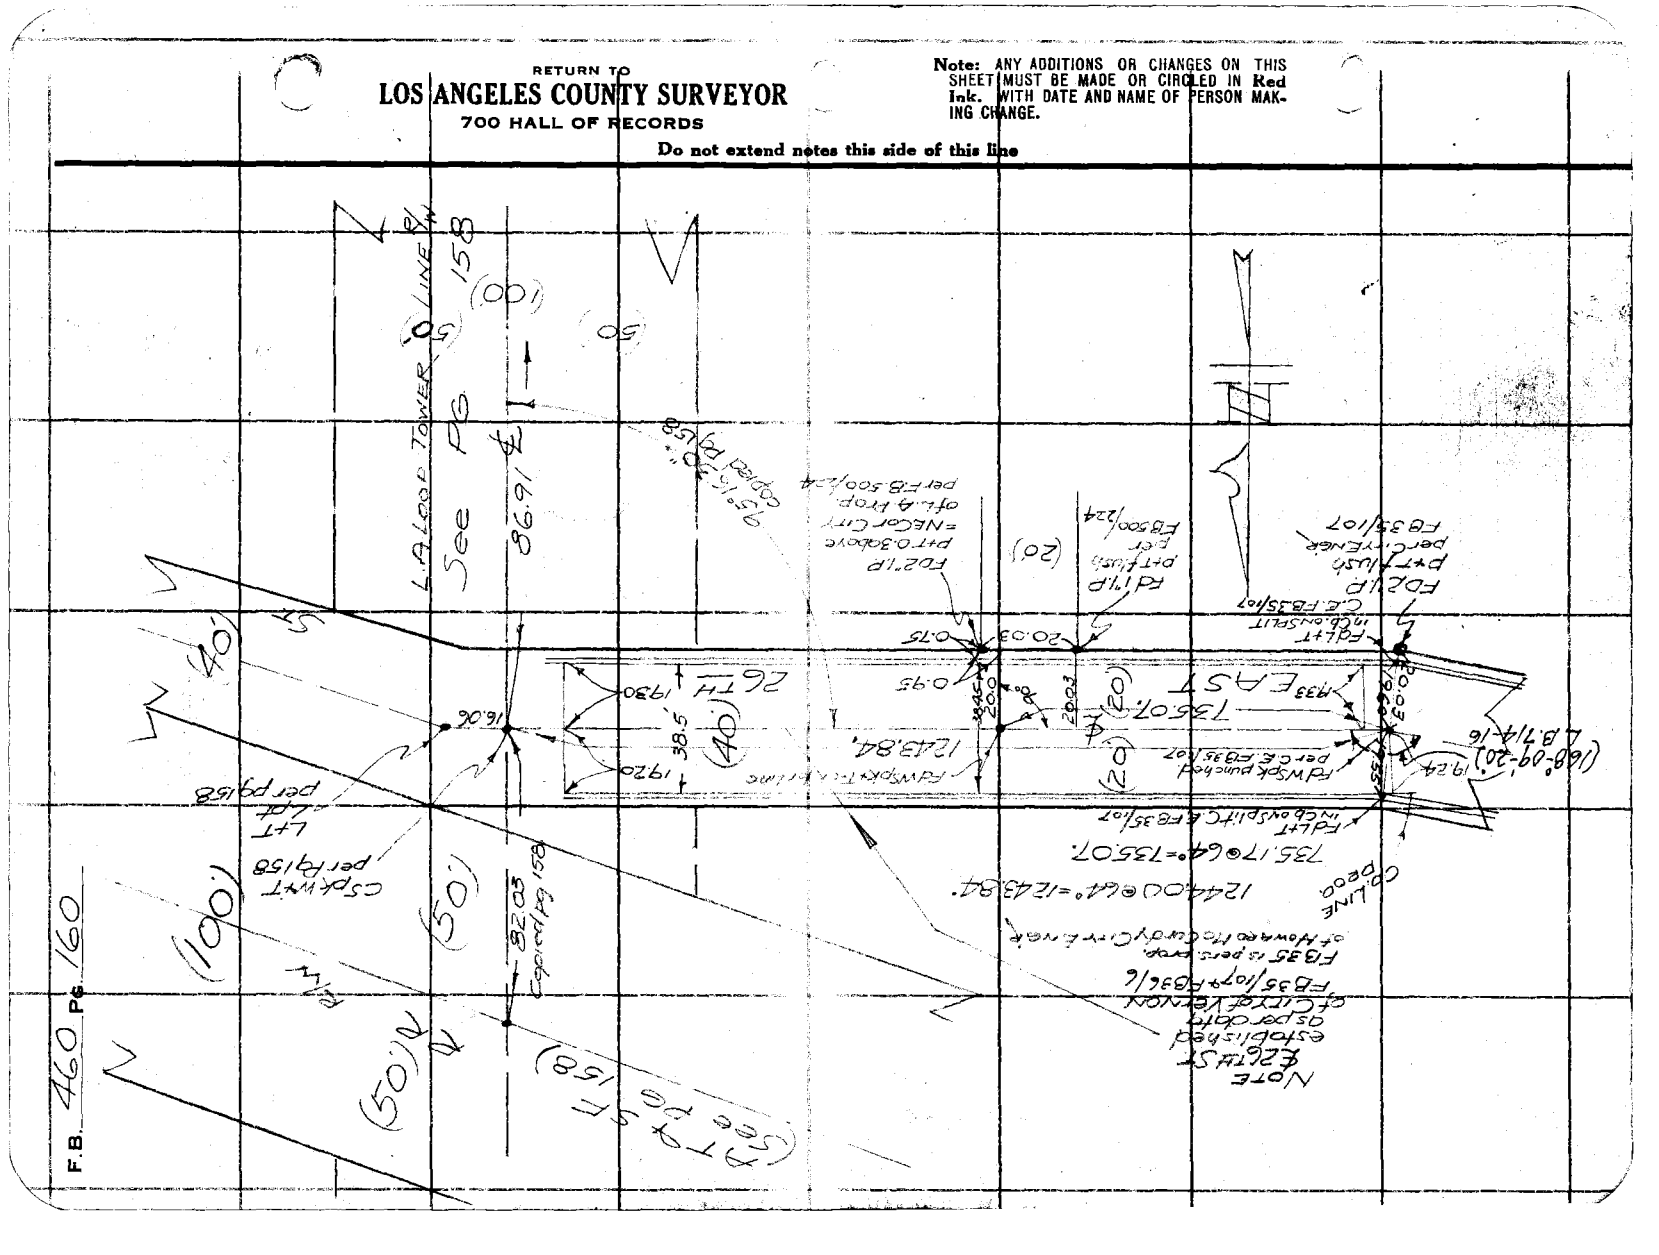
L.A. Lood Tower
See PG 86.91
(100')
(50')
(40')
(60')
(20')
(80')
(50')
(100')
158
160
460
F.B.
PG
Cor. Lot
Lot
Cor.
Cor.
Cor.

FORM 247 10M 5-31

RETURN TO
LOS ANGELES COUNTY SURVEYOR
700 HALL OF RECORDS

Note: ANY ADDITIONS OR CHANGES ON THIS SHEET MUST BE MADE OR CIRCLED IN **Red Ink.** WITH DATE AND NAME OF PERSON MAKING CHANGE.

Do not extend notes this side of this line

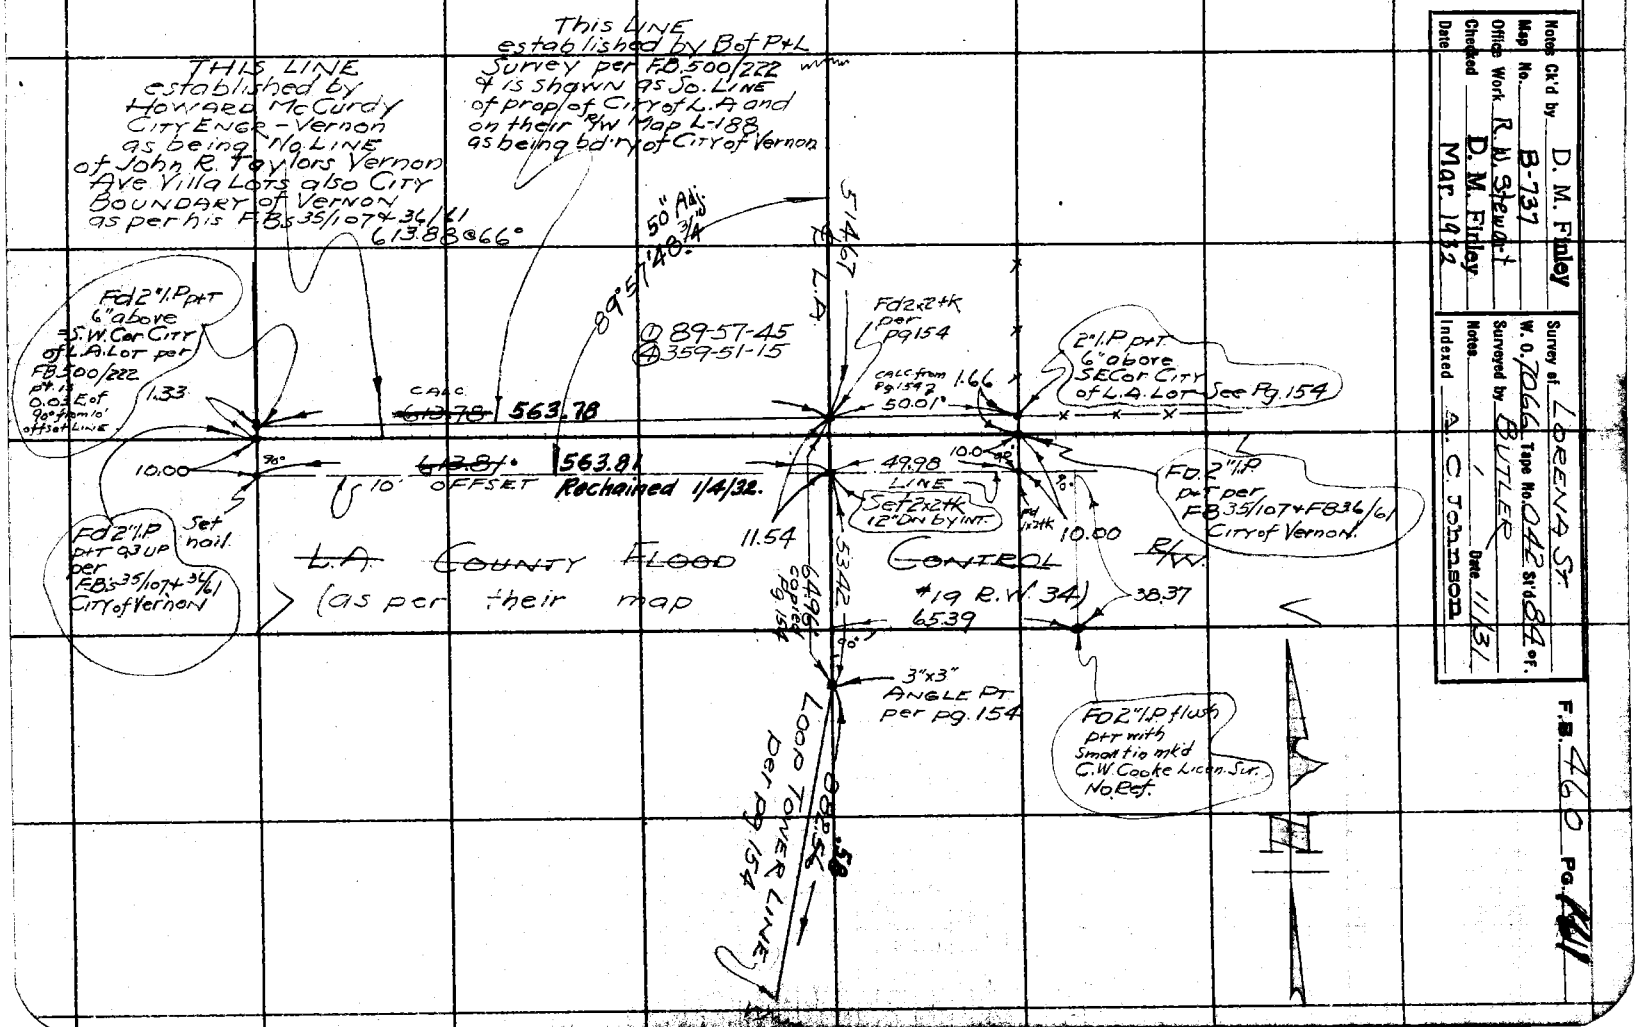

Notes Ck'd by	D. M. Finley
Map No.	B-737
Office Work	R. D. Stewart
Checked	D. M. Finley
Date	Mar. 1932
Survey of	Lorena St.
W. O.	7066
Tape No.	042
Sht.	84 of
Surveyed by	B. Butler
Notes	
Date	11/31
Indexed	A. C. Johnson


RETURN TO

LOS ANGELES COUNTY SURVEYOR

700 HALL OF RECORDS

Note: ANY ADDITIONS OR CHANGES ON THIS SHEET MUST BE MADE OR CIRCLED IN **Red Ink.** WITH DATE AND NAME OF PERSON MAKING CHANGE.

Do not extend notes this side of this line

F.B. 460 Pg 162

Notes Ck'd by	D. M. Finley	Survey of	LORENA ST.
Map No.	B-737	W. O.	7066 Tape No. 042 St'd 84 °F.
Office Work	R. M. Stewart	Surveyed by	BUTLER
Checked	D. M. Finley	Notes	Date 11/31
Date	Mar. 1932	Indexed	A. C. Johnson 11-27-31

F.B. 460 Pg. 163

W.O. 7066
LORENA ST.

TOPOGRAPHY

£ PG. 131

NOTE: NO STATIONING ON TOPOG. ACC'T £0+00 fixed after topog. was taken.

Note: ANY ADDITIONS OR CHANGES ON THIS SHEET MUST BE MADE OR CIRCLED IN Red Ink, WITH DATE AND NAME OF PERSON MAKING CHANGE.

Do not extend notes this side of this line

RETURN TO
LOS ANGELES COUNTY SURVEYOR
700 HALL OF RECORDS

FORM 847 10M 8-31

RETURN TO

LOS ANGELES COUNTY SURVEYOR

700 HALL OF RECORDS

Note: ANY ADDITIONS OR CHANGES ON THIS SHEET MUST BE MADE OR CIRCLED IN **Red Ink.** WITH DATE AND NAME OF PERSON MAKING CHANGE.

Do not extend notes this side of this line

F.B. 460 Pg 164

Notes Ck'd by	D. M. Finley	Survey of	LORENA ST.
Map No.	B-737	W. O.	7066 Tape No. 042 St'd 84 °F.
Office Work	R. W. Stewart	Surveyed by	BUTLER
Checked	D. M. Finley	Notes	" Date 11/31
Date	Mar. 1932	Indexed	A. C. Johnson

F.B. 460 Pg. 165

Note: ANY ADDITIONS OR CHANGES ON THIS SHEET MUST BE MADE OR CIRCLED IN Red Ink, WITH DATE AND NAME OF PERSON MAKING CHANGE.

RETURN TO
LOS ANGELES COUNTY SURVEYOR
720 HALL OF RECORDS
Do not extend notes this side of this line

CONT BOT NEXT PG

Stock of Steel Rails ± 15' High MOVABLE

Spur Track Stan. Gauge

P.P. high line E & W

Bumpers

as per Pg. 135

49.2

86.8

64.8

Sewer M.H.

No fence

R/W LINE 619.28 Co. Pg. 135

94.6

79.9

95.4

NOTE TOPOG Taken to a line 80'E. of ℄ BISSELL Prod

15.2 Trolley Pole

4.72 ⊥

1x2 Split Trocks per Pg 135

4.72 ⊥

94.8

10.16

19.1

Block Signal

(120')

(60')

P.E. RR R/W

TOWER LOOP

182°15' Chord Pg 135

15.8

P.P.

3 STRAND ±300 BARB-WIRE

1480 LINE per

14.65

13.4 Pg 135

2x2 Pg 135

(15')

(40')

2" D.G. Surface

(25')

18.1

31.3

25.4

A.S.P.S. WATER VALVE

9.9

61.10

WALK

Randolph

ST.

P.P.

1½" I.P. ANGLE PT. per pg. 135

L.A. ST.

Sewer M.H. ℄ Line hits ctr Set punches N & S rim

WALK

Surface

WALK

24.06

See Pg 135

BISSELL

(50')

15'

FORM 247 10M 5-31

RETURN TO

LOS ANGELES COUNTY SURVEYOR

700 HALL OF RECORDS

Note: ANY ADDITIONS OR CHANGES ON THIS SHEET MUST BE MADE OR CIRCLED IN Red Ink. WITH DATE AND NAME OF PERSON MAKING CHANGE.

Do not extend notes this side of this line

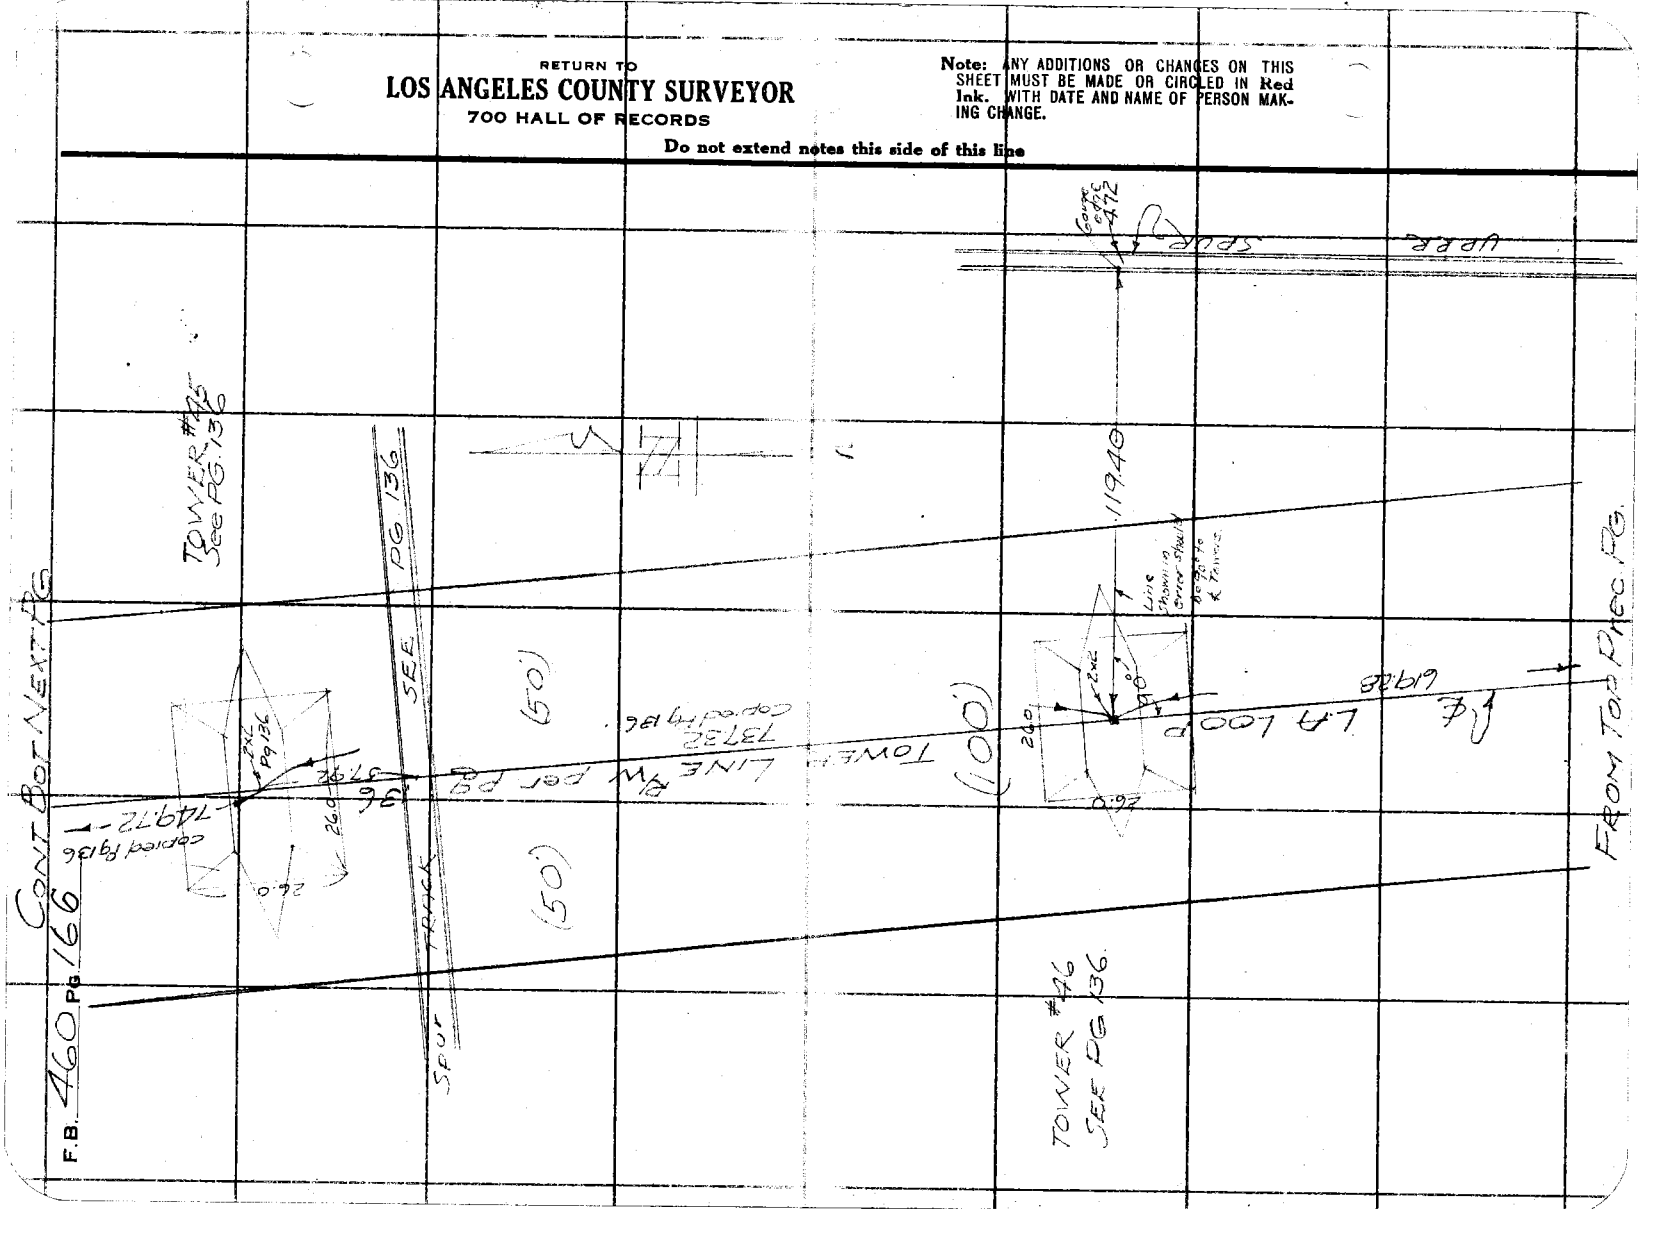

Notes Ck'd by	D. M. Finley	Survey of	LORENA ST.
Map No.	B-737	W. O. 7066	Tape No 042 St'd 84°F.
Office Work	R. W. Stewart	Surveyed by	BUTLER
Checked	D. M. Finley	Notes "	Date 11/31
Date	Mar. 1932	Indexed	A. C. Johnson

F.B. 460 PG. 167

CONT BOT NEXT PG

Note: ANY ADDITIONS OR CHANGES ON THIS SHEET MUST BE MADE OR CIRCLED IN Red Ink, WITH DATE AND NAME OF PERSON MAKING CHANGE.

RETURN TO
LOS ANGELES COUNTY SURVEYOR
700 HALL OF RECORDS
Do not extend notes this side of this line

FORM 247 10M 5-31

Rocor Pacific Frog & Switch Works

Structural Steel Gantry Crane & Steel Yard

Woven Wire Fence 2" iron Posts ± 12' apart

60.63

327.3

(50') (50')

R/W per PG 137

TOWER LINE

30.3

19.1

68.7

317.15

13' Av. Width 12'

79.0

1 Story Corr. Iron Bldg.

Bergstrom Steel Company

144.6

½" Rock & Oil Pave.

13.5 13.5

2" I.P. Centered in Tower #44 per pg 137

270

13.0

13.6

272

68.52

7.2 2.5 1.85

Conc. walk

ANGLE PT 1½ I.P. per pg 137

57.7

1.47

Bell Co. Manhole

Fire Hydrant

68.6

60.5

1.3

Vernon water valve

Asphaltic Conc. pave.

SLAUSON

1' Conc. Gutter

40.3

LOOP I

7.0

69.1 50 57.6

5" Conc. Sidewalk

Ed Lft prod. in cb ok for line prod.

Bell Co. Manhole 3'6" x 1.6 1'6" Sq. Face Curb

P.P.

L.A. Co. Surv. 74972 Copied PG 137

(50') (50')

FROM TOP Prec. PG

To Bot Next Pg.

F.B. 460 Pg. 168

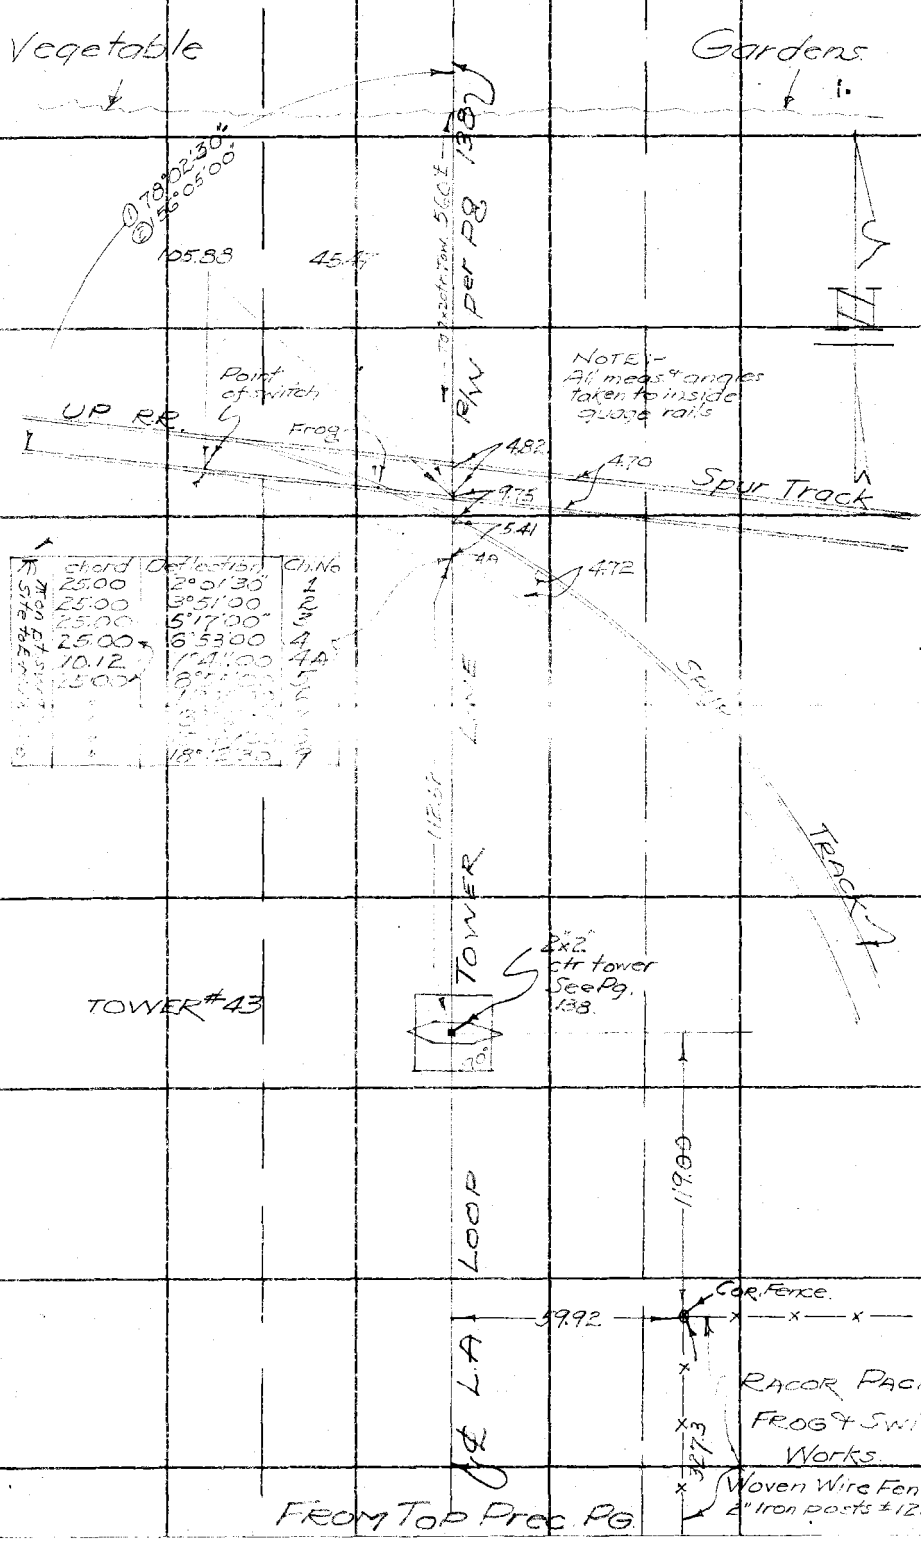

Chord	Deflection	Ch. No
25.00	2°01'30"	1
25.00	3°51'00"	2
25.00	5°17'00"	3
25.00	6°53'00"	4
10.12	(24'00"	4A
25.00	8°[illegible]	5
	[illegible]	6
	[illegible]	7
	18°E 30	

From Top Prec. Pg

RETURN TO
LOS ANGELES COUNTY SURVEYOR
700 HALL OF RECORDS

Note: ANY ADDITIONS OR CHANGES ON THIS SHEET MUST BE MADE OR CIRCLED IN Red Ink. WITH DATE AND NAME OF PERSON MAKING CHANGE.

Do not extend notes this side of this line

Notes Ck'd by	D. M Finley	Survey of	LORENA ST.
Map No.	B-737	W. O. 7066	Tape No. 042 St'd 84 °F.
Office Work	R.W. Stewart.	Surveyed by	BUTLER
Checked	D. M. Finley	Notes	" Date 11/31
Date	Mar. 1932	Indexed	A. C. Johnson

F.B. 460 PG. 169

To Bot. Next Pg

(50') R/W (50')

143+144

L+T & Int per pg. 144

L+T per pg. 144.

38.50 ± Conc gutter cent'd in Roadway 0.80 wide 38.50 ± 14.10

50TH

20' Strip

50.0

Macadam pave. of rdwy in roadway ST.

Note: ANY ADDITIONS OR CHANGES ON THIS SHEET MUST BE MADE OR CIRCLED IN Red Ink, WITH DATE AND NAME OF PERSON MAKING CHANGE.

Do not extend notes this side of this line

RETURN TO LOS ANGELES COUNTY SURVEYOR 700 HALL OF RECORDS

98.27

0.23

LINE

PGS

Vegetable

2"x2" per pg. 144

Gardens.

TOWER +144

(100')

Per

LINE

PP 1

59.7

Sewer MH

CSpk W+T per pg. 143

Existing Sewer.

(20')

19.4

13.3

1/2"

Rock

+0.9

1.8

0.70

0.L 50.0

pave. 9'

9'

(40')

(20')

FRUITLAND

257.03

AVE.

2"x2"+k per pg. 143

36.25

27.80

27.25

36.30

GARDENS

1962

VEGETABLE

L.A. Loop

℄ pgs 143

From Top Prec. Pg.

FORM 247 10M 5-31

TO BOT. NEXT PG

F.B. 460 PG. 170

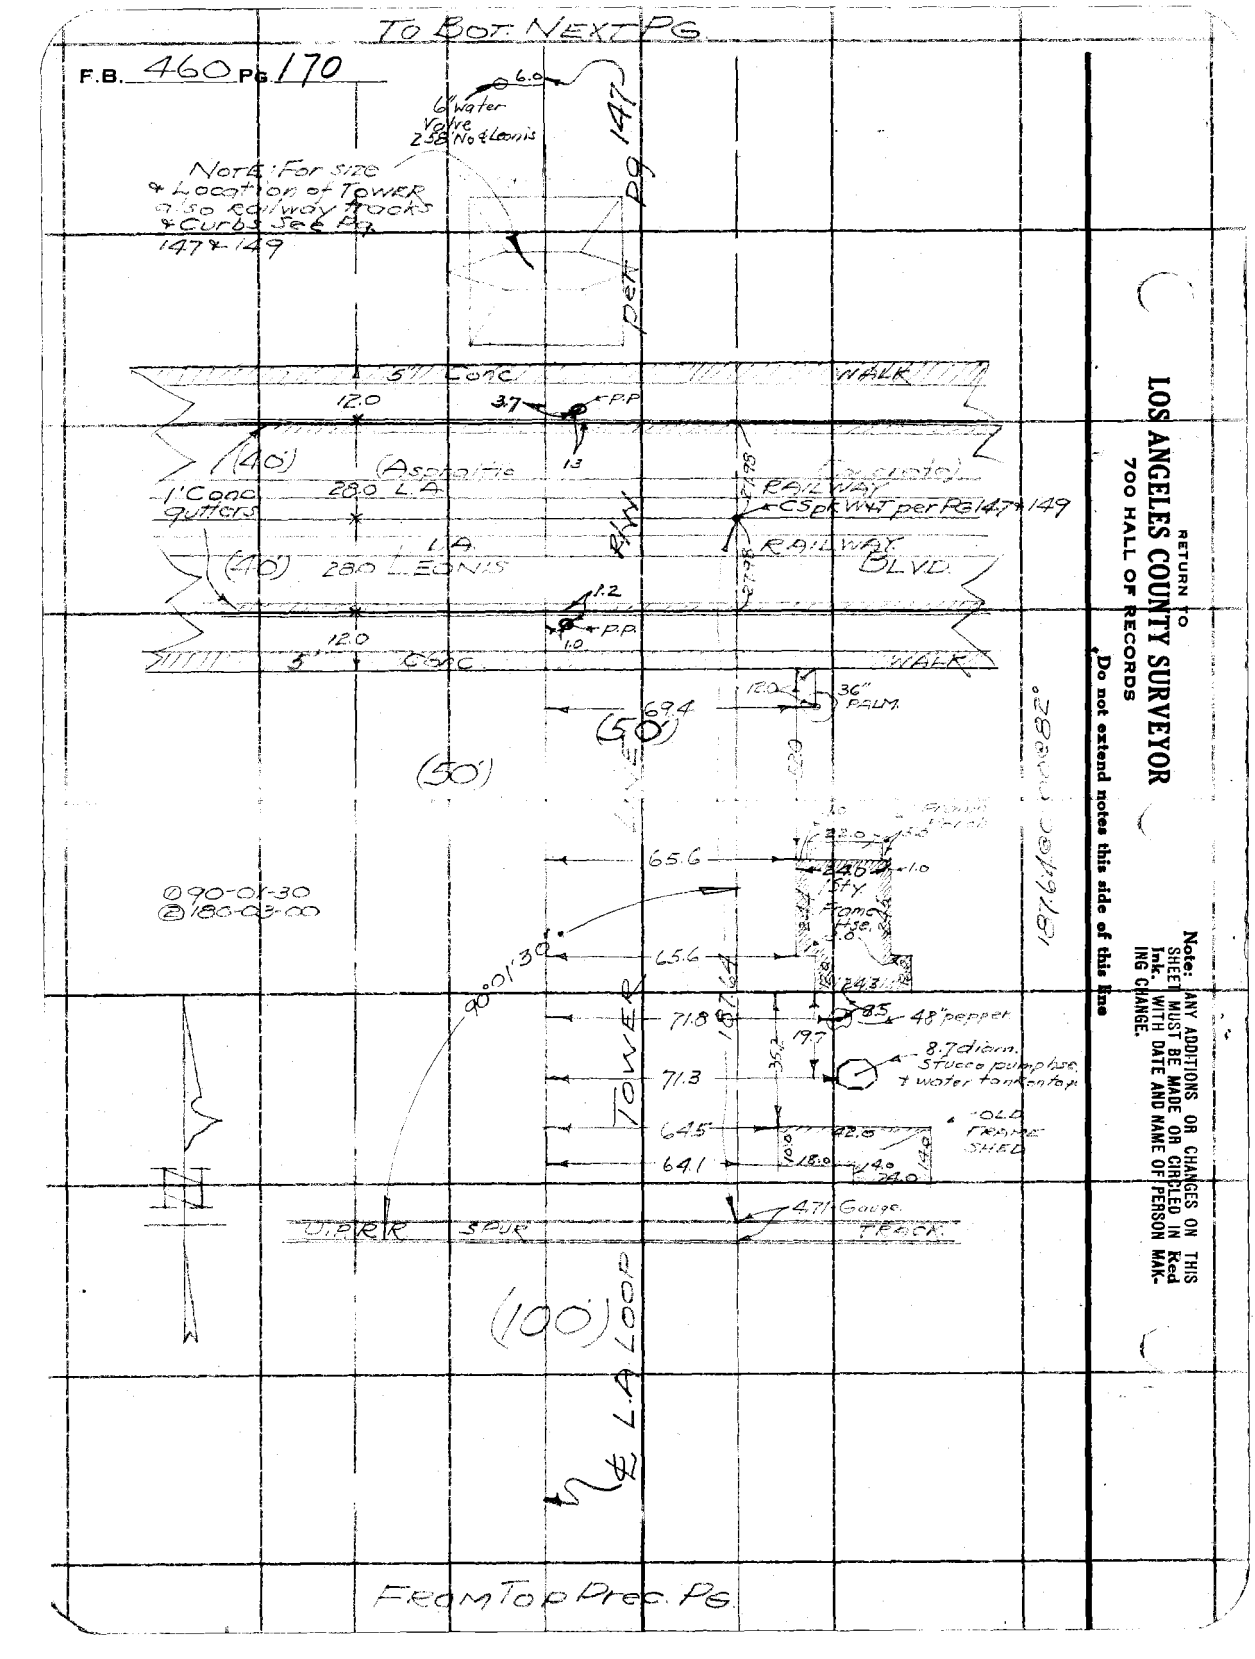

RETURN TO
LOS ANGELES COUNTY SURVEYOR
700 HALL OF RECORDS

Do not extend notes this side of this line

Note: ANY ADDITIONS OR CHANGES ON THIS SHEET MUST BE MADE OR CIRCLED IN Red Ink. WITH DATE AND NAME OF PERSON MAKING CHANGE.

Notes Ck'd by	D. M. Finley	Survey of	LORENA ST.
Map No.	B-737	W. O.	7066 Tape No. 042 St'd 84 °F.
Office Work	R. W. Stewart	Surveyed by	BUTLER
Checked	D. M. Finley	Notes	" Date 11/31
Date	Mar. 1932	Indexed	A. C. Johnson

F.B. 460 Pg. 171

Note: ANY ADDITIONS OR CHANGES ON THIS SHEET MUST BE MADE OR CIRCLED IN Red Ink. WITH DATE AND NAME OF PERSON MAKING CHANGE.

RETURN TO
LOS ANGELES COUNTY SURVEYOR
700 HALL OF RECORDS
Do not extend notes this side of this line.

LINE RW as per pg. 148

Acct scarcity of Topog bet PACKERS AVE & ST SHOWN AS COUNTY ROAD TOP PG 154 all topog is shown on & NOTES Pgs 148 to 154. Separate Topog Notes inc. & No. of County Rd. begin next pg.

For Size & Location of this Tower See Pg 148.

(25') PACKERS

(25') TOPOG SHOWN on & Survey

L+T per pg 148.

AVE. (50')

PG. 148

(50') (50')

LOOP TOWER

12500

6" PALM 6" poplar 6" poplar

P.P. 25.5 43.6 6.4

48.1 5.3 90° 5.3

1.2

set nail

(100')

L.A. & S.L. R.R.

333' to ℄ Packers Ave.

Resting on Conc. Sills

Bevel Wall

1.0

42.0

36.0

70.4

70.1

Conc. Water Restroom Elev. 272'

6" CI Water Valve

7.0

FROM Top Prec. PG.

FORM 847 10M 8-31

CONT BOT NEXT PG.

F.B. 460 PG. 172

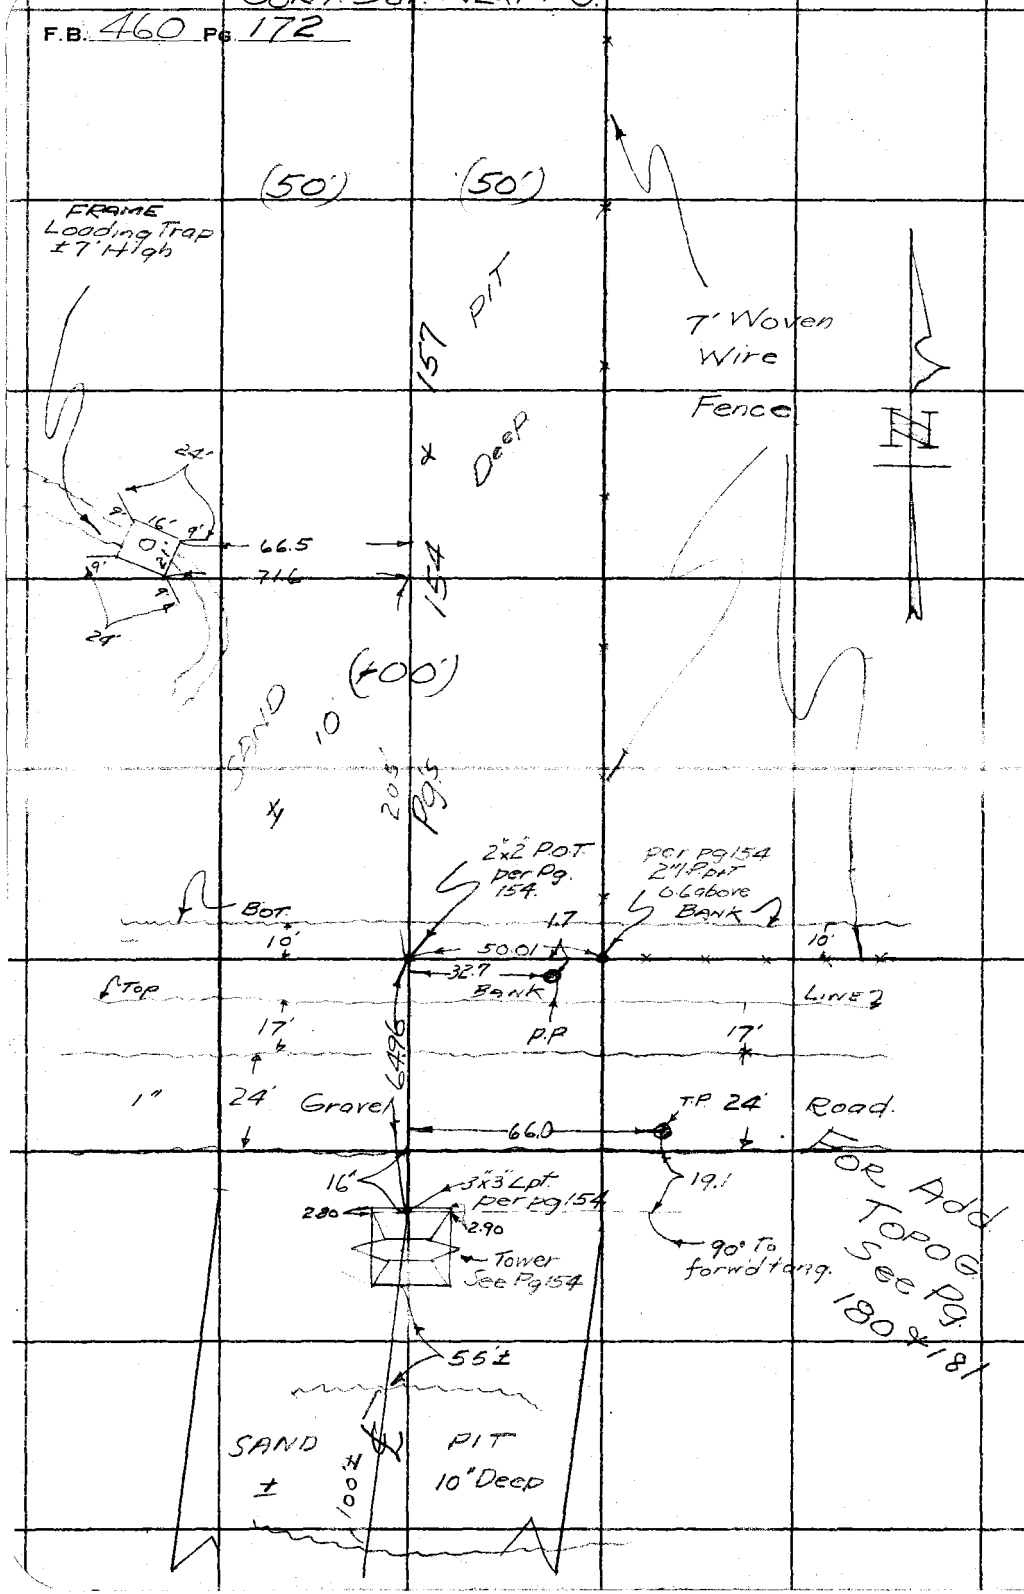

RETURN TO
LOS ANGELES COUNTY SURVEYOR
700 HALL OF RECORDS

Do not extend notes this side of this line

Note: ANY ADDITIONS OR CHANGES ON THIS SHEET MUST BE MADE OR CIRCLED IN Red Ink. WITH DATE AND NAME OF PERSON MAKING CHANGE.

Notes Ck'd by	D. M. Finley	Survey of	LORENA ST.
Map No.	B-737	W. O.	7066 Tape No. 042 St'd 84 °F.
Office Work	R. W. Stewart	Surveyed by	BUTLER
Checked	D. M. Finley	Notes	Date 11/31
Date	Mar 1932	Indexed	A. C. Johnson


CONT BOT NEXT PG.

RUNWAY

419

Yards next pg.

A.T.+S.F.R.R. Spur Tracks - Stan. Gauge.

Feeding (1 200' Long) SHED

Feeding fences

157

4.72

56.15

56.30

50.0

0.10

2.40

17.6

No Line City of L.A. prop See Pg 157

2x2 perpg 157

2"I.P. Cor fence

121.34 copied Pg 157

Tower See Pg 157

188.2

Stock Feeding Yards

Livestock See Notes on

89.33 copied Pg 157

(50')

PG.

(50')

50.1

Fence

935

PIT 10' Deep

394

Wire

Woven

(100')

1 Sty Frame BARN Corr. Roof

CONT FROM TOP PREC. PG.

RETURN TO
LOS ANGELES COUNTY SURVEYOR
700 HALL OF RECORDS
Do not extend notes this side of this line

Note: ANY ADDITIONS OR CHANGES ON THIS SHEET MUST BE MADE OR CIRCLED IN Red Ink, WITH DATE AND NAME OF PERSON MAKING CHANGE.

FORM 247 10M 5-31

F.B. 460 PG 174

AT+SF

(See

20' Macadam pave. Centered in ST.

end cb.

Telegraph pole

8"x8" R.R. Sign Post

guy pole

RR R/W

NEXT PG)

T.P.

T.P.

60

21.9

14.7

23.6

23.2

24.6

19.9

19.20

32.0

20.8

19.6

19.5

20.2

41.4

16.06

1.0

19.40

19.32

20.9

19.30

10.22

34.6

19.25

20.1

59.25

26.5

58.4

6.17

71.1

73.5

12.5

7.9

8.4

8.0

8.0

8.0

FORM 847 10M 5-31

RETURN TO
LOS ANGELES COUNTY SURVEYOR
700 HALL OF RECORDS

Note: ANY ADDITIONS OR CHANGES ON THIS SHEET MUST BE MADE OR CIRCLED IN **Red Ink**, WITH DATE AND NAME OF PERSON MAKING CHANGE.

Do not extend notes this side of this line

Notes Ck'd by D. M. Finley
Map No. B-737
Office Work R. M. Stewart
Checked D. M. Finley
Date Mar 1932

Survey of LORENA ST.
W. O. 7066 Tape No. 042 Sht. 3 of
Surveyed by BUTZLER
Notes "
Indexed A. C. Johnson Date 11/31

F.B. 460 Pg. 175

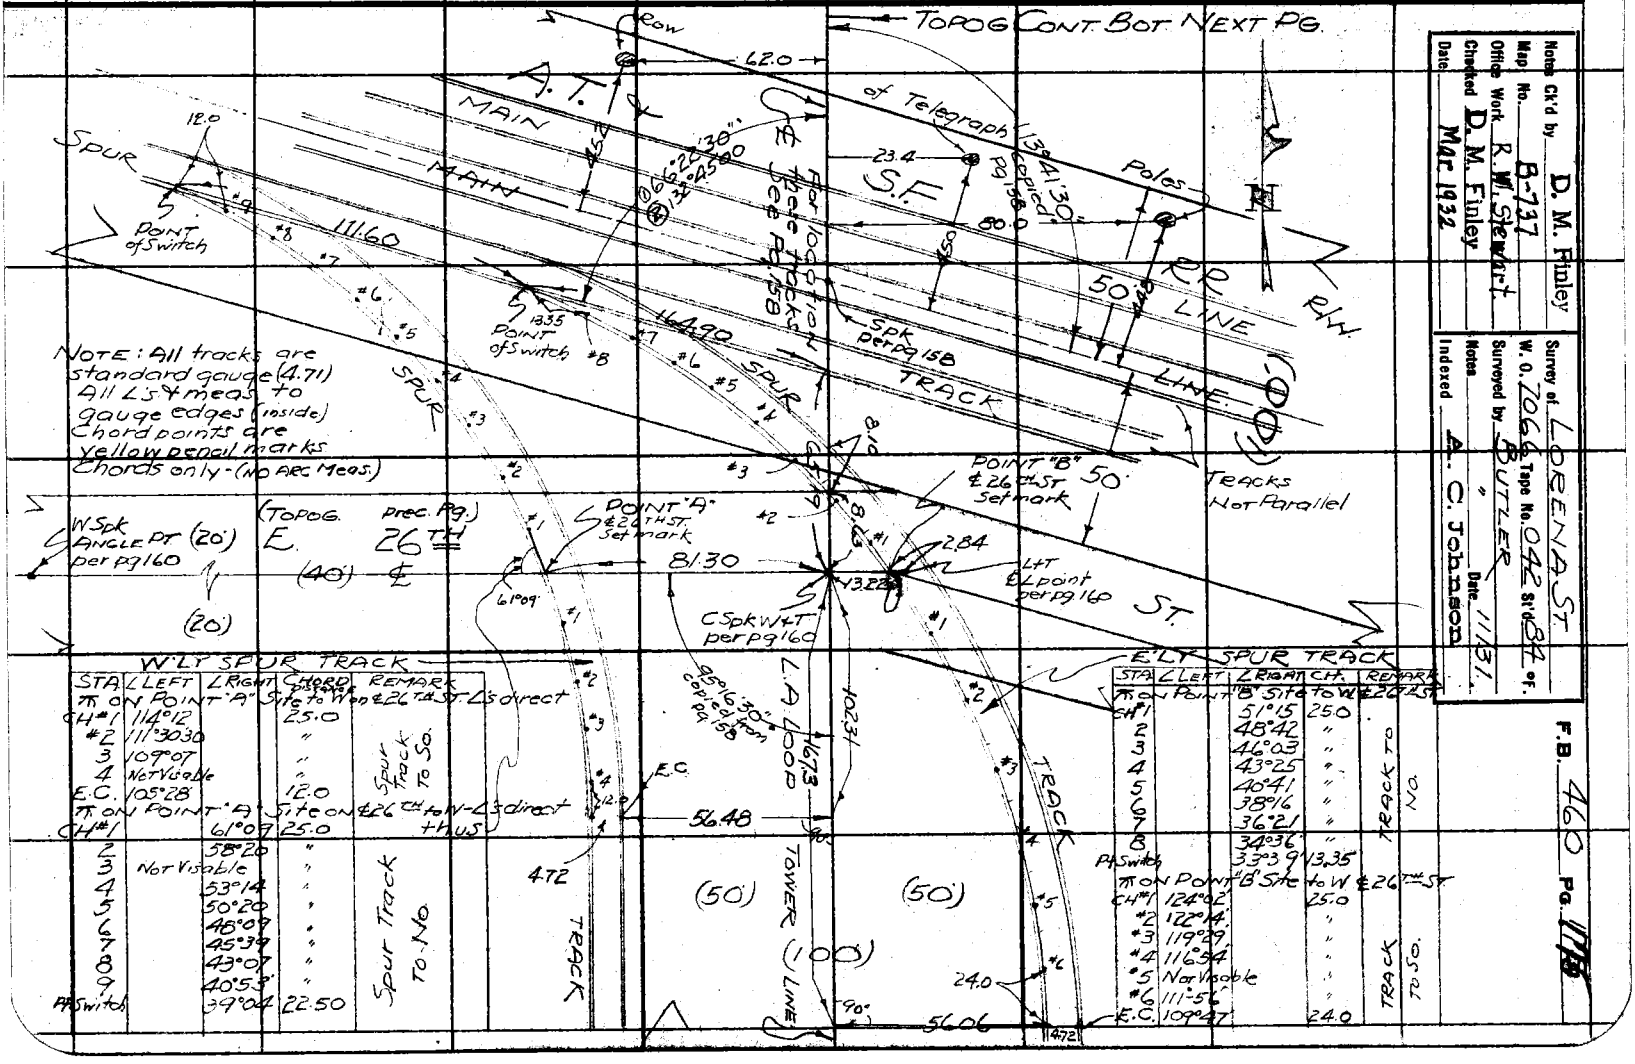

NOTE: All tracks are standard gauge (4.71)
All L's & meas to gauge edges (inside)
Chord points are yellow pencil marks
Chords only - (No Arc Meas)

W'LY SPUR TRACK

STA	∠ LEFT	∠ RIGHT	CHORD	REMARKS
	ℸ on POINT "A"		Site to W ℄ 26TH ST. L's direct	
CH #1	114°12'		25.0	
#2	111°30'30		"	
3	109°07'		"	
4	Not Visable		"	Spur Track to So.
E.C.	105°28'		12.0	
	ℸ on POINT "A"		Site on ℄ 26TH to W L's direct + N & S	
CH #1		61°09'	25.0	
2		58°20'	"	
3	Not Visable		"	
4		53°14'	"	
5		50°20'	"	
6		48°07'	"	
7		45°39'	"	Spur Track to No.
8		43°07'	"	
9		40°53'	"	
PA Switch		39°04'	22.50	

E'LY SPUR TRACK

STA	∠ LEFT	∠ RIGHT	CH.	REMARKS
	ℸ on POINT "B"		Site to W ℄ 26TH ST.	
CH #1		51°15'	25.0	
2		48°42'	"	
3		46°03'	"	
4		43°25'	"	
5		40°41'	"	
6		38°16'	"	Track to No.
7		36°21'	"	
8		34°36'	"	
PA Switch		33°39'	13.35	
	ℸ on POINT "B"		Site to W ℄ 26TH ST.	
CH #1	124°02'		25.0	
#2	122°14'		"	
#3	119°29'		"	
#4	116°54'		"	
#5	Not Visable		"	Track to So.
#6	111°56'		"	
E.C.	109°47'		24.0	

RETURN TO
LOS ANGELES COUNTY SURVEYOR
700 HALL OF RECORDS

Note: ANY ADDITIONS OR CHANGES ON THIS SHEET MUST BE MADE OR CIRCLED IN **Red Ink.** WITH DATE AND NAME OF PERSON MAKING CHANGE.

Do not extend notes this side of this line

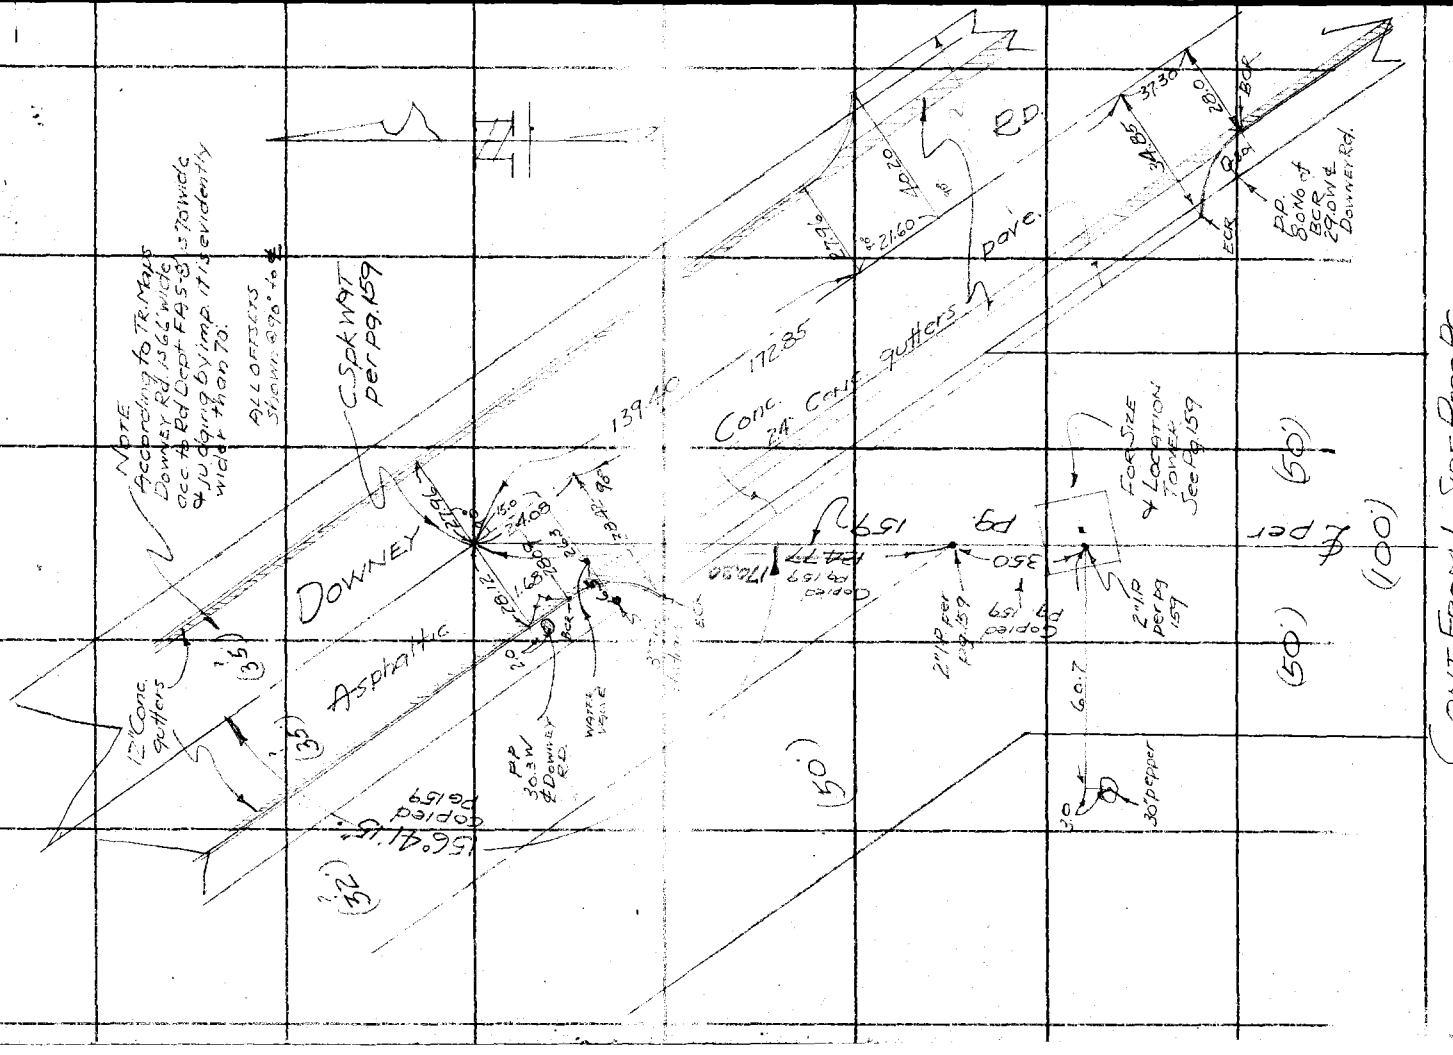

CONT. FROM L SIDE PREC. PG.

F.B. 460 PG. 176

FORM 247 10M 8-31

RETURN TO
LOS ANGELES COUNTY SURVEYOR
700 HALL OF RECORDS

Note: ANY ADDITIONS OR CHANGES ON THIS SHEET MUST BE MADE OR CIRCLED IN Red Ink, WITH DATE AND NAME OF PERSON MAKING CHANGE.

Do not extend notes this side of this line

Notes Ck'd by D. M. Finley
Map No. B-737
Office Work R. W. Stewart
Checked D. M. Finley
Date Mar 1932

Surveyed by Butler
" Date 12/31
Notes
Indexed A. C. Johnson

F.B. 460 Pg. 11

D 174-29-15
M 337-57-00
Adj 174-29-15

624.12 @ 68°

122.84 @ 62°

Ca
T + P
A

Fd 2" I.P. with Cap flush per 714-42 FB 700/96 mkd

122.84 @ 62°

5°30'45" (Calc)
5°30' (Rec per FB 700/96

Fd Bolt with + in pave per 714-42 FB 700/96 Ties N.G.

Fd 4" pipe Set in Conc. with 8" coil mkd L.A.C.E. 158 per FB 700/97

(40')
624.06'
(80')
(40')

3999
40.0 (R)

122.83'
122.79' (R)

BANDINI

CONT. BOT (R) PG. 179

Fd 2" I.P. flush with Cap mkd per FB 714-43 700/97

BLVD.

LAGUNA ST.

839.26 @ 64°

122.83'
122.79' (R)

400.2
400.0' (R)

Fd 2 x 2 Hk per FB 700/98 714-44

400'

837.15'

500.0

Fd Bolt with + in pave per FB 700/96 · 714-42
STA 10+85.0 Hk = 10+88.38 AHD.

174° 29' 15"

Record Curve DATA per FB 700/96 · 714-42
Δ = 5°30'.
& R = 2556.50'.
T = 122.79'.
L = 245.41'.

Fd Bolt with + in pave = Sta 8+38.38 per F.B. 700/97 714-43

Fd 2" I.P. with B.C. + cut No other mark - flush per F.B. 700/98 714-44

Fd 3¼" I.P. P.T. 12" DN IN 6" C.I. Casing & Lid per FB 700/98 & F.C. 679/6'
= STA 714-44 0+00 = W'LY per F.B. 700/98

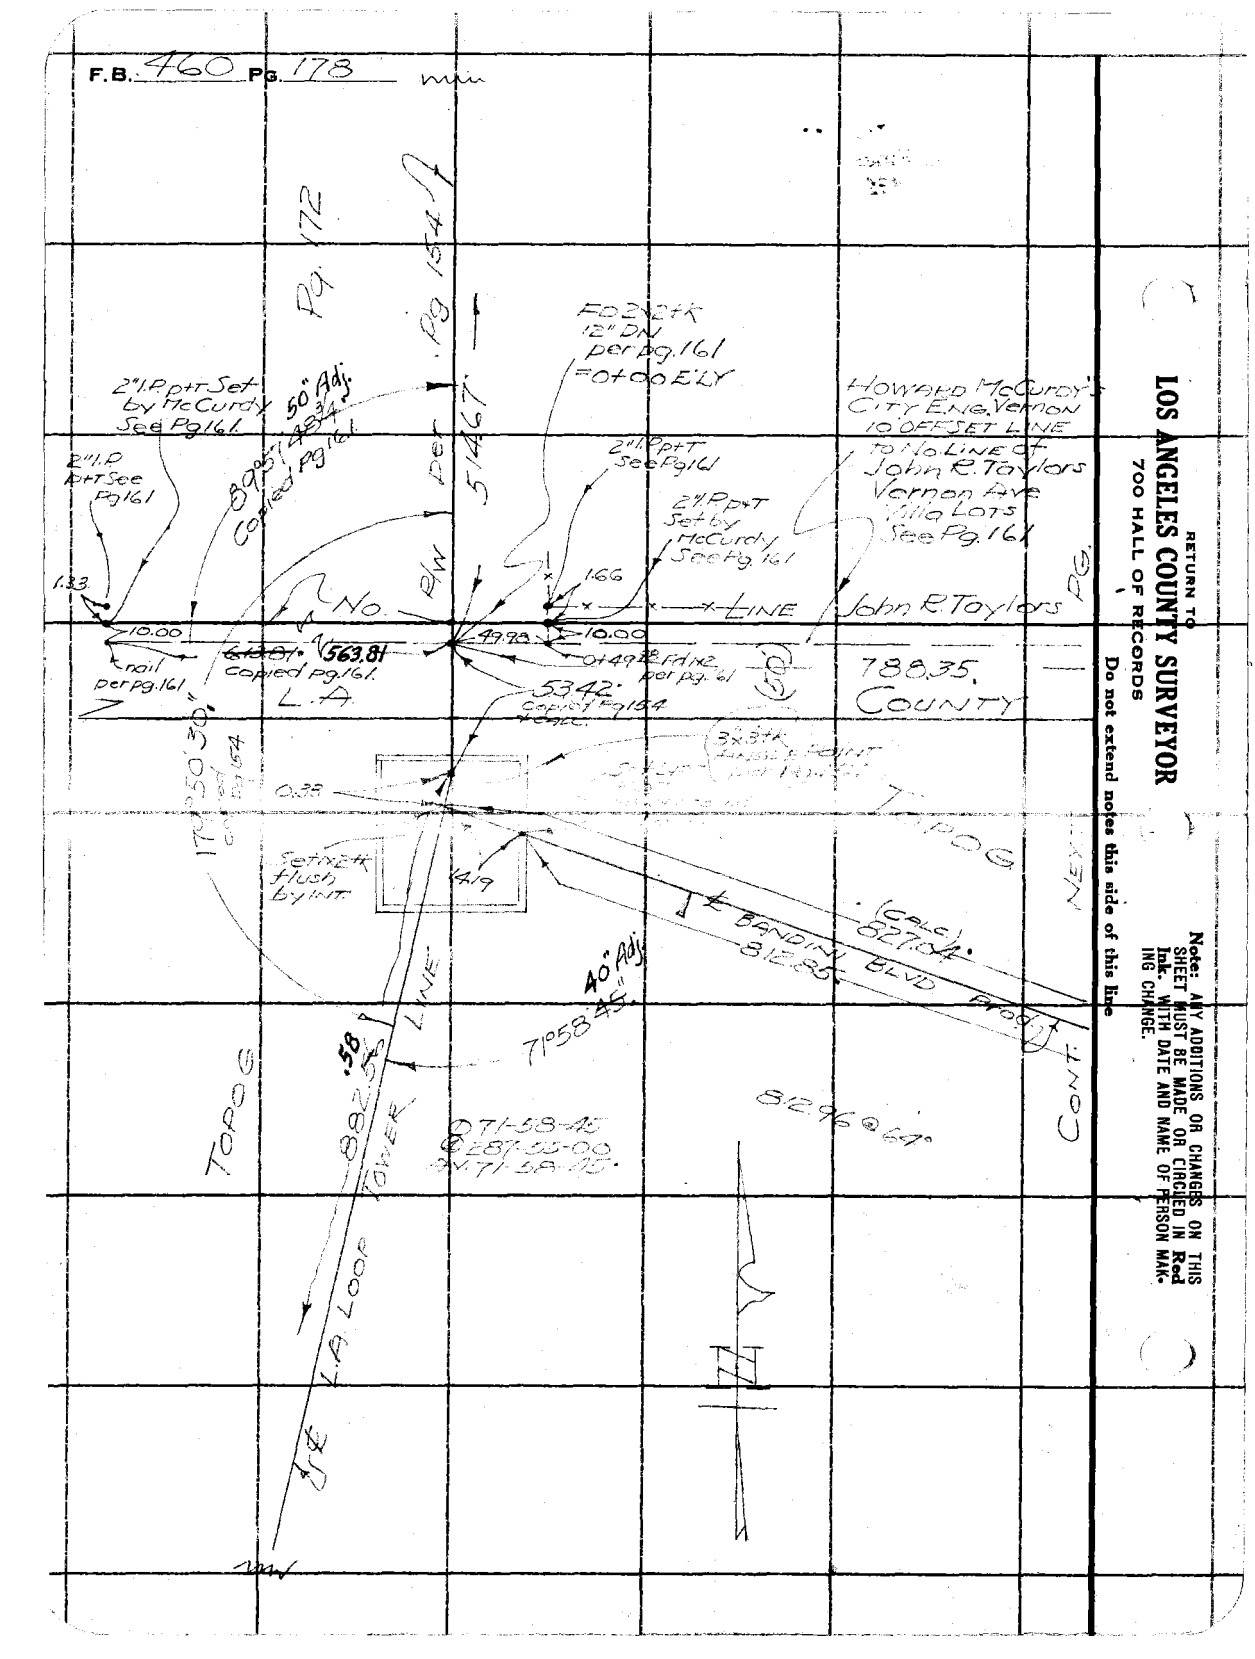

RETURN TO
LOS ANGELES COUNTY SURVEYOR
700 HALL OF RECORDS

Do not extend notes this side of this line

Note: ANY ADDITIONS OR CHANGES ON THIS SHEET MUST BE MADE OR CIRCLED IN Red Ink. WITH DATE AND NAME OF PERSON MAK-ING CHANGE.

Notes Ck'd by D. M. Finley
Map No. B-737
Office Work R. W. Stewart
Checked D. M. Finley
Date Mar. 1932

Survey of LORENA ST.
W. O. 7066 Tape No. 042 St'd 84 °F.
Surveyed by BUTLER
" Date 12/31
Notes
Indexed A. C. Johnson

F.B. 460 PG. 179

Fd L+T prod in Cb. per L.A. Co. Bridge Dept Notes of Job #08-349. used for line

788.49 @ 58°

10' OFFSET LINE.

Fd N+T Set by McCurdy City Engr. Vernon per his FBS 35 X 107 X 36/61

NOTE: N+T checks o/190. ON & DOWNEY & ON 10' OFFSET LINE TO W. Reset CSpk W+T Ties pg. 182

Vernon Ave Villa Lots A

100

(40)

788.35.

FLOOD CONTROL R/W (50)

See also Pg. 161

Rec

(80)

89-32-30

@ 358-10-00

L.A. & S.L. R/W

31.26

31.32 @ 66°

Pg 180

Pg 181

(CALC) 82.04

BANDINI BLVD PROJ

81.85.

Cont. from

107-41-15

@ 70-44-45

AH 107-41-11 1/4

107 41 11 1/4

10" Alj.

SPUR

MAIN LINE

60.42

0.04

(40)

62.406

(40) BANDINI BLVD.

Cont. from Bot Pg 177

Ties Pg 182 Note: Tie on Bridge Note

F.O. CSpk W. per L.A. Co. Bridge Dept Notes of Job #08-349 Notes Spk is punched but by transit in on & Downey R.R. LINE is 0.04 E of punch or on E edge Spk

THIS LINE TO CSpk W. @ Vernon Ave (E'LY Spk) See Pg. 156

Fd nail on split main line Track FB 460 pg 179 L.A. Co Bridge Dept Notes of Job #08-349 Call for N+T.

RETURN TO
LOS ANGELES COUNTY SURVEYOR
700 HALL OF RECORDS
Do not extend notes this side of this line

Note: ANY ADDITIONS OR CHANGES ON THIS SHEET MUST BE MADE OR CIRCLED IN Red Ink, WITH DATE AND NAME OF PERSON MAKING CHANGE.

FORM 247 10M 8-31

F.B. 460 PG. 180

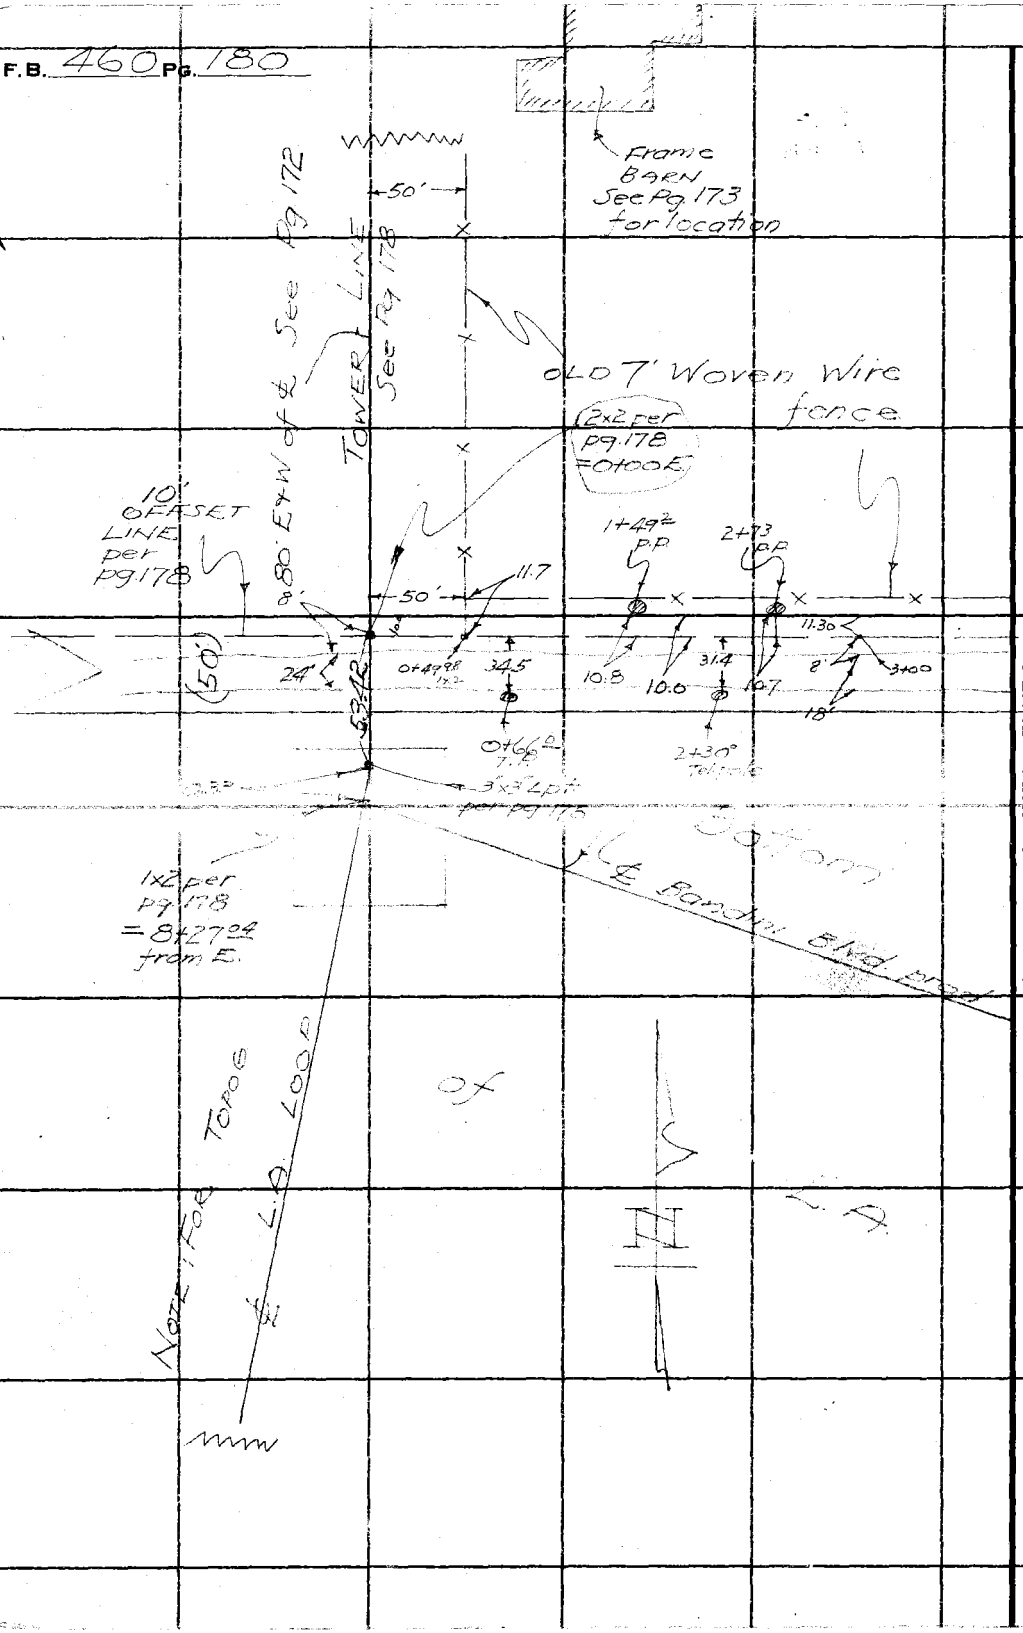
Frame BARN See Pg 173 for location
50'
TOWER LINE See Pg 178
0.80' E+W of ℄ See Pg 172
OLD 7' Woven Wire fence
2x2 per pg 178 = 0+00.0E
10' OFFSET LINE per pg 178
1+49.2 P.P
2+73 P.P
11.7
11.30
24'
0+49.98
34.5
10.8
10.0
3.14
10.7
8'
3+00
18'
0+66.0
2+30° Tangent
3x3 Lpt per pg 175
1x2 per pg 178 = 8+27.04 from E.
Bottom
℄ Bandini Blvd. proj
Note: For Topo ℄ L.A. Loop
℄
Note: ANY ADDITIONS OR CHANGES ON THIS SHEET MUST BE MADE OR CIRCLED IN Red Ink. WITH DATE AND NAME OF PERSON MAKING CHANGE.
RETURN TO
LOS ANGELES COUNTY SURVEYOR
700 HALL OF RECORDS
Do not extend notes this side of this line

Notes Ck'd by D. M. Finley | Survey of LORENA ST.
Map No. B-737 | W. O. 7086 Tape No. 042 St'd 84 °F.
Office Work R. W. Stehn | Surveyed by BUTLER
Checked D. M. Finley | Notes " Date 12/31
Date Mar. 1932 | Indexed CONTRACT DEPT.

F.B. 460 Pg. 181

Notes: ANY ADDITIONS OR CHANGES ON THIS SHEET MUST BE MADE OR CIRCLED IN Red Ink. WITH DATE AND NAME OF PERSON MAKING CHANGE.

Do not extend notes this side of this line

RETURN TO
LOS ANGELES COUNTY SURVEYOR
700 HALL OF RECORDS

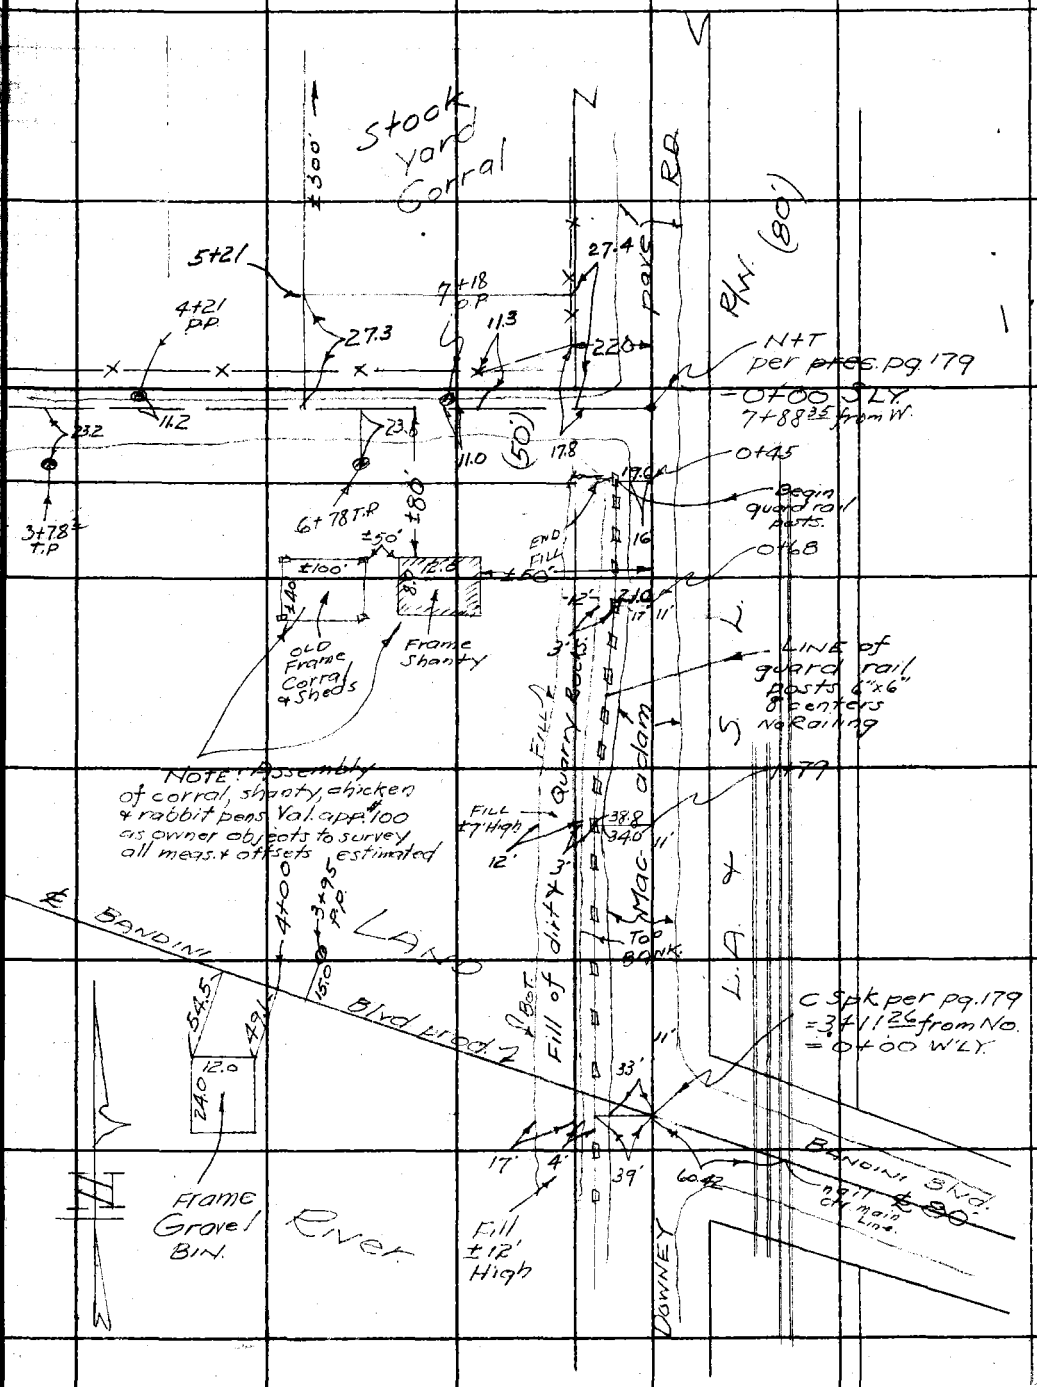

FORM 247 10M 8-31

F.B. 460 Pg. 182

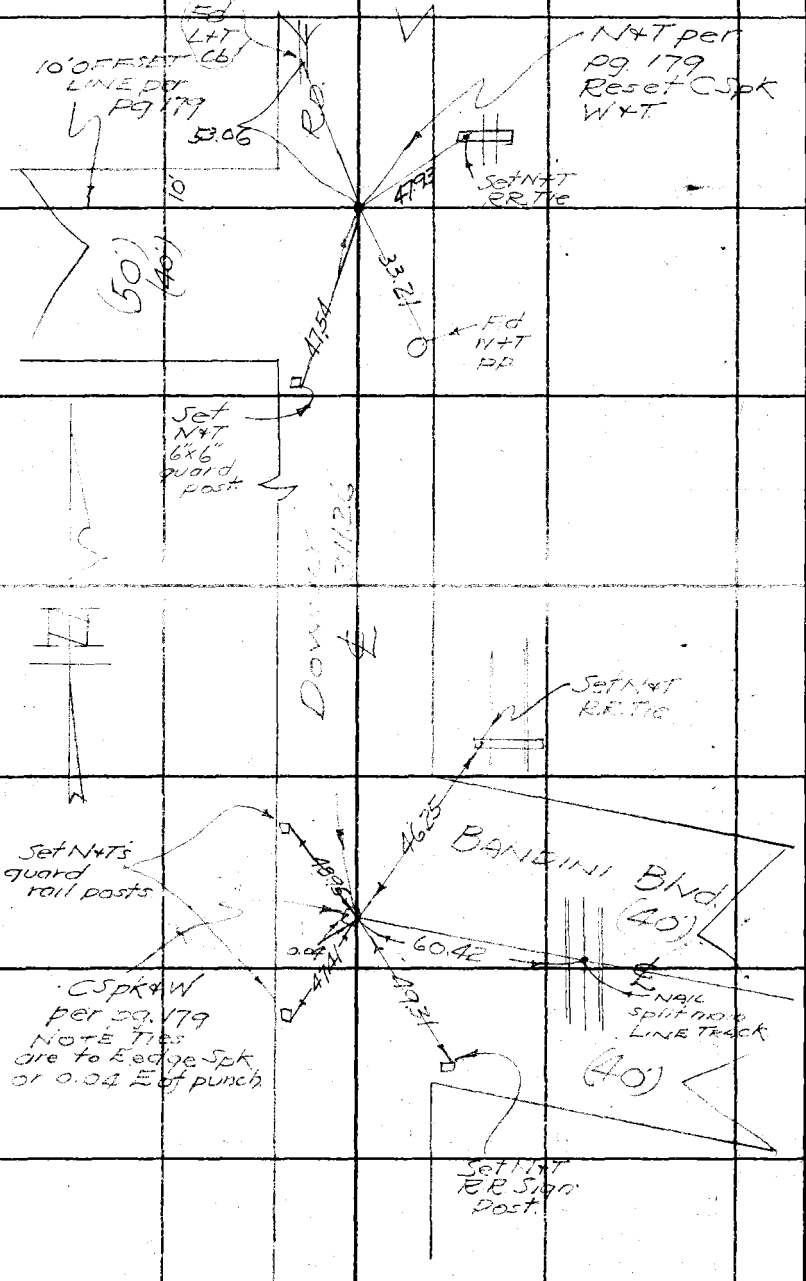

RETURN TO
LOS ANGELES COUNTY SURVEYOR
700 HALL OF RECORDS

Do not extend notes this side of this line

Note: ANY ADDITIONS OR CHANGES ON THIS SHEET MUST BE MADE OR CIRCLED IN Red Ink. WITH DATE AND NAME OF PERSON MAKING CHANGE.