Notes Ck'd by		Survey of		F.B.	PG.
Map No.		W. O.	Tape No.	St'd	°F.
Office Work		Surveyed by			
Checked		Notes	Date		
Date		Indexed			

A81

LOS ANGELES COUNTY SURVEYOR
700 HALL OF RECORDS

Note: Any Additions or Changes on This Sheet Must Be Made by Office Only and Noted on Master Mailing Chart.

FORM 247 10M 11-58

F.B. 481 PG. Index

F.B. 481

PAGES: Index, , 3 to 6 incl., , 8 to 31 incl., , 33 to 40 incl., , 43 to 49 incl., , 51 to 89 incl., , 91 to 119 incl., , 121 to 137 incl., , 139, , 141 to 149 incl., , 151 to 161 incl., , 163 to 167 incl., , 169 to 195 incl.,

RETURN TO LOS ANGELES COUNTY SURVEYOR 140 HALL OF RECORDS

Do not extend notes this side of this line

Note: Any Additions or Changes on This Sheet Must be Made or Circled in Red Ink With Date and Name of Person Making Change.

Notes Ck'd by D. M. Finley
Map No. B-639
Office Work
Checked
Date

Survey of Coyote Ck. Diag. Div. 3
W. O. 995 Tape No. St'd °F.
Surveyed by Rosecrans + Hammond
Notes Date
Indexed A. C. Johnson 2-27-32

F.B. 481 Pg. 3

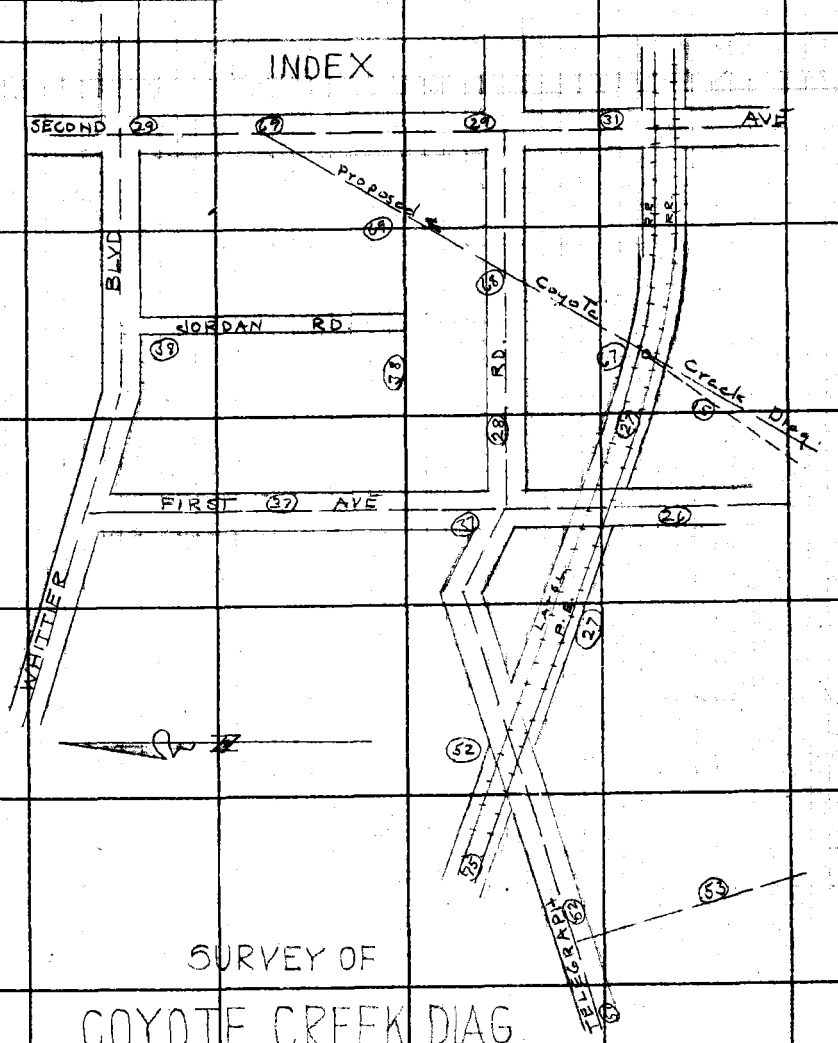

SURVEY OF
COYOTE CREEK DIAG
DIVISION 3
W.O. 995
MAY 1931 JAN. 1932

E.A. Rosecrans — L.S. Hammond
C.M. Helm — H.S. Johnson
C.R. Lawson — L.H. Fenner
L.E. Muse — L.C. Wilson
H.W. Gunderson

Note: ANY ADDITIONS OR CHANGES ON THIS SHEET MUST BE MADE OR CIRCLED IN Red Ink WITH DATE AND NAME OF PERSON MAKING CHANGE.

Do not extend notes this side of this line

RETURN TO
LOS ANGELES COUNTY SURVEYOR
700 HALL OF RECORDS

FORM 247 10M 8-31

RETURN TO
LOS ANGELES COUNTY SURVEYOR
700 HALL OF RECORDS

Note: ANY ADDITIONS OR CHANGES ON THIS SHEET MUST BE MADE OR CIRCLED IN **Red Ink.** WITH DATE AND NAME OF PERSON MAKING CHANGE.

Do not extend notes this side of this line

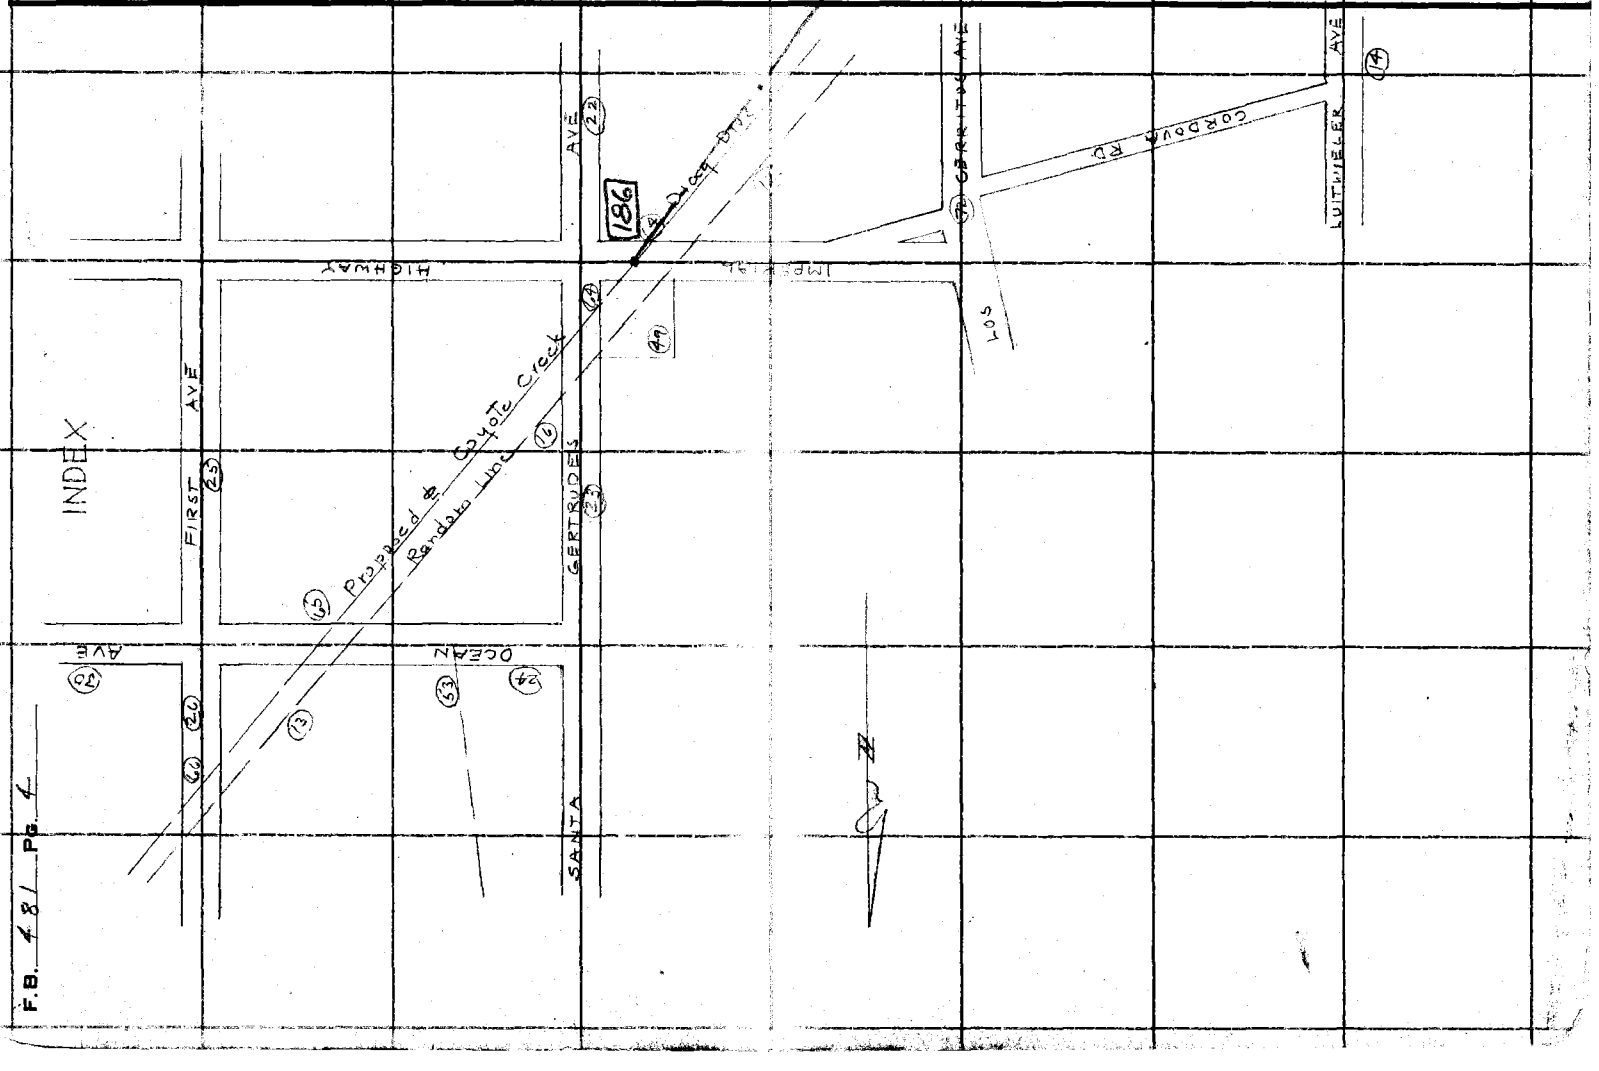

F.B. 481 Pg. 4

Notes Ck'd by D. M. Finley	Survey of Coyote Ck Diag Div 3
Map No. B-633	W. O. 925 Tape No. St'd °F.
Office Work	Surveyed by L. S. Hammond
Checked	Notes L. S. H Date Dec 1931
Date	Indexed A. C. Johnson

F.B. 481 Pg. 5

Note: ANY ADDITIONS OR CHANGES ON THIS SHEET MUST BE MADE OR CIRCLED IN Red Ink WITH DATE AND NAME OF PERSON MAKING CHANGE.

Do not extend notes this side of this line

RETURN TO
LOS ANGELES COUNTY SURVEYOR
700 HALL OF RECORDS

INDEX

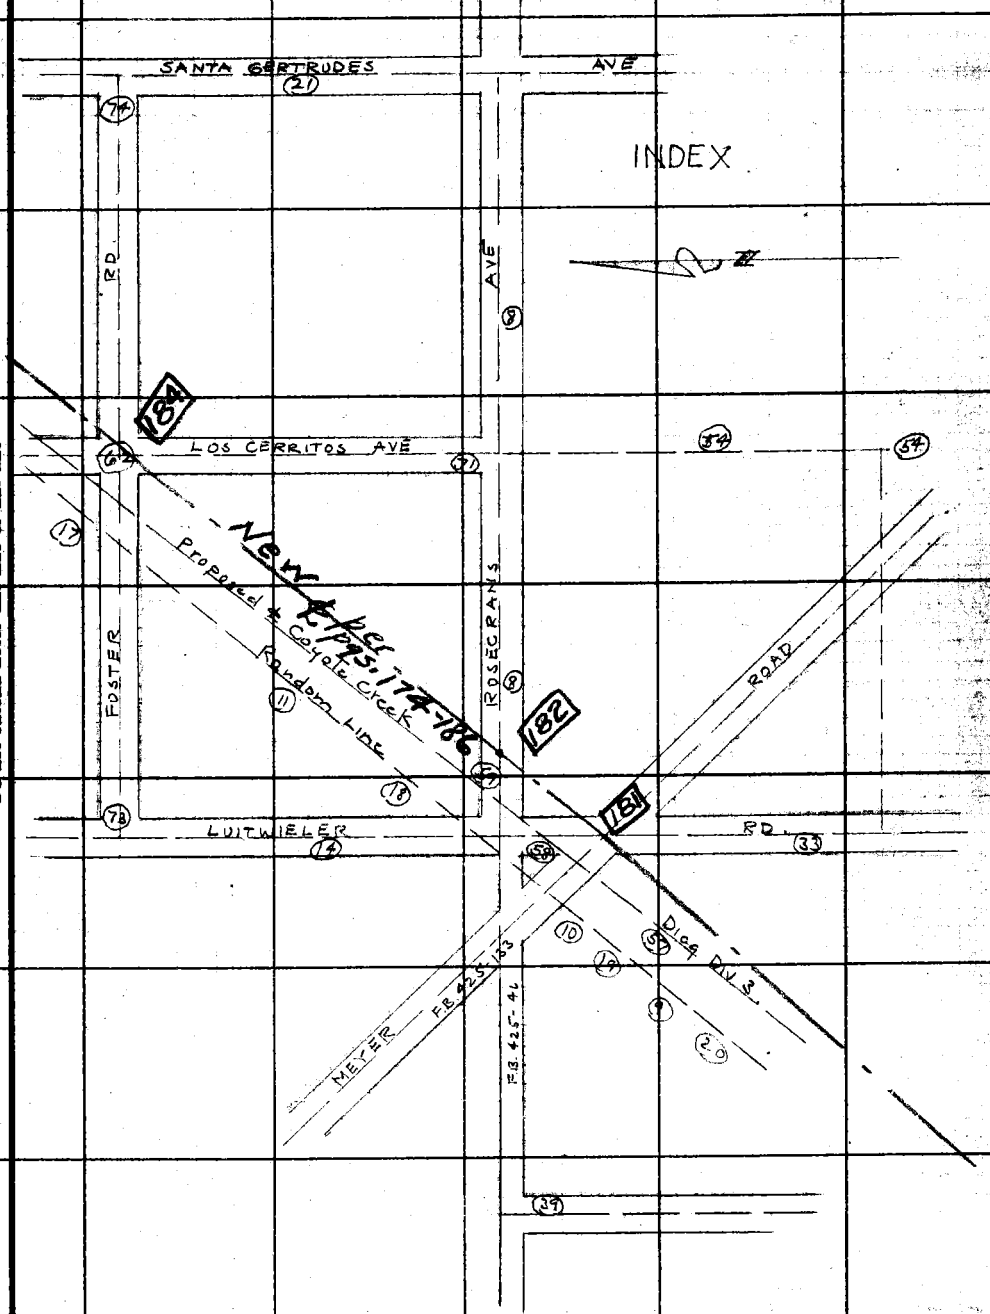

FORM 247 10M 8-31

RETURN TO
LOS ANGELES COUNTY SURVEYOR
700 HALL OF RECORDS

Note: ANY ADDITIONS OR CHANGES ON THIS SHEET MUST BE MADE OR CIRCLED IN **Red Ink.** WITH DATE AND NAME OF PERSON MAKING CHANGE.

Do not extend notes this side of this line

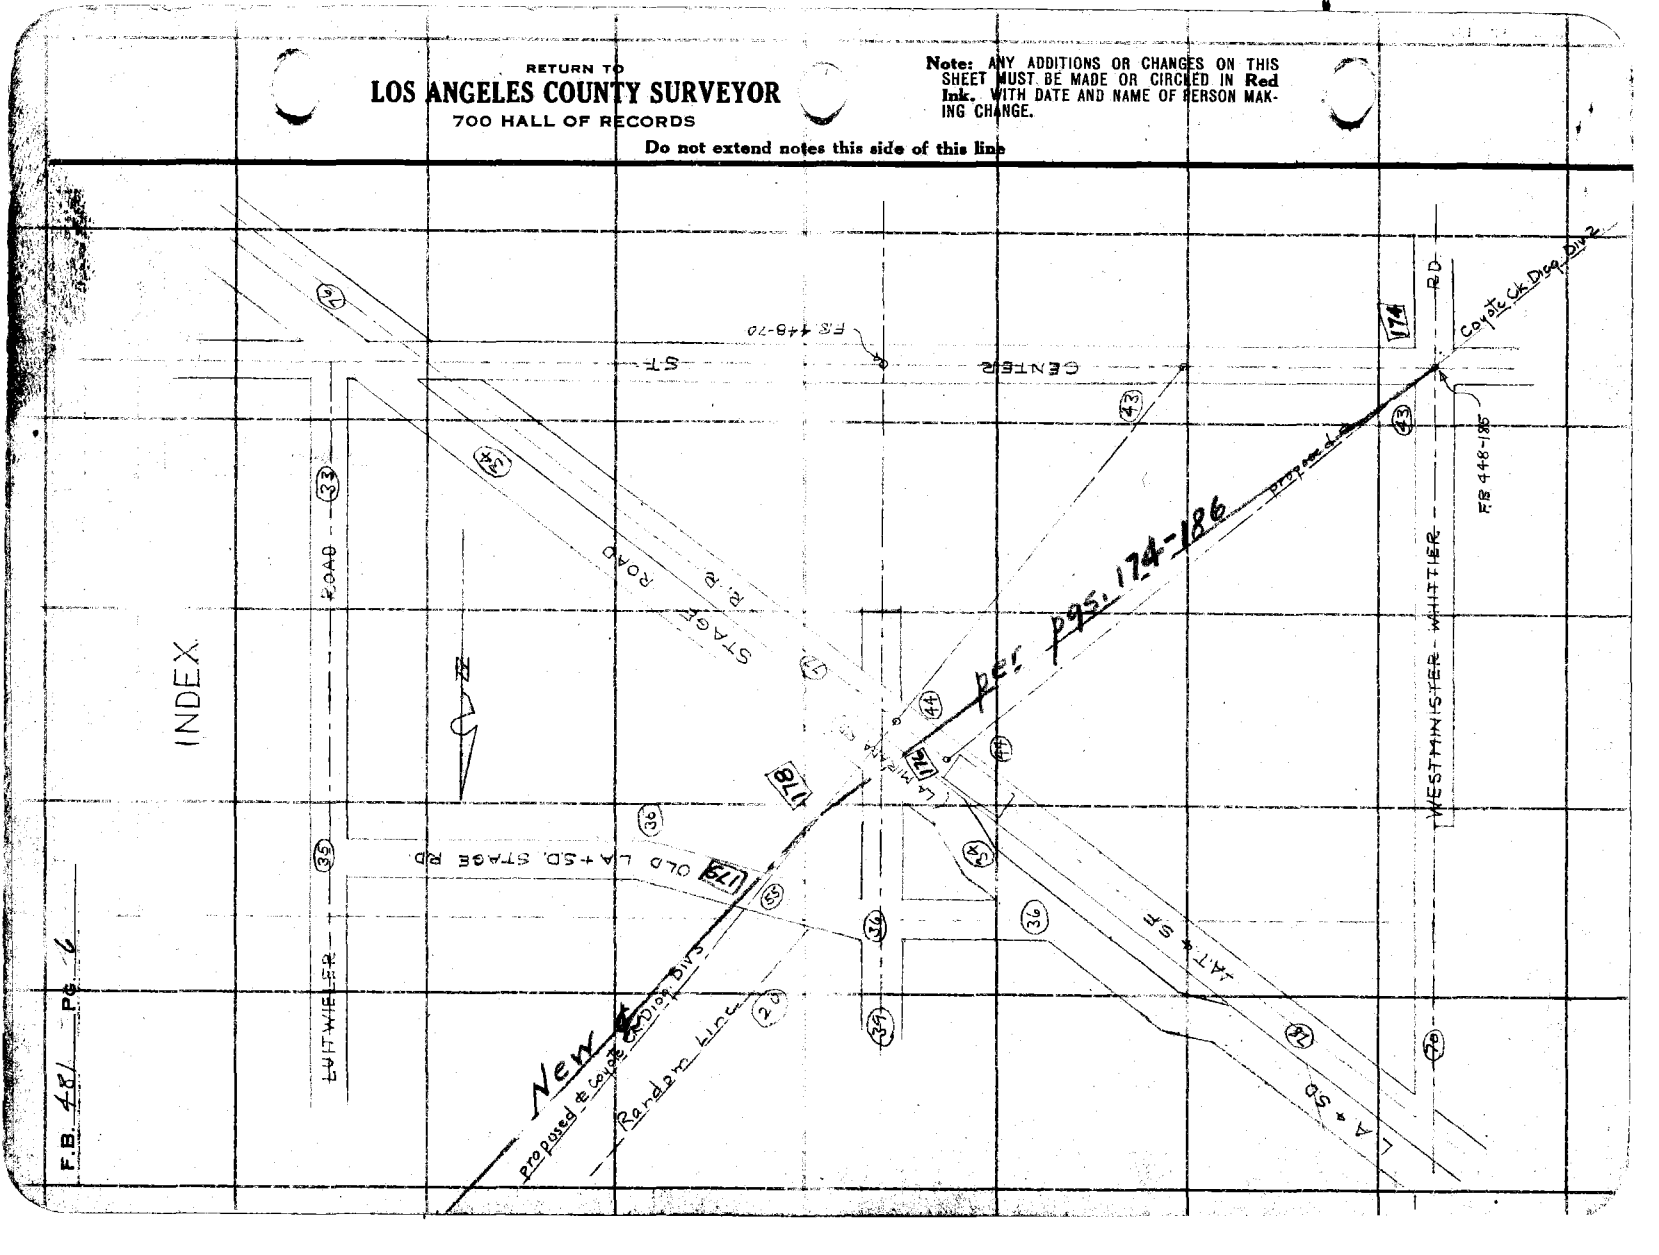

Date _____ Notes by _____ Chief Party _____ F.B. 481 PG. 7

Platted by	W. O. No. 995 D. T. O. No.
Date	Location Cejate Ck. Diag.
Map No.	Surveyed by Rosecrans
Platting C'k'd by	Date June 1931
Date	Indexed A. C.

Notes: ANY ADDITIONS OR CHANGES ON THIS SHEET MUST BE MADE OR CIRCLED IN Red. WITH DATE AND NAME OF PERSON MAKING CHANGE.

Do not extend notes this side of this line

RETURN TO
LOS ANGELES COUNTY SURVEYOR

F.B. 481 Pg. 8 Rosecrans Chief Party Notes by Date 5-8-31

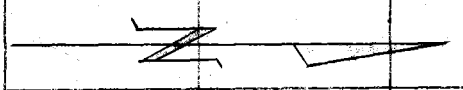

Sec. Cor. Sta 53+26.49 Fr E
Fd 2" I.P. with 3 nails used
center nail. F.B. 425-46
L.S. 15-28

(100' tape Stand @ 76°)

Sec line 4 of S.
F.B. 425-46

539.69 T. 76

86.80
Sta. 47+85.89 Set 2x2
15" Dn.

89°-46'-15"
359°-05'-15"
89°-41'-19"

59.31
Sta 39+58.34 Set 1x2
Flush.

89-46-36
359-04-15
89-46-37

61.42
Sta. 34+60.45 Set 1"x2"
8" Dn.

T. 3 S. R. 11 W.

PET. SEC. 20

N.W. Cor. Sec 14 Fd.
2" I.P. in Conc. 6" Dn
F.B. 258-28+30
C.S.B. 318-2

Set N+T. in P. pole
68.34' @ 00 = 68.34'
199.11 @ 00 = 199.11'
62.00 @ 00 = 62.00'
100.13 @ 7-51 = 99.19'
100.13 @ 00 = 100.13'
99.66 @ 00 = 99.66'
100.46 @ 7-43 = 99.55'
100.17 @ 9-18 = 98.85'
827.44 T. 86 = 827.49

90-04-45
360-18-30
90-04-37 V

497.89 T. 76

797.81 T. 80 = 797.81

E Rosecrans Ave

Fd. 2x2 Flush Z 73-12
Set N+T. in P. pole

63.59
Sta. 26+62
Fd 4" I.P. with brass cap marked as shown flush.
Fd. 4"x4" pine 1' high.

2-9.03 +
198.96'

198.92 T. 80 = 198.96

13.44 Set N+T. in S.W. Cor of Yard.

959.12 - .80 = 858.14

34.24

41.62 Set N+T. water tank platform

Sta. 24+68.06 Set 2x2
8" Dn. 64.63

06.49
Sta. 16+05.57 Set 1"x2"
8" Dn.

Sta. 9+44.67 Set 2x2
12" Dn.

Set N+T. in P. pole

502.37 T. 76

Sec. Line

Sta. 4+42.30 Set 1"x2"
8" Dn.

442.30 T. 76

Sec. Cor. Sta. 0+00 No 14
Fd 6"x6" and nail
Flush Z 73-12
Tr. 332 ft M.B. 36-74

RETURN TO
LOS ANGELES COUNTY SURVEYOR

Do not extend notes this side of this line

Notes: ANY ADDITIONS OR CHANGES ON THIS SHEET MUST BE MADE OR CIRCLED IN Red. WITH DATE AND NAME OF PERSON MAKING CHANGE.

Date 6 Notes by Chief Party F.B. 481 PG. 8

Plotted by
Date
Map No. B-633
Plotting C'k'd by
Date

W. O. No. 995 D. S. O. No.
Location Coyote Ck Diag.
Surveyed by Rosecrans
Date 5-16-31
Indexed A. C. Johnson
6-27-32

Cont. bottom next page

Cont. bottom next page

Note: ANY ADDITIONS OR CHANGES ON THIS SHEET MUST BE MADE OR CIRCLED IN Red. WITH DATE AND NAME OF PERSON MAKING CHANGE.

Do not extend notes this side of this line

RETURN TO LOS ANGELES COUNTY SURVEYOR

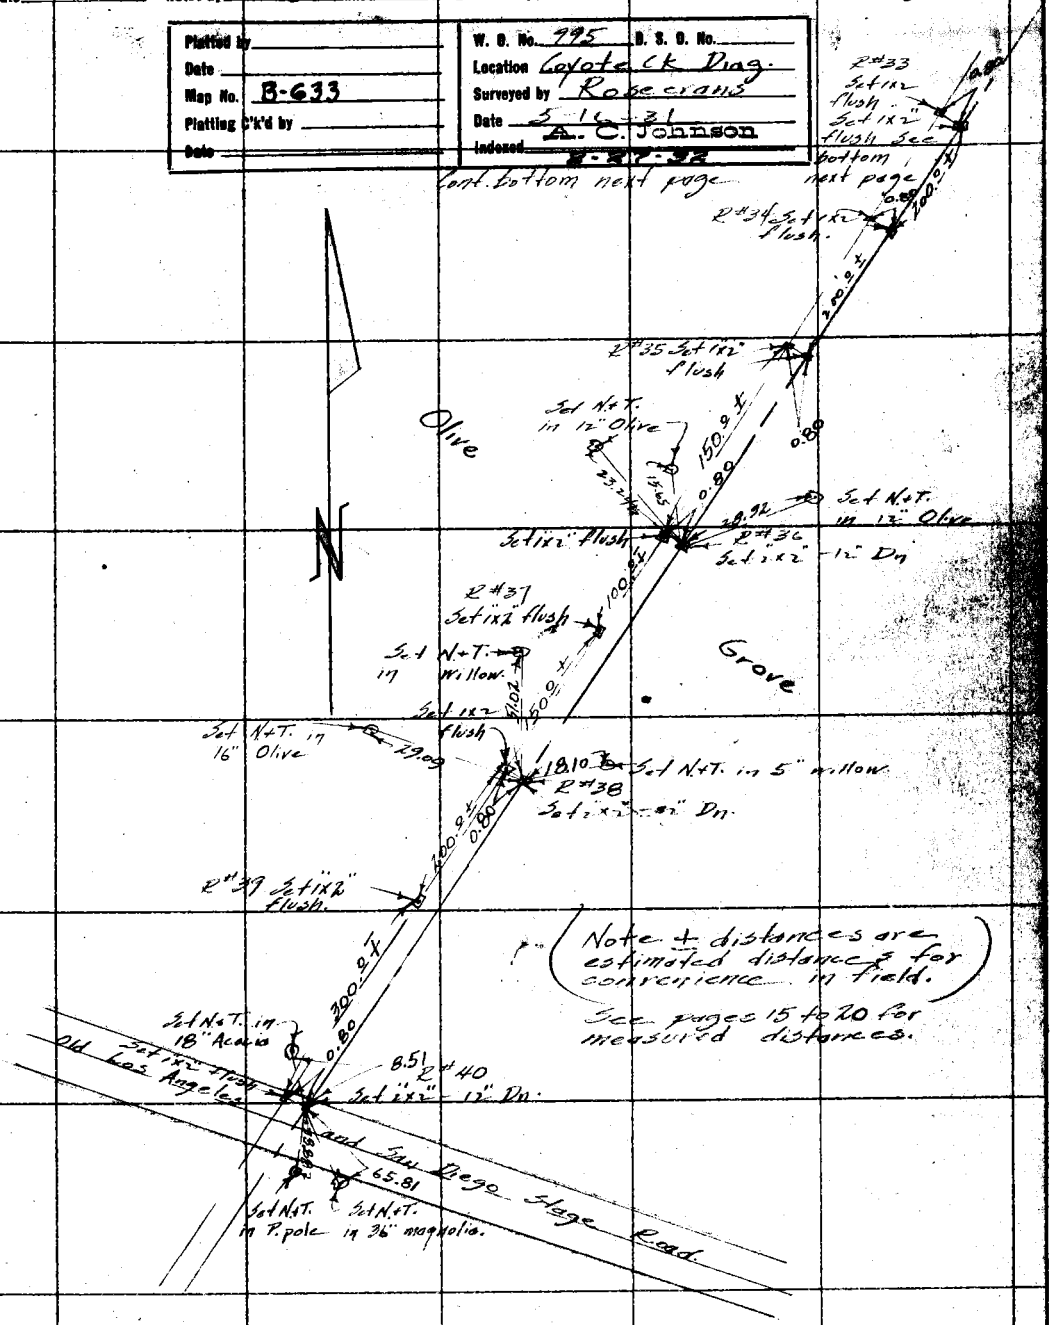

Note ± distances are estimated distances for convenience in field.

See pages 15 to 20 for measured distances.

F.B. 481 Pg. 10 Rosecrans Chief Party Notes by Date 5-16-31

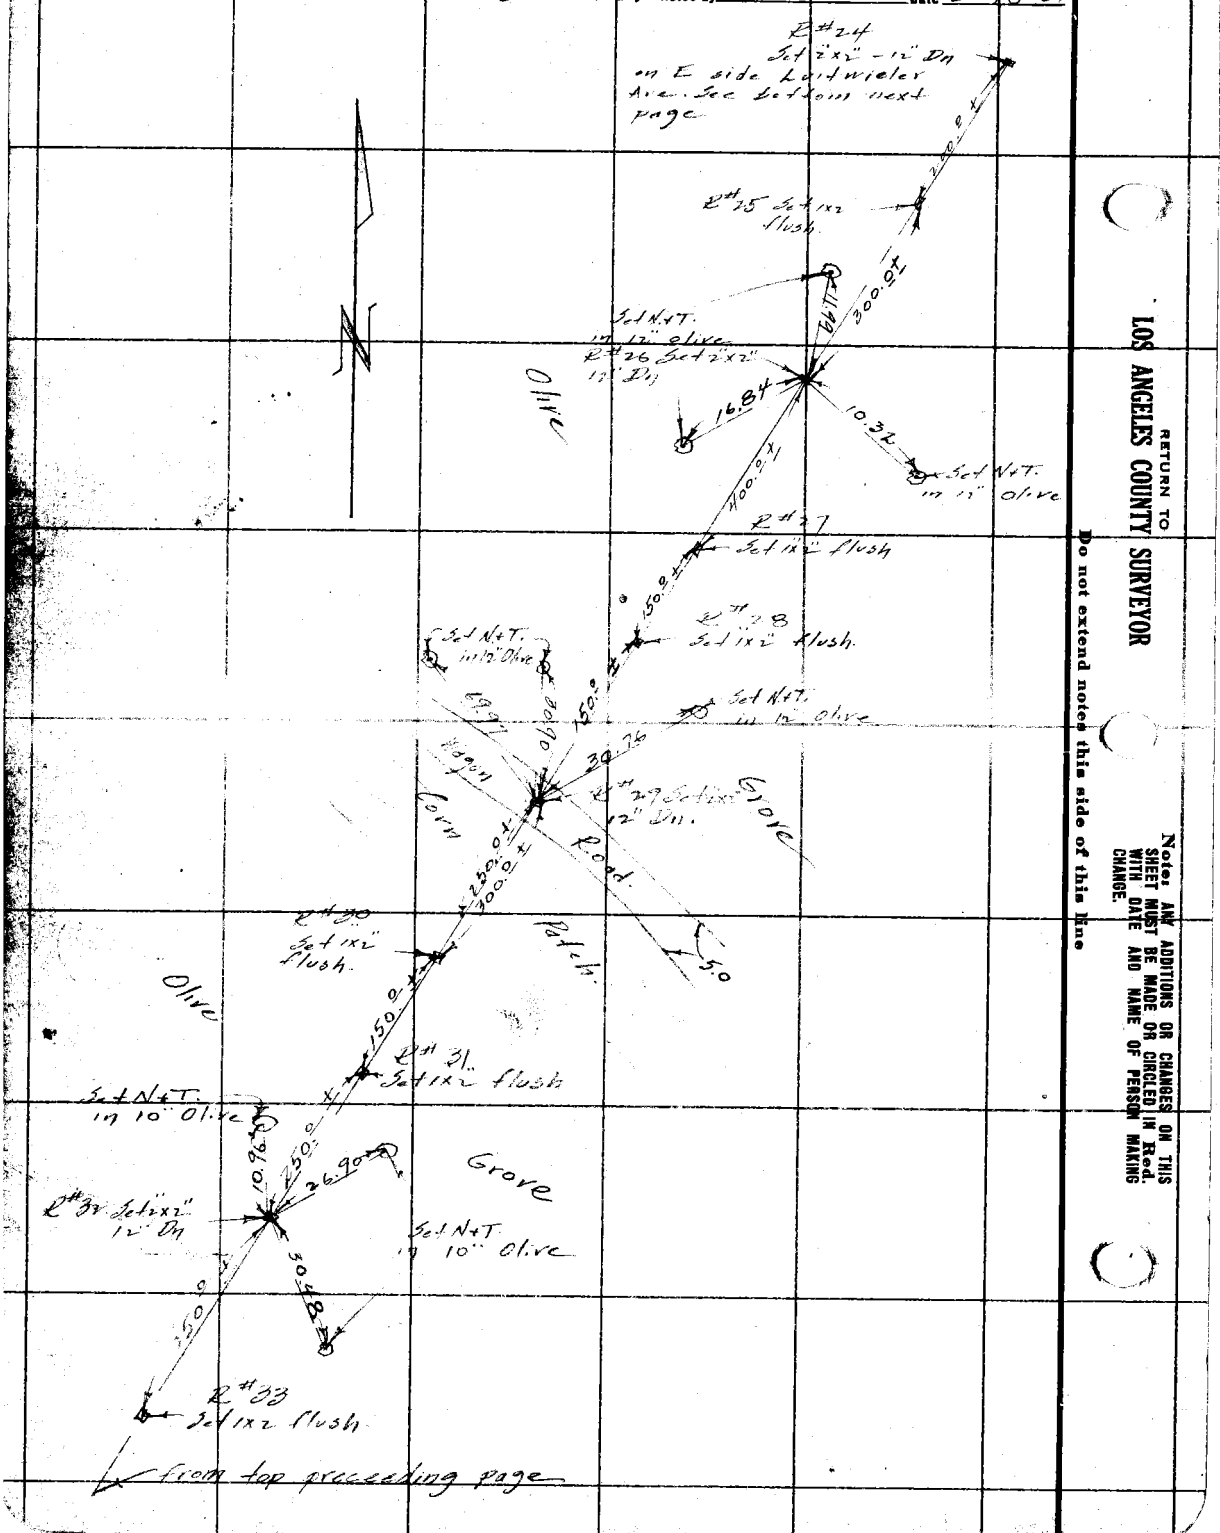

RETURN TO
LOS ANGELES COUNTY SURVEYOR

Do not extend notes this side of this line

Note: ANY ADDITIONS OR CHANGES ON THIS SHEET MUST BE MADE OR CIRCLED IN Red. WITH DATE AND NAME OF PERSON MAKING CHANGE.

Date _____ Notes by _____ Chief Party _____ F.B. 481 Pg. 11

Platted by _____
Date _____
Map No. B-633
Platting C'k'd by _____
Date _____

W. O. No. 995 D. S. O. No. _____
Location Coyote Ck. Diag.
Surveyed by Reservoirs
Date 5-15-31
Indexed A. C. Johnson

Notes: ANY ADDITIONS OR CHANGES ON THIS SHEET MUST BE MADE OR CIRCLED IN Red. WITH DATE AND NAME OF PERSON MAKING CHANGE.

Do not extend notes this side of this line

RETURN TO LOS ANGELES COUNTY SURVEYOR

Cont bottom 443.01 T.72 = 443.00
next page

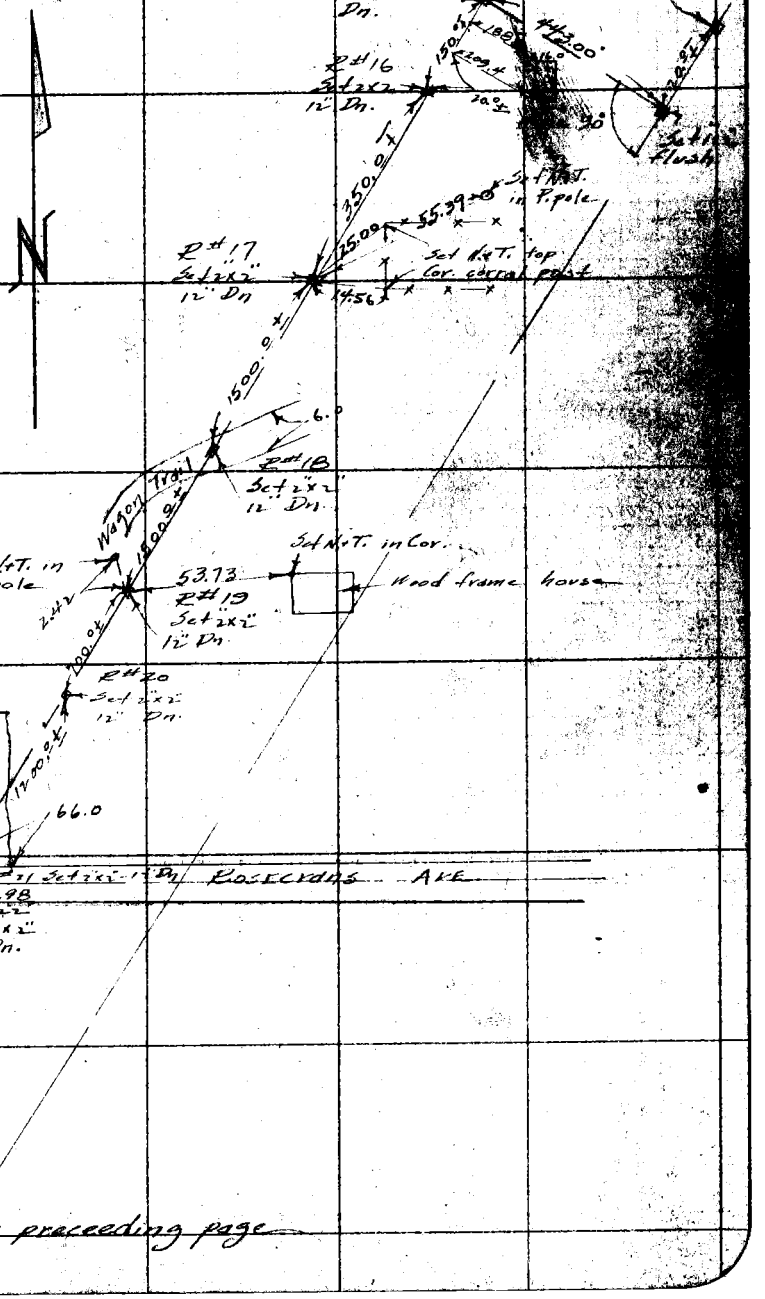

F.B. 481 Pg. 12 Rosecrans Chief Party Notes by Date 5-1-31

Cont. bottom next page

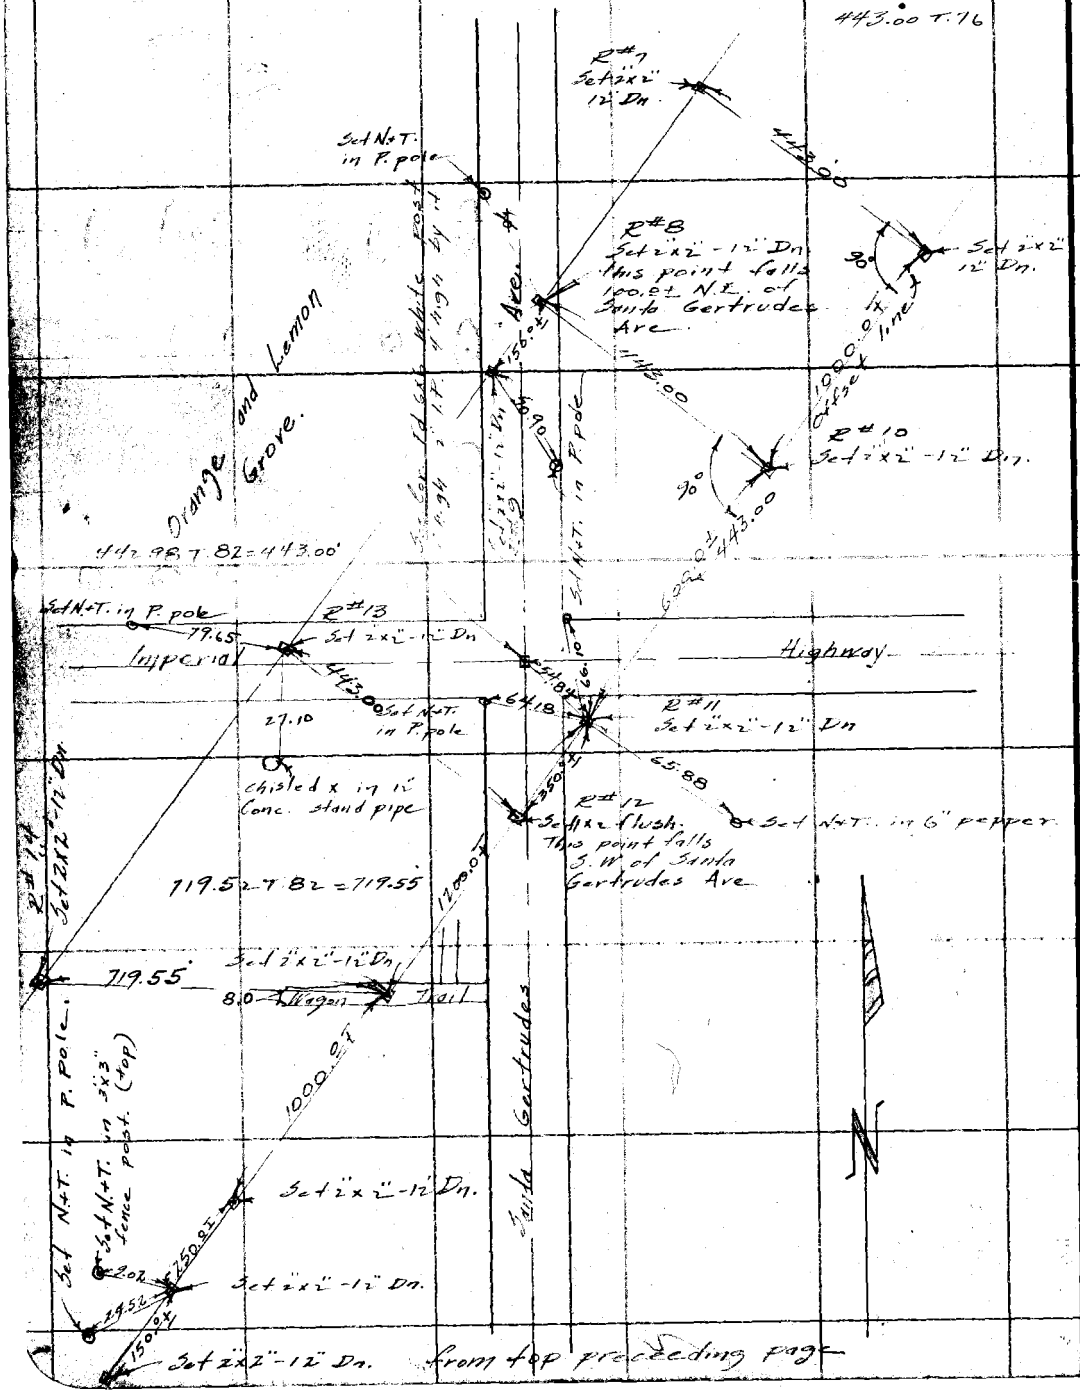

from top preceding page

RETURN TO
LOS ANGELES COUNTY SURVEYOR

Do not extend notes this side of this line

Note: ANY ADDITIONS OR CHANGES ON THIS SHEET MUST BE MADE OR CIRCLED IN Red. WITH DATE AND NAME OF PERSON MAKING CHANGE.

Date _____ Notes by _____ Chief Party _____ F.B. 481 Pg. 13

Platted by _____
Date _____
Map No. B-6
Platting C'k'd by _____
Date _____

W. O. No. 995 U. S. G. No. _____
Location Coyote Ck. Diag.
Surveyed by Rosecrans
Date 5-13-31
Indexed A. C. Johnson

Notes: ANY ADDITIONS OR CHANGES ON THIS SHEET MUST BE MADE IN CIRCLED IN Red. WITH DATE AND NAME OF PERSON MAKING CHANGE.

Do not extend notes this side of this line

RETURN TO LOS ANGELES COUNTY SURVEYOR

442.99 T. 78 = 443.00

S. L. A. R. R.

P. E. R. R.

E#1 Set ½"x2"-12" Dn. 53.13 18.43 51.75 443.00

Set N.+T. in P. pole. E#2 Set ½"x2" 12" Dn. 150.04

E#3 Set ½"x2" 12" Dn. 500.04 1620.04

E#4 Set ½"x2" 12" Dn. 83.6

Beach Ave.

4" Booster pump

443.00 Offset line

E#5 Set ½"x2" 12" Dn. 150.00

Ocean Drive

E#6 Set ½"x2"-12" Dn. 43. of traveled road. (Bridge)

Set N.+T. in P. pole. 15.57

E#7 Set ½"x2"-12" Dn. See Preceding page. 14.00 443.00

90°

Set ½"x2"-12" Dn. See preceding page.

F.B. 481 Pg. 14 Rose-crans Chief Party Notes by Date 5-20-31

Sta. 52+02.35
Sec. Cor. Fd 2" I.P. in
Conc. 6" Dn. F.B. 358-30
C.S. B 318-2

(Tape 3 Stand @ 76°)

10 11

15 14

2" I.P. C.S. B 318-2
F.B. 358-38

Tract 1 line
V 756.71
Per F.B. 358-39

986.45

986.377 88 = 986.45

T. 3 S. R. 11 W.

0.01
Fd 2"x2"-18" Dn, Set
arc 2" I.P. C.S. B 318-2
F.B. 358-30 Tr. 2973
M.B. 31-57

41.37

Sta. 43+15.90 Set
3/4" I.P. flush

O.K.
Sta. 26+61.17 Set Swt.
by por. For 1/4 Sec. Cor.

104° 59' 30"

1694.60

199.66 @ 1.94 = 199.88'
296.81 @ 3.50 T. 92 = 298.22 R. 3 Stand @ 60°
199.67 @ 00 T. 92 = 199.75'
1694.60'

104-59-30
419-58-00
104-59-30

2987

Sta. 36+21.30
Set 3/4" I.P. flush

400.37

400.33 T. 92 = 400.37'

Sta. 22+20.98
Set 3/4" I.P. - 2" Dn.

1421.53

Road

227.51 T. 94 = 227.54'
294.35 @ 3-20 T. 96 = 293.87'
900.00 T. 96 = 900.12'
1421.53'

84° Stand.

Set nail Sta. 7+99.40

Sta. 6+99.58 Fd.
3/4" I.P. 6" above

31.47
31.70

Sta. 6+99.41 Fd
4x4 marked
46 on N 2' above

799.40

399.30 T. 98° = 399.36'
400.00 T. 92 = 400.04'
799.40'

15 14

Sec. Cor. Sta. 0+00 to N.
Fd. 2" I.P. with 3
nails 6" Dn. used
center nail F.B. 426. 46
and 481-8

22 23

RETURN TO
LOS ANGELES COUNTY SURVEYOR
Do not extend notes this side of this line

Notes: ANY ADDITIONS OR CHANGES ON THIS SHEET MUST BE MADE OR CIRCLED IN Red. WITH DATE AND NAME OF PERSON MAKING CHANGE.

Date _____ Notes by _____ Chief Party _____ F.B. 481 PG. 15

Platted by _____
Date _____
Map No. B-633
Platting C'k'd by _____
Date _____

W. O. No. 995 D. S. O. No. _____
Location Coyote Ck. Diag
Surveyed by Rasmussen
Date June 9, 1931
Indexed A. C. Johnson

Cont bottom next page.
Tape Stand @ 84°

R# 5 Sta 20+06.02
Set 2"x2" -12" Dn. Pg. 13

771.02

771.06 T.76 = 771.02

R# 4 Sta 12+35.00
Set 2"x2" -12" Dn. Pg. 13

450.53

450.55 T.76 = 450.53

Sta. 7+84.47. R# 3
Set 2"x2" -12" Dn. Pg. 13

181.14

181.15 T.74 = 181.14

Sta. 6+03.33
R# 2 Set 2"x2" -12" Dn
Pg. 13

603.33

603.37 T.74 = 603.33

Sta 0+00 to S.W.
on random line
R# 1. Set 2"x2"
-12" Dn. Pg 13

Notes ANY ADDITIONS OR CHANGES ON THIS SHEET MUST BE MADE OR CIRCLED IN Red. WITH DATE AND NAME OF PERSON MAKING CHANGE.

Do not extend notes this side of this line

RETURN TO LOS ANGELES COUNTY SURVEYOR

F.B. 481 Pg. 16 Rasmussen Chief Party Notes by Date 6-9-31

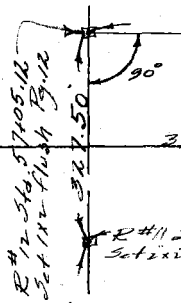

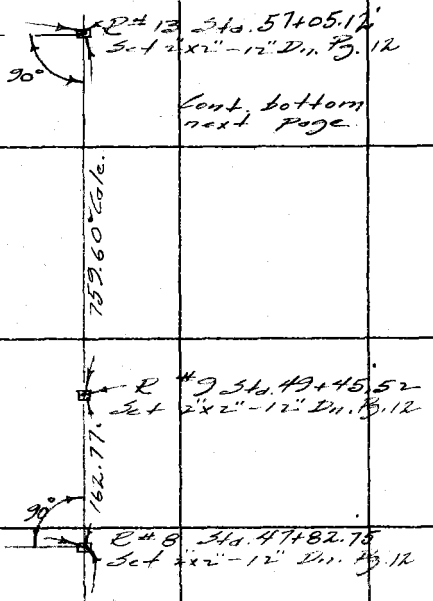

1205.11 T.78 = 1205.06

1367.11 T.78 = 1367.06

204.62 T.76 = 204.61

RETURN TO
LOS ANGELES COUNTY SURVEYOR

Do not extend notes this side of this line

Note: ANY ADDITIONS OR CHANGES ON THIS SHEET MUST BE MADE OR CIRCLED IN Red. WITH DATE AND NAME OF PERSON MAKING CHANGE.

Date _____ Notes by _____ Chief Party _____ F.B. 481 Pg. 67

Platted by _____
Date _____
Map No. B-633
Platting C'k'd by _____
Date _____

W. O. No. 295 D. S. O. No. _____
Location Coyote Ck. Diag.
Surveyed by Rodgers and A. C. Johnson
Date 6-11-31
Indexed _____

Cont. bottom next page.
Tape stand @ 84°

R# 18 Sta. 96+71.47
Set 3"x2"-12" Dn. Bg. N

1197.17 T. 82 = 1197.15

1197.15

R# N Sta. 84+74.32
Set 3"x2"-12" Dn. Bg. N

373.00 T. 78 = 372.99

372.99

R# 16 Sta. 81+01.33
Set 3"x2"-12" Dn. Bg. N

120.47 T. 78 = 120.47

120.47

R# 15 Sta. 79+80.86
Set 3"x2"-12" Dn.
Bg. N

620.38 T. 74 = 620.34

620.34

R# 14 Sta. 73+60.52
Set 3"x2"-12" Dn. Bg. N

1655.42 T 82 = 1655.40

1655.40

Sta. 57+05.12
-12" Dn. See
page

Notes: ANY ADDITIONS OR CHANGES ON THIS SHEET MUST BE MADE OR CIRCLED IN Red. WITH DATE AND NAME OF PERSON MAKING CHANGE.

Do not extend notes this side of this line.

RETURN TO LOS ANGELES COUNTY SURVEYOR

F.B. 481 Pg. 18 Roscrans Chief Party Notes by Date 6-11-31

Cont. bottom next page
Tape Stand @ 84°

223.85 T.76 = 113.84

R# 5 Sta. 132+35.15
Set 1x2 Pg. 10

110.67

110.68 T.74 = 110.67

R# 24 Sta 130+11.31
Set 2x2" - 12" Dii. Pg. 11

R# 23 Sta. 129+00.64
Set 2x2" - 12" Dii. Pg. 11

154.75 T.74 = 154.14

R# 22 Sta 127+45.20
Set 2x2" - 12" Dii. Pg. 11

16.98

16.98 T.74

R# 21 Sta. 127+28.92
Set 2x2" - 12" Dii. Pg. 11

1130.03

1130.10 T.74 = 1130.03

R# 20 Sta. 115+98.89
Set 2"x2" - 12" Dii Pg. 11

591.34

591.34 T.84

R# 19 Sta. 110+07.55
Set 2x2" - 12" Dii. Pg. 11

1336.08

1336.08 T.84

R# 18 Sta 96+71.47
Set 2x2" - 12" Dii. See
preceding page

RETURN TO
LOS ANGELES COUNTY SURVEYOR

Do not extend notes this side of this line

Notes: ANY ADDITIONS OR CHANGES ON THIS SHEET MUST BE MADE OR CIRCLED IN Red. WITH DATE AND NAME OF PERSON MAKING CHANGE.

Date _____ Notes by _____ Chief Party _____ F.B. 481 Pg. 13

Platted by _____
Date _____
Map No. B-633
Platting C'k'd by _____
Date _____

W. O. No. 995 D. S. O. No. _____
Location Coyote Ck Diag.
Surveyed by Rosecrans
Date 6-12-31
Indexed A. C. Johnson

Notes: ANY ADDITIONS OR CHANGES ON THIS SHEET MUST BE MADE OR CIRCLED IN Red. WITH DATE AND NAME OF PERSON MAKING CHANGE.

Do not extend notes this side of this line

RETURN TO LOS ANGELES COUNTY SURVEYOR

Cont. bottom next page

Topo Stand @ 84°

219.69 T·80 = 219.68'

219.68

R# 31 Sta 143+11.63
Set 2x2" -12" Dn. Pg. 10

162.42 T·80 = 162.42'

162.42

R# 31 Sta 146+91.95
Set 1x2 Pg. 10

R# 30 Sta. 145+29.53
Set 1x2" Pg. 10

280.07 T·84

280.07

R# 29 Sta. 142+49.96
Set 2x2" -12" Dn. Pg. 10

177.40 T·76 = 177.39

177.39

R# 28 Sta 140+72.07
Set 1x2 Pg. 10

160.26 T·76 = 160.25'

160.25

R# 27 Sta. 139+11.82
Set 1x2" Pg. 10

427.097·76 = 427.07'

427.07

R# 26 Sta 134+84.75
Set 2x2" -12" Dn. Pg. 10

249.61 T·76 = 249.60'

249.60

R# 25 Sta. 132+36.15
Set 1x2 See top
preceding page

F.B. 481 Pg. 20 Rosecrans Chief Party Notes by Date 6-12-31

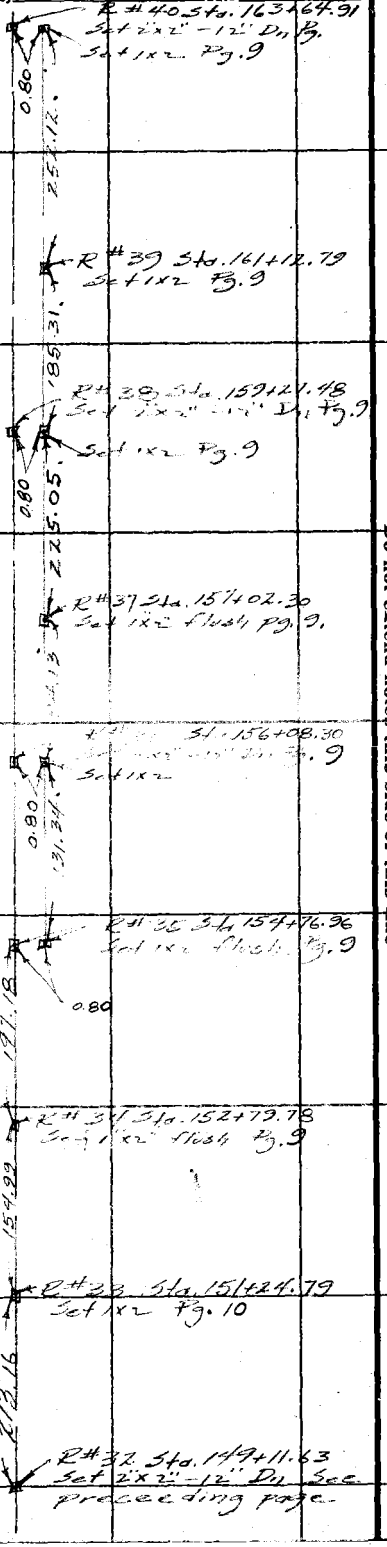

Tape Stand. @ 81°

2.50 - .13 T. 78 = 252.12

185.32 T. 76 = 185.31

225.06 T. 76 = 225.05

34.13 T. 76

131.35 T. 76 = 131.34

197.19 T. 76 = 197.18

155.00 T. 76 = 154.99

213.17 T. 80 = 213.16

RETURN TO
LOS ANGELES COUNTY SURVEYOR

Do not extend notes this side of this line

Notes: ANY ADDITIONS OR CHANGES ON THIS SHEET MUST BE MADE OR CIRCLED IN Red. WITH DATE AND NAME OF PERSON MAKING CHANGE.

Date _____ Notes by _____ Chief Party _____ F.B. 481 Pg. 21

Platted by _____
Date _____
Map No. B-633
Platting C'k'd by _____
Date _____

W. O. No. 995 D. S. O. No. _____
Location Coyote Ck. Diag.
Surveyed by Pescerade
Date 5-21-31
Indexed A. C. Johnson

Note: ANY ADDITIONS OR CHANGES ON THIS SHEET MUST BE MADE OR CIRCLED IN WITH DATE AND NAME OF PERSON MAKING CHANGE.

Do not extend notes this side of this line

RETURN TO LOS ANGELES COUNTY SURVEYOR

Cont bottom next page
(300' type #1 46 Stand. @ 84° used for this half mile

21.0'
Sta 23+52.46 .45
Set 2"x2"-1½" Dn.
Ave. 459.13

29.05 @ .00 = 29.05'
187.18 @ 4.39 = 186.56'
243.58 @ .00 = 243.58'
459.13'

0.70 .26
Sta. 19+00.71 Fd 4"x4" white post 2½' high.
7.00
Sta. 18+93.27 Set 1"x2" flush .26
Gertrudes 207.08

208.55 @ 6.48 T. 84 = 207.08'

Sec. 14

.18 Sec. 13
Sta. 16+86.89 Set 1"x2" flush
0.40 .81
Sta. 13+21.82 Fd 4"x4" White post 2½' high.
P. pole line 710.14 345.77

T. 3 S R. 11 W.

149.00 @ 7.54 = 147.59'
267.07 @ .00 = 267.07'
298.01 @ 7.28 = 295.48'
710.14 T. 84

Sta. 9+76.05 .04 Set 1"x2" flush.
Sta. 9+30.08 .07 Set 1"x2" flush.
45.97 T. 84
7.50
Fd. 4"x4" white post 2½' high.
Sta. 9+22.56 .57

Santa Fe 442.25 .24

145.27 @ .00 = 145.27'
297.32 @ 2.17 = 296.97'
442.24 T. 84

Set N. & T. in P. pole
Sta. 4+94.44 Fd. 4"x4" white post 2½' high.
6.61
Sta. 4+87.83 Set 2"x2"-1½" Dn.
101.00

89-53-00
359-31-45
89-52-56

Set N. & T. in P. pole
89-52-55"
30.31
P. pole
line
0+27.1
22.3
487.83

191.80 @ 4-20 = 191.25'
297.50 @ 4-32 = 296.57'
T. 88
487.82 = 487.83'
Sec. Cor. Sta 0+00 to N.
Fd. 6"x6" and nail flush
2.73+2 Tr. 3339 M.B. 36-74

35.25
Sec. line to W. Pg.
14 13
50.00
23 24
50.00
2"x2"-1½" Dn.
Sta. 0+42.30
Ft. E. Pg. 8

R.P. Set 2"x2" 1½" Dn

F.B. 481 Pg. 22 Rosecrans Chief Party Notes by Date 5-22-31

Cont. bottom next page

11 12 14 13

Sta. 52+99.90 Sec. Cor. Fd 6"x6" post 8" high C.S. B 318-2 F.B. 358-46

159.99 @ 00 = 159.99'
256.00 @ 4-15 = 255.30'
298.92 @ 4-31 = 297.99'
T. 84° 713.28'
Tape Stand @ 84°

713.28
356.87
Sta. 49+43.4 Fd 6x6 -2½' high.

-23.7
Sta. 45+86.61 Set 1x2" flush

24.9
Sta. 45+61.71 Fd 6"x6" -2½' high.

Ave. 415.82

415.80 T. 84° = 415.82
Tape Stand @ 76°

Sta. 42+51.2 Fd 1"x4" white post 2½' high.

Chiseled x in Conc. Standpipe

55.87
Sta. 41+70.79 Set 2"x2" - 12" Dn

Fd. N+T. in P. pole

Sec. 14

T. 3 S. R. 11 W.

Sec. 13

1301.11.

100.01 @ 1201.28 / 1201.01 = 99.76'
1301.04 T. 84
Tape Stand @ 76° = 1301.11'

180-00-00
309-59-45
179-59-56

10.70
Sta. 28+80.39 Fd 1"x4" white post 2½' high.

Sta. 28+69.69 Set 2"x2" - 12" Dn.

69.50
Set N+T. in P. pole

220.15

Sta. 26+49.84 - 6x6" post at ¼ Sec. Cor. has been knocked out reset 1"x2" 12" Dn by ties per F.B. 358-46 C.S.B. 318-2.

119° 59' 55"

220.14 T. 84 = 220.15
Tape Stand @ 76°

297.08

297.03 @ 00 T. 78 = 297.08
Tape Stand @ 84°

100.05

Set N.T. in P. pole

Sta. 23+52.45 Set 2"x2" - 12" Dn
See top preceding page

89.53

RETURN TO
LOS ANGELES COUNTY SURVEYOR
Do not extend notes this side of this line

Note: ANY ADDITIONS OR CHANGES ON THIS SHEET MUST BE MADE OR CIRCLED IN Red. WITH DATE AND NAME OF PERSON MAKING CHANGE.

Date _____ Notes by _____ Chief Party _____ F.B. 481 PG 23

Platted by _____
Date B-633
Map No. _____
Platting C'k'd by _____
Date _____

W. O. No. 295 D. S. O. No. _____
Location Coyote Ck. Diag
Surveyed by Roberdos
Date 5-25-31 C. Johnson
Indexed _____

Note: ANY ADDITIONS OR CHANGES ON THIS SHEET MUST BE MADE OR CIRCLED IN Red. WITH DATE AND NAME OF PERSON MAKING CHANGE.

Do not extend notes this side of this line

RETURN TO LOS ANGELES COUNTY SURVEYOR

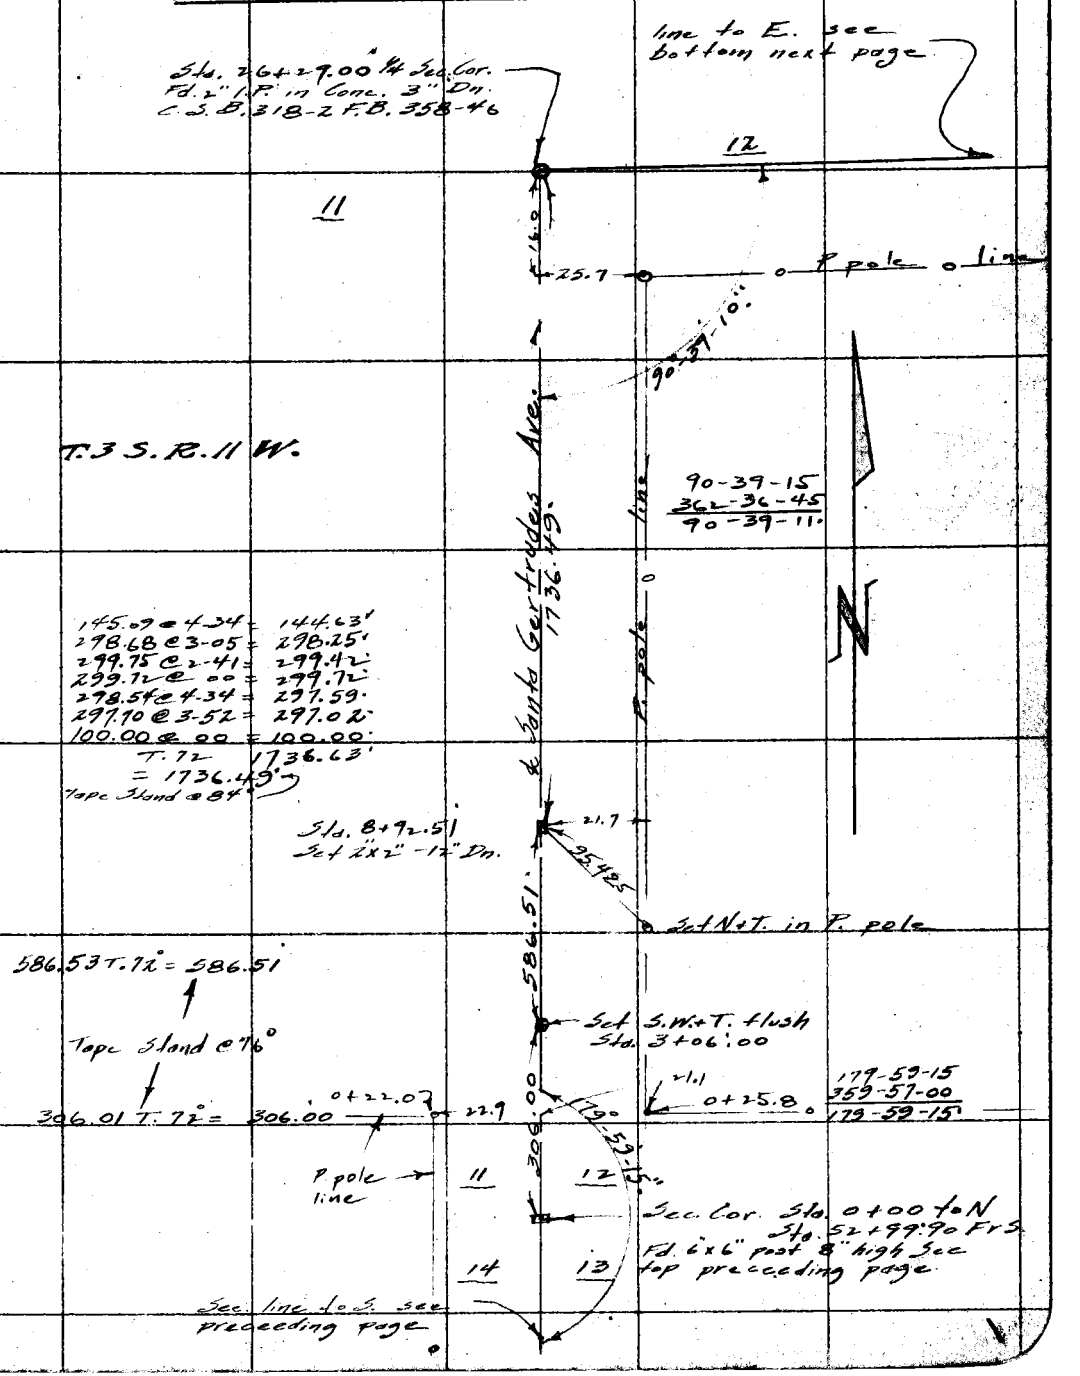

F.B. 481 Pg. 24 Rosecrans Chief Party Notes by Date 5-25-31

(Tape Stand. @ 84°)

Sta. 27+04.06
Ind. & Ocean Ave. and E. First Ave. Fd 1½" I.P. 2" Dn
L.S.B. 318-2 F.B. 358-47
L.S. 3-3

E. First Ave.

line to N. See Pg. 26

line to S. See bottom next page

14.1

16.3

91°-41-15
91°-39-00

88°-25-30

212.40 @ 2-12 = 212.24'
297.87 @ 4-31 = 296.94'
257.24 @ 00 = 257.24'
157.64 @ 4-17 = 157.20'
T. 70° 923.62'
= 923.54'

923.54'

P. pole line

Returned 11-4-31 L.S.H.

88-25-30
353-41-45
88-25-26

Noted this & N.C. was found to pipe of Central Ave.

Sta. 17+80.5'
Set x-in. 12" Dn.

~~91-41-15~~
~~366-17-00~~
~~91-41-15~~

91°-34-30"
366°-17-30"
91°-34-22½"

Sec. 12

Sec. 14

T. 3 S. R. 11 W.

194.95 @ 2-12 = 194.81'
152.06 @ 00 = 152.06'
165.06 @ 3-36 = 164.72'
298.63 @ 3-51 = 297.96'
299.18 @ 2-26 = 298.91'
299.71 @ 2-18 = 299.49'
372.77 @ 00 = 372.77'
T. 68° 1780.71'
= 1780.52'

1780.5'

E. Ocean Ave.

E. pole line

¼ Sec. Cor. Sta. 0+00 to E
Sta. 26+29.00 Fr. S.
See preceding Pg.
Fd. 2" I.P. in Conc. 3" Dn

12

11

RETURN TO
LOS ANGELES COUNTY SURVEYOR

Do not extend notes this side of this line

Note: ANY ADDITIONS OR CHANGES ON THIS SHEET MUST BE MADE OR CIRCLED IN Red. WITH DATE AND NAME OF PERSON MAKING CHANGE.

Date _____ Notes by _____ Chief Party _____ F.B. 4981 Pg. [redacted]

Platted by _____
Date _____
Map No. B-633
Platting C'k'd by _____
Date _____

W. O. No. 795 D. S. O. No. _____
Location Coyote Ck. Diag.
Surveyed by Rescreens
Date 5-26-31
Indexed A. C. Johnson

Chiseled x in top 12" Conc. stand pipe

E.P. 6x12" Dn. on k Prod.

0.04' W. 0.00' N. 35.00

19.8 N&T in P. pole

9.54

To 2x2 at Santa Barbaras per page 64

P. pole line

Sta. 26466.03 Int ℄ First Ave and ℄ Cordoro Rd. Fd 6x6 Flesh C.S. B.318-2 F.B. 358-47

11.67

12.85

130°

98°

Set N&T. in P. pole

Chiseled x in side 2 Conc. standpipe

90°-47'-30"
3°-10'-00"
90°-47'-30"

1490.02 T.72 = 1489.98
Tape Stand. @ 76°

1489.98 Ave.

First ℄

Sec. 12

T. 3 S. R. 11 W.

Sta. 11+76.05 Set nail

11.76.05'

166.04 @ 1.19 = 165.57'
298.05 @ 1.39 = 297.93'
263.79 @ 1.01 = 263.14'
149.69 @ 1.00 = 149.69'
299.80 @ 1.00 = 299.80'
T. 74 1176.13'
= 1176.05'
Tape Stand @ 84°

℄ Ocean Ave

Sta. 0+00 to S. Int ℄ Ocean Ave and ℄ First Ave. Fd 1½" I.P. 6" Dn See Preceding page

RETURN TO
LOS ANGELES COUNTY SURVEYOR

Do not extend notes this side of this line

Note: ANY ADDITIONS OR CHANGES ON THIS SHEET MUST BE MADE OR CIRCLED IN Red. WITH DATE AND NAME OF PERSON MAKING CHANGE.

F.B. 481 Pg. 26 — Rosecrans — Chief Party — Notes by — Date 5-26-31

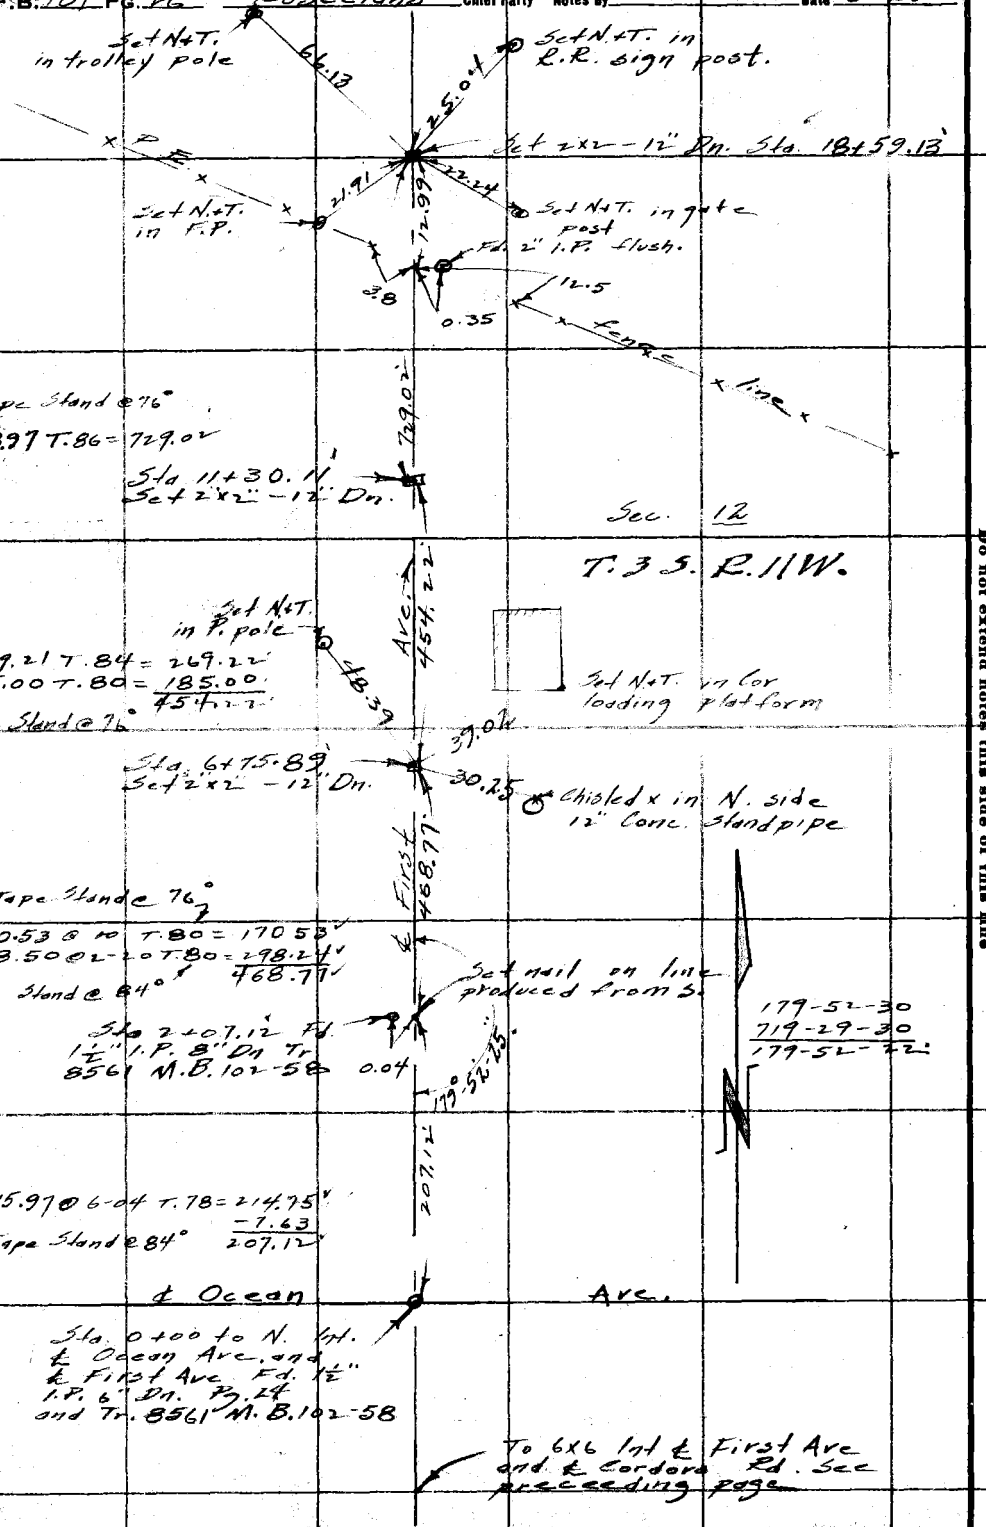

RETURN TO
LOS ANGELES COUNTY SURVEYOR

Do not extend notes this side of this line

Note: ANY ADDITIONS OR CHANGES ON THIS SHEET MUST BE MADE OR CIRCLED IN Red. WITH DATE AND NAME OF PERSON MAKING CHANGE.

Date _____ Notes by _____ Chief Party _____ F.B. 181 Pg. 27

Plotted by _____
Date _____
Map No. B-633
Platting C'k'd by _____
Date _____

W. O. No. 995 D. S. O. No. _____
Location Coyote Ck. Diag
Surveyed by Rosecrans
Date 5-29-31
Indexed A. C. Johnson

Notes: ANY ADDITIONS OR CHANGES ON THIS SHEET MUST BE MADE OR CIRCLED IN Red. WITH DATE AND NAME OF PERSON MAKING CHANGE.

Do not extend notes this side of this line

RETURN TO LOS ANGELES COUNTY SURVEYOR

Fd 4"x4" = nail flush Ely. Cor. lot 6 Tr. 2213 M.B. 23-2 & F.R. 272-80A

(Tape Stand. @ 76°)

Set N&T. in R.R. x sign Post

1552.68 T.92 = 1552.84'

2319 T.86 = 73.80'

53.69 T.8c.

Set 2"x2"-12" On Sec top preceding page

Set N&T. in R.R. x sign post







Fd. old 2x2 redwood stake .12 Pg. P.C. of P.E. & Set 2x2" over it flush.

Set N&T. in trolley pole

Fd. 4"x4" flush Ely. Cor. lot 6 Tr. 2213 M.B. 23-2 & F.R. 272-80A

Set N&T. in trolley pole

P.E. R.R. flush hold Dist. Cors between P.O.P.

141.13 T.88 = 141.14

84.76 T.88 = 84.17

Fd 1"x4" flush Ely Cor. lot 7 Tr. 2213. and F.R. 272-80A.

Set 1"x2" flush with way between Cors

Fd. 2" I.P. in Conc. B.P.s. F.R. 272-80 A.

Road





F.B. 481 Pg. 28 Rosecrans Chief Party Notes by Date 5-29-30

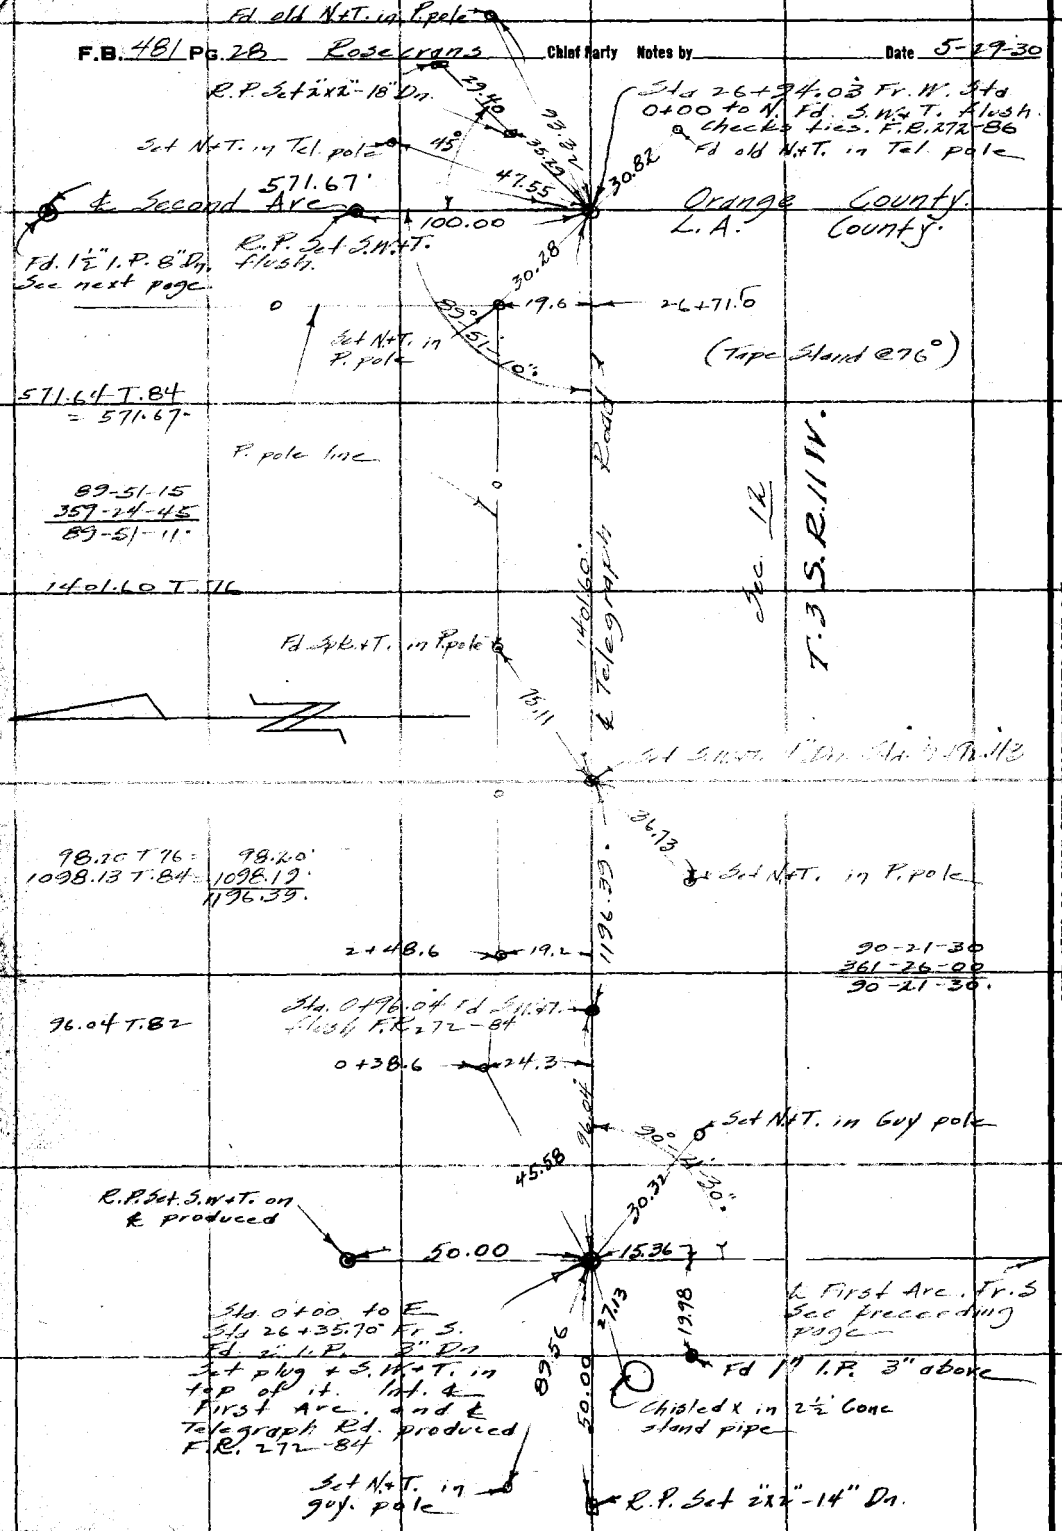

RETURN TO
LOS ANGELES COUNTY SURVEYOR

Do not extend notes this side of this line

Notes: ANY ADDITIONS OR CHANGES ON THIS SHEET MUST BE MADE OR CIRCLED IN Red. WITH DATE AND NAME OF PERSON MAKING CHANGE.

F.B. 481 Pg. 22

Date _____ Notes by _____ Chief Party _____

Platted by _____
Date _____
Map No. B-633
Platting C'k'd by _____
Date _____

W. O. No. 225 B. S. O. No. _____
Location Cerritos Ck. Diag.
Surveyed by Lazzerini
Date 6-1-31
Indexed A. C. Johnson

Note: ANY ADDITIONS OR CHANGES ON THIS SHEET MUST BE MADE OR CIRCLED IN Red. WITH DATE AND NAME OF PERSON MAKING CHANGE.

Do not extend notes this side of this line

RETURN TO LOS ANGELES COUNTY SURVEYOR

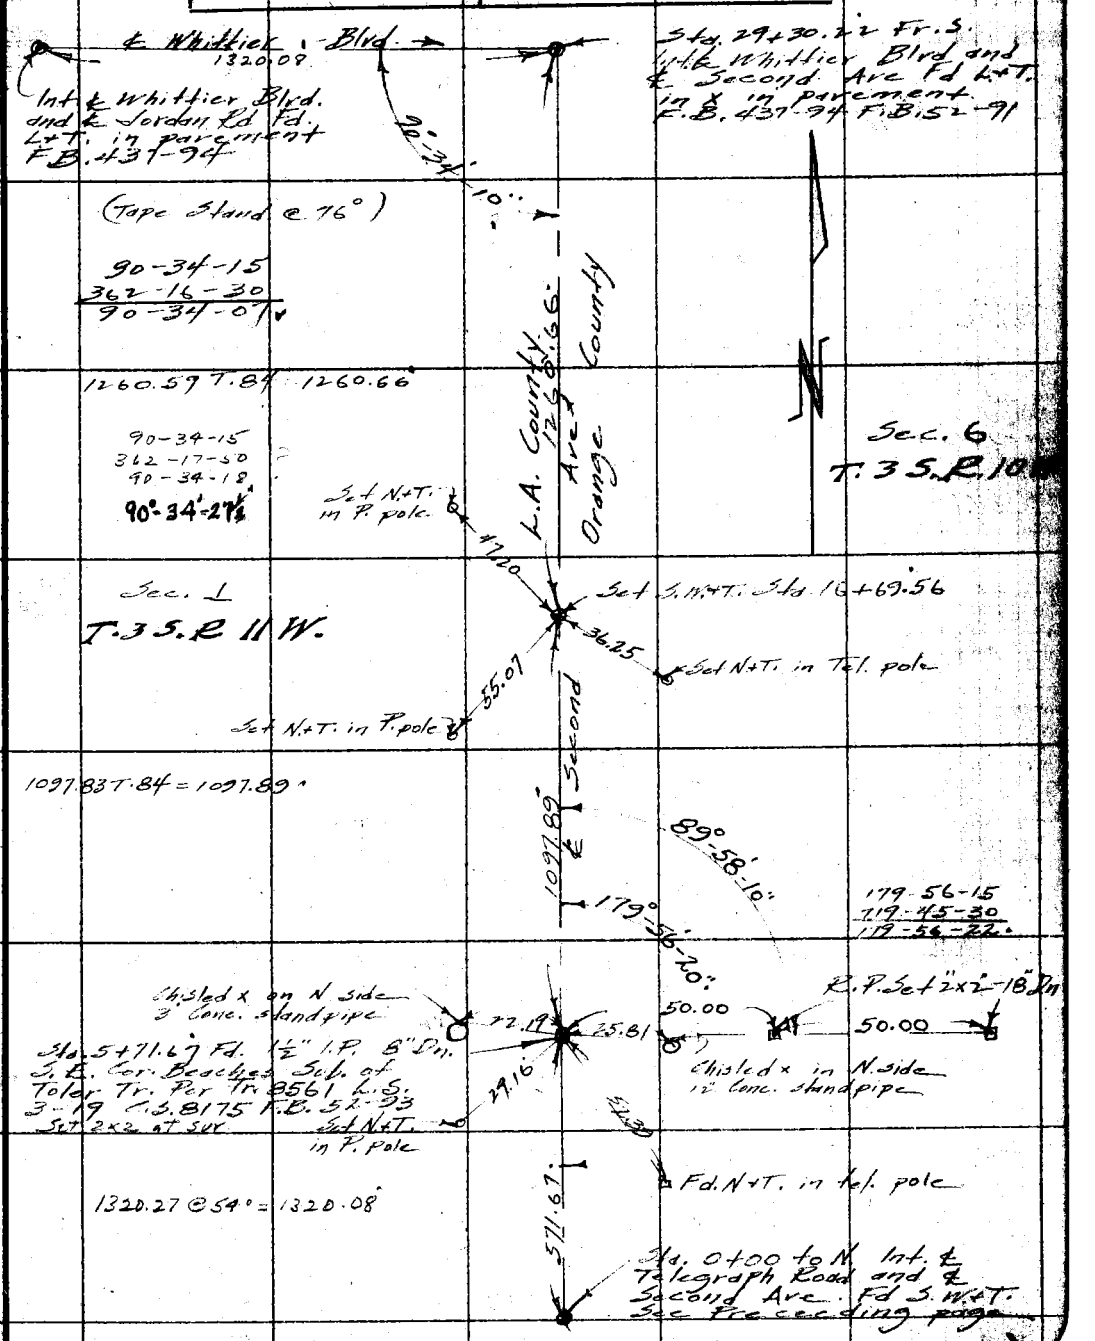

F.B. 481 Pg. 30 Rosecrans Chief Party Notes by Date 6-2-31

T. 3 S. R. 10 W. Sec. 7

R.P. Set 2"x2"-12" Dn. on line Fr. W. Prod.

50.00

Orange County L. A. County.

Sec. line to N. Cont. bottom next page

89° 49' 30"

4701

R.P. Set 2"x2"-18" Dn on line Fr. N. produced.

Sta. 27+13.28 Fr W. Fd 2"x2" and nail at fence Cor.) marked S.H.F. & E. in Cor. Sec. 12 T. 3 S. R. 11 W. C.S. 8175-2 F.B. 52-85

165.76

269.00 @ 00 7' 80 = 258.99'
207.48 @ 4437' 80 = 206.77'
465.76'

Tape Stand @ 84°

50.00 50.00

Sta. 22+47.52 Set 2"x2"-6" Dn

R.P. Set 2"x2"-12" Dn.

0.44 N 00

554.65

Fd 2" I.P. Flush on S½ line Tolerton Tr. Per. Tr. 8561 M.B. 102-58

89-49 15
35 00 45
89-49 11

554.63 + 02 = 554.65'

Tape Stand @ 75°

Sta. 16+22.87 Set 2"x2"-6" Dn

298.40 @ 1.49 = 298.26
106.15
298.82
59.72
763.54 + 02
763.53'

Tape Stand @ 84°

T. 3 S. R. 11 W.

Sec 12

Sta. 9+23.34 Set 2"x2"-12" Dn.

36.43
120.86 @ 3.15 = 120.67'
574.32
198.52 @ 4-33 = 197.89'
929.31'
T. 82 +929.30'

Tape Stand @ 84°

Sta. 14+00.04 R.P. Set 2"x2"-8" Dn.

929.30'

89-43-30
368-53-30
89-43-22

50.00

Sta. 0+50.04 R.P. Set 2"x2"-12" Dn.

89° 43' 25"

50.00

Sta. 0+00.04 Set nail in Pipe on line Fig. 26 Ave See Fig 26

℄ First

0.04

Sta. 0+00 To E Sta. 2+07.12 Fr. S Fd 1½" I.P. 8" Dn. Tr. 8561 M.B. 102-58 and F.B. 491-26

RETURN TO LOS ANGELES COUNTY SURVEYOR

Do not extend notes this side of this line

Notes: ANY ADDITIONS OR CHANGES ON THIS SHEET MUST BE MADE OR CIRCLED IN Red. WITH DATE AND NAME OF PERSON MAKING CHANGE.

Date _____ Notes by _____ Chief Party _____ F.B. 481 Pg. 31

Platted by	W. O. No. 995 D. S. O. No.
Date	Location Coyote Ck Diag.
Map No. B-633	Surveyed by Rosecrans
Platting Ck'd by	Date 6-3-31
Date	Indexed A. C. Johnson

Notes: ANY ADDITIONS OR CHANGES ON THIS SHEET MUST BE MADE OR CIRCLED IN Red. WITH DATE AND NAME OF PERSON MAKING CHANGE.

Do not extend notes this side of this line

RETURN TO LOS ANGELES COUNTY SURVEYOR

Set 3/4" I.P. flush

℄ Telegraph Rd. Pg. 28

12.00

Sta. 24+32.73 Int. ℄ Telegraph Rd and ℄ Second Ave. Rd. S. M.T. flush Pg. 28

90°

90-05-40

280.31

4.0

14'x Machine Shed. 16.3

90-05-45
360-22-46
90-05-41.

224+52.4

4.0

280.30 T.84 = 280.31'

Set 1"x2" flush.

90°

12.00

Sta. 21+52.42 Set 2"x2"-18" Dn.

T.84
1083.99 = 1084.05'
Tape Stand @ 76°

1084.05

Sec. 7
T. 3 S R. 10 W.

Tel. Pole line

12+08.0

20.4

Sta. 11+87.54 S.M.T. Split of rails.

L.A. + S.L.RR track

Angle to split of rails 89°-49'

County

119.17

County

Trolley Pole line

10+98.8

8.80

Sta. 10+90.04 Set 1"x2" Split of rails.

P.E. E.R. track

89°-49'
179 38
89-49.

Angle to split of rails 89°-49'

21.67

Sta. 10+68.37 Set 1"x2"-12" Dn.

Sec. 12
T. 3 S R. 11 W.

167.52 @ 5-32 = 166.73'
279.28 @ 2-13 = 279.02'
T.82 465.75 Stand @ 84°
= 465.74'

387.52 T.82 = 387.54'
853.28'
Tape Stand @ 76°

853.18'

L. A.

Orange

Sta. 2+15.09 Set 2"x2"-12" Dn.

150.77 @ 3-59 = 64.68 / 150.41'
215.09'
Tape Stand @ 84°

215.09'

Sta. 0+00 to N. E. 1/4 Cor. Sec. 12 Fd. 2"x4" stake See preceding page

N

RETURN TO
LOS ANGELES COUNTY SURVEYOR

Note: ANY ADDITIONS OR CHANGES ON THIS SHEET MUST BE MADE OR CIRCLED IN Red. WITH DATE AND NAME OF PERSON MAKING CHANGE.

Do not extend notes this side of this line

F.B. 481 PG. 32

Chief Party _____ Notes by _____ Date _____

Date _____ Notes by _____ Chief Party _____ F.B. 481 Pg. 21

Platted by	W. O. No. 995 D. S. O. No.
Date	Location Coyote Ck. Diag.
Map No. B-633	Surveyed by Lee & Evans
Platting C'k'd by	Date 6-13-31
Date	Indexed A. C. Johnson

Notes. ANY ADDITIONS OR CHANGES ON THIS SHEET MUST BE MADE OR CIRCLED IN Red. WITH DATE AND NAME OF PERSON MAKING CHANGE.

Do not extend notes this side of this line

RETURN TO LOS ANGELES COUNTY SURVEYOR

Top Island = 84°

388.64 T. 84

Row of Acacia trees

25.8 25.5 30'

Old San Diego and L.A. Stage Rd.

25.8 25.5 30'

Row of Acacia trees

4 Sec. Cor. Between Sec. 22 and Sec. 23 Fd. 2"x2" 6" Dn. F.B. 425-45

90° 43' 30"

1/4 sec Line per F.B. 425-134

388.64

Set 2"x2"-12" Dn. Int & Lutzweiler Ave. and & Old San Diego Stage Rd by Splitting Dist. between tree rows to W.

2.78

Set 2"x2"-3" Dn Int & Old San Diego and L.A. Stage Road and & Lutzweiler Ave. by deed 2942:152 and Dist per F.B. 425-45

F.B. 113

Set 3/4" I.P. & T. 1" Dn.

Sec. 22

Sec. 23

2273.90 Lutzweiler

2640.51 F.B. 425-45

2273.90 T. 84

T. 3 S. R. 14 W.

89° 46' 45"
359° 07' 30"
89° 46' 52½"
90° 13' 07½"

℄ Center Sta. 41+15 F.B. 425-44

Int. & Lutzweiler Ave. and & Center St. Fd. 2"x2" 6" Dn. F.B. 425-44

F.B. 481 Pg. 34 Rosecrans Chief Party Notes by _____ Date 6-16-31

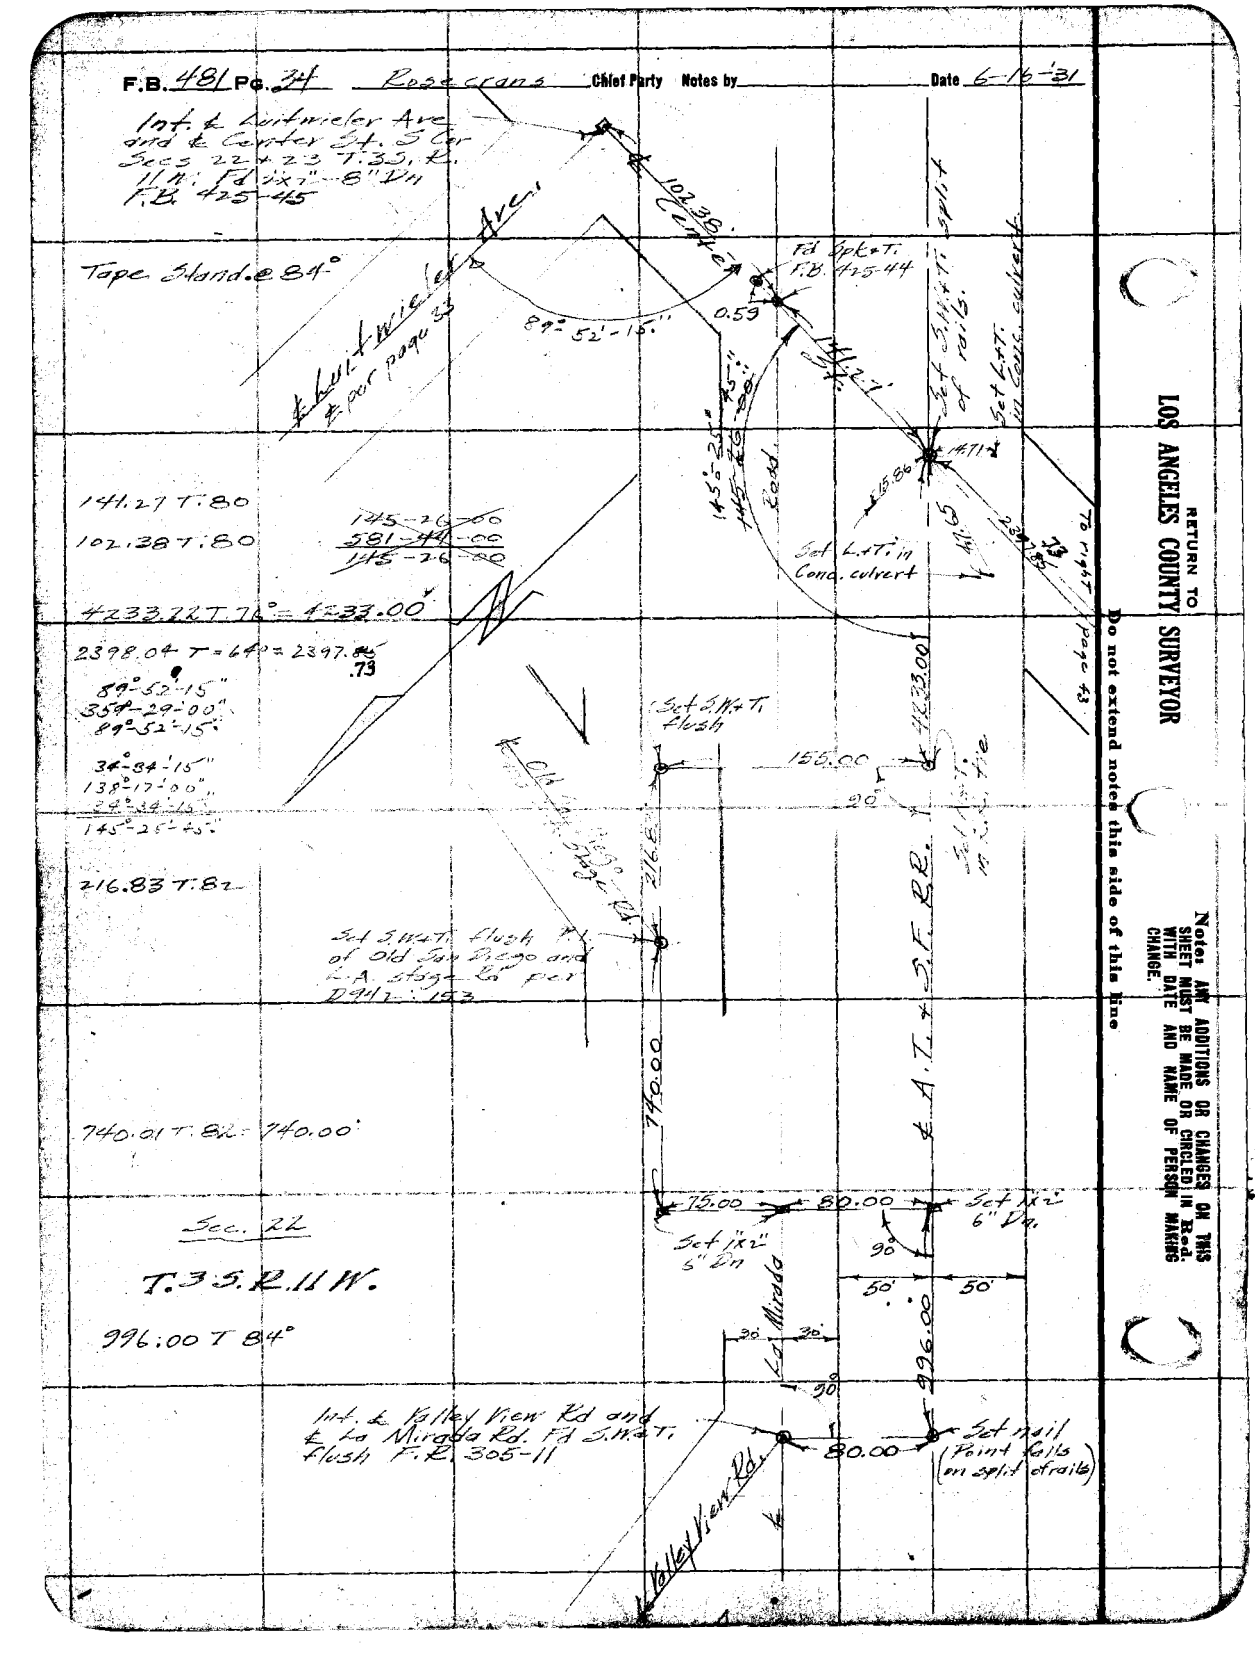

RETURN TO
LOS ANGELES COUNTY SURVEYOR

Do not extend notes this side of this line

Note: ANY ADDITIONS OR CHANGES ON THIS SHEET MUST BE MADE OR CIRCLED IN Red. WITH DATE AND NAME OF PERSON MAKING CHANGE.

Date _____ Noted by _____ Office Party _____ F.B. 481 Pg. 2

Plotted by _____
Date _____
Map No. B-633
Plotting C'k'd by _____
Date _____

W. O. No. 325 S. S. O. No. _____
Location Cajeta Ck Diag
Surveyed by Rosecrans
Date June 16, 1931
Indexed A. C. Johnson

Cont. bottom next page

164-33-00
658-11-45
164-32-56

Fd old broken 2"x2" redwood stake 3" Dn. 1'e- placed in th 1x2"-6"Dn

P.I. Sta. 26+93.67
Fd 2x4" pin
3" Dn No reference
Replaced with 2x2" 6" Dn

0.30
0.05
0.34
55°

Sta. 24+70.24
Fd 2x3" and nail 6" above surface

728.44 T. 82 = 728.43

26.03
728.45
30'
30'

Set N+T. Sta 19+65.24 & between tree rows

646.06 T. 82 = 646.05'

26.0
26.0
646.05'
Tree
Tree
Tree

164°-26'-45"
657-41-15
164-26-45

R.P. Set 2"x2"-12" Dn. on angle spl.

Set N+T. in P. pole

Set N+T. in dead tree

30.28
26.0
30.28
31.82
20.13
19.6
26.4
39.39
164°-26'-45"

(R.P. Set 2"x2"-12" Dn on angle spl.

Set N+T. in dead tree

P.I. Sta. 13+19.19 Set 2"x2" 12" Dn. Int. of & between tree rows from F. & W.

1319.19 T. 84

90-07-45
270-21-15
90-07-30

Sec. 22

T. 3 S. R. 11 W.

25.8
25.8
19.7
25.5
25.5
1319.19
20°-01'-30"

To 4"x4" S.E. Cor. Sec. 22 FB 425-44

Set N+T. in P. pole

0+21.5

38.83

& Lutrwieler

Sta. 0+00 to W. Int. & Lutrwieler Ave & L.A. and San Diego Stage Rd. Set 2"x2"-12" Dn by splitting Nat. between tree rows to W.

R.P. Set 2"x2" 12" Dn. on & Tree Ft. W.

Set N+T. in P. pole

363.73
Ave
N 39°-33' E
26.38

2"x2" on 4" Cor. between Secs. 22 & 23 T. 3 S. R. 11 W. FB 425-44

Note: ANY ADDITIONS OR CHANGES ON THIS SHEET MUST BE MADE OR CIRCLED IN Red. WITH DATE AND NAME OF PERSON MAKING CHANGE.

Do not extend notes this side of this line

RETURN TO LOS ANGELES COUNTY SURVEYOR

F.B. 481 Pg. 36 Reservoirs Chief Party Notes by Date 6-17-31

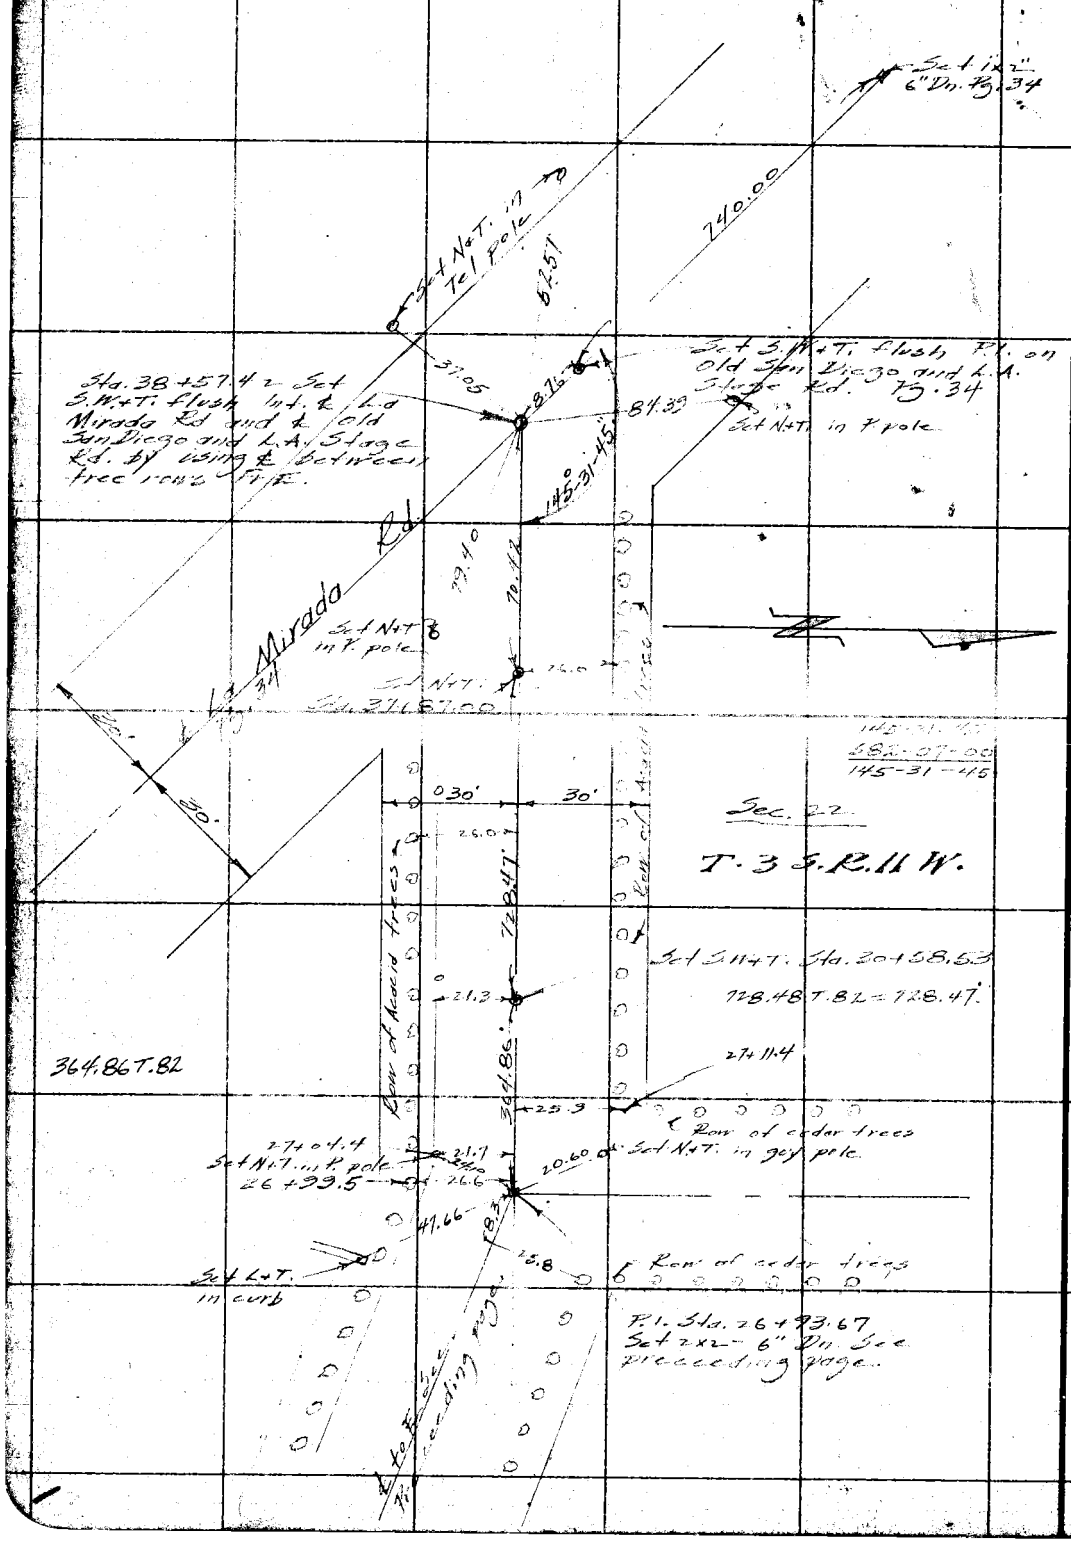

RETURN TO
LOS ANGELES COUNTY SURVEYOR
Do not extend notes this side of this line

Note: ANY ADDITIONS OR CHANGES ON THIS SHEET MUST BE MADE OR CIRCLED IN Red. WITH DATE AND NAME OF PERSON MAKING CHANGE.

Notes Ck'd by D.M. Finley
Map No. B-633
Office Work
Checked
Date

Survey of Coyote Creek Drng Div 3
W. O. 995 Tape No. 025 St'd 74 °F.
Surveyed by L.A. Hammond
Notes L.S.H. Date 9-29-31
Indexed A. C. Johnson

F.B. 481

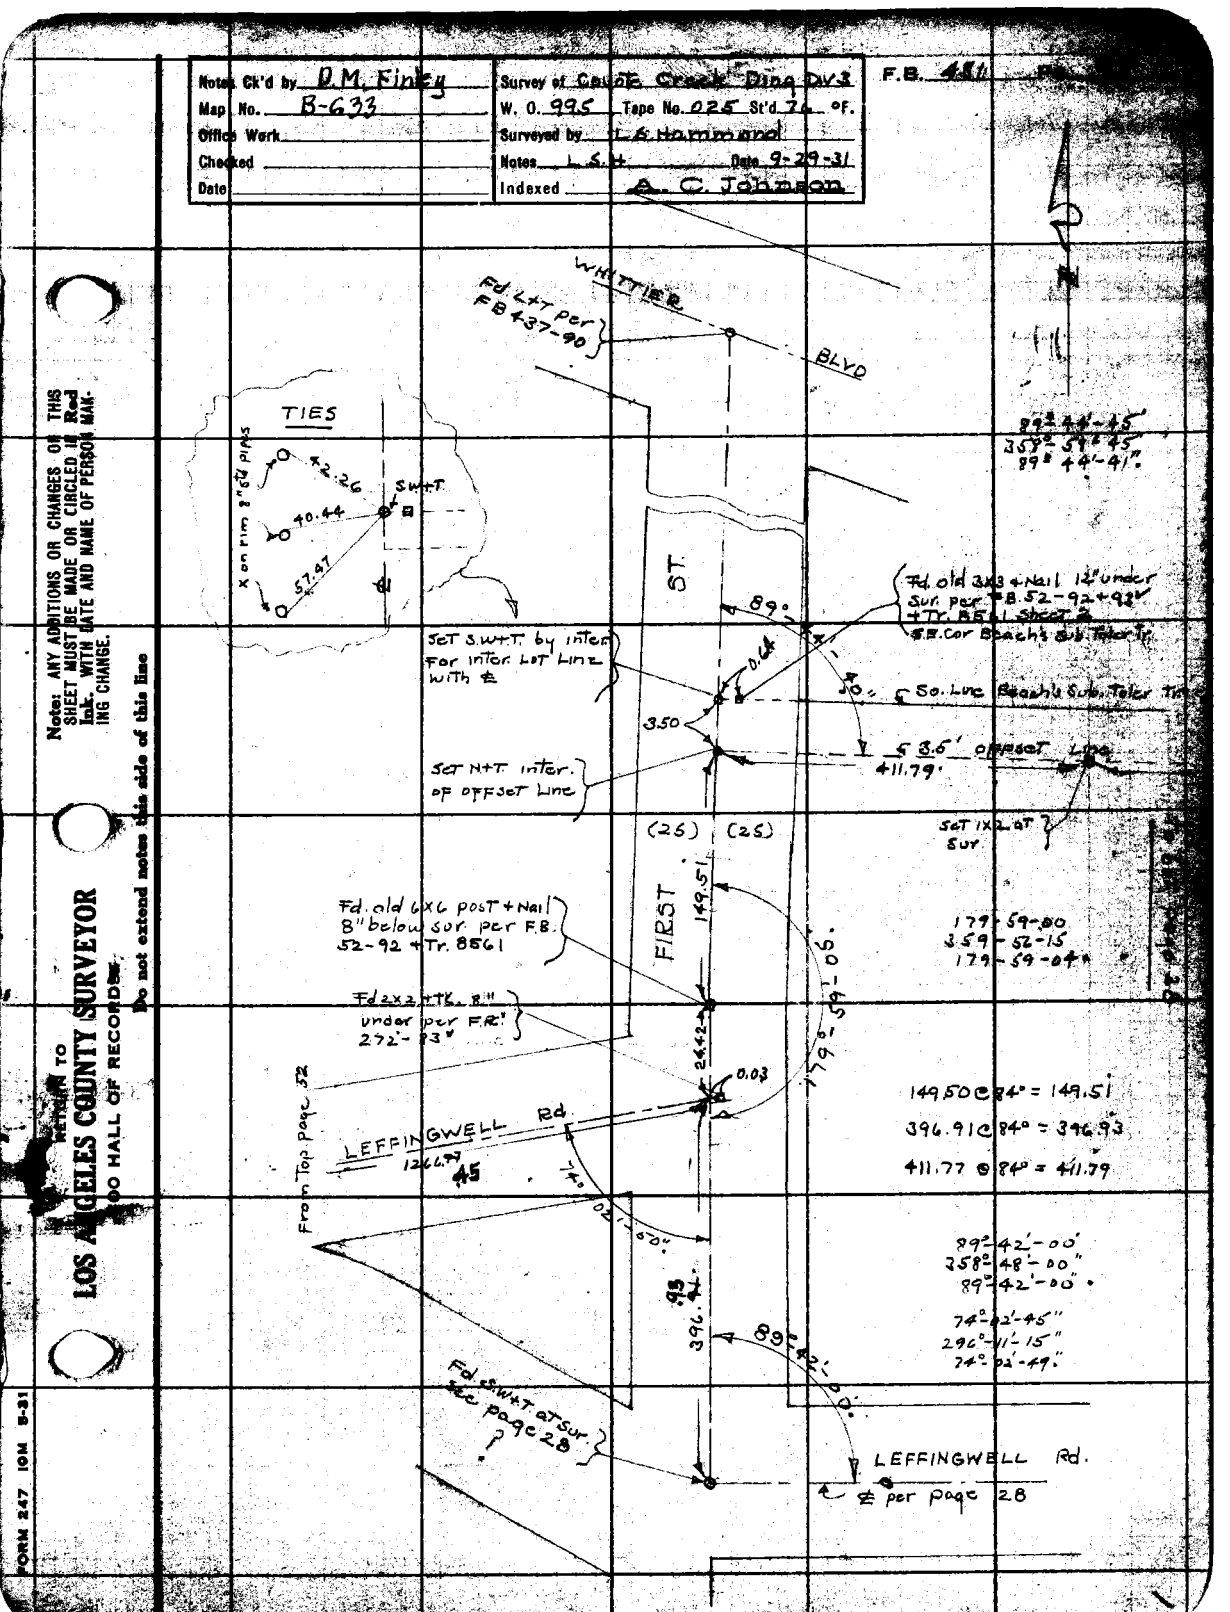

Note: ANY ADDITIONS OR CHANGES OR THIS SHEET MUST BE MADE OR CIRCLED IN Red Ink. WITH DATE AND NAME OF PERSON MAKING CHANGE.

Do not extend notes this side of this line

RETURN TO
LOS ANGELES COUNTY SURVEYOR
320 HALL OF RECORDS.

FORM 247 10M 8-31

F.B. 481 PG. 38

Set N+T on offset line inter

SECOND AVE

℄ per page 29

3.50

90°-12'-15"

Fd 2x2 at sur. Sta 5+71.67 per page 29

90°-12'-15"
360-49'
98°-12'-15"

89°49'-30"
359°-17'-00"
89°-49'-15"
90°-16'-45"

L.S. 3-29

3.5' OFFSET LINE

1318.28'

1048.34 @ 90° = 1048.44'
397.90 @ 84° = 397.92'
561.57 @ 86° = 561.61'
1318.14 @ 92° = 1318.28'
1320.22 @ 52° = 1320.07'

Did not find 3/4" per F.B. 427-95

JORDAN

1320.07

℄

ROAD

1048.44

90°-10'-45"

3.50

Fd L+T in conc pav. per F.B. 427-94

Fd 3x3+ nail 6"dn Sta 13+19.84 per F.B. 427-94

Set 2x2 +T+K 12"dn on inter. with ℄ prod. from North.

Set 1x2 at sur. by inter

561.61'

TIES

2x2

2.63

37.03

X on rim 14" std pipe

42.18

20.38

X rim std pipe

X side conc vent pipe

SO. LINE BEACHS SUB. OF TOLER TR.

397.92'

Set 1x2 at sur.

From right page 37

RETURN TO
LOS ANGELES COUNTY SURVEYOR
700 HALL OF RECORDS

Do not extend notes this side of this line

Note: ANY ADDITIONS OR CHANGES ON THIS SHEET MUST BE MADE OR CIRCLED IN Red Ink. WITH DATE AND NAME OF PERSON MAKING CHANGE.

Date _____ Notes by _____ Chief Party _____ F.B. 167 Pg. [illegible]

Platted by _____
Date _____
Map No. B-633
Platting Ck'd by _____
Date _____

W. O. No. 995 D. S. D. No. _____
Location Coyote Ck. Diag. Div 3
Surveyed by L. C. Hammond
Date Nov 16, 1931
Indexed A. C. Johnson

Notes: ANY ADDITIONS OR CHANGES ON THIS SHEET MUST BE SIGNED OR INITIALED AND DATE WITH NAME OF PERSON MAKING CHANGE.

RETURN TO LOS ANGELES COUNTY SURVEYOR

Do not extend notes this side of this line

Fd 1x2 6" dn per F.B. 425-50

Fd SW+T 8" dn F.B. 425-49

442.27

16.36

3.07

Set N+T by intersection

Fd 1x2 8" dn. per F.B. 425-49

SECTION LINE

ROAD.

89° 57' 15"

Fd 2x2 12" dn ± SEC. cor per F.B. 425-49

359° 49' 45"

89° 57' 20"

SEC.

2136.76

22

(No Name)

503.43 @ 70° = 503.41'

1599.94' = 1599.94'

536.82' 536.82'

2146.76' 2136.76

79.80

Set SW+T P.O.T.

Set x Top. Std. Pipes

80.00

78.80

105° 39' 15"

62° 32' 45"

105° 39' N.

503.41'

105° 39' 10"

OLD L.A. + S.D.

STAGE RD.

6"

Fd 2x2 12" dn per page 36

⊕ per page 35

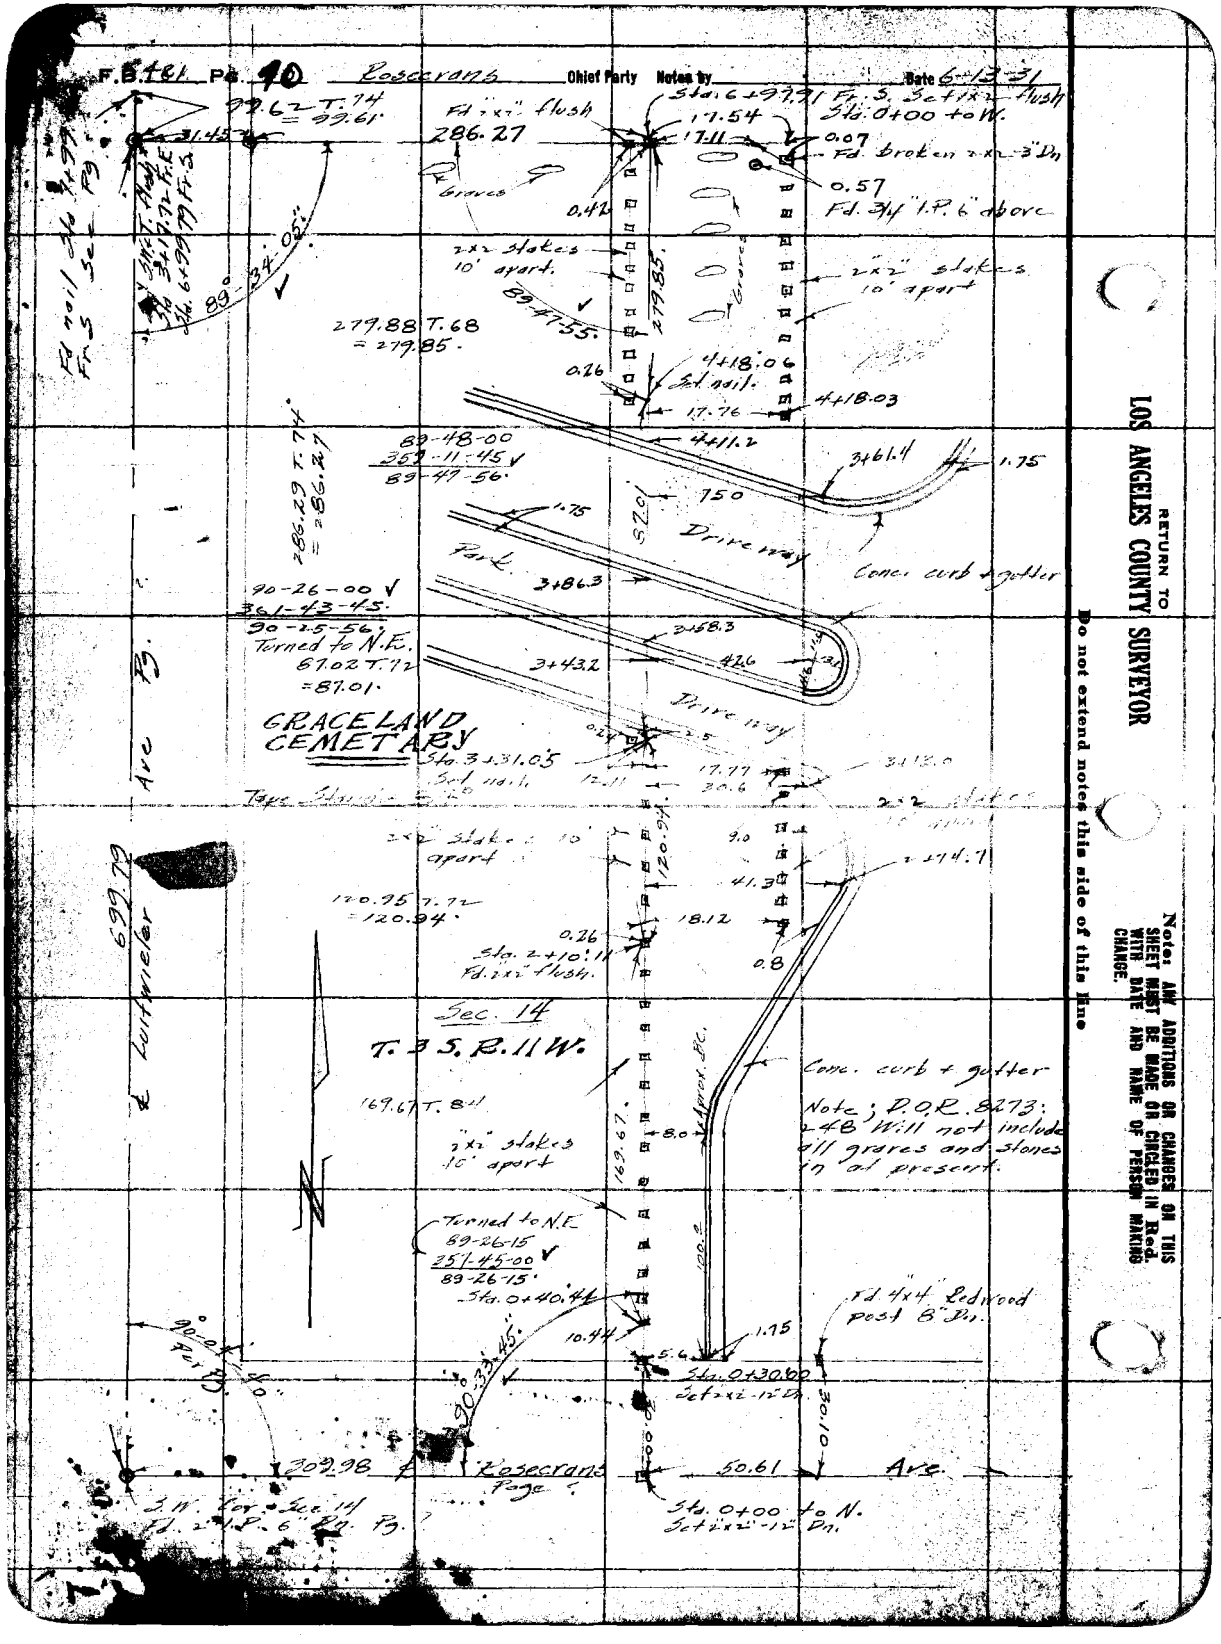
F.B. 181 Pg. 10
Rosecrans
Chief Party
Notes by
Date 6-13-31
99.62 T. 74 = 99.61
31.45
Fd. 1"x1" flush
286.27
Graves
Sta. 6+97.21 Ft. S. Set 1"x2" flush
Sta. 0+00 to W.
17.54
17.11
0.07
Fd. broken 2"x2" 3" Dn.
0.57
Fd. 3/4" I.P. 6" above
0.42
2x2 Stakes 10' apart.
279.85.
89-47-55
279.88 T. 68 = 279.85.
0.26
Set nail.
4+18.06
17.76
4+18.03
89-48-00
269-11-45
89-49-56
4+11.2
3+61.4
1.75
750
Drive way
Conc. curb + gutter
Park.
3+86.3
3+58.3
42.6
3+43.2
90-26-00
360-43-45
90-25-56
Turned to N.E.
87.02 T. 72 = 87.01.
GRACELAND CEMETARY
Sta. 3+31.05
Set nail.
12.11
17.77
30.6
3+12.0
Type Standard
Arc
2x2 Stakes 10' apart
120.94
120.95 T. 72 = 120.94.
9.0
41.3
2+74.7
18.12
0.26
Sta. 2+10.11
Fd. 2"x2" flush.
0.8
Sec. 14
T. 3 S. R. 11 W.
699.79
E. Luitwieler
169.67 T. 84
1"x2" stakes 10' apart
169.67
Apprx. BC.
8.0
Conc. curb + gutter
Note; D.O.R. 8473: 248 Will not include all graves and stones in at present.
Turned to N.E.
89-26-15
251-45-00
89-26-15
Sta. 0+40.44
100.2
10.44
1.75
5.4
Fd. 4"x4" Redwood post 6" Dia.
Sta. 0+30.00
Set 2"x2" 12" Dn.
90-0
90-33-45
30.10
202.98
Rosecrans
Page
50.61
Arc
Sta. 0+00 to N.
Set 2"x2" 12" Dn.
Ft. for Sec. 14
Fd. 2" I.P. 6" Dn. Pg.
RETURN TO
LOS ANGELES COUNTY SURVEYOR
Do not extend notes this side of this line
Note: ANY ADDITIONS OR CHANGES ON THIS SHEET MUST BE MADE OR CIRCLED IN Red. WITH DATE AND NAME OF PERSON MAKING CHANGE.

Notes Ck'd by		Survey of	
Map No.		W. O.	Tape No. St'd °F.
Office Work		Surveyed by	
Checked		Notes	Date
Date		Indexed	

F.B. PG.

Note: Any Additions or Changes on This Sheet Must be Made or Circled in Red Ink With Date and Name of Person Making Change.

Do not extend notes this side of this line

FB 481-41 & 42 ✓
missing —
Timmons
6-27-32 ✓

RETURN TO
LOS ANGELES COUNTY SURVEYOR
7do HALL OF RECORDS

FORM 247 10M 11-35

RETURN TO
LOS ANGELES COUNTY SURVEYOR
700 HALL OF RECORDS

Note: Any Additions or Changes on This Sheet Must be Made or Circled in **Red Ink** With Date and Name of Person Making Change.

Do not extend notes this side of this line

F.B. _____ PG. _____

FORM 247 40M 8-31

RETURN TO
LOS ANGELES COUNTY SURVEYOR
700 HALL OF RECORDS

Note: ANY ADDITIONS OR CHANGES ON THIS SHEET MUST BE MADE OR CIRCLED IN Red Ink, WITH DATE AND NAME OF PERSON MAKING CHANGE.

Do not extend notes this side of this line

Survey of Coyote Ck Diag. Div. 3
M. B. 195 Page 124
Surveyed by F. S. Hammond
Notes A. C. Johnson Date Nov 1951
Indexed

Rough Ck'd by D. M. Finley
Map No. B-6887
Office Work
Checked
Date

WESTMINSTER WHITTIER
To Int about 20
Offset line 331+83.38 Sh't'n
Pobo. 69 Ob'd'n
347.84
38°-40'-30"
154°-41'-25"
38°-40'-55"
21"
2006.72 @ 72°
2006.72 @ 70°
2006.65'
1527.55 @ 64° = 1527.43'
3041
2006.65
19' OFFSET Line
proposed ± Coyote Ck Diag. From So. Prod.
This ℄ Abandoned
Adopted ± per pg. 174
50'
50'
1114.94
CENTER
Fd Mkt. Bp.
109.67
S.P.T. bet pavt. ℄'s
Fd. 531+87.08 Fd L+T in conc. Pave per F.B. 448-185
233.42
± From North
1033.64
Prod.
Ranch
Road
Set 1x2 POT 12" dn.
This ℄ Abandoned
See pg. 174
68.95
SE Mkt. Bp.
420.27
1527.43
ST
Fd L+T in Conc. Pave by Prod. ℄ Pavement ℄ of ST
Fd Mkt. Bp. 4 Tin per Ties F.B. 448-70
1114.94 @ P.I. 44°
1114.88 @ P.C.
333.41 @ 44°
333.39 @ 44°
1114.94
333.42

F.B. 481 Pg. 44

Tape NB 025 STD 76°

To bot page 55

870.875 @ 02° = 870.815
870.90 @ 02° = 870.84
870.83
29.27 @ 02° = 29.27
900.10

Set N+T in Tips

L.A. & S.D. STAGE (LA MIRADA Rd)

RD.

Sta 561+68.19 Set S W+T by intersection

Set 2x2 at sur by intersection

Set N+T edge pave. POT

RR

℄ per page 34

Set S W+T in Tie by intersection Sta. 0+00.

AT & S.F.

289.96

Sta 561+19.65 Set 1x2 ch. pt

Fd 1x2 set by Crumley FB

Set 1x2 POT at sur

73° 18' 45"
252° 59' 00"
73° 14' 45"

84° 03' 15"
336° 13' 00"
84° 03' 15"

818.40'
Coyote Ck Diag. From No.

950.00 @ 72° } 949.96'
949.97 @ 72° }
52.07 @ 66° 22' 06" = 48.24'
289.98 @ 84° = 289.96'

949.85'
left of First No.

proposed ℄ Coyote Ck Diag. From So. Prop.

Set 1x2 POT at sur.

Newberry Park

These ℄'s Abandoned. See pg. 174 for adopted ℄

Sta 561+69.99 on offset line set 1x2 at sur.

47.53

11.52

14.45

Frame Garage

Frame Shed.

1033.64'
proposed

1033.62 @ 80° } 1033.64'
1033.61 @ 80° }

818.41 @ 76° } 818.40'
818.39 @ 76° }

S 8° 00 @ 62° W = 21.11' = 54.07'

N 71° 00 @ 62° W = 137.17' = 49.73'

From Top page 43

RETURN TO
LOS ANGELES COUNTY SURVEYOR
700 HALL OF RECORDS

Do not extend notes this side of this line

Note: ANY ADDITIONS OR CHANGES ON THIS SHEET MUST BE MADE OR CIRCLED IN Red Ink. WITH DATE AND NAME OF PERSON MAKING CHANGE.

Notes Ck'd by D. M. Finley
Map No. B-633
Office Work
Checked
Date

Survey of Coyote Ck Diag. Div 3
W. O. 995 Tape No. 225 St'd 76 °F.
Surveyed by L S Hammond
Notes L S H Date Nov 1931
Indexed A. C. Johnson

F.B. 481 Pg.

To bat. page 42

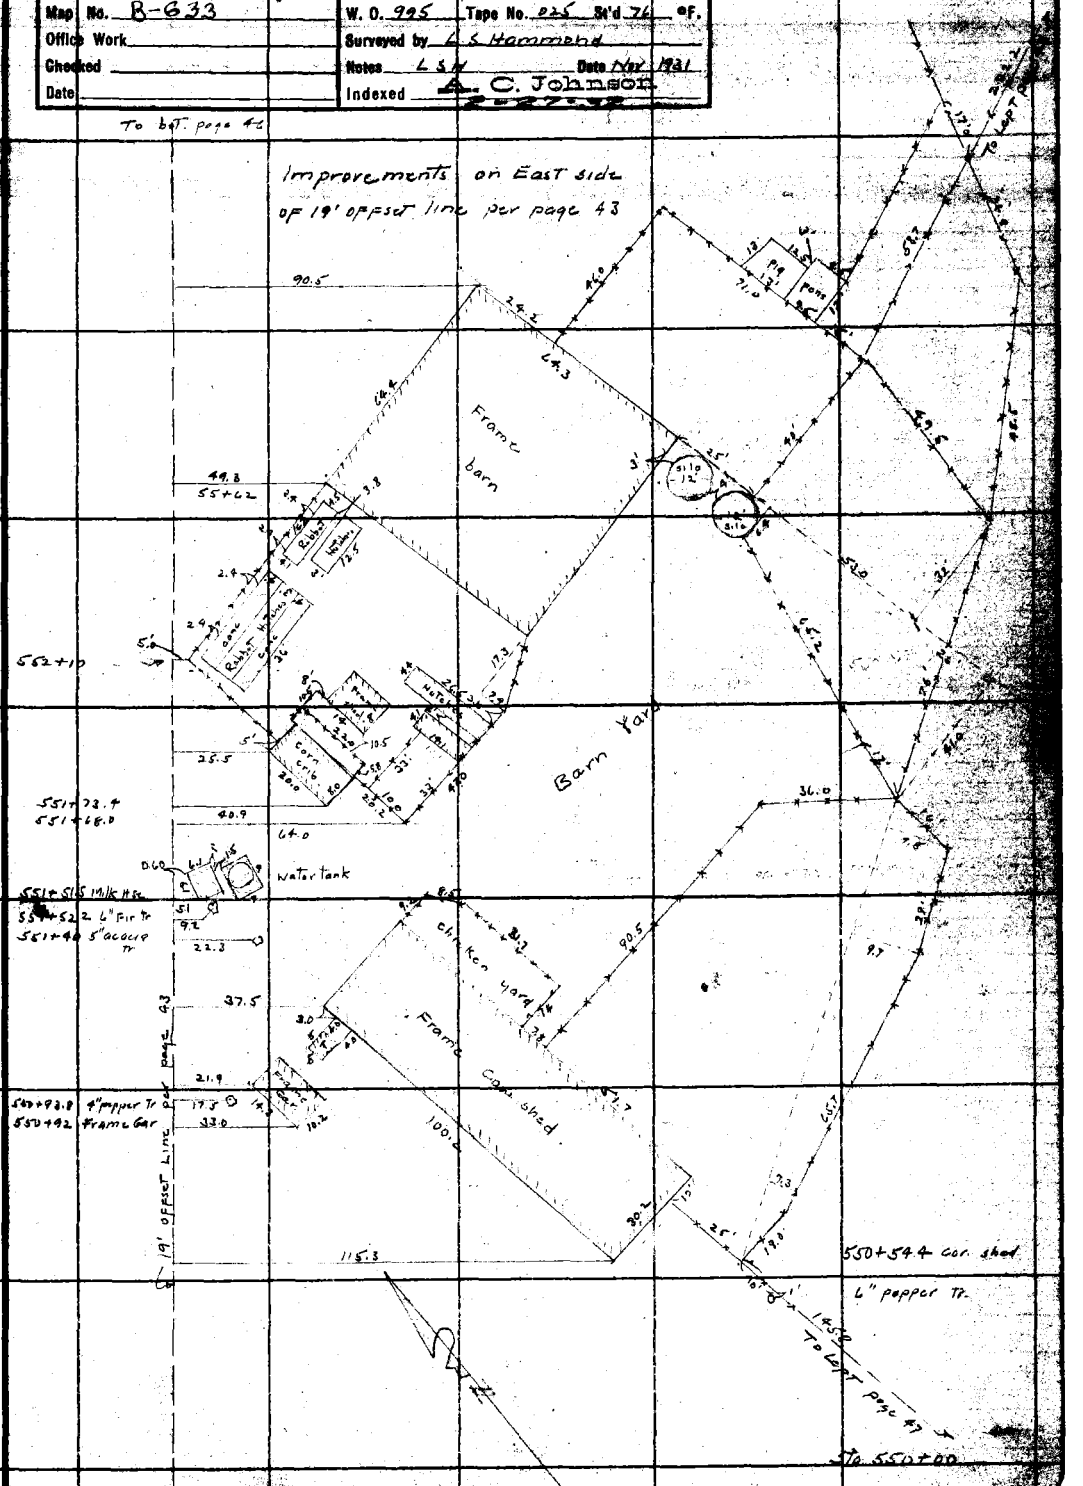
Improvements on East side of 19' offset line per page 43
Frame barn
Barn Yard
Frame Corn shed
Chicken yard
water tank
Rabbit Hutches
Corn crib
Hutch
Hutch
Hutch

F.B. 481 Pg. 46

RETURN TO
LOS ANGELES COUNTY SURVEYOR
700 HALL OF RECORDS

Do not extend notes this side of this line

Note: ANY ADDITIONS OR CHANGES ON THIS SHEET MUST BE MADE OR CIRCLED IN Red Ink. WITH DATE AND NAME OF PERSON MAKING CHANGE.

551+27.8 cor Garage
551+17 18" pepper Tr

550+93.5 4" pepper Tr
550+87.4 2" pepper Tr

550+76.9 8" castor bean Tr + water hyd.
550+69.8 cor fence

550+47.8 cor Fence
550+44.4 cor hse

Sta. 550+00

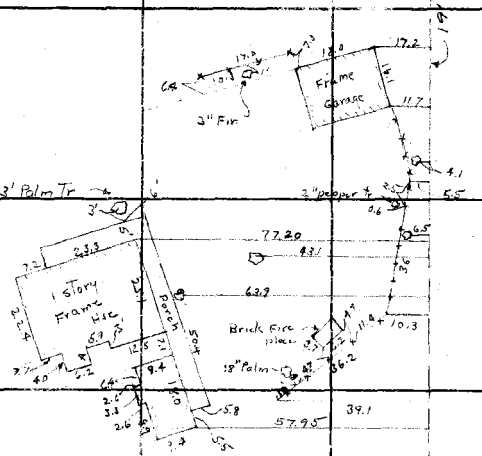

from Top page 45

Notes Ck'd by D. M. Finley
Map No. B-633
Office Work
Checked
Date

Survey of Coyote Creek Diversion
W. O. 995 Tape No. R25 St'd 72 °F.
Surveyed by L.S. Hammond
Notes L.S.H. Date Nov 1936
Indexed A. C. Johnson

F.B. 481 Pg. 47

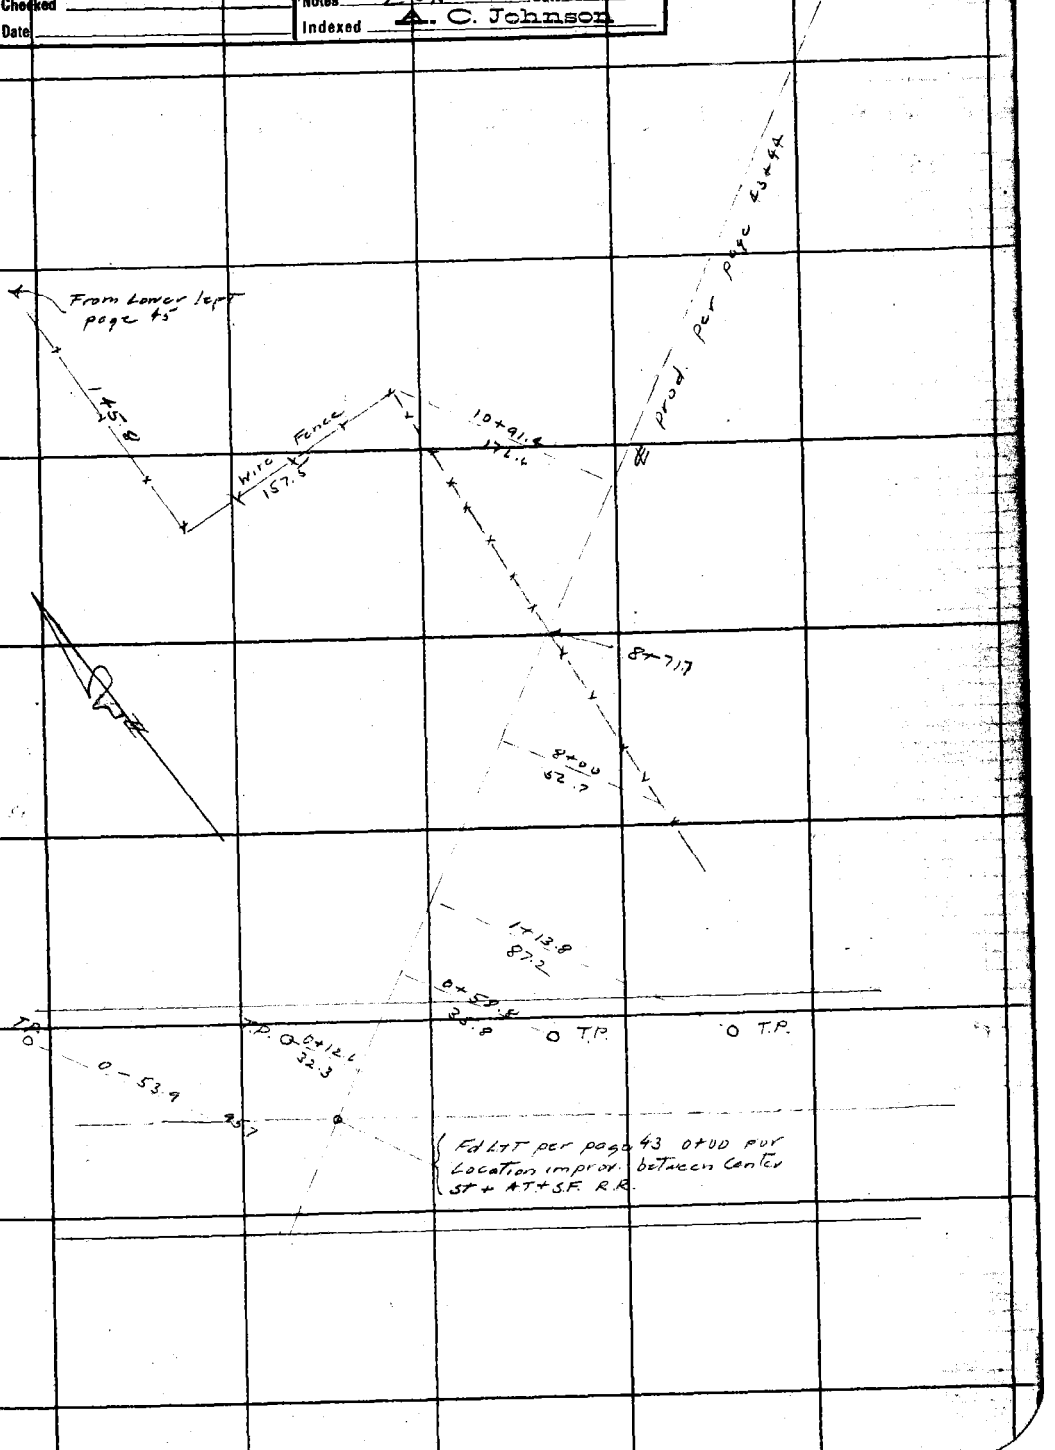

RETURN TO
LOS ANGELES COUNTY SURVEYOR
700 HALL OF RECORDS
Do not extend notes this side of this line

Note: ANY ADDITIONS OR CHANGES ON THIS SHEET MUST BE MADE OR CIRCLED IN Red Ink WITH DATE AND NAME OF PERSON MAKING CHANGE.

FORM 247 10M 8-31

F.B. 481 PG. 49

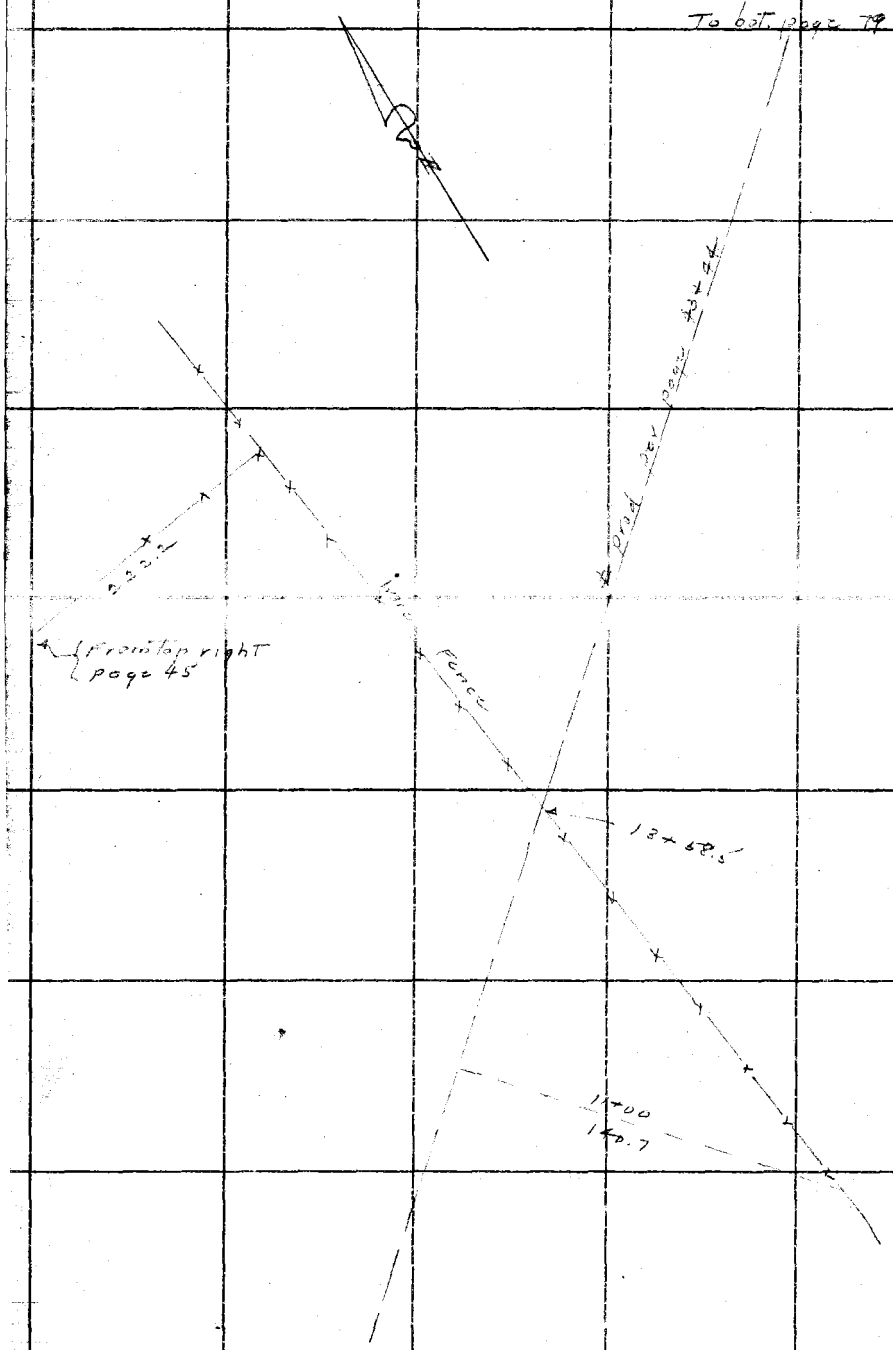

RETURN TO
LOS ANGELES COUNTY SURVEYOR
700 HALL OF RECORDS

Do not extend notes this side of this line

Note: ANY ADDITIONS OR CHANGES ON THIS SHEET MUST BE MADE OR CIRCLED IN Red Ink. WITH DATE AND NAME OF PERSON MAKING CHANGE.

Notes Ck'd by D. M. Finley
Map No. B-633
Office Work
Checked
Date

Survey of Coyote Ck Diag. Div. 3
W. O. 295 Tape No. 450 St'd 72° F.
Surveyed by L. S. Hammond
Notes L. S. H. Date 2-15-32
Indexed A. C. Johnson

F.B. 481 Pg. 48

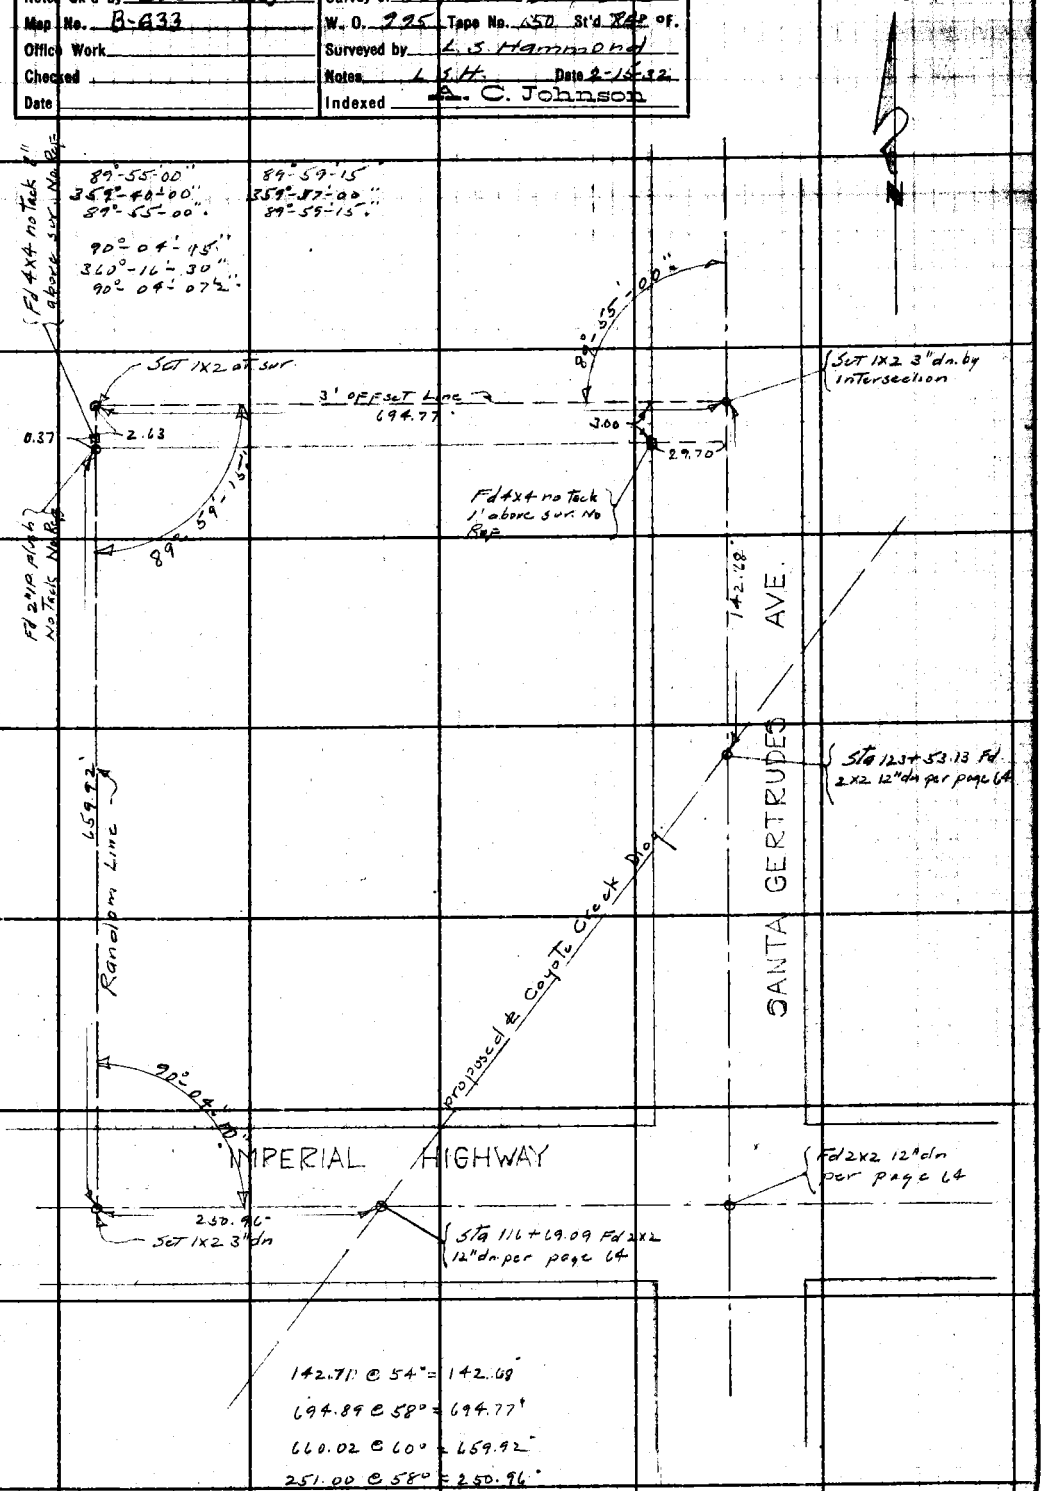

142.71' @ 54" = 142.68'
694.89 @ 58° = 694.77'
660.02 @ 60° = 659.92'
251.00 @ 58° = 250.96'

RETURN TO
LOS ANGELES COUNTY SURVEYOR
700 HALL OF RECORDS

Do not extend notes this side of this line

Notes ANY ADDITIONS OR CHANGES OF THIS SHEET MUST BE MADE OR CIRCLED IN Red Ink. WITH DATE AND NAME OF PERSON MAKING CHANGE.

FORM 247 10M 8-31

RETURN TO
LOS ANGELES COUNTY SURVEYOR
700 HALL OF RECORDS

Note: ANY ADDITIONS OR CHANGES ON THIS SHEET MUST BE MADE OR CIRCLED IN **Red Ink.** WITH DATE AND NAME OF PERSON MAKING CHANGE.

Do not extend notes this side of this line

F.B. 481 Pg. 57

Notes Ck'd by D. M. Finley
Map No. B-633
Office Work
Checked
Date

Survey of Coyote Ck. Diag. Div. 3
W. O. 995 Tape No. 625 St'd 76° °F.
Surveyed by L. S. Hammond
Notes L. 1. 66 Date Nov 1931
Indexed A. C. Johnson

F.B. 491 Pg. 66

To bot page 52

Fd spk. at sur. per F.R. 272-76

0.02
5.86
25.05

Fd 2" IP N.W. cor Lot 1 Tr. 221

105.28 @ 52° = 104.27'
1208.13 @ 52° = 1242.99'

RD.

1202.97

TELEGRAPH (LEFFINGWELL)

(25') (25')

Fd spk. at sur. per F.R. 272-74 & 75

To L+T at Whittier Blvd. No. ref.

Fd 2" IP in conc. SW. cor Lot 28 Tr. 3359

O.R. M.T.P.P.

105.27

SCOTT (40')

29.04

25.95

6.28

Set 2x2 3" dn. Re-establishment of 1½" I.P. per F.R. 272-74 + Tract 221

AVE.

Set 2x2 6" dn per Ties + dist. F.R. 272-74+75

RETURN TO
LOS ANGELES COUNTY SURVEYOR
700 HALL OF RECORDS

Do not extend notes this side of this line

Note: ANY ADDITIONS OR CHANGES OF THIS SHEET MUST BE MADE OR CIRCLED IN Red Ink. WITH DATE AND NAME OF PERSON MAKING CHANGE.

FORM 247 10M 8-31

F.B. 481 PG. 52

Topa. No. 025 Std 76°

To Left page 37

RETURN TO
LOS ANGELES COUNTY SURVEYOR
700 HALL OF RECORDS
Do not extend notes this side of this line

Note: ANY ADDITIONS OR CHANGES ON THIS SHEET MUST BE MADE OR CIRCLED IN Red Ink. WITH DATE AND NAME OF PERSON MAKING CHANGE.

R.R.

RD.

1266.45'

45°-03'

To S.W'ly & First St. per page 27

Set L+T by Intersection

Fd 2" IP per page 27

Fd 1x2 per page 27

30.00'

435.42

L.A. & S.L.

0.71

Split

42°-03'

115.89'

R.R.

To S.W'ly of First St per page 27

Line

27.00' offset

Set L+T

Fd. +++ per page 27

2.83

Fd 1x2 per page 27

35.28

Set L+T by Intersection

To left page 24

P.E.

5.99

4.50' S.W'ly of rails

(25')

(25')

Fd. 4x4 per page 27

TELEGRAPH (LEFFINGWELL)

1496.32'

45°-03'-45"
180°-12'-45"
45°-03'-41"

139-56-15
177-45-00
134-52-15

90°-00'-30"
360°-01'-45"
90°-00'-26"

660.00 @ 52° = 659.91'
1496.50 @ 58° = 1496.32'
115.90 @ 62° = 115.89'
1266.57 @ 62° = 1266.45'

Set X in std pipe

55.39

2490

0.95

Q 95

EAST LINE OF TRACT 221

To Top page 53

Set X+T in pavement

3273

N.E. Cor Lot 1 Tr. 221 Set 2x2 12" dp. by proportion per Tr. 221 between re-establishment of 1½" I.P. at Scott St. and 4x4 post at First St.

Set L+T by Intersection

59.84'

Set X in std pipe

90°-00'-25"

6.94'

TRACT 221

From Top page 51

Notes Ck'd by D. M. Finley
Map No. B-633
Office Work
Checked
Date

Survey of Coyote C.K. Diag. Div 4
W. O. 995 Tape No. 225 St'd 76.° of
Surveyed by A. S. Hammond
Notes L.S.M. Date Dec 1931
Indexed A. O. Johnson

F.B. 481 Pg. 3

To right page 52

594.80. @ 20° = 594.78'
1955.71 @ 0° 5' = 1955.61'
368.79 @ 2° 8' = 368.77'

104° 19' 45"
57° 18' 30"
104° 19' 37½"

TRACT 221

Set 1x2 12" dn. P.O.T.

1955.61' TRACT 221

368.27' EAST LINE of

Fd 2" I.P. per page 24

Fd 3½" I.P. S.E. Cor Lot 9 Tr. 221

(N 84° 33' E 685.02 Rec.)

104.

9.35'

44.6'

594.78'

OCEAN AVE.

SANTA GERTRUDES AVE

To ½" I.P. of Fence SE per page 24

Set 2x2 12" dn. by intersection

Note: ANY ADDITIONS OR CHANGES ON THIS SHEET MUST BE MADE IN RED INK, WITH DATE AND NAME OF PERSON MAKING CHANGE.

Do not extend notes this side of this line

RETURN TO LOS ANGELES COUNTY SURVEYOR MAP RECORDS

FORM 247 10M 8-31

F.B. 481 Pg. 54

Fd 4" I.P. per page 8.

ROSECRANS AVE

℄ per page 8

0.03

89°-59'-30"

SEC. 23

41°-25'-15"
166°-41'-00"
41°-25'-15"

89°-59'-30"
359°-58'-00"
89°-59'-30"

90°-00'-45"
360°-03'-30"
90°-00'-52½"

2640.33 @ 70° = 2640.23'

2640.72

To orig. pge 59

MEYER

41°-25'-15"

20°-0'-55"

¼ Sec. Line per F.B. 425-134

Fd 2x2 12" do. per F.B. 425-134

RD

Center Sec 23 Fd. 4" I.P. per F.B. 425-134

RETURN TO
LOS ANGELES COUNTY SURVEYOR
700 HALL OF RECORDS

Do not extend notes this side of this line

Note: ANY ADDITIONS OR CHANGES ON THIS SHEET MUST BE MADE OR CIRCLED IN Red Ink. WITH DATE AND NAME OF PERSON MAKING CHANGE.

FORM 247 10M 8-31

RETURN TO
LOS ANGELES COUNTY SURVEYOR
700 HALL OF RECORDS

Note: ANY ADDITIONS OR CHANGES ON THIS SHEET MUST BE MADE OR CIRCLED IN **Red Ink.** WITH DATE AND NAME OF PERSON MAKING CHANGE.

Do not extend notes this side of this line

Notes Ck'd by D. M. Finley
Map No. B-623
Office Work
Checked
Date

Survey of Coyote Ck. Diag. Blvd.
W. O. 995 Tape No. 025 Sht. 7 of
Surveyed by L.S. Hammond
Notes L.S.H. Date Oct. 1931
Indexed A. C. Johnson

F.B. 481 Pg.

OLD L.A. S.D.

To 2x2 per page 35

Set X cut on curb

R=40 Fd 2x2 12" dn See page 9

Set 2x2 at Sur. See page 9

1 1/4°-57'-45" 99°-57'-00" 1 1/4°-57'-45" 65°02'-15"

Fd 1x2 at Sur. See page 9.

R=36 Fd 2x2 12" dn. See page 9

0.80

Random Line

90°

144.16

See page 9

705.01 @ 74° = } 705.00
705.01 @ 74° = }

324.42 @ 68° = } 324.40
324.42 @ 68° = }

246.97 @ 70° = } 246.98
246.99 @ 70° = }

107.81 @ 68° = 107.80

To bot. page 56

Set X in cor. iron culvert

30.29

2.85

51.57

102.89

COYOTE CREEK DIAG.

705.00'

proposed

324.40'

246.98'

(SD')

VOID
see pg. 179.

& per pg. 179

From Top page 44

Set Nail PK

Sta 9+49.83 Set 2x2 12" dn. calc dist. from Random Line

Sta 10+ by Int

Set Short

Sta 17+26.49 Set 2x2 12" dn. Calc. dist. from Random Line

Sta 20+50.90 Set 1x2 at Sur.

STAGE RD

Fd. N+T Sta. 19+45.24 per page 35

RETURN TO
LOS ANGELES COUNTY SURVEYOR
700 HALL OF RECORDS

Note: ANY ADDITIONS OR CHANGES ON THIS SHEET MUST BE MADE OR CIRCLED IN **Red Ink.** WITH DATE AND NAME OF PERSON MAKING CHANGE.

Do not extend notes this side of this line

Tape N 23° 25' W 74°

F.B. 481 Pg. 56

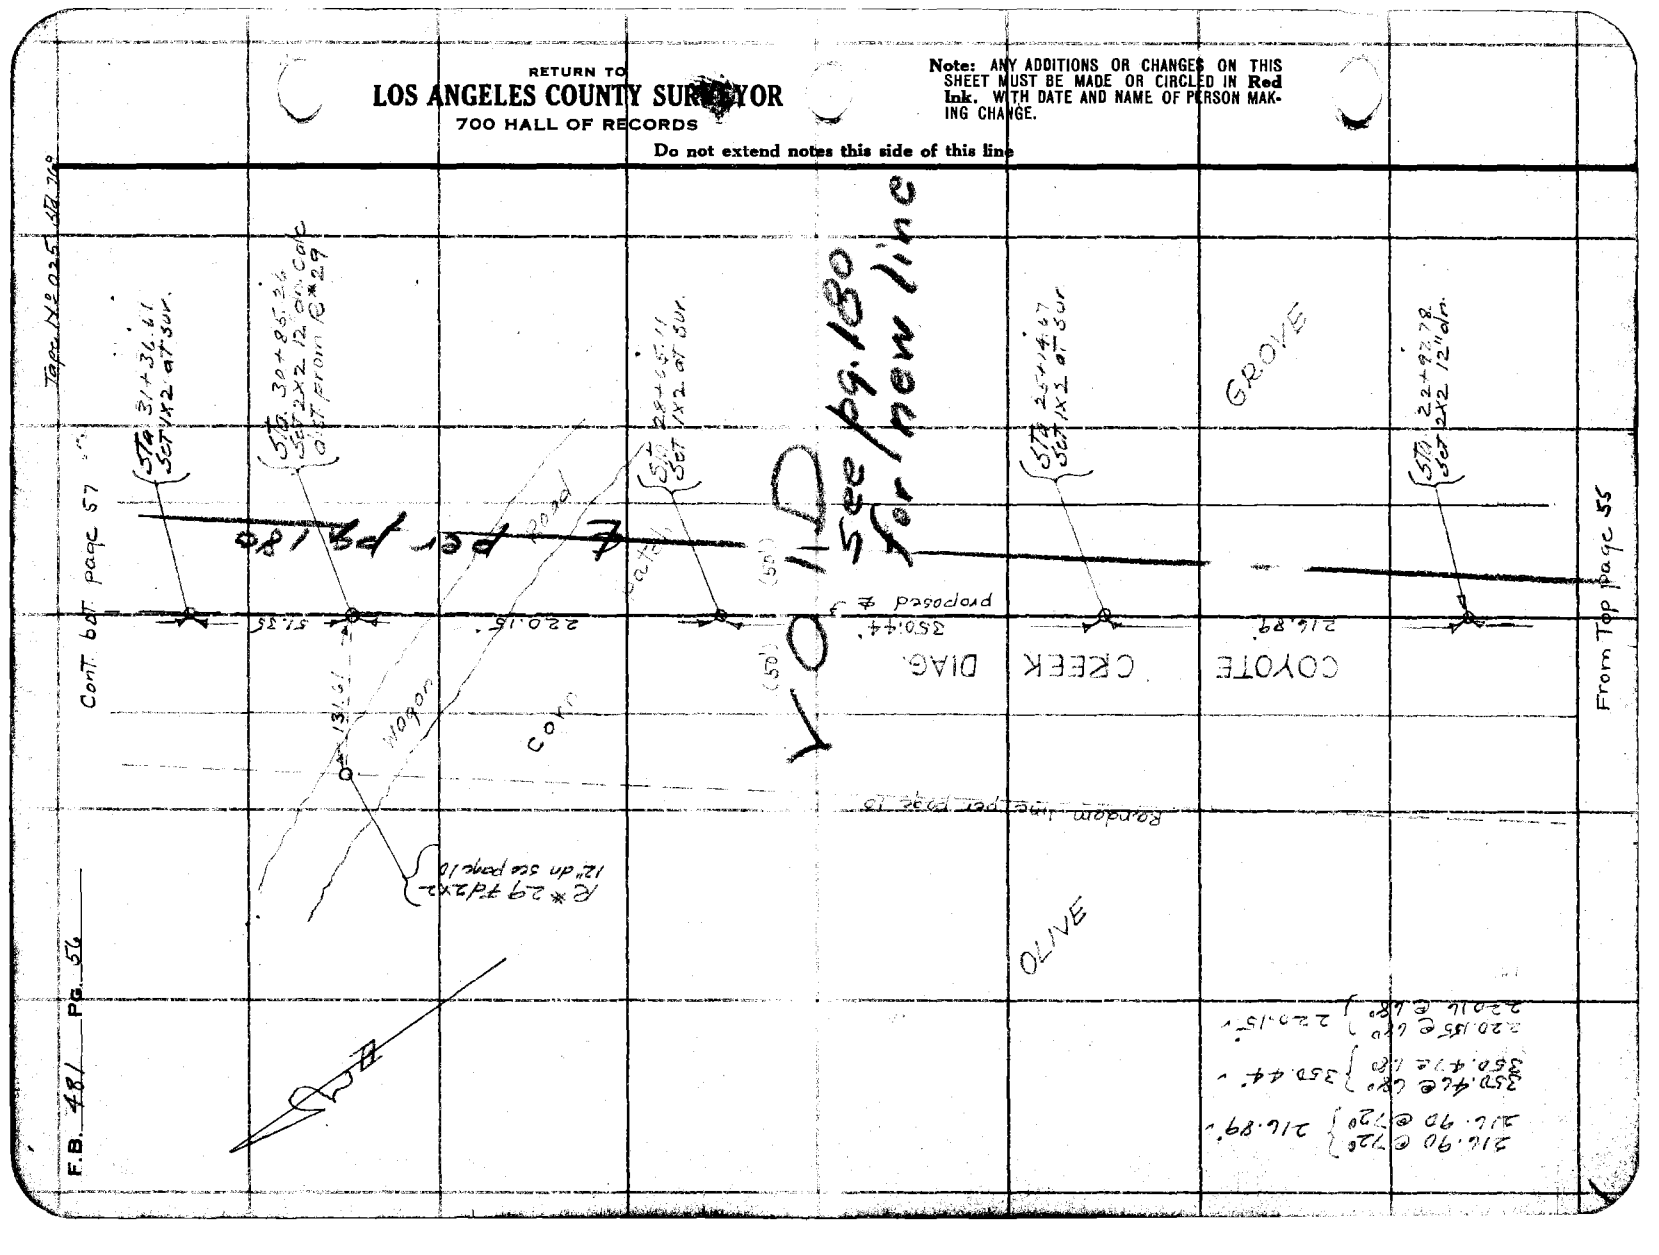

Notes Ck'd by D. M. Finley
Map No. B-633
Office Work
Checked
Date

Survey of Coyote Ck Diag Div 3
W. O. 995 Tape No. 025 Std 70° F.
Surveyed by L.S. Hammond
Notes L S H Date Oct 1931
Indexed A. C. Johnson

F.B. 481 Pg. 57

To bot page 58

Sta 38+90.19
Set 2x2 12" dn.

p9.180

per

Sta 37+50.25
Set 1x2 at sur

OLIVE

VOID
See p9.180 for new

(80') (50')

139.94

GROVE

Sta 35+45.8
Set 1x2 at Sur

Random Line per Page 10 7

204.94

Sta 34+23.09
Set 2x2 12" dn.

122.27 proposed

COYOTE CREEK DIAG

114.42

Sta 33+08.62
Set 1x2 at sur.

172.01

From top page 5

139.935 @ 72°
139.94 @ 72°
139.94'

172.02 @ 72°
172.00 @ 72°
172.01'

114.415 @ 72°
114.42 @ 72°
114.42'

122.27 @ 72°
122.28 @ 72°
122.27'

204.95 @ 72°
204.95 @ 72°
204.94'

RETURN TO
LOS ANGELES COUNTY SURVEYOR
700 HALL OF RECORDS

Notes: ANY ADDITIONS OR CHANGES OF THIS SHEET MUST BE MADE OR CIRCLED IN Red Ink, WITH DATE AND NAME OF PERSON MAKING CHANGE.

Do not extend notes this side of this line

FORM 247 10M 8-31

RETURN TO
LOS ANGELES COUNTY SURVEYOR
700 HALL OF RECORDS

Note: ANY ADDITIONS OR CHANGES ON THIS SHEET MUST BE MADE OR CIRCLED IN **Red Ink.** WITH DATE AND NAME OF PERSON MAKING CHANGE.

Do not extend notes this side of this line

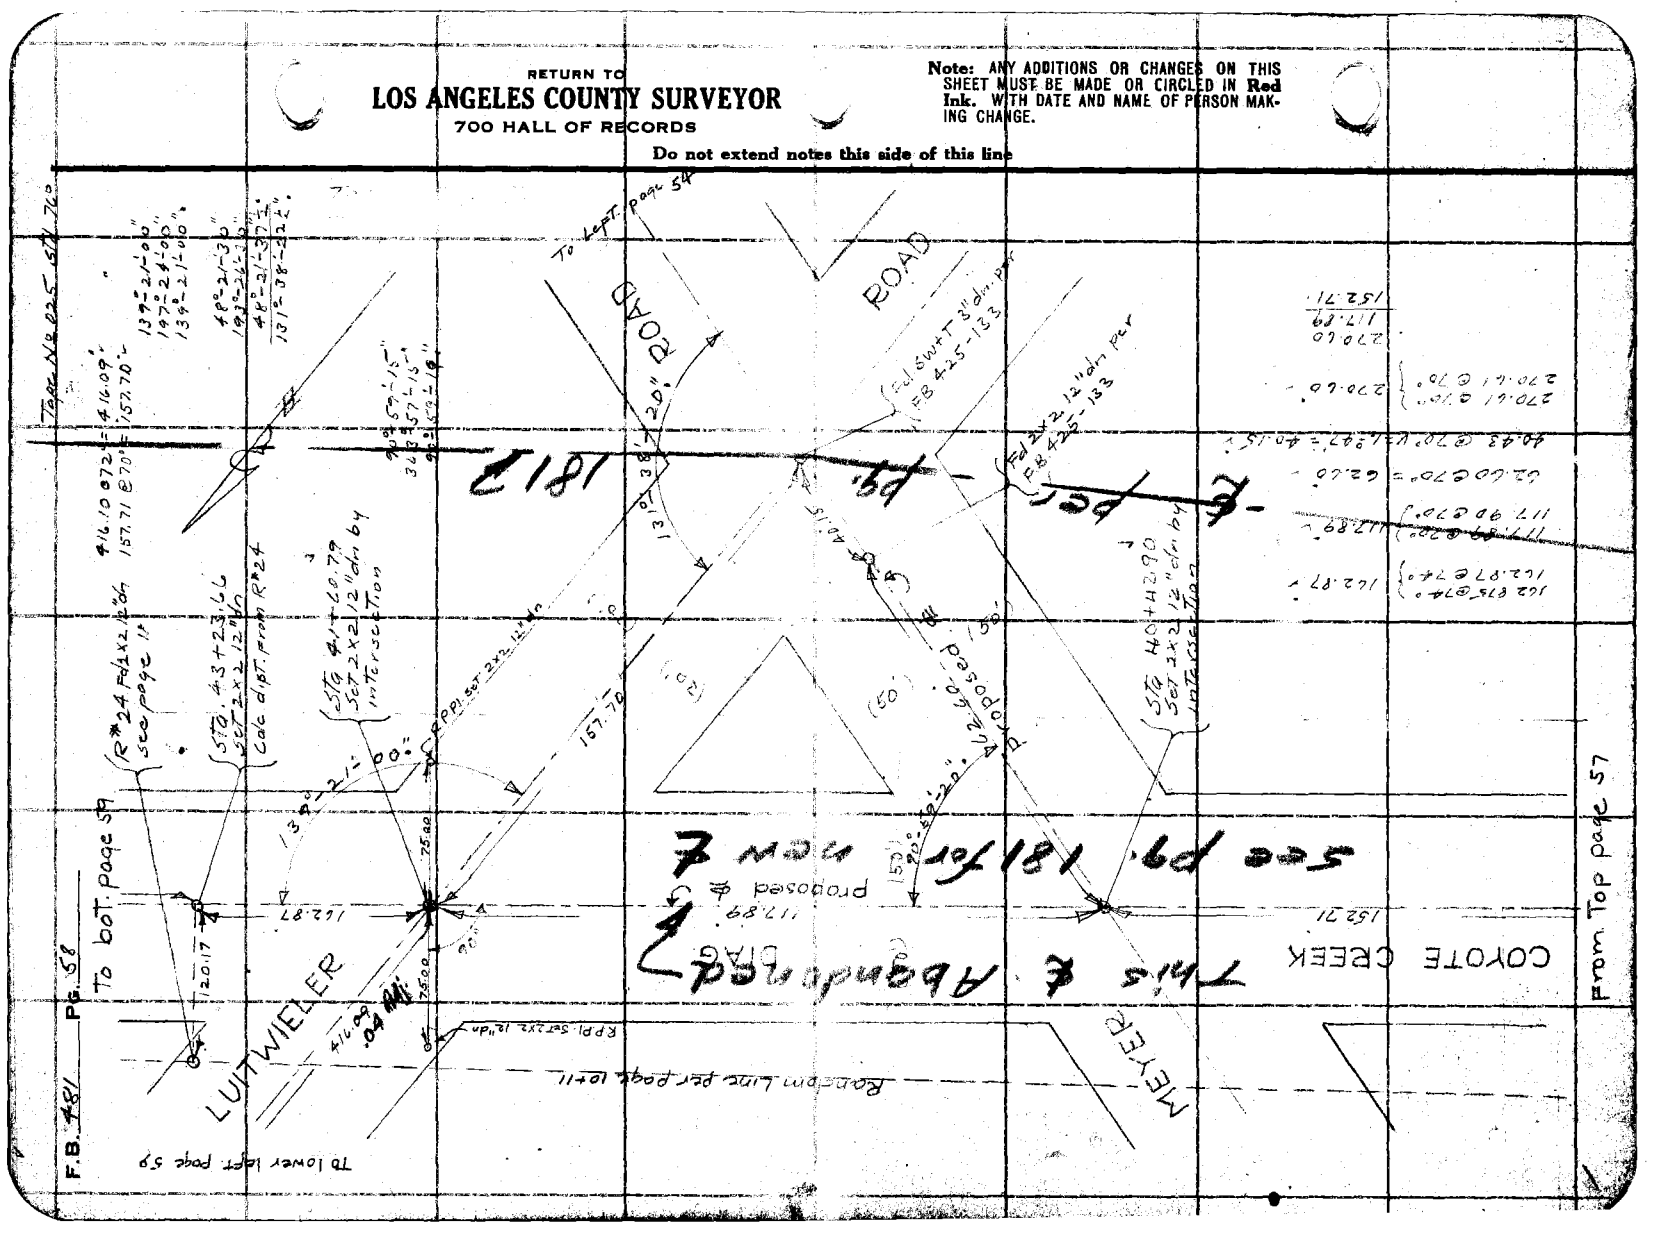
To Left Page 58
ROAD

FORM 247 10M 5-21

RETURN TO
LOS ANGELES COUNTY SURVEYOR
700 HALL OF RECORDS

Note: ANY ADDITIONS OR CHANGES ON THIS SHEET MUST BE MADE OR CIRCLED IN **Red Ink.** WITH DATE AND NAME OF PERSON MAKING CHANGE.

Do not extend notes this side of this line

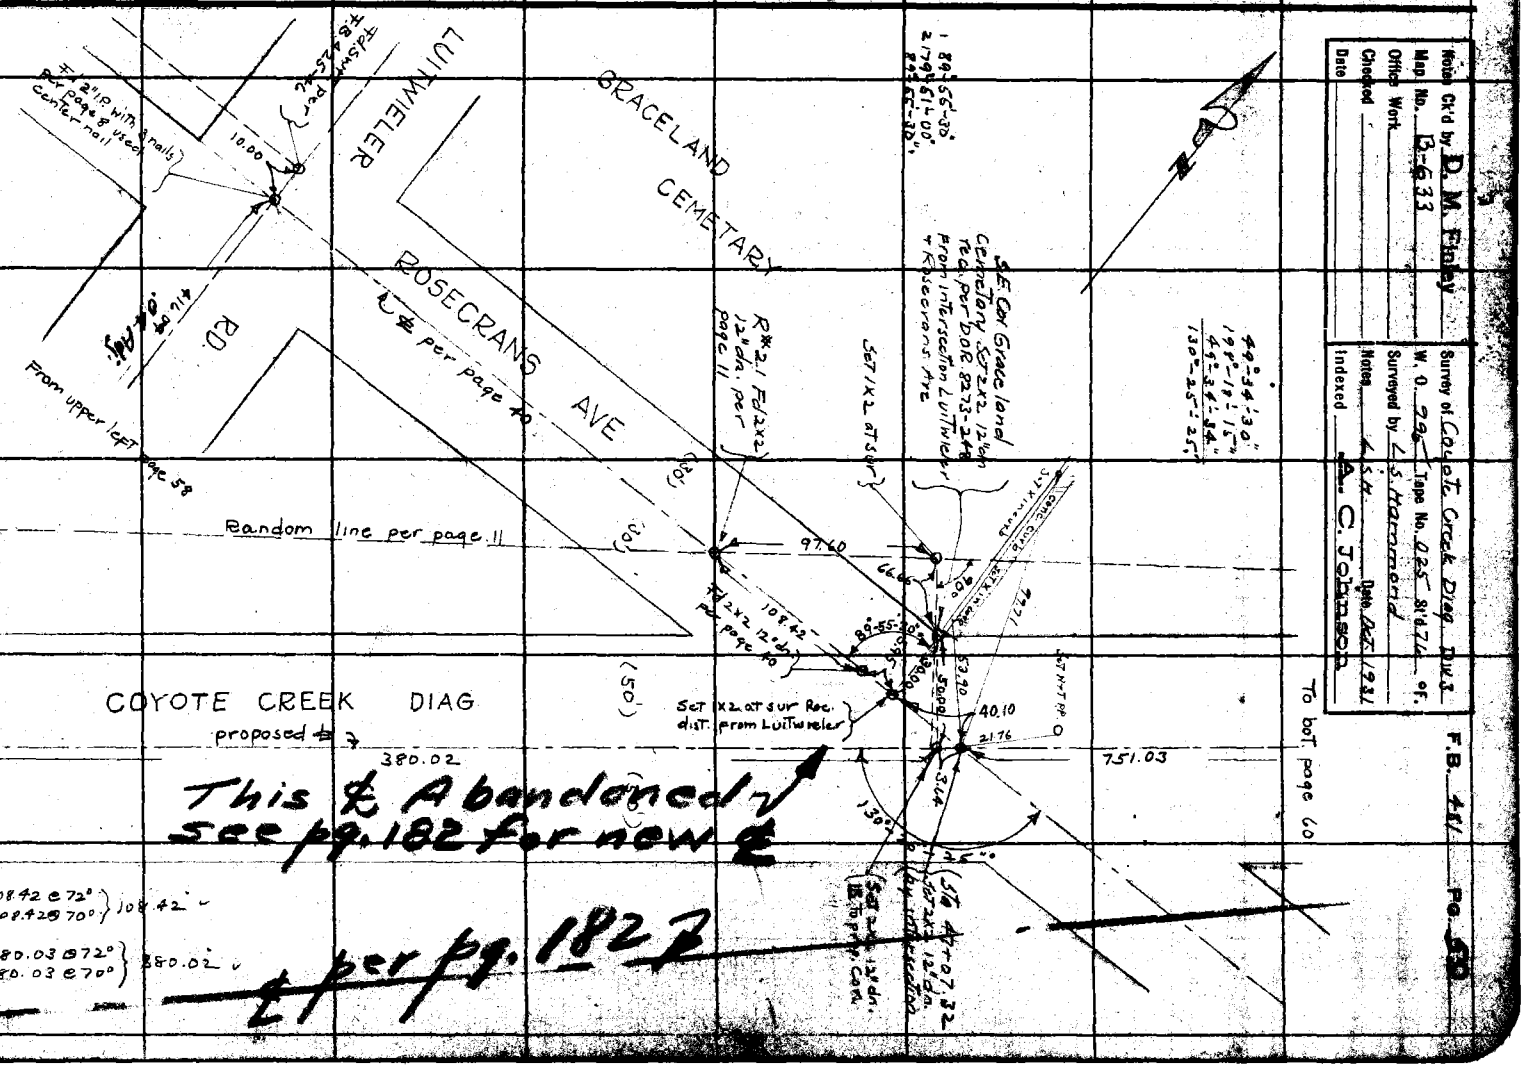
LUITWIELER
GRACELAND CEMETARY
ROSECRANS AVE
Rd.
Random line per page 11
COYOTE CREEK DIAG
proposed ℄
380.02
751.03
97.60
108.42
40.10
21.76
From Top page 58
To bot. page 60
From upper left page 58
℄ per page 10
Set 1x2 at sur Rec. dist. from Luitwieler
Set 1x2 at sur

RETURN TO
LOS ANGELES COUNTY SURVEYOR
700 HALL OF RECORDS

Note: ANY ADDITIONS OR CHANGES ON THIS SHEET MUST BE MADE OR CIRCLED IN **Red Ink.** WITH DATE AND NAME OF PERSON MAKING CHANGE.

Do not extend notes this side of this line

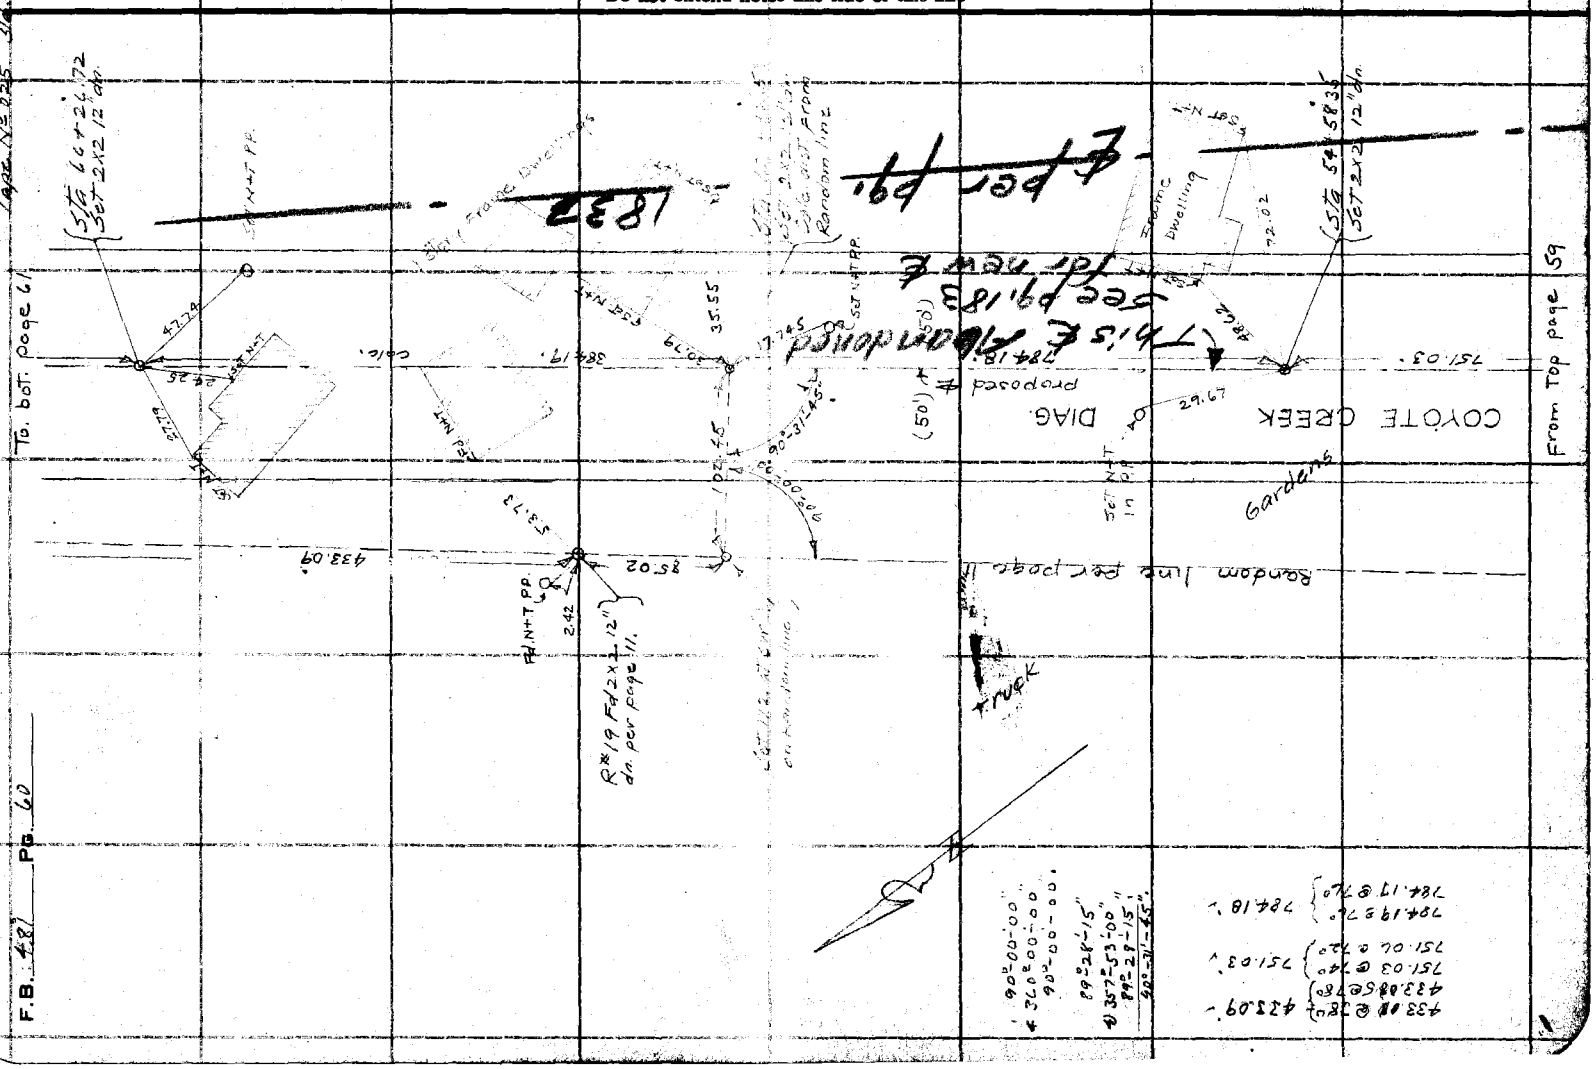

F.B. 487 Pg. 60

FORM 247 10M 8-31

RETURN TO
LOS ANGELES COUNTY SURVEYOR
700 HALL OF RECORDS

Note: ANY ADDITIONS OR CHANGES ON THIS SHEET MUST BE MADE OR CIRCLED IN Red Ink. WITH DATE AND NAME OF PERSON MAKING CHANGE.

Do not extend notes this side of this line

Notes Ck'd by D. M. Finley
Map No. B-633
Office Work
Checked
Date

Survey of Coyote Creek Diag. Div 3
W. O. 285 Tape No. 50 Std 68° F.
Surveyed by E. S. Hammond
Notes L.S.H. Date Oct 1934
Indexed A. C. Johnson

F.B. 482 Pg. 61

Set 1X2 12" Hn. on Random line

Random Line per page 11

89°-28'-15" 4) S 89°-28'-15" E 899.28 (L9)

90°-00'-00" 1) S 90°-00'-00" E

0°-00'-00"

89°-28'-15" E (Plats)

93.67

COYOTE CREEK DIAG.

(50')

(50')

344.47

180.60

133.92

902.99

To bot page 62

From Top page 60

See Pg. 1838

Set pg. 1838

STA 677+00 Set 2x2 12" Hn. dist. from Random line

STA 674+13.45 POT Set 2x2 12" Hn.

STA 670+9.10 POT Set 2x2 12" Hn.

903.10 @ 64° } 902.99
903.12 @ 64° }

344.51 @ 64° } 344.47
344.51 @ 64° }

133.92 @ 76° } 133.92
133.93 @ 76° }

45.00 @ 62°
135.00 @ 62° 49.42 = 134.11

RETURN TO
LOS ANGELES COUNTY SURVEYOR
700 HALL OF RECORDS

Note: ANY ADDITIONS OR CHANGES ON THIS SHEET MUST BE MADE OR CIRCLED IN **Red Ink.** WITH DATE AND NAME OF PERSON MAKING CHANGE.

Do not extend notes this side of this line

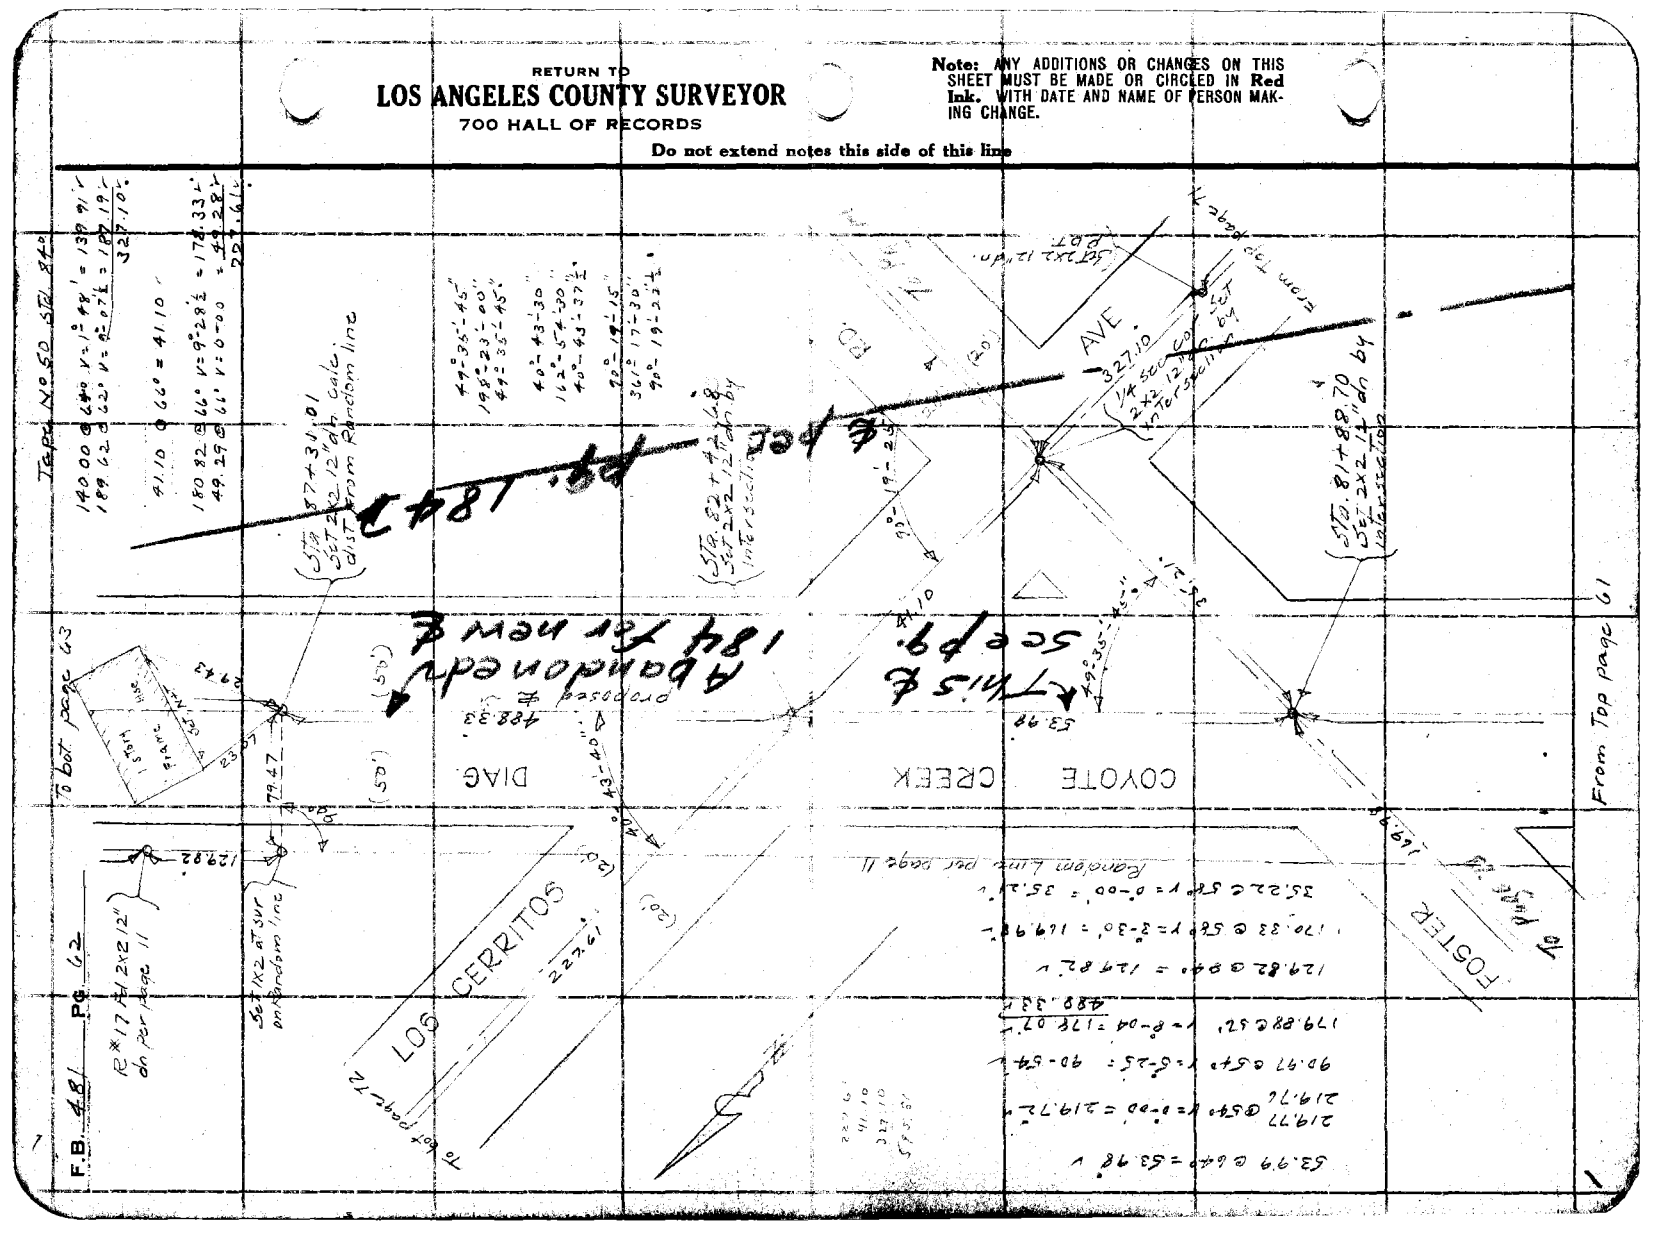
COYOTE CREEK
DIAG.
LOS CERRITOS
FOSTER
AVE
Abandoned 184 Per new ℄
This ℄ Sep. 184
℄ Pce

FORM 247 10M 8-31

RETURN TO
LOS ANGELES COUNTY SURVEYOR
700 HALL OF RECORDS

Note: ANY ADDITIONS OR CHANGES ON THIS SHEET MUST BE MADE OR CIRCLED IN Red Ink. WITH DATE AND NAME OF PERSON MAKING CHANGE.

Do not extend notes this side of this line

Notes Ck'd by D. M. Finley
Map No. B-6.33
Office Work
Checked
Date

Survey of Coyote Ck Drg. Div. 4
W.O. 224 Tract No. SD 84 Sht. of
Surveyed by A. S. Hartmonel Date 5 Nov 1841
Notes: L. & T. C. Johnson
Indexed

F.B. 481 Pg. 48

R200.00 @ 60° V = 2°-08' = 199.85'
228.94 } @ 60° = 228.89'
228.93 }

428.72'
1259.47'
1688.19'

373.10 @ 58° } = 373.03'
373.09 @ 60° }

120.51 @ 67° } = 120.49'
120.52 @ 67° }

211.00 @ 52° V = 8°16' = 208.77'
283.50 @ 60° V = 6°31' = 281.63'
180.11 @ 60° V = 8°21' = 129.92'
620.32'

153.00 @ 58° = 152.97'
199.87 @ 60° V = 3°58' = 199.38'
229.29 } @ 60° = 229.24'
229.28 }
300.50 @ 60° V = 3°05' = 299.52'
180.00 } @ 60° = 129.98'
180.01 }
250.38 @ 60° V = 7°09' = 248.89'
1259.47'

R*1 Rd 2x2 12" dn per page 11

R*15 Rd 2x2 12" dn per page 11

R*14 Rd 2x2 12" dn per page 11

373.03

120.49

Random Line per page 11

90°

90°

67.98

COYOTE CREEK DIAG. (50')

This E Abandoned
See Pg. 185

623.34 calc

620.32'

1688.19'

(50')

From Top page 62

To bot page 64

New E per Pg 185

93+67.85 Set 2x2 12" dn calc dist from R*15

99+74.47 Set 2x2 12" dn calc dist from R*14

Tape No 50 Sta 84'

F.B. 481 Pg. 64

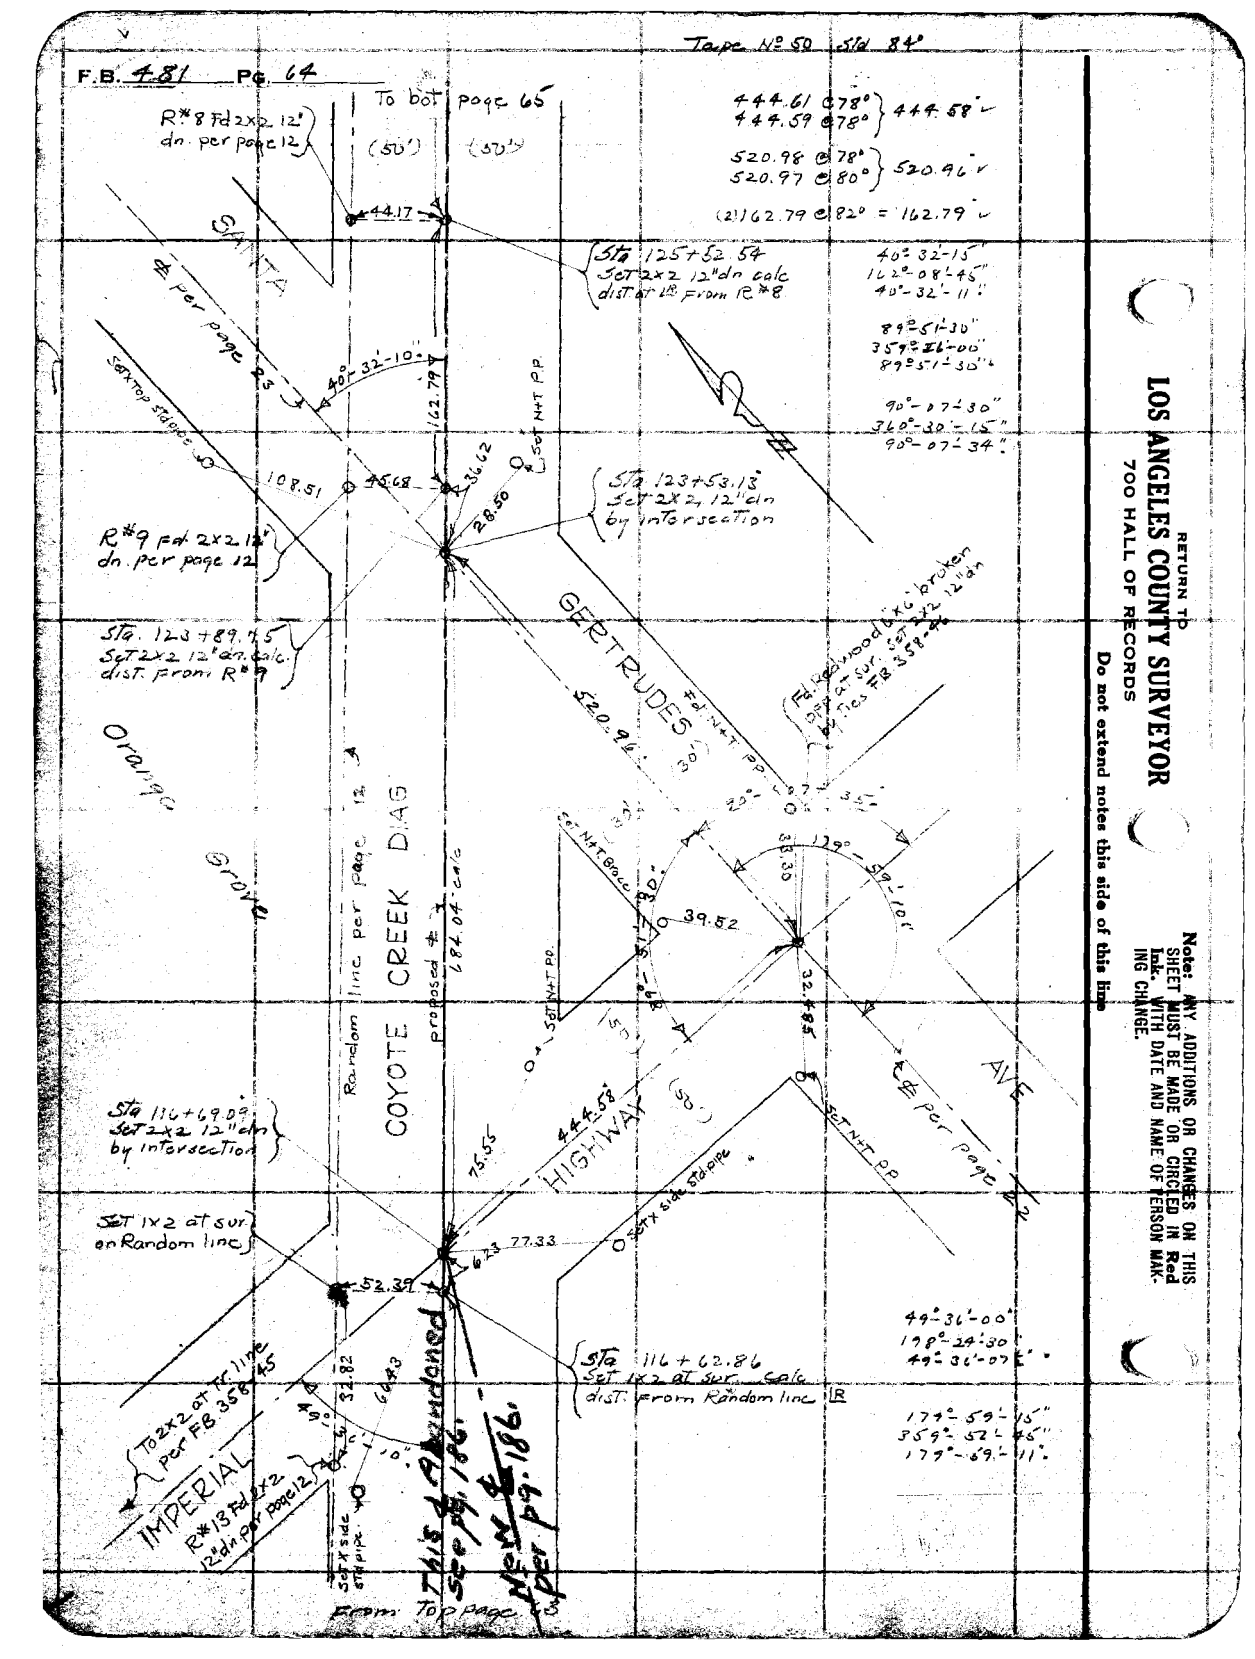

RETURN TO
LOS ANGELES COUNTY SURVEYOR
700 HALL OF RECORDS
Do not extend notes this side of this line

Note: ANY ADDITIONS OR CHANGES ON THIS SHEET MUST BE MADE OR CIRCLED IN Red Ink. WITH DATE AND NAME OF PERSON MAKING CHANGE.

FORM 247 10M 8-31

RETURN TO
LOS ANGELES COUNTY SURVEYOR
700 HALL OF RECORDS

Note: ANY ADDITIONS OR CHANGES ON THIS SHEET MUST BE MADE OR CIRCLED IN Red Ink, WITH DATE AND NAME OF PERSON MAKING CHANGE.

Do not extend notes this side of this line

Field Bk'd by D. M. Finley
Bk. No. B-643
Drawn by
Checked
Date
Survey of Coyote Creek Diversion Dike
Bk. No. 996 Tract No. Rancho Los Cerritos
Surveyed by L. S. Hammond
Date March 1931
Indexed
Traced
Checked
Date

538.14 @ 82° 538.15 @ 82° = 538.13'

296.94 @ 82° V = 1°45' = 296.88'

140.98 @ 82° V = 0°09' = 140.17'

230.155 @ 82° 230.145 @ 82° = 230.15' 1205.25'

225.87 @ 80° 225.96 @ 80° = 225.85'

175.29 @ 78° 175.29 @ 78° = 175.28'

299.10 @ 78° V = 4°-16' = 298.26'

105.00 @ 70° V = 0°-00 = 104.99'

277.77 @ 70° V = 6°-03 = 276.19'

108.90 @ 72° V = 0°-00' = 108.38'

178.55 @ 72° V = 8°-51 = 176.41'

177.13 @ 78° V = 0°-00 = 177.13'

COYOTE CREEK
1205.25'

DIAG.
1141.35'
proposed ± 5

OCEAN

POINT P.B.

Fd 2x2 12" dn S/B 17+80.52 P.C. page 24 R=676 (2 ea)

Fd 2x2 12" dn S/B 153+21.43 Sect 2x2 12" dn, Calc d.s.t. LB from R=5

R=5 Fd 2x2 12" dn per page 13

R=7 Fd 2x2 12" dn per page 13

S/B 139+83.64 Sect 2x2 12" dn on Top bank of Earthen Reservoir

S/B 137+57.79 Sect 2x2 12" dn Calc d.s.t. or LB from R=7

S/B 151+24.99 Sect 2x2 12" dn Calc d.s.t. or LB from R=6

S/B 151+54.35 Sect 2x2 12" dn Intersection

Rawhiding per page 13

To bot. page 66

From top page 44

33.04 225.85 51.01 20.42 29.36 175.29 18.53 134.215 (55') (65')

151°-11'-50" 151°-11'-50" 28°-48'-10" 28°-48'-10"

AVE

To bot. page 24

P.B. 281

RETURN TO
LOS ANGELES COUNTY SURVEYOR
700 HALL OF RECORDS

Note: ANY ADDITIONS OR CHANGES ON THIS SHEET MUST BE MADE OR CIRCLED IN **Red Ink.** WITH DATE AND NAME OF PERSON MAKING CHANGE.

Do not extend notes this side of this line

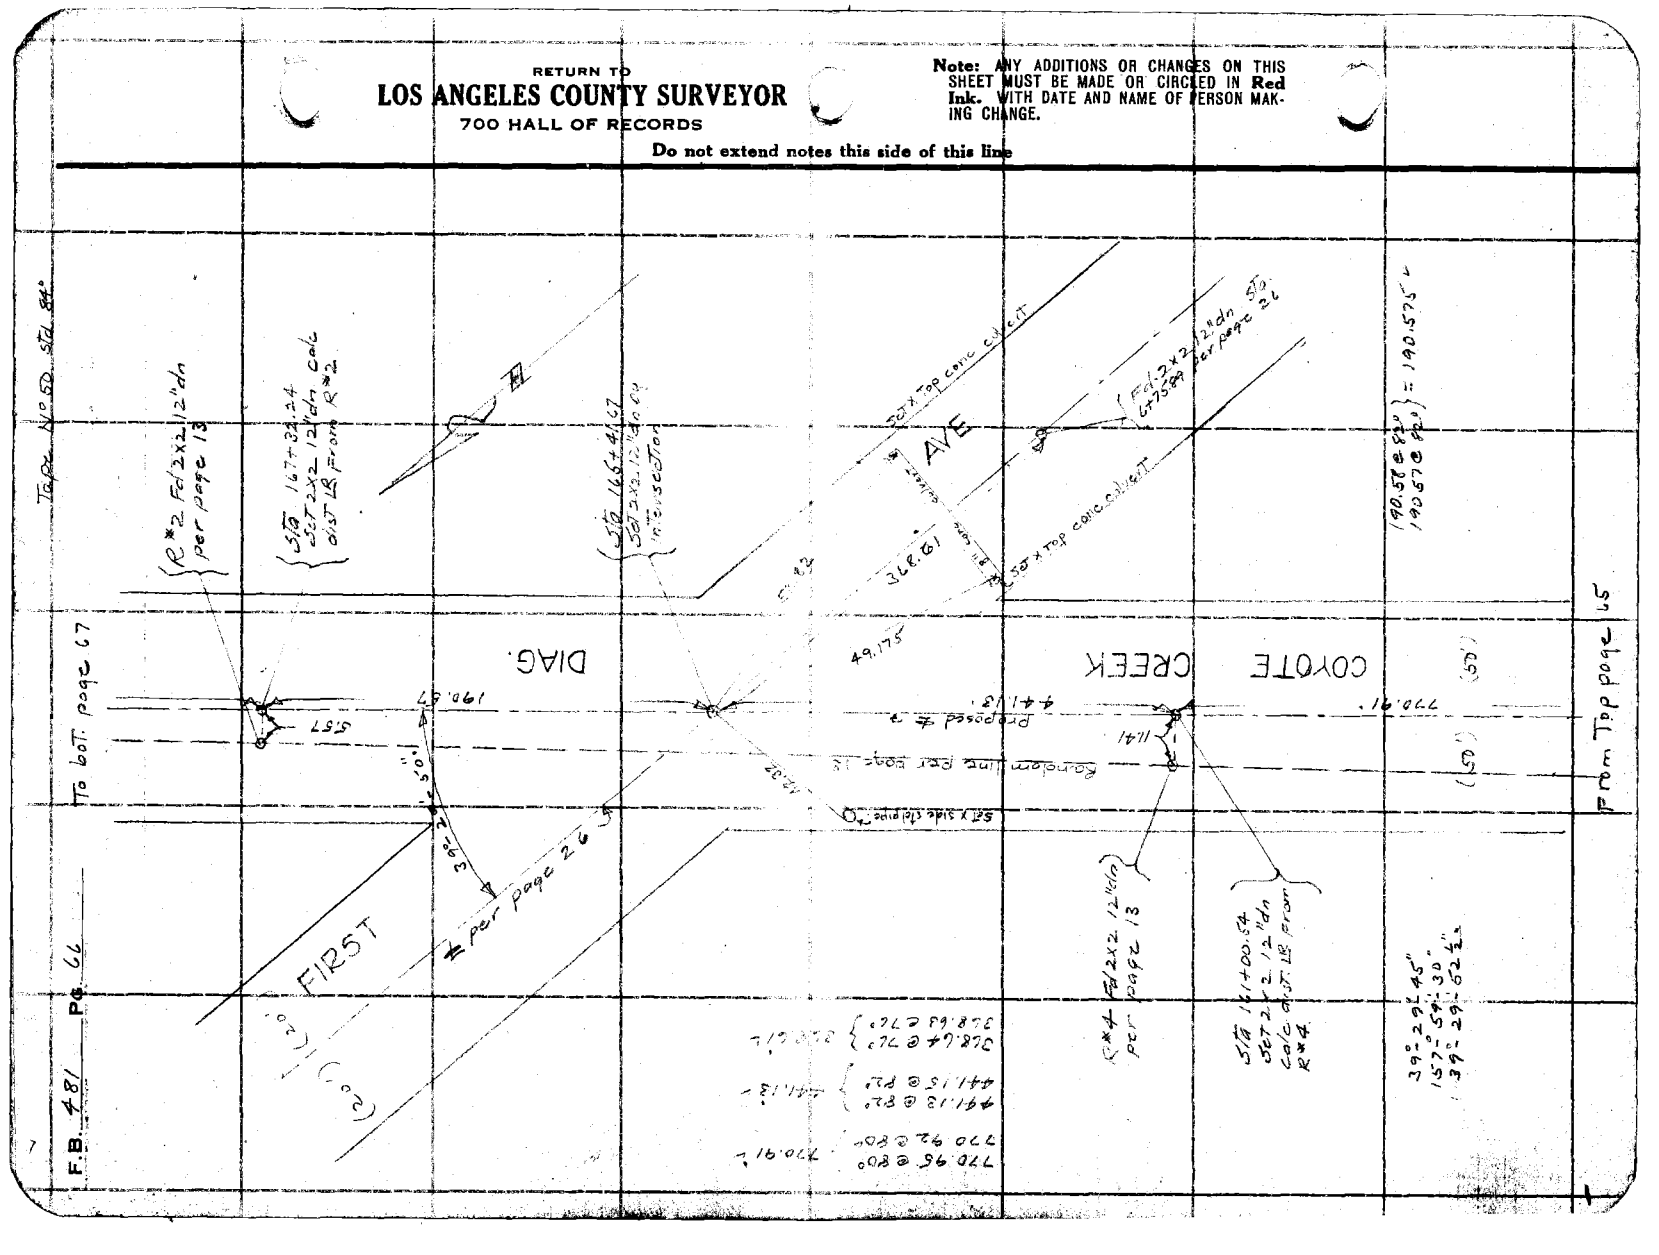

Notes Ck'd by D. M. Finley
Map No. B-633
Office Work
Checked
Date

Survey of Coyote Ck Diag Div 3
W. O. 795 Tape No. 225 St'd 76° °F.
Surveyed by L. S. Hammond
Notes L. S. H. Date Dec. 1931
Indexed A. C. Johnson

F.B. 481 Pg. 67

To bot page 66

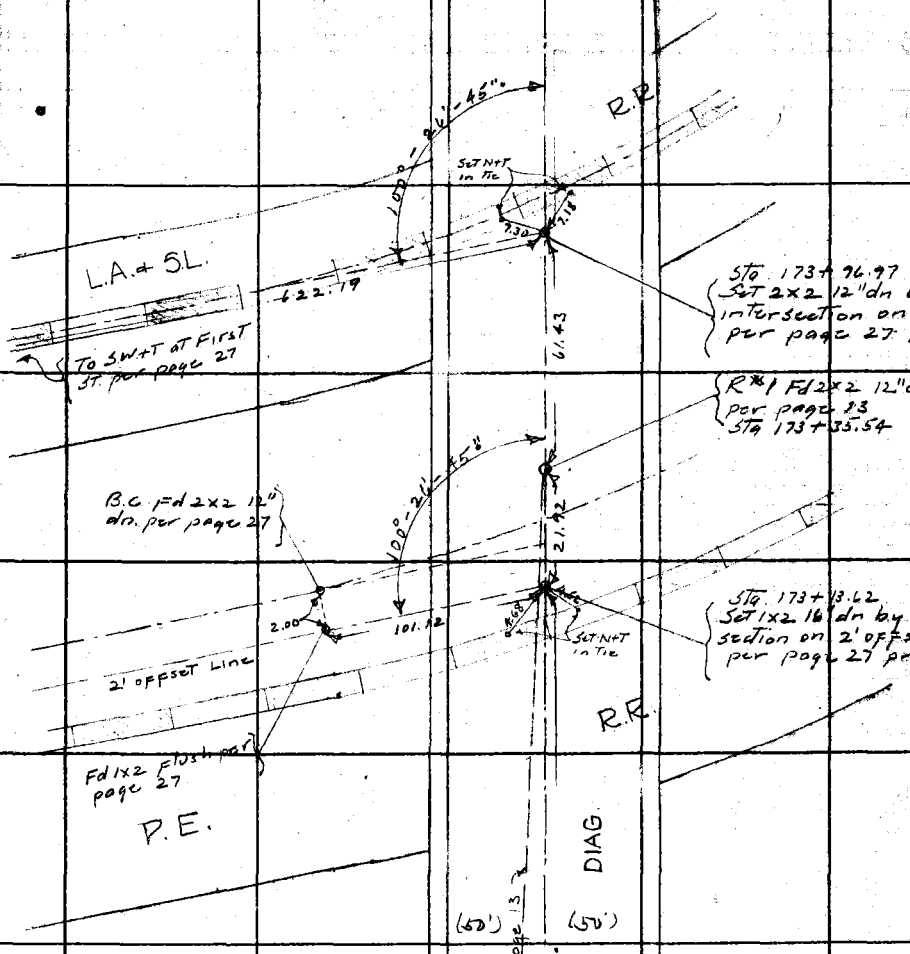

100° 26' 45"
41 47' 00"
100° 26' 45"

100° 26' 45"
41 47' 00"
100° 26' 45"

61.43 @ 74° = 61.43' ℄
101.12 @ 74° = 101.12' ℄

100.000 @ 60° V = 9° 18' = 98.68' ℄
477.85 @ 60°
477.82 @ 60° } 477.78' ℄
4.92 @ 60° = 4.92'
583.38' ℄

622.21 @ 72° = 622.19 ℄

From Top page 66

RETURN TO
LOS ANGELES COUNTY SURVEYOR
700 HALL OF RECORDS
Do not extend notes this side of this line

Notes: ANY ADDITIONS OR CHANGES ON THIS SHEET MUST BE MADE OR CIRCLED IN Red Ink. WITH DATE AND NAME OF PERSON MAKING CHANGE.

FORM 247 10M 8-31

Tape N=02 E Sta 7+60

F.B. 481 Pg. 68

To bot page 69

(1) 89°-45'-45"
(4) 359°-02'-15"
(8) 358°-05'-30"
89°-45'-41"

(1) 139°-54'-30"
(4) 179°-37'-30"
(8) 39°-15'-30"
139°-54'-26"

(1) 42°-57'-45"
(4) 171°-51'-15"
(8) 343°-42'-45"
42°-57'-51"

Sta 186+14.58
Set L+T. calc
dist. from SW+T.
336.905 in dist

Fd SW+T Sta 12+92.43 per page 28

Set SW+T on ℄ Telegraph Rd

TELEGRAPH

336.905
362.77' ℄ per page 28

So.-N+T To O

89°-45'-40"

DIAG (50') (50') BROVE

ORANGE (50') (50')

COYOTE CREEK

Proposed ℄

553.28

432.42'

Random 834.86

74.34' calc

S F.H.C. spk + tin p.p. RD.

42°-57'-50"

50°-08'-45" calc

50.56

57.01

25.865

55.54

1 set x in stel pipe

50°-08'-45" calc

56.74

432.45 @ 18° = 432.43
432.43 @ 70° = 432.41
432.42'

336.91 @ 72° = 336.90
336.92 @ 72° = 336.91
336.905'

834.87 @ 74° = 834.86
834.85 @ 74° = 834.84
834.85'

10.44 @ 58° = 10.44'
100.00 @ 58° = 98.86'
544.90 @ 58°
544.88 @ 58° } 544.83'
654.13'

Sta. 180+51.40
POT. Set 2x2 12" dn

129°-41'-25"

654.13'

From Top page 67

RETURN TO
LOS ANGELES COUNTY SURVEYOR
700 HALL OF RECORDS
Do not extend notes this side of this line

Note: ANY ADDITIONS OR CHANGES ON THIS SHEET MUST BE MADE OR CIRCLED IN Red Ink WITH DATE AND NAME OF PERSON MAKING CHANGE.

Notes Ck'd by D. M. Finley
Map No. B-633
Office Work
Checked
Date

Survey of Coyote Ck. Diag. Div 3
W. O. 795 Tape No. 226 Std 74° °F.
Surveyed by L. S. Hammond
Notes L. S. H. Date Dec 1931
Indexed A. C. Johnson

F.B. 481 Pg. 29

(1) 89°-51'-30"
(2) 358°-26'-30"
(3) 3[illegible]
[illegible]°-51'-30"

(1) 136°-58'-52"
(2) 182°-54'-42"
(3) 16°-58'-58"
136°-58'-49"

(D) [illegible]
(A) 136-58-41½
(B) 136-59-50⅝

Fd. M+T. P.P.
70.45 S
Fd. SW+T. Sta. 16+49.56 per page 29
Sta. 207+52.68 Set SW+T calc. dist From Sta.
22.19
23.46 S
Set X in curb
Set N+T P.P.
9.68 R
39°-51'-25" calc
SECOND
10.22
Set X mark
(25')
(25')
ORANGE
DIAG.
(50')
1400.86 calc.
(50')
COYOTE CREEK
GROVE
179°-56'-30"
89°-51'-30"
Fd 2x2 per page 29
350
Fd N+T. per page 29
ST.
50°-12'-05" Beach's Sub. Tolex Jr.
Line
763.49
Sta. 193+55.92 Set 2x2 12" dn by calc.
of
Offset 135.85
50° Line
35'
(50')
(50')
Set 1x2 12" dn on apparent Line
58°-50"
136°
Fd 1x2 per page 38
Line

RETURN TO
LOS ANGELES COUNTY SURVEYOR
700 HALL OF RECORDS

Notes: ANY ADDITIONS OR CHANGES ON THIS SHEET MUST BE MADE OR CIRCLED IN Red Ink WITH DATE AND NAME OF PERSON MAKING CHANGE.

Do not extend notes this side of this line

FORM 247 10M 5-31

F.B. 4481 Pg. 70

Tape N° 025 Std 76°

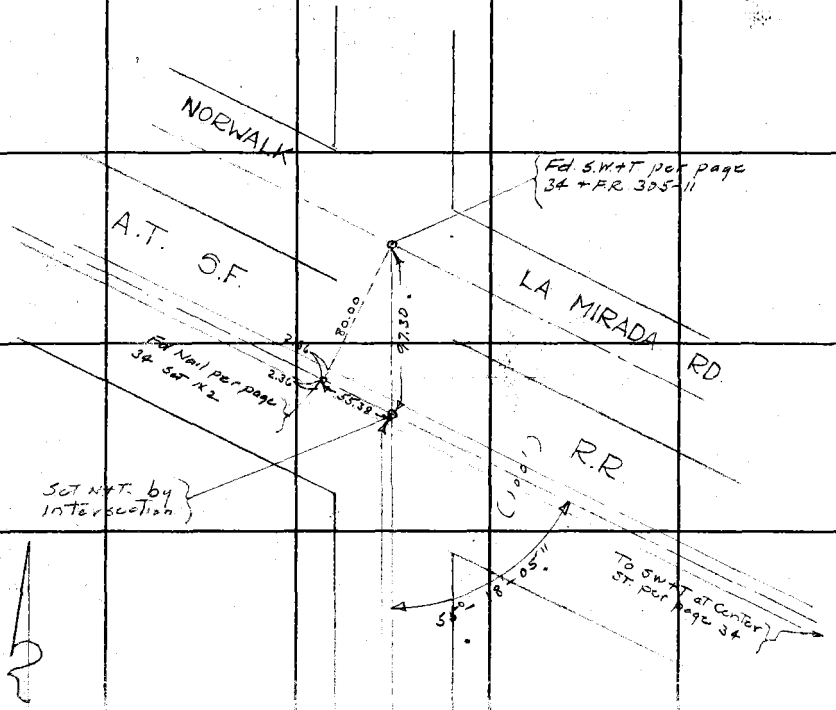

97.31 @ 66° = 97.30' ✓

1600.50 @ 64° = 1599.88' ✓
1878.90 @ 66° = 1878.78' ✓
3478.66' ✓

55°-18'-00"
221°-12'-15"
55°-18'-04" ✓

From left page 43

RETURN TO
LOS ANGELES COUNTY SURVEYOR
700 HALL OF RECORDS

Do not extend notes this side of this line

Note: ANY ADDITIONS OR CHANGES ON THIS SHEET MUST BE MADE OR CIRCLED IN Red Ink. WITH DATE AND NAME OF PERSON MAKING CHANGE.

Notes Ck'd by D. M. Finley
Map No. B-633
Office Work
Checked
Date

Survey of Coyote Ck. Diag Div 3
W. O. 985 Tape No. 60 St'd 84° of.
Surveyed by L. S. Hammond
Notes L. S. H. Date Nov 1931
Indexed A. C. Johnson

F.B. 481 Pg. 74

To lower right page 62

Notes ANY ADDITIONS OR CHANGES ON THIS SHEET MUST BE MADE OR CIRCLED IN Red Ink, WITH DATE AND NAME OF PERSON MAKING CHANGE.

Do not extend notes this side of this line

RETURN TO
LOS ANGELES COUNTY SURVEYOR
700 HALL OF RECORDS

AVE

458.88'

25.14

Nail & Tag

2.82

23.35

Set 2X2 12" dn. P.O.T.

cloth covered Frame over Flowers

457.13'

CERRITOS

LOS

(20')

(20')

1413.89'

Set Nail & Tag

13.94

26.06

38.52

Set 2X2 12" dn P.O.T

89°-41'-40"

ROSECRANS

AVE

(20')

(20')

E per page 8

0.03

Fd 4" I.P. with brass cap at Sec. 1/4 Sec. Cor. Sec. page 8

89°-41'-85"
358°-46'-30"
89°-41'-37½"




FORM 247 10M 8-31

RETURN TO
LOS ANGELES COUNTY SURVEYOR
700 HALL OF RECORDS

Note: ANY ADDITIONS OR CHANGES ON THIS SHEET MUST BE MADE OR CIRCLED IN **Red Ink.** WITH DATE AND NAME OF PERSON MAKING CHANGE.

Do not extend notes this side of this line

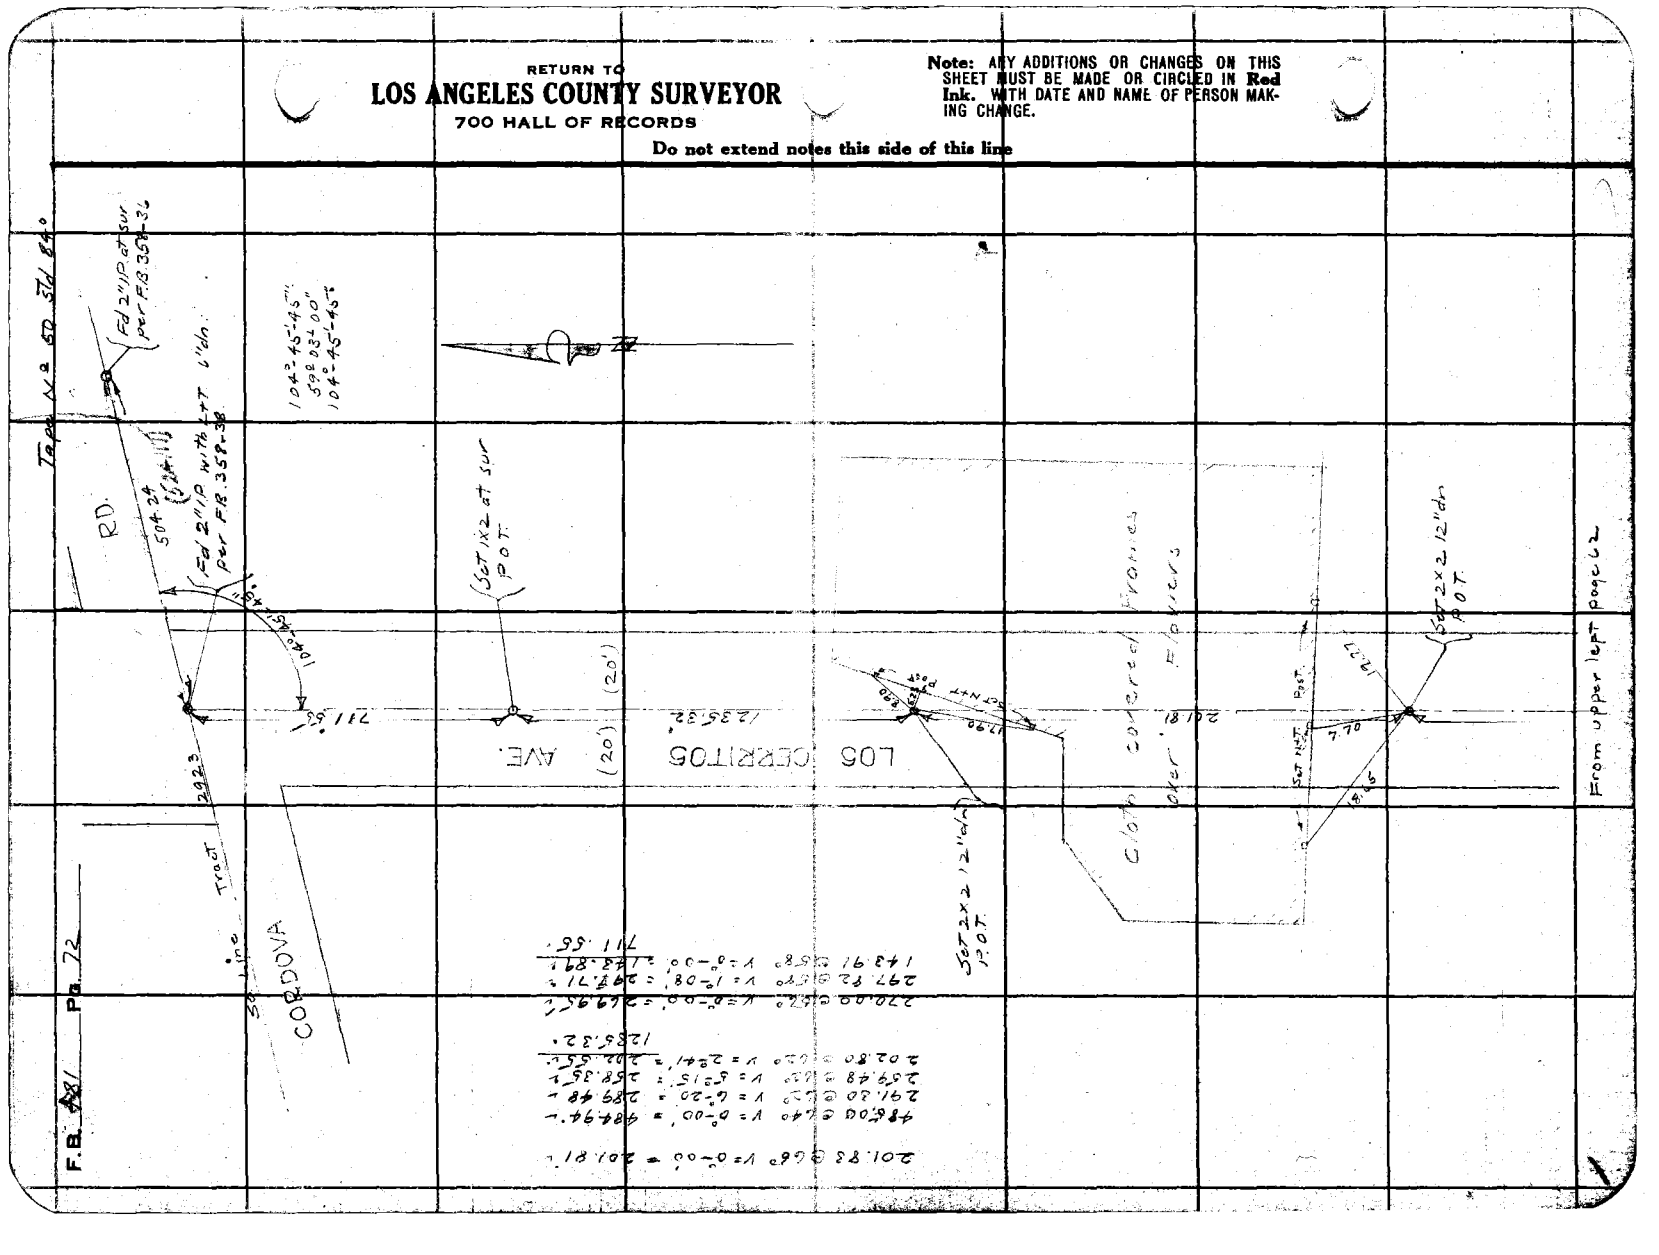

F.B. 481 Pg. 72

Noted Ck'd by D. M. Finley
Map No. B-693
Office Work
Checked
Date

Survey of Coyote Ck Drag Div 3
W. O. Tape No. 50 St'd 84° °F.
Surveyed by L. S. Hammond
Notes L. S. H. Date Nov 1981
Indexed A. C. Johnson

F.B. 481 Pg. 58

To Lower left page 62

Notes ANY ADDITIONS OR CHANGES ON THIS SHEET MUST BE MADE OR CIRCLED IN Red Ink, WITH DATE AND NAME OF PERSON MAKING CHANGE.

RETURN TO
LOS ANGELES COUNTY SURVEYOR
700 HALL OF RECORDS

Do not extend notes this side of this line

39.13 @ 62° R = 1420' = 36.99'
300.00 @ 42° R = 2143'30" = 279.62'
157.47 @ 62° R = 145' = 157.45'
494.06'

155.00 @ 62° R = 2552' = 154.79'
300.00 @ 62° R = 6403' = 278.29'
1122.81 @ 62° R = 0800' = 1122.45'
132.83 @ 58° R = 10134'30" = 130.06'
37.14 @ 58° R = 3700' = 37.13'
1742.42'

210.72 @ 58° R = 10°00' = 210.68'

90°-05'-45"
360°-23'-30"
90°-05'-52½"
89°-54'-07½"

P.O.T. Set 1x2 6" dn.

(20') (20') 210.68'

P.O.T. Set 1x2 6" dn.

FOSTER RD.

1742.42'

P.O.T. Set 1x2 6" dn.

494.06'

89°54'07½" E

LUITWIELER RD.

℄ per page 14

29.87

(33')

¼ Sec. cor Fd. 5/8" IPT per page 14

Fd. 5/8" IPT per page 14

(30')

45.40

R.P. Set 2x2, 12" dn.

FORM 247 10M 5-81

Tape No. 57 Std 84°

F.B. 481 Pg. 74

¼ cor Fd 2x2 12" dn.
per page 22

SANTA GERTRUDES AVE.

≠ per page 22

≠ per page 21

30

30

239.79

89° 51' 15"

90° 08' 15"

89° 51' 15"
359° 24' 45"
89° 51' 11"

90° 08' 15"
360° 33' 00"
90° 08' 15"

300.00 @ 52° V = 1°-13'-30" = 299.88'
229.88 @ 52° V = 2°-32' = 229.61'
299.09 @ 66° V = 4°-43' = 298.04'
126.19 @ 66° V = 2°-12' = 125.44'
170.26 @ 66° V = 0°-06' = 170.24'
1123.21'

158.93 @ 70° = 158.92'

1150.34 @ 66° = 1150.21'

239.82 @ 66° = 239.79'

1150.21

20 20

RD.

P.O.T. SET 1x2 6" dn.

SET N+T

2.49

7.27

SET N+T

Hse.

Frame Barn 158.92

SET N+T

Shed

SET N+T

9.29

34.45

P.O.T. SET 1x2 6" dn.

FOSTER

1123.21

From upper right page 62

RETURN TO
LOS ANGELES COUNTY SURVEYOR
700 HALL OF RECORDS

Do not extend notes this side of this line

Note: ANY ADDITIONS OR CHANGES ON THIS SHEET MUST BE MADE OR CIRCLED IN Red Ink. WITH DATE AND NAME OF PERSON MAKING CHANGE.

F.B. 481 Pg. 79

Notes Ck'd by D. M. Finley
Map No. B-633
Office Work
Checked
Date

Survey of Coyote Ck. Diag. Ors
W. O. 925 Tape No. 225 Std. 74° of.
Surveyed by A. S. Harmon
Notes A. S. H. Date Dec. 1932
Indexed A. C. Johnson

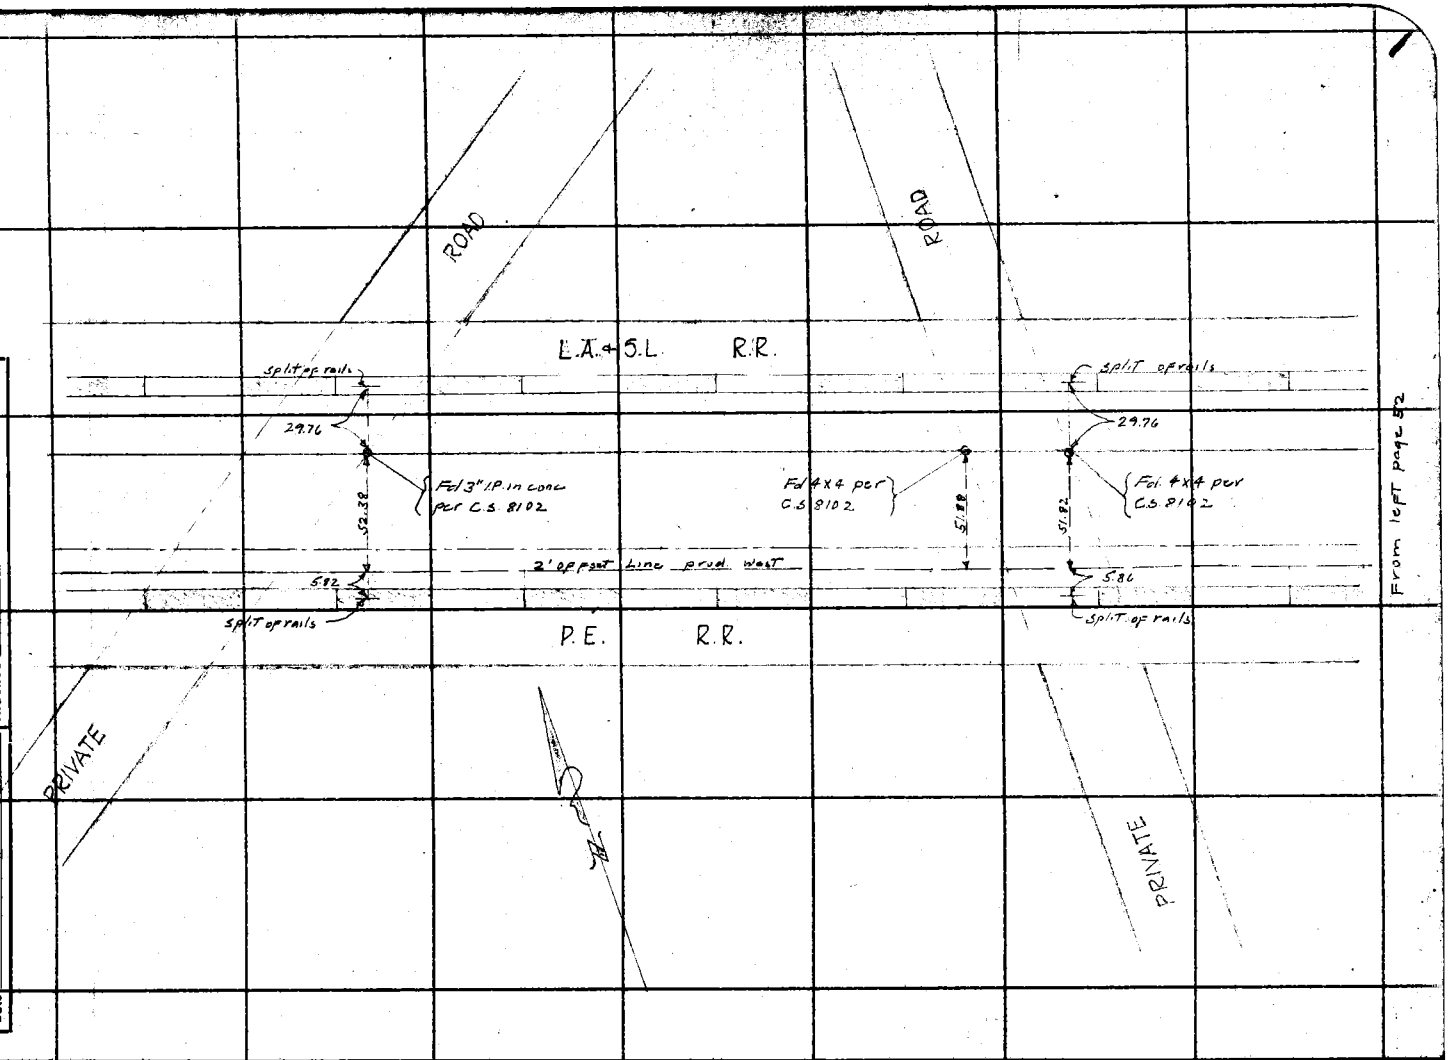

From left page 82

RETURN TO
LOS ANGELES COUNTY SURVEYOR
700 HALL OF RECORDS

Do not extend notes this side of this line

Note: ANY ADDITIONS OR CHANGES ON THIS SHEET MUST BE MADE OR CIRCLED IN Red Ink. WITH DATE AND NAME OF PERSON MAKING CHANGE.

FORM 247 10M 8-31

RETURN TO
LOS ANGELES COUNTY SURVEYOR
700 HALL OF RECORDS

Note: ANY ADDITIONS OR CHANGES ON THIS SHEET MUST BE MADE OR CIRCLED IN **Red Ink.** WITH DATE AND NAME OF PERSON MAKING CHANGE.

Do not extend notes this side of this line

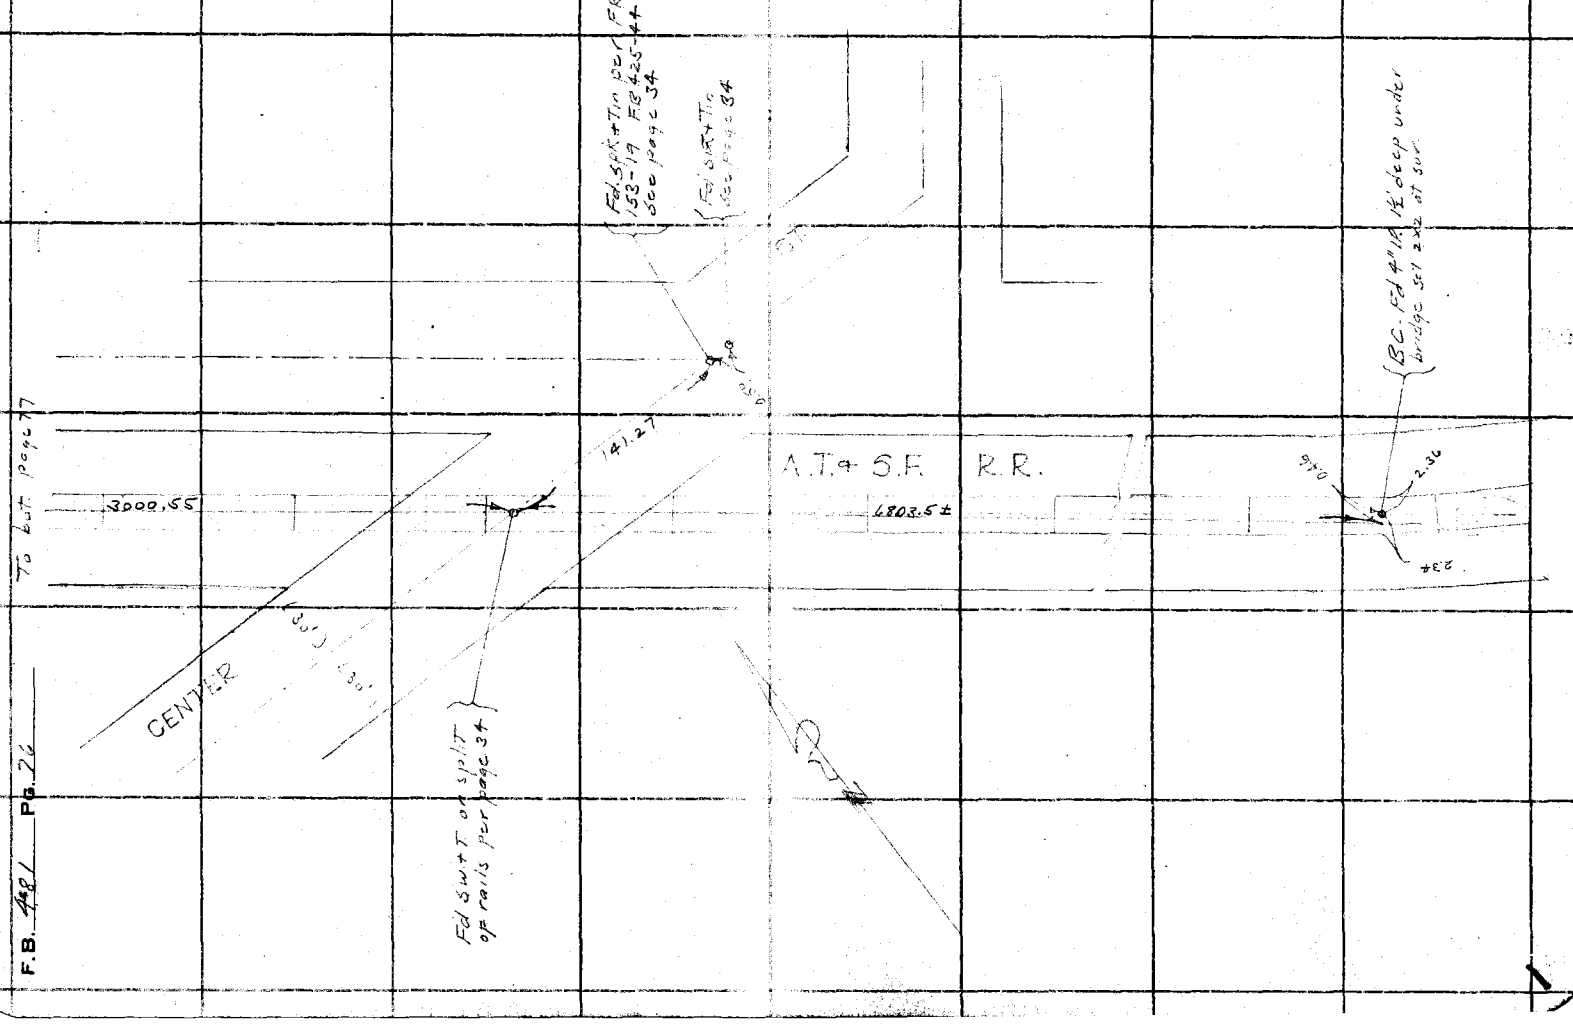

F.B. 448 Pg. 26

Notes Ck'd by D. M. Finley
Map No. B-633
Office Work
Checked
Date

Survey of Coyote Ck. Diag Div 3
W. O. 785 Tape No. St'd °F.
Surveyed by L. S. Hammond
Notes L. S. H. Date Dec. 1934
Indexed A. C. Johnson

F.B. 481 Pg. 77

To bot page 78

79.85

Fd spk per R.D.P.B. 121-119 FR. 153-21

A.T.+S.F. R.R.

285.85

Fd 3" IP 3' below grade No Tack

0.63

559.61

COYOTE CREEK

(50')

(50')

2.59

2.12

DIAG.

Fd SW+T in Tie per page 44

From Top page 76

Notes: ANY ADDITIONS OR CHANGES ON THIS SHEET MUST BE MADE OR CIRCLED IN Red Ink, WITH DATE AND NAME OF PERSON MAKING CHANGE.

Do not extend notes this side of this line

RETURN TO
LOS ANGELES COUNTY SURVEYOR
700 HALL OF RECORDS

FORM 247 10M 8-31

F.B. 4481 Pg. 78

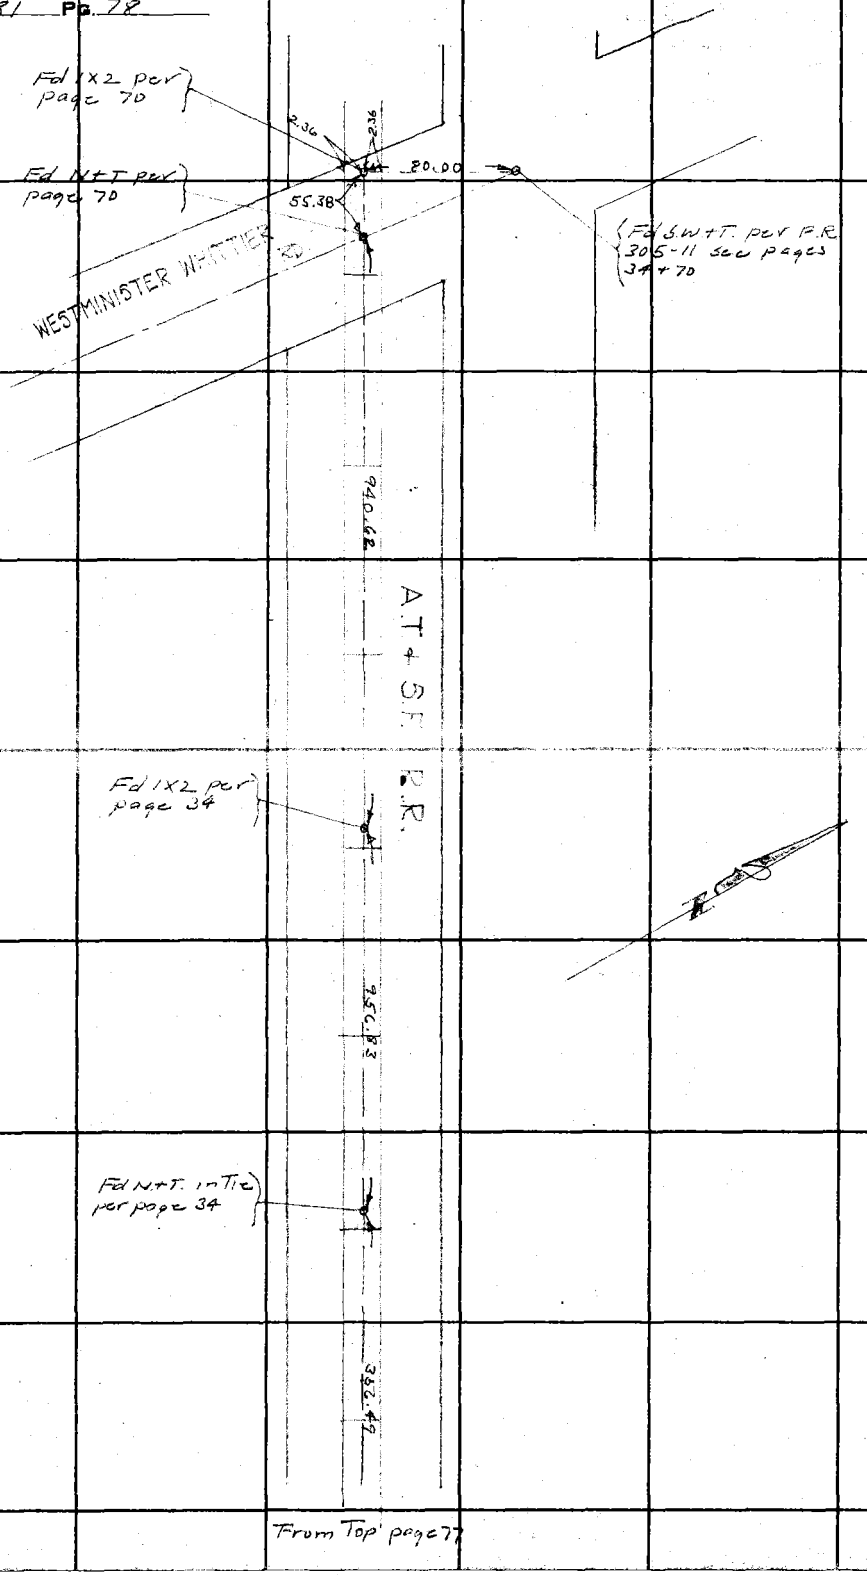

RETURN TO
LOS ANGELES COUNTY SURVEYOR
700 HALL OF RECORDS

Do not extend notes this side of this line

Note: ANY ADDITIONS OR CHANGES ON THIS SHEET MUST BE MADE OR CIRCLED IN **Red** Ink., WITH DATE AND NAME OF PERSON MAKING CHANGE.

Notes Ck'd by D. M. Finley
Map No. B-633
Office Work
Checked
Date

Survey of Coyote Ck. Diag. D 4.3
W. O. 995 Tape No. St'd of
Surveyed by L. S. Hammond
Notes L. S. H. Date Dec 1954
Indexed A. C. Johnson

F.B. 481 Pg. 79

Notice: ANY ADDITIONS OR CHANGES ON THIS SHEET MUST BE MADE OR CIRCLED IN Red Ink, WITH DATE AND NAME OF PERSON MAKING CHANGE.

Do not extend notes this side of this line

RETURN TO
LOS ANGELES COUNTY SURVEYOR
700 HALL OF RECORDS

To bot. page 80

Note
Stationing used is for location of improvements only 0+00 at ℄ of RR.

7+36.1 clump of 6.8" and 1 12" willows
26.0
7+42.9
42.0
6+63.2 18" olive tr
93.3
6+00
88.8
ditch
open
5+00
12'
18+41
COYOTE CREEK DIAG
Pg 47
Field
open
0+91.5
Pavement
22.8
1'
0+68.7
Fd N+T per page 44
53.2
℄ TP 0+65.7
16.0 ℄ T.P. 0+48.7
Sta. 0+00 Fd SHT page 44
2.12
32.2.60
* per page 34
2.59
Wooden
Bridge
154.5
22
9.8
8.7
7.8
10.6
7.2
8.7
T.P.
79.0
77.6
T.P.
19.3
5.0
24.6
0.57

From Top page 48

FORM 247 10M 8-31

F.B. 481 Pg. 80 To bott. page 81

From top page 79

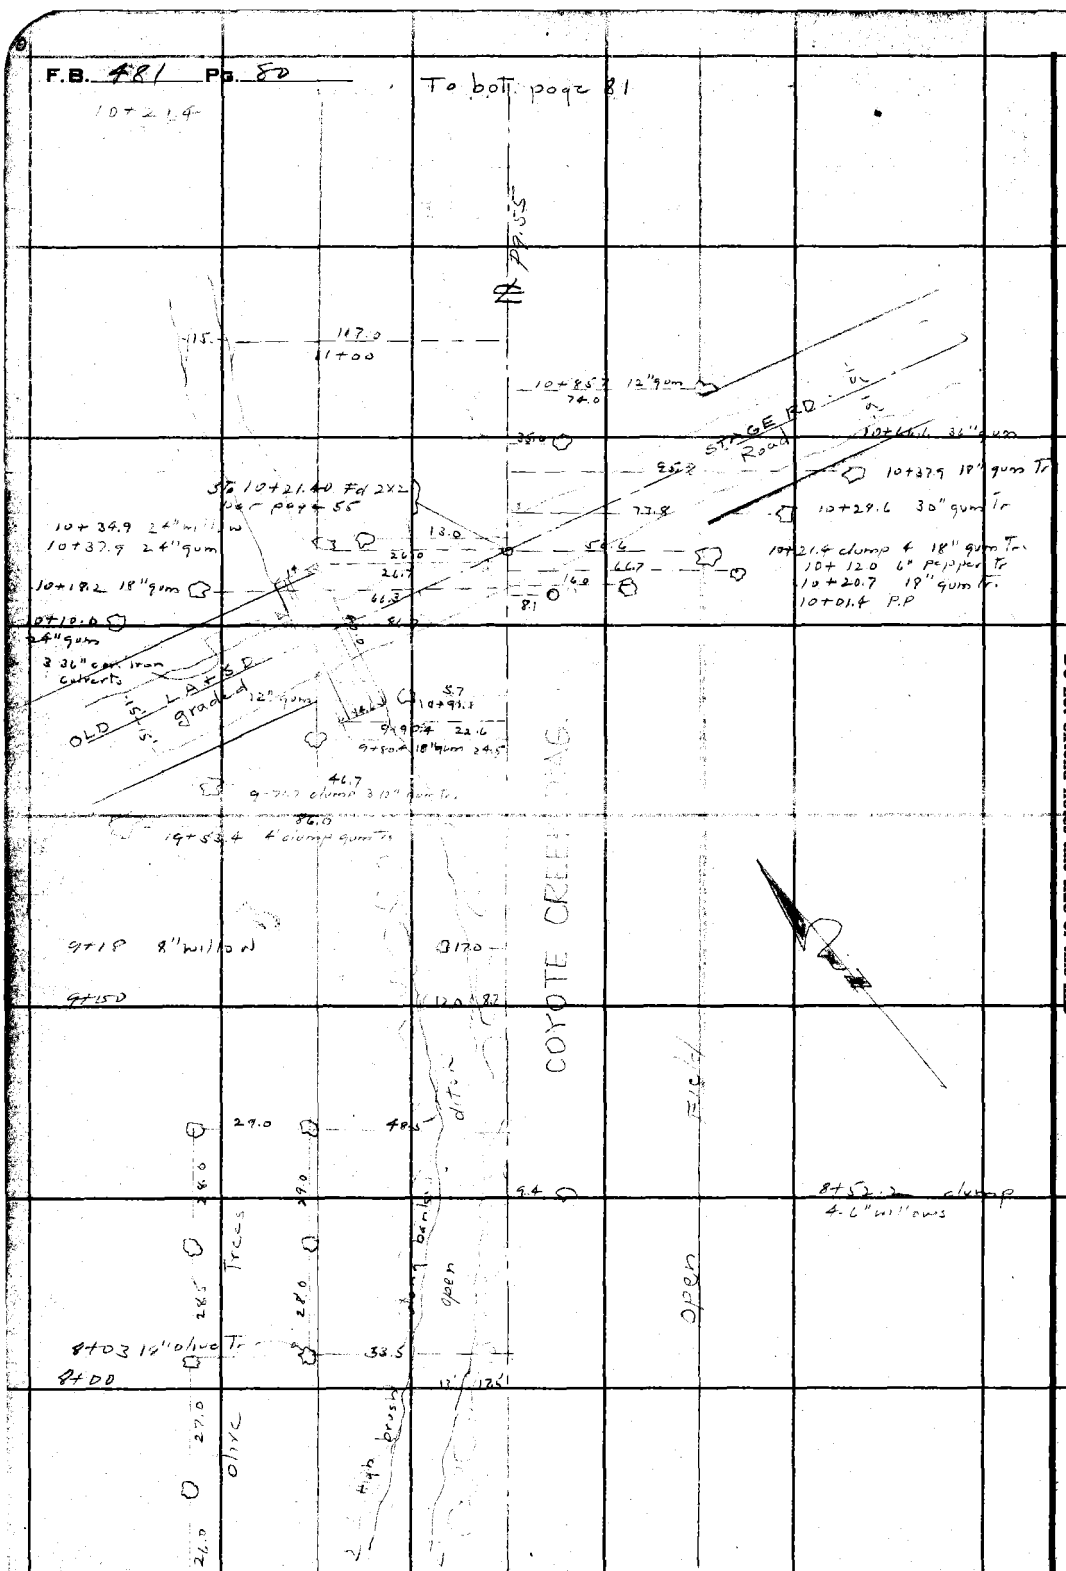

RETURN TO
LOS ANGELES COUNTY SURVEYOR
700 HALL OF RECORDS

Note: ANY ADDITIONS OR CHANGES ON THIS SHEET MUST BE MADE OR CIRCLED IN Red Ink. WITH DATE AND NAME OF PERSON MAKING CHANGE.

Do not extend notes this side of this line

79.2 L 43.0 R

Note: Ck'd by D. M. Finley
Map No. B-633
Office Work
Checked
Date

Survey of Coyote Ck Diag Div 3
W. O. 995 Tape No. Sl'd of.
Surveyed by L. S. Hammond
Notes H. S. Johnson Date 12-20-31
Indexed A. C. Johnson

F.B. 481 Pg. 82

43.0 out
20+66.6

Edge Of Olive Grove

Sta 20+50.80 Ahead
Per F.B. 481-55

To Bot Pg. 82

20.5

88.0

20+05.2

40°

+24.0 +83 Edge Of Olive

78.2 19+62.5

40°
+50

OLIVE GROVE
Av. Dia = 20"

19+11.6 19.2 Edge of Olive Grove

20.5

19+28.4 4.2

81.5 19+06.6

COYOTE CR'K DIAG.

+50

20.5

101.0 18+35.45

17+50

Sta. 17+26.40
2 x 2 12" under
Per F.B. 481-55

From Top page 80

RETURN TO
LOS ANGELES COUNTY SURVEYOR
700 HALL OF RECORDS

Do not extend notes this side of this line

Notes: ANY ADDITIONS OR CHANGES ON THIS SHEET MUST BE MADE OR CIRCLED IN Red Ink, WITH DATE AND NAME OF PERSON MAKING CHANGE.

FORM 247 10M 5-51

F.B. 481 Pg. 82

To Bot Pg. -83

RETURN TO
LOS ANGELES COUNTY SURVEYOR
700 HALL OF RECORDS

Do not extend notes this side of this line

Note: ANY ADDITIONS OR CHANGES ON THIS SHEET MUST BE MADE OR CIRCLED IN Red Ink. WITH DATE AND NAME OF PERSON MAKING CHANGE.

231+93 — 88.5 — 20.5 — Edge Of Olive Grove

Sta. 22+97.76
2X2 12" Under
Per F.B. 481-56

20.5 — 20.5 — 20.5 — 81.0 — 22+71.0 — Edge Of Olive Grove

OLIVE GROVE Av. Dia. 20"

COYOTE CR.

21+68.5 — 36.6 — Edge Of Olive Grove

21+22.6 — 46.2 — 20.5 — Edge Of Olive Grove

2.0 out

20.5 — 20+83.4

84.4 — 20+62.8

From Top Pg. 81

From Top

Notes Ck'd by D. M. Finley
Map No. B-633
Office Work
Checked
Date

Survey of Coyote Ck Dia
W. O. 995 Tape No. St'd °F.
Surveyed by L. S. Hammond
Notes H. S. Johnson Date 12-23-31
Indexed A. C. Johnson

F.B. 481 Pg. 83

To Bot Pg. 84

9.2

Sta 26+56.5

Sta 26+07.
1.3' offset.

86.0

25+82.7

106.1

Sta 25+14.7
1x2 Flush
F.B. 481-56

COYOTE CK DIAG.

℄

Edge Of Olive Grove

OLIVE GROVE
Av. Dia. 20'

24+23.3

29.0

20.5

Edge Of Olive Grove

+50

20.5

75.9

23+30

From Top Pg. 82

23+00

Notes: ANY ADDITIONS OR CHANGES ON THIS SHEET MUST BE MADE OR CIRCLED IN Red Ink. WITH DATE AND NAME OF PERSON MAKING CHANGE.

Do not extend notes this side of this line

RETURN TO
LOS ANGELES COUNTY SURVEYOR
700 HALL OF RECORDS

FORM 247 10M 5-31

F.B. 481 Pg. 84

To Bot Pg. 85

29+58.6 — 70.9 → Edge of Olive (orch.)

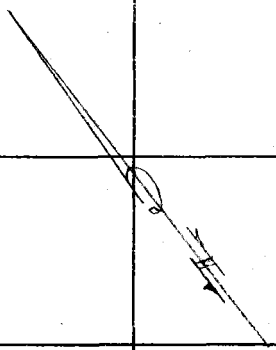

Cultivated Land

℄

Cultivated — 67.5 → 27+81.2

55.7 → 27+66.7

72.3 → 27+54.7

Grove

46.4 → 27+25.1

Av. Dia 20'

DIAG.

Edge of Olive

33.7 → 26+81.2

123.5 → 26+61.7

COYOTE C'K.

96.8 → 26+30.4

From Top Pg. 82

RETURN TO
LOS ANGELES COUNTY SURVEYOR
700 HALL OF RECORDS

Do not extend notes this side of this line

Note: ANY ADDITIONS OR CHANGES ON THIS SHEET MUST BE MADE OR CIRCLED IN Red Ink. WITH DATE AND NAME OF PERSON MAKING CHANGE.

Notes Ck'd by D. M. Finley
Map No. B-633
Office Work
Checked
Date

Survey of Coyote Crk Diag.
W. O. Tape No. St'd °F.
Surveyed by L. S. Hammond
Notes H. S. Johnson Date 12-29-31
Indexed A. C. Johnson

F.B. 481 Pg. 85

Note: ANY ADDITIONS OR CHANGES OF THIS SHEET MUST BE MADE OR CIRCLED IN Red Ink. WITH DATE AND NAME OF PERSON MAKING CHANGE.

RETURN TO
LOS ANGELES COUNTY SURVEYOR
700 HALL OF RECORDS

Do not extend notes this side of this line

To Bat. Pg. 82

OLIVE GROVE AV. DIA 20'

Spaced in 20 Ft Sq.

COYOTE CRK DIAG.

75.3
32+79.5
32+89.6
66.5
(Out! gone)
gone
gone
gone
gone
gone
81.2
31+96.
31+81.8
89.2
gone
gone
(31+60.7
L 7.9 out)
78.0
31+52.1
85.4
31+42.1
56.5
180.0
13.2
31+18.0
41.8
31+15.8
20.2
31+07.3
31+04.8 = 25.0 out
30+98.5
83.1
31+00.7 = 55.0 out
30+53.6
98.0
30+12.5
52.7
30+47.9
30+43.2
78.5
30+31.4
34.9+3'
76.7
33.1
47.0
29+86.1
73.7
29+74.3
59.2

From Top Pg. 84

FORM 247 10M 8-31

F.B. 481 Pg. 82

To Bot. Pg. 87

RETURN TO
LOS ANGELES COUNTY SURVEYOR
700 HALL OF RECORDS

Do not extend notes this side of this line

Note: ANY ADDITIONS OR CHANGES ON THIS SHEET MUST BE MADE OR CIRCLED IN Red Ink. WITH DATE AND NAME OF PERSON MAKING CHANGE.

9.3 1
35+78.8
3.5
35+65.3
78.6
Sta. 35+43.3
Fd 1x2
(Flush)
9.3
97.6
345.0
gone
gone
gone
gone
gone
Sta. 34+13.04
2x2 in grade
Per F.B. 481-5
COYOTE CREEK
OLIVE GROVE AV. DIA 20"
Spaced in 20 Ft Sq.
gone
gone
gone
gone
Sta. 33+08.6 2
1x2 Per F.B. 481-5
89.6
324 93.3
324 83.1
84.1

From Top Pg. 85

Notes Ck'd by D. M. Finley
Map No. B-633
Office Work
Checked
Date

Survey of COYOTE CK DIAG.
W. O. 995 Tape No. St'd °F.
Surveyed by L. S. Hammond
Notes H.S. Johnson Date 12-30-31
Indexed A. C. Johnson

F.B. 481 Pg. 47

To Bot Pg. 88

Sta. 38+90.19
Fd 1/2" I.P. Flush
Per F.B. 481-57

38+91.2 — 97.8 →

38+74.2 — 99.5 → gone

gone

gone

OLIVE GROVE AV. DIA. 20"

Sta. 37+50.25
Fd 1x2 Flush
Per F.B. 481-57

95.2 → 37+34.0

COYOTE CK DIAG.

gone

77.5 → 35+91.14

35+78.4 → 92.5 →

From Top Pg. 82

RETURN TO
LOS ANGELES COUNTY SURVEYOR
700 HALL OF RECORDS

Notes: ANY ADDITIONS OR CHANGES ON THIS SHEET MUST BE MADE OR CIRCLED IN Red Ink, WITH DATE AND NAME OF PERSON MAKING CHANGE.

Do not extend notes this side of this line

FORM 247 10M 5-31

RETURN TO
LOS ANGELES COUNTY SURVEYOR
700 HALL OF RECORDS

Note: ANY ADDITIONS OR CHANGES ON THIS SHEET MUST BE MADE OR CIRCLED IN **Red Ink.** WITH DATE AND NAME OF PERSON MAKING CHANGE.

Do not extend notes this side of this line

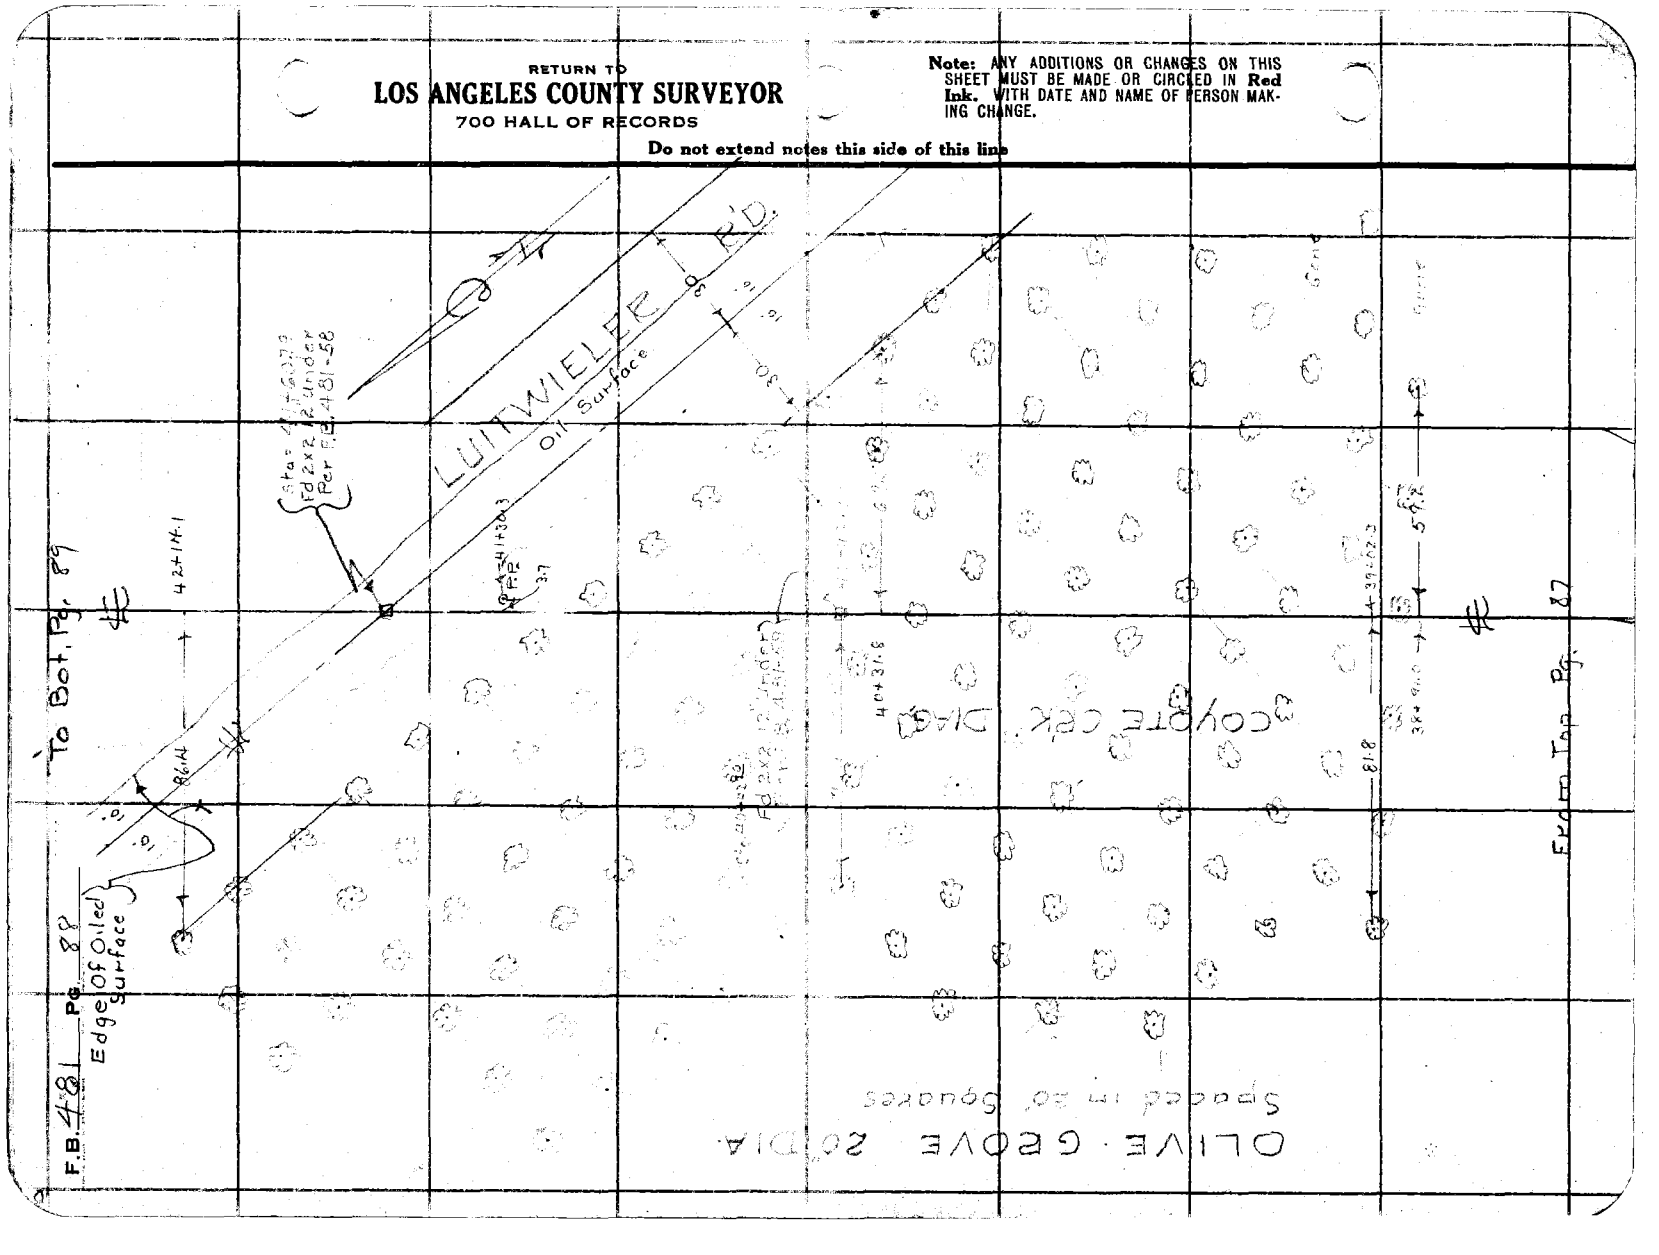

Notes Ck'd by D. M. Finley	Survey of Coyote Creek Diag
Map No. B-633	W. O. 595 Tape No. St'd °F.
Office Work	Surveyed by L. S. Hammond
Checked	Notes H. S. Johnson Date 12-31-31
Date	Indexed A. C. Johnson

F.B. 481 Pg. 89

To bot. Page 91

TRUCK GARDEN LAND

℄

ROSECRANS AVE

DIAGONAL

GRACELAND CEMETARY

COYOTE CREEK

92.3

47+57.9

2-3"

Conc. Curb

Conc. Curb

8" Pepper

47+08.5

67.1

P.P.

16.6

47+20.8

47+08.2

74.5

55.7

50.40

47+05

67.3

47+02.1

46+99.1

Four Graves

Two Graves

Sta = 47+07.32
50.2 Y2 12" Under
Per. F.B. 481-39

From Top Pg. 88

RETURN TO
LOS ANGELES COUNTY SURVEYOR
700 HALL OF RECORDS

Note: ANY ADDITIONS OR CHANGES ON THIS SHEET MUST BE MADE OR CIRCLED IN Red Ink, WITH DATE AND NAME OF PERSON MAKING CHANGE.

Do not extend notes this side of this line

FORM 247 10M 8-31

RETURN TO

LOS ANGELES COUNTY SURVEYOR

700 HALL OF RECORDS

Note: ANY ADDITIONS OR CHANGES ON THIS SHEET MUST BE MADE OR CIRCLED IN **Red Ink.** WITH DATE AND NAME OF PERSON MAKING CHANGE.

Do not extend notes this side of this line

F.B. 481 Pg 20

Notes Ck'd by D. M. Finley
Map No. B-693
Office Work
Checked
Date

Survey of Coyote Ck-Diag Div 3
W. O. 925 Tape No. Std OF.
Surveyed by L S Hammond
Notes L.S.H. Date Dec 1931
Indexed A. C. Johnson

F.B. 481 Pg. 91

To bot. page 92

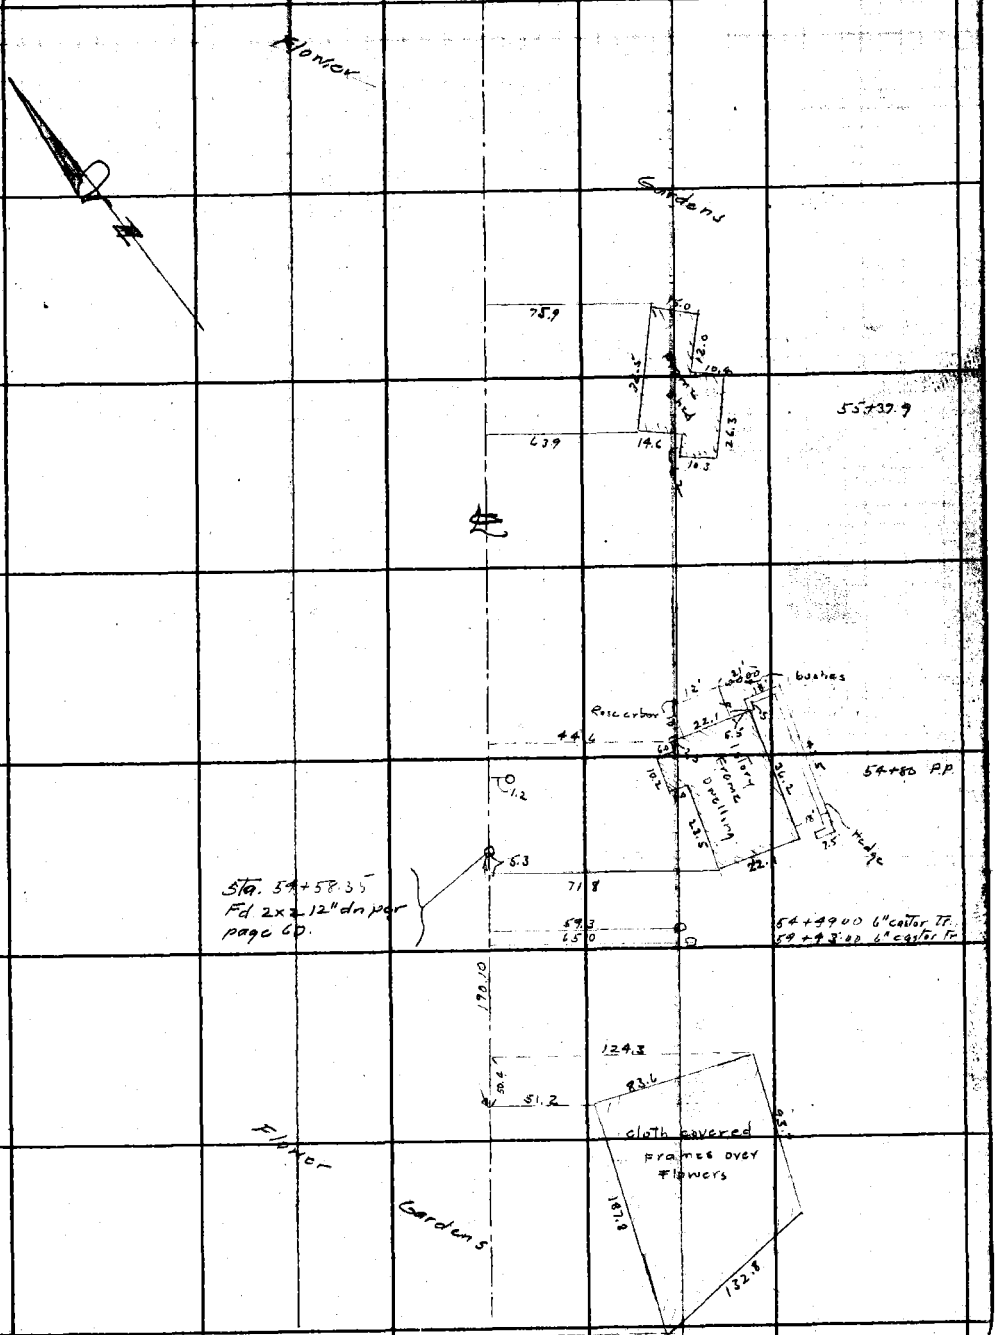

From Top page 89

RETURN TO
LOS ANGELES COUNTY SURVEYOR
700 HALL OF RECORDS
Do not extend notes this side of this line

Note: ANY ADDITIONS OR CHANGES ON THIS SHEET MUST BE MADE OR CIRCLED IN Red Ink, WITH DATE AND NAME OF PERSON MAKING CHANGE.

FORM 247 (OM 5-31)

F.B. 481 Pg. 92

To bot page 93

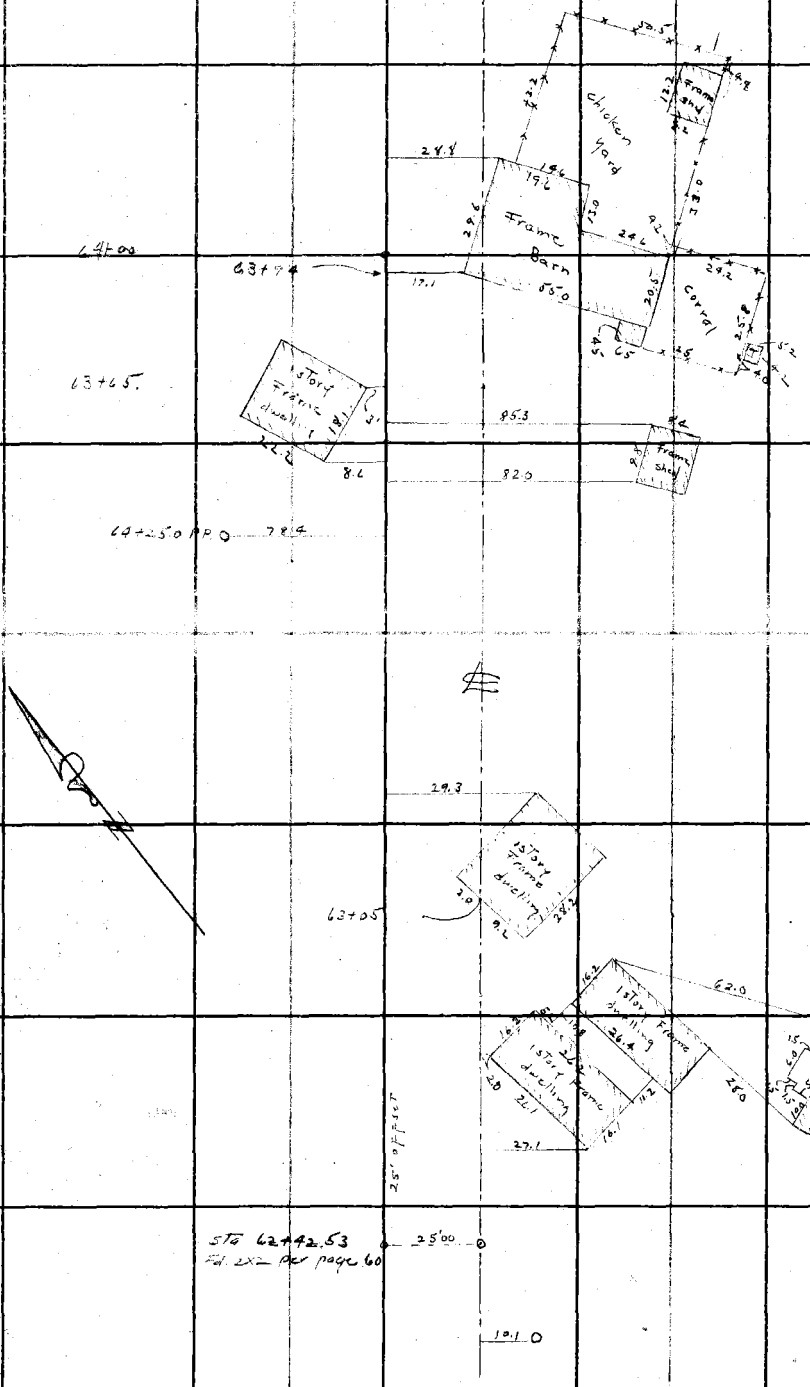

From Top page 91

RETURN TO
LOS ANGELES COUNTY SURVEYOR
700 HALL OF RECORDS

Do not extend notes this side of this line

Note: ANY ADDITIONS OR CHANGES ON THIS SHEET MUST BE MADE OR CIRCLED IN Red Ink. WITH DATE AND NAME OF PERSON MAKING CHANGE.

Notes Cl'd by D. M. Finley
Map No. B-633
Office Work
Checked
Date

Survey of COYOTE CRK DIAG
W. O. 995 Tape No. St'd °F.
Surveyed by L. S. Hammond
Notes H.S. Johnson Date 1-6-32
Indexed A. C. Johnson

F.B. 481 Pg. 93

To bot. page 96

126.60 → 74+13.6

12x12 Wooden Box
Elevated Irrigation Line

53.0 → 73+64.2

73+45.3 → 18.0 → GARDEN

73+38.1
73+30.0
11.0 → 40.2

73+18.3 → 78.4

Sta = 66+24.72
FD 2x2 12" Unoc.
Tie FB A81-59

40' → 65+

66+09.9
66+09.3
66+06.4
66+00.2
10.2
Shed
Frame Barn
16.2
66+02.1
21.1
9.7
Frame House
24.1
18.4
65+94.5
18.6 PP
65+91.7
3" Fence Tree
65+88.4
65+86.9
3/4" Water Hyd
16.2
11.8
4.3
65+76.7
65+69.6
21.4 S. out From Offset.
Latrine
10.2
Frame Garage & Dwelling
9.5
5.0
3/4" Water Hyd
16.2
30.5
18.1
Frame Garage
18.1
22.0 → 65+12.8
27.9

40' Offset
PP 51.6 → 64+66.7
14' Offset Line

From Top page 92

RETURN TO
LOS ANGELES COUNTY SURVEYOR
700 HALL OF RECORDS
Do not extend notes this side of this line

Note: ANY ADDITIONS OR CHANGES ON THIS SHEET MUST BE MADE OR CIRCLED IN Red Ink, WITH DATE AND NAME OF PERSON MAKING CHANGE.

FORM 247 10M 8-31

RETURN TO
LOS ANGELES COUNTY SURVEYOR
700 HALL OF RECORDS

Note: ANY ADDITIONS OR CHANGES ON THIS SHEET MUST BE MADE OR CIRCLED IN **Red Ink.** WITH DATE AND NAME OF PERSON MAKING CHANGE.

Do not extend notes this side of this line

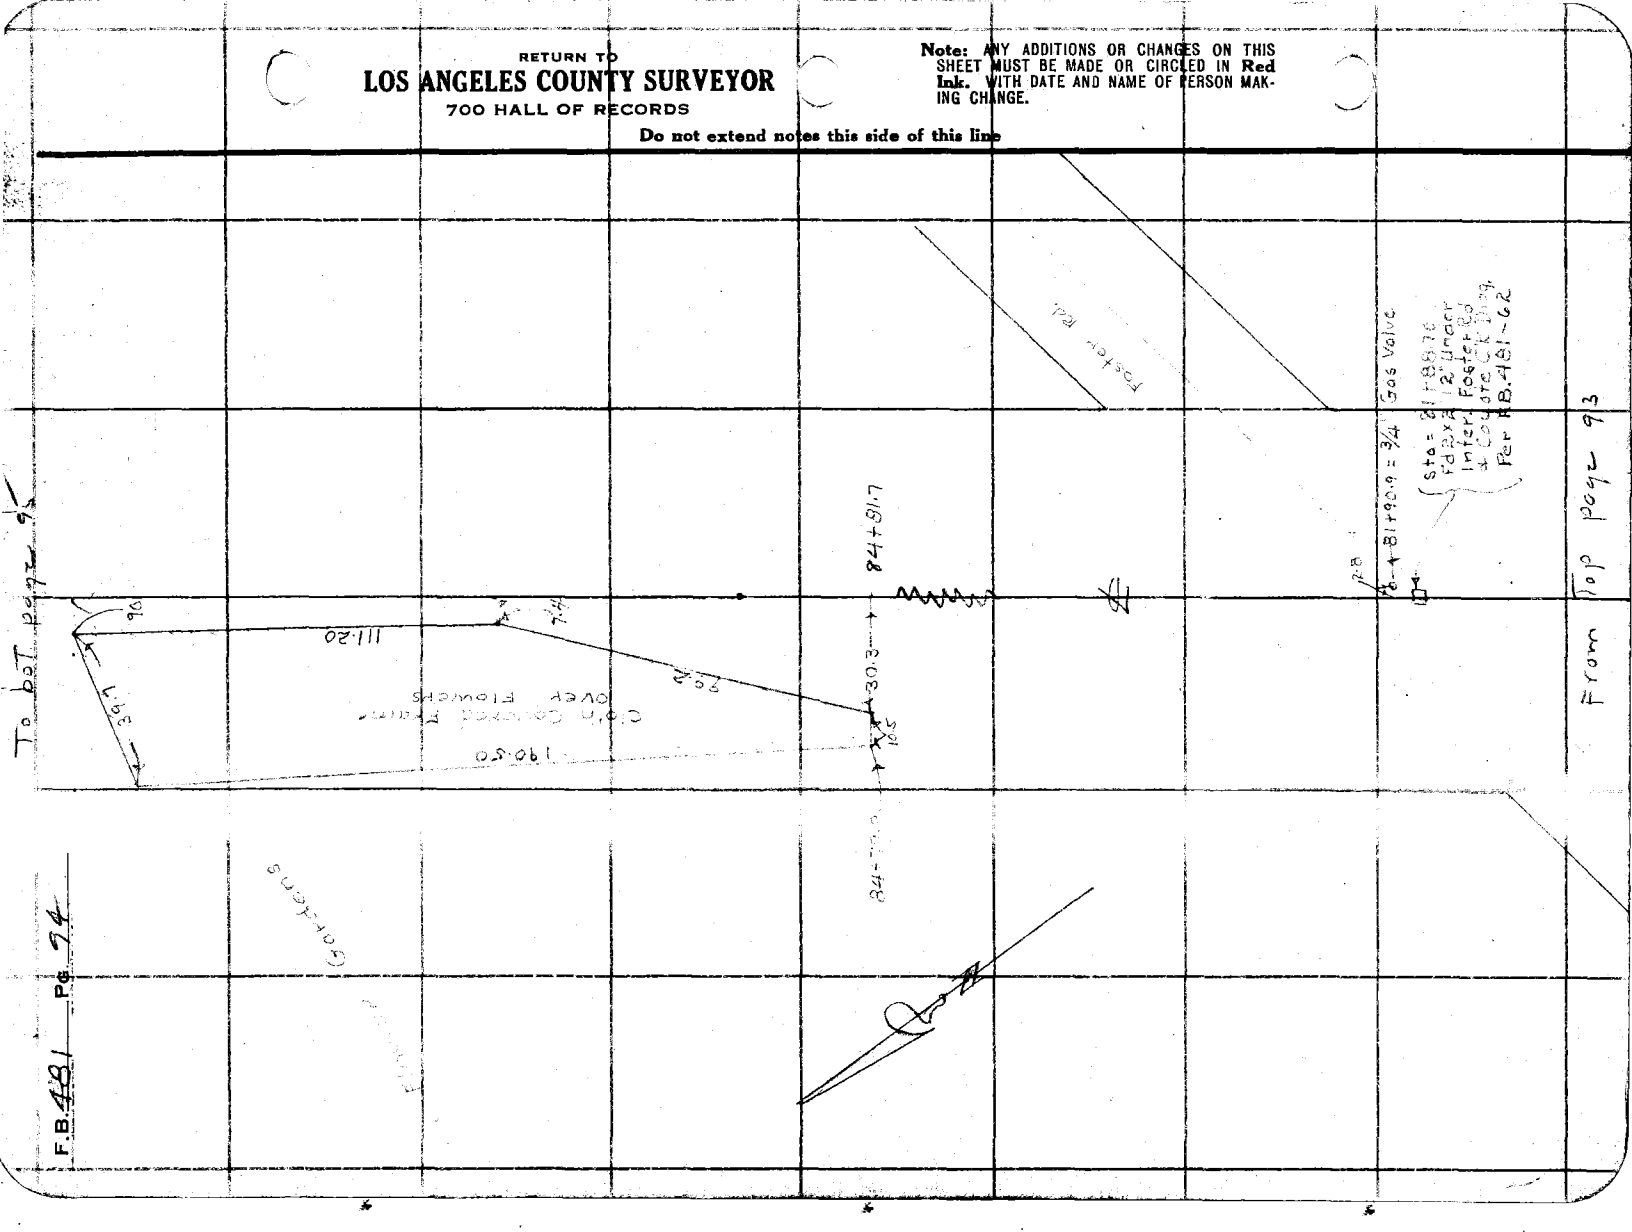

Notes Ck'd by D. M. Finley
Map No. B-633
Office Work
Checked
Date

Survey of Coyote Cr'k Ditch
W. O. 995 Tape No. St'd °F.
Surveyed by L. S. Hammond
Notes H. S. Johnson Date 1-5-32
Indexed A. C. Johnson

F.B. 481 Pg. 95

To bot page 96

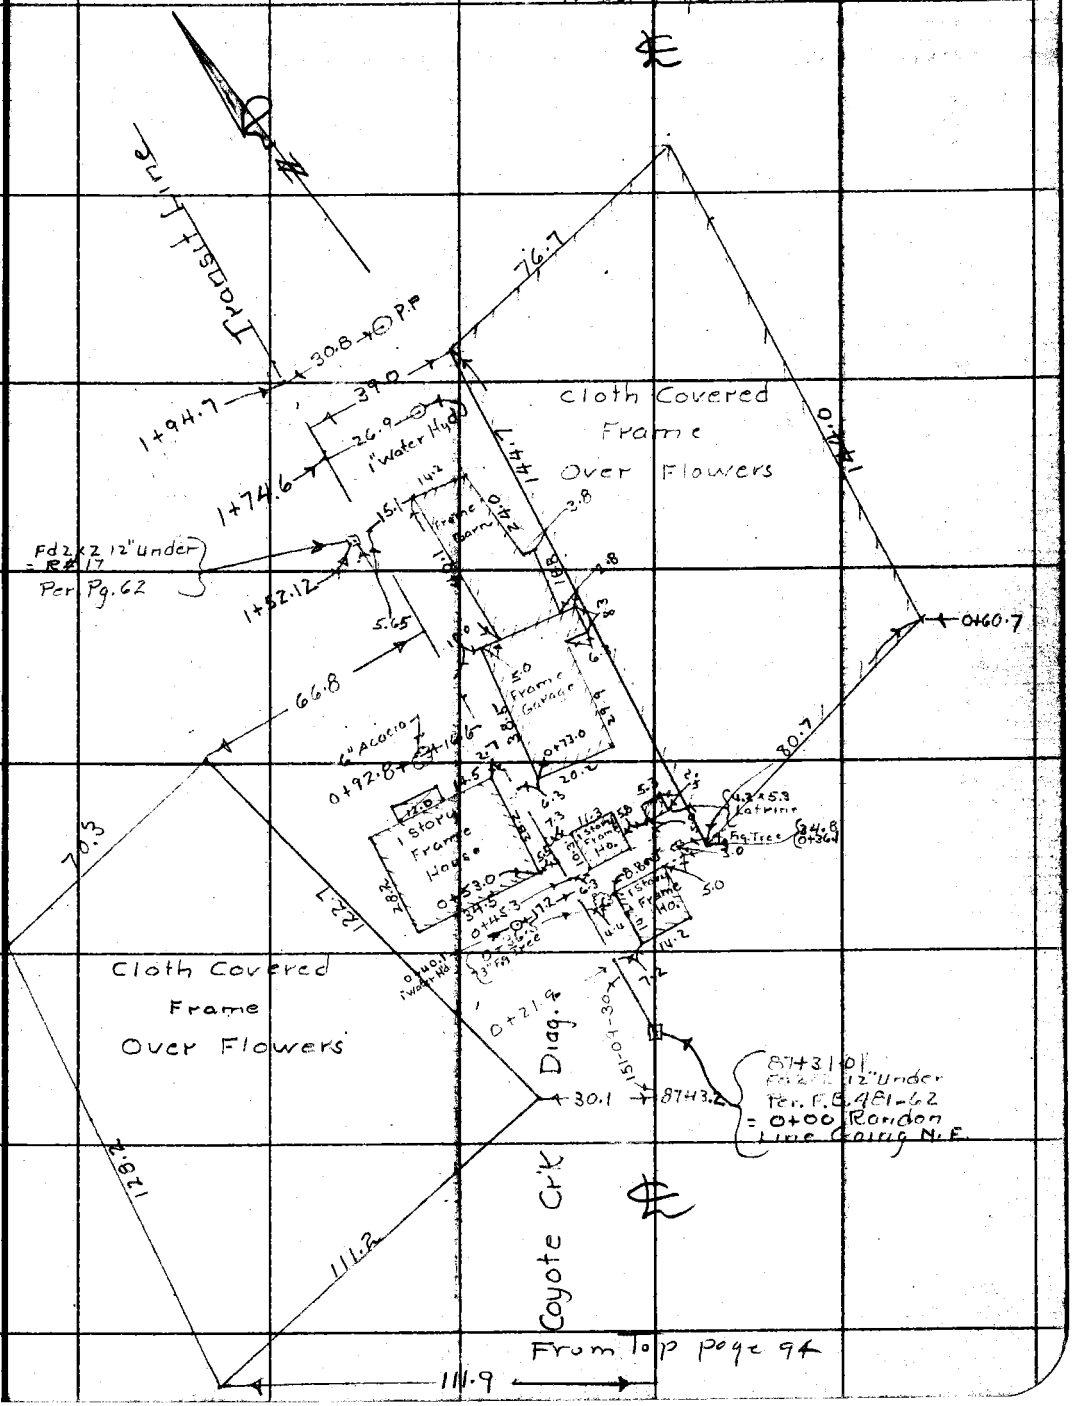

RETURN TO
LOS ANGELES COUNTY SURVEYOR
700 HALL OF RECORDS
Do not extend notes this side of this line

Note: ANY ADDITIONS OR CHANGES ON THIS SHEET MUST BE MADE OR CIRCLED IN Red Ink WITH DATE AND NAME OF PERSON MAKING CHANGE.

FORM 247 10M 8-31

F.B. 481 Pg. 96

To bot page 97

Sta = 93+54.35
Fd 2x2 12" Wit. Cor
Per. F.B. 481-63

93+54.0 93+23.6

92+99.1 93.0

½" Avocado Trees

75.7 92+85.7

89.9 92+90

87.8

170.5

91+55.3 27.9

Row

Cloth Covered Frame over Flowers

14.8 28.9 91+81.5

Gone

Mixed Fruit Tree Avocado 3"

14.3

190.7

90+64.8 104.9

Mixed Fruit

90+37.5 70.4

90+28.9 66.7 3" Willows

90+20.0 157.5 70.9 P.P. 90+22.5

From Top page 95

RETURN TO
LOS ANGELES COUNTY SURVEYOR
700 HALL OF RECORDS

Do not extend notes this side of this line

Note: ANY ADDITIONS OR CHANGES ON THIS SHEET MUST BE MADE OR CIRCLED IN Red Ink WITH DATE AND NAME OF PERSON MAKING CHANGE.

Notes Ck'd by D. M. Finley
Map No. B-633
Office Work
Checked
Date

Survey of COYOTE CRK DIAG. F.B. 481 Pg. 97
W. O. 995 Tape No. St'd °F.
Surveyed by L. S. Hammond
Notes H. S. Johnson Date 1/6/32
Indexed A. C. Johnson

To Rt. Side Pg. 98

101+21.3 ← 48.8 → 0 12" Conc. Std. Pipe

101+00

Coyote Crk Diag.

Sta. = 99+74.67
Fd. 2X2 12" under
Per F.B. 481-63

Truck Gardens

12" Conc. Std. P. ← 61.0' → 99+00.5

Truck Gardens

95+55.6 ← 59.1 →

95+31.8 ← 42.9 → 77.4 →
95+30.7

2" Avocado Trees

95+07.2 ← 69.5 →
95+02.9 ← 32.6 →

94+87.7 ← 66.4 →

From Top page 96

Note: ANY ADDITIONS OR CHANGES ON THIS SHEET MUST BE MADE OR CIRCLED IN Red Ink. WITH DATE AND NAME OF PERSON MAKING CHANGE.

Do not extend notes this side of this line

RETURN TO
LOS ANGELES COUNTY SURVEYOR
700 HALL OF RECORDS

FORM 247 10M 8-31

RETURN TO
LOS ANGELES COUNTY SURVEYOR
700 HALL OF RECORDS

Note: ANY ADDITIONS OR CHANGES ON THIS SHEET MUST BE MADE OR CIRCLED IN **Red Ink.** WITH DATE AND NAME OF PERSON MAKING CHANGE.

Do not extend notes this side of this line

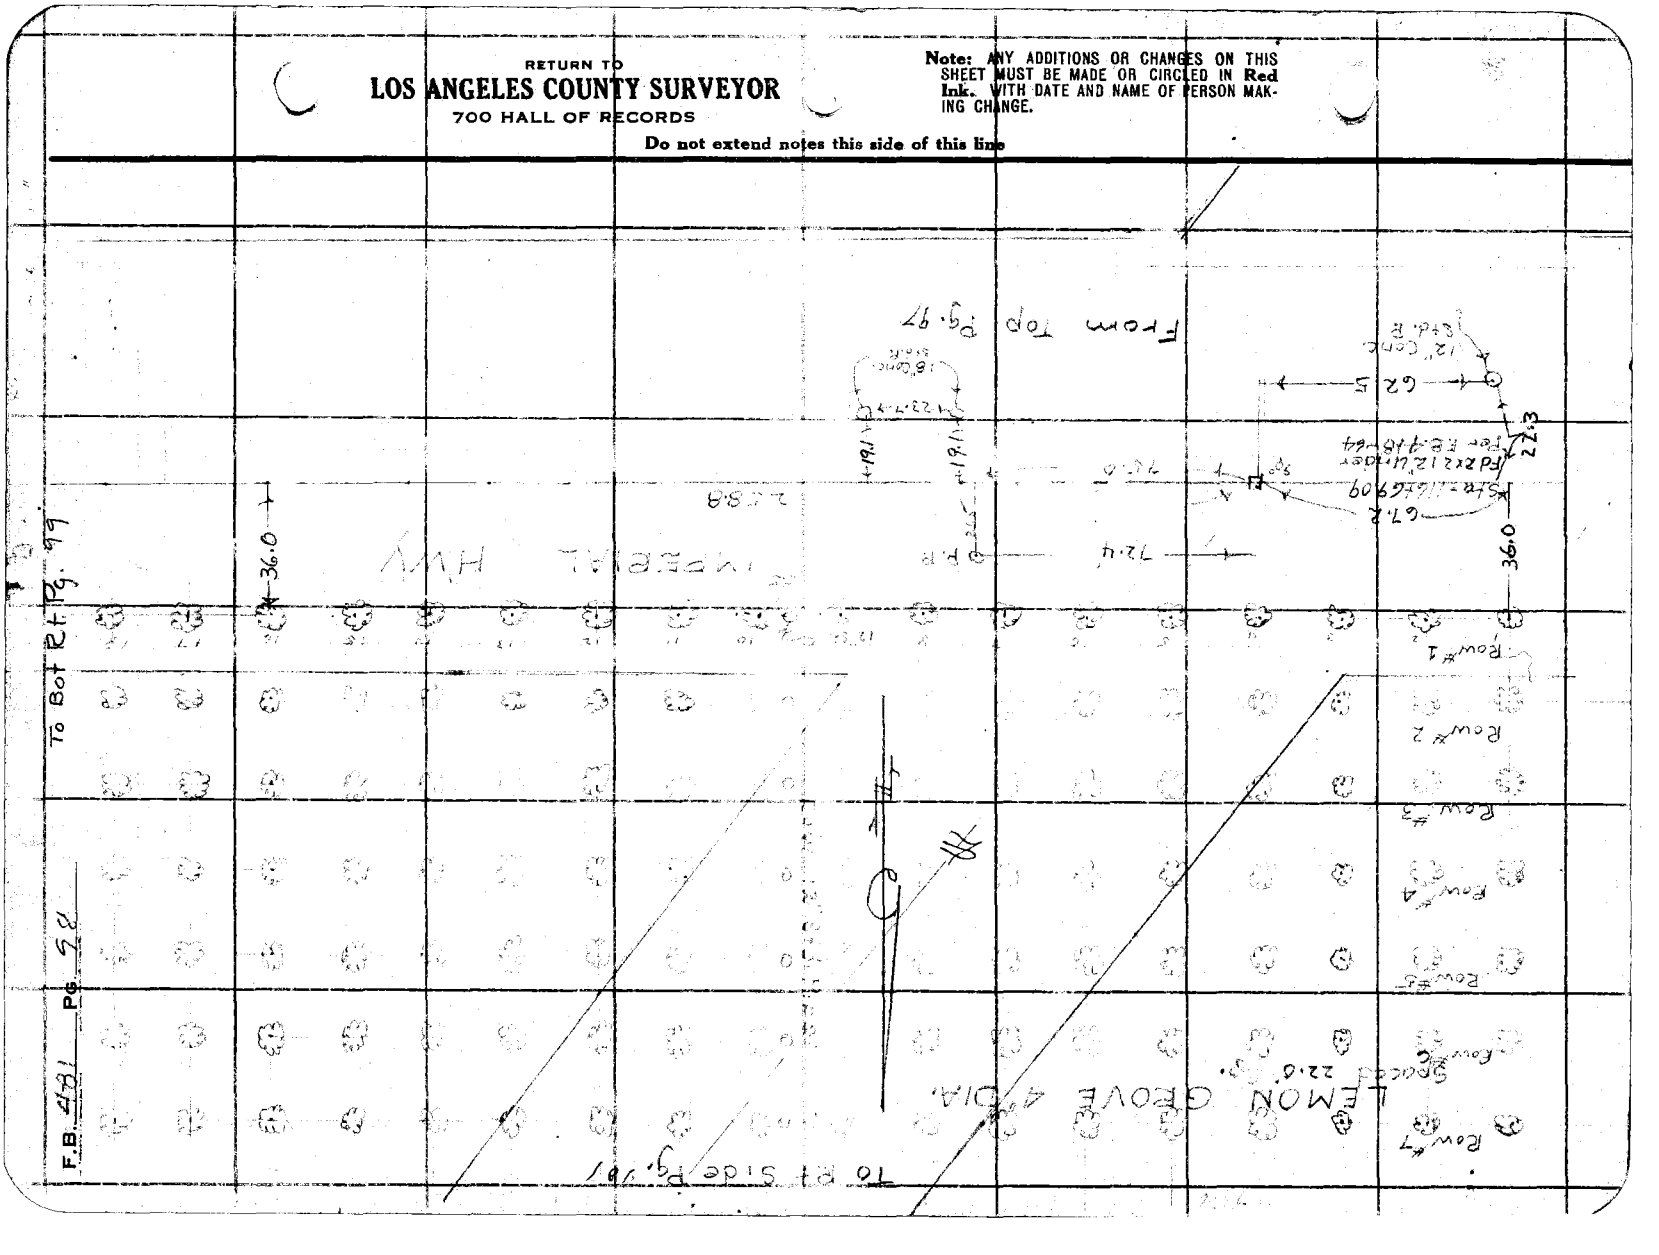

FORM 247 10M 5-31

RETURN TO
LOS ANGELES COUNTY SURVEYOR
700 HALL OF RECORDS

Note: ANY ADDITIONS OR CHANGES ON THIS SHEET MUST BE MADE OR CIRCLED IN Red Ink. WITH DATE AND NAME OF PERSON MAKING CHANGE.

Do not extend notes this side of this line

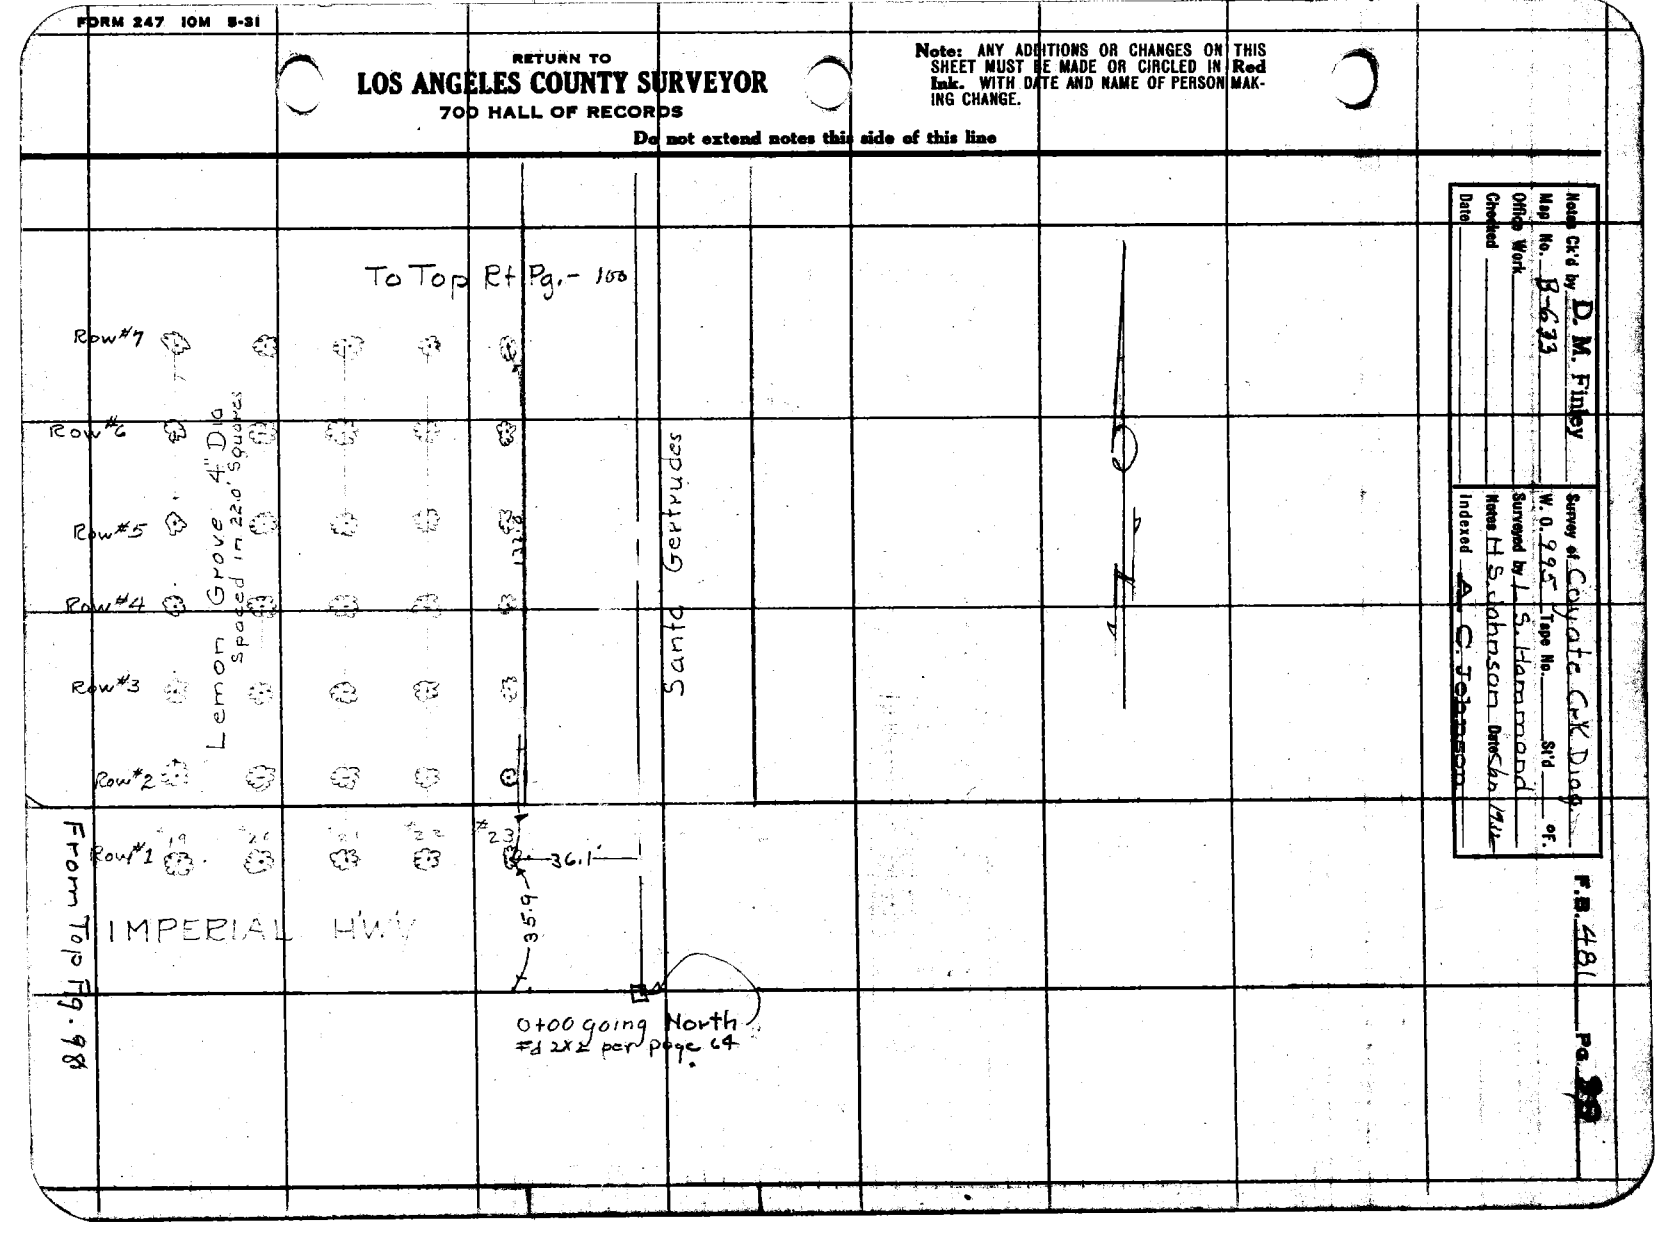

Notes Ck'd by D. M. Finley
Map No. B-623
Office Work
Checked
Date

Survey of Covote Crk Drag of.
W. O. 995 Tape No. Std
Surveyed by H. S. Johnson Hammond
Notes H. S. Johnson Date 6/6/52
Indexed A. C. Johnson


RETURN TO
LOS ANGELES COUNTY SURVEYOR
700 HALL OF RECORDS

Note: ANY ADDITIONS OR CHANGES ON THIS SHEET MUST BE MADE OR CIRCLED IN **Red Ink.** WITH DATE AND NAME OF PERSON MAKING CHANGE.

Do not extend notes this side of this line

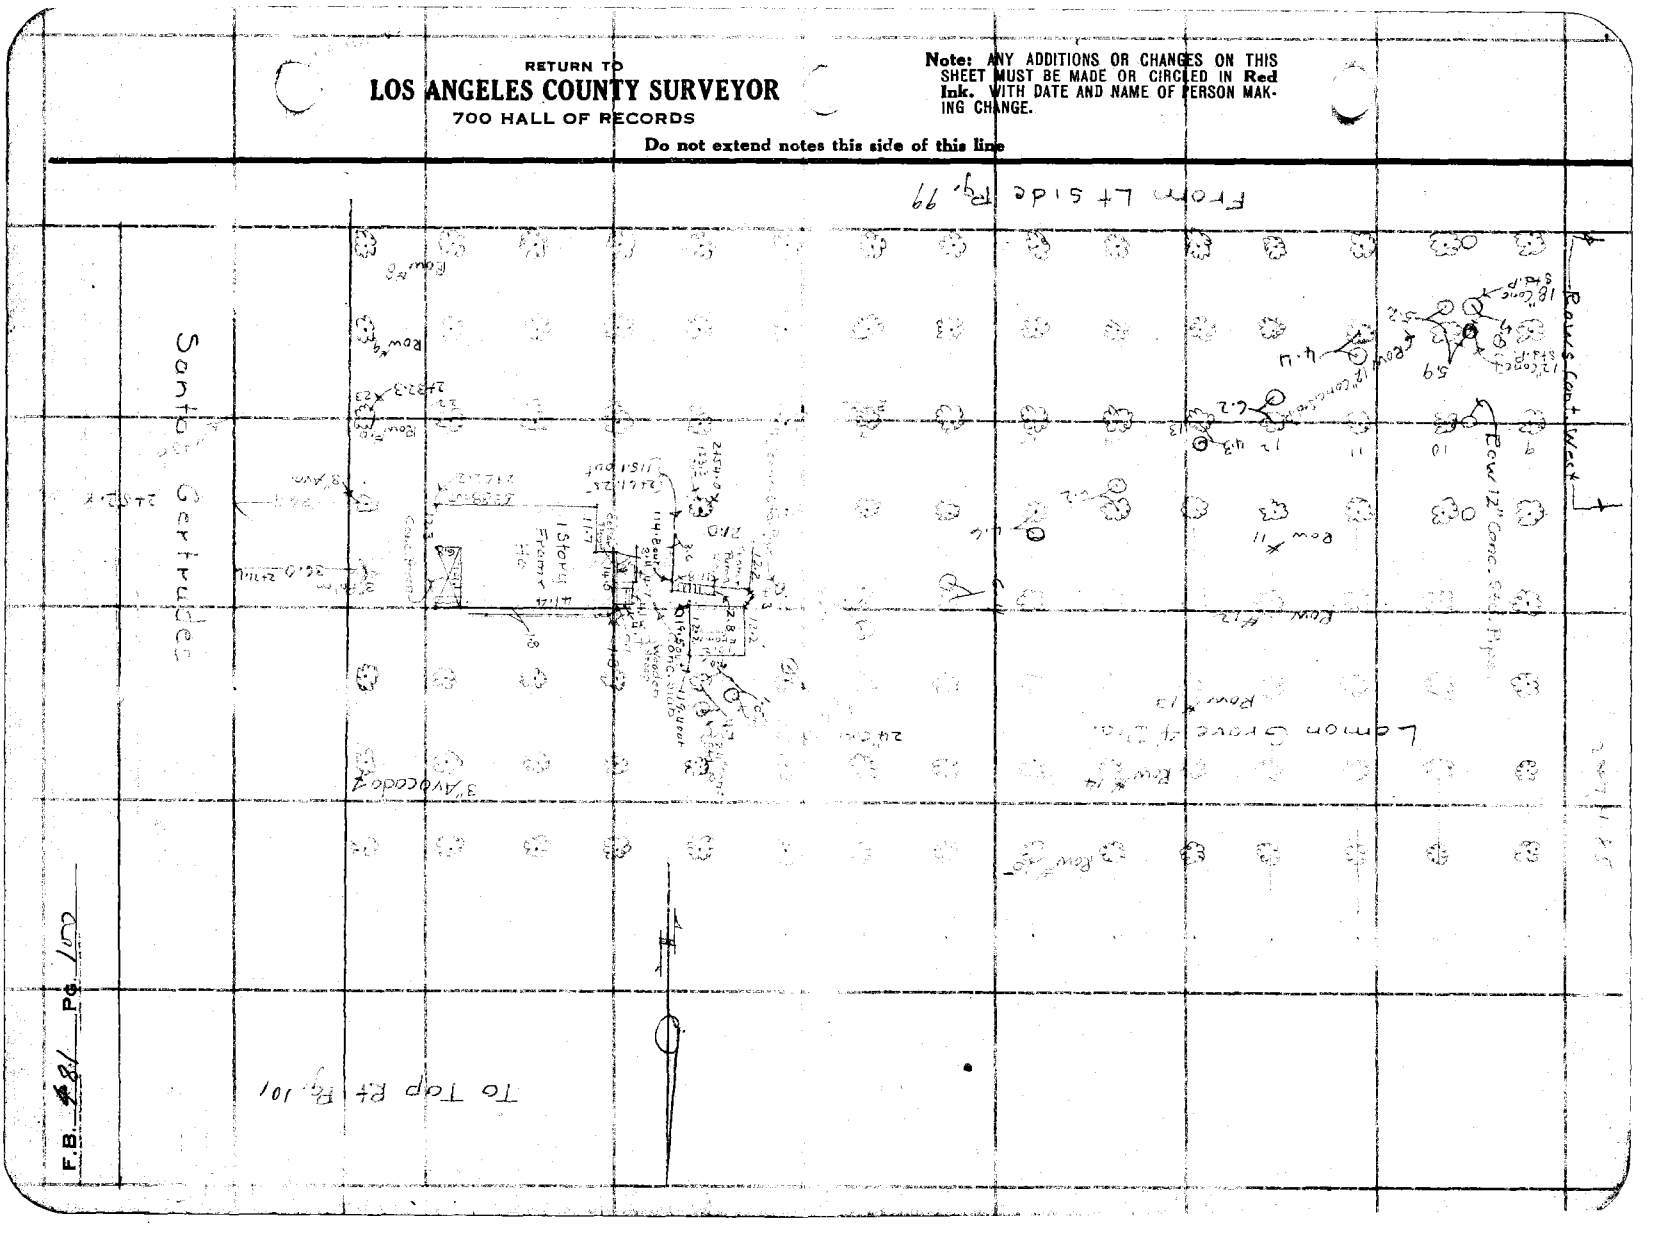

F.B. 481 Pg. 100

FORM 247 ION 5-21

RETURN TO
LOS ANGELES COUNTY SURVEYOR
700 HALL OF RECORDS

Note: ANY ADDITIONS OR CHANGES ON THIS SHEET MUST BE MADE OR CIRCLED IN Red Ink. WITH DATE AND NAME OF PERSON MAKING CHANGE.

Do not extend notes this side of this line

123.1 126.1 3+79.4 35.9 5+59.8 (19.8) To Bot. Page 102

Road Data by D. M. Finley
Map No. B-633
Office Work
Checked
Date

Survey of Coyote Ck Drainage Dist
W. O. 235 Tape No. 81'd of
Surveyed by J. C. McMenamin
Notes
Indexed Date Jan 1962
C. Johnson

F.B. 481 Page

ORANGE GROVE
Average Dia. 6"

Sta. 123+53.13
2x2 12 Under
Per F.B. 481-64

5+39.7 + 21.7 = O.P.P.

Rd.

Santa Gertrudes

Apple

87.5 Rail Fence

4+51.0 4+45.0

12 Std P

58.7 57.6 66.5

Fence 18' 180.0 Rail Fence 29.2

35.7 44.0 Corral

Frame Barn

122.1 out

3+79.4 = 126.1 out

Goat Shed 16.4 Loth Hen Ho. 3.1

Wire Fence 32.9

Conc. Apron 5.2 53.7 17.7 26.6

Tool Shed 10.0 16.0

4'Dr. 36.4 3+85.2

67.1 110.6 3+79.2 Barn
3+71.5
70.6 3+66.4 Chg.
22.0 36.3 3+63.3
Frame Garage 25.4 3+58.7
18' 25.5

Lem. Lem. Lemons

6" Orange Trees Beg. of Row 16
5.3 5.3 5.3 5.3 5.2

Row 12" Conc. Std. Pipes

4'x4' 131.8 out 3+63.6 132.3 out

Lemon Trees

Coyote Ck Drainage

From Lt. Side Pg. 100

F.B. 481 Pg. 102

To bot page 103

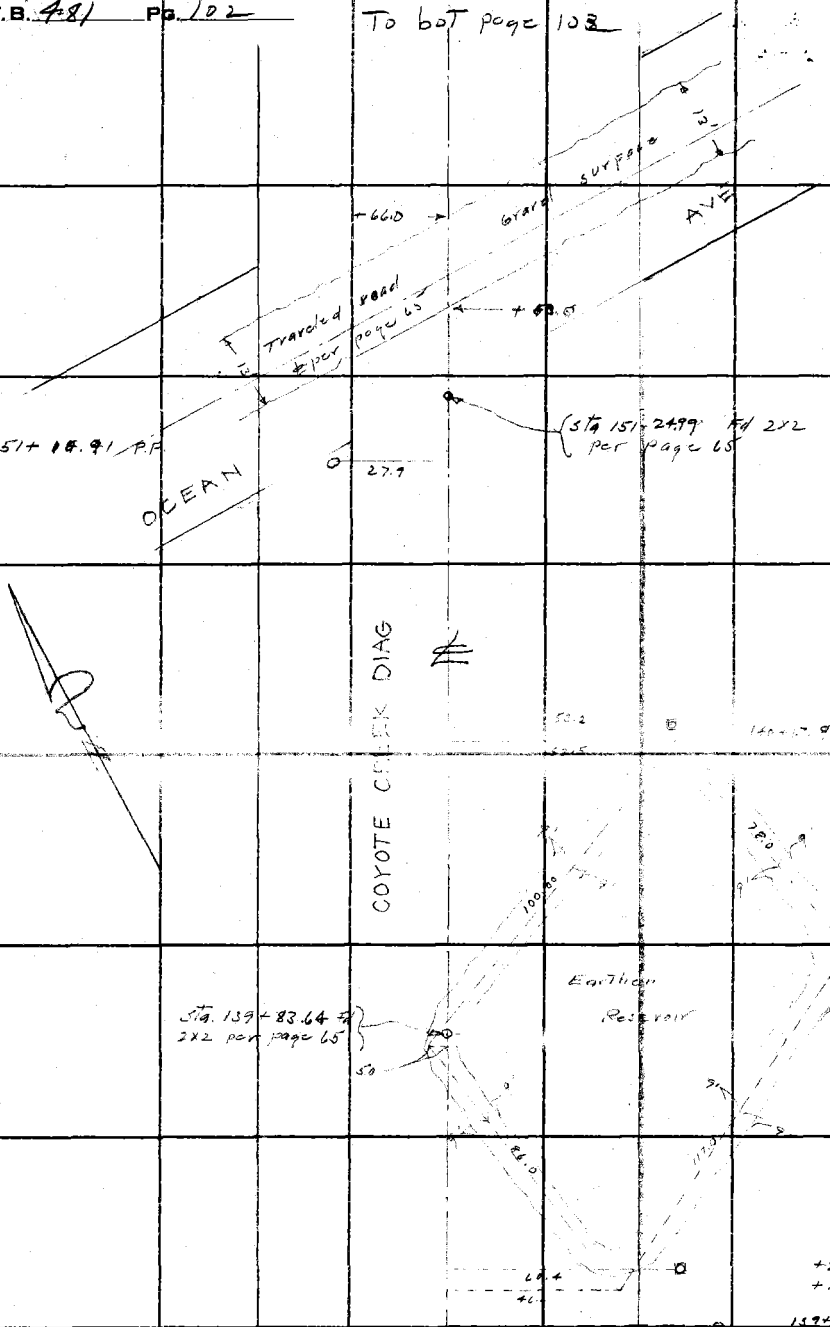

From Top left page 101

RETURN TO
LOS ANGELES COUNTY SURVEYOR
700 HALL OF RECORDS

Do not extend notes this side of this line

Note: ANY ADDITIONS OR CHANGES ON THIS SHEET MUST BE MADE OR CIRCLED IN Red Ink. WITH DATE AND NAME OF PERSON MAKING CHANGE.

Notes Ck'd by D. M. Finley
Map No. B-633
Office Work
Checked
Date

Survey of Coyote Ck. Diag. Dwg
W. O. 995 Tape No. St'd of.
Surveyed by L. S. Hammabel
Notes L. S. H. Date 5 Jan 1931
Indexed A. C. Johnson

F.B. 481 Pg. 103

To bot page 104

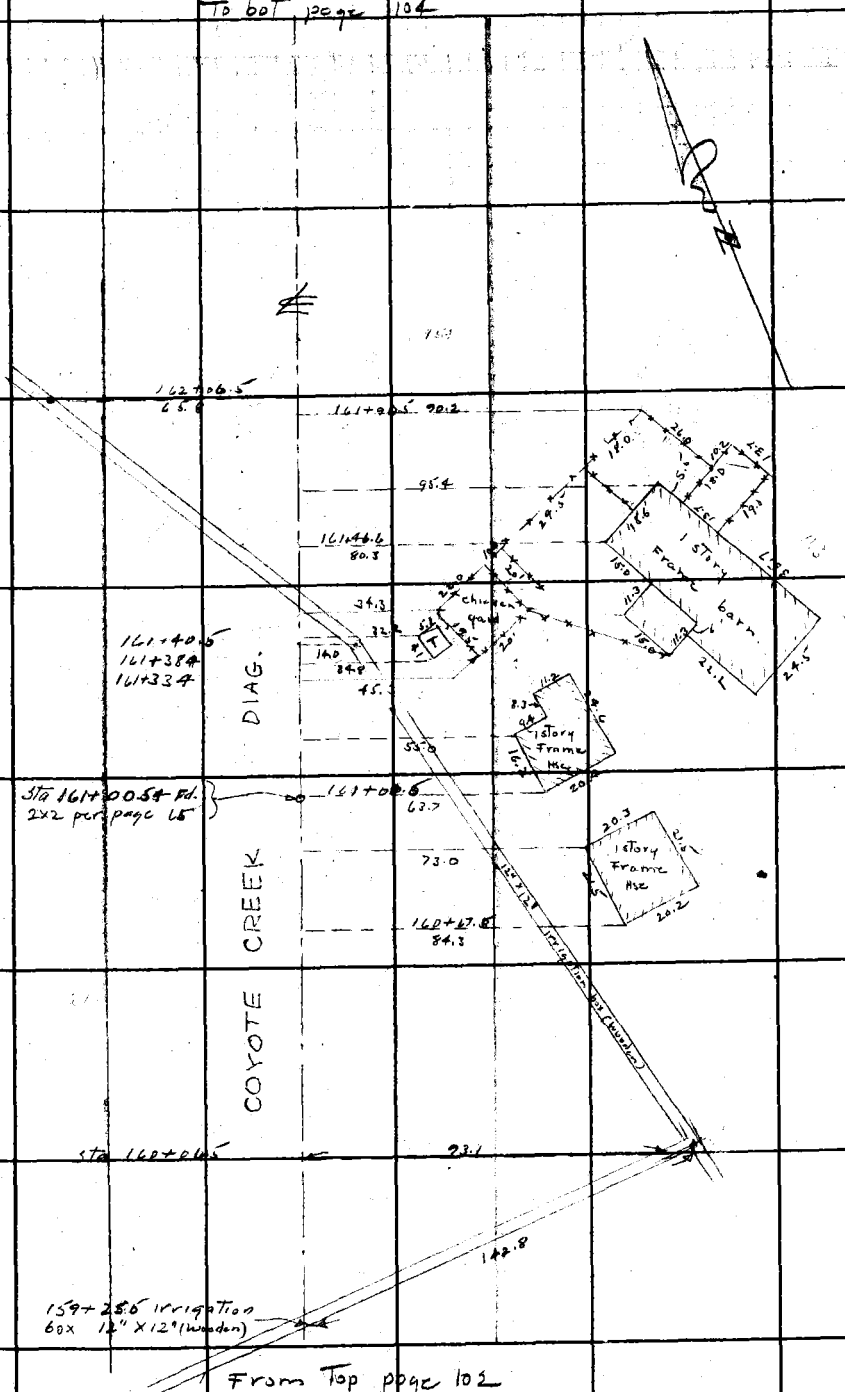

RETURN TO
LOS ANGELES COUNTY SURVEYOR
700 HALL OF RECORDS
Do not extend notes this side of this line

Note: ANY ADDITIONS OR CHANGES ON THIS SHEET MUST BE MADE OR CIRCLED IN Red Ink WITH DATE AND NAME OF PERSON MAKING CHANGE.

FORM 247 10M 8-31

To bot page 105

F.B. 481 Pg. 104

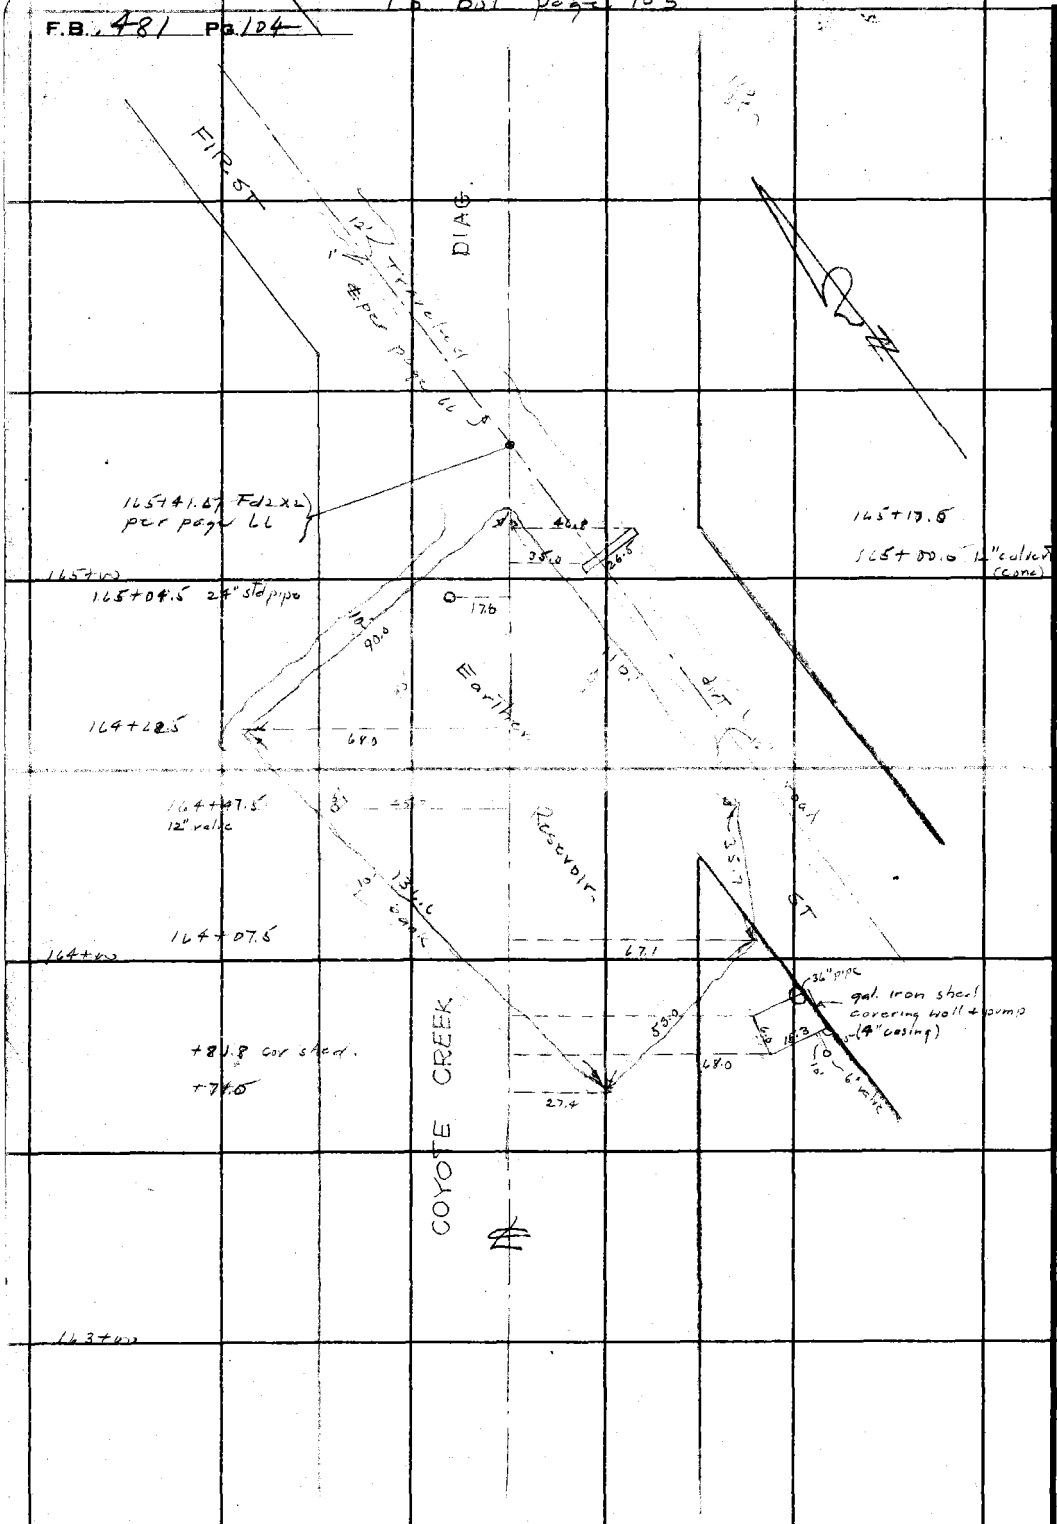

RETURN TO
LOS ANGELES COUNTY SURVEYOR
700 HALL OF RECORDS

Do not extend notes this side of this line

Note: ANY ADDITIONS OR CHANGES ON THIS SHEET MUST BE MADE OR CIRCLED IN Red Ink. WITH DATE AND NAME OF PERSON MAKING CHANGE.

Notes Ck'd by D. M. Finley	Survey of Coyote Ck. Diag. Div. 3	F.B. 484	Pg. 105
Map No. B-633	W. O. 995 Tape No.	St'd °F.	
Office Work	Surveyed by L. S. Hammond		
Checked	Notes L. S. H.	Date Dec 1931	
Date	Indexed A. C. Johnson		

To bot page 104

Note: ANY ADDITIONS OR CHANGES ON THIS SHEET MUST BE MADE OR CIRCLED IN Red Ink. WITH DATE AND NAME OF PERSON MAKING CHANGE.

RETURN TO
LOS ANGELES COUNTY SURVEYOR
700 HALL OF RECORDS

Do not extend notes this side of this line

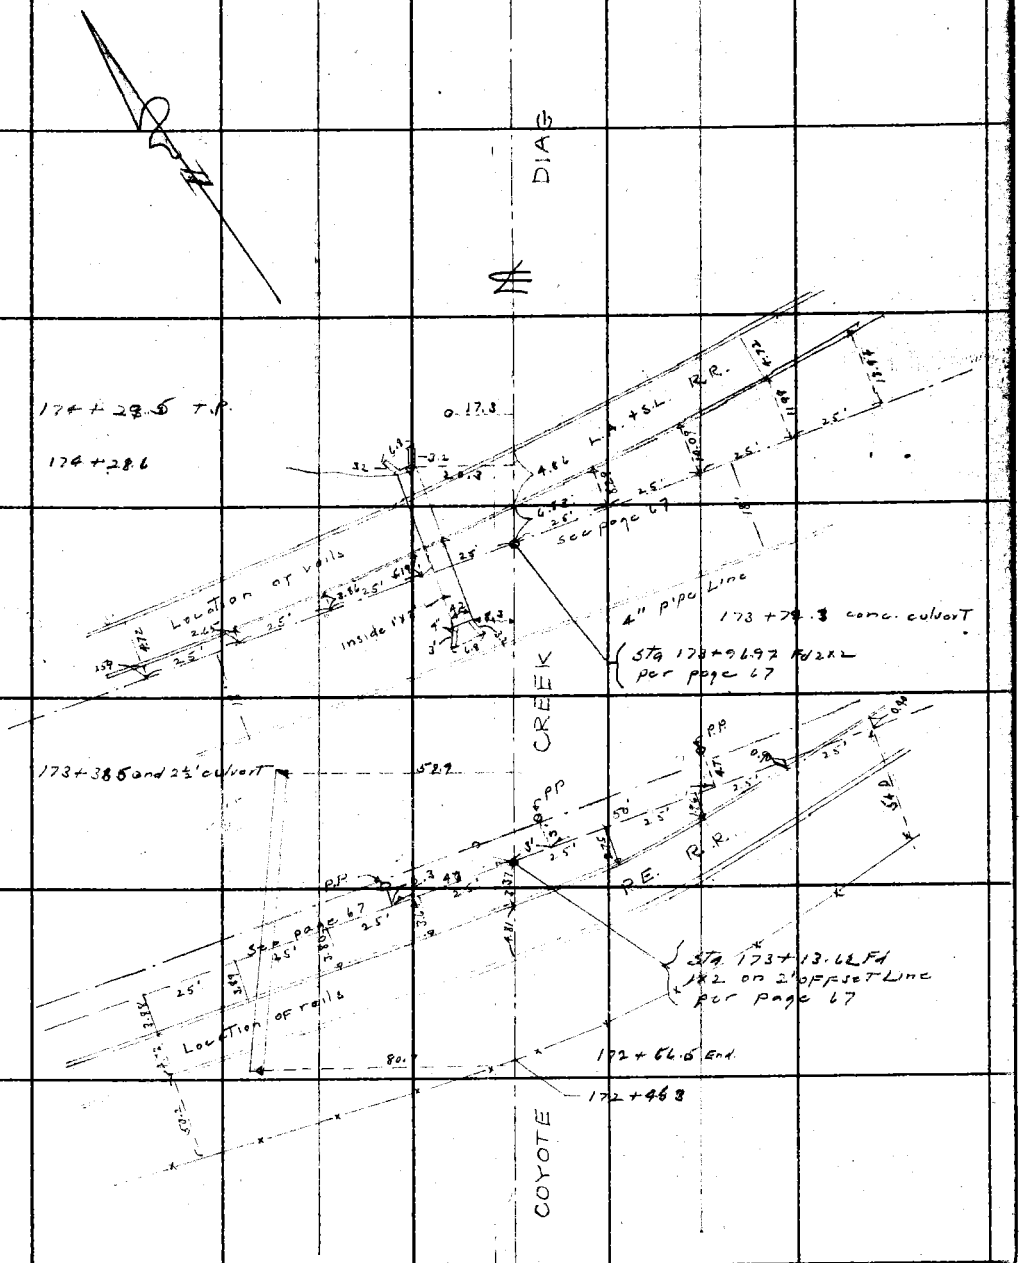

From Top page 104

FORM 247 10M 5-31

F.B. 48-1 PG. 106

cont bot page 107

Row 2" irrig 2 @ 22' 5'

4" Trees 22' apart N+S

Grove 22' apart N+S

Spaced

180+40.4

205

205

179-96.3

From Top page 105

RETURN TO
LOS ANGELES COUNTY SURVEYOR
700 HALL OF RECORDS

Do not extend notes this side of this line

Note: ANY ADDITIONS OR CHANGES ON THIS SHEET MUST BE MADE OR CIRCLED IN Red Ink. WITH DATE AND NAME OF PERSON MAKING CHANGE.

Map No. B-633	W. O. 995 Tape No. St'd °F.
Office Work	Surveyed by L. S. Hammond
Checked	Notes L S H Date Dec 1932
Date	Indexed A. C. Johnson

F.B. 481 Pg. 107

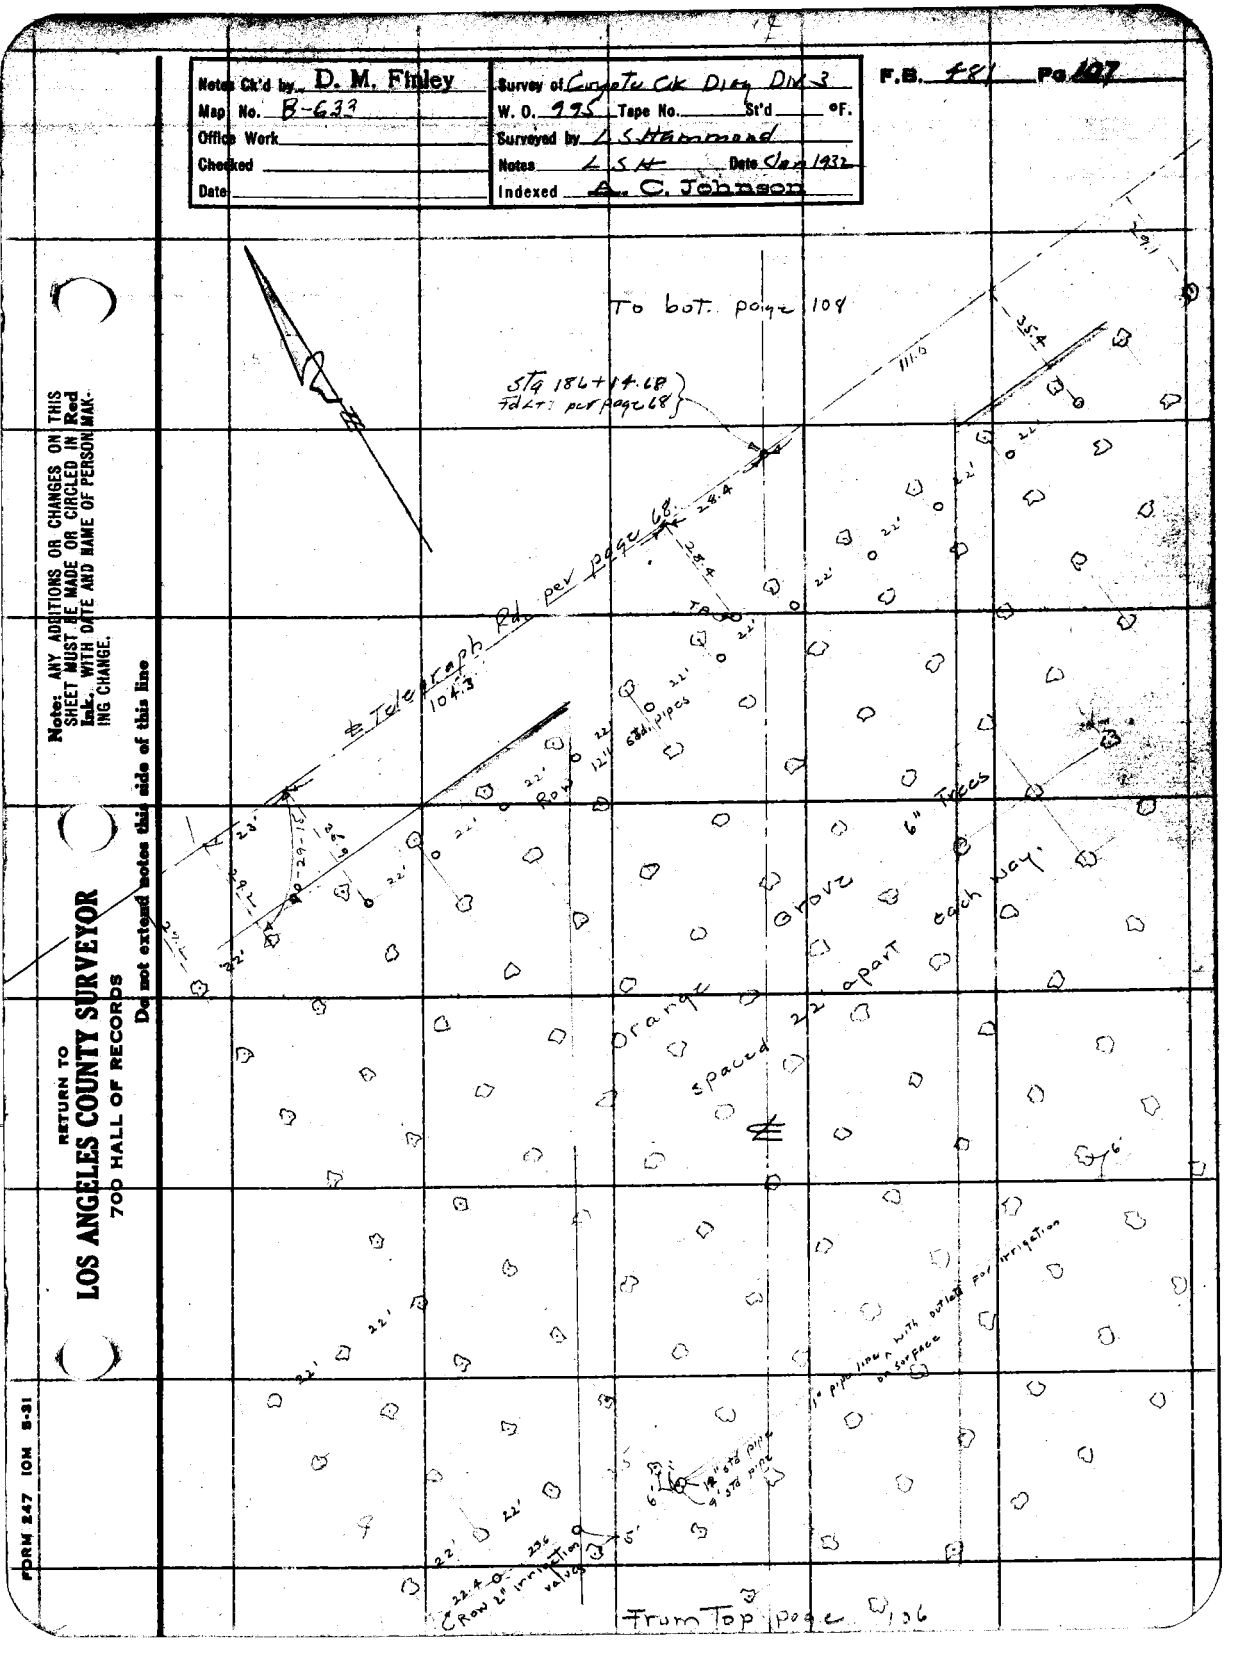

Note: ANY ADDITIONS OR CHANGES ON THIS SHEET MUST BE MADE OR CIRCLED IN Red Ink, WITH DATE AND NAME OF PERSON MAKING CHANGE.

Do not extend notes this side of this line

RETURN TO
LOS ANGELES COUNTY SURVEYOR
700 HALL OF RECORDS

FORM 247 10M 8-31

RETURN TO

LOS ANGELES COUNTY SURVEYOR

700 HALL OF RECORDS

Note: ANY ADDITIONS OR CHANGES ON THIS SHEET MUST BE MADE OR CIRCLED IN **Red Ink.** WITH DATE AND NAME OF PERSON MAKING CHANGE.

Do not extend notes this side of this line

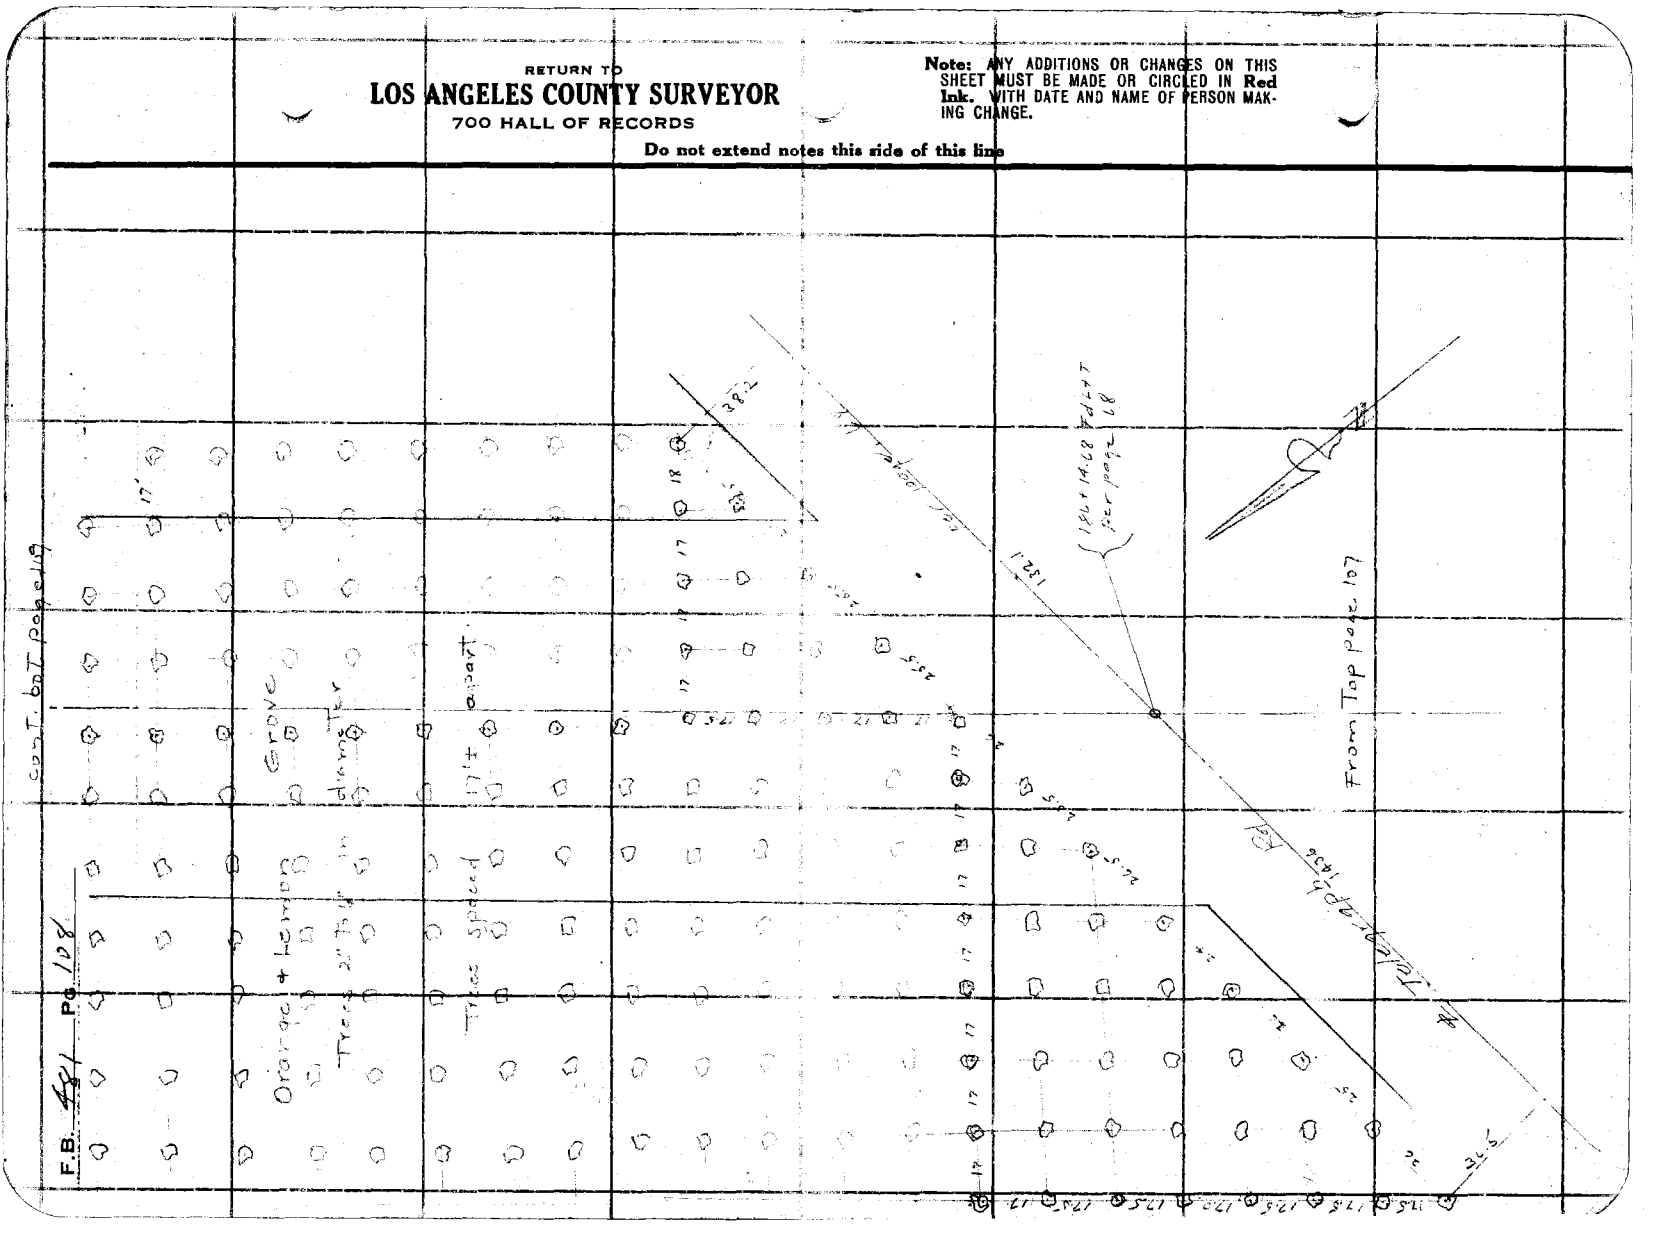

Notes Ck'd by D. M. Finley
Map No. B-633
Office Work
Checked
Date

W. O. 995 Tape No. St'd °F.
Surveyed by L. S. Hammond
Notes L. S. H. Date
Indexed A. C. Johnson

F.B. 481 Pg. 109

To bot page 110

Orange + Lemon Grove

Trees 2" To 6" in diameter

Trees spaced 17' apart

12'

17' 17' 17'

From Top page 108

Note: ANY ADDITIONS OR CHANGES ON THIS SHEET MUST BE MADE OR CIRCLED IN Red Ink. WITH DATE AND NAME OF PERSON MAKING CHANGE.

Do not extend notes this side of this line

RETURN TO
LOS ANGELES COUNTY SURVEYOR
700 HALL OF RECORDS

FORM 247 10M 8-31

RETURN TO
LOS ANGELES COUNTY SURVEYOR
700 HALL OF RECORDS

Note: ANY ADDITIONS OR CHANGES ON THIS SHEET MUST BE MADE OR CIRCLED IN **Red Ink.** WITH DATE AND NAME OF PERSON MAKING CHANGE.

Do not extend notes this side of this line

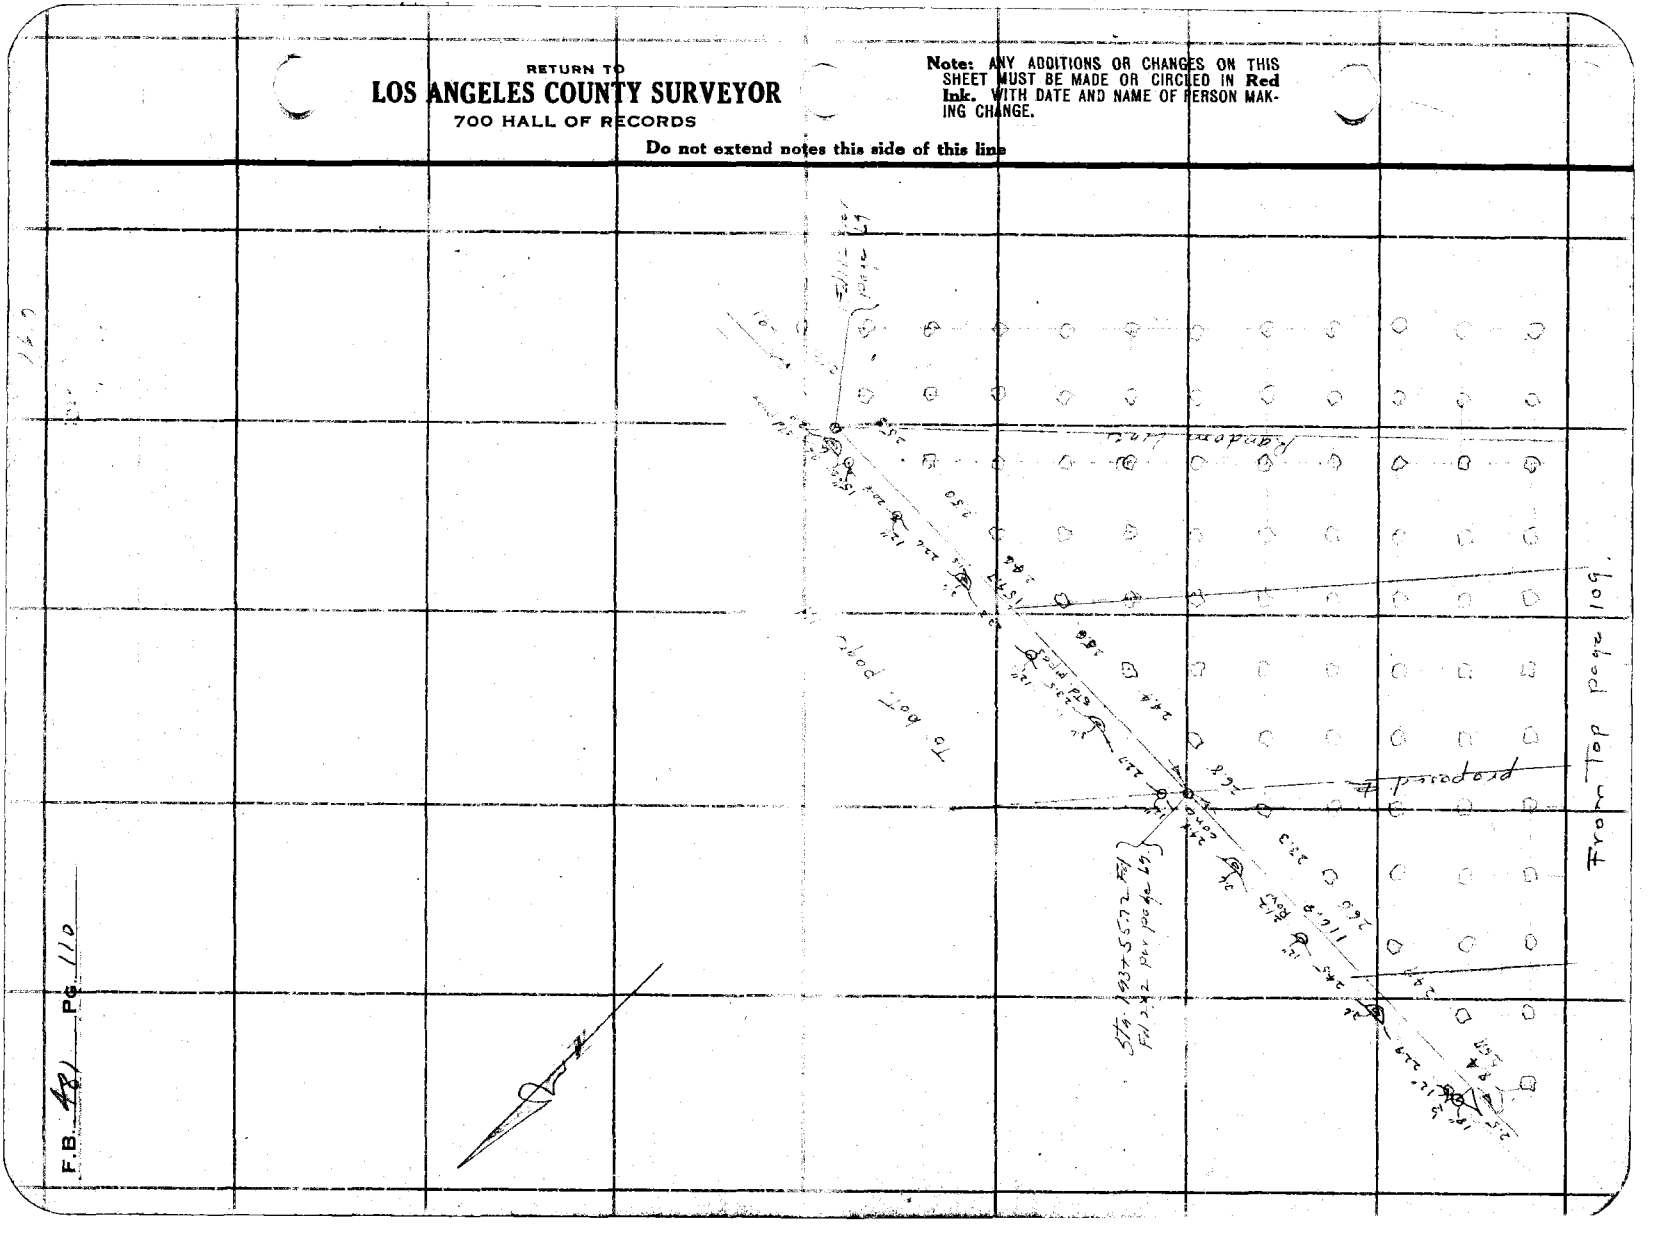

F.B. 421 Pg. 110

Notes Ck'd by	D. M. Finley	Survey of	Coyote Ck Diversion Dike
Map No.	B-633	W. O.	995
Office Work		Tape No.	St'd °F.
Checked		Surveyed by	L. S. Hammond
Date		Notes	L S H Date Jan 1932
		Indexed	A. C. Johnson

F.B. 481 Pg. 111

To bot. page 112

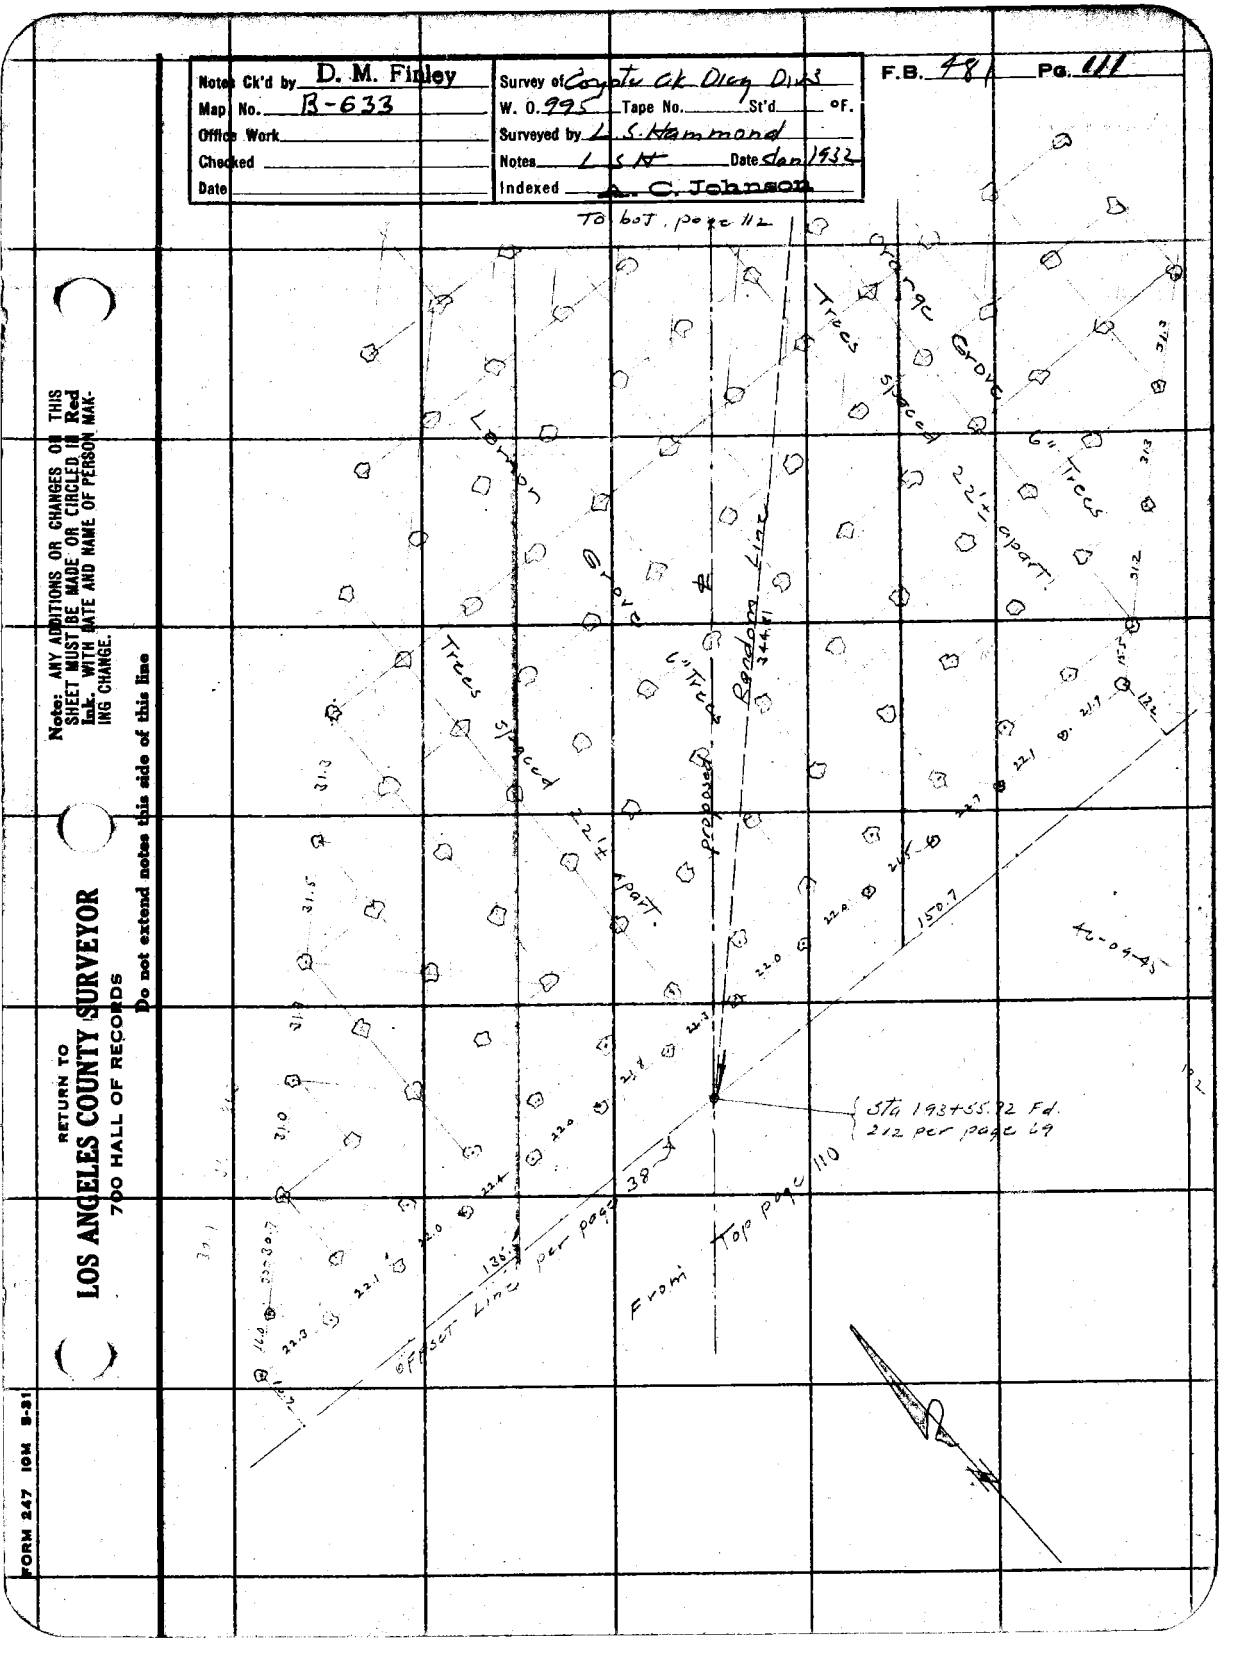

RETURN TO
LOS ANGELES COUNTY SURVEYOR
700 HALL OF RECORDS

Note: ANY ADDITIONS OR CHANGES OF THIS SHEET MUST BE MADE OR CIRCLED IN Red Ink. WITH DATE AND NAME OF PERSON MAKING CHANGE.

Do not extend notes this side of this line

FORM 247 10M 5-31

RETURN TO

LOS ANGELES COUNTY SURVEYOR

700 HALL OF RECORDS

Note: ANY ADDITIONS OR CHANGES ON THIS SHEET MUST BE MADE OR CIRCLED IN **Red Ink.** WITH DATE AND NAME OF PERSON MAKING CHANGE.

Do not extend notes this side of this line

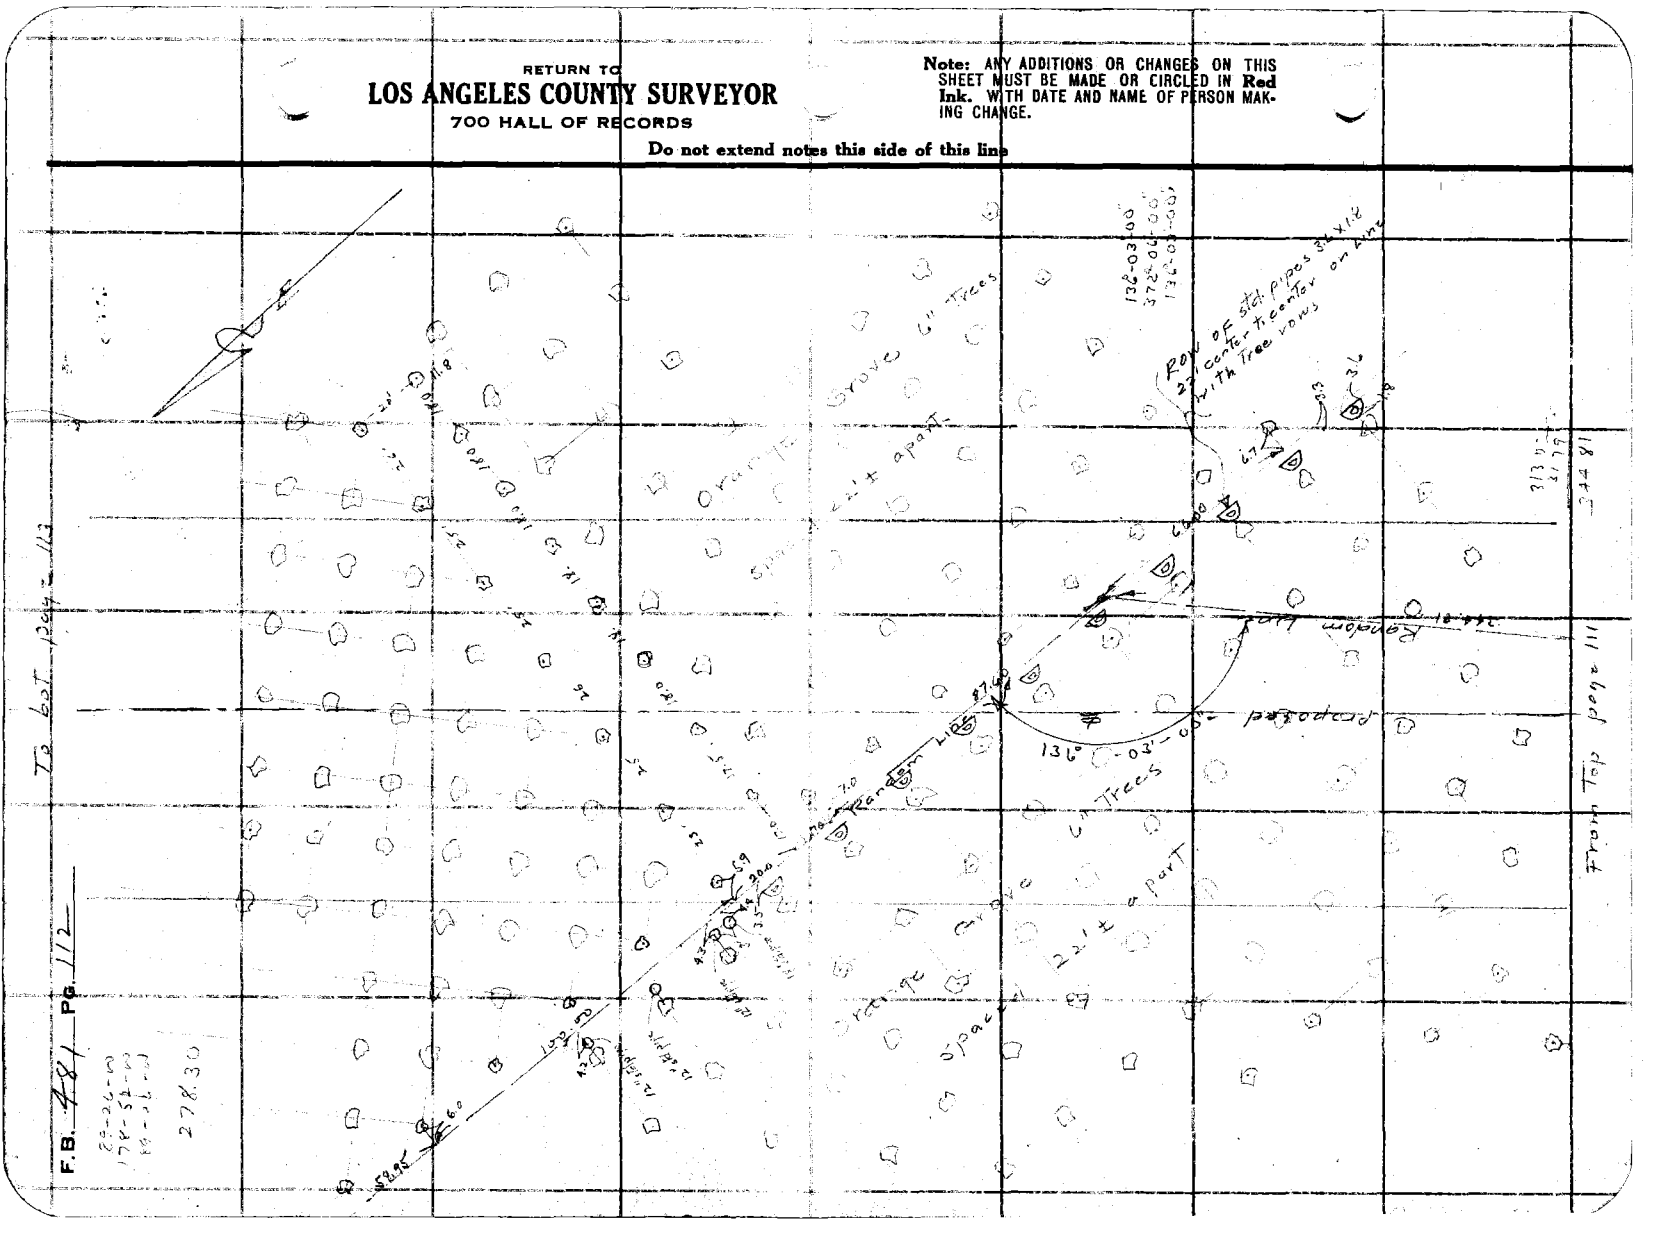

Date	Indexed A. C. Johnson		

To bot. page 114

8" Orange Trees spaced 24' N-S

+25' E+W. intersect with Lemons

Post 12" Std Pipes

To bot page 116

6" Trees

Orange Grove spaced 25' apart

Random Line

S.E. 1/4 Sec. 12

Set IN 2

From Top page 112

89°-26'-00"
179°-52'-00"
89°-26'-00"

Note: ANY ADDITIONS OR CHANGES ON THIS SHEET MUST BE MADE OR CIRCLED IN Red Ink. WITH DATE AND NAME OF PERSON MAKING CHANGE.

RETURN TO
LOS ANGELES COUNTY SURVEYOR
700 HALL OF RECORDS

Do not extend notes this side of this line

FORM 247 10M 5-31

F.B. 481 Pg. 114

To bot. page 115

RETURN TO
LOS ANGELES COUNTY SURVEYOR
700 HALL OF RECORDS

Note: ANY ADDITIONS OR CHANGES ON THIS SHEET MUST BE MADE OR CIRCLED IN Red Ink. WITH DATE AND NAME OF PERSON MAKING CHANGE.

Do not extend notes this side of this line

Grove

Orange Trees spaced 24' N+S

8" orange Trees spaced 24' N+S
+25' S+W intersect with Lemon Trees

From Top page 113

FORM 247 10M 5-31

RETURN TO
LOS ANGELES COUNTY SURVEYOR
700 HALL OF RECORDS

Note: ANY ADDITIONS OR CHANGES ON THIS SHEET MUST BE MADE OR CIRCLED IN **Red Ink.** WITH DATE AND NAME OF PERSON MAKING CHANGE.

Do not extend notes this side of this line

Notes Ck'd by D. M. Finley
Map No. B-633
Office Work
Checked
Date



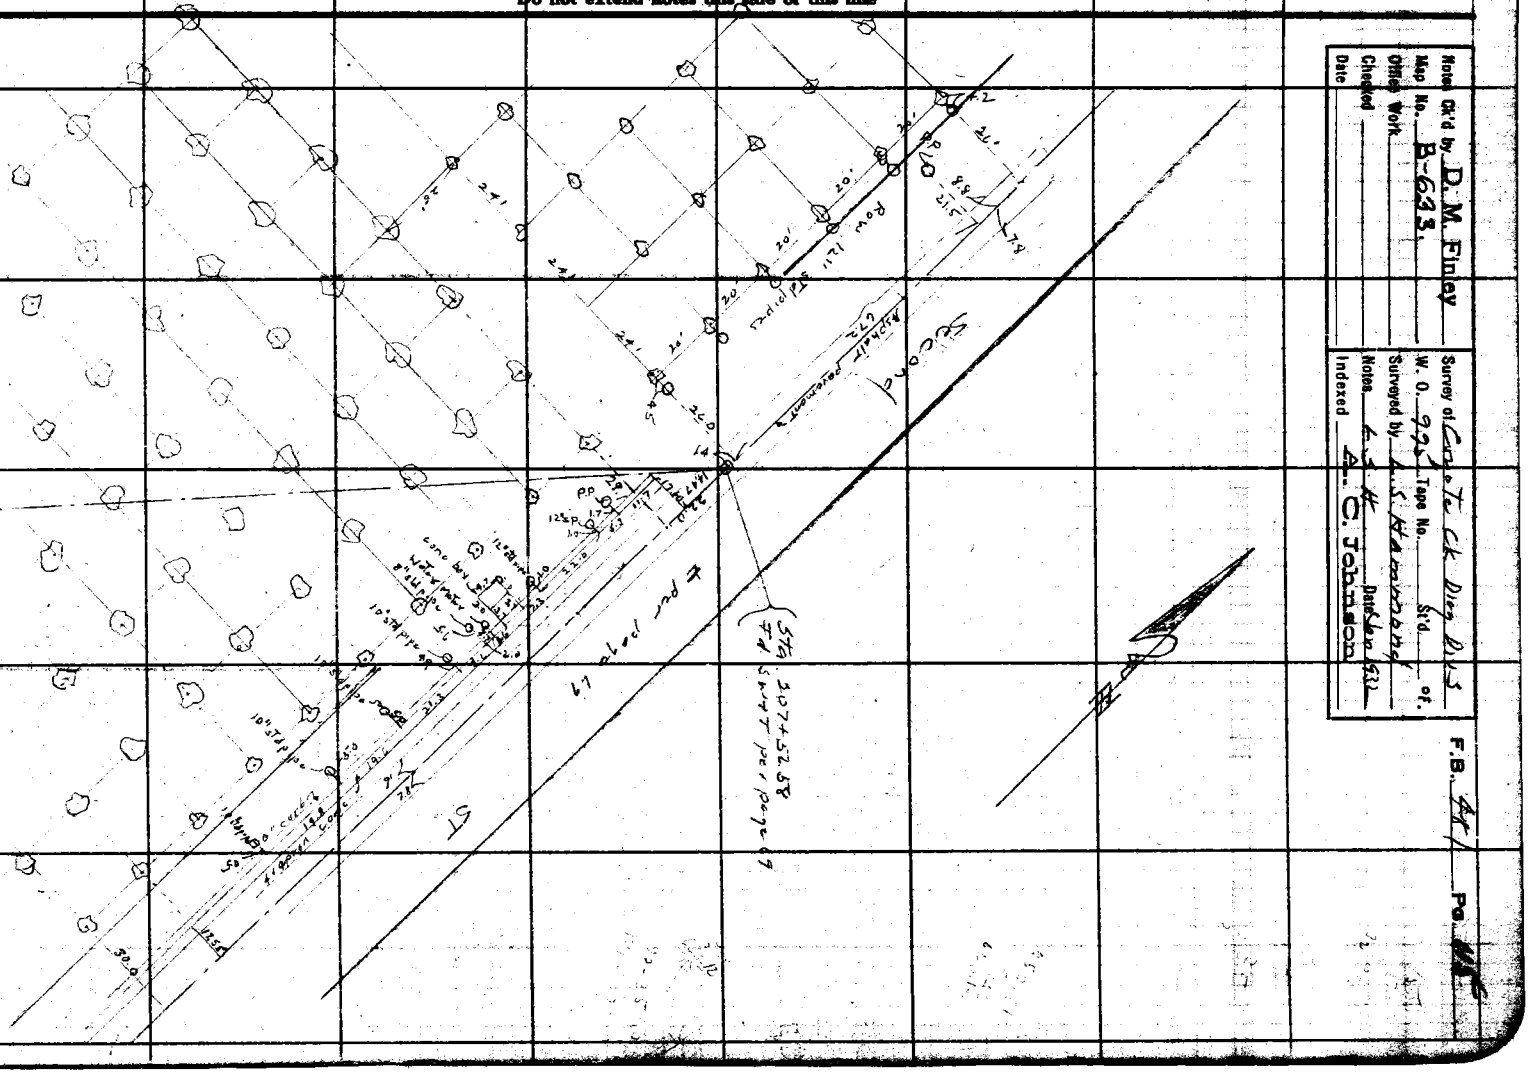

RETURN TO
LOS ANGELES COUNTY SURVEYOR
700 HALL OF RECORDS

Note: ANY ADDITIONS OR CHANGES ON THIS SHEET MUST BE MADE OR CIRCLED IN **Red Ink.** WITH DATE AND NAME OF PERSON MAKING CHANGE.

Do not extend notes this side of this line

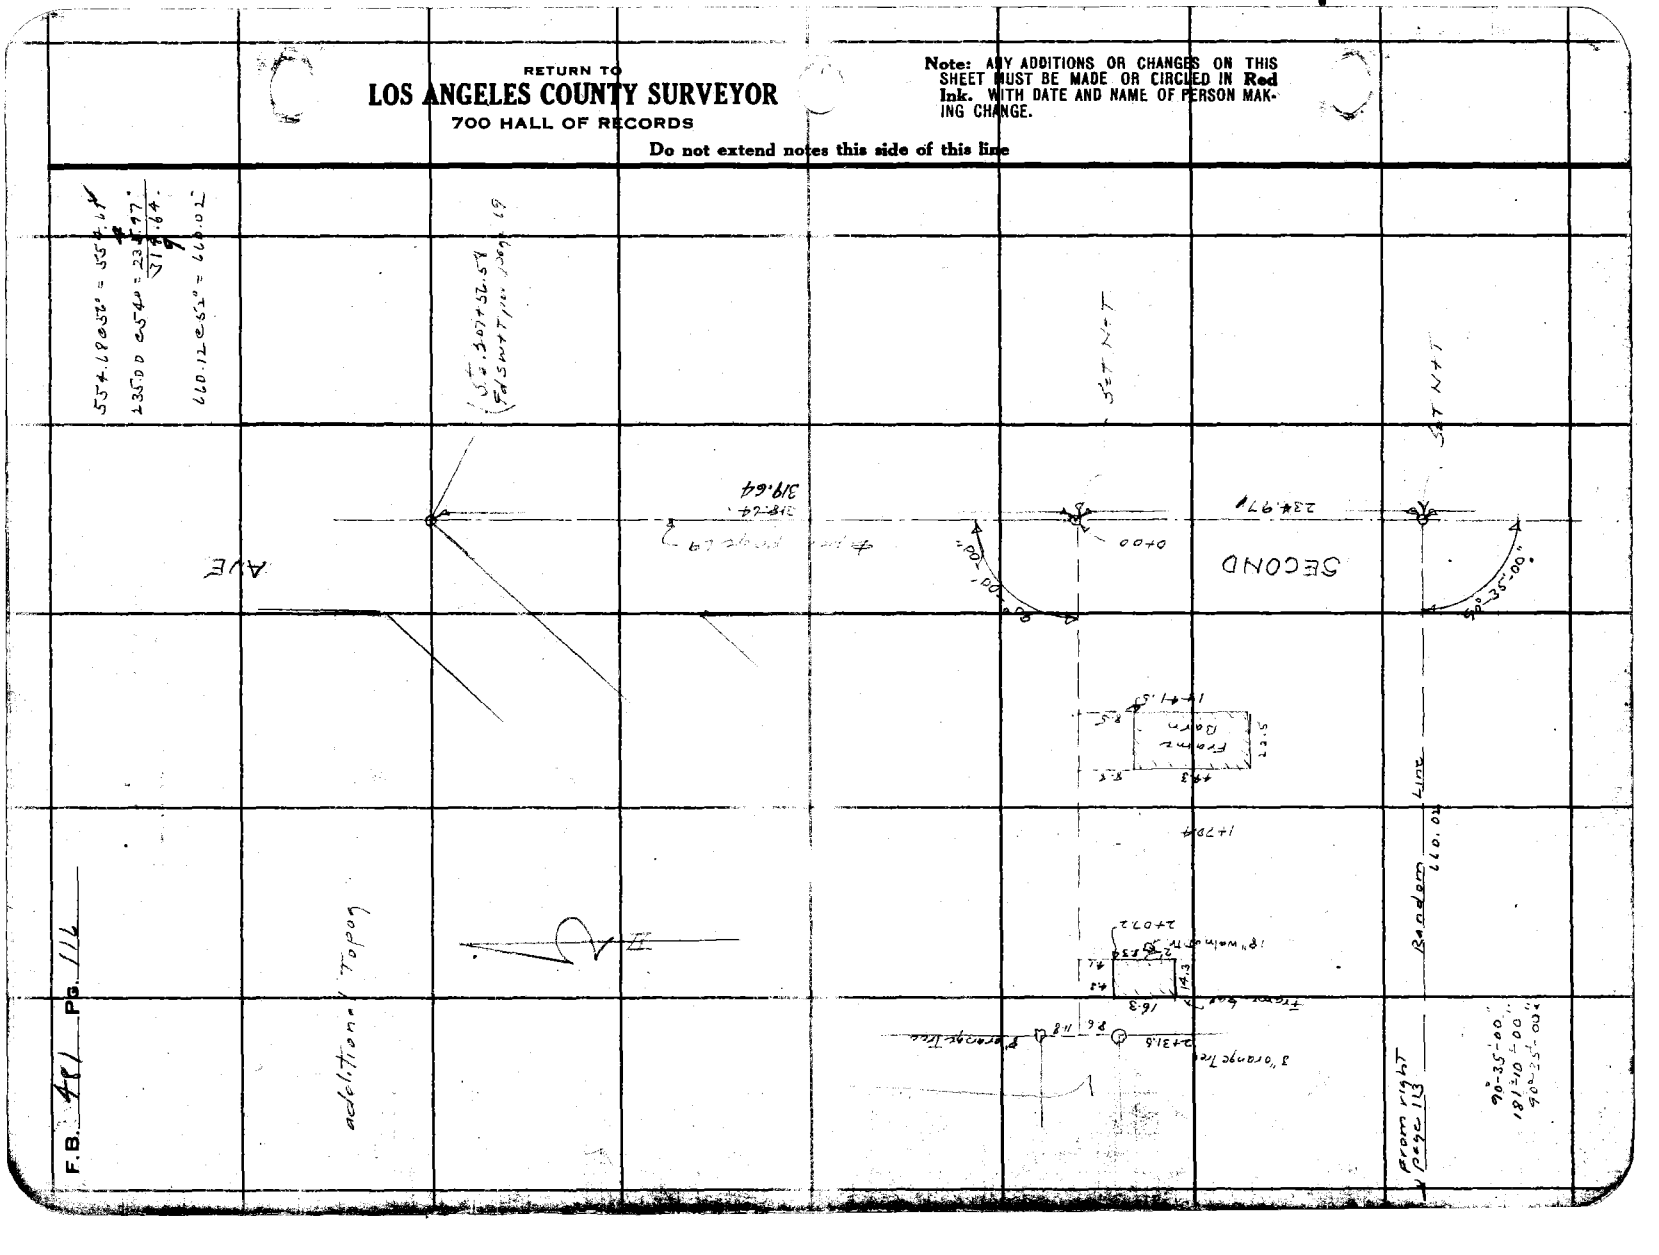

Notes Ck'd by
Map No.
Office Work Rice
Checked
Date

Survey of Coyote Creek Diag.
W. O. 995 Tape No. 051 St'd 84 °F.
Surveyed by Evans
Notes HE Date 1-10-33
Indexed A. C. Johnson 4-29-33

F.B. 481 Pg. 117

(To B.C. p9. 119)

RELOCATION OF A PORTION OF PROP'D. COYOTE CREEK DIAGONAL
P.S. 117-119

(For former alignment see F.B. 448-24)

(To F.B. 446-83 & 87)

(118-17-15)
(115-08-45)

Ranch Line

(CERRITOS) AVE

To Sta 201.58

(30)

(30)

131°-17-10" F.R. M.B. 1054

Fd. chr. nail in conc. 12' deep, set in 14" round iron box, per Tr. 10548, See F.B. 453-32 & F.A. 245-4 (on Ranch line & on E. side St. Prod.)

W. spk. P.T. F.P.

30.00

38.14

87.50

Sewer M.H. P.T. Grey P.

51.18

Fd. W. spk. P.T. P.P.

Set 2x2-14" deep, by Instm.

Prop'd. COYOTE CREEK DIAG'L.

(30)

117.11

284°

(89°-49-15)
(359°-17-15)
(89°-49-18" W

75.74 Adj.
75.73

89°-49-20"

(30)

(30)

85.96

STATE ST.

Fd. 2x2-6" d. F.A. 245-70 (on line both ways)

Proposed R/W Line

Fd. Punch Mk. in conc. mon. 24" dn. In 1" Sm. pc. F.B. 366 pg. 127

Fd. Punch Mk. in conc. mon. 24" dn. In 1" Sm. pc. F.B. 366 pg. 127

Fd. 3/4" I.P. conc. filled & nail 1.5' dn. P.T. of Proposed State St. per F.B. 366-127

HATHAWAY AVE.

(82°-36-45)
(330°-27-30)
82°-36-52½"

Notes: ANY ADDITIONS OR CHANGES ON THIS SHEET, MUST BE MADE OR CIRCLED IN Red Ink, WITH DATE AND NAME OF PERSON MAKING CHANGE.

Do not extend notes this side of this line

RETURN TO
LOS ANGELES COUNTY SURVEYOR
700 HALL OF RECORDS

FORM 247 10M 3-51

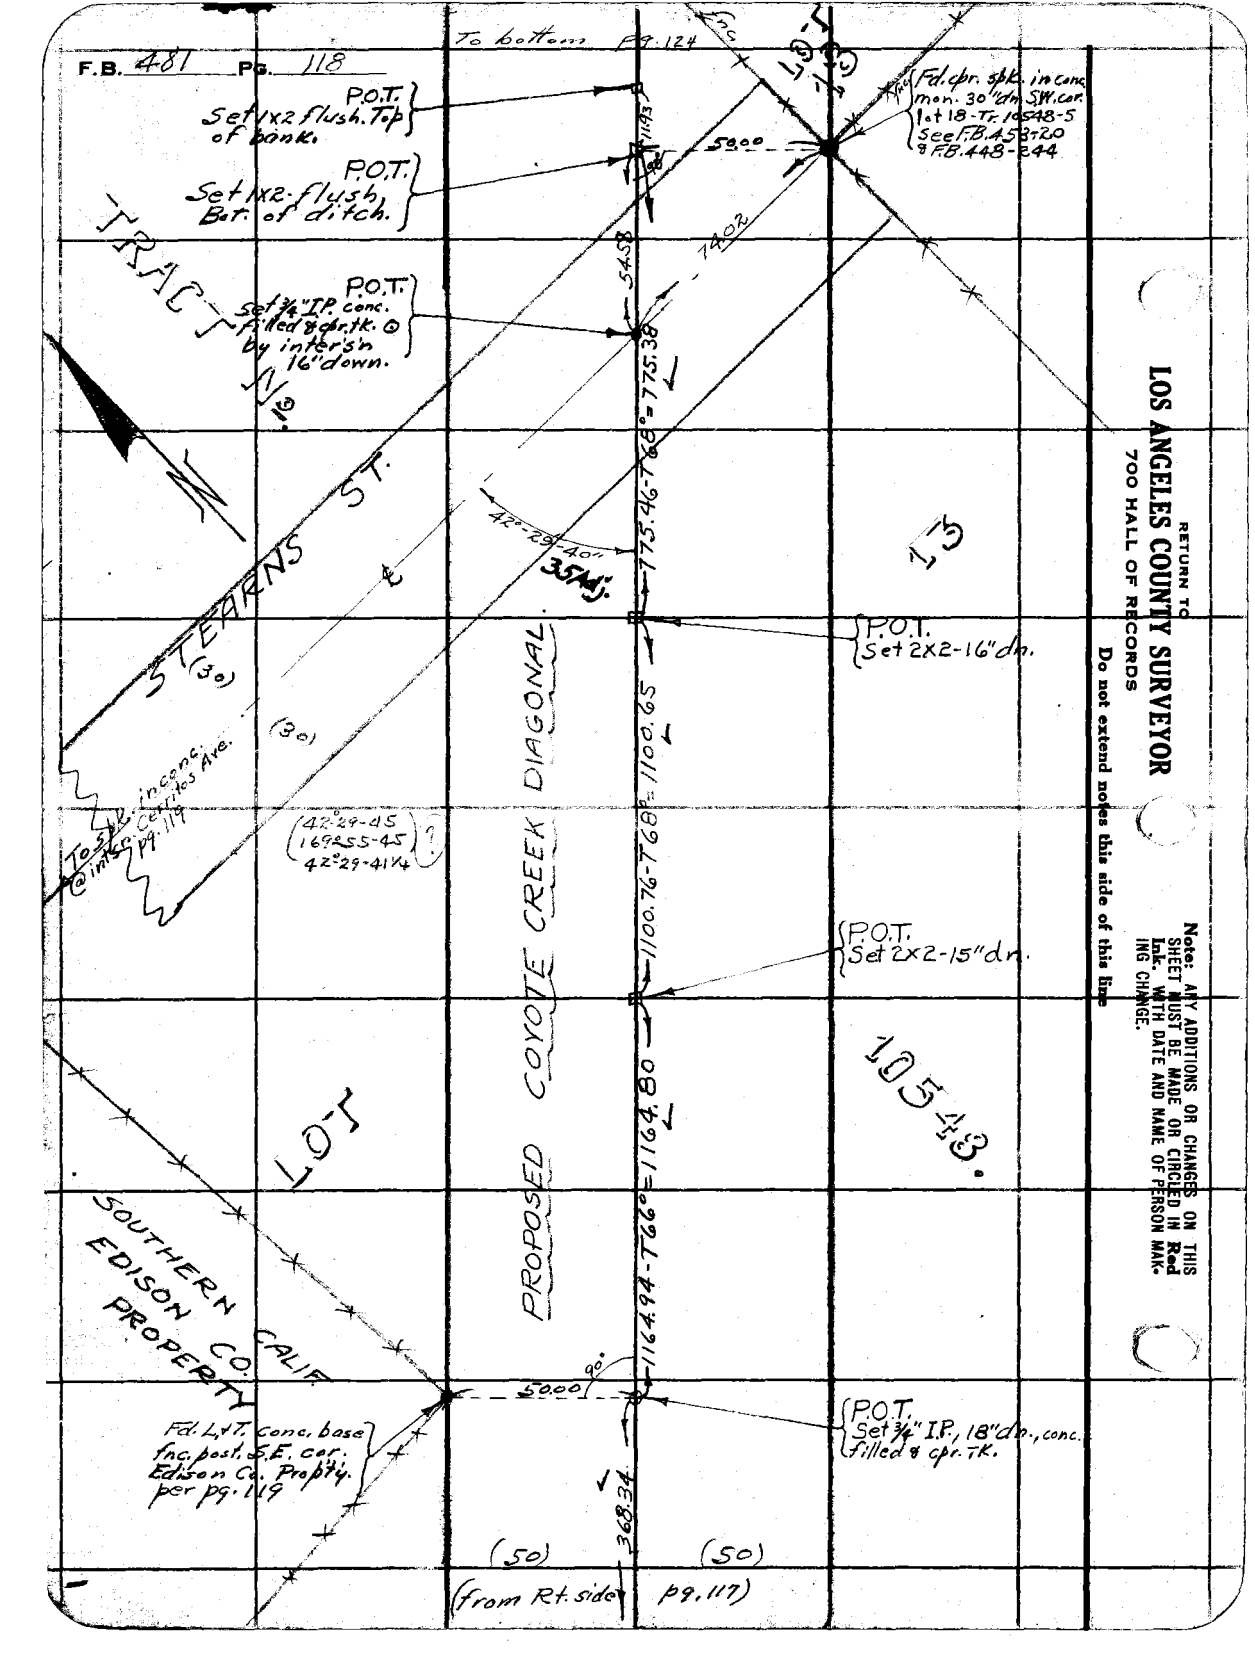
F.B. 481 Pg. 118
To bottom Pg. 124
P.O.T. Set 1x2 flush. Top of bank.
P.O.T. Set 1x2 flush, Bot. of ditch.
P.O.T. Set ¾" I.P. conc. filled & cpr. tk. ⊙ by inters'n 16" down.
Fd. cpr. spk. in conc. mon. 30" dn. S.W. cor. lot 18 - Tr. 10548-5 See F.B. 458-20 & F.B. 448-244
58.00
1143
54.58
740.2
775.46-T68°=775.38
42°-29'-40"
35.44
TRACT
STEARNS ST.
(30)
13
P.O.T. Set 2x2-16" dn.
To S.E. cor. @ int's'n
(30)
(42°-29-45 169255-45 42°29-41¼)
1100.76-T68°=1100.65
P.O.T. Set 2x2-15" dn.
PROPOSED COYOTE CREEK DIAGONAL
LOT
10543.
SOUTHERN CALIF. EDISON CO. PROPERTY
1164.80
1164.94-T66°=1164.80
90°
50.00
Fd. L.&T. conc. base inc. post S.E. cor. Edison Co. Prop'ty. per pg. 119
P.O.T. Set ¾" I.P., 18" dp., conc. filled & cpr. TK.
368.34
(50)
(50)
(From Rt. side pg. 117)
RETURN TO
LOS ANGELES COUNTY SURVEYOR
700 HALL OF RECORDS
Do not extend notes this side of this line
Note: ANY ADDITIONS OR CHANGES ON THIS SHEET MUST BE MADE OR CIRCLED IN Red Ink. WITH DATE AND NAME OF PERSON MAKING CHANGE.

Notes Ck'd by
Map No.
Office Work Rice
Checked
Date

Survey of Coyote Creek Diag. F.B. 481 Pg. 119
W. O. 995 Tape No. 051 St'd 84°F.
Surveyed by Evans
Notes HE Date 1-9-33
Indexed A. C. Johnson

Note: ANY ADDITIONS OR CHANGES ON THIS SHEET MUST BE MADE OR CIRCLED IN Red Ink, WITH DATE AND NAME OF PERSON MAKING CHANGE.

Do not extend notes this side of this line

RETURN TO
LOS ANGELES COUNTY SURVEYOR
700 HALL OF RECORDS

FORM 247 10M 5-31

N.T.F.P. 2.26 N.T.F.P. 11.14 cpr.spk. in conc. (24"dn. F.B. 453-20) (89°48'45" / 359°15'15") 89°48'48¾ To spk. in conc. Tok pg. 118 (89°57' / 359°56") 89°59'

STEARNS

Fd. N.T. PP 9.00 cpr.spk. in conc. 24"dn. See F.B. 453-20

(30) (30)

N.O.T. F.M. ST.

Fd. cpr. nail & conc. mon. in round iron box. Mon. 12" below rd. Surface. See F.B. 453-20 & F.A. 245-70

AVE.

Fd. 2" I.P. conc. filled & T. flush See Tr. 10548 & F.B. 453-21

Set S.W.T.

By per F.B. 453-20 22.22

80°-48'-48" Rec. & Meas.

Set L.T. conc. base of F.P.

Set L.T conc. base Fnc. Post by rec. angle & dist. from & Cerritos Ave. (N. face Fnc. Post) 0.32 N. of line.

2x12 Fnc.

Pipe wire Fnc.

29.97 100.00 Rec. & Meas. 300.00

V. edge F.P. on line.

PROP'Y OF SOUTHERN CALIF. EDISON CO. (See Tr. 10548)

(89°59'38" Rec.) 89°59'00"

CERRITOS

(2455.39 calc. Rec.) 2455.33 - T 6.2° = 2295.29

(290.39 calc.) (290.39 Rec.)

90°-01'-00" (90°-00'-22" Rec.)

Pipe wire Fnc.

(290.29 calc.) (290.39 Rec.) 2455.33 - T 6.2° = 2295.29 (2455.39 Rec. calc.)

89°-48'-46" Rec. & Meas.

Fd. 2" I.P. conc. filled 8" T. 6" dn. See Tr. 10548 & F.B. 453-21

Set L.T. conc. base of Fnc. Post.

Pipe wire Fnc.

Set L.T conc. base Fnc. Post by rec. angle & dist. from & Cerritos Ave. F.P. 0.09 W. of back line.

Edge F.P. 5.45 N. of line

29.95 10.05 100.00 Rec. & Meas. 300.00

calc. 29.97

330.45 Rec. & Meas.

Set S.W.T.

(89°48'45" / 359°15'15") 89°48'48¾

(90°01'00" / 360°04'00") 90°01'00"

TR. NR. 10548.

To conc. Mon. 201.60 - T 6.6° = 201.58 Centerline Survey St. pg.

(from top pg. N7)

RETURN TO

LOS ANGELES COUNTY SURVEYOR

700 HALL OF RECORDS

Note: ANY ADDITIONS OR CHANGES ON THIS SHEET MUST BE MADE OR CIRCLED IN **Red Ink.** WITH DATE AND NAME OF PERSON MAKING CHANGE.

Do not extend notes this side of this line

F.B. 481 Pg. 120

Notes Ck'd by	Survey of Los Coyotes Diagonal
Map No.	W. O. 995 Tape No. St'd of.
Office Work	Surveyed by K. D. Moore
Checked	Notes Moore Date 1-27-33
Date	Indexed by C. Johnson 3-14-33

F.B. 481 PG. [illegible]

STAKING
of
TRAFFIC CIRCLE
at
STATE ST, BENNETT AVE, HATHAWAY
and
LOS COYOTES DIAGONAL
W O # 995

Note: ANY ADDITIONS OR CHANGES ON THIS SHEET MUST BE MADE OR CIRCLED IN Red Ink, WITH DATE AND NAME OF PERSON MAKING CHANGE.

Do not extend notes this side of this line

RETURN TO
LOS ANGELES COUNTY SURVEYOR
700 HALL OF RECORDS

FORM 347 10M 8-31

F.B. 481 PG. 127

RETURN TO
LOS ANGELES COUNTY SURVEYOR
700 HALL OF RECORDS

Do not extend notes this side of this line

Note: ANY ADDITIONS OR CHANGES ON THIS SHEET MUST BE MADE OR CIRCLED IN Red Ink WITH DATE AND NAME OF PERSON MAK-ING CHANGE.

To 1X2 at Termino FB 366-83

To S.T+W FB 481-119

BENNET

Set C.S.Mon. 18" deep Marked as shown

Set 2x2

Set 1x2

Set 1x1

Set N+T

Set L+T

Fd. 2" I.P.

Fd. S.T&W FB 481-119

COUNTY SURVEYORS CENTER LINE OF BENNET AVE MONUMENT

COUNTY SURVEYORS CENTER LINE OF HATHAWAY MONUMENT

COUNTY SURVEYORS CENTER LINE OF STATE ST. MONUMENT

COUNTY SURVEYORS CENTER LINE OF CIRCLE MONUMENT

COUNTY SURVEYORS INTER. BENNETT-AVE + STATE ST. MONUMENT

5' offset Line to HATHAWAY

STATE ST.

Fd Conc. Nail FB 481-117

Fd 2x2 FB 481-117 Set C.S.Mon 18" deep - Marked as Shown

Fd Punch Mark in Conc. Mon. FB 481-117

Set 481 in Mon

Set C.S.Mon. 18" deep Marked as shown

Set 2x2 12" deep

Set 2x2 18" deep

To C.S.Mon. # Termino FB 366-84

A= 81°-33-05
R= 42'
T= 39.47
L= 88.22

A= 74-03-51
R= 27.
T= 20.37
L= 34.90

A= 1-10-00
R= 247
L= 5.03

A= 71°-04-00"
R= 42'
T= 30.00
L= 52.10

A= 5-06-00
R= 247
L= 21.99

A= 72-33-50
R= 62'
T= 45.51
L= 78.52

A= 64°-49'-55"
R= 62'
T= 39.87
L= 70.15

A= 93°-
R= 247'
L= 402.10

A= 19-15-23
R= 247
L= 83.01

183.00

162.73

257.6

72.2

87.11

85.96

39.73

180.

327.

221

Note: Ck'd by McPherson
Map No. B-828
Office Work Pool
Checked McPherson
Date Mar. 1933

Survey of Los Coyotes Diagonal
W. O. 995 Tape No. 033 St'd 66 °F.
Surveyed by L. D. Moore
Notes Moore Date 1-27-33
Indexed A. C. Johnson

F.B. 481 Pg. 123

RETURN TO
LOS ANGELES COUNTY SURVEYOR
700 HALL OF RECORDS
Do not extend notes this side of this line

Note: ANY ADDITIONS OR CHANGES ON THIS SHEET MUST BE MADE OR CIRCLED IN Red Ink, WITH DATE AND NAME OF PERSON MAKING CHANGE.

FORM 247 10M 8-31

LOS COYOTES

Δ=19°15'-23" L=83.01 R=247

Set 1x2

Δ= 70-11-23 R=102' T=71.67 L=124.95

Set 2x2

Fd. 3/4" I.P. 18" deep F.B. 481-118

Set C.S.Mon 18" deep Marked as shown

COUNTY SURVEYORS CENTER LINE OF LOS COYOTES MONUMENT

Δ=63-30-02 R=47 T=29.14 L=52.17

Δ=0°-30'-14" R=247' L=2.60

Δ=74°-47'-32" R=47 T=35.18 L=61.28

STATE ST.

COUNTY SURVEYORS INTER. STATE ST. & HATHAWAY MONUMENT

Fd. 3/4" I.P. F.B. 481-117 Replaced with C.S.Mon 18" deep Marked as shown

Fd. 5/4 W in conc. Mon 18" deep F.B. 366-127

Fd. L+T. in conc. Mon 12" deep F.B. 366-127

Δ=70°-08-03 R=22' T=15.44 L=26.93

Δ=2°-36'-14" R=247' L=11.23

Δ=72°-09'-42" T=26.96 L=46.60 R=37'

COUNTY SURVEYORS CENTER LINE OF STATE ST. MONUMENT

Fd 2x2 F.B. 481-117 Replaced with C.S.Mon 18" deep Marked as shown

COUNTY SURVEYORS INTER. HATHAWAY & LOS COYOTES MONUMENT

L = 402.10 Δ=93°-16'-22" R=247'

Δ=68°-44'-56" R=62' T=42.41 L=74.39

HATHAWAY

COUNTY SURVEYORS CENTER LINE OF HATHAWAY MONUMENT

To 3/4" IP - 6 Ditmore FB 366-128

To bottom pg. 125

F.B. 481 Pg. 124

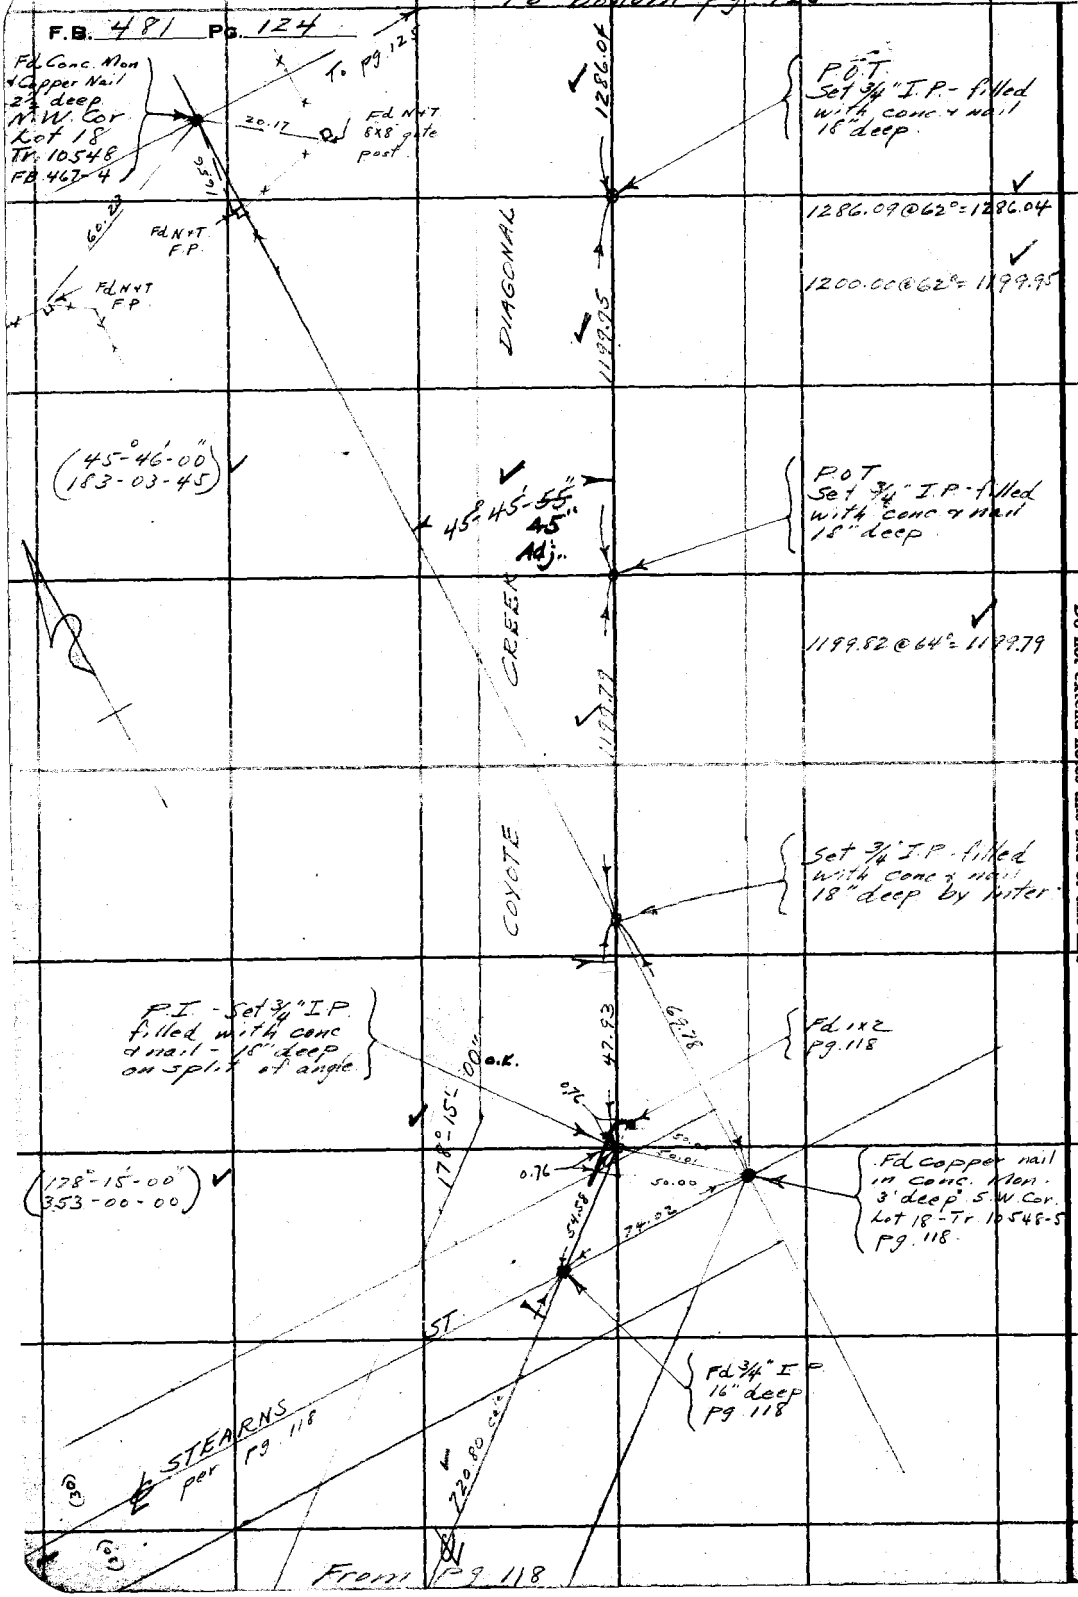

RETURN TO
LOS ANGELES COUNTY SURVEYOR
700 HALL OF RECORDS

Do not extend notes this side of this line

Note: ANY ADDITIONS OR CHANGES ON THIS SHEET MUST BE MADE OR CIRCLED IN Red Ink. WITH DATE AND NAME OF PERSON MAKING CHANGE.

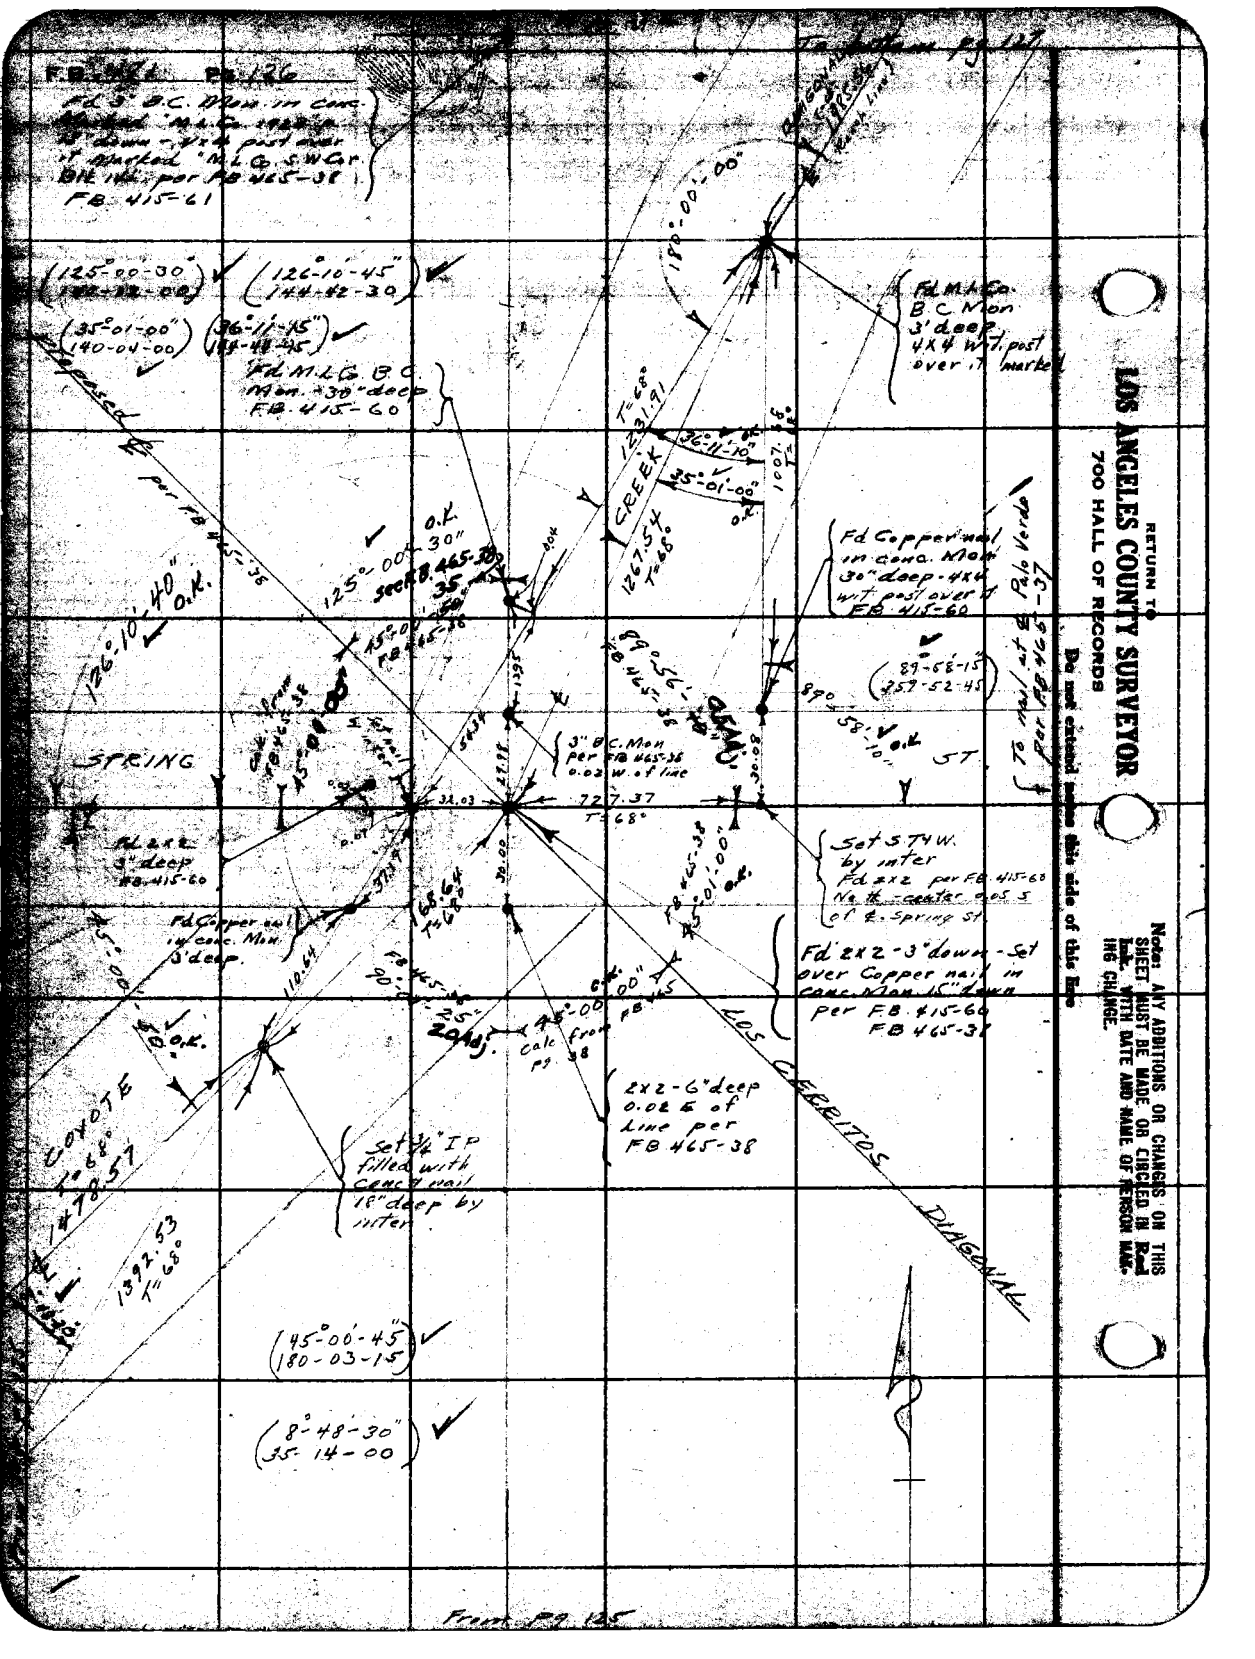
Fd 3" B.C. Mon in conc. Marked "M.L.Co. 1948" 0.2 down - X in post over it marked "M.L.Co. S.W.Cor." Bnd. Mon. per F.B. 465-38
F.B. 415-61
Transition see Pg. 127
Fd M.L.Co. B.C. Mon 3' deep 4X4 W.T. post over it marked
Fd M.L.Co. B.C. Mon. +38" deep F.B. 415-60
CREEK
Fd Copper nail in conc. Mon 30" deep - 4X4 W.T. post over it F.B. 415-60
Fd 3" B.C. Mon per F.B. 465-36 0.02 W. of line
STRING
Set nail & tin. 3" deep F.B. 415-60
Fd Copper nail in conc. Mon. 3' deep.
Set 5.74 W. by inter Fd 2x2 per F.B. 415-60 No. th. center 0.05 S. of E. Spring St.
Fd 2x2 - 3" down - Set over Copper nail in conc. Mon. 15" down per F.B. 415-60 F.B. 465-37
LOS CERRITOS
DIAGONAL
2x2 - 6" deep 0.02 E of Line per F.B. 465-38
Set 3/4" I.P. filled with Cenc'l nail 18" deep by inter.
Adj.
Calc from P9
Front P9 125
RETURN TO
LOS ANGELES COUNTY SURVEYOR
700 HALL OF RECORDS
Do not extend notes this side of this line
Notes: ANY ADDITIONS OR CHANGES ON THIS SHEET MUST BE MADE OR CIRCLED IN Red Ink WITH DATE AND NAME OF PERSON MAKING CHANGE.

Notes Ck'd by McPherson	Survey of Coyote Creek Diag	F.B. 484	Pg. 125
Map No. B-633	W. O. 995 Tape No. 033 St'd 68 °F.		
Office Work Rice	Surveyed by L D Moore		
Checked	Notes Moore Date 2-8-33		
Date	Indexed A. C. Johnson		

To bottom pg. 126

(115°-40-00" / 102-39-30) ✓

236.54 @ 60° = 236.53 ✓

968.79 @ 62° = 968.75 ✓

SPRING ST. to pg 124

Fd 2 x 2 - over C S Mon per F.B. 445-59 F.B. 445-39

DIAGONAL

T=68°
1478.57

1392.53
T=78°

Fd Conc. Mon. N Copper nail - 30" deep F.B. 445-60

(106°-51'-30" / 67-25-30)

Fd Copper nail in Conc. Mon - 2½ deep S.E. Cor. Lot 20 T. 10548 F.B. 467-38

Fd NYT - F.P.

106°-51'-25" O.K.

115°-30'-55" O.K.

236.53

Set ¾" I.P. filled with Conc. and nail - 18" deep by tinner

Fd NYT F.P.

32.30

89.42

Fd NYT - F.P.

(45°-00'-00" / 180-00-00) ✓

COYOTE CREEK

Set ¾" I.P. filled with Conc. & nail - 18" deep

(45°-00'-15" / 180-01-15) ✓

45°-00'

45°-00'-00" / 44°-59'-55" Adj. ✓

30.00 / 30.14 Adj.

Fd Conc. Mon. Copper nail 4" deep F.B. 445-59

1117.34 @ 62° = 1117.30 ✓

1117.30

13.26

35.40

Fd Copper nail in Conc. Mon. 2½ deep T. 10548 F.B. 467-4

(89°-59'-45" / 359-58-45) ✓

89°-59'-15" O.K.

89°-59'-40"

35 Adj. O.K.

(89°-59'-15" / 359-57-00) ✓

Fd Copper Nail in Conc. Mon. 2½ deep

44°-15'-00" / 44°-15'-00" Adj. ✓

45°-45'-45" / 45 Adj.

(44°-15'-00" / 177-00-30) ✓

(45°-45'-45" / 183-02-30) ✓

1286.04

Set NYT F.P.

34.97

19.89

Set ¾" Conc. 12"x12" Bound

Fd NYT F.P.

From pg. 124

From top pg. 124

RETURN TO
LOS ANGELES COUNTY SURVEYOR
700 HALL OF RECORDS

Note: ANY ADDITIONS OR CHANGES ON THIS SHEET MUST BE MADE OR CIRCLED IN Red Ink, WITH DATE AND NAME OF PERSON MAKING CHANGE.

Do not extend notes this side of this line

FORM 247 10M 8-31

Notes Ck'd by MSA
Map No. 8-623
Office Work Rice
Checked
Date

Survey of Coyote Diag
W. O. 995 Page No. 025 21'd 68 of
Surveyed by L. D. Moore
Notes Moore Date 3-13-53
Indexed A. C. Johnson

F.B. 481 Pg. 22

Note: ANY ADDITIONS OR CHANGES OF THIS SHEET MUST BE MADE OR CIRCLED IN Red Ink, WITH DATE AND NAME OF PERSON MAKING CHANGE.

Do not extend notes this side of this line

RETURN TO
LOS ANGELES COUNTY SURVEYOR
700 HALL OF RECORDS

FORM 847 10M 8-51

Set Punch Mark in edge of Bronze Cap by inter

Fd. City of Long Beach Mon. 1855 Bronze Cap 4" x mark in Top - 3' deep. - Tr. 9265 in conc.

Fd. M.L.Co. B.C. Mon. in conc. 3' deep Tr 9265

(36-09-15) 144-37-15

(126°-26-15") 145-45-30

(53-34-00) 214-16-05

Fd City of Long Beach B.C. Mon. in conc. - 3' deep - 4x4 post set over it Marked

Fd City of Long Beach Mon. 1852 B.C. in Conc. 3' deep Tr 9265

CITY OF LONG BEACH

COYOTE CREEK

DIAGONAL

126°-26'-20"

53°-34'-00"

T=68° 710.40

T=68° 571.66

Fd 2" IP + Copper spk in conc. - 3' deep Tr 9265

(90°-16'-45") 361-06-30

90°-16'-42"

Set 6d nail in 4x4 by inter

Fd City of Long Beach B.C. Mon. in Conc. 3' deep 4x4 4'x4' set flush over it

(126°-13'-00") 144-52-00

126°-13'-00"

53°-46' O.K.

T=68° 545.41

Fd. Conc. Mon + Pk. in 2" IP 3' deep - 4x4 H.T. post set over it Marked "N. Line Sec. 23 and Ranch Line"

740.89 T=68°

(53°-46'-30") (215-06-00)

T=68° 1441.50

(90°-04'-15") 360-16-30

90°-04'-10" O.K.

19.01

Fd N+T P.P.

44.07 O.K.

Fd Conc. Mon. + Spk - 3' deep.

Fd 4"T in conc. Mon. City of Long Beach 1854

T=68° 1885.56

0.89

0.26

Fd. M.L.Co. B.C. Mon 3' deep. - 4x4 H.T. Post Set over it Marked "S. Line Blk and E. Grant Line"

From Tie Pg. 126

F.B. 481 PG 128

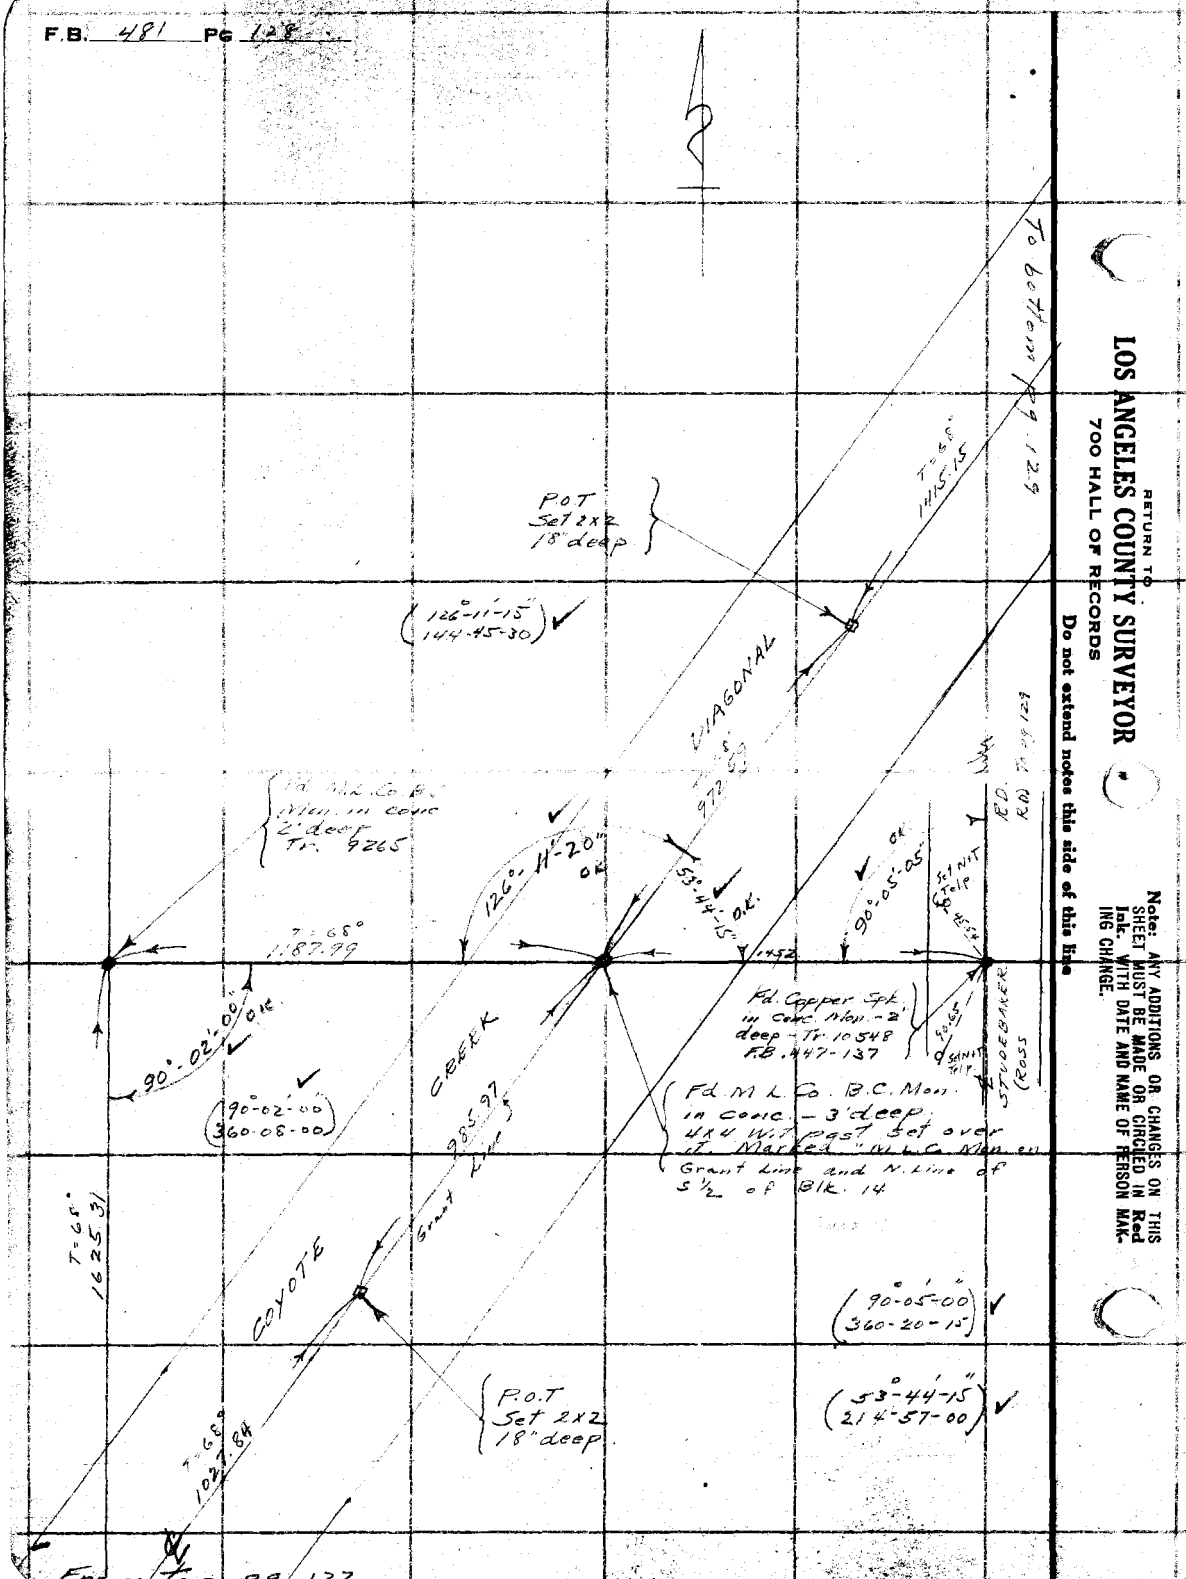
RETURN TO
LOS ANGELES COUNTY SURVEYOR
700 HALL OF RECORDS
Do not extend notes this side of this line
Note: ANY ADDITIONS OR CHANGES ON THIS SHEET MUST BE MADE OR CIRCLED IN Red Ink. WITH DATE AND NAME OF PERSON MAKING CHANGE.
T=65°
1115.15
P.O.T Set 2x2 18" deep
(126°-11'-15")
(144-45-30)
DIAGONAL
972.69
E.D. R.W. P.B. 128
Fd. M.L.Co. B.C. Mon. in conc. 2' deep Tr. 9265
126°-11'-20" OK
53°-44'-15" O.K.
90°-05'-05" OK
S.I. NIT Tr. Tr.
1452
T=65°
1187.99
90°-02'-00" OK
(90°-02'-00")
(360-08-00)
CREEK
985.97
Grant Line
Fd. Copper Spk. in conc. Mon. - 2' deep - Tr. 10548 F.B. 447-137
S.I. NIT Tr. Tr.
STUDEBAKER (ROSS
Fd M.L.Co. B.C. Mon. in conc. - 3' deep 4"x4" wit past set over it Marked "M.L.Co. Mon." on Grant Line and N. Line of S 1/2 of Blk. 14
T=65°
1625.31
COYOTE
Grant Line
(90°-05'-00")
(360-20-15")
(53°-44'-15")
(214-57-00")
P.O.T Set 2x2 18" deep
T=65°
1037.84
From Top P9 127

Notes Ck'd by MS Thurman
Map No. B-633
Office Work Rice
Checked
Date

Survey of Coyote Diag
W. O. 295 Tape No. 025 Sht 4 of 6 Sh.
Surveyed by L. D. Moore
Notes Moore Date 3-16-33
Indexed A. C. Johnson

F. B. 448 Pg. 128

Fd NAT. PT. ℄

CARSON ℄

Fd NAT. Tp. "O"

Fd. L.A.T. on granite rock 2' deep F.B. 447-128

T = 68° 382.18 ST To Pg 130

Fd NAT. Tp.

"O" To bottom pg. 130

(S 89°-59'-00" E 59-56-00)

727.15 per F.B. 447-128 ROAD (Bend)

S 89° 59' 00" E DIAGONAL 437.58 calc.

Set 3x12" 2' deep by meter

671.44 Prod.

Δ = 2°-33'-30"
R = 2000
L = 89.30
T = 44.66

E.C. Set 2x2 12" deep

(177°-26'-30" 349-46-00)

177°-26'-30" O.K.

Set 1x2 by meter

Fd 1x2 F.B. 448-43

32.27

Ranch

29.11

38

CREEK

63.05

S 53°-56'-15" E 146.03 O.K.

Line

Set 1x2 by meter

(106°-22'-30" 287-31-00)

(75°-38'-00" 302-34-00)

B.C. Set 2x2 12" deep

Fd. M.L.C. B.C. Mon. 2' deep & 4x4 wit. post over it.

1606

13.

S 70°-44'-15" E 282-57-00 Calc

#4-Fd 1/2" F.B. 448-44

Fd 4x4 wit. post 4 n.o.i Set over M.L.Co. B.C. Mon. F.B. 448-43 F.B. 447-128

COYOTE

1415.15

Grant Line

From top Pg 128

Fd Copper Spk. in Conc. plug - 3 deep 4x4 wit. post 1 n.o.i over ℄ Common Cor Co. Los Coyotes & Los Coyotes Rancho F.B. 446-43, 250

FT

STUDEBAKER

(EOSS

(20)

(20)

(70°-44'-15" 282-57-00)

From Pg 128

Note: ANY ADDITIONS OR CHANGES ON THIS SHEET MUST BE MADE OR CIRCLED IN Red Ink WITH DATE AND NAME OF PERSON MAKING CHANGE.

Do not extend notes this side of this line

RETURN TO
LOS ANGELES COUNTY SURVEYOR
700 HALL OF RECORDS

FORM 847 10M 8-31

F.B. 461 Pg 130

To bottom pg 131

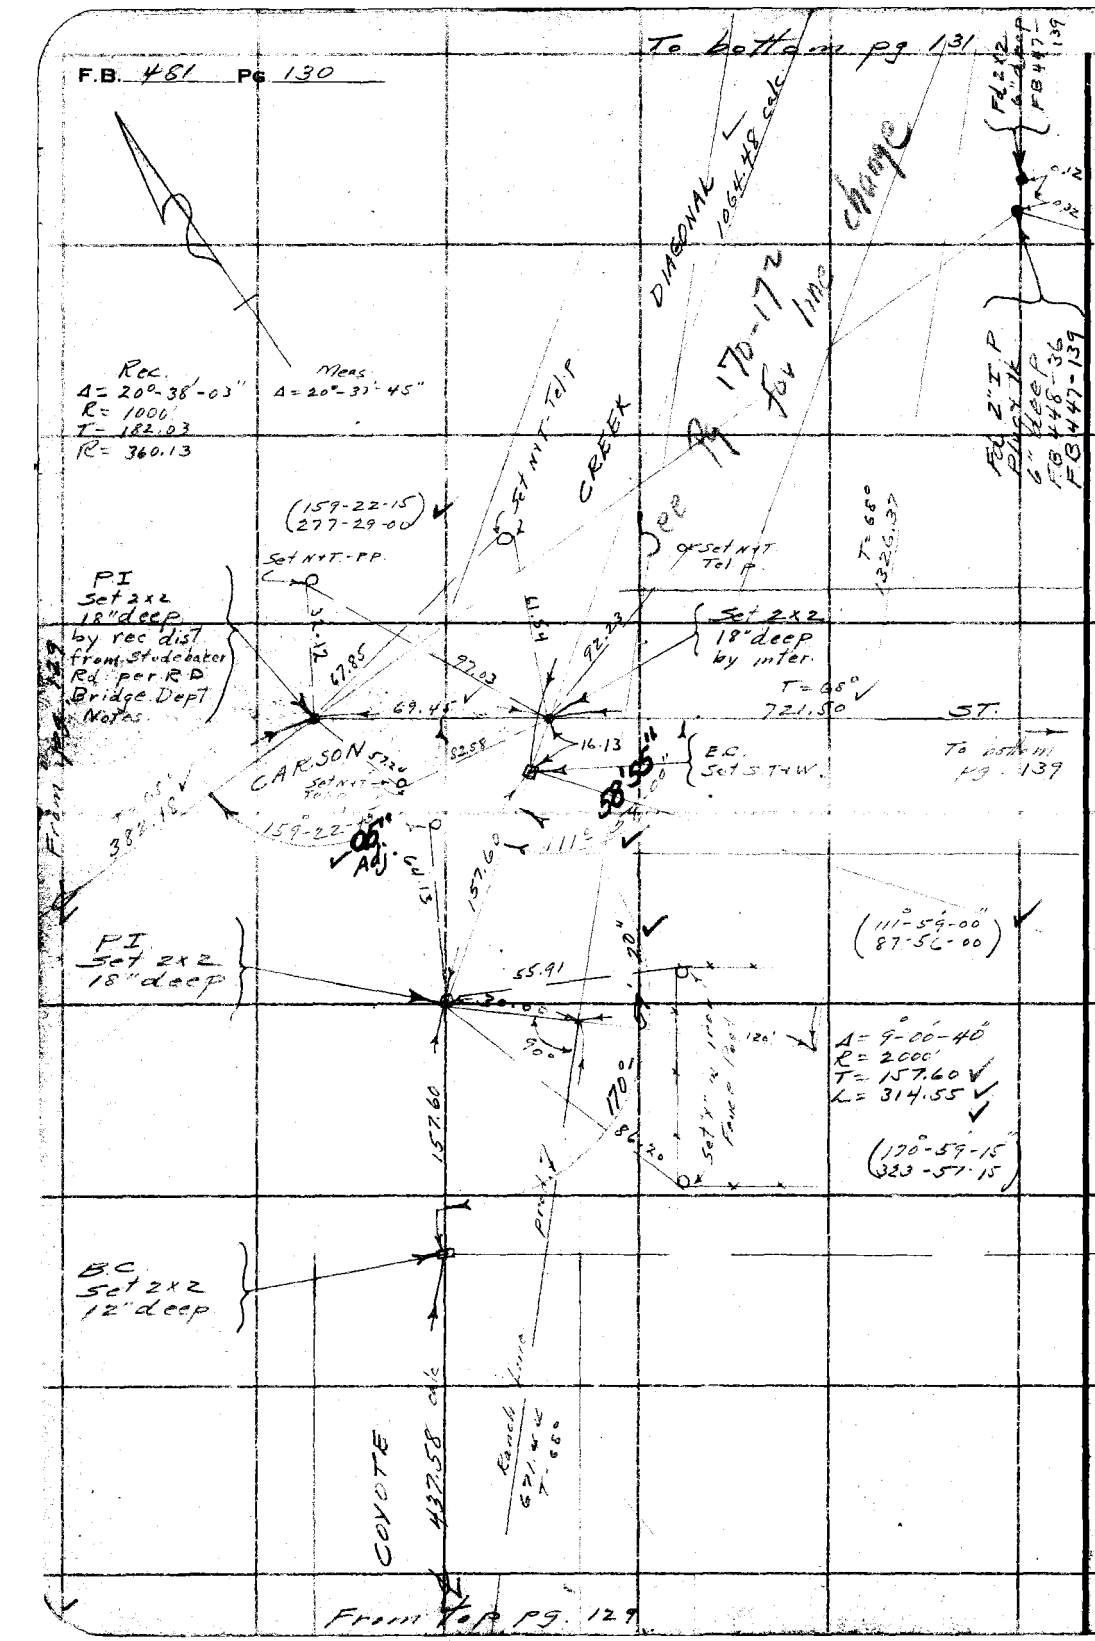

RETURN TO
LOS ANGELES COUNTY SURVEYOR
700 HALL OF RECORDS
Do not extend notes this side of this line

Note: ANY ADDITIONS OR CHANGES ON THIS SHEET MUST BE MADE OR CIRCLED IN Red Ink. WITH DATE AND NAME OF PERSON MAKING CHANGE.

Notes Ck'd by McPherson
Map No. B-633
Office Work Rice
Checked
Date

Survey of Coyote Diag
W. O. 995 Tape No. 025 St'd [illegible]
Surveyed by L.D. Moore
Notes Moore Date 3-24-61
Indexed C. Johnson



























RETURN TO
LOS ANGELES COUNTY SURVEYOR
700 HALL OF RECORDS

Do not extend notes this side of this line

Note: ANY ADDITIONS OR CHANGES ON THIS SHEET MUST BE MADE OR CIRCLED IN Red Ink. WITH DATE AND NAME OF PERSON MAKING CHANGE.

FORM 847 10M 8-61

F.B. 4161 Pg 132

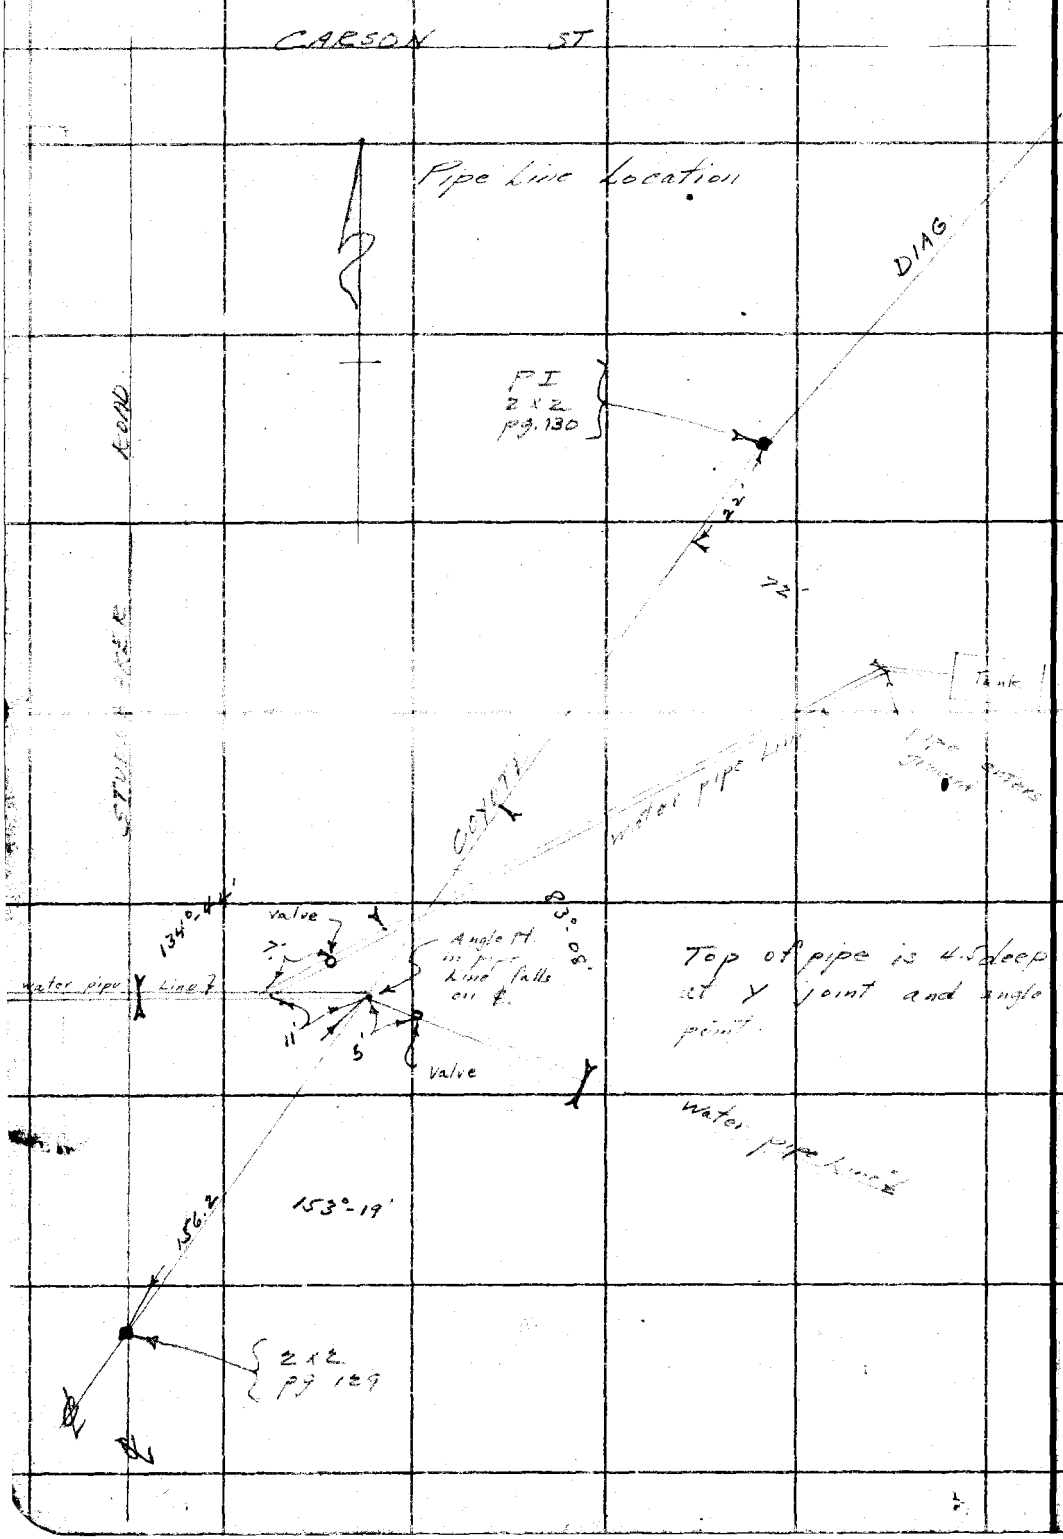

RETURN TO
LOS ANGELES COUNTY SURVEYOR
700 HALL OF RECORDS

Do not extend notes this side of this line

Note: ANY ADDITIONS OR CHANGES ON THIS SHEET MUST BE MADE OR CIRCLED IN Red Ink. WITH DATE AND NAME OF PERSON MAKING CHANGE.

Notes Ck'd by McPherson
Map No. B-633
Office Work Rice
Checked Drew
Date Nov. 1936

Survey of Coyote Diag.
W. O. 995 Tape No. 025 St'd 68 °F.
Surveyed by L D Moore
Notes Moore Date 3-30-33
Indexed L. C. Johnson

F.B. 481 Pg. 133

To bottom pg. 134

(46°-29-30"
185-58-00)

Sta. #25
Fd 4"x4"-3' high
Y & T. - Set over
M.L. Co. Mon. per
F.B. 468-31

198.90
F.B. 468-31

T=66°
660.30

46°-29-30"
25" Adj.

Set 2x2
18" deep
by inter

31.82

Sta.
Fd
Y & T.
M.L. C
F.B. 468-31

55°-20'-00"
25" Adj.

S 70.33

(55°-20-00"
221-20-00)

SAN GABRIEL

Set 2x2
18" deep
by inter

CREEK

1298.95

216.68
T=60°

Fd 2x2
6" deep
F.B. 468-14

52.20

P.O.T.
Set 2x2
12" deep
Top of bank

P.I. 4
4x4
F.B. 468-14

COYOTE

T=68°
284.31

P.O.T.
Set 2x2
12" deep
Top of bank

RIVER

100.00 @ 44°@ 6'-2.5" = 99.37
30.58 @ 68°@level = 30.58
1295

Front to pg. 131

Note: ANY ADDITIONS OR CHANGES OF ANY KIND MADE ON THIS SHEET AFTER IT HAS BEEN FILED WILL INVALIDATE THE MAP OR SURVEY UNLESS SUCH ADDITIONS OR CHANGES ARE SURVEYED AND MAPPED AS REQUIRED BY LAW.

RETURN TO
LOS ANGELES COUNTY SURVEYOR
700 HALL OF RECORDS
Do not upload notes this side of this line

FORM 247 10M 8-31

RETURN TO
LOS ANGELES COUNTY SURVEYOR
700 HALL OF RECORDS

Note: ANY ADDITIONS OR CHANGES ON THIS SHEET MUST BE MADE OR CIRCLED IN Red Ink. WITH DATE AND NAME OF PERSON MAKING CHANGE.

Do not extend notes this side of this line

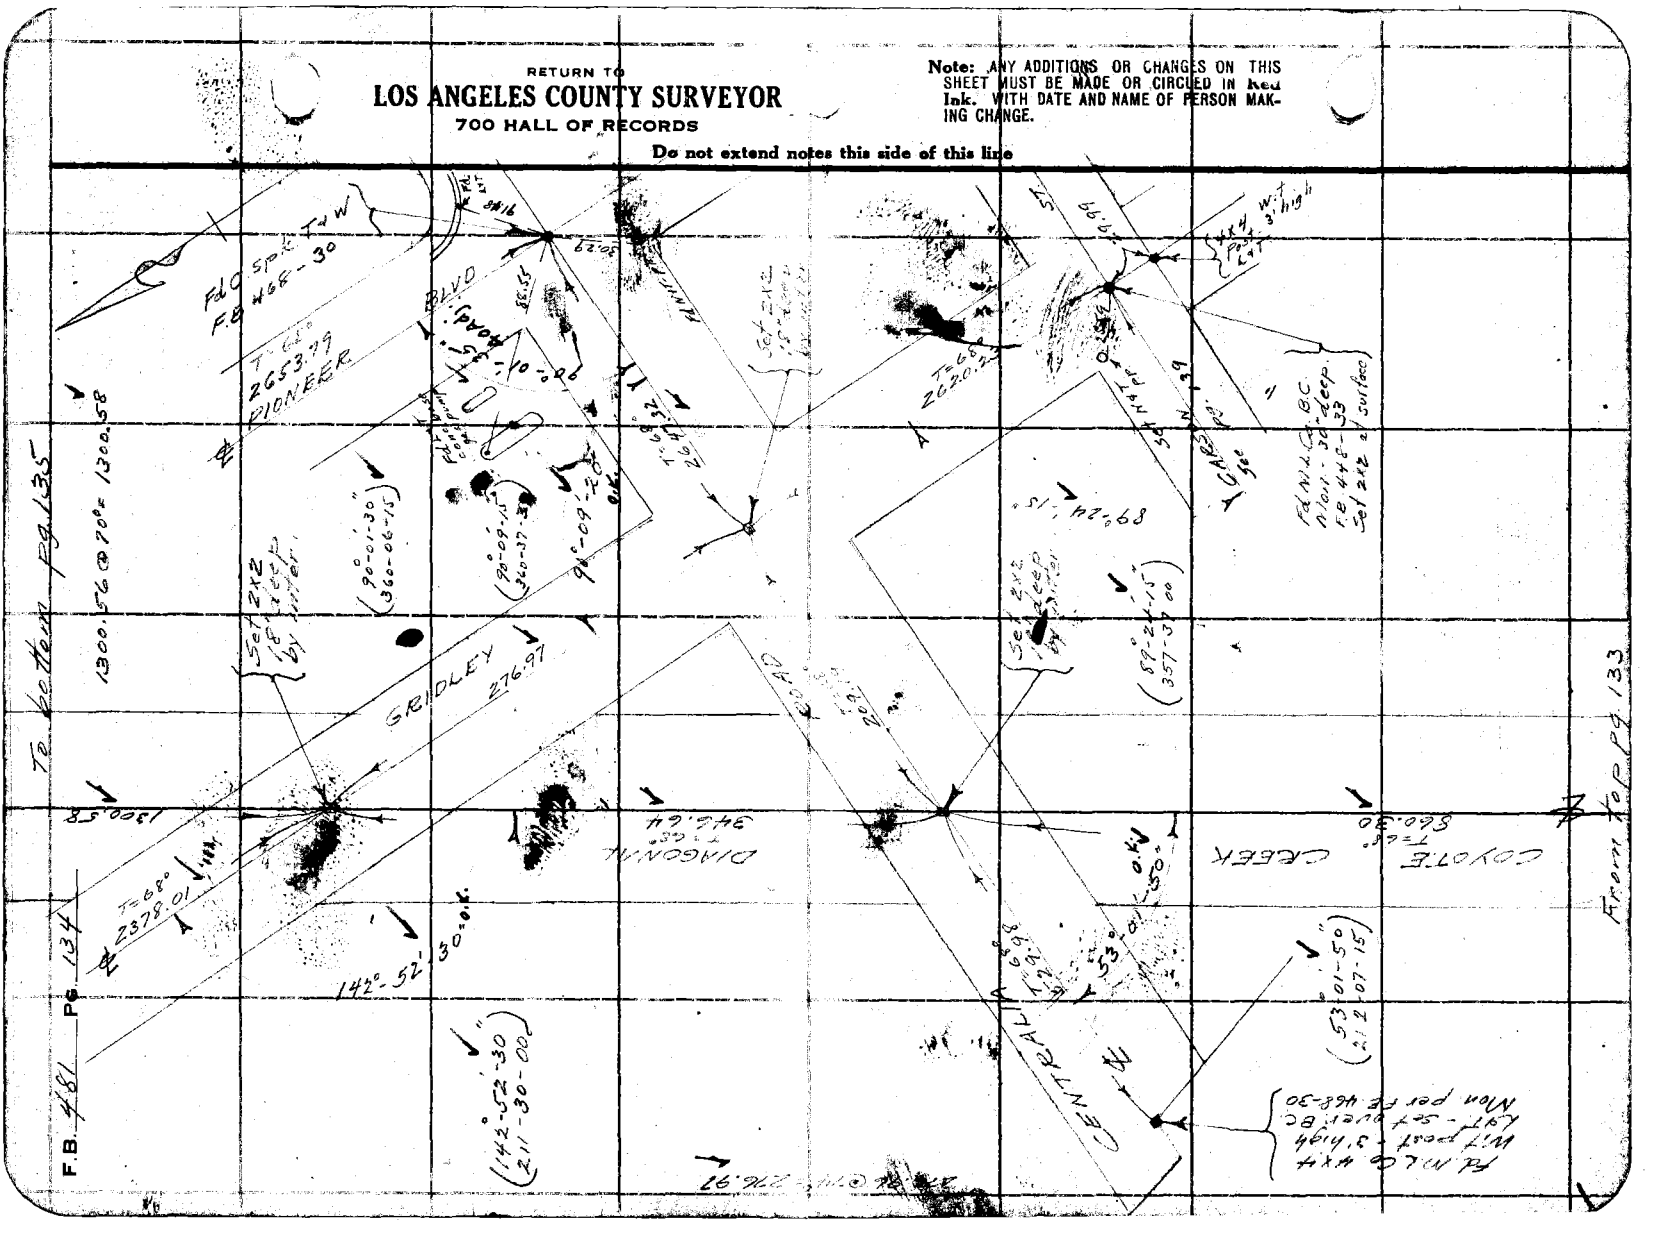

Notes Ck'd by Mc Kinnon
Map No. B-633
Units Work Rice
Checked Drew
Date NOV. 1936

Survey of Coyote Diag.
W. O. 995 Tape No. 225 St'd 68 °F.
Surveyed by E. D. Moore
Notes Moore Date 3-31-37
Indexed A. C. Johnson

F.B. 448 Pg.

To bottom pg. 136

Set S.T+W by inter

Set 1x2

Set N.T.P.P.

Set N.T. P.P.

Set N.T. P.P.

PIONEER

T=45

1146.98

30' offset Line

COYOTE CREEK DIAGONAL

1434.89 @ 64° = 1434.86

1512.56 @ 64° = 1512.52

(36-56-45)
(147-43-15)

(90-00-00)
(360-00-00)

(53-03-30)
(212-14-15)

Fd N+T Top P.P.

Fd N+T Tel P

Fd 2x2 + T.C. 10d nail - 0.07 N FB 448-10

Set N+T P.P.

ANAHEIM Set 1x2

1795.76 T=68°

Set 2x2 18" deep by inter

1674.43 @ 70° = 1674.45

(90-00-00)
(360-00-00)

POT Set 2x2 18" deep

(89-48-45)
(359-11-30)

GRIDLEY

T=45°
2378.01

From top pg. 134

RETURN TO
LOS ANGELES COUNTY SURVEYOR
700 HALL OF RECORDS

Note: ANY ADDITIONS OR CHANGES OF THIS SHEET MUST BE MADE ON CIRCLED IN Red Ink. WITH DATE AND NAME OF PERSON MAKING CHANGE.

Do not extend notes this side of this line

FORM 247 10M 5-31

F.B. 481 PG. 136

To bottom pg. 137

568.53
Rechained.
HE 9/4/35

DIAGONAL

B.C. - 3114 76.89
Set 2x2 - 18" dn.
HE 9/4/35

Set 2x2
18" deep
by jutter
309+87.13

189.76

Fd 2x2
12" deep
FB 331-55
FB 446-173

Fd NYT PP

Proposed ℄

CENTURY BLVD.
883.84
T=66°

119.07

Fd 2x2 - 18" deep
FB 331-55
FB 446-172

CREEK
T=65°
Calc.

(89°-53-45)
(359-35-00)

Set NYT PP

1106.50

125.00

Set 2x2
18" deep
by jutter

LINCOLN
1131.90
T=65°

Fd STW
& Plug

Set NYT PP

P.O.T.
Set 2x2
18" deep

COYOTE
T=65°
Calc.

(53°-00-15")
212-01-00)

PIONEER BLVD

Fd STW

Fd STW
FB 446-171

P.O.T.
Set 2x2
15" deep

(90°-03-45")
(360-15-15)

Set 1x2

From top pg. 135

RETURN TO
LOS ANGELES COUNTY SURVEYOR
700 HALL OF RECORDS

Do not extend notes this side of this line

Note: ANY ADDITIONS OR CHANGES ON THIS SHEET MUST BE MADE OR CIRCLED IN Red Ink. WITH DATE AND NAME OF PERSON MAKING CHANGE.

Notes Ck'd by MS Pherson	Survey of Coyote Diag
Map No. B-623	W. O. 995 Tape No. 019 St'd 68 °F.
Office Work Rice	Surveyed by L.D. Moore
Checked Drew	Notes Moore Date 5-2-33
Date Nov. 1936	Indexed A. C. Johnson

F.B. 481 PG. 137

RETURN TO
LOS ANGELES COUNTY SURVEYOR
700 HALL OF RECORDS

Note: ANY ADDITIONS OR CHANGES OF THIS SHEET MUST BE MADE OR CIRCLED IN Red Ink. WITH DATE AND NAME OF PERSON MAKING CHANGE.

Do not extend notes this side of this line

FORM 247 10M 8-31

Orangethorpe Ave (First St.)

Old Edom Rd. 130'

Set 4"x4"x30" Adjusted 1936

Set Nail & Tag - 174

Set 2"x2" 18" deep

Set Nail & Tag

Set 2"x2" 18" deep

Set 2"x2" 18" deep

Set 2"x2" 18" deep

RETURN TO

LOS ANGELES COUNTY SURVEYOR

700 HALL OF RECORDS

Note: ANY ADDITIONS OR CHANGES ON THIS SHEET MUST BE MADE OR CIRCLED IN Red ink. WITH DATE AND NAME OF PERSON MAKING CHANGE.

Do not extend notes this side of this line

F.B. 481 Pg. 138

Notes Ck'd by	M.S. Pherson	Survey of	Coyote Diag
Map No.	B-633	W. O.	995 Tape No. 019 St'd 68 °F.
Office Work	Rice	Surveyed by	L. D. Moore
Checked	Drew	Notes	Moore Date 4-19-33
Date	Nov. 1936	Indexed	A. C. Johnson

F.B. 481 Pg. 139

Note: ANY ADDITIONS OR CHANGES ON THIS SHEET MUST BE MADE OR CIRCLED IN Red Ink, WITH DATE AND NAME OF PERSON MAKING CHANGE.

Do not extend notes this side of this line

RETURN TO
LOS ANGELES COUNTY SURVEYOR
700 HALL OF RECORDS

FORM 247 10M 8-31

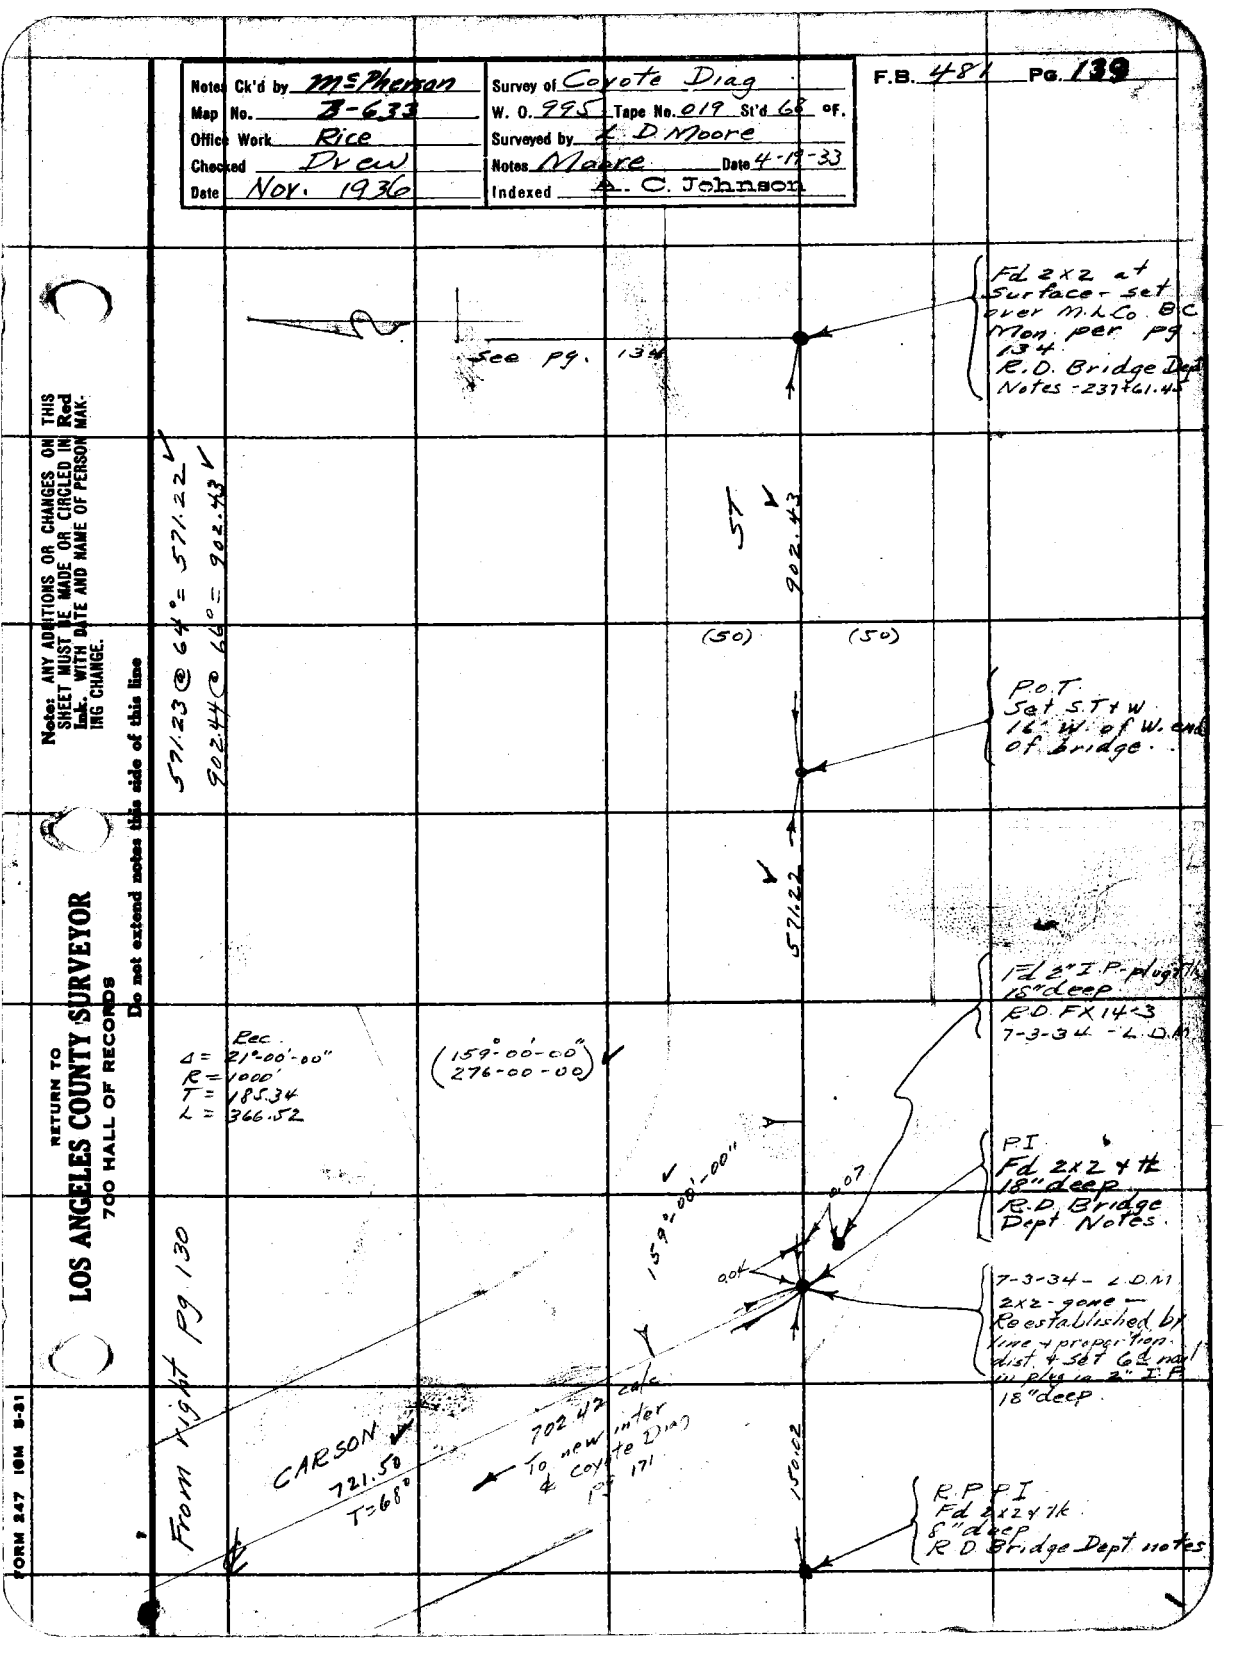

RETURN TO

LOS ANGELES COUNTY SURVEYOR

700 HALL OF RECORDS

Note: ANY ADDITIONS OR CHANGES ON THIS SHEET MUST BE MADE OR CIRCLED IN **Red Ink.** WITH DATE AND NAME OF PERSON MAKING CHANGE.

Do not extend notes this side of this line

F.B. 481 Pg. 140

Notes Ck'd by		Survey of Coyote Diag	F.B. 481 PG. 81
Map No.		W. O. 995 Tape No.	St'd °F.
Office Work		Surveyed by L D Moore	
Checked		Notes Moore	Date 4-25-33
Date		Indexed A. C. Johnson 4-26-33	

Note: ANY ADDITIONS OR CHANGES ON THIS SHEET MUST BE MADE OR CIRCLED IN Red Ink, WITH DATE AND NAME OF PERSON MAKING CHANGE.

Do not extend notes this side of this line

RETURN TO
LOS ANGELES COUNTY SURVEYOR
700 HALL OF RECORDS

TOPOGRAPHY
on
COYOTE DIAGONAL
from
HATHAWAY
to
W.O #1995

FORM 247 10M 5-31

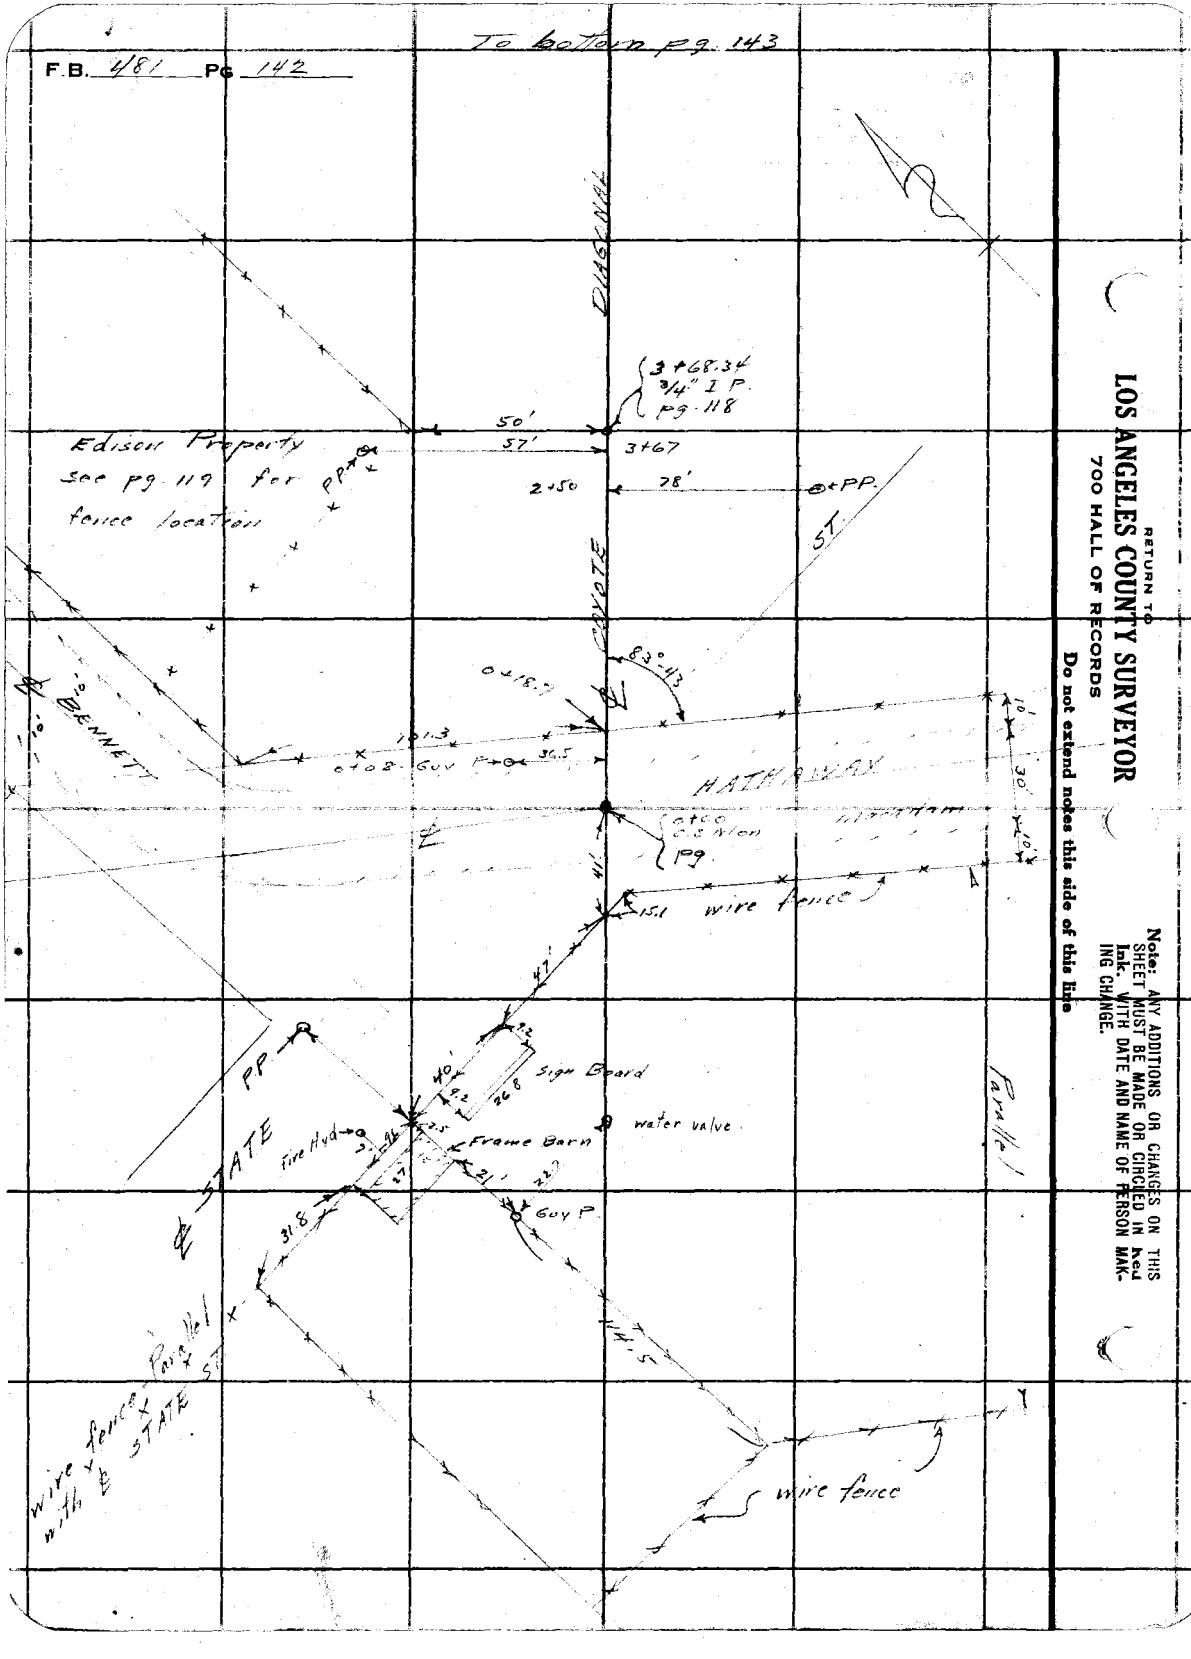
To bottom pg. 143
F.B. 481 Pg 142
DIAGONAL
3+68.34
3/4" I P.
pg. 118
50'
57'
3+67
Edison Property
see pg. 119 for pp
fence location
2+50
28'
℄PP.
ST.
83°-11'
0+18.9
BENNETT
101.3
0+02. Guy P
30.5
HATHAWAY
Gate
Corner
pg.
15.1 wire fence
47'
PP
Sign Board
40'
26.8
Fire Hyd
Frame Barn
water valve
STATE
Guy P
31.8
Parallel
wire fence with ℄ STATE
wire fence
RETURN TO
LOS ANGELES COUNTY SURVEYOR
700 HALL OF RECORDS
Do not extend notes this side of this line
Note: ANY ADDITIONS OR CHANGES ON THIS SHEET MUST BE MADE OR CIRCLED IN Red Ink. WITH DATE AND NAME OF PERSON MAKING CHANGE.

Notes Ck'd by	Survey of Coyote Diag
Map No.	W. O. 995 Tape No. St'd °F.
Office Work Rice	Surveyed by L.D. Moore
Checked	Notes Moore Date 4-25-53
Date	Indexed A. C. Johnson

F.B. 481 PG. 143

To bottom pg. 144

Note: ANY ADDITIONS OR CHANGES ON THIS SHEET MUST BE MADE OR CHCLED IN Red Ink WITH NATE AND NAME OF PERSON MAKING CHANGE.

Do not extend notes this side of this line

RETURN TO
LOS ANGELES COUNTY SURVEYOR
700 HALL OF RECORDS

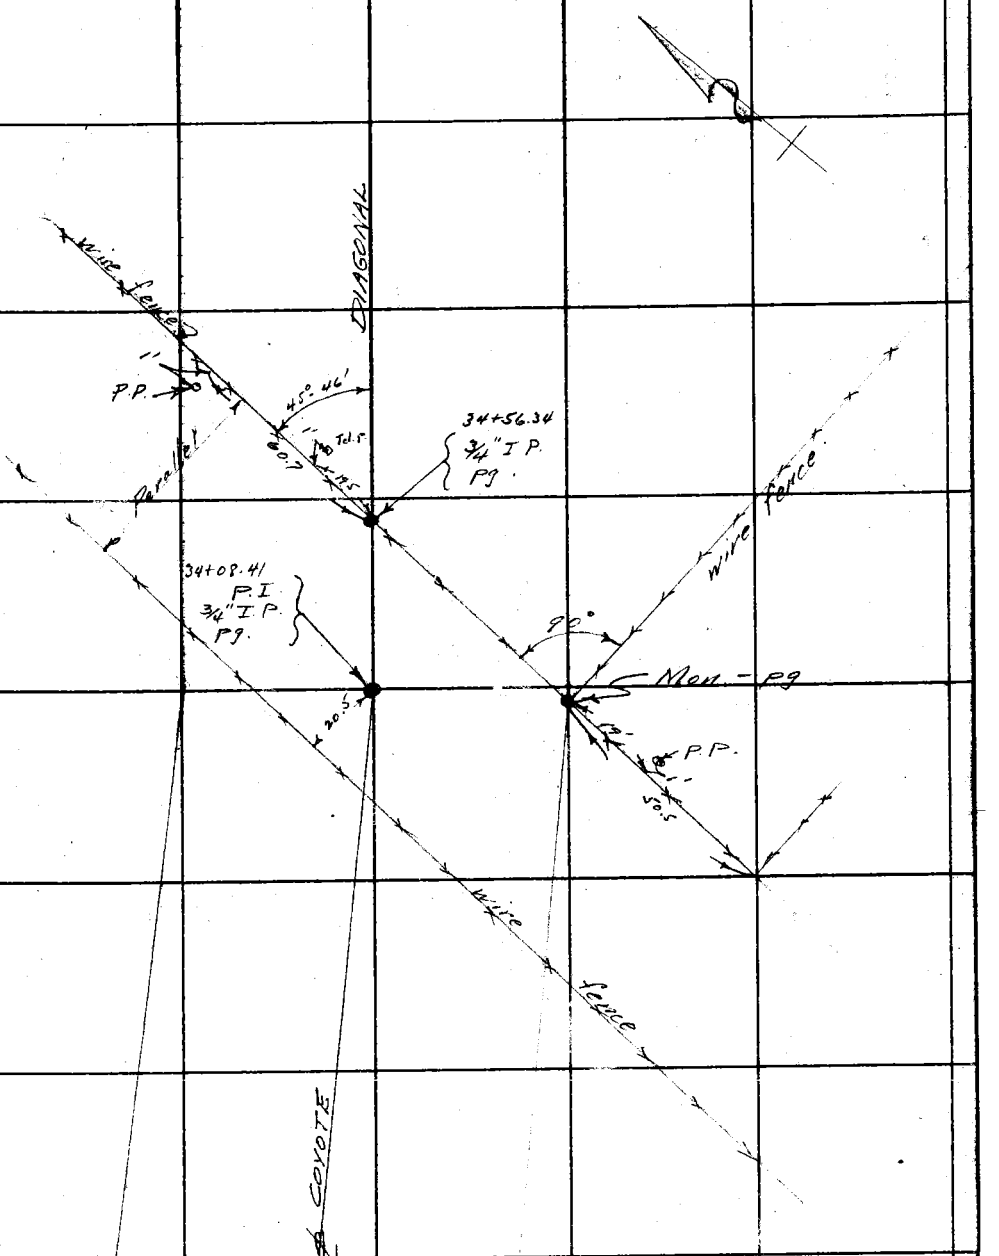

From top pg. 142

FORM 847 10M 5-51

To bottom pg 145

F.B. 481 PG. 144

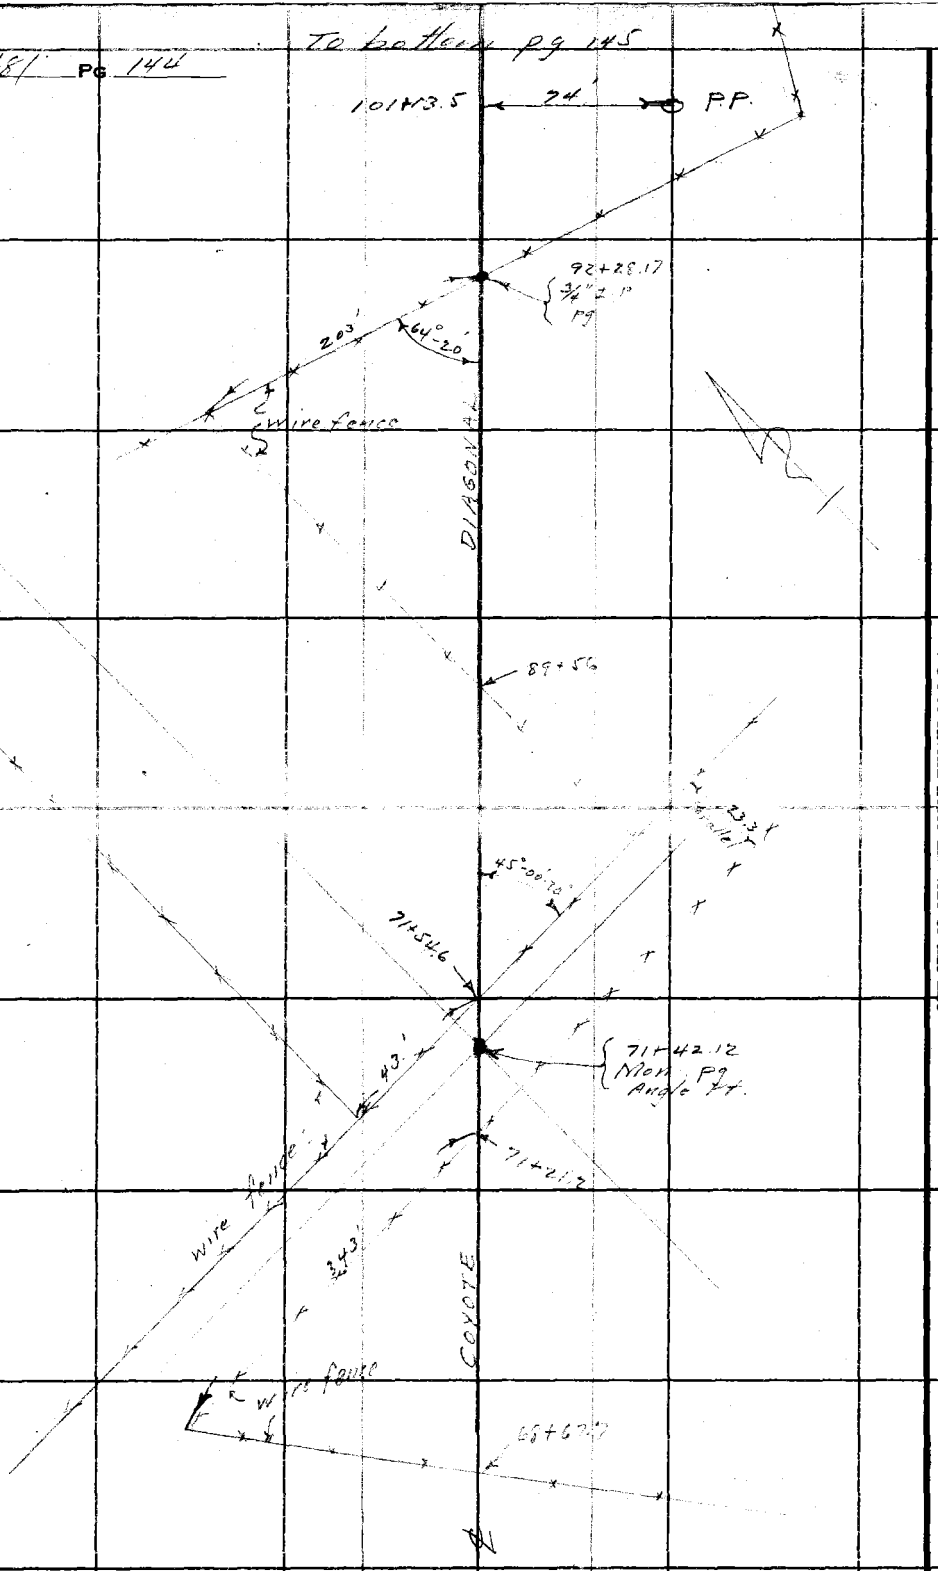

From top pg. 143

RETURN TO
LOS ANGELES COUNTY SURVEYOR
700 HALL OF RECORDS

Do not extend notes this side of this line

Note: ANY ADDITIONS OR CHANGES ON THIS SHEET MUST BE MADE OR CIRCLED IN Red Ink. WITH DATE AND NAME OF PERSON MAKING CHANGE.

Notes Ck'd by	Survey of Coyote Diag
Map No.	W. O. 995 Tape No. St'd °F.
Office Work Rice	Surveyed by L.D. Moore
Checked	Notes Moore Date 4-25-33
Date	Indexed A. C. Johnson

F.B. 481 Pg. 145

To bottom pg. 146

121+47.92 Mon. Pg.

DIAGONAL

ST.

Tel. P.

P.P.

26.4'

20'

11'

73.5'

50.2'

108+80.38 2x2 pg.

36'

21'

Tel P.

30'

13.5'

44.4'

8'

108'

45°

P.P.

35'

8.8'

10'

SPRING

Macadam

COYOTE

107+06.74 3/4" I P pg.

102+59.5 P.P.

60'

8°45'

From Top pg. 144

RETURN TO
LOS ANGELES COUNTY SURVEYOR
700 HALL OF RECORDS

Note: ANY ADDITIONS OR CHANGES OF THIS SHEET MUST BE MADE OR CIRCLED IN Red Ink. WITH DATE AND NAME OF PERSON MAKING CHANGE.

Do not extend notes this side of this line

FORM 847 10M 5-31

To bottom Pg 147

F.B. 481 Pg. 146

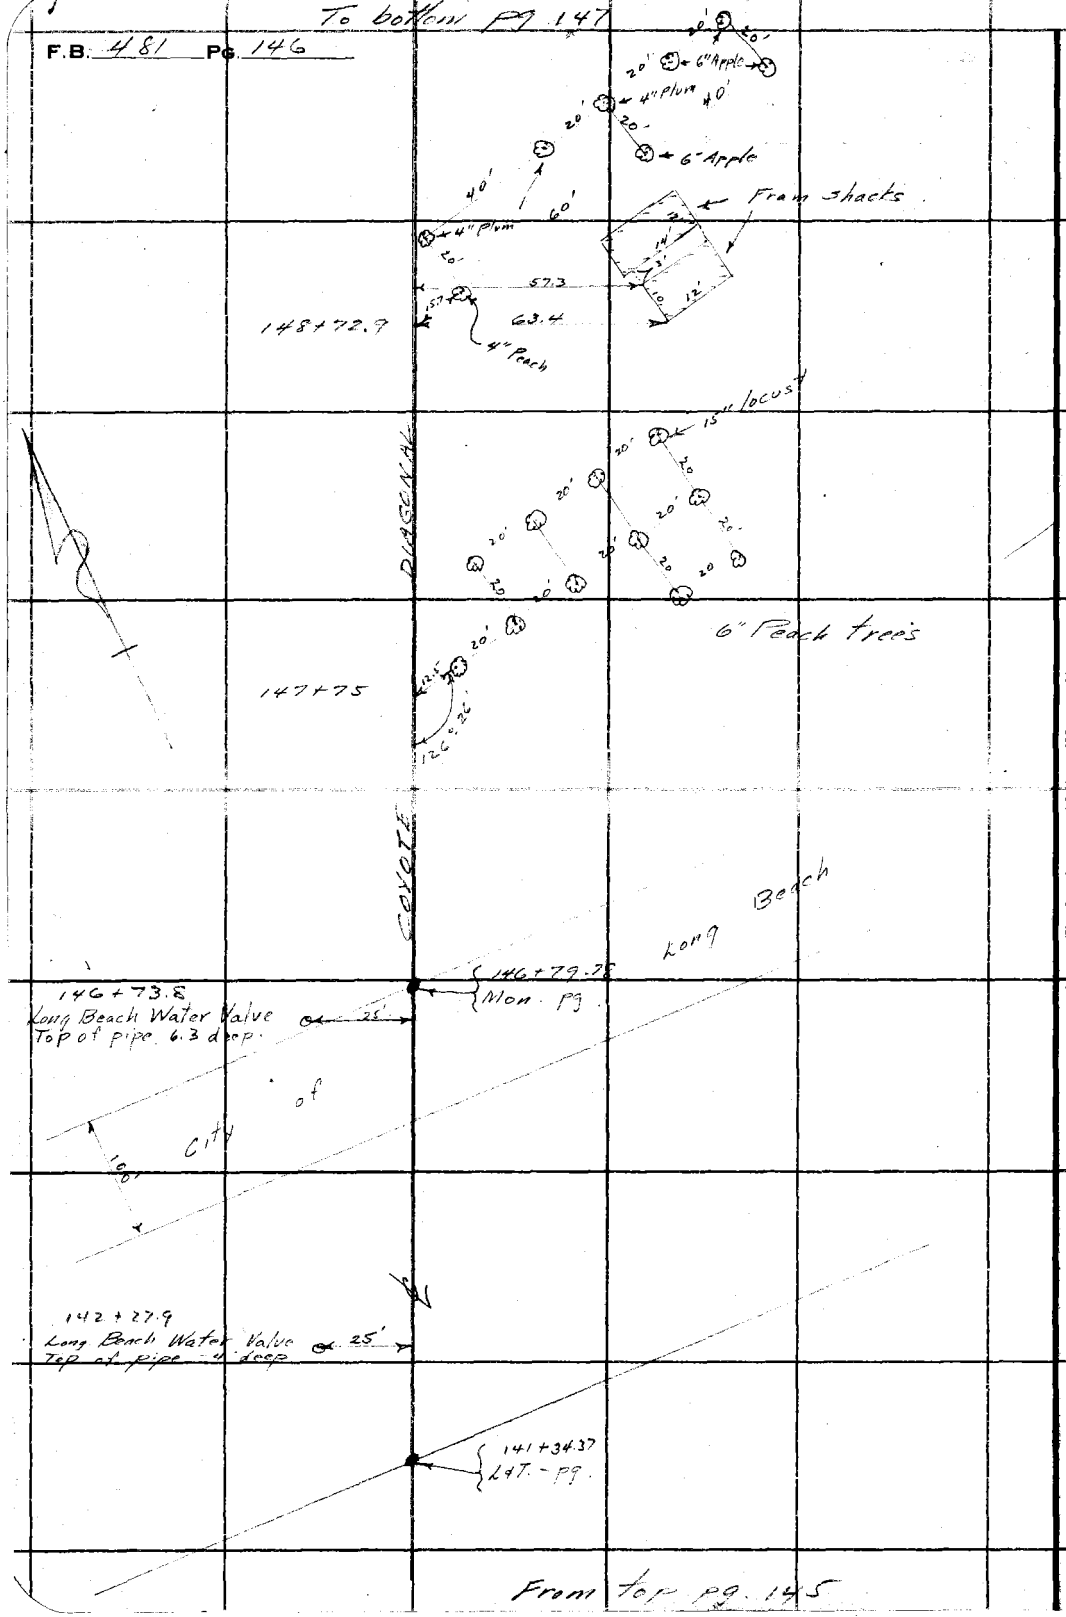

From Top Pg. 145

RETURN TO
LOS ANGELES COUNTY SURVEYOR
700 HALL OF RECORDS

Do not extend notes this side of this line

Note: ANY ADDITIONS OR CHANGES ON THIS SHEET MUST BE MADE OR CIRCLED IN Red Ink. WITH DATE AND NAME OF PERSON MAKING CHANGE.

Notes Ck'd by	Survey of Coyote Diag
Map No.	W. O. 995 Tape No. St'd °F.
Office Work Rice	Surveyed by E. D. Moore
Checked	Notes Moore Date 4-25-33
Date	Indexed A. C. Johnson

F.B. 461 PG. 147

To bottom pg. 148

153+90.18
Punch Mark on Mon. Pg.

153+70.7
Long Beach Water Valve
Top 4" Pipe
7' deep

20.5

DIAGONAL

COYOTE

Apples

10" 6" Apples

3/4" water well - see FB 445 -

4" Pipe

steel windmill

4-6" Apples

149+97

4" Pipe

Elevated Wood Water tank. 10' dia
See F.B. 448 -

149+18

From top pg. 140

Note: ANY ADDITIONS OR CHANGES ON THIS SHEET MUST BE MADE OR CIRCLED IN Red Ink. WITH DATE AND NAME OF PERSON MAKING CHANGE.

RETURN TO
LOS ANGELES COUNTY SURVEYOR
720 HALL OF RECORDS

Do not extend notes this side of this line

FORM 247 10M 5-31

F.B. 481 Pg 148

To bottom pg 149

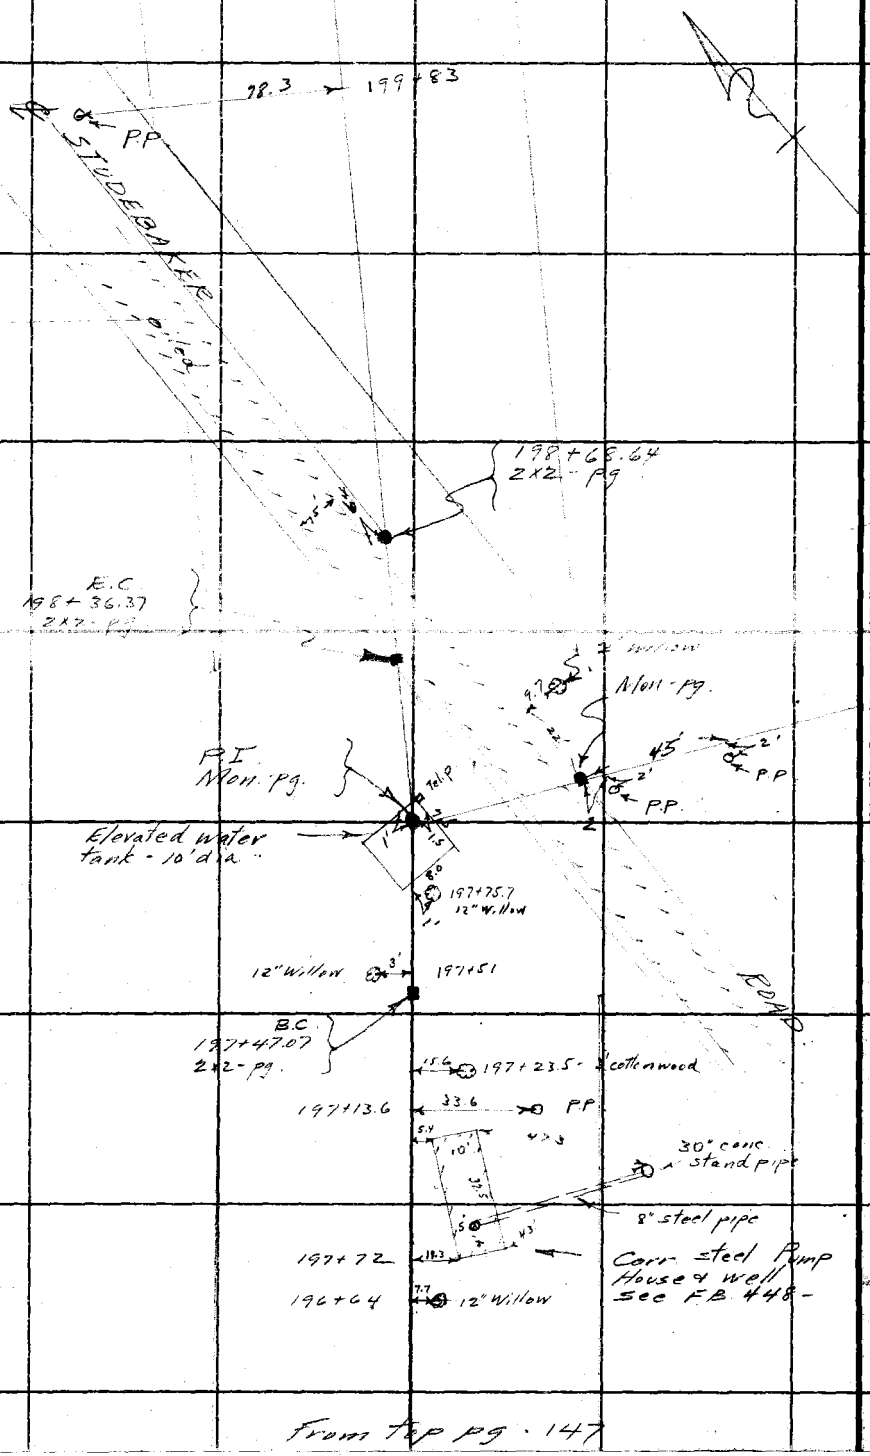

From top pg. 147

RETURN TO
LOS ANGELES COUNTY SURVEYOR
700 HALL OF RECORDS

Do not extend notes this side of this line

Note: ANY ADDITIONS OR CHANGES ON THIS SHEET MUST BE MADE OR CIRCLED IN Ink WITH DATE AND NAME OF PERSON MAKING CHANGE.

Notes Ck'd by	Survey of Coyote Diag
Map No.	W. O. 295 Tape No. St'd °F.
Office Work Rice	Surveyed by L. D. Moore
Checked	Notes Moore Date 4-25-33
Date	Indexed A. C. Johnson

F.B. 484 PG. 149

Note: ANY ADDITIONS OR CHANGES OF THIS SHEET MUST BE MADE OR CIRCLED IN Red Ink. WITH DATE AND NAME OF PERSON MAKING CHANGE.

RETURN TO
LOS ANGELES COUNTY SURVEYOR
700 HALL OF RECORDS
Do not extend notes this side of this line

FORM 847 10M 5-31

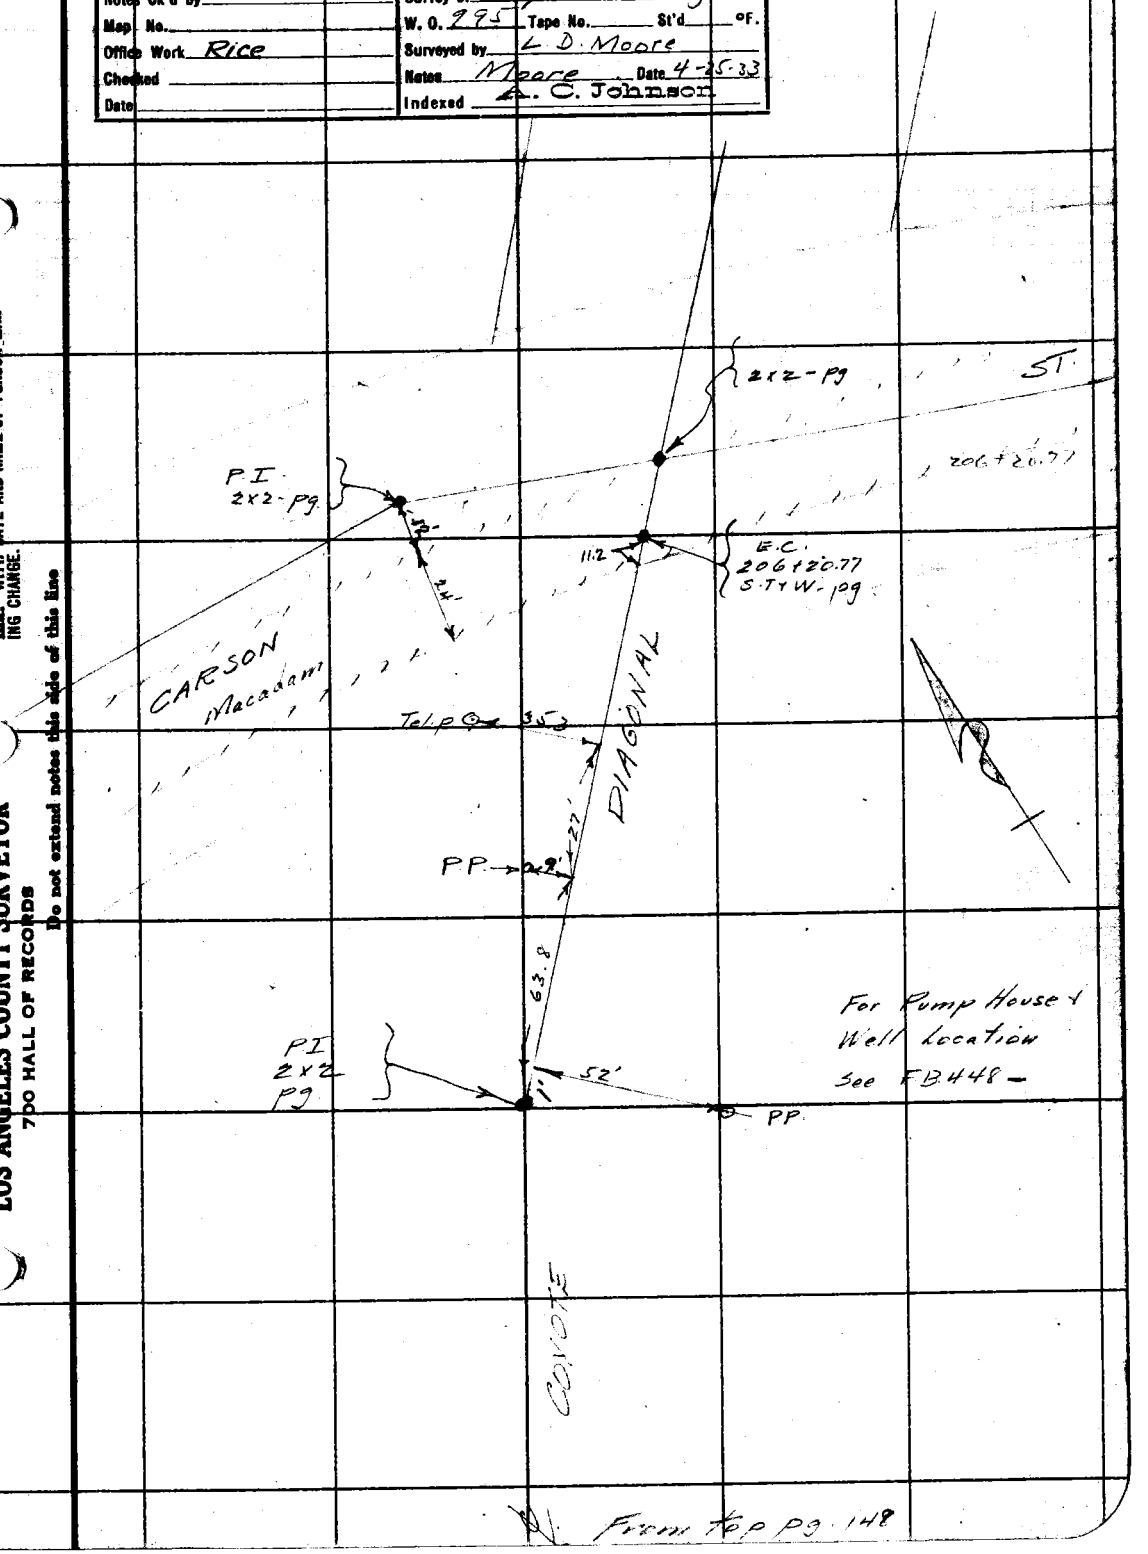

For Pump House & Well Location See FB 448—

From Top Pg. 148

RETURN TO

LOS ANGELES COUNTY SURVEYOR

700 HALL OF RECORDS

Note: ANY ADDITIONS OR CHANGES ON THIS SHEET MUST BE MADE OR CIRCLED IN Red Ink. WITH DATE AND NAME OF PERSON MAKING CHANGE.

Do not extend notes this side of this line

F.B. 481 PG 150

Notes Ck'd by	Survey of Coyote Diag
Map No.	W. O. 995 Tape No. St'd OF.
Office Work Rice	Surveyed by L. P. Moore
Checked	Notes Moore Date 5-2-33
Date	Indexed A. C. Johnson

F.B. 481 PG. 151

To Botham pg. 152

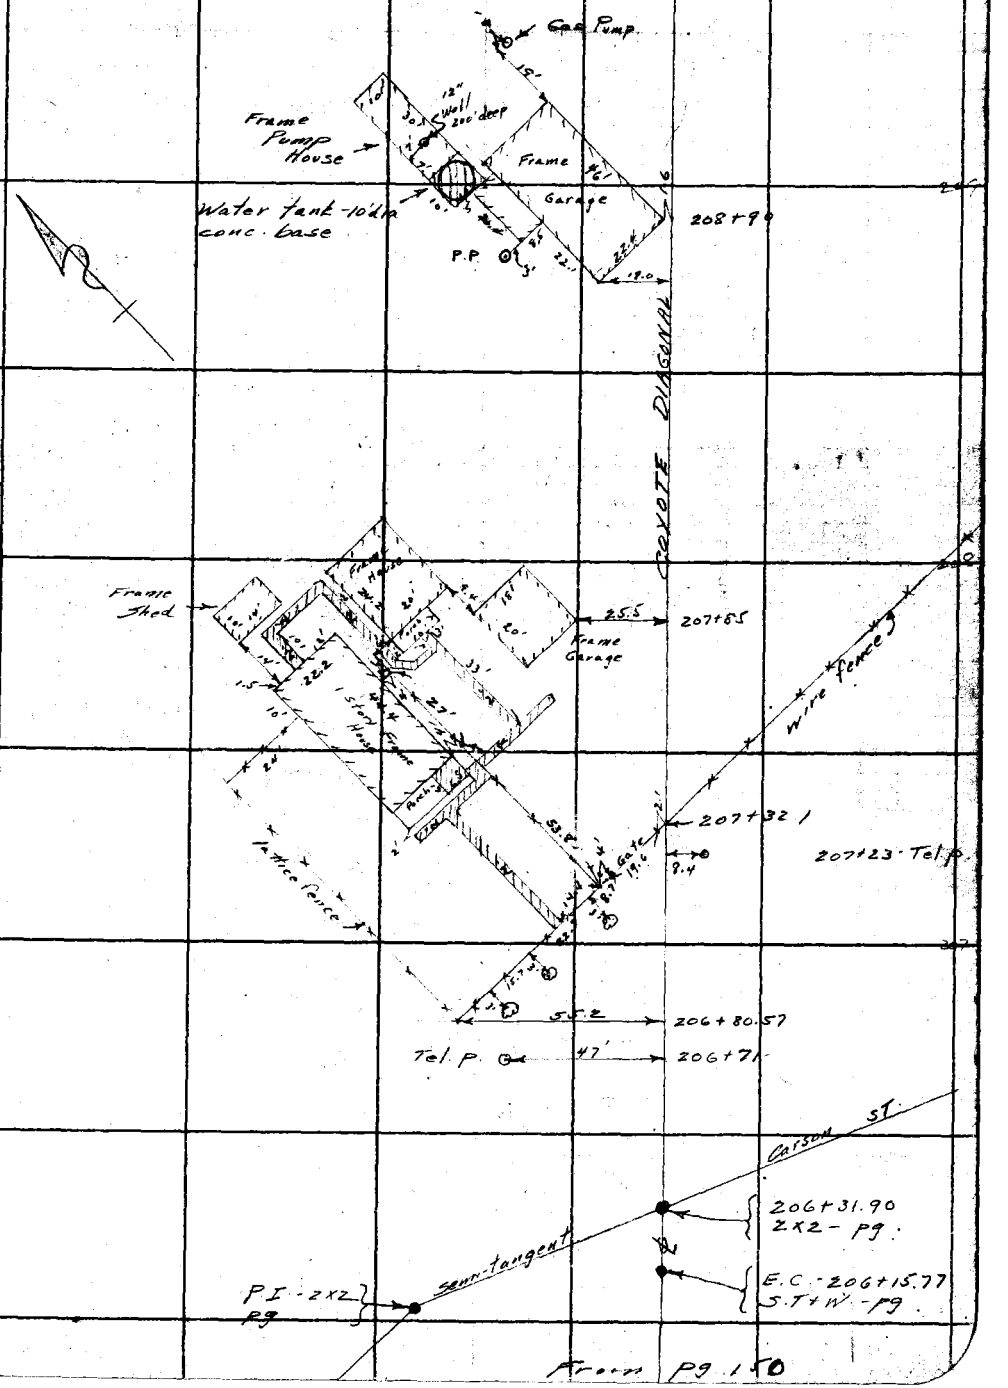

From pg. 150

RETURN TO
LOS ANGELES COUNTY SURVEYOR
700 HALL OF RECORDS
Do not extend notes this side of this line

Note: ANY ADDITIONS OR CHANGES ON THIS SHEET MUST BE MADE OR CIRCLED IN Red Ink WITH DATE AND NAME OF PERSON MAKING CHANGE.

FORM 247 10M 8-31

F.B. 481 Pg 152

To bottom pg. 153

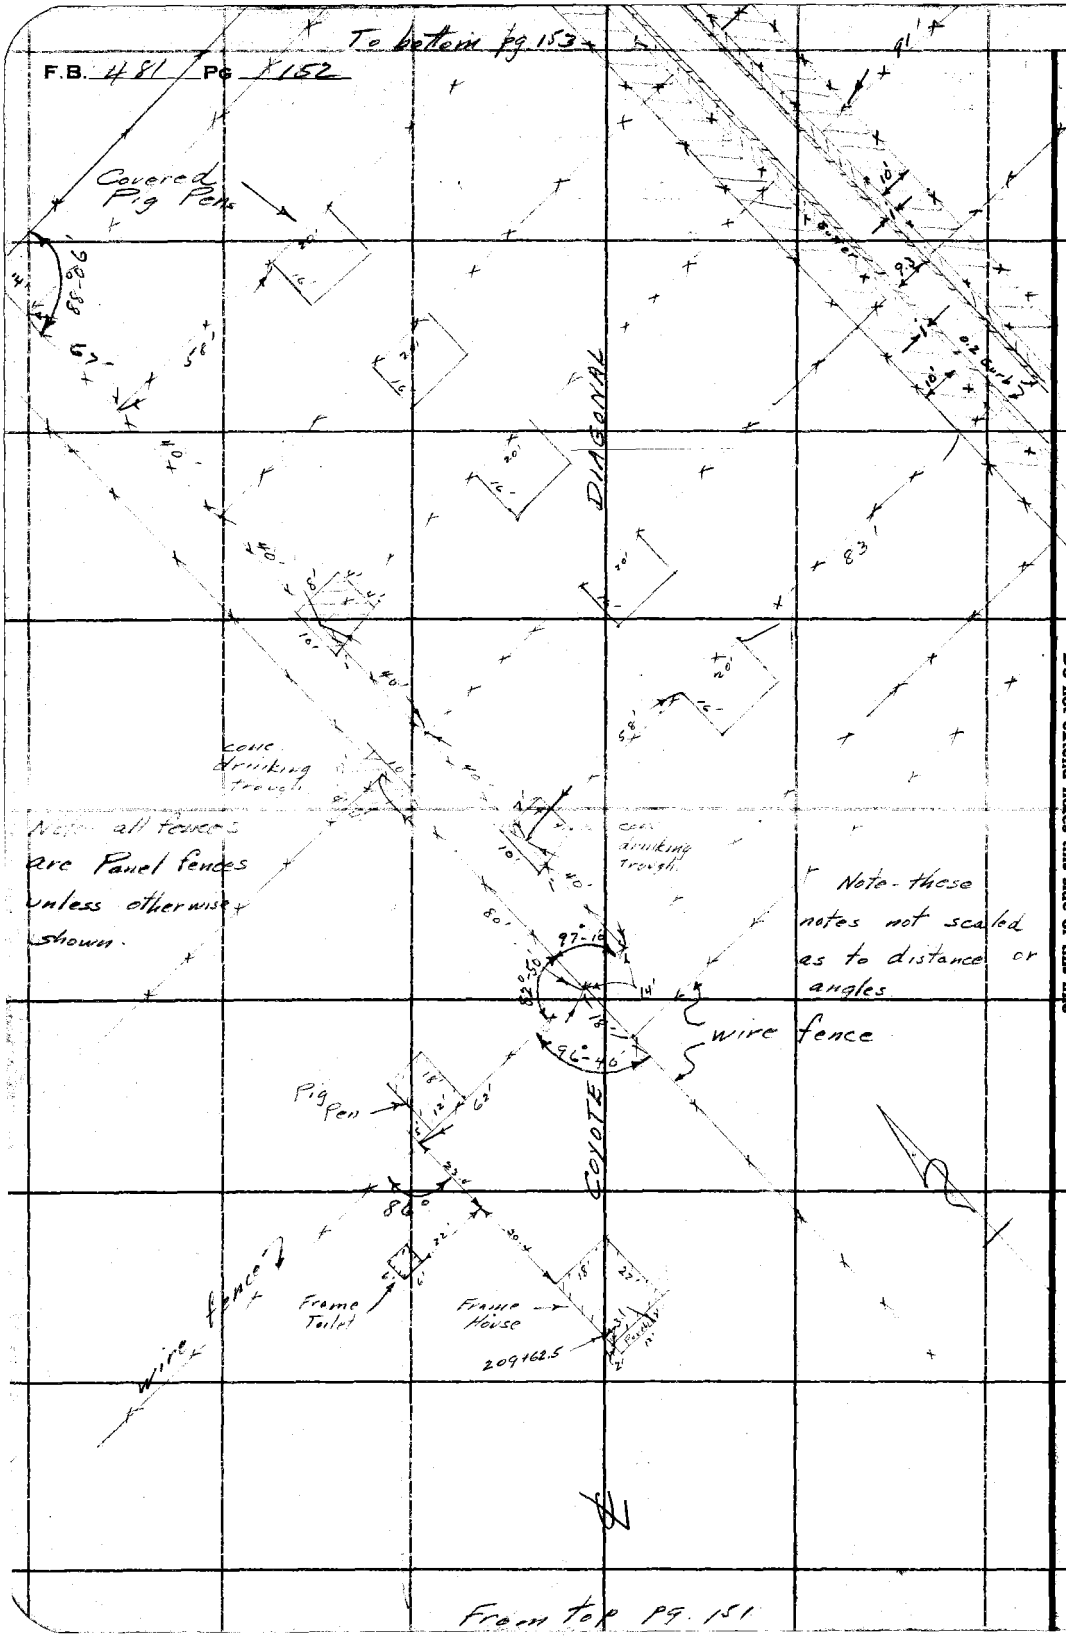

RETURN TO
LOS ANGELES COUNTY SURVEYOR
700 HALL OF RECORDS

Do not extend notes this side of this line

Note: ANY ADDITIONS OR CHANGES ON THIS SHEET MUST BE MADE OR CIRCLED IN Red Ink. WITH DATE AND NAME OF PERSON MAKING CHANGE.

Notes Ck'd by _____
Map No. _____
Office Work Rice
Checked _____
Date _____

Survey of Coyote Diag
W. O. 995 Tape No. _____ Sh'd _____ 9F.
Surveyed by L. D. Moore
Notes Moore Date 5-3-33
Indexed A. C. Johnson

F.B. 481 Pg. 153

To bottom pg 154

Covered Pig Pens

Cone Drinking Troughs

covered pens Pig

DIAGONAL

COYOTE

From top pg. 152

Notes: ANY ADDITIONS OR CHANGES ON THIS SHEET MUST BE MADE OR CIRCLED IN Red Ink. WITH DATE AND NAME OF PERSON MAK-ING CHANGE.

Do not extend notes this side of this line

RETURN TO
LOS ANGELES COUNTY SURVEYOR
700 HALL OF RECORDS

FORM 247 10M 5-31

F.B. 481 Pg. 154

To bottom pg 155

Note- Topog between Sta 210+00 and Sta 217 not drawn to scale

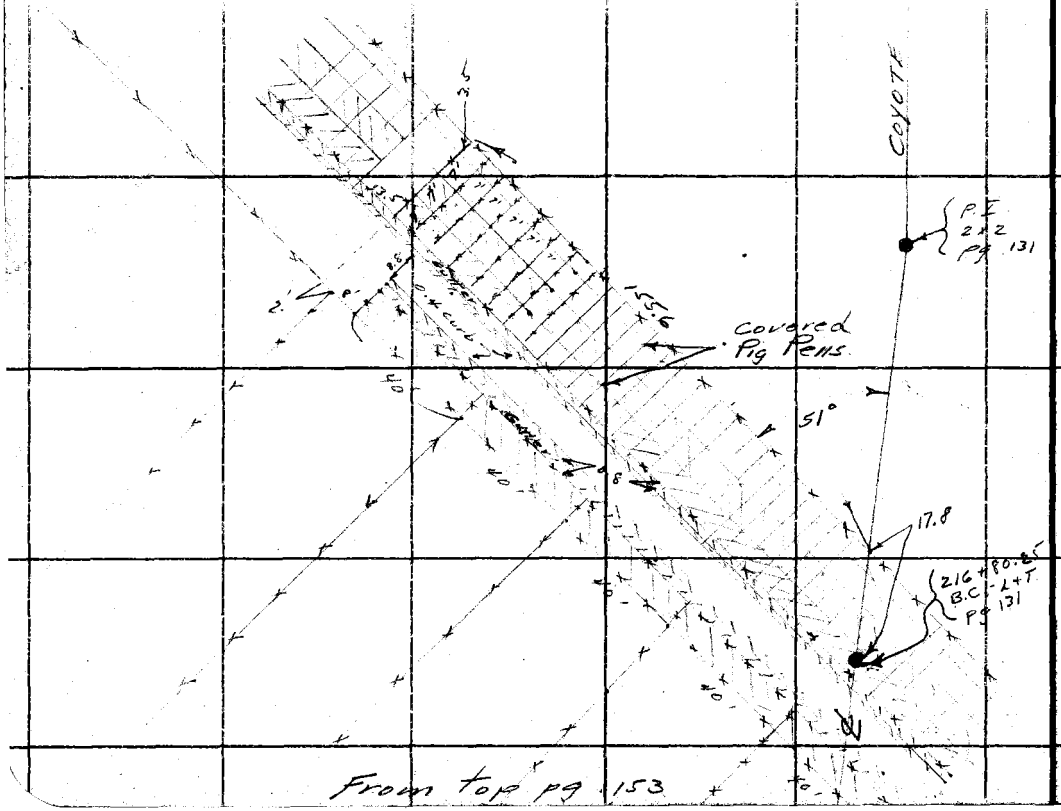

RETURN TO
LOS ANGELES COUNTY SURVEYOR
700 HALL OF RECORDS

Do not extend notes this side of this line

Note: ANY ADDITIONS OR CHANGES ON THIS SHEET MUST BE MADE OR CIRCLED IN Red Ink. WITH DATE AND NAME OF PERSON MAKING CHANGE.

Notes Ck'd by	Survey of Coyote Diag
Map No.	W. O. 295 Tape No. St'd of
Office Work Rice	Surveyed by L. D. Moore
Checked	Notes Moore Date 5-3-33
Date	Indexed A. C. Johnson

F.B. 481 Pg. 155

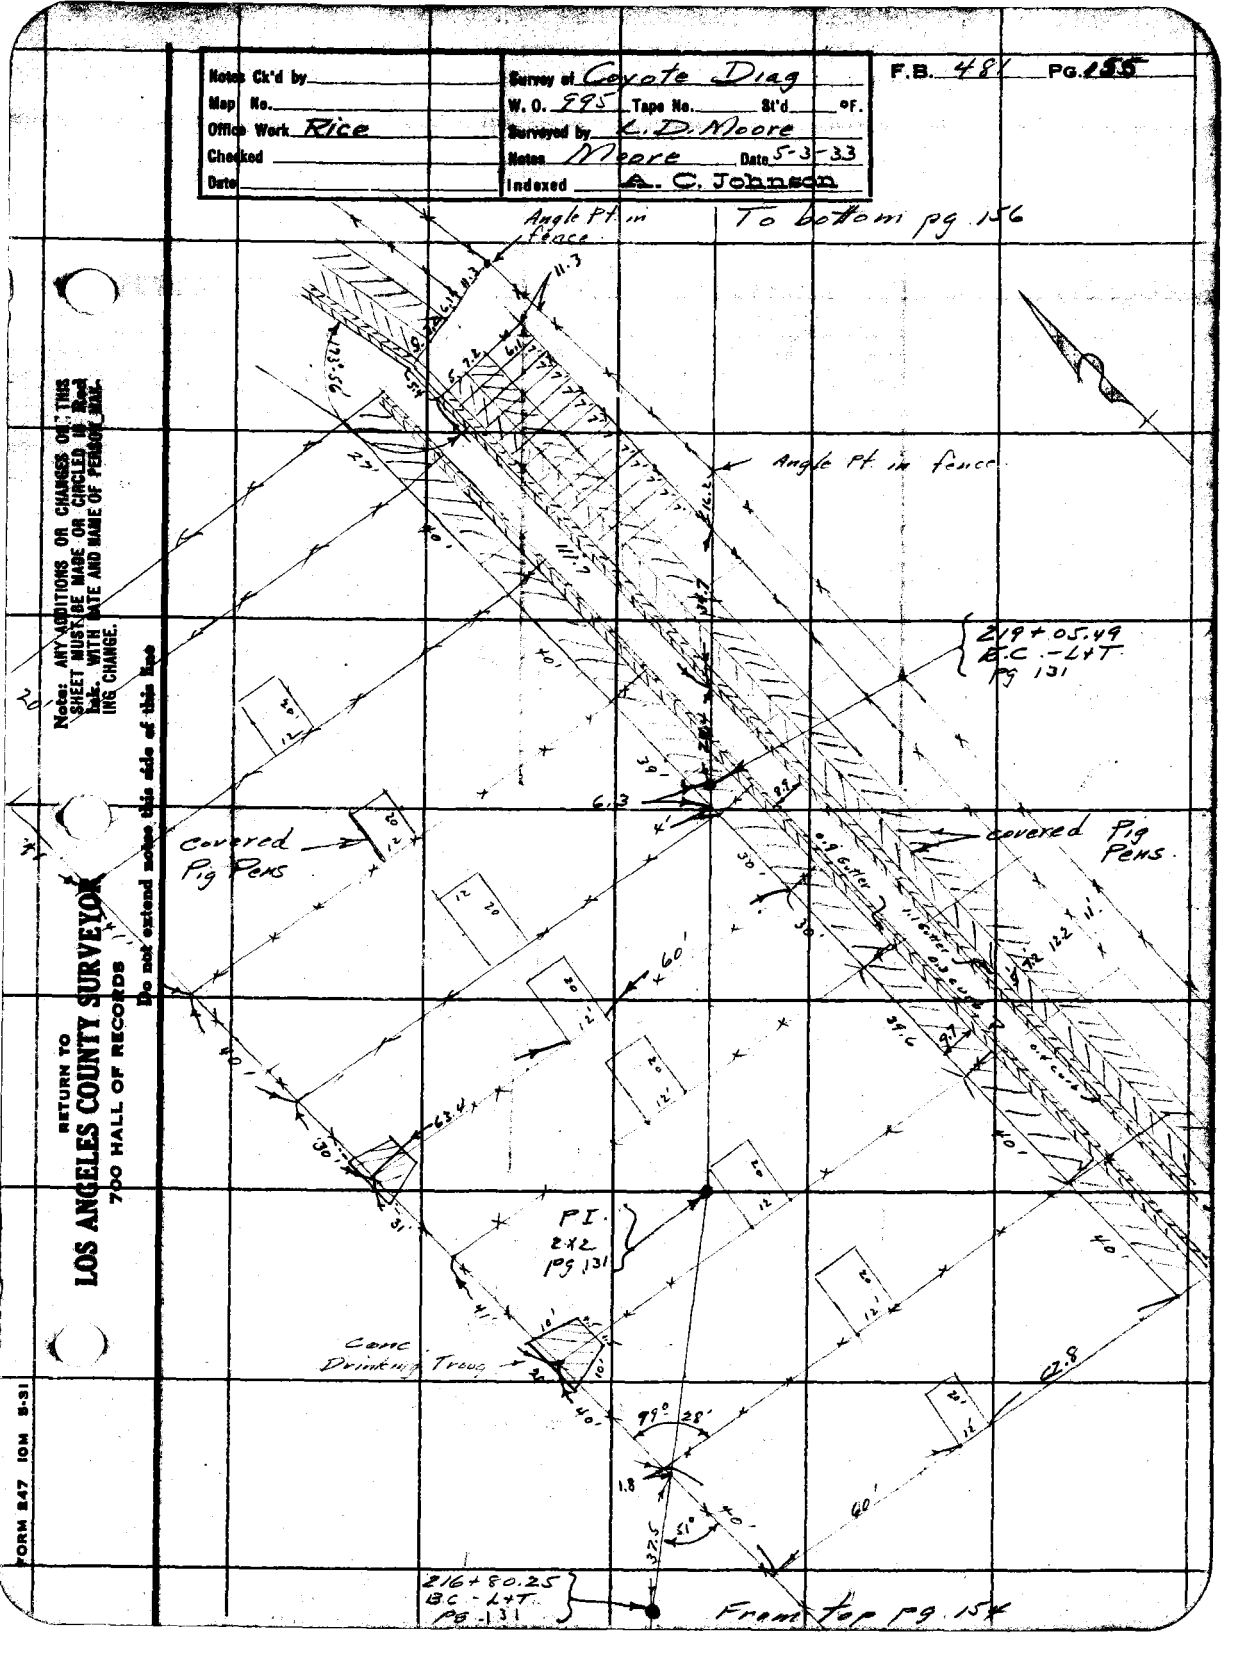

RETURN TO
LOS ANGELES COUNTY SURVEYOR
700 HALL OF RECORDS

Note: ANY ADDITIONS OR CHANGES ON THIS SHEET MUST BE MADE OR CIRCLED IN Red Ink. WITH DATE AND NAME OF PERSON MAKING CHANGE.

Do not extend notes this side of this line

FORM 847 10M 8-31

RETURN TO
LOS ANGELES COUNTY SURVEYOR
700 HALL OF RECORDS

Note: ANY ADDITIONS OR CHANGES ON THIS SHEET MUST BE MADE OR CIRCLED IN Red Ink. WITH DATE AND NAME OF PERSON MAKING CHANGE.

Do not extend notes this side of this line

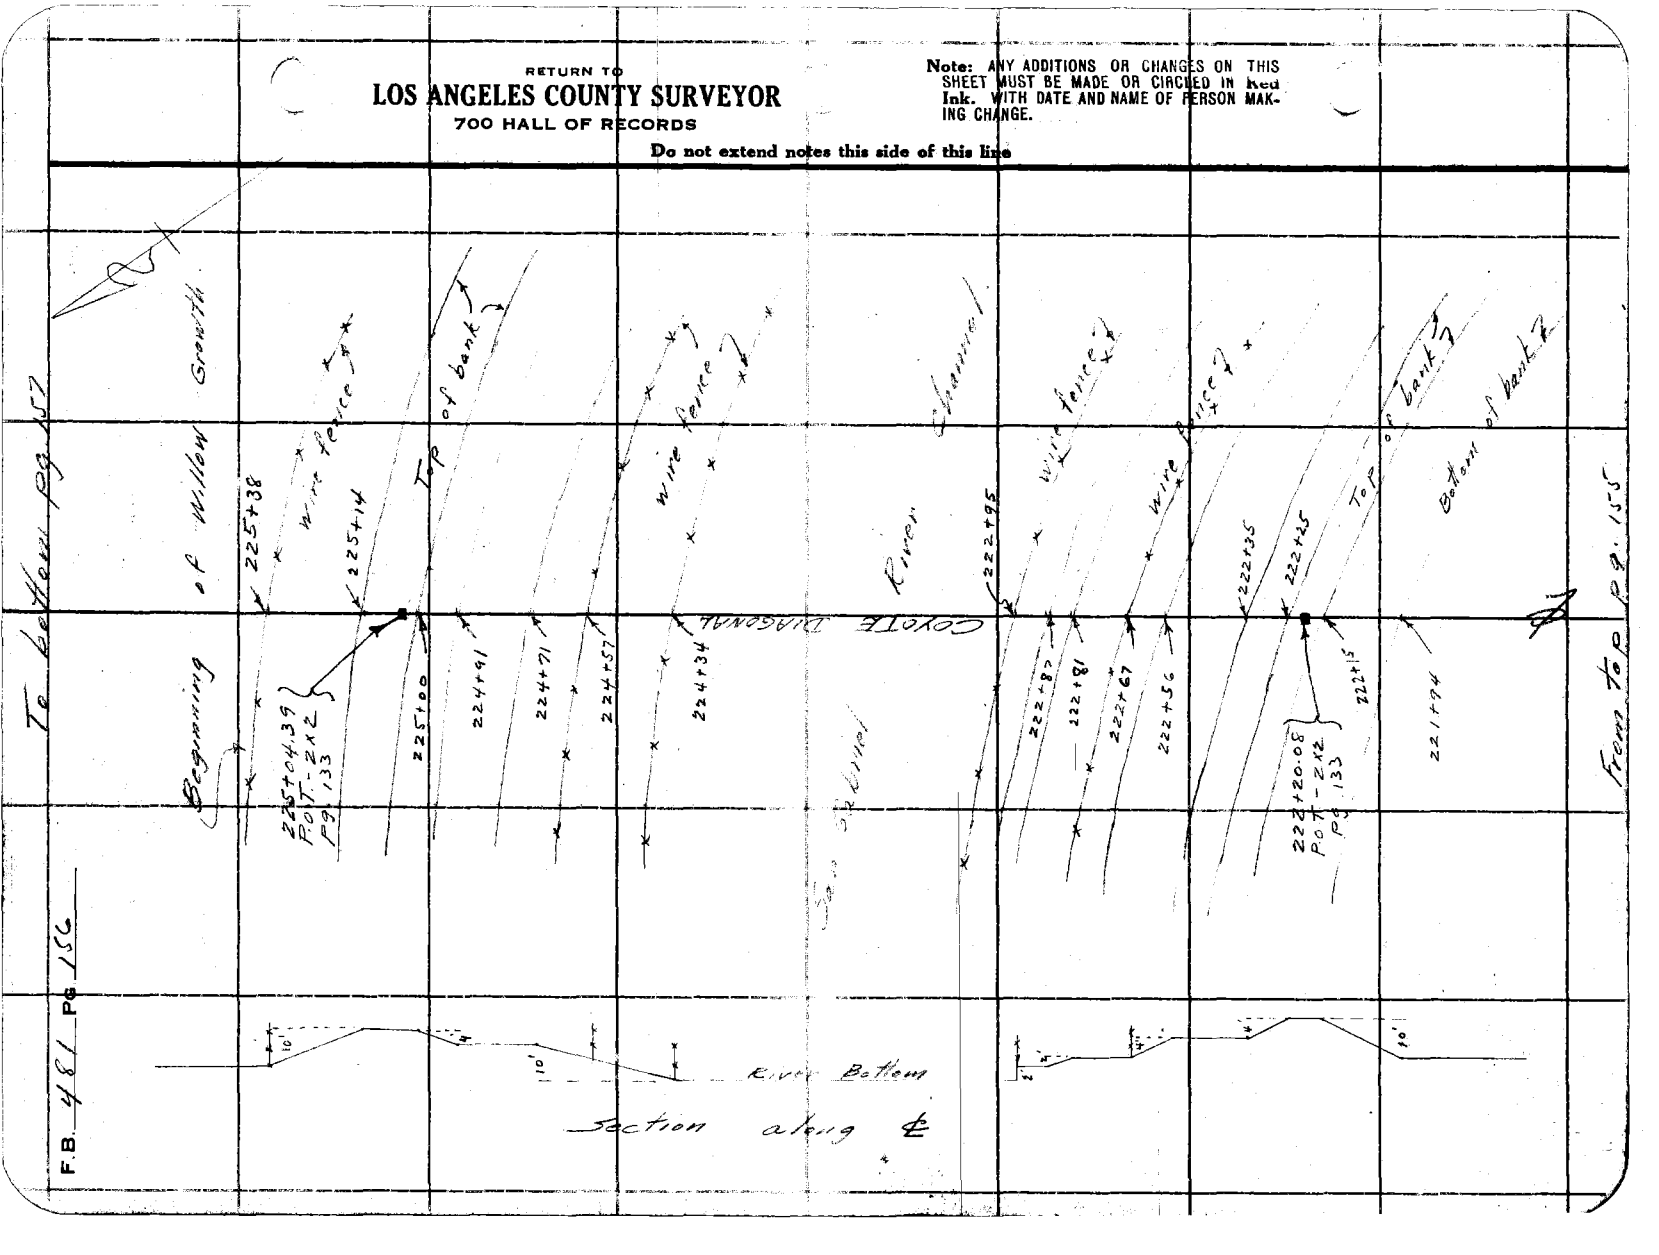

Notes Ck'd by
Map No.
Office Work Rice
Checked
Date

Survey of Coyote Diag.
W. O. 995 Tape No. St'd °F.
Surveyed by L. D. Moore
Notes Moore Date 5-3-33
Indexed A. C. Johnson

F.B. 48 Pg. 137

To bottom pg. 158

DIAGONAL

269+81 P.P. Q 38'

269+94.41
2x2 - pg 135

ANAHEIM
0' rd.

Line 7

265+75

standpipe

irrig

44'

265+41

valve

25'

Land

Cultivated

237+08

Growth

ROAD

End of willow

CENTRALIA

236+72.74
2x2 - pg 134

COYOTE

wire fence

16°29'30"

228+12.44
2x2 - pg 133

318

Angle in F.B. 46 & 31

From Top pg. 156

Note: ANY ADDITIONS OR CHANGES ON THIS SHEET MUST BE MADE OR CIRCLED IN Red Ink, WITH DATE AND NAME OF PERSON MAKING CHANGE.

Do not extend notes this side of this line

RETURN TO
LOS ANGELES COUNTY SURVEYOR
700 HALL OF RECORDS

FORM 647 10M 8-31

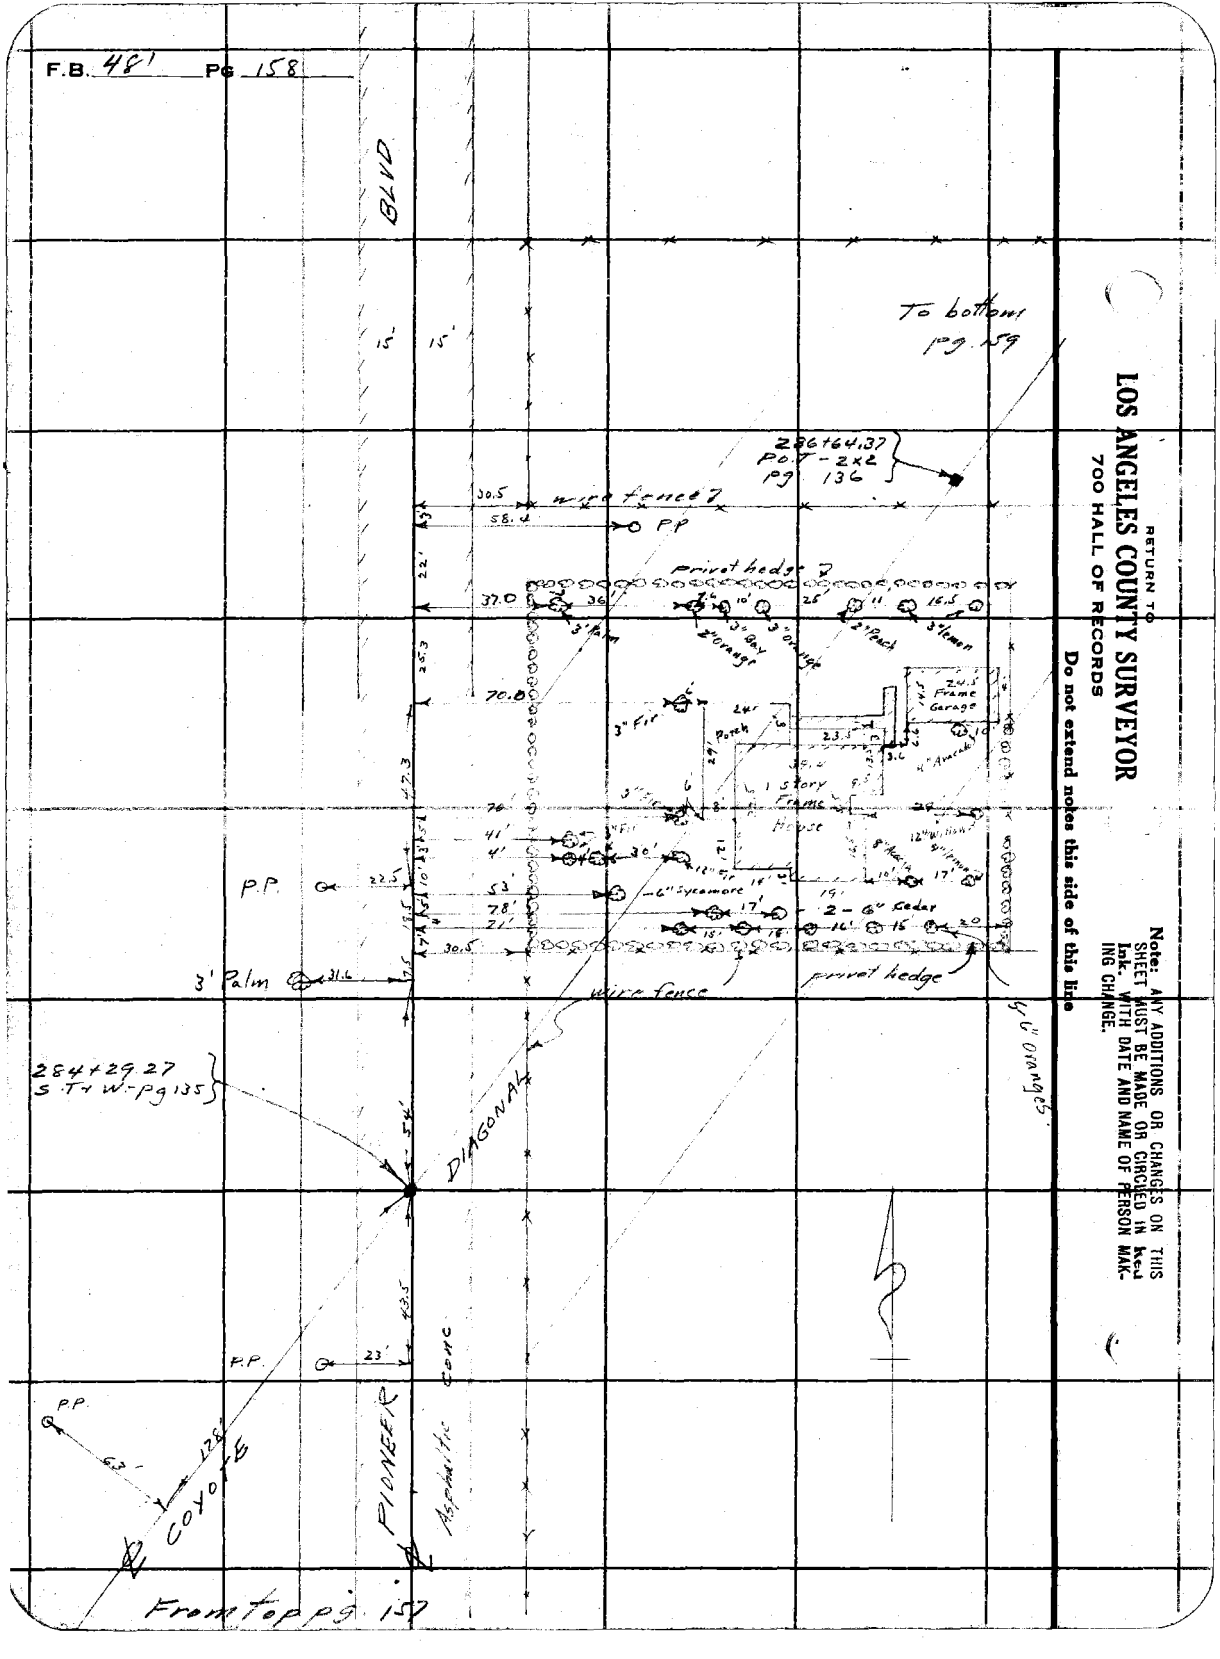
F.B. 481 Pg 158
BLVD
15'
15'
To bottom pg. 159
286+64.37
POT - 2x2
pg 136
wire fence
PP
private hedge
3' Palm
2" orange
3" Oak
3" orange
2" Peach
3 lemon
2 Sty Frame Garage
3" Fir
Porch
1 Story Frame House
12" Willow
8" Mulberry
6" Sycamore
2 - 6" Cedar
6" Oranges
P.P.
3' Palm
wire fence
284+29.27
S.T+W-pg 135
DIAGONAL
P.P.
PP
COYOTE
PIONEER
Asphaltic Conc
From top pg. 157
RETURN TO
LOS ANGELES COUNTY SURVEYOR
700 HALL OF RECORDS
Do not extend notes this side of this line
Note: ANY ADDITIONS OR CHANGES ON THIS SHEET MUST BE MADE OR CIRCLED IN Red Ink. WITH DATE AND NAME OF PERSON MAKING CHANGE.

Notes Ck'd by		Survey of Cerete Diag	F.B. 481 PG. 159
Map No.		W. O. 995 Tape No.	St'd °F.
Office Work Rice		Surveyed by L. D. Moore	
Checked		Notes Moore Date 5-3-33	
Date		Indexed E. C. Johnson	

To bottom pg. 160

296+55.6

7.7

6" Pears.

DIAGONAL

65'

COYOTE

37°56

294+20.6

293+98.63
P.O.T - 2×2
Pg 136

80'

Frame
Hay Barn

56.5

54'

46'

291+17.4

fence

wire

288+69.4

From top pg. 158

Note: ANY ADDITIONS OR CHANGES OR THIS SHEET MUST BE MADE OR CIRCLED IN Red Ink. WITH DATE AND NAME OF PERSON MAKING CHANGE.

Do not extend notes this side of this line

RETURN TO
LOS ANGELES COUNTY SURVEYOR
700 HALL OF RECORDS

FORM 247 10M 5-31

RETURN TO
LOS ANGELES COUNTY SURVEYOR
700 HALL OF RECORDS

Note: ANY ADDITIONS OR CHANGES ON THIS SHEET MUST BE MADE OR CIRCLED IN Red Ink. WITH DATE AND NAME OF PERSON MAKING CHANGE.

Do not extend notes this side of this line

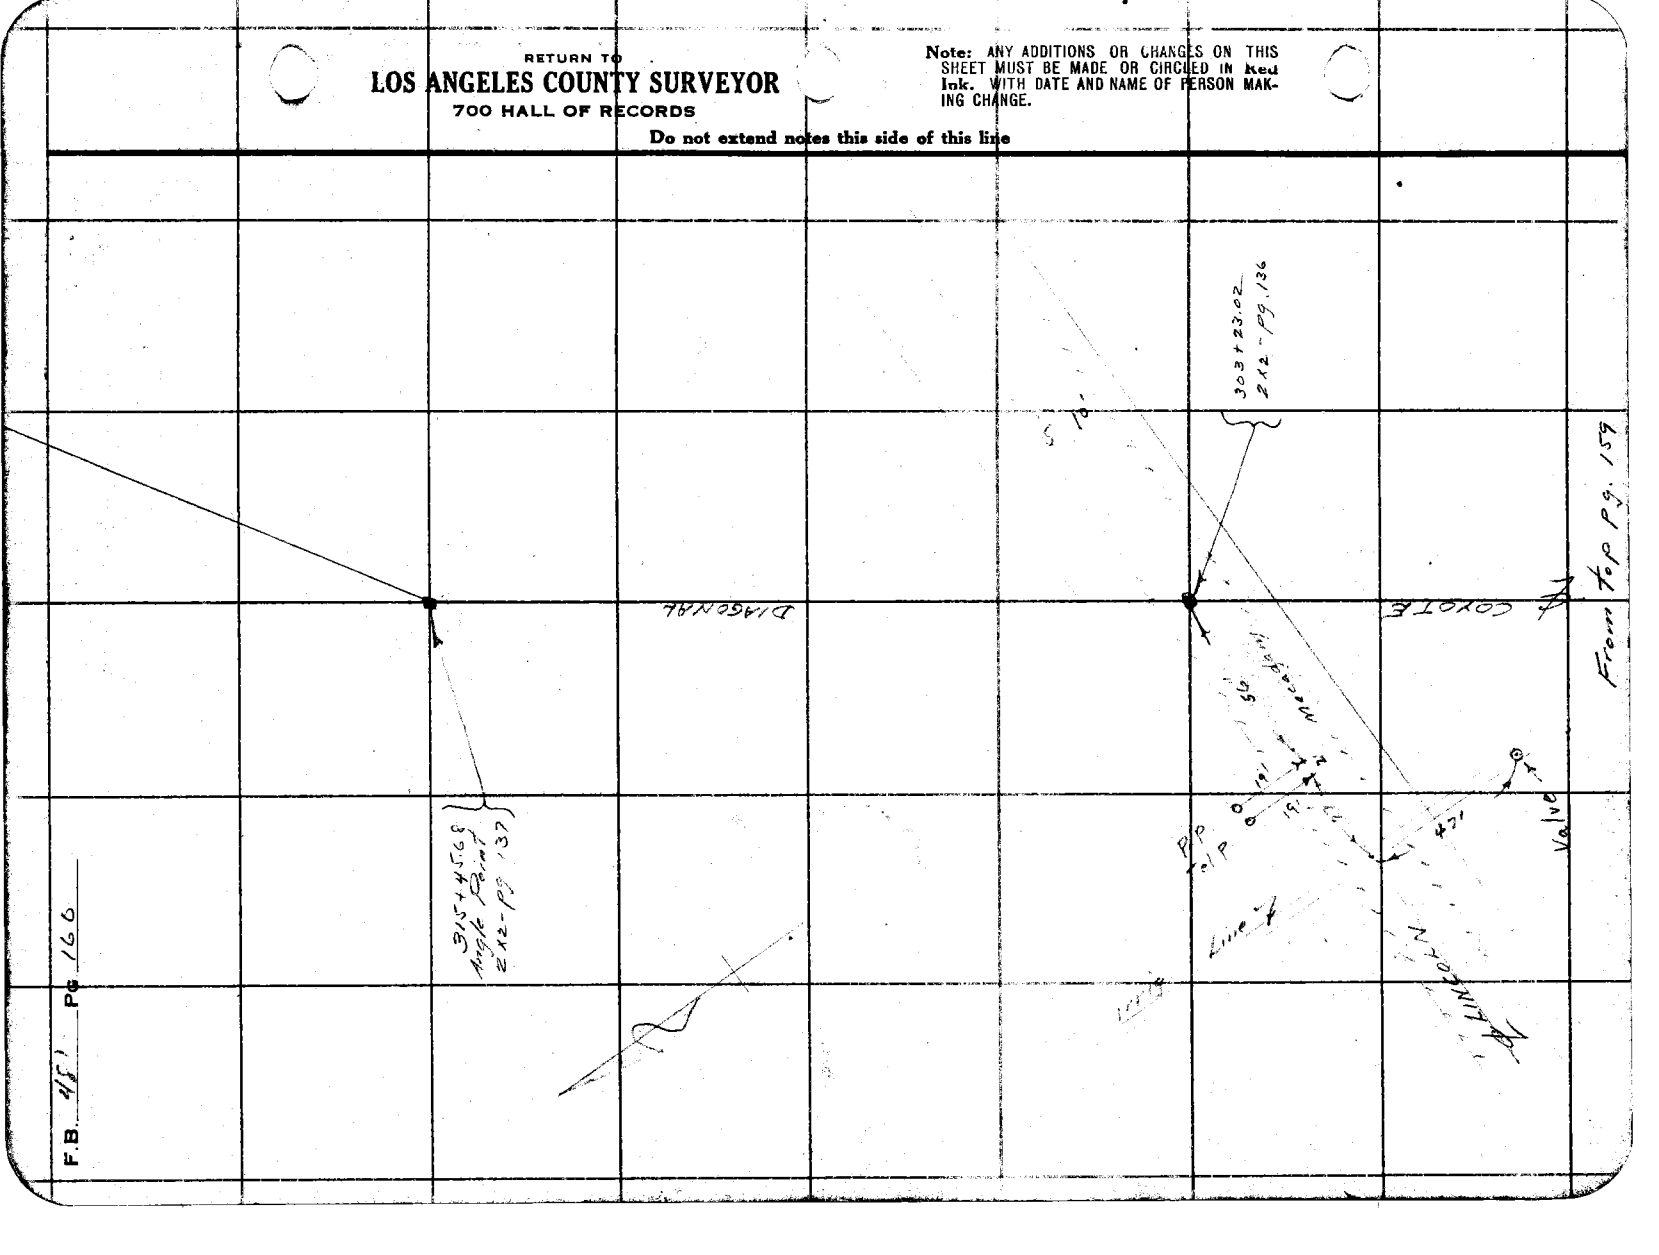

F.B. 4/5' PG 166

Date _____ Notes by _____ Chief Party _____ F.B. 481 Pg. 161

Platted by	W. O. No. 7995 D. S. O. No.
Date	Location Coyote Creek Diag.
Map No.	Surveyed by Evans
Platting C'k'd by	Date 1/15/34
Date	Indexed A. C. Johnson 1-16-34

Notes: ANY ADDITIONS OR CHANGES ON THIS SHEET MUST BE MADE OR CIRCLED IN Red. WITH DATE AND NAME OF PERSON MAKING CHANGE.

Do not extend notes this side of this line

RETURN TO
LOS ANGELES COUNTY SURVEYOR

Proposed

Position of old S 4X4 - F.B. 293/146 Nothing found.

Rec. per F.B. 293/146

0.56 calc.

Set Nail

20.74

Fd. 2" I.P. Rd nail per F.B. 293/146

2334 F.B. 293/146

(50)

50' HATHAWAY ST.

(50)

Set 2X2 Flush

73.03 cal'd M.

30.00

90°

Set 2X2 18" dp.

Ca. 6" Rec. (1028)

Fd. Conc. mon. + B.C. 18" dp., on line per L.B. 514/38

TERMINO AVE.

(30)

(30)

N

(66.66 Rec.)

Set 2X2 Flush.

30.00

Set Nail

90°

50.005 cal'd M.

STATE

(50)

ST.

(50)

Fd. Long Beach conc. mon. + brass cap, in iron box 14" dp. per L.B. 514/34, 35 & F.B. 293/146

RETURN TO

LOS ANGELES COUNTY SURVEYOR

Note: ANY ADDITIONS OR CHANGES ON THIS SHEET MUST BE MADE OR CIRCLED IN Red. WITH DATE AND NAME OF PERSON MAKING CHANGE.

Do not extend notes this side of this line

F.B. _____ P.G. _____ Chief Party _____ Notes by _____ Date _____

Notes Ck'd by	Survey of Coyote Ck Diag
Map No.	W. O. 7995 Tape No. 245 St'd 84 of F.
Office Work	Surveyed by Rosecrans
Checked	Notes Date 5-28-34
Date	Indexed H. C. Johnson

5-31-34

F.B. 481 Pg. 163

Note: ANY ADDITIONS OR CHANGES ON THIS SHEET MUST BE MADE OR CIRCLED IN Red Ink, WITH DATE AND NAME OF PERSON MAKING CHANGE.

Do not extend notes this side of this line

RETURN TO
LOS ANGELES COUNTY SURVEYOR
700 HALL OF RECORDS

FORM 247 10M 5-31

Line Change

COYOTE CREEK DIAGONAL

from Carson St. to San Gabriel River northeast of Long Beach.

Job 7995

Party E. A. Rosecrans
H. S. Johnson
J. A. Milless
T. H. Baker

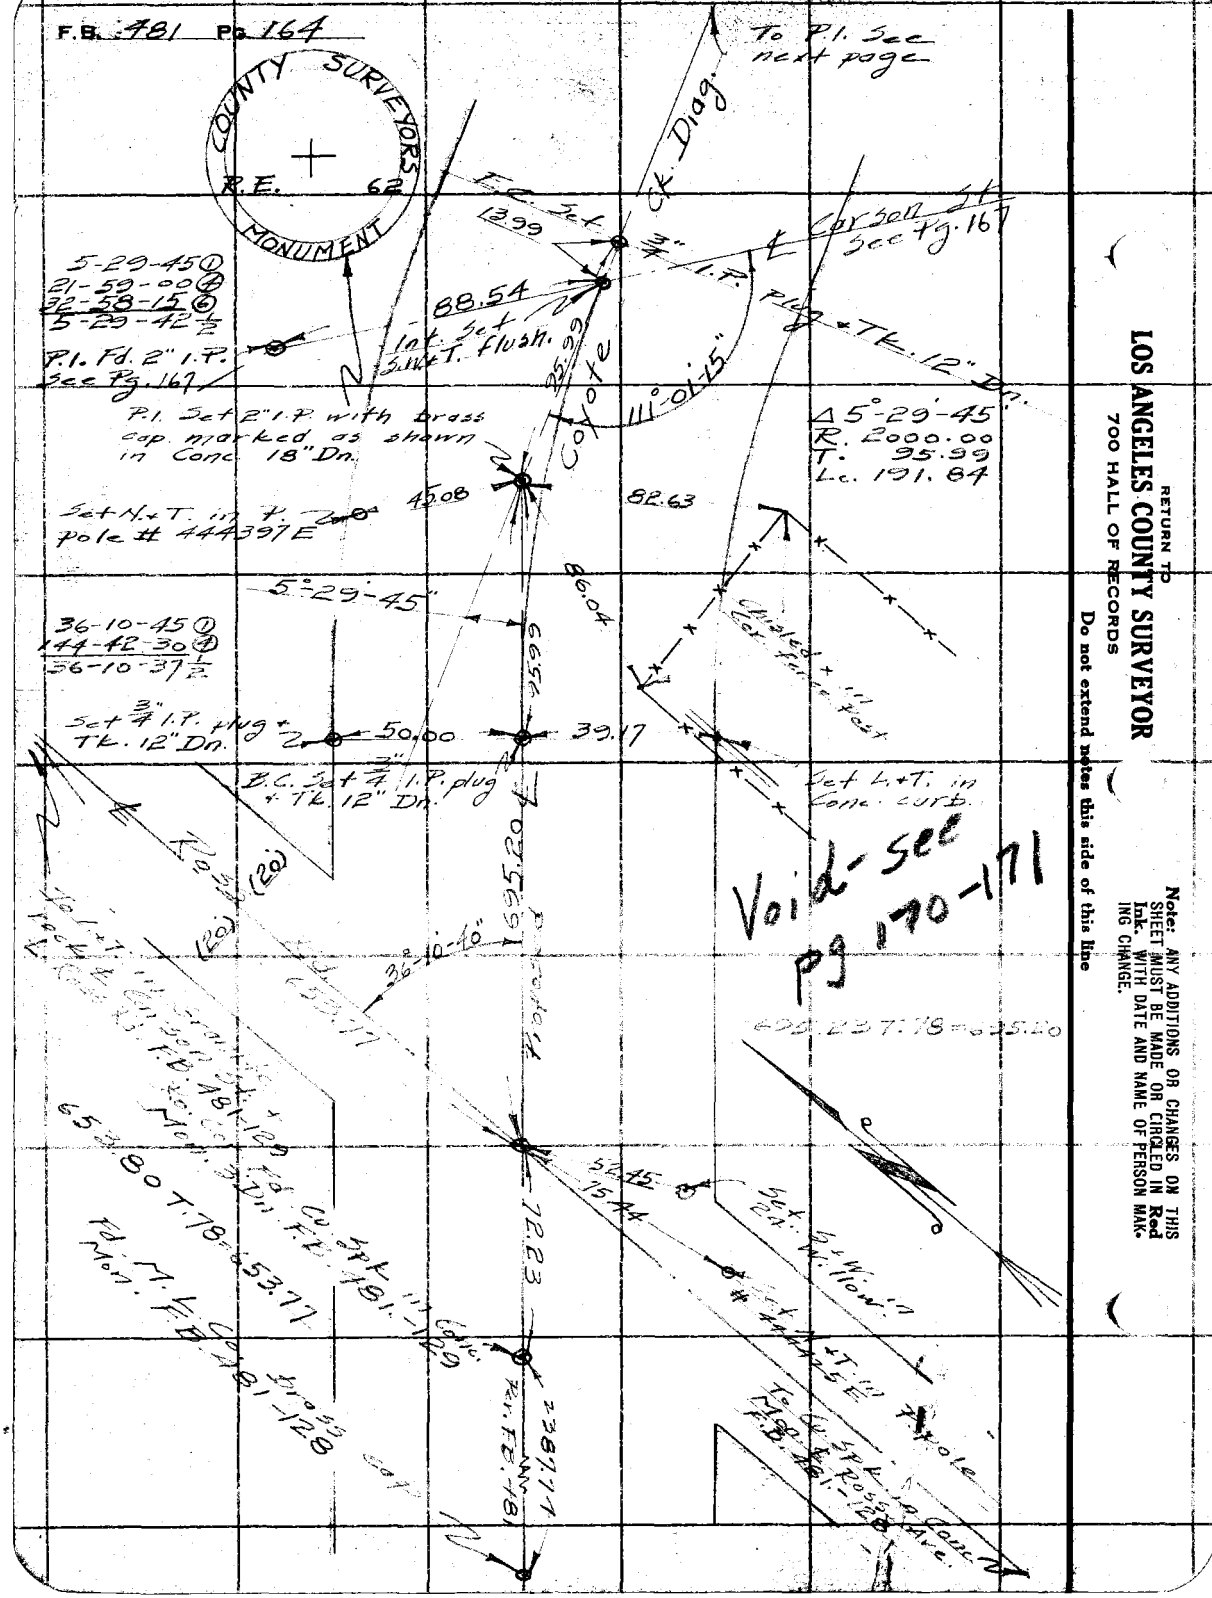
F.B. 481 Pg. 164
COUNTY SURVEYORS MONUMENT
R.E. 62
To P.I. Sec next page
Ck. Diag.
E.C. Set 13.99
Corson St. See Pg. 167
5-29-45 ①
21-59-00 ②
32-58-15 ③
5-29-42½
P.I. Fd. 2" I.P. See Pg. 167
88.54
Int. Set ¾" I.P. Flush. S.W.L.T.
35.99
Coyote
111°-01-15"
P.I. Set 2" I.P. with brass cap marked as shown in Conc. 18" Dn.
Δ 5°-29'-45"
R. 2000.00
T. 95.99
L.c. 191.87
Set N.+T. in ↓. pole # 444397E
45.08
82.63
86.04
5°-29'-45"
36-10-45 ①
144-42-30 ②
56-10-37½
Set ¾" I.P. in NG Tk. 12" Dn.
50.00
39.17
B.C. Set ¾" I.P. plug + Tk. 12" Dn.
Set N.+T. in Conc. curb.
Void-see pg 170-171
Re 30 (20)
36°-10'-16"
72.23
Set N.+T. in Conc. curb.
Set Ex. W. Willow in
Set N.+T. in Conc. curb.
Ex. Pole
St. Rd. 91 Ave.
Re 30 (20)
Fd. Mon. Cor. Fd. 2" I.P. 1.1' Deep

Notes Ck'd by		Survey of Coyote Ck Diag	F.B. 481 Pg. 165
Map No.		W. O. 7995 Tape No. e45 St'd 6' of.	
Office Work		Surveyed by Rosecrans	
Checked		Notes	Date 5-29-34
Date		Indexed	A. C. Johnson

Set N.+T. in Cor. feed pen

Fd 2×2" P.O.T. 12" Dn. top of dyk ← F.B. 481-133.

P.C. 219.65
31.43
314.08 T. 78 = 314.07

P.C. Set L.+T. in Conc. floor of feed pen.

Fd. L.+T. F.B. 481-131

0.71

28.57 30.26 9.57 2.85

Set N.+T. in Cor Feed pen.
5-29-00 ①
21-56-00 ②
32-34-15 ③
5-29-00 ½

Δ 5°-29'-00"
R 2000.00
T. 95.77
Lc 191.40

95.77 Diagonal 5°-29'-00"

10.48 12.89 12.68 12.07

P.I. Set 2" I.P. with brass cap marked "..." as shown in Conc. 18 Dn.

Set N.+T. in Cor. of hog shed.

Set N.+T. in hog pen fence

95.77 Coyote Creek

COUNTY SURVEYOR R.E. 62

P.C. 18 Dn. Set 3" I.P. Plug + Tk

Set N.+T. in pen fence

4.53 16.56 7.14 15.95

Set N.+T. in fence

hog

Coyote

Void - see Pg. 172

1064.69 to P.O.T. 12" Dn. Tk preceding P.I. Plug

Mkd. "..." Box P.O.T.

RETURN TO
LOS ANGELES COUNTY SURVEYOR
700 HALL OF RECORDS

Do not extend notes this side of this line

Note: ANY ADDITIONS OR CHANGES ON THIS SHEET MUST BE MADE OR CIRCLED IN Red Ink, WITH DATE AND NAME OF PERSON MAKING CHANGE.

FORM 247 10M 5-31

F.B. 481 Pg. 166

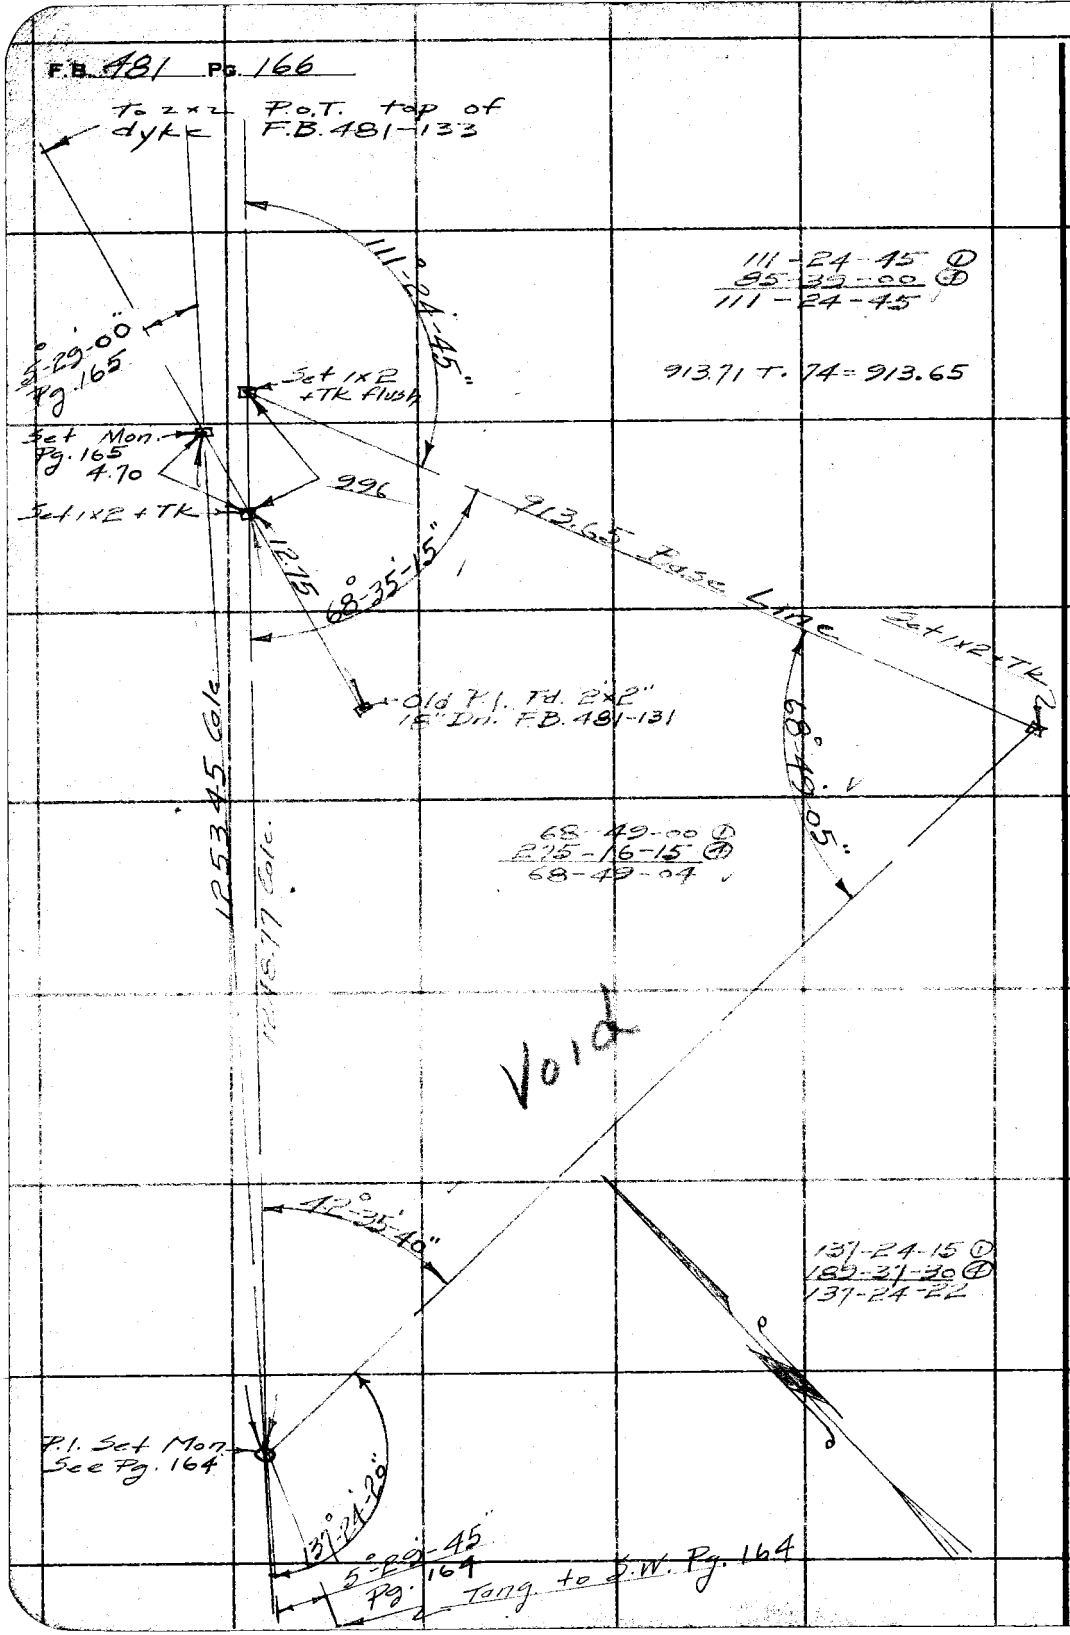

RETURN TO
LOS ANGELES COUNTY SURVEYOR
700 HALL OF RECORDS

Do not extend notes this side of this line

Note: ANY ADDITIONS OR CHANGES ON THIS SHEET MUST BE MADE OR CIRCLED IN Red Ink. WITH DATE AND NAME OF PERSON MAKING CHANGE.

Notes Ck'd by		Survey of Coyote Ck. Diag.	F.B. 481 Pg. 167
Map No.		W. O. 7795 Tape No. 045 St'd 84 °F.	
Office Work		Surveyed by Rosecrans	
Checked		Notes	Date 5-28-34
Date		Indexed	C. Johnson

RETURN TO
LOS ANGELES COUNTY SURVEYOR
700 HALL OF RECORDS

Note: ANY ADDITIONS OR CHANGES ON THIS SHEET MUST BE MADE OR CIRCLED IN Red Ink, WITH DATE AND NAME OF PERSON MAKING CHANGE.

Do not extend notes this side of this line

FORM 247 10M 8-31

652.77
Ross Ave
(20) (20)
Ø 3/4" I.P. Flush
0.2' S. & 0.2' E. of Mon.
S. 164

RETURN TO

LOS ANGELES COUNTY SURVEYOR

700 HALL OF RECORDS

Note: ANY ADDITIONS OR CHANGES ON THIS SHEET MUST BE MADE OR CIRCLED IN **Red Ink.** WITH DATE AND NAME OF PERSON MAKING CHANGE.

Do not extend notes this side of this line

F.B. 481 Pg. 168

Notes Ck'd by AAK	Survey of Coyote Diag.
Map No. B-633-2	W. O. 7995 Tape No. St'd 68° °F.
Office Work	Surveyed by L D Moore
Checked	Notes Moore Date 7-3-34
Date	Indexed A. C. Johnson 9-5-34

F.B. 481 Pg. 169

Note: ANY ADDITIONS OR CHANGES ON THIS SHEET MUST BE MADE OR CIRCLED IN Red Ink. WITH DATE AND NAME OF PERSON MAK-ING CHANGE.

Do not extend notes this side of this line

RETURN TO
LOS ANGELES COUNTY SURVEYOR
700 HALL OF RECORDS

℄ CHANGE
COYOTE CREEK DIAGONAL
from
CARSON ST
to
SAN GABRIEL RIVER
Job # 7995

Party
Moore
Fenner
Bowers
Nichols

July 3, 1934

FORM 247 10M 8-31

F.B. 481 Pg. 170

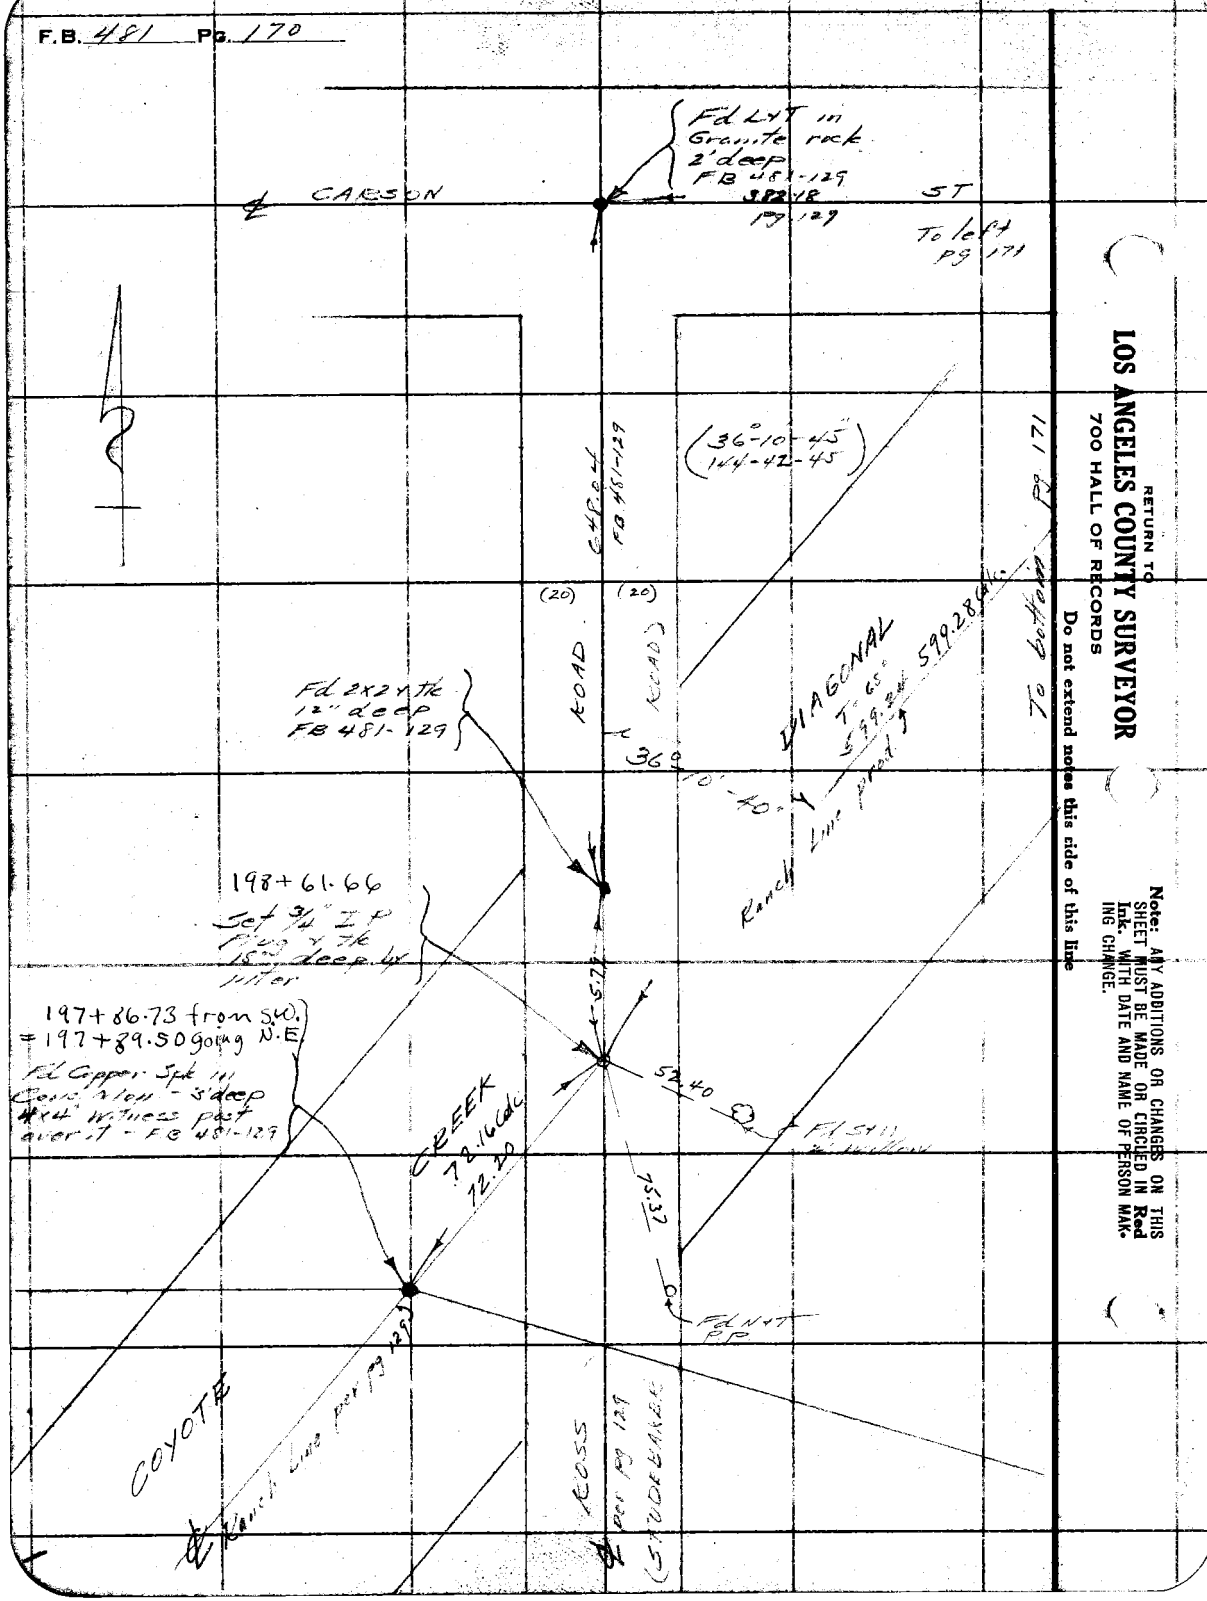

RETURN TO
LOS ANGELES COUNTY SURVEYOR
700 HALL OF RECORDS
Do not extend notes this side of this line

Note: ANY ADDITIONS OR CHANGES ON THIS SHEET MUST BE MADE OR CIRCLED IN **Red Ink.** WITH DATE AND NAME OF PERSON MAKING CHANGE.

Notes Ck'd by WAR	Survey of Coyote Diag
Map No. B-633-2	W. O. 7295 Tape No. St'd 66 ft.
Office Work	Surveyed by L D Moore
Checked	Notes N Moore Date 7-3-34
Date	Indexed A. C. Johnson

F.B. 481 PG. 171

To bottom pg. 172

(111°-01'-30"
64-05-45)

(42°-36'-30"
170-26-00)

CREEK DIAGONAL
1060.90 calc.
1060.87 Adj.

206+52.78
BC
Set 3/4" IP
Plug in Tk
18" deep.

Fd N+T
Tel.P

Fd N+T
PP

PI
Fd 2x2
EB 481-130
18" deep.

Fd 2" IP
Plug in Tk
18" deep
E.D. Fr 14-2

11.57
32.12
67.85
72.37
13.86 calc.
13.92
85.10
88.48 Calc.
88.53
69.45
19.08
2X2
Pg 130
0.15

Set ST+W
by inter.

To PI
Pg 139

702 x 2 calc. ST

To 172-19.17

159°-22'-05"
Pg 130

Pg 129
382.18

CARSON

82.01
42°-36'-30"
36.4

111°-01'-25"

PI - Set C.S. Mon. - 2" I.P.
+ BC in conc - 18" deep
and marked as shown

COUNTY SURVEYORS

R.E. 62
MONUMENT

From upper right Pg 170

45.13

Fd N+T
PP

174°-30'-15"

82.56

Fd "X" in
iron fence
post

COYOTE

T=47.99
95.99

Δ = 5°-29'-45"
R = 2000
T = 95.99
L 191.84

(174°-30'-15"
3.38-01-00)

Set 3/4" IP
Plug in Tk
18" deep

50.00

39.01

Set L+T
Conc. Transformer Base

204+60.94
BC
Set 3/4" IP
Plug in Tk
18" deep

T=25.00
599.24

From right Pg 170

RETURN TO
LOS ANGELES COUNTY SURVEYOR
700 HALL OF RECORDS

Do not extend notes this side of this line

Note: ANY ADDITIONS OR CHANGES ON THIS SHEET MUST BE MADE OR CIRCLED IN Red Ink, WITH DATE AND NAME OF PERSON MAKING CHANGE.

FORM 247 10M 8-31

F.B. 481 Pg. 172

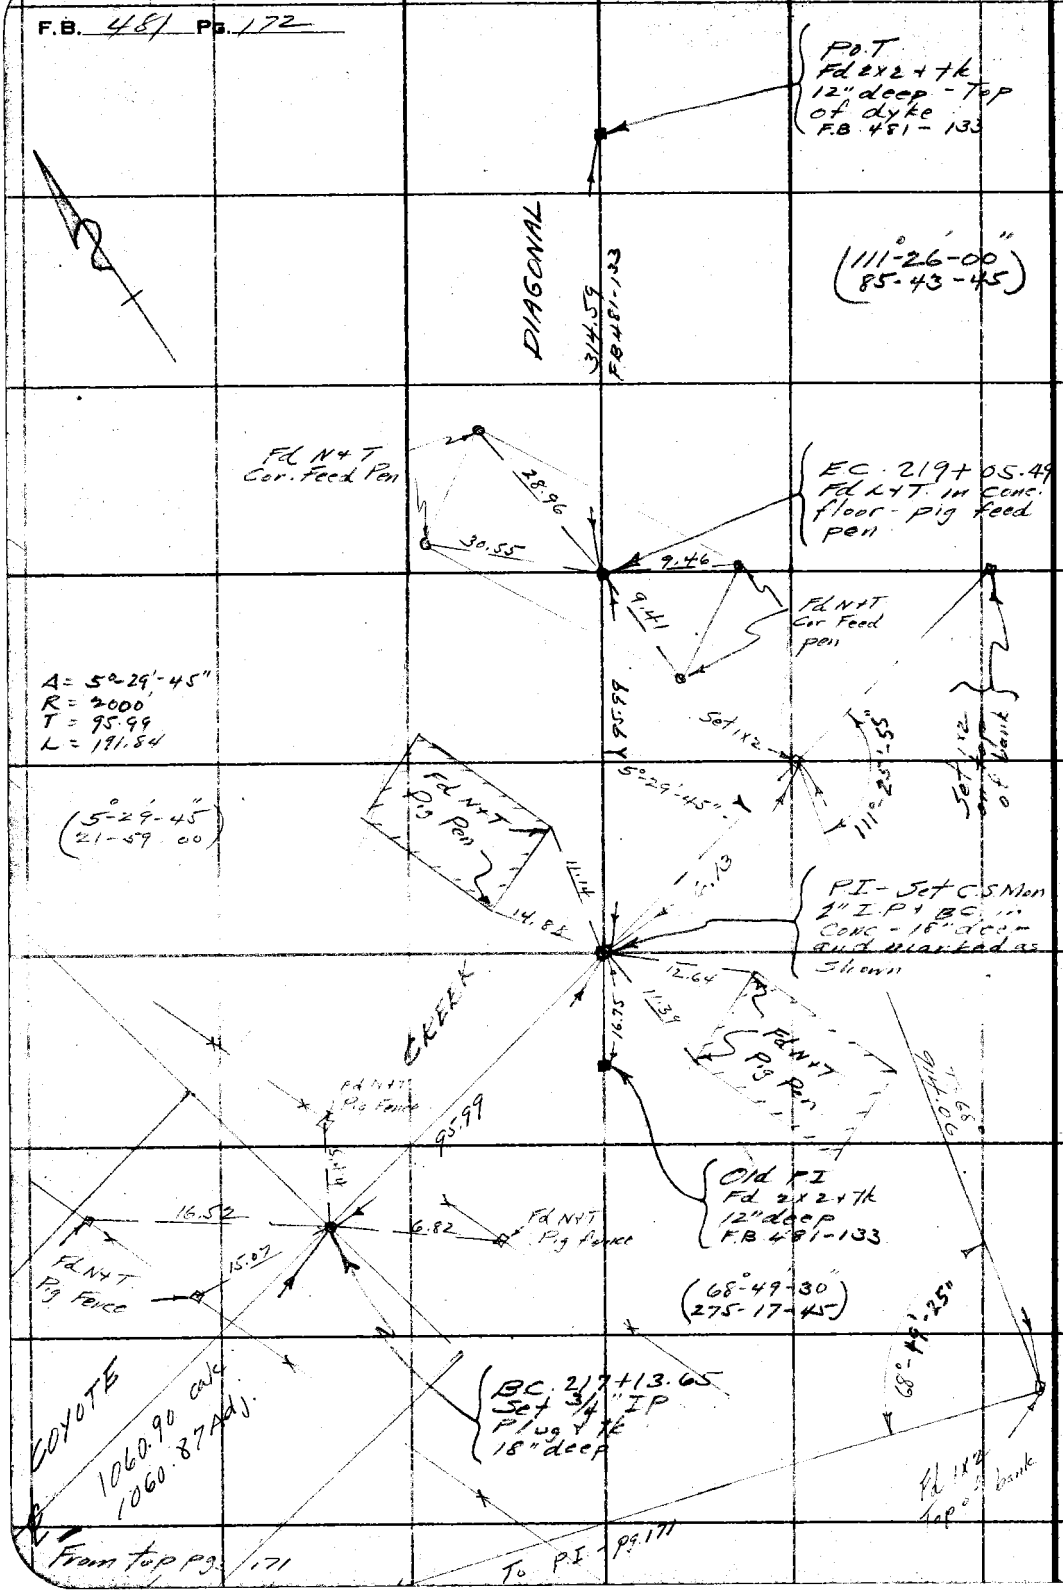

RETURN TO
LOS ANGELES COUNTY SURVEYOR
700 HALL OF RECORDS

Do not extend notes this side of this line

Note: ANY ADDITIONS OR CHANGES ON THIS SHEET MUST BE MADE OR CIRCLED IN Red Ink. WITH DATE AND NAME OF PERSON MAKING CHANGE.

Notes Ck'd by		Survey of Coyote Diag.	F.B. 481 PG. 173
Map No.		W. O. 7995 Tape No 967 St'd 84 OF.	
Office Work		Surveyed by Evans	
Checked		Notes HE Date 8/15/35	
Date		Indexed A. C. Johnson 9-10-35	

COYOTE DIAG.

Line Change from CENTER ST to IMPERIAL HIGWY.

Tape #967 - Normal @ 84°

For old & sec pgs. 43, 44, & 55 to 64.

Evans
Martin
Brock
Verify.

Note: ANY ADDITIONS OR CHANGES ON THIS SHEET MUST BE MADE OR CIRCLED IN Red Ink WITH DATE AND NAME OF PERSON MAKING CHANGE.

Do not extend notes this side of this line

RETURN TO
LOS ANGELES COUNTY SURVEYOR
700 HALL OF RECORDS

FORM 247 BM 2-34

RETURN TO
LOS ANGELES COUNTY SURVEYOR
700 HALL OF RECORDS

Note: ANY ADDITIONS OR CHANGES ON THIS SHEET MUST BE MADE OR CIRCLED IN **Red Ink** WITH DATE AND NAME OF PERSON MAKING CHANGE.

Do not extend notes this side of this line

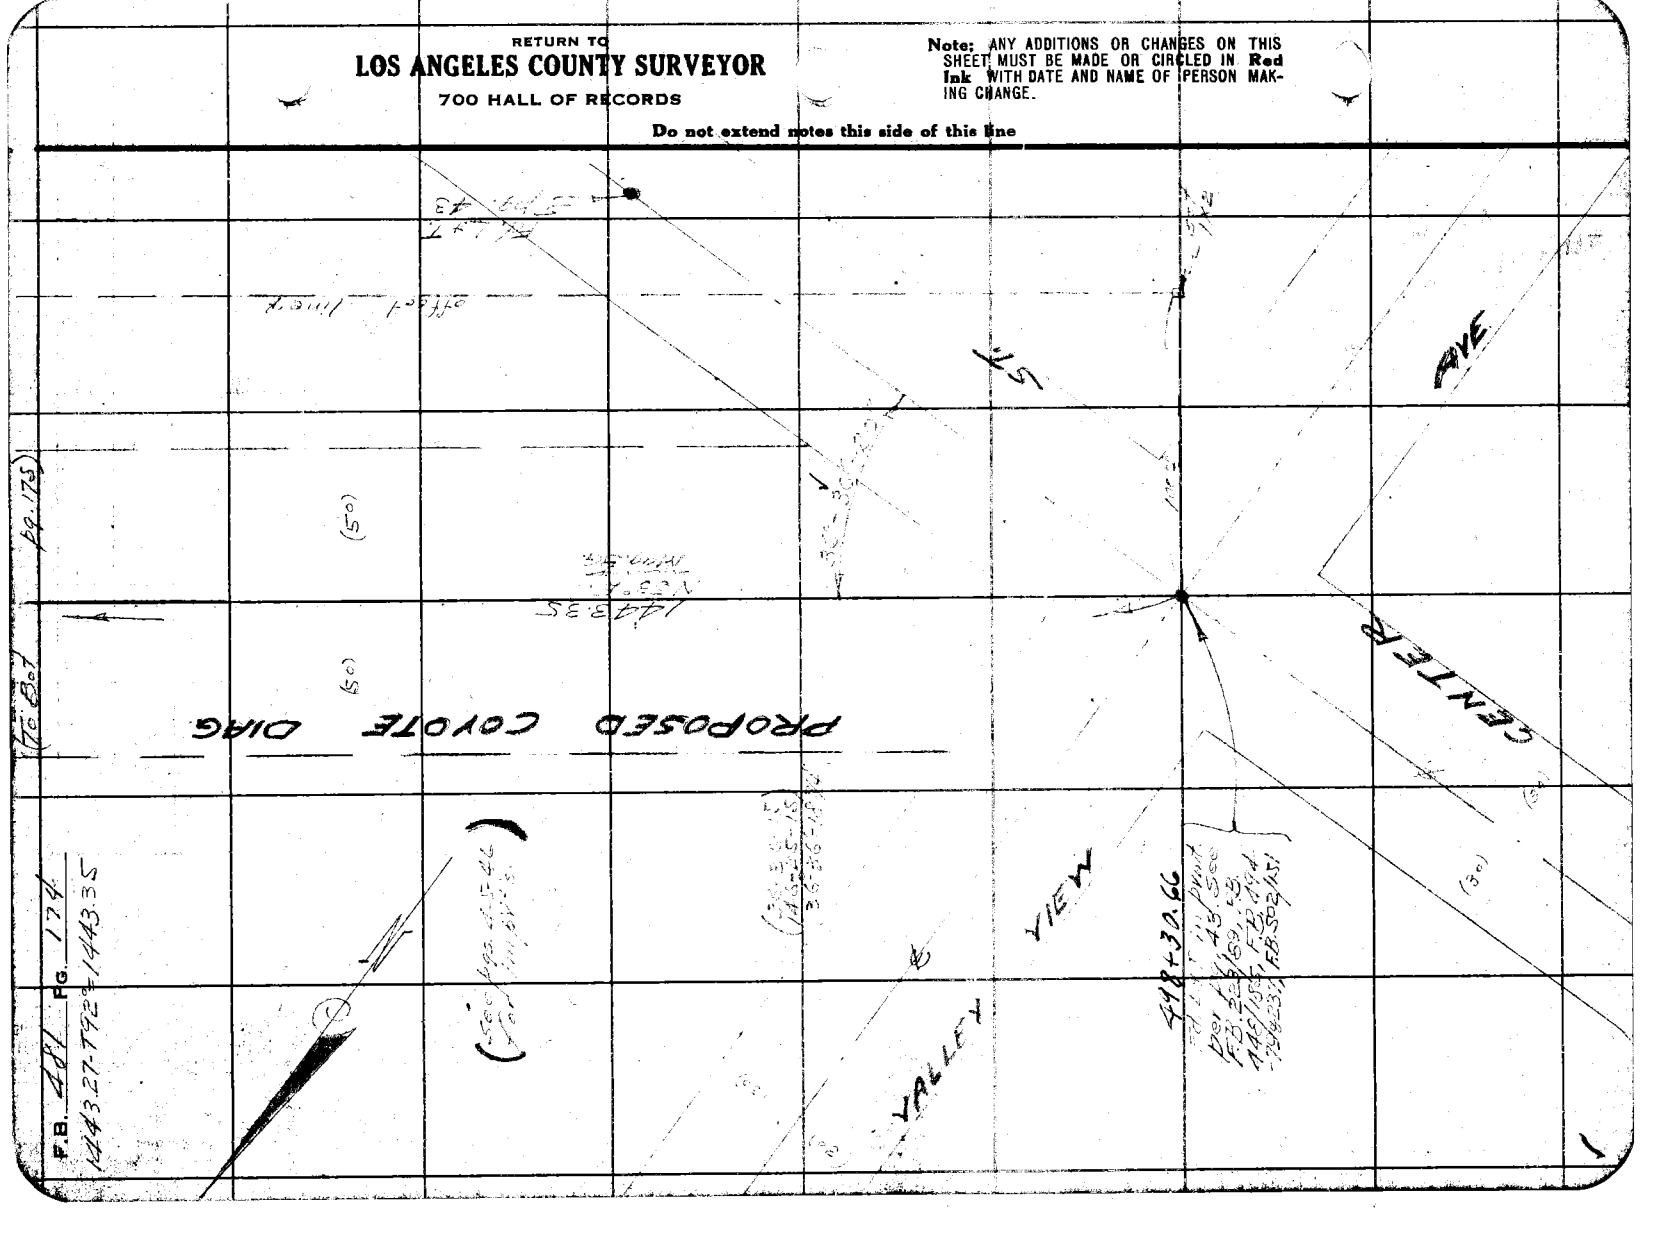

FORM 247 8M 2-34

RETURN TO

LOS ANGELES COUNTY SURVEYOR

700 HALL OF RECORDS

Note: ANY ADDITIONS OR CHANGES ON THIS SHEET MUST BE MADE OR CIRCLED IN **Red Ink** WITH DATE AND NAME OF PERSON MAKING CHANGE.

Do not extend notes this side of this line

Notes Ck'd by Drew

Map No.

Office Work

Checked

Date

Survey of

W. O. Tape No Std

Surveyed by Notes

Indexed Date

F.B. Pg. 175

PROPOSED COYOTE DIAG.

144335

offset Line

(50)

(50)

1227.98

(To Dist. Pg. 176)

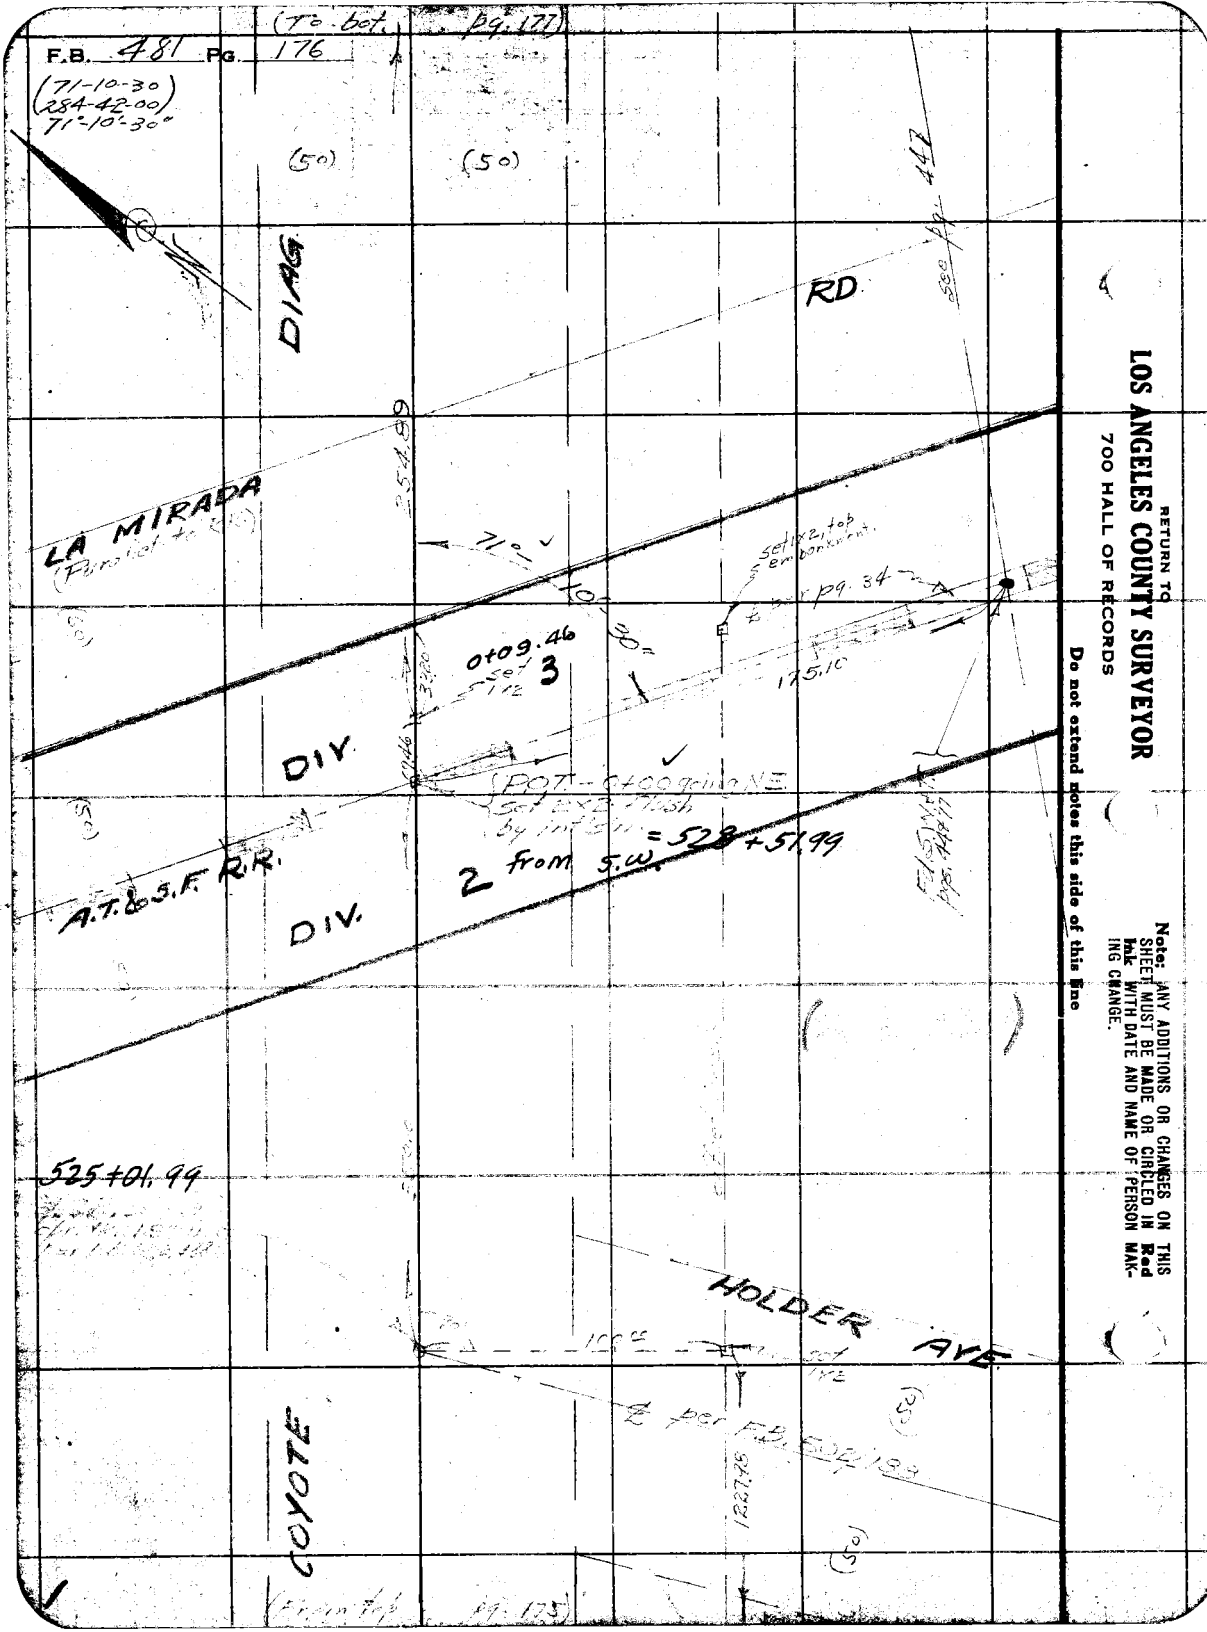

RETURN TO
LOS ANGELES COUNTY SURVEYOR
700 HALL OF RECORDS

Do not extend notes this side of this line

Note: ANY ADDITIONS OR CHANGES ON THIS SHEET MUST BE MADE OR CIRCLED IN **Red Ink** WITH DATE AND NAME OF PERSON MAKING CHANGE.

FORM 247 5M 2-34

RETURN TO

LOS ANGELES COUNTY SURVEYOR

700 HALL OF RECORDS

Note: ANY ADDITIONS OR CHANGES ON THIS SHEET MUST BE MADE OR CIRCLED IN **Red Ink** WITH DATE AND NAME OF PERSON MAKING CHANGE.

Do not extend notes this side of this line

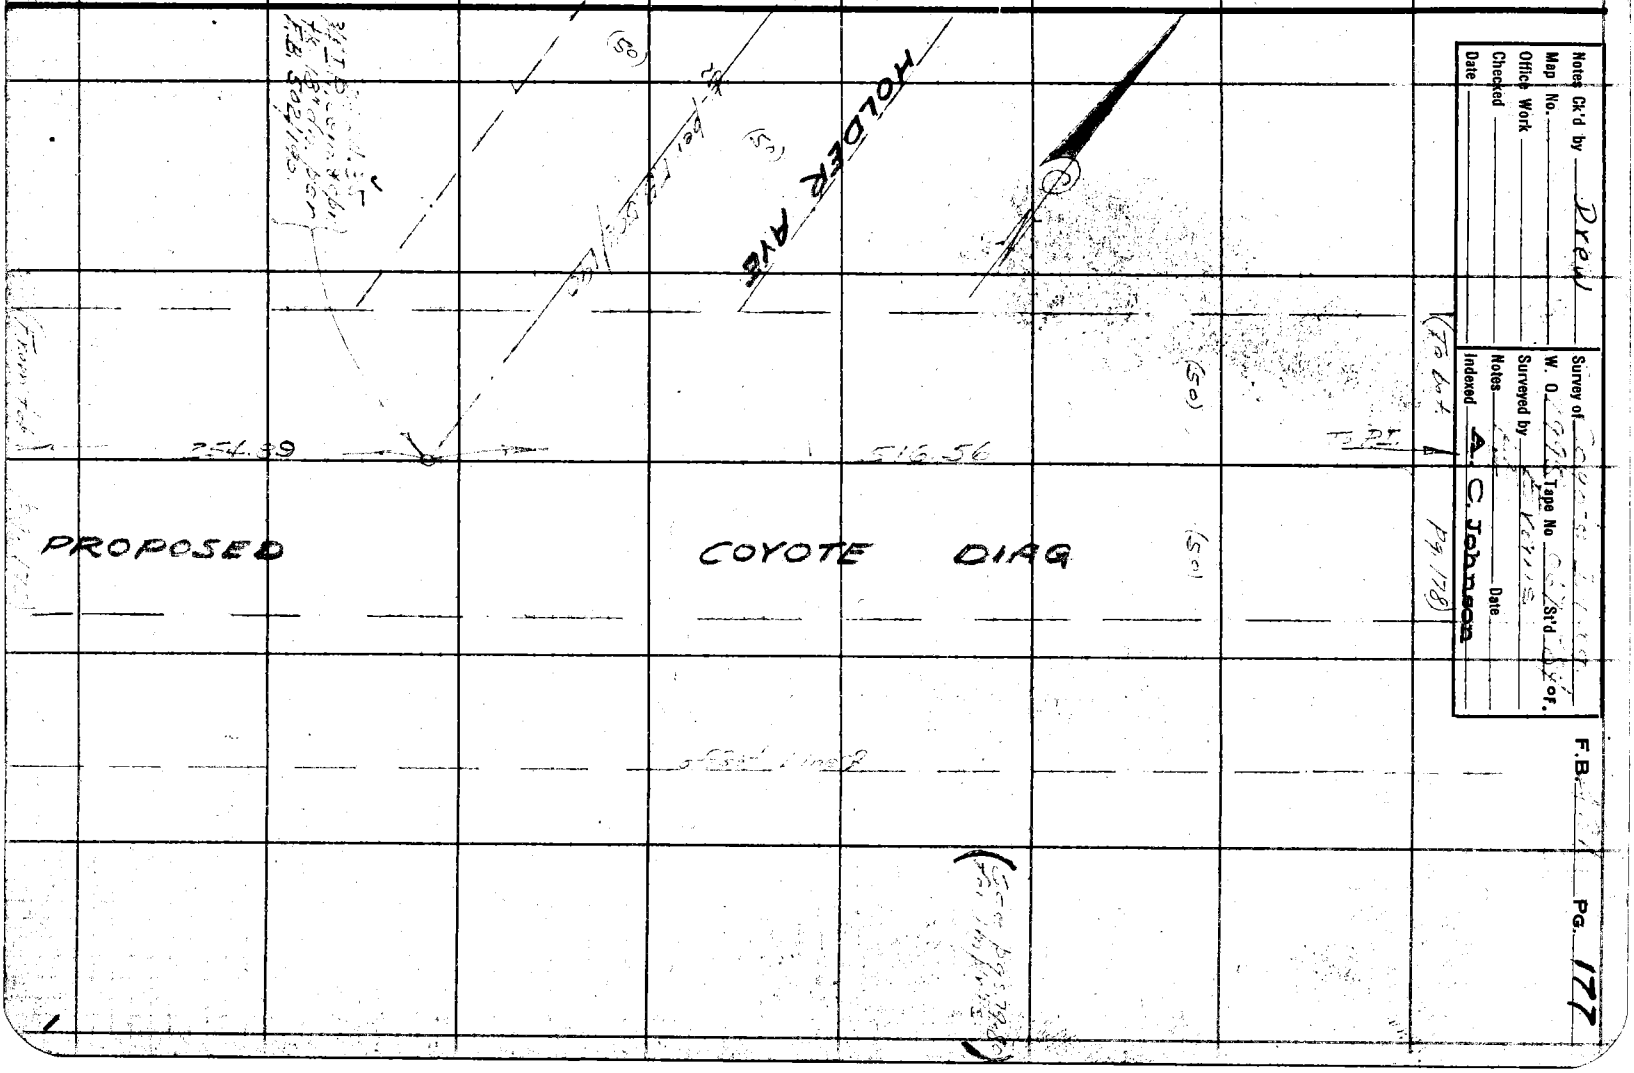

Notes Ck'd by Drew

Map No.

Office Work

Checked

Date

Survey of

W. O. Tape No

Surveyed by Ck'd by

Notes

Date

Indexed A. C. Johnson

F.B. Pg. 177

RETURN TO
LOS ANGELES COUNTY SURVEYOR
700 HALL OF RECORDS

Note: ANY ADDITIONS OR CHANGES ON THIS SHEET MUST BE MADE OR CIRCLED IN **Red Ink** WITH DATE AND NAME OF PERSON MAKING CHANGE.

Do not extend notes this side of this line

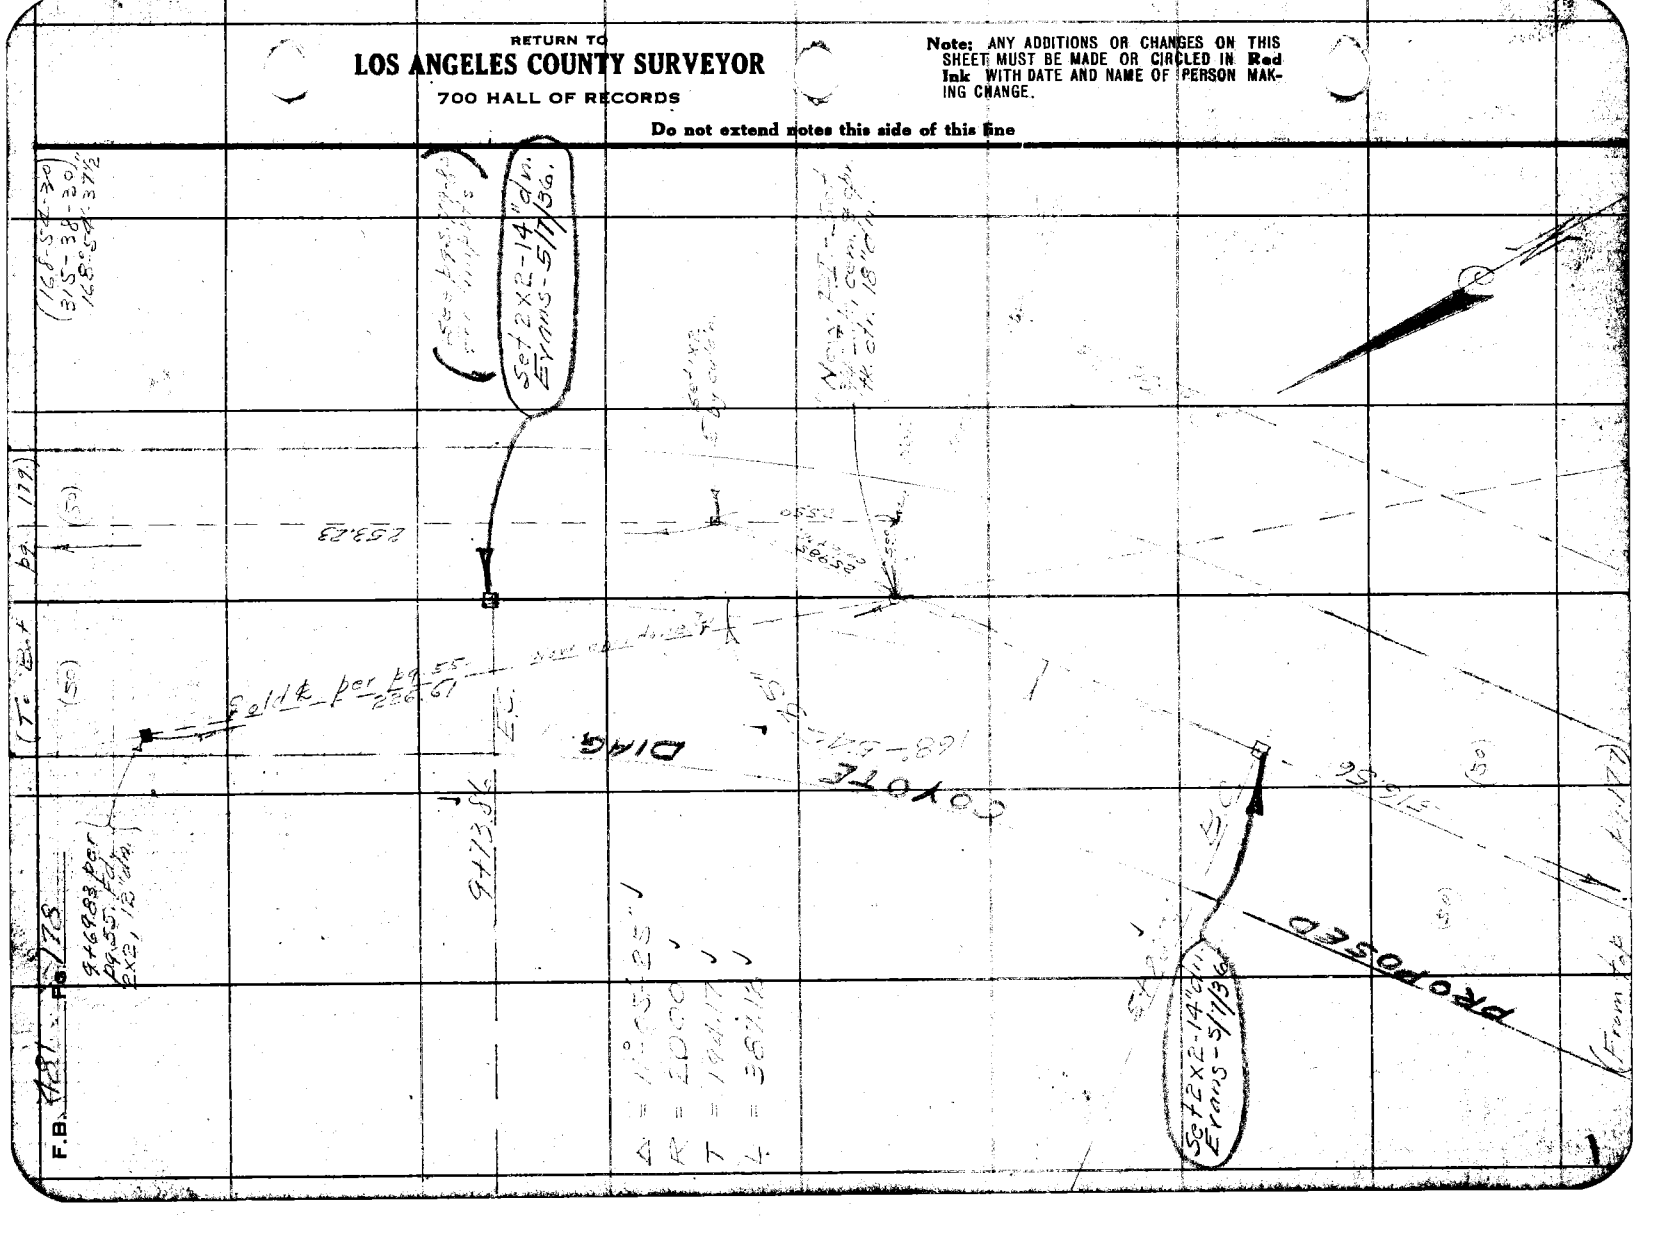
Set 2X2-14" Grvs. Evans-5/1/36
Set 2X2-14" Grvs. Evans-5/1/36
PROPOSED

FORM 247 5M 2-34

RETURN TO
LOS ANGELES COUNTY SURVEYOR
700 HALL OF RECORDS

Note: ANY ADDITIONS OR CHANGES ON THIS SHEET MUST BE MADE OR CIRCLED IN **Red Ink** WITH DATE AND NAME OF PERSON MAKING CHANGE.

Do not extend notes this side of this line

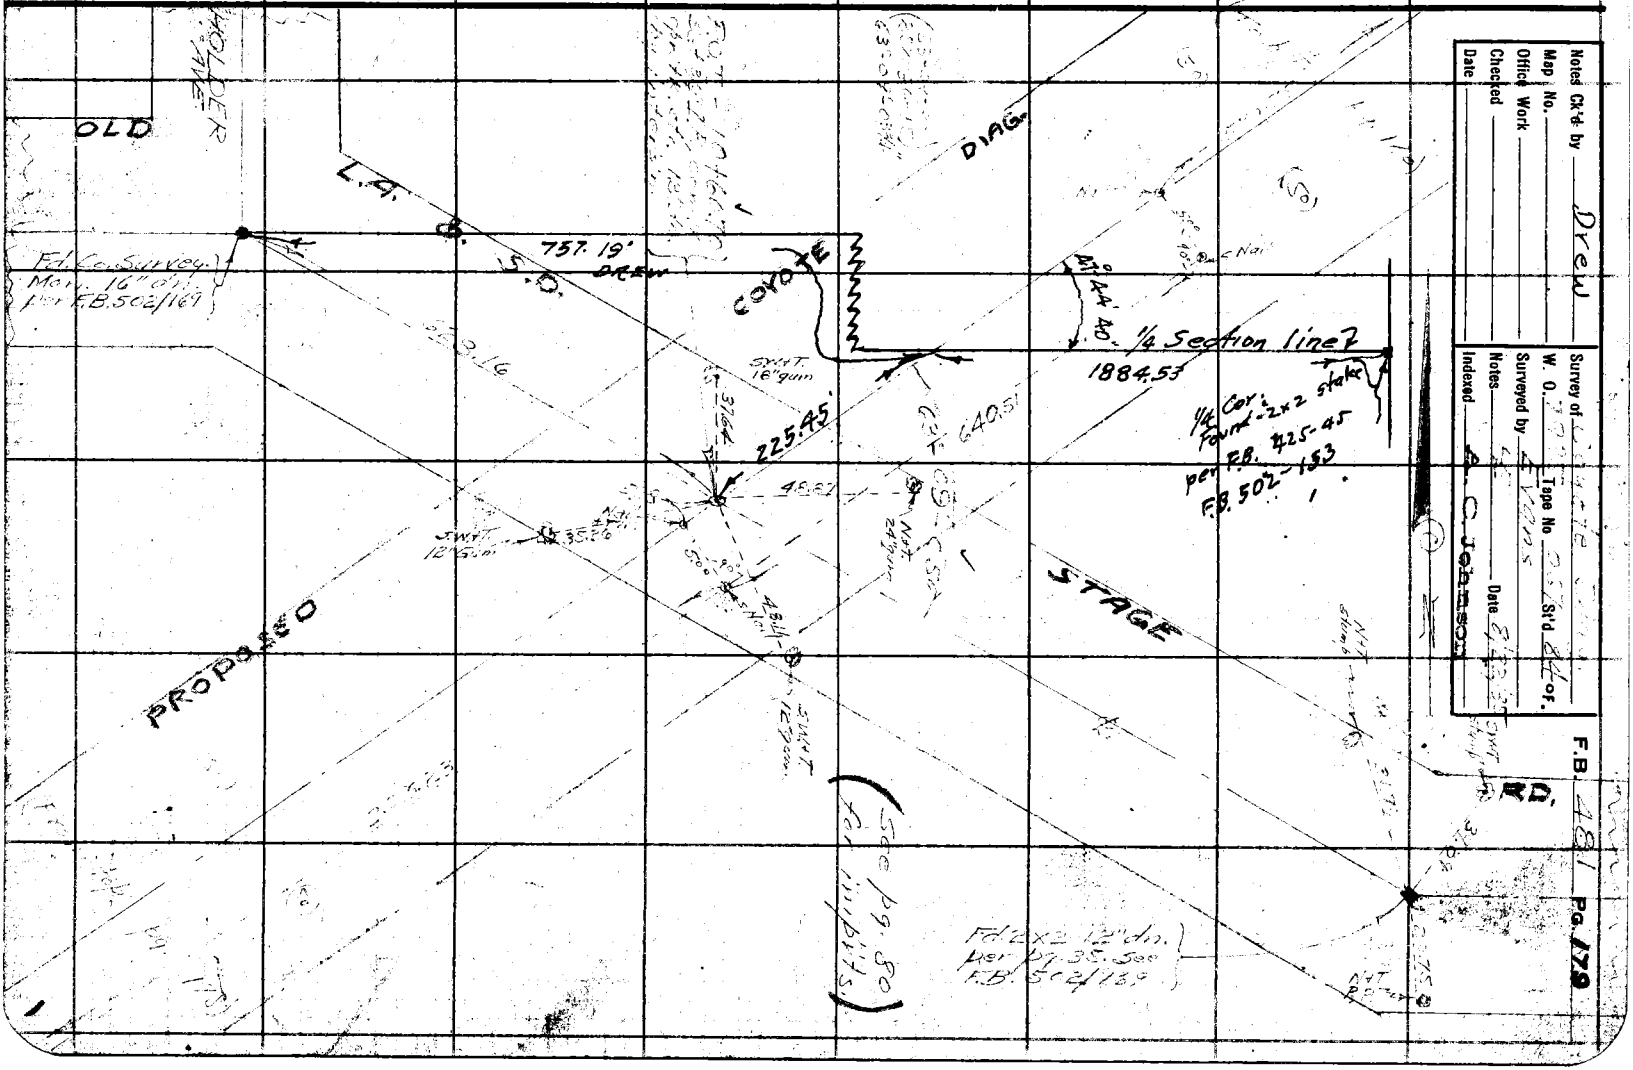

Noted Ck'd by Drew
Map No.
Office Work
Checked
Date

Survey of
W. O. Tape No Std
Surveyed by
Notes Date
Indexed A. C. Johnson

F.B. 481 PG. 179

RETURN TO
LOS ANGELES COUNTY SURVEYOR
700 HALL OF RECORDS

Note: ANY ADDITIONS OR CHANGES ON THIS SHEET MUST BE MADE OR CIRCLED IN **Red Ink** WITH DATE AND NAME OF PERSON MAKING CHANGE.

Do not extend notes this side of this line

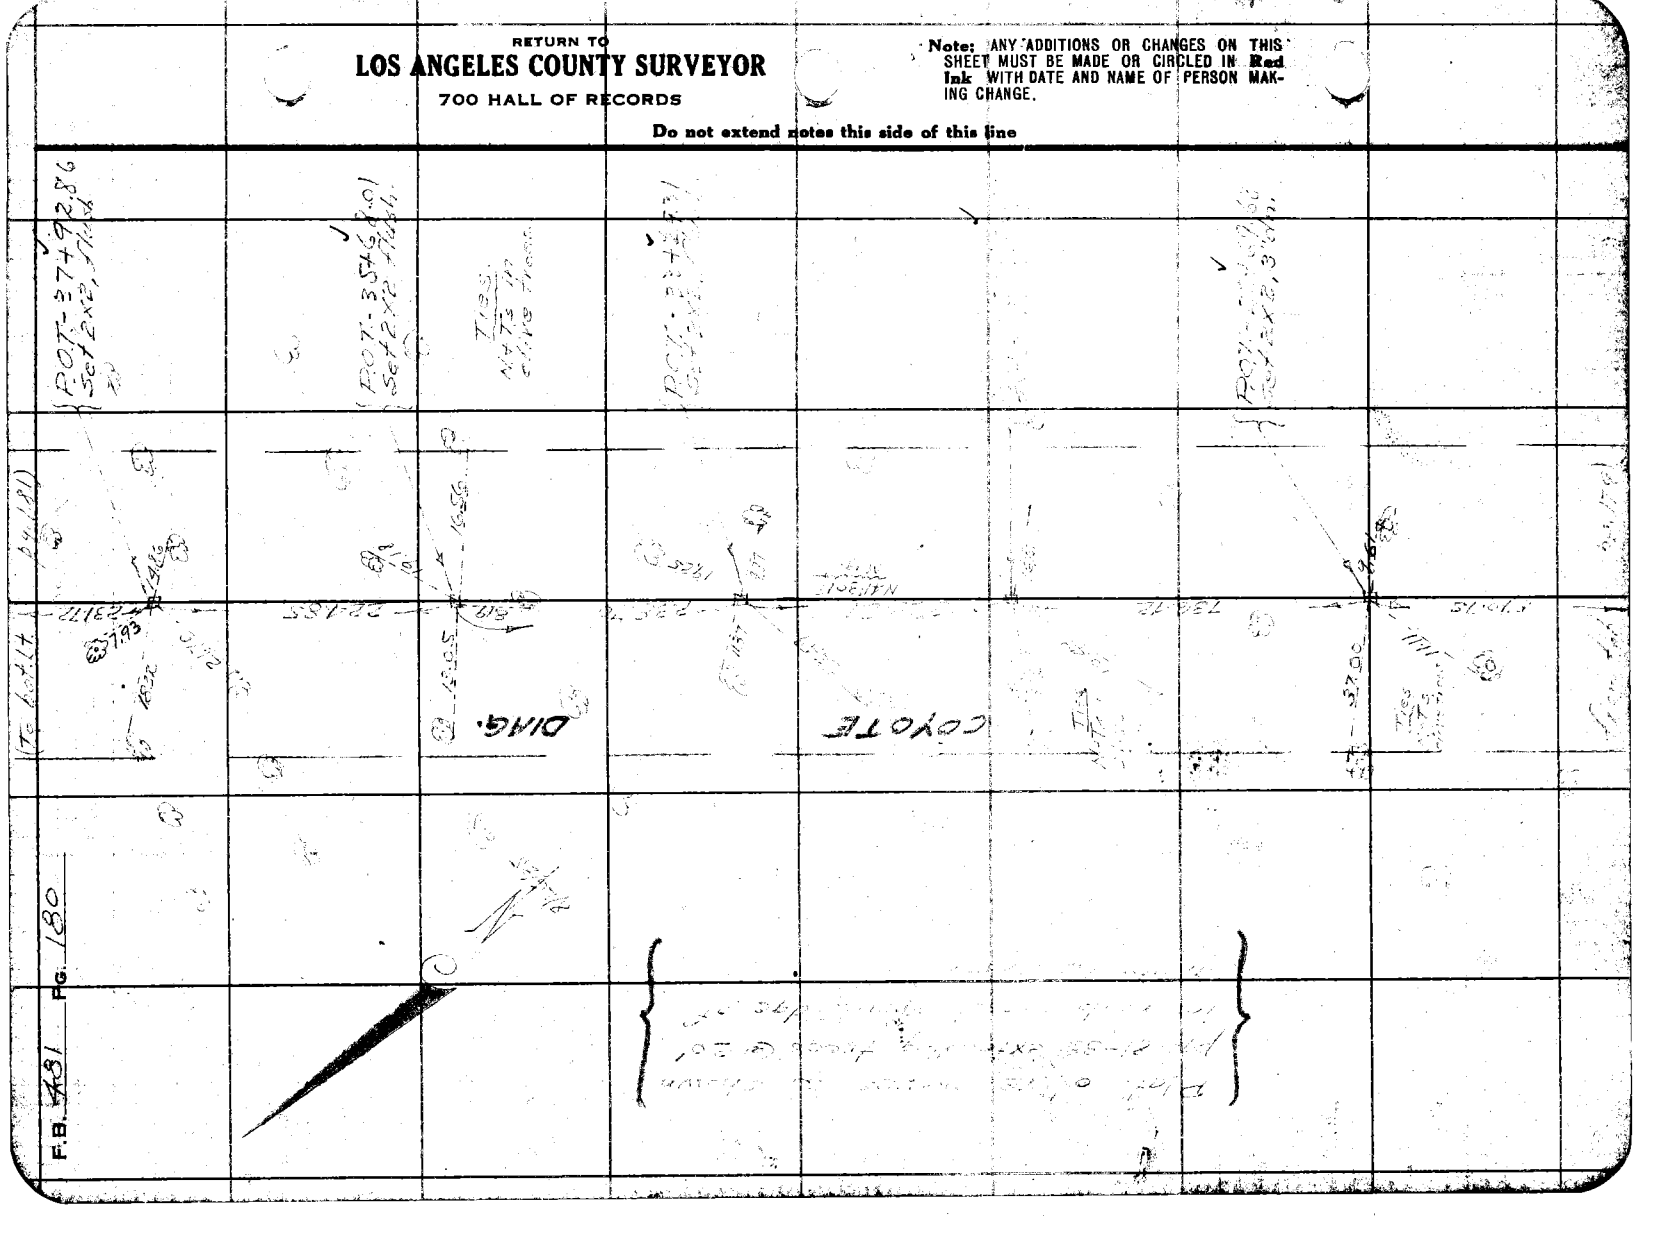

F.B. 1481 PG. 180

FORM 247 5M 2-34

RETURN TO
LOS ANGELES COUNTY SURVEYOR
700 HALL OF RECORDS

Note: ANY ADDITIONS OR CHANGES ON THIS SHEET MUST BE MADE OR CIRCLED IN Red Ink WITH DATE AND NAME OF PERSON MAKING CHANGE.

Do not extend notes this side of this line

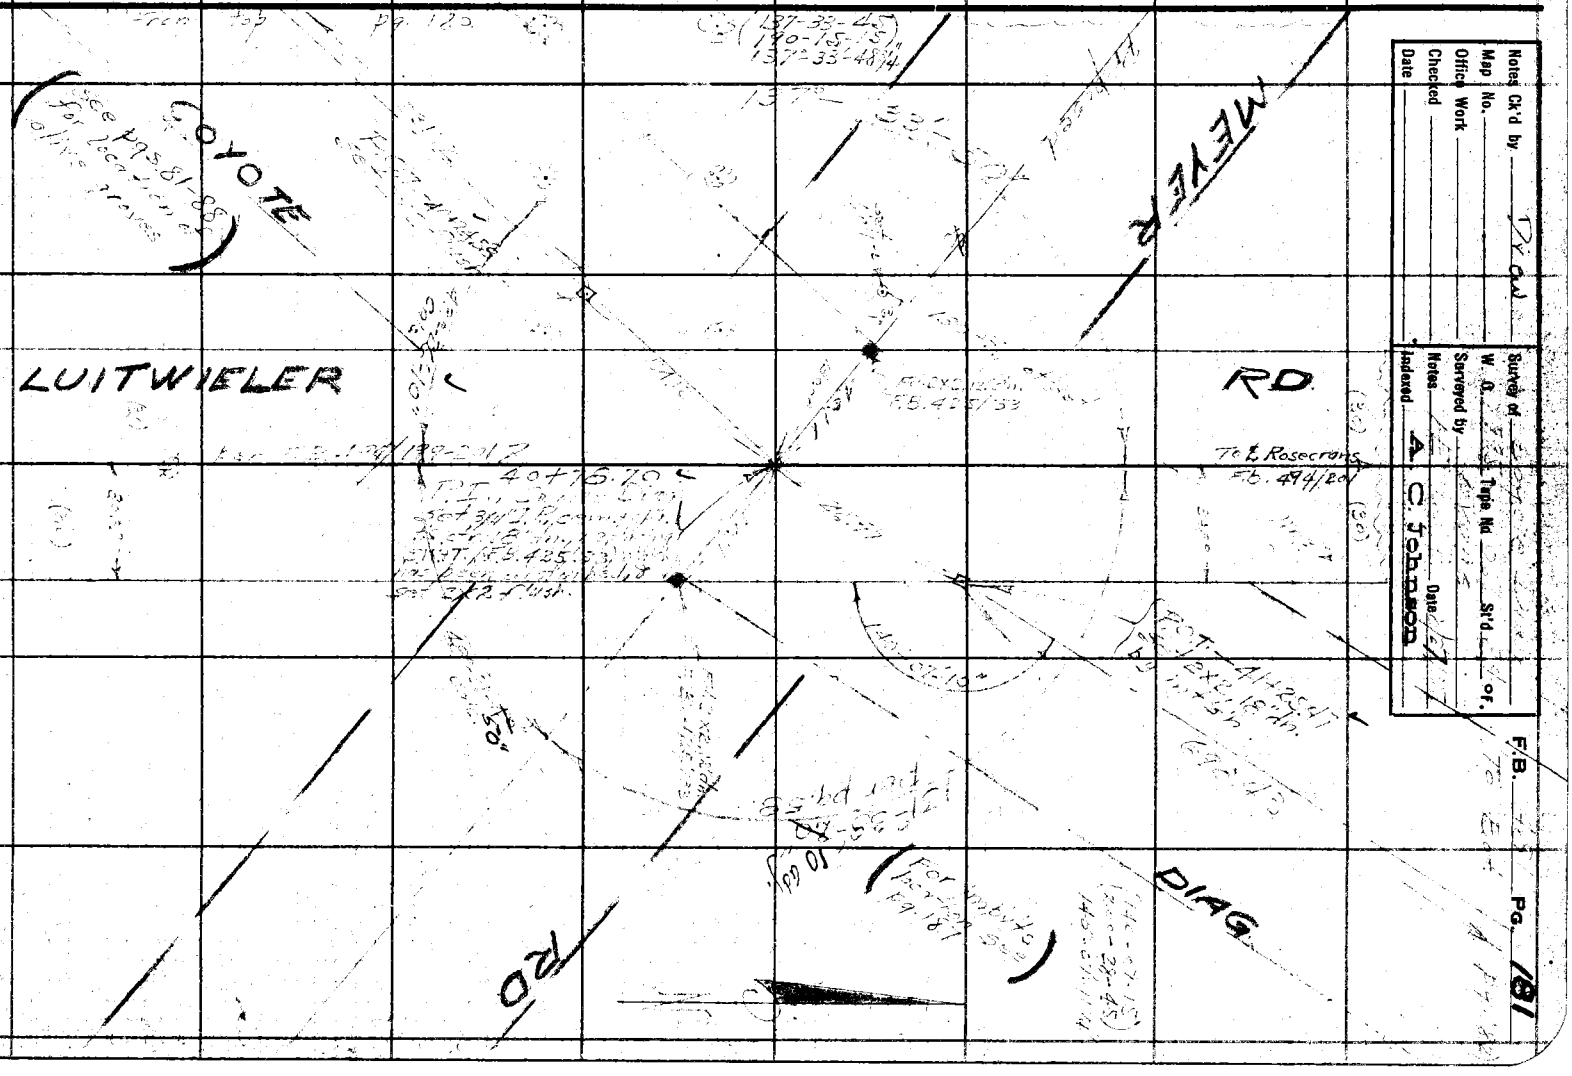
COYOTE
MEYER
LUITWIELER
RD.
DIAG.
RD
T. E. Rosecrans
F.B. 494/201
Pg. 120
See Pgs 81-83 for location of line & ties
Tie
Tie
Tie

RETURN TO
LOS ANGELES COUNTY SURVEYOR
700 HALL OF RECORDS

Note: ANY ADDITIONS OR CHANGES ON THIS SHEET MUST BE MADE OR CIRCLED IN **Red Ink** WITH DATE AND NAME OF PERSON MAKING CHANGE.

Do not extend notes this side of this line

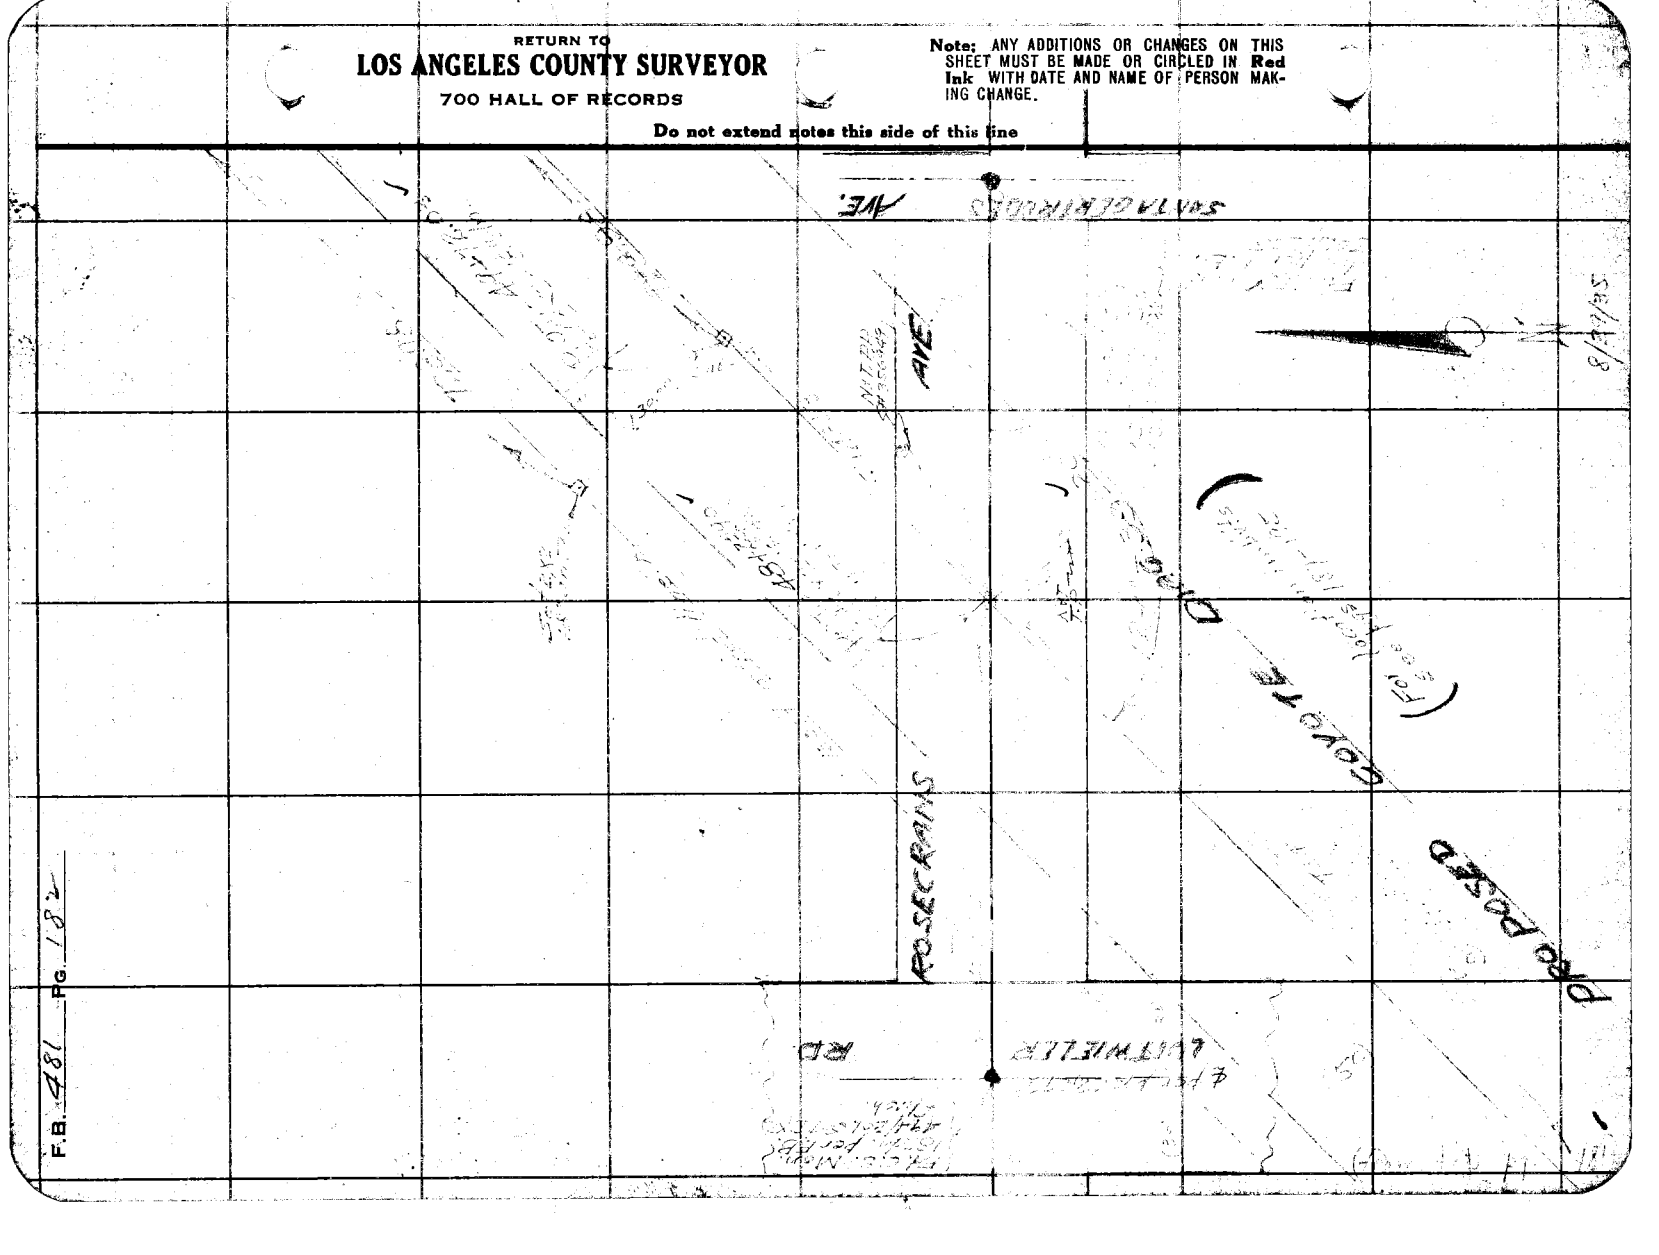

FORM 247 5M 2-34

RETURN TO
LOS ANGELES COUNTY SURVEYOR
700 HALL OF RECORDS

Note: ANY ADDITIONS OR CHANGES ON THIS SHEET MUST BE MADE OR CIRCLED IN **Red Ink** WITH DATE AND NAME OF PERSON MAKING CHANGE.

Do not extend notes this side of this line

Notes Ck'd by Drew
Map No.
Office Work
Checked
Date

Survey of Coyote Diag
W. O. 7253 Tape No 27 St'd 66 ft. of.
Surveyed by E. Kraus
Notes
Indexed A. C. Johnson Date 2-13-63

F.B. 487 Pg. 183

VR & RR-T 53°= 728.92

65 ft. - T 7½° - 68.62

1435.24-T 74°=1438.15

7258.92

1435.15

N37-30E
Mag. By.

PROPOSED COYOTE DIAG.

(For location see Sht. 16)

(POT-63+81.23
Set 2x2, 15" down)

RETURN TO
LOS ANGELES COUNTY SURVEYOR
700 HALL OF RECORDS

Note: ANY ADDITIONS OR CHANGES ON THIS SHEET MUST BE MADE OR CIRCLED IN **Red Ink** WITH DATE AND NAME OF PERSON MAKING CHANGE.

Do not extend notes this side of this line

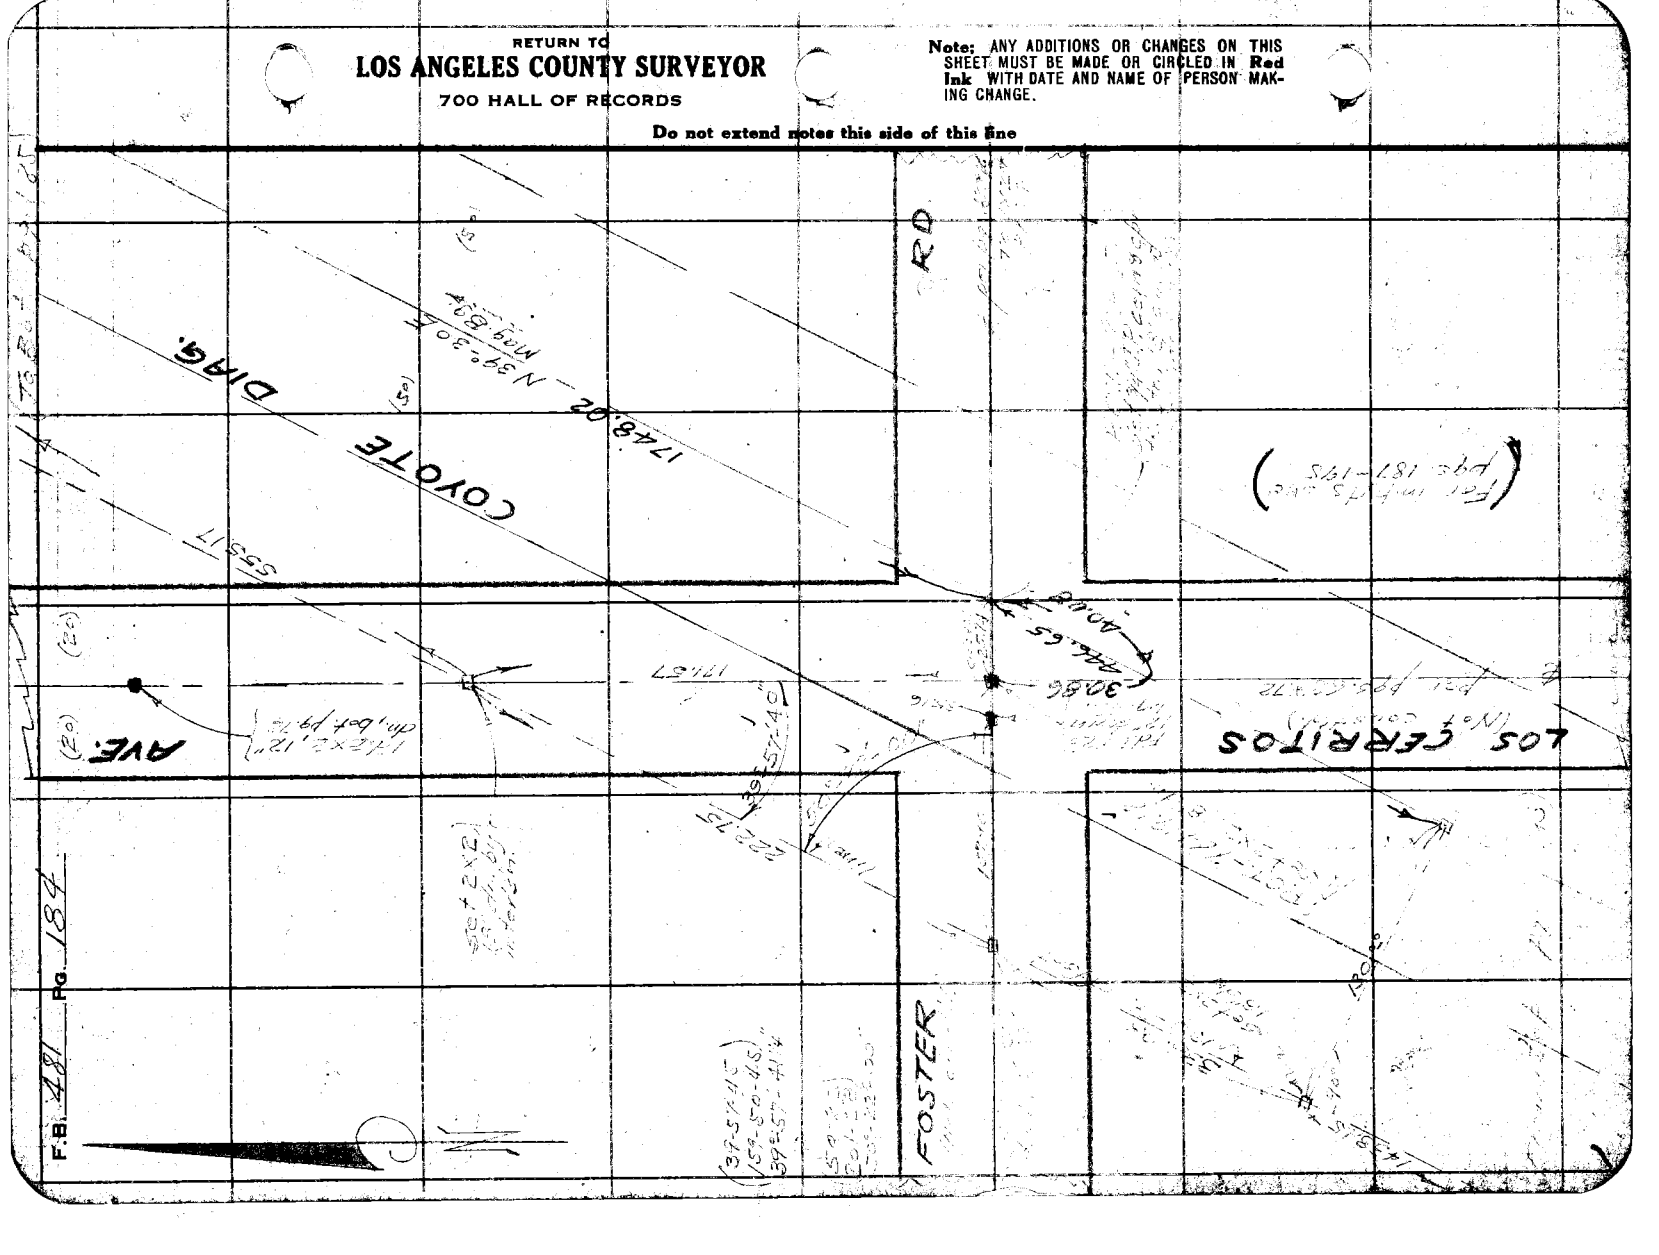
RD
COYOTE DIAG.
AVE.
FOSTER
LOS CERRITOS
1748.02 - N39°-30'E
Proj. Bdy.
(Pol. Inf. Ds. Sec. Pge. 187-195)
30.86
244.65
Adopted
117.57
S57°40'E
122.72
S39°57'45"E
(S39°57'45"E 159.50 M.S.)
S39°57'45"E 41.14'

FORM 247 5M 2-34

RETURN TO
LOS ANGELES COUNTY SURVEYOR
700 HALL OF RECORDS

Note: ANY ADDITIONS OR CHANGES ON THIS SHEET MUST BE MADE OR CIRCLED IN **Red Ink** WITH DATE AND NAME OF PERSON MAKING CHANGE.

Do not extend notes this side of this line

P.O.T. Set 2x2 - 18" Galv.

595.11

COYOTE

DIAG.

1748.02'

135.93

P.O.T. Set 2x2 - 18" Galv.

1503.93

P.O.T. - 19711385 Set 2x2, 18" Galv.

(For Graphic Sec Page 187-195)

Notes Ck'd by RV & W

Map No.

Office Work

Checked

Date

Survey of Coyote Diag.

W.O. 2733 Tape No 927 St'd 14' OF.

Surveyed by E Keyes

Notes

Date 9/3/35

Indexed

Checked A. C. Johnson

F.B. 428 Pg. 185

RETURN TO
LOS ANGELES COUNTY SURVEYOR
700 HALL OF RECORDS

Note: ANY ADDITIONS OR CHANGES ON THIS SHEET MUST BE MADE OR CIRCLED IN **Red Ink** WITH DATE AND NAME OF PERSON MAKING CHANGE.

Do not extend notes this side of this line

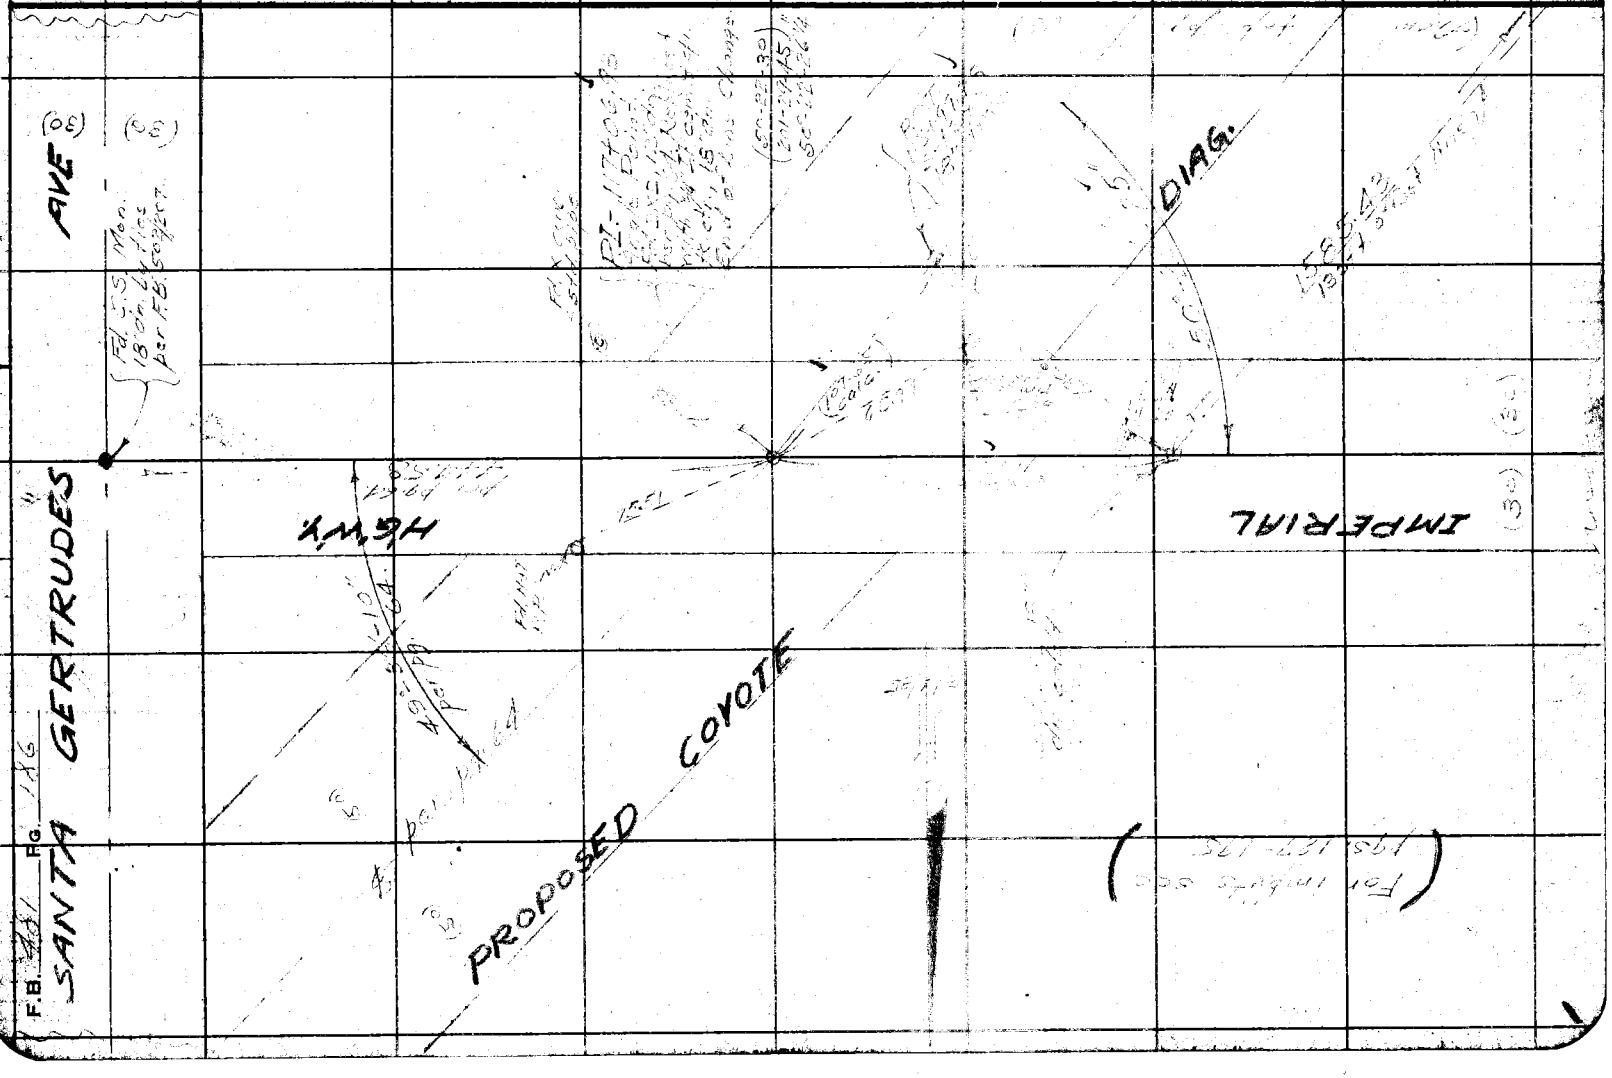

Notes Ck'd by	Trew	Survey of	COYOTE CREEK
Map No.		W. O.	7325
Office Work		Tape No.	St'd ___ OF.
Checked		Surveyed by	EVANS
Date		Notes	BIELA Date 9-5-35
		Indexed	A. C. Johnson


Note: ANY ADDITIONS OR CHANGES ON THIS SHEET MUST BE MADE OR CIRCLED IN Red Ink WITH DATE AND NAME OF PERSON MAKING CHANGE.

Do not extend notes this side of this line

RETURN TO
LOS ANGELES COUNTY SURVEYOR
700 HALL OF RECORDS

FORM 247 BM 2-34

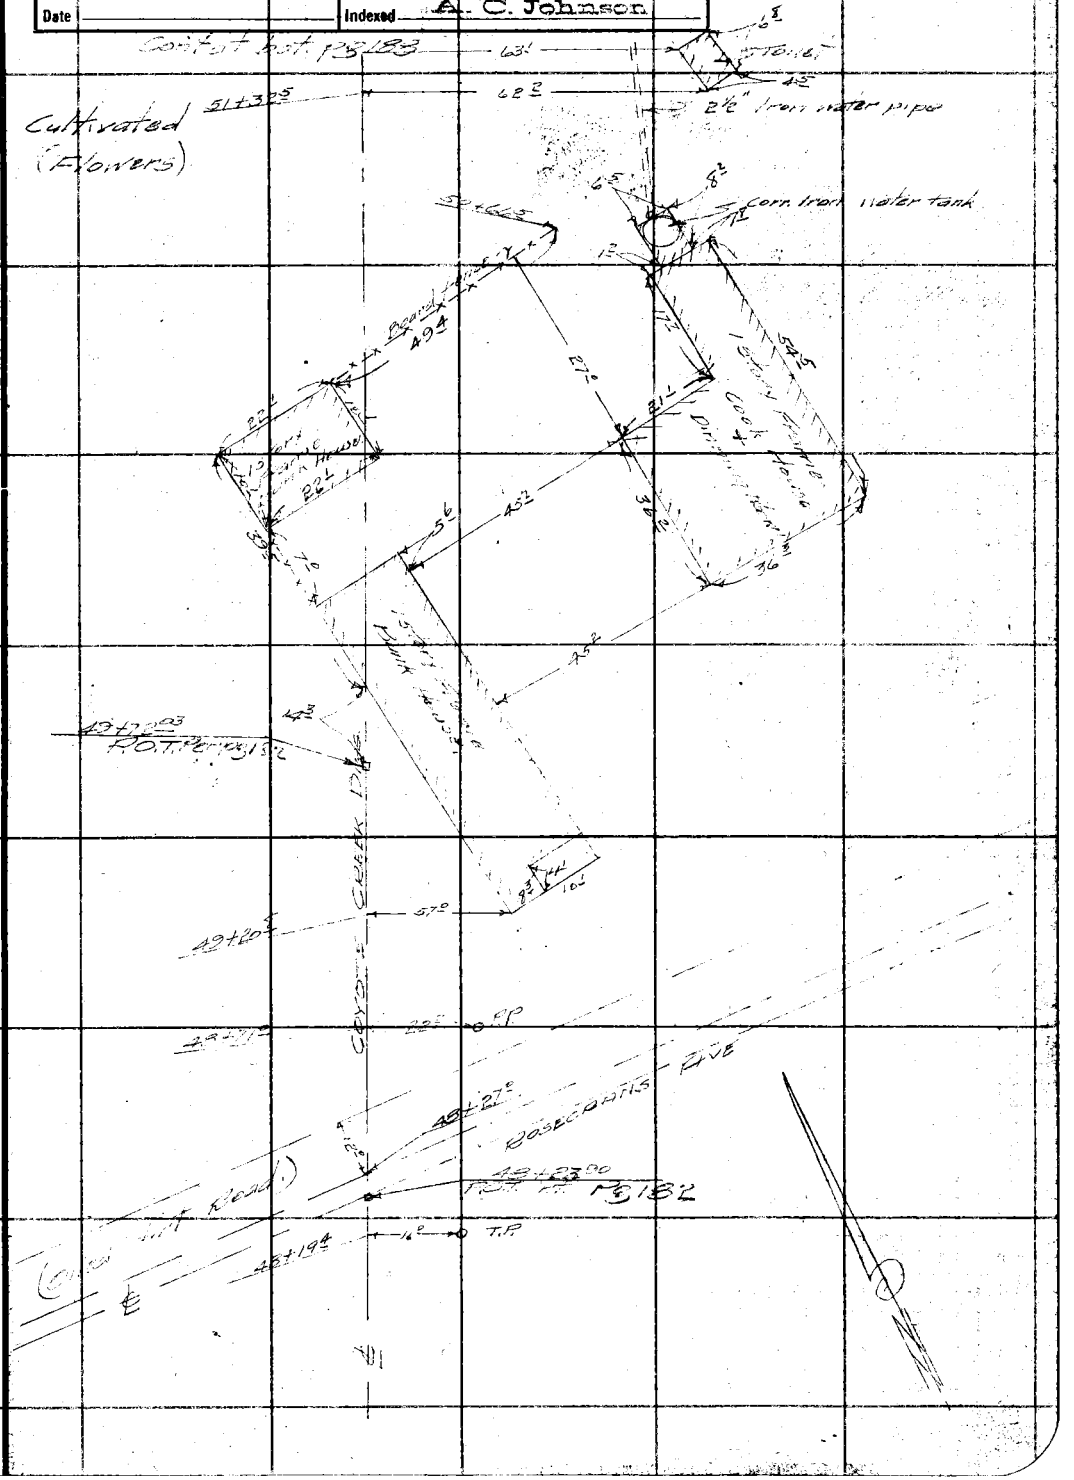

RETURN TO

LOS ANGELES COUNTY SURVEYOR

700 HALL OF RECORDS

Note; ANY ADDITIONS OR CHANGES ON THIS SHEET MUST BE MADE OR CIRCLED IN Ink WITH DATE AND NAME OF PERSON MAKING CHANGE.

Do not extend notes this side of this line

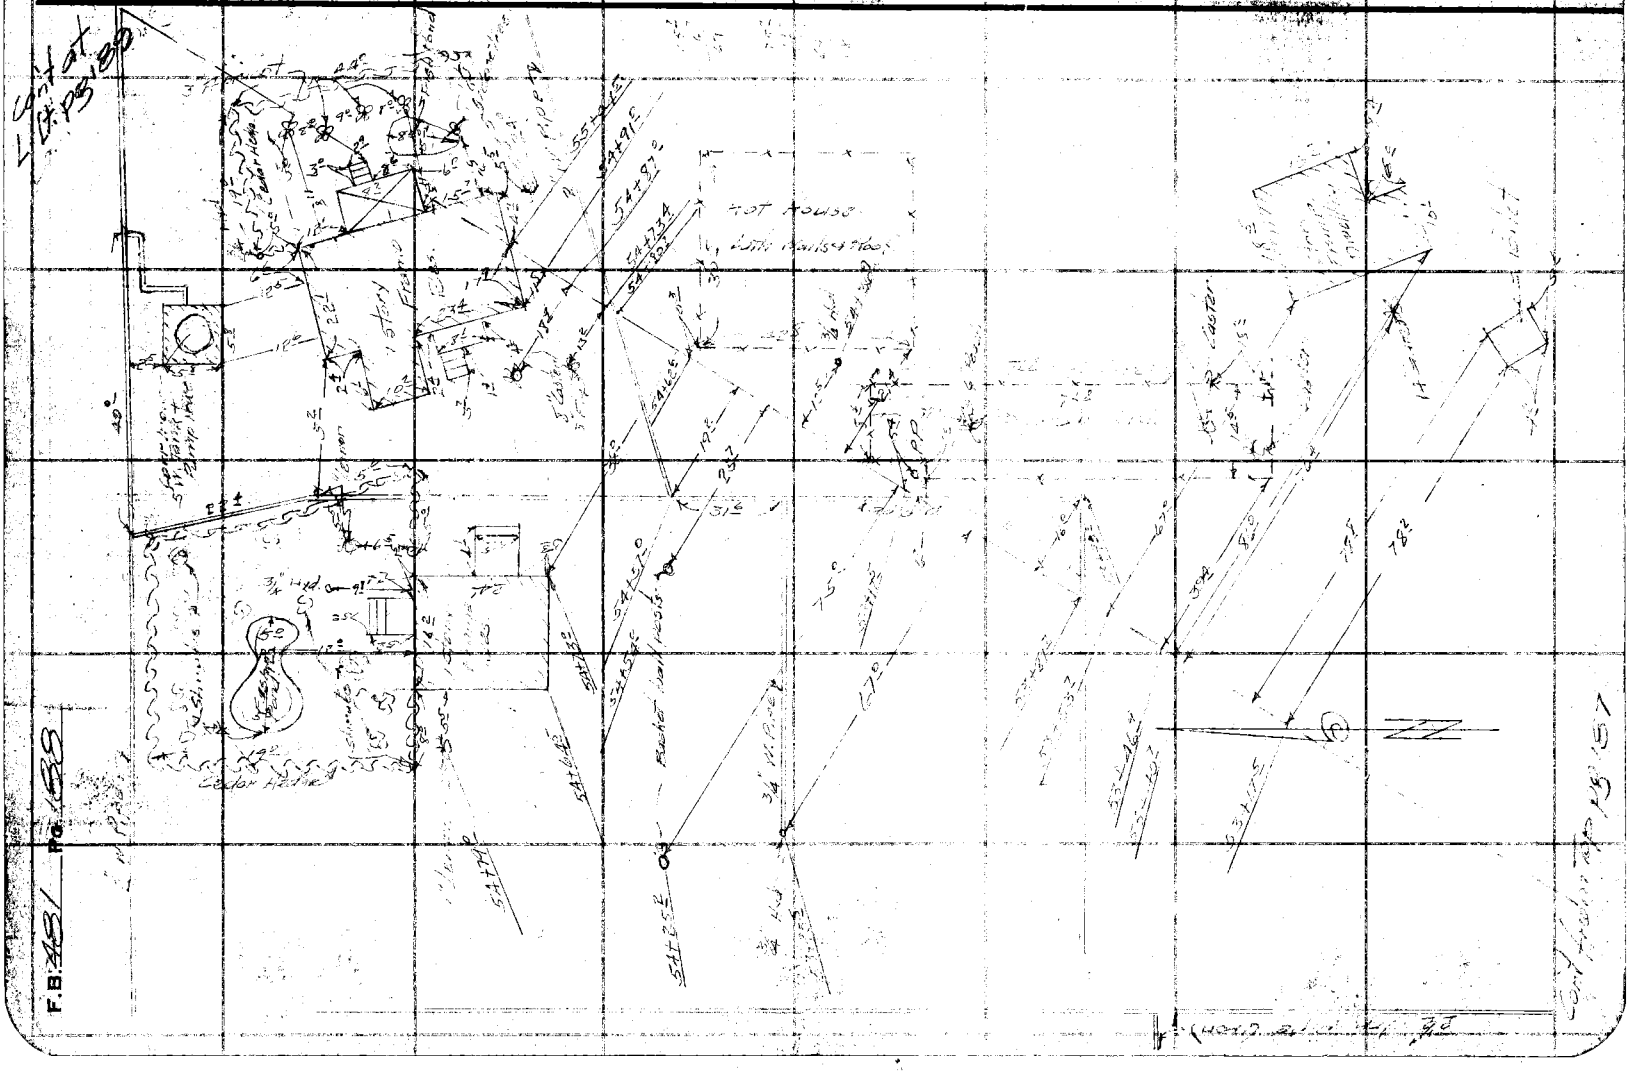

Notes Ck'd by	Drew	Survey of	COYOTE CREEK D.M.G.
Map No.		W. O.	7925
Office Work		Tape No	St'd °F.
Checked		Surveyed by	E. Davis
Date		Notes	Brock Date 9-5-35
		Indexed	A. C. Johnson

F. B. 481 Pg. 189

Note: ANY ADDITIONS OR CHANGES ON THIS SHEET MUST BE MADE OR CIRCLED IN Red Ink WITH DATE AND NAME OF PERSON MAKING CHANGE.

Do not extend notes this side of this line

RETURN TO
LOS ANGELES COUNTY SURVEYOR
700 HALL OF RECORDS

FORM 347 BM 2-34

RETURN TO

LOS ANGELES COUNTY SURVEYOR

700 HALL OF RECORDS

Note; ANY ADDITIONS OR CHANGES ON THIS SHEET MUST BE MADE OR CIRCLED IN Red Ink WITH DATE AND NAME OF PERSON MAKING CHANGE.

Do not extend notes this side of this line

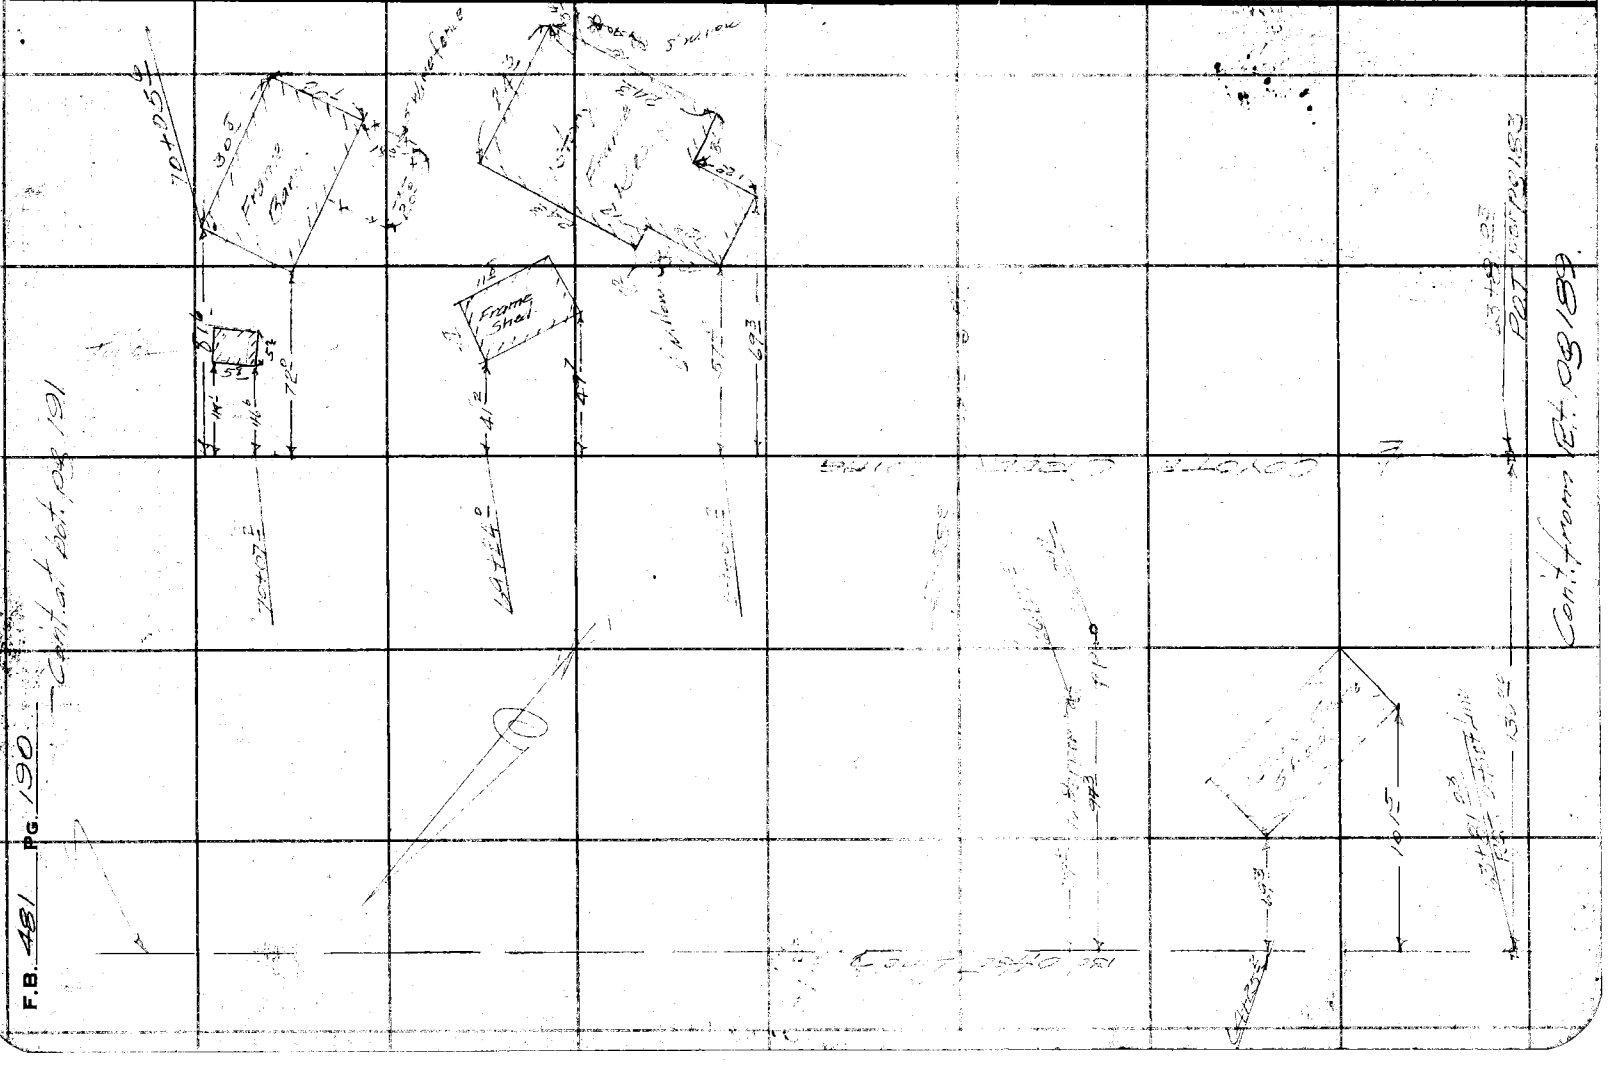

Notes Ck'd by Drew		Survey of COYOTE CREEK DIKE	F.B. 481 Pg. 191
Map No.		W. O. 7992 Tape No St'd of.	
Office Work		Surveyed by EVANS	
Checked		Notes PINCK Date 9-4-35	
Date		Indexed A. C. Johnson	

Cont. of Lt. Pg 192

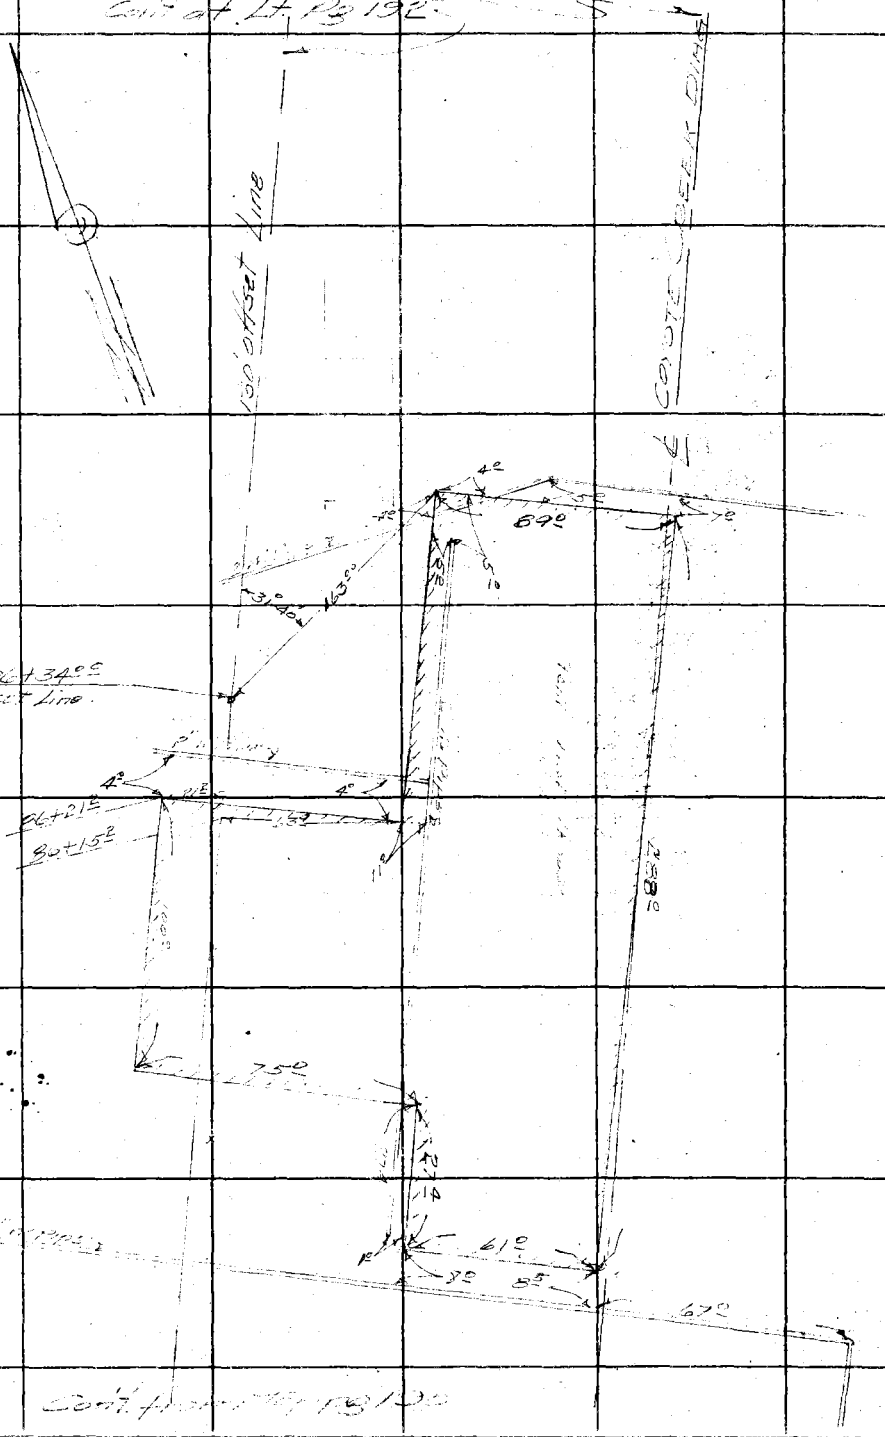

Cont. from Pg 193

Notes: ANY ADDITIONS OR CHANGES ON THIS SHEET MUST BE MADE OR CIRCLED IN Red Ink WITH DATE AND NAME OF PERSON MAKING CHANGE.

Do not extend notes this side of this line

LOS ANGELES COUNTY SURVEYOR

700 HALL OF RECORDS

FORM 247 SM 2-34

RETURN TO

LOS ANGELES COUNTY SURVEYOR

700 HALL OF RECORDS

Note: ANY ADDITIONS OR CHANGES ON THIS SHEET MUST BE MADE OR CIRCLED IN **Red Ink** WITH DATE AND NAME OF PERSON MAKING CHANGE.

Do not extend notes this side of this line

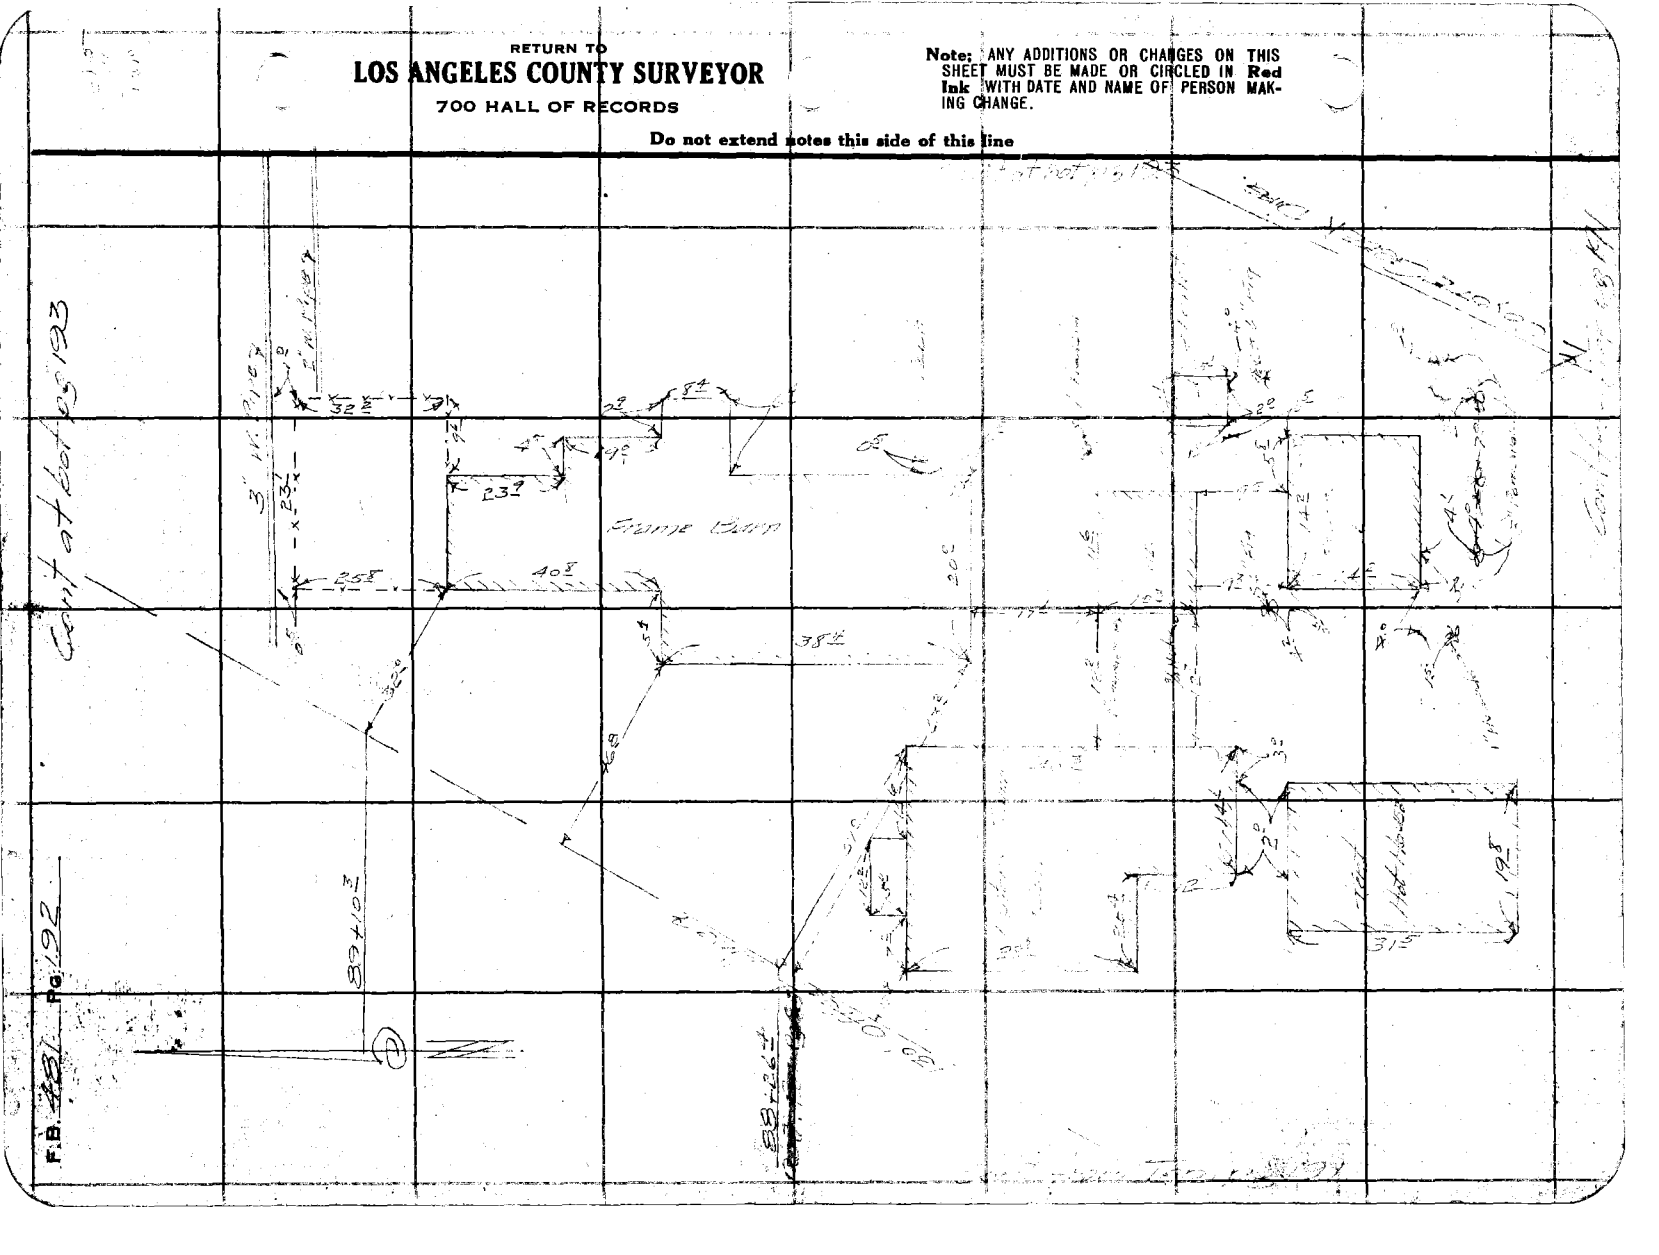

Notes Ck'd by DRW	Survey of COYOTE CREEK DIKE
Map No.	W.O. 7995 Tape No St'd of.
Office Work	Surveyed by EVANS
Checked	Notes Date 9-6-35
Date	Indexed C. C. Johnson

F.B. 781 Pg. 193

Contains 92+96

Cont. from 192

Note: ANY ADDITIONS OR CHANGES ON THIS SHEET MUST BE MADE OR CIRCLED IN Red Ink WITH DATE AND NAME OF PERSON MAKING CHANGE.

Do not extend notes this side of this line

RETURN TO
LOS ANGELES COUNTY SURVEYOR
700 HALL OF RECORDS

FORM 247 SM 2-34

RETURN TO

LOS ANGELES COUNTY SURVEYOR

700 HALL OF RECORDS

Note; ANY ADDITIONS OR CHANGES ON THIS SHEET MUST BE MADE OR CIRCLED IN **Red Ink** WITH DATE AND NAME OF PERSON MAKING CHANGE.

Do not extend notes this side of this line

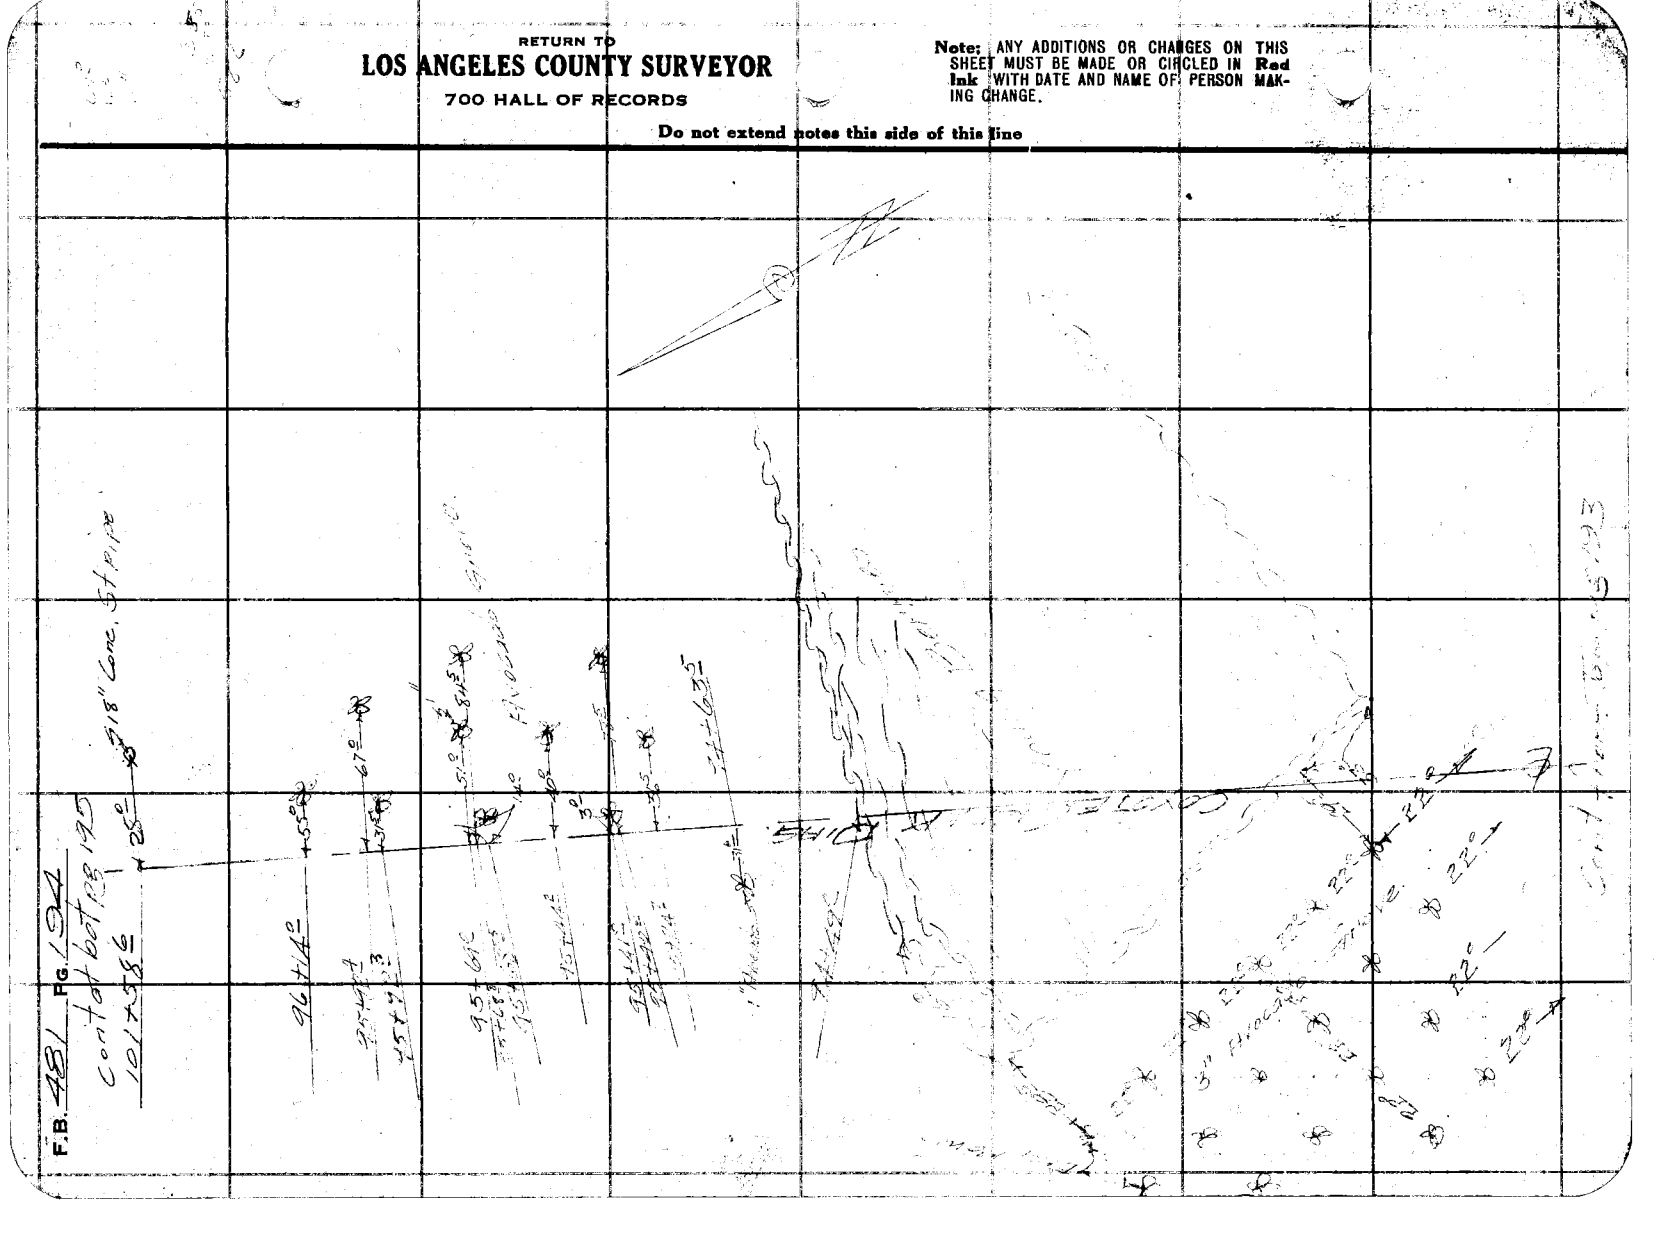

Notes Ck'd by	Drw	Survey of	COYOTE CREEK [illegible]
Map No.		W. O.	7225
Office Work		Tape No	St'd OF.
Checked		Surveyed by	Evans
Date		Notes	Bridges Date 7-6-35
		Indexed	A. C. Johnson

F.B. 431 Pg. 195

Note: ANY ADDITIONS OR CHANGES ON THIS SHEET MUST BE MADE OR CIRCLED IN Red Ink WITH DATE AND NAME OF PERSON MAKING CHANGE.

Do not extend notes this side of this line

RETURN TO
LOS ANGELES COUNTY SURVEYOR
700 HALL OF RECORDS

FORM 247 SM 2-34

RETURN TO

LOS ANGELES COUNTY SURVEYOR

700 HALL OF RECORDS

Note: ANY ADDITIONS OR CHANGES ON THIS SHEET MUST BE MADE OR CIRCLED IN **Red Ink** WITH DATE AND NAME OF PERSON MAKING CHANGE.

Do not extend notes this side of this line

F.B. _____ PG. _____

Notes Ck'd by	Survey of Los Coyotes Diagonal F.B. 481 Pg. 197
Map No.	W. O. 7995 Tape No. 073 St'd 68 °F
Office Work	Surveyed by LV Moore
Checked	Notes LV Moore Date 11-17-41
Date	Indexed 11-27-41

Note: Any Additions or Changes on This Sheet Must be Made in Red Ink With Date and Name of Person Making Change

Do not extend notes this side of this line.

RETURN TO
LOS ANGELES COUNTY SURVEYOR
700 HALL OF RECORDS

CENTER LINE CHANGE
LOS COYOTES DIAGONAL
FROM
BELLFLOWER BLVD.
TO
SPRING ST.
Job # 7995

Moore
Wilson
Scott
Mitchell

LINE CHANGE MADE IN NOV. 1941
C.S.B - 633-1

FORM 247 5M 10-39


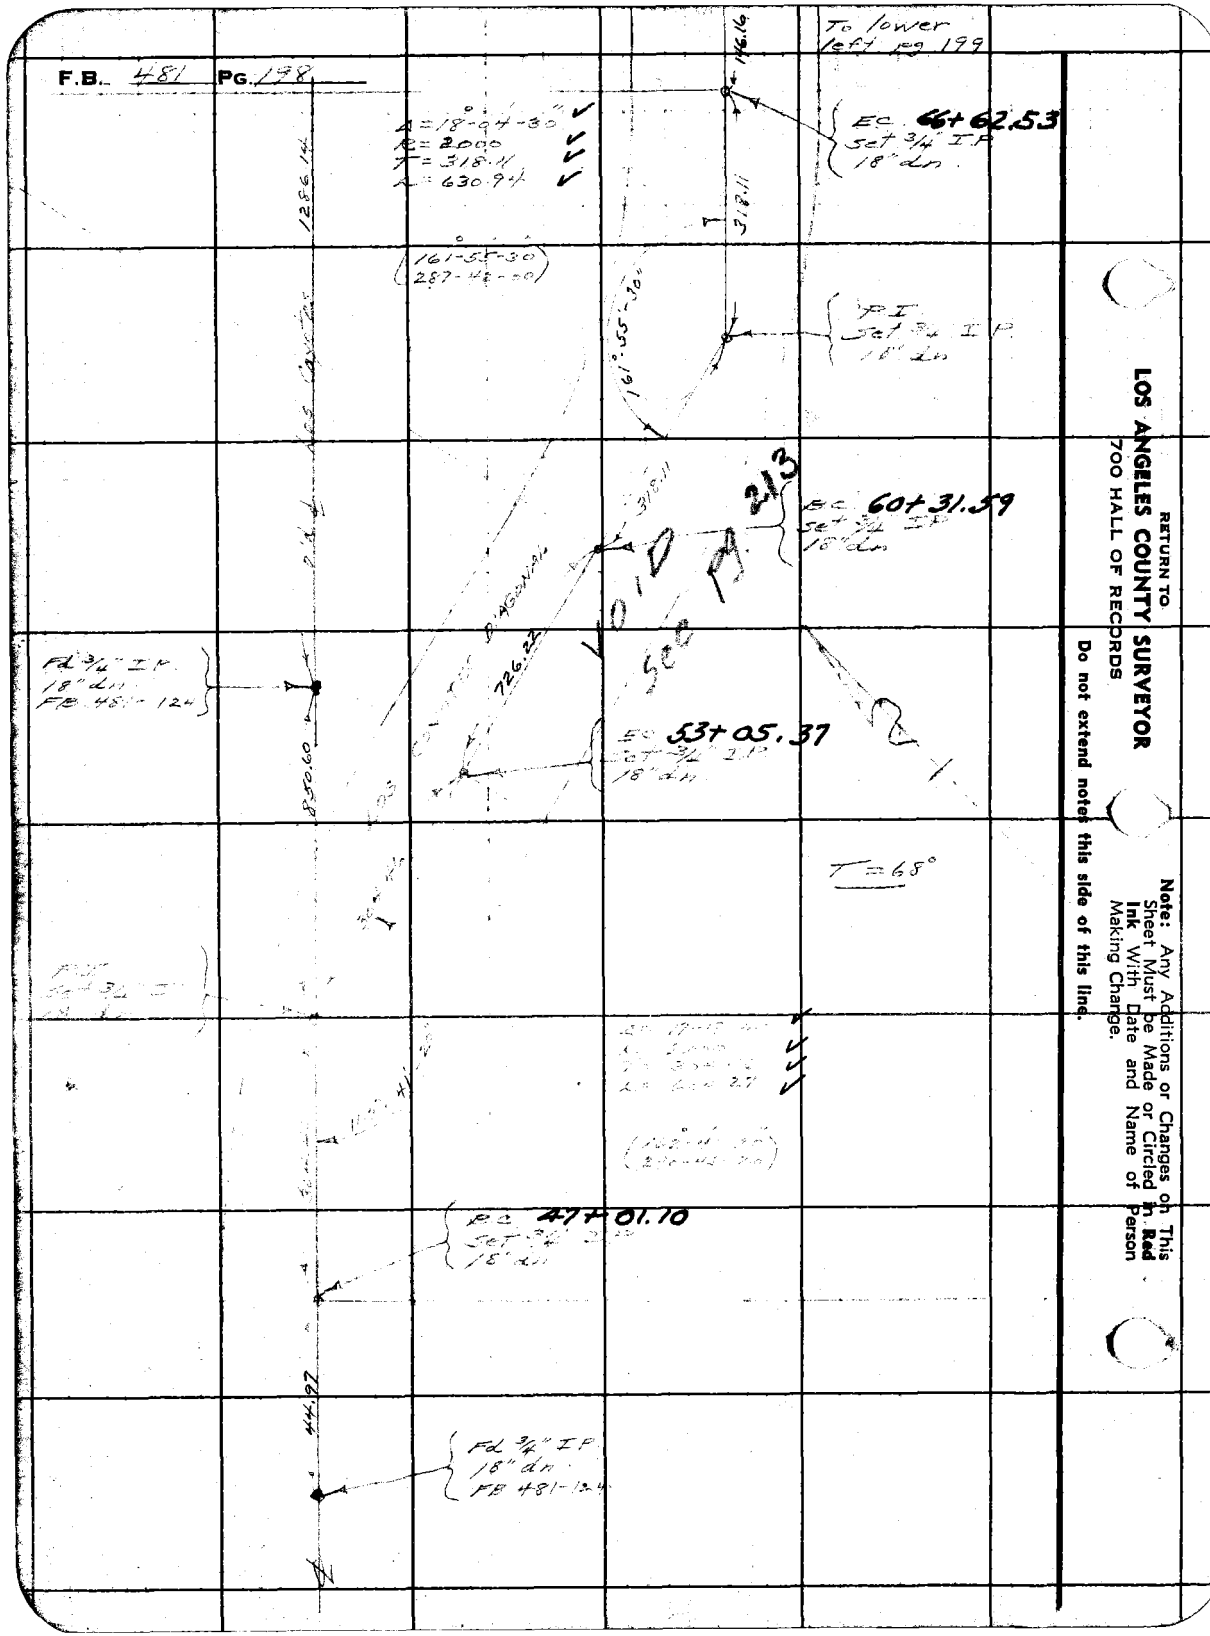

RETURN TO
LOS ANGELES COUNTY SURVEYOR
700 HALL OF RECORDS

Do not extend notes this side of this line.

Note: Any Additions or Changes on This Sheet Must be Made or Circled in Red Ink With Date and Name of Person Making Change.

Notes Ck'd by K.R.M.	Survey of Los Angeles Dist.
Map No. B-633-1	W. O. 2799 Tape No. 073 St'd 68°F
Office Work	Surveyed by Direct
Checked	Notes Date 11-19-41
Date	Indexed A. C. Jones

F.B. 481 Pg. 199

RETURN TO
LOS ANGELES COUNTY SURVEYOR
700 HALL OF RECORDS

Note: Any Additions or Changes on This Sheet Must be Made or Circled in Red Ink With Date and Name of Person Making Change

Do not extend notes this side of this line.

T = 68°

45-00-30
180-02-00

96+03.12
95+80.02
Set 3/4" I.P. 18" in.

82+08.33
81+96.02
Set 3/4" I.P. 18" in.

177.41

394.79

45-20-30

607.29

76+01.04
75+88.74
Set 3/4" I.P. 18" in. by tinner

390.00

551.53

To copper nail in conc. Disc 2' in. FB 467 - FB 481-125

DIAGONAL
817.42

62-37-20

(62-37-20
250-29-40)

Fd. 3/4" I.P. FB 467-22

Fd. 3/4" I.P. FB 467-22 FB 481-125

Fd. 3/4" I.P. FB 467-22

Set 3/4" I.P. 18" in. by tinner
68+08.69

151.55

LOS COYOTES

Set 3/4" I.P. 18" in. by tinner
72+71.31

AVOID

T.C.

(135-10-00
180-00-20)

To 3/4" I.P. FB 467 FB 481-125

From Top FB 198

From Top FB 178

B.C. Fd. 3/4" I.P. 18" in. FB 467-22

FORM 247 5M 10-39

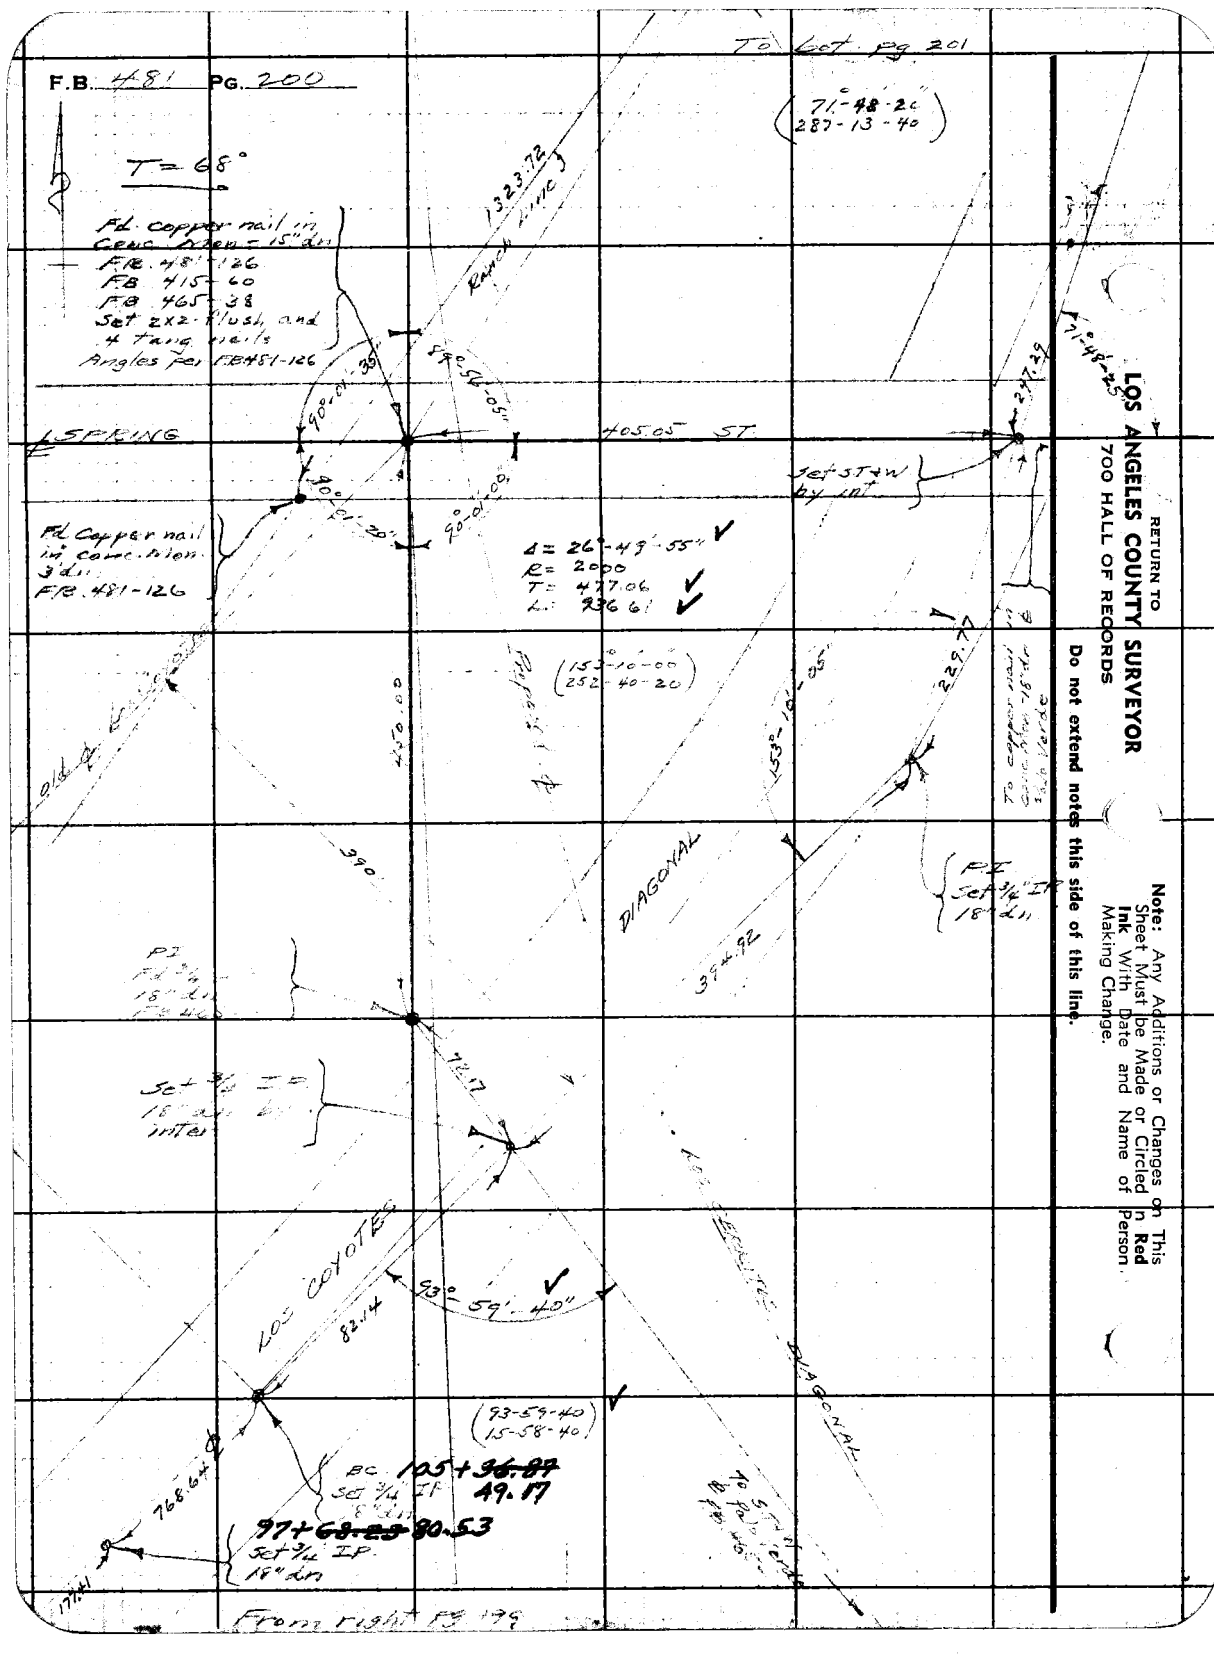

RETURN TO
LOS ANGELES COUNTY SURVEYOR
700 HALL OF RECORDS

Do not extend notes this side of this line.

Note: Any Additions or Changes on This Sheet Must be Made or Circled in **Red Ink** With Date and Name of Person Making Change.

Notes Ck'd by K.R.M.	Survey of Los Coyotes Diag.
Map No. C.S. B-623-1	W. O. 799 Tape No. 073 St'd 68 °F
Office Work	Surveyed by Moore
Checked	Notes Moore Date 11-25-41
Date	Indexed A. C. Johnson

F.B. 481 Pg. 201

To M.L.Co.
B.C. N10°E
3 Ln. 4x4
post set over
N10°E.
FB 481-127

T=68°

Equation: ~~125+99.89~~ 126+12.19
from S.W. = 124+36.41
going S.E. per Pg. 126, 127

~~126+12.19~~
~~125+99.89~~
EC
Set 3/4" IP
18" Ln

DIAGONAL

2328.9

PT
Set 3/4" IP
18" Ln.

Δ = 18-01-25
R = 1500
T = 237.89
L = 471.86

161°-58'-35"

5560

232.89

PT ML Co
BC N10°E-3 Ln
FB 481-126

161°-58'-40"
287-54-20

~~40.33~~
~~121+28.03~~
BC
Set 3/4" IP
18" Ln

1323.72
Ranch Line

LOS COYOTES

654.48

~~85.78~~
~~114+73.48~~
EC
Set 3/4" IP
18" Ln

247.29

From Top Pg. 200

RETURN TO
LOS ANGELES COUNTY SURVEYOR
700 HALL OF RECORDS

Note: Any Additions or Changes on This Sheet Must be Made or Circled in Red Ink With Date and Name of Person Making Change

Do not extend notes this side of this line.

FORM 247 5M 10-39

RETURN TO
LOS ANGELES COUNTY SURVEYOR
700 HALL OF RECORDS

Note: Any Additions or Changes on This Sheet Must be Made or Circled in **Red Ink** With Date and Name of Person Making Change.

Do not extend notes this side of this line.

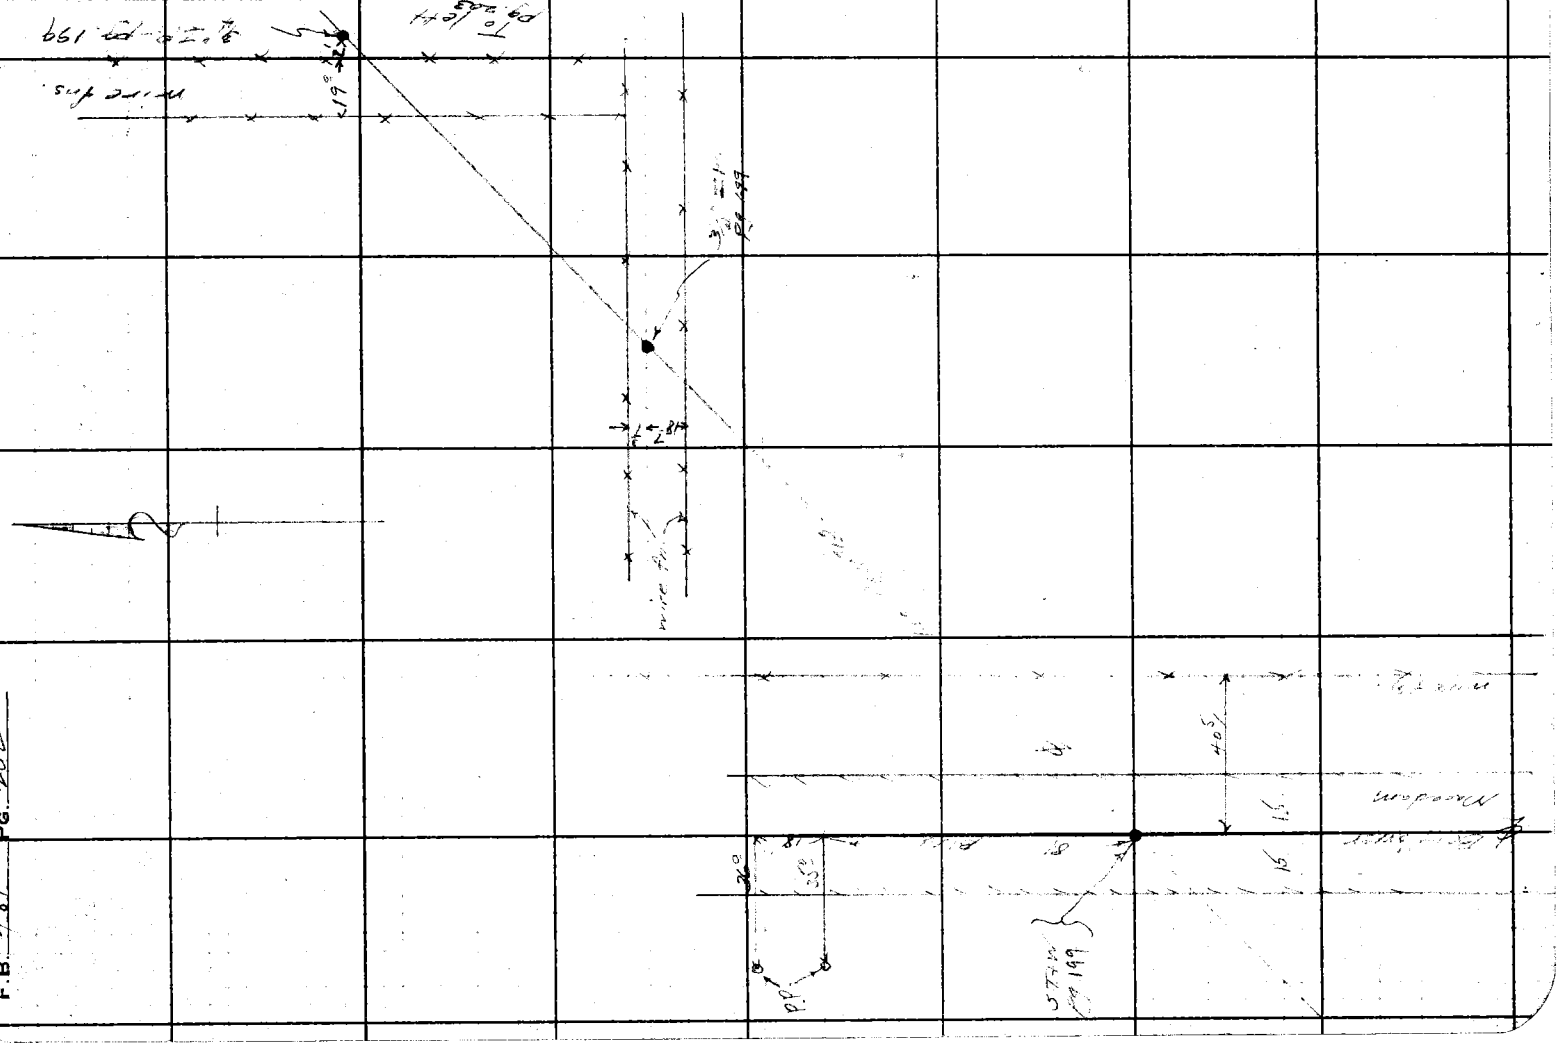

F.B. 481 Pg. 202

Notes Ck'd by	Survey of Los Coyotes Diag
Map No.	W. O. 7995 Tape No. St'd °F
Office Work	Surveyed by LY Moore
Checked	Notes LY Moore Date 11-24-41
Date	Indexed A. C. Jenkins

F.B. 481 Pg. 203

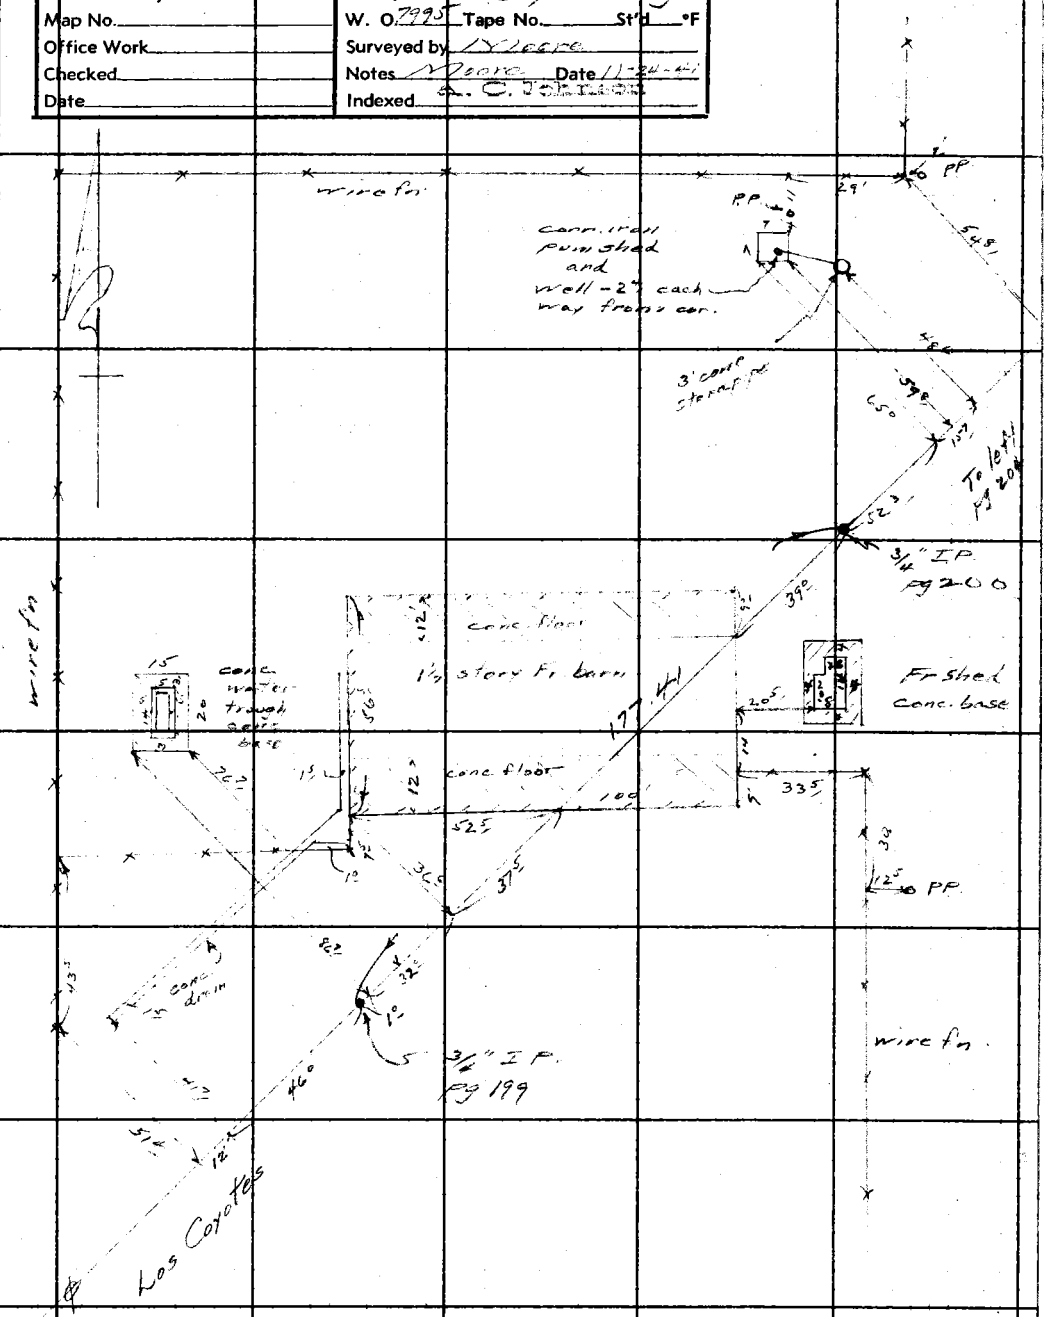

Note: Any Additions or Changes on This Sheet Must be Made or Circled in Red Ink With Date and Name of Person Making Change

Do not extend notes this side of this line.

RETURN TO
LOS ANGELES COUNTY SURVEYOR
700 HALL OF RECORDS

FORM 247 5M 10-39

RETURN TO
LOS ANGELES COUNTY SURVEYOR
700 HALL OF RECORDS

Note: Any Additions or Changes on This Sheet Must be Made or Circled in **Red Ink** With Date and Name of Person Making Change.

Do not extend notes this side of this line.

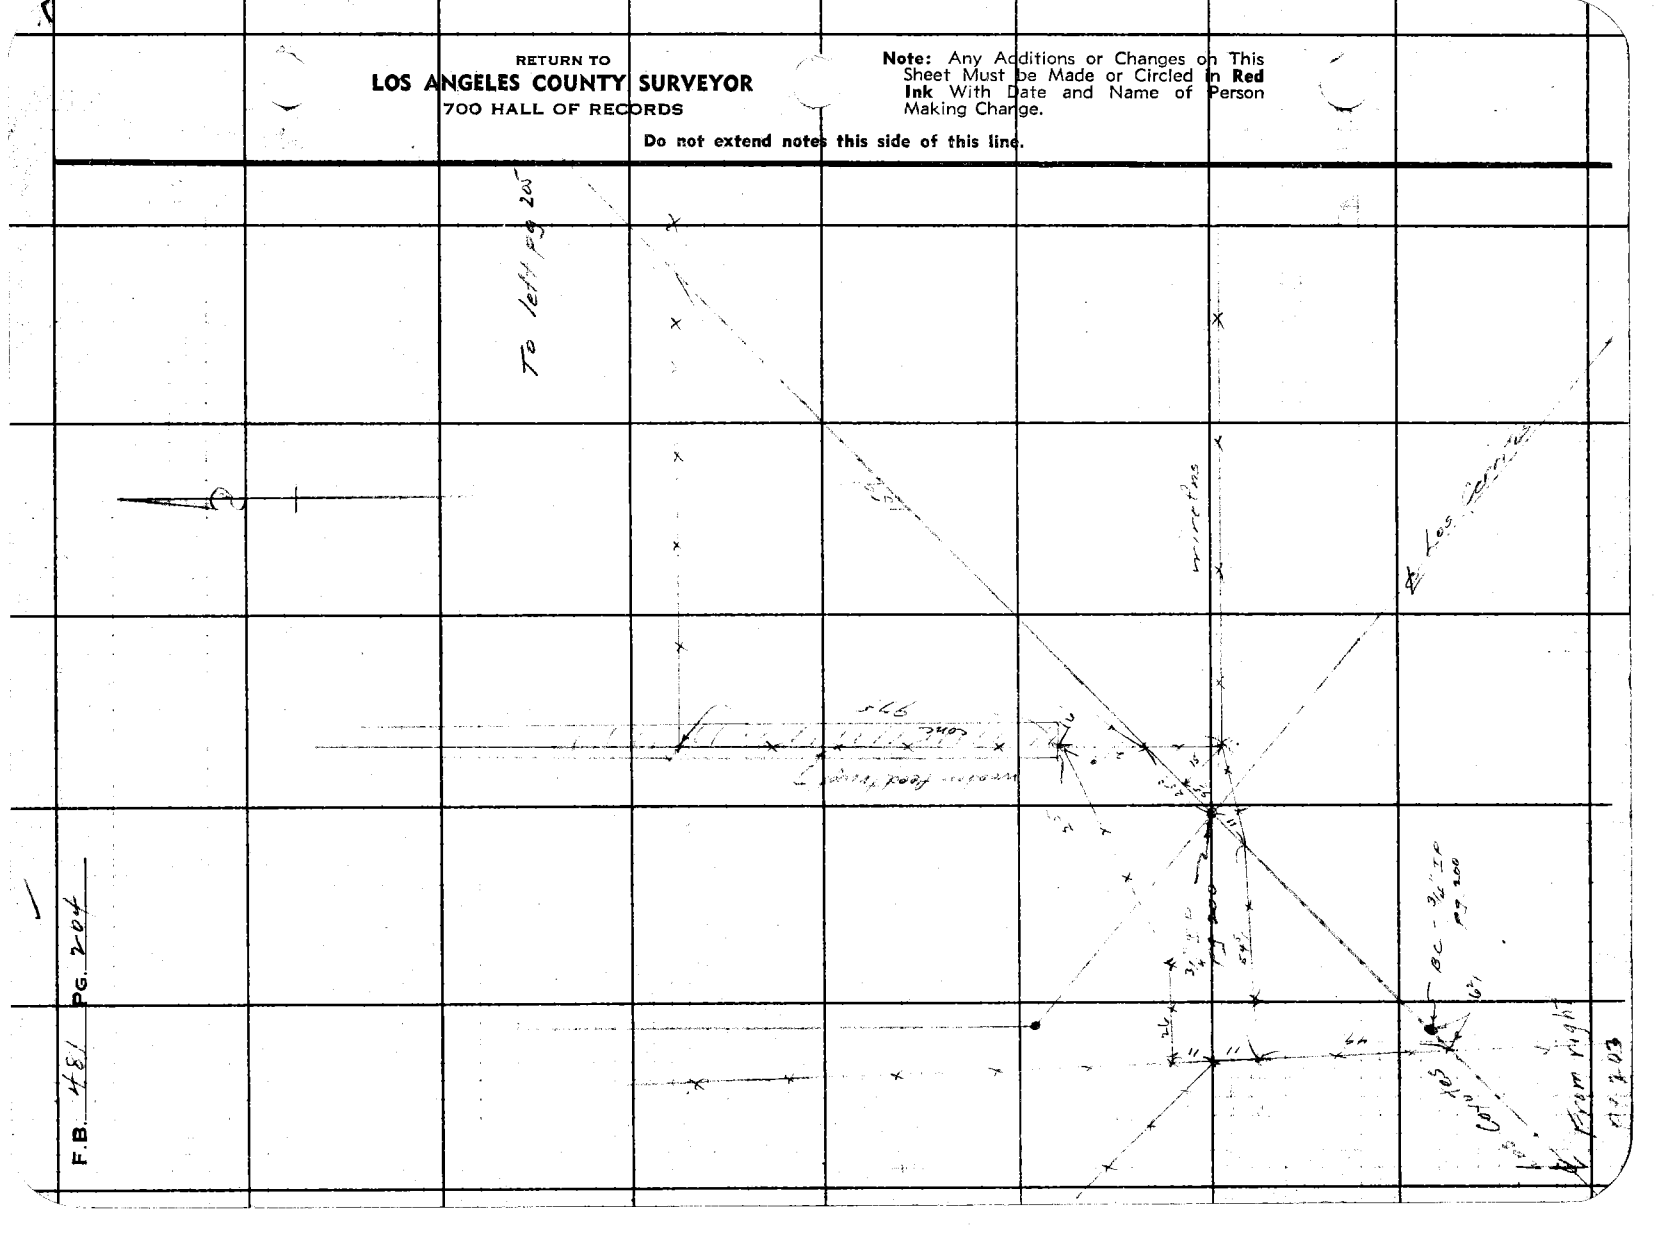
To left fig 20

Notes Ck'd by	Survey of Los Coyotes Dairy
Map No. C.S.B-636.	W. O. 7995 Tape No. St'd °F
Office Work J.P. Price	Surveyed by Moore
Checked	Notes Moore Date 11-25-41
Date	Indexed E. O. Johnson

F.B. 481 Pg. 205

Note: Any Additions or Changes on This Sheet Must be Made or Circled in Red Ink With Date and Name of Person Making Change

Do not extend notes this side of this line.

RETURN TO
LOS ANGELES COUNTY SURVEYOR
700 HALL OF RECORDS

FORM 247 5M 10-39

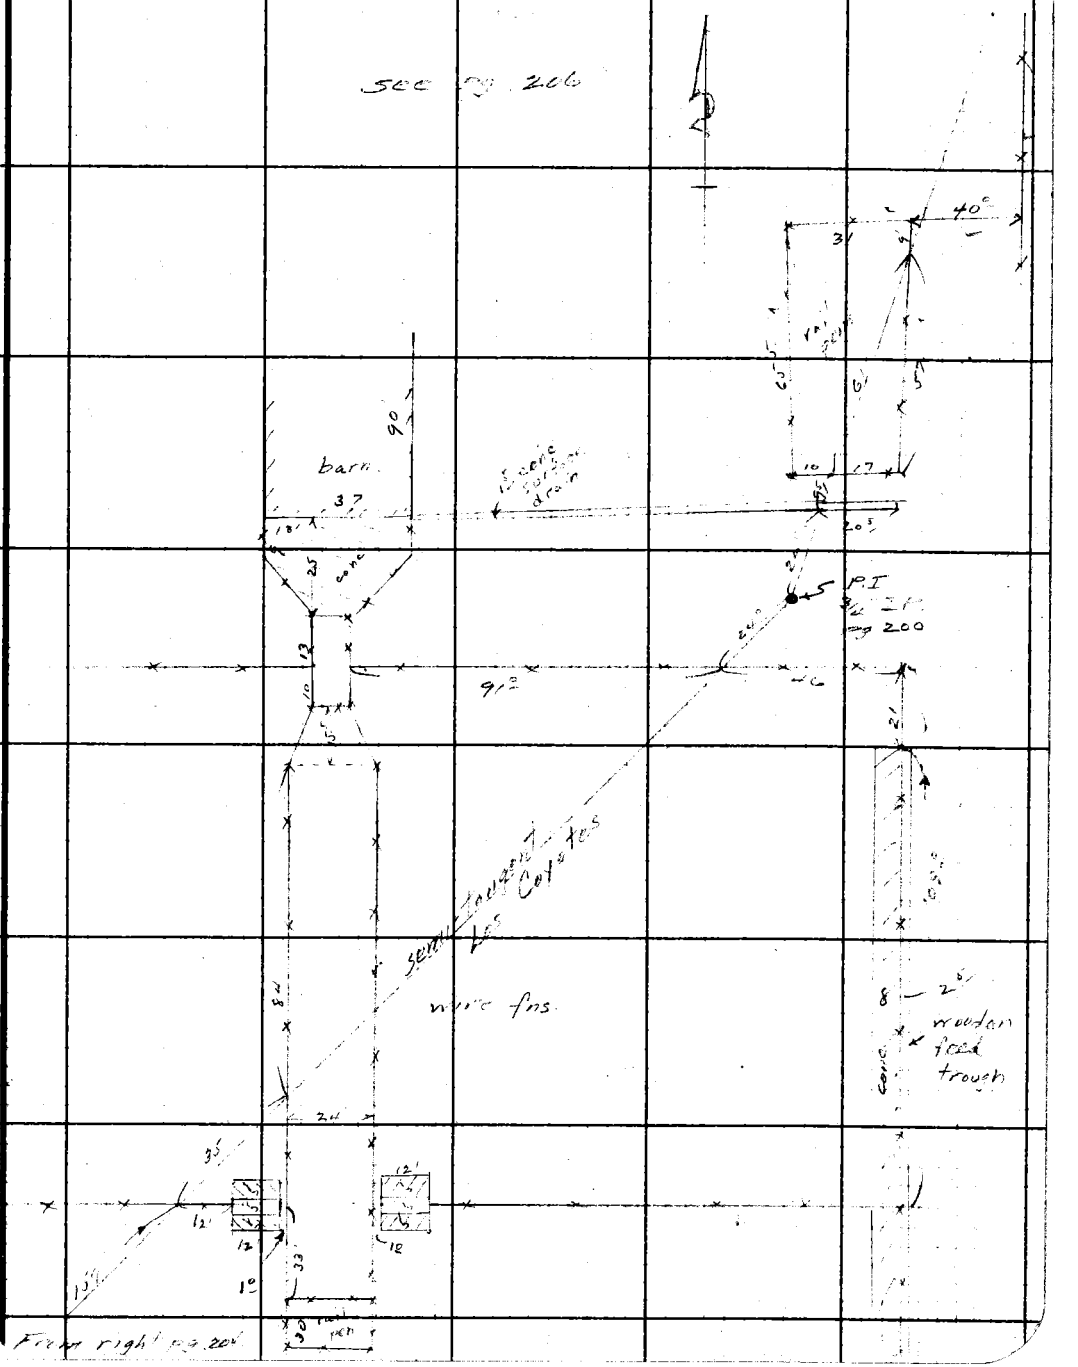

F.B. 481 PG. 206

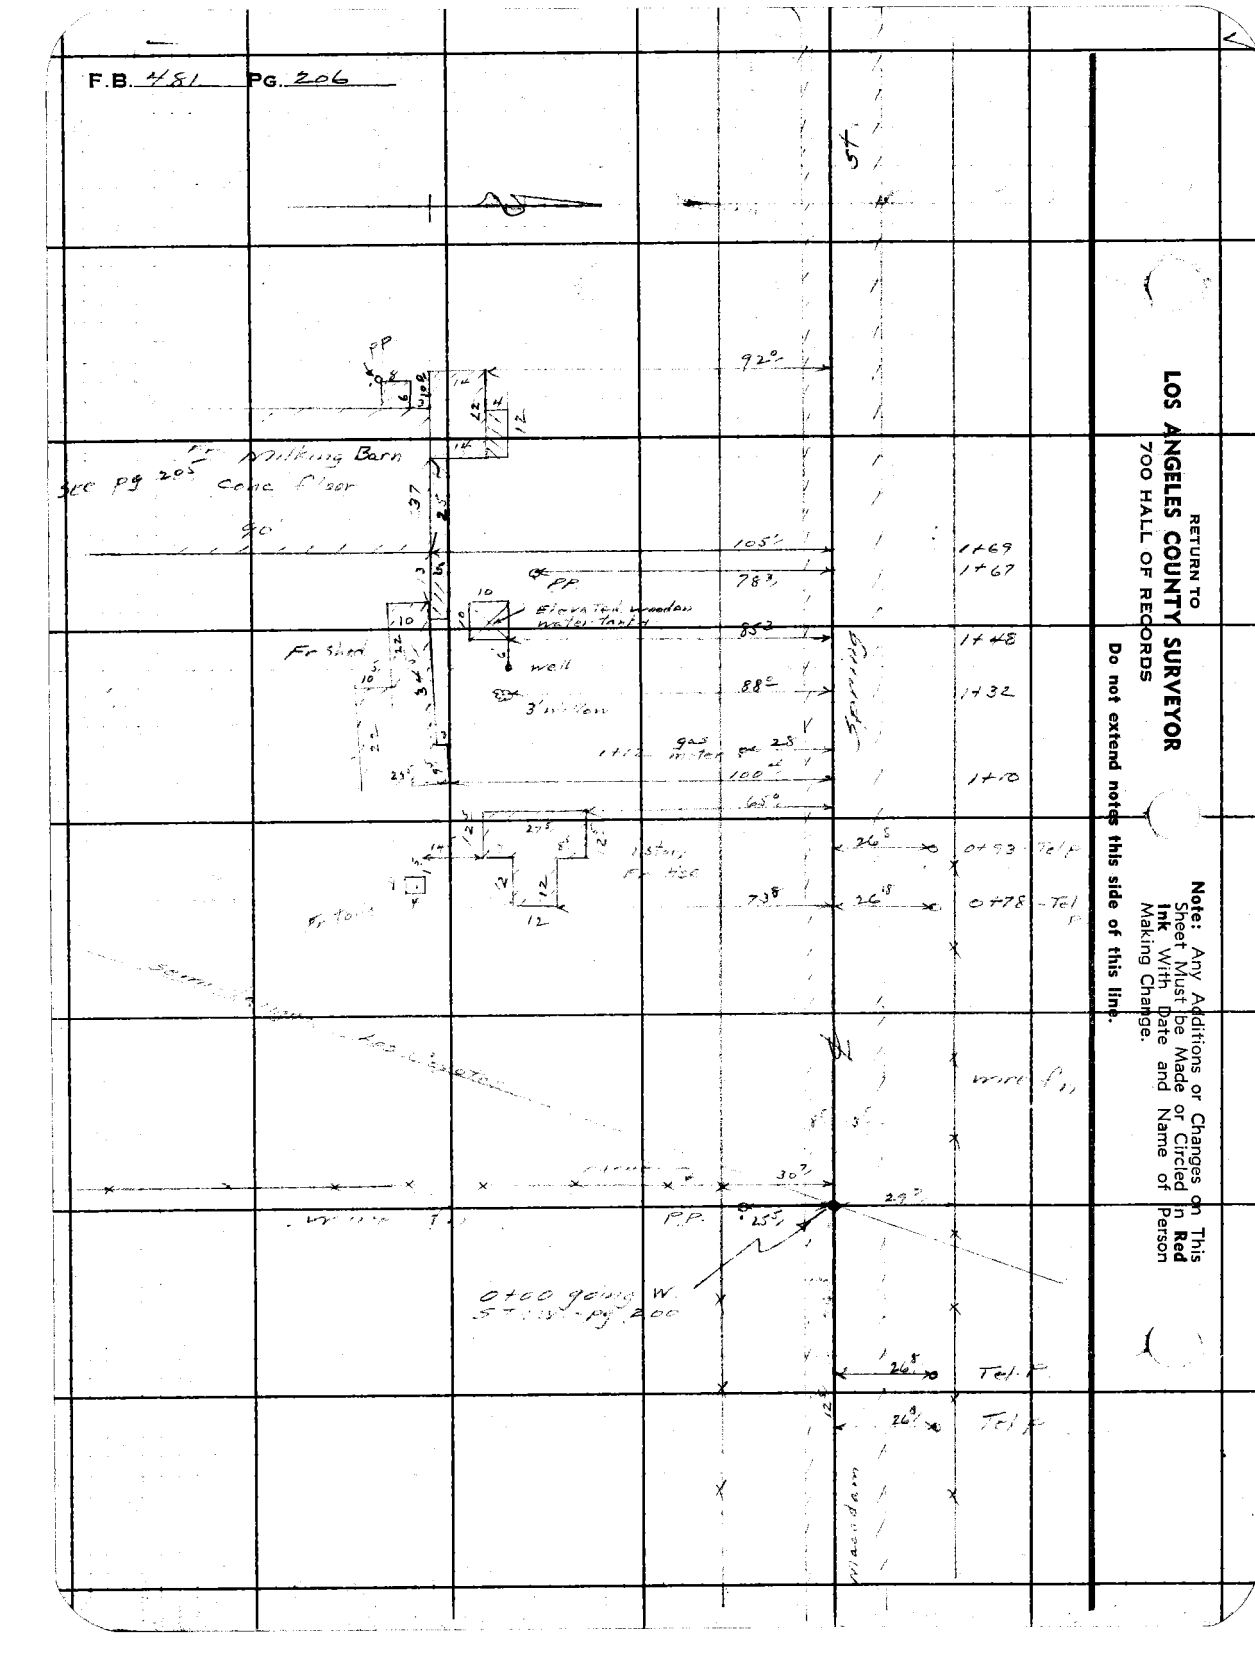
RETURN TO
LOS ANGELES COUNTY SURVEYOR
700 HALL OF RECORDS
Do not extend notes this side of this line.
Note: Any Additions or Changes on This Sheet Must be Made or Circled in Red Ink With Date and Name of Person Making Change.
PP
92°
See pg 205
Conc floor
90'
105'
78'
85'
88'
Elevated wooden water tank
well
3" iron pipe
Fr shed
Spring
1469
1467
1448
1432
1410
0493
0478
Tel P
30'
29'
25'
PP
0700 going W
Stn 13 - pg 200
Tel P
Tel P
Wire fence

Notes Ck'd by K.R.M.	Survey of Los Coyotes Diag.	F.B. 481	Pg. 207
Map No. B-633-2	W. O. 7295 Tape No. 073 St'd 68 °F		
Office Work [illegible]	Surveyed by Moore		
Checked	Notes Moore Date 11-27-41		
Date Jan. 1942	Indexed 12-10-41		

CENTER LINE CHANGE
OF
LOS COYOTES DIAGONAL
AT
STUDEBAKER ROAD
AND
CARSON ST
Jobⁿ 7295

Moore
Wiley
Scott
Traverse

Note: Any Additions or Changes on This Sheet Must be Made in Red Ink or Circled in Red Ink With Date and Name of Person Making Change

Do not extend notes this side of this line.

RETURN TO
LOS ANGELES COUNTY SURVEYOR
700 HALL OF RECORDS

FORM 247 5M 10-39

RETURN TO
LOS ANGELES COUNTY SURVEYOR
700 HALL OF RECORDS

Note: Any Additions or Changes on This Sheet Must be Made or Circled in **Red Ink** With Date and Name of Person Making Change.

Do not extend notes this side of this line.

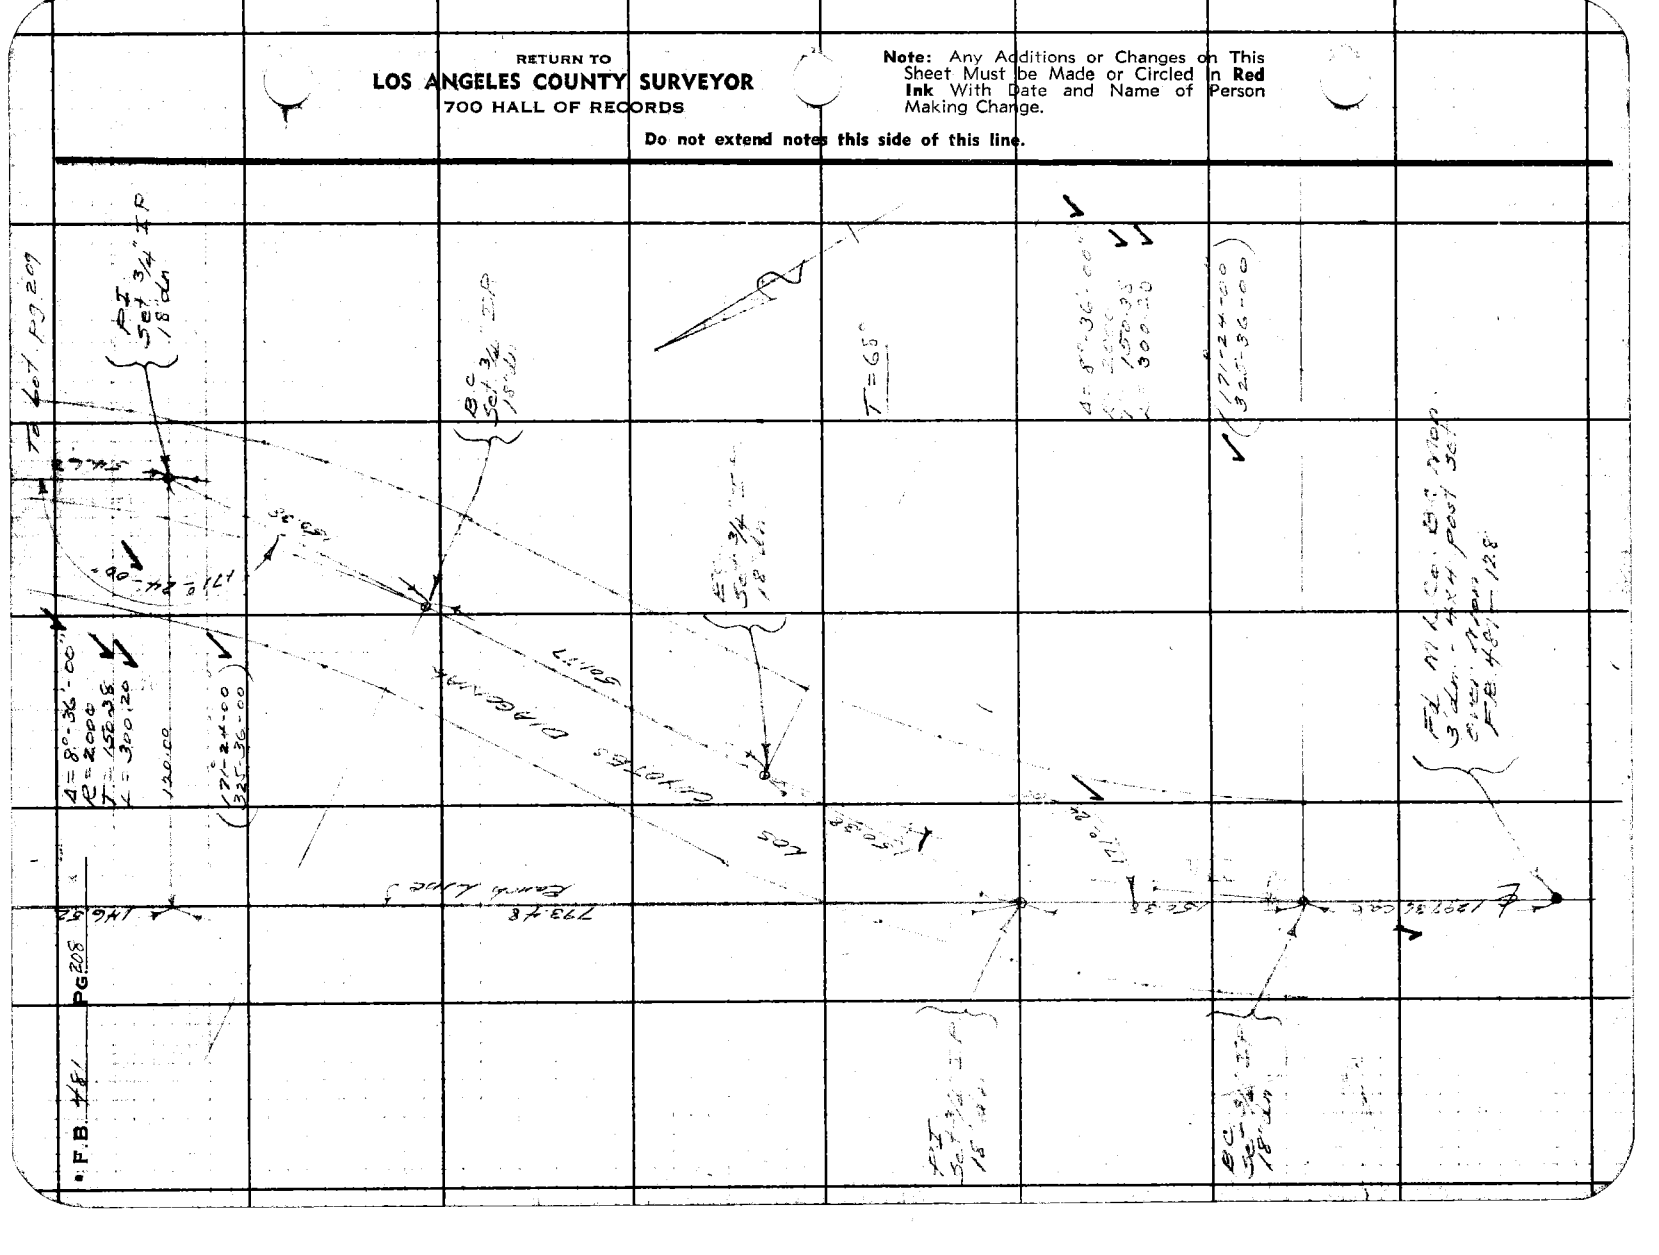

FORM 247 5M 10-39

RETURN TO
LOS ANGELES COUNTY SURVEYOR
700 HALL OF RECORDS

Note: Any Additions or Changes on This Sheet Must be Made or Circled in **Red Ink** With Date and Name of Person Making Change

Do not extend notes this side of this line.

Notes Ck'd by
Map No. 3-633-2
Office Work
Checked
Date

Survey of Los Coyotes Diag.
W. O. 293 Tape No. 823 Sht. 1 of 1 °F
Surveyed by
Notes Date
Indexed

°F.B. PG. 209

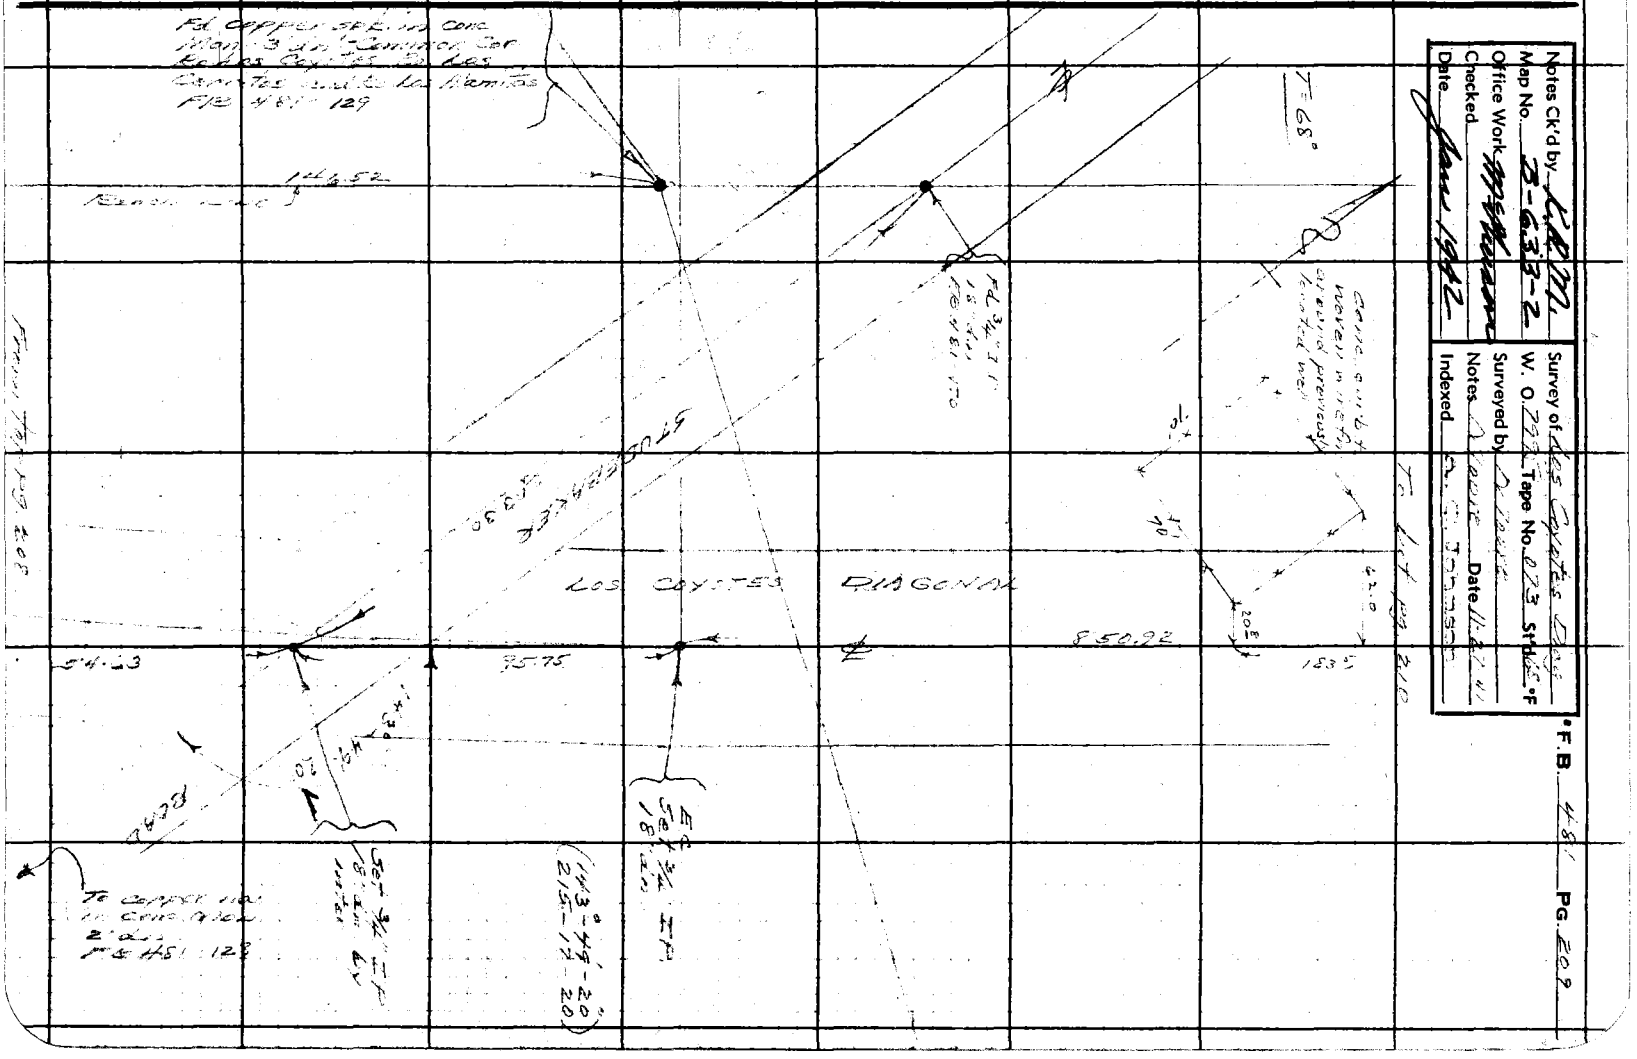

RETURN TO
LOS ANGELES COUNTY SURVEYOR
700 HALL OF RECORDS

Note: Any Additions or Changes on This Sheet Must be Made or Circled in **Red Ink** With Date and Name of Person Making Change.

Do not extend notes this side of this line.

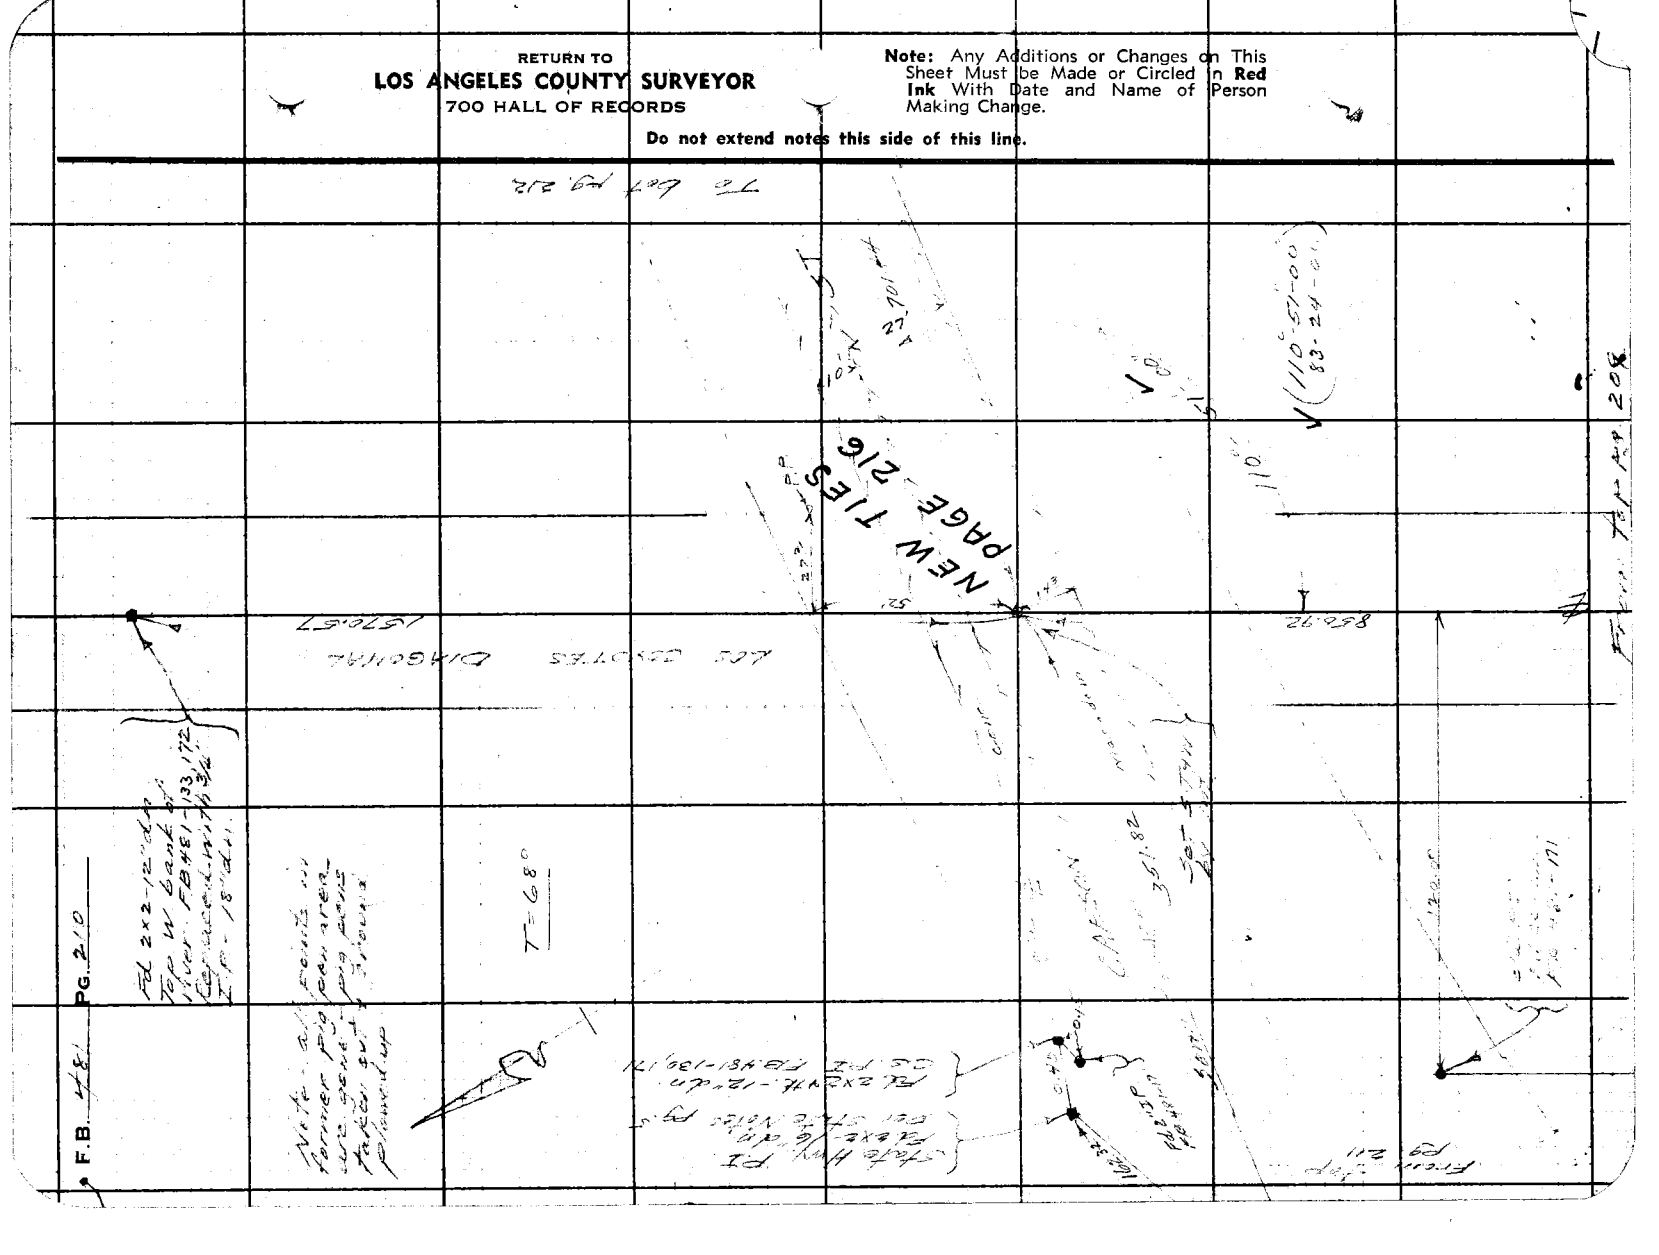

Notes Ck'd by KR.M.	Survey of Lot Control Proj
Map No. B-633-2	W. O. 2995 Tape No. D 73 Std 66' °F
Office Work MGK	Surveyed by [illegible]
Checked	Notes Moore Date 12-8-41
Date Jan 1942	Indexed

°F.B. 448 Pg. 21

Note: Any Additions or Changes on This Sheet Must be Made or Circled in Red Ink With Date and Name of Person Making Change

Do not extend notes this side of this line.

RETURN TO
LOS ANGELES COUNTY SURVEYOR
700 HALL OF RECORDS

FORM 247 5M 10-39

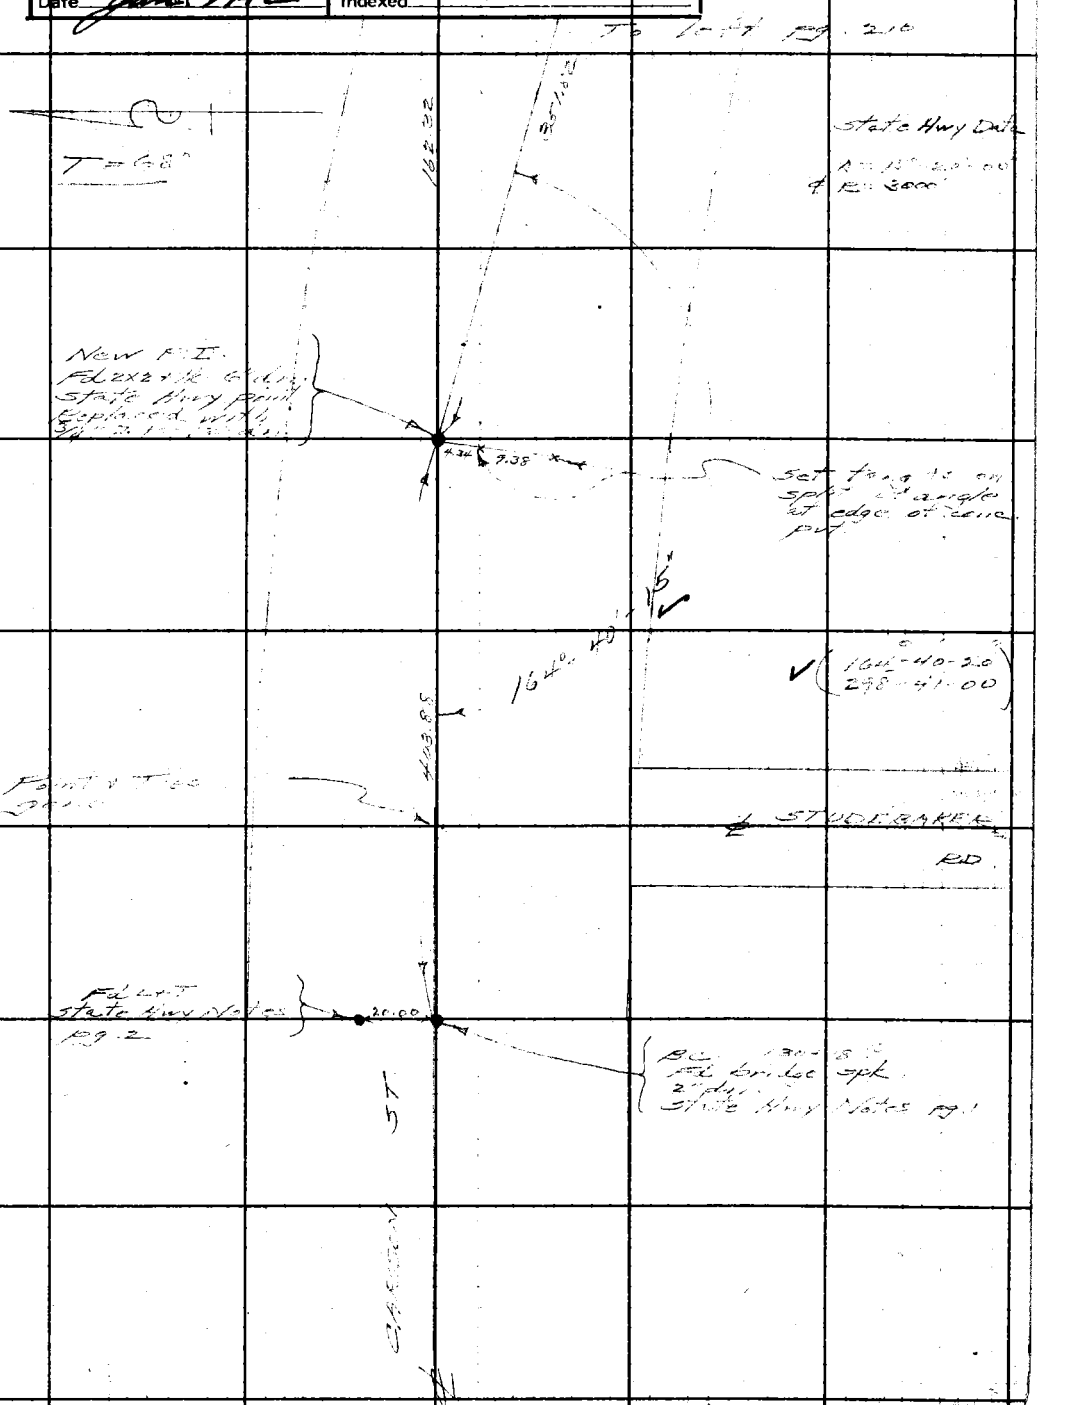

RETURN TO
LOS ANGELES COUNTY SURVEYOR
700 HALL OF RECORDS

Note: Any Additions or Changes on This Sheet Must be Made or Circled in **Red Ink** With Date and Name of Person Making Change.

Do not extend notes this side of this line.

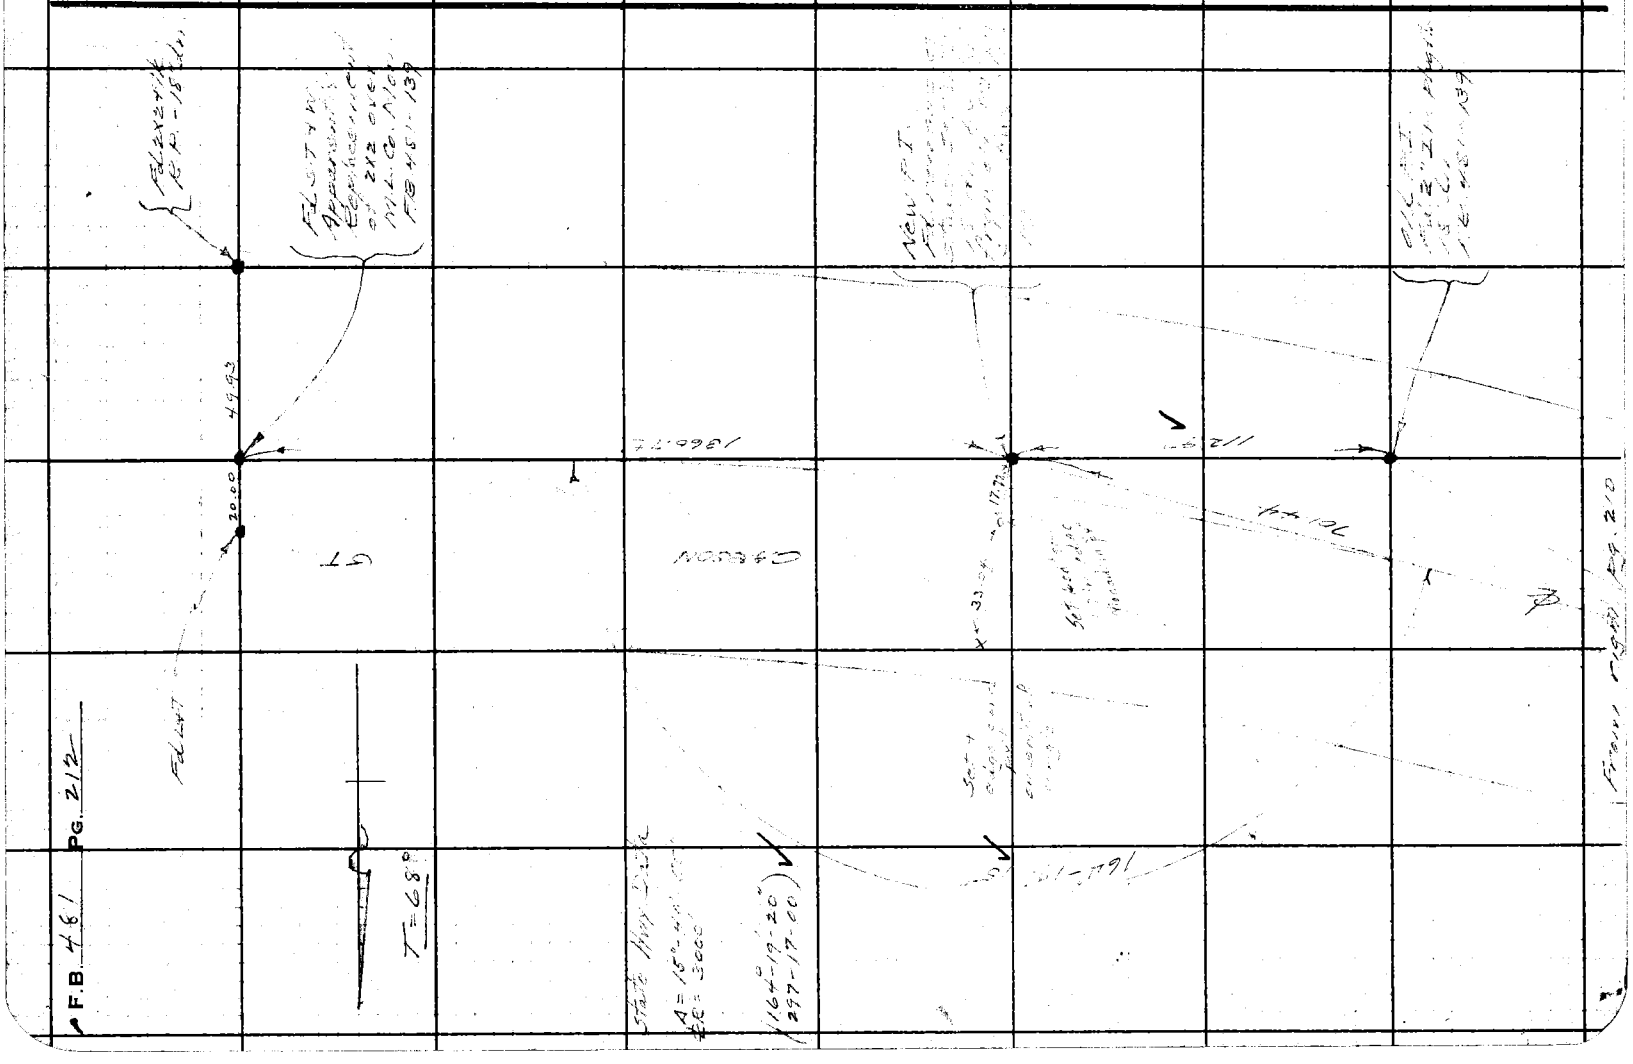

Notes Ck'd by MBhamer
Map No. B-633-1
Office Work
Checked
Date

Survey of Los Coyotes Diag.
W. O. 7995 Tape No. St'd 68 °F
Surveyed by Moore
Notes Moore Date 2-10-41
Indexed 3-18-42

F.B. 481 Pg. 213

To left pg. 214

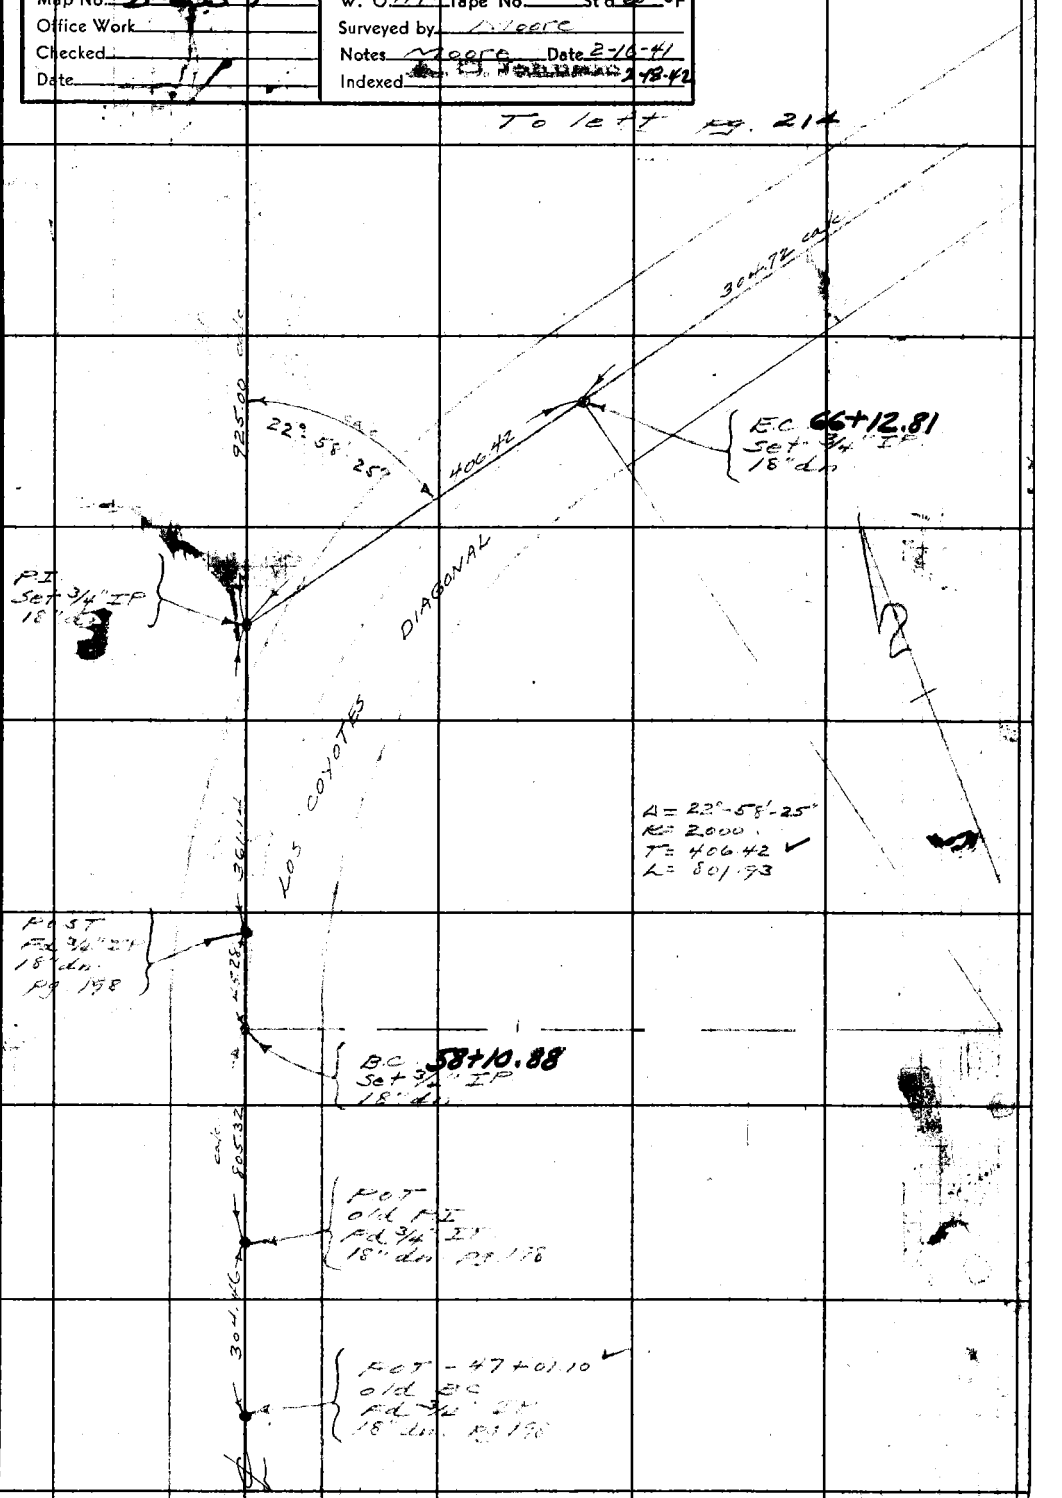

Note: Any Additions or Changes on This Sheet Must be Made or Circled in Red Ink With Date and Name of Person Making Change.

Do not extend notes this side of this line.

RETURN TO
LOS ANGELES COUNTY SURVEYOR
700 HALL OF RECORDS

FORM 247 5M 11-41

F.B. 481 PG. 214

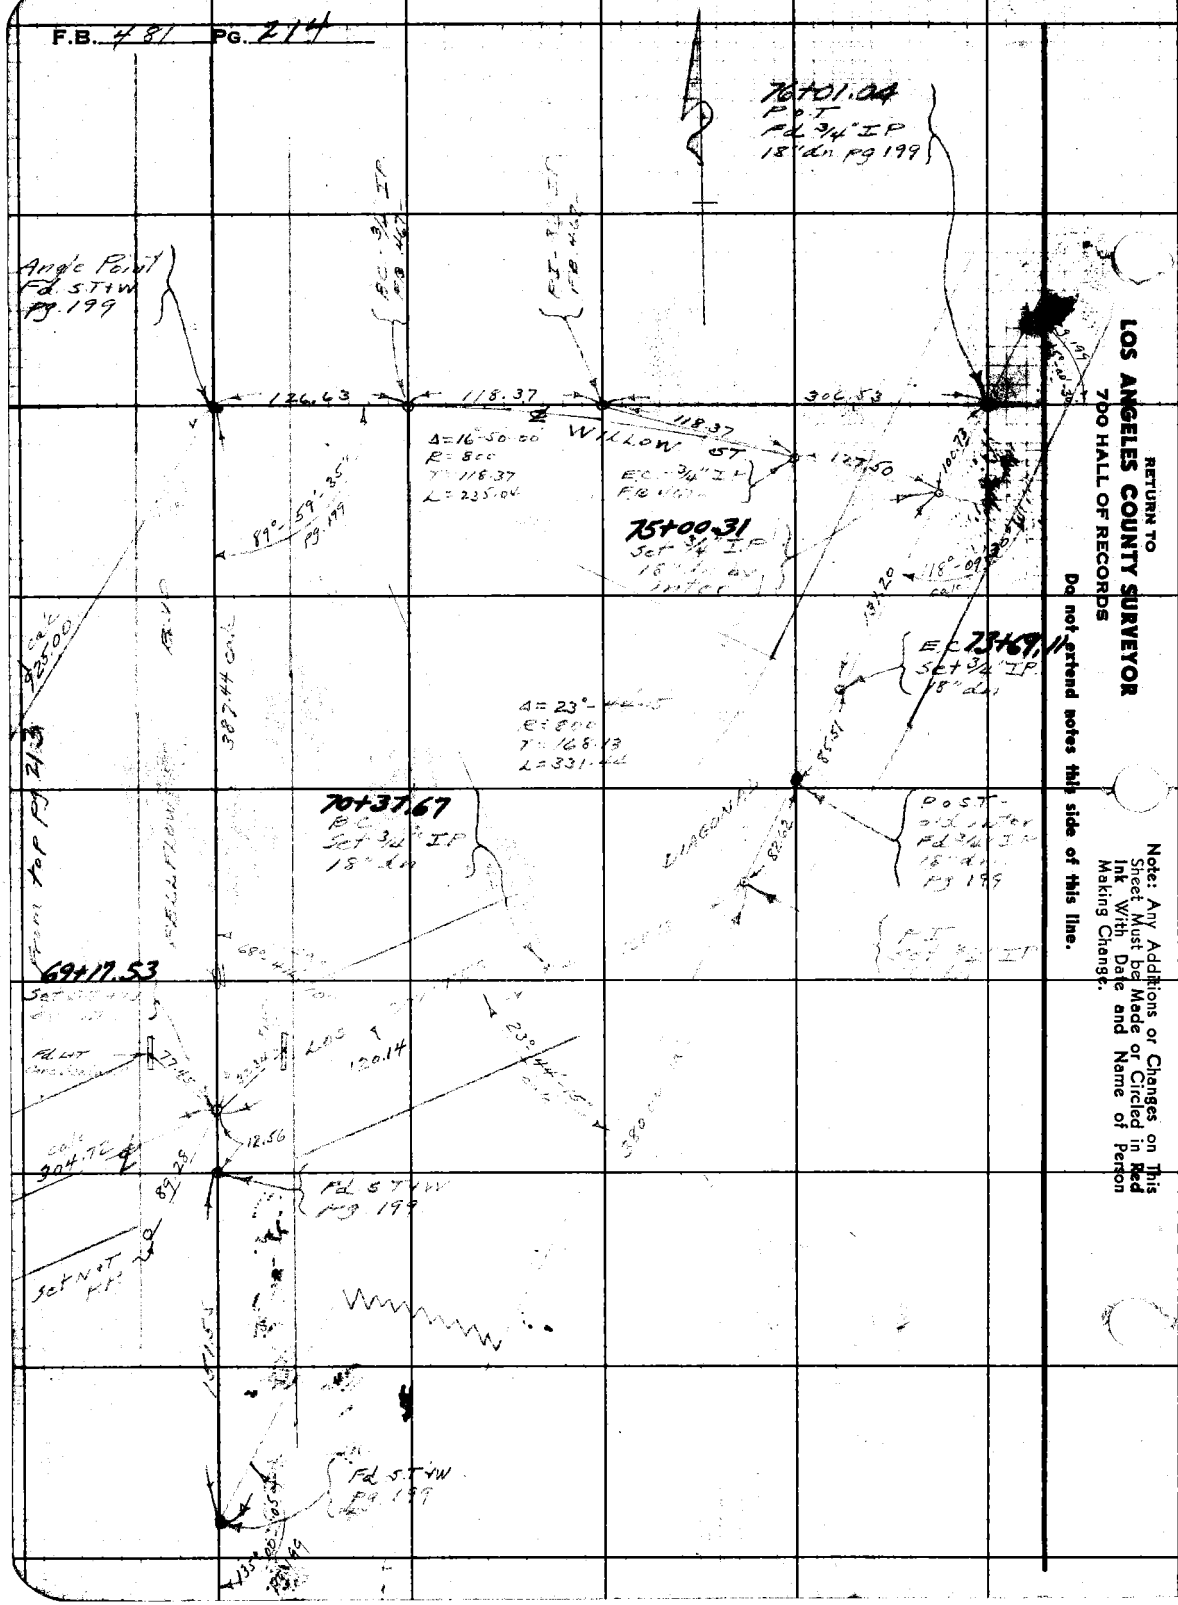

RETURN TO
LOS ANGELES COUNTY SURVEYOR
700 HALL OF RECORDS

Do not extend notes this side of this line.

Note: Any Additions or Changes on This Sheet Must be Made or Circled in Red Ink With Date and Name of Person Making Change.

Notes Ck'd by	Survey of Los Angeles Dist.
Map No.	W. O. Tape No. 0118 St'd. 68 °F
Office Work	Surveyed by Wallace
Checked	Notes E C W Date 6-22-50
Date	Indexed C. Johnson 6-29-50

F. B. 481 / Pg. 215

To bot Pg.

TIES AT CARSON ST

(New) P.I. Set Large B Spk. W
Rec. — ST from
P.O.T. Studebaker Rd
A344-001 Pg. 4

Note: Any Additions or Changes on This Sheet Must be Made or Circled in Red Ink With Date and Name of Person Making Change.

Do not extend notes this side of this line.

RETURN TO
LOS ANGELES COUNTY SURVEYOR
726 LOS ANGELES COUNTY
ENGINEERING BLDG.

17° 56' A344-001 Pg. State notes

S 25.47 S 0°18° = S 25°53'

S 25.53'

B.C. 132+14.61

CARSON

132+61.70 P.O.T.
Fd. W Spk-T
State Hwy Notes
A344-001 Pg. 3

3.00'

184.40'

STUDEBAKER RD.

Pavement

P.O.T.
Fd. B Spk. W
A344-001 Pg. 2

30.2'

P.O.T. 116+77.00'
Fd. C Spk-W
A344-001 Pg 2

76F309S 247 10M 1-49

F. B. 481 PG. 216

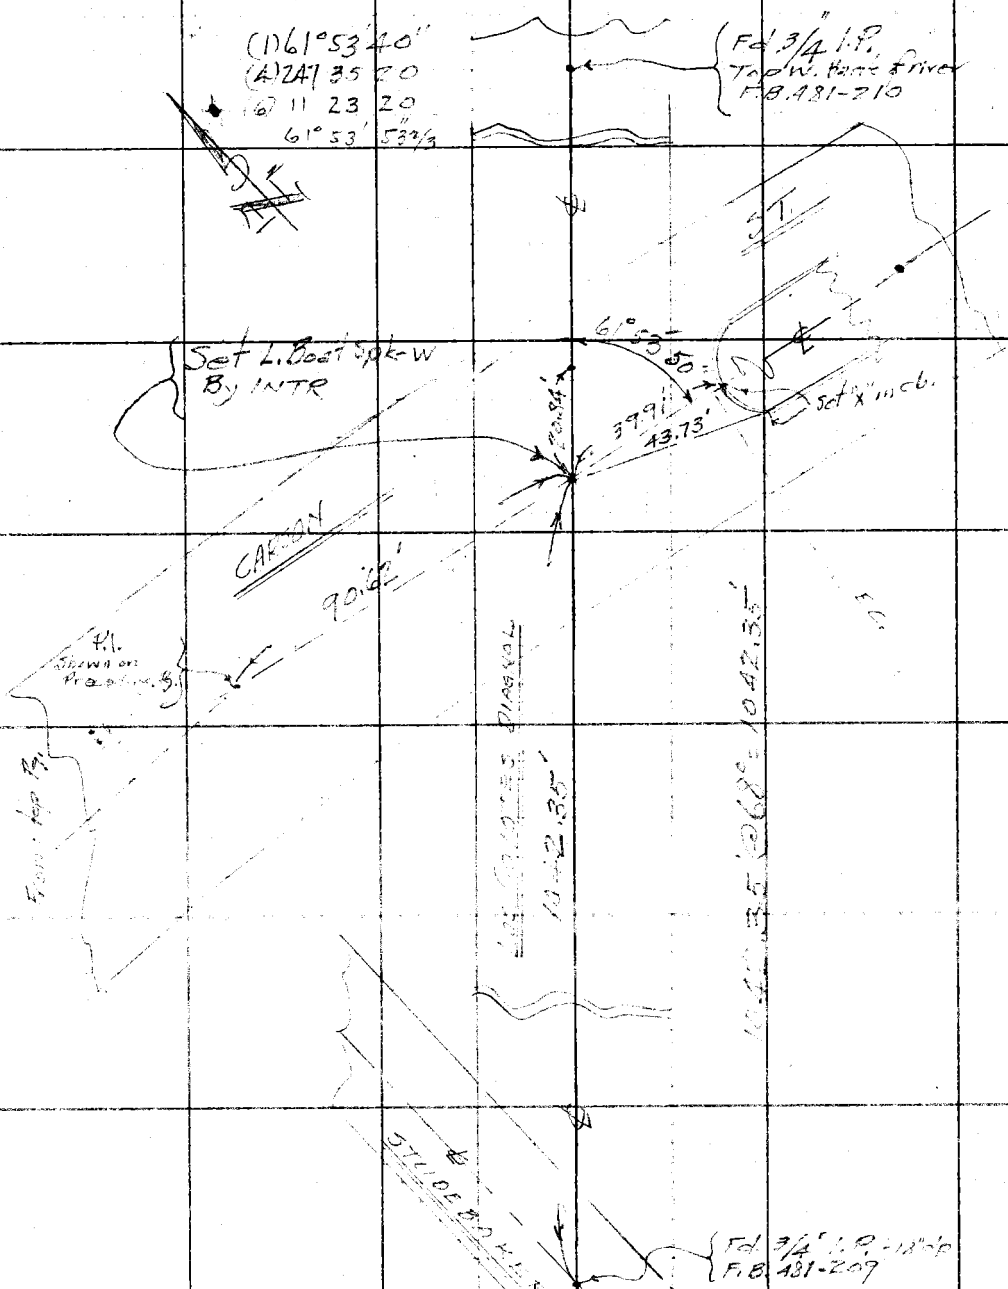

RETURN TO
LOS ANGELES COUNTY SURVEYOR
726 LOS ANGELES COUNTY
ENGINEERING BLDG.

Do not extend notes this side of this line.

Note: Any Additions or Changes on This Sheet Must be Made or Circled in Red Ink With Date and Name of Person Making Change.

Notes Ck'd by RRM	Survey of LOS COYOTES DIAG
Map No.	W. O. 7995 Tape No. 29 St'd. 44 °F
Office Work	Surveyed by FH Blanchard
Checked	Notes FHB Date 11-26-51
Date	Indexed A. C. Johnson 12-3-51

F. B. 481 PG. 217

SURVEY OF

LOS COYOTES DIAGONAL

J.N. 7995

Starting at a point 1000'± S W of the int. of Carson St. & Studebaker Rd thence N. & E. to the int. of Pioneer Blvd. about 800'± N. of int. of Del Amo & Pioneer Blvd.

Reference

FB 959
FB 1138
FB 481

PARTY

Blanchard
English
York
Frishmann
Gross

Note: Any Additions or Changes on This Sheet Must be Made or Circled in Red Ink With Date and Name of Person Making Change.

Do not extend notes this side of this line.

RETURN TO
LOS ANGELES COUNTY SURVEYOR
726 LOS ANGELES COUNTY
ENGINEERING BLDG.

76F309S 247 2-51

RETURN TO
LOS ANGELES COUNTY SURVEYOR
726 LOS ANGELES COUNTY
ENGINEERING BLDG.

Note: Any Additions or Changes on This Sheet Must be Made or Circled in Red Ink With Date and Name of Person Making Change.

Do not extend notes this side of this line.

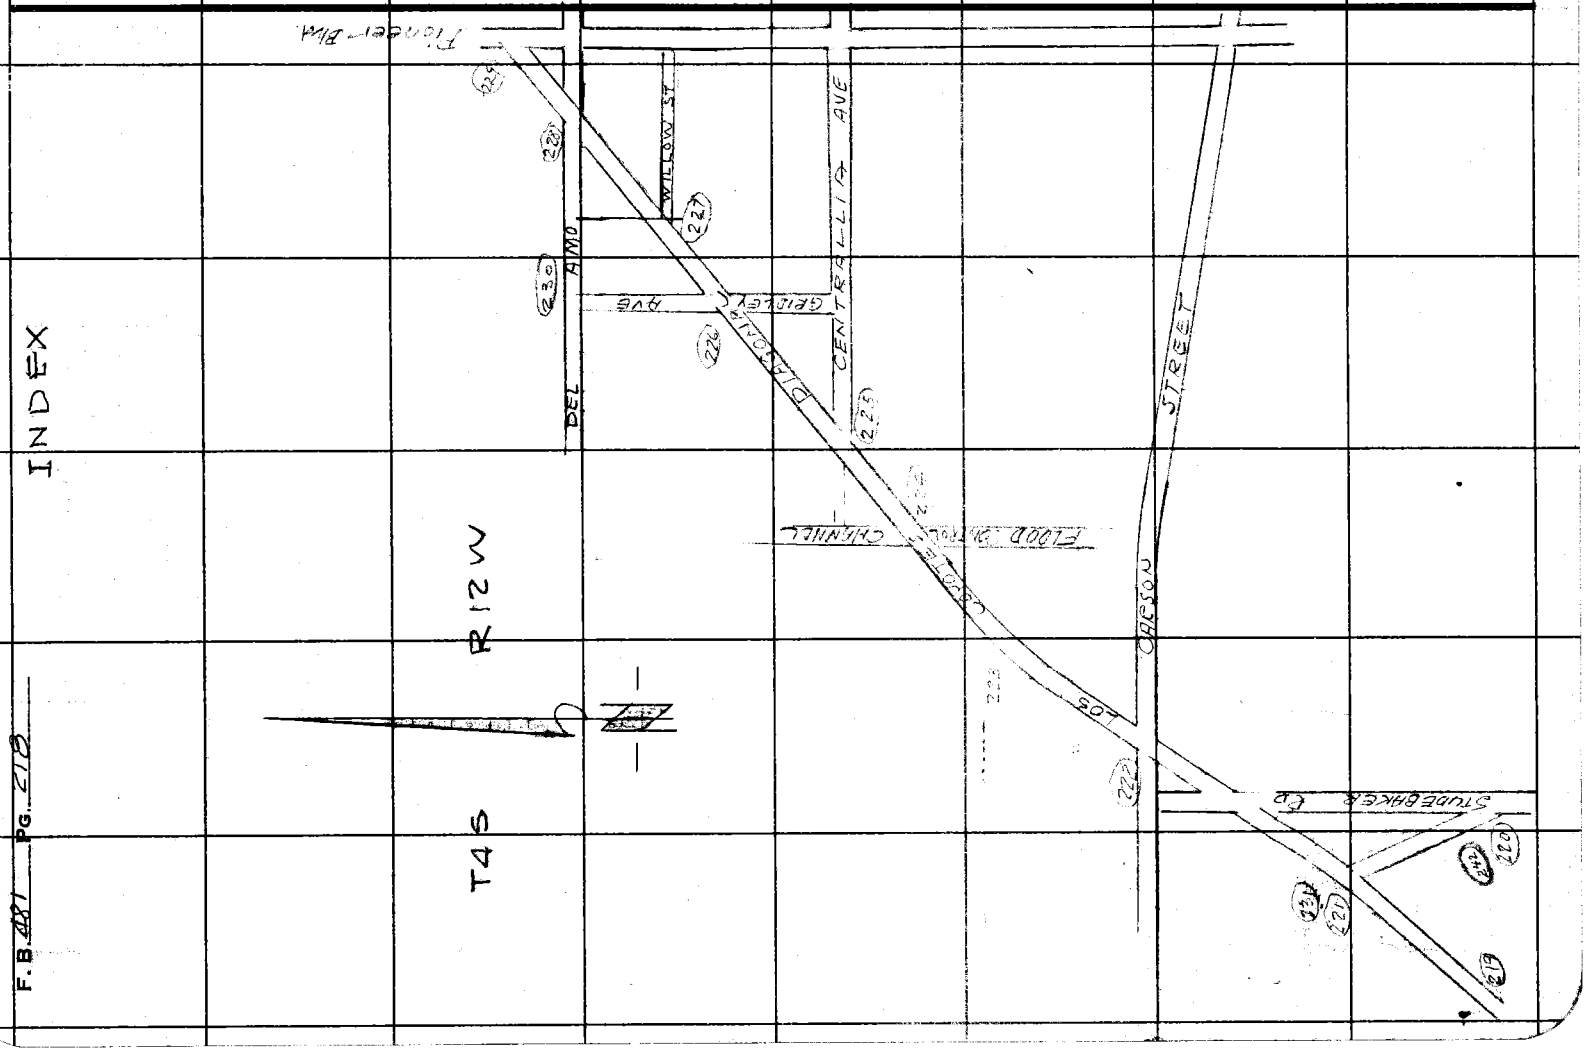

Notes Ck'd by KRM
Map No.
Office Work
Checked
Date

Survey of LOS COYOTES DIAG
W. O. 7995 Tape No.) St'd 84 °F
Surveyed by F.H.Blanchard
Notes F.H.B Date 11-14-51
Indexed A. C. Johnson

F. B. 481 PG. 219

Note: Any Additions or Changes on This Sheet Must be Made or Circled in Red Ink, With Date and Name of Person Making Change.

Do not extend notes this side of this line.

RETURN TO
LOS ANGELES COUNTY SURVEYOR
726 LOS ANGELES COUNTY ENGINEERING BLDG.

last pg - 221

Montana Land Co. Mon. Pg. 222

TRACT 9265

TRACT 10548

2123.72 to P.I. To Montana Land Co. Mon.

This pt. gone former says he destroyed it when he hit it with rooter

173+98.39 P.O.T.

LOS COYOTE DIAGONAL

201.81 Rec FB 481-128-127

1382.50

1343.81

Angle Point per C.S.B — 633+2A.
160 + 55.18 going N.E.

fd City of Long Beach B.C. mon. 1855 x in cntr PM 0.11 N in edge of cap. ties to Punch mark FB 481-127

360° 09' 20" Copied

T-66
4383.01 @ 0°00 = 4382.50
T-66
4382.99 @ 0°00 = 4382.48

693.48

Set X in 4" I.P.

33.05

19.62

42.82

0.11

Set nail & T in P.P. #829922E

Set 1" I.P. in 2" I.P. Sign post

Adopted ℄

fd City of Long Beach B.C. mon. 1855 x in cntr set in 14" well.

PALOS VERDE

571.66

Fd B.C. Mon. in hand hole

LOS COYOTES DIAG

Montana Land Co mon

PM

0.11

1.02

City of Long Beach mon

28.82

PALOS VERDE

NOTE — I find just 1' diff. between my chaining of FB 481-127-128, I think FB 481-127 chained to Montana Land Co. mon. and arrow is to wrong point. I double chained the dist. and checked within .02

76F3095 247 2-51

RETURN TO
LOS ANGELES COUNTY SURVEYOR
726 LOS ANGELES COUNTY
ENGINEERING BLDG.

Note: Any Additions or Changes on This Sheet Must be Made or Circled in Red Ink With Date and Name of Person Making Change.

Do not extend notes this side of this line.

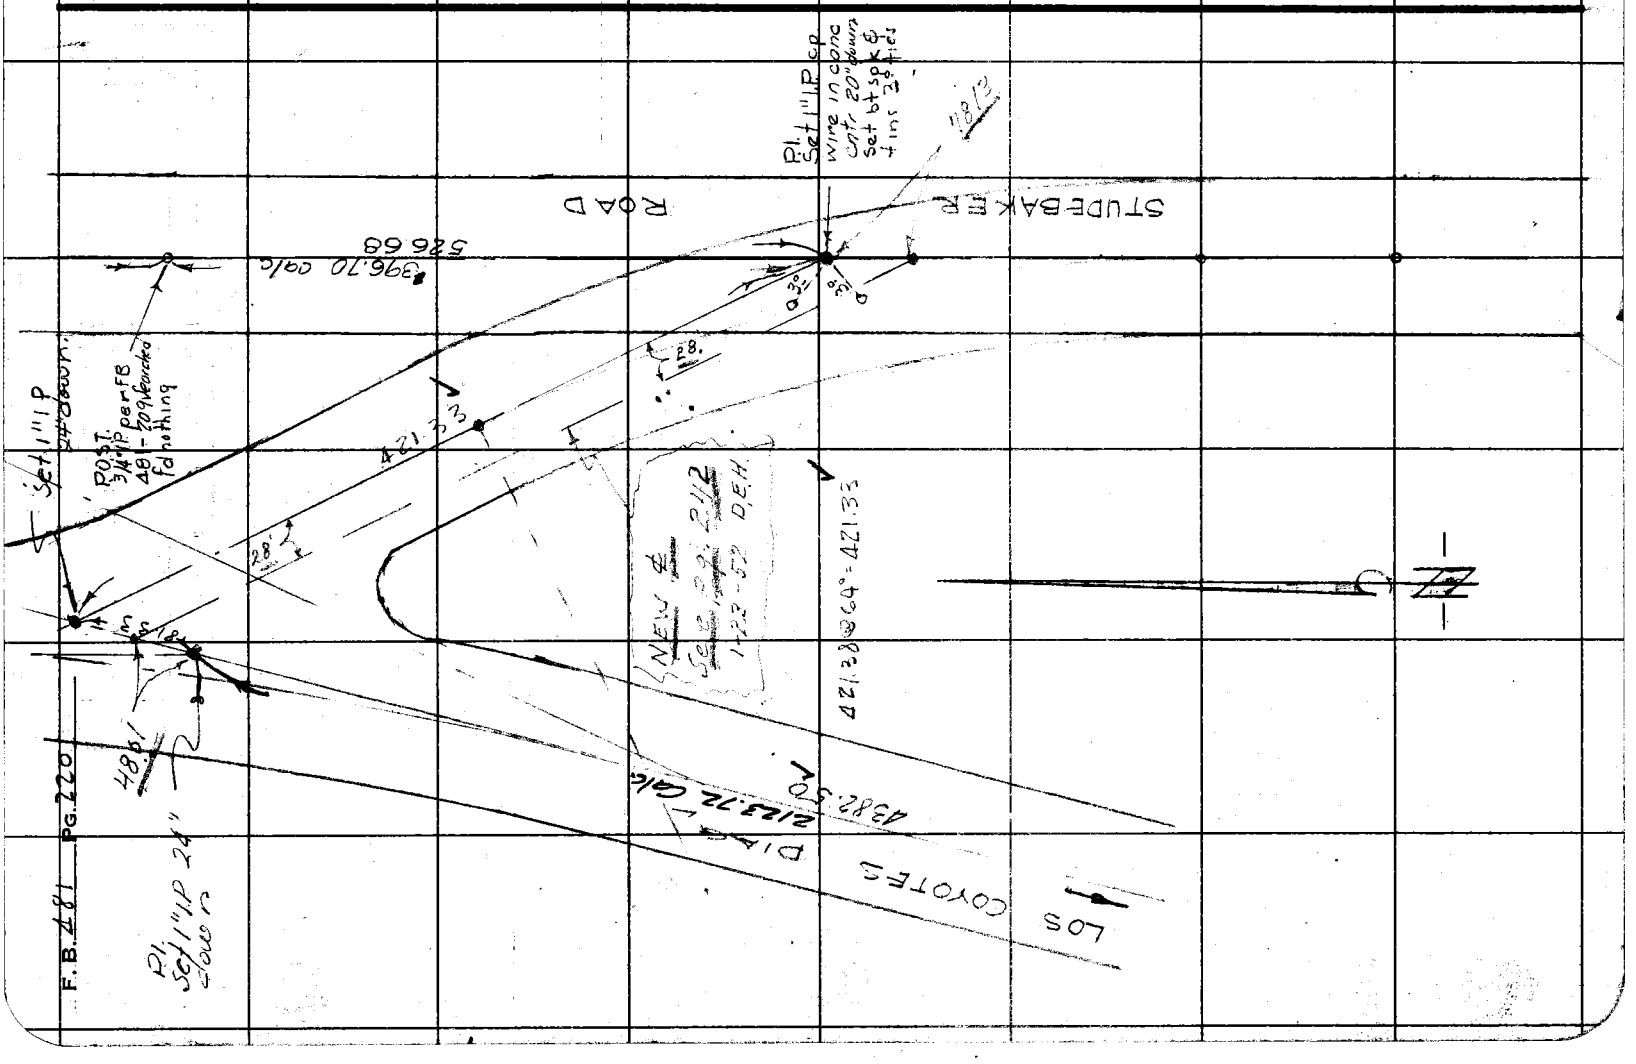

Notes Ck'd by KRM	Survey of LOS COYOTES DIAG.
Map No.	W. O. 7995 Tape No. ? St'd. 84 °F
Office Work	Surveyed by FH BLANCHARD
Checked	Notes BLANCHARD Date 11-15-51
Date	Indexed A. C. Johnson

F.B. 481 Pg. 221

bot pg 222

Note: Any Additions or Changes on This Sheet Must be Made or Circled in Red Ink With Date and Name of Person Making Change.

Do not extend notes this side of this line.

RETURN TO
LOS ANGELES COUNTY SURVEYOR
726 LOS ANGELES COUNTY
ENGINEERING BLDG.

T-68
551.64 @ 0°00 = 551.58
2) 288° 08' 40"
4) 216° 17' 20"
6) 144° 26' 00"
144° 04' 20"

551.58

Pl. COR. common to Rancho Los Cerritos Los Coyotes & Los Alamitos

24" willow

fd Montana Land Co B.C. Mon. 24" down per FB 481-129

24.62

Set 1" I.P. 24" down

Set 1" I.P. 24" down by int.

Δ = 21° 15' 00"
R = 2000
T = 375.19
L = 741.76

See Pg. 242 for this Curve.

Pl. Set 1" I.P. 24" down

158° 45' 00"

116.48

84.33

161.00

42.70

set nail in 24" willow

Set in 24" Standpipe

fd base of old 2x2 set per 481-128 Line FB 481-128

POST per FB 481-209 Searched fd nothing

STUDEBAKER ROAD

2) 317° 30' 00"
4) 275° 00' 00"
6) 232° 30' 00"
158° 45' 00"

57° 10' 40"

-NOTE-
TIES ON PAGE 231

DIAGONAL

COYOTES

4382.50

T-84°
81.33 @ 0°00 = 81.33

2) 42° 00' 00"
4) 84° 00' 00"
6) 126° 00' 00"
21° 00' 00"

2) 114° 21' 20"
4) 228° 42' 40"
6) 343° 04' 00"
57° 10' 40"

Searched fd nothing

Searched fd nothing

LOS

tap pg 219

Pl. Set 1" I.P. 20" down, set 1 x at surface set 6t spk & tin 3 ties

396.70 c/a/c
526.68

21° 00' 00"

0.3'
0.3'

76F309S 247 2-51

F.B. 481 PG. 222

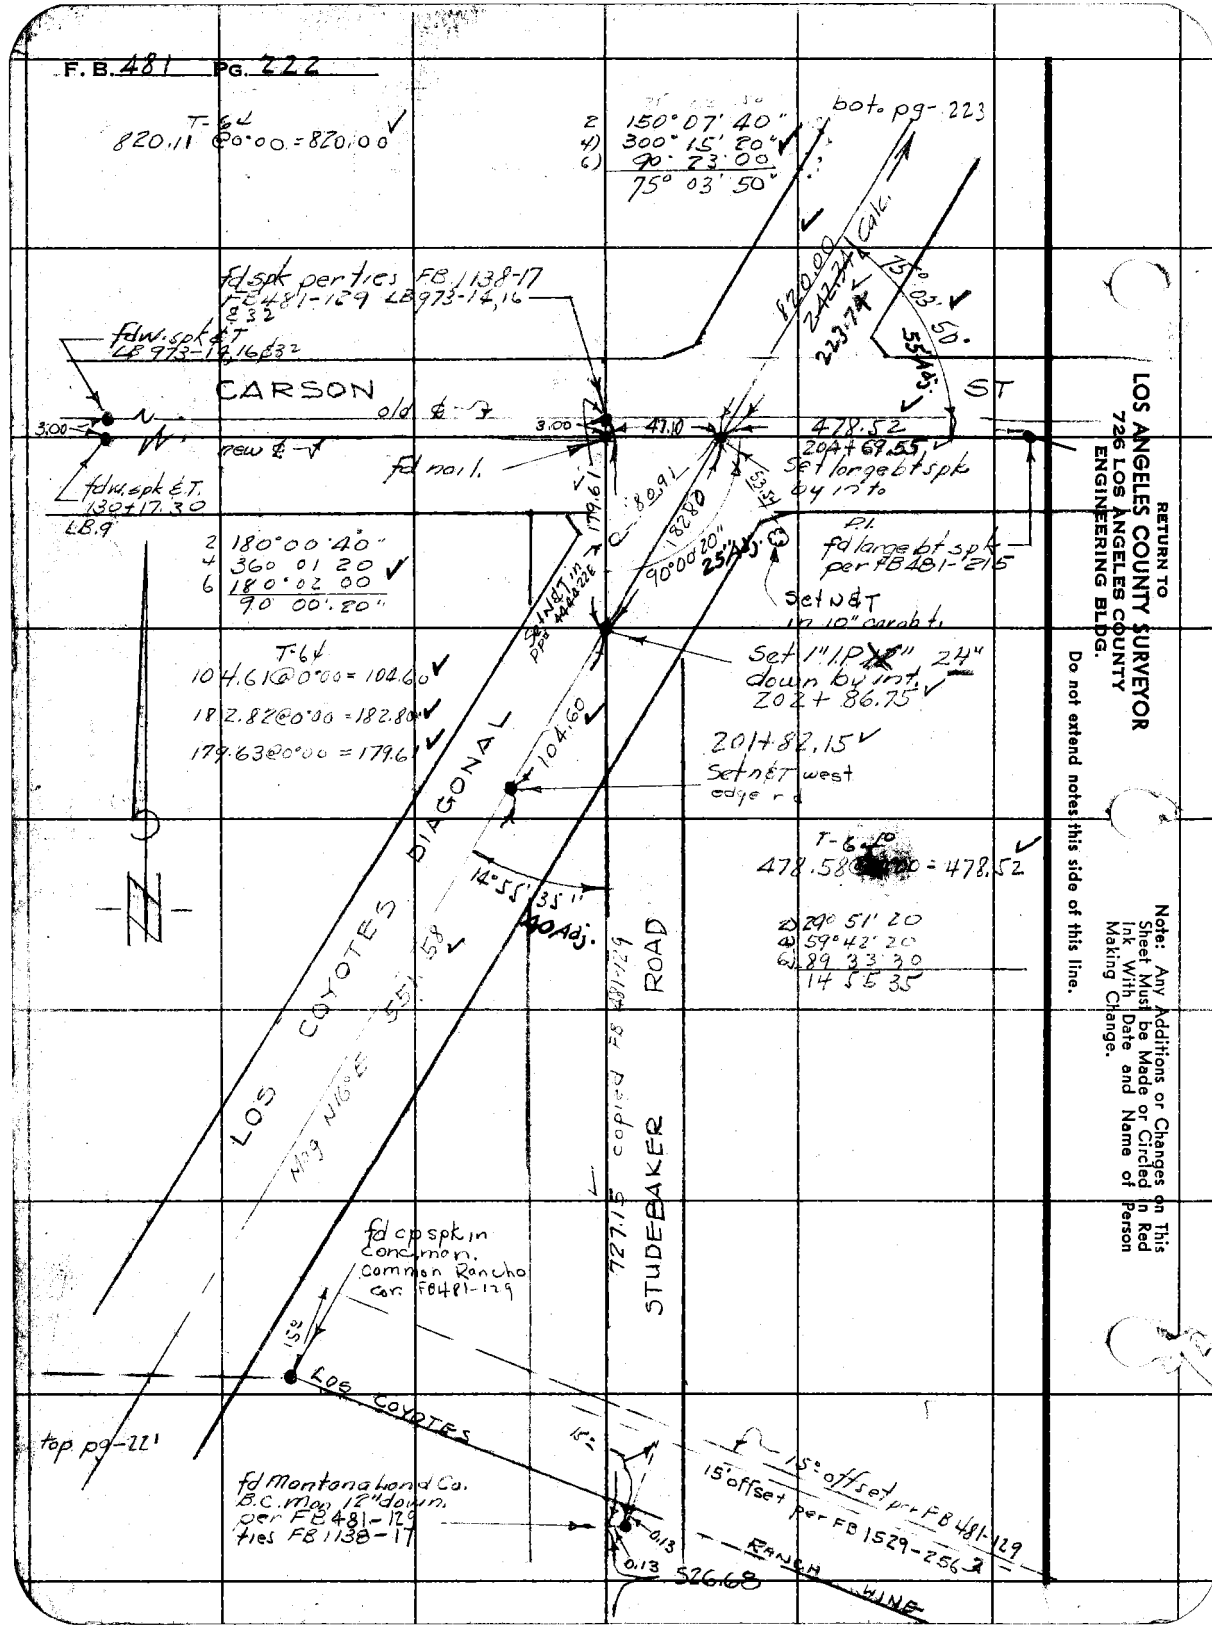

RETURN TO
LOS ANGELES COUNTY SURVEYOR
726 LOS ANGELES COUNTY
ENGINEERING BLDG.

Do not extend notes this side of this line.

Note: Any Additions or Changes on This Sheet Must be Made or Circled in Red Ink With Date and Name of Person Making Change.

Notes Ck'd by KRM	Survey of LOS COYOTES DIAG
Map No.	W. O. 7995 Tape No. 29 St'd 84 °F
Office Work	Surveyed by FH Blanchard
Checked	Notes FHB. Date 11-16-51
Date	Indexed A. C. Johnson

F. B. 481 Pg. 223

Note: Any Additions or Changes of This Sheet Must be Made or Circled in Red Ink With Date and Name of Person Making Change.

Do not extend notes this side of this line.

RETURN TO
LOS ANGELES COUNTY SURVEYOR
726 LOS ANGELES COUNTY
ENGINEERING BLDG.

76F309S 247 2-51

Sot #9 2x2

T-62
1202.55 @ 0°00 = 1202.38
237.42 @ 2°01 = 237.25
1439.63

1439.63

2) 300° 18' 20"
3) 240° 36' 40"
4) 180° 54' 40"
150° 09' 07

ADOPTED ℄

1912.80 Calc
DIAG

217+13.14 B.C.

Δ = 29° 50' 55"
R = 2000
T = 533.07
L = 1041

Δ = 29-13-00
R = 2000
T = 521.27
L = 1019.85

Set 1" I.P. 12" dn

74.99

New PT
Set 1" I.P.-P&Tk.
dn (30") per staking
plans.
Set 2x2" P&Tk. over
I.P. (dn. 10")
1-24-52 D.E.K.

150° 09' 05"

LOS COYOTES

820.00

207+11.84 B.C.
206+93.29 B.C.

Top pg 222

F. B. 481 PG. 224

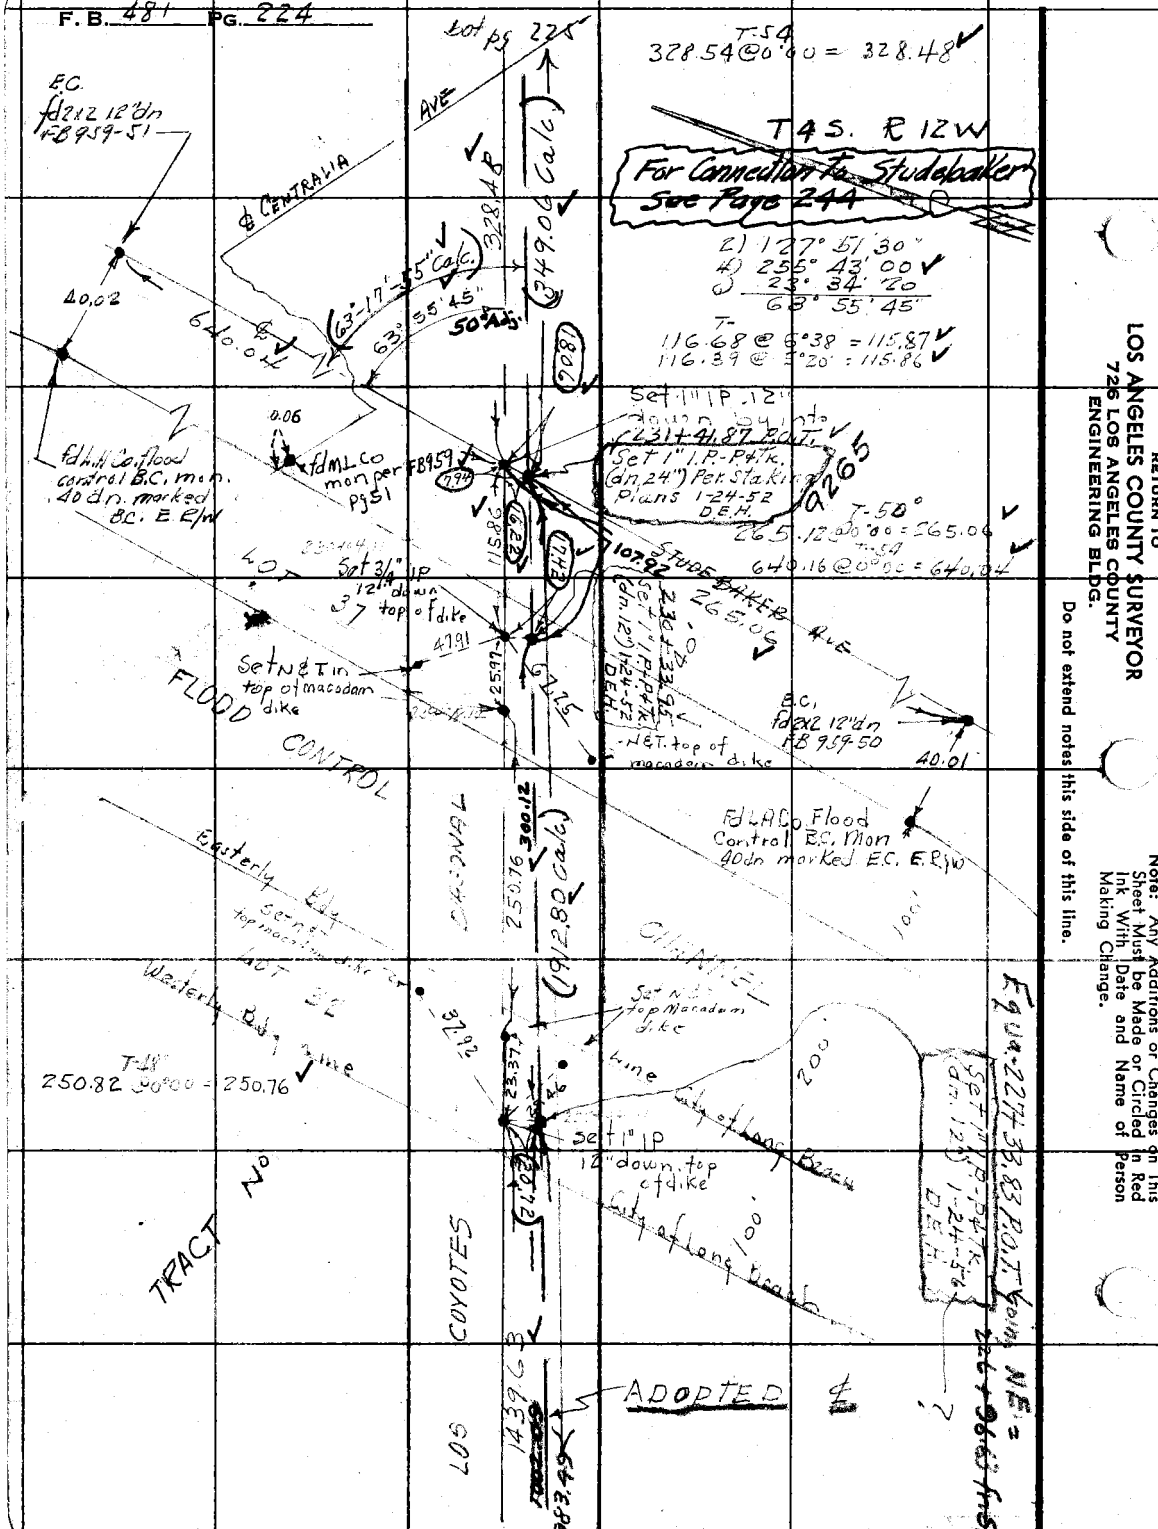
Lot pg 225
AVE
E.C. fd 2x2 12"dn FB 959-51
E. CENTRALIA
40.02
640.04
63°-17'-55" Calc.
63° 55' 45"
50' Axis
328.48
349.04 Calc.
T-54
328.54 @ 0°40' = 328.48
T 4 S. R 12 W
For Connection to Studebaker
See Page 244
2) 127° 51' 30"
4) 255° 43' 00"
3) 23° 34' 20"
68° 55' 45"
T-
116.68 @ 5°38' = 115.87
116.39 @ 5°20' = 115.86
RETURN TO
LOS ANGELES COUNTY SURVEYOR
726 LOS ANGELES COUNTY
ENGINEERING BLDG.
Do not extend notes this side of this line.
Note: Any Additions or Changes on This Sheet Must be Made or Circled in Red Ink With Date and Name of Person Making Change.
fd LACo flood control B.C. mon. 40 dn. marked B.C. E E/W
0.06
fd MLCo mon per FB 959 pg 51
Set 1" IP 12" down on pt. (431+41.87 P.O.T. (Set 1" I.P.-P&K. (dn. 24") Per Staking Plans 1-24-52 D.E.H.
T-50°
265.12 @ 0°40' = 265.06
T-54
640.16 @ 0°00' = 640.04
9265
115.86
Set 3/4" IP 12" down top of dike
Set N & T in top of macadam dike
FLOOD CONTROL
265.06
E.C. fd 2x2 12"dn FB 959-50
40.01
Easterly B.L.
Set N & T top macadam dike
Westerly B.L.
T-18
250.82 @ 0°40' = 250.76
250.76
300.12
(1912.80 Calc.)
Set N & T top Macadam dike
Set 1" IP 12" down top of dike
200'
100'
TRACT No
COYOTES
LOS
1439.63
ADOPTED
top pg 223

Notes Ck'd by KAM	Survey of Los Coyotes Diag.
Map No.	W. O. 7995 Tape No. 29 St'd. 84 °F
Office Work	Surveyed by F H Blanchard
Checked	Notes F H B. Date 11-26-51
Date	Indexed A. C. Johnson

F. B. 481 Pg. 225

Left side pg 226

PRO. E. STUDEBAKER RD. See pg. 244

T. 4 S. R. 12 W.

LOS COYOTES DIAGONAL

1066.02

300.94

2.73 Calc.

2) 88° 52' 15"
4) 177° 44' 30"
6) 266° 36' 40"
44° 26' 05"

234 at 30.93 P.O.T.

Set 1" I.P. + T.K. (dr. 14") Per Staking Plans. 1-24-52 DEH

Lt. bot pg 226

fd M.L.Co. BC MON. set in well, 2' down. FB 959-51

44° 26' 05" Calc.

(3.3')

CENTRALIA AVE

Set NAT on fence Post 0.34 N 16.96 17.6 W

Set 1" I.P by int. 12" down

set nat. in fence Post

38.08

24.84

Set NAT in fence Post

328.4P

349.06 Calc.

ADOPTED

Top pg 224

Top pg 224

Top pg 224

Note: Any Additions or Changes of This Sheet Must be Made or Circled in Red Ink With Date and Name of Person Making Change.

Do not extend notes this side of this line.

RETURN TO
LOS ANGELES COUNTY SURVEYOR
726 LOS ANGELES COUNTY
ENGINEERING BLDG.

76F3095 247 2-51

F.B. 481 PG. 226

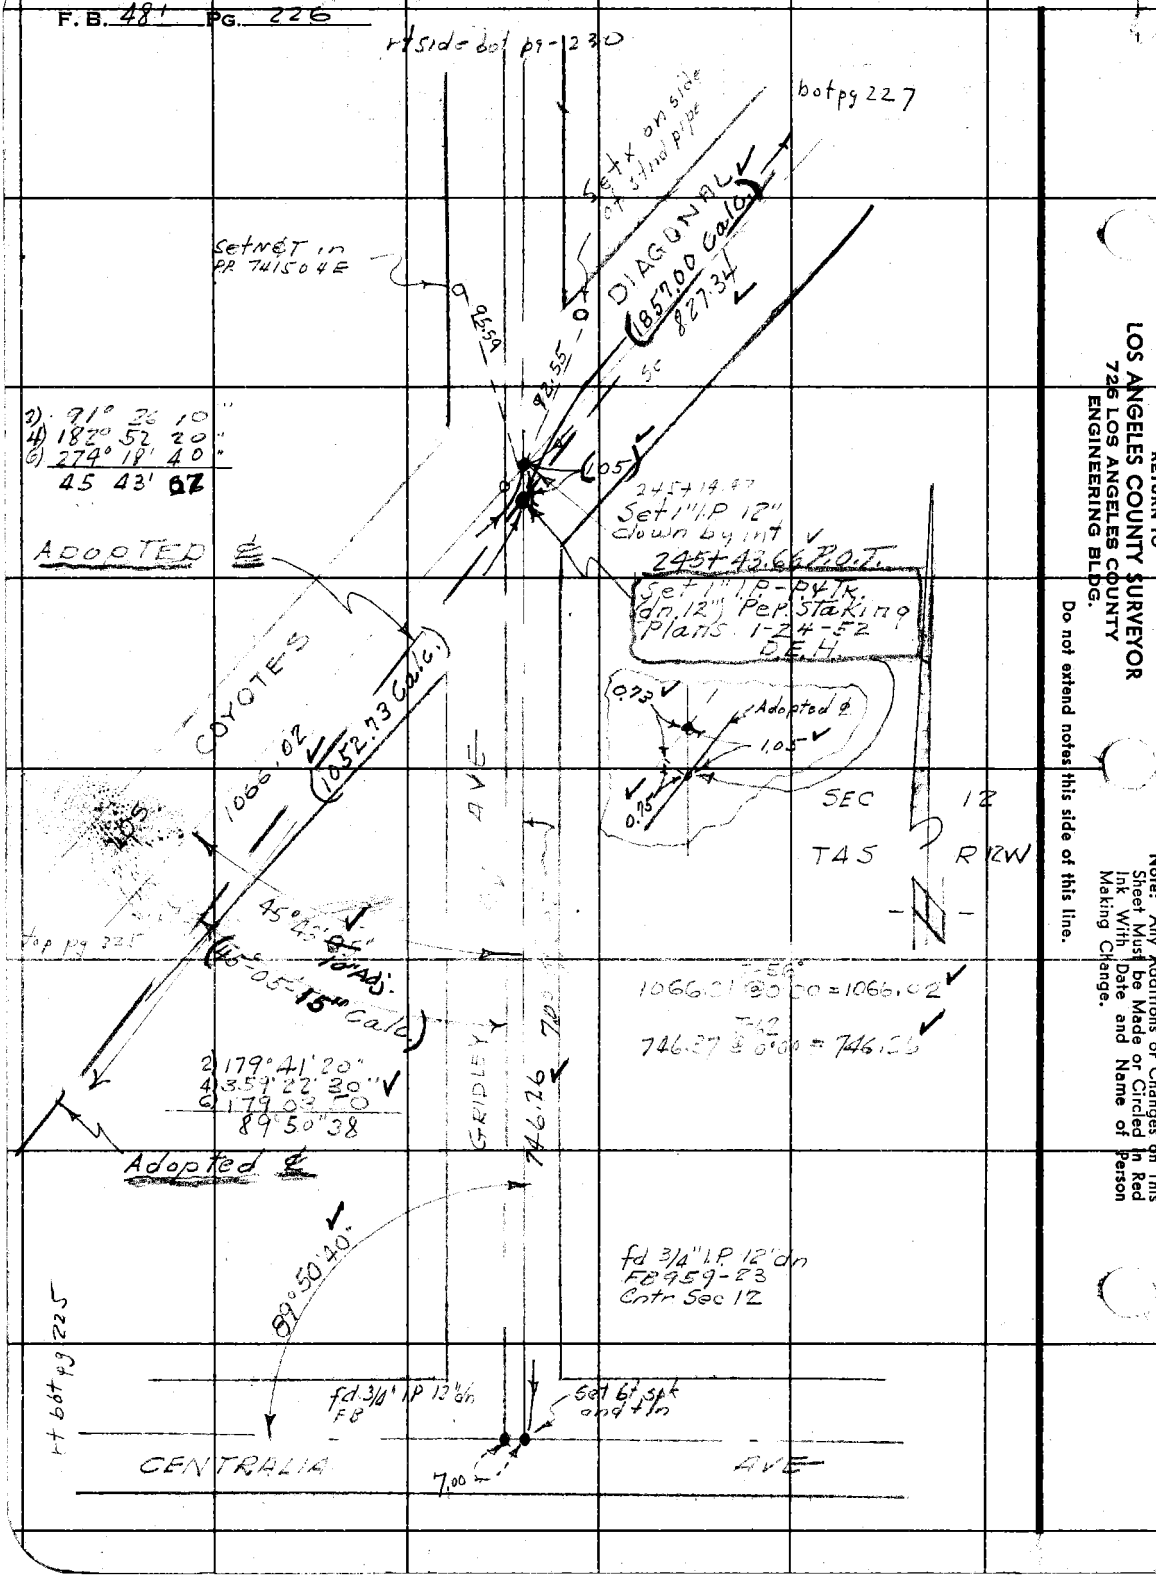

RETURN TO
LOS ANGELES COUNTY SURVEYOR
726 LOS ANGELES COUNTY
ENGINEERING BLDG.

Do not extend notes this side of this line.

Note: Any Additions or Changes on This Sheet Must be Made or Circled in Red Ink With Date and Name of Person Making Change.

Notes Ck'd by KRM		Survey of LOS COYOTES DIAG	F.B. 4R1 Pg. 227
Map No.		W. O. 7995 Tape No. 29 St'd. 84 °F	
Office Work		Surveyed by FHBlanchard	
Checked		Notes FHB Date 11-26-51	
Date		Indexed R. C. Johnson	

Ft side pg 230

End pg 228

622.15 @ 0°00' = 622.12

888.28 @ 0°00' = 888.16

622.12 TRACT LINE (44°-54'-35" Ca. 16.)

837.29 Ca. 16.

888.16

2) 91° 05' 00"
+ 182° 10' 00"
3) 273° 15' 00"
45° 32' 30"
264.00.66 P.O.T.

45° 32' 30"

Calc. inter. Nothing
Set (flooded)
1-28-52 D.E.H.

2766

1994

1937

set n&t in fence ✱

24.65

Set 1" IP flush by 2

31.31

fd 3/4" IP 14" deep
E81.07.182

25.68

DIAG

WILLOW STREET

ADOPTED

1857.00 Ca. 16.

1009.44

set n&T in fence post

LOS COYOTES

6.70

22.32

set n&T in fenced

Set 1R2

827.34

1009.67 @ 0°00' = 1009.44

827.45 @ 0°00' = 827.34

Top pg 226

Note: Any Additions or Changes on This Sheet Must be Made or Circled in Red Ink With Date and Name of Person Making Change.

Do not extend notes this side of this line.

RETURN TO
LOS ANGELES COUNTY SURVEYOR
726 LOS ANGELES COUNTY
ENGINEERING BLDG.

76F3095 247 2-51

F. B. 481 Pg. 228

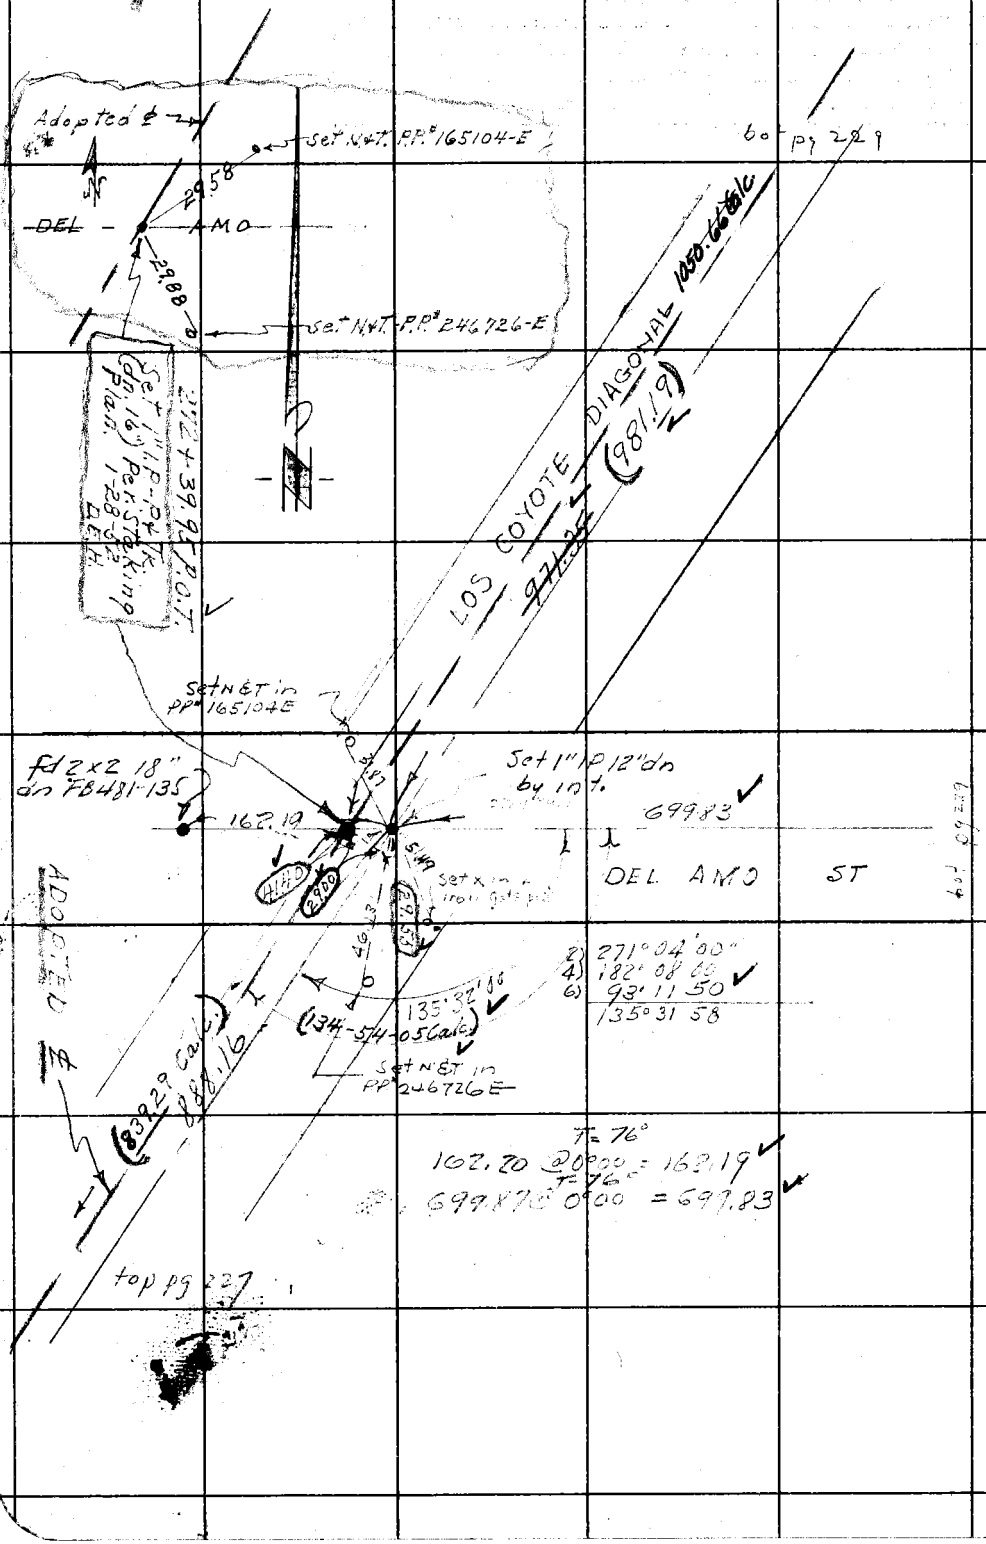

RETURN TO
LOS ANGELES COUNTY SURVEYOR
726 LOS ANGELES COUNTY
ENGINEERING BLDG.

Do not extend notes this side of this line.

Note: Any Additions or Changes on This Sheet Must be Made or Circled in Red Ink With Date and Name of Person Making Change.

Notes Ck'd by KRM	Survey of LOS COYOTES I LVD
Map No.	W. O. 7995 Tape No. 29 St'd. 84 °F
Office Work	Surveyed by F H Blanchard
Checked	Notes FHB Date 11-28-51
Date	Indexed R C Johnson

F. B. 481 Pg. 229

Note: Any Additions or Changes on This Sheet Must be Made or Circled in Red Ink With Date and Name of Person Making Change.

Do not record notes this side of this line.

RETURN TO
LOS ANGELES COUNTY SURVEYOR
726 LOS ANGELES COUNTY
ENGINEERING BLDG.

Fd C.S.Mon. dr 9" in H.H. RE 329 Porter 2-14-52 Porter

Per F.B. 1187-148

2.0 ± 195.54

To Be Mon. in handhole

BLVD.

L.A.Co.Sur.Cont.Sys. Monument C-6 F.B. 932-59 Porter 2-14-52

T4S R12W

282+90.61 End of Survey

Set S.W.&T. in fence post

Set N.&T. in P.P. 531487E

Set Large 6d spike by int. 282+10.76

Set N.&T. in Gar. fence post

Adopted ±

TGG

971.46 @ 0°00 = 971.25

687.46 @ 0°00 = 687.38

2) 91° 02' 20"
4) 182° 04' 50
6) 273° 07' 00
45° 31' 10

Rechained 1-28-52 DEH

981.15 @ 0-00'-74" = 981.19

100' Tape @ 0.22 Std. 68°

COYOTE

45°31'10"

(44-33-15 Calc)

PIONEER

1050.66 G&LO S 981.19

Set 1" IP 12" in

DEL AMO

699.83

Trip pg 228

Note: This mon. is Trans. Sta. C-7 F.B. 932-61-62 L.A.Co.Sur.Cont. Trav. Sta. Series 5 to C-7 Porter 2-14-52

Fd B.C.Mon. in handhole

76F309S 247 2-51

RETURN TO
LOS ANGELES COUNTY SURVEYOR
726 LOS ANGELES COUNTY
ENGINEERING BLDG.

Note: Any Additions or Changes on This Sheet Must be Made or Circled in Red Ink With Date and Name of Person Making Change.

Do not extend notes this side of this line.

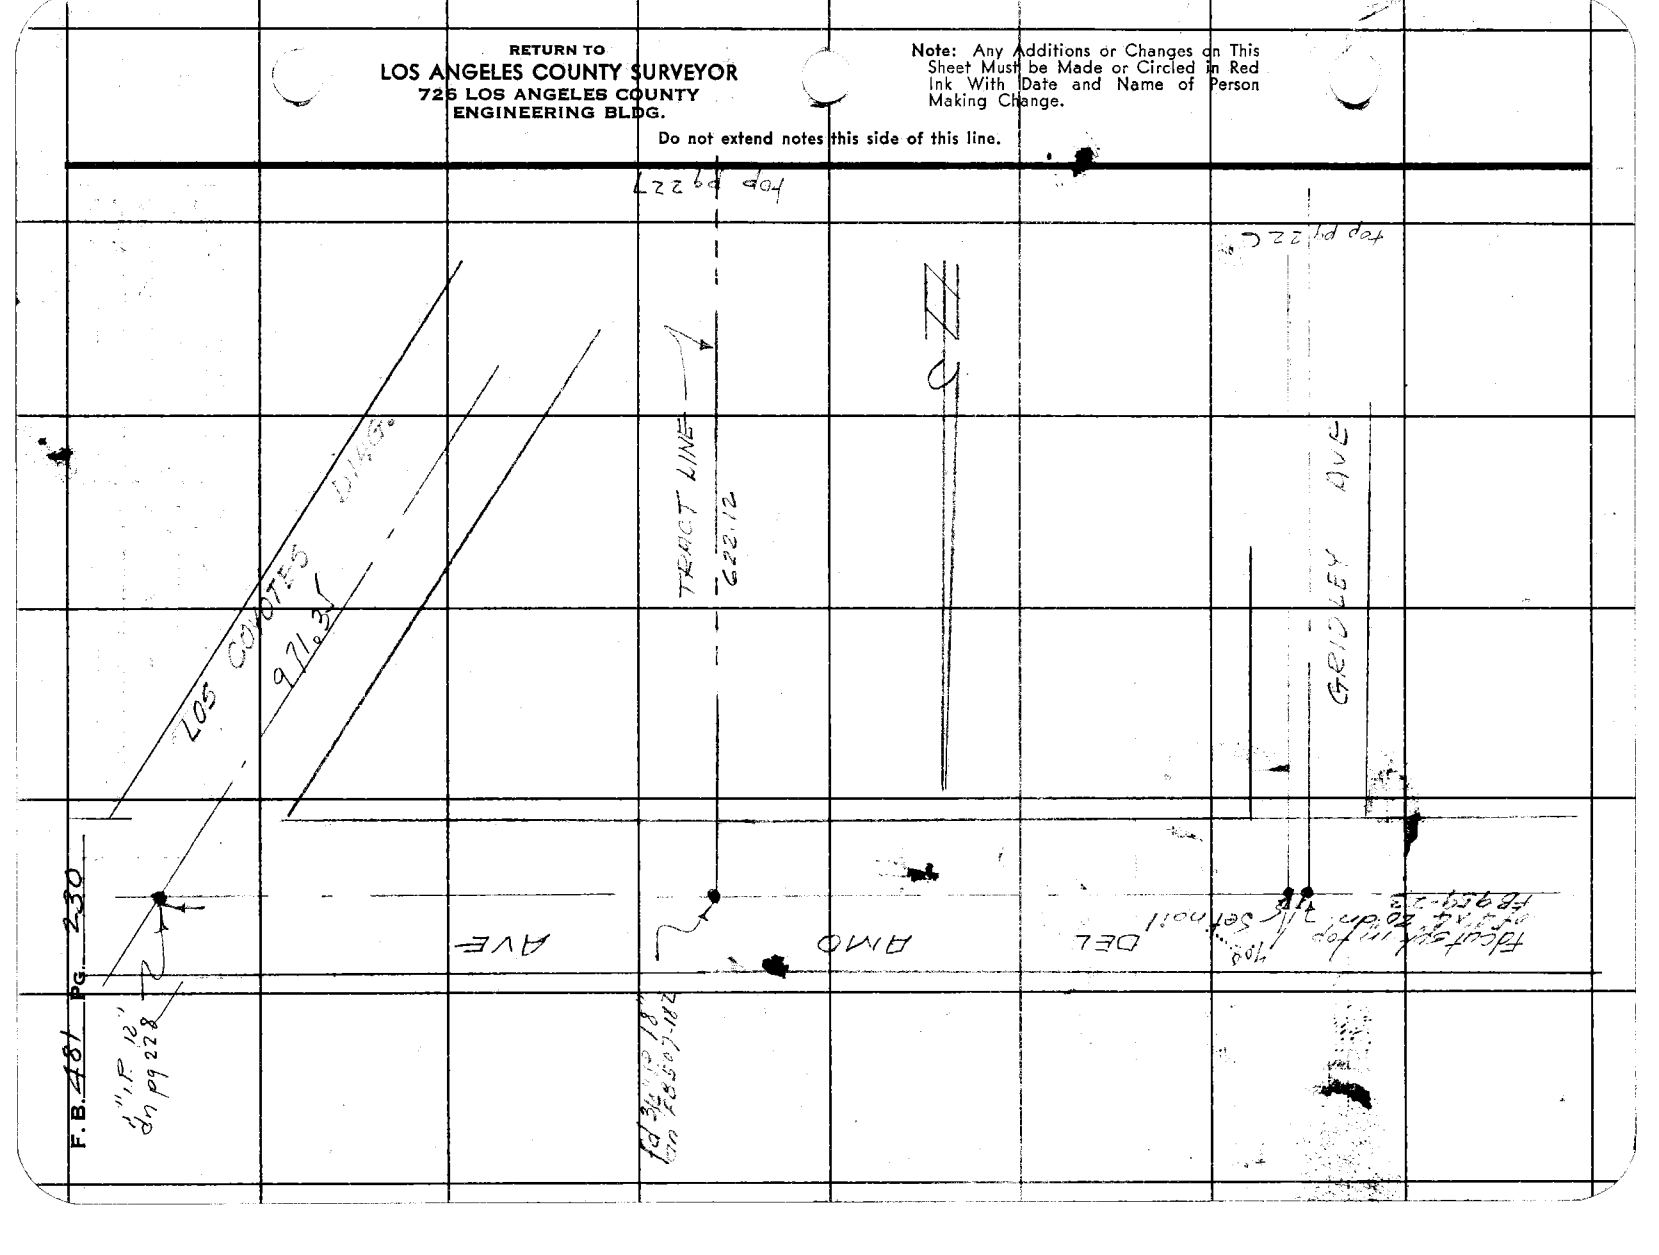

Notes Ck'd by	Survey of Los Coyotes Diag
Map No.	W. O. 7996 Tape No. 29 St'd. 84 °F
Office Work	Surveyed by F H Blanchard
Checked	Notes F H B Date 11-30-51
Date	Indexed

F. B. 481 Pg. 231

Note: Any Additions or Changes on This Sheet Must be Made or Circled in Red Ink With Date and Name of Person Making Change.

Do not extend notes this side of this line.

RETURN TO
LOS ANGELES COUNTY SURVEYOR
726 LOS ANGELES COUNTY
ENGINEERING BLDG.

76F3095 247 2-51

TIES pg - 221

12" Sycamore
Set N&T
42.24
3.58
30" willow
fd Montana land Co. Mon.
56.22
73.35
34.62
fd old 2x2
48.34
26.68
Set N&T in 18" willow
76.93
T. PUMPHSE.
1" I.P. pg. 221 24' down
(101.9 ±)
99.64
Set X in 24" stnd pipe
42.70
50.24
1" I.P. Pg. 242 (dn. 24')
(105° ±)
161.00
(73° ±)
75.03
1" I.P. pg. 221 24' dn.
(101° ±)
142.70
16.48
29.69
81.32
1" I.P. Pg. 242 (dn. 24')
Pt. pg. 221 1" I.P. 24' dn.
SEE PG 221
See Pg. 242
D.E.H.
Los Coyotes Diag.
STATE BLDG.

RETURN TO
LOS ANGELES COUNTY SURVEYOR
726 LOS ANGELES COUNTY
ENGINEERING BLDG.

Note: Any Additions or Changes on This Sheet Must be Made or Circled in Red Ink With Date and Name of Person Making Change.

Do not extend notes this side of this line.

F. B. _____ PG. 488

Notes Ck'd by	Survey of Los Coyotes Diag.
Map No.	W. O. 7995 Tape No. 29 St'd. 84 °F
Office Work	Surveyed by F H Blanchard
Checked	Notes F H C Date 1-3-51
Date	Indexed A. C. Johnson

F. B. _____ Pg. 8 2

Los Coyotes Diag.

Plus & Offset

J.N. 7995

Note: Any Additions or Changes on This Sheet Must be Made or Circled in Red Ink With Date and Name of Person Making Change.

Do not extend notes this side of this line.

RETURN TO
LOS ANGELES COUNTY SURVEYOR
726 LOS ANGELES COUNTY
ENGINEERING BLDG.

76F3095 247 2-51

RETURN TO
LOS ANGELES COUNTY SURVEYOR
726 LOS ANGELES COUNTY
ENGINEERING BLDG.

Note: Any Additions or Changes on This Sheet Must be Made or Circled in Red Ink With Date and Name of Person Making Change.

Do not extend notes this side of this line.

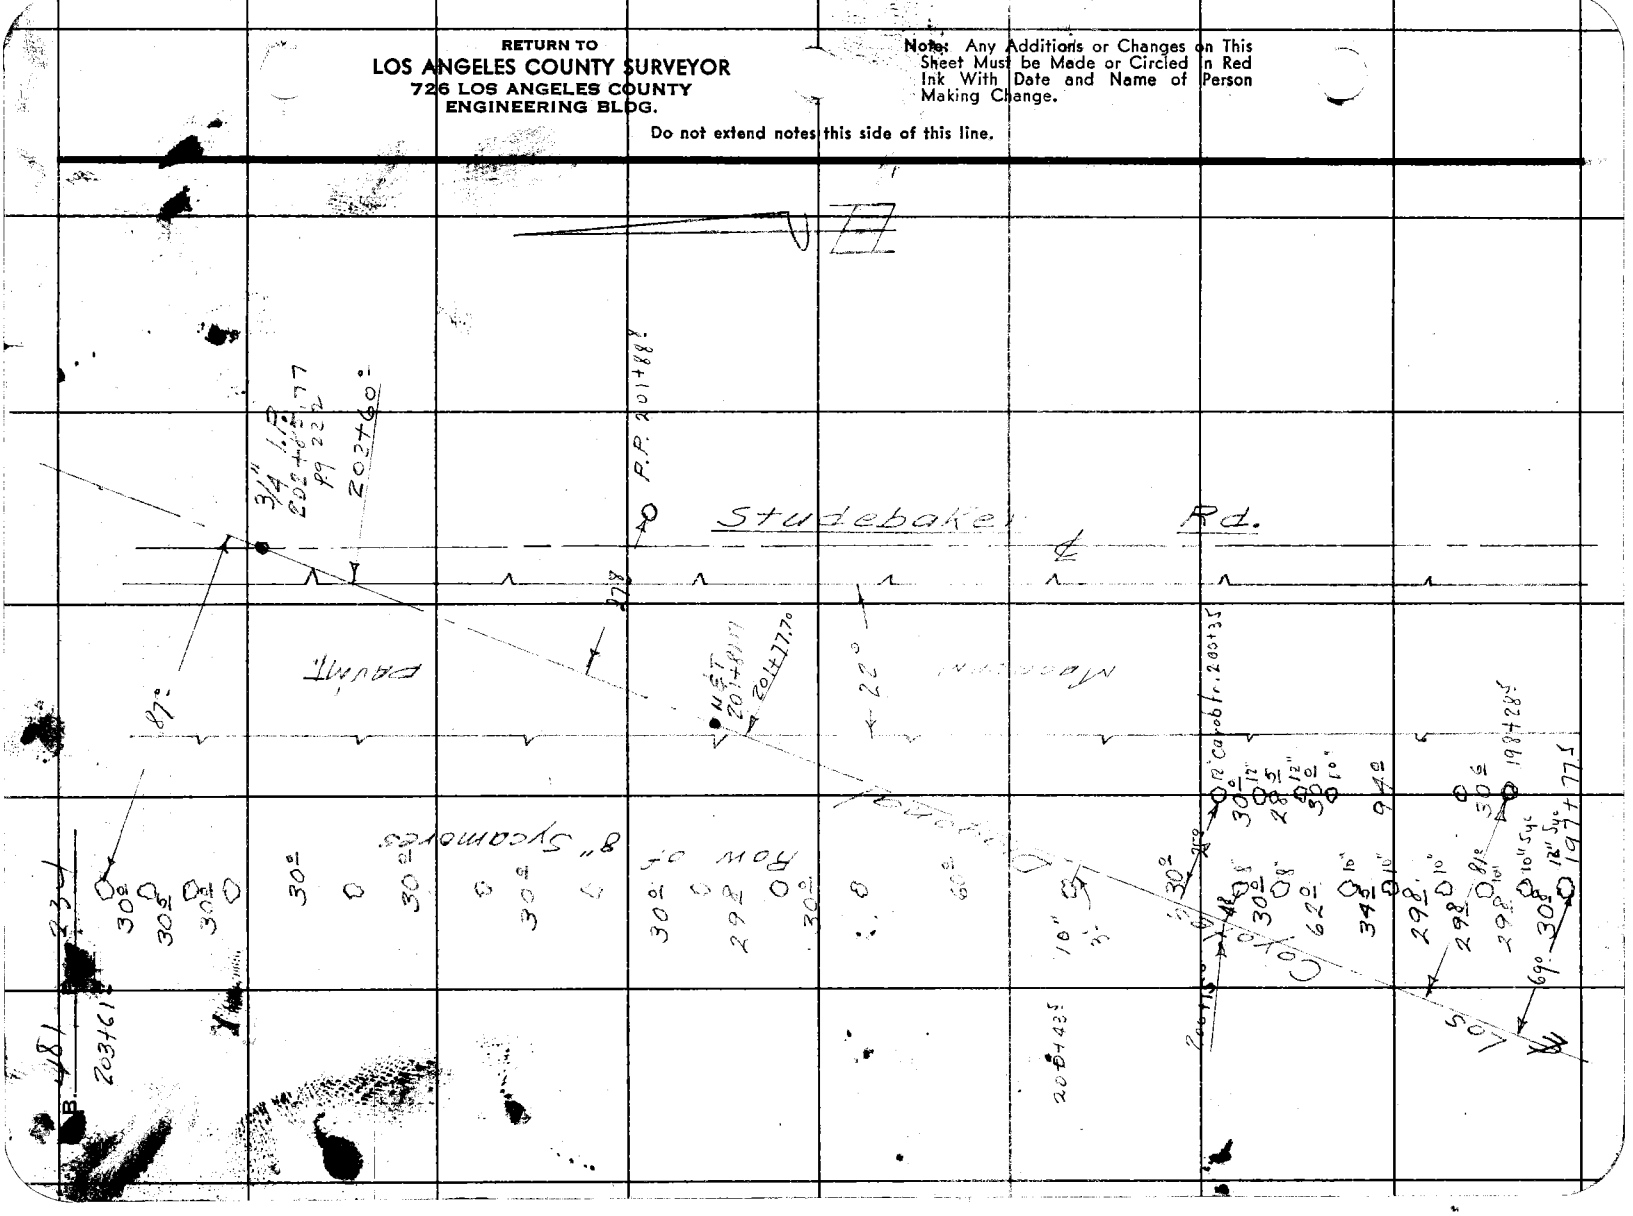
Studebaker Rd.
P.P. 201+88
87°
22°
30'
30'
30'

76F309S 247 2-51

RETURN TO
LOS ANGELES COUNTY SURVEYOR
726 LOS ANGELES COUNTY
ENGINEERING BLDG.

Note: Any Additions or Changes on This Sheet Must be Made or Circled in Red Ink With Date and Name of Person Making Change.

Do not extend notes this side of this line.

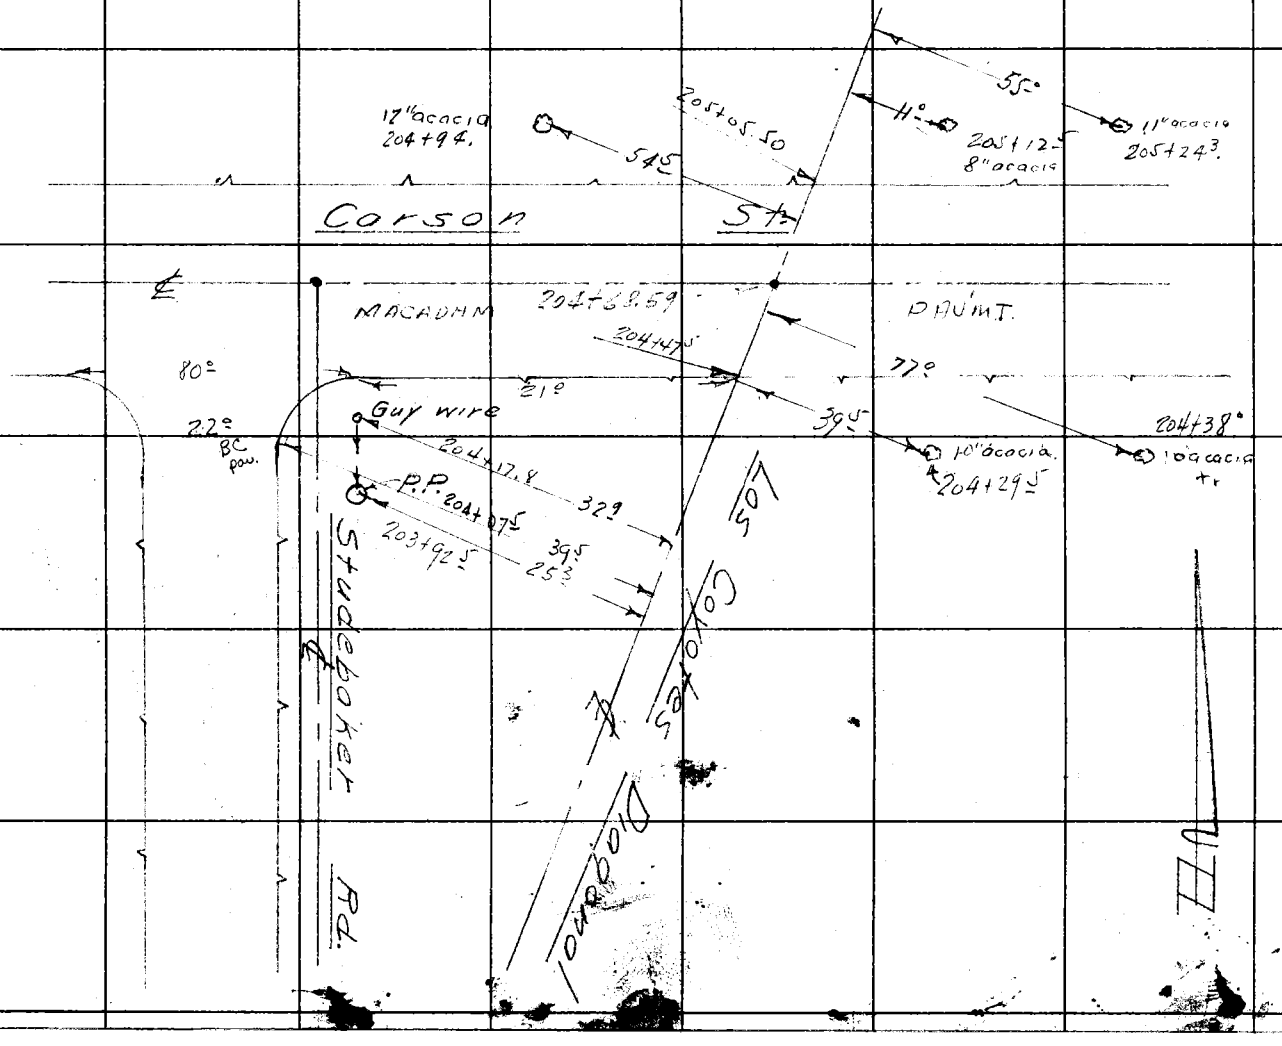

Notes Ck'd by
Map No.
Office Work
Checked
Date

Survey of LOS COYOTES DIAG. °F
W. O. 7995 Tape No. 2 Std. 82
Surveyed by: F. Flaherty & C. Johnson
Notes Date 11-30-51
Indexed

F. B. #84 Pg. 25

F. B. 481 PG. 236

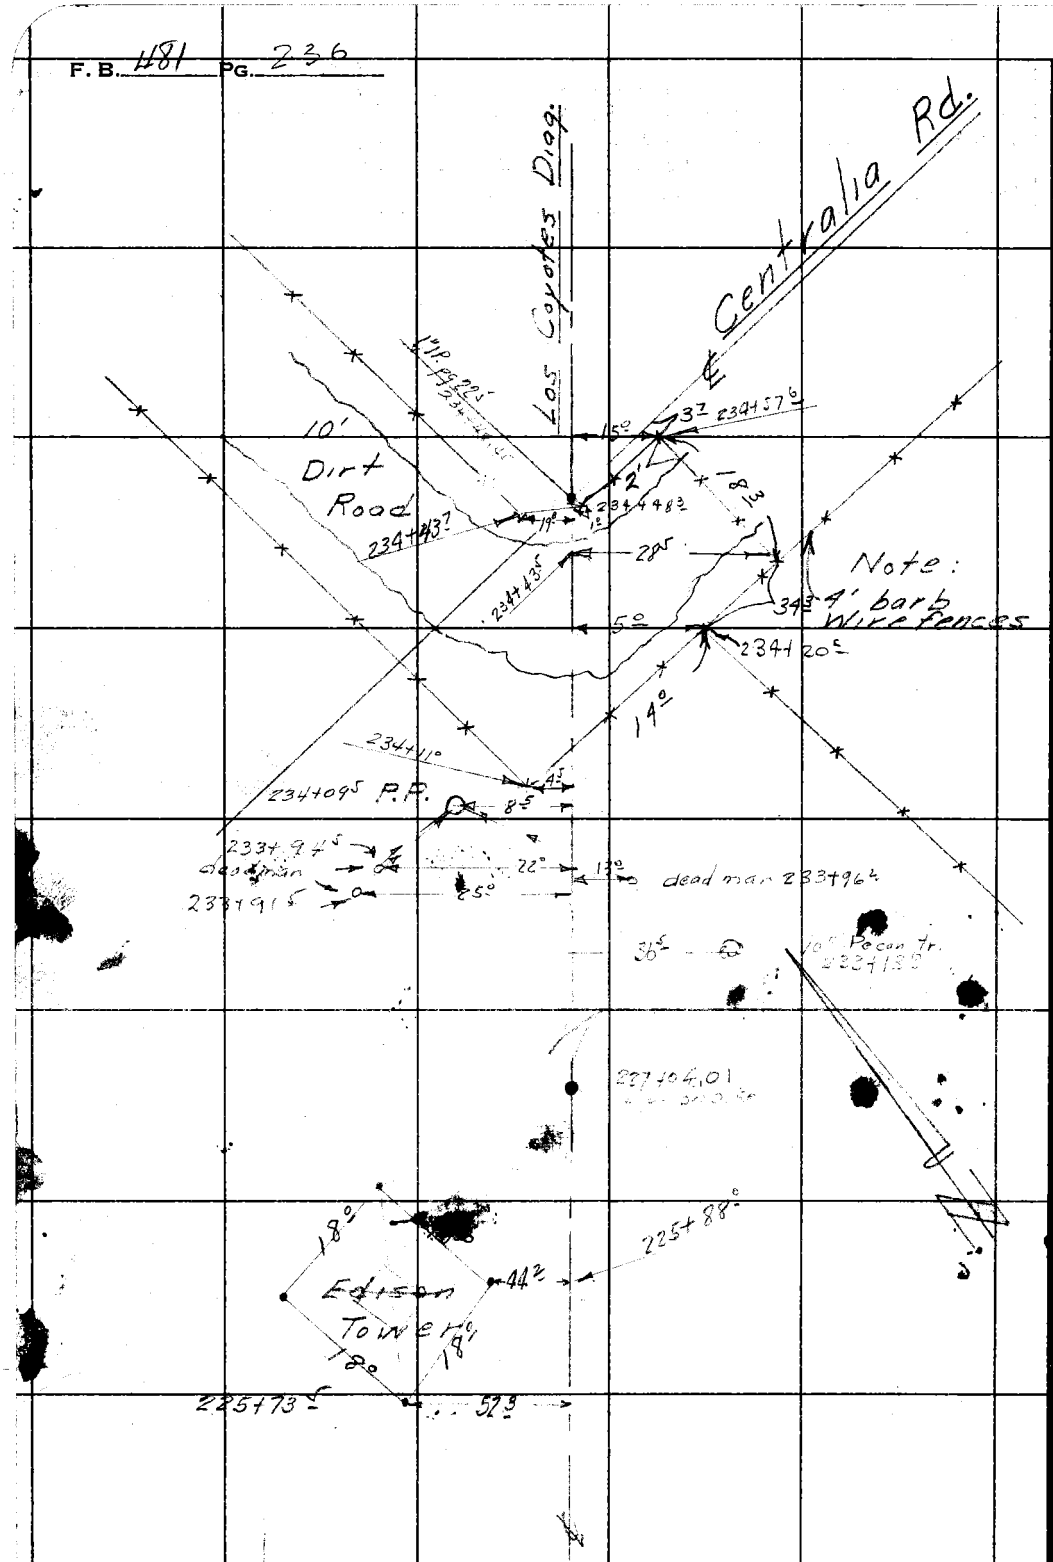

RETURN TO
LOS ANGELES COUNTY SURVEYOR
726 LOS ANGELES COUNTY
ENGINEERING BLDG.

Do not extend notes this side of this line.

Note: Any Additions or Changes on This Sheet Must Be Made or Circled In Red Ink With Date and Name of Person Making Change.

Notes Ck'd by	Survey of
Map No.	W. O. Tape No. St'd. °F
Office Work	Surveyed by
Checked	Notes Date
Date	Indexed K. C. Johnson

F. B. 481 Pg. 237

254+16.6 — 64° — 3 strand 4' bard Wire fn.

92°

253+50.8

1X2 P.O.T. 253+41.81

Note: Any Additions or Changes on This Sheet Must be Made or Circled in Red Ink With Date and Name of Person Making Change.

Do not extend notes this side of this line.

RETURN TO
LOS ANGELES COUNTY SURVEYOR
726 LOS ANGELES COUNTY
ENGINEERING BLDG.

10' Dirt Road

246+01.4 — 34° — 24" Stand. Pipe

℄ 7- Grid Line

P.R. 245+77.6 — 73°

3/4" I.P. 245+14.47

Offset

119° — 24" Stand. Pipe 244+51.0

Rd.

81° — P.P. 244+28.0

76F309S 247 2-51

F. B. 481 PG. 228

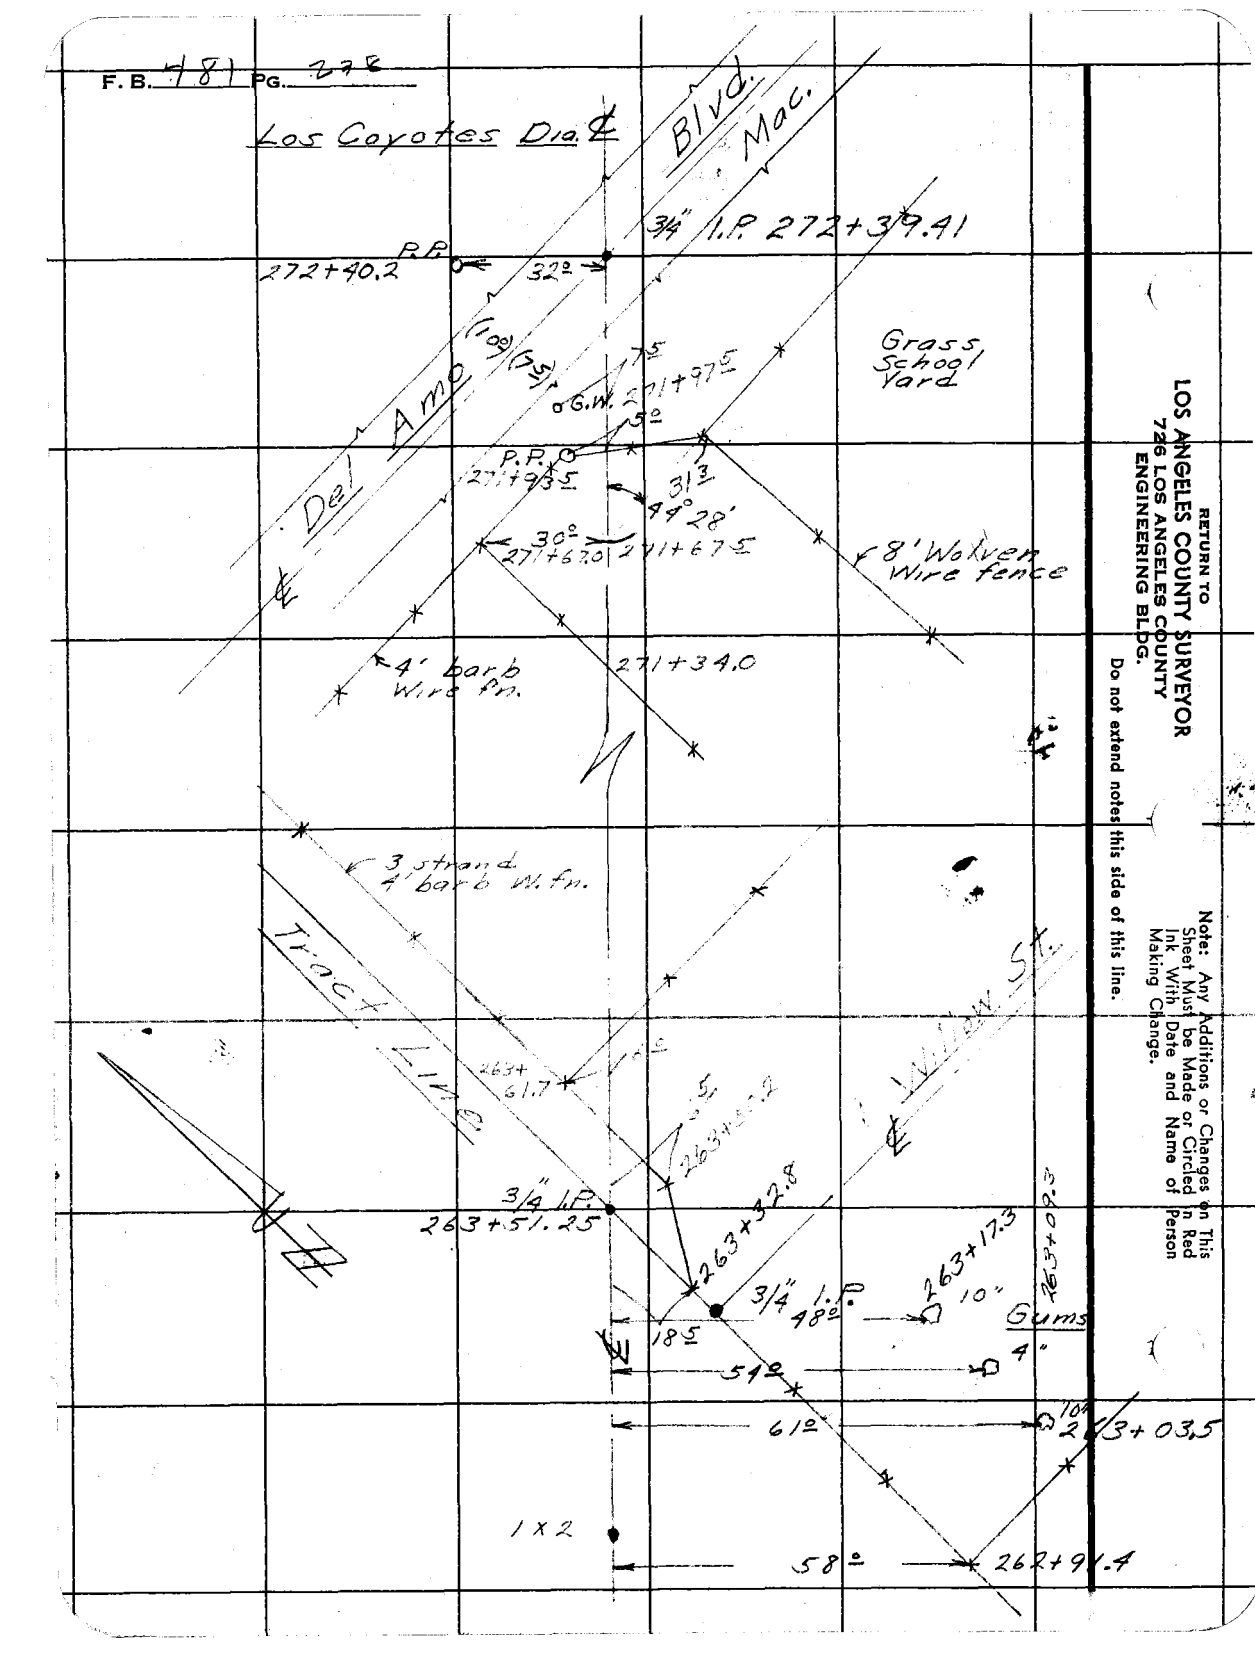

RETURN TO
LOS ANGELES COUNTY SURVEYOR
726 LOS ANGELES COUNTY
ENGINEERING BLDG.

Do not extend notes this side of this line.

Note: Any Additions or Changes on This Sheet Must be Made or Circled in Red Ink With Date and Name of Person Making Change.

76F309S 247 2-51

RETURN TO
LOS ANGELES COUNTY SURVEYOR
726 LOS ANGELES COUNTY
ENGINEERING BLDG.

Note: Any Additions or Changes on This Sheet Must be Made or Circled in Red Ink With Date and Name of Person Making Change.

Do not extend notes this side of this line.

Notes Ck'd by
Map No.
Office Work
Checked
Date

Survey of
W. O. Tape No. Std. °F
Surveyed by
Notes Date
Indexed W. C. Johnson

F. B. 48 Pg. 39

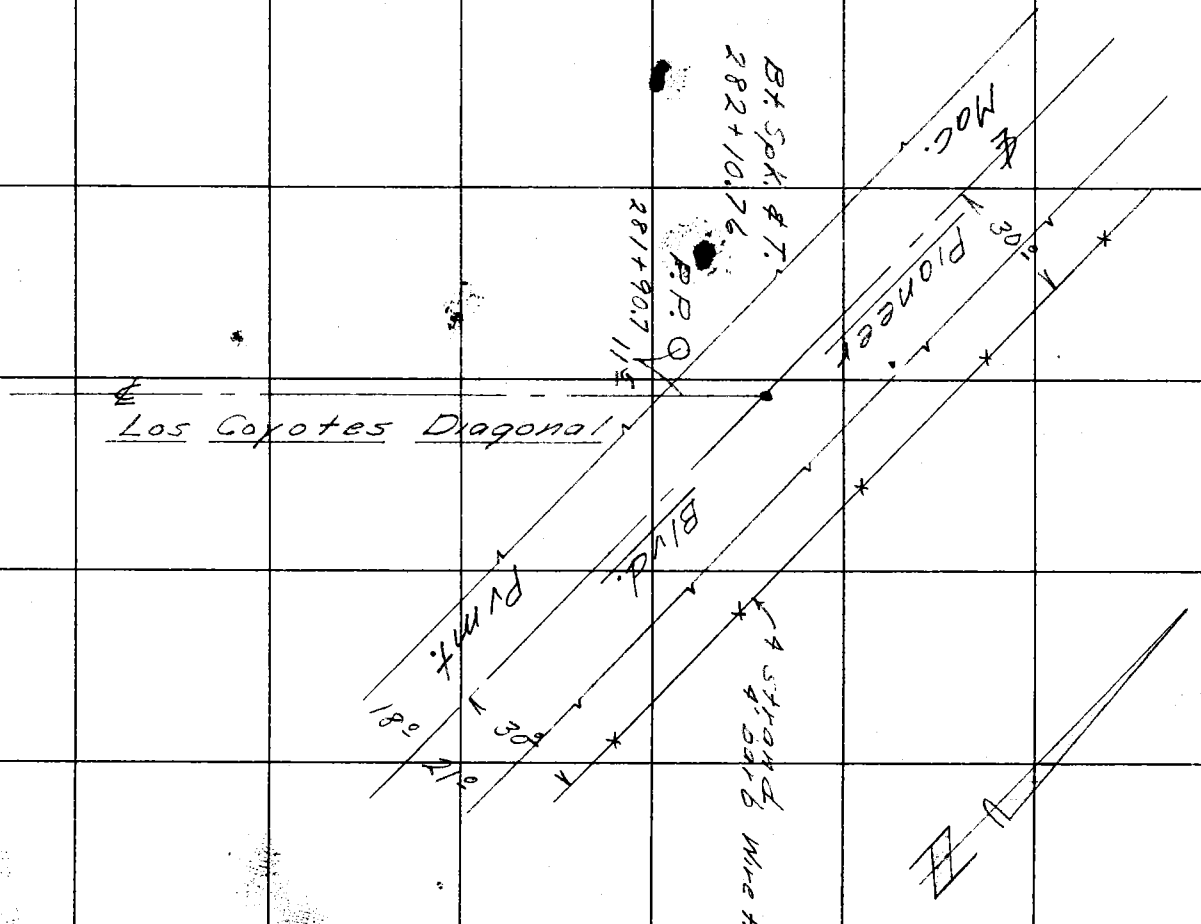

RETURN TO
LOS ANGELES COUNTY SURVEYOR
726 LOS ANGELES COUNTY
ENGINEERING BLDG.

Note: Any Additions or Changes on This Sheet Must be Made or Circled in Red Ink With Date and Name of Person Making Change.

Do not extend notes this side of this line.

F. B. 481 PG. 44

Notes Ck'd by	Survey of Los Coyotes Diag.
Map No.	W. O. 7995 Tape No. 0122 St'd. 68 °F
Office Work	Surveyed by D.E. Holmes
Checked	Notes D.E.H. Date 1-23-52
Date	Indexed A. C. Johnson 2-1-52

F. B. 481 PG. 241

J.N. 7995

LOS COYOTES DIAG.

LINE CHANGE of STUDEBAKER Rd. (INTER) So. of CARSON ST.

Holmes
Barilotti
Bowles

Notes: Any Additions or Changes on This Sheet Must be Made or Circled in Red Ink With Date and Name of Person Making Change.

Do not extend notes this side of this line.

RETURN TO
LOS ANGELES COUNTY SURVEYOR
726 LOS ANGELES COUNTY
ENGINEERING BLDG.

76F3095 247 10M 1-49

RETURN TO
LOS ANGELES COUNTY SURVEYOR
726 LOS ANGELES COUNTY
ENGINEERING BLDG.

Note: Any Additions or Changes on This Sheet Must be Made or Circled in Red Ink With Date and Name of Person Making Change.

Do not extend notes this side of this line.

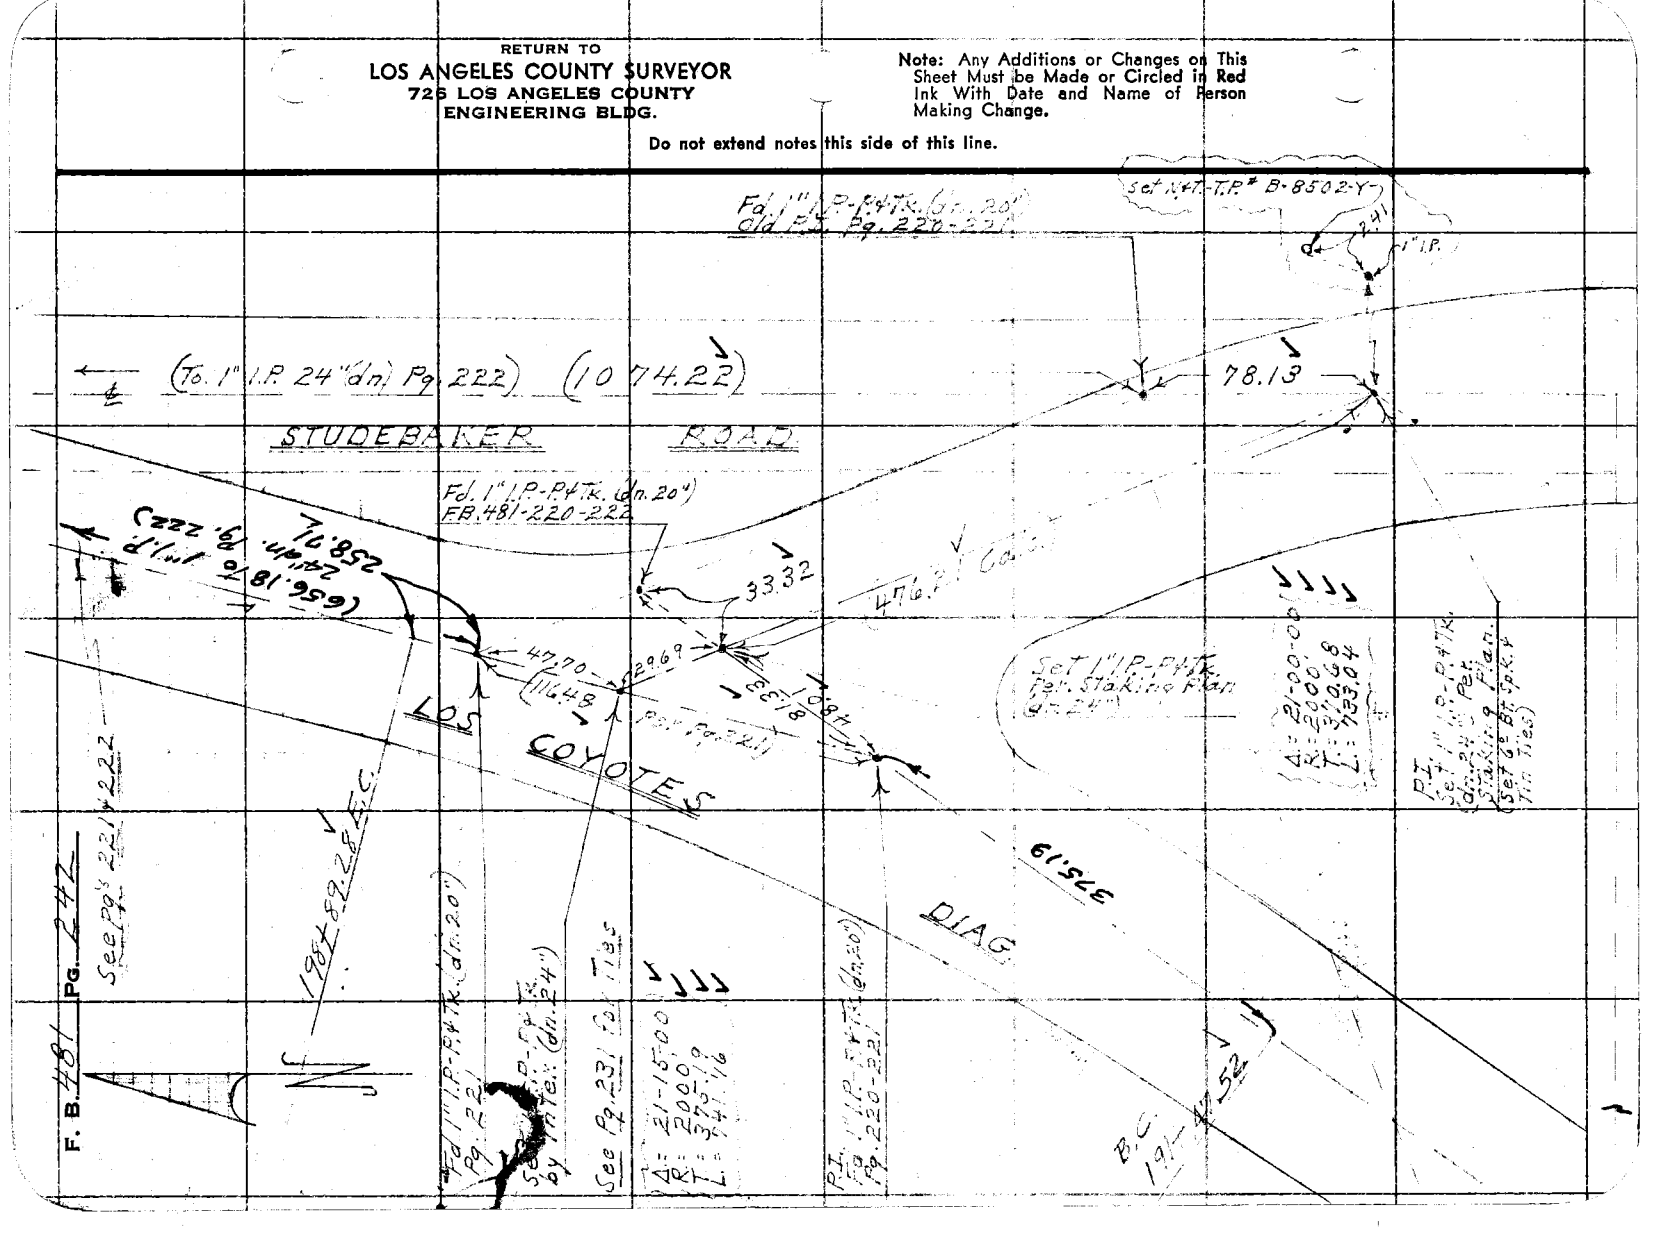

Notes Ck'd by	Survey of Los Coyotes Diag.
Map No.	W. O. 7995 Tape No. 0122 St'd. 68 °F
Office Work	Surveyed by D.E. Holmes
Checked	Notes DEH. Date 1-29-52
Date	Indexed E. C. Johnson

F. B. 481 Pg. 243

J.N. 7995

LOS COYOTES DIAG.

PRO. LINE CHANGE of INTER.

STUDEBAKER & Rd. E. of S.G. RIVER.

Holmes
Bartlett
Bowles

Note New & Los Coyotes Diag. PTS were checked through & Fd. To be on line.

Note: Any Additions or Changes on This Sheet Must be Made or Circled in Red Ink With Date and Name of Person Making Change.

Do not extend notes this side of this line.

RETURN TO
LOS ANGELES COUNTY SURVEYOR
726 LOS ANGELES COUNTY
ENGINEERING BLDG.

76F3098 247 10M 1-49

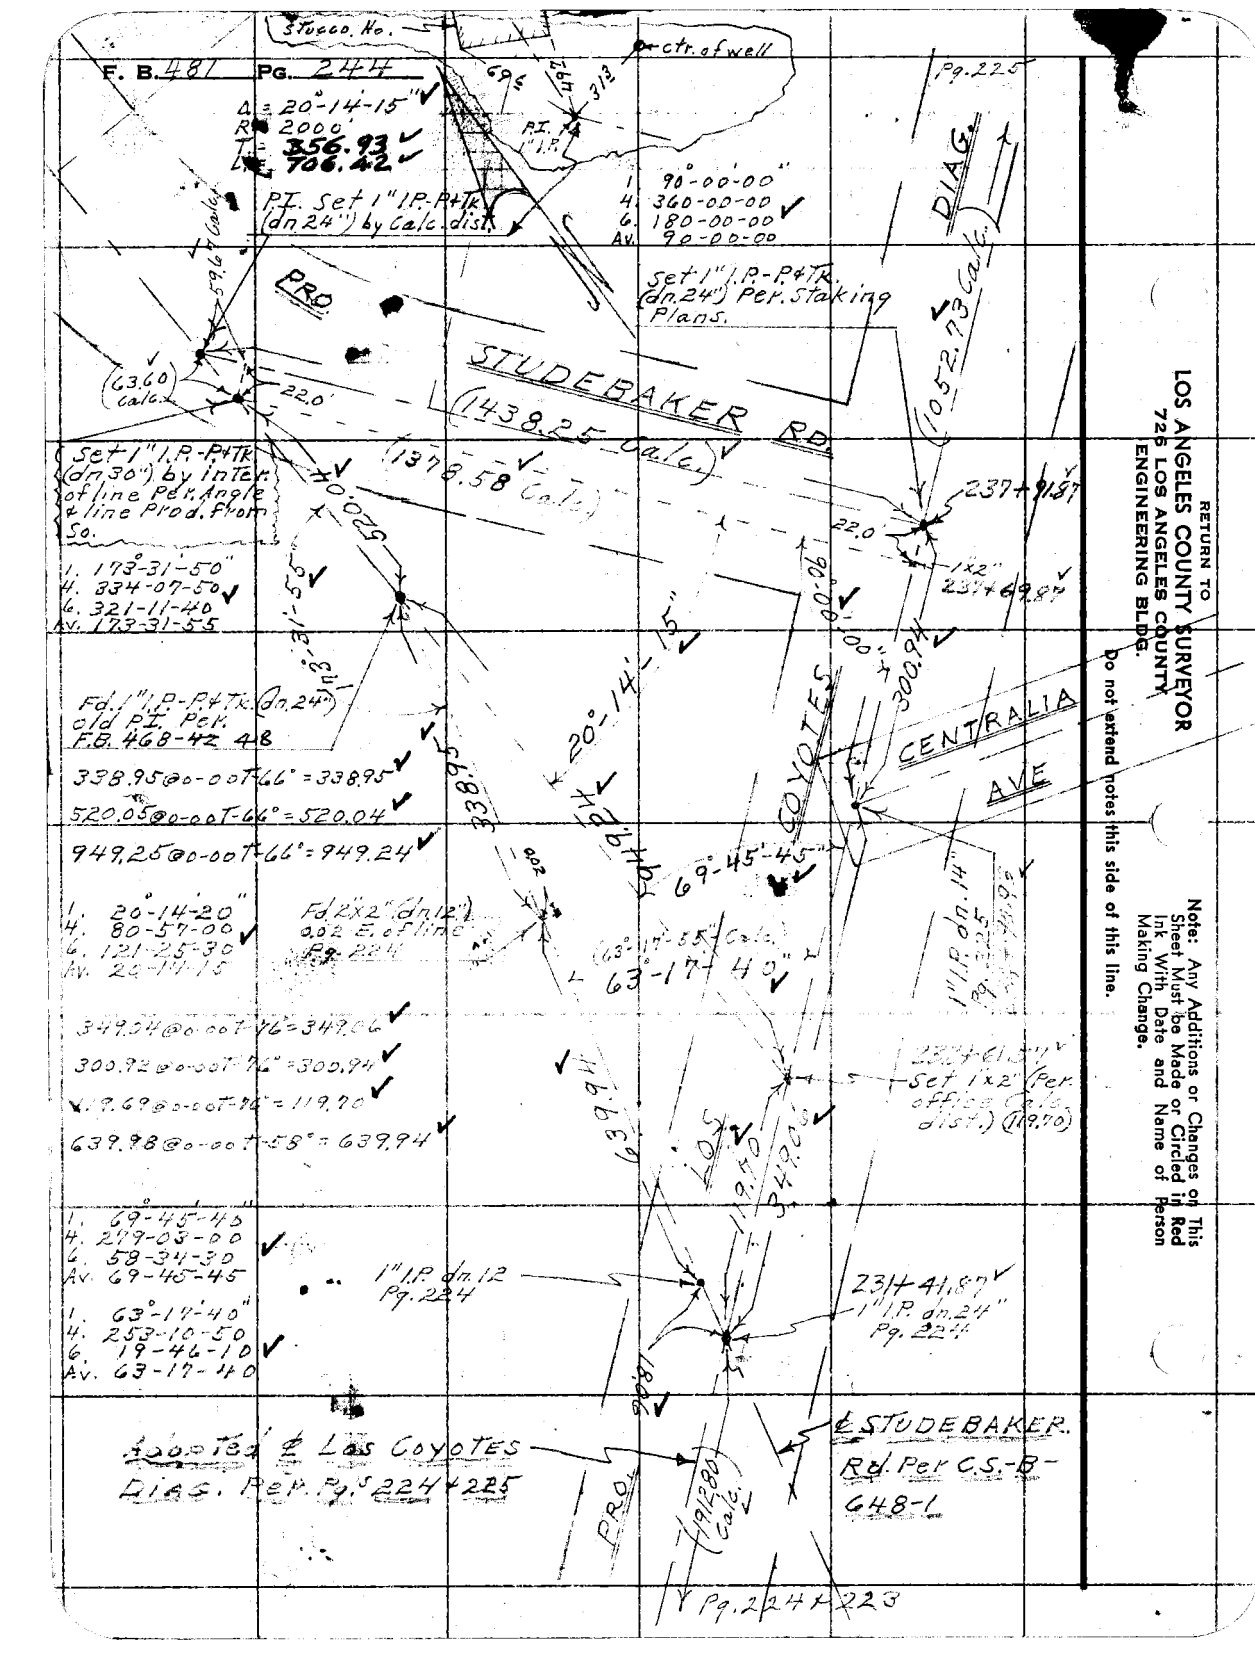

RETURN TO
LOS ANGELES COUNTY SURVEYOR
725 LOS ANGELES COUNTY
ENGINEERING BLDG.

Note: Any Additions or Changes on This Sheet Must be Made or Circled in Red Ink With Date and Name of Person Making Change.

Do not extend notes this side of this line.

Notes Ck'd by	Survey of
Map No. C.S.B. 648-1	W. O. 7995 Tape No. St'd. °F
Office Work T.H.B.	Surveyed by
Checked W.T.L.	Notes Date
Date APRIL 1952	Indexed A. C. Johnson 4-11-52

F. B. 481 Pg. 245

J.O. 7995

LOS COYOTES DIAG.

Location of Improvements on Flood Control Right of Way

rel. to C.L. of S.C.E. R/W.

Note: Any Additions or Changes on This Sheet Must be Made or Circled in Red Ink With Date and Name of Person Making Change.

Do not extend notes this side of this line.

RETURN TO
LOS ANGELES COUNTY SURVEYOR
726 LOS ANGELES COUNTY
ENGINEERING BLDG.

76F3085 247 2-51

RETURN TO
LOS ANGELES COUNTY SURVEYOR
726 LOS ANGELES COUNTY
ENGINEERING BLDG.

Note: Any Additions or Changes on This Sheet Must be Made or Circled in Red Ink With Date and Name of Person Making Change.

Do not extend notes this side of this line.

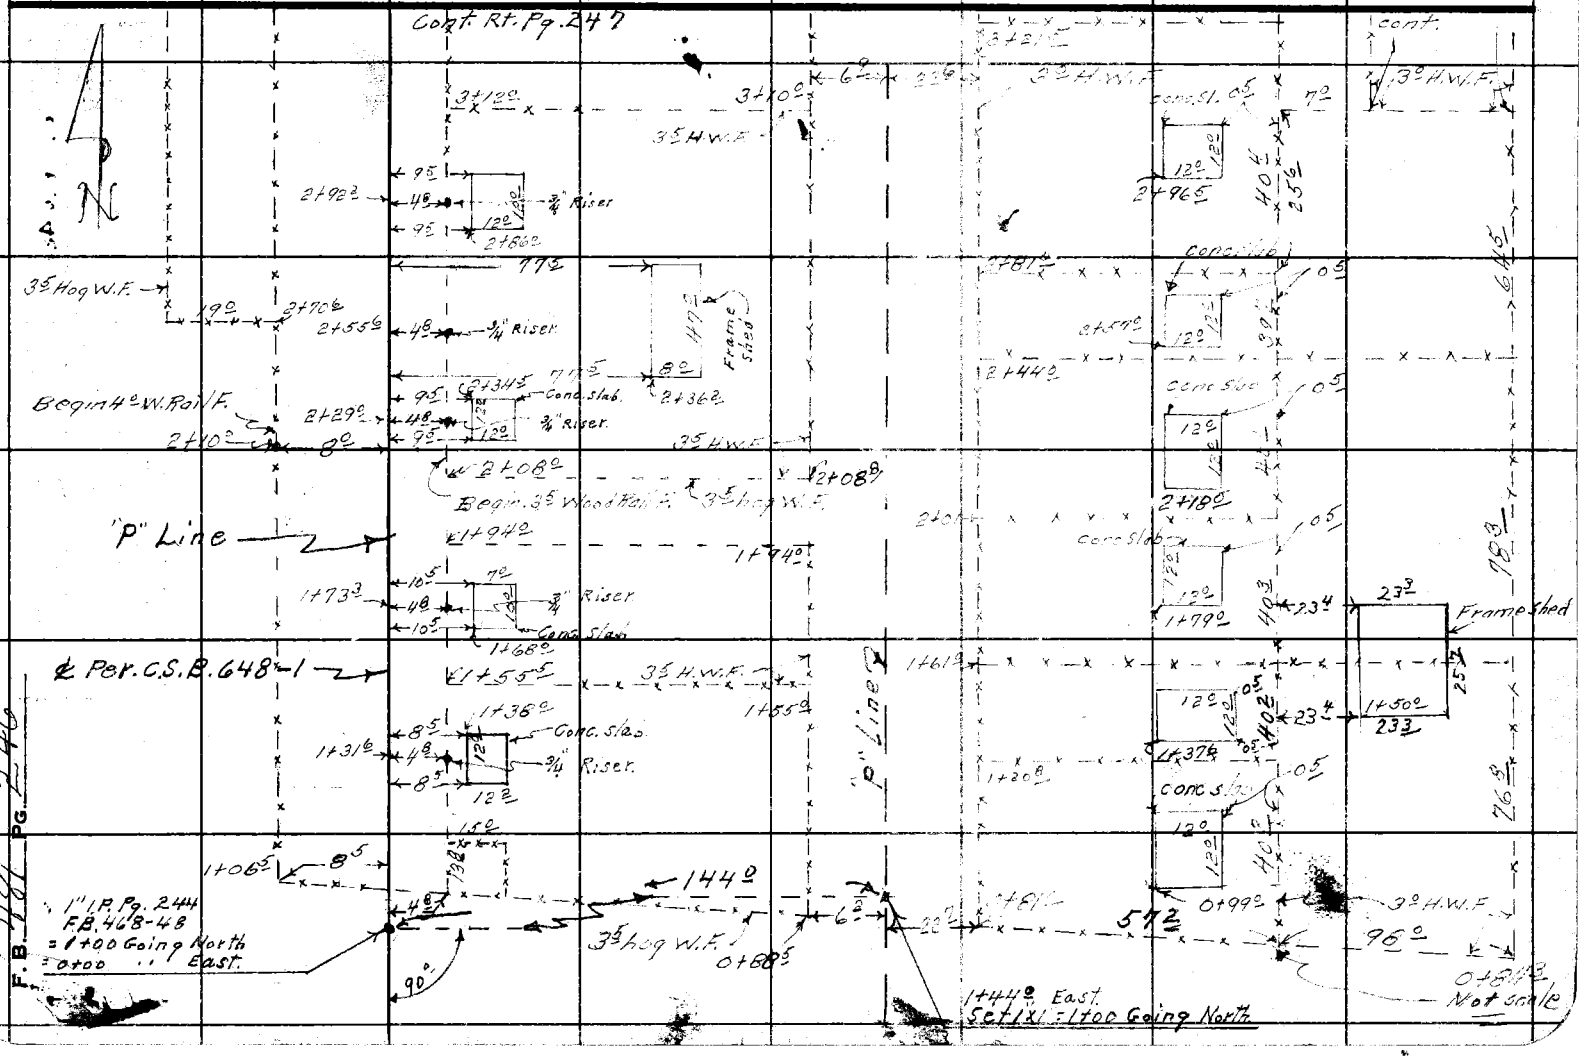

Notes Ck'd by	Survey of Los Coyotes Diag.
Map No. C.S.B.648-1	W. O. 7995 Tape No. St'd. °F
Office Work T. H. B	Surveyed by O. E. Holmes
Checked W. J. L	Notes A. R. B Date 4-4-52
Date APRIL 1952	Indexed E. C. Johnson

F. B. 484 Pg. 244

Note: Any Additions or Changes on This Sheet Must be Made or Circled in Red Ink With Date and Name of Person Making Change.

Do not extend notes this side of this line.

RETURN TO
LOS ANGELES COUNTY SURVEYOR
726 LOS ANGELES COUNTY
ENGINEERING BLDG.

Cont. from Rt. Pg. 248

Cont. on Pg. 246

Cont. on Pg. 246

Cont. from Rt. Pg. 248

76F309S 247 2-51

RETURN TO
LOS ANGELES COUNTY SURVEYOR
726 LOS ANGELES COUNTY
ENGINEERING BLDG.

Note: Any Additions or Changes on This Sheet Must be Made or Circled in Red Ink With Date and Name of Person Making Change.

Do not extend notes this side of this line.

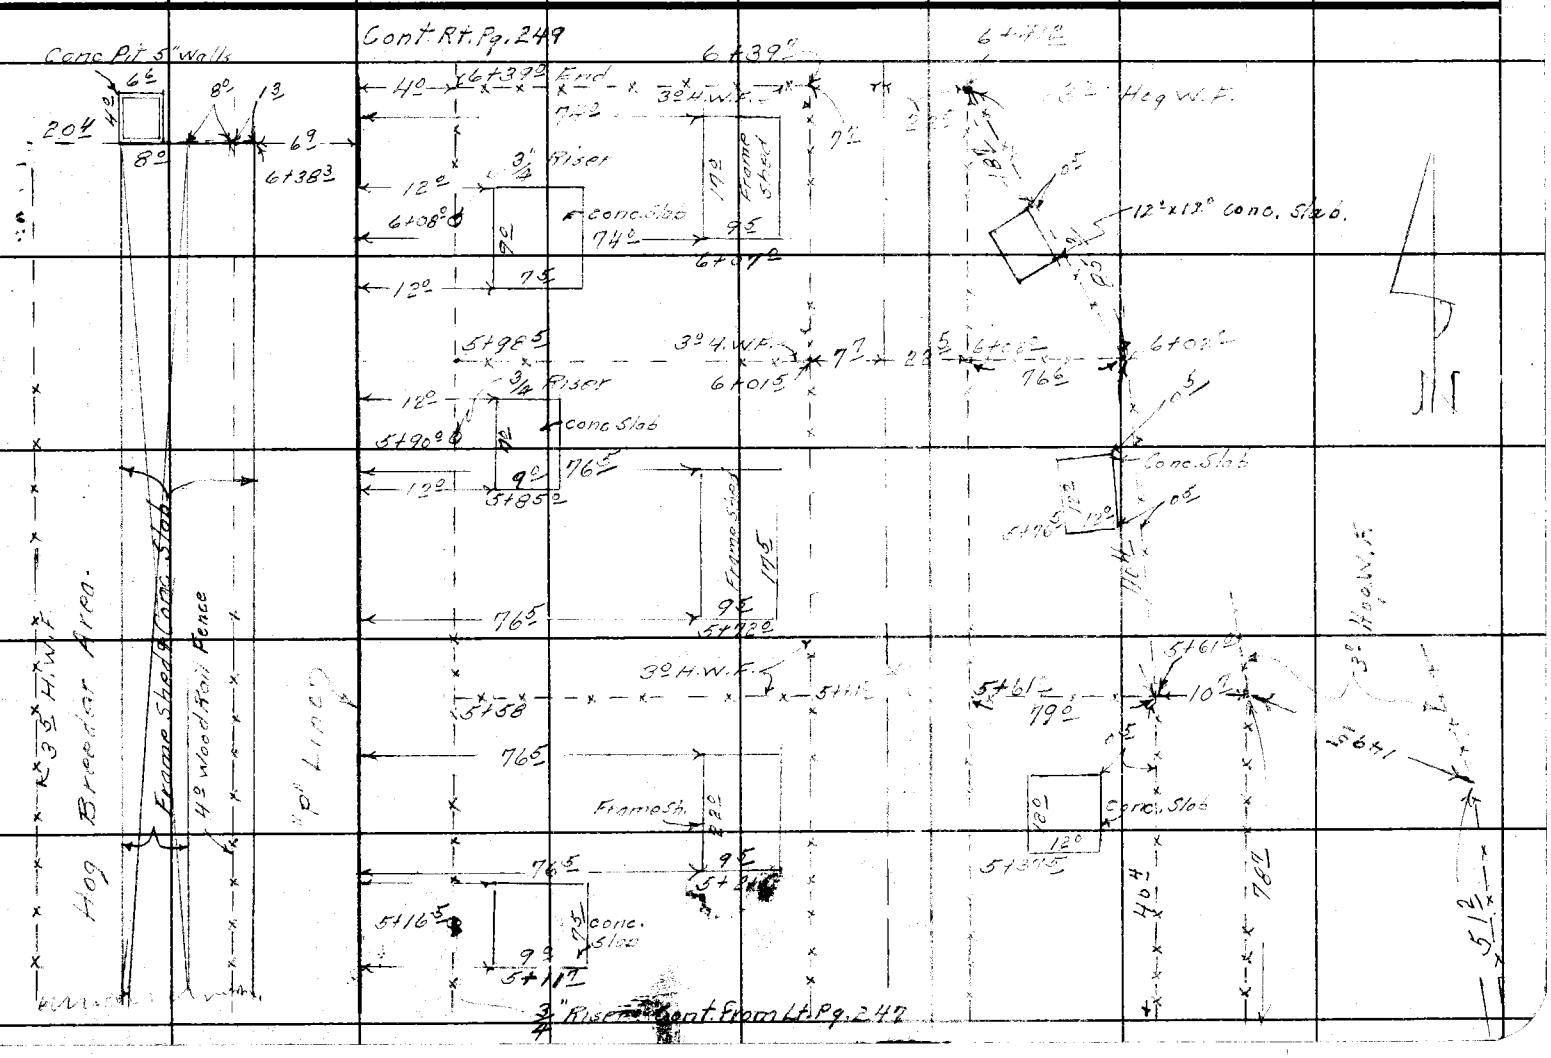

F.B. 1461 PG. 248

76F3095 247 2-51

RETURN TO
LOS ANGELES COUNTY SURVEYOR
726 LOS ANGELES COUNTY
ENGINEERING BLDG.

Note: Any Additions or Changes on This Sheet Must be Made or Circled in Red Ink With Date and Name of Person Making Change.

Do not extend notes this side of this line.

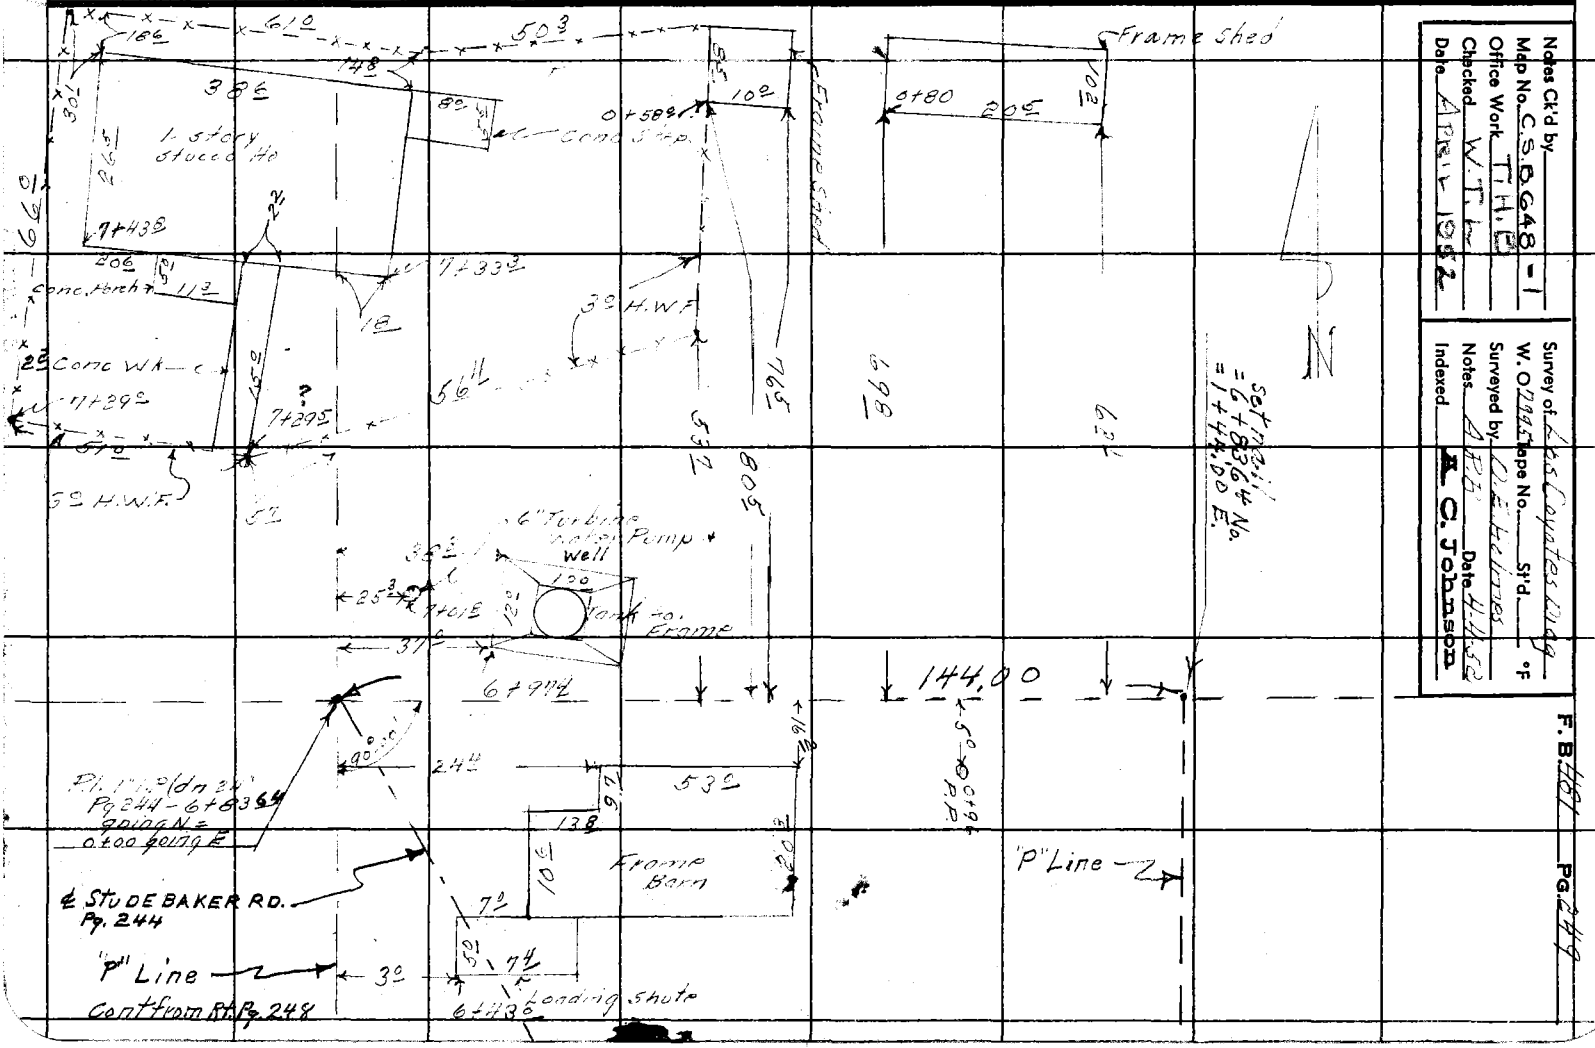

Notes Ck'd by _____
Map No. C.S. 0648 - 1
Office Work T.H.B.
Checked W.T.L.
Date April 1952

Survey of Los Coyotes Quad
W. O. 2222 Tape No. _____ St'd _____ °F
Surveyed by A.F.D. & C.E. Holmes
Notes _____ Date 4-1952
Indexed _____ R. C. Johnson


RETURN TO
LOS ANGELES COUNTY SURVEYOR
726 LOS ANGELES COUNTY
ENGINEERING BLDG.

Note: Any Additions or Changes on This Sheet Must be Made or Circled in Red Ink With Date and Name of Person Making Change.

Do not extend notes this side of this line.

F. B. _____ PG. _____

Notes Ck'd by	Survey of Los Coyotes Blvd. F. B. 481 Pg. 251
Map No.	JN 0074.32 Tape 0144 Std 68 °F
Office Work	Surveyed by H E Granquist
Checked	Notes H E G Date 8/1957
Date	Indexed C. Johnson 8-23-57

Note: Any Additions or Changes on this Sheet Must be Made or Circled in Red Ink With Date and Name of Person Making Change.

PLEASE RETURN TO
LOS ANGELES COUNTY ENGINEER
700 Los Angeles County Engineering Bldg.
Do not extend this side of this line.

J.N. 0074.32

Los Coyotes Blvd.

Reseting Lost Proposed ℄ Points (C.S.B 633)
for staking Sly R/W. for Inspection.

West of Pioneer Blvd
& Nly of Centralia St.
From Gridley Rd.
To P/L Nly of 205th St.

Index Next Pg. 252
F.B. 481 Pg. 251 to Pg 258

H E Granquist Chief
F. E. Brooks Jr. Str.
E. Martinez Head Chain
K. Meyers Head Chain
H. Birlew.

76F3095 S&E #247 1-56

PLEASE RETURN TO
LOS ANGELES COUNTY ENGINEER
700 LOS ANGELES COUNTY ENGINEERING BLDG.

Note: Any Additions or Changes on This Sheet Must be Made or Circled in Red Ink With Date and Name of Person Making Change.

Do not extend this side of this line.

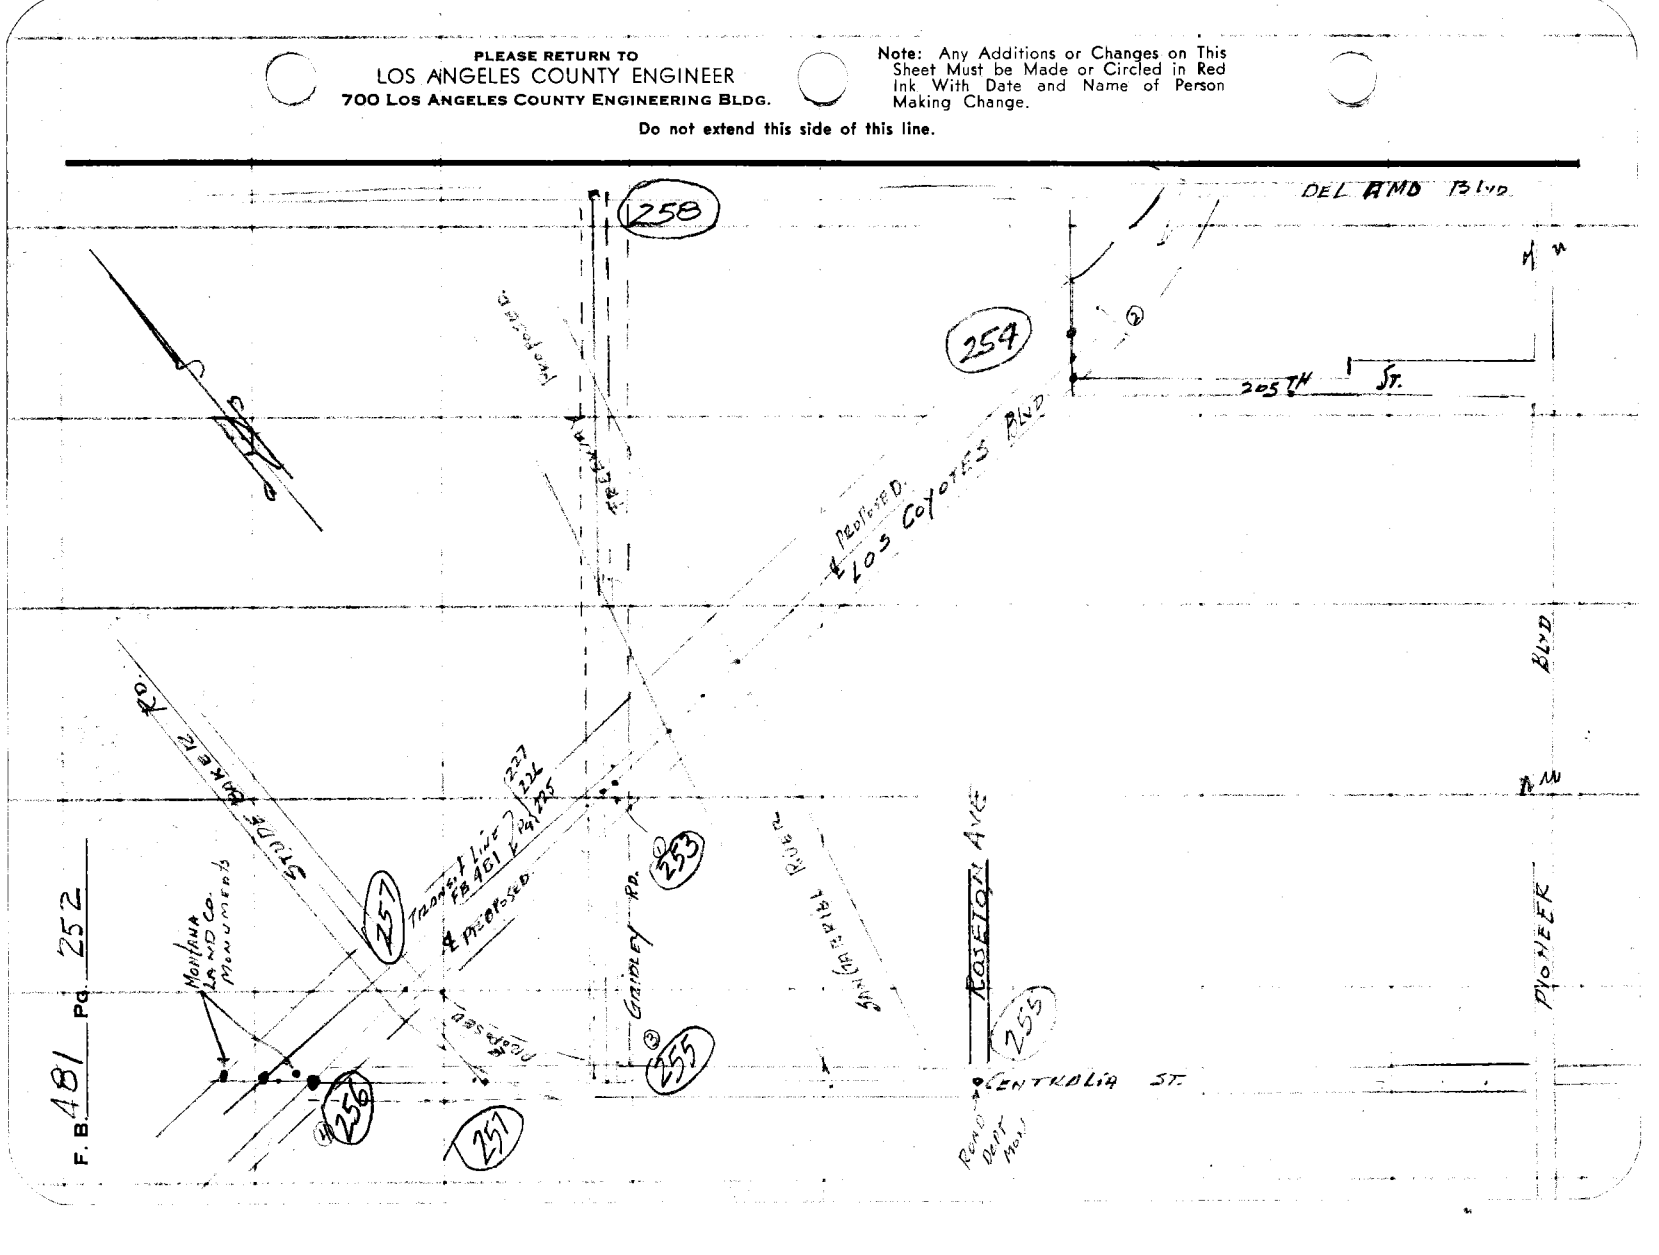

Notes Ck'd by	Survey of Los Coyotes Dwg.
Map No.	JN 00"A 32 Tape 01VU Std 68 °F
Office Work	Surveyed by H.E. GRANQUIST
Checked	Notes L.B.G. Date 8/14/57
Date	Indexed C. Johnson

F.B. 481 PG. 253

D 134-54-20"
C 179-37-40
A 134-54-25
B 89-26-40
A 134-54-26 1/3

Cont Pg D 258

Cont Pg C 254 L.S.

Note: Any Additions or Changes on This Sheet Must be Made or Circled in Red Ink With Date and Name of Person Making Change.

Do not extend this side of this line.

PLEASE RETURN TO
LOS ANGELES COUNTY ENGINEER
700 LOS ANGELES COUNTY ENGINEERING BLDG.

76F309S S&E #247 1-56

LOS COYOTES

GRIDLEY RD.

PT. INT SET by G.L. dist. from SET in line STA. POT 2454+33.78

(Proposed 46.10 W (S&E 673)

FD 3/4" I.P. in M.H. (Co. St. Relaying Blvd.)

(20 7.00)

FD X. Side of 24" conc. stnd. pipe BLVD.

FD NAT P.P. #741604E

N 44°19'05" E 7.13 PROPOSED CSB. 633

TRANS. LINE

1857.00 FROM 481-226 FROM 481 227. Pg 224

1" I.P. Pg 481-226 1.05 OFFD.

CVM: 3.88

103.41'

FD 3/4" I.P. 4 TAG. 26 W.P.

741.82@70°=741.72
300.91@90°=300.95

50.08

90°

7.00

M CALC. 6.98

POT SET 3/4" IP & K.A.G. ENGR. TAG. 20" DP by I.C.E. Mark Scribed here SEE FB 481 P226 CALL FOR 1" IP THIS POINT NOTED. = Sta. 2454+43.66 Ahd CSB. 633.

M=134°54'27"

CALC. MAP: 134°54'45"

50.00

RP Pot Set 5/8" IP & TAG 2" DP.

131.39

TO I.P. N=741.92

JUDGE PARKER Rd. (741.91 MAP. CSB. 633)

40 Cont Pg. B 257

SET NAT. P.P. #498003E (ALEM = 738.16 (MAP = 738.21)

7 FOOT OFFSET LINE

M=745.16

7.00

7.00

4" VALVE JTING

SET X 8" Smd pipe

IRR. LINE

Cont Pg A 255 L.S.

PLEASE RETURN TO
LOS ANGELES COUNTY ENGINEER
700 LOS ANGELES COUNTY ENGINEERING BLDG.

Note: Any Additions or Changes on This Sheet Must be Made or Circled in Red Ink With Date and Name of Person Making Change.

Do not extend this side of this line.

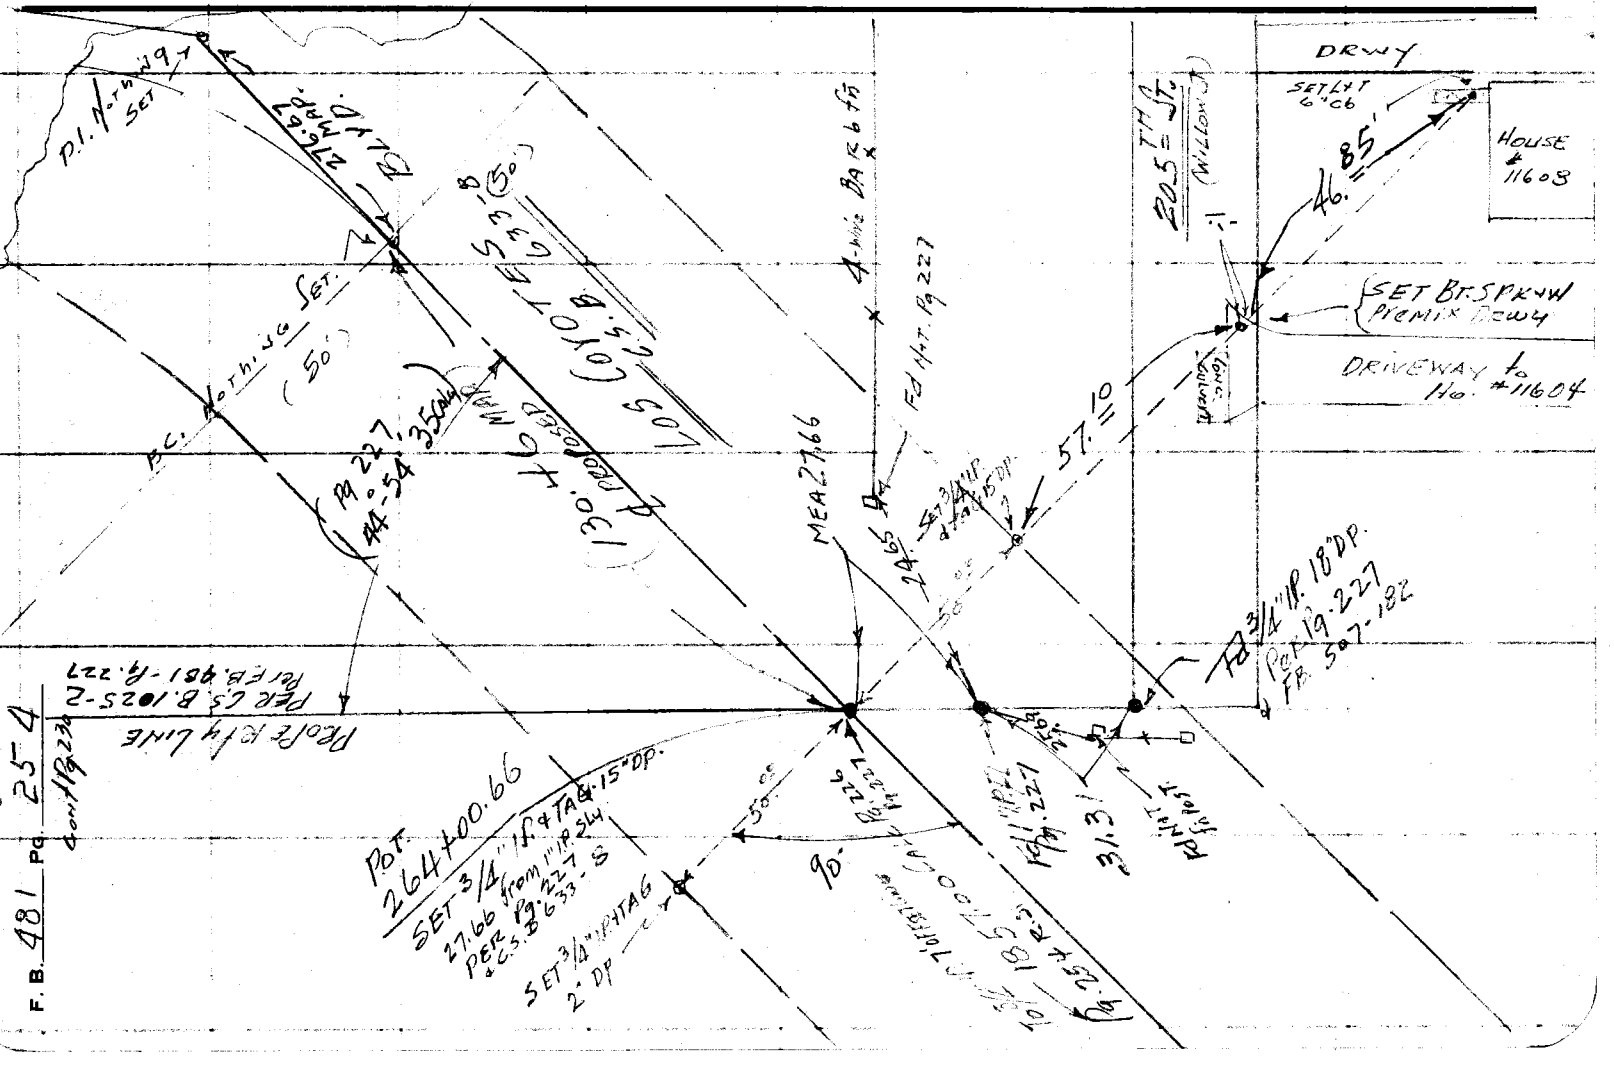

Notes Ck'd by	Survey of Los Coyotes Blvd.
Map No.	JN 0074.32 Tape 0140 Std LB °F
Office Work	Surveyed by H.E. GRANQUIST
Checked	Notes H.E.G. Dated 2/14/57
Date	Indexed C. Johnson

F. B. 481 PG. 255

89-50-40 E
359-22-40 W
89-50-40 E
179-04-00 E
89-50-40 E

Note: Any Additions or Changes on This Sheet Must be Made or Circled in Red Ink With Date and Name of Person Making Change.

PLEASE RETURN TO
LOS ANGELES COUNTY ENGINEER
700 Los Angeles County Engineering Bldg.

Do not extend this side of this line.

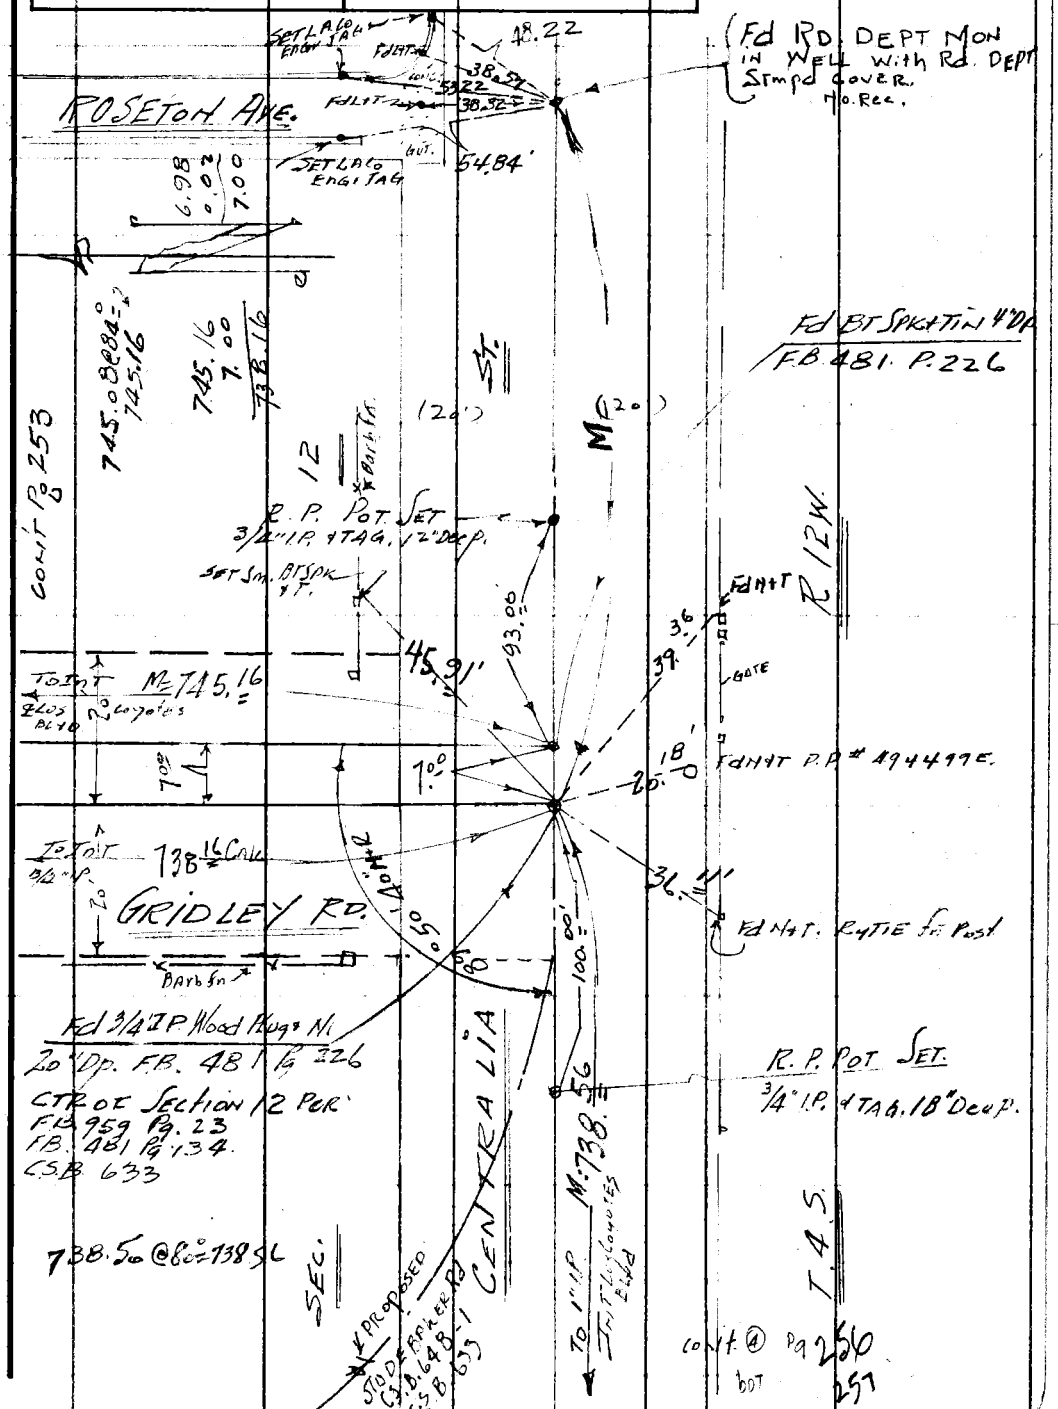

76F309S S&E #247 1-56

PLEASE RETURN TO
LOS ANGELES COUNTY ENGINEER
700 LOS ANGELES COUNTY ENGINEERING BLDG.

Note: Any Additions or Changes on This Sheet Must be Made or Circled in Red Ink With Date and Name of Person Making Change.

Do not extend this side of this line.

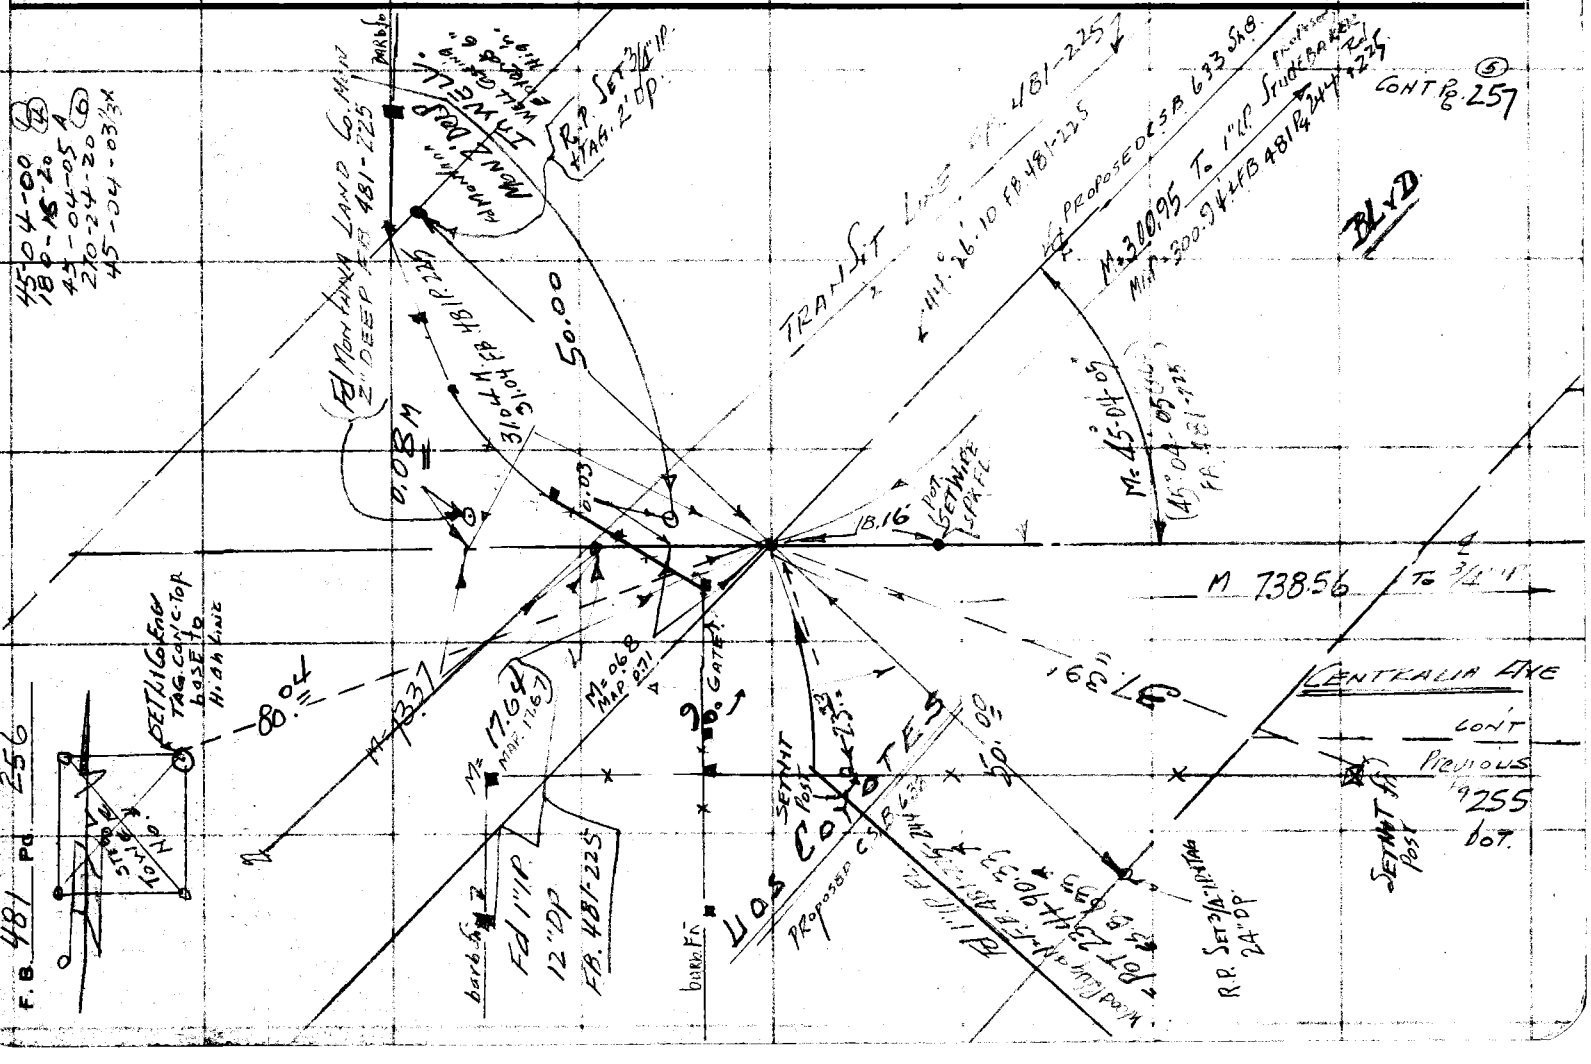
TRANSIT Line
PROPOSED CSB 633 SAB
M 738.56
CENTRALIA AVE
CONT PREVIOUS
CONTINUED
M 17.64
M 13.37
M 45°04'05"
M 0.68
50.00
80.04
CONT PG. 257
BLVD
F.B. 481 Pg. 256
F.B. 481 Pg. 225
SET NAIL & TAG
SET 3/4" IP
SET NAIL POST
SET 3/4" IP 24" DP
FD 1" IP 12" DP

Notes Ck'd by	Survey of Los Coyotes Blvd
Map No.	JN 6074.X Tape #44 Std. 68 °F
Office Work	Surveyed by H.E. Gianquist
Checked	Notes H.E.G. Date 8/10/57
Date	Indexed C. Johnson

F. B. 481 Pg. 257

Fd. 1" I.P. PLUG IT K 2' DEEP PER FB A91 P8244 Pg. 2268

L.S.B. 633 POT STATION 237+91.87

SEE FB 481-244

SET. POT R.P. A 3/4" I.P. TAG 2.0p.

1" I.P. FL Pg. 256

100.00

WEED PATCH

℄ PROPOSED

12.20 CALC MAP.

M = 300.93 MAP: 300.94

M = 741.92 MAP 741.91

50 TO 14" I.P. GRIDLEY RD

℄ PROPOSED C.S.B. 633-B

Nothing Set.

LOS COYOTES BLVD.

100.00'

Post Set 3/4 I.P. & TAG 2' DP.

CONT Pg 253

℄ CURVE DATA PER L.S.B. 633-B

Δ = 44° 55' 55"

R = 700.00

T = 289.46

L = 548.95

CENTERLINE 136.66 MEA

(40')

(40')

℄ PROPOSED STD. DEDICATION

P.I. Nothing Set.

EC

3 1/4 I.P. Pg. 255

PLEASE RETURN TO
LOS ANGELES COUNTY ENGINEER
700 LOS ANGELES COUNTY ENGINEERING BLDG.

Note: Any Additions or Changes on this Sheet Must be Made or Circled in Red Ink With Date and Name of Person Making Change.

Do not extend this side of this line.

76F3095 S&E #247 1-56

F. B. 481 PG. 258 (6)

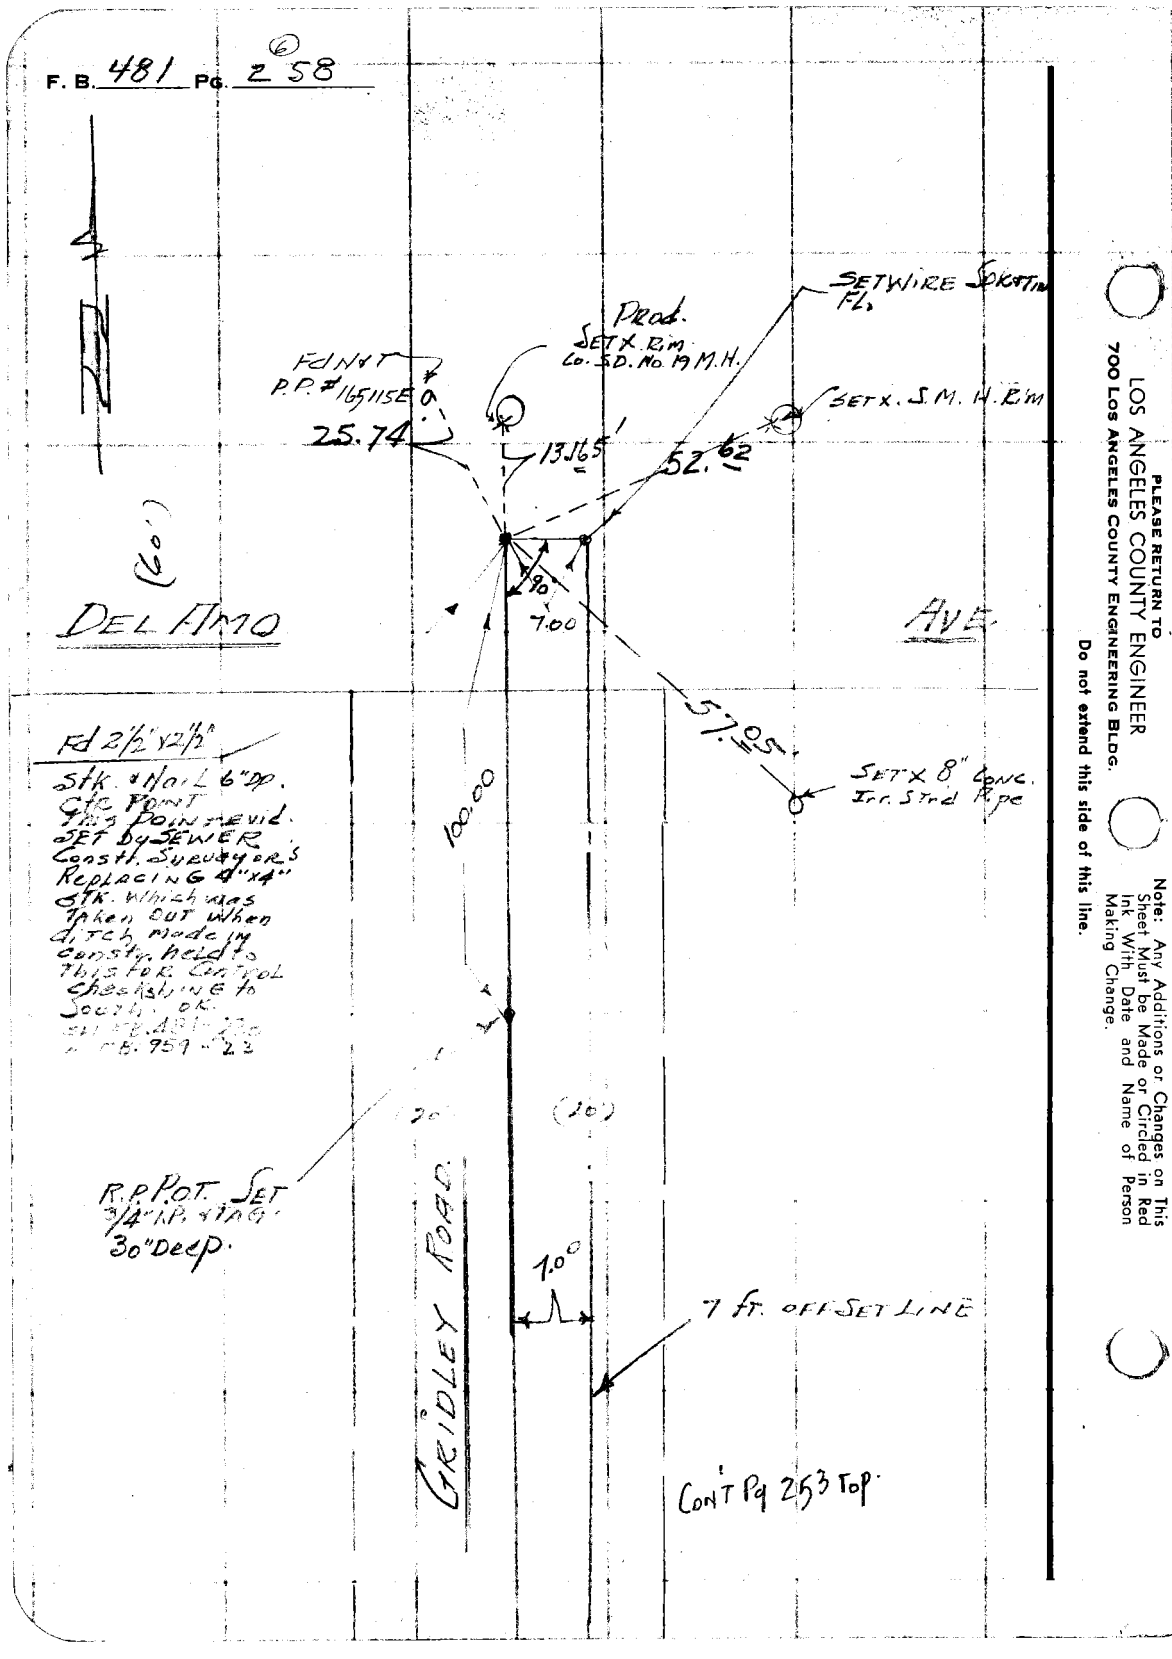

PLEASE RETURN TO
LOS ANGELES COUNTY ENGINEER
700 LOS ANGELES COUNTY ENGINEERING BLDG.

Do not extend this side of this line.

Note: Any Additions or Changes on This Sheet Must be Made or Circled in Red Ink With Date and Name of Person Making Change.

Notes Ck'd by		Survey of	
Map No.		W. O.	Tape No. St'd. °F
Office Work		Surveyed by	
Checked		Notes	Date
Date		Indexed	

F.B. 481 PG.

16.96
13.37

6310
52004
58364

Note: Any Additions or Changes on This Sheet Must Be Made or Circled in Red Ink With Date and Name of Person Making Change.

Do not extend notes this side of this line.

RETURN TO
LOS ANGELES COUNTY SURVEYOR
700 HALL OF RECORDS

FORM 647-SM 11-61

RETURN TO
LOS ANGELES COUNTY SURVEYOR
700 HALL OF RECORDS

Do not extend work outside of this line.

Note: Any Additions or Changes on This Sheet Must be Made or Circled in Red Ink With Date and Name of Person Making Change.

481

F.B.____ PG.____