Notes Ck'd by Drew	Survey of
Map No.	W. O. Tape No. St'd °F.
Checked	Notes Date
Date	Indexed A. C. Johnson 4-14-34

F.B. 502 Pg. 1

INDEX

Norwalk Road - W.O. 7089

Pages 2 to 53 (inc.)

Note: ANY ADDITIONS OR CHANGES OR THIS SHEET MUST BE MADE OR CIRCLED IN Red Ink. WITH DATE AND NAME OF PERSON MAKING CHANGE.

Do not extend notes this side of this line

RETURN TO
LOS ANGELES COUNTY SURVEYOR
700 HALL OF RECORDS

NORWALK ROAD

FROM

ORANGE CO. LINE TO ROSECRANS AVE.

Right of Way to be 80' Wide
C.S. Map to be B-804.

FORM 247 [illegible]

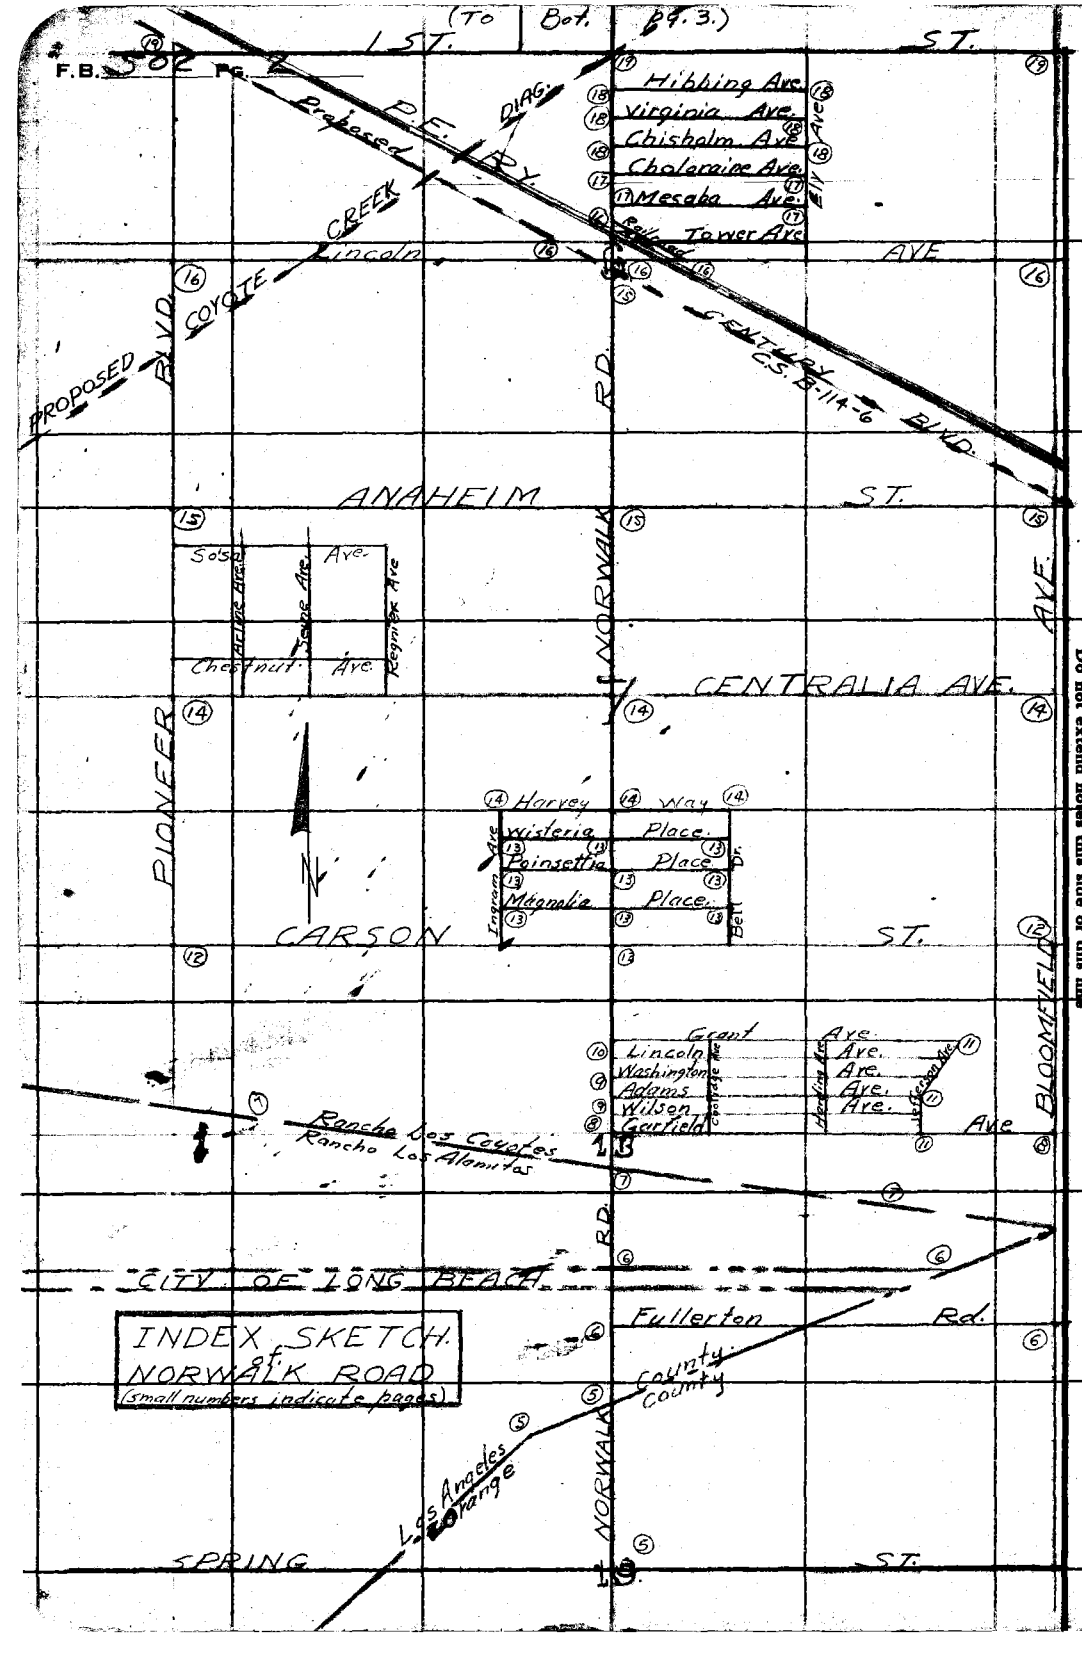

RETURN TO
LOS ANGELES COUNTY SURVEYOR
700 HALL OF RECORDS

Do not extend notes this side of this line

Note: ANY ADDITIONS OR CHANGES ON THIS SHEET MUST BE MADE OR CIRCLED IN Red Ink WITH DATE AND NAME OF PERSON MAKING CHANGE.

FORM 247 10M 8-31

RETURN TO
LOS ANGELES COUNTY SURVEYOR
700 HALL OF RECORDS

Note: ANY ADDITIONS OR CHANGES ON THIS SHEET MUST BE MADE OR CIRCLED IN **Red Ink.** WITH DATE AND NAME OF PERSON MAKING CHANGE.

Do not extend notes this side of this line

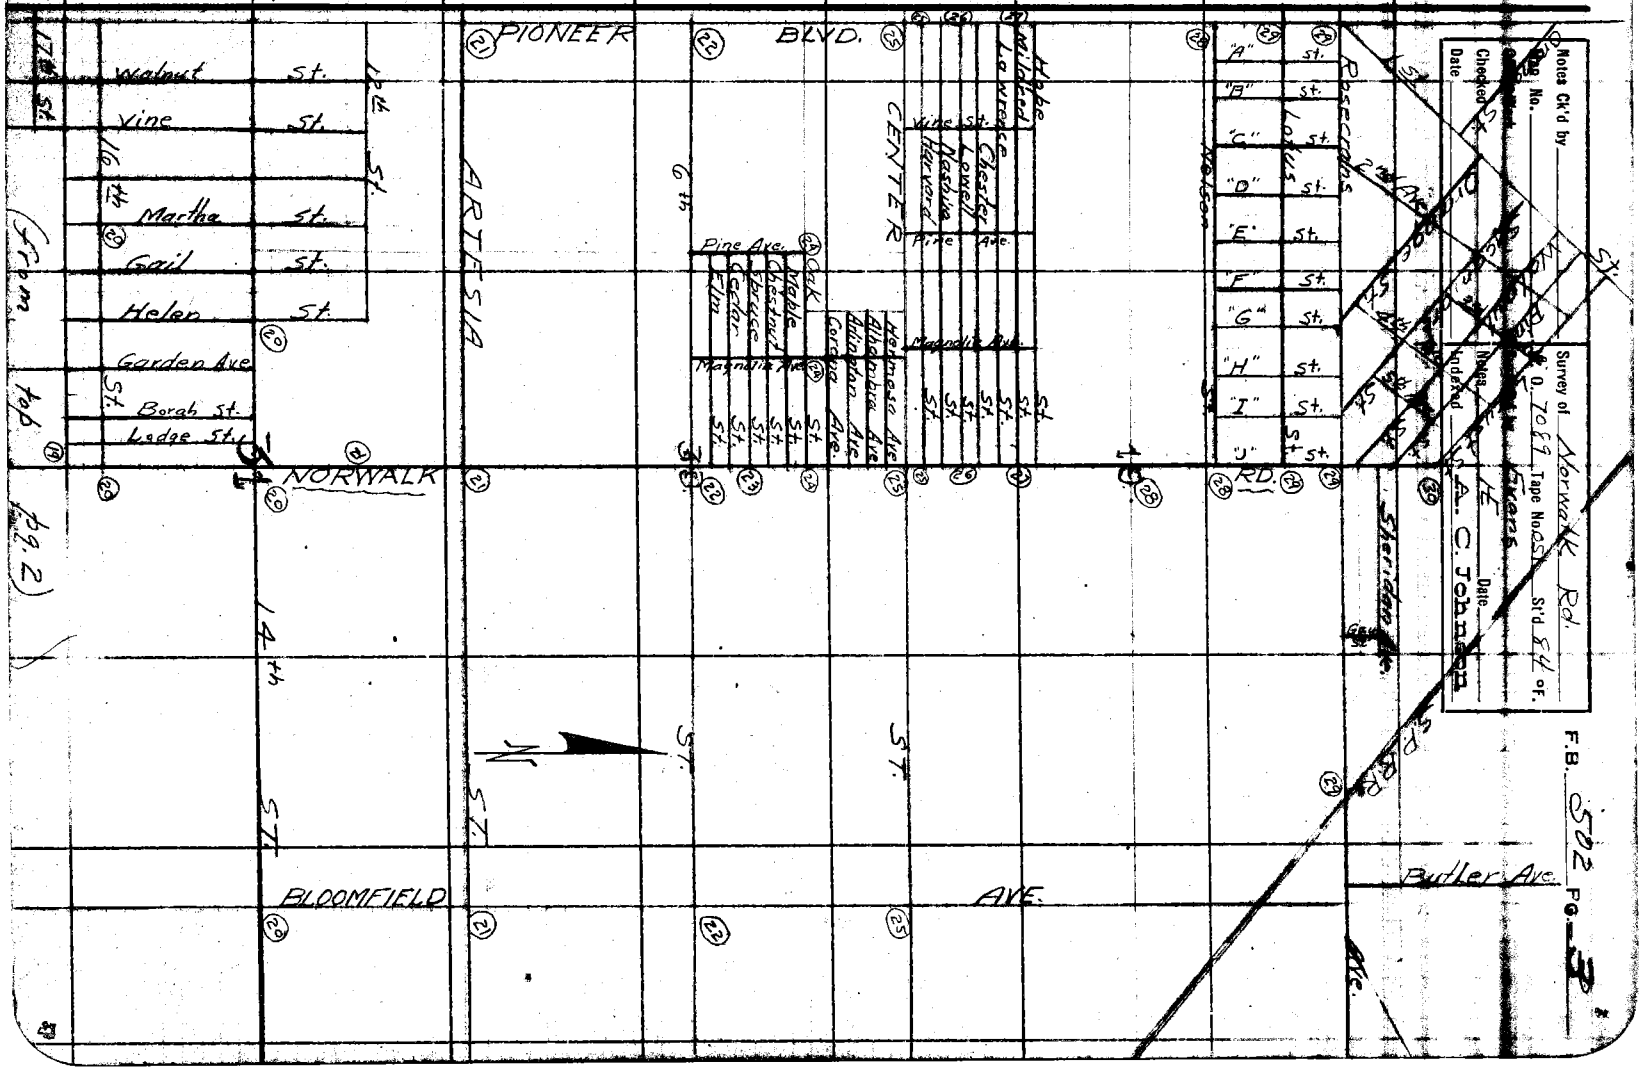

F.B. 502 PG. 4

SURVEY OF NORWALK ROAD from L.A. COUNTY LINE NORTH, TO ROSECRANS AVE.

Surveyed 1932-1933

Party.
Hugh F. Evans - Dep.
Henry L. Martin - Inst.
Geo. F. Brock - H.C.
Daniel W. Reynolds - R.C.
Willis T. Lind - R.C.

Tape #051 - 100.00 @ 84° F.

Index Sketch & Survey pgs. 2 & 3.
pgs. 5 to 30
Location Impvts. pgs. 31 to 53 (inc.)

RETURN TO
LOS ANGELES COUNTY SURVEYOR
700 HALL OF RECORDS

Do not extend notes this side of this line

Note: ANY ADDITIONS OR CHANGES ON THIS SHEET MUST BE MADE OR CIRCLED IN Red Ink. WITH DATE AND NAME OF PERSON MAKING CHANGE.

Notes Ck'd by Drew	Survey of Norwalk Rd.	F.B. 502 Pg. 5
Map No. B-804	W. O. 7022 Tape No. 221 St'd 64 oF.	
Office Work White Rec	Surveyed by Evans	
Checked	Notes H. Date 8-26-32	
Date	Indexed A. C. Johnson 10-7-32	

(To Bk. 502 Pg. 6)

Note: ANY ADDITIONS OR CHANGES OR THIS SHEET MUST BE MADE OR CIRCLED IN Red Ink. WITH DATE AND NAME OF PERSON MAKING CHANGE.

RETURN TO
LOS ANGELES COUNTY SURVEYOR
700 HALL OF RECORDS

Do not extend notes this side of this line

FORM 247 10M 5-31

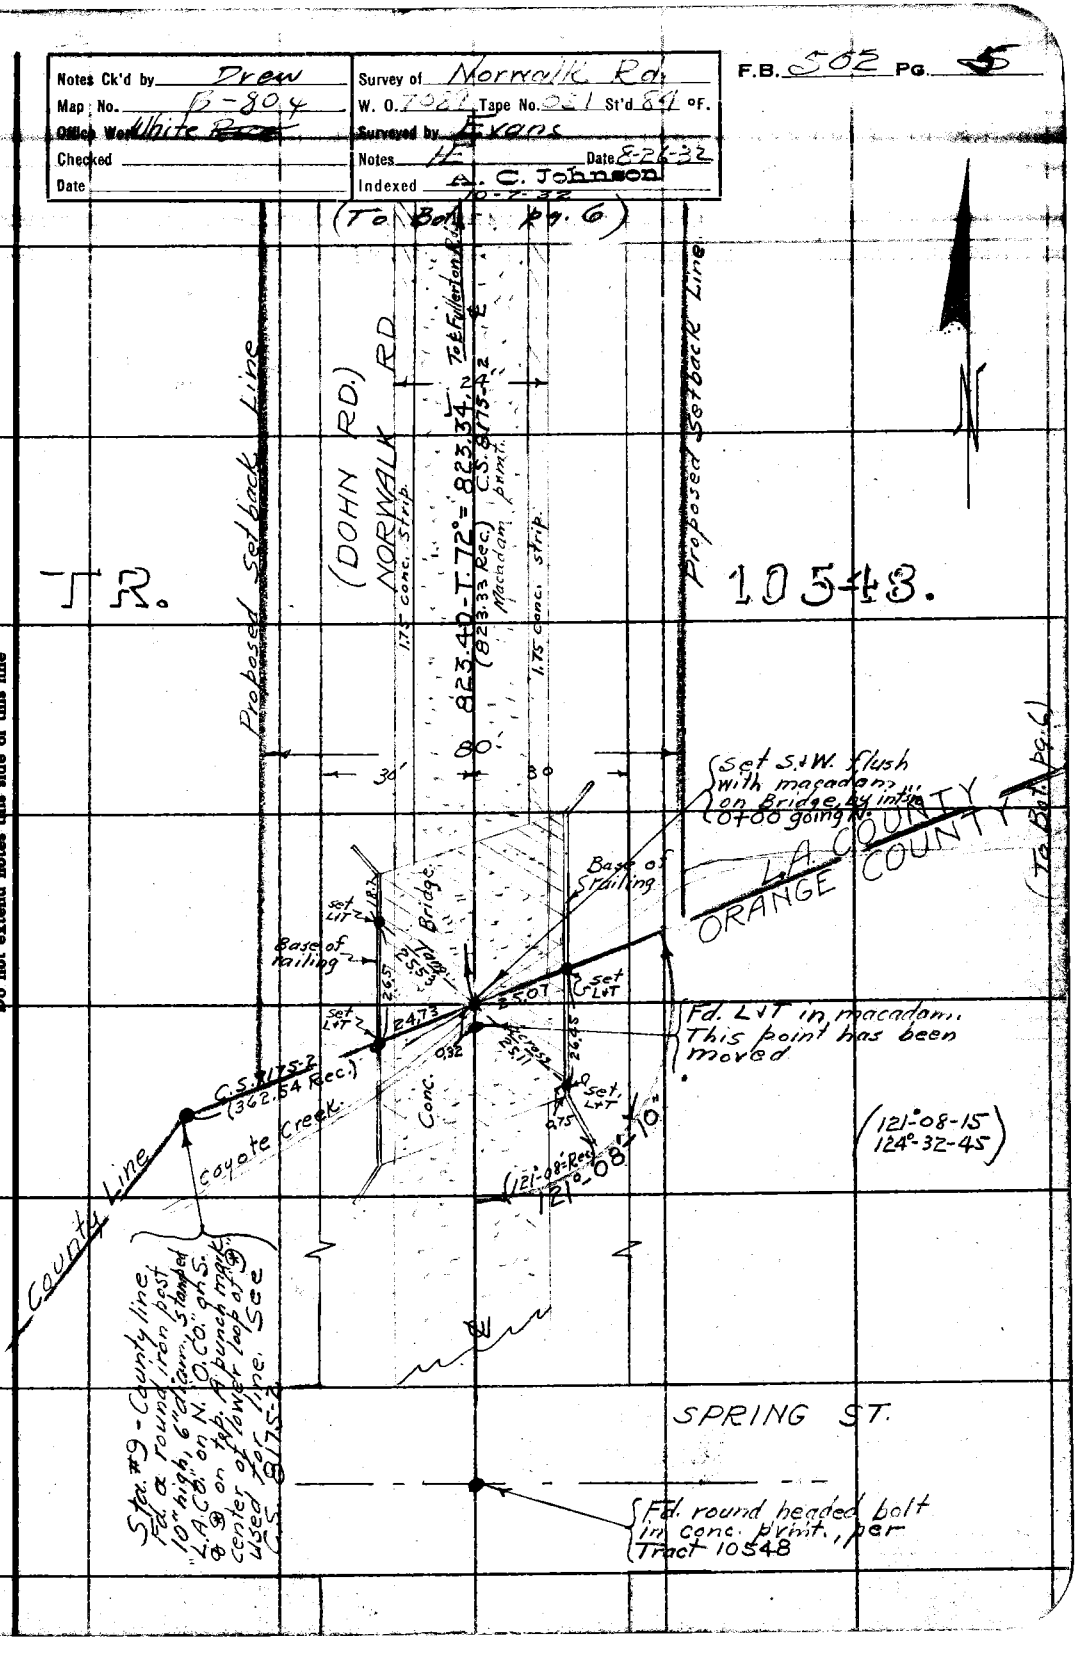

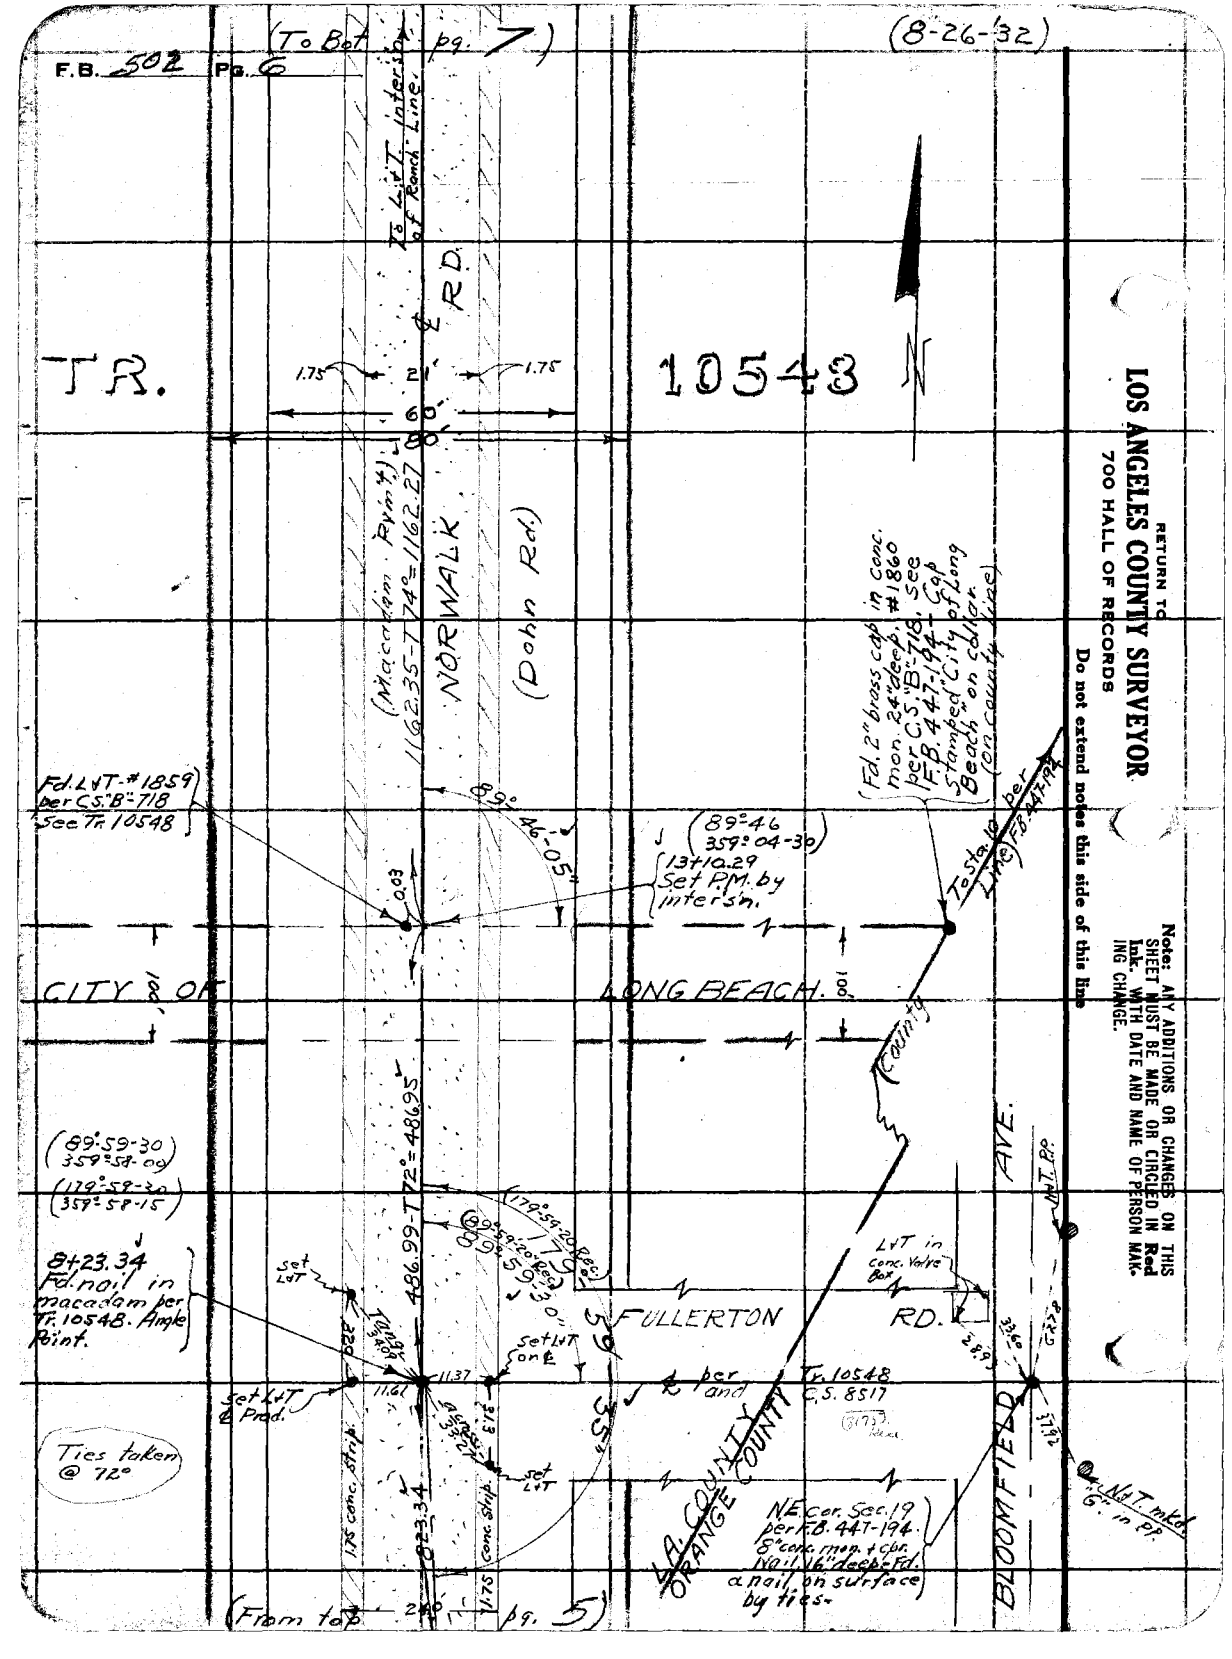
F.B. 502 Pg. 6
(To Bot. pg. 7)
(8-26-32)
To L. & T. intersn. of Road Line.
TR.
1.75
21'
1.75
60'
80'
1054 3
& R.D.
(Macadam Pvmt.)
1162.35-T 74°=1162.27
NORWALK
(Dohn Rd.)
Fd. L & T. #1859 per C.S. B-718 See Tr. 10548
89°
46'-05"
0.03
(89°46
359°04-30)
J
1371 0.29
Set P.M. by intersn.
(Fd. 2" brass cap in conc. mon. 24" deep, #1860 per C.S. B-718, see F.B. 447-194. Cap Stamped "City of Long Beach" on collar (on county line)
To Sta. 10 per L.M.E. F.B. 447-194
CITY OF
LONG BEACH.
100'
County
AVE.
(89°59-30
359°58-00)
(179°58-30
359°58-15)
J
8423.34
Fd. nail in macadam per Tr. 10548. Ample Point.
Set L&T
Set L&T on ℄
486.99-T 72°=486.95
(179°59-20 Rec.)
89°59'-20" 90°00'-40"
89°59'-30"
Set L&T on ℄
L&T in conc. Valve Box
FULLERTON
RD.
per and Tr. 10548 C.S. 8517
Set L&T & Pnd.
11.61
11.37
Ties taken @ 72°
1.75 conc. Strip
1023.34
1.75 conc. Strip
L.A. COUNTY
ORANGE COUNTY
NE cor. Sec. 19 per F.B. 447-194. 5" conc. mon. & cor. Nail 1/16" deep; Fd. a nail on surface by ties.
BLOOMFIELD
Nail & T. mkd. "G" in pr.
(From top pg. 5)
RETURN TO
LOS ANGELES COUNTY SURVEYOR
700 HALL OF RECORDS
Do not extend notes this side of this line
Note: ANY ADDITIONS OR CHANGES ON THIS SHEET MUST BE MADE OR CIRCLED IN Red Ink WITH DATE AND NAME OF PERSON MAKING CHANGE.

Notes Ck'd by Drew	Survey of Norwalk Rd.
Map No. B-804	W. O. 7089 Tape No. 057 St'd 54° F.
Office Work White	Surveyed by Evans
Checked Drew	Notes LE Date 8-29-32
Date Jan 1935	Indexed A. C. Johnson

F.B. 502 Pg. 7

(To Lt. Side - Ap. B)

PIONEER BVD.

To Garfield Ave.

℄

Proposed Setback Line

(69°-19-15)
(277°-16-45)

L.S. 18-36.

9'-10"
15 od.

69°

80.0

RD.

662.86-T84°

Fd. Conc. Mon. w/ Cpr. Tk. with 4"x4" white post marked (2.54 dr.) per F.B. 448-39

(178°-35-30)
(354°-22)

Fd. conc. Mon. w/ Cpr. Tk. 3.0' dn. in 4"x4"x72" white post set on Tgt. Mon. 3.0' above grnd. for marker

178°-35'-30"

Line 2

9.88

set nail

20.0 Lt. 54½ Lt. 1069 Lt. 1.5 Lt.

across 20.35

set Lt+x

set Lt 1.5

24+72.56
Angle Point
Fd. L.T. per Tr. 10548. (In chiseled □)

Fd. conc. Mon. Cpr. Tk. ctr. 3.0' dn. in with 4"x4" white post 3.0' high, above mon. for marker.

Fd. 1½-2" high S.E. Co. Ltr. per F.B. 447-194

(John Rd.)

NORWALK

1162.27

Re Los Garatos

Re Los Alamitos

45(M)

70°-43'-50"

60'

80'

Proposed Setback

1.75 conc. strip

from Lt of L.B. 4'

1.75 conc. strip

Tg. Sta. 10 Co. Ltr. per F.B. 447-194

(70°-43-45)
(282°-55-15)

TR.

10548

(From top pg. 6)

RETURN TO
LOS ANGELES COUNTY SURVEYOR
700 HALL OF RECORDS

Note: ANY ADDITIONS OR CHANGES OF THIS SHEET MUST BE MADE OR CIRCLED IN Red Ink. WITH DATE AND NAME OF PERSON MAKING CHANGE.

Do not extend notes this side of this line

FORM 247 ION 5-31

F.B. 502 Pg. 8

(8-31-32)

N

L.S. 15-9.

31+35.42
Set S.W.P.T.
by Intersin

proposed setback Line

From Mark

(Dohn Rd.)
NORWALK RD.

1.75' Conc. strip
from ℄

40'

80'

662.86

(Macadam Print.)

1.75' Conc. strip.

39.71

45.23

277.05 To ℄ Wilson Ave.
(237.32 Rec.)
237.34 Prop'd

To Bar 1.75 Pg 9

40.00

set
VX1

15'

31+75.13
Fd. 2" I.P. w/plug flush
per Tr. 7114 & F.B. 447-195
Set Tk. center
used for proportion.

L = 31.42
90°-24
(90°22'45" Rec.)

proposed Setback Line.
(90°-24
361°-35-45)

(165.81 Rec.)

14.80

Fd. 2" I.P. P.T.
flush per L.S.
18-36

COOLIDGE AVE

50'

Fd. 2" I.P. + Plug
Tr. 7114.
used center

40.26

HARDING AVE

60'

℄ per

GARFIELD

15'

40'

Fd. 2" I.P. + Plug +
6" high - Tr. 7114
used Center

40.28

JEFFERSON AVE.

50'

15'

L.S. 13-36.

F.B. 447-195

Fd. 2X2-18" dn.
by ties per F.B.
447-195

AVE.

BLOOMFIELD

℄ per F.B. 447-195

AVE.

RETURN TO
LOS ANGELES COUNTY SURVEYOR
700 HALL OF RECORDS

Do not extend notes this side of this line

Note: ANY ADDITIONS OR CHANGES ON THIS SHEET MUST BE MADE OR CIRCLED IN Red Ink. WITH DATE AND NAME OF PERSON MAKING CHANGE.

Notes Ck'd by Drew | Survey of Norwalk Rd.
Map No. B-804 | W. O. 1059 Tape No. St'd of.
Office Work White | Surveyed by Evans
Checked Drew | Notes H Date 9-1-32
Date Jan. 1935 | Indexed C. Johnson

F.B. 502 Pg. 9

(To Left side pg. 10)

(90°23-45) (361°-34-45)

N

T.14.

pg. 111

40' 20' 21' 45'

262.02 To Meas. (262.02 Rec.)

90°-23'-40" (90°-22-45 Rec.)

set L+T

WASHINGTON AVE (15' oiled surface)

To 3/4" Pipe in Jefferson pg. 11.

39+36.55 - Set S.W.+T. by Prop'n.

set L+T & Prod.

1144 1131

set L+T on ℄

set L+T

Line

Setback

Proposed

262.04 Prop'd (262.02 Rec.) R.D.

90° (90°-22-45" Rec.)

3'-40" N.E.

(90°-23-45) (361°-34-45)

Side

36+74.51 - Set S.W.+T. by Prop'n.

set L+T & Prod.

1146 1143

set L+T on ℄

ADAMS AVE. (10' oiled surface)

To 3/4" Pipe at Jefferson pg. 11

L.S. 16-9

(JOHN RD. 1.75 conc. St.)

(Macadam 262.04 Prop'd R/W (262.02 Rec.) NORWALK 1.75 conc. St.)

90° (90°-22-45" Rec.)

35' E.

T.R.

(90°-23-30) (361°-34-30)

34+12.47 - Set S.W.+T. by Prop'n.

set L+T & Prod.

1137 1159

set L+T ℄

WILSON AVE. (10' oiled surface)

To 3/4" Pipe in Jefferson pg. 11

277.05

(From Rt. side pg. 8)

(To left pg. 111)

Note: ANY ADDITIONS OR CHANGES OF THIS SHEET MUST BE MADE OR CIRCLED IN Red Ink, WITH DATE AND NAME OF PERSON MAKING CHANGE.

RETURN TO LOS ANGELES COUNTY SURVEYOR 700 HALL OF RECORDS

Do not extend notes this side of this line

FORM 247 10M 8-31

RETURN TO
LOS ANGELES COUNTY SURVEYOR
700 HALL OF RECORDS

Note: ANY ADDITIONS OR CHANGES ON THIS SHEET MUST BE MADE OR CIRCLED IN **Red Ink.** WITH DATE AND NAME OF PERSON MAKING CHANGE.

Do not extend notes this side of this line

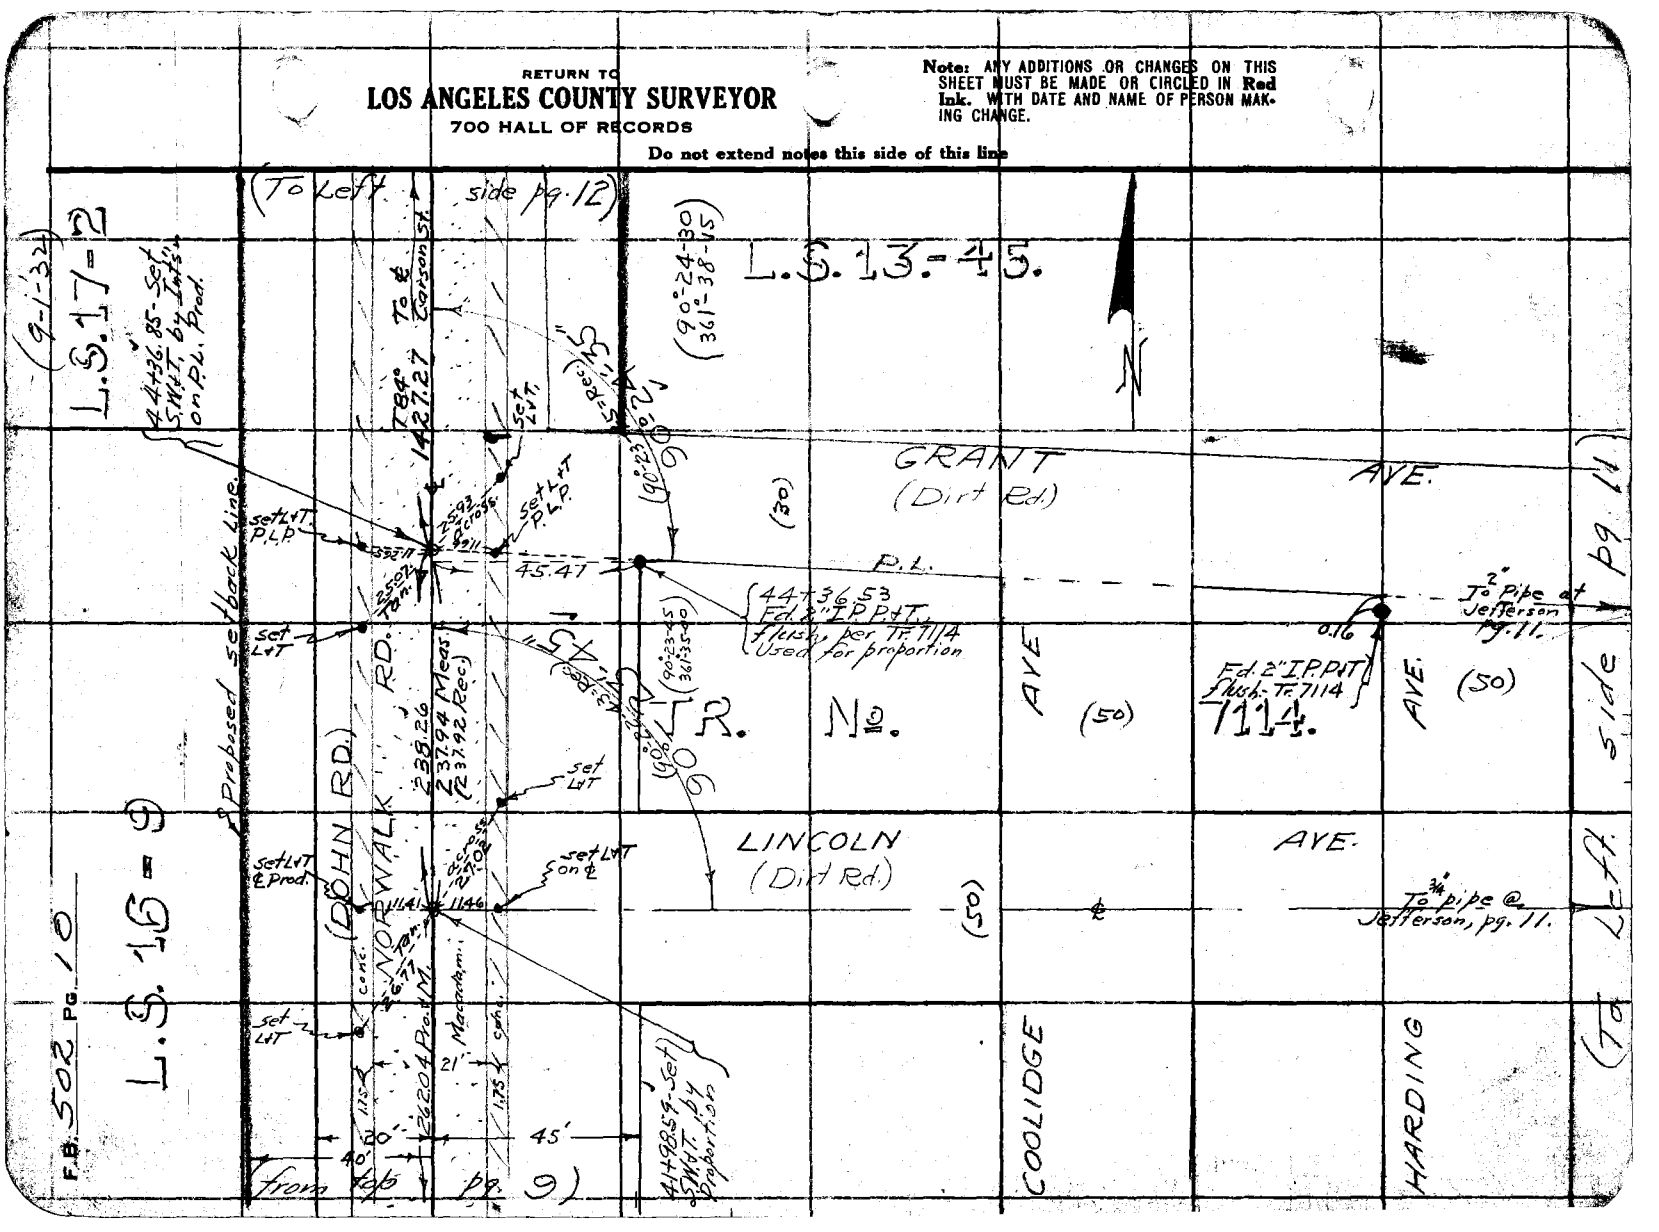

Notes Ck'd by Drew	Survey of Norwalk Rd.
Map No. B-80X	W. O. 7088 Tape No. 051 St'd 84 °F.
Other Work White	Compared by Evans
Checked Drew	Notes H Date 9-1-32
Date Jan 1935	Indexed A. C. Johnson

F.B. 502 PG. 11

Fd 2" I.P. + plug per Tr. 7114. Flush Set tack center

GRANT AVE. P.L.

Set 3/4" I.P. cement filled + Cpr. Tk., 18" deep, by Proportion

LINCOLN AVE.

Set 3/4" I.P. cement filled + Cpr. Tk. by Proportion - 18" down

WASHINGTON AVE.

Set 3/4" I.P. cement filled + Cpr. Tk. 18" deep.

ADAMS AVE.

Identical

Fd. 2" I.P. PpT per Tr. 7114 Flush

Set 1x1

WILSON AVE.

Set 3/4" I.P. filled with cement + Cpr. Tk. center by proportion 18" deep

Identical

Fd. 2" I.P., 3" high per Tr. 7114 See pg. 158

Set 1x1

GARFIELD AVE.

(See pg. 8)

Adams Ave

Wilson Ave.

Jefferson

garage

Ties @ 82°

Ties @ 84°

Note: ANY ADDITIONS OR CHANGES OR THIS SHEET MUST BE MADE OR CIRCLED IN Red Ink, WITH DATE AND NAME OF PERSON MAKING CHANGE.

Do not extend notes this side of this line

RETURN TO
LOS ANGELES COUNTY SURVEYOR
700 HALL OF RECORDS

FORM 247 10M 8-31

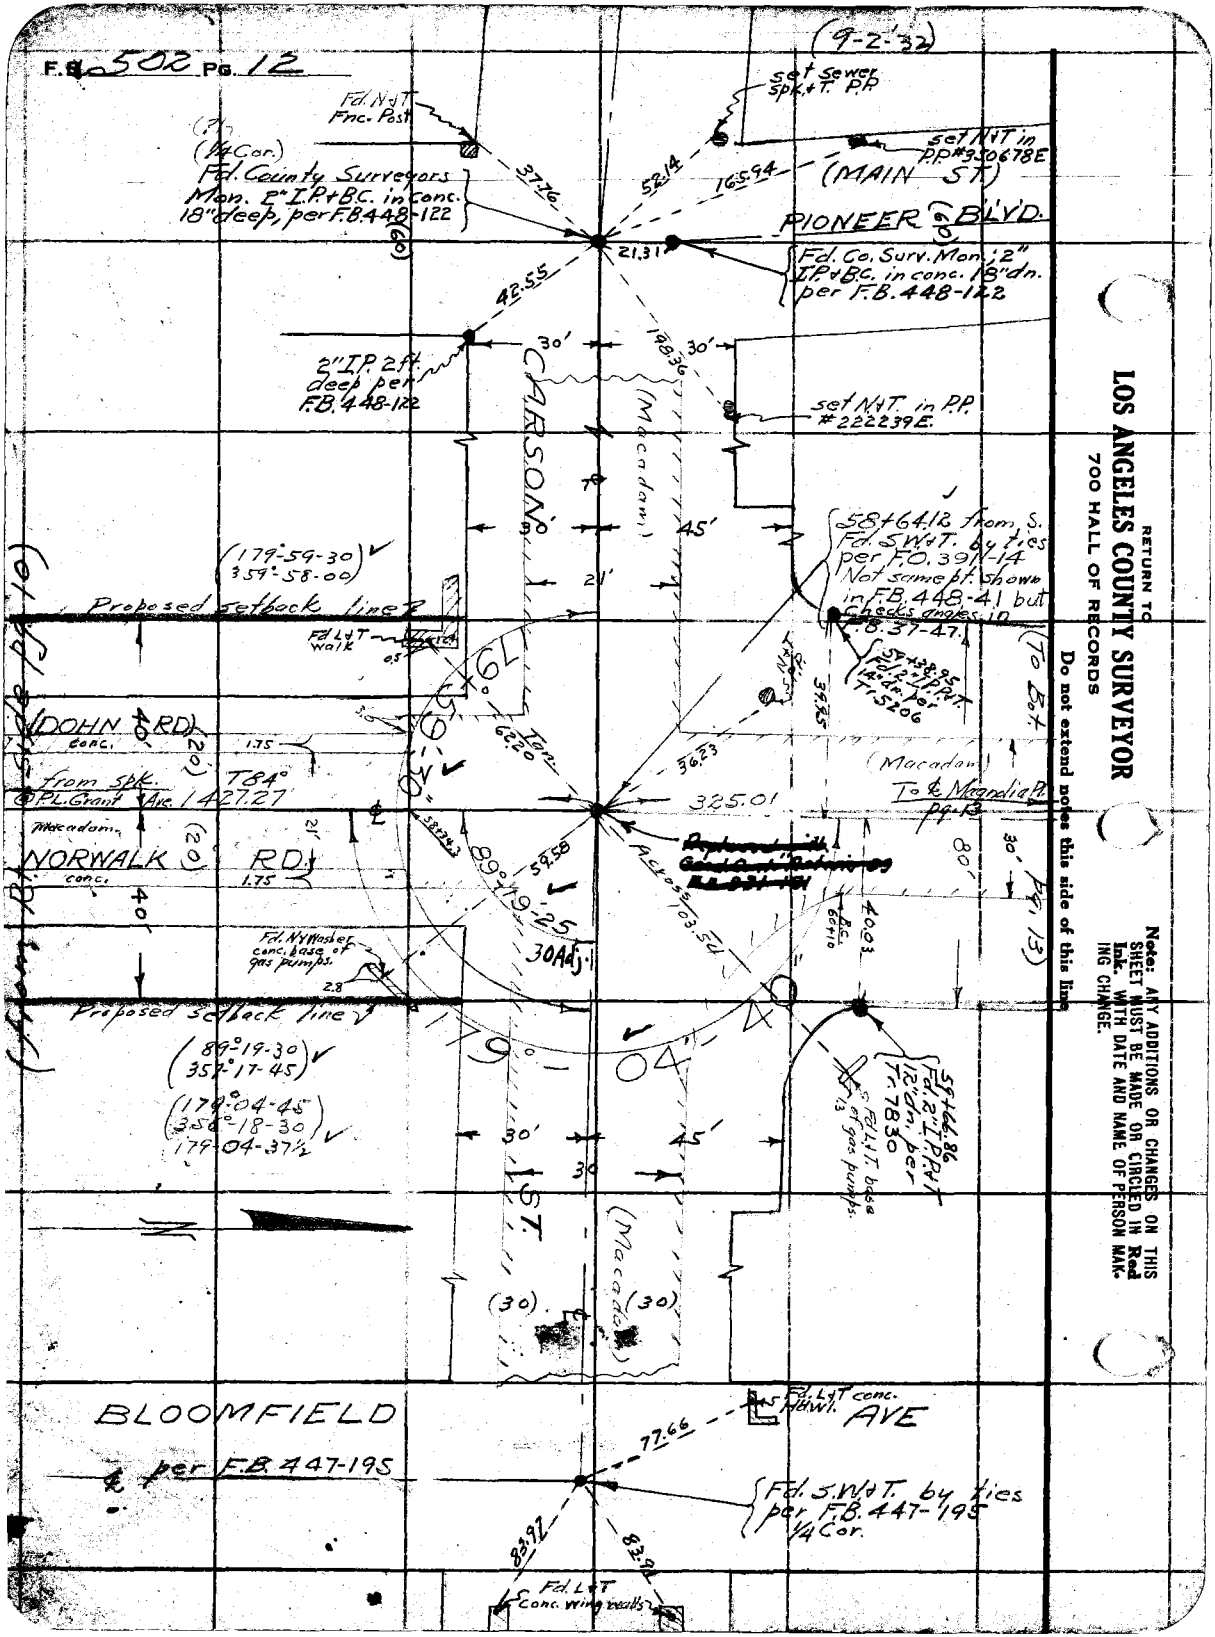
F.B. 502 Pg. 12
(9-2-32)
Fd. N & T Fnc. Post
(N Cor.)
Fd. County Surveyors Mon. 2" I.P. & B.C. in conc. 18" deep, per F.B. 448-122
37.76
52.14
165.94
set sewer spk. & T. P.P.
set N&T in P.P. #330678E
(MAIN ST)
PIONEER (60) BLVD.
21.31
Fd. Co. Surv. Mon.; 2" I.P. & B.C. in conc. 18" dn. per F.B. 448-122
42.55
2" I.P. 2 Ft. deep per F.B. 448-122
30'
198.36
30'
set N&T. in P.P. #222239E.
CARSON ST.
(Macadam)
79
45'
21'
(179°59-30)
359°-58-00)
Proposed setback line
Fd. L & T walk
S 88° 64.12 from S. Fd. S.W. & T. by ties per F.O. 391-14 Not same pt. shown in F.B. 448-41 but checks angles in F.B. 37-47.
S 88° 43.95 Fd. 2" I.P. P.P. T 15206
(To Ext.)
(DOHN RD) conc.
40'
(20)
1.75
from spk. @ PL. Grant Ave.
T 84° 1427.27
79°-30'
Tan 62.20
36.23
325.01
To Magnolia Pl. pg. 13
(Macadam)
NORWALK RD.
conc.
1.75
(20)
40'
Fd. N.Y. Washer conc. base of gas pumps.
2.8
89°-19-25
30 Adj.
Adds 103.51
40.03
Pg. 13
80'
30'
Proposed setback line
(89°-19-30)
(357°-17-45)
(179°-04-45)
(358°-18-30)
179°-04-37½
179°-04'
S 88° 46.86 Fd. 2" I.P. P.P. T. 7830
Fd. L & T base of gas pumps.
30'
45'
30
167.11
(30)
(Macadam)
(30)
BLOOMFIELD
per F.B. 447-195
Fd. L & T conc. Nwl. AVE
77.66
Fd. S.W. & T. by ties per F.B. 447-195 1/4 Cor.
83.97
83.94
Fd. L & T Conc. wing walls
RETURN TO
LOS ANGELES COUNTY SURVEYOR
700 HALL OF RECORDS
Do not extend notes this side of this line
Note: ANY ADDITIONS OR CHANGES ON THIS SHEET MUST BE MADE OR CIRCLED IN Red Ink. WITH DATE AND NAME OF PERSON MAKING CHANGE.

Notes Ck'd by Drew | Survey of Norwalk Rd.
Map No. B-894 | W. O. 7089 Tape No. 051 St'd 84 OF.
Checked Drew | Notes
Date Jan 1935 | Date 12-28-32
Indexed A. C. Johnson

F.B. 502 PG. 13

Note: ANY ADDITIONS OR CHANGES OF THIS SHEET MUST BE MADE OR CIRCLED IN Red Ink. WITH DATE AND NAME OF PERSON MAKING CHANGE.

Do not extend notes this side of this line

RETURN TO
LOS ANGELES COUNTY SURVEYOR
700 HALL OF RECORDS

Wistaria Place

Poinsettia Place

Magnolia St.

Norwalk Road

Ingram Drive

20' oiled surf. St.

19' oiled roadway

(dirt rd.)

P.O.T.-68+49.11 (20' oiled roadway) Set L.+T. by int'sn.

P.O.T.-65+19.12 Fd. S.W&T per Rd. F.O. 391-13

P.O.T.-61+89.13 Set S.W.T. by Intersection.

Fd. 2" I.P.P.T. 18"dn.-F.O.391 & 23.12 & Tr. 5206

Fd. 2" I.P.P.T. 18"dn.-F.O.391 pg. 18 & Tr. 5206

Fd. 3" I.P.P.T. per F.O. 391-13 & Tr. 5806 (12.00nw)

Fd. 2" I.P.P.T. 12"dn. per F.O. 391-13 & Tr. 5206

Fd. 2" I.P.P.T. 16" deep per F.O. 391-13 Set Tr. 5206

Fd. 3" I.P.P.T. 12"dn. per F.O. 391-13 & Tr. 5206

Fd. 3/4" I.P. (No Tk.) 14" deep per F.O. 391-12

Fd. 3/4" I.P. (No Tk.) 8" deep.

Fd. 3/4" I.P. 8" dn. Notch

Fd. 3/4" I.P. (No Tk.) 6" dn. per F.O. 391-13

Fd. 1½" I.P. No Tk. 14" dn., per F.O. 391-13

Fd. 3/4" I.P. (No Tk.) 6" dn. per Rd. F.O. 391-13

Fd. 3/4" I.P., 10" dn. per Rd. F.B.-F.O. 391-13 No Tack.

Fd. 2" I.P.P.T. per F.O. 391-13 & Tr. 5806

Fd. conc. mon. stk. etc., 24" per F.O. 391-13

Fd. 2" I.P.P.T. per F.O. 391-13 & Tr. 5206

Fd. 2" I.P.P.T. 12"dn. per F.O. 391-13 & Tr. 5206

Fd. 2" I.P.P.T. per F.O. 391-13 Set Tr. 5206

Fd. 3/4" iron bar per F.O. 391-13

Fd. 3/4" I.P. 6"dn. Notch

Fd. 3/4" I.P. (No Tk.) Ye. dn. per Rd. F.O. 391-13

Fd. 3/4" I.P. 8" dn. Notch








(89°-45-15 359°-01-00 89°-45-15)

(90°-15-45 361°-03-30 90°-15-52½)

(90°-15-15 361°-01-30 90°-15-52½)

(89°-44-45 359°-59-00 89°-44-45)

(Ties @ 70°)

(Ties @ 60°)

(Calc.)

(Meas.)

(Rec.)

(Maccadam Pvmt.)

N.H.T. Shelter

N.H.T. Bus Shelter

N.H.T. Bench

N.H.T. Bldg. stop & sign post.

N.H.T. Bldg. stop sign.

N.H.T. Headwall

N.H.T. P.P.

L.+T. Headwall

L.+T. Bldg. stop & sign post.

Nail

Tack

Ø

Ø

Ø

RETURN TO

LOS ANGELES COUNTY SURVEYOR

700 HALL OF RECORDS

Note: ANY ADDITIONS OR CHANGES ON THIS SHEET MUST BE MADE OR CIRCLED IN **Red Ink.** WITH DATE AND NAME OF PERSON MAKING CHANGE.

Do not extend notes this side of this line

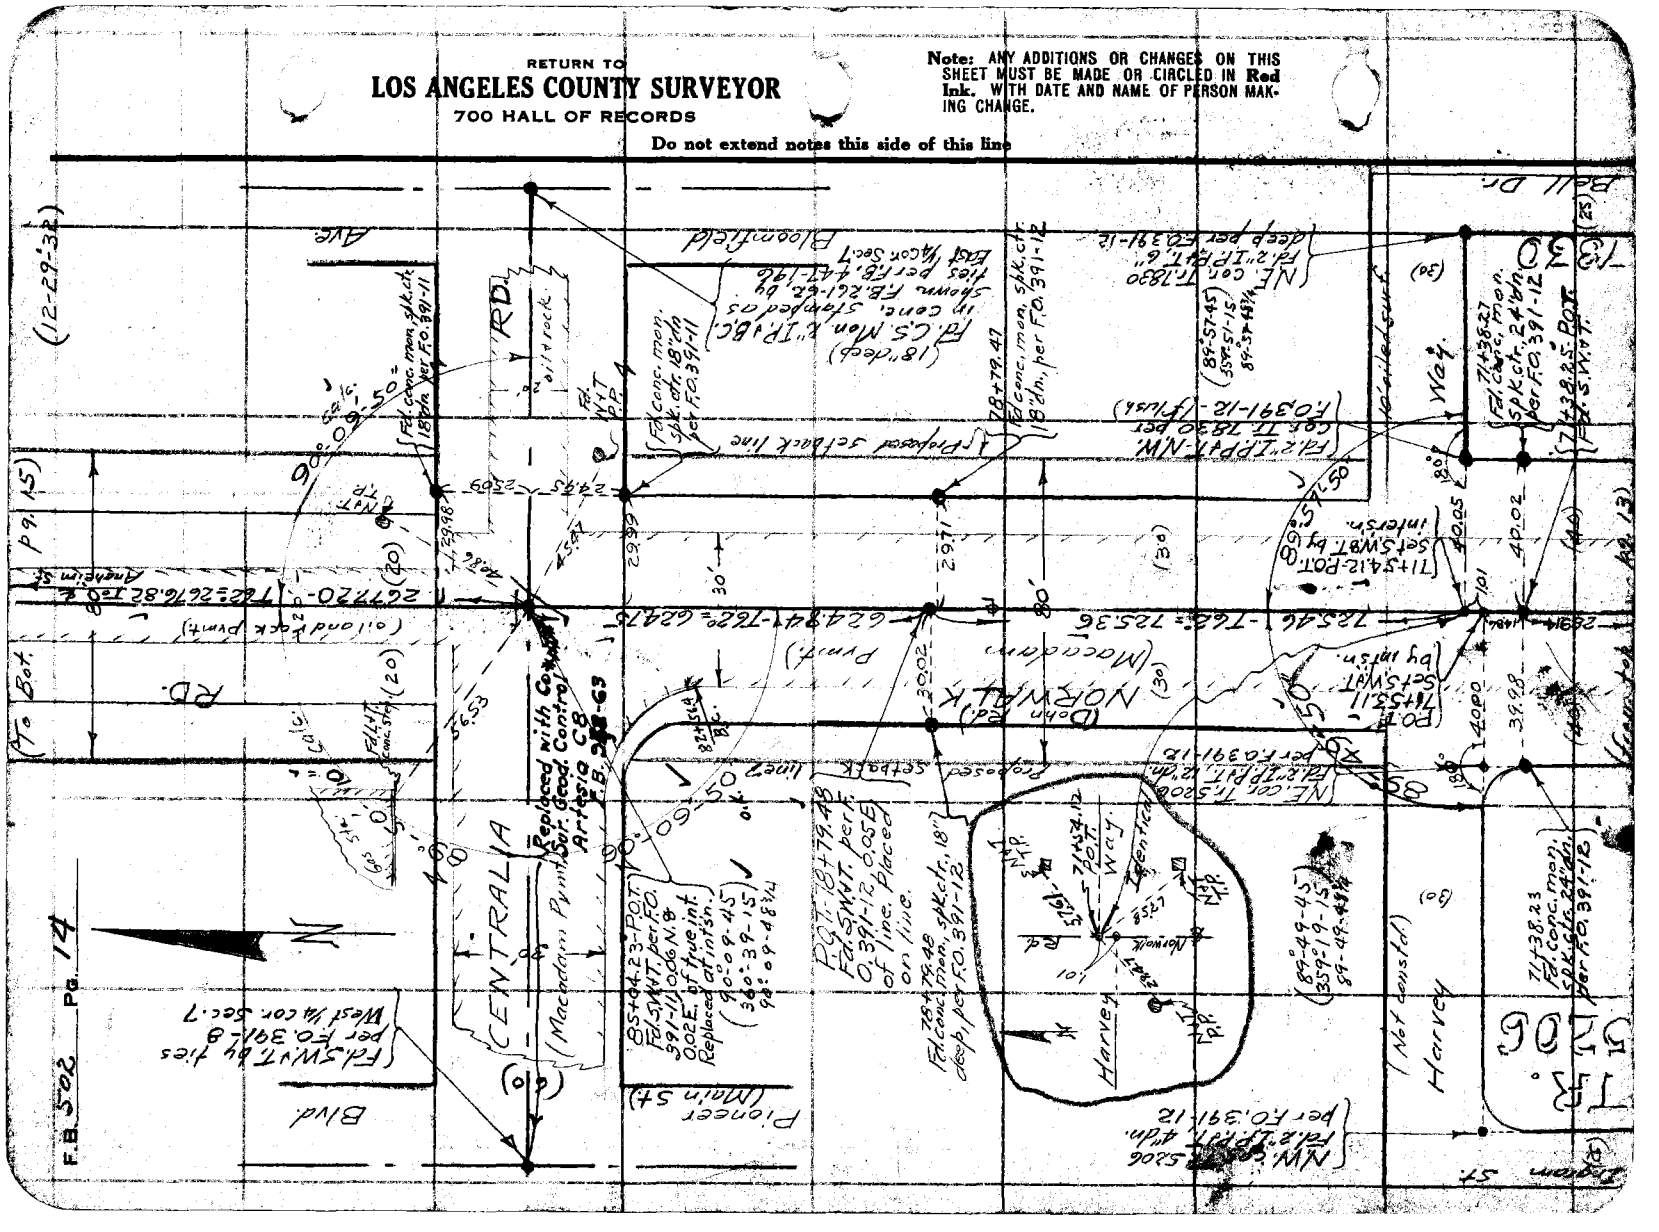
Bell Dr.
Ave
Bloomfield
RD.
Harvey Way
Harvey
Blvd
CENTRALIA
NORWALK
Pioneer (Main St)
Proposed setback line
Proposed with Corners Set Geod. Control Artesia CS 2-63 F.B. 288-63
Replaced with FD.SWT per F.O. 391-11 006 N.8° 002E. of true int. Replaced at intsn.
Set SWT by intersn.
Set SWT
Set SWT by intersn.
Fd. SWT by ties per F.O. 391-8
West ¼ cor. Sec. 7
Fd. conc. mon. 18"dp. per F.O. 391-11
Fd. conc. mon. spk. on 18"dp. per F.O. 391-11
Fd. conc. mon. 18"dp.
Fd. conc. mon. spk. on 18"dp. per F.O. 391-12
Fd. conc. mon. spk. on 18"dp. per F.O. 391-12
Fd. conc. mon. spk. ch. 24"dp. per F.O. 391-12
Fd. conc. mon. spk. ch. 22"dp. per F.O. 391-12
Fd. conc. mon. spk. ch. 18

Notes Ck'd by Drew | Survey of Norwalk Rd.
Map No. B-894 | W. O. 7089 Tape No. 051 St'd 84 °F.
Checked Drew | Notes H. C. Jones
Date Jan 1935 | Indexed Date 12-30-32

F.B. 502 Pg. 15

(To Bk. 13 pg. 10)

133+28.13
Fd. conc. mon., spk. ctr., 24"dn. per Rd. F.A. 46-76

20.00

POT.-132+80.54
Fd. 2X2, 12"dn. per F.B. 331-56. Tack) not on & Century.

(20) (20)

Set P.M. Tack

3004.22 @ 68° = 3003.91'
2641.92 @ 68° = 2641.67'

SEC.
T. 4 S.

R. 11 W.

132+02.58
Fd. conc. mon. spk. ctr., 24"dn. per Rd. F.A. 46-76

Proposed setback line

20.01

N

Note: ANY ADDITIONS OR CHANGES OF THIS SHEET MUST BE MADE OR CIRCLED IN Red Ink. WITH DATE AND NAME OF PERSON MAKING CHANGE.

Do not extend notes this side of this line

RETURN TO
LOS ANGELES COUNTY SURVEYOR
720 HALL OF RECORDS

SOUTHERN CALIFORNIA EDISON CO. STATION

P.O.T.-125+86.39
Set S.W. + T.

Fd. 2" I.P. & B.C. in conc., 6" down.

126+76.61
125+91.60

30.03 29.96
30.05 30.00

52°-53-00
211°-32-15
52°-53-03¾

52°-53-05" adj.

Proposed 38' Back line

Probable CENTURY BLVD. C.S.B-114

Fd. 2" I.P. & B.C. in conc. 8"dn. mkd. as shown on 1943

1254.28

ROAD

Fd. 2X2 P.O.T. 18"dn. per F.B. 331-56. Sec. 7 T. 4 S. R. 11 W. F.B. 447-146. Fd. N+T

Fd. S.N+T. by ties per F.B. 391-47 N.W. cor. Sec. 7.

(89°-44-45
358°-59-00
89°-44-45

45"

Set N+T Top of F.P.

Fd. S.N+T Spk. in F.P.

89°-44-45"

50' M.C.

Set N+T Top of F.P.

Fd. N+T F.P.

Set N+T Tel. P.

Set N+T Top of F.P.

Fd. N+T F.P.

(60)

28.32

99.76

Fd. N+T F.P.

87.18

Rec. 112.44

(oil & rock)

3003.91'

2641.67

ANAHEIM

BLOOMFIELD

Set N+T F.P.

Set N+T F.P.

(60)

PIONEER

(John Rd.) NORWALK

Fd. S.N+T. 24"dn.

Set N+T

(oil & rock)

Fd. 2X2 Plugs by ties F.B. 447-146. This point is the intersection of the E. line of Sec. 7 T. 4 S. R. 11 W. and the N. line of Sec. 18 T. 4 S. R. 12 W.

NW Cor. Sec. 7 T. 4 S. R. 11 W. 1" I.P. 1.2' in mon. well. F.B. 261-57. See F.B. 37-47 & 331-56 NW 1/4 cor. Sec. 7.

Mon. 18"dn. mkd. as shown in F.B.

FORM 247 10M 8-31

RETURN TO

LOS ANGELES COUNTY SURVEYOR

700 HALL OF RECORDS

Note: ANY ADDITIONS OR CHANGES ON THIS SHEET MUST BE MADE OR CIRCLED IN **Red Ink.** WITH DATE AND NAME OF PERSON MAKING CHANGE.

Do not extend notes this side of this line

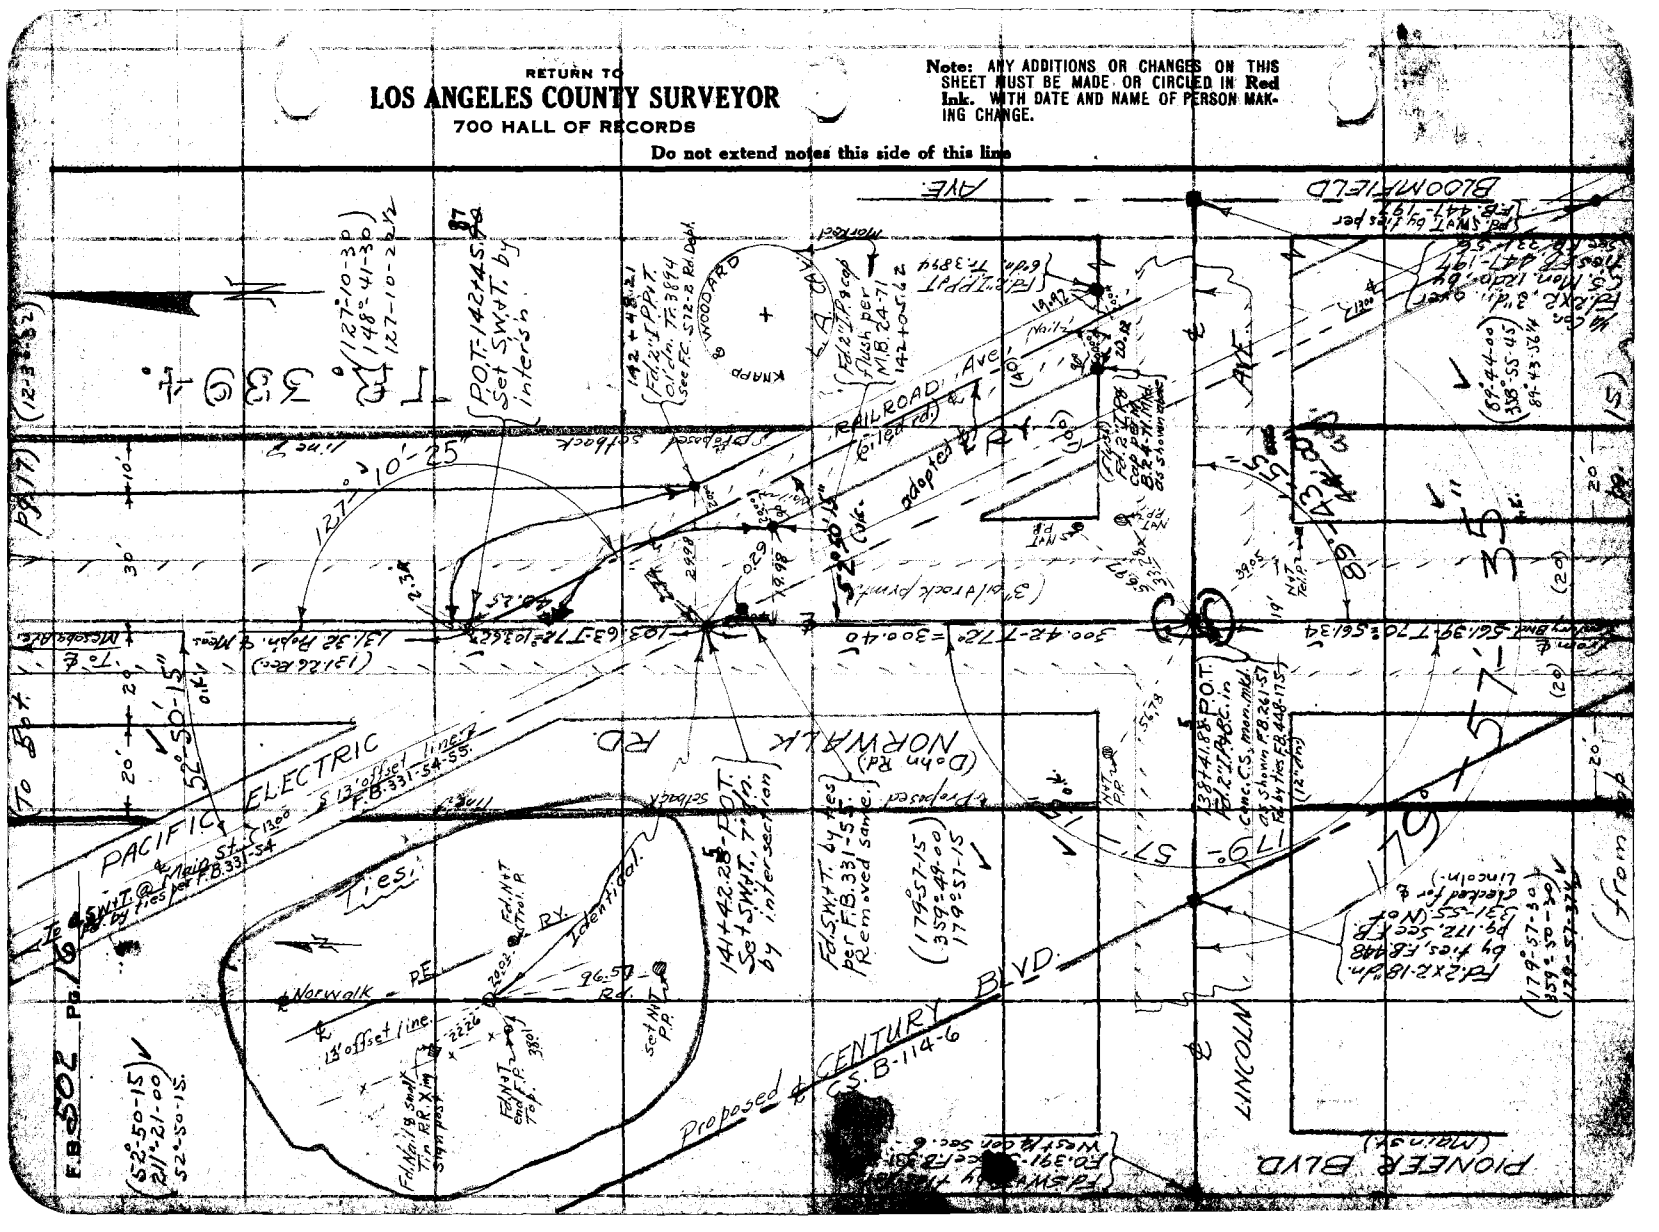
AVE.
BLOOMFIELD
RAILROAD AVE.
(adopted)
NORWALK RD.
(Dohn Rd.)
PACIFIC ELECTRIC
Norwalk
CENTURY BLVD.
Proposed
LINCOLN
PIONEER BLVD
(Main St.)
POT-142+45.2
Set SWIT. by
intersn.
141+42.2 POT.
Set SWIT. 7' Rt.
by intersection
FdSWIT. 64 ties
Per F.B. 331-54
Removed same.
FdSWIT. by ties
Per F.B. 331-54
Set SWIT. @ Intersn
by ties per F.B. 331-54
13' offset line
Identical.
Set NAIL & P.P.
Fd. Nail & Washer
Tie R.R. X'ing
Stamped "L.S."
Fd. NAIL
Tie P.P.
Fd. NAIL
Ident. P.P.
Fd. 1" IPPT
Cor. in Mon. Well
See F.C. 572-B Rel. Dept.
Fd. 2" IPPT
Flush per
M.B. 24-71
Fd. 2" IPPT
Flush
Fd. 3/4" IPPT
Flush
Fd. 3/4" IPPT
Flush
Fd. 3/4

Notes Ck'd by Drew
Map No. R-804
Other Work White
Checked Drew
Date Jan 1935

Survey of Norwalk Rd
W. O. 7088 Tape No. 051 St'd 84 of.
Corrected by Evans
Notes E Date 1-5-32
Indexed A. C. Johnson

F.B. 502 Pg. 17

(To Bk. 18)

Note: ANY ADDITIONS OR CHANGES ON THIS SHEET MUST BE MADE OR CIRCLED IN Red Ink, WITH DATE AND NAME OF PERSON MAKING CHANGE.

Do not extend notes this side of this line

RETURN TO
LOS ANGELES COUNTY SURVEYOR
700 HALL OF RECORDS

(90°23-45)
361°34-45)
90°23-41¼

(20)
(30)
20'
RD.
264.07-T74°=264.05 to Eng. Sta. on Ave.
10' con. walk
(25)
125 125
(Clint Rd.)
to Fire Rd Dept.
AVE.

Fd 2½ R.P. 12' dn. per Rd. Dept. F.C. 572-14

22.35
20.03
31.12
31.56
Set L.T. Tacheometric
(oil & gravel)
CHOLRAINE AVE. (50)
8" curb
walk

Fd 2x2, 6" dn by ties per F.C. 572-15

146+41.52 P.O.T. Set 2x2-8' dn. by Inter'sn.

(90°23-30
361°34-00)

(26400 Rec.
264.11 Meas.
(3' soil rock p'mt.)
Proposed setback line?
Proposed
(50)

(26400 Rec.
264.01 Prolon. S.M.
79795-T80°=79793 Meas.
(79773 Rec.)

Note: Points on Ely Ave not checked for & Ely Ave.

143+77.22 P.O.T. Set 3/4 I.P. by Proportion

(Not const'd)

By proportion Set ¾" I.P.P.T. 24" deep. (Cp. Tk.)

40.00

MESABA AVE.

Set ¾" I.P.P.B. 3' in Tk. 3' W. of Prod.

R. 47 W.
T. 5 S.

(Dohr NORWALK Rd.)
From & Railroad Ave. 395.43 M. (395.26 R.)
(131.26 R.)
Railroad Ave. 131.32 Prolon. S.M.
20'
(20)
(30)
10'
(from Bk. 69, 16)

(533.73 Rec.)
533.86 Prolon. S.M.
(25)
ALLY
Fd 2" I.P.P.T. Mush. Tr. 3894 Leaning N.W.
12.52
set N&T
5 F.F.
LINCOLN
AVE.
Fd 2x2-12" dn. F.C. 572-6.
set N&T
F.F.
set N&T By Fascia
30.97

FORM 247 10M 8-31

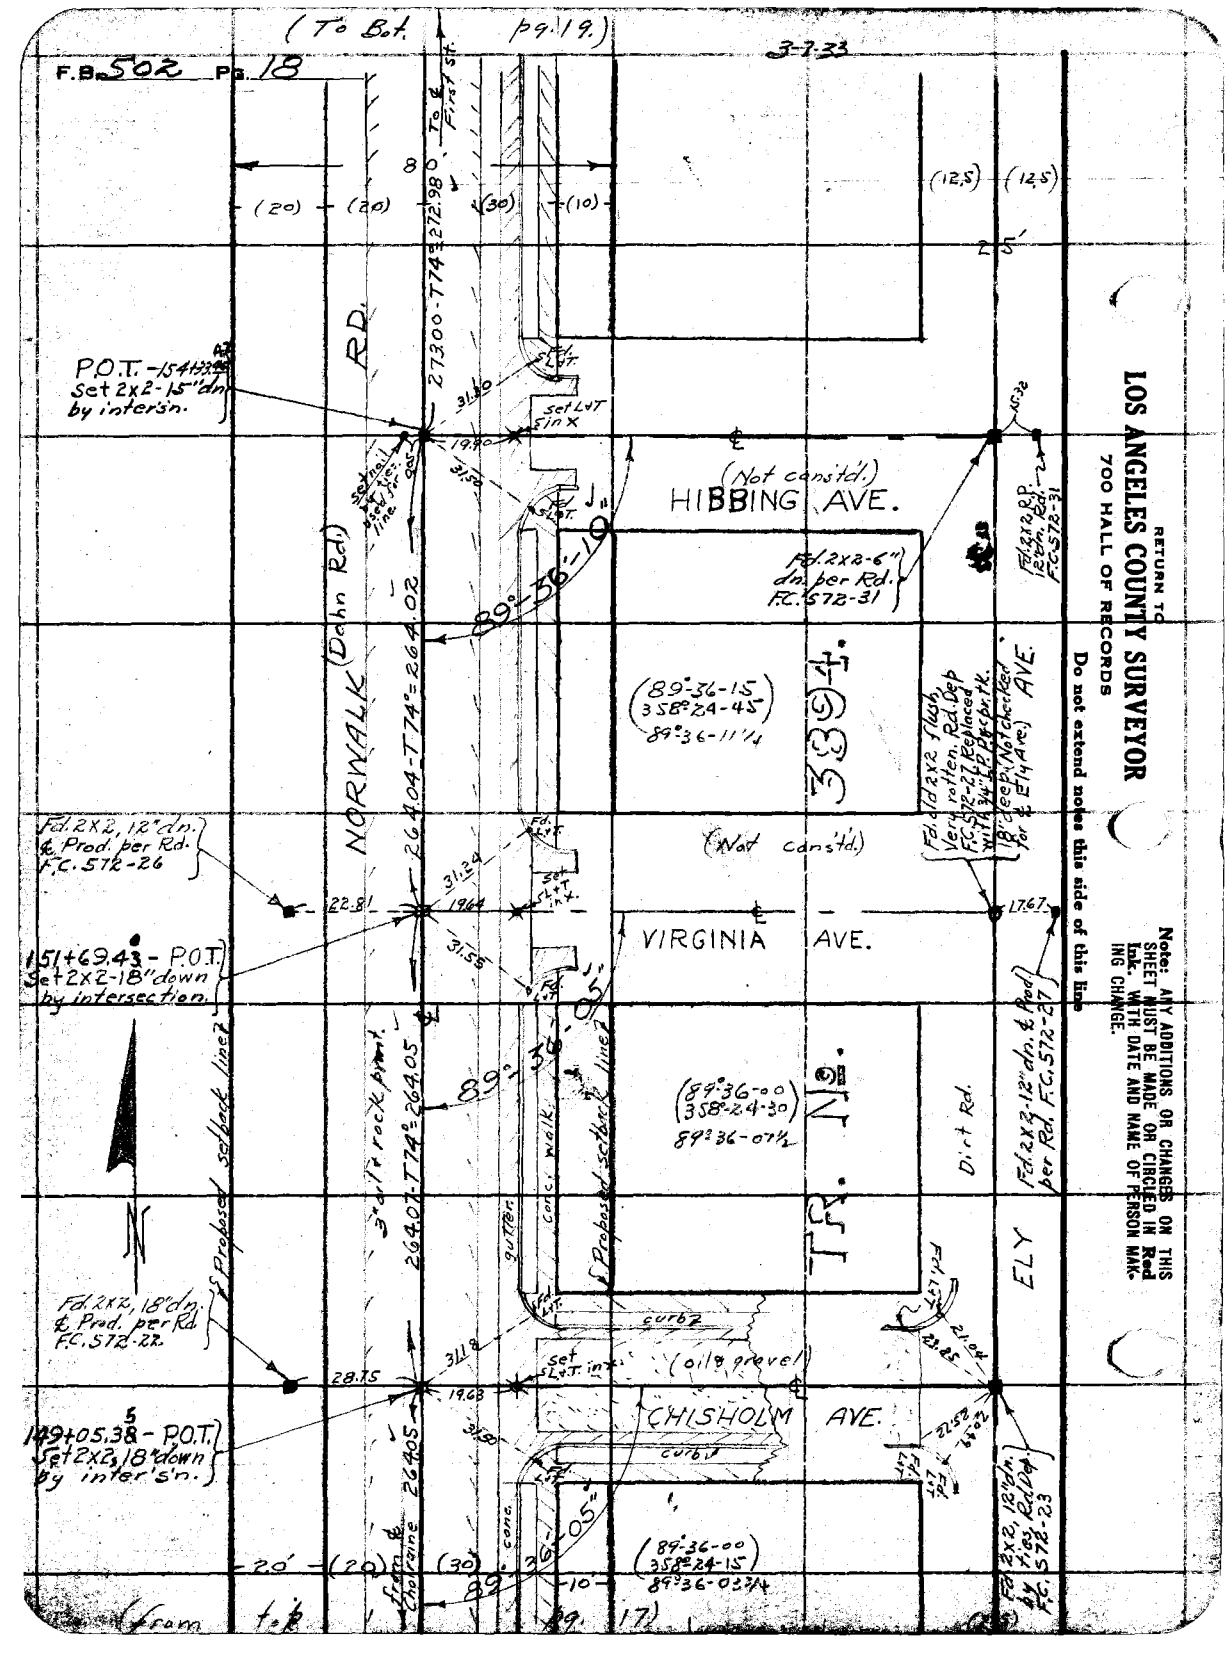
(To Bk. pg. 19)
F.B. 502 Pg. 18
3-7-33
NORWALK (Dahn Rd.)
27300-T74=272.98'
26404-T74=264.02
26402-T74=264.05
26405
HIBBING AVE.
(Not consid.)
VIRGINIA AVE.
CHISHOLM AVE.
Dirt Rd.
ELY
3394
N. 5° E.
P.O.T. -154+33.43 Set 2x2-15" dn by inter'sn.
151+69.43 - P.O.T. Set 2x2-18" down by intersection.
149+05.38 - P.O.T. Set 2x2, 18" down by inter's'n.
Fd. 2X2, 12" dn. & Prod. per Rd. F.C. 572-26
Fd. 2x2, 18" dn. & Prod. per Rd. F.C. 572-22
Fd. 2x2-6" dn. per Rd. F.C. 572-31
Fd. 2x2, 12" dn. & Prod. per Rd. F.C. 572-27
Fd. 2x2, 18" dn. per Rd. F.C. 572-23
Fd. 1/2" I.P. 12" dn. Rd. F.C. 572-31
Fd. 2x2 flush, Very rotten, Rd. Dep. F.C. 572-21 Replaced with 3/4" I.P. Mk. "X" 18" deep. Not checked for ℄ (14 Ave.)
(89°36-15) 358°24-45 89°36-11½
(89°36-00) 358°24-30 89°36-07½
(89°36-00) 358°24-15 89°36-03½
Probable setback line
3-4" rock mon.
Conc. walk
gutter
curb
(oil & gravel)
Conc.
Chicago
from
to
RETURN TO
LOS ANGELES COUNTY SURVEYOR
700 HALL OF RECORDS
Do not extend notes this side of this line
Note: ANY ADDITIONS OR CHANGES ON THIS SHEET MUST BE MADE OR CIRCLED IN Red Ink. WITH DATE AND NAME OF PERSON MAKING CHANGE.

Notes Ck'd by Drew	Survey of Norwalk Rd.
Map No. B-804-2	W. O. 7089 Tape No. 051 St'd 84 °F.
Computed from K.K. 440-214	Surveyed by [illegible]
Checked Drew	Notes LE Date 3-7-33
Date Jan 1935	Indexed

F.B. 502 Pg. 19

RETURN TO
LOS ANGELES COUNTY SURVEYOR
700 HALL OF RECORDS

Do not extend notes this side of this line

Note: ANY ADDITIONS OR CHANGES OF THIS SHEET MUST BE MADE OR CIRCLED IN Red Ink. WITH DATE AND NAME OF PERSON MAKING CHANGE.

FORM 227 10M 1-61

(To Bdy. Tr. 20)

T.R. 7032

(40) (20) (20)

10' 10' 10'

264.43 to ℄

170+31.48
Fd. 2" I.P.P.&T.
Flush. S.E. Cor.
Tr. 7032. Sec.
Rd. F.B. 634-33

41.28

0.05

08

170+31.14
Fd. 2" I.P.P. & T. 1/2"
do. per F.B. 448-174
& Rd. F.C. 634-33

(DOWN RD) ℄ NORWALK RD.

Proposed setback Line

(89°-36-15)
358°-25-00
89°-36-15

1324.82 T.69 = 1324.68

Replaced w.M.
Geod. Cont. Mon.
"Artesia"
F.B. 932-69

Fd. curb pk. in prmt. by ties per R.S. F.O. 391-2 & F.B. 261-56 & F.B. 331-54 Sec. Cor.

Fd. curb pk. & tack in conc. prmt. & ck. in macadam surface Per F.B. 261-56 F.B. 448-174 N. ¼ Cor. Sec. 6

Proposed Setback Line

Pickle Creek Diag.
F.B. 448-174

(90°-24-15)
361°-36-30
90°-24-07½

Fd. 6 pk. 0.02 N. of ℄ Sec. F.B. 448-175

BLOOMFIELD AVE.

ST.) BLVD.

(20) (20) (20)

FIRST ST.

conc. prmt.

set N.P. P.P.

3 set 4 sewer Spks. Temp. Ties

Set 4 S.W.I.T.'s Temp. Tres.

Sec. Cor. Fd. 4 x 4 I.S. Tan 2.0' Nat. 6" below surf. Concrete Set 3/4" I.P. By W.H.S.P. & Loads now fd. & obliterated. (See F.B. 448-63 & 514-Rec. 2-54)

(MAIN PIONEER)

Fd. 1 x 2 - 330+41.41 per F.B. 448-174

(51°-39-30)
(20°-38-15)
51°-39-33¾

51°-39-35"
30 Mj.

3" o/o track prmt.

conc. gutter

conc. w/k.

ELY AVE

Fd. L & T 0.02 S. & No Ref.

(69°-36-00)
358°-24-00
89°-36-00

(90°-23-30)
361°-34-15
90°-23-33¼

(20) (30) (10)

10' 10' 10'

(From W.)

RETURN TO
LOS ANGELES COUNTY SURVEYOR
700 HALL OF RECORDS

Note: ANY ADDITIONS OR CHANGES ON THIS SHEET MUST BE MADE OR CIRCLED IN **Red Ink.** WITH DATE AND NAME OF PERSON MAKING CHANGE.

Do not extend notes this side of this line

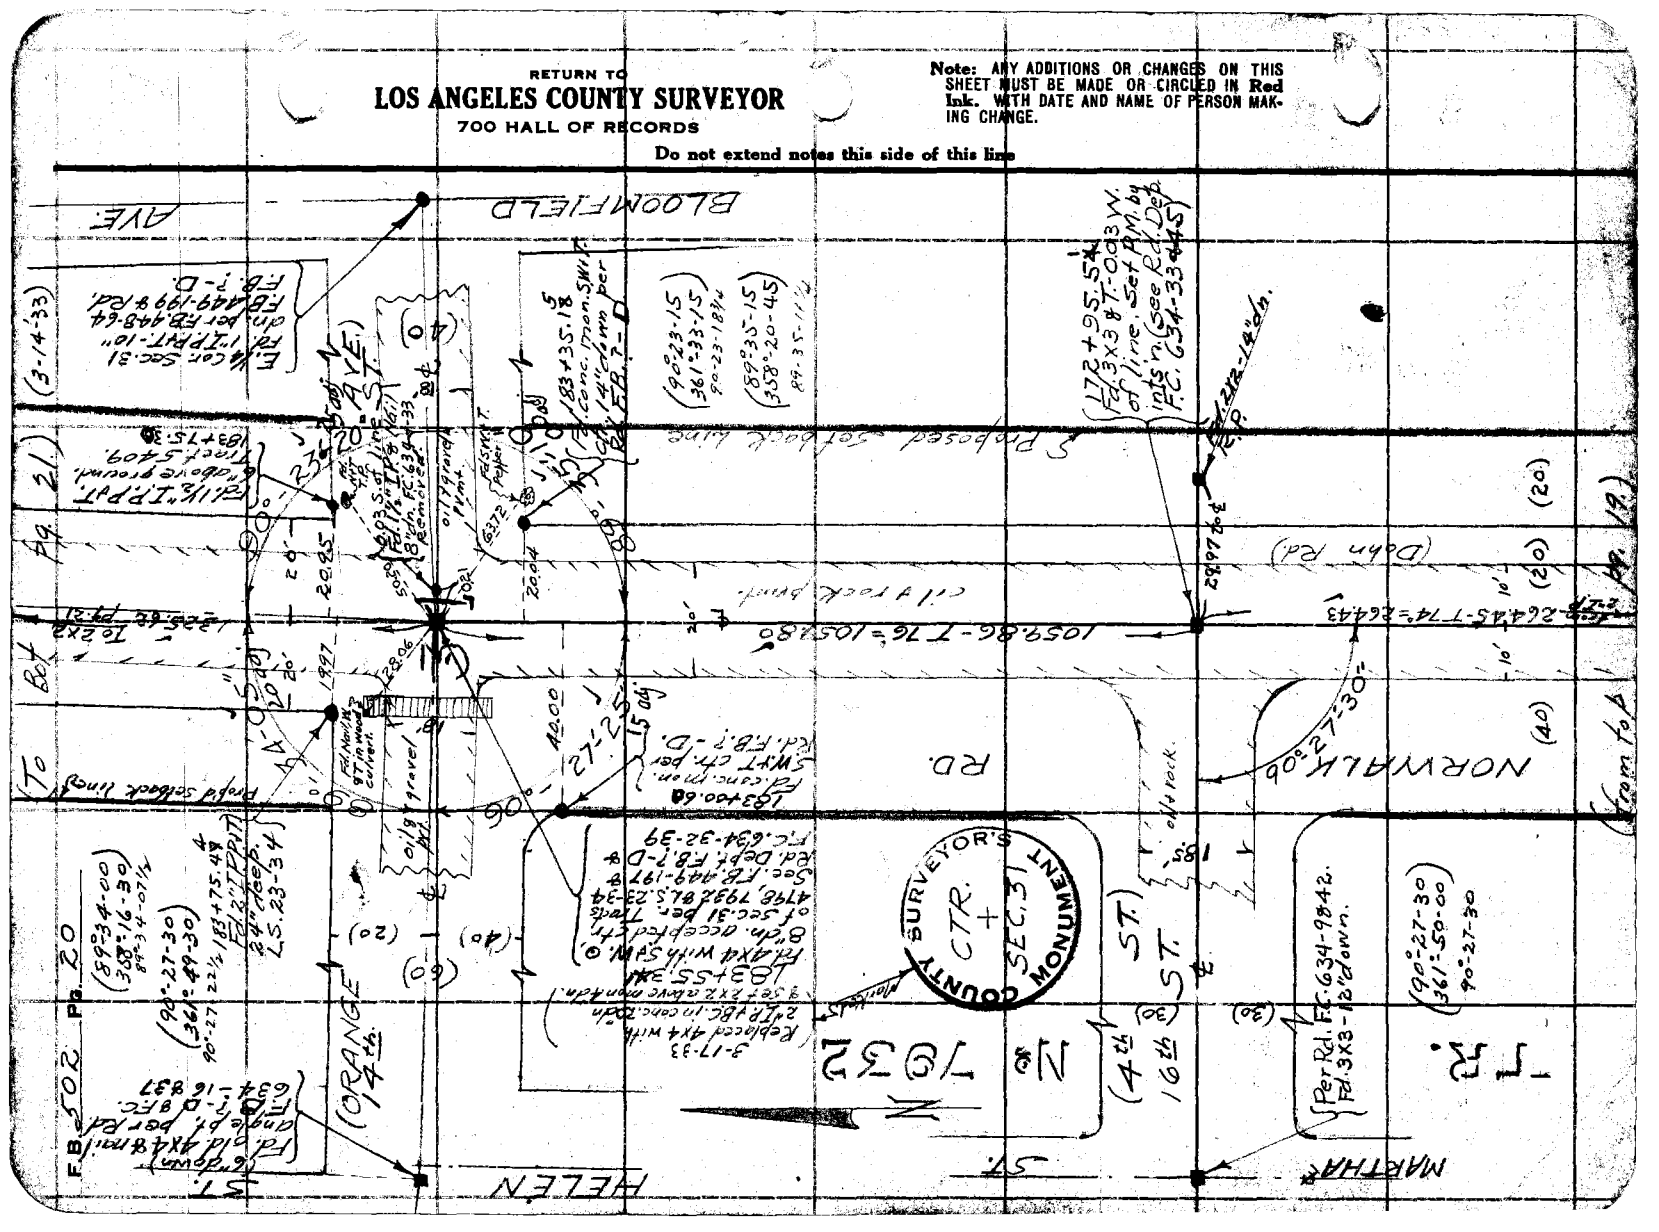
BLOOMFIELD AVE.
Proposed Setback Line
City Rock Bund.
Dahn Rd.
NORWALK RD.
SURVEYOR'S CTR. + COUNTY MONUMENT
SEC. 31
T 3 S
R 11 W
4th ST.
16th ST.
MARTHA ST.
HELEN ST.
ORANGE (4th)
Prop'd Setback line
Old gravel
Old rock
Per Rd. F.C. 634-9842.
Rd. 3X3-12"down.
Rd. 3X3 & T-093 W. of line, Set P.M. by ints'n. (see Rd. Dep. F.C. 634-33 & 45)

Notes Ck'd by Drew	Survey of Norwalk Rd.	F.B. 502 Pg. 21
Map No. B-804-2	W. O. 7089 Tape No. 251 St'd 54 oF.	
Office Work KKMORIN	Surveyed by Keese	
Checked Drew	Notes H Date 3-15-33	
Date Jan 1935	Indexed Johnson	

Note: ANY ADDITIONS OR CHANGES OF THIS SHEET MUST BE MADE OR CIRCLED IN Red Ink, WITH DATE AND NAME OF PERSON MAKING CHANGE.

Do not extend notes this side of this line

RETURN TO
LOS ANGELES COUNTY SURVEYOR
700 HALL OF RECORDS

(To Bot. 49. 22)

BLVD. (S 17° E.) ARTESIA AVE.

Fd. L+T tack in X in concrete, F.B. 231-51 See F.B. 449-194-195 for ties. Sec. Cor.

(89°-28-45) 359°-55-00 89°-28-45"

40' 40' 45° 30' 20' 18' 90°-32-15

2652.35 To Cor. Sec. 30

(90°-32-15) 362°-09-15 90°-32-18¾"

Fd. L+T. in conc. pvmt. See F.B. 449-194-195 for ties. Sec. Cor.

89°-28-45" 45°-31½" Set Nail P.P. 20' Fd. Nail T.P. 20.44 6.29

conc. Pvmt.

(30) (30) (30) 30 29 31 32

Fd. Nail P.P. 18' 89° 35.59 Fd. Nail & Tag "LS 5599" 0.07' E. of T.P.

(90°-22-45) 361°-31-15 90°-22-48¾"

O.K. 50' 18' 89° 20+10.7 Fd. L+T in pvmt. See F.B. 449-196 for ties. ¼ Sec. Cor.

(89°-36-00) 358°-24-30 89°-36-07½"

PIONEER (Main St.) Setback

T. 3 S. R. 11 W.

S 17° E. 1329.78 - T66° - 1329.92

Proposed (Dun Rd.) NORWALK RD. (Oil & Rock Pvmt.) Proposed

31.

196+80.98 Fd. 2"x2"x6" dn. no tack. Set nail on E. ¼ ¼ Cor. per L.S. 23-34 See Tr. 5409.

196+81.10 Fd. 2" I.P. P+T 18" dn. L.S. 23-34

40' 20' 20' 40'

196+80.90 Fd. 1½" I.P. P+T flush. Tr. 5409 See Rd. F.B. ?-C.

19.92 20.58

20.00 20.01

196+60.95 Fd. conc. mon. 5 N+T on Sta. 14" dn. per Rd. Dep. F.B. ?-C.

1325.78 - T66° - 1325.62

196+60.95 Fd. conc. mon. 5 N+T on 16" down per Rd. F.B. ?-C.

T. 3 S. R. 11 W. S. 23-34.

TR. 5409.

(From Top 44. 20.)

FORM 257 10M 8-31

RETURN TO
LOS ANGELES COUNTY SURVEYOR
700 HALL OF RECORDS

Note: ANY ADDITIONS OR CHANGES ON THIS SHEET MUST BE MADE OR CIRCLED IN **Red Ink**, WITH DATE AND NAME OF PERSON MAKING CHANGE.

Do not extend notes this side of this line

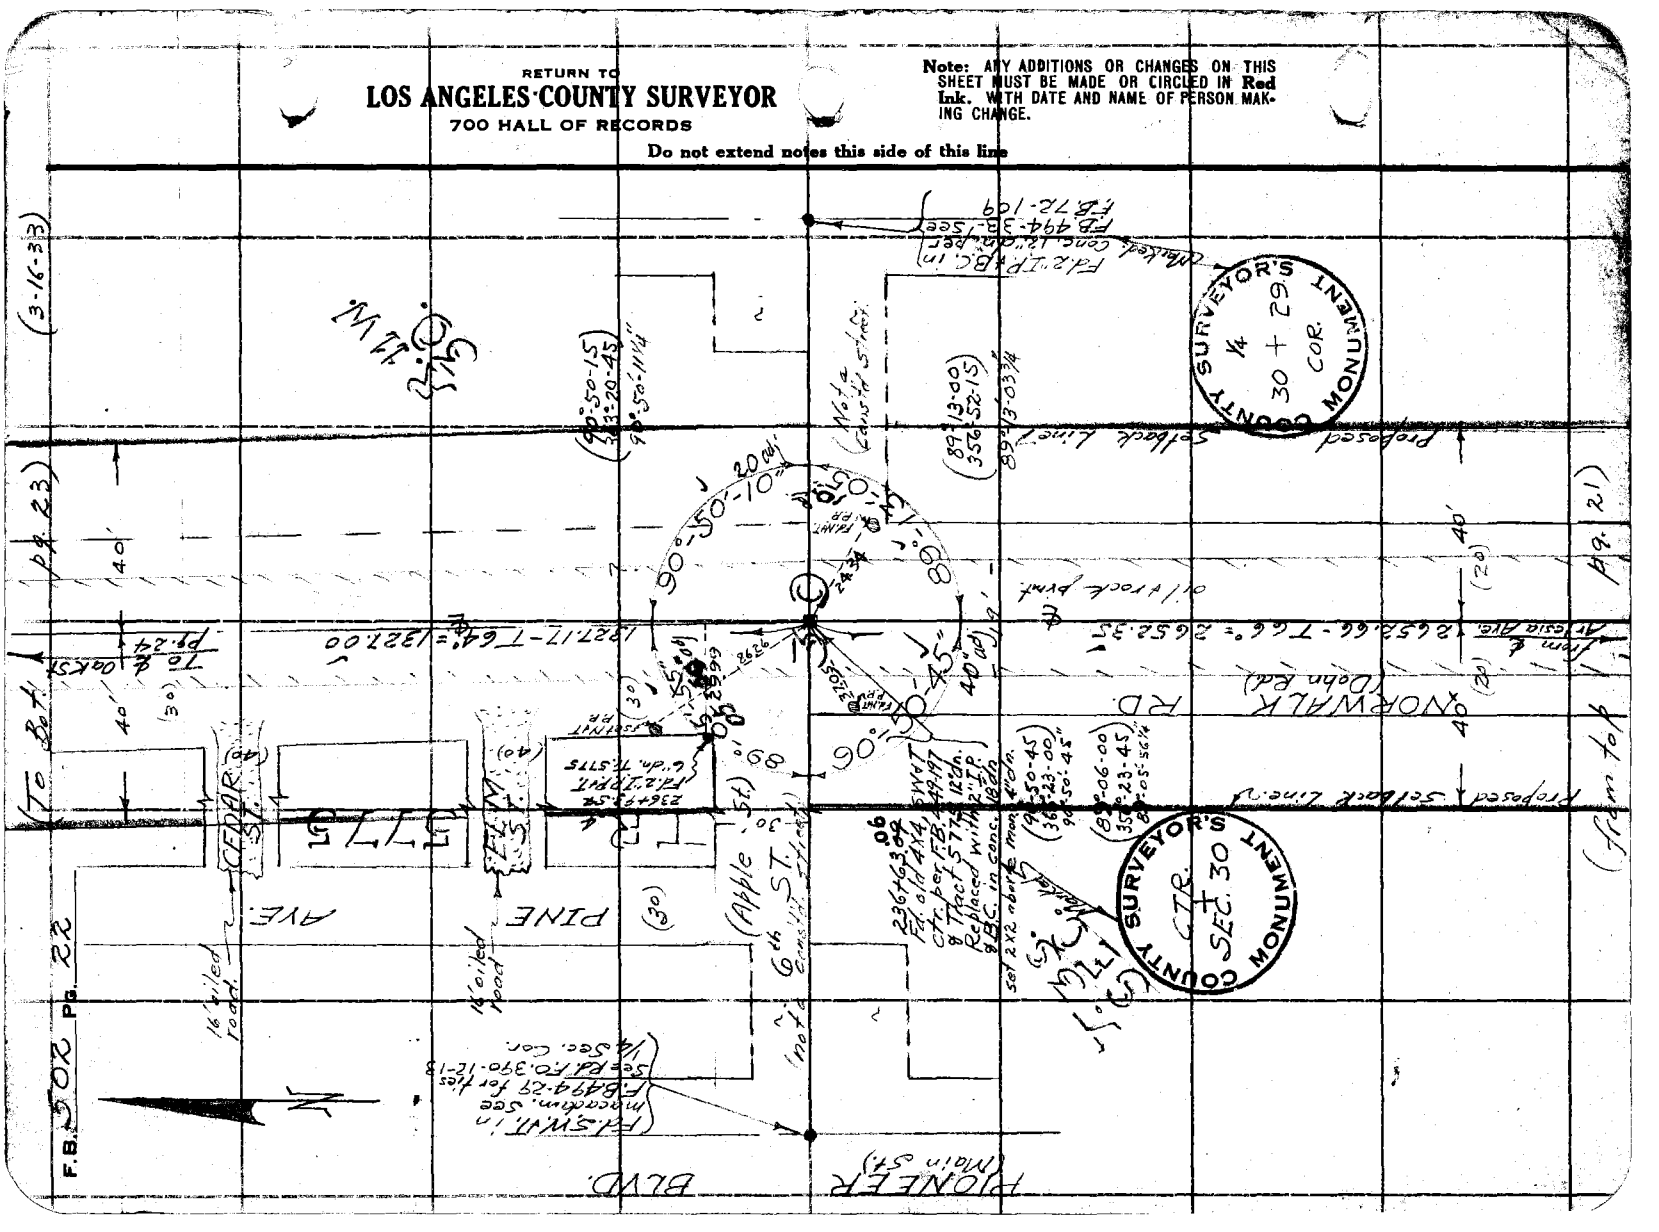
SURVEYOR'S MONUMENT
¼ 30 + 29 COR.
SURVEYOR'S MONUMENT
¼ SEC. 30 CTR.
NORWALK RD. (Dohn Rd.)
PIONEER BLVD. (Main St.)
(Apple St.)
Proposed Setback Line
Old Rock Bank

Notes Ck'd by Drew	Survey of Norwalk Rd
Map No. B-804-2	W. O. 7089 Tape No. 051 St'd 64 °F.
Office Work K.H. Morin	Surveyed by Evans
Checked Drew	Notes H2 Date 3-16-33
Date Jan 1935	Indexed A. C. Johnson

F.B. 502 Pg. 23

(To Bot. Pg. 24)

(30) (20)

To Oak St. ℄

40' 40'

20'

SEC.

5775.

(30) (40)

RD.

oil rock Prnt.

(Not a const'd st.)

MAPLE ST.

(40)

AVE. NO. AVE.

132700

CHESTNUT ST.

(Not a const'd st.) (40)

PINE

T.R.

MAGNOLIA

NORWALK (Dohn Rd.) ℄

SPRUCE ST.

16' oiled Rd.

(40)

40' 40'

(30) (40)

(90)

(From top Pg. 22)

Form C.G. Sec. 30

.6G.

RETURN TO
LOS ANGELES COUNTY SURVEYOR
700 HALL OF RECORDS

Do not extend notes this side of this line

Note: ANY ADDITIONS OR CHANGES ON THIS SHEET MUST BE MADE OR CIRCLED IN Red Ink, WITH DATE AND NAME OF PERSON MAKING CHANGE.

FORM 247 10M 8-31

RETURN TO
LOS ANGELES COUNTY SURVEYOR
700 HALL OF RECORDS

Note: ANY ADDITIONS OR CHANGES ON THIS SHEET MUST BE MADE OR CIRCLED IN **Red Ink.** WITH DATE AND NAME OF PERSON MAKING CHANGE.

Do not extend notes this side of this line

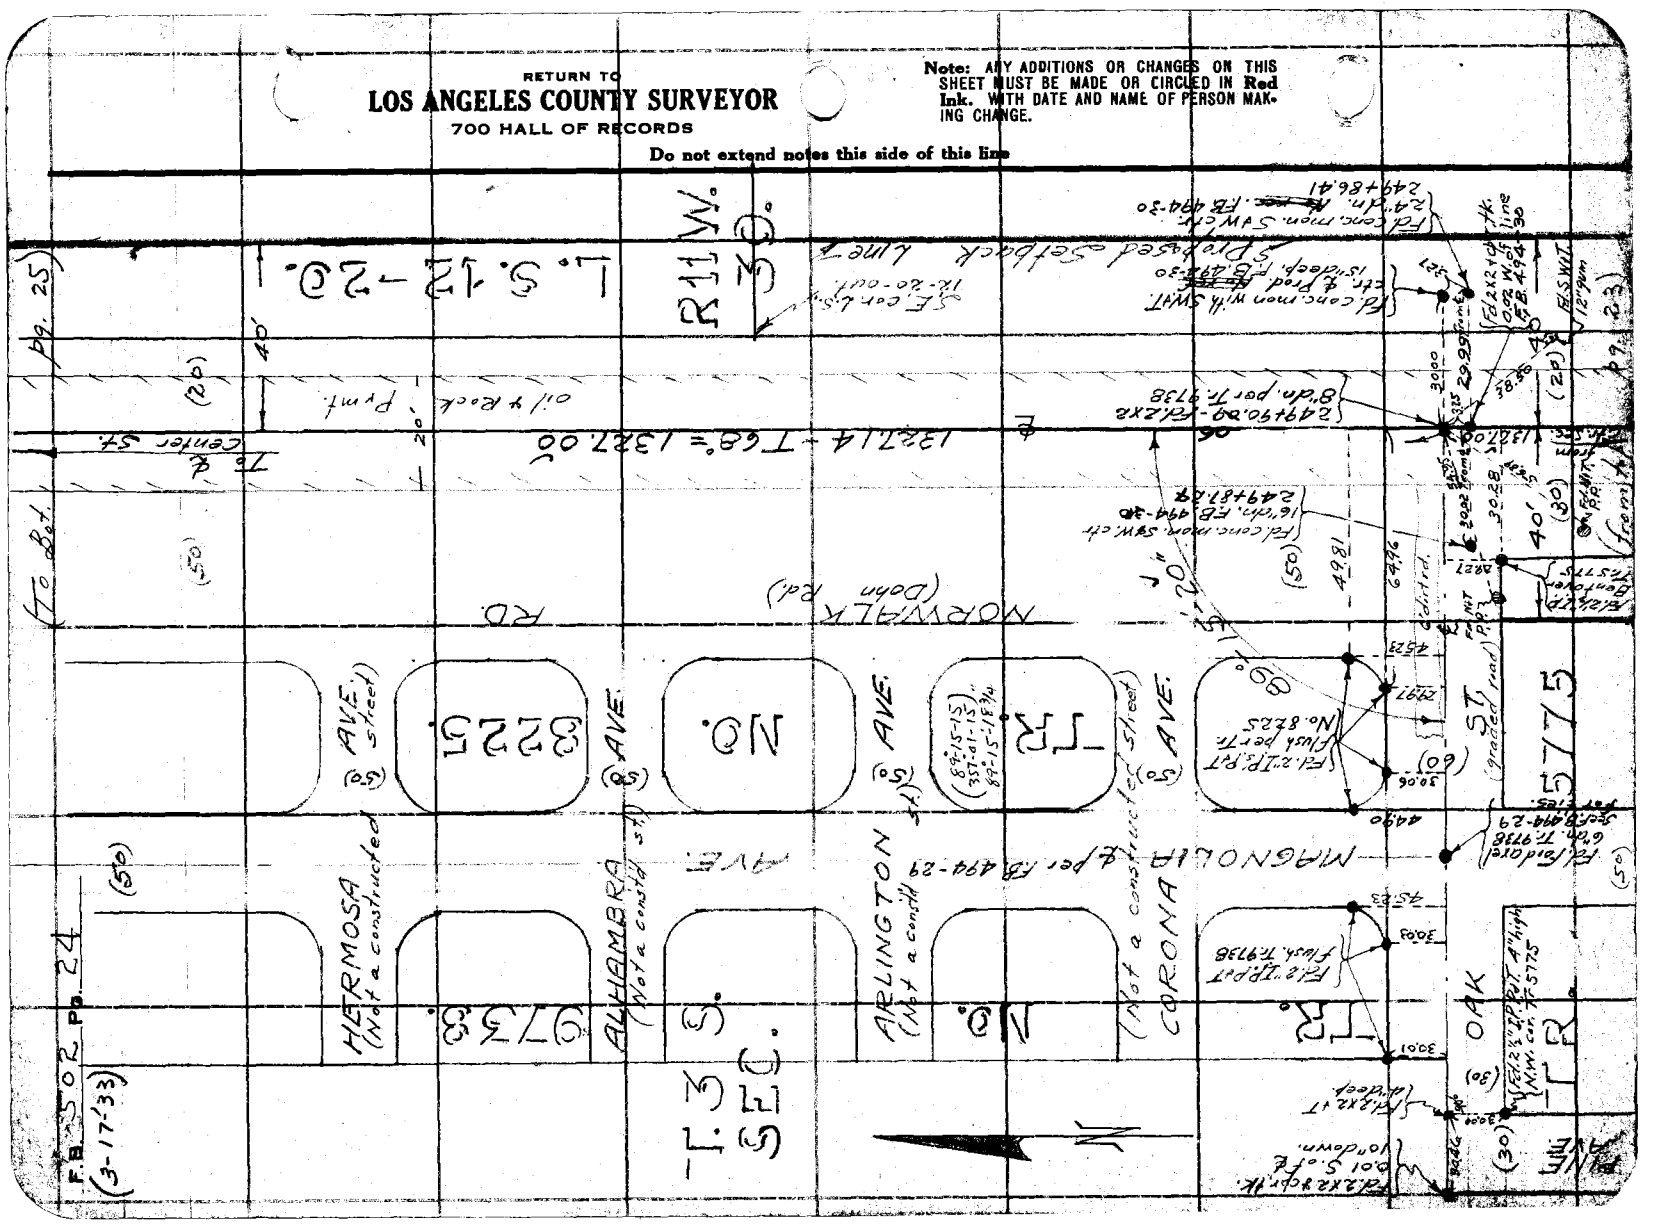
L. S. 12-20.
R11 W.
T1 S.
R12 W.
MAGNOLIA Ave.
NORWALK RD.
(Dohn Rd)
Center St.
To Bat.
Pg. 25
Pg. 24
F.B. 502
(3-17-33)
HERMOSA
(Not a constructed st)
ALHAMBRA
(Not a constructed st)
ARLINGTON
(Not a constructed st)
CORONA
(Not a constructed st)
OAK
PINE

Notes Ck'd by Draw | Survey of Norwalk Rd.
Map No. B-804-2 | W. O. 7089 Tape No. 051 St'd 84 °F.
Checked Drew | Notes HE
Date Jan 1935 | Date 3-17-33
Indexed A. C. Johnson

F.B. 502 Pg. 25

(To Bk A pg. 26)

(84°54-15 / 359°36-30 / 89°54-07½)

SEC. 10 T. 1 S. R. 13 W. S.B.M.

HARVARD ST.

BLVD.

(Not a const'd street.)

(Not a const'd street.)

Nevada St.

8' traversed rd.

(Easement per F.R. 301-117)

Fd. 3X3-8'dn Rd. F.R. 301-13884 265+75.48 See F.D. 21-174 set 3/4" I.P. cem. & pr. nail ⊙ 18" down on ℄ prod.

40.00

(90°06-15 / 360°-25-15 / 90°-06-15¼)

COUNTY SURVEYOR MONUMENT T. 3 S. R. 11 W. SEC. 19 + R. 11 W. SEC. 30 S. HWY. 1/4 Cor.

263+17.08 1/4 Sec. Cor. Fd. 2X2, 6"d/n by ties per F.B. 494-30. Fd a 2" I.P.P.T. 24" dn, under 2X2. See Rd. F.R. 153-5 F.R. 301-83. Replaced I.P. with 2" I.P.B.C. in Conc. 20" dn, & set 2X2 over mon. 4' down.

Fd. 2X2-6"d/n-F.B. 494-33 See E.B. 172-106-E.R. 103-96

Fd. 5" H.O.T. per F.B. 494-27 See E.B. 334-250, F.B. 345-6, Fd. F.B. 390-11, F.R. 304-3 & F.D. 393-17 (Ties F.B. 494-27)

(89°54-15 / 359°36-30 / 89°54-07½)

10' RD.

Fd. 2" I.P.P.T. Conc. 97. ⊙ F.B. 494-30

263+41.18 ± 5 Dubbed

258.43 - 77.8° = 258.02

263+47.08 Fd. 1" Conc. mon. ± 5 pk. 18"dn F.B. 494-30

24.65

263+47.08

25.00

25.00

CENTER ST.

Macadam pvmt.

PIONEER (Main St.)

(90°39-45 / 362°39-30 / 90°-39-52½)

262+37.88 262+37.98 49.80

Fd. 2" I.P.P.T. Flush. Tie 8225

79.43

1327.00'

NORWALK (Dohn Rd.) from Oak St.

oil & rock pvmt.

89°-19-40"

(89°-19-45 / 359°-18-30 / 89°-19-37½)

BLOOMFIELD AVE.

T. 3 S. R. 11 W. S.B.M.

SEC. (from top pg. 24)

30.

RETURN TO
LOS ANGELES COUNTY SURVEYOR
700 HALL OF RECORDS

Note: ANY ADDITIONS OR CHANGES OF THIS SHEET MUST BE MADE OR CIRCLED IN Red Ink, WITH DATE AND NAME OF PERSON MAKING CHANGE.

Do not extend notes this side of this line

FORM 247 10M 8-31

RETURN TO
LOS ANGELES COUNTY SURVEYOR
700 HALL OF RECORDS

Note: ANY ADDITIONS OR CHANGES ON THIS SHEET MUST BE MADE OR CIRCLED IN **Red Ink.** WITH DATE AND NAME OF PERSON MAKING CHANGE.

Do not extend notes this side of this line

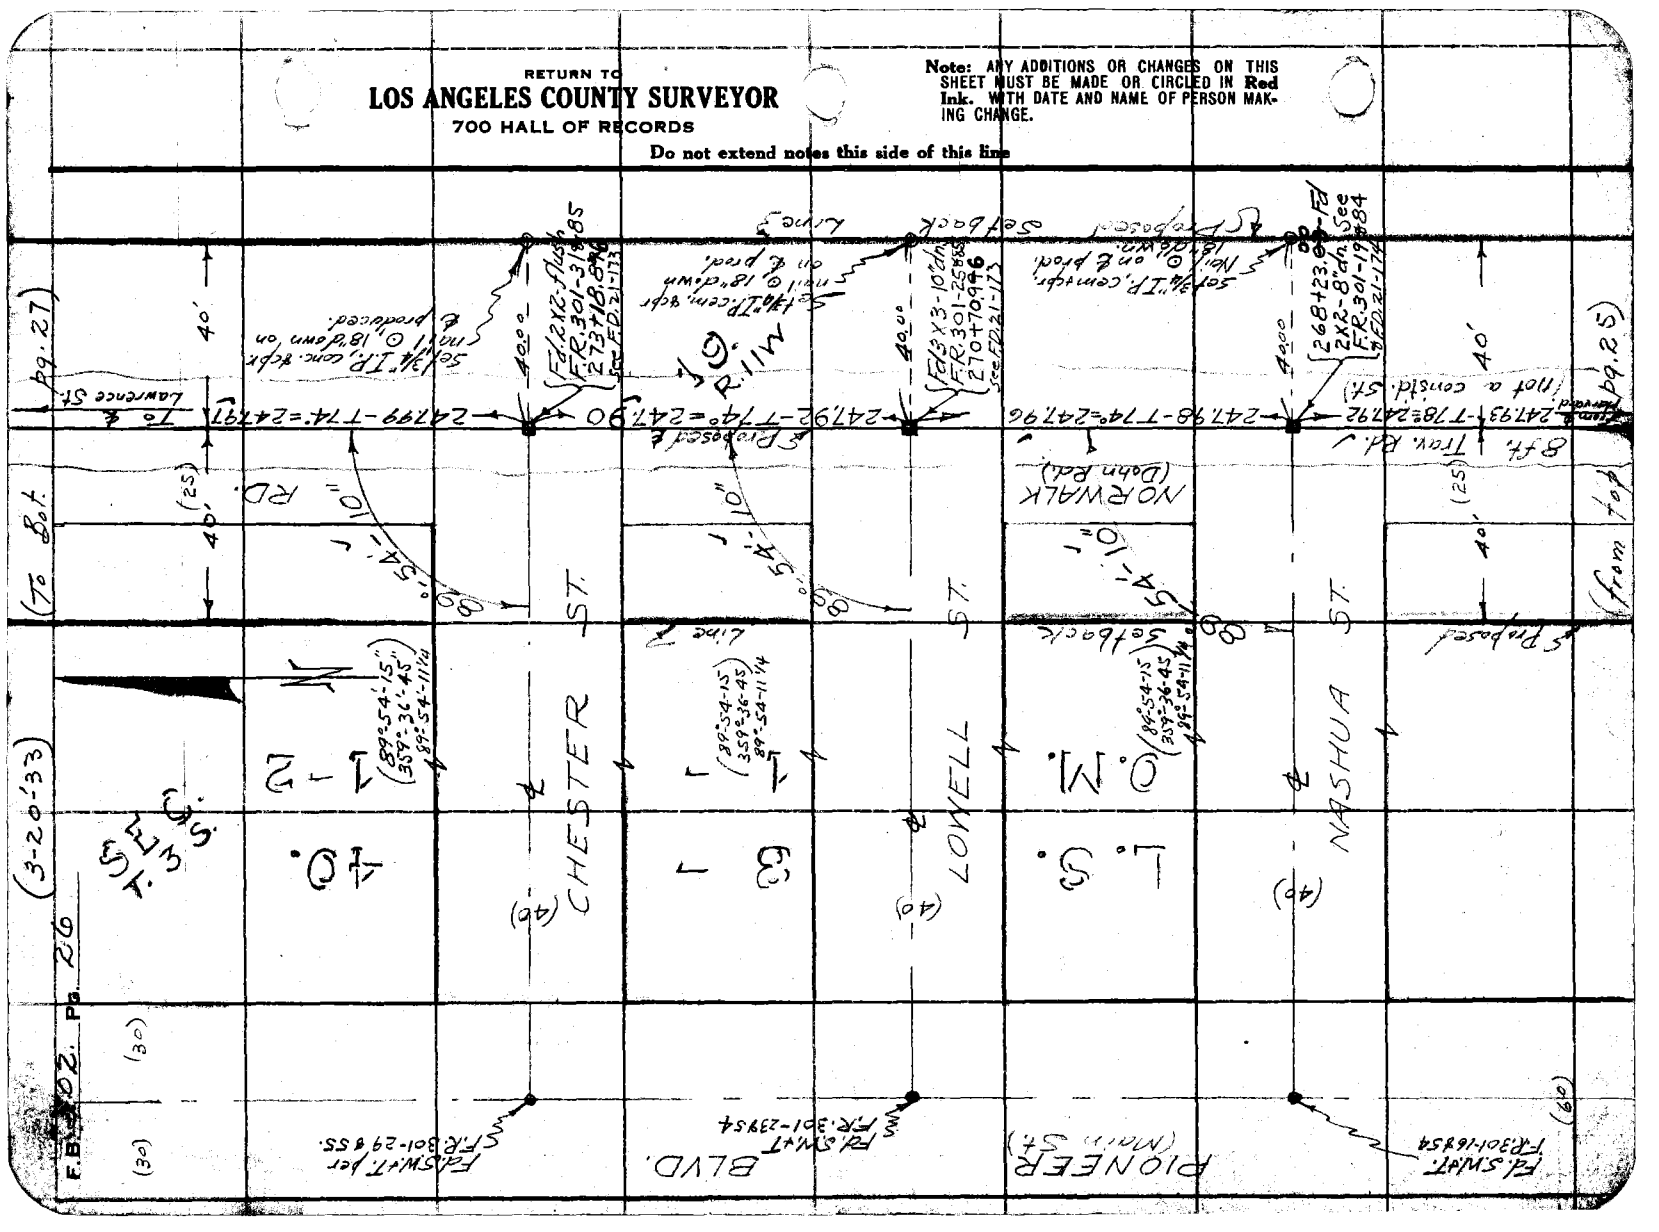

Notes Ck'd by Drew		Survey of Norwalk Rd	F.B. 502 Pg. 27
Map No. B-804-2		W. O. 7067 Tape No. 51 St'd 6' OF.	
Office Work K.K. 1-08-35		Surveyed by A.E. Hall	
Checked Drew		Notes H Date 3-21-35	
Date Jan 1935		Indexed A. C. Johnson	

RETURN TO
LOS ANGELES COUNTY SURVEYOR
700 HALL OF RECORDS
Do not extend notes this side of this line

Note: ANY ADDITIONS OR CHANGES ON THIS SHEET MUST BE MADE OR CIRCLED IN Red Ink, WITH DATE AND NAME OF PERSON MAKING CHANGE.

FORM 247 10M 8-31

(To Bk. pg. & 8)

(60) Fd. 12" T.P.P.T. 18" min. East F.R. 301-87 280+85.55 — 40.00 (30) — 40.00 — To center of Sec. 19 — Line

Fd. SMT per F.R. 301-47856

(39.60) HOPE ST. (41.137)

Fd. 4" I.P.P.T. Chain F.R. 301-47856

0.05 — 21.38 — 925.40

280+42.89 Fd. 3X3 - 6'dn F.R. 301 - 49-87 Tack 0.02 W. of line moved on line. See F.D. 21-171

Set 1¾" I.P. cem. & pk. nail @ 24" dn.

40.00 — Setback — 60.06 — 160.06 — (25) — 41 RD. — 6" — Setback

Fd. SMT per F.R. 301-41856

Set ¾" I.P. cem. & pk. nail @, 18" down

(40) MILDRED ST. — 40.00 — 228.03 — T 74° — 228.02 — Irregular — 6" Trav. Rd. — Fd. SMT Sunk Stump

(90°-05'-45") (360°-23'-00") 90°-05'-45"

278+14.87 Fd. 2X2 - flush See F.R. 301-43886 & F.D. 21-172

Fd. SMT per F.R. 301-41856

PIONEER (Main St.)

Set ¾" I.P. cem. & pk. nail @, 18" down

31.78 — 90.00 — 54'-10" — NORWALK (Down Rd.) — Proposed — Not a cons. Fd. street — Fd. NIT-36" Gum.

(90°-05'-45") (360°-23'-00") 90°-05'-45"

Proposed

Set ¾" I.P. cem. & chr. eng. ctr., 18" down & Prod.

Proposed — 248.03 — T 74° — 248.01 — Barnwall — 89° — 54'-10" — (40) LAWRENCE ST. — 40.00

Fd. SMT per F.R. 301-35 & 55

(89°-54'-15") (359°-36'-45") 89°-36'-11"

275+66.86 Fd. 3X3 - 10" dn. F.R. 301-37986 & F.D. 21-172

(S) L. O. M. — 247.91 — Center St. — (25) — 40'

(30) (30) (from top pg. 26)

RETURN TO
LOS ANGELES COUNTY SURVEYOR
700 HALL OF RECORDS

Note: ANY ADDITIONS OR CHANGES ON THIS SHEET MUST BE MADE OR CIRCLED IN **Red Ink.** WITH DATE AND NAME OF PERSON MAKING CHANGE.

Do not extend notes this side of this line

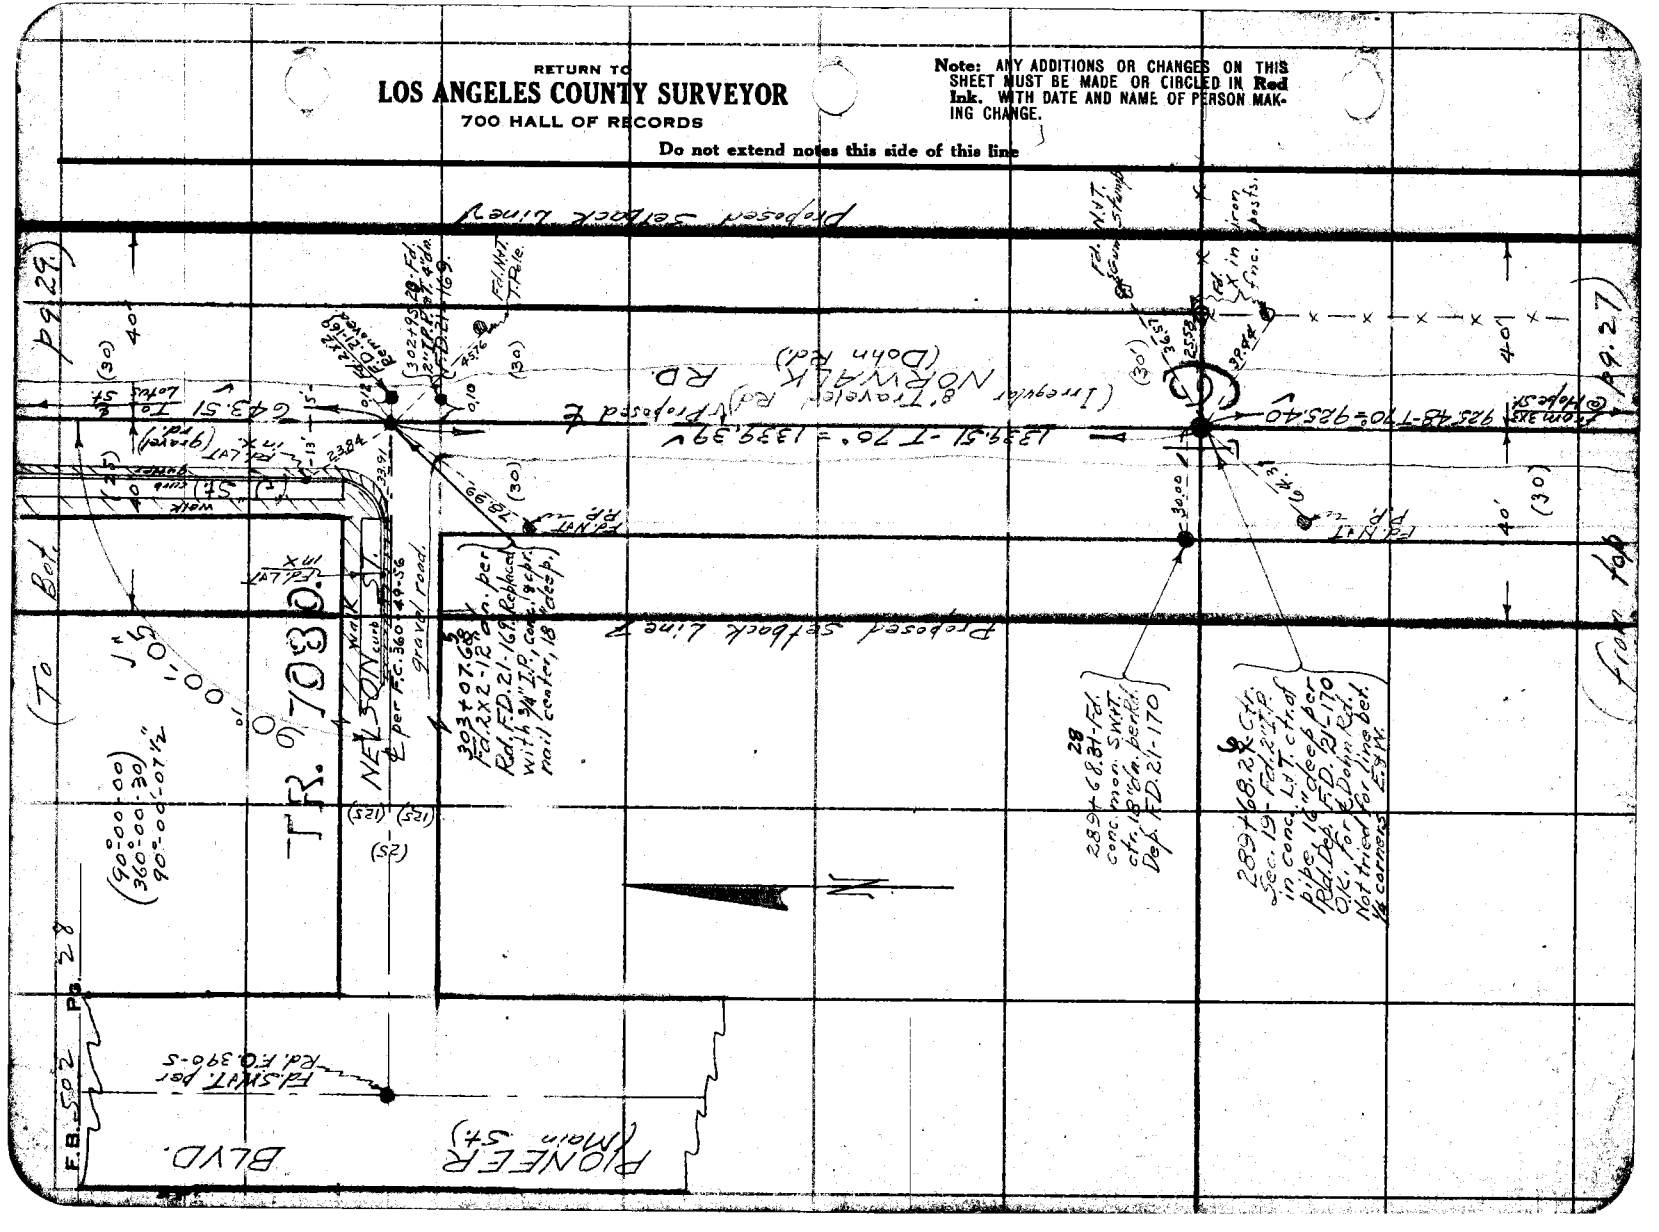
Proposed Setback Line
Proposed Setback Line
(Irregular R/W Varies)
Proposed ℄ RD.
NORWALK
(Dohn Rd.)
TR. 07030.
NELSON
Mark St.
Gravel road.
Fd. 2x2-12 Ld. per Rd. F.D. 21-169 Replaced with 3/4" I.P. cond. & ps. mail creek, 18" deep

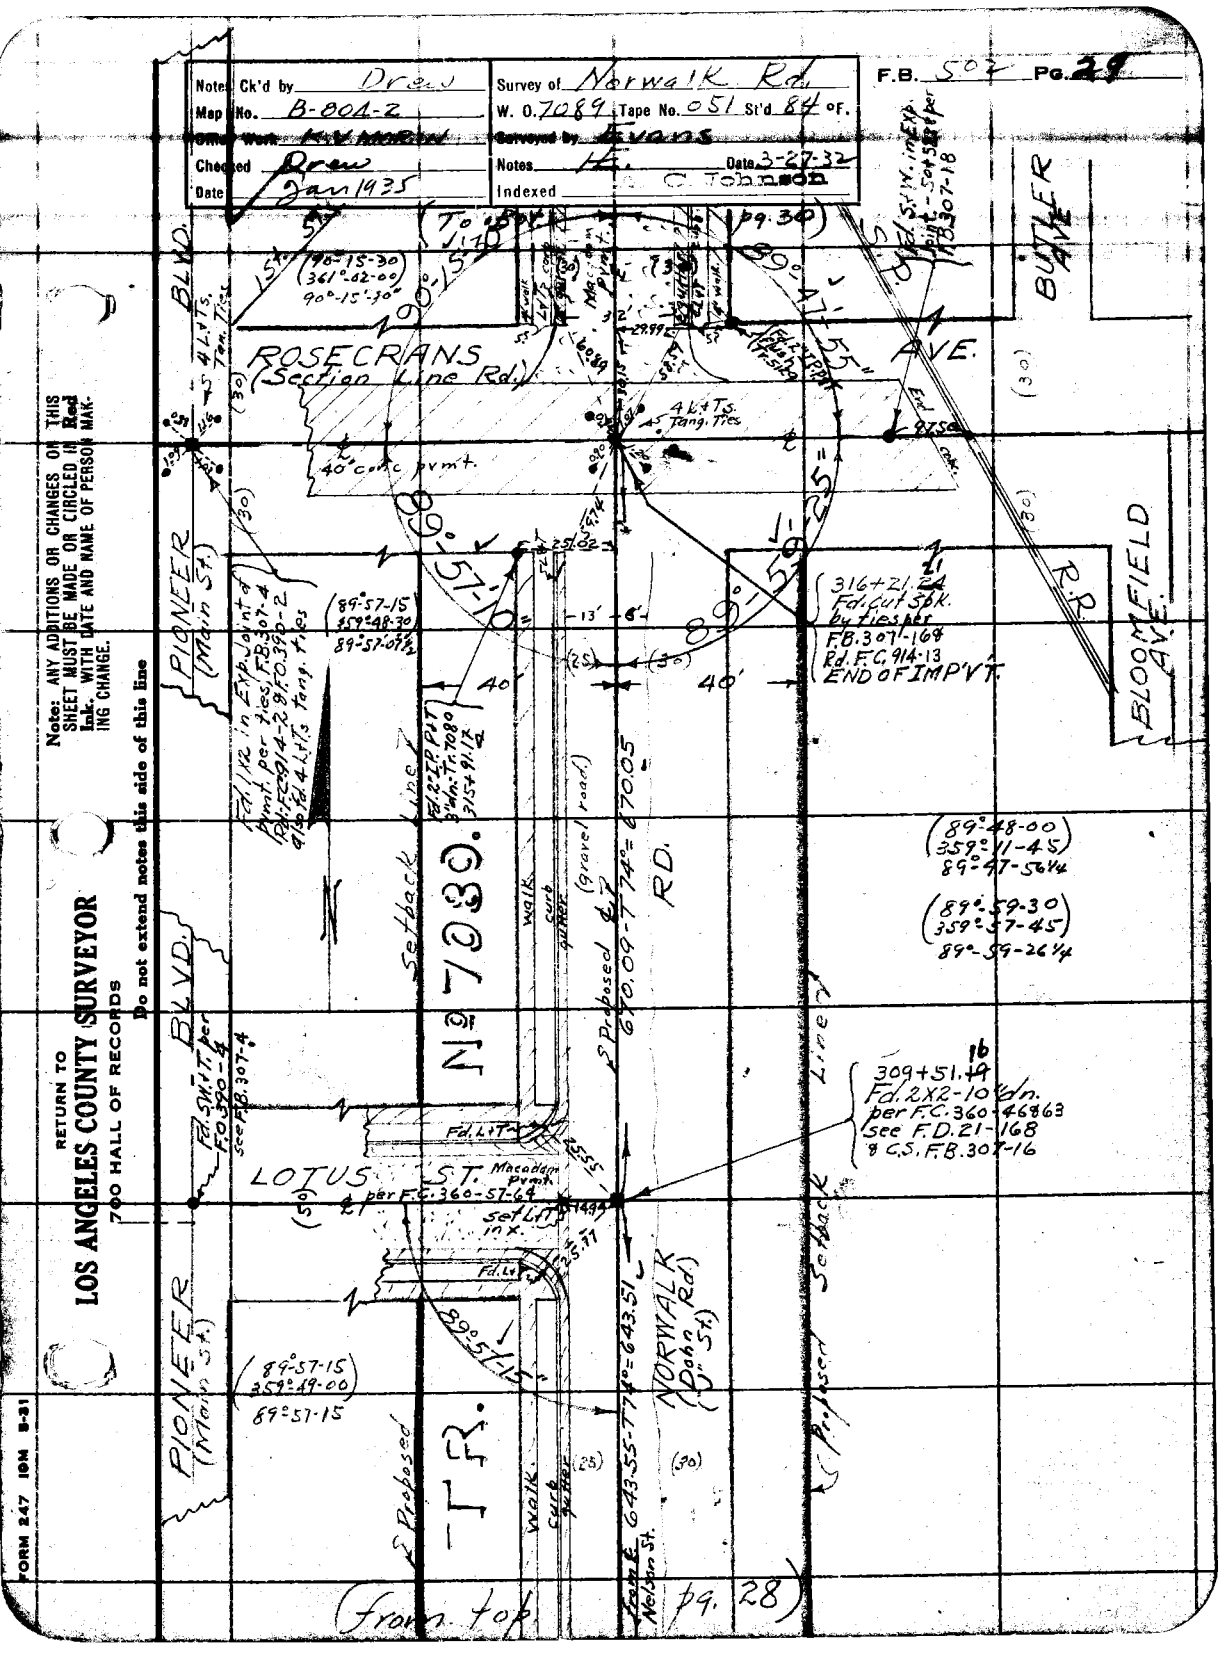
Note: Ck'd by Drew
Map No. B-804-2
Checked Drew
Date Jan 1935
Survey of Norwalk Rd
W. O. 7089 Tape No. 051 St'd 84 °F.
Surveyed by Evans
Notes H. C. Johnson
Date 3-27-32
Indexed
F.B. 507 Pg. 29
Note: ANY ADDITIONS OR CHANGES OR CHANGES ON THIS SHEET MUST BE MADE OR CIRCLED IN Red Ink, WITH DATE AND NAME OF PERSON MAKING CHANGE.
Do not extend notes this side of this line
RETURN TO
LOS ANGELES COUNTY SURVEYOR
700 HALL OF RECORDS
FORM 247 10M 8-31
ROSECRANS (Section Line Rd.)
PIONEER BLVD. (Main St.)
BUTLER AVE.
BLOOMFIELD AVE.
R.R.
LOTUS ST.
NORWALK (Dodge St.) RD.
N 7089.
Setback Line
Proposed ℄
(gravel road)
walk
curb
gutter
40' conc pvmt.
Macadam Pvmt.
Fd. 4 L.T.s. Tan. Ties
Fd. 1/2 in Exp. Joint & Pvmt. per Ties. F.B. 307-4
Fd. 2" I.P. P.U.T. Bm. in T. 7089 3.15 + 91.12
Fd. 5/8" I.R. in Exp. Joint per F.C. 360-57-69
Fd. 2 x 2 - 10" d/n. per F.C. 360-46863 see F.D. 21-168 & C.S. F.B. 307-16
316+21.24 Fd. cut 30°K. by ties per F.B. 307-168 Rd. F.C. 914-13 END OF IMP'VT.
309+51.19
(89°-57-15 359°-49-00 89°-57-15)
(89°-48-00 359°-11-45 89°-47-56¼)
(89°-59-30 359°-37-45 89°-59-26¼)
Fd. 5/8" I.R. in Exp. Joint - 5.04 S. & 5.58 E. per F.B. 307-18

RETURN TO
LOS ANGELES COUNTY SURVEYOR
700 HALL OF RECORDS

Note: ANY ADDITIONS OR CHANGES ON THIS SHEET MUST BE MADE OR CIRCLED IN **Red Ink.** WITH DATE AND NAME OF PERSON MAKING CHANGE.

Do not extend notes this side of this line

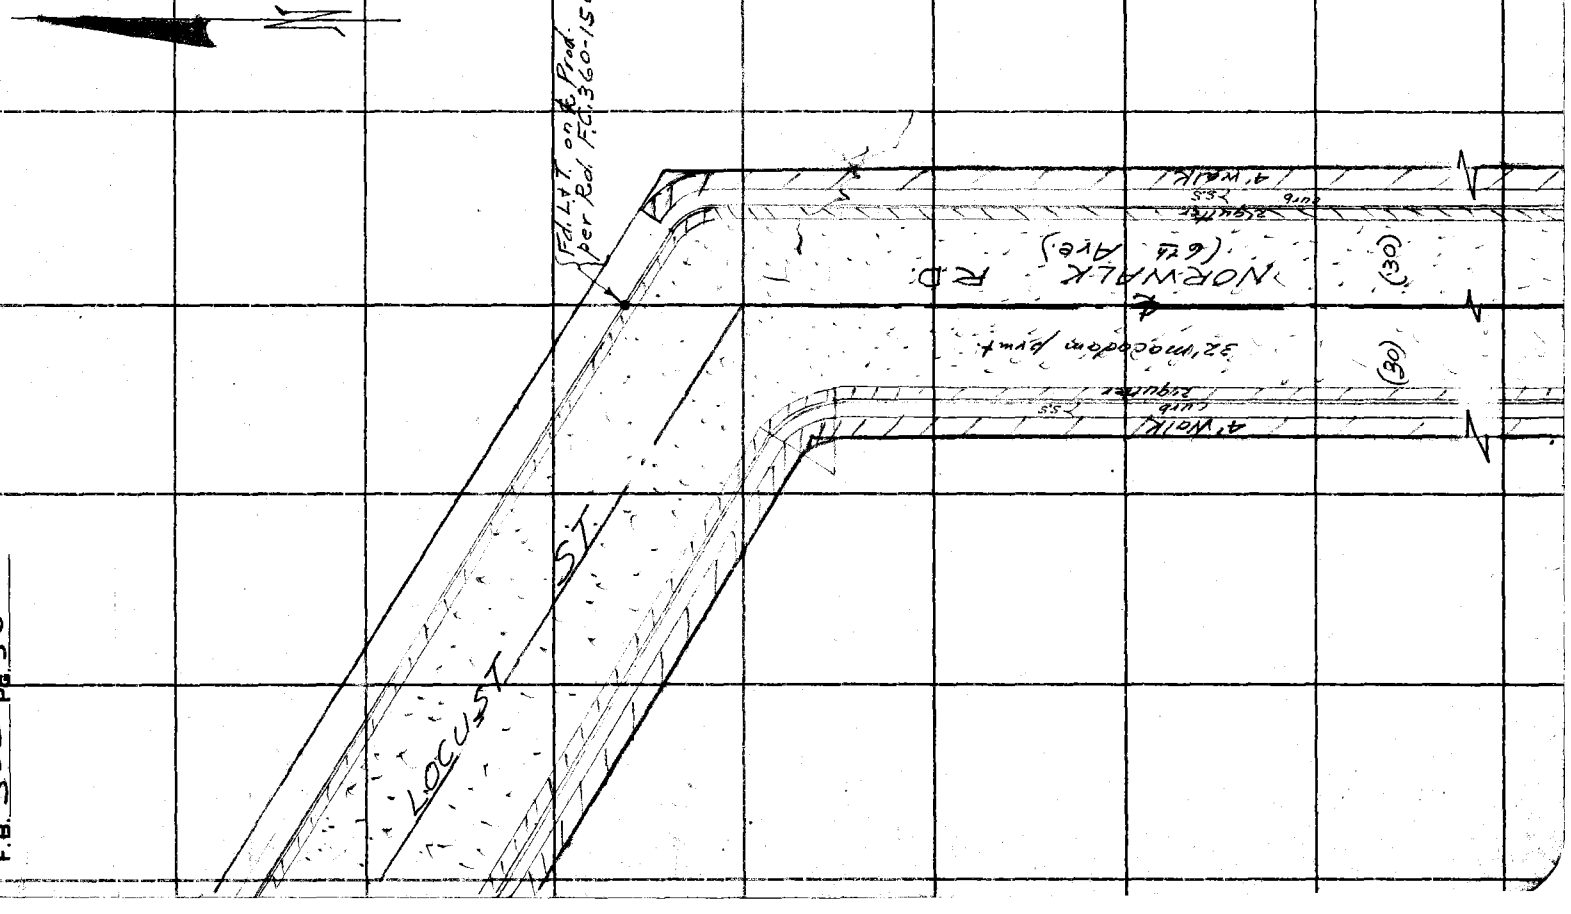

F.B. 502 Pg. 36

Notes Ck'd by Drew	Survey of Norwalk Rd.
Map No. B-804	W. O. 1682 Tape No. 051 St'd 64 °F.
Office Work K.V. Morin	Surveyed by Evans
Checked Drew	Notes LL Date 3-30-33
Date Jan. 1935	Indexed C. Johnson 4-14-33

F.B. 502 Pg. 31

(To Bot. pg. 32)

Note: ANY ADDITIONS OR CHANGES OF THIS SHEET MUST BE MADE OR CIRCLED IN Red Ink, WITH DATE AND NAME OF PERSON MAKING CHANGE.

Do not extend notes this side of this line

RETURN TO
LOS ANGELES COUNTY SURVEYOR
700 HALL OF RECORDS

FORM 247 10M 8-31

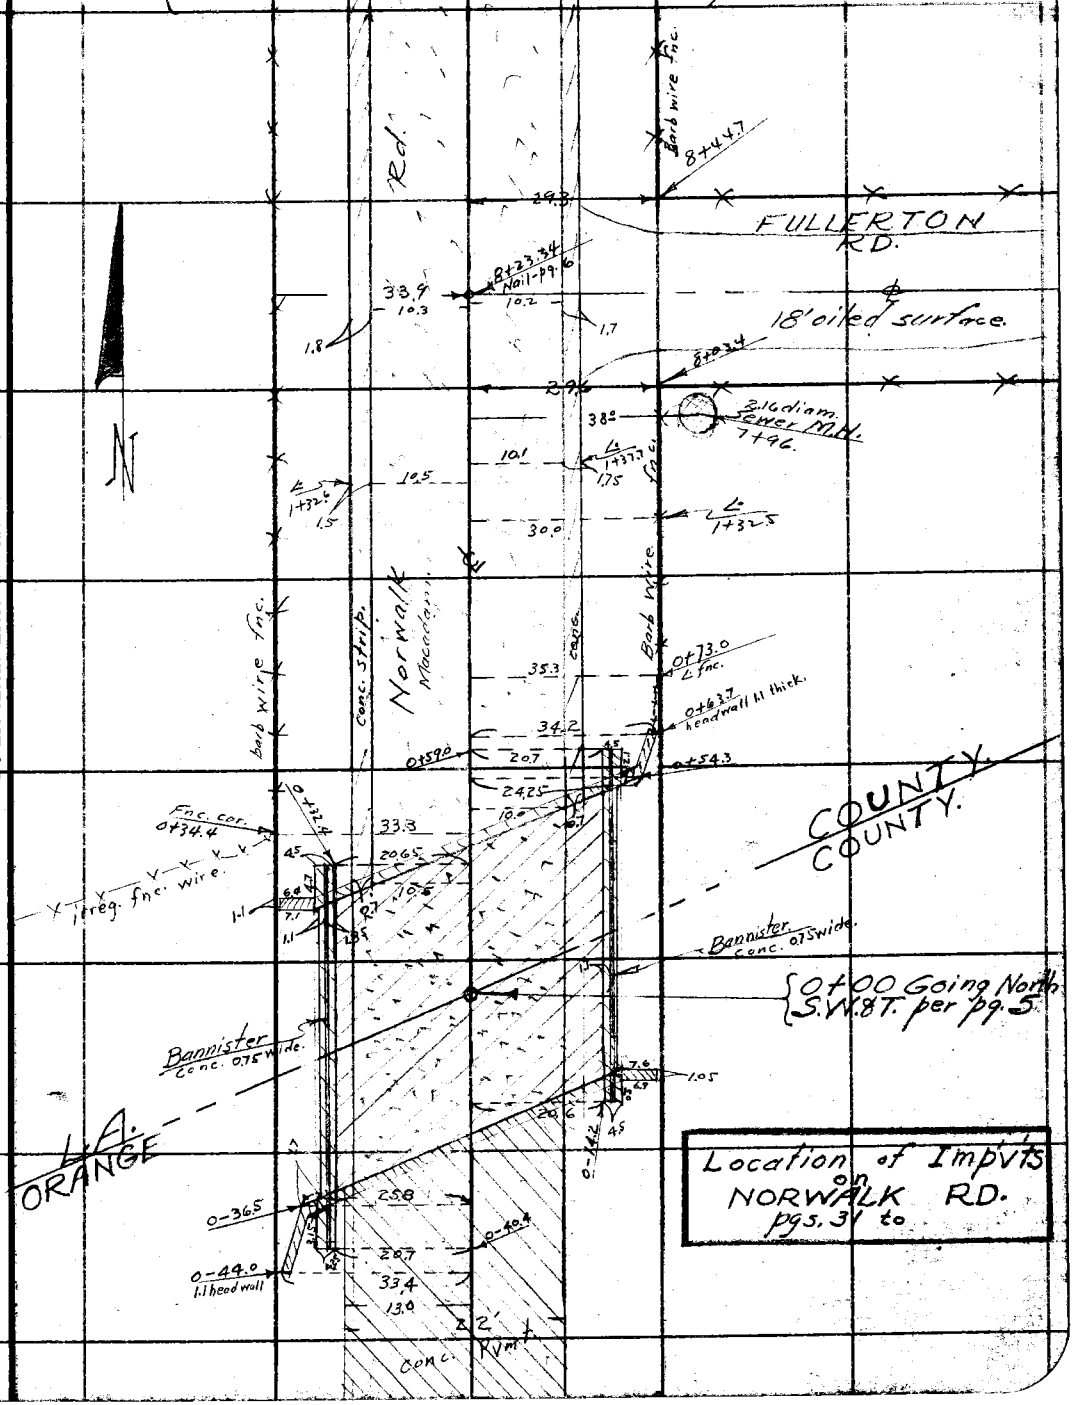

Location of Imp's on NORWALK RD. pgs. 31 to

(To Bot. pg. 33) (3-30-33)

F.B. 502 PG. 32

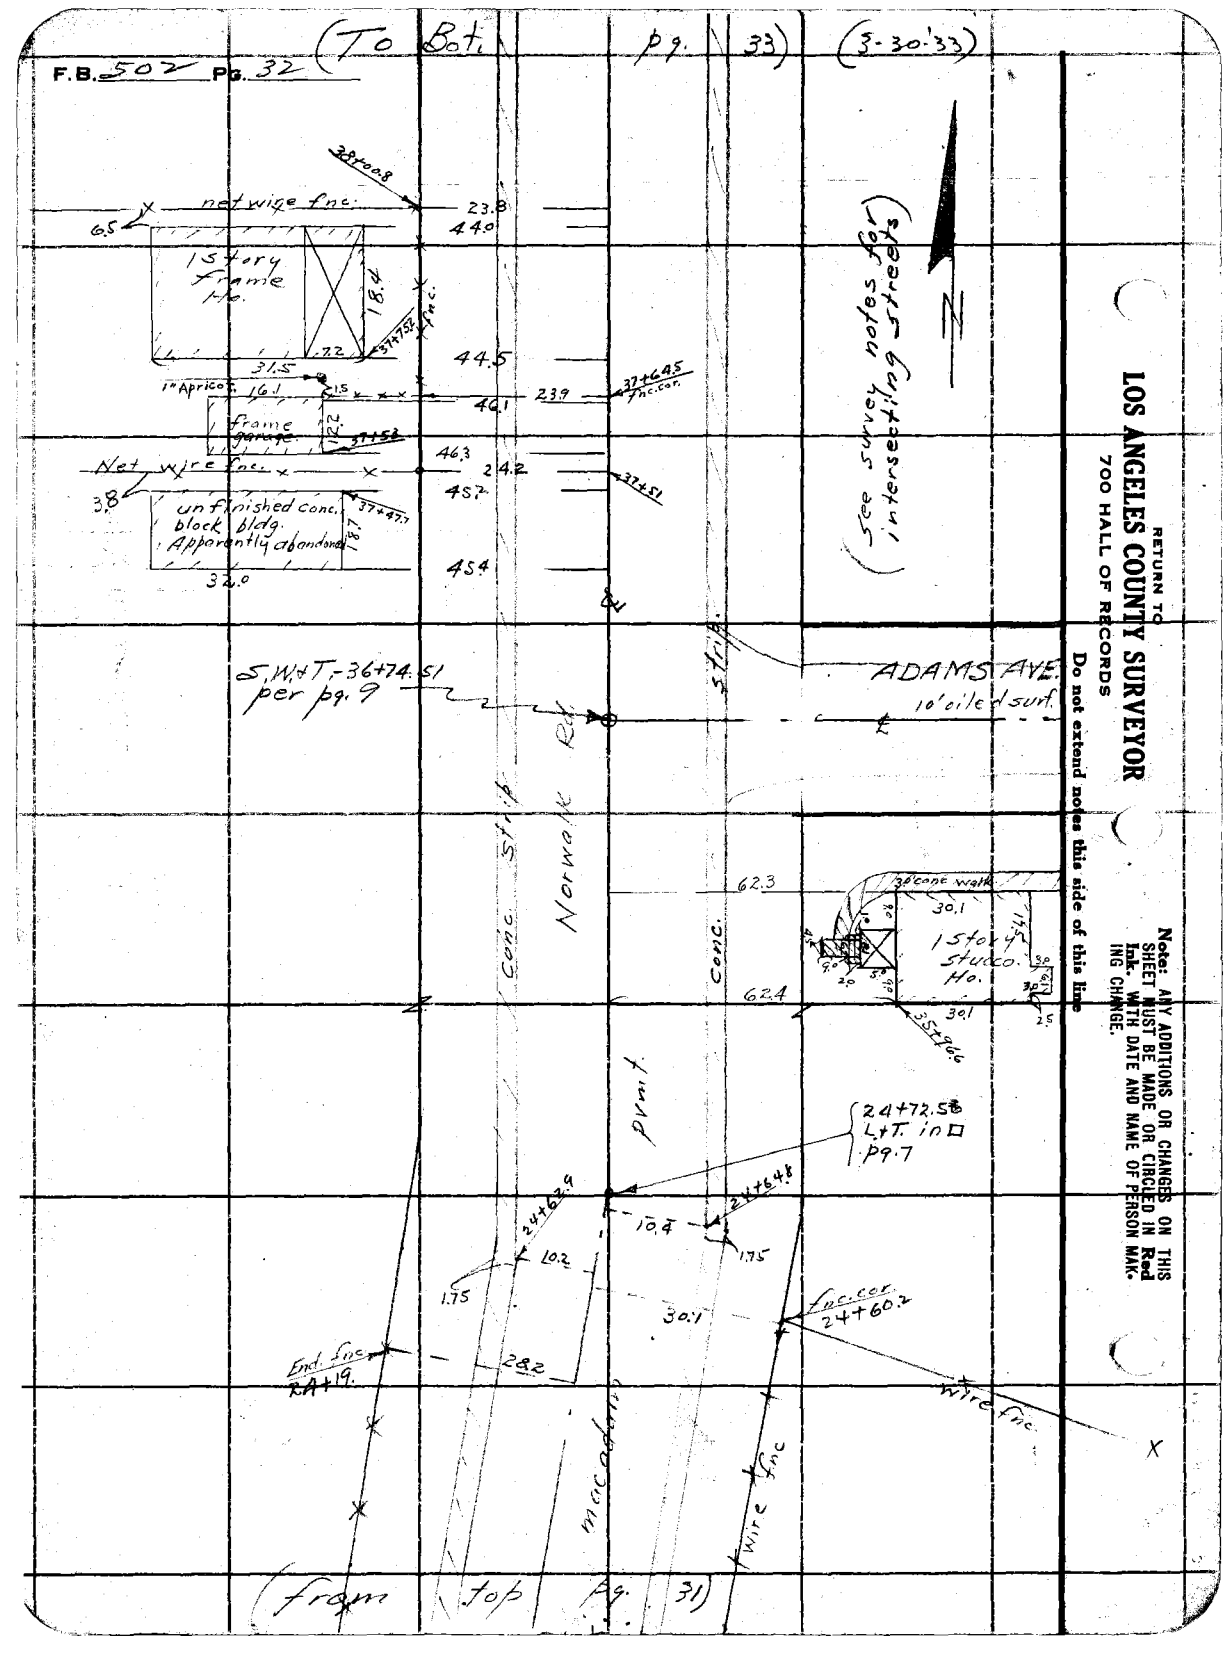

RETURN TO
LOS ANGELES COUNTY SURVEYOR
700 HALL OF RECORDS

Do not extend notes this side of this line

Note: ANY ADDITIONS OR CHANGES ON THIS SHEET MUST BE MADE OR CIRCLED IN Red Ink. WITH DATE AND NAME OF PERSON MAKING CHANGE.

Notes Ck'd by	Drew	Survey of	Norwalk Rd.
Map No.	B-804	W. O.	2089
Office Work	K. V. Morin	Tape No.	05
Checked	Drew	Surveyed by	Evans
Date	Jan 1935	Notes	Date 3-30-33
		Indexed	A. C. Johnson

F.B. 592 Pg. 33

(To 1508 pg. 14.2 | 34)

Note: ANY ADDITIONS OR CHANGES OF THIS SHEET MUST BE MADE OR CIRCLED IN Red Ink. WITH DATE AND NAME OF PERSON MAKING CHANGE.

RETURN TO
LOS ANGELES COUNTY SURVEYOR
700 HALL OF RECORDS

Do not extend notes this side of this line

4.0 Conc. culvert.

47+42.7 Hdwl.

See survey notes for description of intersecting streets

Net wire fnc.

15 story stucco

Conc. Walk

Grant Ave.

SW'ly T. - 44+36.85 per pg. 10

Rd. Strip Pkwy. ℄

SW'ly T. 39+36.55 pg. 9

Washington Ave. 15' oiled surface. ℄

Norwalk Meadam

1.75 Conc. Strip

1 Story House (Frame)

conc. wall 1.2 high.

4.6 conc. walk.

38+47

38+48.8 Gas Filler

38+42.2

38+41

1 Story Conc. block Store and Dwelling.

Conc. ribbon driveway

40.4

2.0 con. Walk.

Conc.

(from top pg. 32)

FORM 247 10M 5-31

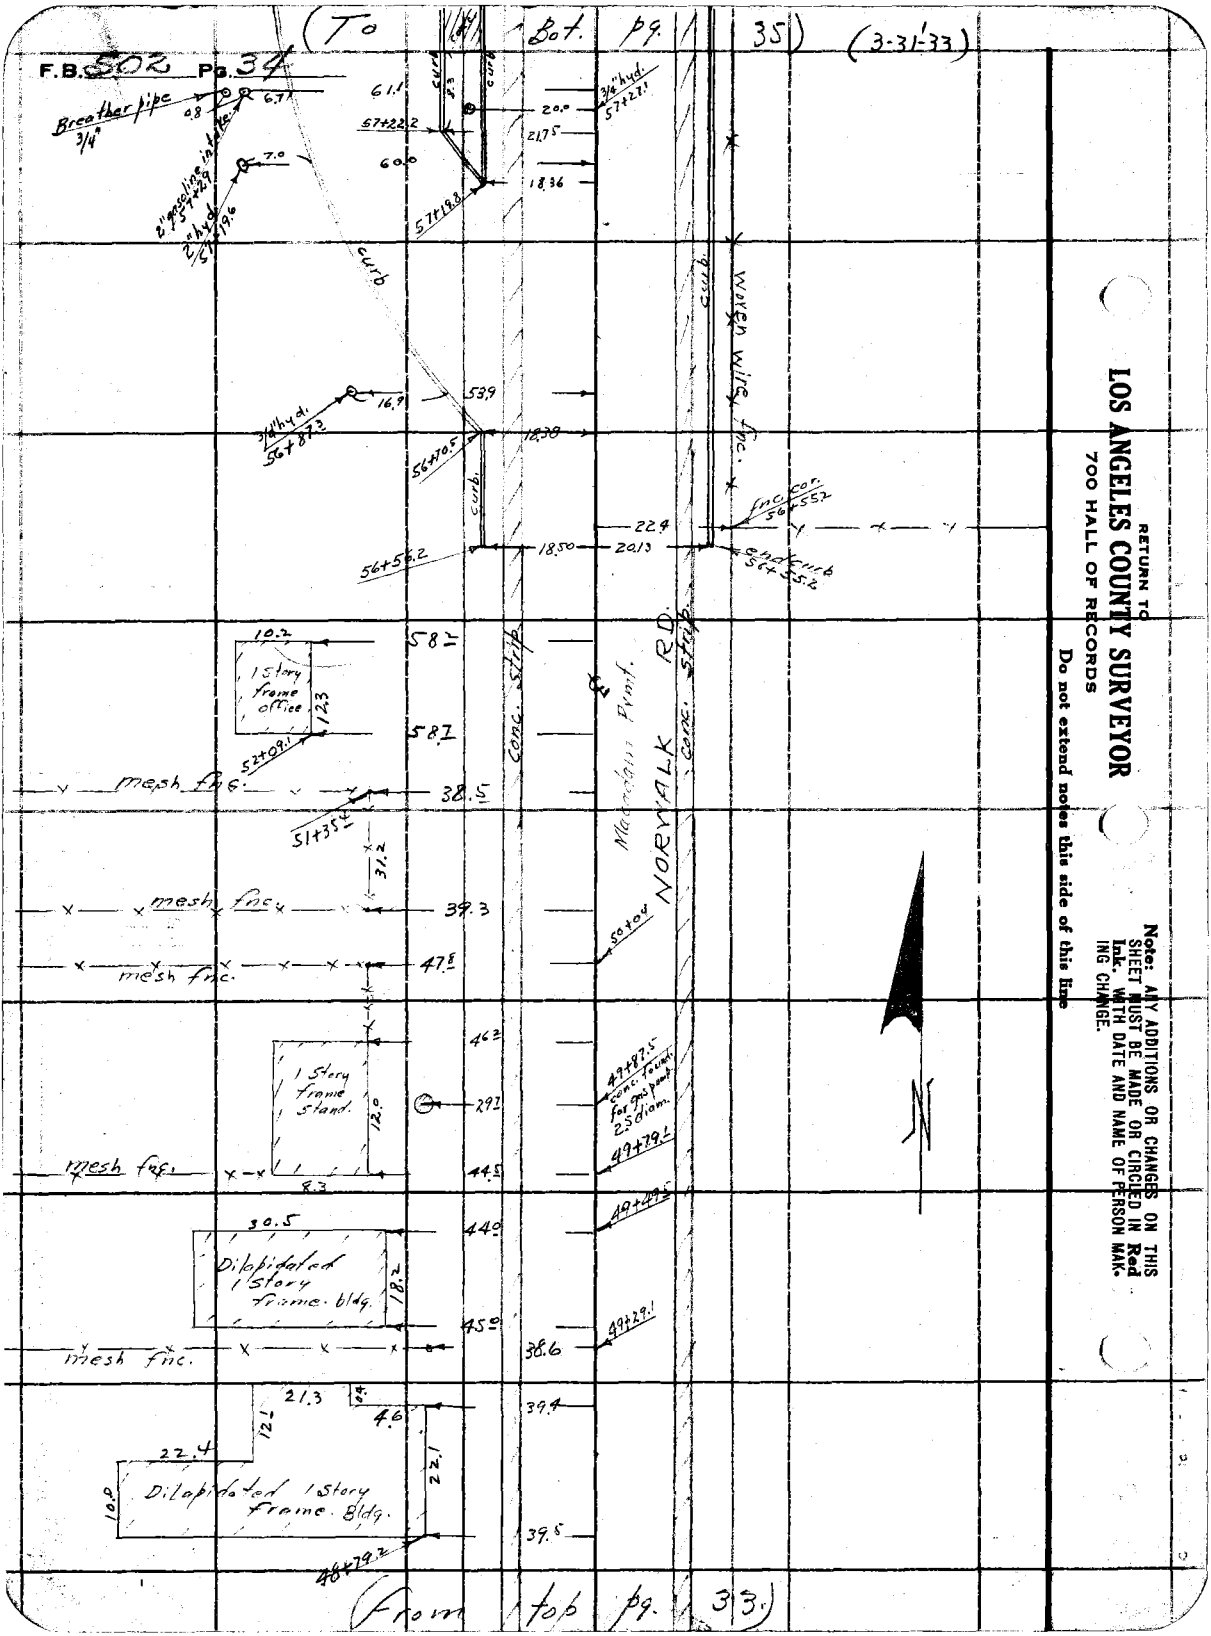

RETURN TO
LOS ANGELES COUNTY SURVEYOR
700 HALL OF RECORDS

Do not extend notes this side of this line

Note: ANY ADDITIONS OR CHANGES ON THIS SHEET MUST BE MADE OR CIRCLED IN Red Ink, WITH DATE AND NAME OF PERSON MAKING CHANGE.

Notes Ck'd by	Drew	Survey of	Norwalk Rd.
Map No.	B-804	W. O.	7089
Office Work	K. V. Morin	Surveyed by	Eng.
Checked	Drew	Notes	
Date	Jan 1935	Indexed	A. C. Johnson

Tape No. 051 St'd 8' Date 3-31-33

F.B. 502 Pg. 35

(To Bk. 36)

Note: ANY ADDITIONS OR CHANGES OF THIS SHEET MUST BE MADE OR CIRCLED IN Red Ink, WITH DATE AND NAME OF PERSON MAKING CHANGE.

Do not extend notes this side of this line

RETURN TO
LOS ANGELES COUNTY SURVEYOR
700 HALL OF RECORDS

FORM 267 10M 8-31

fnc.
34.4
19.9
35.6
35.8
40.3
40.4
Brick barbecue Pit & chimney
4.8
Frame Bldg 1 story
14.2
10.2
60+34.1
Norwalk Rd.
Macadam Pvmt.
30'
57.1
1.8.3
1 story frame Bldg.
56.7
60+34.3
gasoline intakes.
Steel Service Sta.
64.3
Pumps
134
25.3
59+36.3
75.2
3.0
197.4
CARSON
Pg. 12
S.W.T.
58+64.12
Pg. 12
ST.
Macadam Pvmt.
58+35
102
3.0
curb
58+34.9
18.0
3.5 walk
49.3
1 story frame Bldg.
45.4
conc. walk
curb
41.6
45
57+88.6
57+72.4
44.50
29.15
10.45
43.5
58+81.9
58+18.5
24.4
20.04
1.8 conc. St. & C.
curb
58+34.7
58+33.9 gasintakes
3/4" hyd.
58+24.4
64.2
11.5
Gas pumps
Service Sta.
42.5
57+81.7
27.52
E.C. 57+81.2
62.6
57+61.7
3/4" hyd.
9.5
59.1
57+53.9
18.32
57+51.5
21.78
20.06
B.C. 57+43.1
3/4" hyd.
57+50.5
curb
curb
22.1
57+35.1
Fnc. Cor.
Gas pumps
57+35.6
20.2
(From Top Pg. 34)

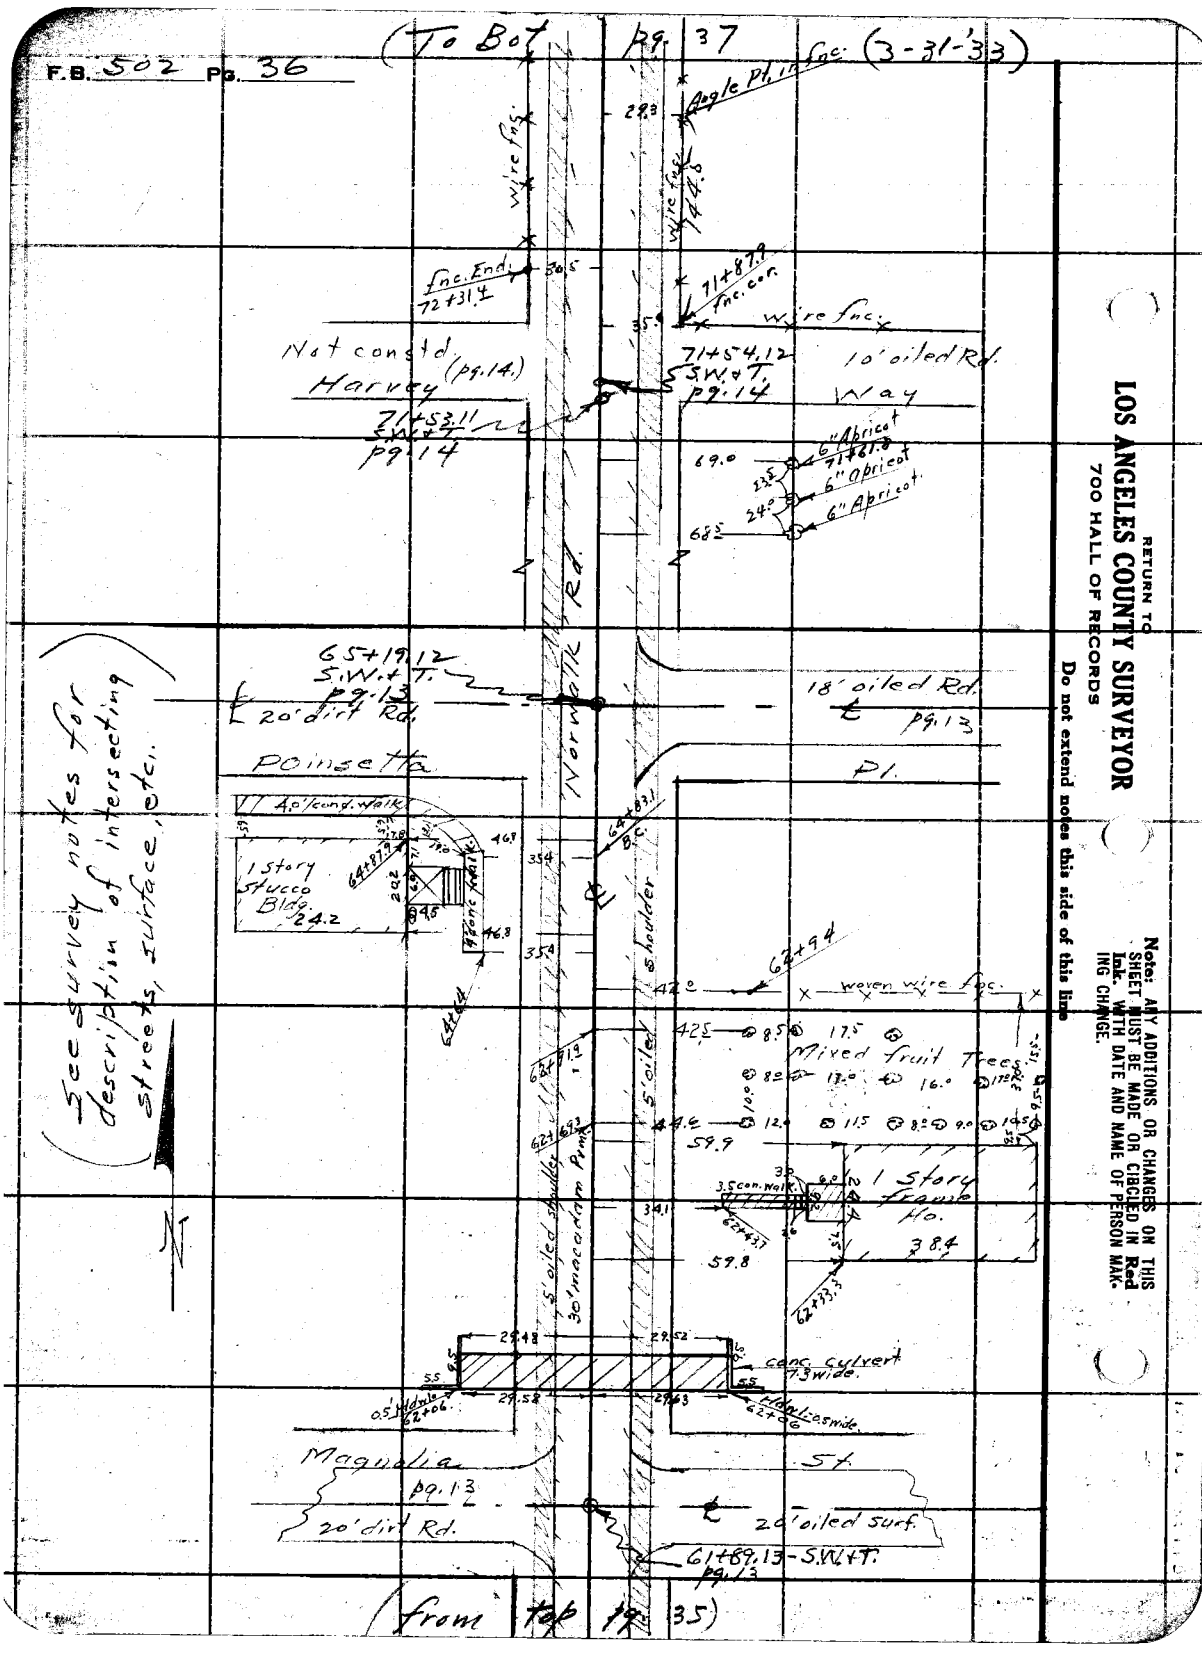

RETURN TO
LOS ANGELES COUNTY SURVEYOR
700 HALL OF RECORDS

Do not extend notes this side of this line

Note: ANY ADDITIONS OR CHANGES ON THIS SHEET MUST BE MADE OR CIRCLED IN Red Ink WITH DATE AND NAME OF PERSON MAKING CHANGE.

Notes Ck'd by Drew	Survey of Norwalk Rd.
Map No. B-804	W. O. 7089 Tape No. 957 St'd 84 OF.
Office Work K.Y. Morin	Surveyed by Evans.
Checked Drew	Notes LE Date 4-7-33
Date Jan 1935	Indexed A. C. Johnson

F.B. 502 Pg. 37

(To Bef. Pg. 38)

Note: ANY ADDITIONS OR CHANGES ON THIS SHEET MUST BE MADE OR CIRCLED IN Red Ink. WITH DATE AND NAME OF PERSON MAKING CHANGE.

Do not extend notes this side of this line

RETURN TO
LOS ANGELES COUNTY SURVEYOR
700 HALL OF RECORDS

FORM 247 10M 5-31

5' oiled shoulder

CENTRALIA

RD.

10' 10'

15' 15'

oil rock

SW&T.-85+04.23 per pg. 14

Approx. E.C.

78.

Approx. B.C. 83+45

15' 15'

83+08

62.

conc. fish pond.

10' 6' 11' 6.5'

82+84.9

conc. driveway

16'

32.6

32.6

27.4 29.4 R.O.

82+41.8

22.9

conc. drive

35.2

35.2

curb does not come around to driveway.

fnc. cor. 80+88.5

29.8

fnc. cor 80+79.5

5' oiled shoulder

NORWALK

Macadam Pvmt.

5' oiled shoulder

fnc. cor. 78+50.4

31.0

fnc. cor. 78+44.5

24.5

24.6

headwall 78+45.5

fnc. cor. 78+39.7

12.0 2.5

37.5

30.2

7.3 2.5

12.0

conc. culvert

78+39.7

24.5

24.6

(From Top pg. 36)

F.B. 502 Pg. 38

(To Bot. pg. 39)

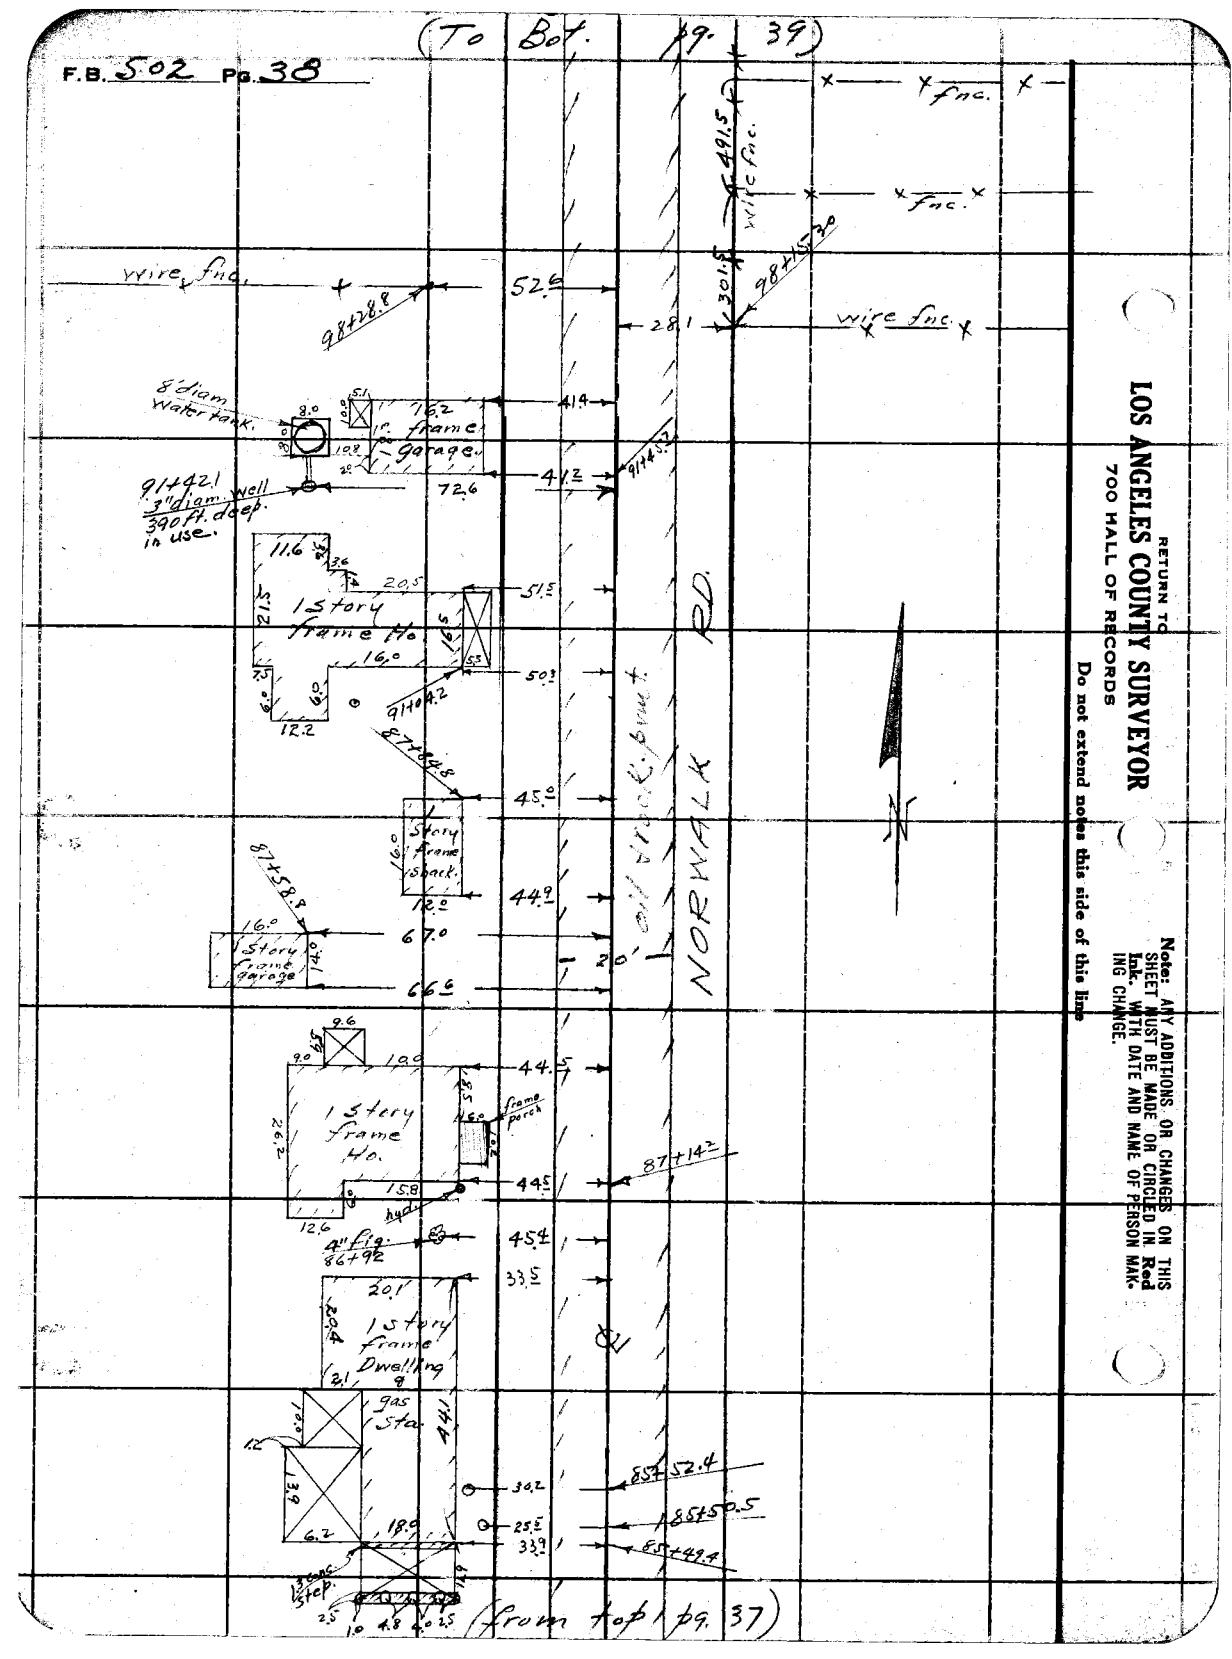

RETURN TO
LOS ANGELES COUNTY SURVEYOR
700 HALL OF RECORDS

Do not extend notes this side of this line

Note: ANY ADDITIONS OR CHANGES ON THIS SHEET MUST BE MADE OR CIRCLED IN Red Ink, WITH DATE AND NAME OF PERSON MAKING CHANGE.

Notes Ck'd by Drew	Survey of Norwalk Rd.
Map No. B-804	W. O. 7089 Tape No. 051 St'd 84 °F.
Office Work K.Y. Maria	Surveyed by Evans.
Checked Drew	Notes — Date 4-7-33
Date Jan 1935	Indexed A. C. Johnson

F.B. 502 Pg. 39

(To Bk. Pg. 40)

Note: ANY ADDITIONS OR CHANGES ON THIS SHEET MUST BE MADE OR CIRCLED IN Red Ink. WITH DATE AND NAME OF PERSON MAKING CHANGE.

Do not extend notes this side of this line

RETURN TO
LOS ANGELES COUNTY SURVEYOR
700 HALL OF RECORDS

FORM 247 10M 8-31

19'

wire fnc.

19.2

163.7

RD.

20.1

116+89.7

18.2 18.0 17.5 19.5

wire fnc.

29.5

116+61.2

19.1

38.7

Mixed fruit trees 3" diam.

17.5 17.7 18.5

116+75.8

22.0

116+71.8

116+74.7

4" Plum

fnc.

25.5

22.0

67.4

1 Story frame House.

6" Apricot

6" orange 116+26.6

69.0

59.9

24.2

18.7

6" orange 116+24.7

fnc.

116+22.0

22.5 orange trees 3" diam.

22.0

22.0

40.3

66.9

30.2

25.3

22.3

115+94.5

115+93.9

6" orange

fac. end 114+84

21.4

NORWALK

wire fnc.

112+02.7

wire fnc.

22.2

ANAKEIM

111+61.06 C.S. Mon. Pg. 15

ST.

oil track

p'mt.

28.4

111+62.5

fnc.

18.6

111+47.7

oil track p'mt.

19'

fnc.

(From to Bk. Pg. 38)

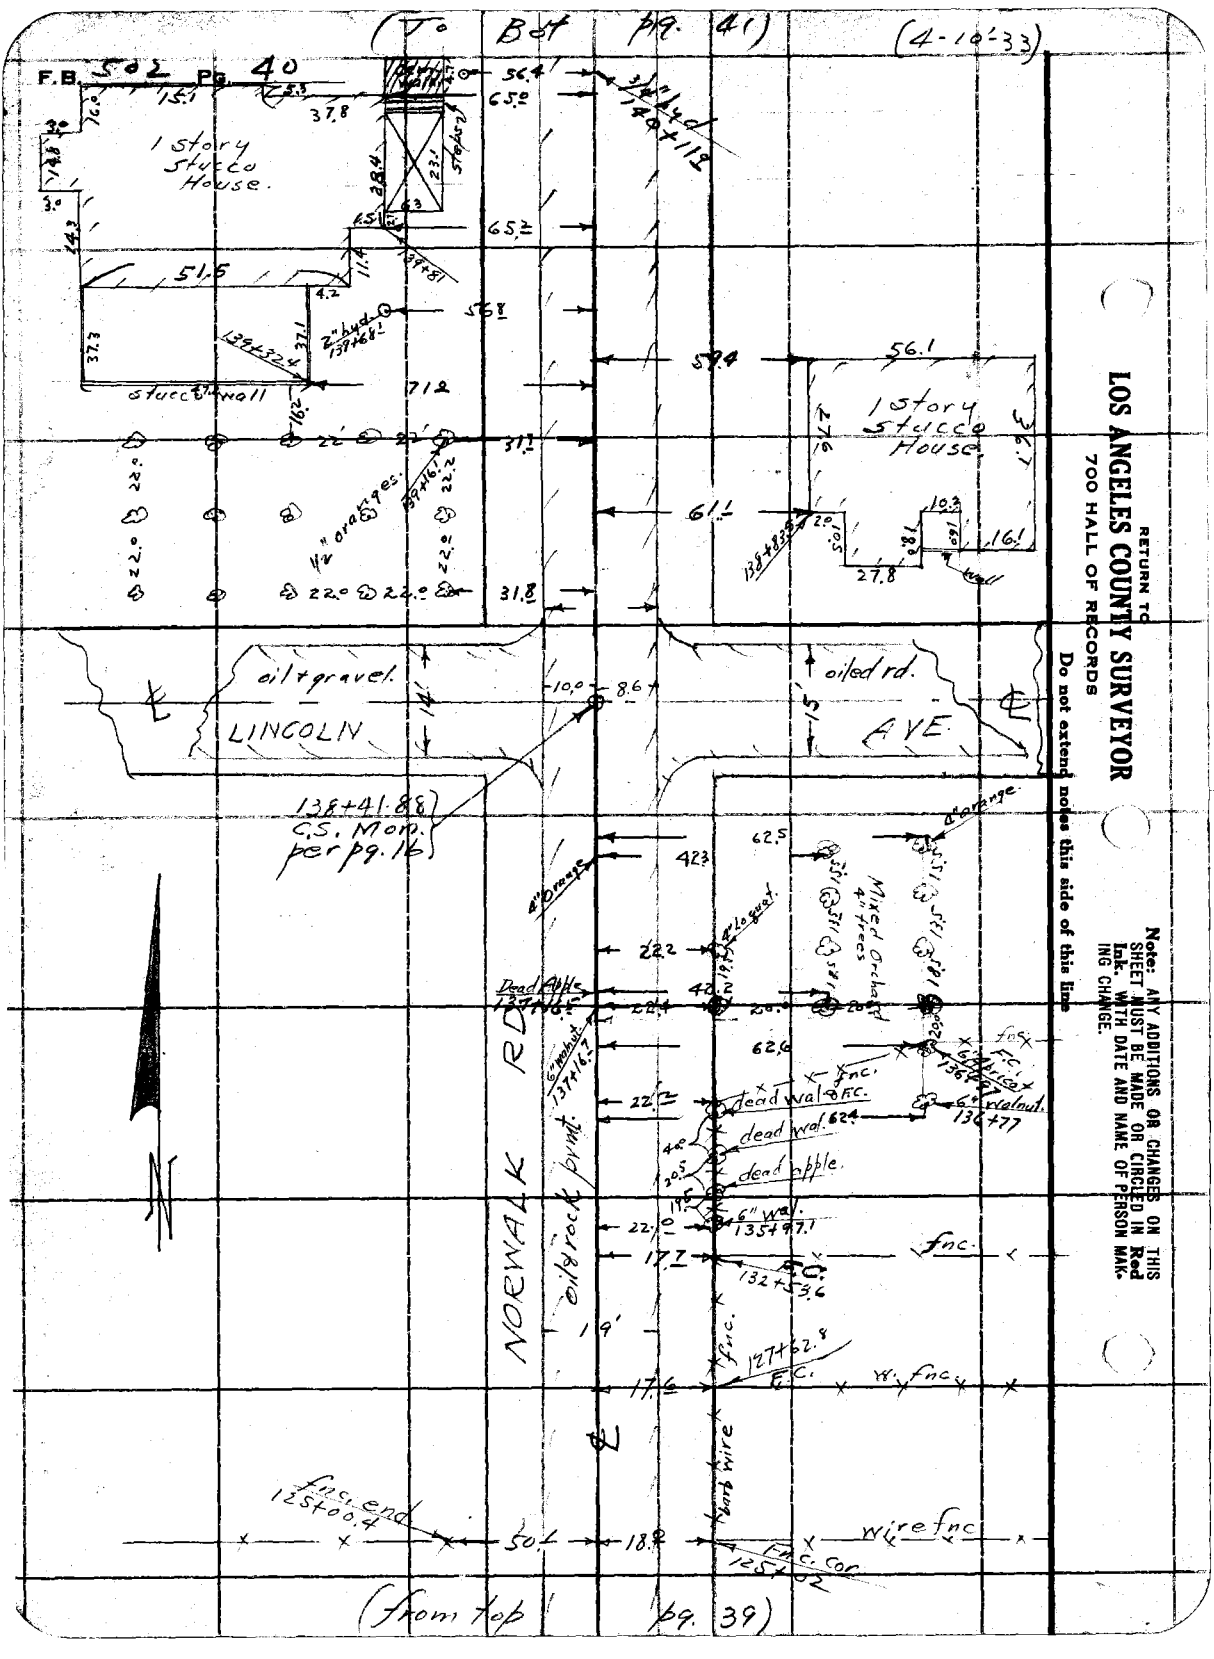

RETURN TO
LOS ANGELES COUNTY SURVEYOR
700 HALL OF RECORDS

Do not extend notes this side of this line

Note: ANY ADDITIONS OR CHANGES ON THIS SHEET MUST BE MADE OR CIRCLED IN Red Ink. WITH DATE AND NAME OF PERSON MAKING CHANGE.

Notes Ck'd by Drew	Survey of Norwalk Rd.
Map No. B-804	W. O. 7089 Tape No. 051 St'd 84 °F.
Office Work K.V. Morin	Surveyed by [illegible]
Checked Drew	Notes [illegible] Date 4-10-33
Date Jan 1935	Indexed A. C. Johnson

F.B. 502 Pg. 41

Note: ANY ADDITIONS OR CHANGES ON THIS SHEET MUST BE MADE OR CIRCLED IN Red Ink. WITH DATE AND NAME OF PERSON MAKING CHANGE.

Do not extend notes this side of this line

RETURN TO
LOS ANGELES COUNTY SURVEYOR
700 HALL OF RECORDS

FORM 247 10M 8-31

(From fb 49 40)

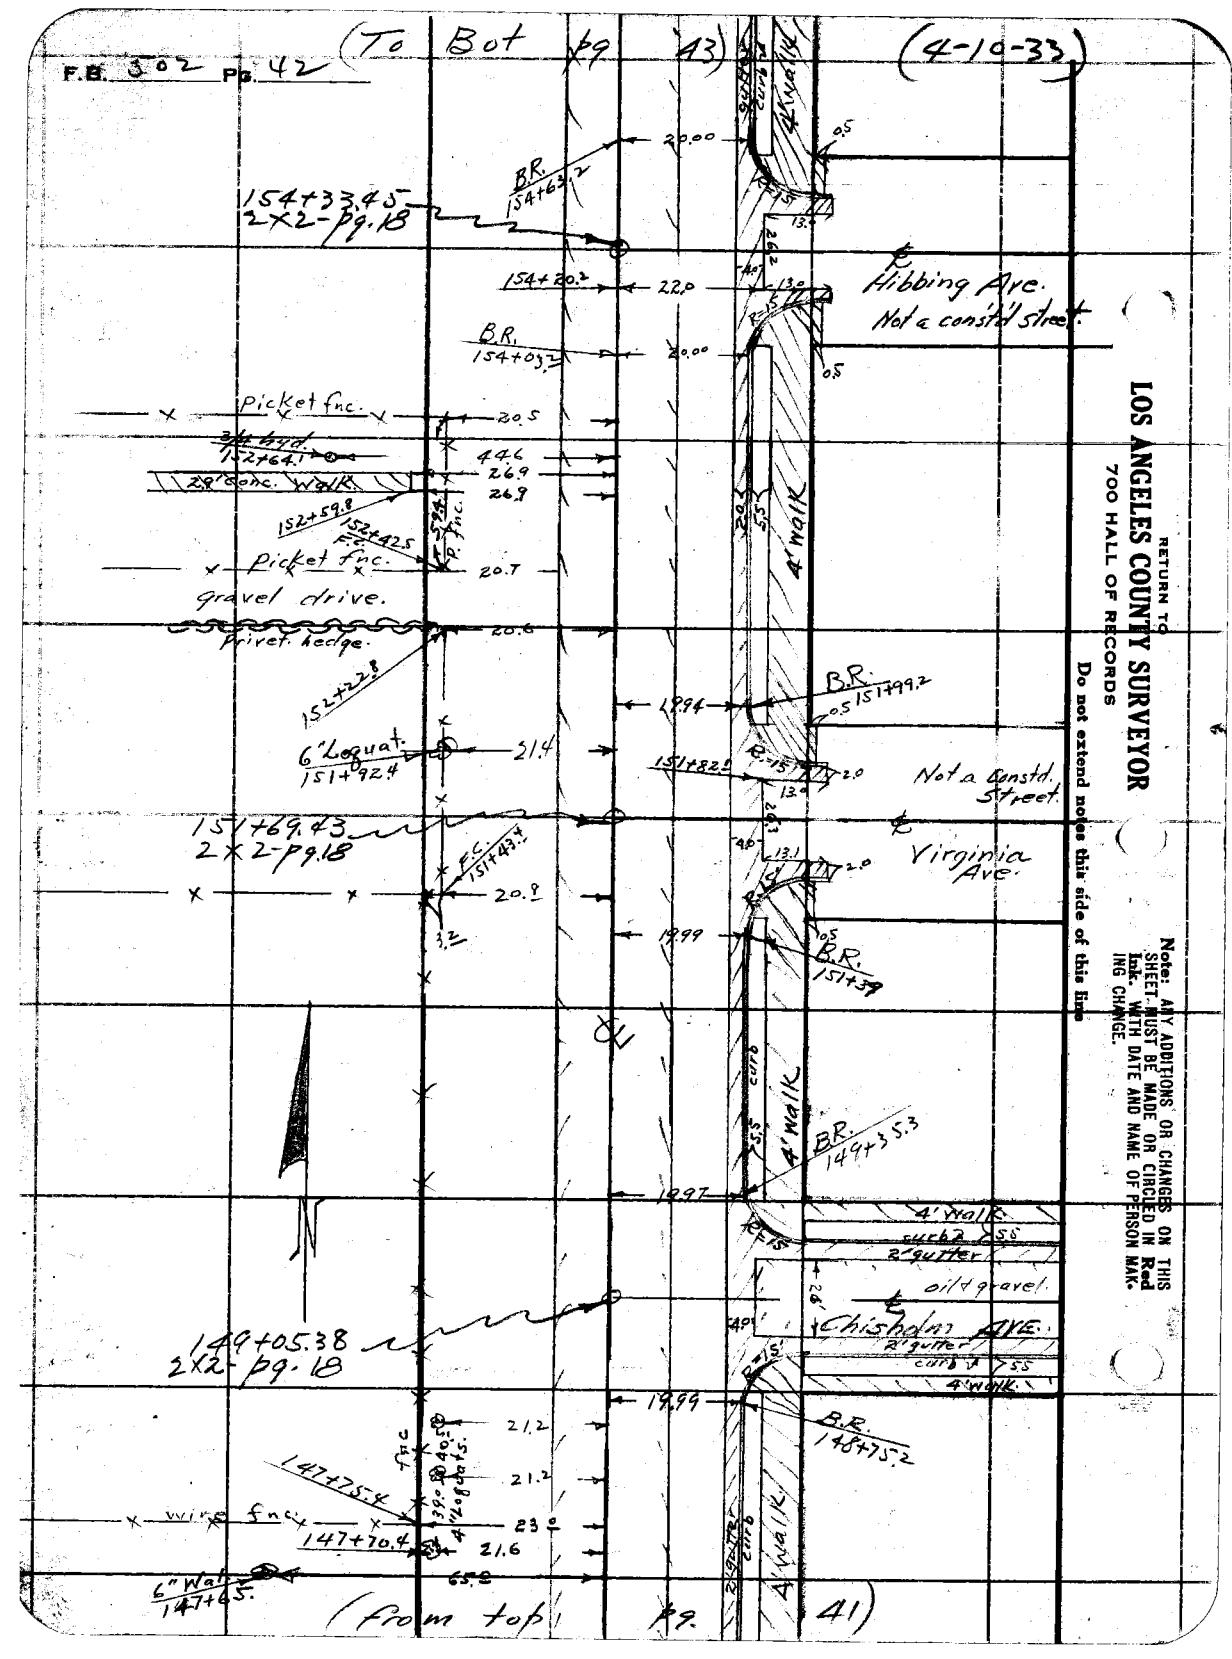
F.B. 302 Pg. 42
(To Bot pg 43)
(4-10-33)
154+33.45
2X2-Pg.18
BR 154+63.2
20.00
0.5
154+20.2
22.0
℄ Hibbing Ave.
Not a constd street.
B.R. 154+03.2
20.00
0.5
picket fnc.
20.5
3/4" bolt 152+64.1
446
26.9
26.9
29' Conc. Walk
152+59.8
152+42.5
F.C.
picket fnc.
20.7
gravel drive.
privet hedge.
20.6
152+22.8
4' walk
B.R. 151+99.2
19.94
0.5
21.4
151+82.5
R=15
2.0
13.0
Not a constd. street.
151+69.43
2X2-Pg.18
F.C. 151+43.4
20.8
3.2
40'
13.1
2.0
Virginia Ave.
19.99
0.5
B.R. 151+39
℄
4' walk
B.R. 149+35.3
19.97
4' walk
curb & gutter
oil & gravel
℄ Chisholm Ave.
2' gutter
curb & gutter
4' walk
149+05.38
2X2-Pg.18
19.99
B.R. 148+75.2
21.2
21.2
147+75.4
wire fnc.
147+70.4
23.0
21.6
65.2
6" Walnut 147+65.
4' walk
(from top pg. 41)
RETURN TO
LOS ANGELES COUNTY SURVEYOR
700 HALL OF RECORDS
Do not extend notes this side of this line
Note: ANY ADDITIONS OR CHANGES ON THIS SHEET MUST BE MADE OR CIRCLED IN Red Ink. WITH DATE AND NAME OF PERSON MAKING CHANGE.

Notes Ck'd by Drew	Survey of Norwalk Rd	F.B. 502 Pg. 43	
Map No. B-804-2	W. O. 7089 Tape No. 051 St'd 6¢ of.		
Office Work by K V Moore	Surveyed by Evans		
Checked Drew	Notes	Date 4-1-33	
Date Jan 1935	Indexed A. C. Johnson		

(To Bot 10' + 19.7 Pg. 44)

W. fnc.

F.C. 159+41

23.7

Oil + Rock Pvmt.

Frame Toilet

8.3

5.3

1 Story frame Garage.

40.6

26.3

157+94.1

W. fnc.

RD.

157+59 F.C.

157+83.8

157+83.7

52.5

52.5

52.0

23.9

157+83.3

10.8

1 Story frame Service Sta.

Gas intake

Gas intake

Gas intake

5.1

Pumps

17 33 35

157+36.2 F.C.

W. fnc.

FIRST

31.5

52.6

ST.

Approx.

30' R.

Macadam

30' R.

Approx.

Conc.

Pvmt.

31.0

45.0

31.0

45.0

B.C.

30' R.

B.C.

157+06.4 SOK-pg. 195

156+46.2

156+18.7

17.8

17.8

20.55

40

22.4

1 Story frame Ho.

5.5

10'

10'

50.2

155+97.4

155+46.2

30.1

1 Story frame Ho.

50.2

50.1

50.2

Oil + rock Pvmt.

NORWALK

4' walk

155+49.1

gas meter

1 Story frame House.

50.2

(From Hop 179.42)

Note: ANY ADDITIONS OR CHANGES ON THIS SHEET MUST BE MADE OR CIRCLED IN Red Ink. WITH DATE AND NAME OF PERSON MAKING CHANGE.

Do not extend notes this side of this line

RETURN TO
LOS ANGELES COUNTY SURVEYOR
700 HALL OF RECORDS

FORM 247 10M 8-31

F.B. 502 Pg. 44 (To Bot. pg. 43)

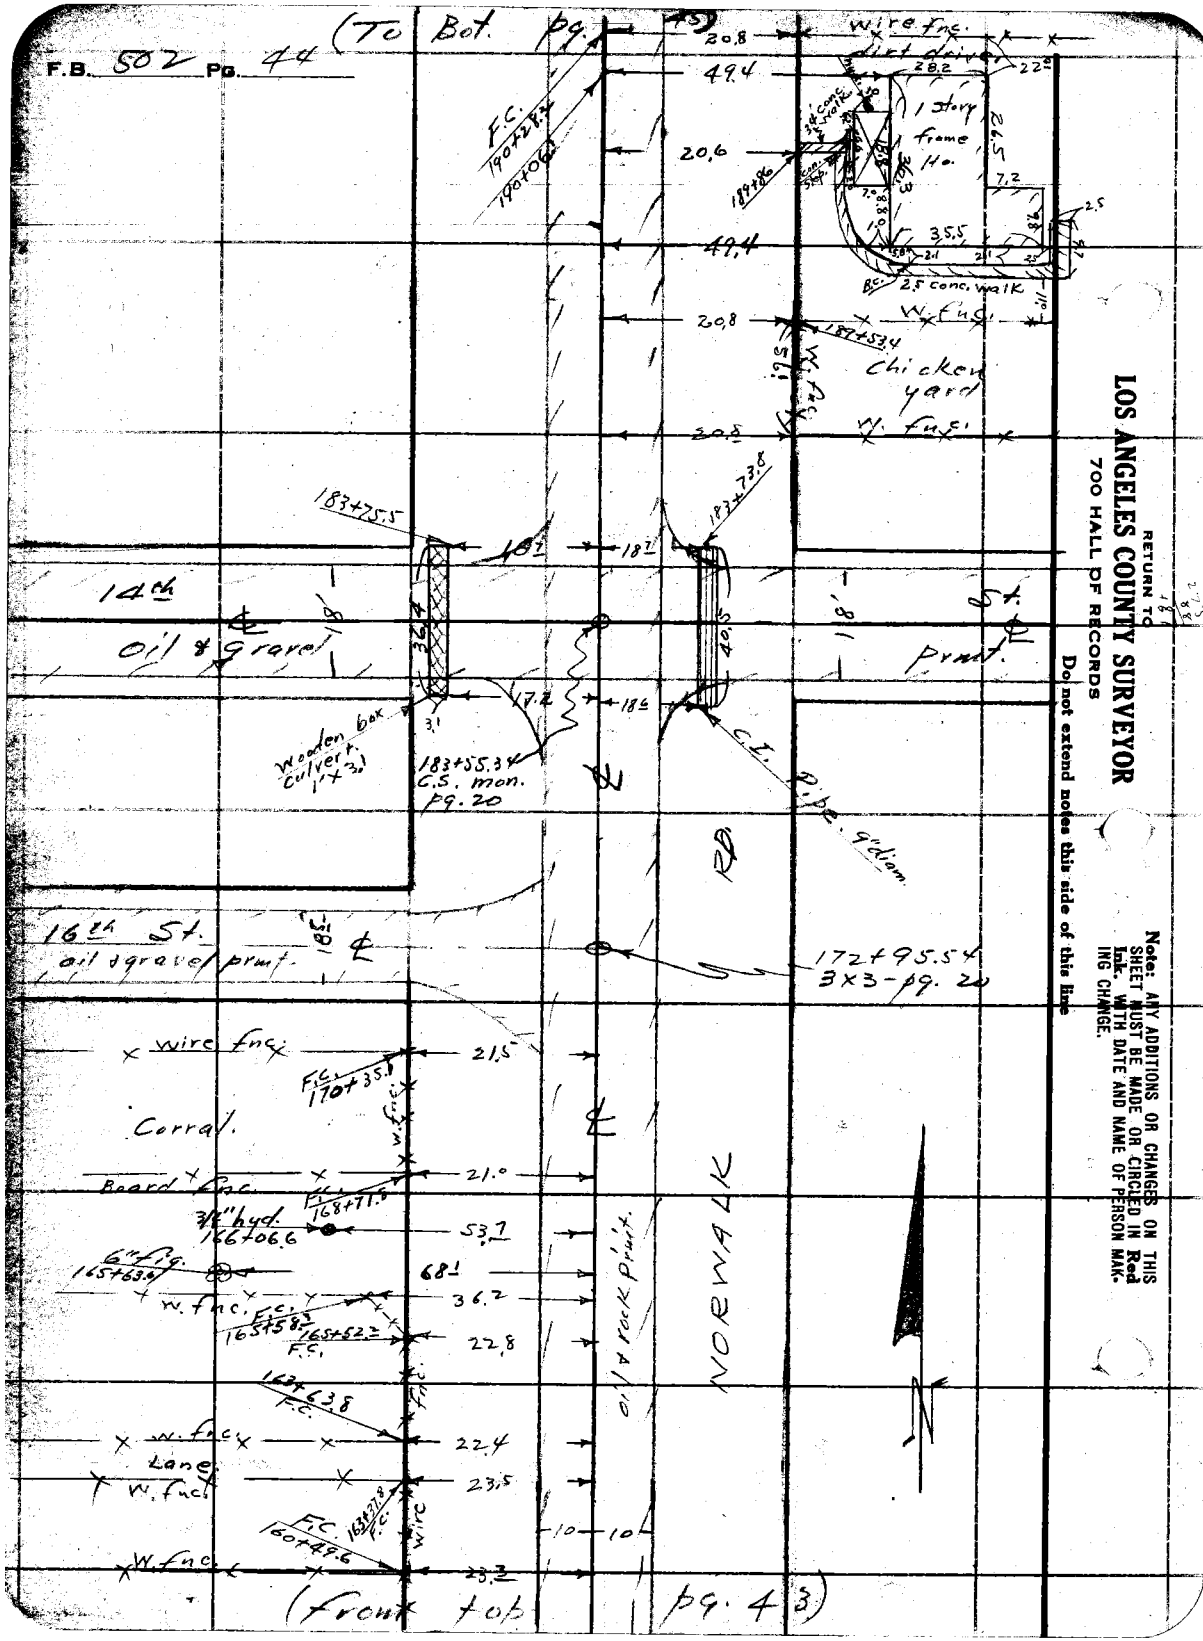

RETURN TO
LOS ANGELES COUNTY SURVEYOR
700 HALL OF RECORDS

Do not extend notes this side of this line

Note: ANY ADDITIONS OR CHANGES ON THIS SHEET MUST BE MADE OR CIRCLED IN Red Ink. WITH DATE AND NAME OF PERSON MAKING CHANGE.

Map No. B-804-2	W. O. 7089 Tape No. 051 St'd 84 of.
Checked Drew	Notes	Date 4-11-33
Date Jan 1935	Indexed A. C. Johnson

(To Bot pg. 46)

Note: ANY ADDITIONS OR CHANGES OF THIS SHEET MUST BE MADE OR CIRCLED IN Red Ink, WITH DATE AND NAME OF PERSON MAKING CHANGE.

Do not extend notes this side of this line

RETURN TO
LOS ANGELES COUNTY SURVEYOR
700 HALL OF RECORDS

FORM 247 10M 8-31

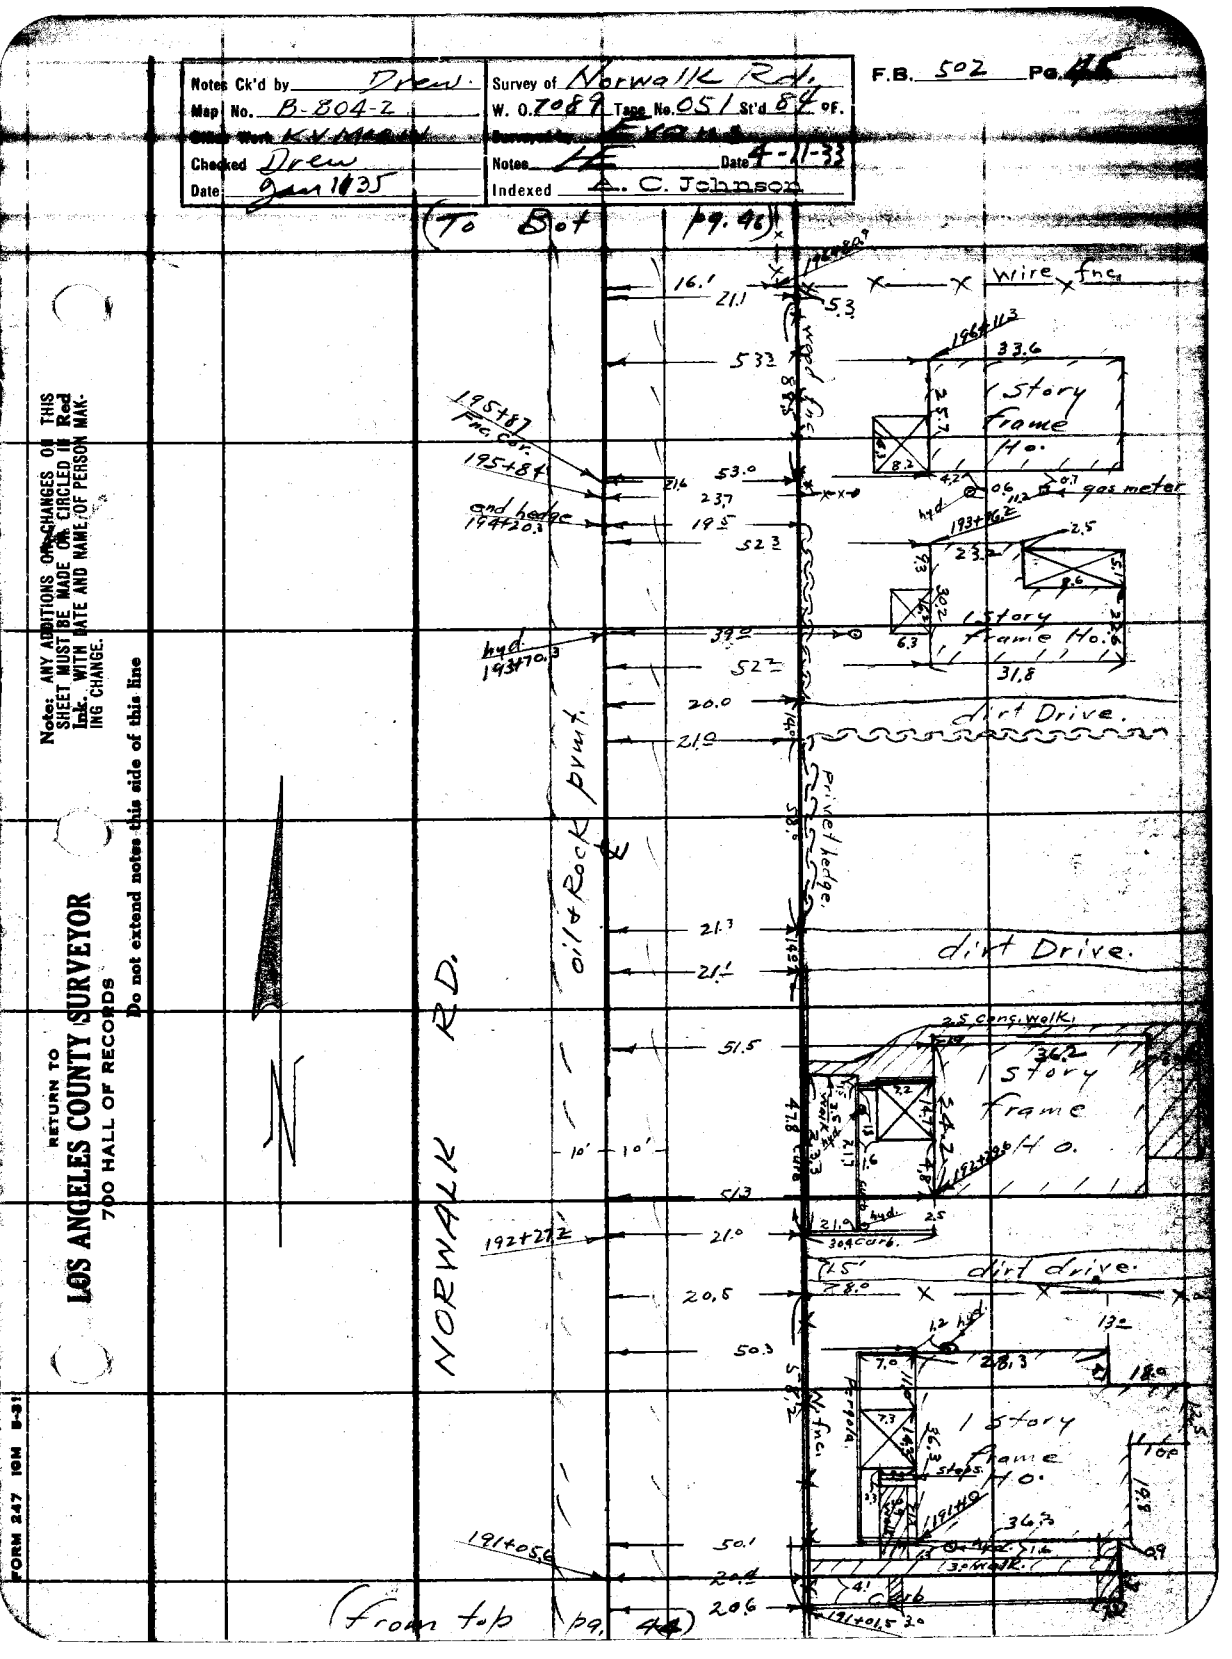

F.B. 502 Pg. 46 (To Bot. pg. 47) (4-11-33)

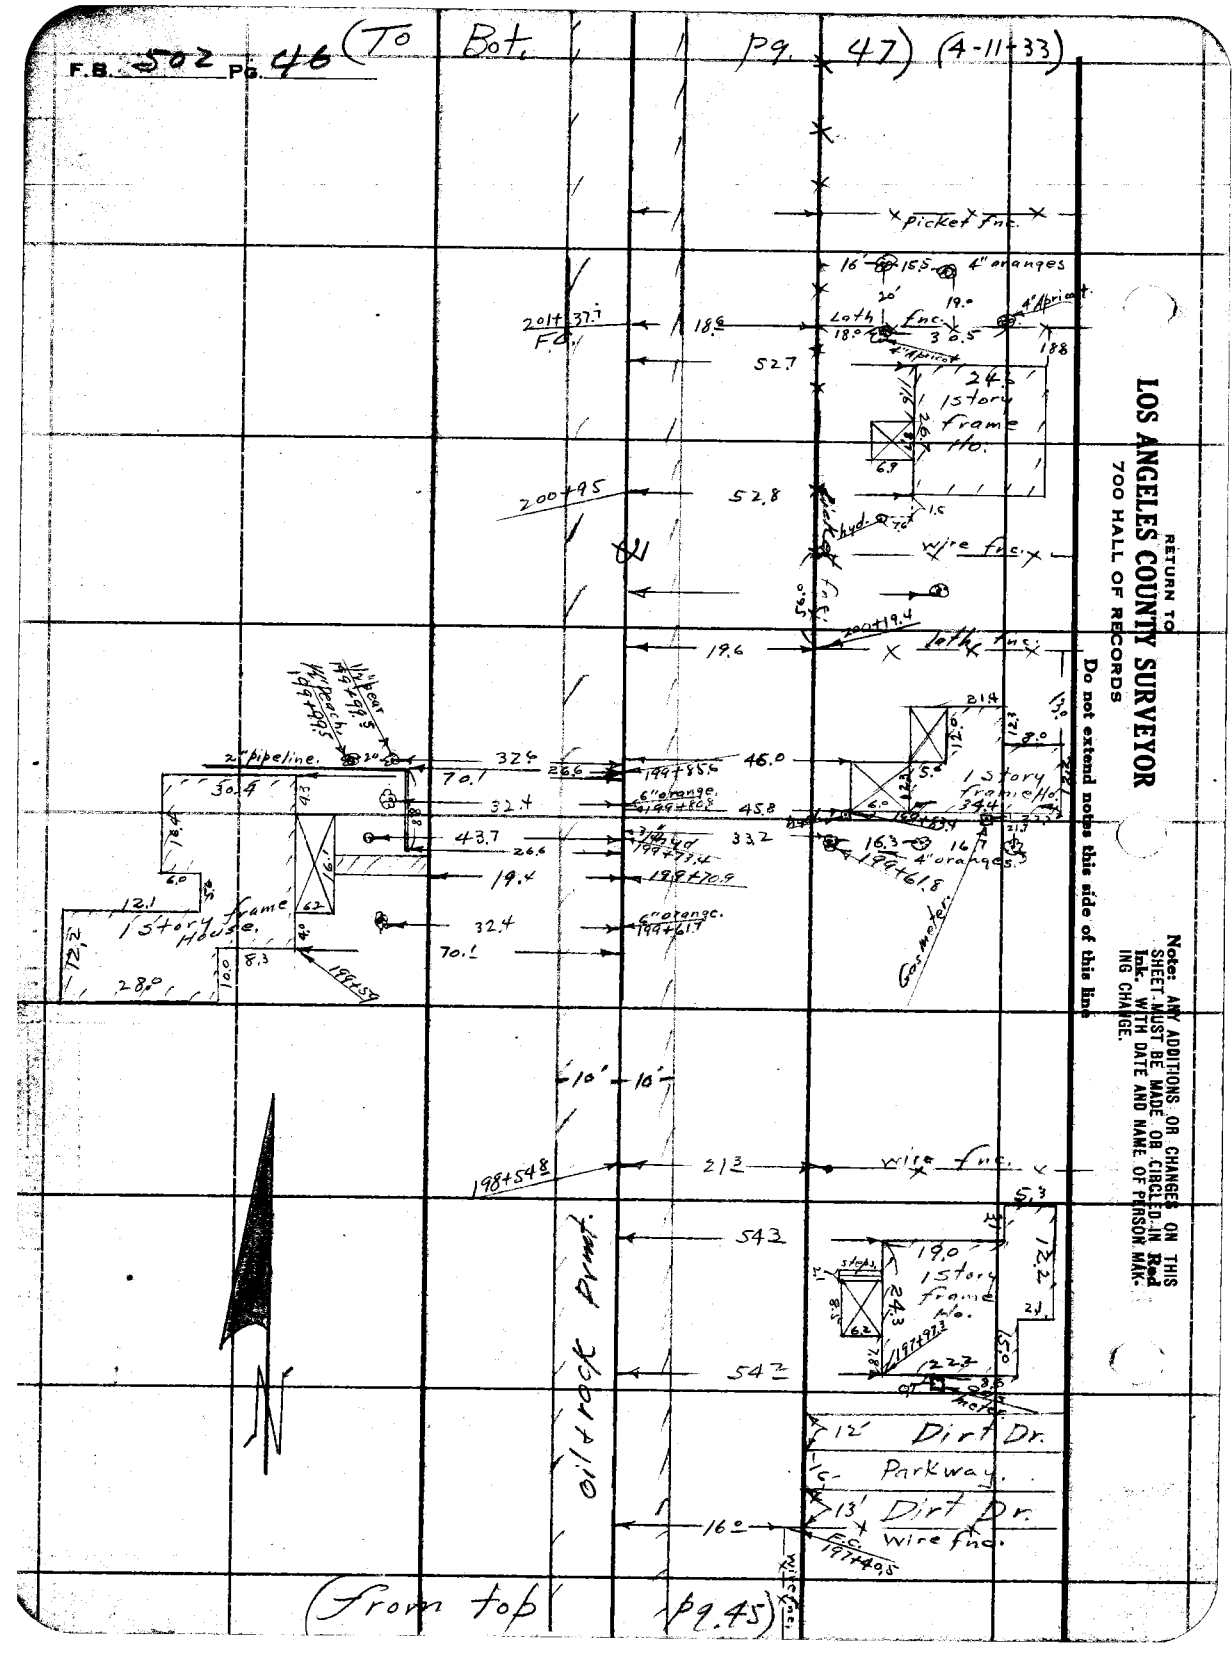

RETURN TO
LOS ANGELES COUNTY SURVEYOR
700 HALL OF RECORDS

Do not extend notes this side of this line

Notes: ANY ADDITIONS OR CHANGES ON THIS SHEET MUST BE MADE OR CIRCLED IN Red Ink. WITH DATE AND NAME OF PERSON MAKING CHANGE.

Notes Ck'd by Drew	Survey of Norwalk Rd.	F.B. 502	Pg. 47
Map No. B-804-2	W. O. 7089 Tape No. 051 St'd 84 of F.		
Office Work K.V. Corbin	Surveyed by Evans		
Checked Drew	Notes H Date 4-12-33		
Date Jan 1935	Indexed A. C. Johnson		

(To Bot. Pg. 48)

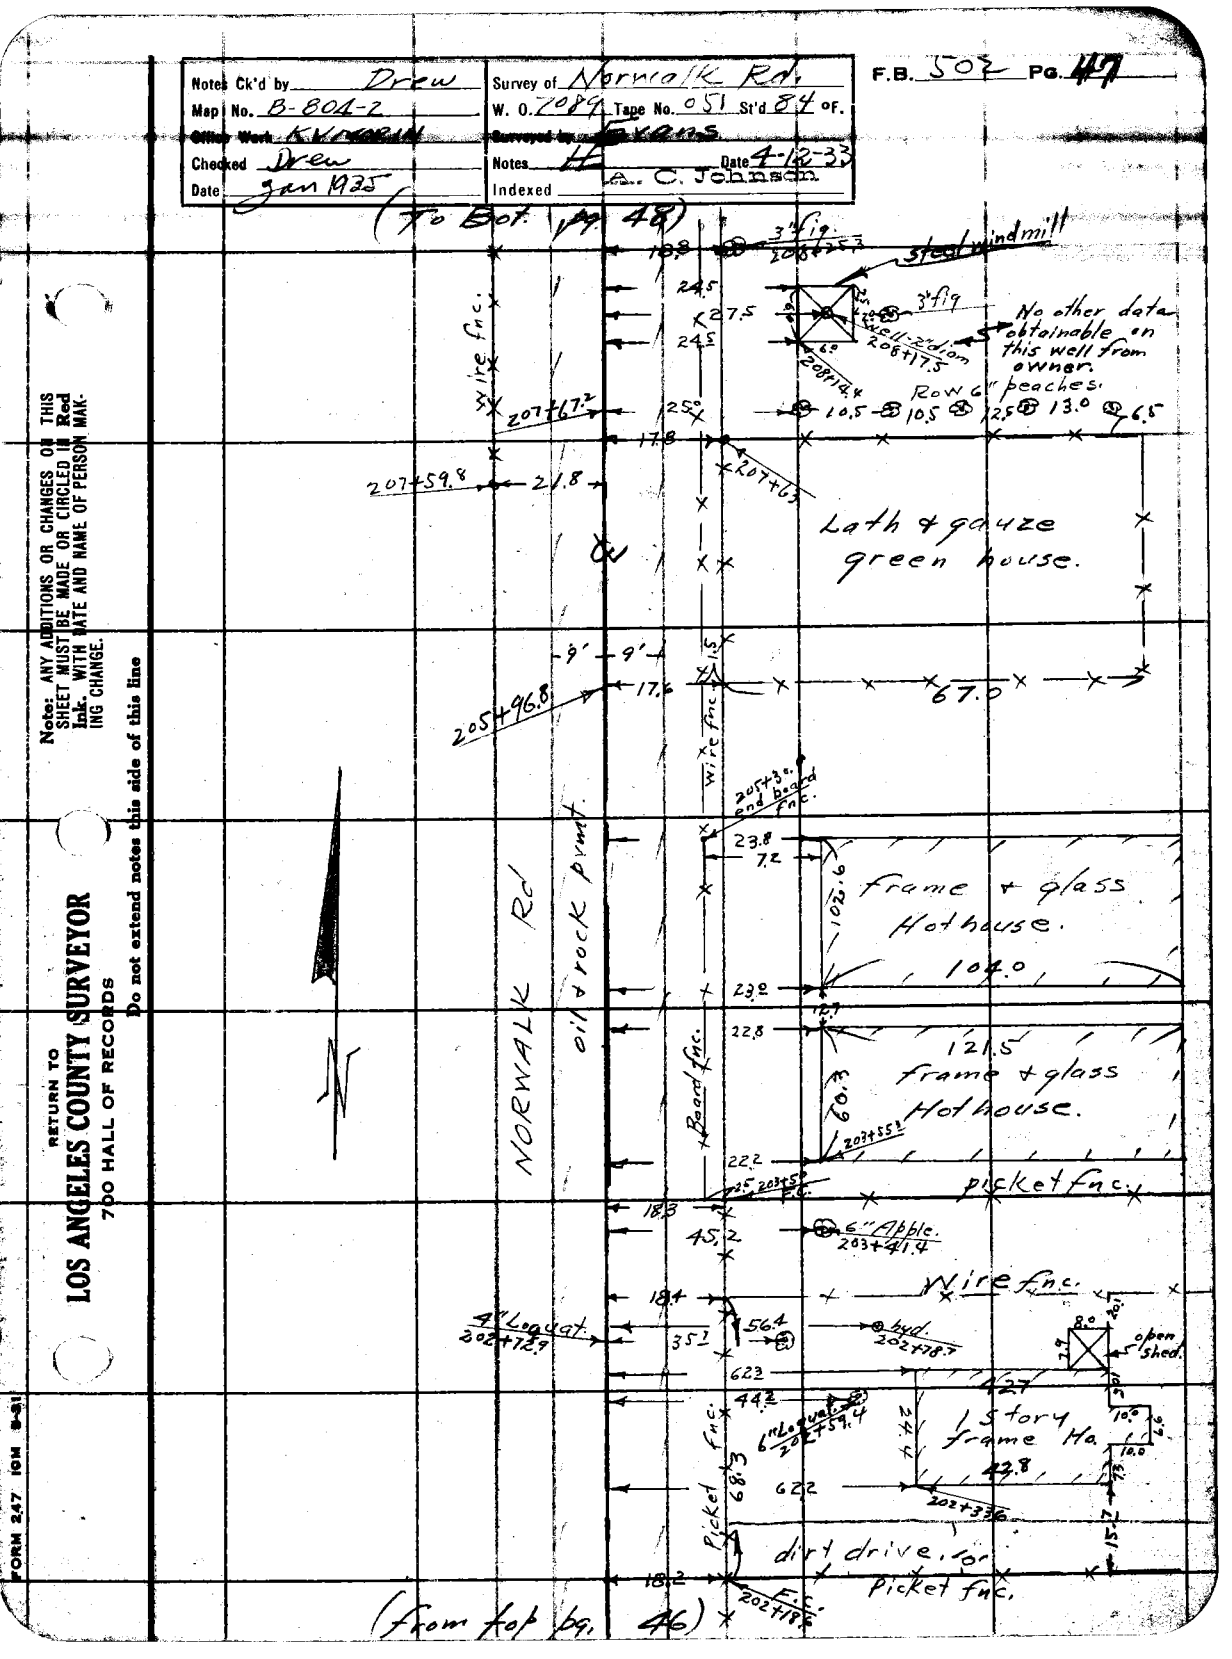

(From top pg. 46)

Note: ANY ADDITIONS OR CHANGES ON THIS SHEET MUST BE MADE OR CIRCLED IN Red Ink. WITH DATE AND NAME OF PERSON MAKING CHANGE.

Do not extend notes this side of this line

RETURN TO
LOS ANGELES COUNTY SURVEYOR
700 HALL OF RECORDS

FORM 247 10M 8-31

F.B. 502 PG. 48

(To 80.4 pg. 48)

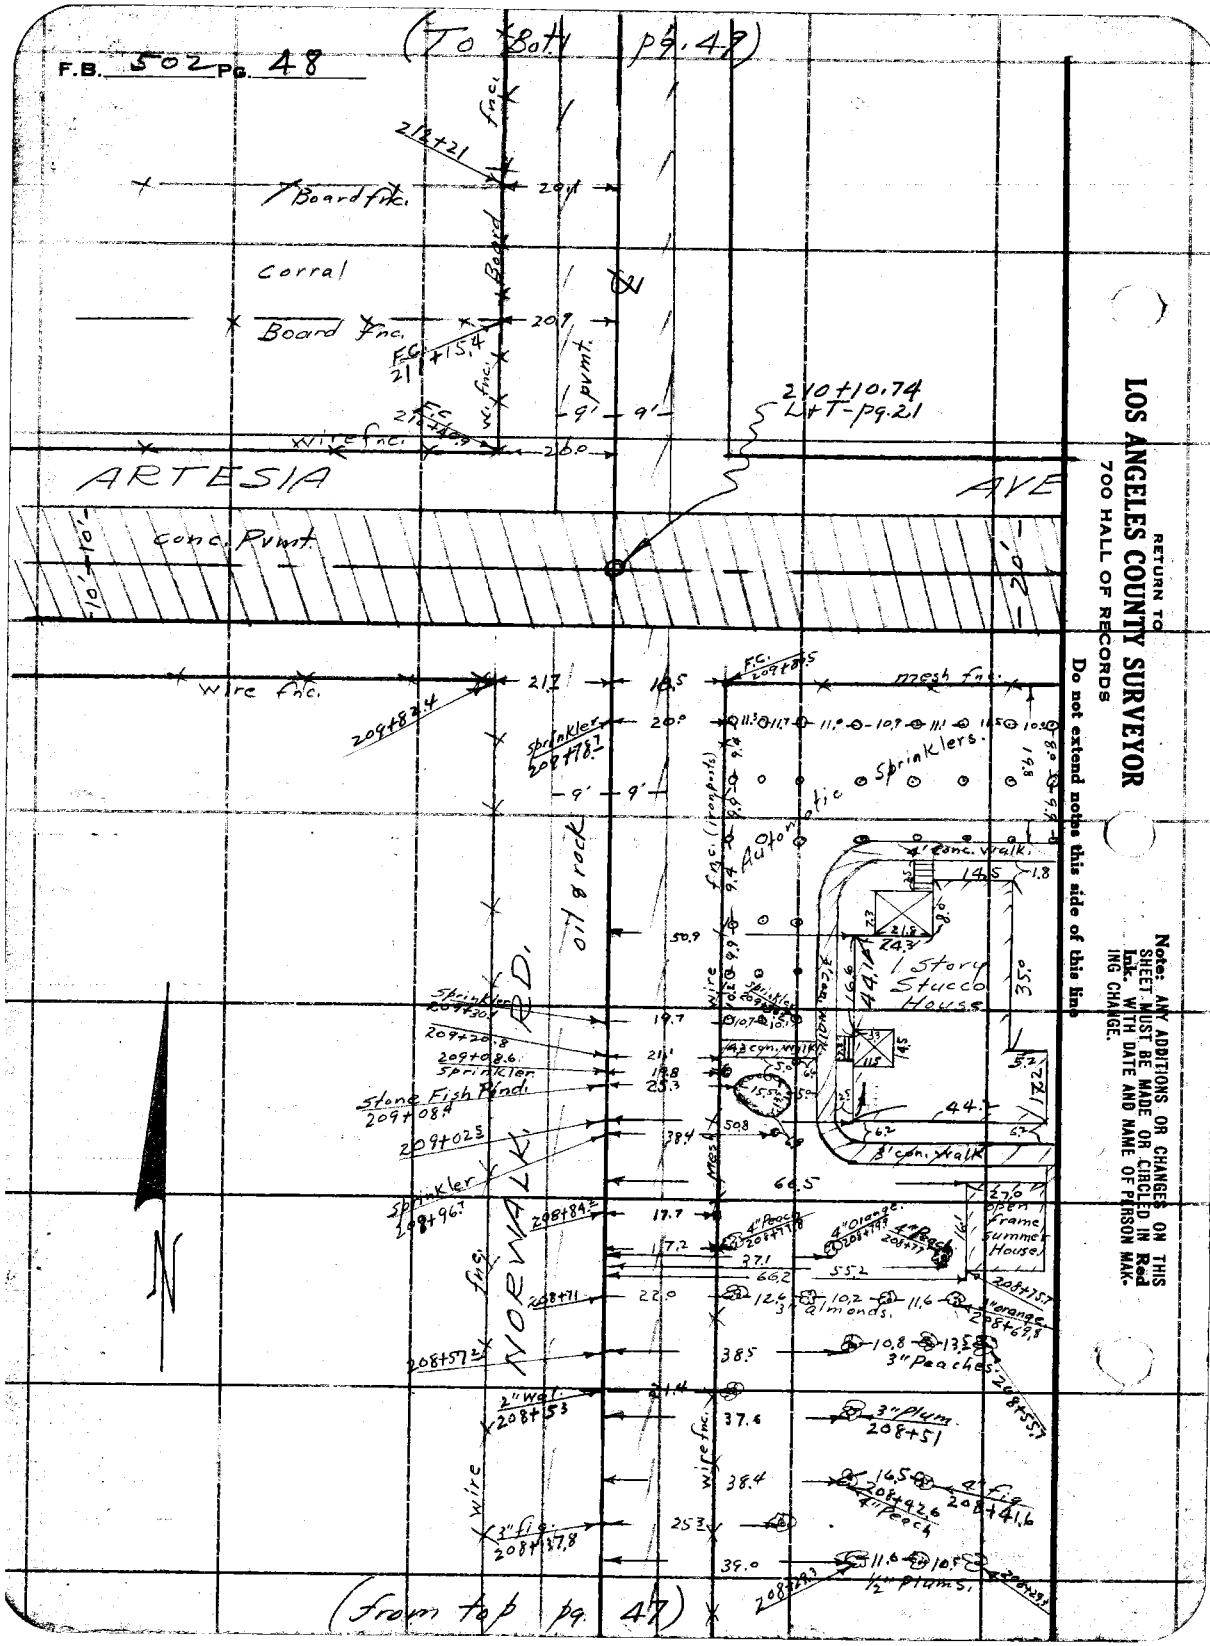

RETURN TO
LOS ANGELES COUNTY SURVEYOR
700 HALL OF RECORDS

Do not extend notes this side of this line

Notes: ANY ADDITIONS OR CHANGES ON THIS SHEET MUST BE MADE OR CIRCLED IN Red Ink. WITH DATE AND NAME OF PERSON MAKING CHANGE.

Notes Ck'd by Drew	Survey of Norwalk Rd.	F.B. 502 Pg. 49
Map No. B-804-2	W. O. 7089 Tape No. 2-1 St'd 87 of F.	
Office Work K.V. MARIN	Surveyed by [illegible]	
Checked Drew	Notes [illegible] Date 4-12-33	
Date Jan 1935	Indexed A. C. Johnson	

(To 1 Bot Pg. 50)

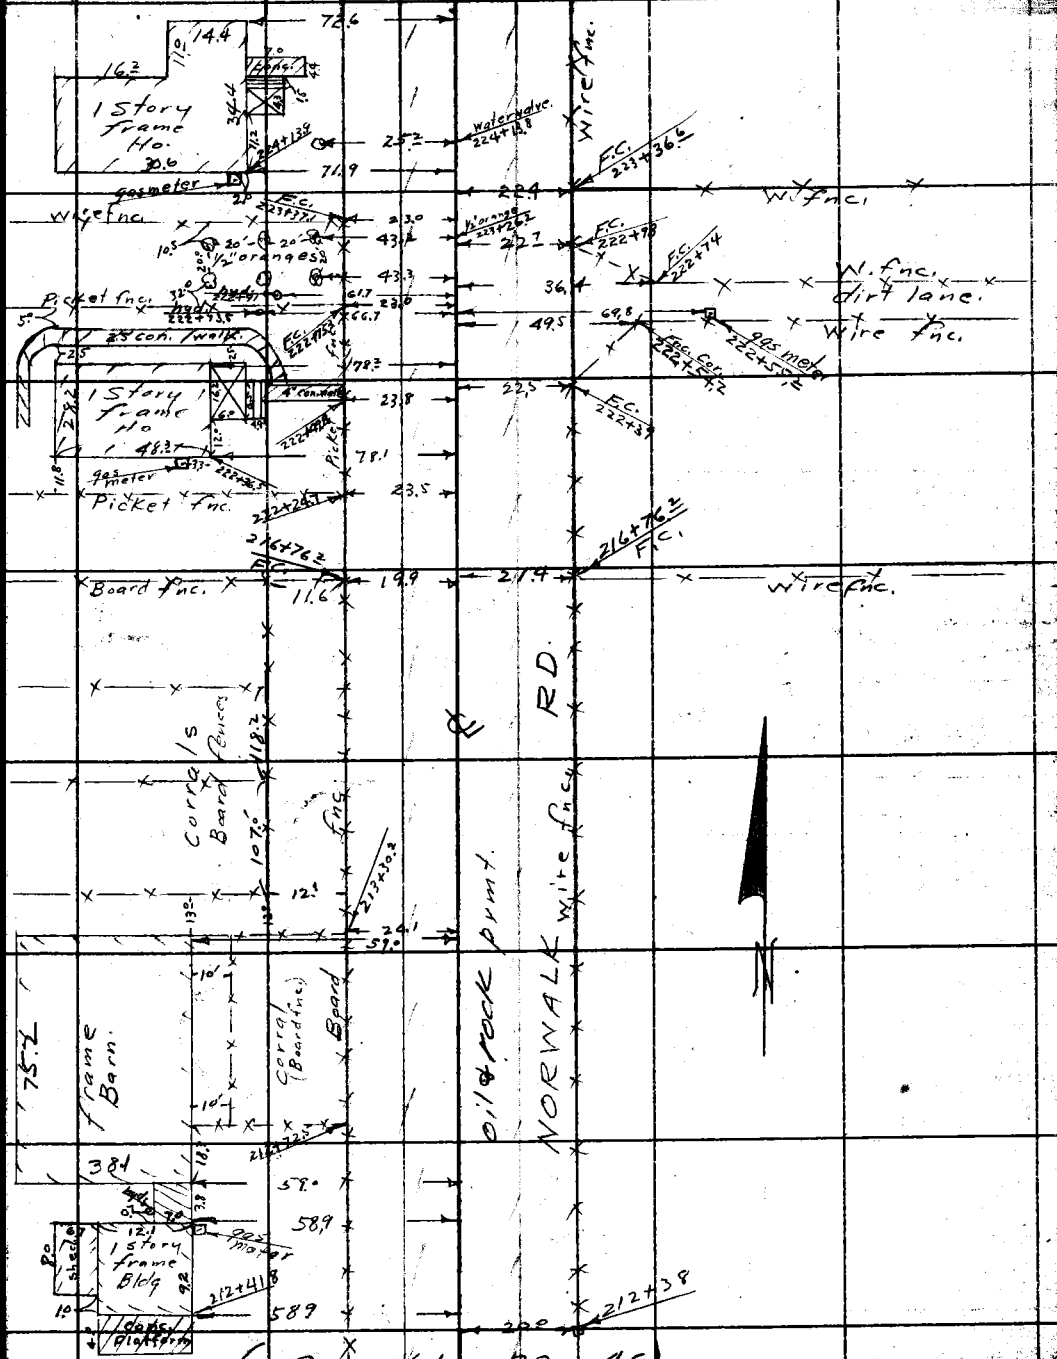

Note: ANY ADDITIONS OR CHANGES OF THIS SHEET MUST BE MADE OR CIRCLED IN Red Ink WITH DATE AND NAME OF PERSON MAKING CHANGE.

Do not extend notes this side of this line

RETURN TO
LOS ANGELES COUNTY SURVEYOR
700 HALL OF RECORDS

FORM 247 ROM 8-31

(To Bot. Pg. 51)

F.B. 502 Pg. 50

(From T/P Pg. 49)

RETURN TO
LOS ANGELES COUNTY SURVEYOR
700 HALL OF RECORDS

Do not extend notes this side of this line

Note: ANY ADDITIONS OR CHANGES ON THIS SHEET MUST BE MADE OR CIRCLED IN Red Ink. WITH DATE AND NAME OF PERSON MAKING CHANGE.

Notes Ck'd by Drew | Survey of Norwalk Rd. | F.B. 502 Pg. 51
Map No. B-804-2 | W. O. 1088 Tape No. 051 St'd 2.4 of F.
Office Work by K. Knoerl | Computed by Evans
Checked Drew | Notes K | Date 4-13-35
Date Jan 1935 | Indexed A. C. Jones

(To Bot. pg. 52)

(See survey notes for cross streets)

Note: ANY ADDITIONS OR CHANGES OR THIS SHEET MUST BE MADE OR CIRCLED IN Red Ink, WITH DATE AND NAME OF PERSON MAKING CHANGE.

Do not extend notes this side of this line

RETURN TO
LOS ANGELES COUNTY SURVEYOR
700 HALL OF RECORDS

FORM 247 10M 8-31

Trellis
Wire fnc.
58.7
262+06.4
19.3
1 Story Frame House.
9.7
27.2
55.4
34.8
24.3
0.3
6.0
27.6
5.0
1 Story Frame House.
22.3
16.1
+10'
-10'
24.4
242+11.3
3/4" Lead
242+10.2
22.1
16.2
10.1
9.0
Dirt dr.
12.4
56.4
1 Story Frame Ho.
16.3
3.5
16.3
55.9
55.9
237+14.4
237+40.0
3/4" Lead
43.4
14.5
43.8
½" orange
1.0 ft. ⊕
½" Peach
237+06.2
63.0
237+05.6
44.6
6th St.
(Apple St.)
(Not a constd Street)
Wire fnc.
236+49.2
F.C.
(Not a constd St.)
236+31.7
F.C.
18.4
19'
236+63.09
C.S. Mon. per pg. 22
Barbed fnc.
235+31.2
F.C.
Wire fnc.
30.7
Wire fnc.
Oil rock pvmt.
EC.
234+91.2
32.5
Fnc.
6" orange
233+96.3
41.5
3/4" Lead
233+91.4
72'
(From to pg. 50)

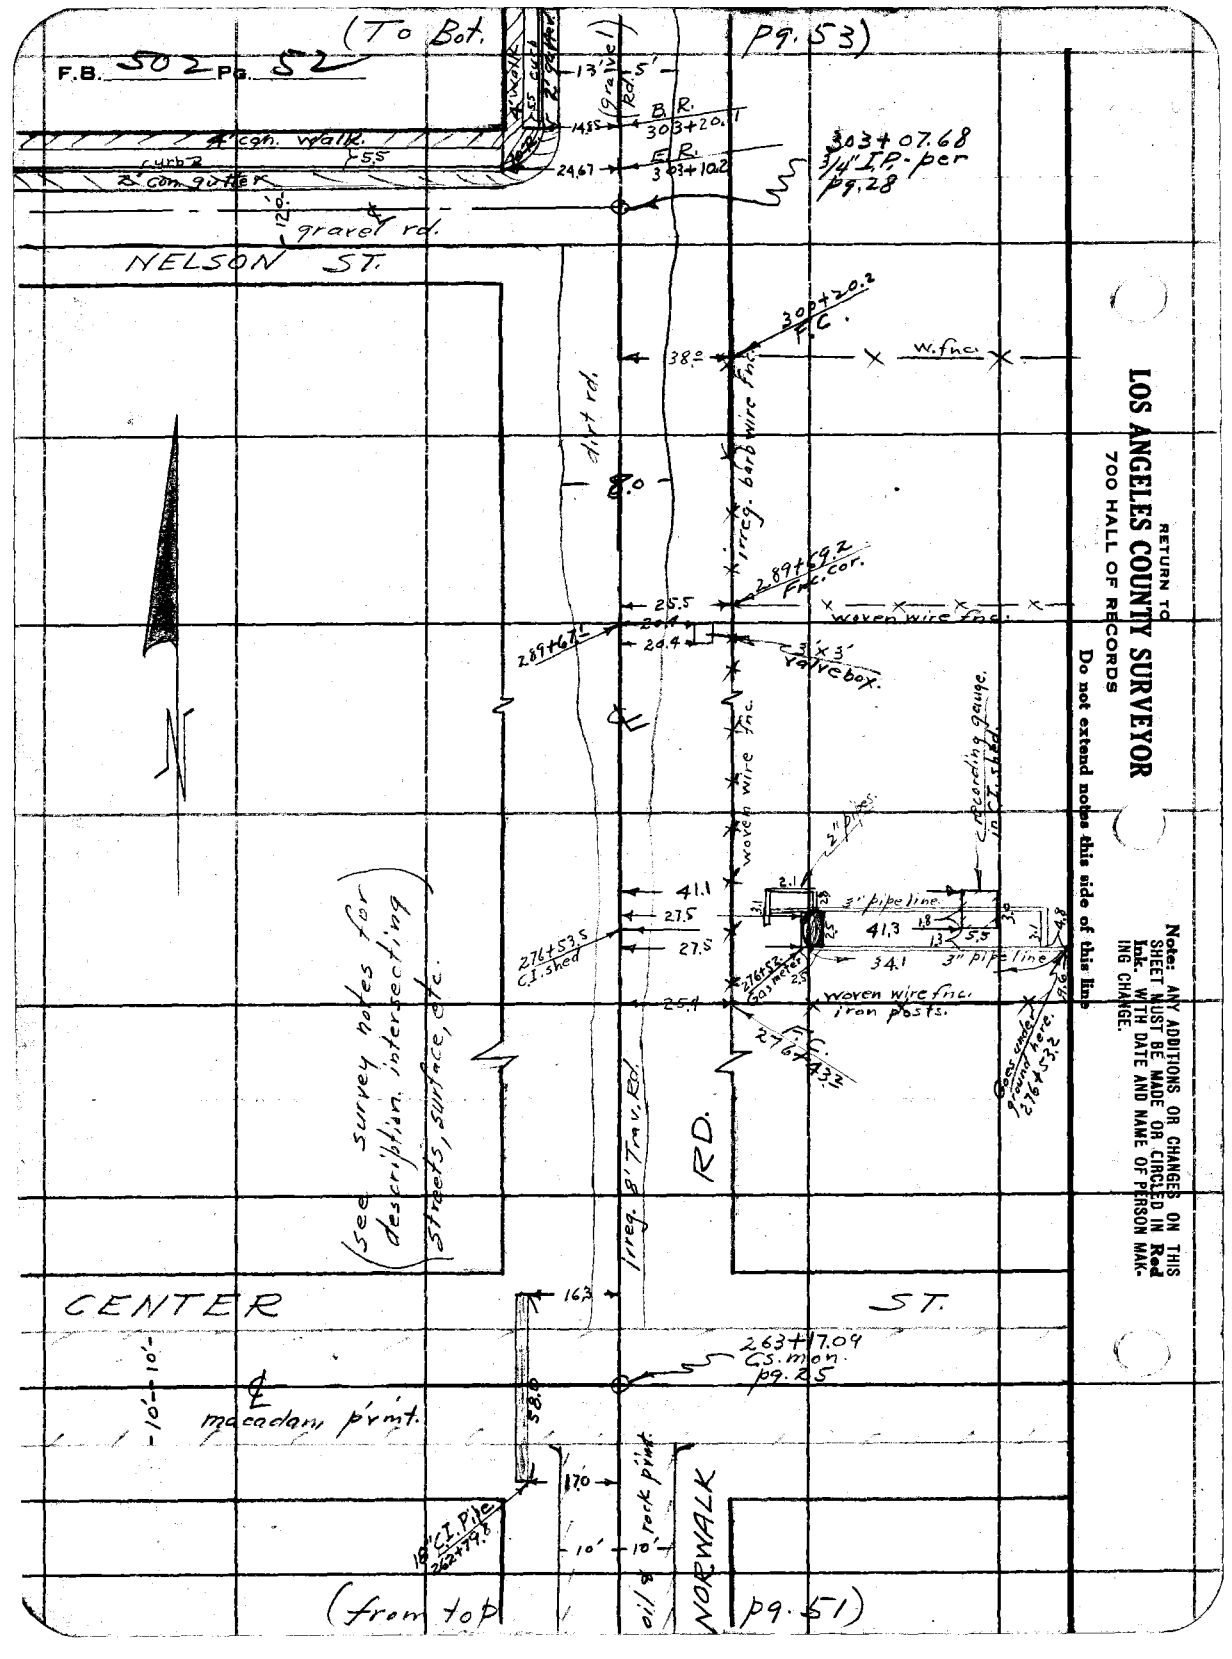

RETURN TO
LOS ANGELES COUNTY SURVEYOR
700 HALL OF RECORDS
Do not extend notes this side of this line

Notes: ANY ADDITIONS OR CHANGES ON THIS SHEET MUST BE MADE OR CIRCLED IN Red Ink. WITH DATE AND NAME OF PERSON MAKING CHANGE.

Notes Ck'd by Drew | Survey of Norwalk Rd.
Map No. B-804-2 | W. O. 7089 Tape No. 051 St'd. 84 °F.
Office Work K.F.Martin | Surveyed by Evans
Checked Drew | Notes HE Date 4-13-33
Date Jan 1935 | Indexed E. C. Johnson

F.B. 502 Pg. 53

Mesb frac

End of survey

316+21.24
Cut spk. pg. 29
End of survey

Macadam

38.0 37.7

9.0 22.1 10.2

20' 20'

Conc Pmt.

ROSECRANS AVE.

20' 20'

34.5 19.

Conc curb & gutter 315+71.3

3' tiled S.D. face

14.93

5.5 6.0

58°

90" Walnut Ø 315+17.1

4' Walk. curb & gutter

5.5

road

B.R. 309+76.5

14.85

4' Walk. curb & gutter 5.5

E.R. 309+66.2

24.75

(Macadam Pmt.)

6.0

LOTUS ST.

309+51.19
2X2 - pg. 29

4.8

24" gutter curb 5.5

25.12

E.R. 309+36.2

4' Walk.

B.R. 309+26.2

14.92

4' Walk 5.5

gravel road

NORWALK RD.

21' gutter

Note: ANY ADDITIONS OR CHANGES ON THIS SHEET MUST BE MADE OR CIRCLED IN Red Ink, WITH DATE AND NAME OF PERSON MAKING CHANGE.

Do not extend notes this side of this line

RETURN TO
LOS ANGELES COUNTY SURVEYOR
700 HALL OF RECORDS

FORM 247 10M 8-31

RETURN TO

LOS ANGELES COUNTY SURVEYOR

700 HALL OF RECORDS

Note: ANY ADDITIONS OR CHANGES ON THIS SHEET MUST BE MADE OR CIRCLED IN **Red Ink.** WITH DATE AND NAME OF PERSON MAKING CHANGE.

Do not extend notes this side of this line

F.B. 502 Pg. 54

Notes Ck'd by Drew	Survey of Ocaso Ave
Map No. B-823	W. O. 7090 Tape No. 033 St'd 66 °F.
Office Work	Surveyed by A. D. Moore
Checked Drew	Notes Moore Date 12/32
Date Mar 1934	Indexed A. C. Johnson 12-29-1932

F.B. 502 Pg. 26

Note: ANY ADDITIONS OR CHANGES ON THIS SHEET MUST BE MADE OR CIRCLED IN Red Ink. WITH DATE AND NAME OF PERSON MAKING CHANGE.

Do not extend notes this side of this line

RETURN TO
LOS ANGELES COUNTY SURVEYOR
700 HALL OF RECORDS

SURVEY
of
OCASO AVE.
from
6th ST
to
IMPERIAL HIGHWAY
W O.# 7090

Party
Moore
VanFleet
Fenner
Newman
Harris

Dec. 6-19, 1932

FORM 847 10M 8-31

F.B. 502 Pg. 76

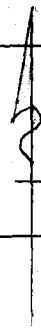

IMPERIAL HIGHWAY

84

83

DIAGONAL

FOSTER ROAD

82

Proposed COYOTE AVE

81

ROSECRANS AVE

For Topog See pgs. 85-94

Proposed

80

80

NEYER ROAD

OSTRO

79

CENTER ST

LA MIRADA

AT&SF

78

ROAD

RR

ST

77

RETURN TO
LOS ANGELES COUNTY SURVEYOR
700 HALL OF RECORDS

Do not extend notes this side of this line

Note: ANY ADDITIONS OR CHANGES ON THIS SHEET MUST BE MADE OR CIRCLED IN Red Ink. WITH DATE AND NAME OF PERSON MAKING CHANGE.

Notes Ck'd by Drew	Survey of Ocaso Ave
Map No. B-823	W. O. 7090 Tape No. 033 St'd 68 °F.
Office Work Rice	Surveyed by L. D. Moore
Checked Drew	Notes Moore Date 12-7-32
Date Mar 1934	Indexed C. Johnson

F.B. 502 PG. 77

To bottom, pg. 78

(30) (30)

2641.18 FB 494-86

L.A. Co. Bdy

Orange Co. Bdy

OCASO AVE

T. 68°

654.22

Fd NYT PP

Fd NYT - Tel. P

84.30

48.56

89° 50' 05" adj.

FB 494-86

2640.20

L.A. Co. Bdy

Orange Co. Bdy

To L.A. Co. Bdy Post #27
6" iron Pipe with
+ in center
FB 494-86

Fd NYT - PP

10.83

95.38

Fd NYT - PP

0+00 going North
L.A. Co. Bdy Post #28
Fd 6" iron post - #28
stamped on top - L.A. Co. on
N.W. - O. Co on S.E. side
Punch Mark in center
Post 2' above ground
FB 52-76
FB 494-86

RETURN TO
LOS ANGELES COUNTY SURVEYOR
700 HALL OF RECORDS

Do not extend notes this side of this line

Note: ANY ADDITIONS OR CHANGES ON THIS SHEET MUST BE MADE OR CIRCLED IN Red Ink. WITH DATE AND NAME OF PERSON MAKING CHANGE.

FORM 247 10M 5-31

RETURN TO
LOS ANGELES COUNTY SURVEYOR
700 HALL OF RECORDS

Note: ANY ADDITIONS OR CHANGES ON THIS SHEET MUST BE MADE OR CIRCLED IN **Red Ink.** WITH DATE AND NAME OF PERSON MAKING CHANGE.

Do not extend notes this side of this line

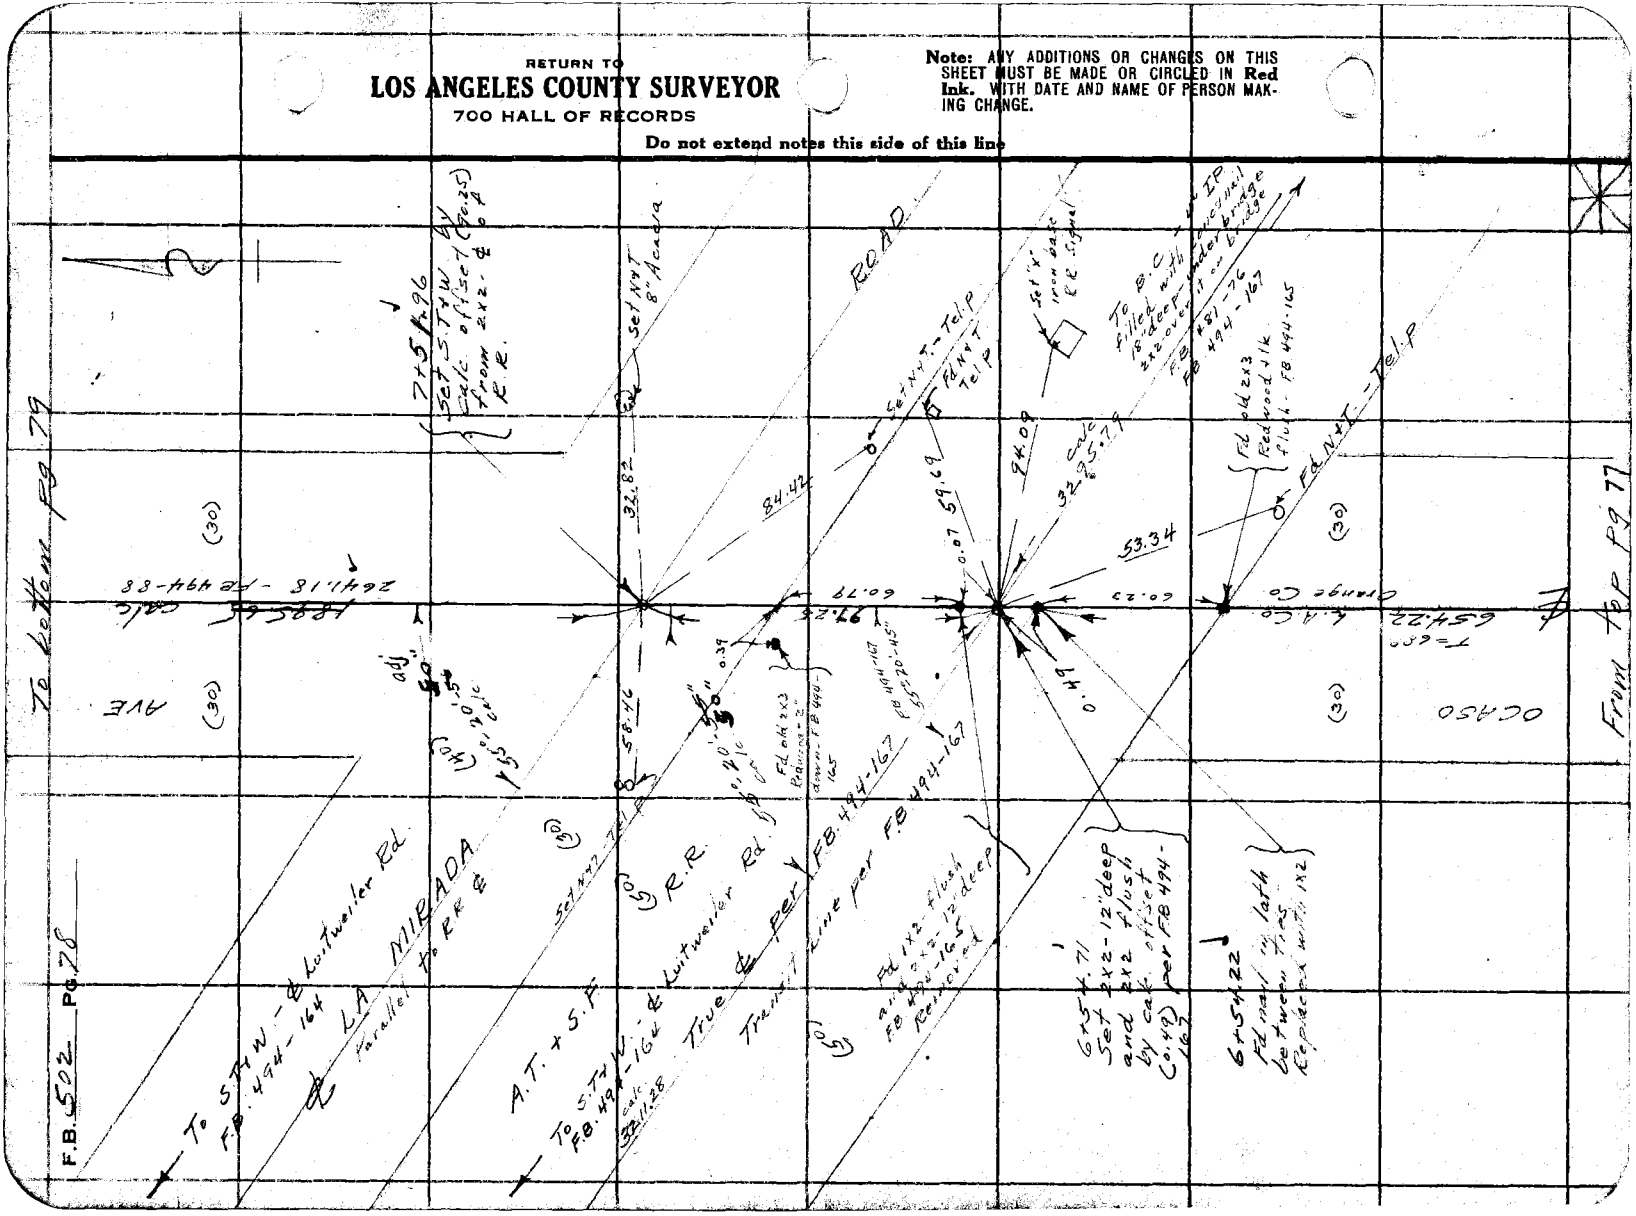

Notes Ck'd by Drew	Survey of Ocaso Ave
Map No. B-823	W.O. 7070 Tape No. 023 St'd 66 °F.
Office Work Rees	Surveyed by L. D. Moore
Checked Drew	Notes Moore Date 12-7-32
Date Mar 1934	Indexed A. C. Johnson

F.B. 512 Pg. 79

To bottom pg 80

40'

(40)

AVE

1320.30

1319.76 @ 70° = 1319.78

1320.28 @ 70° = 1320.30

3960.96
P.O.T
Set 2x2
18" deep

Note: ANY ADDITIONS OR CHANGES OR THIS SHEET MUST BE MADE OR CIRCLED IN Red Ink. WITH DATE AND NAME OF PERSON MAKING CHANGE.

Do not extend notes this side of this line

RETURN TO
LOS ANGELES COUNTY SURVEYOR
700 HALL OF RECORDS

2641.18
L.A Co Bdy. Post
#29 - Fd 6" iron
post - #29 stamped
on top - L.A Co on
NW - O. Co on S.E
Side - Post 2' above
ground - Punch Mark
in Center
FB 2-78
FB 494-88

1319.78

SANTA GERTRUDES AVE

L.A Co Bdy

O Co Bdy

QUITWEILER RD

FENCE PP

CENTER

FB 494-88

90°

01'-10"

01'

2641.94
FB 494-88

85-29

FENCE

Fd. C.S. Mon
18" deep - 3x12
Brass Tag
FB 494-88

Guy P

L.A Co Bdy
2675.46
FB 494-89

O. Co. Bdy

36.80

23.90

36.72

4.67

Fd "X" - irrig. outlet

50'

L.A Co Bdy
Post #30
6" iron post
1' above grd
Punch mark in
center
FB 494-89

OCASO

2641.18
FB 494-88

From top pg 78

FORM 247 10M 8-31

RETURN TO
LOS ANGELES COUNTY SURVEYOR
700 HALL OF RECORDS

Note: ANY ADDITIONS OR CHANGES ON THIS SHEET MUST BE MADE OR CIRCLED IN **Red Ink.** WITH DATE AND NAME OF PERSON MAKING CHANGE.

Do not extend notes this side of this line

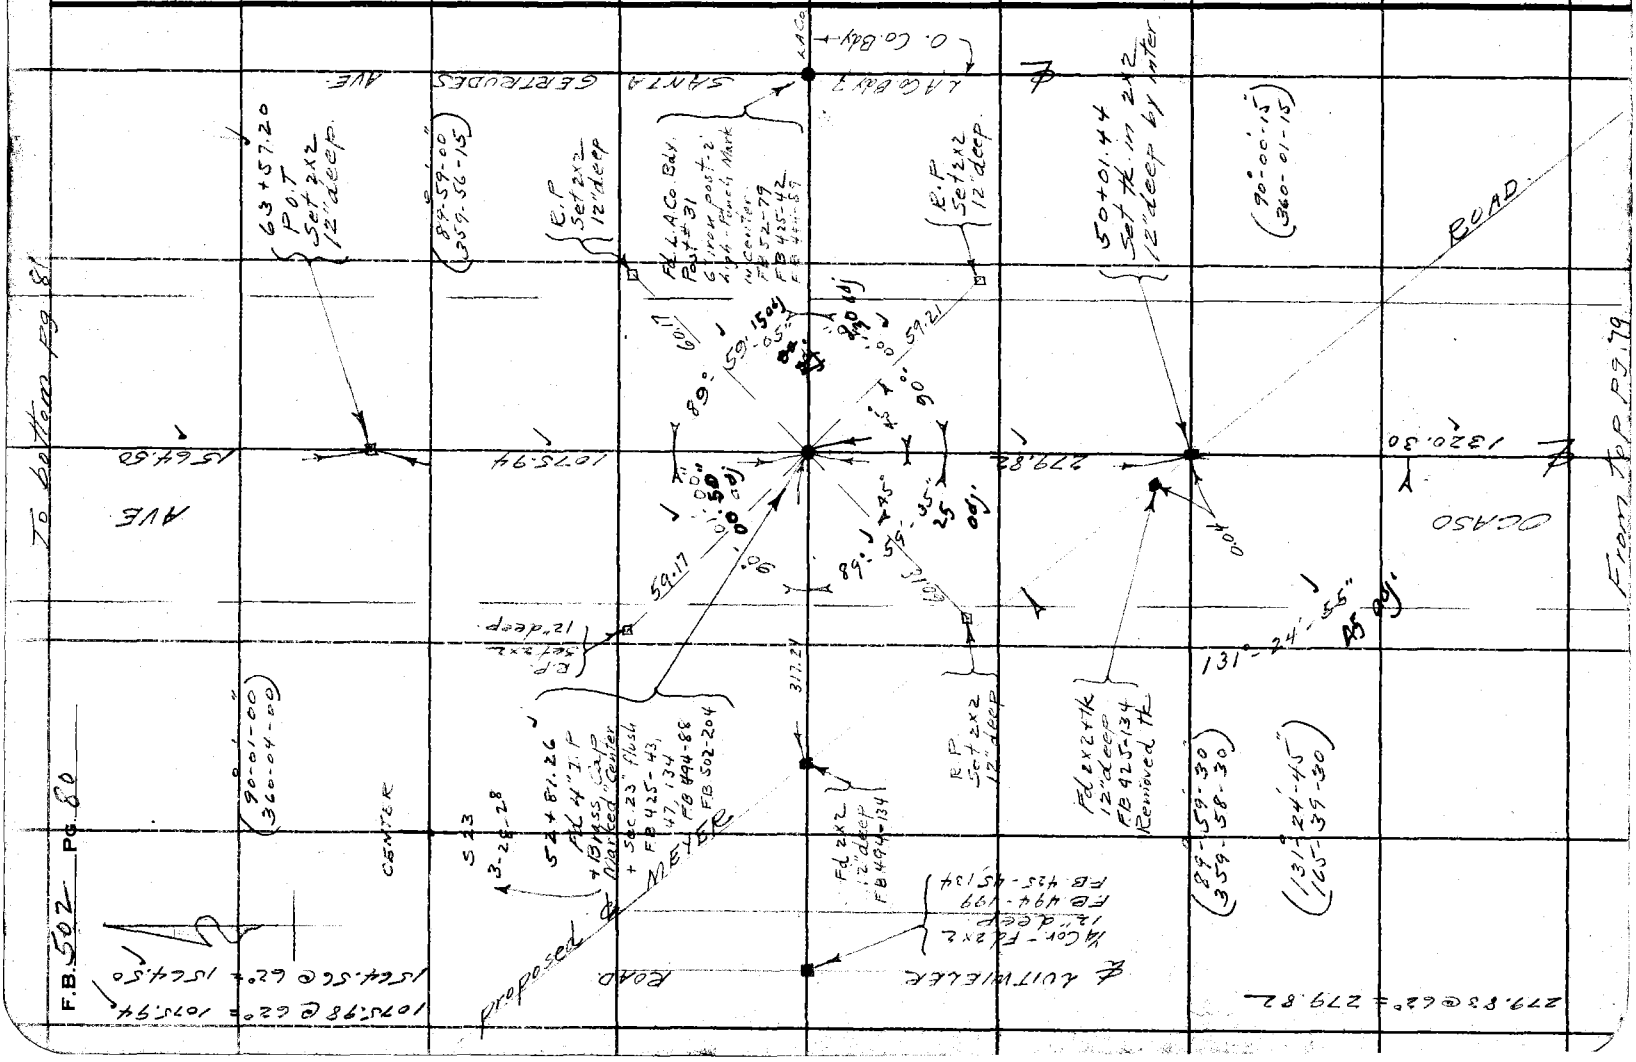

Notes Ck'd by Prew	Survey of Case Ave.
Map No. B-823	W. O. 7090 Tape No. 033 St'd 68 °F.
Office Work Rice	Surveyed by L. D. Moore
Checked Drew	Notes R. Moore Date 12-5-32
Date Mar 1934	Indexed A. C. Johnson

F.B. 502 Pg. 81

To bottom pg 82

Note: ANY ADDITIONS OR CHANGES ON THIS SHEET MUST BE MADE OR CIRCLED IN Red Ink. WITH DATE AND NAME OF PERSON MAKING CHANGE.

Do not extend notes this side of this line

RETURN TO
LOS ANGELES COUNTY SURVEYOR
700 HALL OF RECORDS

97+86.75
P.O.T.
Fd 2x2 - 12" deep
FB 481-71

456.68
FB 481-71

PET. SEC Co.
S 14
4
S 23
3-28-28

AVE

451.13
FB 481-11

(89°-41'-45")
(35-8-46-45)

40' 40'

Office Fenced

79+21.70
Fd. 4" I.P. & B.C. - Marked as shown above - bearing East - Straight line it up and put it on line - calling 6.03 south of position per FB 48[illegible] and FB 481-71 - Inter position same as above references. Pipe is flush

Fd N+T - Post
1.3 N
1.6
26.06
3E 5W

93+35.62
P.O.T.
Fd 2x2
12" deep
FB 481-71

1413.92
FB 481-71

(20) (20)

CERRITOS

Fd N+T-PP

ROAD

R.P. Set 2x2 12" deep

Fd N+T-PP

41-40 Adj.

89°-41'

59.71

49.34

59.16

ROSECRANS (30)

15°

198.86

R.P. Set 2x2 12" deep

AVE

57.02

56.61

57.28

57.99

Fd 2x2 12" deep FB 481-8

89°-59'

59.30 Tang

59.79 Tang

(30)

Fd NAIL Tel P.

Fd. Nail in washer in 12" olive

QUITWEILER

36.19

24.07

Fd 2x2-3" deep Set over C.S. Mon 18" deep per FB 494-20 N.W. Cor Sec 23 T3S-R11W FB 481-8

(89°-59'-30")
(359-58-00)

40 adj.

R.P. Set 2x2 12" deep

OCASO

1564.50

R.P. Set 2x2 12" deep

Fd C.S. Mon. 18" deep N.E. Cor. Sec. 23 T3S-R11W FB 502-20 FB 481-8

SANTA GERTRUDES

Tang. 2x2 12" deep R.P.'s

From top pg 80

FORM 247 10M 5-31

RETURN TO
LOS ANGELES COUNTY SURVEYOR
700 HALL OF RECORDS

Note: ANY ADDITIONS OR CHANGES ON THIS SHEET MUST BE MADE OR CIRCLED IN **Red Ink.** WITH DATE AND NAME OF PERSON MAKING CHANGE.

Do not extend notes this side of this line

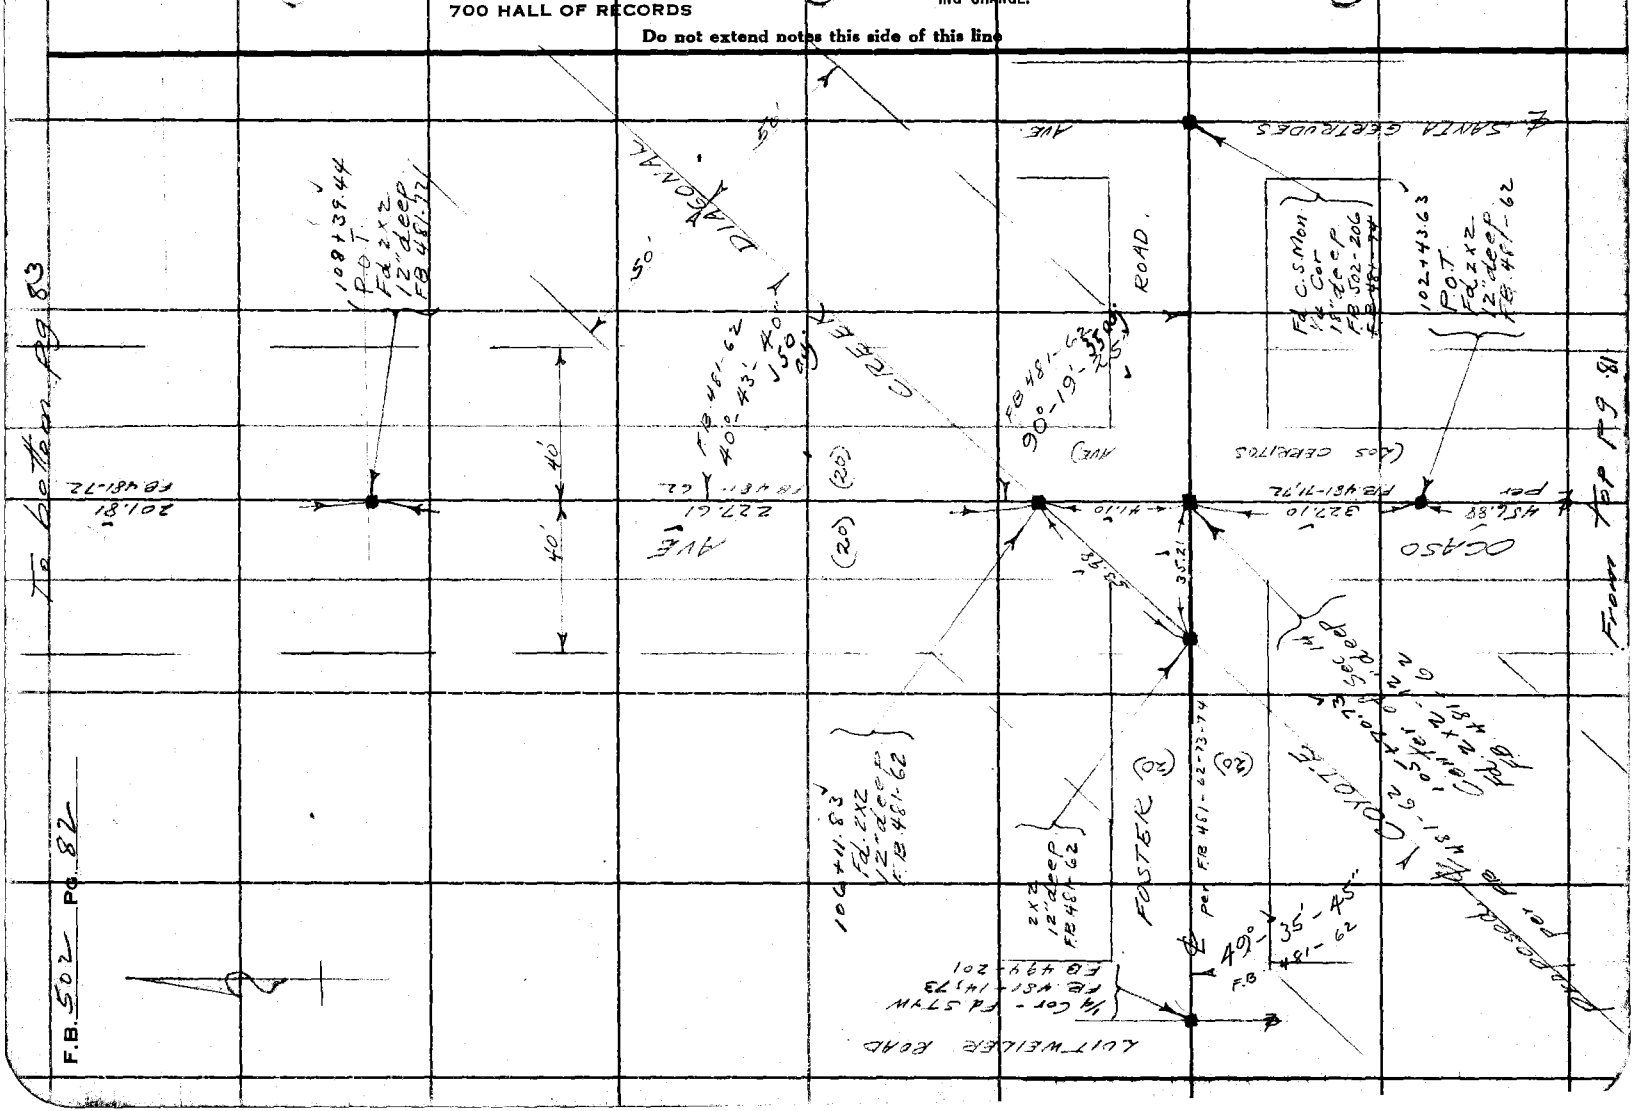
108+39.44
P.O.T.
Fd. 2"x2"
12" deep
F.B. 481-62
Fd. C.S.Mon
1/4 Cor
15" deep
F.B. 502-206
F.B. 481-62
102+43.63
P.O.T.
Fd. 2"x2"
12" deep
F.B. 481-62
104+11.83
Fd. 2"x2"
12" deep
F.B. 481-62
2"x2"
12" deep
F.B. 481-62
1/4 Cor - Fd STAW
F.B. 481-62-73-74
F.B. 481-1473
F.B. 499-201
Per F.B. 481-62-73-74
Per F.B. 481-62

Notes Ck'd by	Drew	Survey of	Ocaso Ave
Map No.	B-823	W. O.	7090
Office Work	[illegible]	Surveyed by	L. D. Moore
Checked	Drew	Notes	L Moore
Date	Mar 1934	Indexed	A. C. Johnson 12-23-1932

Tape No. ____ St'd ____ °F.

Date 12-19-32

F.B. 502 Pg. 85

TOPOGRAPHY
on
OCASO AVE
from
6th ST
to
IMPERIAL HIGHWAY
W.O.# 7090

Dec. 19, 1932

For ℄ See Pgs 77-84

Note: ANY ADDITIONS OR CHANGES ON THIS SHEET MUST BE MADE OR CIRCLED IN Red Ink, WITH DATE AND NAME OF PERSON MAKING CHANGE.

Do not extend notes this side of this line

RETURN TO
LOS ANGELES COUNTY SURVEYOR
700 HALL OF RECORDS

FORM 247 10M 8-31

RETURN TO

LOS ANGELES COUNTY SURVEYOR

700 HALL OF RECORDS

Note: ANY ADDITIONS OR CHANGES ON THIS SHEET MUST BE MADE OR CIRCLED IN **Red Ink.** WITH DATE AND NAME OF PERSON MAKING CHANGE.

Do not extend notes this side of this line

F.B. 502 Pg. 86

Notes Ck'd by	Drew	Survey of	Ocaso Ave
Map No.	B-823	W. O.	7090
Office Work	Rec	Tape No.	033
Checked	Drew	St'd	66 °F.
Date	Mar 1934	Surveyed by	K D Moore
		Notes	Moore
		Date	12-8-32
		Indexed	A. C. Johnson

F.B. 502 Pg. 83

To bottom Pg. 84

Fd old N+T - 6" orange

Set "X" in cor. iron fence post

(147°-56'-15" 231-45-00)

P.I. 131+03.45
Fd 2x2
18" deep
F.B. 358-38

Fd old N+T - 6" orange

(147°-56'-15" 231-45-00)

Set "X" in cor. iron fence post.

Fd old N+T 6" orange

B.C. 190+24.60
2x2-12" deep
F.B. 358-44

AVE

129+92.55
2x2-12" deep
F.B. 358-43

184+90.26
2x2-12" deep
F.B. 358-43

485.17
F.B. 358-43

F.B. 358-38

Fd 2" I.P. set in conc 6" high
F.B. 358-38, 43

129+88.12
Fd 2" I.P. with L+T
6" deep
F.B. 358-38, 43
F.B. 481-72
See Marginal sketch for ties

2" I.P.
F.B. 358-36
F.B. 481-72

EC-181+89.70
2x2-12" deep
F.B. 358-42

Fd N+T-PP.

Fd "X" conc. irreg outline

Ocaso Ave

122+76.57
P.O.T.
Fd 1x2 flush
F.B. 481-72
Replaced with 2x2-12" deep

2" I.P. + L+T

Fd N+T PP.

Ocaso

110+91.25
P.O.T.
Fd 2x2
12" deep
F.B. 481-72

From top Pg. 82

RETURN TO
LOS ANGELES COUNTY SURVEYOR
700 HALL OF RECORDS

Note: ANY ADDITIONS OR CHANGES ON THIS SHEET MUST BE MADE OR CIRCLED IN Red Ink. WITH DATE AND NAME OF PERSON MAKING CHANGE.

Do not extend notes this side of this line

FORM 247 10M 8-31

F.B. 502 Pg. 84

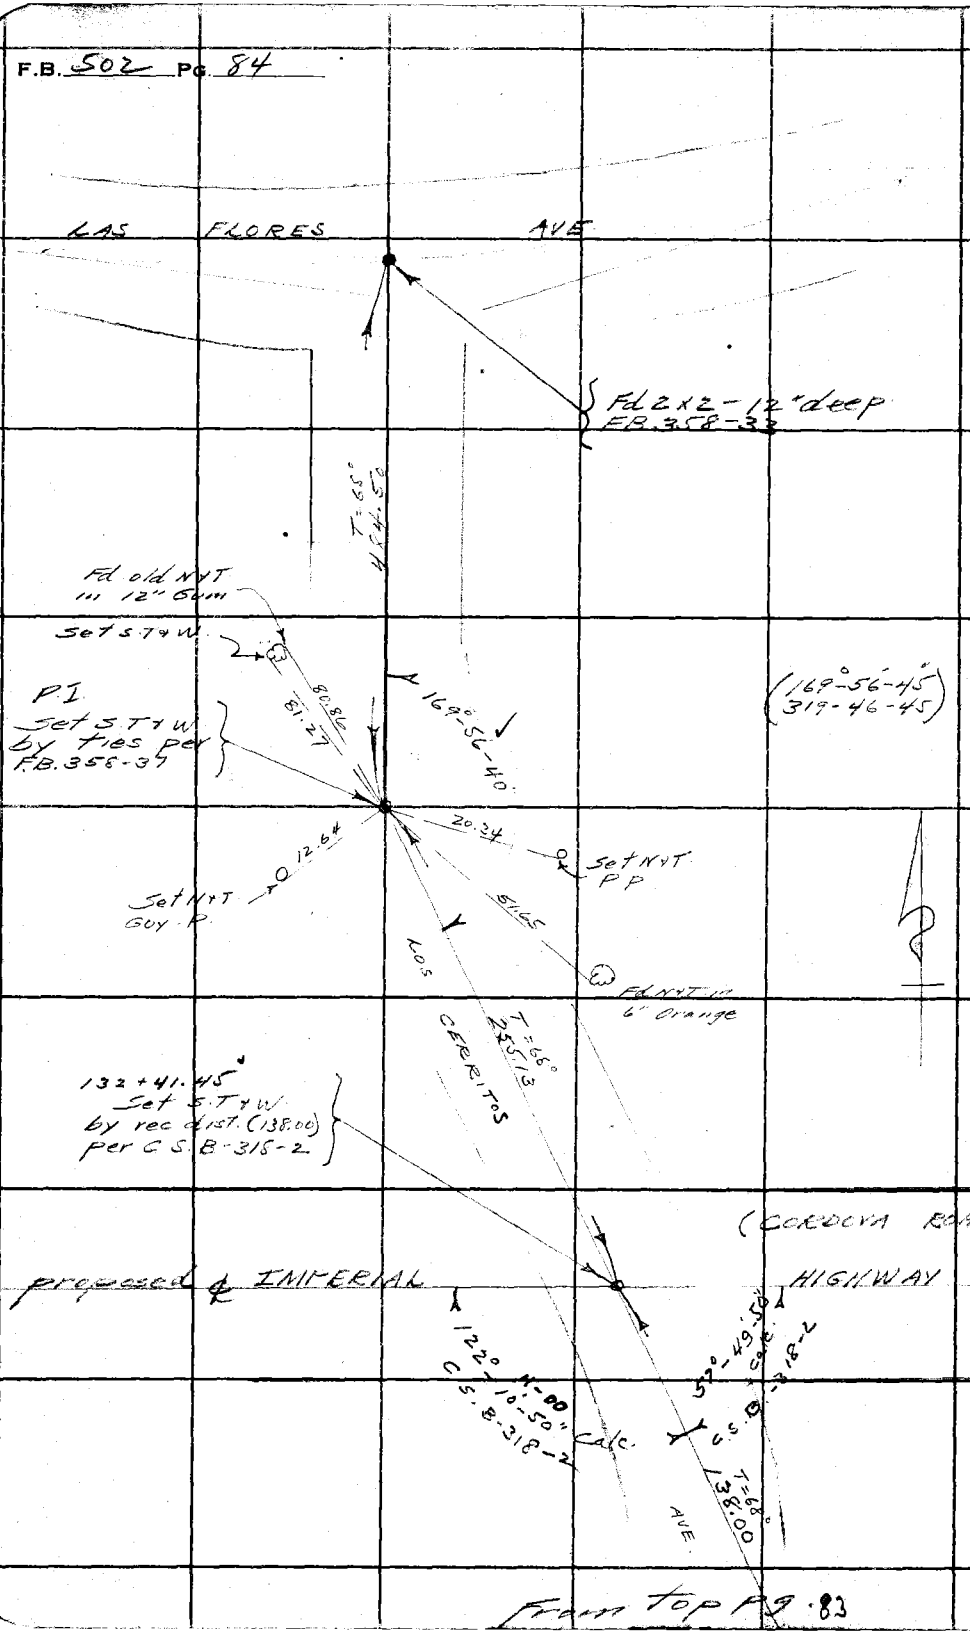

From top Pg. 83

RETURN TO
LOS ANGELES COUNTY SURVEYOR
700 HALL OF RECORDS

Do not extend notes this side of this line

Note: ANY ADDITIONS OR CHANGES ON THIS SHEET MUST BE MADE OR CIRCLED IN Red Ink. WITH DATE AND NAME OF PERSON MAKING CHANGE.

Notes Ck'd by Drew
Map No. B-233
Office Work Rec
Checked Drew
Date Mar 1934

Survey of Ocaso Ave
W. O. 7090 Tape No. ____ St'd ____ °F.
Surveyed by C. D. Moore
Notes Moore Date 12-19-32
Indexed A. C. Johnson

F.B. 502 Pg. 87

To both pg. 88

Note: ANY ADDITIONS OR CHANGES ON THIS SHEET MUST BE MADE OR CIRCLED IN Red Ink. WITH DATE AND NAME OF PERSON MAKING CHANGE.

Do not extend notes this side of this line

RETURN TO
LOS ANGELES COUNTY SURVEYOR
700 HALL OF RECORDS

FORM 247 10M 5-31

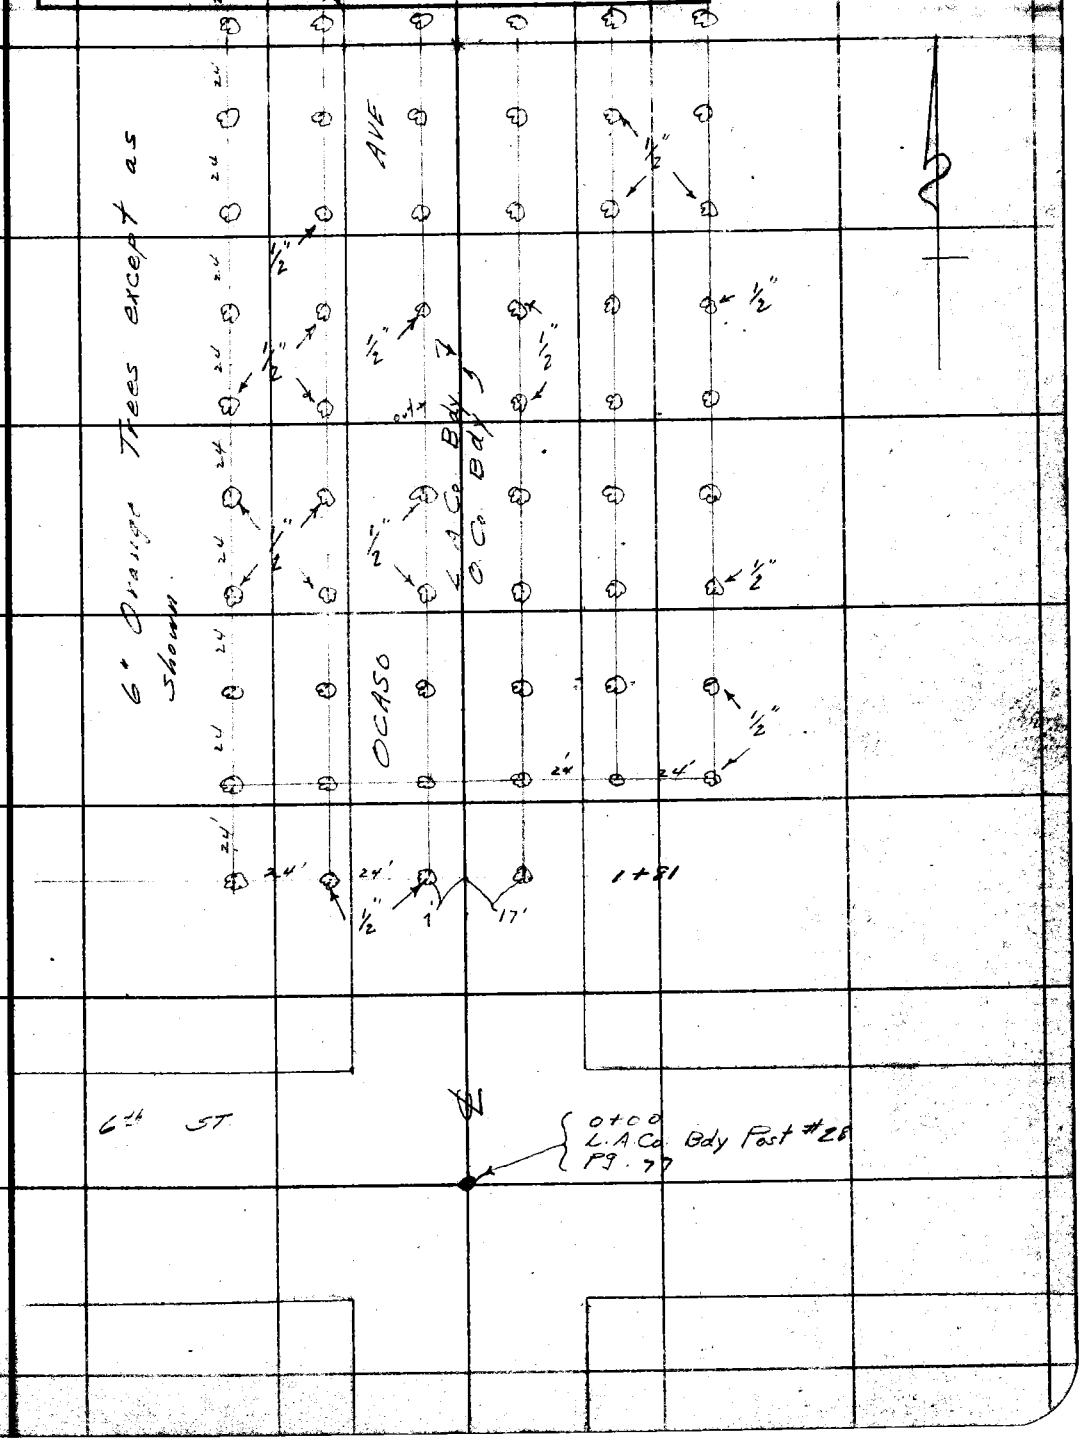

RETURN TO
LOS ANGELES COUNTY SURVEYOR
700 HALL OF RECORDS

Note: ANY ADDITIONS OR CHANGES ON THIS SHEET MUST BE MADE OR CIRCLED IN **Red Ink.** WITH DATE AND NAME OF PERSON MAKING CHANGE.

Do not extend notes this side of this line

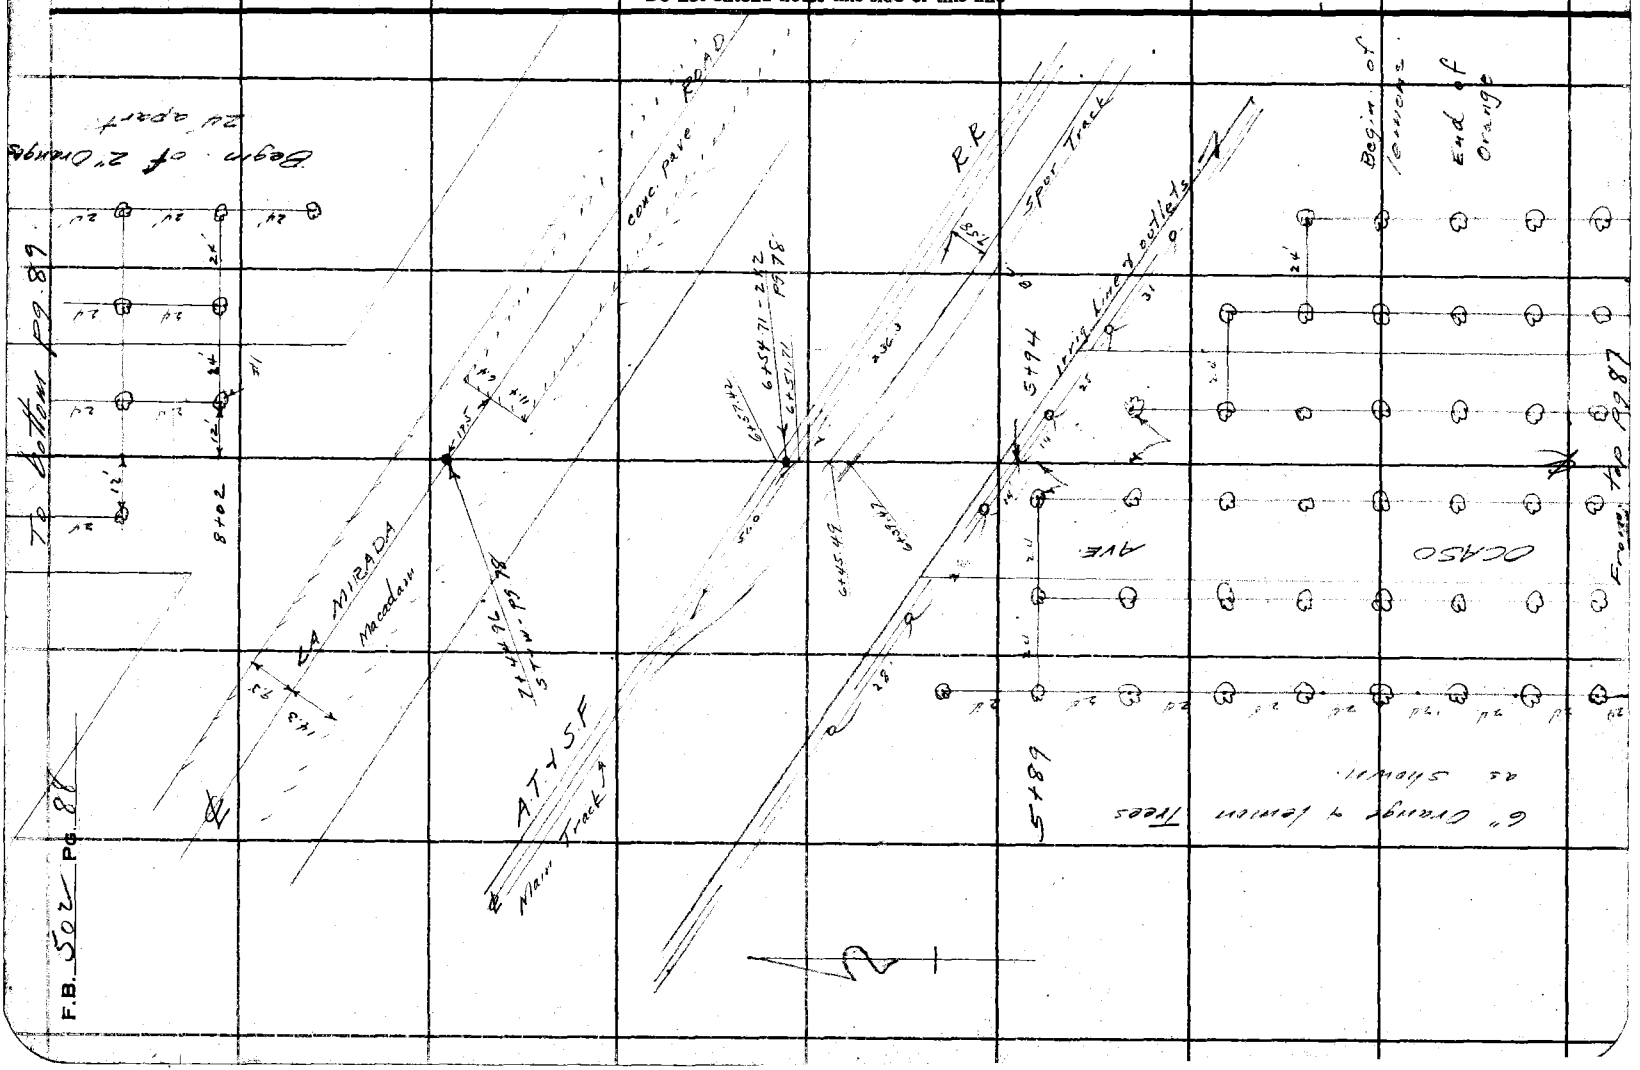

Notes Ck'd by Drew	Survey of
Map No. B-823	W. O. 2090 Tape No. St'd of.
Office Work Rice	Surveyed by L. D. Moore
Checked Drew	Notes Moore Date 12-19-32
Date Mar 1934	Indexed A. C. Johnson

F.B. 503 Pg. 89

To bottom Pg 90

Note: ANY ADDITIONS OR CHANGES ON THIS SHEET MUST BE MADE OR CIRCLED IN Red Ink. WITH DATE AND NAME OF PERSON MAKING CHANGE.

Do not extend notes this side of this line

RETURN TO
LOS ANGELES COUNTY SURVEYOR
700 HALL OF RECORDS

FORM 247 10M 8-31

From Top Pg 88

F.B. 502 Pg. 90

To bottom pg. 91

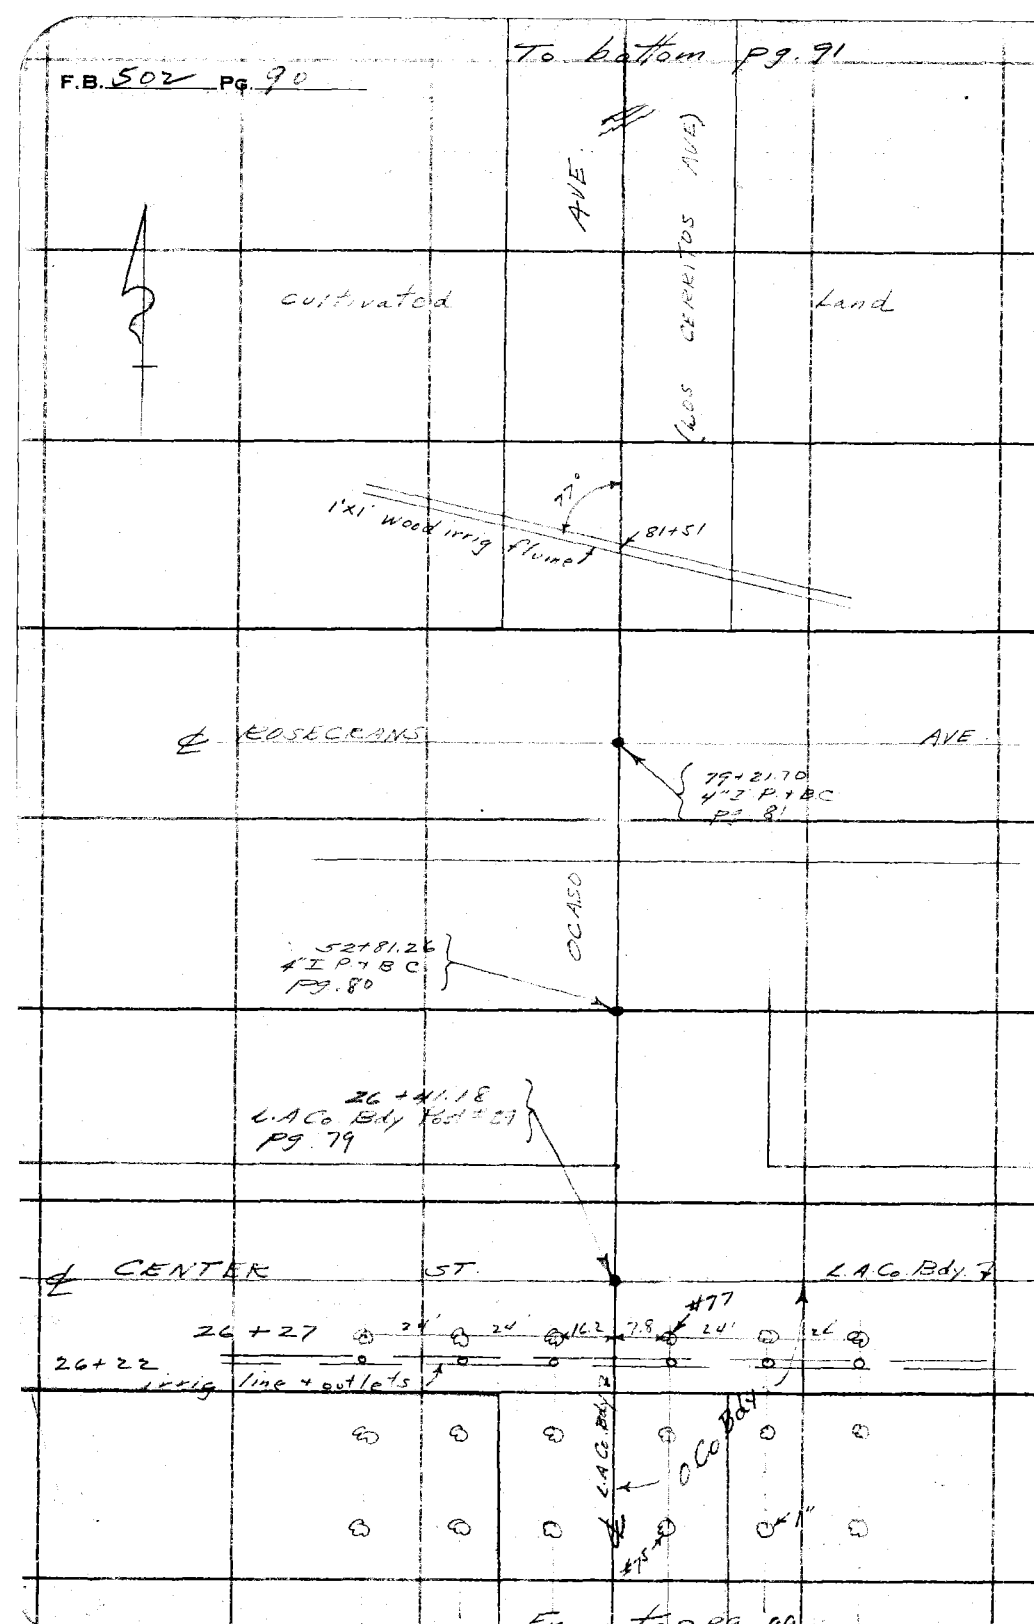

From top pg 89

RETURN TO
LOS ANGELES COUNTY SURVEYOR
700 HALL OF RECORDS

Do not extend notes this side of this line

Note: ANY ADDITIONS OR CHANGES ON THIS SHEET MUST BE MADE OR CIRCLED IN Red Ink. WITH DATE AND NAME OF PERSON MAKING CHANGE.

Notes Ck'd by Drew	Survey of Ocaso Ave
Map No. R-823	W. O. 7090 Tape No. St'd ° F.
Office Work Rec.	Surveyed by L. D. Moore
Checked Drew	Notes Moore Date 12-19-32
Date Mar 1934	Indexed A. C. Johnson

F.B. 502 Pg. 91

To bottom Pg. 92

Note: ANY ADDITIONS OR CHANGES ON THIS SHEET MUST BE MADE OR CIRCLED IN Red Ink, WITH DATE AND NAME OF PERSON MAKING CHANGE.

RETURN TO
LOS ANGELES COUNTY SURVEYOR
700 HALL OF RECORDS
Do not extend notes this side of this line

OCASO AVE (LOS CERRITOS AVE)

Begin 2 rows of 2" oranges

22' 31.3 123+86.5

wire fence 5' 30.88 123+77

stucco wall R=10' 123+63

50.0

123+37

123+29

123+22

14' 1 Story Stucco House 62'

55.9 123+07

stucco wall & wire fence

wire fence 7

2-2" Avacados 21.7' 22' 21.17 122+91 22.3 122+87

2-2" oranges 22' 33.3 122+78

1/2" persimmon 44.3 122+66

22.3 122+58

2-2" Avacados 22' 33.4 122+50

2-3" Pears 24' 44.3 122+45

2" orange 55.0 122+34

4-1/2" Avacado 6' 6' 5' 55.6 122+27

122+76.57 2x2 - pg 83

- 8 - 1/2" Avacados

From Top pg 90

FORM 247 10M 8-31

RETURN TO

LOS ANGELES COUNTY SURVEYOR

700 HALL OF RECORDS

Note: ANY ADDITIONS OR CHANGES ON THIS SHEET MUST BE MADE OR CIRCLED IN **Red Ink.** WITH DATE AND NAME OF PERSON MAKING CHANGE.

Do not extend notes this side of this line

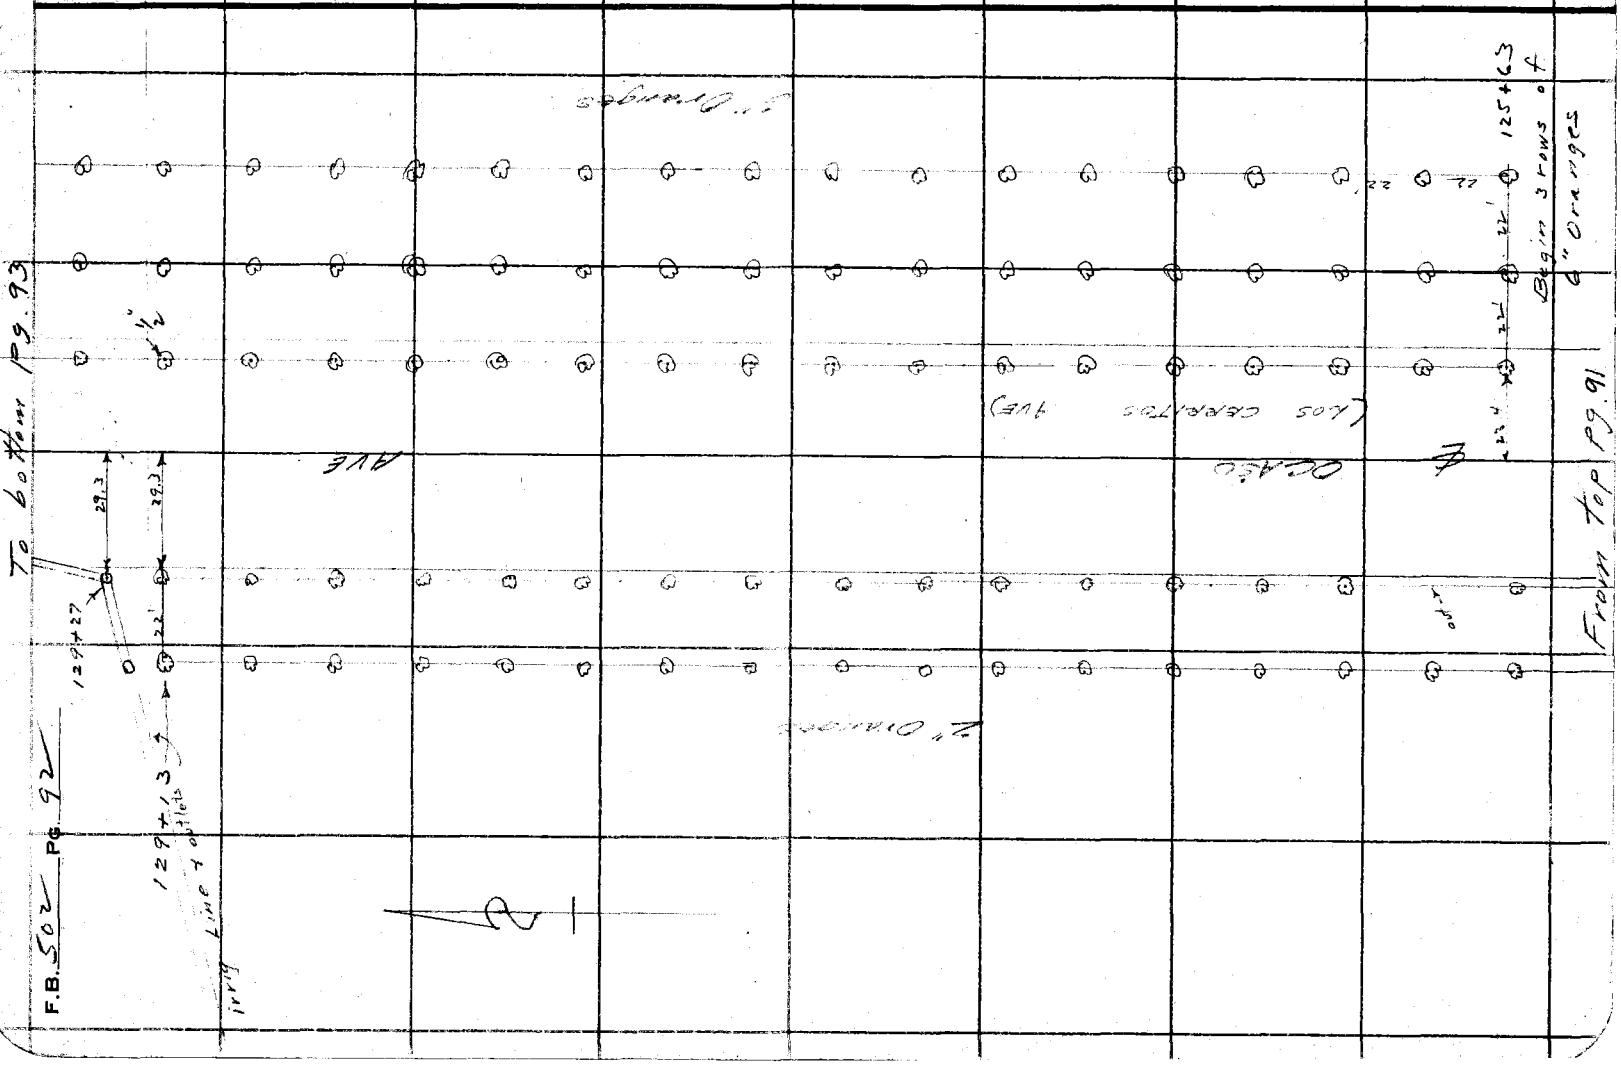

Notes Ck'd by Drew	Survey of Ocaso	F.B. 502 Pg. 93	
Map No. B-823	W. O. 7090	Tape No.	St'd °F.
Office Work Rees	Surveyed by L.D. Moore		
Checked Drew	Notes Moore	Date 12-19-32	
Date Mar 1934	Indexed A. C. Johnson		

Note: ANY ADDITIONS OR CHANGES ON THIS SHEET MUST BE MADE OR CIRCLED IN Red Ink, WITH DATE AND NAME OF PERSON MAKING CHANGE.

Do not extend notes this side of this line

RETURN TO
LOS ANGELES COUNTY SURVEYOR
700 HALL OF RECORDS

FORM 247 10M 8-31

(CORDOVA ROAD)
IMPERIAL HIGHWAY
AVE
OCASO CREEK
1 story Stucco House
6" Oranges
Irrig. line & outlets
132+24
132+13
131+65
131+55
131+44
131+35
P.I. 131+03.45 Pg. 83
130+63.7
130+57
130+52
130+49
130+44
130+28.5
130+06 - 30" Standpipe - 4 valve box
129+88.12 2" I.P. Pg. 83
129+82 End of 6" oranges
From Top Pg. 92

RETURN TO

LOS ANGELES COUNTY SURVEYOR

700 HALL OF RECORDS

Note: ANY ADDITIONS OR CHANGES ON THIS SHEET MUST BE MADE OR CIRCLED IN **Red Ink.** WITH DATE AND NAME OF PERSON MAKING CHANGE.

Do not extend notes this side of this line

F.B. 502 Pg 94

Date _____ Notes by _____ Chief Party _____ F. B. 502 PG. 135

Plotted by Taylor
Date
Map No.
Plotting Checked by
Date

W. O. No. 7086 Sec. of Map
Location Holder Ave.
Surveyed by Rosecrans
Date 9-26-32
A. C. Johnson
Recorded

HOLDER AVE. SURVEY.

WO. 7086.

Sept. and Oct. 1932.

From S. ¼ Cor. of Sec. 27 T. 3 S. R. 11 W., also the ℄ of Artesia Ave. to N. ¼ Cor. of Sec. 15 T. 3 S., also the ℄ of Imperial Highway.

Party E. A. Rosecrans
P. W. Atkins
F. H. Blanchard
H. H. Reynolds

Tape #.022
Transit #16858

RETURN TO LOS ANGELES COUNTY SURVEYOR

Do not write on this side of this line

Notice: ANY ADDITIONS OR CHANGES ON THIS SHEET MUST BE MADE BY CIRCLED IN RED WITH DATE AND NAME OF PERSON MAKING CHANGE.

F.B. 502 Pg. 136 Rosecrans Chief Party Notes by Date 11-15-32

Center St.

Index to notes.

Holder Ave.

(44 to 150)

T. 3 S. R. 11 W.

Sec. 27

Manchester Blvd.

Southern Pacific R.R.

Proposed ℄

Artesia Ave.

(150) (141) (143) (142) (140) (142) (139)

RETURN TO
LOS ANGELES COUNTY SURVEYOR
Do not extend notes this side of this line

Notes: ANY ADDITIONS OR CHANGES ON THIS SHEET MUST BE MADE OR CIRCLED IN Red. WITH DATE AND NAME OF PERSON MAKING CHANGE.

Date _____ Notes by _____ Chief Party _____ F. B. 502 Pg. 47

Platted by Taylor
Date
Map No.
Plotting C'k'd by
Date

W. O. No. 1000 D. C. O. No.
Location Holder Ave.
Surveyed by Rosecrans
Date Nov. 1932
Inked by C. Johnson

Note: ANY ADDITIONS OR CHANGES ON THIS SHEET MUST BE MADE OR CIRCLED IN Red. WITH DATE AND NAME OF PERSON MAKING CHANGE.

Do not extend notes this side of this line

RETURN TO
LOS ANGELES COUNTY SURVEYOR

Index to notes.

Rosecrans Ave.

Holder Ave.

Topo 2. 172 To 178

Old L. A and San Diego Stage Rd

La Mirada

A. T. and S. F.

Coyote Creek Diagonal

T. 3 S. R. 11 W.

Sec. 22

Valley View Ave.

Proposed ℄

Proposed R. R. Road

Line Change pg. 187 E

Center St.

150 151 152 153 154 155 156 157 158 159 160 168 169 171 187 188 189 190

RETURN TO

LOS ANGELES COUNTY SURVEYOR

Notes: ANY ADDITIONS OR CHANGES ON THIS SHEET MUST BE MADE OR CIRCLED IN **Red.** WITH DATE AND NAME OF PERSON MAKING CHANGE.

Do not extend notes this side of this line

Date

Notes by

Chief Party

Form 5 Rev. 1963

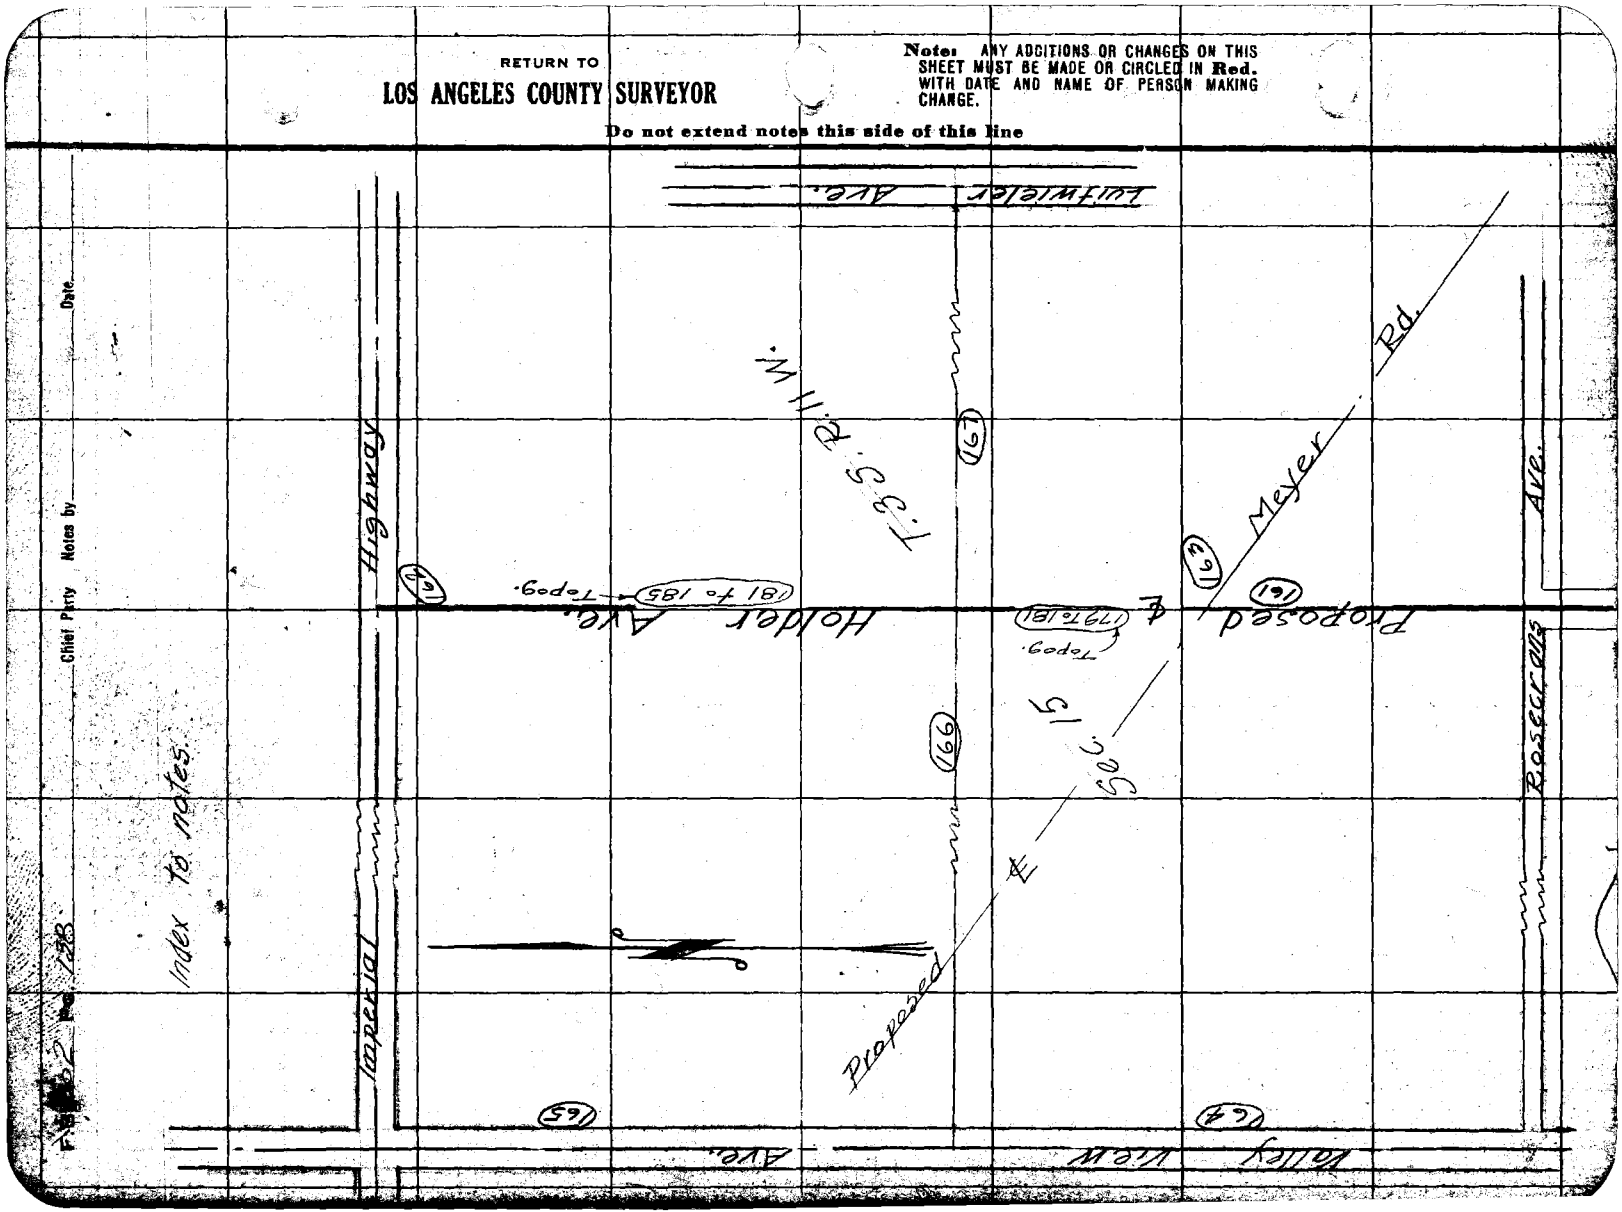

Notes Ck'd by Dyer	Survey of Taylor Ave		F.B. 502 Pg. 27
Map No. C.S. B-820	W. O. 7686	Tape No. 022	St'd 84 °F.
Office Work Taylor	Surveyed by Roscrans		
Checked Dyer	Notes	Date 8-26-32	
Date July-1934	Indexed A. C. Johnson		

Cont. bottom next page.

To 3 Mi T. in R.R. E with

pro. left page 27 See next page

2.0

10" Conc. standpipe Sta. 9+80.0

14" Conc. irrigation valve Sta. 9+50.0

1585.74 T. 80 = 1585.76

1585.70

325.66 T. 82

90°-11'-10" adj

Sta. 2+64+55.50

T. Sta. 4+49.20

P.C. Sta. 4+15.12

Rd. Lead-mill

3.55

2.82

Int. Sta. 0+00 to N. Set L.T. Ft. 54 N. producing 1.14

Artesia (30)

8.93

325.66

Ave.

Conc. pavement.

2.09

3.61

Fd. L.T.

50.00

(30)

10'

10'

Sta. 27+20.49

T. Sta. 4+49.20 + 2.00

50.00

R.P. 3/4" x 24" Iron pipe

1.18 Dn. N. Set Ft.

Note: ANY ADDITIONS OR CHANGES OF THIS SHEET MUST BE MADE IN Red Ink, WITH DATE AND NAME OF PERSON MAKING CHANGE.

Do not extend notes this side of this line

RETURN TO
LOS ANGELES COUNTY SURVEYOR
700 HALL OF RECORDS

FORM 247 10M 8-31

RETURN TO

LOS ANGELES COUNTY SURVEYOR

700 HALL OF RECORDS

Note: ANY ADDITIONS OR CHANGES ON THIS SHEET MUST BE MADE OR CIRCLED IN **Red Ink.** WITH DATE AND NAME OF PERSON MAKING CHANGE.

Do not extend notes this side of this line

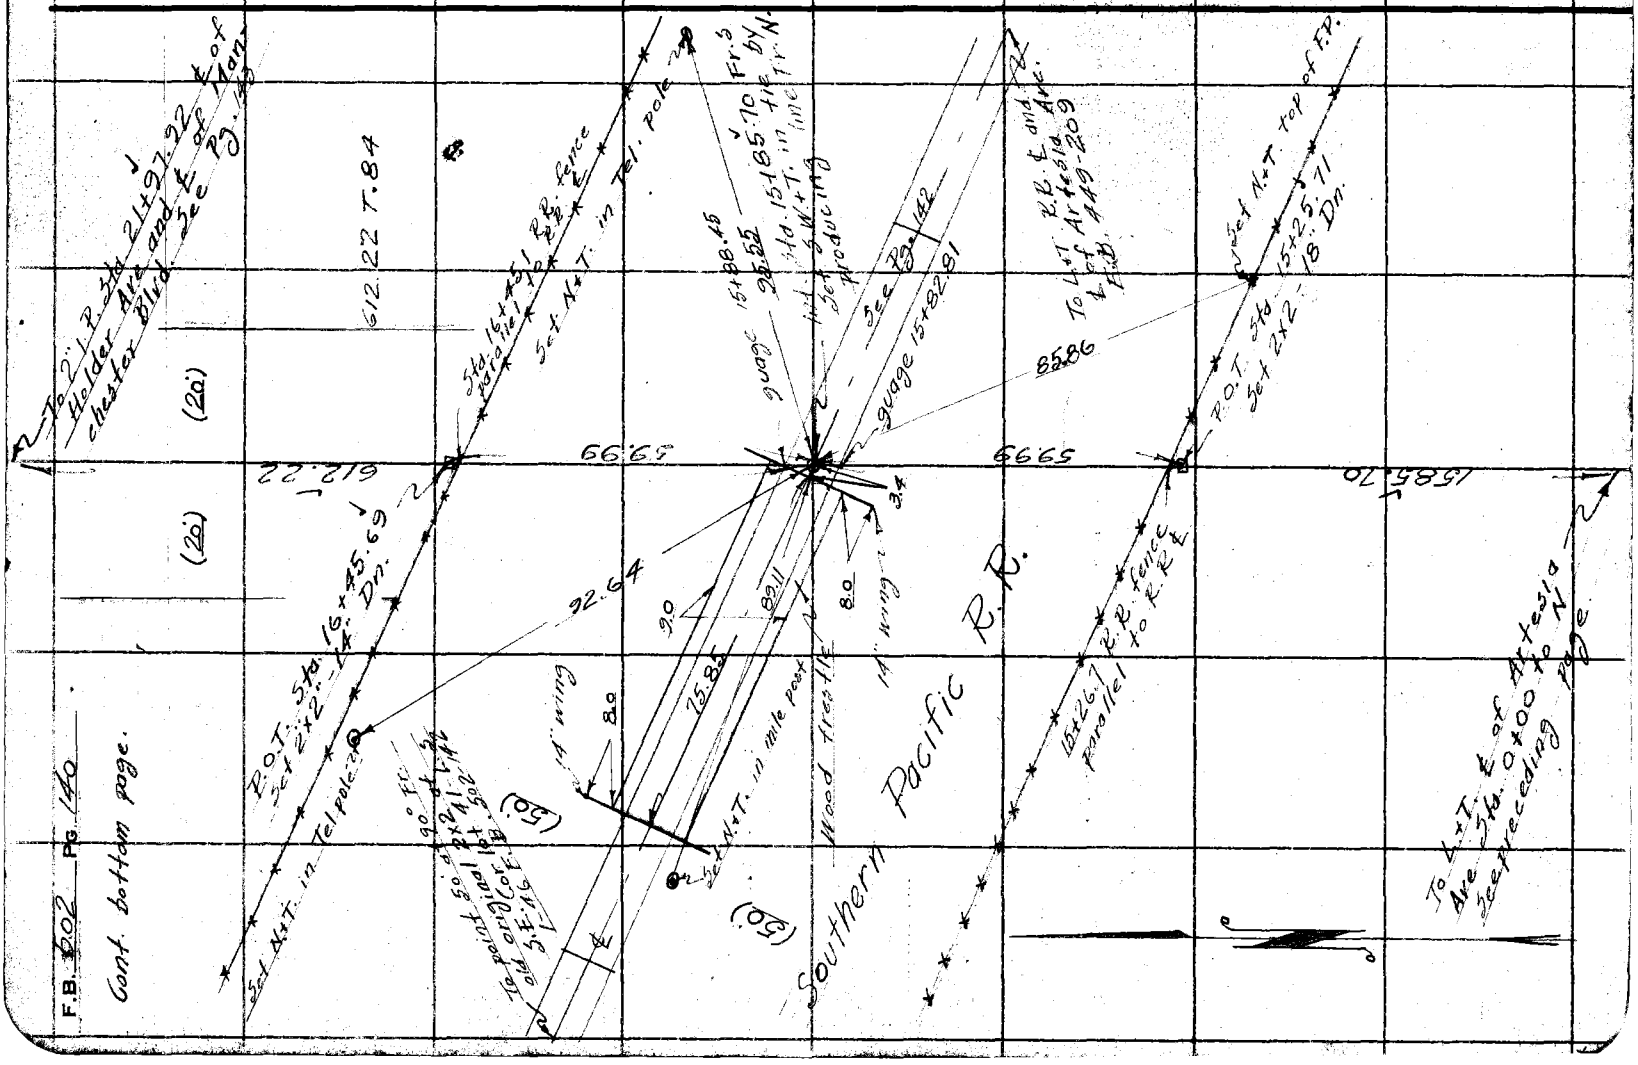

Notes Ck'd by Drew	Survey of Hoover Ave	F.B. 502	Pg. 141
Map No. CS B-820	W.O. 2086 Tape No. 062 Ck'd 84 of F.		
Office Work Taylor	Surveyed by Bowman		
Checked Drew	Notes	Date 9-29-32	
Date July 1934	Indexed A. C. Johnson		

Note: ANY ADDITIONS OR CHANGES ON THIS SHEET MUST BE MADE IOR CIRCLED IN Red Ink. WITH DATE AND NAME OF PERSON MAKING CHANGE.

RETURN TO
LOS ANGELES COUNTY SURVEYOR
700 HALL OF RECORDS

Do not extend notes this side of this line

Set 1x2" flush Sta. 29+11.87 x 553°E.

5.15

Fd. old 2x2" pine stake flush Sta 29+13.19

270.54

26+55.5

270.56 T. 14 = 270.54

5.19

Sta. 26+42.59 Fd. old 2x2" pine stake flush

Sta 26+41.33 Set 1x2" flush

1320.14 15' offset line

1320.23 T. 14 = 1320.14

Fence

5.00

13+21.32 Ft. E. Fd. 2" I.P. and conc. N. Cor. lots 42+43 F.B. 103-86 F.B. 494-80

Sta. 13+21.19 nail in L.S. 1-46

Set 1x2" Sta. 13+21.19

Fence

1321.19

1321.28 T. 14 = 1321.13

5.00

Sta. 0+00 to W. Fd. 2" I.P. and conc. 6" above nail in Conc. F.B. 494-81 + 103-87 and F.B. 167 N.E. Cor. lot 44 L.S. 1-46

Sta. 0+00 Set 1x2" flush

FORM 247 10M 8-31

F.B. 502 Pg. 142

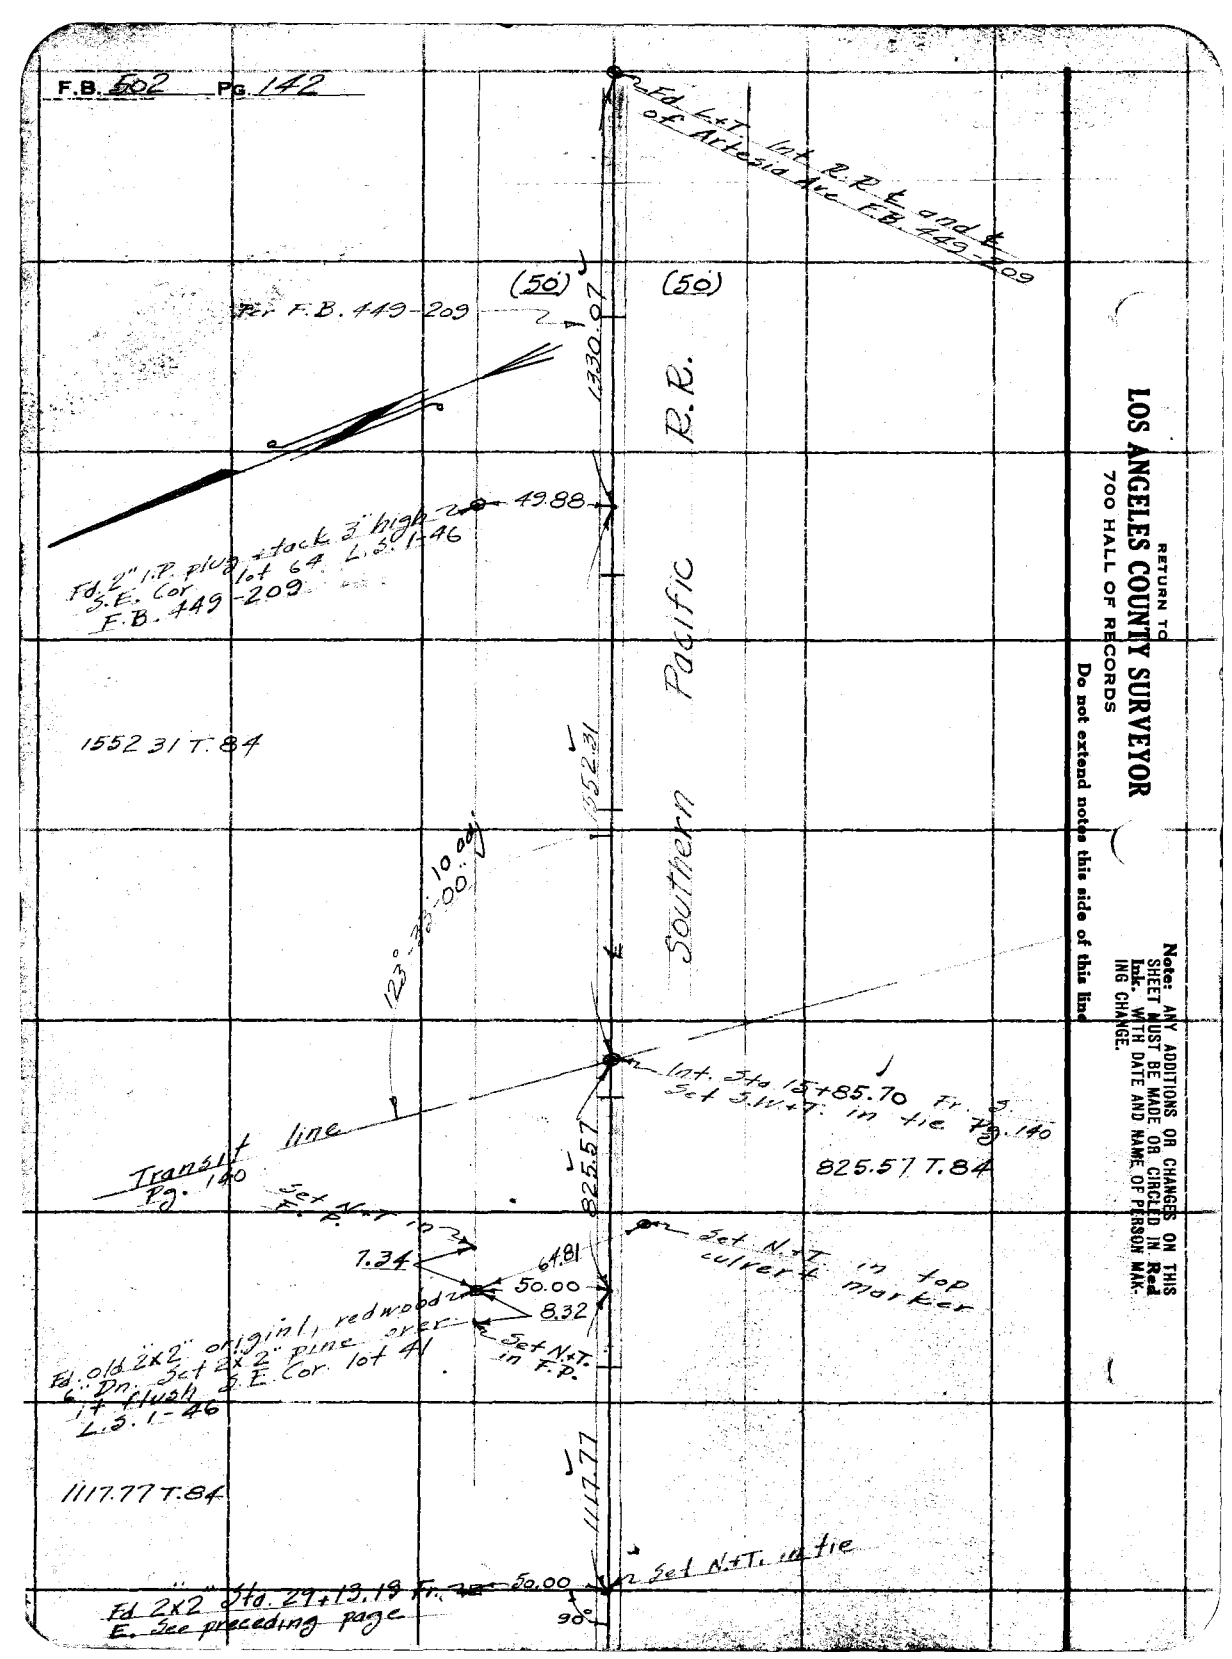

RETURN TO
LOS ANGELES COUNTY SURVEYOR
700 HALL OF RECORDS

Do not extend notes this side of this line

Note: ANY ADDITIONS OR CHANGES ON THIS SHEET MUST BE MADE OR CIRCLED IN **Red Ink** WITH DATE AND NAME OF PERSON MAKING CHANGE.

Notes Ck'd by Drew	Survey of Holder Ave.
Map No. B-8491	W. O. 7086 Tape No. 922 St'd 84 oF.
Office Work Taylor	Surveyed by Rosecrans
Checked Drew	Notes Date 8-31-32
Date July 1934	Indexed C. Jacobson

F.B. 502 Pg. 143

Cont. bottom

Sta. 0+00 Fd 2" I.P. in Conc. and N. & W. line

1321.32

5.00

5.00

Fence

5' offset line Pg. 141

Sta. 26+23.15 Set 1/2" Flush

Sta. 13+21.32 Fr. ℄ Sta. 26+28.15 in Pg. 141 1" I.P. and nail 0.6' above Dn Sta. Conc. 3" P. 18 S.E. Set, 24" out 15.00 out and N.W. Fr. ℄

56-27-00
225-48-00 ⓐ
338-42-00 ⓑ
56-27-00

(20) (20)

89°53'30" 20 adj

89-53-30
359-34-00 ⓐ
179-21-00 ⓑ
89 53 30

500.22 T.86 = 500.23

500.23

To 2" I.P. with Spk. center Sta. 601+57.74 Blvd. & Manchester F.A. 41-221 P.O.T.

123-12-00
132-48-15 ⓐ
19-12-30 ⓒ
123-12 05

41.77

Sta. 0+00 I.P. in Conc. 19 Dn

Sta. 2+39.69 Fd 2" Spk. center in F.A. 41-221

Manchester ℄

56°27'00" 26-45 adj

50.02

123°-12'-05" 89°-49'-30" 19 (50)

Sta. 21+37.92 Fd 2" I.P. with Spk. center 18 Dn of C.S. 8818 Int. F.B. 103-86

50.01

Blvd.

(50)

Sta. with F.A.

21+56.16 Fd 2" I.P. Spk center 18 Dn A1-221

41.76

To 3" W.T. Sta. 15+85.70 ℄ of Southern Pacific R.R. Sec Pg. 140

To 2" I.P. in Conc 5" Dn ℄ and W. line Manchester Blvd and Tr. 7251 F.A. 41-224

612.22

Note: ANY ADDITIONS OR CHANGES OF THIS SHEET MUST BE MADE OR CIRCLED IN Red Ink WITH DATE AND NAME OF PERSON MAKING CHANGE.

Do not extend notes this side of this line

RETURN TO
LOS ANGELES COUNTY SURVEYOR
700 HALL OF RECORDS

FORM 247 10M 8-31

F.B. 502 Pg. 144

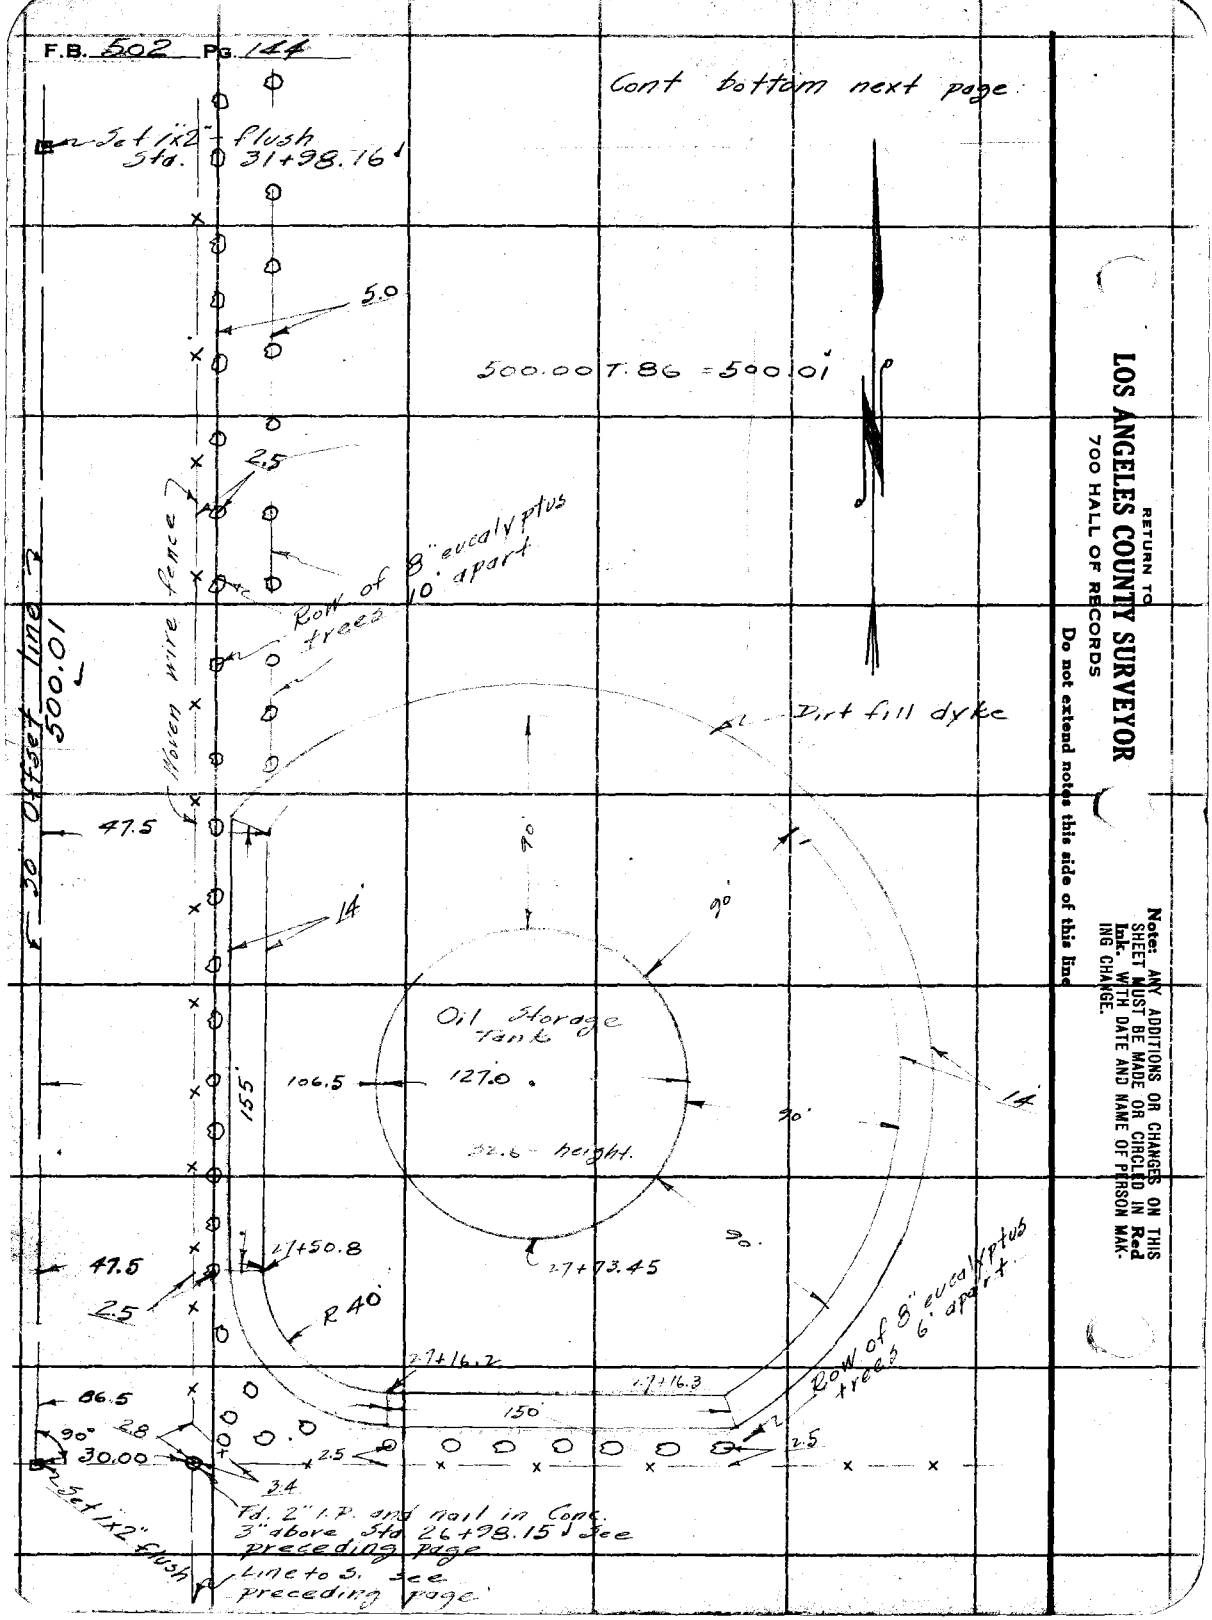

RETURN TO
LOS ANGELES COUNTY SURVEYOR
700 HALL OF RECORDS

Do not extend notes this side of this line

Note: ANY ADDITIONS OR CHANGES ON THIS SHEET MUST BE MADE OR CIRCLED IN Red Ink. WITH DATE AND NAME OF PERSON MAKING CHANGE.

Notes Ck'd by Drew	Survey of Holder Ave
Map No. 2-820	W. O. 7086 Tape No. 022 St'd 84 °F.
Office Work Taylor	Surveyed by Castellano
Checked Drew	Notes Date 8-31-32
Date July - 1934	Indexed A. C. Johnson

F.B. 502 Pg. 145

Cont bottom next page

500.00 T.86 = 500.01

Set 1x2 flush 36+98.1

Set 1x2 flush 36+98.16 See preceding page

30.0

5.0

Row of 8" Gum trees 10' apart

56.7

30 Offset Line 500.01

2.5

130'

Dirt fill dyke

14'

90.0

Steel Oil Storage Tank 33' High

125.7

Wire fence

14'

32+36.0

90°

54.4

Wire fence

32+18.2

90°

30'

5.0

Row of 8" Gum trees 10' apart.

Note: ANY ADDITIONS OR CHANGES OR THIS SHEET MUST BE MADE IN OR CIRCLED IN Red Ink. WITH DATE AND NAME OF PERSON MAKING CHANGE.

Do not extend notes this side of this line

RETURN TO
LOS ANGELES COUNTY SURVEYOR
700 HALL OF RECORDS

FORM 247 10M 8-31

F.B. 502 Pg. 146

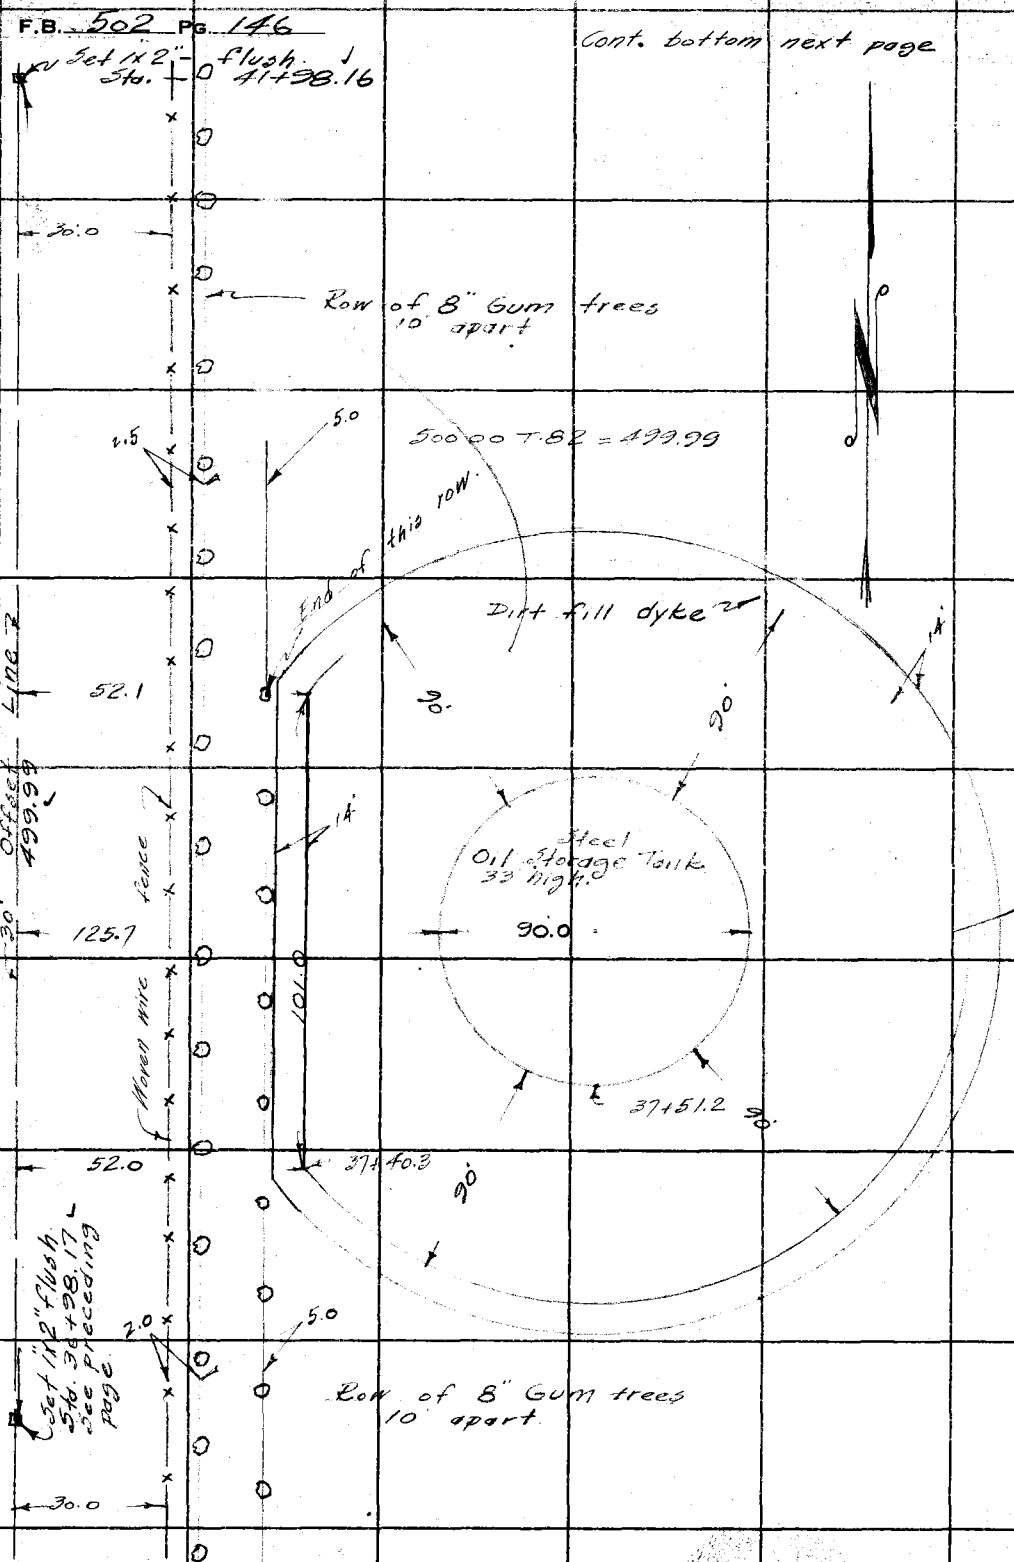

RETURN TO
LOS ANGELES COUNTY SURVEYOR
700 HALL OF RECORDS

Do not extend notes this side of this line

Note: ANY ADDITIONS OR CHANGES ON THIS SHEET MUST BE MADE OR CIRCLED IN Red Ink. WITH DATE AND NAME OF PERSON MAKING CHANGE.

Notes Ck'd by Dre	Survey of Holder Ave
Map No. B-820	W. O. 7686 Tape No. 022 St'd 84 °F.
Office Work Taylor	Surveyed by Rosecrans
Checked Dre	Notes Date 8-31-32
Date July 1934	Indexed A. C. Tamson

F.B. 308 PG. 147

Note: ANY ADDITIONS OR CHANGES OF THIS SHEET MUST BE MADE IN OR CIRCLED IN Red Ink. WITH DATE AND NAME OF PERSON MAKING CHANGE.

Do not extend notes this side of this line

RETURN TO
LOS ANGELES COUNTY SURVEYOR
700 HALL OF RECORDS

Cont. bottom next page

14+28.2 Beginning of Row of 8" Gum trees 10' apart.

Row of 8" Gum trees 10' apart.

Set 1"x2" Plug Sta. 14+38.13

2.5

30.0

140.00 T. 74 = 439.97

Dirt fill dyke

45.8

30' Offset Line 2 439.97

Fence

106.4

30'

194.0

Woven Wire

120'

Steel Oil Storage tank 40' high.

90°

12+62.6

12+00.2

46.3

Set 1"x2" Plug Sta. 11+98.16 See preceding page

2.5

14'

FORM 247 10M 8-31

RETURN TO

LOS ANGELES COUNTY SURVEYOR

700 HALL OF RECORDS

Note: ANY ADDITIONS OR CHANGES ON THIS SHEET MUST BE MADE OR CIRCLED IN **Red Ink.** WITH DATE AND NAME OF PERSON MAKING CHANGE.

Do not extend notes this side of this line

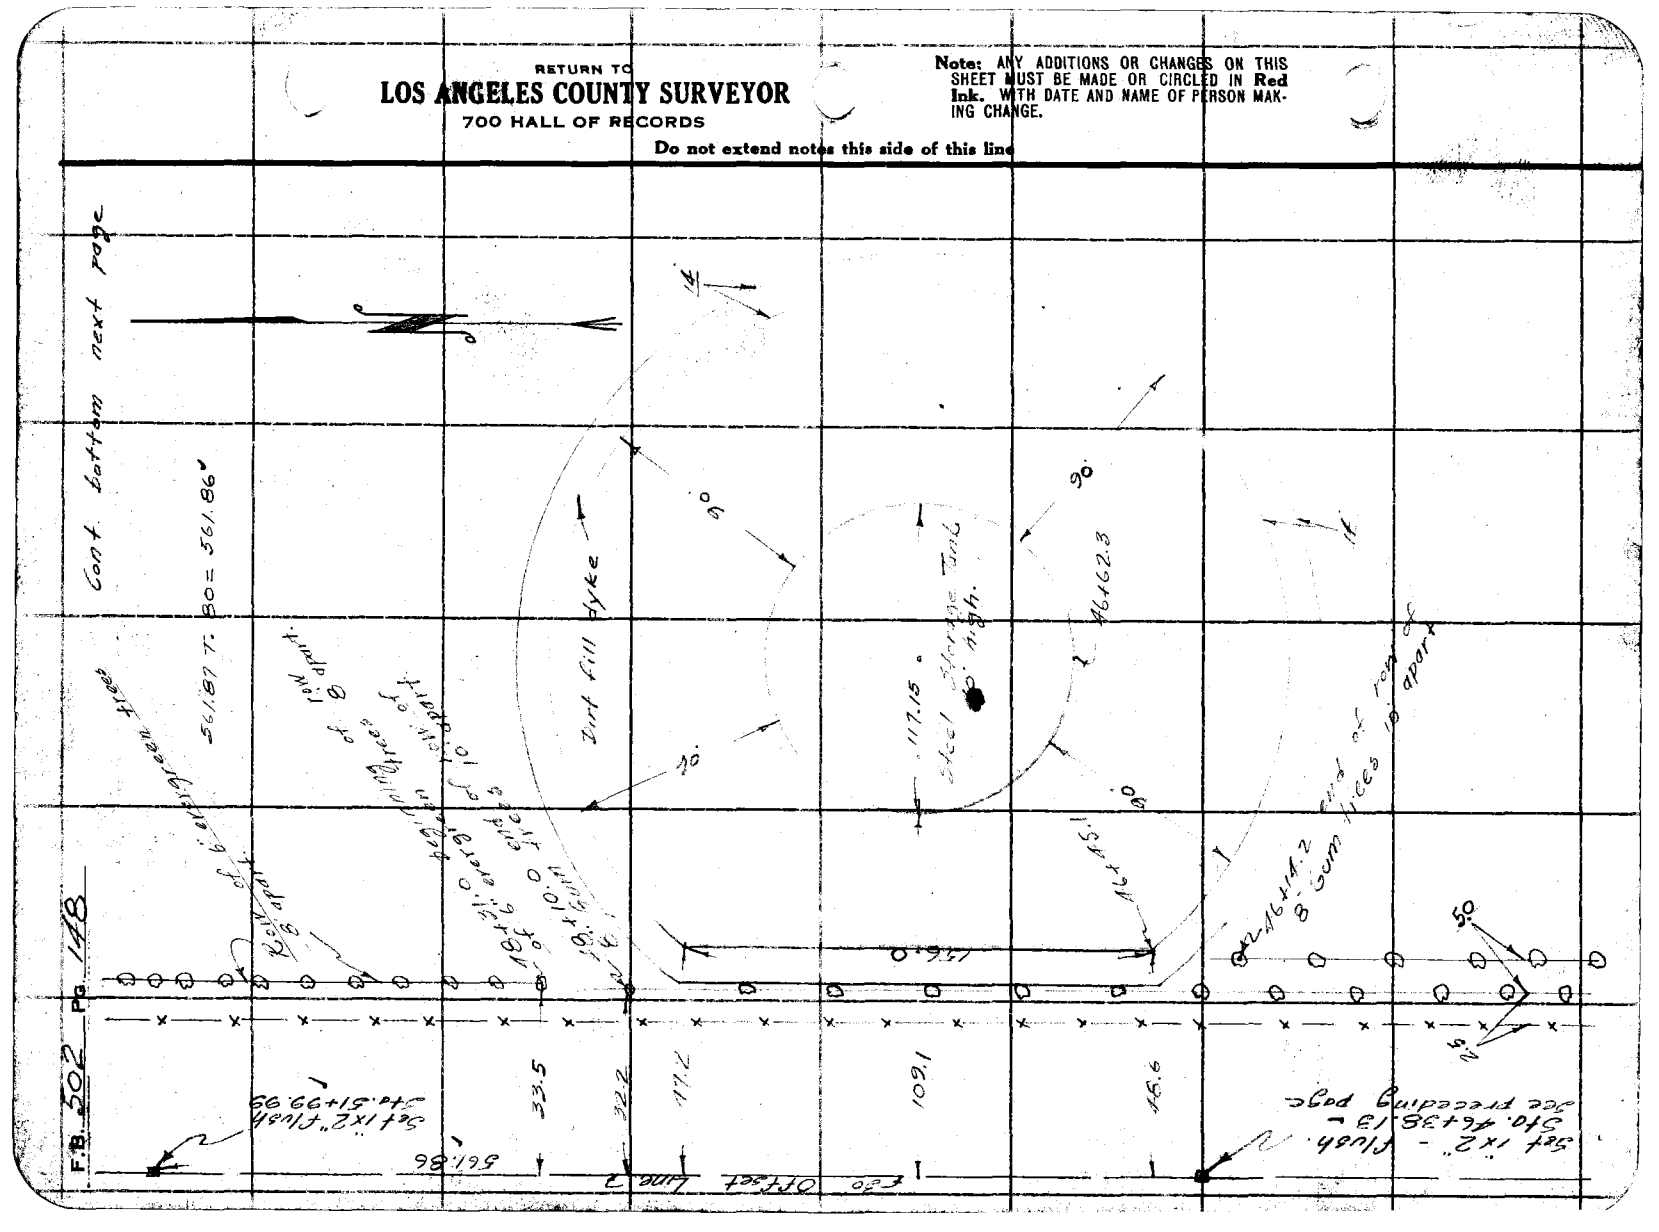

Notes Ck'd by	Drew	Survey of	Holmes Ave
Map No.	B-820	W. O.	7086
Office Work	Zyda	Tape No.	022
Checked	Drew	Surveyed by	Cosgrans
Date	July 1934	Notes	
		Date	9-2-32
		Indexed	A. C. Johnson

F.B. 502 Pg 149

Center St.

See next page.

30.00

Sta. 53+39.38 Fd. 2" I.P. plug + nail 4.7 Dp See next page

Sta. 53+39.24 Fd. 2" I.P. 5.62 N.E.

53+09.3

8" iron guard post 53+10.6

55.4

29.9

39.6

53+08.3

2 Gum tree

65.6

53+09.3

69.8

60.8

10" acacia 53+00.5

1" Hydrant 52+98.1

3.0

conc. walk

25.4

4 gum tree 9.4

61.2

27.5

52+74.4

10" Palm

8" Palm 52+74.4

25.0

4 gum tree

24.8

end of row of 6' evergreen trees 8' apart

1" Hydrant 52+50.7

60.3

58.2

Porch

6.6

31.3

Conc walk 93.2

2.5

20.5

8.7

1.8

1.8

24.7

1 Gum tree

Row of 8' evergreen trees 8' apart.

139.46

28.3

40.5

40.5

1 Floor Frame House

1 Gum tree

25.0

52+11.9

10" Pear tree 52+07.9

78.9

52+01.9

1" water hydrant

52+01.9

60.3

83.1

3.0

Porch 8.0

13.0

3.5

51+94.1

10" umbrella tree

2" fire hydrant 51+68.0

76.7

89.6

82.5

51+51.1

12.1

Wood garage

16.5

Set 1x2" 5/8 51+99.99 See preceding page

Line

30 Offset

82.5

Woven wire fence

Note: ANY ADDITIONS OR CHANGES OF THIS SHEET MUST BE MADE IN OR CIRCLED IN Red Ink. WITH DATE AND NAME OF PERSON MAKING CHANGE.

RETURN TO

LOS ANGELES COUNTY SURVEYOR

700 HALL OF RECORDS

Do not extend notes this side of this line

FORM 247 10M 8-31

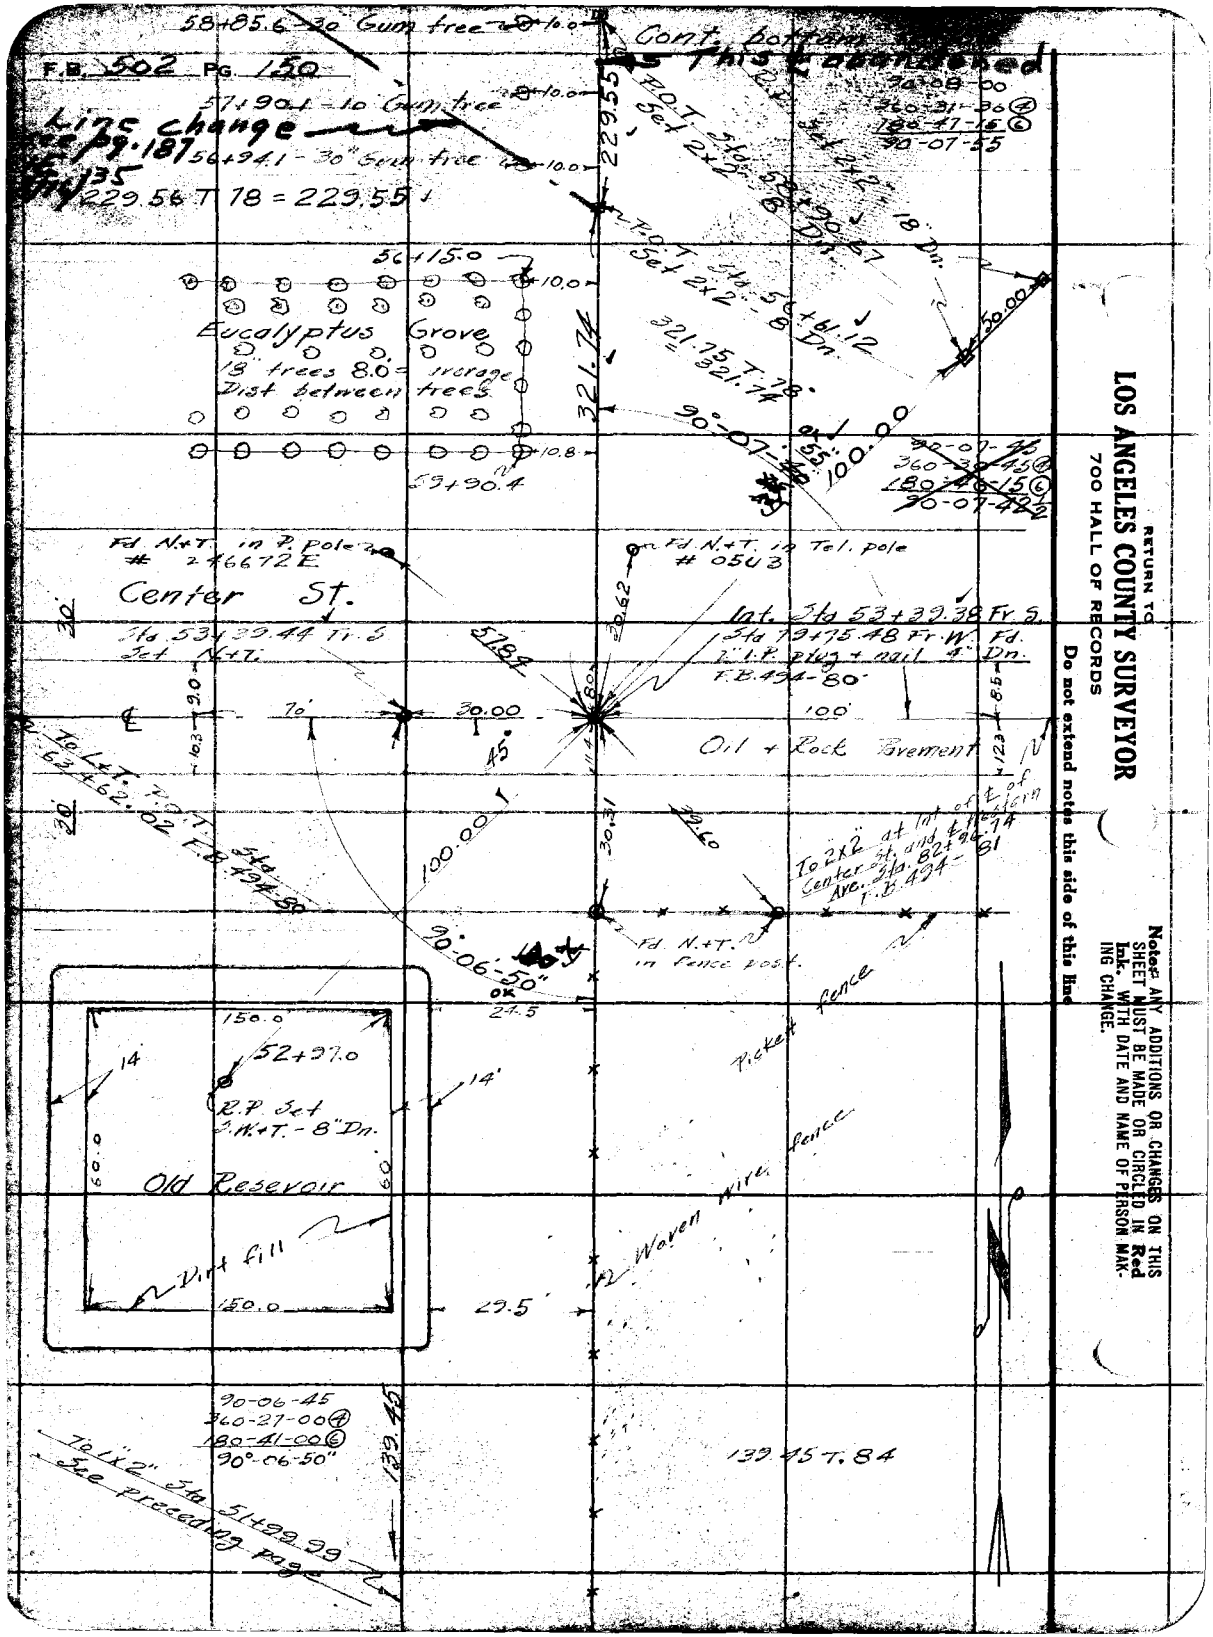
F.B. 502 PG. 150
58+85.6 30" Gum tree
57+90.1 - 10" Gum tree
56+94.1 - 30" Gum tree
Cont. bottom of this sketched
Eucalyptus Grove
18 trees 8.0 = average
Dist between trees
Fd. N.+T. in P. pole # 246672E
Center St.
Sta 53+39.44 T. 6 Sct N.+T.
Fd. N.+T. in Tel. pole # 0503
Sta 53+29.38 Fr. S.
Sta 19+75.48 Ft. W. Fd. 2" I.P. plug + nail 4" Dn.
T.B. 434-80
Oil + Rock Pavement
To 2x2 at Int. of Eastern Center St. and Eighth Ave. Sta. 82+ T.B. 434-
Fd. N.+T. in fence post.
Picket fence
Woven wire fence
Old Reservoir
Dirt fill
90-06-45
360-27-00 (4)
180-41-00 (5)
90°-06-50"
To 1x2" Sta 51+29.99
See preceding page
139.45 T. 84
Lat. change
Fr 135
229.56 T 78 = 229.55
RETURN TO
LOS ANGELES COUNTY SURVEYOR
700 HALL OF RECORDS
Do not extend notes this side of this line
Note: ANY ADDITIONS OR CHANGES ON THIS SHEET MUST BE MADE OR CIRCLED IN Red Ink. WITH DATE AND NAME OF PERSON MAKING CHANGE.

Notes Ck'd by	Drew	Survey of	Holder Ave
Map No.	B-820	W. O.	7086 Tape No. 022 St'd 82 °F.
Office Work	[illegible]	Surveyed by	Rosecrans
Checked	Drew	Notes	Date 9-6-32
Date	July 1934	Indexed	A. C. Johnson

F.B. 502 Pg. 151

Note: ANY ADDITIONS OR CHANGES OF THIS SHEET MUST BE MADE IN OR CIRCLED IN Red Ink. WITH DATE AND NAME OF PERSON MAKING CHANGE.

RETURN TO
LOS ANGELES COUNTY SURVEYOR
700 HALL OF RECORDS
Do not extend notes this side of this line

FORM 247 10M 8-31

cont. bottom next page

W. T. Sta. 26+09.96

610.00 T. 82 = 609.99

19+99.97

0.36

30.01

1.82 L.T. 18" mgl. in cone. 1.82 Rt. 13+66.03 Rd. Spike 1.7 Rt. Mag + Tack Flush

(30) (30)

13+28.8 30.0

Lone

1999.97

Valley View Ave.

1999.91

31+18.0 29.3

Sec. 21

90-07-30
360-29-15 ©
180-44-30 ©
90-07-25

Sec. 22

Lone

0+30.7 29.0

90°-07'-25"

(30)

℄ Center St.

(30)

Sec. 28

Sec. 27

RETURN TO

LOS ANGELES COUNTY SURVEYOR

700 HALL OF RECORDS

Note: ANY ADDITIONS OR CHANGES ON THIS SHEET MUST BE MADE OR CIRCLED IN **Red Ink.** WITH DATE AND NAME OF PERSON MAKING CHANGE.

Do not extend notes this side of this line

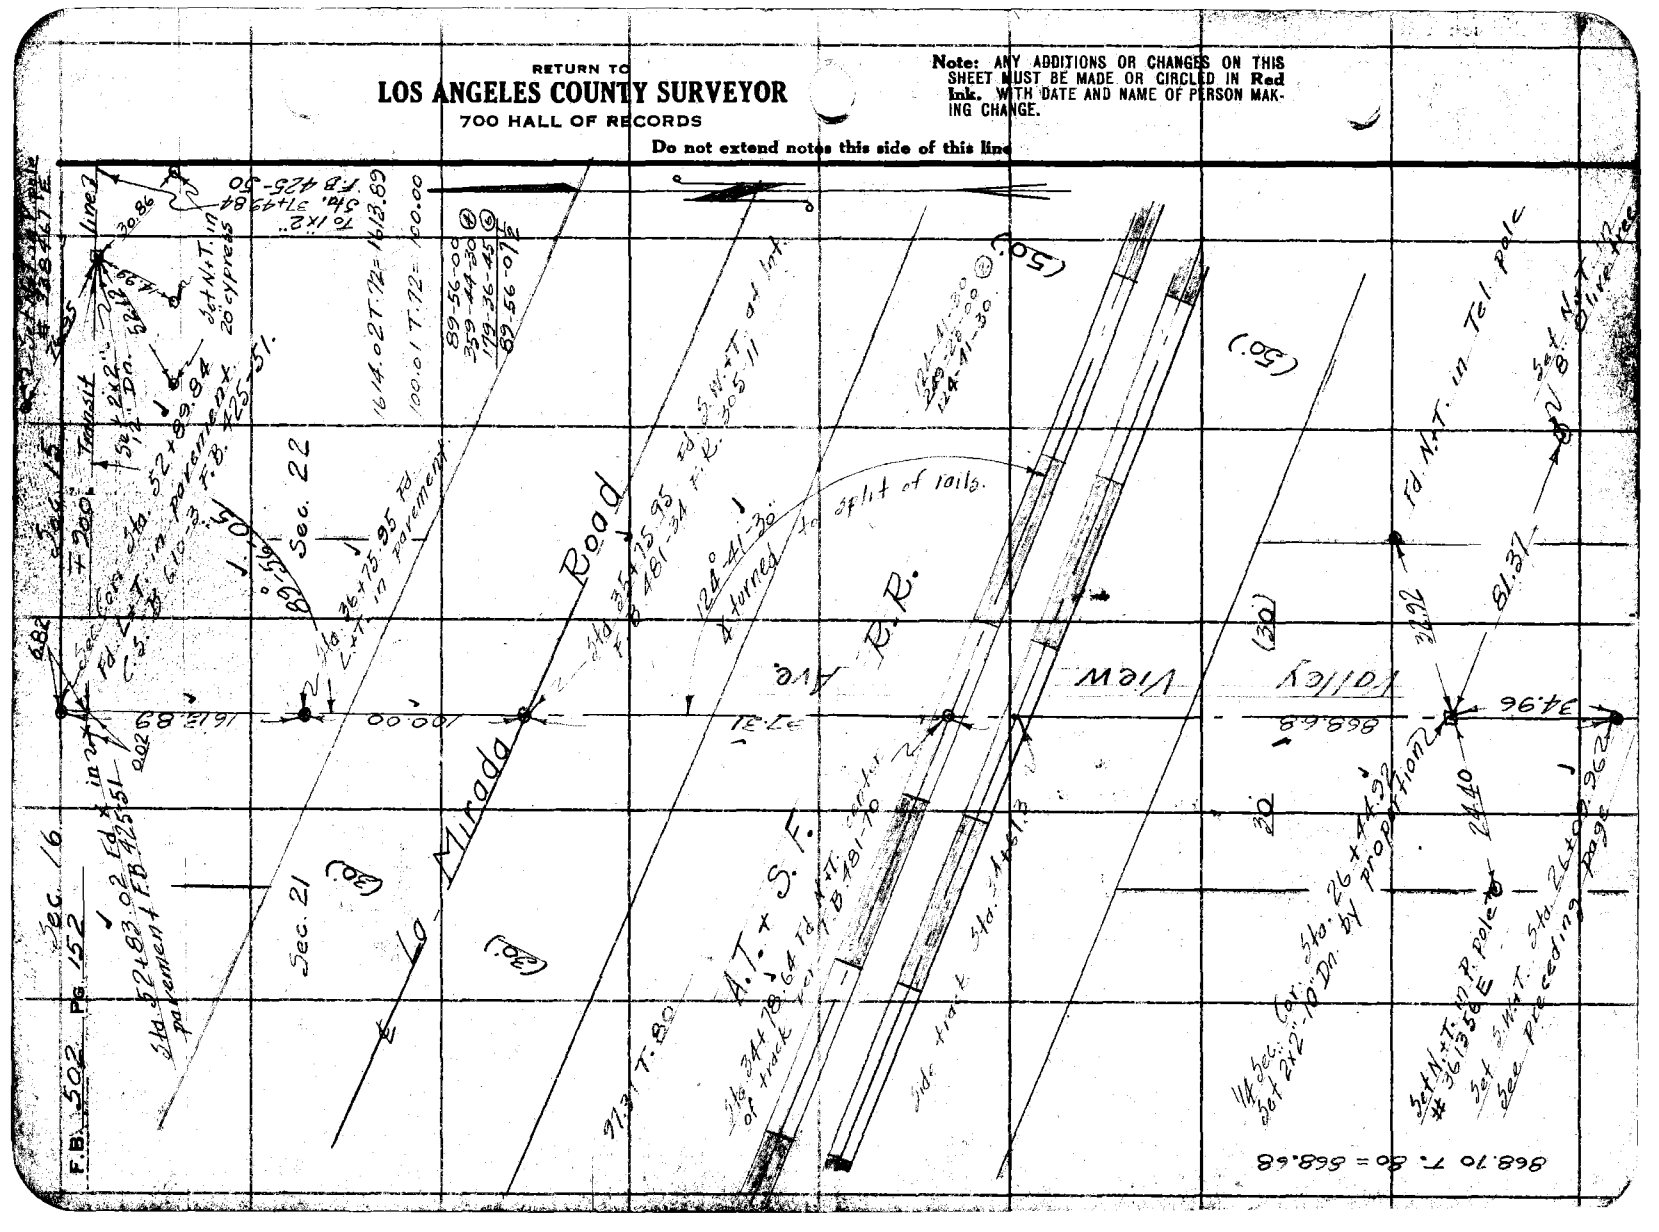
La Mirada Road
A.T. & S.F. R.R.
Valley View Ave.
Sec. 21
Sec. 22
Sec. 16
Sec. 15
Transit
F.B. 502 Pg. 152
1612.89
100.00
868.68
34.96
81.31
89°56'
124°41'30"
Tel. pole
Fd. N.I.T. in Tel. pole
Fd. N.I.T. in pavement
Fd. N.I.T. in Tel. pole
Set N.I.T. in Tel. pole
Set N.I.T. in pavement
Set 2x2" Stk.
Set 2x2" Stk.
Fd. 2x2" Stk.
Fd. 2x2" Stk.
Fd.

Notes Ck'd by Drew	Survey of Holder Ave.
Map No. B-820	W. O. 7086 Tape No. 022 St'd 84 °F.
Office Work Taylor	Surveyed by Rosecrans
Checked Drew	Notes Date 9 14 32
Date July 1934	Indexed A. C. Johns

F.B. 502 PG. 138

Note: ANY ADDITIONS OR CHANGES OF THIS SHEET MUST BE MADE IN Red Ink. WITH DATE AND NAME OF PERSON MAKING CHANGE.

Do not extend notes this side of this line

RETURN TO
LOS ANGELES COUNTY SURVEYOR
700 HALL OF RECORDS

FORM 247 10M 8-31

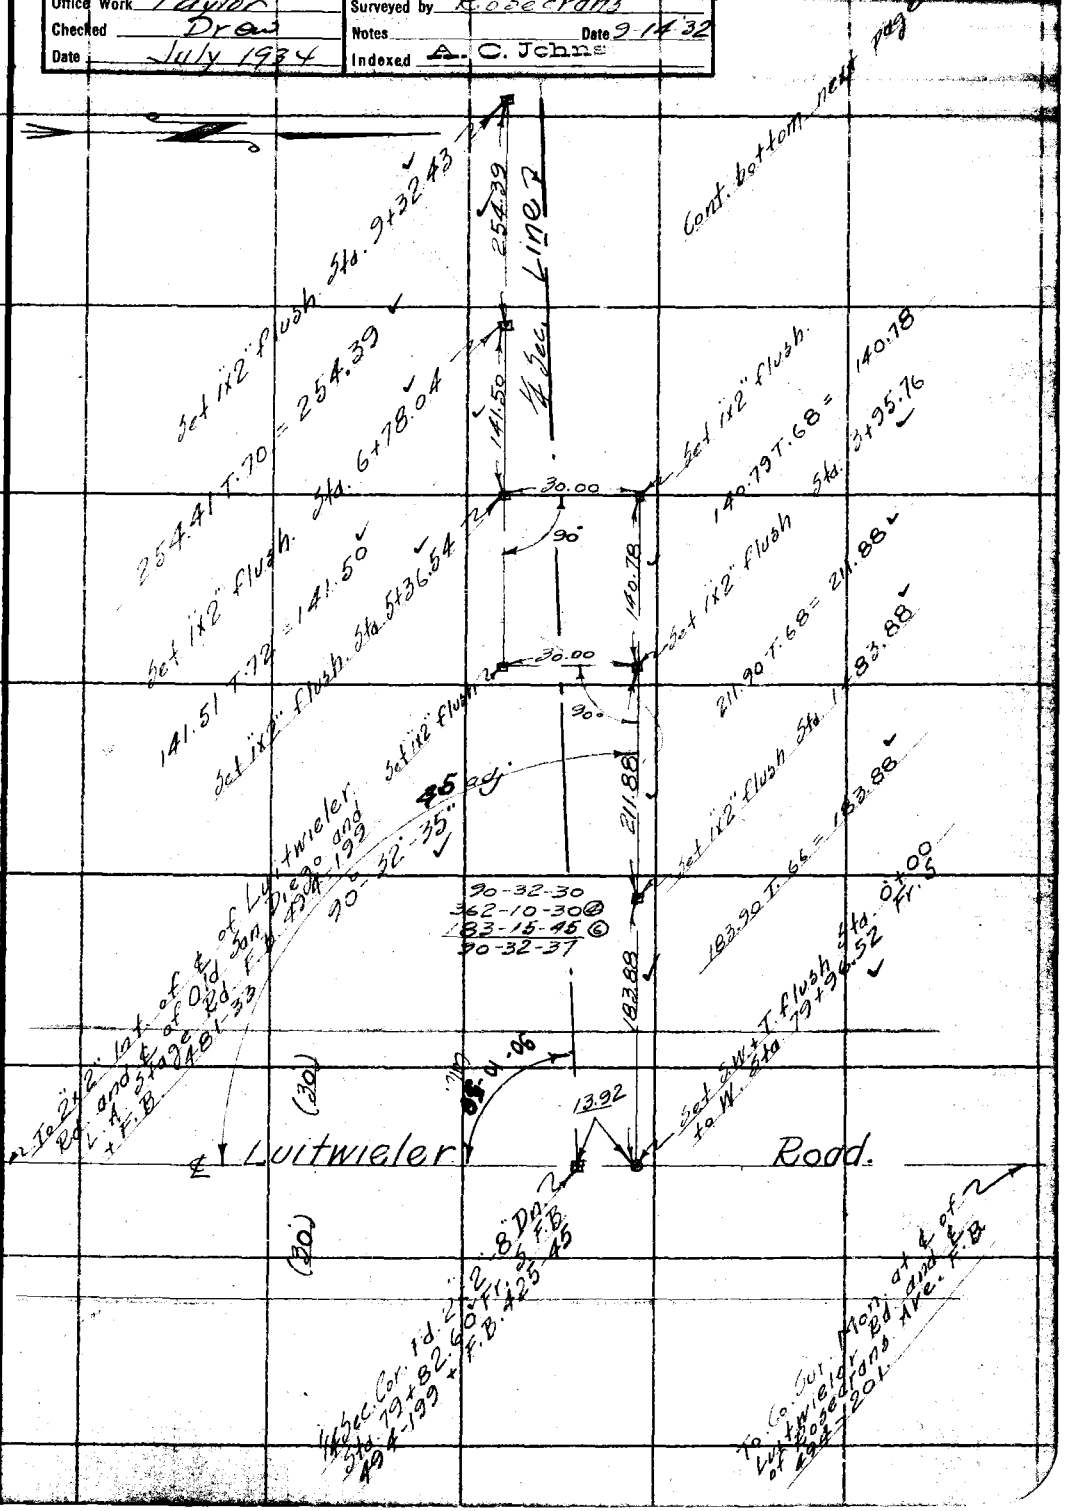

F.B. 502 Pg. 154

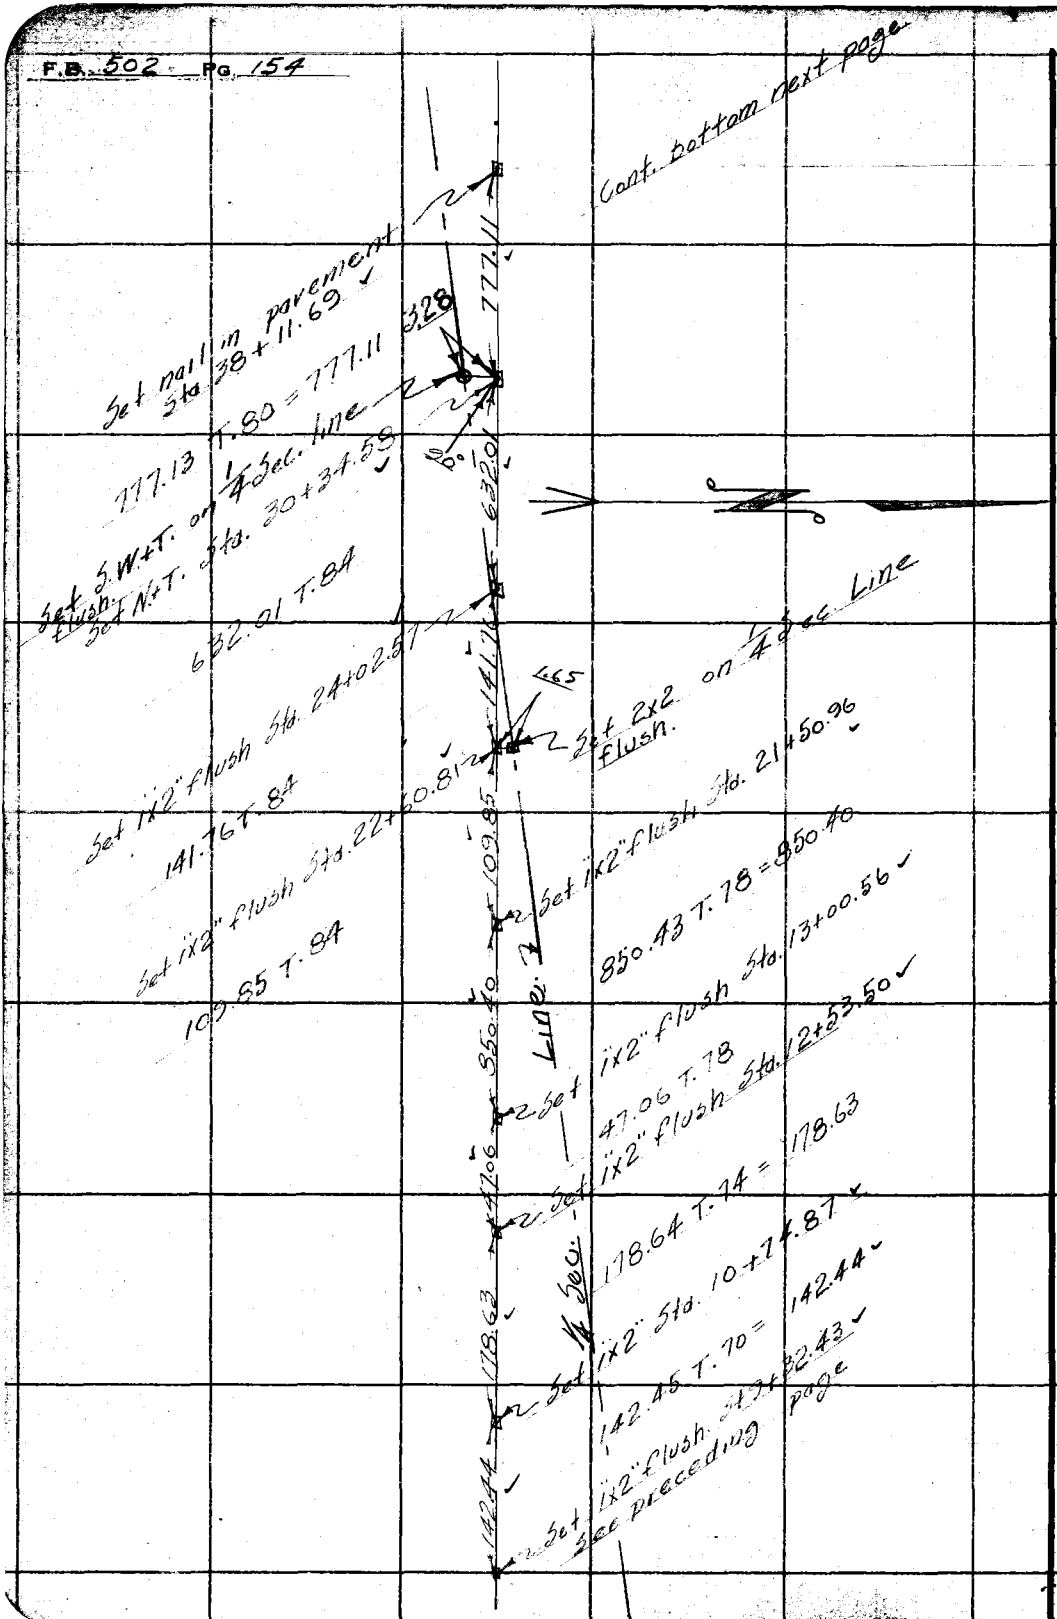

RETURN TO
LOS ANGELES COUNTY SURVEYOR
700 HALL OF RECORDS

Do not extend notes this side of this line

Note: ANY ADDITIONS OR CHANGES ON THIS SHEET MUST BE MADE OR CIRCLED IN Red Ink. WITH DATE AND NAME OF PERSON MAKING CHANGE.

Notes Ck'd by Drew	Survey of Halder Ave.
Map No. B-820	W. O. 7086 Tape No. 022 St'd 66 °F.
Office Work Taylor	Surveyed by Rosecrans
Checked Drew	Notes Date 3-14-32
Date July 1934	Indexed A. C. Jobes

F.B. 522 PG. 155

Note: ANY ADDITIONS OR CHANGES ON THIS SHEET MUST BE MADE OR CIRCLED IN Red Ink. WITH DATE AND NAME OF PERSON MAKING CHANGE.

RETURN TO
LOS ANGELES COUNTY SURVEYOR
700 HALL OF RECORDS
Do not extend notes this side of this line.

FORM 247 10M 8-31

N To V.T. Int. of Center St. and Valley View & See pg. 151

(30)

℄ Valley View Ave.

17.63

n. Int. Sta. 52+83.51 ✓ Fr. S. Sta. 26 x 62.55 ✓ Set 3/4" ✓

(30')

J. .32

Sta. 26+62.10 Dn

1/4 Sec. Cor. Fr. S. Set 2" ✓ pg. 152.

J. .10

15.00

n. Int. at Sec. Cor. Sta. 52+83.51 Fr. S. pg. 152. See

90°-32'-10"

90-32-15
362-08-45
183-13-00
90-32-10

1120.52 ✓

1120.56 T. 38 = 1120.52 ✓

Sta. 41+62.99 ✓ Set 1"x2" Flush ✓

351.31 T. 80 = 351.30 ✓

351.30 ✓

Sta. 38+11.69 ✓ Set nail in pavement See preceding page.

RETURN TO
LOS ANGELES COUNTY SURVEYOR
700 HALL OF RECORDS

Note: ANY ADDITIONS OR CHANGES ON THIS SHEET MUST BE MADE OR CIRCLED IN **Red Ink.** WITH DATE AND NAME OF PERSON MAKING CHANGE.

Do not extend notes this side of this line

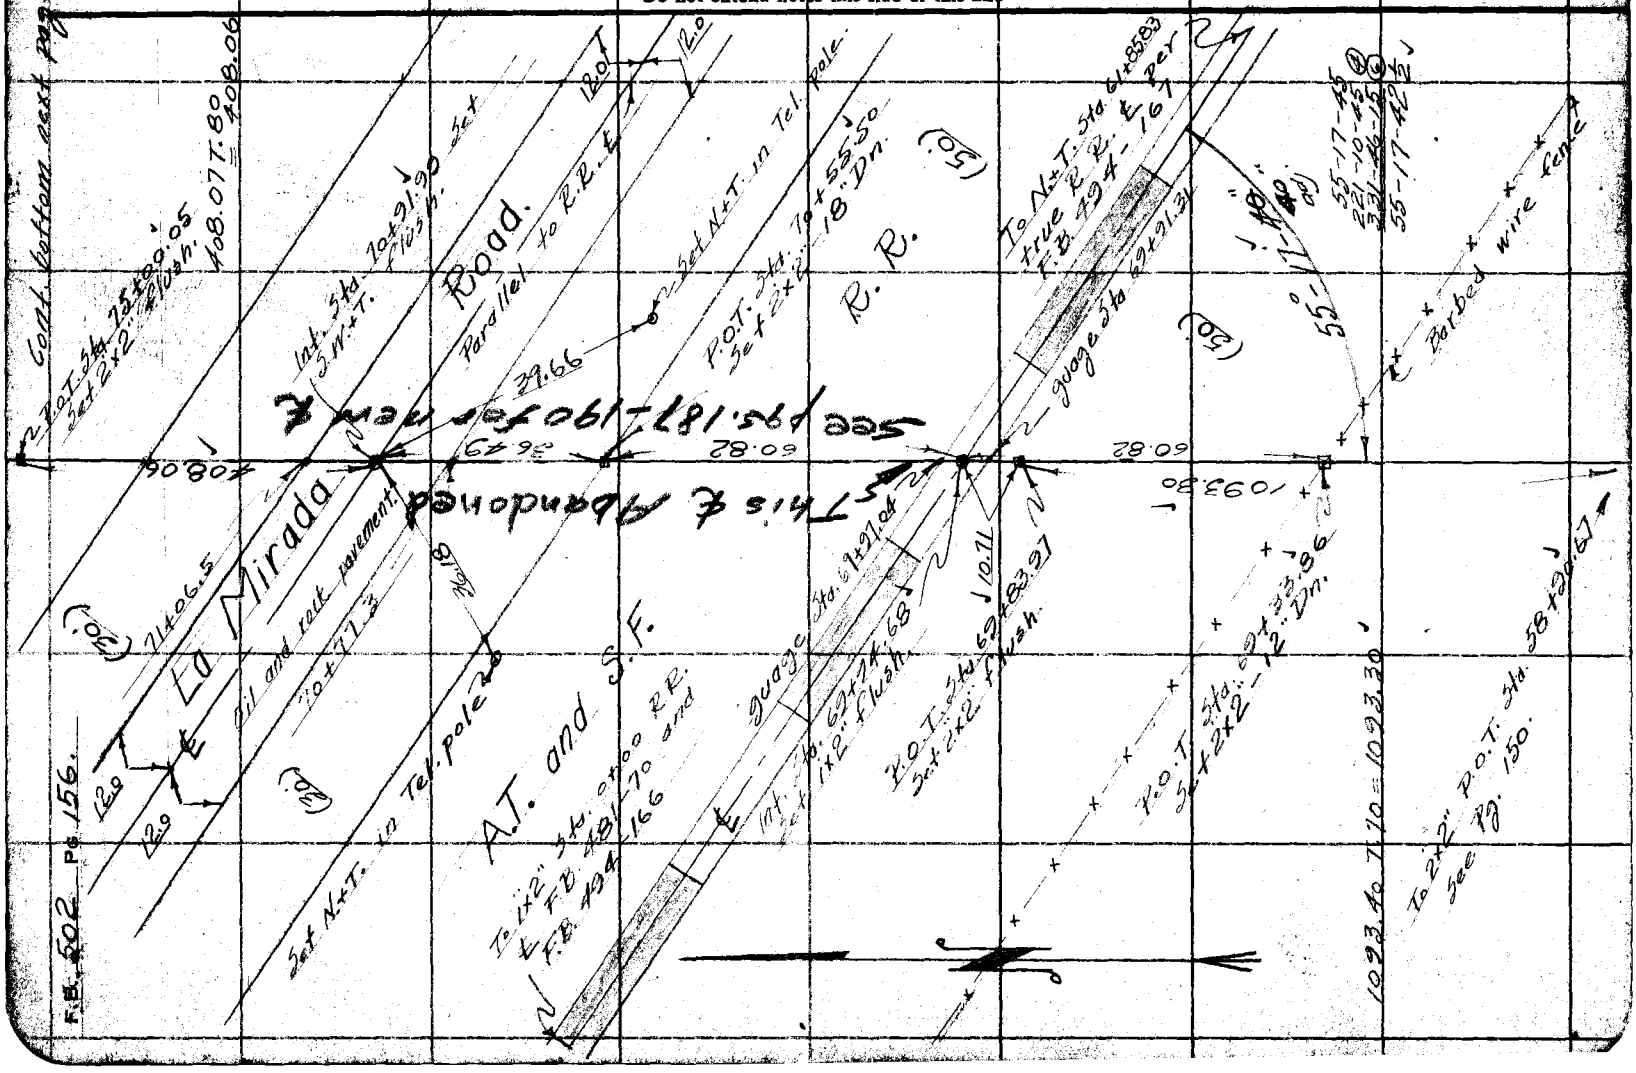

Notes Ck'd by Drew		Survey of Holder Ave.	
Map No. B-922		W. O. 7086 Tract No. 022 Sh'd 04 of	
Office Work Taylor		Surveyed by Rosecrans	
Checked Drew		Notes	Date 3-19-32
Date July 1934		Indexed A. C. Johnson	

F.B. 502 Pg. 147

Cont. bottom next page.




















































Note: ANY ADDITIONS OR CHANGES ON THIS SHEET MUST BE MADE IN Red Ink. WITH DATE AND NAME OF PERSON MAKING CHANGE.

Do not extend notes this side of this line

RETURN TO
LOS ANGELES COUNTY SURVEYOR
700 HALL OF RECORDS

FORM 247 10M 5-31

F.B. 602 PG. 158

Cont. bottom Pg. 161.

Sta. 106+10.11 = Sta. 26+41.78 Ft. E.

Set 1x1 flush 2

0.56

Set 1x1 Sta. 26+41.89 See Pg 159

℄ Transit Line

See Pg 157+160

Sec. Line 7

Rosecrans ℄ 1/4 Sec Cor. 2

1514

89°-46-30 Cal.

Ave.

Sta 1062+24.97 12" Dn. See Co. Sur.

Set 2x2 18" Dn. Pg. 160 Mon.

(30')

89°-46-30 2001

Tot. N. of T. Sta 0+00 See Pg 159

To W

1058.99

(30')

(30')

1059.09 T.70 = 1058.99

89-46-30

357 06-15 ①

178-33-45 ②

89-46-32 ±

Ave.

Sta 1054+65.98 Set S.W.+T. flush 2

727.93

Holder

727.98 T.74 = 727.93

563.74

563.78 T.74 = 563.74

Sta. 88+38.05 Set N+T. 2

Sta. 88 flush

Sta. 82+74.31 Set S.W+T.

flush See preceding page.

RETURN TO
LOS ANGELES COUNTY SURVEYOR
700 HALL OF RECORDS

Do not extend notes this side of this line

Note: ANY ADDITIONS OR CHANGES ON THIS SHEET MUST BE MADE OR CIRCLED IN Red Ink. WITH DATE AND NAME OF PERSON MAKING CHANGE.

Notes Ck'd by Drew	Survey of Holder Ave
Map No. B-820	W. O. 7671 Type No. 022 St'd 84 °F.
Office Work Taylor	Surveyed by Rosecrans
Checked Drew	Notes Date 10-13-32
Date July 1934	Indexed A. C. Johnson

F.B. 502 Pg. 37

Note: ANY ADDITIONS OR CHANGES OR THIS SHEET MUST BE MADE OR CIRCLED IN Red Ink. WITH DATE AND NAME OF PERSON MAKING CHANGE.

RETURN TO
LOS ANGELES COUNTY SURVEYOR
700 HALL OF RECORDS
Do not extend notes this side of this line

Cont. bottom next page

1326.50 T. 78 = 1326.45

Sta. 13+26.45 Set 1x1 flush.

Line 2

1326.45

2641.79

Line 1

Sta. 0+00 to N. 2 L.E.B. 494.201 Set temporary P.T. which with L to N. falls 0.02 E of Int. & prod. Fr. S.

Cor. Mon. 18" Dia. 2 Ft. Co. Sur. Mon. Ft. Co. of Lutwieler Rd and Rosecrans Ave. F.B. 494-201.

65.36	@ 0-00	T. 66 =	65.37
100.28	@ 6-41	T. 66 =	99.59
100.70	@ 6-46	T. 66 =	99.99
99.76	@ 3-25	T. 66 =	99.57
285.00	@ 0-00	T. 66 =	284.97
			649.49

649.49 Const.

Sta. 6+65.28 Set 1x1 flush.

100.89 @ 5-00 T. 66 = 100.50
85.47 @ 6-21 T. 66 = 84.94
185.44

89-55-15 ⑤
359-21-45 ⑥
179-21-45
89-55-17½

85.44

Sta. 4+79.84 Set 1x2" flush.

95.28 @ 6-23 T. 66 = 94.68

94.68

Sta. 3+85.16 Set 1x2 flush

385.21 @ 0-00 T. 66 = 385.16

90-13-30
360-54-00 ④
181-21-15 ⑥
90°-13'-32½

Adopted Section Mon.

90°-13'-30" Rad

90°-13'-35" Calc.

89°-55'-20" adj.

385.16

15.04

Sta. 0+00 to N. 1 Set S.W.T. Flush

Ia 2x2" ⊥ of Lutwieler Rd. and projected ⊥ Rad. Co. to Cor. F.B. 481-58.

416.04

F.B. 522 Pg. 160

℄ Valley View Ave.

Pg. 152

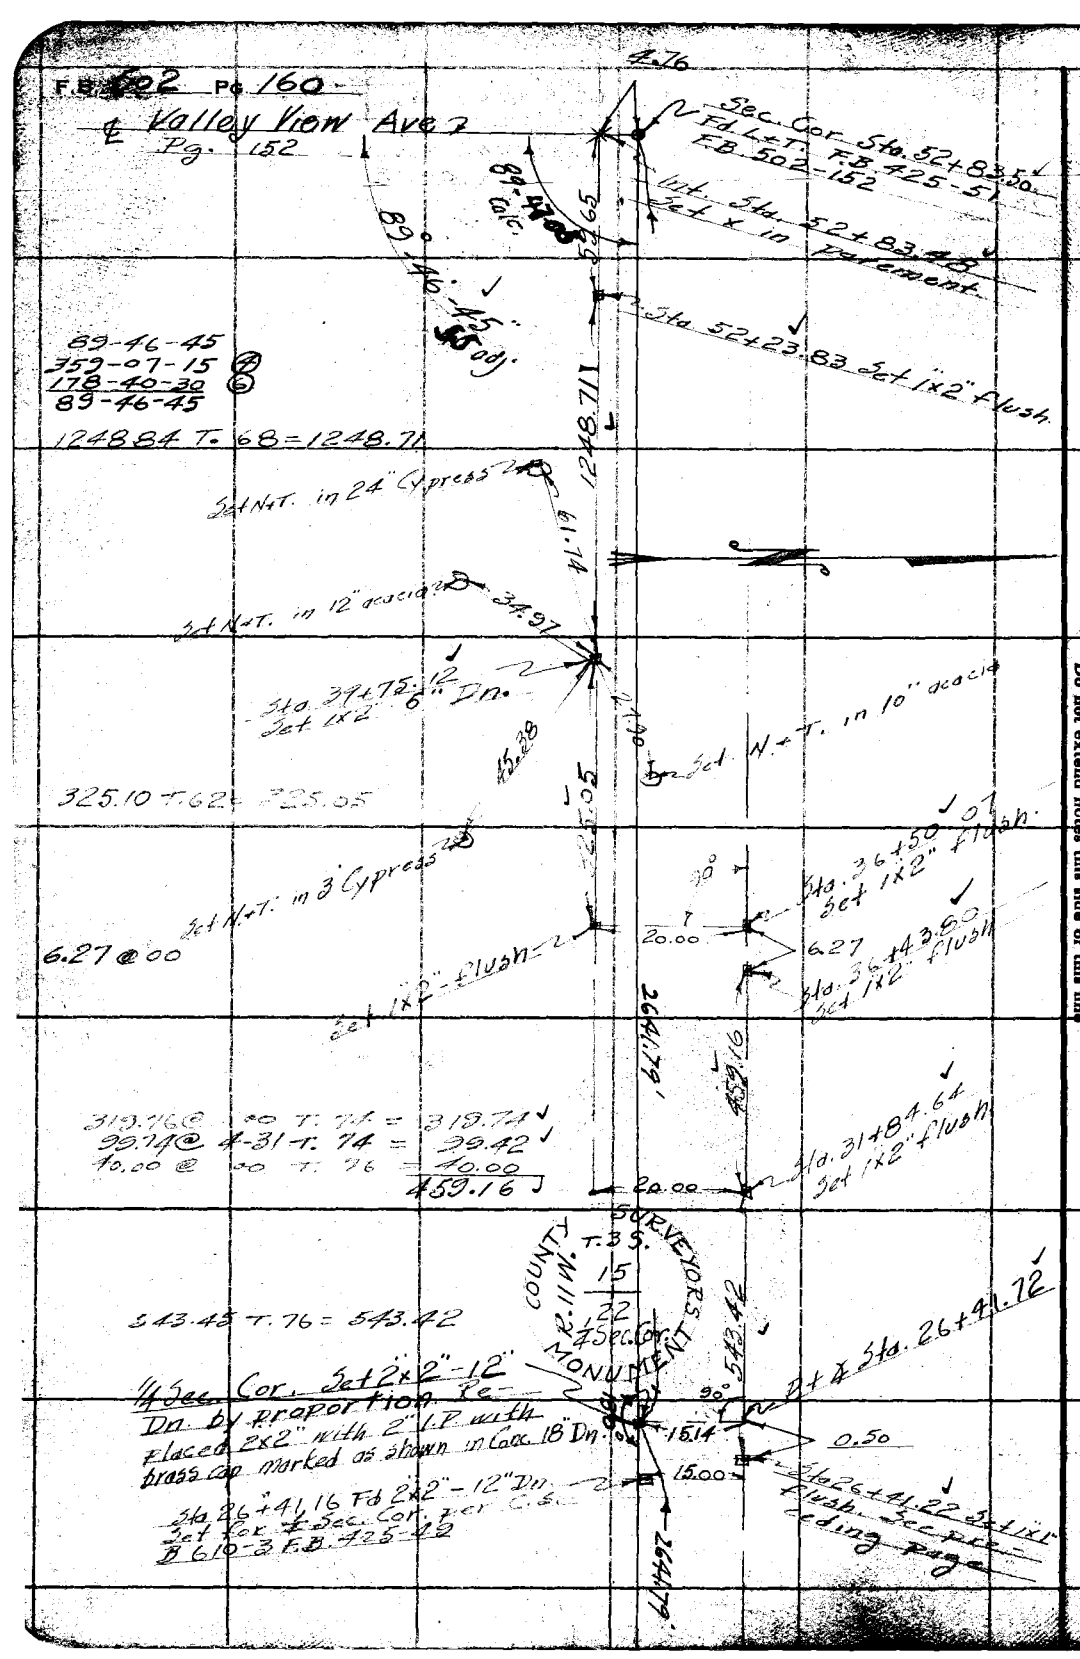

RETURN TO
LOS ANGELES COUNTY SURVEYOR
700 HALL OF RECORDS

Do not extend notes this side of this line

Note: ANY ADDITIONS OR CHANGES ON THIS SHEET MUST BE MADE OR CIRCLED IN **Red** Ink, WITH DATE AND NAME OF PERSON MAKING CHANGE.

Notes Ck'd by Drew	Survey of Holder Ave.
Map No. B-930	W. O. 2086 Tape No. 962 St'd 84 °F.
Office Work Taylor	Surveyed by R. Rosecrans
Checked Drew	Notes Date 10-2-33
Date July -1934	Indexed A. C. Johnson

F.B. 502 Pg. 161

Note: ANY ADDITIONS OR CHANGES ON THIS SHEET MUST BE MADE OR CIRCLED IN Red Ink, WITH DATE AND NAME OF PERSON MAKING CHANGE.

RETURN TO
LOS ANGELES COUNTY SURVEYOR
700 HALL OF RECORDS
Do not extend notes this side of this line

FORM 247 10M 8-31

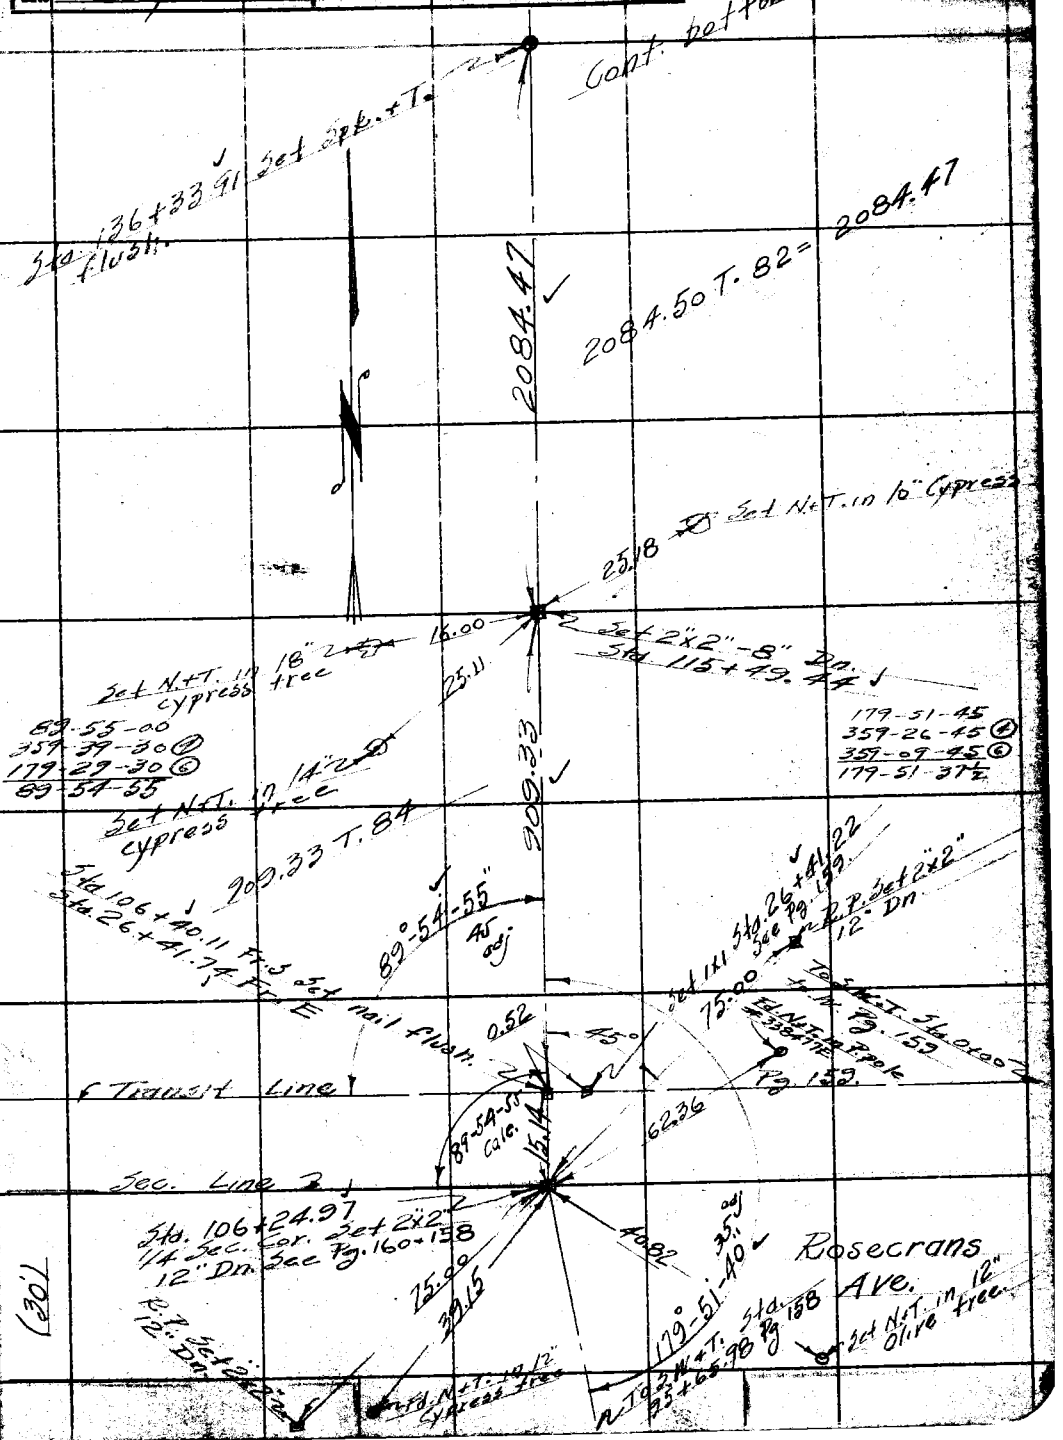

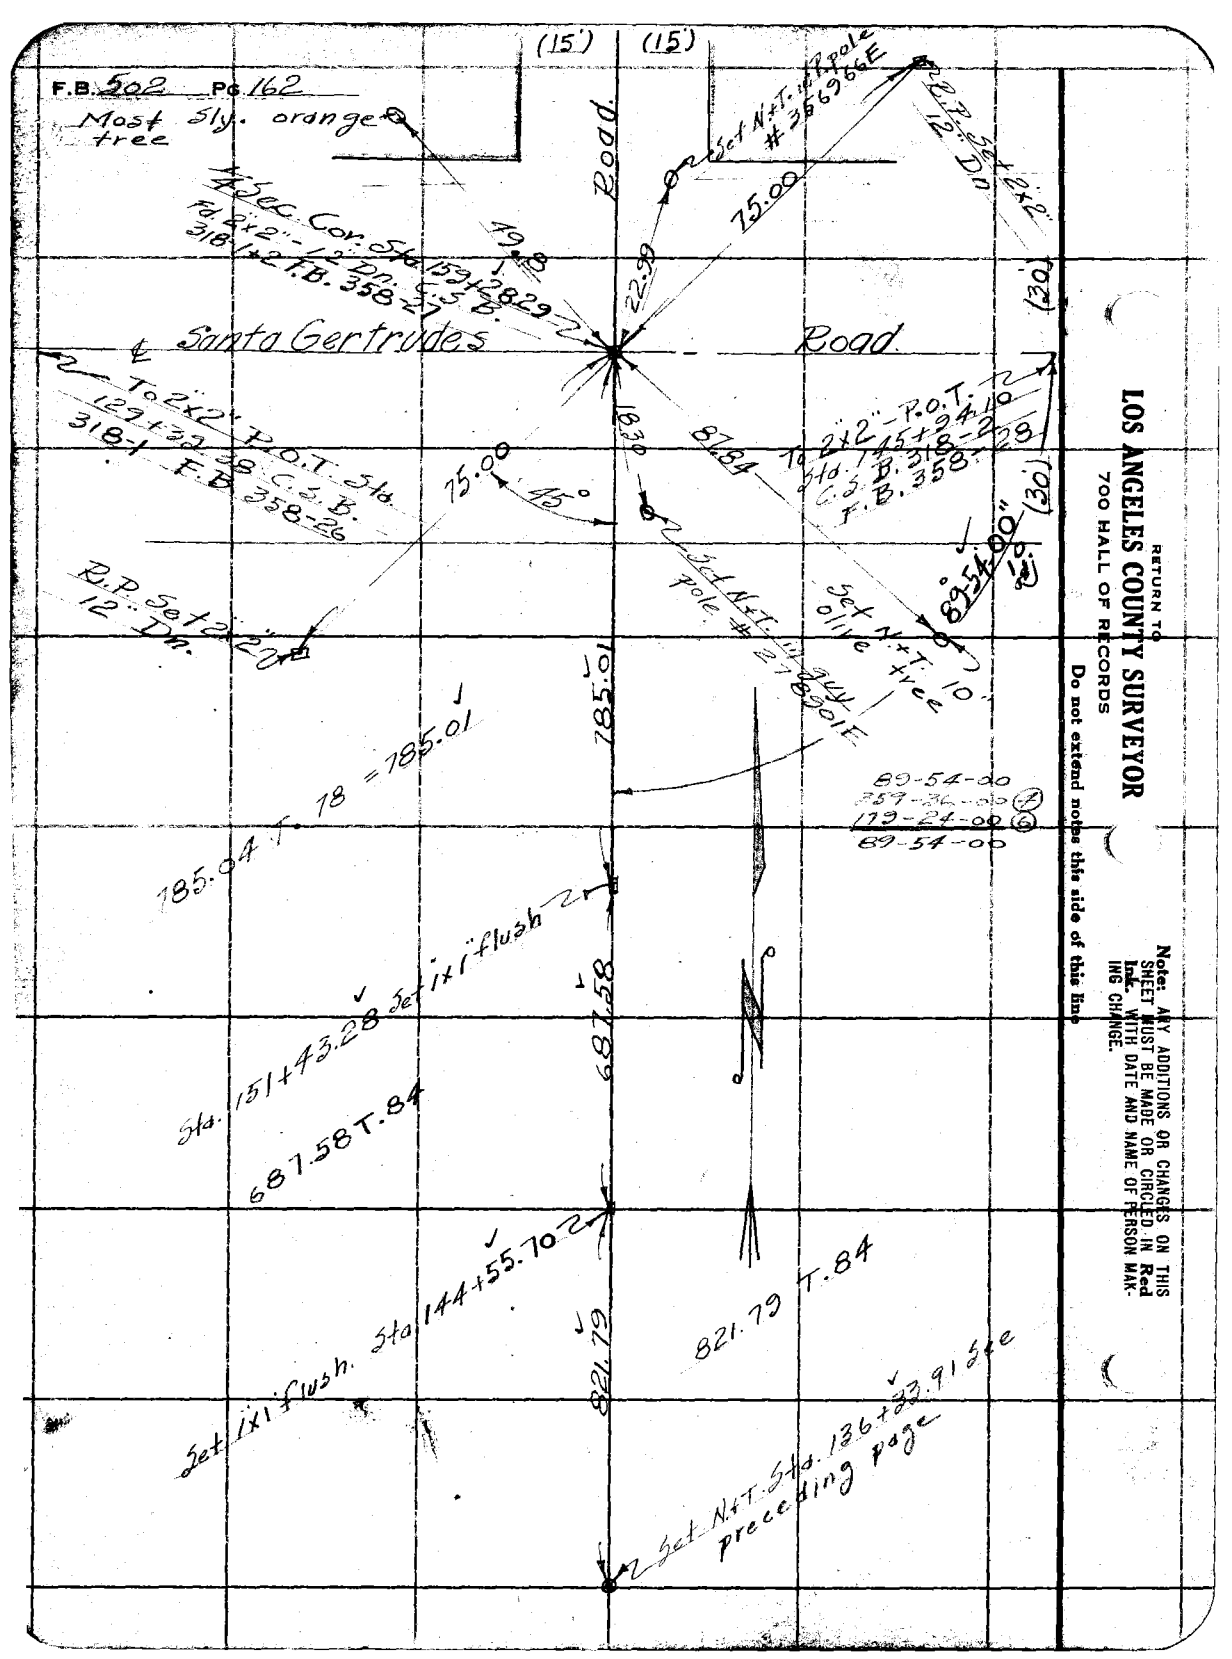
F.B. 502 Pg. 162
Most sly. orange tree
(15')
(15')
Road.
Set N.&T. in pole #3569 66E
R.P. Set 12" Dn. 2x2"
75.00
19.8
22.39
(30')
Santa Gertrudes
Road.
To 2x2" P.O.T. Sta. 153+28.29
Rd 2x2"-12 Dn. C.S.B. 318-1 F.B. 358-27
To 2x2" P.O.T. Sta. 129+32.58 C.S.B. 318-1 F.B. 358-26
To 2x2" P.O.T. 145+94.10 Sta. C.S.B. 318-2 F.B. 358-28
18.30
81.84
75.00
45°
89°54'00"
(30')
10'
Set N.&T. pole #2789 01E
Set N.&T. olive tree
R.P. Set 12" Dn. 2x2"
185.01
185.01
18
185.04
89-54-00
89-54-00
Set 1x1 flush
Sta. 151+43.28
687.58
687.58 T.84
Set 1x1 flush. Sta. 144+55.70
821.79
821.79 T.84
Set N.&T. Sta. 136+33.91 See preceding page
RETURN TO
LOS ANGELES COUNTY SURVEYOR
700 HALL OF RECORDS
Do not extend notes this side of this line
Note: ANY ADDITIONS OR CHANGES ON THIS SHEET MUST BE MADE OR CIRCLED IN Red Ink. WITH DATE AND NAME OF PERSON MAKING CHANGE.

FORM 247 10M 8-31

RETURN TO

LOS ANGELES COUNTY SURVEYOR

700 HALL OF RECORDS

Note: ANY ADDITIONS OR CHANGES ON THIS SHEET MUST BE MADE OR CIRCLED IN **Red Ink.** WITH DATE AND NAME OF PERSON MAKING CHANGE.

Do not extend notes this side of this line

Notes Ck'd by _____

Map No. _____

Office Work _____

Checked _____

Date _____

Survey of Tract No. 022 Sht. 8 of 8 sht.

Surveyed by Rosecrans

Notes _____ Date 10-27-32

Indexed A. C. Johnson

F.B. 502 Pg. 163

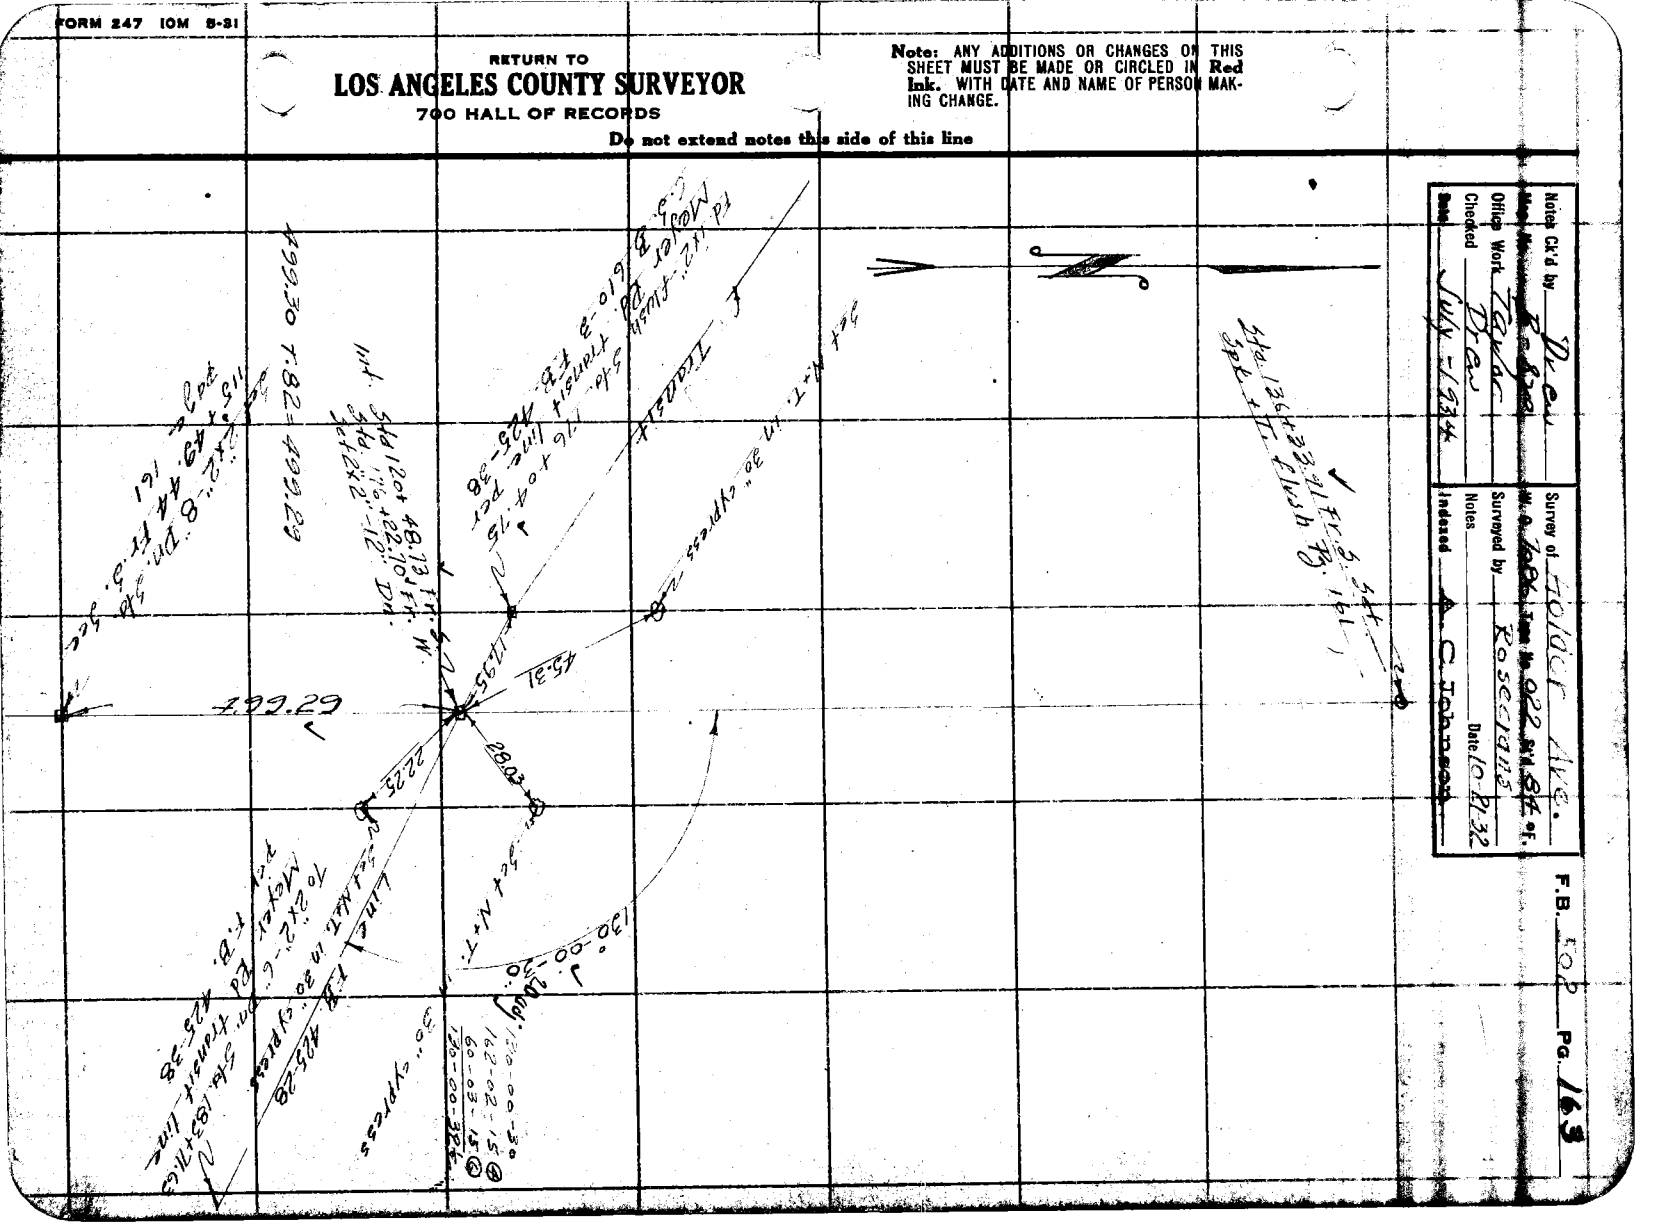
499.30 T.82 = 499.29
499.29
45.31
1135
2803
2225
Line
Tangent
Curve
Sta. 120+48.73 Ft. W.
Sta. 136+33.71 Ft. W.
Sta. 125+38
Sta. 115+49.44
Sta. 120+22.10 Ft. Dia.
30" cypress

F.B. 502 Pg. 164

Cont. bottom next page

Fd. 3 W.T. in 30" cypress tree

Set N.T. in Tel. pole

Set N.T. in P. pole #1160 E

Foster Rd.

(20)

(20)

(30')

(30)

Valley View Ave.

Sta 26+51.88 Pavement F.B. 425-52

Sta 6+60.66 P.T. Sta 5+15.11 Pavement F.B. 425-52

Sec. Cor. Sta 0+00 to N Fd. L+T. in Conc. Set C.3.B.610-3 F.B. 425-51

Transit line Pg. 160

Lot. Set temporary P.T.

To 1x2 Sta. 39+15.12 See Pg. 160.

RETURN TO
LOS ANGELES COUNTY SURVEYOR
700 HALL OF RECORDS

Do not extend notes this side of this line

Note: ANY ADDITIONS OR CHANGES ON THIS SHEET MUST BE MADE OR CIRCLED IN Red Ink WITH DATE AND NAME OF PERSON MAKING CHANGE.

Notes Ck'd by Drew	Survey of Holder Ave
Map No. B-820	W. O. 7086 Tape No. 022 St'd [illegible] °F.
Office Work Taylor	Surveyed by Rosecrans
Checked Drew	Notes Date 10-24-32
Date July-1934	Indexed A. C. Johnson

F.B. 502 Pg. 165

Sec. 9

(80)

Sec. 10

(30)

℄ Lindbergh Blvd.

(30)

(50)

(30)

Lot Sec. Cor. Sta. 52+03.75 Fd 2" I.P.
℄ T. in pavement F.B. 350
25 C.S.B. 318-2

Sec. 16

(30)

(30)

89°-53'-35" W F.B. 335-25

Sec. 15

2663.56 T. 76 = 2663.42

T. 3 S. R. 11 W.

℄ 2663.42

Valley View Ave.

℄ Fd. ℄ T. Sta 26+40.33 Fd 3/4"
See preceding page.

RETURN TO
LOS ANGELES COUNTY SURVEYOR
700 HALL OF RECORDS

Do not extend notes this side of this line

Note: ANY ADDITIONS OR CHANGES OF THIS SHEET MUST BE MADE OR CIRCLED IN Red Ink, WITH DATE AND NAME OF PERSON MAKING CHANGE.

FORM 347 10M 8-31

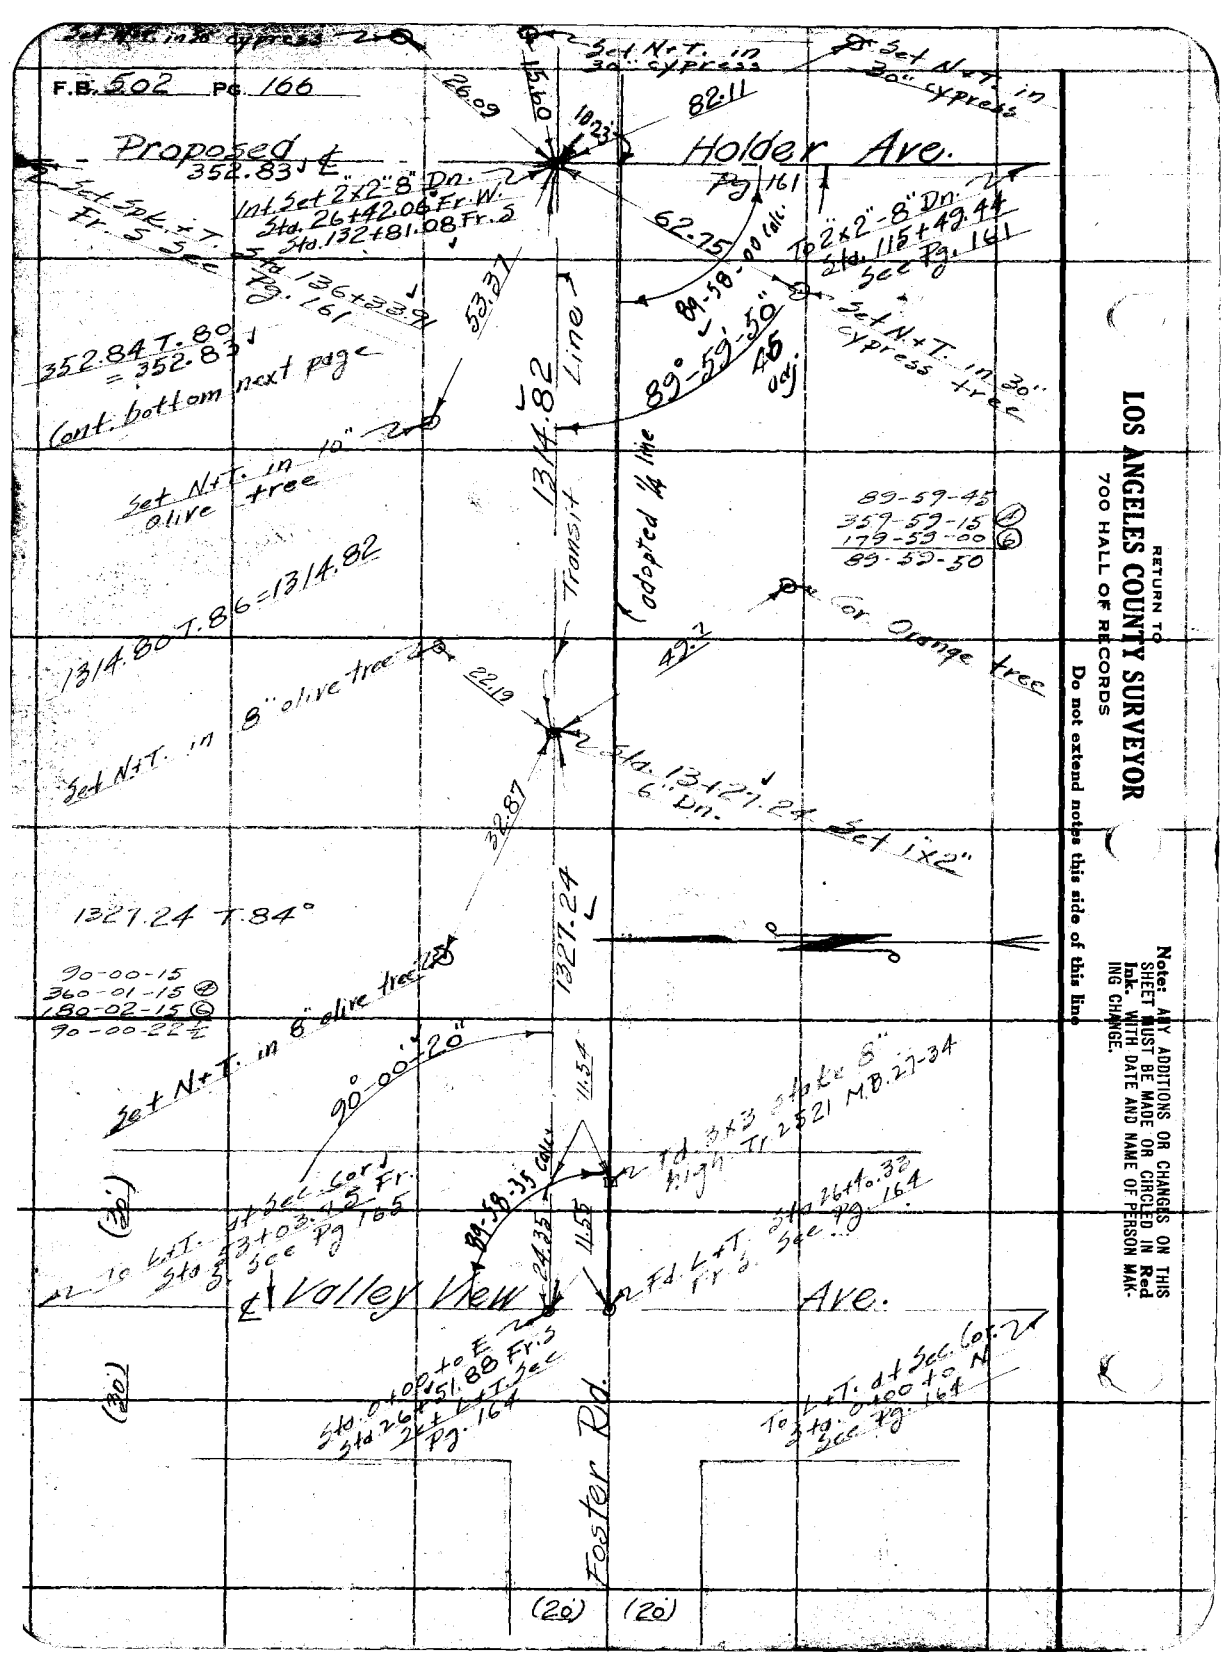

RETURN TO
LOS ANGELES COUNTY SURVEYOR
700 HALL OF RECORDS

Do not extend notes this side of this line

Note: ANY ADDITIONS OR CHANGES ON THIS SHEET MUST BE MADE OR CIRCLED IN Red Ink. WITH DATE AND NAME OF PERSON MAKING CHANGE.

Notes Ck'd by	Drew	Survey of	Holder Ave.
Map No.	B-820	W. O.	7086 Tape No. 022 St'd 84 °F.
Office Work	Taylor	Surveyed by	Rosecrans
Checked	Drew	Notes	Date 10-21-32
Date	July-1934	Indexed	L. C. Johnson

F.B. 502 Pg. 167

Note: ANY ADDITIONS OR CHANGES ON THIS SHEET MUST BE MADE OR CIRCLED IN Red Ink WITH DATE AND NAME OF PERSON MAKING CHANGE.

RETURN TO
LOS ANGELES COUNTY SURVEYOR
700 HALL OF RECORDS
Do not extend notes this side of this line

FORM 247 10M 8-31

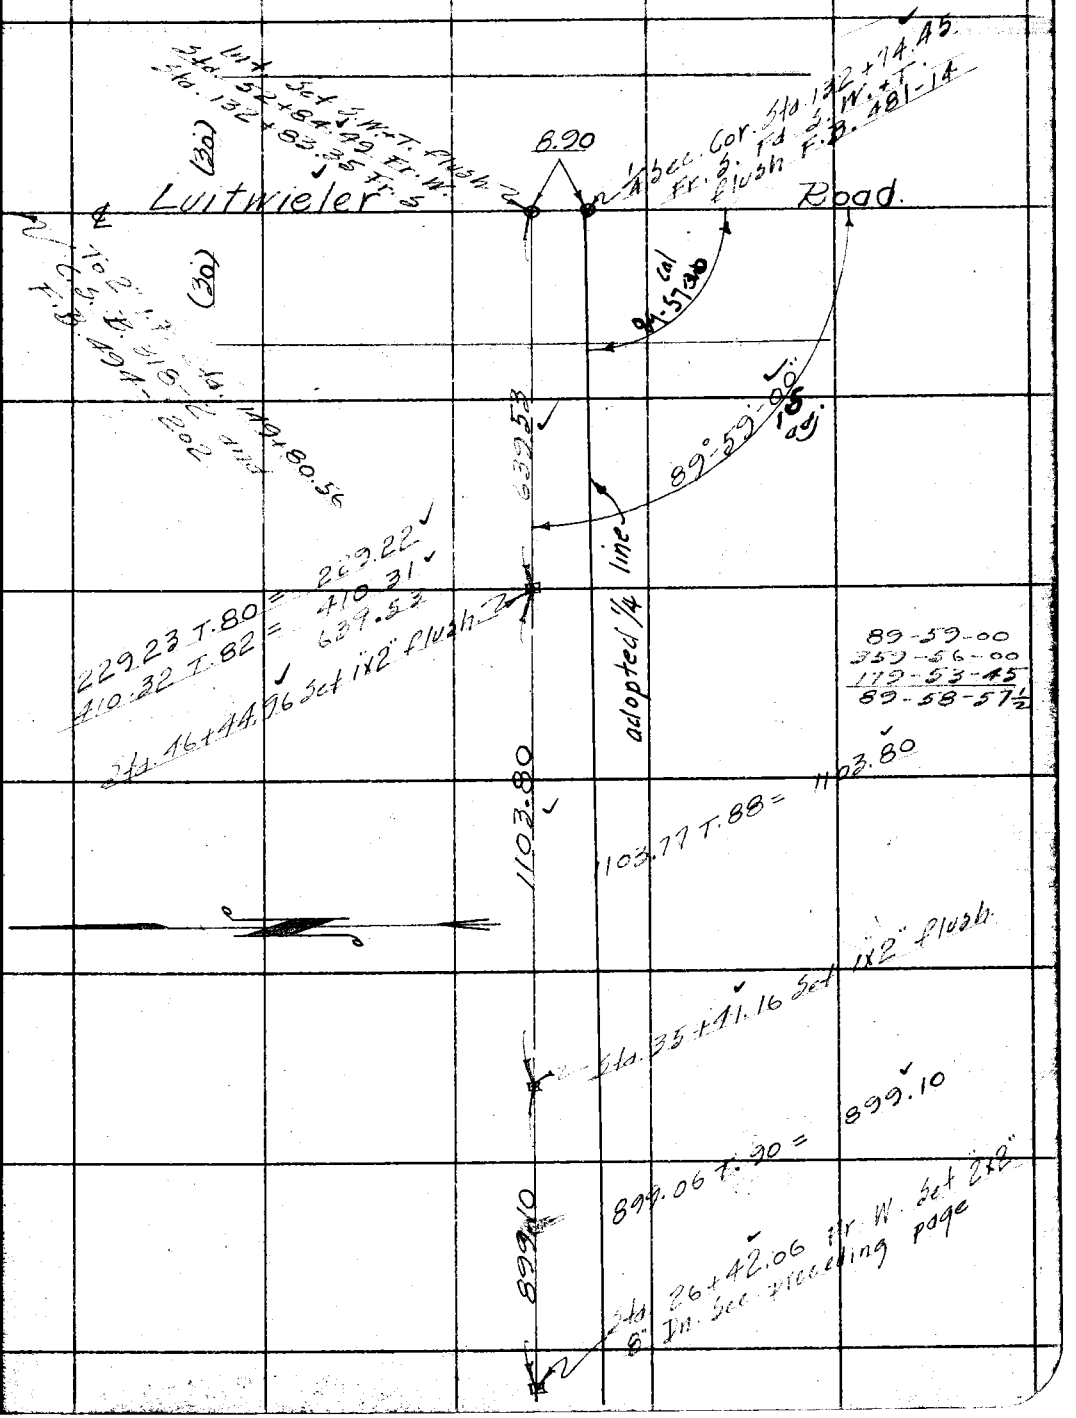

RETURN TO
LOS ANGELES COUNTY SURVEYOR
700 HALL OF RECORDS

Note: ANY ADDITIONS OR CHANGES ON THIS SHEET MUST BE MADE OR CIRCLED IN **Red Ink.** WITH DATE AND NAME OF PERSON MAKING CHANGE.

Do not extend notes this side of this line

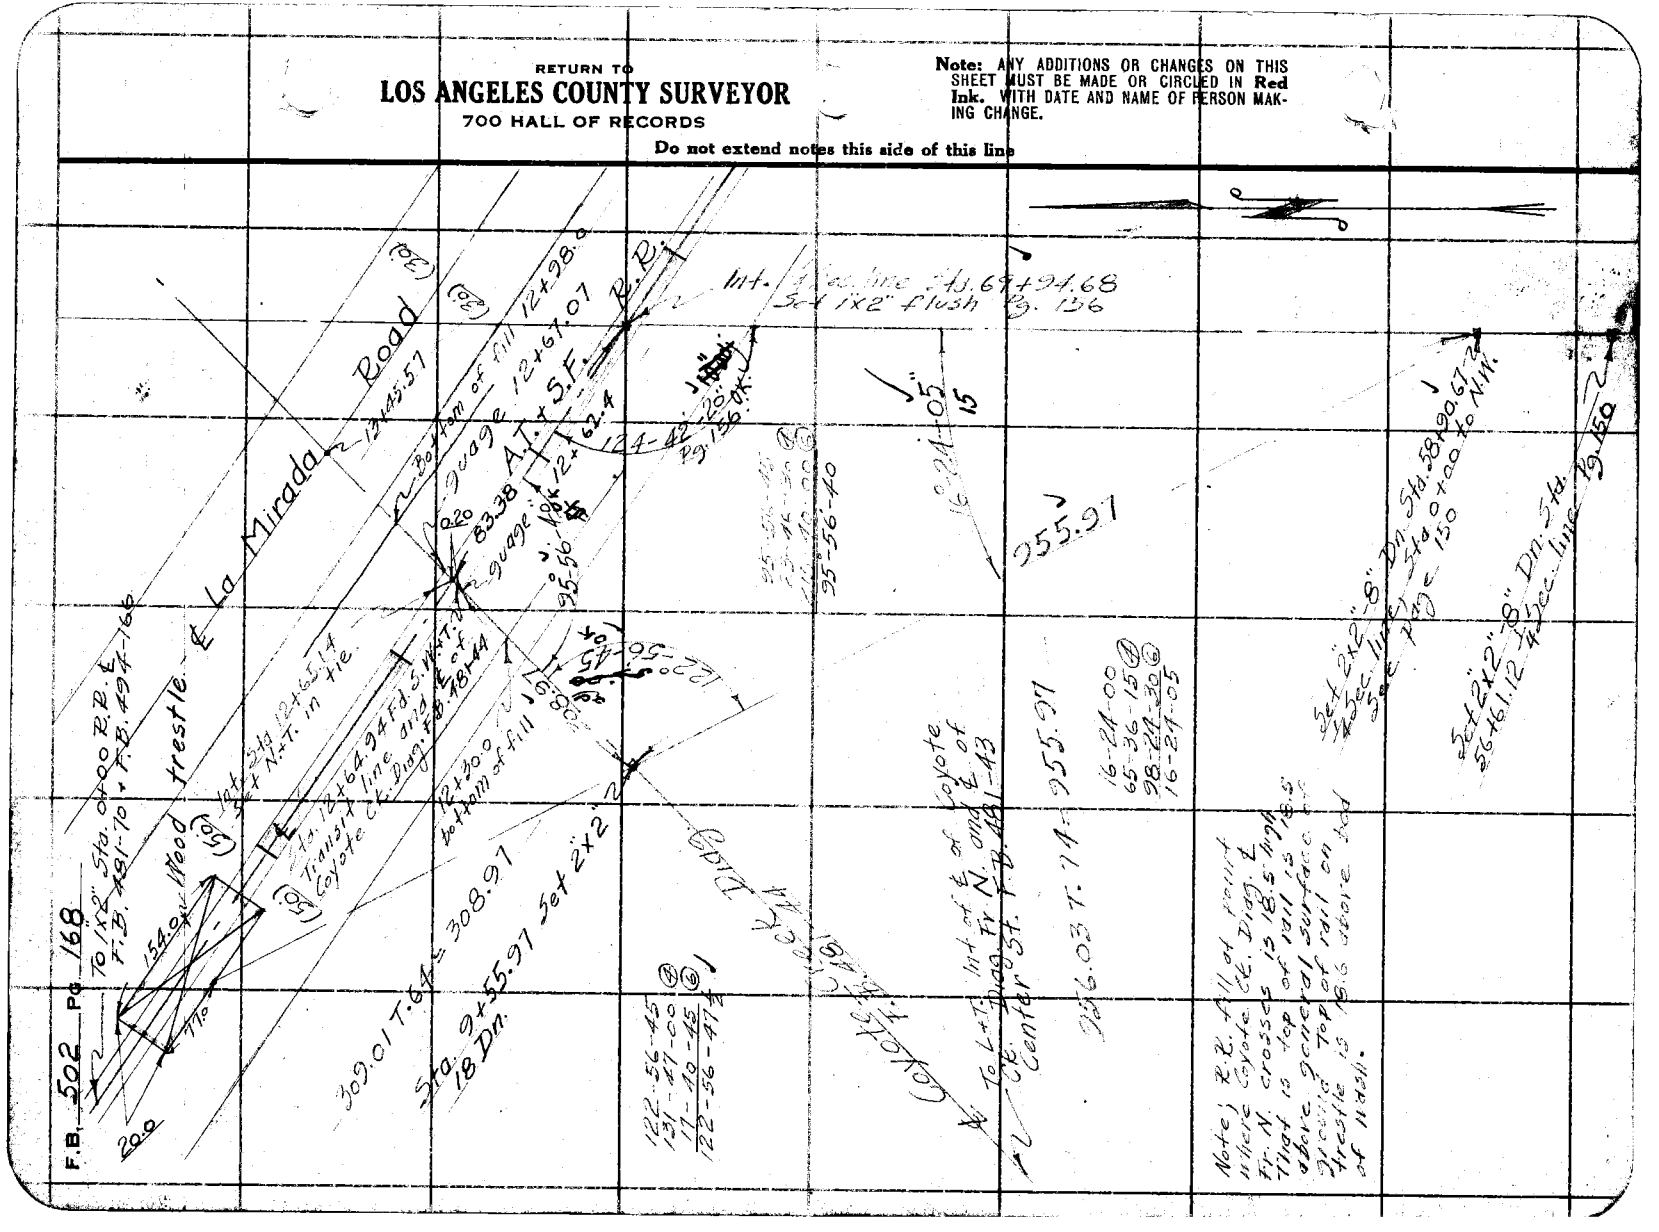

FORM 247 10M 5-31

RETURN TO
LOS ANGELES COUNTY SURVEYOR
700 HALL OF RECORDS

Note: ANY ADDITIONS OR CHANGES ON THIS SHEET MUST BE MADE OR CIRCLED IN **Red Ink.** WITH DATE AND NAME OF PERSON MAKING CHANGE.

Do not extend notes this side of this line

Notes Ck'd by B-820
Office Work Traylor
Checked Drew
Date July 1932

Survey of Holder Ave
W. O. 7886 Topo No. 822 Sh'd 8 ft. of
Surveyed by Rose crews
Notes
Indexed Date 10-28-32
C. C. Johnson

F.B. 502 PG. 169

Holder Ave

(30) (30)

90°-10' 1,150 S.S. "C" 24.167

105°-25'-25" 15 adj.

105-25-30 ①
62-21-15
213-32-30 ⑥
105-35-25

164-32-45
298-11-00 ④
267-16-45 ⑤
164-32-47½

To 2"x2" E.I.W. Cor. of Sec 23 T. 3 S.

(30) (30)

℄ Old L.A.

℄ 02 T. 3 S. 151

Cor. 11 W. 16 Dm

and San Diego Stage

1312.06 Z.1 T. 1 S. 151

2"x2"-12" Pen Dr. 0.7

13+19.12 Pen 481-35

35.99 164-32-45

Rd.

1312.11 T. 78 = 1313.06

1 C. 2"x2" 12" Pen. 5+4a. 75+00.05 156

RETURN TO

LOS ANGELES COUNTY SURVEYOR

700 HALL OF RECORDS

Note: ANY ADDITIONS OR CHANGES ON THIS SHEET MUST BE MADE OR CIRCLED IN **Red Ink.** WITH DATE AND NAME OF PERSON MAKING CHANGE.

Do not extend notes this side of this line

F.B. 502 PG. 170

Notes Ck'd by Drew	Survey of Walnut Ave		F.B. 502 Pg. 171
Map No. B.T. 220	W.O. 1886 Topo No. 222 M'd 90 °F.		
Office Work Taylor	Surveyed by Roseveare		
Checked Drew	Notes	Date 10-31-32	
Date July 1934	Indexed	C. Johnson	

Cont. bottom next page.

Co. Surv. Mon. 75 Sec. 27 Center 151

end of olives on east side

Olive Grove.

8" to 14" trees

Water line

out

out

out

out

out

Open ditch 2' to 3' deep

Set 2"x2" Sta. 75+00.06 See Pg. 155

Note: ANY ADDITIONS OR CHANGES OF THIS SHEET MUST BE MADE OR CIRCLED IN Red Ink, WITH DATE AND NAME OF PERSON MAKING CHANGE.

Do not extend notes this side of this line

RETURN TO
LOS ANGELES COUNTY SURVEYOR
700 HALL OF RECORDS

FORM 247 10M 8-31

F.B. 502 Pg. 172

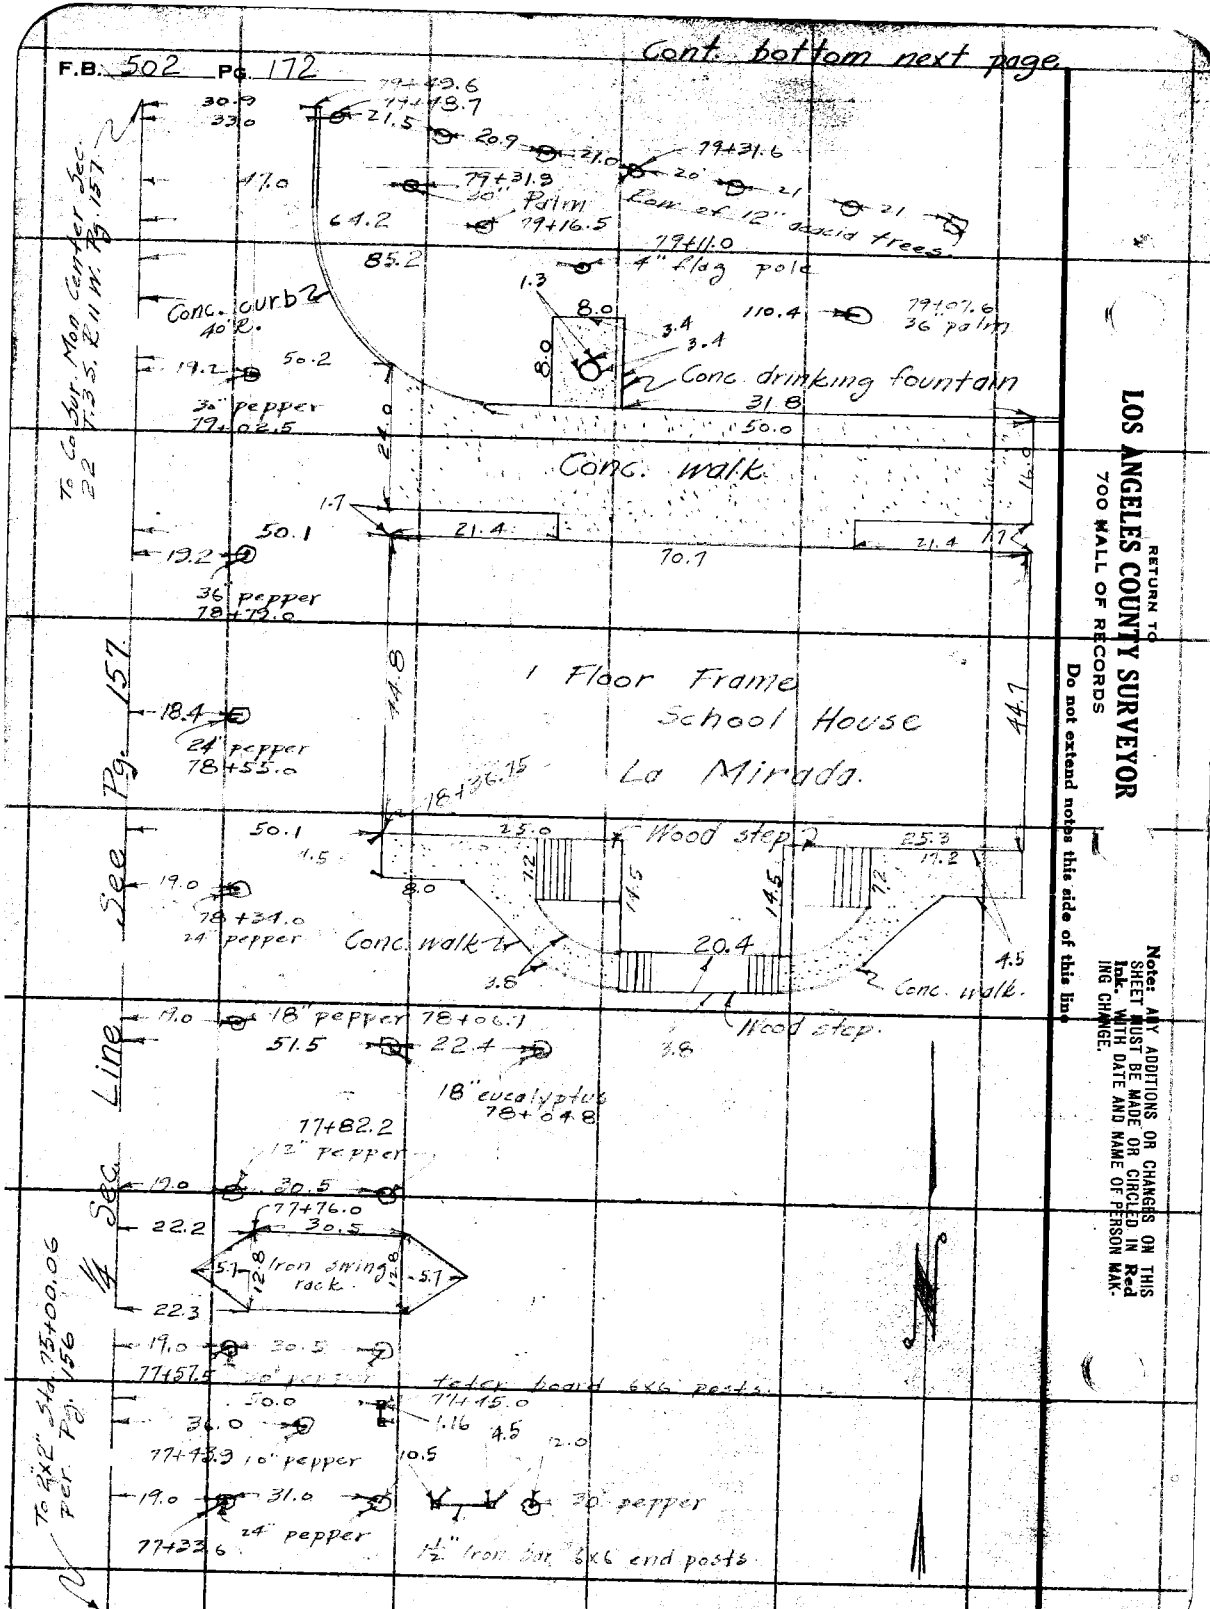

RETURN TO
LOS ANGELES COUNTY SURVEYOR
700 HALL OF RECORDS

Do not extend notes this side of this line

Note: ANY ADDITIONS OR CHANGES ON THIS SHEET MUST BE MADE OR CIRCLED IN Red Ink. WITH DATE AND NAME OF PERSON MAKING CHANGE.

Notes Ck'd by Drew	Survey of Holder Ave
Map No. B-820	W. O. 7084 Tape No. 022 St'd 54 °F.
Office Work Taylor	Surveyed by Rosecrans
Checked Drew	Notes Date 11-36
Date July 4-1934	Indexed A. C. Johnson

F.B. 502 Pg. 173

Note: ANY ADDITIONS OR CHANGES ON THIS SHEET MUST BE MADE OR CIRCLED IN Red Ink. WITH DATE AND NAME OF PERSON MAKING CHANGE.

Do not extend notes this side of this line

RETURN TO
LOS ANGELES COUNTY SURVEYOR
700 HALL OF RECORDS

FORM 547 10M 8-31

Cont. bottom next page

To 2"I.P. Sta. 82+74.31 Sec. Pg. 158

81+13.6 S. end of row of 18" cypress trees 30± apart.

81+23.9 S. end of lemons

N end of olives 81+03.4

81+02.8 S. end of row of 18" cypress trees 25± apart.

Lemon Grove

Olive Grove

Dirt Road.

80+54.6

55.1

89°-49'-10" Pg 157

80+43.7

54.0

S. end of lemons

18" acacia

80+38.2 12" cypress

80+22.8 12" cypress

80+10.2

58.5

12" acacia

80+07.7

S. end of olives

105.25 S. 25°-25'-E.

Old L.A. and San Diego Stage Rd.

79+88.2 12" acacia tree

79+66.2

79+59.3

46.9

18" acacia tree

N. end of olives

79+23.7

79+04.1

Oiled Road.

Center line of Stage Rd. as per Pg. 157

Tan. 79+82.21

Olive Grove

To 2"x2" Sta. 75+00.06 per Pg. 156

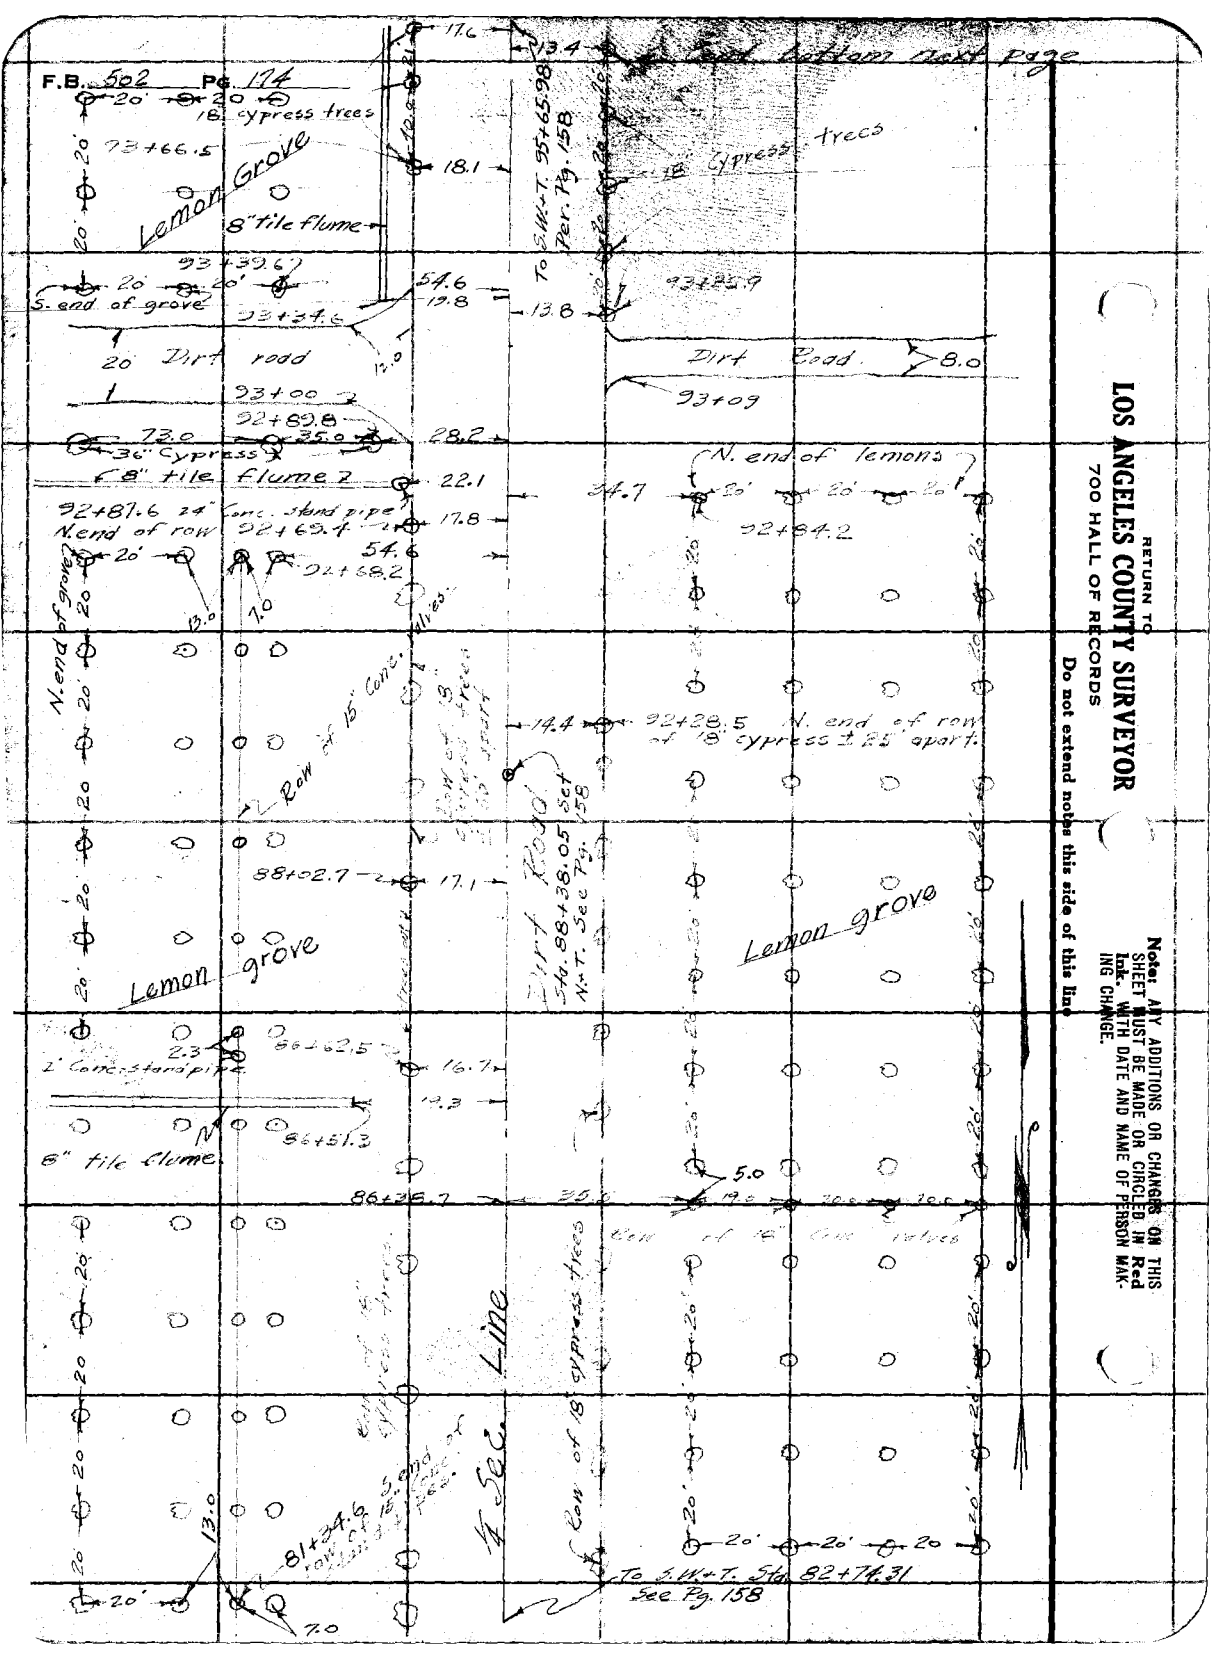
F.B. 502 Pg. 174
Lemon Grove
8" tile flume
18" cypress trees
Dirt road
36" Cypress
8" tile flume
24" Conc. stand pipe
N. end of row
S. end of grove
N. end of lemons
N. end of row of 18" cypress 25' apart.
Dirt Road
Lemon grove
2' Conc. stand pipe
6" tile flume
Line
To S.W.+T. Sta. 82+74.31
See Pg. 158
To S.W.+T. 95+65.98 Per. Pg. 158
Set Notroom next Page
RETURN TO
LOS ANGELES COUNTY SURVEYOR
700 HALL OF RECORDS
Do not extend notes this side of this line
Note: ANY ADDITIONS OR CHANGES ON THIS SHEET MUST BE MADE OR CIRCLED IN Red Ink, WITH DATE AND NAME OF PERSON MAKING CHANGE.

Notes Ck'd by Drew	Survey of Holder Ave
Map No. B-820	W. O. 1086 Tape No. 922 St'd 87 °F.
Office Work Taylor	Surveyed by Roseveare
Checked Drew	Notes Date 11-9-32
Date July-1934	Indexed A. C. Johnson

F.B. 302 PG. 175

Cont bottom next page

Note: ANY ADDITIONS OR CHANGES ON THIS SHEET MUST BE MADE OR CIRCLED IN Red Ink, WITH DATE AND NAME OF PERSON MAKING CHANGE.

RETURN TO
LOS ANGELES COUNTY SURVEYOR
700 HALL OF RECORDS
Do not extend notes this side of this line

FORM 247 10M 8-31

16 Co. Sur. Mon. of 4 Sec. Cor. Sta. 106+24.97 Pg. 158

Road

Dirt

8" tile flume ?

Row 30" cypress trees

Line ?

Set 3.11+T. Sta. 95+65.38 Pg. 158

95+56.7

95+36.2

95+27.6

95+81.0

10" acacia

3" peach

3" peach

Cone. fish pond

Cone. slab

8" pine

Cone. fish pond

Wood fence

1 F. floor frame Bunk House

To 4+T. Sta. 88+38.05 Per Pg. 158

5" oleander Hedge

94+27.9

30" pepper

30" pepper

10" pepper

30" pepper

F.B. 502 PG. 176

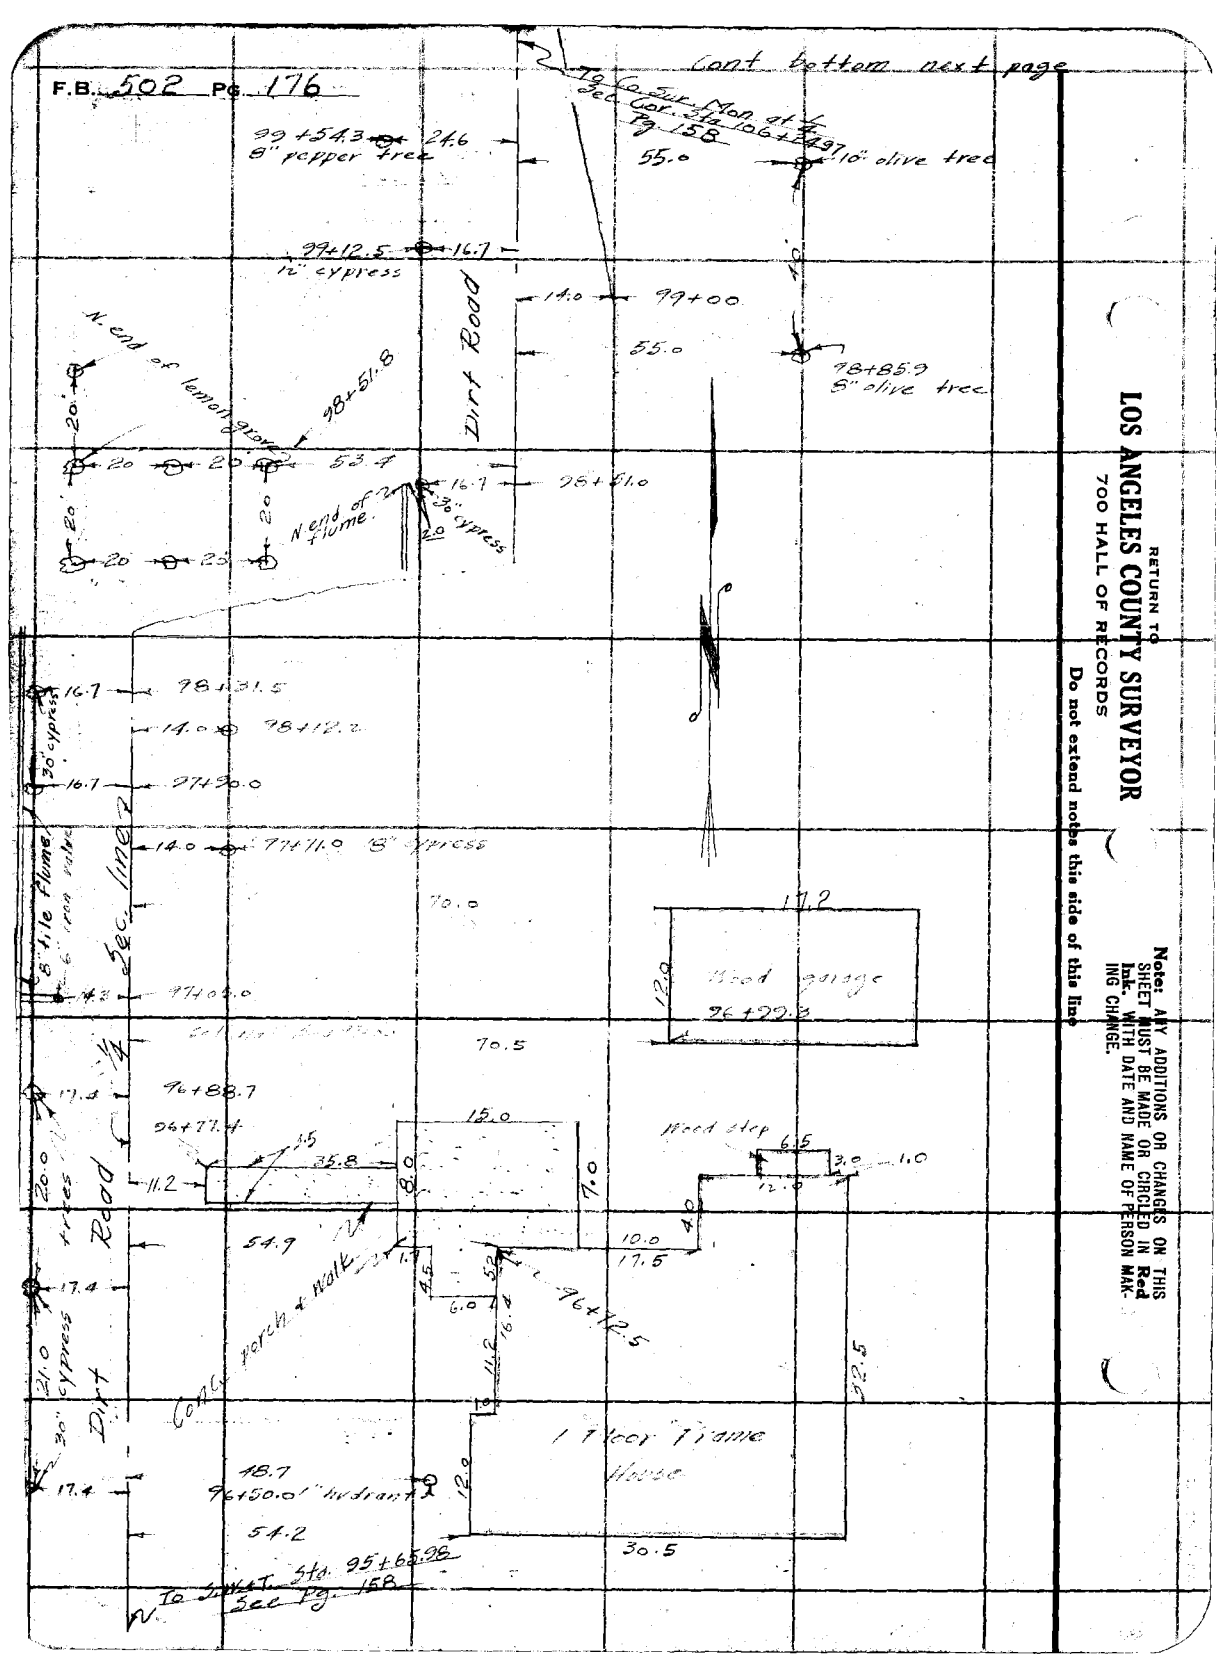

RETURN TO
LOS ANGELES COUNTY SURVEYOR
700 HALL OF RECORDS

Do not extend notes this side of this line

Note: ANY ADDITIONS OR CHANGES ON THIS SHEET MUST BE MADE OR CIRCLED IN Red Ink. WITH DATE AND NAME OF PERSON MAKING CHANGE.

Notes Ck'd by Drew
Office Work Taylor
Checked Drew
Date July 1934

Survey of Holder Ave
Surveyed by Rosecrans
Notes
Date 11-2-32
Inspected C. Johnson

F.B. 502 PG. 177

cont. bottom next page

Note: ANY ADDITIONS OR CHANGES ON THIS SHEET MUST BE MADE OR CIRCLED IN Red Ink. WITH DATE AND NAME OF PERSON MAKING CHANGE.

RETURN TO
LOS ANGELES COUNTY SURVEYOR
700 HALL OF RECORDS
Do not extend notes this side of this line

FORM 247 10M 5-31

20' 20' 20'

104+00.0 4" pepper

17.5

E. to Co. Cor. Sub. Sta. Mon. at E. Sec. 106+24.97 R.D. 158

103+95.0 5" gum tree 21.7
17.2

Shrubs and small trees 20 15.0 50'

27.2

14.0 103+74. 8" pepper.

27.2

103+68.7 20" Gum 45.4

103+70

103+65.5 14" palm 57.0

103+61.0 4' century plant 34.0

8" pine

103+63.0

103+51.0 14" palm 58.0

103+46.5 24" pepper 52.3

16.0 103+46.5 4" pepper.

103+30.0 20.4

20" cypress

16.4 18" cypress 103+26.0

103+26

10' 10'

103+12.5 24" pepper 24.9

E. Sec. Line T.

Olive Grove

35.6 20' 20'

104+15.0

20 102+00

Dirt Road

20 100+50.0

To S. W. Cor. Sta. 25+65.98 See R.D. 158

F.B. C.A. 502 Pg. 178

Cont. bottom next page.

To 2½" I.P. Sta. 115+49.44
8" Dia. Pg. 161

8" pepper 103+61.0 — 15.0 — 6.0 — 6.0 — 16.4 — 103+23.0 — 18" cypress

18" cypress 108+83.0 — 15.0

18" cypress 108+22.0 — 15.0 — 16.4 — 108+22.0 — 18" cypress

16.4 — 108+03.0 — 18" cypress

16.4 — 107+42.2 — 18" cypress

5.0 8.0

2191

106+05.2
N. end of grove

106+11.2 Dn.
Mon. 12"

Cor. 1/4
Sec. Co. Sur.
Set
See Pg. 160.

36.6 — 20' — 20' — 20' — 20'

10'

180.0 — 18.0

Lime Rd.
Dirt road.

103+68.6 — 15.0
30" cypress

10'

103+30.0 8" acacia — 18.2

103+12.0 8" Gum — 27.1

grove

olive

10'

22.0 — 23.0

Shrubs + small trees

8" acacia — 17.4 — 104+26.2

10'

2" Gum

53.0

4" Tin — 10.0 — 104+40.3

10.0

104+29.5 — 21.0

22.0

53.0

8" Gum
104+28.5

To 3.1/4" I.P. Pg. 158 — 16.2 — 104+66.98

10'

20' — 20' — 20' — 20' — 20'

RETURN TO
LOS ANGELES COUNTY SURVEYOR
700 HALL OF RECORDS
Do not extend notes this side of this line

Note: ANY ADDITIONS OR CHANGES ON THIS SHEET MUST BE MADE OR CIRCLED IN Red Ink. WITH DATE AND NAME OF PERSON MAKING CHANGE.

Notes Ck'd by	Dixon	Survey of	Hoover Ave.
Map No.	B-6216	W. O.	7081
Office Work	Taylor	Surveyed by	Rosenlund
Checked	Dixon	Notes	
Date	July 1934	Indexed	A. C. Johnson

F.B. 302 PG. 179

Cont bottom next page

24' 24' 24' 24' 46.6

2" water hydrant 117+73.9

24' 24' 46.6

S end of lemon grove

1.0

117+01.0

8.4

16.5 116+91.0 24" cypress

116+75.8 8" iron valve

16.5 115+90.0 16" cypress

16.5 115+60.0 12" cypress

9'x9" conc. flume

2.0 1.0

Sta 115+49.44 5" DD. See Pg 161 See Ex 2

16.5 114+88.8 12" cypress

Row of 18" cypress trees ±20' apart

16.6 114+68.6 18" cypress

E. Sec. Line

114+58.5 29.7 6' dump of trees not

14.3

114+28.5

114+19.5 8" CMP culvert

8.9

16.1 113+67.0 18" cypress

113+05.0 S end of row of 18" cypress trees ±20' apart

16.0

9'x9" conc. flume

6" iron valve 111+35.0

13.5

16.2 6" iron valve 111+38.5

Dirt Road

To Co. Sur. Mon at E¼ Sec Cor Sta 106+24.27 Pg 160

N

Note: ANY ADDITIONS OR CHANGES OR THIS SHEET MUST BE MADE OR CIRCLED IN Red Ink, WITH DATE AND NAME OF PERSON MAKING CHANGE.

Do not extend notes this side of this line

RETURN TO
LOS ANGELES COUNTY SURVEYOR
700 HALL OF RECORDS

FORM 247 10M 3-31

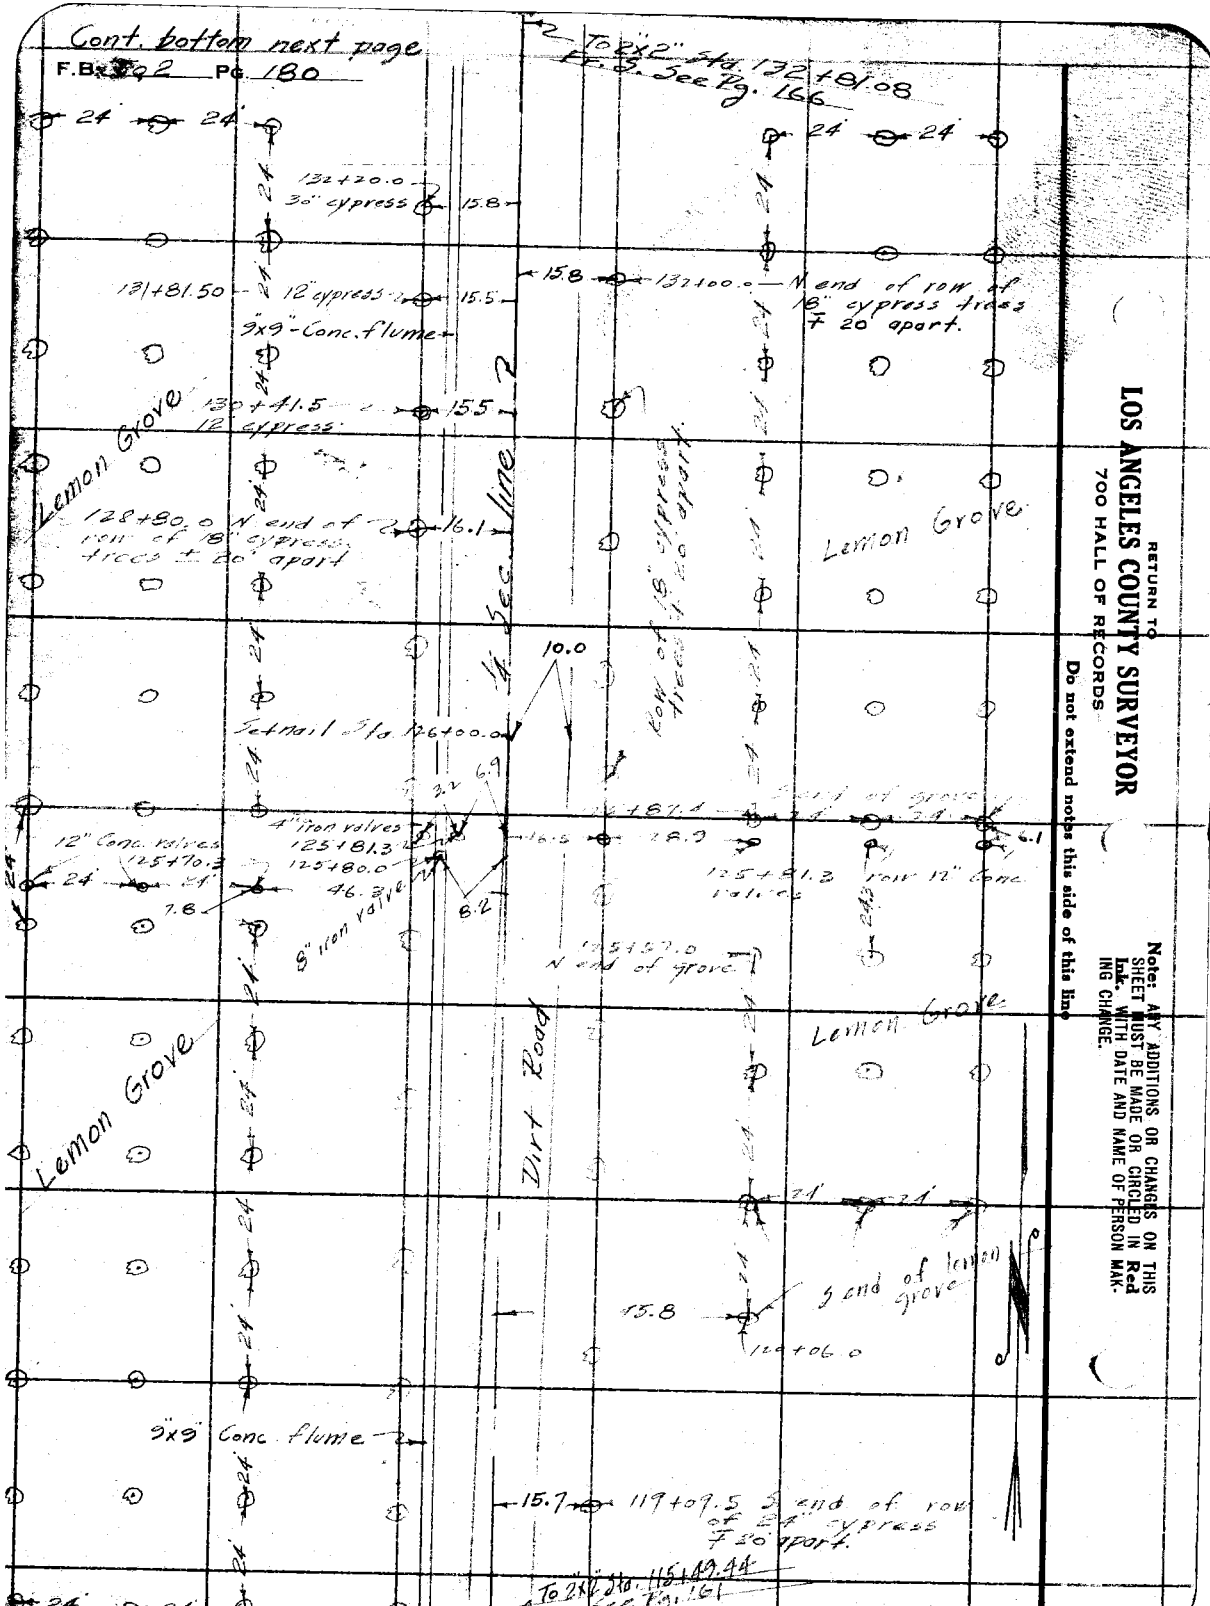
Cont. bottom next page
F.B. 702 Pg. 180
To 2½" dia 132+81.08 E.S. See Pg. 166
24
24
132+20.0
30" cypress
15.8
131+81.50
12" cypress
15.5
9x9"-Conc. flume
130+41.5
12 cypress
15.5
15.8
132+00.0 N end of row of 16" cypress trees ± 20' apart.
Lemon Grove
128+80.0 N end of row of 18" cypress trees ± 20' apart
16.1
Sec. line
Lemon Grove
10.0
Set nail & tag 126+00.0
4" iron valves
125+81.3
125+80.0
46.3
12" Conc. valves
125+70.3
7.8
6.9
6.2
9" iron valve
125+81.2 row 12" conc
125+67.0 N end of grove
Lemon Grove
Dirt Road
Lemon Grove
15.8
S end of lemon grove
124+06.0
9x9" Conc. flume
15.7
119+09.5 S end of row of 24" cypress ± 20' apart.
To 2½" dia. 116+49.44 See Pg. 161
RETURN TO
LOS ANGELES COUNTY SURVEYOR
700 HALL OF RECORDS
Do not extend notes this side of this line
Note: ANY ADDITIONS OR CHANGES ON THIS SHEET MUST BE MADE OR CIRCLED IN Red Ink. WITH DATE AND NAME OF PERSON MAKING CHANGE.

Notes Ck'd by	Drew	Survey of	Holder Ave.
Map No.	B 82	W. O.	1686
Office Work	Taylor	Surveyed by	Rosecrans
Checked	Drew	Notes	Date 11 7 32
Date	July 1934	Indexed	A. C. Johnson

F.B. 502 PG. 181

Cont. bottom next page.

136+80.3 15.8 8" cypress

136+33.91 Fd. N+T. Pg. 161






























Note: ANY ADDITIONS OR CHANGES ON THIS SHEET MUST BE MADE OR CIRCLED IN Red Ink, WITH DATE AND NAME OF PERSON MAKING CHANGE.

RETURN TO LOS ANGELES COUNTY SURVEYOR 700 HALL OF RECORDS

Do not extend notes this side of this line

FORM 247 10M 8-31

F.B. 502 Pg. 182

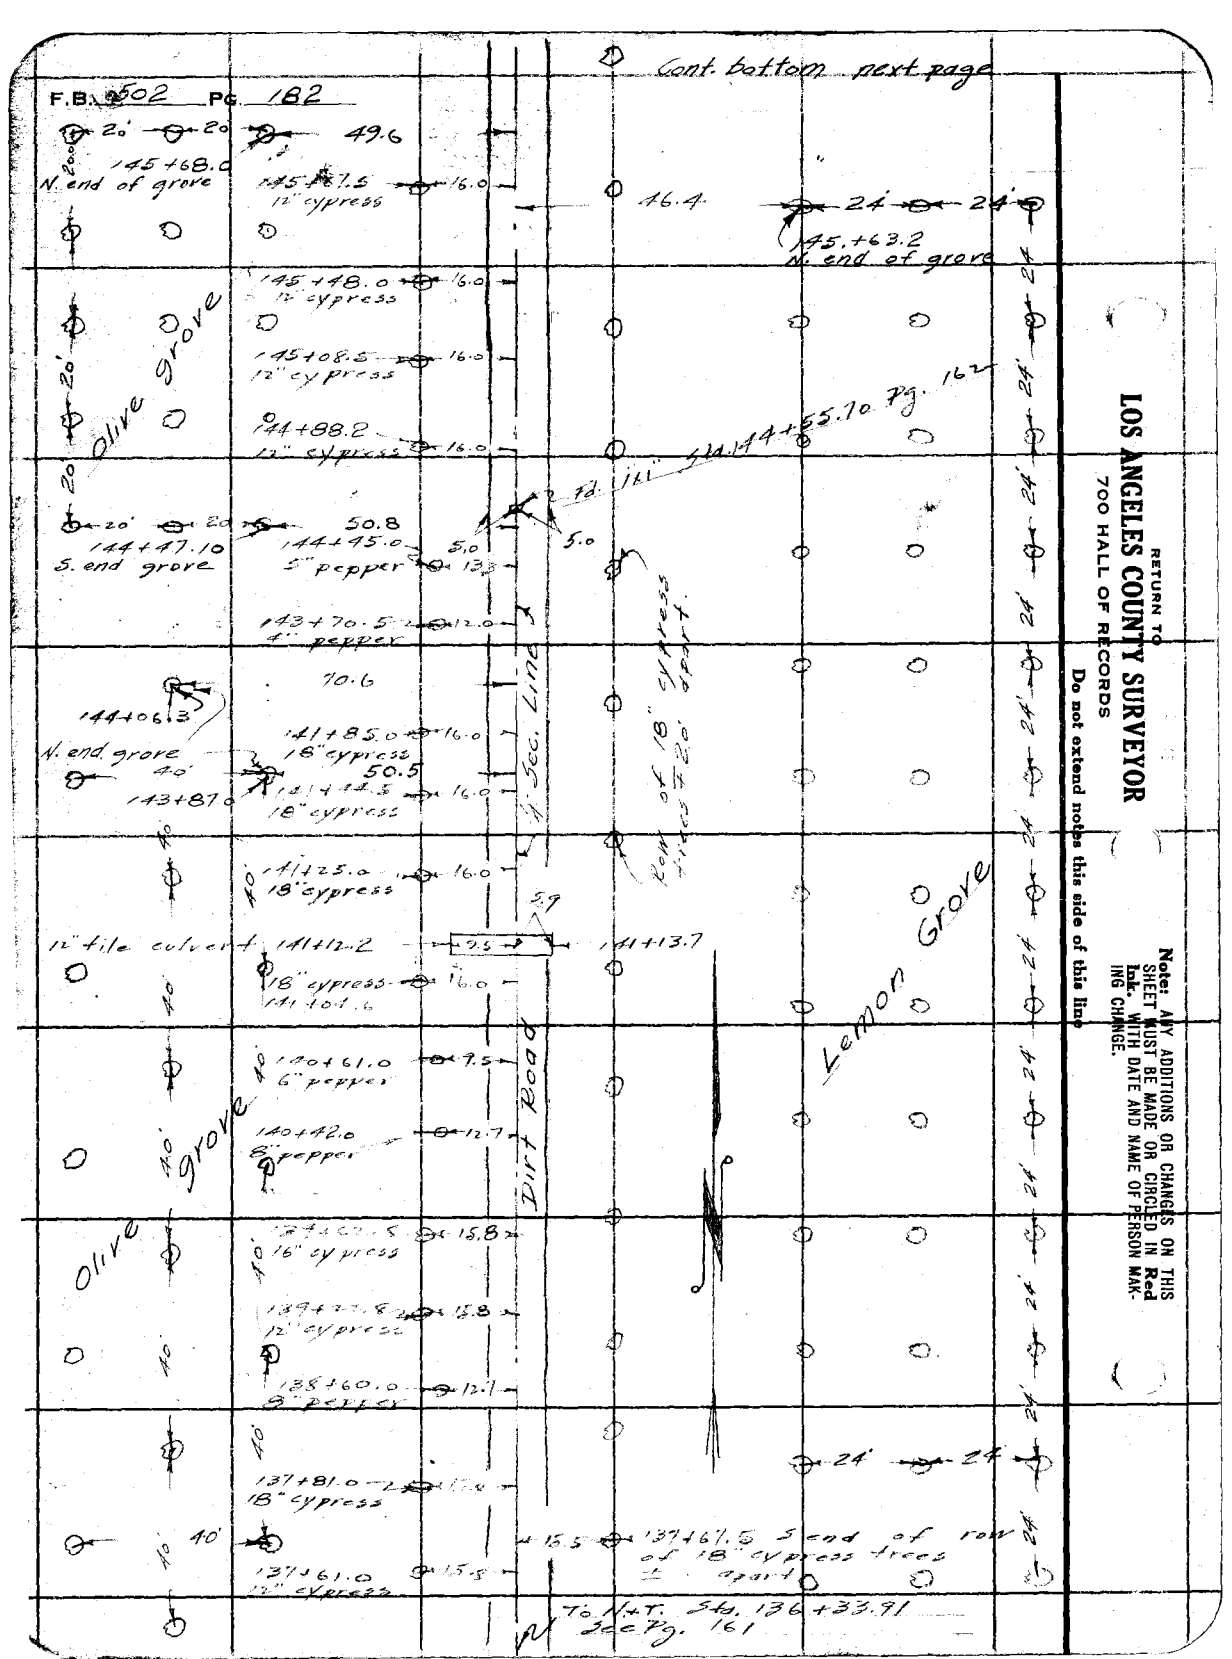

RETURN TO
LOS ANGELES COUNTY SURVEYOR
700 HALL OF RECORDS

Do not extend notes this side of this line

Note: ANY ADDITIONS OR CHANGES ON THIS SHEET MUST BE MADE OR CIRCLED IN Red Ink. WITH DATE AND NAME OF PERSON MAKING CHANGE.

Notes Ck'd by	Drew	Survey of	Holder Ave
Map No.		W. O.	Page No.	Bk.	Of.
Office Work	Taylor	Surveyed by	Rosecrans
Checked	Drew	Notes	Date 11-2-32
Date	July 1937	Indexed	A. C. Johnson

F.B. 502 Pg. 183

Notes: ANY ADDITIONS OR CHANGES ON THIS SHEET MUST BE MADE OR CIRCLED IN Red Ink, WITH DATE AND NAME OF PERSON MAKING CHANGE.

Do not extend notes this side of this line

RETURN TO
LOS ANGELES COUNTY SURVEYOR
700 HALL OF RECORDS

FORM 247 10M 8-31

153+54.3 12+43.0 at
20' 20' 20'
Rt 2"x2" at 153+28.29 Cor. Pg. 162
Sec. Line
151+43.25
Olive Grove 6" to 12" trees
5.0 5.0

RETURN TO
LOS ANGELES COUNTY SURVEYOR
700 HALL OF RECORDS

Note: ANY ADDITIONS OR CHANGES ON THIS SHEET MUST BE MADE OR CIRCLED IN **Red Ink.** WITH DATE AND NAME OF PERSON MAKING CHANGE.

Do not extend notes this side of this line

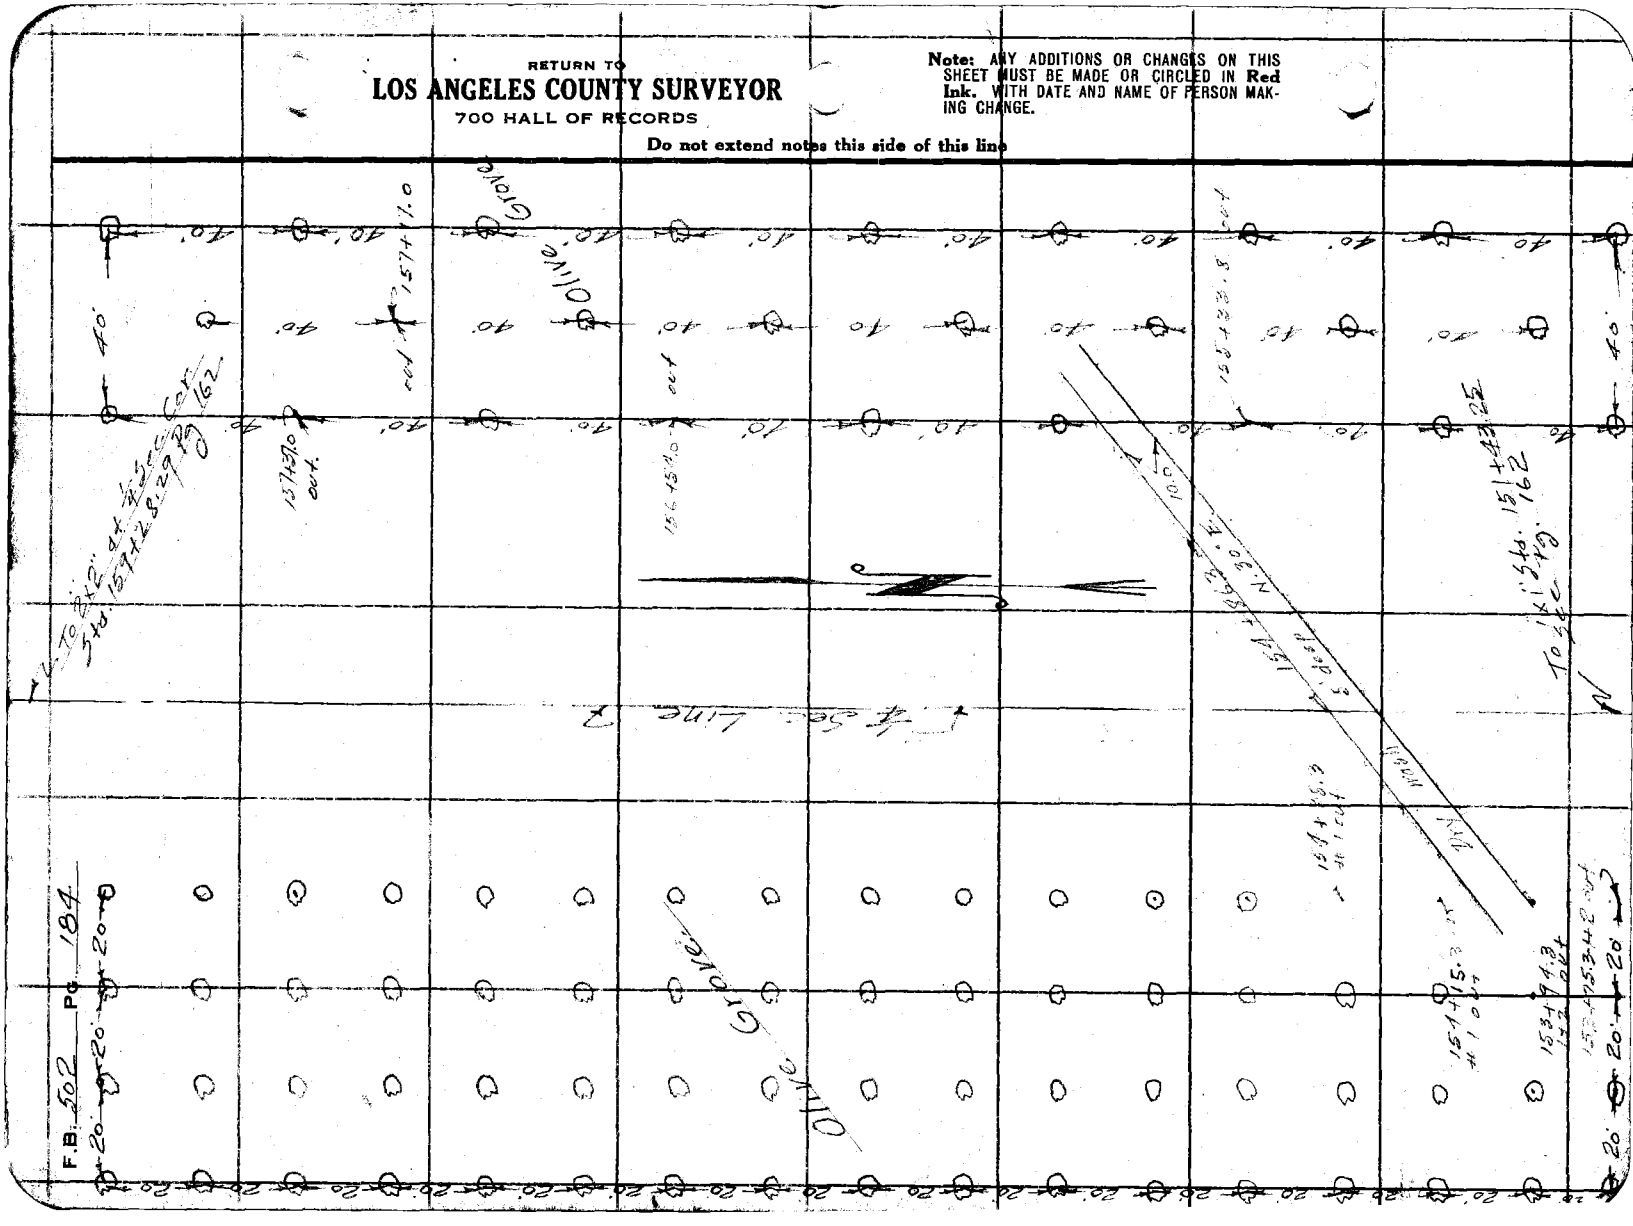

Map No. [illegible]	W.O. [illegible] Tape No. 622 St'd 24 of F.
Office Work Taylor	Surveyed by [illegible]
Checked Drew	Notes Date 11-7-32
Date July 1934	Indexed A. C. Johnson

F.B. 302 PG. 185

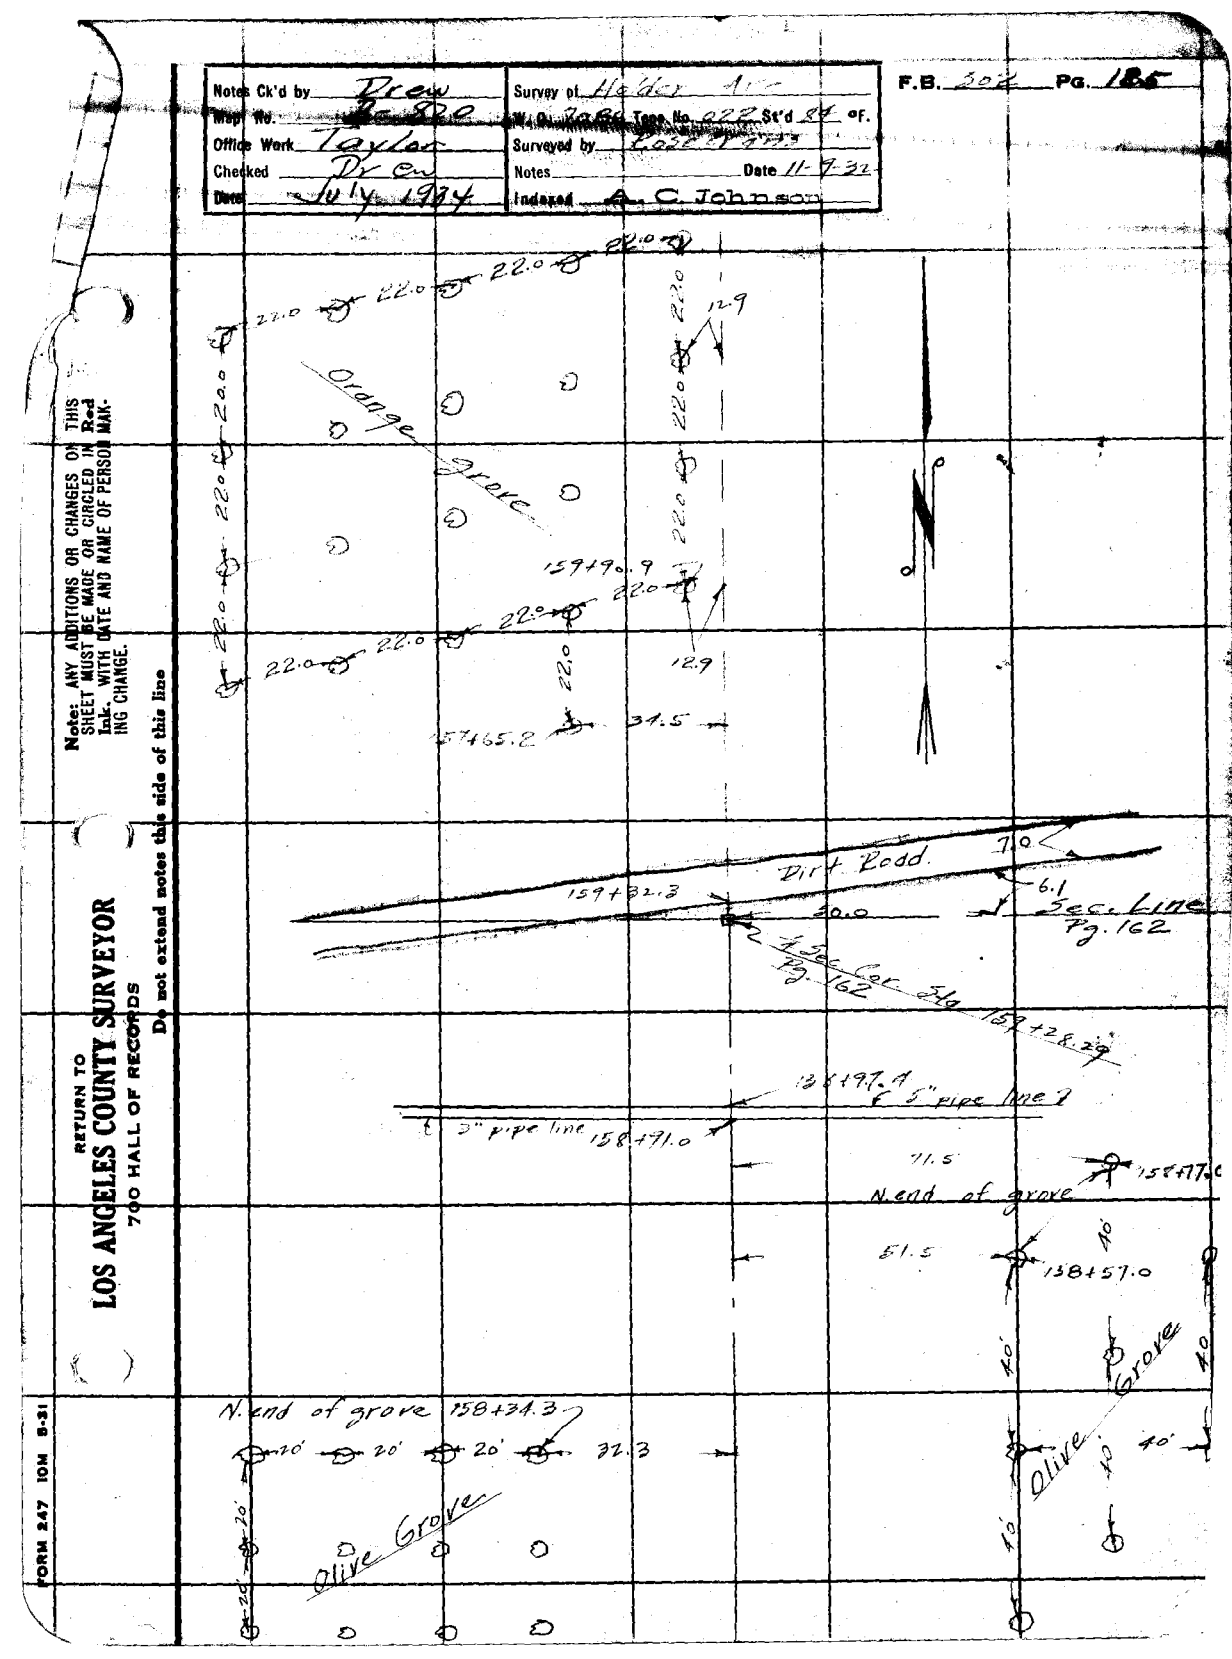

Notes: ANY ADDITIONS OR CHANGES OR THIS SHEET MUST BE MADE OR CIRCLED IN Red Ink, WITH DATE AND NAME OF PERSON MAKING CHANGE.

Do not extend notes this side of this line

RETURN TO
LOS ANGELES COUNTY SURVEYOR
700 HALL OF RECORDS

FORM 247 10M 8-31

RETURN TO

LOS ANGELES COUNTY SURVEYOR

700 HALL OF RECORDS

Note: ANY ADDITIONS OR CHANGES ON THIS SHEET MUST BE MADE OR CIRCLED IN **Red Ink.** WITH DATE AND NAME OF PERSON MAKING CHANGE.

Do not extend notes this side of this line

F.B. 502 Pg. 186

Notes Ck'd by	Survey of Holder Ave
Map No. B-820	W. O. Tape No St'd. °F.
Office Work Wood	Surveyed by Evans
Checked	Notes Date
Date	Indexed C. Johnson 9-10-36

F.B. PG. 187

(5-46-45)
5-07-90
15.0-46-45W

old P.O.T. per pgs. 155, 156, 157 Elevations changed.

Set 2x2-12" dm. Evans-5/7/36

58+44.16 E.C.

old P.O.T.-56+61.12 = P.I. New L.i.c. Fd. 2x2, 8" dp. per pg. 150. Replaced with 3/4" I. P. cem'd ch. tk. etc., 18" dn.

HOLDER

Δ = 21°-13'-15"
R = 1000
T = 187.33'
L = 370.37

15.0-46-45=

Set 2x2-16" dm. Evans-5/7/36

54+73.79 B.C.

(52.17 per pg. 150)

AVE

Set S.W.H.T. flush above pipe 5/7/36 Evans

CENTER

ST.

(53+39.38 Ft. So. P.R.L.E. Ry. 5 dn. per Ties pg. 150.

RETURN TO
LOS ANGELES COUNTY SURVEYOR
700 HALL OF RECORDS

Note: ANY ADDITIONS OR CHANGES ON THIS SHEET MUST BE MADE OR CIRCLED IN Red Ink WITH DATE AND NAME OF PERSON MAKING CHANGE.

Do not extend notes this side of this line

FORM 247 BM 2-34

RETURN TO
LOS ANGELES COUNTY SURVEYOR
700 HALL OF RECORDS

Note: ANY ADDITIONS OR CHANGES ON THIS SHEET MUST BE MADE OR CIRCLED IN **Red Ink** WITH DATE AND NAME OF PERSON MAKING CHANGE.

Do not extend notes this side of this line

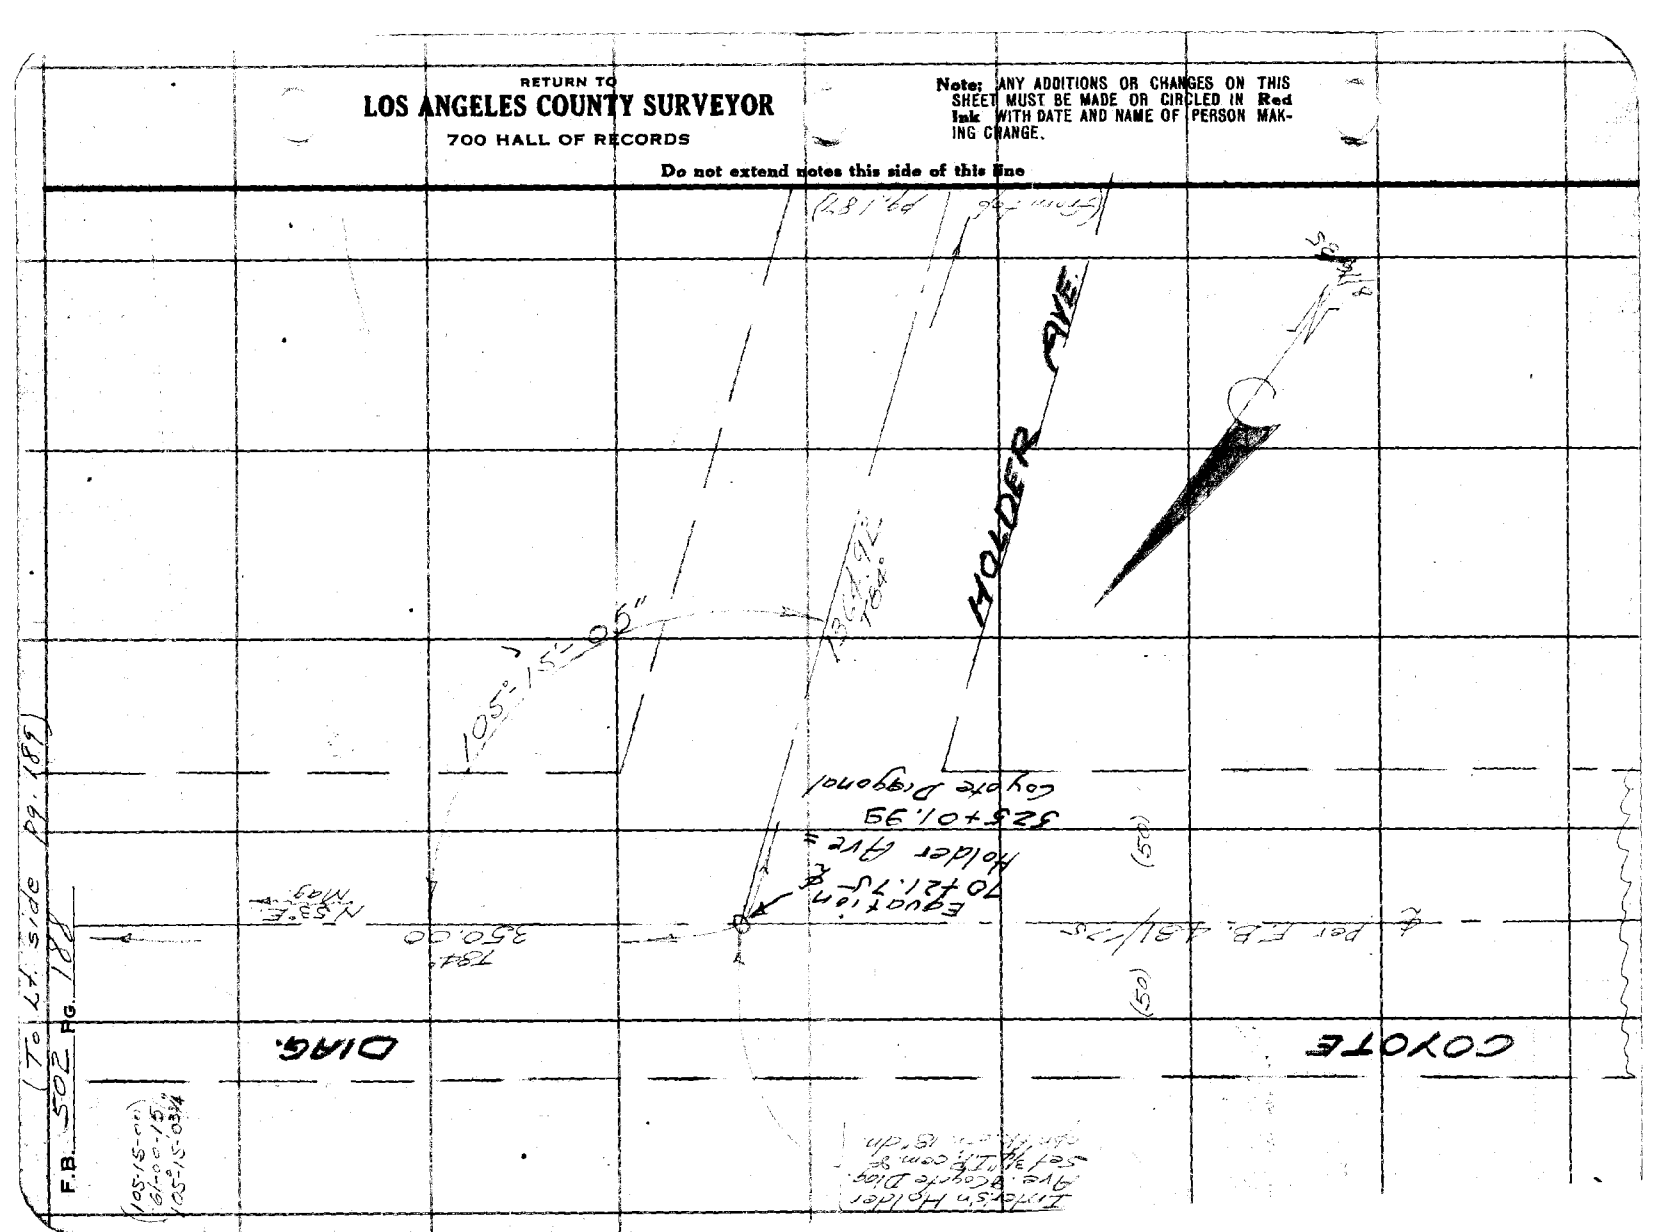

F.B. 502 PG. 181

(To 171 side pg. 180)

(105-15-11)
(67-00-15)
(52-15-03)

Notes Ck'd by	Survey of Holder Ave
Map No. B-820	W. O. 7606 Tape No ____ St'd ____ of.
Office Work Wood	Surveyed by E. KRAUS
Checked	Notes ____ Date 6/1/55
Date	Indexed L. C Johnson

F.B. 502 Pg. 189

LA MIRADA RD
(Parallel to R/R)

A.T.&S.F. R.R.

(60)
(50)
(55)
(50)
(50)

264.35

71° 10' 30"
Per F.B. 481/176

DIAG

350.00
F.B. 481/176

175.10
164'

Fd. 3x2 Sksh.
per F.B. 481/176

EB.

481/34

Sta. 0+00
Fd. SW.I.T.
F.B. 481-
44 & 77

COYOTE

Note: ANY ADDITIONS OR CHANGES ON THIS SHEET MUST BE MADE OR CIRCLED IN Red Ink WITH DATE AND NAME OF PERSON MAKING CHANGE.

Do not extend notes this side of this line

RETURN TO
LOS ANGELES COUNTY SURVEYOR
700 HALL OF RECORDS

FORM 247 SM 2-34

RETURN TO
LOS ANGELES COUNTY SURVEYOR
700 HALL OF RECORDS

Note: ANY ADDITIONS OR CHANGES ON THIS SHEET MUST BE MADE OR CIRCLED IN **Red Ink** WITH DATE AND NAME OF PERSON MAKING CHANGE.

Do not extend notes this side of this line

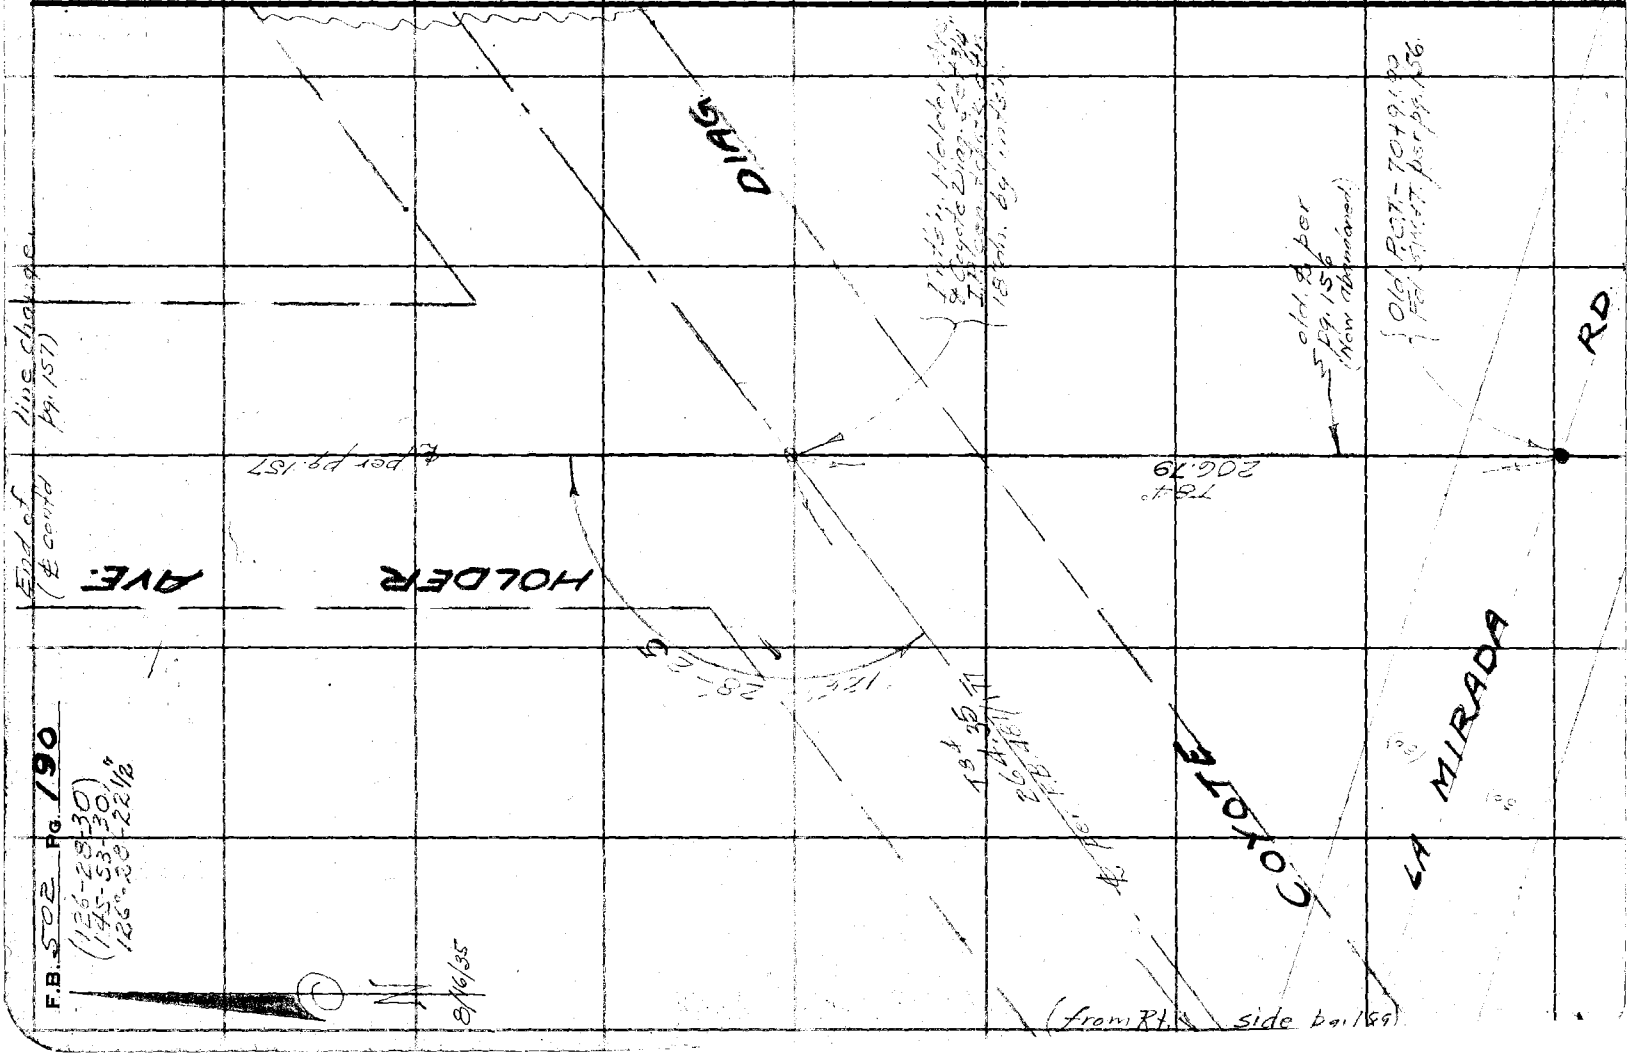

Notes Ck'd by W.H.B
Map No. B-806
Office Work O.T. Pack
Checked Blackmer
Date March 1933

Survey of Santa Gertrudes Ave
W. O. 7094 Tape No. St'd °F.
Surveyed by [illegible]
Notes Moore Date 9/32
Indexed A. C. Johnson 10-7-32

F.B. 502 Pg. 201

Note: ANY ADDITIONS OR CHANGES ON THIS SHEET MUST BE MADE OR CIRCLED IN Red Ink. WITH DATE AND NAME OF PERSON MAKING CHANGE.

RETURN TO
LOS ANGELES COUNTY SURVEYOR
700 HALL OF RECORDS
Do not extend notes this side of this line

FORM 247 10M 8-31

SURVEY
of
SANTA GERTRUDES AVE
from
CENTER ST
NORTH
to
IMPERIAL HIGHWAY
W.C. #7094

Party
Moore
Van Fleet
Fenner
Nauman

Sept 12-17, 1932

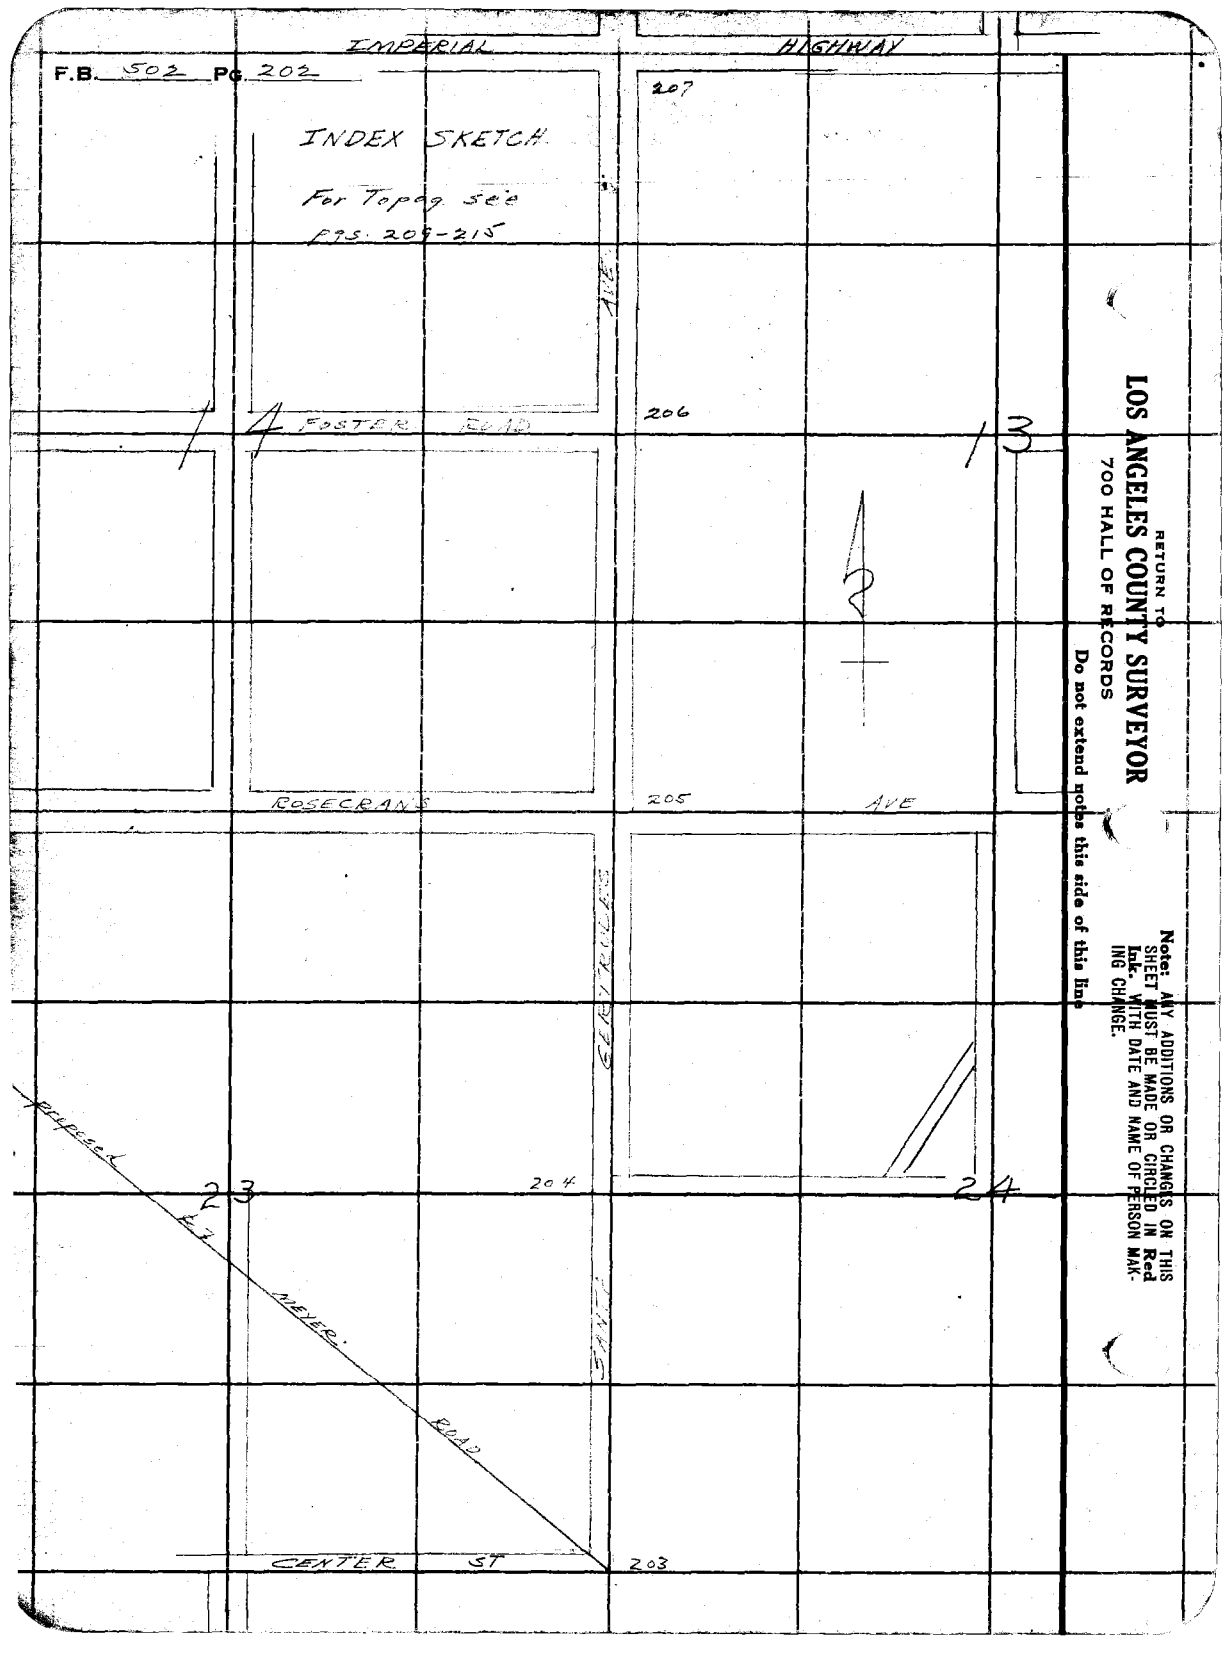
F.B. 502 PG. 202
INDEX SKETCH
For Topog. see
PGS. 209-215
IMPERIAL HIGHWAY
207
206
205
204
203
FOSTER RD
ROSECRANS AVE
CENTER ST
MEYER ROAD
1
4
13
23
24
2
RETURN TO
LOS ANGELES COUNTY SURVEYOR
700 HALL OF RECORDS
Do not extend notes this side of this line
Note: ANY ADDITIONS OR CHANGES ON THIS SHEET MUST BE MADE OR CIRCLED IN Red Ink. WITH DATE AND NAME OF PERSON MAKING CHANGE.

Map No. B-906		W. O. 7094 Tape No. 033 St'd 66 ft.	
Office Work O.L. Pack		Surveyed by L. D. Moore	
Checked Blackmer		Notes Moore Date 9-12-32	
Date March 1933		Indexed C. Johnson	

To bottom pg. 204

Note: ANY ADDITIONS OR CHANGES ON THIS SHEET MUST BE MADE OR CIRCLED IN Red Ink. WITH DATE AND NAME OF PERSON MAKING CHANGE.

RETURN TO
LOS ANGELES COUNTY SURVEYOR
720 HALL OF RECORDS
Do not extend notes this side of this line

AVE

910.68

Set 2x2 18" deep

40.00

40.00

Set 2x2 18" deep

867.91 @ 72° = 867.93

861.20 @ 84° = 861.29

110.54 @ 84° = 910.63

(30)

17+29.22
P.O.T.
Set 2x2
18" deep

GEETELLES
861.29
L.A. County
Orange County

RETIES THEAS
SEE F.B. 1803 P. 98

8+67.93
P.O.T.
Set 2x2
18" deep

Set 2x2 18" deep

40.00

40.00

Set 2x2 18" deep.

proposed per C.S. 610-3

MEYER ROAD

SANTA

867.93

For Topog. see pg. 210

C.S. B-610-3
48°-25'-45"

RETIES SEE
F.B. 1803 P. 97
8/23/57

Fd. 494-89
89°-51'-00"

Fd wire spk. + T
24" Gum

To BDRY Post No. 29
SEE F.B. 1803 P. 103 to 107

(29)

CENTER ST

44.69

50.44

Fd. S.T. + W.
Top 18" stump.

L.A. County
Orange County

1784.22

per F.B. 494-89

51.59

13.45

To 2x2 - P.O.T.
12" deep.

0+00
Fd. L.A. Co. Bdy Post #30
6" iron post - #30 stamped
on top - O Co on SE side
L.A. Co. on NW side on edge
of bank - 1' above ground
Punch Mark in Center.
Fd 4x4 N. of Mon.
F.B. 52-79
F.B. 425-421
F.B. 494-89

OUT
8/23/57
Granwall Co.
party

Fd. S.T. + W.
4" Gum

FORM 247 10M 8-31

To Bottom Pg 205

F.B. 502 Pg 204

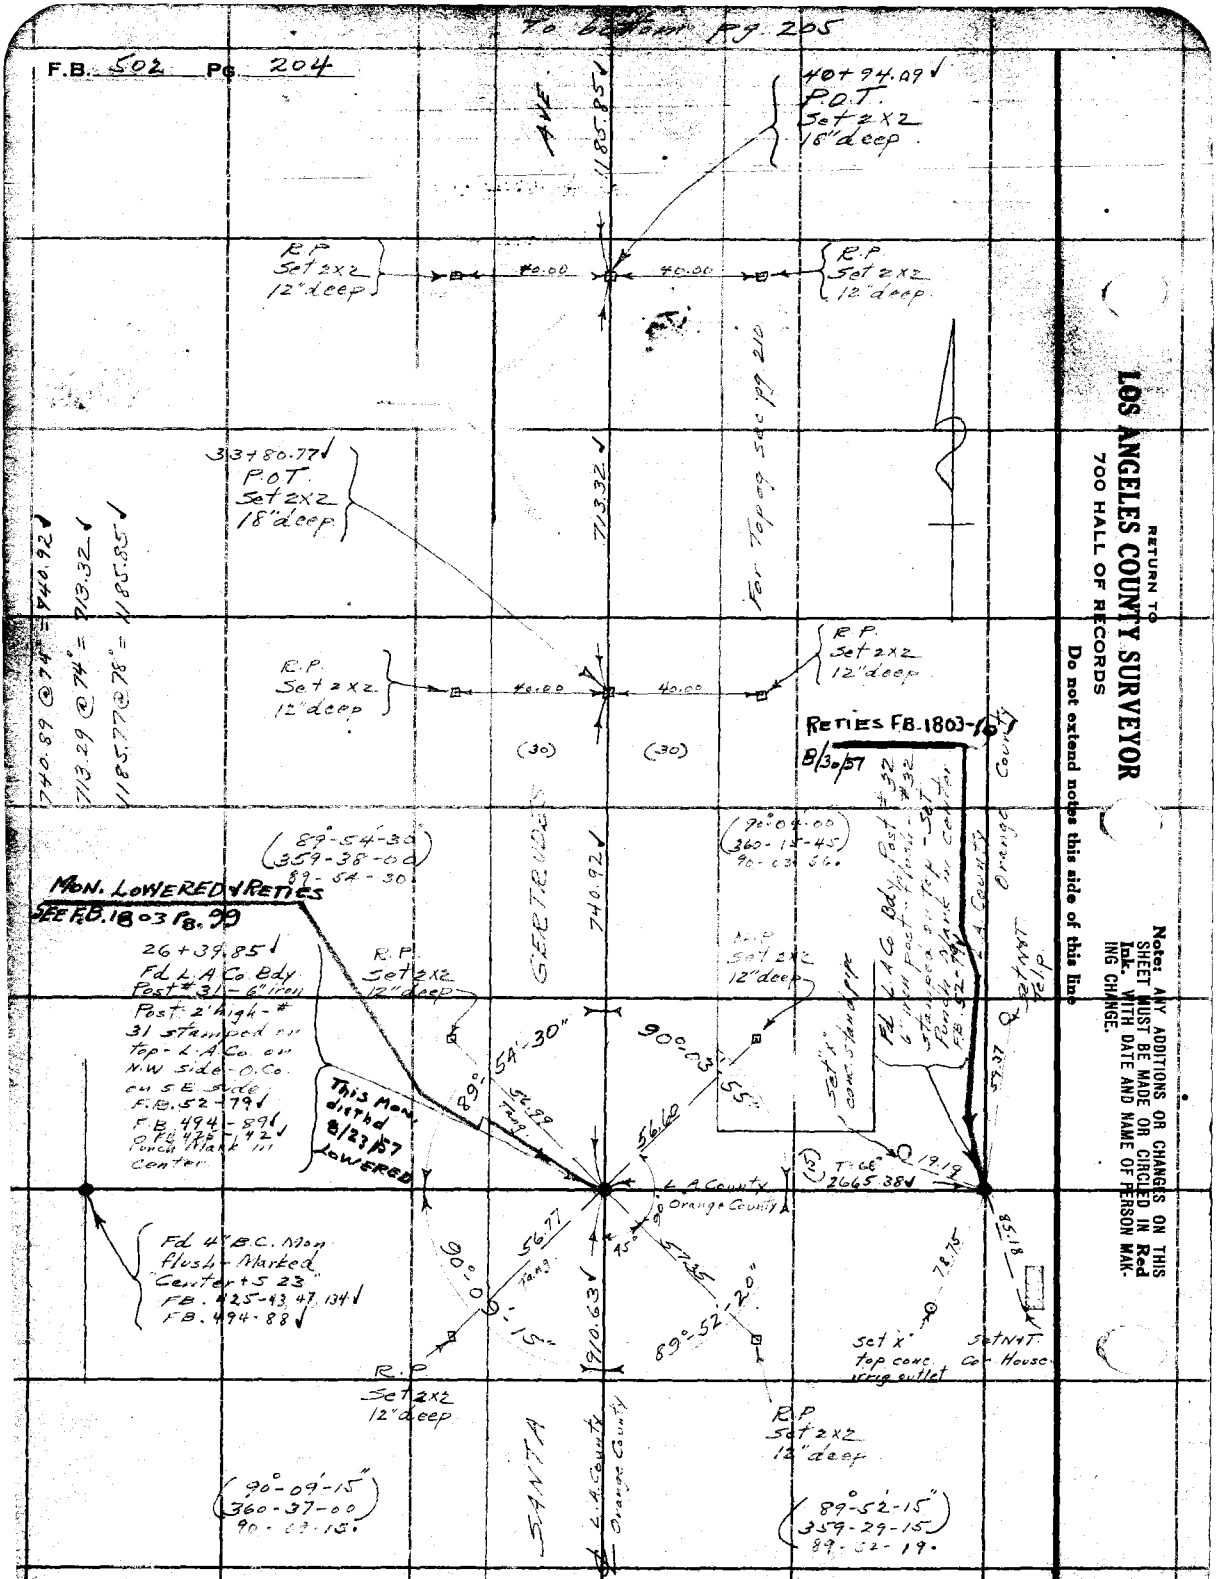

From Top Pg. 203

RETURN TO
LOS ANGELES COUNTY SURVEYOR
700 HALL OF RECORDS

Do not extend notes this side of this line

Note: ANY ADDITIONS OR CHANGES ON THIS SHEET MUST BE MADE OR CIRCLED IN Red Ink. WITH DATE AND NAME OF PERSON MAKING CHANGE.

Map No. B-806	W. O. 7094 Tape No. 033 St'd 68° °F.
Office Work O.L. Pack	Surveyed by R.D. Meek
Checked Blackmar	Notes Moore Date 9-18-32
Date March 1933	Indexed A. C. Johnson

F.B. 502 Pg. 206

to bottom pg 206

Reclaiming -10-22-32
300' Land Tape #42 Std @ 84° F.
272.73 @ 54°-30 = 221.88
216.59 @ 84° @ 42-24 = 215.79
487.82

299.60 @ 84°-42-44 = 279.26
154.33 @ 84° level = 151.33
450.59

Note: ANY ADDITIONS OR CHANGES ON THIS SHEET MUST BE MADE OR CIRCLED IN Red Ink. WITH DATE AND NAME OF PERSON MAKING CHANGE.

Do not extend notes this side of this line

RETURN TO
LOS ANGELES COUNTY SURVEYOR
700 HALL OF RECORDS

293.13 @ 80° @ 1 = 293.12
157.91 @ 84° @ 42-27 = 157.43
450.55

300.88 @ 84° @ 4-41 = 300.01
186.64 @ 84° @ 2-41 = 187.71
487.72

.62 .85

AVE 4237.45

For T, Page, See, Pg 210

GEN'L NOTES

450.59
450.55

57+67.86
P.O.T.
Fd 2x2 x 1/4
12" deep

300' Tape #42
Std @ 84° F.

R.P.
Set 2x2
12" deep

40.00 40.00

50.30

Fd N&T PP

(30) (30)

(89°-53'-00")
359-31-30
89-52-59.

(90°-07'-30")
360-30-30
90-07-39.

Fd L.A.C. Bdy Post #33
6" iron post flush -
#33 stamped on top
2" I.P. 2' high - 1' in W
Set P.K. in Nail in Center
FB 52-81

487.821
487.724

Fd 2x2
8" deep.
FB 48-81

Set N&T PP

R.P.
Set 2x2
12" deep

90°

Set N&T PP

106.84

73.45

ROSECRANS AVE

89-52-50

(30)

#4230
per FB 481-81

56.61

RETIES

68.56

Set N&T Bridge

88.48

Set N&T PP 6' above ground

90°-05'-35"

(30)

5728 Tang

1185.85

45°

5728

R.P.
Set 2x2
12" deep

(90°-05'-30")
360-22-30
90-05-37.

52+79.94
Fd 6x6 ℄ nail - flush
S.E. Cor. Sec. 14-T3S-R11W
F.B. 52-79
F.B. 481-8, 21
Replaced with C.S. Mon
2" I.P. & B.C. in conc.
18" deep. - Marked as
shown on right side
of this page
2" I.P. - 3 high for
marker - 1/4"

89°-54'-00"

(89°-54'-00")
359-36-00
89-54-00

SANTA

COUNTY SURVEYOR'S MONUMENT
T3S
R11W 14 13 23 24
SEC COR.

L.A. County
Orange County

From top pg 204

FORM 247 10M 8-31

F.B. 502 Pg. 206

To bottom pg. 207

220.14 @ 78° = 220.15
659.55 @ 78° = 659.57

659.59

R.P. Set 2x2 12" deep

40.00 40.00

R.P. Set 2x2 12" deep

81+49.39 P.O.T. Fd 2x2 12" deep F.B. 481-22

69.54

Fd NAIL & T.P.

79+29.24 Fd. 2x2 in Tk. F.B. 481-22, 74 F.B. 358-46 East 1/4 Cor. Sec. 14 T.3S-R11W. Replaced with C.S.Mon. 2" I.P. & B.C. in Conc 15" deep - Marked as shown

220.15

Fd 1x24 Tk 6" deep F.B. 481-74

Fd NAIL & T.P.

Car House

73.26

℄ Por

FOSTER

(30) ROAD

115.21 F.B. 481-74

21.44

89° 51' 15"

40.91 40.70

60.90

27.86

R.P. Pd. 2x2 12" deep Not on line

Fd NAIL & T.P.

(89-51-15) (359-25-00) 89-51-15

(90°-08'-15") (360-32-45) 90-08-11

297.05

90°-08'-15"

299.00	@ 0°-43'	=	299.00
147.21	@ 4°-00'	=	147.21
446.21			446.21

292.92	@ 82°	@ 7°-48'	= 296.54
224.86	@ 82°	@ 4°-40'	= 224.11
194.55	@ 82°	@ 2°-34'	= 174.36
216.86	@ 84°	@ 9°-38'	= 213.80
41.33	@ 84°	@ level	= 41.33
			967.44

R.P. Set 2x2 12" deep

40.00 40.00

R.P. Set 2x2 12" deep

76+32.19 P.O.T. Fd 2x2 x 4 Tk 12" deep F.B. 481-22

(30) (30)

446.26

297.02 @ 82° @ 0°-43' = 299.00
147.58 @ 78° @ 4°-00' = 147.21
446.21

292.92 @ 82° @ 7°-48' = 296.54
224.86 @ 82° @ 4°-40' = 224.11
194.55 @ 82° @ 2°-34' = 174.36
216.86 @ 84° @ 9°-38' = 213.80
41.33 @ 84° @ level = 41.33
967.44

297.16 @ 78° @ 1°-50' = 297.00

For Topo see pg. 211-212

GERTRUDE S

71+85.93 P.O.T. Set 2x2 12" deep

31.82

Set NAIL & T.P.

SANTA

Recharting 7-26-27-32
300' band tape #42 - Std @ 84°

45.00 @ 84° @ level = 45.00
262.79 @ 84° @ 6°-56 = 260.87
147.36 @ 84° @ 4-11 = 146.96
225.09 @ 82° @ 5°-26 = 224.08
292.76 @ 80° @ 6-50 = 290.64
967.56

299.06 @ 78° @ 0°-51 = 299.02
147.52 @ 78° @ 3-28 = 147.24
446.26

297.23 @ 76° @ 1°-52 = 297.05

From top pg. 205

RETURN TO
LOS ANGELES COUNTY SURVEYOR
700 HALL OF RECORDS
Do not extend notes this side of this line

Note: ANY ADDITIONS OR CHANGES ON THIS SHEET MUST BE MADE OR CIRCLED IN Red Ink. WITH DATE AND NAME OF PERSON MAKING CHANGE.

Notes Ck'd by W.H.B.
Map No. B-206
Office Work O.L. Pack
Checked Blackmer
Date March 1933

W. O. 7074 Tape No. 033 Std 68 °F.
Surveyed by E. D. Moore
Notes Moore Date 1-15-34
Indexed A. C. Johnson

F.B. 302 Pg. 207

(84-51-30
358-26-30
89-51-30.

Fd 2x2 to 2x2 - ± Coyote Creek Diag

Fd 2x2 12" deep F.B. 481-641

Fd N+T PP

Fd N+T PP

Fd N+T Guy. P. F.B. 481-641

89°-51'-30" 39.49 520.82 ± per F.B. 481-641 3329

Fd N+T PP

Fd 2x2 12" deep F.B. 358-461

IMPERIAL HIGHWAY

444.58 per F.B. 481-641

1228.35 Acr F.B. 358-461

(CORDOVA ROAD)

Fd "X" cone std pipe

6.47 4.2 6.47 7.30

3249

24.22

Set N+T PP

54.24 34.85 25.37 61.42

Set N+T PP

Fd "X" cone std pipe

Fd N+T PP

89°-51'-30"

Set "X"-conc. irrig outlet

90°-09'-15" 360-37-15 90-09-19.

COUNTY SURVEYOR T3S R11W 11 12 14 13 SEC. COR. MONUMENT

89°-59'-20"

105+79.67 Fd 2x2 x Tk 12" deep N.E. Cor. Sec. 14 T3S - R11W. F.B. 358-461 F.B. 481-641 Replaced with C.S. Mon. 2" I.P. & BC in conc. 18" deep - Marked as shown on left side of this page

105+43 AVE

Set N+T PP (30) (30)

81.0

R.P. Set 2x2 12" deep

40.00 40.00

R.P. Set 2x2 12" deep

25.02 95+24.64 P.O.T. Set 2x2 12" deep

GERTRUDES

88+08.98 P.O.T. Set 2x2 12" deep

Set N+T PP 38.19 60.98 34.62

Set 1" in top conc. irrig. outlet

SANTA

For Topog. See Pg. 213-2

From Top Pg. 206

RETURN TO
LOS ANGELES COUNTY SURVEYOR
700 HALL OF RECORDS

Do not extend notes this side of this line

Note: ANY ADDITIONS OR CHANGES ON THIS SHEET MUST BE MADE OR CIRCLED IN Red Ink, WITH DATE AND NAME OF PERSON MAKING CHANGE.

FORM 247 10M 8-31

RETURN TO

LOS ANGELES COUNTY SURVEYOR

700 HALL OF RECORDS

Note: ANY ADDITIONS OR CHANGES ON THIS SHEET MUST BE MADE OR CIRCLED IN **Red Ink.** WITH DATE AND NAME OF PERSON MAKING CHANGE.

Do not extend notes this side of this line

F.B. 502 Pg. 208

Notes Ck'd by W. H. B.	Survey of Santa Gertrudes Ave	F.B. 502 Pg. 209
Map No. D 806	W. O. 7094 Tape No. ____ St'd ____ oF.	
Office Work C. L. Pack	Surveyed by L. D. Moore	
Checked Blackmer	Notes Moore Date 9-15-32	
Date March 1933	Indexed A. C. Johnson 10-7-32	

TOPOGRAPHY
on
SANTA GERTRUDES AVE
from
CENTER ST
to
IMPERIAL HIGHWAY
W O # 7094

Note: ANY ADDITIONS OR CHANGES ON THIS SHEET MUST BE MADE OR CIRCLED IN Red Ink. WITH DATE AND NAME OF PERSON MAKING CHANGE.

Do not extend notes this side of this line

RETURN TO
LOS ANGELES COUNTY SURVEYOR
700 HALL OF RECORDS

FORM 247 10M 8-31

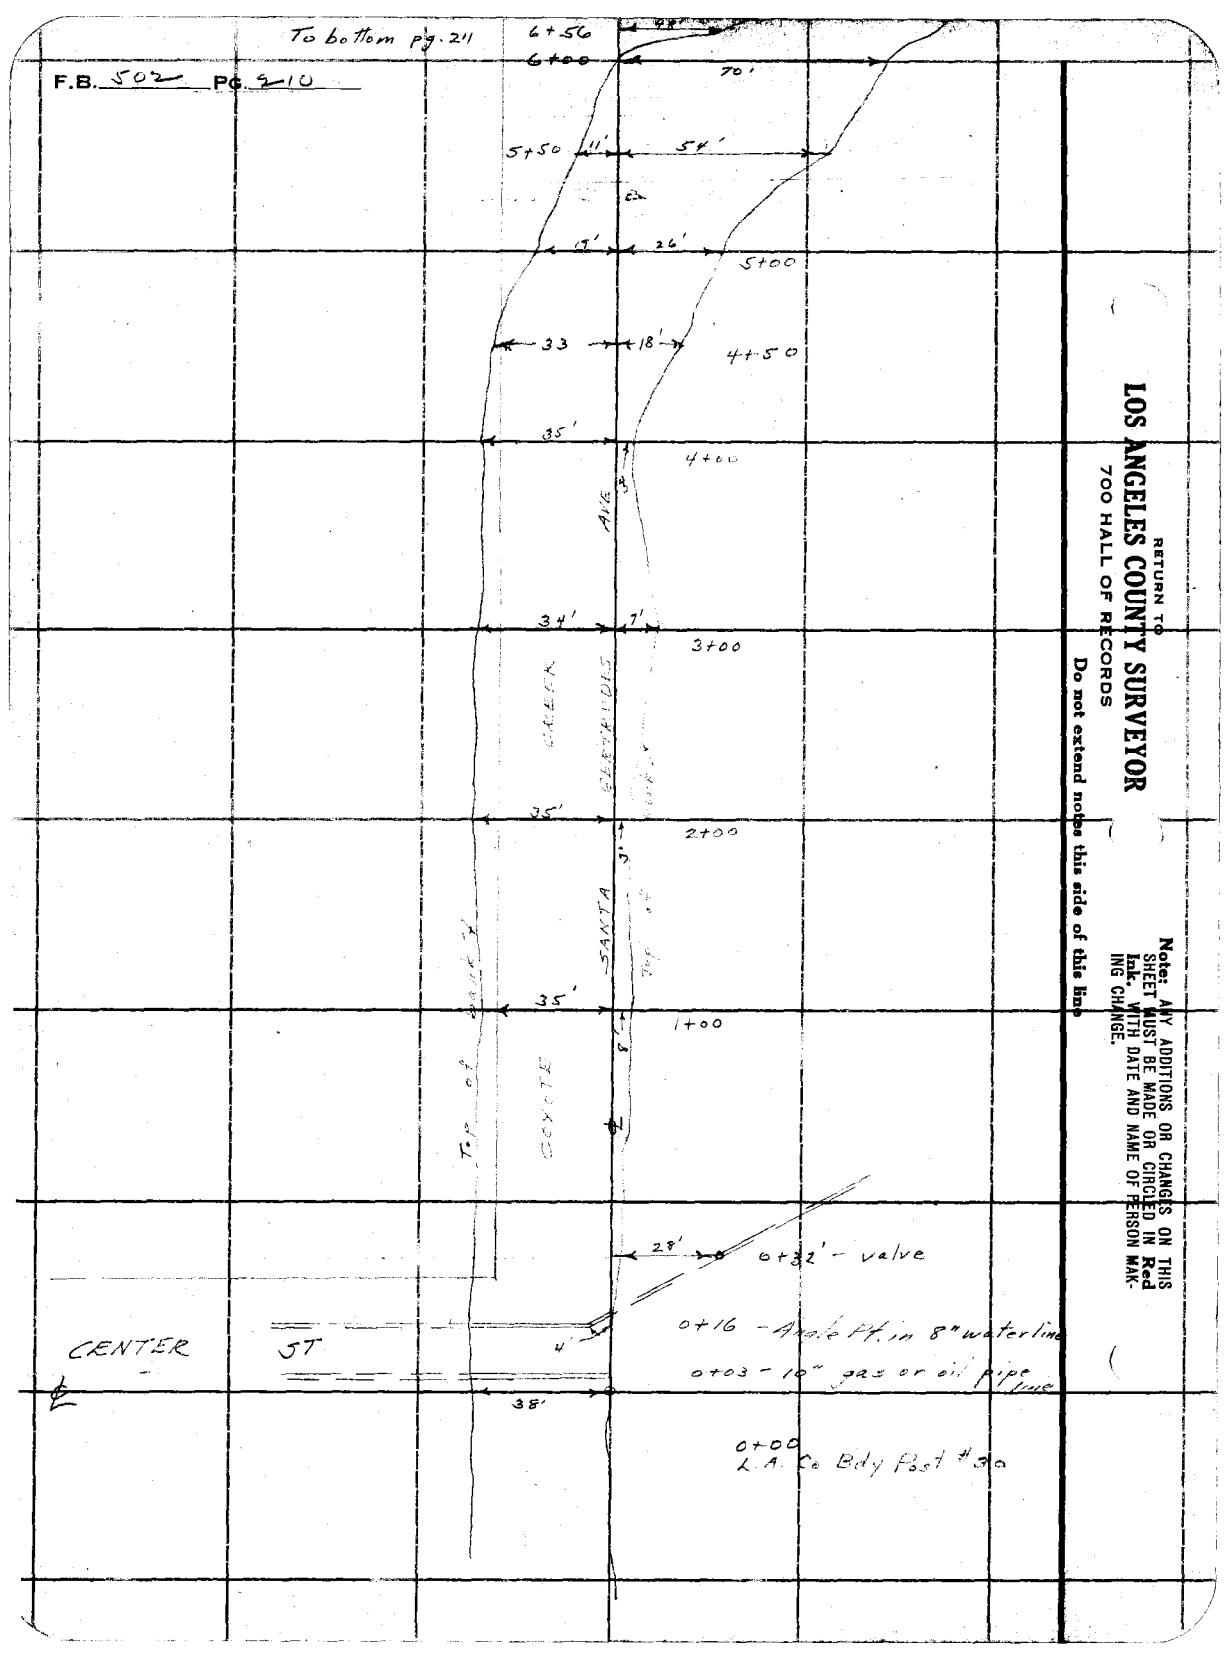

RETURN TO
LOS ANGELES COUNTY SURVEYOR
700 HALL OF RECORDS

Do not extend notes this side of this line

Note: ANY ADDITIONS OR CHANGES ON THIS SHEET MUST BE MADE OR CIRCLED IN Red Ink. WITH DATE AND NAME OF PERSON MAKING CHANGE.

Notes Ck'd by	Survey of Irrig. Sec. [illegible]
Map No. B-806	W. O. 7024 Topo No.	St'd	°F.
Office Work O.L. Pasek	Surveyed by L. D. Moore
Checked Blacknier	Notes Moore	Date 9-15-32
Date March 1933	Indexed A. C. Johnson

F.B. 502 Pg. 211

To bottom Pg 212

78+20 ← 40.2 → 20' Begin. 2 rows of ½" Oranges 30' apart

40'

Top of bank

Earth bank

reservr. 7' high

10' 5' 10' 5' 10'

140'

AVE

76+31.8 C.I. 2x2 pg. 206

40' 76+20

42.7 76+09

21

1" Avocados

SANTA GERTRUDES

21 42.2 73+99

Note: ANY ADDITIONS OR CHANGES ON THIS SHEET MUST BE MADE OR CIRCLED IN Red Ink. WITH DATE AND NAME OF PERSON MAKING CHANGE.

RETURN TO
LOS ANGELES COUNTY SURVEYOR
700 HALL OF RECORDS
Do not extend notes this side of this line

FORM 247 10M 5-31

To bottom pg 213

F.B. 502 Pg 212

1 Story Frame School

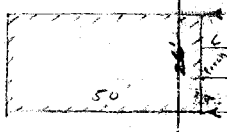

90+73

89+20 39.9 14th 1" orange

89+00 32.9 13th 1" orange & 13th outlet

SEE FIELD NOTES

outlet opposite each tree in front row.

86+59 30' Begin 2 rows of 1" oranges

86+50 33.6 Irrig. line

86+39 40.1 40' 42nd 1½ orange

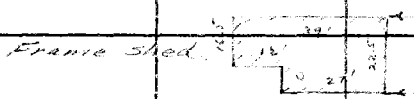

84+83

SANTA

81+18 39.9 16th ½" orange

81+08 40' Irrig. line outlets

80+98 39.9 15th ½" orange

From Top pg. 211

RETURN TO
LOS ANGELES COUNTY SURVEYOR
700 HALL OF RECORDS

Do not extend notes this side of this line

Note: ANY ADDITIONS OR CHANGES ON THIS SHEET MUST BE MADE OR CIRCLED IN Red Ink. WITH DATE AND NAME OF PERSON MAKING CHANGE.

Notes Ck'd by	Survey of Santa Susana
Map No. A-806	W. O. 2094 Tape No. St'd °F.
Office Work O.L.Pack	Surveyed by
Checked Blackmar	Notes Moore Date 9-15-32
Date March 1933	Indexed A. C. Johnson

F.B. 502 PG. 213

To bottom pg 214

20" conc. standpipe — 33.3 → 97+55

19.5 → 97+44

Earth Bank Reservoir 4' high

Top of bank

60'

20' → 95+18

95+24.64 ✓
2x2 - pg. 207

30" conc. stand pipe

Frame shed

elevated water tank. 8' dia.-6' high

corr iron pump shed & well

55.2 → 94+96

55.2 → 94+90

94+80

40.0 → 20 → 95+40
3rd 1" orange irrig line outlets.

40.5

40.0 → 20 → 42nd 1" orange

41.5

1 story frame Shack

22'

36'

41.1 → 94+32

20" conc stand pipe — 27.5 → 93+85.6

20" conc. stand pipe — 27.5 → 92+78.6

From Top pg. 212

Note: ANY ADDITIONS OR CHANGES ON THIS SHEET MUST BE MADE OR CIRCLED IN Red Ink. WITH DATE AND NAME OF PERSON MAKING CHANGE.

Do not extend notes this side of this line

RETURN TO
LOS ANGELES COUNTY SURVEYOR
700 HALL OF RECORDS

FORM 247 10M 8-31

F.B. 502 PG. 214

To bottom pg. 215

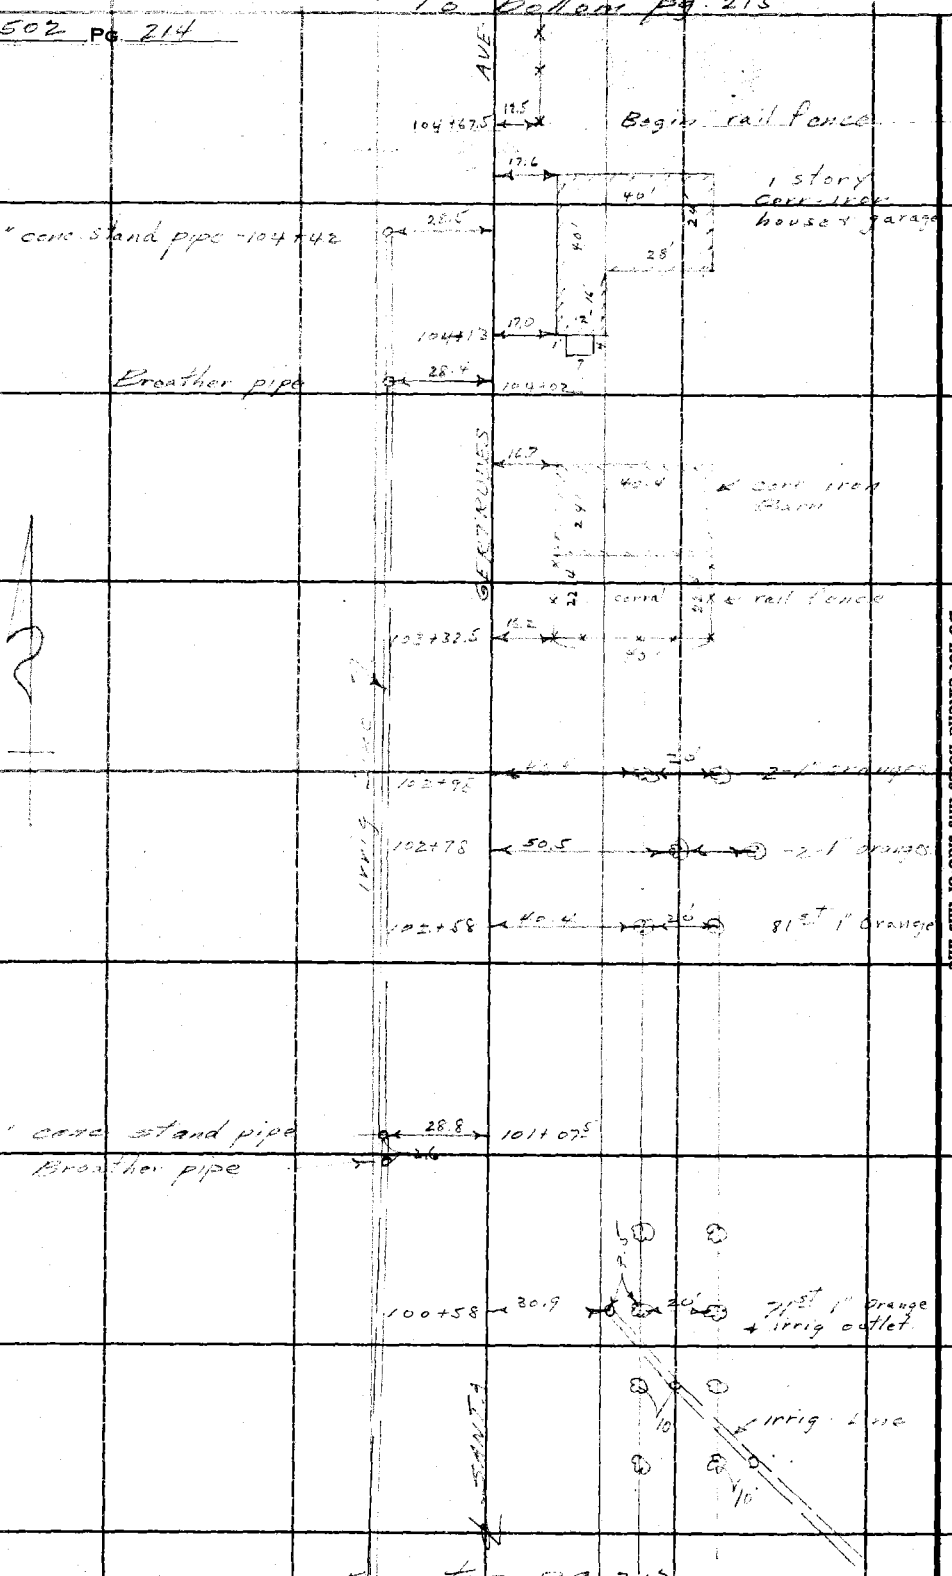

From top pg 213

RETURN TO
LOS ANGELES COUNTY SURVEYOR
700 HALL OF RECORDS

Do not extend notes this side of this line

Note: ANY ADDITIONS OR CHANGES ON THIS SHEET MUST BE MADE OR CIRCLED IN **Red Ink.** WITH DATE AND NAME OF PERSON MAKING CHANGE.

Notes Ck'd by	Survey of
Map No. B-206	W. O. 7094 Tape No. St'd ° F.
Office Work O.L. Pack	Surveyed by L. Neale
Checked Blacknier	Notes Date 3-14-33
Date March 1933	Indexed A. C. Johnson

F.B. Pg. 215

Note: ANY ADDITIONS OR CHANGES ON THIS SHEET MUST BE MADE OR CIRCLED IN Red Ink, WITH DATE AND NAME OF PERSON MAKING CHANGE.

Do not extend notes this side of this line

RETURN TO
LOS ANGELES COUNTY SURVEYOR
700 HALL OF RECORDS

GERTRUDES AVE

105+77.07 N.
2 1/2 R.P. 207

℄ IMPERIAL HIGHWAY

125

105+58 - nail Fence

105+50 - Brother Pipe

℄ SANTA

From top pg. 214

FORM 247 10M 5-31

RETURN TO

LOS ANGELES COUNTY SURVEYOR

700 HALL OF RECORDS

Note: ANY ADDITIONS OR CHANGES ON THIS SHEET MUST BE MADE OR CIRCLED IN **Red Ink.** WITH DATE AND NAME OF PERSON MAKING CHANGE.

Do not extend notes this side of this line

F.B. 502 PG. 216

Notes Ck'd by	Survey of Co. Bdry
Map No. B-1648-2	W.O. 4999 Tape No. 98 St'd. 84° °F
Office Work R.W.M.S.A.	Surveyed by D.E. Holmes
Checked ave	Notes D.E.H. Date 1-31-52
Date 1952	Indexed A. C. J. 2-6-52

F. B. 502 PG. 217

J.N. 4999

L.A. Co. BOUNDRY LINE

REFERENCE PTS TO COR. #33

½ MILE E. of SANTA GERTRUDES on ROSECRANS AVE.

Holmes
Barilotti
Bowles.

Notes: Any Additions or Changes on This Sheet Must be Made or Circled in Red Ink With Date and Name of Person Making Change.

Do not extend notes this side of this line.

RETURN TO
LOS ANGELES COUNTY SURVEYOR
726 LOS ANGELES COUNTY
ENGINEERING BLDG.

76F309B 247 10M 1-49

RETURN TO
LOS ANGELES COUNTY SURVEYOR
726 LOS ANGELES COUNTY
ENGINEERING BLDG.

Note: Any Additions or Changes on This Sheet Must be Made or Circled in Red Ink With Date and Name of Person Making Change.

Do not extend notes this side of this line.

F.B. 502 Pg. 218

1 "89°-51'-10"
4 35°-24'-40
Av. 89-51-10

Fd 1" I.P. Conc base of all Wells (used for control)

Set 1"x2" by rec. Angle from W. for line N.

COUNTY SURVEYOR W. C. R.E. '63.

Witness Cor. Set C.S. mon. dn 12" marked as shown.

RE TIES SEE F.B. 938-194 1/22/54 L.A. COUNTY

Set L.T.

123.65 @ 0-00 T-56" = 123.63 ✓

43.71 @ 0-00 T-56" = 43.70 ✓

150.03 @ 0-00 T-56" = 150.00 ✓

Fd 2"x2" Tk (dn. 12") F.B. 756-9 (used for control)

Fd 2"x2" Tk (dn. 12") F.B. 756-9 used for line.

(317.36 F.B. 756-9)

200.00

190.00

ROSECRANS AVE

200.03 @ 0-00 T-58" = 200.00 ✓

200.03 @ 0-00 T-58" = 200.00 ✓

200.03 @ 0-00 T-58" = 200.00 ✓

190.03 @ 0-00 T-58" = 190.00 ✓

Witness Cor. Fd. C.S. mon. (dn. 30") F.B. 756-9 marked as shown

ORANGE COUNTY

Fd. 6" Iron (Co. Bdry.) Post. (dn. 16") Stamped "33" on Top. F.B. 756-9 F.B. 502-205 F.B. 52-81 S-¼ Cor. Sec. 13, T.3S., R.11.W.

Witness Cor. Fd. C.S. mon. 0.015 W. of line (dn. 12") F.B. 756-9 mon. marked as shown.

Note mon. has moved down slope of steep bank of ravine Set P.K. on top of mon. by Tang. (L.T. & 2"x2") Ties Per F.B. 756-9 W.C. mon's checked o.k. for dist. This Bdry. Post will not stay much longer.

1 90°-10'-30"
4 0-42-20
Av. 90-10-35

Witness Cor. Fd. C.S. mon. (dn. 24") F.B. 756-9 marked as shown. (used for line)

COUNTY SURVEYOR L.A. CO. W. C. O. CO. SURVEYOR R.E. 2177

Notes Ck'd by	Survey of
Map No.	W. O. Tape No. St'd. °F
Office Work	Surveyed by
Checked	Notes Date
Date	Indexed

F. B. Pg. 219

Note: Any Additions or Changes on This Sheet Must be Made or Circled in Red Ink With Date and Name of Person Making Change.

Do not extend notes this side of this line.

RETURN TO
LOS ANGELES COUNTY SURVEYOR
726 LOS ANGELES COUNTY
ENGINEERING BLDG.

76F309S 247 2-51

RETURN TO
LOS ANGELES COUNTY SURVEYOR
726 LOS ANGELES COUNTY
ENGINEERING BLDG.

Note: Any Additions or Changes on This Sheet Must be Made or Circled in Red Ink With Date and Name of Person Making Change.

Do not extend notes this side of this line.

F. B. 502 PG. 220

Notes Ck'd by Drew	Survey of Marquardt Ave.
Map No. 8-321	W. O. 7088 Type No. 022 St'd 84 °F.
Office Work Cox	Surveyed by Rosecrans
Checked Drew	Notes Date 12-V-32
Date Oct 1933	Indexed A. C. Johnson 10-29-32

F.B. 502 Pg 229

Cont. bottom next page.

Artesia Ave

Index to notes.

Road

Ave.

Ave.

T. 3 S. R. 11 W.

County.

14th St.

Sec. 33.

L.A.

County.

Carmelita

Orange

MARQUARDT AVE.

SURVEY

W.O. 7088 Nov-Dec. 193

Party E. A. Rosecrans
F. W. Aitken
F. H. Blanchard
H. A. Reynolds

Transit # 16858

Page # 022

Orangethorpe Ave

Note: ANY ADDITIONS OR CHANGES ON THIS SHEET MUST BE MADE OR CIRCLED IN Red Ink. WITH DATE AND NAME OF PERSON MAKING CHARGE.

Do not extend notes this side of this line

LOS ANGELES COUNTY SURVEYOR
RETURN TO
720 HALL OF RECORDS

Form 347 10M 5-31

F.B. 502 Pg. 223

Cont. bottom next page.

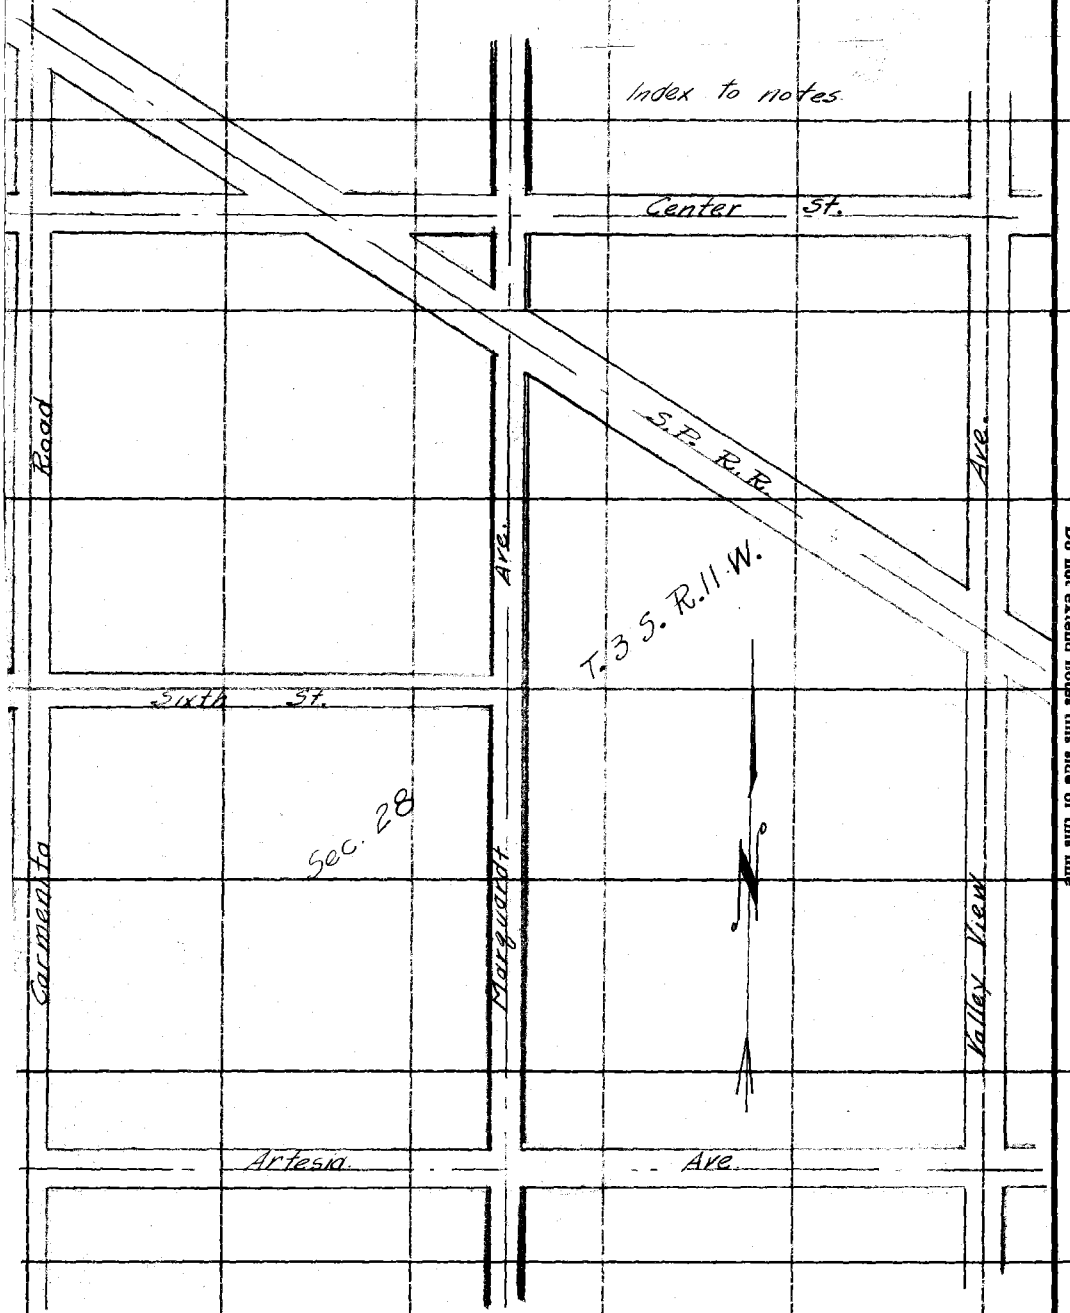

RETURN TO
LOS ANGELES COUNTY SURVEYOR
700 HALL OF RECORDS

Do not extend notes this side of this line

Note: ANY ADDITIONS OR CHANGES ON THIS SHEET MUST BE MADE OR CIRCLED IN Red Ink. WITH DATE AND NAME OF PERSON MAKING CHANGE.

Notes Ck'd by Drew	Survey of Marguardt Ave.
Map No. P-821	W. O. 2088 Type No. 922 St'd Cat. of.
Office Work Cox	Surveyed by Rosecrans
Checked Drew	Notes Date 12-8-32
Date Oct 1932	Indexed A. C. Johnson

F.B. 502 PG. 229

Cont bottom next page.

Rosecrans Blvd.

Index to notes.

La Mirada Road

A.T. & S.F. R.R.

T. 3 S. R. 11 W.

Carmenita Road

Ardella Ave

Sec. 21

Manchester Blvd.

S.P. R.R.

Center St.

Pioneer Ave.

Valley View Ave.

Note: ANY ADDITIONS OR CHANGES ON THIS SHEET MUST BE MADE OR CIRCLED IN Red Ink. WITH DATE AND NAME OF PERSON MAKING CHANGE.

Do not extend notes this side of this line

RETURN TO
LOS ANGELES COUNTY SURVEYOR
700 HALL OF RECORDS

FORM 247 10M 5-31

F.B. 502 PG. 230

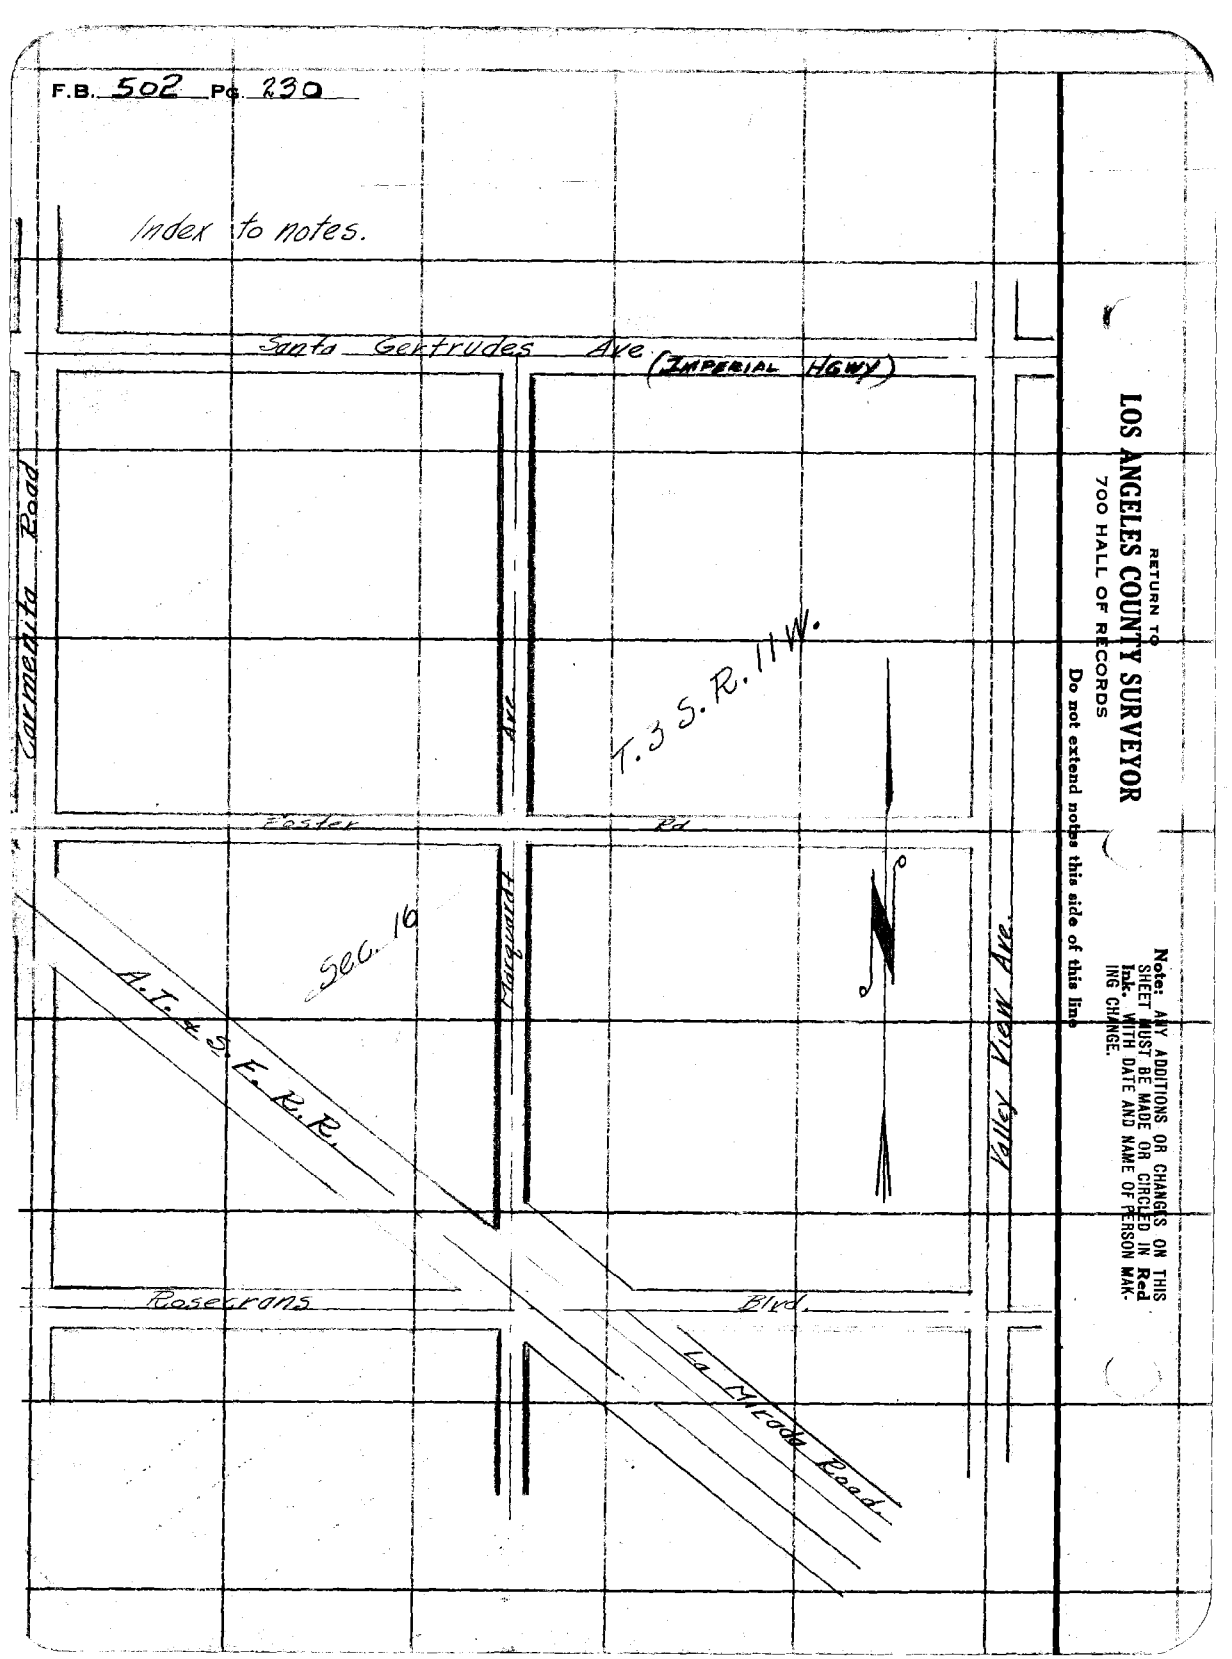

RETURN TO
LOS ANGELES COUNTY SURVEYOR
700 HALL OF RECORDS

Do not extend notes this side of this line

Note: ANY ADDITIONS OR CHANGES ON THIS SHEET MUST BE MADE OR CIRCLED IN Red Ink. WITH DATE AND NAME OF PERSON MAKING CHANGE.

Notes Ck'd by Drew	Survey of Marquardt Ave.
Map No. 3-821	M. B. 10 Pgs. 22 Rec'd Co. Surv.
Office Work Cox	Surveyed by Rosecrans
Checked Drew	Notes Date 11/10/32
Date Oct 1933	Indexed A. C. Johnson

F.B. 502 Pg. 231

Orange County.

℄ Marquart Ave.

(15')

Set N+T. in F.P.

Sta. 0+00 to N. Bdry. of O.C. 6" cast iron post marked 22 on top. S 0° 5' E. 54.10 C.S. 8175-13 F.B. 52-13

60.00

20.00

54.10

44.04

20.00

64.40

Set N+T. in F.P.

Sta. 0+00 to N. Bdry. of O.C. 6" cast iron post marked 21 on top. S 0° 5' E. 44.04 C.S. 8175-2 F.B. 52-20

Orange County

1318.82 T. 84

1318.82

1323.70 T. 84

L.A. County

89-29-15 ④
357-55-45 ③
176-55-15 ②
89-29-12 ①

Note: ANY ADDITIONS OR CHANGES ON THIS SHEET MUST BE MADE OR CIRCLED IN Red Ink. WITH DATE AND NAME OF PERSON MAKING CHANGE.

Do not extend notes this side of this line

RETURN TO
LOS ANGELES COUNTY SURVEYOR
700 HALL OF RECORDS

FORM 247 10M 8-31

RETURN TO
LOS ANGELES COUNTY SURVEYOR
700 HALL OF RECORDS

Note: ANY ADDITIONS OR CHANGES ON THIS SHEET MUST BE MADE OR CIRCLED IN **Red Ink.** WITH DATE AND NAME OF PERSON MAKING CHANGE.

Do not extend notes this side of this line

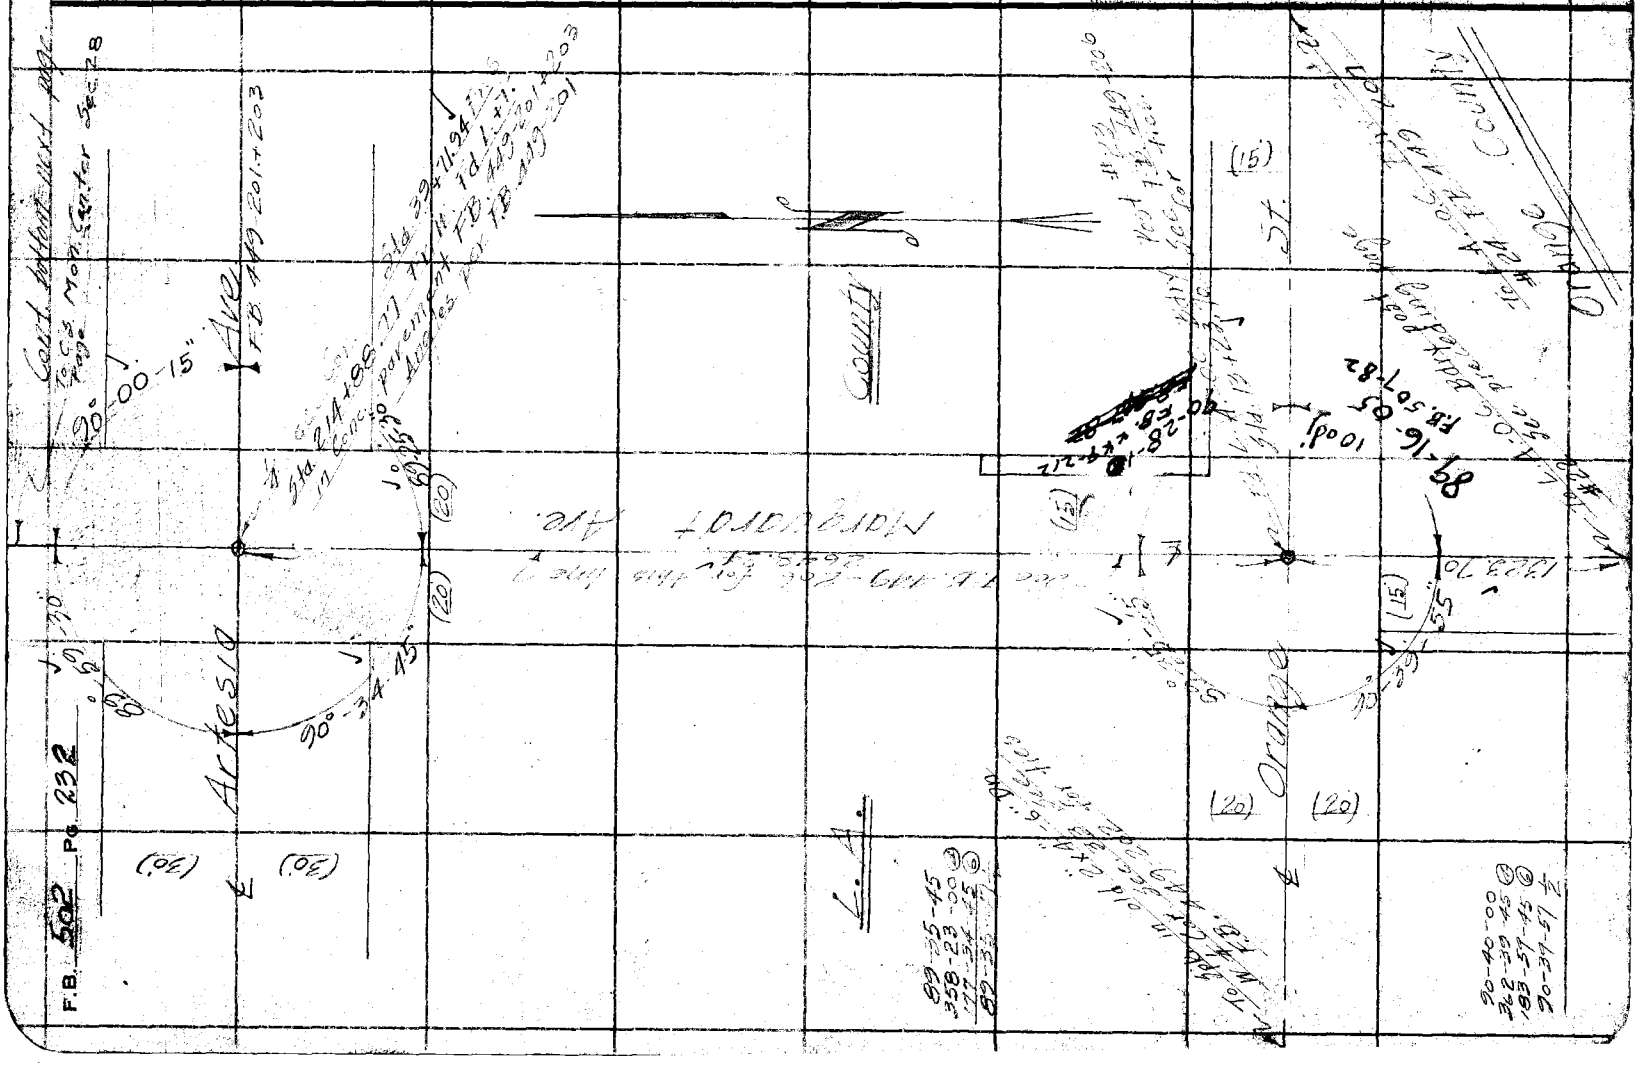

Notes Ck'd by Drew
Survey of Marquardt Ave
Office Work Cox
Surveyed by Rosecrans
Checked Drew
Notes
Date Oct 1923
Indexed A. C. Johnson

F.B. 502 Pg. 28

Note: ANY ADDITIONS OR CHANGES ON THIS SHEET MUST BE MADE OR CIRCLED IN Red Ink, WITH DATE AND NAME OF PERSON MAKING CHANGE.

Do not extend notes this side of this line

RETURN TO
LOS ANGELES COUNTY SURVEYOR
700 HALL OF RECORDS

FORM 247 10M 8-31

Apple St.

Marquardt Ave.

(20)

(20)

(20)

(20)

Sta. 66+55.49 Center Sec. Rd Co Sur. Mon. in B.F.B. 434 A for ties

Co. Sur. Mon. E¼ Cor. Sec. 28 T.3S. R.11W. F.B. 228.

Co. Sur. Mon. W¼ Cor. Sec. 28 T.3S. R.11W. F.B. 448-160

To Co. Sur. Mon. E¼ Cor. Sec. 28 T.3S. R.11W. F.B. 228.

1329.197 T. 70 = 1329.07

1270.59 T. 72 = 1270.49

Fd. 2" I.P. plug + tack 8" Dn. N.W. Cor. Lot 1 Tr. #10187 MB. 174-25

Set N.+T. in P. pole #29 S 80 E 2.68 (S. side)

Int. Sta. 53+26.42 Set 3.W.+T. - 3" Dn.

Cor. F.P.

Set N.+T. in Cor. F.P.

694.39 T. 70 = 694.33

Fd. N.+T. P. Pole #28 S 86 E

Fd. N.+T. in Cor. F.P.

Fd. 2" I.P. plug + tack Lot 1 Tr. 10187

Set N.+T. in A.E. Co. Jog

Tract #10187

2" I.P. plug + tack Dn. S.W. Cor. Lot 2 Tr. 10187 M.B. 174-25

Fd. 2" I.P. plug + tack Dn. Tr. 10187

Int. Sta. 46+32.09 Set 3.W.+T. - 3" Dn.

Set N.+T. in Cor. F.P.

660.19 T. 74 = 660.15

660.15

Fd. 2" I.P. plug + nail Flush S.E. Cor. Lot 2 Tr. 10187 M.B. 174-25

1270.06 T. 78 = 1270.01

Fd. L.+T. in Conc. Sec. preceding Rage

RETURN TO
LOS ANGELES COUNTY SURVEYOR
700 HALL OF RECORDS

Note: ANY ADDITIONS OR CHANGES ON THIS SHEET MUST BE MADE OR CIRCLED IN **Red Ink.** WITH DATE AND NAME OF PERSON MAKING CHANGE.

Do not extend notes this side of this line

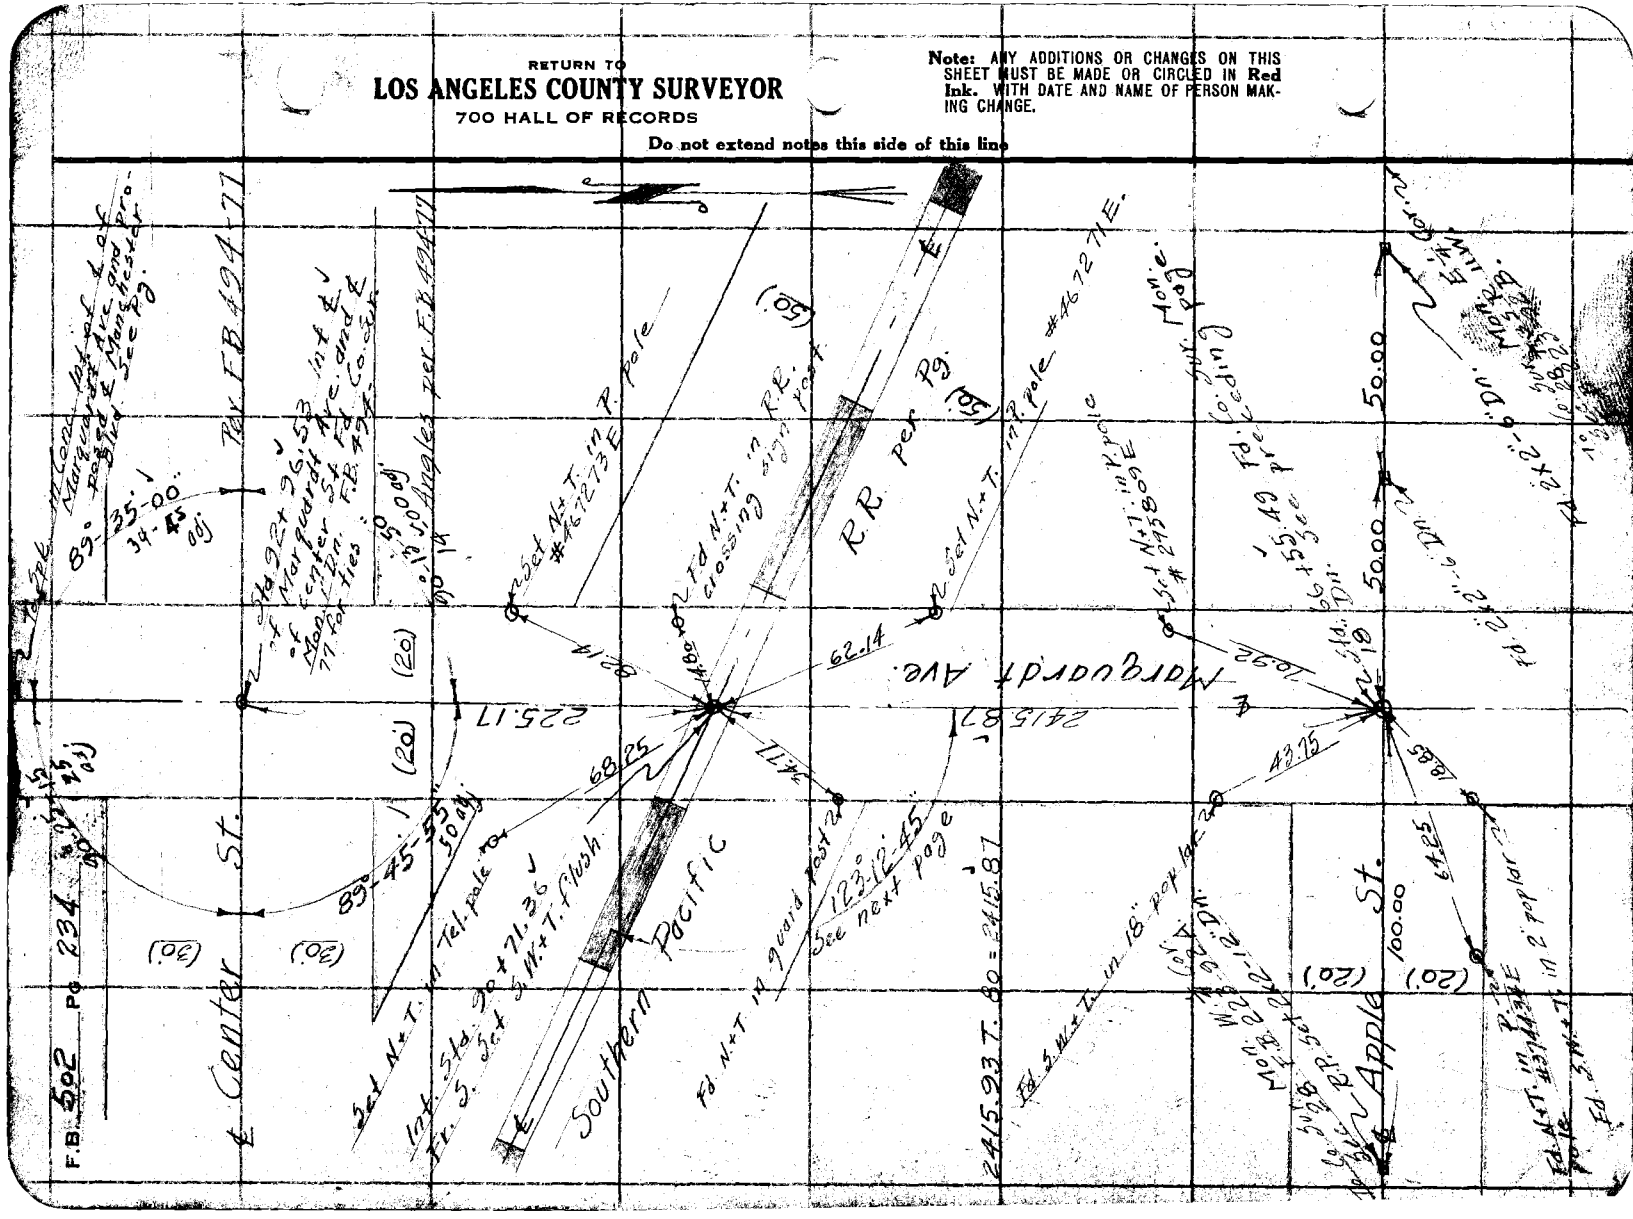
Ter. F.B. 494-77
E. Center St.
Pacific
Southern
Apple St.
R.R. per Pg. 109
Set N.+T. in P. pole #46727 NE.
Set N.+T. in R.R. crossing sign post
Set N.+T. in guard post
Set N.+T. in Tel. pole
Int. Sls. 90+71.36 W.+T. flush

Notes Ck'd by Drew	Survey of Marquardt Ave.
Map No. [illegible]	M. D. [illegible]
Office Work Cox	Surveyed by Rosecrans
Checked Drew	Notes Date 11-16-32
Date Oct 1939	Indexed A. C. Johnson

F.B. 502 Pg. [illegible]

To S.W. & T. Int. of Lot R.R. 2 and 4 next & prog. Center St. Sec

408.50 T.80 = 408.49

123-12-45
132-51-00 ①
13-16-15 ②
123-12-42 ½

123° 12' 45"

R.R.

408.49

To Co. Sur. Mon. between Secs 28 & 21 T. 3 S. R. 11 W. ½ Cor 380 Pg.

(20)

2.40

235

Int. Sec. S.W. & T. from Sta. 30+71.36 Fr. S. See Pg.

Marquardt Ave.

(20)

To Co. Sur. Mon. Center Sec. 28. T. 3 S. R. 11 W. Pg.

Southern Pacific

(50)

(50)

Fd. N. & T. Co. Fr. F.B. 502-142

90°

50.00

R.I. 262 ; Sta. 29+12.4 Fr. F.B. 502-141

Note: ANY ADDITIONS OR CHANGES ON THIS SHEET MUST BE MADE OR CIRCLED IN Red Ink, WITH DATE AND NAME OF PERSON MAKING CHANGE.

Do not extend notes this side of this line

RETURN TO
LOS ANGELES COUNTY SURVEYOR
700 HALL OF RECORDS

FORM 247 10M 5-31

RETURN TO
LOS ANGELES COUNTY SURVEYOR
700 HALL OF RECORDS

Note: ANY ADDITIONS OR CHANGES ON THIS SHEET MUST BE MADE OR CIRCLED IN **Red Ink.** WITH DATE AND NAME OF PERSON MAKING CHANGE.

Do not extend notes this side of this line

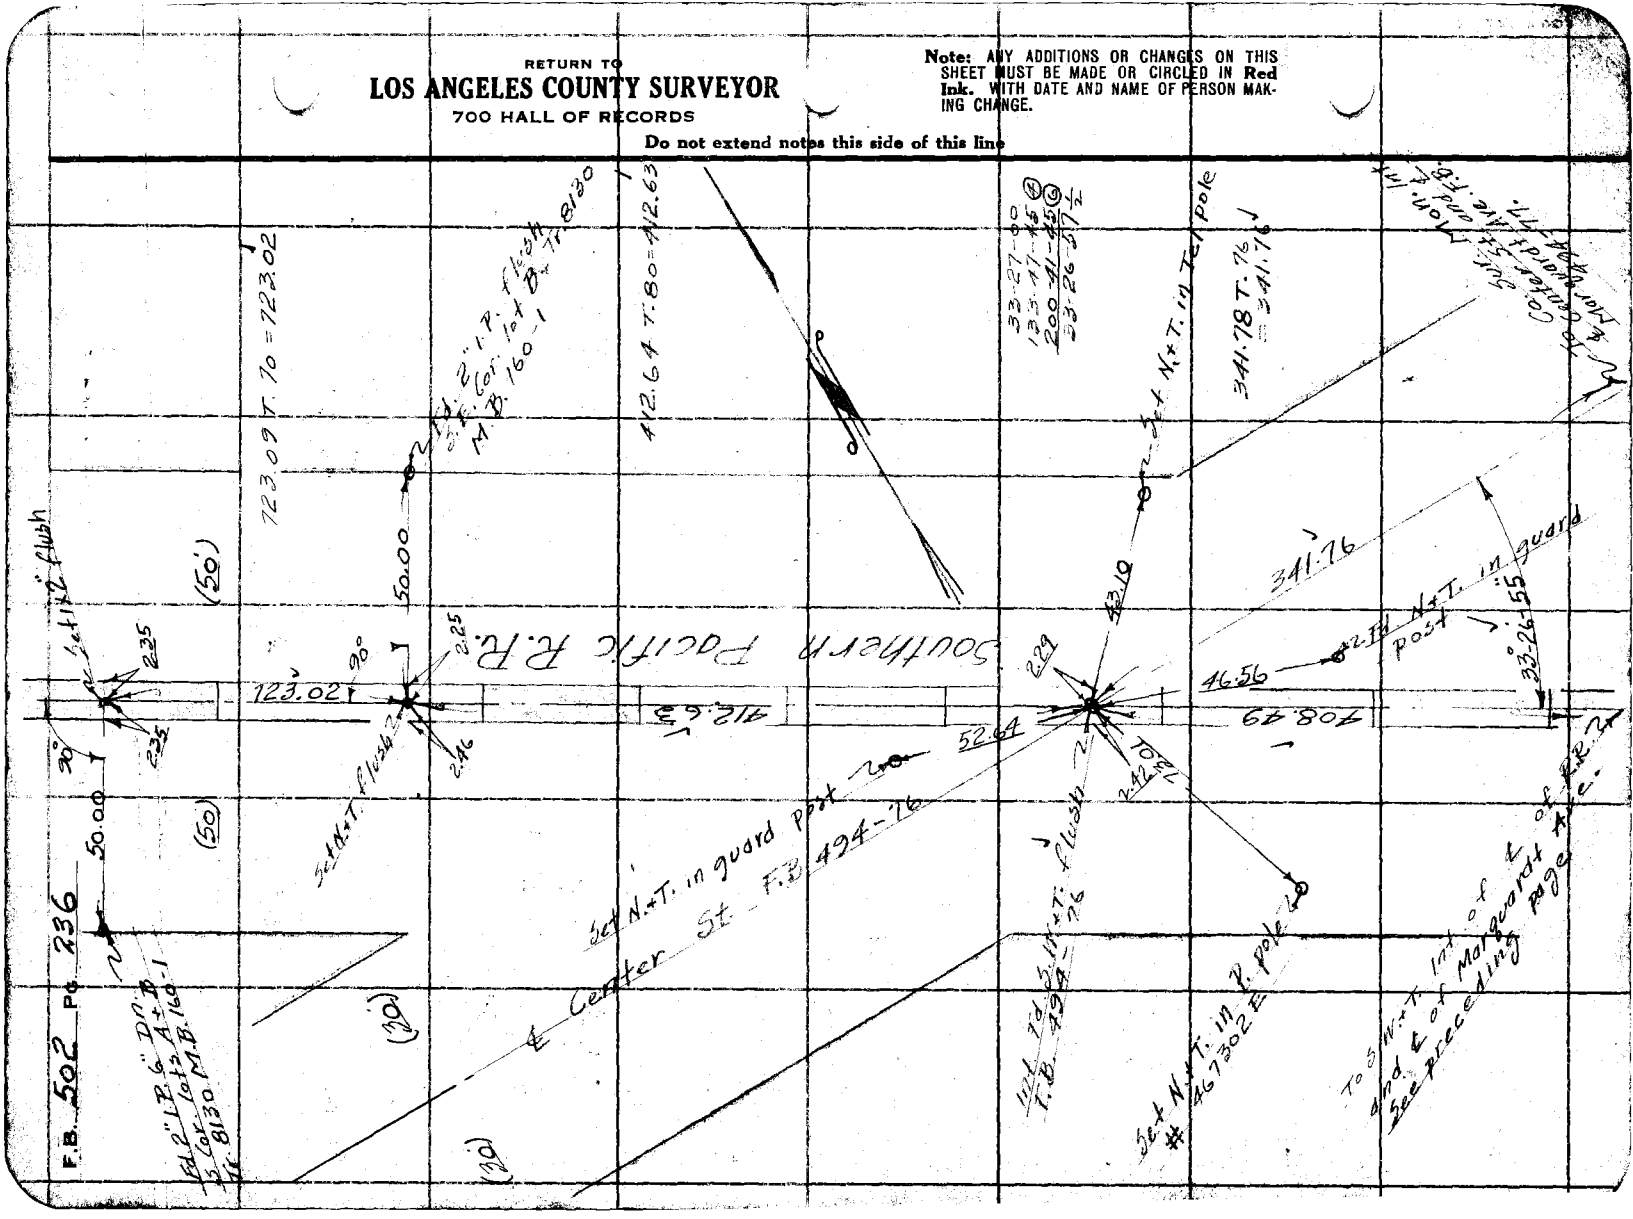

Notes Ck'd by Drew	Survey of Marquardt Ave.
Map No. B-821	Tract No. 7881, Map Bk. 122 and 84 et al.
Office Work Cox	Surveyed by Rosecrans
Checked Drew	Notes _____ Date 11-23-33
Date Oct 1933	Indexed A. C. Johnson

F.B. 502 Pg. 237

Cont. bottom next page

2-Tg. 24+30.38 ✓
S.M.+T. flush. Set

(30) (20)

Rosecrans Ave.

2430.38 ✓

2430.45 T. 80 = 2430.38 ✓

90-13-00
360-52-15 ④
181-18-15 ⑥
90-13-00 ✓

89-54-30
359-37-45 ④
179-26-30 ⑥
89-54-25 ✓

90°-13'-00" ✓
12-55 Od

89°-54'-25" ✓
20 ✓

To L & T. Int. of ℄ of Valley View Ave. and ℄ of Century St. F.B. 494-75

℄ Valley View Ave.

(30) (30)

Sec. Cor. Sta. 0+00 to W.C.S.
Fd. L & T. in pavement
B. 610-3 F.B. 425

To L & T. at Sec. Cor. Int. of ℄ Valley View Ave. and ℄ of Lindbergh Blvd
C.S.B. 318-2 F.B. 358-25

Note: ANY ADDITIONS OR CHANGES ON THIS SHEET MUST BE MADE OR CIRCLED IN Red Ink. WITH DATE AND NAME OF PERSON MAKING CHANGE.

Do not extend notes this side of this line

RETURN TO
LOS ANGELES COUNTY SURVEYOR
700 HALL OF RECORDS

FORM 247 10M 8-31

RETURN TO
LOS ANGELES COUNTY SURVEYOR
700 HALL OF RECORDS

Note: ANY ADDITIONS OR CHANGES ON THIS SHEET MUST BE MADE OR CIRCLED IN **Red Ink.** WITH DATE AND NAME OF PERSON MAKING CHANGE.

Do not extend notes this side of this line

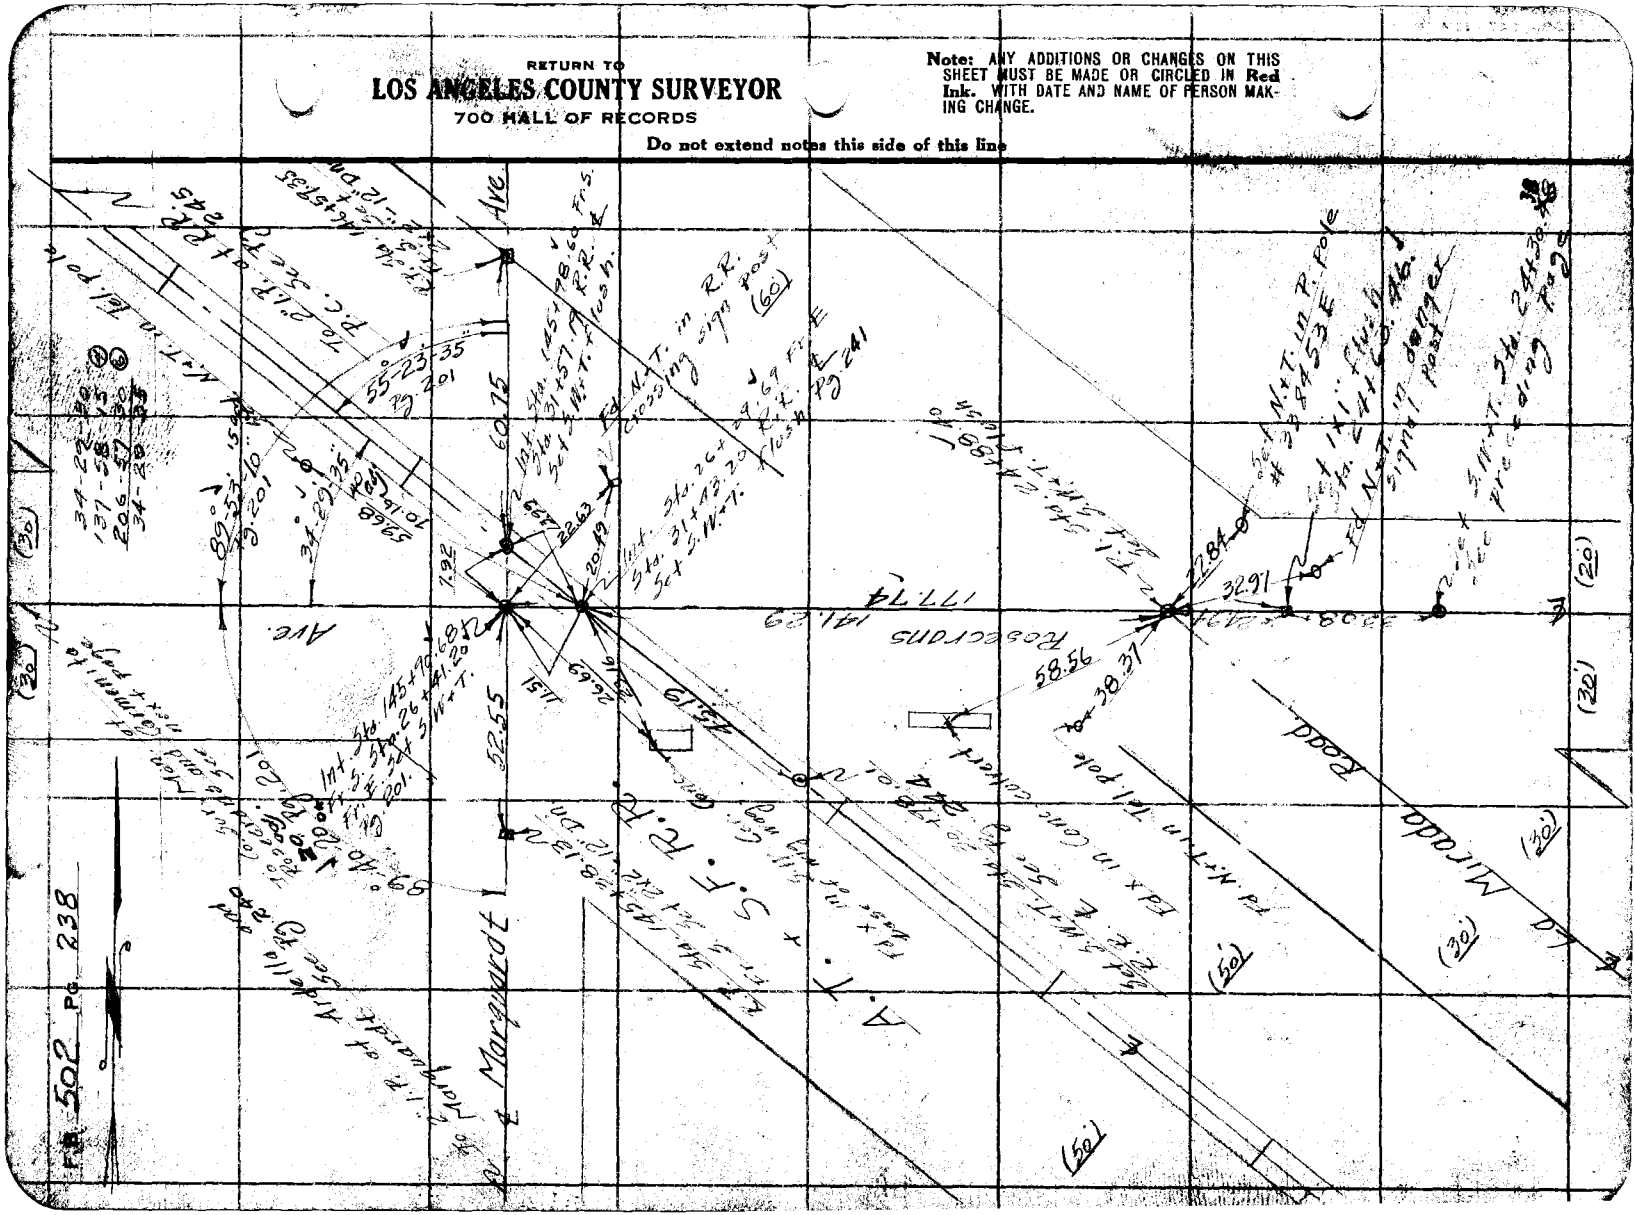

Notes Ck'd by Drew	Survey of Marquardt Ave.
Map No. B-821	W. O. 7688 Topo No. 022 Sh'd 84 of.
Office Work Cox	Surveyed by Rose-Irwin
Checked Drew	Notes Date 11-25-32
Date Oct 1933	Indexed A. C. Johnson

F.B. 502 Pg. 287

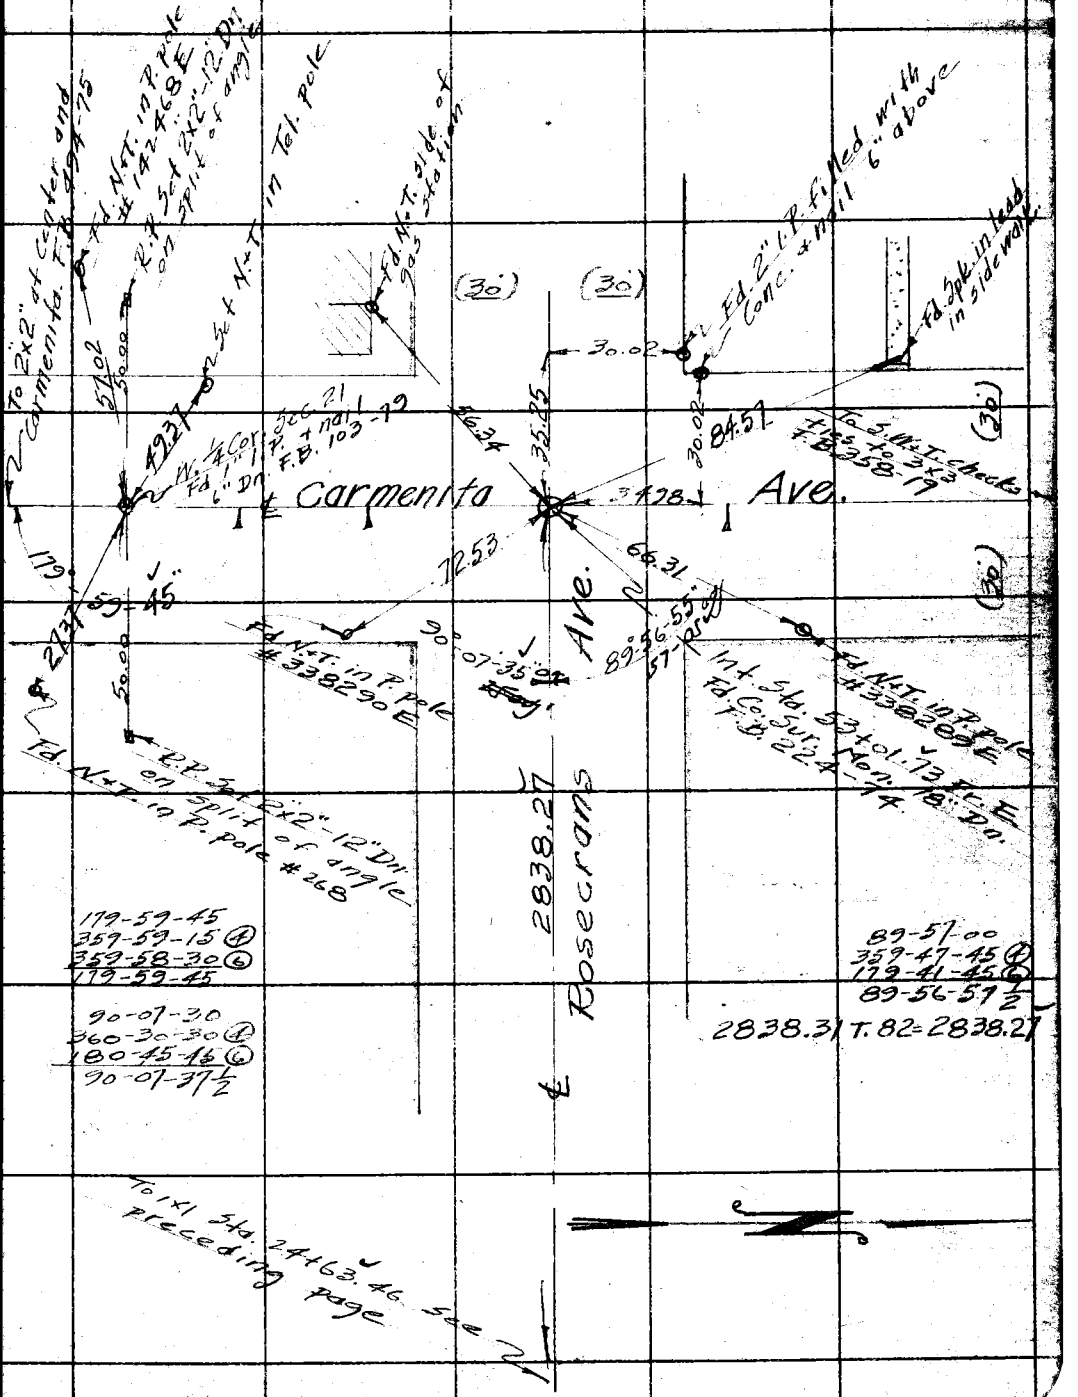

RETURN TO
LOS ANGELES COUNTY SURVEYOR
700 HALL OF RECORDS

Do not extend notes this side of this line

Note: ANY ADDITIONS OR CHANGES ON THIS SHEET MUST BE MADE OR CIRCLED IN Red Ink, WITH DATE AND NAME OF PERSON MAKING CHANGE.

FORM 247 10M 8-31

RETURN TO
LOS ANGELES COUNTY SURVEYOR
700 HALL OF RECORDS

Note: ANY ADDITIONS OR CHANGES ON THIS SHEET MUST BE MADE OR CIRCLED IN **Red Ink.** WITH DATE AND NAME OF PERSON MAKING CHANGE.

Do not extend notes this side of this line

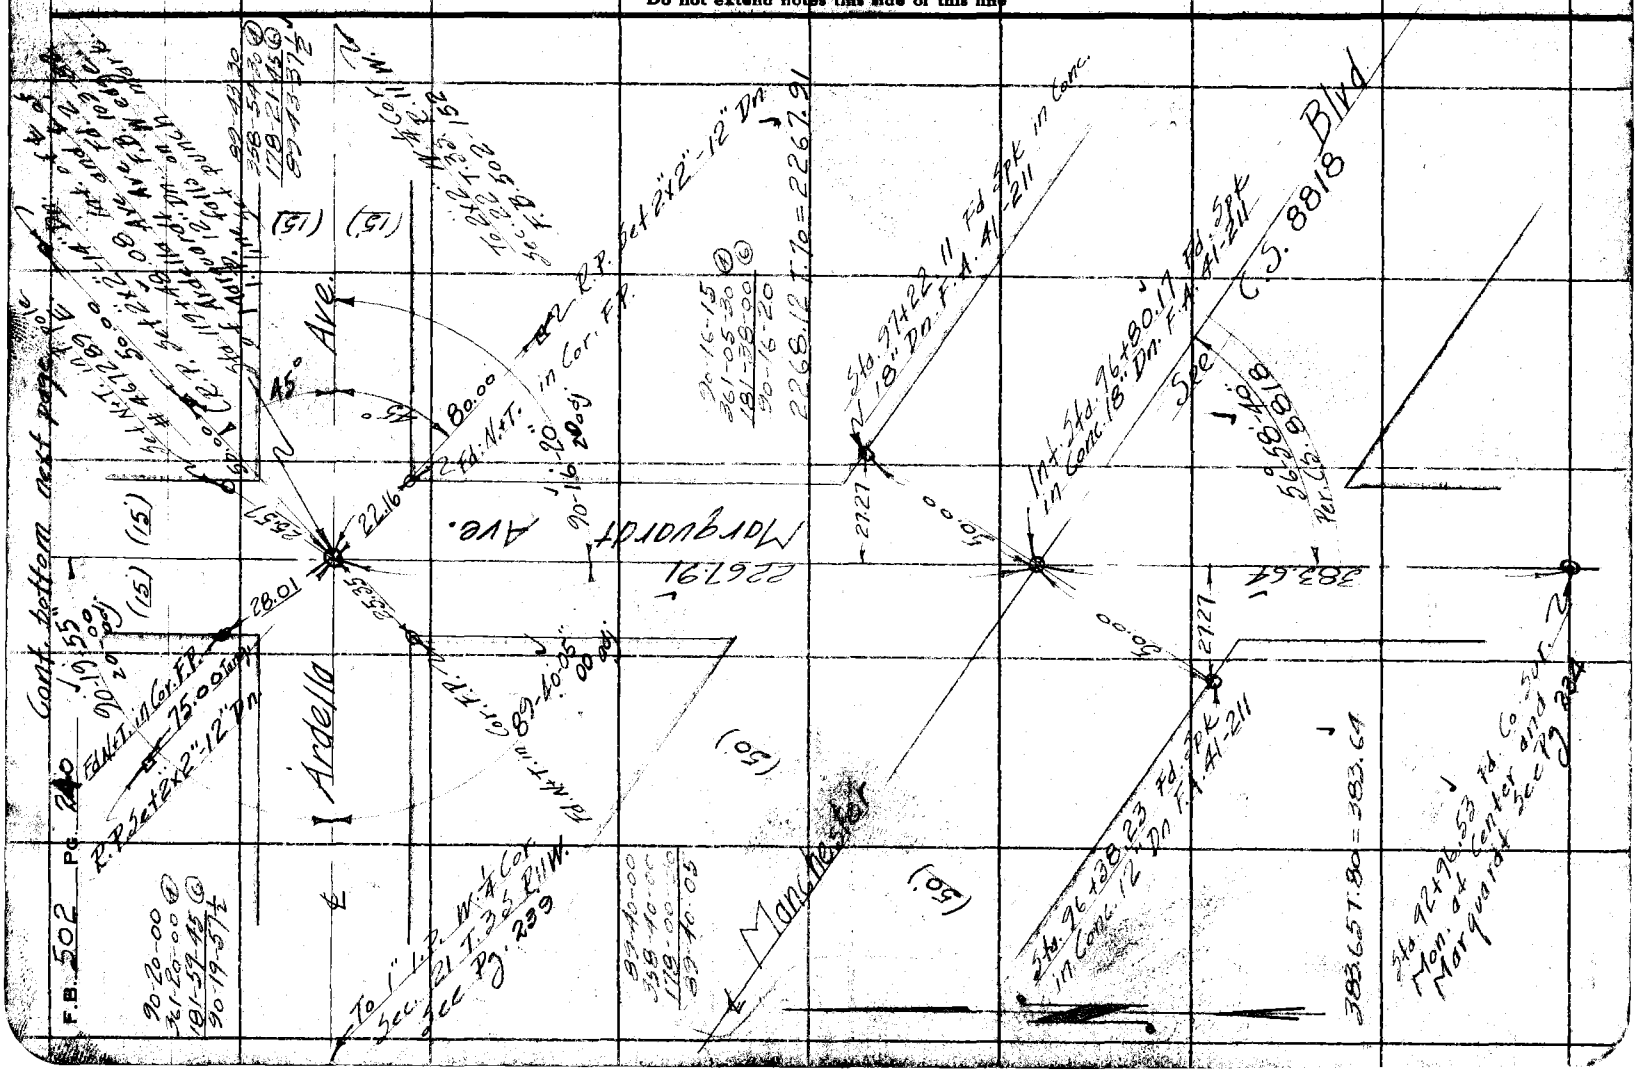
Cont. bottom next page
Ardella
Ave.
Ave.
Manchester
Blvd
C.S. 8818
See
F.B. 502 Pg. 20
To 1" I.P. W. 1/4 Cor. Sec. 21 T. 3 S. R. 11 W. See Pg. 239
Sta. 97+22.11 Fd. Spk in Conc. 1.8' Dn. F.A. 41-211
Int. Sta. 96+80.17 Fd. Spk in Conc. 1.8' Dn. F.A. 41-211
Sta. 96+38.23 Fd. Spk in Conc. 1.2' Dn. F.A. 41-211
Sta. 92+96.53 Fd. Co. Mon. at Center and Marquerite See Pg. 234
R.P. Set 2x2"-12" Dn.
R.P. Set 2x2"-12" Dn.
Fd. Nail & Tag in Cor. F.P.
Fd. Nail & Tag in Cor. F.P.
Fd. Nail & Tag in Cor. F.P

Notes Ck'd by Drew		Survey of Marguardt Ave	F.B. 502 Pg. 241
Map No. B-821		W. O. 7688 Tape No 022 St'd 84 °F.	
Office Work OK		Surveyed By Rosecrans	
Checked Drew		Notes	Date 11-29-32
Date Oct 1933		Indexed A. C. Johnson	

RETURN TO
LOS ANGELES COUNTY SURVEYOR
700 HALL OF RECORDS
Do not extend notes this side of this line

Note: ANY ADDITIONS OR CHANGES ON THIS SHEET MUST BE MADE OR CIRCLED IN Red Ink. WITH DATE AND NAME OF PERSON MAKING CHANGE.

FORM 247 10M 5-31

89-53-15
359-32-45 ⑧
179-19-15 ⑥
89-53-12 ±

To Wire Spk. & T
See Pg. 247

55-23-30
221-34-30 ④
332-21-45 ⑥
55-23-37 ±

Sta. 145+32

(20) (20)

A. T. & S. F. R. R.

102°-17'-41" R. R. Tie
See Pg. 245

89°-53'-10" J. 15 09 ±
55°-23'-35"

Ave

(60)

177.67: 68 - 177.74

See Pg. 238 for

Sta 145+98.60 Fr & 31+51.19 R.R. & Sct. 2 N & T. Flush.

Int. Sta. 264+29.69 Fr. E. & Sct. 3 N & T. Flush.

Int. Sta. 31+40.20 R.R. & Sct. 3 N & T. Flush. 2 Sta. 264+40 Fr. E. Pg. 238

177.74

Int. Sta. 145+20.68 Ft. E. & Sct. 2 N & T. Flush.

34-29-30 ±
3.198
40

(30)

1.92

13.99

11.51

Rosecrans Ave.

25.19

To L.T. of Valley Flow and Easement See Pg. 237

(50)

Set 5 N & T. R.R. & Sta. 30+98.01, Pg. 244

Sct. Sta. 30+00 Pg. 239

89°-40'-20" J. OK.
30.00

1331.43 T. 72 = 1331.32
1311.39 T. 70 = 1311.27
264.60

89-40-15
358-41-15 ④
178-02-00 ⑥
89-40-20

Marguardt
264.60

(15) (15)

19.98

Sta 145+24.49 Fd. 2" I.P. plug & tack 6" deep

Sta. 132+69.64 Fd. bottom of 2" old 2x2" pine stake 18" Vit. M.B. 11-124

9.07

To 2" I.P. Sta. 119+48.08 See preceding page

RETURN TO
LOS ANGELES COUNTY SURVEYOR
700 HALL OF RECORDS

Note: ANY ADDITIONS OR CHANGES ON THIS SHEET MUST BE MADE OR CIRCLED IN **Red Ink.** WITH DATE AND NAME OF PERSON MAKING CHANGE.

Do not extend notes this side of this line

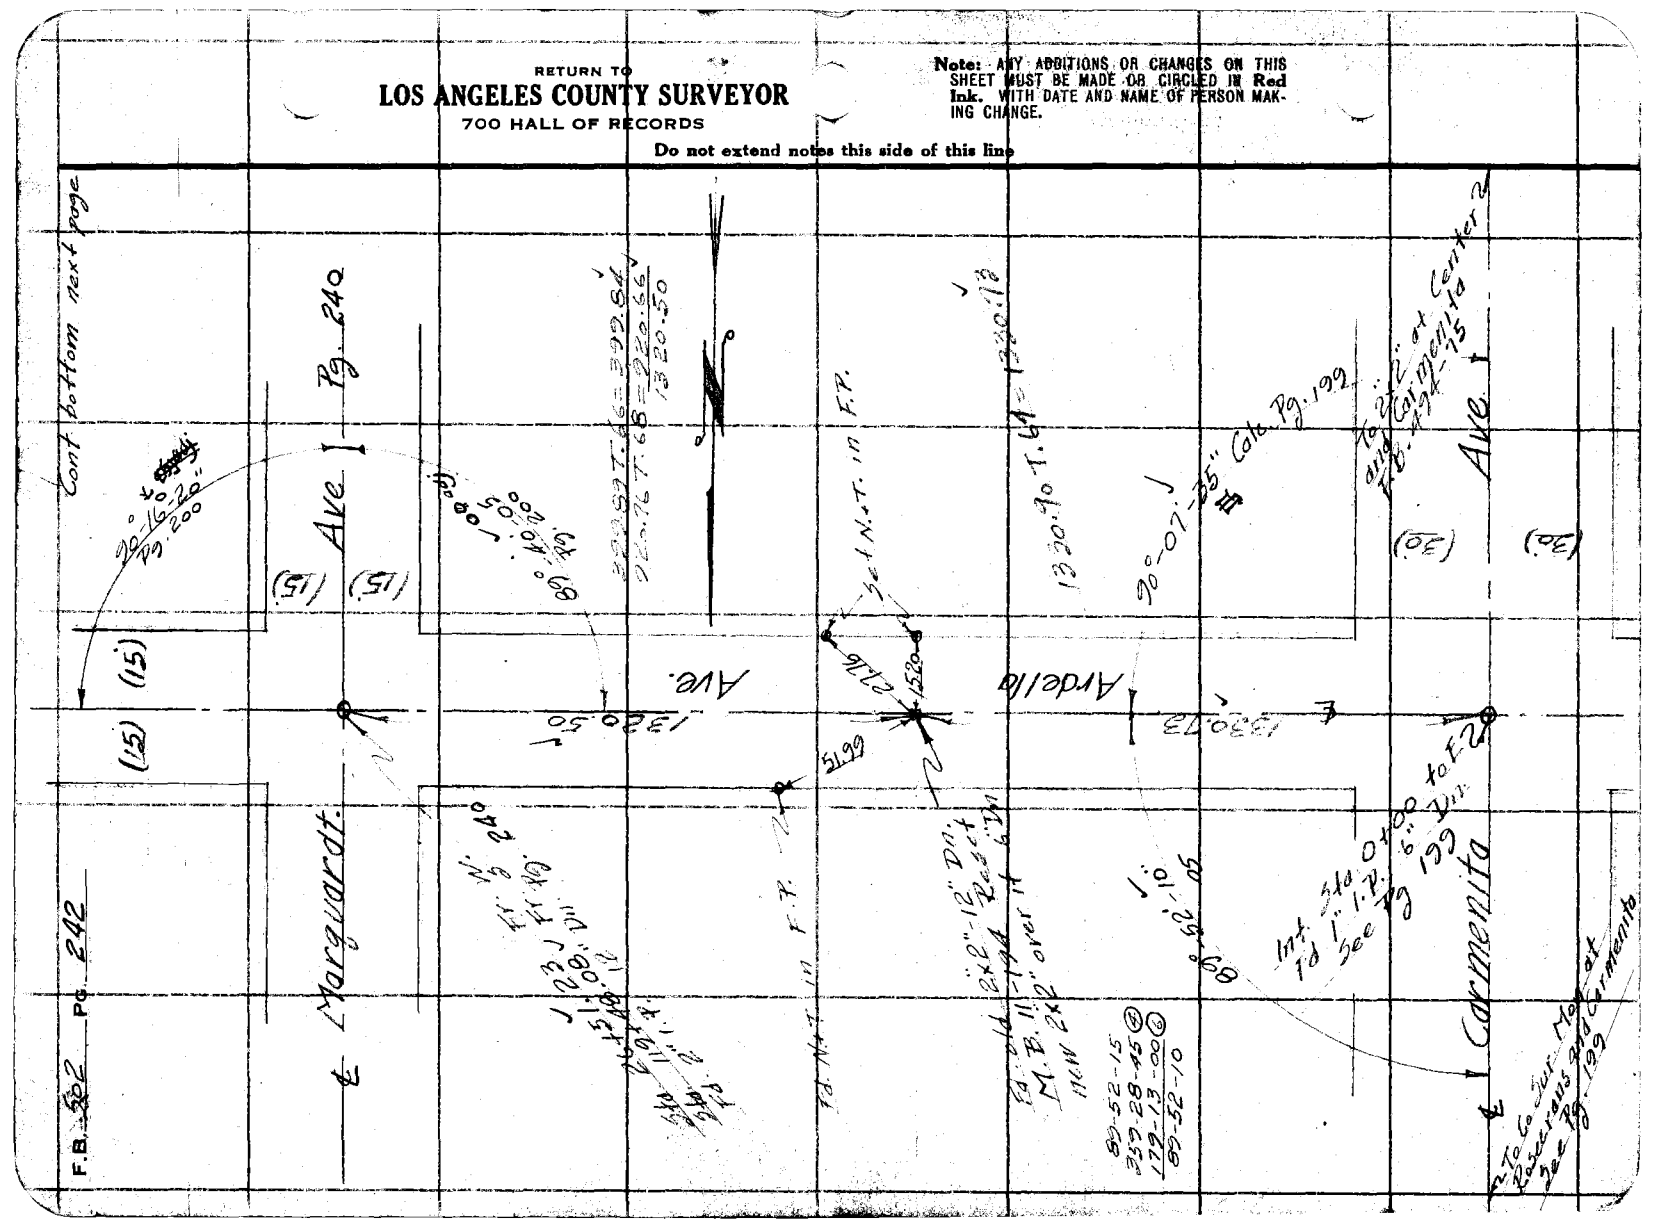
Cont bottom next page
Pg. 240
Ave
(15)
(15)
(15)
Ave.
Ardelia
Ave
(30)
(30)
Marguardt
Carmenita
1320.50'
1320.73'
1320.90' T.64 = 1320.18'
1320.84' T.68 = 1320.56'
1320.84' T.68 = 1320.56'
1320.50

Notes Ck'd by Drew	Survey of Marquardt Ave.
Map No. B-821	W. O. 1088 Type No. 022 Std 84 °F.
Office Work Cox	Surveyed by Rosecrans
Checked Drew	Notes Date 11-30-32
Date Oct 12 33	Indexed A. C. Johnson

F.B. 502 Pg. 243

Note: ANY ADDITIONS OR CHANGES ON THIS SHEET MUST BE MADE OR CIRCLED IN Red Ink, WITH DATE AND NAME OF PERSON MAKING CHANGE.

Do not extend notes this side of this line

RETURN TO
LOS ANGELES COUNTY SURVEYOR
700 HALL OF RECORDS

FORM 247 10M 8-31

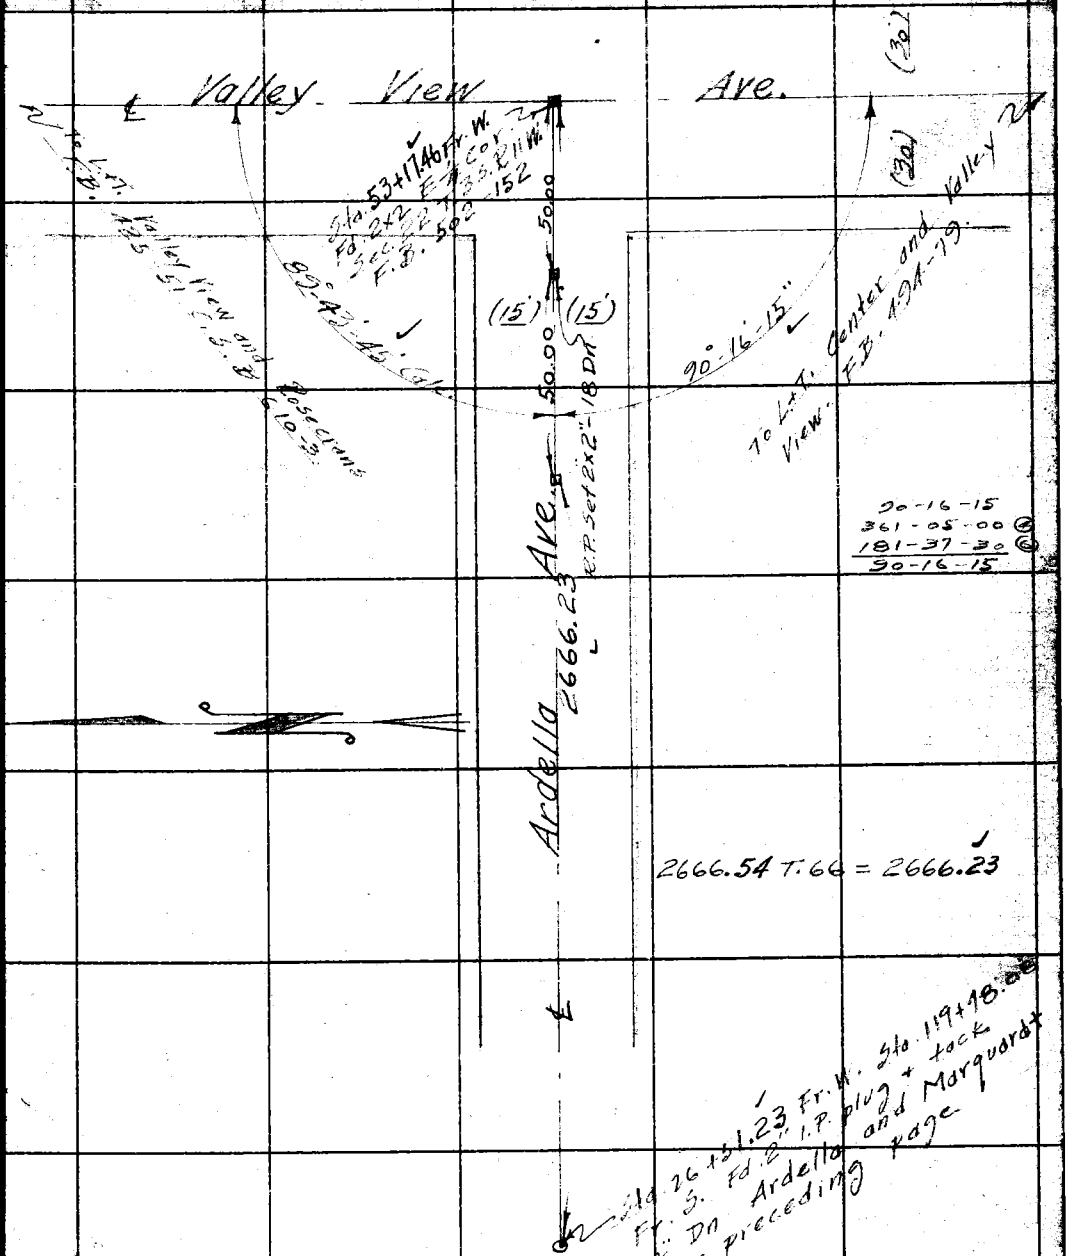

F.B. 502 PG. 244

Cont. bottom next page

Set N.+T. Sta. 44+05.91

Transit line

1308.00 T.72=1307.90

Set N.+T. Sta. 30+98.61

Fd. 2" I.P. plug + nail 12' Dn. Accepted Sta. 21+46.03 P.R. ℄ Sec 2 it as true P.R. ℄ side sketch.

1749.73 T. 74=1749.62

Set N.+T. Sta. 13+48.38

1348.48 T. 74=1348.39

2 To 2" I.P. at P.C.

2.38

2.33

N.+T. 44+05.91

0.81

Set 3/4" I.P. flush

gauge

1307.20

2.37

2.35

2.22

N.+T. 30+98.61

0.51

Set 3/4" I.P. flush

251.98 A.T. & S.F.

To vertical face iron pipe

2.32

2.40

11.43

2" I.P. plug & nail 12' Dn. 21+46.03

0.25

1749.62

Transit line

N.+T. Sta 13+48.38

1348.39

Sta. 0+00 to N.W. Fd 1x2" flush Sta. 0+00 to S.E. per T.B. 38 and T.B. 171 166

A.T. and S.F.R.R.

(50') (50')

Transit line

To iron pipe filled with Conc. and nail at R.R. P.C. T.B. 494-167

RETURN TO
LOS ANGELES COUNTY SURVEYOR
700 HALL OF RECORDS

Do not extend notes this side of this line

Note: ANY ADDITIONS OR CHANGES ON THIS SHEET MUST BE MADE OR CIRCLED IN Red Ink. WITH DATE AND NAME OF PERSON MAKING CHANGE.

Notes Ck'd by Drew	Survey of Marquardt Ave
Map No. B-871	W. O. 7888 Insp. by 922 Sh'd 84 of
Office Work Cox	Surveyed by Rescreans
Checked Drew	Notes A. C. Johnson Date 12-1-32
Date Oct 1933	Indexed

F.B. 502 PG. 245

Sta. 100+22.70 Set N.+T. in face

52.57

2.41

Sta 09+70.13 R.R. P.C. Fd 2½" Dm. Set 2½" I.P. 2" Dm. 2" I.P. 2" Dm. flush over it flush See sketch side

2.29 2.43

4.50

Fd. 2½" I.P. flush

Fd. 4x4" Stake 1" above

Transit line

Sta. 99+70.13 R.P.C. Fd. 2" I.P. 2" Dm. Set 2x2 over it flush

8.80

8.71

1497.99

(50) (50)

1498.15 T. 68 = 1497.96

Set N.+T. Sta. 85+31.71

S.F. R.R.

1507.80

A.T. and

1507.96 T. 68 = 1507.80

Set N.+T. Sta. 70+23.91

1354.20 T. 70 = 1354.08

1354.08

Set N.+T. Sta. 56+69.83

1264.04 T. 70 = 1263.92

1263.92

Transit line

To N.+T. Sta. 44+05.91 See preceding page

Note: ANY ADDITIONS OR CHANGES ON THIS SHEET MUST BE MADE OR CIRCLED IN Red Ink WITH DATE AND NAME OF PERSON MAKING CHANGE.

RETURN TO
LOS ANGELES COUNTY SURVEYOR
700 HALL OF RECORDS
Do not extend notes this side of this line

FORM 247 10M 8-31

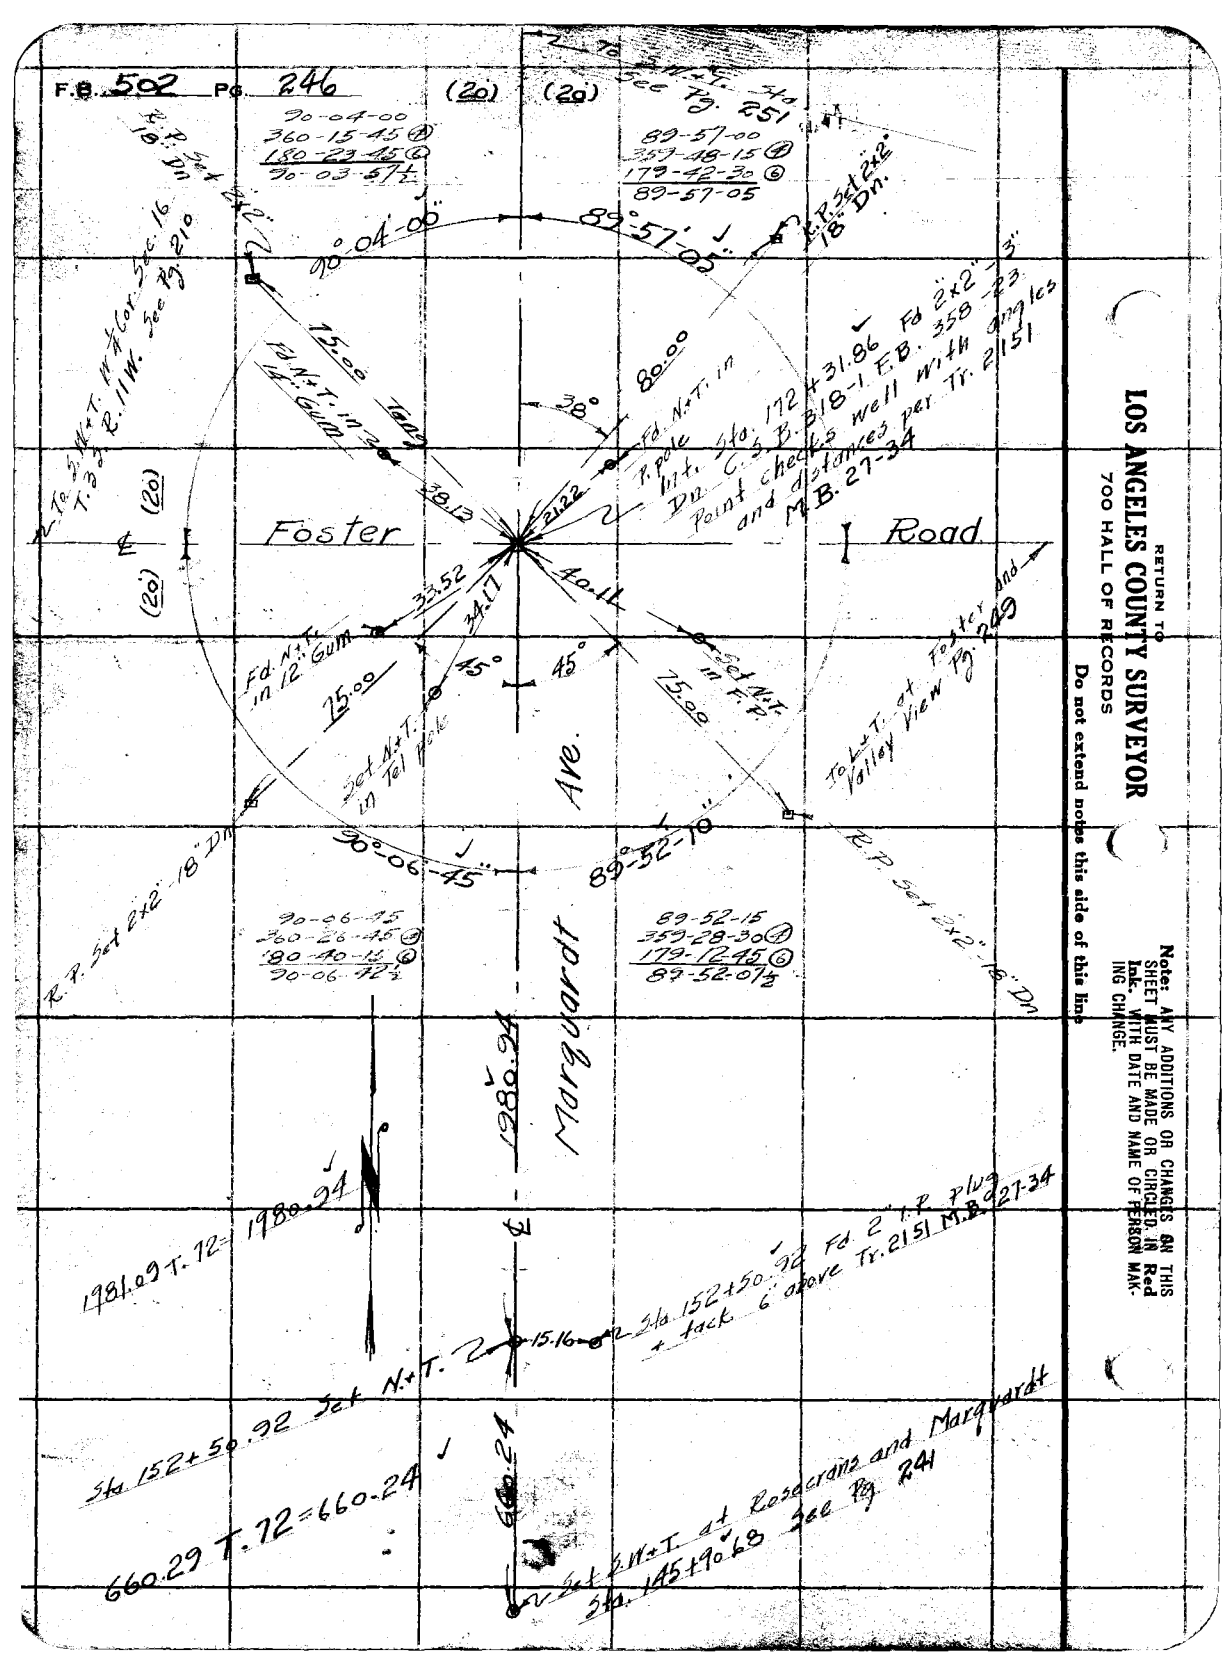

RETURN TO
LOS ANGELES COUNTY SURVEYOR
700 HALL OF RECORDS

Do not extend notes this side of this line

Note: ANY ADDITIONS OR CHANGES ON THIS SHEET MUST BE MADE OR CIRCLED IN Red Ink. WITH DATE AND NAME OF PERSON MAKING CHANGE.

Notes Ck'd by Drew	Survey of Margaret Ave
Map No. B-821	W. O. 1088 Tape No. 22 St'd 34 of F.
Office Work Cox	Surveyed by Roberts
Checked Drew	Notes
Date Oct 1933	Indexed A. C. Johnson Date 12-6-32

F.B. 502 Pg. 247

Note: ANY ADDITIONS OR CHANGES OF THIS SHEET MUST BE MADE OR CIRCLED IN Red Ink. WITH DATE AND NAME OF PERSON MAKING CHANGE.

Do not extend notes this side of this line

RETURN TO
LOS ANGELES COUNTY SURVEYOR
700 HALL OF RECORDS

FORM 247 10M 8-31

F.B. 502 Pg. 248

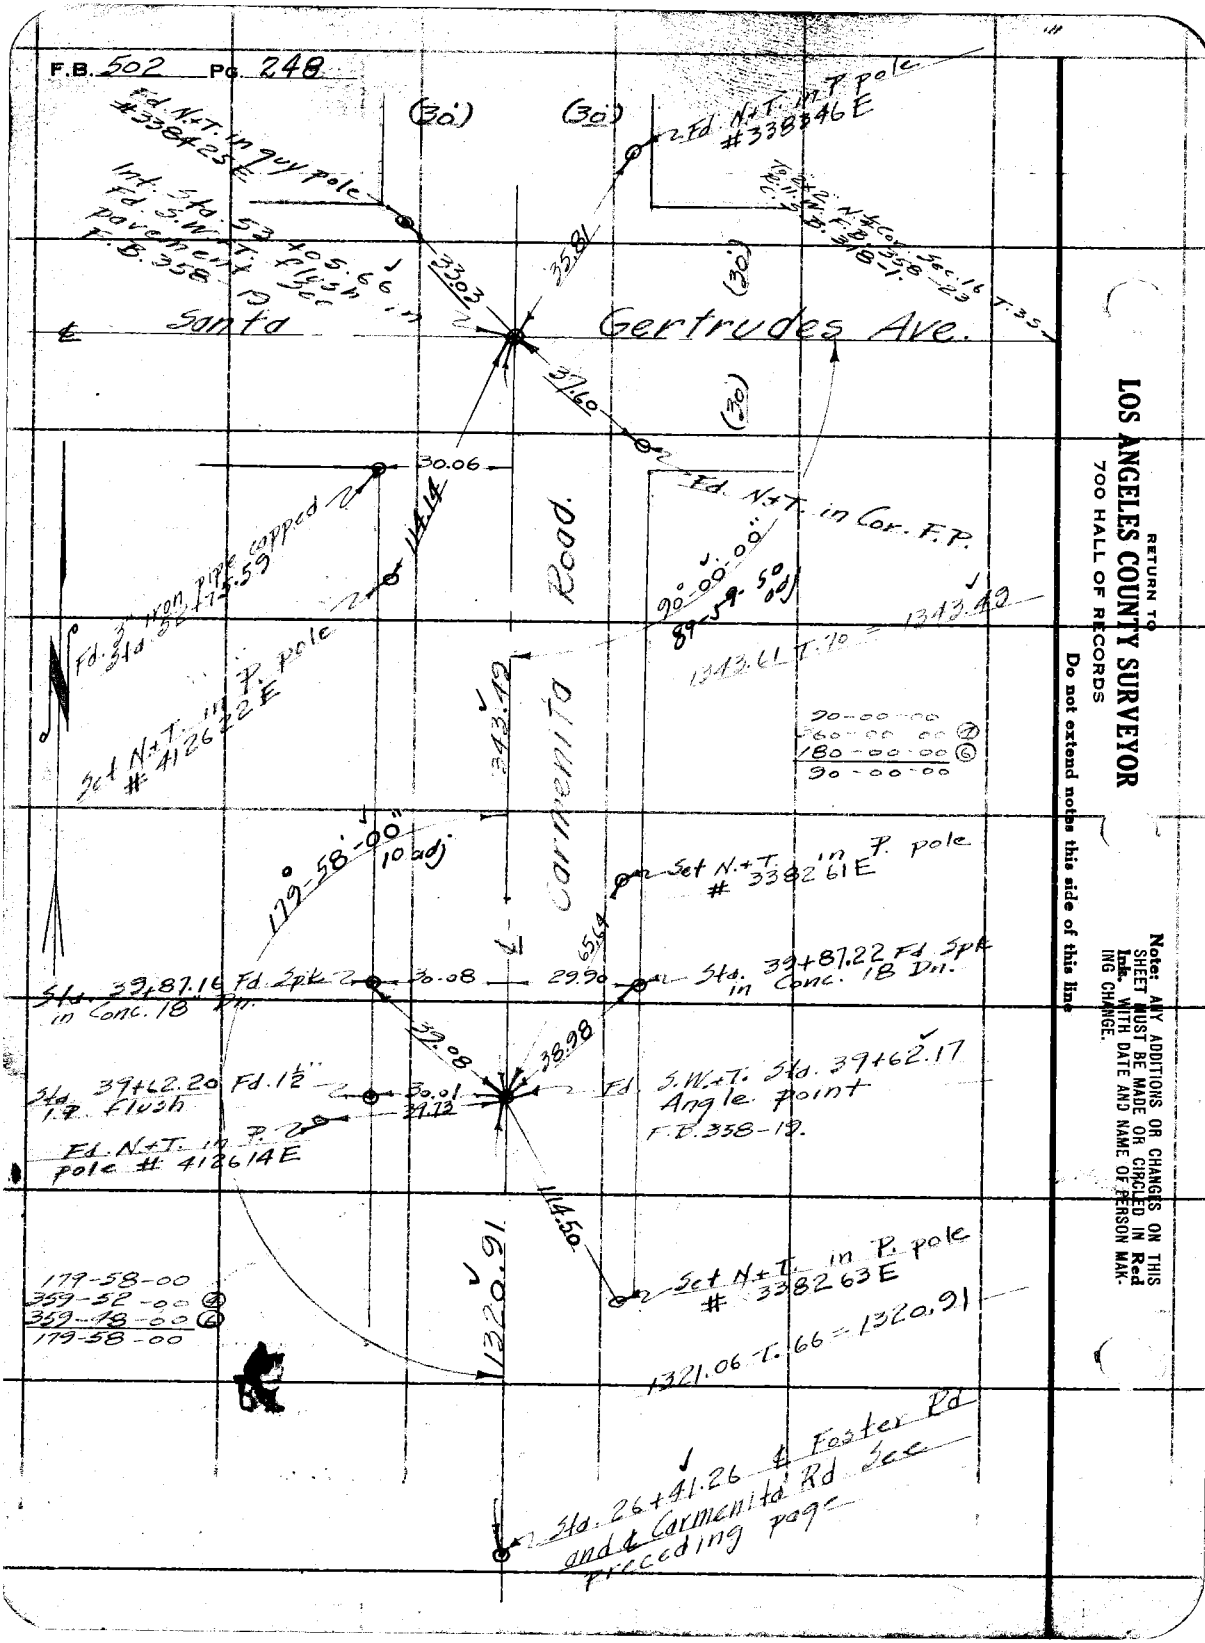

RETURN TO
LOS ANGELES COUNTY SURVEYOR
700 HALL OF RECORDS
Do not extend notes this side of this line

Note: ANY ADDITIONS OR CHANGES ON THIS SHEET MUST BE MADE OR CIRCLED IN Red Ink WITH DATE AND NAME OF PERSON MAKING CHANGE.

Notes Ck'd by Drew		Survey of Marguardt Ave.	F.B. 502 Pg. 249
Map No. B-821		W. O. 1088 Tape No: 022 St'd 64 °F.	
Office Work Cox		Surveyed by Rosecrans	
Checked Drew		Notes	Date 12 7 32
Date Oct 1933		Indexed A. C. Johnson	

Cont. bottom next page

To S.W.T. W¼ Cor. Sec. 16 T.3 S. R.11 W. See next page.

(20) (20)

℄ Marguardt Ave. Pg. 246

(20)

Pg. 206 (20)

Int. Sta. 26+41.7 Fd. 1" I.P. Fr. 3" Dm. See Pg. 246

Sta. 172+31.86 Fr. 3" Dm. 2×2"

180°01-05"

Foster Road

1468.40

1468.61 T. 62 = 1468.40

Sta. 11+73.28 Fd. 2" I.P. 6" above N. Cor. Lot 142 Fr. 2181 M.B. 27-34

2a.00

Sta. 11+73.57 Set N.W.T. Plug & Tack

89-53-15
359-33-00 (8)
179-19-30 (6)
89-53-15

576.59 T. 60 = 576.50

576.50

Sta. 5+27.07 Set S.W.T. Plug & Tack

R.P. 597.17 T. 58 = 597.07

R.P. Set 2×2-14" Dm.

N.T. in P. Pole #50243 E

N.T. in Tel Pole

R.P. Set 2×2-14" Dm.

Tel. T. at Gate Valley View Ave. F.B. 38-22

12.00

45°

45°

60°

597.07

61.59

35.38

78.00

(30)

℄ Valley View Ave.

(30)

Int. Sta. 0+00 to W. 12.5-52 F.B. 610-3 Ed. L. A. C. S.

64.21

Fd. N.T. in P. Pole #41 E

Note: ANY ADDITIONS OR CHANGES ON THIS SHEET MUST BE MADE OR CIRCLED IN Red Ink. WITH DATE AND NAME OF PERSON MAKING CHANGE.

RETURN TO
LOS ANGELES COUNTY SURVEYOR
700 HALL OF RECORDS
Do not extend notes this side of this line

FORM 247 10M 8-31

RETURN TO
LOS ANGELES COUNTY SURVEYOR
700 HALL OF RECORDS

Note: ANY ADDITIONS OR CHANGES ON THIS SHEET MUST BE MADE OR CIRCLED IN **Red Ink.** WITH DATE AND NAME OF PERSON MAKING CHANGE.

Do not extend notes this side of this line

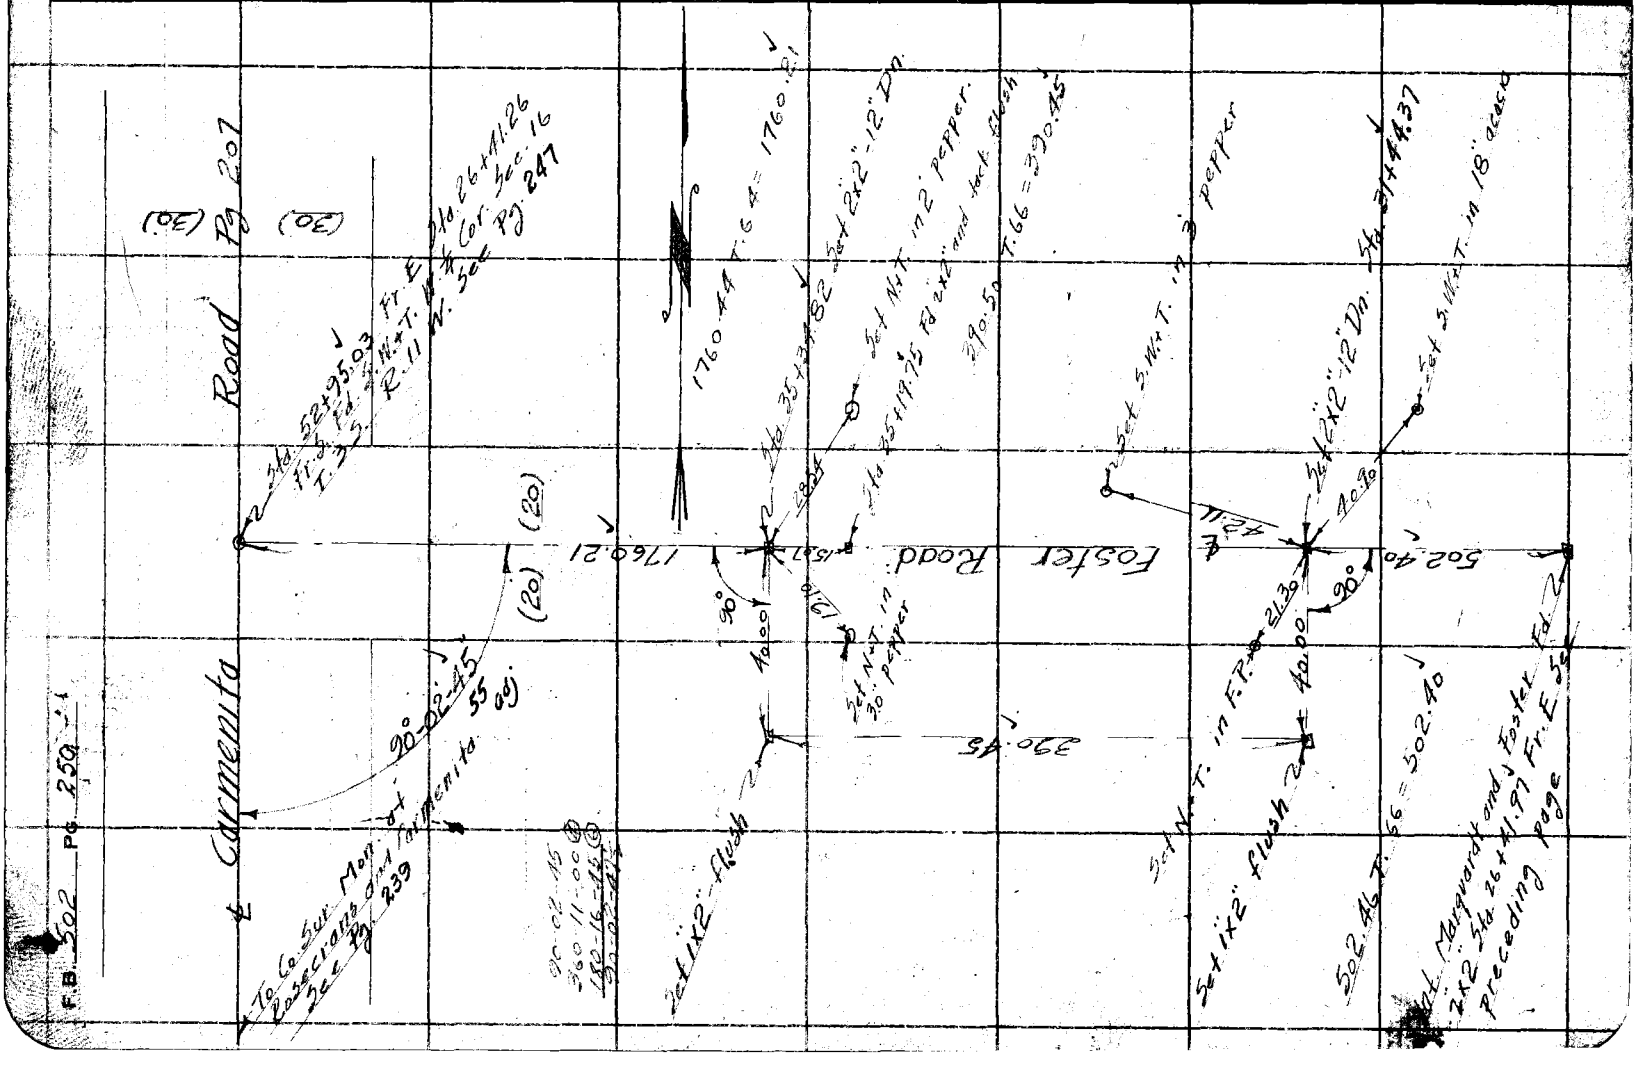

F.B. 502 Pg 259

Notes Ck'd by Drew	Survey of Marguardt Ave
Map No. B-821	W. O. 7088 Topo No. 022 St'd 84 °F.
Office Work Cox	Surveyed by Rosecrans
Checked Drew	Notes Date 12-8-32
Date Oct 1933	Indexed A. C. Johnson

F.B. 502 Pg. 257

Note: ANY ADDITIONS OR CHANGES ON THIS SHEET MUST BE MADE OR CIRCLED IN Red Ink. WITH DATE AND NAME OF PERSON MAKING CHANGE.

RETURN TO
LOS ANGELES COUNTY SURVEYOR
700 HALL OF RECORDS

Do not extend notes this side of this line

Set N.+T. in P. Pole #356998E

(30') Santa Gertrudes Ave.

To S.W.+T. Gertrudes and Pge 29.249

Int. of ℄ of Marguardt and Santa Gertrudes Sta. 198+95.54 Fd 2"x2" 12" Dn. F.B. 358-23 C.S.B. 318-1

1328.64 59.81 2354

89°57'-10" 15 adj

Int. of Santa Carmenita ℄

(20') (20')

R.P. Sta. 198+35.13 Fd 2"x2"-12" Dn. F.B. 358-2

R.P. Sta. 197+91.41 Fd 2"x2"-12" Dn. F.B. 358-23

1329.88 T.56 = 1328.64

Set N.+T. in Cor. F.P.

89-57-15
359-48-45 ④
179-43-00 ⑤
89-57-10
239.14 T.58 = 239.10
60.24 T.60

23.84 21.63 13.54

Sta 185+66.90 Set 2"x2"-12" Dn

Set N.+T. in F.P.

Set N.+T. in T. Pole #246567E

600.15 839.25

Set N.+T. in F.P.

832.25 Marguardt Ave.

Set N.+T in F.P.

34.45 49.19

Fd N.+T. in T. Pole #116624E Sta 172+27.65

Set N.+T. in F.P.

23.40

Set 2 M.T. Flush

Fd 2"x2" Sta. 172+31.86 of Marguardt and Foster

495.87 T.60 = 495.79

495.77

FORM 247 10M 8-31

RETURN TO

LOS ANGELES COUNTY SURVEYOR

700 HALL OF RECORDS

Note: ANY ADDITIONS OR CHANGES ON THIS SHEET MUST BE MADE OR CIRCLED IN **Red Ink.** WITH DATE AND NAME OF PERSON MAKING CHANGE.

Do not extend notes this side of this line

F.B. 502 Pg. 252

5-220
1320

4/[redacted]53

Please ascertain if there is a C. S. Mon (Brass Cap) on Marguardt Ave between Foster Ave and Imperial Hwy. (See index sketch pg 220) Ed. Hewitt says that he saw one on approx. the 1/4-1/4 line. It is not tied to the new tract and he says the power line is not in the R/w in relation to it. Please advise.

If found get description, marking etc ~~of tie to~~ Marquardt. Hugh.

Notes Ck'd by Drew	Survey of [illegible]	F.B. ____ Pg. 253
Map No. B-921	W. O. 1088 Tape No. 222 St'd 84 °F.	
Office Work Cox	Surveyed by Rosecrans	
Checked Drew	Notes ____ Date 12-9-32	
Date Oct 1933	Indexed A. C. Johns 12-20-32	

Cont. bottom next page

Old Rd.

1+50.0
1+41.7
16.1
18.8
1.0
Wing

1+76.4
10.4
Wing
9.0
14.0
10.1
1.0
1+11.1
Bridge
Creek

Wood

2+77.0
Wing
Coyote
Wing
2+59.7
16.3
21.5
26.7
1.2
1.0
2+73.3
2+67.6
1.0
2+50.6
1+15.4
20.8
20.1
Ave.

Margaret

0+97.0 - 10" gum tree - 18.6

Bank of oil

0+100 to N. 1/4 cor. Sec. 31 T. 1 S. R. 10 W.
Bdy. post # 22 Pg. 231

24.3
8.6
Barbed wire fence

Note: ANY ADDITIONS OR CHANGES ON THIS SHEET MUST BE MADE OR CIRCLED IN Red Ink, WITH DATE AND NAME OF PERSON MAKING CHANGE.

Do not extend notes this side of this line

RETURN TO
LOS ANGELES COUNTY SURVEYOR
700 HALL OF RECORDS

FORM 247 10M 8-31

F.B. 502 PG. 254

Contd on bottom pg 255

RETURN TO
LOS ANGELES COUNTY SURVEYOR
700 HALL OF RECORDS
Do not extend notes this side of this line

Note: ANY ADDITIONS OR CHANGES ON THIS SHEET MUST BE MADE OR CIRCLED IN Red Ink. WITH DATE AND NAME OF PERSON MAKING CHANGE.

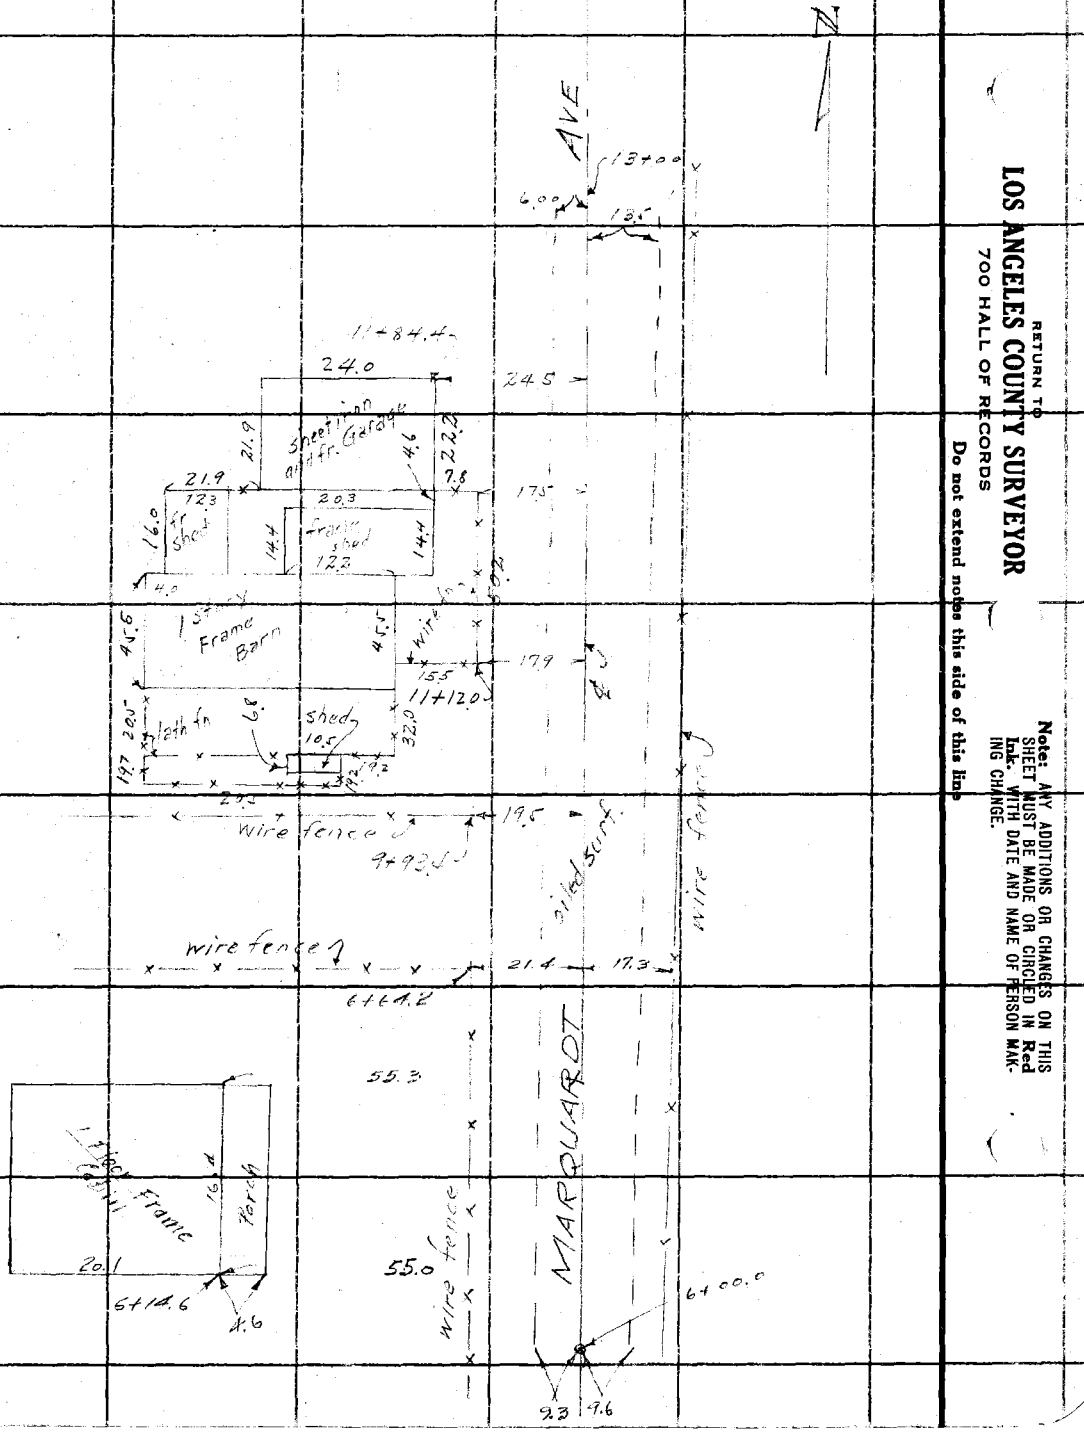

Notes Ck'd by Drew	Survey of Marquardt M.C.
Map No. B-821	W. O. 1066 Type No. 022 St'd 84 of.
Office Work Cox	Surveyed by P.W. Atkins
Checked Drew	Notes Same Date Dec 13'32.
Date Oct 1933	Indexed C. Johnson

F.B. 502 Pg. 255

Note: ANY ADDITIONS OR CHANGES ON THIS SHEET MUST BE MADE OR CIRCLED IN Red Ink. WITH DATE AND NAME OF PERSON MAKING CHANGE.

RETURN TO
LOS ANGELES COUNTY SURVEYOR
700 HALL OF RECORDS
Do not extend notes this side of this line

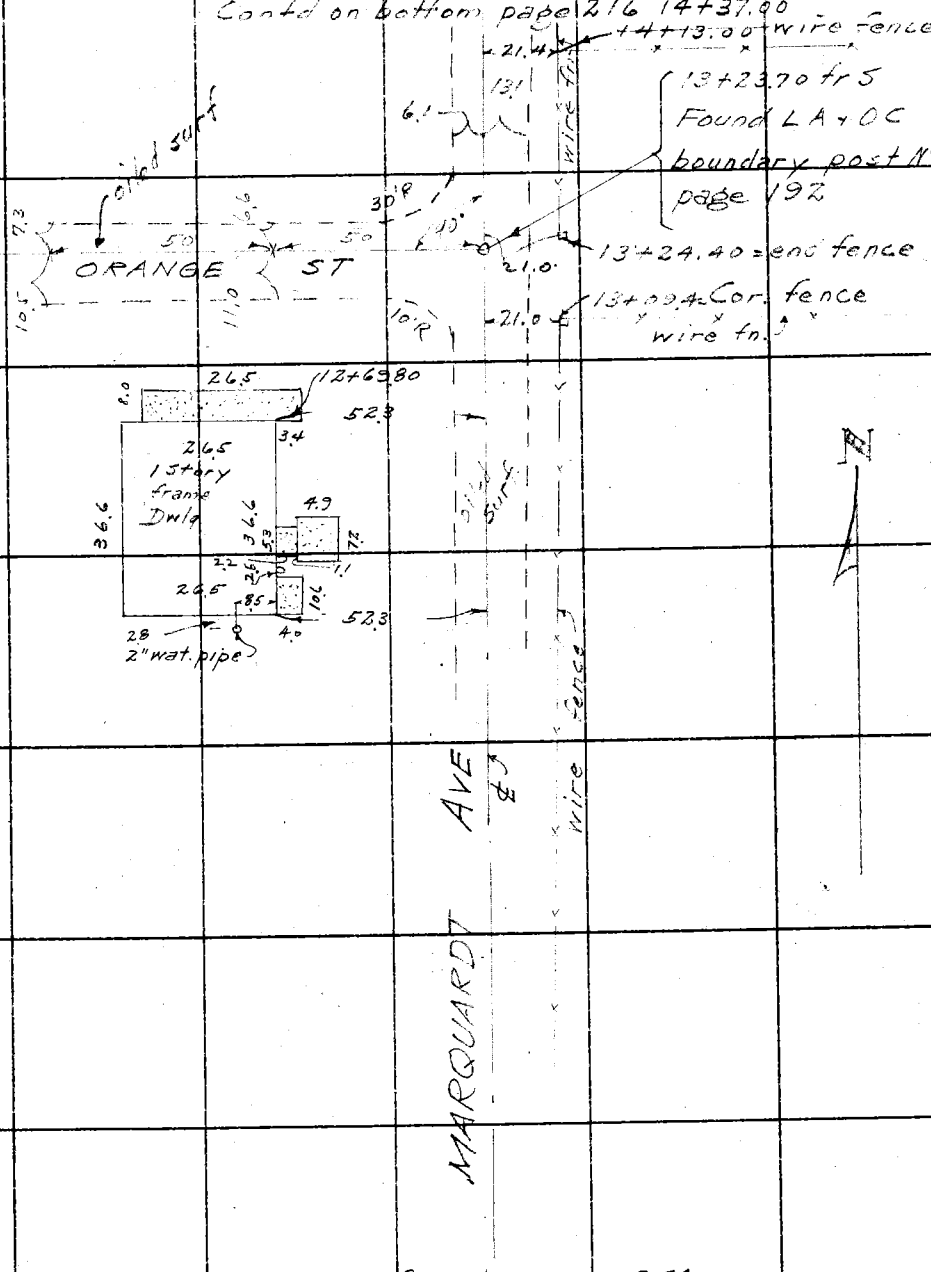

FORM 247 10M 8-31

F.B. 502 Pg. 216

Contd on bottom page 217

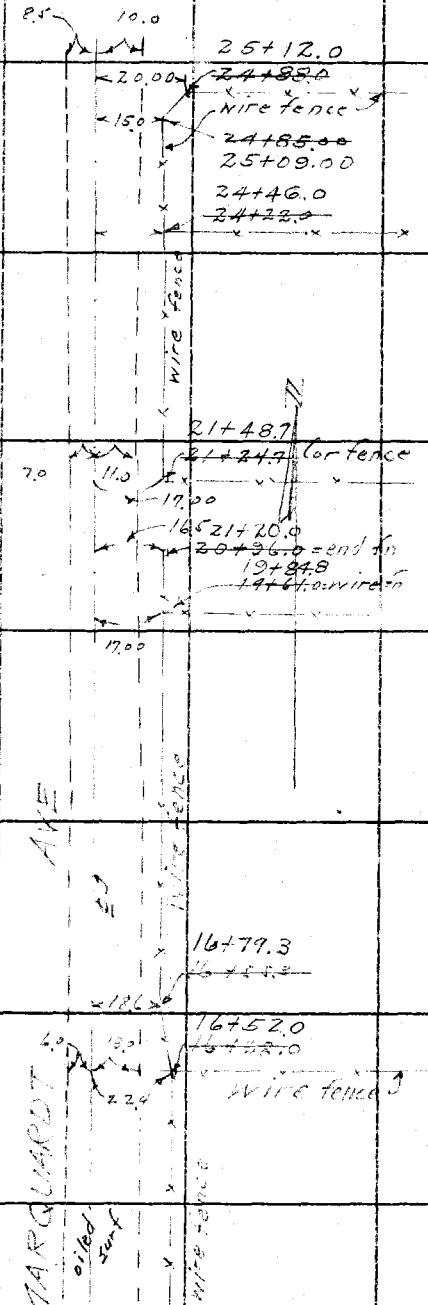

Contd from top page 215

RETURN TO
LOS ANGELES COUNTY SURVEYOR
700 HALL OF RECORDS

Do not extend notes this side of this line

Note: ANY ADDITIONS OR CHANGES ON THIS SHEET MUST BE MADE OR CIRCLED IN Red Ink. WITH DATE AND NAME OF PERSON MAKING CHANGE.

Notes Ck'd by Drew	Survey of Marquardt Ave
Map No. B-821	W. O. 7088 Type No. 022 St'd 84 °F.
Office Work Cox	Surveyed by P.W. Atkins
Checked Drew	Notes same Date Dec. 13'32.
Date Oct 1933	Indexed A. C. Johnson

F.B. 502 Pg 257

Contd on bottom page 258

Note: ANY ADDITIONS OR CHANGES ON THIS SHEET MUST BE MADE OR CIRCLED IN Red Ink. WITH DATE AND NAME OF PERSON MAKING CHANGE.

RETURN TO
LOS ANGELES COUNTY SURVEYOR
720 HALL OF RECORDS
Do not extend notes this side of this line

AVE

MARQUARDT

9.0 9.0

732 28.2 53 1 Story frame dwelling 12.0 22.0 73.2 28+07.3 6.1

Frame Garage 6.6 2.0 14 23.7 oiled surf

8" orange trs

16.00 26+45.4 wire fence 20.2

15.0 26+26.0 23.6 18.0

8" 17.0 8" 17.2 8" 17.0 8" 10"

Row orange trees

Gate post 26+17.6 Gate post 17.4

Cor. house 26+04.9 16.5 Shade tree 25+94.5

68.0

12.5 6.0 8.1 24.5 22.5 1 Story frame Dwelling 18.7 8.3 24 4.0 Water M. C. 1" W&T H 7.0 1.0 Porch 33.0 6.1

T 3" 33.2 Picket fence 57.0 Picket fence 68.3 Board fence 29.5 12.3

25+82.2 Gate post Gate post 25+64.4 Palm tree 19.0 T 4" 4" T

Palm tree

Row orange trs

Picket fence 4" 16.5 8" 16.5 8" 6" 8.5 17.5 29.5 10.0 20.00

Cor fn 25+63.1

25+12.0 end wooden fence

Contd from top page 216

FORM 247 10M 8-31

F.B. 502 PG. 258

Contd. on bottom page 260

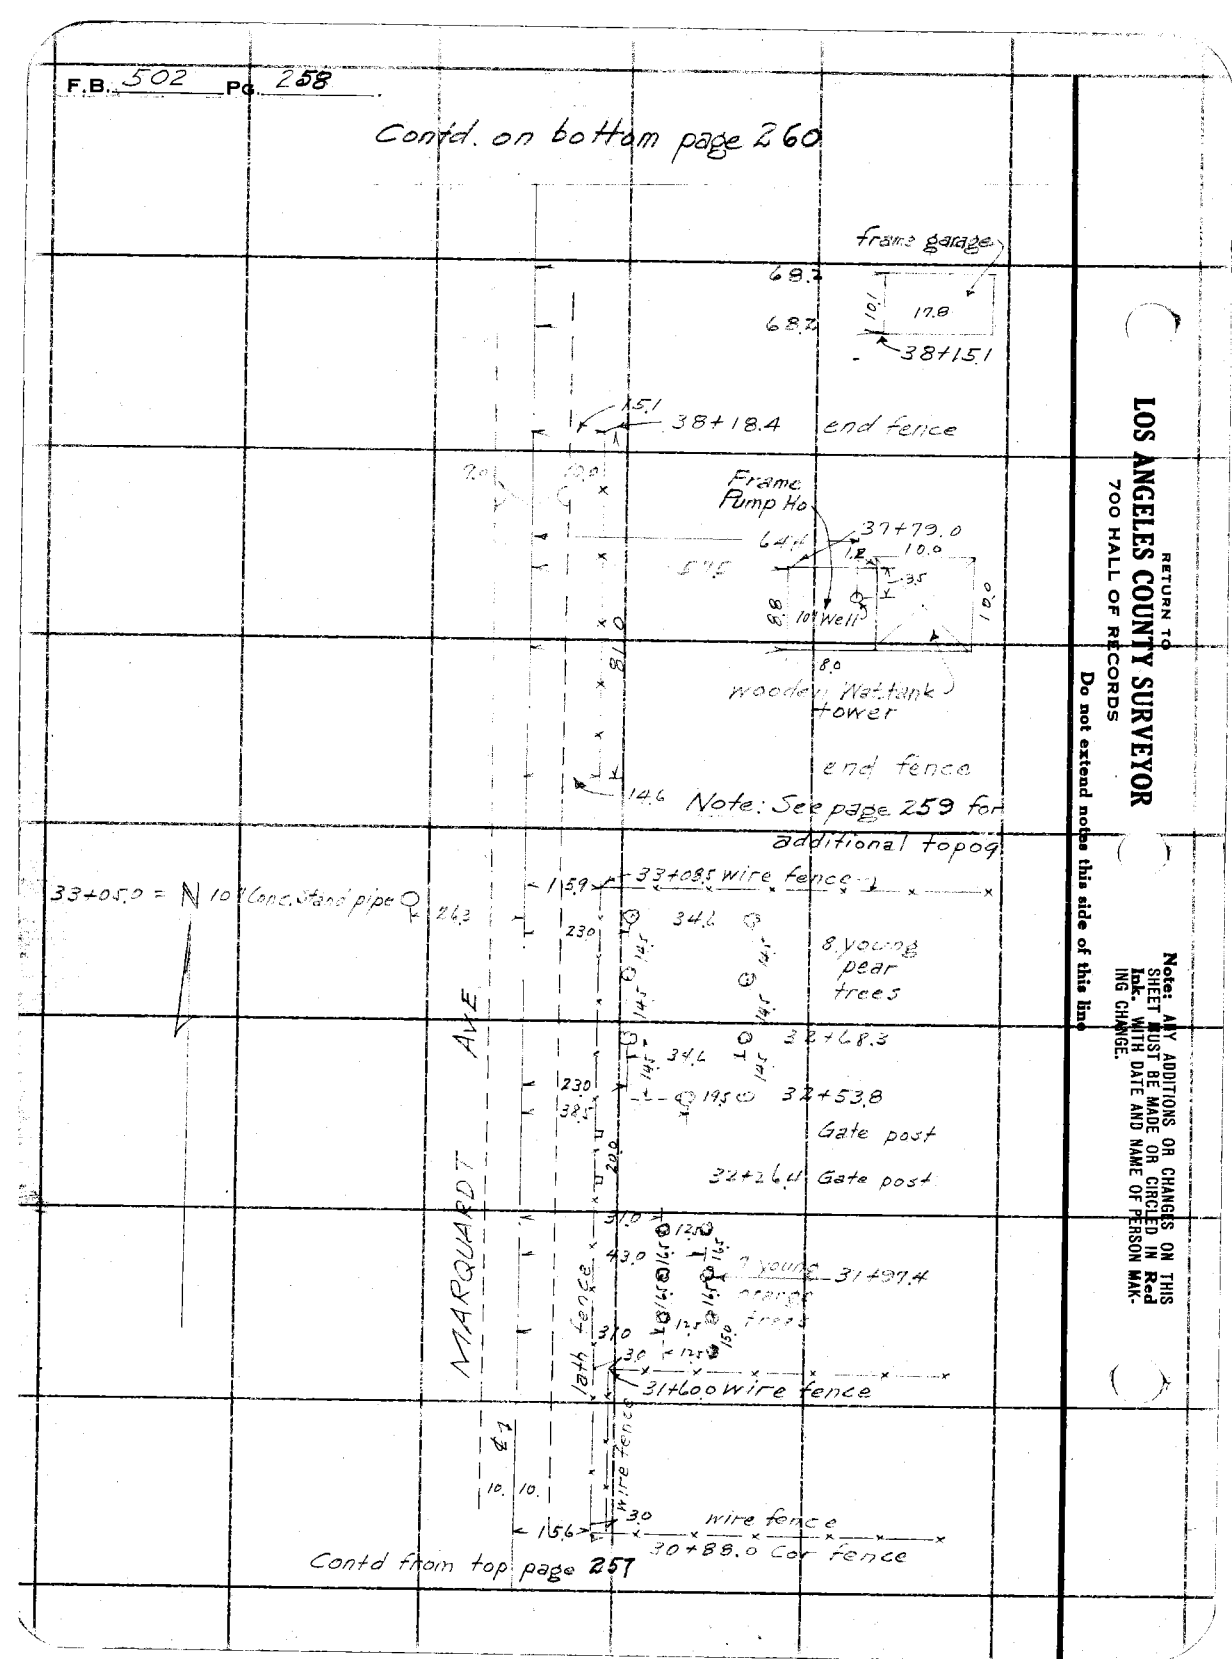

RETURN TO
LOS ANGELES COUNTY SURVEYOR
700 HALL OF RECORDS

Do not extend notes this side of this line

Note: ANY ADDITIONS OR CHANGES ON THIS SHEET MUST BE MADE OR CIRCLED IN Red Ink. WITH DATE AND NAME OF PERSON MAKING CHANGE.

Notes Ck'd by Drew	Survey of Marquardt Ave
Map No. B-824	W. O. 7088 Tape No. 022 St'd 84 °F.
Office Work Cox	Surveyed by PW Ashins
Checked Drew	Notes Same Date Dec 14, 32.
Date Oct 1933	Indexed A. C. Johnson

F.B. 502 Pg. 259

Note: ANY ADDITIONS OR CHANGES ON THIS SHEET MUST BE MADE OR CIRCLED IN Red Ink. WITH DATE AND NAME OF PERSON MAKING CHANGE.

Do not extend notes this side of this line

RETURN TO
LOS ANGELES COUNTY SURVEYOR
700 HALL OF RECORDS

FORM 247 10M 8-31

Note: Topog. shown on this page is additional.

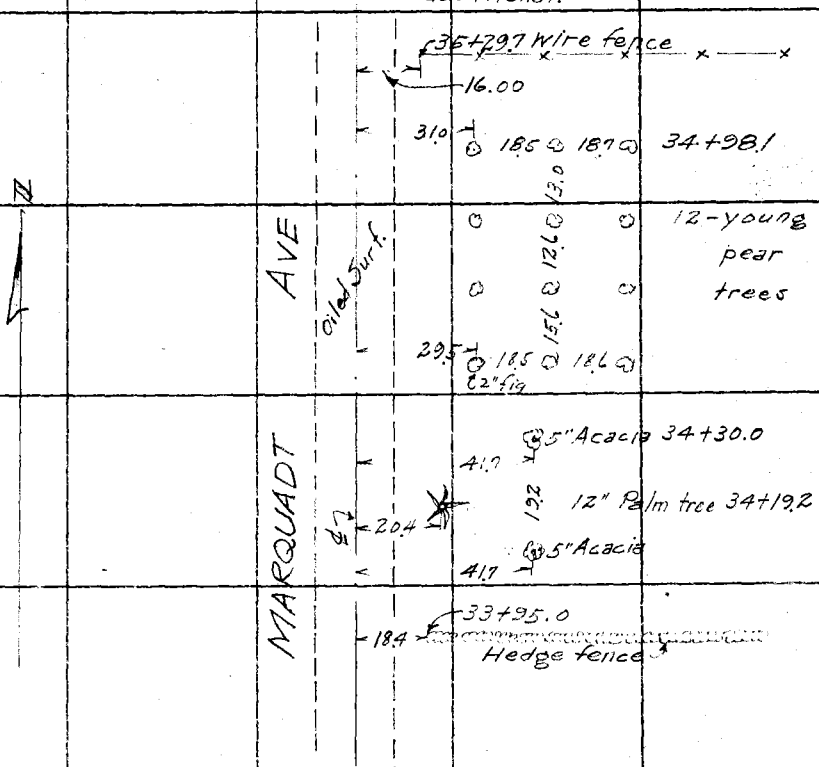

F.B. 502 Pg. 260

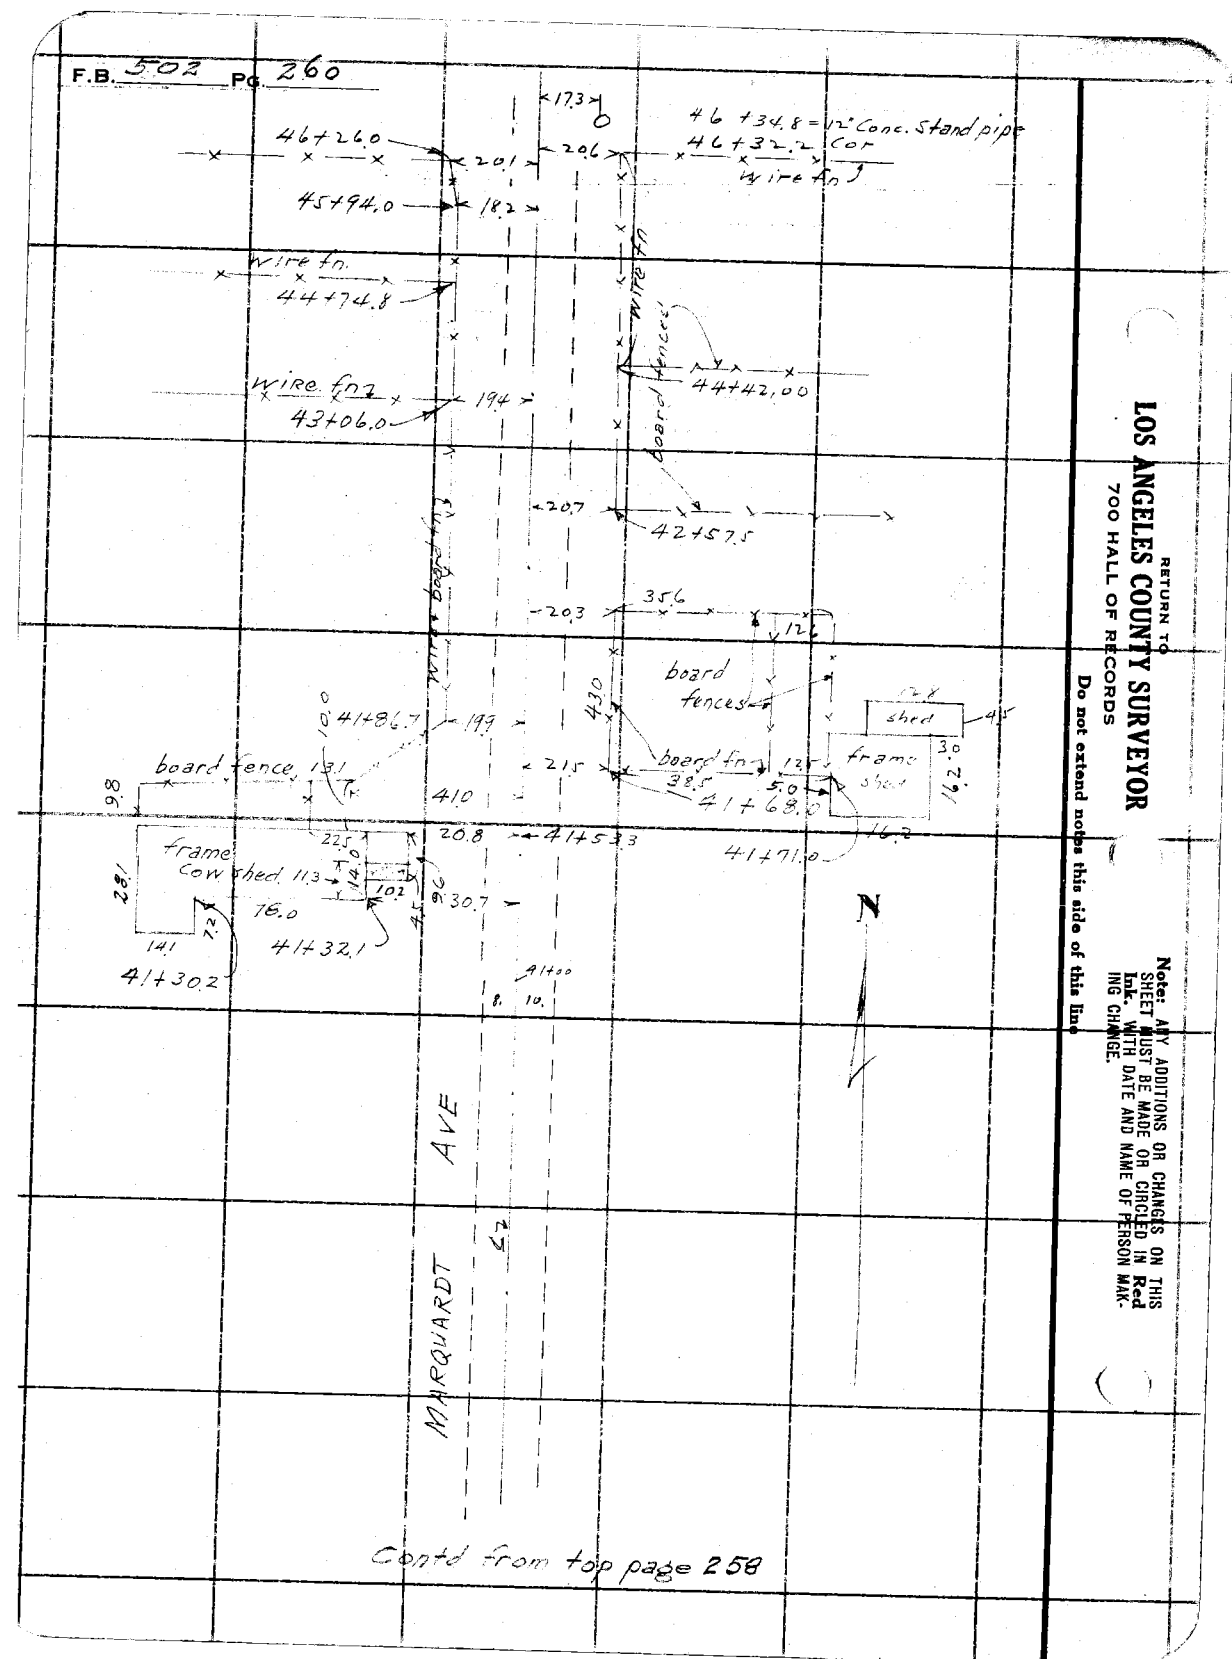

Contd from top page 258

RETURN TO
LOS ANGELES COUNTY SURVEYOR
700 HALL OF RECORDS

Do not extend notes this side of this line

Note: ANY ADDITIONS OR CHANGES ON THIS SHEET MUST BE MADE OR CIRCLED IN Red Ink. WITH DATE AND NAME OF PERSON MAKING CHANGE.

Notes Ck'd by Drew	Survey of Marquardt Ave
Map No. B-821	W. O. 7088 Tape No. 027 St'd 84 °F.
Office Work Cox	Surveyed by PW A H W S
Checked Drew	Notes same Date Dec. 14'33.
Date Oct 1933	Indexed A. C. Johnson

F.B. 502 Pg. 261

N

Notes: ANY ADDITIONS OR CHANGES ON THIS SHEET MUST BE MADE OR CIRCLED IN Red Ink. WITH DATE AND NAME OF PERSON MAKING CHANGE.

RETURN TO
LOS ANGELES COUNTY SURVEYOR
700 HALL OF RECORDS
Do not extend notes this side of this line

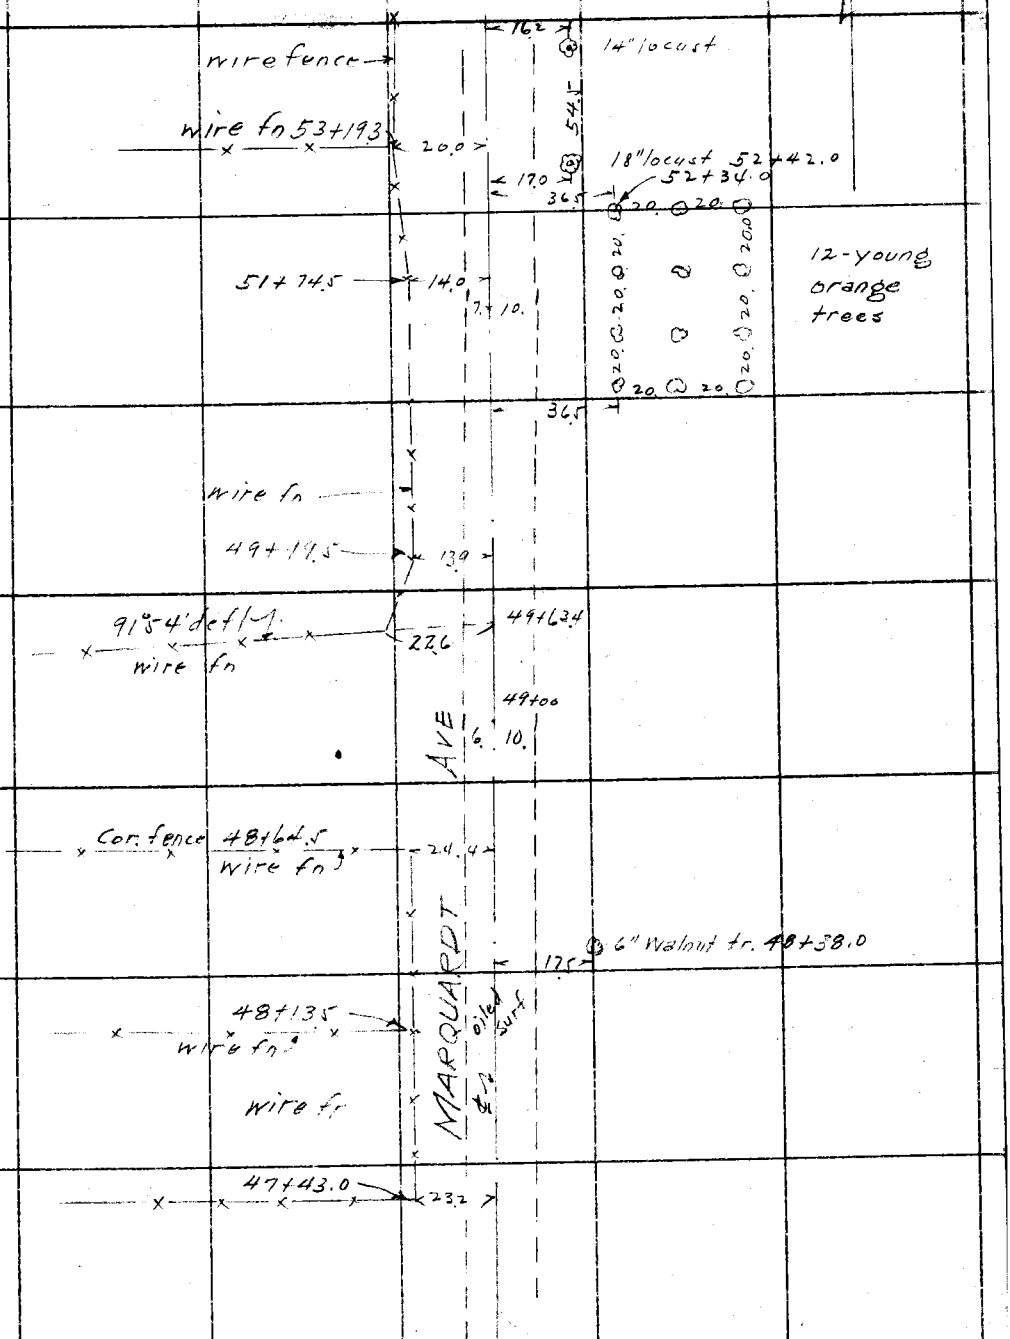

FORM 247 10M 8-31

F.B. 502 Pg. 262

Contd on bottom page 263

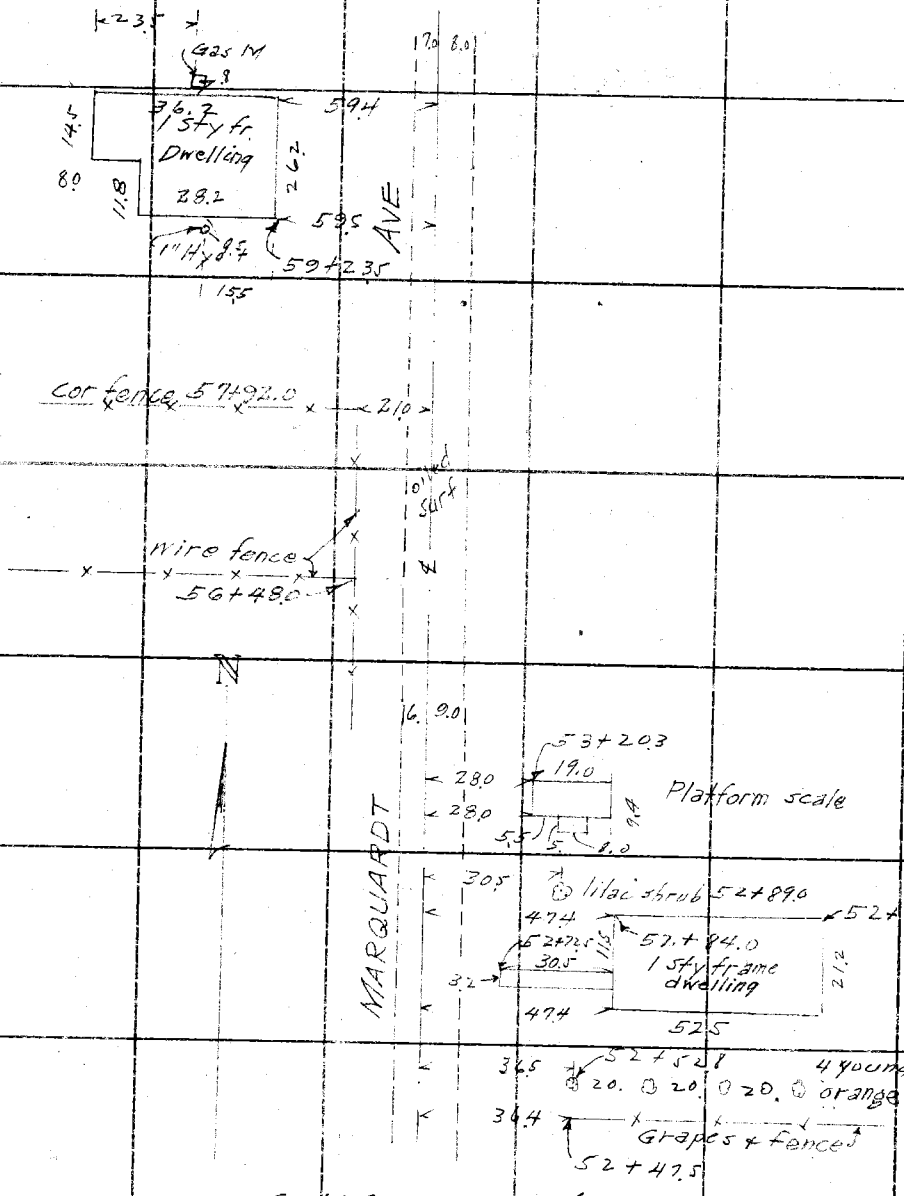

Contd from top page 261

RETURN TO
LOS ANGELES COUNTY SURVEYOR
700 HALL OF RECORDS

Do not extend notes this side of this line

Note: ANY ADDITIONS OR CHANGES ON THIS SHEET MUST BE MADE OR CIRCLED IN Red Ink. WITH DATE AND NAME OF PERSON MAKING CHANGE.

Notes Ck'd by Drew	Survey of Marquardt Ave
Map No. B-821	W. O. 7088 Type No. 022 St'd 84 °F.
Office Work Cox	Surveyed by PW Atkins
Checked Drew	Notes Same Date Dec. 15, 32
Date Oct 1939	Indexed A. C. Johnson

F.B. 502 Pg. 263

Contd on bottom page 264

wire fence

66+97.0 24" Poplar

66+88 wire fence cor

66+73.9

5" wat valv

APPLE ST

66+44.4 24" Poplar tr

66+55.49 Fd Co. Surv Mon page 232

13.8

14.8

20.1

50.

50.

2.0

2.0

15.8

56.4

2.93

65+09.0 24" Palm tr

2-8" orange trs 65+16.7

56.3

65+02.4

32.5

12.5

2.0

18.7

12.5

1 sty fr. Ho

64+77.0 21" shade tr.

2.97

30.2

56.5

64+61.0 = 30" Palm tr

64+44.0 = 18" orange

64+13.0 = 48" Gum tree

16.5

16.6

63+59.0 = 60" Gum tree

63+27.0 = 30" Gum tree

62+10.0 = 24" Gum tree

62+71.5 = 28" Gum tree

62+59.0 = 26" Gum tree

16.0

AVE

MARQUARDT

oiled surf

Contd from top page 262

N

Note: ANY ADDITIONS OR CHANGES ON THIS SHEET MUST BE MADE OR CIRCLED IN Red Ink. WITH DATE AND NAME OF PERSON MAKING CHANGE.

Do not extend notes this side of this line

RETURN TO
LOS ANGELES COUNTY SURVEYOR
700 HALL OF RECORDS

FORM 247 10M 8-31

F.B. 502 Pg. 267

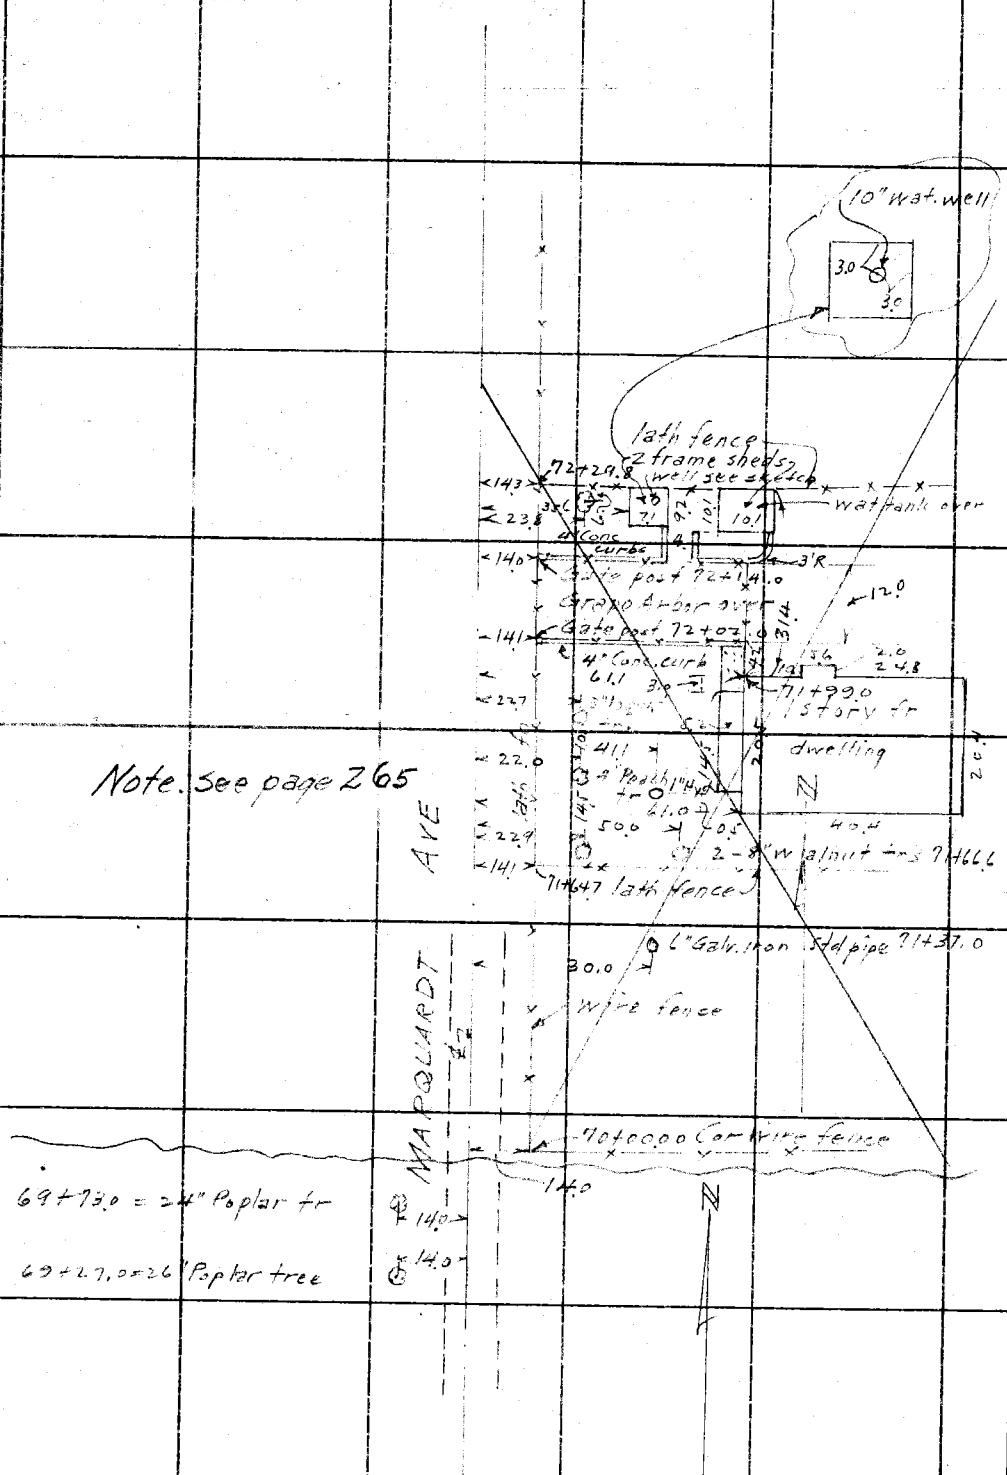

Note. See page 265

RETURN TO
LOS ANGELES COUNTY SURVEYOR
700 HALL OF RECORDS
Do not extend notes this side of this line

Note: ANY ADDITIONS OR CHANGES ON THIS SHEET MUST BE MADE OR CIRCLED IN Red Ink. WITH DATE AND NAME OF PERSON MAKING CHANGE.

Notes Ck'd by Drew	Survey of Marquardt Ave
Map No. B-821	W. O. 7088 Tape No. 022 St'd 1' oF.
Office Work Cox	Surveyed by D/A/H/H/T
Checked Drew	Notes same Date Dec 14'37
Date Oct 1937	Indexed A. C. Johnson

F.B. 50X Pg 265

Contd on bottom page 26'

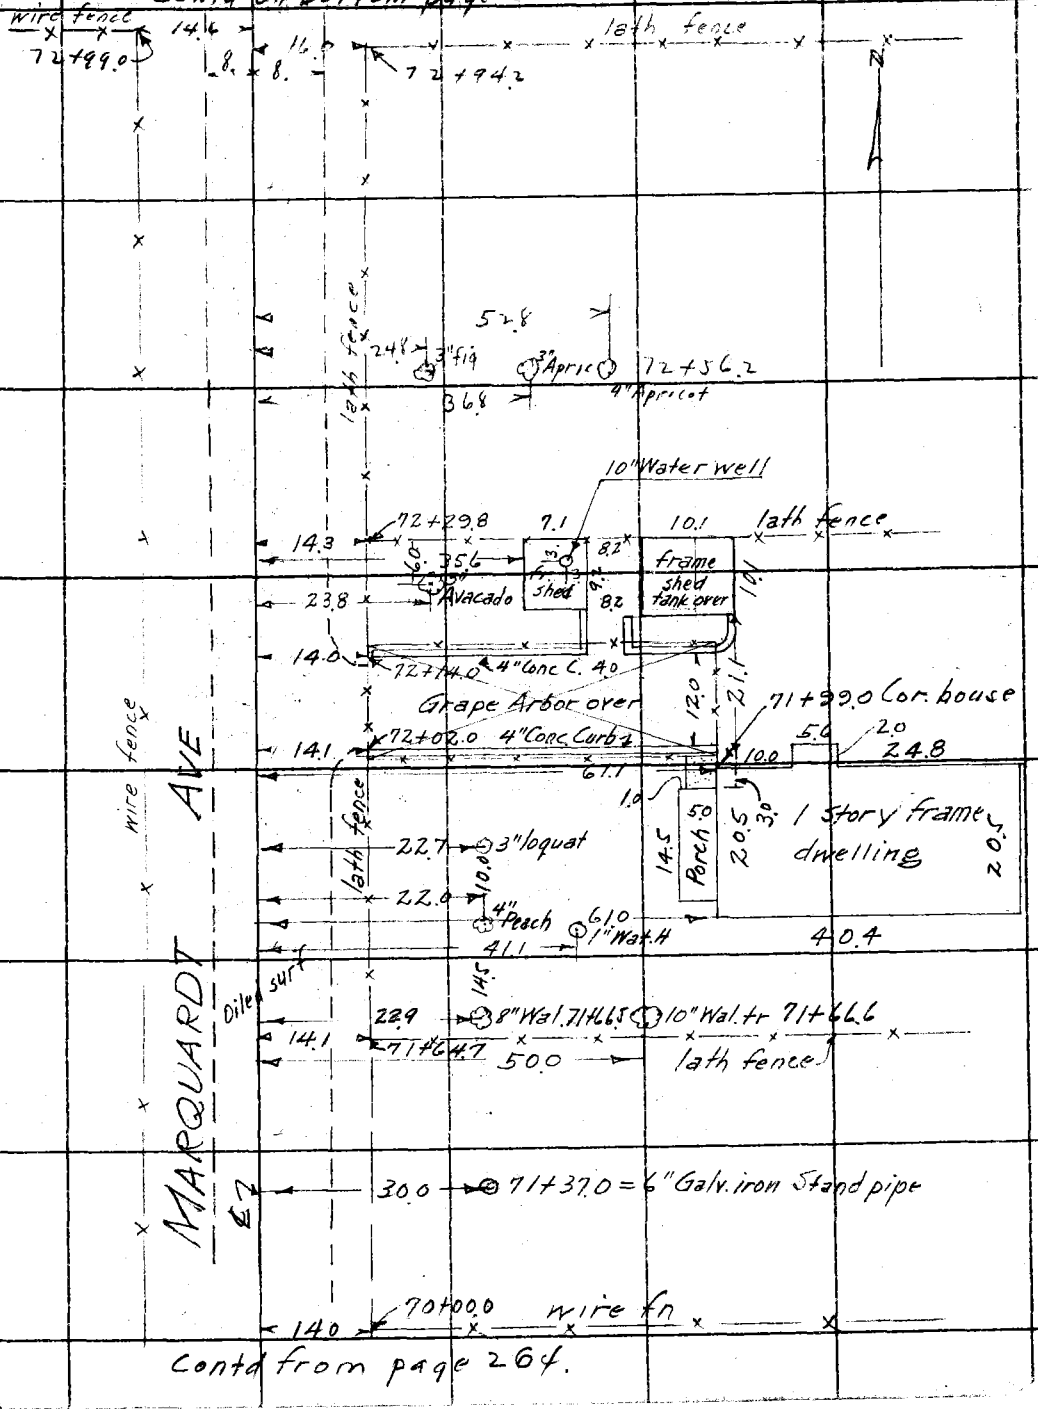

Contd from page 264.

Notes: ANY ADDITIONS OR CHANGES ON THIS SHEET MUST BE MADE OR CIRCLED IN Red Ink. WITH DATE AND NAME OF PERSON MAKING CHANGE.

RETURN TO
LOS ANGELES COUNTY SURVEYOR
700 HALL OF RECORDS
Do not extend notes this side of this line

FORM 247 10M 8-31

F.B. 502 Pg 226

Contd on bottom page 227

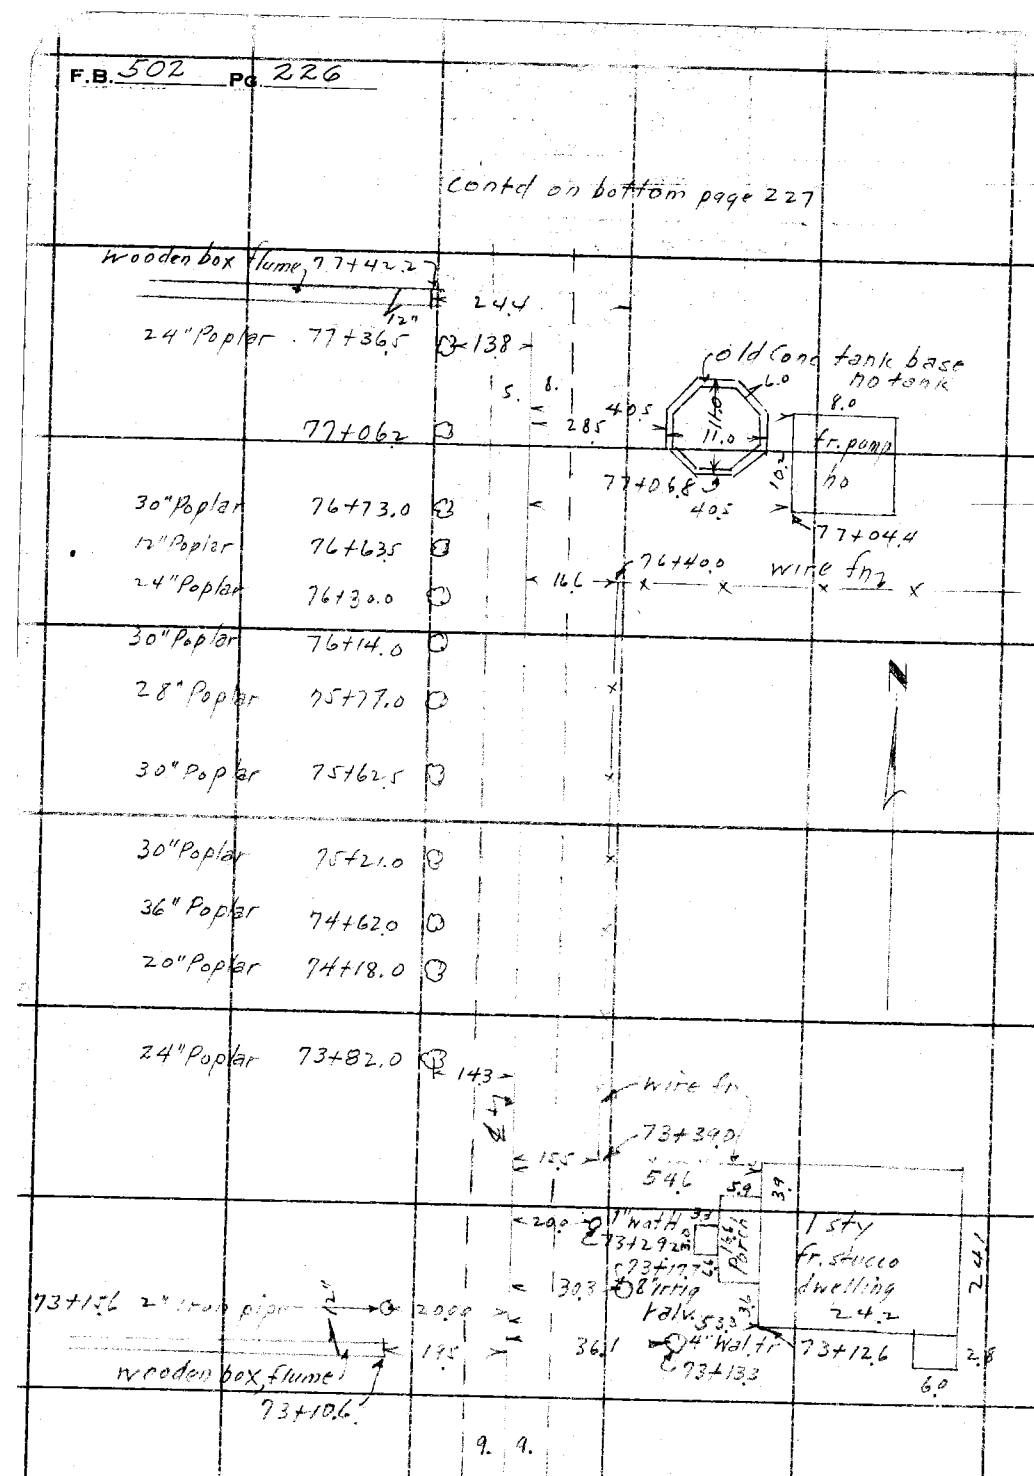

Contd from top page 225

RETURN TO
LOS ANGELES COUNTY SURVEYOR
700 HALL OF RECORDS

Do not extend notes this side of this line

Note: ANY ADDITIONS OR CHANGES ON THIS SHEET MUST BE MADE OR CIRCLED IN Red Ink. WITH DATE AND NAME OF PERSON MAKING CHANGE.

Notes Ck'd by Drew	Survey of Marquardt Ave
Map No. B-824	W. O. 7088 Tape No. 0 v 2 St'd E W °F.
Office Work Cox	Surveyed by R. Stevens
Checked Drew	Notes Cane Date Dec 15, 1933
Date Oct 1933	Indexed A. C. Johnson

F.B. 504 PG. 267

Contd on bottom pg 268

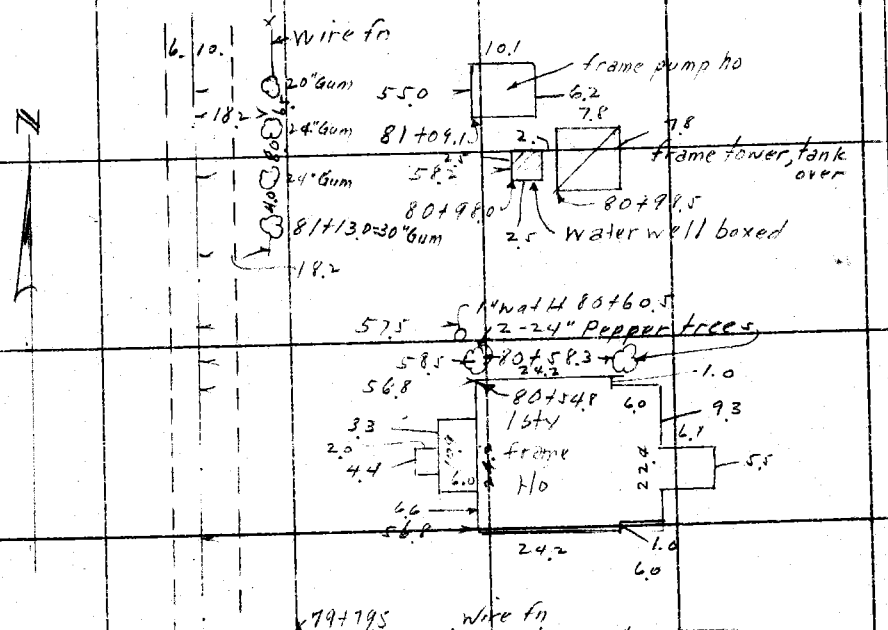

Contd from top pg 266

Note: ANY ADDITIONS OR CHANGES ON THIS SHEET MUST BE MADE OR CIRCLED IN Red Ink. WITH DATE AND NAME OF PERSON MAKING CHANGE.

Do not extend notes this side of this line

RETURN TO
LOS ANGELES COUNTY SURVEYOR
700 HALL OF RECORDS

FORM 247 10M 8-31

F.B. 502 PG. 268

Contd on bottom page 269

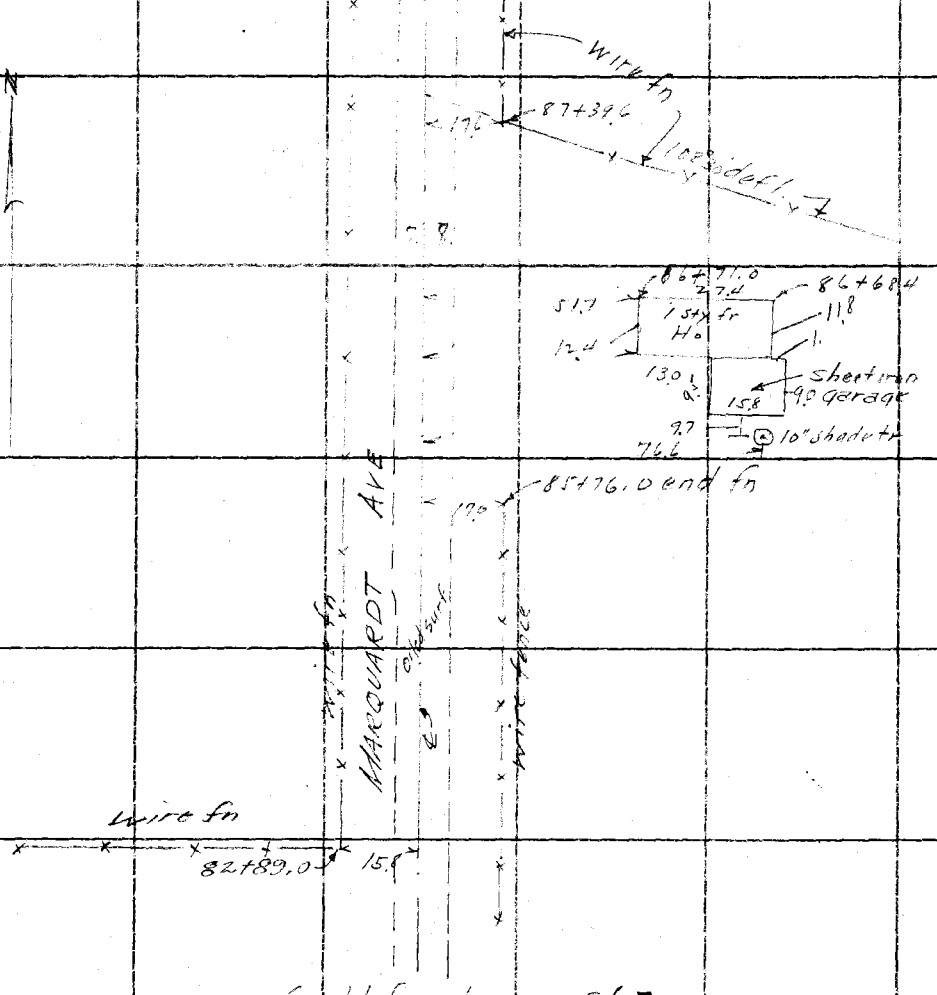

Contd from top page 267

RETURN TO
LOS ANGELES COUNTY SURVEYOR
700 HALL OF RECORDS

Do not extend notes this side of this line

Note: ANY ADDITIONS OR CHANGES ON THIS SHEET MUST BE MADE OR CIRCLED IN Red Ink. WITH DATE AND NAME OF PERSON MAKING CHANGE.

Notes Ck'd by Drew	Survey of Marguardt Ave
Map No. B-821	W.O. 7088 Topo No. 222 Sht'd 8 of
Office Work Cox	Surveyed by P.W. Atkins
Checked Drew	Notes Loose Date Dec. 1937
Date Oct 1937	Indexed A. C. Johnson

F.B. 502 Pg. 269

Contd to Latham page 260

Note: ANY ADDITIONS OR CHANGES ON THIS SHEET MUST BE MADE OR CIRCLED IN Red Ink WITH DATE AND NAME OF PERSON MAKING CHANGE.

RETURN TO
LOS ANGELES COUNTY SURVEYOR
720 HALL OF RECORDS
Do not extend notes this side of this line

AVE

wire fence

91+40.8 157 91+22.0

91+15.0 6.0 9. 14.5

S.P. R.R. 56°41' 115.11'

90+91.6 30.6 27.3 144

Note: Board fence Cattle passes

90+74.6 21.8 90+74.6 5.0 14.0

90+69.8 148 90+65.6 0.00

Gutter Gutter

90+50.1 30 158

board fence

90+21.9 158

wire fence

169 90+02.3 6.9

MARQUARDT oiled surf.

wire fence

Contd from top page 268

FORM 247 10M 8-31

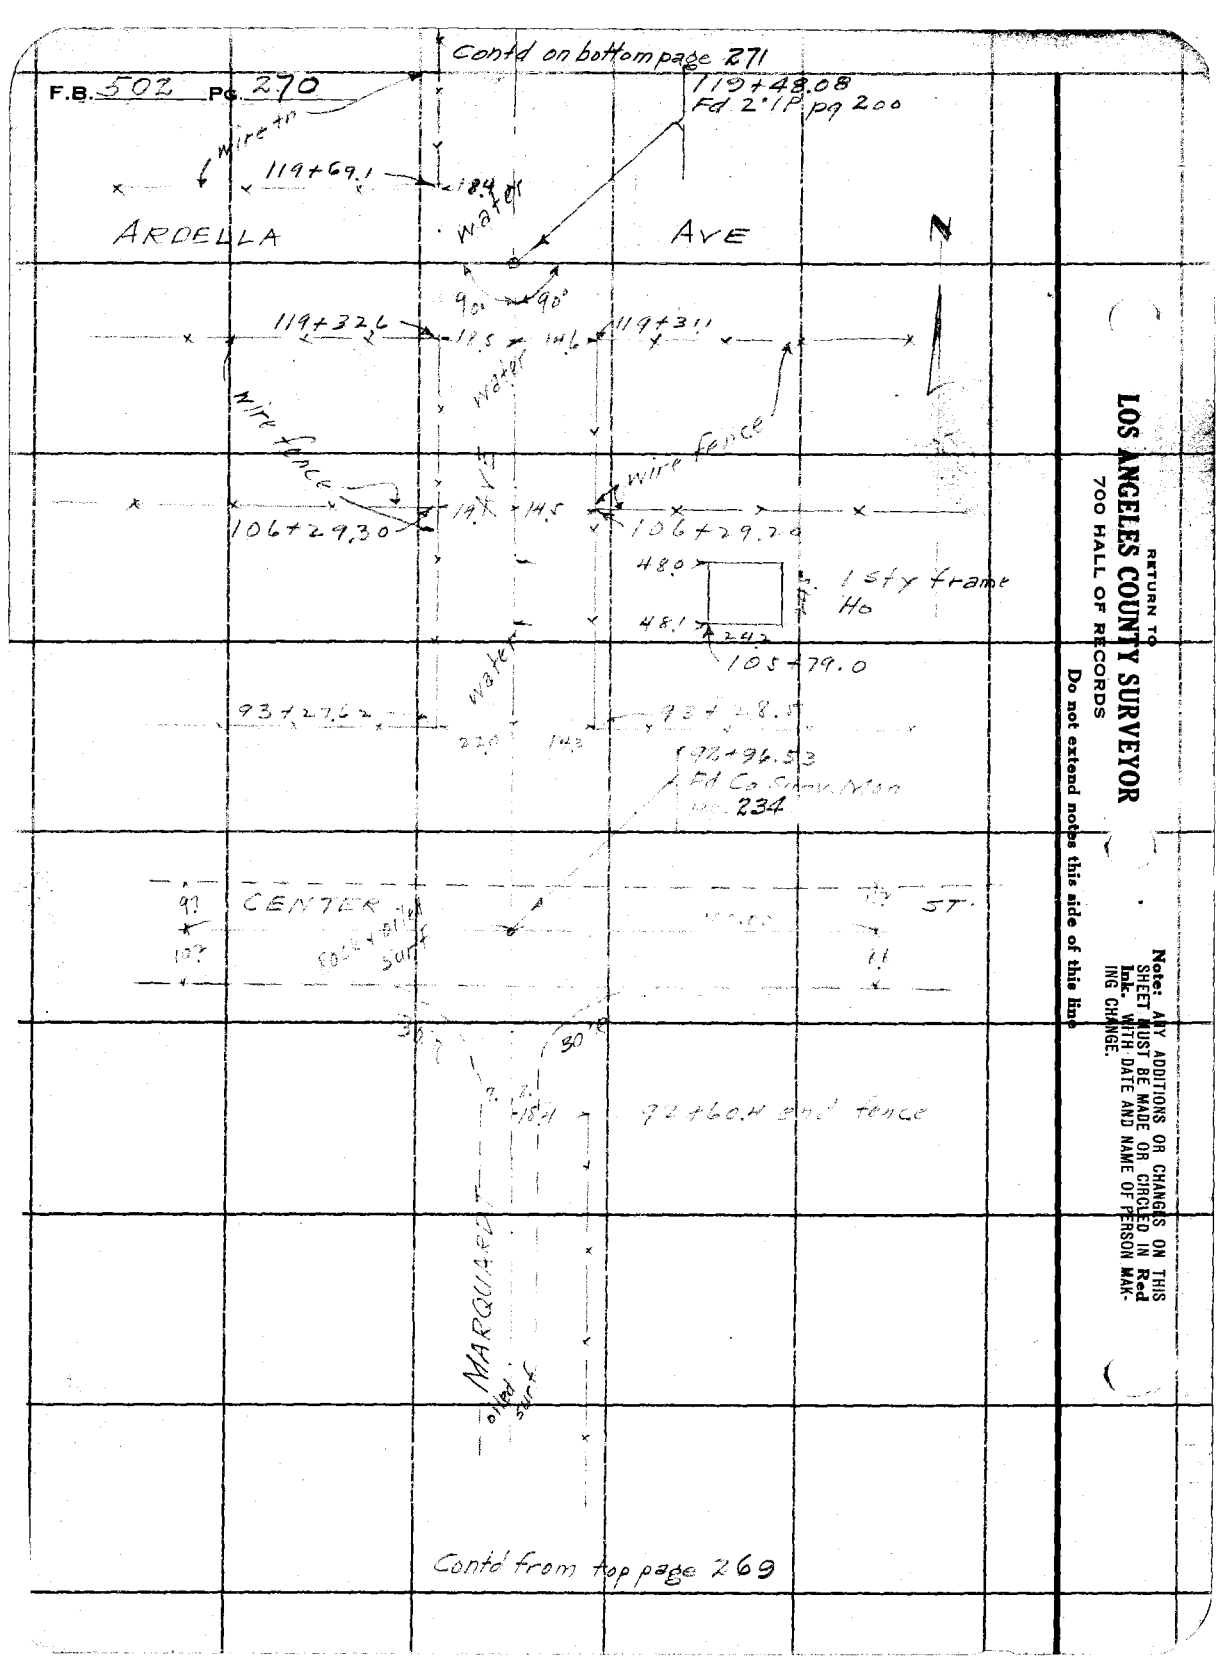

RETURN TO
LOS ANGELES COUNTY SURVEYOR
700 HALL OF RECORDS

Do not extend notes this side of this line

Note: ANY ADDITIONS OR CHANGES ON THIS SHEET MUST BE MADE OR CIRCLED IN **Red Ink.** WITH DATE AND NAME OF PERSON MAKING CHANGE.

Notes Ck'd by Drew	Survey of Marquardt Ave.
Map No. B-821	W. O. 2088 Tape No. 022 Sh'd 84 of
Office Work Cox	Surveyed by P.W. Atkins
Checked Drew	Notes same Date Dec 16 1932
Date Oct 1933	Indexed A. C. Johnson

F.B. 5[illegible] PG. 271

Contd on bottom page 272

MARQUARDT AVE

8. S. 133+00

dirt road

Woodenbridge No. 181

Set Nail 132+00.00 fr S

Cor fn. 131+96.7

131+95.0

131+89.0

Creek flow

Creek flow 100.00 defl.

Creek flow

dirt Road

131+03.0

40.0

131+40

130+40.0

45.0

129+80.1

50.00

78.5

131+12.4

33.7

Contd from top 270

Std 122+00 dirt road begins

RETURN TO
LOS ANGELES COUNTY SURVEYOR
700 HALL OF RECORDS

Note: ANY ADDITIONS OR CHANGES ON THIS SHEET MUST BE MADE OR CIRCLED IN Red Ink. WITH DATE AND NAME OF PERSON MAKING CHANGE.

Do not extend notes this side of this line

FORM 247 10M 8-31

F.B. 502 Pg. 272

Contd on bottom page 273

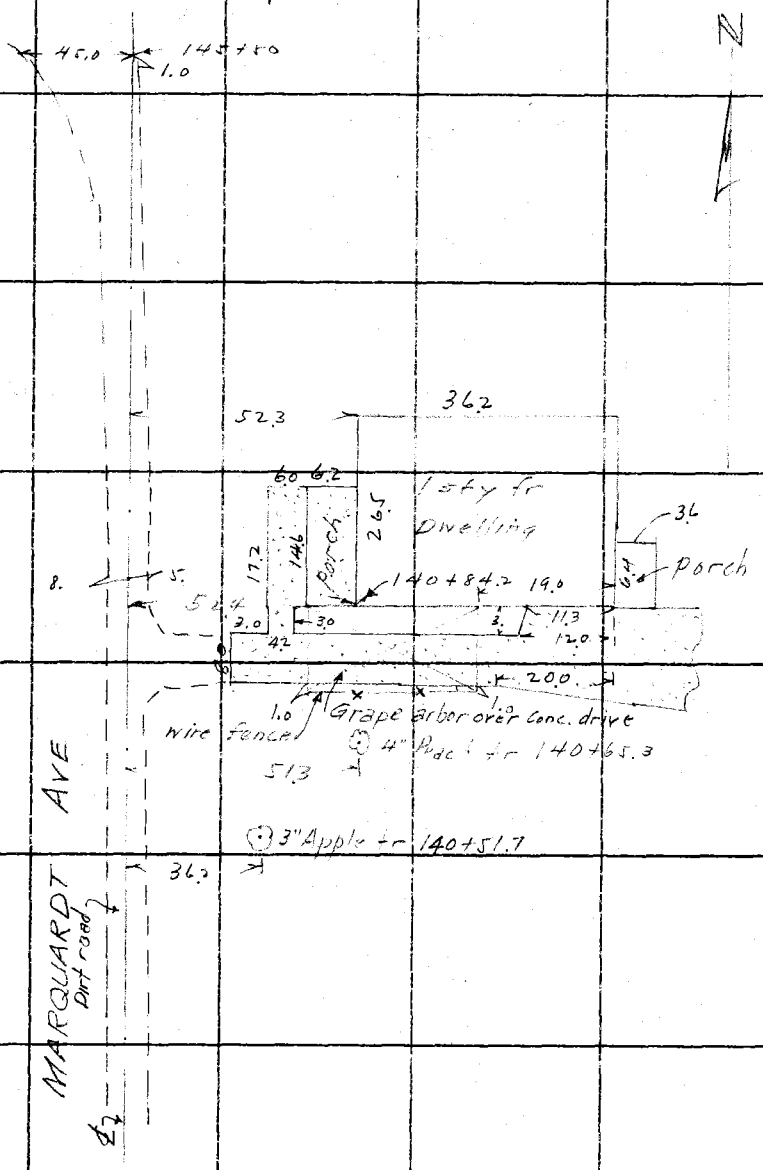

Contd from top page 271

RETURN TO
LOS ANGELES COUNTY SURVEYOR
700 HALL OF RECORDS

Do not extend notes this side of this line

Note: ANY ADDITIONS OR CHANGES ON THIS SHEET MUST BE MADE OR CIRCLED IN Red Ink. WITH DATE AND NAME OF PERSON MAKING CHANGE.

Notes Ck'd by Drew	Survey of Marquardt Ave
Map No. B-821	Tape No. 022 Std @ 68 °F.
Office Work Cox	Surveyed by PW Adkins
Checked Drew	Notes [illegible] Date Dec 16 3x
Date Sept 1938	Indexed A. C. Johnson

F.B. [illegible] Pg. 273

N

Cont'd on bottom pg 234

wooden box culvert

20.0

2.5 x 1.2

wire fence

146+98.5

147+00

2.0

146+67.5

16.3

Rock + oiled surf.

30.00

20.0

146+41.3

Metal cattle pass

146+30.2

37.6

32.6

146+28.7

146+23.8

28.6

wire fence

146+19.0

45.8

146+01.42

Rock + oiled surf.

24" vit drain pipe

38.0

90°

90°

10.6

10.8

77.0

11.5

50.0

Rock + oil surf.

14.2

9.85

7.0

8.0

9.2

9.0

14.6

145+67.4

13.4

8.0

145+64.2

17.2

145+59.6 conc. bat. box

145+65.9 Signal base Conc.

dirt road

213

145+24.9

MARQUARDT AV.

dirt road

wire fence

Contd. from top page 272

RETURN TO
LOS ANGELES COUNTY SURVEYOR
700 HALL OF RECORDS
Do not extend notes this side of this line

Note: ANY ADDITIONS OR CHANGES ON THIS SHEET MUST BE MADE OR CIRCLED IN Red Ink, WITH DATE AND NAME OF PERSON MAKING CHANGE.

FORM 247 10M 8-51

F.B. 502 Pg. 274

Contd on bottom page 275

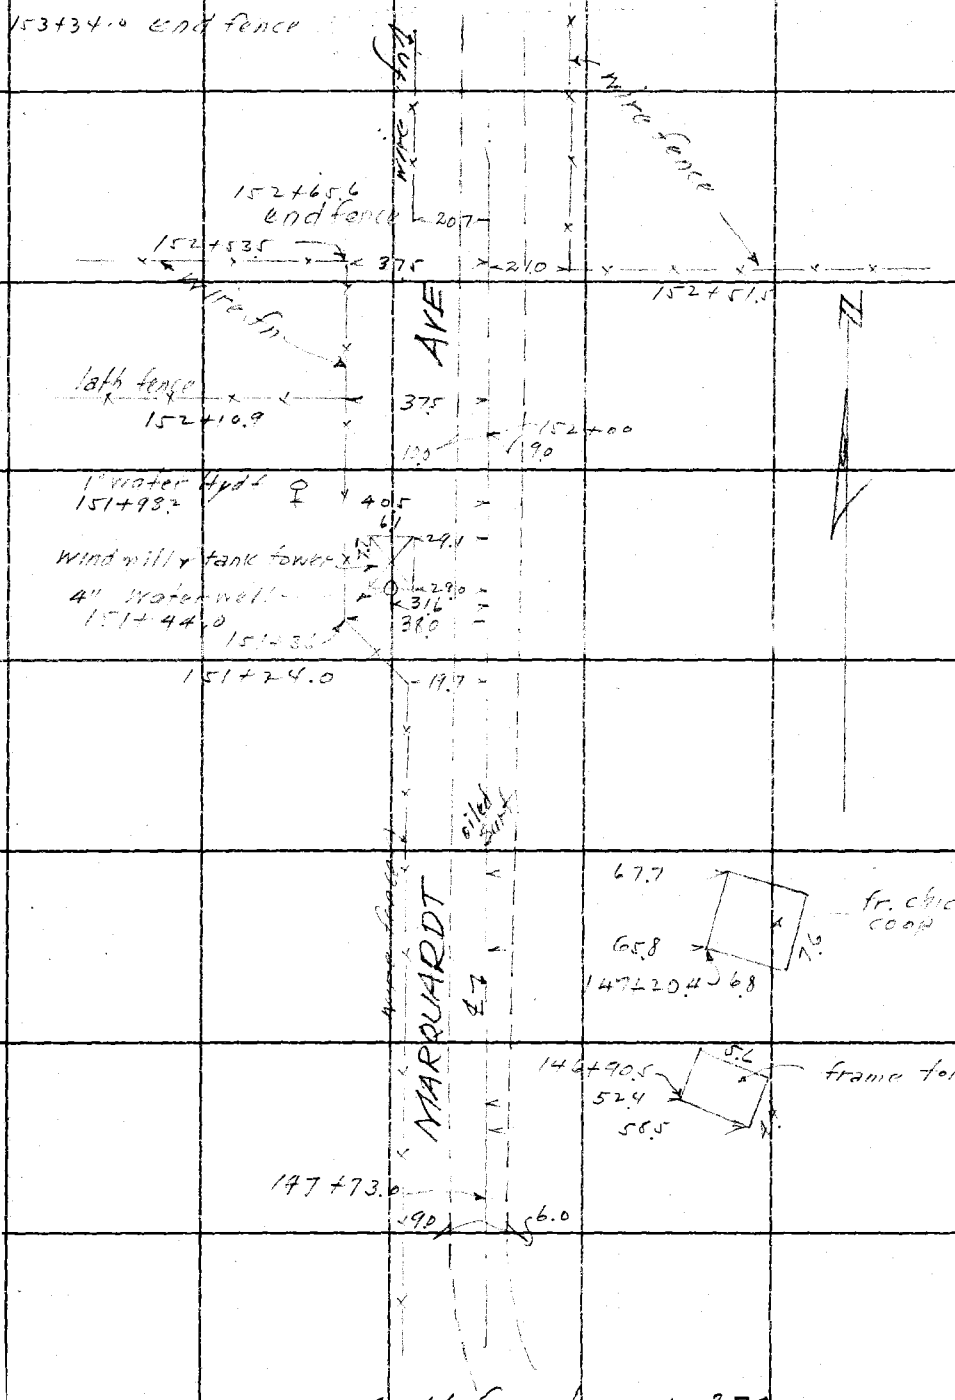

Contd from top page 273

RETURN TO
LOS ANGELES COUNTY SURVEYOR
700 HALL OF RECORDS

Do not extend notes this side of this line

Note: ANY ADDITIONS OR CHANGES ON THIS SHEET MUST BE MADE OR CIRCLED IN Red Ink. WITH DATE AND NAME OF PERSON MAKING CHANGE.

Notes Ck'd by Drew	Survey of Marguardt Ave
Map No. B-921	W. O. 7088 Tape No. 022 044 84 ft.
Office Work Cox	Surveyed by FM Atkins
Checked Drew	Notes same Date Dec. 19, 32
Date Oct 1933	Indexed A. C. Johnson

F.B. 502 Pg. 275

Cont'd on bottom page 276

Note: ANY ADDITIONS OR CHANGES ON THIS SHEET MUST BE MADE OR CIRCLED IN Red Ink. WITH DATE AND NAME OF PERSON MAKING CHANGE.

Do not extend notes this side of this line

RETURN TO
LOS ANGELES COUNTY SURVEYOR
700 HALL OF RECORDS

FORM 247 10M 8-31

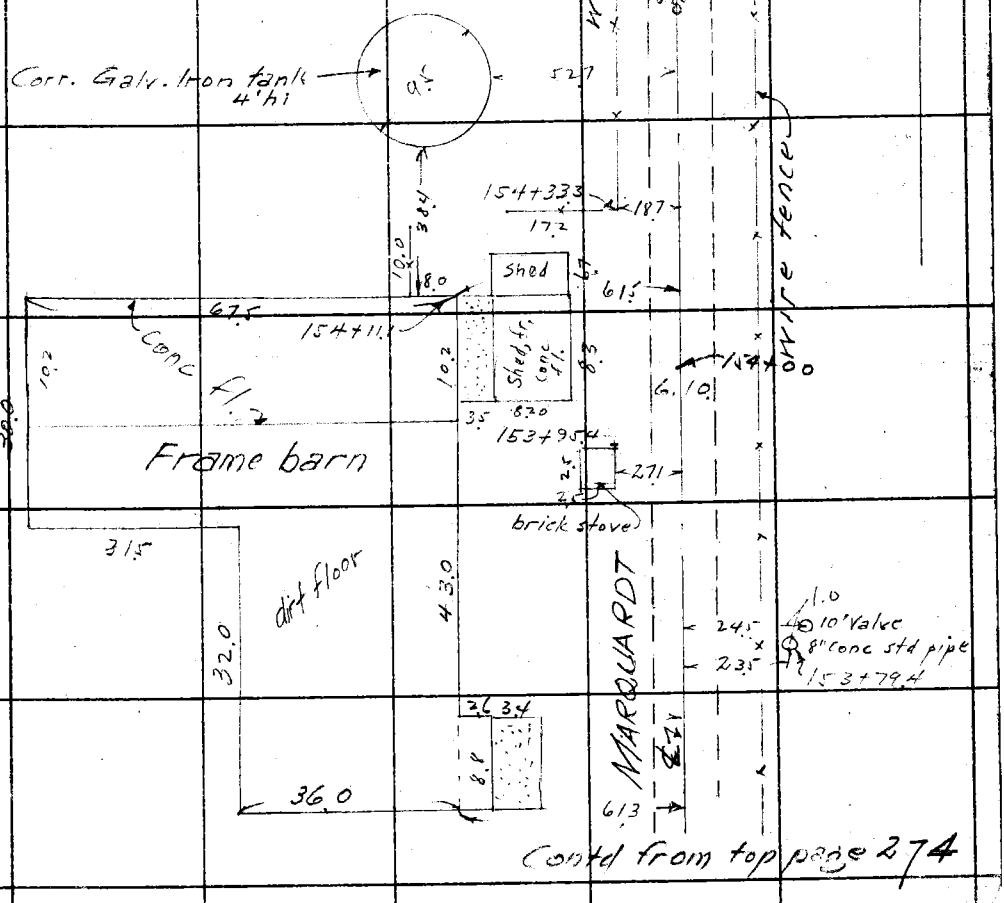

F.B. 502 PG 276

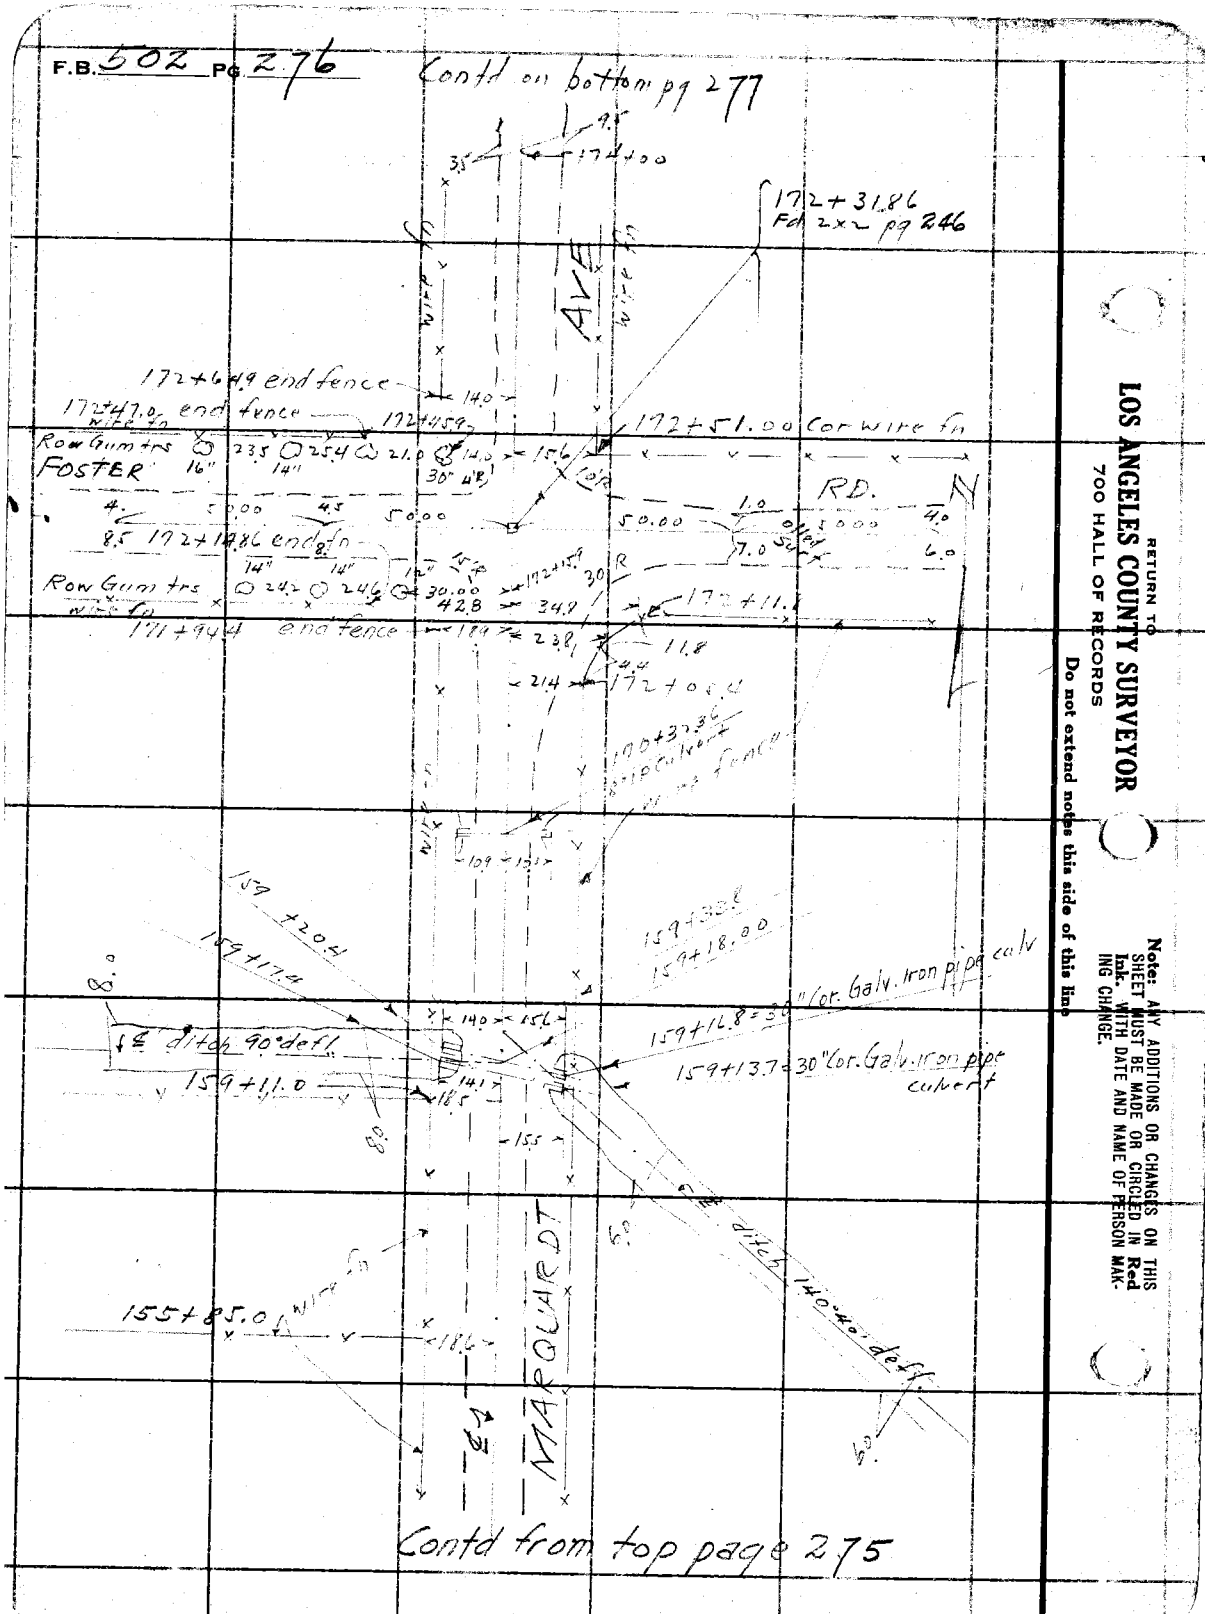

RETURN TO
LOS ANGELES COUNTY SURVEYOR
700 HALL OF RECORDS

Do not extend notes this side of this line

Note: ANY ADDITIONS OR CHANGES ON THIS SHEET MUST BE MADE OR CIRCLED IN Red Ink WITH DATE AND NAME OF PERSON MAKING CHANGE.

Notes Ck'd by Drew	Survey of Marquardt Ave
Map No. B-821	W. O. 7044 Tape No. [illegible] St'd [illegible] oF.
Office Work Cox	Surveyed by DE Bellows
Checked Drew	Notes 2 sheets Date Dec 19, 32
Date Oct 1932	Indexed A. C. Johnson

F.B. 502 Pg 277

Air 185+26.90
Fd 2 x 4 on 251

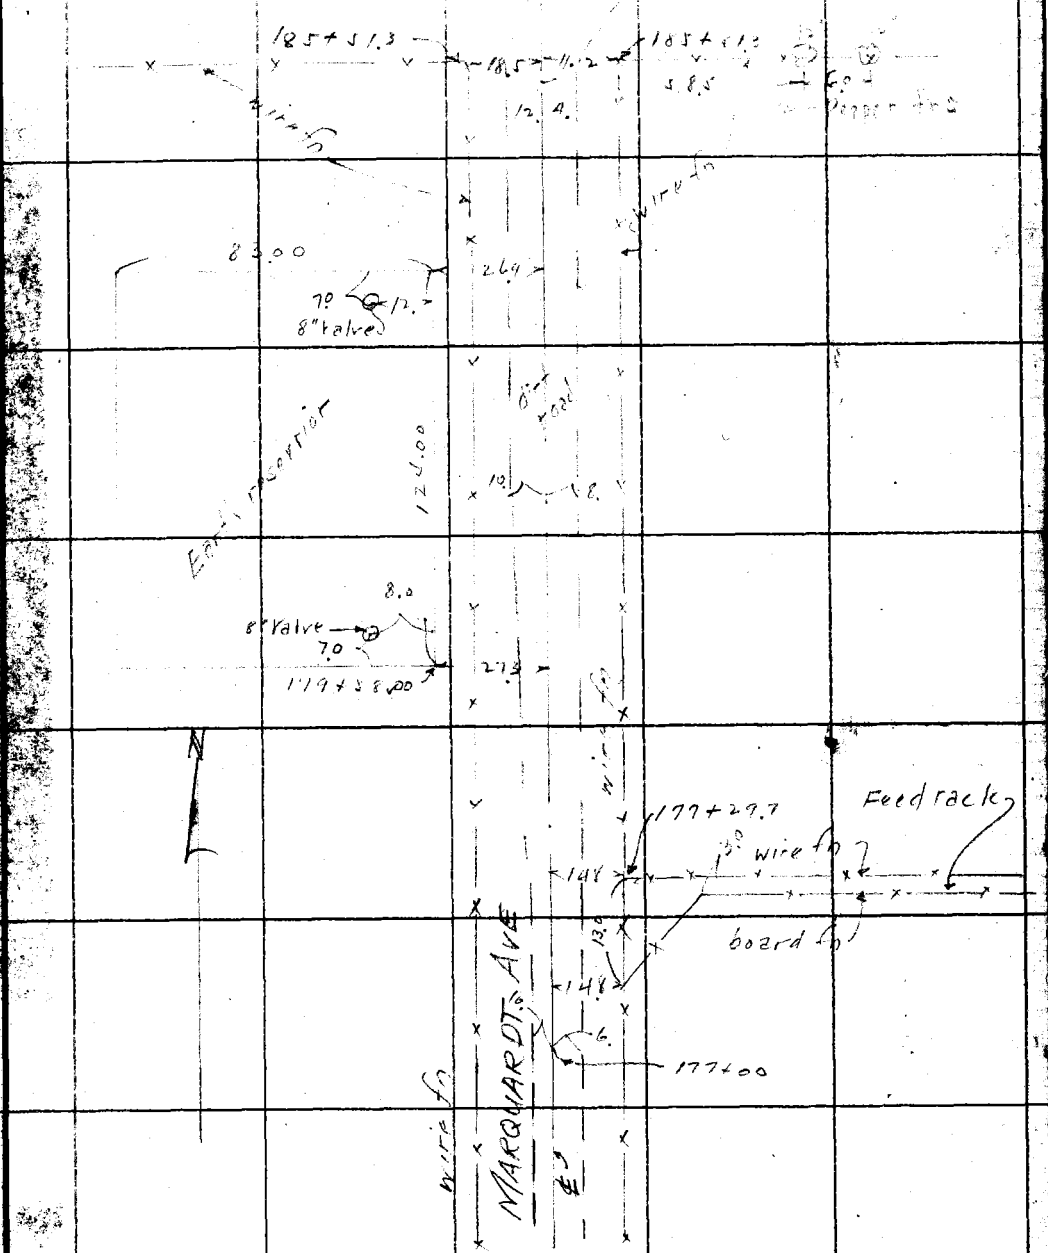

Contd from top pg 276