Ck'd by

Check

Survey of Fairchild Park
W. O. 7165 Tape No. St'd. 62° °F
Surveyed by [illegible]
Notes 11 Date 12-16-49
Indexed C. Johnson 12-16-49

F. B. 505 Pg. 7

LOCATION OF
WEST WALL
OF
FAIRCHILD PARK
CALTADENA
W. 7165

12-16-49
[illegible]

505

Dun Figured Location of Wall as being
O.K. to Gerhardy of Park Dept.

F. B. 505 PG. 8

RETURN TO
LOS ANGELES COUNTY SURVEYOR
728 LOS ANGELES COUNTY
ENGINEERING BLDG.

Do not extend notes this side of this line.

Note: Any Additions or Changes on This Sheet Must be Made or Circled in Red Ink With Date and Name of Person Making Change.

N.W. Cor. Park
Fd. U.S. Mon. Cor
F.B. 52-100
F.B. 525-1

6+..4

5.00

4.95

90°

6+00

5.00

5+00

4.95

4+00

5.05

3+00

5.01

2+00

5.00

1+00

4.95

Rock & Conc. Wall.

0+01.10

5.00

0+00
Going Int.

90°

5.00

S.W. Cor. Park
Fd. U.S. Mon. 3' Under
F.B. 28-100.

CONC. ST.

Notes Ck'd by 11-10-32 Smith, S.H.		Survey of Altadena Park	
Map No.		W. O. 7165 Tape No.	St'd °F.
Sheet Work		Computed by K.D. Moore	
Checked		Notes Moore	Date 11-1-32
Date		Indexed A. C. Johnson 11-4-32	

F.B. 505 Pg. 9

Note: R.P. changed both location and grade of baseball diamond and eliminated tennis court — May 1933. (see L.B. 699-5 for further details).

SURVEY
for
BASEBALL DIAMOND
and
TENNIS COURT AREA

ALTADENA PARK
(old L.A. County Nursery).
W.O.# 7165.

Party

Moore
[illegible]
[illegible]
[illegible]

For Grades see L.B. 699 — pp 5-22.

8756
7952
16708

8579
7952
16531

Note: ANY ADDITIONS OR CHANGES OR THIS SHEET MUST BE MADE OR CIRCLED IN Red Ink, WITH DATE AND NAME OF PERSON MAKING CHANGE.

Do not extend notes this side of this line

RETURN TO
LOS ANGELES COUNTY SURVEYOR
700 HALL OF RECORDS

FORM 347 10M 8-31

F.B. 505 Pg. 10

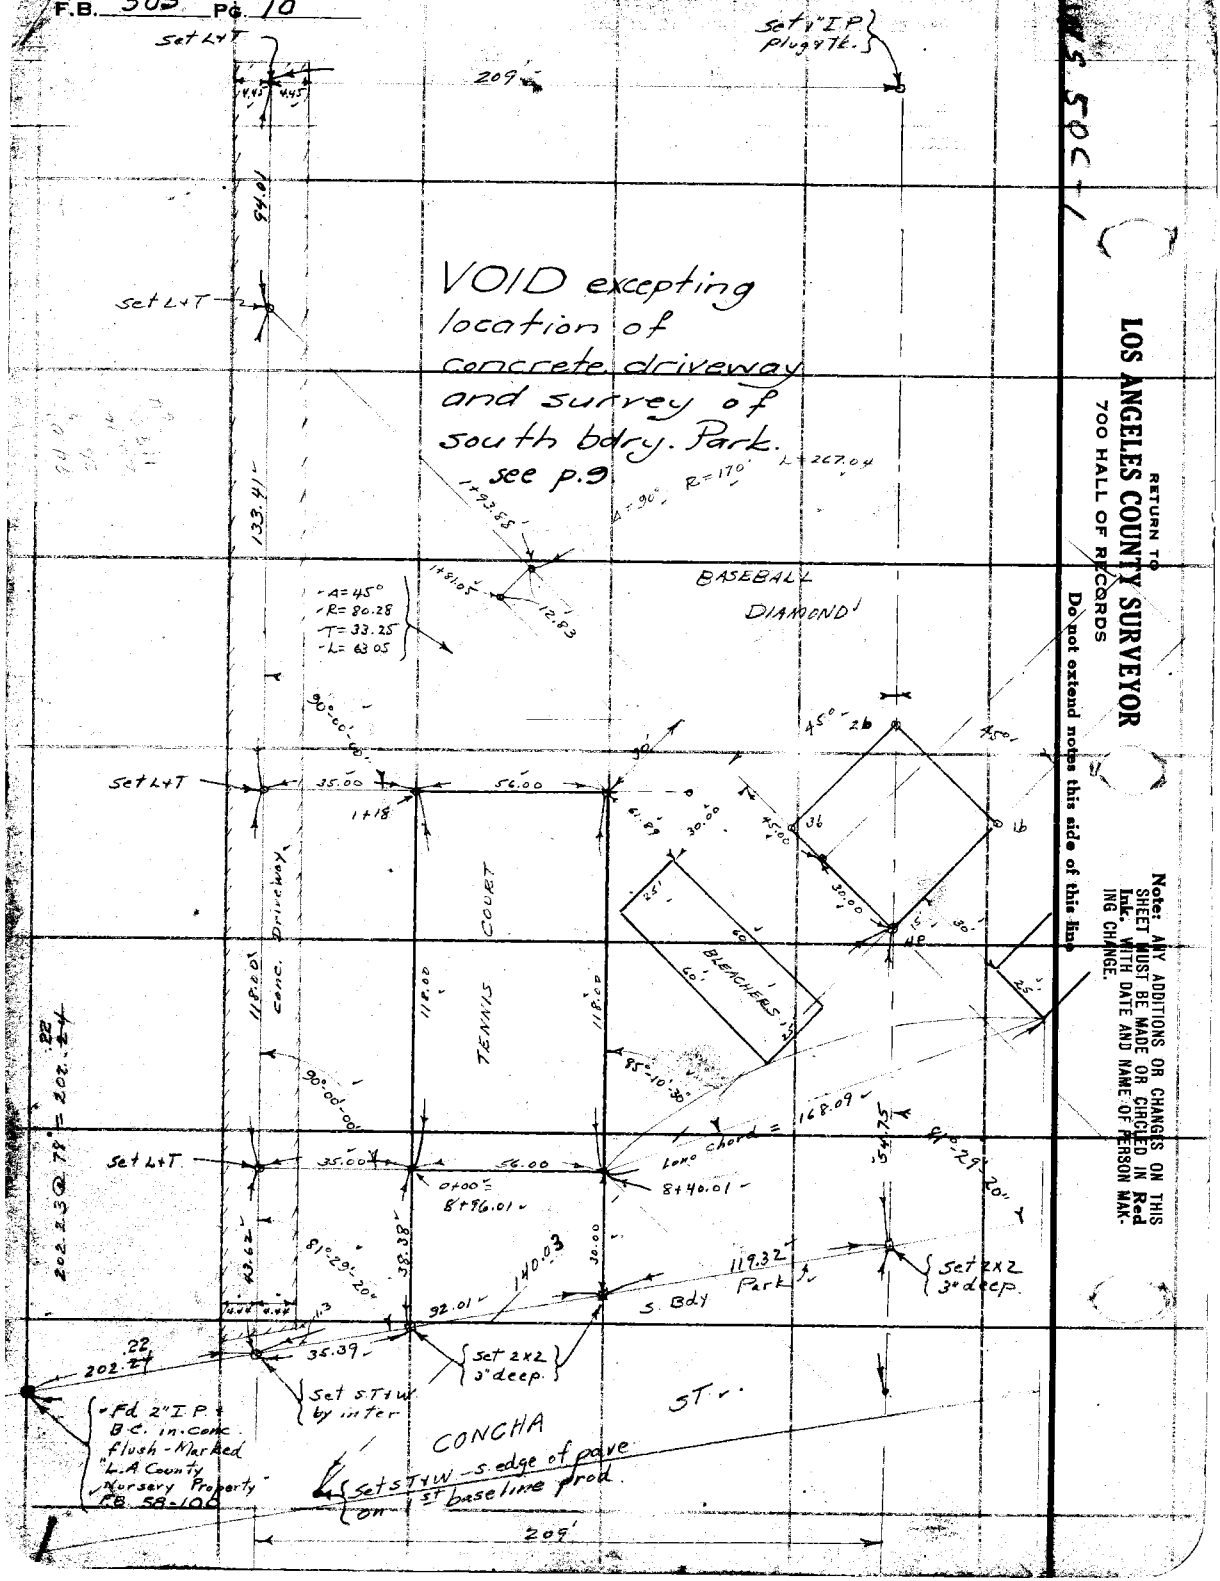

RETURN TO
LOS ANGELES COUNTY SURVEYOR
700 HALL OF RECORDS

Do not extend notes this side of this line

Note: ANY ADDITIONS OR CHANGES ON THIS SHEET MUST BE MADE OR CIRCLED IN Red Ink. WITH DATE AND NAME OF PERSON MAKING CHANGE.

Notes Ck'd by Smith, J.H. 11-15-32.	Survey of Altadena Park
Map No.	W. O. 7165 Tape No. St'd °F.
Office Work	Surveyed by W. D. Moore
Checked	Notes W Moore Date 10-31-32
Date	Indexed A. C. Johnson

F.B. 505 Pg. 11

W.S. 59C-1

Note: ANY ADDITIONS OR CHANGES ON THIS SHEET MUST BE MADE OR CIRCLED IN Red Ink, WITH DATE AND NAME OF PERSON MAKING CHANGE.

RETURN TO
LOS ANGELES COUNTY SURVEYOR
700 HALL OF RECORDS
Do not extend notes this side of this line

Δ = 90°
R = 170'
L = 268.94

BASE BALL DIAMOND

VOID per p. 9-10.

4+60.92
30.00
4+90.92

Δ = 75°-56'-50"
R = 40'
T = 31.22
L = 53.02

45°
95°
55.00
5+43.94
66.71
6+10.65
30.00
2L
3b
1b
40.00
30.00
15.00
30.00
H.P.
60'
25'
BLEACHERS
60'
25'
49°-44'-30"
140.03
6+70.65
232.08 @ 80° = 232.07 to
77°
81°-29'-20"
52'-15"
Tine
Long chord = 168.09
54.47
232.07 to
S. Bdy. Park
119.32
overall = 645.62
(F.B. 58-100-645.70)
Set 2x2 3" deep
29.47
Fd 2" I PYB.C. in conc - flush Marked "L.A. County Nursery Property" F.B. 58-100
Set S.T+W S. edge of pave on ℄ diamond prod.
CONCHA
ST
Set S.T+W S. edge of pave on 3rd baseline prod.
Δ = 24°-15'-30"
R = 400'
T = 85.97
Chd = 168.09
L = 169.36

FORM 247 10M 8-31

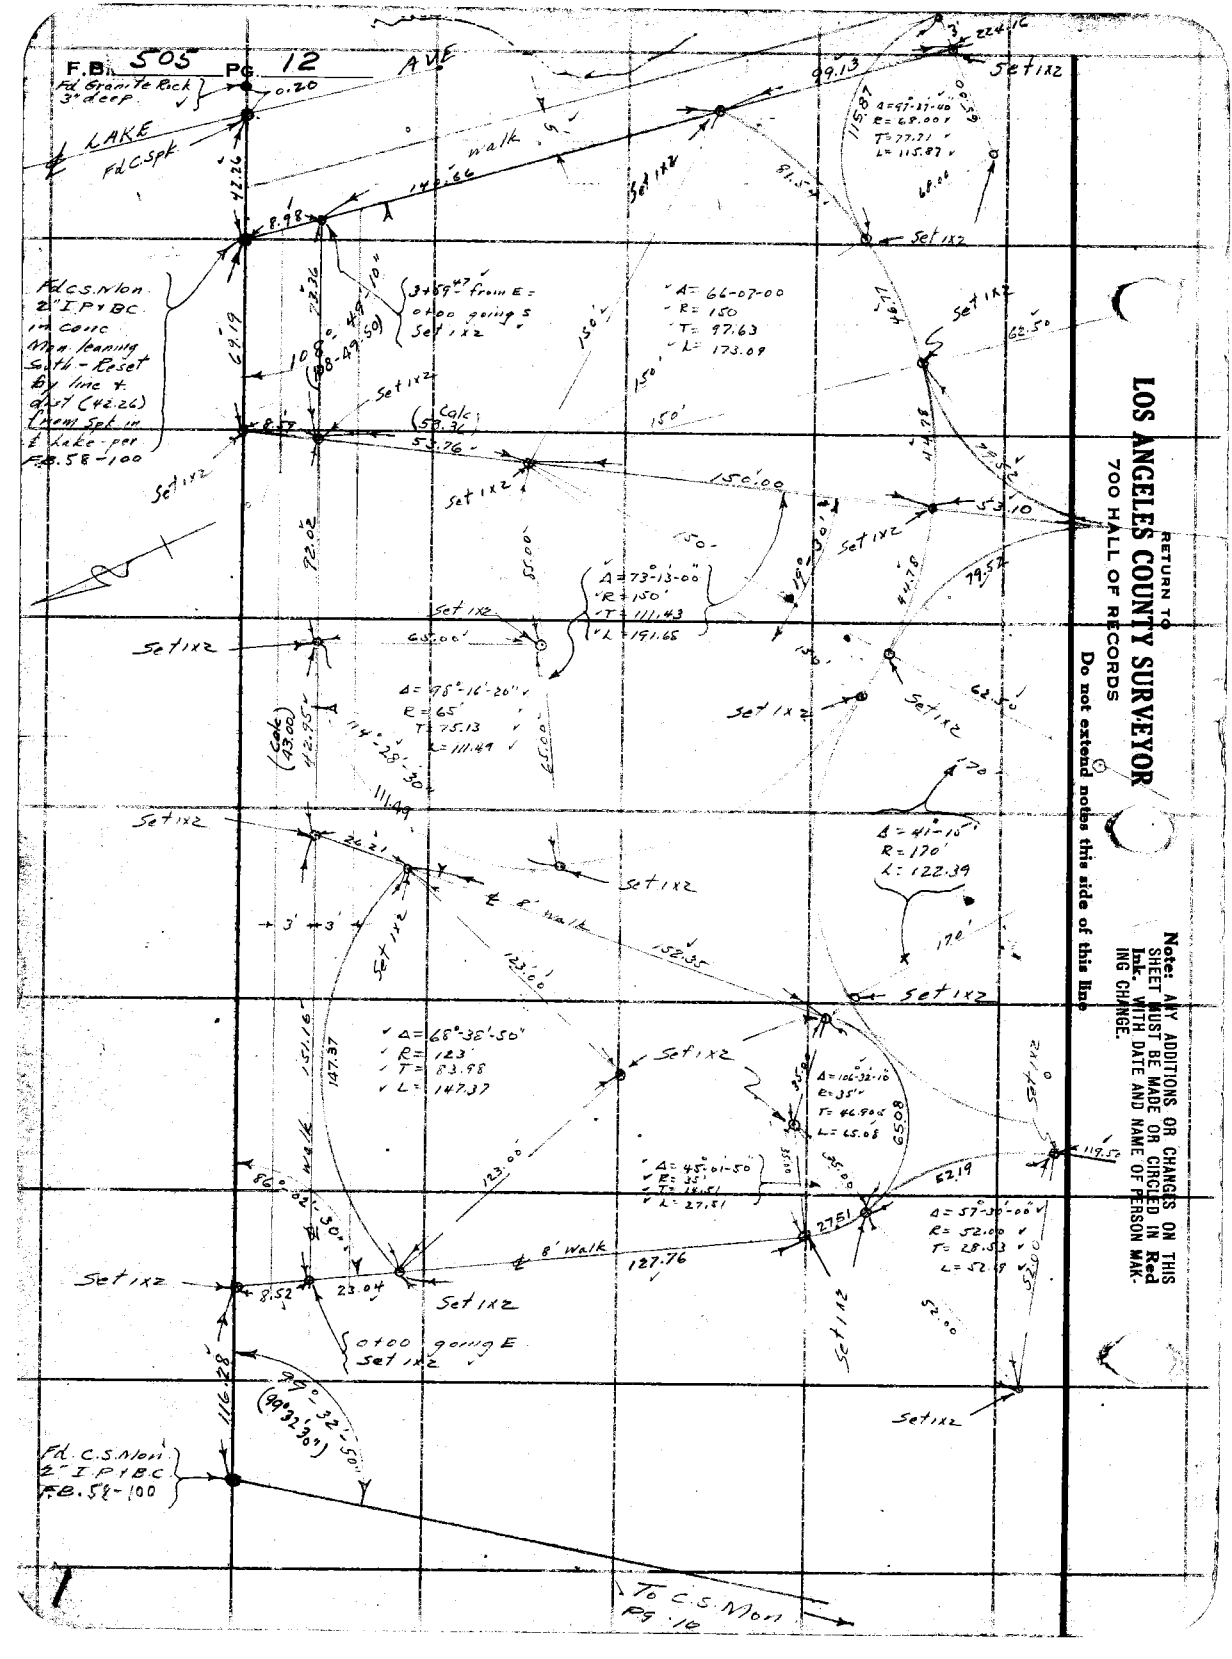

RETURN TO
LOS ANGELES COUNTY SURVEYOR
700 HALL OF RECORDS

Do not extend notes this side of this line

Note: ANY ADDITIONS OR CHANGES ON THIS SHEET MUST BE MADE OR CIRCLED IN **Red Ink**, WITH DATE AND NAME OF PERSON MAKING CHANGE.

Notes Ck'd by Smith, J.H. 5-9-33	Survey of Altadena Park	F.B. 505	PG. 12
Map No.	W. O. 7165 Tape No. 7165 St'd 68 °F.		
Office Work	Surveyed by L. D. Nieser		
Checked	Notes Nieser Date 4-4-33		
Date	Indexed A. C. Johnson 5-10-33		

MS 556-1

Note: ANY ADDITIONS OR CHANGES OF THIS SHEET MUST BE MADE OR CIRCLED IN Red Ink, WITH DATE AND NAME OF PERSON MAKING CHANGE.

RETURN TO
LOS ANGELES COUNTY SURVEYOR
700 HALL OF RECORDS

Do not extend notes this side of this line

FORM 247 10M 5-31

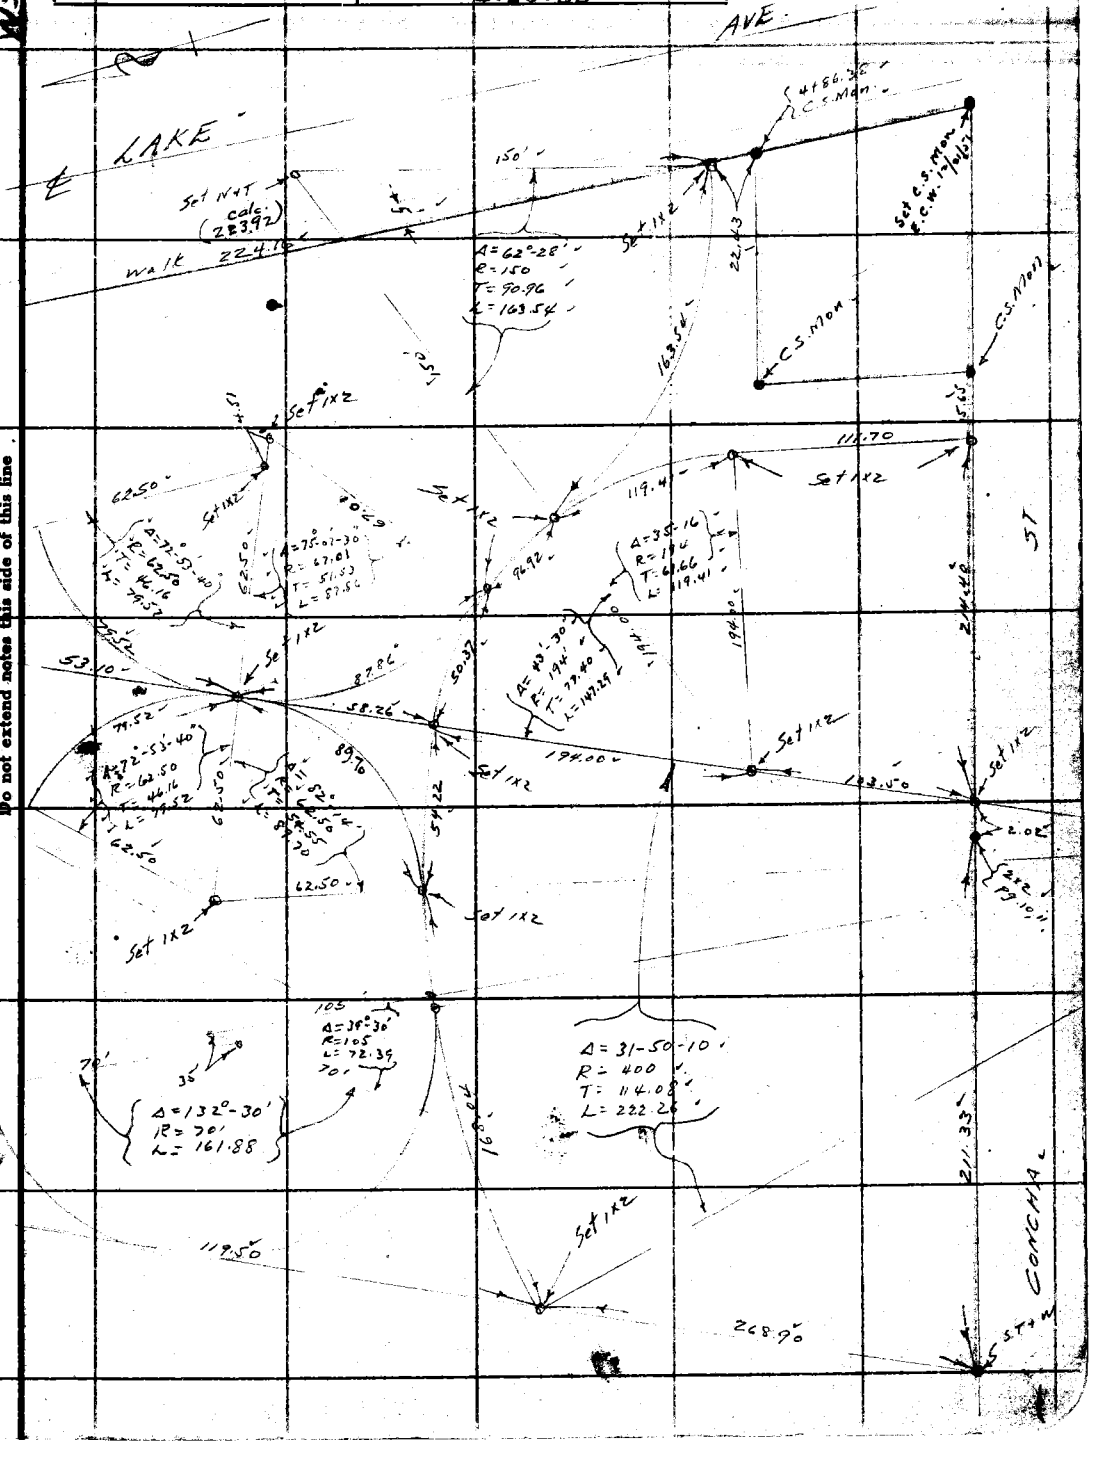

F.B. 505 Pg. 14

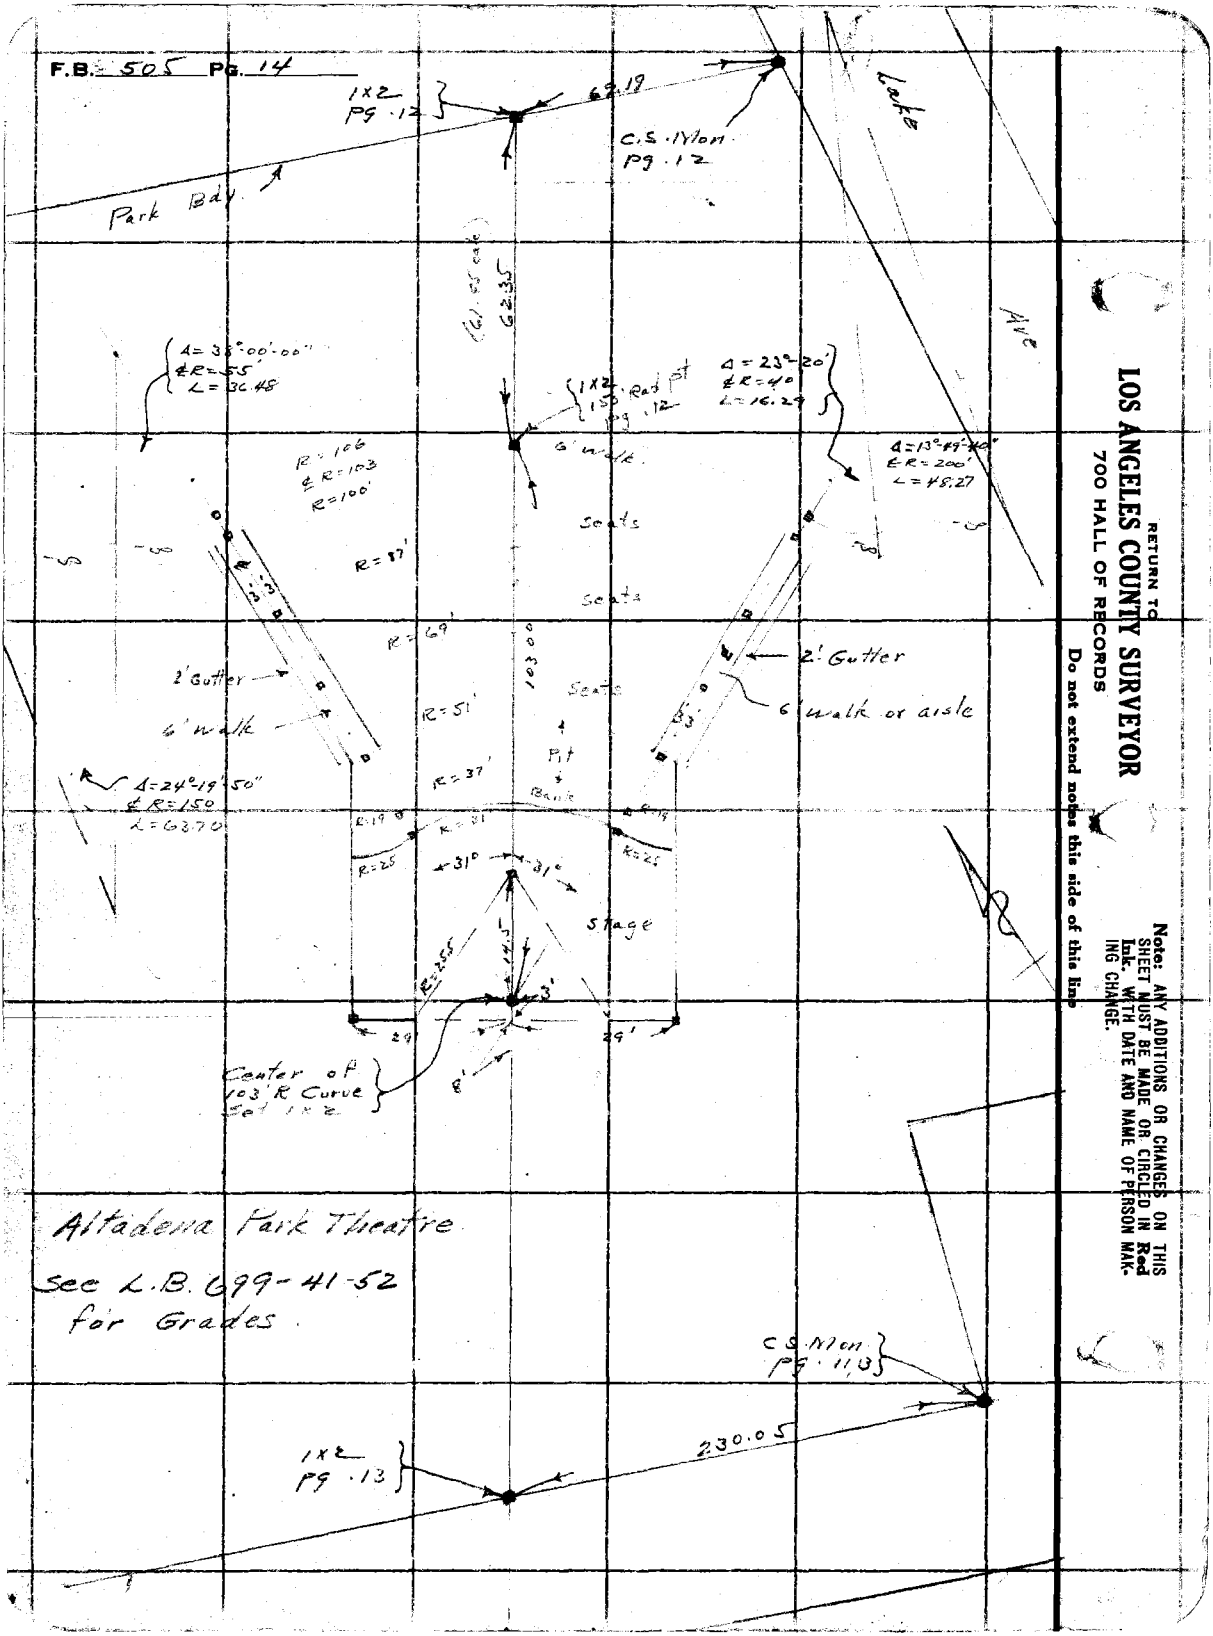

Altadena Park Theatre

See L.B. 699-41-52 for Grades.

RETURN TO
LOS ANGELES COUNTY SURVEYOR
700 HALL OF RECORDS
Do not extend notes this side of this line

Note: ANY ADDITIONS OR CHANGES ON THIS SHEET MUST BE MADE OR CIRCLED IN Red Ink. WITH DATE AND NAME OF PERSON MAKING CHANGE.

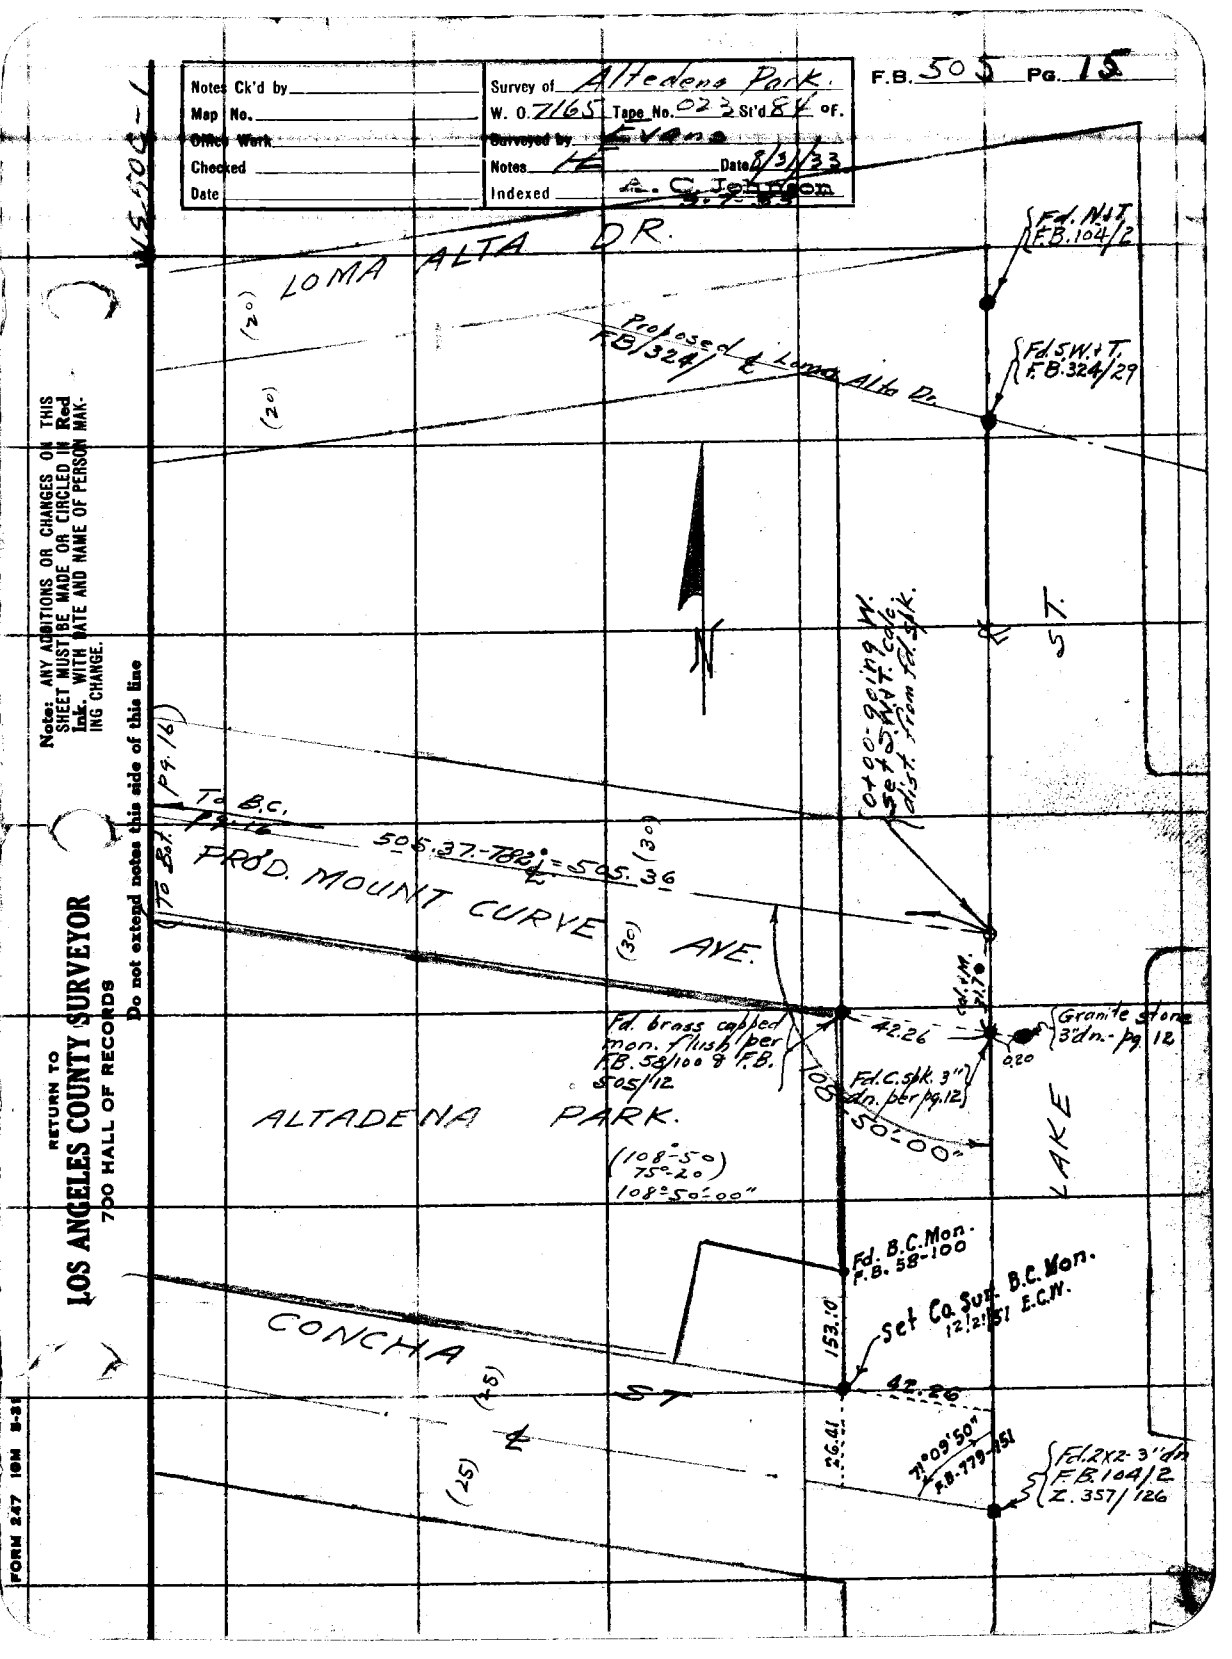
Notes Ck'd by
Map No.
Office Work
Checked
Date
Survey of Altadena Park.
W. O. 7165 Tape No. 023 St'd 8 ft. of.
Surveyed by Evans
Notes H Date 8/3/33
Indexed A. C. Johnson
F.B. 505 Pg. 15
LOMA ALTA DR.
(20)
(20)
Proposed ℄ Loma Alta Dr.
Fd. N.I.T. F.B. 104/2
Fd. S.W.I.T. F.B. 324/29
Note: ANY ADDITIONS OR CHANGES ON THIS SHEET MUST BE MADE OR CIRCLED IN Red Ink. WITH DATE AND NAME OF PERSON MAKING CHANGE.
Do not extend notes this side of this line
RETURN TO
LOS ANGELES COUNTY SURVEYOR
720 HALL OF RECORDS
To B.C. Pg. 16
To B.C. Pg. 16
505.37-788 ℄ = 505.36
(30)
PROD. MOUNT CURVE
(30)
AVE.
Fd. brass capped mon. flush per R.B. 58/100 & F.B. 505/12
ALTADENA PARK.
(108°-50 75°-20 108°50'00"
42.26
Granite Stone 3'dn.- pg 12
Fd. C.S.pk. 3" dn. per pg. 12
108°50'00"
LAKE
Fd. B.C. Mon. F.B. 58-100
Set Co. Sur. B.C. Mon. 12'2'51 E.C.W.
153.10'
CONCHA
ST
(45)
(45)
42.26
26.41
71°09'50" F.B. 779-151
Fd. 2X2- 3' dn F.B. 104/2 L. 357/126
FORM 247 10M 8-31

RETURN TO
LOS ANGELES COUNTY SURVEYOR
700 HALL OF RECORDS

Note: ANY ADDITIONS OR CHANGES ON THIS SHEET MUST BE MADE OR CIRCLED IN **Red Ink.** WITH DATE AND NAME OF PERSON MAKING CHANGE.

Do not extend notes this side of this line

M.S. 50C-1

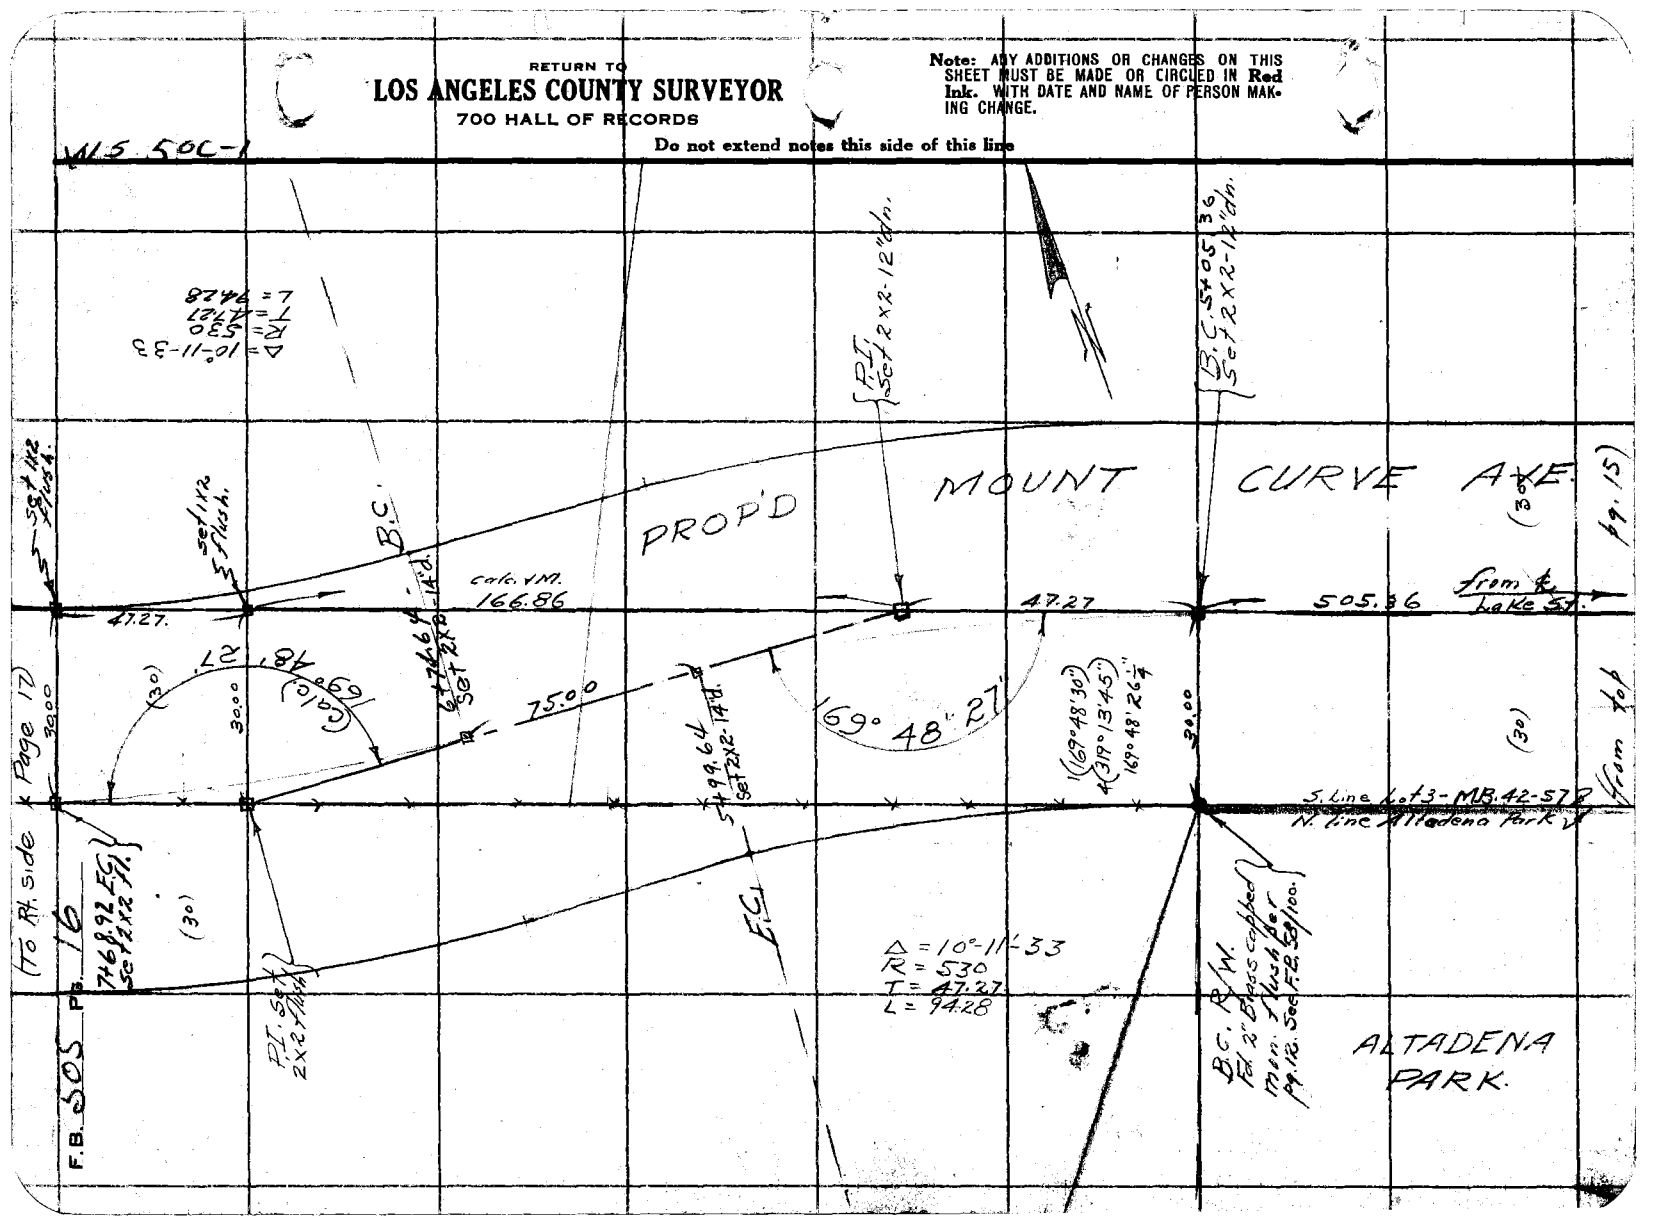

M.5.50c-1

Notes Ck'd by	Survey of Altadena Park
Map No.	W. O. 7165 Tape No. 023 St'd 84 °F.
Office Work	Surveyed by Evans
Checked	Notes H. Martin Date 7-1-33
Date	Indexed A. C. Johnson 9-7-33

F.B. 505 Pg. 17

RETURN TO
LOS ANGELES COUNTY SURVEYOR
700 HALL OF RECORDS
Do not extend notes this side of this line

Note: ANY ADDITIONS OR CHANGES OR THIS SHEET MUST BE MADE IOR CIRCLED IN Red Ink. WITH DATE AND NAME OF PERSON MAKING CHANGE.

LOMA ALTA DR.

Fd. S.W. by Ties Per. F.B. 58-100 F.B. 324-29

687.20 T=84°

80° 27' 50"

1/4 (80° 27' 45" / 3.21° 51' 15") 80° 27' 48 3/4

set 1"x2" Flush.

T84 106.58 from 1+2 P&T 99.16

Set S.W.&T. by Inter.

set L.&T. in Curb

15.48

308.83 T=88° = 308.84

Propd. Mount Curve Ave

Set L.&T. Tan. Prod. in Curb

15.49

30.42 Calc. 20.12

21.13

Fd. 2" I.P. P&T. Flush

Set S.W.&T. & Inter. 11+89.38 From East

Marengo Ave Per. F.B. 324-29

Foothill Blvd. (Piedmont Dr.)

Fd. S.W.&T. by ties Per. F.B. 104-6

FORM 247 10M 8-31

F.B. _____ PG. 18

9561

8-30-60

RETURN TO
LOS ANGELES COUNTY SURVEYOR
700 HALL OF RECORDS

Do not extend notes this side of this line

Note: ANY ADDITIONS OR CHANGES ON THIS SHEET MUST BE MADE OR CIRCLED IN Red Ink. WITH DATE AND NAME OF PERSON MAKING CHANGE.

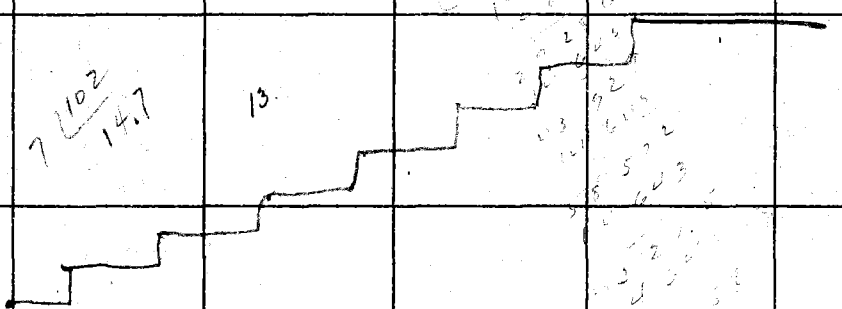

Form 307 5M 10-34

PLEASE RETURN TO
LOS ANGELES COUNTY SURVEYOR
700 HALL OF RECORDS

NOTE: ANY ADDITIONS OR CHANGES ON THIS SHEET MUST BE MADE OR CIRCLED IN RED INK, WITH DATE AND NAME OF PERSON MAKING CHANGE

Do not extend notes this side of this line

Profile No.____ Notes Red____ Platted____ Job No. 1465 Division No.____

X-Sec. No.____ Date____ Date AUG 1 1936 Survey of____

Notes Chkd.____ Checked____ Survey by____ Notes____

Date JUL 30 1936 Date____ Map No.____ Indexed____ Date____

L.B. 5015 PG. 21

STATION	B. S.	H. I.	F. S	ELEV.	
B.M.	10 52	1640 85		1630 33	B.M. [illegible]
6+00			10 5	1630 4	S.W. Cor. Park - Top Stone Ditch
			11 3	1629 6	8' R Top Ditch
			12 5	1628 4	8' R Bottom "
			12 7	1628 2	14' R Gutter
			[illegible]	1631 9	10 L
6+[illegible]			11 7	1629 2	Top [illegible] Bottom Stone Ditch
6+[illegible]			[illegible]	1629 2	" " "
6+[illegible]			10 5	1630 4	" Top "
6+[illegible]			7 8	1633 1	" Top Stone Wall
			7 5	1633 4	10 L " "
			10 5	1630 4	8' R
			[illegible]	1628 3	12' R Gutter
7+00			9 7	1631 2	FL Bottom Stone Wall
			7 3	1633 6	FL - Top " "
			7 3	1633 6	2.5 L " "
			6 9	1634 0	10' L - TS
			4 6	1636 3	2.5' L
			9 9	1631 0	7.5' R
			12 3	1628 6	13.5' R - gutter

Form 307 5M 10-34

PLEASE RETURN TO
LOS ANGELES COUNTY SURVEYOR
700 HALL OF RECORDS

NOTE: ANY ADDITIONS OR CHANGES ON THIS SHEET MUST BE MADE OR CIRCLED IN RED INK, WITH DATE AND NAME OF PERSON MAKING CHANGE

Do not extend notes this side of this line

Profile No. ____ Plotted AUG 1 1936 Date ____ X-Sec. No. ____

Job. No. 7165 Division No. ____ Notes Red ____ Date ____ Notes Chkd. R. S. B. Checked ____ Date JUL 30 1936 Date ____

Survey of ALTADENA PARKS Notes LDM Notes ____ Date ____

Survey by L.D. Moore Notes ____ Date ____

Indexed A. C. Johnson Date ____

FB. 485 P. 22

STATION	B. S.	H. I.	F. S	ELEV.		
7+50		1640 85	82	1632 7	P.L. Bott. stone wall	
			64	1634 5	P.L. Top " "	
			64	1634 5	3.5 L " " "	
			60	1634 9	5'L - T.S	
			22	1633 7	19'L - T. Bank	
			21	1638 8	30'L	
			56	1633 3	7' R	
			111	1627 5	13' R gutter	
8+00			67	1634 2	P.L. - Bott. stone wall	
			55	1635 4	P.L. Top " "	
			55	1634 4	2.5 L " " " +	T.S.
			12	1638 7	12'L - T. Bank	
			19	1639 0	26'L	
			72	1633 7	7'R	
			101	1630 8	13½ R - gutter	
8+23			66	1634 3	P.L. - Bott. stone wall	
			48	1636 1	P.L. Top "	
			48	1636 1	2.5 L " "	+ T.S
			20	1638 9	9' L - T. Bank	
			19	1639 0	20' L " "	
			68	1634 1	6' R	

Form 307 5M 10-34

PLEASE RETURN TO
LOS ANGELES COUNTY SURVEYOR
700 HALL OF RECORDS

NOTE: ANY ADDITIONS OR CHANGES ON THIS SHEET MUST BE MADE OR CIRCLED IN RED INK, WITH DATE AND NAME OF PERSON MAKING CHANGE

Do not extend notes this side of this line

B.S. 505 P.G. 24 | Job. No. 765 | Division No. | Notes Red | Plotted C. J. TERRY | Profile No.
Survey of ALTADENA | Date | Date AUG 1 1936 | X-Sec. No.
Survey by [illegible] | Notes [illegible] | Notes Chkd. | Checked | Date
Notes by A. C. Johnson | Date | Date JUL 30 1936 | Date

STATION	B. S.	H. I.	F. S	ELEV.	
9+54		1640 94	53	1632 6	12' R - Driveway
8+93			68	1634 1	PL - end conc. drive
			54	1635 5	13'L edge " "
			81	1632 8	12'R Driveway
9+00			61	1634 8	PL
			46	1636 3	13'L
			75	1633 4	6'R
			80	1632 9	12'R
9+07			58	1635 1	PL
			40	1636 9	14'L
			66	1634 3	7'R
			80	1632 9	12' R - gutter
9+28			53	1635 6	PL - Begin + Bot Stonewall
			36	1637 3	PL " Top "
			36	1637 3	2.5 L " " "
			32	1637 7	20' L
			56	1635 3	7' R
			77	1633 2	12 R - gutter
9+50			50	1635 9	PL - Bot Stonewall
			30	1637 9	PL - Top "
			30	1637 9	2.5 L - " " "

Form 307 5M 10-34

PLEASE RETURN TO
LOS ANGELES COUNTY SURVEYOR
700 HALL OF RECORDS

NOTE: ANY ADDITIONS OR CHANGES ON THIS SHEET MUST BE MADE OR CIRCLED IN RED INK, WITH DATE AND NAME OF PERSON MAKING CHANGE

Do not extend notes this side of this line

STATION	B. S.	H. I.	F. S	ELEV.		
8+23		1645.85	94	1631 5	14' R gutter	
8+31			63	1634 6	PL - Ext. Stone wall	
			47	1636 2	PL - Top " "	
			41	1636 2	2.5 L " " " "	
			35	1637 4	17' L	
			69	1634 0	7' R	
			93	1631 6	14' R gutter	
T.P.	326	1640.94	317	1637 68		
8+15			60	1634 9	PL - Ext + end stone wall	
			45	1636 3	PL - top " " "	
			46	1636 3	2.5 L " " "	
			52	1635 7	5' L	
			36	1637 3	15' L	
			64	1634 5	5' R	
			92	1631 7	11' R gutter	
8+72			62	1634 7	PL	
			42	1636 7	14' L	
			66	1634 3	3' L	
			84	1632 5	11' R gutter	
8+54			69	1634 0	PL - end conc. drive	
			54	1635 5	15' L - edge " "	

Profile Notes Red. No. ____ Platted G. J. TERRY Job No. 7165 Division No. ____
X-Sec. Date ____ Date AUG 1 1936 Survey of ALTADENA PARK
No. ____ Notes Chkd. S. M. Checked ____ Survey by LOMAX Notes LDM Date 7-29-36
Date 1936 Date ____ Map No. ____ Indexed A. C. Johnson Date ____

E.B. 665 PG. 3

Form 307 5M 11-35

PLEASE RETURN TO
LOS ANGELES COUNTY SURVEYOR
700 HALL OF RECORDS

NOTE: ANY ADDITIONS OR CHANGES ON THIS SHEET MUST BE MADE OR CIRCLED IN RED INK, WITH DATE AND NAME OF PERSON MAKING CHANGE

Do not extend notes this side of this line

Profile No. ____ X-Sec. No. ____ Notes Red ____ Date ____ Plotted ____ Date ____ Job No. 7[illegible] Division No. ____ Notes Chkd. [illegible] Date [illegible] Checked ____ Date ____ Survey of [illegible] Survey by ____ Notes ____ Map No. ____ Indexed ____ Date ____

F.B. 505 PG. 25

STATION	B. S.	H. I.	F. S.	ELEV.		
[illegible]		1644.94	35	637 4	12' L	
			28	1639 1	20' L	
			6 [illegible]	1[illegible]	8' R	
			[illegible]	1[illegible]	[illegible] R	[illegible]
T.P.	9.58	1645.1	2.34	1[illegible]		
P.I. 94			116	1[illegible]	[illegible]	[illegible]
			98	1638 4	"	Top "
			95	1639 4	25 L	" "
			102	1638 0	3' L	
			[illegible]	1638 0	14 L	
			[illegible]	1638 0	21 L	
			135	1635 4	10' R	[illegible]
			140	1634 2	16' R	
			[illegible]	1634 1	19 L	
104 [illegible]			109	1635 3	8 L	[illegible]
			[illegible]	1639 1	"	Top "
			[illegible]	1639 1	24 L	
			96	1[illegible] 6	[illegible]	
			[illegible]	1[illegible] 3	[illegible]	
			[illegible]	1639 2	20 L	
			118	1636 4	9' R	

Form 307 5M 11-35

PLEASE RETURN TO
LOS ANGELES COUNTY SURVEYOR
700 HALL OF RECORDS

NOTE: ANY ADDITIONS OR CHANGES ON THIS SHEET MUST BE MADE OR CIRCLED IN RED INK, WITH DATE AND NAME OF PERSON MAKING CHANGE

Do not extend notes this side of this line

F. B. 5245 PG. 46 | Job No. 7165 Division No. | Notes Red. | Plotted AUG 1 1956 | Profile No.
Survey of ALTADENA | Date | Date | X-Sec. No.
Survey by L.D. MOORE | Notes | Notes Chkd. | Checked
Indexed A. C. Johnson | Date | Date JUL 30 1956 | Date

STATION	B. S.	H. I.	F. S.	ELEV.	
		164[illegible] 1[illegible]	136	165[illegible]	13'R gutter
10+50			101	[illegible]	PL - Post [illegible]
			81	[illegible]	" " "
			81	[illegible]	" " "
			81	164[illegible]	12'L - Top bank
			00	[illegible]	45'L - Top bank
			00	[illegible]	50'L
			113	[illegible]	9'R
			129	[illegible]	13'R gutter
TP	7.90	164.66	7.02	160.75	
16+51			107	163[illegible]	PL - Bot. Basin Retain Stonework
			78	164[illegible]	PL - Top " "
			78	[illegible]	2.5'L " "
			73	164[illegible]	15'L " "
			06	164[illegible]	36'L " "
			06	164[illegible]	45'L
			118	163[illegible]	[illegible]
			103	163[illegible]	12'R gutter
11+00			[illegible]	163[illegible]	PL - edge Stonework
			103	163[illegible]	5'L - Back " " - Top Bottom
			71	164[illegible]	12'L - front edge [illegible] 5 risers

Form 307 5M 11-35

PLEASE RETURN TO
LOS ANGELES COUNTY SURVEYOR
700 HALL OF RECORDS

NOTE: ANY ADDITIONS OR CHANGES ON THIS SHEET MUST BE MADE OR CIRCLED IN RED INK, WITH DATE AND NAME OF PERSON MAKING CHANGE

Do not extend notes this side of this line

STATION	B. S.	H. I.	F. S.	ELEV.		
117+00		1665 6'			16[illegible] L - Back [illegible]	[illegible]
			38	1644 9'	21 L - Front "	" (5 inches
			38	1644 9'	21 L - Back "	"
			[illegible]	1645 1'	33 L Top of [illegible]	(5 inches
			13 0	1650 1'	13 P - Gutter	
[illegible]			10[illegible]	[illegible] 5'	PL & Begin return	[illegible]
			74	1641 3'		
			74	1641 3'	"	"
			[illegible]	[illegible] 6'	11 L	
			06	[illegible] 1'	30 L	
			112	[illegible] 7'	9 R	
			120	[illegible] 6'	12 R	
118+00			[illegible]	[illegible] 1'	[illegible]	
			[illegible]	[illegible] 5'		
			[illegible]	1641 5'		
			62	1643 2'		
			5[illegible]	[illegible] 1'	[illegible] - BK	
			08	1642 [illegible]	[illegible]	
			[illegible]	[illegible] 3'	5 R	
			12	1637 3'	12 R [illegible]	
T.P.	1.97	1652 2'	7.39	1645.27		

Profile
No. _____ Notes Red _____ Plotted _____ Job No. _____ Division No. _____
X-Sec. _____ Date _____ Date _____ Survey of _____
No. _____ Notes Chkd. S. J. Date 3-4-36 Checked _____ Date _____ Survey by _____ Notes _____ Date _____
Date 11-3-35 Map No. _____ Indexed A. C. Johnson

F. B. 505 PG. 27

Form 307 5M 11-35

PLEASE RETURN TO
LOS ANGELES COUNTY SURVEYOR
700 HALL OF RECORDS

NOTE: ANY ADDITIONS OR CHANGES ON THIS SHEET MUST BE MADE OR CIRCLED IN RED INK, WITH DATE AND NAME OF PERSON MAKING CHANGE

Do not extend notes this side of this line

F. B. 5505 Pg. 28 | Job No. 7135 Division No. _____ Notes Red. _____ Date _____ Plotted _____ Date _____ Profile No. _____


Surveyed by L. D. Adkisson

Indexed A. E. Johnson

STATION	B. S.	H. I.	F. S.	ELEV.		
12+50		*16512	11 2		PL	
			11 0		3'L	7.5
			75		92	
			73		14'L	
			31		33'L	7.5
			30		40'L	
			12 4		7'R	
			136		13'R gutter	
13+00			99		PL	
			97		3'L	7.5
			93		3'L	
			70		22'L	
			25		47'L	
			103		6'R	
			122		13'R	
13+50			88		PL	
			58			
			71		9'L	7.5
			70		22'L	
			93		7'R	
			112		13'R gutter	

Form 307 5M 10-34

PLEASE RETURN TO
LOS ANGELES COUNTY SURVEYOR
700 HALL OF RECORDS

NOTE: ANY ADDITIONS OR CHANGES ON THIS SHEET MUST BE MADE OR CIRCLED IN RED INK, WITH DATE AND NAME OF PERSON MAKING CHANGE

Do not extend notes this side of this line

STATION	B. S.	H. I.	F. S	ELEV.		
		1651.24				
T.P.	5.37	1649.08	7.53	1643.71		
13+00			5.7	1643.4	P.L.	
			5.8	1643.3	4' L - T.S.	
			4.7	1643.4	7' L - T.B.	
			3.8	1643.3	22 L	
			6.6	1643.5	7' R	
			7.9	1643.2	12.5 R - gutter	
13+31.5			4.7		P.L. - S.E. Cor Park	
			3.8		16' L	
			5.4		7 R	
			7.2		12 R - gutter	
T.P.	6.22	1643.15	2.15	1646.93		
Rd. Desc. BM #5			4.47	1648.68	BM #5 — L.H.T. in S. Curb return N.E. Cor. Cuesta & Lake. L.X. 1462 El. = 1648.68	

Profile Notes Red. Platted C. J. TERRY Job No. 765 Division No. V
Notes Chkd. Checked Survey by Notes Date 7-29-36
No. Date JUL 30 1936 Map No. Indexed A. C. Johnson
B. 565 Pg. 99

Book 515 P.G. 30 | Job. No. 7165 | Division No. V | Notes Red | Plotted C. J. TERRY | Profile

Survey of Altadena Park | Date | Date AUG 4 1936 | No.

Survey by Moore | Notes Moore | Notes Chkd. | Checked | X-Sec.

Indexed A. C. Johnson | Date | Date | Date | No.

STATION	B.S.	H.I.	F.S	ELEV.	
					S.D.
					H.D.
					V.A.
					R
					V.D.

Form 307 5M 10-34

PLEASE RETURN TO
LOS ANGELES COUNTY SURVEYOR
700 HALL OF RECORDS

Do not extend notes this side of this line

NOTE: ANY ADDITIONS OR CHANGES ON THIS SHEET MUST BE MADE OR CIRCLED IN RED INK, WITH DATE AND NAME OF PERSON MAKING CHANGE

Form 307 5M 11-35

PLEASE RETURN TO
LOS ANGELES COUNTY SURVEYOR
700 HALL OF RECORDS

NOTE: ANY ADDITIONS OR CHANGES ON THIS SHEET MUST BE MADE OR CIRCLED IN RED INK, WITH DATE AND NAME OF PERSON MAKING CHANGE

Do not extend notes this side of this line

STATION	B. S.	H. I.	F. S.	ELEV.	
B.M. 1	11 18	1641 5'		1630 33'	B.M. – U.S. Mon. – S.W. cor. Park
					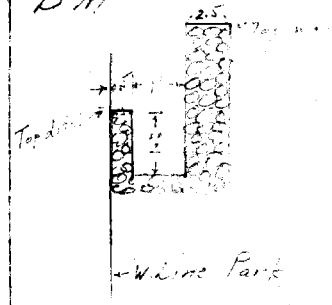
0+00			11 2	[illegible]	S.W. cor. Park + Top [illegible]
			8 4	16331	1.5 R – Top [illegible]
			8 4	16331	4.0 R " "
			10 7	16308	10 L
0+12			9 5	16320	P.L. + Top of Wall
			7 6	16339	1.5 R Top Wall
			7 6	16339	4.0 R " "
			7 3	16321	15' R
0+38			9 6	16319	10 L
			8 4	16331	P.L. + Top of Wall
			6 3	16335	1.5 R + Top [illegible]
			6 3	16335	4.0 R " "
			5 2	16335	7 R – T.S.
			3 0	16345	15 R – T.B.
			2 7	16348	1/ 20' R

Profile No. ____ Notes Red. ____ F. S. ____ Plotted ____ Job No. 2165 Division No. 6
X-Sec. No. ____ Date 11-6-35 Date ____ Survey of ____
Notes Chkd. S. Checked ____ Survey by ____ Notes ____ Date 7-29-36
Date 11-7-1935 Date ____ Map No. ____ Indexed A. C. Johnson

F. B. 565 PG. 31

Form 307 5M 11-35

PLEASE RETURN TO
LOS ANGELES COUNTY SURVEYOR
700 HALL OF RECORDS

NOTE: ANY ADDITIONS OR CHANGES ON THIS SHEET MUST BE MADE OR CIRCLED IN RED INK, WITH DATE AND NAME OF PERSON MAKING CHANGE

Do not extend notes this side of this line

F.B. 505 PG. 32 | Job No. 1165 | Division No. L | Notes Red | Profile No. | X-Sec. No.
Survey by A. C. Johnson | Notes | Notes Ckd. | Checked
Indexed A. C. Johnson | Date | Date | Date

STATION	B. S.	H. I.	F. S.	ELEV.		
0+28		1641 51	86	1632 9	10'L	
0+56			66	349	PL. - T ditch	
			49	366	1.5 - T wall	
			04	366	4 - 4 T.S.	
			14	391	R - T.P.	
			24	31		
			62	347	10'L	
0+73			42	3	PL.	
			31	38	1.5 - end 3.5 wall - Begin 1 wall	
			31	38	40 R	
			26	38	10' R	
			19	39	25 R	
			02	39	10'R	
1+00			15	40	PL + T.D. ditch	
			09	40	2' R	
			05	40	20' R	
			12	40	10'L	
T.P.	11 43	1652 50	014	1641 37		
1+24			93	43	PL + Begin Curve Flume	
			93	43	2' R - " " "	
			101	42	20' R	
			93	43	10'L	

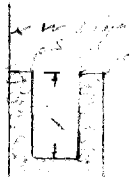

Form 307 5M 11-35

PLEASE RETURN TO
LOS ANGELES COUNTY SURVEYOR
700 HALL OF RECORDS

NOTE: ANY ADDITIONS OR CHANGES ON THIS SHEET MUST BE MADE OR CIRCLED IN RED INK, WITH DATE AND NAME OF PERSON MAKING CHANGE

Do not extend notes this side of this line

STATION	B. S.	H. I.	F. S.	ELEV.		
11+50		1652.50	72	1645.3	PL + T Stone	
			72	45 3	2' R " "	
			57	45 8	20' R	
			71	45 4	10' L	
2+00			27	49 8	PL + T + Stone	
			27	49 8	2' R " "	
			29	49 6	R	
			23	50 2	L	
T P	1.24	1653.56	018	1652.32		
2+50			85	52 1	PL + T + Stone	
			85	50 1	2' R " "	
			77	56 4	13' R	
			70	56 2	20' R	
			84	552	10' L	
3+00			53	60 3	PL + T + Stone	
			33	60 3	2' R " "	
			10	58 1	8' R	
			13	58 3	30' R	
			37	59 1	10' L	
T P	1.17	1654.25	002	1652.58		

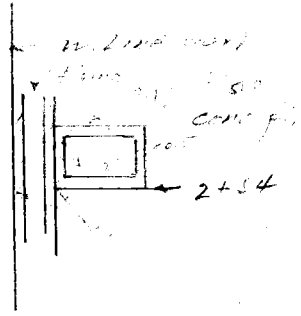

Profile
No.
X-Sec.
No.
Notes Red
Date
Notes Chkd.
Date
Map No.
Plotted
Date
Checked
Date
Indexed
Job No. 2765 Division No. V
Survey of
Survey by
Notes
Date
Date
Date
F. B. 565 Pg. 33

Form 307 5M 11-35

PLEASE RETURN TO
LOS ANGELES COUNTY SURVEYOR
700 HALL OF RECORDS

NOTE: ANY ADDITIONS OR CHANGES ON THIS SHEET MUST BE MADE OR CIRCLED IN RED INK, WITH DATE AND NAME OF PERSON MAKING CHANGE

Do not extend notes this side of this line

F.B. 505 Pg. 34 | Job No. 2165 | Division No. V | Notes Red. F. S. Ed. | Plotted C. J. TERRY | Profile No. | X-Sec. No.

Survey of [illegible] | Date 2/11 1936 | Notes Chkd. [illegible] | Date 3/11 1936 | Checked [illegible] | Date

Survey by [illegible] | Notes [illegible] | Date

Indexed A. C. Johnson

STATION	B. S.	H. I.	F. S.	ELEV.	
[illegible]		1672 25	10	1665 2	[illegible]
			10	65 2	
				69 2	
			6	69 1	
			11	63 5	
				63 6	
			13	64	
				64	
				64	
				64	
				73	
				72	
				72	
				70	
				64	
T P	931	1684 36	20	32	
4+18					

Form 307 5M 11-35

PLEASE RETURN TO
LOS ANGELES COUNTY SURVEYOR
700 HALL OF RECORDS

NOTE: ANY ADDITIONS OR CHANGES ON THIS SHEET MUST BE MADE OR CIRCLED IN RED INK, WITH DATE AND NAME OF PERSON MAKING CHANGE

Do not extend notes this side of this line

STATION	B. S.	H. I.	F. S.	ELEV.		
5+00		1650.36	6.7	1643.7	PL.	
			5.5	78 6.	28' R	
			6.2	18 1.	16' L	
5+25			4.1	60 5.	PL. & Bot. Bank	
			2.1	6 3.	PL. & Top Bank	
			2.1	2 3.	5' R	
			2.1	2 3.	12' R	
			2.4	1 3.	10' R 130°	
			3.1	2 3.	20' R	
			3.6	3 3.	10' L	
7+00		1649.63	0.4	1649.2		
7+50			12.3	37 3.	PL.	
			9.0	28 3.		
			9.2	28 3.		
			5.1	32 3.	16' R	
			7.0	32 3.	22' L	
			11.8	32 3.	40' L	
5+60			10.8	32 3.	12' L	
			9.3	32 3.		
			6.0	32 3.	24' L	

Profile

No. ____ Notes Red S. B. Plotted ____ Job No. ____ Division No. ____

X-Sec. ____ Date 11-3-1935 Date ____ Survey of ____

No. ____ Notes Chkd. → Checked ____ Survey by ____ Notes ____ Date ____

Date 11-1-1935 Date ____ Map No. ____ Indexed A. C. Johnson

F. B. 505 Pg. 35

Form 307 5M 11-35

PLEASE RETURN TO
LOS ANGELES COUNTY SURVEYOR
700 HALL OF RECORDS

NOTE: ANY ADDITIONS OR CHANGES ON THIS SHEET MUST BE MADE OR CIRCLED IN RED INK, WITH DATE AND NAME OF PERSON MAKING CHANGE

Do not extend notes this side of this line

F. B. 505 Pg. 36 | Job No. 765 Division No. V | Notes Rod Date 7/31 | Plotted Date | Checked Date | Profile No. | X-Sec. No.

Survey of [illegible] Notes [illegible] Notes Ckd. R.S.B. Date 7/31

Survey by A. C. Johnson Date [illegible]

Indexed [illegible]

STATION	B. S.	H. I.	F. S.	ELEV.	
5+[illegible]		[illegible]	[illegible]	[illegible]	4' R
			62	[illegible]	10' R
			60	[illegible]	20' R
			105	[illegible]	[illegible]
5+90			94	[illegible]	P.L. + Bot. [illegible]
			74	[illegible]	" Top "
			74	[illegible]	2' R " "
			55	[illegible]	10' R
			52	[illegible]	20' R
			51	[illegible]	6' L [illegible]
			[illegible]	[illegible]	10' L
6+[illegible]			[illegible]	[illegible]	P.L. + End top stonework
			[illegible]	[illegible]	[illegible]
			[illegible]	[illegible]	[illegible]
			[illegible]	[illegible]	[illegible]
			[illegible]	[illegible]	[illegible]
			[illegible]	[illegible]	[illegible]
			[illegible]	[illegible]	[illegible]
6+20			[illegible]	[illegible]	[illegible]
			42	[illegible]	15' R
			42	[illegible]	10' L
TP.			355	[illegible]	

Form 307 5M 11-35

PLEASE RETURN TO
LOS ANGELES COUNTY SURVEYOR
700 HALL OF RECORDS

NOTE: ANY ADDITIONS OR CHANGES ON THIS SHEET MUST BE MADE OR CIRCLED IN RED INK, WITH DATE AND NAME OF PERSON MAKING CHANGE

Do not extend notes this side of this line

STATION	B. S.	H. I.	F. S.	ELEV.		
T.P.	1.13	1692.21		1591.08		
T.P.	2.29	1692.75	11.75	1680.46		
T.P.	2.11	1688.56	11.67	1677.45		
T.P.	2.21	1687.52	11.87	1675.31		
T.P.	2.05	1645.76	11.90	1643.71		
	1.00	1637.98	8.72	1636.98		
B.M.			7.68	1630.30		

Profile No. _____ Notes Red _____ Plotted _____ Job No. _____ Division No. _____

X-Sec. No. _____ Date _____ Survey of _____

Notes Chkd. R. S. Date _____ Checked _____ Survey by _____ Notes _____ Date _____

Date 1-9-38 Map No. _____ Indexed A. C. Jabbour Date _____

F.B. 5055 Pg. 37

F. B. 505 PG. 38 | Job No. | Division No. | Notes Red. | Plotted | Profile

Survey of | Date | Date | No.

Survey by | Notes | Notes Chkd. | Checked | X-Sec.

Indexed A. C. Johnson | Date | Date | Date | No.

STATION	B. S.	H. I.	F. S.	ELEV.

Form 307 5M 11-35

PLEASE RETURN TO
LOS ANGELES COUNTY SURVEYOR
700 HALL OF RECORDS

Do not extend notes this side of this line

NOTE: ANY ADDITIONS OR CHANGES ON THIS SHEET MUST BE MADE OR CIRCLED IN RED INK, WITH DATE AND NAME OF PERSON MAKING CHANGE

Notes Ck'd by	Survey of
Map No.	W. O. Tape No. St'd °F.
Office Work C. J. TERRY	Surveyed by L. D. Moore
Checked	Notes Date
Date	Indexed A. C. Johnson

F.B. 505 Pg. 39

Note: Any Additions or Changes on This Sheet Must be Made in Red Ink With Date and Name of Person Making Change.

Do not extend notes this side of this line

RETURN TO
LOS ANGELES COUNTY SURVEYOR
720 HALL OF RECORDS

FORM 247 10M 11-35

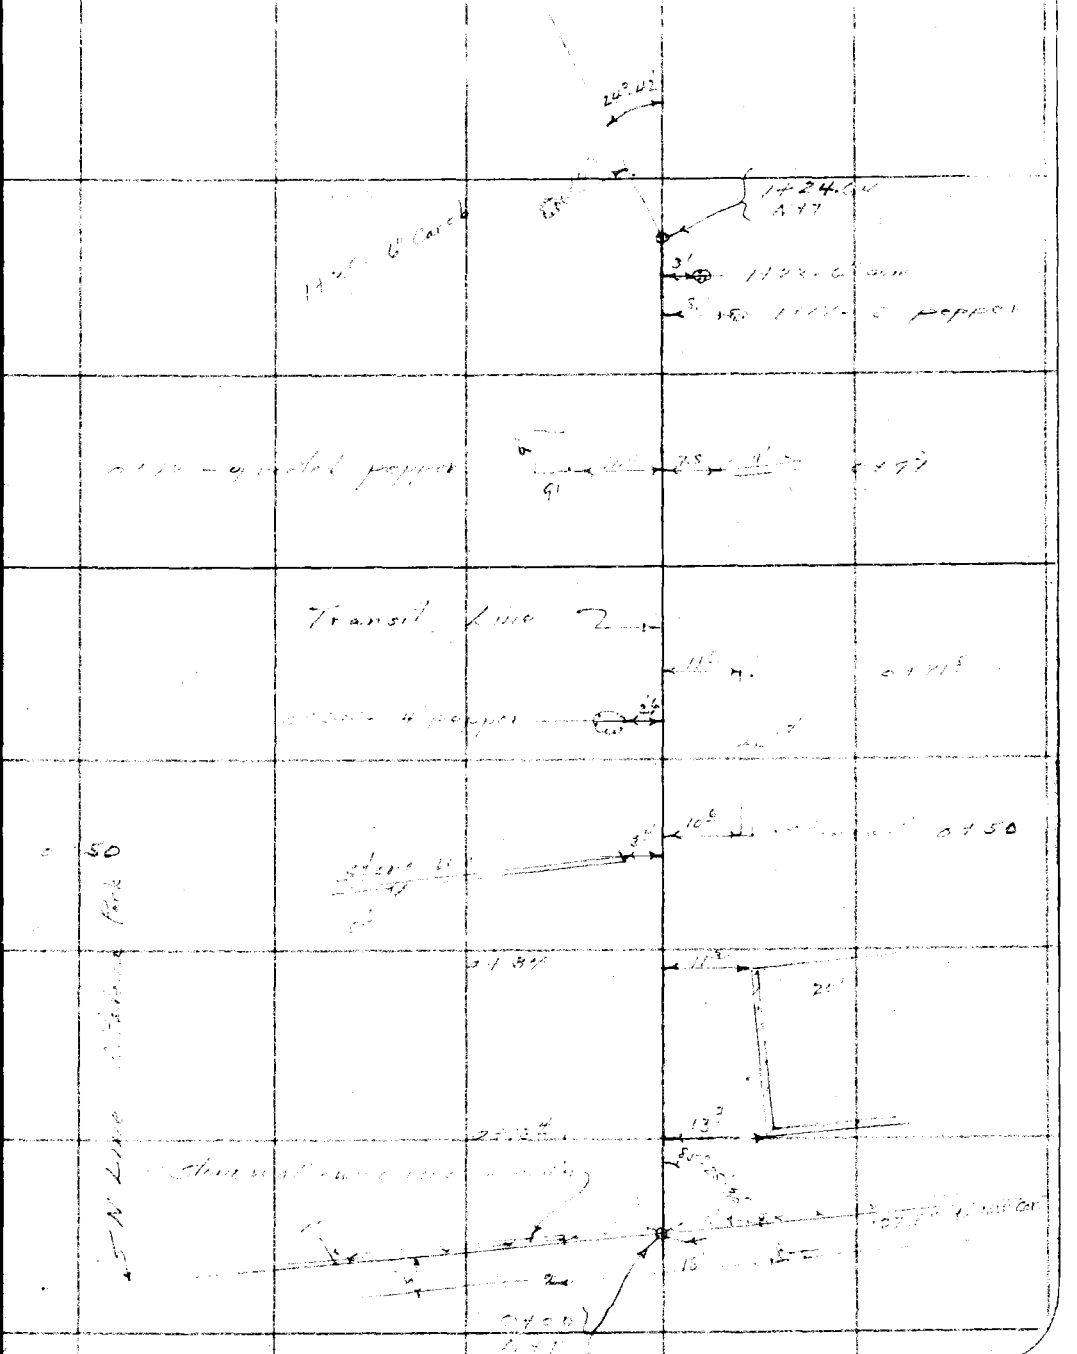

F.B. 505 PG. 40

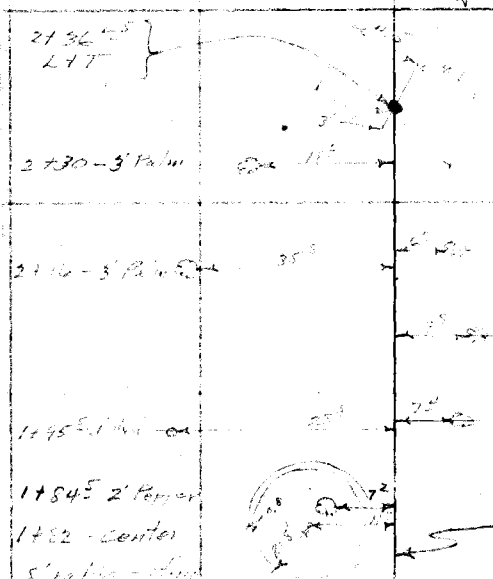

RETURN TO
LOS ANGELES COUNTY SURVEYOR
700 HALL OF RECORDS

Note: Any Additions or Changes on This Sheet Must be Made or Circled in Red Ink With Date and Name of Person Making Change.

Do not extend notes this side of this line

Form 307 5M 11-35

PLEASE RETURN TO
LOS ANGELES COUNTY SURVEYOR
700 HALL OF RECORDS

NOTE: ANY ADDITIONS OR CHANGES ON THIS SHEET MUST BE MADE OR CIRCLED IN RED INK, WITH DATE AND NAME OF PERSON MAKING CHANGE

Do not extend notes this side of this line

STATION	B. S.	H. I.	F. S.	ELEV.		
T.P.	9.61	1100.69		1091.08	Sec. 29, T. 3 S., R. 9 W., S.B.B.&M.	
2+30			4.20	96.49	Transit Line prod. S.	
			5.21	95.48	20'R	
			3.28	97.41	20'L	
4+00			1.00	96.69	To set nail & tack in stake for	
			5.11	95.58	9'R	
			4.62	96.07	7'L	Face
			5.73	95.96	20'R	Back
			5.[illegible]	[illegible]	20'R	Face
			[illegible]	[illegible]	21	[illegible]
			[illegible]	[illegible]	[illegible]	[illegible]
			[illegible]	[illegible]	[illegible]	[illegible]
			[illegible]	[illegible]	[illegible]	[illegible]
			[illegible]	[illegible]	[illegible]	[illegible]
			3.3	[illegible]	7'L	
			4.02	[illegible]	5'R	Face
			[illegible]	[illegible]	[illegible]	[illegible]
			[illegible]	[illegible]	[illegible]	[illegible]
			[illegible]	[illegible]	[illegible]	[illegible]
			[illegible]	[illegible]	20'R	Back
			[illegible]	[illegible]	21'L	[illegible]
			[illegible]	[illegible]	[illegible]	[illegible]
			3.87	[illegible]	[illegible]	[illegible]

Profile
No.
X-Sec.
No.
Notes Red R. S. D. Plotted
Date JUL 8 1936 Job No. 765 Division No. K
Notes Chkd Checked Survey of
Date JUL Date Survey by Notes Date
Map No. Indexed A. C. Johnson

F.B. 505 Pg. 41

Form 307 5M 11-35

PLEASE RETURN TO
LOS ANGELES COUNTY SURVEYOR
700 HALL OF RECORDS

NOTE: ANY ADDITIONS OR CHANGES ON THIS SHEET MUST BE MADE OR CIRCLED IN RED INK, WITH DATE AND NAME OF PERSON MAKING CHANGE

Do not extend notes this side of this line

F.B. 505 Pg. 42 | Job No. 2765 | Division No. | Notes Red | Plotted | Prefile
Survey of | Date | Notes Chkd. | Checked | No.
Survey by A. C. Johnson | Notes | Date | Date | X-Sec.
Indexed | Date | Date | No.

STATION	B. S.	H. I.	F. S.	ELEV.		
0+00		1700.69	3.73	1697.46	20.2	- Ground
			7.38	93.11	3.0	7 "
0+05			1.0	93.2	T.L.	
			5.	95.7	6'R	Ground
			5.1	94.9	20'R	"
			2.8	96.4	6'L	"
			3.8	94.3	20'L	
0+20			5.2		T.L.	
			6.4		13'R	- T. curb wall
			5.3			" " "
			6.5		20'R	T. " "
			4.3			Ground " "
			5.0		6'L	
			4.3		9.2	
0+25			6.5		12'R	- T. curb wall
			5.5		12'R	Ground " " - Top lower wall
			7.1		13'R	Ground " "
0+34			5.2		T.L.	
			5.0		11'R	- T. " "
			9.3		11'R	Ground " " - Top lower wall
			7.3		20'R	- Top curb slope

Form 307 5M 11-35

PLEASE RETURN TO
LOS ANGELES COUNTY SURVEYOR
700 HALL OF RECORDS

NOTE: ANY ADDITIONS OR CHANGES ON THIS SHEET MUST BE MADE OR CIRCLED IN RED INK, WITH DATE AND NAME OF PERSON MAKING CHANGE

Do not extend notes this side of this line

STATION	B. S.	H. I.	F. S.	ELEV.		
0+34		1700 69'	77	1693.0'	S'L	
			66	94.1'	20'L	
0+50			102	70.5'	T.L.	
			79	90.8'	34'L - B. on N	
			87	82.0'	34'L T. "	
			81	92.2'	20'L T. "	
			98	[illegible]	20'L B. " - S [illegible]	
			102	[illegible]	10' R B. Stone [illegible]	
			88	[illegible]	10' R T. " "	
			86	[illegible]	13' L T. "	
			97	[illegible]	13' R B. " "	
			99	[illegible]	[illegible]	
0+45			115	[illegible]	T.L.	
			[illegible]	[illegible]	[illegible] B.	
			[illegible]	[illegible]	[illegible] T.	
			[illegible]	[illegible]	13' R T. "	
			96	[illegible]	[illegible]	
			[illegible]	[illegible]	20' L	
T.P.	[illegible]	[illegible]	1188	[illegible]		
0+15			[illegible]	[illegible]	T.L.	
			[illegible]	[illegible]	[illegible] B.	

Profile No. _____ X-Sec. No. _____

Notes Red. B. S. Plotted _____ Job No. [illegible] Division No. [illegible]
Date JL 21 1933 Date _____ Survey of _____
Notes Chkd. _____ Checked _____ Survey by _____ Notes _____ Date _____
Date JL 21 1933 Date _____ Map No. _____ Indexed A. C. Jaburg

F.B. 505 Pg. 43

Form 307 5M 11-35

PLEASE RETURN TO
LOS ANGELES COUNTY SURVEYOR
700 HALL OF RECORDS

NOTE: ANY ADDITIONS OR CHANGES ON THIS SHEET MUST BE MADE OR CIRCLED IN RED INK, WITH DATE AND NAME OF PERSON MAKING CHANGE

Do not extend notes this side of this line

F. B. 585 PG. 44

Job No. 7165 Division No. 4 Notes Red Date 3/11 81 Plotted Date Checked Date

Survey of Alley

Survey by C. Johnson Notes Date

Indexed A. Notes Chkd. Date 3/11 81

Profile No. X-Sec. No.

STATION	B. S.	H. I.	F. S.	ELEV.	

Form 307 5M 11-35

PLEASE RETURN TO
LOS ANGELES COUNTY SURVEYOR
700 HALL OF RECORDS

NOTE: ANY ADDITIONS OR CHANGES ON THIS SHEET MUST BE MADE OR CIRCLED IN RED INK, WITH DATE AND NAME OF PERSON MAKING CHANGE

Do not extend notes this side of this line

STATION	B. S.	H. I.	F. S.	ELEV.		
T.P.	2.64	168.42		165.78		
1+82			2.0	166	T.L.	
			2.5	165	3'L.	
			0.7	167	3'L.	
			0.7	167	11'L.	
			0.6	167	19'L.	
			1.8	166	10'L.	
			3.6	165	2'L.	
1+			4.2	164	T.L.	
			2.8	165	11'L.	
			0.6	167	1'L.	
			2.4	166	3'L.	
			4.6	164	T.L.	
2+10			5.2	163	T.L.	
			5.7	162	5'L.	
			3.6	164	2'L.	
			5.5	162	6'L.	
			4.5	163	20'L.	
			3.5	164	40'L.	
2+32.5			7.91	160	℄ cross drive - forward long. pvt 3'R of L	
			7.80	160	45R - Sout	

Profile No. _____ Notes Rd. 3 Plotted 3. Job No. 1185 Division No. 6

X-Sec. No. _____ Date 3/31 1935 Date 1 1935 Survey of _____

Notes Chkd. 3 Checked _____ Survey by _____ Notes _____

Dated 4/1 1935 Date _____ Map No. _____ Indexed A. C. John Date _____

F.B. 505 PG. 45

Form 307 5M 11-35

PLEASE RETURN TO
LOS ANGELES COUNTY SURVEYOR
700 HALL OF RECORDS

NOTE: ANY ADDITIONS OR CHANGES ON THIS SHEET MUST BE MADE OR CIRCLED IN RED INK, WITH DATE AND NAME OF PERSON MAKING CHANGE

Do not extend notes this side of this line

F.B. 585 Pg. 46 | Job No. [illegible] Division No. [illegible] Notes Red. [illegible] Plotted [illegible] Profile No.
Survey of [illegible] Date JUL 31 1936 Date [illegible] X-Sec. No.
Survey by A. C. Johnson Notes Chkd. [illegible] Checked [illegible]
Indexed [illegible] Date JUL 31 1936 Date [illegible]

STATION	B. S.	H. I.	F. S.	ELEV.		
[illegible]		[illegible]	[illegible]	1673 7'	20' R	
			7 51	73 64'	4.5 L	[illegible]
			7 99	73 5'	20 L	
7+00			[illegible]	71 82	"	"
			9 41	71 97'	4.5 R	"
			9 97	71 97'	" L	" "
TP	[illegible]	[illegible]	[illegible]	[illegible]		
3+[illegible]			[illegible]	[illegible]	"	"
			3 56	[illegible]	4.5 R	"
			3 84	[illegible]	" L	"
3+50			[illegible]	[illegible]	"	
			[illegible]	[illegible]	4.5 R	"
			[illegible]	[illegible]	" L	"
3+72			[illegible]	[illegible]	"	"
			[illegible]	[illegible]	4.5 R	"
			[illegible]			
			[illegible]			
			[illegible]			
			[illegible]			
7+00	[illegible]	[illegible]	[illegible]	[illegible]		
[illegible]			[illegible]		L	"
			[illegible]		4.5 R	"

Form 307 5M 11-35

PLEASE RETURN TO
LOS ANGELES COUNTY SURVEYOR
700 HALL OF RECORDS

NOTE: ANY ADDITIONS OR CHANGES ON THIS SHEET MUST BE MADE OR CIRCLED IN RED INK, WITH DATE AND NAME OF PERSON MAKING CHANGE

Do not extend notes this side of this line

STATION	B. S.	H. I.	F. S.	ELEV.		
4/		1455 Cl	139	3742	4.5 R	T Cor
			192	56		B
			133	5		T
2 - 5			210	5 71	L	
			69	5	4.5 R	T B
			120	52	4.5 R	T.
			194	5	4.5 L	B
			628	5	4.5 L	T
5 4 - 6					L	
				15		
			36	11		
			34	6	4.5 L	B
			20	4	4.5 L	T
7 - 8		1440 1	41 54			
			5	21	L	
			52	4		
				42		
			5 50	41		
			43	42		
			10 47	3	L	
			2 34	32		

Profile
No.
X-Sec.
No.
Notes Red
Date
Notes Chkd.
Date
Plotted
Date
Checked
Date
Job No.
Survey of
Survey by
Map No.
Division No.
Notes
Indexed A. C. Johnson
Date
Date

F. B. 505 PG. 47

Form 307 5M 11-35

PLEASE RETURN TO
LOS ANGELES COUNTY SURVEYOR
700 HALL OF RECORDS

NOTE: ANY ADDITIONS OR CHANGES ON THIS SHEET MUST BE MADE OR CIRCLED IN RED INK, WITH DATE AND NAME OF PERSON MAKING CHANGE

Do not extend notes this side of this line

F.B. 505 PG. 48 | Job No. ____ Division No. ____ Notes Red. ____ Plotted ____ No. ____ Profile

Survey of ____ Date JUL 31 1936 Date ____ X-Sec.

Survey by A. C. Johnson Notes Chkd ____ Checked ____ No.

Indexed ____ Notes ____ Date ____ Date JUL 31 1936 Date ____

STATION	B. S.	H. I.	F. S.	ELEV.		
C		1647.10	0			T-Curb
			32			
			72			7
			1150	35	&	
			41		& R	
			76		& R	T
			1137			
			1171	3		7
		1639.9	1045		65	
6+33			479		&	
					& R	
			4			
				16		

Notes Ck'd by	Survey of
Map No. 69-17-2	W. O. 7165 Tape No. St'd °F.
Office Work C. I. Terry	Surveyed by K. D. Moore
Checked J.A.L.	Notes K. Moore Date 11-15-35
Date	Indexed A. C. Johnson 3-10-36

F.B. 505 PG. 49

Note: Any Additions or Changes on This Sheet Must be Made or Circled in Red Ink With Date and Name of Person Making Change.

Do not extend notes this side of this line

RETURN TO
LOS ANGELES COUNTY SURVEYOR
700 HALL OF RECORDS

FORM 247 10M 11-35

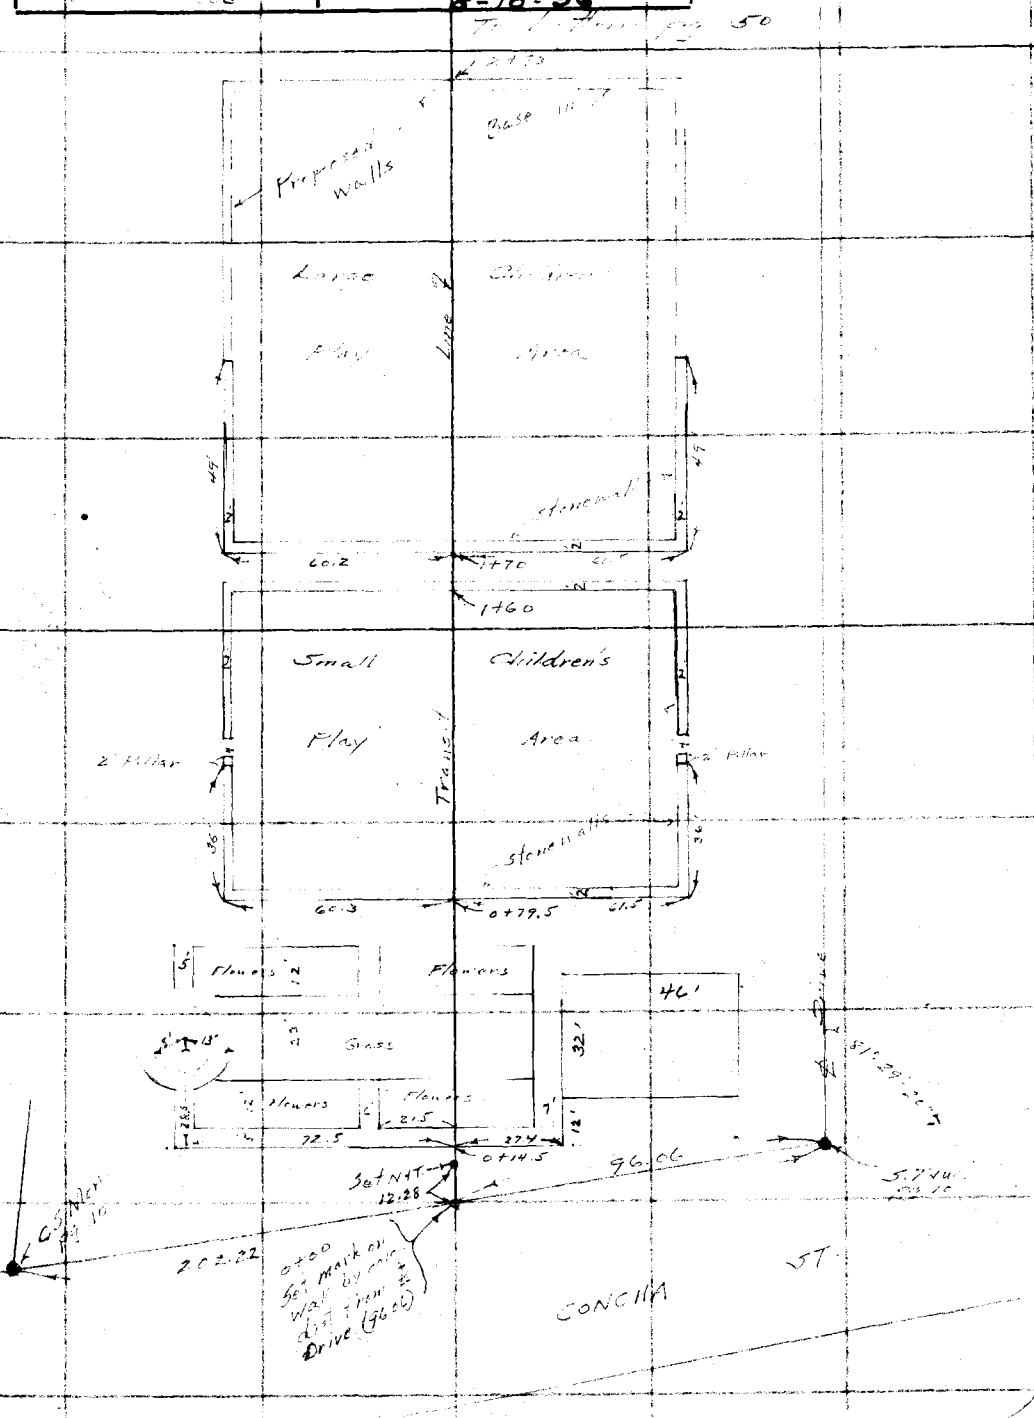

RETURN TO
LOS ANGELES COUNTY SURVEYOR
700 HALL OF RECORDS

Note: Any Additions or Changes on This Sheet Must be Made or Circled in **Red Ink** With Date and Name of Person Making Change.

Do not extend notes this side of this line


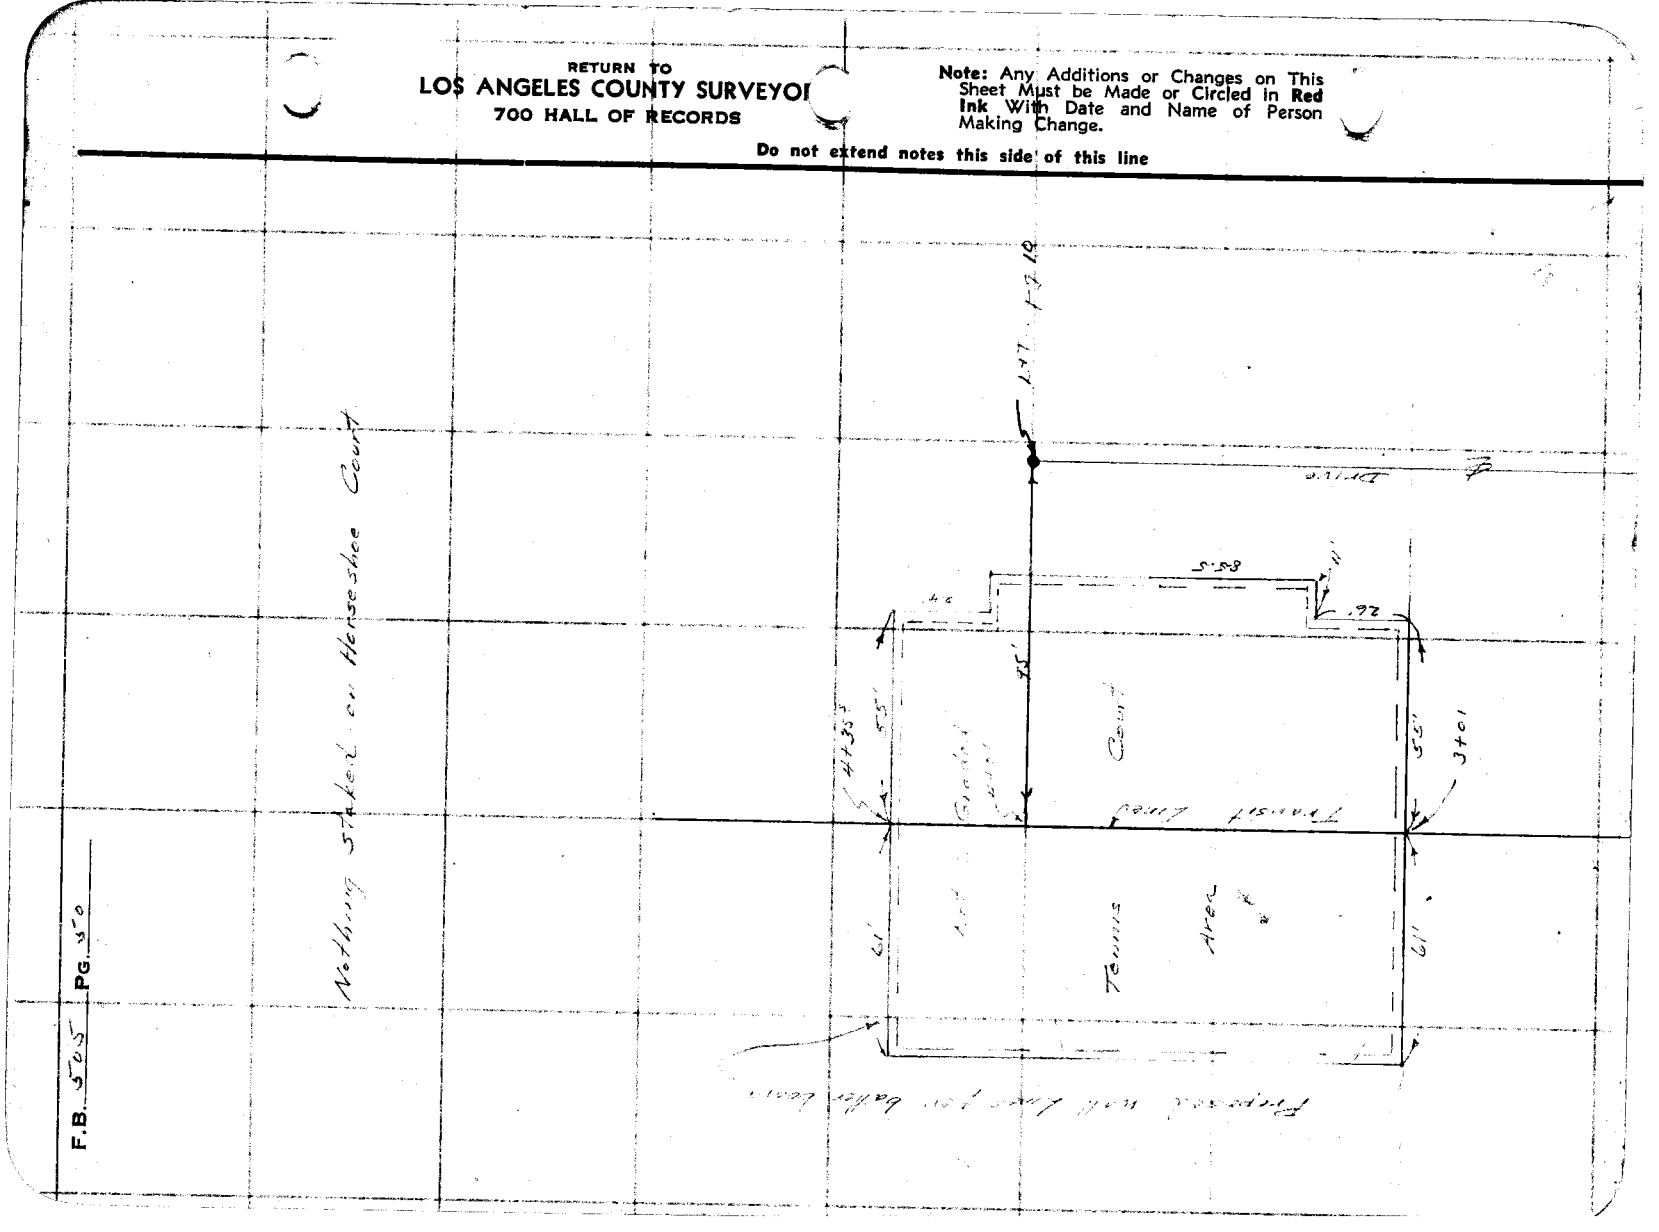

Form 307 5M 11-35

PLEASE RETURN TO
LOS ANGELES COUNTY SURVEYOR
700 HALL OF RECORDS

NOTE: ANY ADDITIONS OR CHANGES ON THIS SHEET MUST BE MADE OR CIRCLED IN RED INK, WITH DATE AND NAME OF PERSON MAKING CHANGE

Do not extend notes this side of this line

STATION	B. S.	H. I.	F. S.	ELEV.		
T.P.	6.76	1668.53		1661.77	℄ Dirt - 3150 - Ty 46	
4+01			28	1665.7	Transit Line	
			32	1665.3	50' R	
3+70			35	1665.0	55' L	
3+16			38	1664.7	T L	
			40	1664.5	55' L	
			40	1664.5	50' R	
2+96			64	1662.1	T.L.	
T.P.	2.85	1658.50	1088	1657.65		
2+50			33	1655.2	T L.	
			31	1655.4	58' L	
			34	1655.1	58' R	
1+71			35	1655.0	T L. Top "	
			34	1655.1	60 L " "	
			33	1655.2	61' R " "	
1+20			98	1649.5	T.L. Bot. "	
			90	1649.5	60' L " "	
			85	1650.0	61' R " "	
1+61			102	1648.3	T.L. Top "	
			102	1648.3	60' L " "	
			101	1648.4	61' R " "	

Profile No. ____ Notes Red ____ Plotted ____ Job No. ____ Division No. ____

X-Sec. No. ____ Date ____ Survey of ____

Notes Chkd ____ Date ____ Checked ____ Date ____ Survey by ____ Notes ____ Date ____

Map No. ____ Indexed ____

F. B. 505 Pg. 51

Date 10-10-36

Form 307 5M 11-35

PLEASE RETURN TO
LOS ANGELES COUNTY SURVEYOR
700 HALL OF RECORDS

NOTE: ANY ADDITIONS OR CHANGES ON THIS SHEET MUST BE MADE OR CIRCLED IN RED INK, WITH DATE AND NAME OF PERSON MAKING CHANGE

Do not extend notes this side of this line

F. B. 505 Pg. 52 | Job No. 7155 | Division No. V | Profile No. | X-Sec. No.
Survey of | Notes Red | Date | Plotted | Date
Survey by A. C. Johnson | Notes | Date | Notes Chkd | Date | Checked | Date
Indexed

STATION	B. S.	H. I.	F. S.	ELEV.		
		1655 50				
T.P.	0.61	1647.33 ✓	11.78	1645.72 ✓		
1+60			19	16454	TL · Bot wall	
			20	16453	55' L " "	
			18	16455	59.5 R " "	
1+22			23	16450	TL	
			21	16452	55' L " "	
		+	07	16480	60' L Top " - 1 Wall	
			23	16450	59.5 R Bot "	
		+	07	16450	59.5 R Top "	
0+80			25	16448	TL Top "	
			21	16448	60' L Top "	
			23	16450	60' R Bot "	
0+79.5			24	16399	TL Bot "	
			26	16397	60' L " "	
			20	16403	61' R " "	
0+57			81	16392	27 R	
0+44.5			85	16388	TL	
			84	16389	27 R	
			86	16387	72 L	
T.P.			565	41.68 ✓	Top Curb - 5750	41.69 49.47

RETURN TO
LOS ANGELES COUNTY SURVEYOR
700 HALL OF RECORDS

Note: Any Additions or Changes on This Sheet Must be Made or Circled in Red Ink With Date and Name of Person Making Change.

Do not extend notes this side of this line

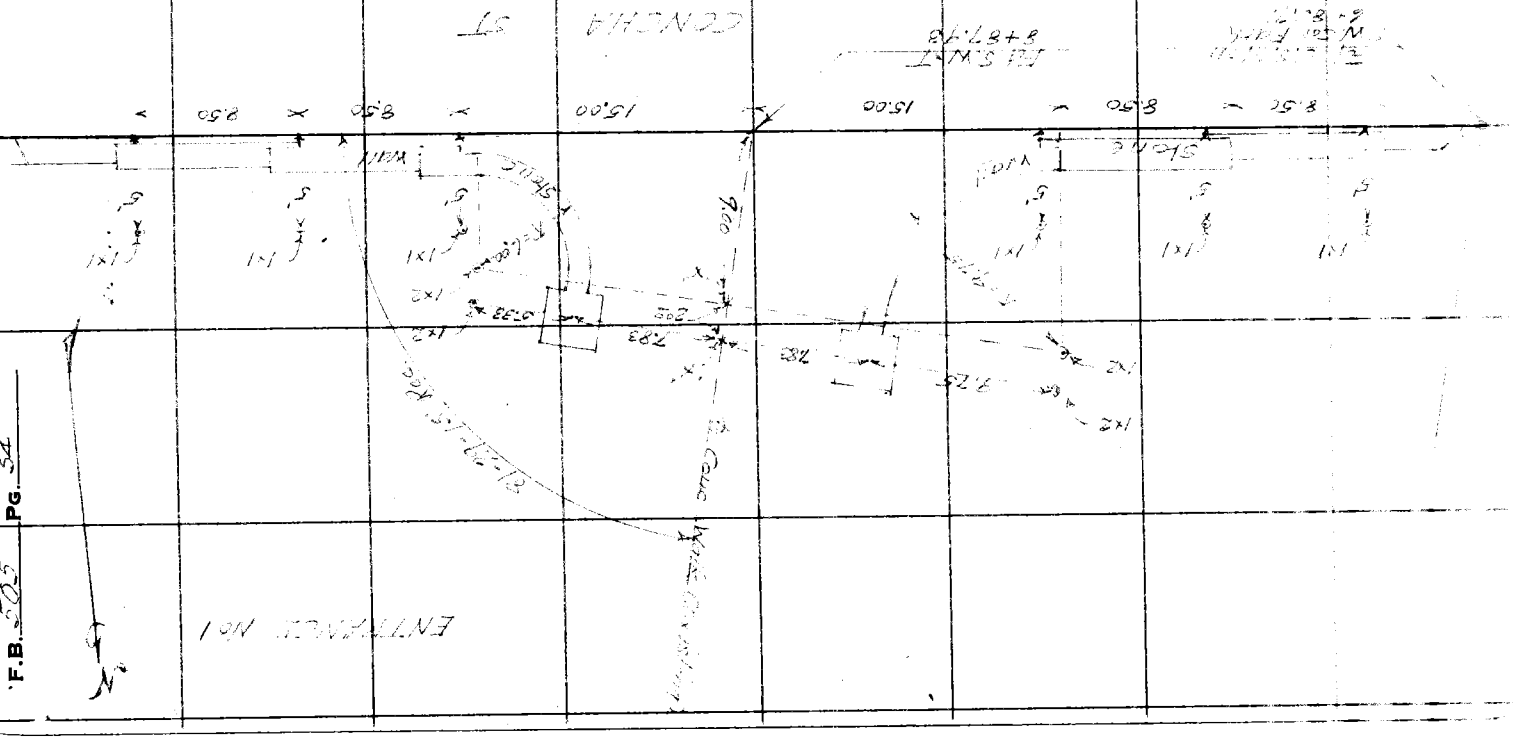

FORM 247 10M 11-35

RETURN TO
LOS ANGELES COUNTY SURVEYOR
700 HALL OF RECORDS

Note: Any Additions or Changes on This Sheet Must be Made or Circled in **Red Ink** With Date and Name of Person Making Change.

Do not extend notes this side of this line

Notes Ck'd by _____
Map No. _____
Office Work _____
Checked _____
Date _____

Survey of ALTADENA PARK
W. O. 7165 Tape No. _____ Std. _____ °F.
Surveyed by W.A. Miller
Notes Miller - Date 7-3-1937
Indexed A. C. Johnson 8-24-38


ALTADENA PARK
UNIT 7165

ENTRANCE NO 1
OF
CONCRETE

MONUMENT
BRASS
STENCIL
SURVEY

Notes Ck'd by	Survey of Altadena Park
Map No.	W. O. 7165 Tape No. St'd °F.
Office Work	Surveyed by W.A. Miller
Checked	Notes Miller Date 3-4-1937
Date	Indexed A. C. Johnson

F.B. 504 Pg. 55

ALTADENA PARK
J.N. 7165

ENTRANCE NO 5

Miller
Braden
Stewart
Clinite
Johnson

Note: Any Additions or Changes on This Sheet Must be Made or Circled in Red Ink With Date and Name of Person Making Change.

Do not extend notes this side of this line

RETURN TO
LOS ANGELES COUNTY SURVEYOR
700 HALL OF RECORDS

FORM 247 10M 11-35

RETURN TO
LOS ANGELES COUNTY SURVEYOR
700 HALL OF RECORDS

Note: Any Additions or Changes on This Sheet Must be Made or Circled in **Red Ink** With Date and Name of Person Making Change.

Do not extend notes this side of this line

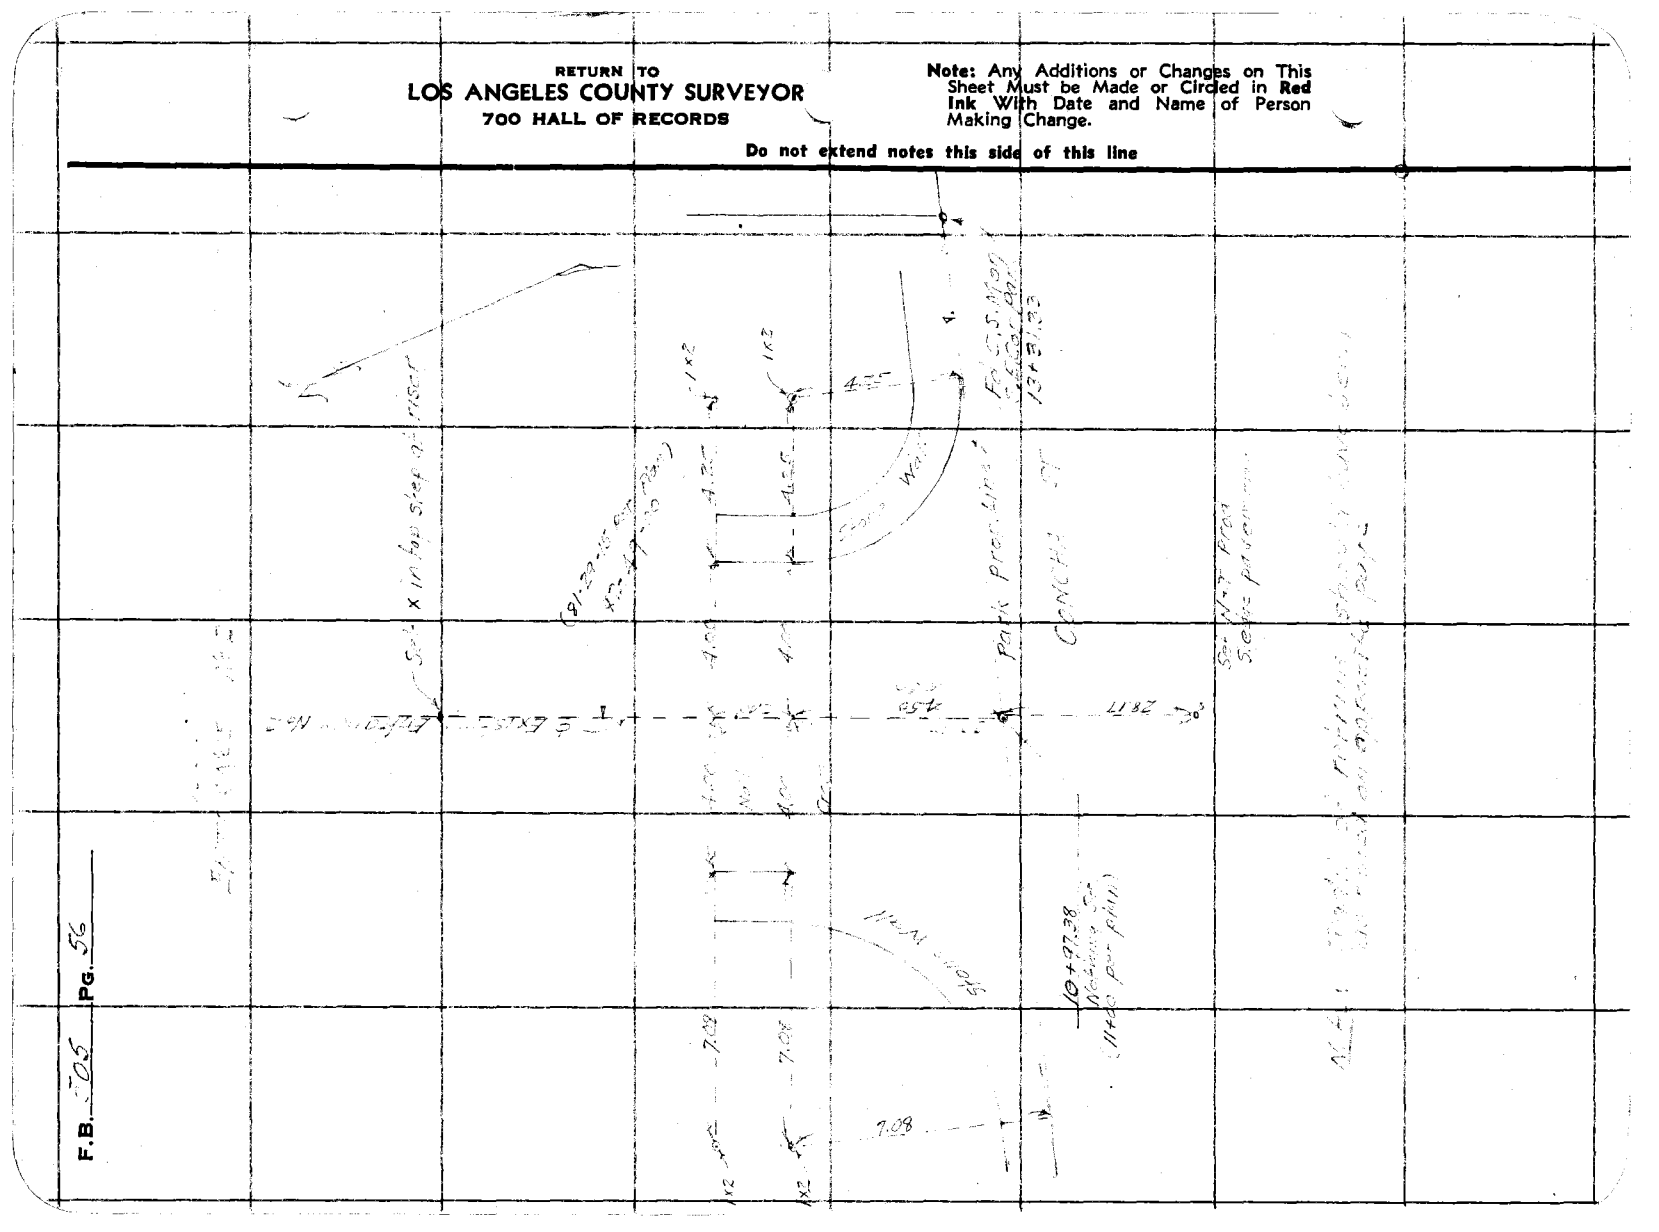

F.B. 305 Pg. 56

FORM 247 10M 11-35

RETURN TO
LOS ANGELES COUNTY SURVEYOR
700 HALL OF RECORDS

Note: Any Additions or Changes on This Sheet Must be Made or Circled in **Red Ink** With Date and Name of Person Making Change.

Do not extend notes this side of this line

Notes Ck'd by
Map No.
Office Work
Checked
Date

Survey of
W. O. Tape No. St'd °F.
Surveyed by
Notes
Indexed Date

F.B. PG.

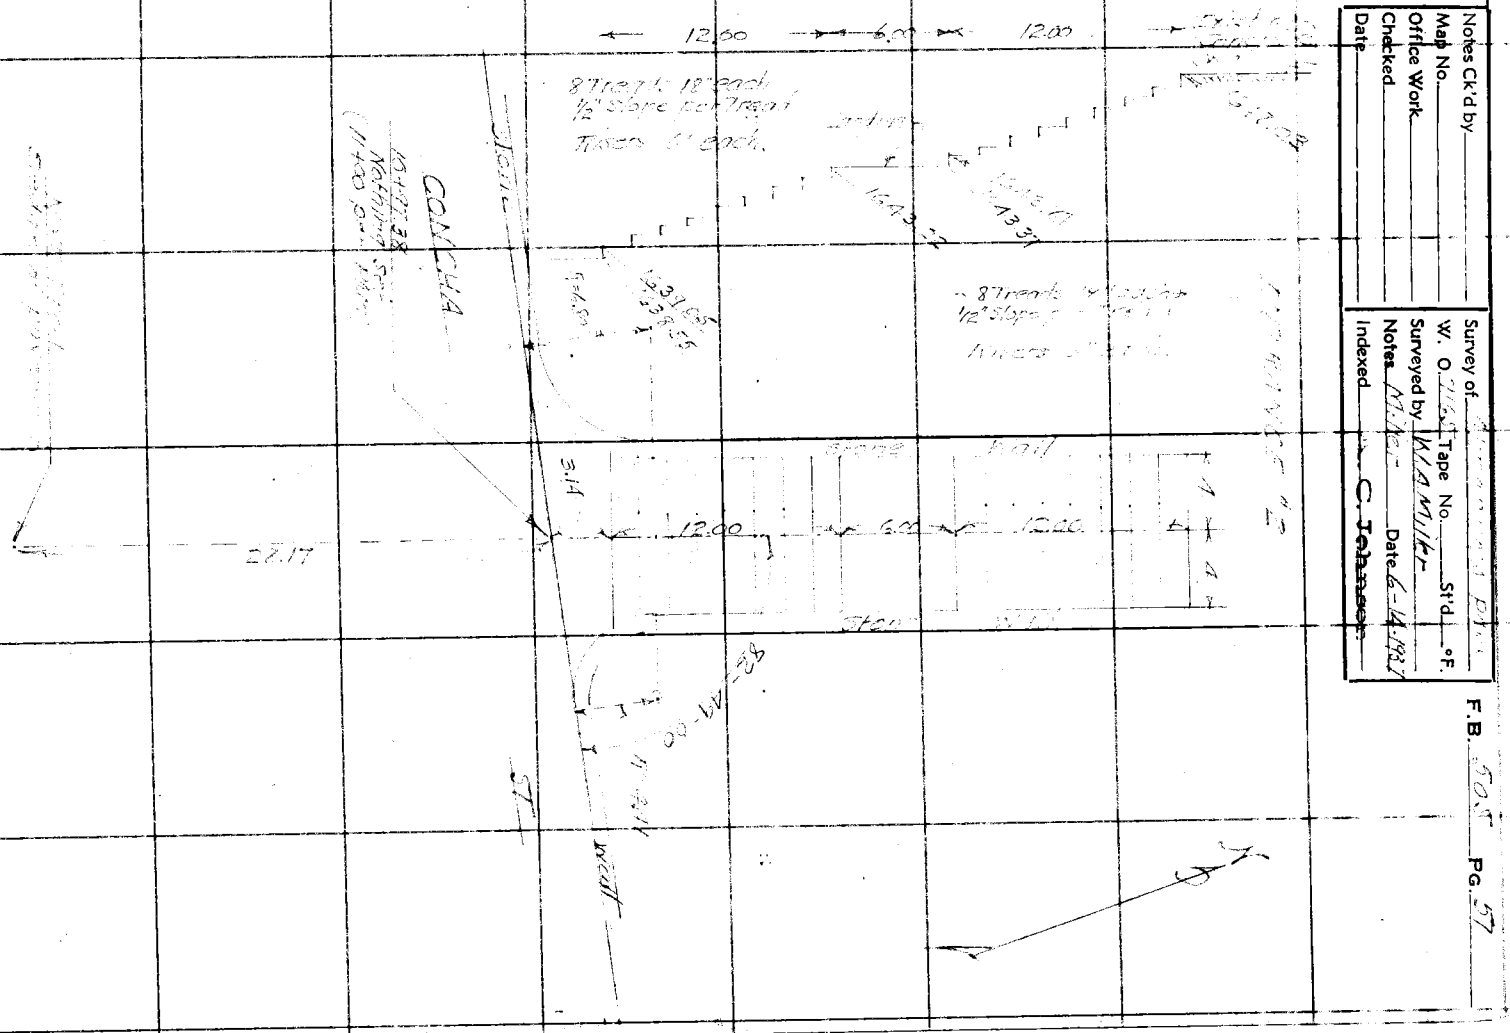

RETURN TO
LOS ANGELES COUNTY SURVEYOR
700 HALL OF RECORDS

Note: Any Additions or Changes on This Sheet Must be Made or Circled in **Red Ink** With Date and Name of Person Making Change.

Do not extend notes this side of this line

F.B. 505 Pg. 51

Notes Ck'd by	Survey of Altadena Park
Map No.	W. O. 716.5 Tape No. St'd °F.
Office Work	Surveyed by W A Miller
Checked	Notes Miller Date 3-4-1931
Date	Indexed A. C. Johnson

F.B. 505 Pg. 59

ALTADENA PARK
N 7 W 5

ENTRANCE No 3
OFF
CONCHA ST

Miller
Braden
Stewart
Clarke
Johnston

Note: Any Additions or Changes on This Sheet Must be Made or Circled in Red Ink With Date and Name of Person Making Change.

Do not extend notes this side of this line

RETURN TO
LOS ANGELES COUNTY SURVEYOR
700 HALL OF RECORDS

FORM 247 10M 11-45

RETURN TO
LOS ANGELES COUNTY SURVEYOR
700 HALL OF RECORDS

Note: Any Additions or Changes on This Sheet Must be Made or Circled in **Red Ink** With Date and Name of Person Making Change.

Do not extend notes this side of this line

F.B. 5057 PG. 60

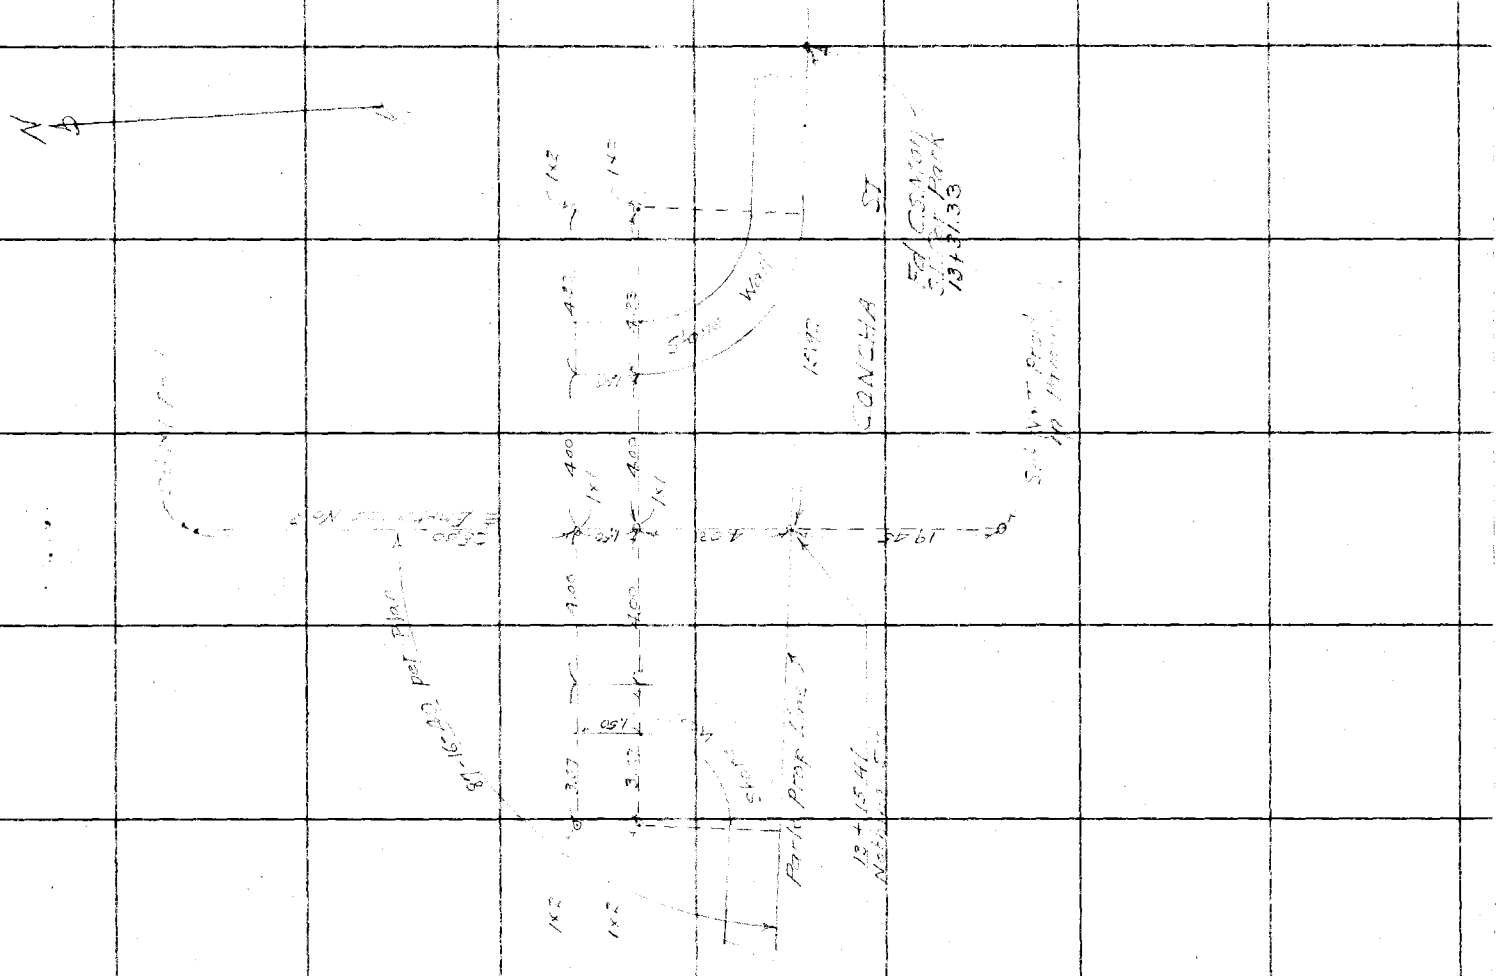

Notes Ck'd by	Survey of
Map No.	W. O. Tape No. St'd °F.
Office Work	Surveyed by
Checked	Notes Date
Date	Indexed A. C. Johnson 8-24-39

F.B. 505 PG. 61

ALTADENA PARK
CNTY 455

ALIGNMENT

Note: Any Additions or Changes on This Sheet Must be Made or Circled in Red Ink With Date and Name of Person Making Change.

Do not extend notes this side of this line

RETURN TO
LOS ANGELES COUNTY SURVEYOR
700 HALL OF RECORDS

FORM 247 10M 11-35

F.B. 505 Pg. 62

Con at bottom: Dyc 63

1+70	19-15-20
+80	20-33-35
+90	22-31-45
496.96 EC	23-40-00

Δ=47-20-00
R=175'
T=76.70
L=144.57

Set 1"x

10' Offset 2x2

Set 1"x1"

Set "X"

Δ=40-50-15
R=60'
T=22.34
L=42.76

Set "X"

Shake Wall

Set "X"

11.56

Set "X"

2+03.82 BC	
+10	2-57-00
+30	7-43-30
+50	12-30-00
+70	17-16-30
+96.58 EC	20-25-00

RETURN TO
LOS ANGELES COUNTY SURVEYOR
700 HALL OF RECORDS

Note: Any Additions or Changes on This Sheet Must be Made or Circled in Red Ink With Date and Name of Person Making Change.

Do not extend notes this side of this line

Notes Ck'd by	Survey of
Map No.	W. O. 7165 Tape No. St'd °F.
Office Work	Surveyed by W.A. Miller
Checked	Notes Date 7-27-37
Date	Indexed C. Johnson

F.B. [illegible] PG. 13

Note: Any Additions or Changes on This Sheet Must be Made or Circled in Red Ink With Date and Name of Person Making Change

Do not extend notes this side of this line

RETURN TO
LOS ANGELES COUNTY SURVEYOR
700 HALL OF RECORDS

0+44.10 ℄
+20 1-11-15
+30 3-53-05
+40 6-18-45
+47.87 ℄ 7-30-00

Rd N 47

150' to ℄ of Rd

189.45

14.00

0+14

Δ= 15-00-00
R= 118 ℄
T= 15.54
L= 30.89

0+47.87
Gate

End Wall 0+58

Set N 47

7.5

2+53.39

See next page for change in ℄ of Storm Wall From McClure Ave to 3+15 in Wall

Δ= 47-20-00
R= 175 ℄
T= 76.70
L= 144.57

0+52.37 ℄S
+60 1-14-45
+70 3-33-00
+80 4-31-15
+90 6-09-25
1+00 7-47-40
+10 9-25-10
+20 11-04-05
+30 12-42-25
+40 14-20-40
+50 15-58-55
+60 17-37-05

Continued on next page

FORM 247 10M 11-35

F.B. 505 PG. 64

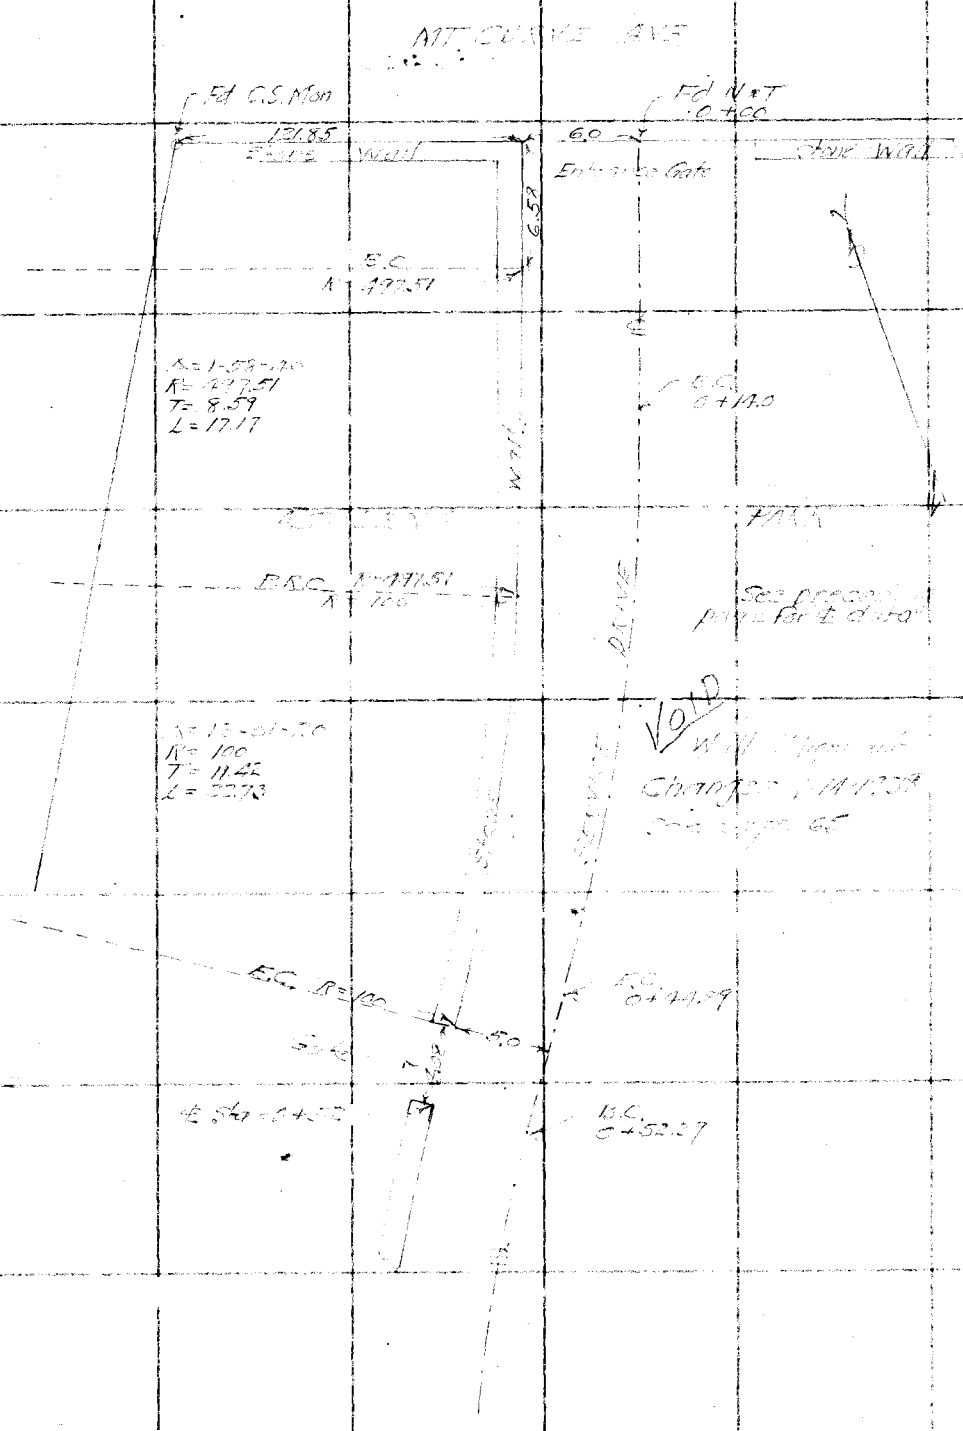

RETURN TO
LOS ANGELES COUNTY SURVEYOR
700 HALL OF RECORDS

Note: Any Additions or Changes on This Sheet Must be Made or Circled in Red Ink With Date and Name of Person Making Change.

Do not extend notes this side of this line

Notes Ck'd by	Survey of
Map No.	W. O. Tape No. St'd °F.
Office Work	Surveyed by W.A.Miller
Checked	Notes Miller Date 5-17-1928
Date	Indexed A. C. Johnson

F.B. Pg.

Note: Any Additions or Changes on This Sheet Must be Made or Circled in Red Ink With Date and Name of Person Making Change.

Do not extend notes this side of this line

RETURN TO
LOS ANGELES COUNTY SURVEYOR
720 HALL OF RECORDS

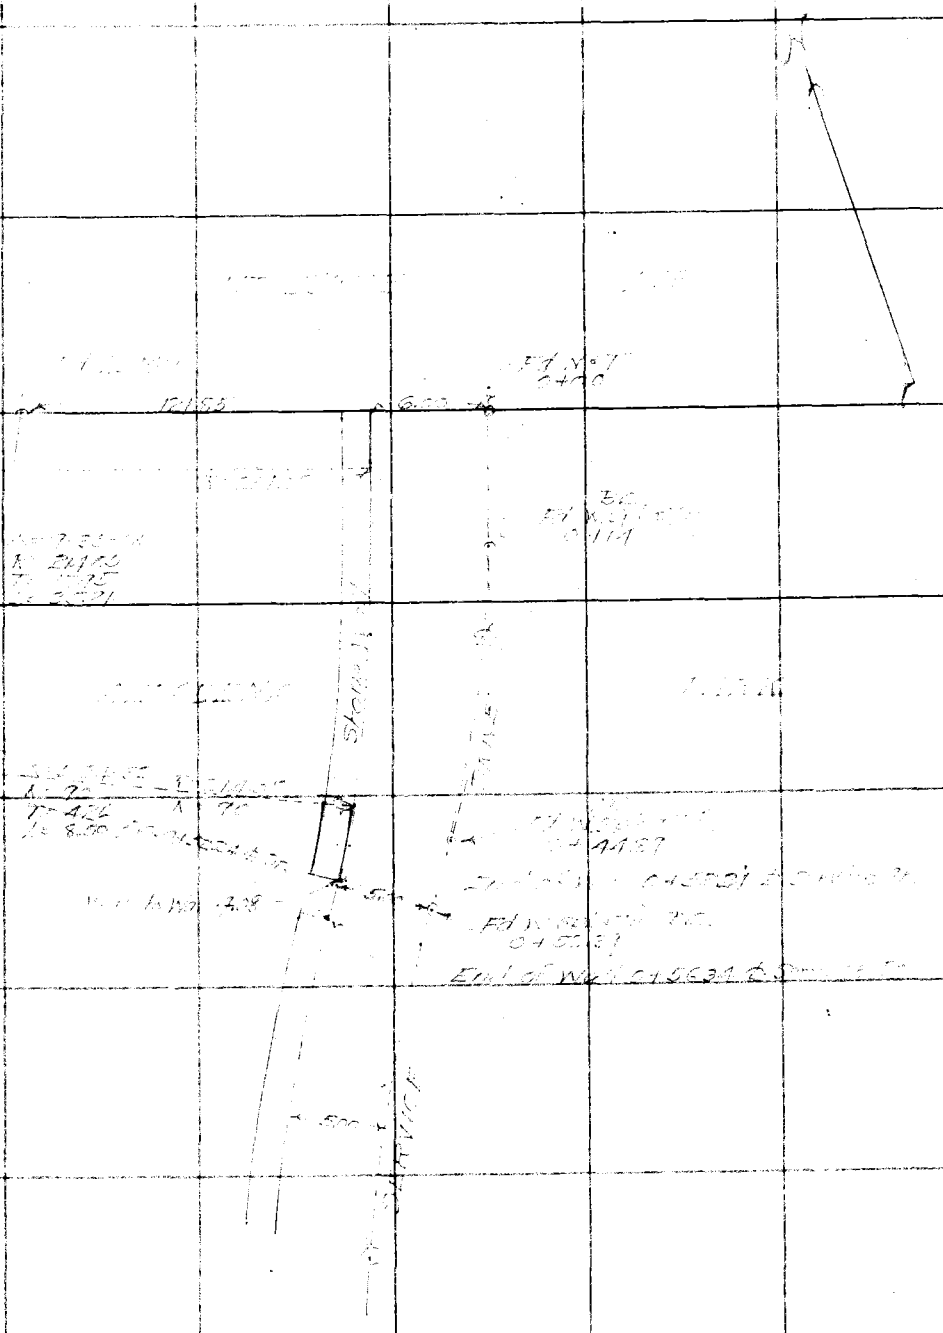

FORM 247 10M 11-38

RETURN TO
LOS ANGELES COUNTY SURVEYOR
700 HALL OF RECORDS

Note: Any Additions or Changes on This Sheet Must be Made or Circled in **Red Ink** With Date and Name of Person Making Change.

Do not extend notes this side of this line

F.B. _____ PG. _____

FORM 247 10M 11-38

RETURN TO
LOS ANGELES COUNTY SURVEYOR
700 HALL OF RECORDS

Note: Any Additions or Changes on This Sheet Must be Made or Circled in **Red Ink** With Date and Name of Person Making Change.

Do not extend notes this side of this line

Notes Ck'd by
Map No.
Office Work
Checked
Date

Survey of
W. O.
Tape No. St'd. °F.
Surveyed by
Notes Date
Indexed

F.B. PG.

RETURN TO
LOS ANGELES COUNTY SURVEYOR
700 HALL OF RECORDS

Note: Any Additions or Changes on This Sheet Must be Made or Circled in **Red Ink** With Date and Name of Person Making Change.

Do not extend notes this side of this line

F.B. 505 PG. 68

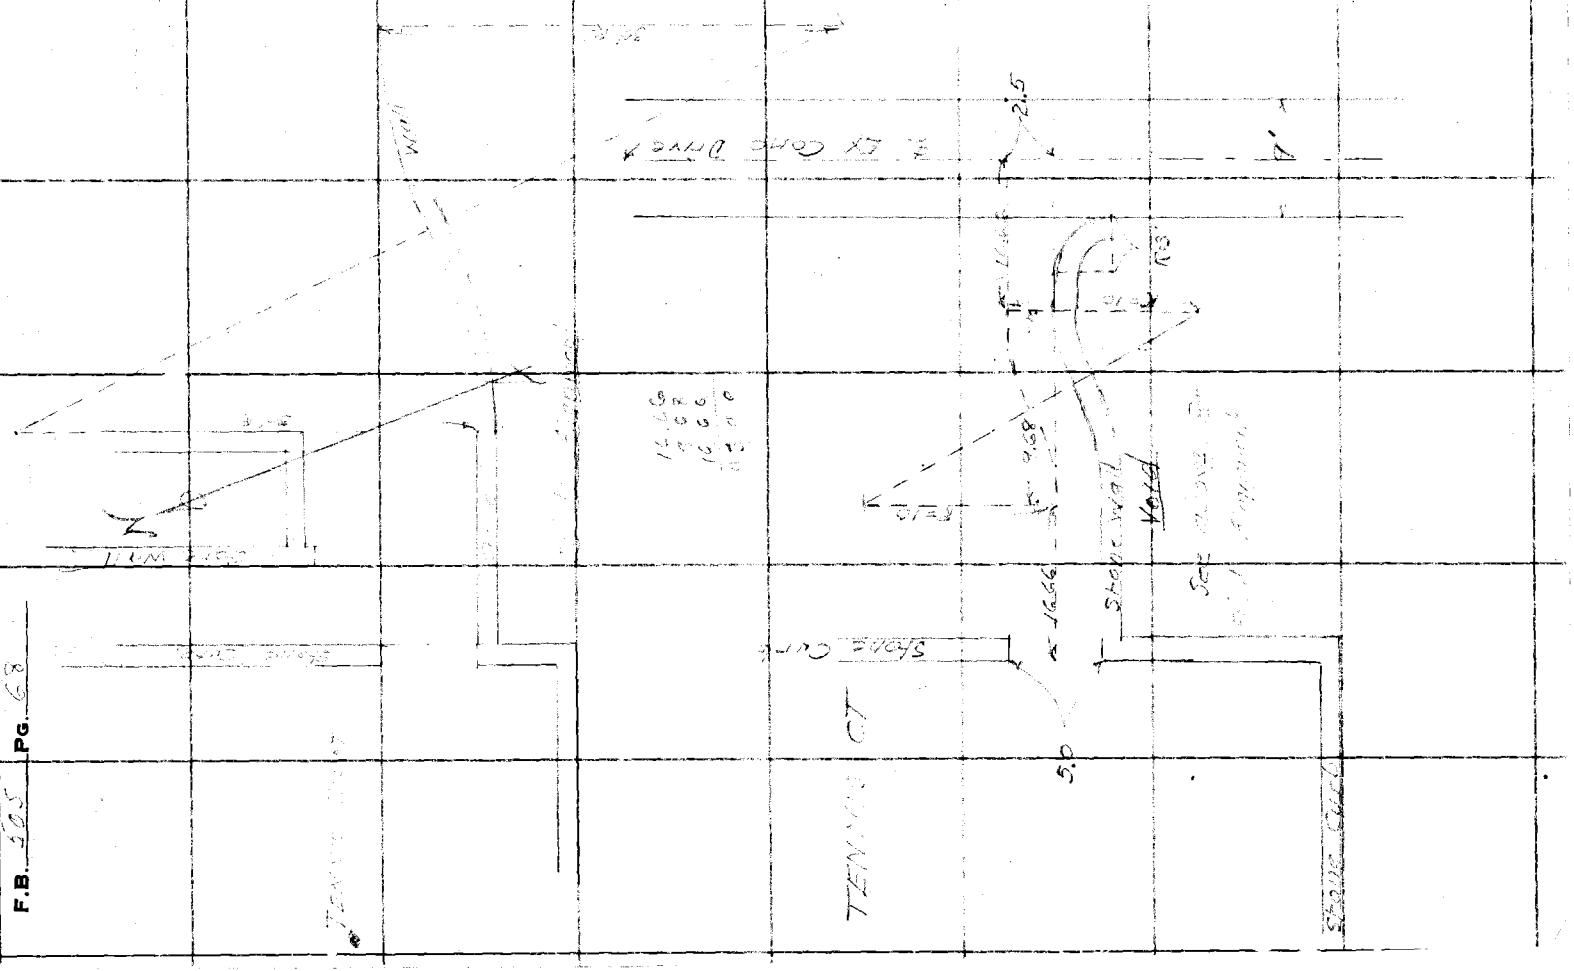

Notes Ck'd by	Survey of Altadena Park	F.B. 505	Pg. 69
Map No.	W. O. 7165 Tape No. St'd °F.		
Office Work	Surveyed by H.A. Muller		
Checked	Notes Date 1927		
Date	Indexed A. C. Johnson		

Altadena Park
J.N. 7165

Location New Water Pipe

Note: Any Additions or Changes on This Sheet Must be Made or Circled in Red Ink With Date and Name of Person Making Change.

Do not extend notes this side of this line

RETURN TO
LOS ANGELES COUNTY SURVEYOR
700 HALL OF RECORDS

FORM 247 10M 11-38

RETURN TO
LOS ANGELES COUNTY SURVEYOR
700 HALL OF RECORDS

Note: Any Additions or Changes on This Sheet Must be Made or Circled in Red Ink With Date and Name of Person Making Change.

Do not extend notes this side of this line

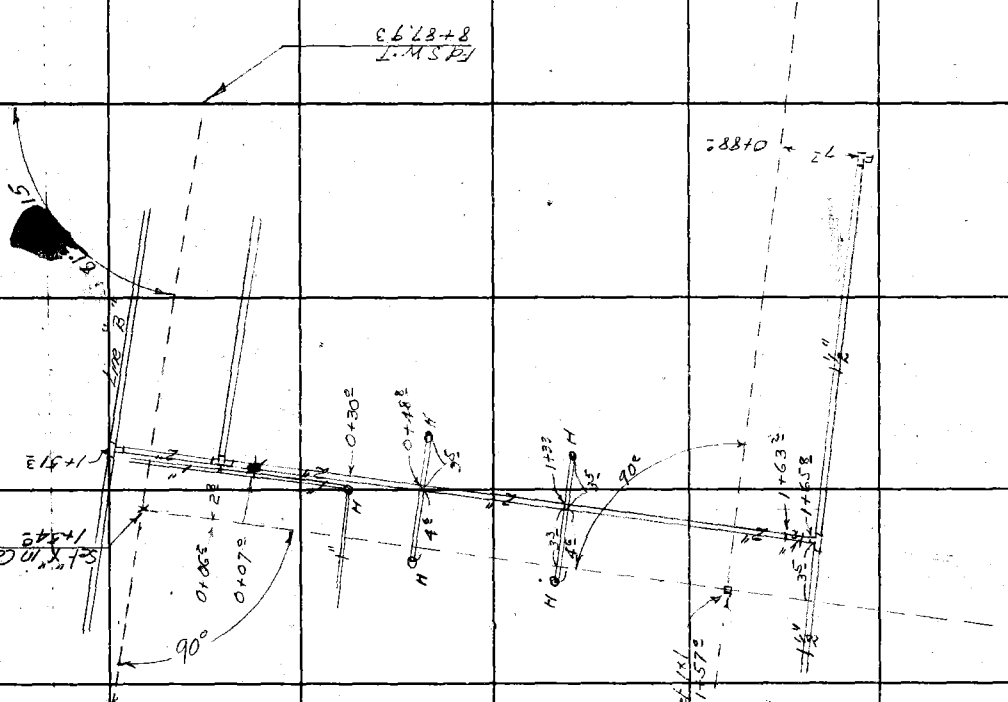

F.B. 505 PG. 70

Notes Ck'd by		Survey of Altadena Park	F.B. 505 Pg. 71
Map No.		W. O. 7164 Tape No.	St'd °F.
Checked		Notes Miller	Date 7-2-1937
Date		Indexed	A. C. Johnson

Con at bottom page 66

Set 1×1 3+00

90°

Transit Line

Line "D"

Line "A"

Line "C"

Line "B"

Set 1×1 0+80

Set "X" in Conc 1+57

Fd. S.W.T. 2+87.93 going NW

Plug Cap

Note: Any Additions or Changes on This Sheet Must be Made or Circled in Red Ink With Date and Name of Person Making Change.

Do not extend plots this side of this line

RETURN TO
LOS ANGELES COUNTY SURVEYOR
700 HALL OF RECORDS

FORM 847 10M 11-38

RETURN TO
LOS ANGELES COUNTY SURVEYOR
700 HALL OF RECORDS

Note: Any Additions or Changes on This Sheet Must be Made or Circled in Red Ink With Date and Name of Person Making Change.

Do not extend notes this side of this line

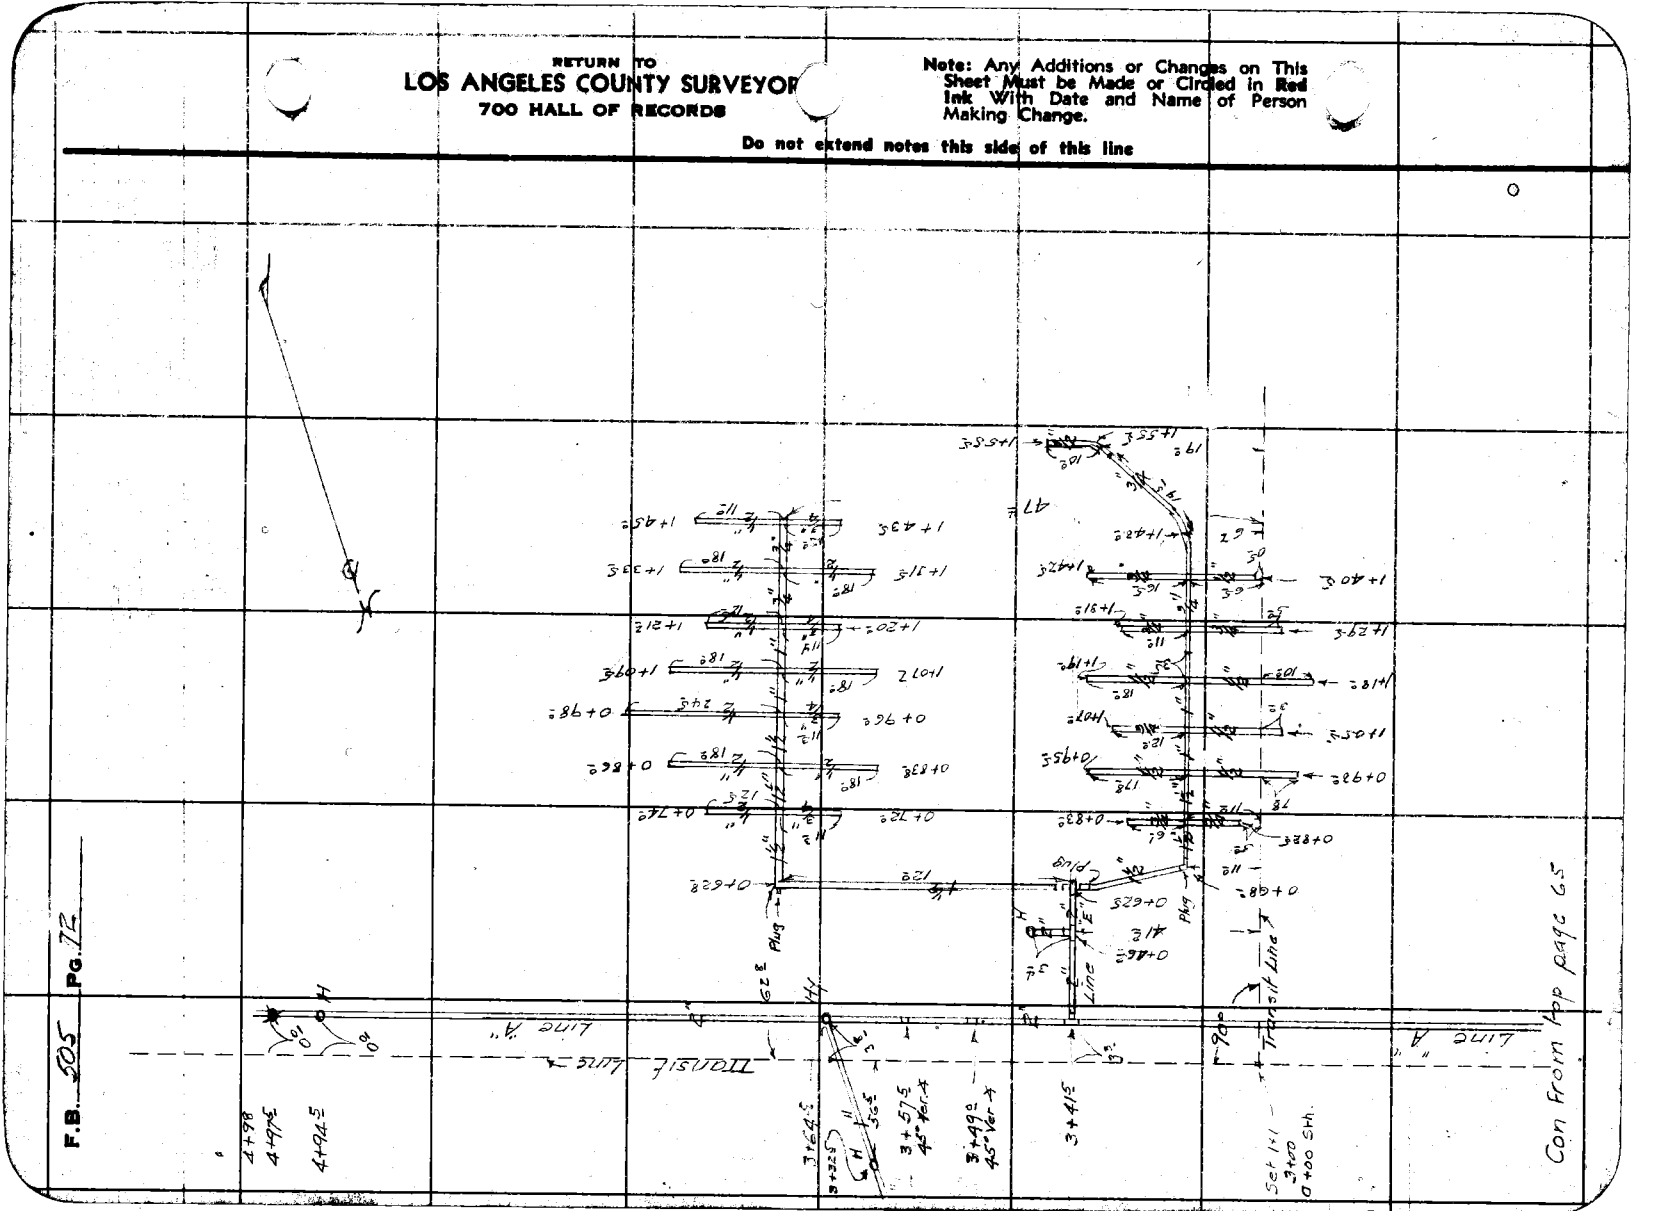

FORM 247 10M 11-38

RETURN TO
LOS ANGELES COUNTY SURVEYOR
700 HALL OF RECORDS

Note: Any Additions or Changes on This Sheet Must be Made or Circled in Red Ink With Date and Name of Person Making Change.

Do not extend notes this side of this line

Notes Ck'd by
Map No.
Office Work
Checked
Date

Survey of
W. O. Tape No. St'd °F.
Surveyed by
Notes
Date
Indexed C. Johnson

F.B. 504 PG. 73

RETURN TO
LOS ANGELES COUNTY SURVEYOR
700 HALL OF RECORDS

Note: Any Additions or Changes on This Sheet Must be Made or Circled in Red Ink With Date and Name of Person Making Change.

Do not extend notes this side of this line

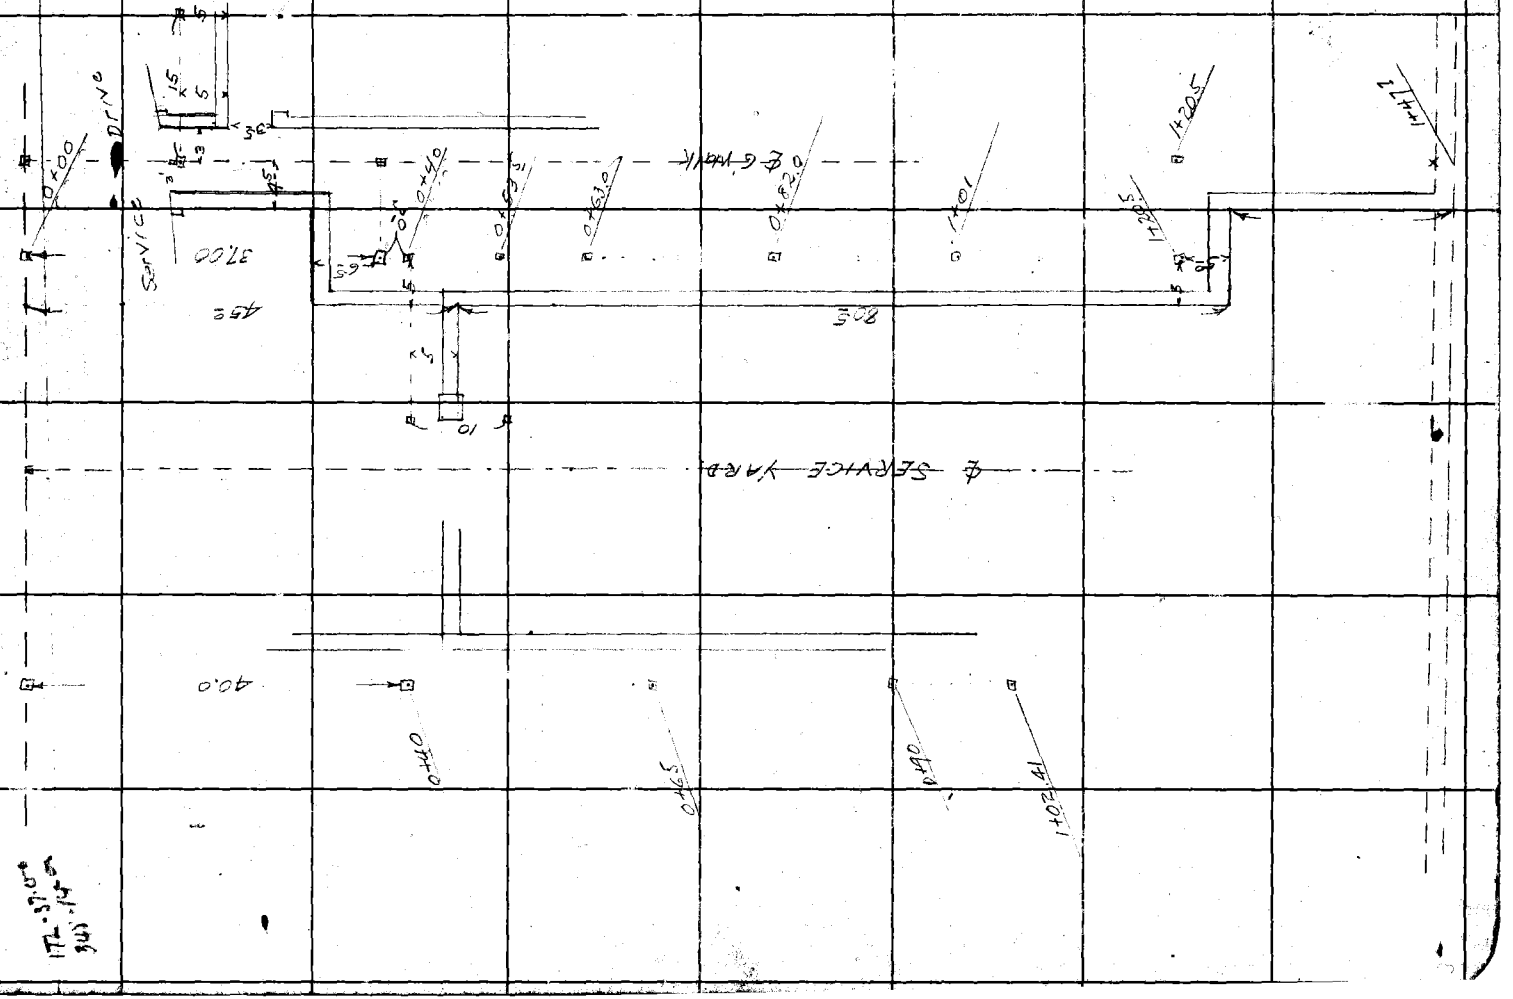

F.B. 505 Pg. 74

Notes Ck'd by	Survey of ANTELOPE PARK	F.B. 505 Pg. 75
Map No.	W. O. 7165 Tape No. St'd °F.	
Office Work	Surveyed by [illegible]	
Checked	Notes Miller Date	
Date	Indexed A. C. Johnson	

Note: See L.B. 857-237 to 241 for Rough Grades

See page 76 for Aisles "2" & "3"

See F.B. 748-18

Set 2x2 Prod 1' on bottom Step

Set 2x2 Prod

Driveway

Aisle #1

Aisle #2

AUDITORIUM

STAGE

OUTDOOR THEATRE

Set x on Wall Prod

Set x on Wall Prod

Radii Center 0+00

N35 Axis

Note: Any Additions or Changes on This Sheet Must be Made or Circled in Red Ink With Date and Name of Person Making Change.

Do not extend plates this side of this line

RETURN TO
LOS ANGELES COUNTY SURVEYOR
700 HALL OF RECORDS

FORM 247 10M 11-38

F.B. 505 Pg. 76

See L.B 857-237 to 241 For Rough Grades

See page 75 for Aisles "1" & "4"

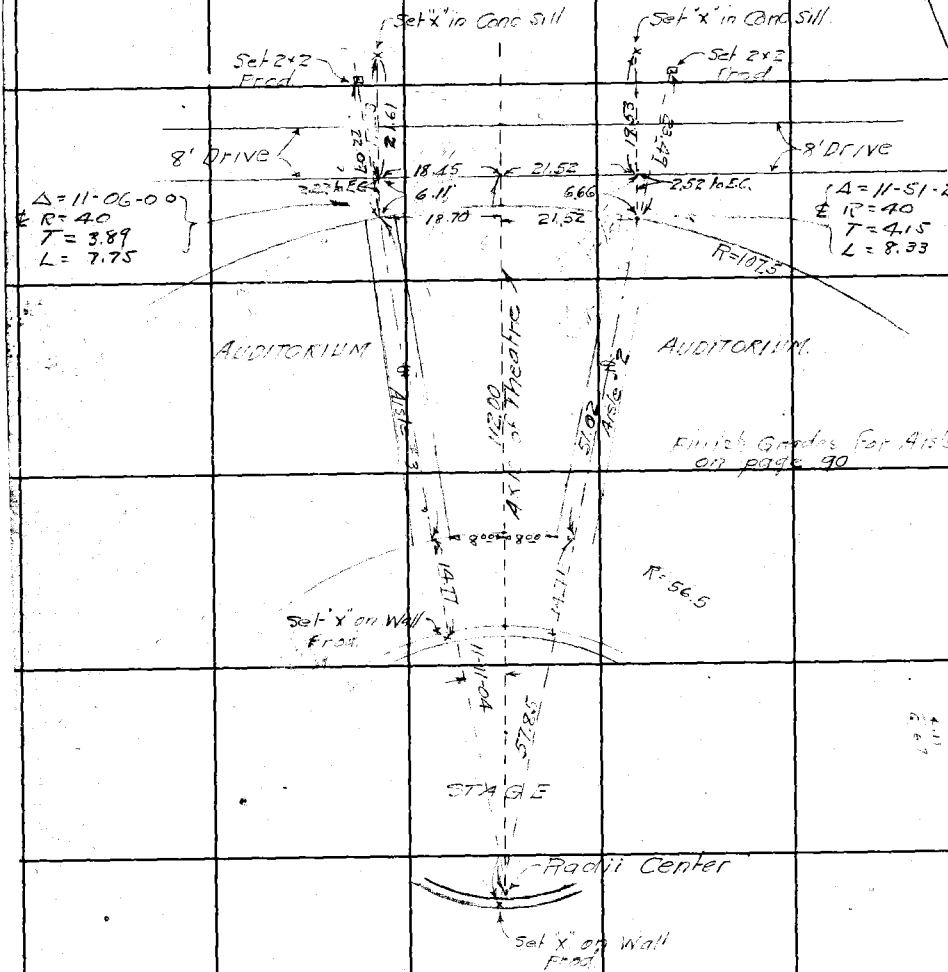

RETURN TO
LOS ANGELES COUNTY SURVEYOR
700 HALL OF RECORDS

Note: Any Additions or Changes on This Sheet Must be Made or Circled in Red Ink With Date and Name of Person Making Change.

Do not extend notes this side of this line

FORM 247 10M 11-38

RETURN TO
LOS ANGELES COUNTY SURVEYOR
700 HALL OF RECORDS

Note: Any Additions or Changes on This Sheet Must be Made or Circled in Red Ink With Date and Name of Person Making Change.

Do not extend notes this side of this line

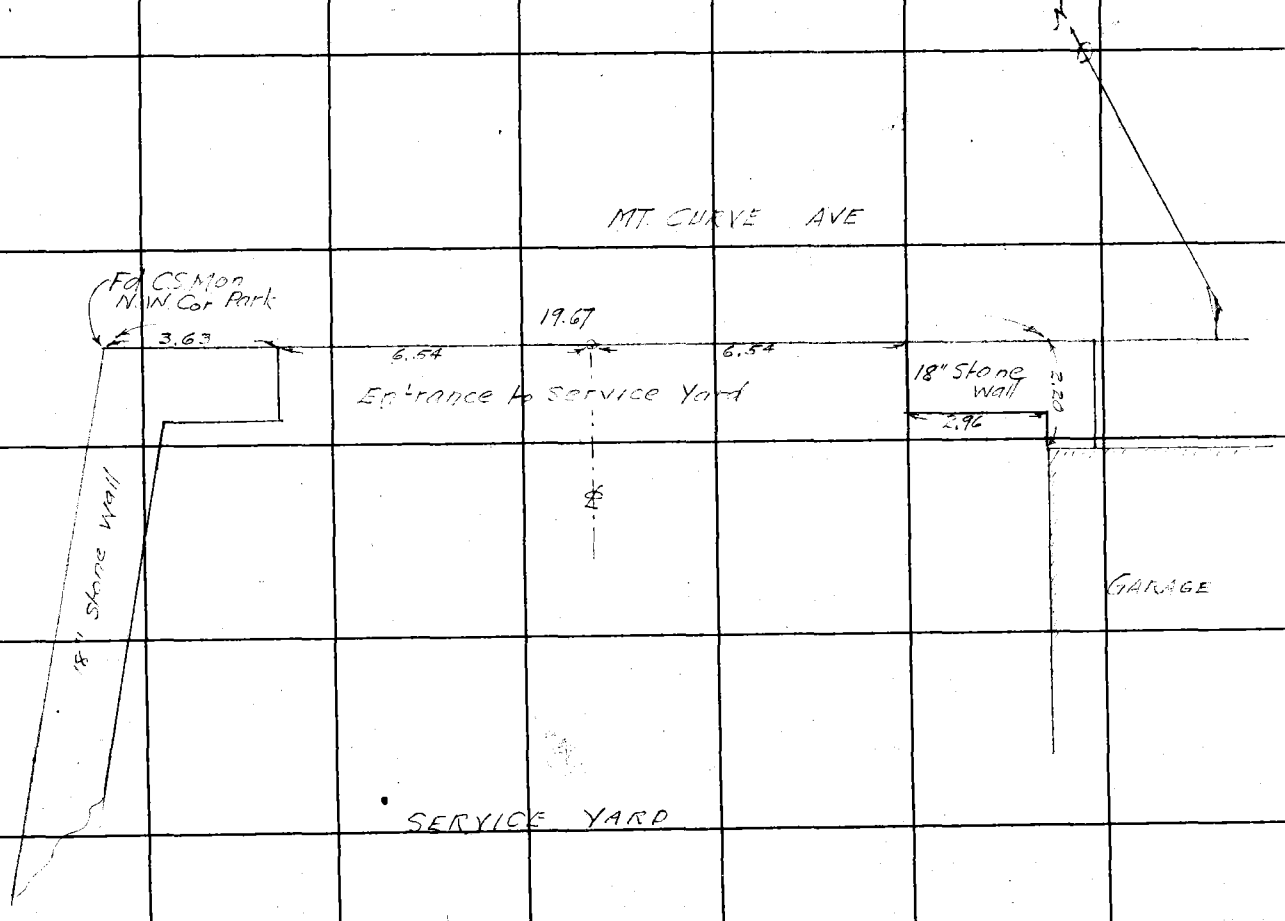

Notes Ck'd by _____
Map No. _____
Office Work _____
Checked _____
Date _____

Survey of INTAKE PARK
W. O. 7165 Tape No. _____ St'd. _____ F.
Surveyed by Miller Date 6-29-1927
Notes _____
Indexed _____ C. Johnson

F.B. 504 PG. 77

RETURN TO
LOS ANGELES COUNTY SURVEYOR
700 HALL OF RECORDS

Note: Any Additions or Changes on This Sheet Must be Made or Circled in Red Ink With Date and Name of Person Making Change.

Do not extend notes this side of this line

F.B. 505 Pg. 78

Notes Ck'd by	Survey of Altadena Park
Map No.	W. O 7165 Tape No. St'd °F.
Office Work	Surveyed by W.A. Miller
Checked	Notes NNler Date 1-11-1938
Date	Indexed A. C. Johnson

F.B. 505 Pg. 79

Altadena Park
J.N. 7165

Brick Walks
Caretakers Cottage.

Note: Any Additions or Changes on This Sheet Must be Made or Circled in Red Ink With Date and Name of Person Making Change.

Do not extend notes this side of this line

RETURN TO
LOS ANGELES COUNTY SURVEYOR
700 HALL OF RECORDS

FORM 247 10M 11-35

F.B. 505 Pg. 80

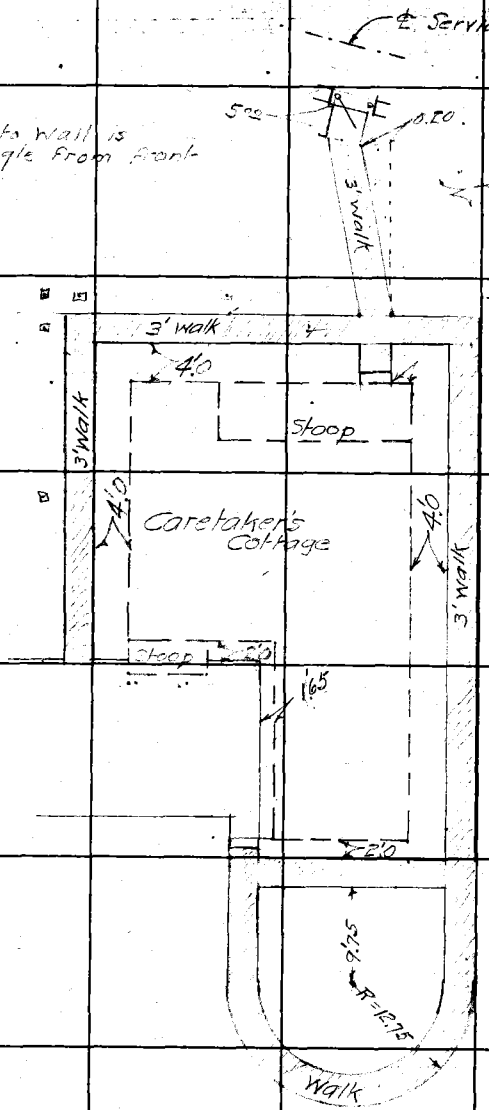

Walk from stoop to wall is 0.20 off right angle from front line of stoop

RETURN TO
LOS ANGELES COUNTY SURVEYOR
700 HALL OF RECORDS

Note: Any Additions or Changes on This Sheet Must be Made or Circled in Red Ink With Date and Name of Person Making Change.

Do not extend notes this side of this line

Notes Ck'd by	Survey of Altadena Park	F.B. 505	Pg. 81
Map No.	W. O. 7165 Tape No. St'd °F.		
Office Work	Surveyed by [illegible]		
Checked	Notes Miller Date Feb 1938		
Date	Indexed A. C. Johnson		

ALTADENA PARK
JN. 7165

SUPPLY WATER LINE
LAKE AVE TO HORSESHOE CT.
THROUGH OUTDOOR THEATRE SITE

Miller
Braden
Gunderson
Walkermire

Note: Any Additions or Changes on This Sheet Must be Made or Circled in Red Ink With Date and Name of Person Making Change.

Do not extend notes this side of this line

RETURN TO
LOS ANGELES COUNTY SURVEYOR
700 HALL OF RECORDS

FORM 247 10M 11-38

F.B. 505 Pg. 82

RETURN TO
LOS ANGELES COUNTY SURVEYOR
700 HALL OF RECORDS

Note: Any Additions or Changes on This Sheet Must be Made or Circled in Red Ink With Date and Name of Person Making Change.

Do not extend notes this side of this line

FORM 247 10M 11-58

RETURN TO
LOS ANGELES COUNTY SURVEYOR
700 HALL OF RECORDS

Note: Any Additions or Changes on This Sheet Must be Made or Circled in Red Ink With Date and Name of Person Making Change.

Do not extend notes this side of this line

Notes Ck'd by
Map No.
Office Work
Checked
Date

Survey of Alhadena Park
W. O. 7163 Tape No. Std. °F.
Surveyed by Miller Date Feb 1938
Notes
Indexed A. C. Johnson

F.B. 203 Pg. 83

681

RETURN TO
LOS ANGELES COUNTY SURVEYOR
700 HALL OF RECORDS

Note: Any Additions or Changes on This Sheet Must be Made or Circled in Red Ink With Date and Name of Person Making Change.

Do not extend notes this side of this line

F.B. 505 PG. 84

Notes Ck'd by
Map No.
Office Work
Checked
Date

Survey of ALTADENA PARK
W. O. 7165 Tape No. St'd °F.
Surveyed by WAMITE?
Notes Miller Date 2-16-1938
Indexed A. C. Johnson

F.B. 505 Pg. 85

ALTADENA PARK
J.N. 7165

SHELTER GATES.

Miller
Braden
Gunderson
Walter mire

Note: Any Additions or Changes on This Sheet Must be Made or Circled in Red Ink With Date and Name of Person Making Change.

Do not extend notes this side of this line

RETURN TO
LOS ANGELES COUNTY SURVEYOR
700 HALL OF RECORDS

FORM 247 10M 11-38

F.B. 505 Pg. 86

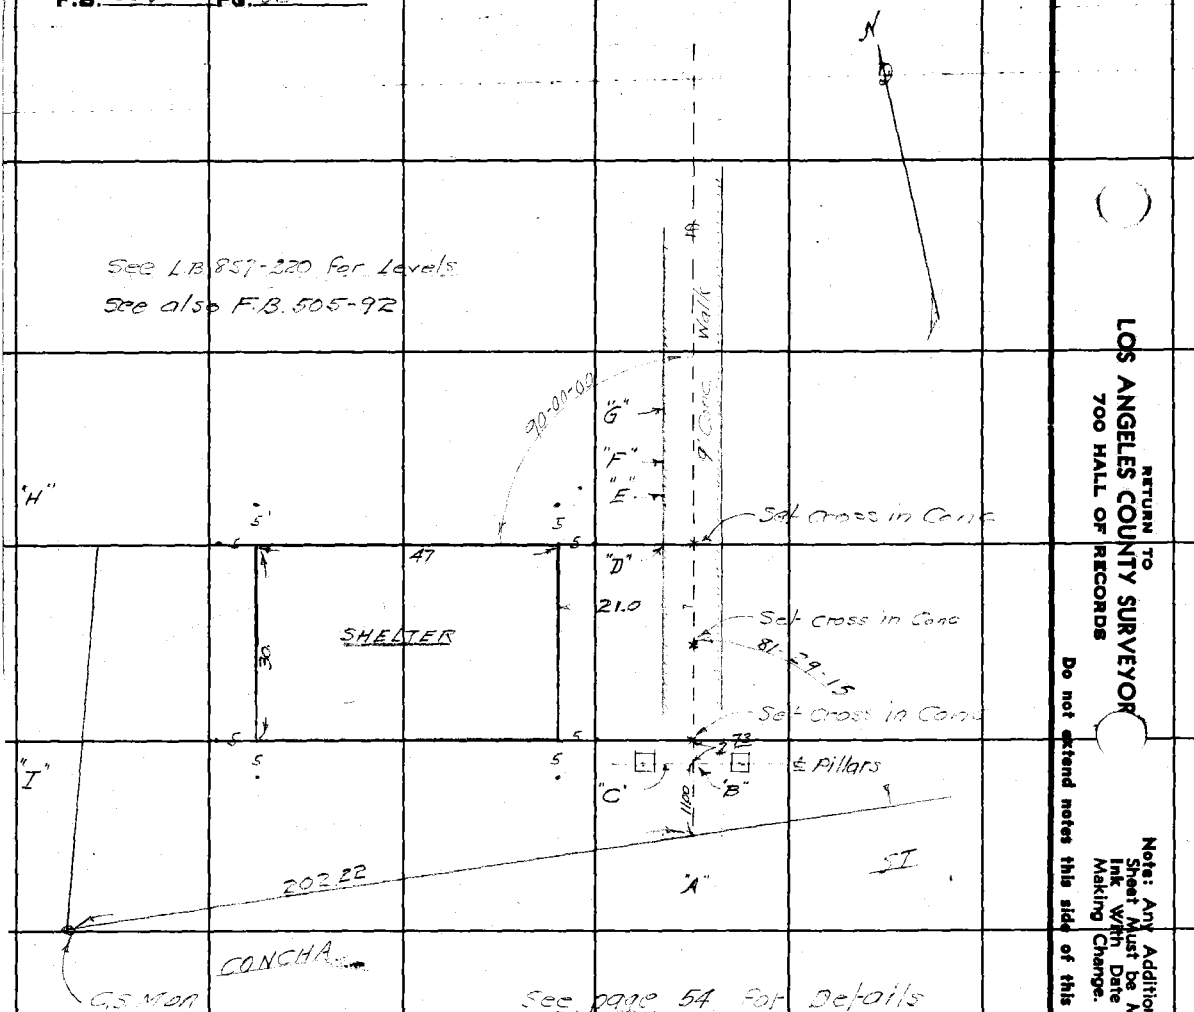

RETURN TO
LOS ANGELES COUNTY SURVEYOR
700 HALL OF RECORDS

Note: Any Additions or Changes on This Sheet Must be Made or Circled in Red Ink With Date and Name of Person Making Change.

Do not extend notes this side of this line

Notes Ck'd by
Map No.
Office Work
Checked
Date

Survey of ALTADENA PARK
W. O. 7165 Tape No. St'd °F.
Surveyed by W.A. MILLER
Notes Date
A. C. Johnson
Indexed

F.B. 505 PG. 87

ALTADENA PARK
JN 7165

WALLS & STEPS
N.E. OF STAGE
OUTDOOR THEATRE

Miller-
Brandon
Gunderson
Waltermire

Note: Any Additions or Changes on This Sheet Must be Made or Circled in Red Ink With Date and Name of Person Making Change.

Do not extend notes this side of this line

RETURN TO
LOS ANGELES COUNTY SURVEYOR
700 HALL OF RECORDS

FORM 247 10M 11-58

RETURN TO
LOS ANGELES COUNTY SURVEYOR
700 HALL OF RECORDS

Note: Any Additions or Changes on This Sheet Must be Made or Circled in Red Ink With Date and Name of Person Making Change.

Do not extend notes this side of this line

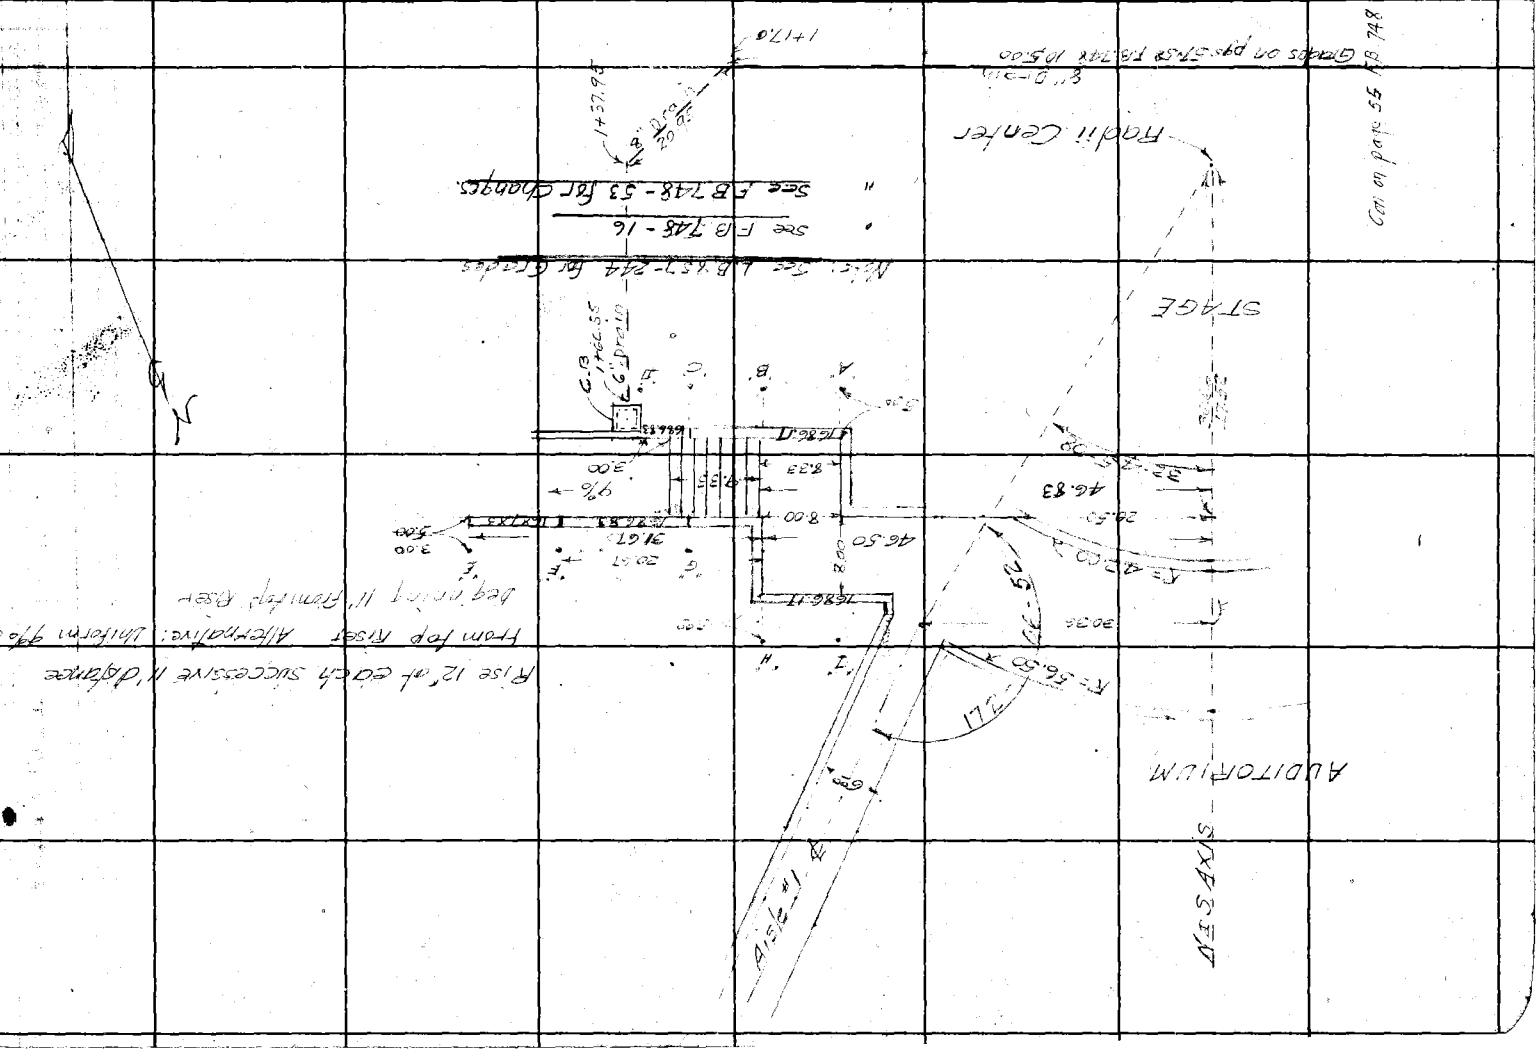

Profile No. | Notes Red. | Plotted | Job No. 7165 | Division No. | F. B. 505 Pg. 89

X-Sec. No. | Notes Chkd. | Checked | Survey of ALTADENA PARK

Date | Date | Survey by W.A. Miller | Notes Miller | Date 3-4-1938

Date | Date | Map No. | Traverse

ALTADENA PARK

JN 7165

CURB GRADES

AISLES #2 & #3

OUTDOOR THEATRE

Miller
Braden
Gunderson
Walkemire

STATION	B. S.	H. I.	F. S.	ELEV.

NOTE: ANY ADDITIONS OR CHANGES ON THIS SHEET MUST BE MADE OR CIRCLED IN RED INK, WITH DATE AND NAME OF PERSON MAKING CHANGE

Do not extend notes this side of this line

PLEASE RETURN TO
LOS ANGELES COUNTY SURVEYOR
700 HALL OF RECORDS

Form 307 5M 10-37

Form 307 5M 10-37

PLEASE RETURN TO
LOS ANGELES COUNTY SURVEYOR
700 HALL OF RECORDS

NOTE: ANY ADDITIONS OR CHANGES ON THIS SHEET MUST BE MADE OR CIRCLED IN RED INK, WITH DATE AND NAME OF PERSON MAKING CHANGE

Do not extend notes this side of this line

F. B. 505 Pg. 90 | Job No. 7165 Division No. | Notes Red. | Plotted | Profile
Survey of ALTADENA PARK | Date | No.
Survey by W.A. Miller | Notes Miller 3-4-1938 | Notes Chkd. | Checked | X-Sec.
Indexed A. C. Johnson | Date | Date | Date | No.

STATION	B. S.	H. I.	F. S.	ELEV.	Finish Grade	
T.B.M.	4.34	1691.27		1686.93		T.B.M. El 1686.93 L.B. 857-238 Chis □ on Rock Wall S side of Stage - N & S Axis Outdoor Theatre.
0+57.25			7.83		1683.44	
+60.25			7.29		1683.98	NOTE: 0+00 = Radii Point 124.5 from Recreation Bldg. on N & S ℄
+63.25			6.72		1684.55	
+66.25			6.09		1685.18	See page 76 for Sketch.
+69.25			5.46		1685.81	Set 1×6" Tin on ℄ Aisles
+72.25			4.75		1686.52	Set 1×1 blue tops for grade on appox ℄ Aisles
+78.25			3.25		1689.02	
+87.25			0.76		1690.51	
T.P.	10.23	1700.74	0.76	1690.51		
0+96.25			7.47		1693.27	
1+07.5			3.72		1697.02	
T.B.M.			1.57	1699.19		T.B.M. El 1697.18 L.B. 857-40 X in W end conc sill of W basement entrance of Recreation Bldg.

Profile No. ____ X-Sec. No. ____

Notes Red. ____ Date ____ Notes Chkd. ____ Date ____

Plotted ____ Date ____ Checked ____ Date ____

Job No. 7165 Division No. ____ Survey of ALTADENA PARK Survey by W.A. Miller Map No. ____

F. B. 505 PG. 91 Notes Miller Date 3-10-1938 Indexed ____ Date ____

ALTADENA PARK
J.N. 7165

LEVELS
FOR
PERGOLA DESIGN

Miller
Brogan
Gunderson
Wolfermire

STATION	B. S.	H. I.	F. S.	ELEV.

NOTE: ANY ADDITIONS OR CHANGES ON THIS SHEET MUST BE MADE OR CIRCLED IN RED INK, WITH DATE AND NAME OF PERSON MAKING CHANGE

Do not extend notes this side of this line

PLEASE RETURN TO
LOS ANGELES COUNTY SURVEYOR
700 HALL OF RECORDS

Form 307 5M 10-37

Form 307 5M 10-37

PLEASE RETURN TO
LOS ANGELES COUNTY SURVEYOR
700 HALL OF RECORDS

NOTE: ANY ADDITIONS OR CHANGES ON THIS SHEET MUST BE MADE OR CIRCLED IN RED INK, WITH DATE AND NAME OF PERSON MAKING CHANGE

Do not extend notes this side of this line

F. B. 505 Pg. 92 | Job No. 716.5 | Division No. | Profile
Survey of ALTADENA PARK | Notes Red. | Plotted
Survey by W.A. Miller | Date | No.
Indexed A. C. Johnson | Notes Chkd. 3-10-1938 | Checked | X-Sec.
Date | Date | No.

STATION	B. S.	H. I.	F. S.	ELEV.		
B.M. "A"	11.64	1641.97		1630.33	B.M. El. 1630.33 L.B. 699-6 C.S. Mon S.W. Cor Park	
N. Gutter Concha St			10.65	1631.32	On ℄ prod of 9' Conc Walk in Park.	
"B"			6.83	1635.14	℄ Stone Pillars ℄ 9' Conc Walk	
"C"			6.69	1635.28	℄ " " N. edge 9' Conc Walk.	
"D"			3.36	1638.61	N. edge 9' Conc Walk opp. N.E. Cor Pergola	
"E"		See sketch page 86	2.53	1639.14	" " " " 23.5 N of E & W ℄ of Pergola	
"F"			2.05	1639.92	" " " " 28.5 " " " "	
"G"			1.20	1640.77	" " " " 37 " " " "	
"H"			2.43	1639.54	W. end of 5' walk N of Pergola - Existing	
"I"			3.25	1638.72	" " S. of " - Existing	
B.M.			11.64	1630.33	See above	
Top Slab Grade 3-21-1938					Grade	
B.M.	11.95	1642.28		1630.33		See above
S.W. Cor			2.78		1639.50	Top of slab
Ctr. West Side			2.78		1639.50	" "
N.W. Cor			2.78		1639.50	" "
Ctr. North Side			2.68		1639.60	" "
N.E. Cor			2.78		1639.50	" "
Ctr. East Side			2.78		1639.50	" "
S.E. Cor.			2.78		1639.50	" "
Ctr. South Side			2.68		1639.60	" "

Form 307 SM 10-34

PLEASE RETURN TO
LOS ANGELES COUNTY SURVEYOR
700 HALL OF RECORDS

NOTE: ANY ADDITIONS OR CHANGES ON THIS SHEET MUST BE MADE OR CIRCLED IN RED INK, WITH DATE AND NAME OF PERSON MAKING CHANGE

Do not extend notes this side of this line

STATION	B. S.	H. I.	F. S	ELEV.	Grade		
		1642.28					
Ctr. Pergola			2.68		1639.60	Top of Slab	
B.M.						El. 1630.33 L.B. 6976 C.S. Man	
						B.M. SW Car Park	

Profile Notes Red. ____ Platted ____ Job No. 7165 Division No. ____
No. ____ Date ____ Date ____ Survey of Altadena Park
X. Sec. Notes Chkd. ____ Checked ____ Survey by W.A. Miller Notes Miller Date 3-21-1938
E.B. 505 Pg. 93

505 P.G. 94 | Job. No. | Division No. | Notes Red | Plotted | Profile

Survey of | Date | Date | No.

Survey by | Notes | Notes Chkd. | Checked | X-Sec.

Indexed A. C. Johnson | Date | Date | Date | No.

STATION	B. S.	H. I.	F. S	ELEV.

Form 307 5M 10-34

PLEASE RETURN TO
LOS ANGELES COUNTY SURVEYOR
700 HALL OF RECORDS

Do not extend notes this side of this line

NOTE: ANY ADDITIONS OR CHANGES ON THIS SHEET MUST BE MADE OR CIRCLED IN RED INK, WITH DATE AND NAME OF PERSON MAKING CHANGE

Profile No. _____ X-Sec.

Notes Red. _____ Platted _____ Job No. 7165 Division No. _____

Date _____ Date _____ Survey of ALTADENA PARK

Notes Chkd. _____ Checked _____ Survey by W.A.MILLER Notes Miller Date 3-22-1938

L. B. 505 Pg. 95

ALTADENA PARK
JN 7165

LINE & GRADES
RISERS & TREADS
AT
AUDITORIUM

Miller
Braden
Gunderson
Wallermire

NOTE: ANY ADDITIONS OR CHANGES ON THIS SHEET MUST BE MADE OR CIRCLED IN RED INK, WITH DATE AND NAME OF PERSON MAKING CHANGE

Do not extend notes this side of this line

STATION	B. S.	H. I.	F. S	ELEV.

PLEASE RETURN TO
LOS ANGELES COUNTY SURVEYOR
700 HALL OF RECORDS

Form 307 SM 10-34

Form 307 5M 10-34

PLEASE RETURN TO
LOS ANGELES COUNTY SURVEYOR
700 HALL OF RECORDS

NOTE: ANY ADDITIONS OR CHANGES ON THIS SHEET MUST BE MADE ON CIRCLED IN RED INK, WITH DATE AND NAME OF PERSON MAKING CHANGE

1697.33
BS 87
10.52

Do not extend notes this side of this line

Profile No. ____ Plotted ____
Notes Red ____ Date ____ Checked ____ X-Sec. No. ____
Tab. No. 765 Division No. ____ Date ____ Notes Chkd. ____ Date ____
Survey of ALTADENA PARK Notes Miller 3-22-38 Date ____
Survey by W.A. Miller
Indexed A. C. Johnson
Cont. P.G. 76

STATION	B. S.	H. I.	F. S	ELEV.	Top of Risers	
T.B.M.	10.40	1697.33		1686.93		El. 1686.93 L.B. 857-238 chis □ on Rock Wall T.B.M. S. side of stage N-S. Axis of Outdoor Theatre
0+94.5			4.08		1693.25	For Riser at 0+95.5
1+03.5			2.08		1695.25	" " " 1+01.5
0+85.5			6.84		1690.49	" " " 0+86.5
T.P.	8.02	1703.27	2.08	1695.25		
T.B.M.			4.10	1699.17		El. 1699.18 L.B. 857-40 X in W. end conc. sill of W. basement entrance of Recreation Bldg.
	3-24-1938					
T.B.M.	10.02	1696.95		1686.93		See above.
0+85.5			6.46		1690.49	For Riser at 0+86.5
0+94.5			3.70		1693.25	" " " 0+95.5
1+03.5			1.70		1695.25	" " " 1+01.5
T.P.	4.75	1700.00	1.70	1695.25		
T.B.M.			0.84	1699.16		See above.

Profile No. ____ X-Sec. ____ Notes Red. ____ Date ____ Notes Chkd. ____ Platted ____ Date ____ Checked ____ Job No. 7165 Division No. ____ Survey of ALTADENA PARK Survey by W.A.Miller Notes Miller Date 3-24-1938

E.B. 505 Pg. 97

ALTADENA PARK

J.N. 7165

LINE & GRADE

EAST AISLE & EAST WALL

OF

AUDITORIUM

See F.B. 748-24 for reset.

Miller
Braden
Gunderson
Winterpalre

STATION	B.S.	H.I.	F.S	ELEV.

NOTE: ANY ADDITIONS OR CHANGES ON THIS SHEET MUST BE MADE OR CIRCLED IN RED INK, WITH DATE AND NAME OF PERSON MAKING CHANGE

Do not extend notes this side of this line

PLEASE RETURN TO LOS ANGELES COUNTY SURVEYOR 700 HALL OF RECORDS

Form 327 6M 10-34

Form 307 5M 10-34

PLEASE RETURN TO
LOS ANGELES COUNTY SURVEYOR
700 HALL OF RECORDS

NOTE: ANY ADDITIONS OR CHANGES ON THIS SHEET MUST BE MADE OR CIRCLED IN RED INK, WITH DATE AND NAME OF PERSON MAKING CHANGE

Do not extend notes this side of this line

Profile No. | Plotted Date | Checked Date | X-Sec. No. | Date

Job No. 765 Division No. | Notes Red. Date | Notes Chkd. Date

Survey of ALTADENA PARK

Survey by W.A. Miller 2-24-1938 Notes C. Johnson Date

Indexed

STATION	B. S.	H. I.	F. S	ELEV.	Finish Grade.	
T.B.M.	6.47	1693.40		1686.93		TBM El. 1686.93 L.B. 857-238 Chiseled on Rock Wall S Side of Stage N°S Axis of Outdoor Theatre
0+56 ±						
0+60.25			9.42		1683.98	℄ Aisle = 7' West.
+63.25			8.85		1684.55	"
+66.25			8.22		1685.18	"
+69.25			7.59		1685.81	"
+72.25			6.88		1686.52	"
+78.25			5.38		1688.02	"
+87.25			2.89		1690.51	"
+96.25			0.13		1693.27	"
		WALL				
0+60.25			7.23		1686.17	Top wall Stakes 7' E. of ℄ of Aisle
+63.25			7.10		1686.30	" "
+66.25			6.66		1686.80	" "
+69.25			6.01		1687.39	" "
+72.25			5.30		1688.10	" "
+78.25			3.80		1689.60	" "
+87.25			1.31		1692.09	" "
T.P.	9.835	1700.14	3.10	1690.30		
+96.25			5.29		1694.85	" "
			OVER			

See F.B. 748-24 Forrest.

Form 307 SM 10-34

PLEASE RETURN TO
LOS ANGELES COUNTY SURVEYOR
700 HALL OF RECORDS

NOTE: ANY ADDITIONS OR CHANGES ON THIS SHEET MUST BE MADE OR CIRCLED IN RED INK, WITH DATE AND NAME OF PERSON MAKING CHANGE

Do not extend notes this side of this line

Profile No. ____ Notes Red. ____ Platted ____ Job No. 765 Division No. ____
X-Sec. ____ Date ____ Date ____ Survey of ALTADENA Lands
Notes Clkd. ____ Checked ____ Survey by WATTLES Notes A. C. Johnson Date 3-25-1938

STATION	B. S.	H. I.	F. S	ELEV.		
		3-25-1938				
		1700 Aisle 4				
1+05.25			3.87		1696.27	℄ Aisle
			Wall			
~~1+05.25~~			~~2.39~~		~~1697.77~~	~~Top wall~~
T.B.M.			0.97	1699.17		T.B.M. El. 1699.18 L.B. 857-40 X in W end Conc. sill of W. basement entrance of Recreation Bldg.
	3-30-1938					
T.B.M.	10.70	1697.63		1686.93		T.B.M. El. 1686.93 L.B. 857-238 Chis'd on Rock Wall S. Side of Stage N. 25 Axis of Outdoor Theatre
T.P.	5.45	1780.29	2.79	1694.84		
1+02.25			3.52		1696.77	Top wall
1+05.25			2.75		1697.54	"
1+08.25			2.18		1698.11	"
1+11.25			1.84		1698.45	"
1+14.25			1.73		1698.56	"
1+19.54 B.C.			1.73		1698.56	" 6.5 48.71 1+19.54
1+21.71 E.C.			1.73		1698.56	"
1+23.88 E.C.			1.73		1698.56	"
1+28.11 Face of Cb 8' Drive			1.73		1698.56	" Face of Wall Station 1+28.11
T.B.M.			1.12	1699.17		T.B.M. El. 1699.18 L.B. 857-40 X in W end Conc. sill of W. basement entrance of Recreation Bldg.

F.S./CD Job No. Division No. Notes Red Plotted Profile

Survey of Date Date No.

Survey by Notes Notes Chkd. Checked X-Sec.

Indexed Date Date Date No.

STATION	B. S.	H. I.	F. S	ELEV.

Form 307 5M 10-34

PLEASE RETURN TO
LOS ANGELES COUNTY SURVEYOR
700 HALL OF RECORDS

Do not extend notes this side of this line

NOTE: ANY ADDITIONS OR CHANGES ON THIS SHEET MUST BE MADE OR CIRCLED IN RED INK, WITH DATE AND NAME OF PERSON MAKING CHANGE

Notes Ck'd by Drew		Survey of Baldwin Park Fire Lot	F.B. 505 Pg. 101
Map No. B-982		W. O. 7186 Tape No.	St'd 68 °F.
Office Work [illegible]		Surveyed by L D Moore	
Checked Drew		Notes Moore	Date 5-31-33
Date 1-26-34		Indexed A. C. Johnson 6-1-33	

Note: ANY ADDITIONS OR CHANGES OF THIS SHEET MUST BE MADE OR CIRCLED IN Red Ink. WITH DATE AND NAME OF PERSON MAKING CHANGE.

Do not extend notes this side of this line

RETURN TO
LOS ANGELES COUNTY SURVEYOR
700 HALL OF RECORDS

FORM 247 10M 8-31

BALDWIN PARK FIRE STATION LOT.

SURVEY
for
BALDWIN PARK FIRE STATION LOT
The Easterly 150' of
Lot 7 - TRACT # 2102.
W O # 7186

Party
Moore
Van Fleet
Fenner
Kelley
Wilson

May 29 1933

For X Sections see
L.B. 377 - ~~451-458~~
201 - 207

F.B. 505 PG. 102

INDEX SKETCH

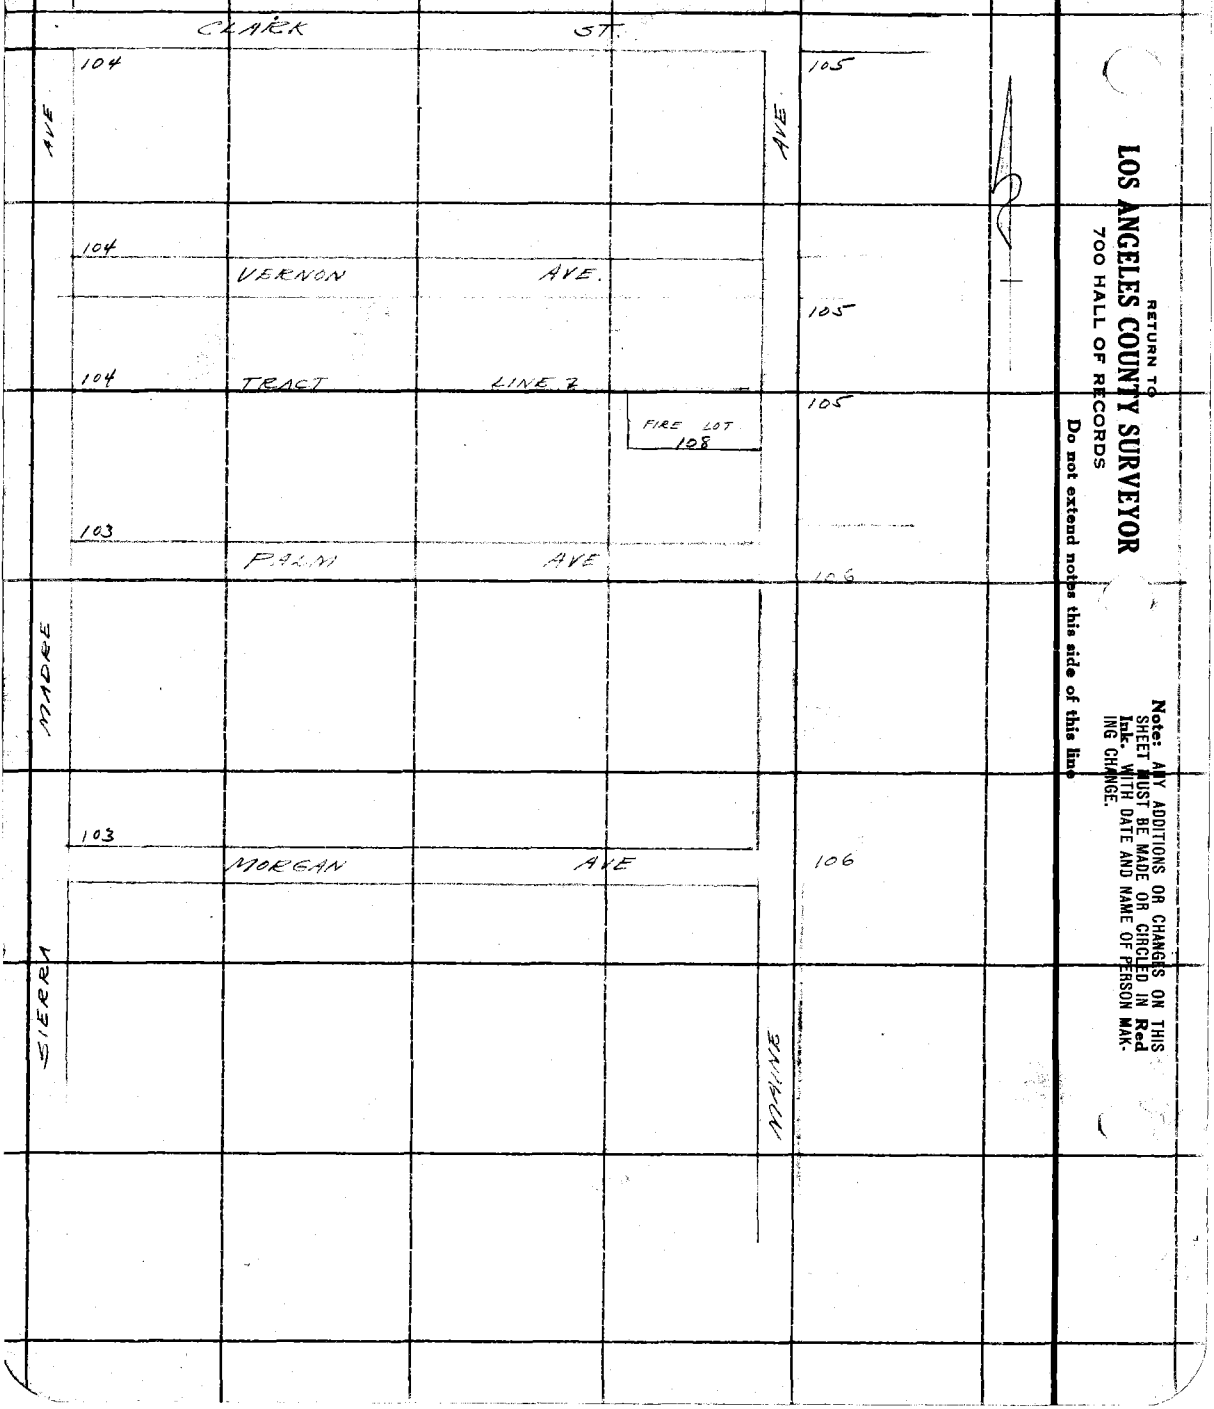

RETURN TO
LOS ANGELES COUNTY SURVEYOR
700 HALL OF RECORDS

Do not extend notes this side of this line

Notes: ANY ADDITIONS OR CHANGES ON THIS SHEET MUST BE MADE OR CIRCLED IN Red Ink. WITH DATE AND NAME OF PERSON MAKING CHANGE.

Notes Ck'd by Drew	Survey of [illegible]
Map No. B-982	W. O. 2186 Tape No. 039 St'd 68 °F.
Office Work R.W.M°A.	Surveyed by Y D Moore
Checked Drew	Notes Moore Date 5-31-33
Date 1-26-34	Indexed A. C. Johnson

F.B. 505 Pg. 103

To Location Pg 104

MS 46 2-4

(90°-00'-00")
(359-57-30) ✓

Fd. NAT 6" Orange

354.63 calc

- 0.08

189.98 T=68°

89 59 65 ✓

Fd 2x2x12" deep FB 372-26

48.14

50.4

19.98

0.07

41.35

PALM AVE

(25) 30 (25) 30

To 1077 Pg. 106

Fd 2x2 Flush FB 372-26

Fd NAT 6" Orange

Set 1x2 by miter

Note: ANY ADDITIONS OR CHANGES ON THIS SHEET MUST BE MADE OR CIRCLED IN Red Ink, WITH DATE AND NAME OF PERSON MAKING CHANGE.

AVE

+ 0.21 calc

297.44

302.49 T=68°

30' 30' 25'

Line J

RETURN TO
LOS ANGELES COUNTY SURVEYOR
700 HALL OF RECORDS
Do not extend notes this side of this line

STAKED MARKER

5' OFF SET

Proposed ℄

Fd. NAT 6" orange

(89°-58'-45")
(359-54-45) ✓

Fd 2x2x12" 2' deep FB 372-27,41

5.10

5.00

89° 58'-40" ✓

30

+ 0.37

5.05

20.00

Proposed ℄

1319.75 T=65°

Set 1x2 by miter

58.34

Fd. 2" I.P. Plug x 12" 2' deep F.B 372-26, 27 41

(25) 30 MORGAN AVE

To 1077 Pg. 106

C.S Mon 2' deep

FORM 247 10M 8-31

RETURN TO

LOS ANGELES COUNTY SURVEYOR

700 HALL OF RECORDS

Note: ANY ADDITIONS OR CHANGES ON THIS SHEET MUST BE MADE OR CIRCLED IN **Red Ink.** WITH DATE AND NAME OF PERSON MAKING CHANGE.

Do not extend notes this side of this line

W.S. 46 D-4

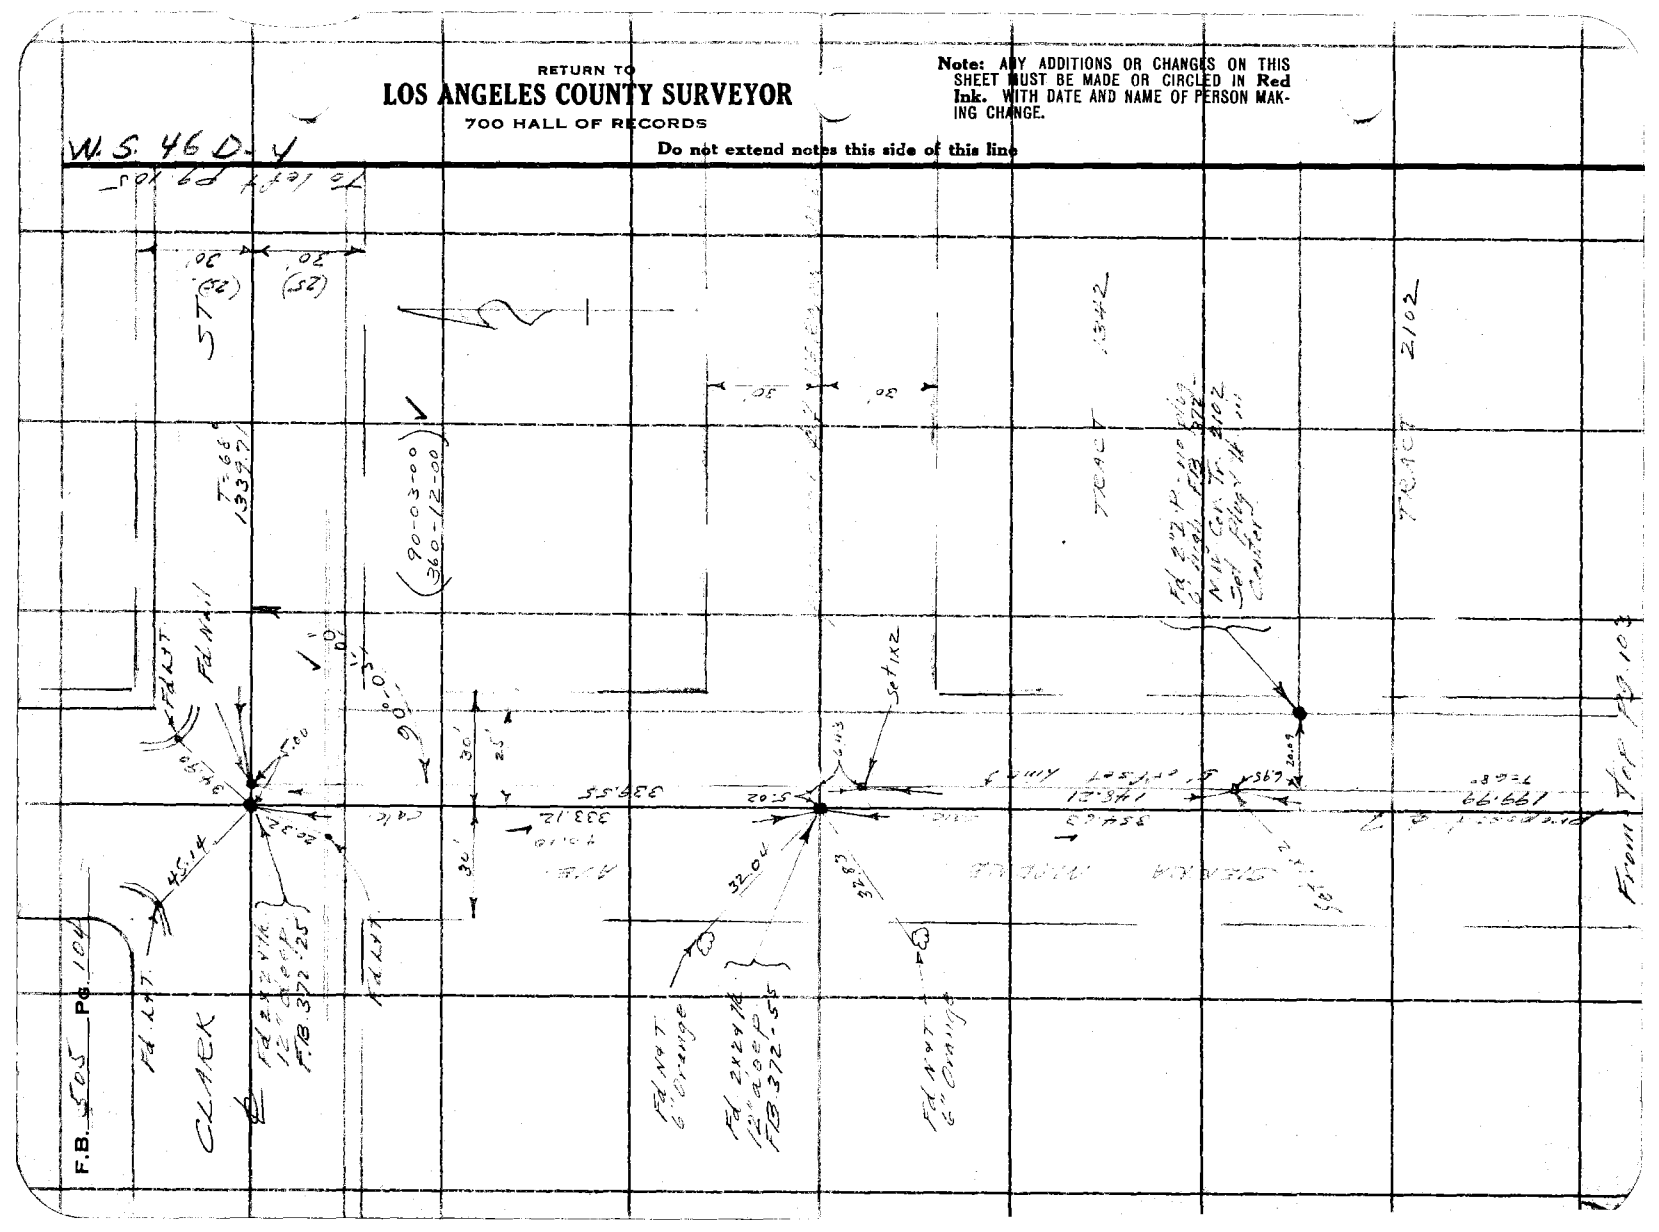
50'
(25')
30'
(25')
T-66
13342
(90-03-00)
(360-12-00)
60.0'
30'
25'
30'
339.55
333.12

Notes Ck'd by Drew	Survey of Eastern Park
Map No. B-982	W. O. 2166 Type No. 039 St'd 66 °F.
Office Work R.W.M.&A.	Surveyed by L. D. Moore
Checked Drew	Notes Moore Date 5-31-33
Date 1-26-34	Indexed L. C. Johnson

F.B. [illegible] Pg. 105

M.S. 46 D-4

M.S. 1944 Pg. 162

Fd. L+T.

CLARK

T=68°
1339.71

ST.

Fd. Nail in lead.
FB 372-14
FB 465-107

Fd. L+T.

Fd. L+T.

(89°-57'-15")
(359-49-00)

T=68°
287.54

+0.15

Fd. N+T.
FB 465-106

AVE.

33.96

VERNON AVE
Not constructed.

17.35

VERNON AVE.
Not constructed.

Fd. N+T.
FB 465-106

T=68°
162.86

+0.03

45'
(35)

45'
(35)

TRACT 1342

Set N+T.
per C.S. B-321

TRACT 2102

MAINE
T=65°
192.87

+0.04

To top Pg.

Note: ANY ADDITIONS OR CHANGES ON THIS SHEET MUST BE MADE OR CIRCLED IN Red Ink, WITH DATE AND NAME OF PERSON MAKING CHANGE.

RETURN TO
LOS ANGELES COUNTY SURVEYOR
700 HALL OF RECORDS

Do not extend notes this side of this line

FORM 247 (OM 8-31)

RETURN TO
LOS ANGELES COUNTY SURVEYOR
700 HALL OF RECORDS

Note: ANY ADDITIONS OR CHANGES ON THIS SHEET MUST BE MADE OR CIRCLED IN **Red Ink.** WITH DATE AND NAME OF PERSON MAKING CHANGE.

Do not extend notes this side of this line

W.S. 46 D-4

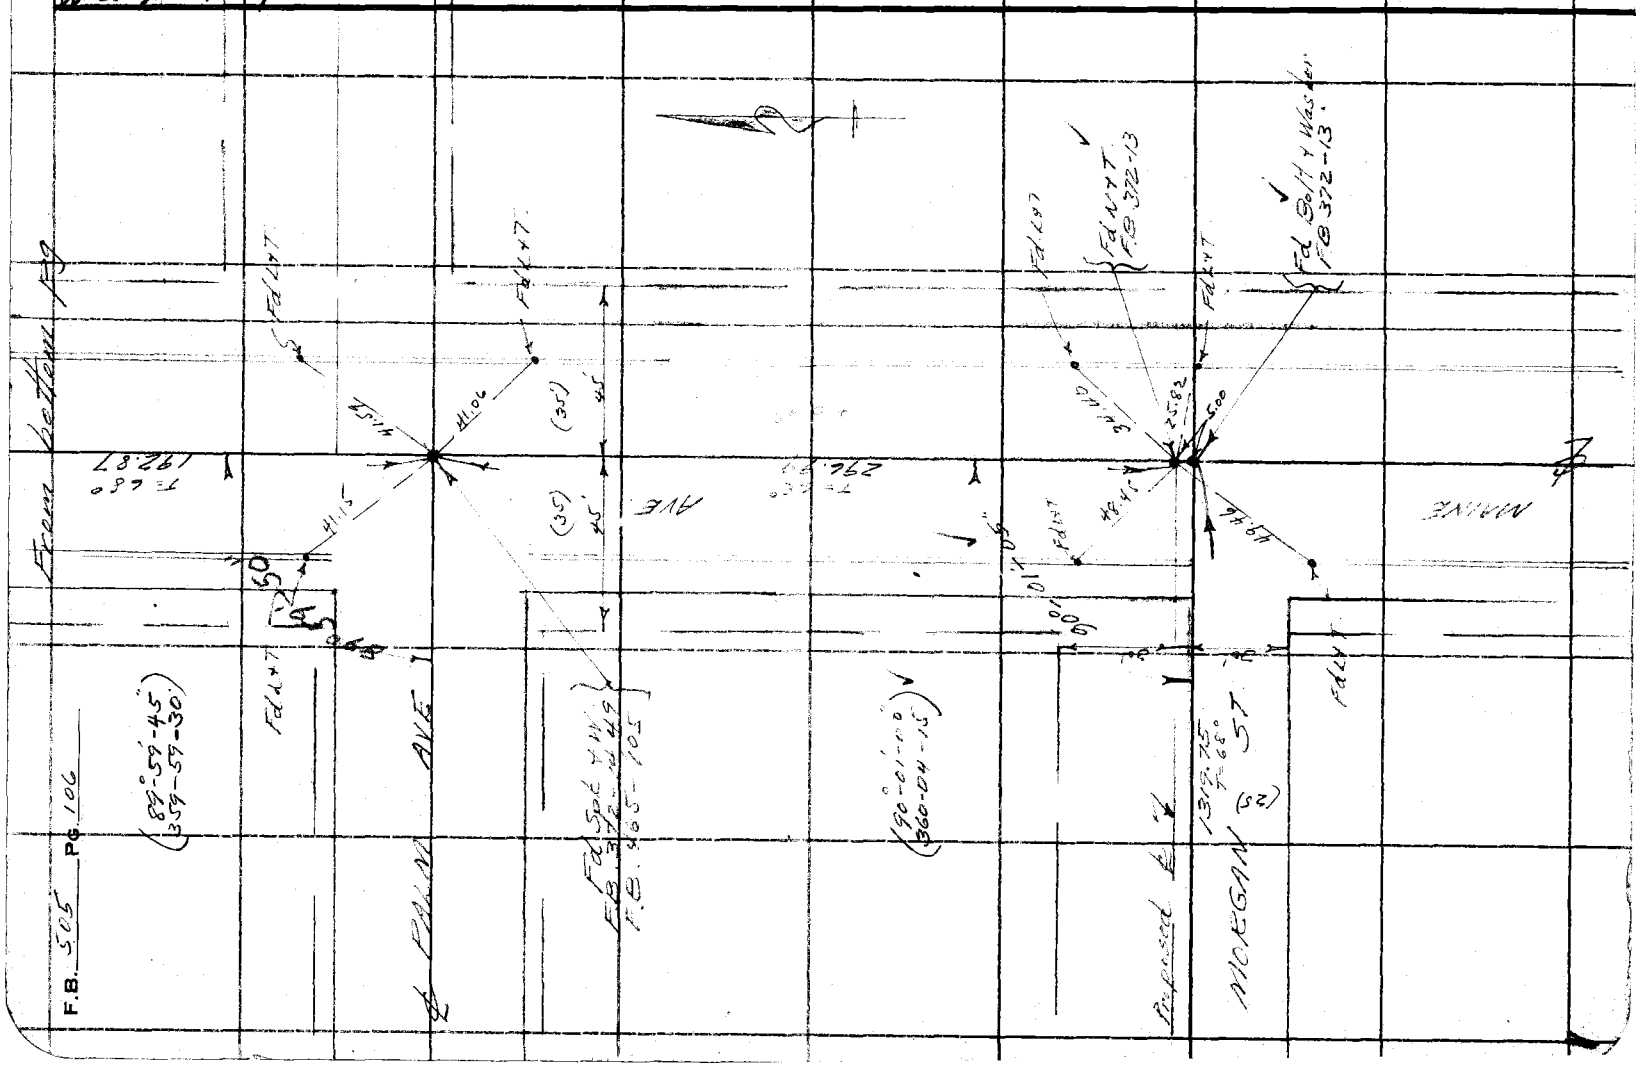
Fd 1/2" I.P.
FB 372-13
Fd 1/2" I.P.
FB 372-13
Fd 1/2" I.P.
Was dis.
FB 372-13
Fd 1/2" I.P.
Fd 1/2" I.P.
Fd 1/2" I.P.

Notes Ck'd by Drew	Survey of Baldwin Park Tract	F.B. 508	Pg. 107
Map No. B-982	W. O. 7186 Tape No.	St'd	°F.
Office Work R.W.M.A.	Surveyed by K.S. Moore		
Checked Drew	Notes Mark	Date 5-31-33	
Date 1-26-34	Indexed		

Note: ANY ADDITIONS OR CHANGES ON THIS SHEET MUST BE MADE OR CIRCLED IN Red Ink, WITH DATE AND NAME OF PERSON MAKING CHANGE.

Do not extend notes this side of this line

RETURN TO
LOS ANGELES COUNTY SURVEYOR
700 HALL OF RECORDS

FORM 247 10M 8-31

Location of Wire fences along W. line of Tr. 2102 Fences are in very poor condition

MAINE AVE

Chat 99.05

Frame Garage 30' 20'

Frame Shed 10'

1.9

0.9

16.8

0.3

0.2

130.7

Tract 1342

Tract 2102

0.3

70.6

0.2

105'

2" I.P PG 104

5' offset Line

proposed ℄ SIERRA MADRE AVE

F.B. 505 Pg. 108

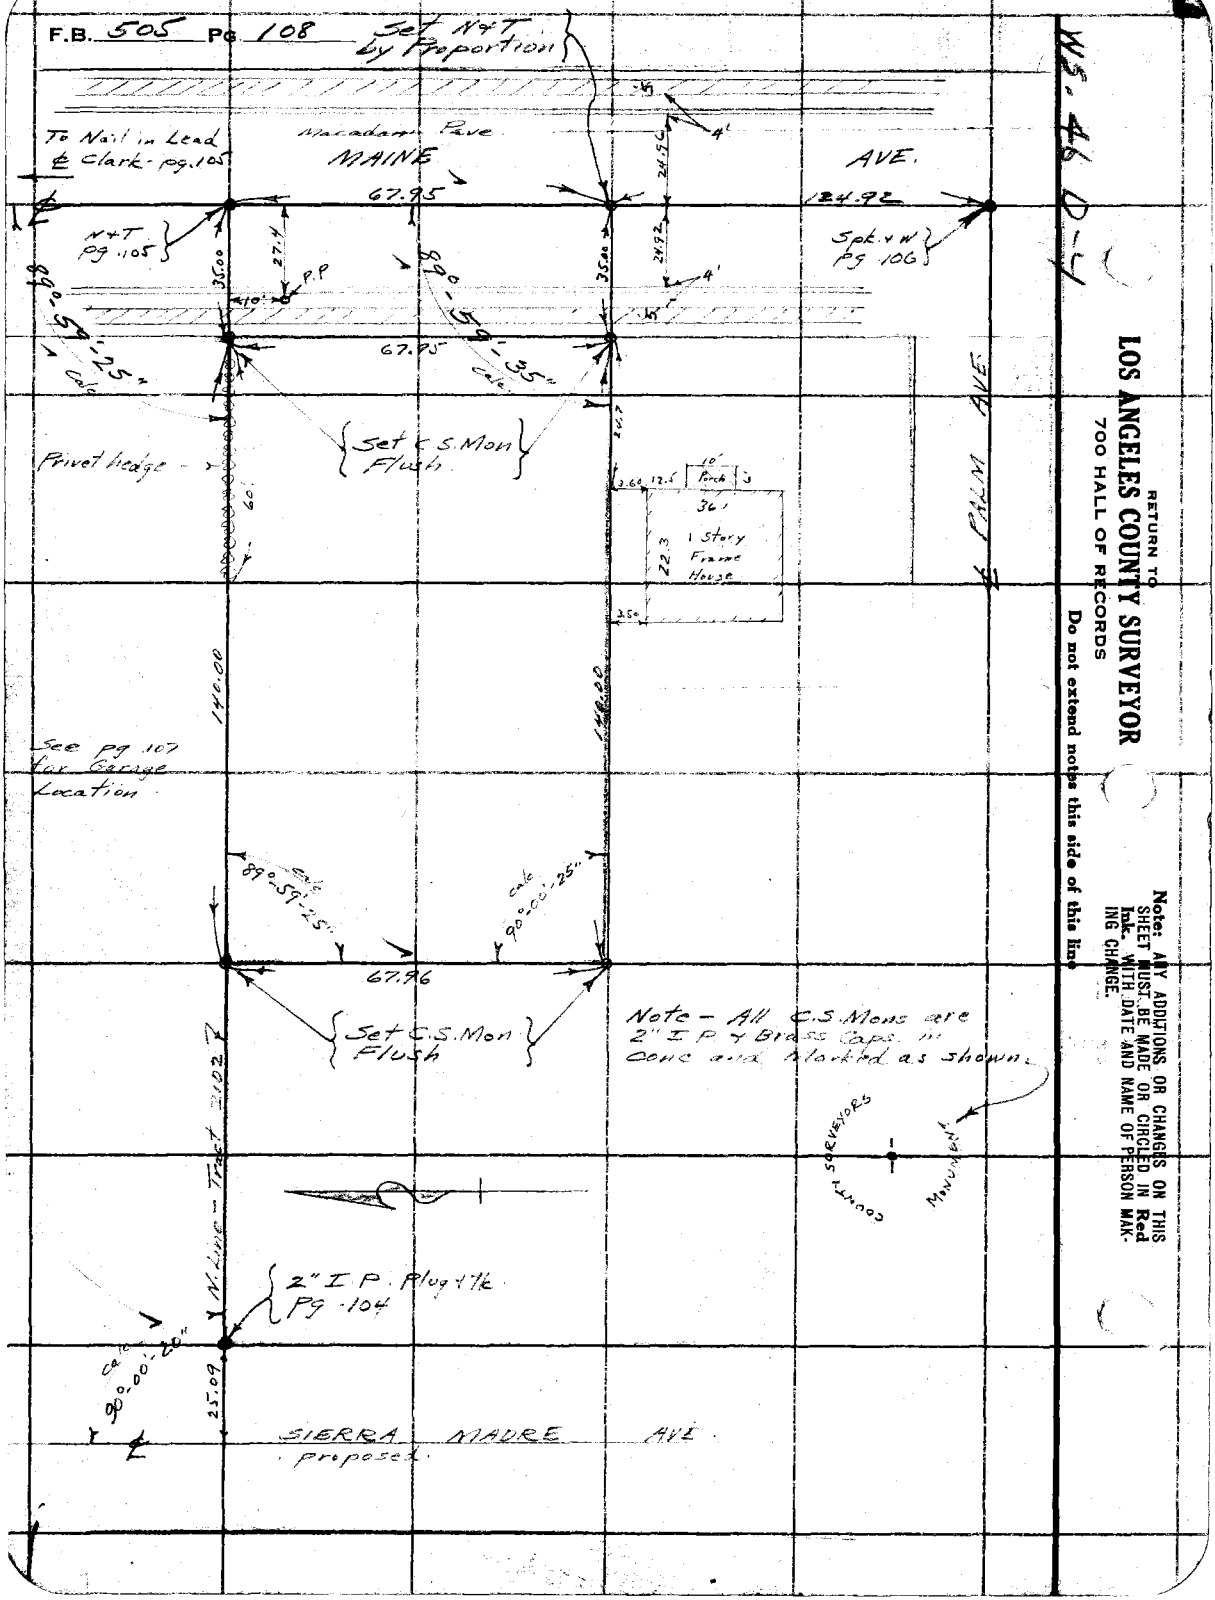

RETURN TO
LOS ANGELES COUNTY SURVEYOR
700 HALL OF RECORDS

Do not extend notes this side of this line

Note: ANY ADDITIONS OR CHANGES ON THIS SHEET MUST BE MADE OR CIRCLED IN **Red Ink.** WITH DATE AND NAME OF PERSON MAKING CHANGE.

Notes Ck'd by Drew	Survey of
Map No. 8-943	W. O. [illegible] Tape No. 035 St'd [illegible] °F.
Office Work [illegible]	Surveyed by [illegible]
Checked Drew	Notes Moore Date 9-26-33
Date 10-9-33	Indexed A. C. Johnson

F.B. 505 PG. 111

Note: ANY ADDITIONS OR CHANGES ON THIS SHEET MUST BE MADE OR CIRCLED IN Red Ink. WITH DATE AND NAME OF PERSON MAKING CHANGE.

Do not extend notes this side of this line

RETURN TO
LOS ANGELES COUNTY SURVEYOR
700 HALL OF RECORDS

FORM 247 10M 8-31

SURVEY
of
LOT 18—BLOCK 38
E. S. FIELDS OCCIDENTAL HEIGHTS TRACT
for
LAGUNA FIRE STATION
Job # 8002

Party
Moore
VanFleet
Bowers
Harris

Sept. 26, 1933

See F.B. 735:7 for Cross Sections

RETURN TO

LOS ANGELES COUNTY SURVEYOR

700 HALL OF RECORDS

Note: ANY ADDITIONS OR CHANGES ON THIS SHEET MUST BE MADE OR CIRCLED IN Red Ink. WITH DATE AND NAME OF PERSON MAKING CHANGE.

Do not extend notes this side of this line

WS 2E-2

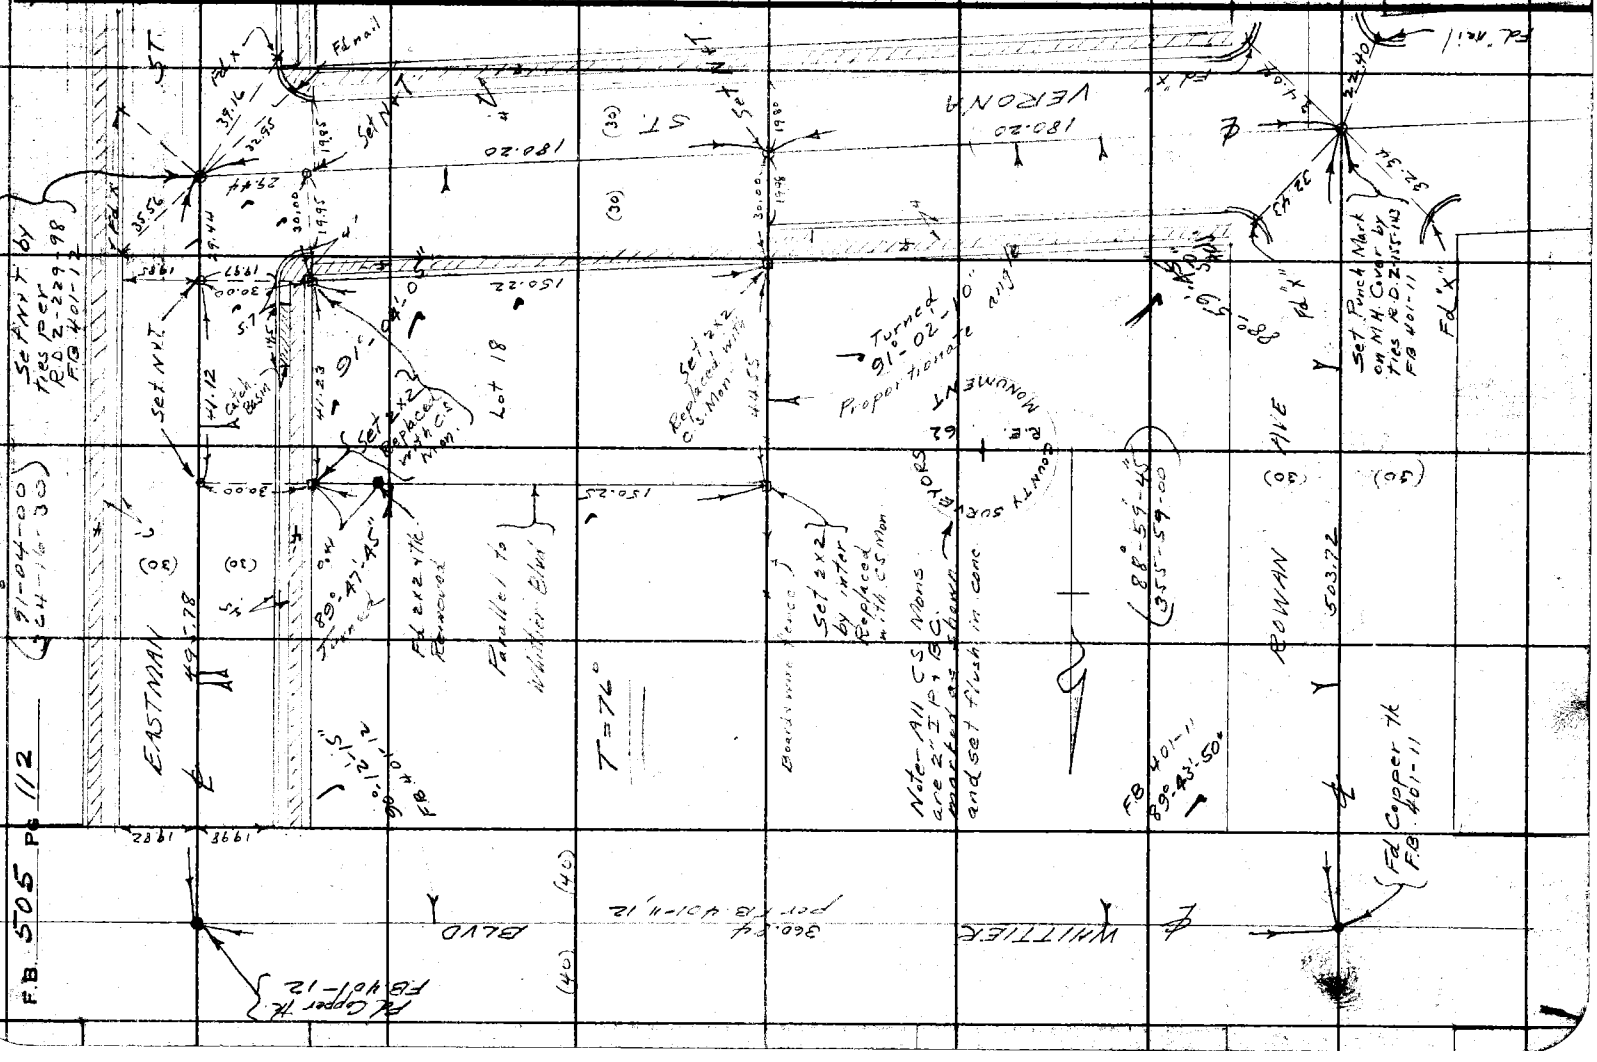

Notes Ck'd by Drew	Survey of Escondido Fire Lot
Map No. B-952	W. O. 5010 Tape No. 2/ St'd 84 oF.
Office Work Tate	Surveyed by L. D. Moore
Checked Rosan	Notes Moore Date 10-20-33
Date Jan 34	Indexed A. C. Johnson 10-24-33

F.B. 505 PG. 115

Note: ANY ADDITIONS OR CHANGES OF THIS SHEET MUST BE MADE OR CIRCLED IN Red Ink. WITH DATE AND NAME OF PERSON MAKING CHANGE.

RETURN TO
LOS ANGELES COUNTY SURVEYOR
700 HALL OF RECORDS

Do not extend notes this side of this line

FORM 247 10M 8-31

SURVEY
of
ESCONDIDO FIRE LOT
a part of
LOT 126 - TRACT 9289
Job # 5010

Oct 19, 20, 1933

Party
Moore
Johnson
Fenner
Harris

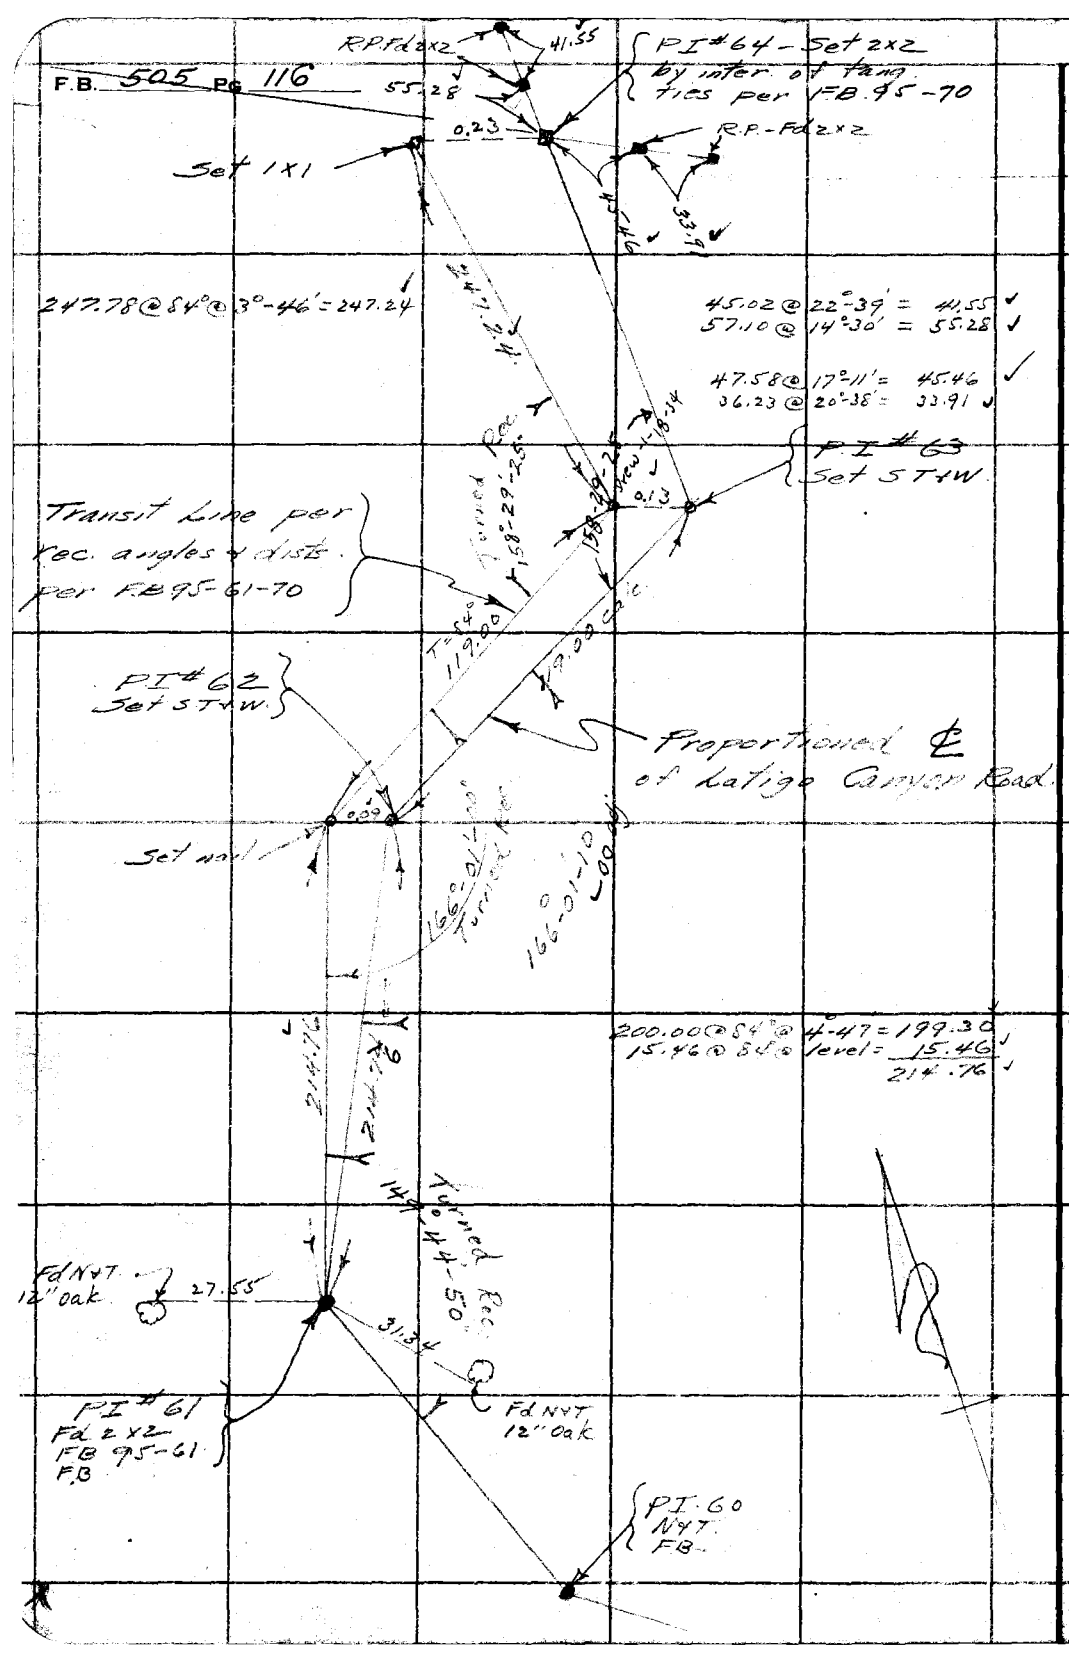
F.B. 505 PG 116
RP Fd 2x2
41.55
55.28
0.23
Set 1x1
PI #64 - Set 2x2 by inter. of tang. ties per F.B. 95-70
R.P. - Fd 2x2
45.46
33.91
247.78 @ 84° @ 3°-46' = 247.24
45.02 @ 22°-39' = 41.55
57.10 @ 14°-30' = 55.28
47.58 @ 17°-11' = 45.46
36.23 @ 20°-38' = 33.91
PI #63 Set 5 T+W
New 1-8-14
9.13
Transit Line per rec. angles & dists. per F.B. 95-61-70
T = 84.00
119.00
199.22 Calc.
PI #62 Set 5 T+W.
Proportional ℄ of Latigo Canyon Road.
0.39
Set nail
166-01-10 Turned
166-01-10 Calc.
200.00 @ 84° @ 4-47 = 199.30
15.46 @ 84° @ level = 15.46
214.76
214.76
214.76
14
Fd NAT. 12" Oak
27.55
31.34
PI #61 Fd 2 x 2 F.B. 95-61 F.B.
Fd NAT. 12" Oak
PI 60 NAT. F.B.
RETURN TO
LOS ANGELES COUNTY SURVEYOR
700 HALL OF RECORDS
Do not extend notes this side of this line
Note: ANY ADDITIONS OR CHANGES ON THIS SHEET MUST BE MADE OR CIRCLED IN Red Ink. WITH DATE AND NAME OF PERSON MAKING CHANGE.

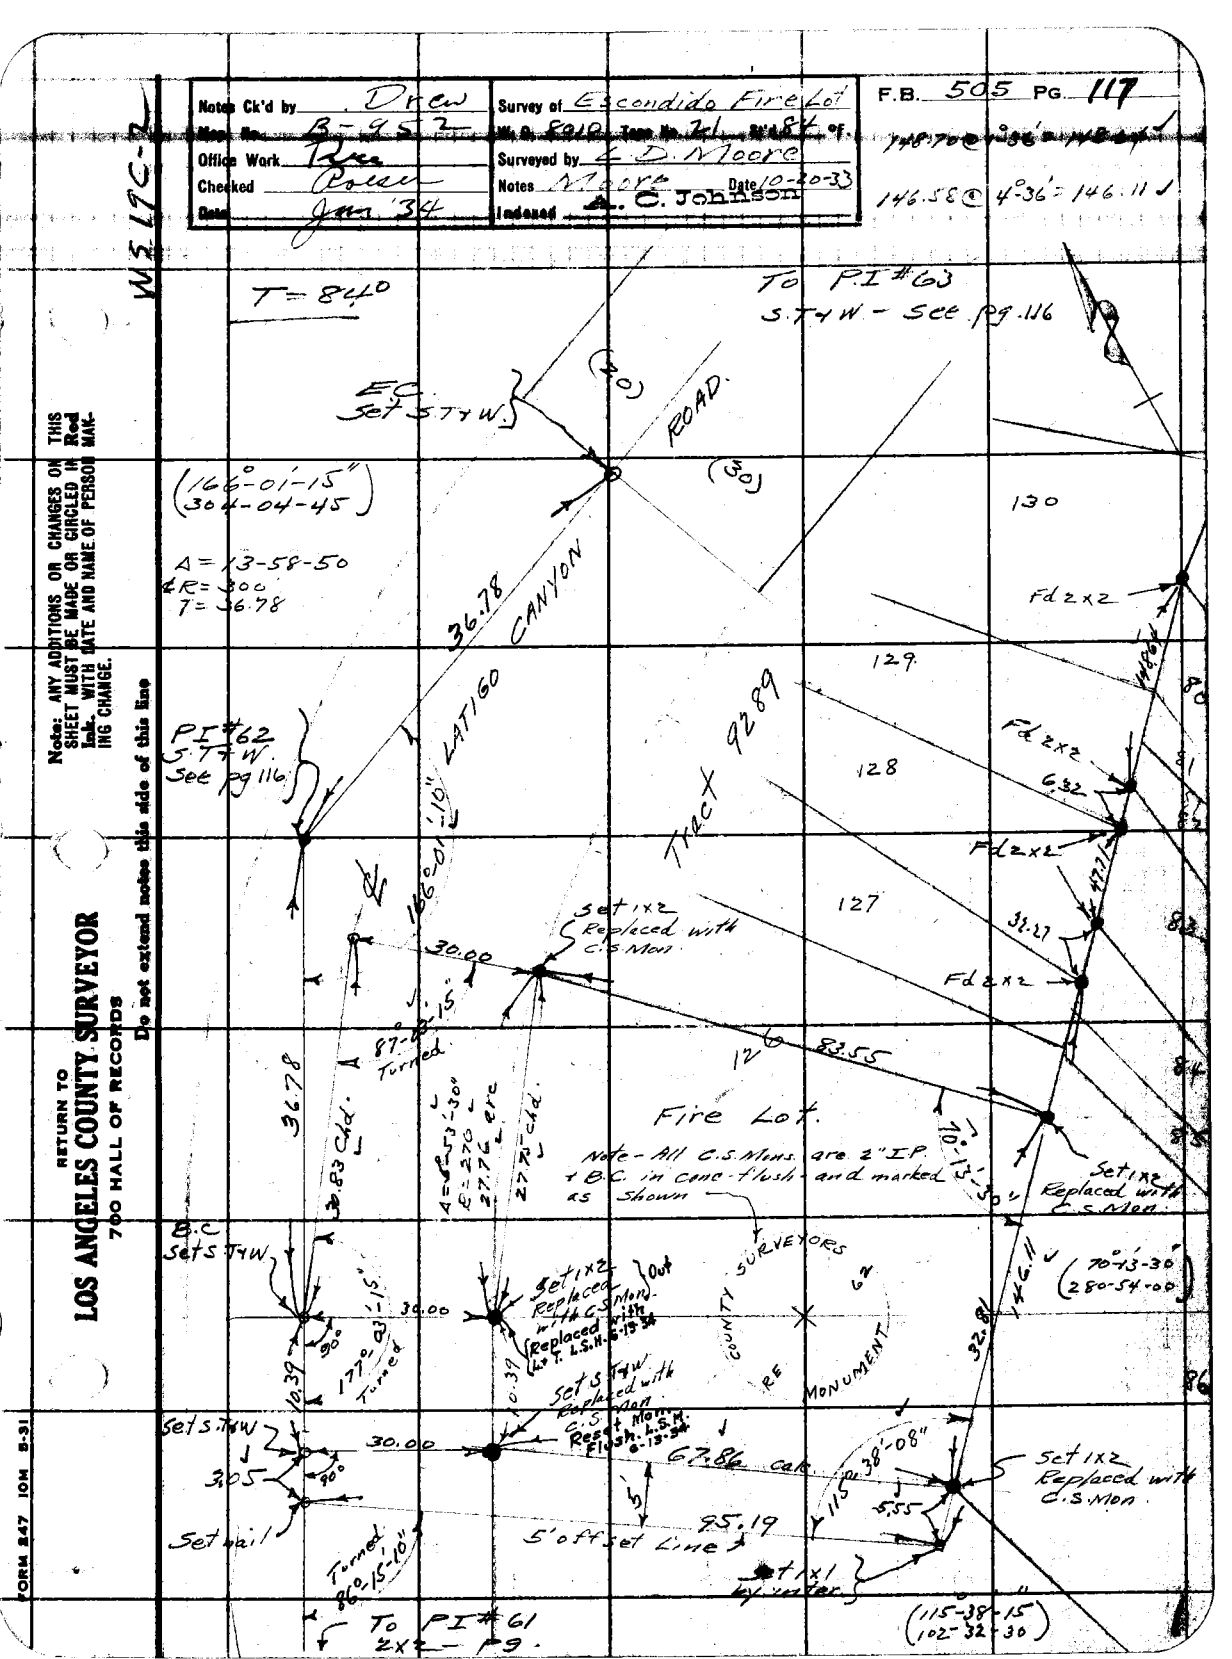
Notes Ck'd by Drew
Map No. B-952
Office Work Rec
Checked Polar
Date Jan '34
Survey of Escondido Fire Lot
Surveyed by E. D. Moore
Notes Moore Date 10-20-33
Indexed A. C. Johnson
F.B. 505 PG. 117
W 2 L 9 C-2
T = 84.40
To P.I #63
S.T+W - See pg. 116
EC Set S.T+W
(30)
ROAD.
(30)
(166°-01'-15")
(304-04-45)
Δ = 13-58-50
R = 300
T = 36.78
36.78
CANYON
130
Fd 2x2
129
Fd 2x2
6.32
128
Fd 2x2
127
Fd 2x2
31.27
P.I #62
S.T+W
See pg 116
166°01'-15" LAT 160
TRACT 9289
Set 1x2
Replaced with
C.S. Mon.
30.00
87°-0'
Turned
36.78
30.83 Cd.
A = 57°-30'
R = 270
27.76 Arc
27.8 Cd.
12
83.55
Fire Lot.
Note - All C.S. Mons. are 2" IP
+ B.C. in conc - flush - and marked
as shown
Set 1x2
Replaced with
C.S. Mon.
B.C
Set S.T+W
Set 1x2
Replaced
with C.S. Mon.
Out
Replaced with
L.S.M. 6-13-34
30.00
90°
177°-03'-15"
Turned
10.39
10.39
Set S.T+W
Replaced with
C.S. Mon.
Reset Mon.
Flush. L.S.M.
6-13-34
COUNTY SURVEYORS
6"
RE
MONUMENT
Set S.T+W
30.00
90°
3.05
Set nail
Turned
90°-15'-10"
67.86 Cal.
5' off set Line
95.19
1"x1"
by center
115°-38'-08"
5.55
32.8
146.11
(70°-13'-30")
(280-54-00)
(115-38-15)
(102-32-30)
To P.I #61
2x2 - P.9.
148.70 @ 3°-36' = 148.64
146.58 @ 4°-36' = 146.11
Note: ANY ADDITIONS OR CHANGES ON THIS SHEET MUST BE MADE OR CIRCLED IN Red Ink, WITH DATE AND NAME OF PERSON MAKING CHANGE.
RETURN TO
LOS ANGELES COUNTY SURVEYOR
700 HALL OF RECORDS
Do not extend notes this side of this line
FORM 247 10M 8-31

F.B. 505 Pg. 118

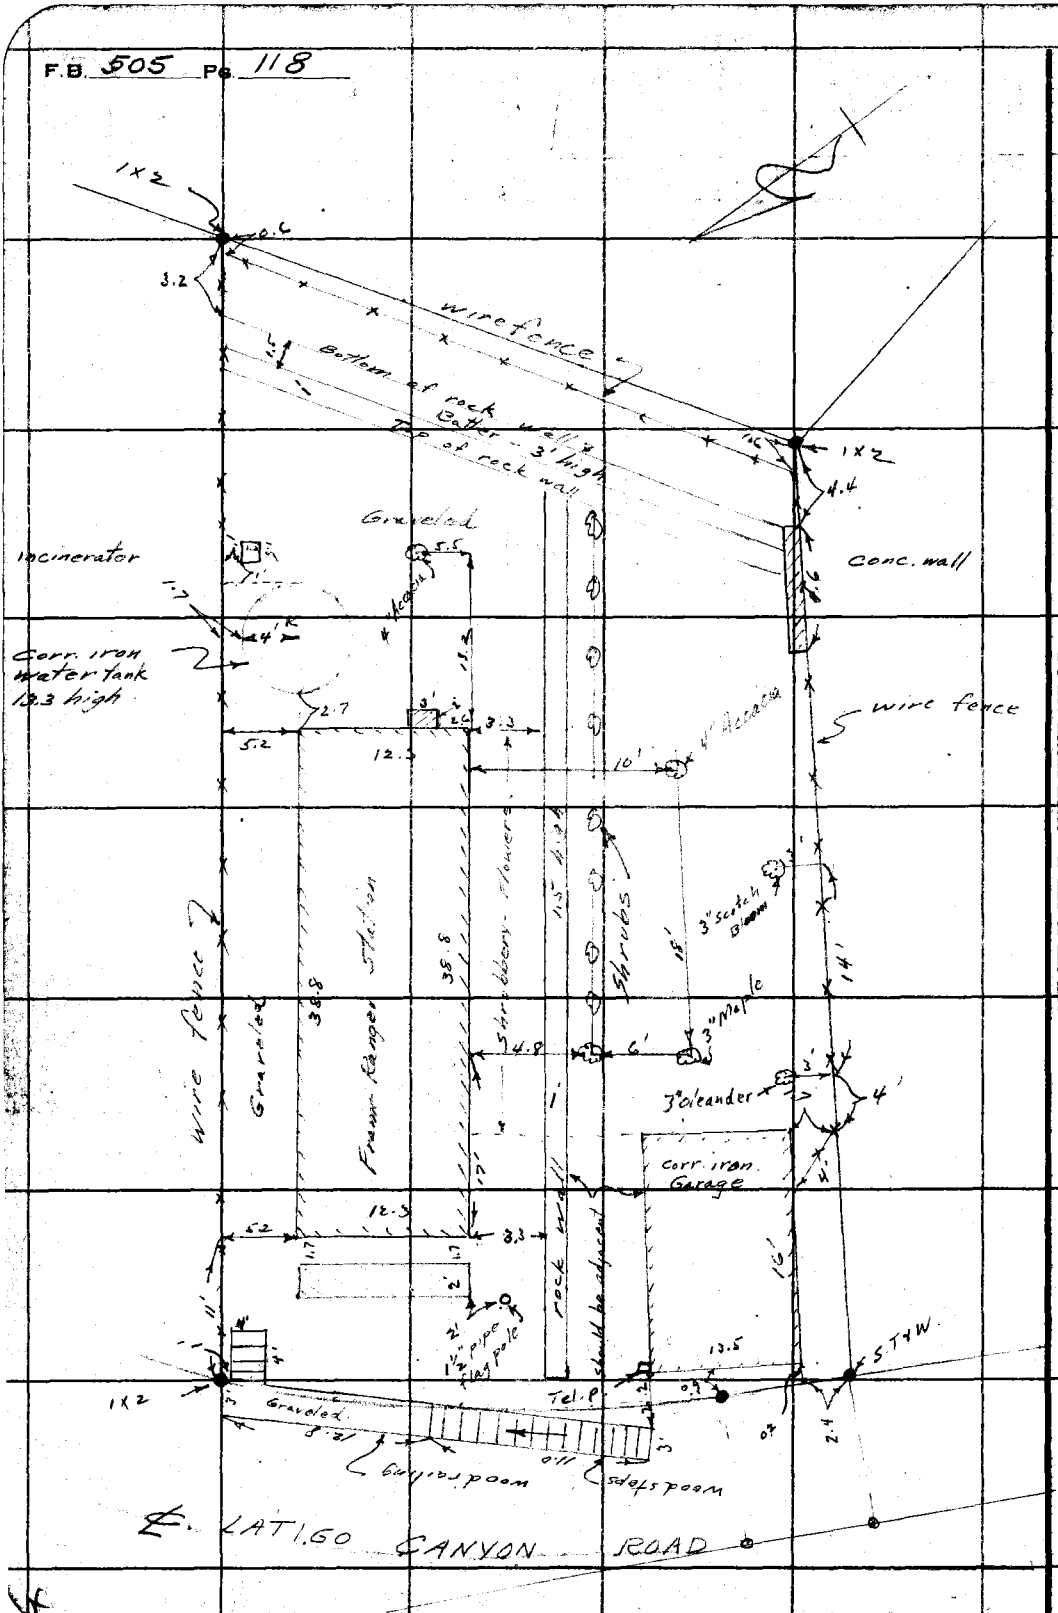

RETURN TO
LOS ANGELES COUNTY SURVEYOR
700 HALL OF RECORDS

Do not extend notes this side of this line

Note: ANY ADDITIONS OR CHANGES ON THIS SHEET MUST BE MADE OR CIRCLED IN Red Ink. WITH DATE AND NAME OF PERSON MAKING CHANGE.

Notes Ck'd by	Dr Ory	Survey of	Escondido Fwy Ln
Map No.	B-952	Mi. P. R.O.W.	Twp No.	Rt'd	°F.
Office Work	Juca	Surveyed by	[illegible]
Checked	Coun	Notes	[illegible]	Date	10-27-33
Date	Jan '34	Indexed	A. C. Johnson

F.B. 705 PG. 119

Note: ANY ADDITIONS OR CHANGES ON THIS SHEET MUST BE MADE OR CIRCLED IN Red Ink. WITH DATE AND NAME OF PERSON MAKING CHANGE.

RETURN TO
LOS ANGELES COUNTY SURVEYOR
700 HALL OF RECORDS
Do not extend notes this side of this line

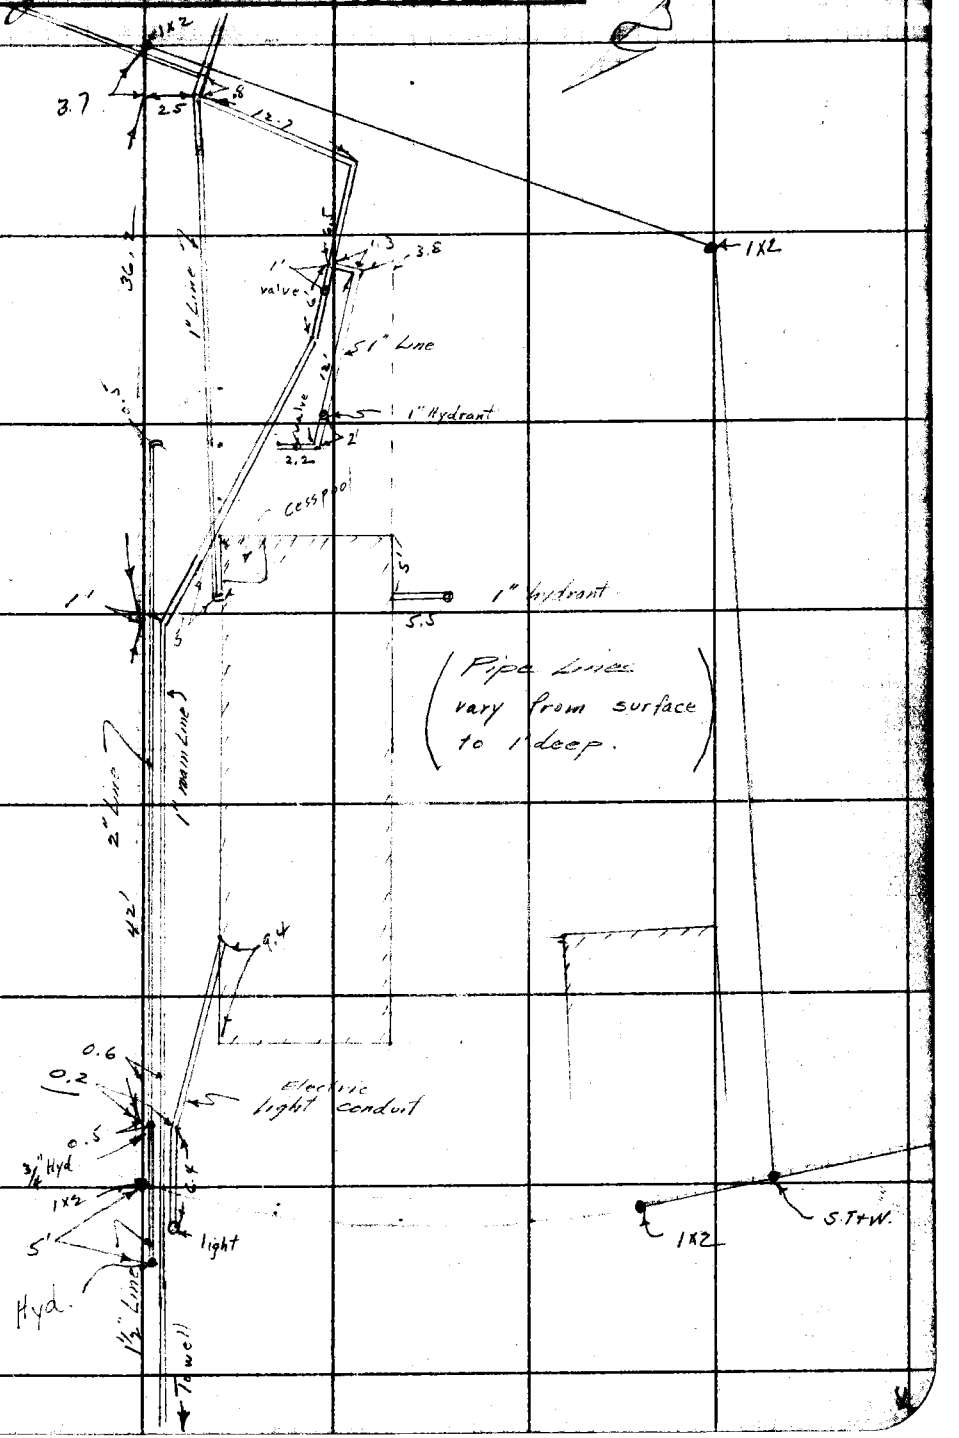

FORM 847 10M 8-31

RETURN TO

LOS ANGELES COUNTY SURVEYOR

700 HALL OF RECORDS

Note: ANY ADDITIONS OR CHANGES ON THIS SHEET MUST BE MADE OR CIRCLED IN Red Ink. WITH DATE AND NAME OF PERSON MAKING CHANGE.

Do not extend notes this side of this line

F.B. 505 Pg 69

89-41

Notes Ck'd by
Map No.
Office Work
Checked
Date

Survey of Latigo Canyon Pole Line
W. O. 8004 Tape No. 2 St'd 84 °F.
Surveyed by [illegible]
Notes Moore Date 10-16-33
Indexed A. C. Johnson 10-25-33

F.B. 308 Pg. 125

Notes: ANY ADDITIONS OR CHANGES OF THIS SHEET MUST BE MADE OR CIRCLED IN Red Ink. WITH DATE AND NAME OF PERSON MAKING CHANGE.

RETURN TO
LOS ANGELES COUNTY SURVEYOR
700 HALL OF RECORDS
Do not extend notes this side of this line

SURVEY
to
FLAG RIGHT OF WAY
of
LATIGO CANYON ROAD
from
Sta. 171+27.18 to Sta. 118+10.00
and
Sta. 72+85.62 to Sta. 0+00
for
FORESTRY DEPT. POLE LINE.
Job # 8004

Party
Moore
Johnson
Fenner
Harris

Oct. 13 - 19, 1933

FORM 247 10M 8-31

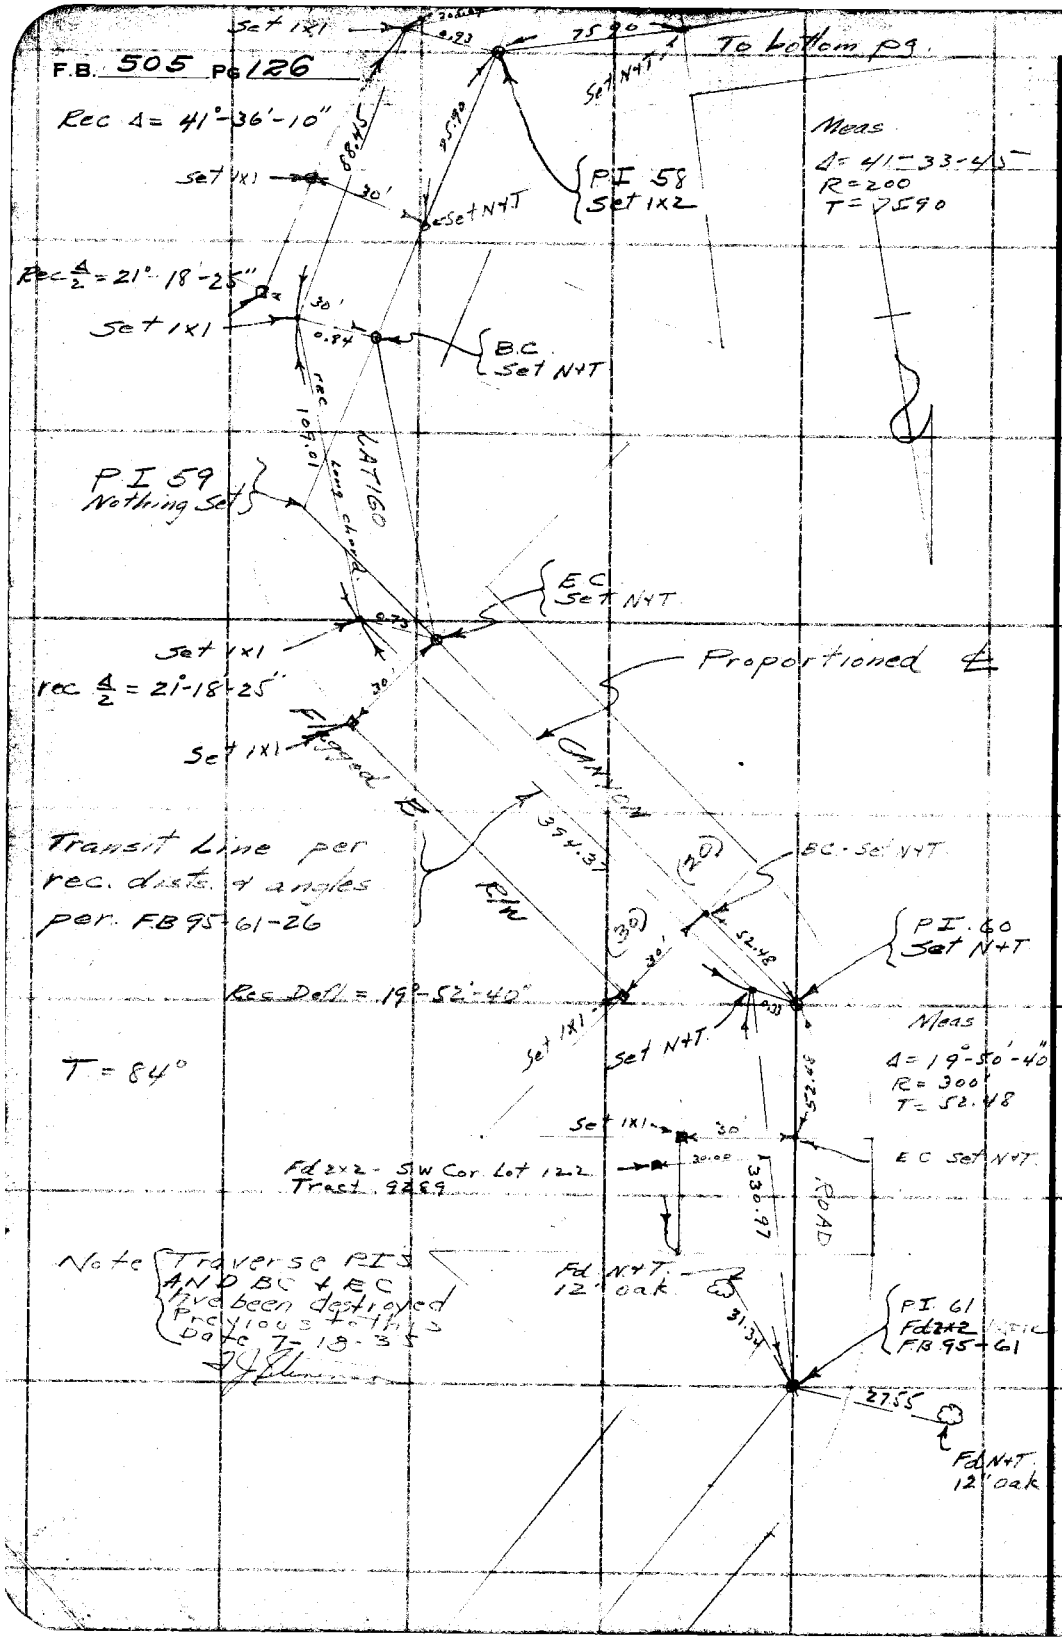

RETURN TO
LOS ANGELES COUNTY SURVEYOR
700 HALL OF RECORDS

Do not extend notes this side of this line

Note: ANY ADDITIONS OR CHANGES ON THIS SHEET MUST BE MADE OR CIRCLED IN Red Ink, WITH DATE AND NAME OF PERSON MAKING CHANGE.

Notes Ck'd by	Survey of La Liga Canyon Pole Line
Map No.	W. O. Book Tape No. 21 Sh'd. 84 P.F.
Office Work	Surveyed by L. D. Moore
Checked	Notes Moore Date 10-16-33
Date	Indexed

F.B. 505 PG. 127

PI 54 Set Tie ties FB 95-26

RPRI 94 Fd 2x2

To pg.

Set 1x2

S 86° 30' W 95.37

38.08

RPRI Fd 2x2

202.59

Set 1x1

30'

Set N+T

79.13

Rec Δ = 76°-43'-30"

T = 84°

Set 1x2

193

PI 55 Set 1x2

Meas

Δ = 76-43-15

R = 100

T = 78.15

151.19

Set N+T

30'

ROAD

Rec Δ/2 = 22°-42'-45"

Set 1x2

178

Set 1x1

B.C Set 1x1

P.I. 56 Nothing Set

Set 1x1

Flagged W. R/W

Rec Δ/2 = 22°-42'-45"

Set 1x1

162

EC Set 1x1

Transit Line per rec. angles & dist. per F.B. 95-61-26

MAIN

Proportioned ℄

Set 1x1

30'

Set 1x1

Set N+T

Meas

Δ = 73-07-45

R = 200'

T = 74.17

Rec Δ = 73°-10'-30"

Set 1x1

Set 1x1

Flagged E. R/W.

(30)

LAT GO

20509

114

P.I. 57 Set 1x1

74.17

Set N+T

(30)

From Top P3

(30)

Set 1x1

RETURN TO
LOS ANGELES COUNTY SURVEYOR
7DO HALL OF RECORDS

Note: ANY ADDITIONS OR CHANGES OF THIS SHEET MUST BE MADE OR CIRCLED IN Red Ink, WITH DATE AND NAME OF PERSON MAKING CHANGE.

Do not extend notes this side of this line

FORM 247 10M 5-31

RETURN TO
LOS ANGELES COUNTY SURVEYOR
700 HALL OF RECORDS

Note: ANY ADDITIONS OR CHANGES ON THIS SHEET MUST BE MADE OR CIRCLED IN Red Ink. WITH DATE AND NAME OF PERSON MAKING CHANGE.

Do not extend notes this side of this line

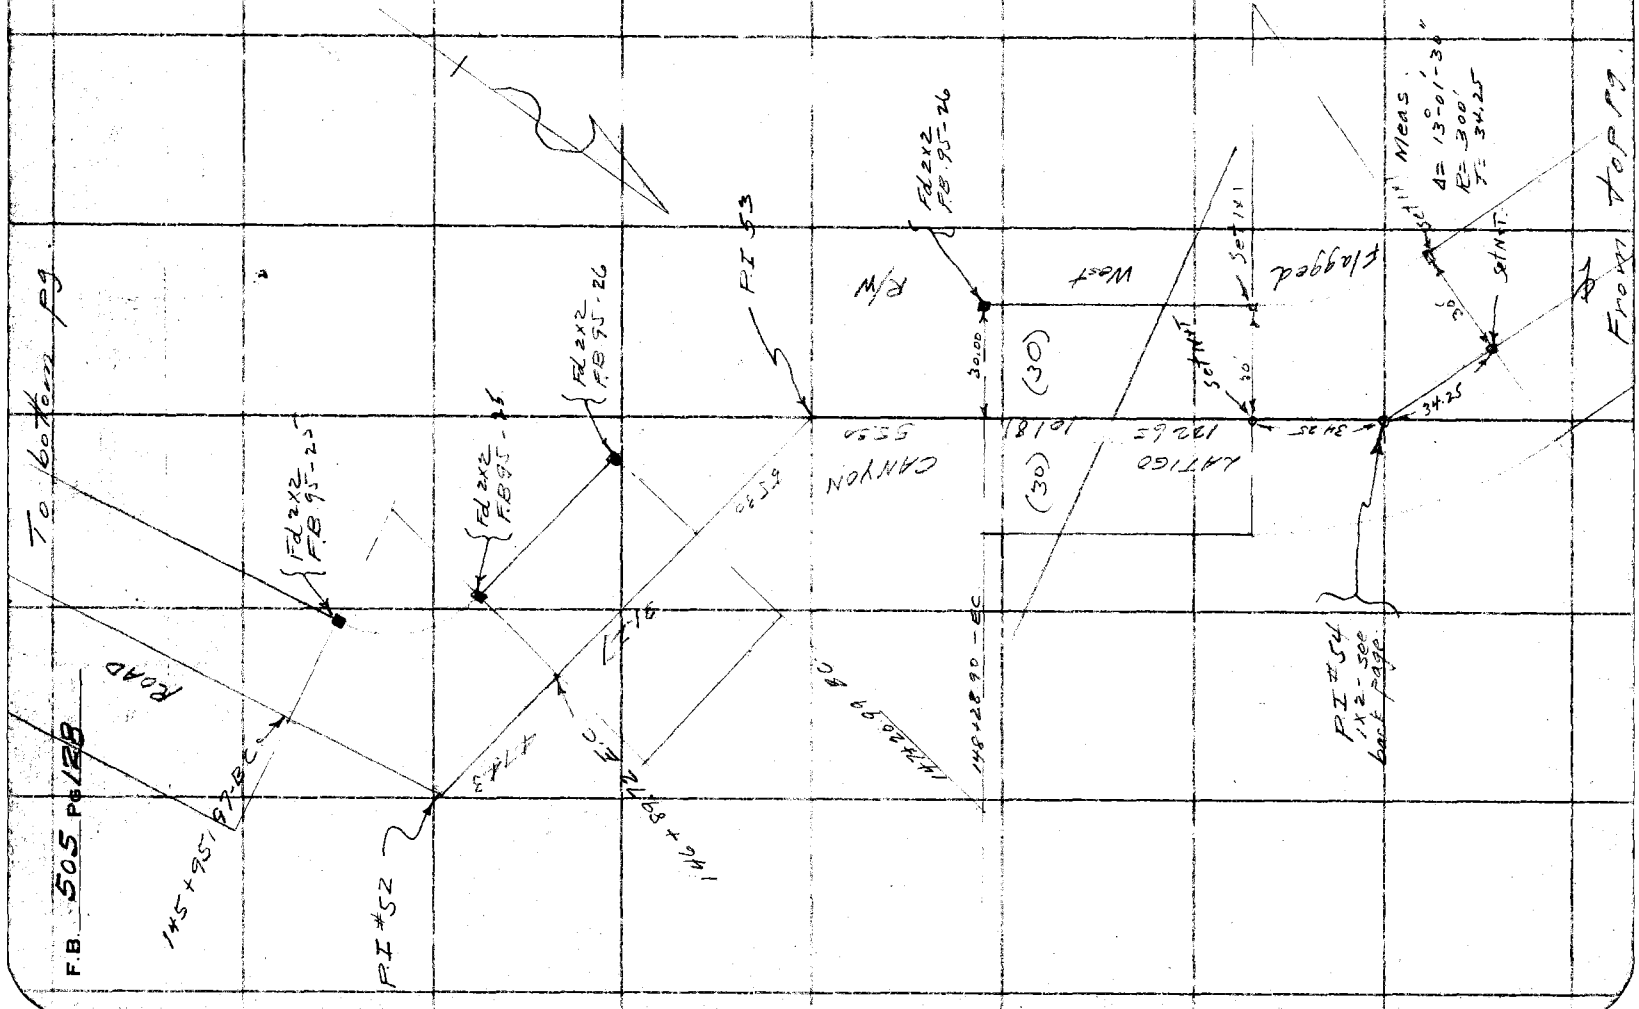

Notes Ck'd by	Survey of La Liga Canal
Maps No.	W. O. 8004 Tape No. 21 St'd 84 of.
Office Work	Surveyed by L. D. Moore
Checked	Notes Moore Date 10-17-33
Base	Indexed A. C. Johnson

F.B. 505 PG. 129

Note: ANY ADDITIONS OR CHANGES ON THIS SHEET MUST BE MADE OR CIRCLED IN Red Ink. WITH DATE AND NAME OF PERSON MAKING CHANGE.

Do not extend notes this side of this line

RETURN TO
LOS ANGELES COUNTY SURVEYOR
700 HALL OF RECORDS

FORM 247 10M 5-31

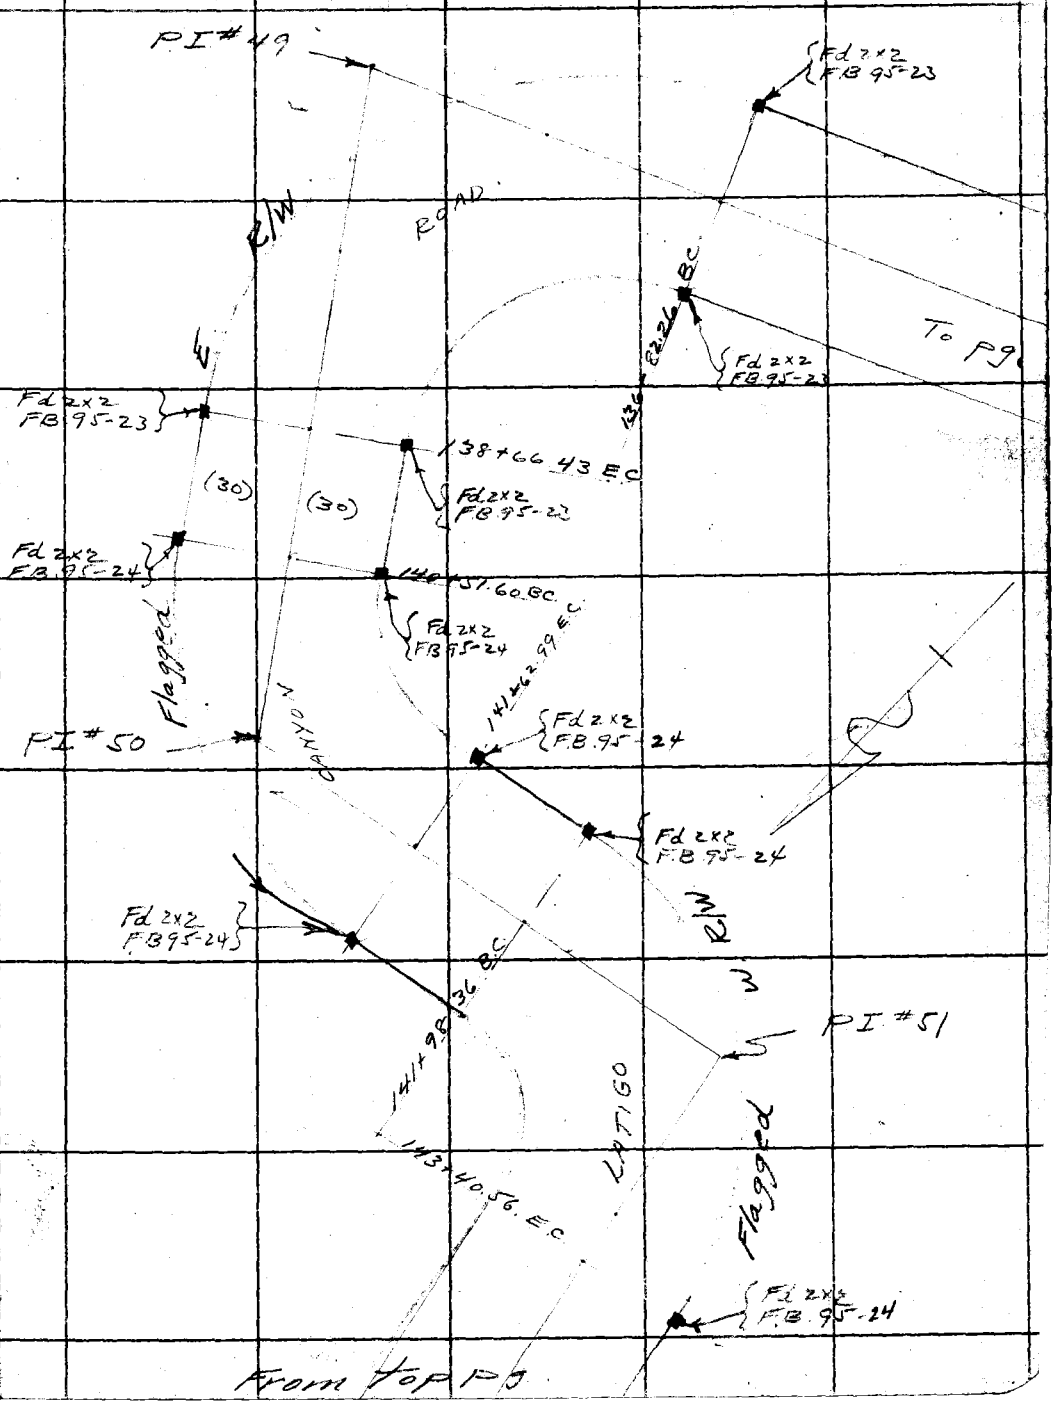

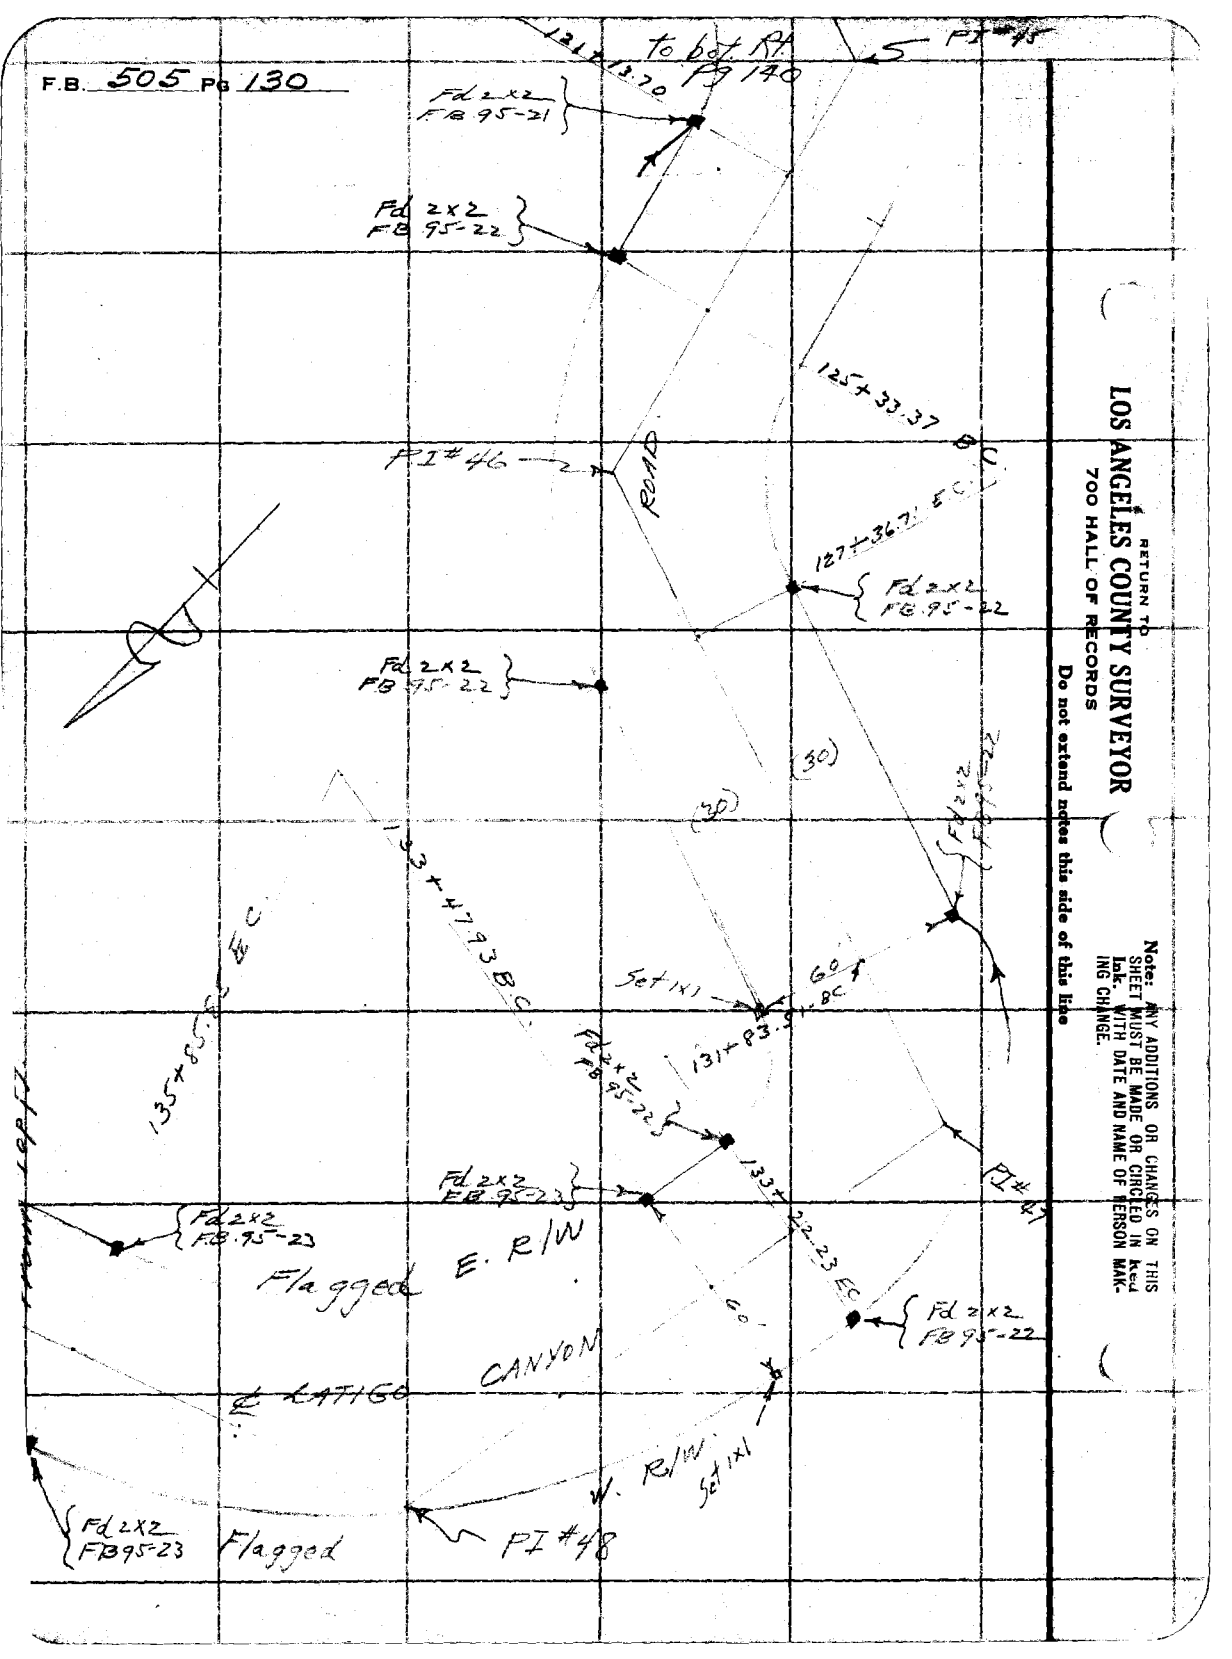
F.B. 505 Pg 130
to bot RP Pg 140
PI #45
Fd 2x2 FB 95-21
Fd 2x2 FB 95-22
125+33.37 BC
PI #46
ROAD
127+36.71 EC
Fd 2x2 FB 95-22
Fd 2x2 FB 95-22
(30)
(30)
133+47.93 BC
Set 1x1
60'
131+83.
135+85.
Fd 2x2 FB 95-22
133+
Fd 2x2 FB 95-22
Fd 2x2 FB 95-23
Flagged E. R/W
22-23 EC
Fd 2x2 FB 95-22
CANYON
LATIGO
W. R/W
Set 1x1
Fd 2x2 FB 95-23
Flagged
PI #48
RETURN TO
LOS ANGELES COUNTY SURVEYOR
700 HALL OF RECORDS
Do not extend notes this side of this line
Note: ANY ADDITIONS OR CHANGES ON THIS SHEET MUST BE MADE OR CIRCLED IN Red Ink. WITH DATE AND NAME OF PERSON MAKING CHANGE.

Notes Ck'd by	Survey of Latigo Canyon Pole Line
Map No.	W. O. 8004 Tape No. 21 St'd 8" OF.
Office Work	Surveyed by Moore
Checked	Notes Moore Date 10-16-33
Date	Indexed E. C. J.

F.B. 505 PG. 131

To bottom Pg 145

Fd 2x2
FB 95-12

P.I. # 25

Fd 2x2
FB 95-12

Fd 2x2
FB 95-13

63+78.89 E.C.

P.I. # 26

68+90.38 B.C.

Flagged

From lower left Pg. 145

69+21.93 E.S.

Fd 2x2
FB 95-13

(30) (30)

60' Set 1x1

Fd 2x2
FB 95-13

70+50.00 B.C.

60'

Set 1x1

72+85.62 B.C.

Fd 2x2
FB 95-13

LATIGO CANYON ROAD

Curve # 27

Note: ANY ADDITIONS OR CHANGES OR THIS SHEET MUST BE MADE OR CANCELED IN Red Ink. WITH DATE AND NAME OF PERSON MAKING CHANGE.

Do not extend notes this side of this line

RETURN TO
LOS ANGELES COUNTY SURVEYOR
700 HALL OF RECORDS

FORM 847 10M 8-31

F.B. 505 Pg 132

To bottom pg.

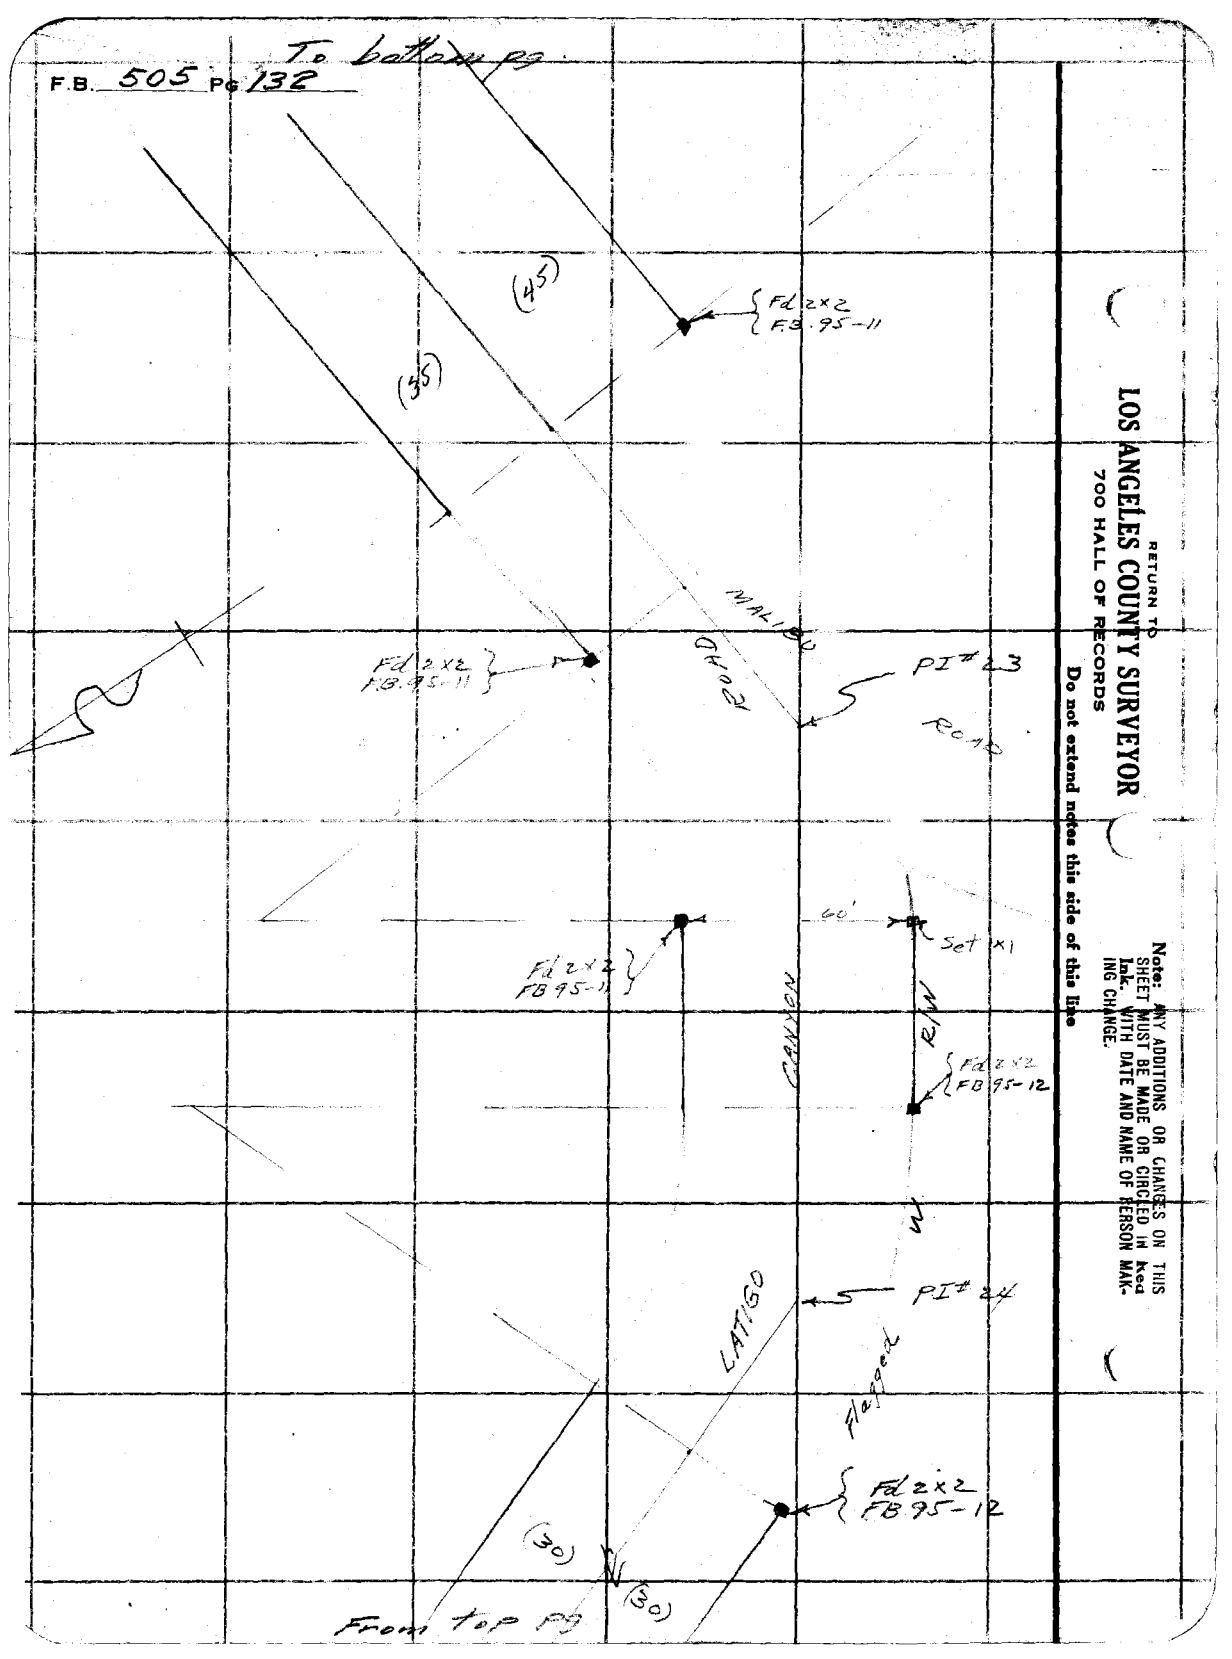

From top pg

RETURN TO
LOS ANGELES COUNTY SURVEYOR
700 HALL OF RECORDS

Do not extend notes this side of this line

Note: ANY ADDITIONS OR CHANGES ON THIS SHEET MUST BE MADE OR CIRCLED in Red Ink, WITH DATE AND NAME OF PERSON MAKING CHANGE.

Notes Ck'd by	Survey of Latigo Canyon Pipeline
Map No.	W. O. 8004 Tape No. 21 St'd 6" oF.
Office Work	Surveyed by L. D. Moore
Checked	Notes Moore Date 10-18-33
Date	Indexed A. C. Johnson

F.B. 505 PG. 133

To bottom P.I.

46+29.65 BC

P.I. # 20

Fd 2 x 2 F.B. 95-10

Fd 2 x 2 F.B. 95-10

P.I. # 21

47+62.89 BC

49+32.09 EC

Fd 2 x 2 F.B. 95-10

(30) (30)

LATIGO CANYON

P/L

MALIBU ROAD

Fd 2 x 2 F.B. 95-10

P.I. # 22

(35) (40)

From top P.I.

Note: ANY ADDITIONS OR CHANGES OF THIS SHEET MUST BE MADE OR CIRCLED IN Red Ink. WITH DATE AND NAME OF PERSON MAKING CHANGE.

Do not extend notes this side of this line

RETURN TO
LOS ANGELES COUNTY SURVEYOR
700 HALL OF RECORDS

FORM 847 10M 5-31

F.B. 505 Pg 134

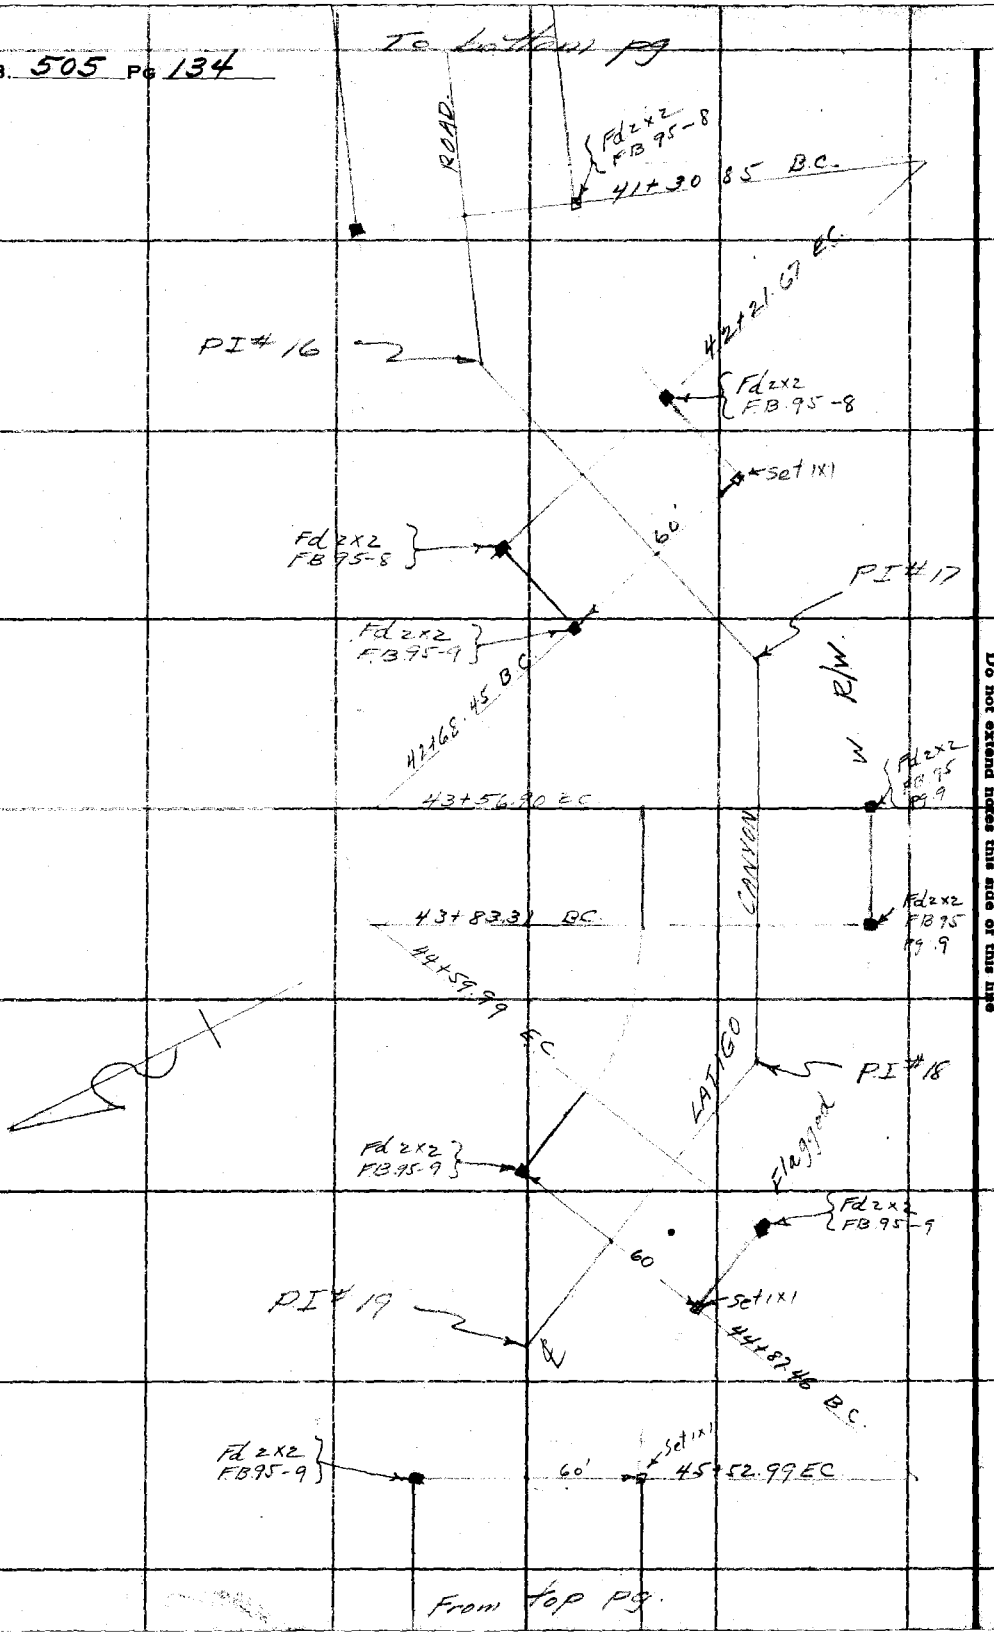

RETURN TO
LOS ANGELES COUNTY SURVEYOR
700 HALL OF RECORDS
Do not extend notes this side of this line

Note: ANY ADDITIONS OR CHANGES ON THIS SHEET MUST BE MADE OR CIRCLED IN Red Ink. WITH DATE AND NAME OF PERSON MAKING CHANGE.

To bottom pg.

F.B. 505 PG. 135

Notes Ck'd by	Survey of Lady Canyon Pole Line
Map No.	W. O. 8004 Tape No. 21 St'd 66 OF.
Office Work	Surveyed by L. D. Moore
Checked	Notes Moore Date 10-28-33
Date	Indexed E. C. Jenkins

Note: ANY ADDITIONS OR CHANGES OR THIS SHEET MUST BE MADE OR CIRCLED IN Red Ink. WITH DATE AND NAME OF PERSON MAKING CHANGE.

RETURN TO
LOS ANGELES COUNTY SURVEYOR
700 HALL OF RECORDS
Do not extend notes this side of this line

FORM 847 10M 5-31

Fd 2x2 FB. 95-7

29+77.54 B.C.

39+63.77 E.C.

ROAD

P.I. #13

Fd 2x2 FB. 95-7

Fd 2x2 FB. 95-7

P.I. #14

Fd 2x2 FB. 95-7

CANYON

32+49.64 B.C.

34+15.52 E.C.

Fd 2x2 FB. 95-8

(30) (30)

Fd 2x2 FB 95-8

36+54.22 B.C.

P.I. #15

Flagged

37+56.70 E.C.

Fd 2x2 FB 95-8

From top pg.

F.B. 505 PG. 136

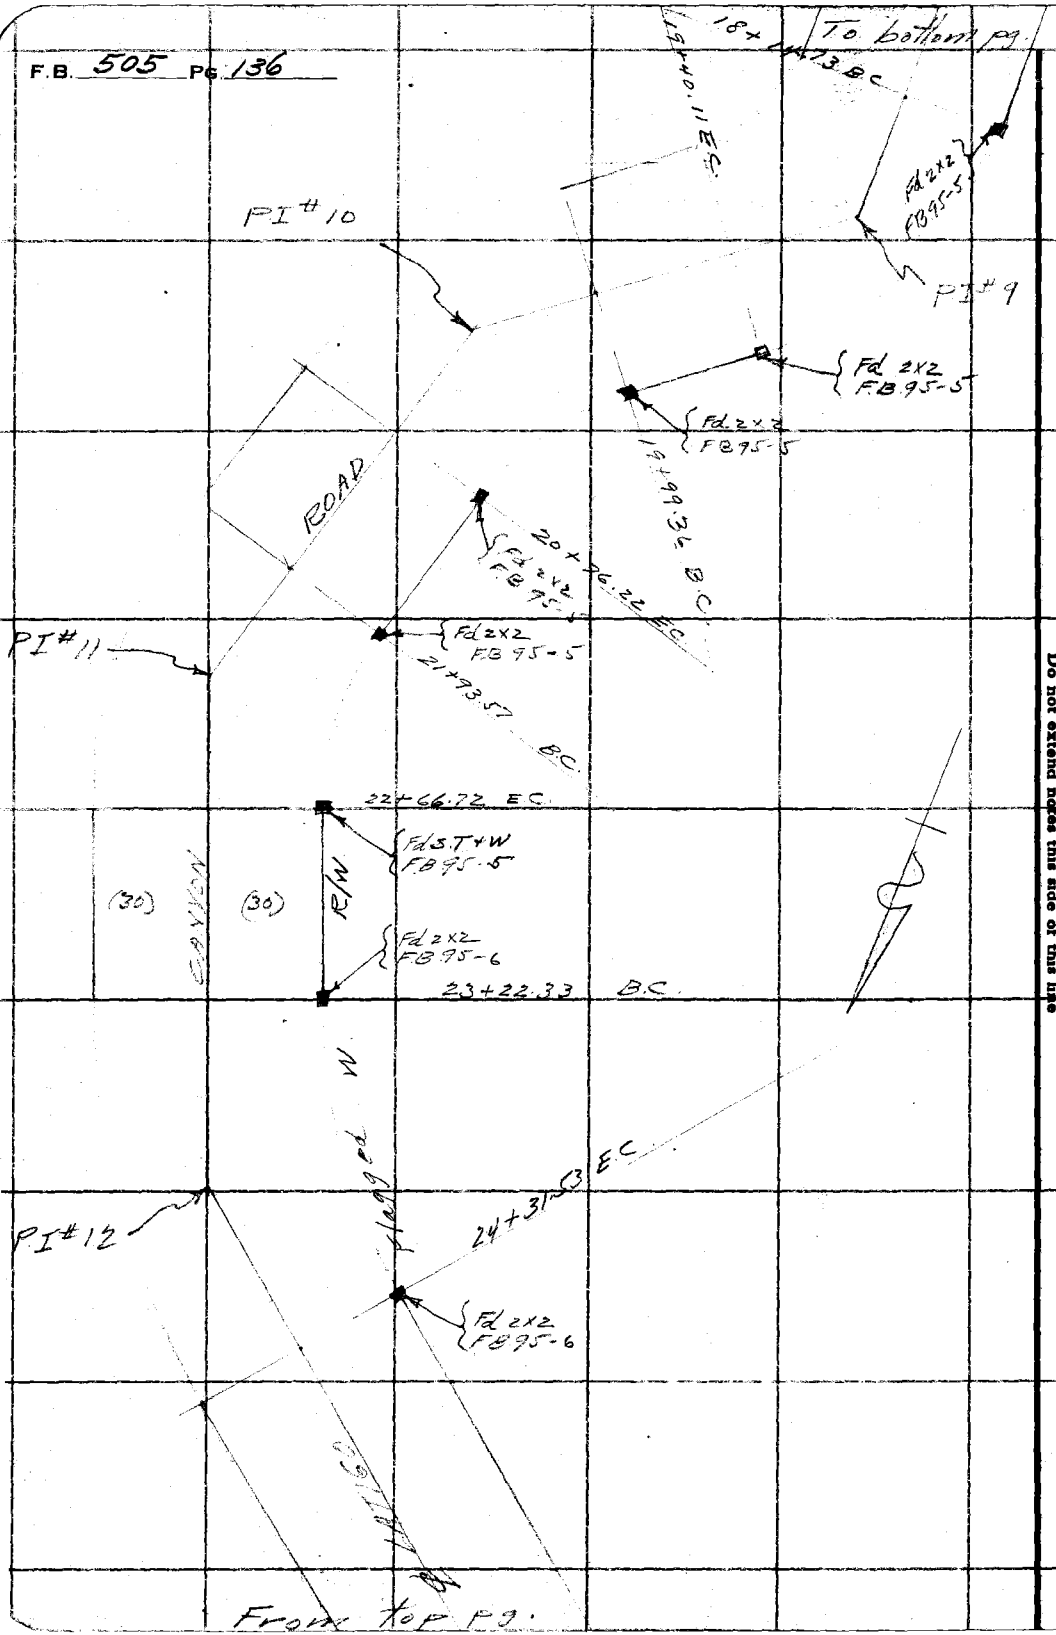

RETURN TO
LOS ANGELES COUNTY SURVEYOR
700 HALL OF RECORDS
Do not extend notes this side of this line

Note: ANY ADDITIONS OR CHANGES ON THIS SHEET MUST BE MADE OR CIRCLED IN Red Ink. WITH DATE AND NAME OF PERSON MAKING CHANGE.

Notes Ck'd by	Survey of Latigo Canyon Fire Line
Map No.	W. O. 6004 Tape No. 12 Sht. 54 of
Office Work	Surveyed by L. D. Moore
Checked	Notes Moore Date 10-11-33
Date	Indexed A. C. Johnson

F.B. 805 PG. 137

To following pg.

Fd 2x2 F.B. 95-3

9+04.14 B.C.

P.I. # 5

9+80.00 E.C.

Fd 2x2 F.B. 95-3

ROAD

10+96.75 B.C.

11+63.01 E.C.

Fd 2x2 F.B. 95-3

P.I. # 6

Fd 2x2 F.B. 95-4

(30)

(30)

B.C.

13+77.00

P.I. # 8

16+50.00 B.C.

15+86.44

CANYON

CURVE #1

12+82.50

E.C.

LATIGO

Fd 2x2 F.B. 95-4

Fd 2x2 F.B. 95-4

From Top pg.

RETURN TO
LOS ANGELES COUNTY SURVEYOR
700 HALL OF RECORDS
Do not extend notes this side of this line

Note: ANY ADDITIONS OR CHANGES OF THIS SHEET MUST BE MADE OR CIRCLED IN Red Ink, WITH DATE AND NAME OF PERSON MAKING CHANGE.

FORM 847 10M 5-31

RETURN TO
LOS ANGELES COUNTY SURVEYOR
700 HALL OF RECORDS

Note: ANY ADDITIONS OR CHANGES ON THIS SHEET MUST BE MADE OR CIRCLED IN Red Ink. WITH DATE AND NAME OF PERSON MAKING CHANGE.

Do not extend notes this side of this line

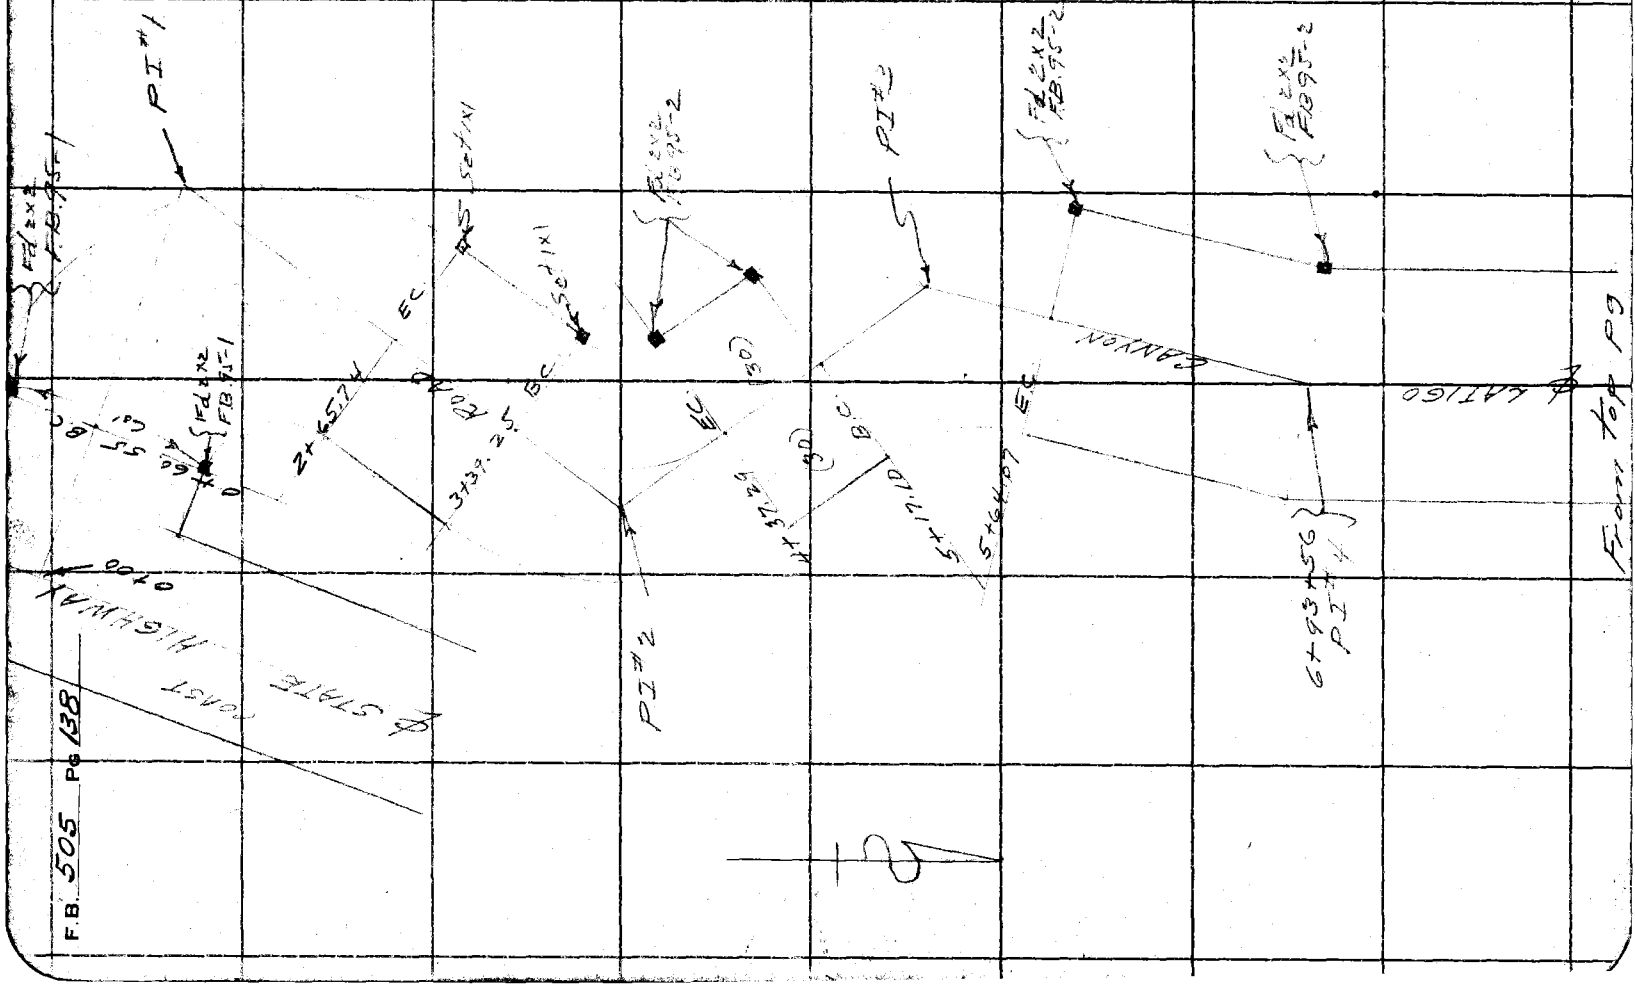

Notes Ck'd by		Survey of La Tigo Can. Rd.	F.B. 505 Pg. 139
Misc. No.		W. O. 8004 Topo No.	St'd
Office Work		Surveyed by L. S. Moore	of.
Checked		Notes Moore Date 11-15-34	
Date		Indexed A. C. Johnson 11-20-34	

Note: ANY ADDITIONS OR CHANGES ON THIS SHEET MUST BE MADE OR CIRCLED IN Red Ink WITH DATE AND NAME OF PERSON MAKING CHANGE.

Do not extend notes this side of this line

SURVEY
to
FLAG RIGHT OF WAY
of
LATIGO CANYON ROAD
from
Sta. 118+10.00 to Sta. 72+85.62
for
FORESTRY DEPT POLE LINE
Job #8004

Moore
Atkins
Fenner
Taylor

Nov. 15, 16, 1934

RETURN TO
LOS ANGELES COUNTY SURVEYOR
700 HALL OF RECORDS

FORM 247 BM 2-34

RETURN TO
LOS ANGELES COUNTY SURVEYOR
700 HALL OF RECORDS

Note; ANY ADDITIONS OR CHANGES ON THIS SHEET MUST BE MADE OR CIRCLED IN **Red Ink** WITH DATE AND NAME OF PERSON MAKING CHANGE.

Do not extend notes this side of this line

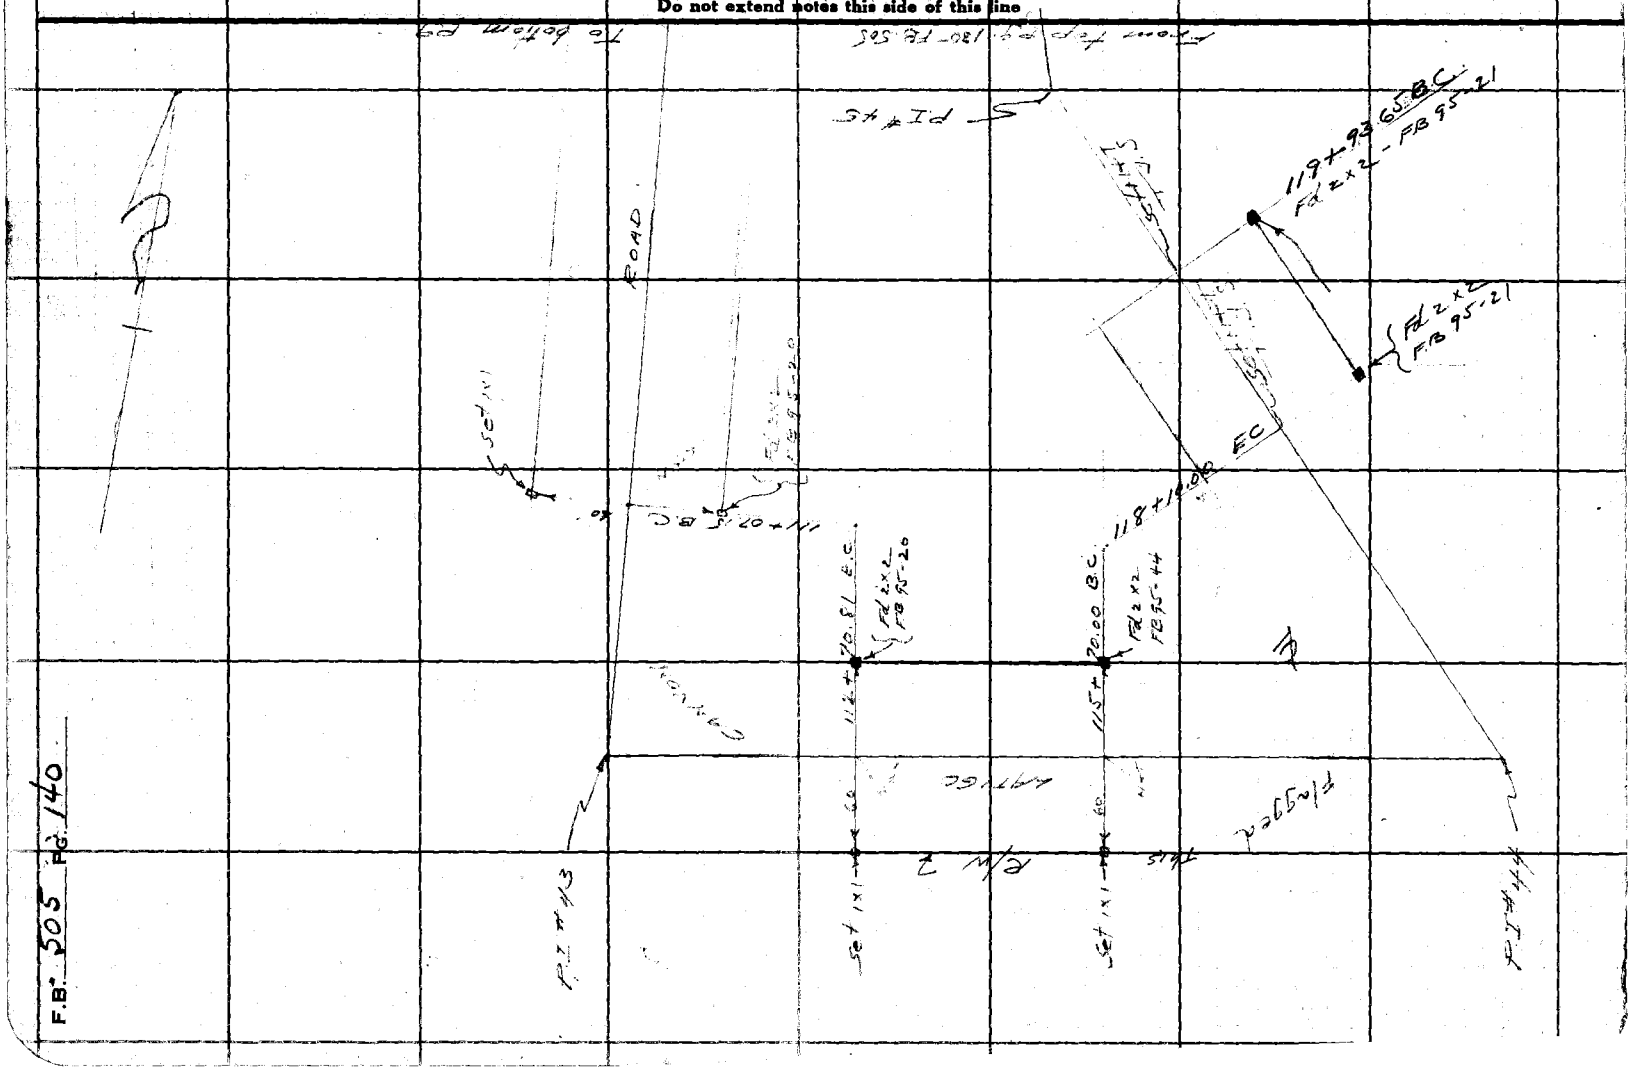

F.B. 505 Pg. 140

F.B. 505 Pg. 141

Notes Ck'd by
Map No.
Office Work
Checked
Date

Surveyed by Moore Date 11-15-34
Notes
Indexed C. Johnson

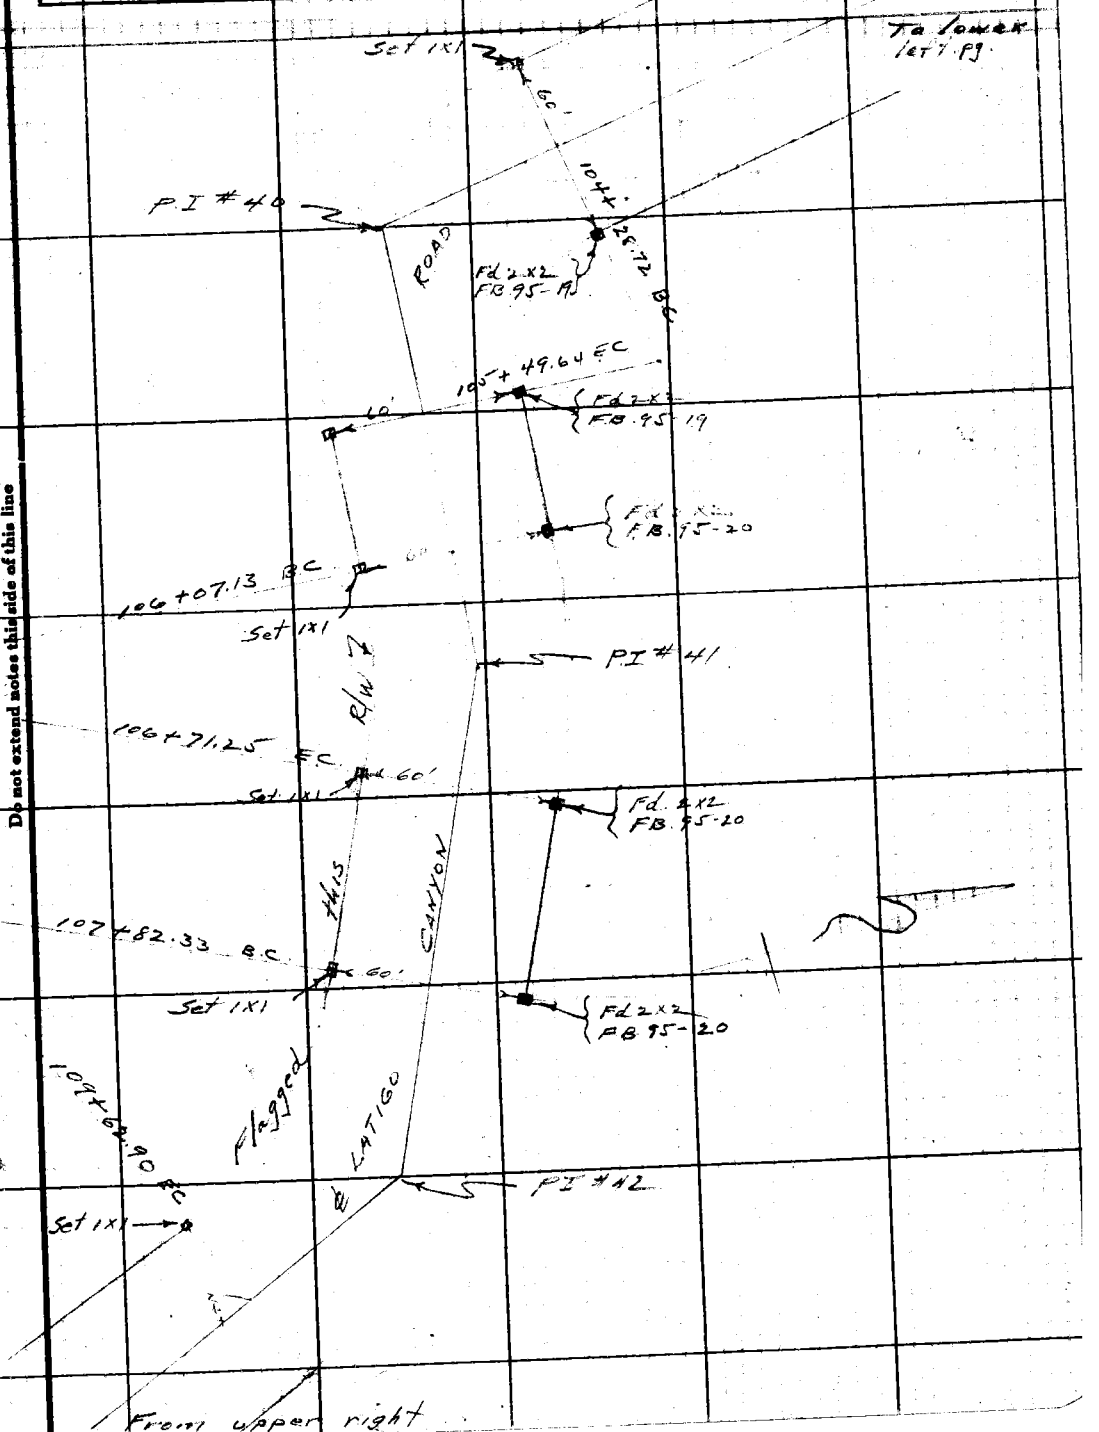

RETURN TO
LOS ANGELES COUNTY SURVEYOR
700 HALL OF RECORDS

Note: ANY ADDITIONS OR CHANGES ON THIS SHEET MUST BE MADE OR CIRCLED IN Red Ink WITH DATE AND NAME OF PERSON MAKING CHANGE.

Do not extend notes this side of this line

FORM 247 5M 2-34

RETURN TO
LOS ANGELES COUNTY SURVEYOR
700 HALL OF RECORDS

Note: ANY ADDITIONS OR CHANGES ON THIS SHEET MUST BE MADE OR CIRCLED IN **Red Ink** WITH DATE AND NAME OF PERSON MAKING CHANGE.

Do not extend notes this side of this line

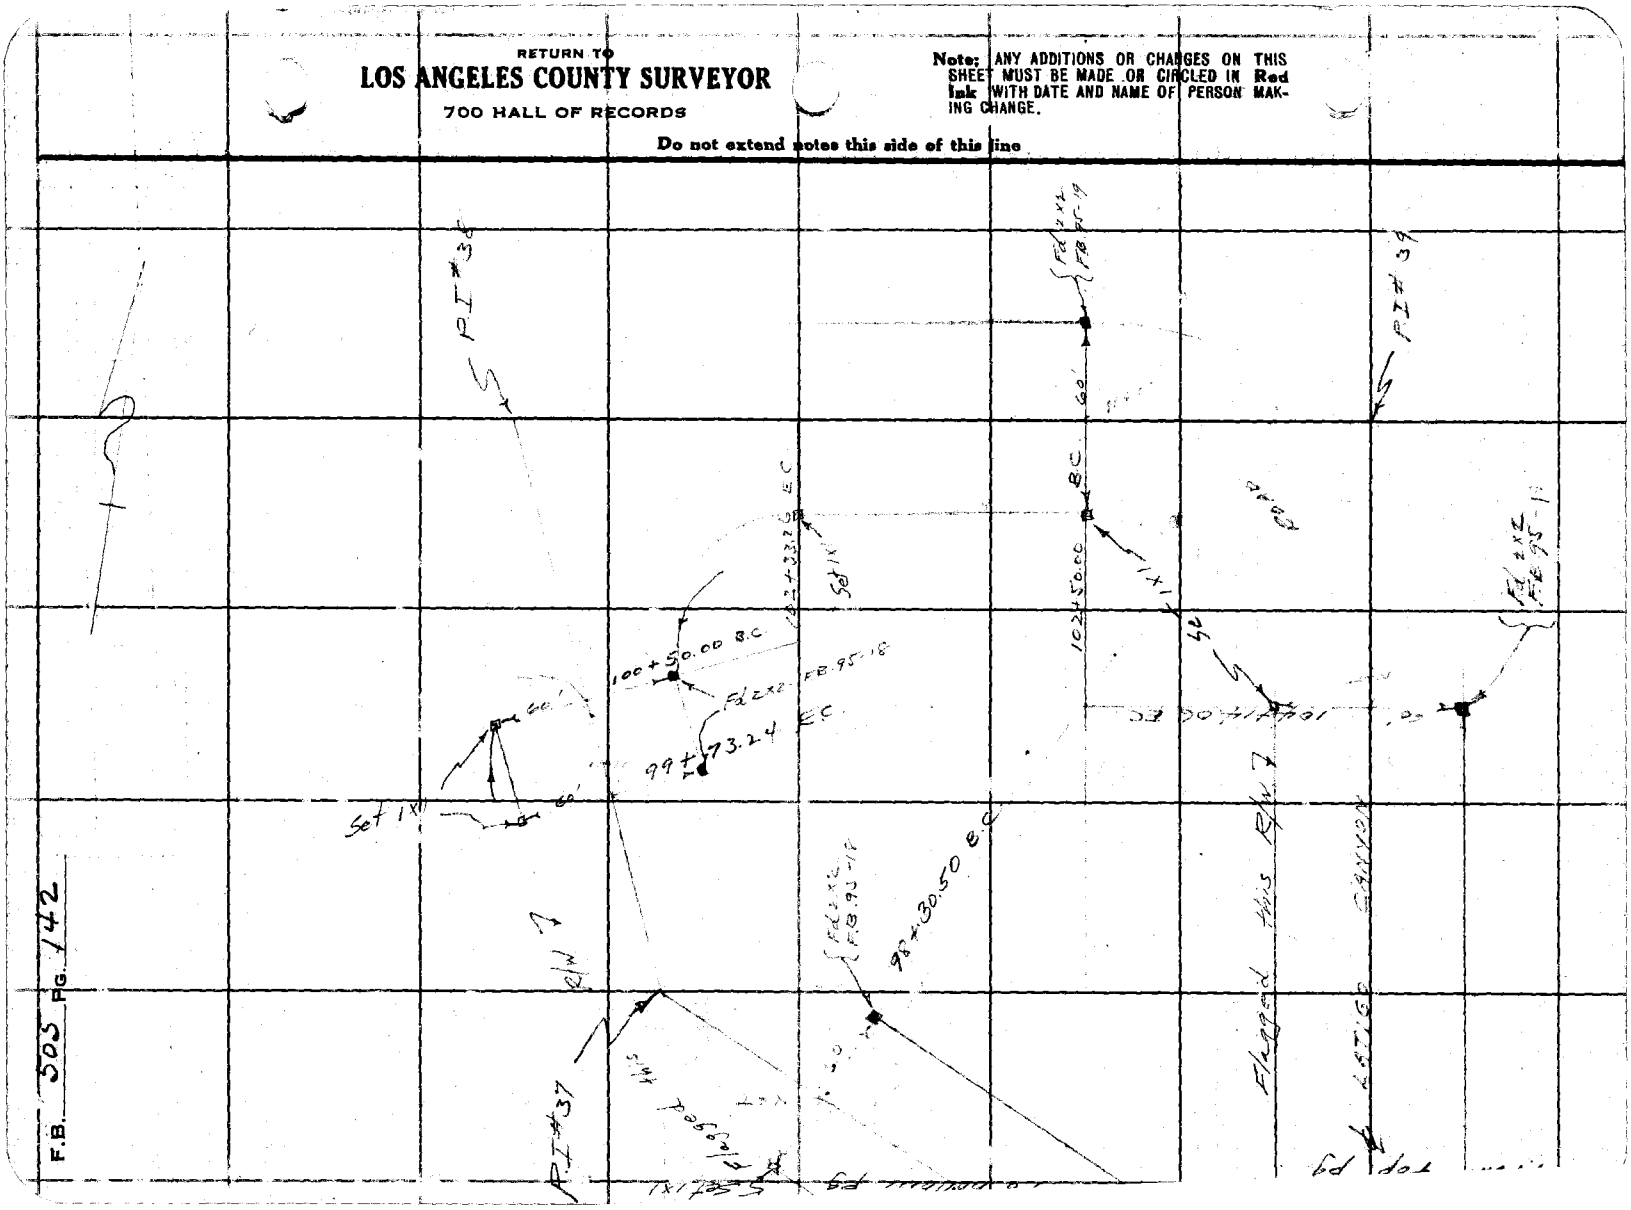

Notes Ck'd by		Survey of Latigo Canyon Flo. Line	F.B. 505 Pg. 143
Office Work		W. O. 8004 Tape No	St'd Of.
Checked		Surveyed by	
Date		Notes Moore Date 11-14-34	
		Indexed C. Johnson	

Note: ANY ADDITIONS OR CHANGES ON THIS SHEET MUST BE MADE OR CIRCLED IN Red Ink WITH DATE AND NAME OF PERSON MAKING CHANGE.

Do not extend notes this side of this line

RETURN TO
LOS ANGELES COUNTY SURVEYOR
700 HALL OF RECORDS

To bottom pg

Set 1x1

PI # 34

92+50.00 P.C.

Fd 2x2 F.B. 95-16

Fd 2x2 F.B. 95-17

60'

Set 1x1

PI # 35

92+77.91 P.C.

60'

Set 1x1

93+72.66 E.C.

60' ±His R/W

Flagged

Fd 2x2 F.B. 95-17

60' LATIGO CANYON

954+87.09 B.C.

Set 1x1

Fd 2x2 F.B. 95-17

Set 1x1

PI # 36

60'

Fd 2x2 F.B. 95-17

From upper left pg

FORM 247 SM 2-34

F.B. 505 PG. 144

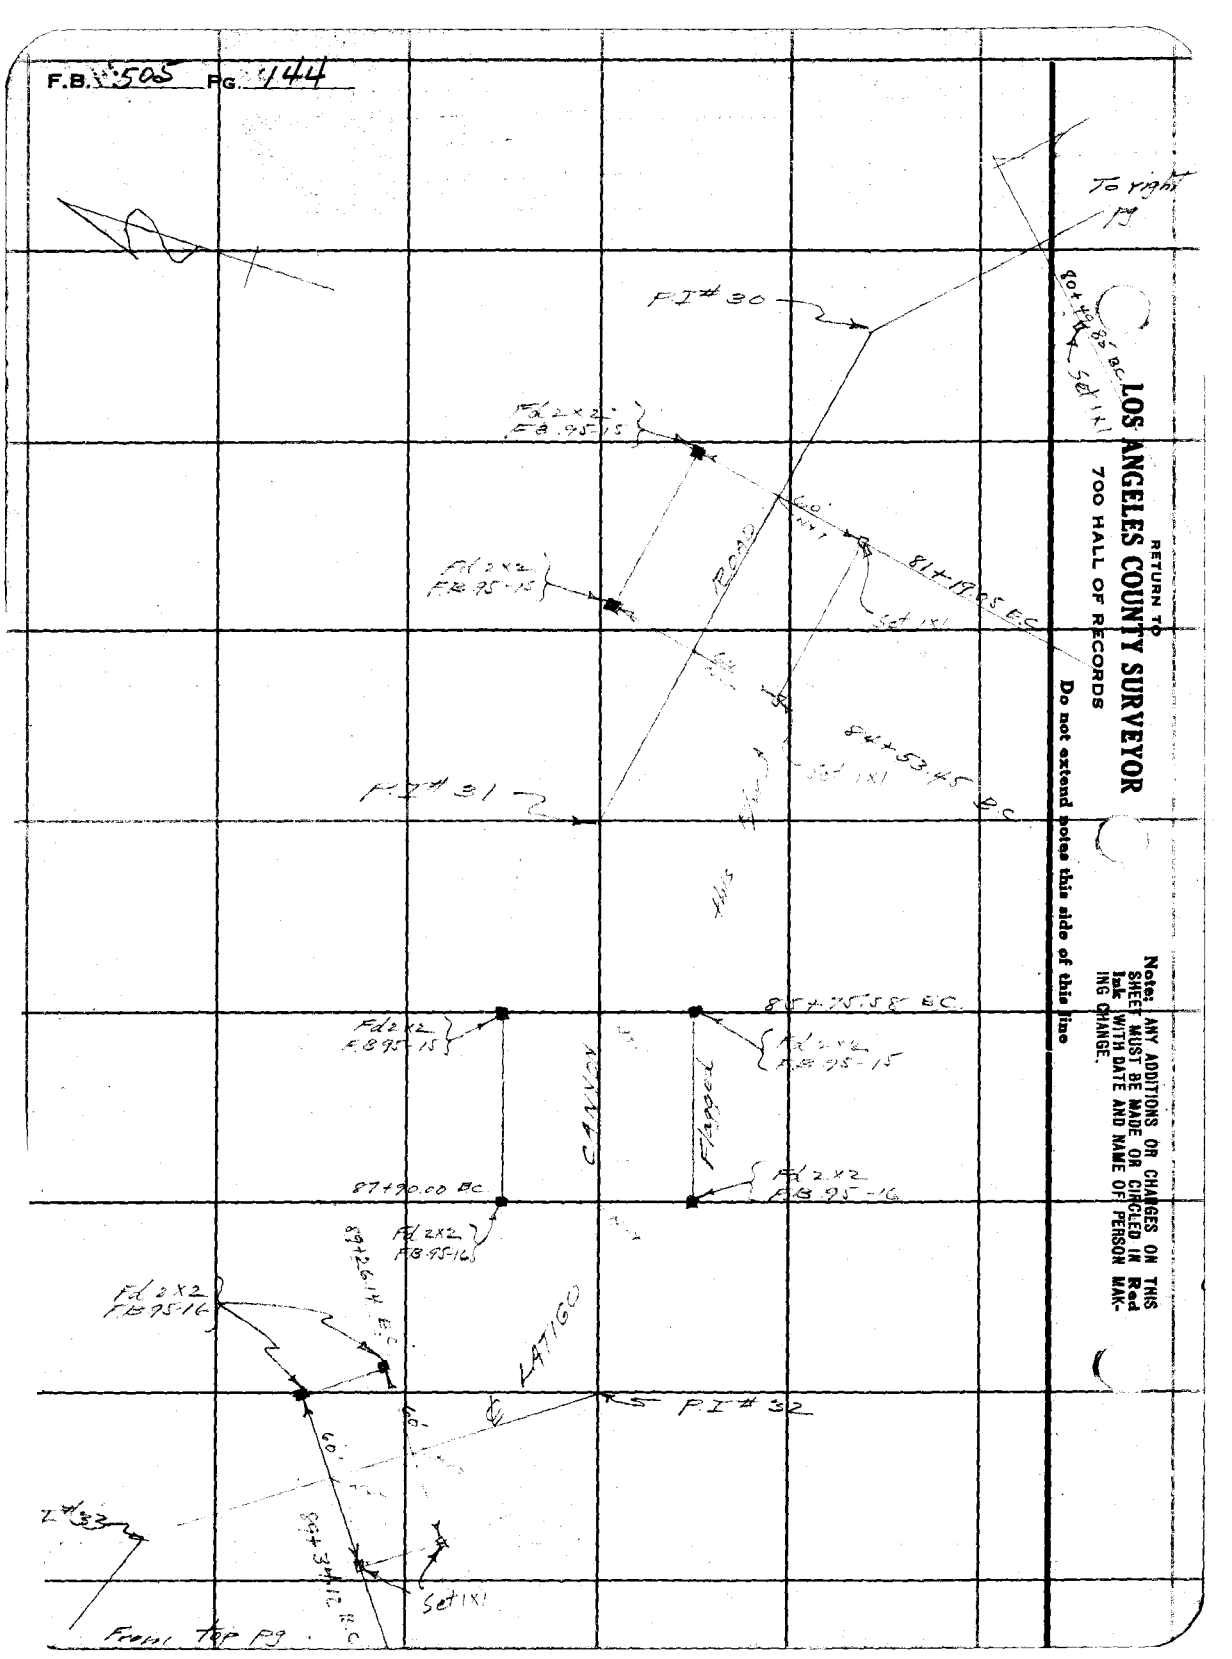

RETURN TO
LOS ANGELES COUNTY SURVEYOR
700 HALL OF RECORDS

Do not extend notes this side of this line

Note: ANY ADDITIONS OR CHANGES ON THIS SHEET MUST BE MADE OR CIRCLED IN Red Ink WITH DATE AND NAME OF PERSON MAKING CHANGE.

Notes Ck'd by	Survey of Latigo Canyon Rd.
Map No.	W. O. 6004 Tape No St'd ° F.
Office Work	Surveyed by [illegible]
Checked	Notes Moore Date 11-16-34
Date	Indexed C. Johnson

F.B. 505 Pg. 145

Note: ANY ADDITIONS OR CHANGES ON THIS SHEET MUST BE MADE OR CIRCLED IN Red Ink WITH DATE AND NAME OF PERSON MAKING CHANGE.

RETURN TO
LOS ANGELES COUNTY SURVEYOR
700 HALL OF RECORDS

Do not extend notes this side of this line

FORM 247 BM 2-34

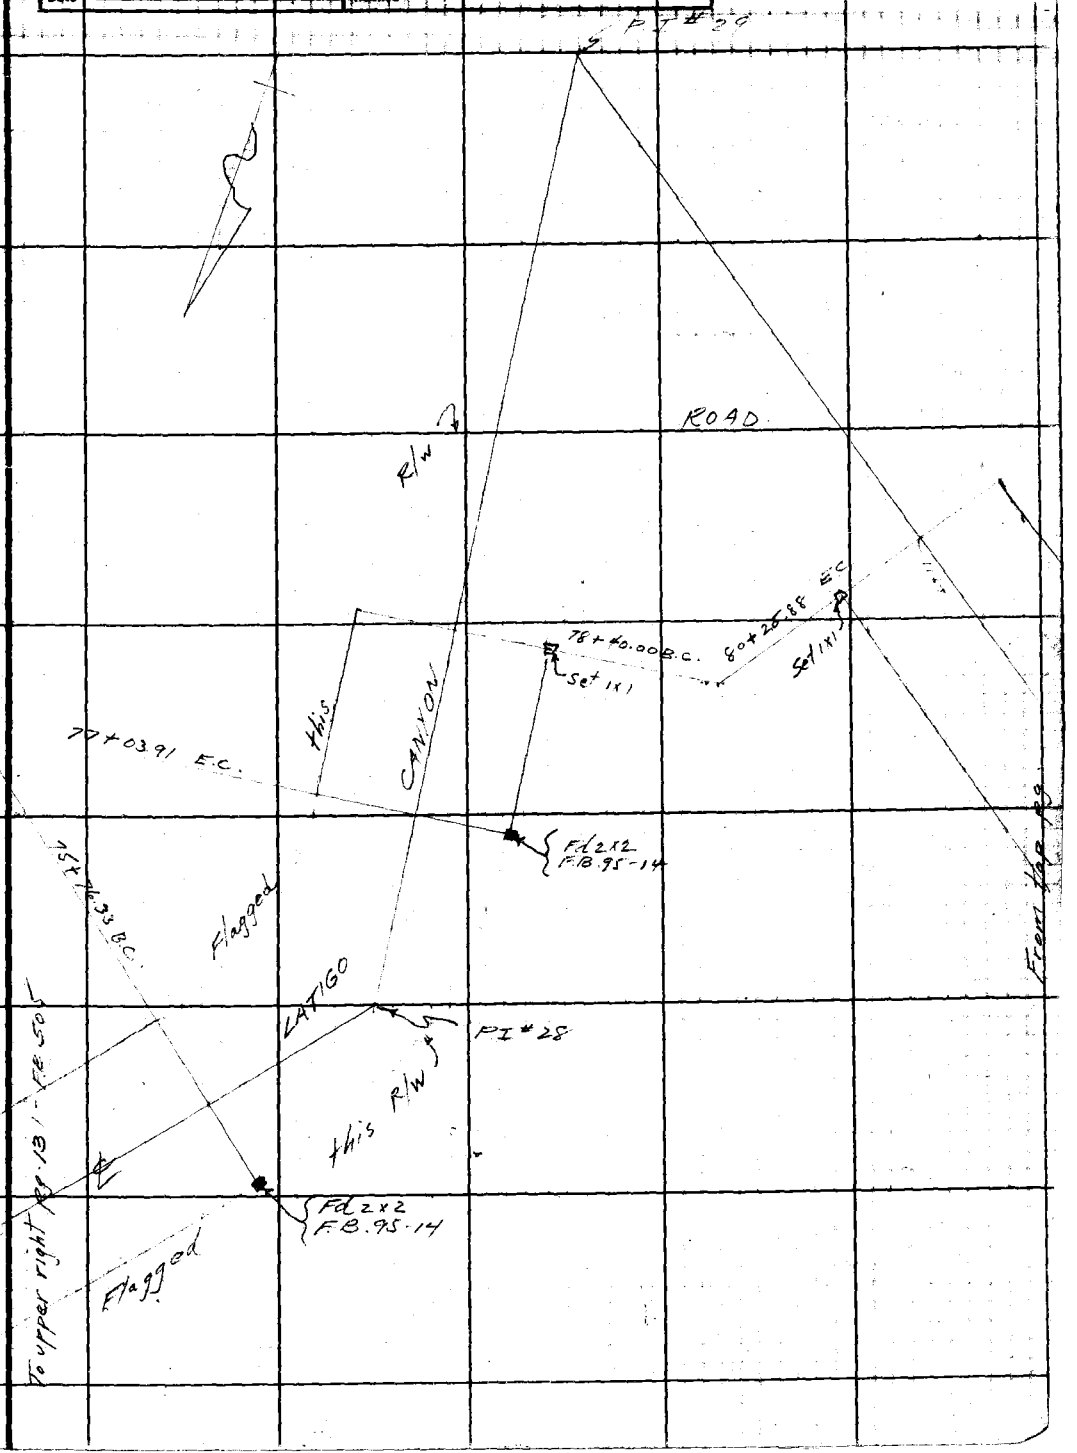

RETURN TO

LOS ANGELES COUNTY SURVEYOR

700 HALL OF RECORDS

Note: ANY ADDITIONS OR CHANGES ON THIS SHEET MUST BE MADE OR CIRCLED IN **Red Ink** WITH DATE AND NAME OF PERSON MAKING CHANGE.

Do not extend notes this side of this line

F.B. 503 Pg. 146

Notes Ck'd by McPherson	Survey of Castaic Patrol Sta.
Map No. R.T. 968	W. O. 8022 Type No. ____ St'd ____ °F.
Office Work Wood	Surveyed by Howard.
Checked McPherson	Notes ____ Date 12/8-33
Date Dec. 1934	Indexed A. C. Johnson 12-12-33

F.B. 505 PG. 149

B-968

SURVEY OF PROPOSED FIRE LOTS NEAR CASTAIC

Note: ANY ADDITIONS OR CHANGES ON THIS SHEET MUST BE MADE IN Red Ink, WITH DATE AND NAME OF PERSON MAKING CHANGE.

Do not extend notes this side of this line

RETURN TO
LOS ANGELES COUNTY SURVEYOR
720 HALL OF RECORDS

FORM 247 10M 8-31

F.B. 505 PG. 150

RETURN TO
LOS ANGELES COUNTY SURVEYOR
700 HALL OF RECORDS
Do not extend notes this side of this line

Note: ANY ADDITIONS OR CHANGES ON THIS SHEET MUST BE MADE OR CIRCLED IN Red Ink. WITH DATE AND NAME OF PERSON MAKING CHANGE.

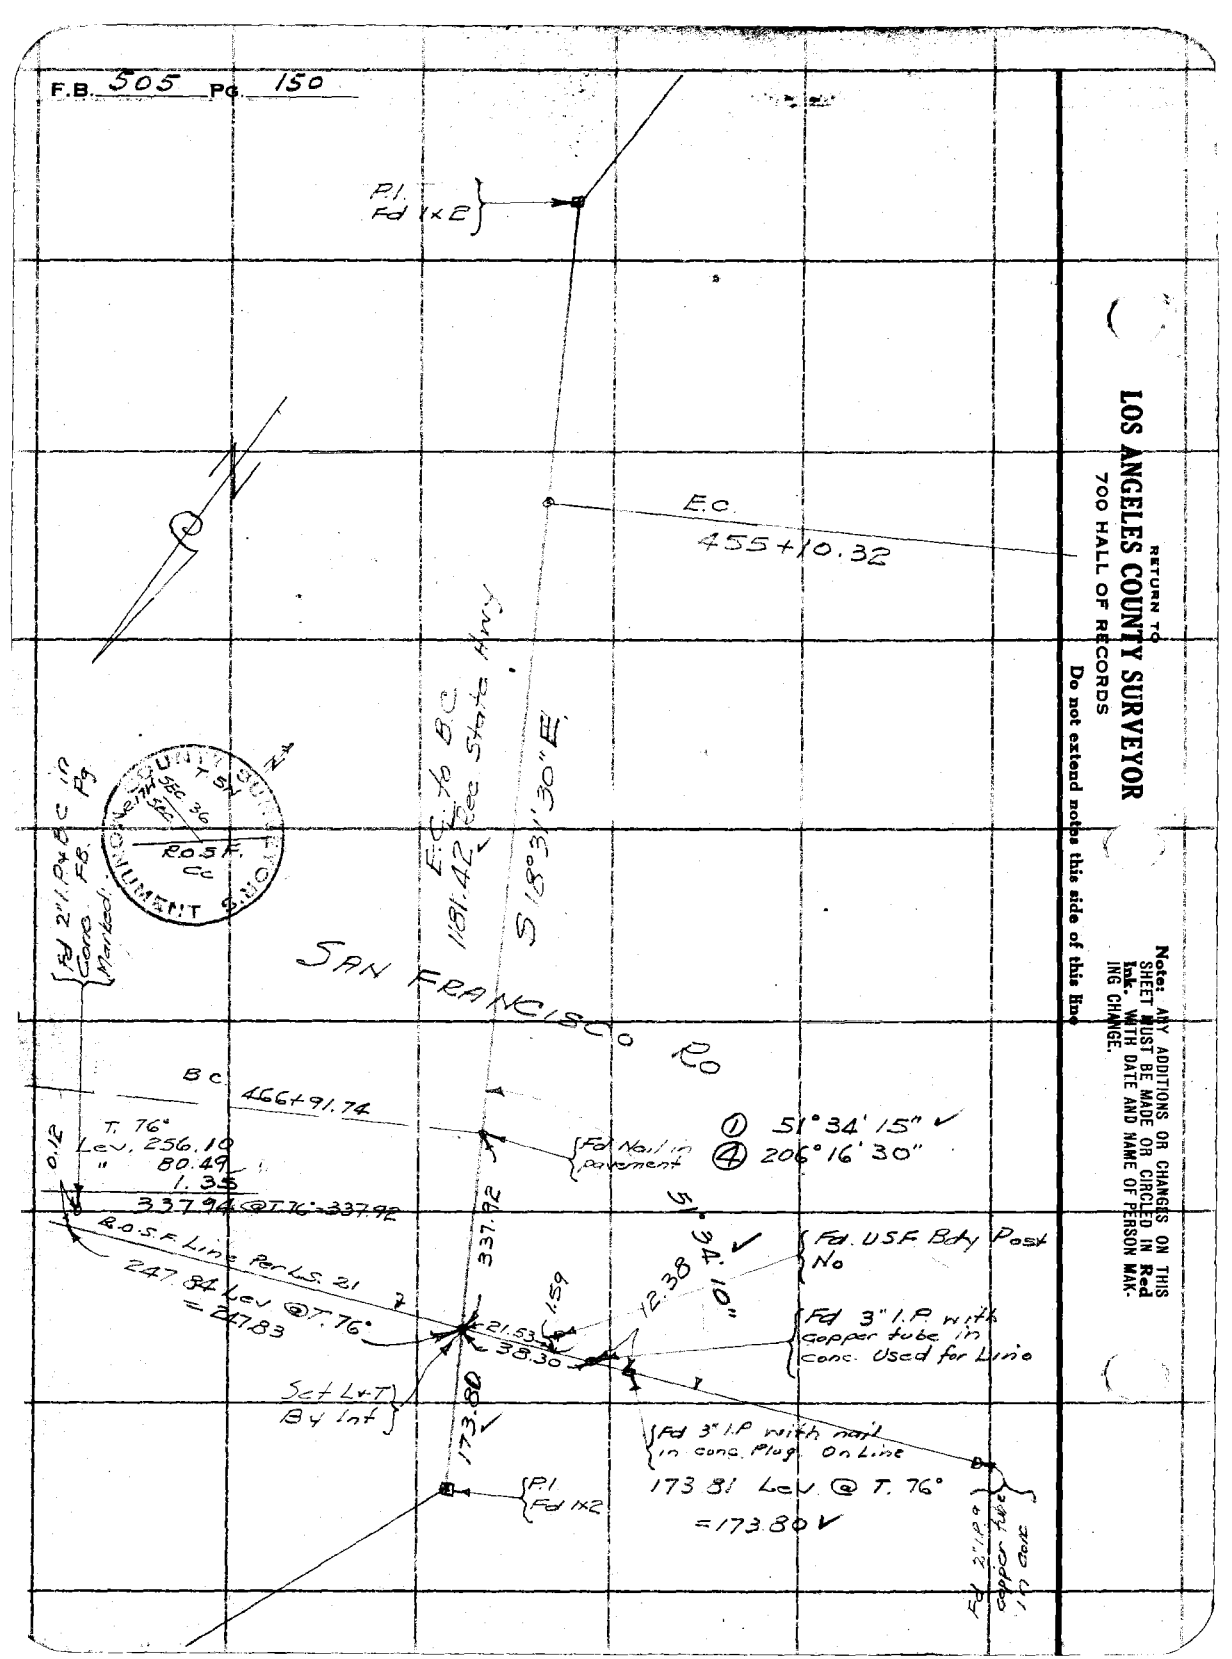

Notes Ck'd by M.E. Pherson	Survey of Castaic Patrol Site
Map No. B-968	W. O. 8028 Topo No. 36 St'd 527 °F.
Office Work Wood	Surveyed by E. C. Howard
Checked Mc Pherson	Notes F.D. Date 12-9-33
Date Dec. 1934	Indexed C. Johnson

F.B. 505 Pg. 151

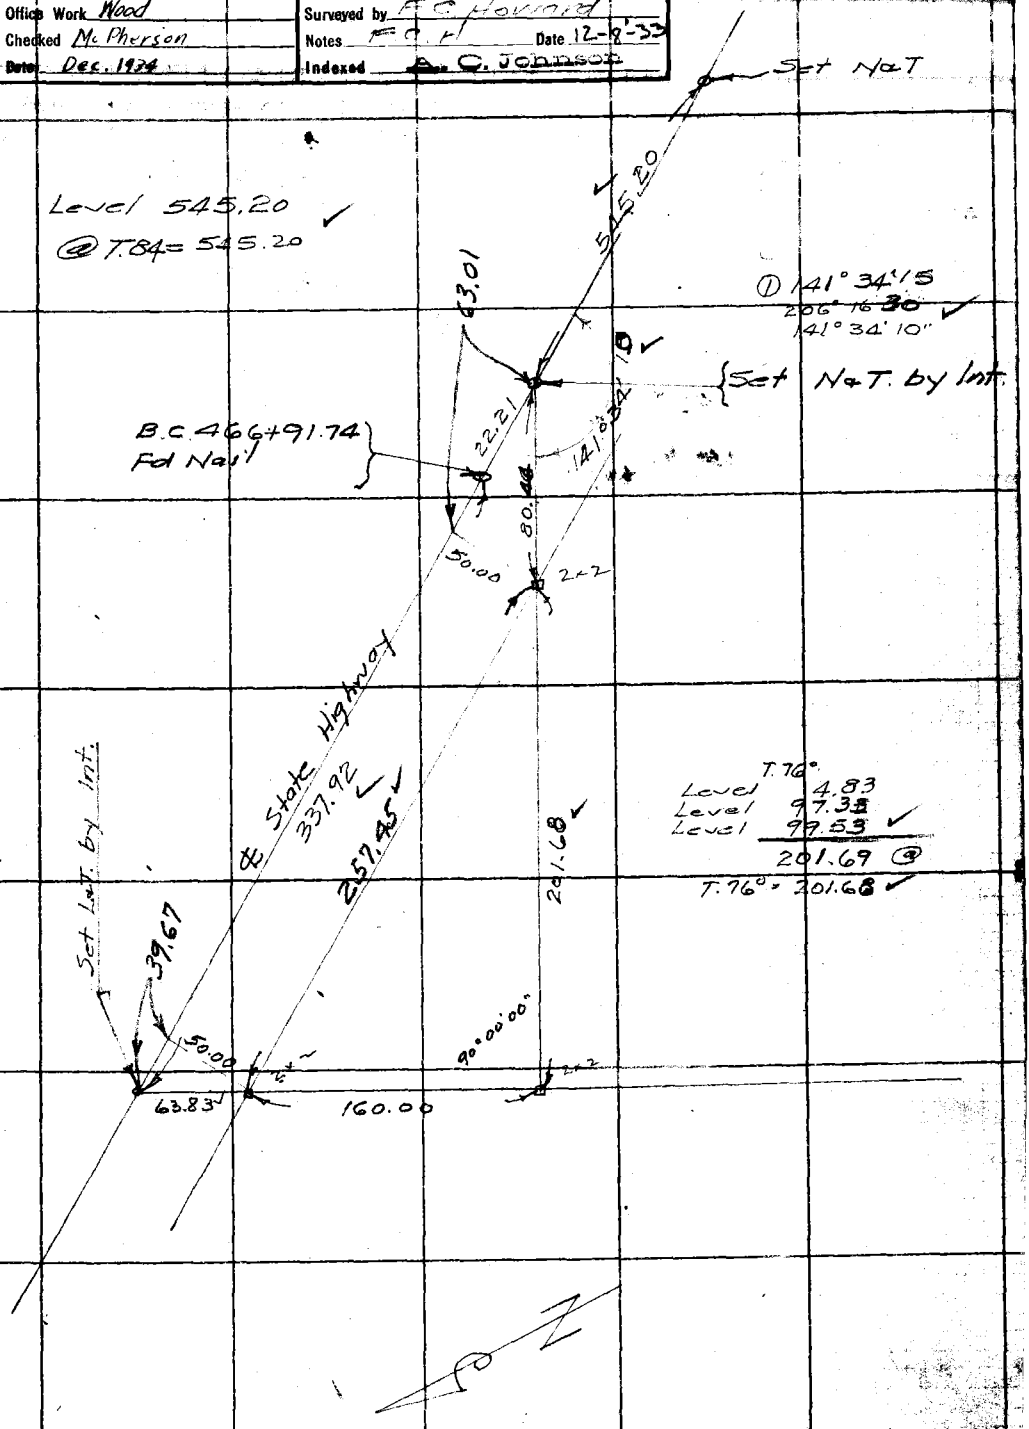

Notes: ANY ADDITIONS OR CHANGES ON THIS SHEET MUST BE MADE IN Red Ink. WITH DATE AND NAME OF PERSON MAKING CHANGE.

Do not extend notes this side of this line

RETURN TO
LOS ANGELES COUNTY SURVEYOR
700 HALL OF RECORDS

FORM 247 10M 8-31

F.B. 505 PG. 152

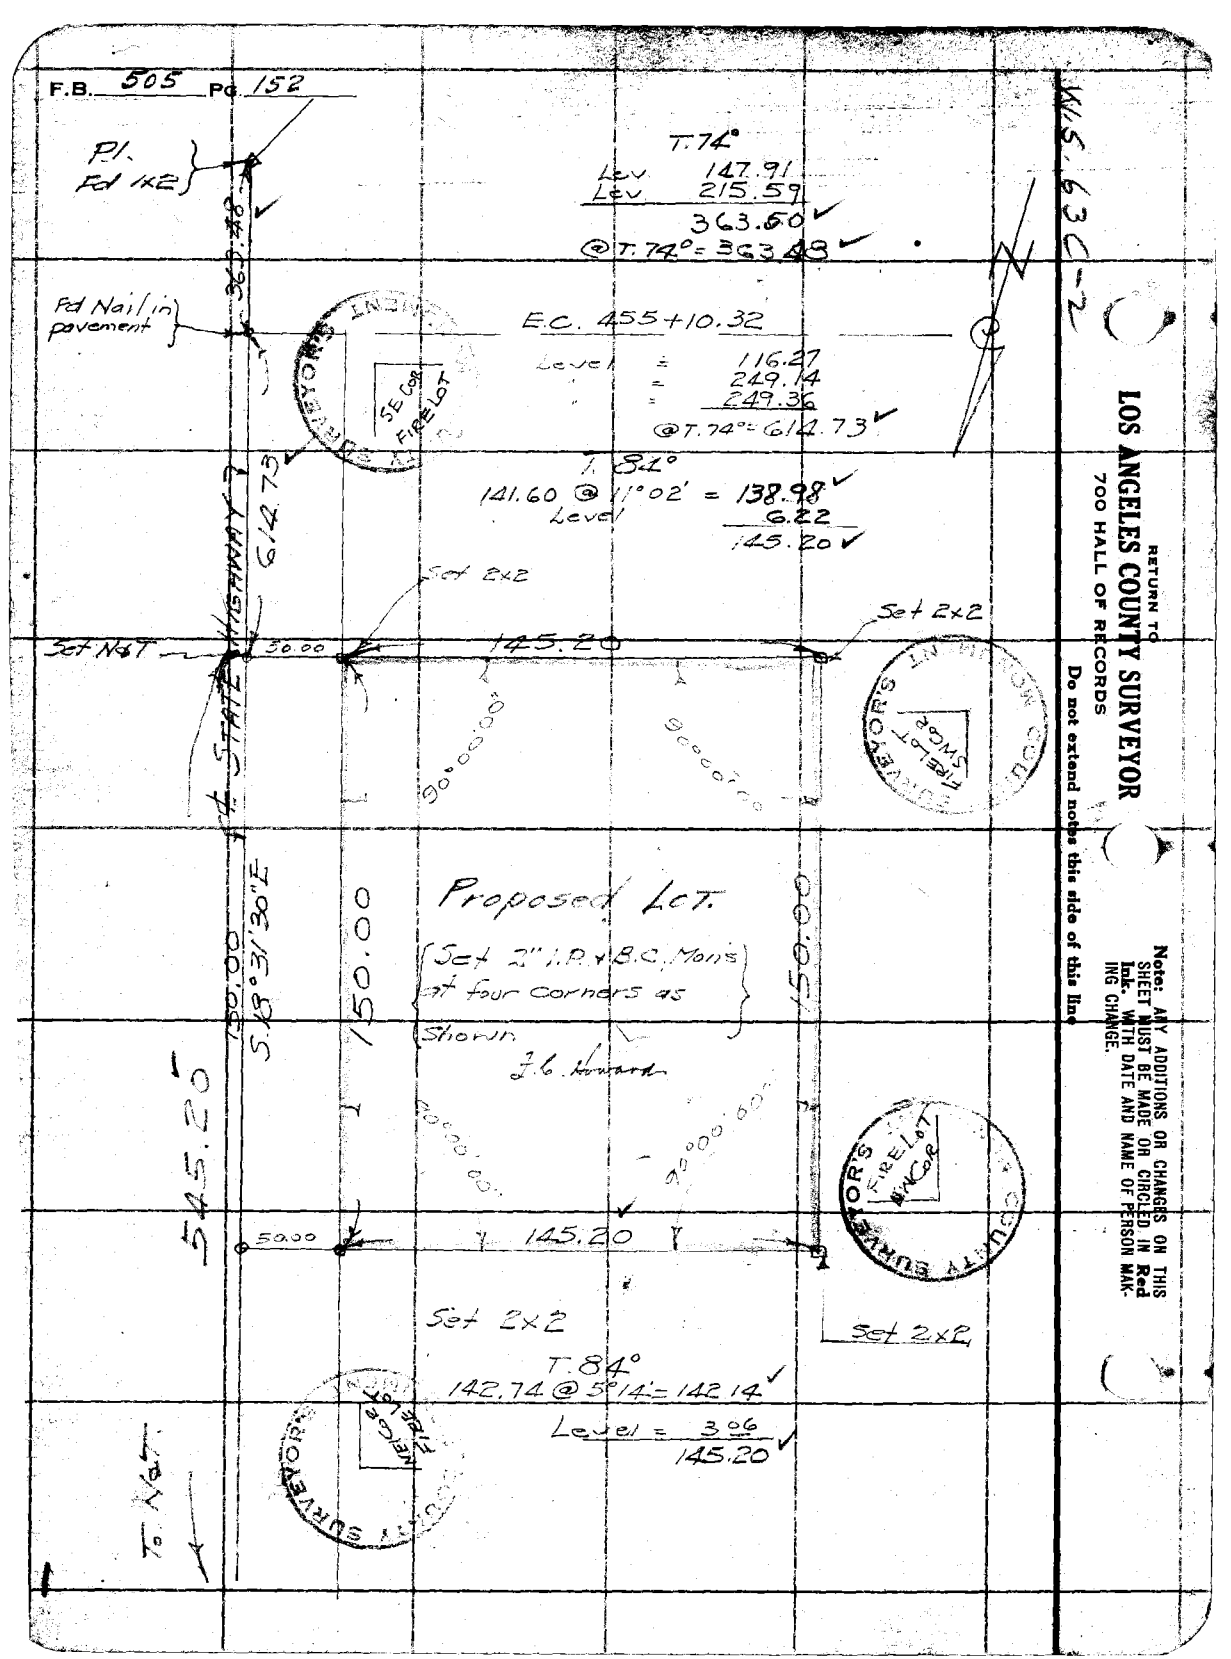

RETURN TO
LOS ANGELES COUNTY SURVEYOR
700 HALL OF RECORDS

Do not extend notes this side of this line

Note: ANY ADDITIONS OR CHANGES ON THIS SHEET MUST BE MADE OR CIRCLED IN Red Ink. WITH DATE AND NAME OF PERSON MAKING CHANGE.

Notes Ck'd by Blackmer	Survey of Castaic Patrol Stn
Map No. B-968	W. O. 8077 Tape No 17 St'd 34 or.
Office Work Wood & McPherson	Surveyed by EC Hartard
Checked Blackmer	Notes EC H Date 10-4-34
Date Dec. 1934	Indexed A. C. Johnson 10-4-34

F.B. 503 Pg 153

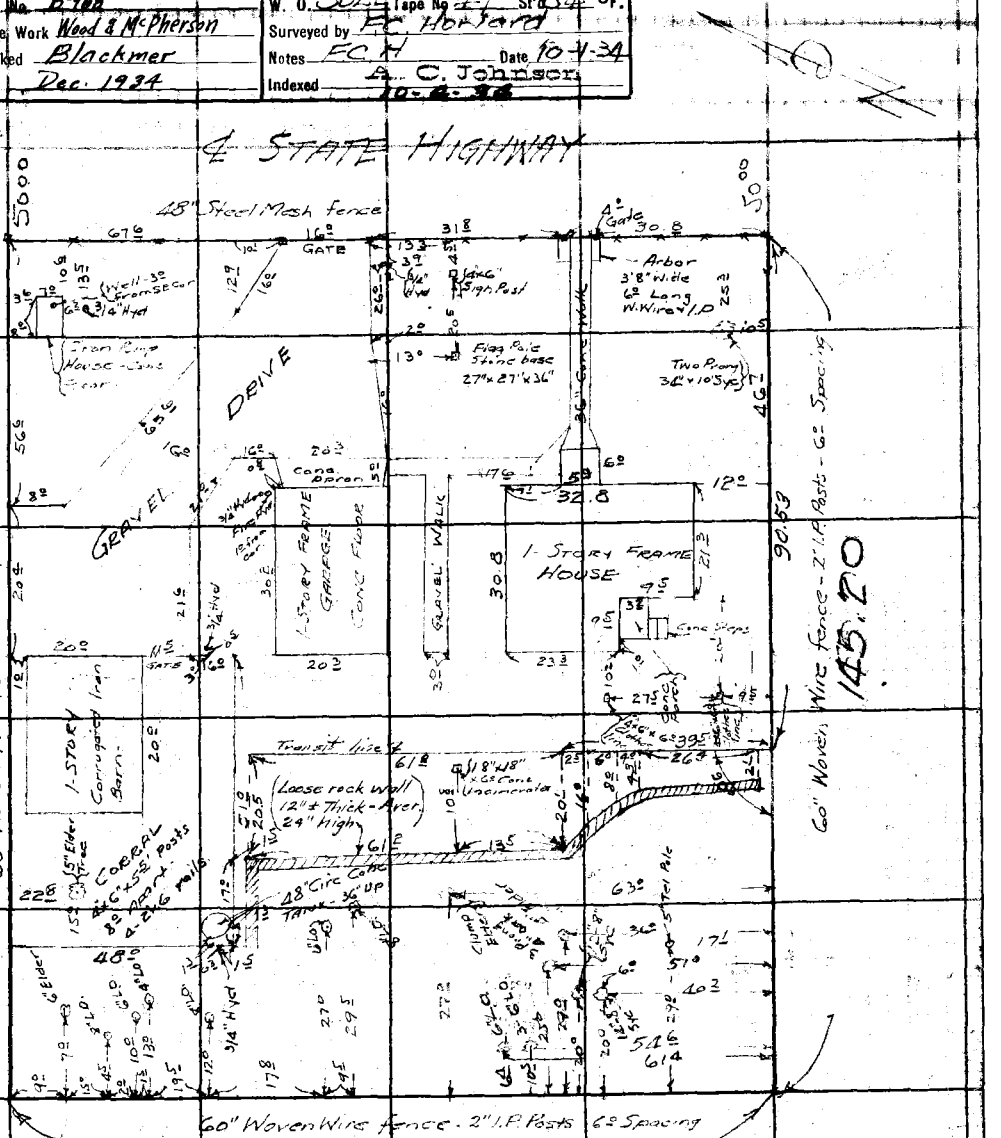

Notes: ANY ADDITIONS OR CHANGES ON THIS SHEET MUST BE MADE OR CIRCLED IN Red Ink WITH DATE AND NAME OF PERSON MAKING CHANGE.

Do not extend notes this side of this line

RETURN TO
LOS ANGELES COUNTY SURVEYOR
700 HALL OF RECORDS 1

CASTAIC PATROL STATION

See Pgs 155 to 157 for Stadia Topog

See LB 783 Pg 301 to 305 for B.M.s.

FORM 247 BM 2-34

F.B. 503 Pg. 154

Inst At 1×2 #2 — + 5.25 — #1 — 5.25 — Elev 4.60 — ℄ State Hwy opp SE Cor " " NE "

1×2 #1 — 5.25 — C4 +126.87 — 38 +128.14 — 1×2 #1 Ctr top Water tank — 1×2 #2 Ctr top Water tank

#2 Set 1×2

S18°31'30"E 185.33'

117.28' — 68.05' — #1 Set 1×2

60°26'00" — Δ 7°33'30" — R 521.25'

FIRE LOT

Calc. S 10°02'15" E 329.33'

N

S 32°00'30" E Calc. 304.12'

@ 23°10' ± @ 20°

Steel Water Tank 37.75' Cir. Cone 3' tank 1.62' above rim. 123 High. 120=Outside Diameter

RETURN TO
LOS ANGELES COUNTY SURVEYOR
700 HALL OF RECORDS

Do not extend notes this side of this line

Note: ANY ADDITIONS OR CHANGES ON THIS SHEET MUST BE MADE OR CIRCLED IN Red Ink WITH DATE AND NAME OF PERSON MAKING CHANGE.

Form 261 1938 3-34

PLEASE RETURN TO
LOS ANGELES COUNTY SURVEYOR
700 HALL OF RECORDS

NOTE: ANY ADDITIONS OR CHANGES ON THIS SURVEY MUST BE MADE OR CIRCLED IN RED INK, WITH DATE AND NAME OF PERSON MAKING CHANGE

Note - Dist Changed

Do not extend notes this side of this line

Note - See LB 783 Pg 34 for Return

Transit at	Sight at	Stadia Intervals	Stadia Distance	Stadia Rod	Horizontal Angle 0° to 360° Right	Horiz. Distance	+ −	Vertical Angle	Elevation of Point	+ Back Sight	+ −	Difference Elevation	Height of Instrument	+ −	Vertical Distance	Notes
1x2 Nail	1x2 Nail								1064.76	5.25			1070.01			See LB 783 Pg 34 for Return
			81.95	4.53½	180 -		−	0	1064.67							Set 1x2 on Line
			50'	5 2	180 -		−	0	1064.1							See LB 783 Pg 33 for Return
			16'	5 2	180 -		−	0	1064.1							S.E. Cor.
			34'	5 1	0 - 0		−	0	1064.2							Ctr Wall
			68.05'	4.46	0 - 0		−	0	1065.55							Prop. Line
			75'	4 6	333 - 55		−	0	1065.1							See LB 783 Pg 33 for Return
			43'	4 6	315 - 05		−	0	1065.1							N.E. Cor.
			32'	5 0	240 - 40		−	0	1065.0							
			57'	5 0	208 - 35		−	0	1065.0							
			86'	5 2	197 - 55		−	0	1064.8							Ctr. Cone Wall
			98'	5 4	210 - 40		−	0	1064.6							Prop. Line
			65'	4 9	219 - 40		−	0	1064.1							" "
			45'	4 9	246 - 40		−	0	1065.1							Ctr. Walk
			46'	4 7	294 - 55		−	0	1065.3							
			88	4 7	321 - 25		−	0	1065.3							
			102	4 4	311 - 30		−	0	1065.6							Prop Line
			85	4 6	294 - 40		−	0	1065.4							"
			79	4 6	284 - 35		−	0	1065.2							
			77	5 0	273 - 40		−	0	1065.0							
			111	3 2	274 - 15		−	0	1064.2							Pt. No. 11

Notes Req. [illegible] Date [illegible] Plotted [illegible] Job No. [illegible] Division No. [illegible]
Date Dec. 1934 Survey of Catholic Report [illegible]
Surveyed by F.C.H. [illegible] F.C.H. [illegible]

Form 301 10M 3-34

PLEASE RETURN TO
LOS ANGELES COUNTY SURVEYOR
700 HALL OF RECORDS

NOTE: ANY ADDITIONS OR CHANGES ON THIS SHEET MUST BE MADE OR CIRCLED IN RED INK, WITH DATE AND NAME OF PERSON MAKING CHANGE

Note-Dist Chained

Do not extend notes this side of this line

Transit at	Sight on	Stadia Intercepts	Stadia Distance	Stadia Rod	Horizontal Angle 0° to 360° Right	Horiz. Distance	+ Vertical Angle —	Elevation of Point	+ Back Sight	+ Difference Elevation —	Height of Instrument	+ Vertical Distance —	REMARKS Station	Left	Right
*1	*2		116	5 0	288 ° 10 '		+ 0 ° 43 '	1066.4	5.25	-3.6	1070.01	+ 1.45	1x2" #1 See LB 783 Pg. 303		
Continued			148	14 5	297 ° 50 '		+ 4 ° 47 '	1067.9		-2.1		+ 12.38	Prop. Line		
			131	r 1	278 ° 15 '		— Lev. ° '	1067.9					Bott. Bank 5° High		
			131	r 0	274 ° 30 '		+ 2 ° 22 '	1073.1		+3.1		+ 5.41			
			148	9 0	274 ° 40 '		+ 8 ° 15 '	1082.5		+12.5		+ 21.46	Prop. Line		
			161	8 0	295 ° 25 '		+ 6 ° 50 '	1081.3		+11.3		+ 19.29	N.W. Cor.		
			158	6 0	254 ° 10 '		+ 10 ° 20 '	1092.8		+22.8		+ 28.81	Prop. Line		
			173	7 0	240 ° 45 '		+ 11 ° 41 '	1098.8		+28.8		+ 35.77	S.W. Cor.		
			157	10 0	237 ° 30 '		+ 9 ° 27 '	1086.1		+16.1		+ 26.43	Prop. Line		
			148	4 0	244 ° 10 '		+ 6 ° 50 '	1083.1		+13.1		+ 17.24			
			119	3 6	249 ° 15 '		— Lev. ° '	1066.4					Bott. Wall.		
			111	2 9	244 ° 50 '		— " ° '	1066.1					" "		
			89	4 7	248 ° 30 '		— " ° '	1065.3							
			63	4 8	243 ° 00 '		— " ° '	1065.2							
			123	21 0	229 ° 45 '		+ 8 ° 55 '	1068.3		-1.7		+ 19.30	Bott. Wall		
			5	7 5	55 ° 50 '		— Lev. ° '	1062.5					Bott. 2-18" Gal. Iron Culv.s		
			57	7 7	175 ° 20 '		— " ° '	1062.3			In Gutter		Bott. 2-18" " " "		
				r 90	° '		— Lev. ° '	1067.11					Fd. Wire Spk in Syc. Tree		
			Calc. 304.12 Ch. 185.39	r 0	87 ° 33'30"	Left	+ 23 ° 10 '	1198.15		+128.14 ~~+126.87~~		+ 130.14 ~~+128.87~~	~~May be Stake B.M.~~ See LB 783 Pg 305 Top Cntr. 12' diam Steel Water Tank		
				3 83	0 ° '		— Lev. ° '	1066.18					1 x 2 = 2 See LB 783 Pg. 303		

Add'n'l Intersn.

Geography Description Legend:
Hill ... H. Bottom Draw ... B.D.
Side of Hill ... S.H. Bottom Wash ... B.W.
Side of Draw ... S.D. Bottom of Ridge ... B.R.
Side of Ridge ... S.R. Top of Ridge ... T.R.
Head of Draw ... H.D. Top of Slope ... T.S.

Inter. of Draw, V.D.'s ... Int.
Break in Slope ... Br.Sl.
Steep Slope ... S.Sl.
Top of Cliff ... T.Cl.
Bottom of Cliff ... B.Cl.
Top of Spur ... T.Sp.
Bottom Canyon ... B.Cn.
Side of Canyon ... S.Cn.
Top of Bank ... T.B.
Bottom of Bank ... B.B.
Top of Cut ... T.C.
Bottom of Cut ... B.C.
Top of Fill ... T.F.
Bottom of Fill ... B.F.
Swale ... Sw.
Flat ... Fl.
Stream ... Str.
Trail ... Tr.
Pavement ... Pvt.
Edge of Road ... E.Rd.
Fence ... Fce.
Int. Fences ... V.Fce.
Ditch ... Di.
Telephone Pole ... T.P.
Power Pole ... P.P.
Culvert ... Cul.
Transmission Tr. Line ... Tr.Ln.
Fence ... Fce.
Cross-Fence ... C.Fce.
Side-Pl. ... S.Pl.
Sycamore ... Sy.
Cedar ... Ce.
Eucalyptus ... Eu.
Plus combinations of these and all common standard abbreviations.

Form 381 10M 3-34

PLEASE RETURN TO
LOS ANGELES COUNTY SURVEYOR
700 HALL OF RECORDS

NOTE: ANY ADDITIONS OR CHANGES ON THIS SHEET MUST BE MADE OR CIRCLED IN RED INK, WITH DATE AND NAME OF PERSON MAKING CHANGE

Note - Dist. Chained

Do not extend notes this side of this line

Transit at	Sight on	Stadia Intercepts	Stadia Distance	Stadia Rod—	Horizontal Angle 0° to 360° Right	Horiz. Distance	+ −	Vertical Angle	Elevation of Point	Back Sight	+ −	Difference Elevation	Height of Instrument	+	Vertical Distance	REMARKS Station	Left	Right
1X2	1X2				° '			° '		1								
No 2	No 1								1066 18	500			1071 18					
		Ch.	185.33	6 42	0 0 00			Lev.	1064 76	3						1X2 #1 Ck. Shot		
				5 25				"	1065 93	4						& State Hwy		
				4 60				"	1066 58	5		126.87			128.87	Opp. S.E. Cor. Lot		
		Calc.	349.33	V 0	60 76 00		+	20 15	1198 05	6	+	126.87		+	128.87	" N.E. Cor Lot		
										7						Top Ctr. Water Tk. 1.6		
										8						Higher than Ctr. of Tk.		
										9						and 13.65 above Bottom		
										10						of Tank		
										11								
										12								
Date Dec. 1934 Division No. 8027 Job No. F.B. [illegible]
Plotted [illegible] Date [illegible] Surveyed by F.C. Howard Notes F.C.H. Computed [illegible]
Date [illegible] Date [illegible] Surveyed by [illegible] Notes [illegible]

Form 301 10M 3-34

PLEASE RETURN TO
LOS ANGELES COUNTY SURVEYOR
700 HALL OF RECORDS

NOTE: ANY ADDITIONS OR CHANGES ON THIS SHEET MUST BE MADE OR CIRCLED IN RED INK, WITH DATE AND NAME OF PERSON MAKING CHANGE

Do not extend notes this side of this line

Transit at	Sight on	Stadia Intercepts	Stadia Distance	Stadia Rod—	Horizontal Angle 0° to 360° Right	Horiz. Distance	+ Vertical Angle —	Elevation of Point	+ Back Sight	+ Difference Elevation —	Height of Instrument	+ Vertical Distance —	REMARKS Station	Left	Right
					° ′		° ′		1						
					° ′		° ′		2						
					° ′		° ′		3						
					° ′		° ′		4						
					° ′		° ′		5						
					° ′		° ′		6						
					° ′		° ′		7						
					° ′		° ′		8						
					° ′		• ′		9						
					° ′		° ′		10						
					° ′		° ′		11						
					° ′		• ′		21						

Add'l Inform.

P.B. PG.

Topography Description Legend:
Side Hill...S.H. Bottom Draw B.D.
Side of Draw S.D. Bottom Wash B.W.
Side of Ridge S.R. Top of Ridge T.R.
Head of Draw H.D. Toe of Slope...T.S.

Interv. of Draw V.D.
Draw in Slope...D.S.
Wash " " ...W.S.
Top of Gully...T.Gl.
Bottom of Cliff...B.Cl.
Top of Spur...T.Spr.
Bottom Canyon...B.Cn.

Side of Canyon S.Cn.
Top of Bank...T.B.
Bottom of Bank...B.B.
Top of Cut...T.C.
Bottom of Cut...B.C.
Top of Fill...T.F.
Bottom of Fill...B.F.

Gutter...G.
Curb...C.
Flume...Fl.
Stream...Str.
Trail...Tr.
Pavement...P.
Edge of Road...E.Rd.

Traverse Pt...Tr. Pt.
Fence...Fence
Fire Hydrant...F.H.
Ditch...Ditch
Telephone Pole...T.P.
Power Pole...P.P.
Culvert...Culv.
Intersection...Int.
Pipe Line...P.L.
Gas Line...G.L.
Water Line...W.L.
Oil Line...Oil
Monument...Mon.
Standard...Std.

Notes Ck'd by	Survey of Temple Park
Map No.	W. O. 8026 Tape No. St'd °F.
Office Work	Surveyed by [illegible]
Checked	Notes A.N.H Date
Date	Indexed C. Johnson 1-12-34

F.B. 505 PG. 161

TEMPLE PARK

JN 8026

KAUFFMAN, GOLDEN WEST, GARABALDI AND LAS TUNAS (SAN GABRIEL) AVES

SURVEY

Use Scale of 1"=40'

To be C.S. B-980.

Note: ANY ADDITIONS OR CHANGES ON THIS SHEET MUST BE MADE OR CIRCLED IN Red Ink. WITH DATE AND NAME OF PERSON MAKING CHANGE.

Do not extend notes this side of this line

RETURN TO
LOS ANGELES COUNTY SURVEYOR
700 HALL OF RECORDS

FORM 247 10M 5-31

F.B. 505 Pg. 162

TEMPLE PARK.

Establishing ℄ on Kauffman Ave & Golden West Ave Between Garibaldi Ave & Las Tunas.

Setting Park Corners — Page 163

Ties of Woodruff Ave & ℄ Golden West & Kauffman — " 164

Ties to Buildings on N. Line of Park — " 165

For Sprinkling system see page 303

For Rest rooms 310

RETURN TO
LOS ANGELES COUNTY SURVEYOR
700 HALL OF RECORDS

Do not extend notes this side of this line

Note: ANY ADDITIONS OR CHANGES ON THIS SHEET MUST BE MADE OR CIRCLED IN Red Ink. WITH DATE AND NAME OF PERSON MAK-ING CHANGE.

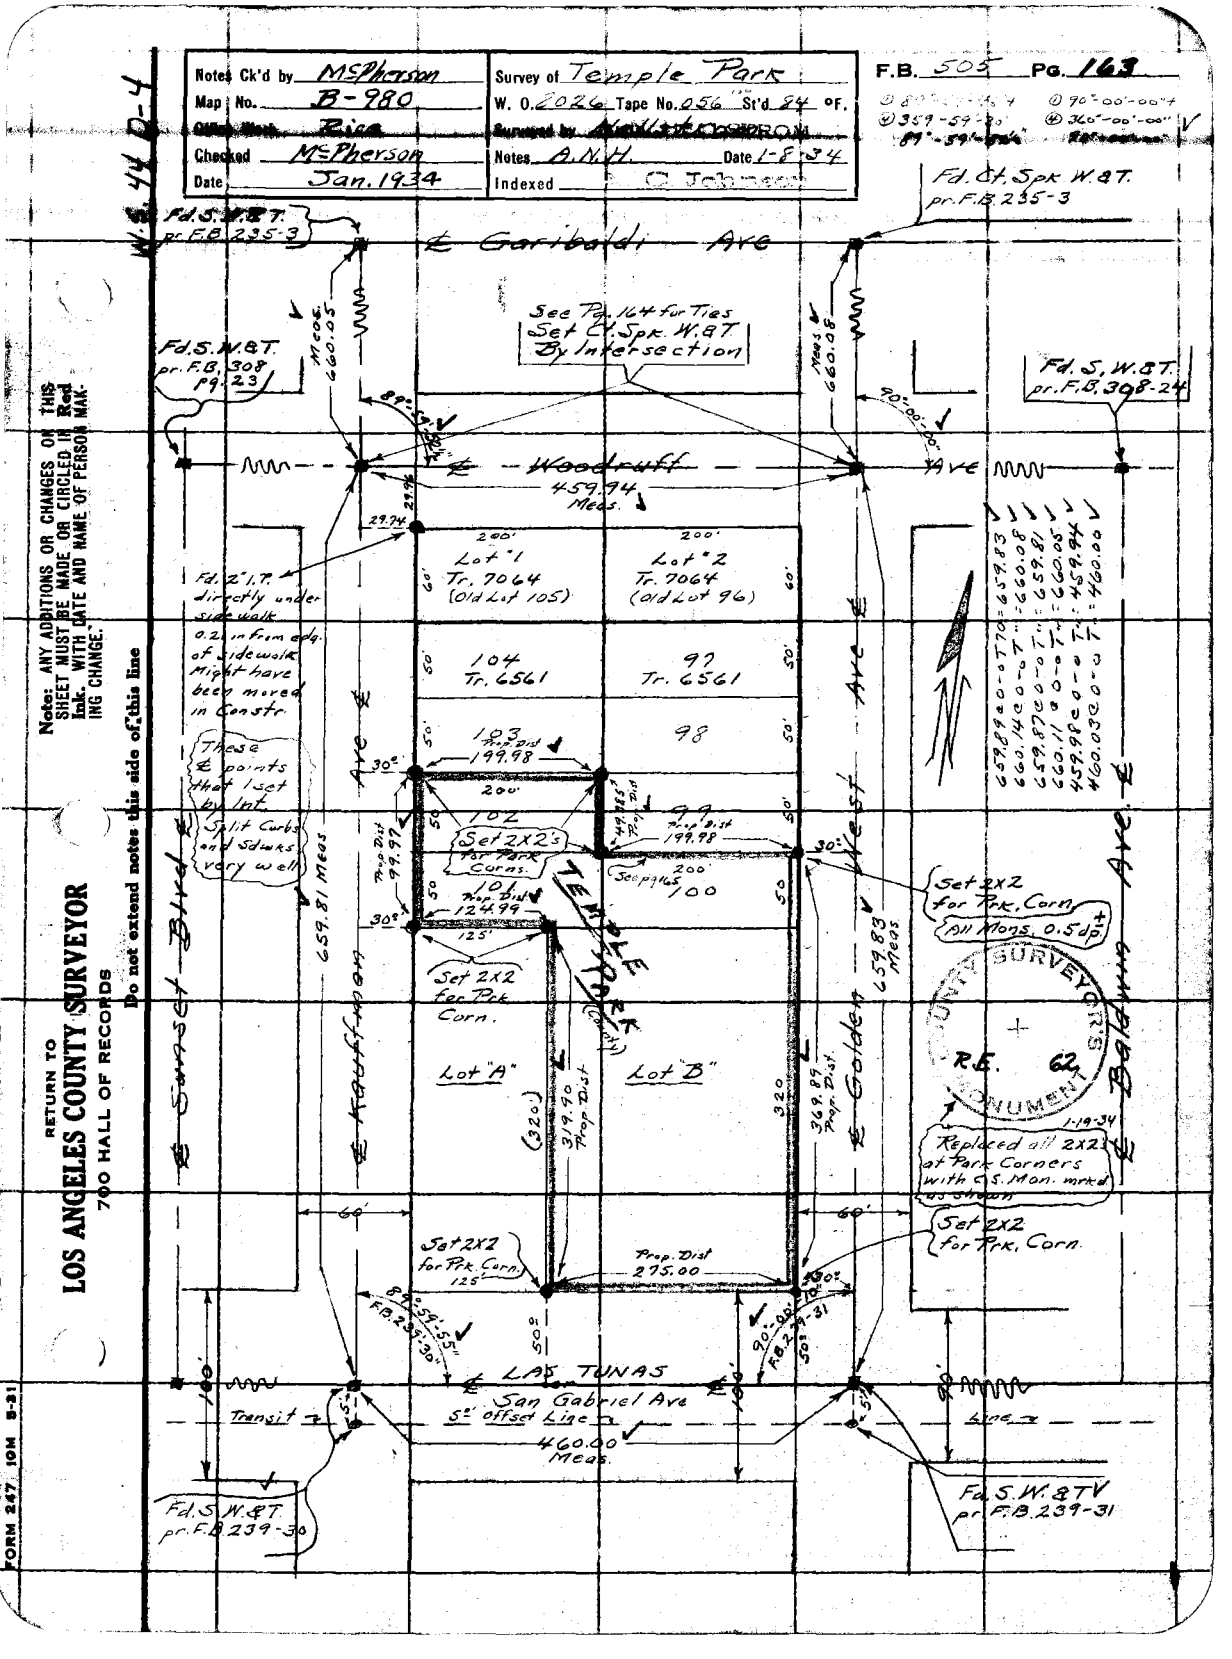
Notes Ck'd by McPherson
Map No. B-980
Checked McPherson
Date Jan. 1934
Survey of Temple Park
W. O. 2026 Tape No. 256 St'd 24 °F.
Notes A.N.H. Date 1-8-34
Indexed C. Johnson
F.B. 505 Pg. 163
W. S. 44 D-4
Fd. S. W. & T. pr. F.B. 235-3
℄ Garibaldi Ave
Fd. Ct. Spk. W. & T. pr. F.B. 235-3
See Pg. 164 for Ties
Set Ct. Spk. W. & T. By Intersection
Fd. S. W. & T. pr. F.B. 308 pg. 23
Fd. S. W. & T. pr. F.B. 308-24
℄ Woodruff Ave
459.94 Meas.
Lot "1" Tr. 7064 (Old Lot 105)
Lot "2" Tr. 7064 (Old Lot 96)
Fd. 2" I.P. directly under side walk 0.2 in from edg. of sidewalk might have been moved in Constr.
These ℄ points that I set by Int. Split Curbs and Sdwks very well
104 Tr. 6561
97 Tr. 6561
98
183 Prop. Dist 199.98
199.98
Set 2X2's for Park Corns.
99
Prop. Dist 199.98
See pg 165
100
Set 2X2 for Park Corn
All Mons. 0.5dp±
℄ Sunset Blvd
℄ Baldwin Ave.
659.81 Meas
659.83 Meas
TEMPLE PARK (Com'l)
Lot "A"
(320)
Lot "B"
319.90 Prop. Dist
369.85 Prop. Dist
320
Set 2X2 for Park Corn. 125'
R.E. 62
Replaced all 2X2's at Park Corners with C.S. Mon. marked as shown
1-19-34
Set 2X2 for Park Corn.
Prop. Dist 275.00
LAS TUNAS
℄ San Gabriel Ave
Transit
5' offset Line
460.00 Meas.
Fd. S. W. & T. pr. F.B. 239-30
Fd. S. W. & T. pr. F.B. 239-31
Note: ANY ADDITIONS OR CHANGES ON THIS SHEET MUST BE MADE OR CIRCLED IN Red Ink. WITH DATE AND NAME OF PERSON MAKING CHANGE.
Do not extend notes this side of this line
RETURN TO
LOS ANGELES COUNTY SURVEYOR
700 HALL OF RECORDS
FORM 247 10M 8-31

RETURN TO
LOS ANGELES COUNTY SURVEYOR
700 HALL OF RECORDS

Note: ANY ADDITIONS OR CHANGES ON THIS SHEET MUST BE MADE OR CIRCLED IN **Red Ink.** WITH DATE AND NAME OF PERSON MAKING CHANGE.

WS. 44 D-4

Do not extend notes this side of this line

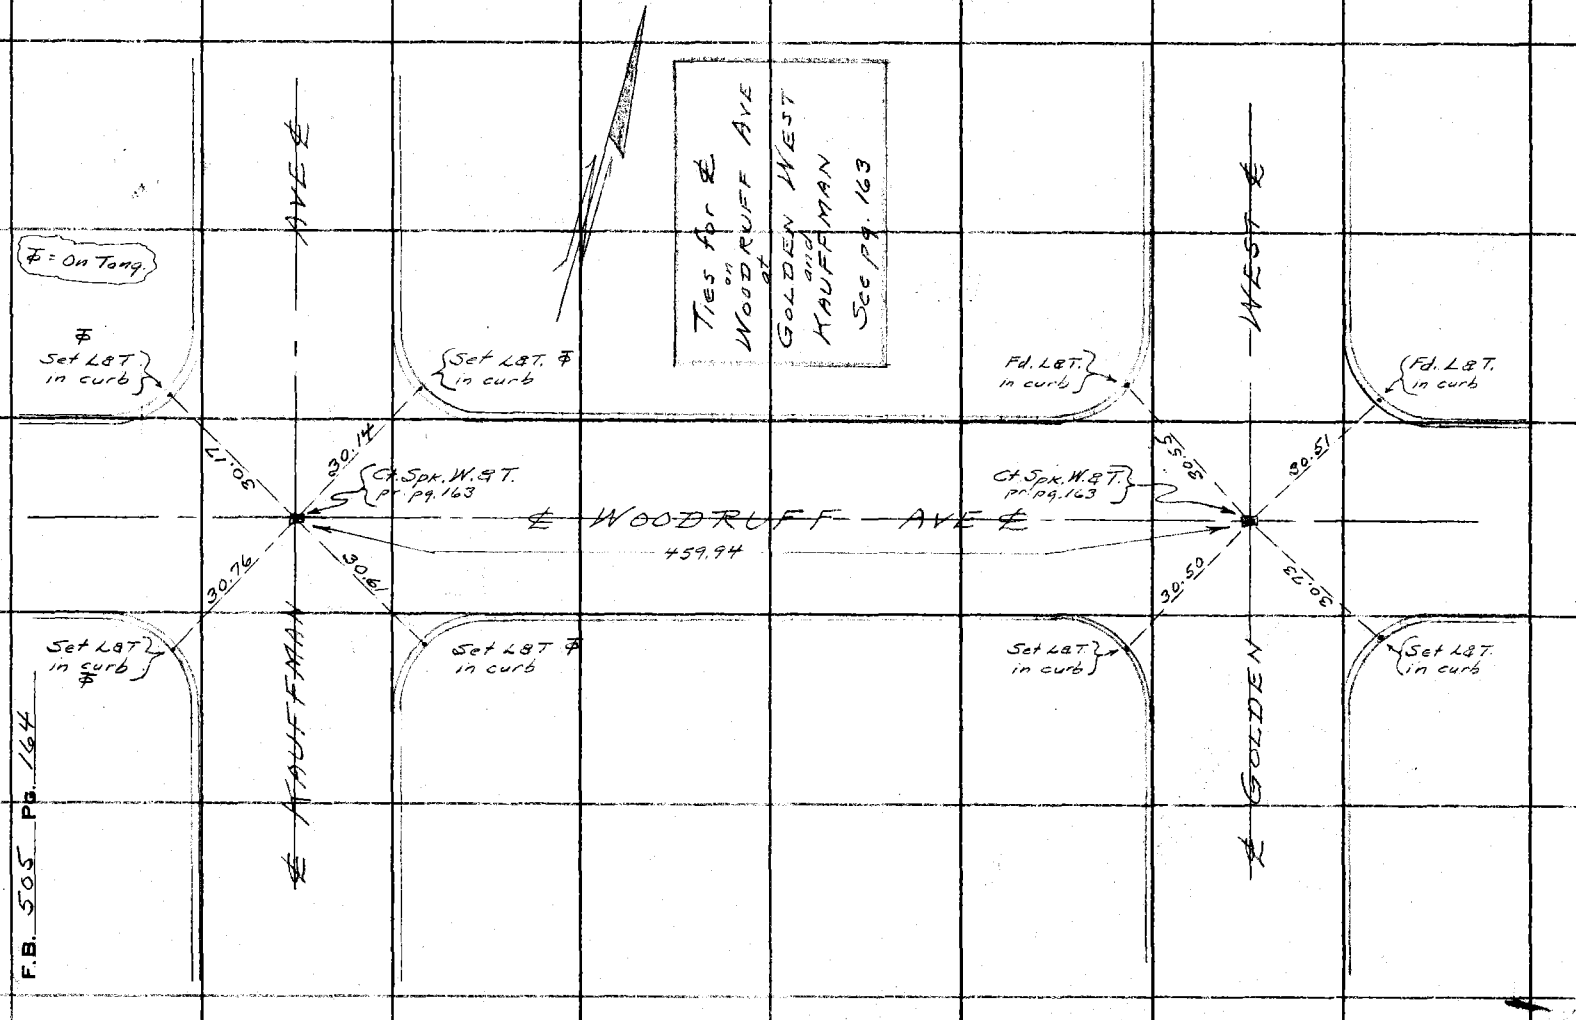

F.B. 505 Pg. 164

Notes Ck'd by McPherson	Survey of Temple Park
Map No. B-980	W. O. 8026 Tape No. St'd 84 °F.
Office Work Lucas	Surveyed by A.N. Hellstrom
Checked McPherson	Notes A.N.H. Date 1-19-34
Date Jan 1934	Indexed A.C. Johnson 1-19-34

F.B. 505 PG. 165

Note: ANY ADDITIONS OR CHANGES ON THIS SHEET MUST BE MADE OR CIRCLED IN Red Ink. WITH DATE AND NAME OF PERSON MAKING CHANGE.

RETURN TO
LOS ANGELES COUNTY SURVEYOR
700 HALL OF RECORDS
Do not extend notes this side of this line

FORM 247 10M 8-31

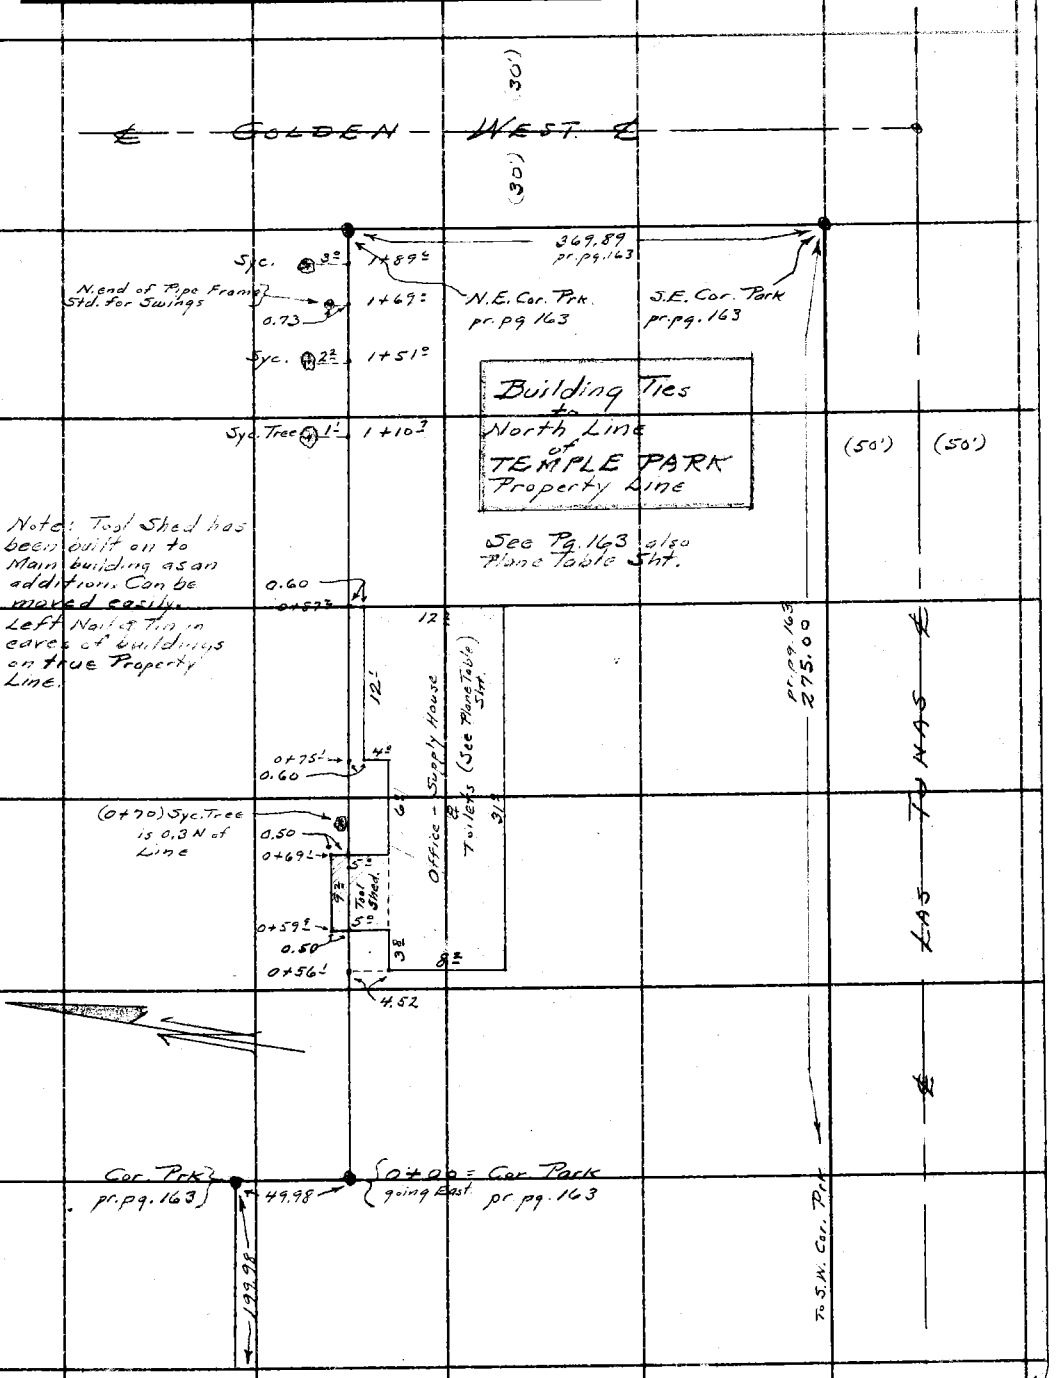

RETURN TO
LOS ANGELES COUNTY SURVEYOR
700 HALL OF RECORDS

Note: ANY ADDITIONS OR CHANGES ON THIS SHEET MUST BE MADE OR CIRCLED IN Red Ink. WITH DATE AND NAME OF PERSON MAKING CHANGE.

Do not extend notes this side of this line

F.B. 505 PG. 166

FORM 247 10M 5-31

RETURN TO
LOS ANGELES COUNTY SURVEYOR
700 HALL OF RECORDS

Note: ANY ADDITIONS OR CHANGES ON THIS SHEET MUST BE MADE OR CIRCLED IN **Red Ink.** WITH DATE AND NAME OF PERSON MAKING CHANGE.

Do not extend notes this side of this line

Notes Ck'd by MacPherson
Map No. B. 994
Comp. Work by Dixon
Checked
Date 1-31-34

Survey of Michillinda Tract
W. O. 8027 Tape No. 21 St'd 8' of.
Surveyed by A.N.H. & Hollstrom
Notes
Indexed A. C. Johnson Date 1-17-34

F.B. 505 PG. 169

100.30@ 0-0 T70 = 100.29
1733.48@ 0-0 T74 = 1733.37

245.06@ 0-0 T64 = 245.03

Establishing
Michillinda Park Corners
By Record from Huntgtn Drive

Checks Sdwks & Curbs O.K.

See M.B. 21 — 14 & 15

① 39°-31'-00"
② 158°-04'-00"
39°-31'-00"

③ 90°-00'-00"
④ 360°-00'-00"
90°-00'-00"

⑤ 39°-15'-00"
⑥ 157°-00'-00"
39°-15'-00"

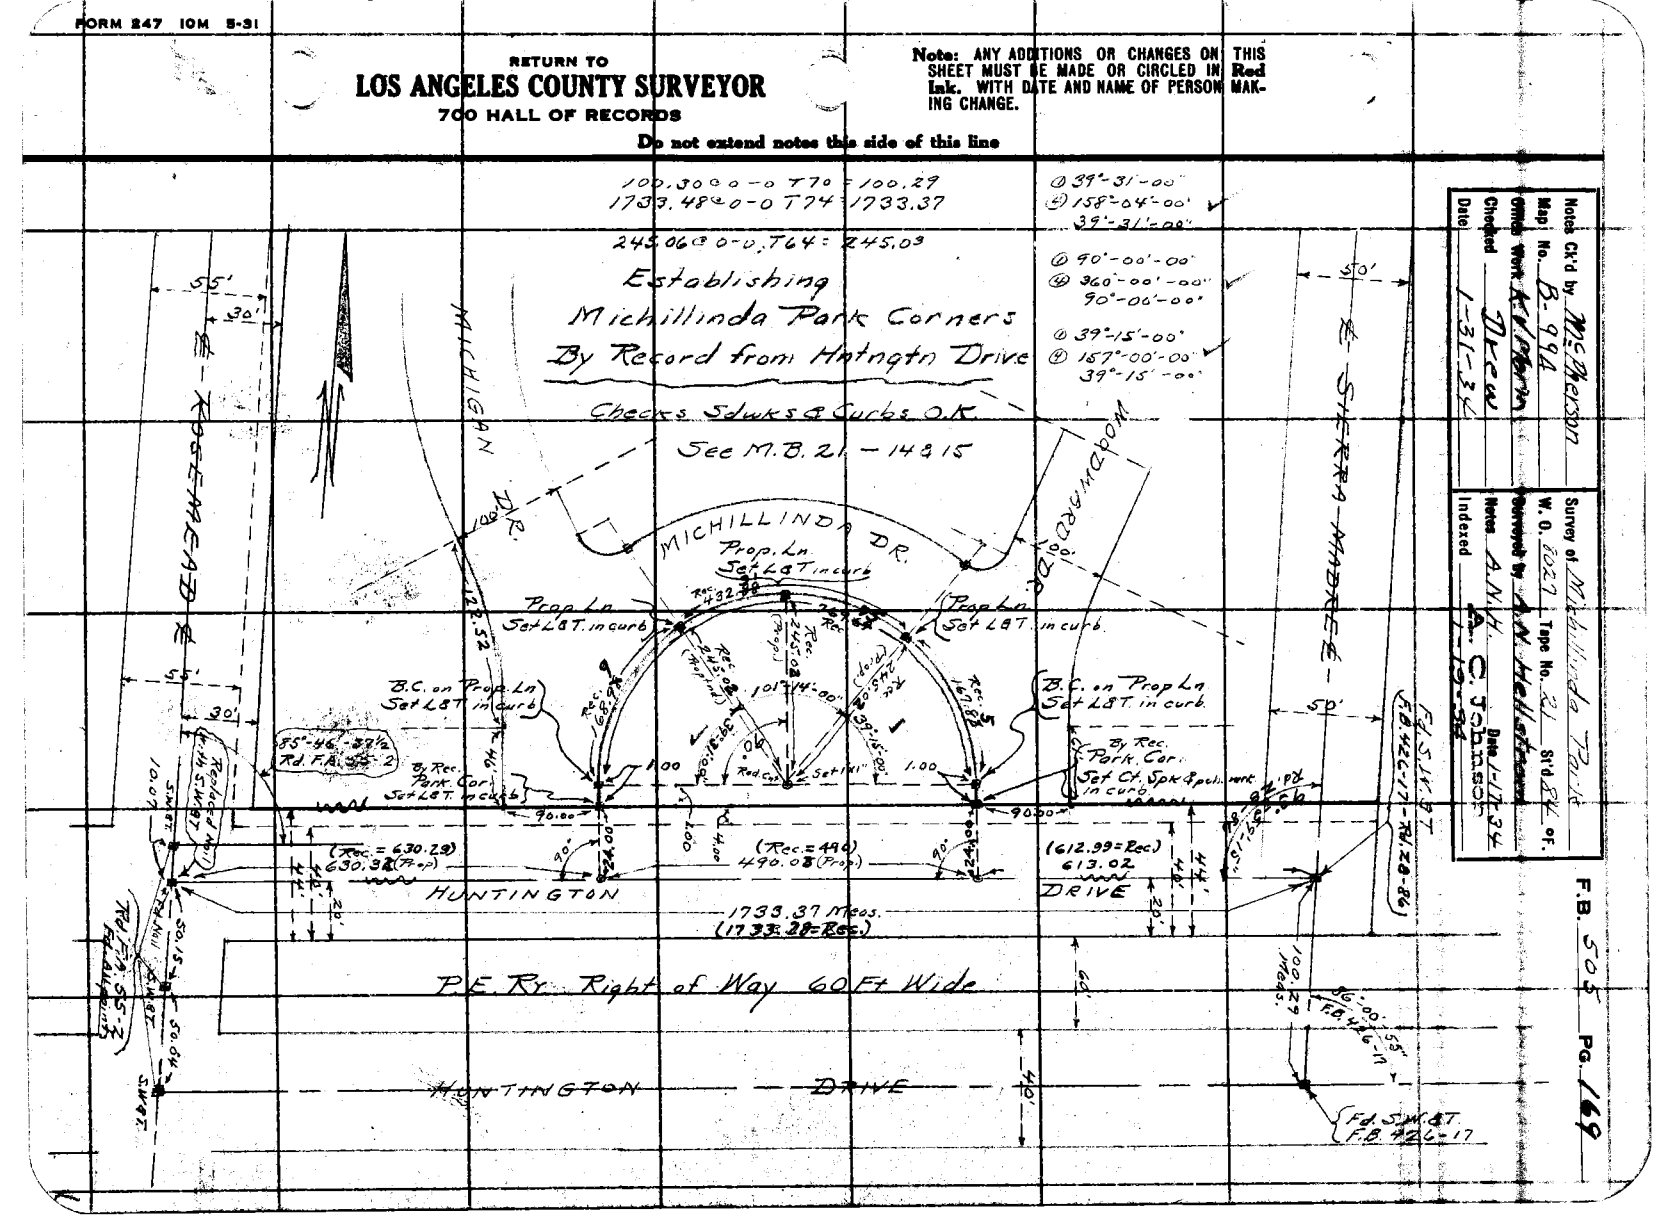

RETURN TO
LOS ANGELES COUNTY SURVEYOR
700 HALL OF RECORDS

Note: ANY ADDITIONS OR CHANGES ON THIS SHEET MUST BE MADE OR CIRCLED IN Red Ink. WITH DATE AND NAME OF PERSON MAKING CHANGE.

Do not extend notes this side of this line

F.B. 505 Pg. 17

Notes Ck'd by	Survey of [illegible]
Map No. D-224	W. O.	Tape No.	St'd	°F
Office Work WGVD	Surveyed by A.N.HELLEKSON
Checked TO	Notes	Date
Date 10-3-49	Indexed E. C. Johnson 9-6-49

F. B. 505 Pg. 171

Note: Any Additions or Changes on This Sheet Must be Made or Circled in Red Ink With Date and Name of Person Making Change.

Do not extend notes this side of this line.

RETURN TO
LOS ANGELES COUNTY SURVEYOR
700 HALL OF RECORDS

Michillinda Park
Inv. [illegible]

Location of [illegible] Toilet & Stopcock
At Southwest [illegible]

Also Location of Cesspool / Septic Tnk.

FORM 247 5M 5-46

F. B. 505 PG. 172

RETURN TO
LOS ANGELES COUNTY SURVEYOR
700 HALL OF RECORDS

Do not extend notes this side of this line.

Note: Any Additions or Changes on This Sheet Must be Made or Circled in Red Ink With Date and Name of Person Making Change.

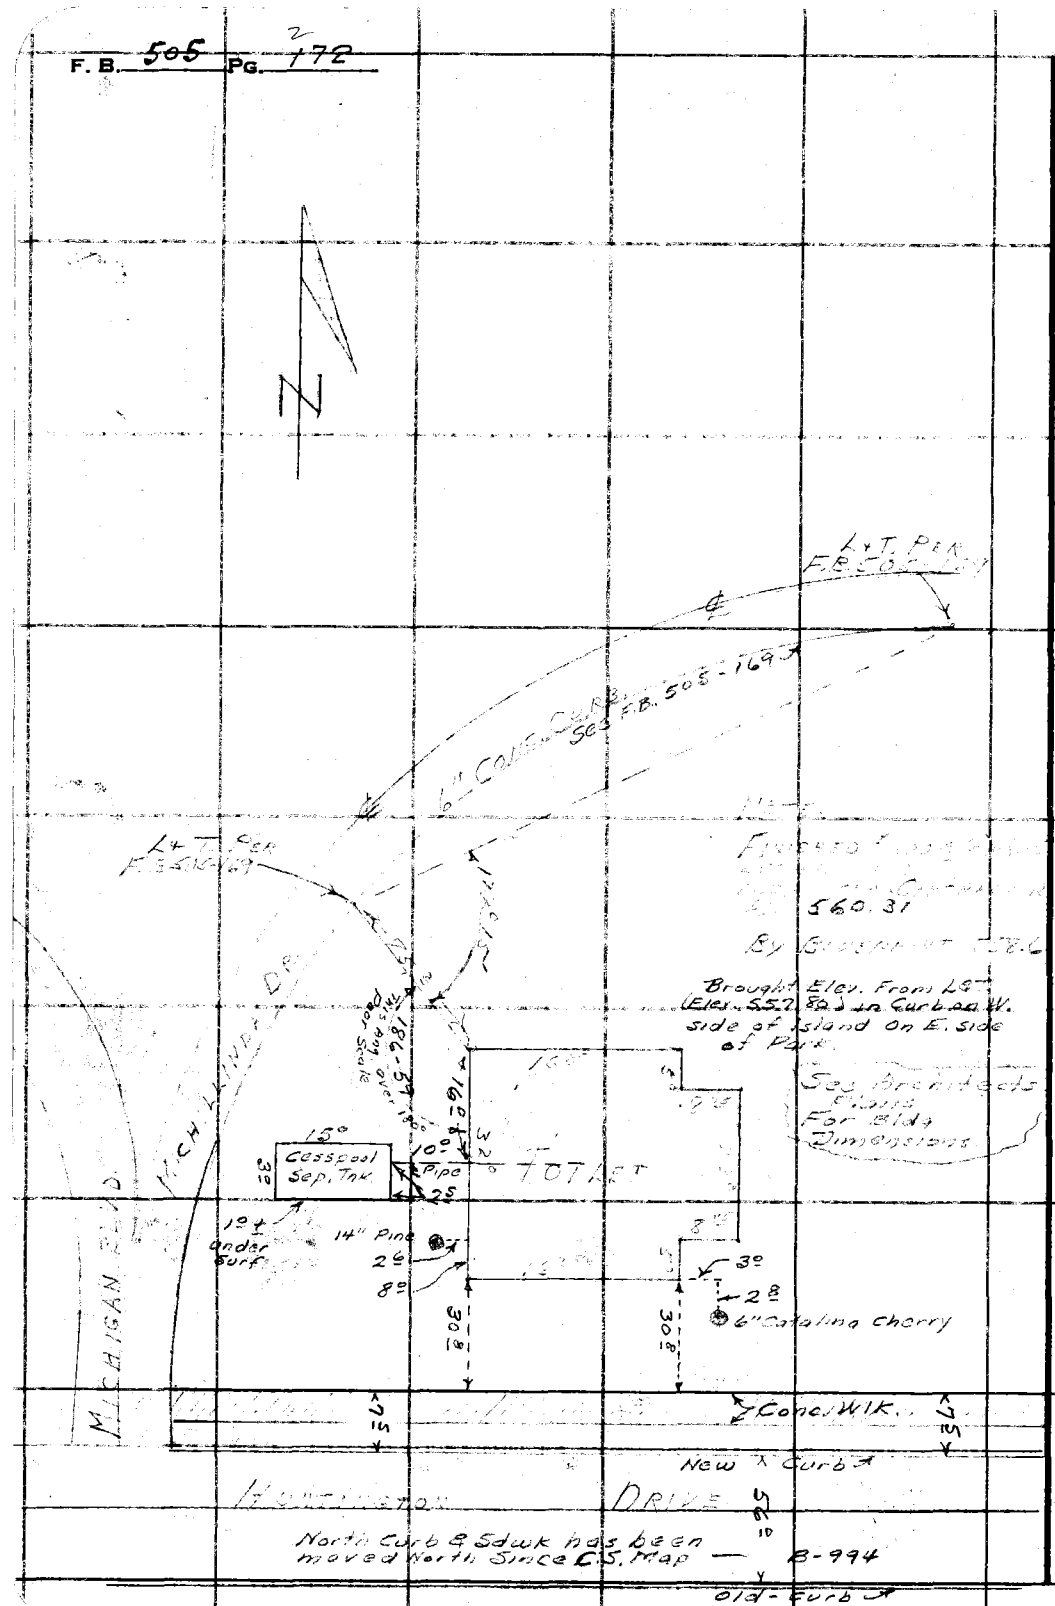

76F309S 247 10M 1-49

RETURN TO
LOS ANGELES COUNTY SURVEYOR
726 LOS ANGELES COUNTY
ENGINEERING BLDG.

Note: Any Additions or Changes on This Sheet Must be Made or Circled in Red Ink With Date and Name of Person Making Change.

Do not extend notes this side of this line.

Notes Ck'd by
Map No.
Office Work
Checked
Date

Survey of
W. O. Tape No. Std. °F
Surveyed by
Notes Date
Indexed

F. B. PG.

RETURN TO
LOS ANGELES COUNTY SURVEYOR
726 LOS ANGELES COUNTY
ENGINEERING BLDG.

Note: Any Additions or Changes on This Sheet Must be Made or Circled in Red Ink With Date and Name of Person Making Change.

Do not extend notes this side of this line.

F. B. 505 Pg. 180

Notes Ck'd by		Survey of	
Map No. B-995		W. O. 8032 Tape No. 060 St'd 76 °F.	
Office Work Kit Morrill		Surveyed by C.E. Brunty	Date 1-29-34
Checked McPherson		Notes	
Date		Indexed A. C. Johnson 1-30-34	

F.B. 505 Pg. 181

Note: ANY ADDITIONS OR CHANGES ON THIS SHEET MUST BE MADE OR CIRCLED IN Red Ink, WITH DATE AND NAME OF PERSON MAKING CHANGE.

Do not extend notes this side of this line

RETURN TO
LOS ANGELES COUNTY SURVEYOR
700 HALL OF RECORDS

RHOADES PARK
(San Dimas)
J. N. 8032.

Brunty
Tomblesom
Wilson
Porter

FORM 247 10M 8-31

F.B. 505 Pg. 182

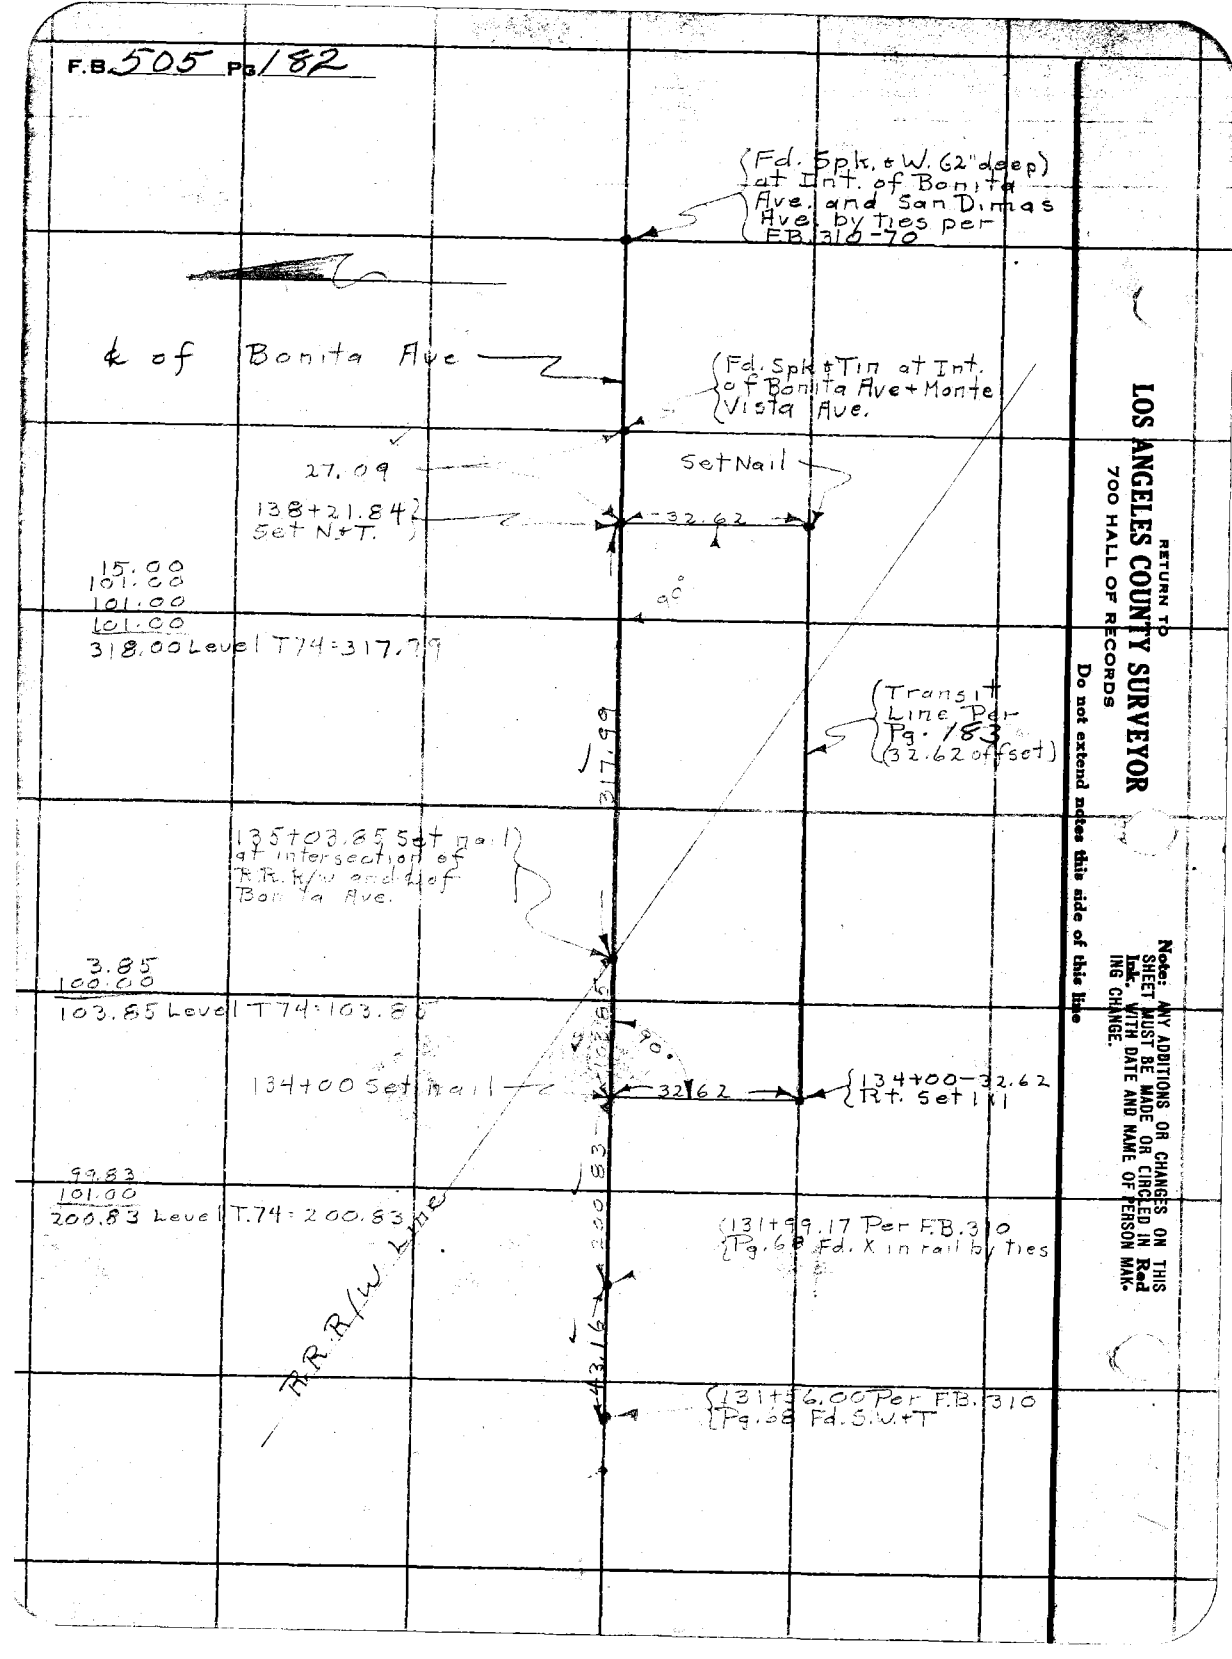

RETURN TO
LOS ANGELES COUNTY SURVEYOR
700 HALL OF RECORDS

Do not extend notes this side of this line

Note: ANY ADDITIONS OR CHANGES ON THIS SHEET MUST BE MADE OR CIRCLED IN Red Ink. WITH DATE AND NAME OF PERSON MAKING CHANGE.

Notes Ck'd by
Map No. B-995
Checked McPherson
Date

Survey of Rhodes Park
W. O. 80[illegible] Tape No. 060 St'd 76 oF.
Notes Brundy Date 1-29-34
Indexed A. C. Jo[illegible]

F.B. 505 Pg 183

Note: ANY ADDITIONS OR CHANGES ON THIS SHEET MUST BE MADE OR CIRCLED IN Red Ink. WITH DATE AND NAME OF PERSON MAKING CHANGE.

RETURN TO
LOS ANGELES COUNTY SURVEYOR
700 HALL OF RECORDS
Do not extend notes this side of this line

138+31.44 offset 0.5 left
138+21.84 — 32.62 offset Pg. 182
Pt=16 outside
138+31.0 offset =65.35
Concrete Drinking Fountain
14.6
15.3
20.5
Lawn
15.2
137+93.0 offset=29.9
6" curb
137+93.0 offset=15.3
Lawn
4.0
137+32.2 offset=32.30
137+31.3 offset=36.0
137+32.3
6.30
3.3
26.0
Band stand
3.7
5.9
Shrub Area
32.62 offset Line Per Pg. 182
136+87.6
6" curb
Offsets shown to outside of curb
135+00 outside edge of 6" Curb
134+75 0.29 Lt.
134+50 1.7 Lt.
134+25 4.6 Lt.
134+19.0 Deadman
1+34.00 - 32.62 Rt. - 1 X 1 per Pg. 182
8.97
133+91.2 Tel. P.
17.7
Ornamental lamp post
133+89.6 Deadman
2.6
End of curb
16.08
133+73.6
133+71.6

FORM 247 10M 5-31

F.B. 505 PG. 184

Note – offsets do not include 32.62 from ℄

Offsets etc. to improvements along line shown on Pg.

Station	offset		Remarks	station	offset		Remarks
134+35.57	16.53	Rt.	West end conc. headwall (24" culvert)	135+	68.5	47.5 Rt.	5" Shrub
134+43.15	17.65	Rt.	East end Concrete headwall (24" culvert)	135+	70.0	38.2 "	4" "
134+66.6	12.95	"	30" Camphor tree	135+	73.5	18.5 "	"
134+73.9	15.9	"	Rose bush	135+	73.0	4.6 "	Rosebush
134+77.8	11.2	"	3" Shrub	135+	73.0	51.4 "	"
134+80.2	2.8	"	U.S.B.M. "S 59-1923 6" Conc. +3" brass disk	135+	79.9	19.9 "	Shrub
134+80.6	22.8	"	Rose bush	135+	89.7	3.5 "	Umbrella Tree
134+82.9	6.9	"	"	135+	88.7	29.7 "	Shrub
134+85.0	1.8	"	Lamp post	135+	92.5	55.3 "	Rosebush
134+87.4	24.0	"	Rose bush	135+	98	5.0 "	"
134+89.9	3.8	"	24" Umbrella tree	136+	01.5	32.0 "	Shrub
134+94.2	26.3	"	8" Cedar shrub	+	01.5	28.6 "	1" Water Hyd
135+01.0	29.2	"	1 Rosebush	+	02.0	43.5 "	Shrub
135+05.0	3.5	"	"	+	02.5	1.6 "	Lamppost
135+13.0	32.6	"	"	+	05.0	5.3 "	Rose bush
135+15.0	3.3	"	Umbrella tree	+	11.0	50.2 "	Taylor Shrub
135+16.5	21.1	"	1" Water Hyd	+	13.5	3.4 "	Umbrella tree
135+19.5	27.4	"	4" shrub	+	17.0	49.8 "	Shrub
+22.4	35.3	"	8" Cedar Shrub	+	19.5	34.4 "	36" Palm
+23.8	4.2	"	Rosebush	+	20.5	3.6 "	Rosebush
+25.5	20.4	"	40" Palm	+	24.5	57.5 "	Shrub
+28.5	4.2	"	Rosebush	+	28.0	3.6 "	Rosebush
+28.5	36.4	"	"	+	33.0	50.7 "	Shrub
+31.4	29.7	"	Shrub	+	39.0	3.7 "	24" Umbrella Tree
+35.0	39.1	"	8" Cedar shrub	+	53.9	35.9 "	Camphor tree
+25.0	10.2	"	Shrub	+	64.0	3.1 "	30" Umbrella tree
+36.0	5.3	"	1" Umbrella tree	+	69.15	0.2 Lt.	End of curb (edge)
+43.4	16.0	"	Century plant	+	67.5	0.3 Lt.	Beg. of curb (" ")
+43.4	33.6	"	Tel. Pole	+	89.0	3.0 Rt.	Umbrella tree
+48.0	3.6	"	Rosebush	+	42.0	46.6 Rt.	1" Water Hyd
+52.0	33.9		Shrub	137 +	06.7	1.5 "	Lamppost
+61.0	46.2		Rose bush	137 +	14.0	3.2 "	Umbrella tree
+62.0	40.9		4" Shrub	137 +	70.5	20.5 "	3" flagpole (I.P.)
+62.0	4.0		Rose bush	137+	91.5	13.2 "	8" Palm
+64.0	31.0		3/4" Water Hyd	137+	91.5	31.8 "	6" Palm
+70.0	26.5		36" Palm	137+	97.4	2.4 "	5" Cedar

RETURN TO
LOS ANGELES COUNTY SURVEYOR
700 HALL OF RECORDS
Do not extend notes this side of this line

Note: ANY ADDITIONS OR CHANGES ON THIS SHEET MUST BE MADE OR CIRCLED IN Red Ink. WITH DATE AND NAME OF PERSON MAKING CHANGE.

Notes Ck'd by McPherson
Map No. B-995
Office Work KUMOEHN
Checked
Date

Survey of Rhoades Park
W. O. 8032 Tape No. St'd °F.
Surveyed by Brunty
Notes Date 1-29-37
Indexed A. C. Johnson

F.B. 505 Pg 185

Station	offset	Remarks
138+09.0	2.4 Rt.	5" Cedar
138+14.8	1.5 Rt.	Lamp post
138+15.5	13.5 "	8" Palm
138+15.5	21.8 "	6" Palm
138+27.8	43.3 "	30" Umbrella tree

Note: ANY ADDITIONS OR CHANGES ON THIS SHEET MUST BE MADE OR CIRCLED IN Red Ink. WITH DATE AND NAME OF PERSON MAKING CHANGE.

Do not extend notes this side of this line

RETURN TO
LOS ANGELES COUNTY SURVEYOR
700 HALL OF RECORDS

FORM 247 10M 8-31

RETURN TO

LOS ANGELES COUNTY SURVEYOR

700 HALL OF RECORDS

Note: ANY ADDITIONS OR CHANGES ON THIS SHEET MUST BE MADE OR CIRCLED IN **Red Ink.** WITH DATE AND NAME OF PERSON MAKING CHANGE.

Do not extend notes this side of this line

F.B. 5105 Pg. 186

Notes Ck'd by	Survey of Chatsworth Fire Patrol Sta
Map No.	W. O. 8023 Tape No. 30 St'd 84° °F.
Office Work	Surveyed by L S Hammond
Checked	Notes L 14 Date May 1934
Date	Indexed A. C. Johnson 5-8-34

F.B. 505 PG. 191

SURVEY OF
CHATSWORTH FIRE PATROL STATION
J.N. 8023

L.S. Hammond — chief
F.H. Blanchard — Inst.
D.W. Reynolds — Hd. ch.
L.T. Cunningham — Rod.

Note: ANY ADDITIONS OR CHANGES ON THIS SHEET MUST BE MADE OR CIRCLED IN Red Ink, WITH DATE AND NAME OF PERSON MAKING CHANGE.

Do not extend notes this side of this line

RETURN TO
LOS ANGELES COUNTY SURVEYOR
700 HALL OF RECORDS

FORM 847 10M 5-31

F.B. 505 PG. 192

—INDEX—

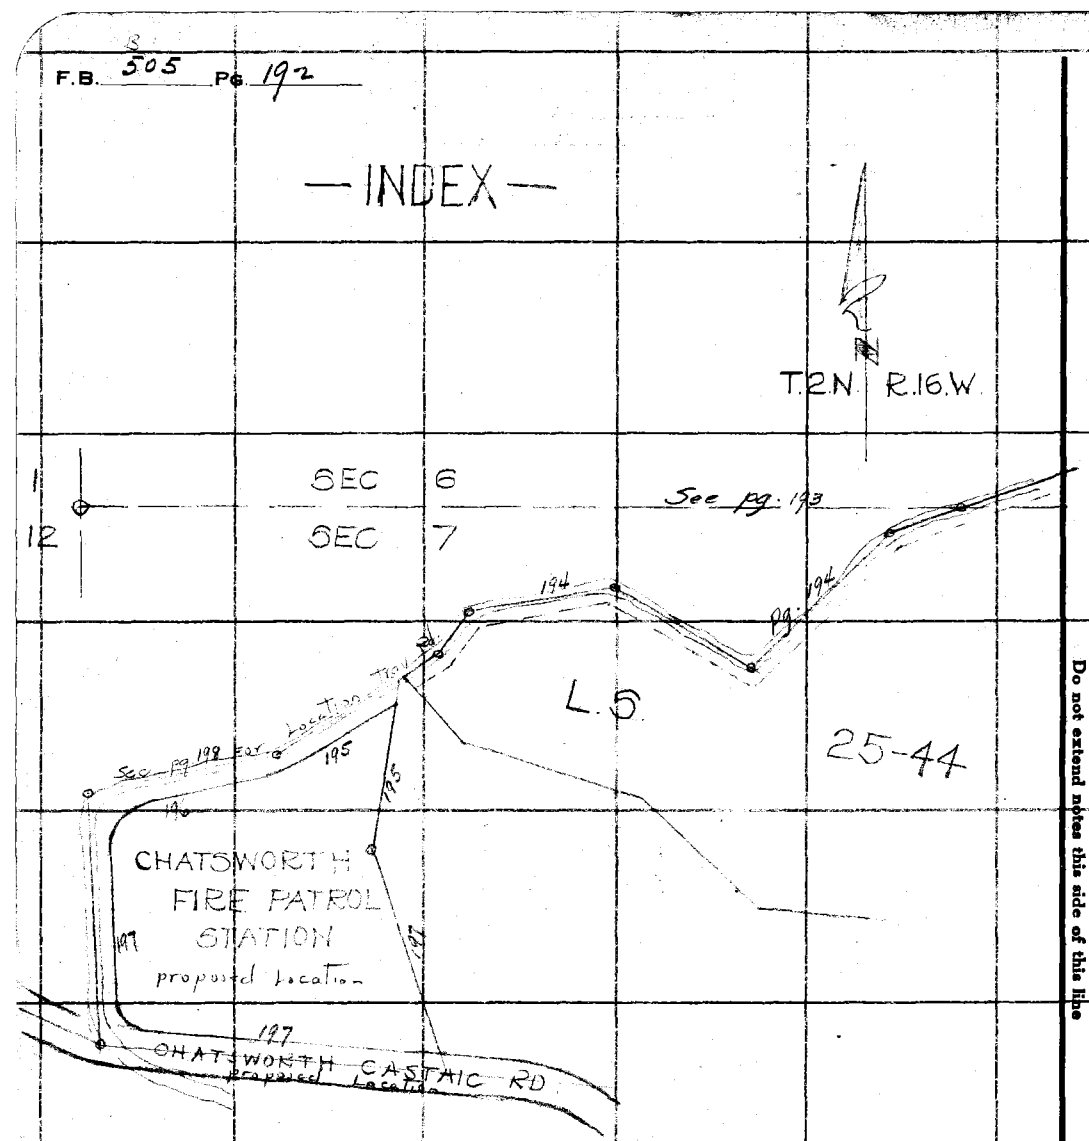

RETURN TO
LOS ANGELES COUNTY SURVEYOR
700 HALL OF RECORDS
Do not extend notes this side of this line

Note: ANY ADDITIONS OR CHANGES ON THIS SHEET MUST BE MADE OR CHECKED IN Red Ink. WITH DATE AND NAME OF PERSON MAKING CHANGE.

Notes Ck'd by	McPherson	Survey of	Chatsworth Estates No 16
Map No.	B-1000	W. O.	8023 Tape No. 30 St'd 84 °F.
Office Work	[illegible]	Surveyed by	[illegible]
Checked	McPherson	Notes	L.S. 14 Date 5-3-34
Date	June 1934	Indexed	A. C. Johnson

F.B. 505 Pg. 193

W.S. 6-K-3

Note: ANY ADDITIONS OR CHANGES ON THIS SHEET MUST BE MADE OR CIRCLED IN Red Ink. WITH DATE AND NAME OF PERSON MAKING CHANGE.

RETURN TO
LOS ANGELES COUNTY SURVEYOR
700 HALL OF RECORDS
Do not extend notes this side of this line

FORM 247 10M 8-31

To Lot pg. 194

Fd 1/2 per F.B. 183-144 & 3982

Fd 1X2 Random Int.

Sec Cor Fd C.S. Mon per F.B. 509-82 - 33-84

MAYAN

Random Set 1X2 Rec 845.03

Fd 1X2 Rec 838.22 S 55-55 W

Fd 2X2 No Tk

Set 1X2 on Rec Line

P.I. #1
Set 1X2 Rec from Sec. Line Inter per L.S. 25-44

Inter.
Set 1X2 Rec dist From Monument Sec 7. per L.S. 25-44

To 14 Cor

44 49 51 53 55 57 59

5 SEC 6 SEC 7

12211.84 Rec

25-44

260.19 e 3°-41' T=78° = 259.64
260.04 e 3°-07
67.24 c 0-40 T=78 = 67.24
926.88
233.00 c 6-40 T=78 = 231.77

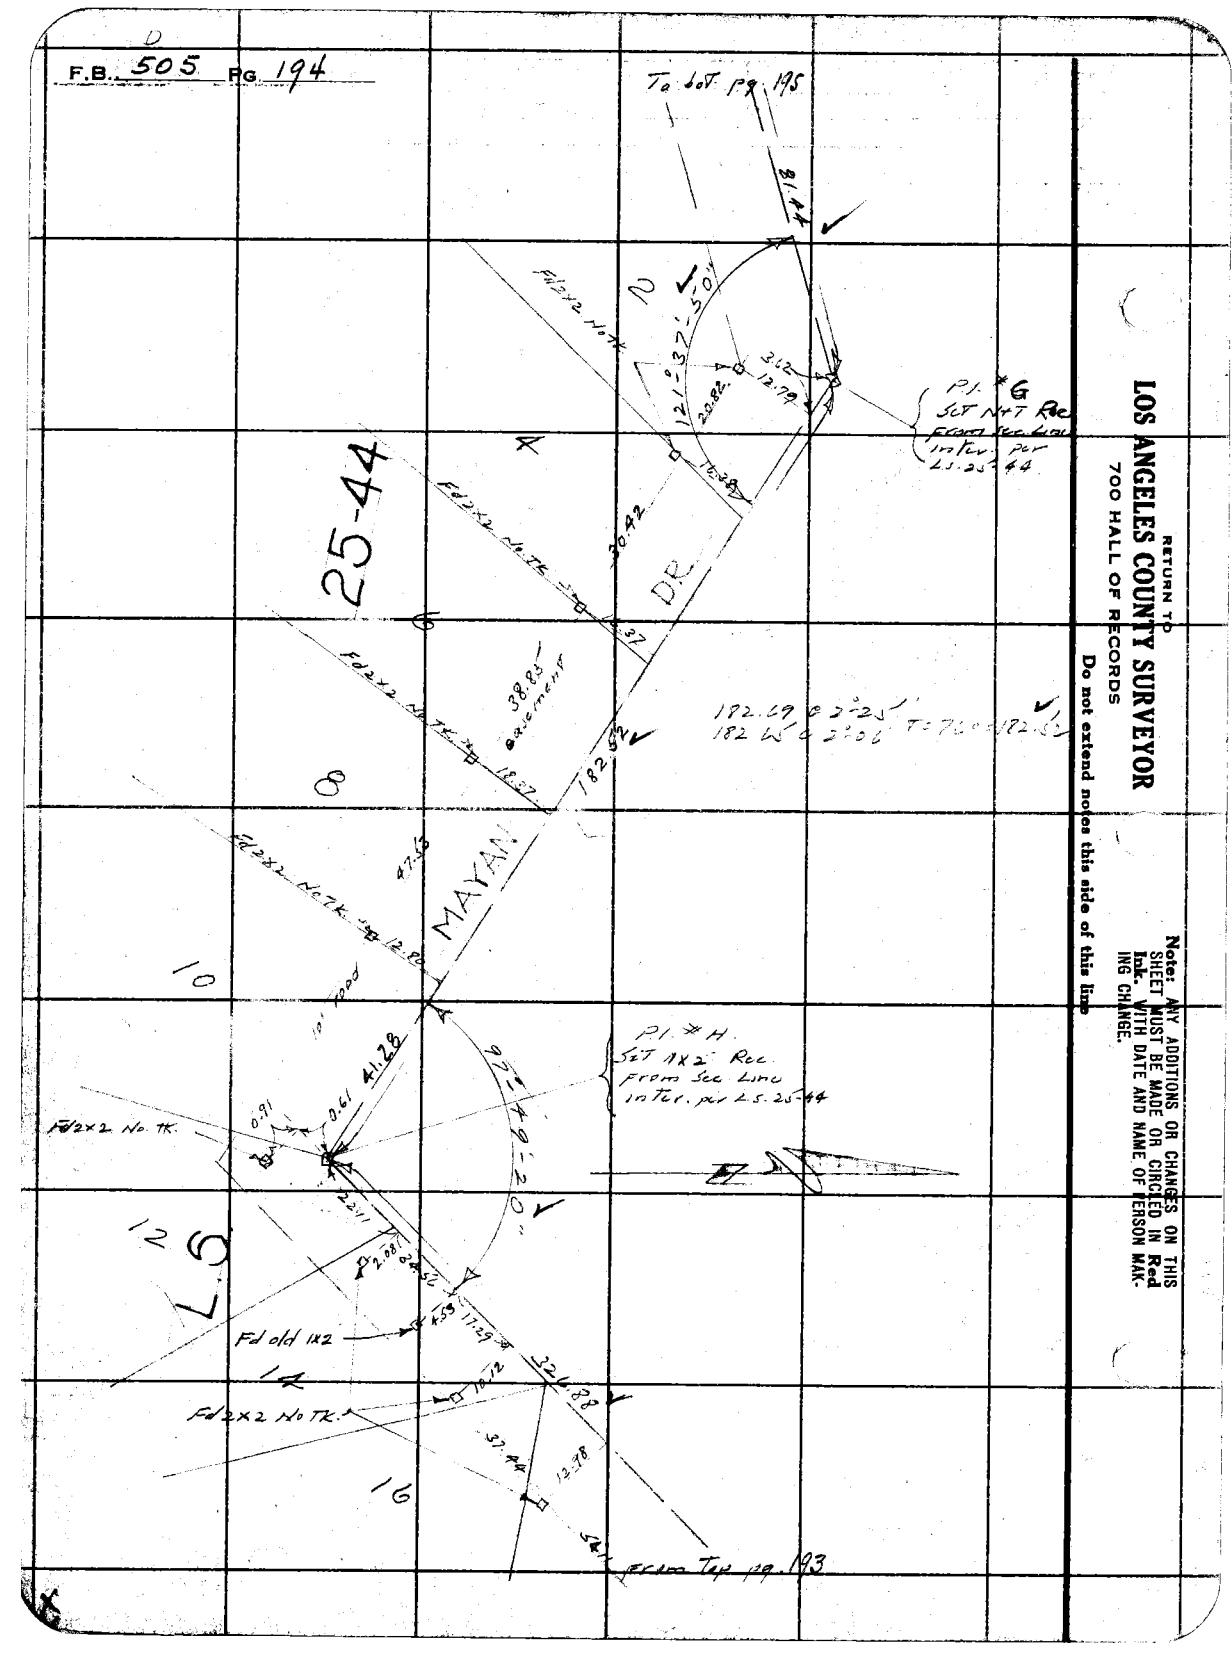

RETURN TO
LOS ANGELES COUNTY SURVEYOR
700 HALL OF RECORDS

Do not extend notes this side of this line

Note: ANY ADDITIONS OR CHANGES ON THIS SHEET MUST BE MADE OR CIRCLED IN **Red Ink.** WITH DATE AND NAME OF PERSON MAKING CHANGE.

Notes Ck'd by McPherson	Survey of Chatsworth Fire Patrol Sta
Map No. B-1000	W. O. 9923 Tape No. 30 St'd D&P of F.
Office Work LOCKED	Surveyed by [illegible]
Checked McPherson	Notes L & N Date 5-4-34
Date June 1934	Indexed L. C. Johnson

F.B. 505 Pg. 195

W.S. 61-3

Note: ANY ADDITIONS OR CHANGES ON THIS SHEET MUST BE MADE OR CIRCLED IN Red Ink. WITH DATE AND NAME OF PERSON MAKING CHANGE.

Do not extend notes this side of this line

RETURN TO
LOS ANGELES COUNTY SURVEYOR
700 HALL OF RECORDS

FORM 247 10M 8-31

To bet. pg 196

CHATSWORTH FIRE PATROL STA
1 Story Frame Proposed

Set 2x2 Cor. of Chatsworth Fire Patrol Sta. Site. Replaced with C.S. Mon 2"dia marked as shown.

Set 3/4" IP 12" +/-

(2) 70°-59'-00"
(4) 141°-57'-00"
(6) 212°-57'-30"
35°-29'-30"
P.I. #D5
Set SWT. Rec from Sec. Line inter per L.S. 25-44

Set NAT by inter.

Set NAT boulder

Fd 2x2 No Tk

Location Tray (Cal)

MOJAVE TR.

MAYAN

DR.

Fd 2x2 No Tk

Fd 2x2 No Tk

P.I. #E
Set NAT Rec from Sec Line inter per L.S. 25-44

P.I. #E
Set NAT Rec from Sec Line inter per L.S. 25-44

81.44 @ 0°-00' T = 76° = 81.44
29.35 @ 0°-00' T = 76° = 29.35
70.92 @ 0°-00' T = 76° = 70.92
108.24 @ 0°-00' T = 76° = 108.23

R 25-4A

From top pg 194

COUNTY SURVEYOR
EL 60'
FIRE 60'

F.B. 505 Pg. 196

W.S. 61C-3

RETURN TO
LOS ANGELES COUNTY SURVEYOR
700 HALL OF RECORDS

Do not extend notes this side of this line

Note: ANY ADDITIONS OR CHANGES ON THIS SHEET MUST BE MADE OR CIRCLED IN Red Ink. WITH DATE AND NAME OF PERSON MAKING CHANGE.

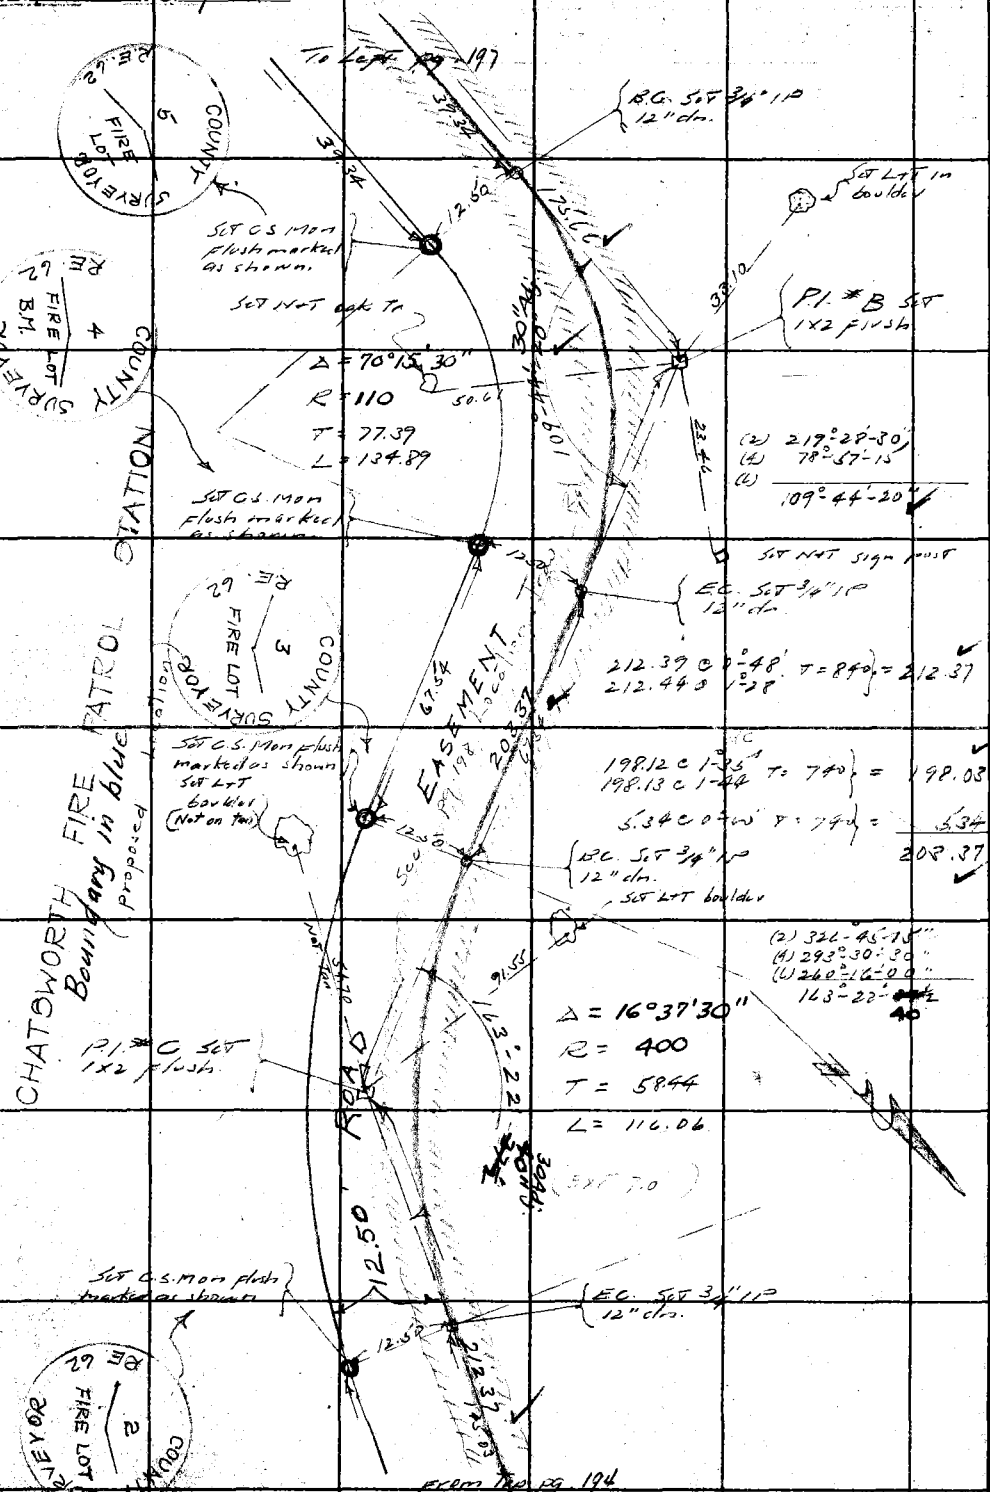

Notes Ck'd by	McPherson	Survey of	Chatsworth Fire Patrol Sta
Map No.	B-1000	W. O.	5042
Office Work		Tape No.	30
Checked	McPherson	Surveyed by	
Date	June 1934	Notes	
		Indexed	A. C. Johnson

F.B. 505 Pg. 197

MS 61 C-3

Notes Ck'd by McPherson; Map No. B-1000; Office Work; Checked McPherson; Date June 1934; Survey of Chatsworth Fire Patrol Sta; W. O. 5042; Tape No. 30; St'd 84 °F.; Surveyed by; Notes; Date 5-4-34; Indexed A. C. Johnson

F.B. 505 Pg. 197

Note: ANY ADDITIONS OR CHANGES ON THIS SHEET MUST BE MADE OR CIRCLED IN Red Ink, WITH DATE AND NAME OF PERSON MAKING CHANGE.

Do not extend notes this side of this line

RETURN TO
LOS ANGELES COUNTY SURVEYOR
700 HALL OF RECORDS

FORM 247 10M 8-31

CHATSWORTH FIRE PATROL STATION
Boundary in blue.



EASEMENT

COUNTY SURVEYOR'S MONUMENT FIRE LOT RE 10

COUNTY SURVEYOR FIRE LOT RE 62

COUNTY SURVEYOR II FIRE LOT RE 62

COUNTY SURVEYORS MONUMENT FIRE LOT RE 62

COUNTY SURVEYOR FIRE LOT RE 62

Set 2x2 flush

Set C.S. mon flush marked as shown

Set 3/4" IP 12" dn.

Set 2x2 flush. Replaced with C.S. mon. marked as shown.

Set 4x4 in boulder

Radial Line

Pl. set nut

Pl. - A Set 1x2 flush

Intr. #5 set 3/4" IP 12" dn

Pl. #6 Fd 1/2" I.P. 6" dn per F.B. 509-20

See pg. 198 for Location Trav. 16

From Trav. pg. 196

From Trav. pg. 197

EC. Set 3/4" IP 12" dn.

122.92 C 0-00 T=88°=122.92

108.37 C 4-16 T=9°40'=108.09
108.57 C 5-21

(2) 324°-29'-15"
(4) 288°-58'-30"
(6) 213°-28'-00"
162°-16'-45"
16°-14'-30"

(2) 192°-52'-00"
(4) 25°-29'-00"
(6) 218°-06'-15"
96°-21'-15"
83°-39'-00"

Δ = 16°-00'-00"
R = 240'
T = 33.73
L = 67.02

Δ = 86°-54'-40"
R = 75'
T = 71.06
L = 113.77

39.03 C 10°-03' T=8°40'=38.43
39.17 C 11°-13'

63.50 C 19°-39' T=8°40'=59.71
63.20 C 18°-02'

102.00 C 0°-00' T=9°40'=101.99
85.80 C 0°-00' T=9°40'=85.80
187.79
-12.19
175.60

F.B. 525 PG. 198

Location Traveled Road along Proposed Station Site (This is an oiled dirt surface)

Inst at	Sight on	Hor ∠	dist	
P1-D	P1-E			
		344-07	112	Wedge oiled surf
		346-29	81	" "
		345-23	45	" "
		322-53	12	" "
		189-50	29	" "
		184-17	67	" "
		182-30	106	" "
		182-30	157	" "
		183-41	216	" "
		184-43	263	" "
		186-04	299	" "
		348-35	133	E edge oiled surf
		350-27	111	"
		354-49	87	" "
		8-25	62	" "
		30-12	14	" "
		158-42	26	" "
		172-19	71	" "
		175-49	115	" "
		178-32	169	" "
		179-45	204	" "
		181-10	248	" "
		182-05	288	" "
		184-45	332	" "
		185-18	379	" "
		12-02	29	edge Trav rd No surf
		53-39	27	" "
		69-26	40	" "
		71-15	65	" "
		79-18	81	" "
		83-13	62	" "
		89-21	38	" "
		109-45	22	" "

Inst at	Sight on	Hor ∠	dist	
P1-D	P1-E			
		157-15	28	edge Trav rd No surf
P1-8	P1-C			
		354-22	76	Wedge oiled surf
		354-22	46	" "
		10-02	21	" "
		84-49	80	" "
		112-25	43	" "
		115-38	78	" "
		113-57	115	" "
		110-12	151	" "
		105-37	176	" "
		104-37	163	" "
		106-23	115	" "
		104-11	79	" "
		96-12	42	" "
		72-20	36	" "
		20-29	33	" "
		13-27	48	" "
		6-35	12	" "
P1-6	P1-A			
		112-32	34	Wedge oiled surf
		112-12	62	" "
		137-27	74	" "
		102-42	101	" "
		101-30	127	" "
		103-00	160	" "
		104-15	187	" "
		100-03	151	" "
		98-30	139	" "
		95-30	119	" "
		95-49	79	" "
		95-05	62	" "
		64-22	27	" "

RETURN TO
LOS ANGELES COUNTY SURVEYOR
700 HALL OF RECORDS

Do not extend notes this side of this line

Note: ANY ADDITIONS OR CHANGES ON THIS SHEET MUST BE MADE OR CIRCLED IN Red Ink. WITH DATE AND NAME OF PERSON MAKING CHANGE.

Notes Ck'd by	Survey of Brown Park
Map No. B-984	W. O. 8025 Tape No. 045 St'd 84 °F.
Office Work Wood	Surveyed by Rosecrans
Checked	Notes Date 1-16-34
Date	Indexed C. Johnson 1-18-34

F.B. 505 PG. 201

Notes ANY ADDITIONS OR CHANGES ON THIS SHEET MUST BE MADE OR CIRCLED IN Red Ink. WITH NAME AND NAME OF PERSON MAKING CHANGE.

RETURN TO
LOS ANGELES COUNTY SURVEYOR
700 HALL OF RECORDS

Do not extend notes this side of this line

FORM 247 10M 5-31

BROWN PARK SURVEY

Job 8025

Lot A Tract 5216 M.B 56-33

Party E.A. Rosecrans
R.C. Bowers
J.A. Winess
K.H. Schneider.

RETURN TO
LOS ANGELES COUNTY SURVEYOR
700 HALL OF RECORDS

Note: ANY ADDITIONS OR CHANGES ON THIS SHEET MUST BE MADE OR CIRCLED IN Red Ink. WITH DATE AND NAME OF PERSON MAKING CHANGE.

Do not extend notes this side of this line

W.S. 51C-5

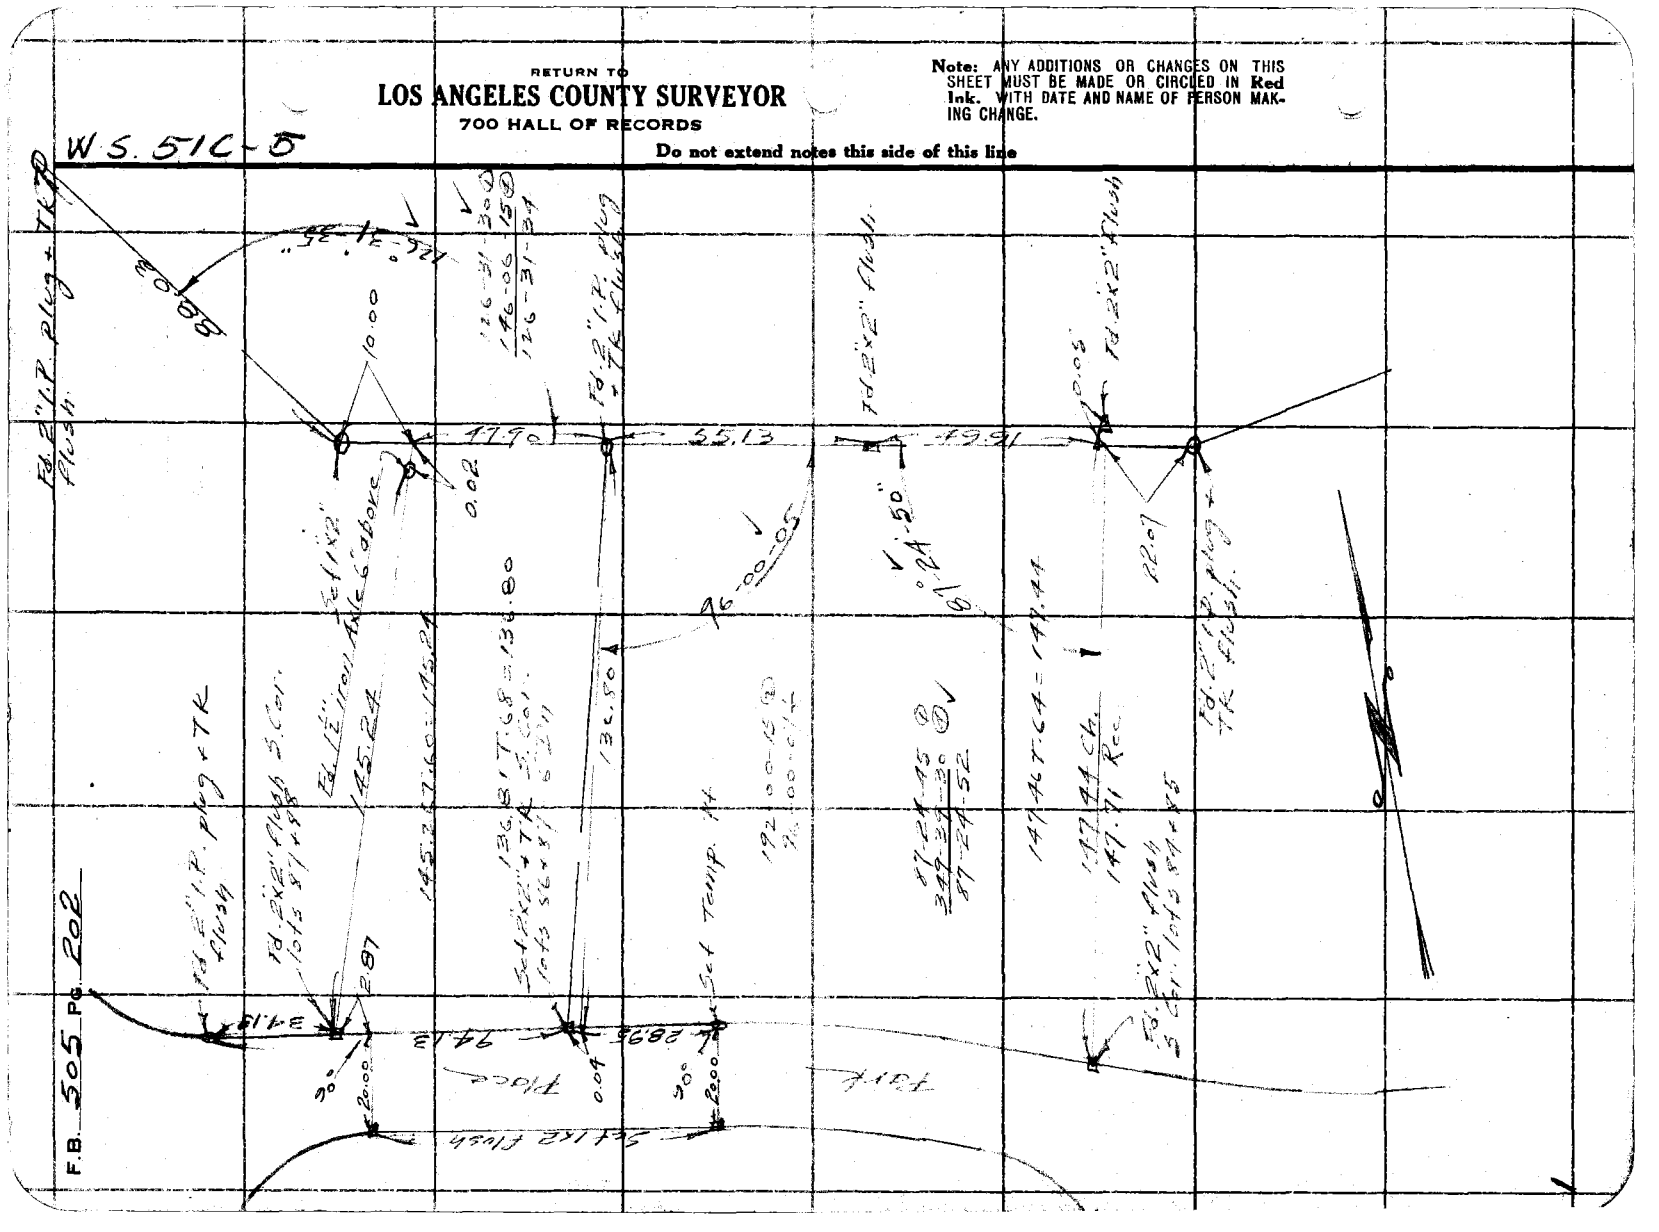
Fd. 2" I.P. plug + TK Flush.
Fd. 2" I.P. plug + TK Flush.
Fd. 2" I.P. plug + TK Flush.
Fd. 2"x2" Flush.
Fd. 2"x2" Flush.
Fd. 2"x2" Flush.
Fd. 2" I.P. plug + TK Flush.
Fd. 2" I.P. plug + TK Flush.

Notes Ck'd by McPherson	Survey of Brown Park
Map No. B-984	W. O. 5225 Tape No. 045 St'd 64 °F.
Office Work Tidd	Surveyed by Escerama
Checked McPherson	Notes Date 1-23-34
Date Feb. 1934	Indexed A. C. Johnson

F.B. 505 PG. 203

Preliminary Boundary Mtc for Cor. Search.

W 5/6-5

Set 1x2 See preceding page

Set 1x2 See preceding page.

Lot A.

Set 1x2

Set 3 W.S.T.

Set 1x2"

Set 1x2

Set 1x2

Set 1x2"

Set 1x2"

Set 1x2

Set 1x2

Set 3 W.S.T.

Set 1x2"

Set 1x2

Set 1x2

Note: ANY ADDITIONS OR CHANGES ON THIS SHEET MUST BE MADE OR CIRCLED IN Red Ink, WITH DATE AND NAME OF PERSON MAKING CHANGE.

Do not extend notes this side of this line

RETURN TO
LOS ANGELES COUNTY SURVEYOR
700 HALL OF RECORDS

FORM 247 10M 8-31

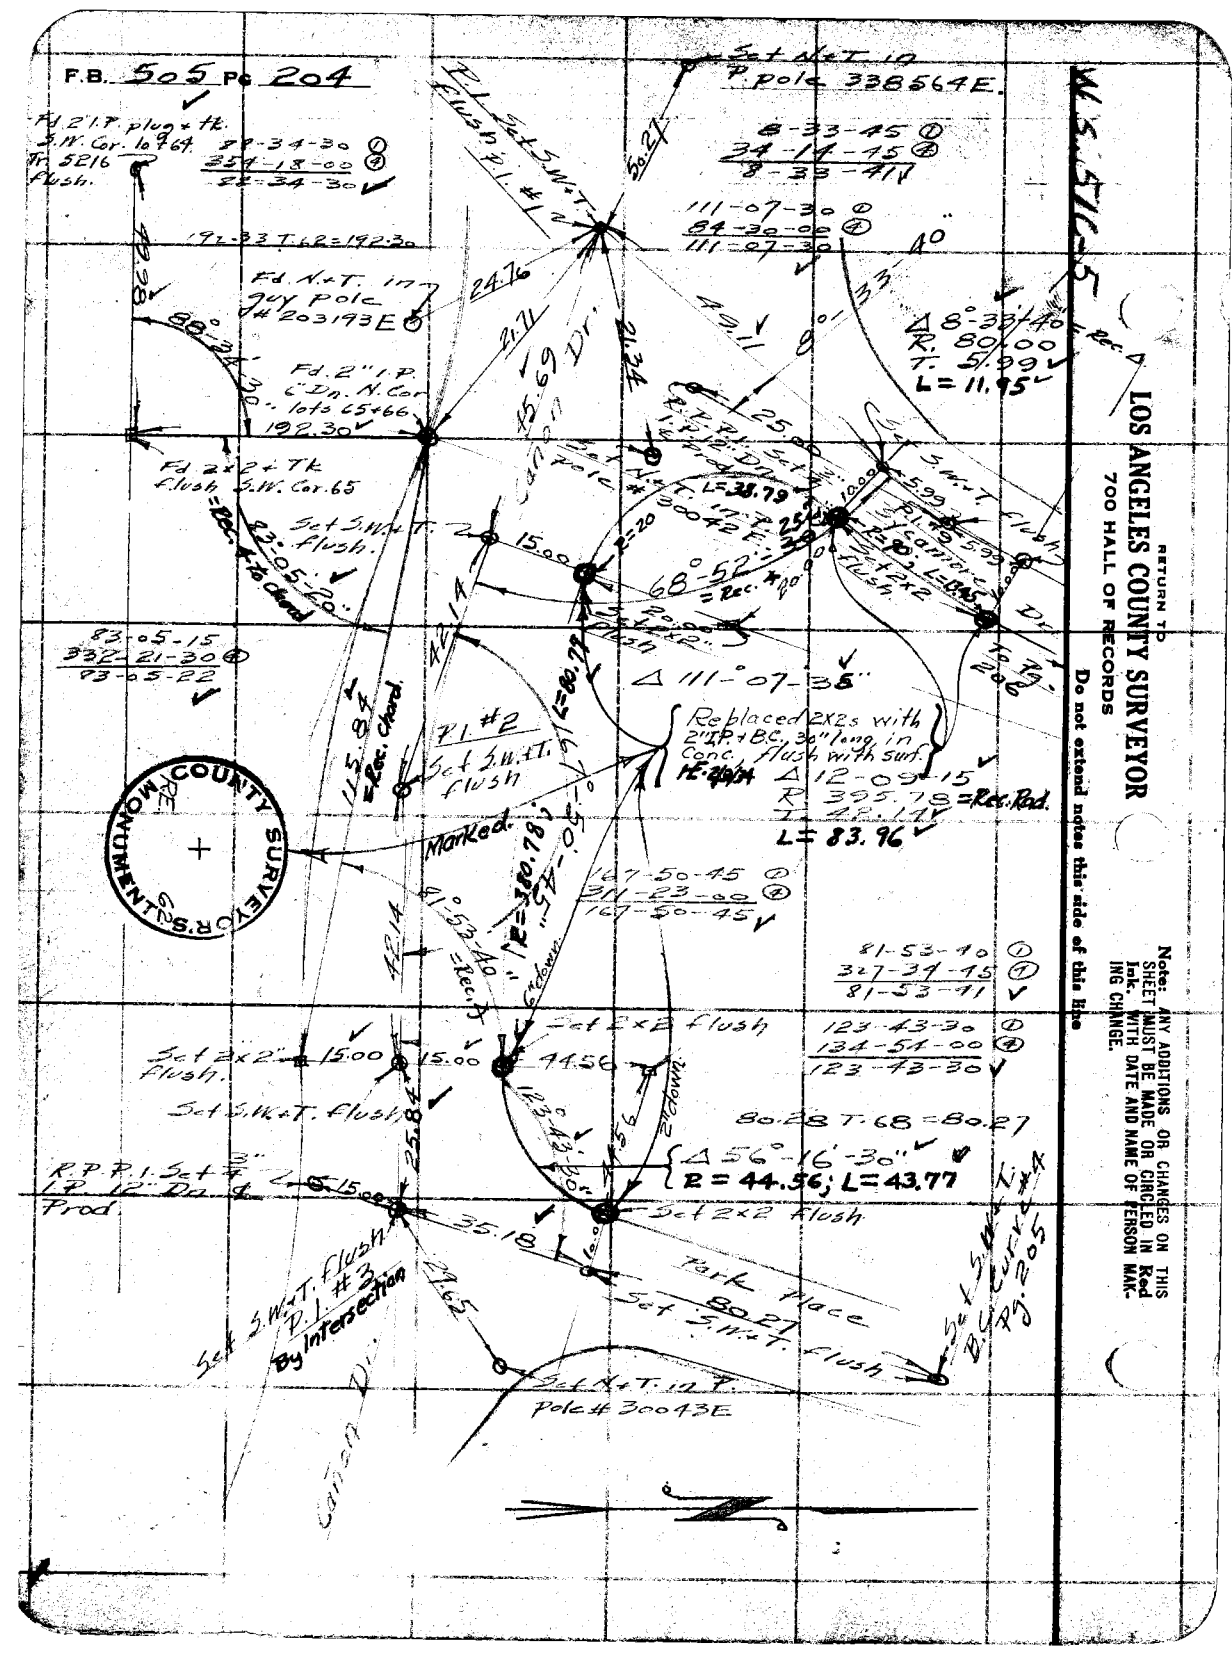
F.B. 505 Pg 204
Fd 2" I.P. plug + tk. S.W. Cor. 16764 Tr. 5216 Flush.
88-34-30
35-18-00
22-34-30
192-33 T. to R = 192.30
Fd. N.+T. in Guy Pole #203193E
88° 34' 30"
Fd. 2" I.P. in Dn. N. Cor. Lots 65+66 192.30
Fd 2x2 + Tk Flush S.W. Cor. 65
Set S.W.+T. Flush.
82-05-20
Rec. 4-16 chord
83-05-15
332-21-30
83-05-22
Set N.+T. in P. Pole 338564E.
8-33-45
34-17-15
8-33-41
111-07-30
84-30-00
111-07-30
Δ 8°-33'-40"
R: 80.00
T: 51.99
L = 11.95
Rec.
Set 2x2 Flush
Δ 111°-07'-35"
Replaced 2x2s with 2" I.P. + B.C. 30" long in Conc. flush with surf.
Δ 12-09-15
R 395.78 = Rec. Rad.
L = 83.96
P.I. #2 Set S.W.+T. flush
Marked
167-50-45
31-23-00
167-50-45
81-53-10
327-39-15
81-53-11
123-43-30
134-51-00
123-43-30
80.28 T. 68 = 80.27
Δ 56°-16'-30"
R = 44.36; L = 43.77
Set 2x2 flush
Park Place
Set S.W.+T. flush
Set N.+T. in P. Pole #300435
Set 2x2 Flush
Set S.W.+T. flush
R.P.P.I. Set + 3" LP 12" Dn. 1.5 Prod
Set S.W.+T. Flush P.I. #3 By Intersection

Notes Ck'd by McKeeson	Survey of Brown Park
Map No. 3-984	W. O. 8029 Tape No. 945 St'd 64 °F.
Office Work Wood	Surveyed By [illegible]
Checked McKeeson	Notes Date 1-10-34
Date Feb. 1934	Indexed A. C. Johnson

F.B. 505 PG. 205

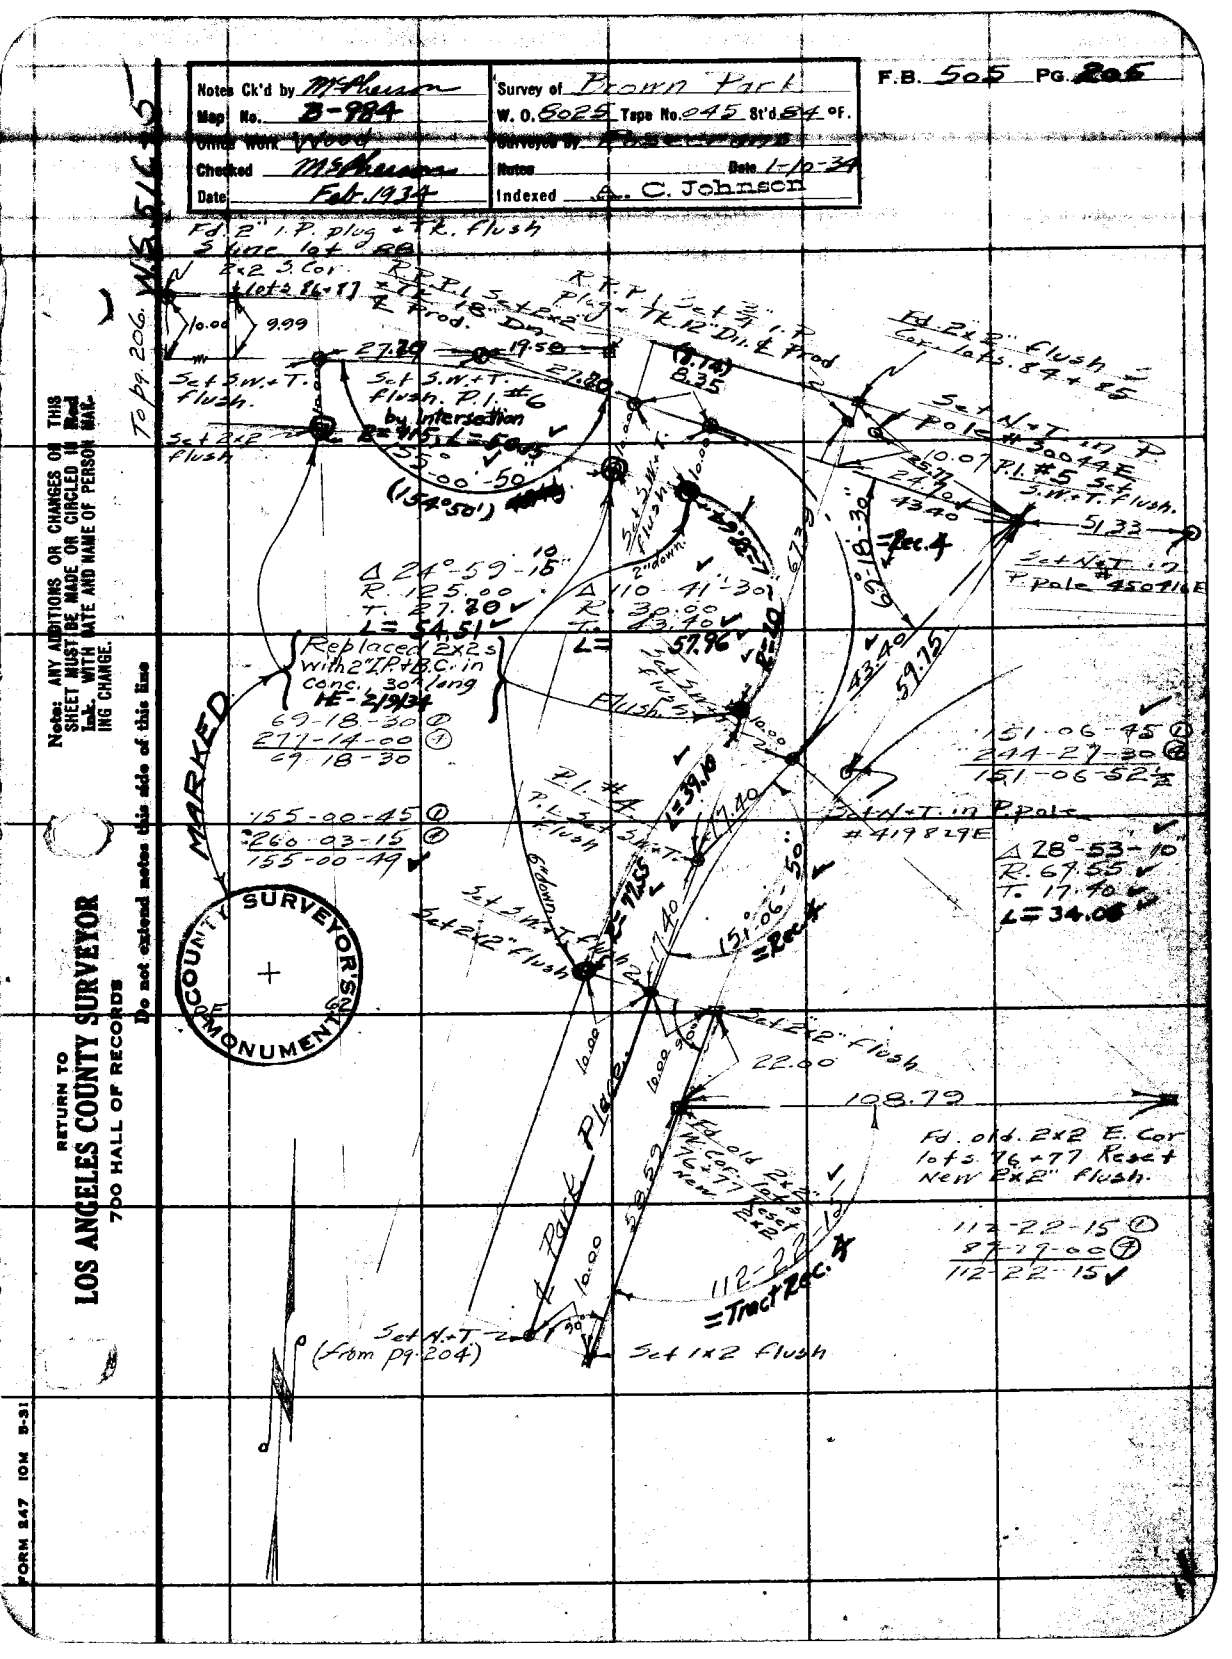

Note: ANY ADDITIONS OR CHANGES OF THIS SHEET MUST BE MADE OR CIRCLED IN Red Ink. WITH DATE AND NAME OF PERSON MAK-ING CHANGE.

Do not extend notes this side of this line

RETURN TO
LOS ANGELES COUNTY SURVEYOR
700 HALL OF RECORDS

FORM 847 10M 8-31

F.B. 505 Pg. 206

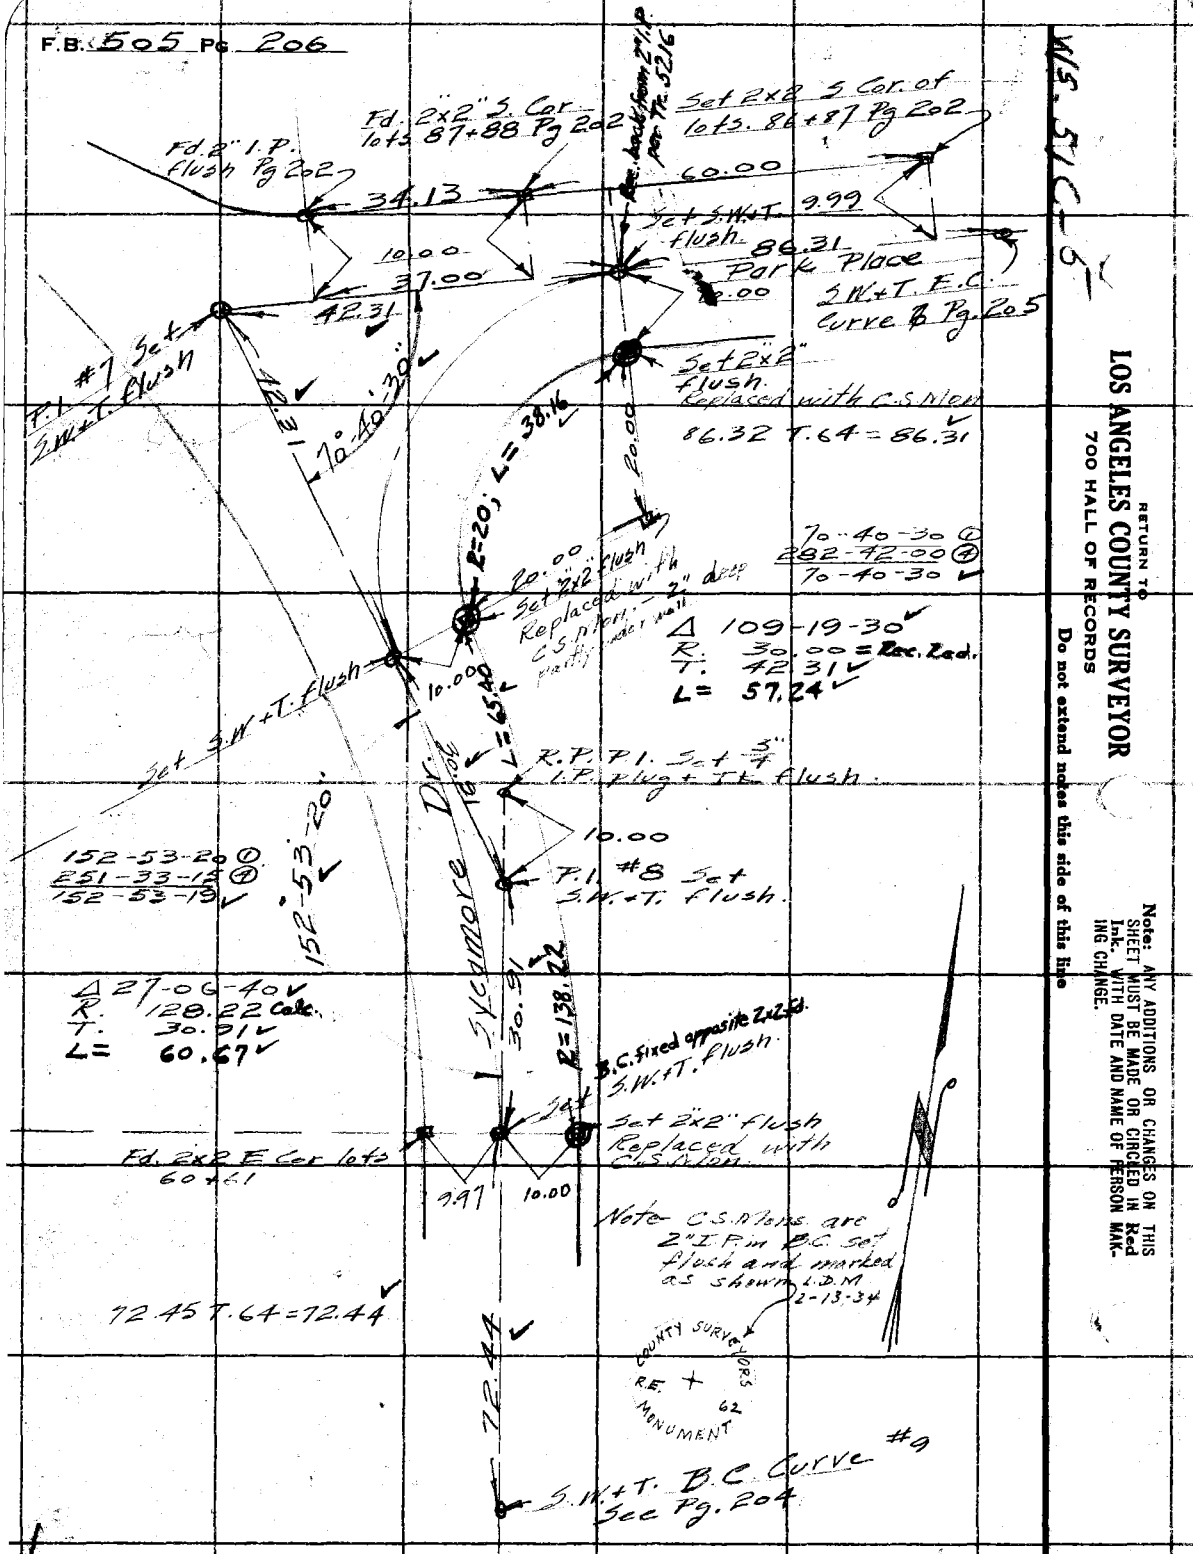

W.S. 57 C-9

RETURN TO
LOS ANGELES COUNTY SURVEYOR
700 HALL OF RECORDS

Do not extend notes this side of this line

Note: ANY ADDITIONS OR CHANGES ON THIS SHEET MUST BE MADE OR CIRCLED IN Red Ink. WITH DATE AND NAME OF PERSON MAKING CHANGE.

Notes Ck'd by	Survey of Brown Ave.
Map No. Br 984	W. O. 8025 Tape No. 245 St'd °F.
Office Work Wood	Surveyed by Rascrans
Checked McPherson	Notes Date 1-14-34
Date Feb. 1934	Indexed A. C. Johnson

F.B. 505 Pg. 207

Cont. bottom next page

3. end of 3/4" water pipe line

Conc. water meter box

10" Syc. 8" Syc. 8" elderberry 10" Syc. 5" Syc. 5" Syc. 4" elderberry 6" Syc 14 Syc. 2" oak 3" elderberry 10" Syc. 3" oak 4" Syc. 8" Syc. 4" Syc. 5" elderberry 18" Syc Tr. 6" Syc. Tr. 14" Syc. Tr. 18" oak power pole

Rock and Dirt Surf.

Rock wall

11 R.

Pl #1 Sta. 0+00 to E. for topog. Pg. 204

Note: ANY ADDITIONS OR CHANGES OF THIS SHEET MUST BE MADE OR CIRCLED IN Red Ink, WITH DATE AND NAME OF PERSON MAKING CHANGE.

Do not extend notes this side of this line

RETURN TO
LOS ANGELES COUNTY SURVEYOR
7DO HALL OF RECORDS

FORM 847 10M 5-31

RETURN TO

LOS ANGELES COUNTY SURVEYOR

700 HALL OF RECORDS

Note: ANY ADDITIONS OR CHANGES ON THIS SHEET MUST BE MADE OR CIRCLED IN Red Ink. WITH DATE AND NAME OF PERSON MAKING CHANGE.

Do not extend notes this side of this line

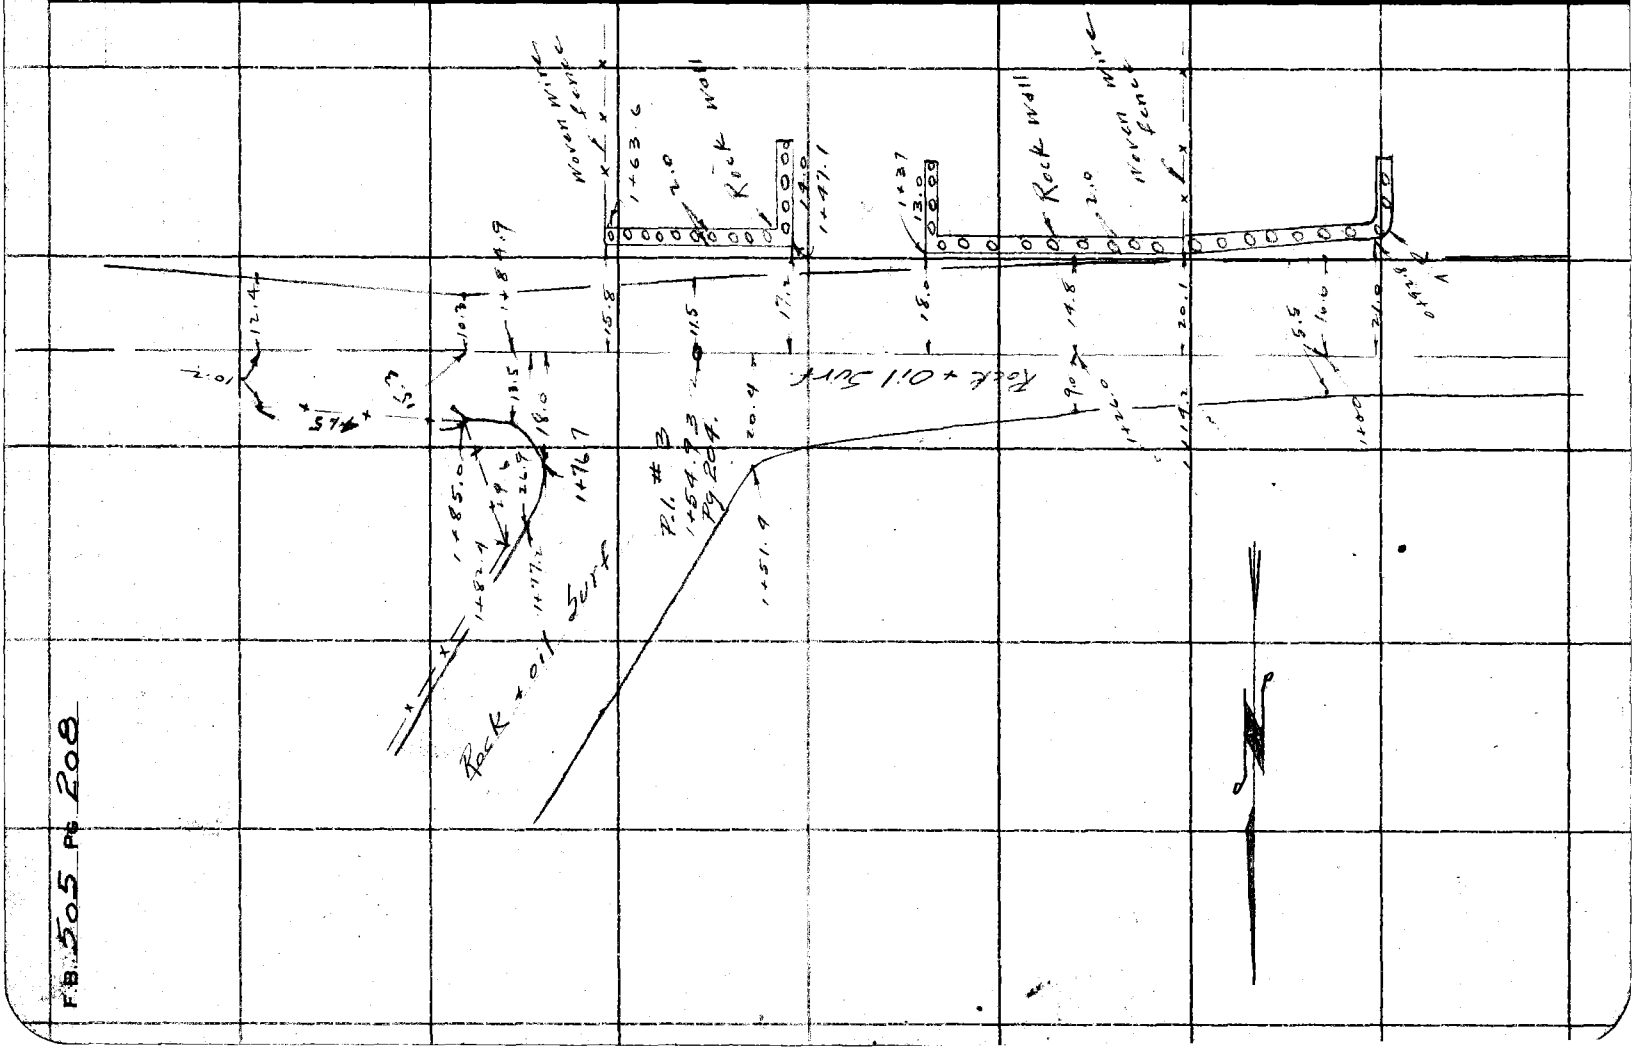

F.B. 505 Pg 208

Notes Ck'd by	Survey of Brown Park
Map No. B-984	W. O. 8025 Tape No. 045 St'd 84 °F.
Office Work YYDDD	Surveyed by Rosecrans
Checked MEBrown	Notes Date 1-4-34
Date Feb. 1934	Indexed A. C. Johnson

F.B. 505 PG. 209

Cont on bottom next page

30" oak 1+59.3 25.9

Wood + Conc Picnic bench 17.6

Porch Conc floor 13.1 6.6 0.9

3-2" oaks 5' = Diam at Base

Fire Supply Station Comfort

1 Floor House Frame

Wooden step

3/4 water line 57.8 1.5 To joint 2" oak 1+12.6

31.5

0+99.0 3" oak. 95.2

Wooden step 4.6 1+19.5

1+40.9 2" oak 14.6

1+32.8 P.L. #4 Pg. 205

1+52.6 24.9

1+33.1 14.2

1+10.5 10.5

Rock + dirt surf

P.L. #3 Sta. 0+00 to N for topog. Pg 209

Note: ANY ADDITIONS OR CHANGES ON THIS SHEET MUST BE MADE OR CIRCLED IN Red Ink. WITH DATE AND NAME OF PERSON MAKING CHANGE.

Do not extend notes this side of this line

RETURN TO
LOS ANGELES COUNTY SURVEYOR
700 HALL OF RECORDS

FORM 847 10M 5-31

F.B. 505 Pg 210

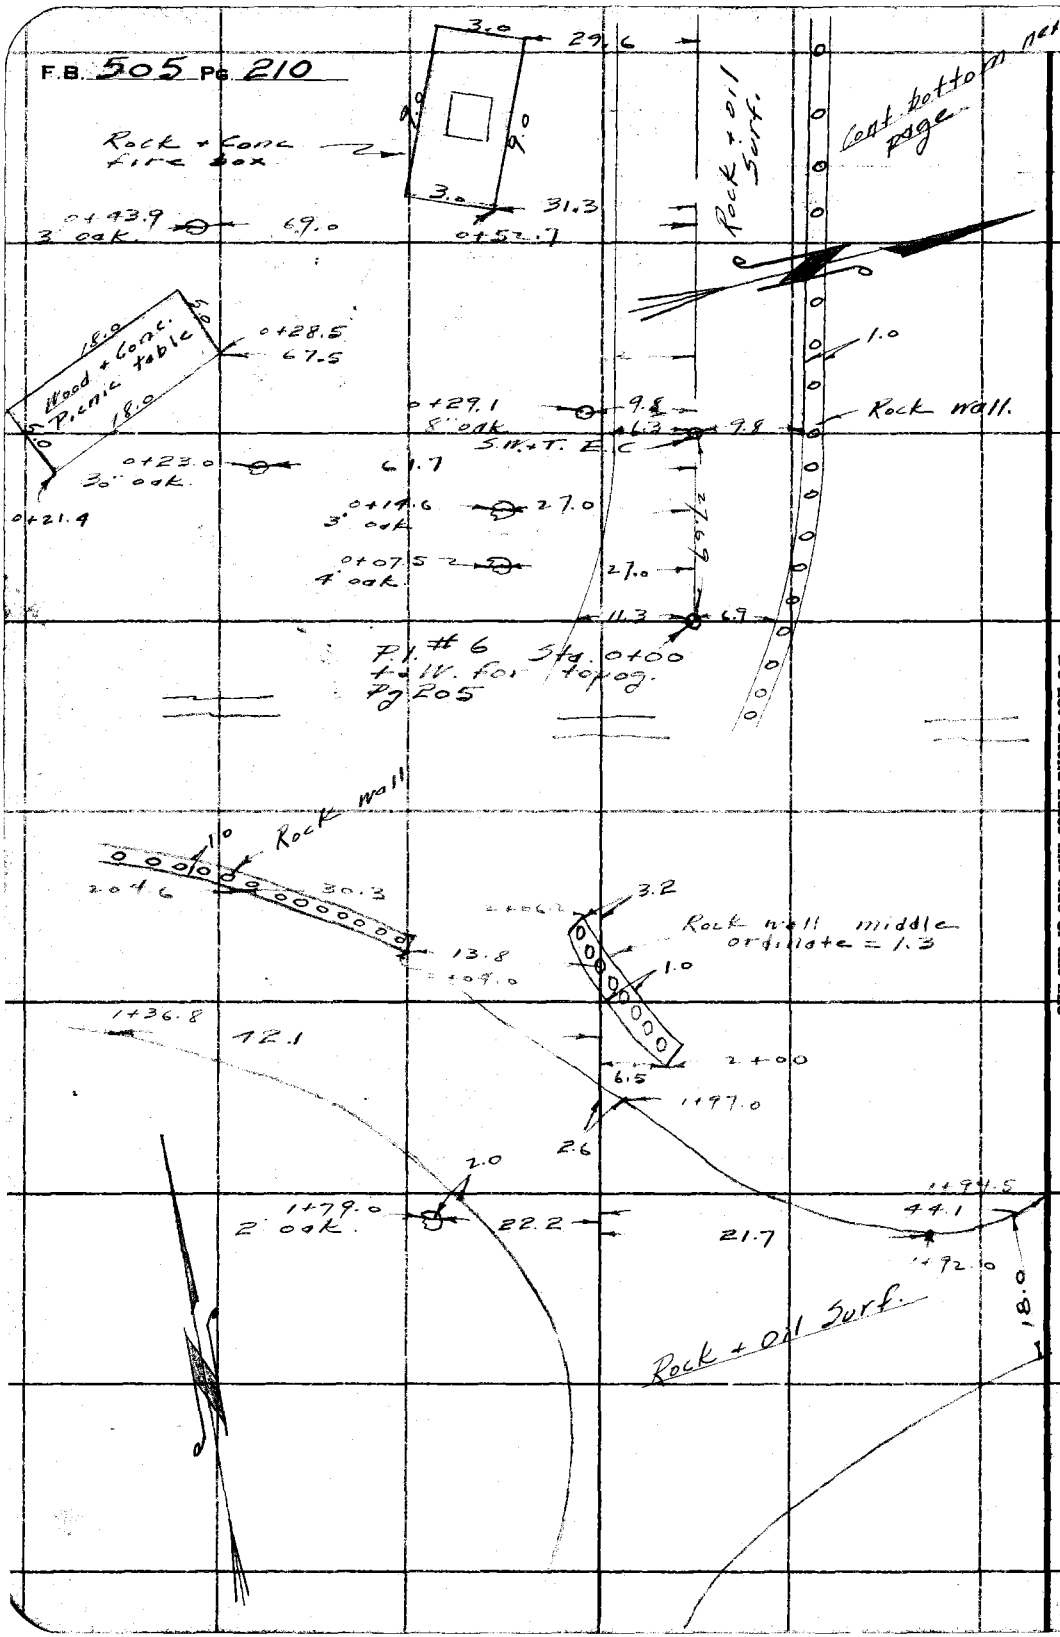

RETURN TO
LOS ANGELES COUNTY SURVEYOR
700 HALL OF RECORDS
Do not extend notes this side of this line

Note: ANY ADDITIONS OR CHANGES ON THIS SHEET MUST BE MADE OR CIRCLED IN Red Ink. WITH DATE AND NAME OF PERSON MAKING CHANGE.

Notes Ck'd by	Survey of Brown Park
Map No. B-984	W. O. 8025 Tape No. 015 St'd 99 °F.
Office Work Wood	Surveyed by Rogers & Johnson
Checked McPherson	Notes Date 1-14-34
Date Feb. 1934	Indexed A. C. Johnson

F.B. 505 PG. 211

Note: ANY ADDITIONS OR CHANGES ON THIS SHEET MUST BE MADE OR CIRCLED IN Red Ink, WITH DATE AND NAME OF PERSON MAKING CHANGE.

RETURN TO
LOS ANGELES COUNTY SURVEYOR
720 HALL OF RECORDS
Do not extend notes this side of this line

FORM 247 10M 5-31

1+72.6
1+54.1
12.1
10.0
2' Ext.
F.1 #7
1+26.31
Pg 206
18.2
30.7
17.5
1+35.7
1+30.1
1+14.0
1+10.3
4" oak
14.8
1+16.6
10.0
10.0
11.8
1.0
Rock Wall
5' oak
1+04.8
38.1
5.0
23.6
1+01.3
5.0
48.9
1+06.4
Wood + Conc. Picnic bench
18.0
18.0
5.0
44.0
Rock + Dirt Surf.
23.6
12.7
0+71.9
10.0
11.0
13.3
1.0
Rock Wall
To meter
See Pg
bot
0+60.6
0+58.2
3" oak
9.3
0+50.1
2" oak
85.5
60.1
62.0
0+34.8
97.8
To house
Pg. 209

RETURN TO

LOS ANGELES COUNTY SURVEYOR

700 HALL OF RECORDS

Note: ANY ADDITIONS OR CHANGES ON THIS SHEET MUST BE MADE OR CIRCLED IN Red Ink. WITH DATE AND NAME OF PERSON MAKING CHANGE.

Do not extend notes this side of this line

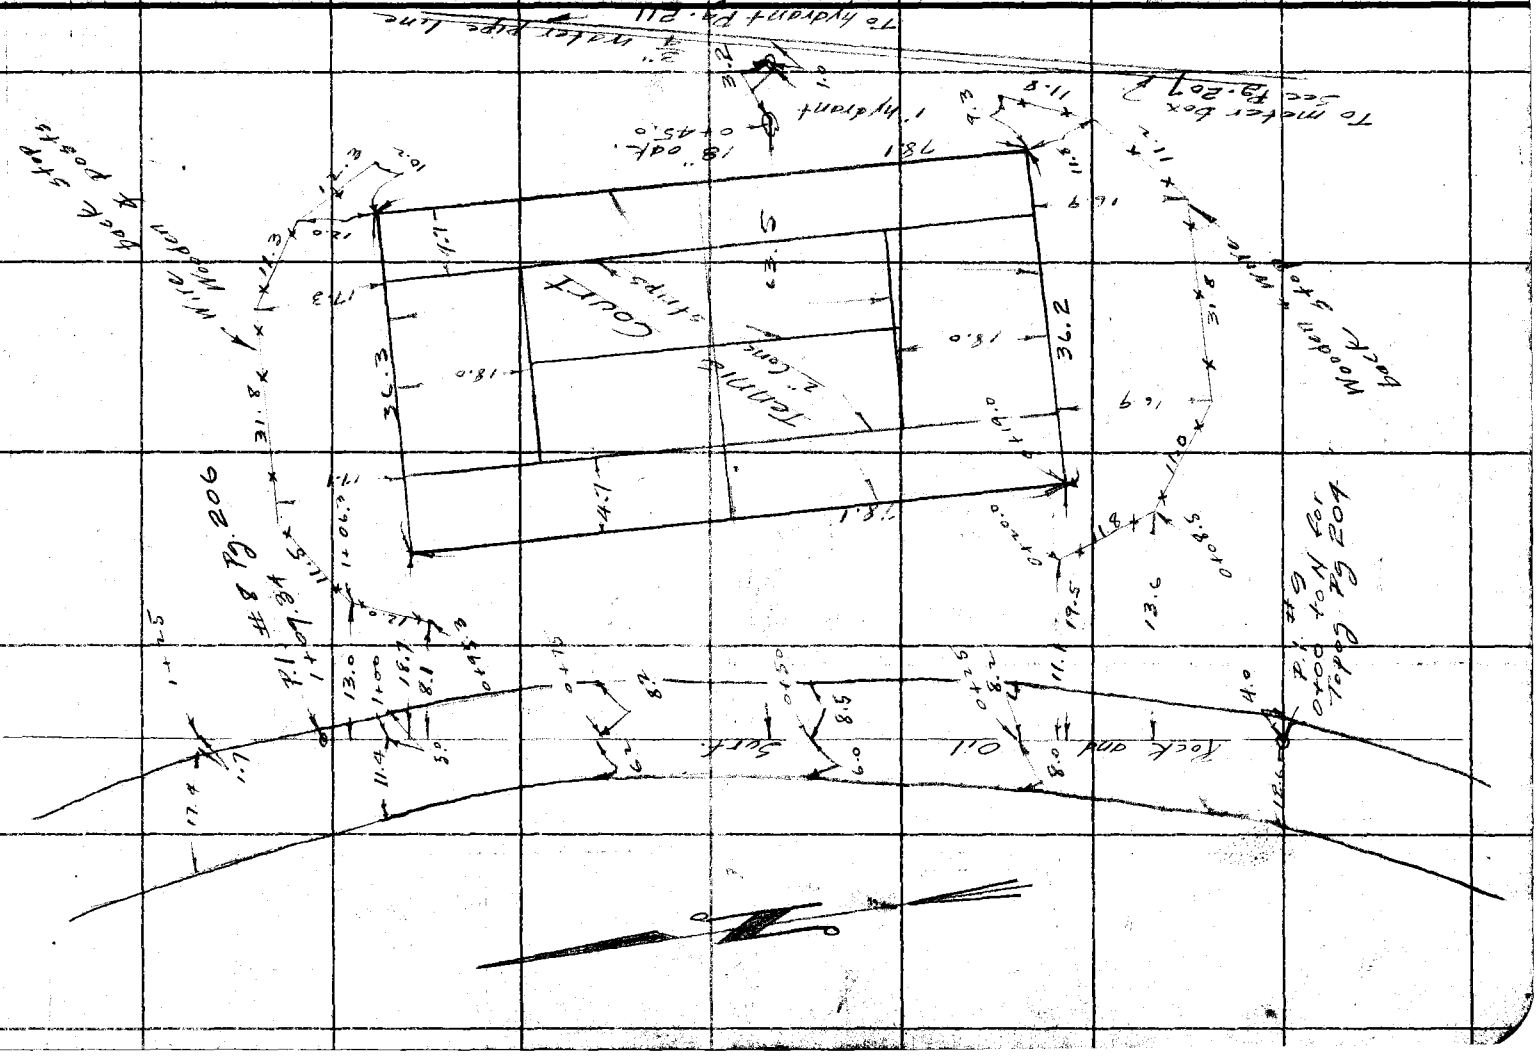

Notes Ck'd by	Survey of McNees Park
Map No. B-990	W. O. 8028 Tape No. 045 St'd 84 °F.
Office Work Rad M.C.A.	Surveyed by Rosecrans
Checked Adk	Notes Date 1-23-34
Date Feb. 34	Indexed A. C. Johnson 1-25-34

F.B. 505 PG. 219

Datum - USC

Survey of
McNEES PARK
Lot 2 Tr. #10411 M.B. 154-2

Job 8028

Party E. A. Rosecrans
R. C. Bowers
J. A. Willess
K. H. Schneider.

Note: ANY ADDITIONS OR CHANGES OF THIS SHEET MUST BE MADE OR CIRCLED IN Red Ink. WITH DATE AND NAME OF PERSON MAKING CHANGE.

RETURN TO
LOS ANGELES COUNTY SURVEYOR
720 HALL OF RECORDS

Do not extend notes this side of this line

FORM 847 10M 8-31

RETURN TO
LOS ANGELES COUNTY SURVEYOR
700 HALL OF RECORDS

Note: ANY ADDITIONS OR CHANGES ON THIS SHEET MUST BE MADE OR CIRCLED IN Red Ink. WITH DATE AND NAME OF PERSON MAKING CHANGE.

Do not extend notes this side of this line

WS 32 B-5

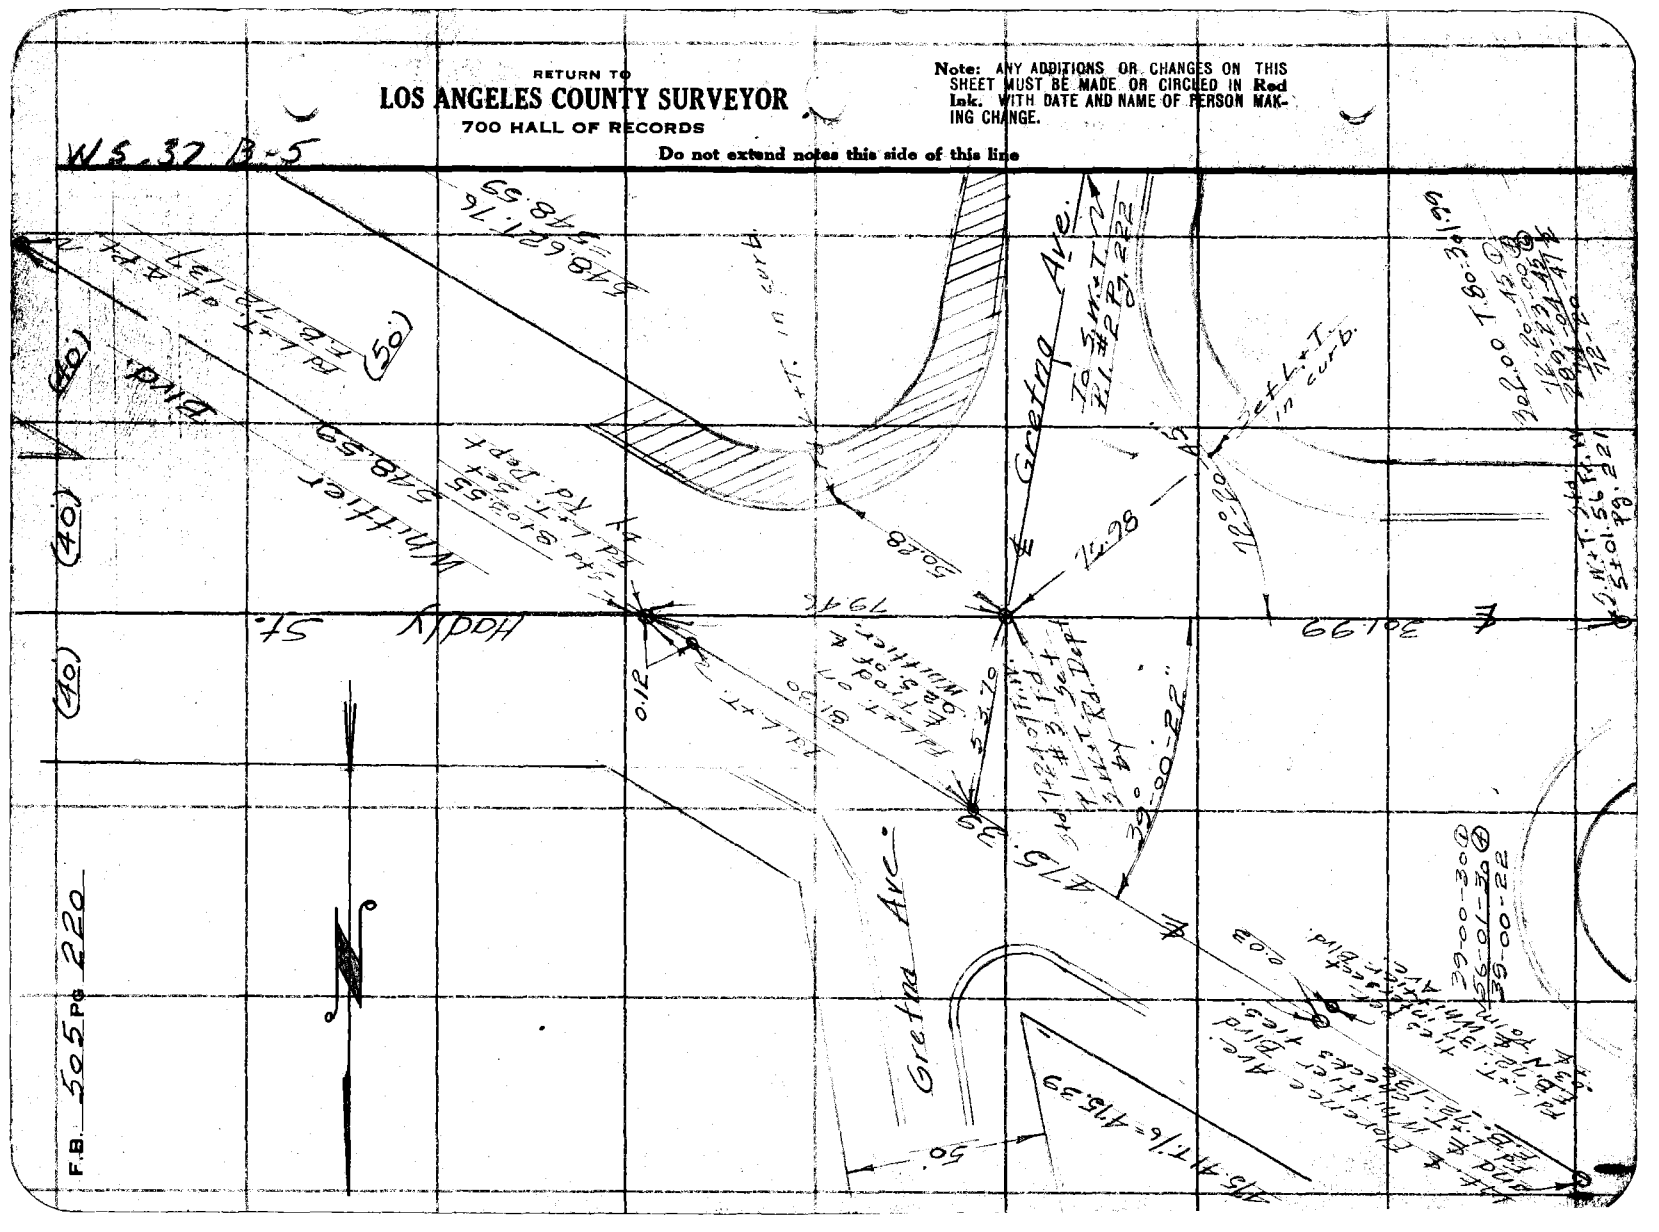

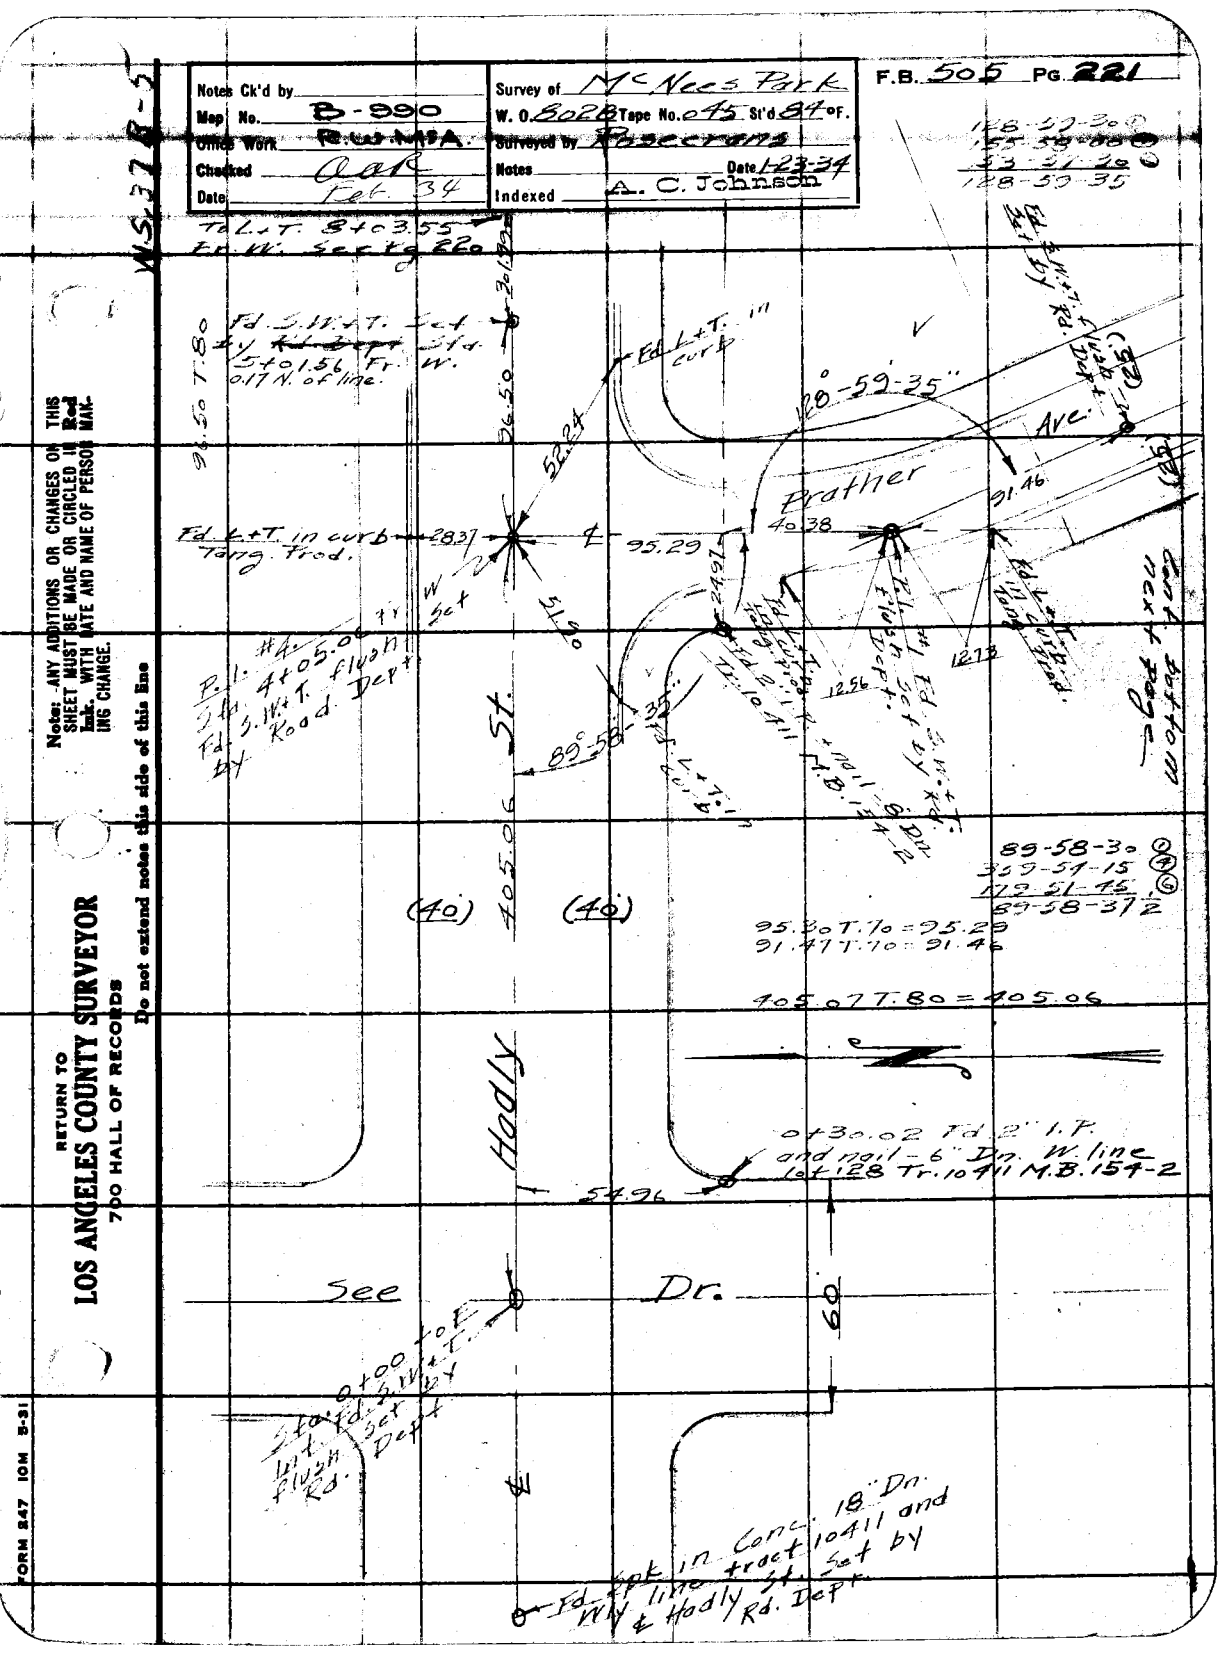
Notes Ck'd by
Map No. B-990
Office Work R.W. M.P.A.
Checked Aac
Date Feb. 34
Survey of McNees Park
W. O. 8028 Tape No. 045 St'd 99 °F.
Surveyed by Bascroms
Notes
Date 1-23-34
Indexed A. C. Johnson
F.B. 505 PG. 221
WS 27 B-5
Tan L.+T. 84 03.55
Fd. W. Sec. Cor.
Fd. L.+T. in curb
Tang. Prod.
Fd. L.+T. in curb
Fd. L.+T. in curb
Prather
Ave.
St.
Hadly
See
Dr.
(40')
(40')
405.06
95.29
51.20
89°-58'-32"
120°-59'-35"
Fd. 2" I.P. and mail - 6" Dn. W. line Lot 128 Tr. 10411 M.B. 154-2
Fd. spk. in Conc. 18" Dn. W'ly line tract 10411 and Hadly St. Set by Rd. Dept.
Fd. L.+T. 0.17 N. of line.
Set Dept. Rd.
Fd. L.+T. in curb
Tang. Prod.
Fd. L.+T. in curb
Fd. L.+T. in curb
Fd. L.+T. in curb

RETURN TO
LOS ANGELES COUNTY SURVEYOR
700 HALL OF RECORDS

Note: ANY ADDITIONS OR CHANGES ON THIS SHEET MUST BE MADE OR CIRCLED IN Red Ink. WITH DATE AND NAME OF PERSON MAKING CHANGE.

W.S 32 B-5

Do not extend notes this side of this line

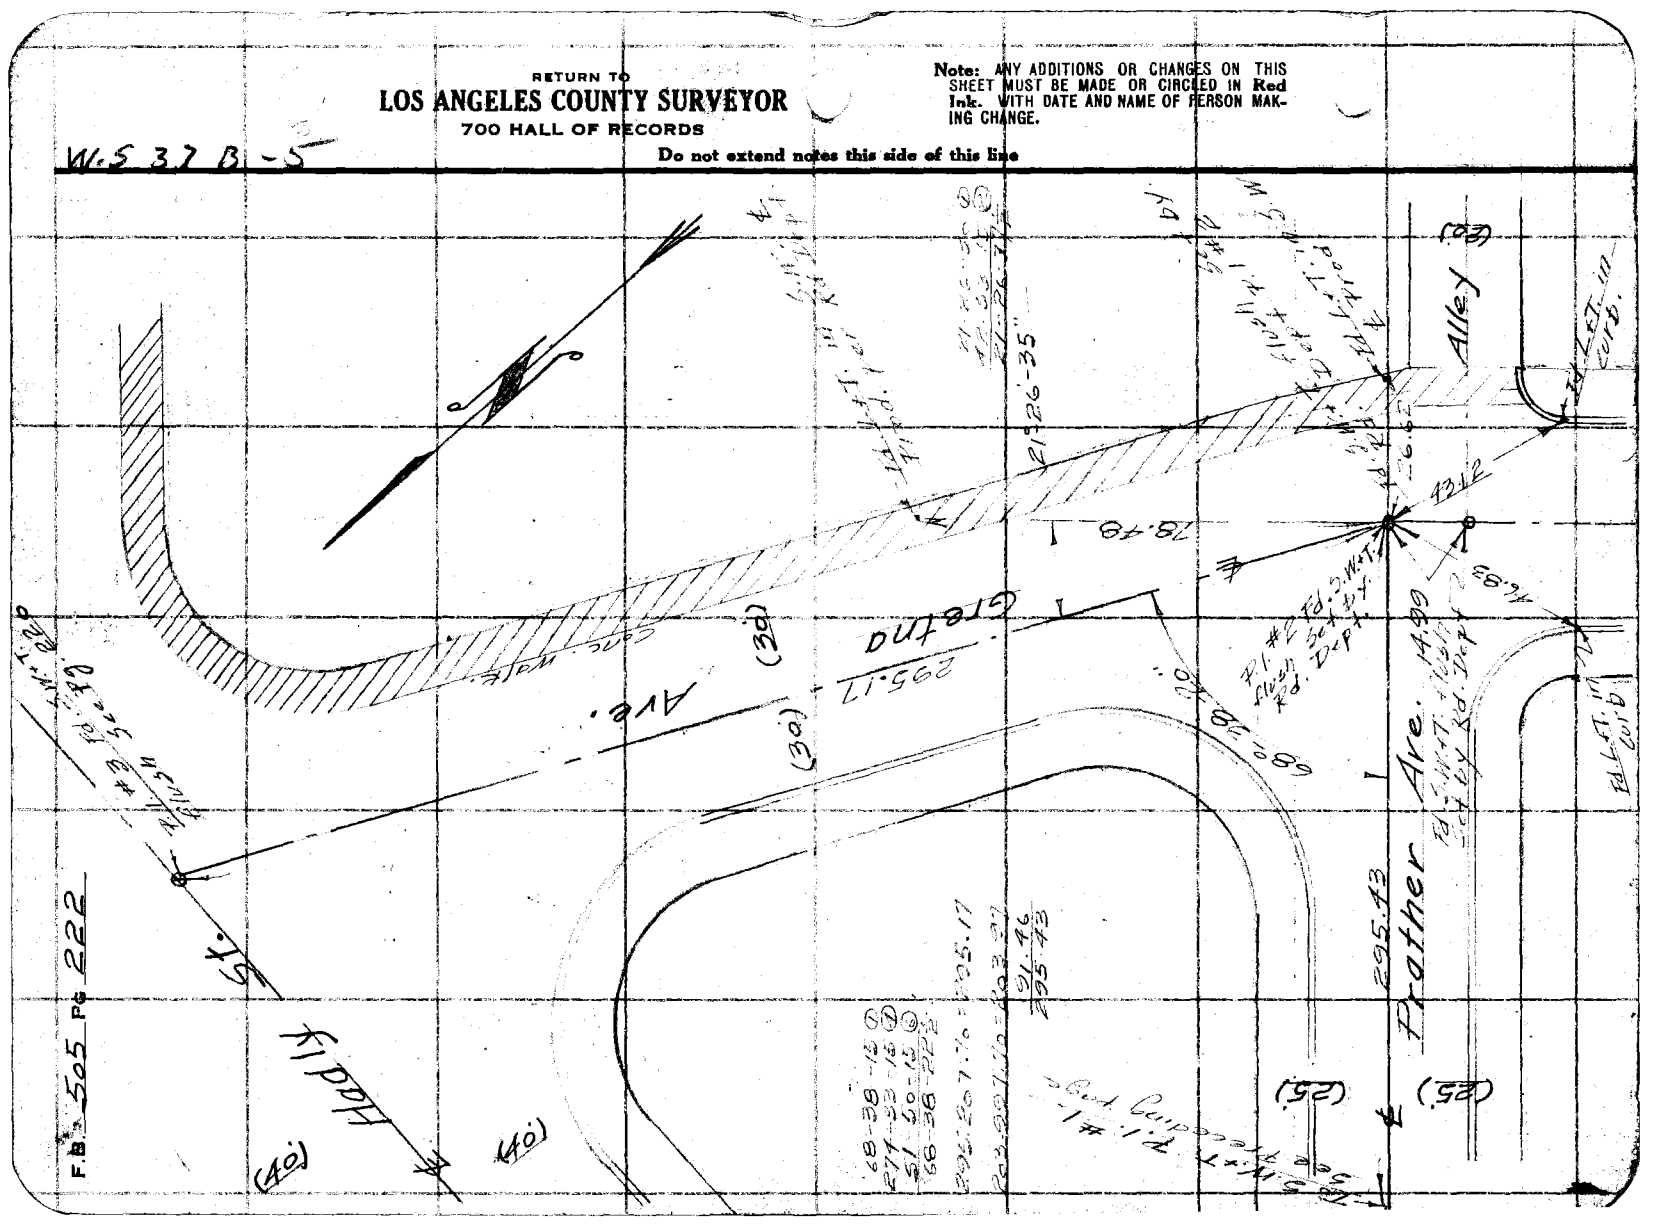

Notes Ck'd by	Survey of McNees Park
Map No. B-990	W. O. 8028 Tape No. 016 St'd 34 °F.
Checked Ack	Surveyed by Rogerson
Date Feb. 34	Notes Date 1-24-34
	Indexed A. C. Johnson

F.B. 505 PG. 223

Cont. bottom next page

Conc. St. light

2 Rather

Rock oil

Conc. gutter

Conc. curb

Conc. sidewalk

Point C at 40.62

Ave.

S.W.T. P.I. #1 0+95.29 Fr N for 1-14

Conc. sidewalk

Conc. curb

Conc gutter

0+68.3 1" hydrant 57.2

0+66.7 - 3" acacia

0+57.1 Conc. water meter

0+54.7 4 2 Point B

Point C at 39.34

6 acacia

Conc. St. Light

0+42.4

17' R.

0+31.6

27' R

0+25.8

Conc. gutter

Rock + oil pavement

Tan. 42.03

48.2

Hadly St.

S.W.T. for 0+00 to 1+00

Conc. gutter

Conc curb

Conc. driveway

Conc. S.W.

Conc St. light conduit 13 m & P.I.C.C. Pvs

RETURN TO
LOS ANGELES COUNTY SURVEYOR
700 HALL OF RECORDS

Do not extend notes this side of this line

Note: ANY ADDITIONS OR CHANGES OF THIS SHEET MUST BE MADE OR CIRCLED IN Red Ink. WITH DATE AND NAME OF PERSON MAK-ING CHANGE.

FORM 847 10M 8-31

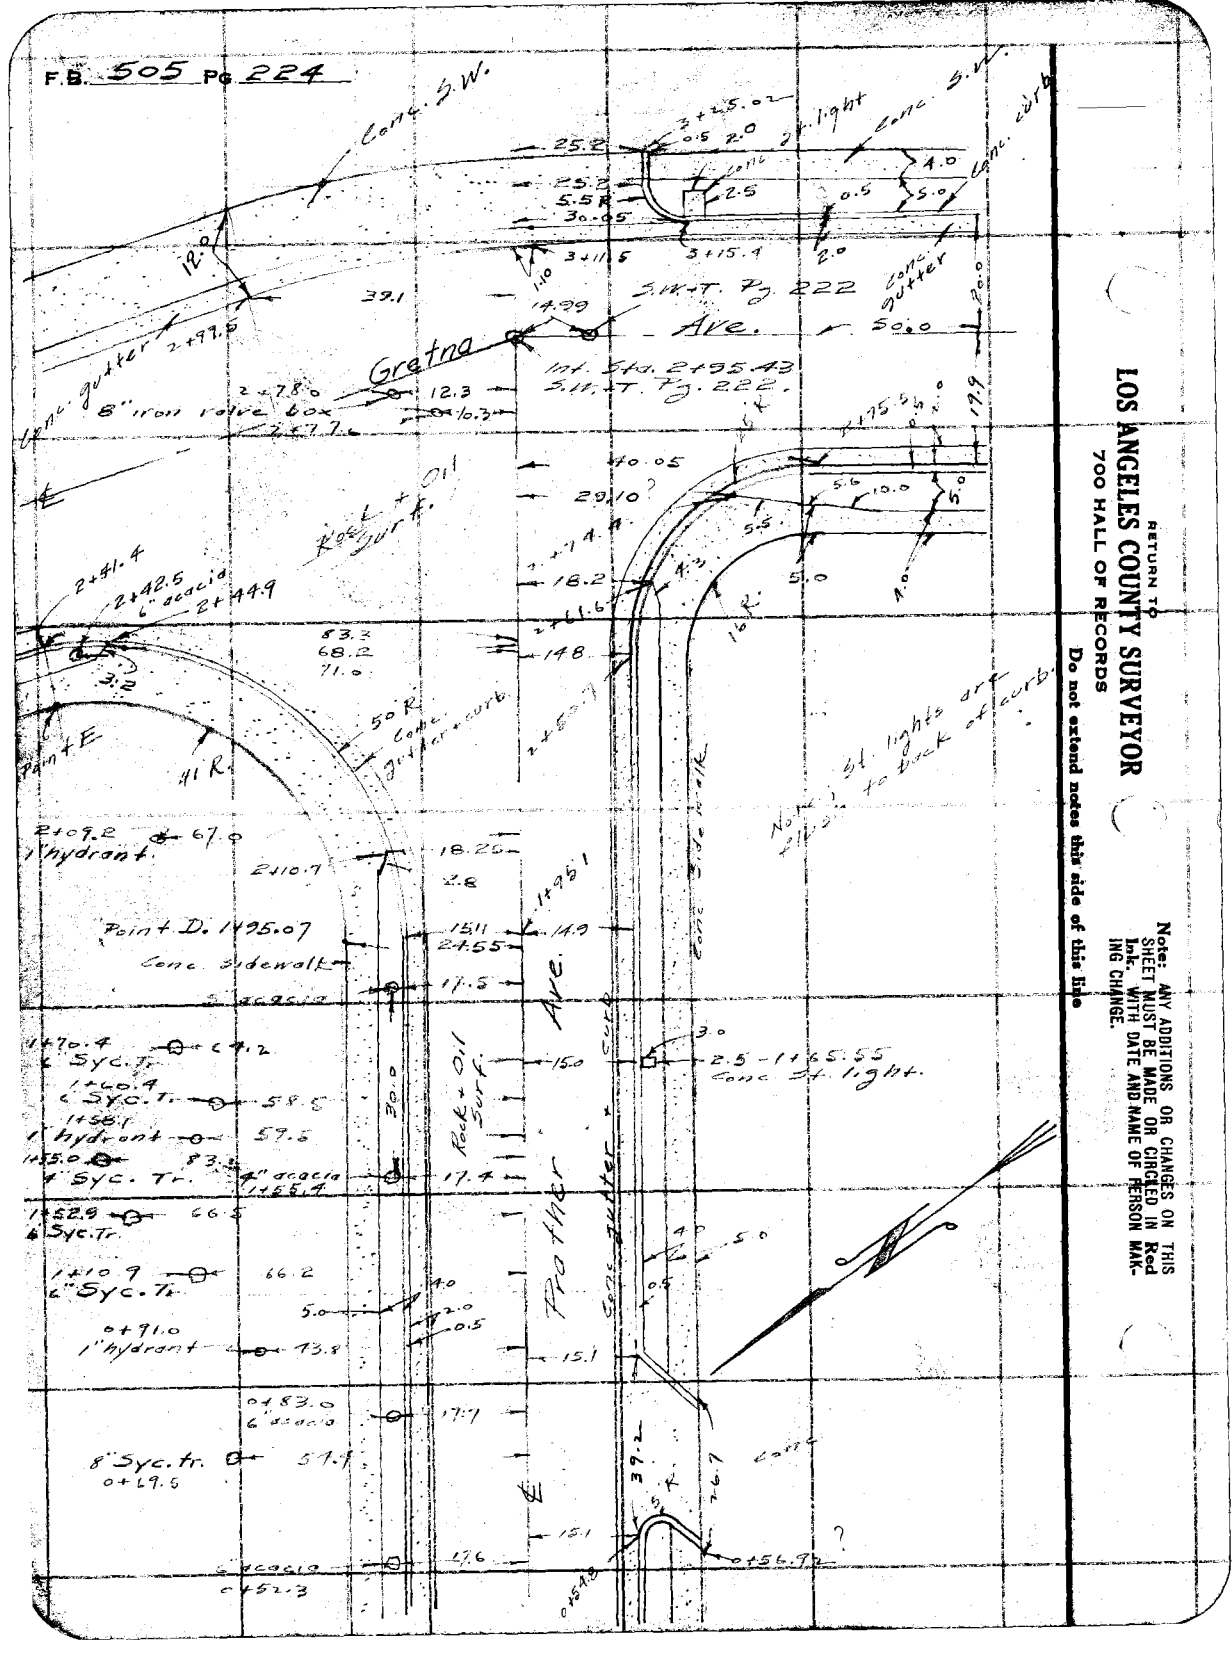
F.B. 505 Pg 224
Conc. S.W.
Conc. curb
2" light
Conc. gutter
S.W.+T. Pg. 222
Ave.
Gretna
Int. Sta. 2+95.43
S.W.+T. Pg. 222.
8" iron valve box
Rock + Oil Surf.
Point E
Point D. 1495.07
Conc. Sidewalk
1" hydrant
6" acacia
6" Syc. Tr.
8" Syc. tr.
Conc. Gutter + curb
Conc. S.W. + curb
Conc. St. light
Pro Amer
Conc. gutter
Conc. curb
St. lights are to back of curb.
RETURN TO
LOS ANGELES COUNTY SURVEYOR
700 HALL OF RECORDS
Do not extend notes this side of this line
Note: ANY ADDITIONS OR CHANGES ON THIS SHEET MUST BE MADE OR CIRCLED IN Red Ink. WITH DATE AND NAME OF PERSON MAKING CHANGE.

Notes Ck'd by
Map No. B-990
Checked 2 Rak
Date Feb. '34

Survey of Mc. Nees Park
W. O. 8028 Tape No. 75 St'd 8ft °F.
Notes
Indexed A. C. Johnson
Date 1-24-34

F.B. 505 Pg. 225


RETURN TO
LOS ANGELES COUNTY SURVEYOR
720 HALL OF RECORDS

Do not extend notes this side of this line

FORM 247 JOM 8-31

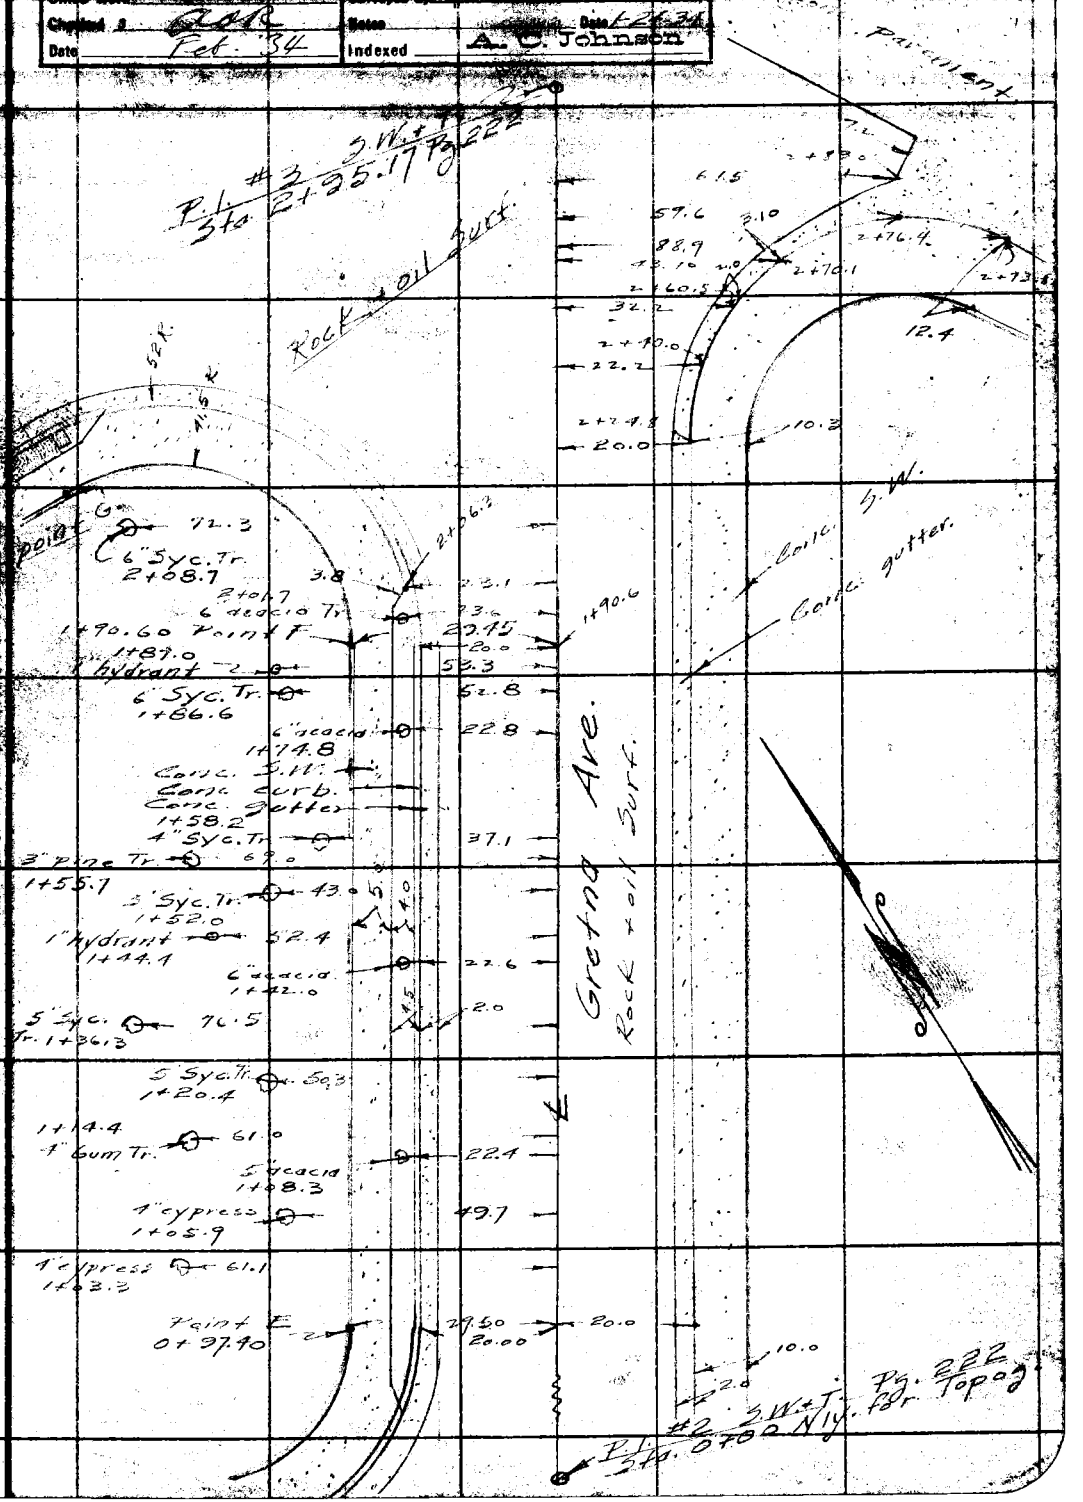

RETURN TO
LOS ANGELES COUNTY SURVEYOR
700 HALL OF RECORDS

Note: ANY ADDITIONS OR CHANGES ON THIS SHEET MUST BE MADE OR CIRCLED IN Red Ink. WITH DATE AND NAME OF PERSON MAKING CHANGE.

Do not extend notes this side of this line

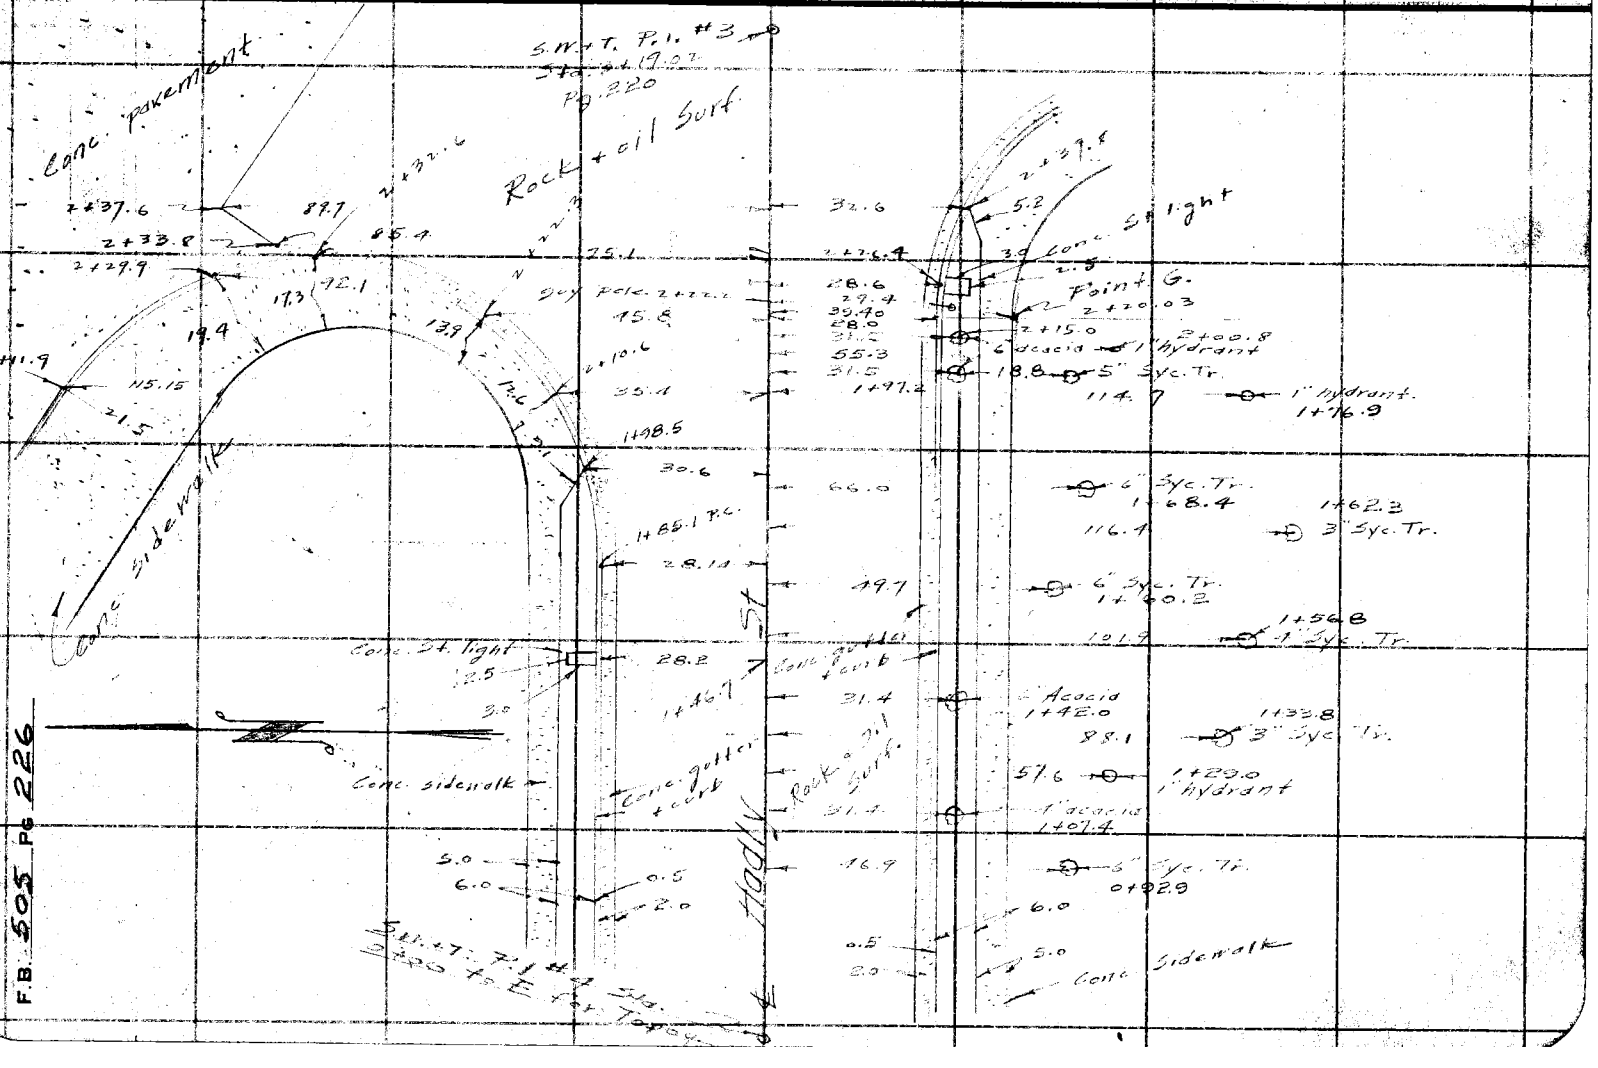

F.B. 505 Pg 226

Notes Ck'd by	Survey of Mc Nees Park
Map No. B-990	W. O. 8028 Tape No. 275 St'd 84 °F.
Checked Gear	Notes
Date Feb. 34	Date 1-25-34
	Indexed A. C. Johnson

F.B. 505 PG. 227

Note: ANY ADDITIONS OR CHANGES OR THIS SHEET MUST BE MADE OR CANCLED IN Red Ink. WITH DATE AND NAME OF PERSON MAKING CHANGE.

RETURN TO
LOS ANGELES COUNTY SURVEYOR
700 HALL OF RECORDS
Do not extend notes this side of this line

FORM 247 10M 8-31

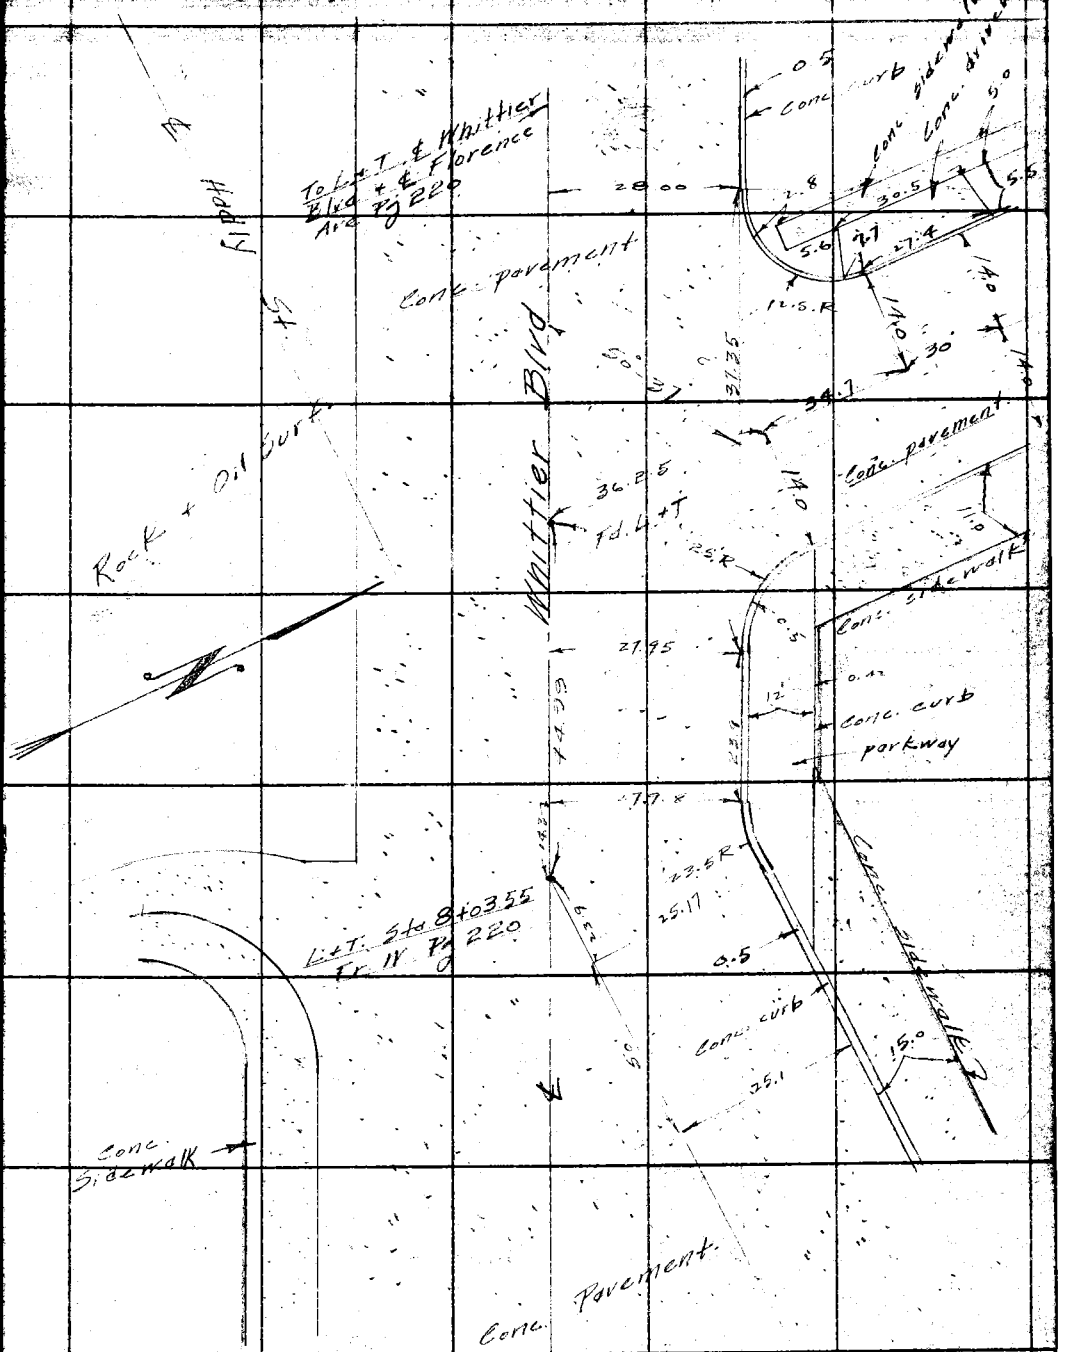

RETURN TO
LOS ANGELES COUNTY SURVEYOR
700 HALL OF RECORDS

Note: ANY ADDITIONS OR CHANGES ON THIS SHEET MUST BE MADE OR CIRCLED IN **Red** Ink. WITH DATE AND NAME OF PERSON MAKING CHANGE.

Do not extend notes this side of this line

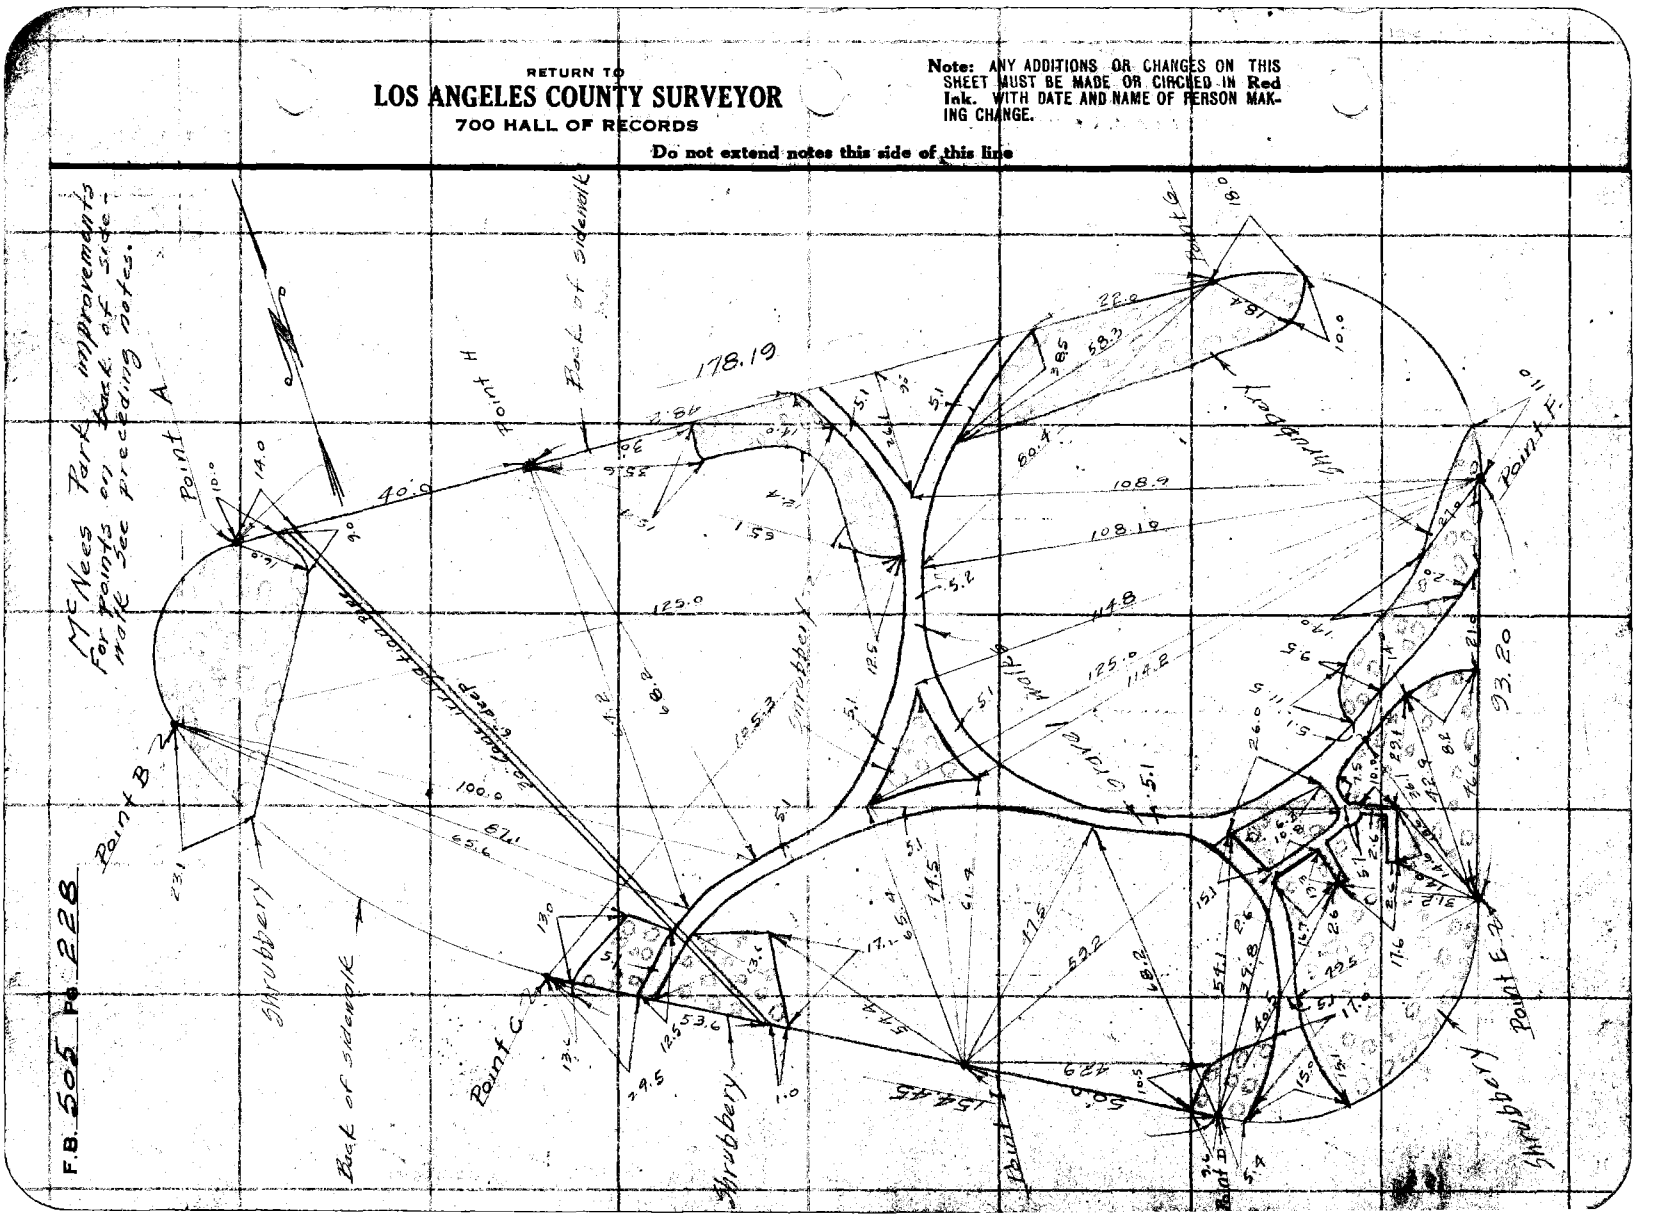

Notes Ck'd by		Survey of Mc Nees Park	
Map No. B-990		W. O. [illegible]	Tape No. [illegible] St'd 84 °F.
Work R.W.M.E.A.		Surveyed by R.T. Dunlap	
Checked CMR		Notes Dunlap	Date 2-16-34
Date Feb. 34		Indexed	A. C. Johnson 2-19-34

F.B. 505 Pg 229

WS 37 B-5

Cont. on Page Left.

McNEES PARK

(40) (40)

ST.

180.15 @ 64°F.

180.13

Δ=89-58-35
R=15.00
T=15.00
L=23.56

Set 2" I.P. in conc. Flush, with Brass Cap Marked

COUNTY SURVEYOR 62 R.E. R.MONUMENT

Δ=51-00-37
R=59.47
T=28.34
L=52.94

PRATHER AVE

154.54

Cont. on Page Left.

90-00

Set Nail

40.00

59.98

Fd. 2" I.P. 24 deep

50.32 24 deep

25.00

90°

0°

40.30

Set Nail

54.99

Fd. N.+T.

P.I. No.1 Fd. C.S.W. 4T. Flush Per F.B. 505-221

P.I. No.4 Fd. C.S.W. Flush Per F.B. 505-221

HADLEY

Note: ANY ADDITIONS OR CHANGES ON THIS SHEET MUST BE MADE OR CIRCLED IN Red Ink. WITH DATE AND NAME OF PERSON MAKING CHANGE.

Do not extend notes this side of this line

RETURN TO
LOS ANGELES COUNTY SURVEYOR
700 HALL OF RECORDS

FORM 247 10M 8-31

F.B. 506 Pg. 230

W.S. 3783-5

RETURN TO
LOS ANGELES COUNTY SURVEYOR
700 HALL OF RECORDS

Do not extend notes this side of this line

Note: ANY ADDITIONS OR CHANGES ON THIS SHEET MUST BE MADE OR CIRCLED IN **Red Ink.** WITH DATE AND NAME OF PERSON MAKING CHANGE.

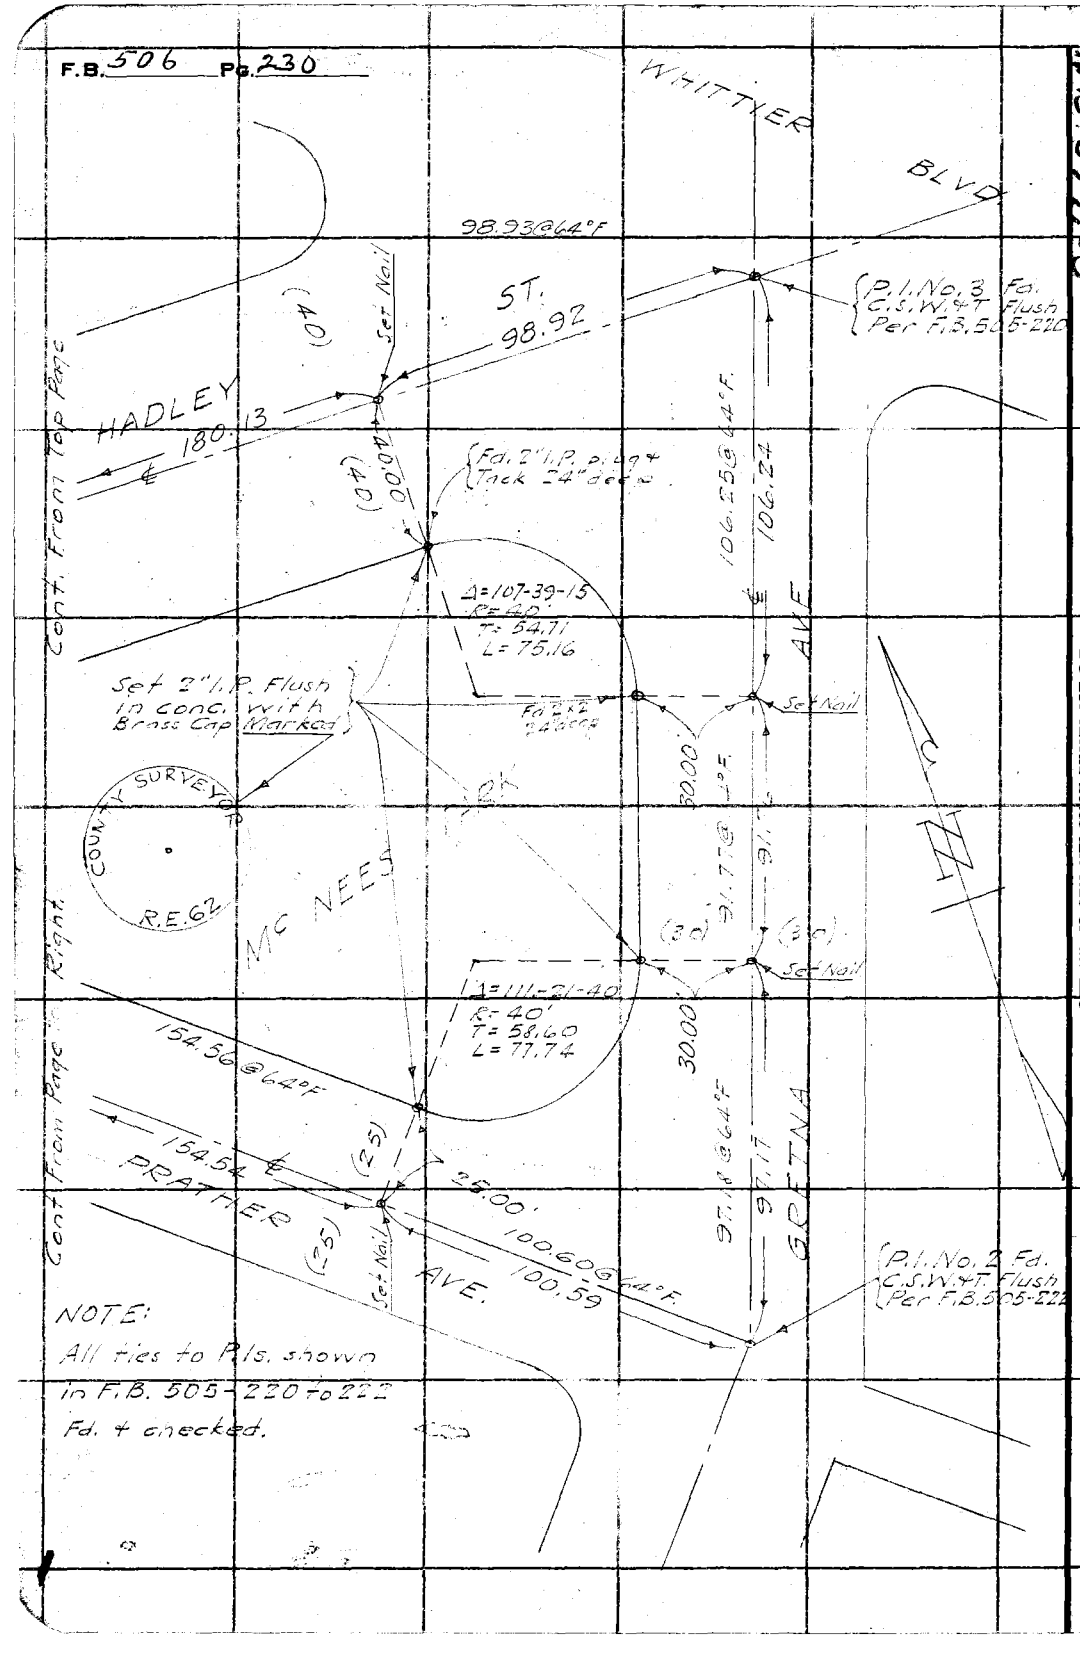

NOTE:
All ties to P.I.s. shown in F.B. 505-220 to 222 Fd. & checked.

Notes Ck'd by	Survey of Atlantic PARK
Map No.	JN 8852.06 Tape Std °F
Office Work	Surveyed by A.S. Curtis
Checked	Notes Curtis Date 12-16-59
Date	Indexed C. Johnson 12-21-59

F. B. 505 PG. 231

J.N. 8852.06
Atlantic Park
Location of
Boiler Room
Etc.

Curtis
Burkholder
Yasui
Manley

Note: Any Additions or Changes on This Sheet Must be Made or Circled in Red Ink With Date and Name of Person Making Change.

Do not extend notes this side of this line.

RETURN TO
LOS ANGELES COUNTY ENGINEER
700 LOS ANGELES COUNTY ENGINEERING BLDG.

76F309S CE #247—3-57

RETURN TO
LOS ANGELES COUNTY ENGINEER
700 LOS ANGELES COUNTY ENGINEERING BLDG.

Note: Any Additions or Changes on This Sheet Must be Made or Circled in Red Ink With Date and Name of Person Making Change.

Do not extend notes this side of this line.

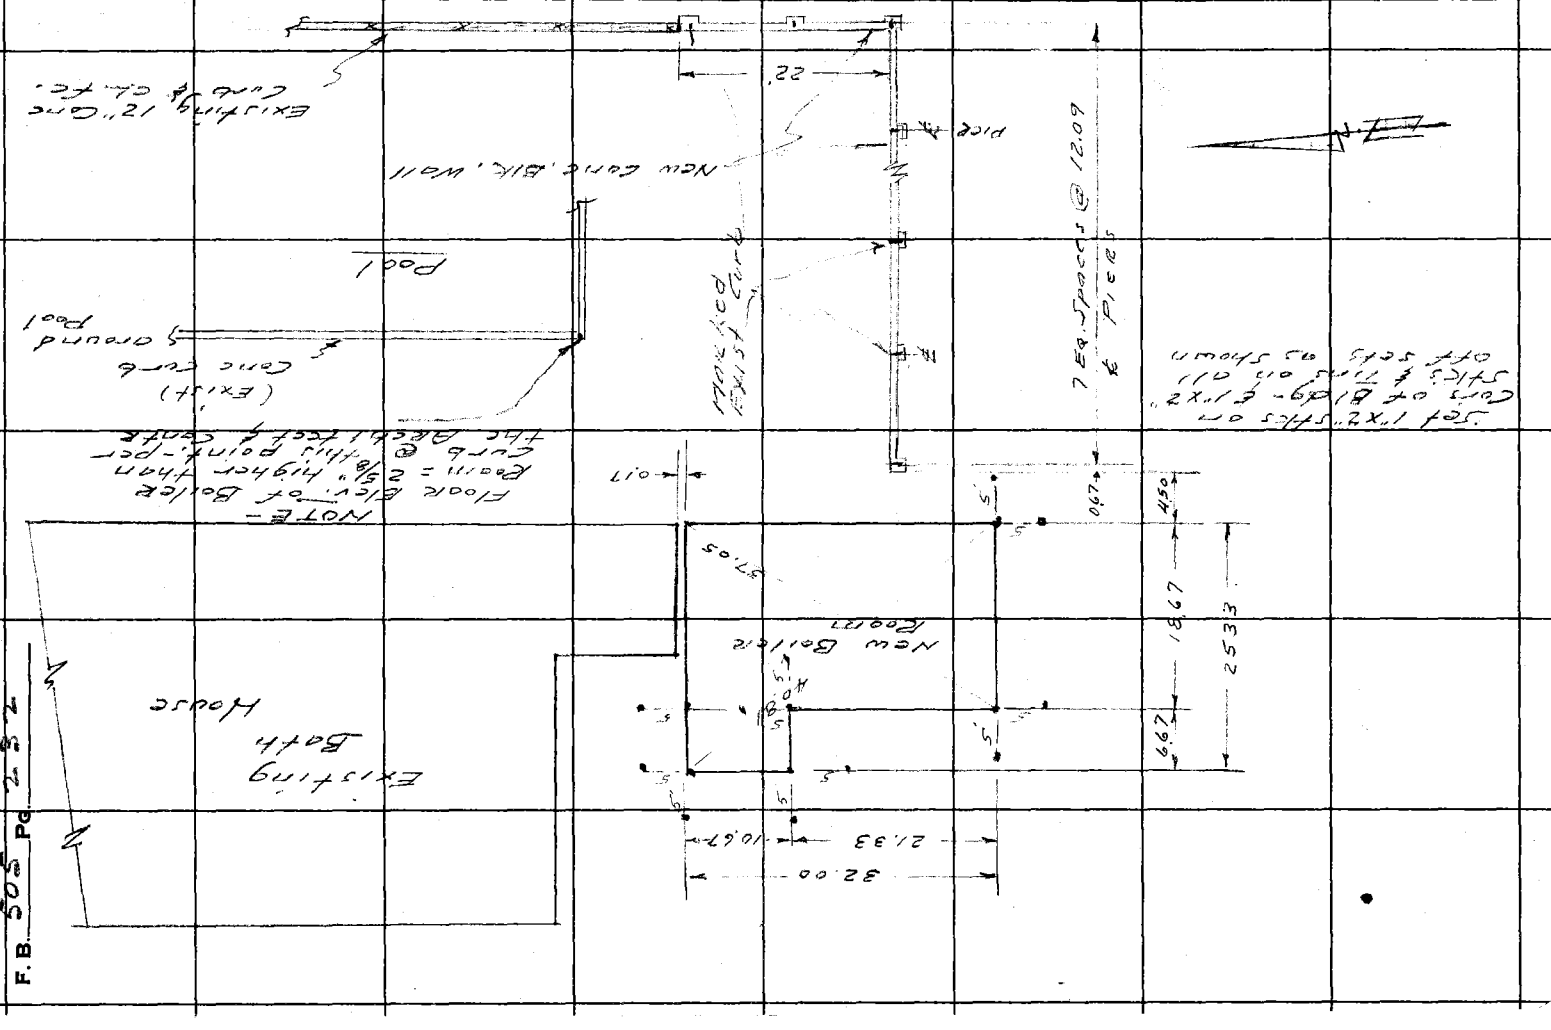

F.B. 505 Pg. 2 & 3

Notes Ck'd by McPherson	Survey of Belvedere Park
Map No. B-989	W. O. 8029 Tape No. 015 St'd 84 °F.
Checked McPherson	Notes Roscrans Date 1-22-34
Date Feb. 1934	Indexed C. Johnson 1-24-34

F.B. 505 Pg. 283

Note: ANY ADDITIONS OR CHANGES OF THIS SHEET MUST BE MADE ON CIRCLED III Red Ink. WITH DATE AND NAME OF PERSON MAKING CHANGE.

Do not extend notes this side of this line

RETURN TO
LOS ANGELES COUNTY SURVEYOR
700 HALL OF RECORDS

FORM 247 10M 8-31

BELVEDERE PARK BOUNDARY

Job 8029

Park consists of Lot A Tr. 7193 M.B. 78-100 + Lot A Tr. 7192 M.B. 78-37+38

Party E. A. Roscrans
R. C. Bowers
J. A. Whelan
K. H. Schneider.

Topog on Plane Table Sheet

Topog. by Plane Table – Scale 1"=20'

RETURN TO
LOS ANGELES COUNTY SURVEYOR
700 HALL OF RECORDS

Note: ANY ADDITIONS OR CHANGES ON THIS SHEET MUST BE MADE OR CIRCLED IN Red Ink. WITH DATE AND NAME OF PERSON MAKING CHANGE.

Do not extend notes this side of this line

36 A 13

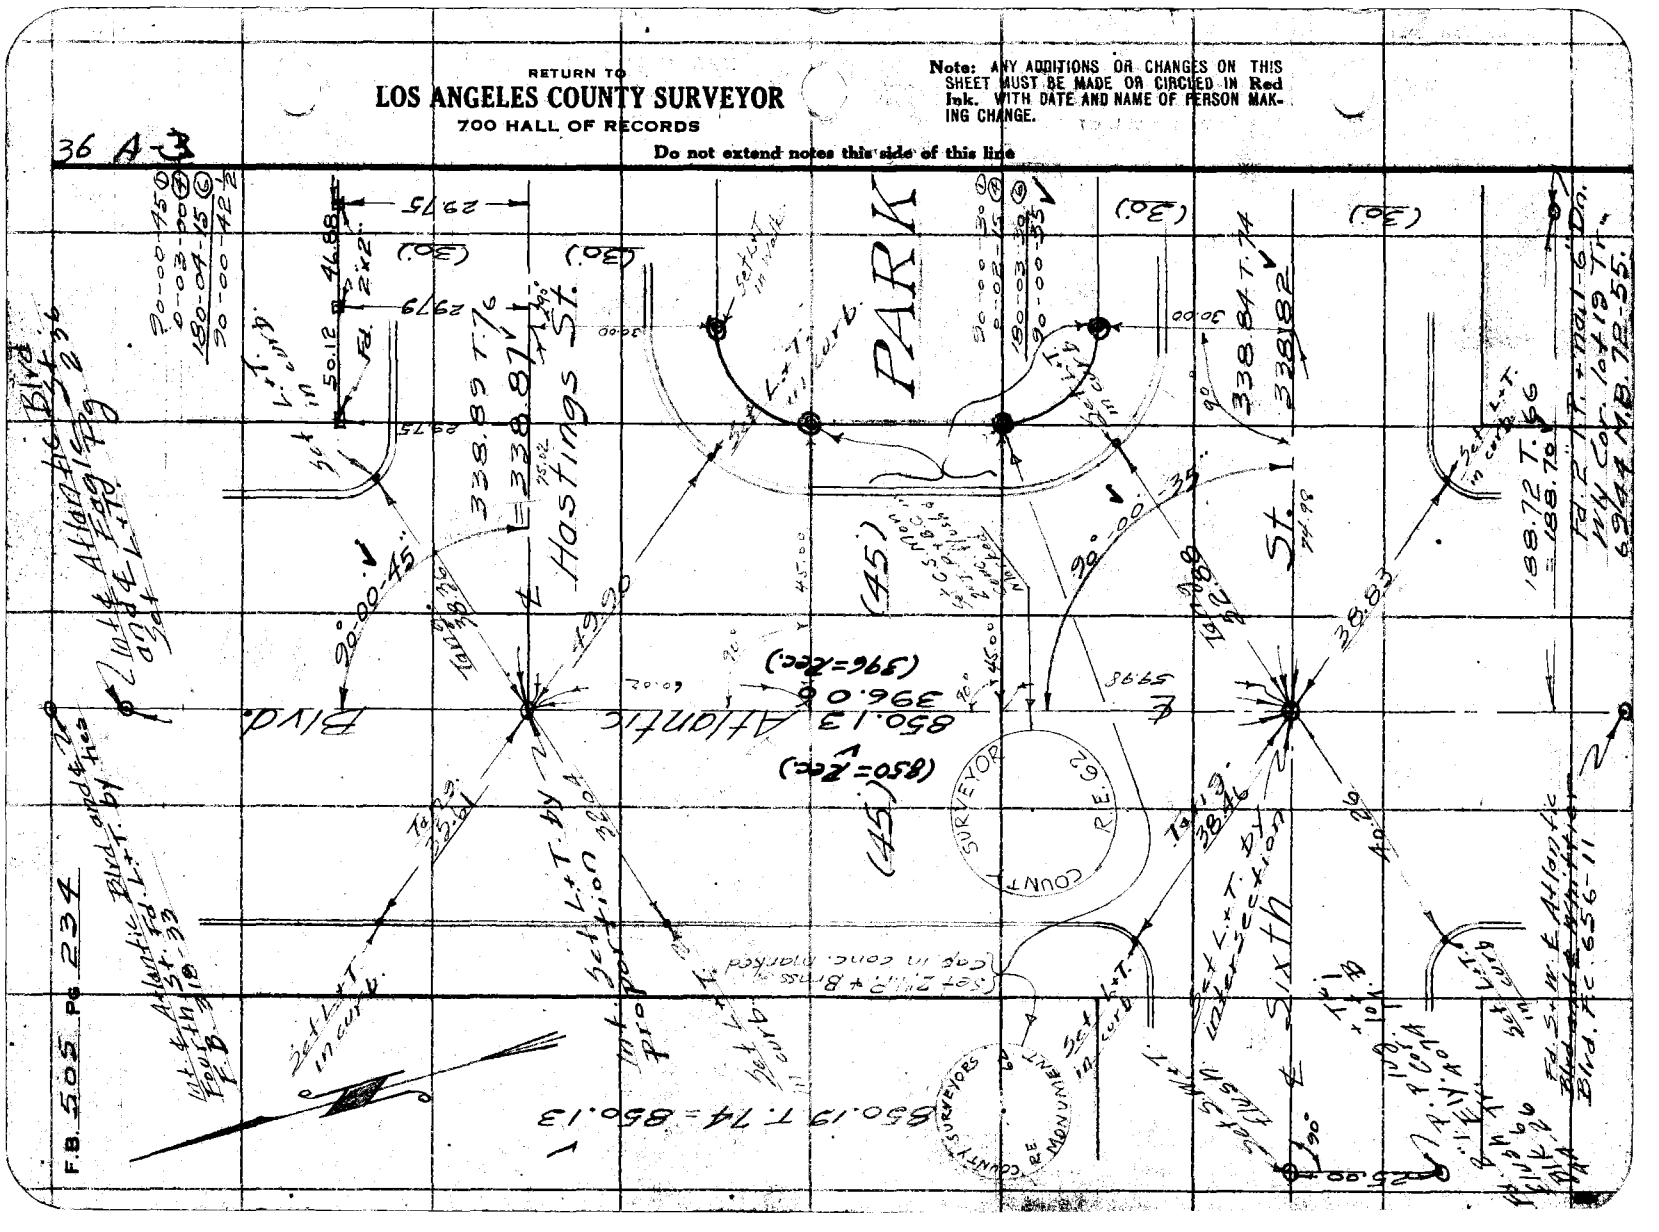
PARK
Hastings St.
Atlantic Blvd.
Sixth
St.
Set L.T. in curb
Set L.T. in curb
Set L.T. in curb

Notes Ck'd by McPherson
Map No. B-989
Checked McPherson
Date Feb. 1934

Survey of Belvedere Park
W. O. 8029 Tape No. 945 St'd
Notes
Indexed C. Johnson

F.B. 506 Pg. 235

M.B. 36 A-3

Notes: ANY ADDITIONS OR CHANGES ON THIS SHEET MUST BE MADE OR CIRCLED IN Red Ink, WITH DATE AND NAME OF PERSON MAK-ING CHANGE.

Do not extend notes to the inside of this line

RETURN TO
LOS ANGELES COUNTY SURVEYOR
700 HALL OF RECORDS

FORM 847 10M 8-31

Hastings St.

PARK

Amalia Ave.

Sixth St.

Ed 2" I.P. + T.K. 6" Dn Proposed E. Beverly Blvd and E. Amalia Ave F.B. 318-34

Ed 2" I.P. + Mud 6" Dn W.W. Cor. Lot 4 Amalia Ct. P.B. 22 Pg. 157

89-59-30 ①
359-58-00 ④
179-56-30 ⑥
89-59-25

46.99 39.88 8490

29.77 29.83 29.75

Set L.+T. curb

Set L.+T. in curb

Set L.+T. by Proportion

Set L.+T. in walk

Set L.+T. in curb

850.14 T. 76 = 850.10

850.10 396.05 (396=2ac)

90-00-15 ①
0-01-30 ④
180-02-15 ⑥
90-00-22½ in N.E.

Set C.S. Mon 2 I.P. P.B.C. in conc flush. Marked

89-59-40

338.82

Set L.+T. by Intersection

Ed 2" I.P. + Mud 6" Dn W.W. Cor. Lot 19 T.T. 9424 M.B. 72-56

150.05 T. 68 = 150.03

954.52 T. 12 = 954.45 (954.24)

Ed 2" I.P. 10" Dn 6" W.W. Cor. Lot 1 P.T. B.

Set S.W.+T. flush. by Proportion

RETURN TO
LOS ANGELES COUNTY SURVEYOR
700 HALL OF RECORDS

Note: ANY ADDITIONS OR CHANGES ON THIS SHEET MUST BE MADE OR CIRCLED IN Red Ink. WITH DATE AND NAME OF PERSON MAKING CHANGE.

Do not extend notes this side of this line

W.S. 36A-2

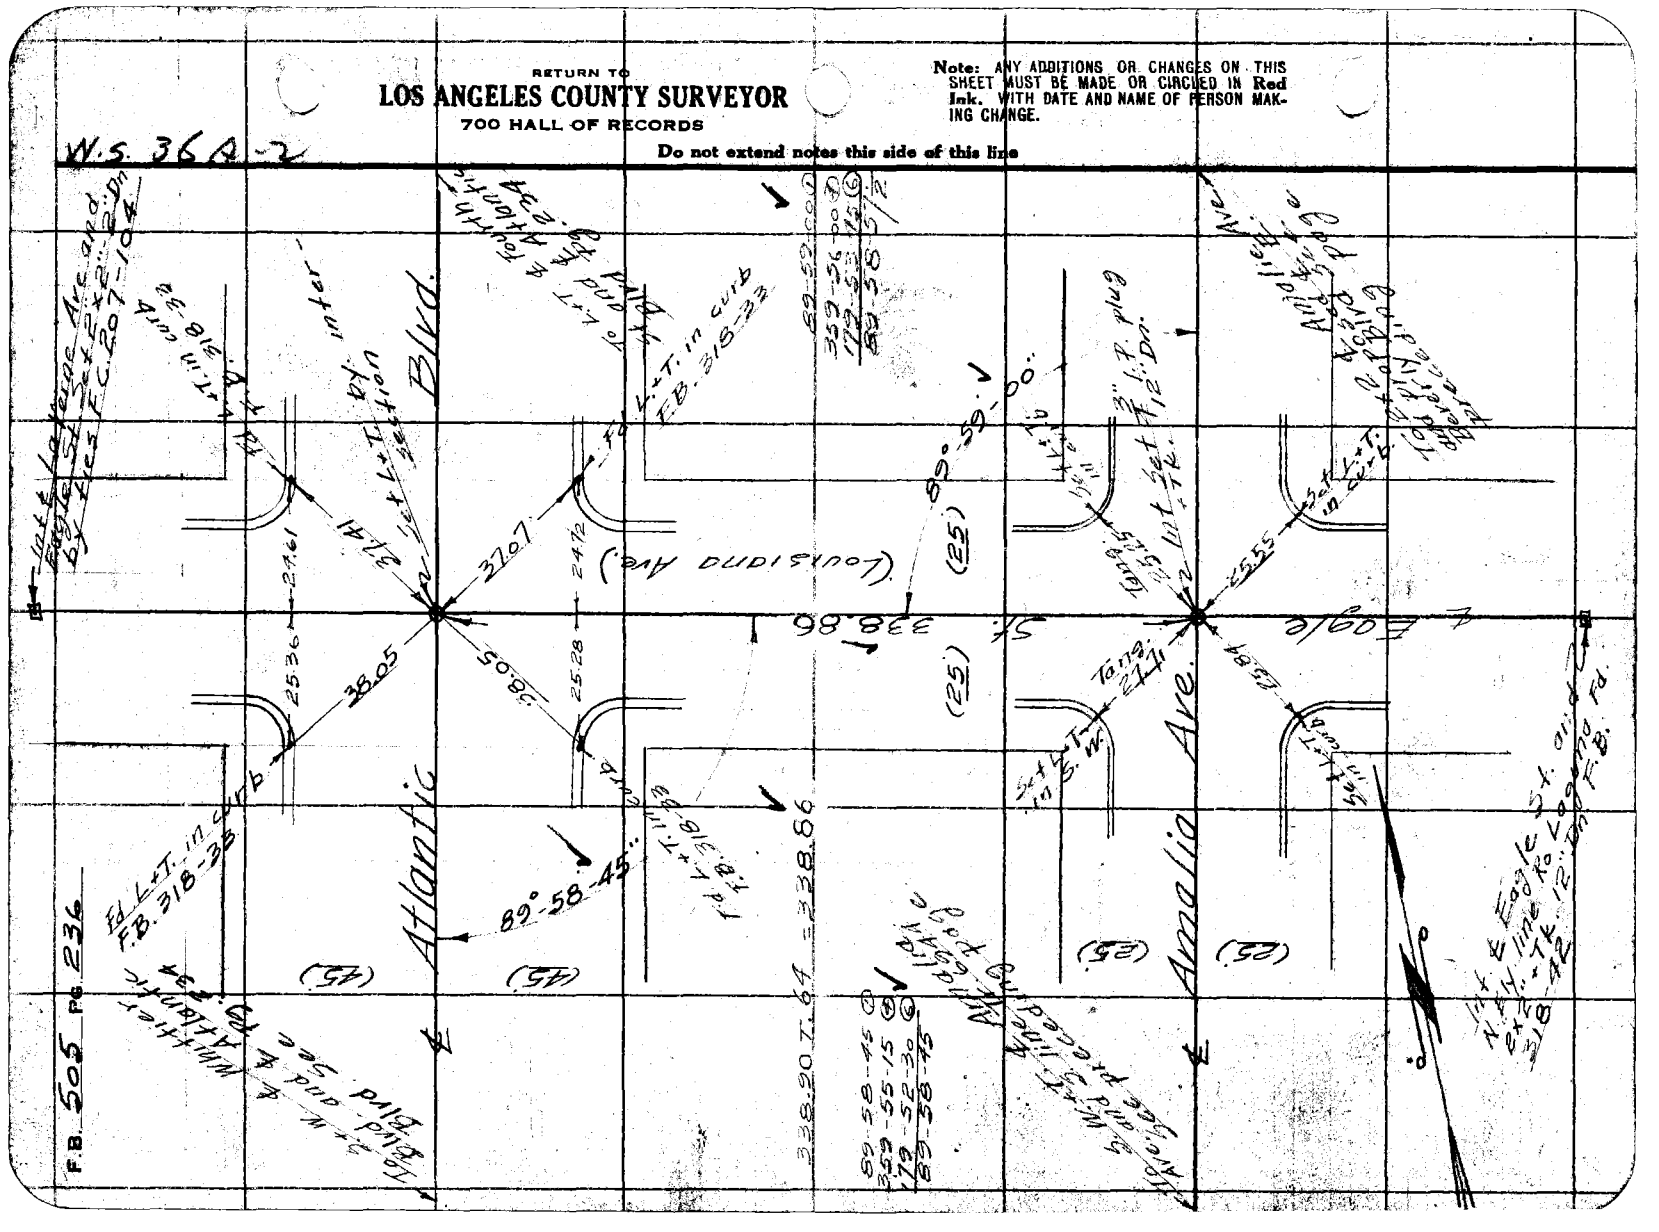

Profile No. | Notes Red. | Plotted | Job No. 8039 | Division No. — VL | F. B. 505 Pg. 237
Date | Date | Survey of BELVEDERE PARK
X-Sec. No. | Notes Chkd. | Checked | Survey by T. Walsh | Notes W. Hall | Date 12-9-36
Date | Date | Map No. | Indexed A. C. | Date 12-14-36

NOTE: ANY ADDITIONS OR CHANGES ON THIS SHEET MUST BE MADE OR CIRCLED IN RED INK, WITH DATE AND NAME OF PERSON MAKING CHANGE

Do not extend notes this side of this line

PLEASE RETURN TO LOS ANGELES COUNTY SURVEYOR 700 HALL OF RECORDS

Form 307 5M 11-35

STATION	B. S.	H. I.	F. S.	ELEV.

BELVEDERE PARK

J.N. 8039

Levels to Establish Bench Marks at Park site. Also elevations of Structures, improvements and subsurface utilities.

T. Walsh
F. Greenwood T
R. Gardner ∅
H. Thorgerson ∅

See Plane Table Sh. G128

Form 307 5M 11-35

PLEASE RETURN TO
LOS ANGELES COUNTY SURVEYOR
700 HALL OF RECORDS

NOTE: ANY ADDITIONS OR CHANGES ON THIS SHEET MUST BE MADE OR CIRCLED IN RED INK, WITH DATE AND NAME OF PERSON MAKING CHANGE

Do not extend notes this side of this line

B.505 Pg. 238 | Job No. 8079 | Division No. | Notes Red. | Platted | Profile
Survey of Belvedere Park | Date | Date | No. | X-Sec.
Survey by Walsh | Notes Walsh | Notes Chkd. | Checked | No.
Indexed | Date 12-9-36 | Date | Date

STATION	B. S.	H. I.	F. S.	ELEV.	
C.S. BM. 471				199 106	C.S. BM # 471 - Hubbard & Belden Ave. N.E. Cor. C. Spk. in N. end of Curb return. L.B. 315-59 ; 531-2 W.S. 36 El. 199.106
	6515.	205621.	2520.	203801.	
	6415.	209 216.	2850	206 366	
	6 460.	212 826			
C.S. BM # 472			2395.	210 431.	C.S. B.M # 472 - Belden Ave. & Sixth St. S.W. Cor. C. Spk in W. end of Curb return. LB - 315-60 - 531-2. W.S. 36 El. 210.248
	3770.	213 201.	4410.	209 791.	
	2830.	212621.	5150.	207 471.	
	4755.	212 226.	4980.	207 246.	
SET BM. # 1	4840.	212086.	4380.	207706.	BM. # 1 Belvedere Park. Sixth st & Amelia Ave. N.W. Cor. L & T. in Ctr of Curb return.
	1400.	212 106.	4610.	207 496.	
	4745.	212 241.	4575.	207 666.	
	4800.	212 466.	4050.	209 416.	
BM # 472	5155.	213 571	3135.	210 436.	See Above
	2660.	213 096.	7270.	205 826.	
	2580.	208 406.	6580.	201 826.	
BM # 471	3360.	205186.	6080.	199 106.	See Above
B.M. # 1	6 820.	214 526		207 706.	
Set B.M # 2	3 -58.	215 704	4280.	210 246.	B.M. # 2 Belvedere Park E. Curb of Amelia 200' N. of ℄ of Sixth St. Set L & T.
B.M. # 1			8 000.	207.704	

Notes Ck'd by	Survey of
Map No.	W. O. Tape No. St'd °F.
Office Work	Surveyed by
Checked	Notes Date
Date	Indexed 4-15-48

F.B. 505 Pg. 239

Note: Any Additions or Changes on This Sheet Must be Made or Circled in Red Ink With Date and Name of Person Making Change

Do not extend notes this side of this line

RETURN TO
LOS ANGELES COUNTY SURVEYOR
700 HALL OF RECORDS

BELVEDERE PARK

JN 5223

January 1938

Emmott
Brock
Naumann
Wilson

FORM 247 10M 11-38

F.B. 505 PG. 240

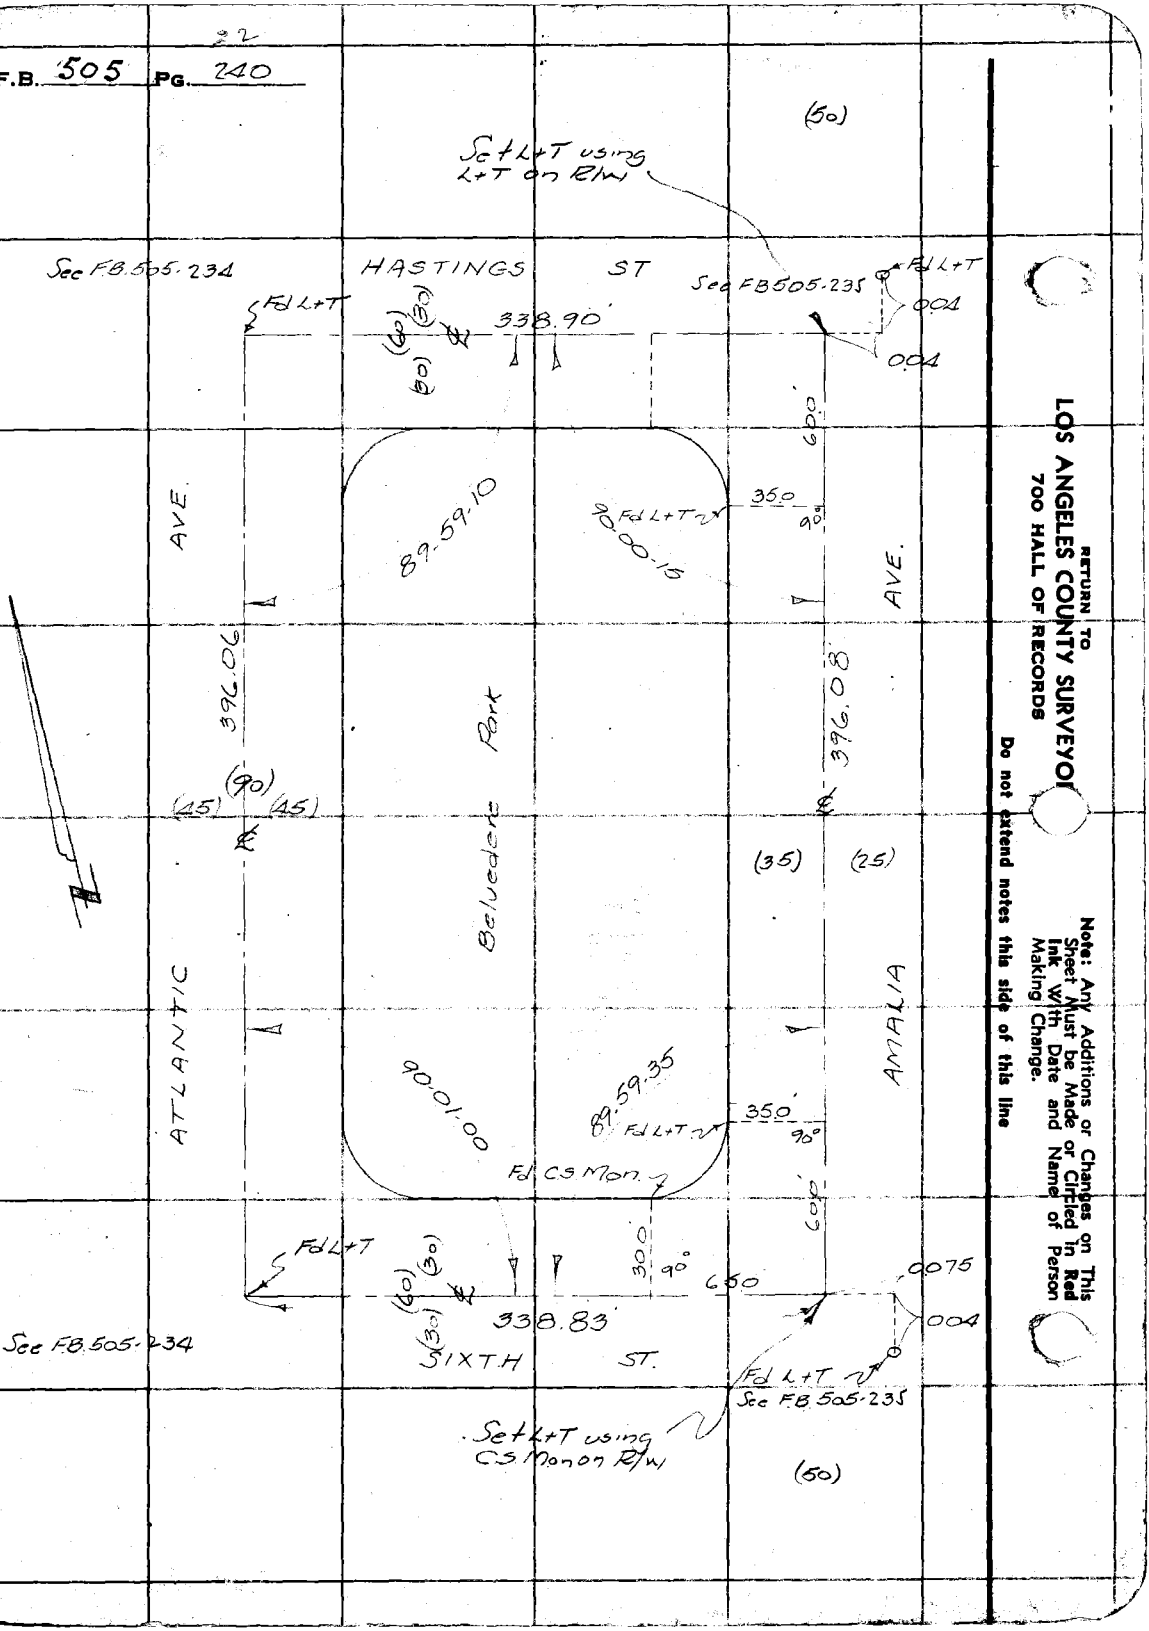

RETURN TO
LOS ANGELES COUNTY SURVEYOR
700 HALL OF RECORDS

Do not extend notes this side of this line

Note: Any Additions or Changes on This Sheet Must be Made or Circled in Red Ink With Date and Name of Person Making Change.

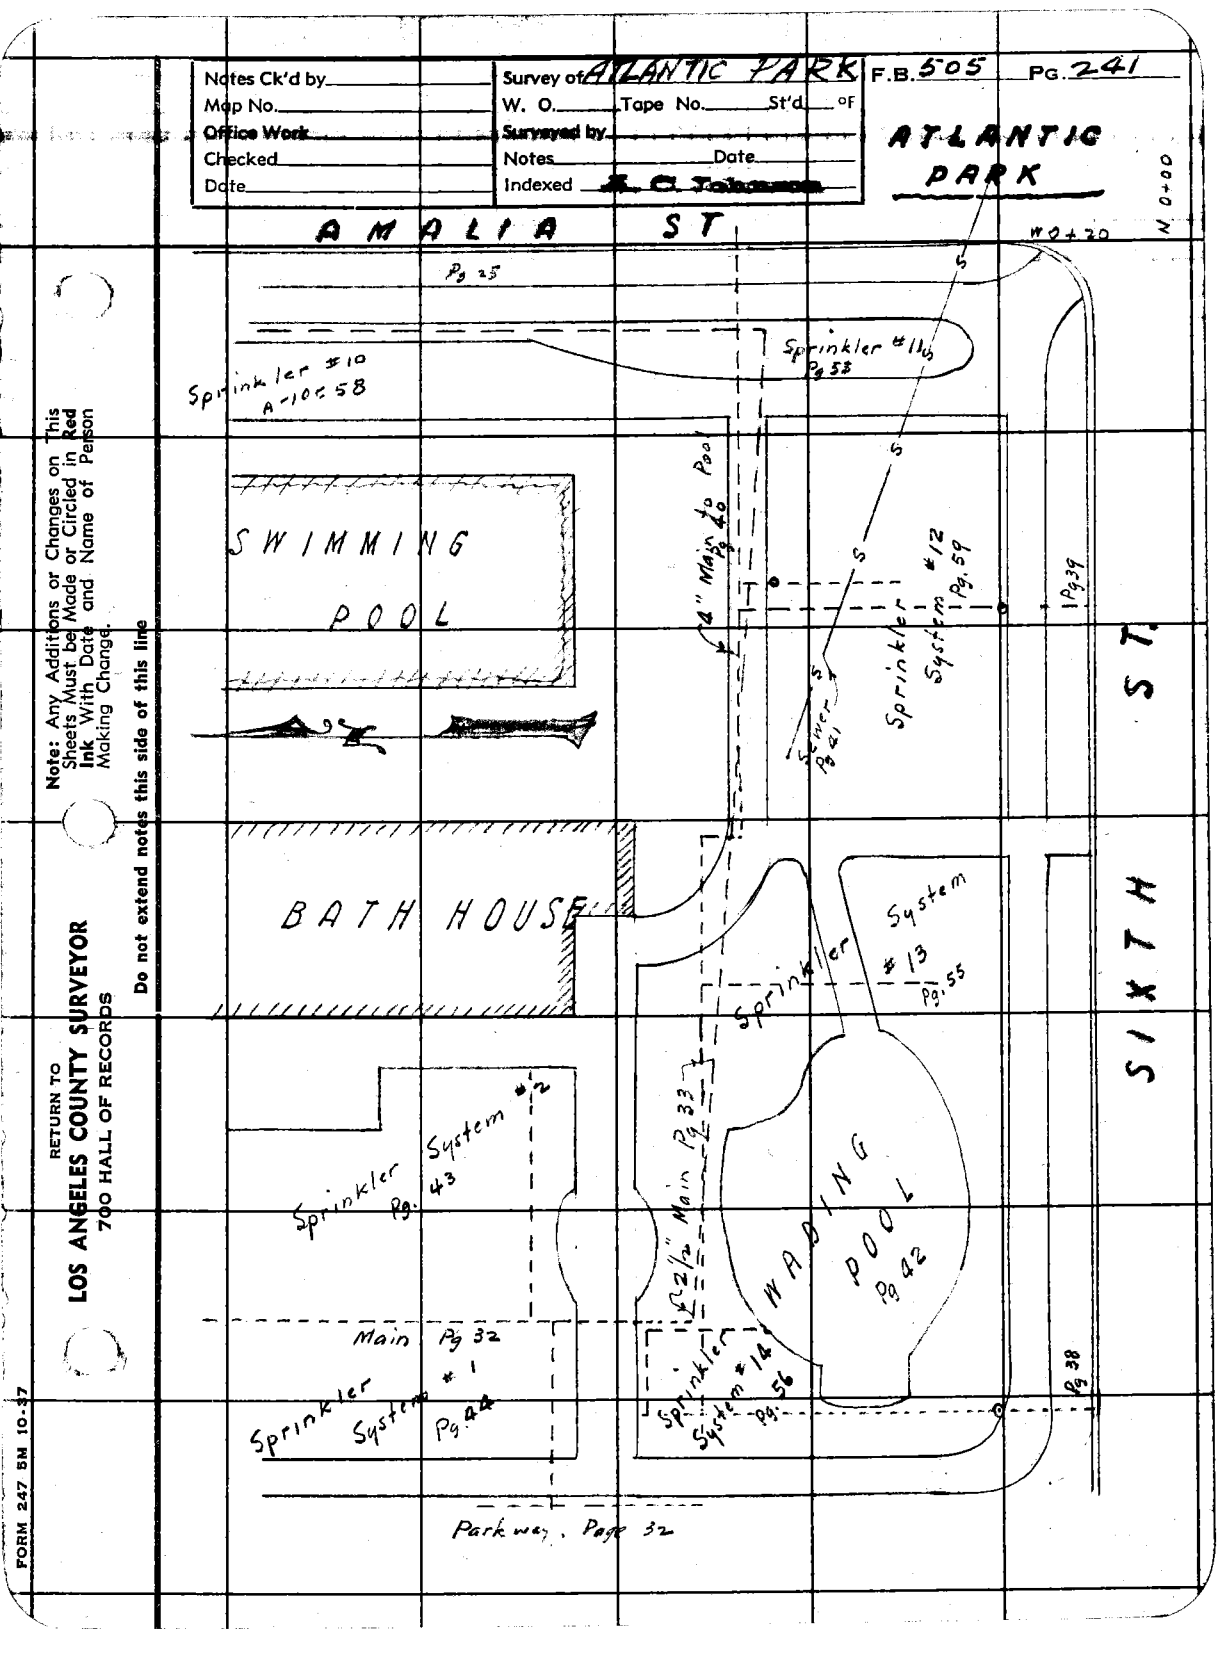
Notes Ck'd by
Map No.
Office Work
Checked
Date
Survey of ATLANTIC PARK
W. O. Tape No. St'd of
Surveyed by
Notes Date
Indexed
F.B. 505 Pg. 241
ATLANTIC PARK
N. 0+00
W 0+20
AMALIA ST
Pg 25
Sprinkler #10 A-10-58
Sprinkler #11 Pg 53
SWIMMING POOL
4" Main to Pool Pg 40
Sprinkler System #12 Pg. 59
Sewer Pg 41
1 Pg 39
BATH HOUSE
Sprinkler System #13 Pg. 55
SIXTH ST.
Sprinkler System #2 Pg. 43
2 1/2" Main Pg 33
WADING POOL Pg 42
Main Pg 32
Sprinkler System #1 Pg. 44
Sprinkler System #14 Pg. 56
Pg 38
Parkway, Page 32
Note: Any Additions or Changes on This Sheets Must be Made or Circled in Red Ink With Date and Name of Person Making Change.
Do not extend notes this side of this line
RETURN TO
LOS ANGELES COUNTY SURVEYOR
700 HALL OF RECORDS
FORM 247 BM 10-57

RETURN TO
LOS ANGELES COUNTY SURVEYOR
700 HALL OF RECORDS

Note: Any Additions or Changes on This Sheets Must be Made or Circled in Red Ink With Date and Name of Person Making Change.

Do not extend notes this side of this line

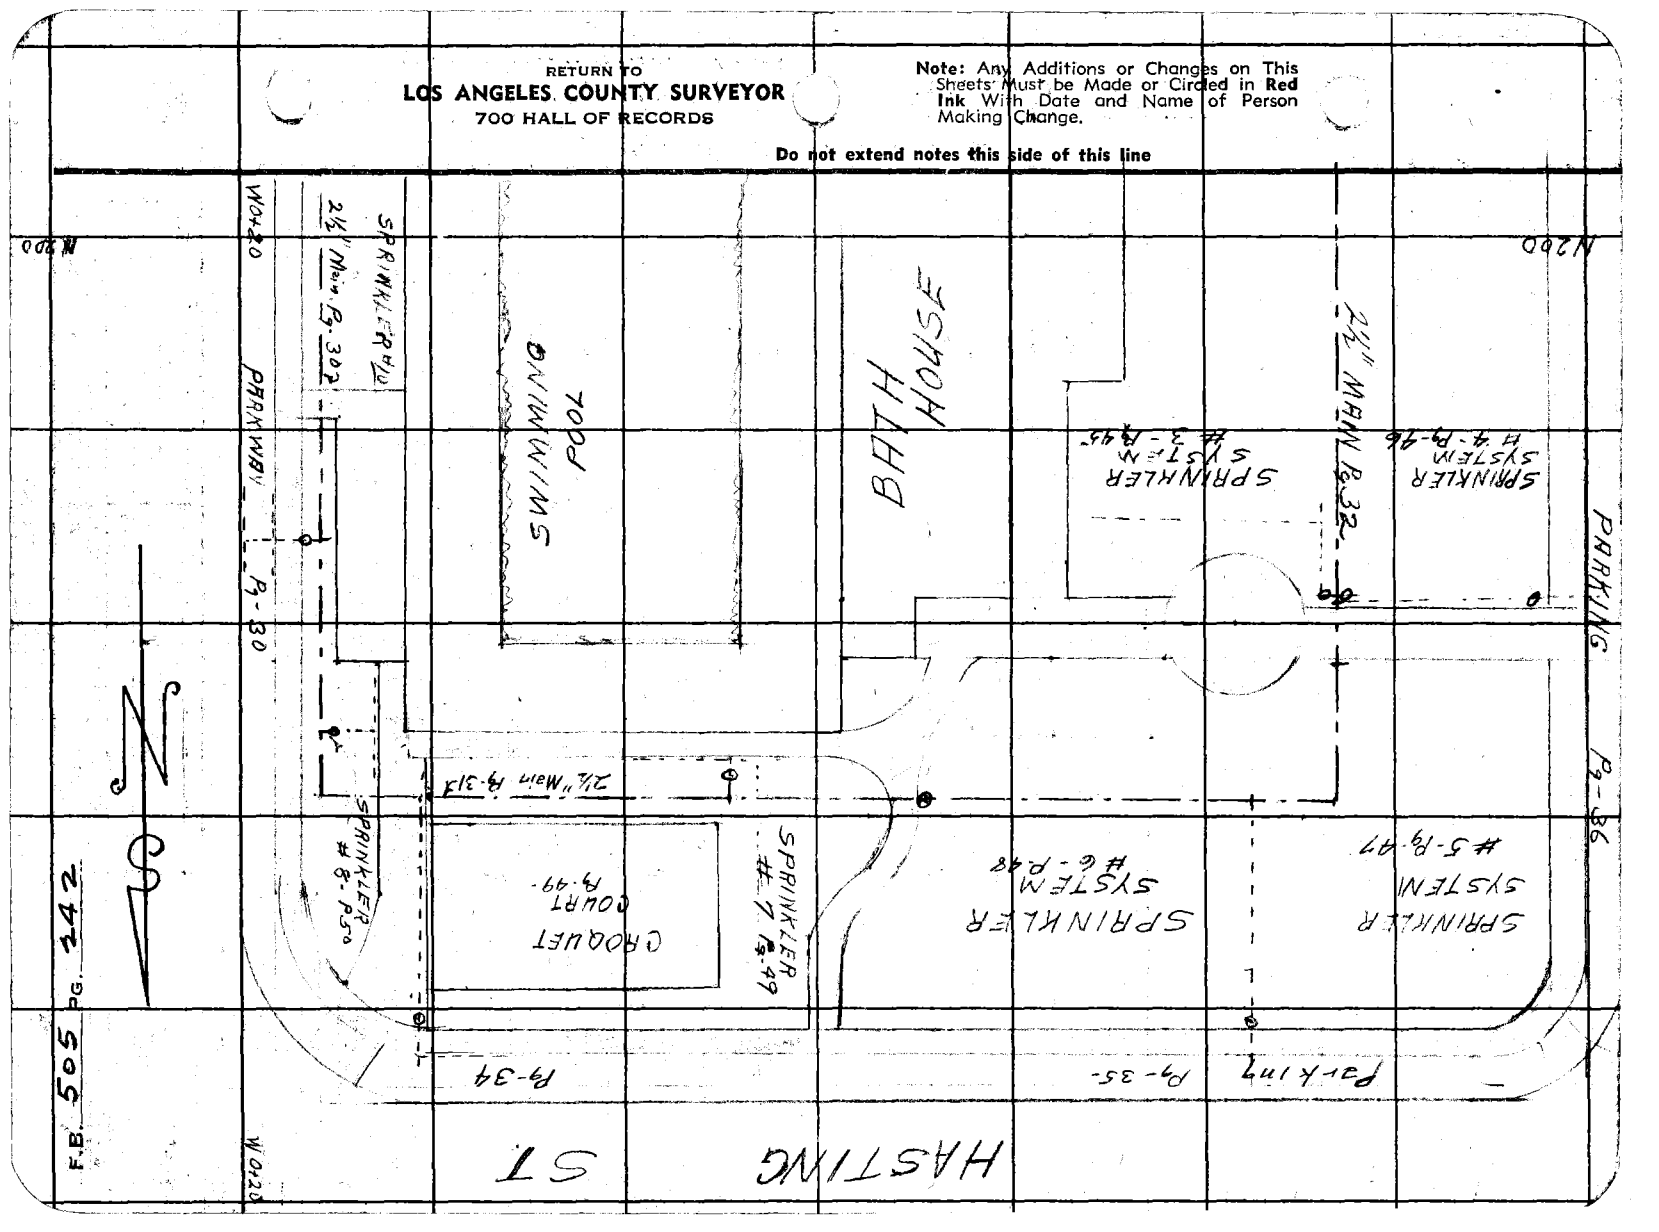

Notes Ck'd by	Survey of Lawndale Park
Map No.	W. O. 8035 Tape No. 061 St'd 66 °F.
Office Work	Surveyed by L. D. Moore
Checked	Notes Moore Date 1-24-34
Date	Indexed A. C. Johnson 1-29-34

F.B. 505 Pg. 243

Note: ANY ADDITIONS OR CHANGES ON THIS SHEET MUST BE MADE OR CIRCLED IN Red Ink WITH DATE AND NAME OF PERSON MAKING CHANGE.

SURVEY
OF
LAWNDALE PARK
being Block 21
IN
LAWNDALE
Job # 8035

Jan. 24-25, 1934

Moore
Fenner
Harris

RETURN TO
LOS ANGELES COUNTY SURVEYOR
700 HALL OF RECORDS
Do not extend notes this side of this line

FORM 247 10M 8-31

F.B. 505 Pg 744

W.S. 25C-2

RETURN TO
LOS ANGELES COUNTY SURVEYOR
700 HALL OF RECORDS

Do not extend notes this side of this line

Note: ANY ADDITIONS OR CHANGES ON THIS SHEET MUST BE MADE OR CIRCLED IN Red Ink. WITH DATE AND NAME OF PERSON MAKING CHANGE.

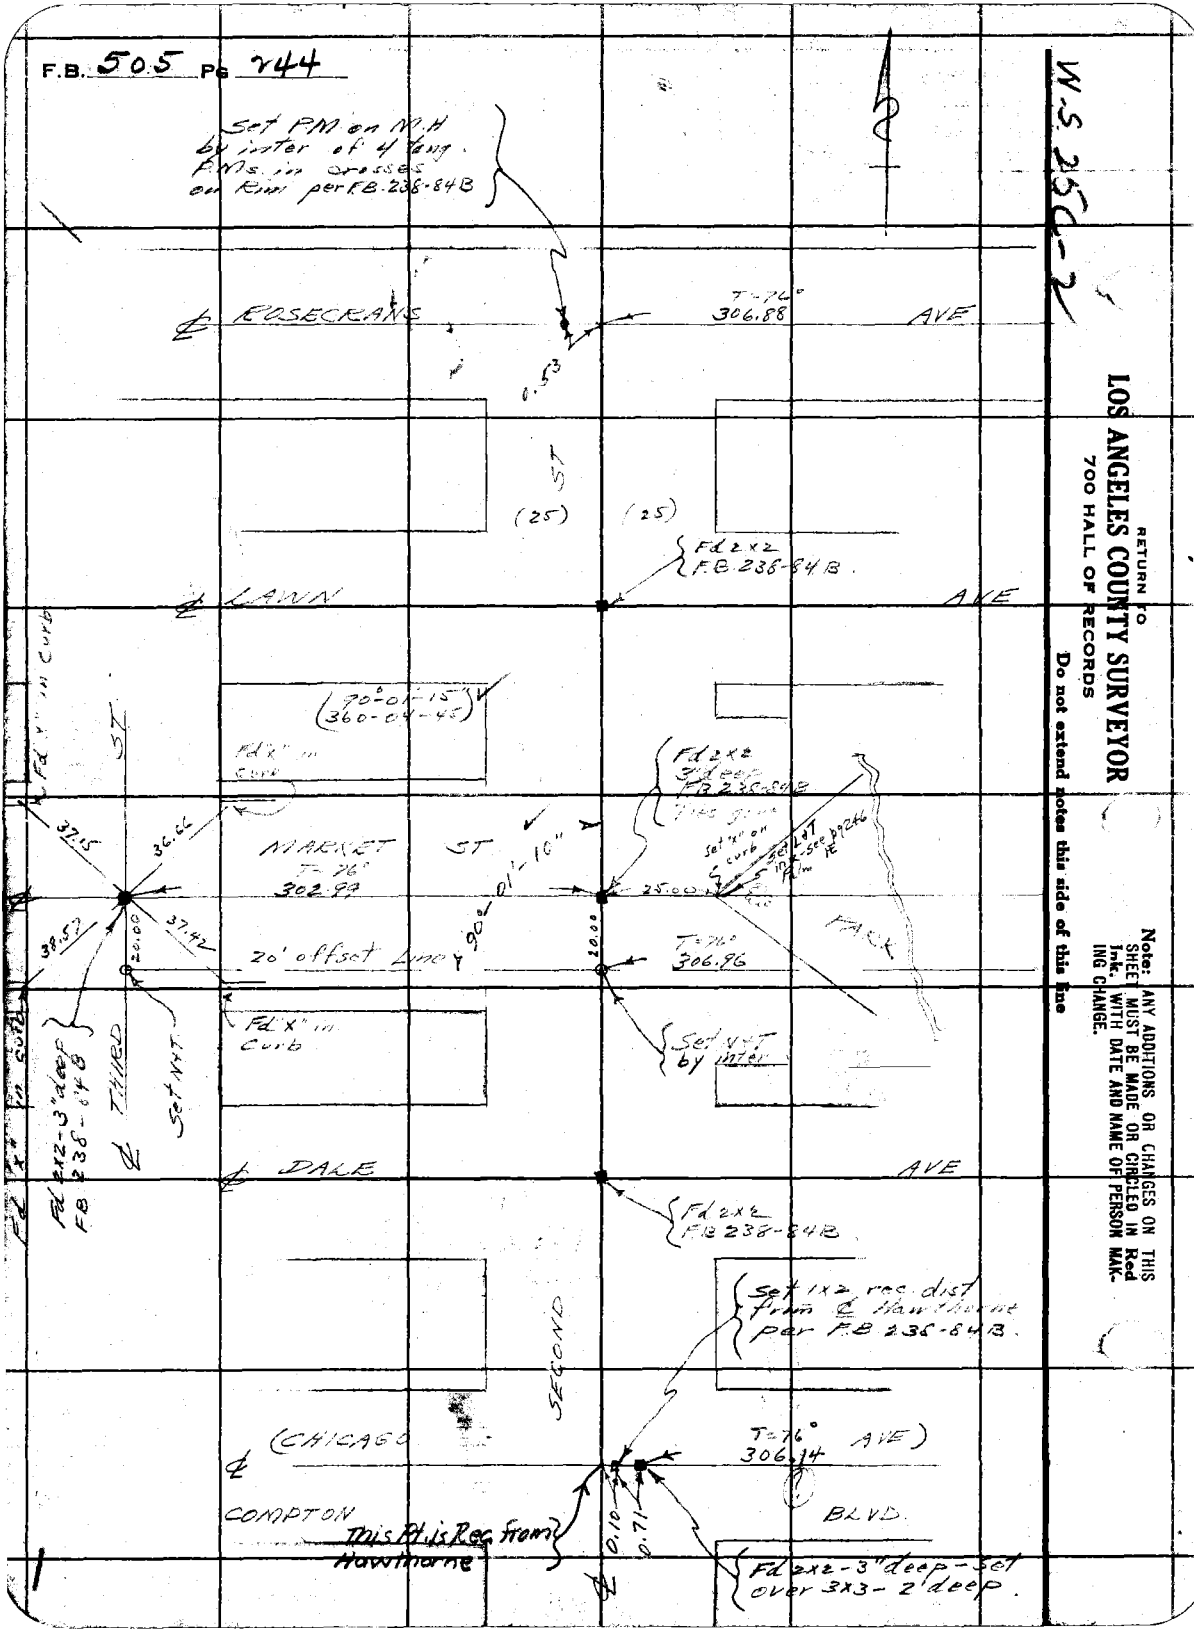

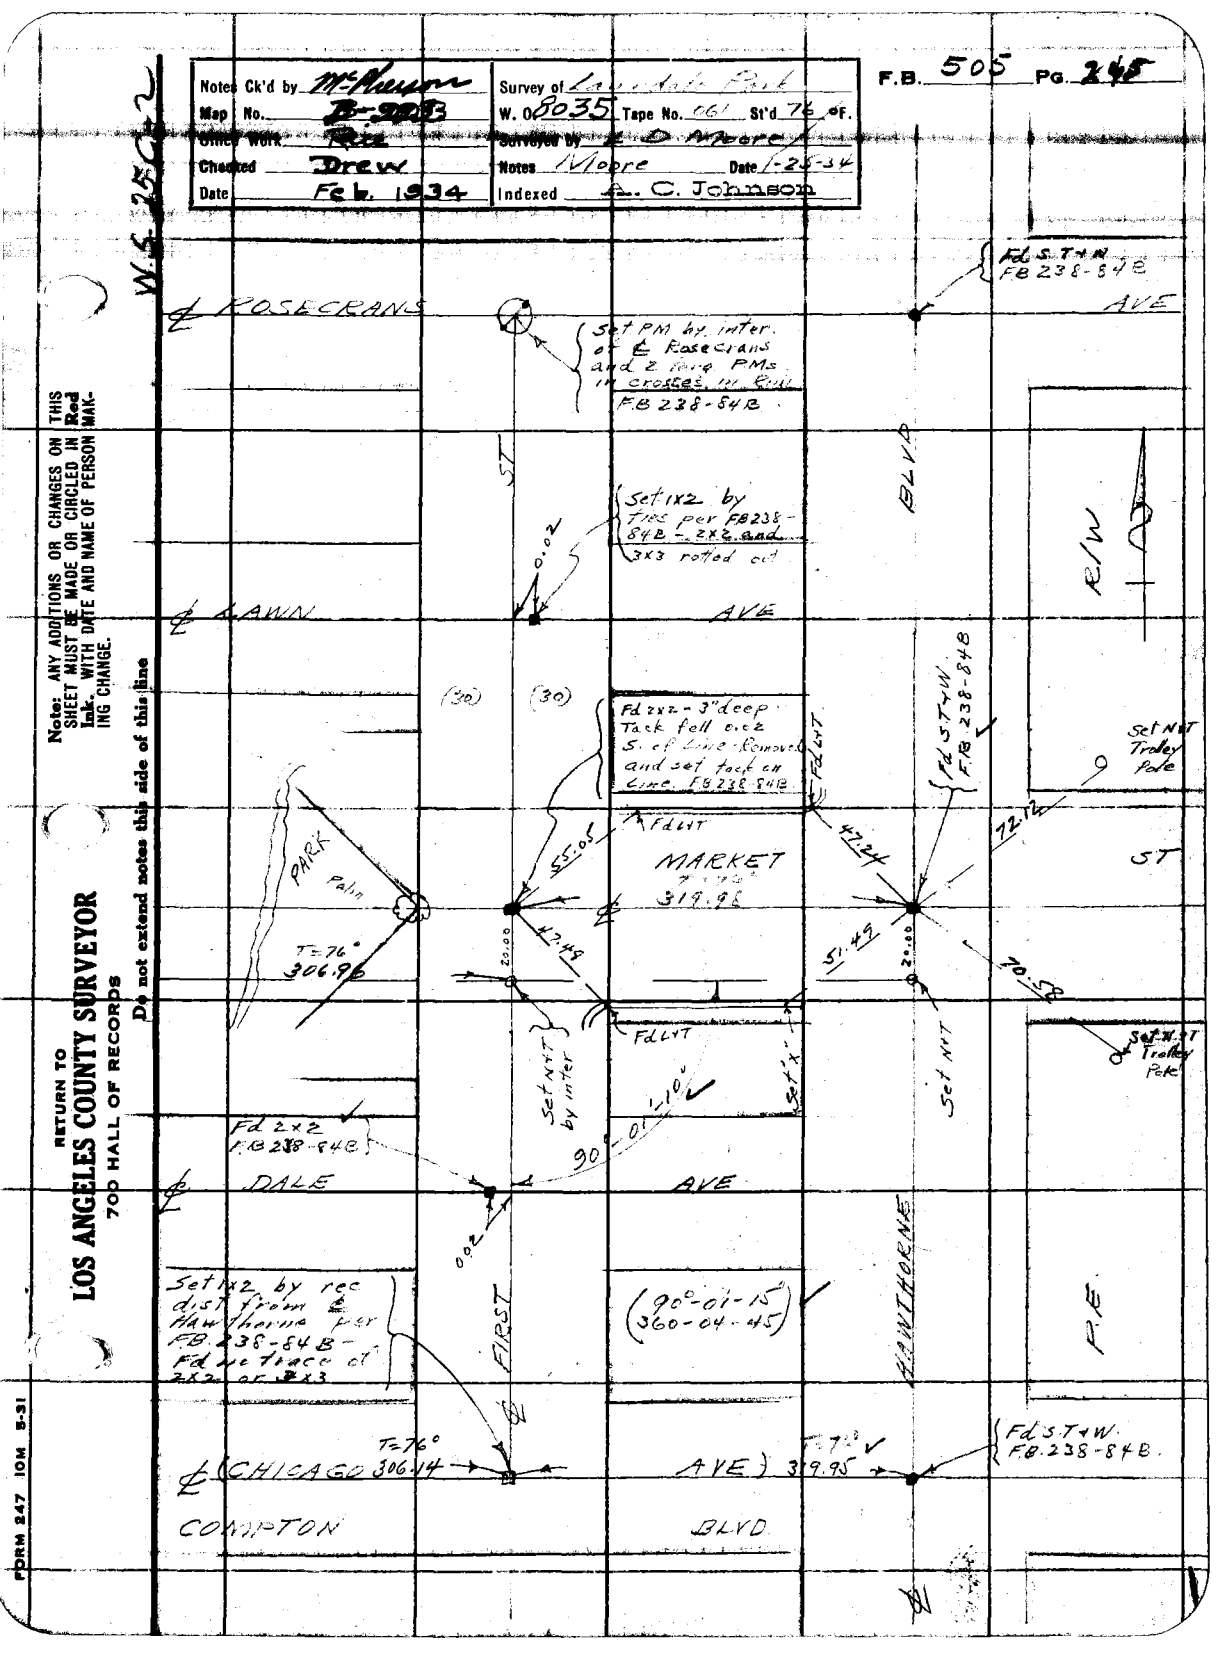
Notes Ck'd by McPherson
Map No. B-2983
Office Work Rec
Checked Drew
Date Feb. 1934
Survey of Lawndale Park
W. O. 8035 Tape No. 661 St'd 76 °F.
Surveyed by L. D. Moore
Notes Moore Date 1-25-34
Indexed A. C. Johnson
W.S. 25C-2
Note: ANY ADDITIONS OR CHANGES ON THIS SHEET MUST BE MADE OR CIRCLED IN Red Ink, WITH DATE AND NAME OF PERSON MAKING CHANGE.
Do not extend notes this side of this line
RETURN TO
LOS ANGELES COUNTY SURVEYOR
700 HALL OF RECORDS
FORM 247 10M 5-31
℄ ROSECRANS AVE
Set PM by inter. of ℄ Rosecrans and 2 long PMs in crosses in Sidewalk FB 238-84B
Fd S.T+W FB 238-84B
℄ DAWN AVE
Set 1x2 by tins per FB 238-84B - 2x2 and 3x3 rotted out
0.02
BLVD
E/W
ST
(30)
(30)
Fd 2x2 - 3" deep Tack fell 0.02 S. of Line - Removed and set tack on Line. FB 238-84B
Fd L/T
Fd S.T+W FB 238-84B
Set N+T Trolley Pole
55.06
MARKET
319.95
47.24
72.72
PARK
Palm
T=76°
306.96
42.49
20.00
51.45
70.58
Set N+T
Fd L/T
Set N+T by inter
1.10' W
90°-01'
Fd 2x2 FB 238-84B
℄ DALE AVE
0.02
Set 1x2 by rec dist from ℄ Hawthorne per FB 238-84B - Fd Notch of 2x2 or 2x3
FIRST
(90°-01'-15")
(360-04-45)
HAWTHORNE
P.E.
T=76°
℄ CHICAGO AVE
306.14
319.95
Fd S.T+W FB 238-84B.
COMPTON BLVD

RETURN TO
LOS ANGELES COUNTY SURVEYOR
700 HALL OF RECORDS

Note: ANY ADDITIONS OR CHANGES ON THIS SHEET MUST BE MADE OR CIRCLED IN Red Ink. WITH DATE AND NAME OF PERSON MAKING CHANGE.

Do not extend notes this side of this line

W.S. 25 C-2

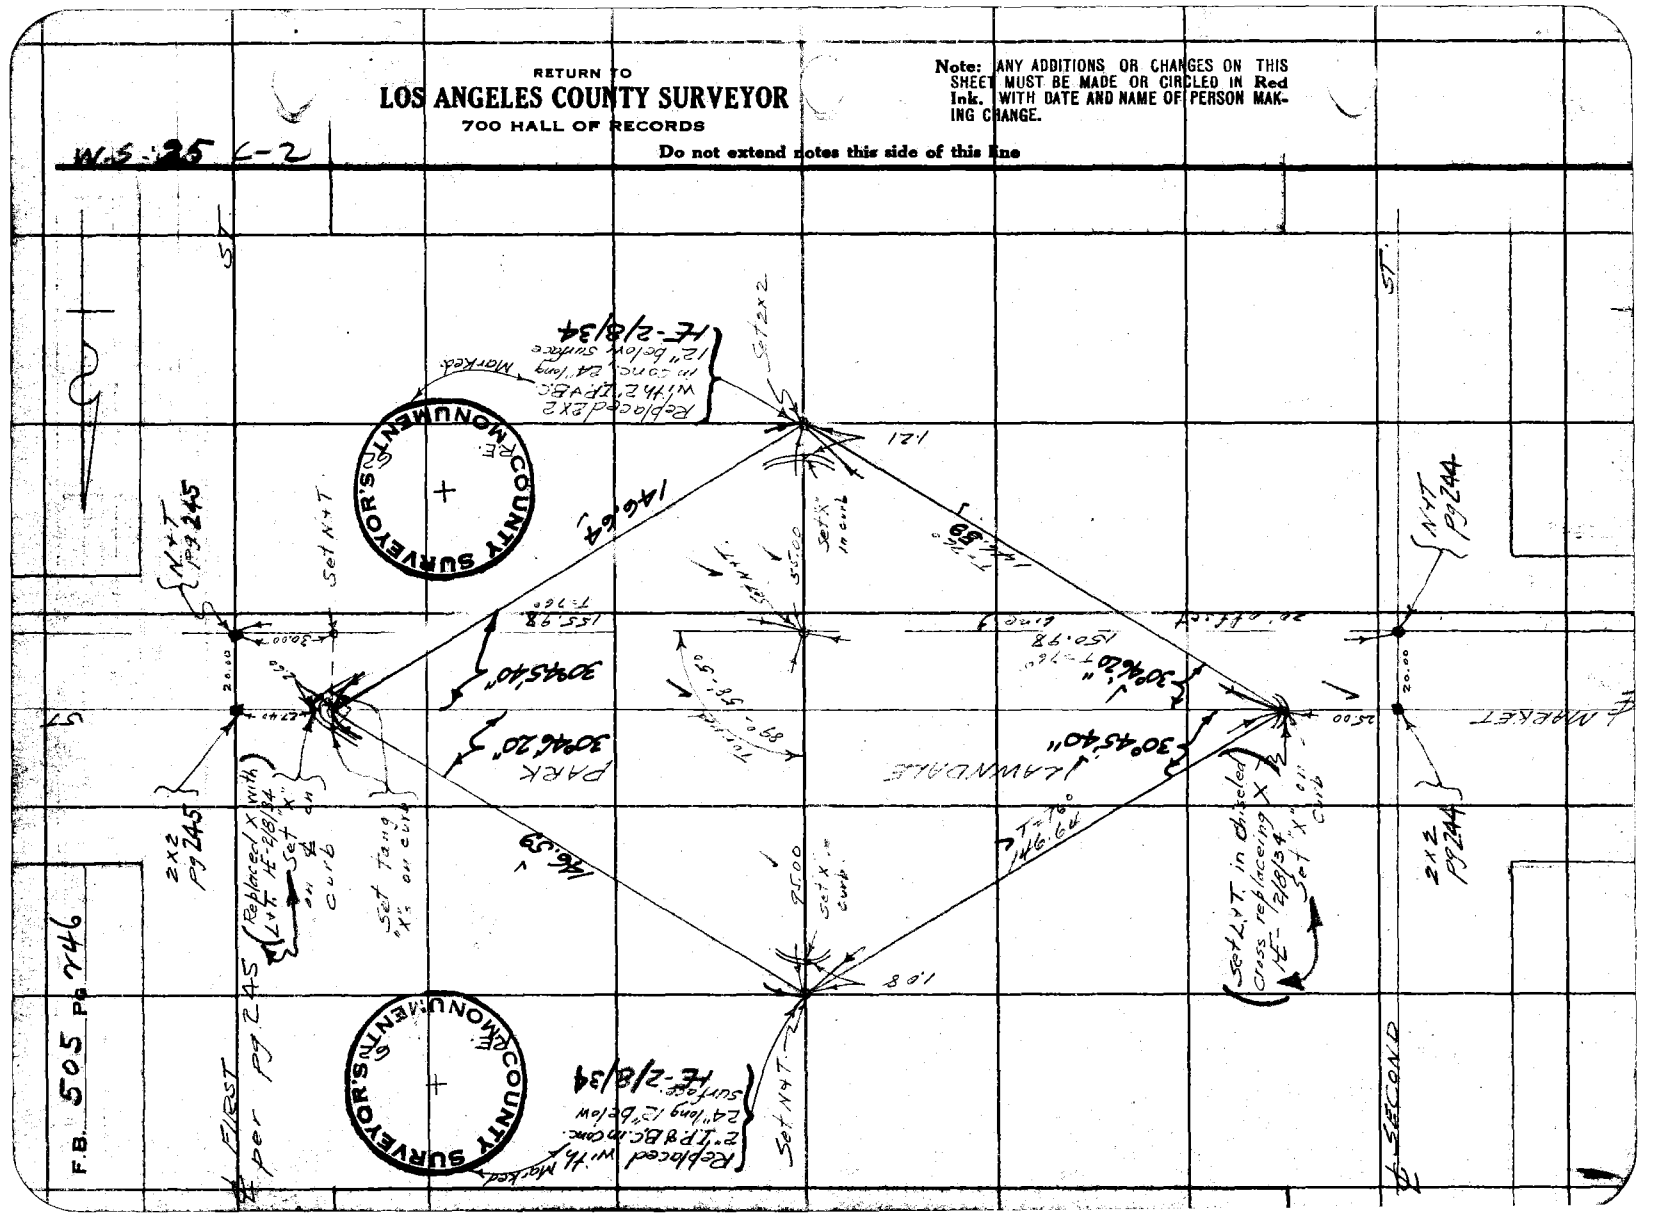

Notes Ck'd by	Survey of Lawndale Park
Map No.	W. O. 8035 Tape No. St'd °F.
Office Work	Surveyed by L. D. Moore
Checked	Notes Profile Date 1-24-34
Date	Indexed A. C. Johnson

F.B. 505 Pg. 247

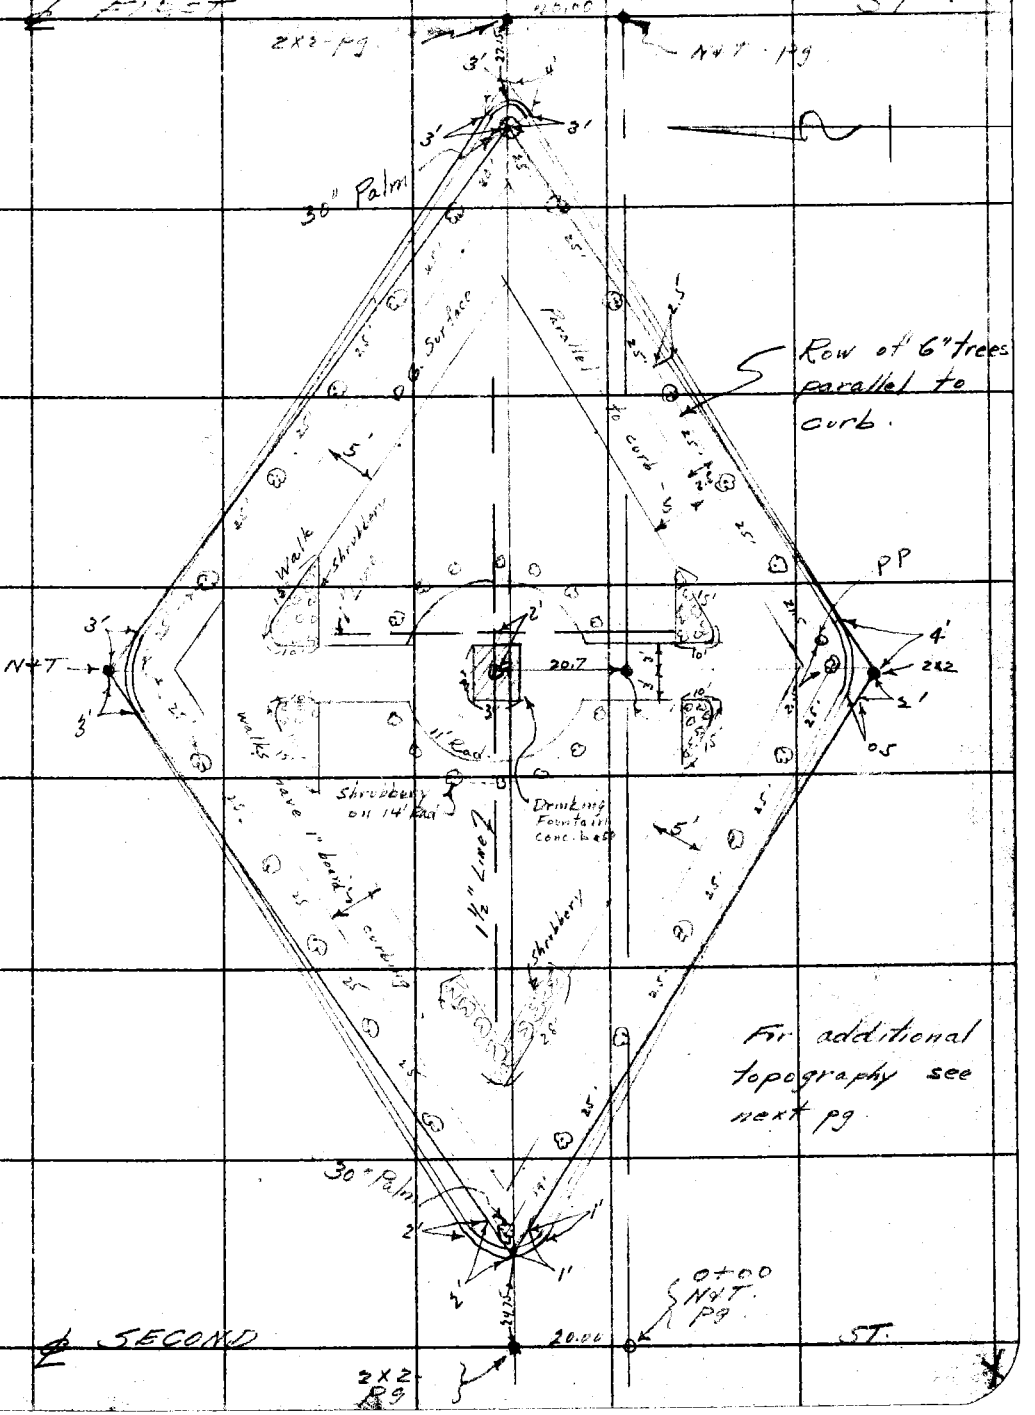

For additional topography see next pg.

Note: ANY ADDITIONS OR CHANGES ON THIS SHEET MUST BE MADE OR CIRCLED IN Red Ink, WITH DATE AND NAME OF PERSON MAKING CHANGE.

Do not extend notes this side of this line

RETURN TO
LOS ANGELES COUNTY SURVEYOR
700 HALL OF RECORDS

FORM 247 10M 5-31

F.B. 505 PG. 748

Topography located from 20' offset Stationing running from ⊙ 22nd St East to 15th St

Sta.	offset				
0+72	20' L	30" Palm			
"	22. L	1" Hyd.			
0+93	21.5 L	6" tree			
	38.0 L	3" "			
1+07	7.0 R	2" "			
1+23	21.0 L	6" "			
"	40.5 L	6" "			
"	2.5 R	6" "			
1+35	13.0 L	3"			
	25.5 L	3" flag pole			
	36.5 L	4" tree			
1+40	26.3 R	24" Palm			
"	68.0 L	" "			
1+54	26.0 R	1" Water Hyd.			
"	70.0 L	" "			
1+60	26.3 R	24" Palm			
"	68.0 L	" "			
1+70	19.0 L	2" tree			
	46.0 L	4" tree			
	55.0 L	2" tree			
1+75	43.0 L	10" tree			
1+87	4.0 L	6" tree			
1+93	24.0 L	2" Pine			
2+00	41.0 L	2" tree			
2+04	23.5 L	6" tree			
2+11	5.0 L	4" Sycamore			
2+28	26.0 L	1" Water Hyd.			
2+30	13.0 L	30" Palm			
"	27.0 L	" "			
2+33	19.0 L	30" Palm			
2+38	12.0 L	24" Palm			
"	28.0 L	" "			
2+42	20' L	" "			
2+50	22.5 L	Shut off Valve			

RETURN TO
LOS ANGELES COUNTY SURVEYOR
700 HALL OF RECORDS
Do not extend notes this side of this line

Note: ANY ADDITIONS OR CHANGES ON THIS SHEET MUST BE MADE OR CIRCLED IN Red Ink. WITH DATE AND NAME OF PERSON MAKING CHANGE.

Profile No. ____ X-Sec. No. ____ | Notes Red. ____ Date ____ Notes Chkd. ____ Date ____ | Plotted ____ Date ____ Checked ____ Date ____ | Job No. 8035 Division No. ____ Survey of LAWNDALE PARK Survey by [illegible] Notes [illegible] Map No. ____ | F. B. 505 Pg. 219 Date [illegible] Indexed [illegible] Date 3-26-40

NOTE: ANY ADDITIONS OR CHANGES ON THIS SHEET MUST BE MADE OR CIRCLED IN RED INK, WITH DATE AND NAME OF PERSON MAKING CHANGE

Do not extend notes this side of this line

PLEASE RETURN TO
LOS ANGELES COUNTY SURVEYOR
700 HALL OF RECORDS

Form 307 5M 10-37

STATION	B. S.	H. I.	F. S.	ELEV.

LAWNDALE PARK

BENCH LEVELS

To Established B.M. for Topography

Nov.

Checked
F.V. Nichols
W.F. Harris

Form 307 5M 10-37

PLEASE RETURN TO
LOS ANGELES COUNTY SURVEYOR
700 HALL OF RECORDS

NOTE: ANY ADDITIONS OR CHANGES ON THIS SHEET MUST BE MADE OR CIRCLED IN RED INK, WITH DATE AND NAME OF PERSON MAKING CHANGE

Do not extend notes this side of this line LB

F. B. 505 Pg. 250 | Job No. 8035 Division No. Notes Red. Plotted Profile
Survey by T. Walsh Notes T. Walsh Date Notes Chkd. Checked No.
Indexed Date Date

STATION	B. S.	H. I.	F. S.	ELEV.	
BM N-53				60 235	BM "N-53" 147th & Bruin Ave. N.M.C.R. E. end of Park & 147th Prod. El. 60.235 FB. 829-60
	3770	64005			
BM N-52			3660	60 345	BM "N-52" 147th & Greenfield Ave. M.C.R. W. end of Park & 147th Prod. El. 60.295 FB. 829-60
	1591	64939			
BM N-51			2975	61 964	BM N-51 147th & Monsell Ave. S.E. Cor. C.Spk & pp. # 280550 E. N.W. face. Elev. 61.955 FB. 829-60
	5373	67337			
BM N-50			2576	64 759	BM. N-50 147th & Kingsdale Ave. S.W. Cor. B.Spk 6'W. of W. end C.R. Elev. 64.766
BM N52				60 345	Above
	5405	65750			
BM			6048	59 702	C.S. Mon. N end of Co. Park 105' N. of "X" in Curb 12" under. FB 505-246
	5380	65082			
BM			6790	58 292	C.S. Mon. S. end of Co. Park 121' So. of X in Curb 12" under. FB 505-246
	5680	63972			
BM "N53			3734	60 238	Above.

Notes Ck'd by		Survey of Lawndale Park	
Map No.		W. O. 8035 Tape No.	Std °F
Office Work		Surveyed by Moore	
Checked		Notes Moore Date 5-6-41	
Date		Indexed A. C. Johnson 6-16-41	

F.B. 505 Pg. 250

STAKING
FOR
LIBRARY
AT
LAWNDALE PARK
Job # 8035

Moore
Ferrier
Lawson
Tower

Note: Any Additions or Changes on This Sheet Must be Made or Circled in Red Ink With Date and Name of Person Making Change

Do not extend notes this side of this line.

RETURN TO
LOS ANGELES COUNTY SURVEYOR
700 HALL OF RECORDS

FORM 247 5M 12-40

RETURN TO
LOS ANGELES COUNTY SURVEYOR
700 HALL OF RECORDS

Note: Any Additions or Changes on This Sheet Must be Made or Circled in **Red Ink** With Date and Name of Person Making Change.

Do not extend notes this side of this line.

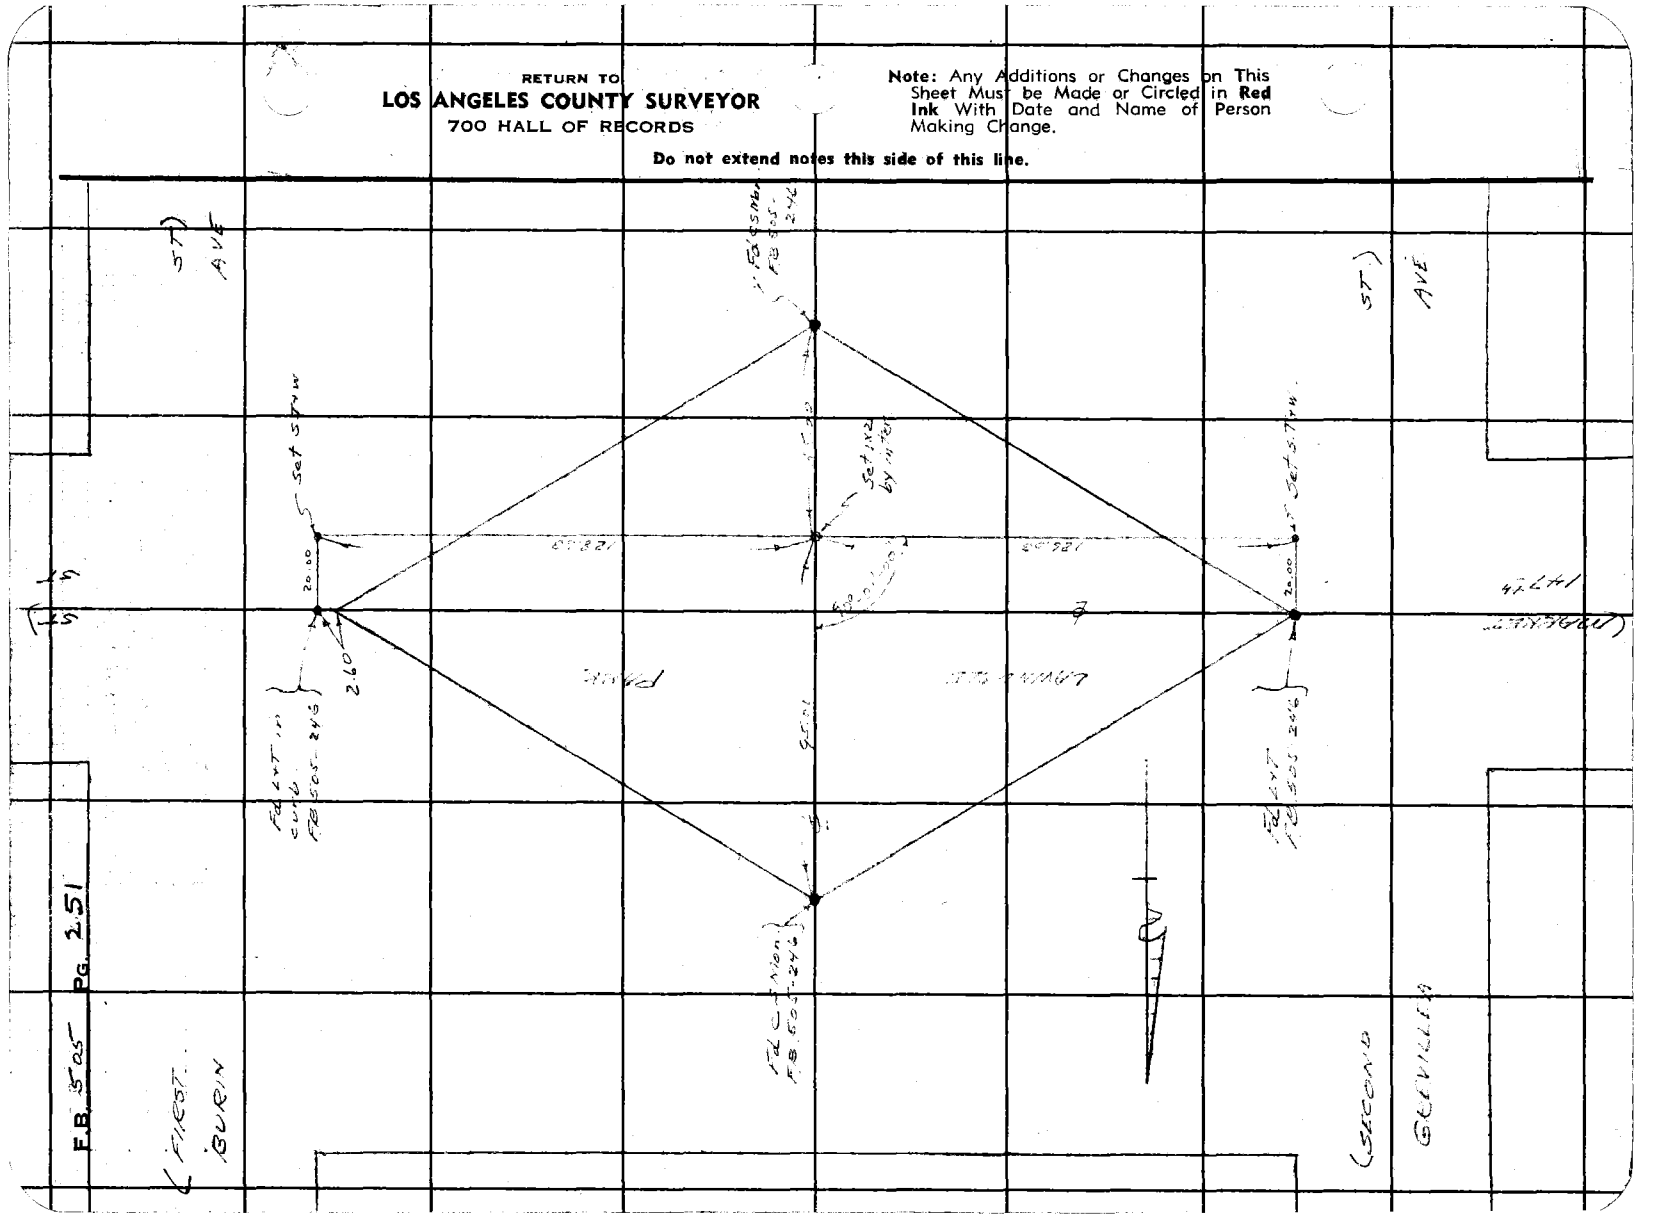
Set 1x2 by tie
20.00
20.00
2.60

Notes Ck'd by	Survey of Lawndale Park
Map No. B-993-2	W. O. 8035 Tape No. Std °F
Office Work C.W. Terry	Surveyed by Moore
Checked W.A. Lyon	Notes Moore Date 5-6-41
Date Nov. 1941	Indexed A. C. Johnson

F. B. 585 Pg. 252

Note: Any Additions or Changes on This Sheet Must be Made or Circled in Red Ink With Date and Name of Person Making Change.

Do not extend notes this side of this line.

RETURN TO
LOS ANGELES COUNTY SURVEYOR
700 HALL OF RECORDS

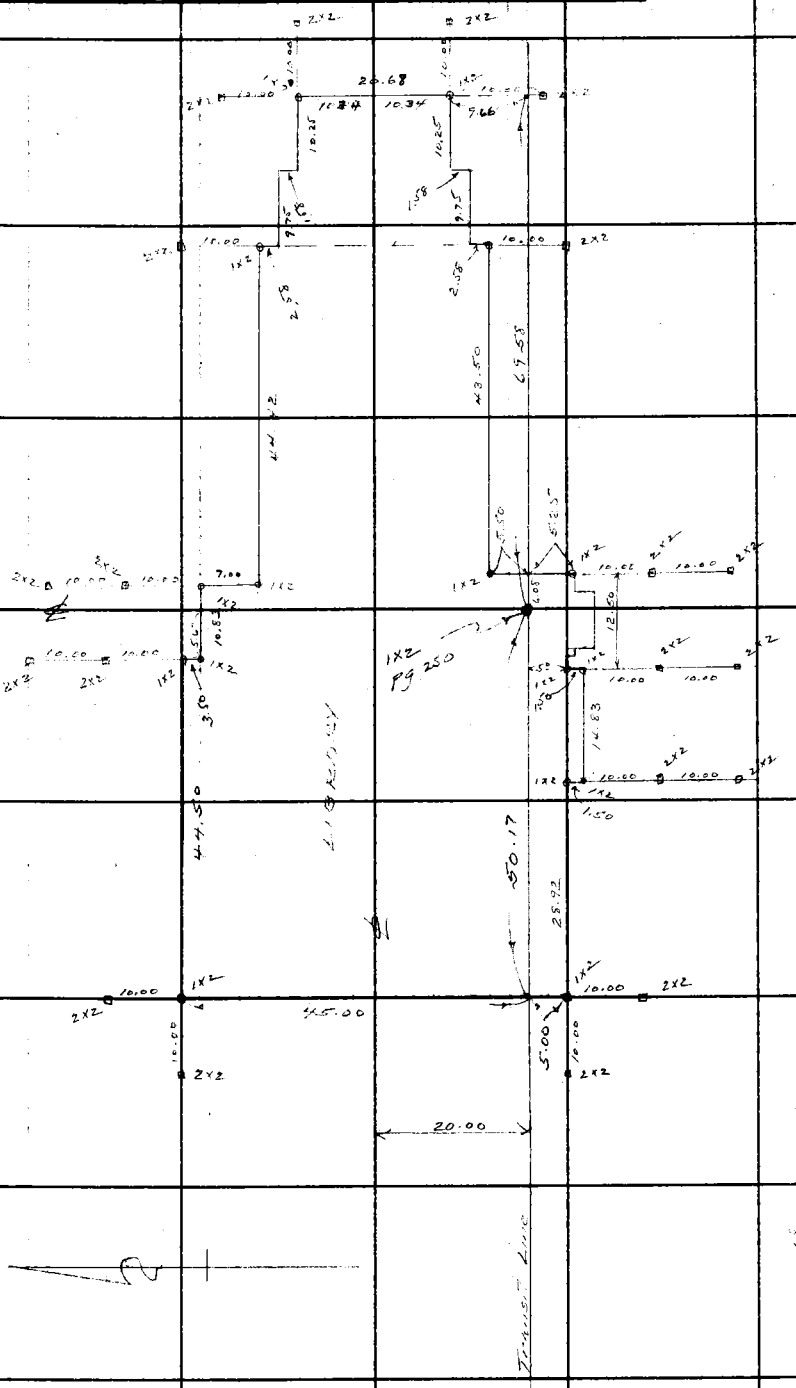

FORM 247 5M 12-40

RETURN TO
LOS ANGELES COUNTY SURVEYOR
700 HALL OF RECORDS

Note: Any Additions or Changes on This Sheet Must be Made or Circled in **Red Ink** With Date and Name of Person Making Change.

Do not extend notes this side of this line.

F.B. 505 PG. 253

1

Notes Ck'd by Drew	Survey of Monteith Park
Map No.	W. O. 8033 Tape No. 061 St'd 76° of.
Office Work	Surveyed by L D Moore
Checked	Notes Moore Date 1-26-34
Date	Indexed A. C. Johnson 1-30-34

F.B. 505 PG. 29

Note: ANY ADDITIONS OR CHANGES ON THIS SHEET MUST BE MADE OR CIRCLED IN Red Ink. WITH DATE AND NAME OF PERSON MAKING CHANGE.

Do not extend notes this side of this line

RETURN TO
LOS ANGELES COUNTY SURVEYOR
700 HALL OF RECORDS

FORM 247 10M 5-31

SURVEY
of
MONTEITH PARK
consisting of
Lots 69, 70, & 71
in
TRACT 9954
Job # 8033

Moore
Fenner
Harris

Jan. 26, 1934

RETURN TO

LOS ANGELES COUNTY SURVEYOR

700 HALL OF RECORDS

Note: ANY ADDITIONS OR CHANGES ON THIS SHEET MUST BE MADE OR CIRCLED IN Red Ink. WITH DATE AND NAME OF PERSON MAKING CHANGE.

Do not extend notes this side of this line

W.S. 24 C-2

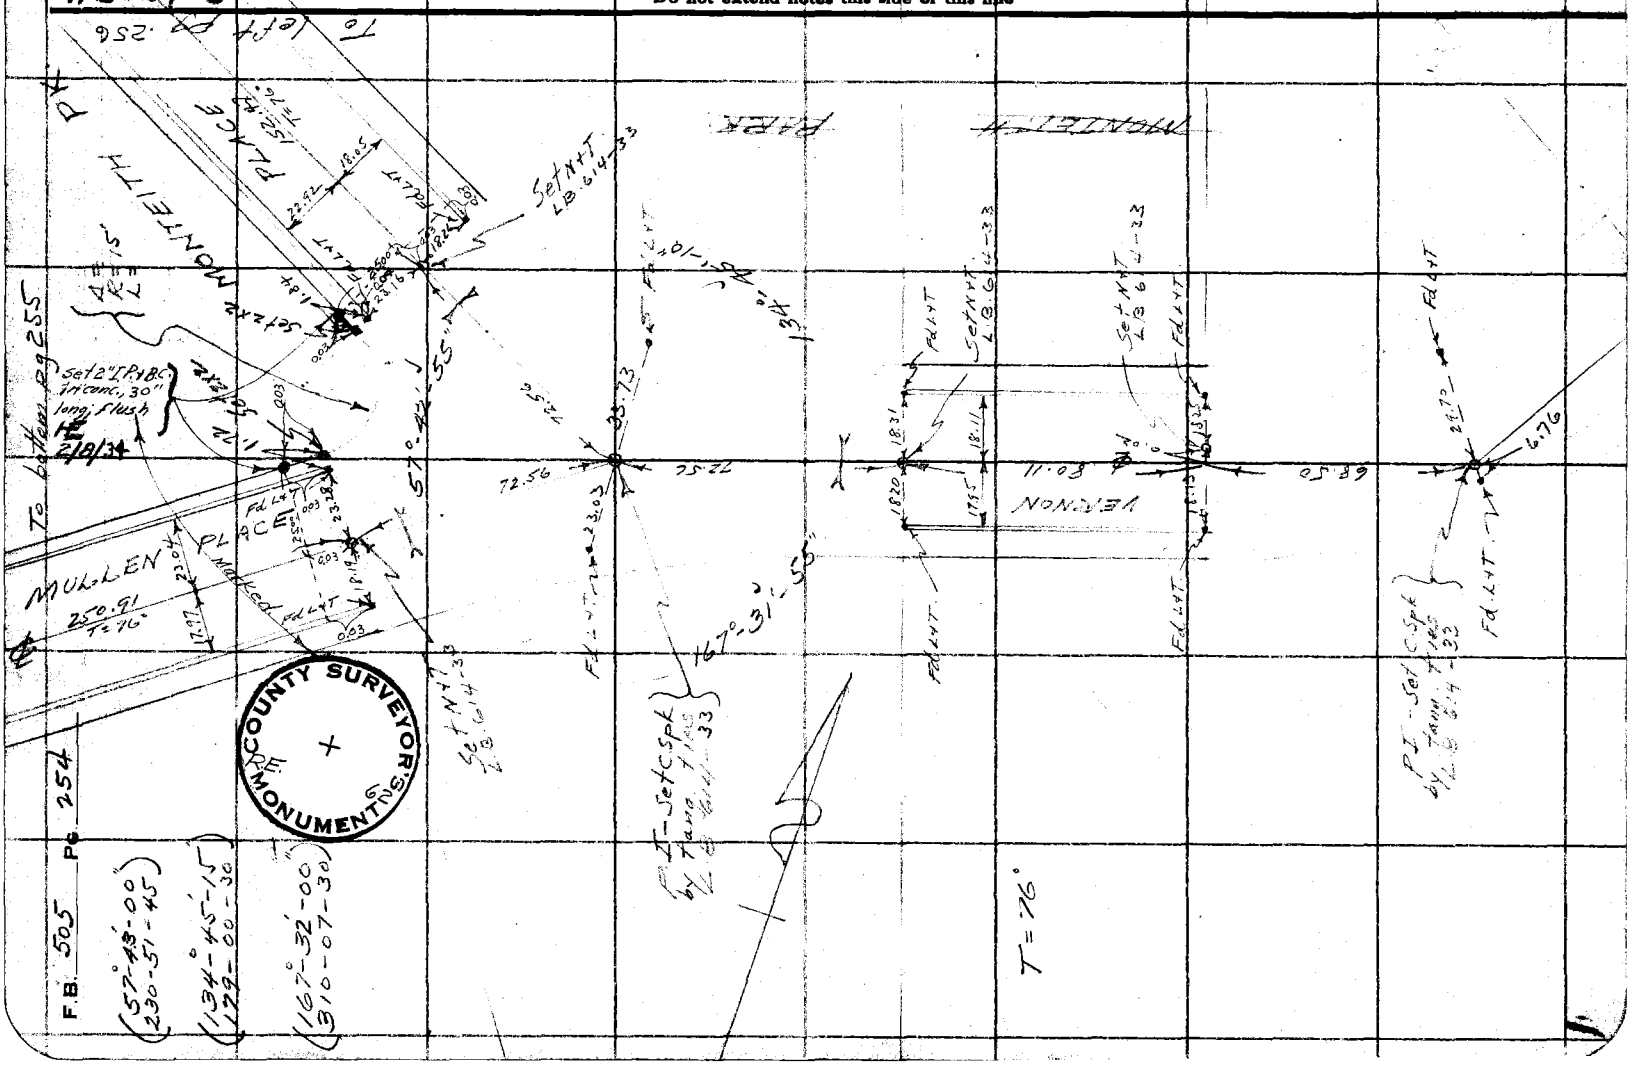

COUNTY SURVEYOR MONUMENTS

F.B. 505 Pg 254

Notes Ck'd by: Drew	Survey of: Monteith Park
Map No.	W. O. 2035 Tape No. 001 St'd 76 °F.
Office Work	Surveyed by: L. D. Moore
Checked	Notes: Moore Date: 1-26-34
Date	Indexed: A. C. Johnson

F.B. 505 Pg. 256

W.S. 24 G-2

Note: ANY ADDITIONS OR CHANGES ON THIS SHEET MUST BE MADE OR CIRCLED IN Red Ink, WITH DATE AND NAME OF PERSON MAKING CHANGE.

RETURN TO
LOS ANGELES COUNTY SURVEYOR
700 HALL OF RECORDS
Do not extend notes this side of this line

Fd Nail
Fd L+T
Set N+T by Tying Files L.B. 614-39
MONTEITH DRIVE
Fd L+T
Set L+T
Set N+T
PI - Set C. Spk. by Tying Files L.B. 614-39
(25°-47'-00" 51-34-00)
Set L+T
Set N+T
Fd L+T Tang prod
Set L+T
Set N+T
Set 2x2
Δ = R = 15' L =
41°-58'-45"
(41°-58'-45" 167-55-00)
Replaced with 2" I.P. Marked
MONTEITH PARK
PLACE
AVE
MULLEN
From Top Pg 254
To Top Pg 256

FORM 247 10M 8-31

F.B. 505 Pg. 256

From lower right pg 255

W.S 24 C 2

RETURN TO
LOS ANGELES COUNTY SURVEYOR
700 HALL OF RECORDS

Do not extend notes this side of this line

Note: ANY ADDITIONS OR CHANGES ON THIS SHEET MUST BE MADE OR CIRCLED IN Red Ink. WITH DATE AND NAME OF PERSON MAKING CHANGE.

MACLLEN

T=76° 38'

COUNTY SURVEYOR'S MONUMENT

MONTEITH PARK

Rec'd. NE-2/8/34

Rec'd Corner with 2" IPP & BC in good condition 0.80 Deep

80°-18'-15"
321-13-30

80.01

Set N+T

23.32

15.22

A= R=30' L=

Fd L+T

PLACE

VERNON T=76° 152.47

Set L+T

23.05

17.98

65.19

Set N+T

Fd L+T

Set C. Spk. by tang lines L.S. 6114-38

AVE

From left pg 254

Notes Ck'd by	Survey of
Map No.	W. O. 5233 Tape No. St'd °F.
Office Work	Surveyed by
Checked	Notes A. C. Johnson Date 5-24-31
Date	Indexed

F.B. 505 PG. 257

Note: ANY ADDITIONS OR CHANGES OR THIS SHEET MUST BE MADE OR CIRCLED IN Red Ink. WITH DATE AND NAME OF PERSON MAKING CHANGE.

Do not extend notes this side of this line

RETURN TO
LOS ANGELES COUNTY SURVEYOR
700 HALL OF RECORDS

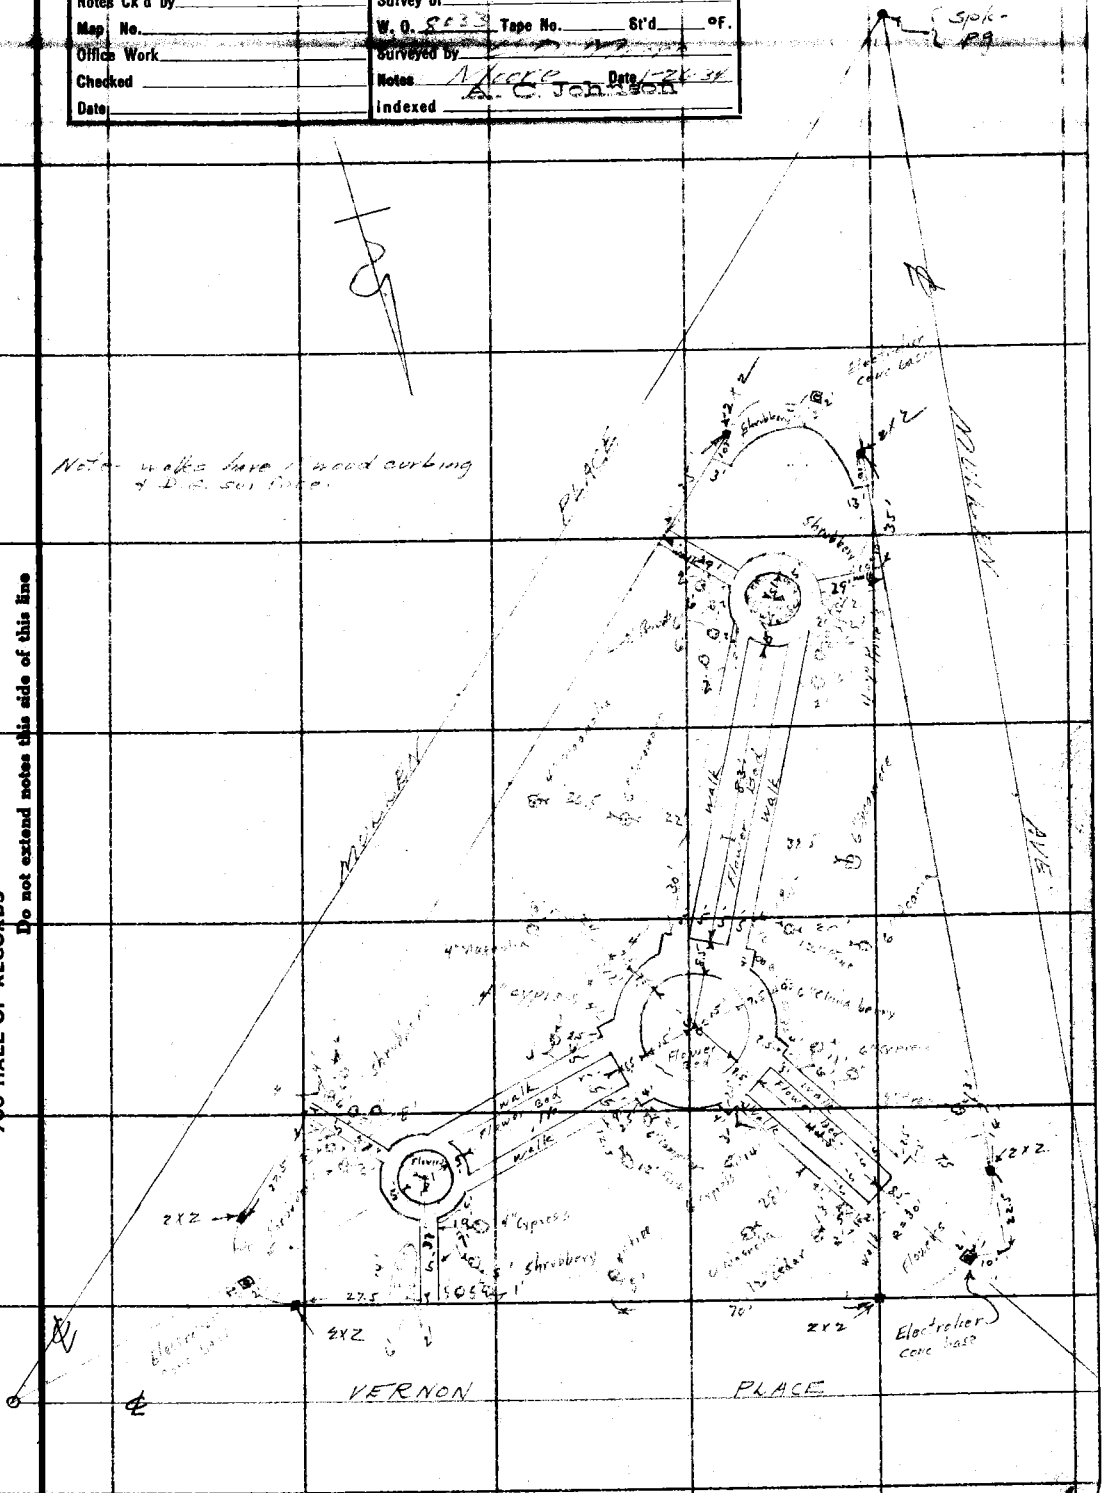

FORM 247 10M 5-31

RETURN TO

LOS ANGELES COUNTY SURVEYOR

700 HALL OF RECORDS

Note: ANY ADDITIONS OR CHANGES ON THIS SHEET MUST BE MADE OR CIRCLED IN **Red Ink.** WITH DATE AND NAME OF PERSON MAKING CHANGE.

Do not extend notes this side of this line

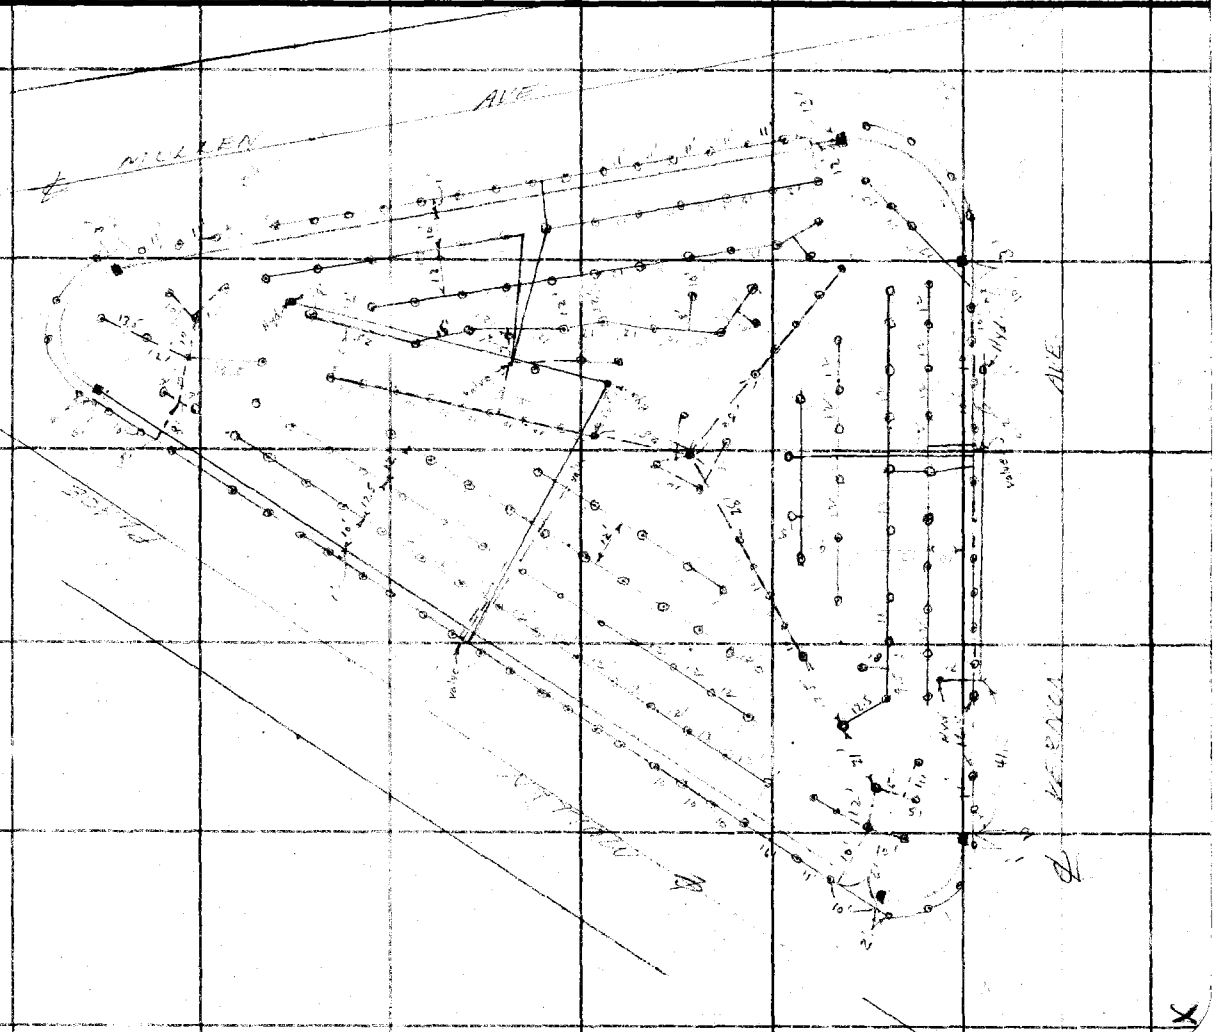

F.B. 505 Pg. 258

RETURN TO
LOS ANGELES COUNTY SURVEYOR
#200 HALL OF RECORDS

Note: ANY ADDITIONS OR CHANGES ON THIS SHEET MUST BE MADE OR CIRCLED IN Ink. WITH DATE AND NAME OF PERSON MAKING CHANGE.

W.S. 51 C-5

Do not extend notes this side of this line

(42.) (33)

End of walk at P.C.

27.11

18.1

Fd. L.T. in curb

40' R

Set L.T. in curb

Blvd.

End of walk at P.C.

Conc. S.W.

14.0

5.0

9.5

5.0

3.0

37.6

72.8'

10.1

13.25

6.1

18.1

27.8

18.7

59.78

51.3

40' R

0.5

Conc. curb

437.62'

Conc. gutter

Fd. 2"x2" T. No. 1 3' Dn.
F.C. 453-2

99-55-15 ①
39-43-15 ②
239-34-30 ③
99-55-45

Fd. S.W.&T. - 2" Dn.
F.C. 453-2.

15.62

0.12

Fd. S.W.&T. - 2" Dn.
F.C. 560-10

99°55'45"

437.67 T. 66 = 437.62'

454.15 T. 66 = 454.10'

Waltonia Drive

68-01-00 ①
272-04-00 ②
18-05-15 ③
68 00 51 R.

454.10'

0.5

3.0

57.19

9.5

10' R

7.0

5.0

16.25

68.7

13

14.0

17.0

68°-01'-00"

74.7

Ocean View

34.17

27.06

25.3

8.8

27.7

30.4

7.0

14.0

40' R.

3.0

0.5

9.5

Conc. gutter

Conc. curb

Conc. S.W.

Set L.T. in Sidewalk

3.5

5.0

6.0

18.1

F.B. 505 Pg

Walk broken off

Fd. L.T. in curb

To cut Spk. & Flush & Del. Mark Rd. & Ocean View Blvd. F.C. 560-18

R.C.E. 6

Bore N. 63 W. 1.94

Notes Ck'd by Drew	Survey of Montrose Park
Map No. B-997	W. O. 8034 Tape No. 045 St'd 84 OF.
Office Work K.V.MORIN	Surveyed by Rosecrans
Checked	Notes Date 1-29-34
Date	Indexed A. C. Johnson E.I. 34

F.B. 505 PG. 261

Note: ANY ADDITIONS OR CHANGES OR THIS SHEET MUST BE MADE OR CIRCLED IN Red Ink. WITH DATE AND NAME OF PERSON MAKING CHANGE.

Do not extend notes this side of this line

RETURN TO
LOS ANGELES COUNTY SURVEYOR
700 HALL OF RECORDS

Montrose Park Survey

Intersection of Glenada Ave and Ocean View Boulevard

Job 8034

Party.

E. A. Rosecrans
R. C. Bowers
J. A. Willess
K. H. Schneider.

FORM 247 10M 5-31

Notes Ck'd by	Survey of Montrose Park
Map No. B-997	W. O. 2024 Tape No. 045 St'd 87 OF.
Office Work Completed	Surveyed by [illegible]
Checked	Notes A. C. Johnson Date 1-29-34
Date	Indexed

F.B. 505 PG. 263

W.S. 6C-5

Notes: ANY ADDITIONS OR CHANGES ON THIS SHEET MUST BE MADE OR CIRCLED IN Red Ink, WITH DATE AND NAME OF PERSON MAKING CHANGE.

Do not extend notes this side of this Line

RETURN TO
LOS ANGELES COUNTY SURVEYOR
700 HALL OF RECORDS

3' Conc Gutter
0.5 Conc curb
Fd x 1' curb
Fd L+T 1' curb
229.91
20.14
P.C.C. Fd. L+T.
P.C. 560-2
3852
3' Conc Gutter
0.5 Conc curb
Crescent Ave.
121.91
121.91 T. 66 121.96
Fd x 1' curb
Fd L+T 1' curb
155-34-15 ①
262-11-00 ②
213-25-30 ③
155-34-15
20.31
20.20
P.C.C. Fd L+T 1' curb
4376
9.5 parkway
5' Conc Sw.
9.5 parkway
5' Conc Sw.
77-52-45"
77-52-30 ①
311-31-00 ④
167-16-15 ⑤
77-52-45 ½
261.26
To S.M.T. T.L.S. and P.R.C. Sta
Back Bdy

FORM 247 10M 8-31

F.B. 505 Pg 264

To S.P.R.R. & Ocean View Blvd Pg. 262

WS 511-C-5

70-12-15 ①
280-49-30 ⑦
61-14-45 ⑤
70-12-27½

168°-59'-35"

454.10'

70°-12'-25" (30 dig)

266.26'

102+2 at P.C.C. See preceding Pg.

168-59-30
315-58-15 ④
253-57-20 ⑥
168-59-35

20.23

20.26

Ed. L.+T. in curb

P.C.C. and P.R.C.'s Fd. L.+T. Bill P.C. 550-11

Ed. L.+T. in curb

5' Conc. S.W.

9.5 Parkway

(35)

(35)

5' Conc. S.W.

9.5 Parkway

0.5 Conc. curb

3' Conc. Gutter

Glenada Ave.

3' Conc. Gutter

0.5 Conc. curb

Ed. L.+T. in curb

P.C.C. set N.+T. by ties P.C. 550-11

20.11

20.57

Ed. L.+T. in curb

RETURN TO
LOS ANGELES COUNTY SURVEYOR
700 HALL OF RECORDS
Do not extend notes this side of this line

Note: ANY ADDITIONS OR CHANGES ON THIS SHEET MUST BE MADE OR CIRCLED IN Red Ink. WITH DATE AND NAME OF PERSON MAKING CHANGE.

Notes Ck'd by
Map No. B-997
Office Work
Checked
Date

Survey of Montrose Park
W. O. 8034 Tape No. 095 St'd 87 °F.
Surveyed by
Notes Date 1-22-34
Indexed A. C. Johnson

F.B. 505 Pg. 265

To 2x2" at T.C.C.
210.4+37.62 Pg. 263

Conc. driveway strips
Shrubbery
Back of curb.
Rock wall
6" Syc. Tr.
Conc. meter box
Park.
1" shade Tr.
1" hydrant
3" pine
0.5 Conc. curb
3' Conc. gutter
5.0 Conc. S.W.
2.5 parkway
4" oak
3" oak
2" oak
Shrubbery
Back of curb.

To 2x2" on E. Ocean View Blvd. 0+00 Ely. for Topog.

Notes: ANY ADDITIONS OR CHANGES OF THIS SHEET MUST BE MADE OR CERCLED IN Red Ink. WITH DATE AND NAME OF PERSON MAKING CHANGE.
Do not extend notes this side of this line

RETURN TO
LOS ANGELES COUNTY SURVEYOR
700 HALL OF RECORDS

FORM 247 10M 5-31

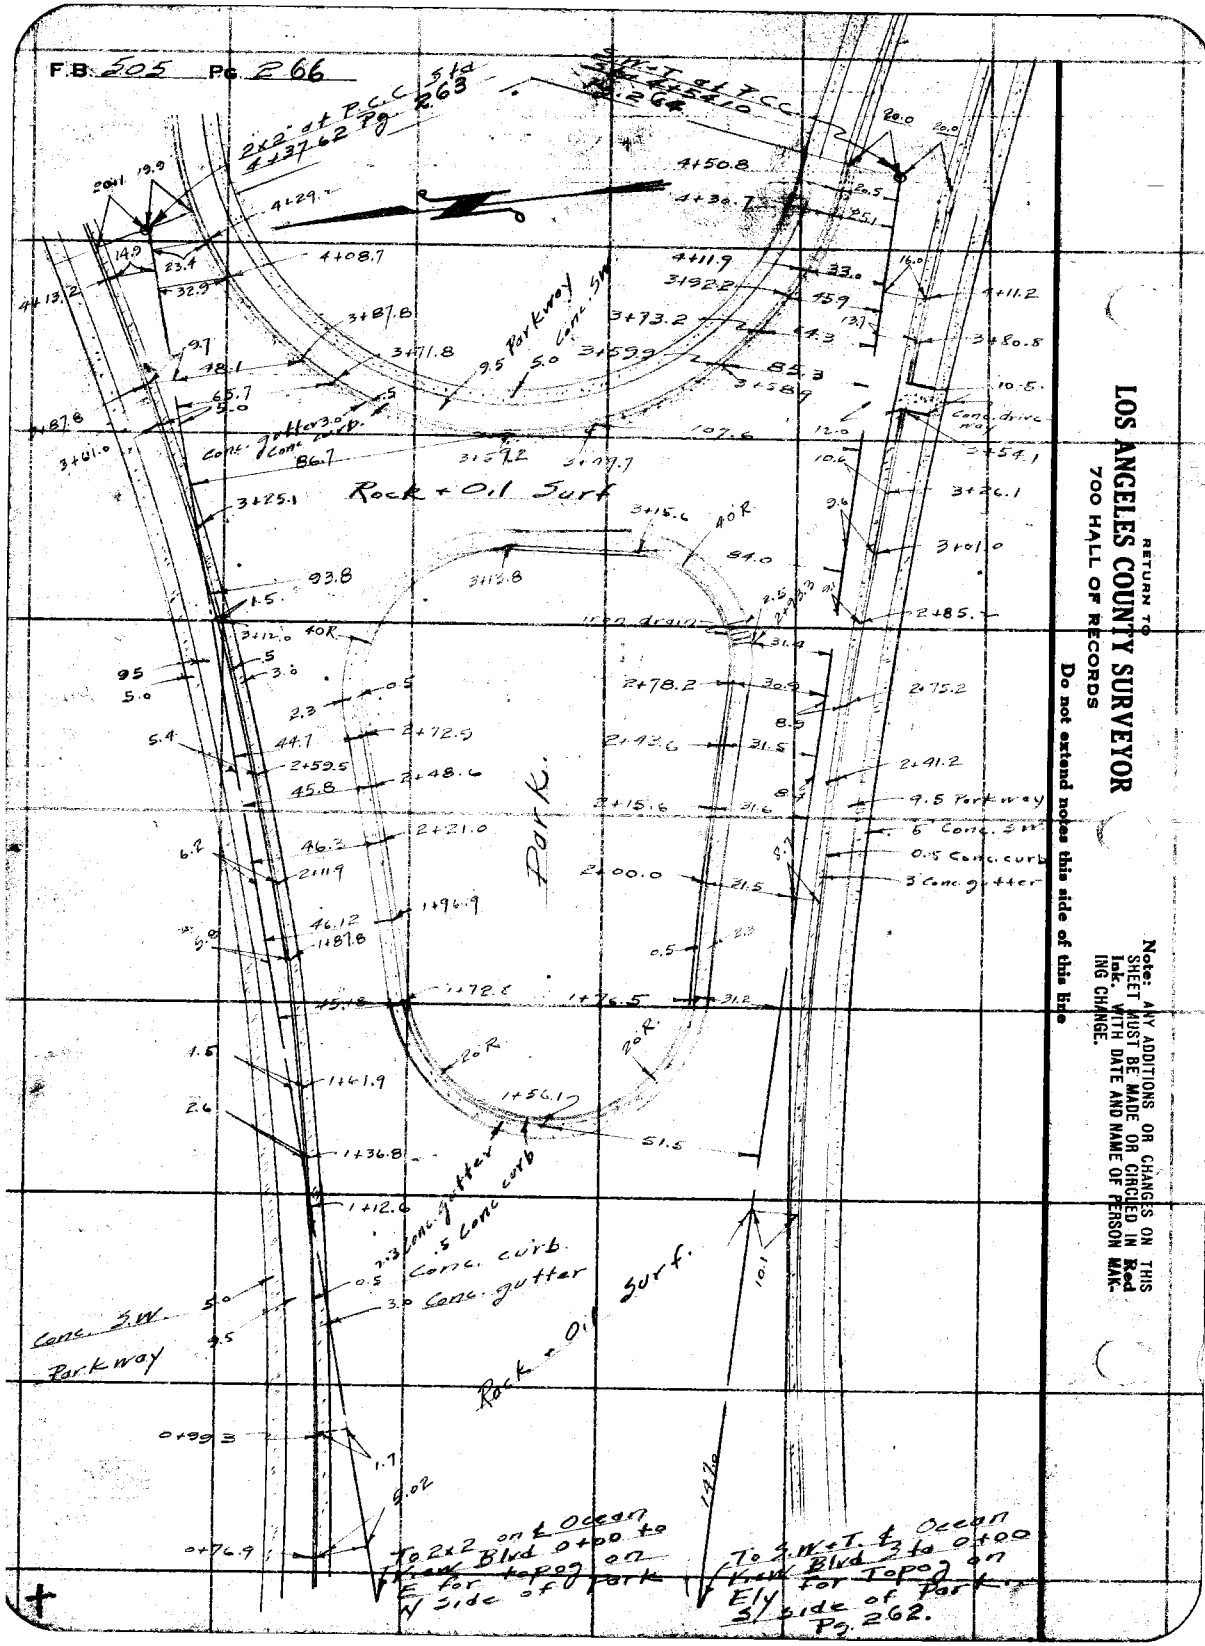

RETURN TO
LOS ANGELES COUNTY SURVEYOR
700 HALL OF RECORDS

Do not extend notes this side of this line

Note: ANY ADDITIONS OR CHANGES ON THIS SHEET MUST BE MADE OR CIRCLED IN Red Ink. WITH DATE AND NAME OF PERSON MAKING CHANGE.

Notes Ck'd by Drew	Survey of Montrose Park
Map No. B-997	W. O. 8034 Tape No. 015 St'd 84 °F.
Office Work KV MORIN	Surveyed by E A Roscrans
Checked	Notes Date 1-29-34
Date	Indexed E. C. Johnson

F.B. 505 PG. 271

Note: ANY ADDITIONS OR CHANGES ON THIS SHEET MUST BE MADE OR CIRCLED IN Red Ink, WITH DATE AND NAME OF PERSON MAKING CHANGE.

Do not extend notes this side of this line

RETURN TO
LOS ANGELES COUNTY SURVEYOR
700 HALL OF RECORDS

FORM 847 10M 8-31

MONTROSE PARK SURVEY

Intersection of Miravista and Orangedale Avenues

Job 8034

Party

E. A. Roscrans
R. C. Bowers
J. A. Willess
K. H. Schneider

F.B. 505 PG 272

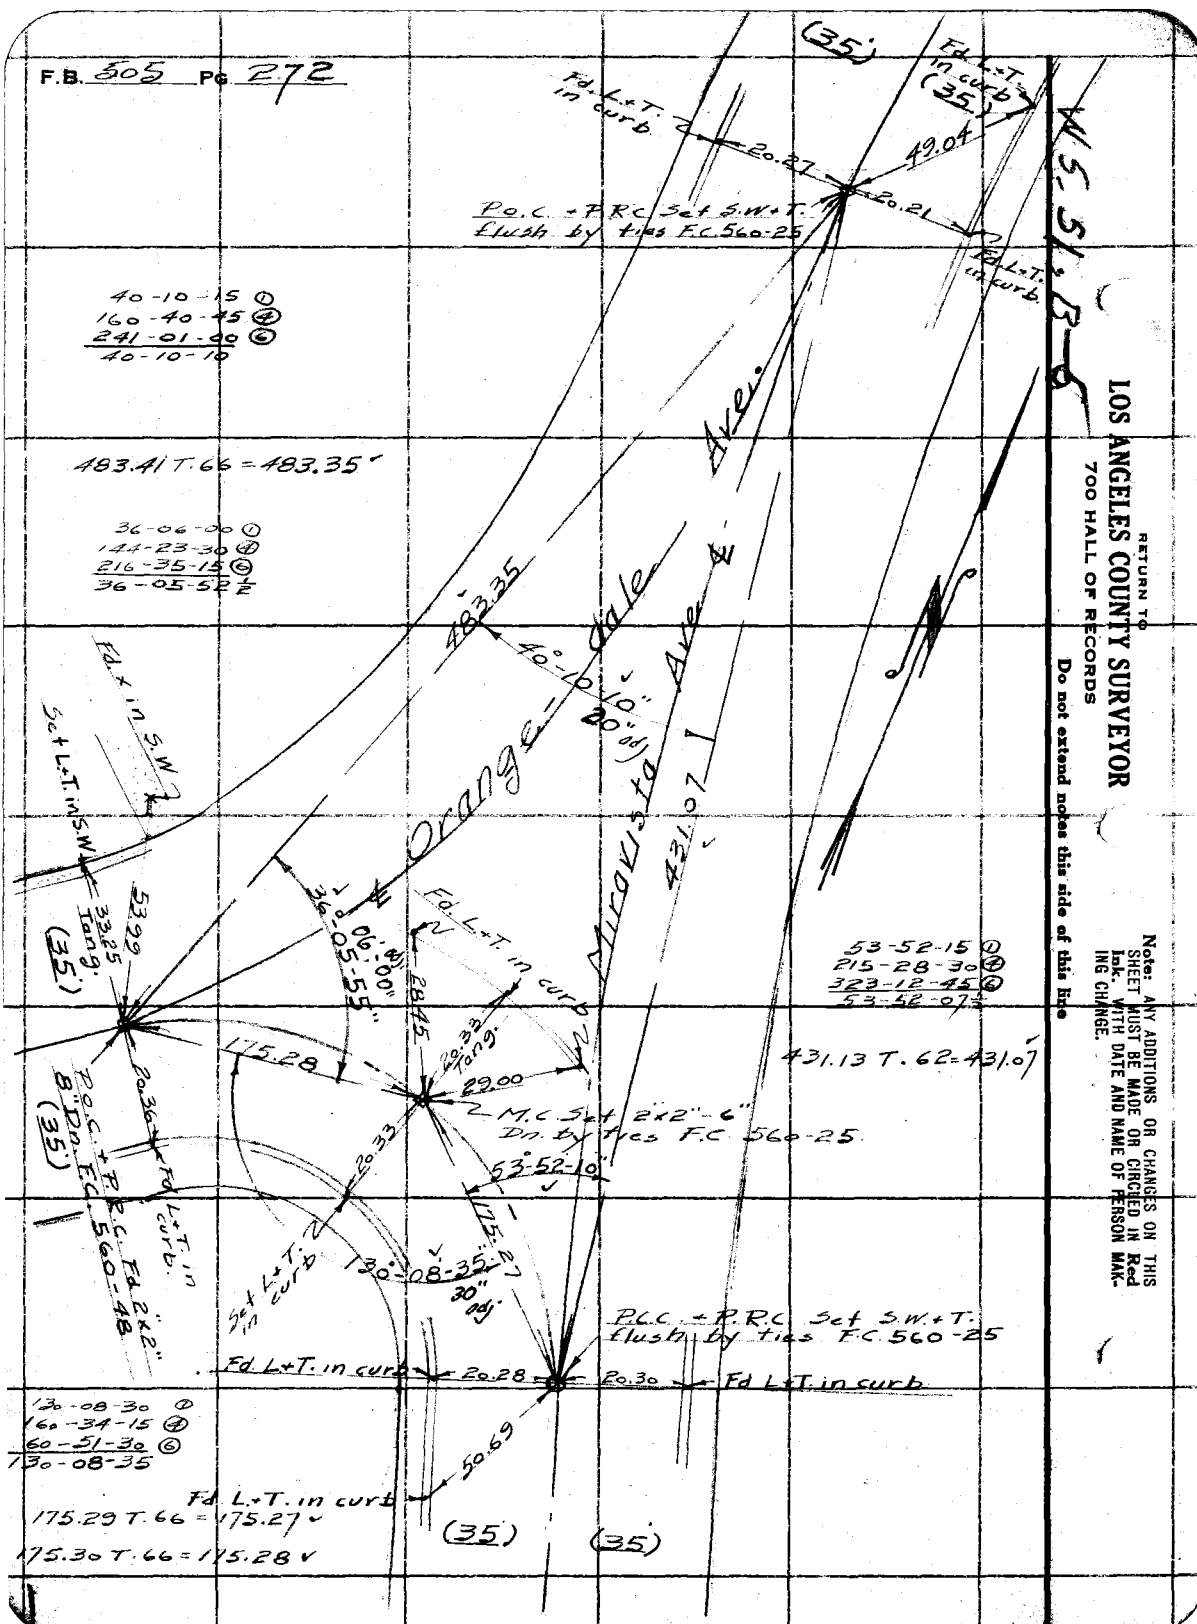

RETURN TO
LOS ANGELES COUNTY SURVEYOR
700 HALL OF RECORDS

Do not extend notes this side of this line

Note: ANY ADDITIONS OR CHANGES ON THIS SHEET MUST BE MADE OR CIRCLED IN Red Ink. WITH DATE AND NAME OF PERSON MAKING CHANGE.

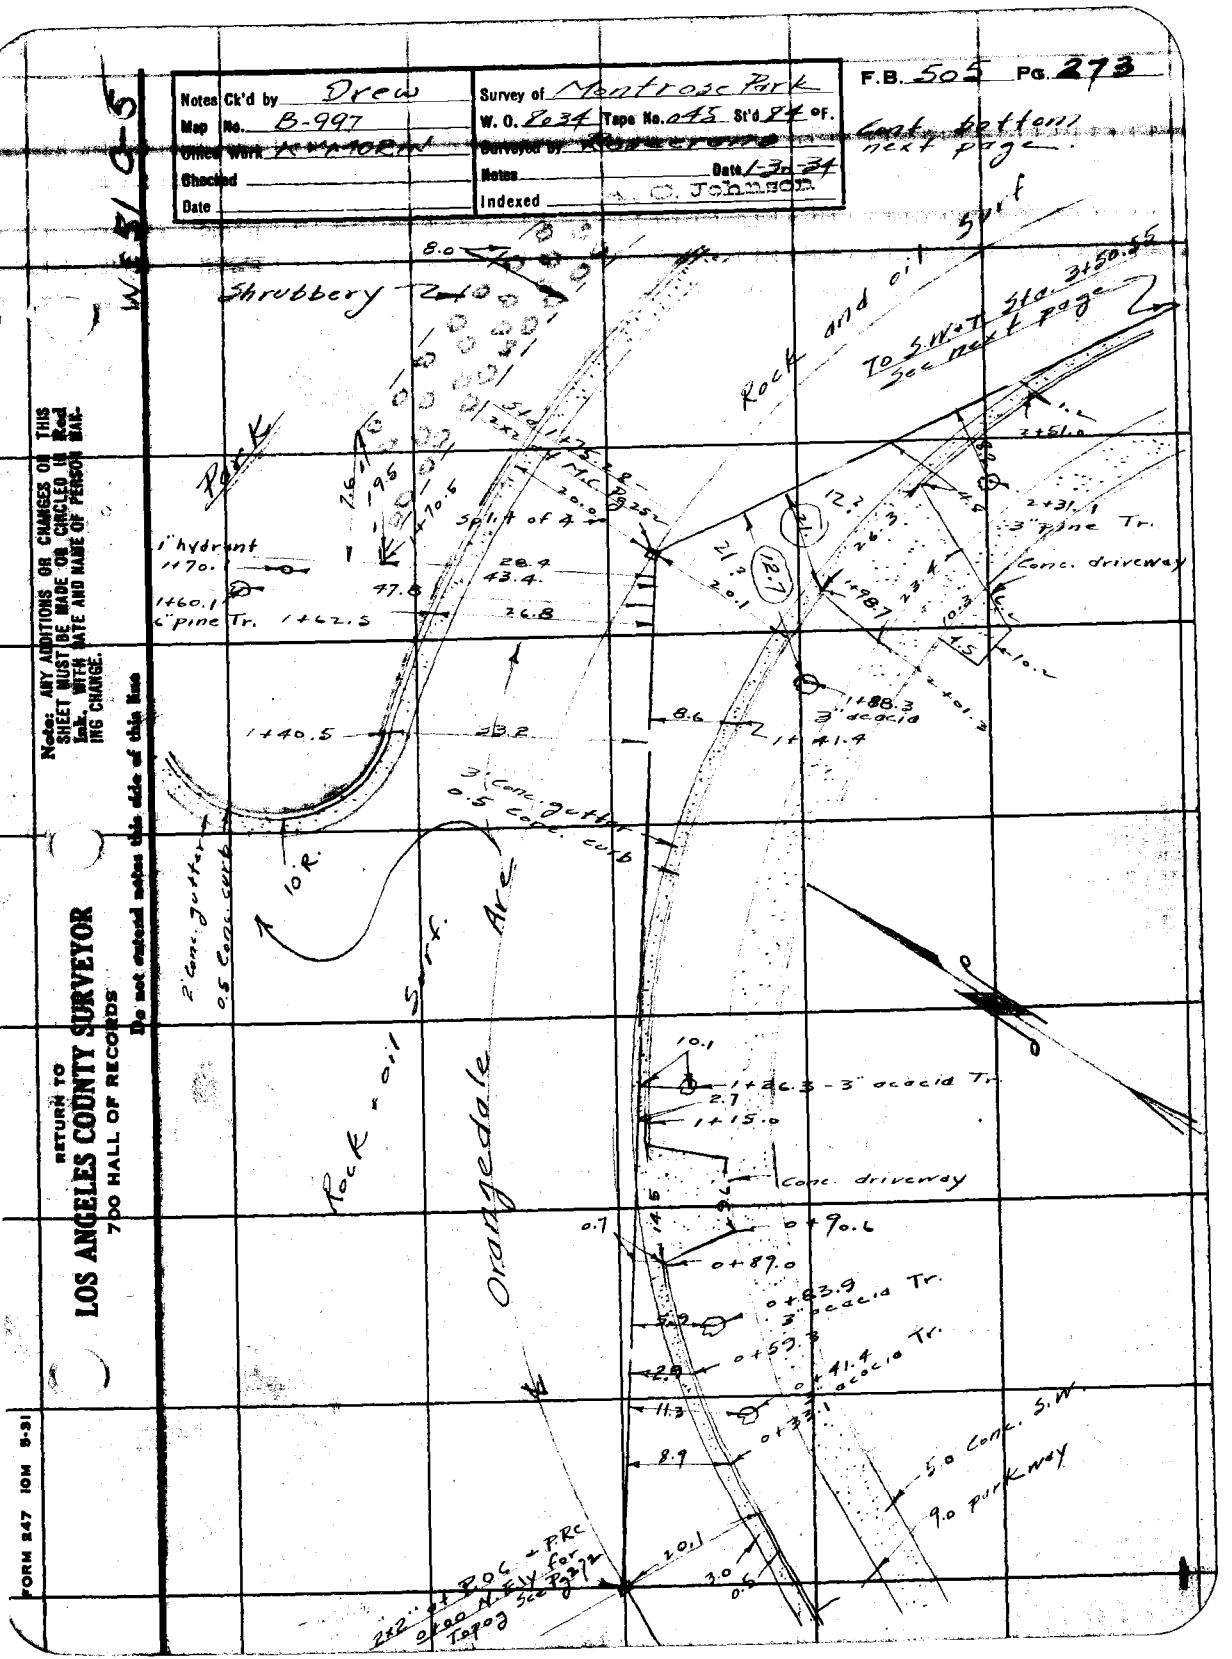
Notes Ck'd by Drew
Map No. B-997
Office Work
Checked
Date
Survey of Montrose Park
Surveyed by
Notes
Date 1-30-34
Indexed C. Johnson
F.B. 505 Pg. 273
Cont. bottom next page.
W 5' G-5
Shrubbery
Rock and oil
To S.W.T. Sta. 3+50.55 See next page
1" hydrant
1170.
1460.1
6" pine Tr. 1462.5
split of 4
3" pine Tr.
Conc. driveway
3" acacia
Conc. gutter
0.5 Conc. curb
10 R.
Rock + oil
Surf.
Orangedale Ave.
3" acacia Tr.
Conc. driveway
5.0 Conc. S.W.
9.0 Parkway
P.O.C. - P.R.C.
0+00 N. 81° W. for
Topog See Page 272
Surf
Note: ANY ADDITIONS OR CHANGES ON THIS SHEET MUST BE MADE OR CIRCLED IN Red Ink, WITH DATE AND NAME OF PERSON MAKING CHANGE.
RETURN TO
LOS ANGELES COUNTY SURVEYOR
700 HALL OF RECORDS
Do not extend notes this side of this line
FORM 247 10M 5-31

RETURN TO
LOS ANGELES COUNTY SURVEYOR
700 HALL OF RECORDS

Note: ANY ADDITIONS OR CHANGES ON THIS SHEET MUST BE MADE OR CIRCLED IN **Red** Ink. WITH DATE AND NAME OF PERSON MAKING CHANGE.

Do not extend notes this side of this line

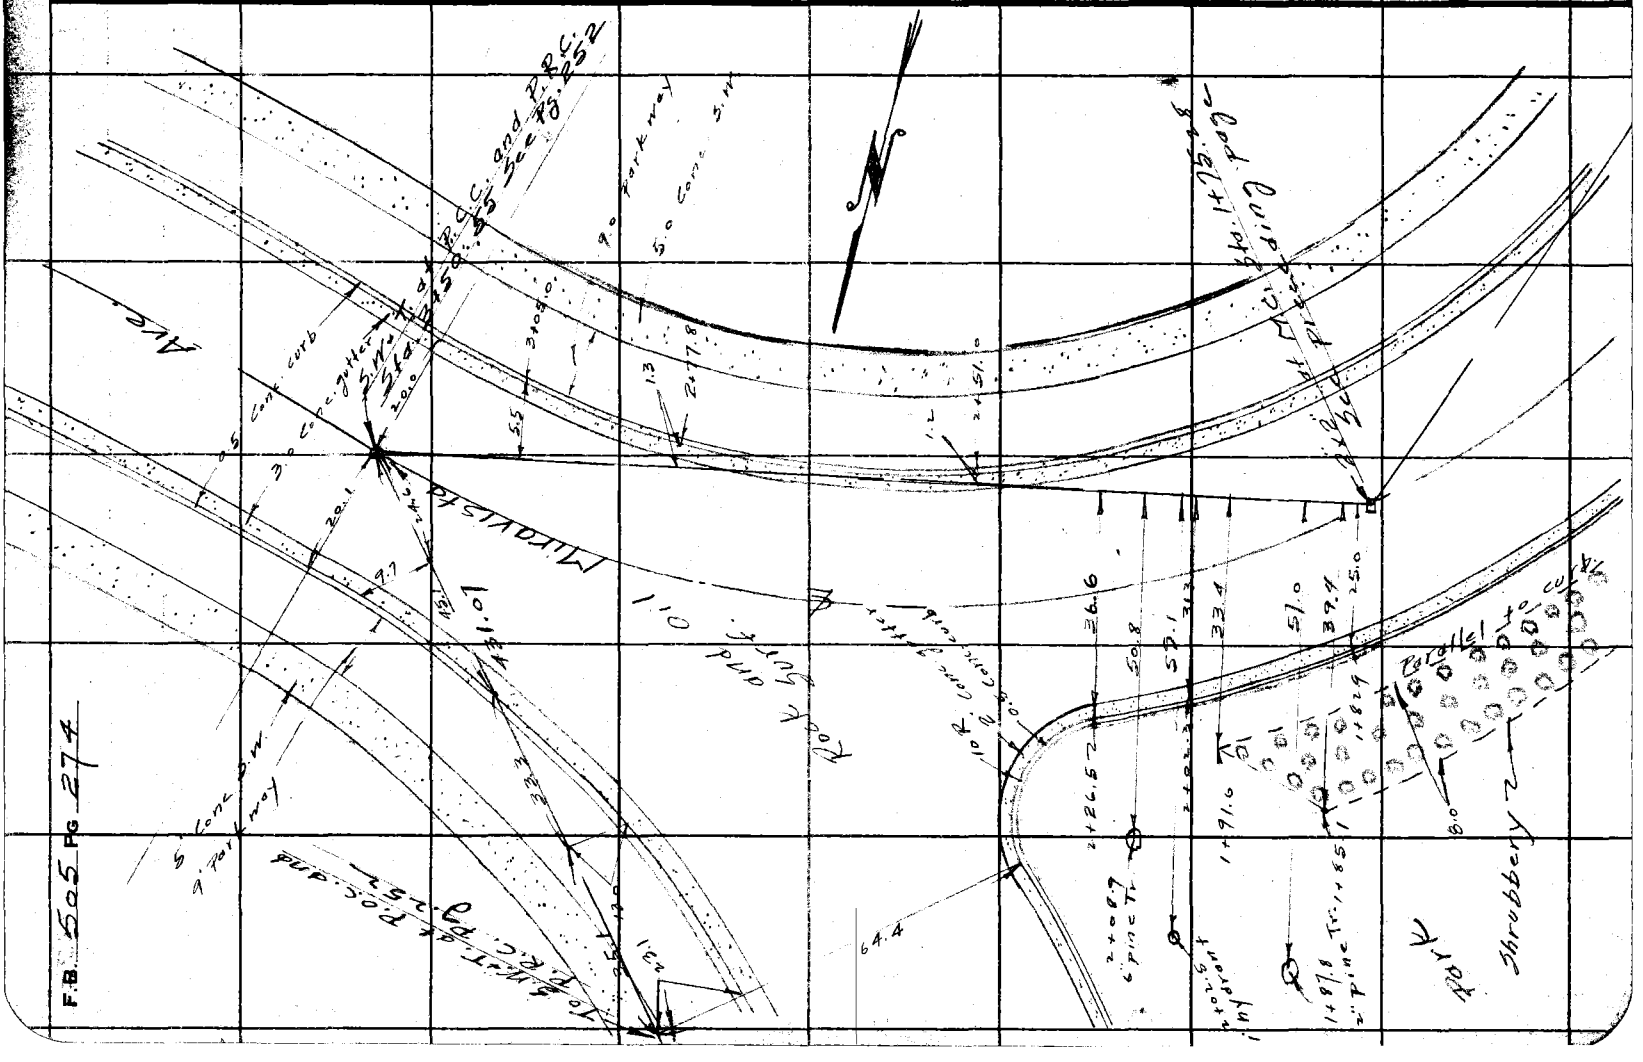

Notes Ck'd by Drew
Map No. B-997
Office Work Approved
Checked
Date

Survey of Montrose Park
W. O. 8034 Tape No. 045 St'd 27 °F.
Surveyed by Assistants
Notes
Date 1-31-34
Indexed A. C. Johnson

F.B. 505 PG. 295

Cont. bottom next page

3' Conc. Gutter
0.6 Conc. curb
Rock and oil surf
10' R
5' Conc. S.W.
9' Parkway
2.7
2+90.4
42.8
1+89.6
2' Conc. gutter
0.5 Conc. curb
57.1
43.5
71.8
43.6
3.6
2+63.6
2+63.7
2+72.3
6" pine
2+42.1
2" pine
2+91.9
55.2
47.9
Conc. meter box
2+33.8
2+36.
2+39.1
+39.2
7.4
Park
Orangedale Ave
3.5
2+22.1
43.8
48.2
47.9
1" Hydrant
2+2.0
2+21.9
Shrubbery
2+4.9
43.1
55.0
2+00.0
47.6
1+95.1
Long Chord
70.0
1+92.3
1+87.1
3" pine
Conc. driveway
41.8
1+70.7
1+84.3
1+56.0
1+56.2
1+45.8
39.8
1+41.5
Rock + Oil surf.
10' R. Pg 273
0+73
0+00
14.9
19.9
2"x2" at P.O.C. and P.R.C.
0+00 to N for Topog

Note: ANY ADDITIONS OR CHANGES OR THIS SHEET MUST BE MADE OR CIRCLED IN Red Ink WITH DATE AND NAME OF PERSON MAKING CHANGE.

Do not extend notes this side of this line

RETURN TO
LOS ANGELES COUNTY SURVEYOR
700 HALL OF RECORDS

FORM 247 10M 5-51

F.B. 505 Pg 276

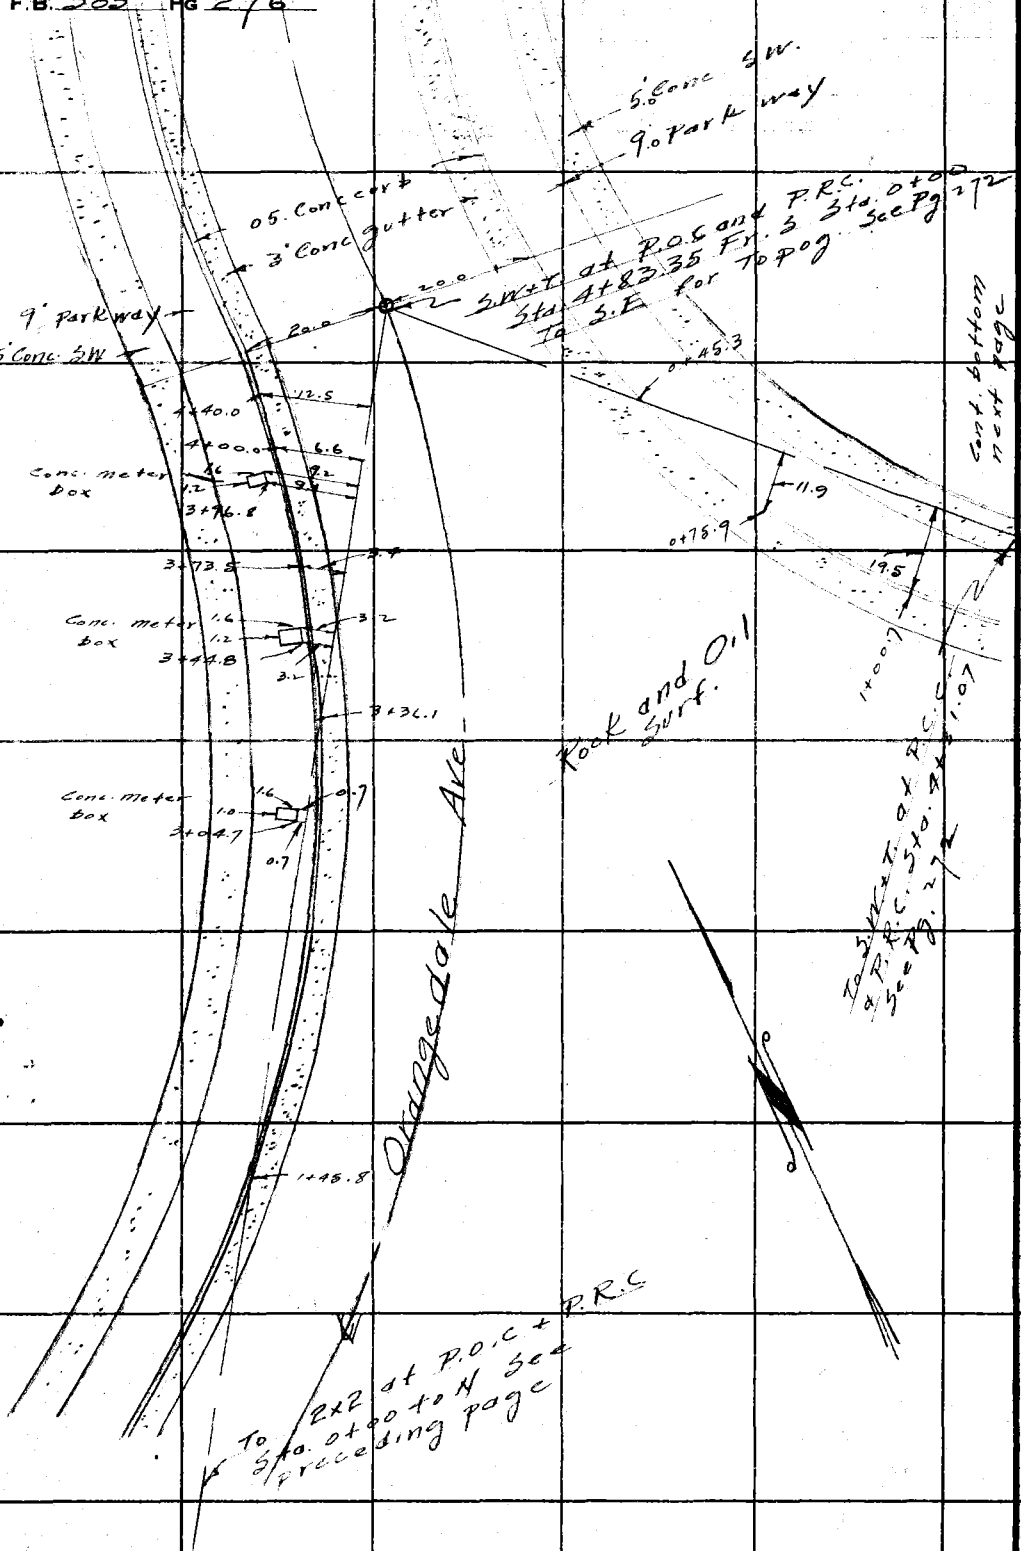

RETURN TO
LOS ANGELES COUNTY SURVEYOR
700 HALL OF RECORDS
Do not extend notes this side of this line

Note: ANY ADDITIONS OR CHANGES ON THIS SHEET MUST BE MADE OR CIRCLED IN Red Ink WITH DATE AND NAME OF PERSON MAKING CHANGE.

Notes	Ck'd by Proc.	Survey of Montrose Park	F.B. 305 Pg. 277
Map	No. B-997	W. O. 8034 Tape No. 045 St'd 87 °F.	
Office Work		Surveyed by	
Checked		Notes	Date 1-31-34
Date		Indexed A. C. Johnson	

Notes: ANY ADDITIONS OR CHANGES OF THIS SHEET MUST BE MADE OR CIRCLED IN Red Ink. WITH DATE AND NAME OF PERSON MAK-ING CHANGE.

Do not extend notes this side of this line

RETURN TO
LOS ANGELES COUNTY SURVEYOR
700 HALL OF RECORDS

FORM 247 10M 8-31

Sta. 1+ P.C.C. and P.R.C. 3+34.4+31.07 Pg. 278

40' R.

3+00
27.2
42.4
25.3
2+84.1-3" pine
30.3
2+82.9
3+00
77.0
72.7
27.9
2+64.7
3" Shade Tr.
33.7
2+56.4
74.8
2+48.0
2+73.8
100.5
2+75.7
1.4
3.5
Stone bench
99.7
5.4
109.7
2+71.5
6" pine
101.0
2.69.8
10.0
Shrubbery
Park.

Long Chord

31.1
2+35.9
3" pine
35.5
2+29.7
35.5
75.8
85.0
39.9
2+22.1
2+46.6
88.2
80.2
2+31.0
2+21.0
2+21.5-1" hydrant

2+00.0
33.7
74.7
1+76.3
Miraflores
1+82.4
2' Conc. gutter
0.5 Conc. curb
10' R.

31.0
1+53.1
26.2
1+26.7
Rock and oil Surf.

5' Conc. Sw.
9' Parkway
0.5 Conc. curb.
3' Conc. gutter

0+45.3

Sta. 0+ P.C.C. and P.R.C. See Sta. 0+00 to S.E. See preceding page

RETURN TO
LOS ANGELES COUNTY SURVEYOR
700 HALL OF RECORDS

Note: ANY ADDITIONS OR CHANGES ON THIS SHEET MUST BE MADE OR CIRCLED IN Red Ink. WITH DATE AND NAME OF PERSON MAKING CHANGE.

Do not extend notes this side of this line

F.B. 505 PG 278

Notes Ck'd by Drew	Survey of
Map No. B-998	W. O. Tape No. St'd °F.
Office Work ~~Drew~~ BX	Surveyed by
Checked Drew	Notes Date
Date 2-15-34	Indexed A. C. Johnson 2-1-34

F.B. 505 PG. 284

ROSEWOOD CIRCLE

J.N. 8038

PARKWAY AT INTERSECTION OF ROSEWOOD AND WESTMOUNT DR

Note: ANY ADDITIONS OR CHANGES ON THIS SHEET MUST BE MADE OR CIRCLED IN Red Ink, WITH DATE AND NAME OF PERSON MAKING CHANGE.

Do not extend notes this side of this line

RETURN TO
LOS ANGELES COUNTY SURVEYOR
700 HALL OF RECORDS

FORM 247 10M 5-31

RETURN TO

LOS ANGELES COUNTY SURVEYOR

700 HALL OF RECORDS

Note: ANY ADDITIONS OR CHANGES ON THIS SHEET MUST BE MADE OR CIRCLED IN **Red Ink.** WITH DATE AND NAME OF PERSON MAKING CHANGE.

Do not extend notes this side of this line

F.B. 505 Pg 78

Notes Ck'd by	Drew	Survey of	Rosewood Park
Map No.	B-998	W. O.	2036
Office Work	Cox	Tape No.	967
Checked	Drew	Surveyed by	Evans
Date	2-15-34	Notes	
		Date	1/24/34
		Indexed	A. C. Johnson

F.B. 505 Pg. 283

(70 Lt. side Pg. 684)

(50) WESTBOURNE DR. (50)

AVE (50) Line

No 5105.

Tangent

(50) HUNTLEY DR. (50)

TRACT

ROSEWOOD (50)

curb curb

15.92 14.97

NORWICH DR.

F.H. L.Y.T curb per Rd. F.C. 9685

Note: ANY ADDITIONS OR CHANGES ON THIS SHEET MUST BE MADE OR CIRCLED IN Red Ink, WITH DATE AND NAME OF PERSON MAKING CHANGE.

Do not extend notes this side of this line

RETURN TO
LOS ANGELES COUNTY SURVEYOR
700 HALL OF RECORDS

FORM 247 JOM 5-31

RETURN TO
LOS ANGELES COUNTY SURVEYOR
700 HALL OF RECORDS

Note: ANY ADDITIONS OR CHANGES ON THIS SHEET MUST BE MADE OR CIRCLED IN Red Ink, WITH DATE AND NAME OF PERSON MAKING CHANGE.

Do not extend notes this side of this line

22 B-3

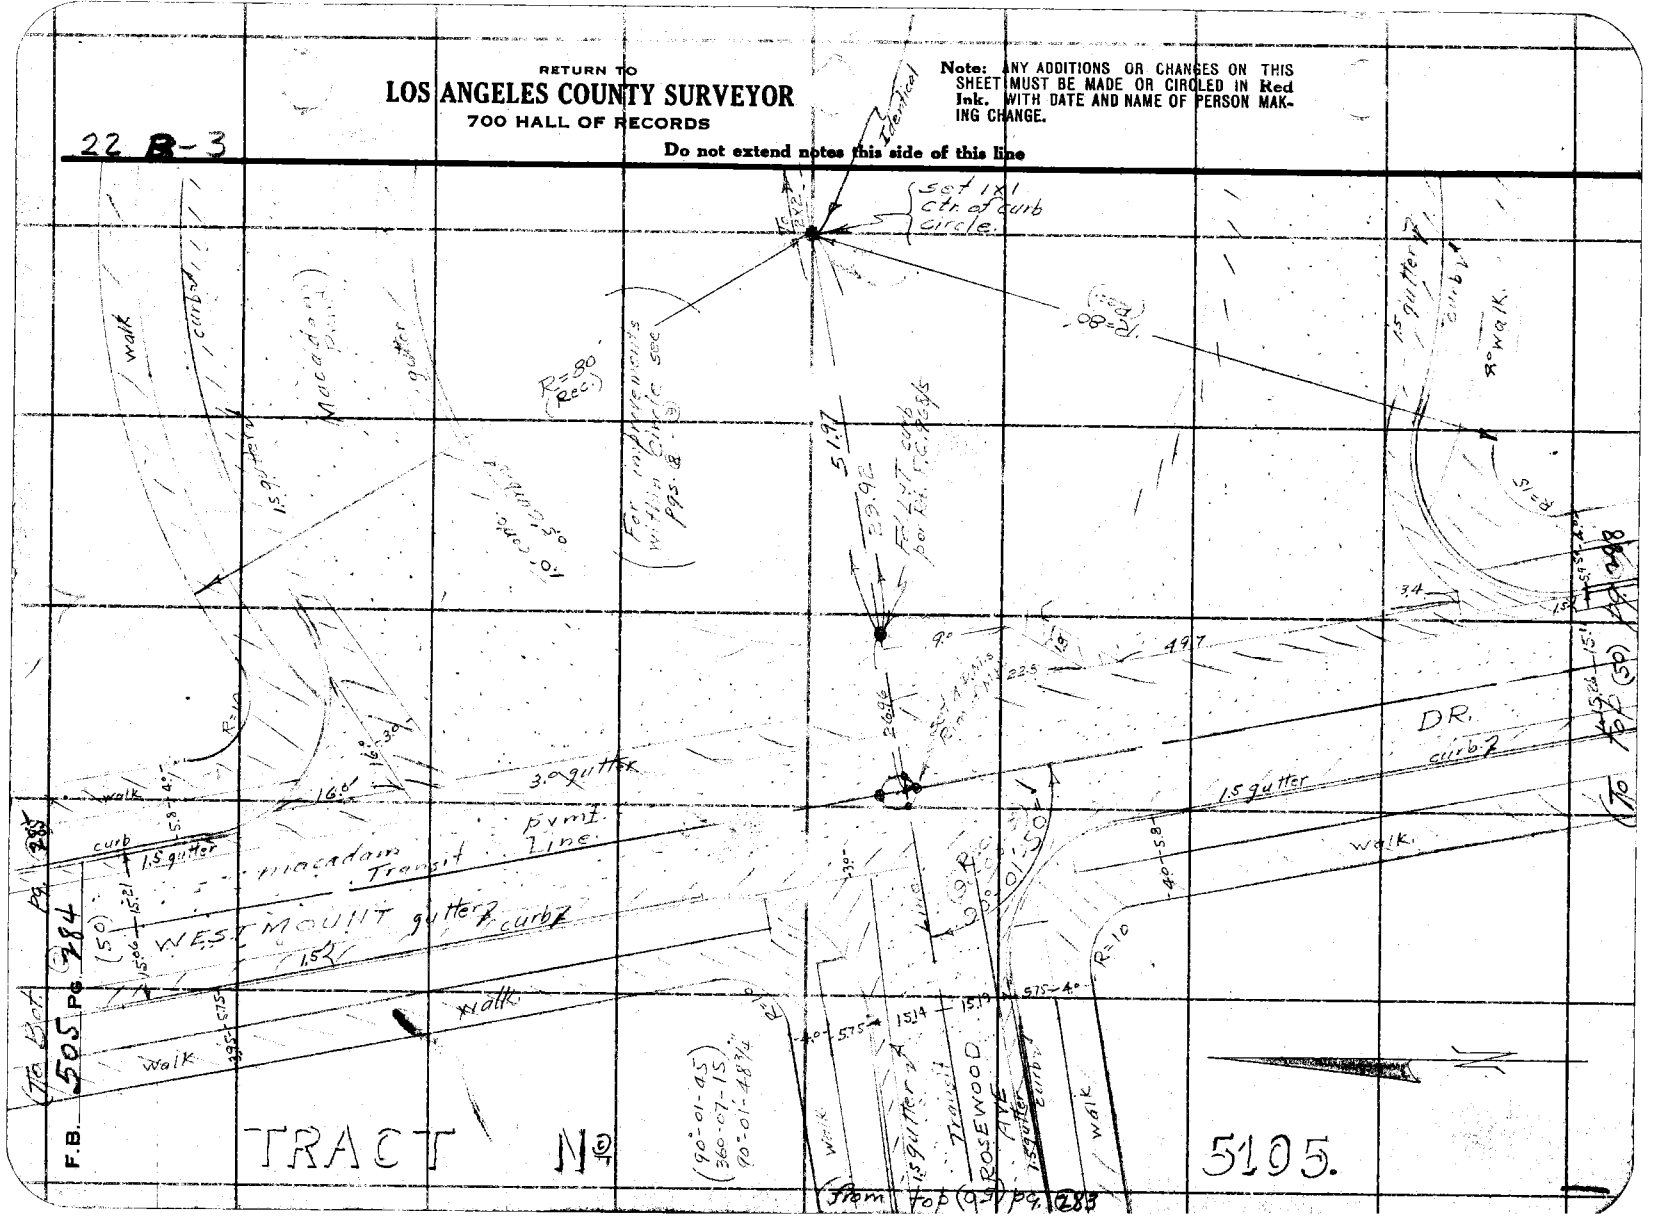

Bet 1533 - 1533 Pg. 289

Notes Ck'd by (50) Drew
Map No. B-9958
Office Work Cox Drew
Checked
Date 2-15-34

Survey of
W. O.
Tape No. 96 / St'd 34 of.
Surveyed by Evans
Notes
Date 1/30/34
Indexed C. Jenkins

F.B. 505 Pg. 285

22 B - 2

Note
The curves on these streets are very irregular, and it is impossible to obtain any distance desired within a s.t. of the streets shown. To arrive at definite Ds it would be necessary to survey the entire tract, since there are no lot corners existing.
H.

WESTERN AVE.

Transit Line

Fd. LAT curb.

R=80' (Rec.)

18' gutter curb

wall

(90-03-00)
(260-12-30)
90°03-07½"

R=10

curb

15' gutter

0.12

Corner 0.5 (90°04-40 Rec.)

Identical.

5.48

3.08

set 2x2 flush by inters'n

Transit Line

34°
321.34 - T 66° = 321.30

Fd. LAT curb.

macadam

ROSEWOOD AVE.

20.13

To st&rt
R La Cienega
Pvmt

15' gu Mar (conc.)

Note: ANY ADDITIONS OR CHANGES ON THIS SHEET MUST BE MADE OR CIRCLED IN Red Ink. WITH DATE AND NAME OF PERSON MAKING CHANGE.

Do not extend notes this side of this line

RETURN TO
LOS ANGELES COUNTY SURVEYOR
700 HALL OF RECORDS

R=90' (Rec.)

R=15'

curb
1.0' gutter

macadam

1.5 conc. gutter

curb

walk

(152°-18-30)
(249-14-00)
152°-18'-30"

TRACT N 5105.

FORM 247 10M 5-31

RETURN TO
LOS ANGELES COUNTY SURVEYOR
700 HALL OF RECORDS

Note: ANY ADDITIONS OR CHANGES ON THIS SHEET MUST BE MADE OR CIRCLED IN Red Ink. WITH DATE AND NAME OF PERSON MAKING CHANGE.

W.S. 22 C-3

Do not extend notes this side of this line

1/30/34

AVE

Fd. Wire Spike & Tag L.A. City F.B. 841/75 9/21/56

City Eng's &

LA CIENEGA BLVD.

Fd. Wire Spike & Tag L.A. City F.B. 841/75 9/21/56

89° 59' 20"

19.91 20.05

TRACT No. 5105.

ROSEWOOD

WEST MOUNT DR.

F.B. 505 Pg. 286

(From Rt. side Pg. 285)

Notes Ck'd by	Drew	Survey of	
Map No.	B-998	W. O.	8038
Office Work	Cox	Tape No.	C67
Checked	Drew	St'd	84
Date	2-15-34	Surveyed by	Evans
		Notes	FE
		Date	1/29/34
		Indexed	A. C. Johnson

F.B. 505 PG. 287

set L4T Line Rod in driveway.

Curb.

Curb.

154 — 1519

(50)

TR. No 5105.

WESTMOUNT DR.

Transit Line.

(from top pg. 284)

Note: ANY ADDITIONS OR CHANGES ON THIS SHEET MUST BE MADE OR CIRCLED IN Red Ink. WITH DATE AND NAME OF PERSON MAKING CHANGE.

Do not extend notes this side of this line

RETURN TO
LOS ANGELES COUNTY SURVEYOR
700 HALL OF RECORDS

FORM 247 10M 8-31

F.B. 505 Pg 288

(From bot. pg. 284) 1/31/34

WESTMOUNT DR.

24.92 Fd. 2x2+Tk. N.W. cor. Lot 6 Blk. I.

25.04 Fd. 2x2+Tk. N.W. cor. Lot 4 Blk. I.

T.R. No. 5105.

(50)

curb

curb

25.09 Fd. 2x2+Tk. N.W. cor. Lot 1 Blk. I.

15.5 15.5

Sot Lot Line Prod.

RETURN TO
LOS ANGELES COUNTY SURVEYOR
700 HALL OF RECORDS

Do not extend notes this side of this line

Note: ANY ADDITIONS OR CHANGES ON THIS SHEET MUST BE MADE OR CIRCLED IN Red Ink. WITH DATE AND NAME OF PERSON MAKING CHANGE.

Notes Ck'd by	Drew	Survey of	Rancho La Brea
Map No.	B-998	W. O.	5053 Tape No. 62 St'd ✗ °F.
Office Work	Cox	Surveyed by	Evans
Checked	Drew	Notes	Date 1/31/34
Date	2-15-34	Indexed	A. C. Johnson

F.B. 505 Pg. 289

Nothing fd. Rd. Light ties S (F.C. 892/6) on a cut.

(70) MELROSE AVE

DR.

(50)

TR. No. 5105.

ALLEY

Fd. P.M.S in Sewer M.H.

1517 — 1522

WEST KNOLL Tract

(From top pg. 285)

Note: ANY ADDITIONS OR CHANGES ON THIS SHEET MUST BE MADE OR CIRCLED IN Red Ink, WITH DATE AND NAME OF PERSON MAKING CHANGE.

Do not extend notes this side of this line

RETURN TO
LOS ANGELES COUNTY SURVEYOR
700 HALL OF RECORDS

FORM 247 10M 5-31

RETURN TO
LOS ANGELES COUNTY SURVEYOR
700 HALL OF RECORDS

Note: ANY ADDITIONS OR CHANGES ON THIS SHEET MUST BE MADE OR CIRCLED IN **Red** Ink. WITH DATE AND NAME OF PERSON MAKING CHANGE.

Do not extend notes this side of this line

Location of Imprvts
ROSEWOOD CIRCLE

1/31/34

F.B. 505 Pg 8490

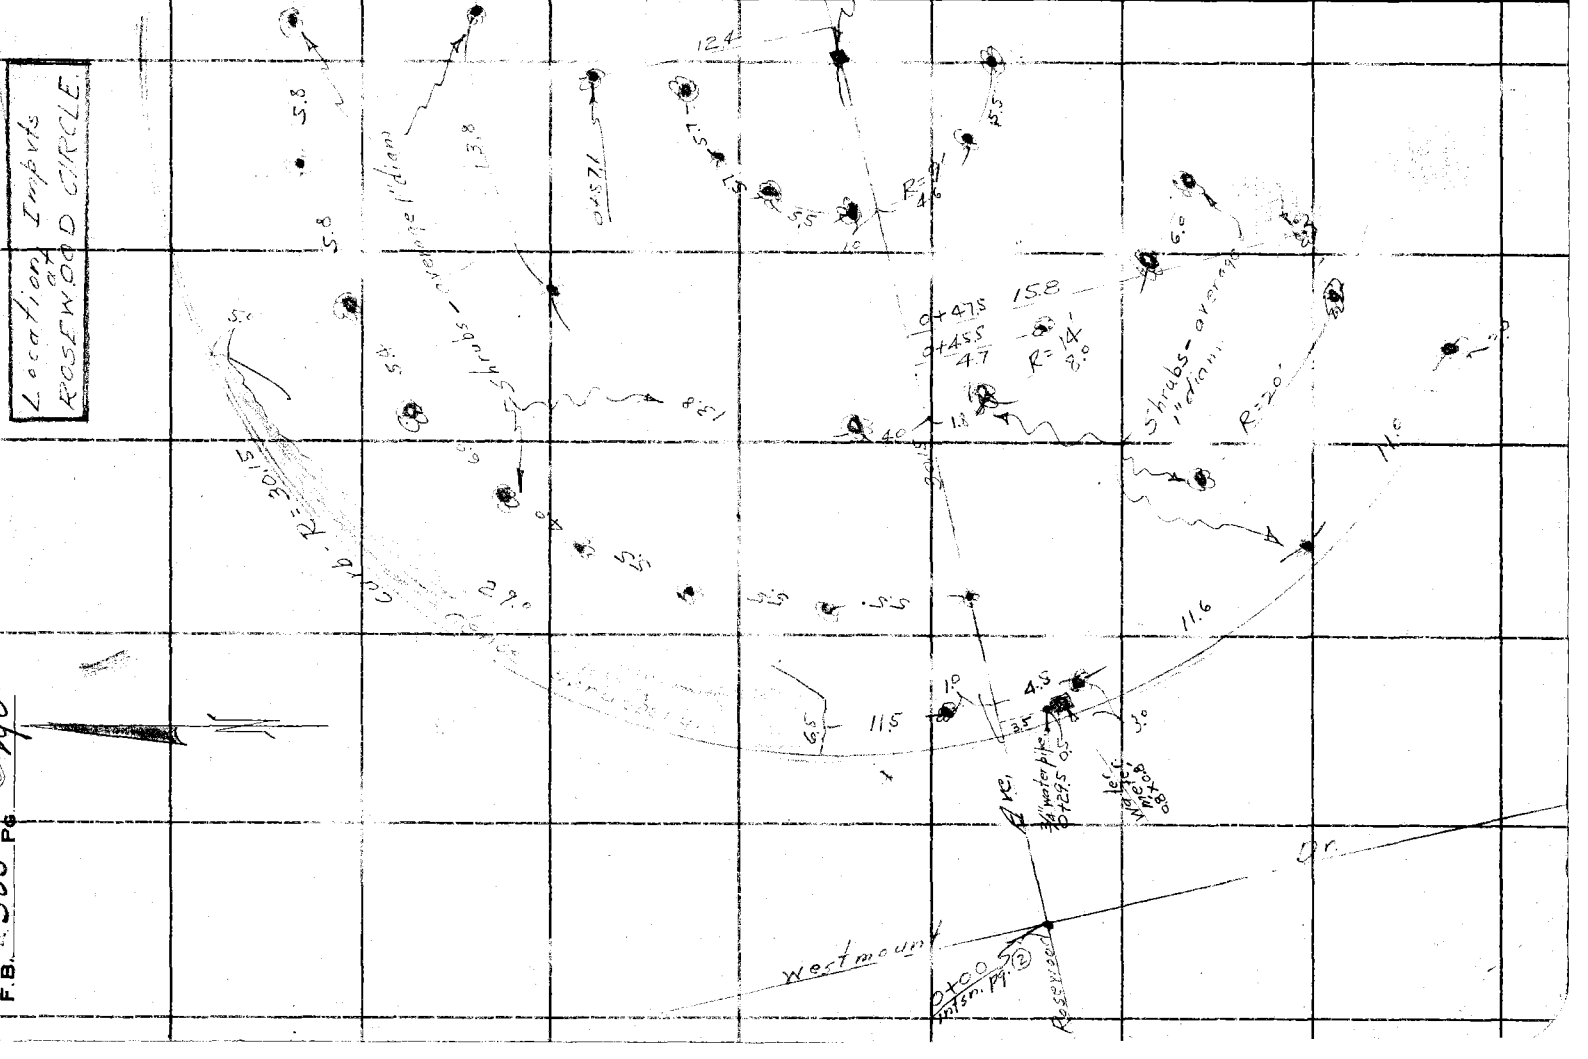

Notes Ck'd by	Drew	Survey of	Partition Map
Map No.	B-928	W. O.	2021
Office Work	Cox	Tape No.	001
Checked	Drew	St'd	24
Date	2-15-34	Surveyed by	Evans
		Notes	
		Date	11/31/34
		Indexed	A. C. Johnson

F.B. 505 PG 291

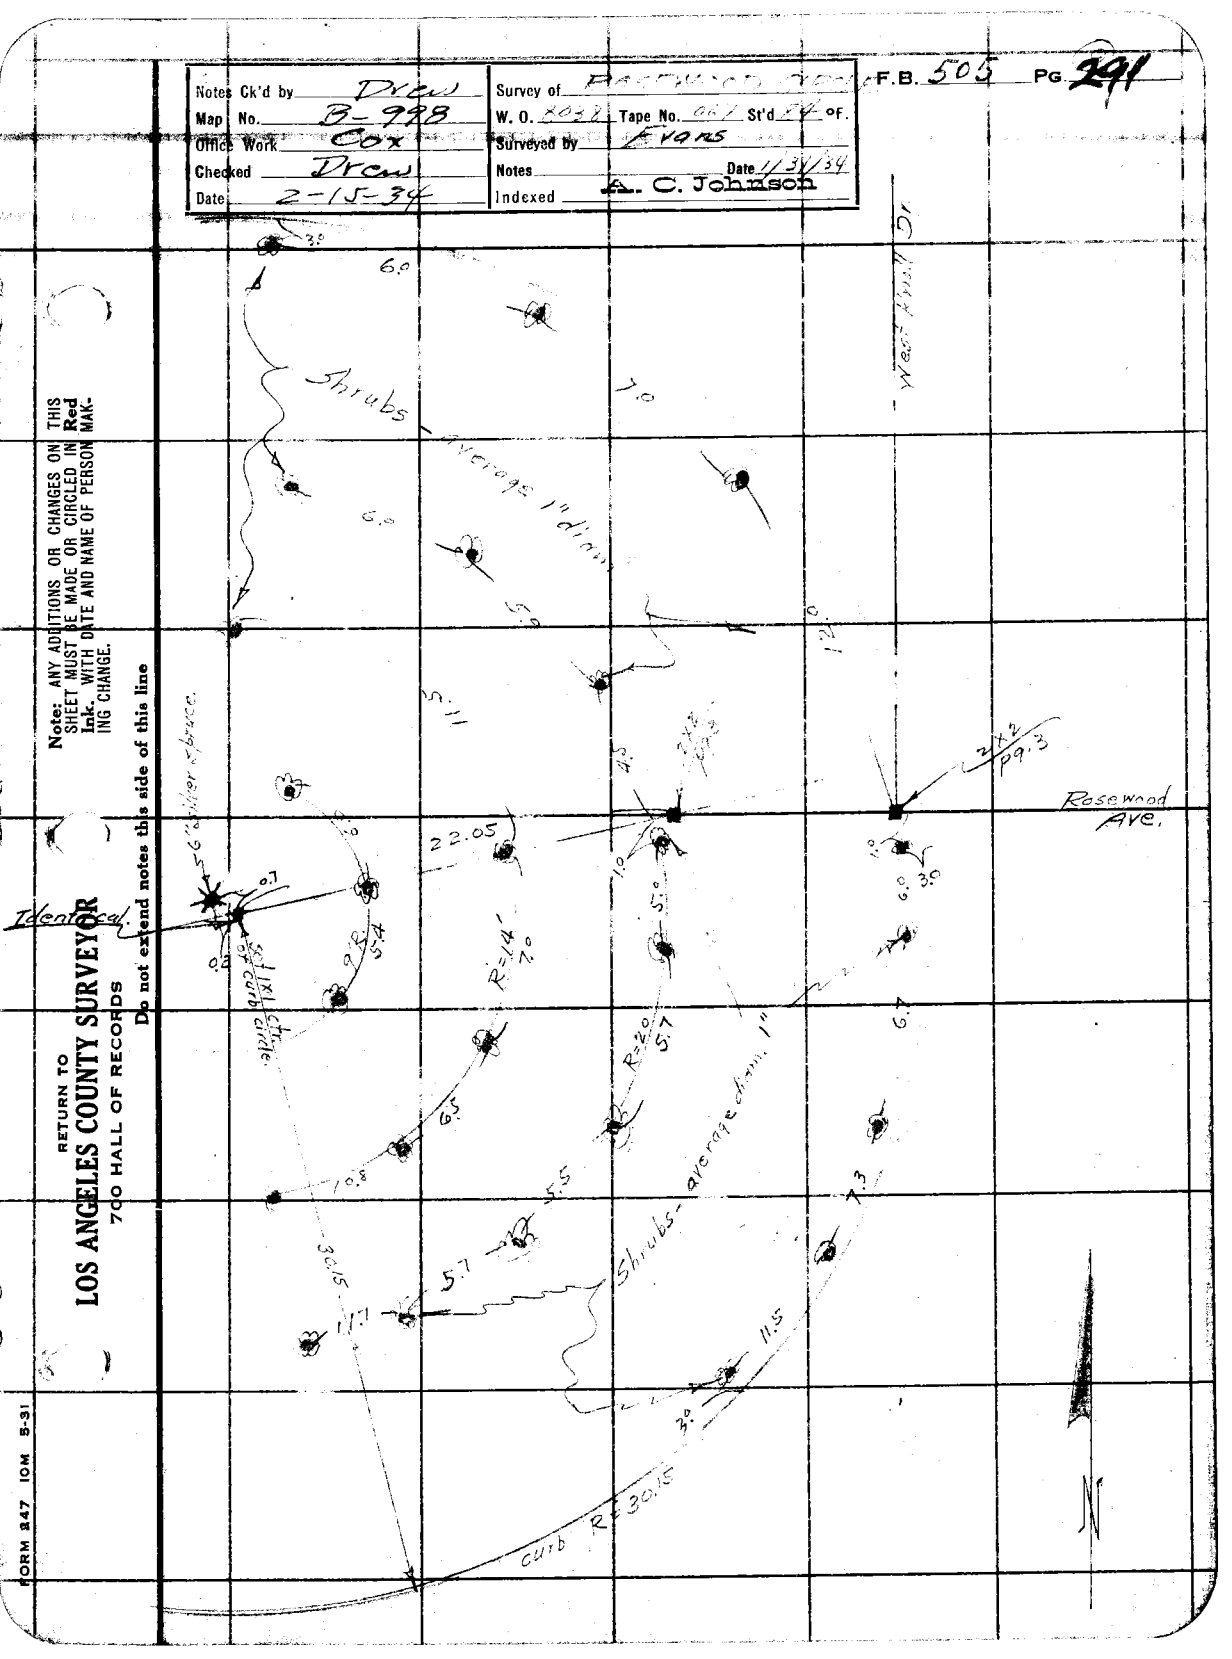

Note: ANY ADDITIONS OR CHANGES ON THIS SHEET MUST BE MADE OR CIRCLED IN Red Ink. WITH DATE AND NAME OF PERSON MAKING CHANGE.

Do not extend notes this side of this line

RETURN TO
LOS ANGELES COUNTY SURVEYOR
720 HALL OF RECORDS

FORM 247 10M 5-31

RETURN TO
LOS ANGELES COUNTY SURVEYOR
700 HALL OF RECORDS

Note: ANY ADDITIONS OR CHANGES ON THIS SHEET MUST BE MADE OR CIRCLED IN Red Ink. WITH DATE AND NAME OF PERSON MAKING CHANGE.

Do not extend notes this side of this line

F.B. 505 Pg. 192

297

Notes Ck'd by	Drew	Survey of	Santa Rosa Park
Map No.	B-660	W. O.	8036 Tape No. 045 St'd 84 °F.
Other Work		Surveyed by	
Checked	Drew	Notes	Date 2-1-34
Date	2-19-34	Indexed	A. C. Johnson

F.B. 505 PG. 297

SANTA ROSA PARK.

At intersection of Santa Rosa Ave. and Woodbury Road, Altadena.

Job 8036

Party.

E. A. Rosecrans
R. C. Bowers
J. A. Willess
K. H. Schneider.

Note: ANY ADDITIONS OR CHANGES OF THIS SHEET MUST BE MADE ON THIS CIRCLED IN Red Ink. WITH DATE AND NAME OF PERSON MAKING CHANGE.

Do not extend notes this side of this line

RETURN TO
LOS ANGELES COUNTY SURVEYOR
700 HALL OF RECORDS

FORM 247 10M 5-31

RETURN TO
LOS ANGELES COUNTY SURVEYOR
700 HALL OF RECORDS

Note: ANY ADDITIONS OR CHANGES ON THIS SHEET MUST BE MADE OR CIRCLED IN **Red Ink.** WITH DATE AND NAME OF PERSON MAKING CHANGE.

Do not extend notes this side of this line

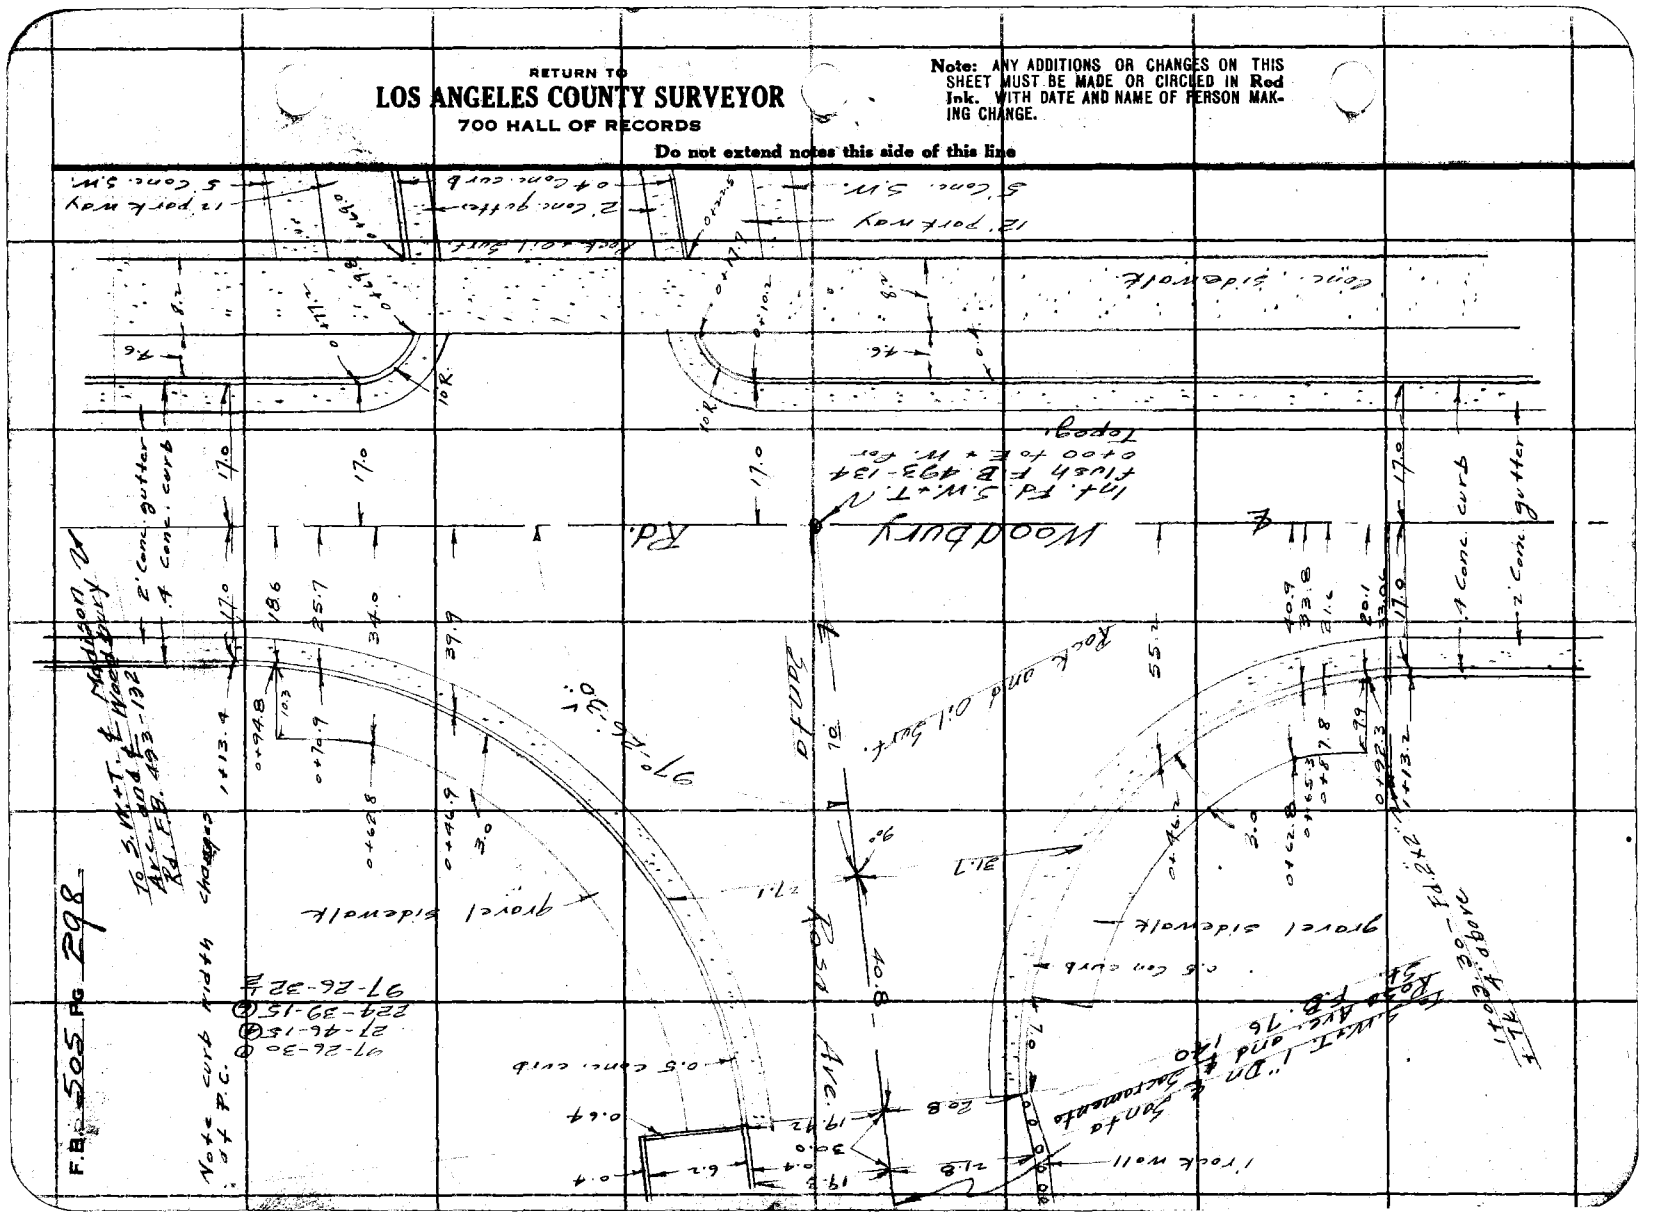

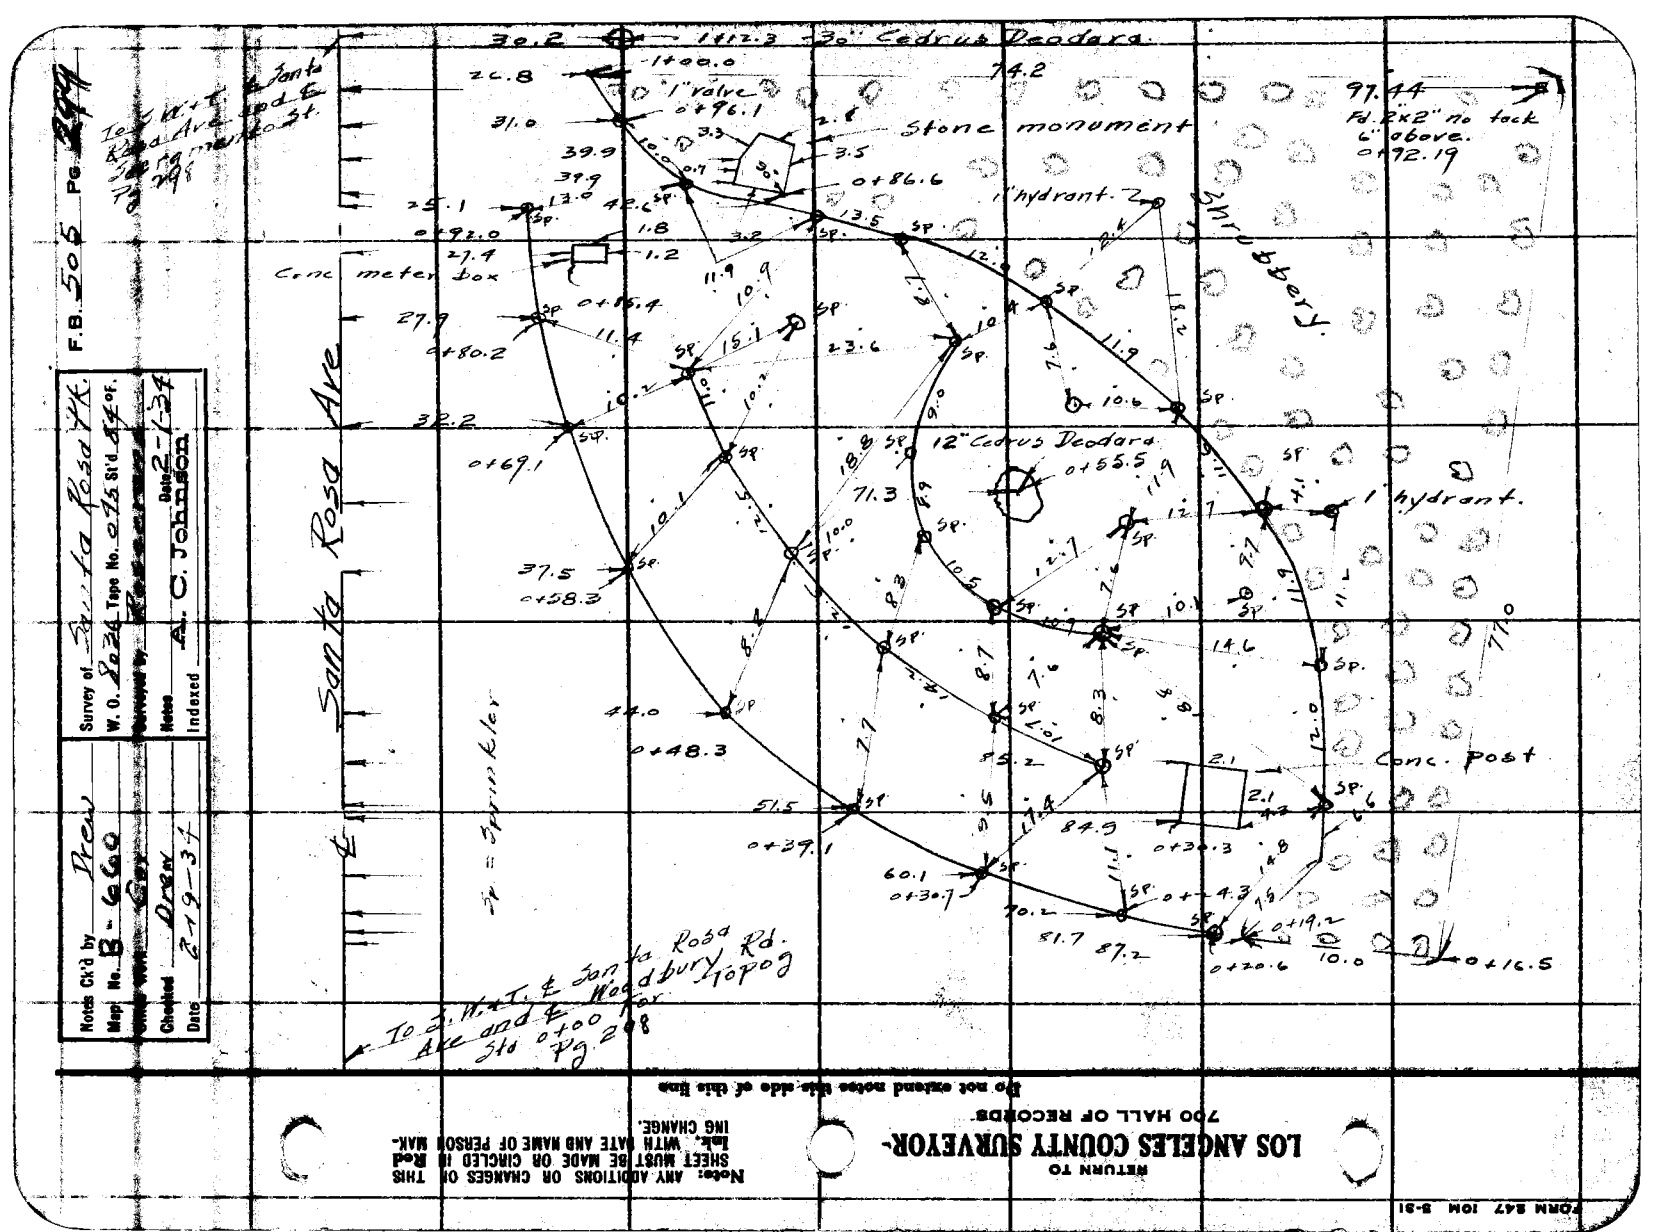
F.B. 505 Pg. 2999
Survey of Santa Rosa Ave.
Surveyed by
Notes A. C. Johnson
Date 2-6-34
Indexed
Notes Ck'd by Prew
Map No. B-6660
Check
Date 2-19-34
Santa Rosa Ave.
Conc meter box
1" valve
Stone monument
1" hydrant
12" Cedrus Deodara
Conc. Post
Woodbury Ave.
RETURN TO
LOS ANGELES COUNTY SURVEYOR-
700 HALL OF RECORDS
Do not extend notes into side of this line
NOTE: ANY ADDITIONS OR CHANGES ON THIS SHEET MUST BE MADE ON CIRCLED IN Red Ink. WITH DATE AND NAME OF PERSON MAKING CHANGE.
FORM 847 10M 8-31

RETURN TO
LOS ANGELES COUNTY SURVEYOR
700 HALL OF RECORDS

Note: ANY ADDITIONS OR CHANGES ON THIS SHEET MUST BE MADE OR CIRCLED IN **Red Ink.** WITH DATE AND NAME OF PERSON MAKING CHANGE.

Do not extend notes this side of this line

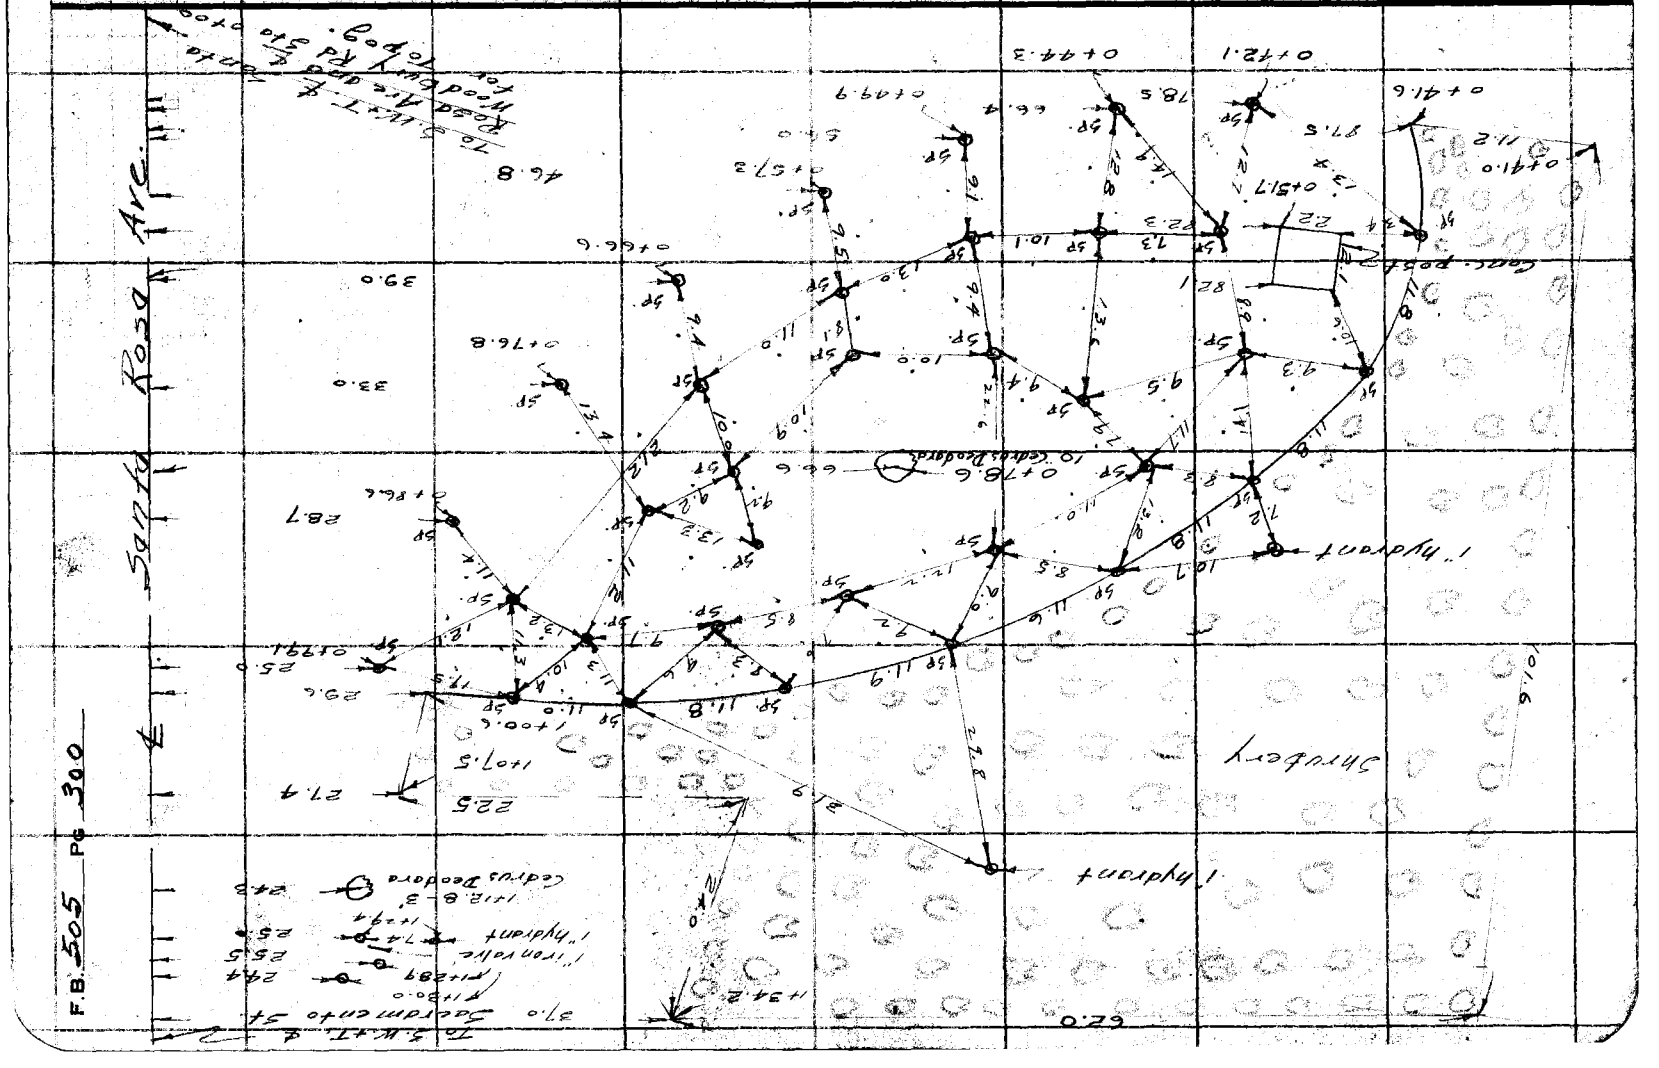

FORM 247 IOM 8-31

RETURN TO
LOS ANGELES COUNTY SURVEYOR
700 HALL OF RECORDS

Note: ANY ADDITIONS OR CHANGES ON THIS SHEET MUST BE MADE OR CIRCLED IN Red Ink. WITH DATE AND NAME OF PERSON MAKING CHANGE.

Do not extend notes this side of this line

W.S. 50 B-2

Noted Ck'd by Drew
Map No. B-660
Compared with Cox
Checked Drew
Date 2-19-34

Survey of Santa Rosa Park
W. O. 803 6 Tape No. 2266 Std. 84 of.
Surveyed by A. T. Dunlap
Notes Dunlap
Indexed A. C. Johnson Date 2-19-34

F.B. 505 Pg. 301

(Set 2" I.Ps. in conc. Flush with Brass Caps Marked)

(50) (20)

(30) WOODBURY ROAD (30)

Fd 2x2

97.01 T=64°F

90-00

97.00'

Fd. C.S.W. & T. Per F.B. 505-298

Set 1x2

37.50'

12.40'

SANTA ROSA AVE. (37.5)

63.10 T=64°F

63.09'

Set Nail

80.01 T=64°

80-00

℄ per F.B. 505-298 (37.5)

30.25

98.33'

98.34 T=64°F

Set Nail

29.34'

37.50 T=64°F

Set Nail

37.50'

9-26-30

0-07-00

60.00'

60.01 T=64°F

(Set 2" I.Ps. in conc. Flush with Brass Caps Marked)

COUNTY SURVEYOR SANTA ROSA PARK 62 MONUMENT

Fd 2x2

Fd 2x2

(30) (30)

RETURN TO

LOS ANGELES COUNTY SURVEYOR

700 HALL OF RECORDS

Note: ANY ADDITIONS OR CHANGES ON THIS SHEET MUST BE MADE OR CIRCLED IN **Red Ink.** WITH DATE AND NAME OF PERSON MAKING CHANGE.

Do not extend notes this side of this line

F.B. 505 Pg. 302

Notes Ck'd by	Survey of	F.B. 505 Pg. 303
Map No.	W. O. Tape No. St'd °F	
Office Work	Surveyed by	
Checked	Notes Date	
Date	Indexed 11-19-40	

TEMPLE PARK

- J.N. 8026 -

Sprinkler Systems

See Pg- 161 For Bdry Survey

Note: Any Additions or Changes on This Sheet Must be Made or Circled in Red Ink With Date and Name of Person Making Change.

Do not extend notes this side of this line.

RETURN TO
LOS ANGELES COUNTY SURVEYOR
700 HALL OF RECORDS.

FORM 247 SM 1039

F.B. 503 Pg 304

Temple Park
Index To Sprinkler System

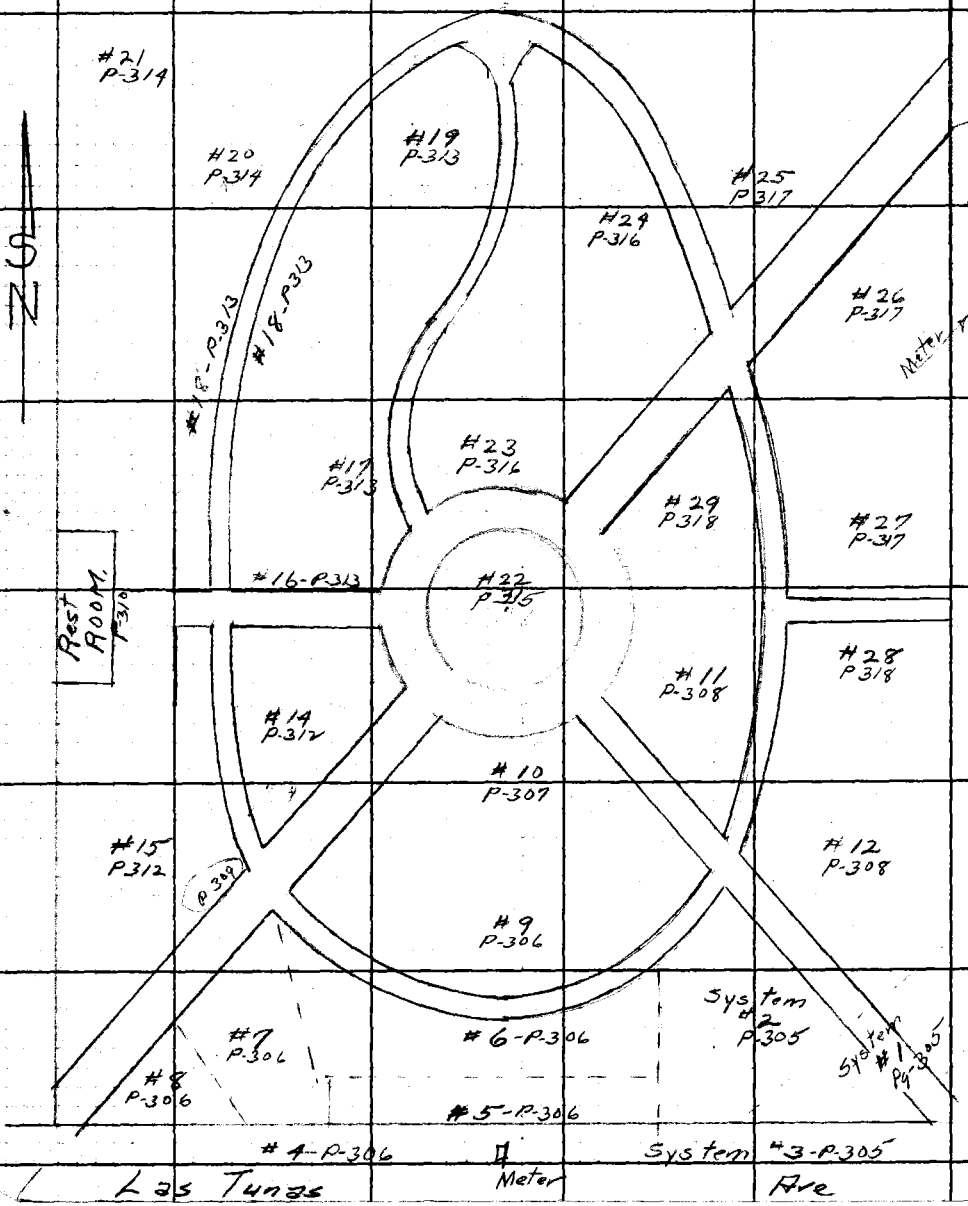

RETURN TO
LOS ANGELES COUNTY SURVEYOR
700 HALL OF RECORDS

Do not extend notes this side of this line.

Note: Any Additions or Changes or This Sheet Must be Made or Circled in Red Ink With Date and Name of Person Making Change.

FORM 247 5M 10-39

RETURN TO
LOS ANGELES COUNTY SURVEYOR
700 HALL OF RECORDS

Note: Any Additions or Changes on This Sheet Must be Made or Circled in **Red Ink** With Date and Name of Person Making Change.

Do not extend notes this side of this line.

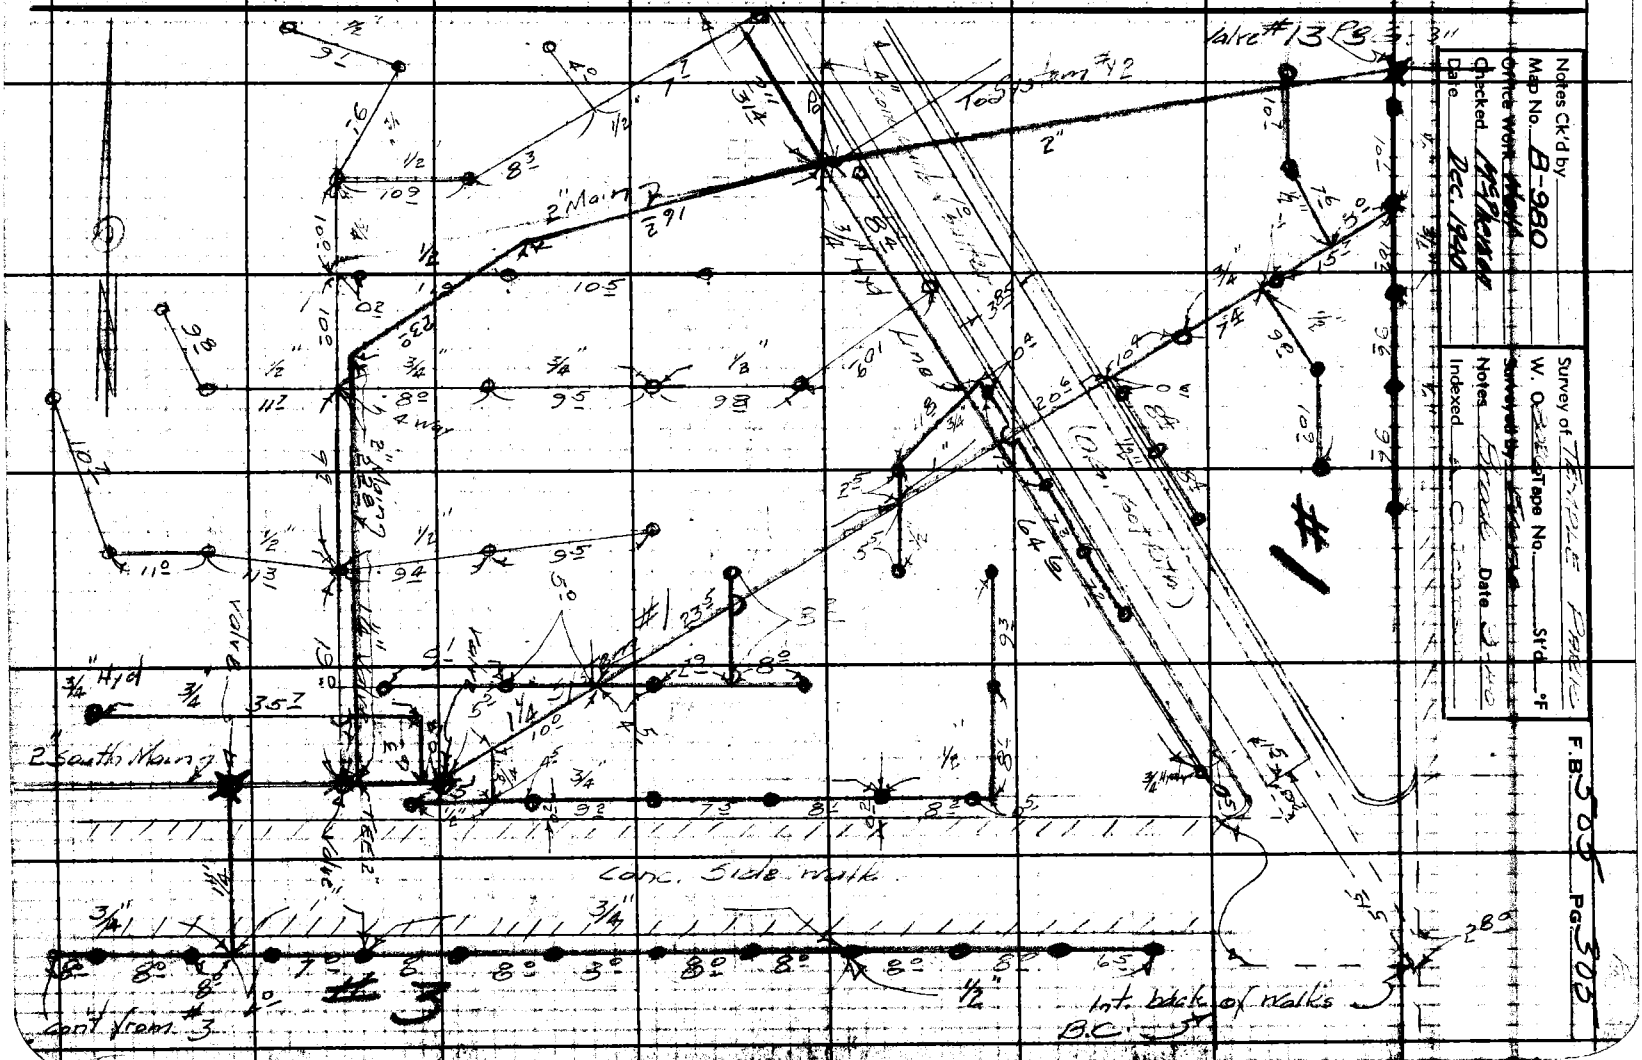

Notes Ck'd by _____
Map No. B-980
Office Work _____
Checked _____
Date Dec. 1940

Survey of _____
W. O. _____ Tape No. _____ St'd _____ °F
Surveyed by _____ Date _____
Notes _____
Indexed _____


RETURN TO
LOS ANGELES COUNTY SURVEYOR
700 HALL OF RECORDS

Note: Any Additions or Changes on This Sheet Must be Made or Circled in Red Ink With Date and Name of Person Making Change.

Do not extend notes this side of this line.

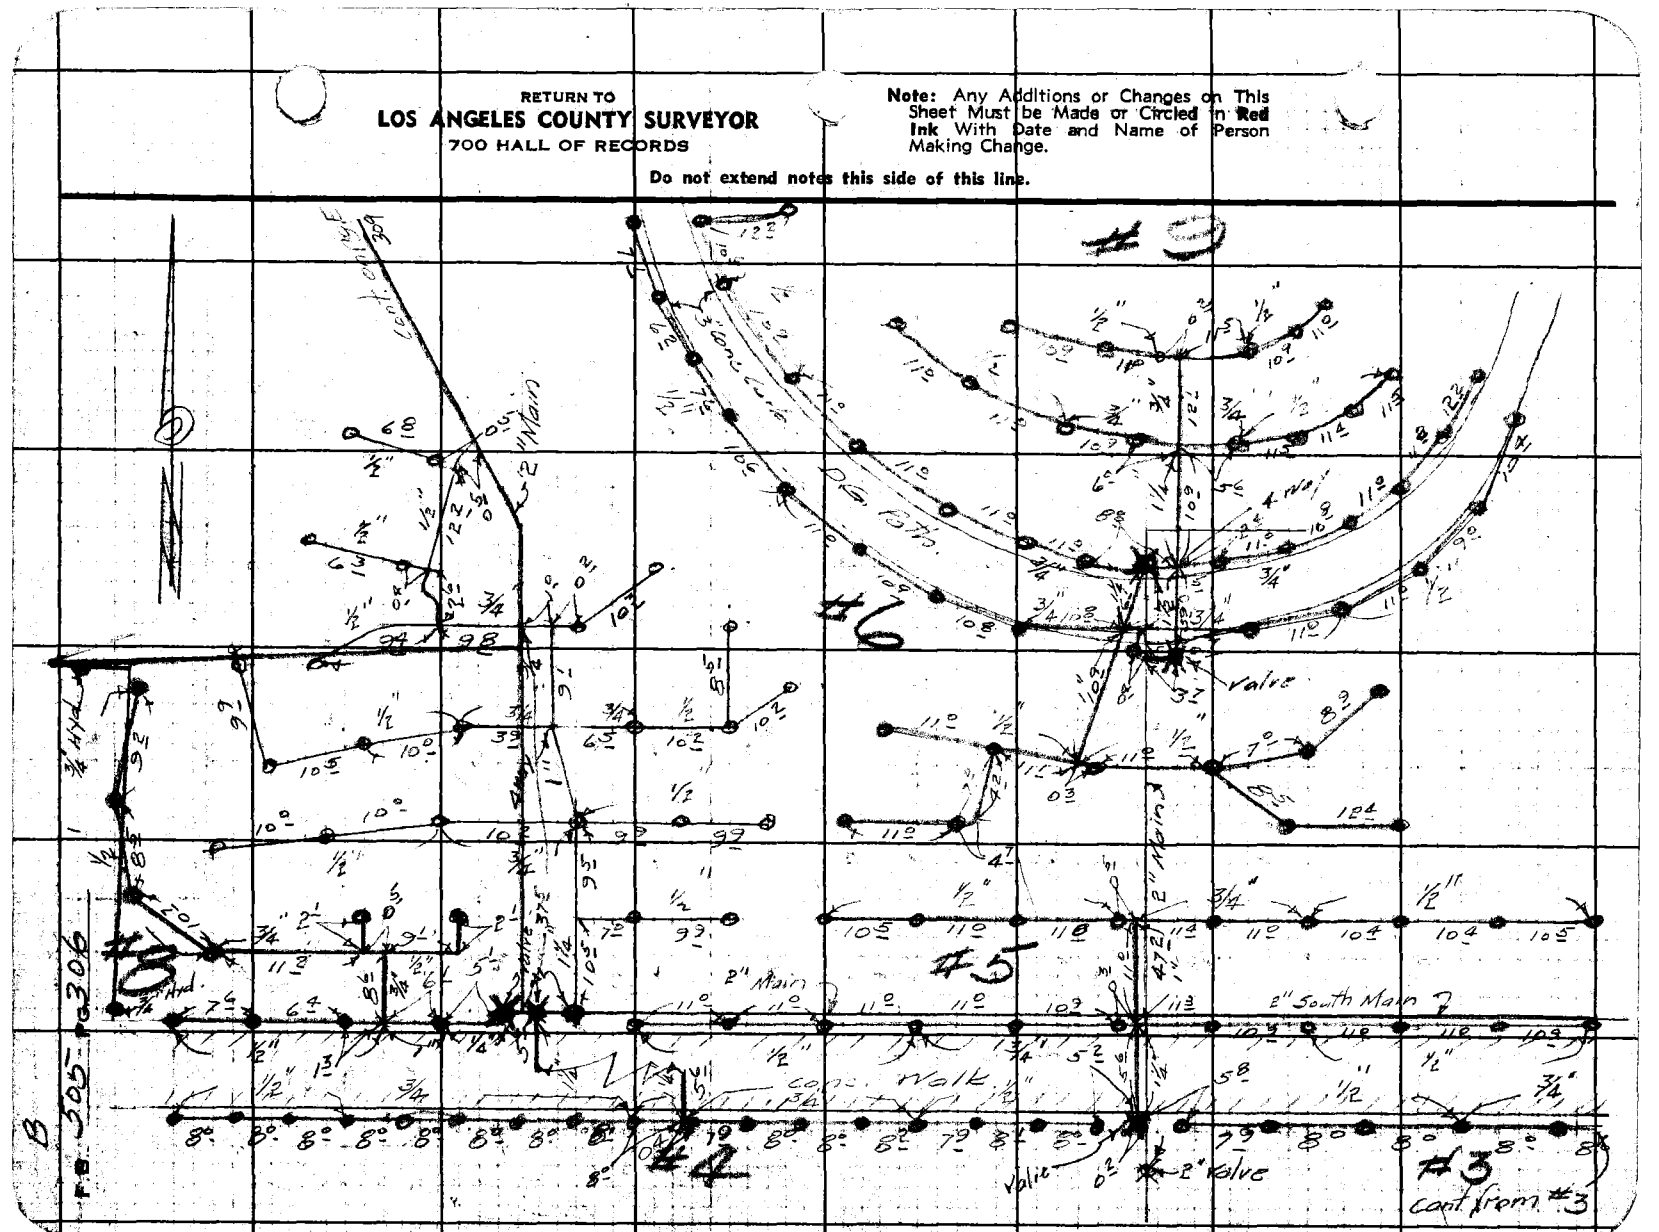

FORM 247 5M 10-39

RETURN TO
LOS ANGELES COUNTY SURVEYOR
700 HALL OF RECORDS

Note: Any Additions or Changes on This Sheet Must be Made or Circled in **Red Ink** With Date and Name of Person Making Change.

Do not extend notes this side of this line.

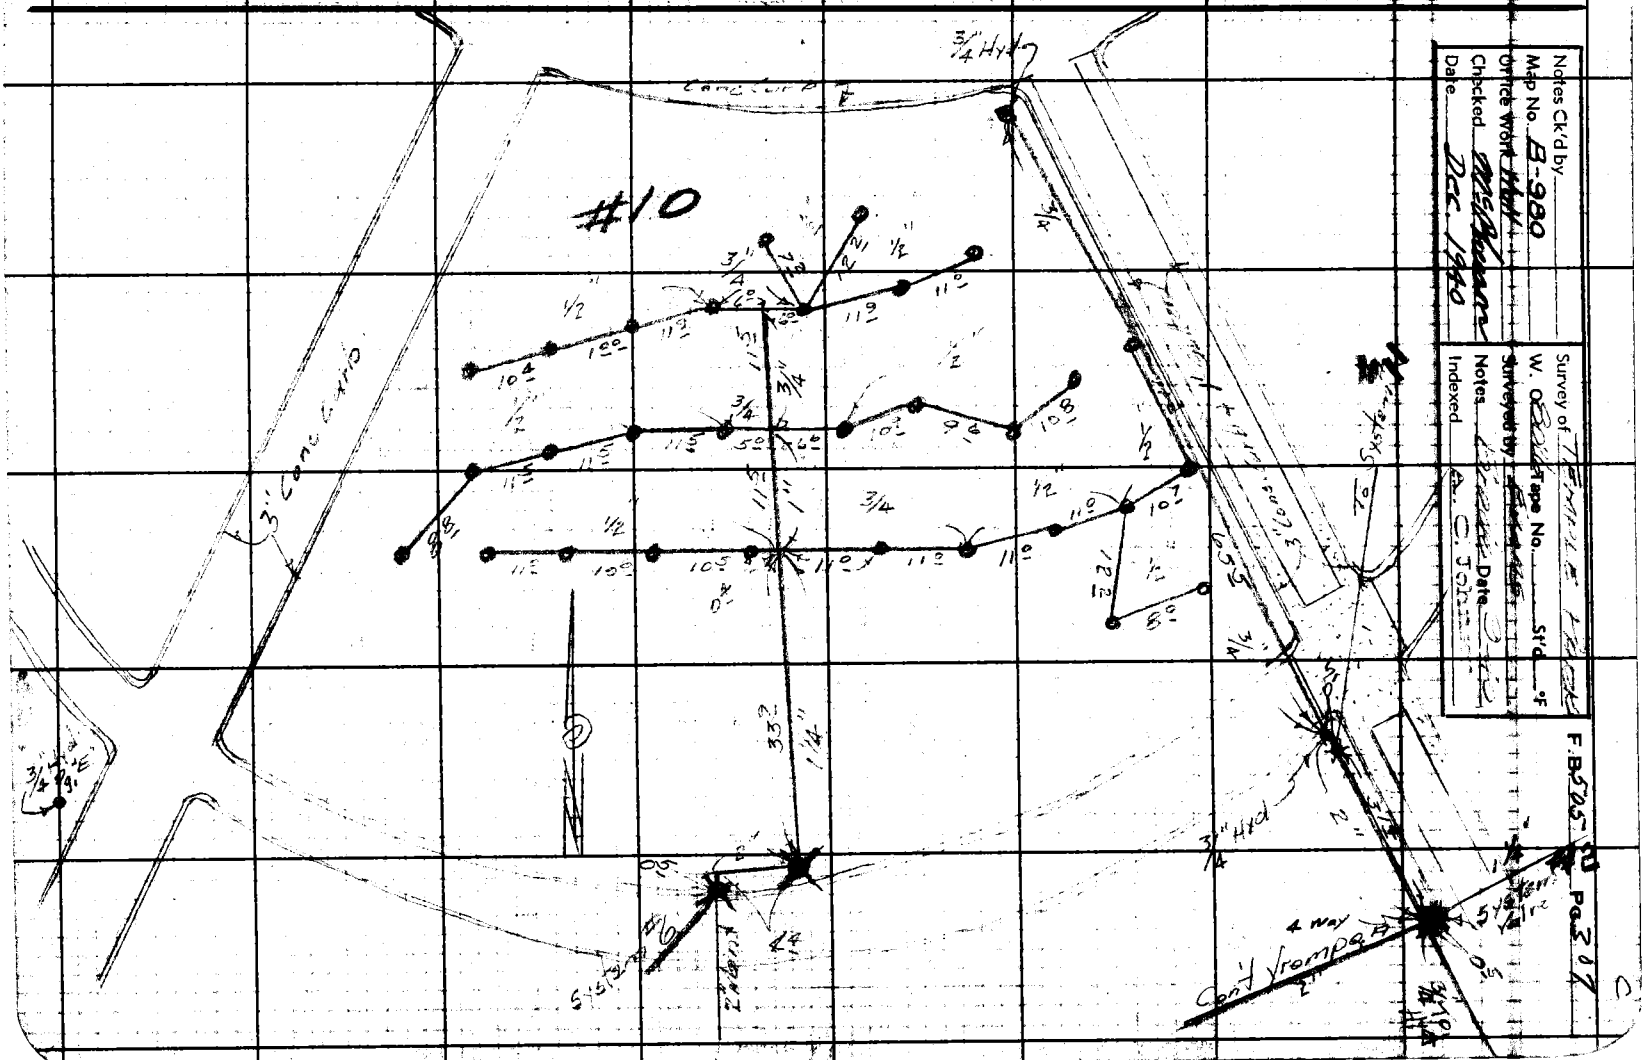

Notes Ck'd by _____
Map No. B-980
Office work Mtl
Checked MSK
Date Dec. 1940

Survey of Temple St. Area
W. O. _____ Tape No. _____ Std. _____ °F
Surveyed by _____ Date _____
Notes _____
Indexed _____ Date _____

RETURN TO
LOS ANGELES COUNTY SURVEYOR
700 HALL OF RECORDS

Note: Any Additions or Changes on This Sheet Must be Made or Circled in Red Ink With Date and Name of Person Making Change.

Do not extend notes this side of this line.

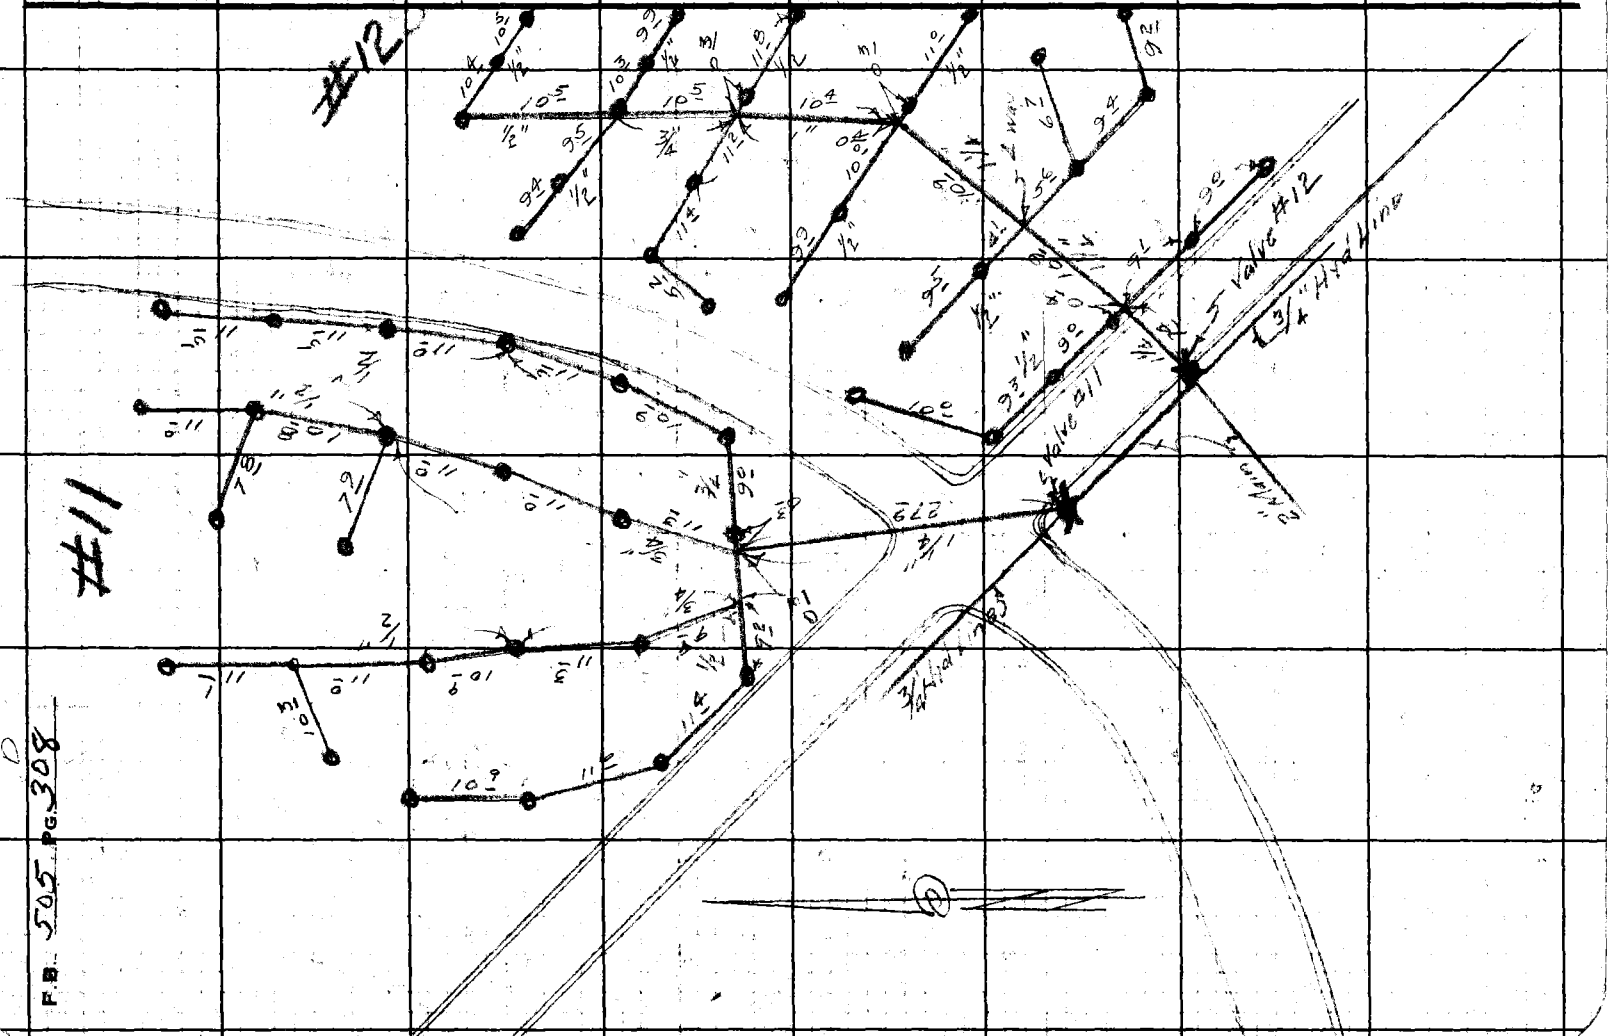

FORM 247 5M 10-39

RETURN TO
LOS ANGELES COUNTY SURVEYOR
700 HALL OF RECORDS

Note: Any Additions or Changes on This Sheet Must be Made or Circled in **Red Ink** With Date and Name of Person Making Change.

Do not extend notes this side of this line.

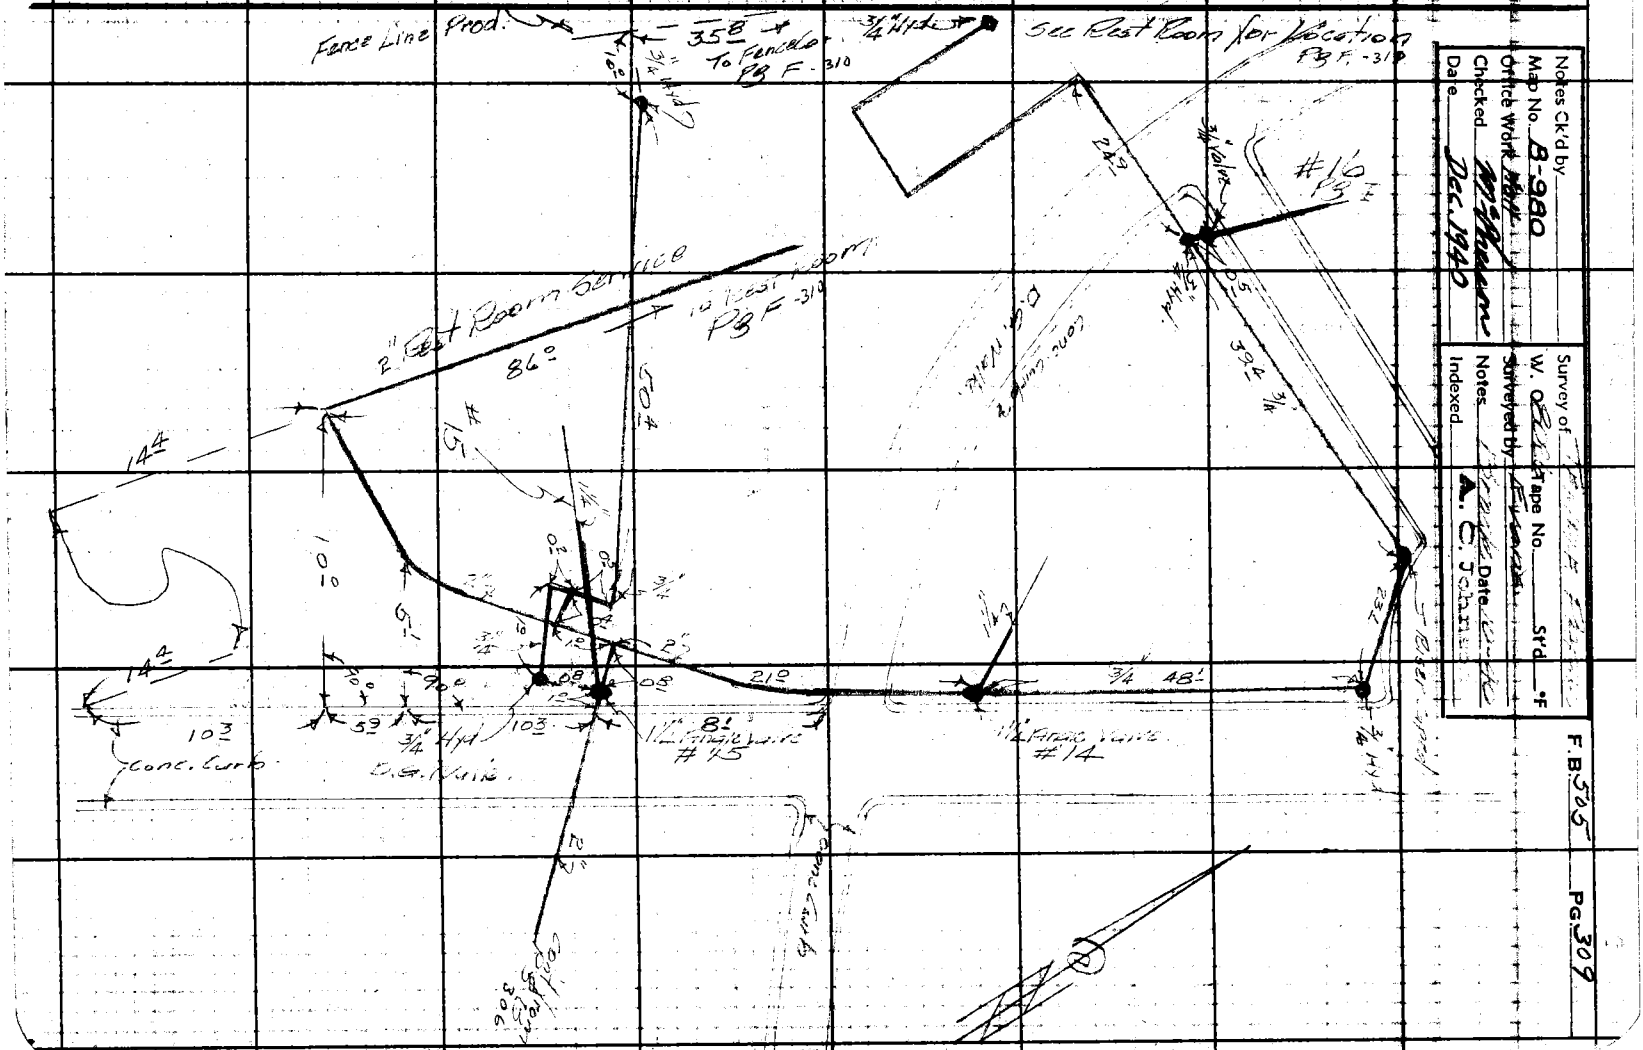

Notes Ck'd by
Map No. B-980
Office Work M. Shannon
Checked M. Shannon
Date Dec. 1940

Survey of W. 62nd St.
Tape No. Std. °F
Surveyed by F. Lyman
Notes
Indexed
A. C. Jahn Date

F.B. 505 PG. 309

RETURN TO
LOS ANGELES COUNTY SURVEYOR
700 HALL OF RECORDS

Note: Any Additions or Changes on This Sheet Must be Made or Circled in **Red Ink** With Date and Name of Person Making Change.

Do not extend notes this side of this line.

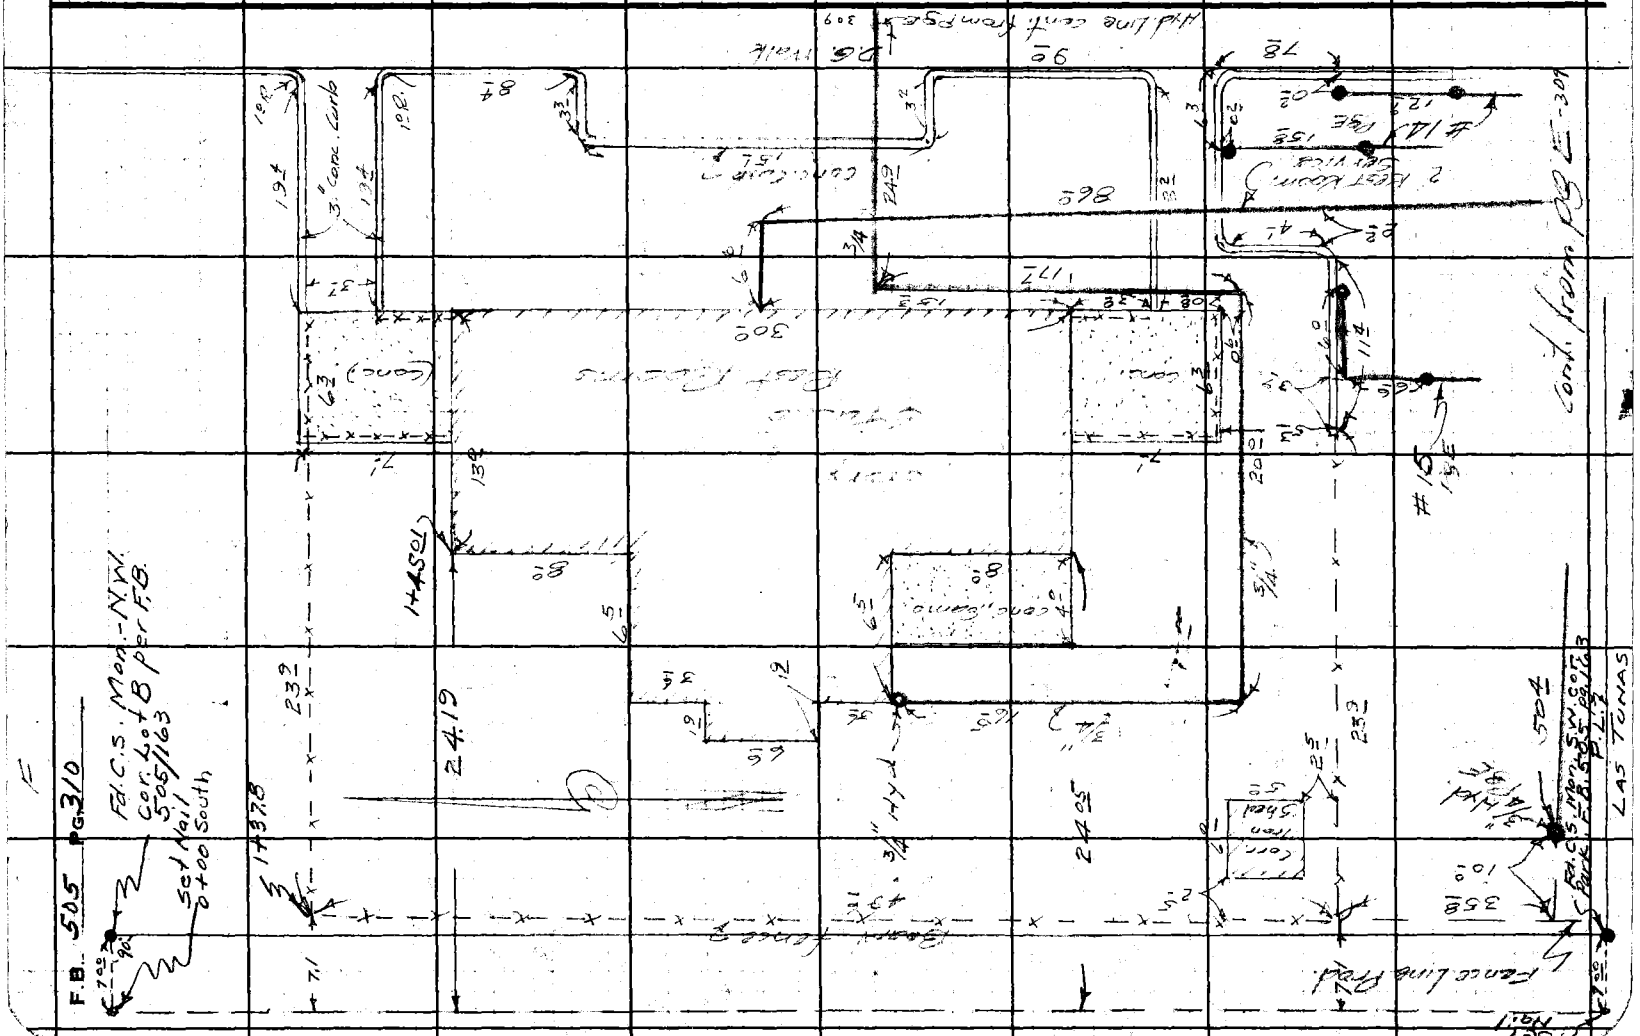
F.B. 505 Pg 310
F.A.C.S. Mon.-N.W.
505/163
Set Nail
0.00 South
Las Tunas
Fence Line Fwd.
Concrete Curb
Fence Line
Wall Line Cont. from Page 309
Cont. from Page 309
#15 15E
#16 15E
#14 15E

FORM 247 5M 10-39

RETURN TO
LOS ANGELES COUNTY SURVEYOR
700 HALL OF RECORDS

Note: Any Additions or Changes on This Sheet Must be Made or Circled in **Red Ink** With Date and Name of Person Making Change.

Do not extend notes this side of this line.

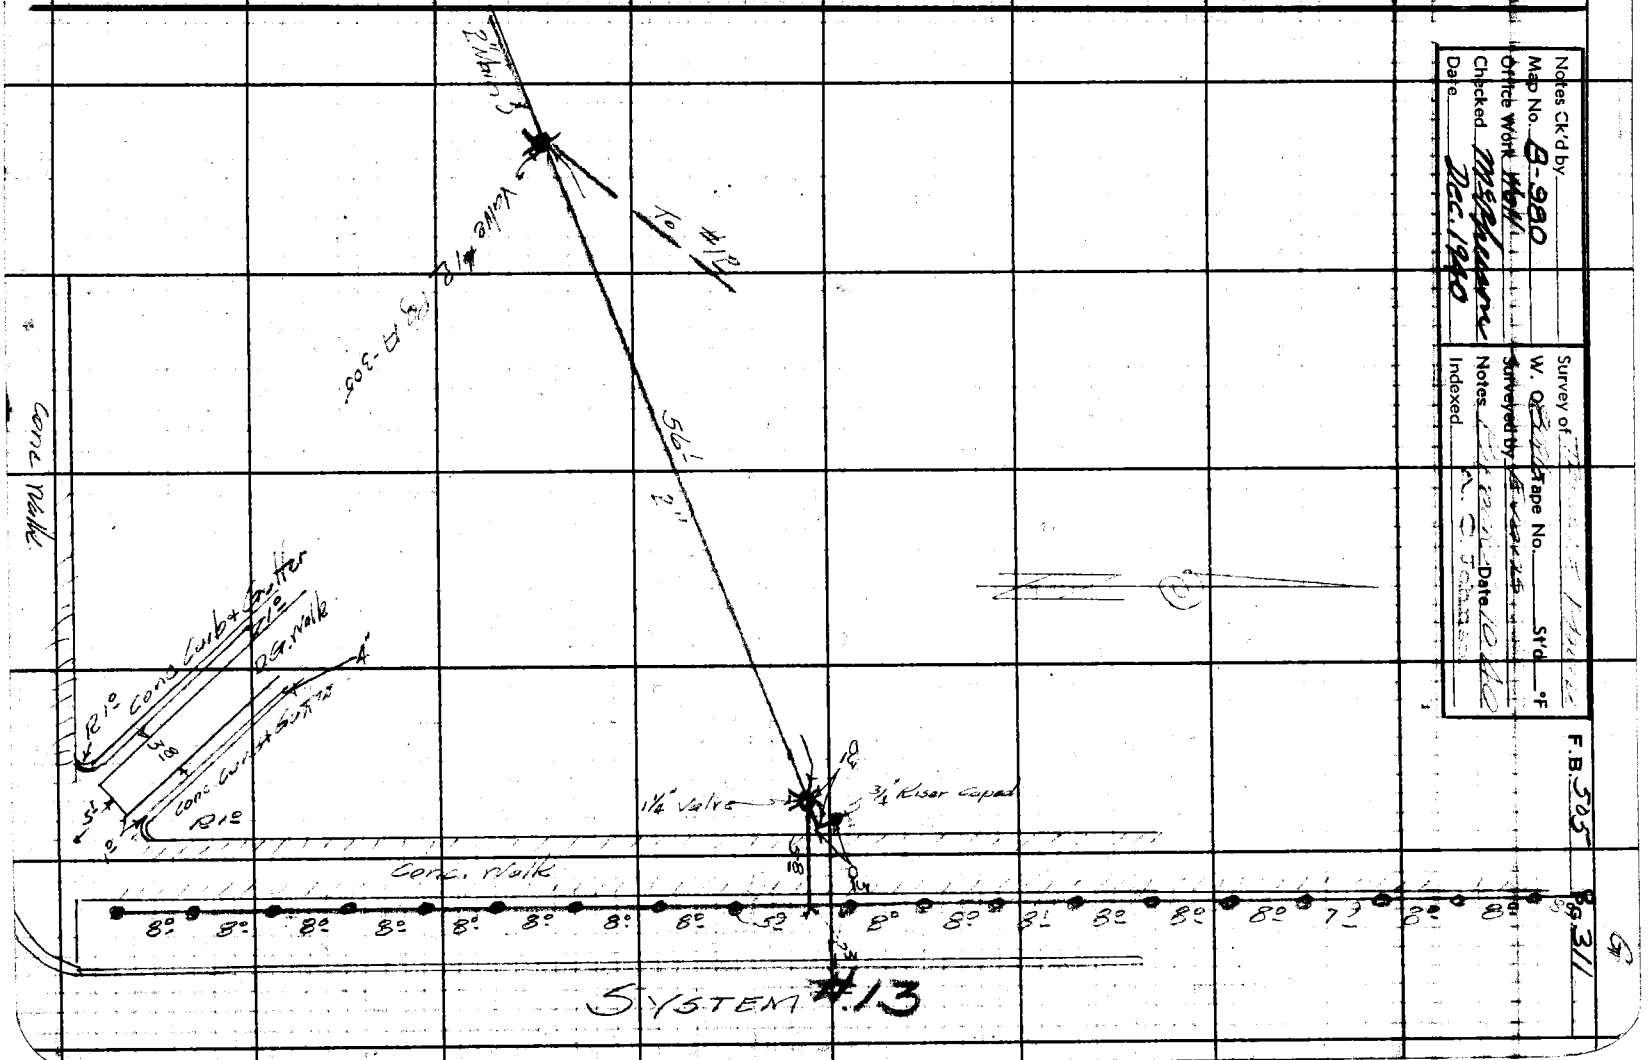

Notes Ck'd by _____
Map No. B-980
Office Work Mtl
Chkcked MSE Pharris
Date DEC. 1940

Survey of W. Q. Tape No. _____ Std _____ °F
Surveyed by _____ Date 12-40
Notes _____
Indexed _____

F.B. 505 Pg 31

RETURN TO
LOS ANGELES COUNTY SURVEYOR
700 HALL OF RECORDS

Note: Any Additions or Changes on This Sheet Must be Made or Circled in **Red Ink** With Date and Name of Person Making Change.

Do not extend notes this side of this line.

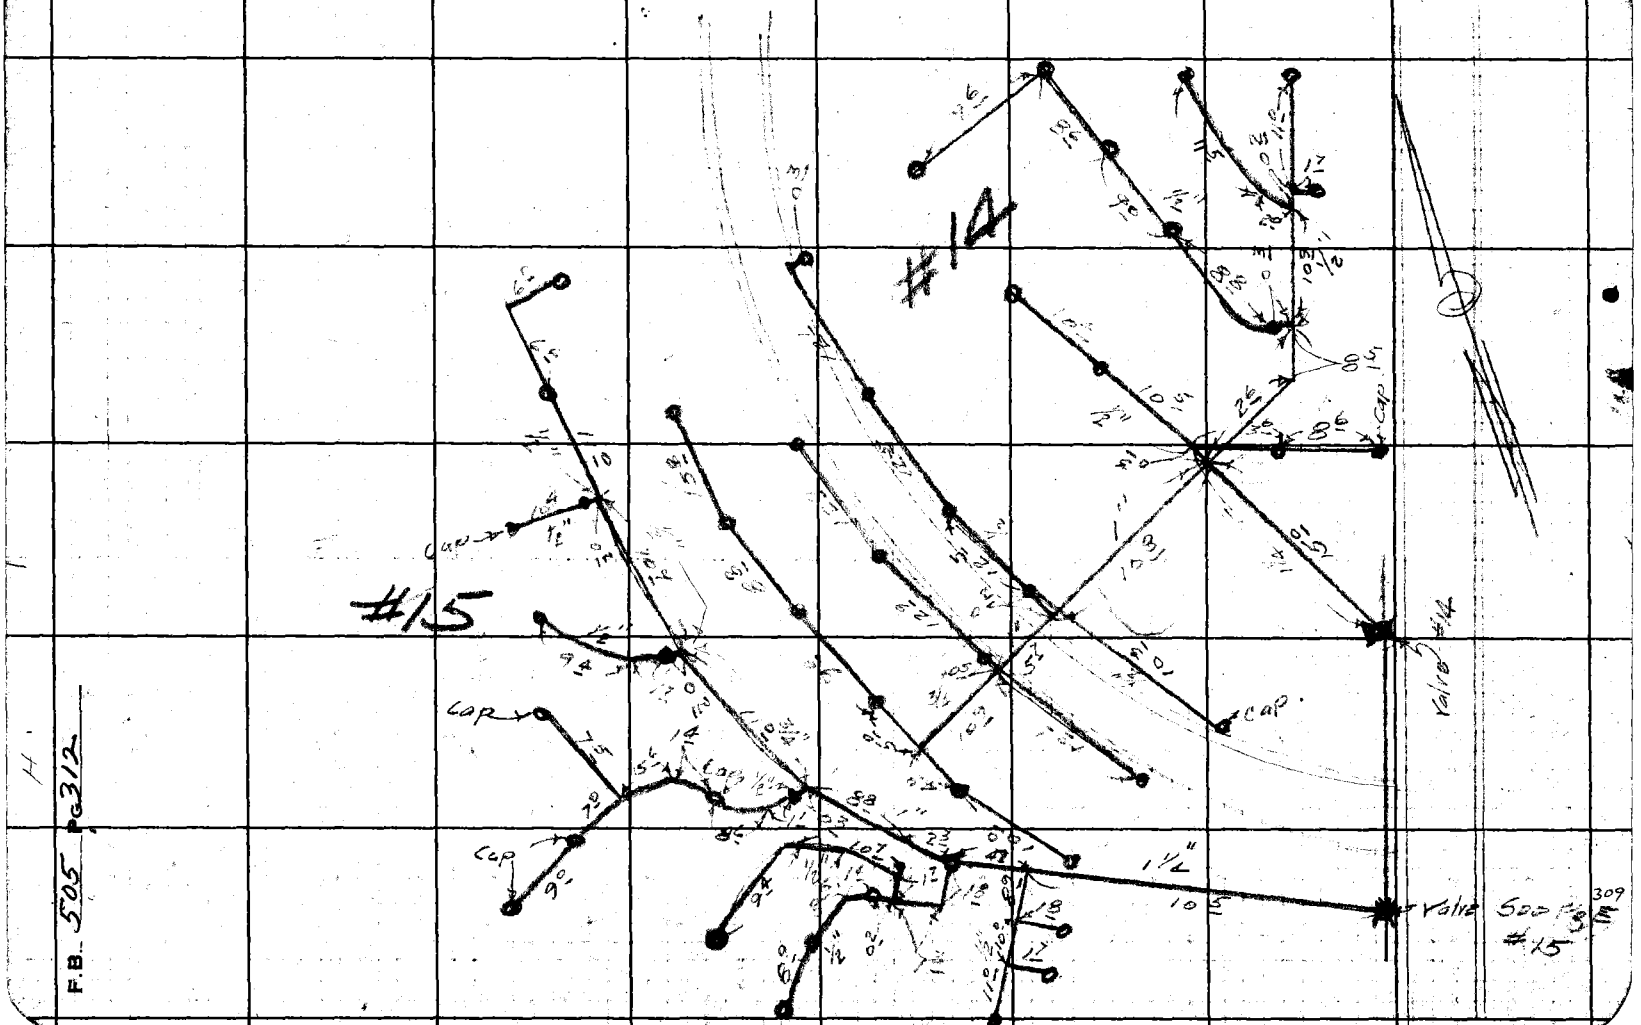


Notes Ck'd by	Survey of
Map No. B-980	W. O.	Tape No.	St'd	of
Office Work Hall	Surveyed by	
Checked McPherson	Notes	Date
Date Dec. 1940	Indexed	

Note: Any Additions or Changes on This Sheets Must be Made or Circled in Red Ink With Date and Name of Person Making Change.

Do not extend notes this side of this line

RETURN TO
LOS ANGELES COUNTY SURVEYOR
700 HALL OF RECORDS

FORM 247 5M 10-37

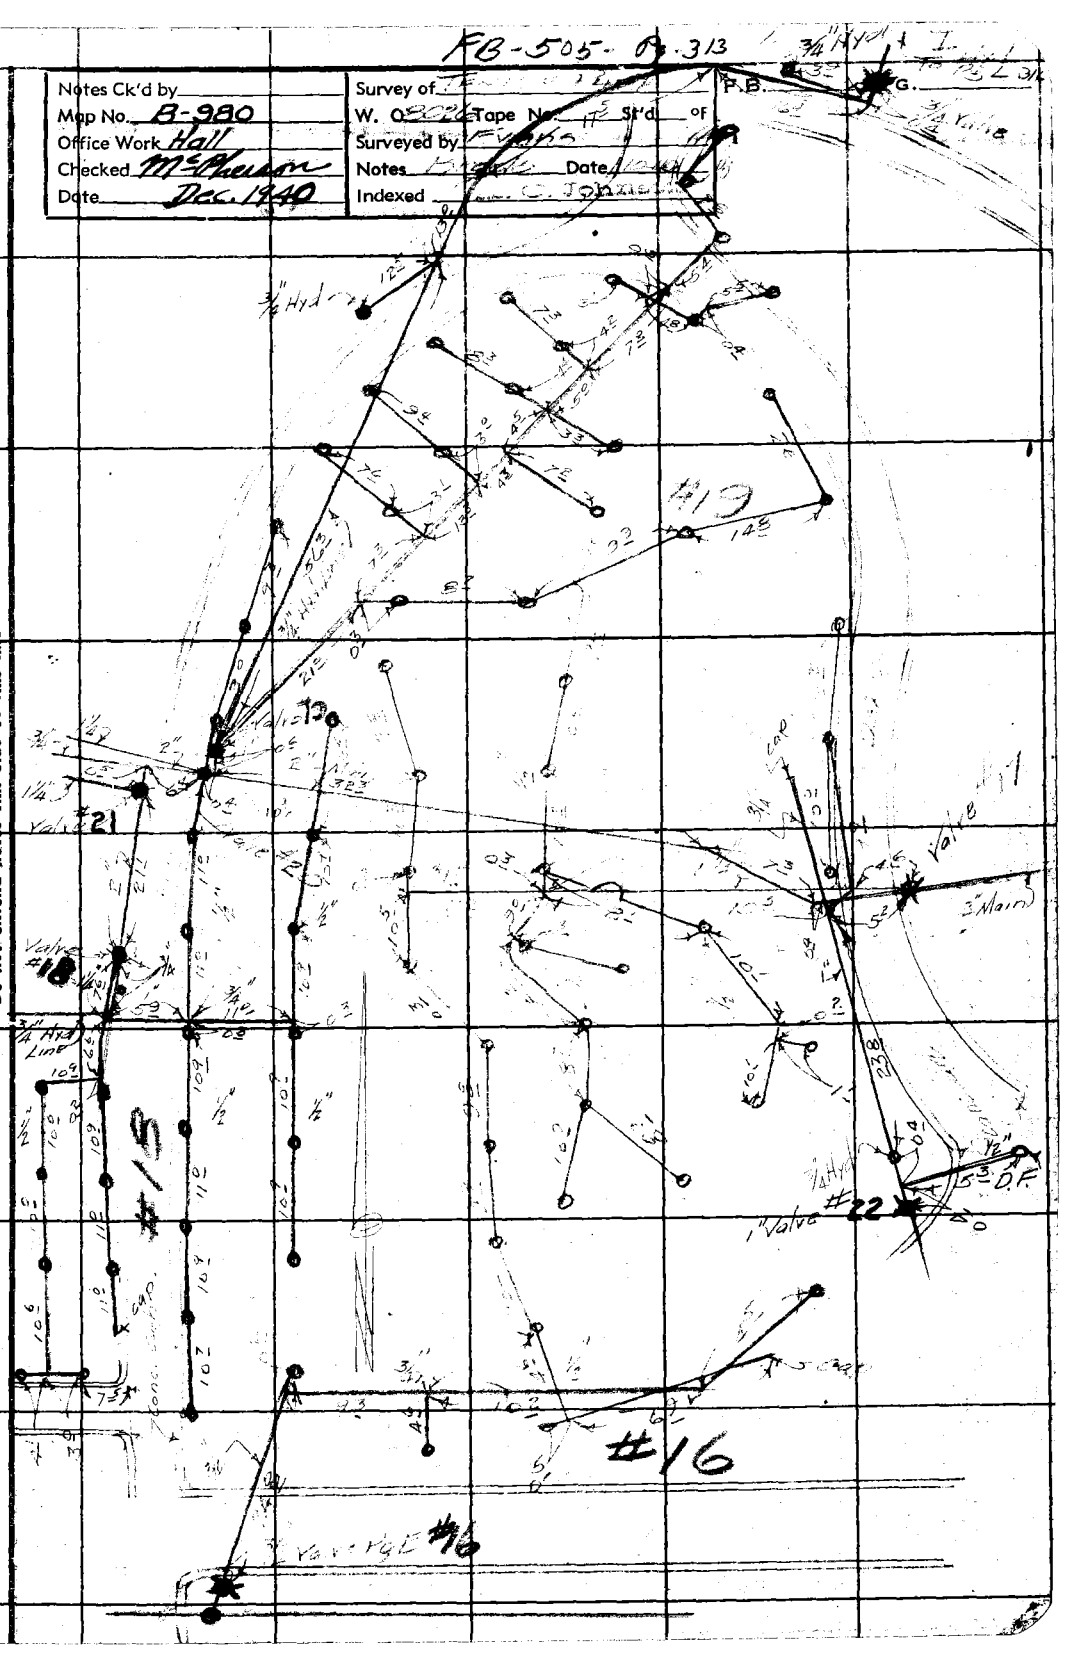

RETURN TO
LOS ANGELES COUNTY SURVEYOR
700 HALL OF RECORDS

Note: Any Additions or Changes on This Sheets Must be Made or Circled in **Red Ink** With Date and Name of Person Making Change.

Do not extend notes this side of this line

F.B. 505 PG. 314

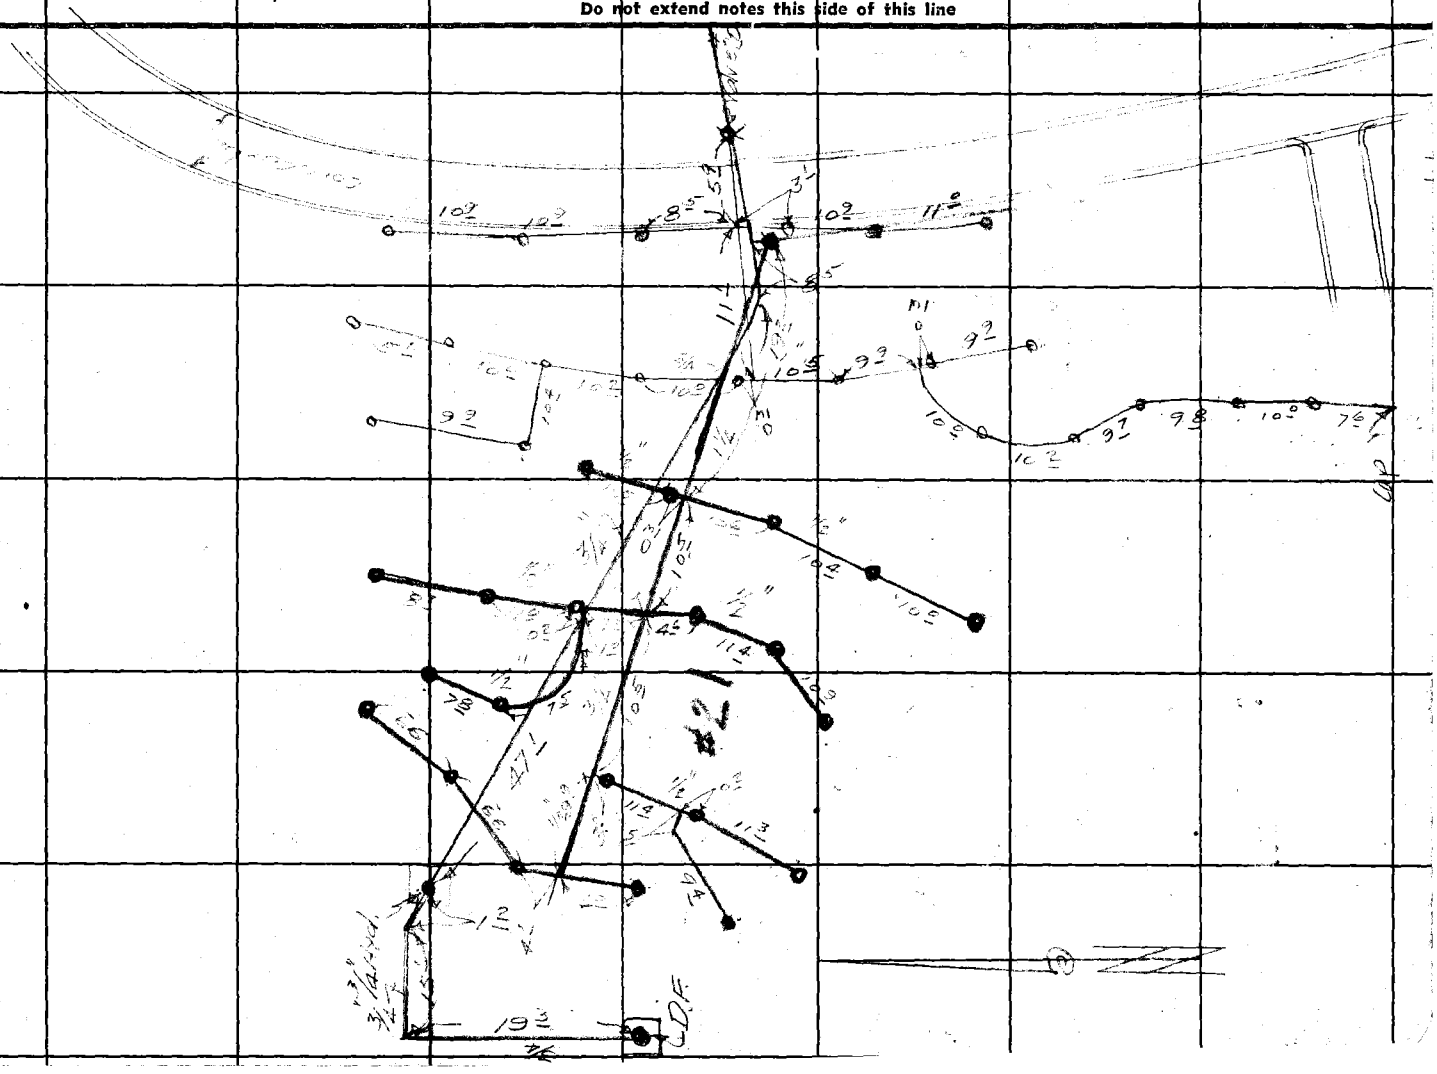

FORM 247 5M 10-35

RETURN TO
LOS ANGELES COUNTY SURVEYOR
700 HALL OF RECORDS

Note: Any Additions or Changes on This Sheet Must be Made or Circled in **Red Ink** With Date and Name of Person Making Change.

Do not extend notes this side of this line.

Notes Ck'd by
Map No. B-980
Date Dec 1940

Survey of
W. O.
Tape No. Std. °F
Notes
Indexed Date

#22

F.B. 585 PG. 375

RETURN TO
LOS ANGELES COUNTY SURVEYOR
700 HALL OF RECORDS

Note: Any Additions or Changes on This Sheet Must be Made or Circled in **Red Ink** With Date and Name of Person Making Change.

Do not extend notes this side of this line.

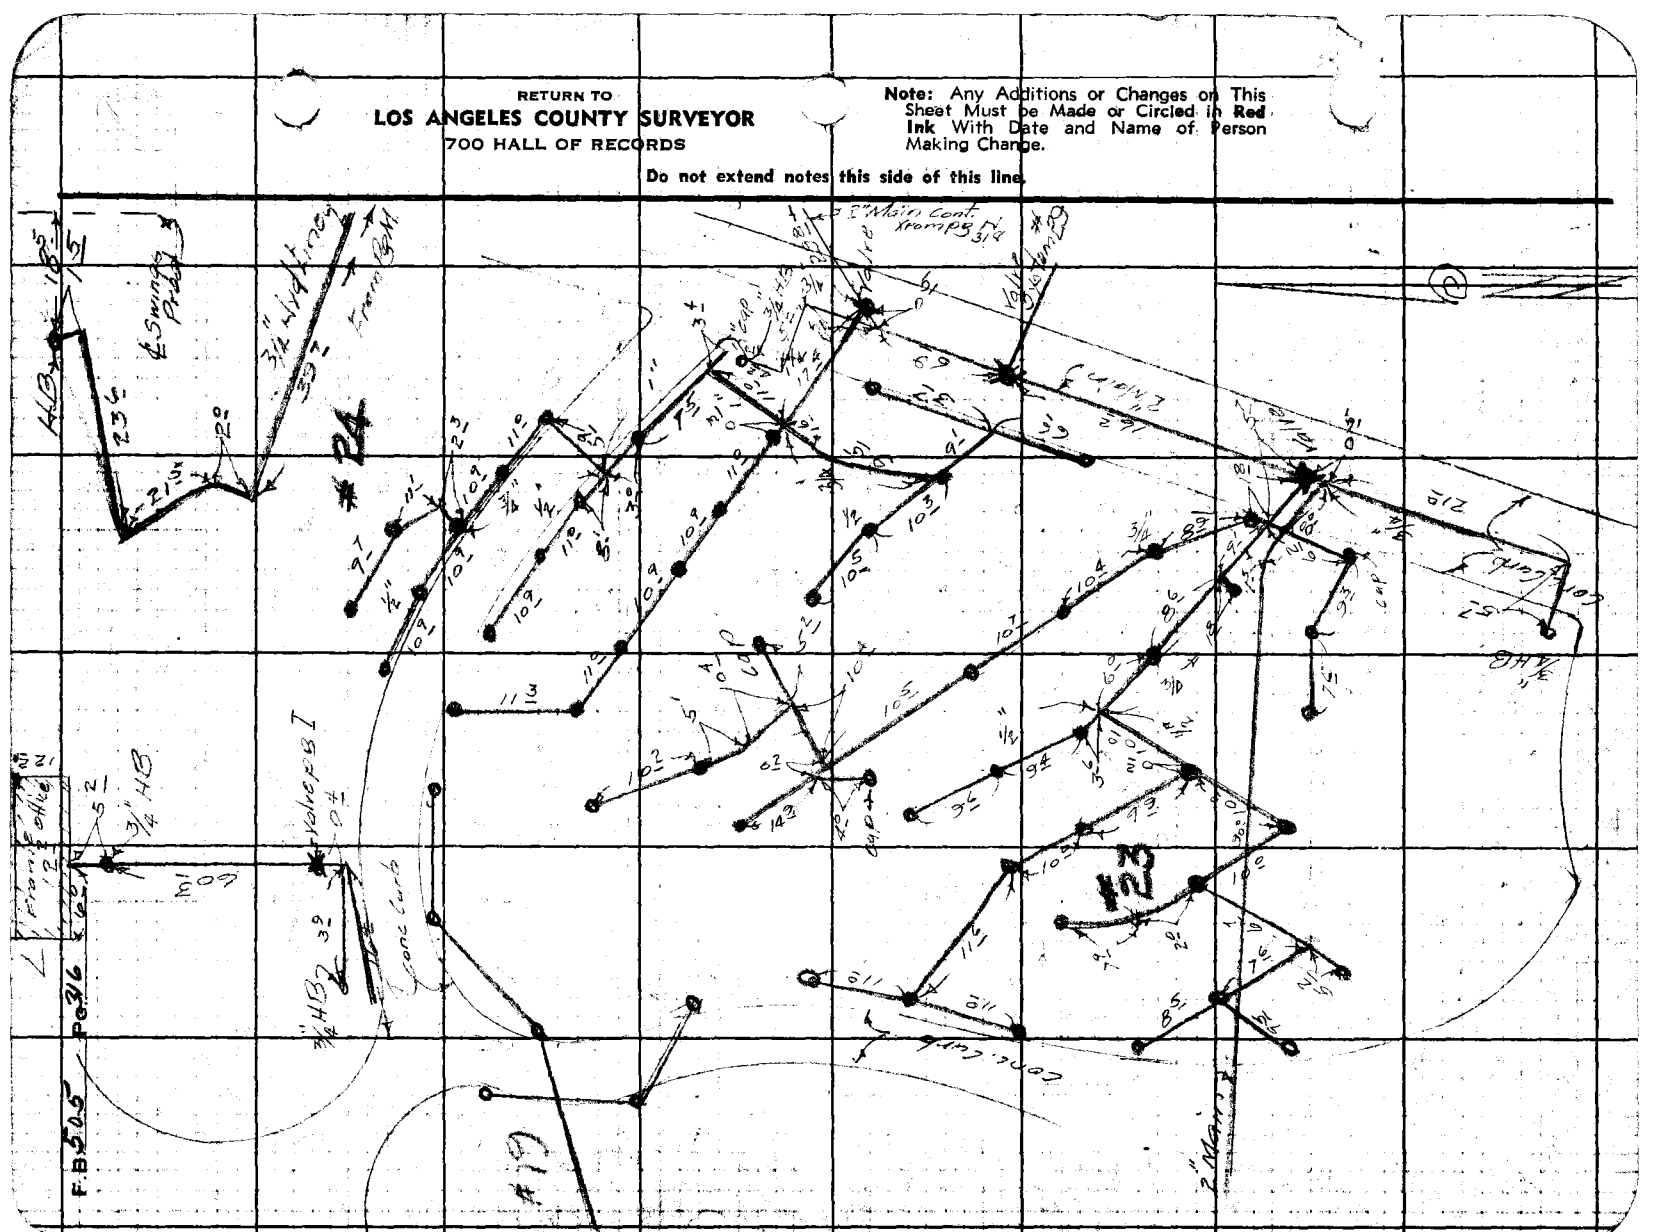

FORM 247 5M 10-39

RETURN TO
LOS ANGELES COUNTY SURVEYOR
700 HALL OF RECORDS

Note: Any Additions or Changes on This Sheet Must be Made or Circled in **Red Ink** With Date and Name of Person Making Change.

Do not extend notes this side of this line.

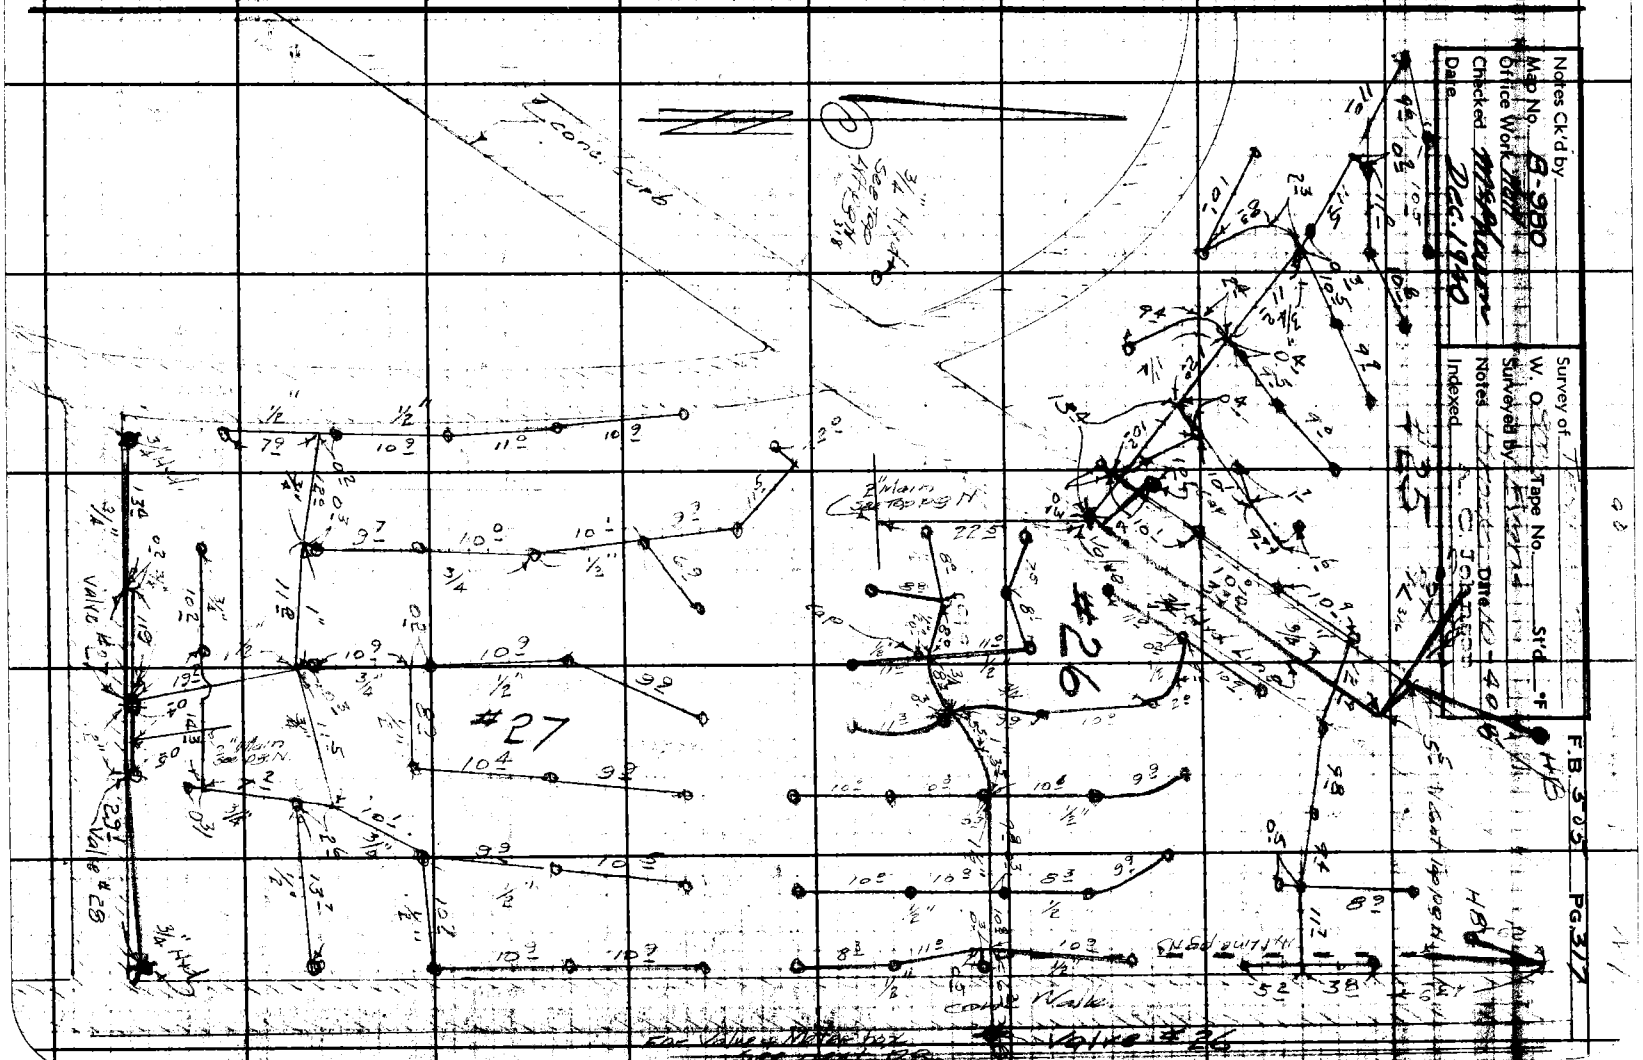

RETURN TO
LOS ANGELES COUNTY SURVEYOR
700 HALL OF RECORDS

Note: Any Additions or Changes on This Sheet Must be Made or Circled in **Red Ink** With Date and Name of Person Making Change.

Do not extend notes this side of this line.

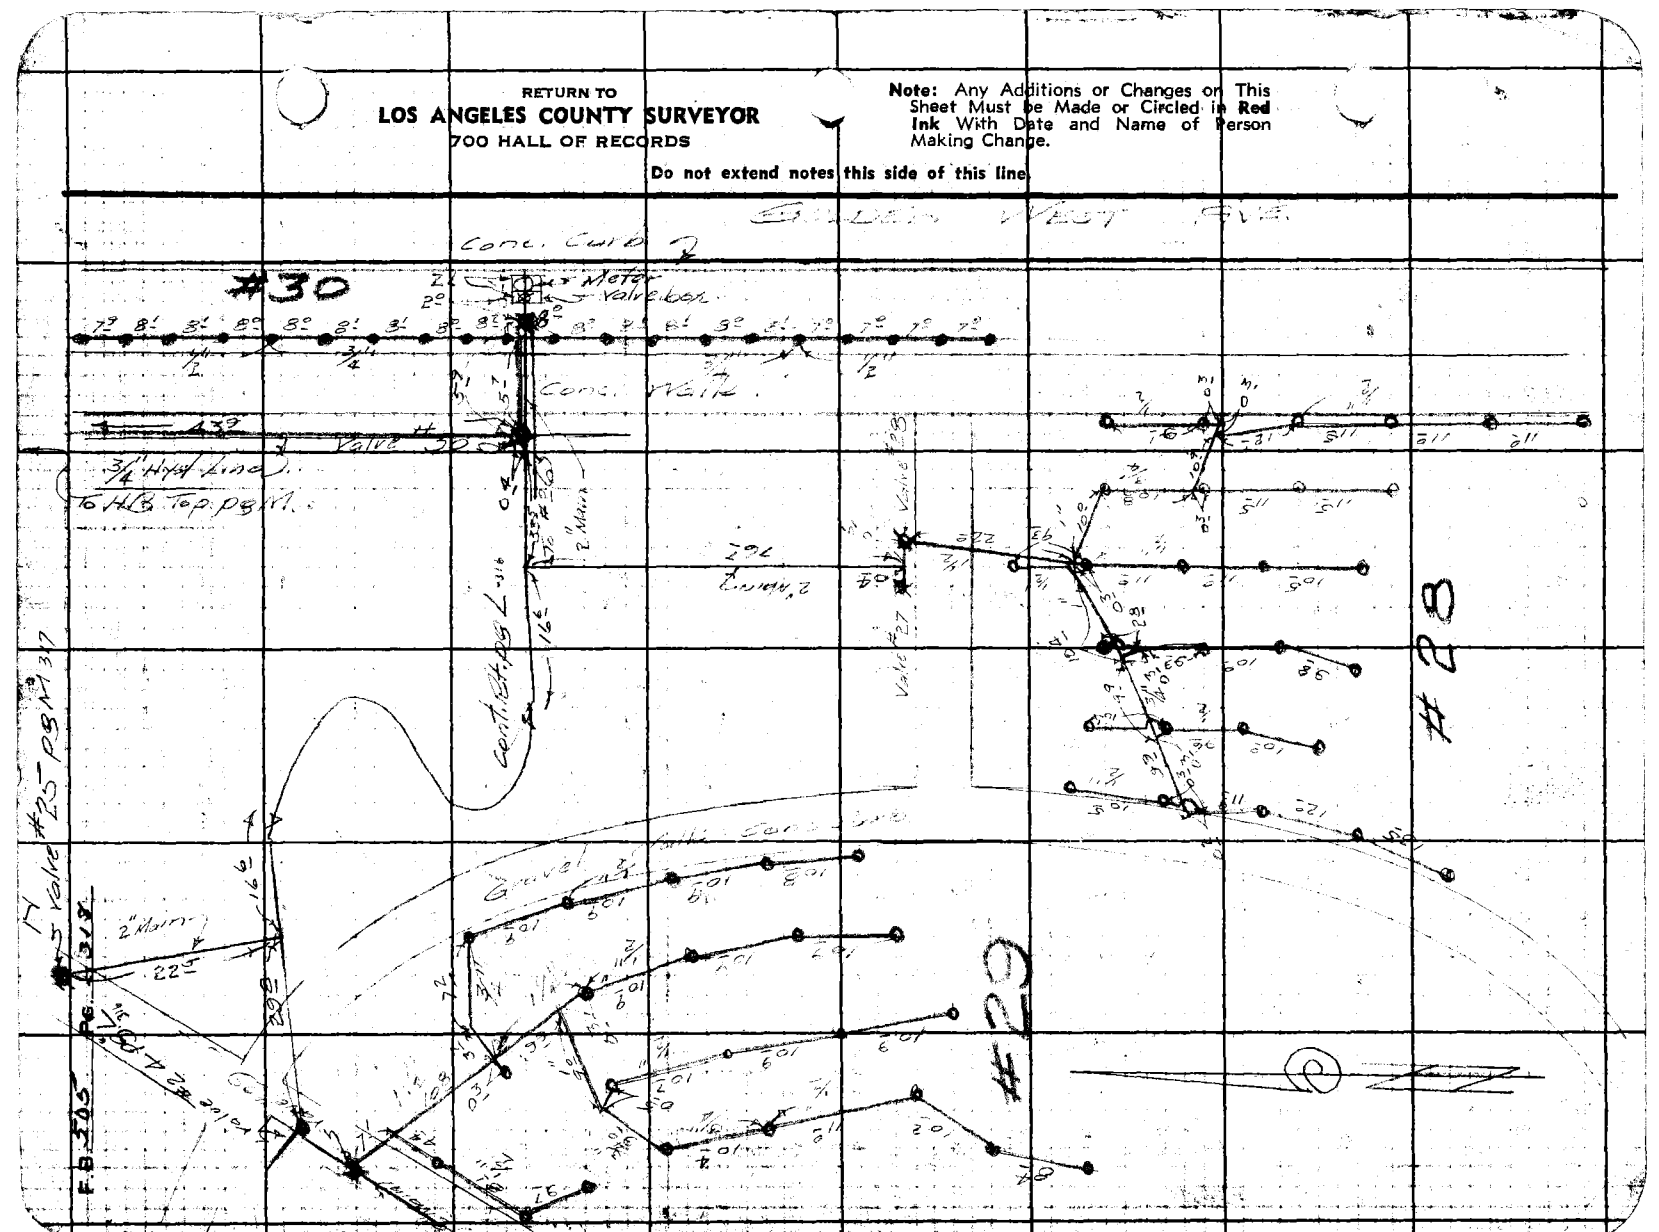

Notes Ck'd by D.M.Finley	Survey of Temple Park
Map No. B-980	W. O. 5026 Tape No. ____ Std ____ °F
Office Work D.A.White	Surveyed by Bradon
Checked D.M.Finley	Notes " Date 7/1-43
Date Oct 1943.	Indexed [illegible]

F.B. 505 Pg. 319

ADDITION
to
TEMPLE PARK

Lot 103 & So. ½ of Lot 104 - Tract 6561

July 1943

W E Bradon
H E Ott
A R Barilotti
J F Bonnet

Note: Any Additions or Changes on This Sheet Must be Made or Circled in Red Ink With Date and Name of Person Making Change.

Do not extend notes this side of this line.

RETURN TO
LOS ANGELES COUNTY SURVEYOR
700 HALL OF RECORDS

FORM 247 5M 12-40

RETURN TO
LOS ANGELES COUNTY SURVEYOR
700 HALL OF RECORDS

Note: Any Additions or Changes on This Sheet Must be Made or Circled in **Red** Ink With Date and Name of Person Making Change.

Do not extend notes this side of this line.

W.S. 440-4

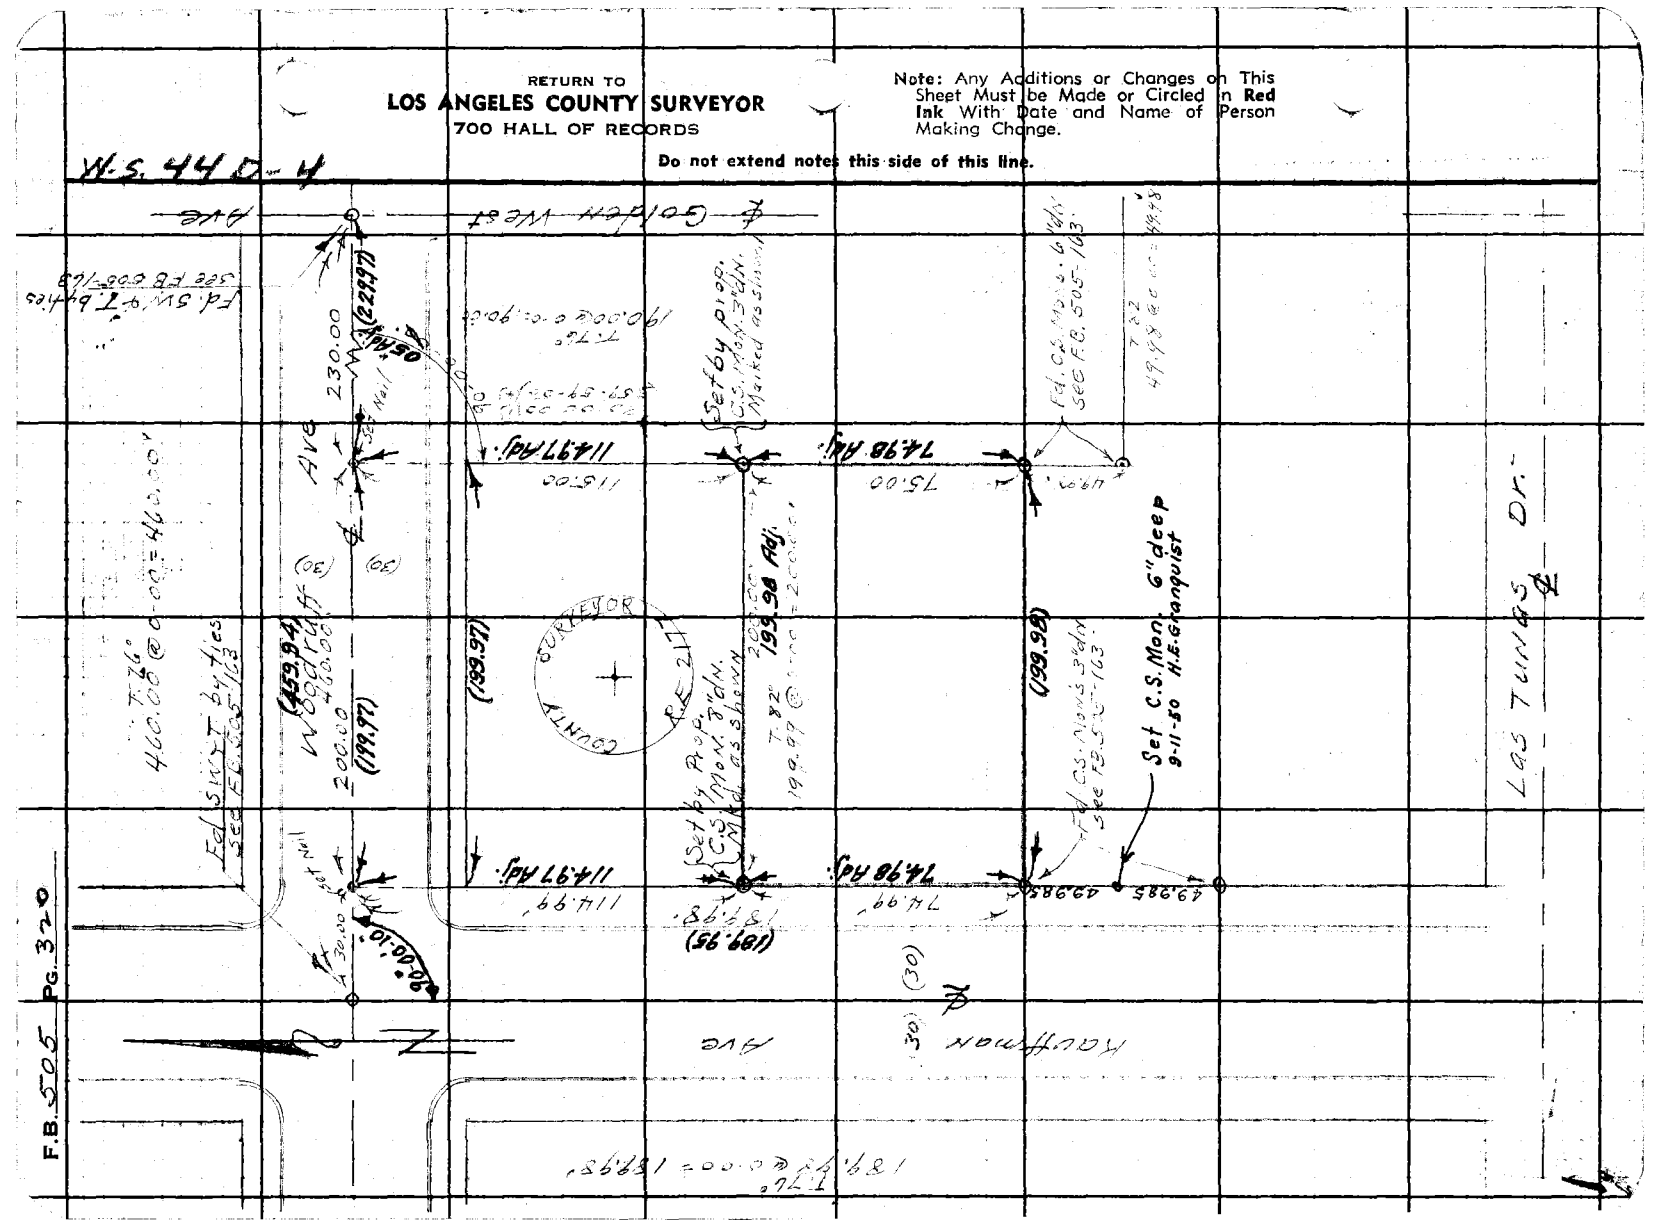

F.B. 505 PG. 320

FORM 307 2M 11-41

PLEASE RETURN TO
LOS ANGELES COUNTY SURVEYOR
700 HALL OF RECORDS

NOTE: ANY ADDITIONS OR CHANGES ON THIS SHEET MUST BE MADE OR CIRCLED IN RED INK, WITH DATE AND NAME OF PERSON MAKING CHANGE

Do not extend notes this side of this line

F.B. 505 Pg. 312 | Job No. 8026 Division No. | Notes Red. | Date | Plotted | Date | No. | Profile

Survey of Temple Park | Notes Clkd. | Date 7-21-43 | Checked | Date | X-Sec. | No.

Survey by K.E. Brandt & Notes Braden 7/1-43 | Indexed | Date | Traced | Date

STATION	B. S.	H. I.	F. S.	ELEV.	
B.M. US 2.23	2147	425092		422.945	ARCADIA - 25.5E of ℄ Baldwin Ave. 132.5 N. of ℄ Walnut Ave. U.S.C.&G.S. Bronze disk in top of block 24" high. Marked West Base No. 3 1923 1934 Adj. Elev. 422.945 See C.B. 38 p. 25
B.M. US 2622			4 096	420.996	ARCADIA - 2.5E of ℄ Baldwin Ave. 32' S. of ℄ Walnut Ave. U.S.C.&G.S. Bronze disk in top of block 24" high. Marked West Base No. 2 1923 1934 Adj. Elev. 420.995 - See C.B. 38 p. 21
T.P.	0 120	421.116	7 191	413.925	
"	2 563	416.735	6 [illegible]	410 637	
"	2 402	413 039	5 995	407044	
"	2 [illegible] 25	409 159	4 970	404219	
"	0 900	405 129	5 630	399 472	
"	1 770	401 244	5 935	395 409	
"	1 058	397 467			BM. Set Las Tunas Dr. & Baldwin Ave - E side Baldwin Ave 130'± N. of ℄ Mod. Las Tunas. Id. Road Nail in Lead in curb (Chis. BM-T-1 in cb.)
B.M. - set			5413	392 054	
↗	3 350	395 404			
B.M. - set			4250	391.154	BM. Set Las Tunas Dr. & Baldwin Ave - N. side Las Tunas 80'± W. of ℄ Baldwin Ave - Fd. Road Nail in Lead in curb (Chis BM-T-2 in cb.)
↗	5 280	396 434			
T.P.	2720	396 172	2 982	393 452	
"	4268	396 925	3 515	392 657	
"	5100	397 515	4 510	392 415	
"	6 030	399 785	3 760	393 755	
"	5197	401 042	3 940	395 845	S.W. Cor. Temple Park - C.S. Mc N. 3" under N. prop. line Las Tunas - 155' W. of ℄ Kauffman Ave. (Rodda Neg. 660)
B.M. Set			4408	396 634	

Profile No. | Notes Red. | Plotted | Job No. 3-26 | Division No. | F B. 505 PG. 321

X-Sec. No. | Notes Chkd. D.M.S. | Checked | Survey of Temple Park

Date 7-21-43 | Date | Survey by W. E. Gradon | Notes [illegible] | Date 7/1-43

Map No. B-980 | Indexed [illegible]

BENCH LEVELS

for

TEMPLE PARK

1924 Adjustment

U.S.G.M. # 2625 & # 2622

July 1943

W. E. Gradon

R. C. Garrett

[illegible]

STATION	B. S.	H. I.	F. S.	ELEV.

NOTE: ANY ADDITIONS OR CHANGES ON THIS SHEET MUST BE MADE OR CIRCLED IN RED INK, WITH DATE AND NAME OF PERSON MAKING CHANGE

Do not extend notes this side of this line

PLEASE RETURN TO
LOS ANGELES COUNTY SURVEYOR
700 HALL OF RECORDS

FORM 307 2M 11-41

FORM 307 2M 11-41

PLEASE RETURN TO
LOS ANGELES COUNTY SURVEYOR
700 HALL OF RECORDS

NOTE: ANY ADDITIONS OR CHANGES ON THIS SHEET MUST BE MADE OR CIRCLED IN RED INK, WITH DATE AND NAME OF PERSON MAKING CHANGE

Do not extend notes this side of this line

Profile Notes Red. Plotted Job No. 8026 Division No.
No. Date Survey of Tract 2196 Park
X-Sec. Notes Chkd. Date Survey by Notes Date
No. Date Checked Map No. Entered A. C. Johnson

F.B. 600 PG. 323

STATION	B. S.	H. I.	F. S.	ELEV.	
				399.634	
T.P.	5.820	405.454	2.793	399.661	
T	5.355	405.511			
BM-Set			4.075	401.436	Park Cor. C.S.Mon. 3"d/N. - 319.93' N. of N.P.L. Las Tunas - 155' E. of E. Kauffman Ave. (Ref. on W. edg. Cap)
T	5.807	407.236			
BM Set			4.550	402.686	Park Cor. C.S.Mon. 3"d/N. E.P.L. Kauffman Ave. 319.89' N. of N.P.L. Las Tunas
T	5.555	408.241			
BM-Set			2.497	403.744	Park Cor. C.S. Mon. 4"d/N. E.P.L. Kauffman Ave. 129.95' S. of S.P.L. Woodruff Ave. (Ref. on E. edg. Cap.)
T	5.450	409.194			
BM-Set			4.895	404.299	Park N.W. Cor. C.S. Mon. 8"d/N. E.P.L. Kauffman Ave 84.99' S. of S.P.L. Woodruff Ave Ref. on S. edg. Cap.
T	1.993	409.294			
BM-Set			5.540	403.754	Park Cor. C.S. Mon. 3"d/N. 85.0' S. of S.P.L. of Woodruff Ave. & 200.0' E. of E.P.L. Kauffman Ave. (Ref. on S. edg. Cap.)
	3.035	406.754			
BM Set			6.743	400.271	Park - N.E. Cor. C.S. Mon. 5"d/N. N.P.L. Golden West 209.93' S. of S.P.L. Woodruff Ave. (Ref. on S. edg. Cap.)
T.P.	6.258	406.557	1.[illegible]	404.816	
"	6.700	411.366	2.247	409.119	
"	1.022	411.539	2.047	412.472	
"	4.363	416.337	5.000	411.834	
"	4.258	416.093	5.185	410.908	
"	3.993	414.906	4.905	409.995	
T	4.020	414.018			

X

FORM 307 2M 11-41

PLEASE RETURN TO
LOS ANGELES COUNTY SURVEYOR
700 HALL OF RECORDS

NOTE: ANY ADDITIONS OR CHANGES ON THIS SHEET MUST BE MADE OR CIRCLED IN RED INK, WITH DATE AND NAME OF PERSON MAKING CHANGE

Do not extend notes this side of this line

FB. 505 PG. 324 | Job No. 9022 Division No. | Notes Red. | Plotted | Profile
Survey of Temple Gate | Date | No.
Survey by [illegible] Notes [illegible] | Date | X-Sec.
Indexed [illegible] Date | Notes Chkd. [illegible] Checked | No.
Date 7-21-43 | Date

STATION	B. S.	H. I.	F. S.	ELEV.		
		H.I. 418.918				
T.P.	4.243	412.804	5.403	407.555		
"	5.552	411.687	1.482	411.317		
"	6.110	412.306	1.675	410.196		
B.M. U.S. 2622			0.310	411.996	411.686 26' E of ℄ Delaware Ave. 32.5' S of ℄ Walnut Ave. U.S. 4.25 in sidewalk 1' conc. block 24" high. Marked west Base No. 2 - 1923 1.32 adj. Elev. 411.993 - Sur. 5.389-25	