B-926
Cox

Survey of Central Ave
W. O. 7106 Tape No. 042 St'd 99 ft.
Surveyed by Rosecrans
Notes
Date 2-1-33
Indexed A. C. Johnson 6-5-33

Barranca St.

Index to notes

TRAL AVE. SURVEY.

W.O. 7106 1933

Mar.

to

Party

E.A. Rosecrans
P.W. Atkins
F.H. Blanchard
H.H. Reynolds
Transit #16650
Tape #042

Monte Vista Ave.

(Puente St.)

Range Ave.

Central Ave.

Glendora Ave.

Rhouse St.

RETURN TO
LOS ANGELES COUNTY SURVEYOR
700 HALL OF RECORDS

Note: ANY ADDITIONS OR CHANGES ON THIS SHEET MUST BE MADE OR CIRCLED IN Red Ink. WITH DATE AND NAME OF PERSON MAKING CHANGE.

Do not extend notes this side of this line

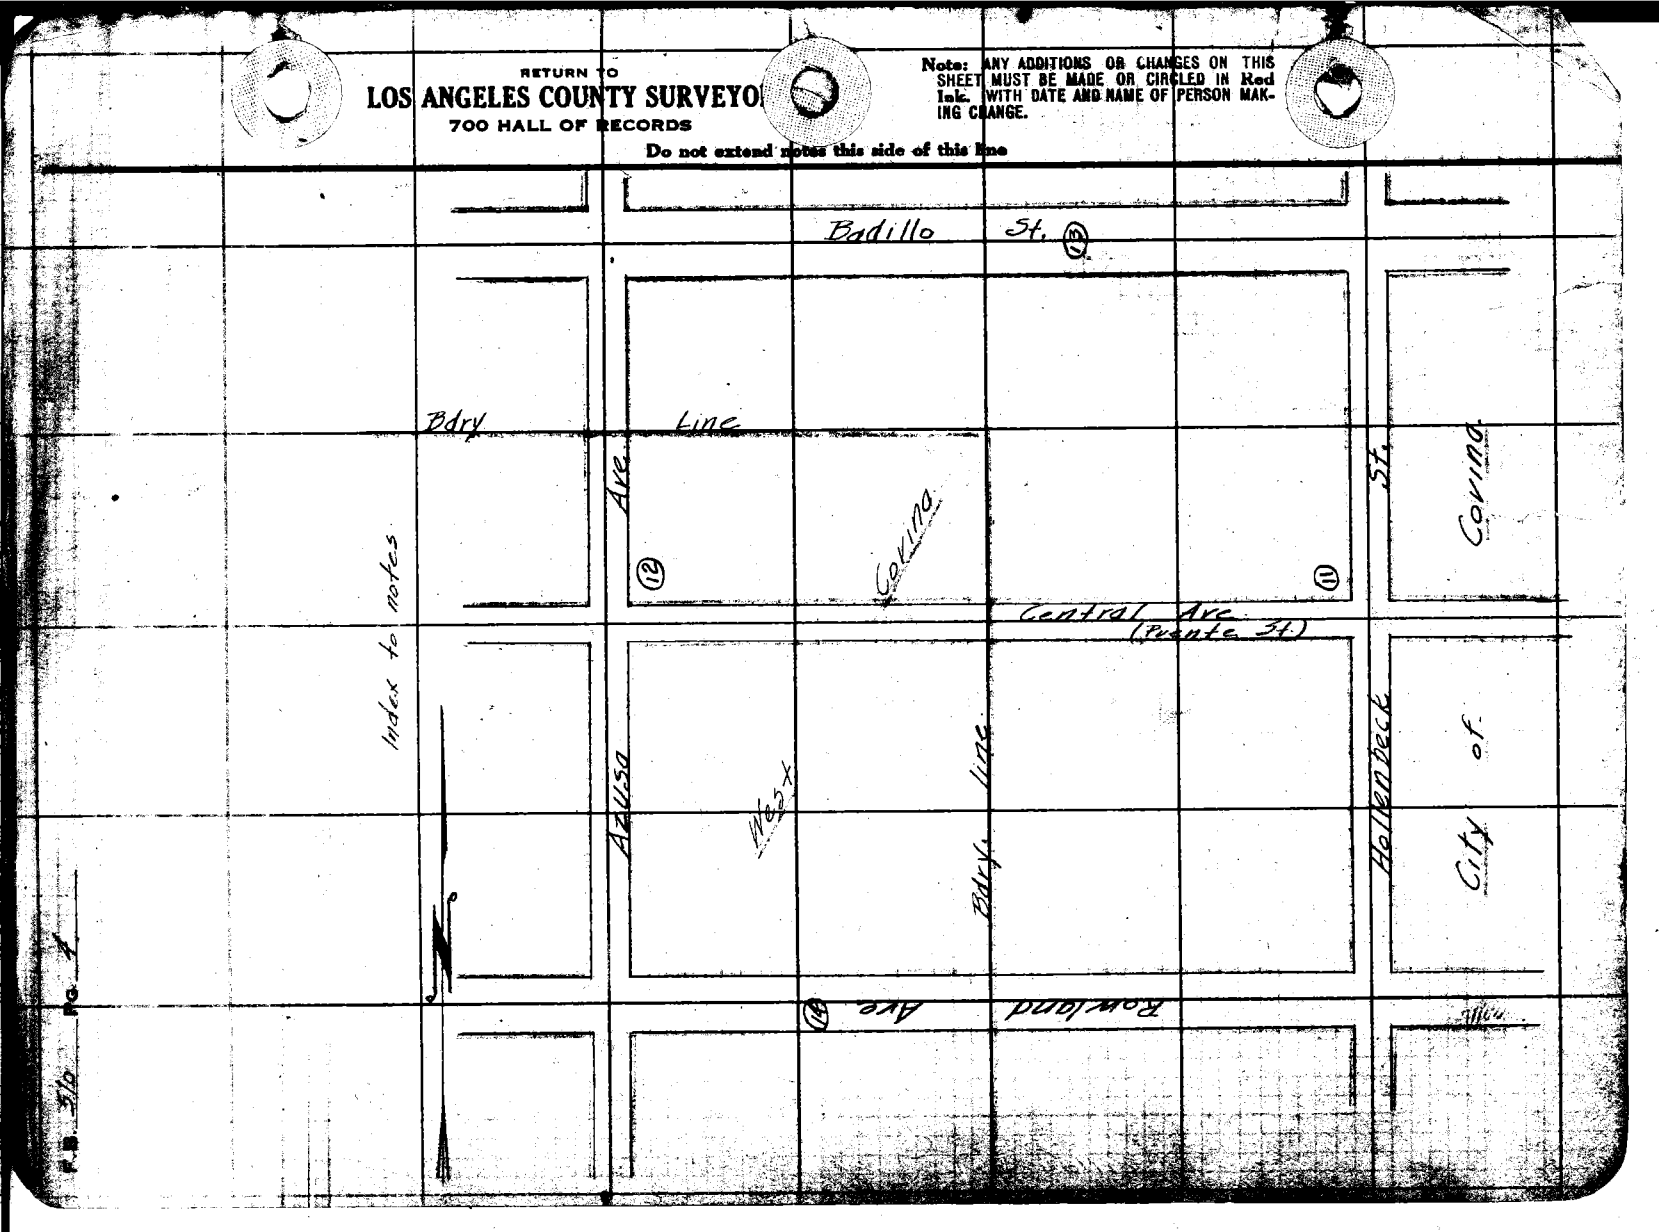

Notes Ck'd by Drew	Survey of Central Ave.	F.B. 510	Pg. 5
Map No. B-926	W. O. 7103 Tape No. 042 St'd. 84 °F.	Cont. bottom next page.	
Office Work Cox	Approved by Rosecrans		
Checked Drew	Notes Date 1-10-33		
Date May 1935	Indexed A. C. Johnson 6-5-33		

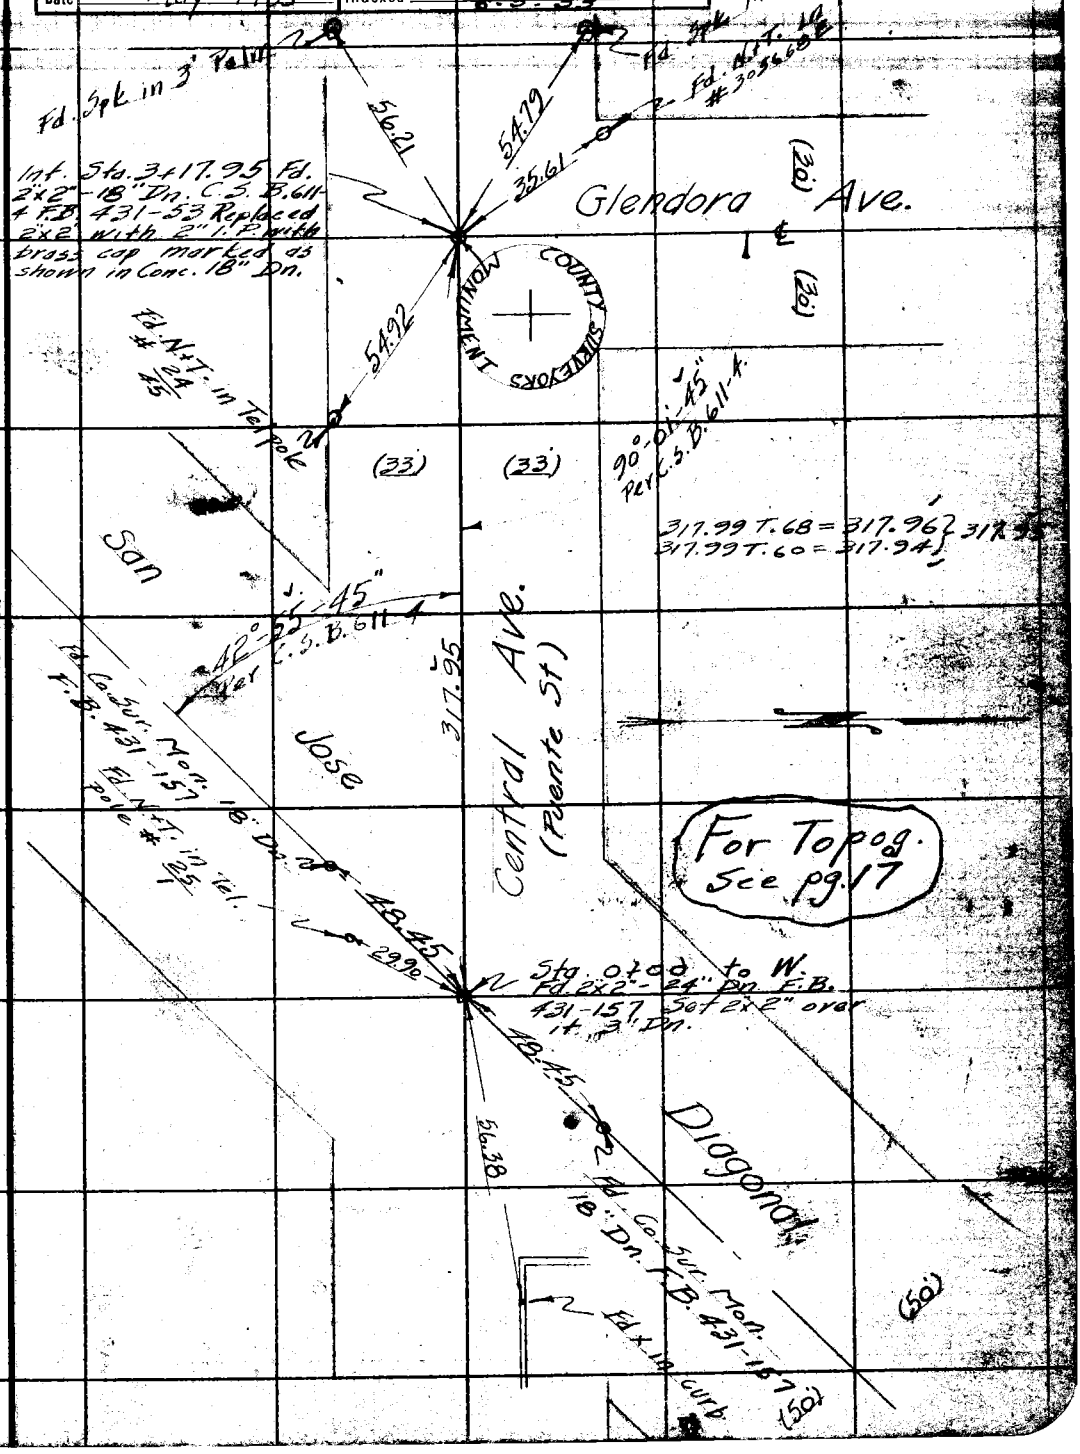

Note: ANY ADDITIONS OR CHANGES ON THIS SHEET MUST BE MADE OR CIRCLED IN Red Ink. WITH DATE AND NAME OF PERSON MAKING CHANGE.

Do not extend notes this side of this line

RETURN TO
LOS ANGELES COUNTY SURVEYOR
700 HALL OF RECORDS

FORM 247 10M 8-31

F.B. 510 Pg. 6

RETURN TO
LOS ANGELES COUNTY SURVEYOR
700 HALL OF RECORDS

Do not extend notes this side of this line

Note: ANY ADDITIONS OR CHANGES ON THIS SHEET MUST BE MADE OR CIRCLED IN Red Ink. WITH DATE AND NAME OF PERSON MAKING CHANGE.

Notes Ck'd by Drew	Survey of Central Ave.		F.B. 510 Pg. 1
Map No. B-926	W. O. 7106	Tape No. 042	St'd 84 °F.
Office Work [illegible]	Surveyed by Rosecrans		
Checked Drew	Notes	Date 1-12-32	
Date May 1935	Indexed A. C. Johnson		

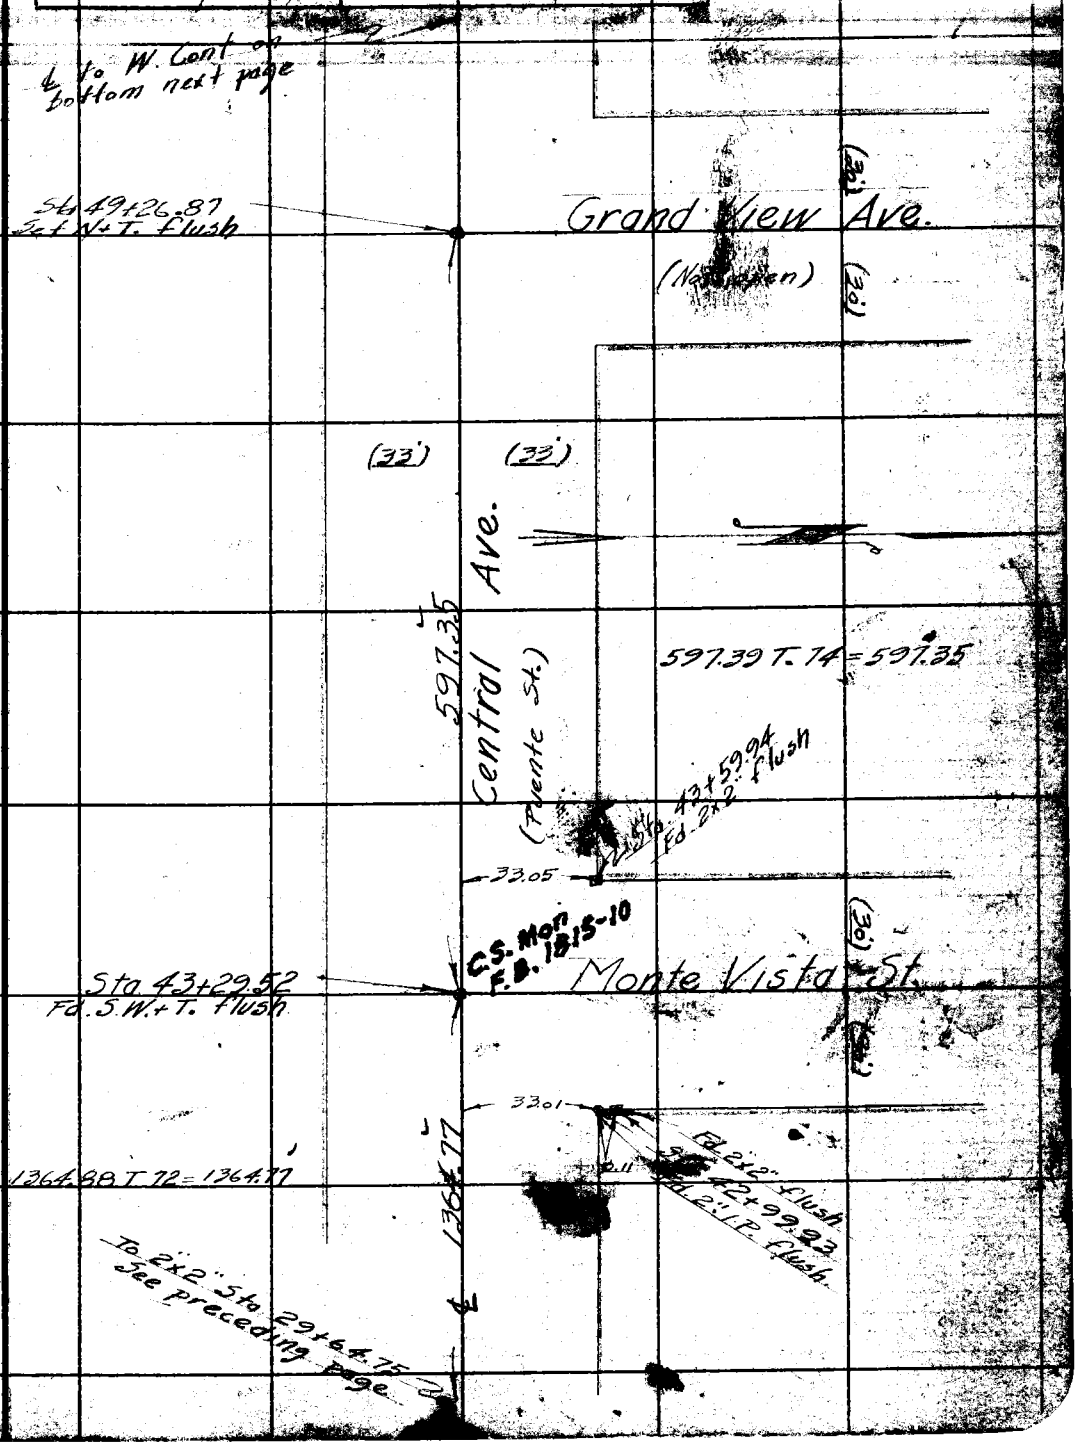

Note: ANY ADDITIONS OR CHANGES ON THIS SHEET MUST BE MADE OR CIRCLED IN Red Ink. WITH DATE AND NAME OF PERSON MAKING CHANGE.

RETURN TO
LOS ANGELES COUNTY SURVEYOR
700 HALL OF RECORDS

Do not extend notes this side of this line

FORM 247 10M 5-31

W.S. 47 D-4

RETURN TO

LOS ANGELES COUNTY SURVEYOR

700 HALL OF RECORDS

Do not extend notes this side of this line

Note: ANY ADDITIONS OR CHANGES ON THIS SHEET MUST BE MADE OR CIRCLED IN Red Ink. WITH DATE AND NAME OF PERSON MAKING CHANGE.

Notes Ck'd by Drew	Survey of Central Ave
Map No. B-926	W. O. 7106 Tape No. 046 St'd 84 °F.
Office Work Cox	Surveyed by Rosecrans
Checked Drew	Notes Date 1-13-33
Date May 1935	Indexed A. C. Johnson

F.B. 510 Pg. 9

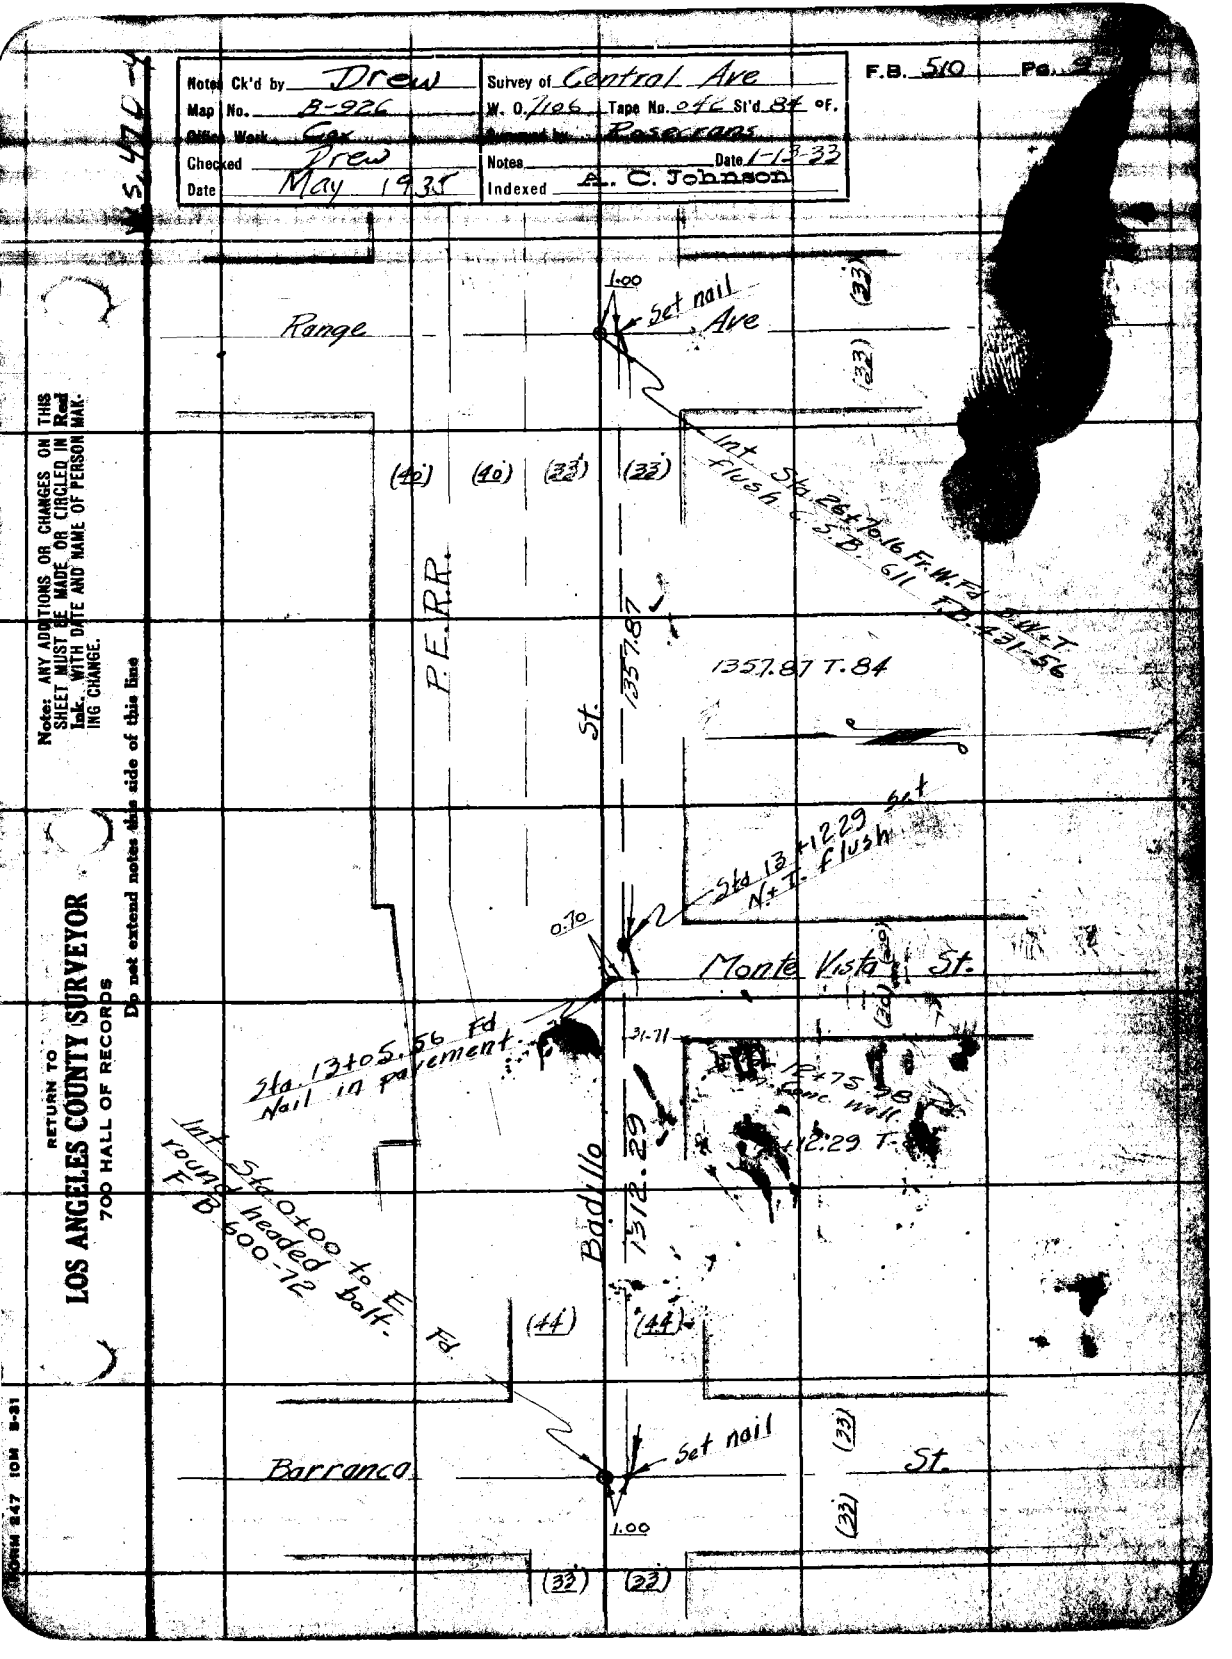

Note: ANY ADDITIONS OR CHANGES ON THIS SHEET MUST BE MADE OR CIRCLED IN Red Ink. WITH DATE AND NAME OF PERSON MAKING CHANGE.

Do not extend notes this side of this line

RETURN TO
LOS ANGELES COUNTY SURVEYOR
700 HALL OF RECORDS

FORM 247 10M 8-31

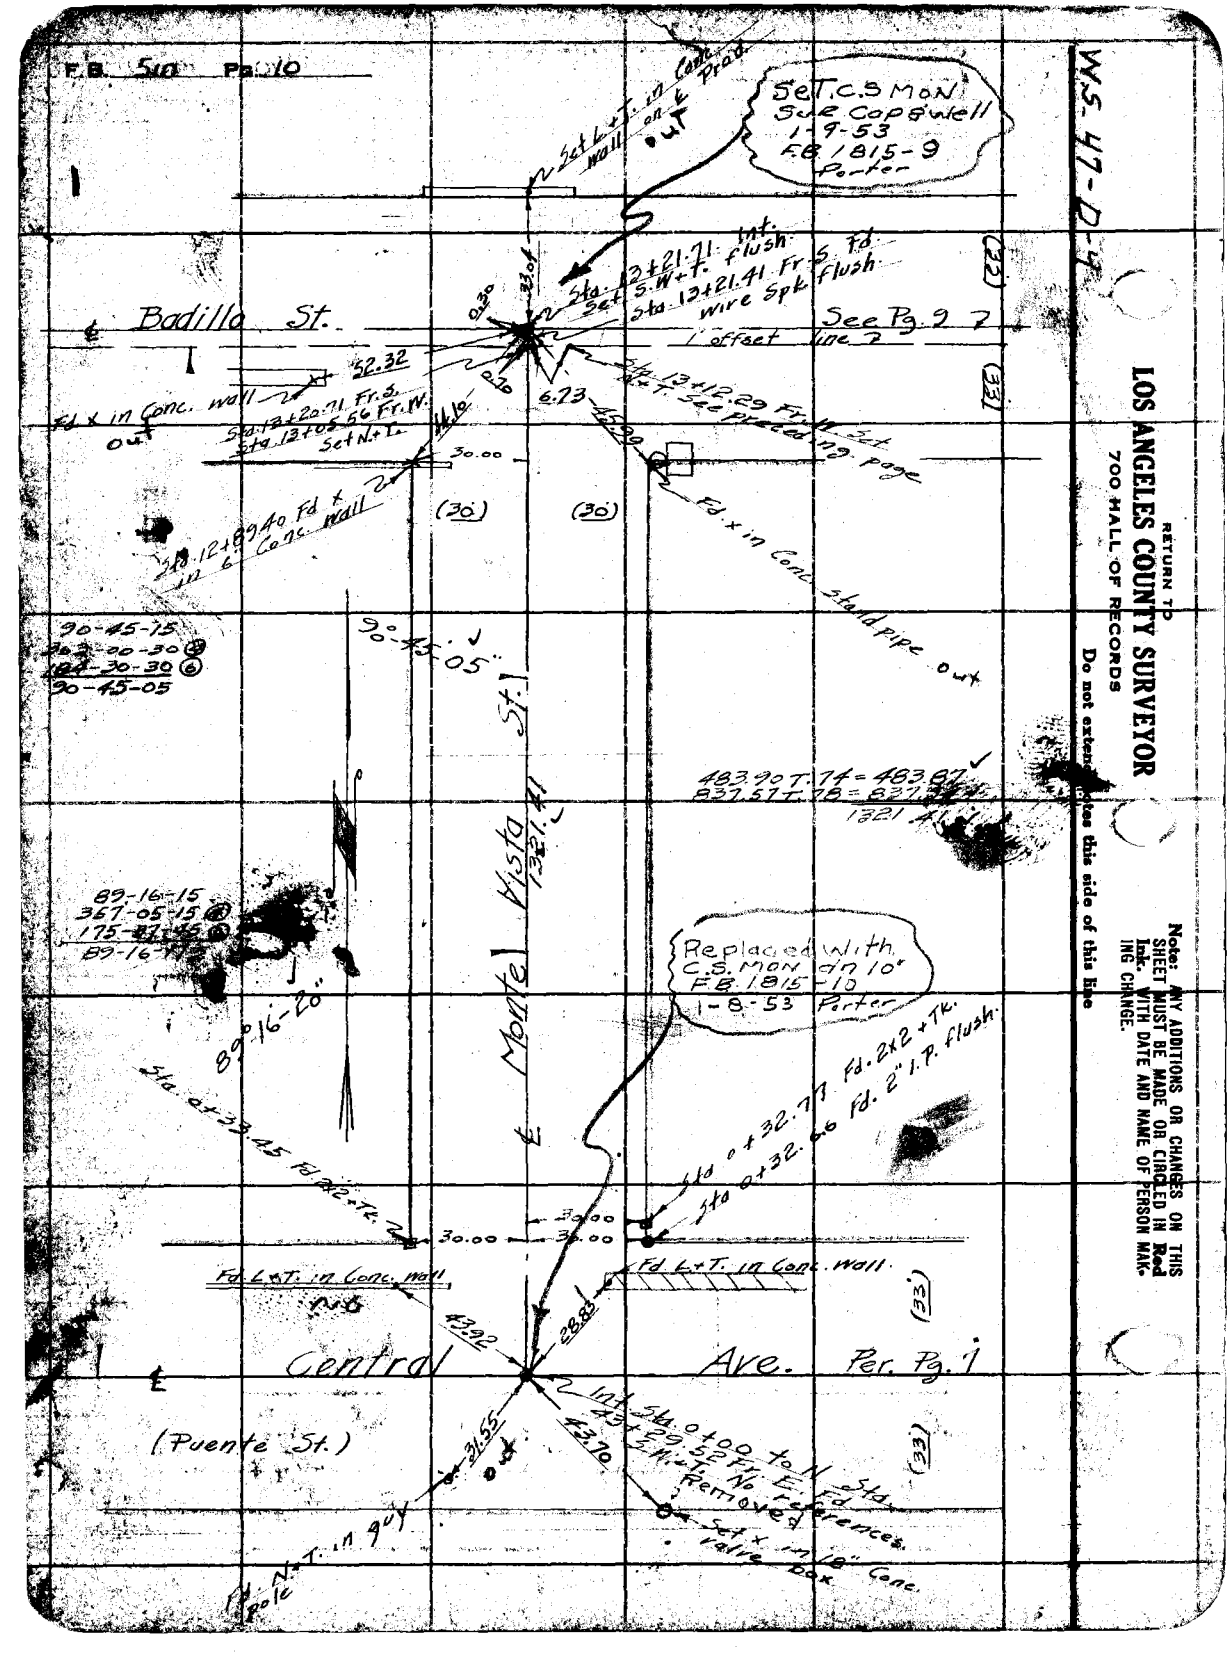
F.B. 510 Pg. 10
W.S. 47-D-4
Set L+T. in Conc. wall on ℄ Prod. out
Set C.S. Mon. Sur. Cap & well 1-9-53 F.B. 1815-9 Porter
Sta. 13+21.71 Int. Set S.W+T. flush
Sta. 13+21.41 Fr. S. Fd. wire Spk. flush
℄ Badilla St.
See Pg. 9
1' offset line
52.32
Fd. x in Conc. wall out
Sta. 13+20.71 Fr. S.
Sta. 13+05.56 Fr. W. Set N+T.
Sta. 13+12.29 Fr. W. Set N+T. See preceding page
30.00
(30)
(30)
Sta. 12+89.40 Fd. x in 6" Conc. wall
Fd. x in Conc. stand pipe out
90-45-15
90-45-05
90°-45'-05"
Monte Vista St.
1321.41
483.90 T.74 = 483.87
837.57 T.78 = 837.
1321.41
89-16-15
367-05-15
89-16-20"
Replaced with C.S. Mon. on 10" F.B. 1815-10 1-8-53 Porter
Sta. 0+33.45 Fd. 2x2+Tk.
Sta. 0+32.77 Fd. 2x2+Tk.
Sta. 0+32.66 Fd. 2" I.P. flush
30.00
30.00
Fd. L+T. in Conc. wall
Fd. L+T. in Conc. wall
43.92
28.83
(33)
Central Ave. Per. Pg. 1
(Puente St.)
Int. Sta. 0+00 to N Sta. 43+29.52 Fr. E. Fd. S.W+T. No references. Removed
31.55
43.70
Set x in 18" Conc. valve box
Fd. N+T. in guy pole
(33)
(33)
(33)
RETURN TO
LOS ANGELES COUNTY SURVEYOR
700 HALL OF RECORDS
Do not extend notes this side of this line
Note: ANY ADDITIONS OR CHANGES ON THIS SHEET MUST BE MADE OR CIRCLED IN Red Ink. WITH DATE AND NAME OF PERSON MAKING CHANGE.

Notes Ck'd by Drew	Survey of Central Ave.	F.B. 510	Pg. 11
Map No. B-926	W. O. 7106 Tape No. 042 St'd 84 °F.		
	Rosecrans		
Checked Drew	Notes Date 1-23-33		
Date May 1935	Indexed A. C. Johnson		

89-16-30
175-38-30 (6)
89-16-25

Cont. bottom next page.

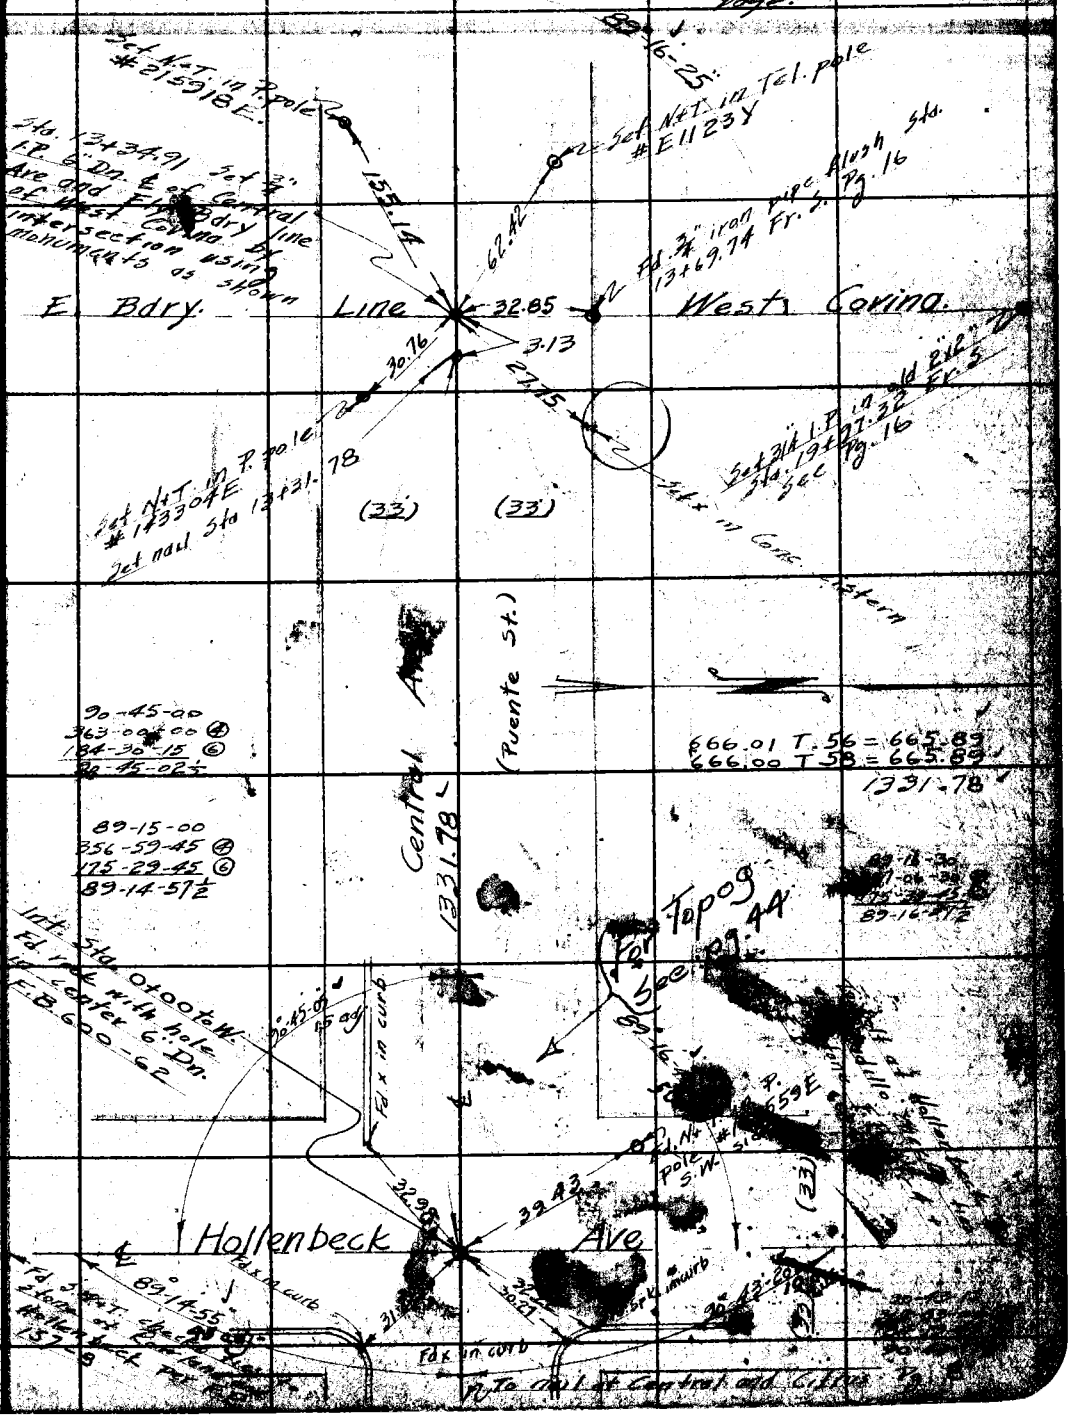

Note: ANY ADDITIONS OR CHANGES ON THIS SHEET MUST BE MADE OR CIRCLED IN Red Ink, WITH DATE AND NAME OF PERSON MAKING CHANGE.

Do not extend notes this side of this line

RETURN TO
LOS ANGELES COUNTY SURVEYOR
700 HALL OF RECORDS

FORM 247 10M 8-31

F.B. 510 Pg. 12

Note:-
Fd. 7"x12"x16" Granite stone
dn. 12" Replaced with C.S. Mon.
dn. 8" Sur cap & well
3' SWET ties
FB 847.25
FB 1815-44
Porter
12-22-52

COUNTY SURVEYOR
R. E. 69

Fd Spk. in Conc. wier

To 1/2 I.P. at ℄ of Rowland and ℄ of Azusa See Pg. 14

Set L+T. in curb

To 1"x2" at Azusa and Bad+110 See Pg. 13

48.15

33.96

(33)

℄ Azusa Ave.

1321.70

1322.03

(33)

31.06

48.12

89°15'55" 40 adj.

Set N+T. in guy pole

Sta. 26+69.92
Fd Granite rock 4"x4" on top 12" dn. hole in center F.R. 90-15
Set 2"x2" over it 3" Dn.

Set N+T. in P. pole #96732E

90°44'10" 20 adj.

Ave.

1338.14

(Puente St.)

1322.18 T.66 = 1322.03

1321.79 T.74 = 1321.70

90-44-15
362-56-45 (4)
184-25-15 (6)
90-44-12½

89-16-00
357-03-45 (4)
175-35-45 (6)
89-15-57½

(33) (33)

1338.35 T.60 = 1338.14

Central

℄

Sta. 13+31.78 Set nail
See preceding page

W.S. 47 C-4

RETURN TO
LOS ANGELES COUNTY SURVEYOR
700 HALL OF RECORDS

Do not extend notes this side of this line

Note: ANY ADDITIONS OR CHANGES ON THIS SHEET MUST BE MADE OR CIRCLED IN Red Ink. WITH DATE AND NAME OF PERSON MAKING CHANGE.

F.B. 510 Pg. 13

Notes Ck'd by Drew	Survey of Central Ave.
Map No. R-926	W. O. 7106 Tape No. 042 St'd 84 of.
	Rosecrans
Checked Drew	Notes Date 1-31-33
Date May 1935	Indexed A. C. Johnson

RETURN TO
LOS ANGELES COUNTY SURVEYOR
700 HALL OF RECORDS

Notes. ANY ADDITIONS OR CHANGES ON THIS SHEET MUST BE MADE OR CIRCLED IN Red Ink WITH DATE AND NAME OF PERSON MAKING CHANGE.

Do not extend notes this side of this line

FORM 247 10M 8-51

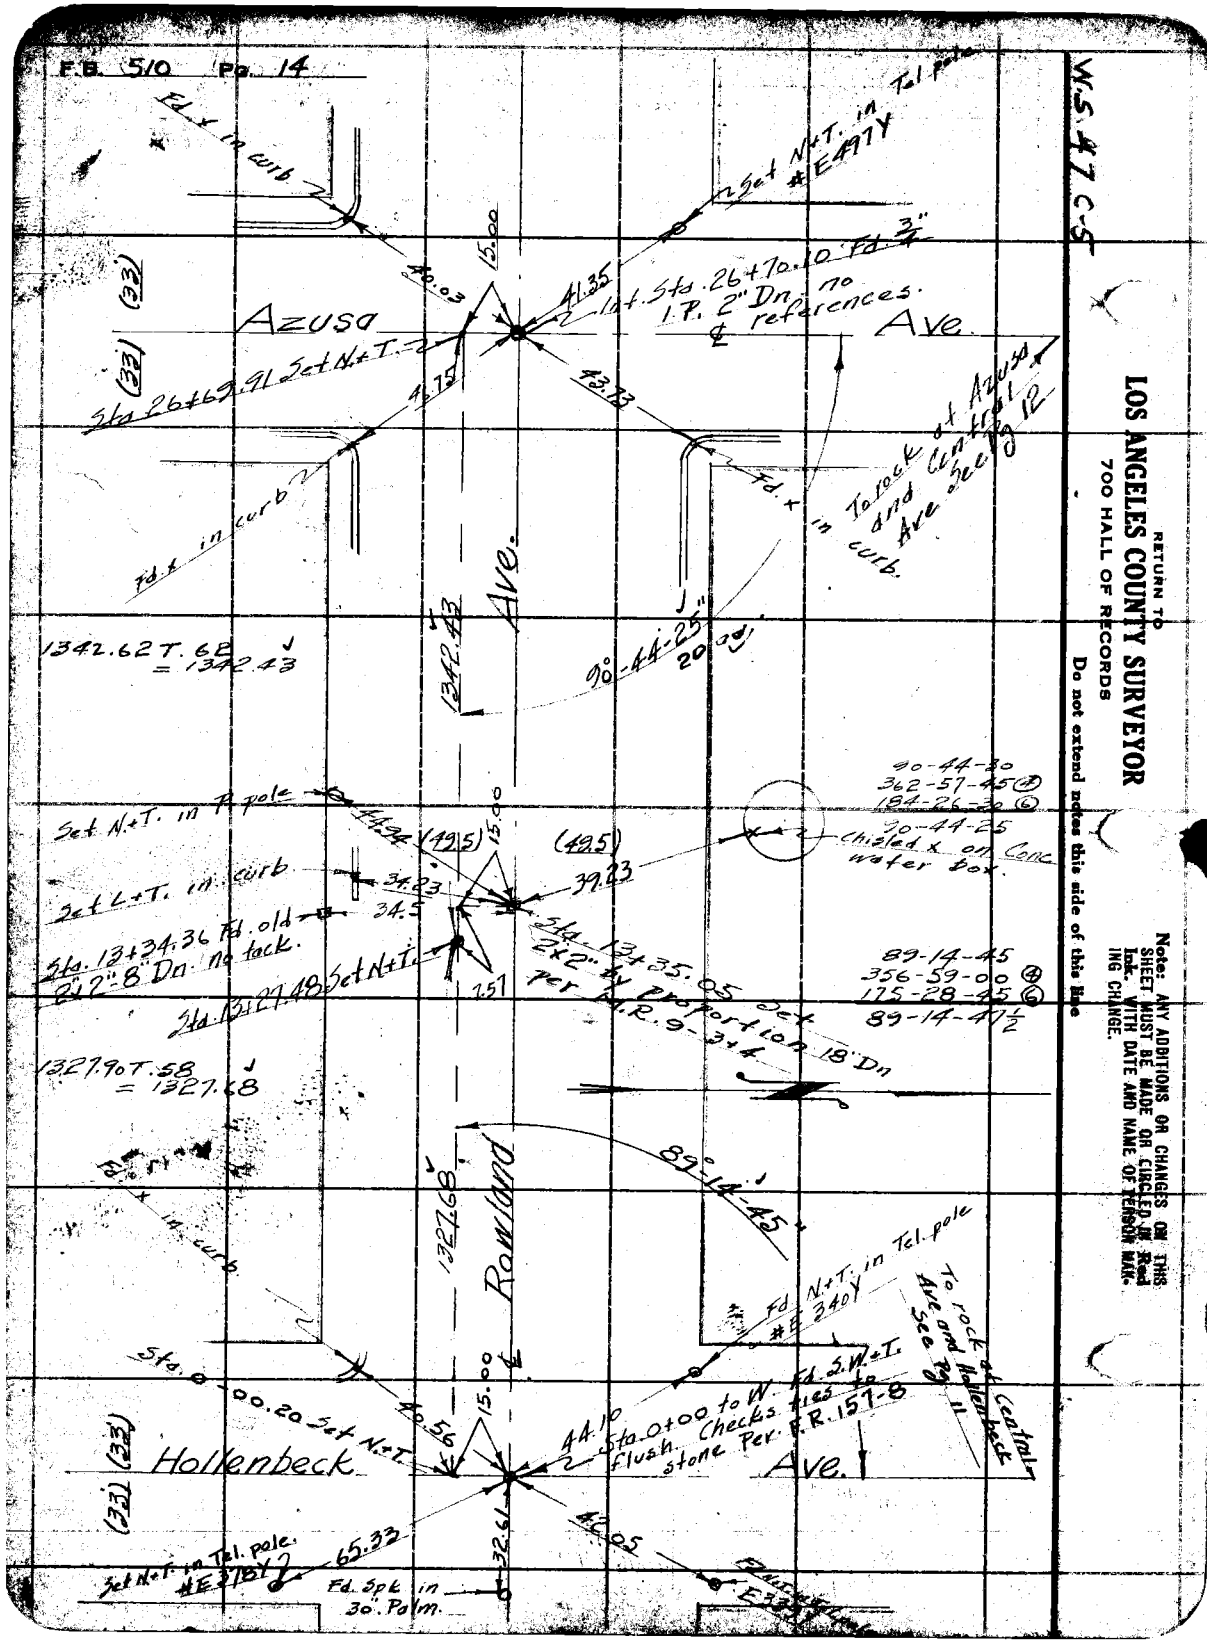
F.B. 510 Pg. 14
W.S. 47 C-5
Fd. x in curb
Set N+T. in Tel pole #E497Y
40.03
15.00
41.35
Int. Sta. 26+70.10 Fd. 3/4" I.P. 2" Dn. no ℄ references.
Azusa
Ave.
(33)
(33)
Sta 26+69.91 Set N+T.
46.75
43.73
Fd. x in curb
Fd. x in curb.
To rock at Azusa and Central Ave See Pg 12
Ave.
1342.43
90°-44-25" 20 adj.
1342.62 T. 68 = 1342.43
90-44-30
362-57-45 ④
184-26-30 ⑥
90-44-25
Chisled x on Conc water box.
Set N+T. in P. pole
44.94
(49.5)
15.00
(49.5)
39.23
Set L+T. in curb
34.23
34.5
Sta. 13+34.36 Fd. old 2"x2"-8" Dn. no tack.
Sta. 13+35.05 Set 2"x2" by proportion 18" Dn per M.R. 9-3+4
7.57
Sta. 13+27.48 Set N+T.
89-14-45
356-59-00 ④
175-28-45 ⑥
89-14-47½
1327.90 T. 58 = 1327.68
89°-14-45"
1327.68
Rowland
Fd. x in curb
Fd. N+T. in Tel. pole #E340Y
To rock at Central Ave and Hollenbeck See Pg 11
Sta. 0-00.20 Set N+T.
40.56
15.00
44.10
Sta. 0+00 to W. Fd. S.W.+T. flush. Checks ties to stone Per. F.R. 157-8
Hollenbeck
Ave.
(33)
(33)
42.05
32.61
65.33
Set N+T. in Tel. pole #E378Y
Fd. Spk in 30" Palm.
E339
RETURN TO
LOS ANGELES COUNTY SURVEYOR
700 HALL OF RECORDS
Do not extend notes this side of this line
Note: ANY ADDITIONS OR CHANGES ON THIS SHEET MUST BE MADE OR CIRCLED IN Red Ink. WITH DATE AND NAME OF PERSON MAKING CHANGE.

Notes Ck'd by Drew	Survey of Central Ave.	F.B. 510	Pg. 15
Map No. B-926	W. O. 7106 Tape No. 042 St'd 84 °F.		
Office Work Cor.	Surveyed by Pasecrans		
Checked Drew	Notes Date 2-20-33		
Date May 1935	Indexed A. C. Johnson		

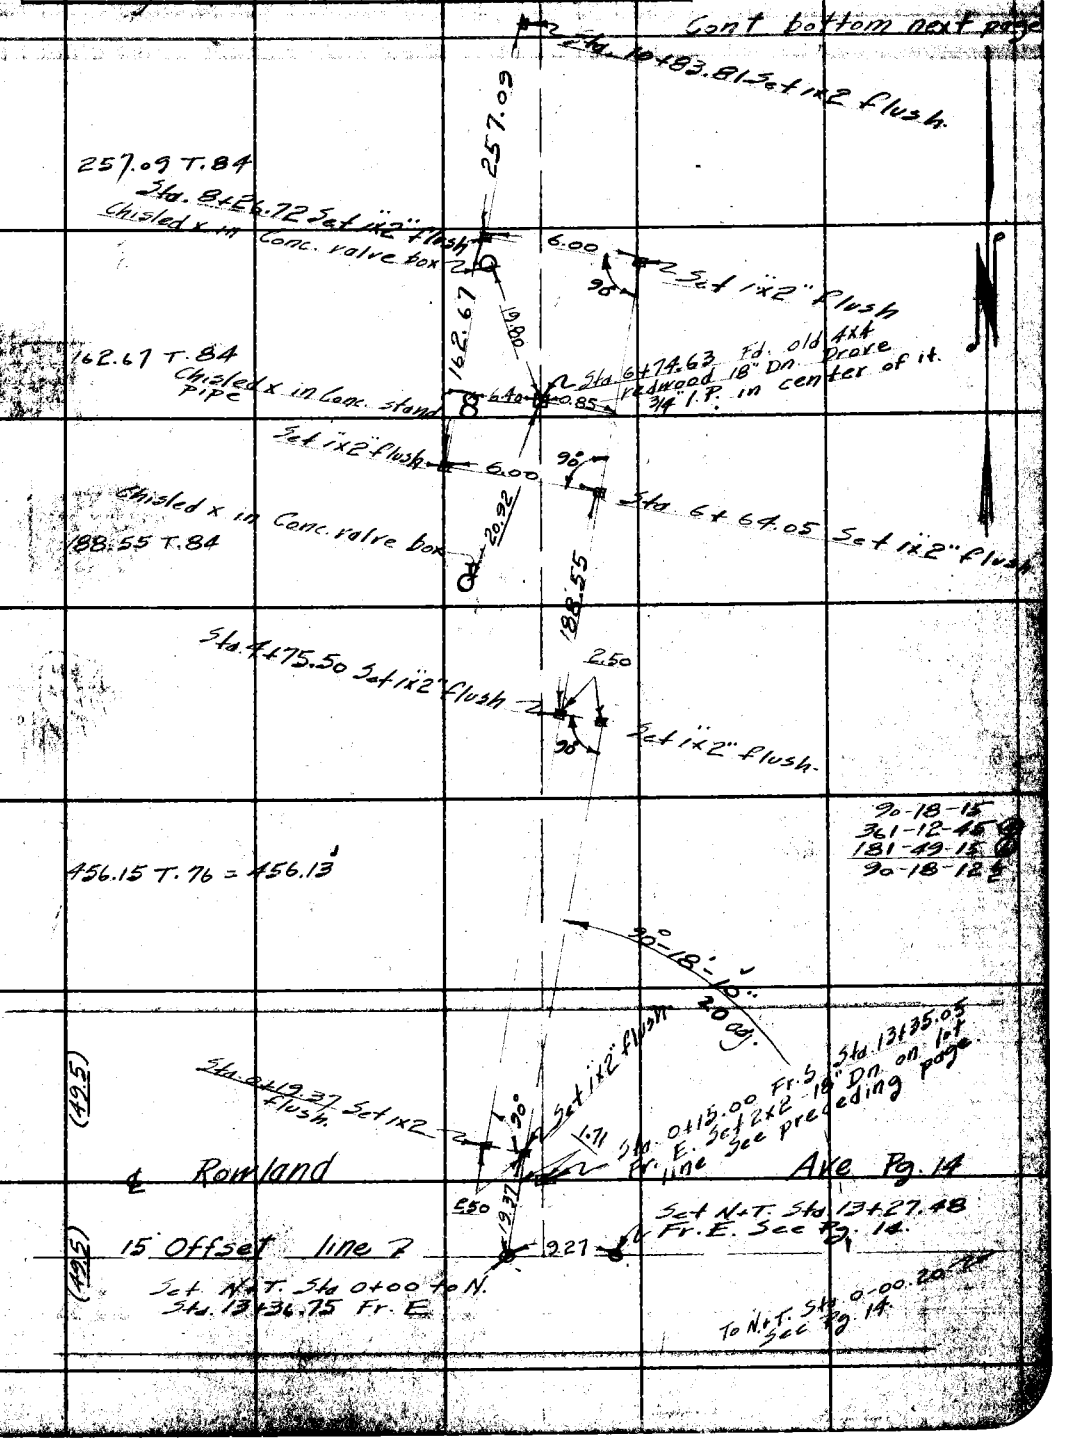

Note: ANY ADDITIONS OR CHANGES ON THIS SHEET MUST BE MADE OR CIRCLED IN Red Ink, WITH DATE AND NAME OF PERSON MAKING CHANGE.

RETURN TO
LOS ANGELES COUNTY SURVEYOR
700 HALL OF RECORDS

Do not extend notes this side of this line

FORM 247 10M 8-31

F.B. 510 Pg. 16

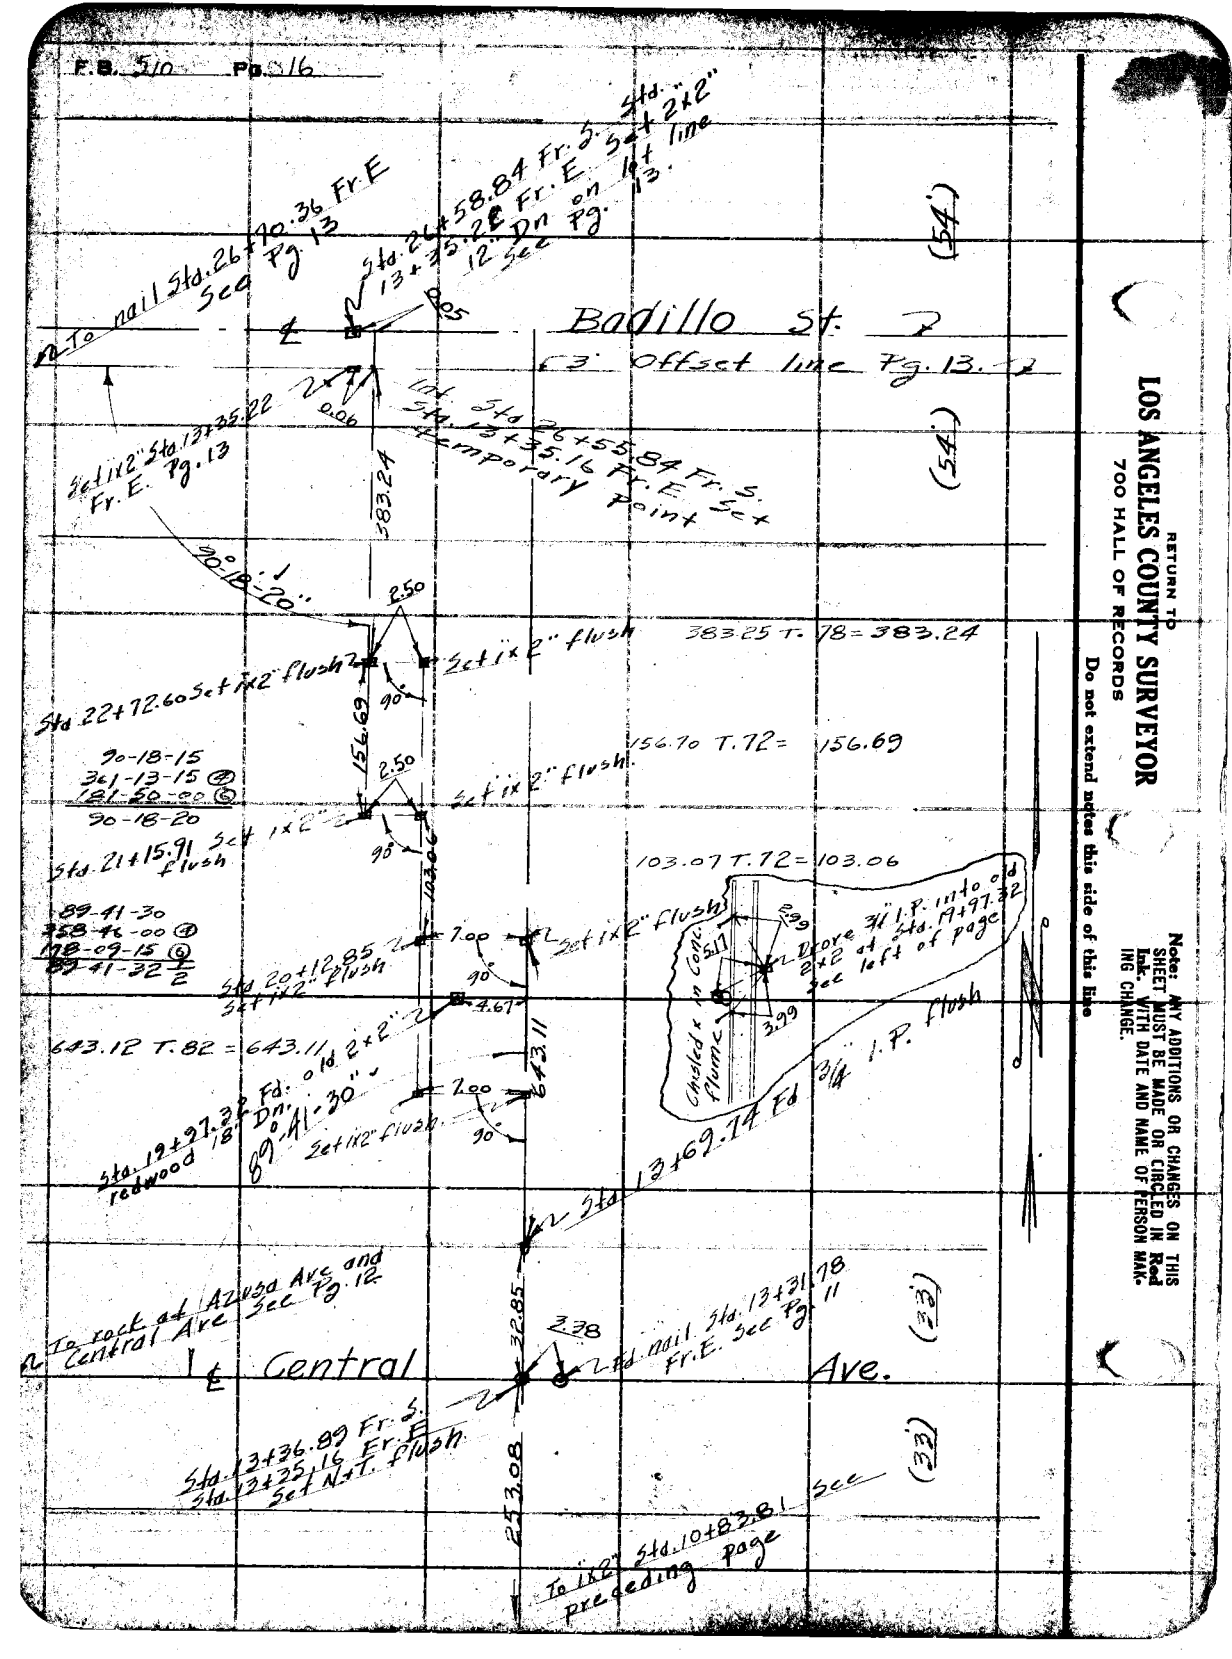

RETURN TO
LOS ANGELES COUNTY SURVEYOR
700 HALL OF RECORDS

Do not extend notes this side of this line

Note: ANY ADDITIONS OR CHANGES ON THIS SHEET MUST BE MADE OR CIRCLED IN Red Ink. WITH DATE AND NAME OF PERSON MAKING CHANGE.

Notes Ck'd by *Drew*	Survey of *Central Ave*
Map No. *B-926*	W. O. *7106* Tape No. *042* St'd *84* °F.
Office Work *Cox*	Surveyed by *Rosecrans*
Checked *Drew*	Notes ___ Date *3-23-33*
Date *May 1935*	Indexed A. C. Johns

F.B. *510* Pg. *17*

Cont. on bottom next page.

Note: ANY ADDITIONS OR CHANGES ON THIS SHEET MUST BE MADE OR CIRCLED IN Red Ink. WITH DATE AND NAME OF PERSON MAKING CHANGE.

Do not extend notes this side of this line

RETURN TO
LOS ANGELES COUNTY SURVEYOR
700 HALL OF RECORDS

FORM 247 10M B-31

RETURN TO
LOS ANGELES COUNTY SURVEYOR
700 HALL OF RECORDS

Note: ANY ADDITIONS OR CHANGES ON THIS SHEET MUST BE MADE OR CIRCLED IN **Red** Ink. WITH DATE AND NAME OF PERSON MAKING CHANGE.

Do not extend notes this side of this line

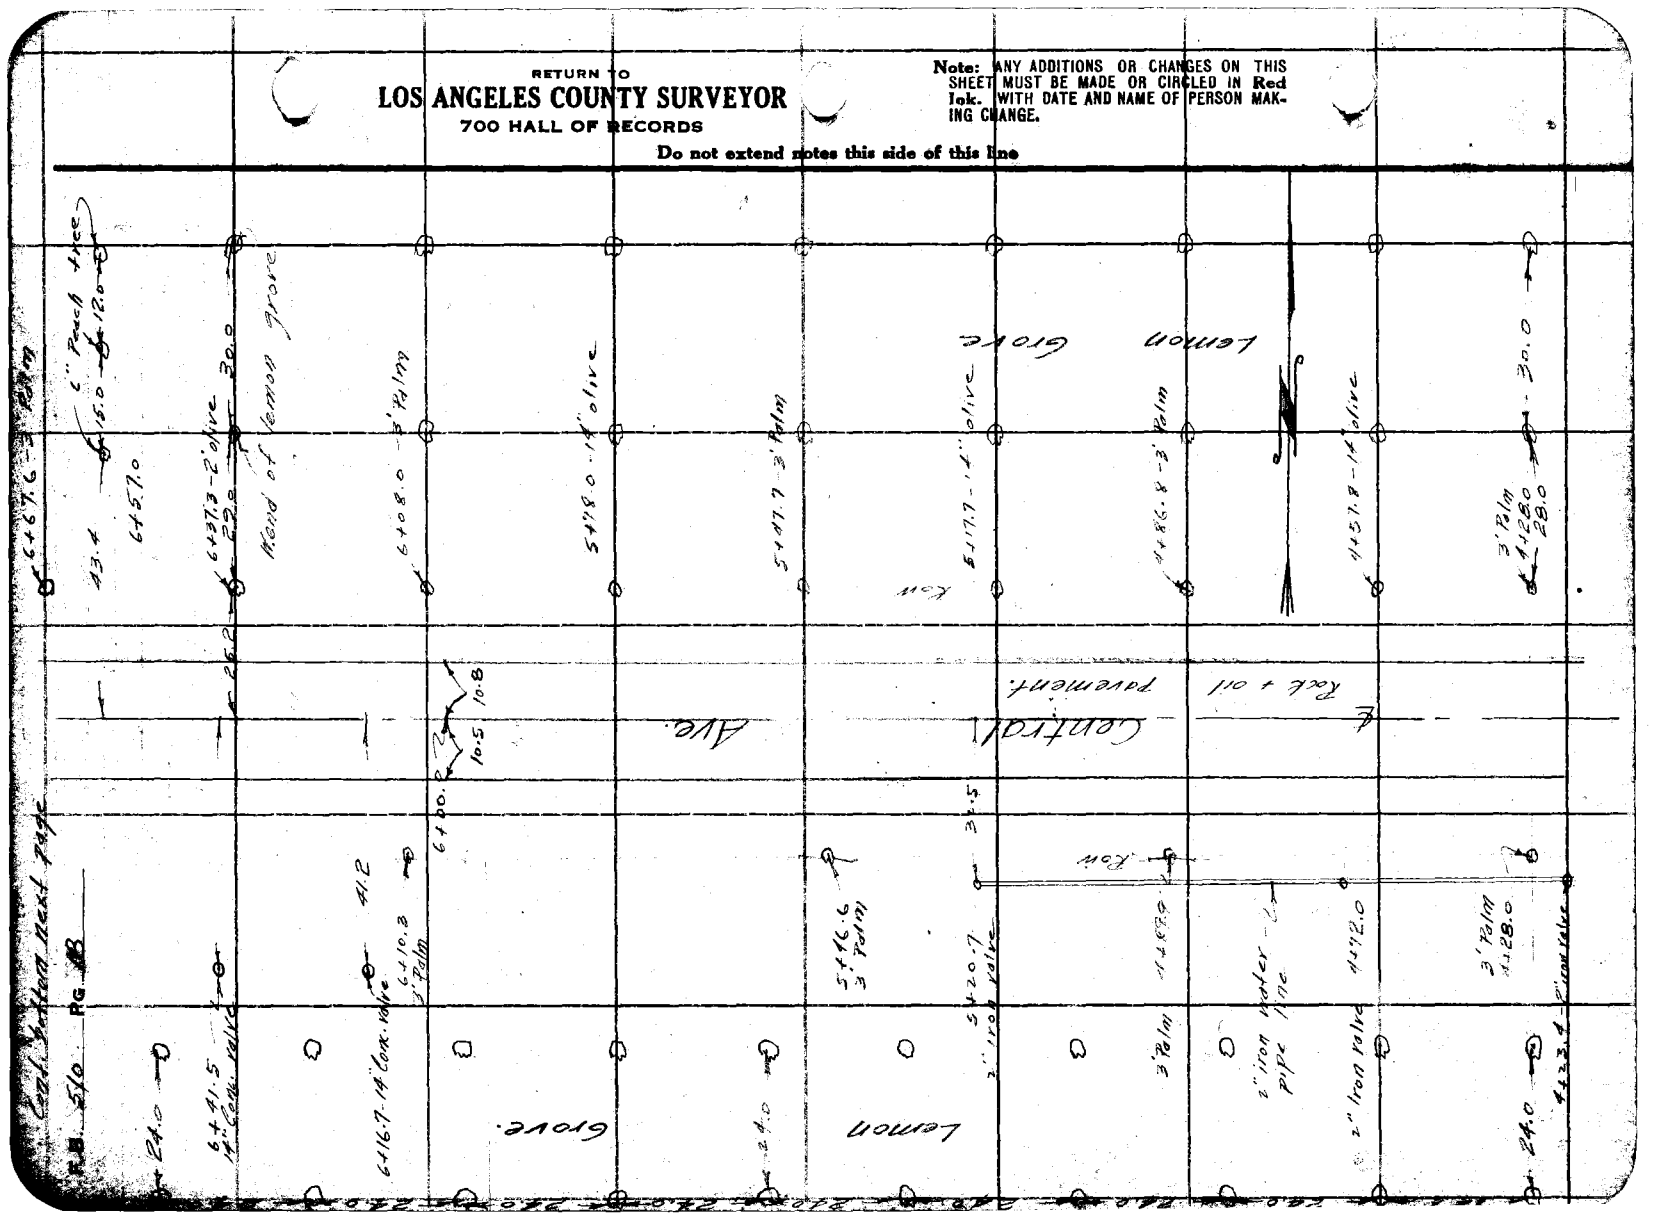

Notes Ck'd by Drew	Survey of Central Ave
Map No. B-926	W. O. 7106 Tape No. 042 St'd 84 °F.
Office Work Cox	Surveyed by [illegible]
Checked Drew	Notes Date 2-23-33
Date May 1935	Indexed A. C. Johns

F.B. 510 Pg. 19

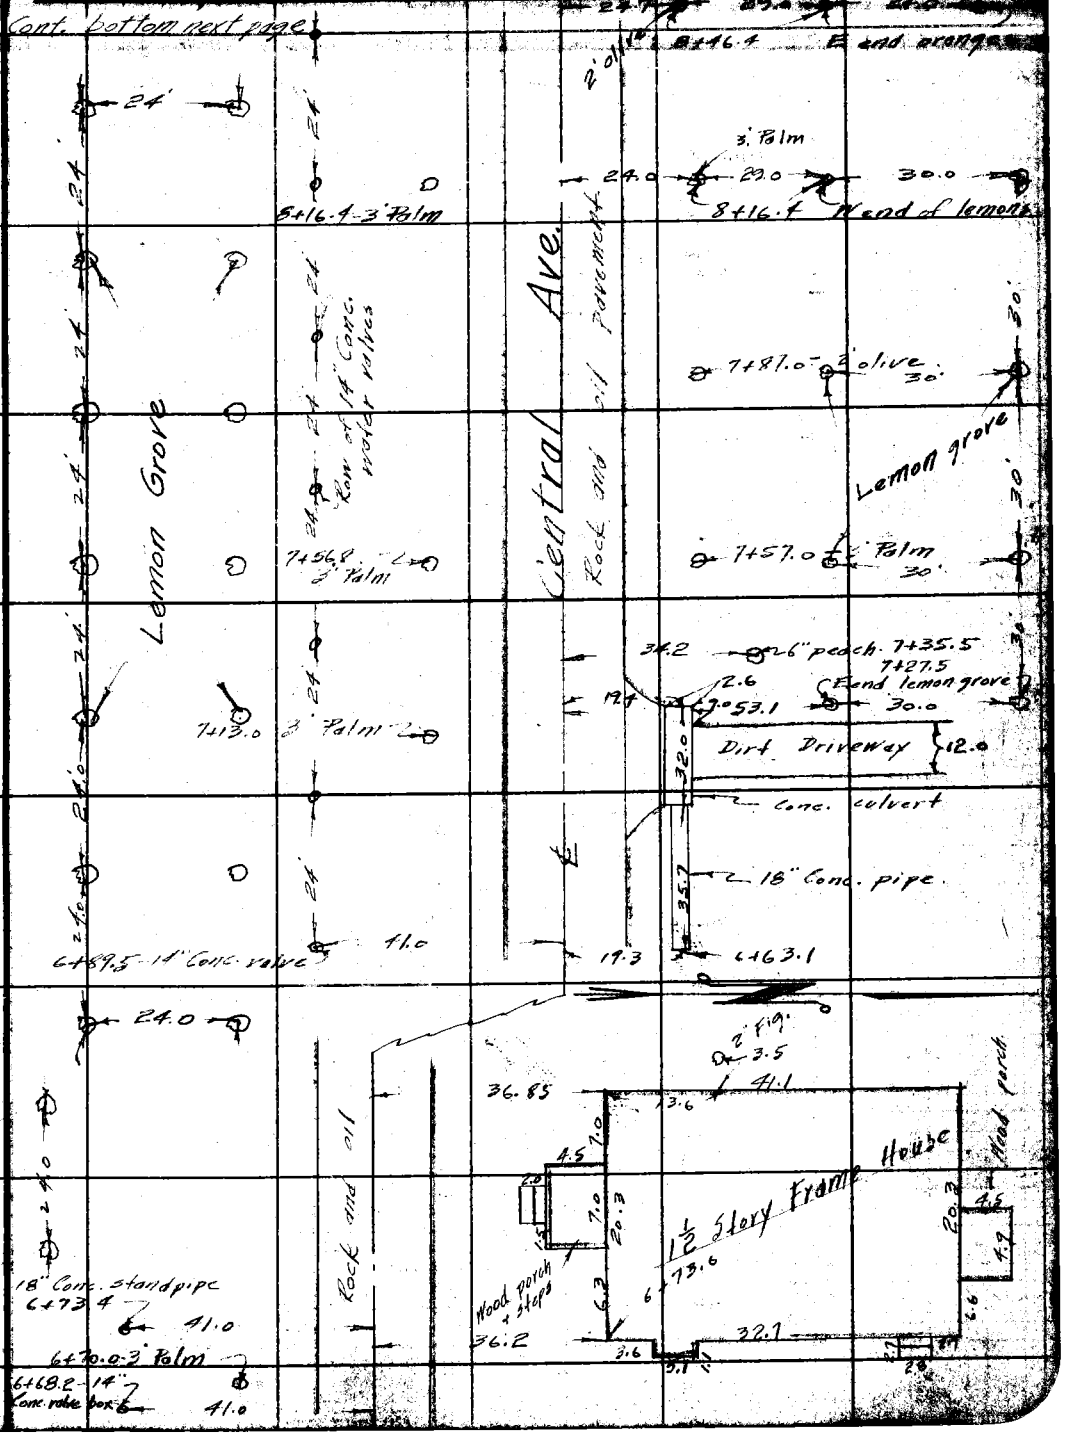

Note: ANY ADDITIONS OR CHANGES ON THIS SHEET MUST BE MADE OR CIRCLED IN Red Ink. WITH DATE AND NAME OF PERSON MAKING CHANGE.

Do not extend notes this side of this line

RETURN TO
LOS ANGELES COUNTY SURVEYOR
700 HALL OF RECORDS

FORM 247 10M 5-31

RETURN TO
LOS ANGELES COUNTY SURVEYOR
700 HALL OF RECORDS

Note: ANY ADDITIONS OR CHANGES ON THIS SHEET MUST BE MADE OR CIRCLED IN Red Ink. WITH DATE AND NAME OF PERSON MAKING CHANGE.

Do not extend notes this side of this line

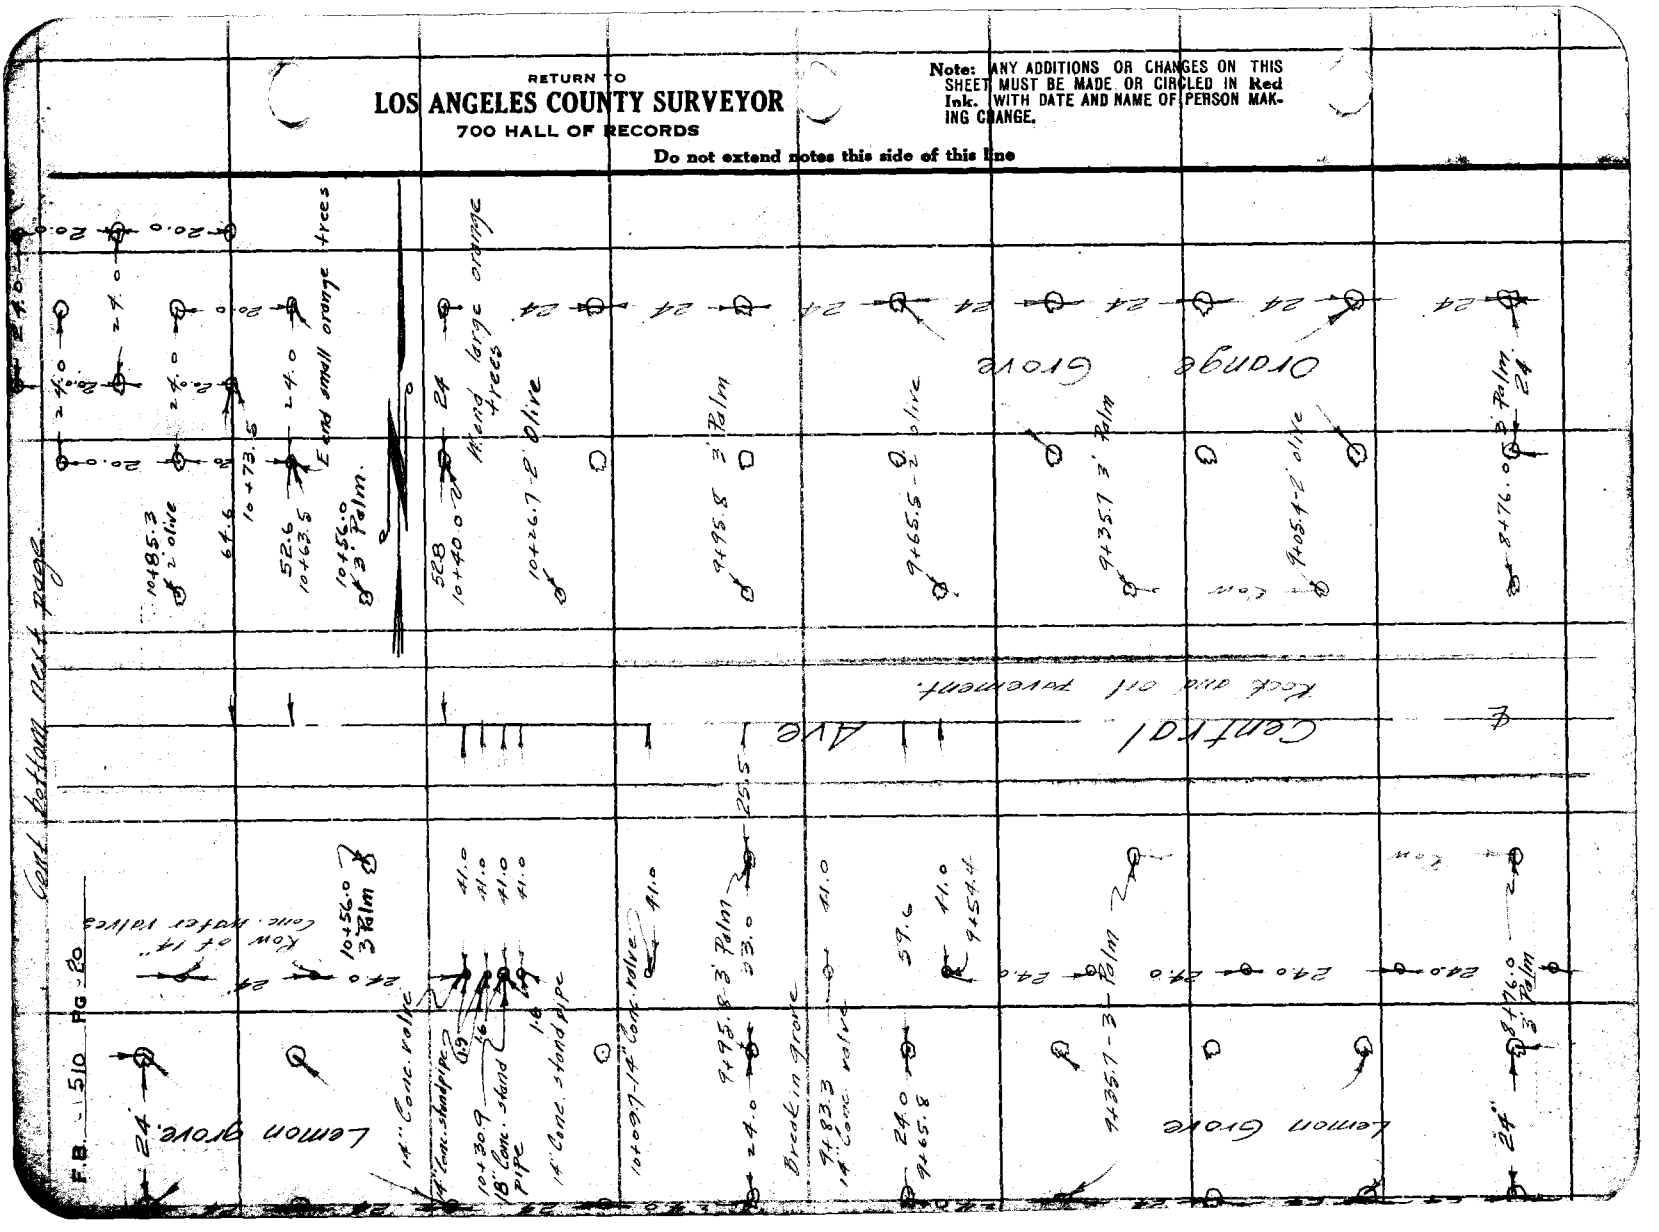

Notes Ck'd by Drew	Survey of Central Ave.
Map No. 8-926	W. O. 7106 Tape No. 042 St'd 84 °F.
Office Work Cox	Surveyed by Rosecrans
Checked Drew	Notes Date 2-23-33
Date May 193-	Indexed A. C. Johnson

F.B. 510 Pg. 21

Cont. Bottom next page

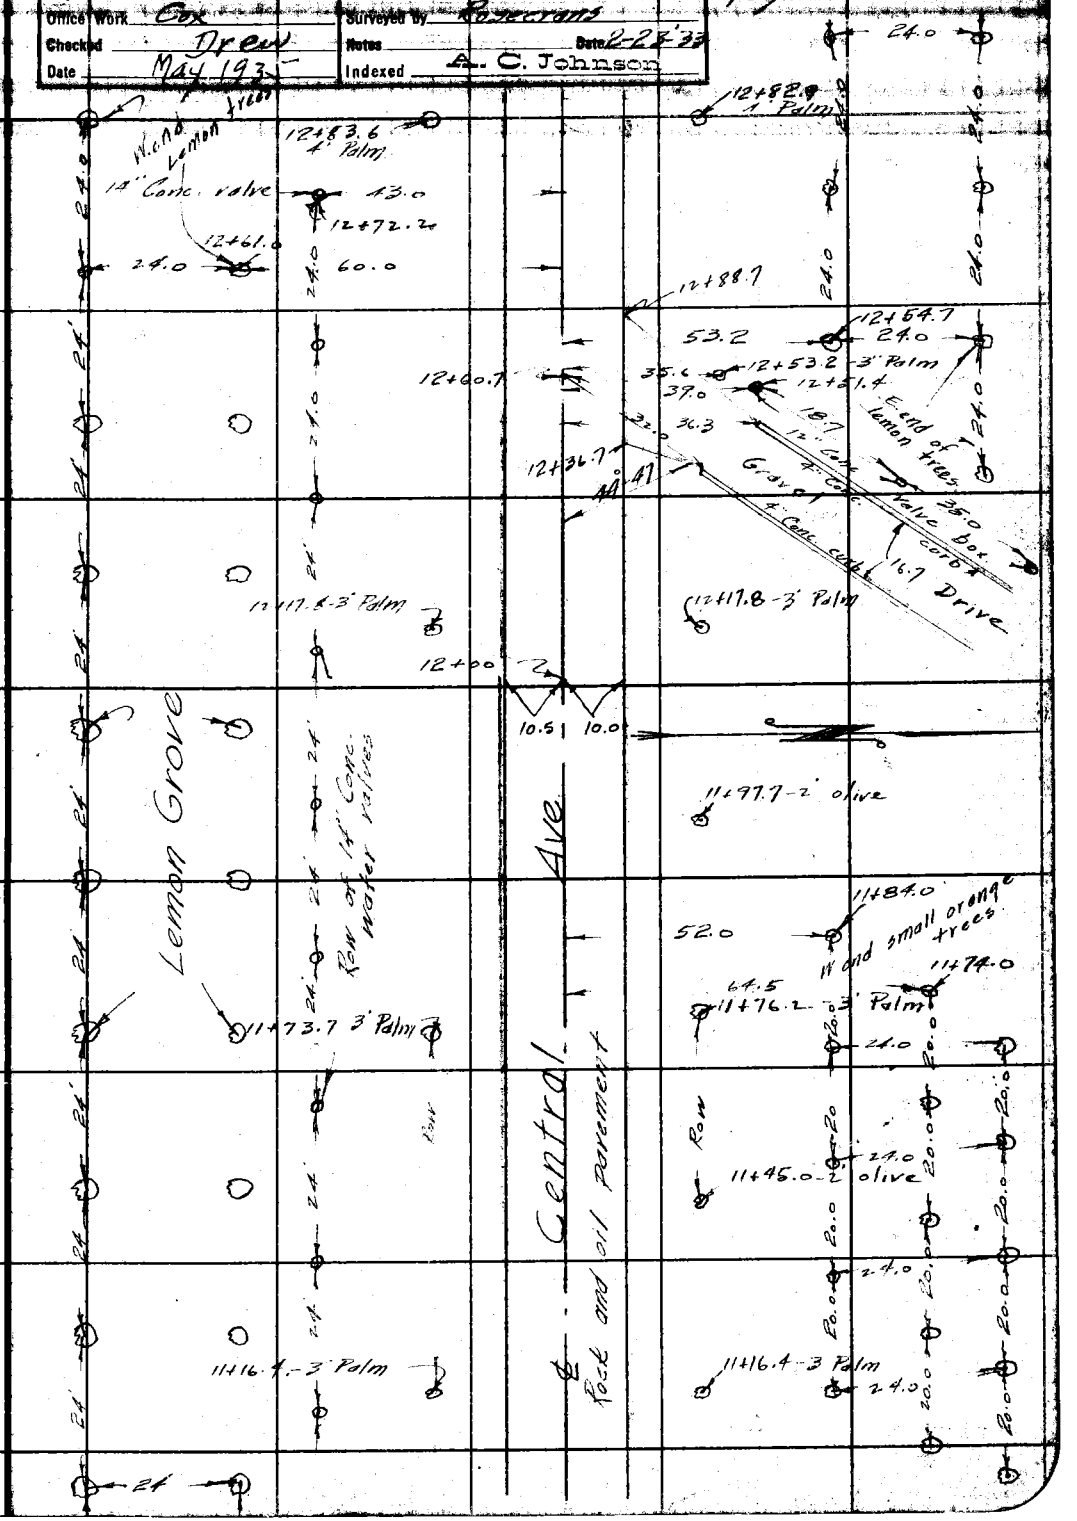

Note: ANY ADDITIONS OR CHANGES ON THIS SHEET MUST BE MADE OR CIRCLED IN Red Ink, WITH DATE AND NAME OF PERSON MAKING CHANGE.

Do not extend notes this side of this line

RETURN TO
LOS ANGELES COUNTY SURVEYOR
700 HALL OF RECORDS

FORM 247 10M 5-31

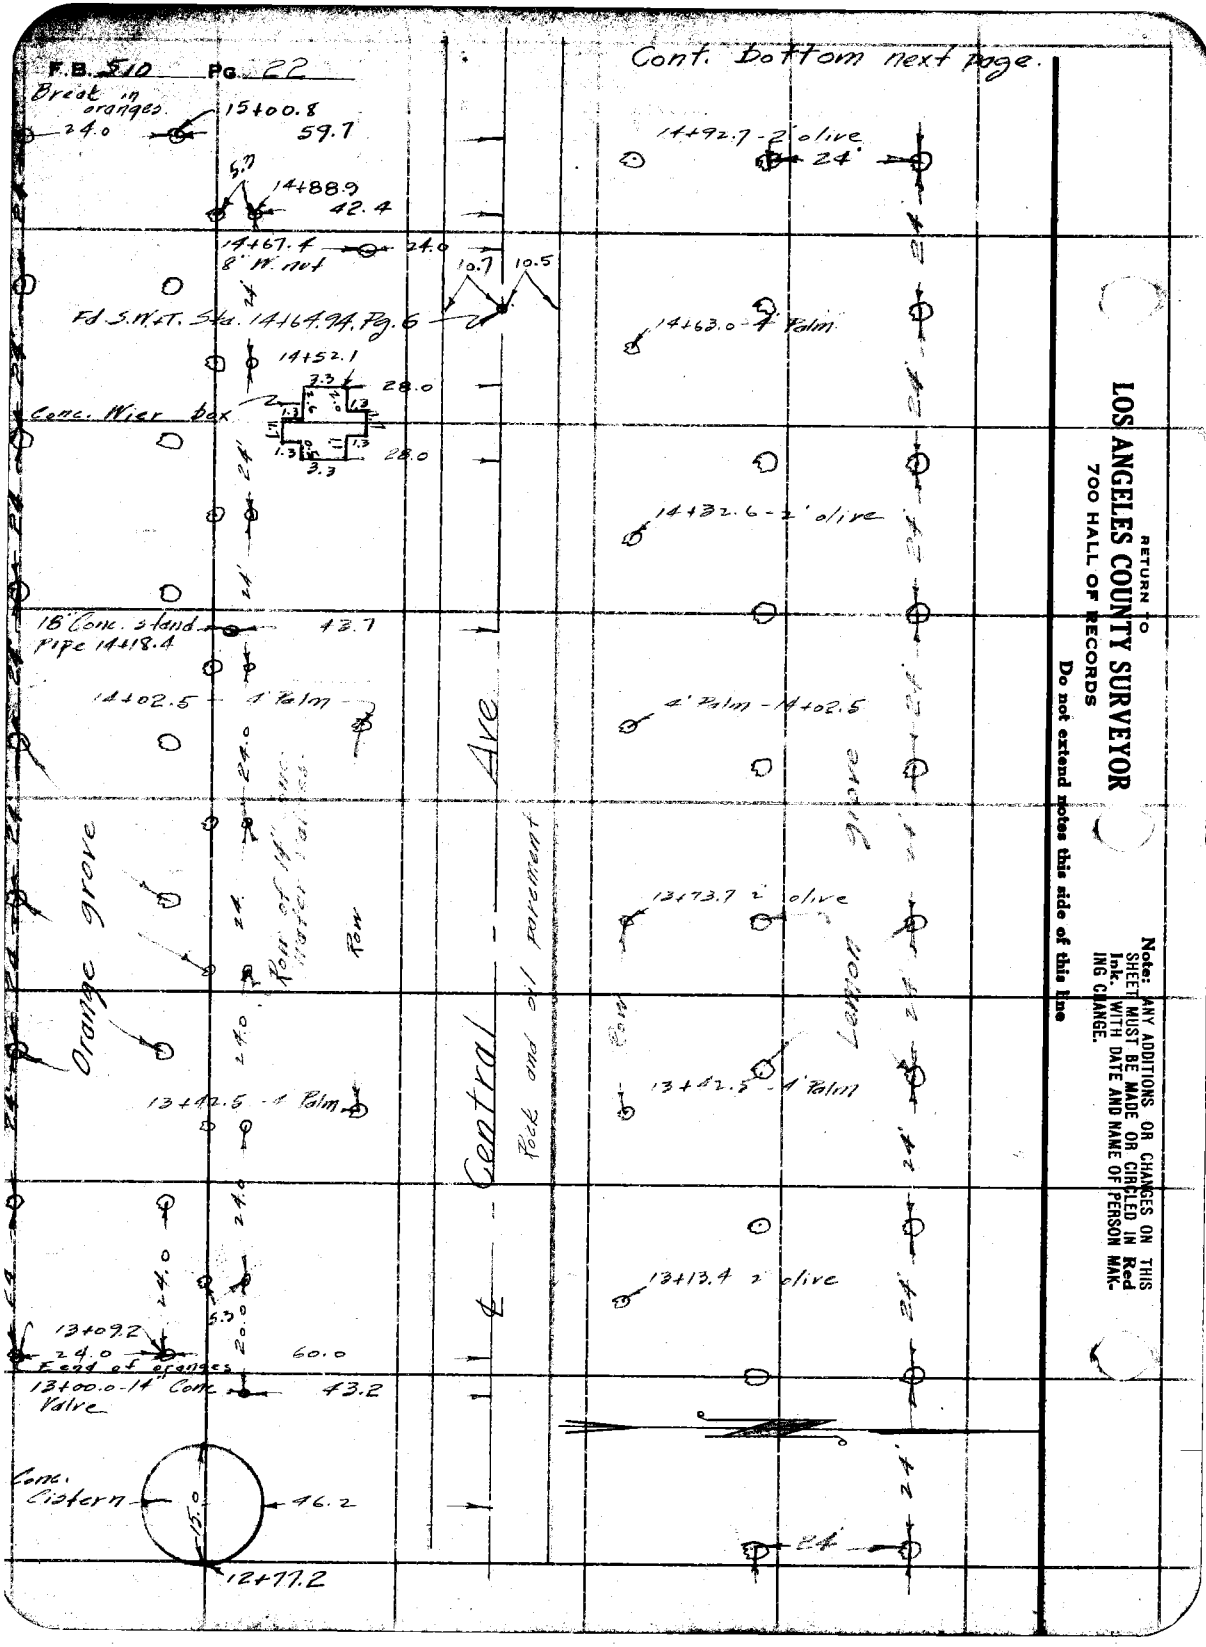

RETURN TO
LOS ANGELES COUNTY SURVEYOR
700 HALL OF RECORDS
Do not extend notes this side of this line

Note: ANY ADDITIONS OR CHANGES ON THIS SHEET MUST BE MADE OR CIRCLED IN Red Ink, WITH DATE AND NAME OF PERSON MAKING CHANGE.

Notes Ck'd by Drew	Survey of Central Ave
Map No. B-926	W. O. 7106 Tape No. 042 St'd 84 °F.
Office Work Cox	Surveyed by Rosecrans
Checked Drew	Notes Date 2-23-33
Date May 1935	Indexed A. C. Johnson

F.B. 510 Pg. [illegible]

Cont. on bottom next page

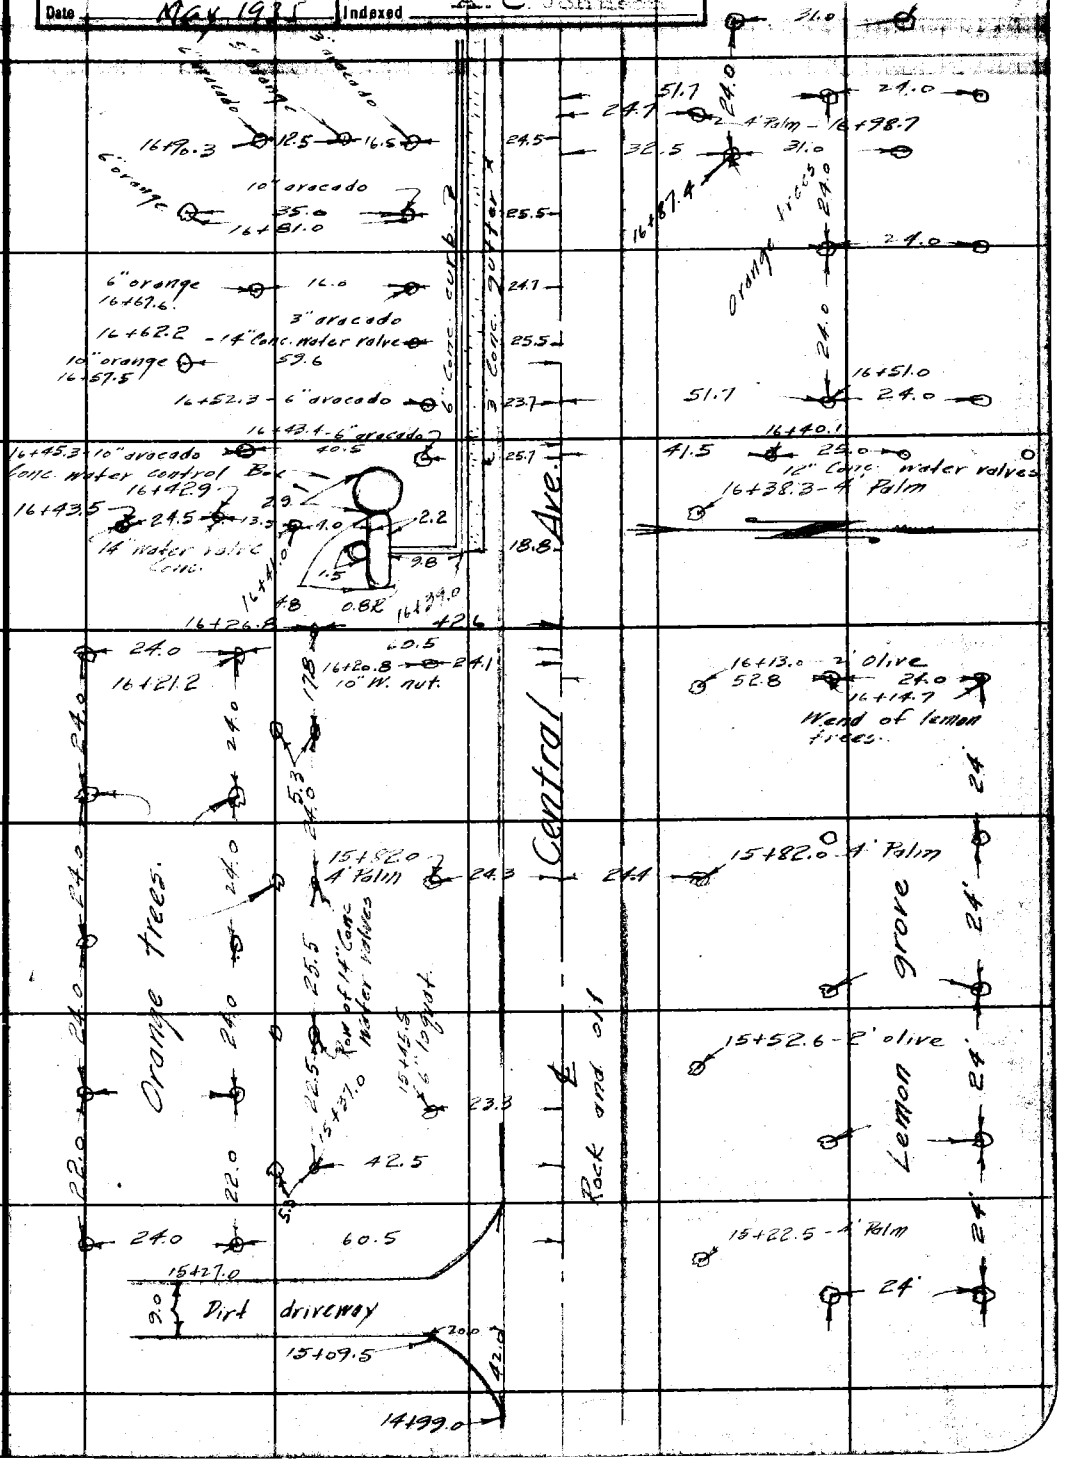

Note: ANY ADDITIONS OR CHANGES ON THIS SHEET MUST BE MADE OR CIRCLED IN Red Ink. WITH DATE AND NAME OF PERSON MAKING CHANGE.

Do not extend notes this side of this line

RETURN TO
LOS ANGELES COUNTY SURVEYOR
700 HALL OF RECORDS

FORM 247 10M 5-31

Cont. bottom next page.

F.B. 510 PG. 24

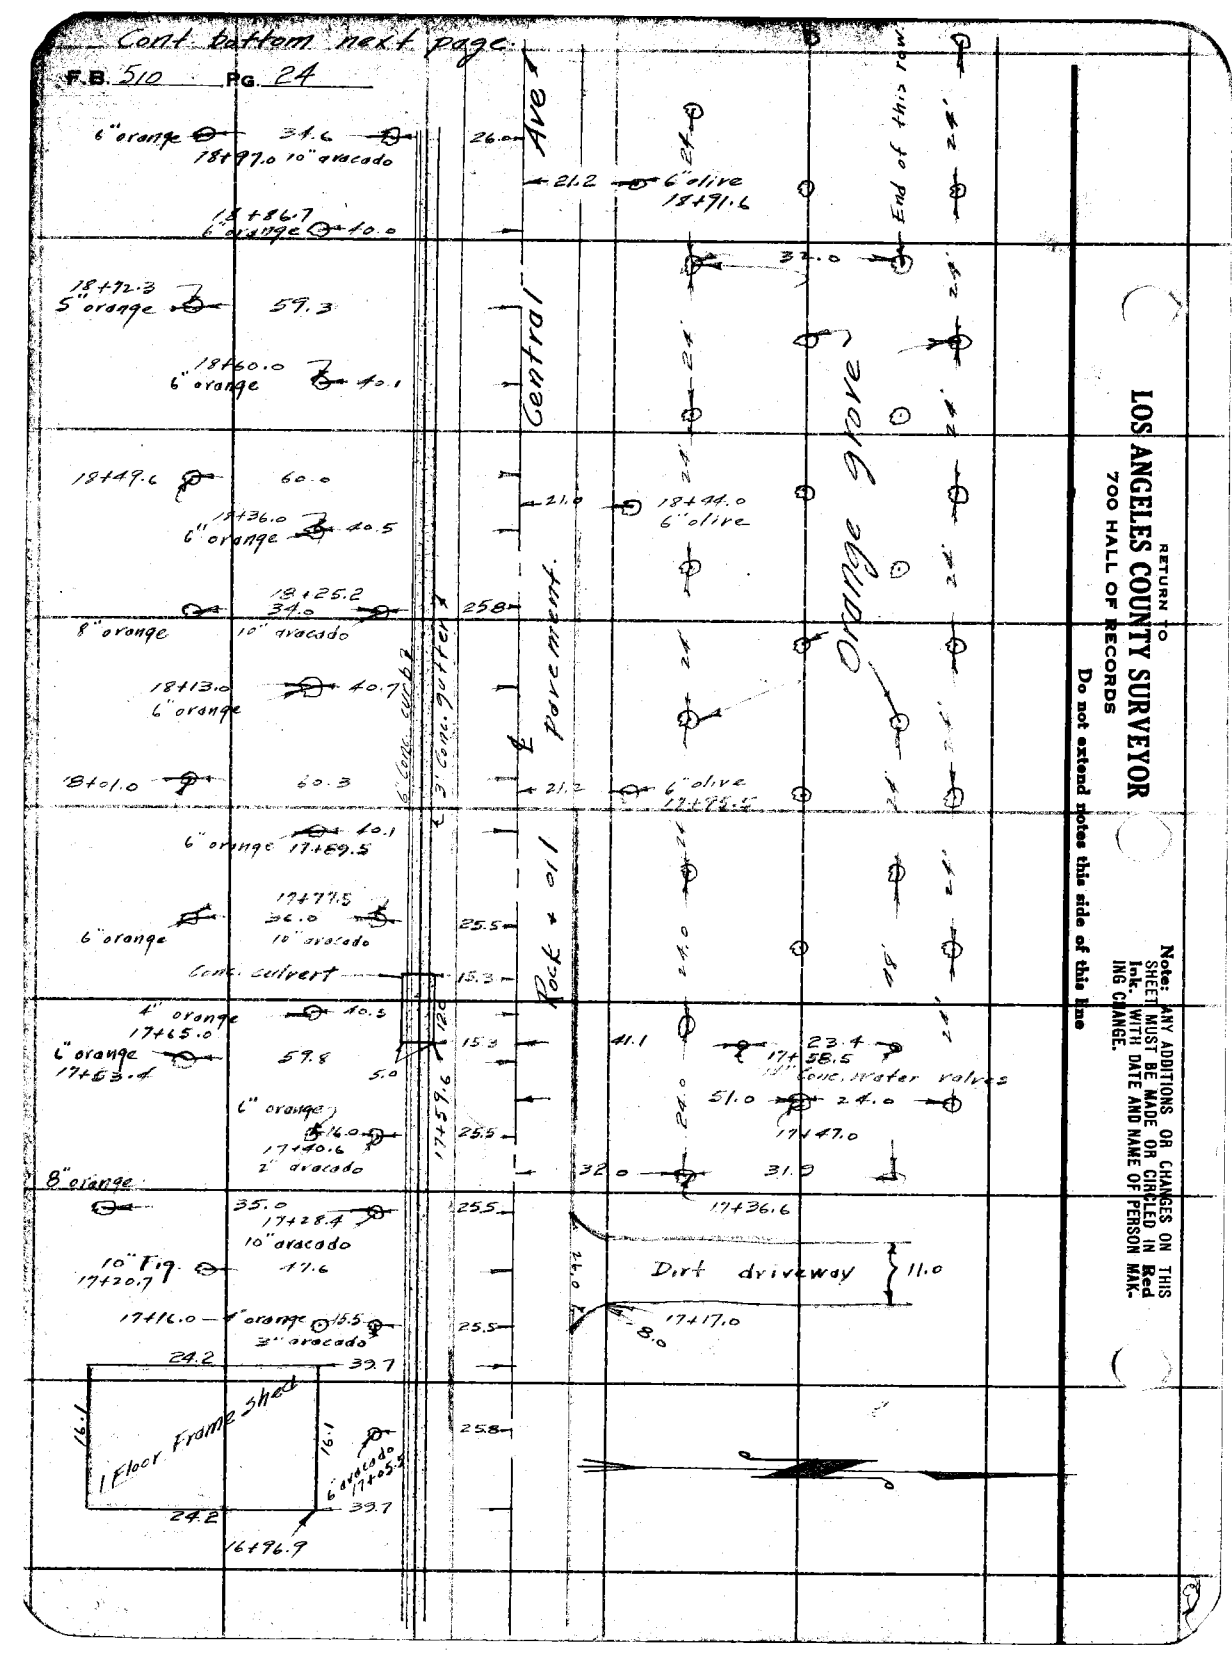

RETURN TO
LOS ANGELES COUNTY SURVEYOR
700 HALL OF RECORDS
Do not extend notes this side of this line

Note: ANY ADDITIONS OR CHANGES ON THIS SHEET MUST BE MADE OR CHANGED IN Red Ink. WITH DATE AND NAME OF PERSON MAK. ING CHANGE.

Notes Ck'd by	Drew	Survey of	Central Ave
Map No.	B-926	W. O.	7106
Office Work	Cox	Tape No.	042
Checked	Drew	Surveyed by	Easterms
Date	May 1935	Notes	
		Indexed	A. C. Johnson

F.B. 510 PG. 25

Cont bottom next page

Note: ANY ADDITIONS OR CHANGES ON THIS SHEET MUST BE MADE OR CIRCLED IN Red Ink. WITH DATE AND NAME OF PERSON MAKING CHANGE.

Do not extend notes this side of this line

RETURN TO
LOS ANGELES COUNTY SURVEYOR
700 HALL OF RECORDS

FORM 247 10M 8-31

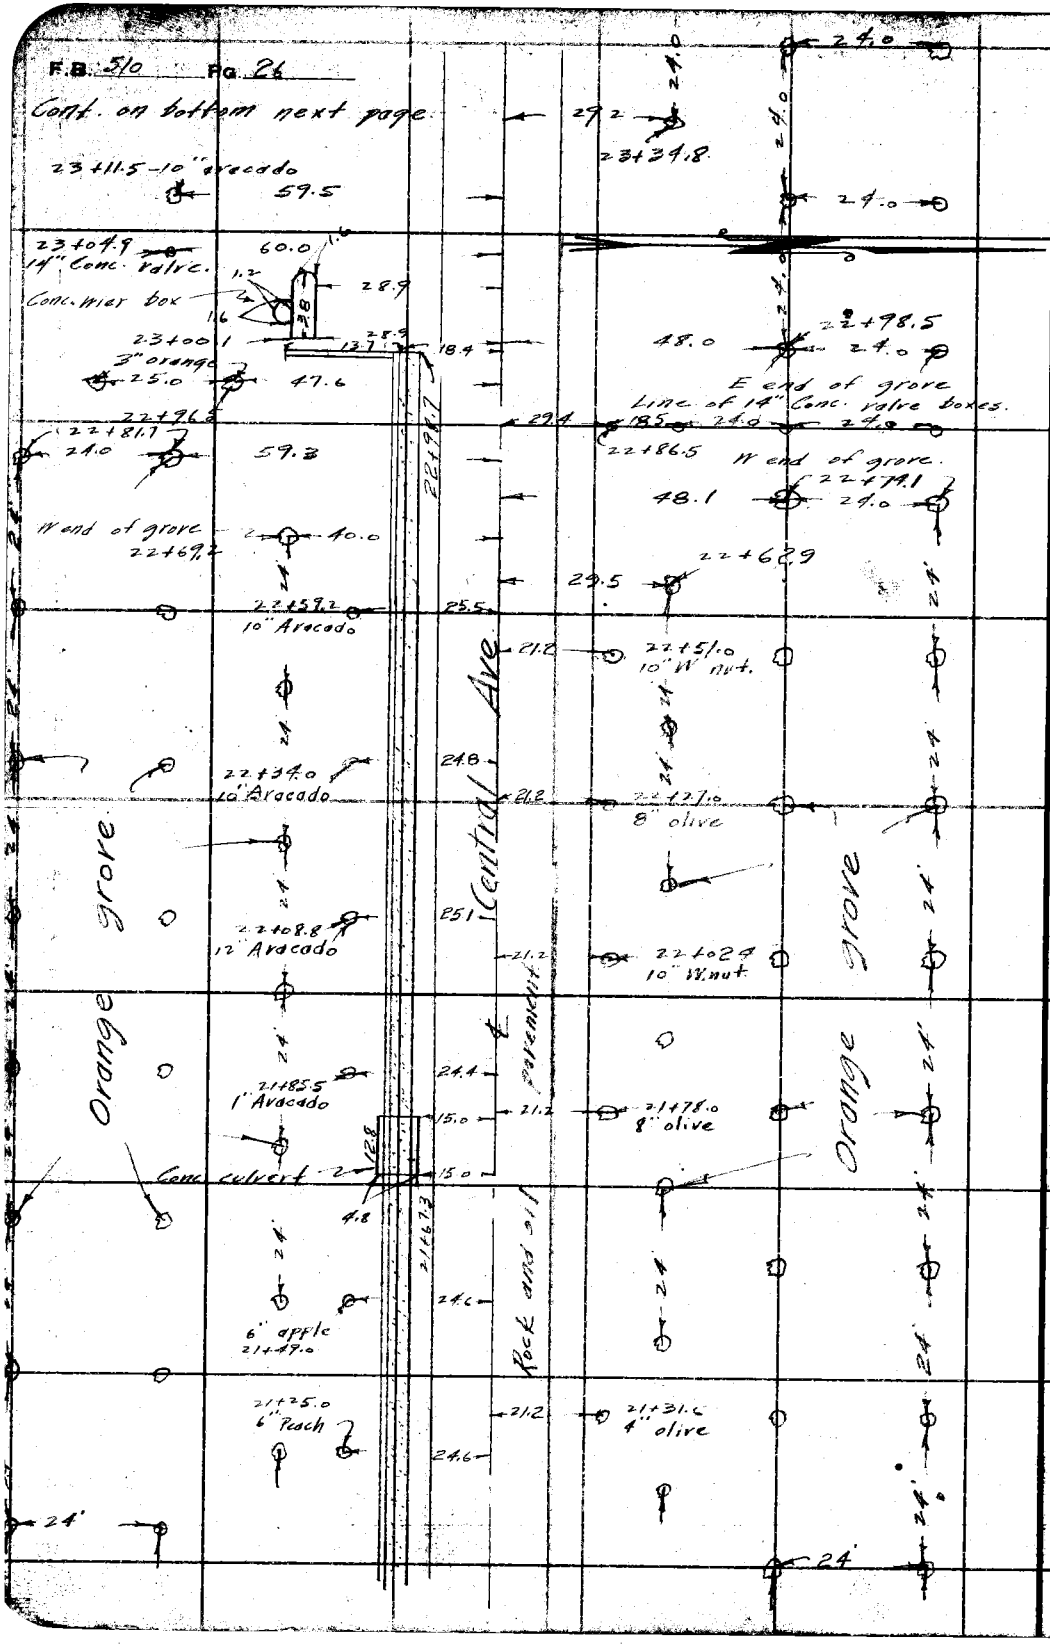

RETURN TO
LOS ANGELES COUNTY SURVEYOR
700 HALL OF RECORDS

Do not extend notes this side of this line

Note: ANY ADDITIONS OR CHANGES ON THIS SHEET MUST BE MADE OR CIRCLED IN Red Ink. WITH DATE AND NAME OF PERSON MAKING CHANGE.

Notes Ck'd by Drew	Survey of Central Ave.	F.B. 510	Pg. 87
Map No. B-926	W. O. 7106 Tape No. 042 St'd 84 of.		
Office Work Cox	Surveyed by Petersons		
Checked Drew	Notes	Date 2-24-33	
Date May 19,35	Indexed A. C. Johnson		

Note: ANY ADDITIONS OR CHANGES ON THIS SHEET MUST BE MADE OR CIRCLED IN Red Ink, WITH DATE AND NAME OF PERSON MAKING CHANGE.

Do not extend notes this side of this line

RETURN TO
LOS ANGELES COUNTY SURVEYOR
700 HALL OF RECORDS

FORM 247 10M 5-31

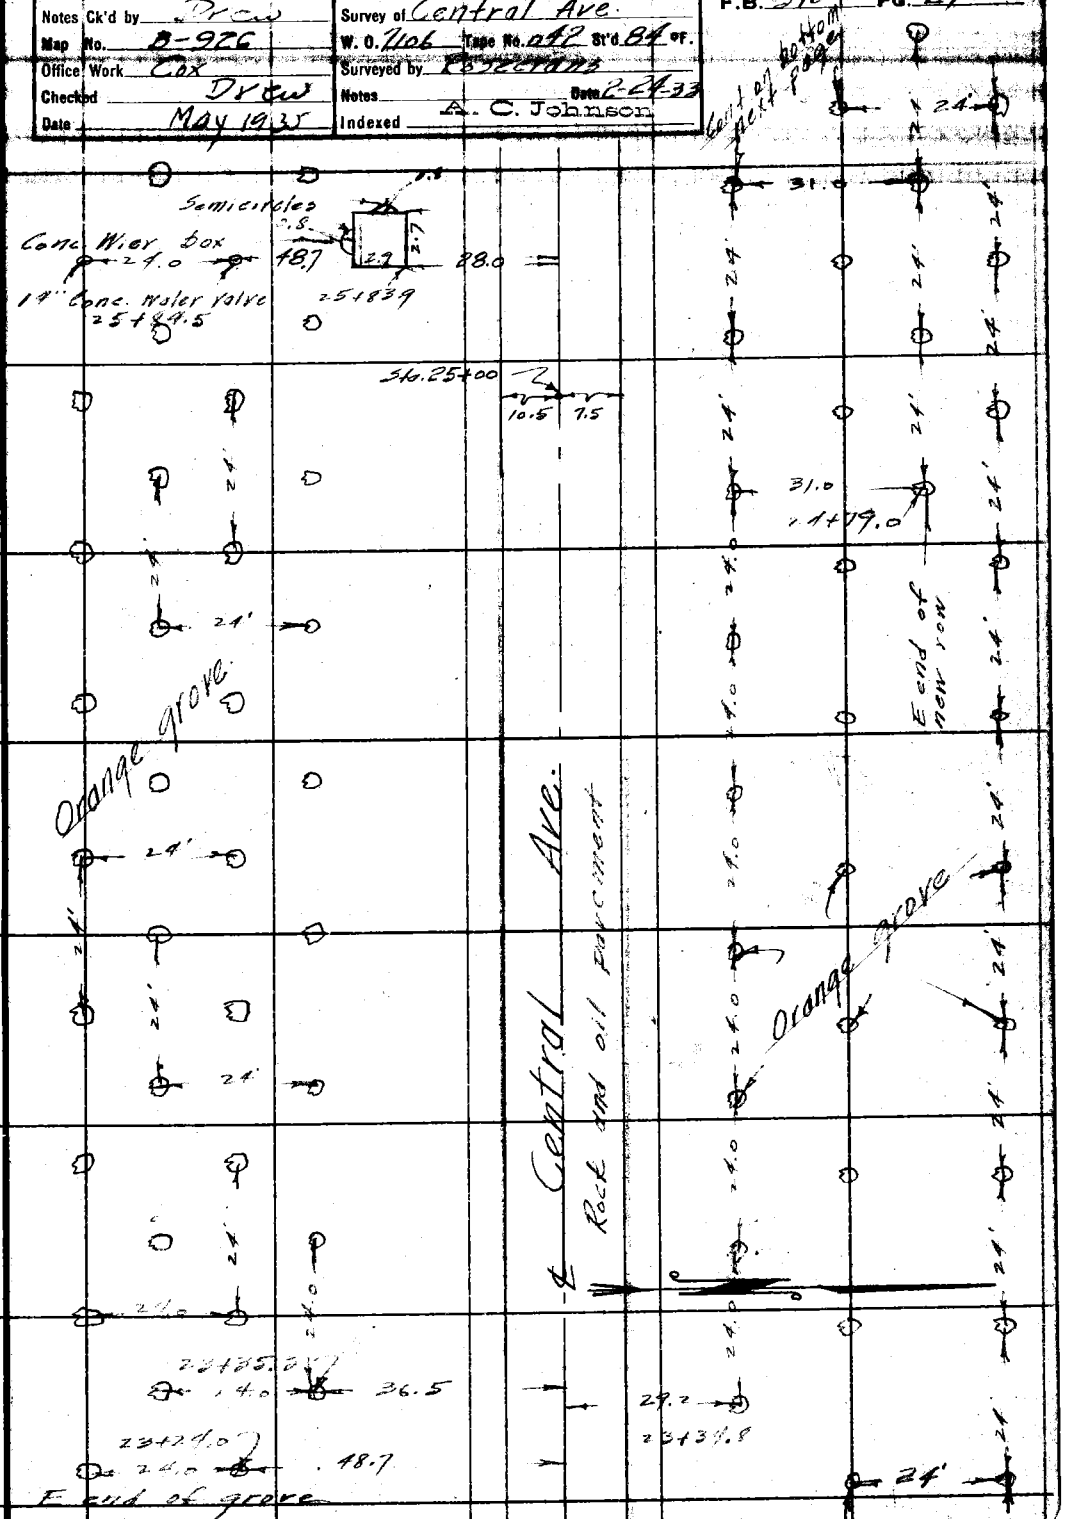

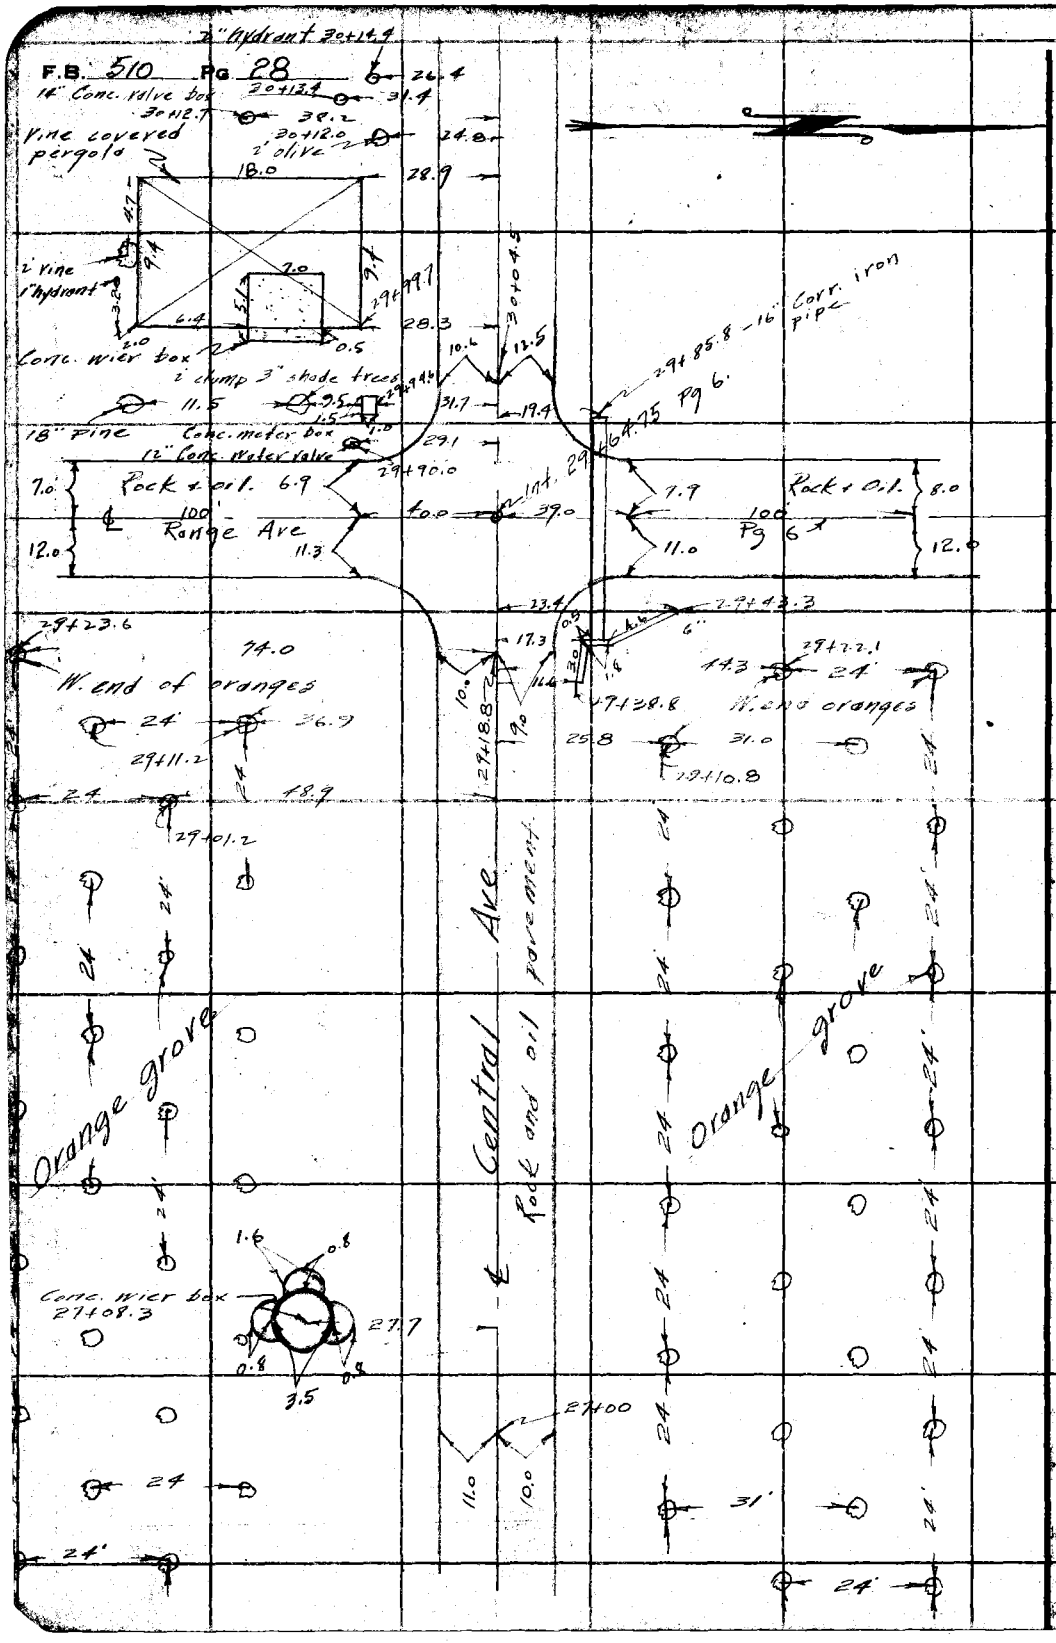

RETURN TO
LOS ANGELES COUNTY SURVEYOR
700 HALL OF RECORDS

Do not extend notes this side of this line

Note: ANY ADDITIONS OR CHANGES ON THIS SHEET MUST BE MADE OR CIRCLED IN Red Ink. WITH DATE AND NAME OF PERSON MAKING CHANGE.

Notes Ck'd by *Drew*	Survey of *Central Ave*
Map No. *B-926*	W. O. *7106* Tape No. *042* St'd *84* °F.
Office Work *Cox*	Surveyed by *Rosecrans*
Checked *Drew*	Notes
Date *May 1935*	Date *2-27-33*
	Indexed *A. C. Johnson*

F.B. *510* Pg. *29*

Cont. on bottom next ~~page~~

Note: ANY ADDITIONS OR CHANGES ON THIS SHEET MUST BE MADE OR CIRCLED IN Red Ink. WITH DATE AND NAME OF PERSON MAKING CHANGE.

Do not extend notes this side of this line

RETURN TO LOS ANGELES COUNTY SURVEYOR 700 HALL OF RECORDS

FORM 247 10M 5-31

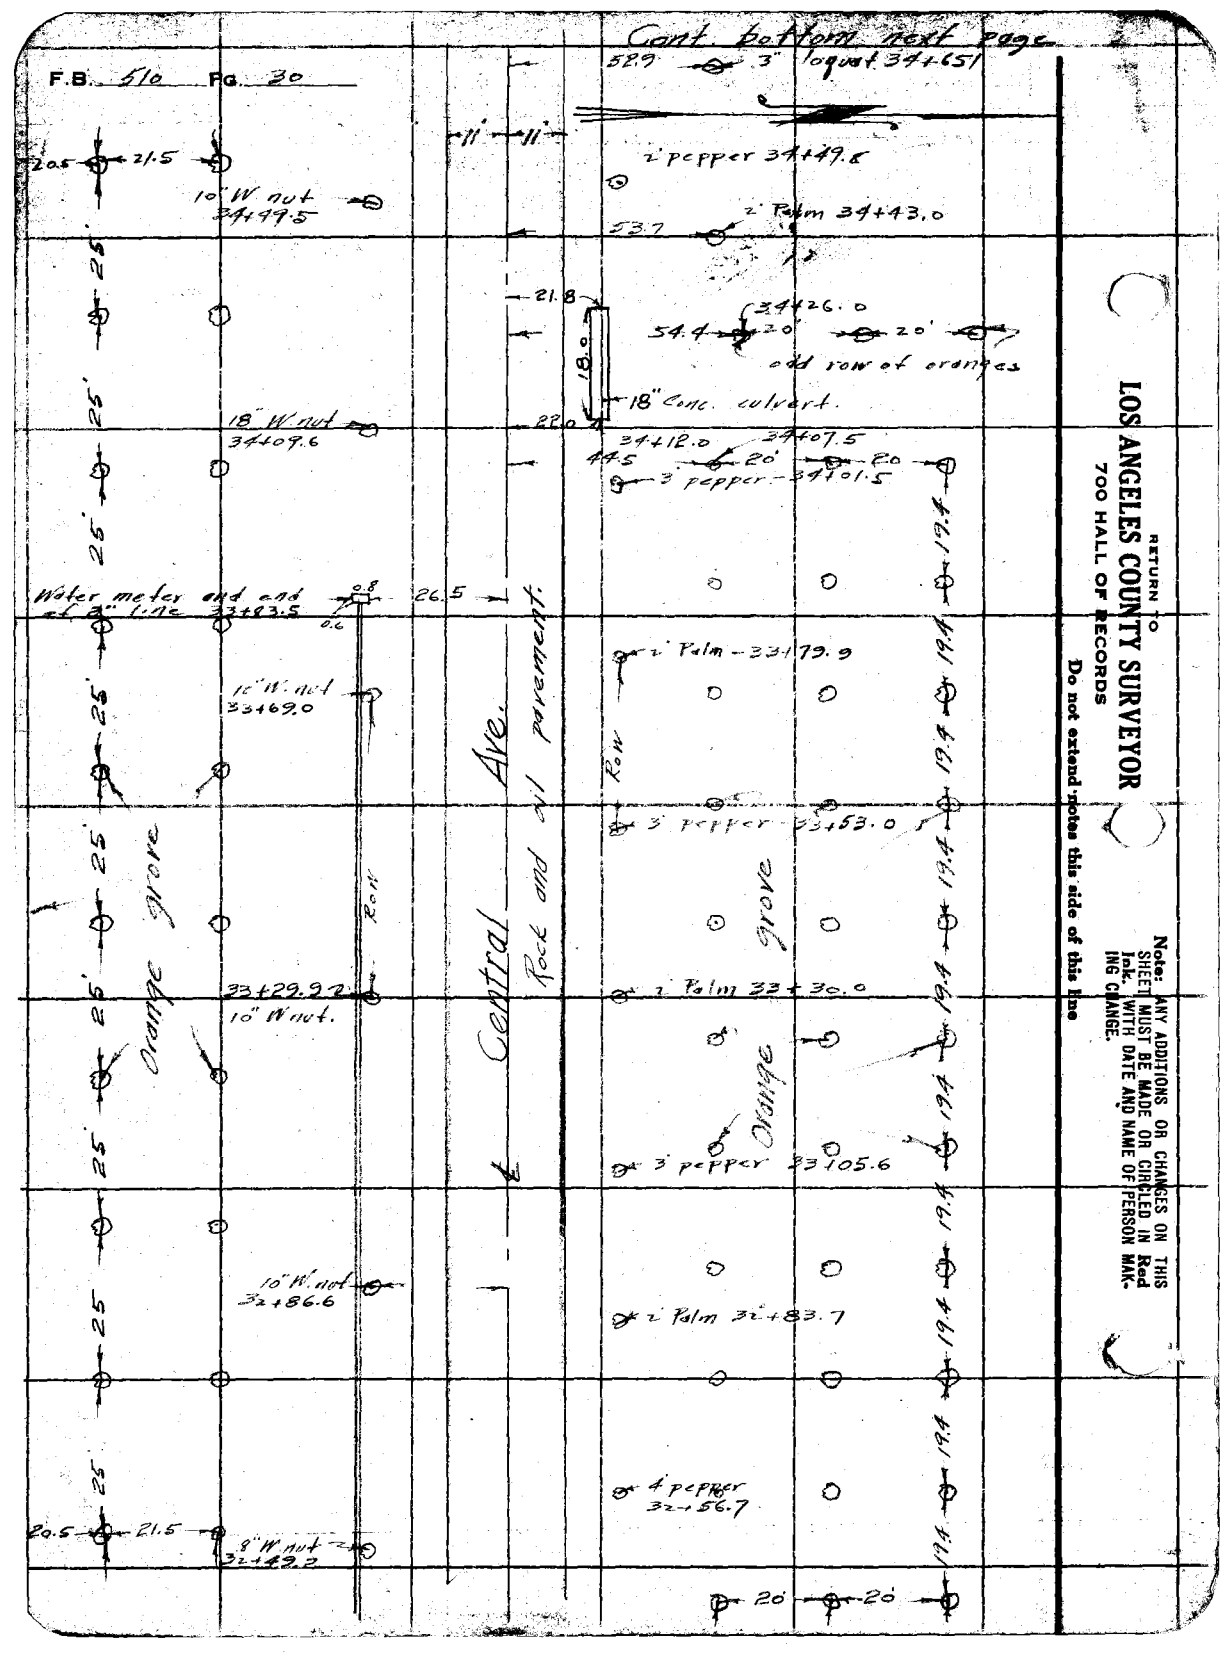
F.B. 510 Pg. 30
Cont. bottom next page
529 3" loquat 34+65.1
11' 11'
2' pepper 34+49.8
20.5 21.5
10" W nut 34+49.5
2' Palm 34+43.0
53.7
21.8
18.0
34+26.0
54.4 20' 20'
odd row of oranges
18" Conc. culvert.
18" W nut 34+09.6
22.0
34+12.0 34+07.5
44.5 20' 20'
3' pepper - 34+01.5
Water meter and end of 2" line 33+83.5
0.8
0.6
26.5
2' Palm - 33+79.9
10" W. nut 33+69.0
3' pepper - 33+53.0
2' Palm 33+30.0
33+29.92
10" W nut.
3' pepper 33+05.6
10" W. nut 32+86.6
2' Palm 32+83.7
4' pepper 32+56.7
20.5 21.5
8" W nut 32+42.2
20' 20'
Central Ave.
Rock and pavement
Orange Grove
Zone
RETURN TO
LOS ANGELES COUNTY SURVEYOR
700 HALL OF RECORDS
Do not extend notes this side of this line
Note: ANY ADDITIONS OR CHANGES ON THIS SHEET MUST BE MADE OR CIRCLED IN Red Ink. WITH DATE AND NAME OF PERSON MAKING CHANGE.

Notes Ck'd by Drew	Survey of Central Ave
Map No. B-926	W. O. 7106 Tape No. 042 St'd 84 °F.
Office Work Cox	Surveyed by Rosecrans
Checked Drew	Notes Date 6-27-33
Date May 1935	Indexed A. C. Johnson

F.B. 510 Pg. 31

Cont. bottom next page

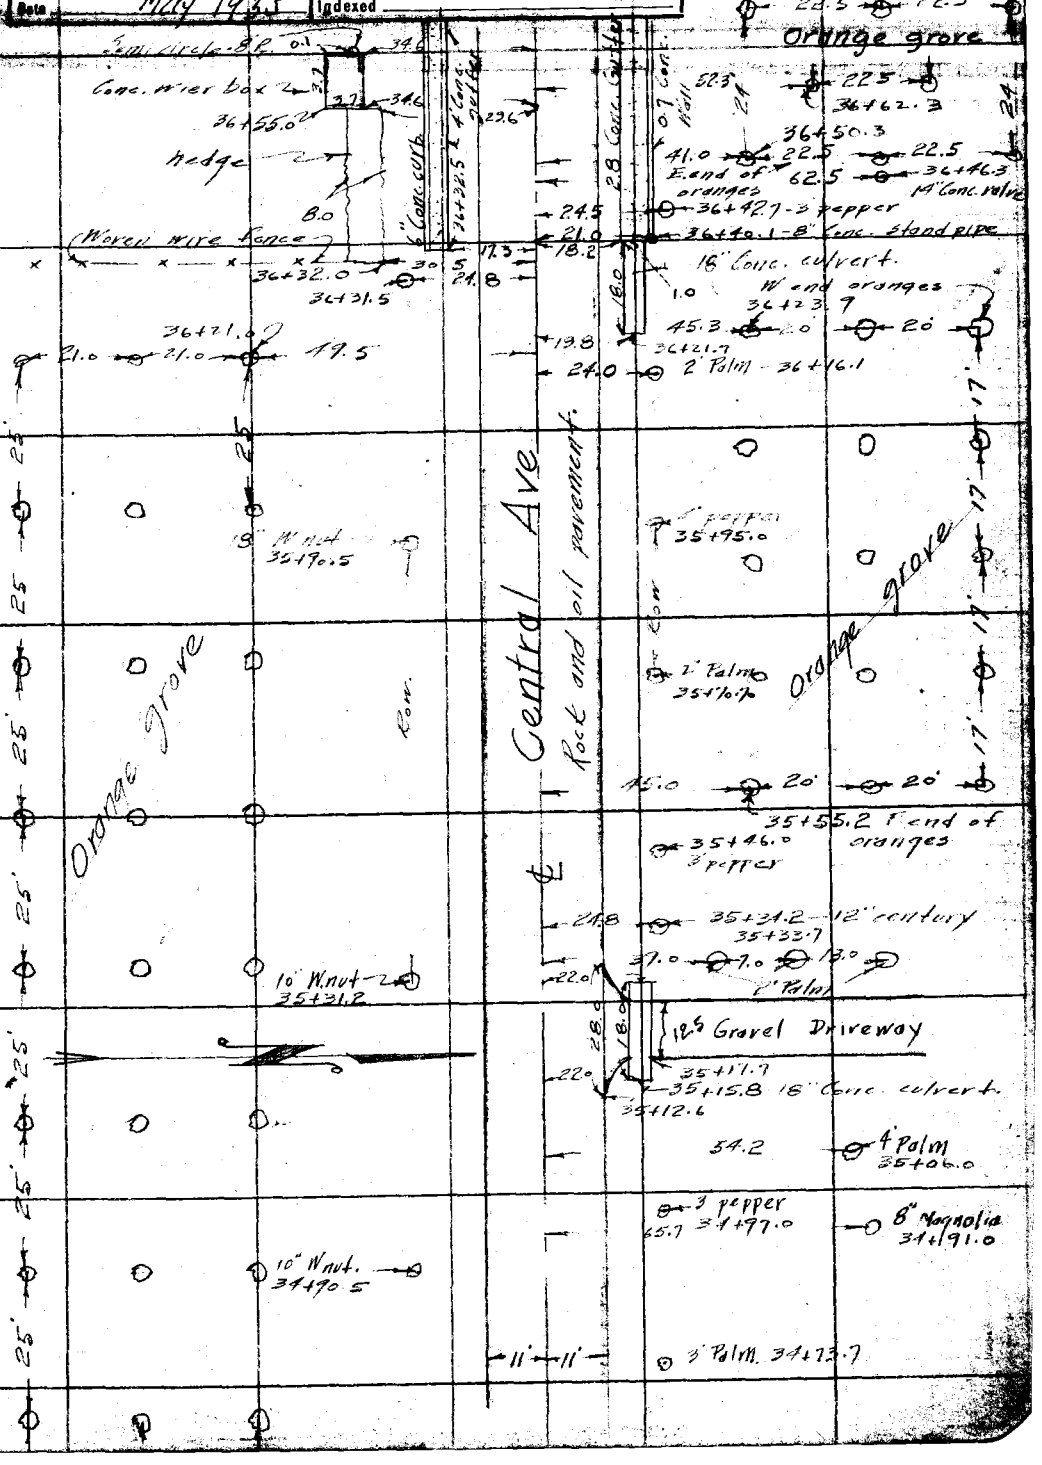

Note: ANY ADDITIONS OR CHANGES ON THIS SHEET MUST BE MADE OR CIRCLED IN Red Ink. WITH DATE AND NAME OF PERSON MAKING CHANGE.

Do not extend notes this side of this line

RETURN TO
LOS ANGELES COUNTY SURVEYOR
700 HALL OF RECORDS

FORM 247 10M 5-31

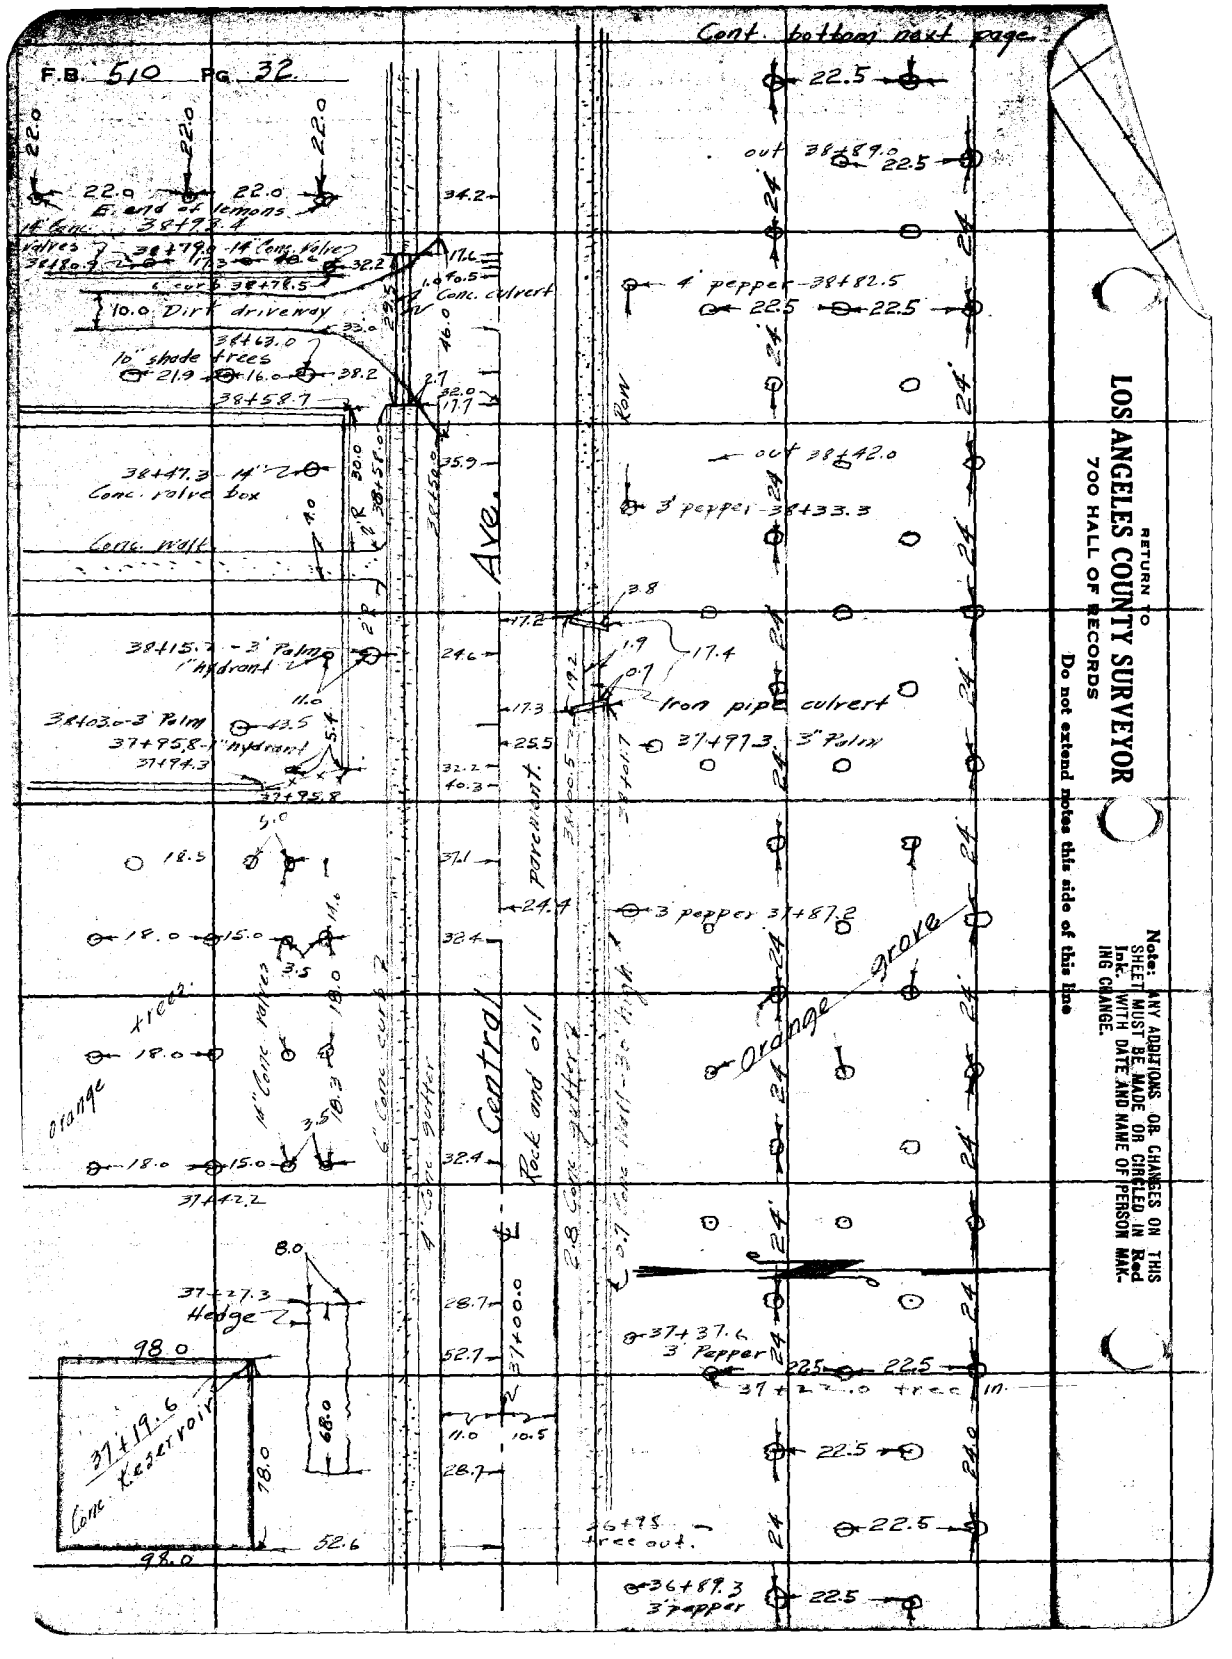

RETURN TO
LOS ANGELES COUNTY SURVEYOR
700 HALL OF RECORDS
Do not extend notes this side of this line
Note: ANY ADDITIONS OR CHANGES ON THIS SHEET MUST BE MADE OR CIRCLED IN Red Ink, WITH DATE AND NAME OF PERSON MAKING CHANGE.

Notes Ck'd by Drew	Survey of Central Ave
Map No. B-926	W. O. 7106 Tape No. 042 Std 84
Office Work Cox	Surveyed by Rosecrans
Checked Drew	Notes Date 2-28-33
Date May 1935	Indexed A. C. Johnson

F.B. 510 PG. 33

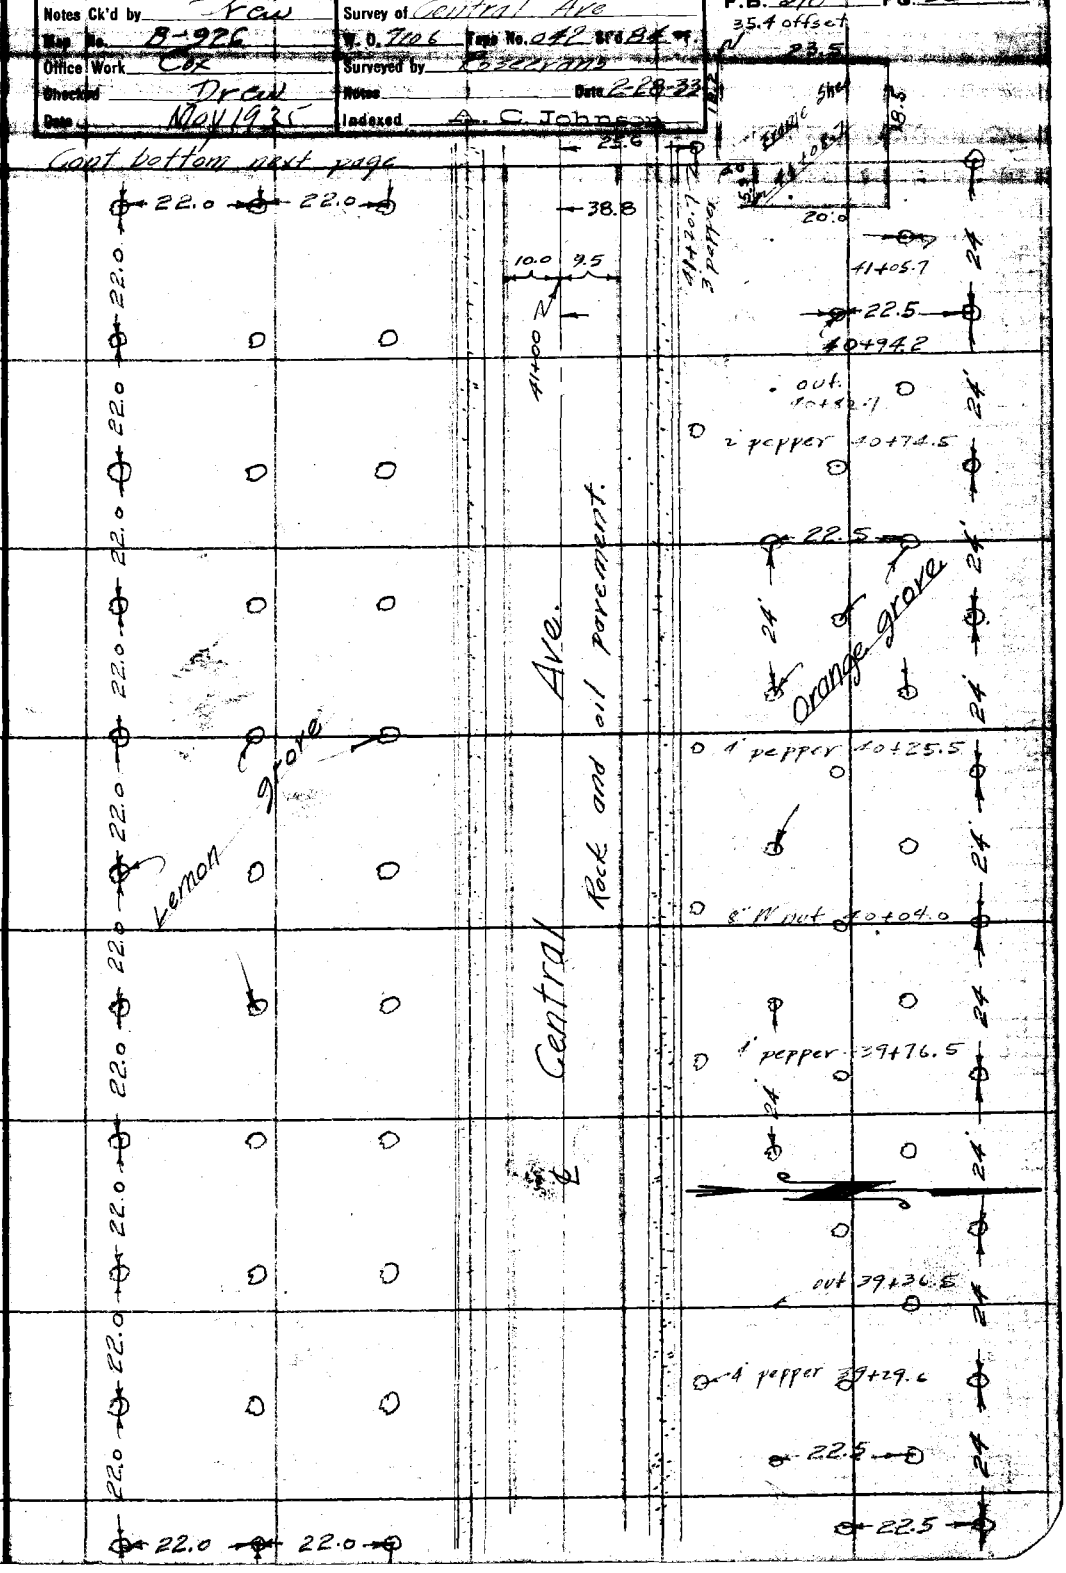

Note: ANY ADDITIONS OR CHANGES ON THIS SHEET MUST BE MADE OR CIRCLED IN Red Ink. WITH DATE AND NAME OF PERSON MAKING CHANGE.

RETURN TO
LOS ANGELES COUNTY SURVEYOR
700 HALL OF RECORDS

Do not extend notes this side of this line

FORM 247 10M 5-31

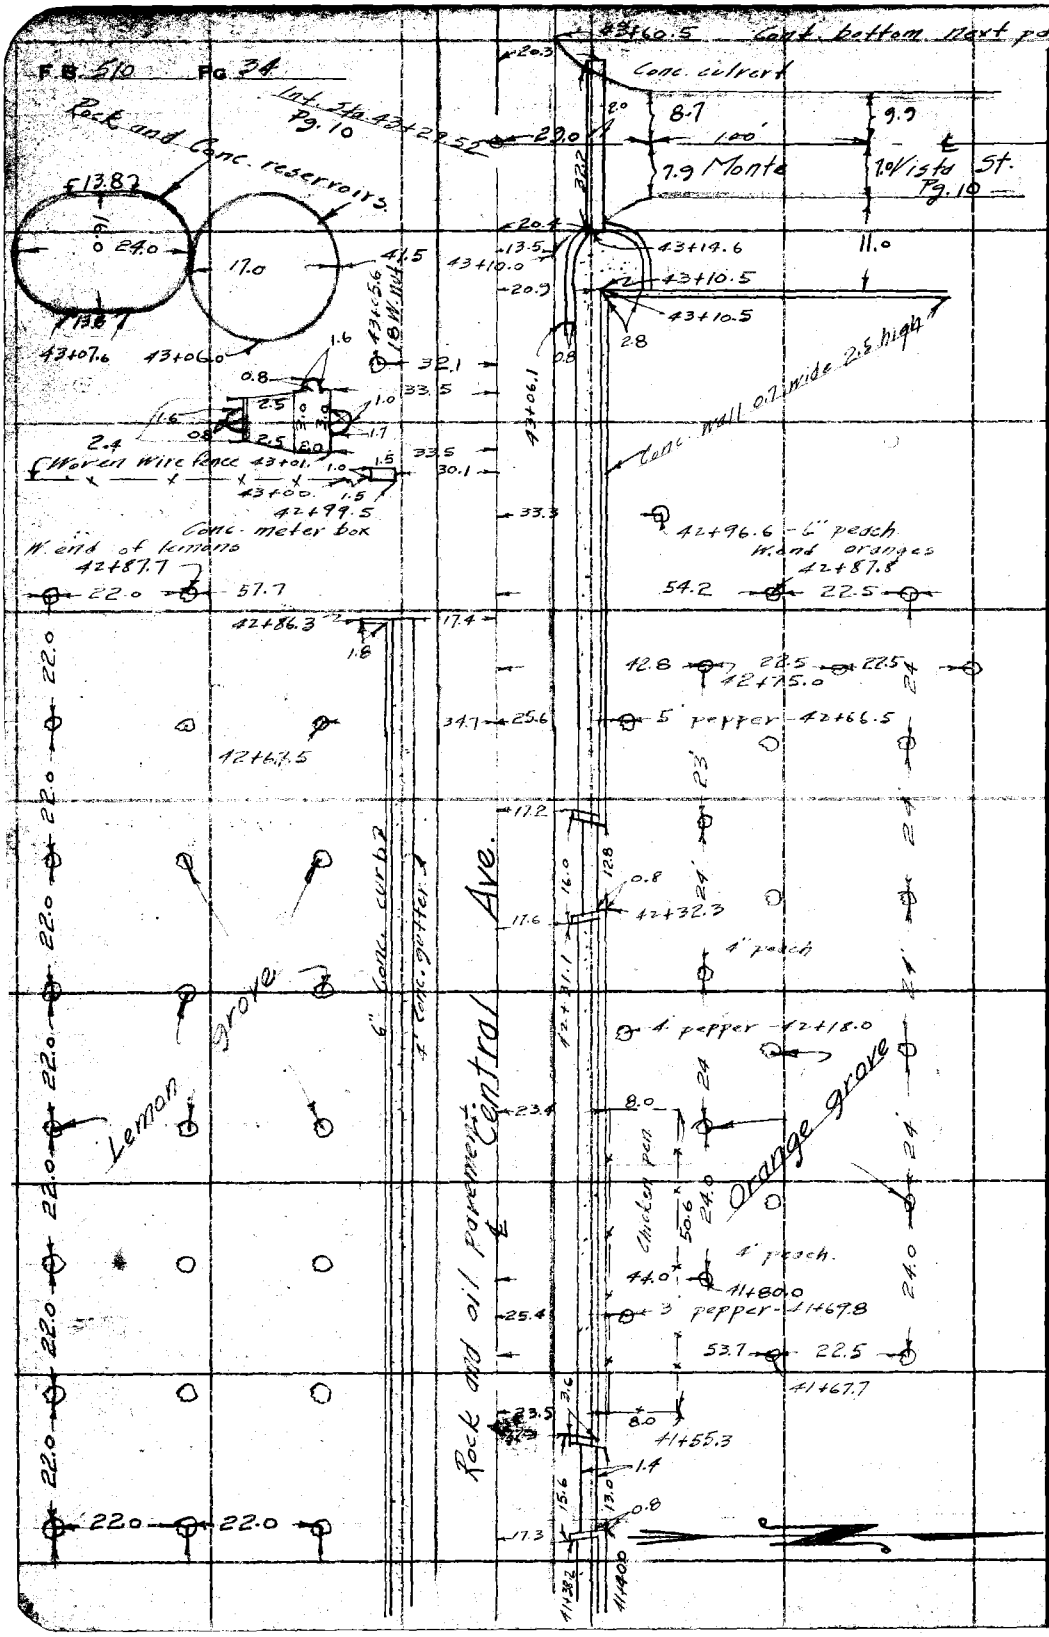

RETURN TO
LOS ANGELES COUNTY SURVEYOR
700 HALL OF RECORDS

Do not extend notes this side of this line

Note: ANY ADDITIONS OR CHANGES ON THIS SHEET MUST BE MADE OR CIRCLED IN Red Ink, WITH DATE AND NAME OF PERSON MAKING CHANGE.

Notes Ck'd by Drew	Survey of Central Ave
Map No. B-926	W. O. 7106 Tape No. 042 St'd 84 °F.
Office Work Cox	Surveyed by Rosecrans
Checked Drew	Notes Date 2-28-33
Date May 1935	Indexed A. C. Johns

F.B. 510 PG. 35

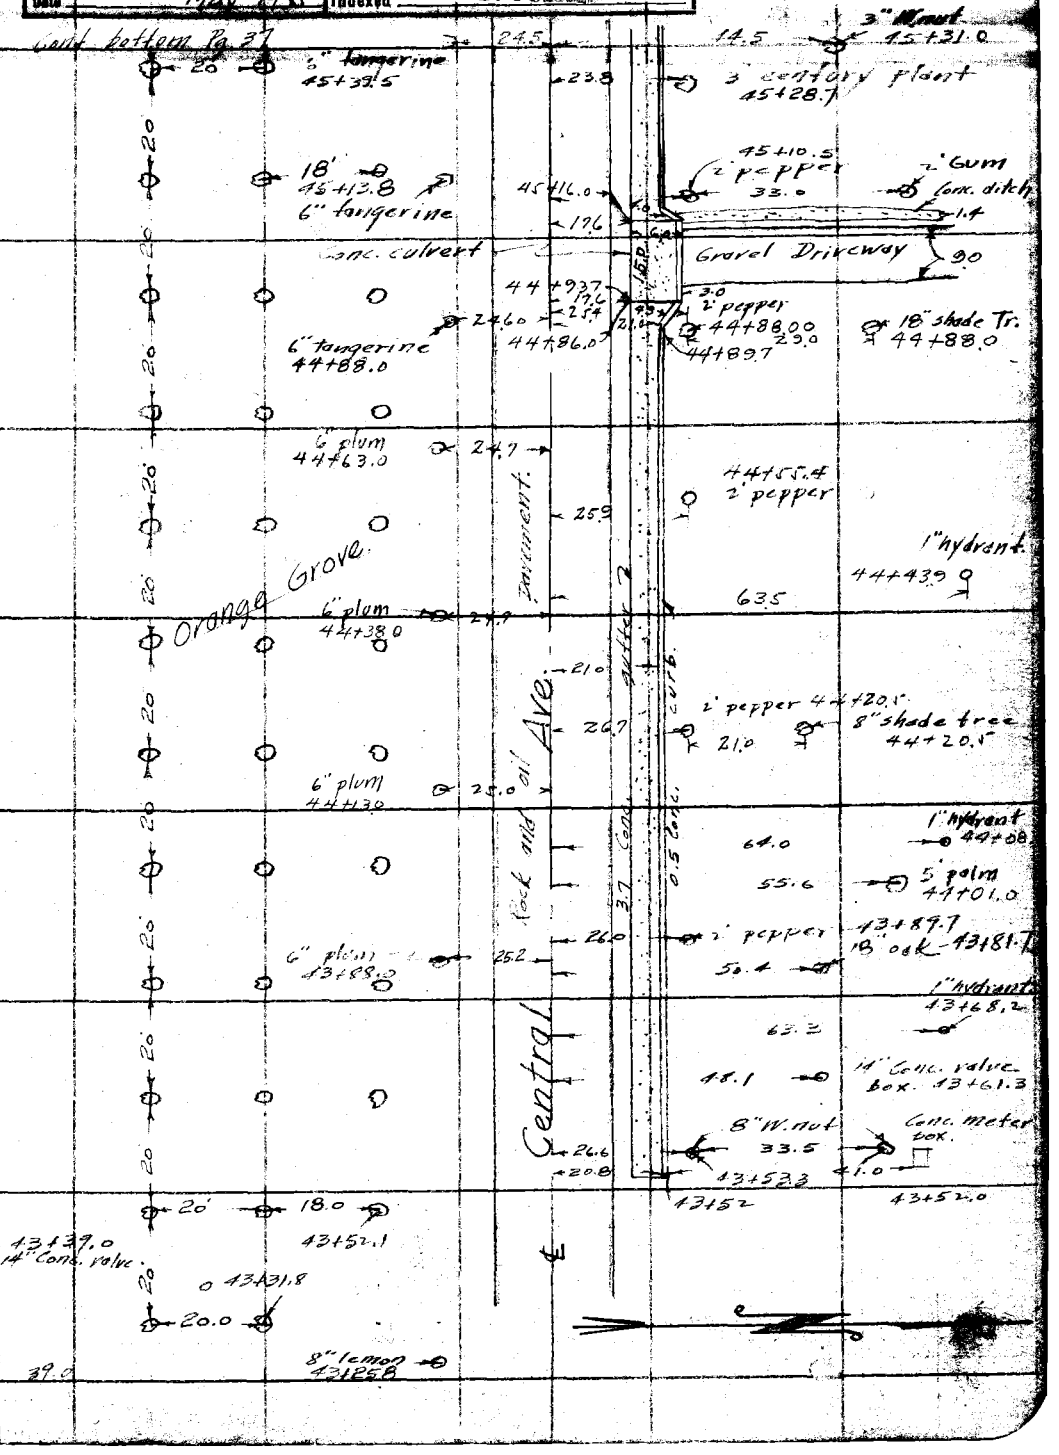

Note: ANY ADDITIONS OR CHANGES ON THIS SHEET MUST BE MADE OR CIRCLED IN Red Ink. WITH DATE AND NAME OF PERSON MAKING CHANGE.

RETURN TO
LOS ANGELES COUNTY SURVEYOR
700 HALL OF RECORDS

Do not extend notes this side of this line

FORM 247 10M 5-31

F.B. 510 PG. 36

Cont. bottom page 39.

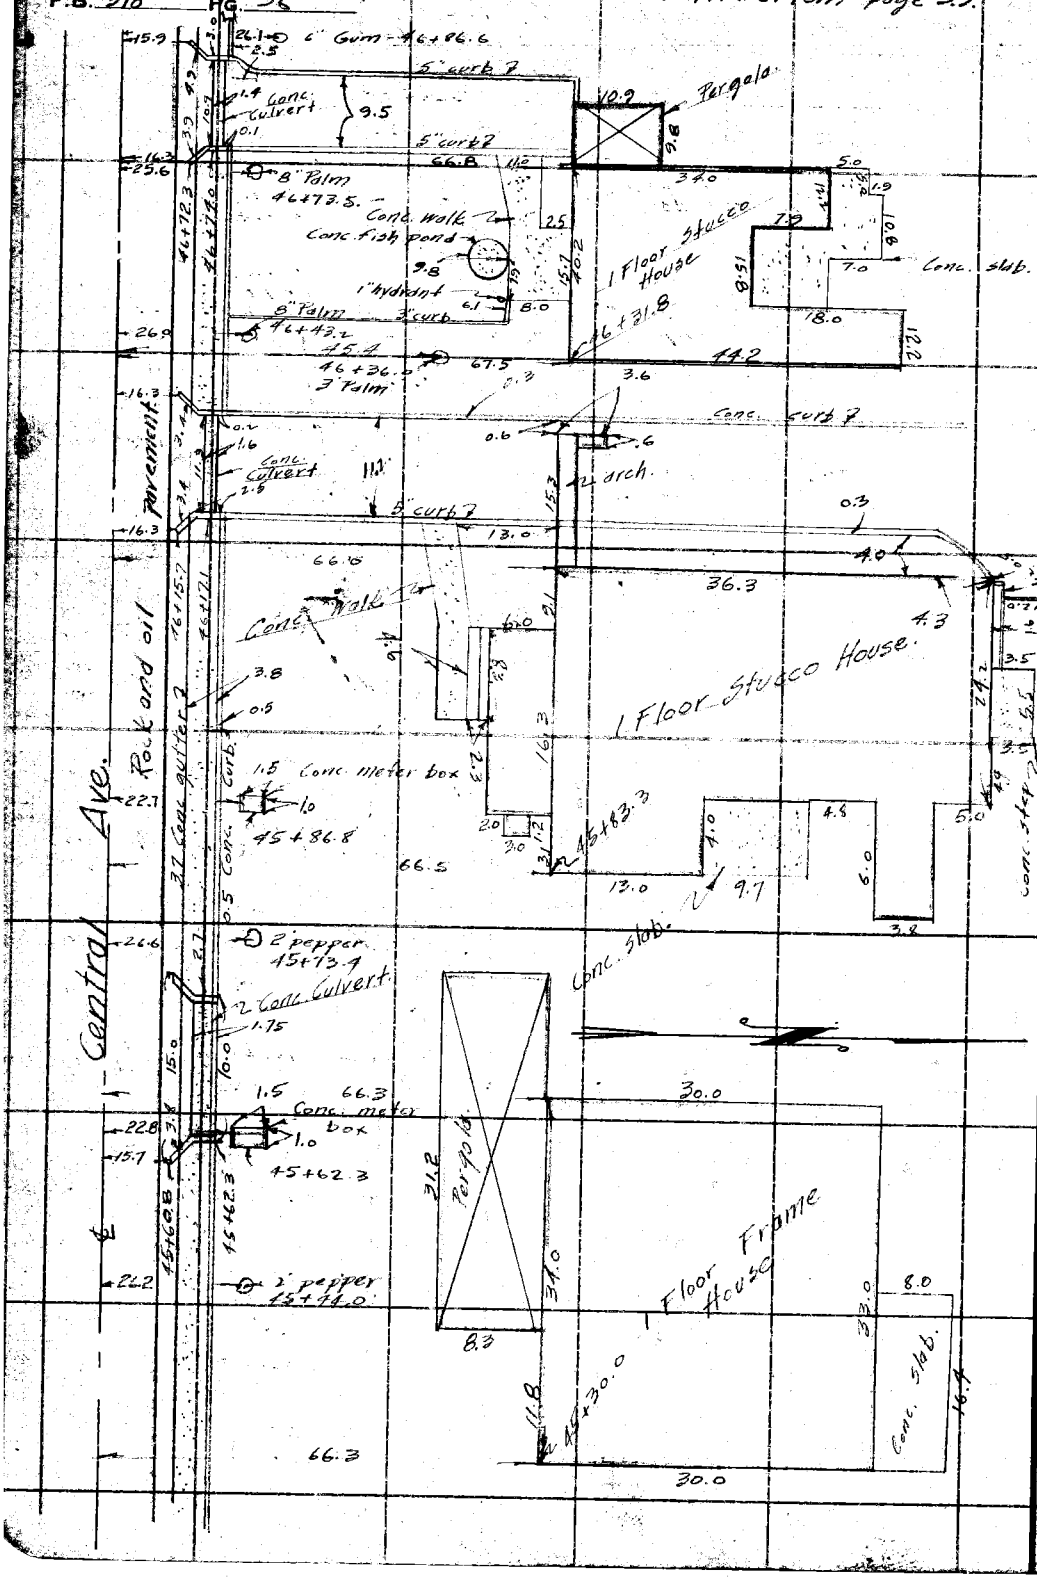

RETURN TO
LOS ANGELES COUNTY SURVEYOR
700 HALL OF RECORDS

Do not extend notes this side of this line

Note: ANY ADDITIONS OR CHANGES ON THIS SHEET MUST BE MADE OR CIRCLED IN Red Ink. WITH DATE AND NAME OF PERSON MAKING CHANGE.

Notes Ck'd by Drew	Survey of Central Ave
Map No. B-926	W. O. 7106 Tape No. 042 St'd 84 °F.
Office Work Cox	Surveyed by Rosecrans
Checked Drew	Notes Date 2-28-33
Date May 1935	Indexed A. C. Johnson

F.B. 510 PG. 37

Cont. bottom page 38

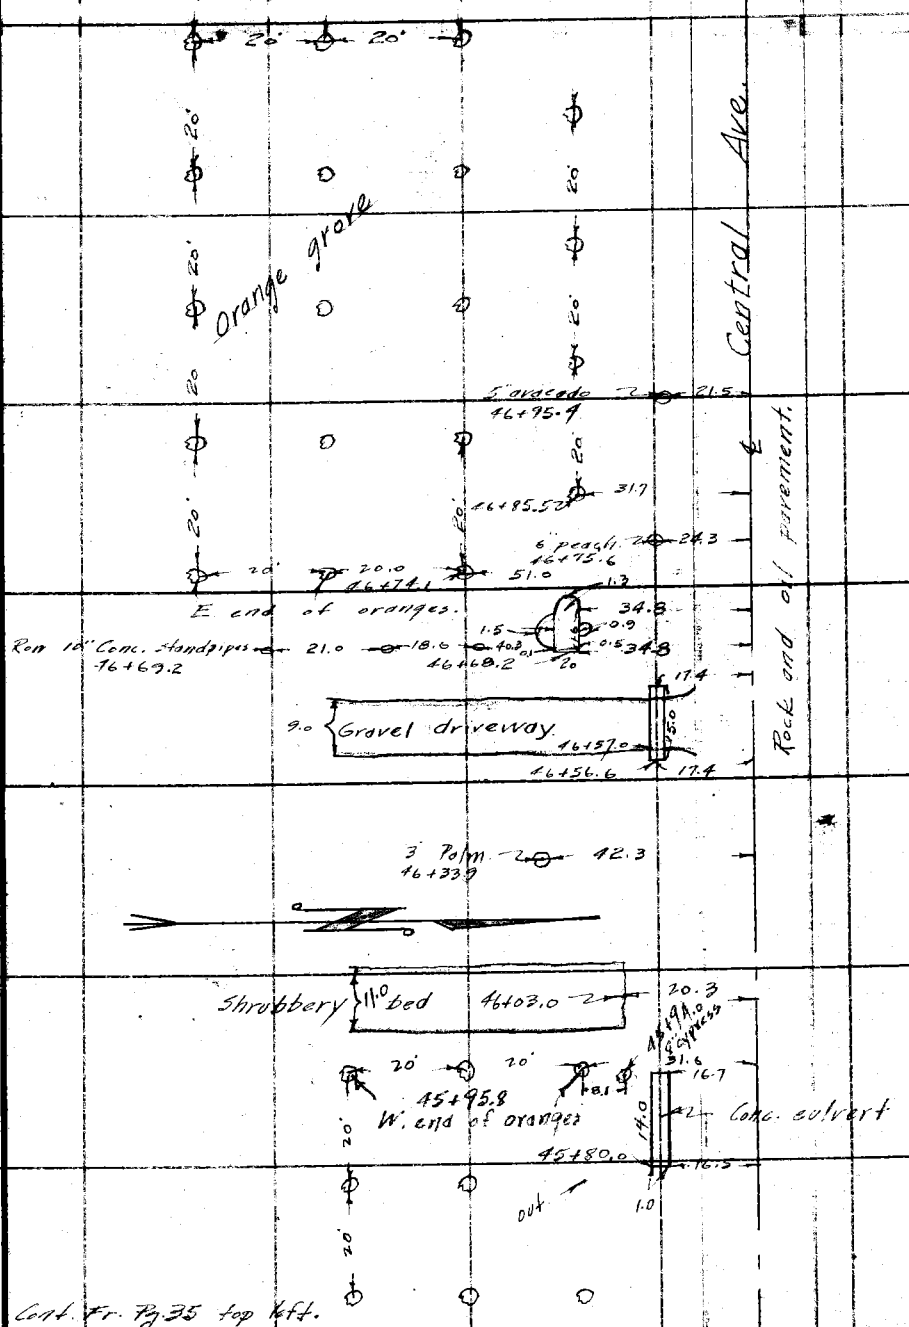

Cont. Fr. Pg. 35 top left.

Note: ANY ADDITIONS OR CHANGES ON THIS SHEET MUST BE MADE OR CIRCLED IN Red Ink. WITH DATE AND NAME OF PERSON MAKING CHANGE.

RETURN TO
LOS ANGELES COUNTY SURVEYOR
700 HALL OF RECORDS

Do not extend notes this side of this line

FORM 247 10M 5-31

F.B. 510 Pg. 38

Cont. bottom page 41.

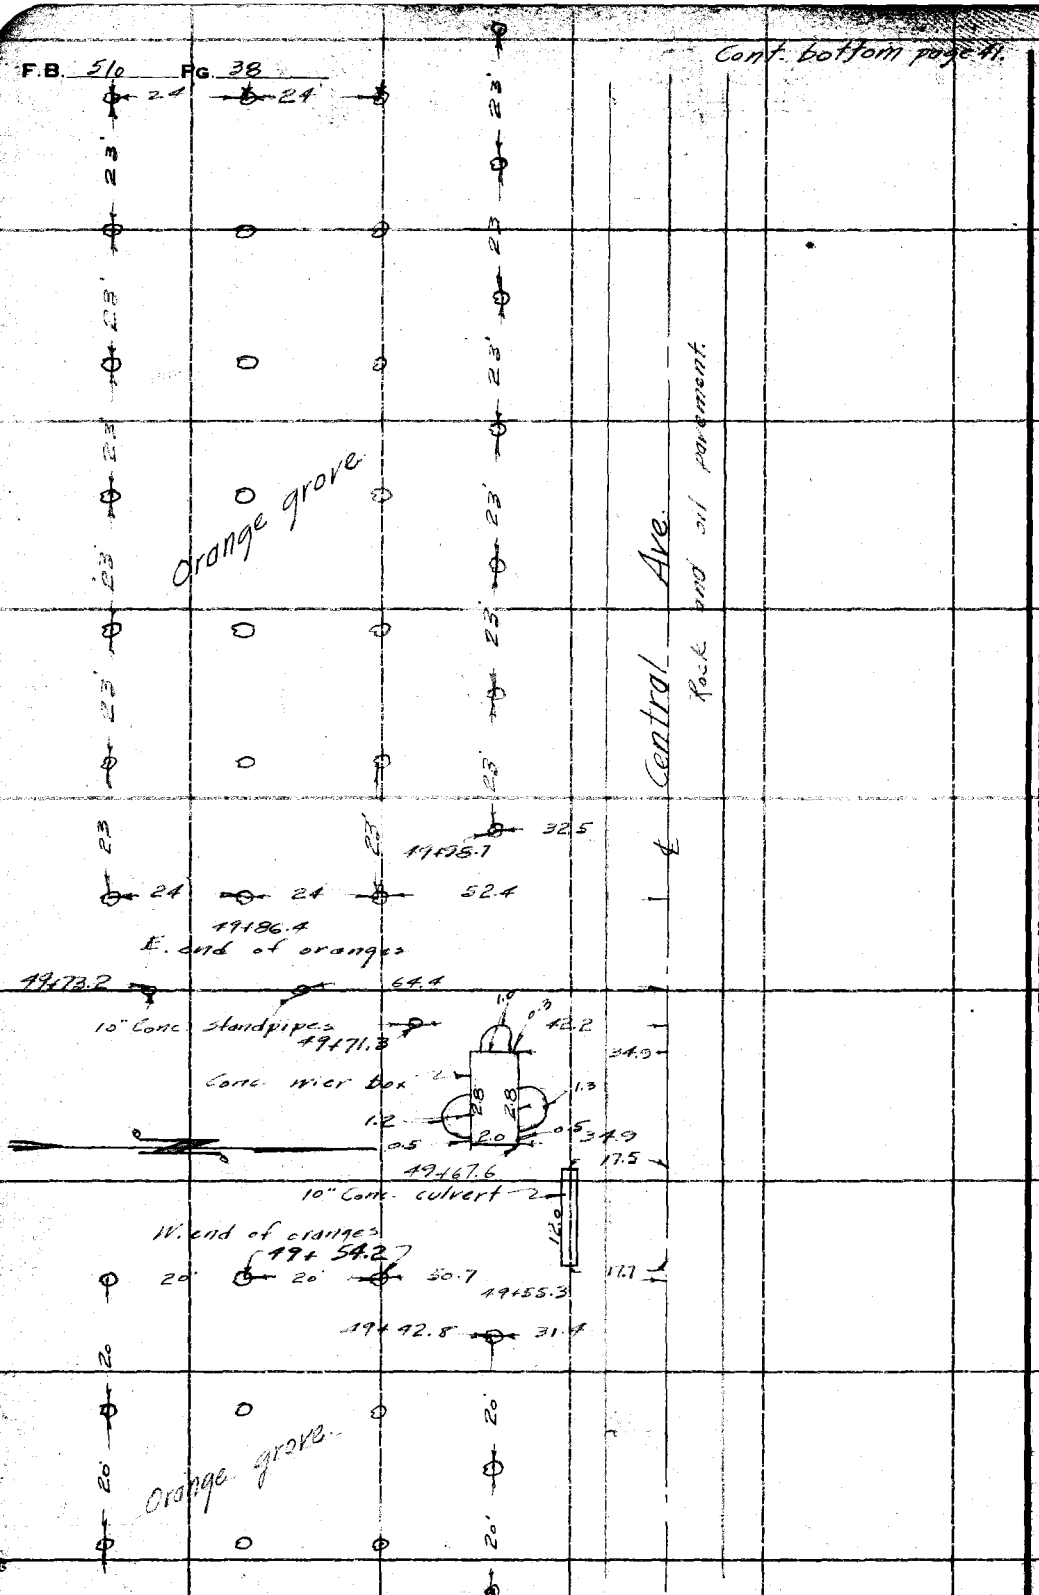

RETURN TO
LOS ANGELES COUNTY SURVEYOR
700 HALL OF RECORDS

Do not extend notes this side of this line

Note: ANY ADDITIONS OR CHANGES ON THIS SHEET MUST BE MADE OR CIRCLED IN Red Ink. WITH DATE AND NAME OF PERSON MAKING CHANGE.

Notes Ck'd by Drew	Survey of Central Ave
Map No. B-926	W. O. 7106 Tape No. 67e St'd 84 °F.
Office Work Dox	Surveyed by Rosecrans
Checked Drew	Notes Date 2-13-35
Date May 1935	Indexed S. C. Johnson

F.B. 510 PG. 37

cont. bottom next page

Note: ANY ADDITIONS OR CHANGES OF THIS SHEET MUST BE MADE OR CIRCLED IN Red Ink, WITH DATE AND NAME OF PERSON MAKING CHANGE.

Do not extend notes this side of this line

RETURN TO
LOS ANGELES COUNTY SURVEYOR
700 HALL OF RECORDS

FORM 847 10M 8-31

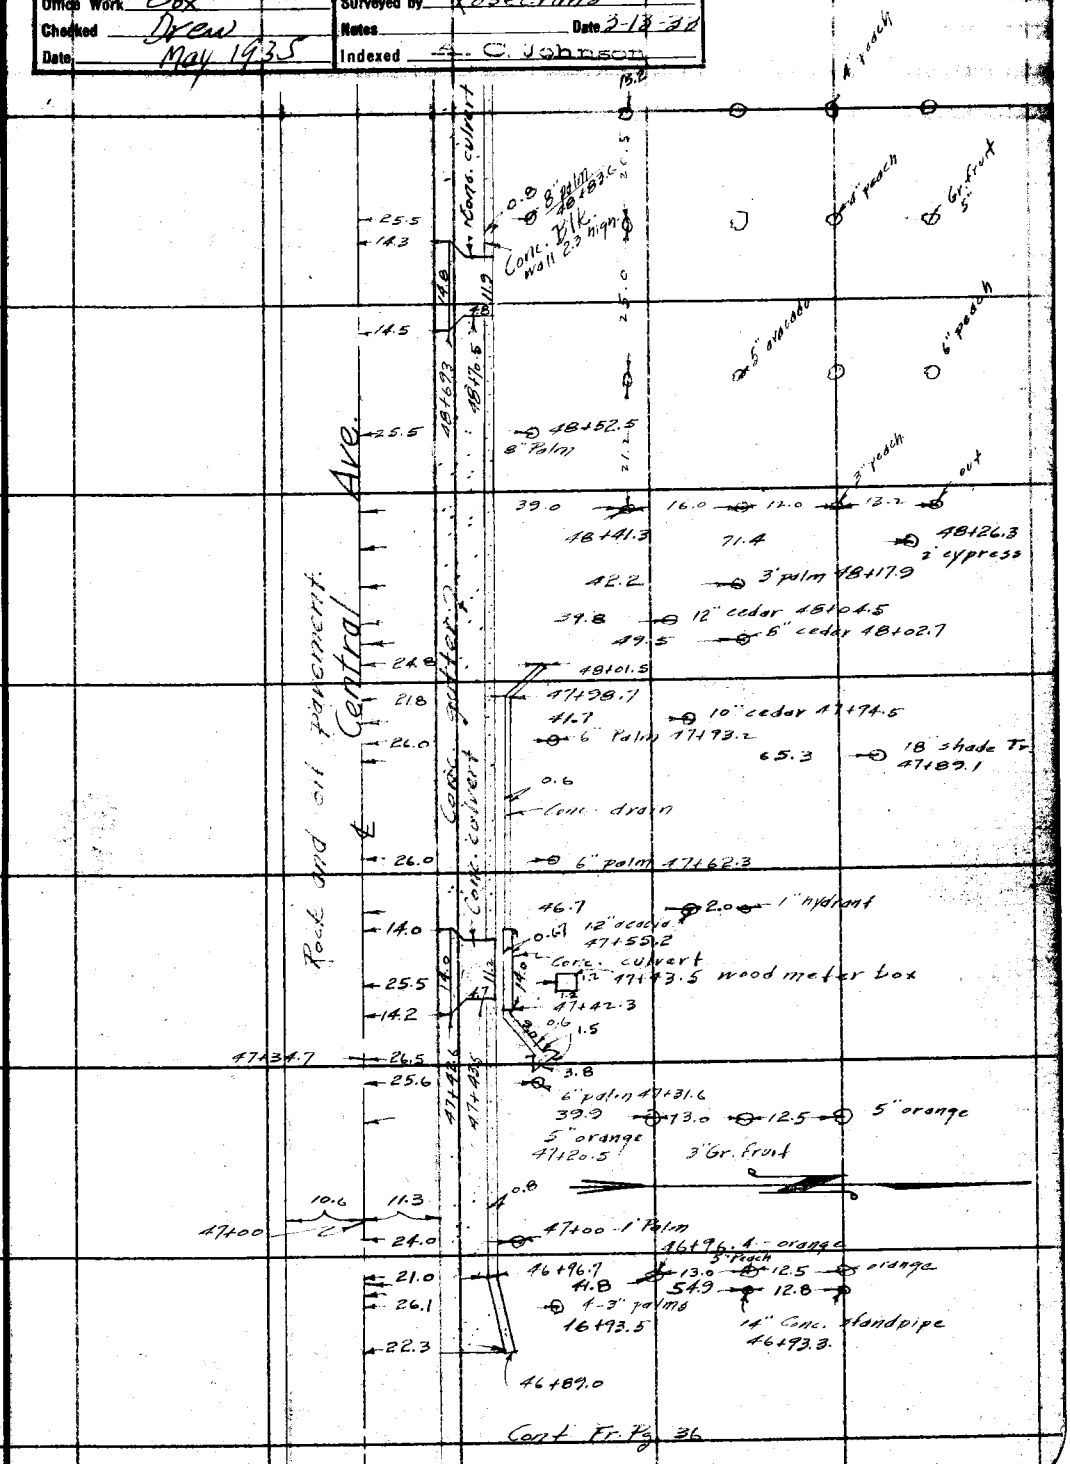

RETURN TO

LOS ANGELES COUNTY SURVEYOR

700 HALL OF RECORDS

Note: ANY ADDITIONS OR CHANGES ON THIS SHEET MUST BE MADE OR CIRCLED IN **Red Ink.** WITH DATE AND NAME OF PERSON MAKING CHANGE.

Do not extend notes this side of this line

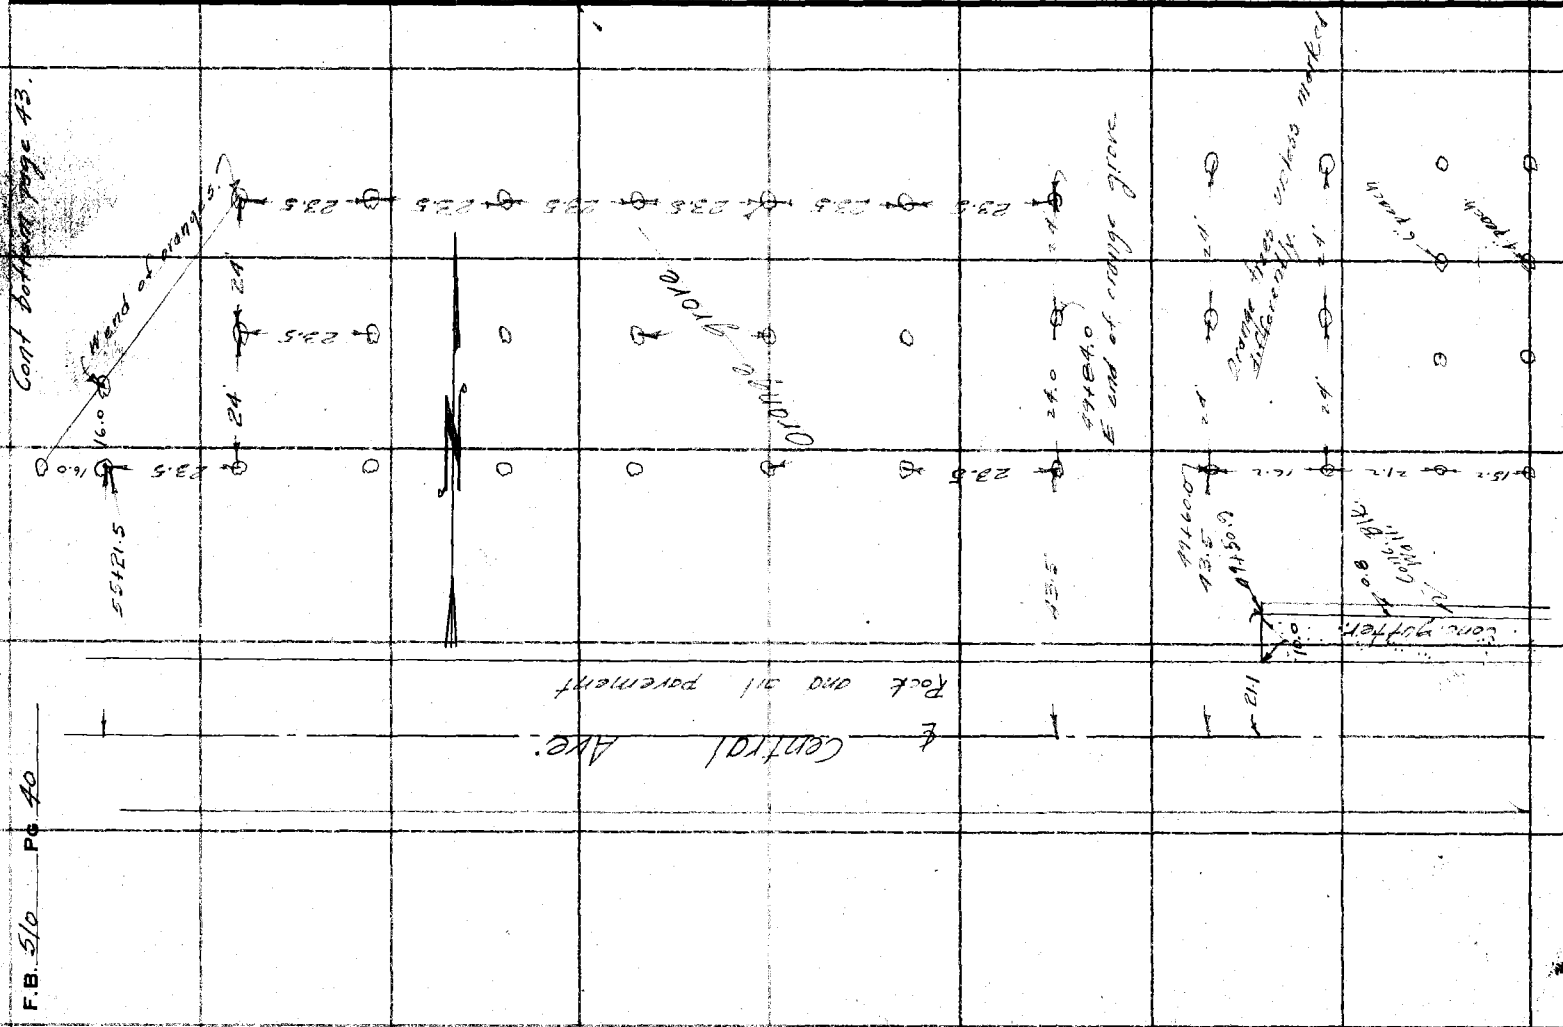

Notes Ck'd by	Survey of Central Ave	F.B. 510 PG. 41
Map No. B-926	W. O. 7106 Tape No. 042 St'd 84 °F.	
Office Work Cox	Surveyed by Rosecrans	
Checked Drew	Notes Date 3-10-33	
Date May 1935	Indexed [illegible]	

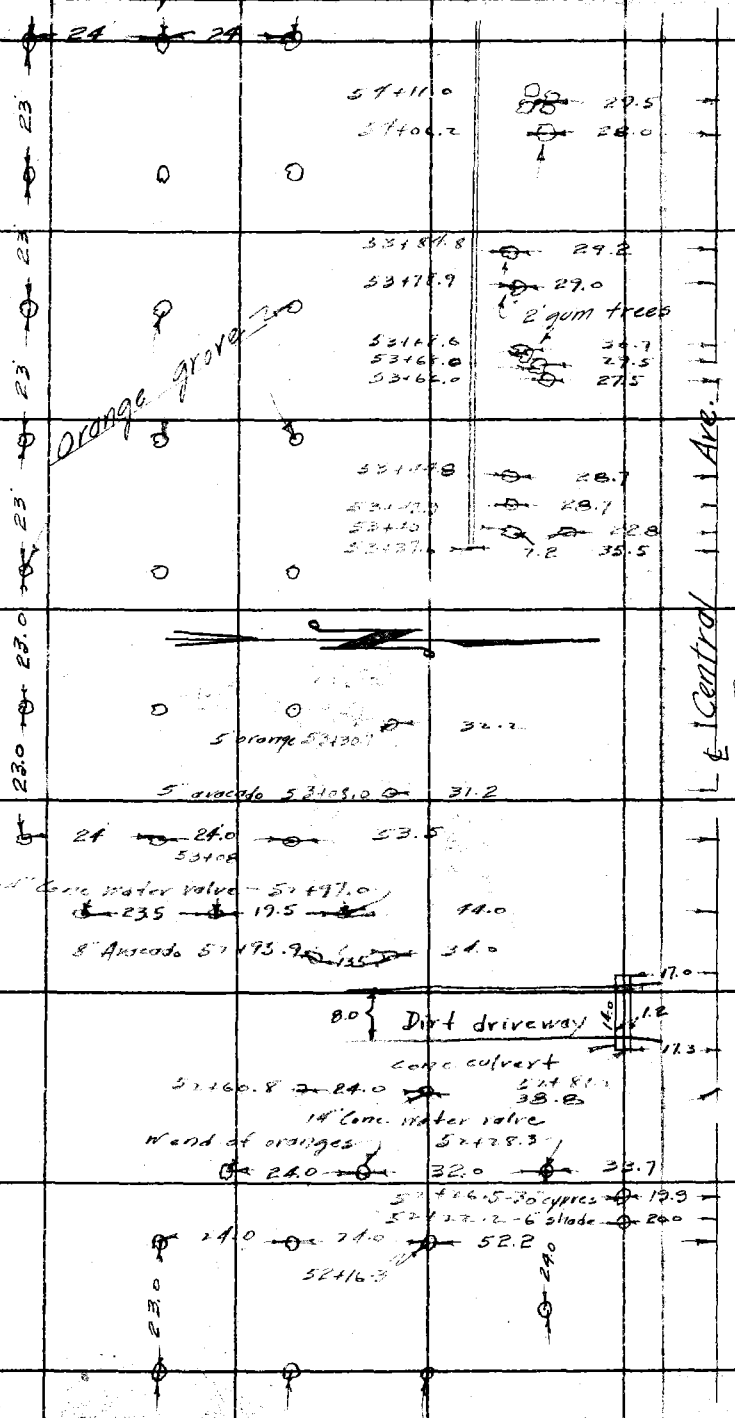

Note: ANY ADDITIONS OR CHANGES OF THIS SHEET MUST BE MADE OR CIRCLED IN Red Ink. WITH DATE AND NAME OF PERSON MAKING CHANGE.

RETURN TO
LOS ANGELES COUNTY SURVEYOR
700 HALL OF RECORDS

Do not extend notes this side of this line

FORM 247 10M 5-31

RETURN TO
LOS ANGELES COUNTY SURVEYOR
700 HALL OF RECORDS

Note: ANY ADDITIONS OR CHANGES ON THIS SHEET MUST BE MADE OR CIRCLED IN **Red Ink.** WITH DATE AND NAME OF PERSON MAKING CHANGE.

Do not extend notes this side of this line

F.B. 510 Pg 42

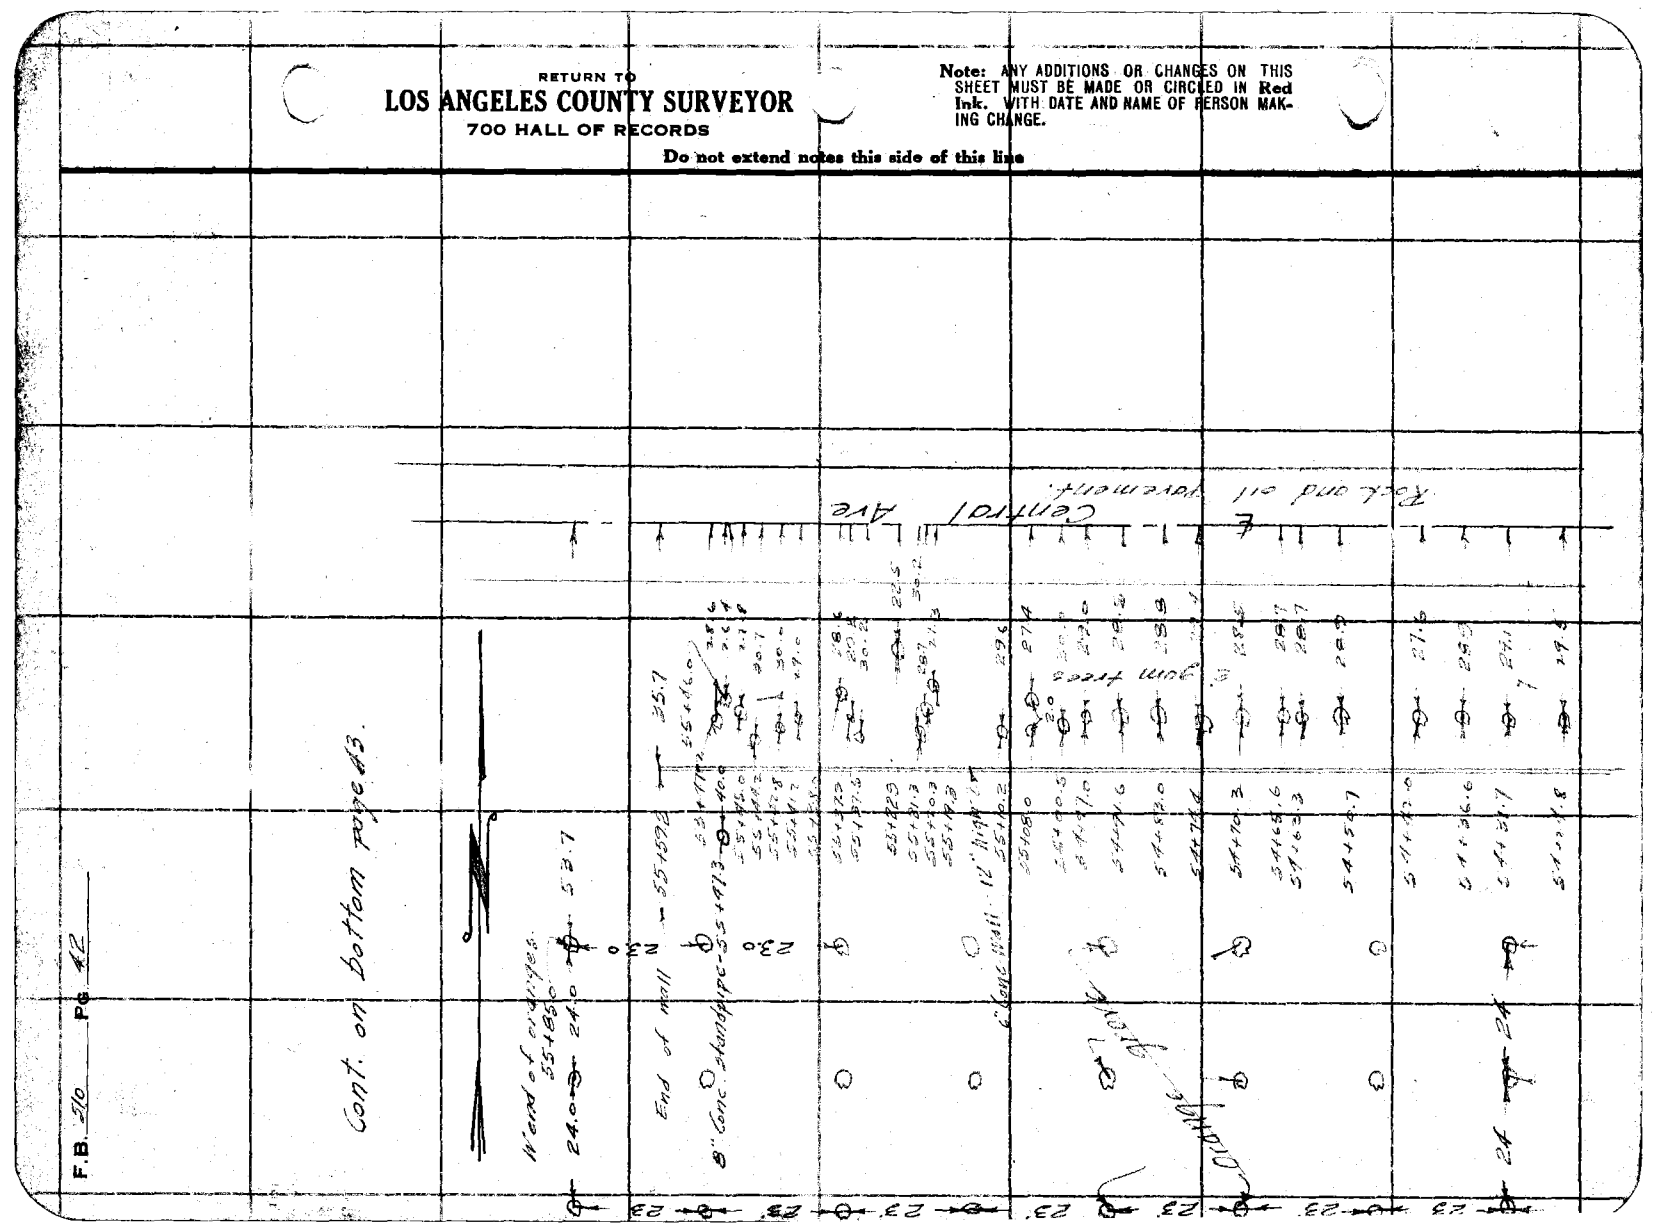

Notes Ck'd by	Survey of Central Ave
Map No. B-926	W. O. 7106 Tape No. 042 St'd 84 °F.
Office Work Cox	Surveyed by Rosecrans
Checked Drew	Notes Date 3-13-33
Date May 1935	Indexed A. C. Johnson

F.B. 510 Pg. 43

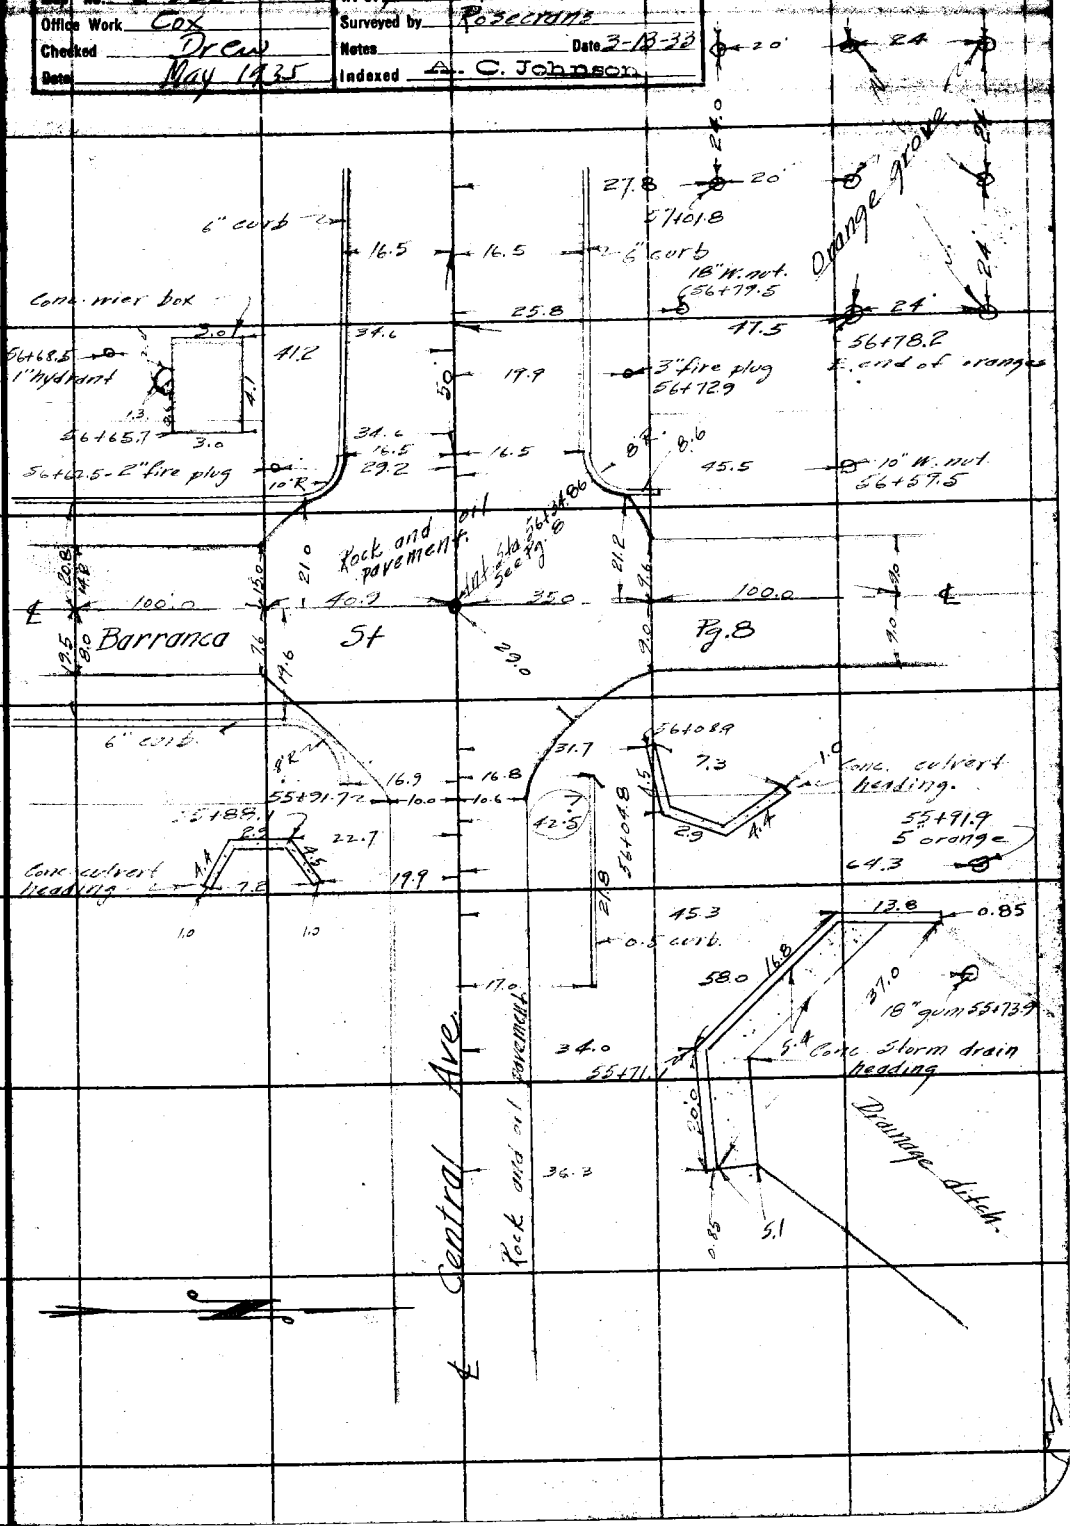

Note: ANY ADDITIONS OR CHANGES ON THIS SHEET MUST BE MADE OR CIRCLED IN Red Ink. WITH DATE AND NAME OF PERSON MAKING CHANGE.

Do not extend notes this side of this line

RETURN TO
LOS ANGELES COUNTY SURVEYOR
700 HALL OF RECORDS

FORM 247 10M 5-31

F.B. 510 Pg. 44

RETURN TO
LOS ANGELES COUNTY SURVEYOR
700 HALL OF RECORDS

Do not extend notes this side of this line

Note: ANY ADDITIONS OR CHANGES ON THIS SHEET MUST BE MADE OR CIRCLED IN Red Ink. WITH DATE AND NAME OF PERSON MAKING CHANGE.

Notes Ck'd by
Map No. B-926
Office Work Cox
Checked Drew
Date May 1935

Survey of Central Ave.
W. O. 7106 Tape No. 042 St'd 94 °F.
Surveyed by Rosecrans
Notes
Date 3-16-32
Indexed A. C. Johnson

F.B. 510 PG. 45

Cont. bottom next page.

RETURN TO
LOS ANGELES COUNTY SURVEYOR
700 HALL OF RECORDS

Note: ANY ADDITIONS OR CHANGES ON THIS SHEET MUST BE MADE OR CIRCLED IN Red Ink. WITH DATE AND NAME OF PERSON MAKING CHANGE.

Do not extend notes this side of this line

FORM 247 10M 5-31

F.B. 510 PG 46

Cont. bottom next page

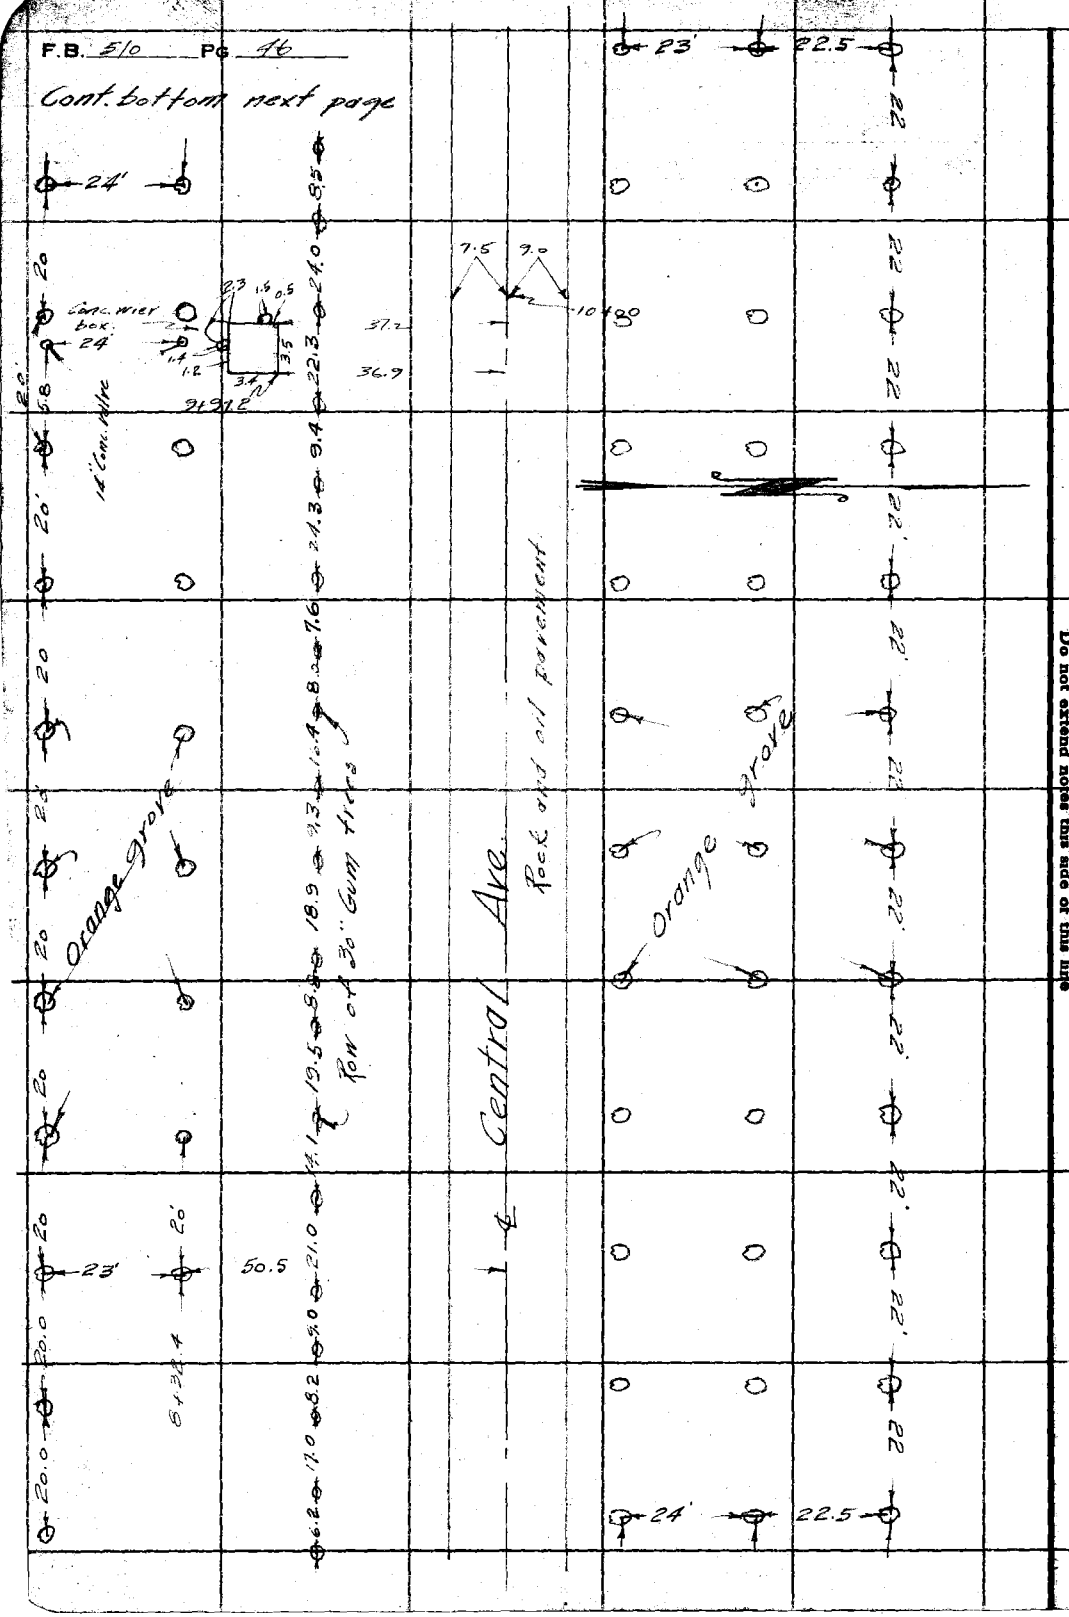

RETURN TO
LOS ANGELES COUNTY SURVEYOR
700 HALL OF RECORDS

Do not extend notes this side of this line

Note: ANY ADDITIONS OR CHANGES ON THIS SHEET MUST BE MADE OR CIRCLED IN Red Ink. WITH DATE AND NAME OF PERSON MAKING CHANGE.

Notes Ck'd by	Survey of Central Ave
Map No. B-926	W. O. 7706 Tape No. 042 St'd 84 °F.
Office Work Cox	Surveyed by Rosecrans
Checked Drew	Notes Date 3-16-33
Date May 1935	Indexed C. Johnson

F.B. 510 PG. 47

Cont. bottom next page.

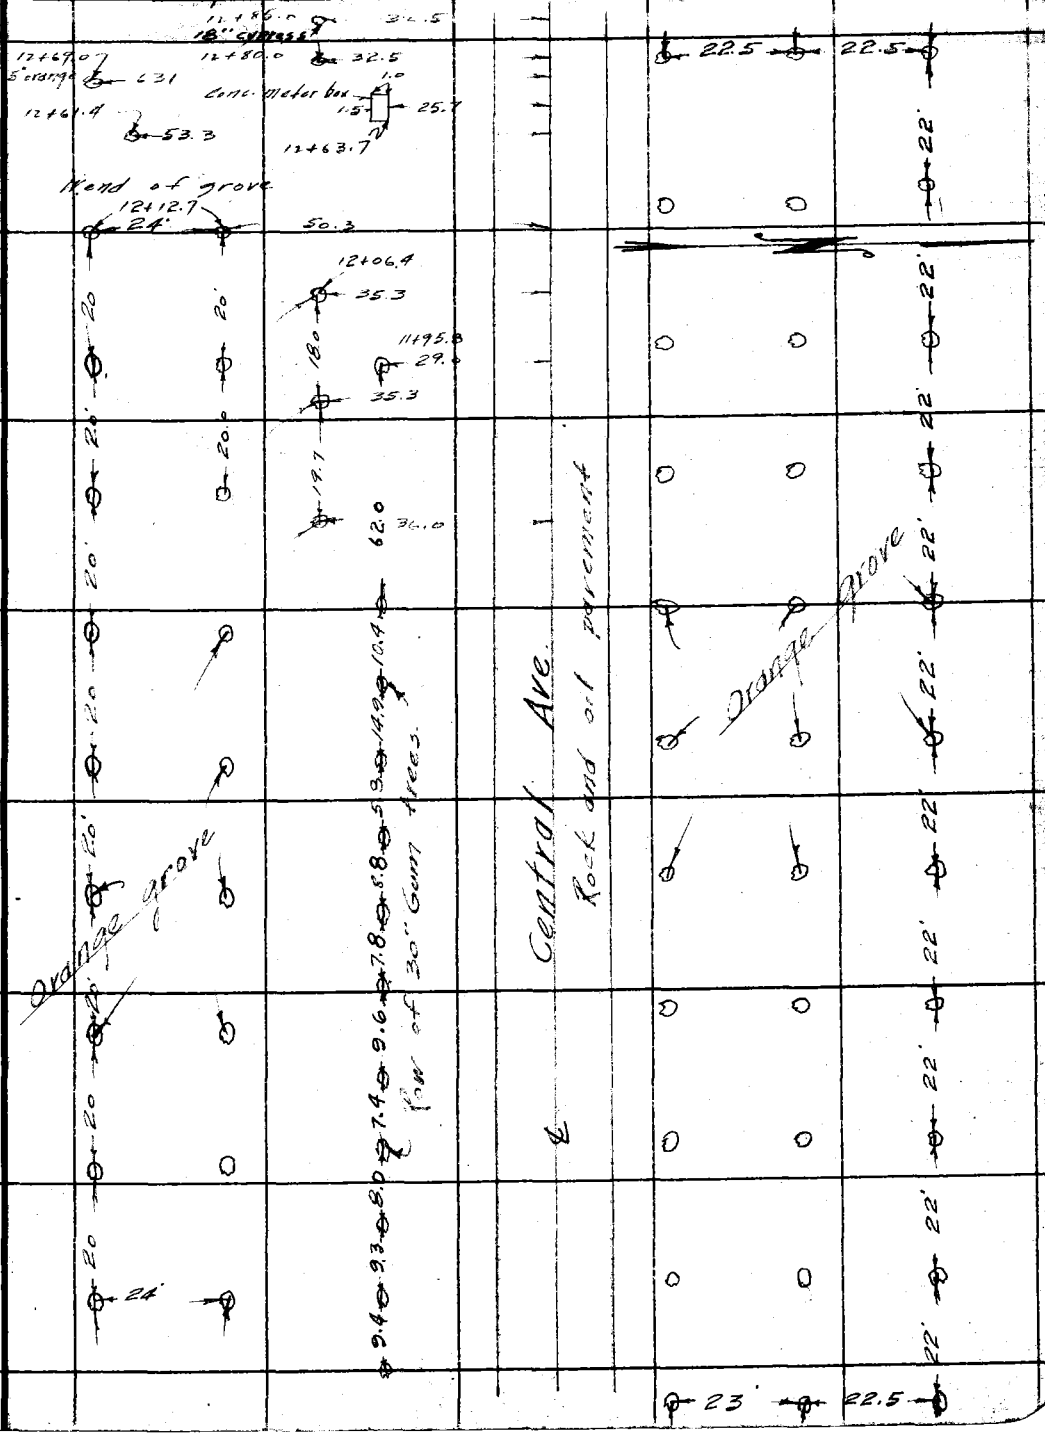

Note: ANY ADDITIONS OR CHANGES OF THIS SHEET MUST BE MADE OR CIRCLED IN Red Ink. WITH DATE AND NAME OF PERSON MAKING CHANGE.

RETURN TO
LOS ANGELES COUNTY SURVEYOR
700 HALL OF RECORDS

Do not extend notes this side of this line

FORM 247 10M 5-31

RETURN TO

LOS ANGELES COUNTY SURVEYOR

700 HALL OF RECORDS

Note: ANY ADDITIONS OR CHANGES ON THIS SHEET MUST BE MADE OR CIRCLED IN **Red Ink.** WITH DATE AND NAME OF PERSON MAKING CHANGE.

Do not extend notes this side of this line

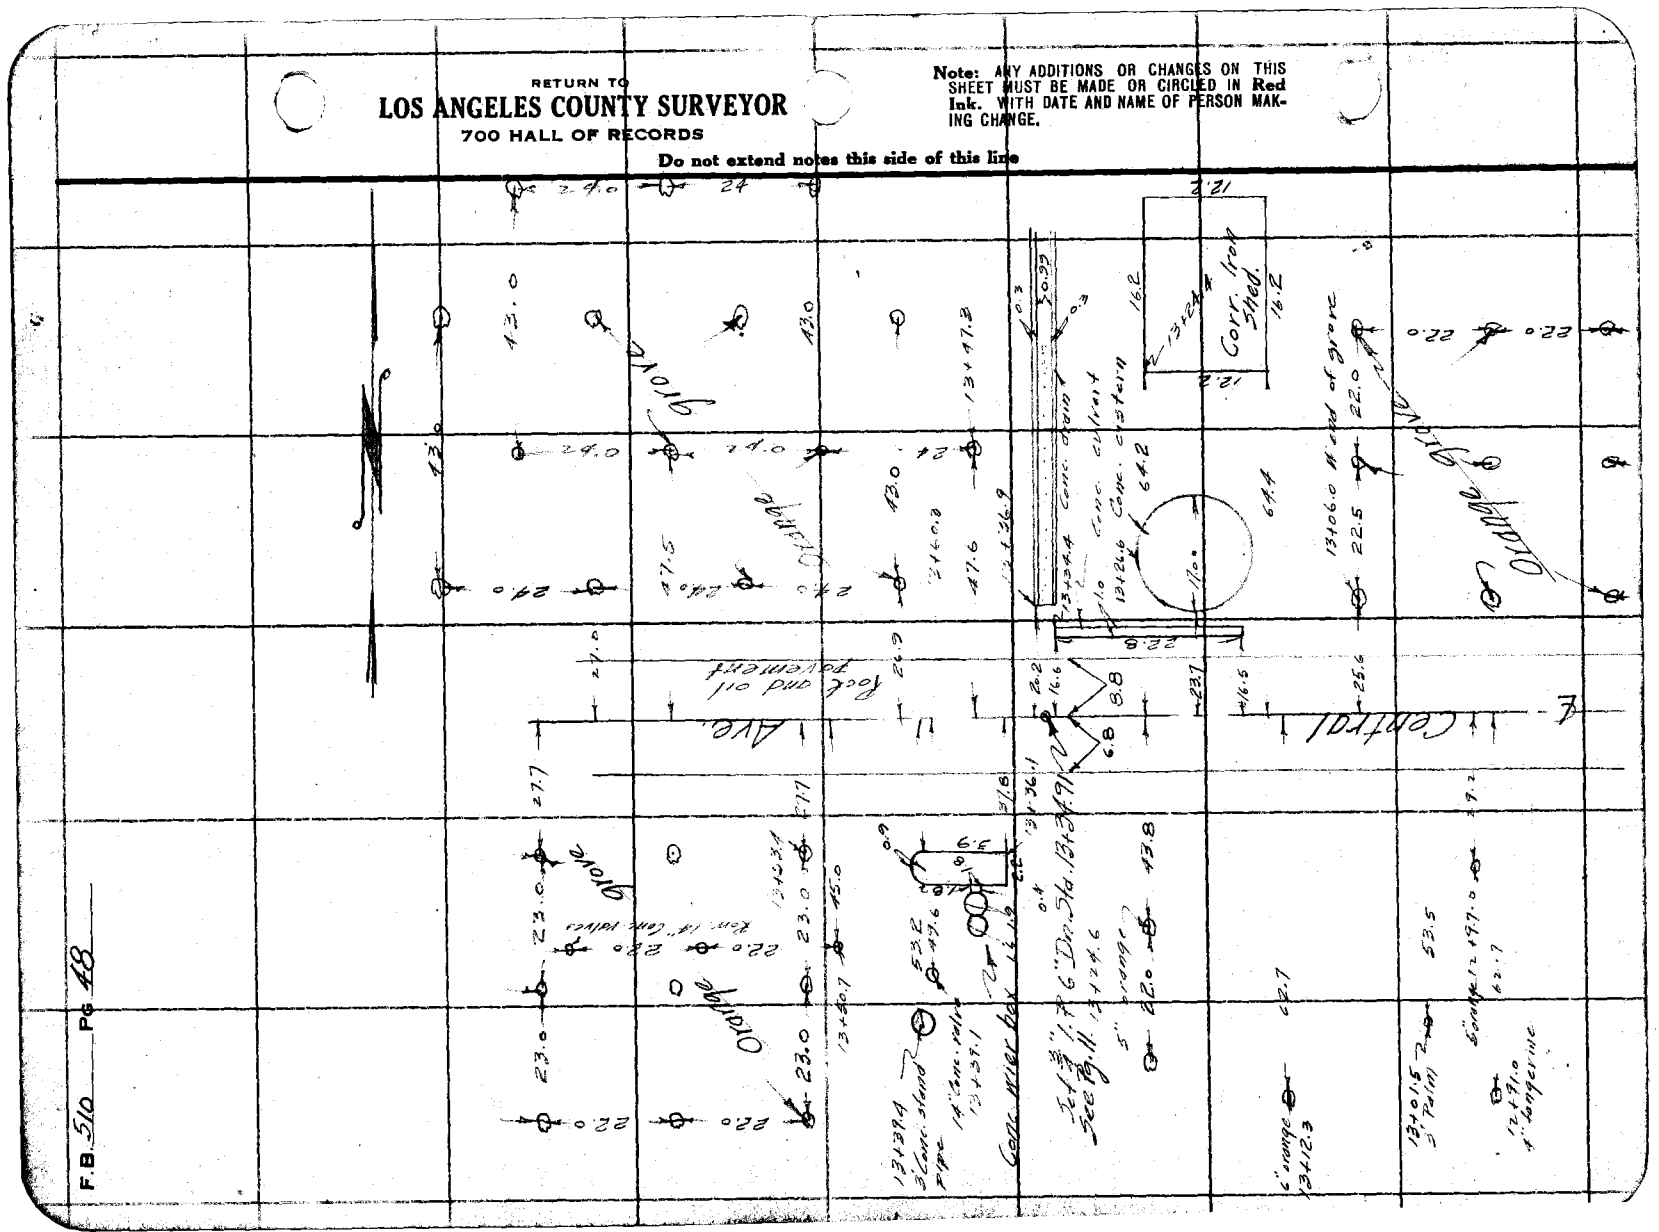

F.B. 510 Pg. 48

Notes Ck'd by Drew	Survey of Badillo St.
Map No.	W. O. 7103 Tape No. 041 St'd 84 °F.
Office Work	Surveyed by Rosecrans
Checked	Notes Date 8-29-33
Date	Indexed A. C. Johnson

F.B. 510 Pg. 19

BADILLO STREET.

W.O. 7103

From proposed San Jose Diagonal E. of City of Covina to Sierra Madre Ave. Baldwin Park.

Mar. to Aug. 1933.

Party. E.A. Rosecrans
F.W. Atkins
J.A. Willess
C.R. Lawson
F.H. Blanchard.

100' tape #42 + #41

Topography Pgs. 100 to 244.

Note: ANY ADDITIONS OR CHANGES ON THIS SHEET MUST BE MADE OR CIRCLED IN Red Ink, WITH DATE AND NAME OF PERSON MAKING CHANGE.

RETURN TO
LOS ANGELES COUNTY SURVEYOR
700 HALL OF RECORDS

Do not extend notes this side of this line

FORM 247 10M 8-31

RETURN TO
LOS ANGELES COUNTY SURVEYOR
700 HALL OF RECORDS

Note: ANY ADDITIONS OR CHANGES ON THIS SHEET MUST BE MADE OR CIRCLED IN **Red Ink.** WITH DATE AND NAME OF PERSON MAKING CHANGE.

Do not extend notes this side of this line

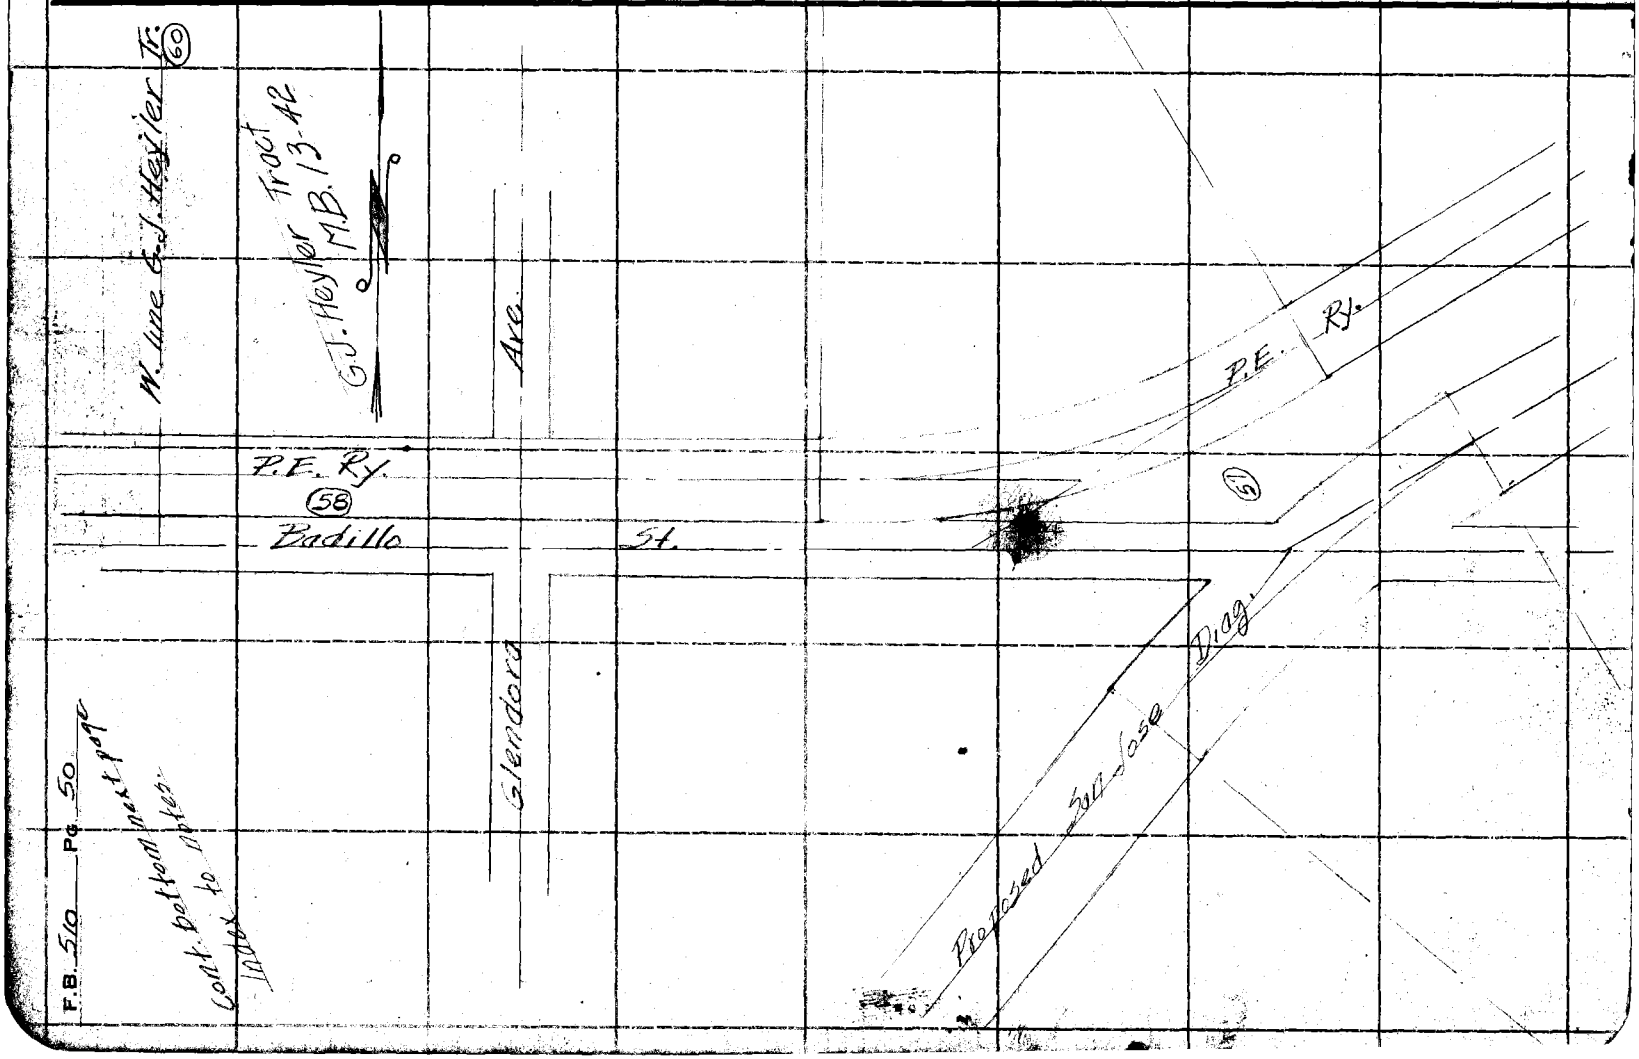

Notes Ck'd by Draw	Survey of Badillo St.
Map No.	W. O. 7103 Tape No. 241 St'd 84 oF.
Office Work	Surveyed by Rosecrans
Checked	Notes Date 8-29-33
Date	Indexed C. Johnson

F.B. 510 Pg 51

Covina.

City of

Barranca St.

Cont. bottom next page

Index to notes

Tract #587 M.B. 15-152.

Badillo St.

(61)

Monte Vista Ave.

P.E. Ry.

Tract #561 M.B. 16-155

(59)

Range Ave.

RETURN TO
LOS ANGELES COUNTY SURVEYOR
700 HALL OF RECORDS
Do not extend notes this side of this line

Note: ANY ADDITIONS OR CHANGES ON THIS SHEET MUST BE MADE OR CIRCLED IN Red Ink, WITH DATE AND NAME OF PERSON MAKING CHANGE.

FORM 247 10M 8-31

RETURN TO
LOS ANGELES COUNTY SURVEYOR
700 HALL OF RECORDS

Note: ANY ADDITIONS OR CHANGES ON THIS SHEET MUST BE MADE OR CIRCLED IN **Red Ink.** WITH DATE AND NAME OF PERSON MAKING CHANGE.

Do not extend notes this side of this line

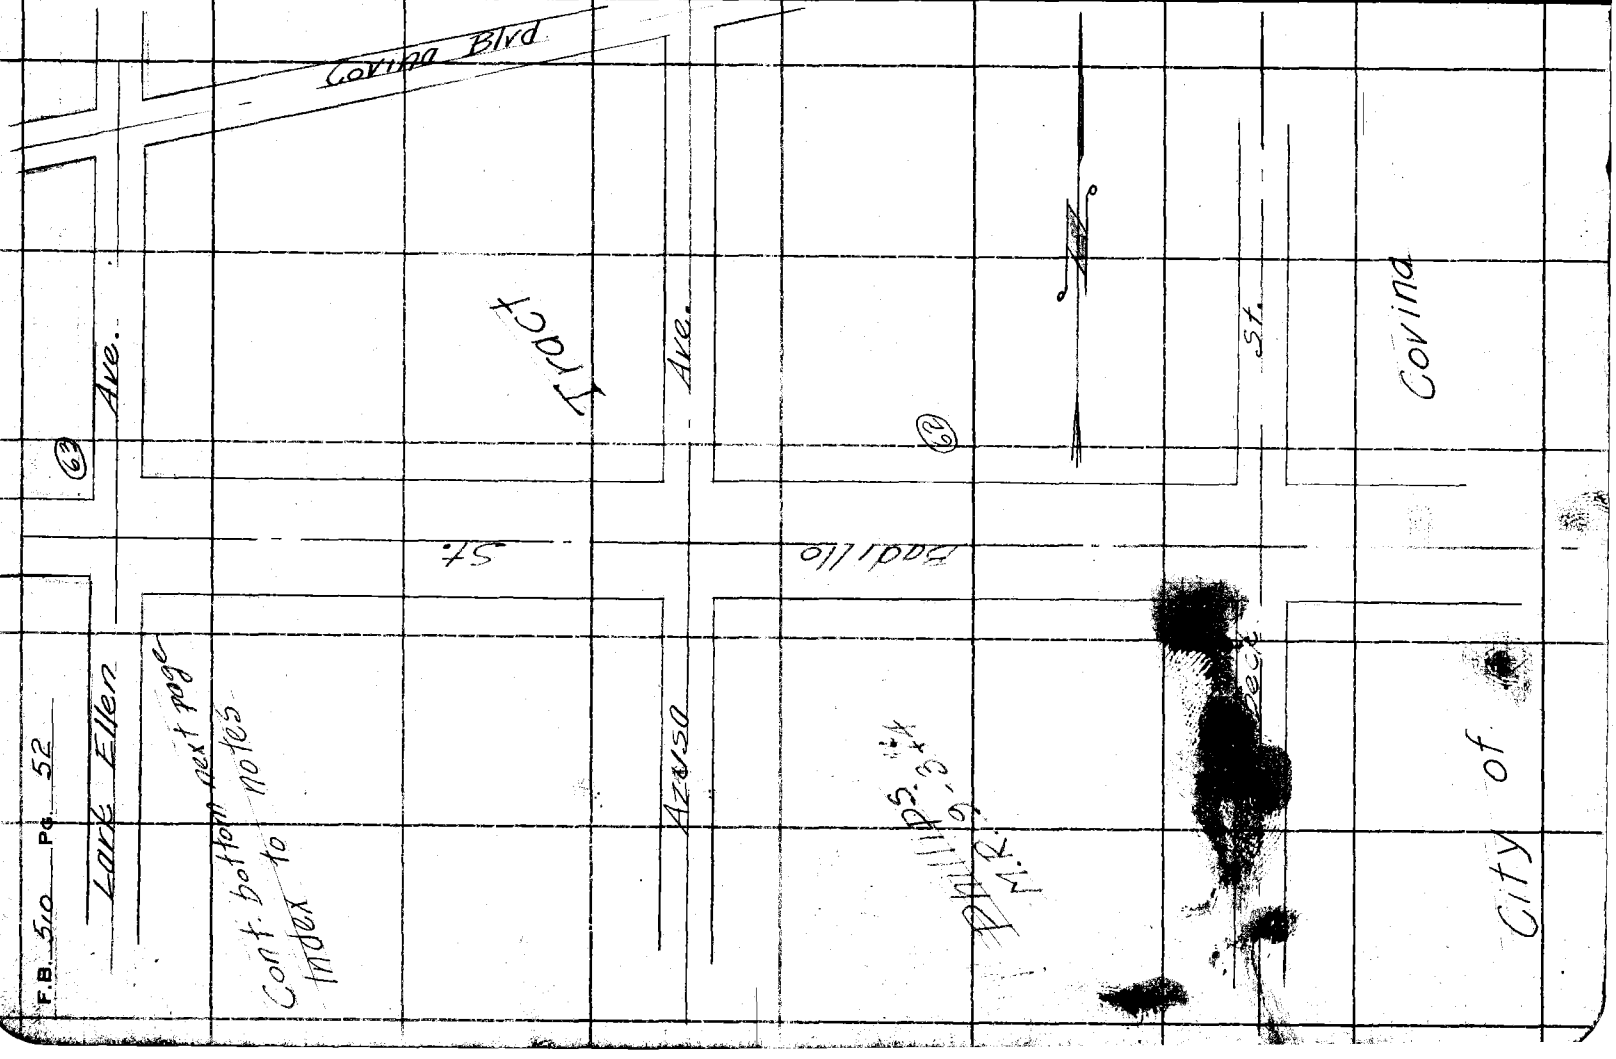

Notes Ck'd by	Survey of Badillo St.
Map No.	W. O. 7103 Tape No. 241 St'd 84 °F.
Office Work	Surveyed by Rosecrans.
Checked	Notes Date 8-29-33
Date	Indexed A. C. Johnson

F.B. 510 Pg 53

Cont. bottom next page
Index to notes.

E. line (75) Tr. 220

Irwindale Ave.

(70)

P.E. Ry. (Badillo St.)

M.B 32-1

Tract # 2986

E. line Tr. #2986

Puente Ave.

(71)

(69)

W. line Rowland Tr. M.B. 42-45

(68)

Ave.

(65)

Vincent

(64) (66) (63)

Tract.

W.R. Rowland M.R 42-45

E. line (67) W.R. Rowland Tr.

Note: ANY ADDITIONS OR CHANGES ON THIS SHEET MUST BE MADE OR CIRCLED IN Red Ink WITH DATE AND NAME OF PERSON MAKING CHANGE.

Do not extend notes this side of this line

RETURN TO
LOS ANGELES COUNTY SURVEYOR
700 HALL OF RECORDS

FORM 247 10M 8-31

F.B. 510 Pg. 54

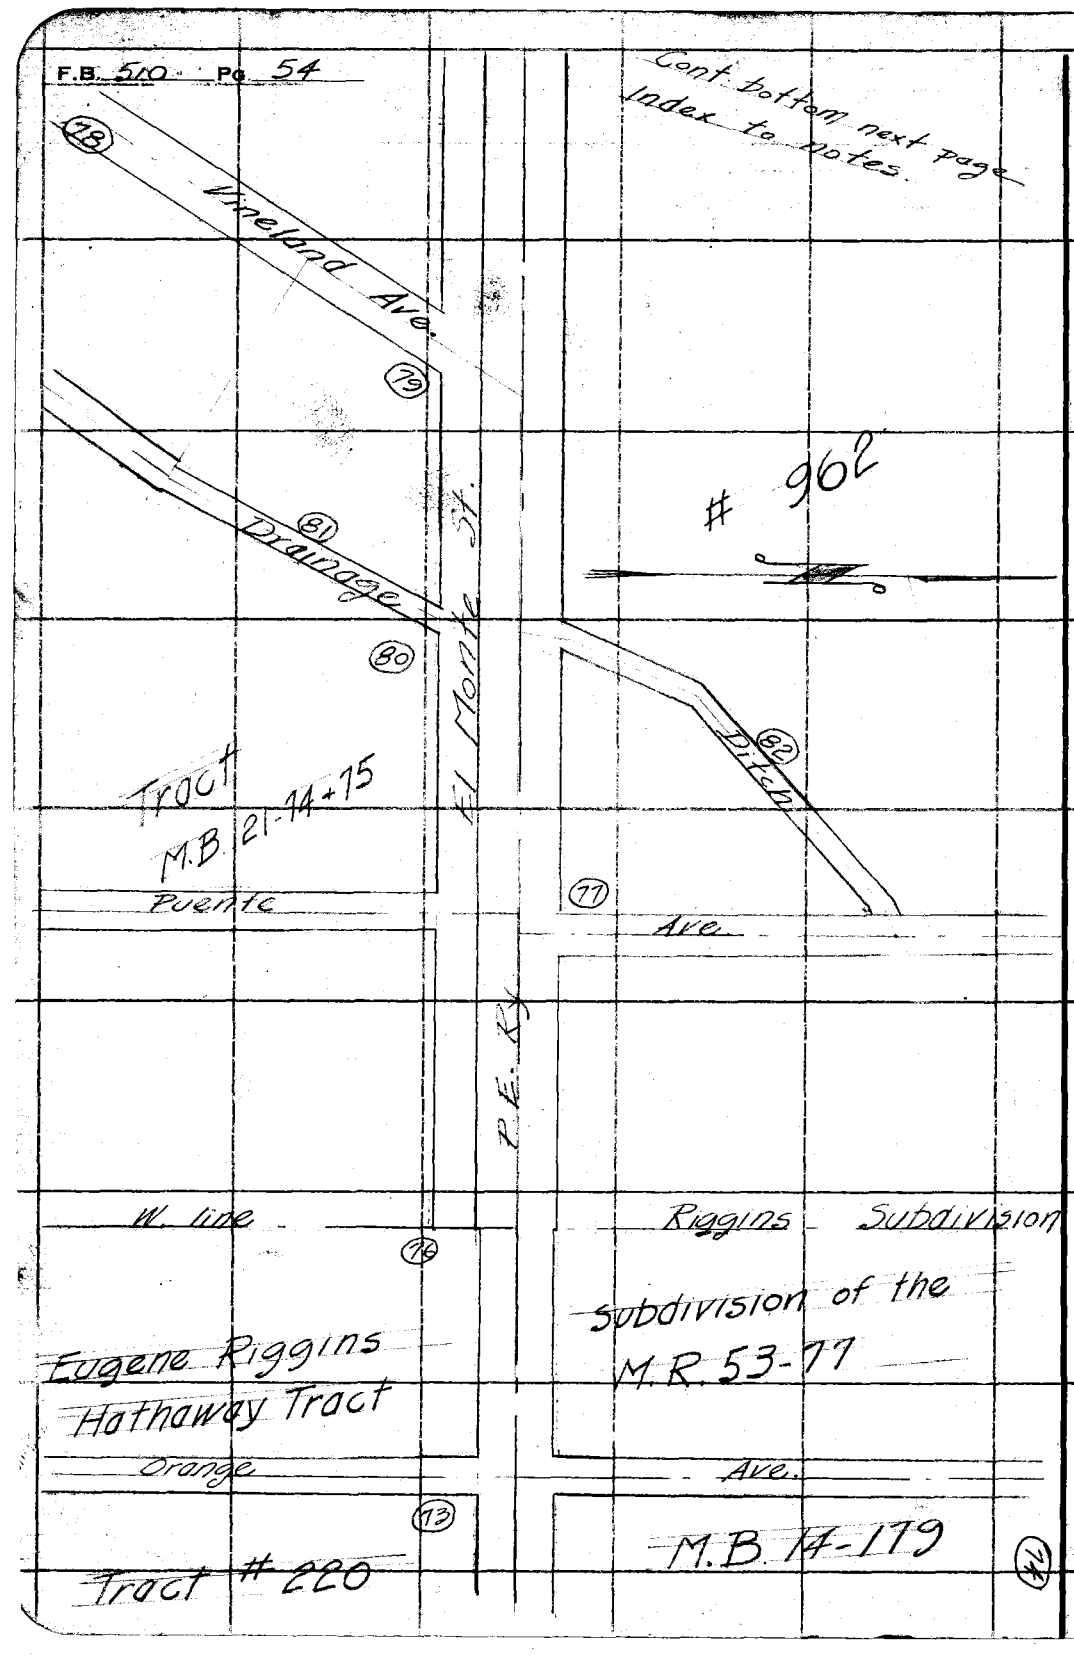

RETURN TO
LOS ANGELES COUNTY SURVEYOR
700 HALL OF RECORDS

Do not extend notes this side of this line

Note: ANY ADDITIONS OR CHANGES ON THIS SHEET MUST BE MADE OR CIRCLED IN **Red Ink.** WITH DATE AND NAME OF PERSON MAKING CHANGE.

Notes Ck'd by	Survey of Badillo St.
Map No.	W. O. 7103 Tape No. 041 St'd 84 °F.
Office Work	Surveyed by Rosecrans
Checked	Notes Date 7-6-33
Date	Indexed A. C. Johnson

F.B. 510 Pg. 55

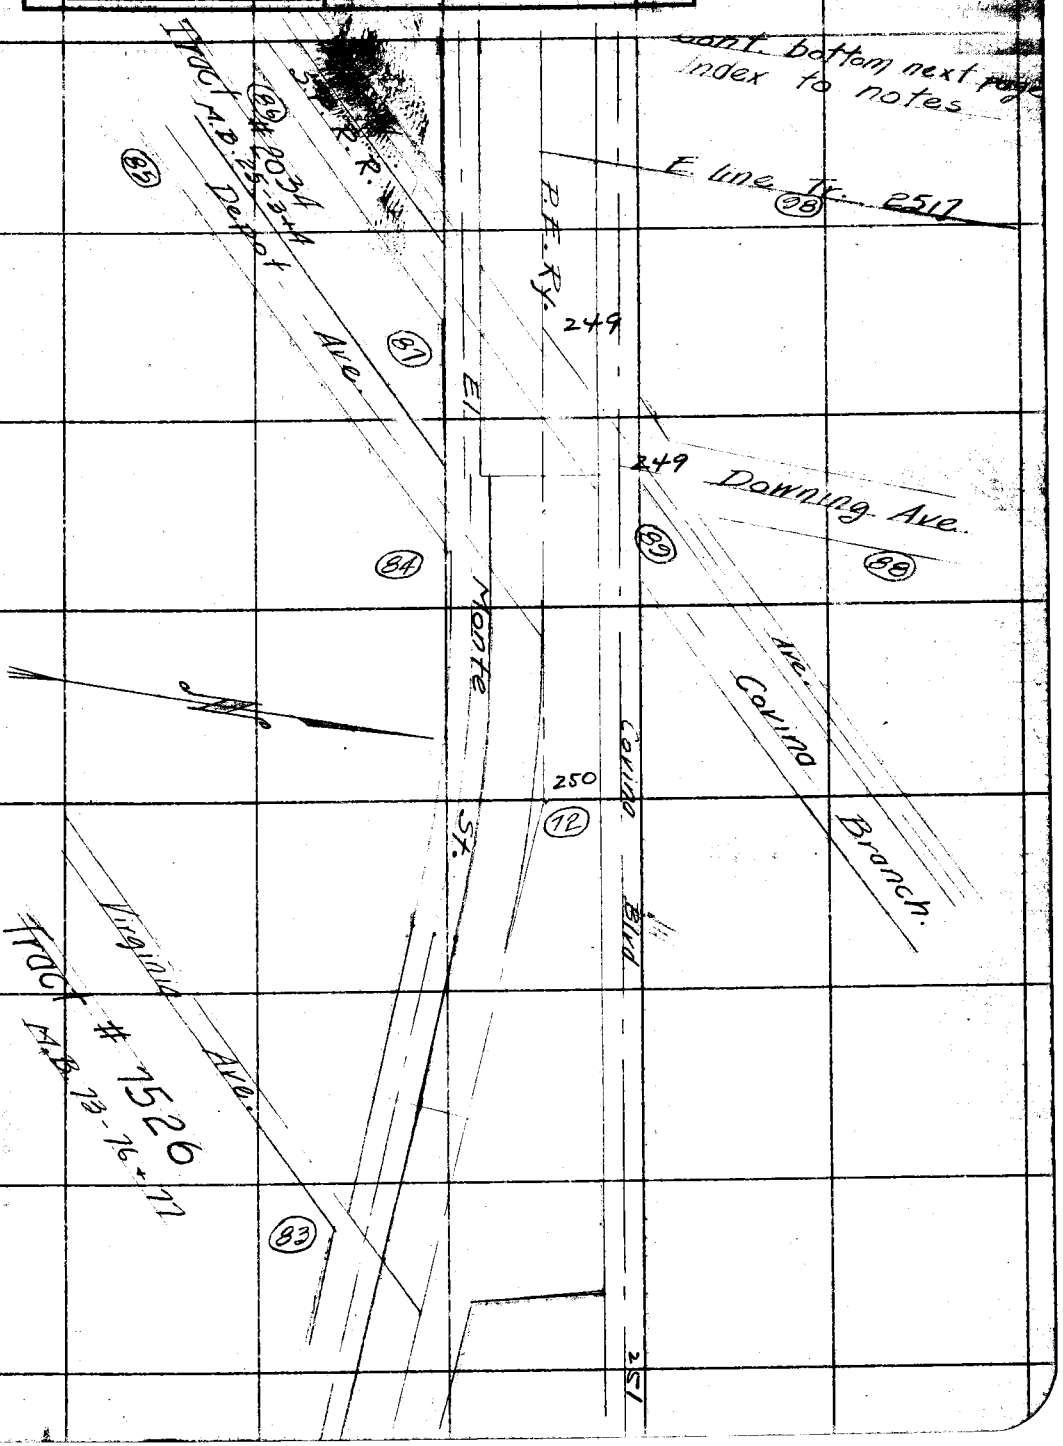

Note: ANY ADDITIONS OR CHANGES ON THIS SHEET MUST BE MADE OR CIRCLED IN Red Ink. WITH DATE AND NAME OF PERSON MAKING CHANGE.

RETURN TO
LOS ANGELES COUNTY SURVEYOR
700 HALL OF RECORDS

Do not extend notes this side of this line

FORM 247 10M 8-31

RETURN TO
LOS ANGELES COUNTY SURVEYOR
700 HALL OF RECORDS

Note: ANY ADDITIONS OR CHANGES ON THIS SHEET MUST BE MADE OR CIRCLED IN **Red Ink.** WITH DATE AND NAME OF PERSON MAKING CHANGE.

Do not extend notes this side of this line

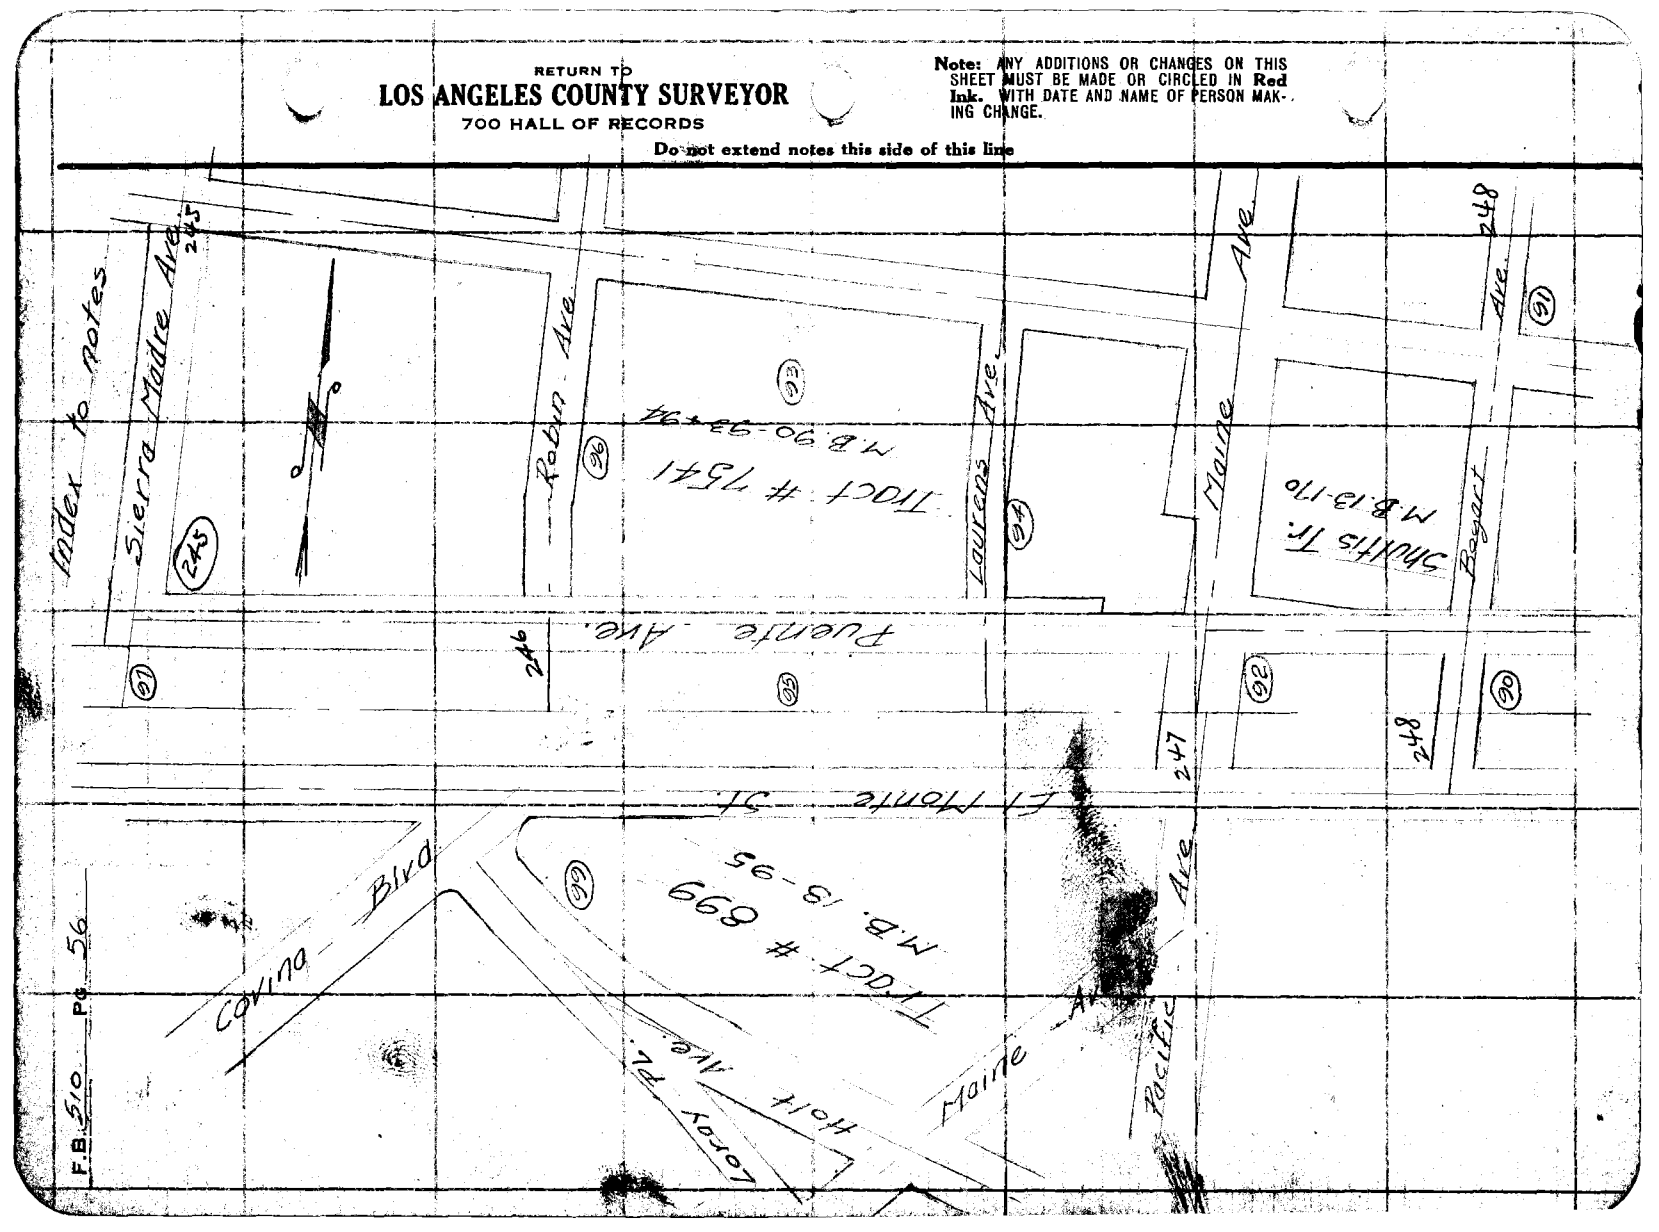

Notes Ck'd by Drew	Survey of Badillo St.
Map No. B-754-1	W. O. 7103 Tape No. 042 St'd 84 °F.
Office Work K.K. Bradstreet	Surveyed by Rosecrans
Checked	Notes Date 3-17-33
Date	Indexed A. C. Johnson

F.B. 510 Pg. 57
No Page 58

Cont. bottom next page

W.S. 48-A-4

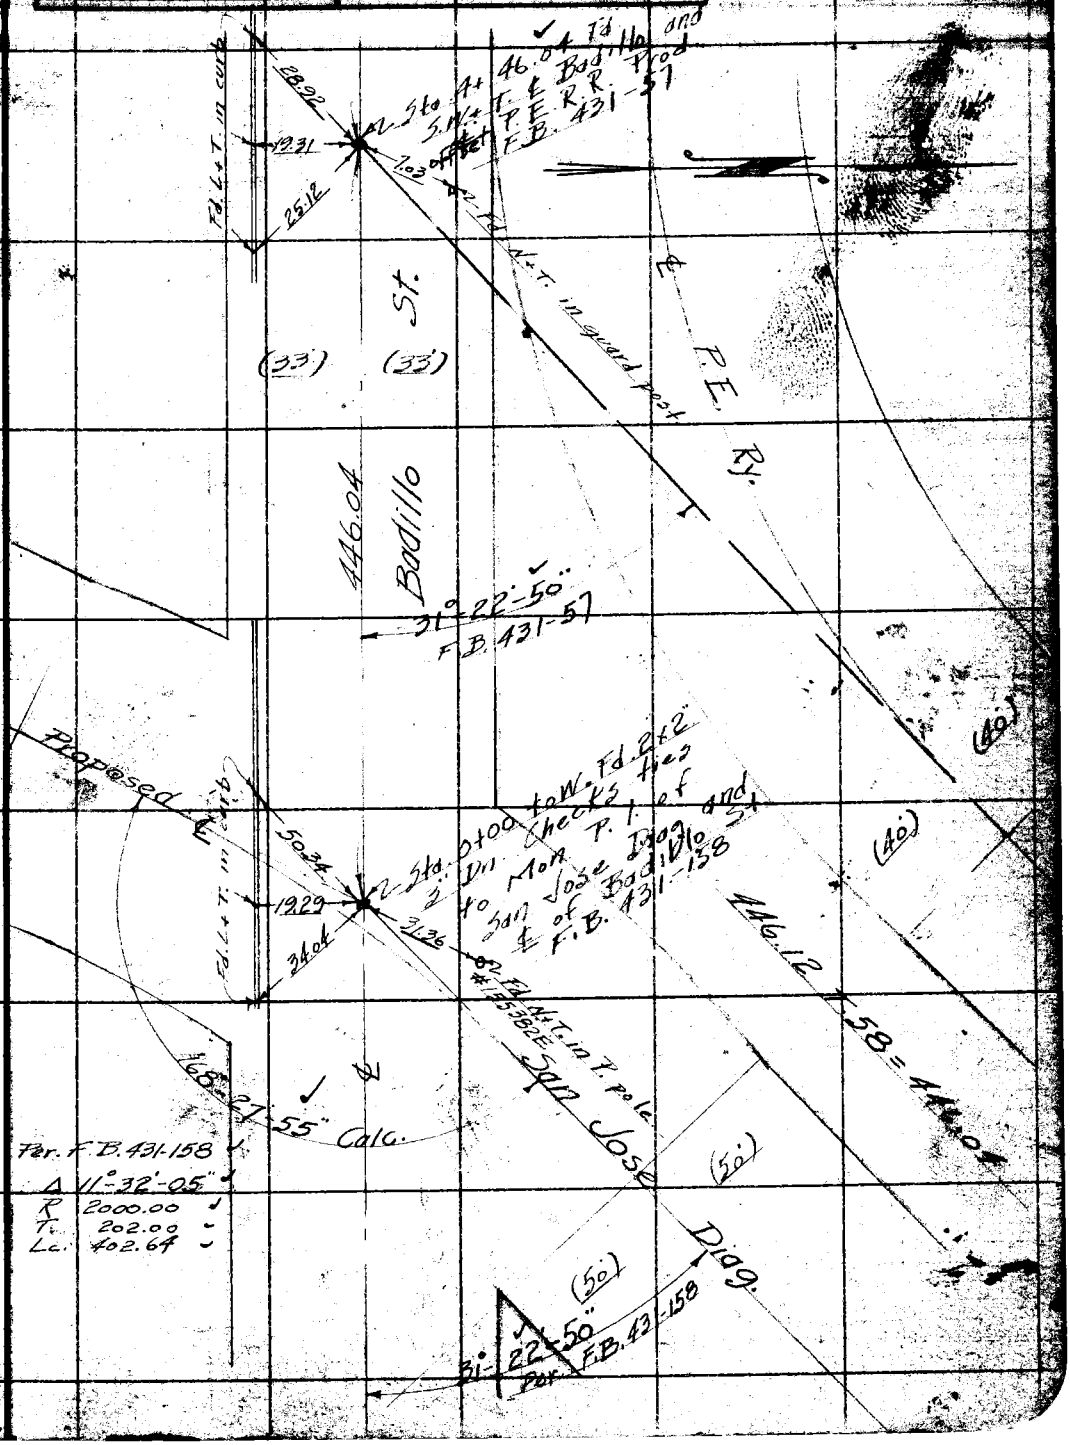

Notes: ANY ADDITIONS OR CHANGES ON THIS SHEET MUST BE MADE OR CIRCLED IN Red Ink WITH DATE AND NAME OF PERSON MAKING CHANGE.

Do not extend notes this side of this line

RETURN TO
LOS ANGELES COUNTY SURVEYOR
700 HALL OF RECORDS

FORM 247 IDM 8-31

RETURN TO

LOS ANGELES COUNTY SURVEYOR

700 HALL OF RECORDS

Do not extend notes this side of this line

Note: ANY ADDITIONS OR CHANGES ON THIS SHEET MUST BE MADE OR CIRCLED IN Red Ink, WITH DATE AND NAME OF PERSON MAKING CHANGE.

Notes Ck'd by Drew	Survey of Badillo St.	F.B. 510
Map No. 8754-1	W. O. 7103 Tape No. 042 St'd 84 of.	
Office Work R.N. Bradstreet	Surveyed by Rosecrans	
Checked	Notes Date 3-17-33	
Date	Indexed L. C. Johnson	

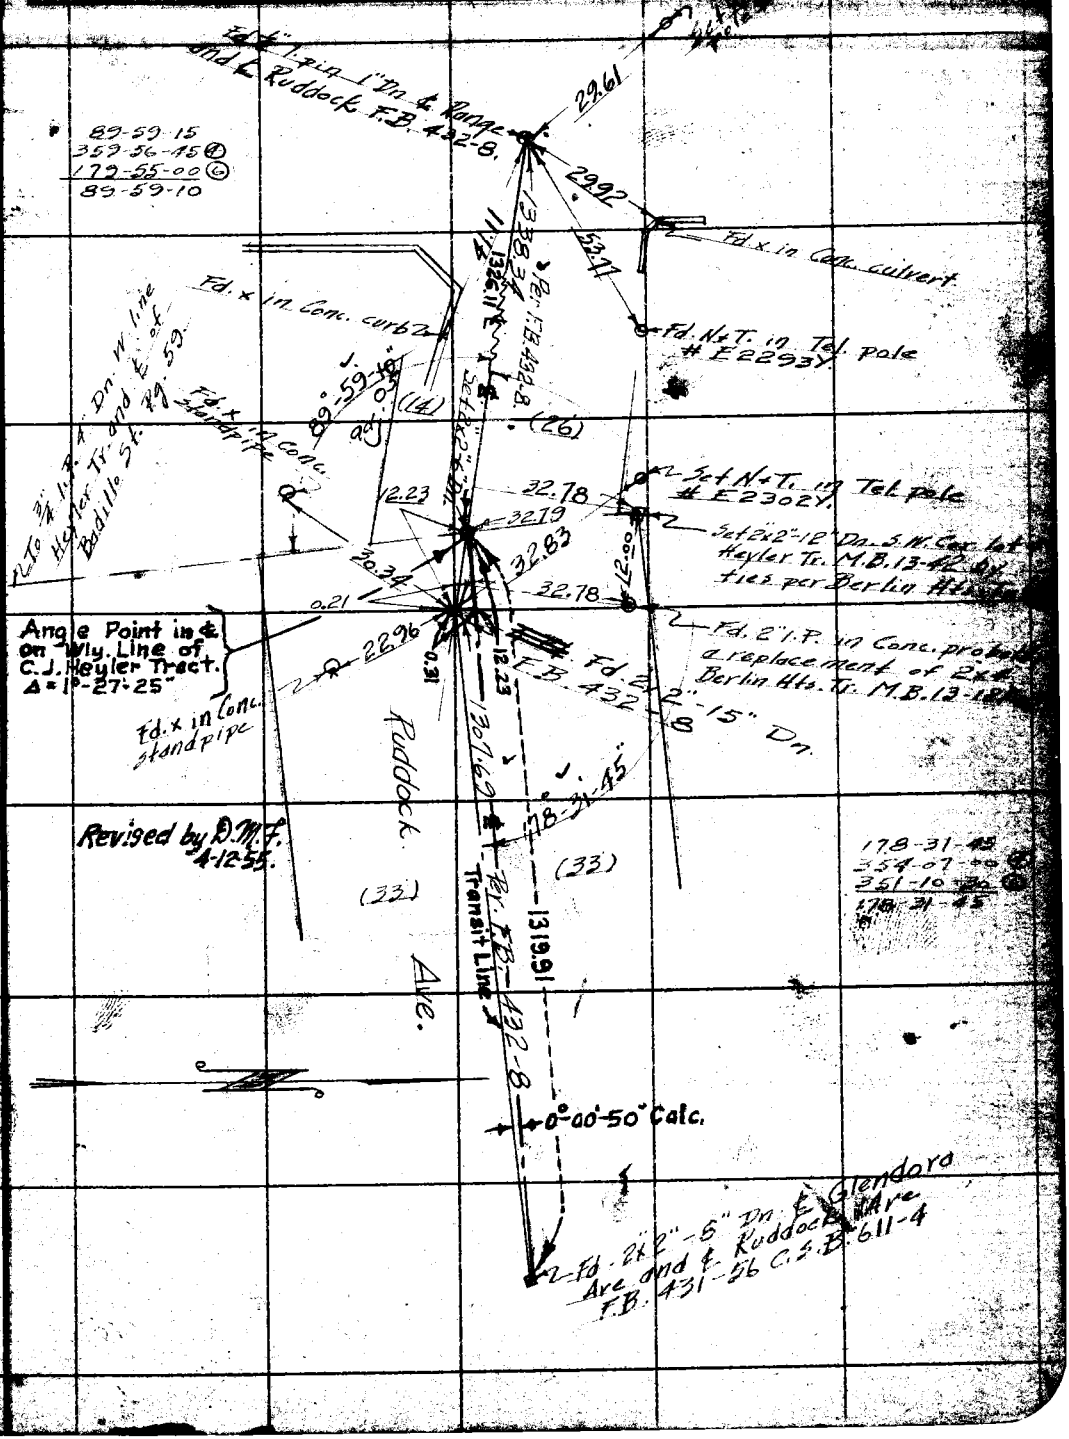

Note: ANY ADDITIONS OR CHANGES ON THIS SHEET MUST BE MADE OR CIRCLED IN Red Ink. WITH DATE AND NAME OF PERSON MAKING CHANGE.

Do not extend notes this side of this line

RETURN TO
LOS ANGELES COUNTY SURVEYOR
700 HALL OF RECORDS

FORM 247 10M 5-31

RETURN TO
LOS ANGELES COUNTY SURVEYOR
700 HALL OF RECORDS

Do not extend notes this side of this line

Note: ANY ADDITIONS OR CHANGES ON THIS SHEET MUST BE MADE, OR CIRCLED IN Red Ink, WITH DATE AND NAME OF PERSON MAKING CHANGE.

Notes Ck'd by Drew	Survey of Badillo St	F.B. 510
[illegible] B-154-2, 3	W. O. 7103 Tape No. 042 St'd 84 °F.	
Office Work H.N. Bradsheet	Surveyed by Rosecrans	
Checked	Notes Date 3-17-33	
	Indexed A. C. Johnson	

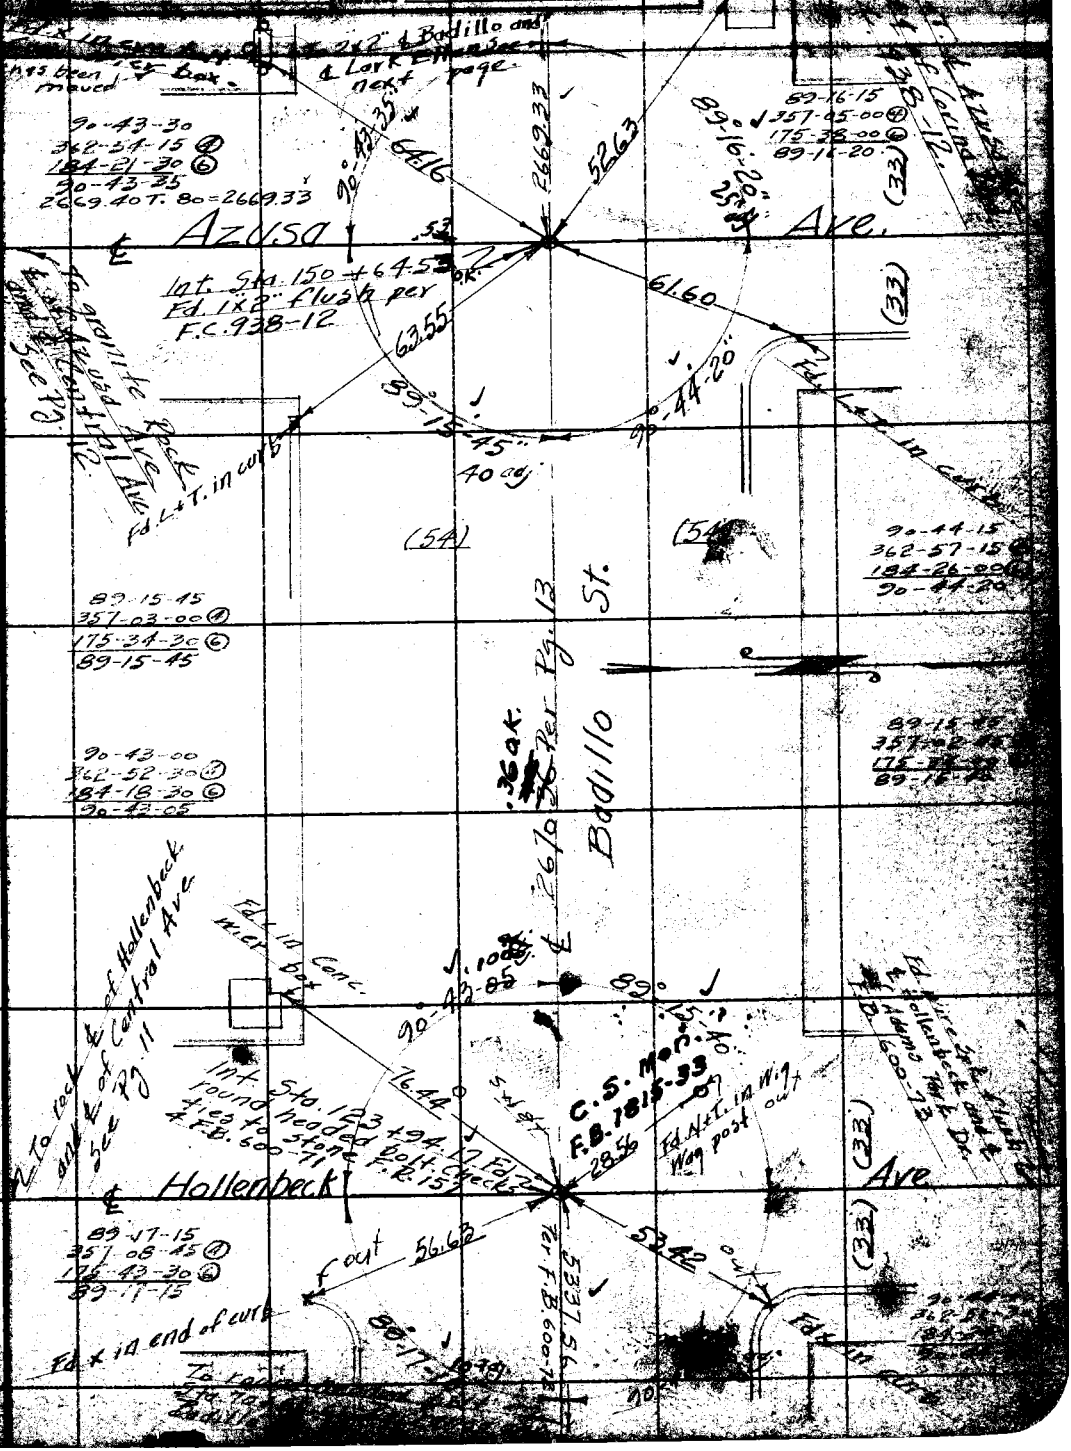

Note: ANY ADDITIONS OR CHANGES ON THIS SHEET MUST BE MADE OR CIRCLED IN INK. WITH DATE AND NAME OF PERSON MAKING CHANGE.

RETURN TO
LOS ANGELES COUNTY SURVEYOR
700 HALL OF RECORDS

Do not extend notes this side of this line

RETURN TO
LOS ANGELES COUNTY SURVEYOR
700 HALL OF RECORDS

Note: ANY ADDITIONS OR CHANGES ON THIS SHEET MUST BE MADE OR CIRCLED IN Red Ink. WITH DATE AND NAME OF PERSON MAKING CHANGE.

Do not extend notes this side of this line

W.S. 47-B-4

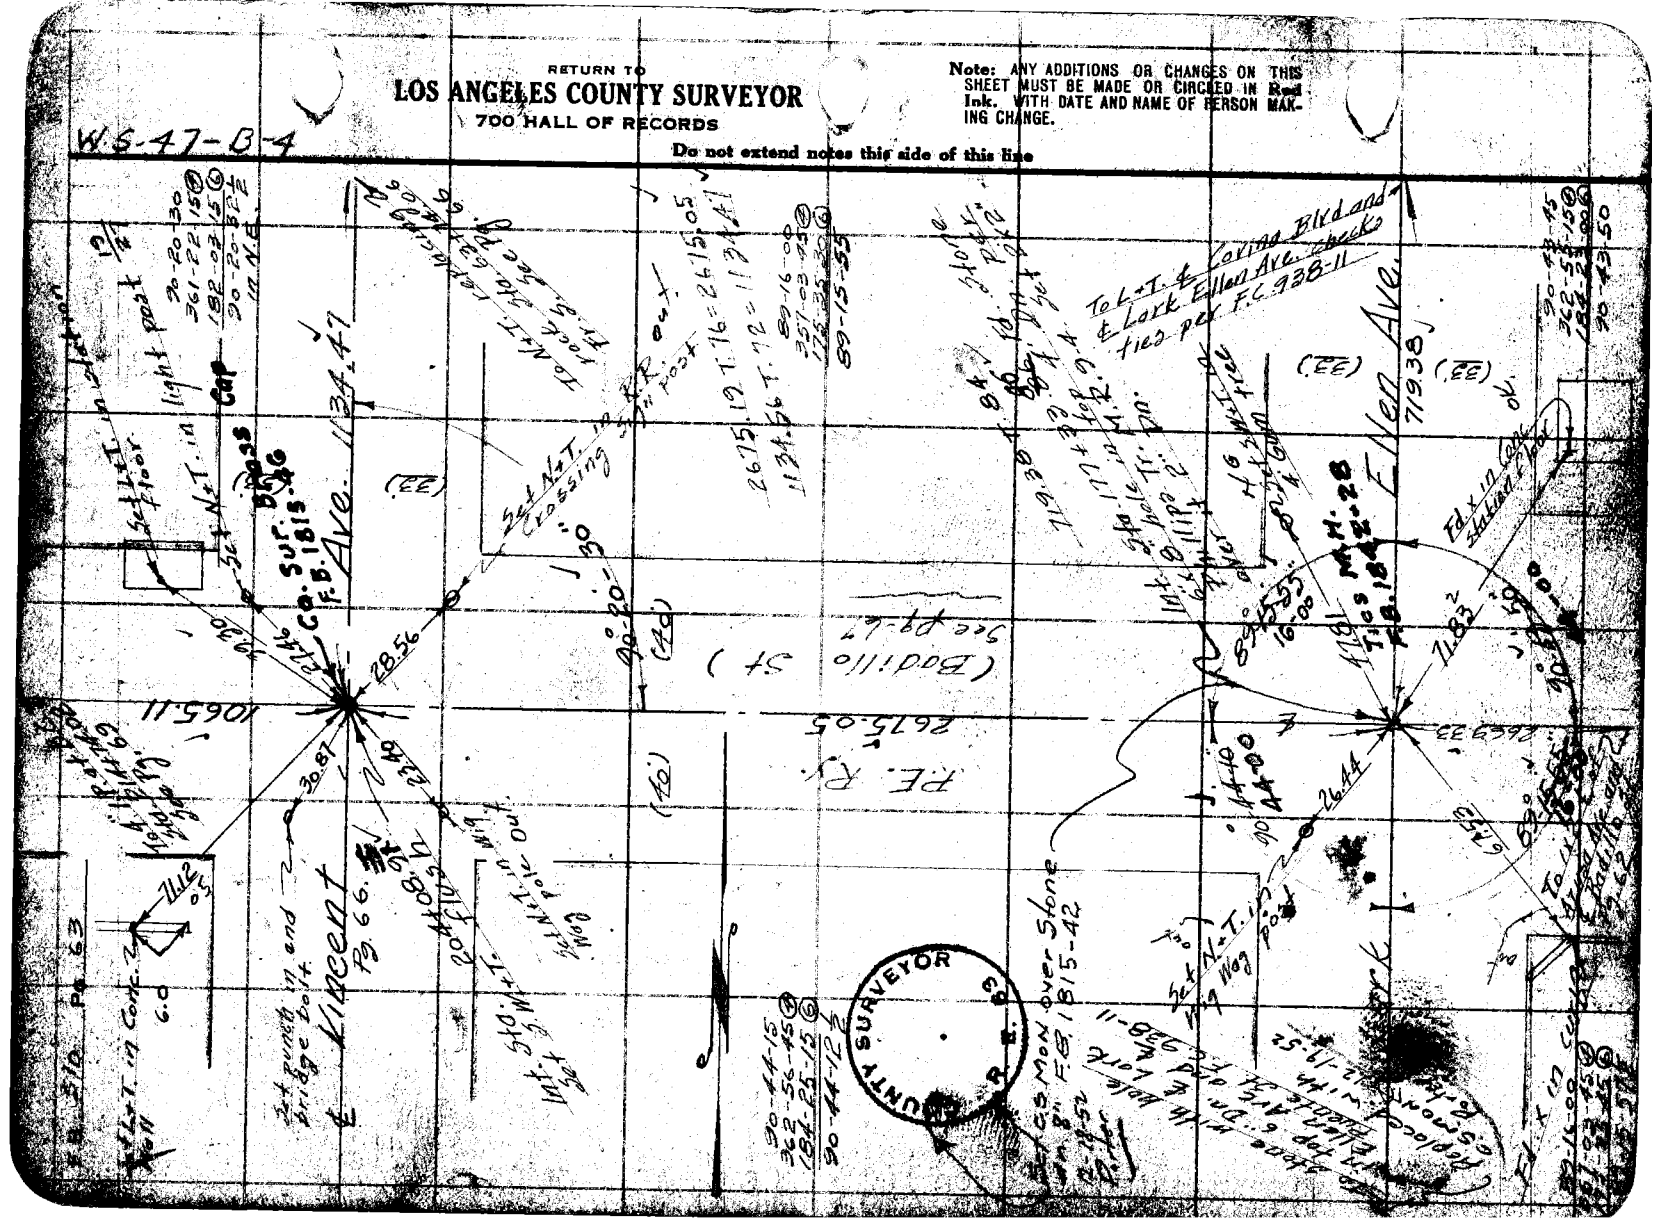

Notes Ck'd by Drew	Survey of Badillo St.
Map No. 8-754-3	W. O. 7103 Tape No. 041 St'd 84 of.
Office Work N.N. Dead Street	Surveyed by Rosecrans
Checked	Notes Date 5-12-33
Date	Indexed A. C. Johnson

F.B. 510 Pg. 64

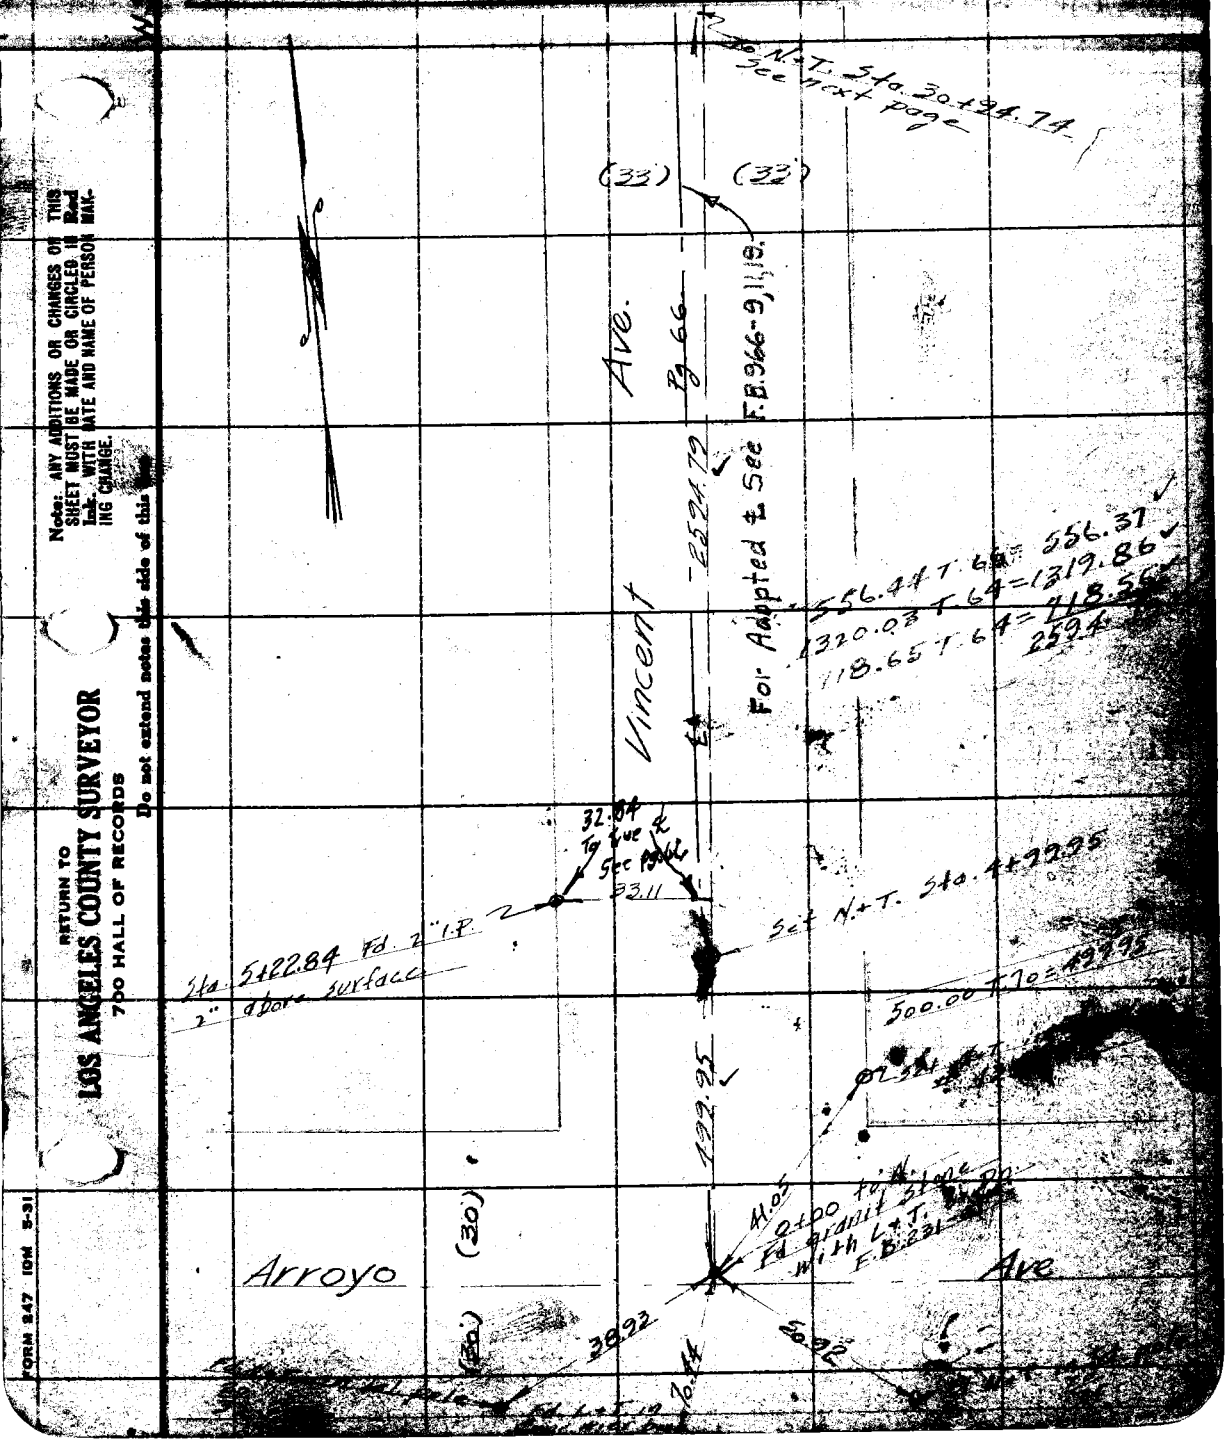

Note: ANY ADDITIONS OR CHANGES OF THIS SHEET MUST BE MADE OR CIRCLED IN Red Ink. WITH DATE AND NAME OF PERSON MAKING CHANGE.

RETURN TO
LOS ANGELES COUNTY SURVEYOR
700 HALL OF RECORDS
Do not extend notes this side of this line

FORM 247 10M 5-31

RETURN TO
LOS ANGELES COUNTY SURVEYOR
700 HALL OF RECORDS

Note: ANY ADDITIONS OR CHANGES ON THIS SHEET MUST BE MADE OR CIRCLED IN Red Ink. WITH DATE AND NAME OF PERSON MAKING CHANGE.

W5.478-4

Do not extend notes this side of this line

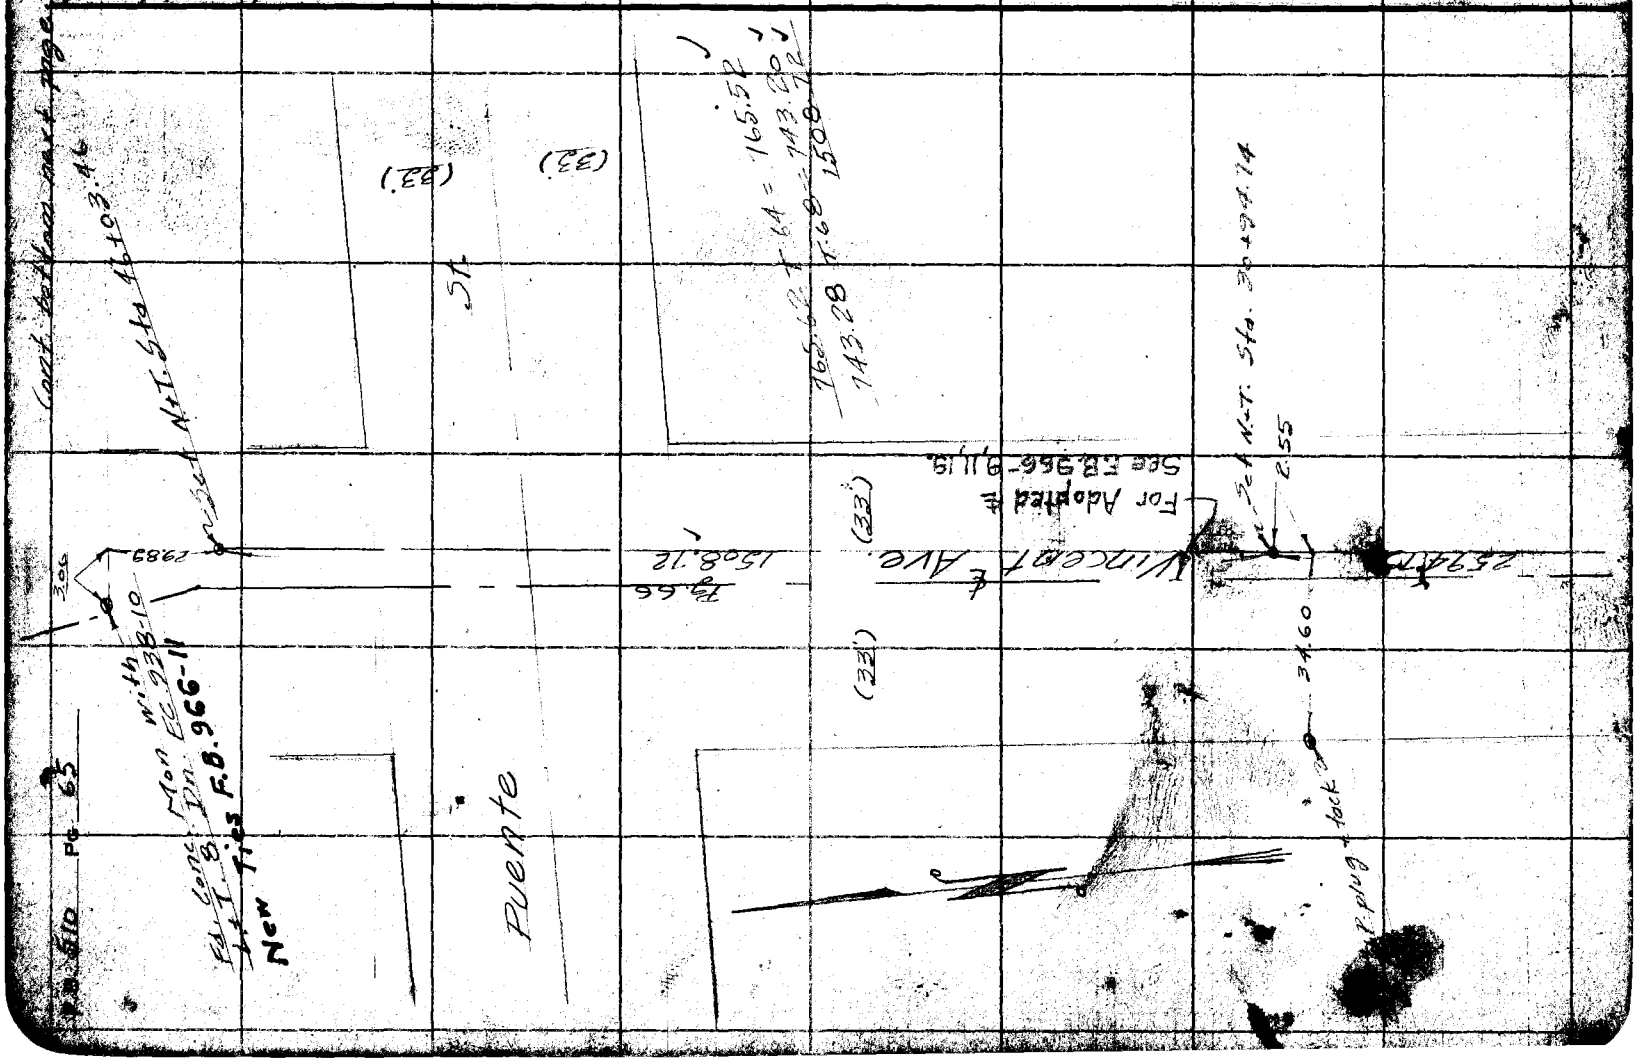

Notes Ck'd by Drew
Map No. B-754-3
Office Work K.N. Bradstreet
Checked
Date

Survey of Patillo St.
W. O. 7102 Tape No. 241 St'd 82 of F.
Surveyed by Roscrans
Notes
Date 5-15-33
Indexed

F.B. 510 Pg. 66

W.S. 47 B-4

Sta. 63+74.06 Fr. ℄ of N.+T. to Replace old rock per F.B. 938-10

℄ Covina

33.55

0.04' In Sta. 63+40.51 Fr. ℄ Fd. ℄ L.+T. Covina Blvd & P.I. F.C. 238-10

1707.17 T. 72 - 1707.04

Road Dept. transit line

Fd. 3 W.+T. in 20" Palm. Sta. 46+33.47 Fd. 4 x 4" Conc. Post with L.+T. 8" Dn. F.C. 238-10

Blvd

175-45-45
343-03-15 (A)
334-34-30 (C)
175-45-45

175° 45' 45"

47.27

21.17

175° 40' 00"

Set Spk. + T. in 36" palm

Fd. 3 W.+T. in 20" palm. Sta. 46+03.46 Pg. 65

Ave. 1775.60

40.41

N.+T.

39.01

35.80

Fd. granite 5 x 6 x 18" 2 ft. on its side

10.40

2.76

Set 3" I.P. plug + tack 2' Dn.

33.02

Set 3" I.P. plug + tack 2' Dn.

Set Spk. + T. in 30" palm

℄ P.I. Set S.W.+T. flush Using Rec. Dist. per M.B. 42-45 Fr. old rock to N. on Covina Blvd. to N. Old rock at 0+00 and 2' to S. Old I.P. at 30+92.19

87° 52' 50"

2.31

28.15

2.25

℄ P.I. in transit line Sta. 45+93.06 Fr. S. Set 3" I.P.

(33)

(33)

Fd. 2" I.P. plug + 2" tack 6" Dn. Sta. 30+92.19 Pg. 65

33.00

Vincent Ave. Transit Line

For Adopted ℄ of Vincent Ave See F.B. 966-9-11-9.

175-40-00
342-40-00 (A)
334-00-00 (C)
175-40-00

32.84'

Sta. 22.84
Fd. 2" I.P. Pg. 64

Fd. granite stone with L.+T. 6" Dn. Sta. 0+00 to N. Pg. 64

RETURN TO
LOS ANGELES COUNTY SURVEYOR
700 HALL OF RECORDS
Do not extend notes this side of this line

Note: ANY ADDITIONS OR CHANGES OF THIS SHEET MUST BE MADE IN OR CIRCLED IN Red Ink. WITH DATE AND NAME OF PERSON MAKING CHANGE.

FORM 247 10M 8-31

RETURN TO
LOS ANGELES COUNTY SURVEYOR
700 HALL OF RECORDS

Note: ANY ADDITIONS OR CHANGES ON THIS SHEET MUST BE MADE OR CIRCLED IN **Red Ink.** WITH DATE AND NAME OF PERSON MAKING CHANGE.

WS 47B-4

Do not extend notes this side of this line

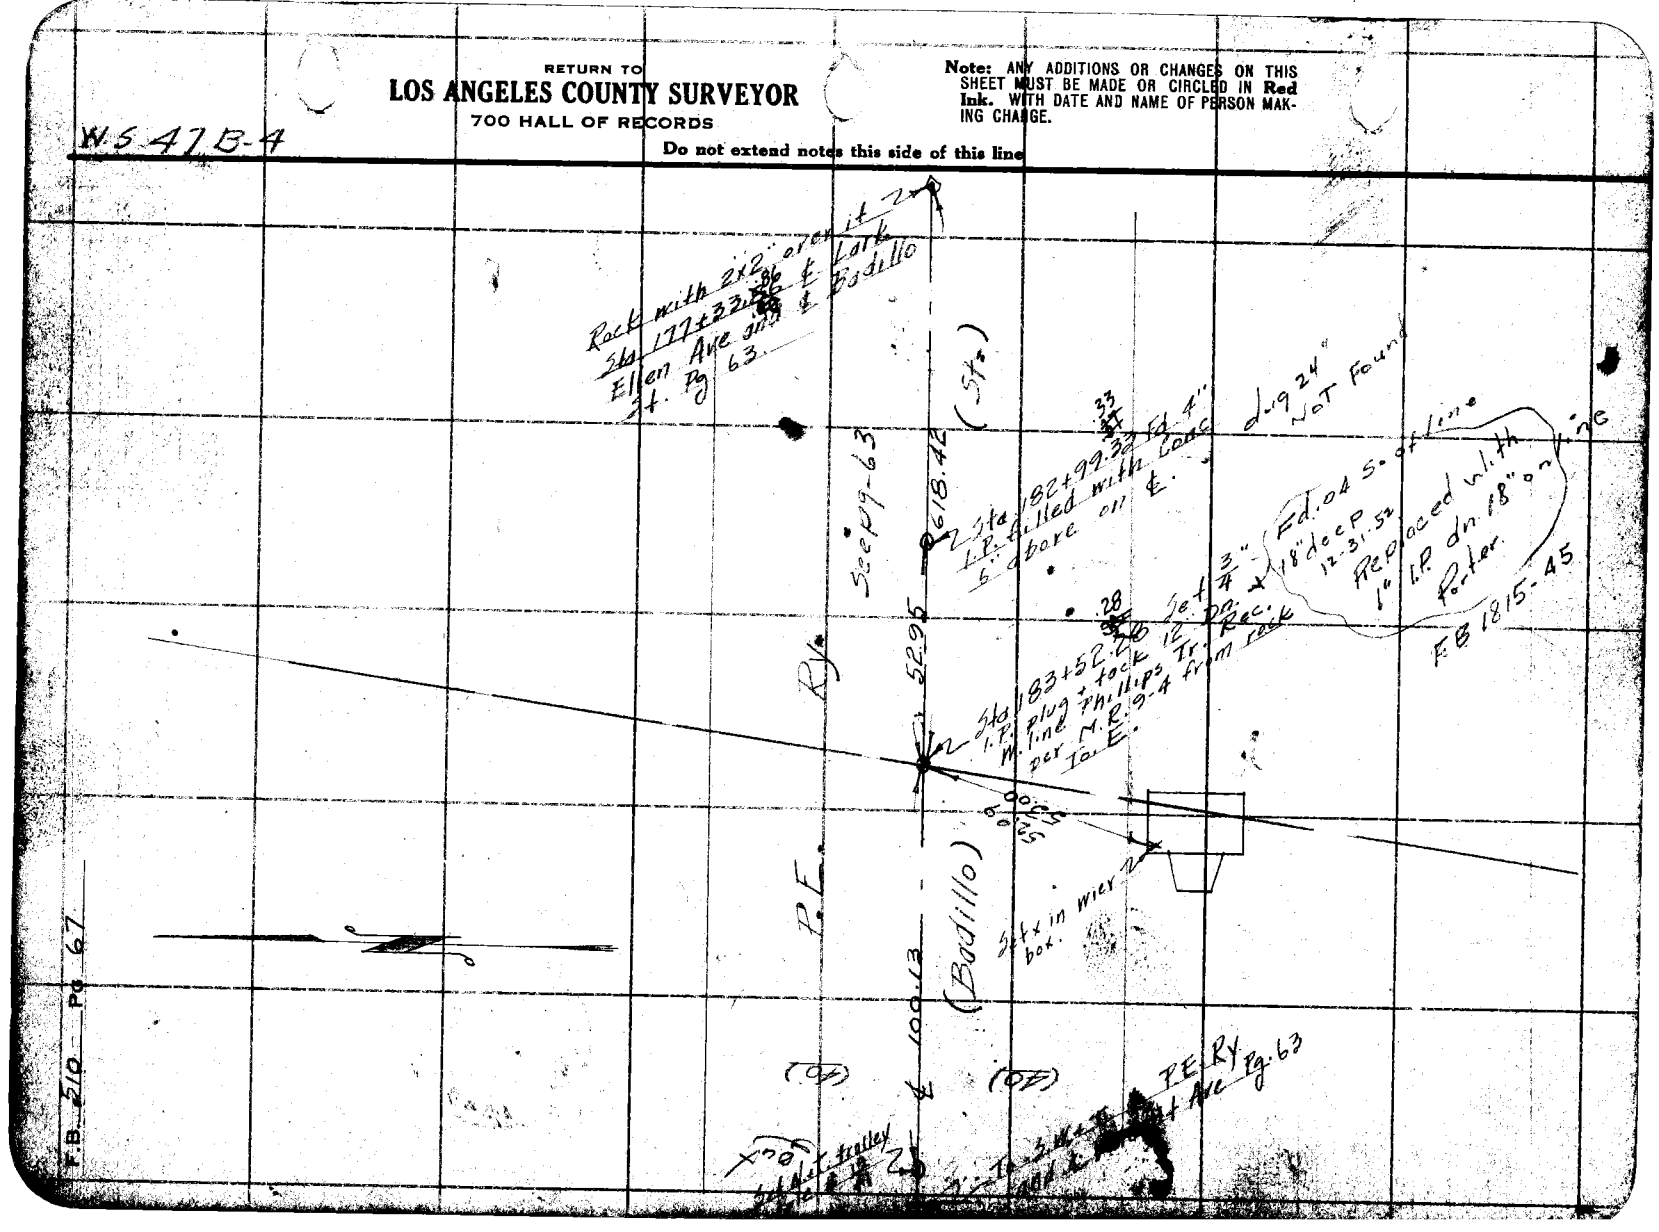

Notes Ck'd by Drew	Survey of Badillo St.
Map No. B-754-4	W. O. 7103 Tape No. 041 St'd 84 °F.
Office Work R.N. Bradstreet	Surveyed by Rosecrans
Checked	Notes Date 5-18-33
Date	Indexed A. C. Johnson

F.B. 510 Pg. 68

W.S. 47 B-4

Note: + tape #081, St. 68°
172.24 @ 0° T. 54°
172.22
Porter 1-2-46

Fd. L.T. in Co. P.L. of Cowing Blvd. per T.C. 938-10

Replaced with C.S. Mon. on 18" 12-31-52 Porter 2x2" on surface

COUNTY SURVEYOR R. E. 63

1127.97 T.72 = 1127.88

177.24 T.76 = 177.23 ?

W Line Rowland Tr. M.B. 42-45

1065.28 T.60 = 1065.11

1127.88

212+69.34 Set N+T 19/21 pole trolley

To S.W.+T. & P.E. Ry. and & Vincent St. Sta. 204+08.9 Pg. 63

(40)

93°-46'-55"

P.E. Ry.
172.22
~~177.23~~
1065.11

32.46

(Badillo St.)

213+01.80 Set 3/4" I.P. plug & tack 12" Dn. Removed

(40)

157.79

B.C. Sta. 214+74.02 Fd. 4" I.P. filled with Conc. and L+T 6" above Sec. Pg. 69

157.80 T.76 = 157.79

Fd. bottom of old 2x4" stake W. Cor. lots 26 + 36 Rowland Tr. M.B. 42-45 per Rd F.B. 65-55 Replaced with 3/4" I.P. 18" Dn.

1049.15

1049.20 T.76 = 1049.15

93-47-00
15-07-45
202-41-45
93-46-57

Fd. old 6x6" post 2' high at Cor. of corral N.E. Cor. lot 25. Rowland Tr. M.B. 42-45 P.B. F.B. 65-55

Note: ANY ADDITIONS OR CHANGES OR THIS SHEET MUST BE MADE OR CIRCLED IN Red Ink. WITH DATE AND NAME OF PERSON MAKING CHANGE.

Do not extend notes this side of this line

RETURN TO
LOS ANGELES COUNTY SURVEYOR
700 HALL OF RECORDS

FORM 247 10M 5-31

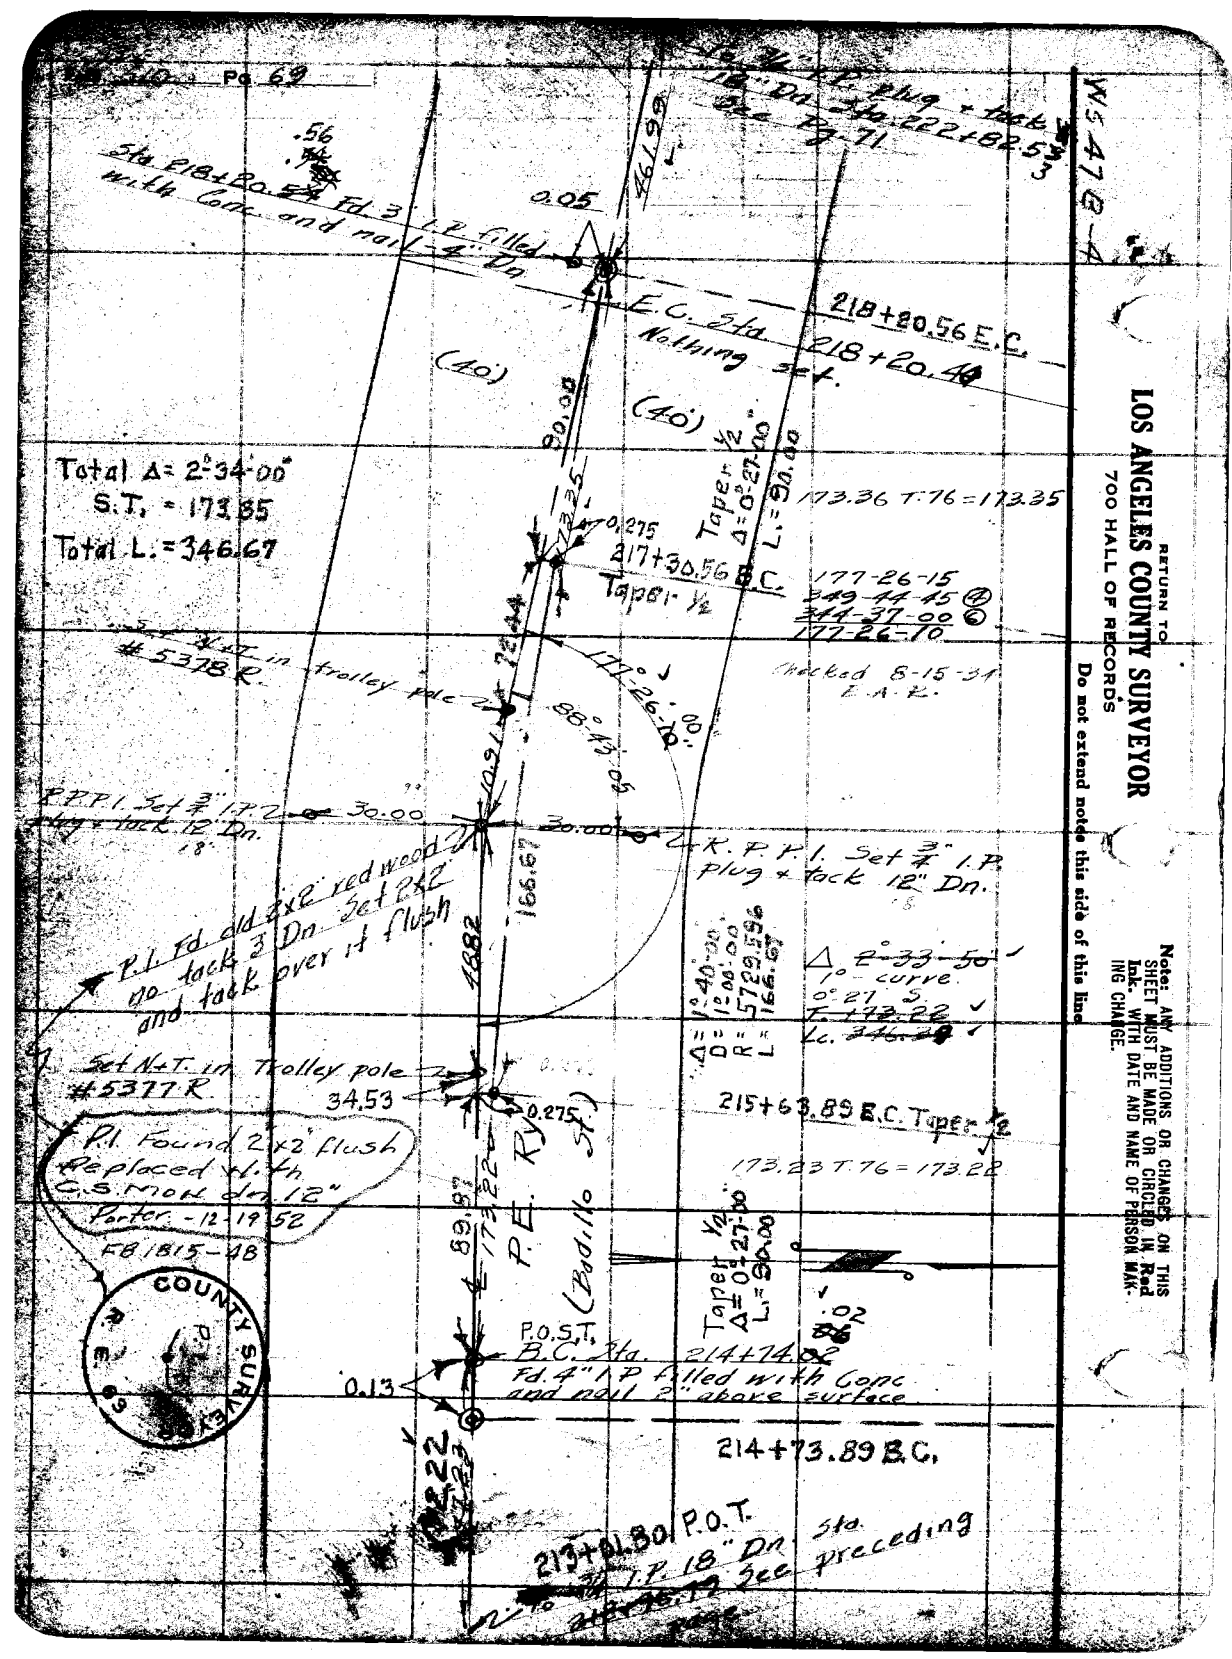
Pg 69
W5 47 @
12" Dn. Sta. 222+82.53
Ry. 71
.56
Sta. 218+20.56 Fd 3" I.P. filled with Conc. and nail 1" Dn.
0.05
46.99
218+20.56 E.C.
Nothing set.
(40')
(40')
80.00
Total Δ = 2°-34-00"
S.T. = 173.35
Total L. = 346.67
0.275
217+30.56 B.C.
Taper ½
Taper ½ Δ = 0°-27-00" L. = 30.00
173.36 T. 76 = 173.35
177-26-15
349-14-45 ④
344-37-00 ⑤
177-26-10
Checked 8-15-31 E.A.R.
X in Trolley pole #5378 R.
177°-26'-00"
88°-43'-00"
72.44
103.17
30.00
30.00
R.P.P.I. Set ¾" I.P. Plug + Tack 12" Dn.
18'
C.K.P.P.I. Set ¾" I.P. Plug + Tack 12" Dn.
P.I. Fd old 2x2 red wood stake 2' Dn. Set P.K. nail & tack over it flush
166.67
1382
Δ = 1°-40'-30"
D = 1°-00'-00"
R = 5729.56
L = 166.67
Δ 2°-33-50" ✓
1° curve
0°-27'-30" ✓
T. 172.22 ✓
Lc. 346.48 ✓
Set N+T. in Trolley pole #5377 R.
34.53
0.275
215+63.89 B.C. Taper ½
173.23 T. 76 = 173.22
P.I. Found 2"x2" flush Replaced w/ 4th C.S. Mon. Dn. 12" Porter - 12-19-52
FB 1815-UB
COUNTY SURVEY
89.97
173.22
P.E. Ry (Bad. No Sp.)
Taper ½ Δ = 0°-27'-30" L. = 30.00
.02
P.O.S.T.
B.C. Sta. 214+74.02
Fd. 4" I.P. filled with Conc. and nail 2" above surface
0.13
214+73.89 B.C.
213+81.80 P.O.T.
T.P. 18" Dn. Sta. 213+46.14 See preceding page
RETURN TO
LOS ANGELES COUNTY SURVEYOR
700 HALL OF RECORDS
Do not extend notes this side of this line
Note: ANY ADDITIONS OR CHANGES ON THIS SHEET MUST BE MADE OR CIRCLED IN Red Ink. WITH DATE AND NAME OF PERSON MAKING CHANGE.

Notes Ck'd by Drew	Survey of Badillo St.
Map No. 3-154-4	W. O. 7103 Tape No. 041 St'd 84 °F.
Office Work N.N. Broadsheet	Surveyed by R. Secrans
Checked	Notes Date 6-8-33
Date	Indexed A. C. Johnson

F.B. 510 Pg. 70

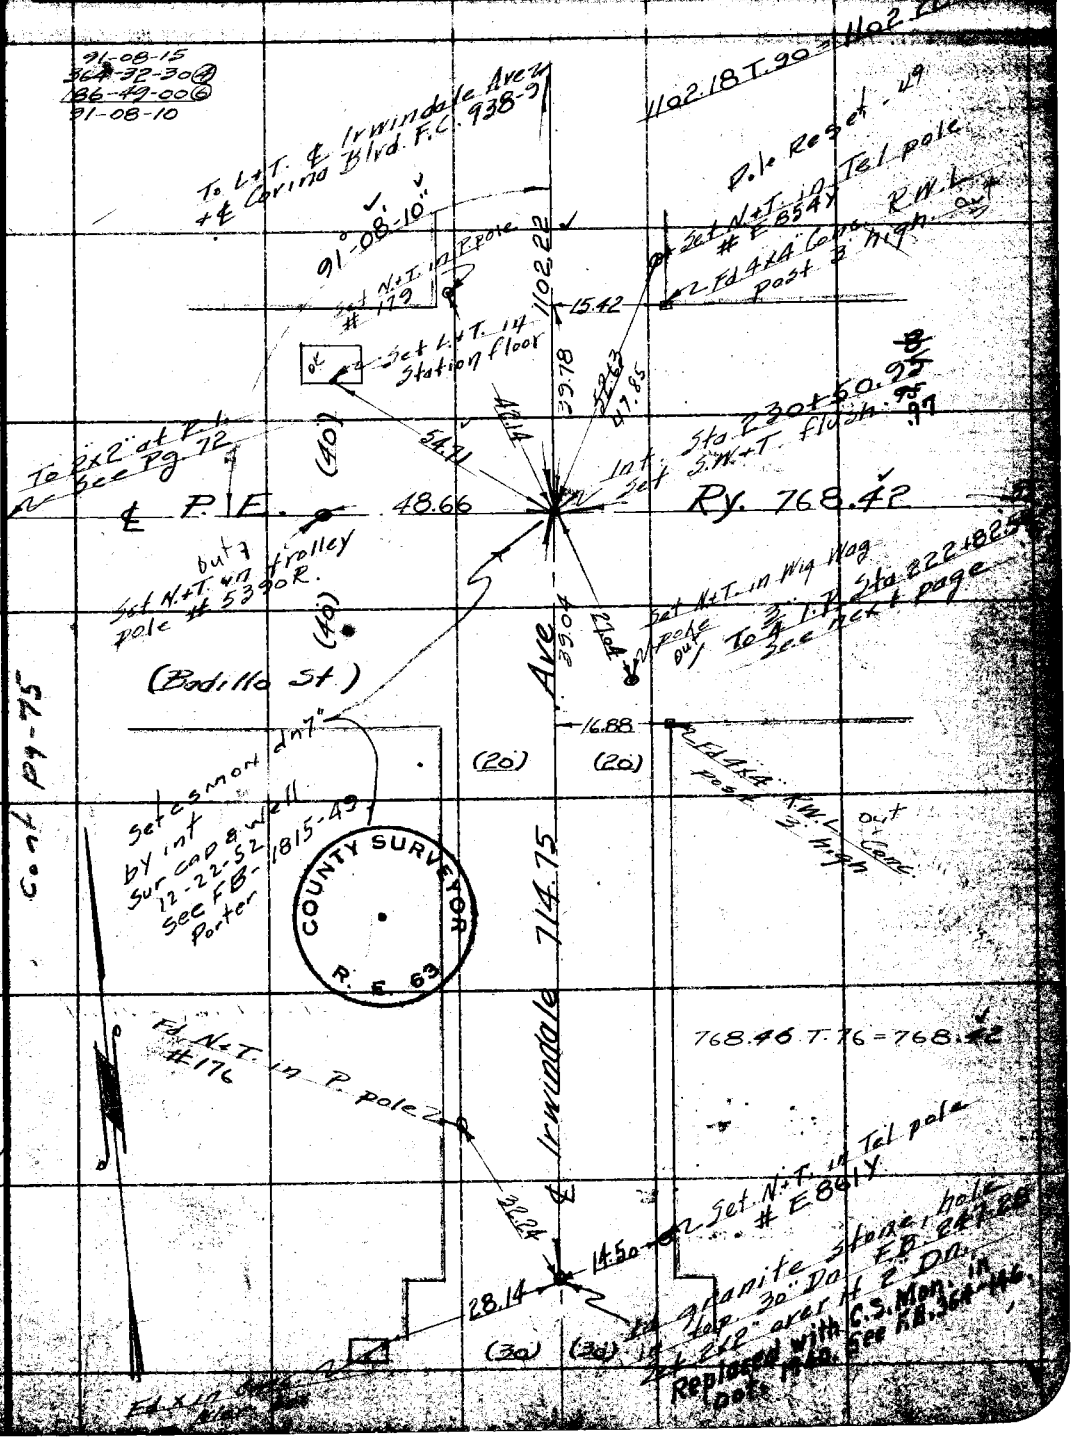

Note: ANY ADDITIONS OR CHANGES ON THIS SHEET MUST BE MADE (OR CIRCLED IN Red Ink. WITH DATE AND NAME OF PERSON MAKING CHANGE.

Do not extend notes this side of this line

RETURN TO
LOS ANGELES COUNTY SURVEYOR
700 HALL OF RECORDS

RETURN TO
LOS ANGELES COUNTY SURVEYOR
700 HALL OF RECORDS

Note: ANY ADDITIONS OR CHANGES ON THIS SHEET MUST BE MADE OR CIRCLED IN Red Ink. WITH DATE AND NAME OF PERSON MAKING CHANGE.

Do not extend notes this side of this line

WS 47 C-4

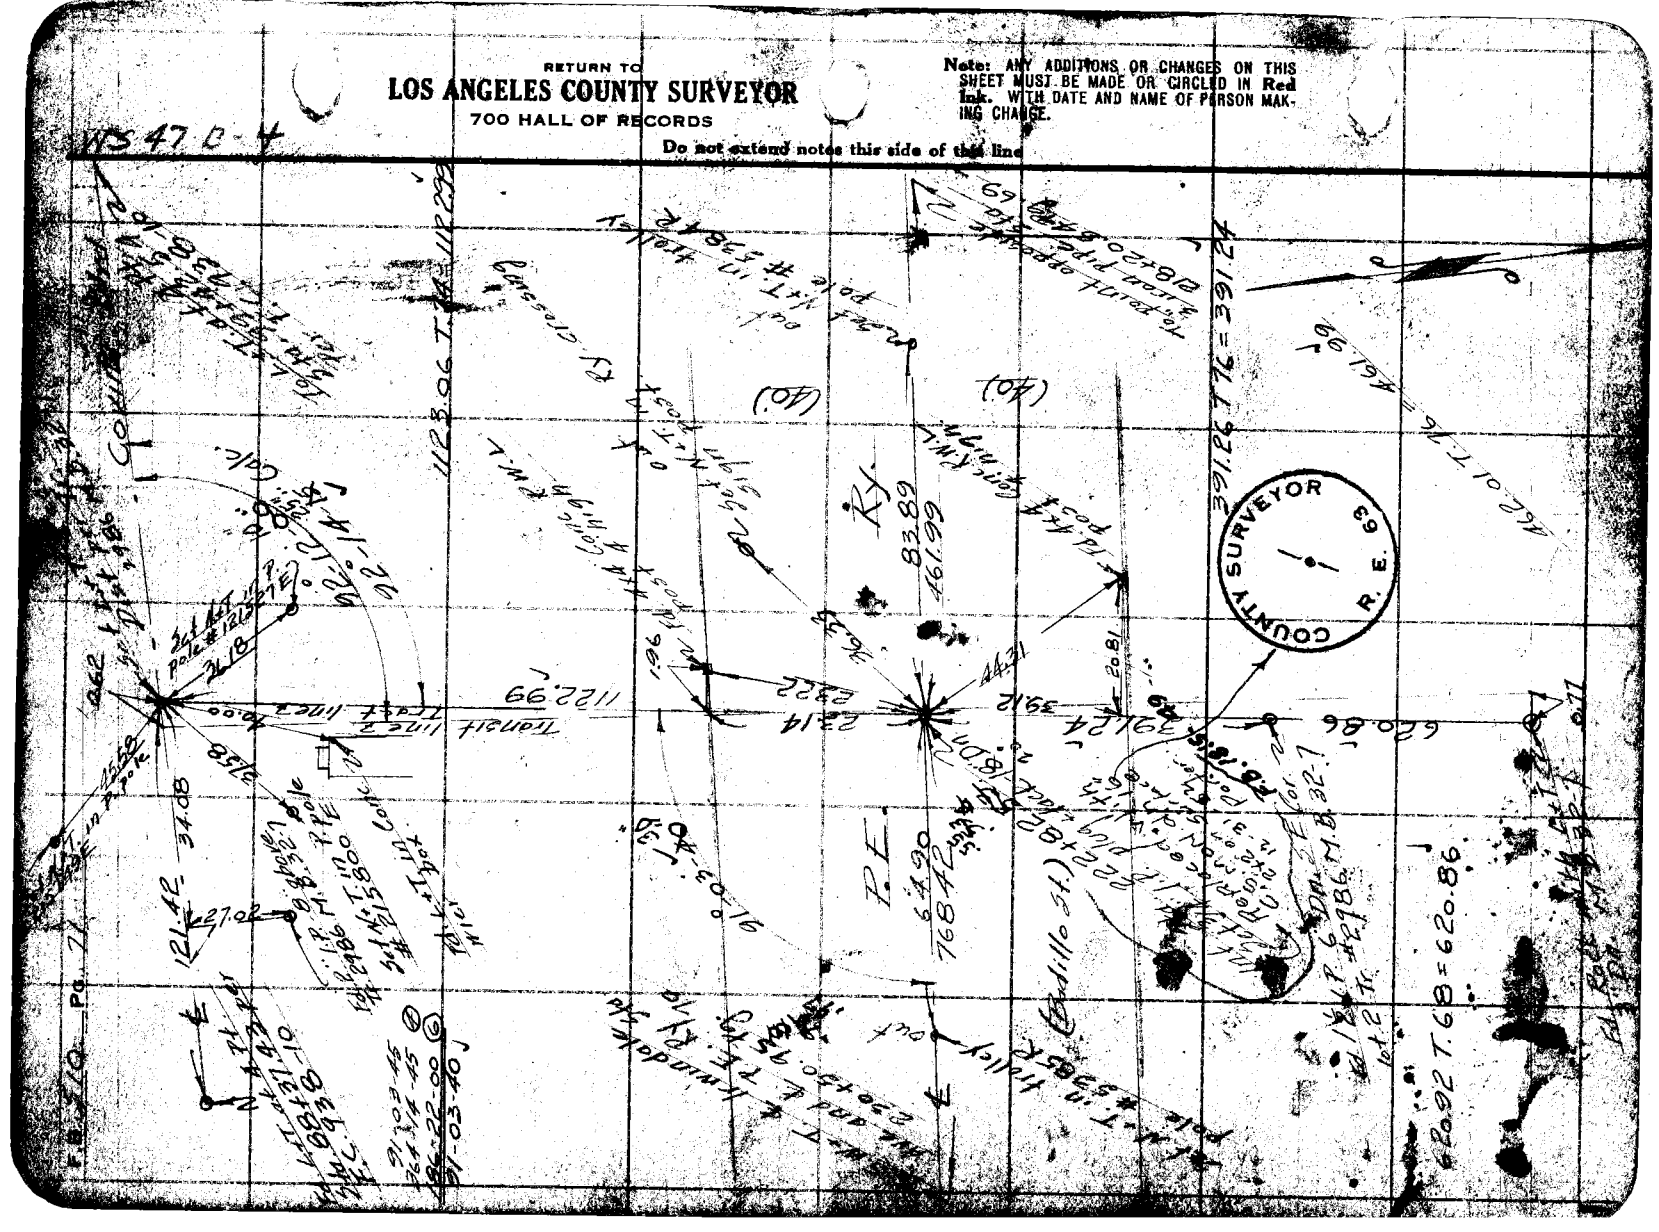

Notes Ck'd by Drew	Survey of Badillo St
[illegible]	W.O. 7103 Tape No. 041 Sta'd 84 °F.
Office Work R.N. Bradstreet	Surveyed by Rosecrans
Checked	Notes Date 6-7-33
	Indexed A. C. Johnson

F.B. 510 Pg. 72

Note
See pgs. 245-250
for ℄ P.E. R/W.
HE 1-15-35

To 3" I.P. at R.R. ℄ P.C.A.
to W.

E.C. Sta. 297+77.60 Fd 3" I.P.
filled with conc and nail
6" Dn.

338.22 T. 84°

169-40-00 ①
286-39-45 ④
249-59-45 ⑥
161-39-57½

338.22

R.R. P.I. Set 3" I.P. 18" Dn
on ℄ Prod Fr. E
Fd. No Pl

Δ 18°-20'-00"
3° Curve
0°-54' S.
T. 338.22
Lc. 670.66

Set N+T. in Trolley
pole #5579R.
out

Fd old 2"x2" d-
3-6-53

50.00

33.62

11.51

12.08

Set N+T. in N end of tres

R.R. P.I. Fd. old 2"x2"
no tack - 3' down Set
2"x2" and tack over it
flush

31.79

168°-40'-00"

44.82

50.00

out

Set N+T. in Trolley pole

Set N+T. in trolley
pole #5578R.

out

R.R. P.I. Set 3" I.P. 18" Dn
on ℄ Prod. Fr. W.

338.29 T. 78 = 338.28

338.28

B.C. Sta. 291+06.48

Sta. 291+06.36 Fd 3"
I.P. filled with Conc
and nail Dn. 3"

0.06

0.06

Sta. 291+06.39 See Pg. 83

To 2"x2" at P.I. to E
See Pg. 69

Note: ANY ADDITIONS OR CHANGES ON THIS SHEET MUST BE MADE OR CIRCLED IN [illegible] Ink. WITH DATE AND NAME OF PERSON [illegible] ING CHANGE.

RETURN TO
LOS ANGELES COUNTY SURVEYOR
700 HALL OF RECORDS
Do not extend notes this side of this line

FORM 247 10M 8-31

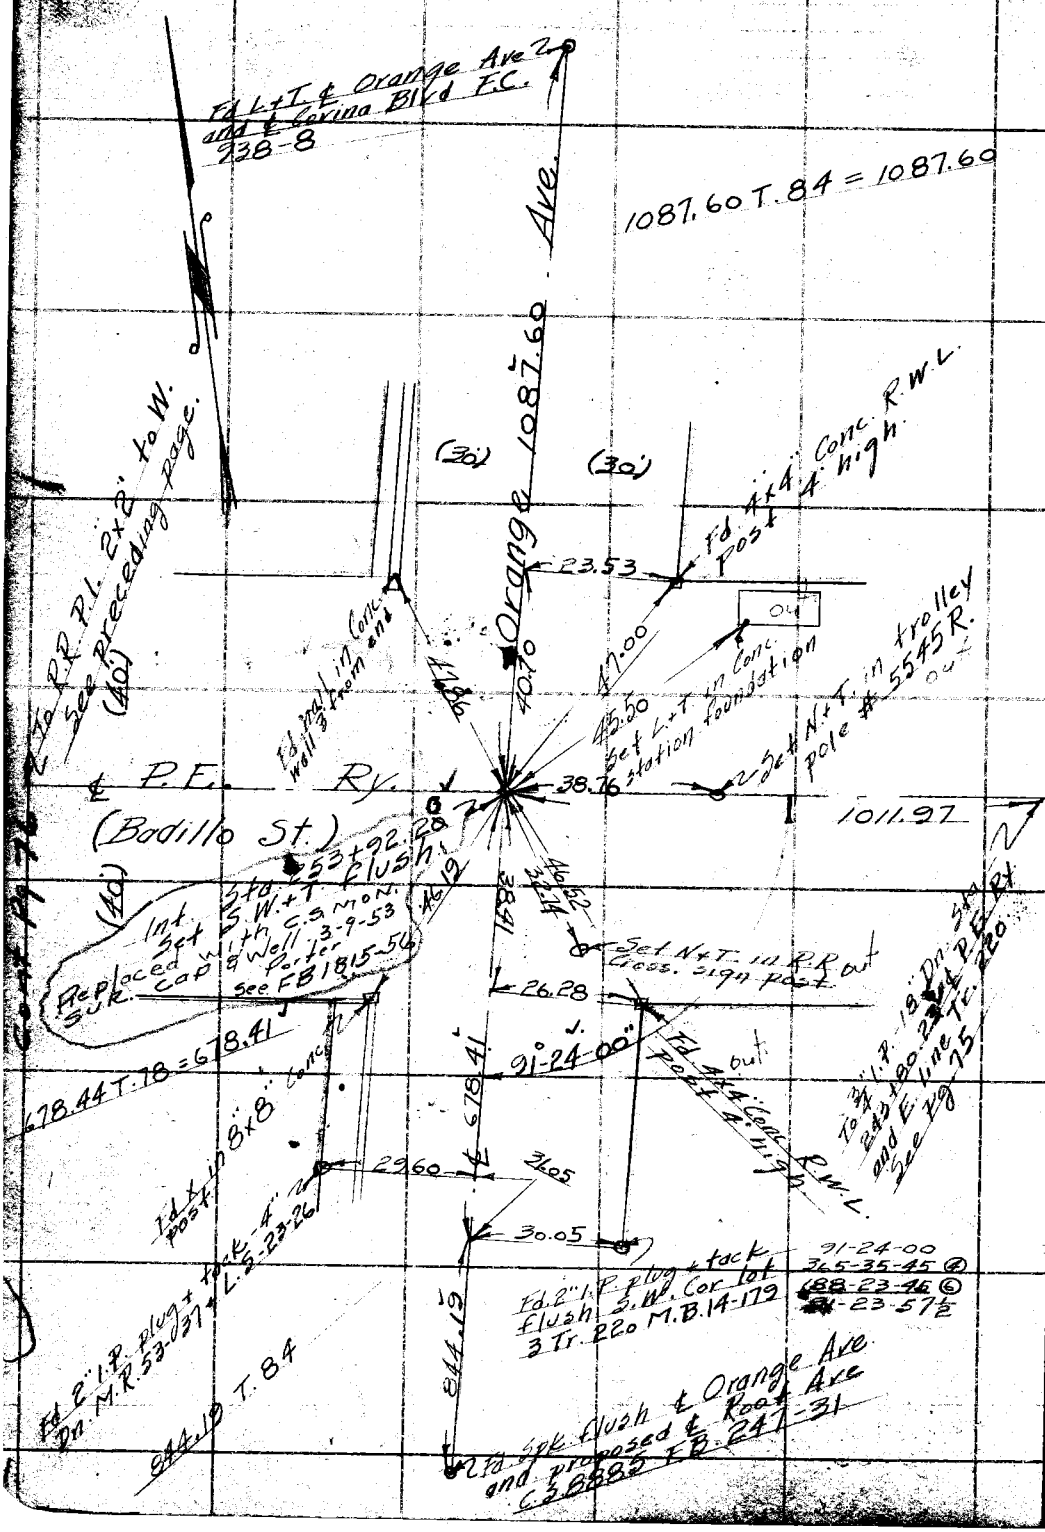

Cont Pg 76

W.S. 47 Q-4

RETURN TO
LOS ANGELES COUNTY SURVEYOR
700 HALL OF RECORDS

Do not extend notes this side of this line

Note: ANY ADDITIONS OR CHANGES ON THIS SHEET MUST BE MADE OR CIRCLED IN Red Ink WITH DATE AND NAME OF PERSON MAKING CHANGE.

W.S. 47 B-4

Notes Ck'd by Drew	Survey of Badillo St
Map No. B-7545	W. O. 7103 Tape No. 041 St'd 84 °F.
Office Work N.N. Broadstreet	Surveyed by Rosecrans
Checked	Notes Date 6-9-33
Date	Indexed A. C. Johnson

F.B. 510 Pg. 74

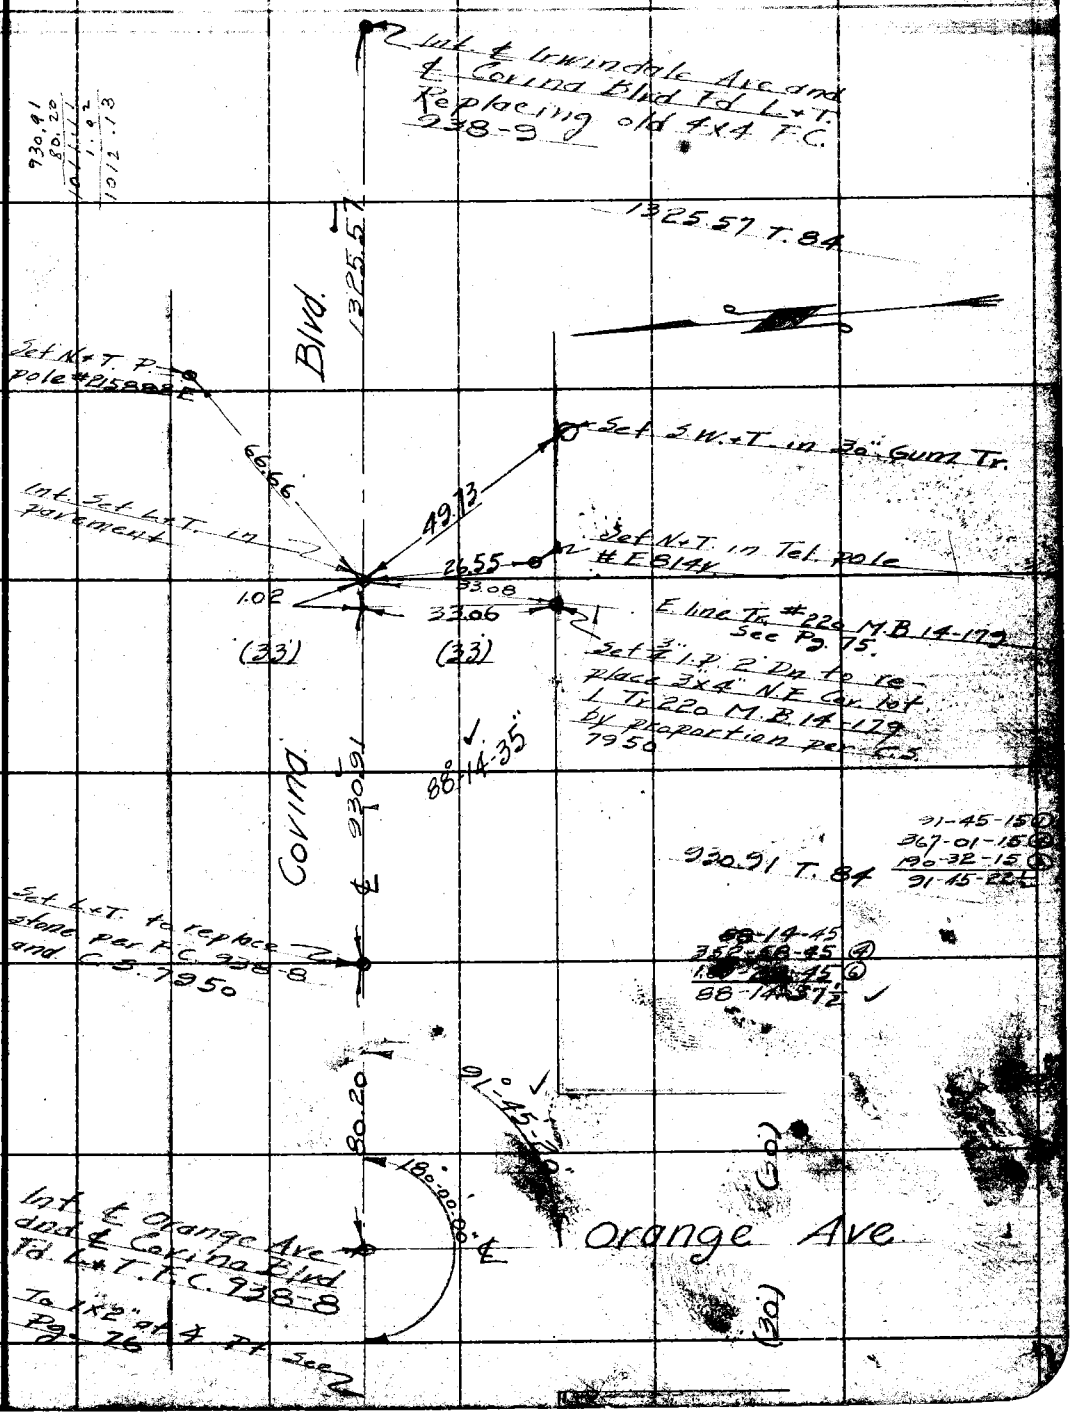

Note: ANY ADDITIONS OR CHANGES ON THIS SHEET MUST BE MADE OR CIRCLED IN Red Ink. WITH DATE AND NAME OF PERSON MAKING CHANGE.

RETURN TO
LOS ANGELES COUNTY SURVEYOR
700 HALL OF RECORDS
Do not extend notes this side of this line

FORM 247 10M 8-31

RETURN TO

LOS ANGELES COUNTY SURVEYOR

700 HALL OF RECORDS

Note: ANY ADDITIONS OR CHANGES ON THIS SHEET MUST BE MADE OR CIRCLED IN **Red Ink.** WITH DATE AND NAME OF PERSON MAKING CHANGE.

WS.478-4

Do not extend notes this side of this line

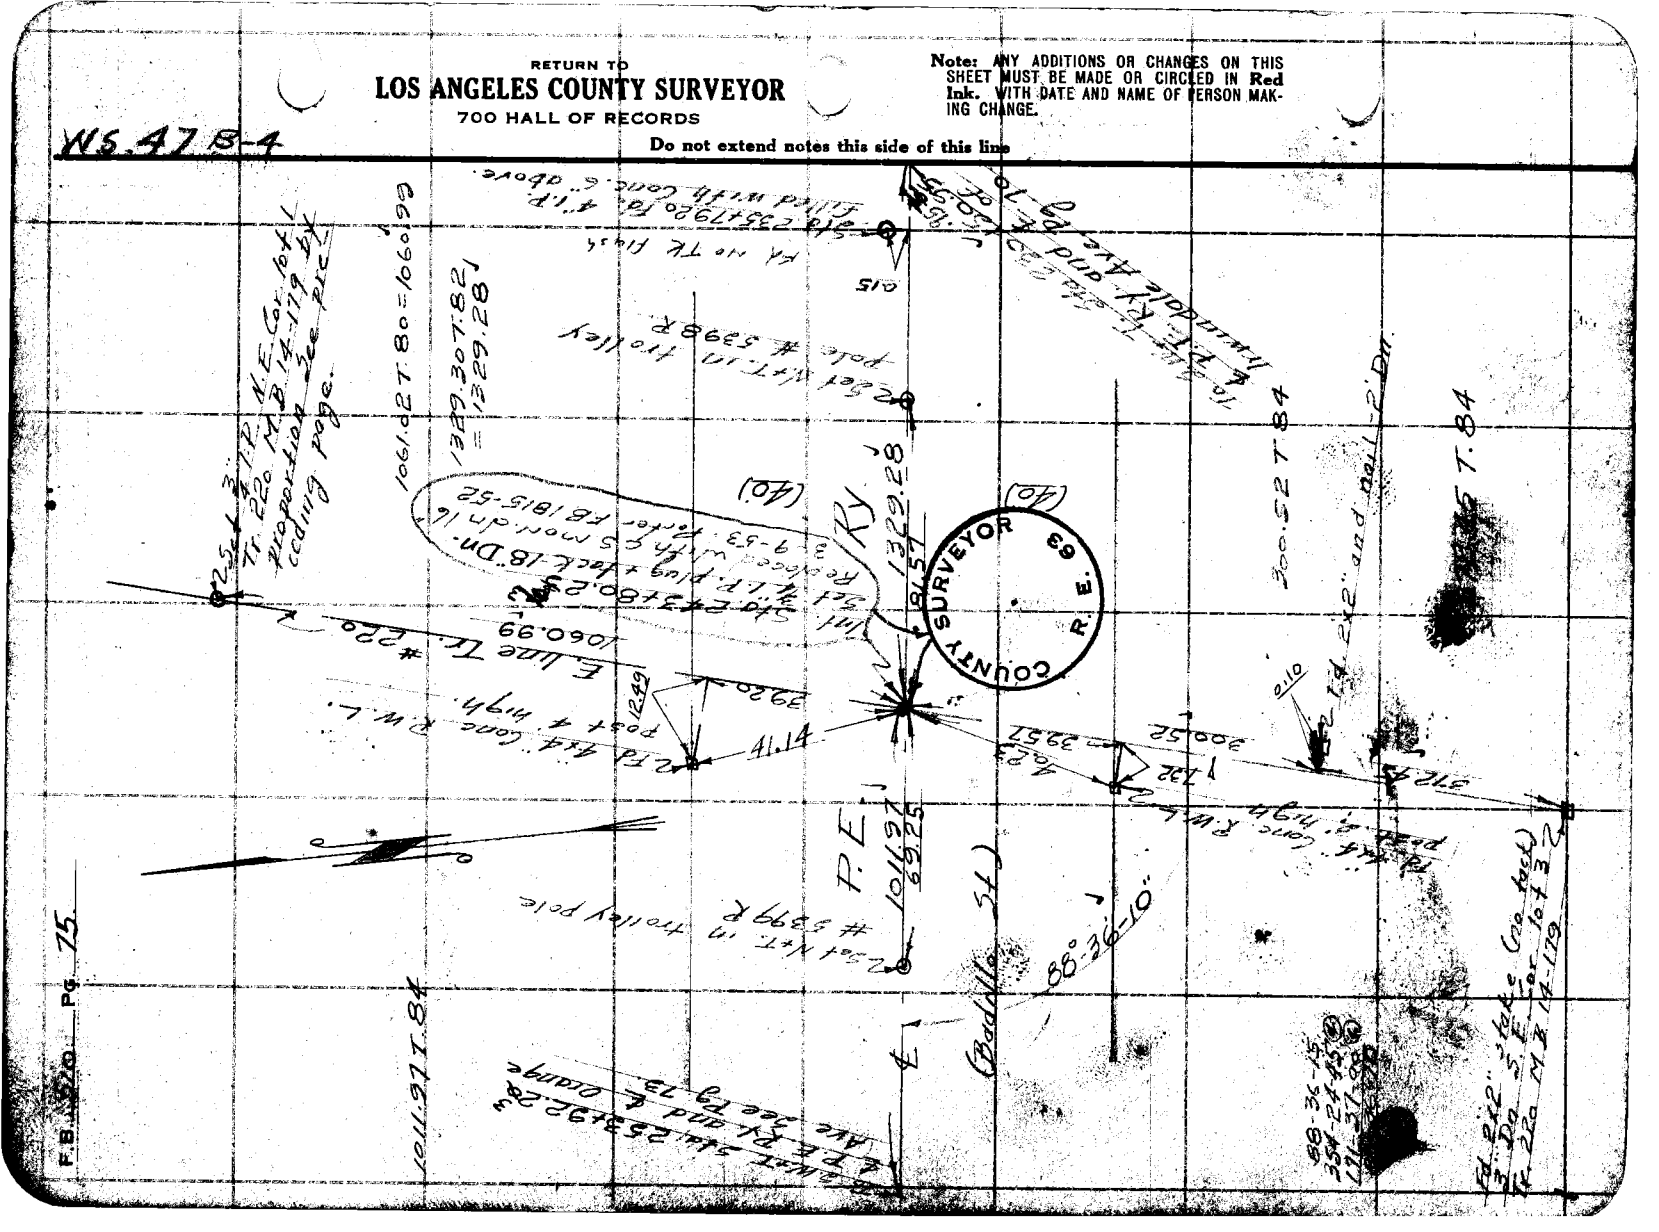

Notes Ck'd by Drew	Survey of Badillo St.
Map No. B-7545	W. O. 7103 Tape No. 041 St'd 84 °F.
Office Work [illegible]	Surveyed by Rosecrans
Checked	Notes Date 6-12-33
Date	Indexed A. C. Johnson

F.B. 510 Pg 76

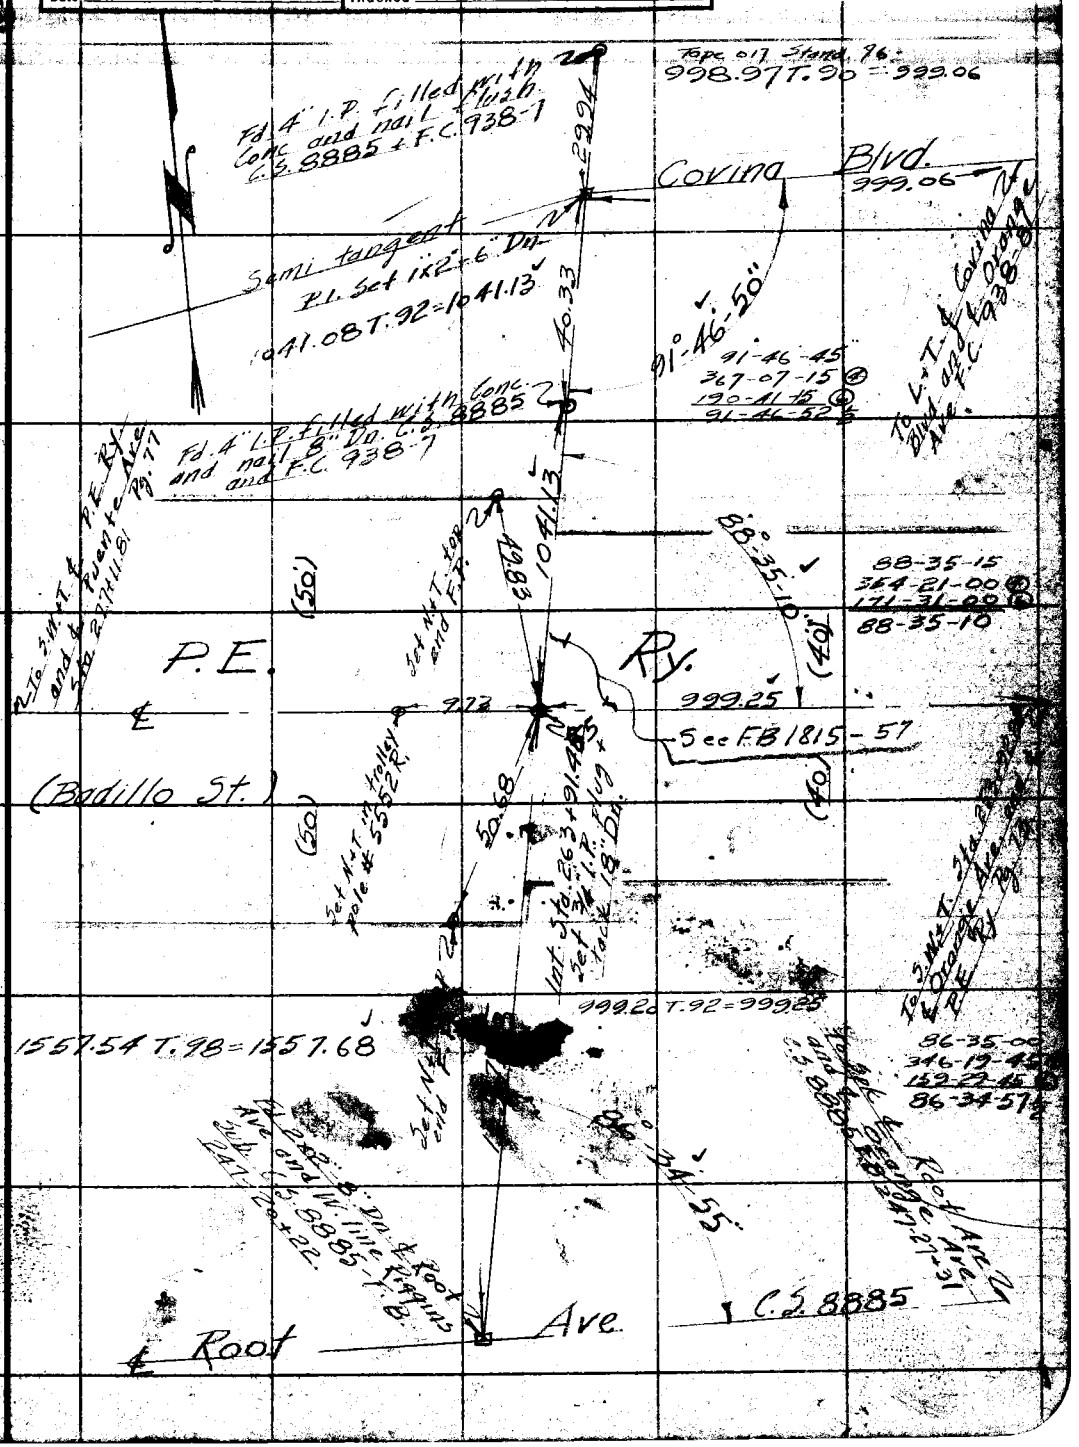

Note: ANY ADDITIONS OR CHANGES ON THIS SHEET MUST BE MADE OR CIRCLED IN Red Ink. WITH DATE AND NAME OF PERSON MAKING CHANGE.

RETURN TO
LOS ANGELES COUNTY SURVEYOR
700 HALL OF RECORDS

Do not extend notes this side of this line

FORM 247 10M 8-31

RETURN TO
LOS ANGELES COUNTY SURVEYOR
700 HALL OF RECORDS

Note: ANY ADDITIONS OR CHANGES ON THIS SHEET MUST BE MADE OR CIRCLED IN **Red** INK WITH DATE AND NAME OF PERSON MAKING CHANGE.

Do not extend notes this side of this line

WS 46 E-4

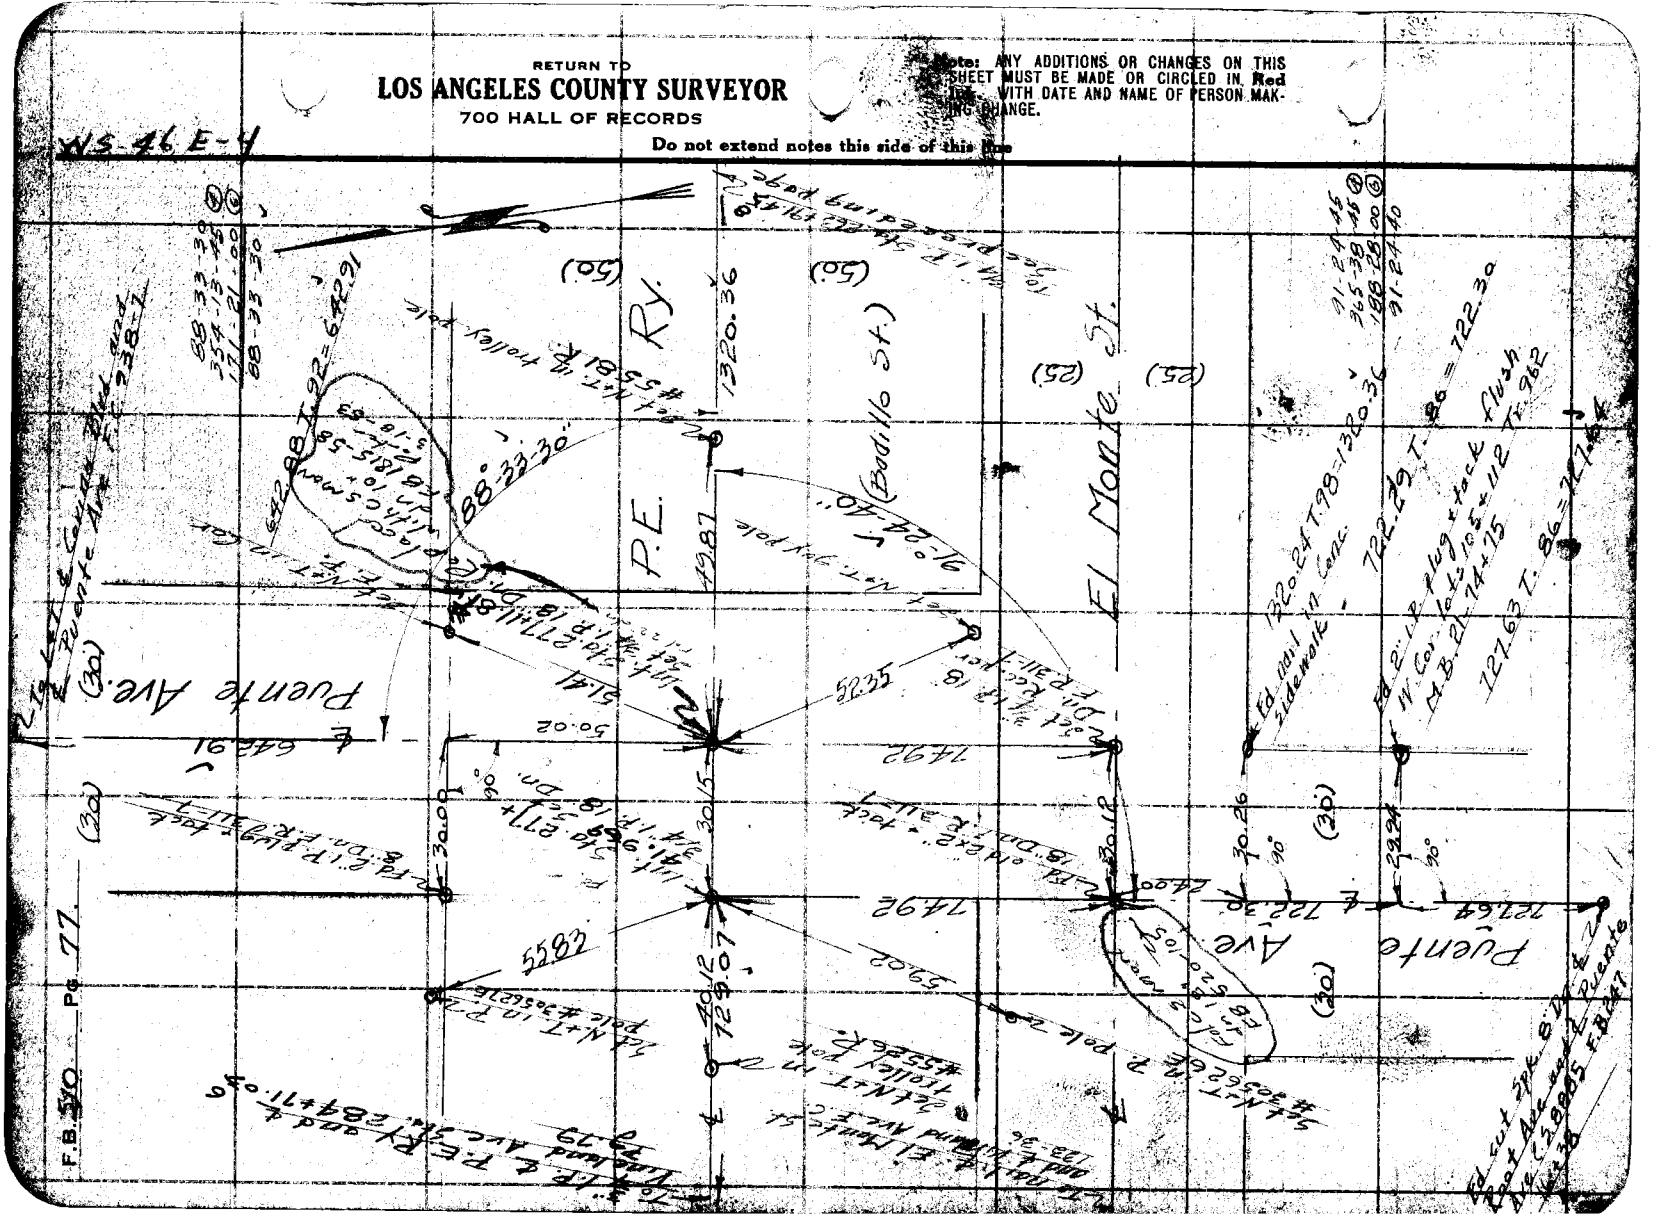

Notes Ck'd by Dr Cw	Survey of Badillo St
Map No. B-754-5	W. O. 7103 Tape No. 041 St'd 84 °F.
Other Work H.N. Braddock	Surveyed by Rosecrans
Checked	Notes Date 6-16-33
Date	Indexed C. Johnson

F.B. 510 Pg 76

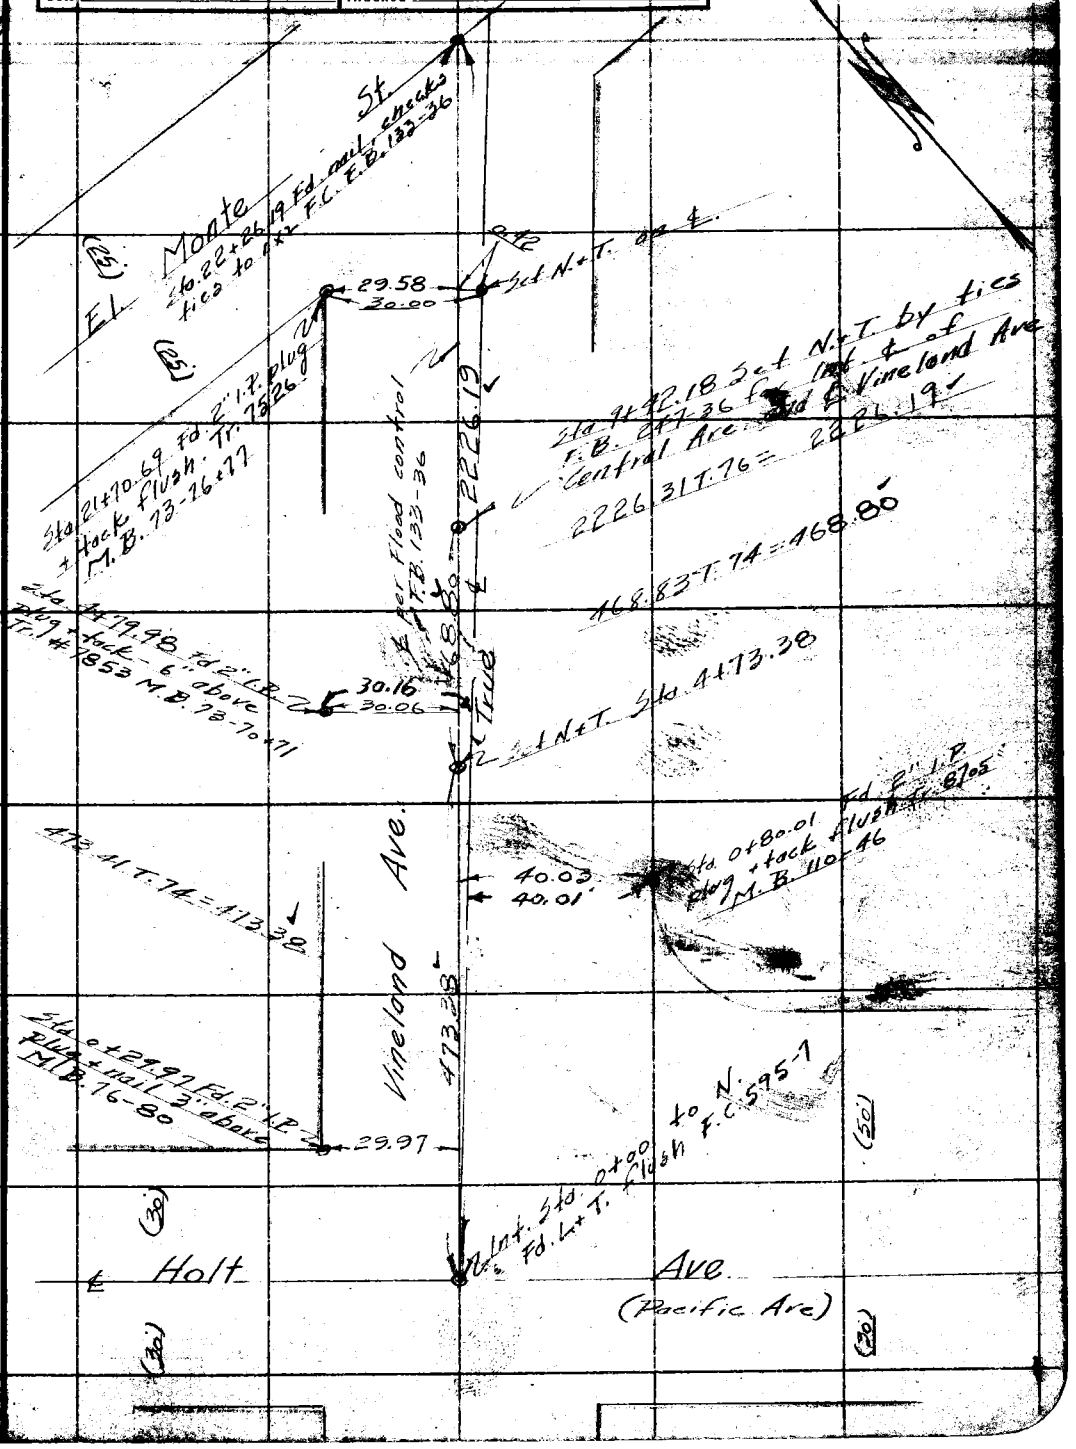

Note: ANY ADDITIONS OR CHANGES ON THIS SHEET MUST BE MADE OR CIRCLED IN Red Ink. WITH DATE AND NAME OF PERSON MAKING CHANGE.

Do not extend notes this side of this line

RETURN TO
LOS ANGELES COUNTY SURVEYOR
700 HALL OF RECORDS

FORM 247 10M 8-31

F.B. 510 Pg. 79

W.S. 46 D-4

RETURN TO
LOS ANGELES COUNTY SURVEYOR
700 HALL OF RECORDS
Do not extend notes this side of this line

Note: ANY ADDITIONS OR CHANGES ON THIS SHEET MUST BE MADE OR CIRCLED IN Red Ink. WITH DATE AND NAME OF PERSON MAKING CHANGE.

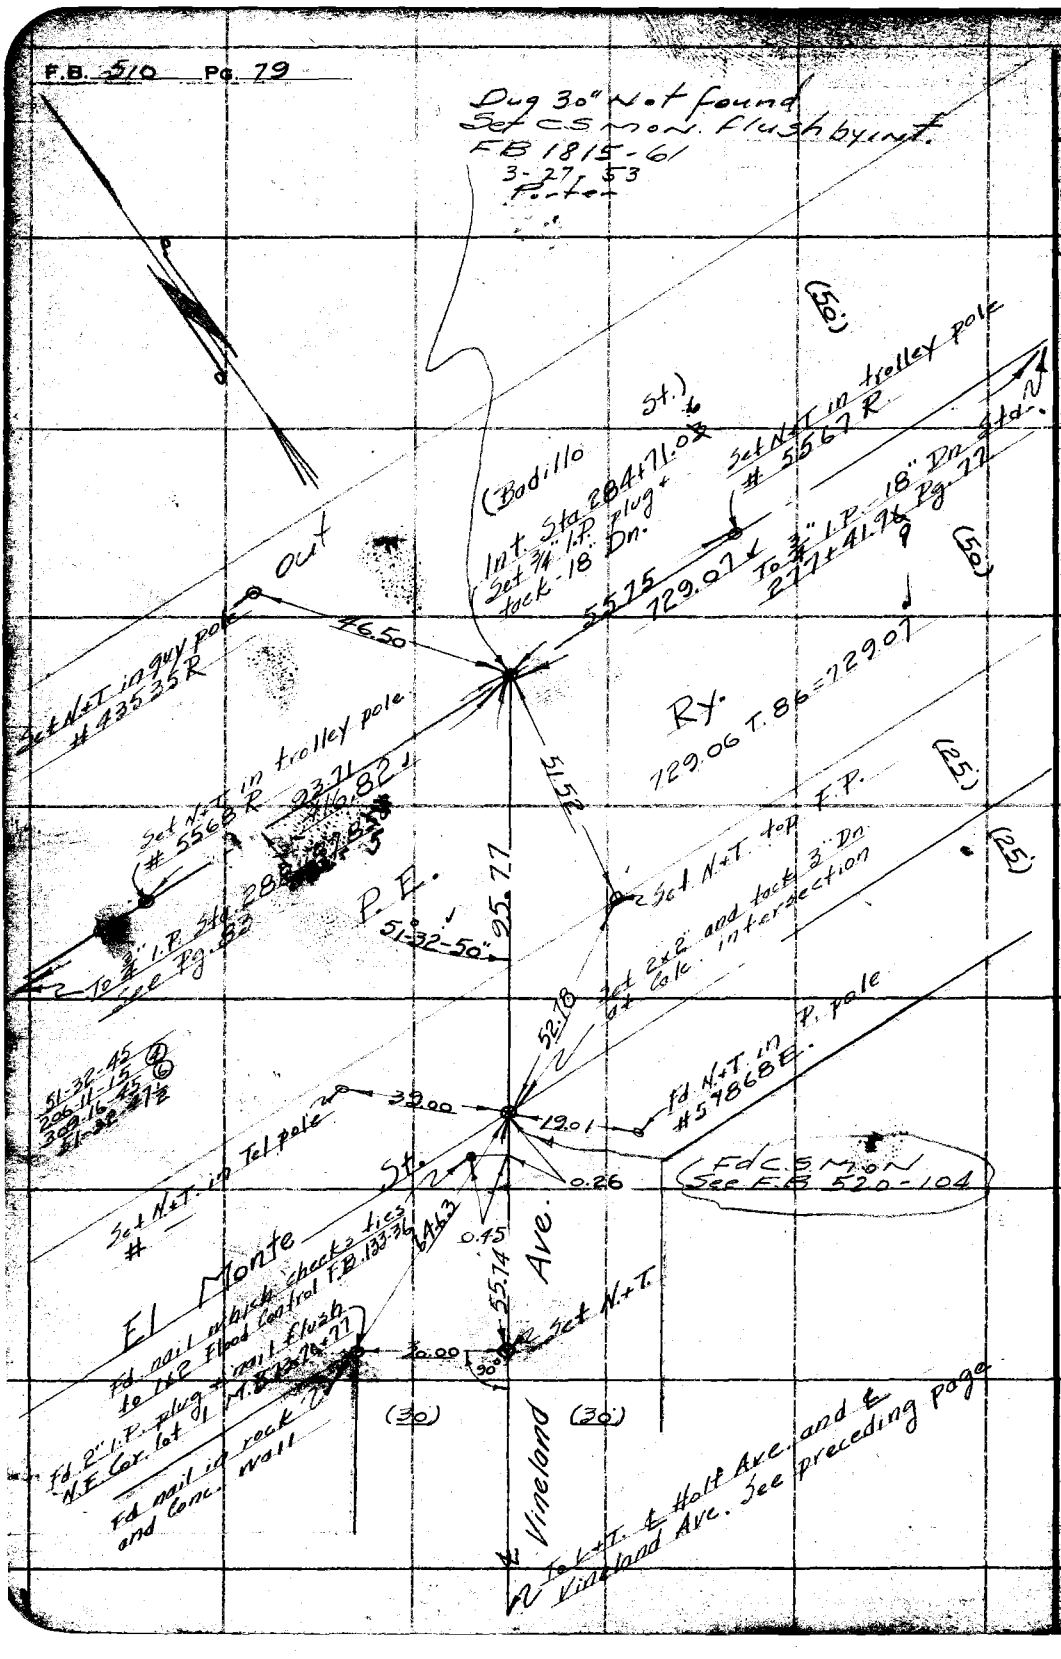

Notes Ck'd by Drew	Survey of Badillo St.
Map No. B-754-5	W. O. 7103 Tape No. 041 St'd 84 °F.
Office Work [illegible]	Surveyed by Rosecrans
Checked	Notes Date 6-19-33
Date	Indexed A. C. Johnson

F.B. 510 Pg. 80

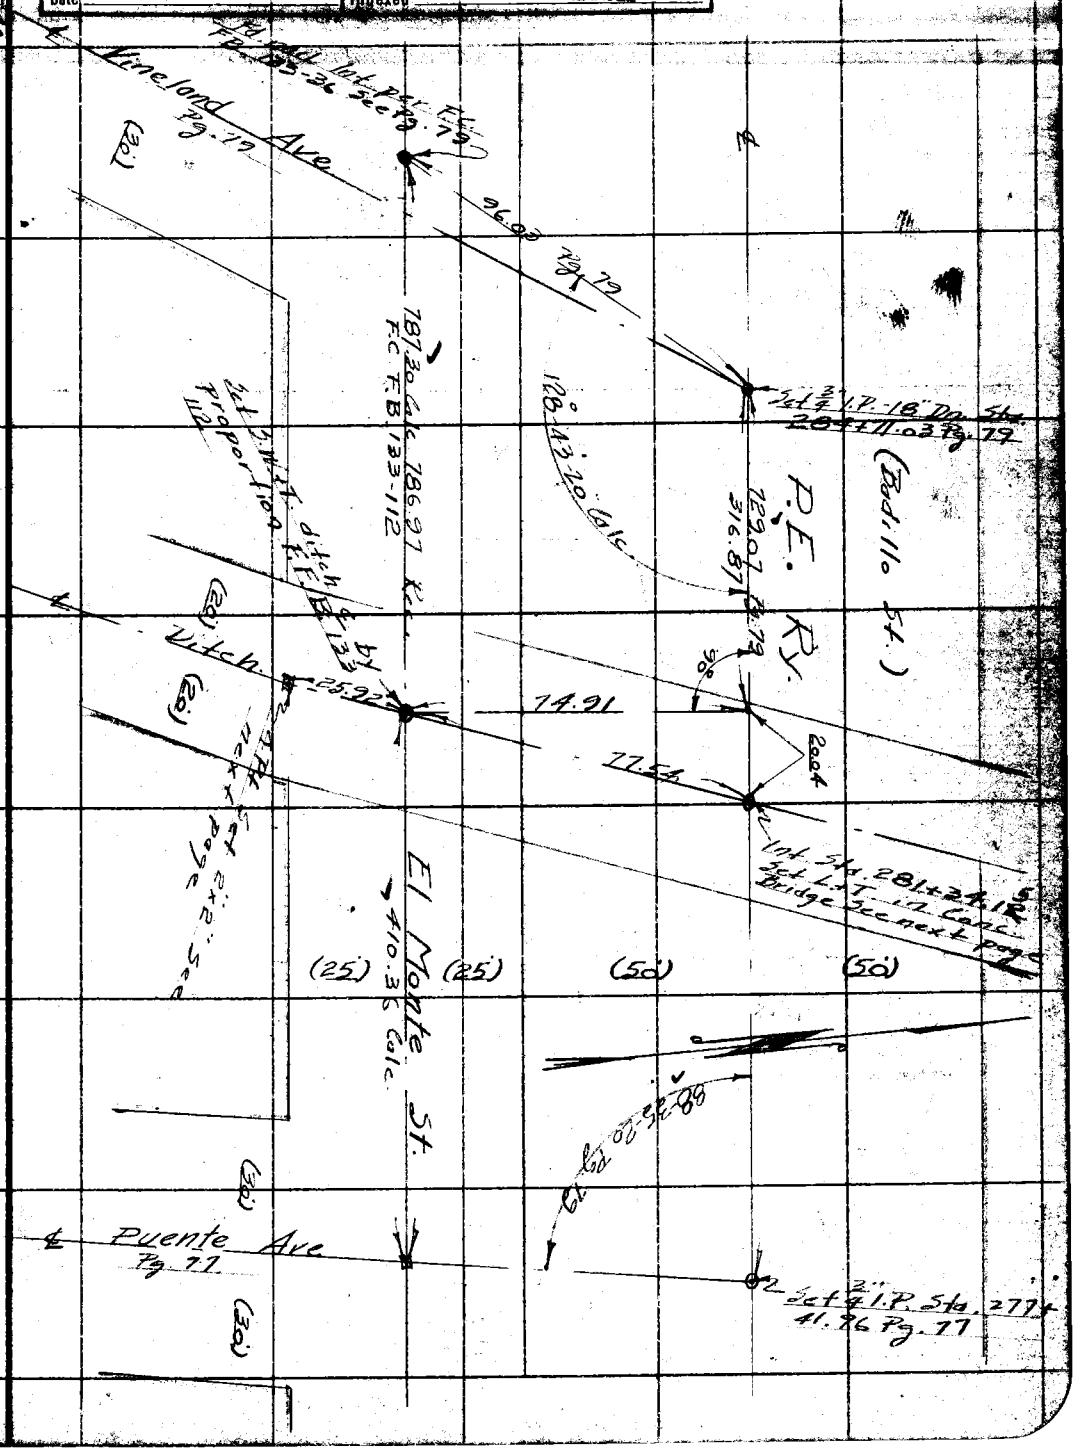

Note: ANY ADDITIONS OR CHANGES ON THIS SHEET MUST BE MADE OR CIRCLED IN Red Ink. WITH DATE AND NAME OF PERSON MAKING CHANGE.

RETURN TO
LOS ANGELES COUNTY SURVEYOR
700 HALL OF RECORDS
Do not extend notes this side of this line

FORM 247 10M 8-31

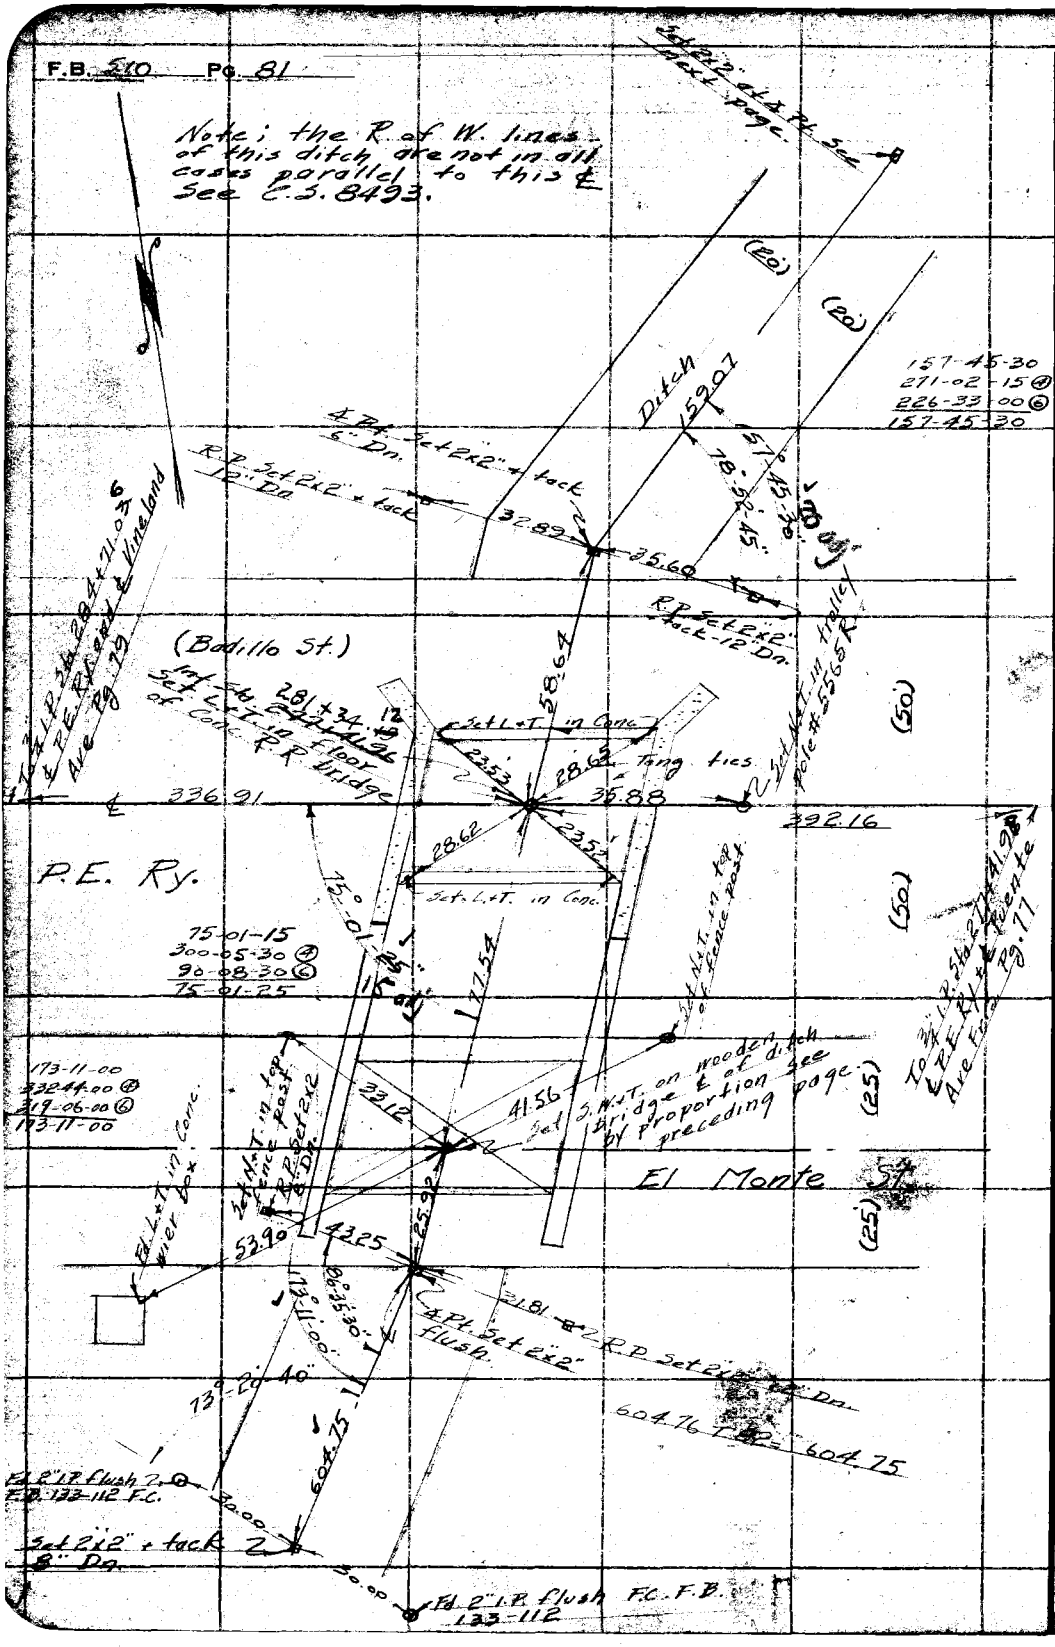

W.S. 46 E-4

RETURN TO
LOS ANGELES COUNTY SURVEYOR
700 HALL OF RECORDS

Do not extend notes this side of this line

Note: ANY ADDITIONS OR CHANGES ON THIS SHEET MUST BE MADE OR CIRCLED IN Red Ink. WITH DATE AND NAME OF PERSON MAKING CHANGE.

Notes Ck'd by Drew	Survey of Badillo St.
Map No. B-754-5	W.O. [illegible] Tape No. 041 [illegible] °F.
Office Work [illegible]	Surveyed by [illegible]
Checked	Notes Date 6-20-33
Date	Indexed A. C. Johnson

F.B. 510 Pg. [illegible]

W.S. 46 E-4

112-44-00
90-56-00 (4)
112-44-00

594.09 T.92 = 594.12

112°-44'-00"

To L.+T. & Corona Blvd. and ℄ Puente Ave. Pg. 77

Set S.W.+T. flush Rec. Dist Fr. S. F.F.B. 133-114

Set x in bridge bolt.

Set x in bridge bolt.

28.30

14.88

(30)

℄ Puente Ave 594.12

Wooden bridge

16.38

26.18

(30)

Set x in bridge bolt

133.18

153°-27'-05"

Set x in bridge bolt.

P.I. Set 2x2"-8" Dn. Rec. ∡ and Dist from Spk on bridge F.F.B 133-114

0.03

1.80

To 3/4 I.P. & Puente Ave. and ℄ El Monte St. Pg. 77

Set nail

Ditch

436.65 Calc. Transit line 2

435.33

175°-04'-00"

03-50

175°02-45

153-27-00
253-48-15 (4)
200-42-30 (6)
153-27-05

435.30 T.94 = 435.33

4 Pt. Set 2x2"-6" Dn. by proportion

0.48

5°54-45

159.07 Calc.

158.59

Set 1x2

(20)

157°-46

(20)

175-04-00 (1)
340-15-45 (4)
330-24-00 (6)
175-04-00

175-02-45
340-11-00 (4)
175-02-45

157-46-15
271-05-30 (4)
157-46-22½

158.58 T.92 = 158.59

4 Pt. Set 2x2"-6" Dn. See preceding page

To L.+T. & P.E.R.R. See preceding page

Note: ANY ADDITIONS OR CHANGES ON THIS SHEET MUST BE MADE OR CIRCLED IN Red Ink. WITH DATE AND NAME OF PERSON MAKING CHANGE.

RETURN TO
LOS ANGELES COUNTY SURVEYOR
700 HALL OF RECORDS

Do not extend notes this side of this line

FORM 247 10M 5-31

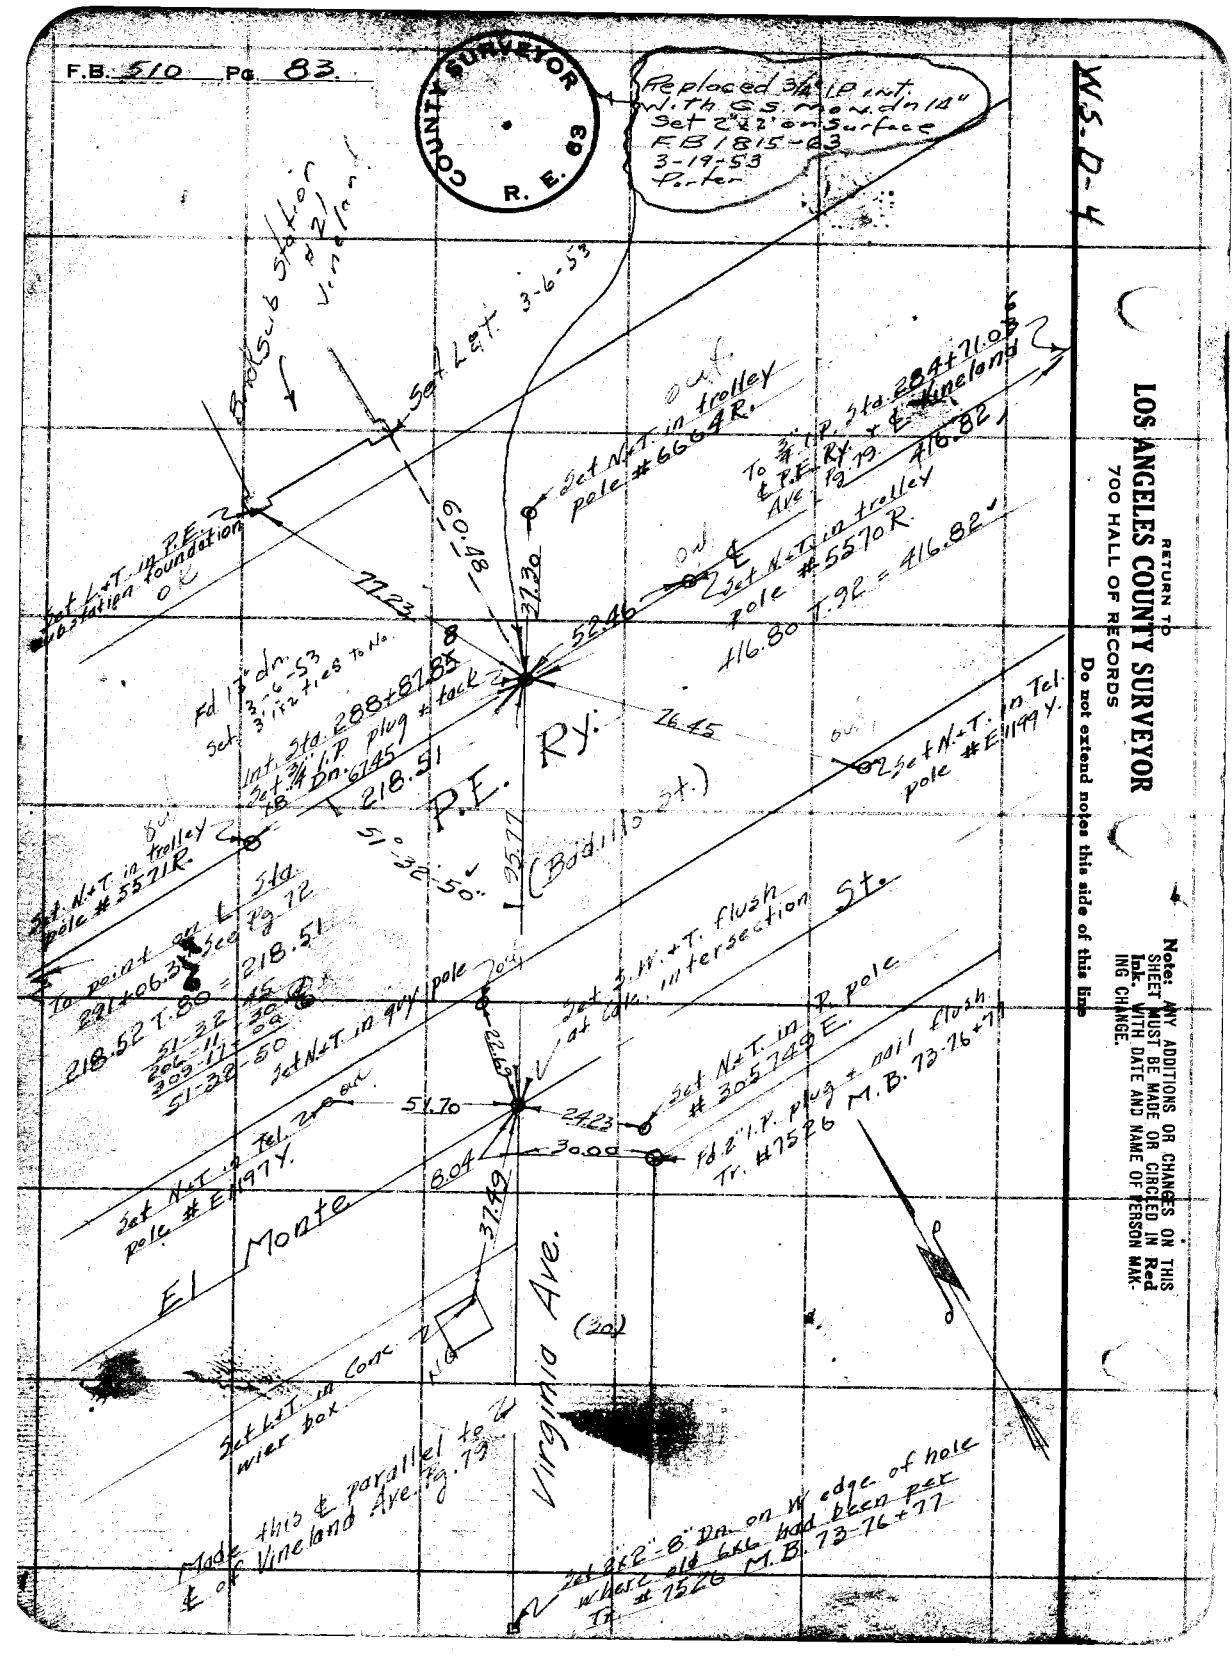
F.B. 510 Pg. 83.
COUNTY SURVEYOR R. E. 63
Replaced 3/4" I.P. int. with G.S. mon. dn 14" Set 2"x2" on surface F.B. 1815-63 3-19-53 Porter
W.S. D-4
Bro. Sub Station #2 Vineland
Set L&T. 3-6-53
Set L&T. in P.E. substation foundation OK
Set N&T. in trolley pole #6664R.
To 3/4" I.P. Sta. 284+71.03 ℄ P.E. Ry. & ℄ Vineland Ave. Pg. 79. 416.82
Set N&T. in trolley pole #5570R.
416.80 T.92 = 416.82
60.48
37.30
77.23
52.46
Fd. 13" dn. 3-6-53 Set 3' 1x2 ties to No.
Int. Sta. 288+87.85 Set 3/4" I.P. plug + tack 18" Dn. 67.45
218.51
76.45
P.E. Ry.
(Badillo St.)
Set N&T. in Tel. pole #E1199Y.
Set N&T. in trolley pole #5571R.
51°-32'-50"
95.77
To point on ℄ Sta. 291+06.3 See Pg. 72
218.52 T.80 = 218.51
51-32-45
206-11-30
309-17-00
51-32-50
Set N&T. in guy pole
Set S.W.&T. flush at calc. intersection
St.
Set N&T. in I.P. pole #305749E.
Fd. 2" I.P. plug + nail flush Tr. #7526 M.B. 73-76+77
22.63
51.70
24.23
30.00
8.04
37.49
Set N&T. in Tel. pole #E1197Y.
El Monte
Virginia Ave.
(30)
Set L&T. in Conc. wier box.
Made this ℄ parallel to ℄ of Vineland Ave. Pg. 79
Set 2x2'-8" Dn. on W edge of hole where old 6x6 had been per Tr. #7526 M.B. 73-76+77
RETURN TO
LOS ANGELES COUNTY SURVEYOR
700 HALL OF RECORDS
Do not extend notes this side of this line
Note: ANY ADDITIONS OR CHANGES ON THIS SHEET MUST BE MADE OR CIRCLED IN Red Ink. WITH DATE AND NAME OF PERSON MAKING CHANGE.

Notes Ck'd by Drew	Survey of Badillo St
Map No. B-754-5	W. D. 7103 Tape No. 041 St'd 84 °F.
Office Work H.H. Brodstreet	Surveyed By Rosecrans
Checked	Notes Date 6-26-33
Date	Indexed A. C. Johnson

F.B. 510 PG. 81

W.S.D.-4

Note: ANY ADDITIONS OR CHANGES ON THIS SHEET MUST BE MADE OR CIRCLED IN Red Ink, WITH DATE AND NAME OF PERSON MAKING CHANGE.

Do not extend notes this side of this line

RETURN TO
LOS ANGELES COUNTY SURVEYOR
700 HALL OF RECORDS

FORM 247 10M 8-31

RETURN TO
LOS ANGELES COUNTY SURVEYOR
700 HALL OF RECORDS

Note: ANY ADDITIONS OR CHANGES ON THIS SHEET MUST BE MADE OR CIRCLED IN **Red Ink.** WITH DATE AND NAME OF PERSON MAKING CHANGE.

W.S. 46 D-4

Do not extend notes this side of this line

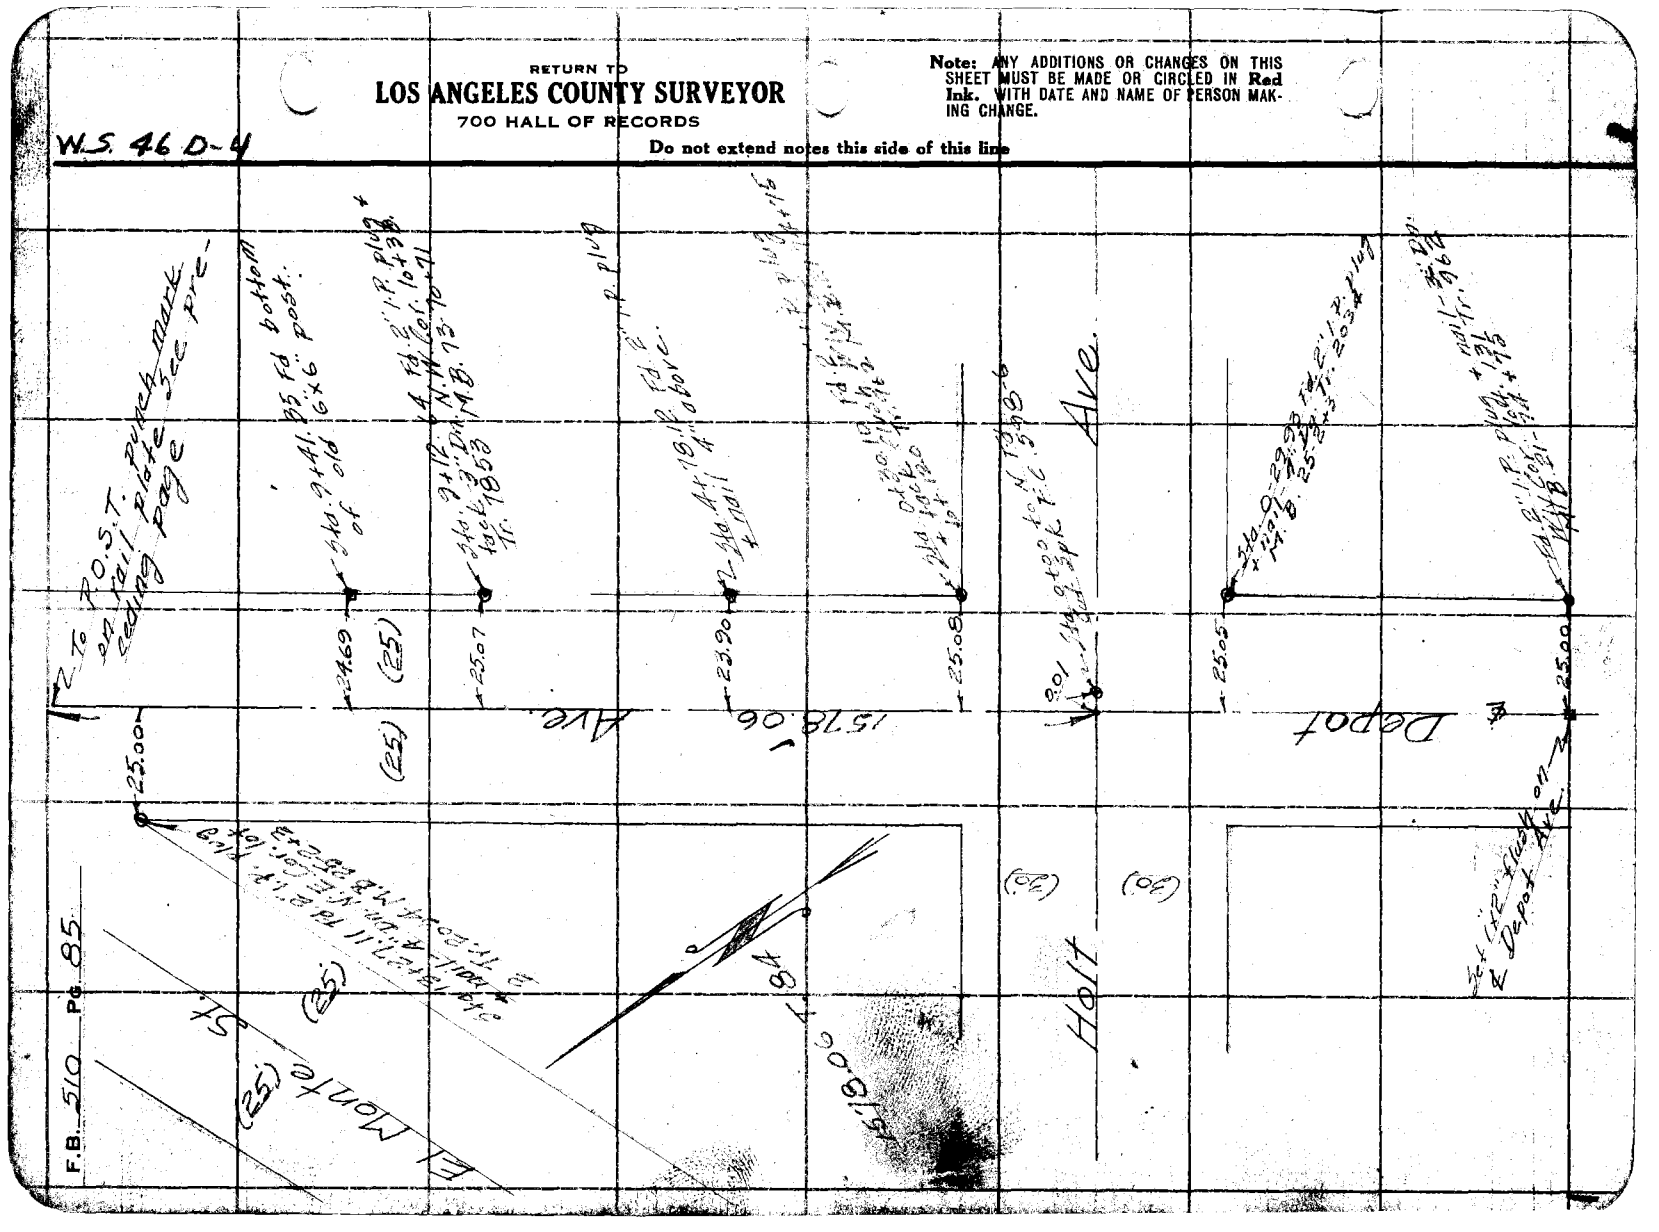

W.S. 46D-4

Notes Ck'd by Drew	Survey of Padillo St
Map No. B-754.5	W. O. 7103 Tape No. 041 St'd 84 °F.
Office Work H.W. Bradstreet	Surveyed by Rosecrans
Checked	Notes Date 6-29-33
Date	Indexed A. C. Johnson

F.B. 510 Pg. 86

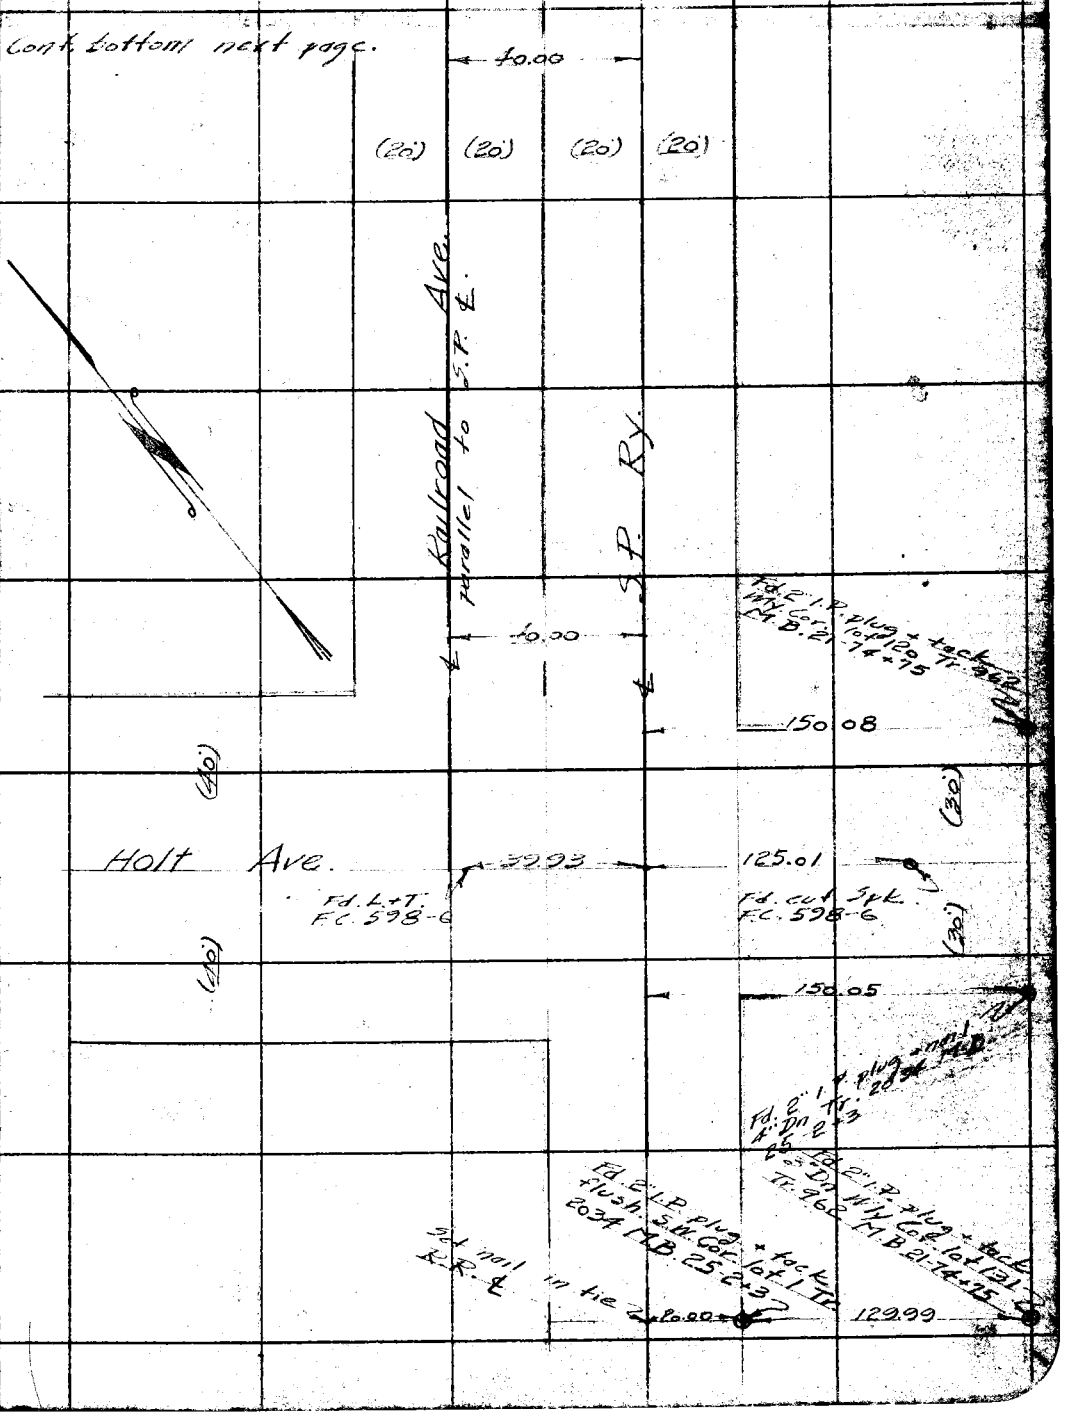

Note: ANY ADDITIONS OR CHANGES ON THIS SHEET MUST BE MADE OR CIRCLED IN Red Ink. WITH DATE AND NAME OF PERSON MAKING CHANGE.

RETURN TO
LOS ANGELES COUNTY SURVEYOR
700 HALL OF RECORDS

Do not extend notes this side of this line

FORM 247 10M 5-31

RETURN TO
LOS ANGELES COUNTY SURVEYOR
700 HALL OF RECORDS

Note: ANY ADDITIONS OR CHANGES ON THIS SHEET MUST BE MADE OR CIRCLED IN **Red Ink.** WITH DATE AND NAME OF PERSON MAKING CHANGE.

Do not extend notes this side of this line

WS. 46 D-4

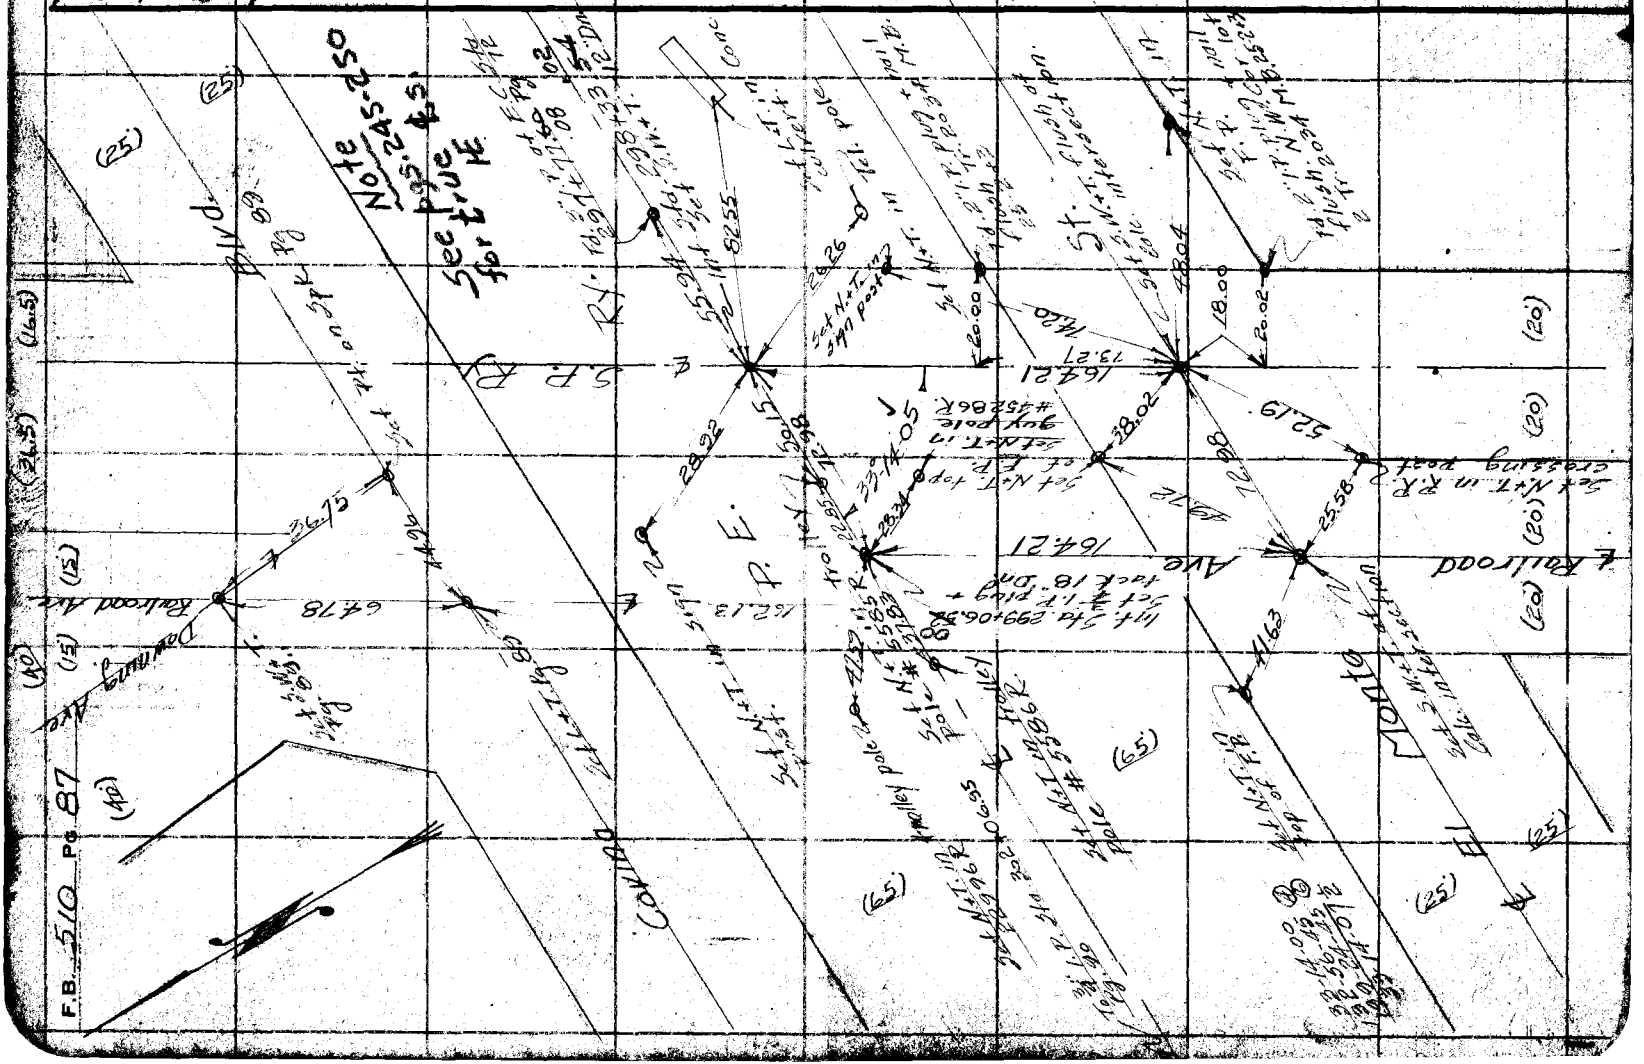

Notes Ck'd by Drew	Survey of Badillo St.
Map No. B-754-5	W. O. 7103 Tape No. 041 St'd 84 °F.
Office Work N.N. Bradstreet	Surveyed by Rosecrans
Checked	Notes Date 6-30-33
Date	Indexed A. C. Johnson

F.B. 510 Pg 88

WB 46-D-4

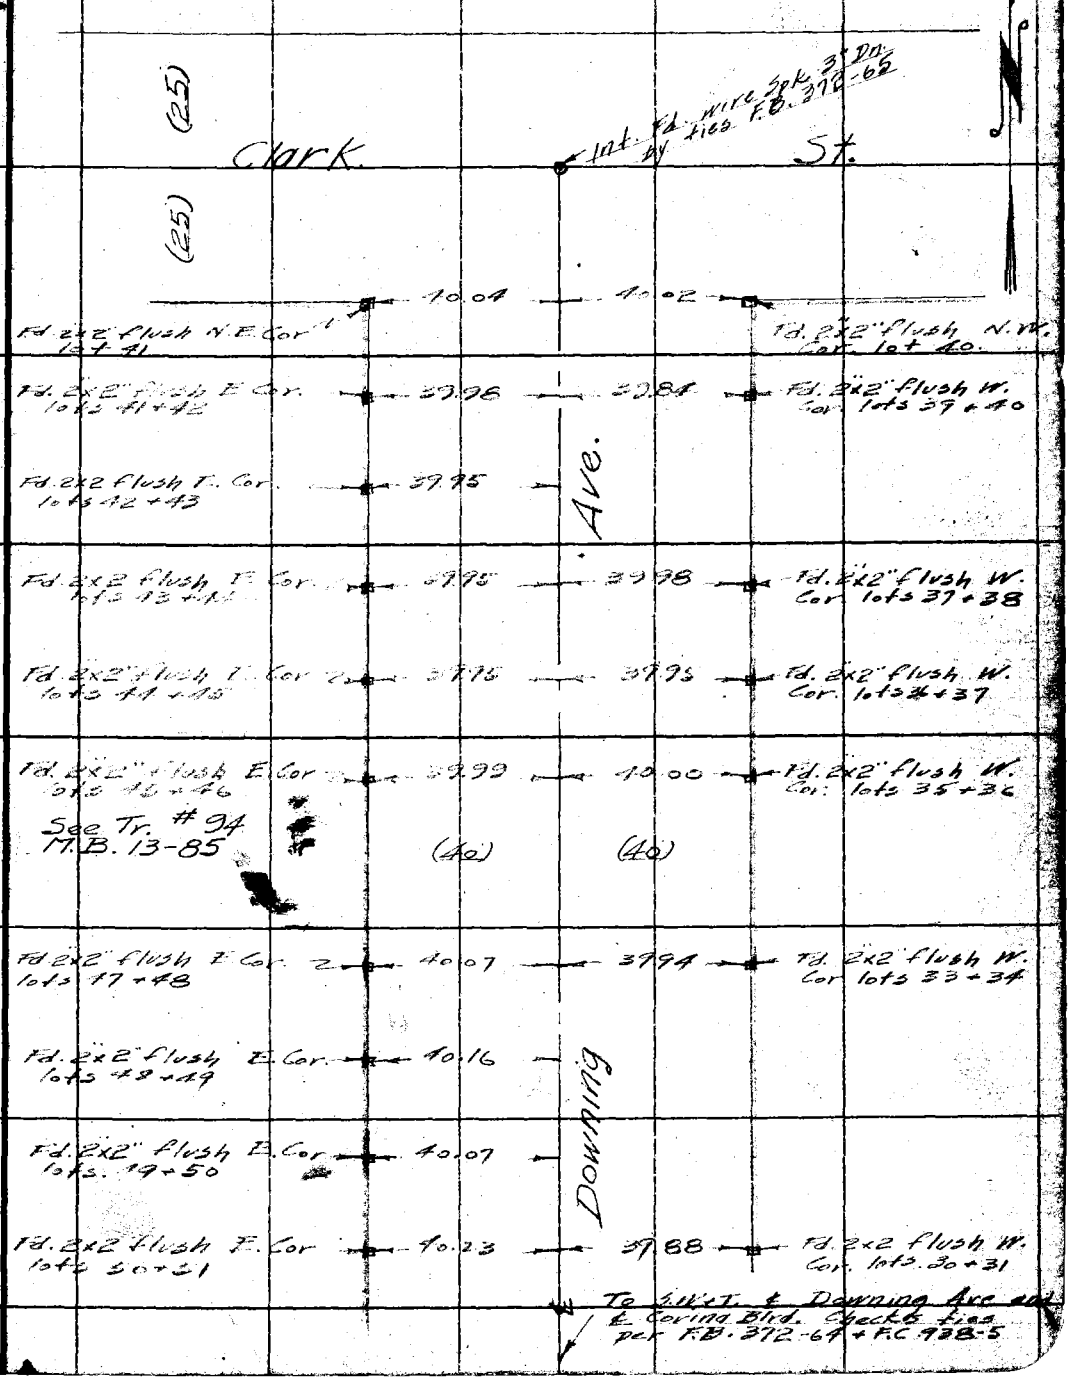

Note: ANY ADDITIONS OR CHANGES ON THIS SHEET MUST BE MADE OR CIRCLED IN Red Ink. WITH DATE AND NAME OF PERSON MAKING CHANGE.

RETURN TO
LOS ANGELES COUNTY SURVEYOR
700 HALL OF RECORDS

Do not extend notes this side of this line

FORM 247 10M 8-31

F.B. 510 PG 89

RETURN TO
LOS ANGELES COUNTY SURVEYOR
700 HALL OF RECORDS

Do not extend notes this side of this line

Note: ANY ADDITIONS OR CHANGES ON THIS SHEET MUST BE MADE OR CIRCLED IN Red Ink. WITH DATE AND NAME OF PERSON MAKING CHANGE.

Notes Ck'd by Drew	Survey of Badillo St.
Reg. No. B-764-5	W.O. 7103 Type No. 041 St'd 84 °F.
Office Work H. N. Bradshaw	Surveyed by Rosecrans
Checked	Notes Date 6-23-33
Date	Indexed A. C. Johnson

F.B. 510 Pg 90

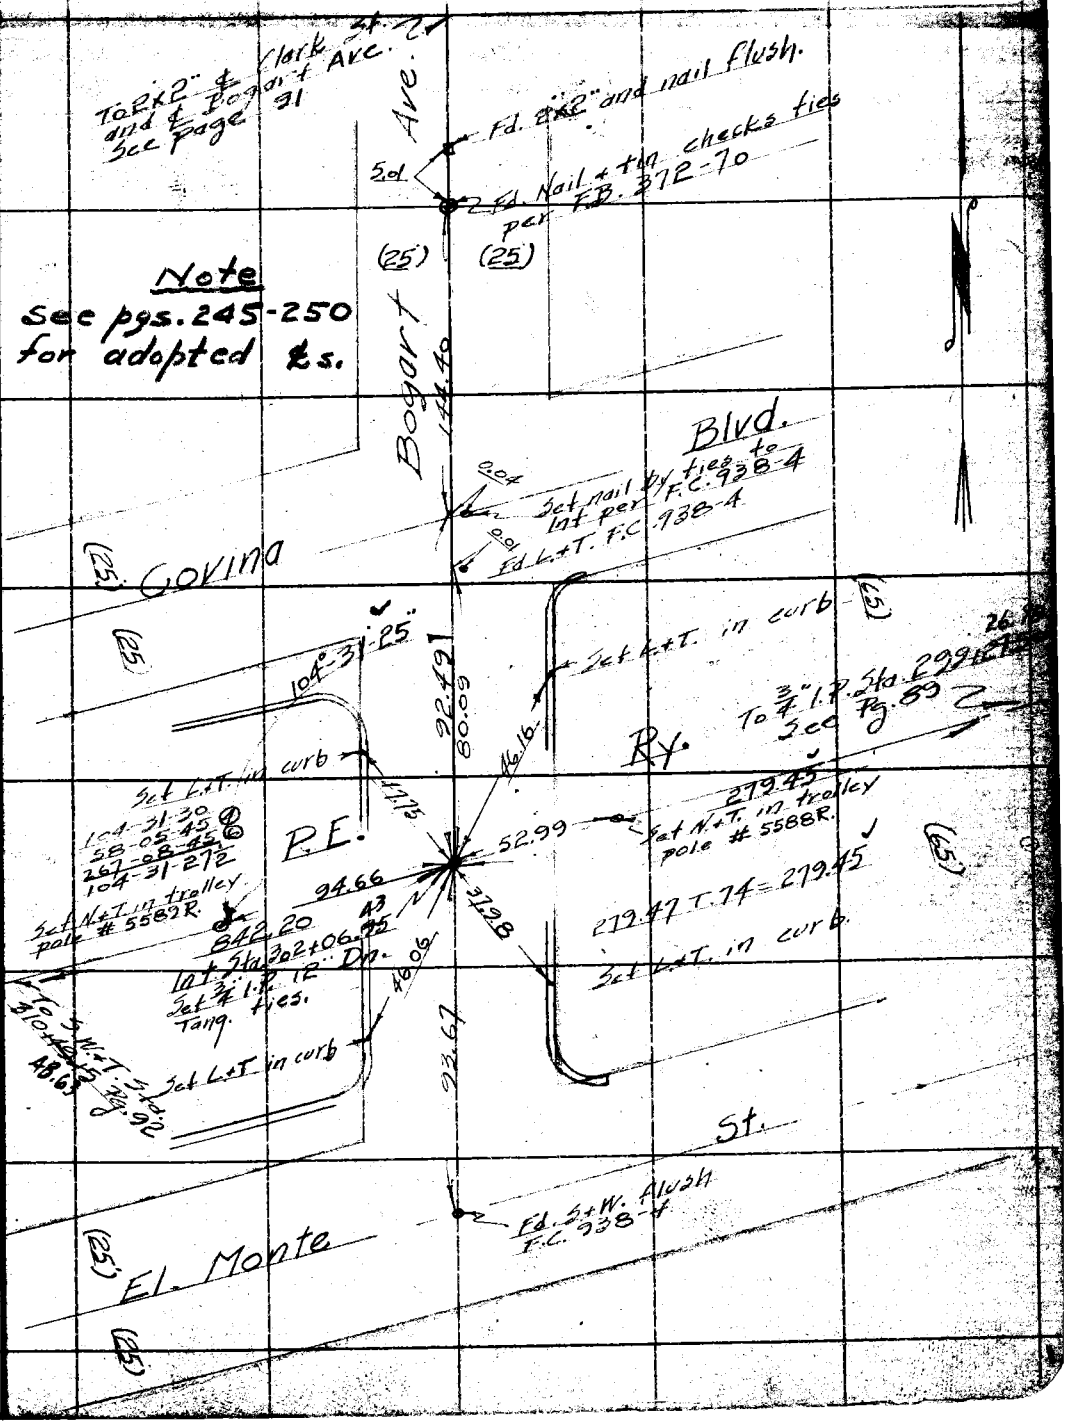

Note: ANY ADDITIONS OR CHANGES ON THIS SHEET MUST BE MADE OR CIRCLED IN Red Ink. WITH DATE AND NAME OF PERSON MAKING CHANGE.

RETURN TO
LOS ANGELES COUNTY SURVEYOR
700 HALL OF RECORDS

Do not extend notes this side of this line

FORM 347 10M 5-31

F.B. 510 PG. 91

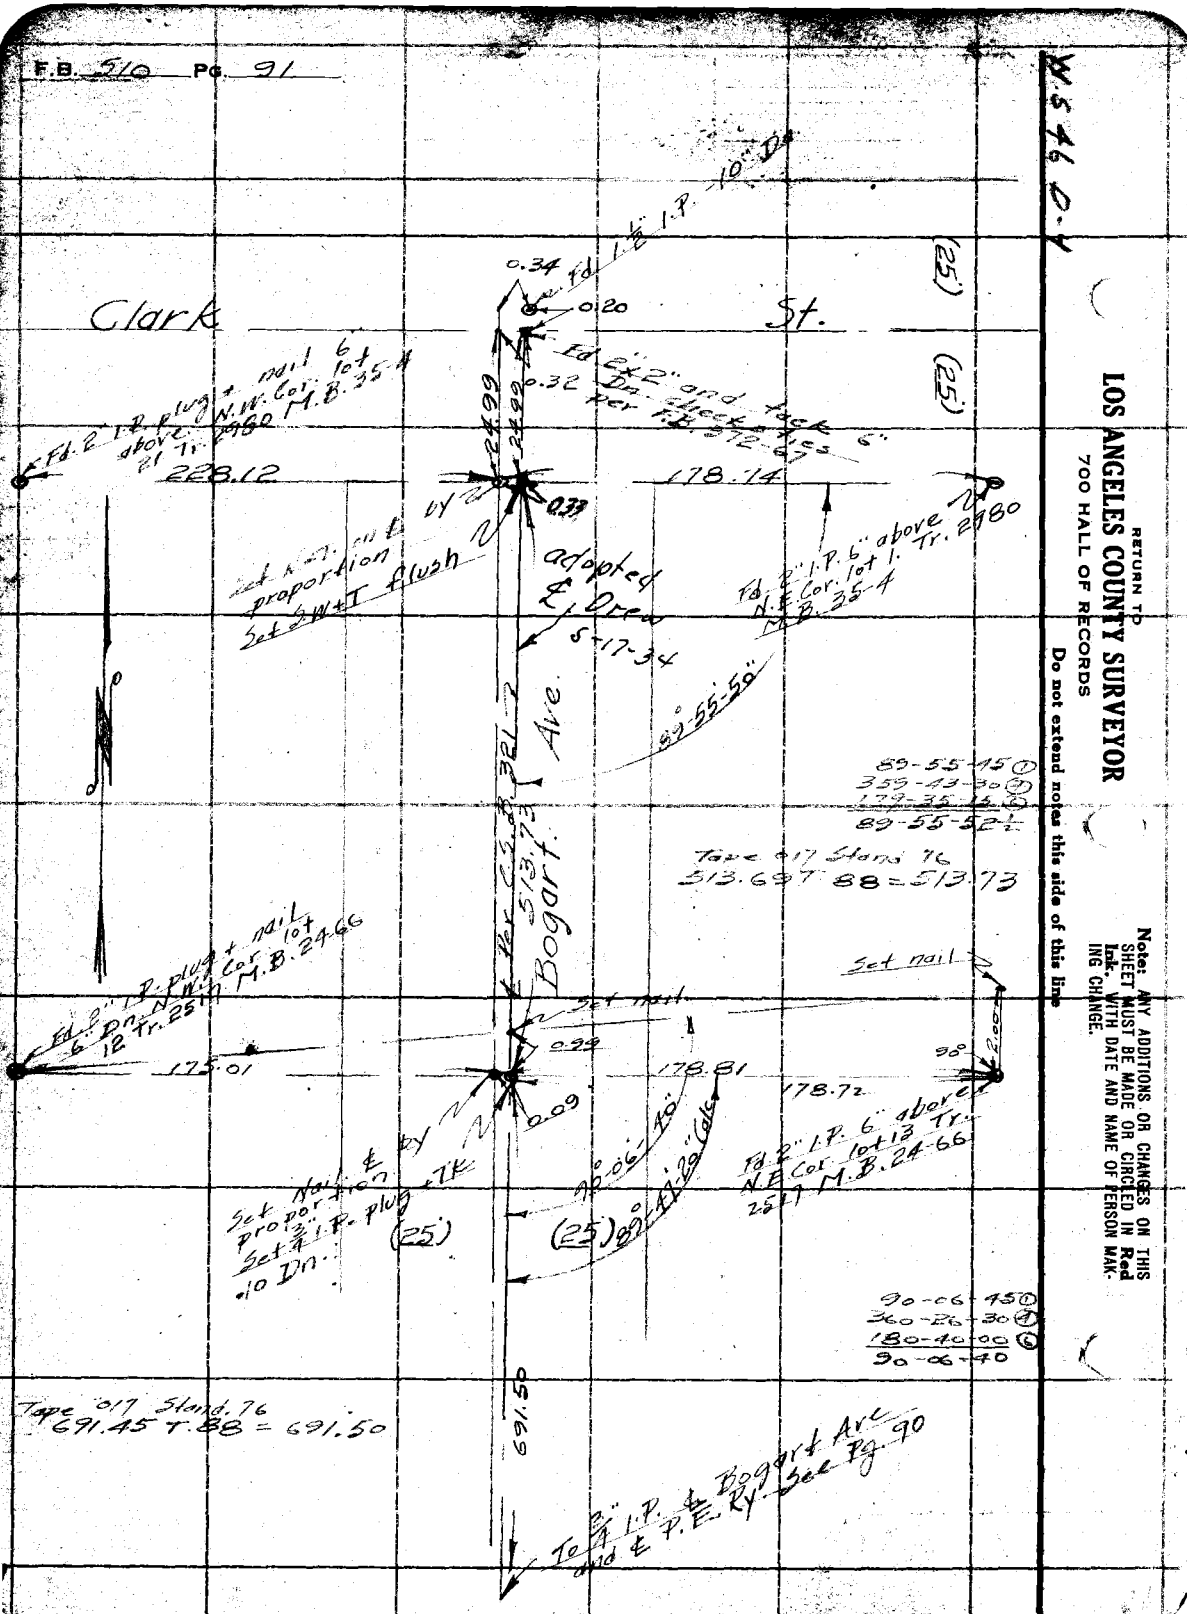

RETURN TO
LOS ANGELES COUNTY SURVEYOR
700 HALL OF RECORDS

Do not extend notes this side of this line

Note: ANY ADDITIONS OR CHANGES ON THIS SHEET MUST BE MADE OR CIRCLED IN Red Ink. WITH DATE AND NAME OF PERSON MAKING CHANGE.

Notes Ck'd by Drew	Survey of Badillo St.
Map No. B-754-5	W. O. 7103 Tape No. 041 St'd 84 °F.
Office Work H.N. Bradstreet	Surveyed by Rosecrans
Checked	Notes Date 7-3-33
Date	Indexed A. C. Johnson

F.B. 510 Pg. 92

WS 46 D-4

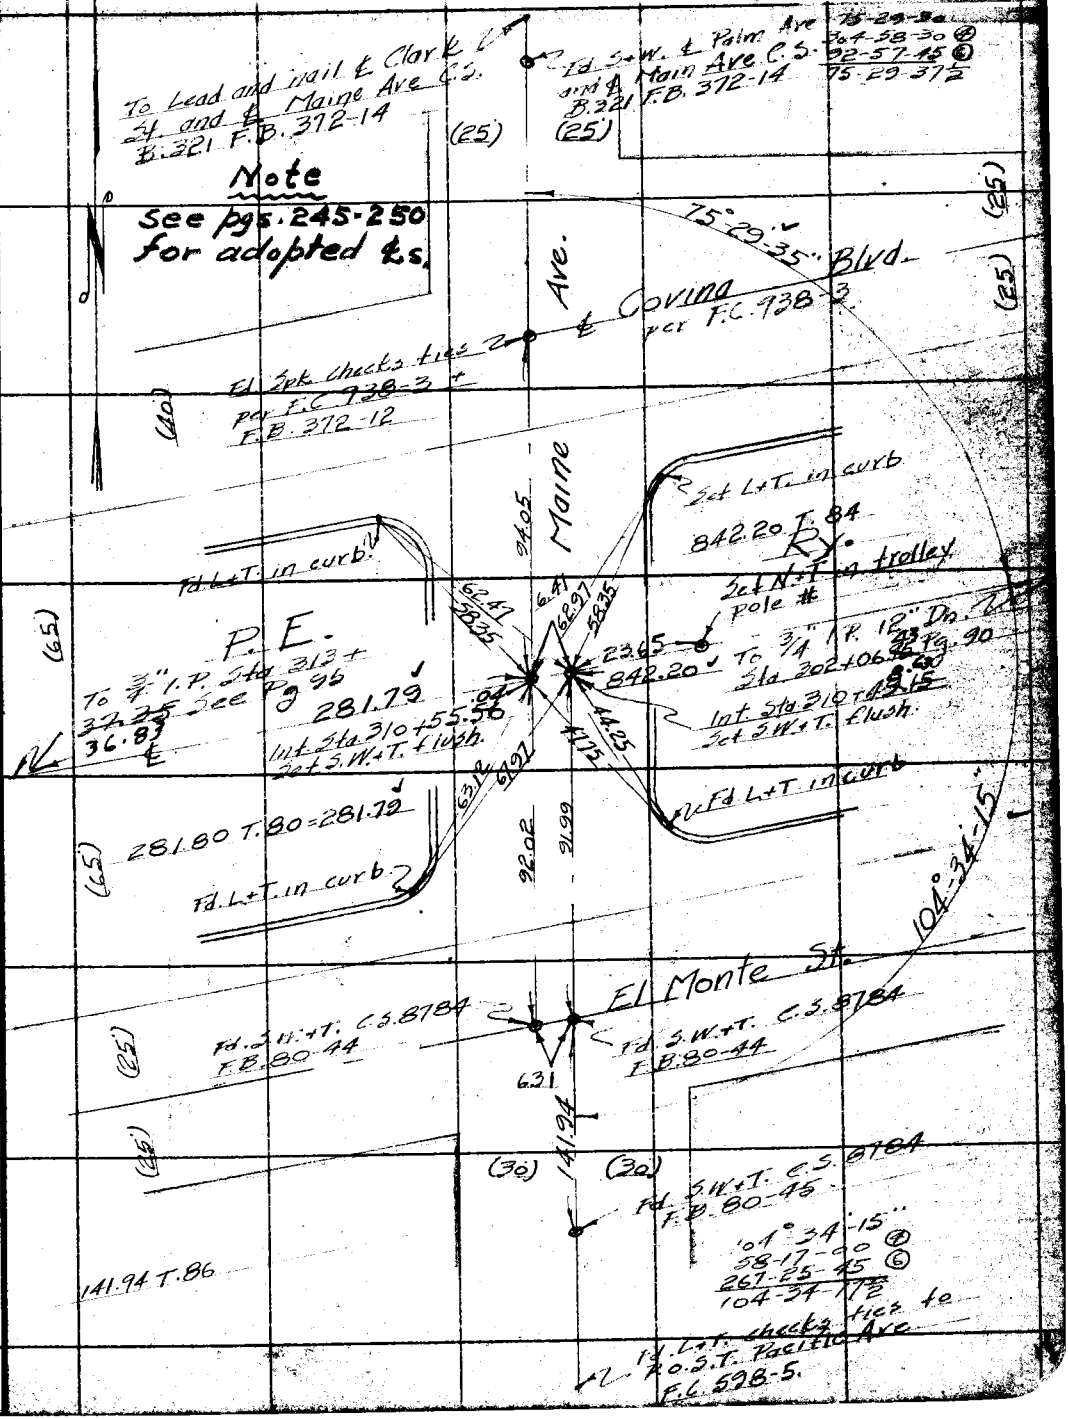

Note: ANY ADDITIONS OR CHANGES ON THIS SHEET MUST BE MADE OR CIRCLED IN Red Ink, WITH DATE AND NAME OF PERSON MAKING CHANGE.

Do not extend notes this side of this line

RETURN TO
LOS ANGELES COUNTY SURVEYOR
700 HALL OF RECORDS

FORM 247 10M 8-31

RETURN TO
LOS ANGELES COUNTY SURVEYOR
700 HALL OF RECORDS

Note: ANY ADDITIONS OR CHANGES ON THIS SHEET MUST BE MADE OR CIRCLED IN **Red Ink.** WITH DATE AND NAME OF PERSON MAKING CHANGE.

Do not extend notes this side of this line

WS 46 D-4

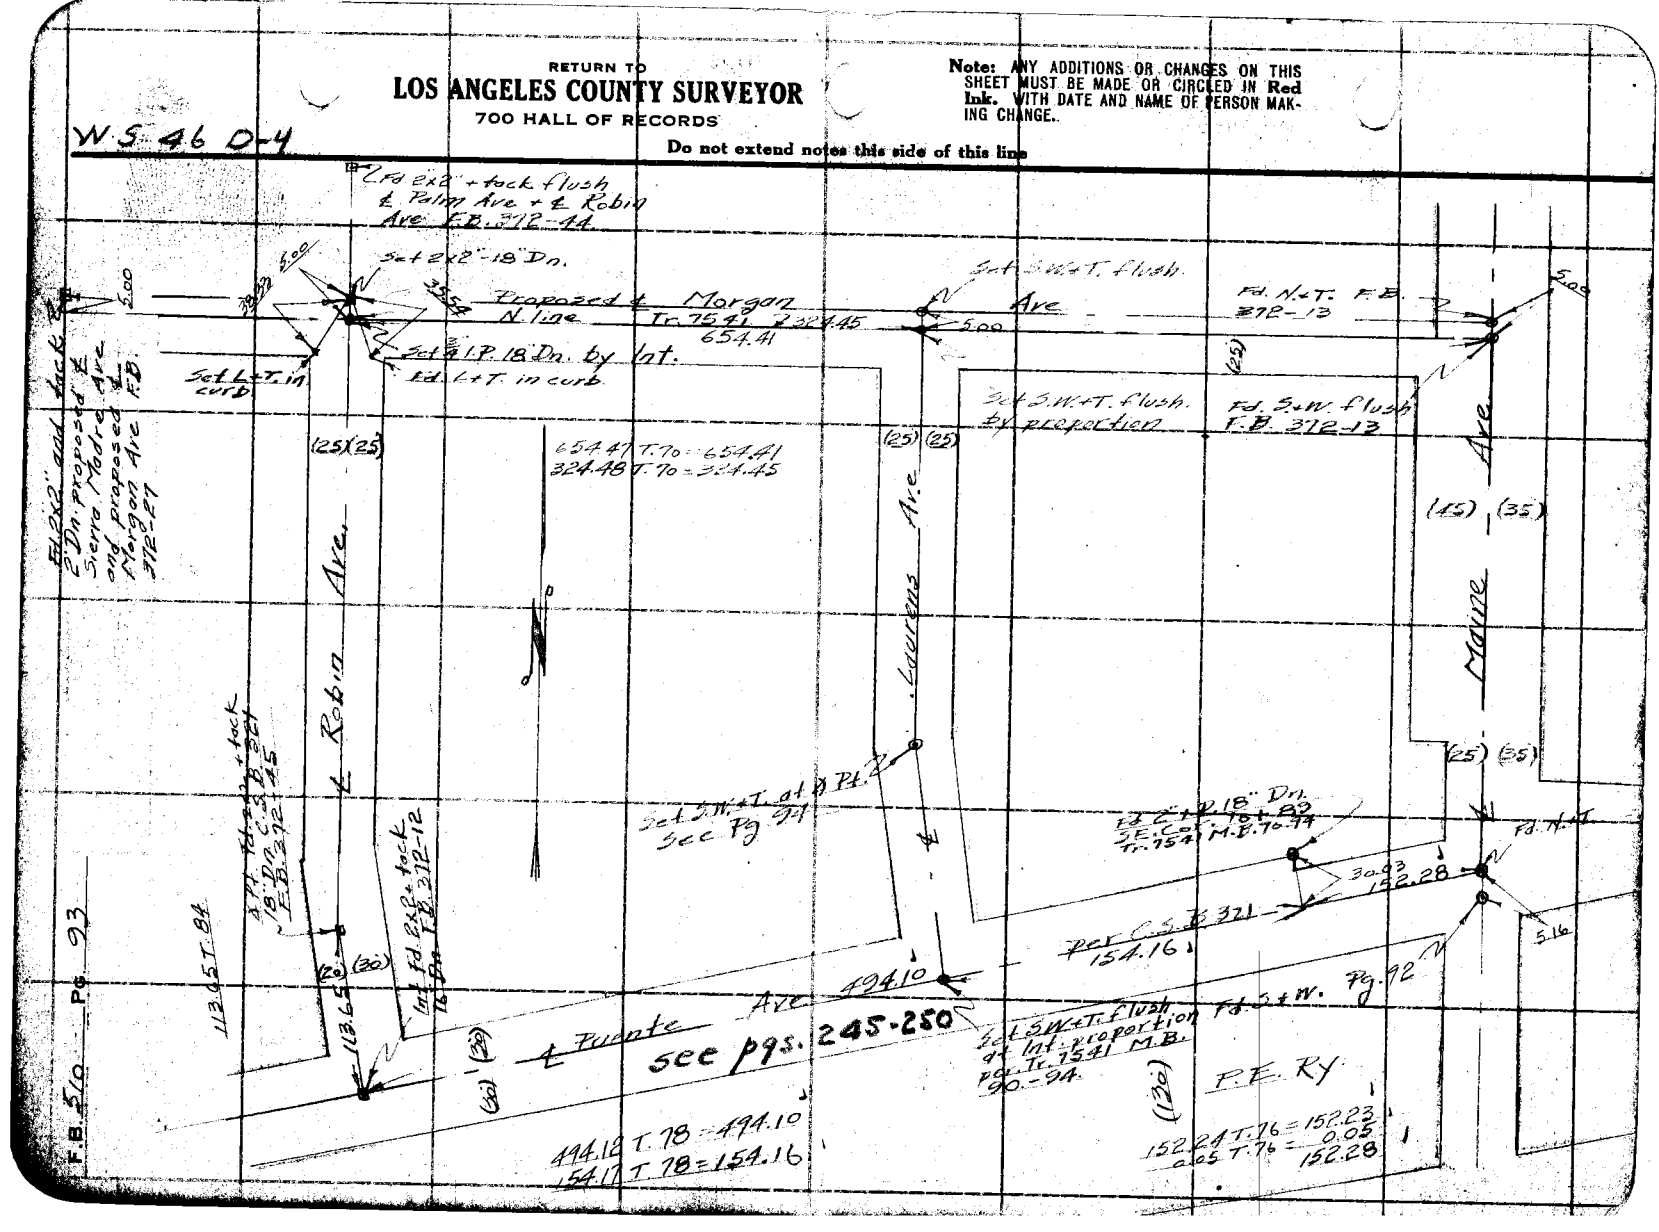

WS 46 R-4

Notes Ck'd by Drew	Survey of Badillo St
Map No. B-754-5	W. O. 7103 Tape No. 41 St'd 84 °F.
Office Work H.N. Bradstreet	Surveyed by Rosecrans
Checked	Notes Date 7-6-33
Date	Indexed A. C. Johnson

F.B. 510 Pg 94

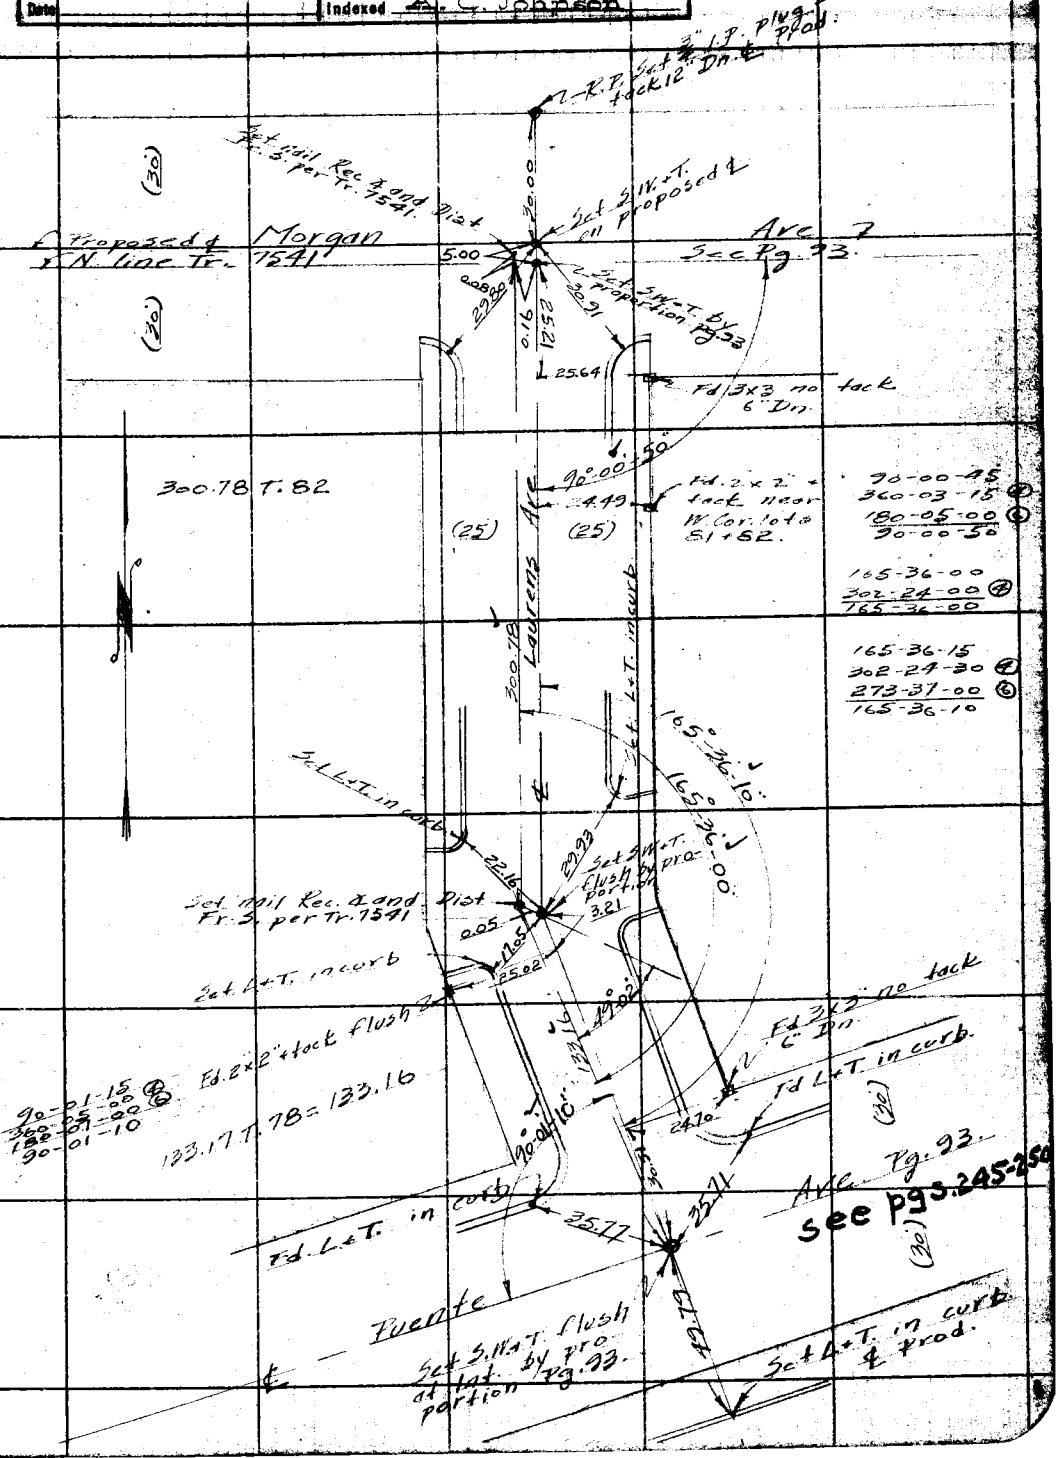

Note: ANY ADDITIONS OR CHANGES ON THIS SHEET MUST BE MADE OR CIRCLED IN Red Ink. WITH DATE AND NAME OF PERSON MAKING CHANGE.

RETURN TO
LOS ANGELES COUNTY SURVEYOR
700 HALL OF RECORDS

Do not extend notes this side of this line

FORM 247 10M 8-31

RETURN TO
LOS ANGELES COUNTY SURVEYOR
700 HALL OF RECORDS

Note: ANY ADDITIONS OR CHANGES ON THIS SHEET MUST BE MADE OR CIRCLED IN **Red Ink.** WITH DATE AND NAME OF PERSON MAKING CHANGE.

Do not extend notes this side of this line

W.S. 46-D-4

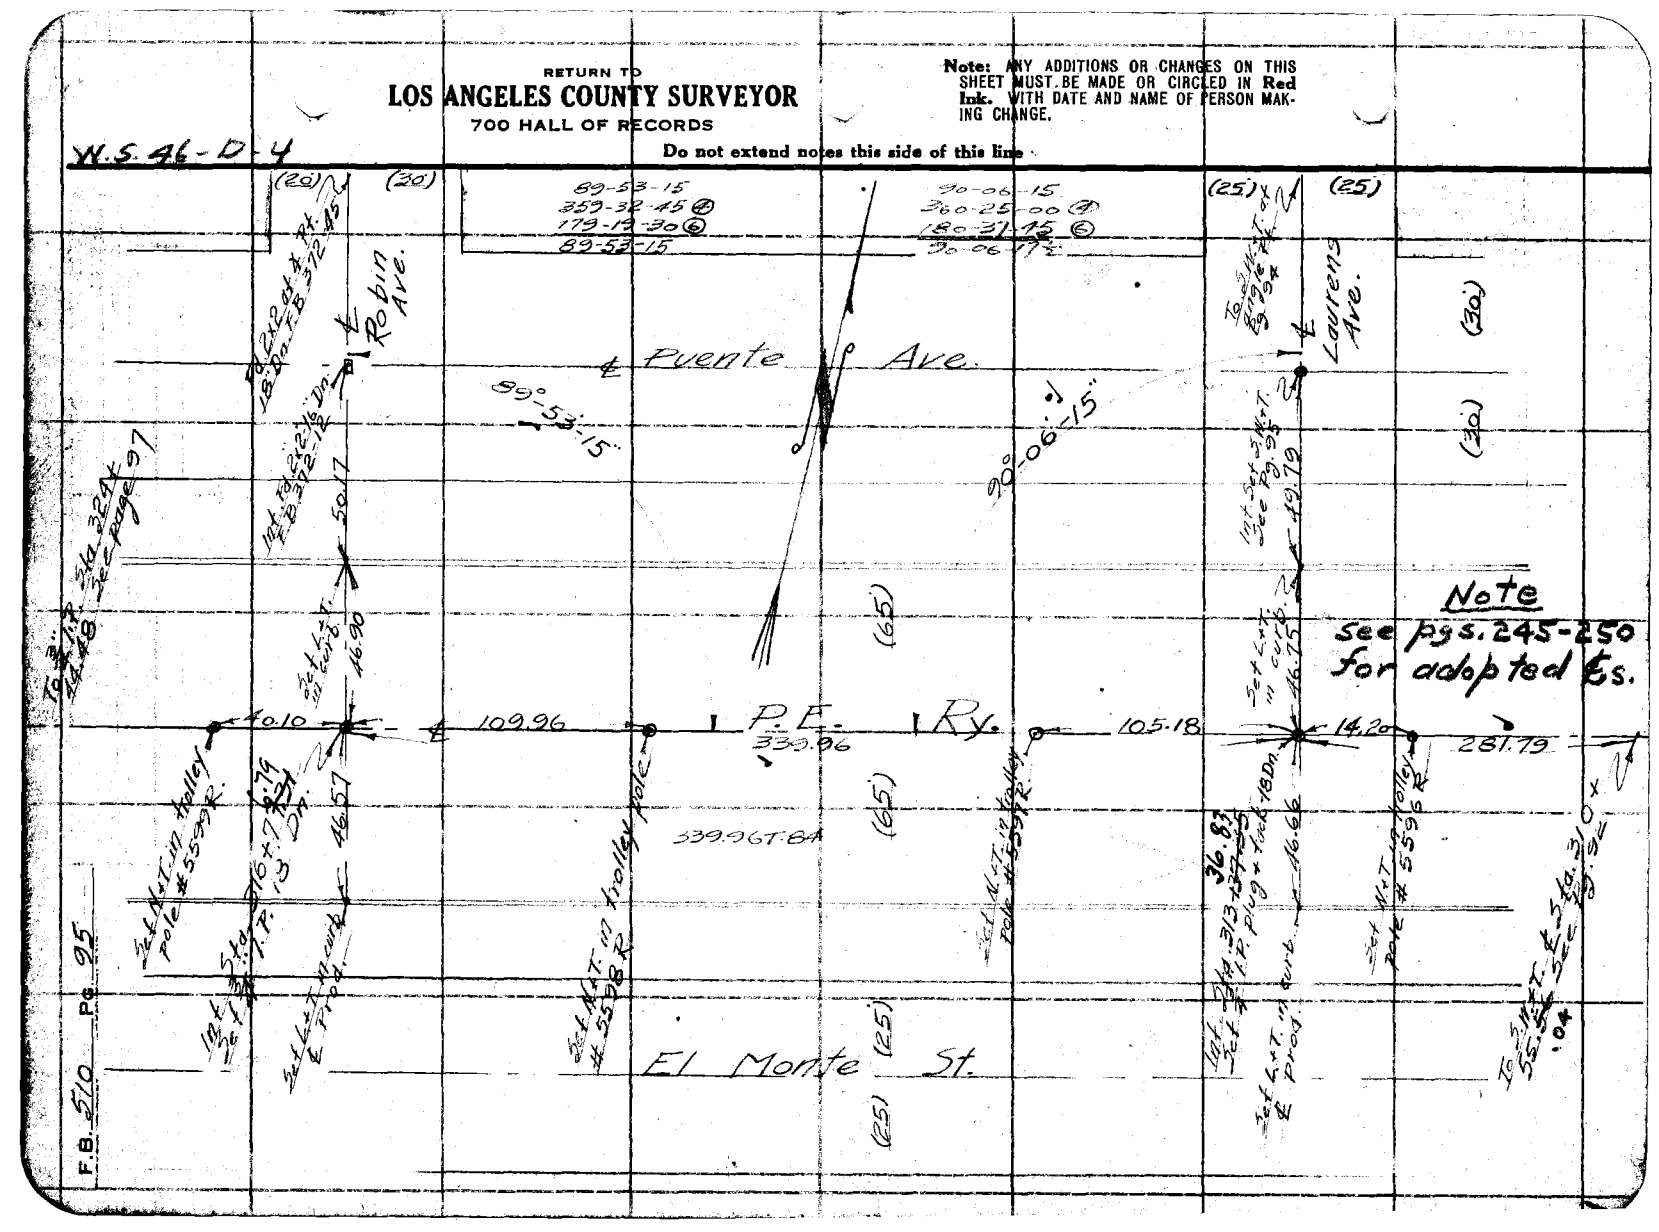

Notes Ck'd by Drew	Survey of Badillo St.
Map No. B-754-5	W. O. 7103 Tape No. 041 St'd 84 °F.
Office Work H.N. Brodstreet	Surveyed by Rosecrans
Checked	Notes Date 7-7-33
Date	Indexed A. C. Johnson

F.B. 510 PG. 96

W.S. 46 D.4

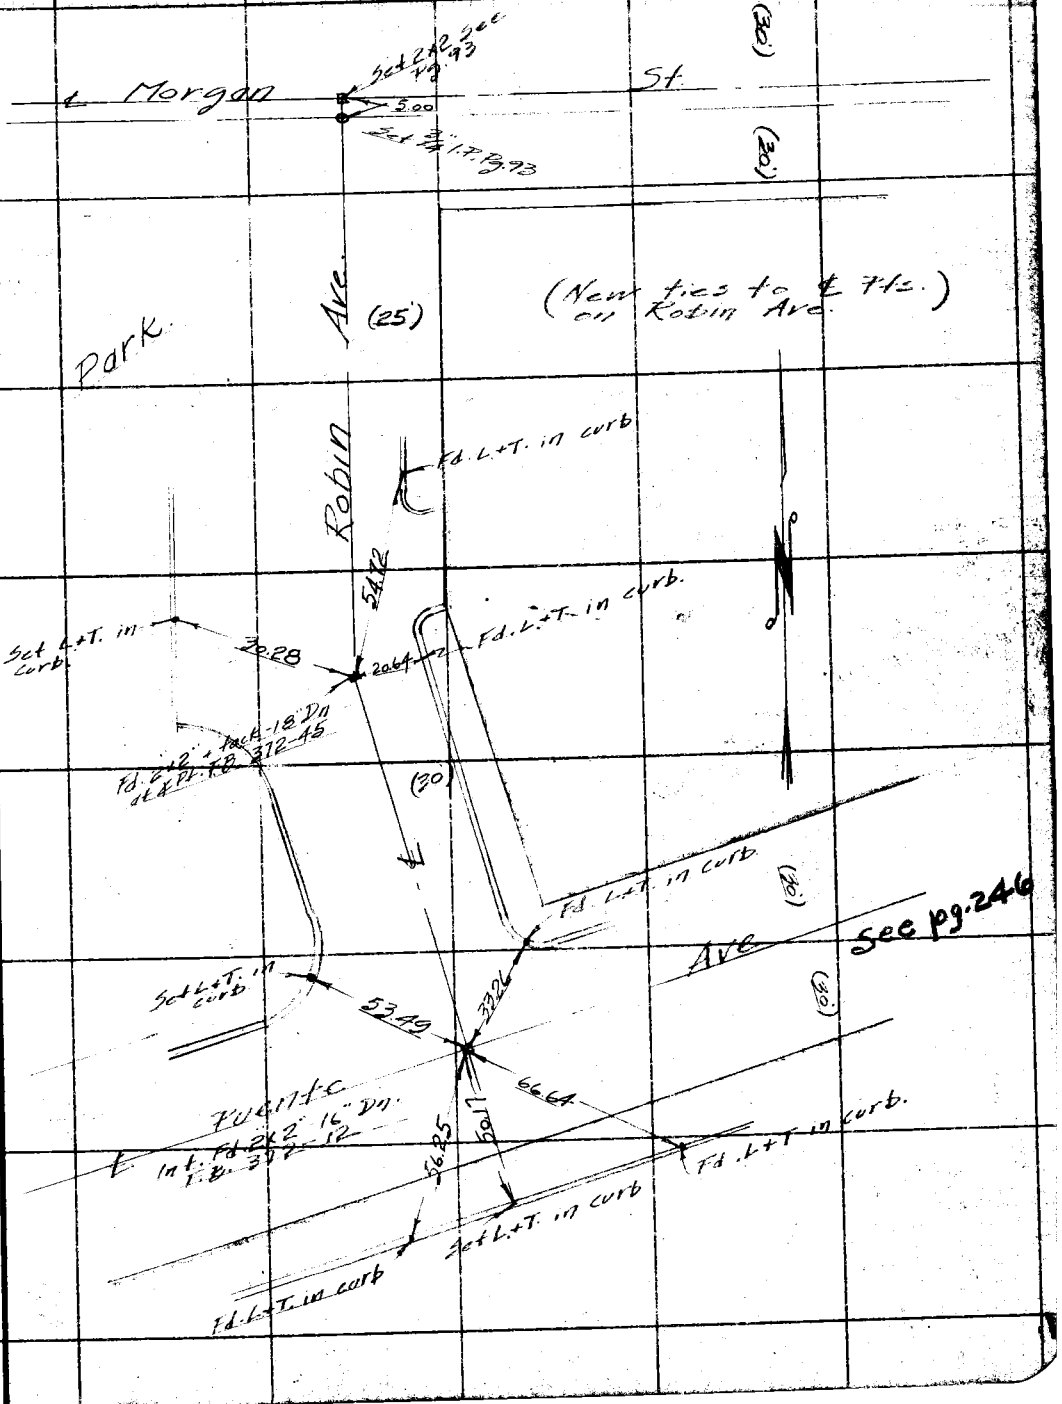

Note: ANY ADDITIONS OR CHANGES ON THIS SHEET MUST BE MADE OR CIRCLED IN Red Ink. WITH DATE AND NAME OF PERSON MAKING CHANGE.

RETURN TO
LOS ANGELES COUNTY SURVEYOR
700 HALL OF RECORDS

Do not extend notes this side of this line

FORM 247 10M 8-31

F.B. 510 PG. 97

W.S. 46-D-4

RETURN TO
LOS ANGELES COUNTY SURVEYOR
700 HALL OF RECORDS

Do not extend notes this side of this line

Note: ANY ADDITIONS OR CHANGES ON THIS SHEET MUST BE MADE OR CIRCLED IN **Red** Ink. WITH DATE AND NAME OF PERSON MAKING CHANGE.

Notes Ck'd by: Drew	Survey of Badillo St.
Map No. [illegible]	W.O. 7103 Tape No. 041 Sta. 84 °F.
Office Work H.N. Bradstreet	Surveyed by Rosecrans
Checked	Notes Date 7-10-33
Date	Indexed C. Johnson

F.B. 510 Pg. 98

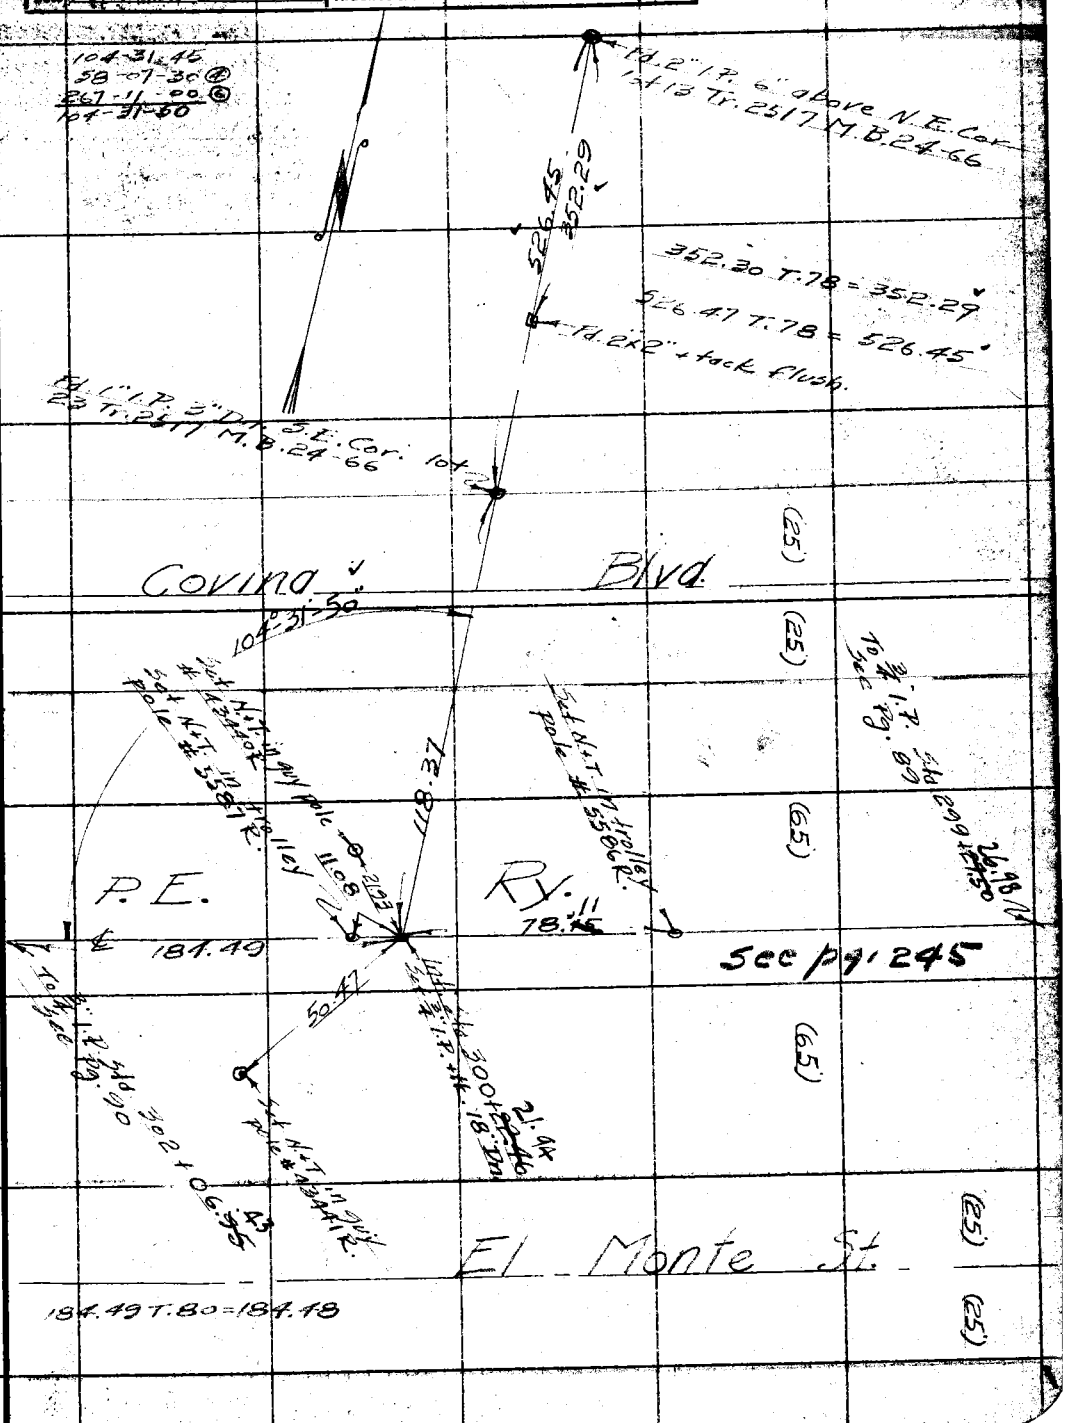

Note: ANY ADDITIONS OR CHANGES ON THIS SHEET MUST BE MADE OR CIRCLED IN Red Ink, WITH DATE AND NAME OF PERSON MAKING CHANGE.

Do not extend notes this side of this line

RETURN TO
LOS ANGELES COUNTY SURVEYOR
700 HALL OF RECORDS

FORM 247 10M 8-31

F.B. 510 Pg 99.

RETURN TO
LOS ANGELES COUNTY SURVEYOR
700 HALL OF RECORDS
Do not extend notes this side of this line

Note: ANY ADDITIONS OR CHANGES ON THIS SHEET MUST BE MADE OR CIRCLED IN Red Ink. WITH DATE AND NAME OF PERSON MAKING CHANGE.

A.46 D-4

Notes Ck'd by	Survey of Badillo St
Map No. 8-[illegible]	W.O. 7103 Tape No. 041 St'd 84 °F.
Office Work H.H. Bradstreet	Surveyed by Roscerans
Checked	Notes Date 7-11-33
Date	Indexed A. C. Johnson

F.B. 510 PG. 100

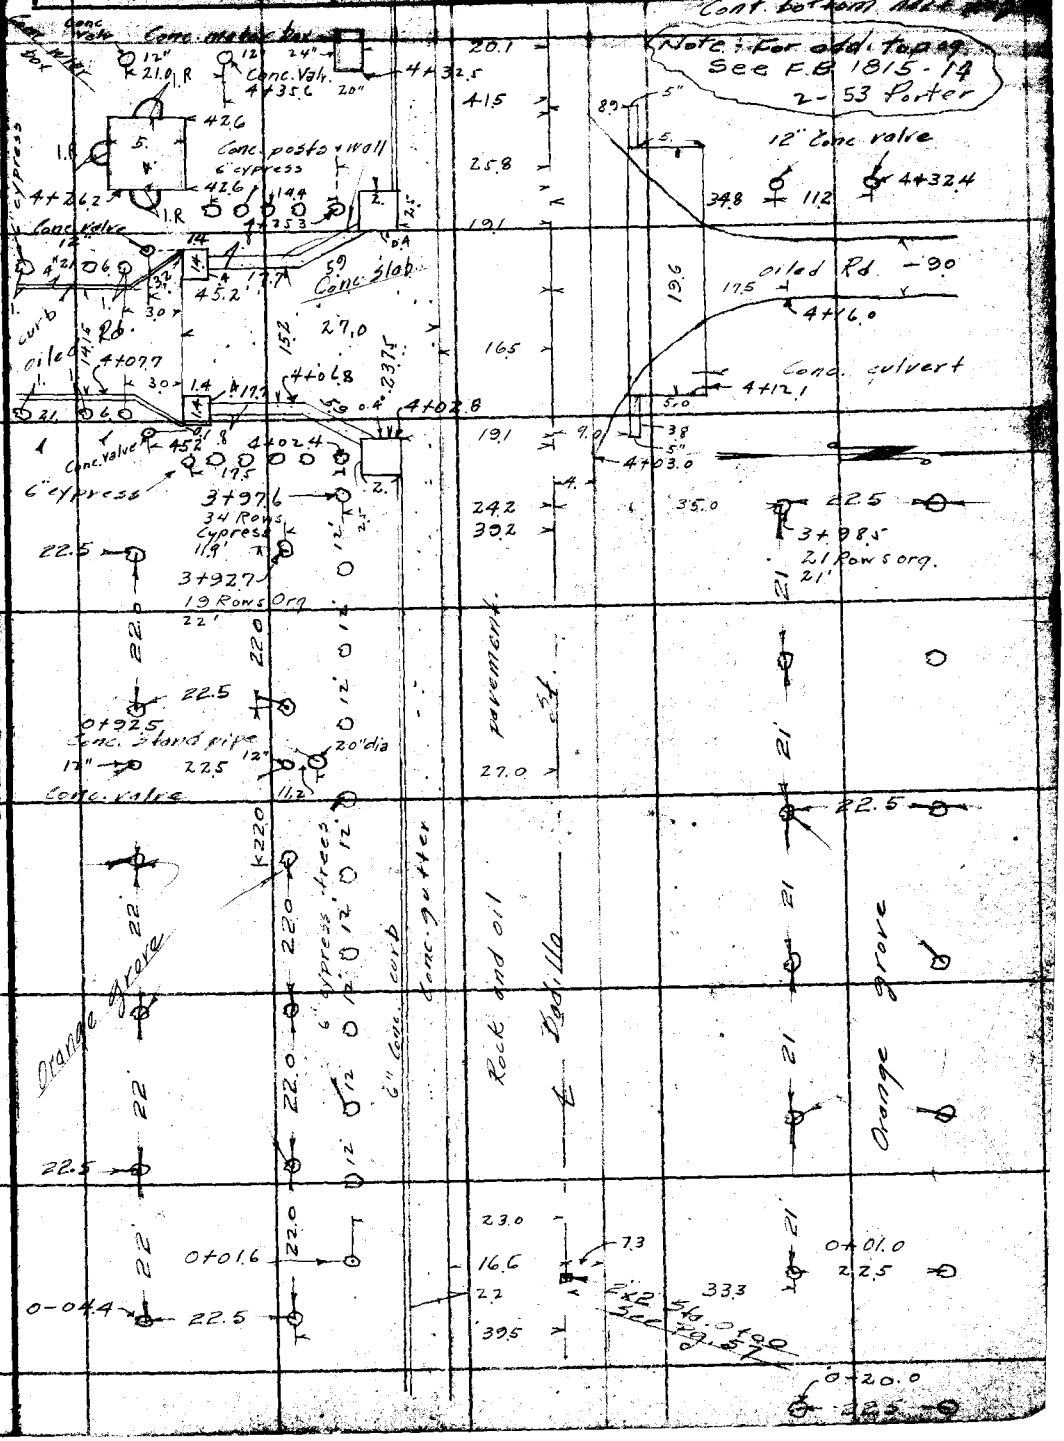

Note: ANY ADDITIONS OR CHANGES ON THIS SHEET MUST BE MADE OR CIRCLED IN Red Ink. WITH DATE AND NAME OF PERSON MAKING CHANGE.

RETURN TO
LOS ANGELES COUNTY SURVEYOR
700 HALL OF RECORDS

Do not extend notes this side of this line

FORM 247 10M 8-31

RETURN TO

LOS ANGELES COUNTY SURVEYOR

700 HALL OF RECORDS

Note: ANY ADDITIONS OR CHANGES ON THIS SHEET MUST BE MADE, OR CIRCLED IN **Red Ink.** WITH DATE AND NAME OF PERSON MAKING CHANGE.

Do not extend notes this side of this line

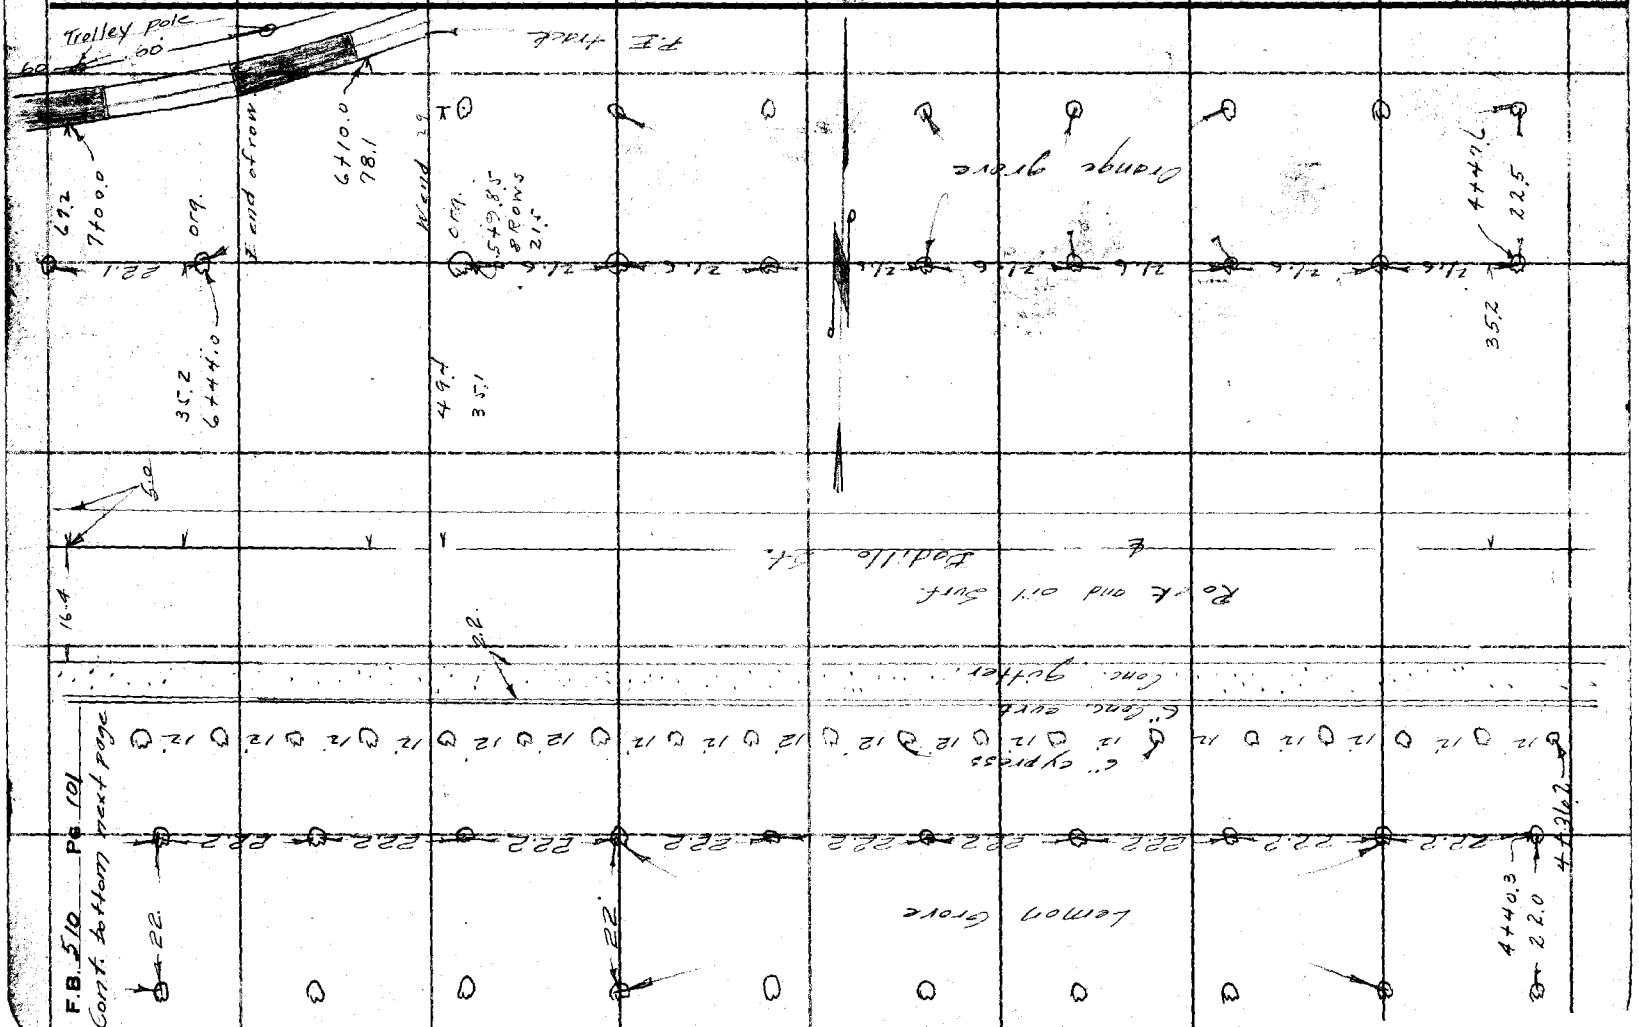

Notes Ck'd by	Survey of Badillo St.
Map No. B-754-1	W.O. 7103 Tape No. 041 St'd 84 °F.
Office Work H.N. Bradstreet	Surveyed by Rosecrans
Checked	Notes Date 7-11-33
Date	Indexed A. C. Johnson

F.B. 510 PG. 102

Cont bottom next page

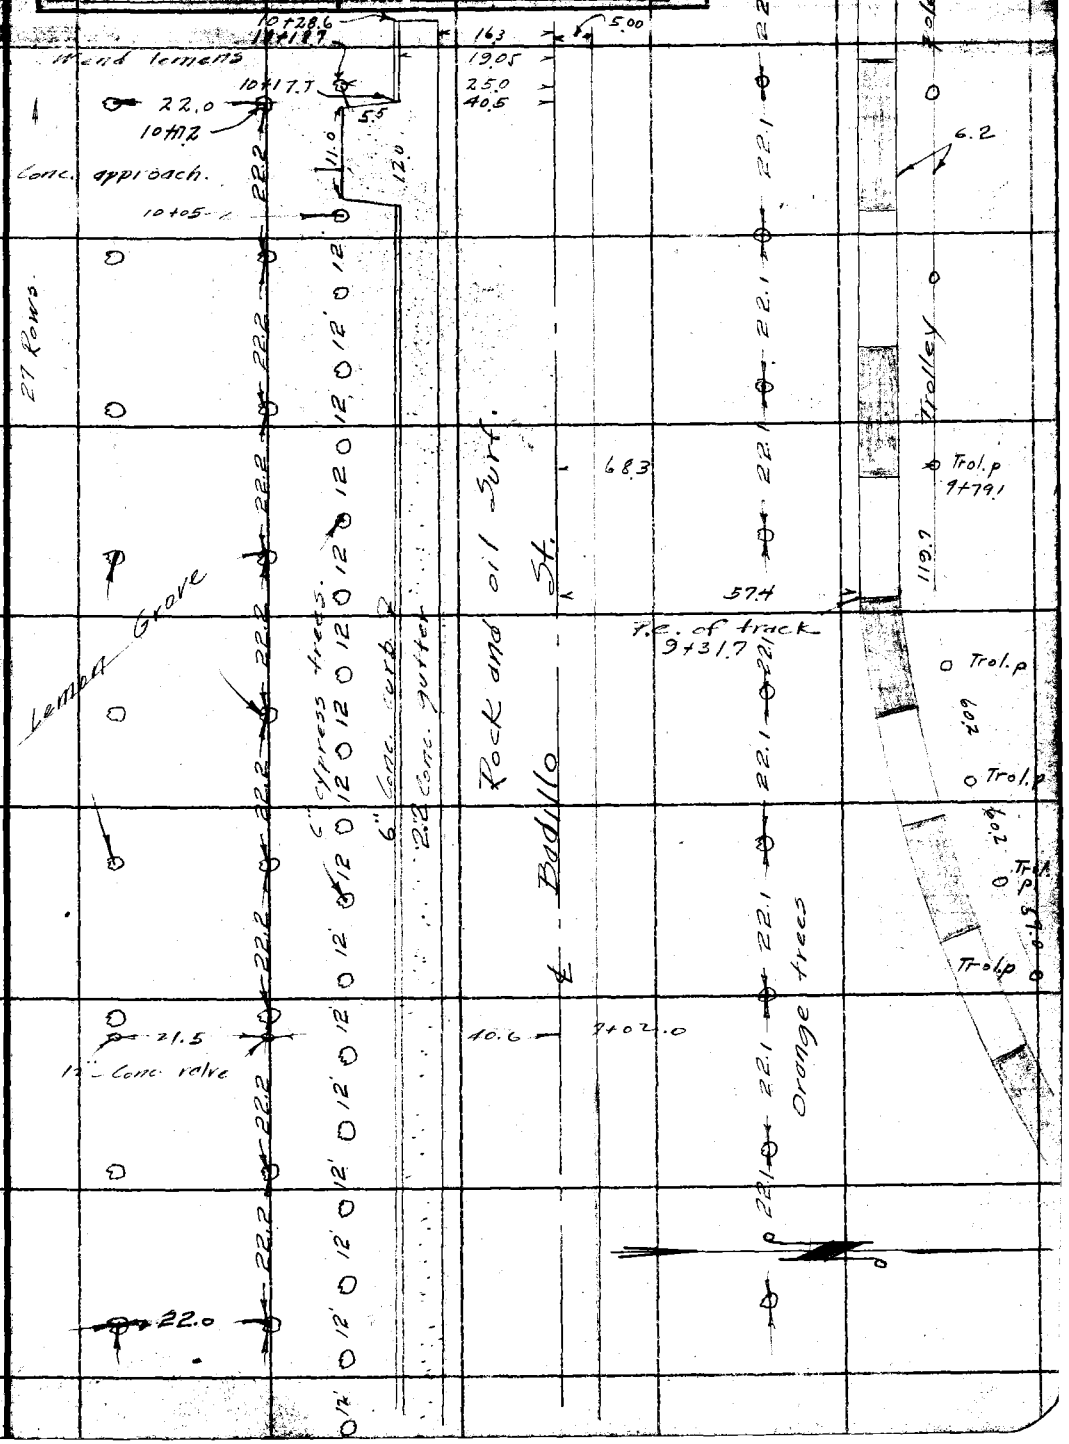

Note: ANY ADDITIONS OR CHANGES ON THIS SHEET MUST BE MADE OR CIRCLED IN Red Ink. WITH DATE AND NAME OF PERSON MAKING CHANGE.

Do not extend notes this side of this line

RETURN TO
LOS ANGELES COUNTY SURVEYOR
700 HALL OF RECORDS

FORM 247 10M 5-31

F.B. 510 Pg. 103

Cont. bottom next page.

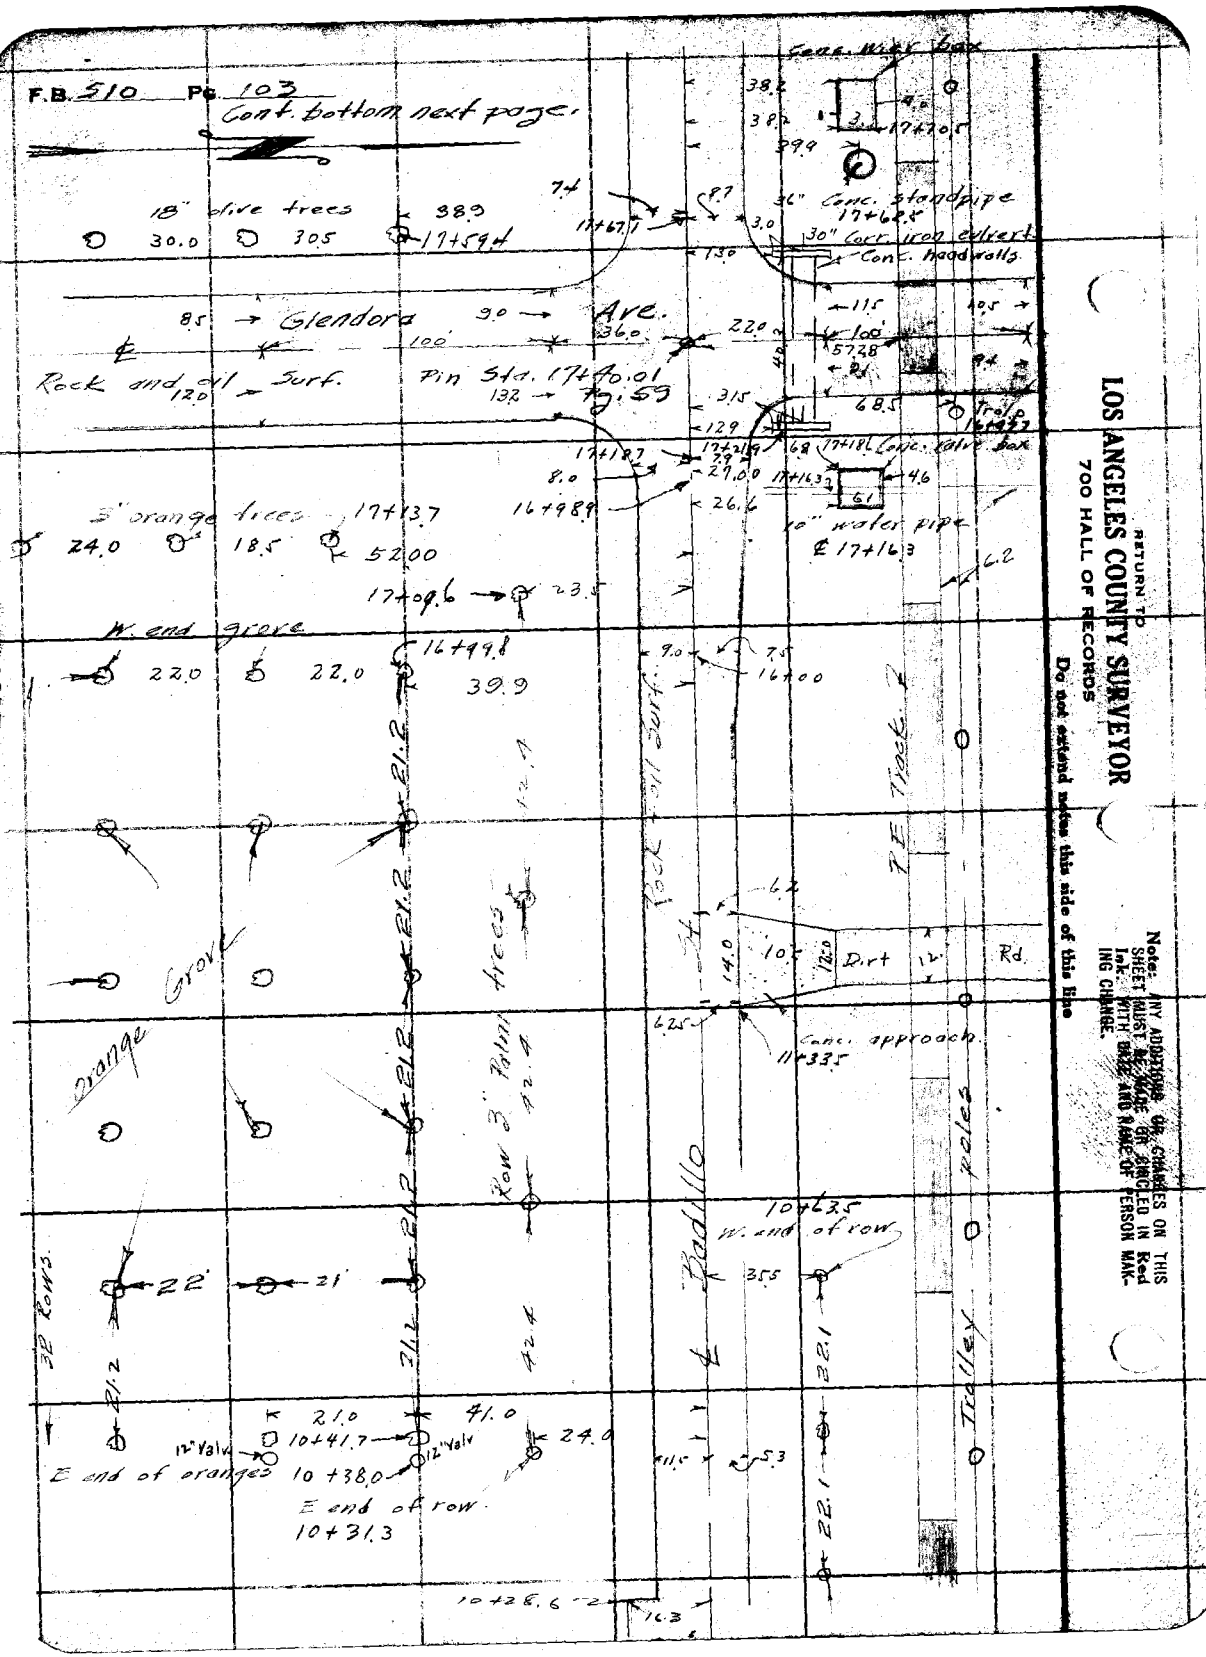

RETURN TO
LOS ANGELES COUNTY SURVEYOR
700 HALL OF RECORDS

Do not extend notes this side of this line

Note: ANY ADDITIONS OR CHANGES ON THIS SHEET MUST BE MADE OR ENCIRCLED IN Red Ink WITH DATE AND NAME OF PERSON MAKING CHANGE.

Notes Ck'd by	Survey of Badillo St.
Map No. B-154-1	W. O. 7103 Tape No. 041 St'd 84 °F.
Office Work K.N. Bradstreet	Surveyed by Roseerans
Checked	Notes Date 7-11-33
Date	Indexed A. C. Johnson

F.B. 510 PG. 104

Cont. on bottom next page.

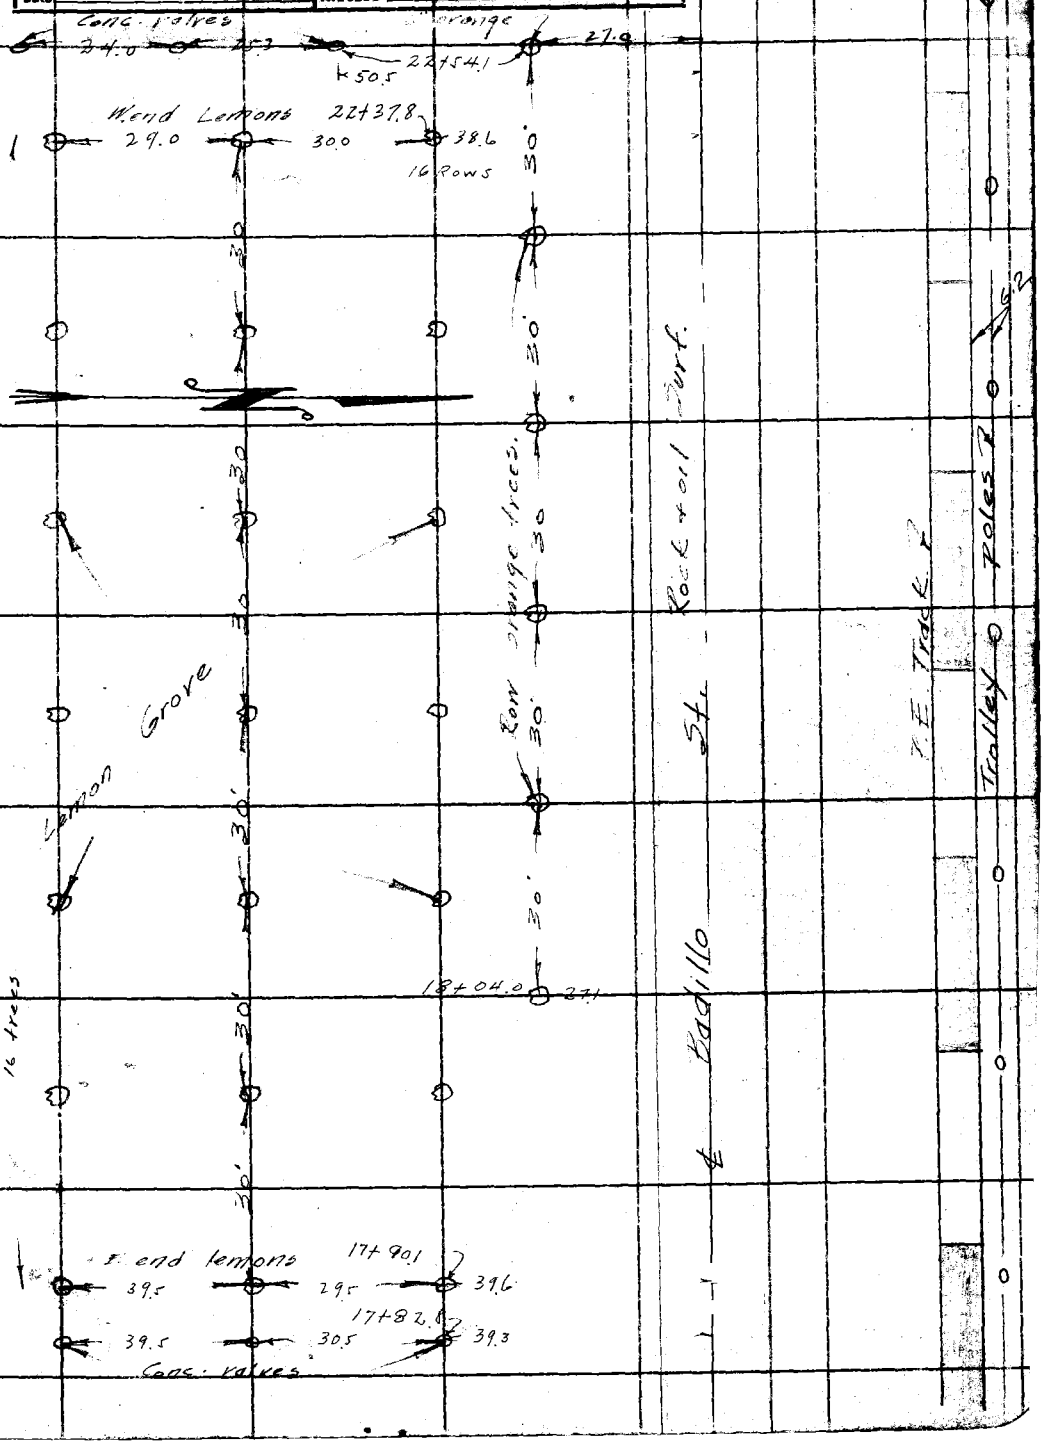

Note: ANY ADDITIONS OR CHANGES ON THIS SHEET MUST BE MADE OR CIRCLED IN Red Ink. WITH DATE AND NAME OF PERSON MAKING CHANGE.

RETURN TO
LOS ANGELES COUNTY SURVEYOR
700 HALL OF RECORDS

Do not extend notes this side of this line

FORM 247 10M 5-31

F.B. 510 PG. 105

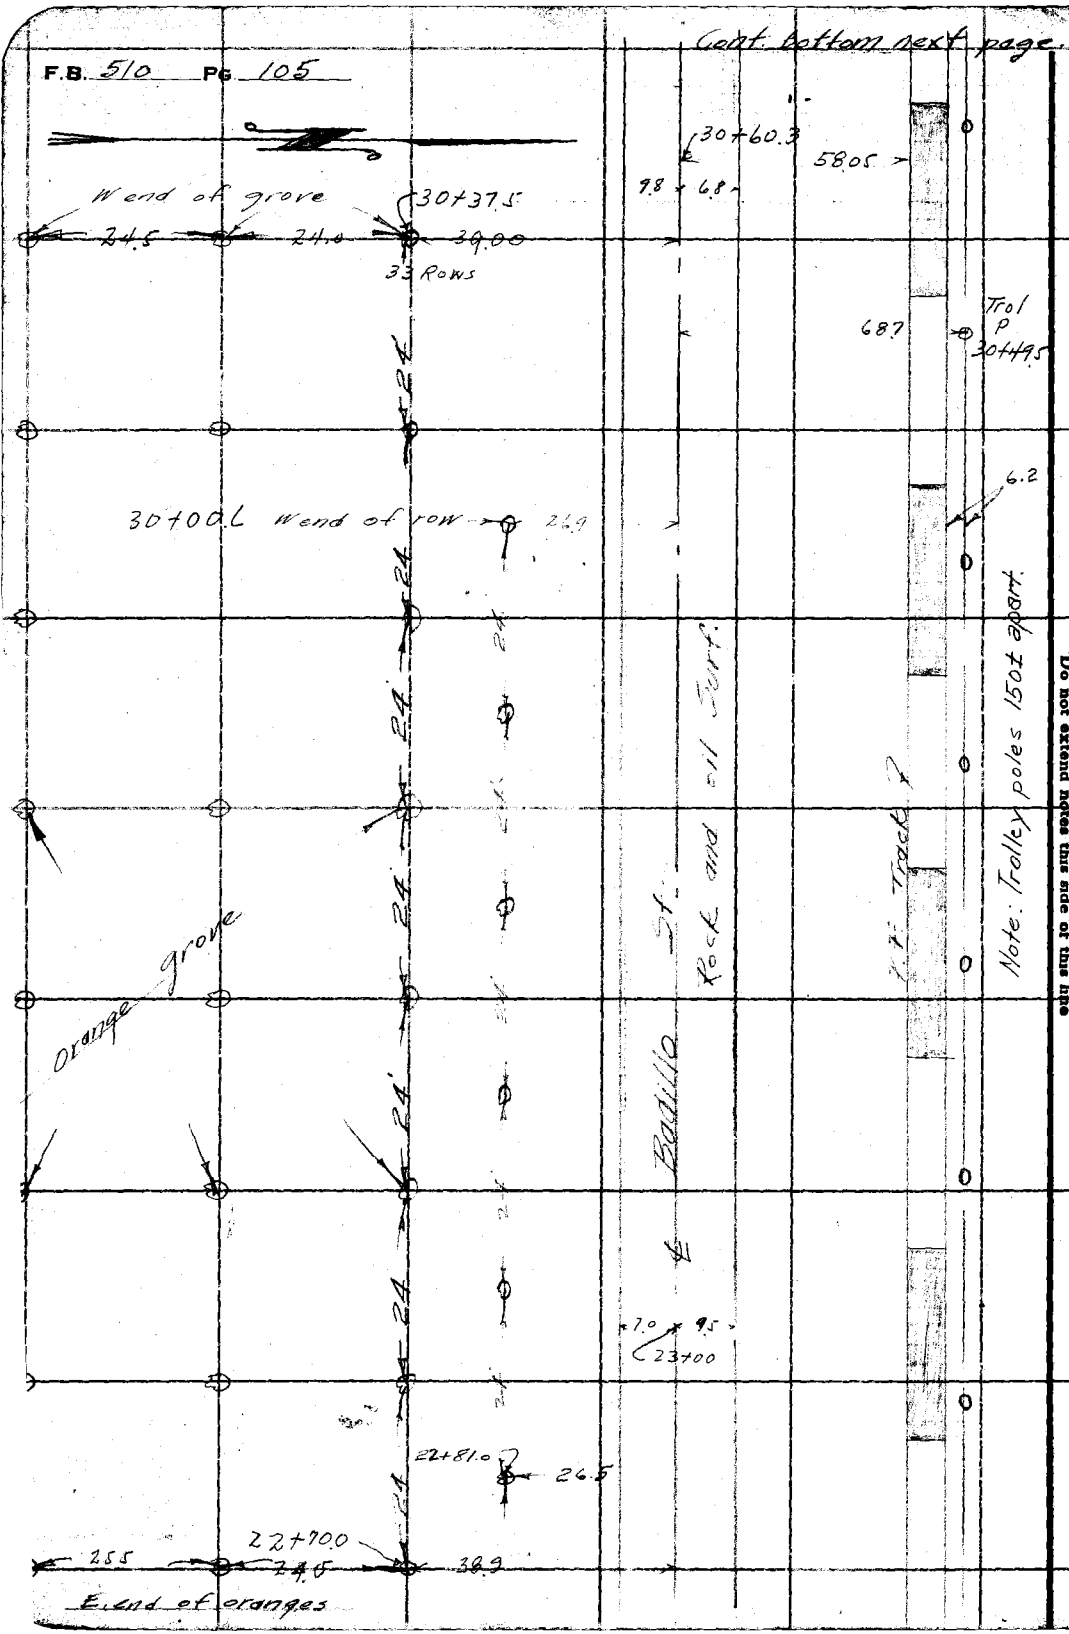

RETURN TO
LOS ANGELES COUNTY SURVEYOR
700 HALL OF RECORDS

Do not extend notes this side of this line

Note: ANY ADDITIONS OR CHANGES ON THIS SHEET MUST BE MADE OR CIRCLED IN Red Ink. WITH DATE AND NAME OF PERSON MAKING CHANGE.

F.B. 510 PG. 106

Notes Ck'd by	Survey of Badillo St.
Map No. B-754-1	W.O. 7103 Tape No. 041 St'd 84 °F.
Office Work H.N. Bradstreet	Surveyed by Rosecrans
Checked	Notes Date 7-11-33
Date	Indexed A. C. Johnson

Cont bottom next page

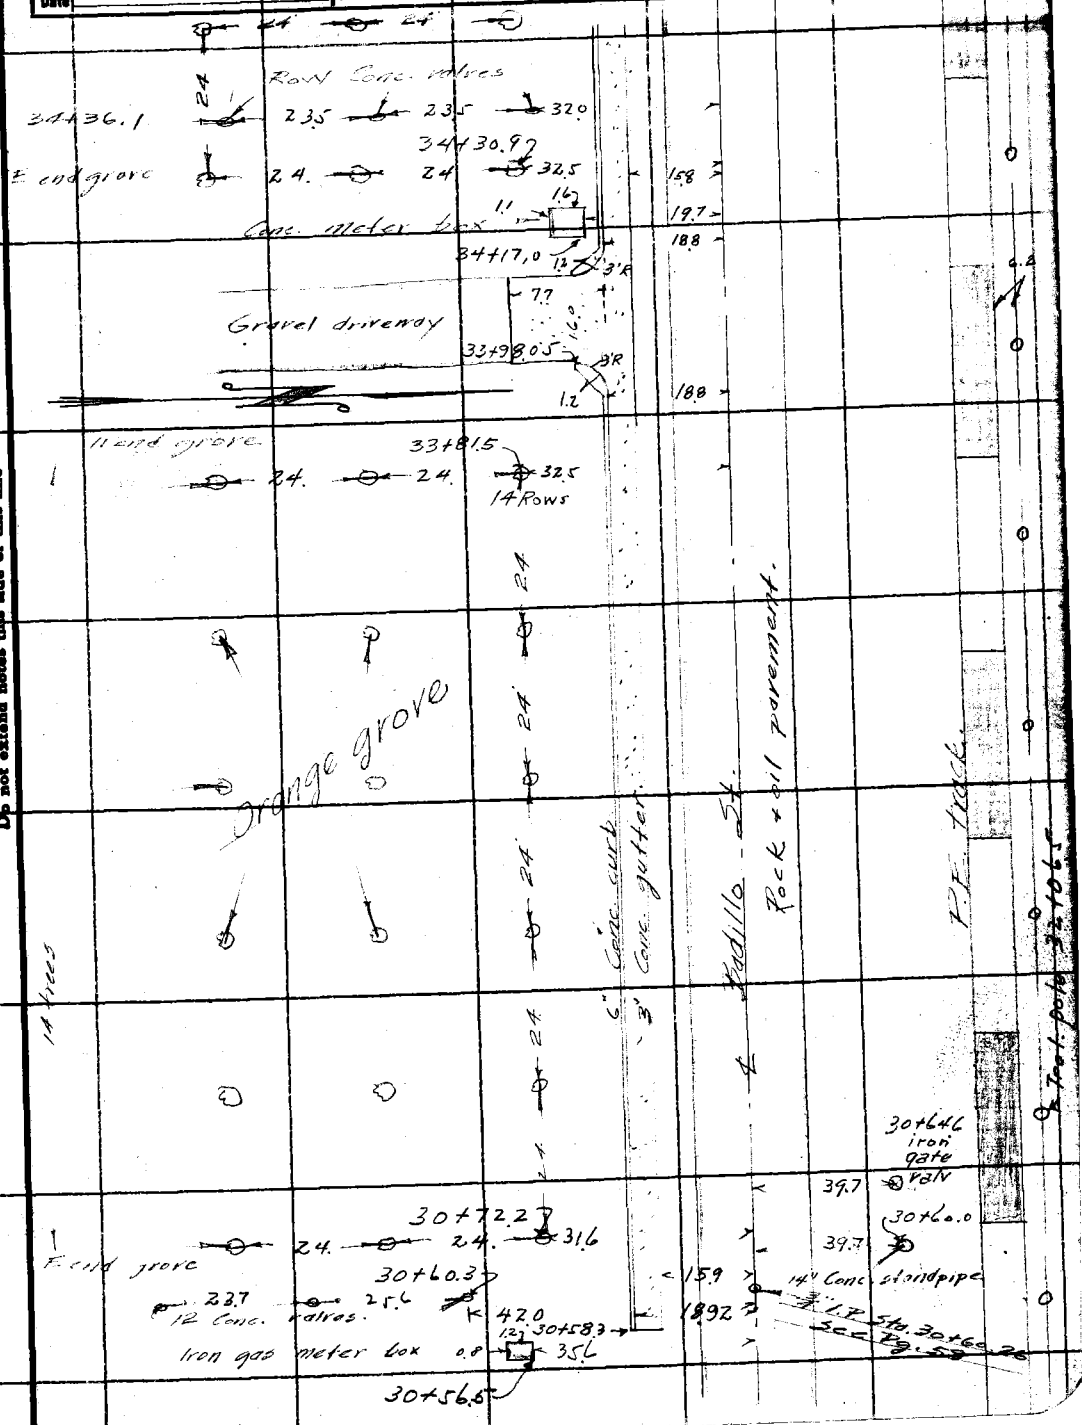

Note: ANY ADDITIONS OR CHANGES ON THIS SHEET MUST BE MADE OR CIRCLED IN Red Ink. WITH DATE AND NAME OF PERSON MAKING CHANGE.

RETURN TO
LOS ANGELES COUNTY SURVEYOR
700 HALL OF RECORDS
Do not extend notes this side of this line

FORM 247 10M 5-31

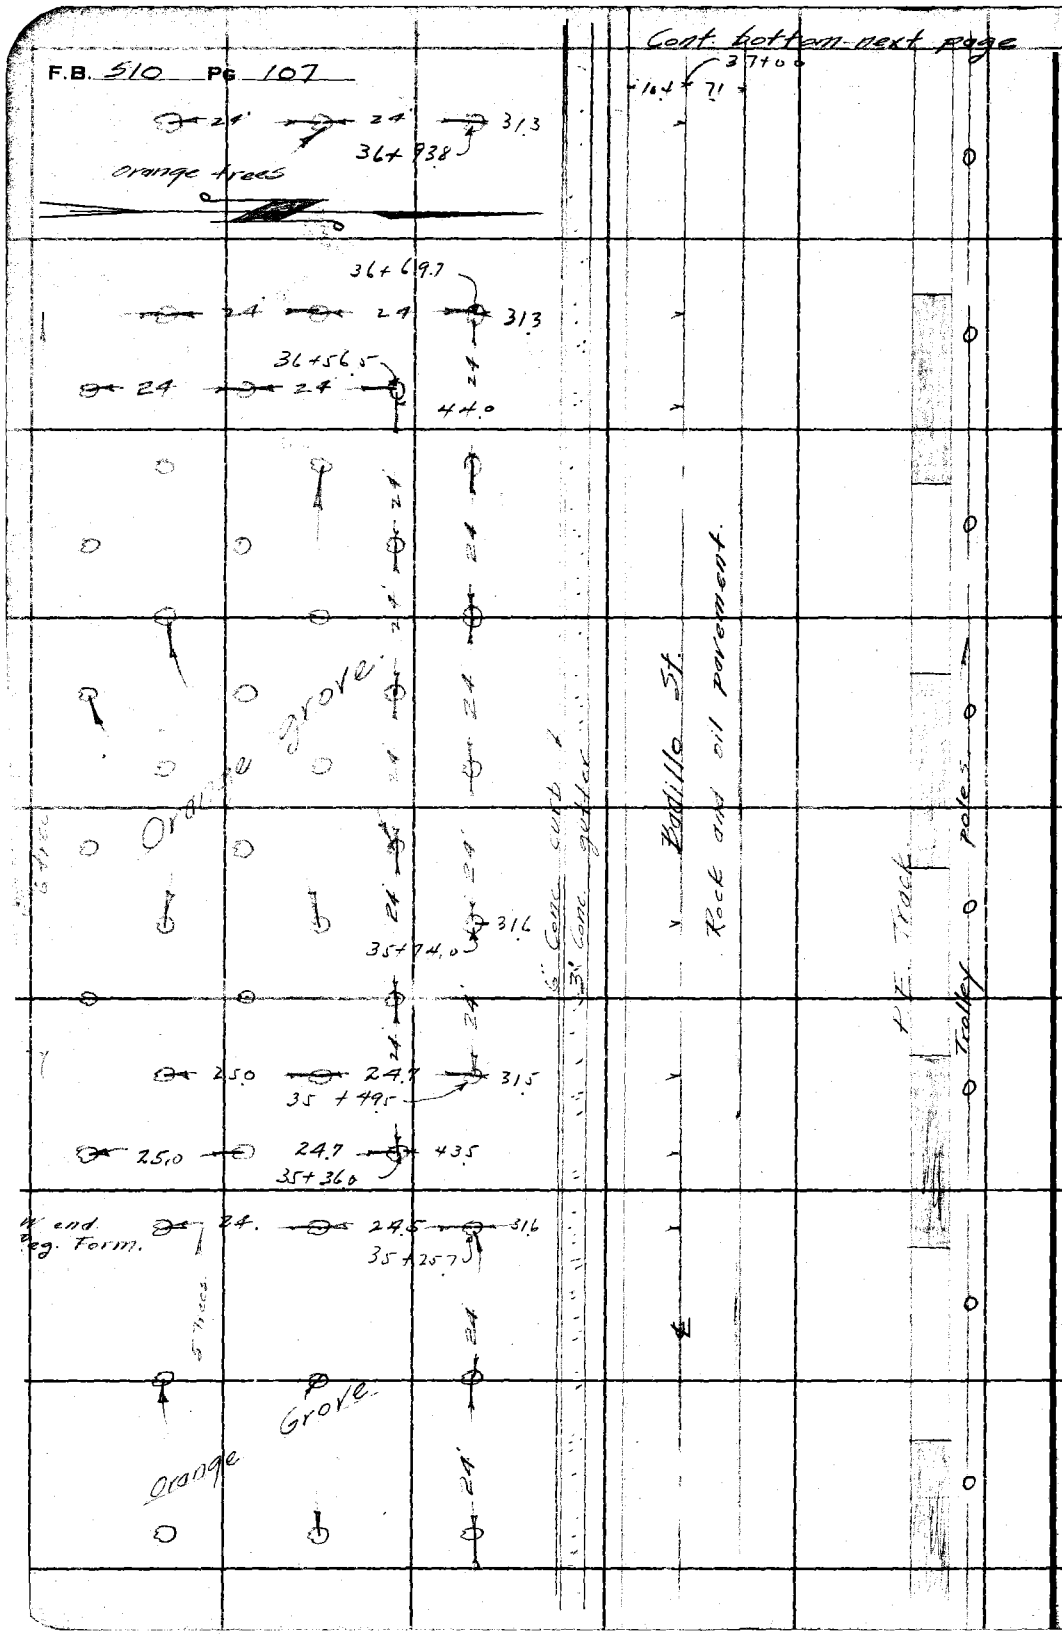

RETURN TO
LOS ANGELES COUNTY SURVEYOR
700 HALL OF RECORDS

Do not extend notes this side of this line

Note: ANY ADDITIONS OR CHANGES ON THIS SHEET MUST BE MADE OR CIRCLED IN Red Ink. WITH DATE AND NAME OF PERSON MAKING CHANGE.

Notes Ck'd by	Survey of Badillo St.
Map No. B-754-1	W.O. 7103 Tape No. 041 St'd 84 °F.
Office Work H N Bradstreet	Surveyed by Roscoe Jones
Checked	Notes Date 7-12-33
Date	Indexed A. C. Johnson

F.B. 510 PG. 108

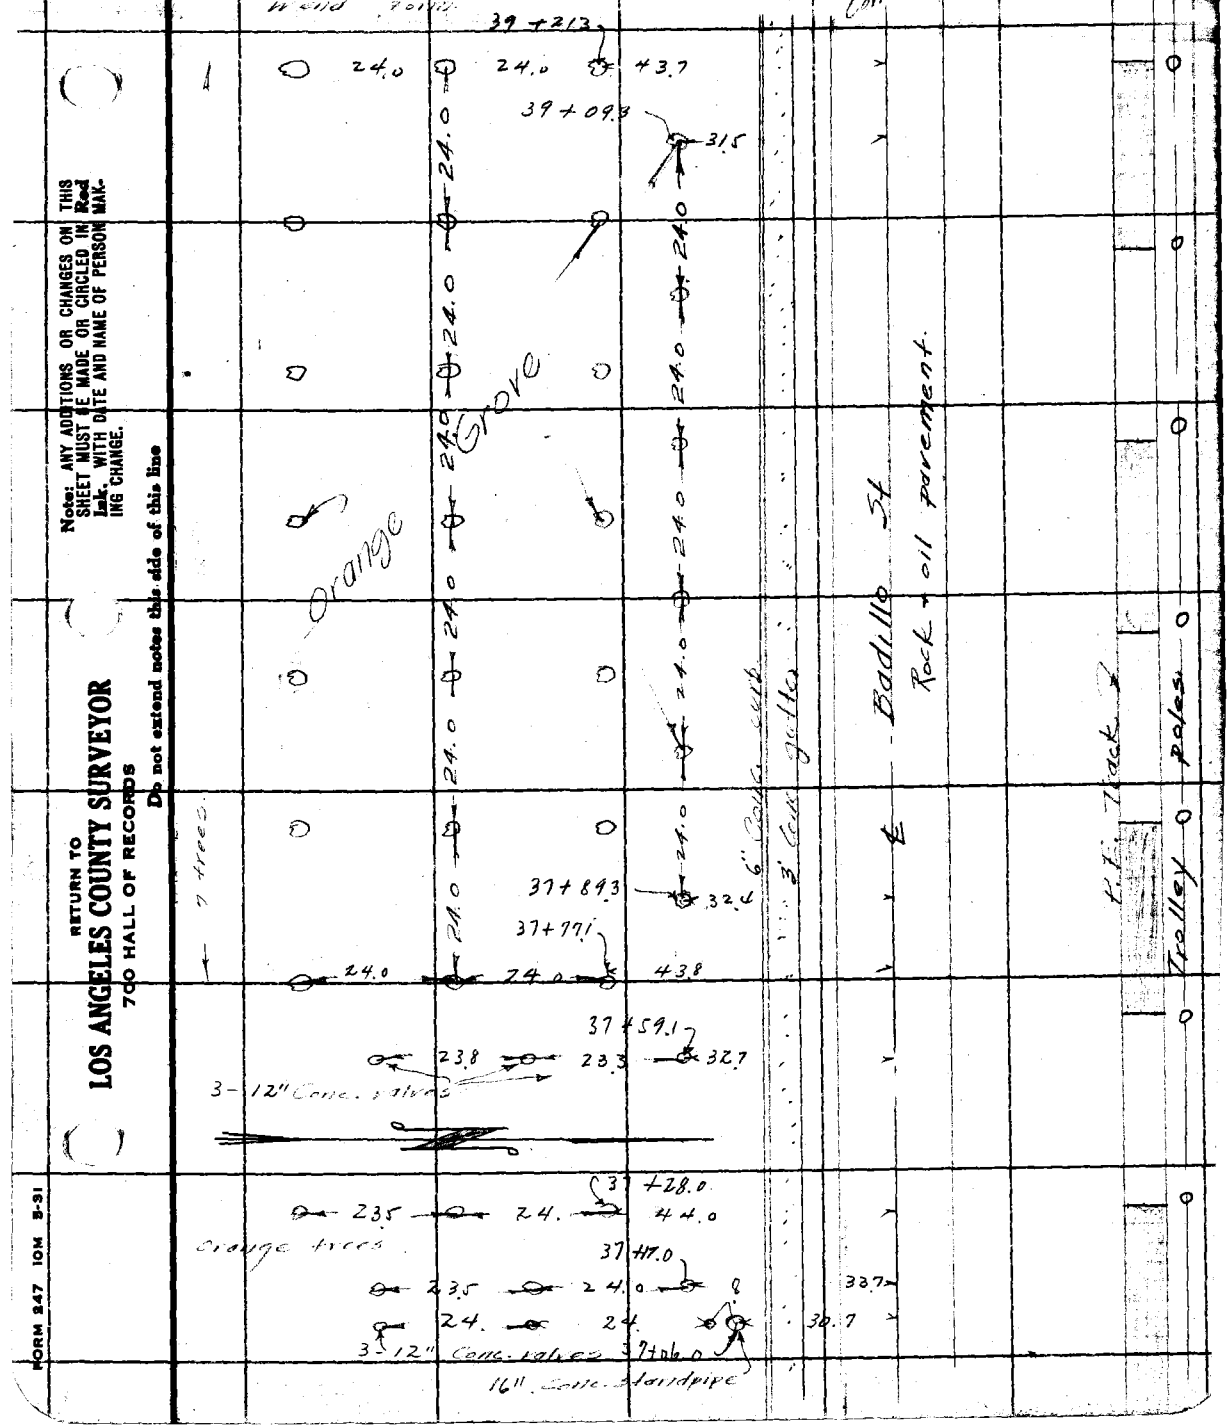

Note: ANY ADDITIONS OR CHANGES ON THIS SHEET MUST BE MADE OR CIRCLED IN Red Ink, WITH DATE AND NAME OF PERSON MAKING CHANGE.

Do not extend notes this side of this line

RETURN TO
LOS ANGELES COUNTY SURVEYOR
700 HALL OF RECORDS

FORM 247 10M 5-31

F.B. 510 PG 109

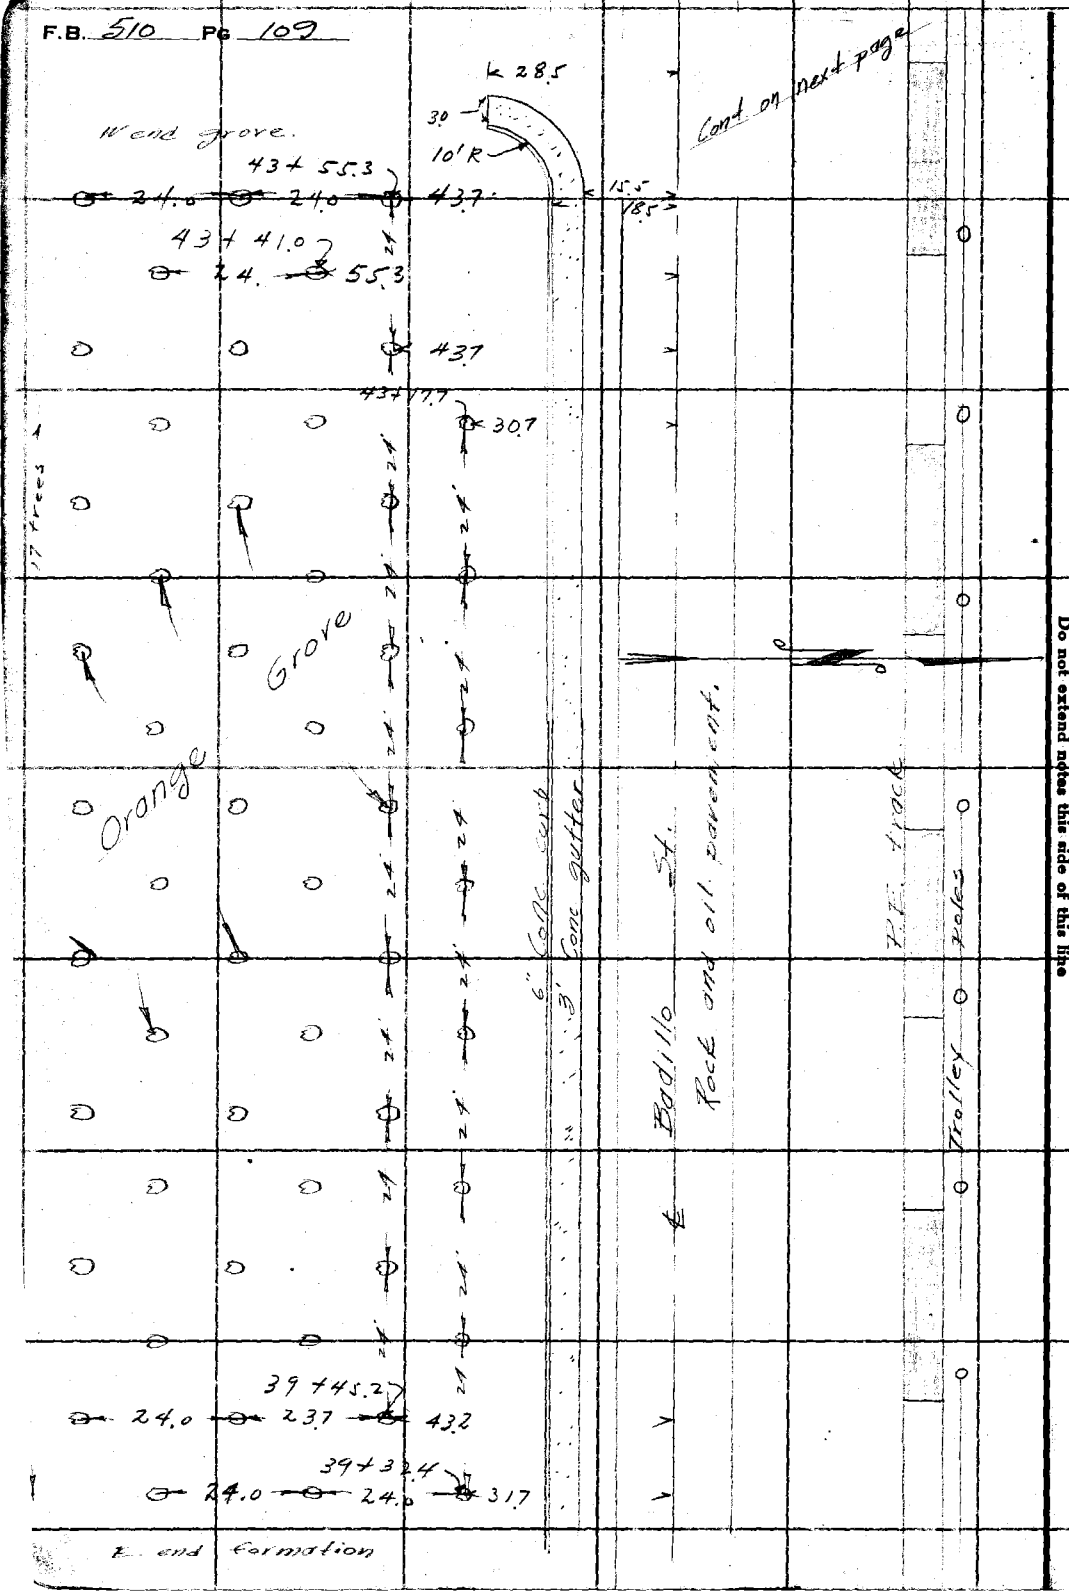

RETURN TO
LOS ANGELES COUNTY SURVEYOR
700 HALL OF RECORDS

Do not extend notes this side of this line

Note: ANY ADDITIONS OR CHANGES ON THIS SHEET MUST BE MADE OR CIRCLED IN Red Ink. WITH DATE AND NAME OF PERSON MAKING CHANGE.

F.B. 510 PG. 110

Notes Ck'd by	Survey of Badillo St.
Map No. [illegible]	W.O. 7103 Tape No. 041 St'd 84 °F.
Office Work H.N. Broadstreet	Surveyed by Rosecrans
Checked	Notes Date 7-12-33
Date	Indexed A. C. Johnson

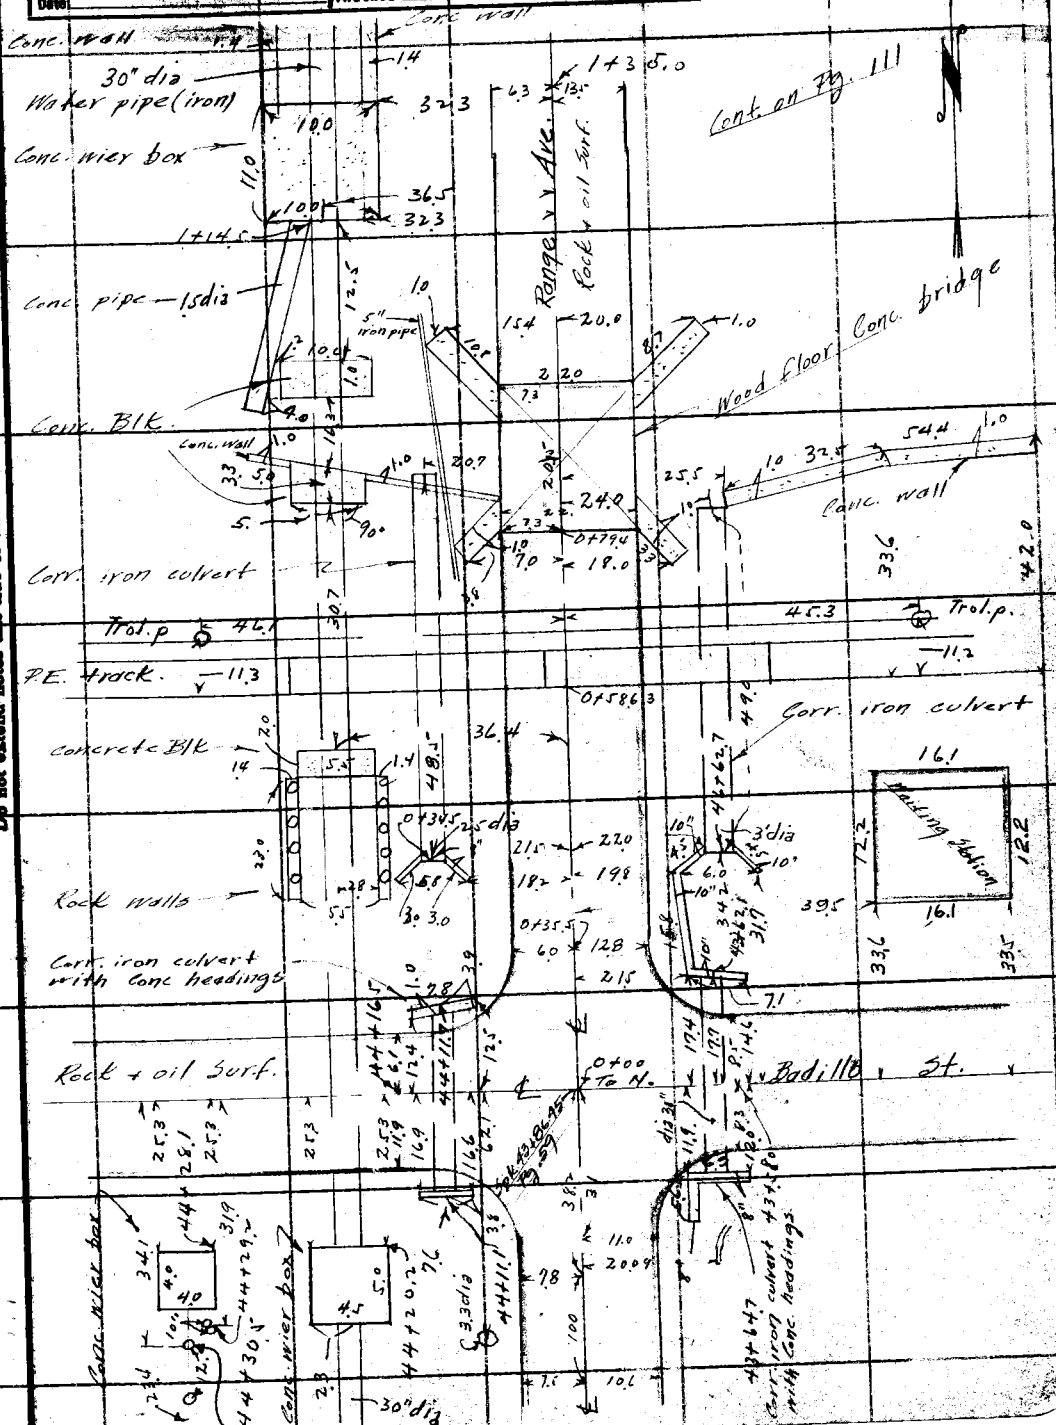

Cont. on Pg. 111

Note: ANY ADDITIONS OR CHANGES ON THIS SHEET MUST BE MADE OR CIRCLED IN Red Ink. WITH DATE AND NAME OF PERSON MAKING CHANGE.

Do not extend notes this side of this line

RETURN TO
LOS ANGELES COUNTY SURVEYOR
700 HALL OF RECORDS

FORM 247 10M 5-31

F.B. 510 Pg 111

Left bottom next page

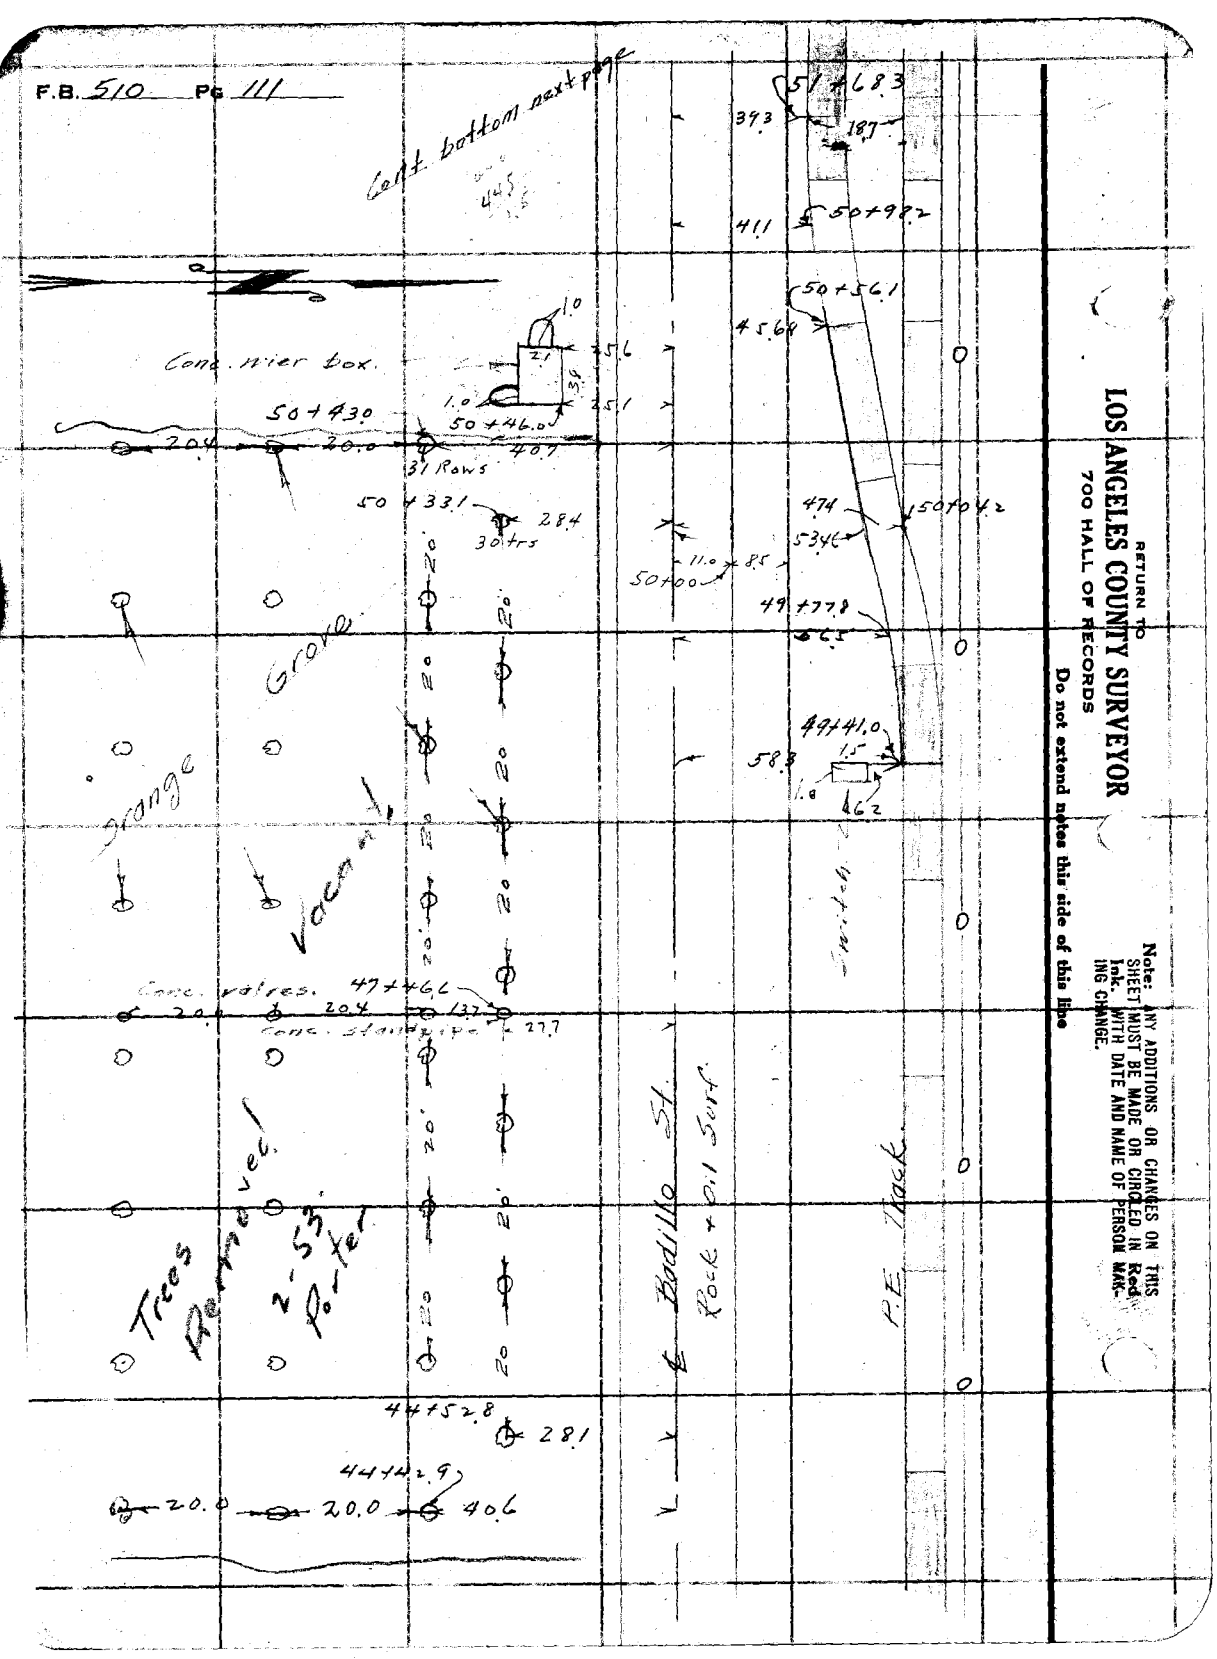

RETURN TO
LOS ANGELES COUNTY SURVEYOR
700 HALL OF RECORDS

Do not extend notes this side of this line

Note: ANY ADDITIONS OR CHANGES ON THIS SHEET MUST BE MADE OR CIRCLED IN Red Ink. WITH DATE AND NAME OF PERSON MAKING CHANGE.

Notes Ck'd by	Survey of Badillo St
Map No. B-754-1	W.O. 7103 Tape No. 041 St'd 84 °F.
Office Work H.N. Bradstreet	Surveyed by Rosecrans
Checked	Notes Date 7-18-33
Date	Indexed A. C. Johnson

F.B. 510 PG. 112

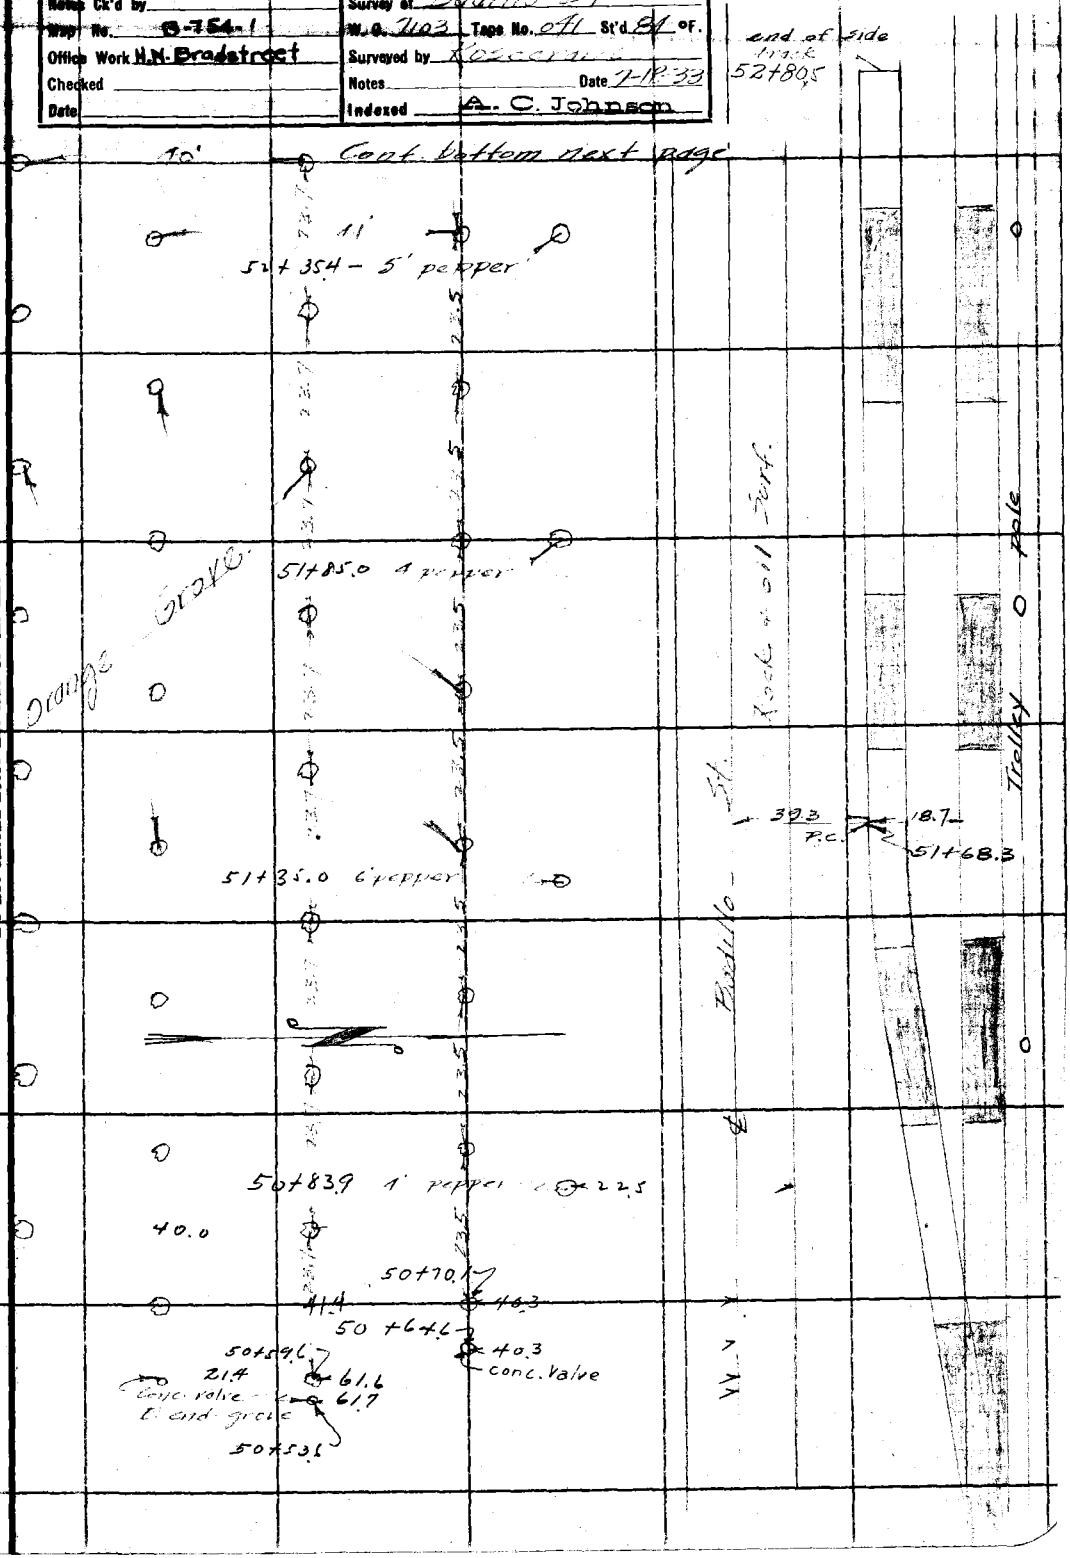

Note: ANY ADDITIONS OR CHANGES ON THIS SHEET MUST BE MADE OR CIRCLED IN Red Ink. WITH DATE AND NAME OF PERSON MAKING CHANGE.

Do not extend notes this side of this line

RETURN TO
LOS ANGELES COUNTY SURVEYOR
700 HALL OF RECORDS

FORM 247 10M 5-31

RETURN TO
LOS ANGELES COUNTY SURVEYOR
700 HALL OF RECORDS

Note: ANY ADDITIONS OR CHANGES ON THIS SHEET MUST BE MADE OR CIRCLED IN Red Ink. WITH DATE AND NAME OF PERSON MAKING CHANGE.

Do not extend notes this side of this line

F.B. 510 PG 113

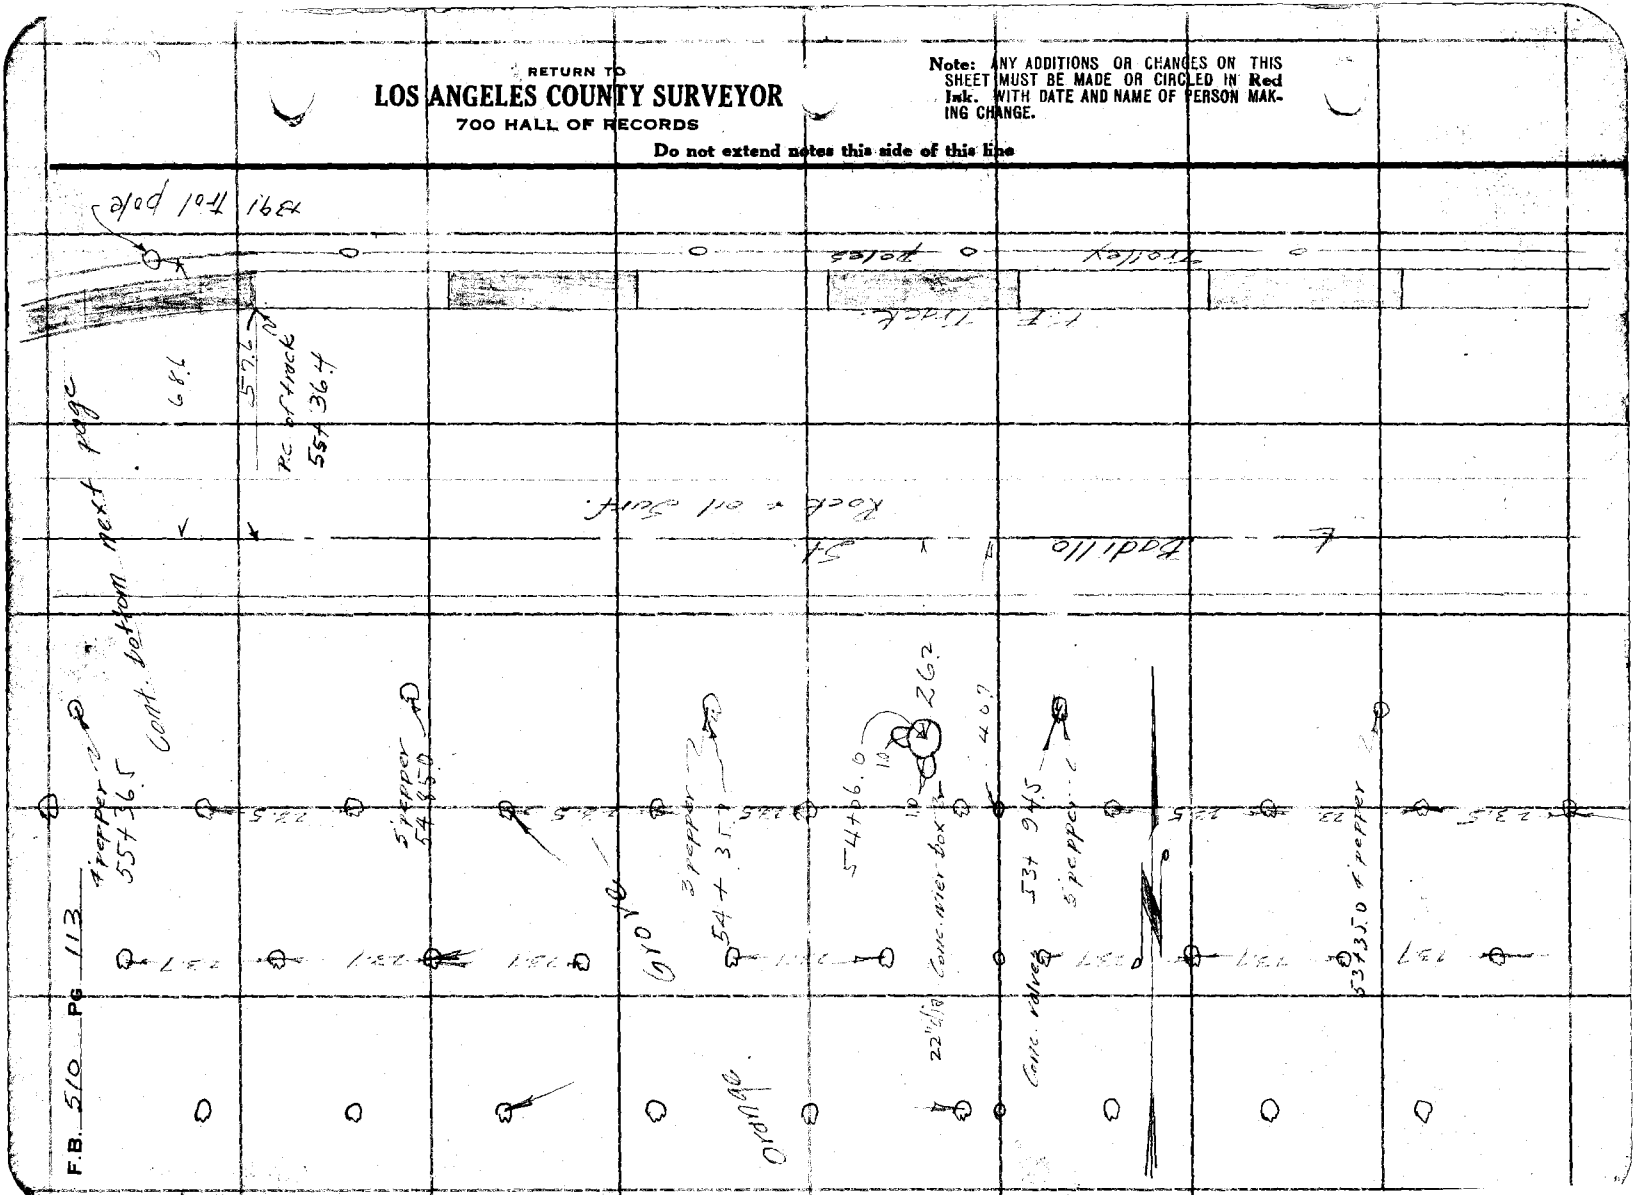

Notes Ck'd by:	Survey of Badillo St.
Map No. B-154-1	W.O. 7103 Tran No. 041 St'd 84 °F.
Office Work H.K. Bradstreet	Surveyed by Rosecrans
Checked	Notes Date 7-12-33
Date	Indexed A. C. Johnson

F.B. 510 PG. 114

Cont bottom Pg 116

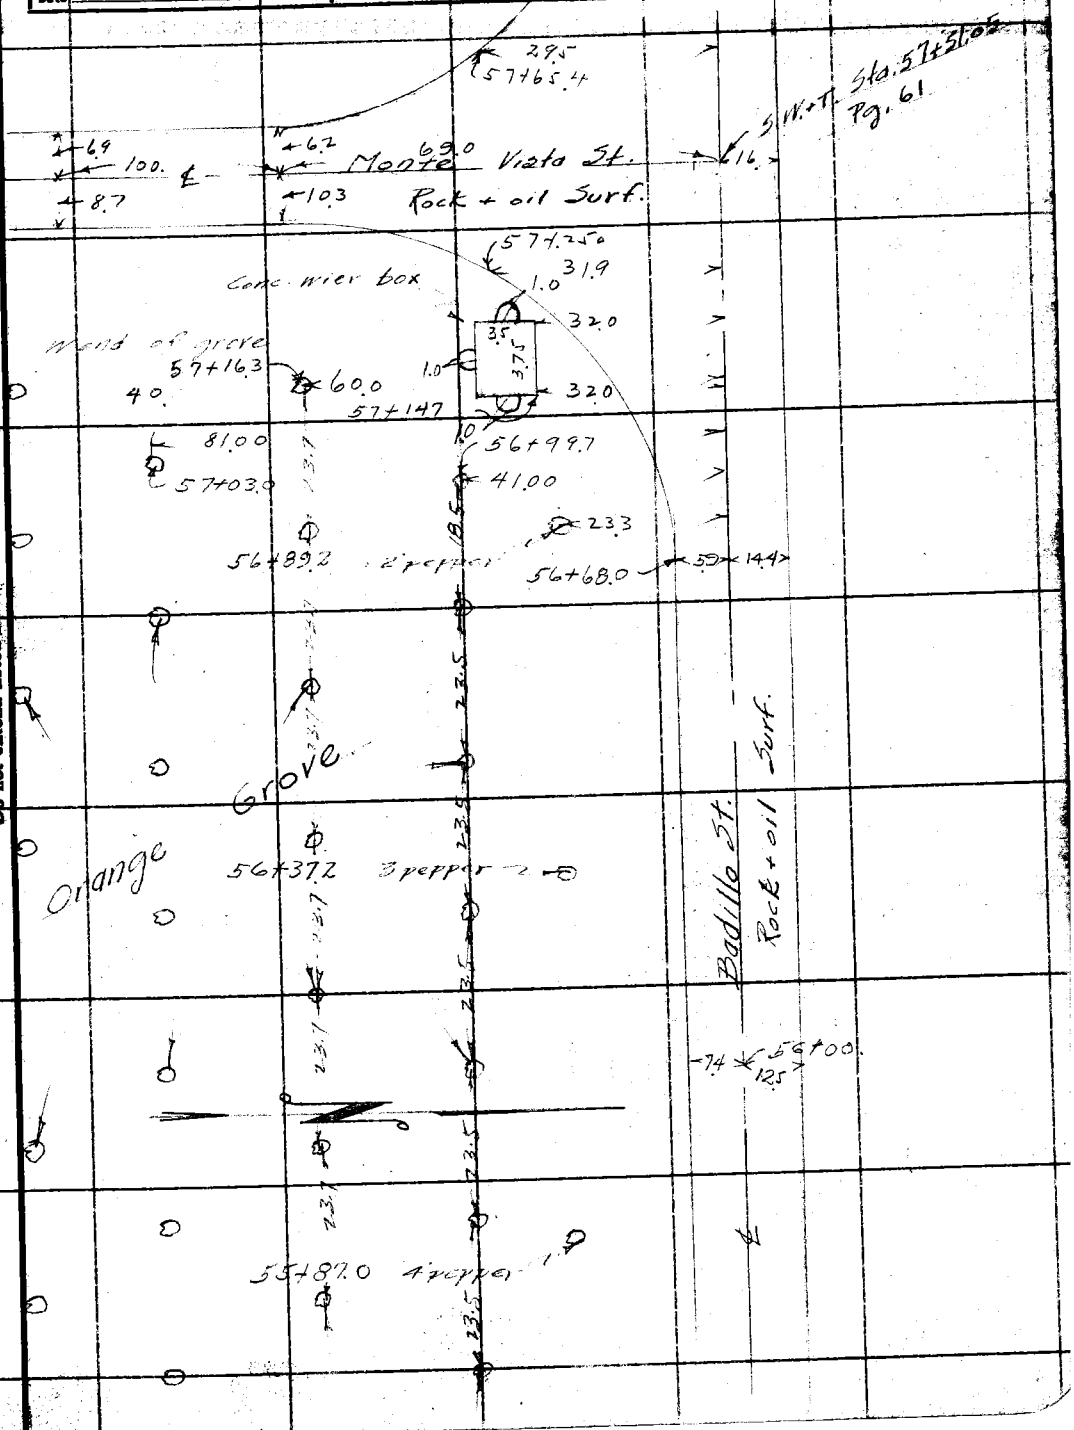

Note: ANY ADDITIONS OR CHANGES ON THIS SHEET MUST BE MADE OR CIRCLED IN Red Ink, WITH DATE AND NAME OF PERSON MAKING CHANGE.

Do not extend notes this side of this line

RETURN TO
LOS ANGELES COUNTY SURVEYOR
700 HALL OF RECORDS

FORM 247 10M 5-31

F.B. 510 Pg 115

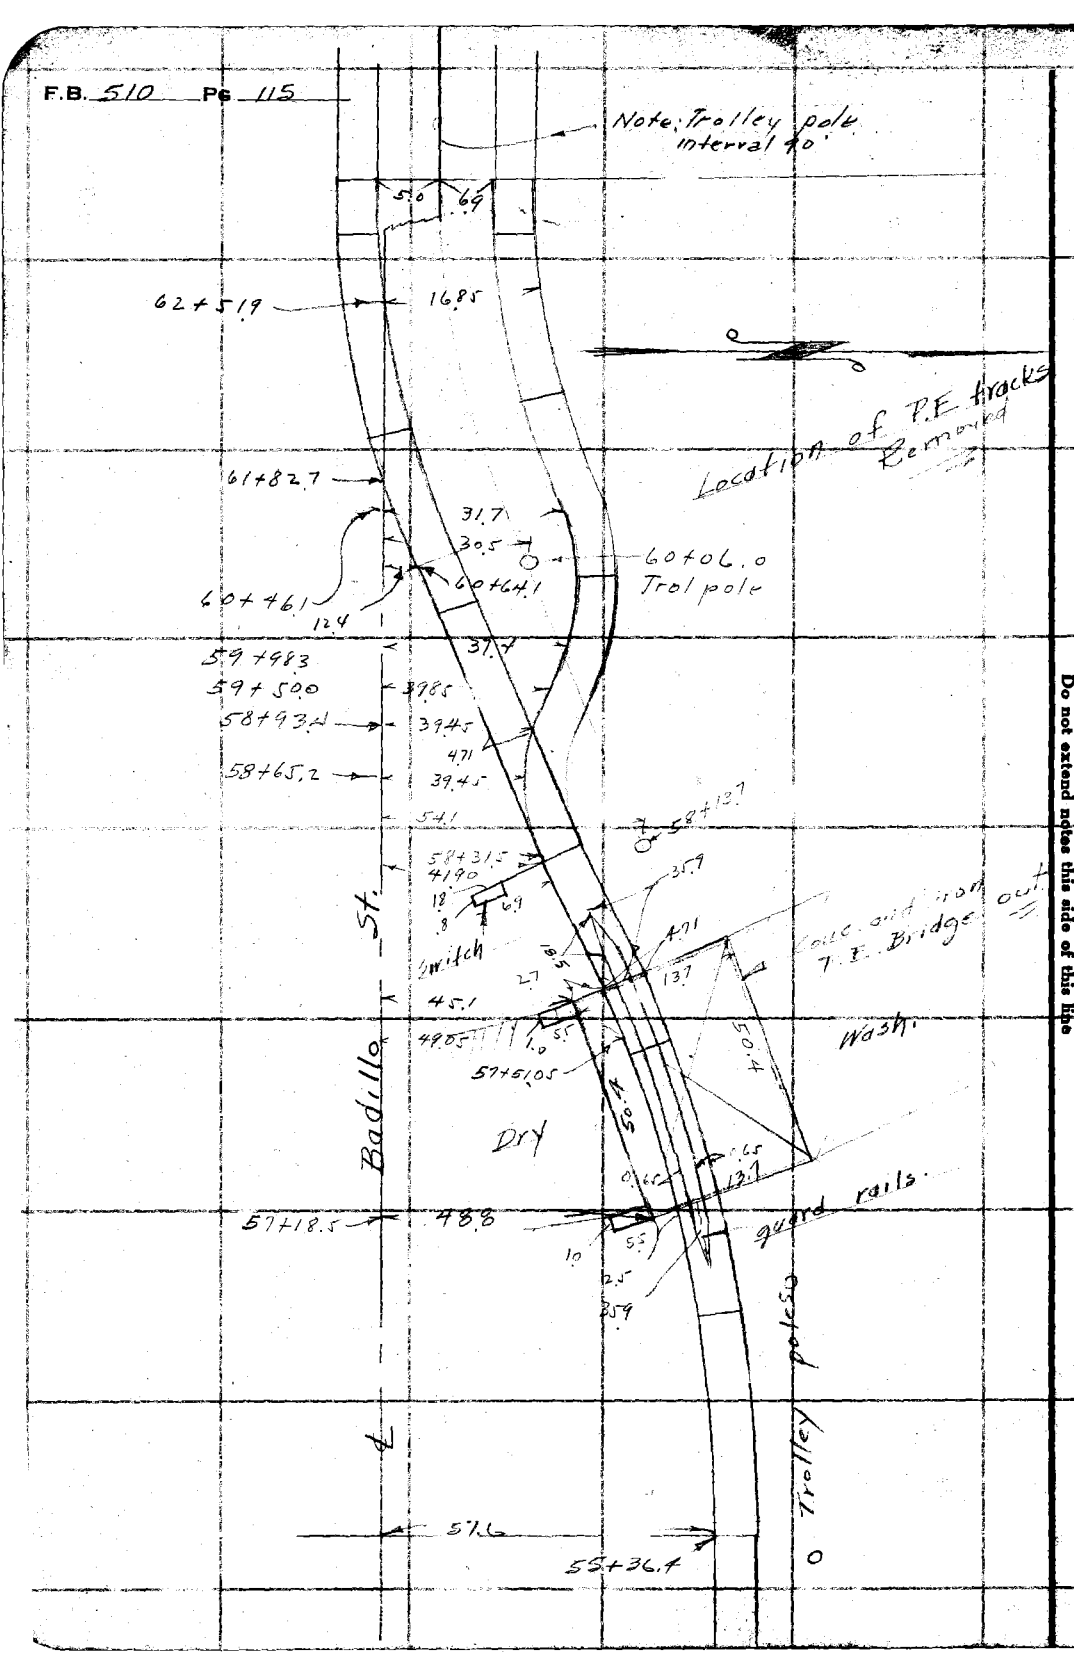

RETURN TO
LOS ANGELES COUNTY SURVEYOR
700 HALL OF RECORDS

Do not extend notes this side of this line

Note: ANY ADDITIONS OR CHANGES ON THIS SHEET MUST BE MADE OR CIRCLED IN Red Ink WITH DATE AND NAME OF PERSON MAKING CHANGE.

Notes Ch'd by	Survey of Badillo St
Map No. B-154-1	W.O. 7103 Tape No. 041 Sh'd 84 of
Office Work H.N. Bradstreet	Surveyed by Rosecrans
Checked	Notes Date 7-13-33
Date	Indexed A. C. Johnson

F.B. 510 PG. 116

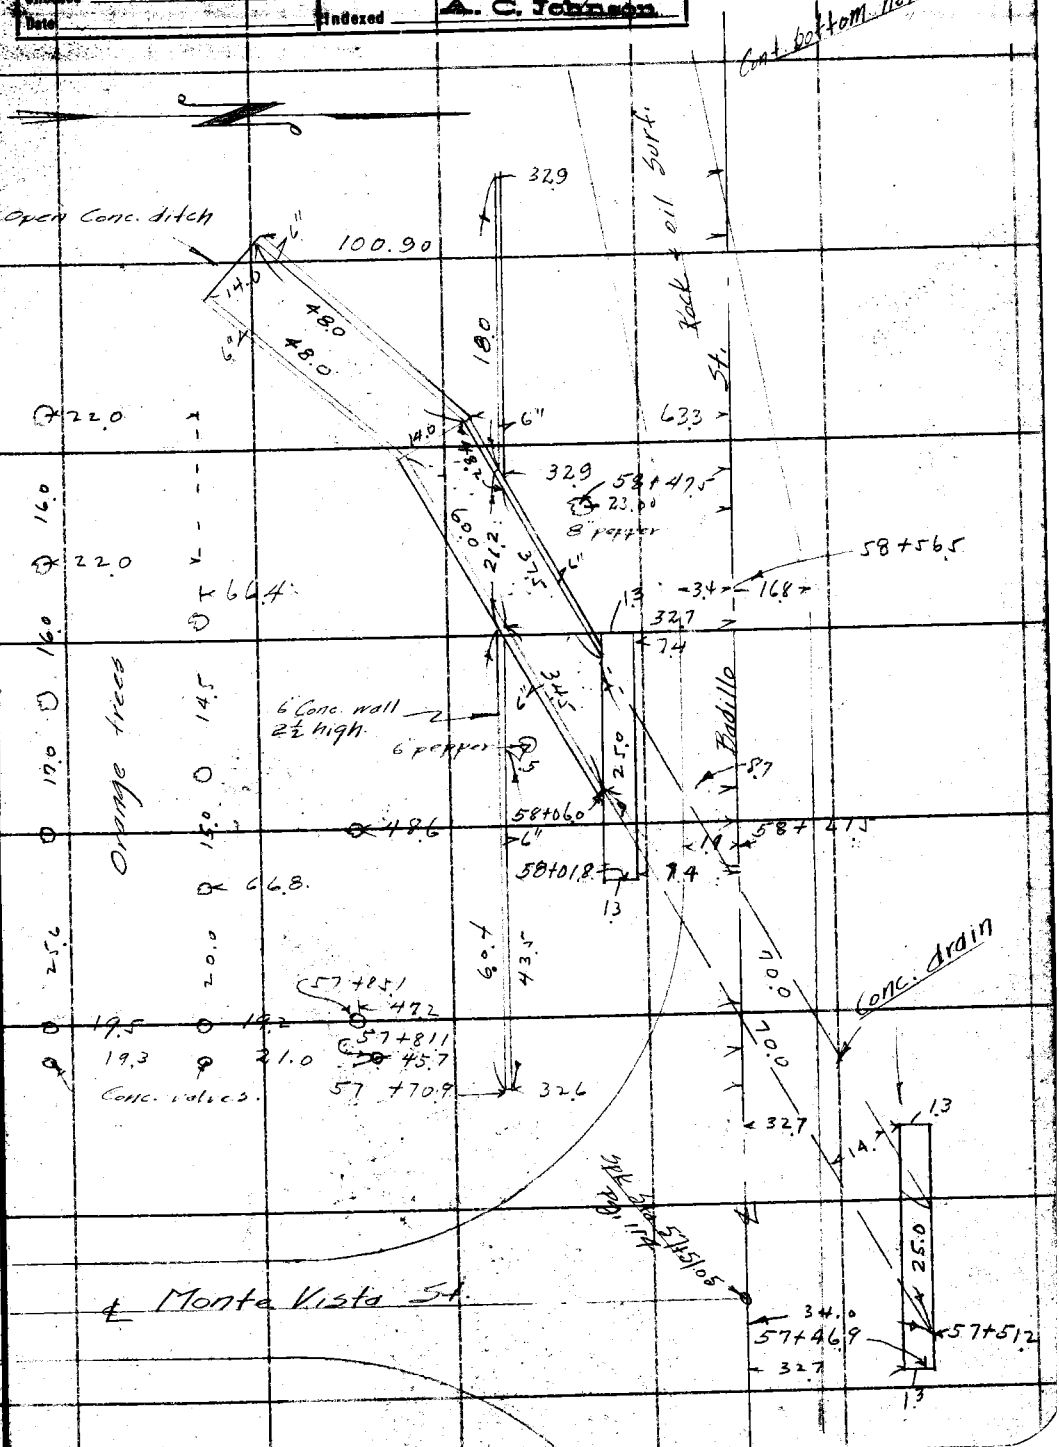

Note: ANY ADDITIONS OR CHANGES ON THIS SHEET MUST BE MADE OR CIRCLED IN Red Ink, WITH DATE AND NAME OF PERSON MAKING CHANGE.

RETURN TO
LOS ANGELES COUNTY SURVEYOR
700 HALL OF RECORDS
Do not extend notes this side of this line

FORM 247 10M 5-31

F.B. 510 Pg. 117

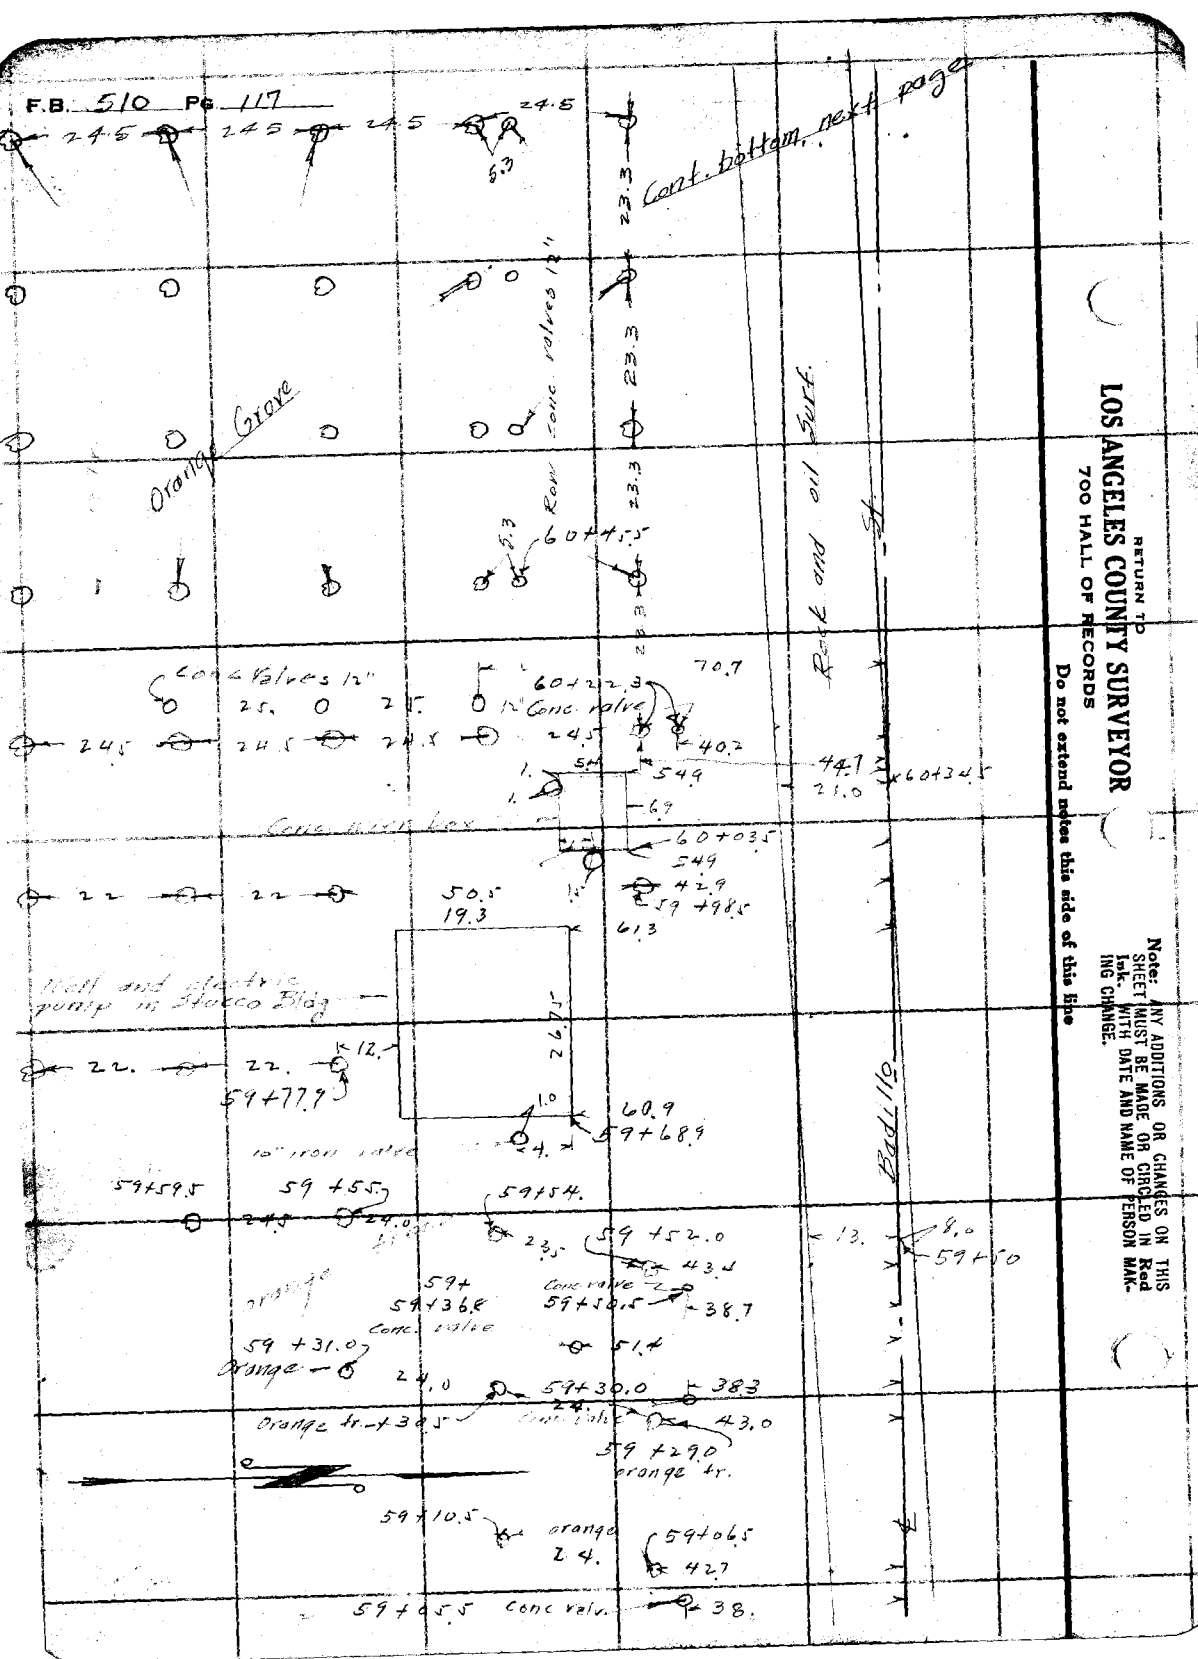

RETURN TO
LOS ANGELES COUNTY SURVEYOR
700 HALL OF RECORDS
Do not extend notes this side of this line

Note: ANY ADDITIONS OR CHANGES ON THIS SHEET MUST BE MADE OR CIRCLED IN Red Ink. WITH DATE AND NAME OF PERSON MAKING CHANGE.

Notes Ck'd by		Survey of Badillo St.	F.B. 510 Pg. 118
Map No. B-754.1		W. O. 7103 Tape No. 041 St'd 66 °F.	
Office Work H.N. Bradstreet		Surveyed by Robertson	
Checked		Notes	Date 7-13-33
Date		Indexed	A. C. Johnson

Cont. bottom next page

Note: ANY ADDITIONS OR CHANGES ON THIS SHEET MUST BE MADE OR CIRCLED IN Red Ink. WITH DATE AND NAME OF PERSON MAKING CHANGE.

Do not extend notes this side of this line

RETURN TO
LOS ANGELES COUNTY SURVEYOR
700 HALL OF RECORDS

FORM 847 10M 8-31

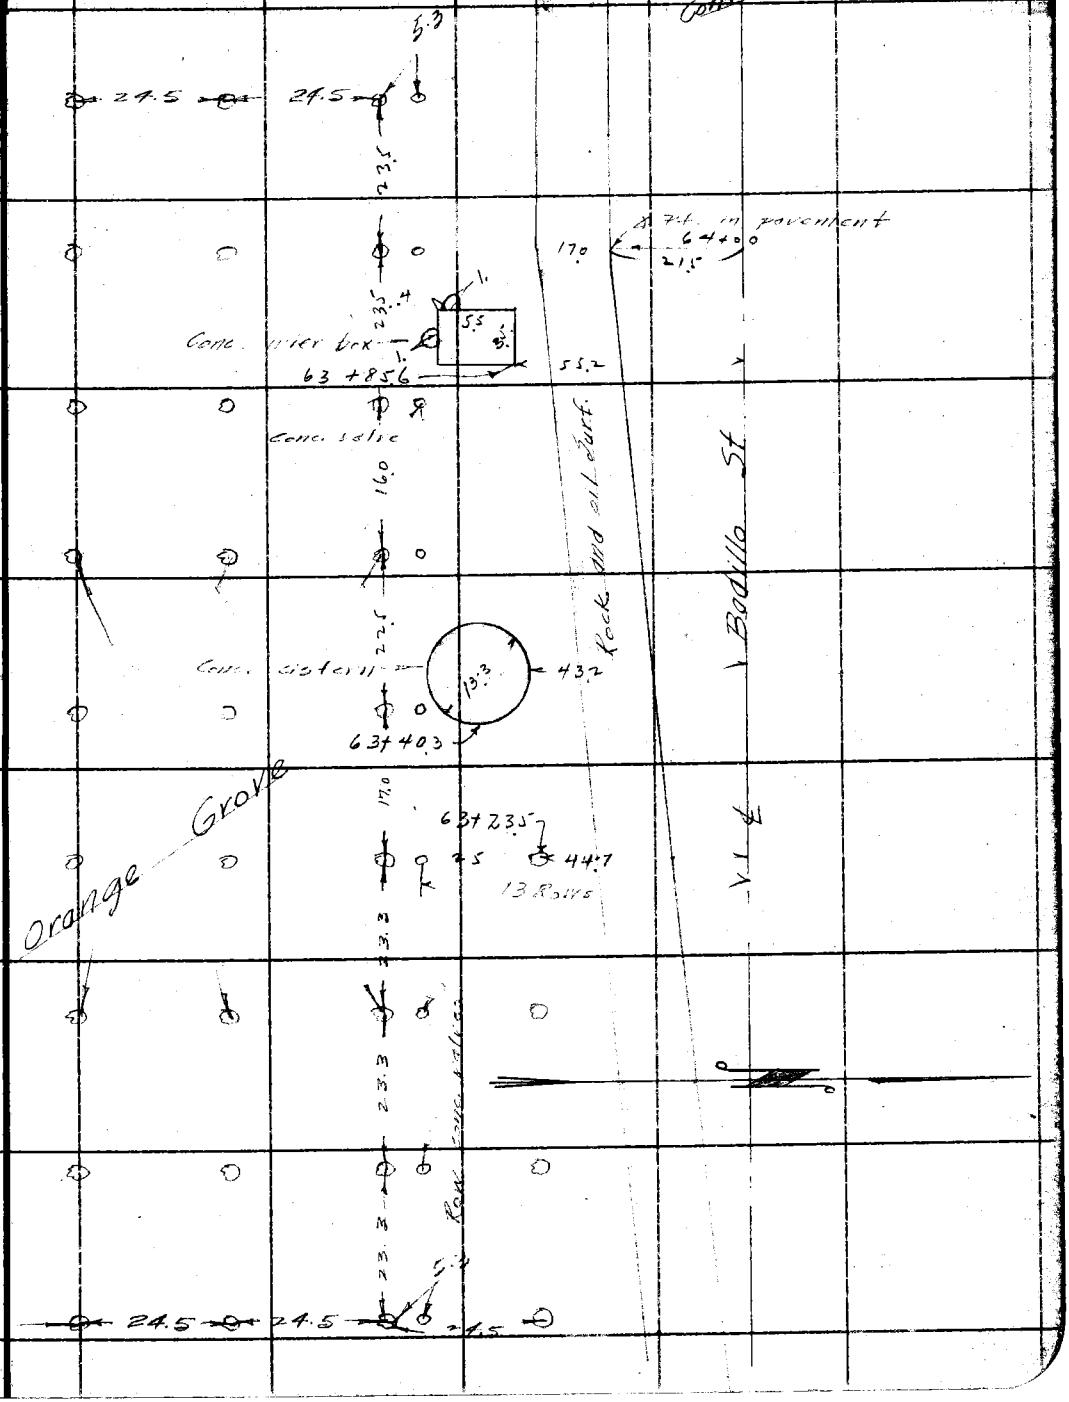

F.B. 510 PG 119

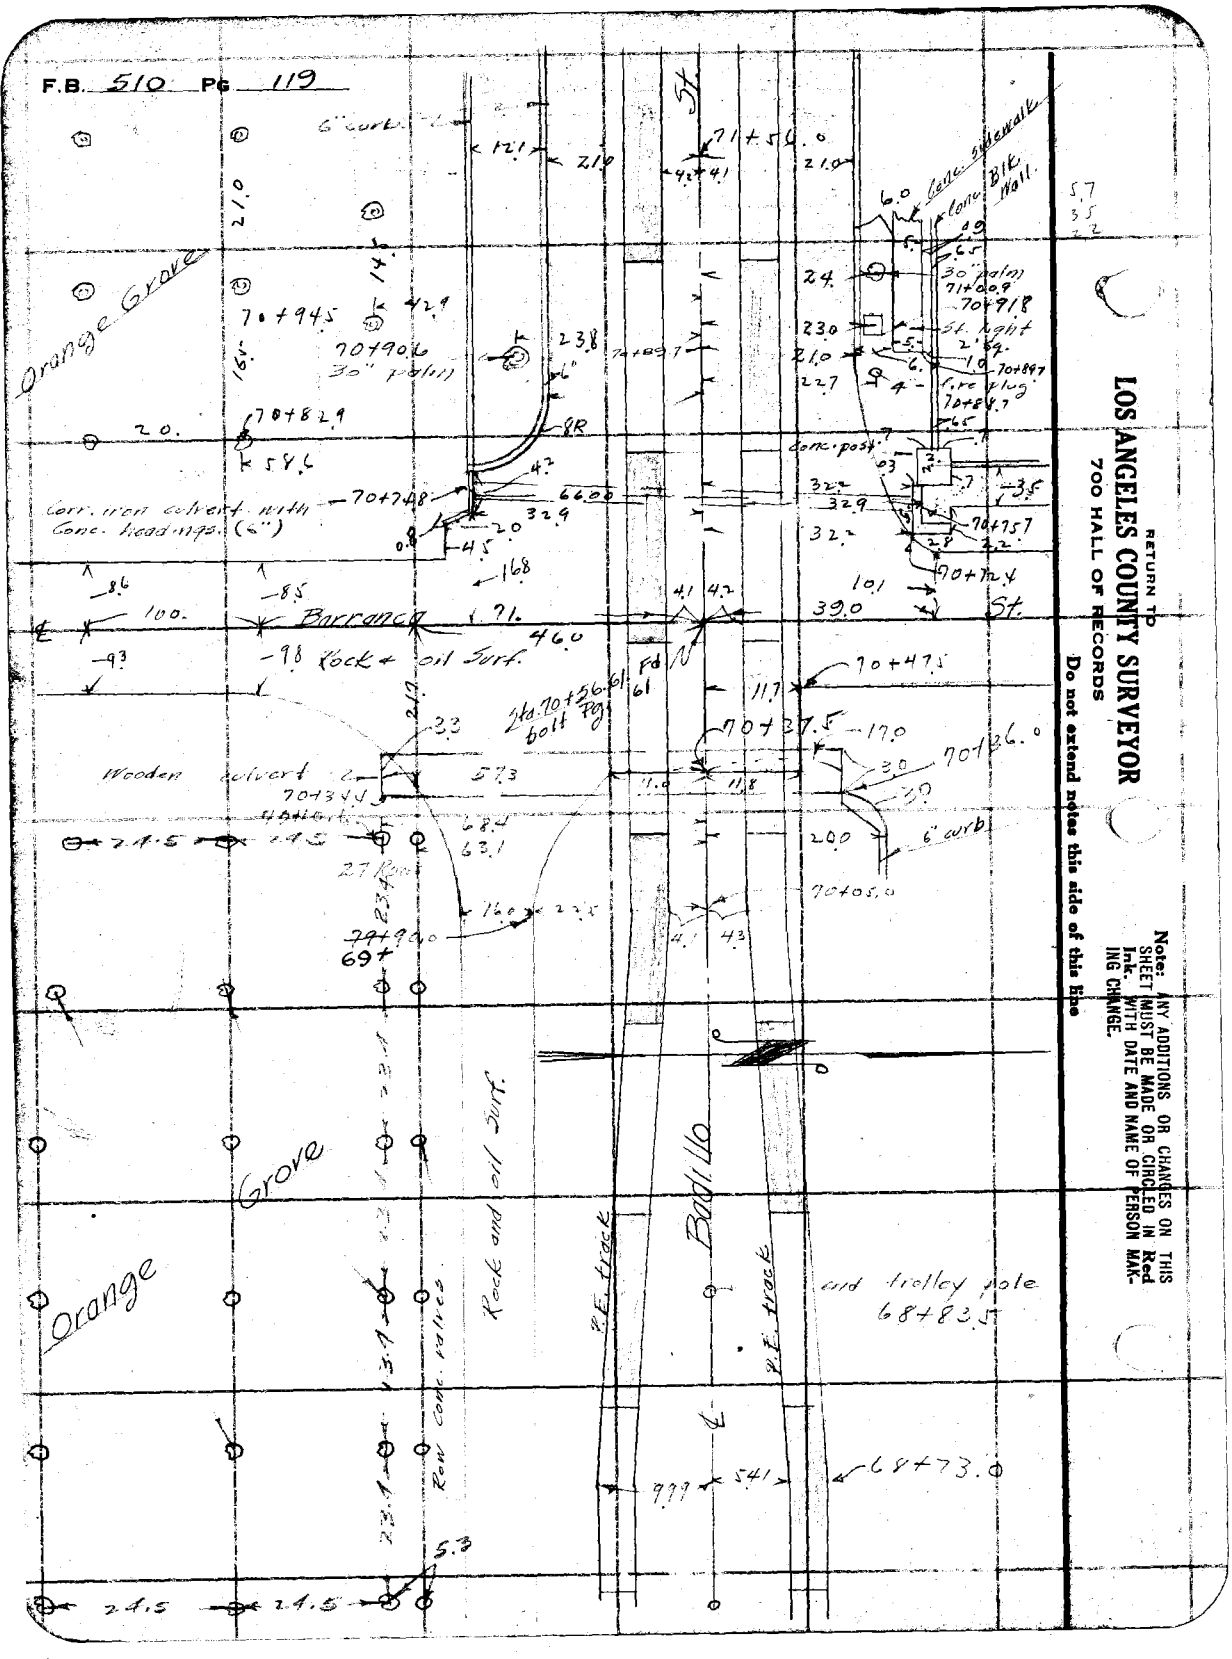

RETURN TO
LOS ANGELES COUNTY SURVEYOR
700 HALL OF RECORDS

Do not extend notes this side of this line

Note: ANY ADDITIONS OR CHANGES ON THIS SHEET MUST BE MADE OR CIRCLED IN Red Ink. WITH DATE AND NAME OF PERSON MAKING CHANGE.

Notes Ck'd by	Survey of Badillo St.
Map No. B-754-1	W. O. 7103 Tape No. 041 St'd 84 °F.
Office Work H.N. Bradstreet	Surveyed by Rosecrans
Checked	Notes Date 7-14-33
Date	Indexed C. Johnson

F.B. 510 PG. 120

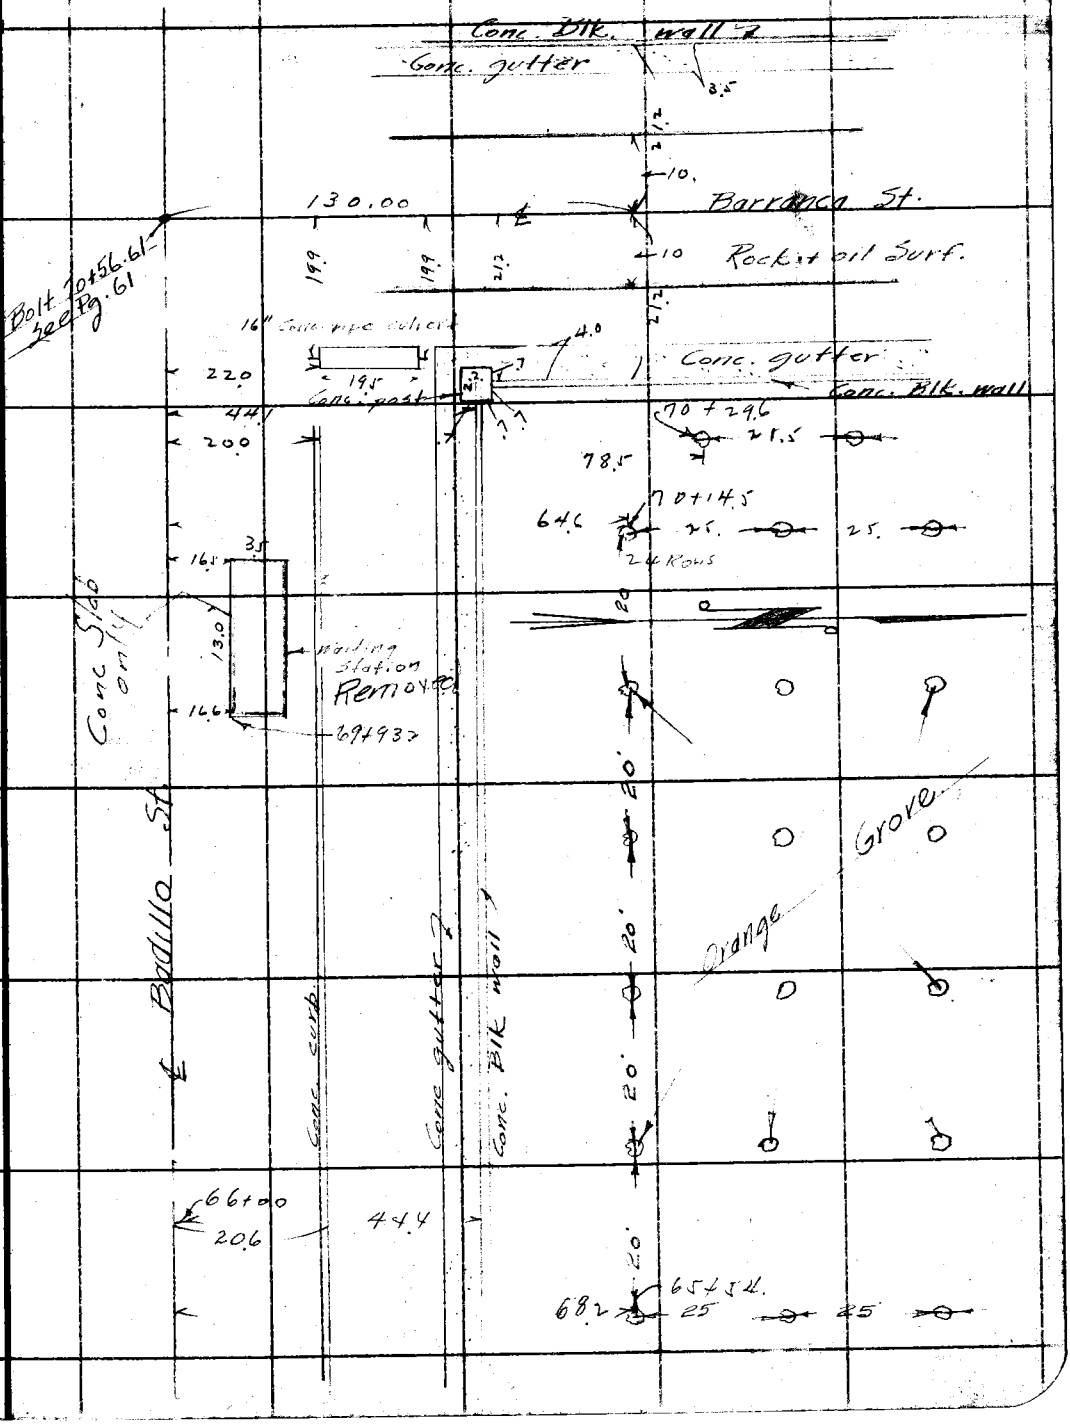

Note: ANY ADDITIONS OR CHANGES ON THIS SHEET MUST BE MADE OR CIRCLED IN Red Ink. WITH DATE AND NAME OF PERSON MAKING CHANGE.

RETURN TO
LOS ANGELES COUNTY SURVEYOR
700 HALL OF RECORDS

Do not extend notes this side of this line

FORM 247 10M 5-31

F.B. 510 Pg 121

Cont. bottom page 120

RETURN TO
LOS ANGELES COUNTY SURVEYOR
700 HALL OF RECORDS
Do not extend notes this side of this line

Note: ANY ADDITIONS OR CHANGES ON THIS SHEET MUST BE MADE OR CIRCLED IN Red Ink. WITH DATE AND NAME OF PERSON MAKING CHANGE.

Notes Ck'd by	Survey of Badillo St.
Map No. B-754-1	W. O. 7103 Tape No. 041 St'd 84 °F.
Office Work N.N. Bradstreet	Surveyed by Rosecrans
Checked	Notes Date 7-13-33
Date	Indexed A. C. Johnson

F.B. 510 PG. 122

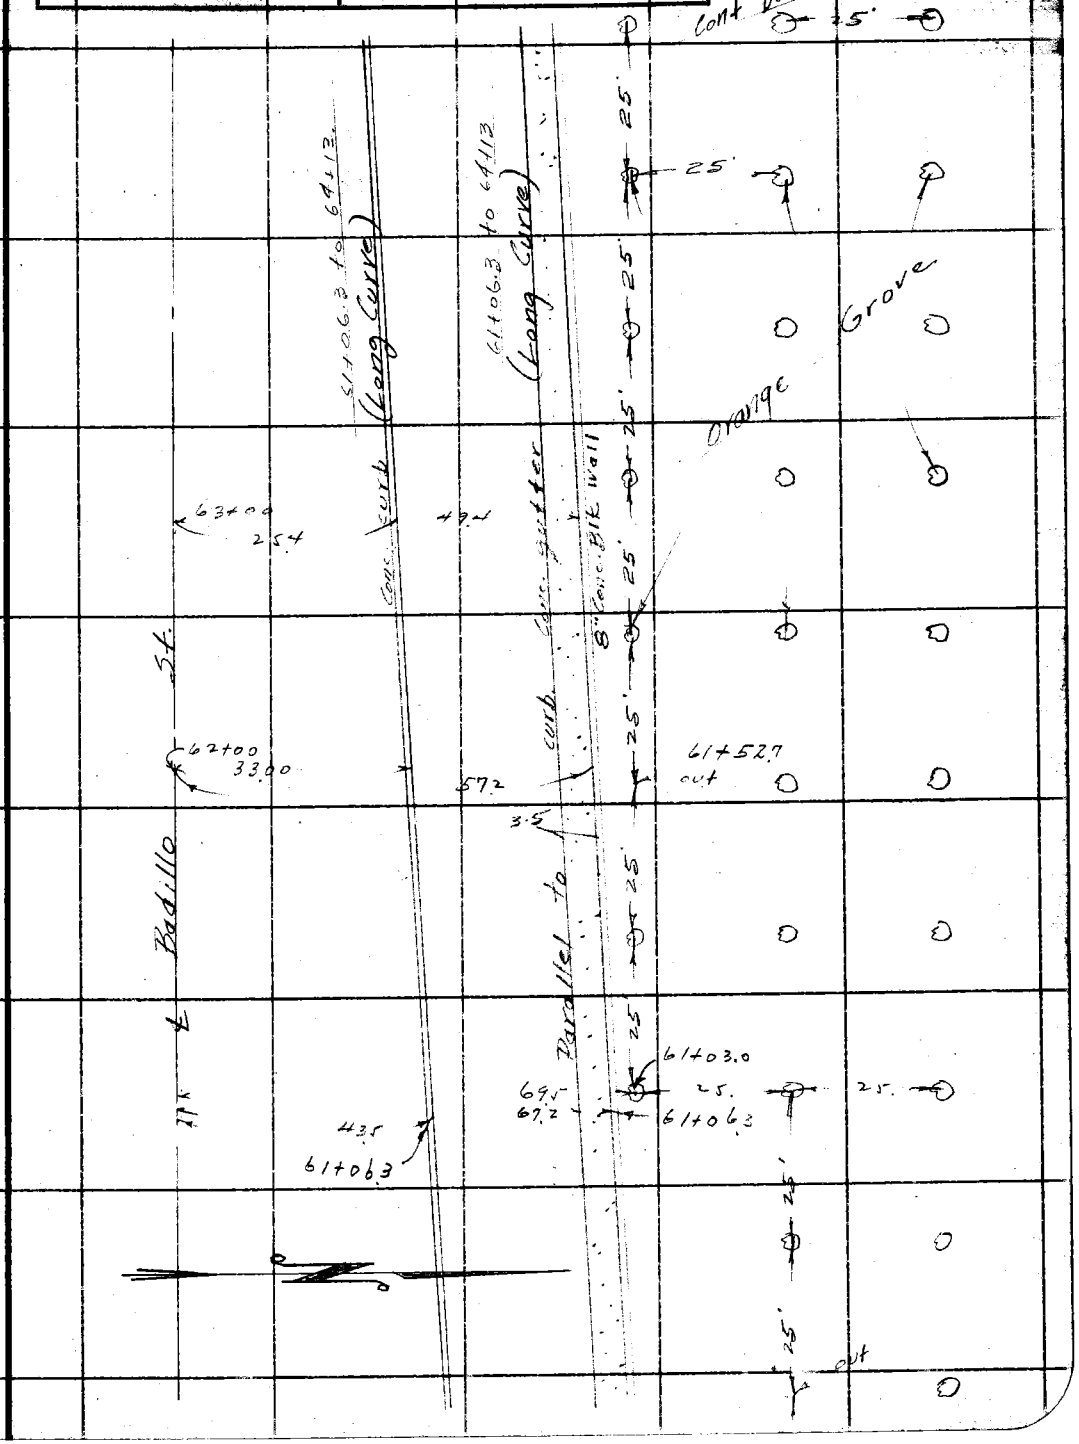

Note: ANY ADDITIONS OR CHANGES ON THIS SHEET MUST BE MADE (OR CIRCLED IN Red Ink. WITH DATE AND NAME OF PERSON MAKING CHANGE.

RETURN TO
LOS ANGELES COUNTY SURVEYOR
700 HALL OF RECORDS

Do not extend notes this side of this line

FORM 247 10M 5-31

F.B. 510 PG. 123

Cont. bottom Pg 122

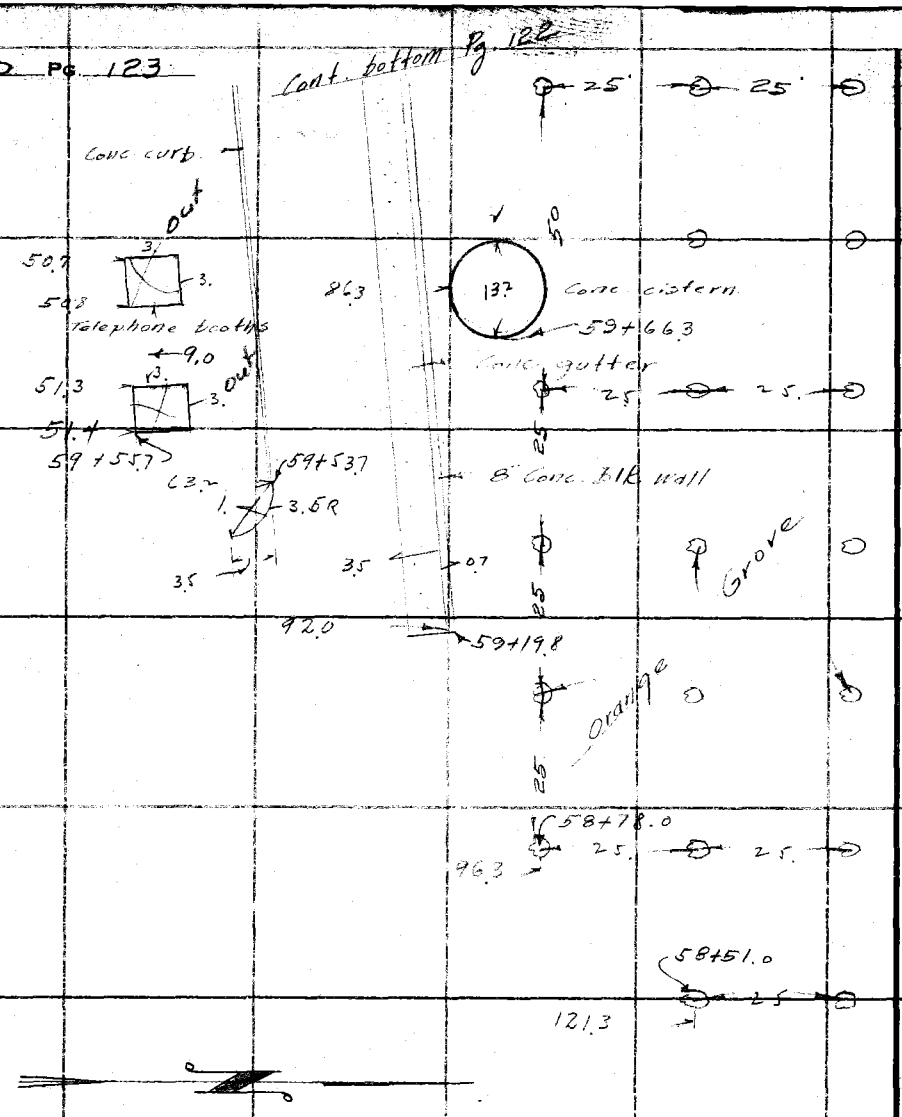

RETURN TO
LOS ANGELES COUNTY SURVEYOR
700 HALL OF RECORDS

Do not extend notes this side of this line

Note: ANY ADDITIONS OR CHANGES ON THIS SHEET MUST BE MADE OR CIRCLED IN Red Ink. WITH DATE AND NAME OF PERSON MAKING CHANGE.

Notes Ck'd by	Survey of Badillo St
Map No. B-754-3	W. O. 7103 Tape No. 04 St'd 84 °F,
Office Work H.N. Bradstreet	Surveyed by [illegible]
Checked	Notes Date 7-13-32
Date	Indexed A. C. Johnson

F.B. 510 PG. 124

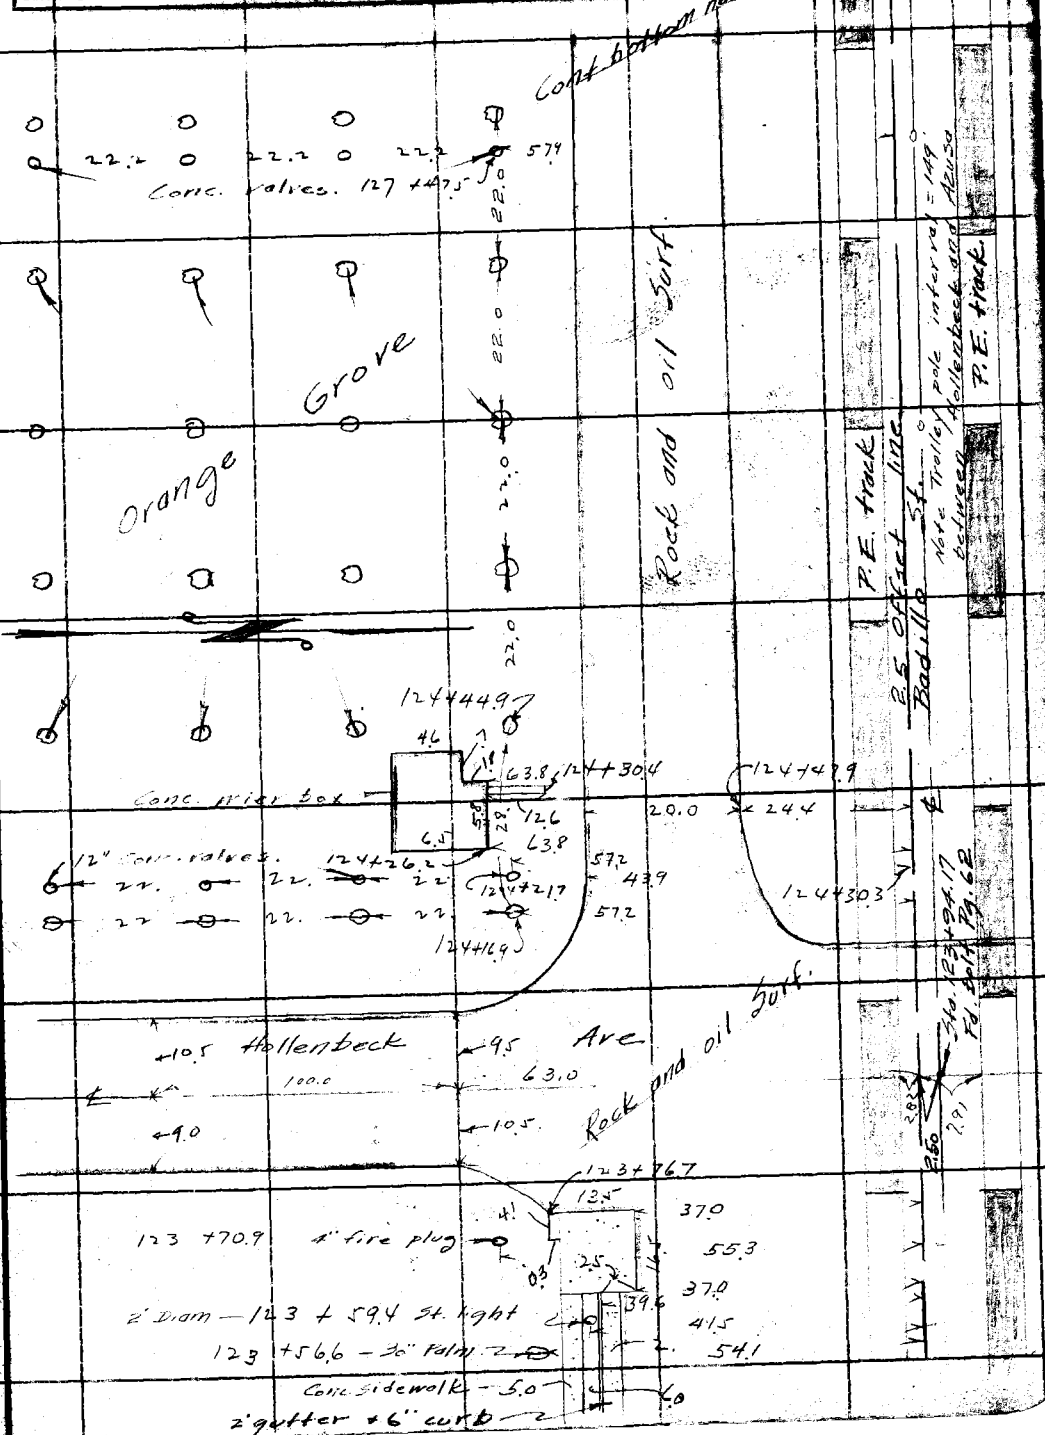

Note: ANY ADDITIONS OR CHANGES ON THIS SHEET MUST BE MADE IOR CIRCLED IN Red Ink. WITH DATE AND NAME OF PERSON MAKING CHANGE.

Do not extend notes this side of this line

RETURN TO
LOS ANGELES COUNTY SURVEYOR
700 HALL OF RECORDS

FORM 247 IOM 5-31

F.B. 510 Pg. 125

Cont. bottom Pg 128

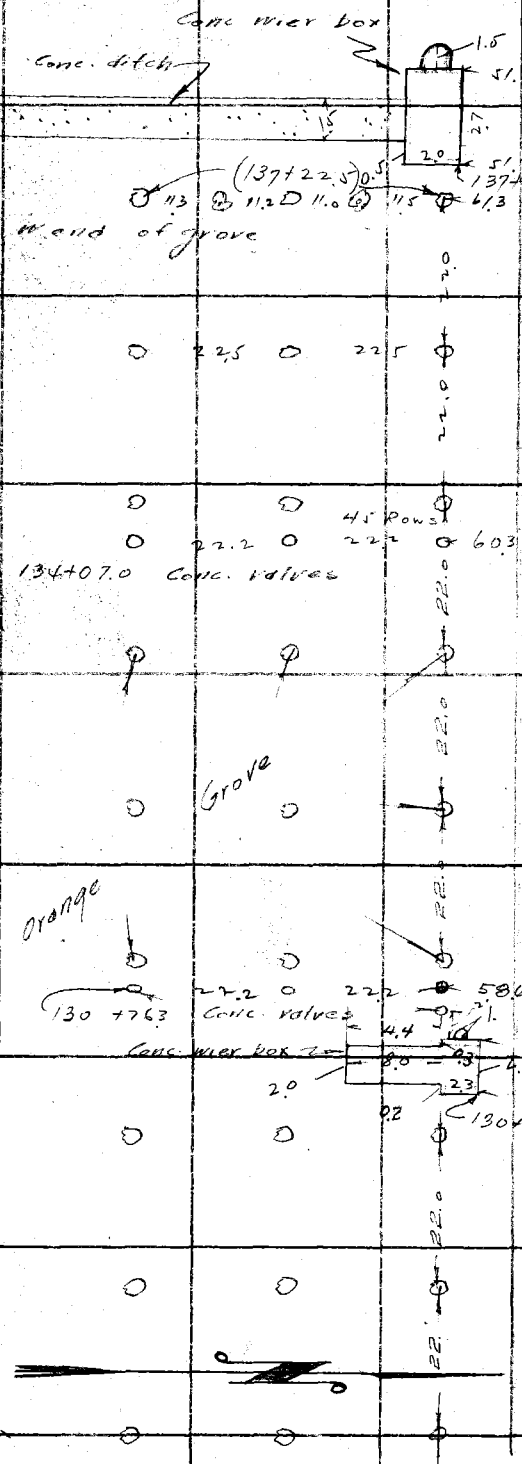

RETURN TO
LOS ANGELES COUNTY SURVEYOR
700 HALL OF RECORDS

Do not extend notes this side of this line

Note: ANY ADDITIONS OR CHANGES ON THIS SHEET MUST BE MADE OR CIRCLED IN Red Ink, WITH DATE AND NAME OF PERSON MAKING CHANGE.

Notes Ck'd by
Map No. B-754-3
Office Work W.N. Bradstreet
Checked
Date

Survey of Bonillo St
W. O. 7103 Tape No. 241 Std 64 °F.
Surveyed by Rosecrans
Notes Date 7-14-33
Indexed A. C. Johnson

F.B. 510 PG. 126

Note: ANY ADDITIONS OR CHANGES ON THIS SHEET MUST BE MADE IOR CIRCLED IN Red Ink, WITH DATE AND, NAME OF PERSON MAKING CHANGE.

Do not extend notes this side of this line

RETURN TO
LOS ANGELES COUNTY SURVEYOR
700 HALL OF RECORDS

FORM 247 10M 8-31

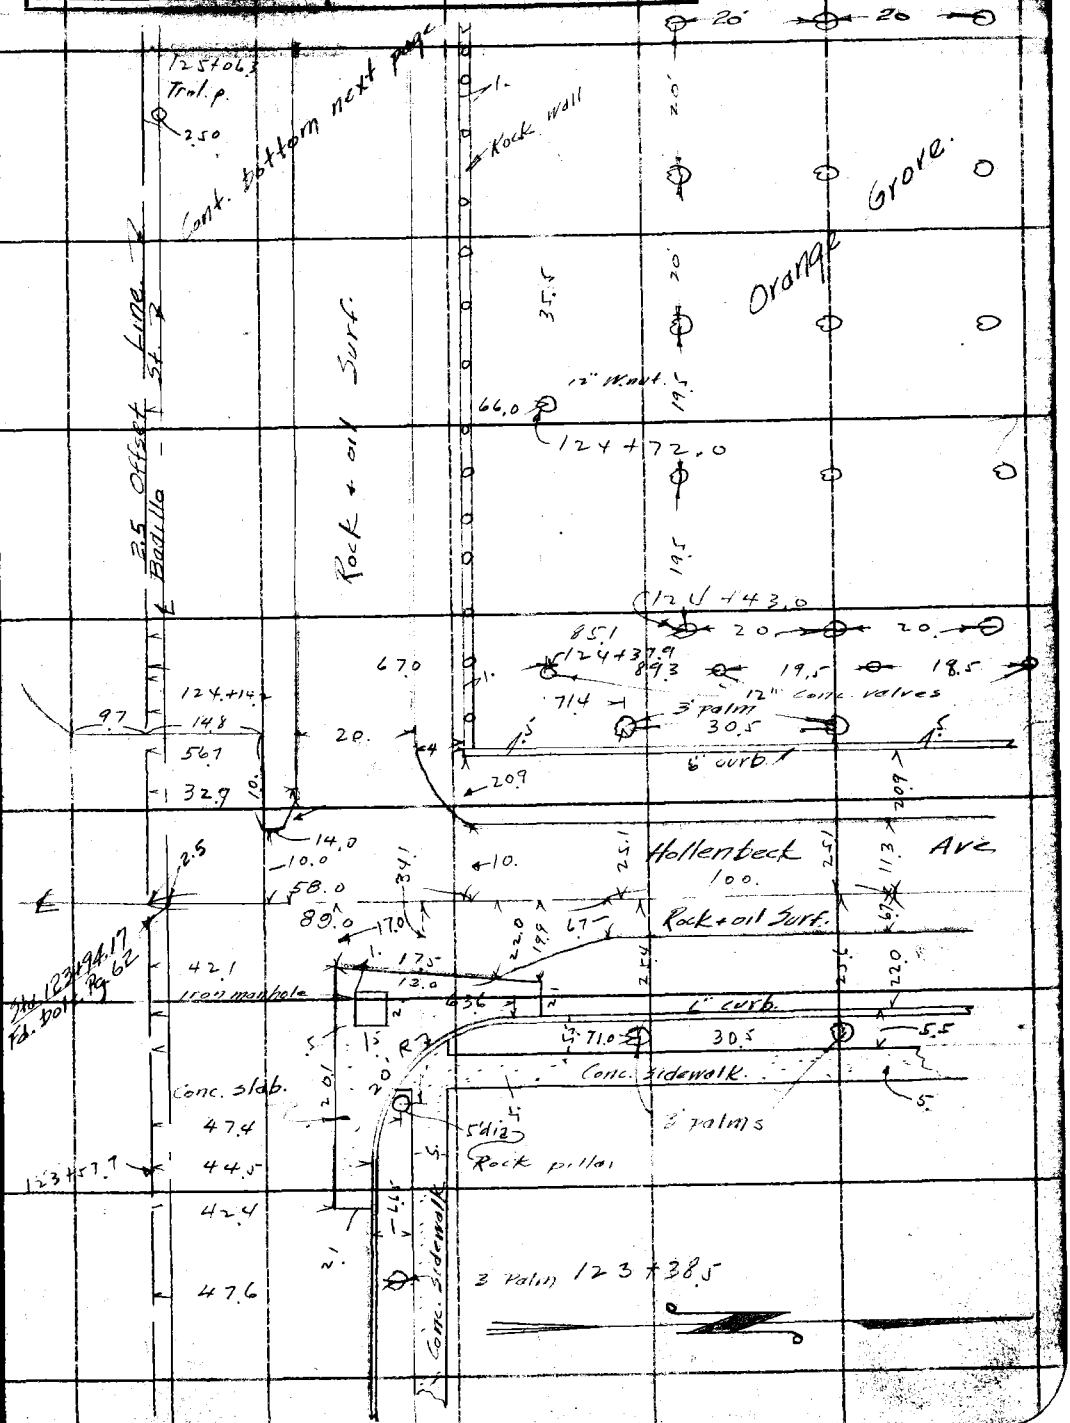

RETURN TO
LOS ANGELES COUNTY SURVEYOR
700 HALL OF RECORDS

Note: ANY ADDITIONS OR CHANGES ON THIS SHEET MUST BE MADE OR CIRCLED IN **Red Ink.** WITH DATE AND NAME OF PERSON MAKING CHANGE.

Do not extend notes this side of this line

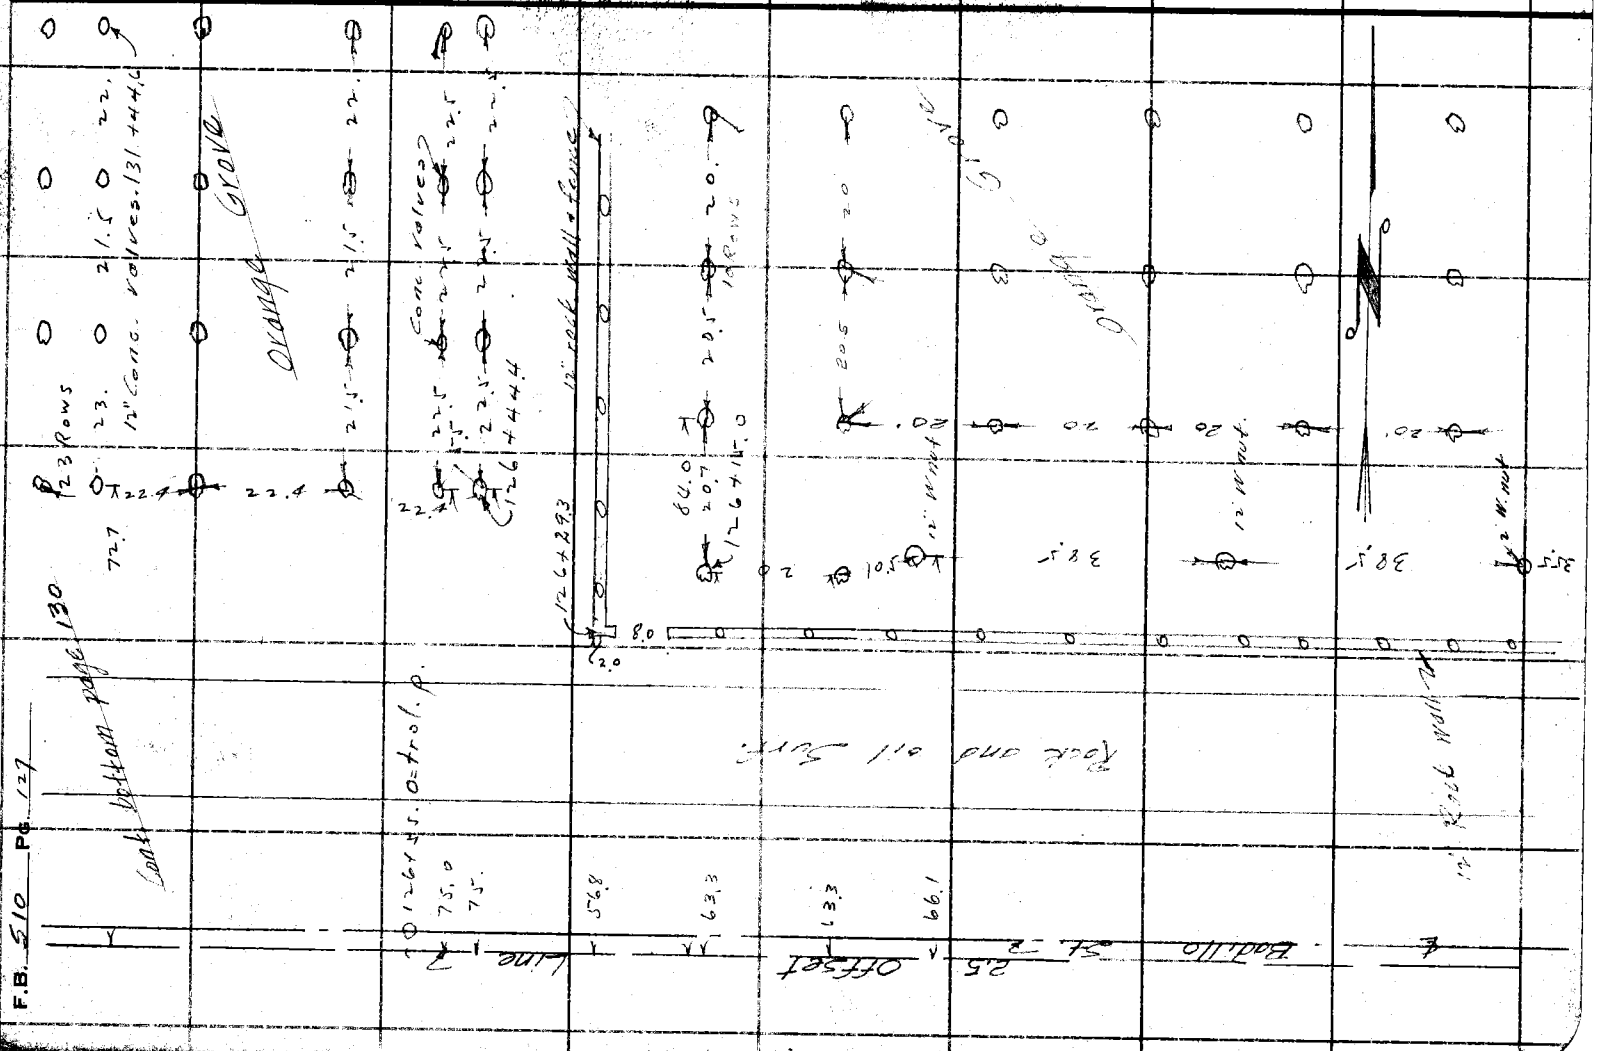

F.B. 510 Pg. 127

Notes Ck'd by	Survey of Padilla St
Map No. B-754-3	W. O. 7103 Tape No. 241 St'd 84 °F.
Office Work H.N. Bradstreet	Surveyed by Escerano
Checked	Notes Date 7-14-32
Date	Indexed C. Johnson

F.B. 510 Pg. 128

Note: ANY ADDITIONS OR CHANGES OF THIS SHEET MUST BE MADE IOR CIRCLED IN Red Ink. WITH DATE AND NAME OF PERSON MAKING CHANGE.

RETURN TO
LOS ANGELES COUNTY SURVEYOR
700 HALL OF RECORDS
Do not extend notes this side of this line

FORM 247 JOM 8-31

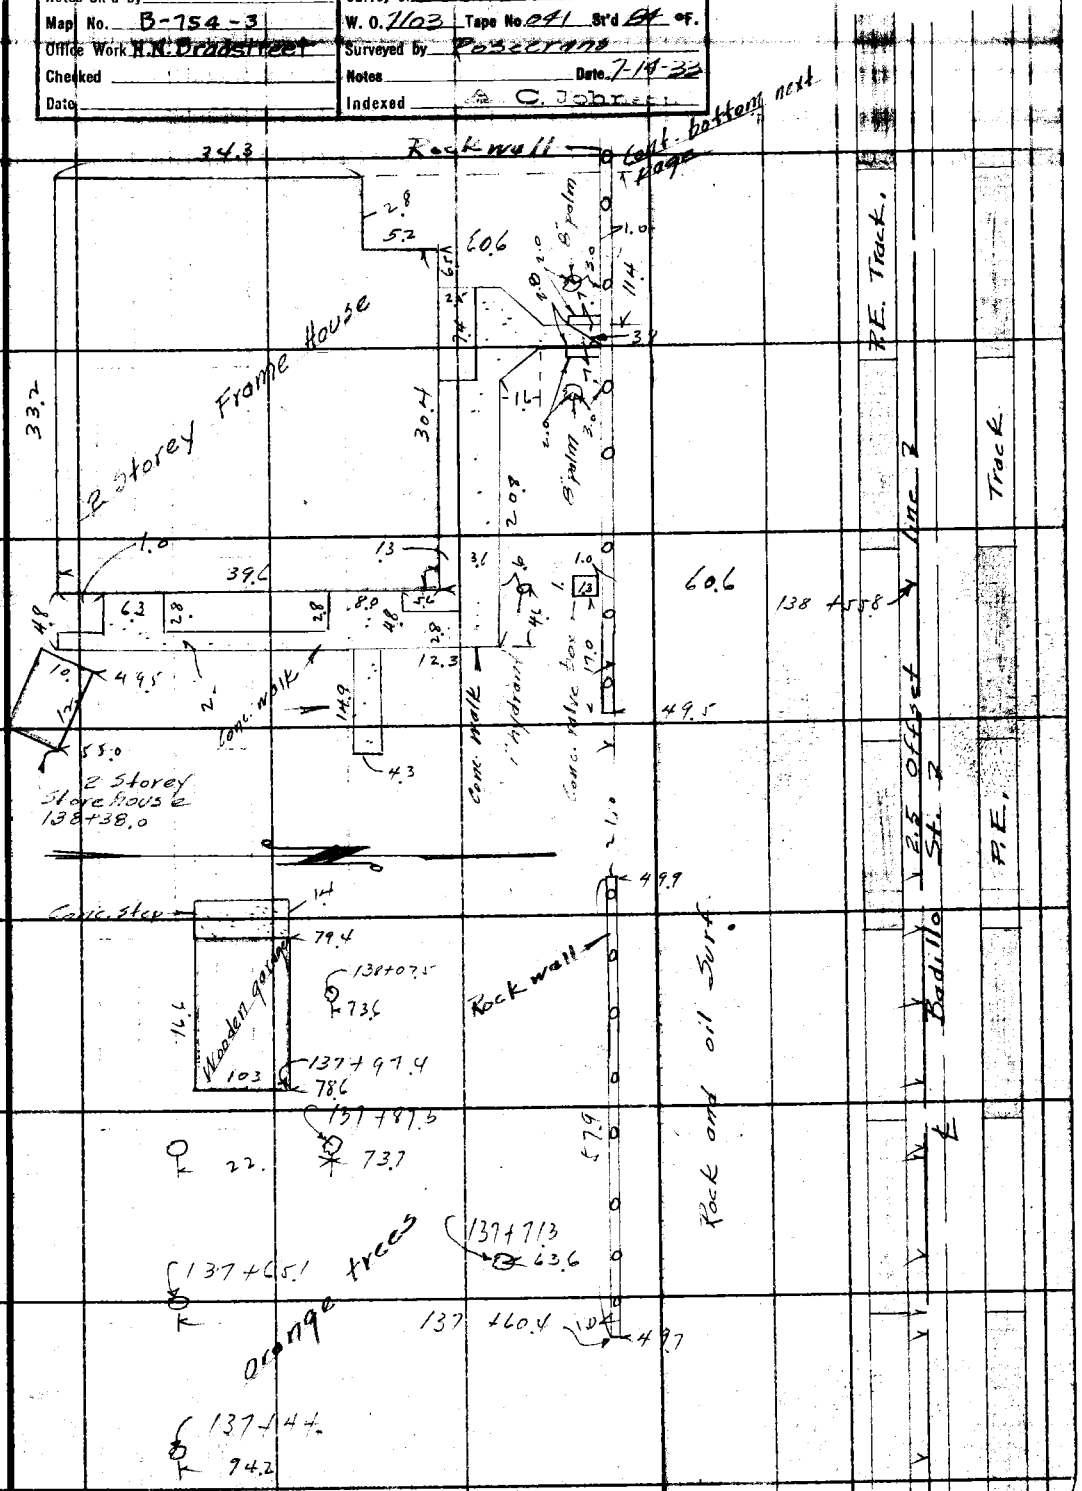

F.B. 510 Pg. 129

Cont. bottom Pg. 134

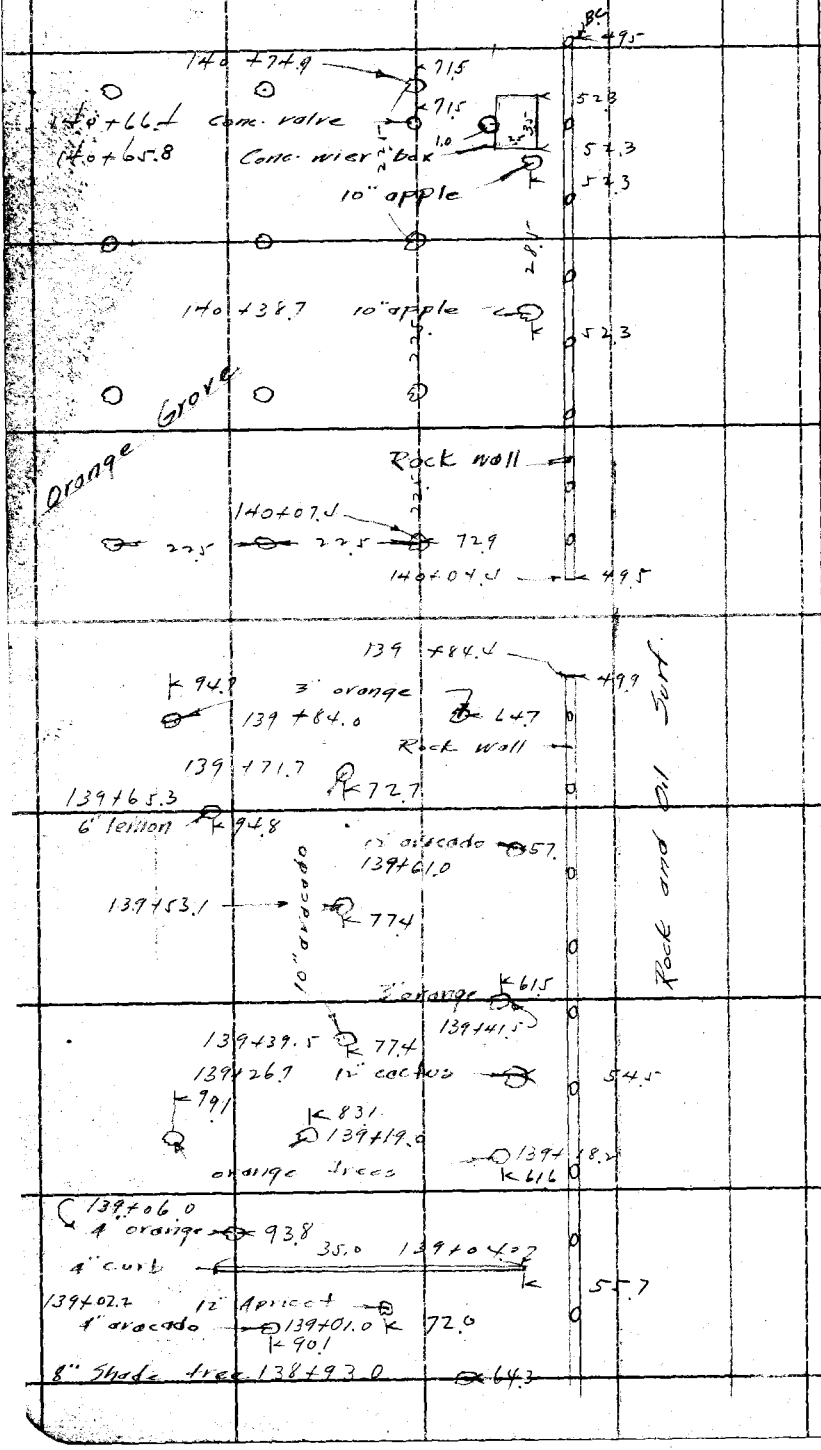

RETURN TO
LOS ANGELES COUNTY SURVEYOR
700 HALL OF RECORDS
Do not extend notes this side of this line

Note: ANY ADDITIONS OR CHANGES ON THIS SHEET MUST BE MADE OR CIRCLED IN Red Ink. WITH DATE AND NAME OF PERSON MAKING CHANGE.

Notes Ck'd by	Survey of Badillo St.
Map No. B-754-3	W. O. 7103 Tape No. 041 St'd 84 °F.
Office Work H.N. Bradstreet	Surveyed by Rosecrans
Checked	Notes Date 7-14-33
Date	Indexed A. C. Johnson

F.B. 510 Pg 130

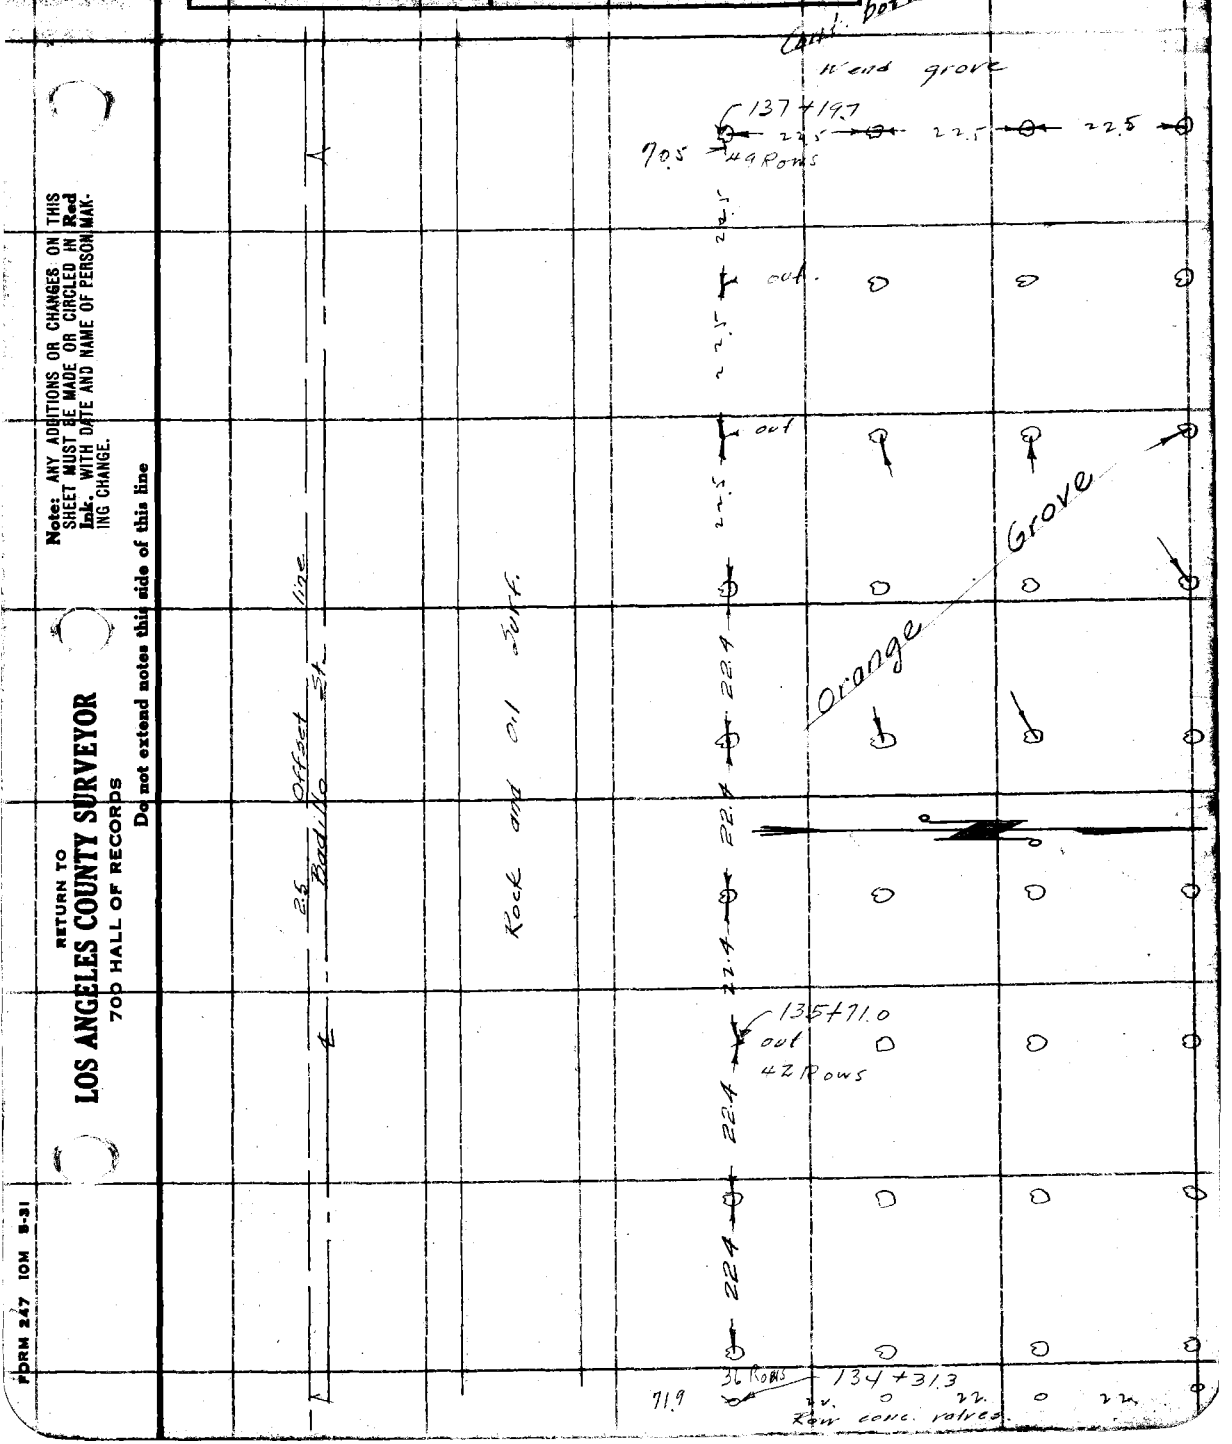

Note: ANY ADDITIONS OR CHANGES ON THIS SHEET MUST BE MADE OR CIRCLED IN Red Ink. WITH DATE AND NAME OF PERSON MAKING CHANGE.

Do not extend notes this side of this line

RETURN TO
LOS ANGELES COUNTY SURVEYOR
700 HALL OF RECORDS

FORM 247 10M 5-31

RETURN TO
LOS ANGELES COUNTY SURVEYOR
700 HALL OF RECORDS

Note: ANY ADDITIONS OR CHANGES ON THIS SHEET MUST BE MADE OR CIRCLED IN **Red Ink.** WITH DATE AND NAME OF PERSON MAKING CHANGE.

Do not extend notes this side of this line

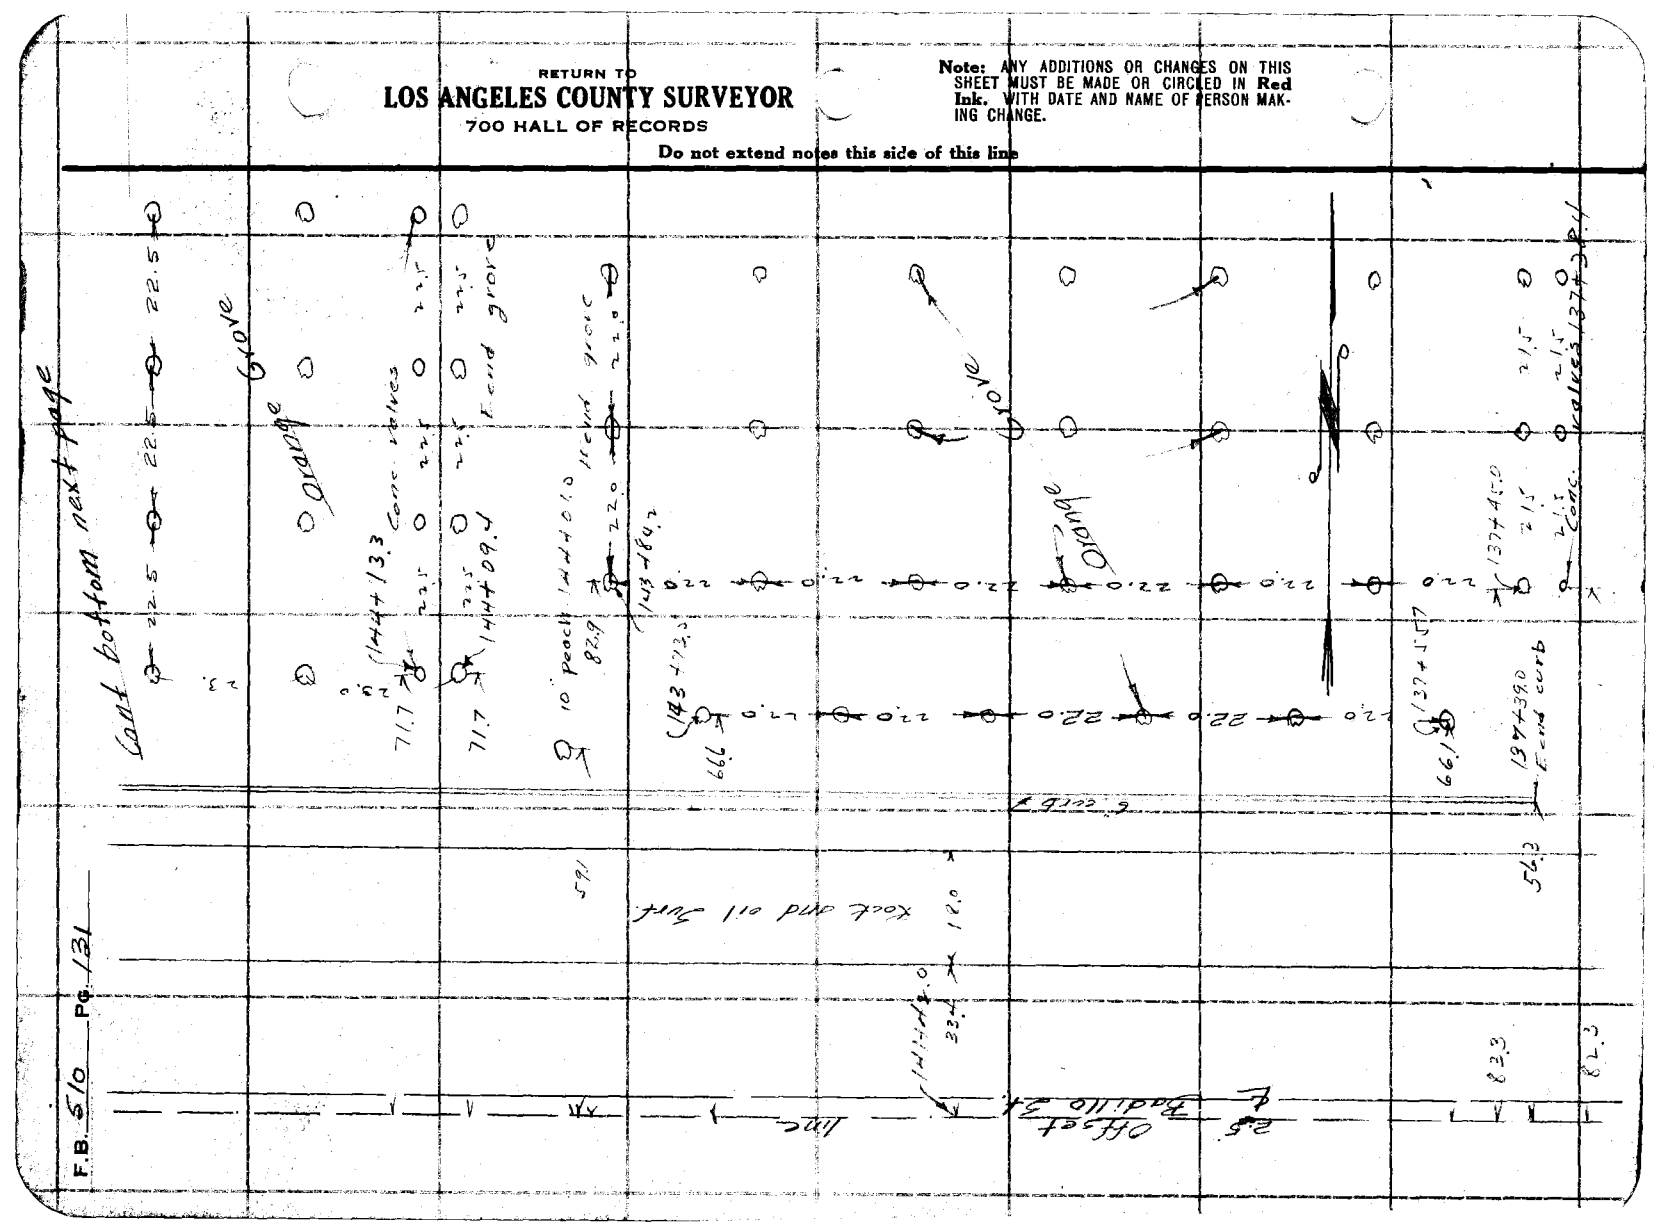

Notes Ck'd by	Survey of Badillo St.
Map No. B-754-3	W. O. 7103 Tape No. 041 St'd 84 °F.
Office Work H.N. Bradstreet	Surveyed by Poscorans
Checked	Notes Date 7-14-33
Date	Indexed A. C. Johnson

F.B. 510 PG. 132

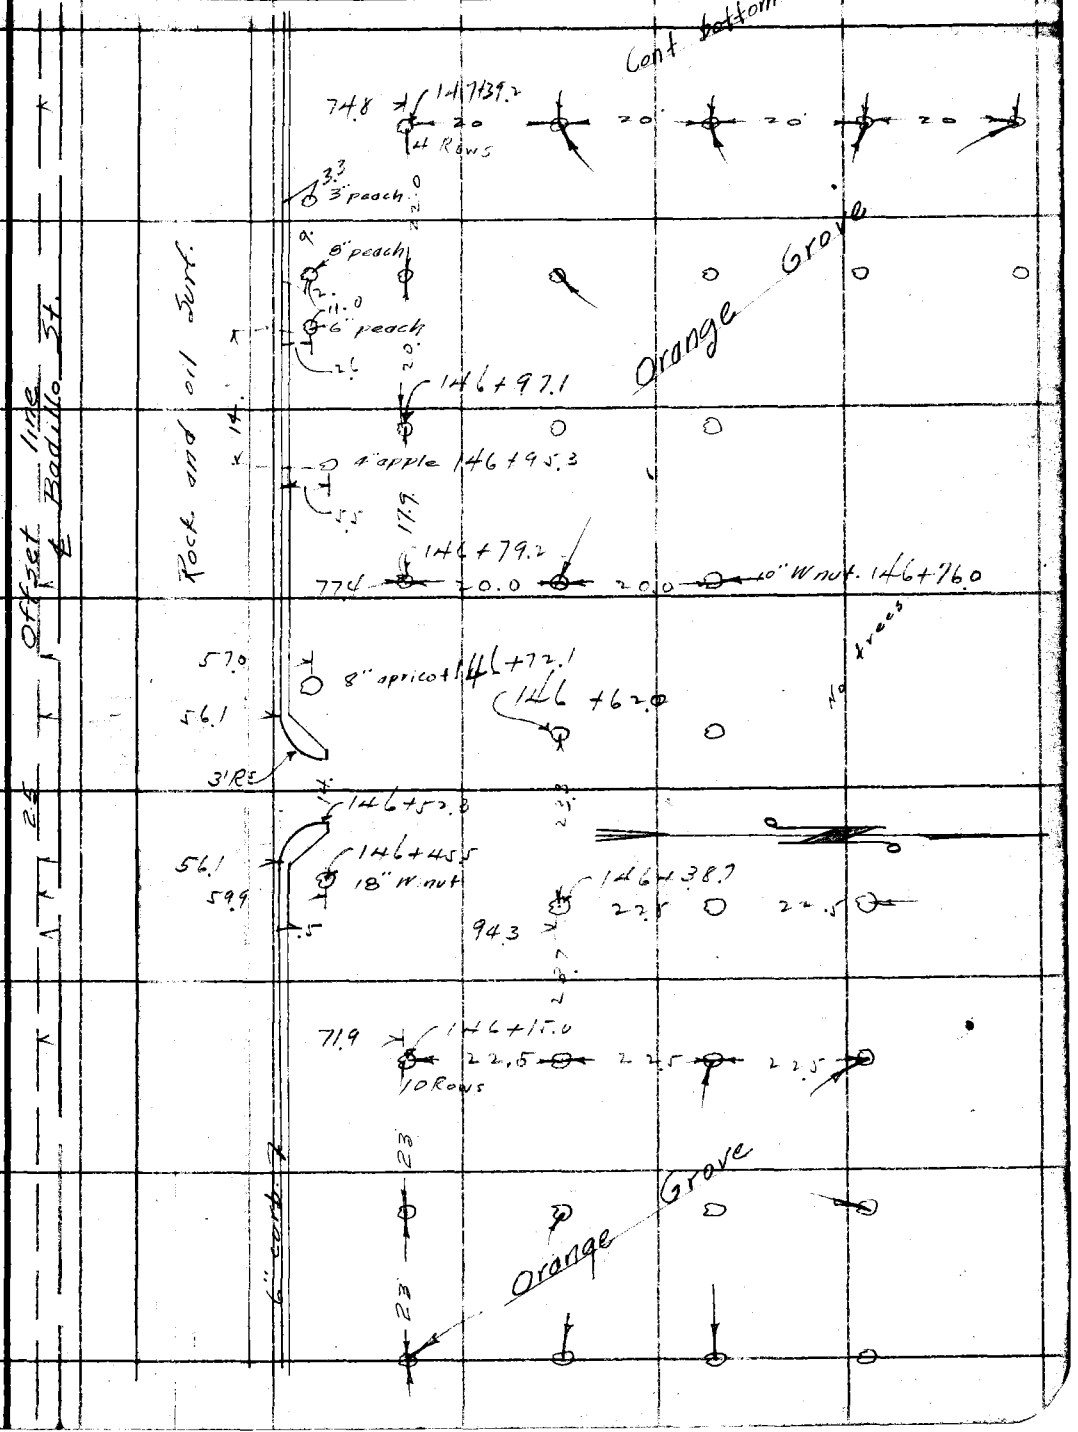

Note: ANY ADDITIONS OR CHANGES ON THIS SHEET MUST BE MADE OR CIRCLED IN Red Ink, WITH DATE AND NAME OF PERSON MAKING CHANGE.

Do not extend notes this side of this line

RETURN TO
LOS ANGELES COUNTY SURVEYOR
700 HALL OF RECORDS

FORM 247 10M 8-31

RETURN TO
LOS ANGELES COUNTY SURVEYOR
700 HALL OF RECORDS

Note: ANY ADDITIONS OR CHANGES ON THIS SHEET MUST BE MADE OR CIRCLED IN **Red Ink.** WITH DATE AND NAME OF PERSON MAKING CHANGE.

Do not extend notes this side of this line

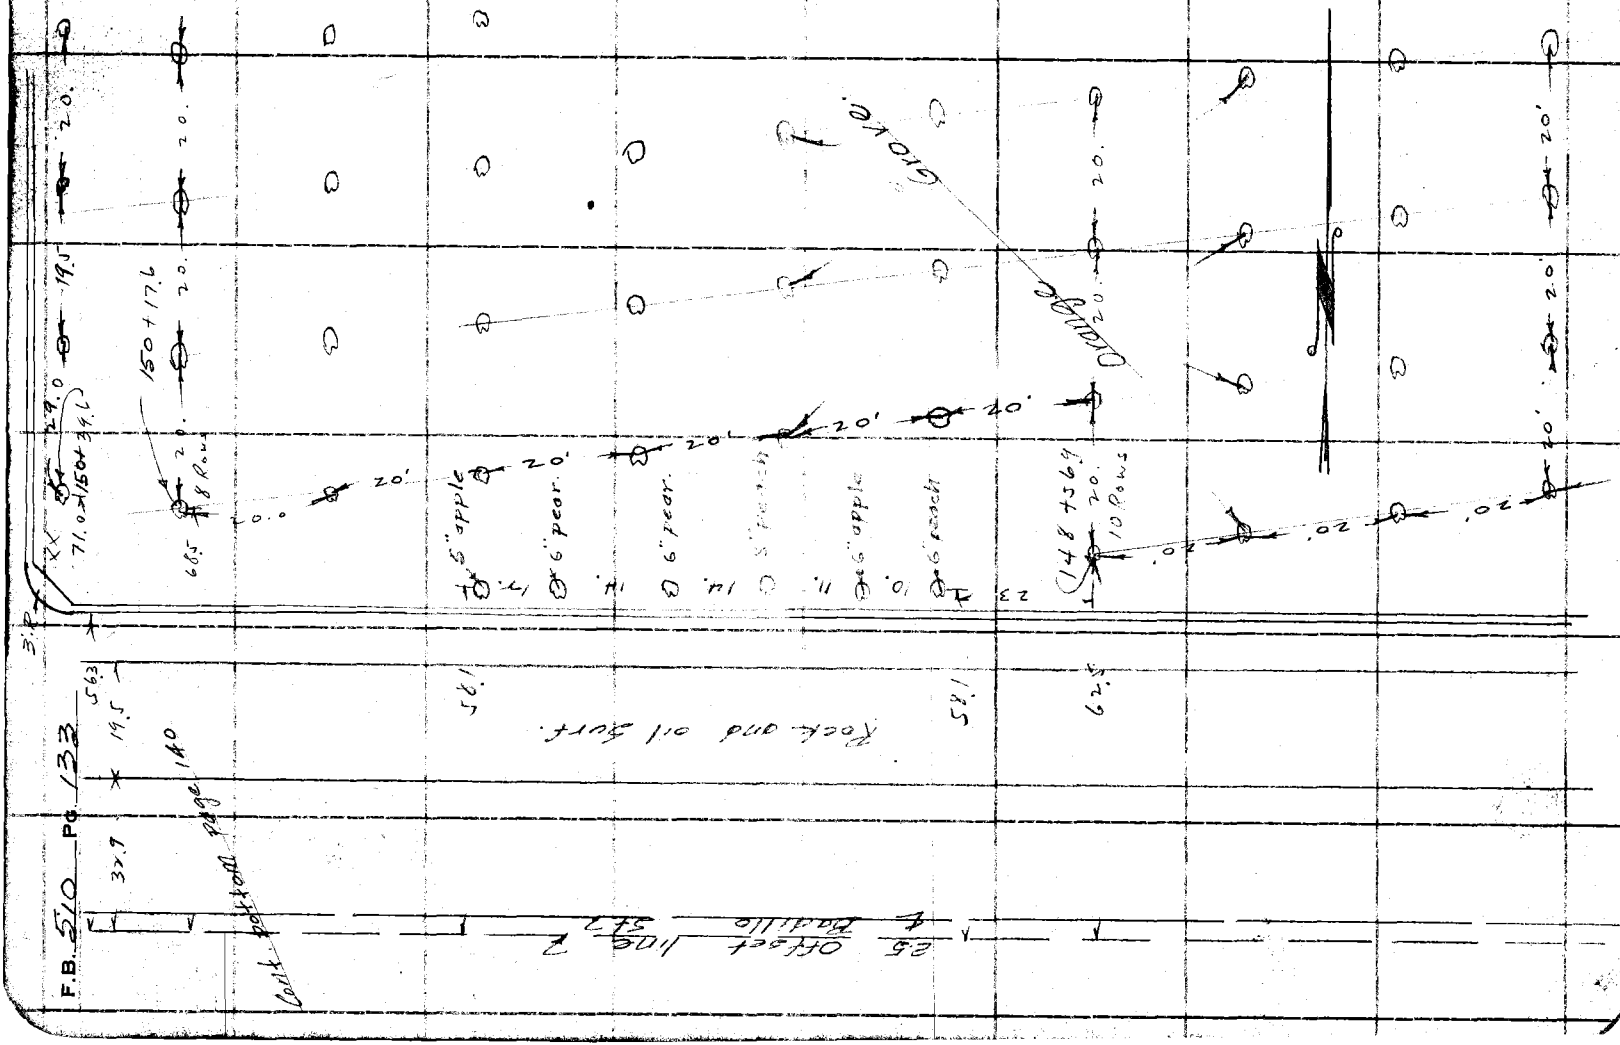

Notes Ck'd by
Map No. B-754-3
Office Work H.N. Bradstreet
Checked
Date

Survey of Lassillo St.
W. O. 7103 Topo No. 041 St'd 84 °F.
Surveyed by Observers
Notes Date 7-14-33
Indexed C. C. Johnson

F.B. 510 Pg. 134

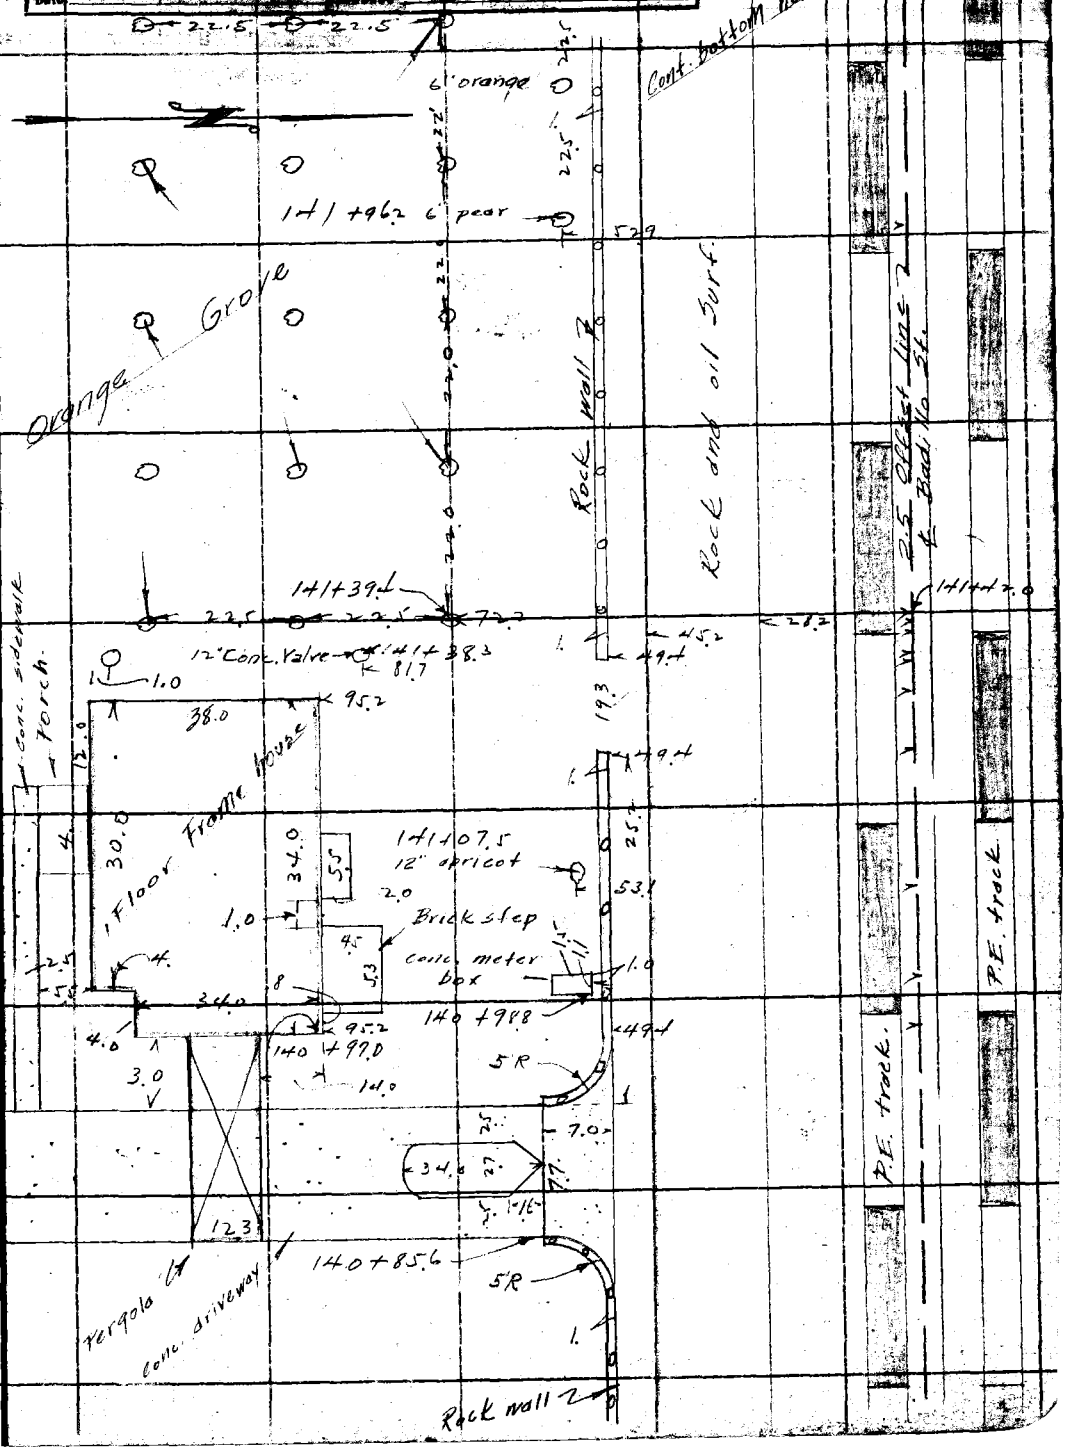

Make ANY ADDITIONS OR CHANGES ON THIS SHEET MUST BE MADE IN Red Ink WITH DATE AND NAME OF PERSON MAKING CHANGE.

Do not extend notes this side of this line

RETURN TO
LOS ANGELES COUNTY SURVEYOR
700 HALL OF RECORDS

FORM 247 10M 8-31

F.B. 510 Pg. 135

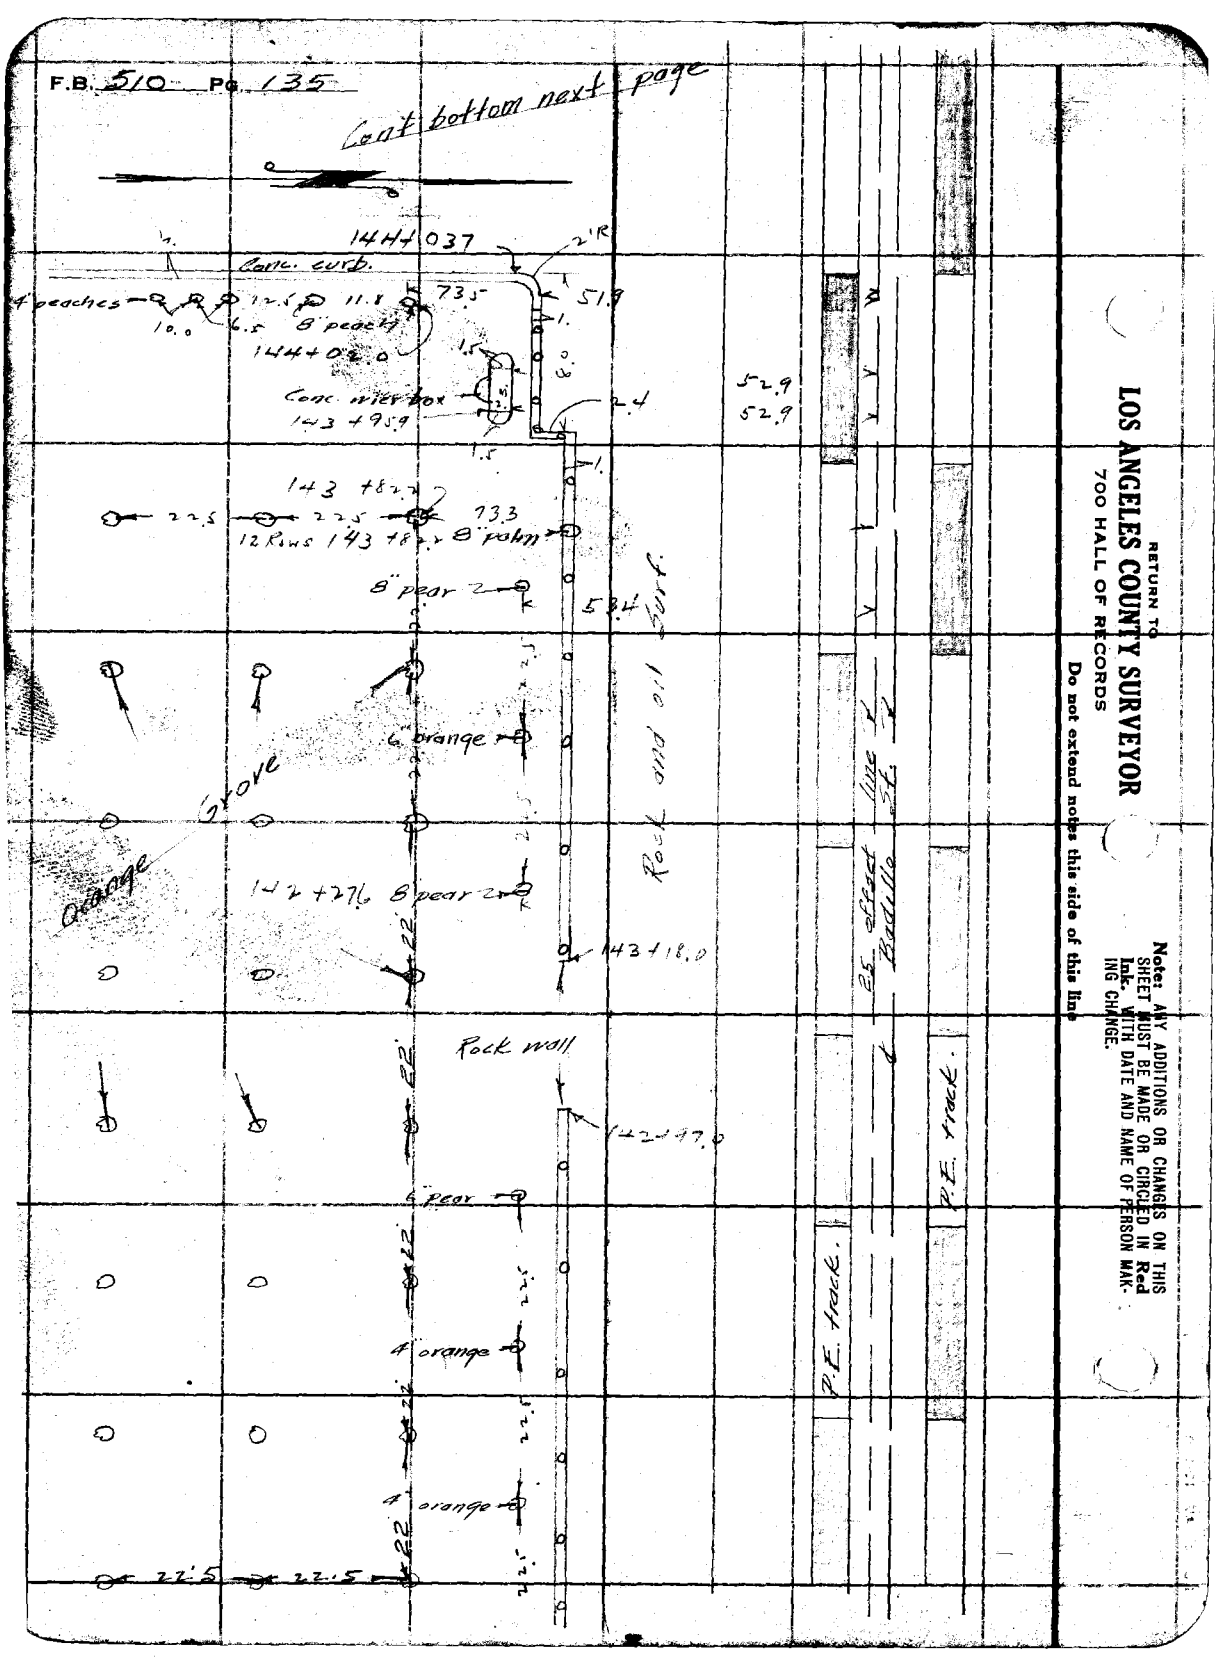

RETURN TO
LOS ANGELES COUNTY SURVEYOR
700 HALL OF RECORDS

Do not extend notes this side of this line

Note: ANY ADDITIONS OR CHANGES ON THIS SHEET MUST BE MADE OR CIRCLED IN Red Ink. WITH DATE AND NAME OF PERSON MAKING CHANGE.

Notes Ck'd by	Survey of Badillo St
Map No. B-154-3	W. O. 7103 Tape No. 041 St'd 84 °F.
Office Work H. N. Bradstreet	Surveyed by Rosecrans
Checked	Notes Date 7-17-33
Date	Indexed A. C. Johnson

F.B. 510 Pg. 136

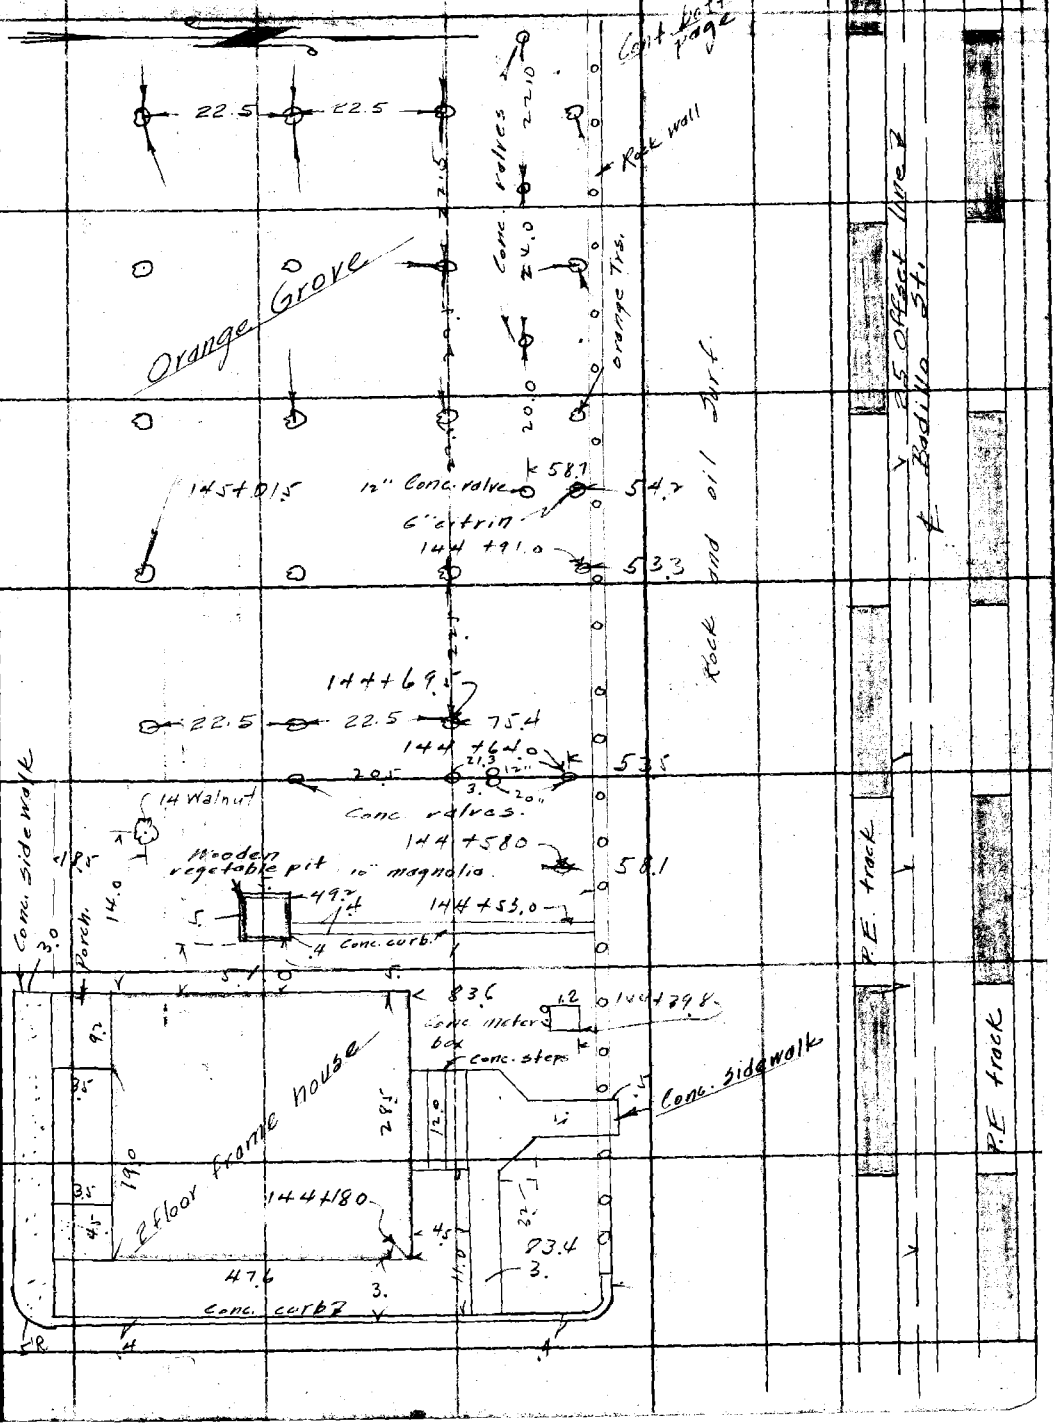

Note: ANY ADDITIONS OR CHANGES ON THIS SHEET MUST BE MADE OR CIRCLED IN Red Ink. WITH DATE AND NAME OF PERSON MAKING CHANGE.

RETURN TO
LOS ANGELES COUNTY SURVEYOR
700 HALL OF RECORDS

Do not extend notes this side of this line

FORM 247 10M 8-31

F.B. 510 Pg. 137

RETURN TO
LOS ANGELES COUNTY SURVEYOR
700 HALL OF RECORDS

Do not extend notes this side of this line

Note: ANY ADDITIONS OR CHANGES ON THIS SHEET MUST BE MADE OR CIRCLED IN Red Ink. WITH DATE AND NAME OF PERSON MAKING CHANGE.

Notes Ck'd by	Survey of Badillo St.
Map No. B-154-[illegible]	W.O. 7103 Tape No. 041 St'd 84 °F.
Office Work H.N. Bradstreet	Surveyed by Rosecrans
Checked	Notes Date 7-17-33
Date	Indexed A. C. Johnson

F.B. 510 Pg. 138

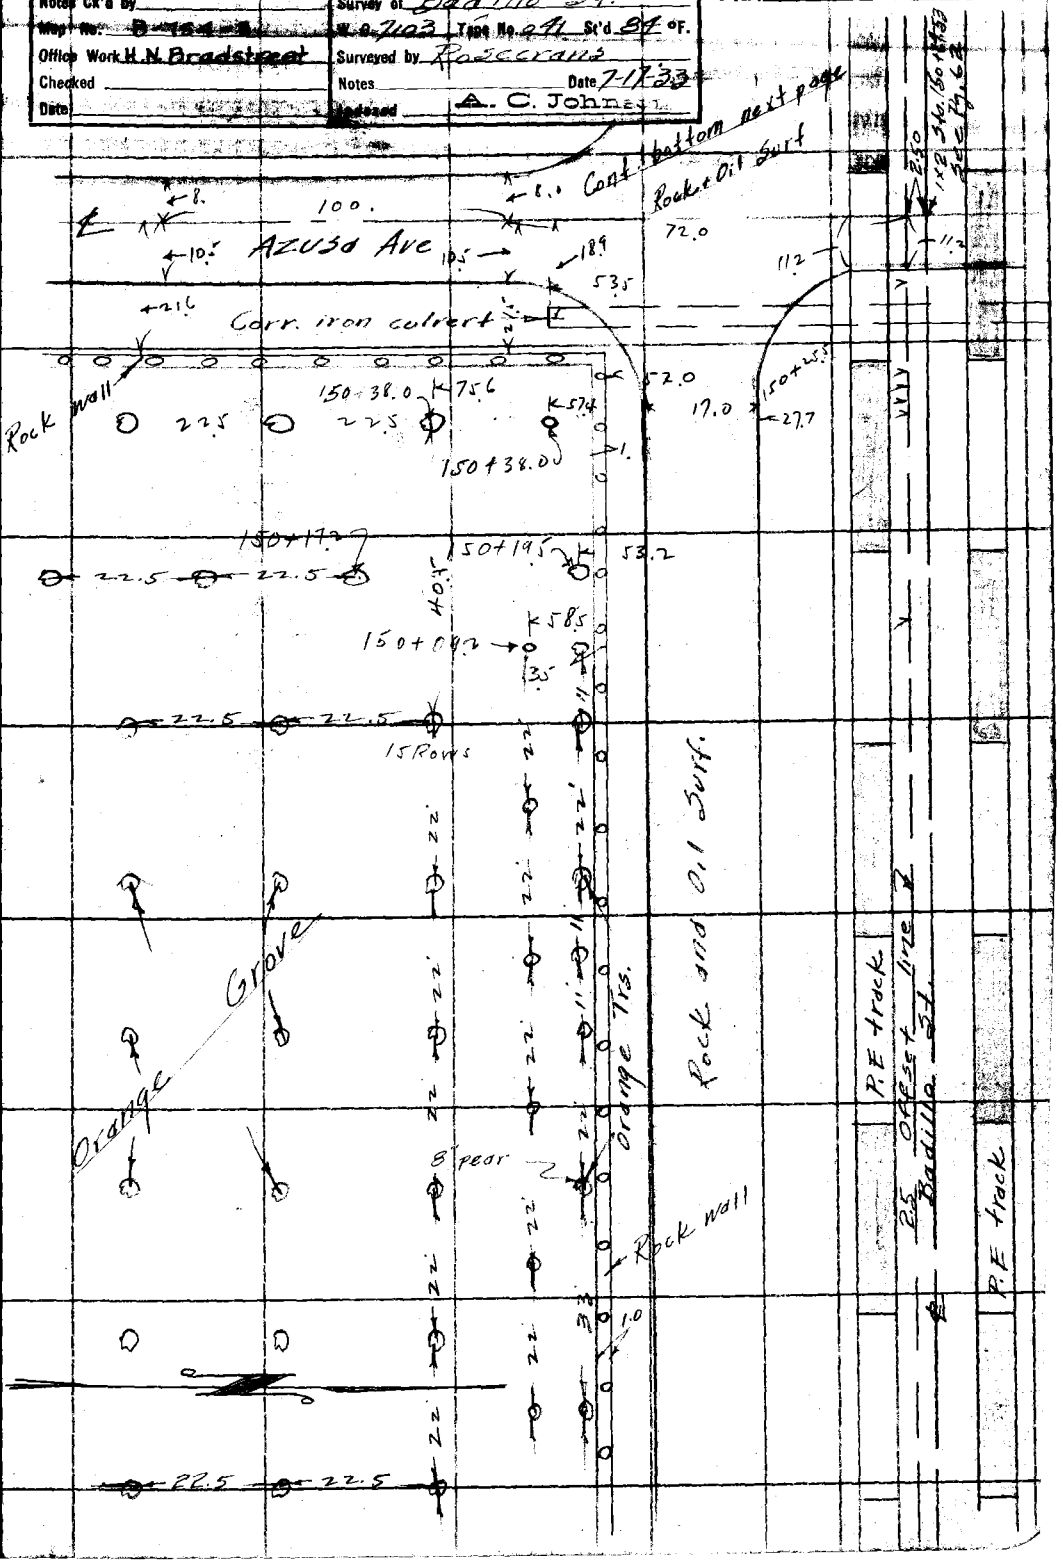

Note: ANY ADDITIONS OR CHANGES ON THIS SHEET MUST BE MADE OR CIRCLED IN Red Ink. WITH DATE AND NAME OF PERSON MAKING CHANGE.

RETURN TO
LOS ANGELES COUNTY SURVEYOR
700 HALL OF RECORDS

Do not extend notes this side of this line

FORM 247 10M 8-31

Cont. bottom page 144

RETURN TO
LOS ANGELES COUNTY SURVEYOR
700 HALL OF RECORDS
Do not extend notes this side of this line
Note: ANY ADDITIONS OR CHANGES ON THIS SHEET MUST BE MADE OR CIRCLED IN Red Ink. WITH DATE AND NAME OF PERSON MAKING CHANGE.

Notes Ck'd by	Survey of Badillo St
Map No. B-754-3	W.O. 7103 Tape No. 041 St'd 84 °F.
Office Work H.N. Bradstreet	Surveyed by Rosecrans
Checked	Notes Date 7-17-33
Date	Indexed A. C. Johnson

F.B. 510 PG. 140

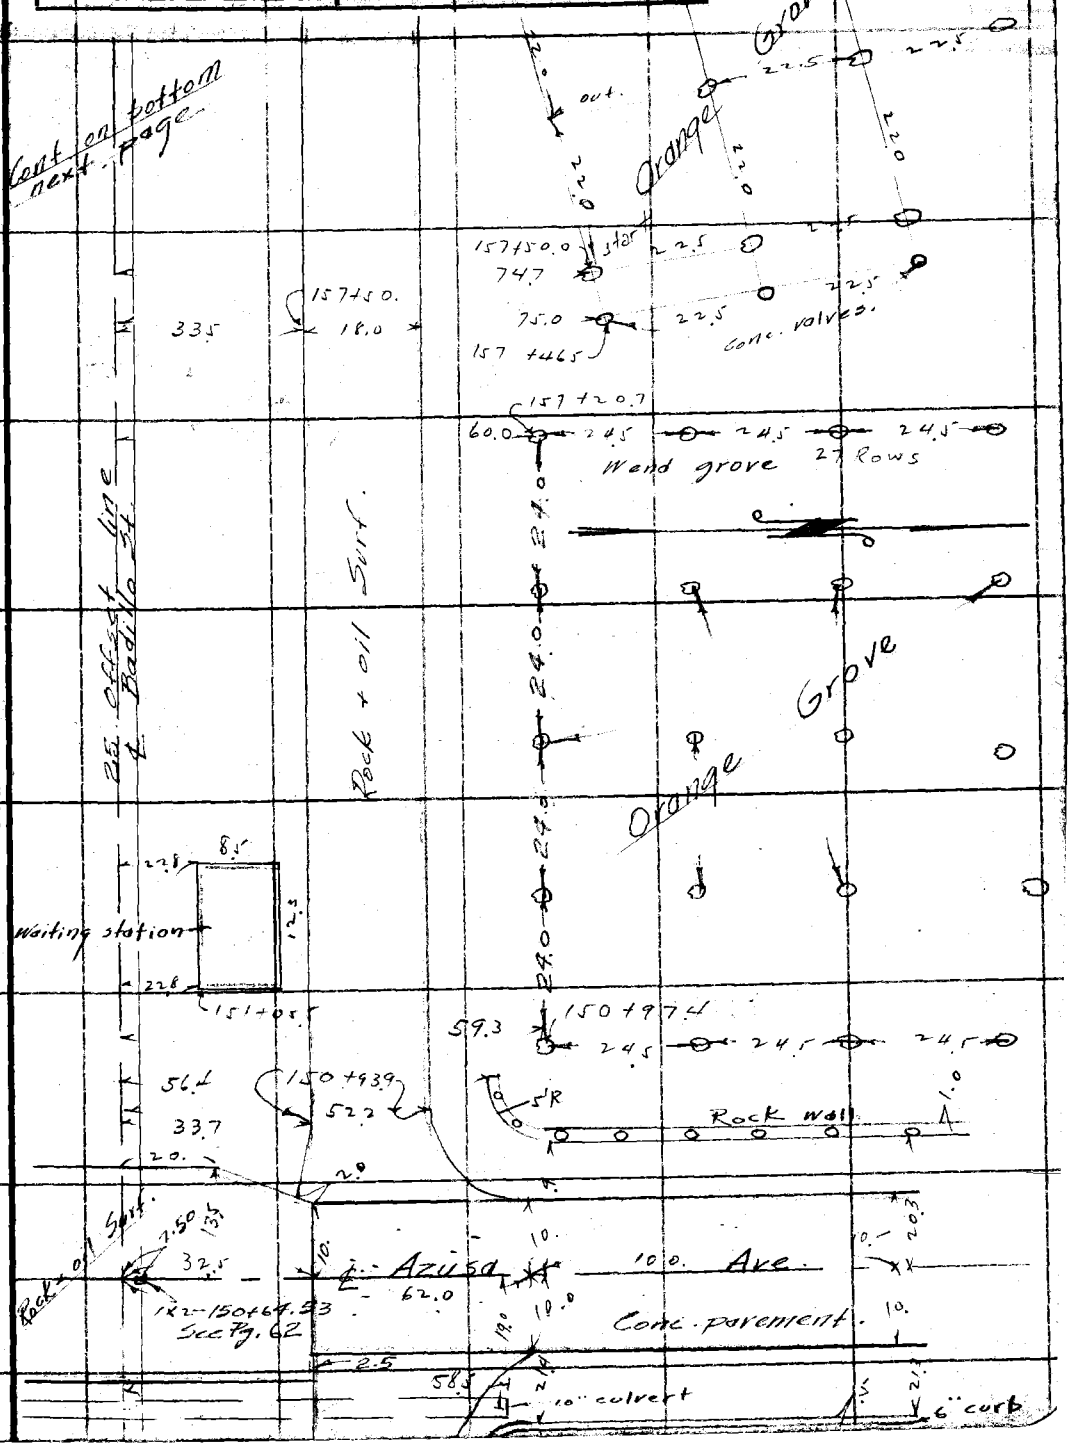

Note: ANY ADDITIONS OR CHANGES ON THIS SHEET MUST BE MADE OR CIRCLED IN Red Ink. WITH DATE AND NAME OF PERSON MAKING CHANGE.

Do not extend notes this side of this line

RETURN TO
LOS ANGELES COUNTY SURVEYOR
700 HALL OF RECORDS

FORM 247 10M 8-31

RETURN TO
LOS ANGELES COUNTY SURVEYOR
700 HALL OF RECORDS

Note: ANY ADDITIONS OR CHANGES ON THIS SHEET MUST BE MADE OR CIRCLED IN **Red Ink.** WITH DATE AND NAME OF PERSON MAKING CHANGE.

Do not extend notes this side of this line

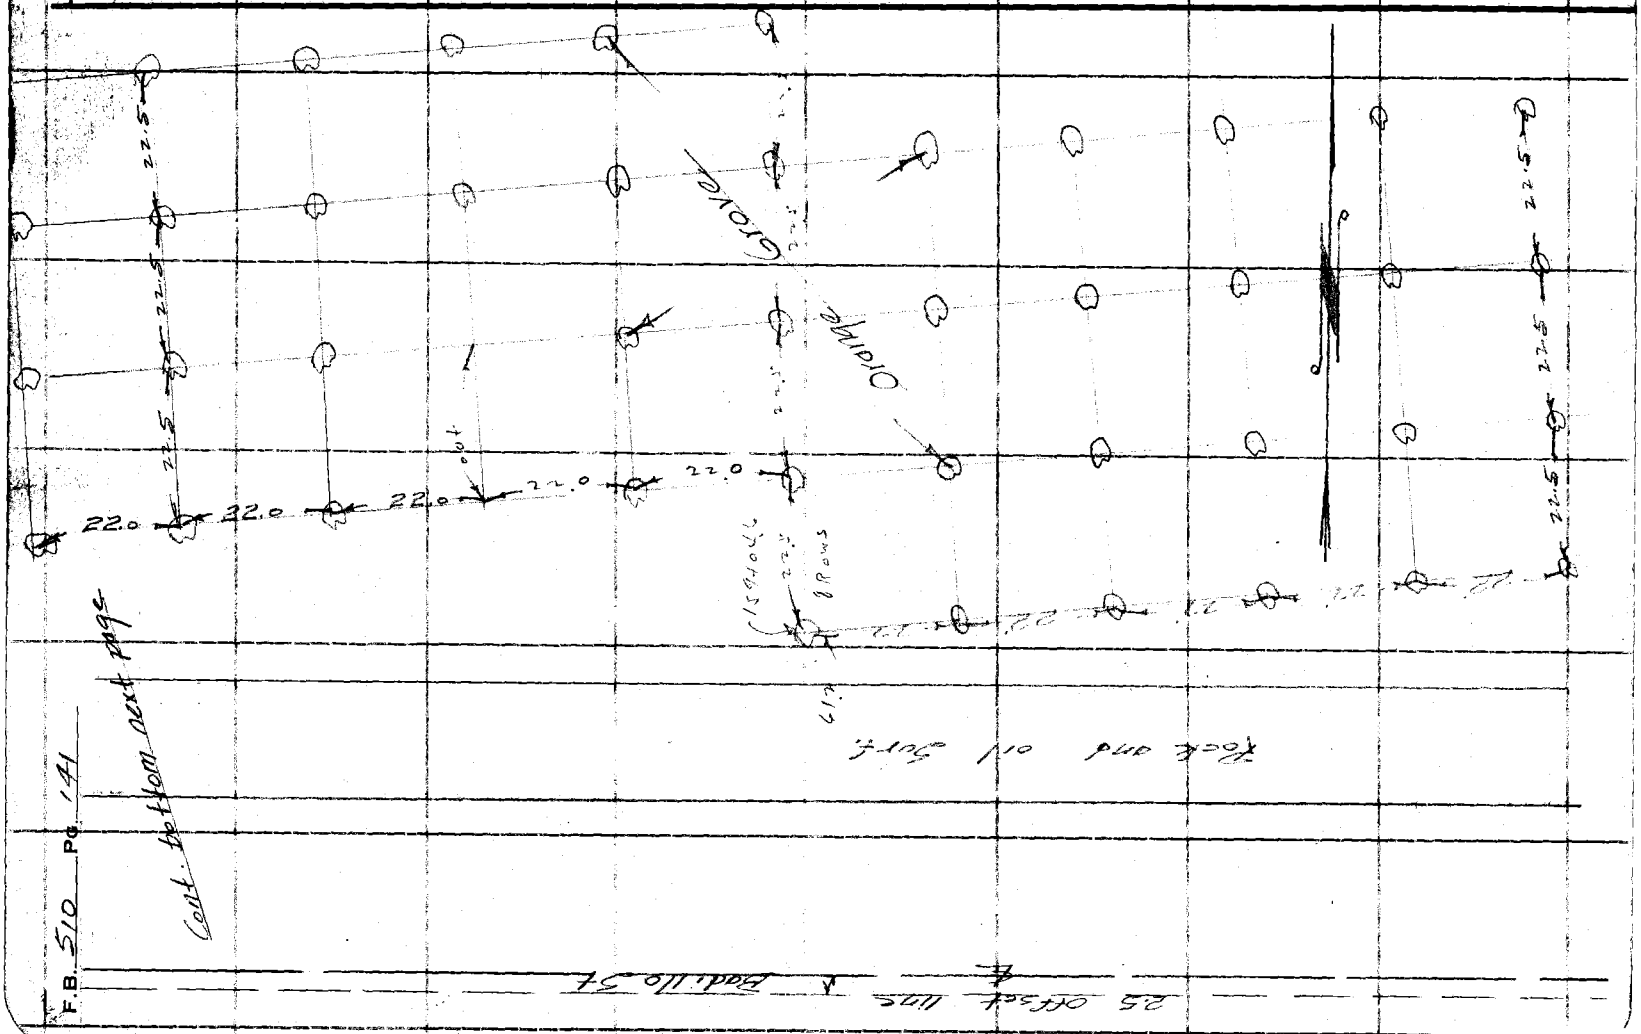

Notes Ck'd by	Survey of Badillo St.
Map No. B-154-3	W.O. 7103 Tape No. 011 St'd 84 °F.
Office Work H.N. Bradstreet	Surveyed by Rosecrans
Checked	Notes Date 7-17-33
Date	Indexed A. C. Johnson

F.B. 510 PG. 142

Cont. bottom next page

5" Conc. curb

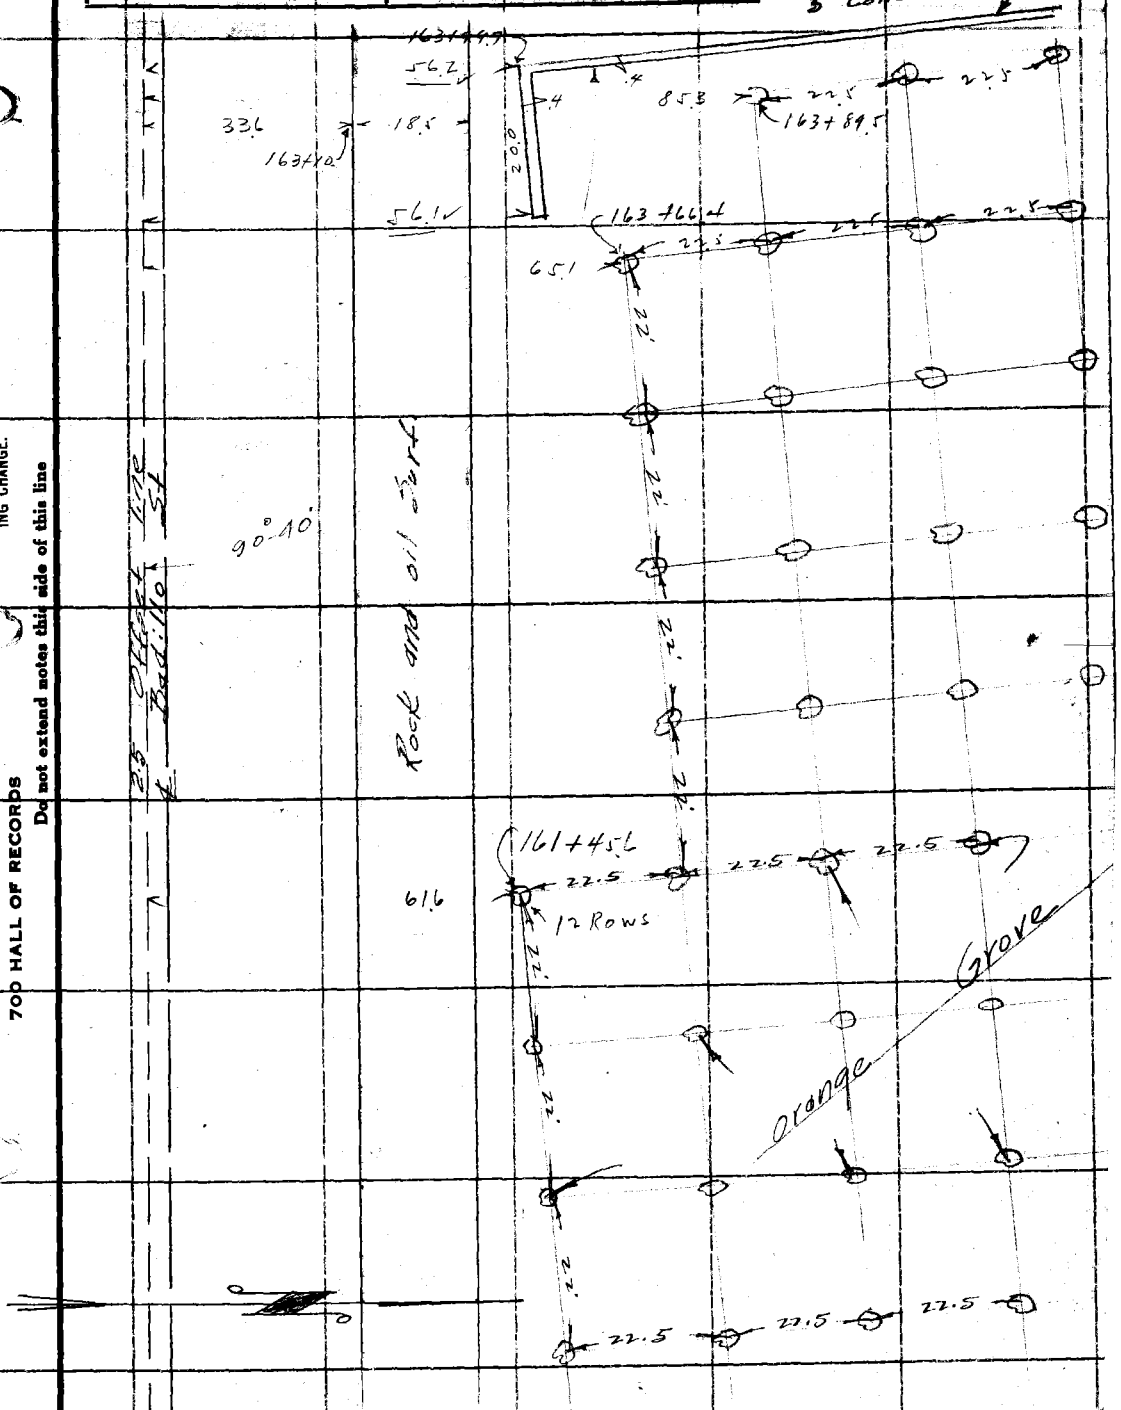

RETURN TO
LOS ANGELES COUNTY SURVEYOR
700 HALL OF RECORDS

Do not extend notes this side of this line

Note: ANY ADDITIONS OR CHANGES ON THIS SHEET MUST BE MADE OR CIRCLED IN Red Ink, WITH DATE AND NAME OF PERSON MAKING CHANGE.

25' Offset Line St. Badillo St.

FORM 247 10M 8-31

F.B. 510 PG. 143

Cont. bottom Pg. 153

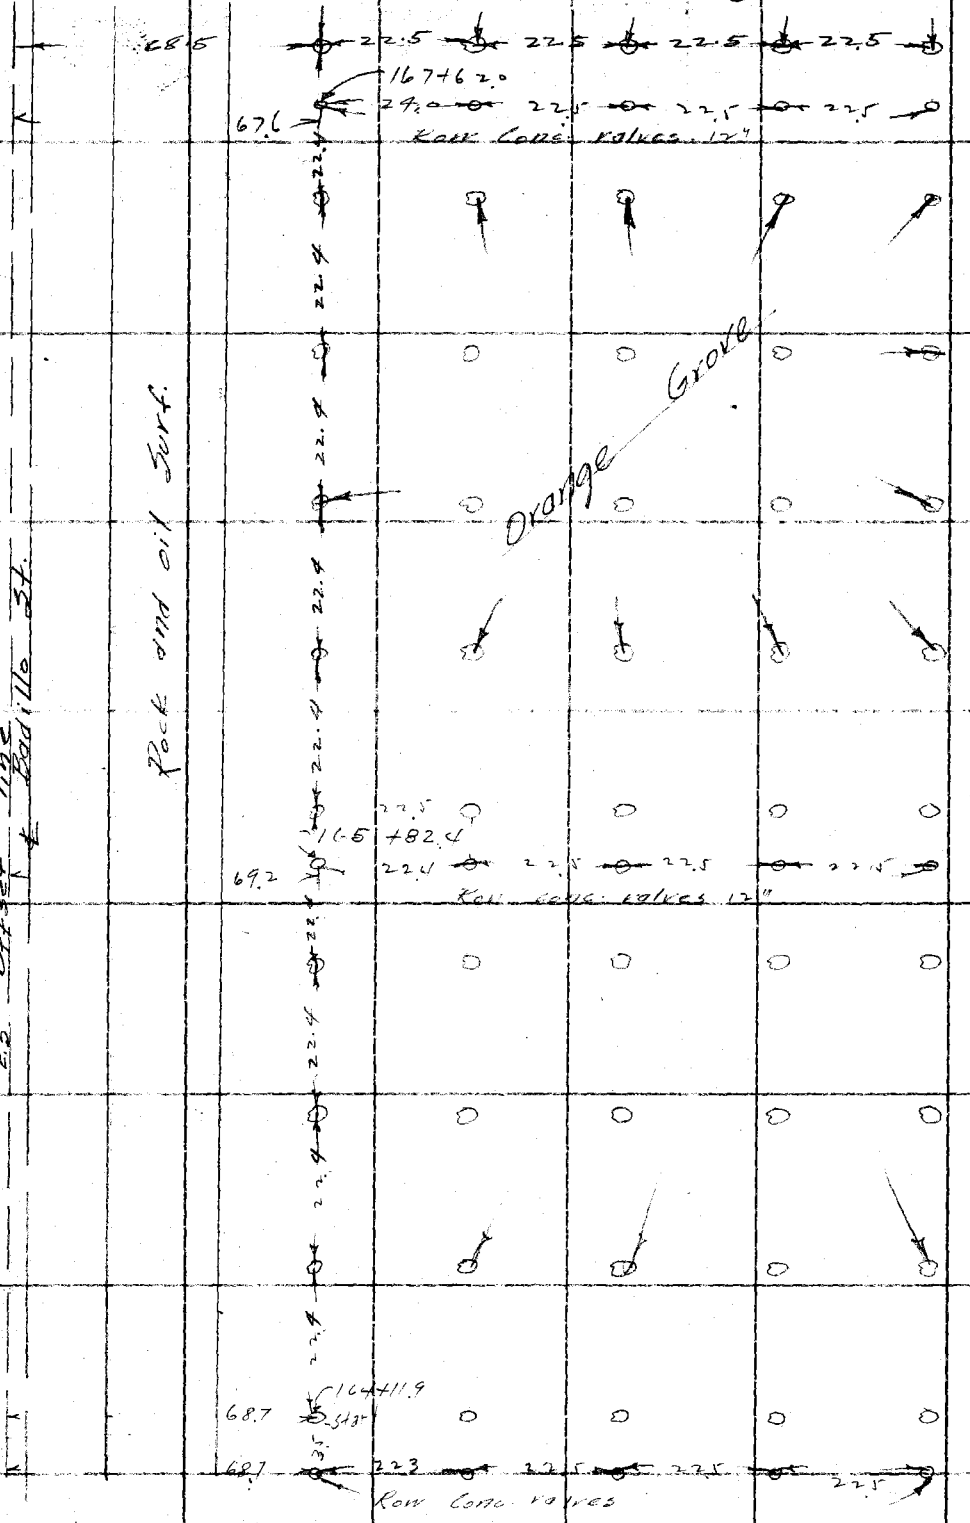

RETURN TO
LOS ANGELES COUNTY SURVEYOR
700 HALL OF RECORDS

Do not extend notes this side of this line

Note: ANY ADDITIONS OR CHANGES ON THIS SHEET MUST BE MADE OR CIRCLED IN Red Ink, WITH DATE AND NAME OF PERSON MAKING CHANGE.

Notes Ck'd by	Survey of Badillo St.
Map No. B-754-3	W. O. 7103 Tape No. 041 St'd 84 °F.
Office Work H.N. Bradstreet	Surveyed by Rosecrans
Checked	Notes Date 7-17-33
Date	Indexed A. C. Johnson

F.B. 510 PG. 144
No. Page 145 in F.B. 510

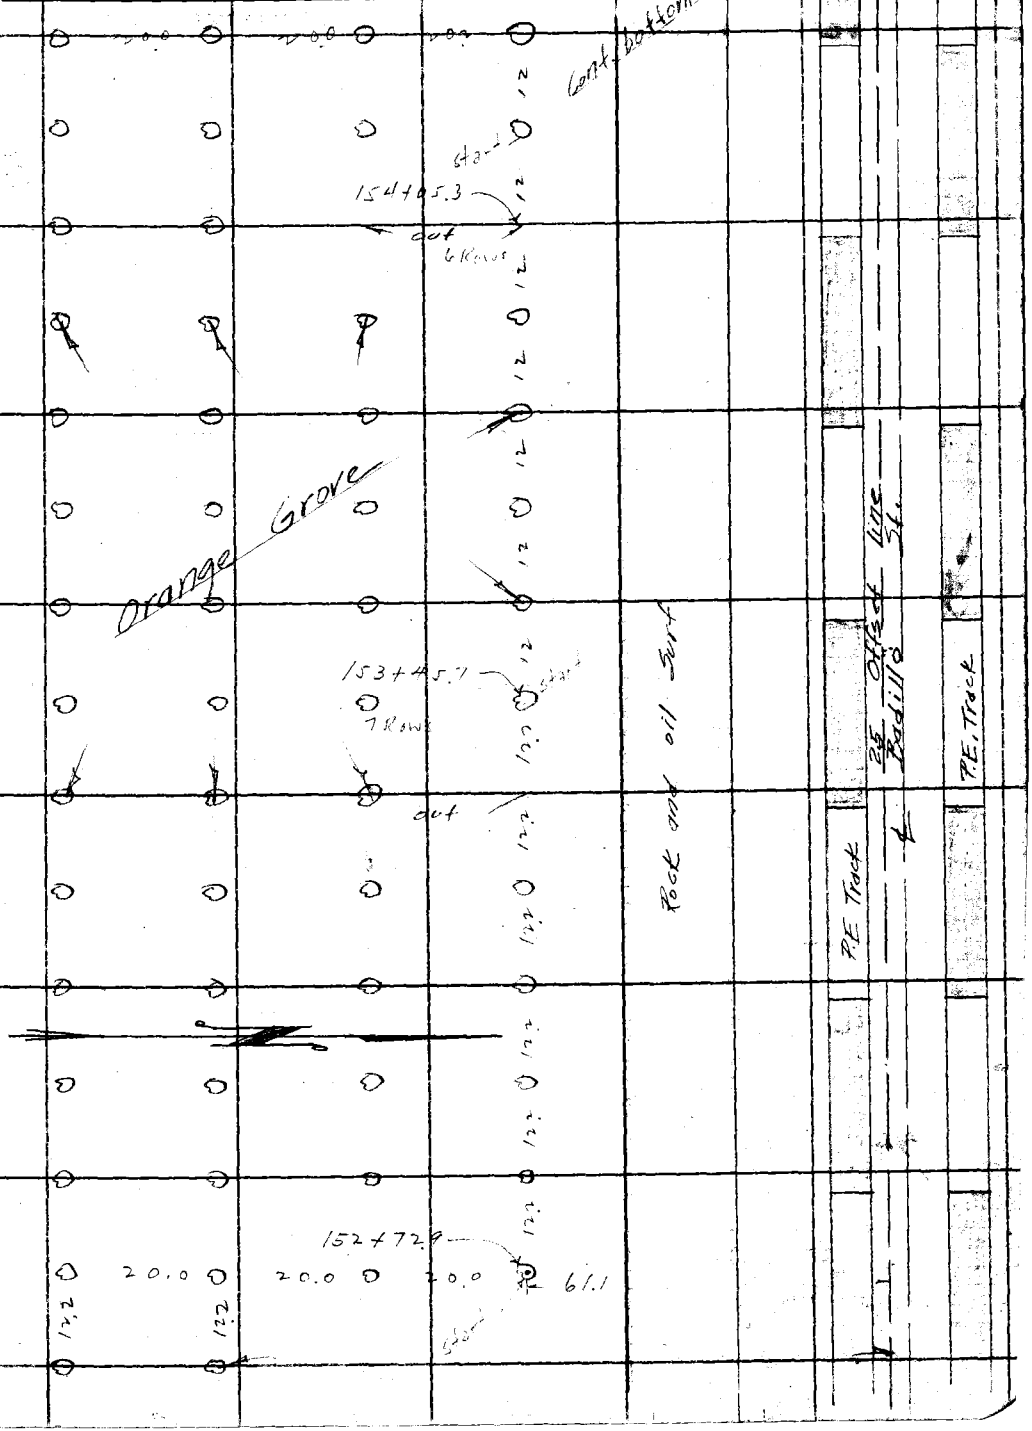

Note: ANY ADDITIONS OR CHANGES ON THIS SHEET MUST BE MADE OR CIRCLED IN Red Ink. WITH DATE AND NAME OF PERSON MAKING CHANGE.

Do not extend notes this side of this line

RETURN TO
LOS ANGELES COUNTY SURVEYOR
700 HALL OF RECORDS

FORM 247 10M 5-31

RETURN TO
LOS ANGELES COUNTY SURVEYOR
700 HALL OF RECORDS

Note: ANY ADDITIONS OR CHANGES ON THIS SHEET MUST BE MADE OR CIRCLED IN Red Ink. WITH DATE AND NAME OF PERSON MAKING CHANGE.

Do not extend notes this side of this line

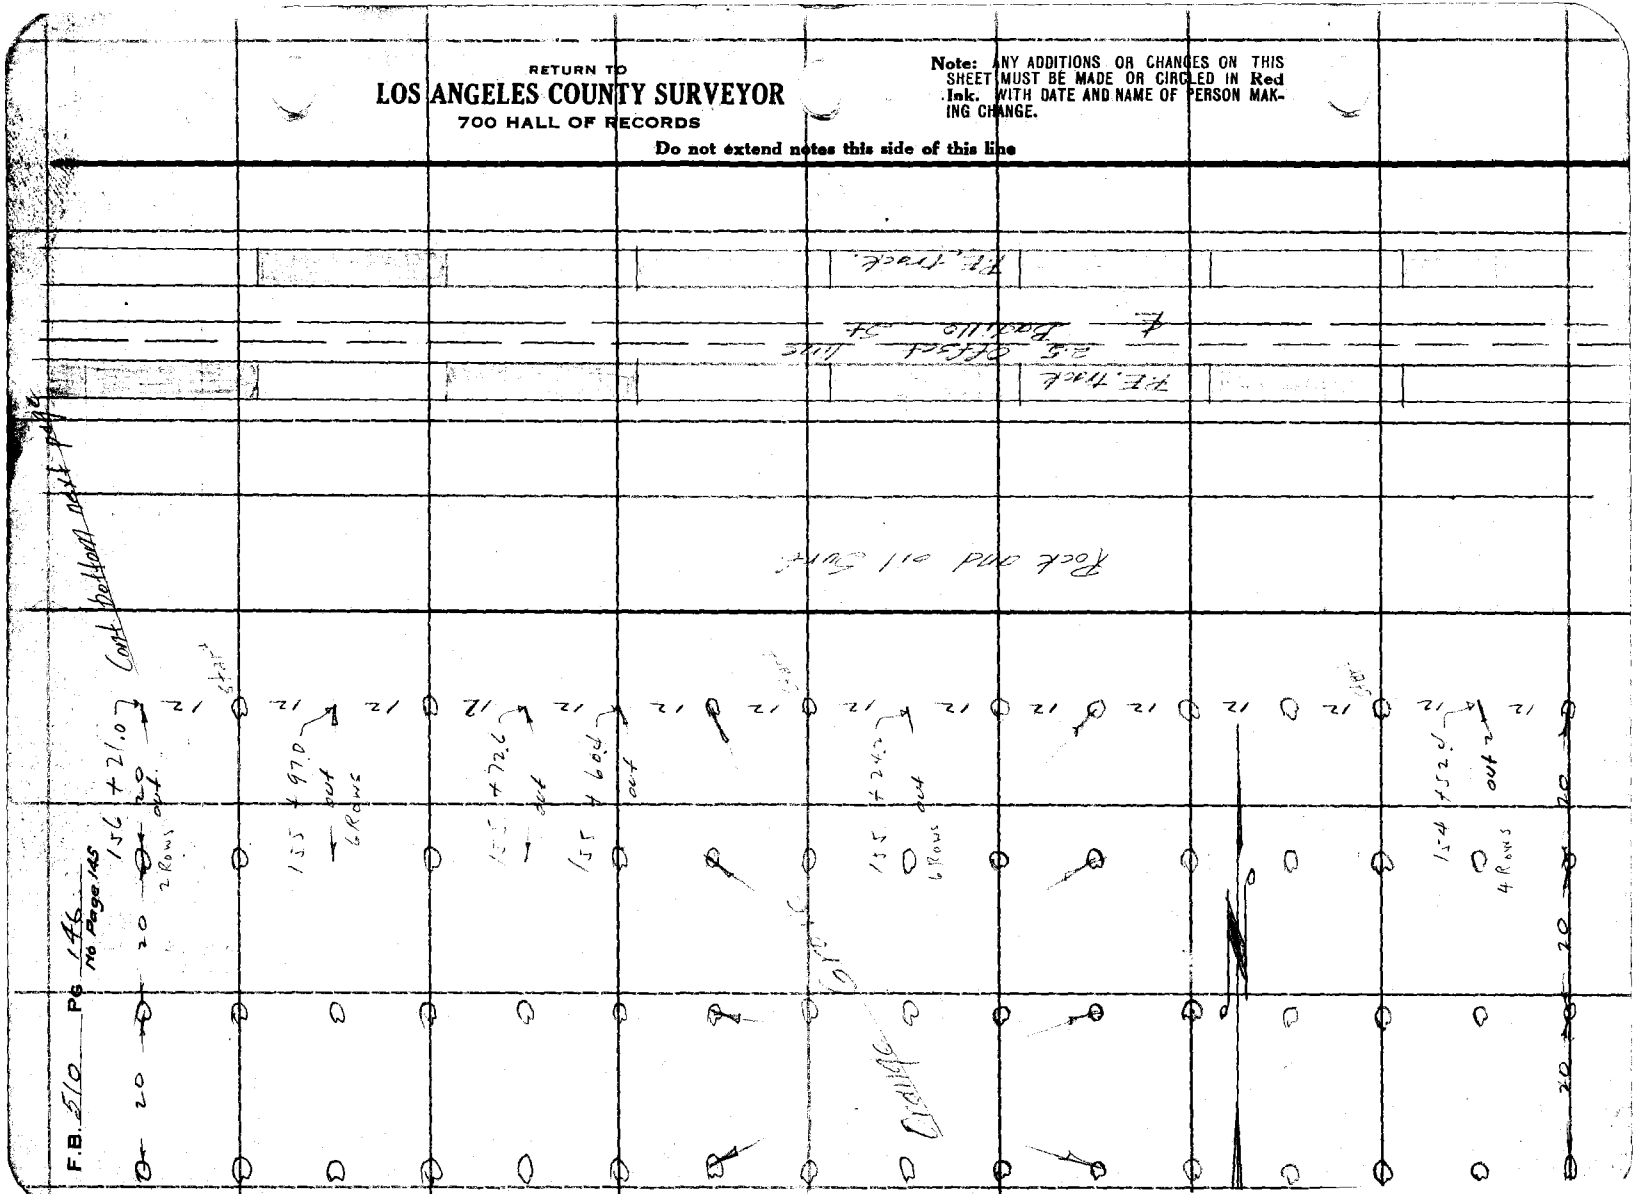

Notes Ck'd by	Survey of Badillo St
Map No. B-754-3	W. O. 7103 Tape No. 041 St'd 84 °F.
Office Work H.N. Broadstreet	Surveyed by Rosecrans
Checked	Notes Date 7-17-33
Date	Indexed A. C. Johnson

F.B. 510 PG. 147

Cont. bottom next page

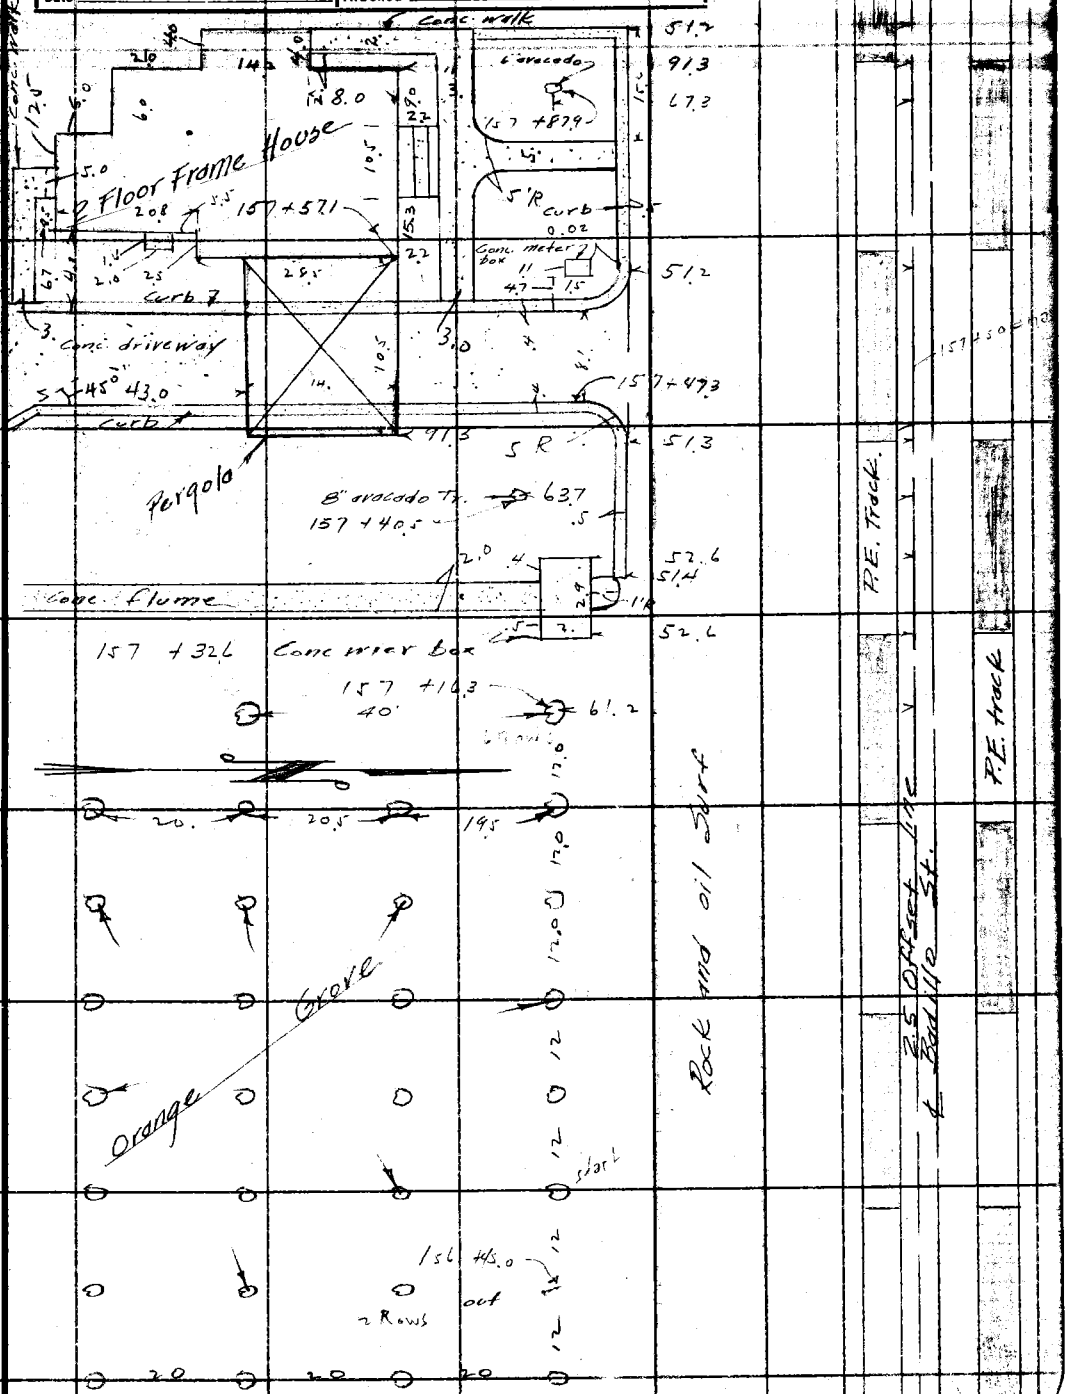

Note: ANY ADDITIONS OR CHANGES ON THIS SHEET MUST BE MADE OR CIRCLED IN RED Ink. WITH DATE AND NAME OF PERSON MAKING CHANGE.

RETURN TO
LOS ANGELES COUNTY SURVEYOR
700 HALL OF RECORDS

Do not extend notes this side of this line

FORM 247 10M 5-31

F.B. 510 PG. 148

RETURN TO
LOS ANGELES COUNTY SURVEYOR
700 HALL OF RECORDS

Do not extend notes this side of this line

Note: ANY ADDITIONS OR CHANGES ON THIS SHEET MUST BE MADE OR CIRCLED IN Red Ink. WITH DATE AND NAME OF PERSON MAKING CHANGE.

Notes Ck'd by	Survey of Badillo St
Map No. B-754-3	W. O. 710 Tape No. 071 St'd 84 °F.
Office Work N.N. Bradstreet	Surveyed by Rosecrans
Checked	Notes Date 7/17/33
Date	Indexed A. C. Johnson

F.B. 510 PG. 149

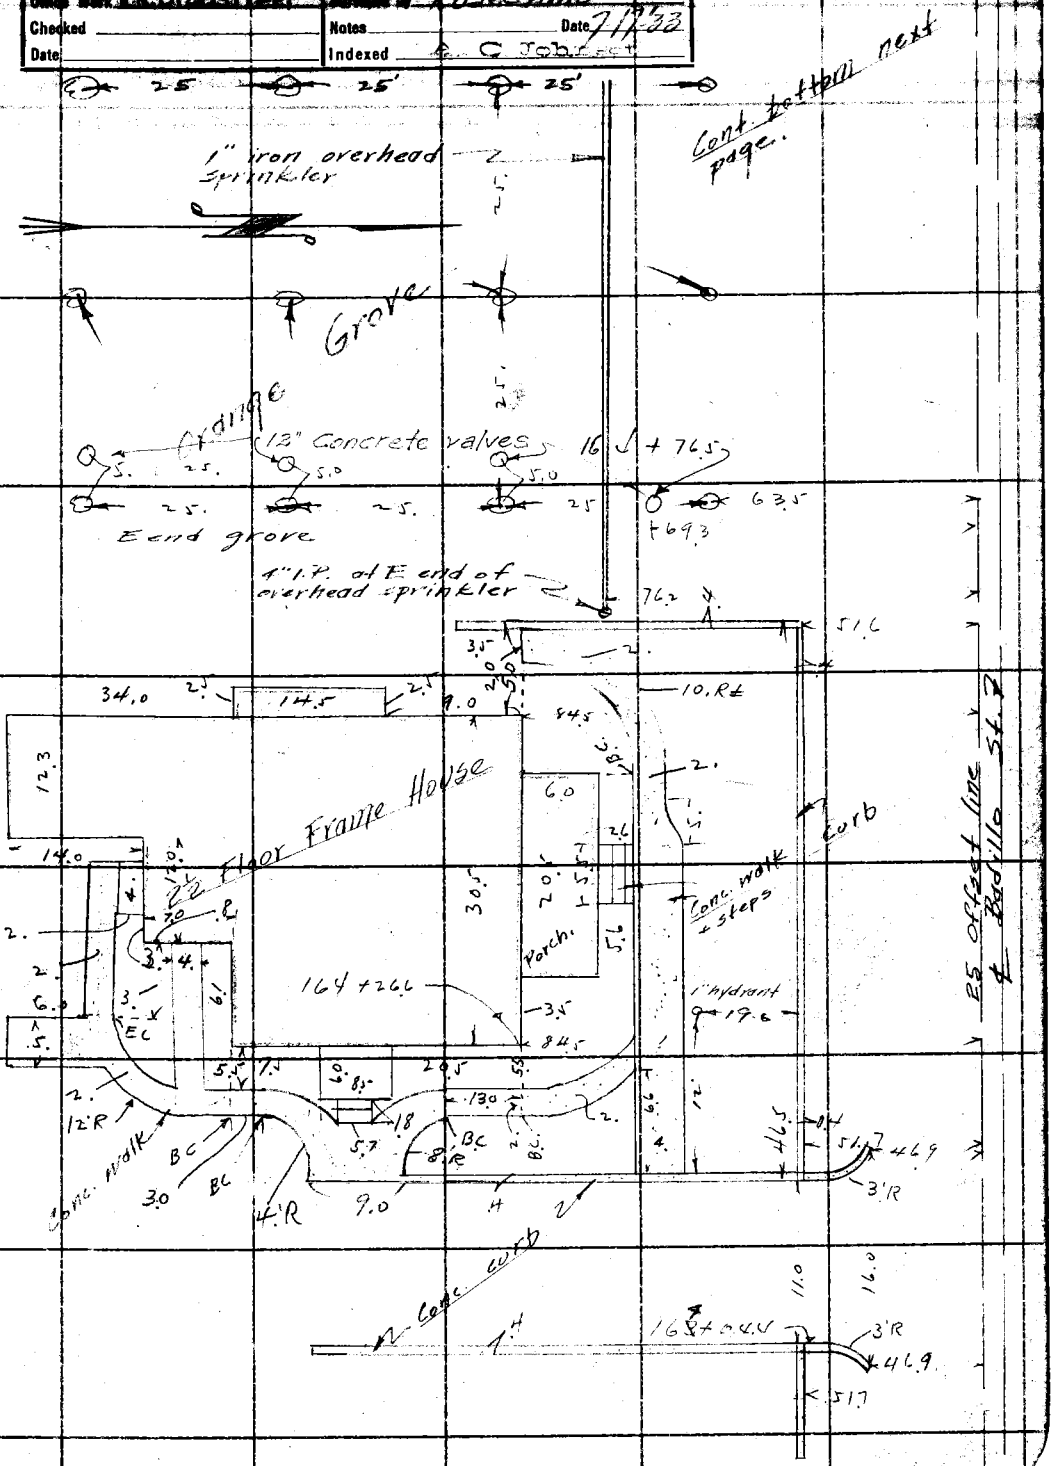

Note: ANY ADDITIONS OR CHANGES ON THIS SHEET MUST BE MADE OR CIRCLED IN Red Ink, WITH DATE AND NAME OF PERSON MAKING CHANGE.

Do not extend notes this side of this line

RETURN TO
LOS ANGELES COUNTY SURVEYOR
700 HALL OF RECORDS

FORM 247 10M 5-31

F.B. 510 Pg. 150

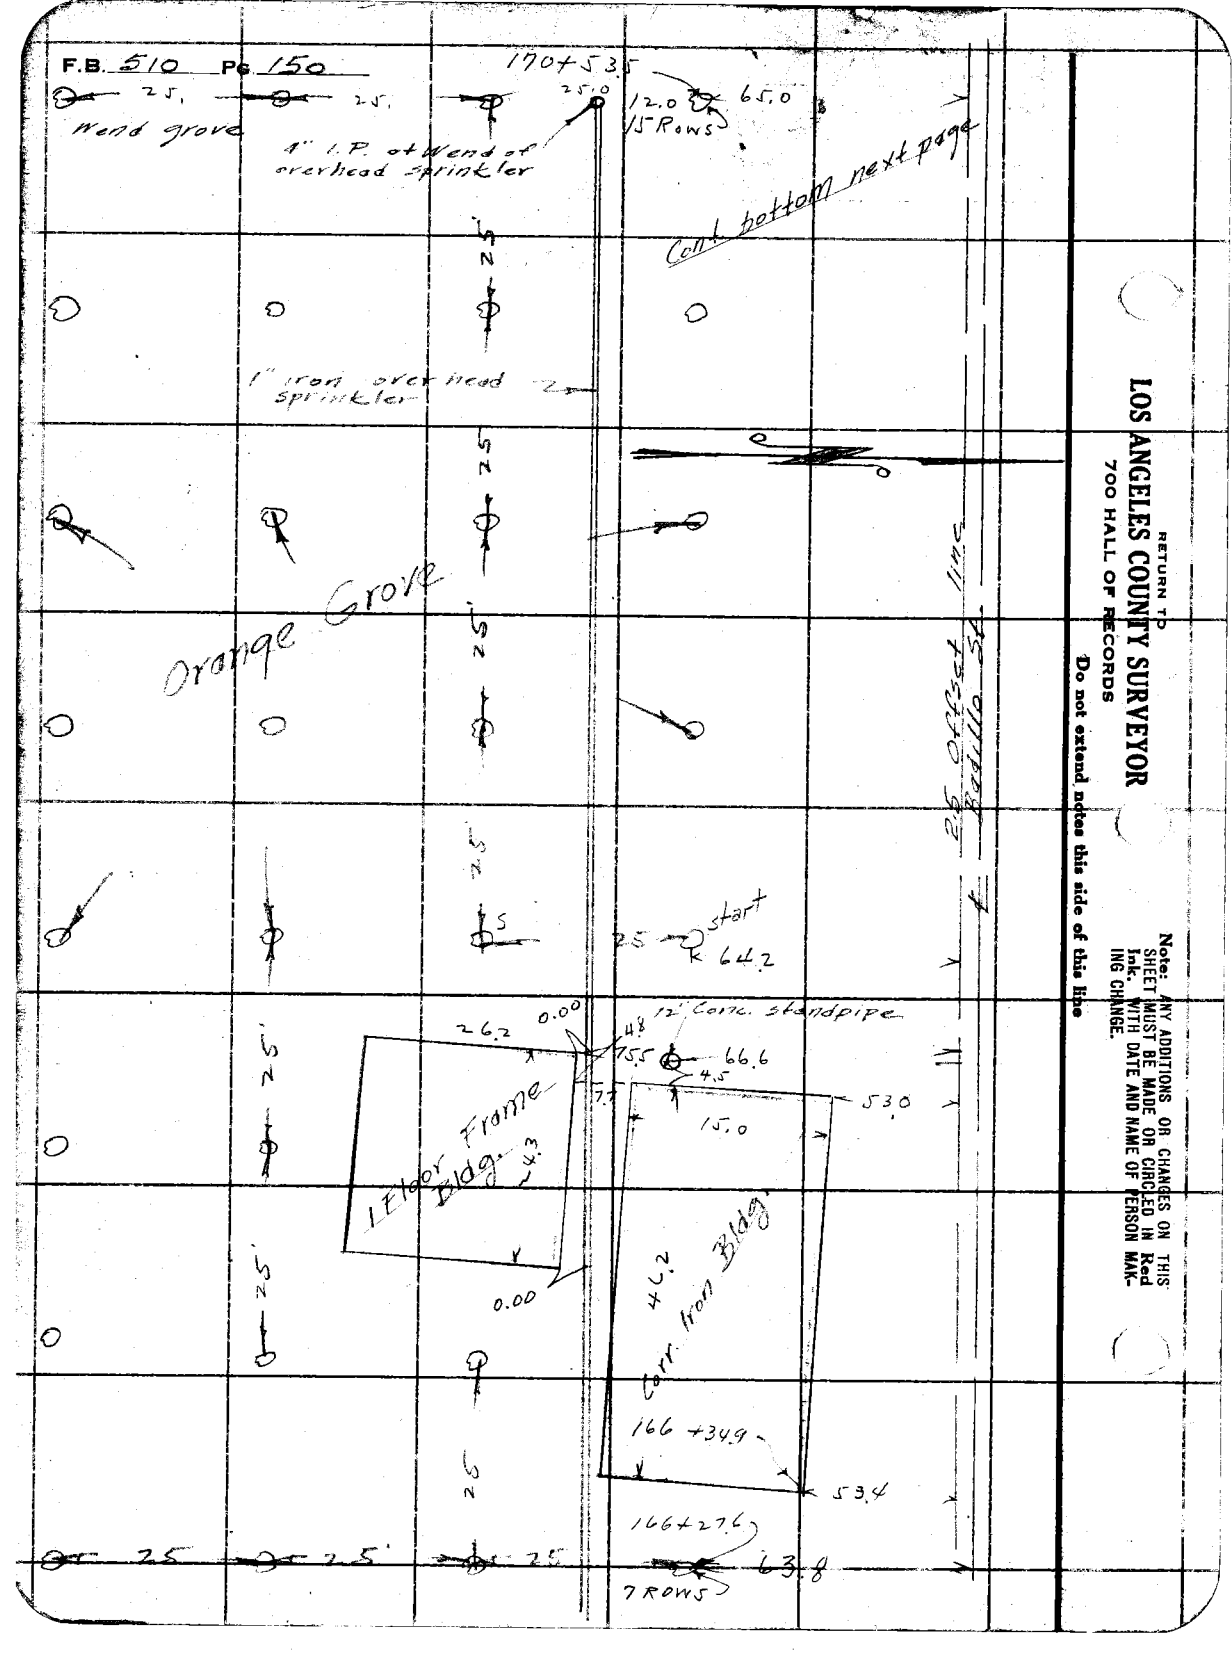

RETURN TO
LOS ANGELES COUNTY SURVEYOR
700 HALL OF RECORDS

Do not extend notes this side of this line

Note: ANY ADDITIONS OR CHANGES ON THIS SHEET MUST BE MADE OR CIRCLED IN Red Ink. WITH DATE AND NAME OF PERSON MAKING CHANGE.

Notes Ck'd by	Survey of Badillo St
Map No. B-754-3	W. O. 7103 Tape No. 071 St'd 84 °F.
Office Work H. N. Bradstreet	Surveyed by Rosecrans
Checked	Notes Date 7-18-33
Date	Indexed A. C. Johnson

F.B. 510 PG. 151

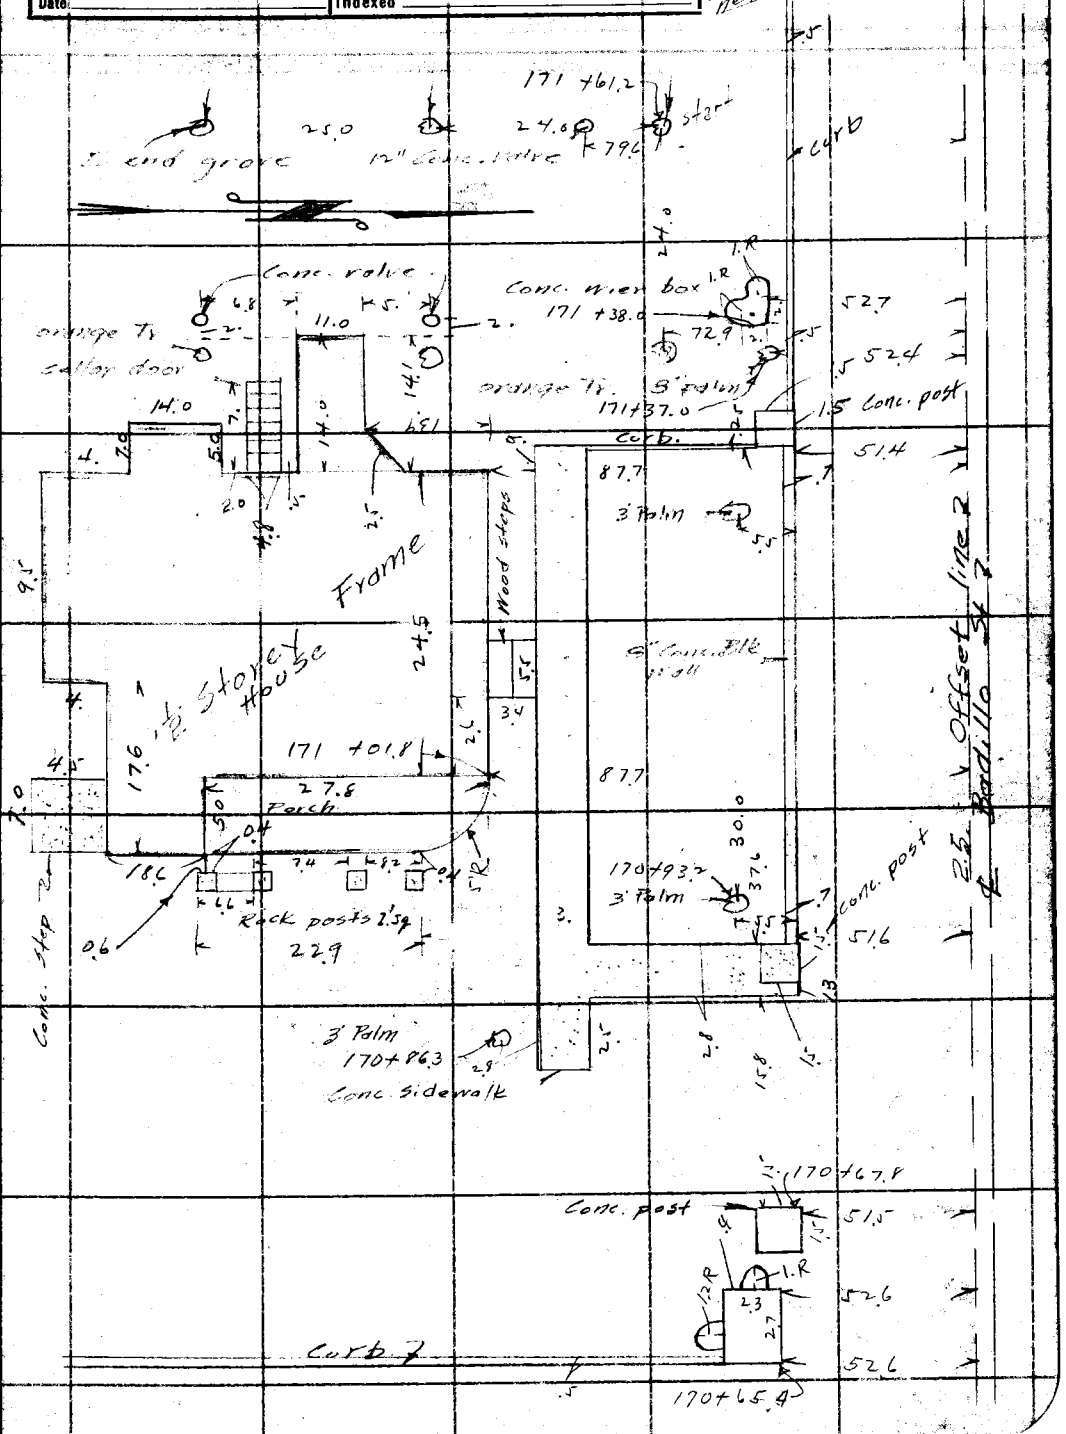

Note: ANY ADDITIONS OR CHANGES ON THIS SHEET MUST BE MADE OR CIRCLED IN Red Ink. WITH DATE AND NAME OF PERSON MAKING CHANGE.

Do not extend notes this side of this line

RETURN TO
LOS ANGELES COUNTY SURVEYOR
700 HALL OF RECORDS

FORM 247 10M 5-31

RETURN TO
LOS ANGELES COUNTY SURVEYOR
700 HALL OF RECORDS

Note: ANY ADDITIONS OR CHANGES ON THIS SHEET MUST BE MADE OR CIRCLED IN Red Ink. WITH DATE AND NAME OF PERSON MAKING CHANGE.

Do not extend notes this side of this line

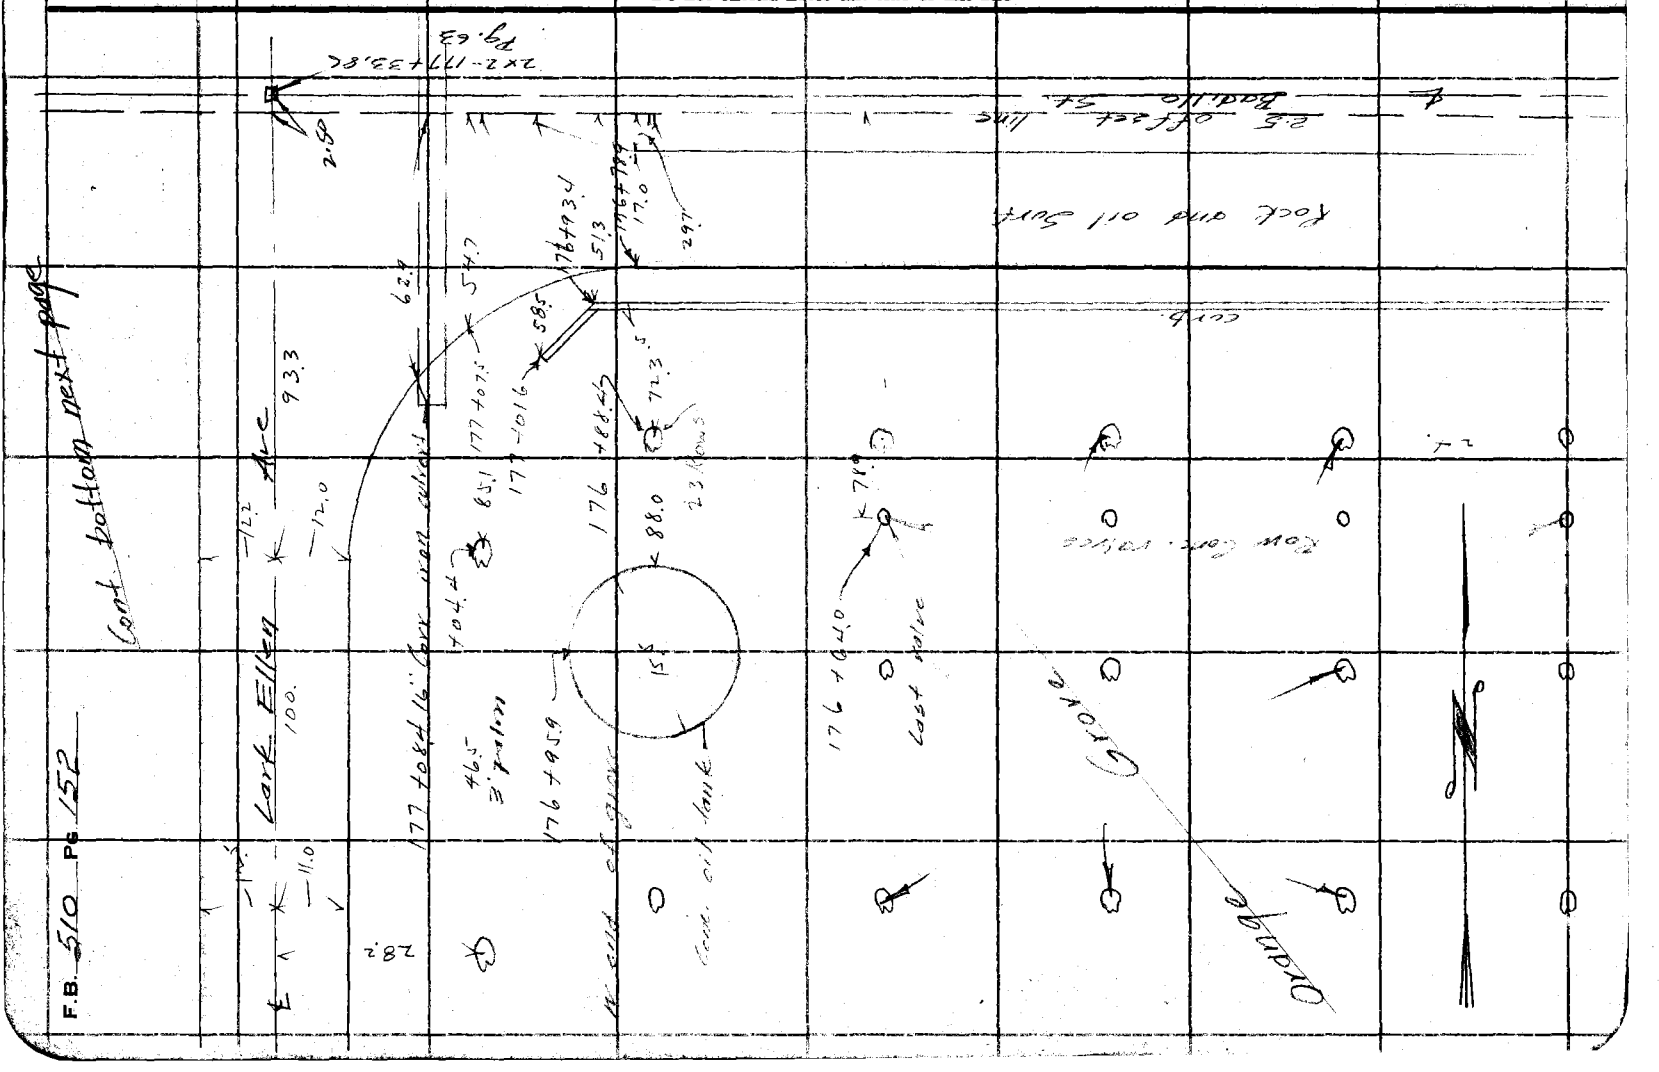

Notes Ck'd by	Survey of Badillo St
Map No. B-154-3	W. O. 7103 Tape No. 641 St'd 84 °F.
Office Work H.N. Brandstreet	Surveyed by Rosecrans
Date	Indexed A. C. Johnson

F.B. 510 PG. 153

Cent. on bottom 154 pg.

Notes: ANY ADDITIONS OR CHANGES ON THIS SHEET MUST BE MADE OR CIRCLED IN Red Ink. WITH DATE AND NAME OF PERSON MAKING CHANGE.

Do not extend notes this side of this line

RETURN TO
LOS ANGELES COUNTY SURVEYOR
700 HALL OF RECORDS

FORM 247 10M 5-31

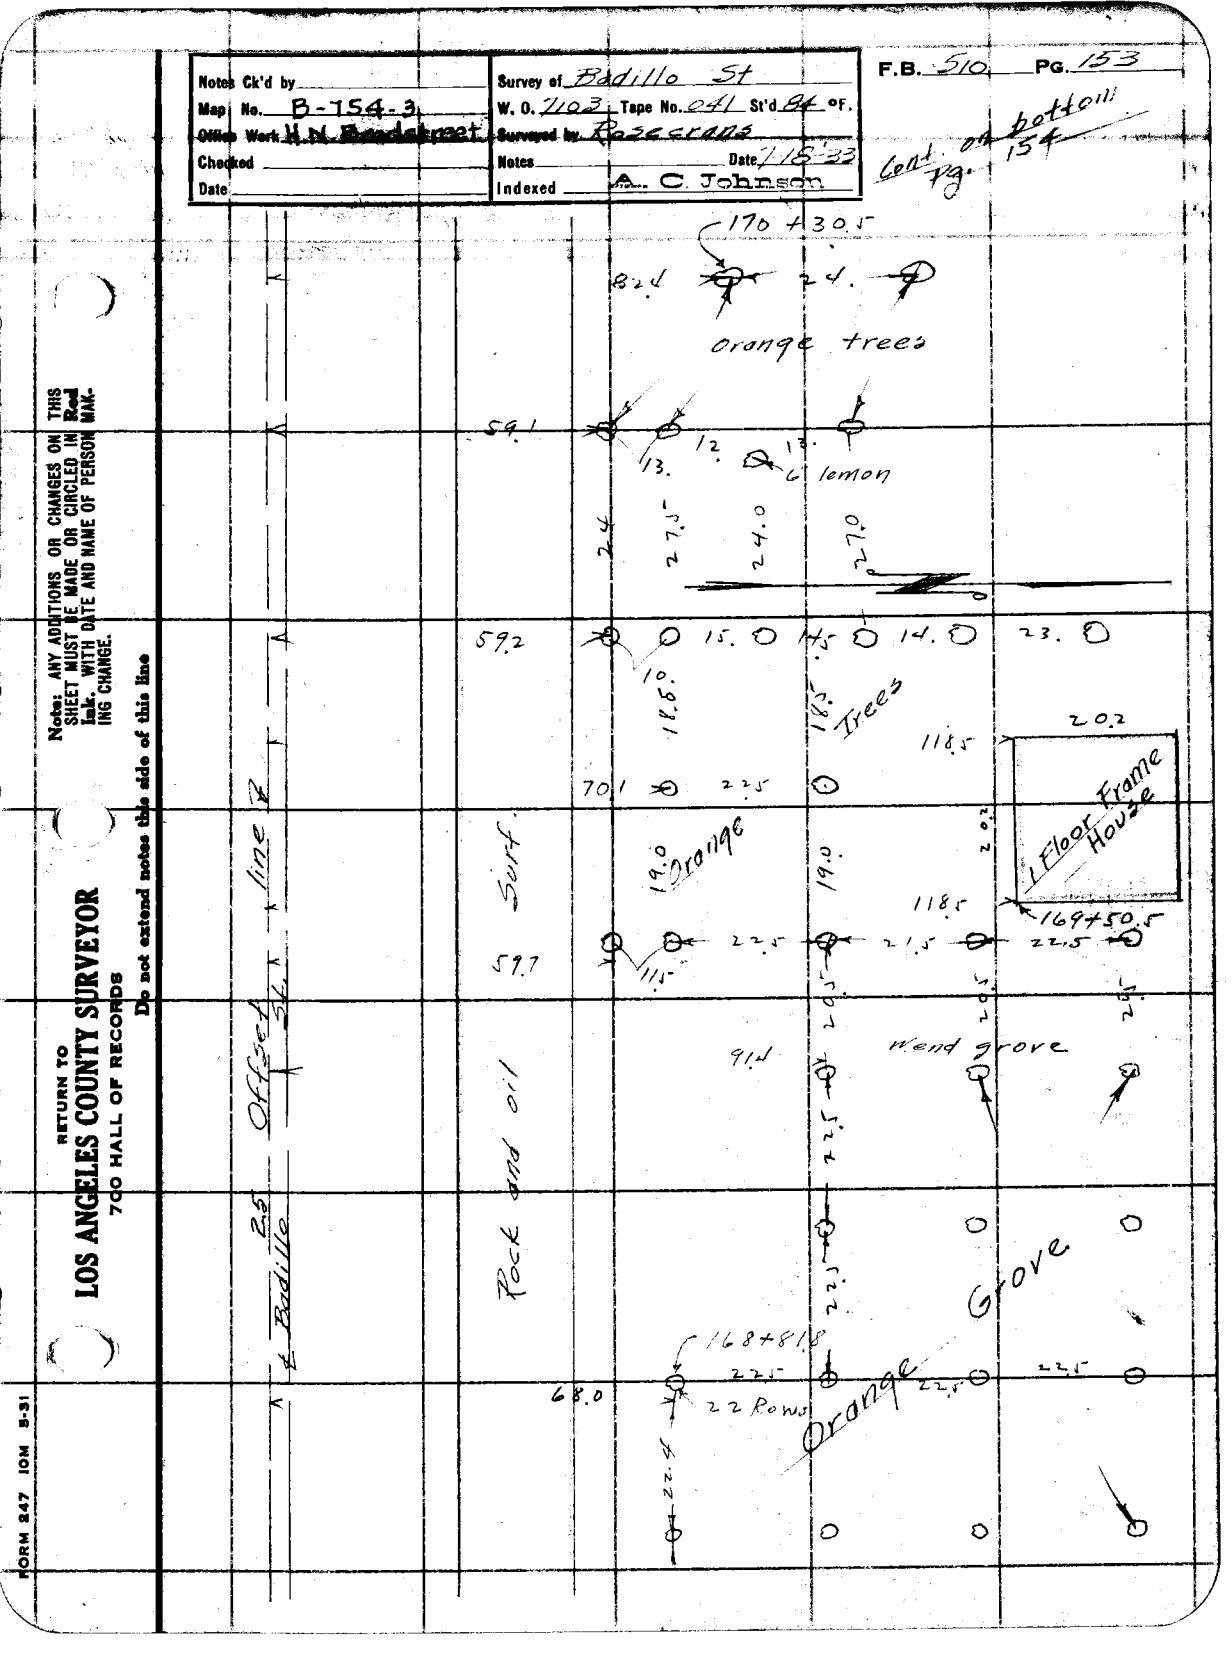

F.B. 510 PG. 154

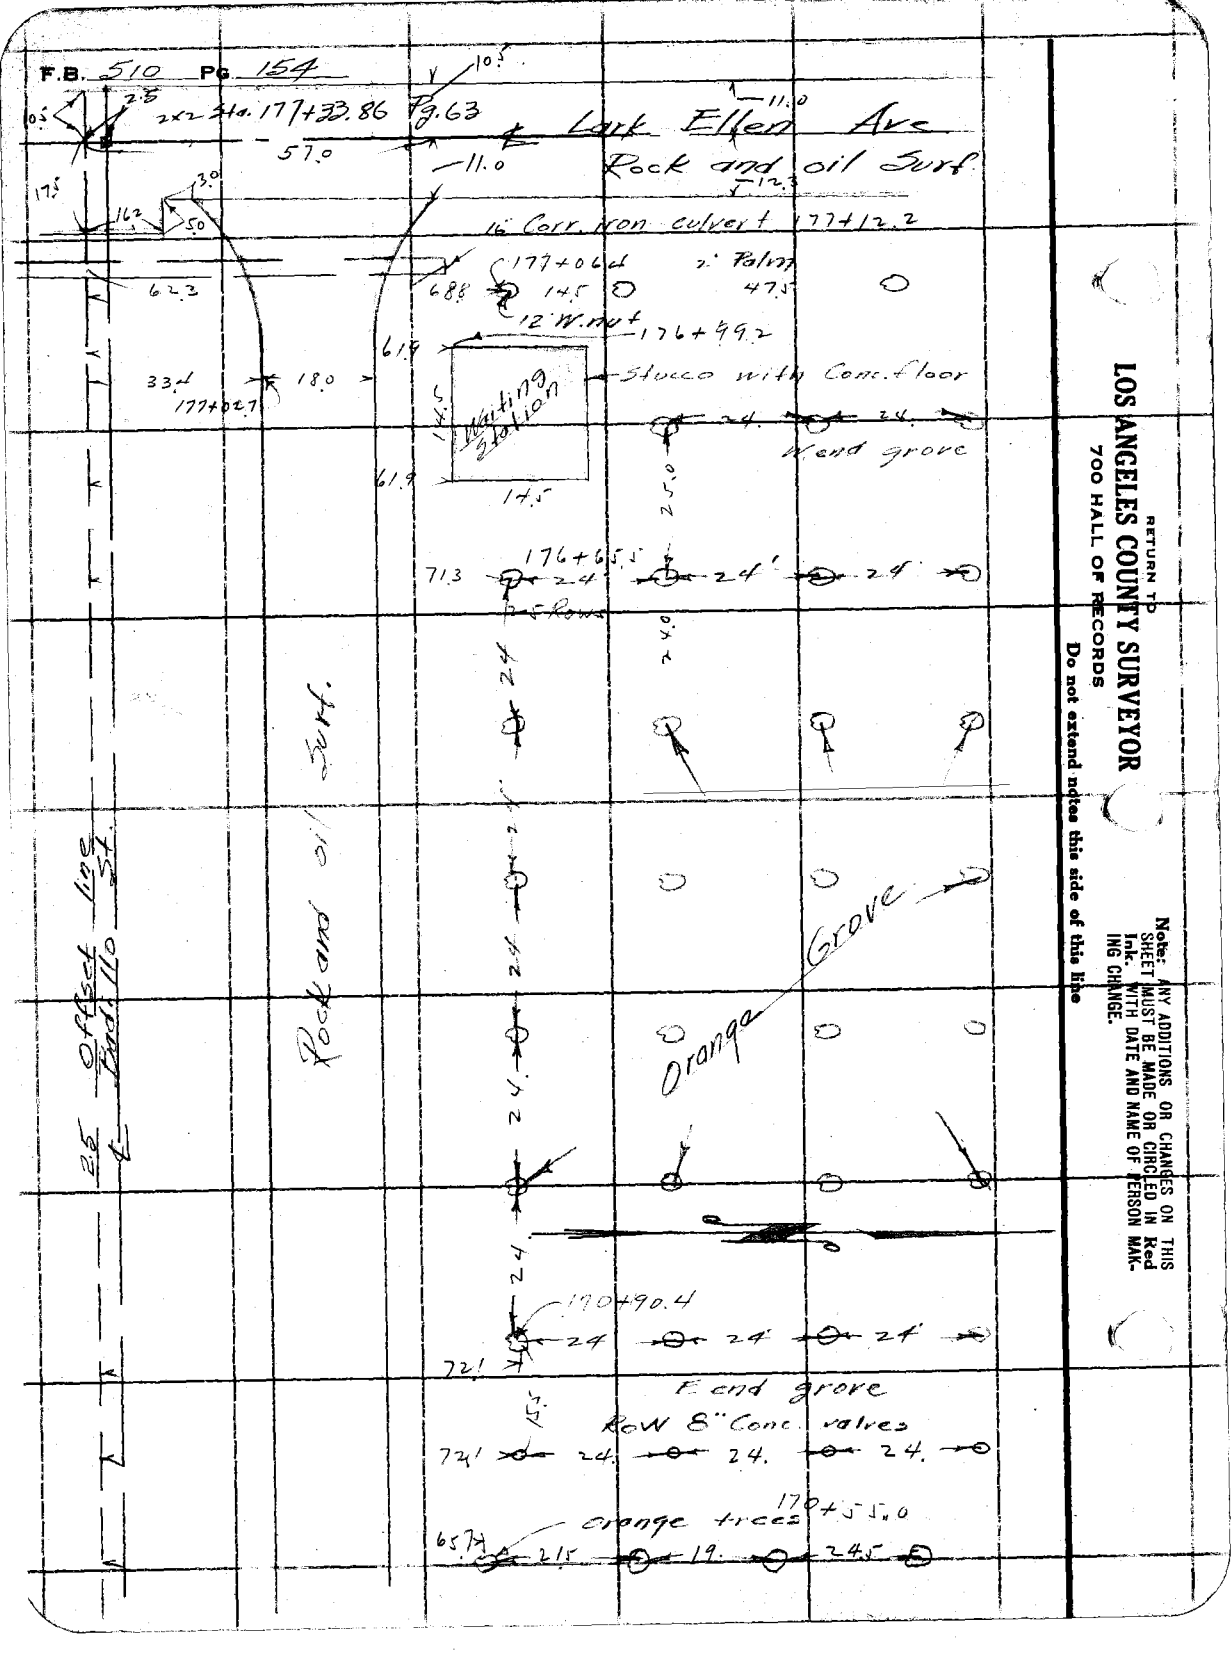

RETURN TO
LOS ANGELES COUNTY SURVEYOR
700 HALL OF RECORDS

Do not extend notes this side of this line

Note: ANY ADDITIONS OR CHANGES ON THIS SHEET MUST BE MADE OR CHECKED IN Red Ink. WITH DATE AND NAME OF PERSON MAKING CHANGE.

Notes Ck'd by	Survey of Badillo St.
Map No. B-154-3	W. O. 1102 Tape No. 011 St'd 60 °F.
Office Work H.N. Bradstreet	Surveyed by Rasecrans
Checked	Notes Date 7-18-33
Date	Indexed A. C. Johnson

F.B. 510 PG. 155

Cont. bottom next page

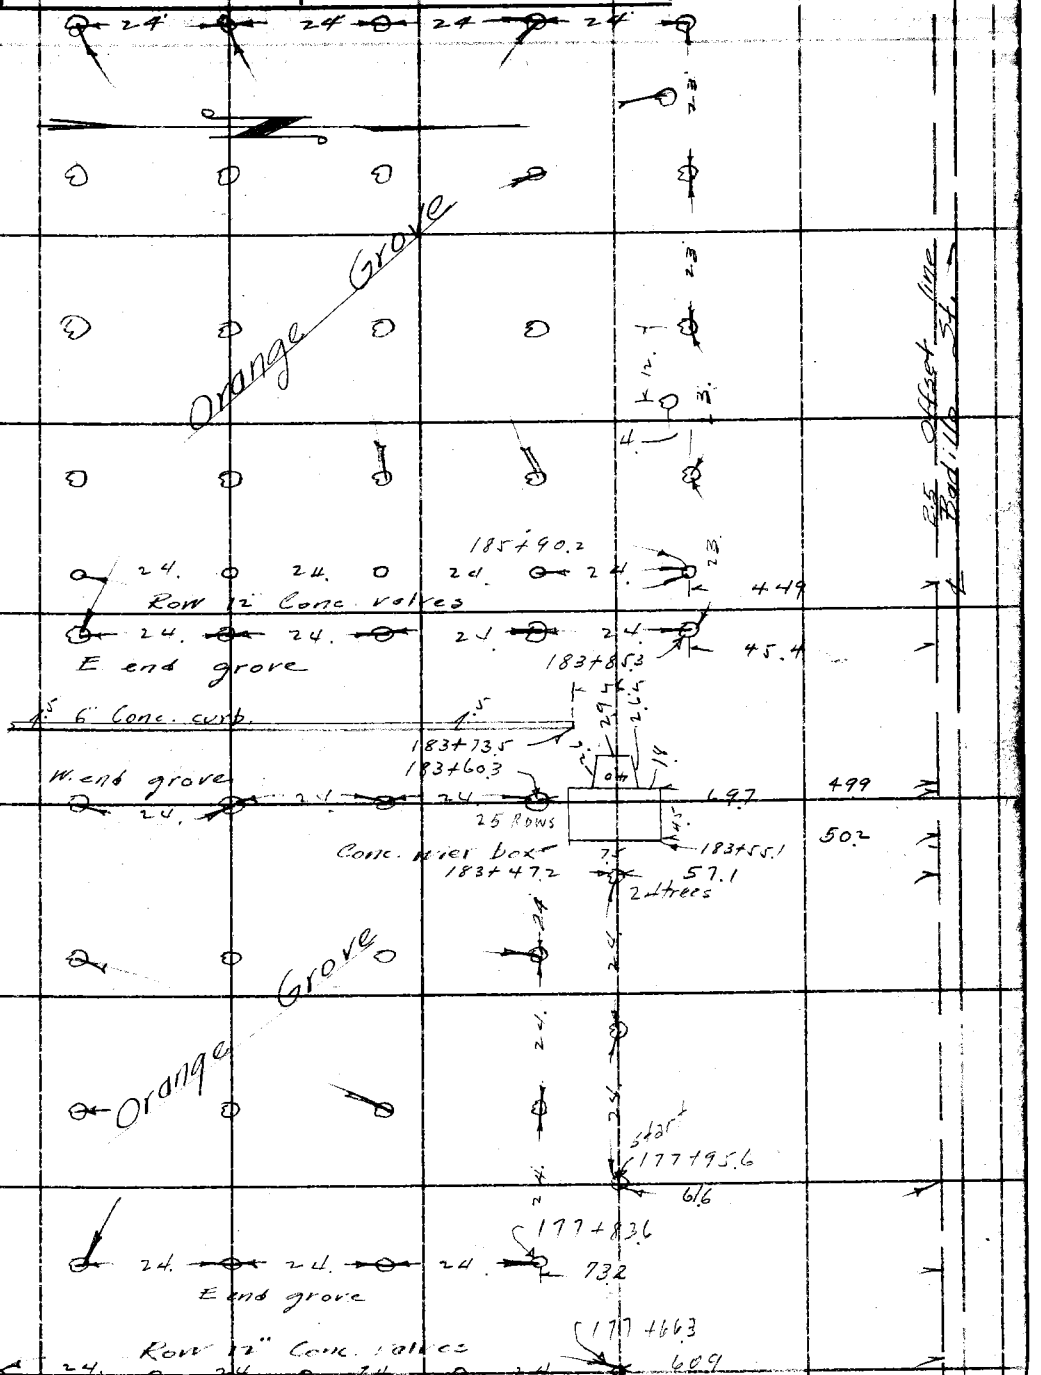

Note: ANY ADDITIONS OR CHANGES ON THIS SHEET MUST BE MADE OR CIRCLED IN Red Ink. WITH DATE AND NAME OF PERSON MAKING CHANGE.

Do not extend notes this side of this line

RETURN TO
LOS ANGELES COUNTY SURVEYOR
700 HALL OF RECORDS

FORM 247 10M 8-31

RETURN TO
LOS ANGELES COUNTY SURVEYOR
700 HALL OF RECORDS

Note: ANY ADDITIONS OR CHANGES ON THIS SHEET MUST BE MADE OR CIRCLED IN Red Ink. WITH DATE AND NAME OF PERSON MAKING CHANGE.

Do not extend notes this side of this line

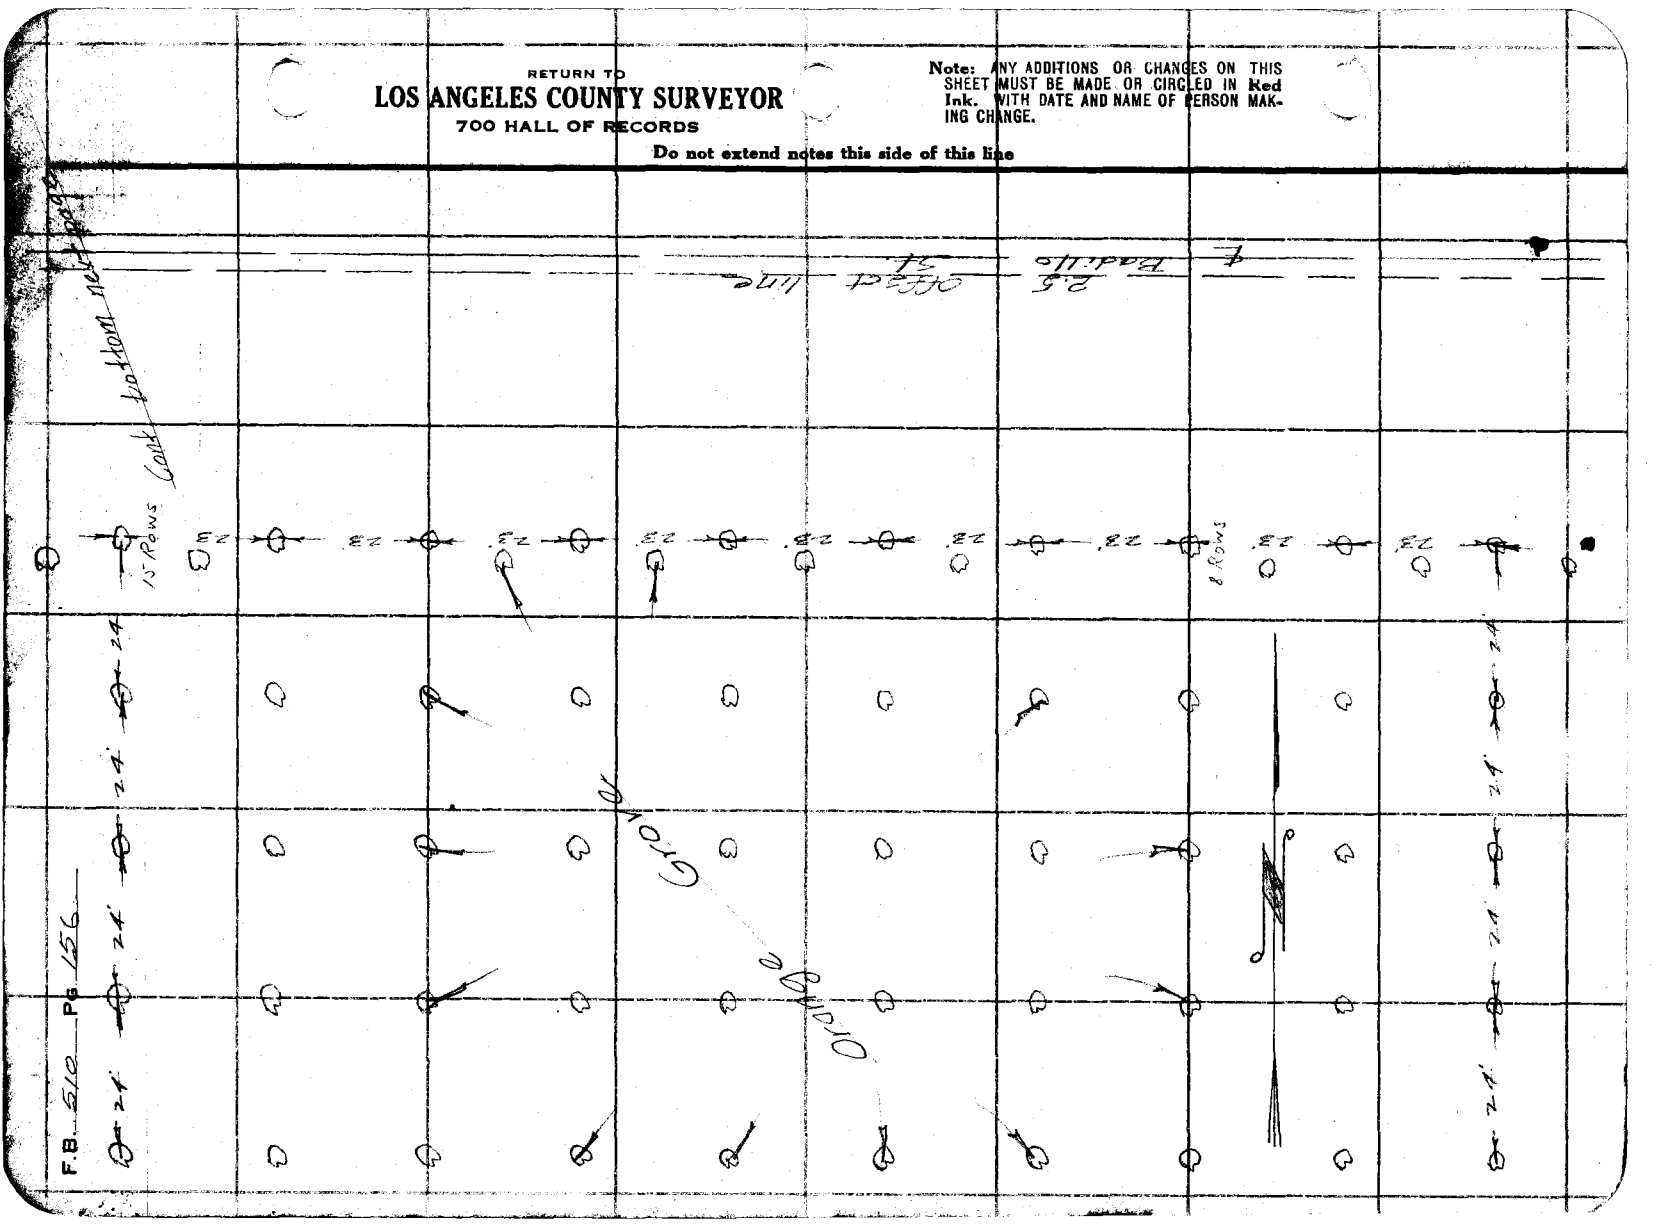

Notes Ck'd by	Survey of Badillo St.
Map No. B-754-3	W. O. 7103 Tape No. 041 St'd 84 °F.
Office Work H.N. Bradstreet	Surveyed by Rosecrans
Checked	Notes Date 7-18-23
Date	Indexed A. C. Johnson

F.B. 510 PG. 157

Cont on bottom next page

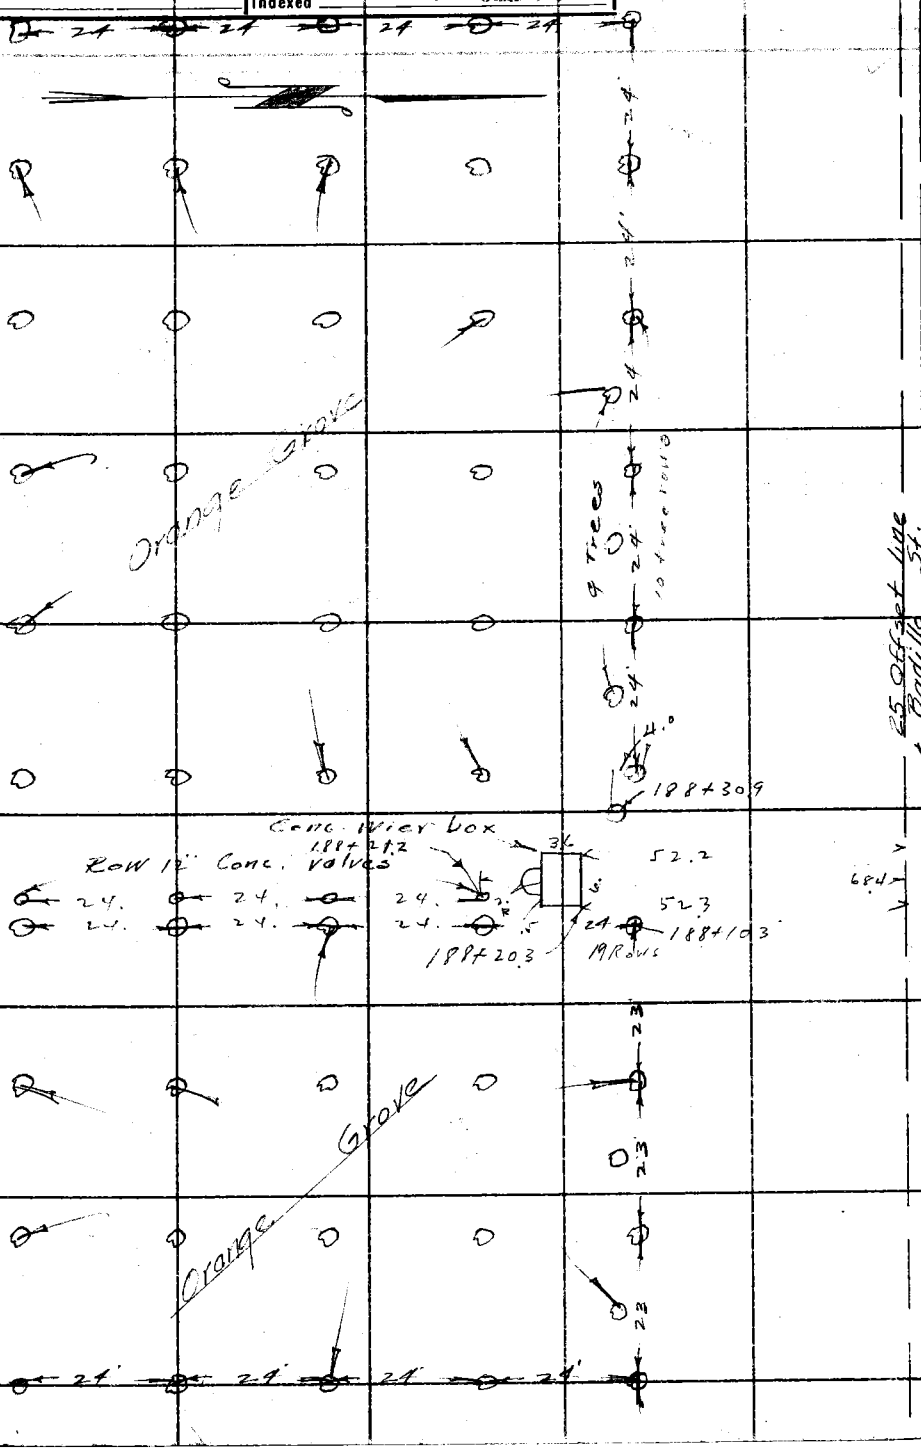

Note: ANY ADDITIONS OR CHANGES ON THIS SHEET MUST BE MADE OR CIRCLED IN Red Ink. WITH DATE AND NAME OF PERSON MAKING CHANGE.

Do not extend notes this side of this line

RETURN TO
LOS ANGELES COUNTY SURVEYOR
700 HALL OF RECORDS

FORM 247 10M 5-31

F.B. 510 Pg. 158

Cont bottom Pg 167

Conc. wier box

Row of Conc valves

E end grove

W. end grove

Grove

Orange

E end grove

W end grove

Grove

Orange

RETURN TO
LOS ANGELES COUNTY SURVEYOR
700 HALL OF RECORDS

Do not extend notes this side of this file

Note: ANY ADDITIONS OR CHANGES ON THIS SHEET MUST BE MADE OR CIRCLED IN Red Ink. WITH DATE AND NAME OF PERSON MAKING CHANGE.

Notes Ck'd by	Survey of Badillo St.
Office Work H.N. Broadstreet	Surveyed by Rosecrans
Checked	Notes Date 7-16-33
Date	Indexed A. C. Johnson

F.B. 510 PG. 157

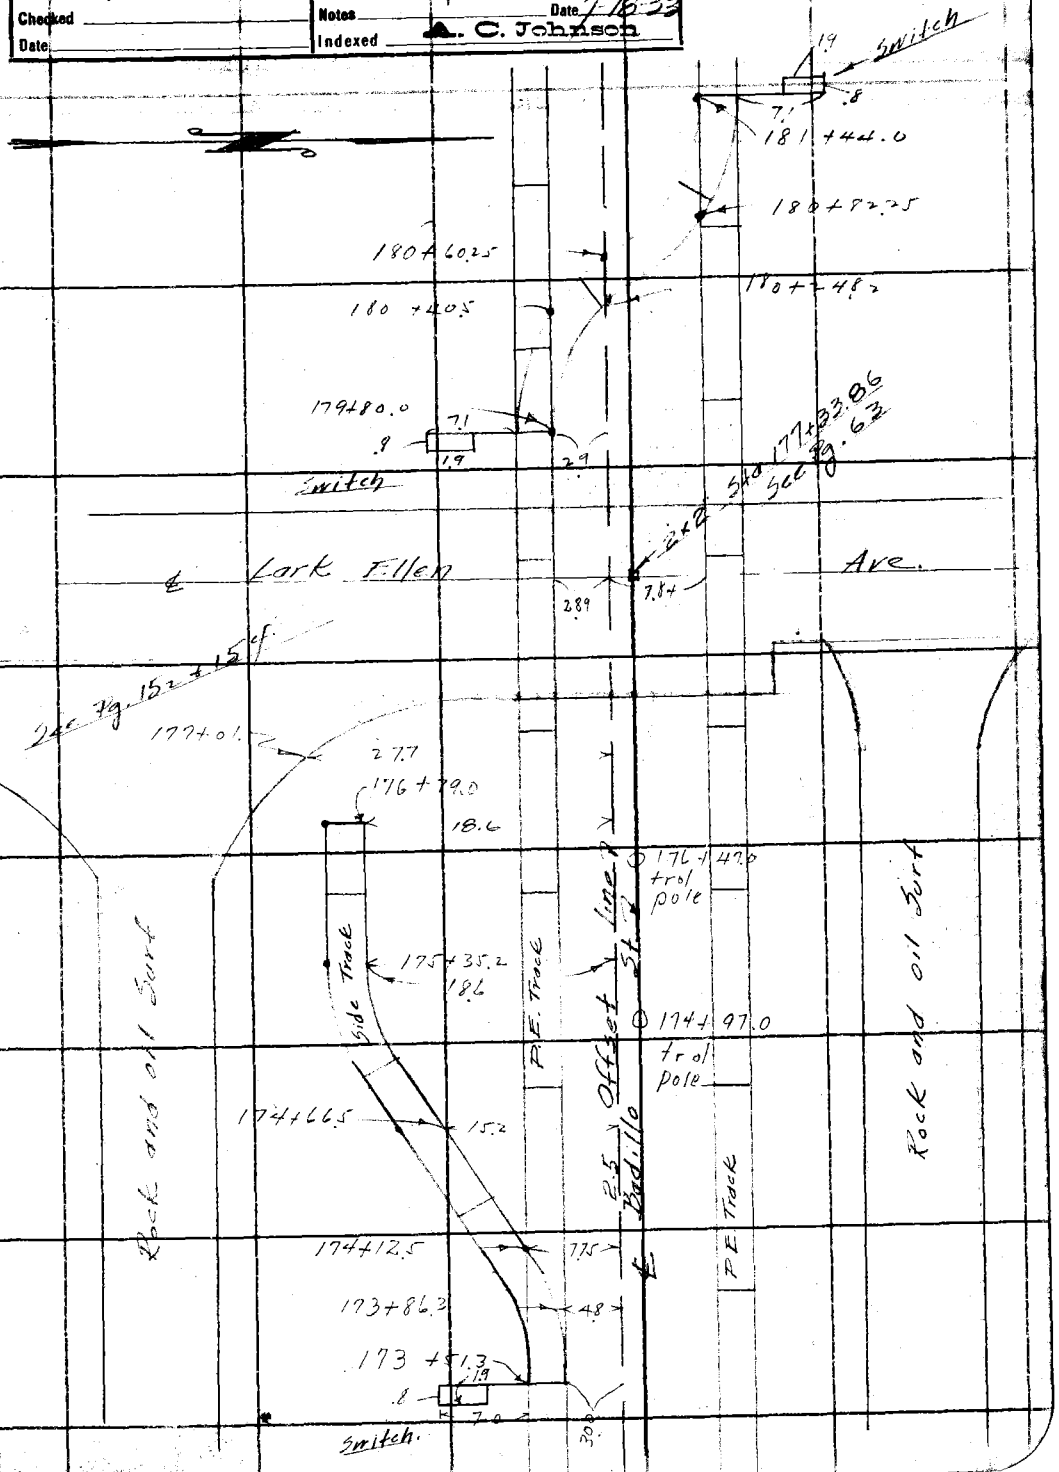

RETURN TO
LOS ANGELES COUNTY SURVEYOR
720 HALL OF RECORDS

Notes: ANY ADDITIONS OR CHANGES ON THIS SHEET MUST BE MADE OR CIRCLED IN Red Ink. WITH DATE AND NAME OF PERSON MAKING CHANGE.

Do not extend notes this side of this line

FORM 247 10M 8-31

F.B. 510 Pg 160

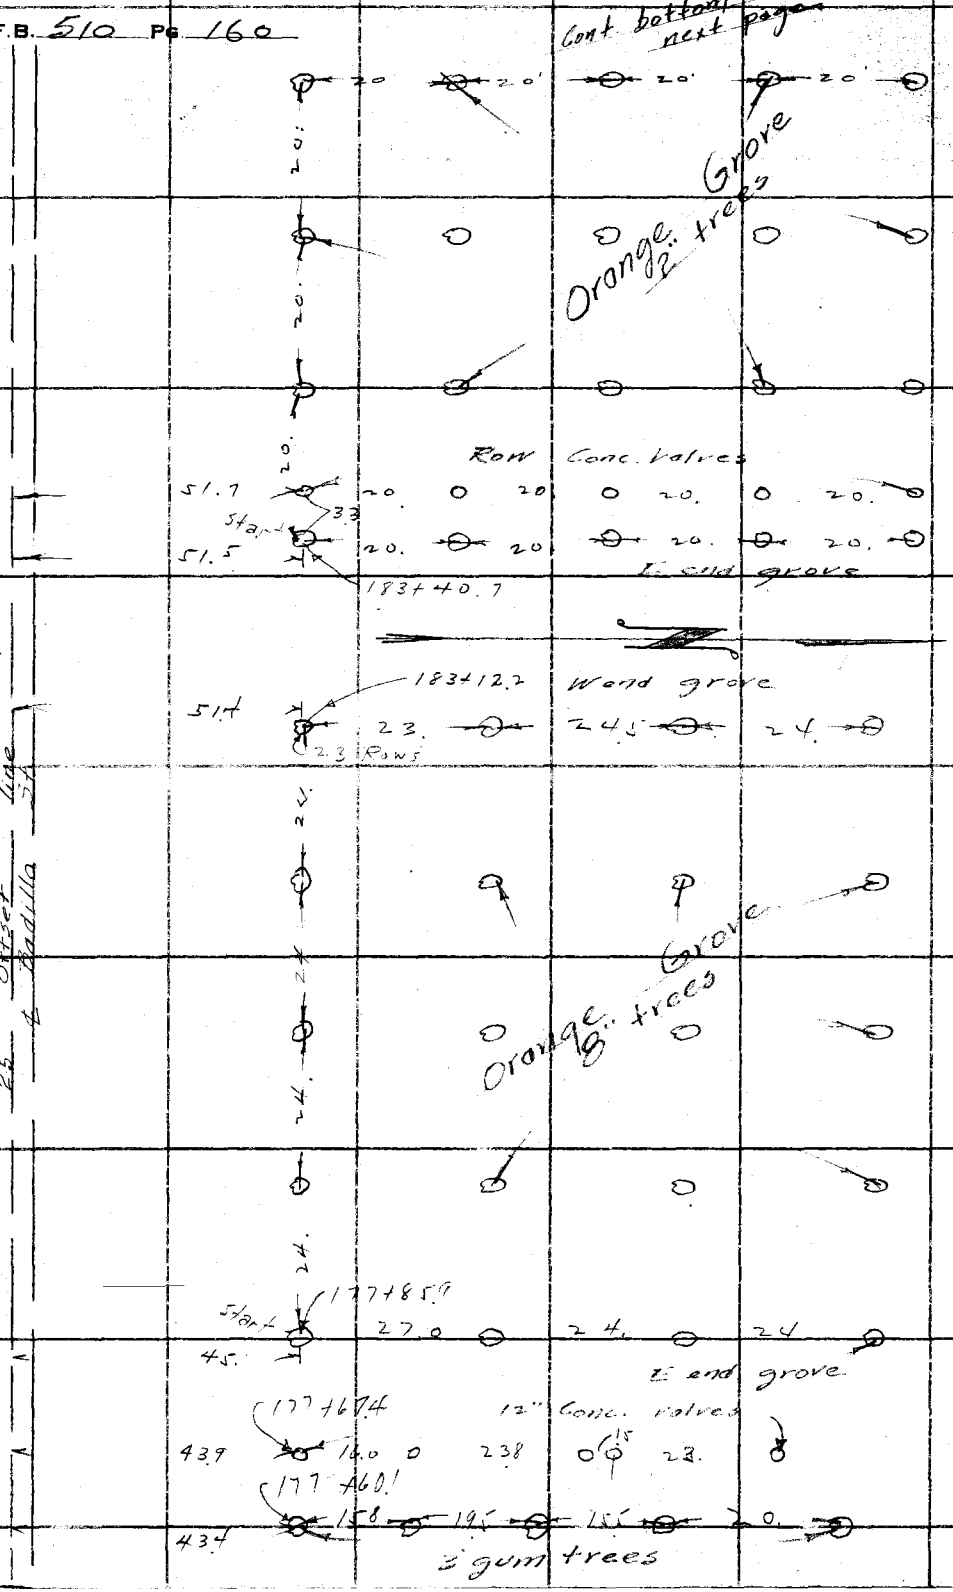

RETURN TO
LOS ANGELES COUNTY SURVEYOR
700 HALL OF RECORDS

Note: ANY ADDITIONS OR CHANGES ON THIS SHEET MUST BE MADE OR CIRCLED IN Red Ink. WITH DATE AND NAME OF PERSON MAKING CHANGE.

Do not extend notes this side of this line

Notes Ck'd by	Survey of Badillo St.
Map No. B-754-3	W. O. 7103 Tape No. 041 St'd 84 °F.
Office Work H.N. Bradstreet	Surveyed by Rosecrans
Checked	Notes Date 7-18-33
Date	Indexed A. C. Johnson

F.B. 510 PG. 161

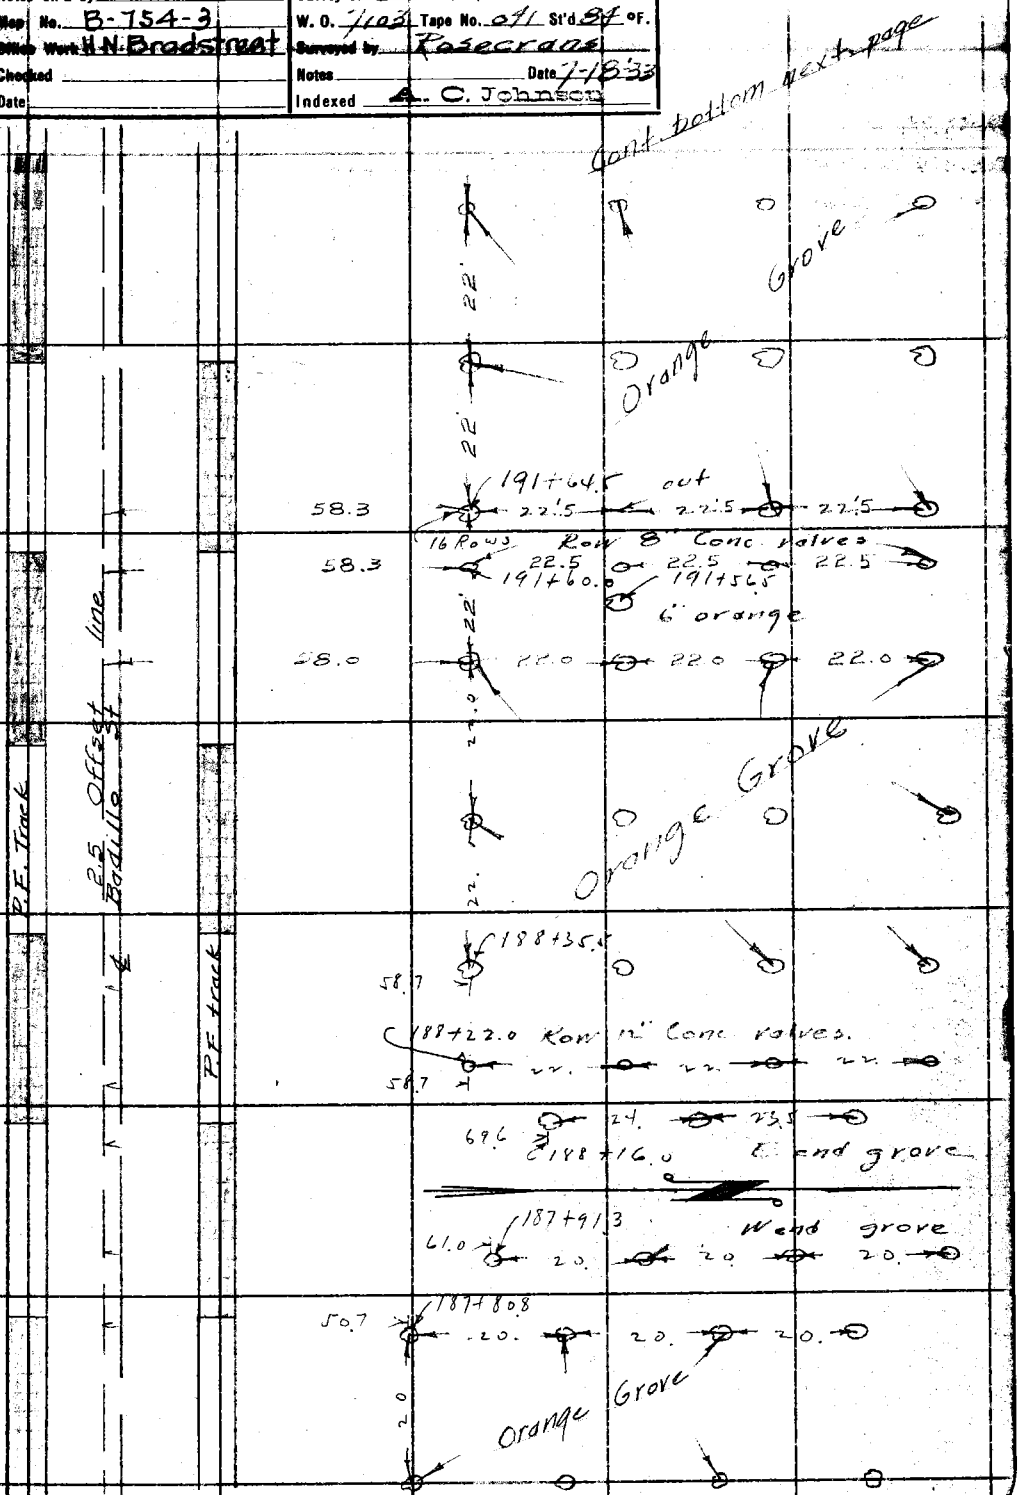

Note: ANY ADDITIONS OR CHANGES ON THIS SHEET MUST BE MADE OR CIRCLED IN Red Ink. WITH DATE AND NAME OF PERSON MAKING CHANGE.

Do not extend notes this side of this line

RETURN TO
LOS ANGELES COUNTY SURVEYOR
700 HALL OF RECORDS

FORM 247 10M 5-31

RETURN TO
LOS ANGELES COUNTY SURVEYOR
700 HALL OF RECORDS

Note: ANY ADDITIONS OR CHANGES ON THIS SHEET MUST BE MADE OR CIRCLED IN **Red Ink.** WITH DATE AND NAME OF PERSON MAKING CHANGE.

Do not extend notes this side of this line

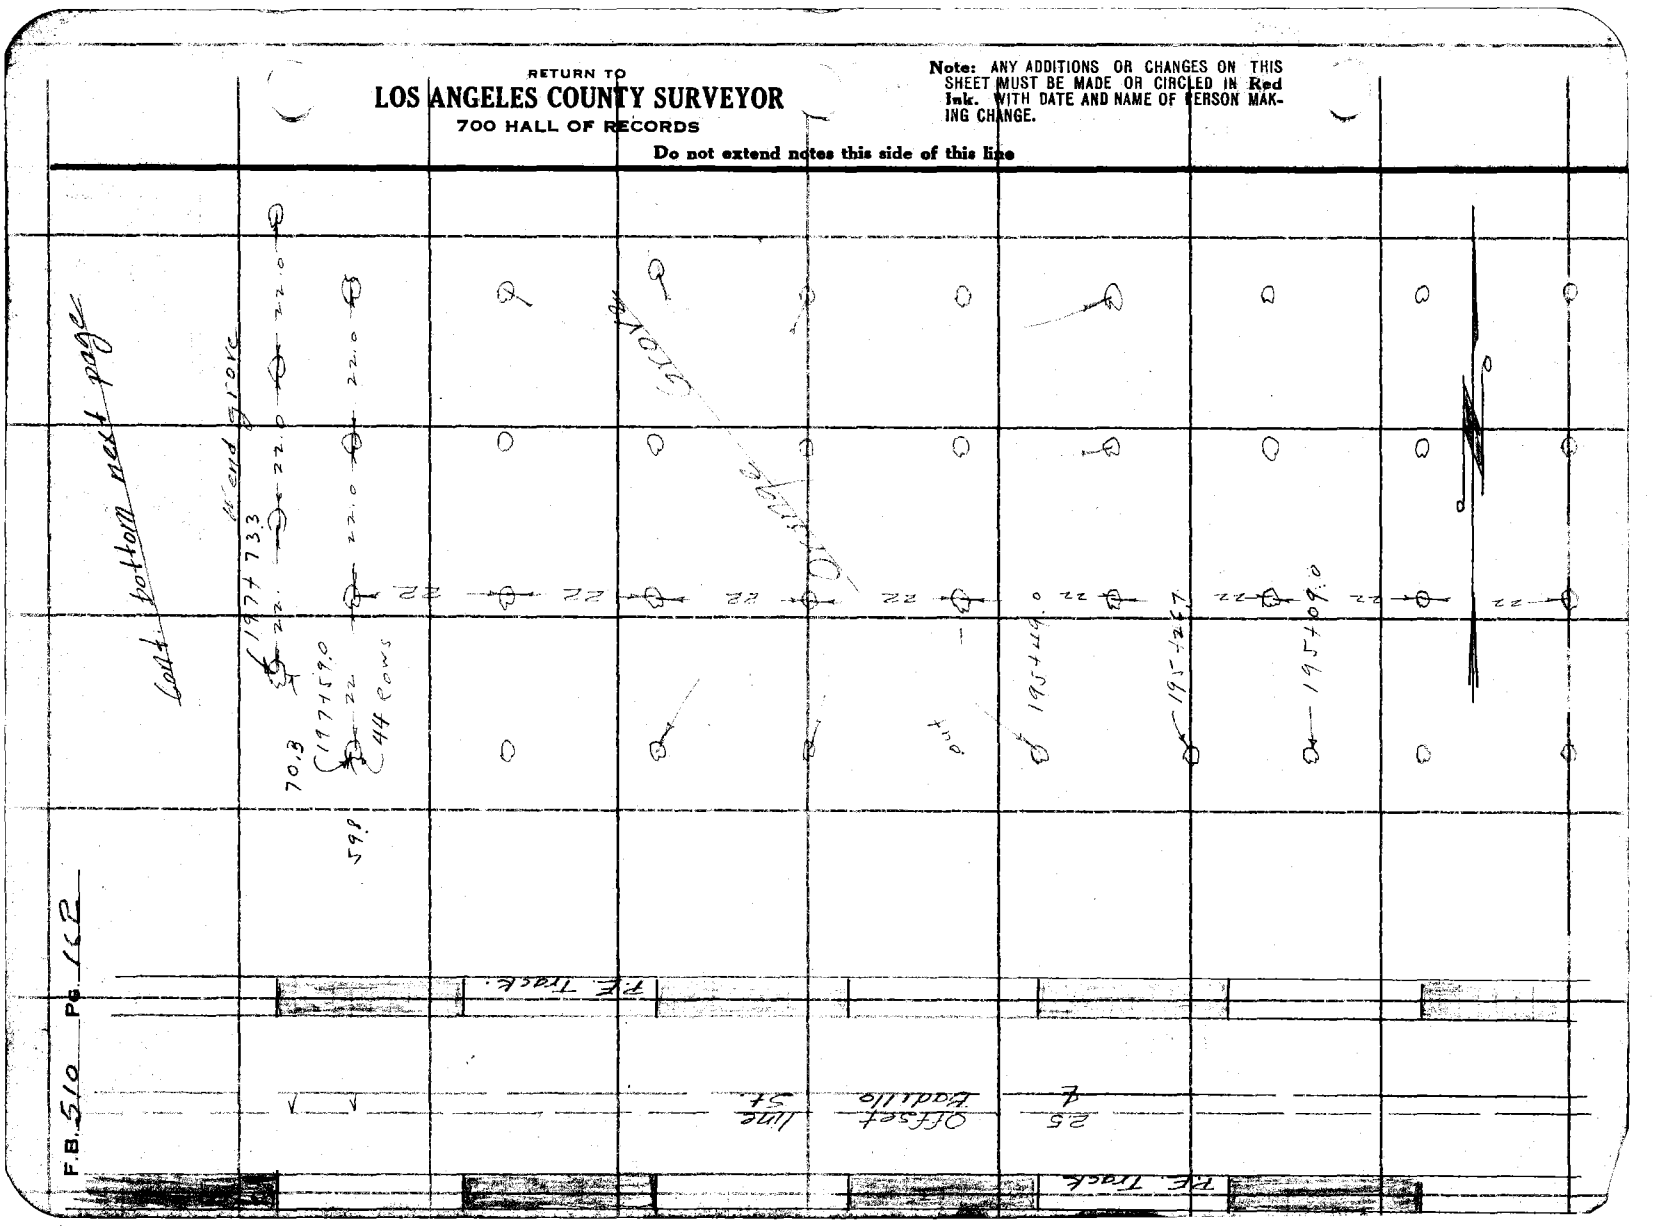

Notes Ck'd by
Map No. B754-3
Office Work H. N. Bradstreet
Checked
Date

Survey of Badillo St.
W. O. 2103 Tape No. 041 St'd 84 OF.
Surveyed by Rosecrans
Notes Date 7-19-33
Indexed A. C. Johnson

F.B. 510 PG. 163

Note: ANY ADDITIONS OR CHANGES ON THIS SHEET MUST BE MADE OR CIRCLED IN Red Ink. WITH DATE AND NAME OF PERSON MAKING CHANGE.

Do not extend notes this side of this line

RETURN TO
LOS ANGELES COUNTY SURVEYOR
700 HALL OF RECORDS

FORM 247 10M 5-31

F.B. 510 Pg 164

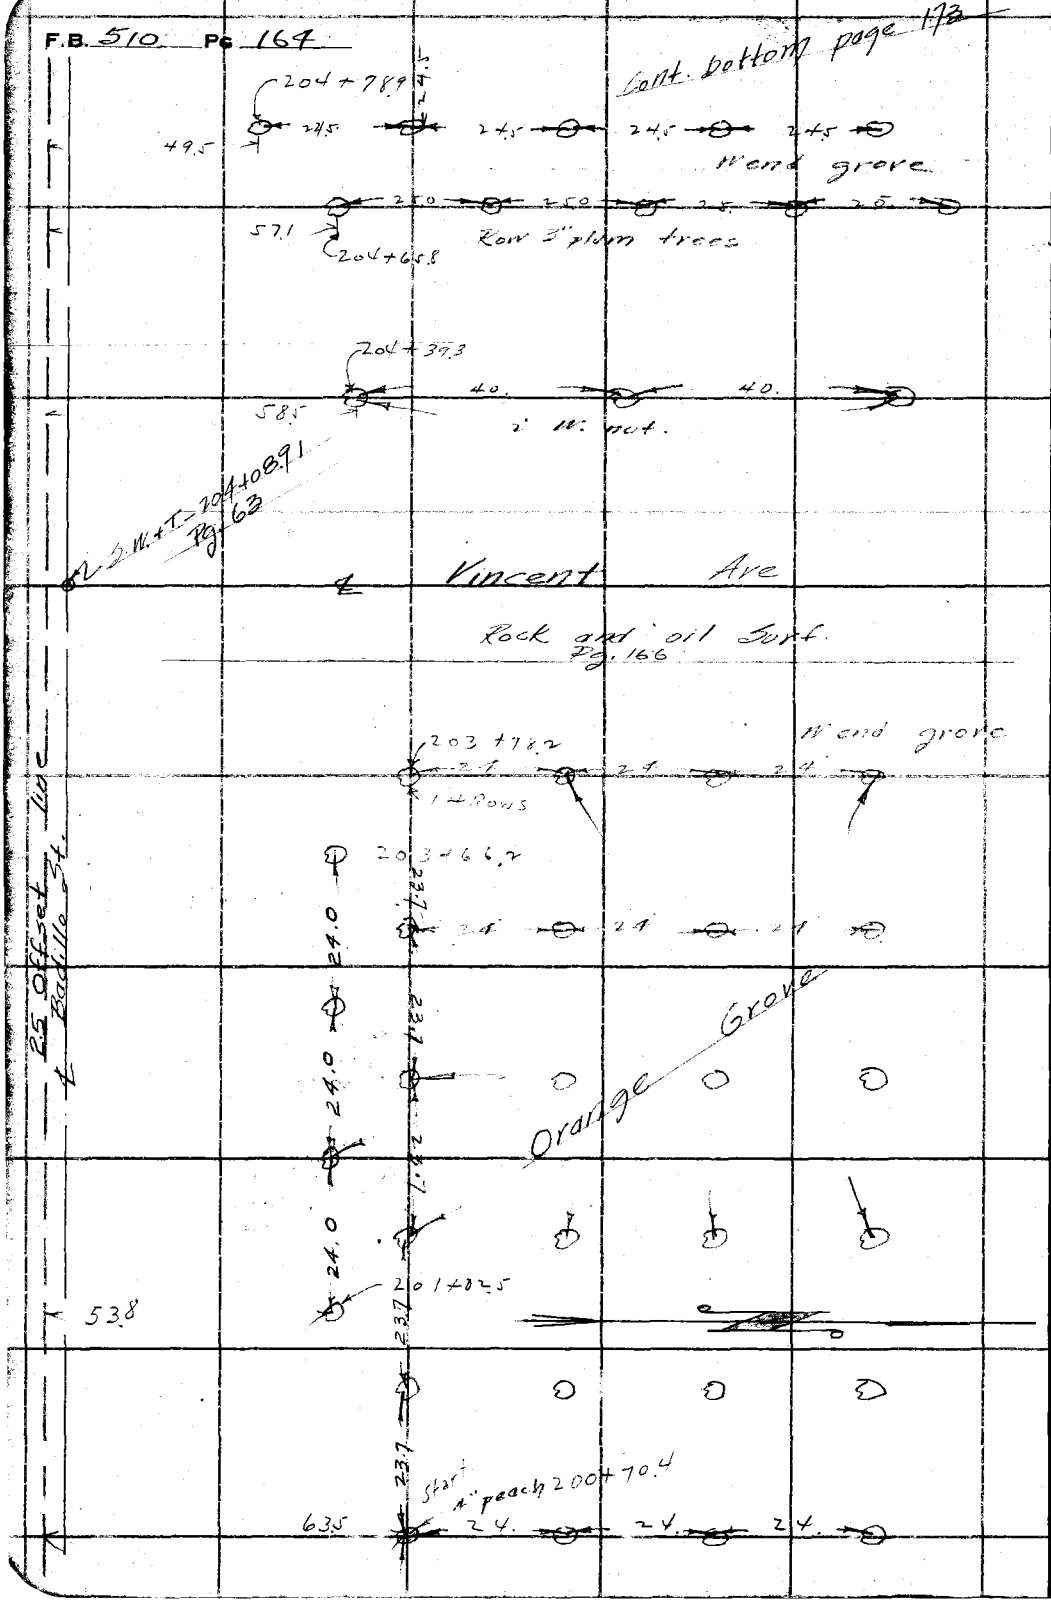

RETURN TO
LOS ANGELES COUNTY SURVEYOR
700 HALL OF RECORDS

Do not extend notes this side of this line

Note: ANY ADDITIONS OR CHANGES ON THIS SHEET MUST BE MADE OR CIRCLED IN Red Ink. WITH DATE AND NAME OF PERSON MAKING CHANGE.

Notes Ck'd by	Survey of Badillo St
Map No. B-754-3	W. O. 7103 Tape No. 0-11 St'd 84 °F.
Office Work H.N. Rosecrans	Computed by Rosecrans
Checked	Notes Date 7-18-32
Date	Indexed A. C. Johnson

F.B. 510 PG. 165

Notes: ANY ADDITIONS OR CHANGES ON THIS SHEET MUST BE MADE OR CIRCLED IN Red Ink. WITH DATE AND NAME OF PERSON MAKING CHANGE.

Do not extend notes this side of this line

RETURN TO
LOS ANGELES COUNTY SURVEYOR
700 HALL OF RECORDS

FORM 247 10M 8-31

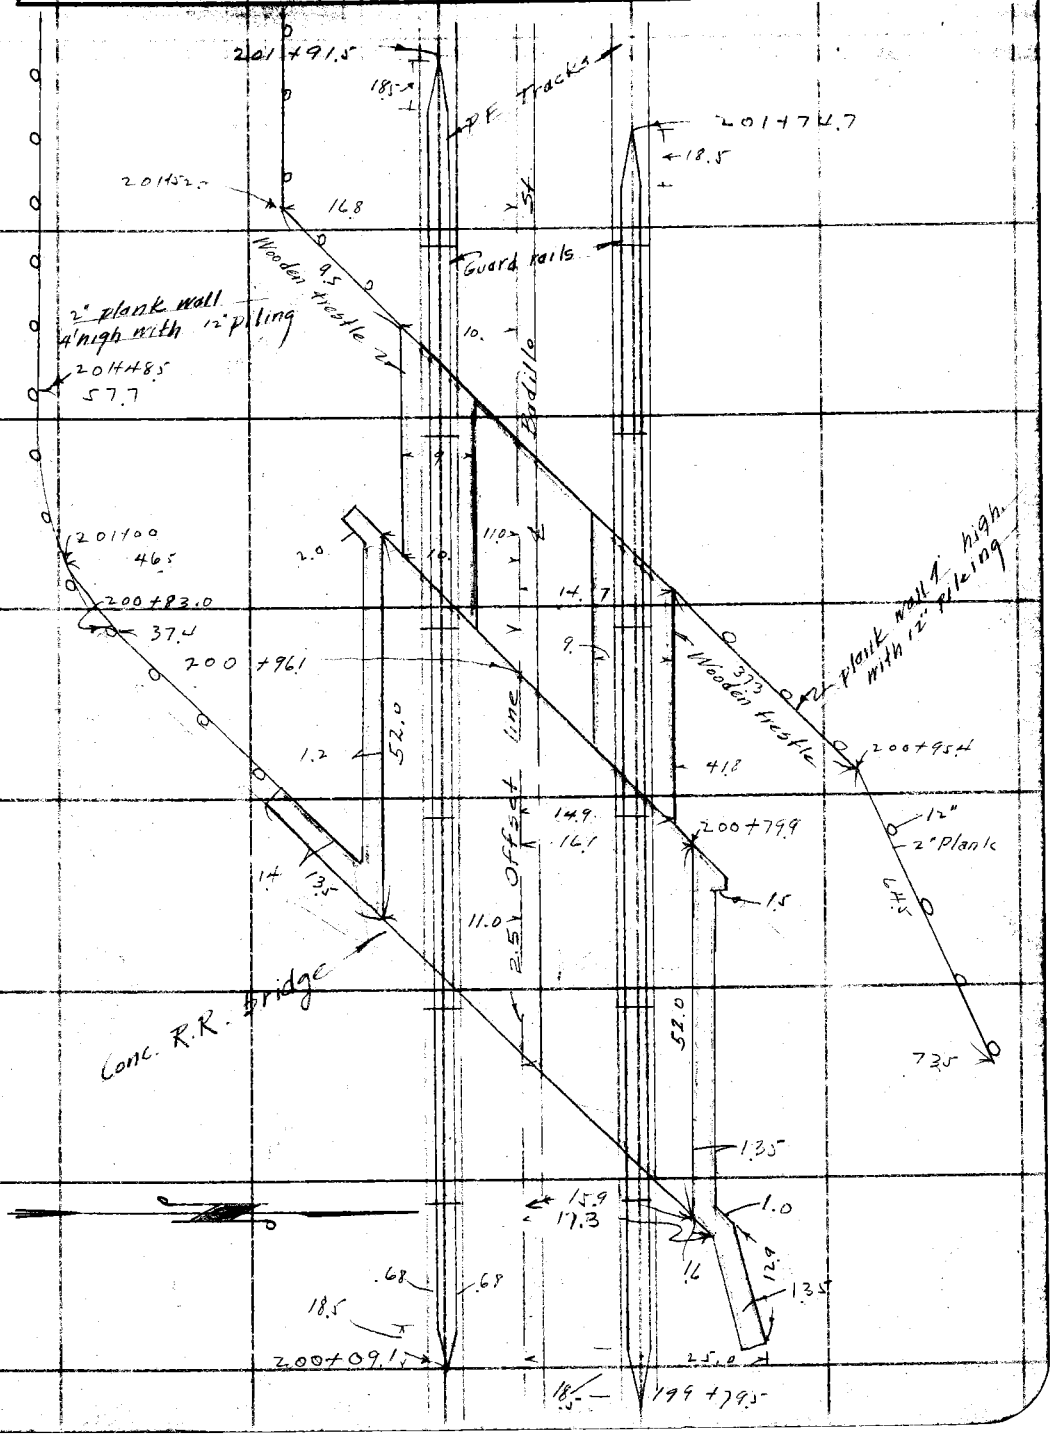

F.B. 510 PG 166

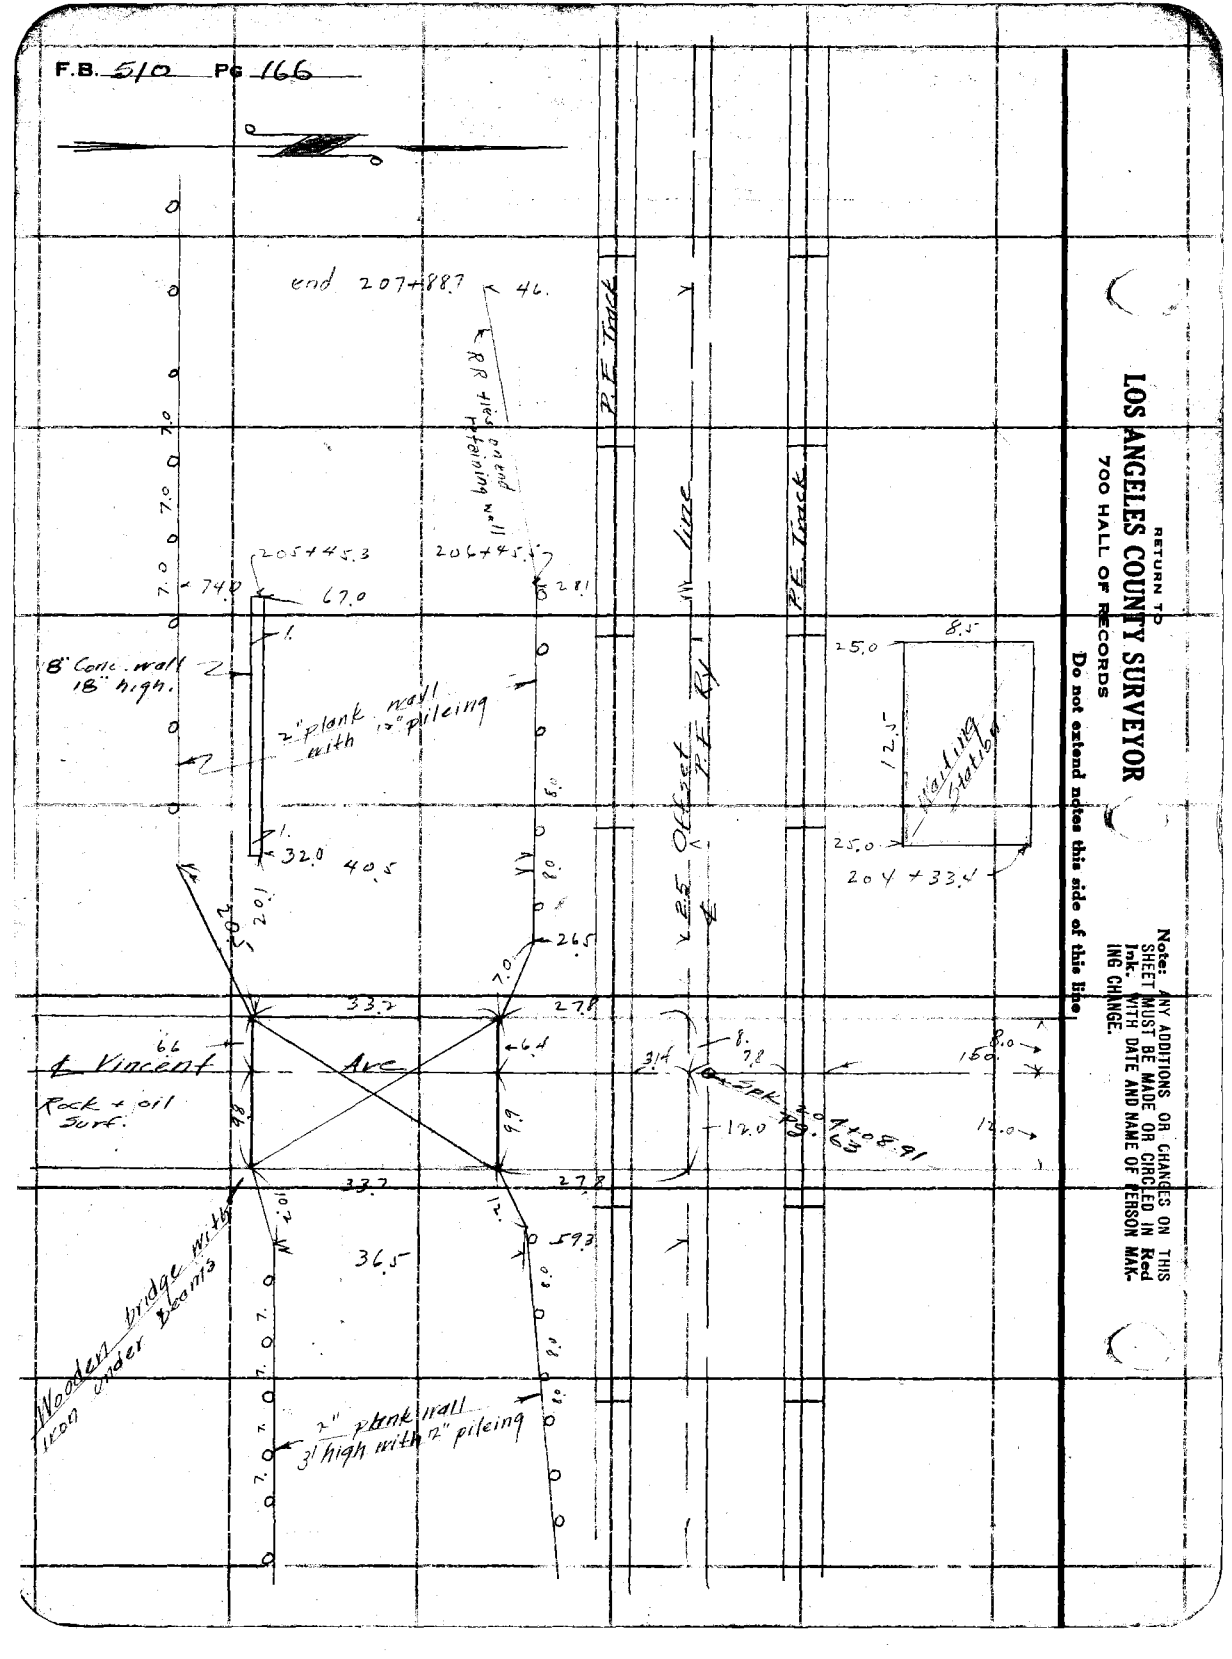

RETURN TO
LOS ANGELES COUNTY SURVEYOR
700 HALL OF RECORDS

Do not extend notes this side of this line

Note: ANY ADDITIONS OR CHANGES ON THIS SHEET MUST BE MADE OR CIRCLED IN Red Ink. WITH DATE AND NAME OF PERSON MAKING CHANGE.

Notes Ck'd by	Survey of Bedillo St
Map No. B-754-4	W. O. 1103 Tape No. 0-11 St'd 84 °F.
Office Work H.N. Broadstreet	Surveyed by Rosecrans
Checked	Notes Date 7/12/52
Date	Indexed A. C. Johnson

F.B. 510 PG. 167

Cont. bottom next page

23.5 23.5 23.5 23.6

199+98.0 3" Peach

199+89.6 3" plum

199+73.9

199+67.1 3" plum

199+59.0

199+43.3 6" plum

Grove 199+13.0 6" Wnut

Orang e

198+97.5 6" plum

198+73.5 6" peach

8" Wlnut

198+50.3

198+22.9

10" I.9

198+08.0

10" I.9 K 59.9

23.5 23.5 23.5 23.5

2.5 Offset Line E. Bedillo St.

RETURN TO
LOS ANGELES COUNTY SURVEYOR
700 HALL OF RECORDS

Note: ANY ADDITIONS OR CHANGES ON THIS SHEET MUST BE MADE OR CIRCLED IN Red Ink. WITH DATE AND NAME OF PERSON MAKING CHANGE.

Do not extend notes this side of this line

FORM 847 10M 8-31

F.B. 510 PG. 168

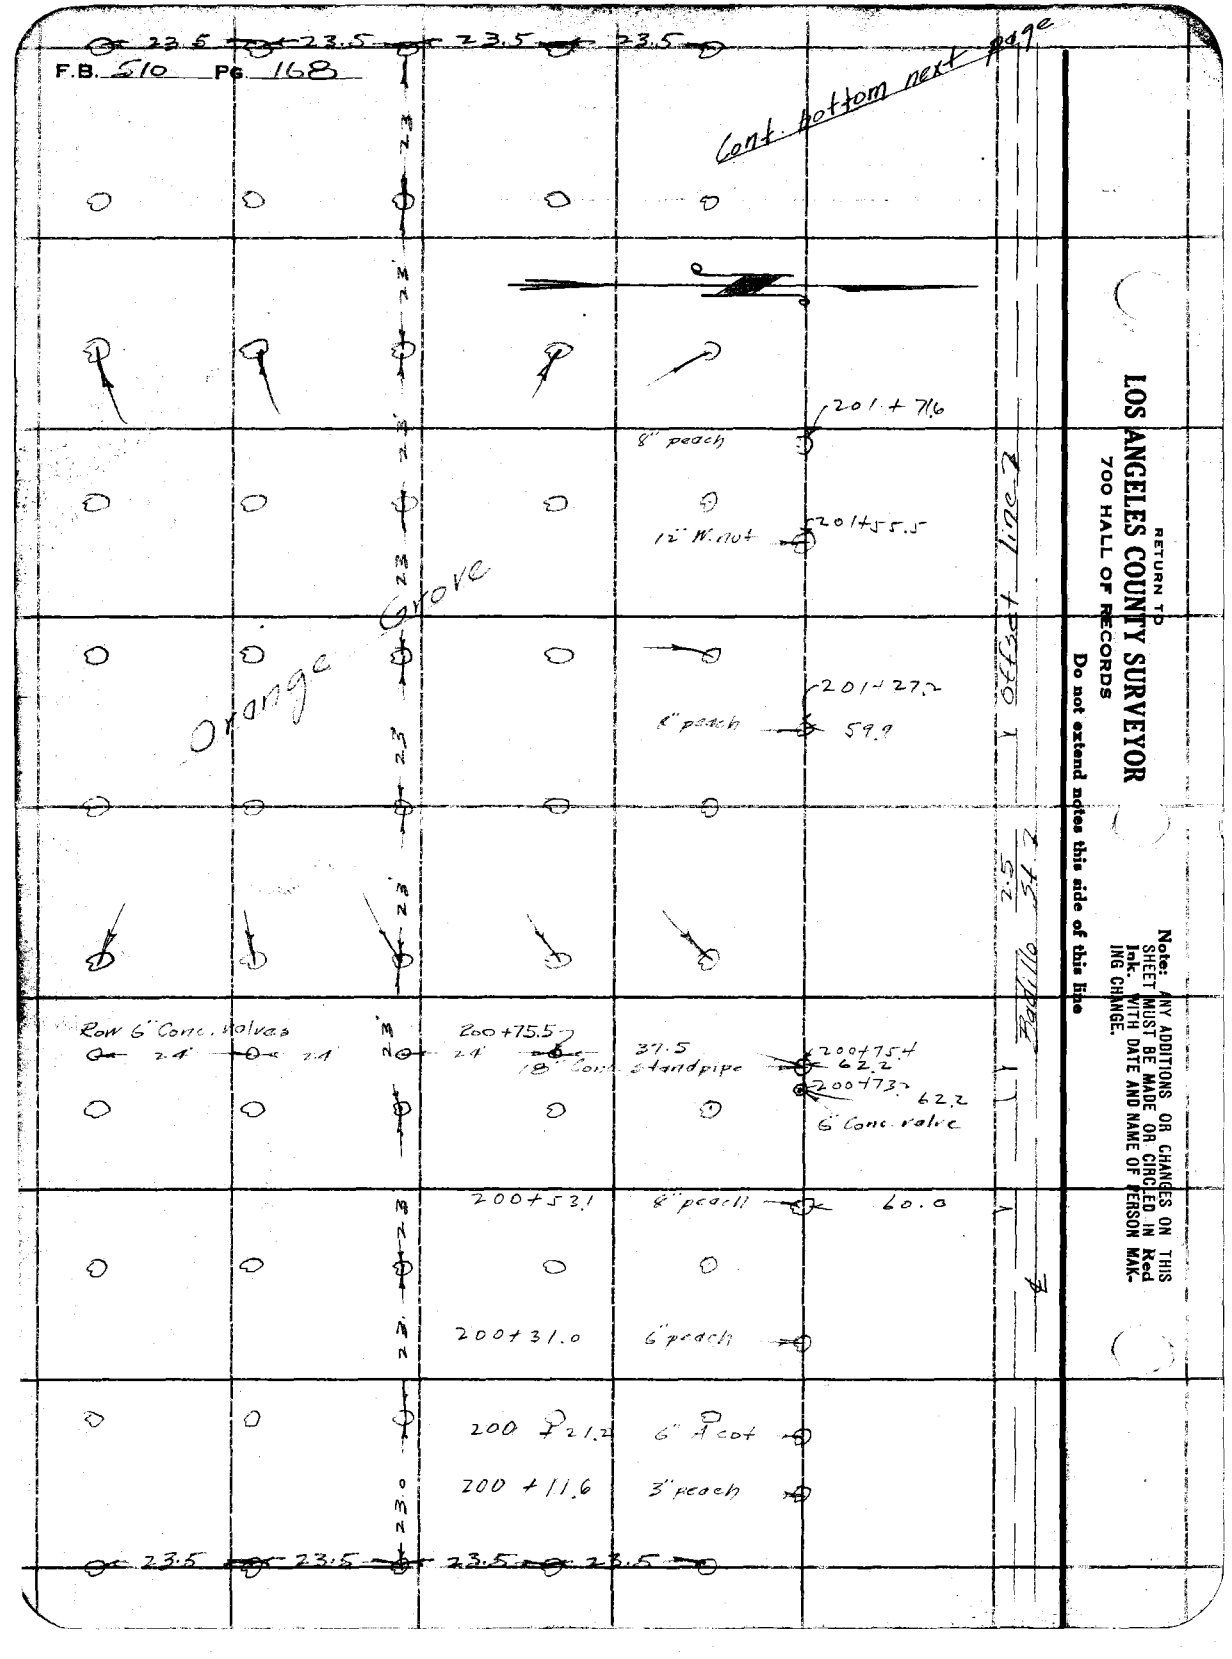

RETURN TO
LOS ANGELES COUNTY SURVEYOR
700 HALL OF RECORDS

Do not extend notes this side of this line

Note: ANY ADDITIONS OR CHANGES ON THIS SHEET MUST BE MADE OR CIRCLED IN Red Ink. WITH DATE AND NAME OF PERSON MAKING CHANGE.

Notes Ck'd by	Survey of Padillo St
Map No. B-754-4	W. O. 7103 Tape No. 071 St'd 84 °F.
Office Work H.N. Bradstreet	Surveyed by Rosecrans
Checked	Notes Date 7-19-33
Date	Indexed A. C. Johnson

F.B. 510 PG. 169

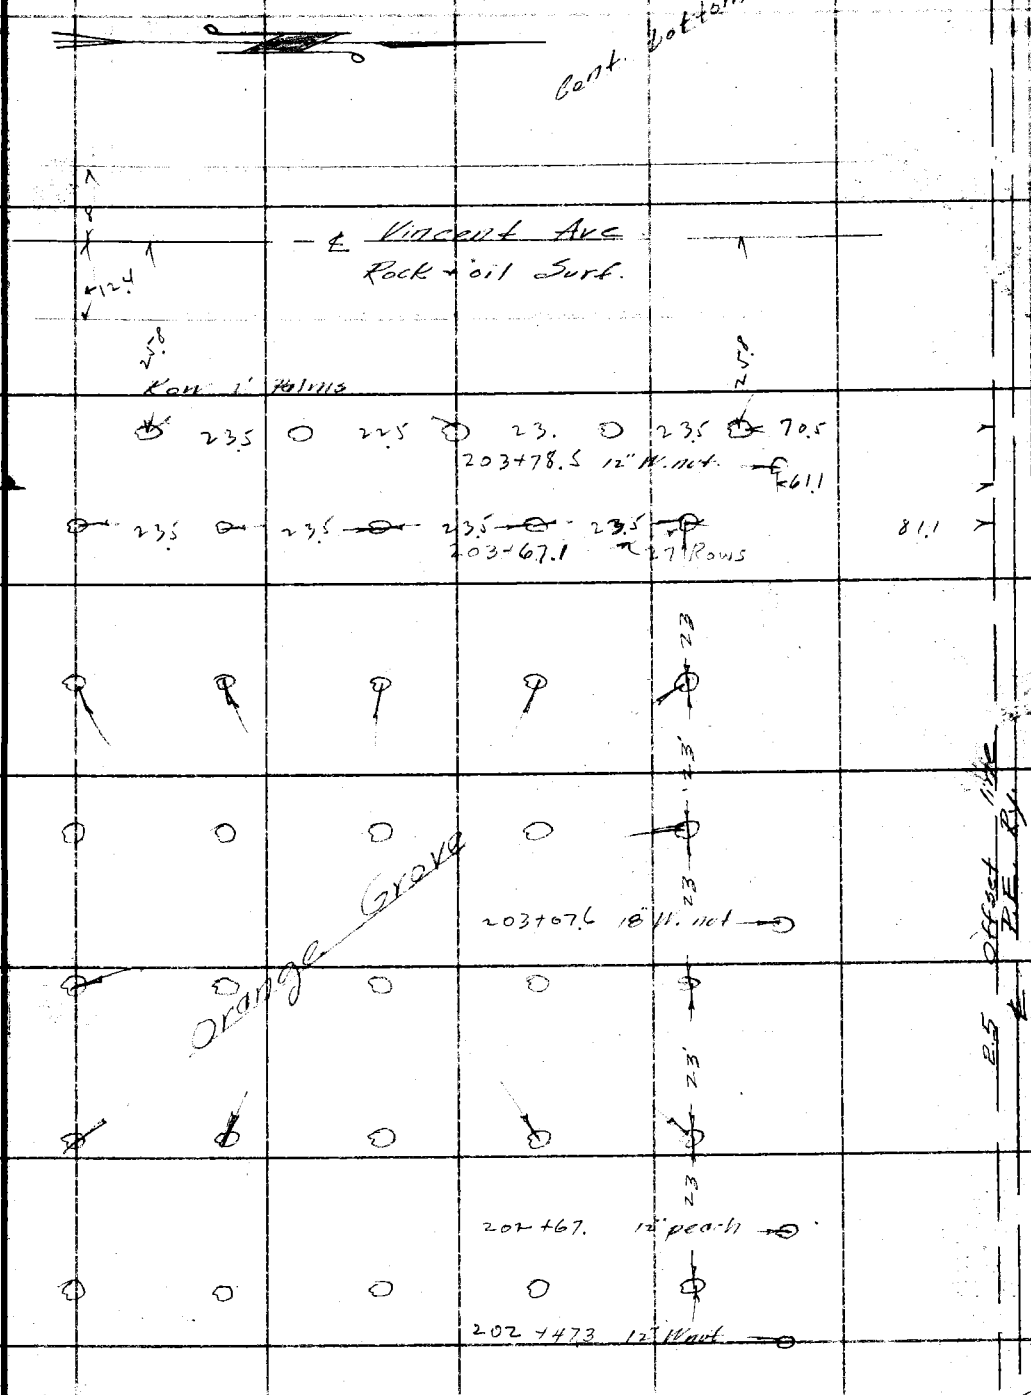

Note: ANY ADDITIONS OR CHANGES ON THIS SHEET MUST BE MADE OR CIRCLED IN Red Ink. WITH DATE AND NAME OF PERSON MAKING CHANGE.

RETURN TO
LOS ANGELES COUNTY SURVEYOR
700 HALL OF RECORDS

Do not extend notes this side of this line

FORM 247 10M 5-31

F.B. 510 PG. 170

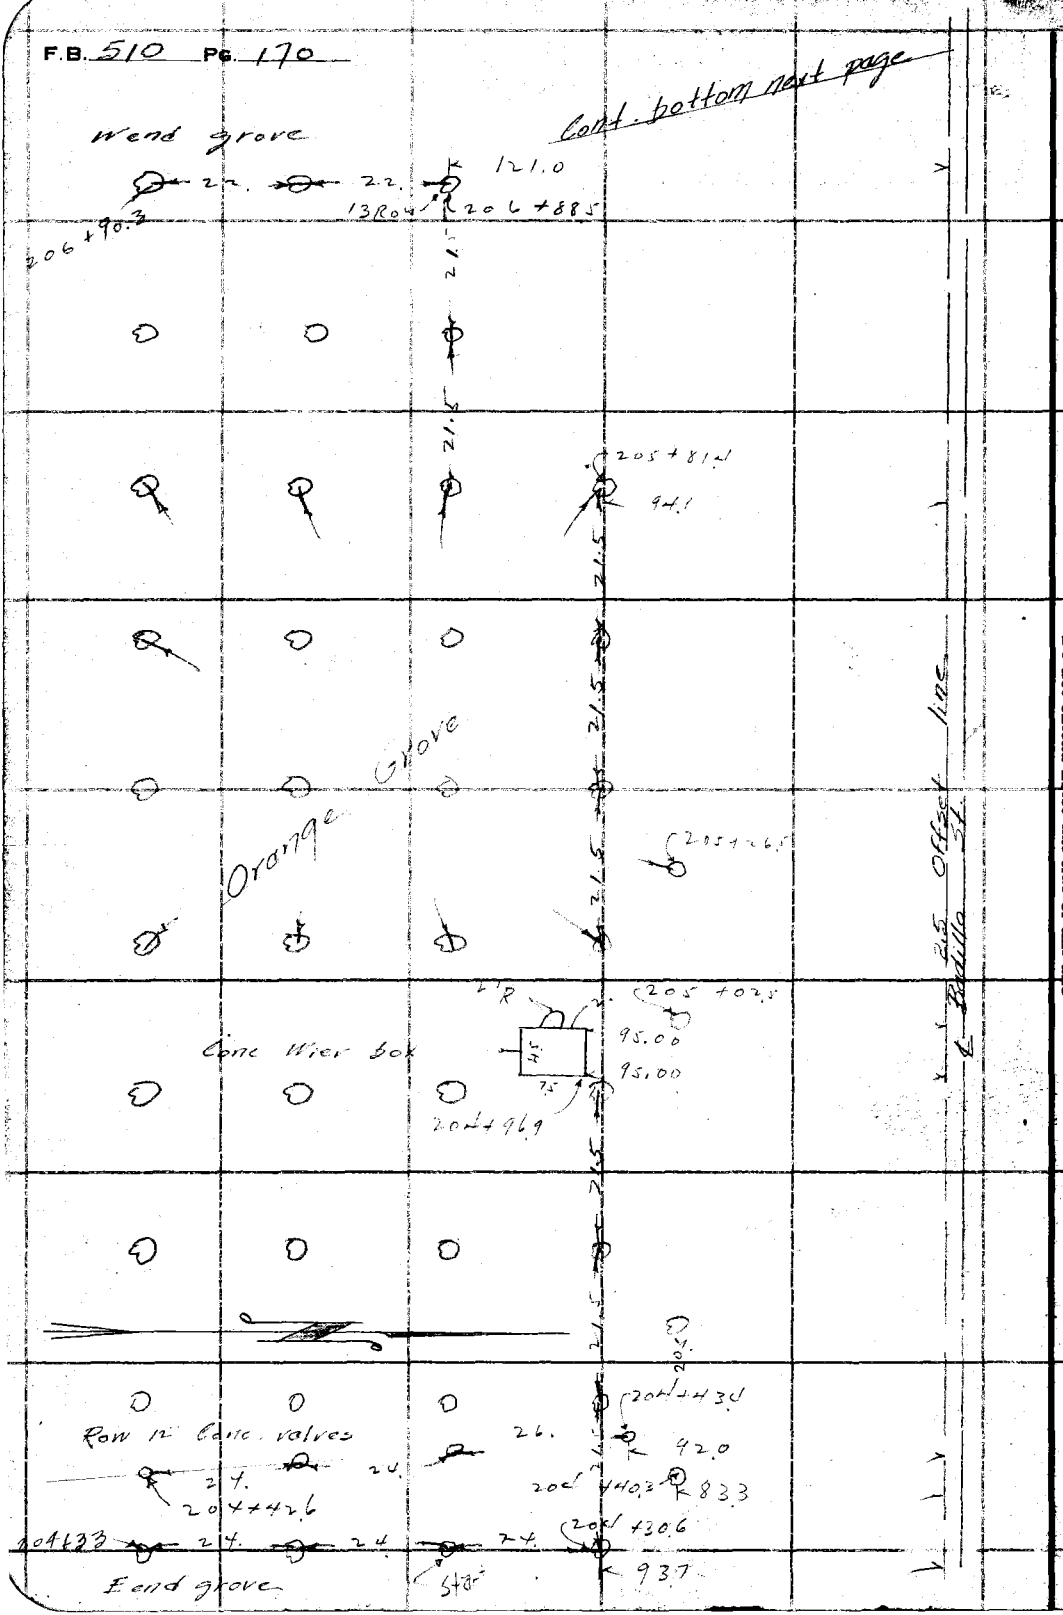

RETURN TO
LOS ANGELES COUNTY SURVEYOR
700 HALL OF RECORDS

Do not extend notes this side of this line

Note: ANY ADDITIONS OR CHANGES ON THIS SHEET MUST BE MADE OR CIRCLED IN Red Ink. WITH DATE AND NAME OF PERSON MAKING CHANGE.

Notes Ck'd by	Survey of Badillo St
Map No. B-754-4	W. O. 7103 Tape No. 041 St'd 84 °F.
Office Work H.N. Bradstreet	Surveyed by Kosearans
Checked	Notes Date 7-19-33
Date	Indexed A. C. [illegible]

F.B. 519 PG. 171

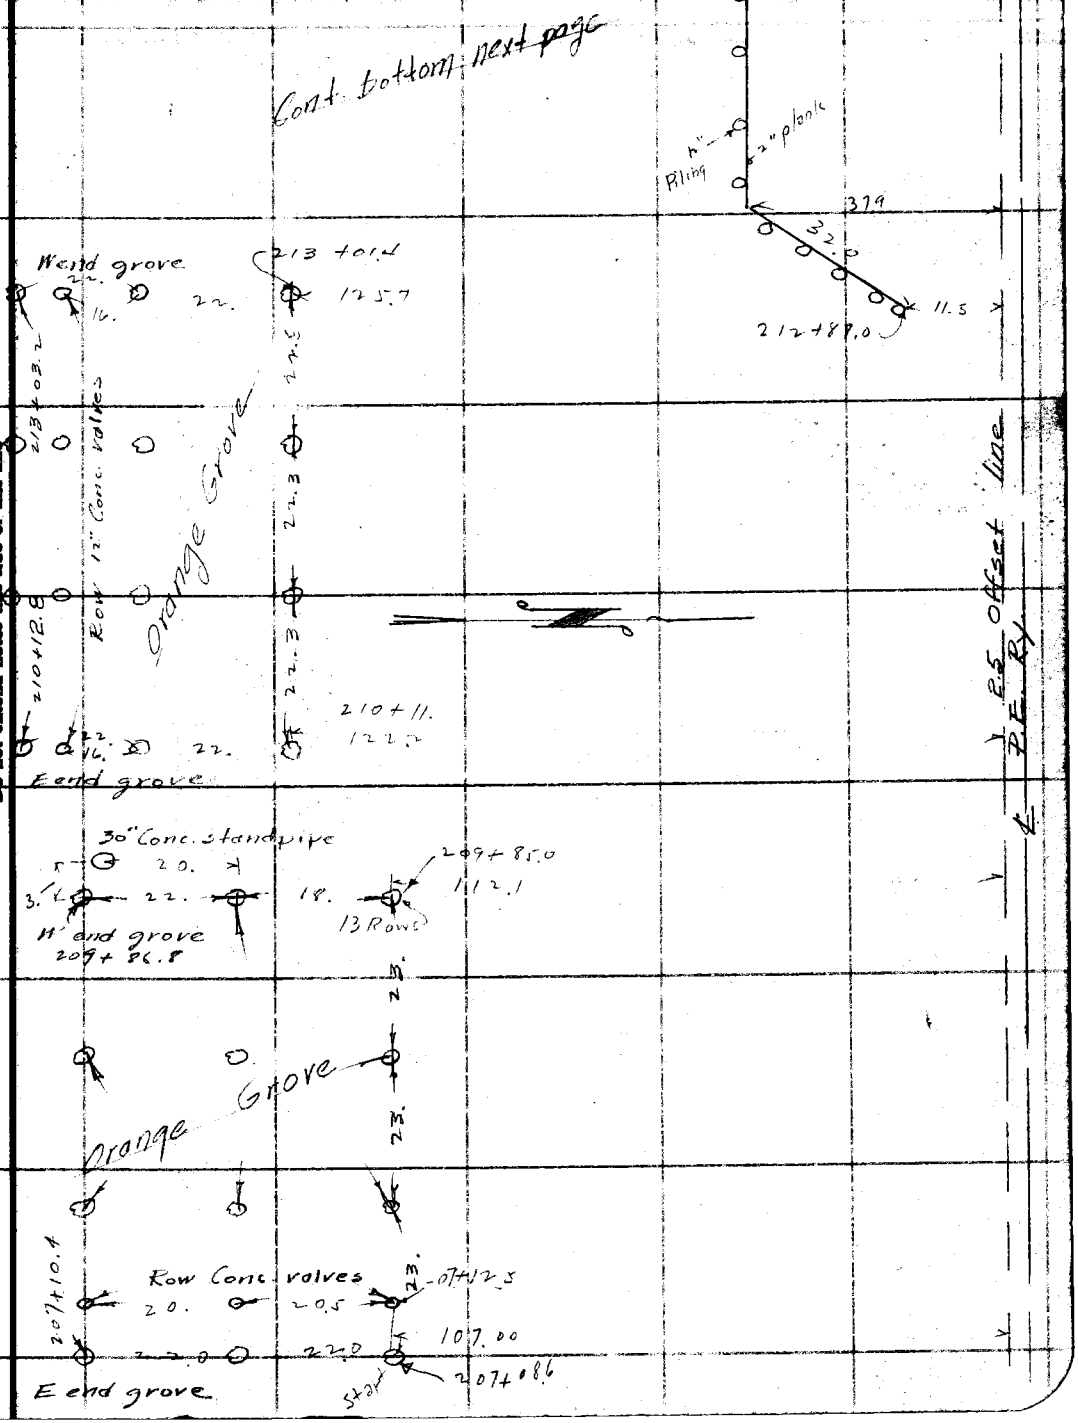

Note: ANY ADDITIONS OR CHANGES ON THIS SHEET MUST BE MADE OR CIRCLED IN Red Ink, WITH DATE AND NAME OF PERSON MAKING CHANGE.

Do not extend notes this side of this line

RETURN TO
LOS ANGELES COUNTY SURVEYOR
700 HALL OF RECORDS

FORM 247 10M 5-31

F.B. 510 Pg 172

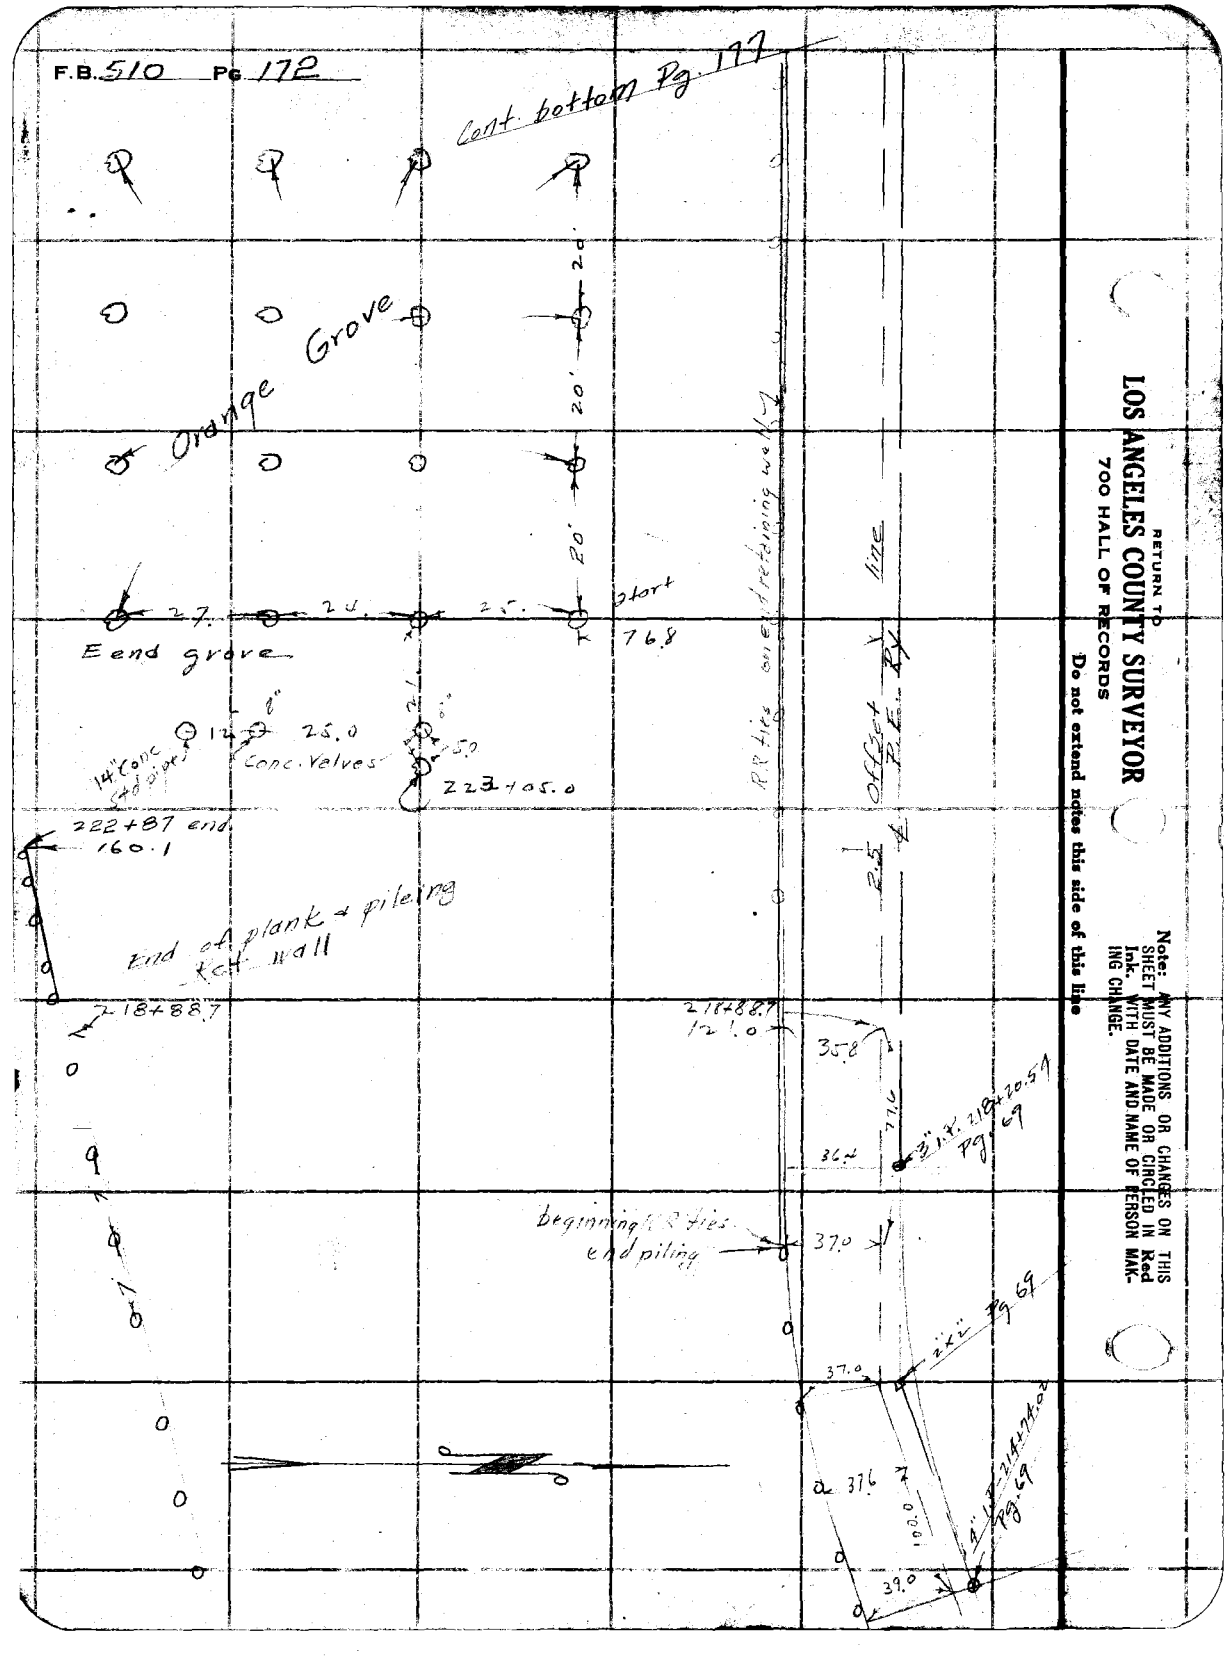

RETURN TO
LOS ANGELES COUNTY SURVEYOR
700 HALL OF RECORDS
Do not extend notes this side of this line

Note: ANY ADDITIONS OR CHANGES ON THIS SHEET MUST BE MADE OR CIRCLED IN Red Ink. WITH DATE AND NAME OF PERSON MAKING CHANGE.

Notes Ck'd by
Map No. B-154-4
Office Work H.N. Bradstreet
Checked
Date

Survey of Badillo St.
W. O. 7103 Tape No. 241 St'd 84 °F.
Surveyed by Rosecrans
Notes Date 7-19-33
Indexed A. C. Tolman

F.B. 510 PG. 173

Cont. bottom next page

Notes: ANY ADDITIONS OR CHANGES ON THIS SHEET MUST BE MADE OR CIRCLED IN Red Ink, WITH DATE AND NAME OF PERSON MAKING CHANGE.

Do not extend notes this side of this line

RETURN TO
LOS ANGELES COUNTY SURVEYOR
700 HALL OF RECORDS

FORM 247 10M 3-31

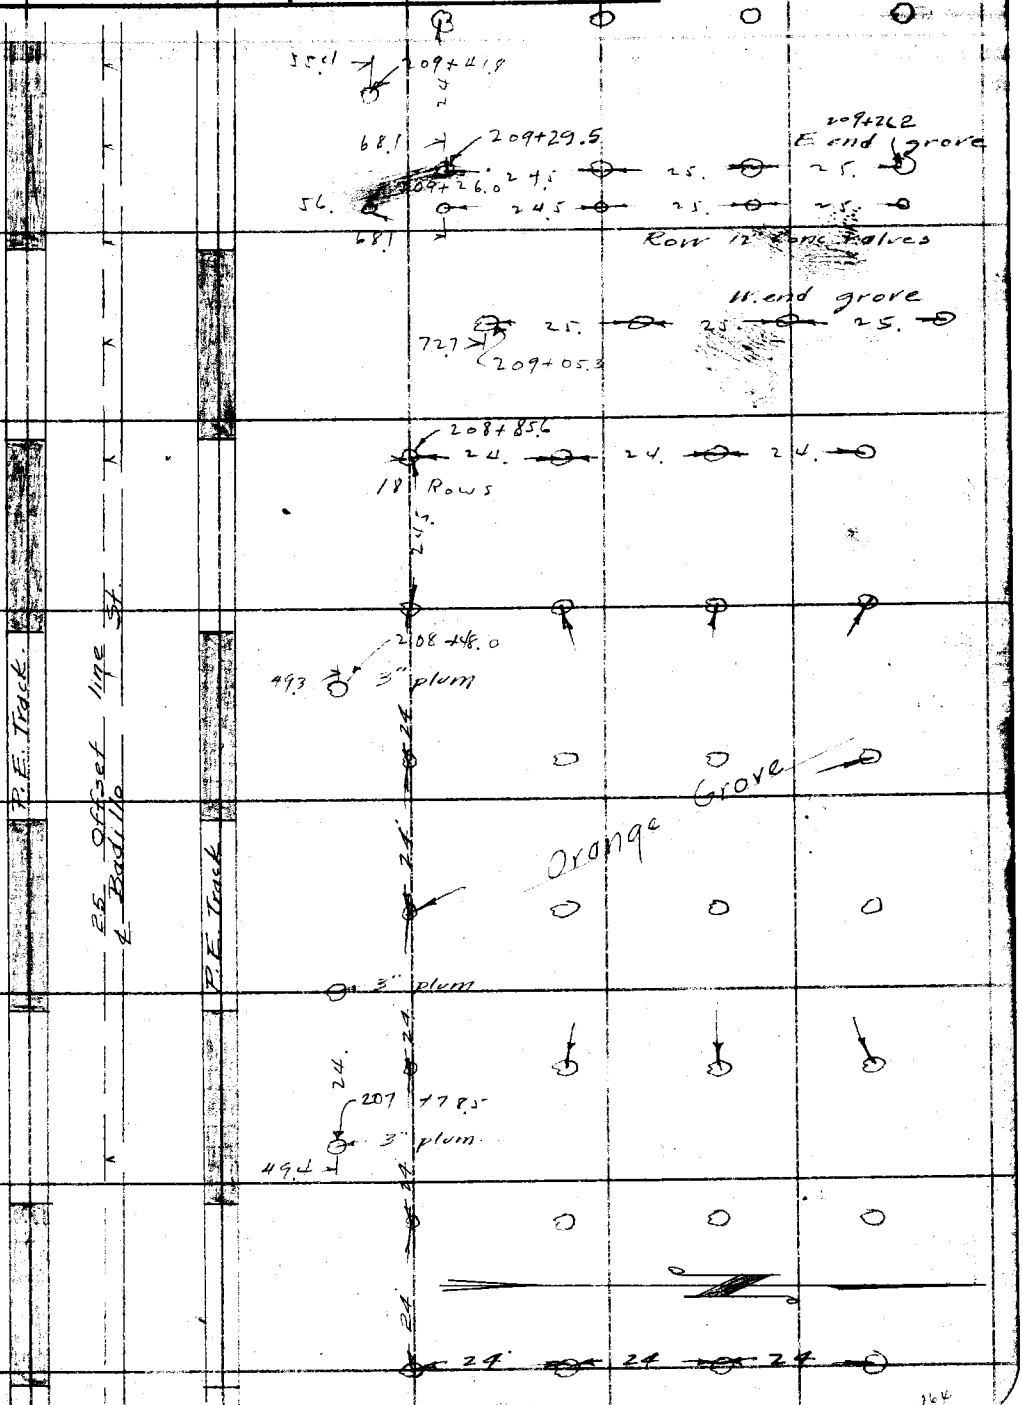

164

F.B. 510 PG 174

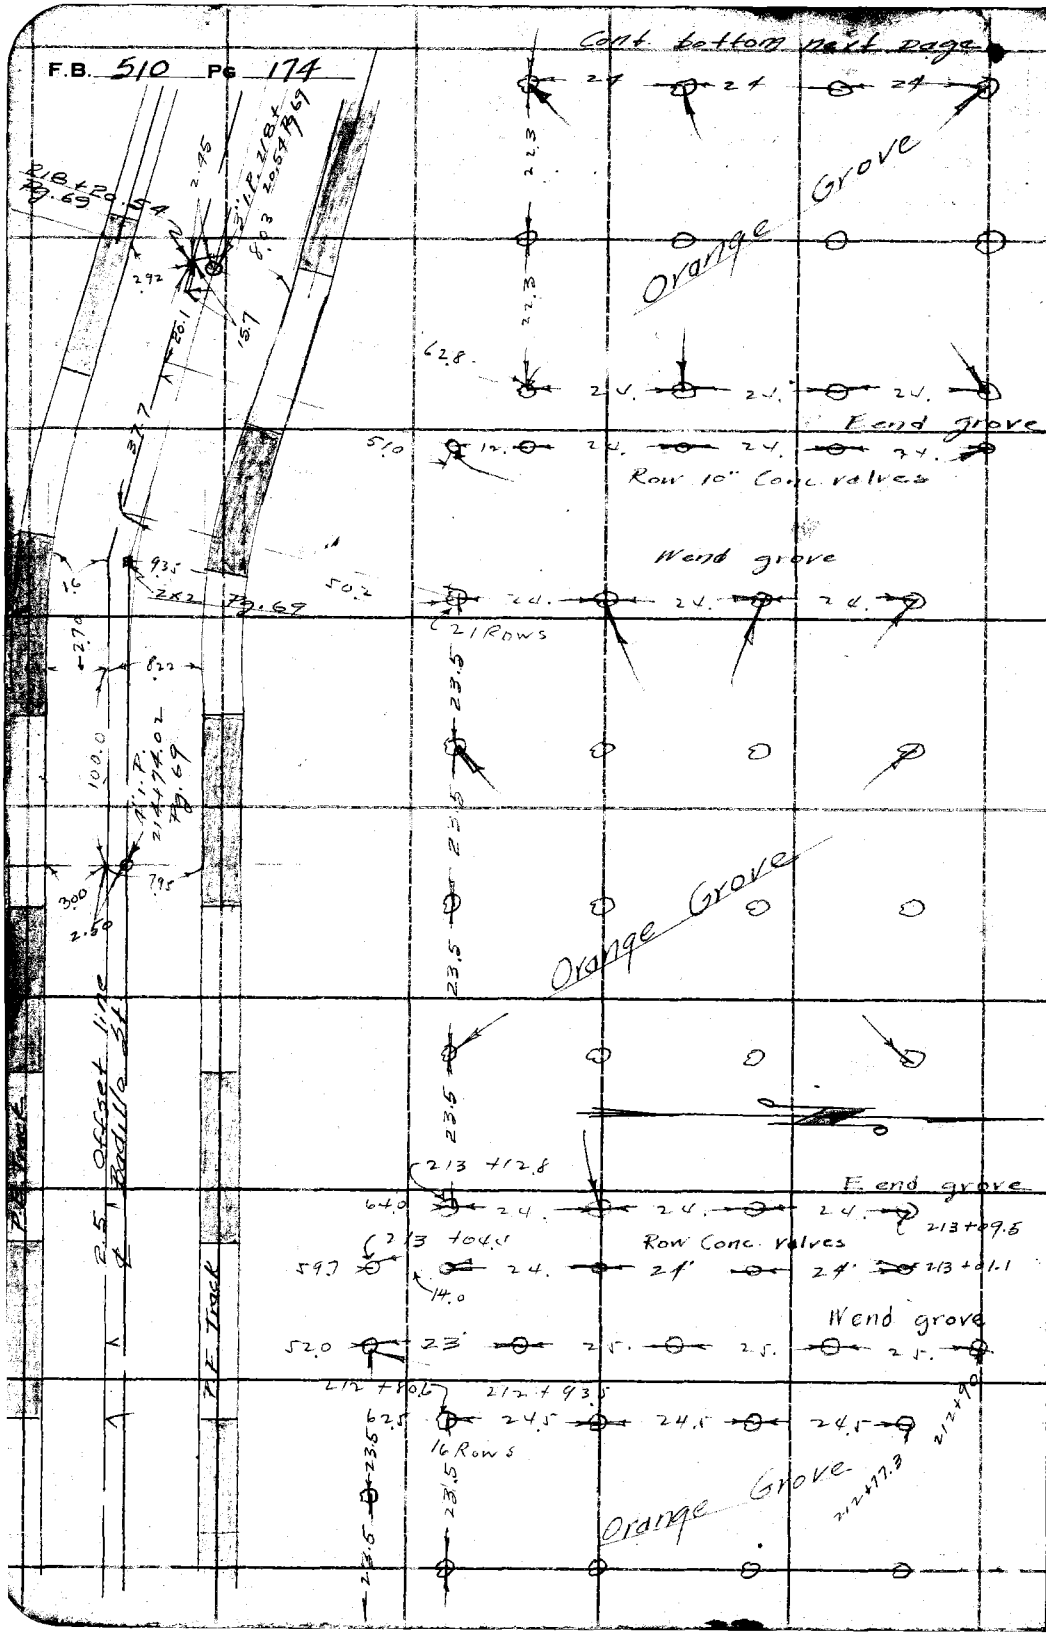

RETURN TO
LOS ANGELES COUNTY SURVEYOR
700 HALL OF RECORDS

Do not extend notes this side of this line

Note: ANY ADDITIONS OR CHANGES ON THIS SHEET MUST BE MADE OR CIRCLED IN Red Ink. WITH DATE AND NAME OF PERSON MAKING CHANGE.

Notes Ck'd by	Survey of Badillo St.
Map No. B-754-4	W. O. 7103 Tape No. 011 St'd 84 °F.
Office Work H.N. Bradstreet	Surveyed by Rosecrans
Checked	Notes Date 7-19-33
Date	Indexed A. C. Johnson

F.B. 510 PG. 175

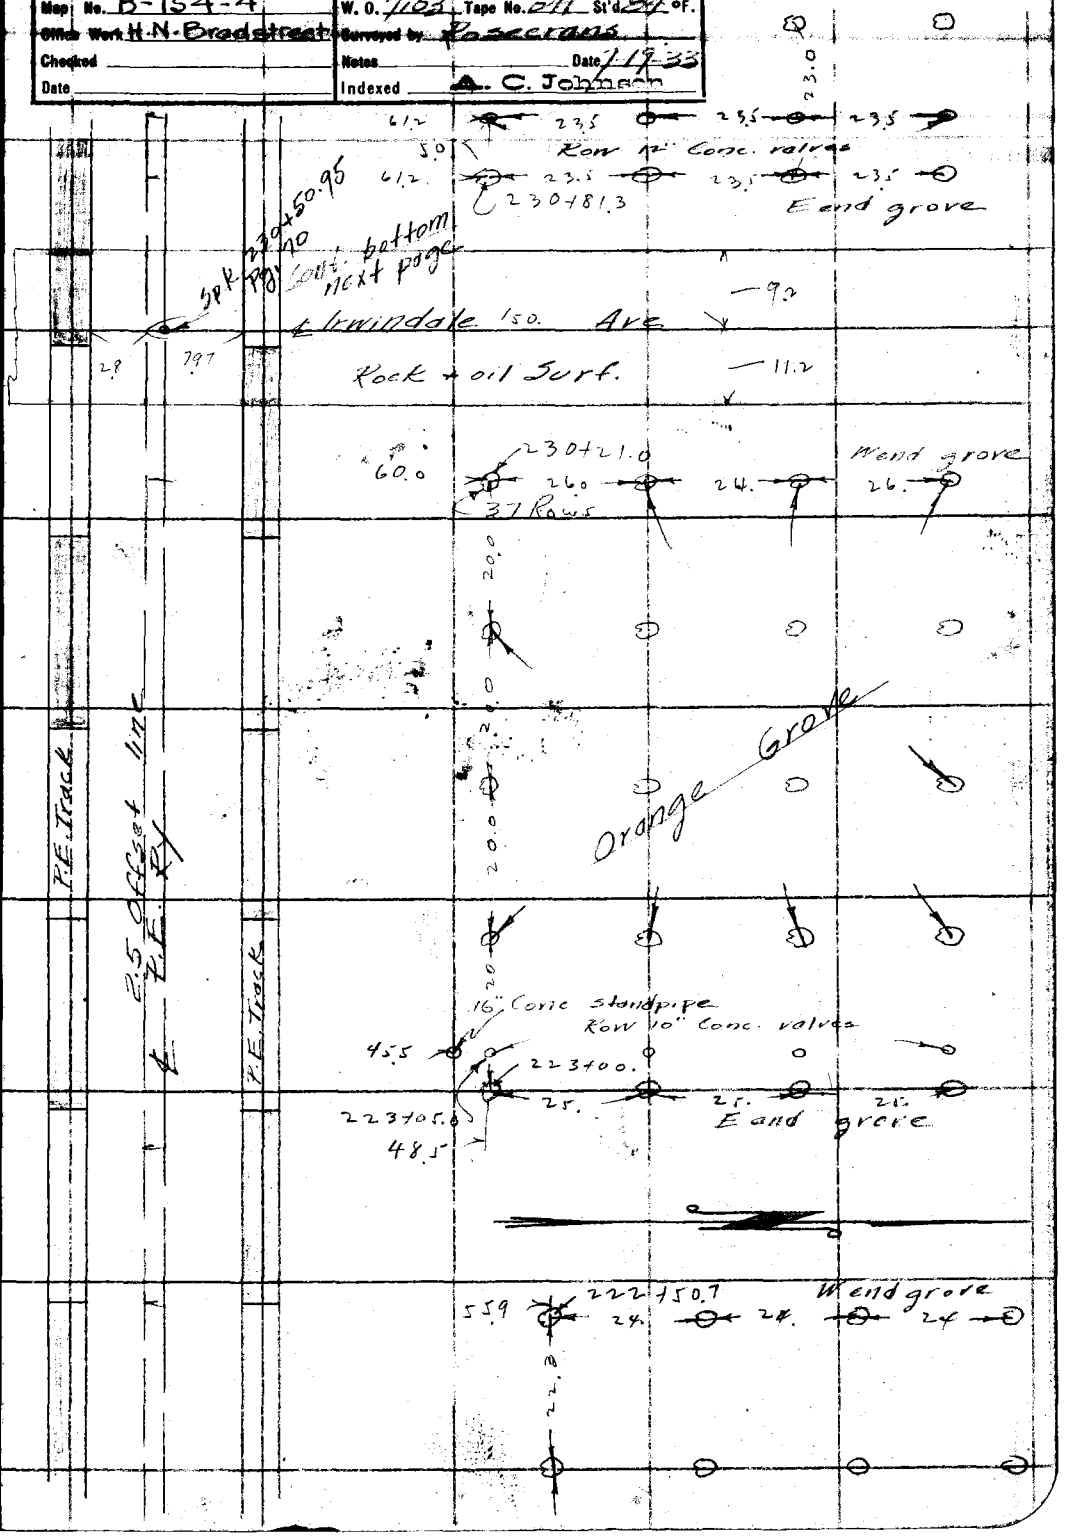

Note: ANY ADDITIONS OR CHANGES ON THIS SHEET MUST BE MADE OR CIRCLED IN Red Ink. WITH DATE AND NAME OF PERSON MAKING CHANGE.

Do not extend notes this side of this line

RETURN TO
LOS ANGELES COUNTY SURVEYOR
700 HALL OF RECORDS

FORM 247 10M 5-31

F.B. 510 Pg 176

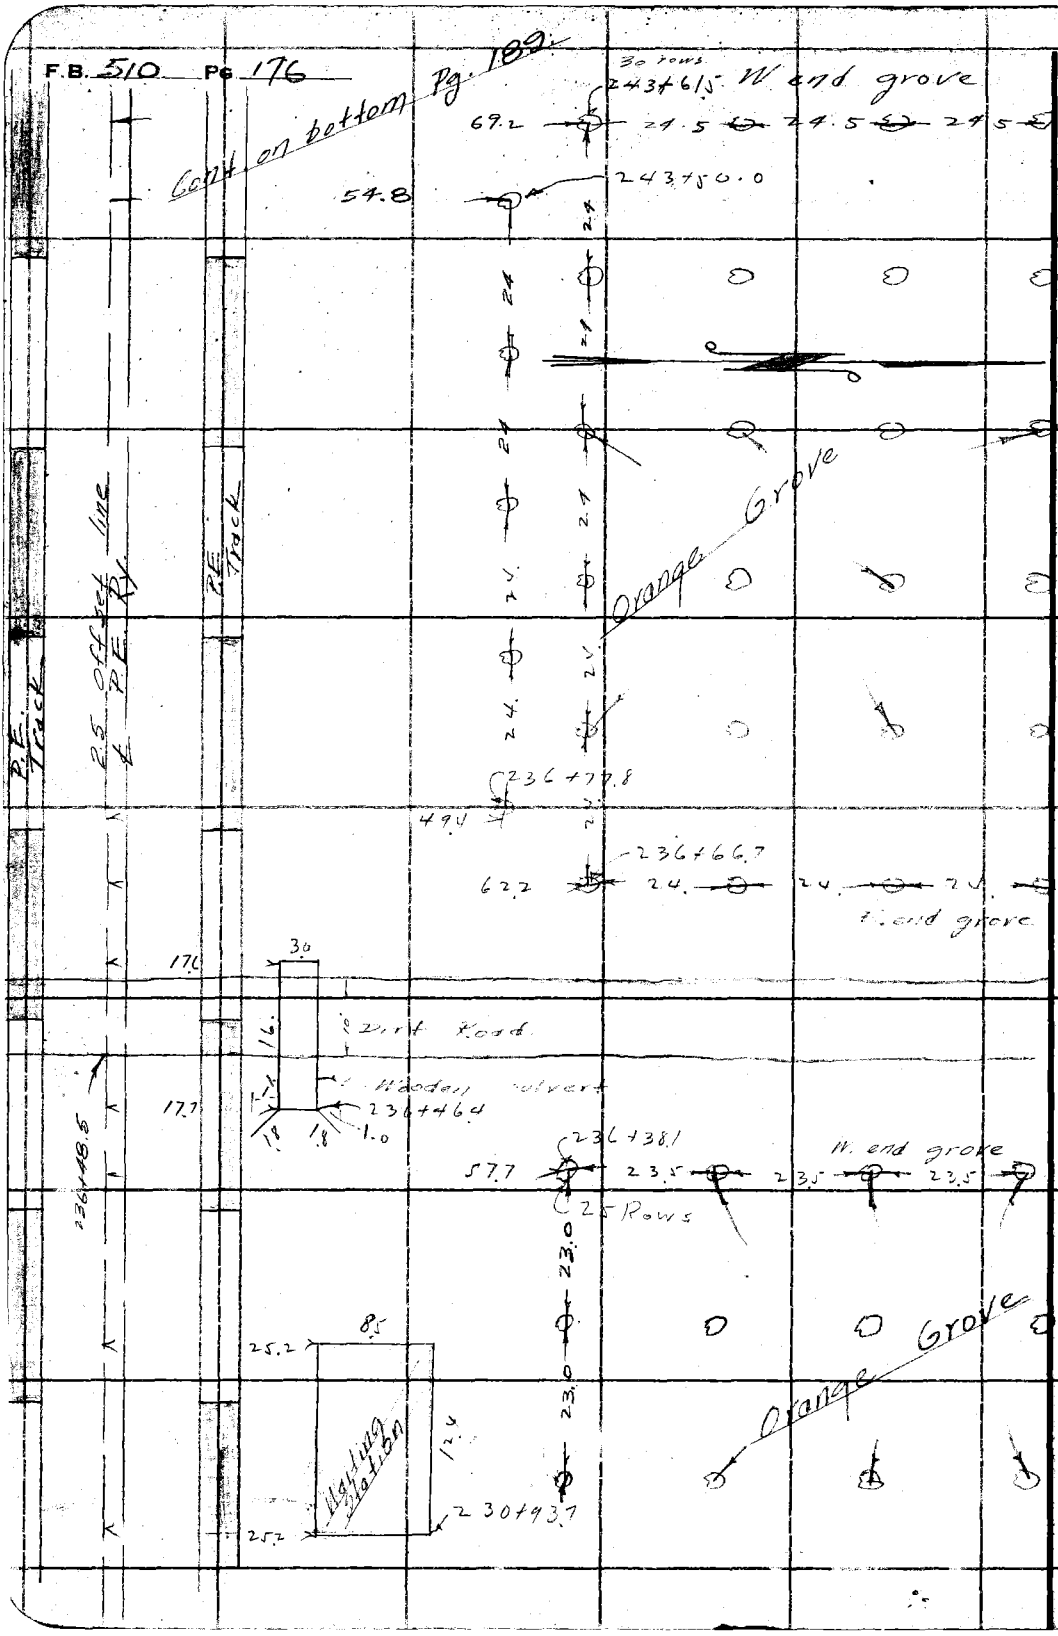

RETURN TO
LOS ANGELES COUNTY SURVEYOR
700 HALL OF RECORDS
Do not extend notes this side of this line

Note: ANY ADDITIONS OR CHANGES ON THIS SHEET MUST BE MADE OR CIRCLED IN Red Ink. WITH DATE AND NAME OF PERSON MAKING CHANGE.

Notes Ck'd by	Survey of Badillo St.
Map No. B-154-4	W. O. 7103 Tape No. 041 St'd 84 °F.
Office Work H.N. Bradstreet	Surveyed by Rosecrans
Checked	Notes Date 7-18-33
Date	Indexed A. C. Johnson

F.B. 510 PG. 177

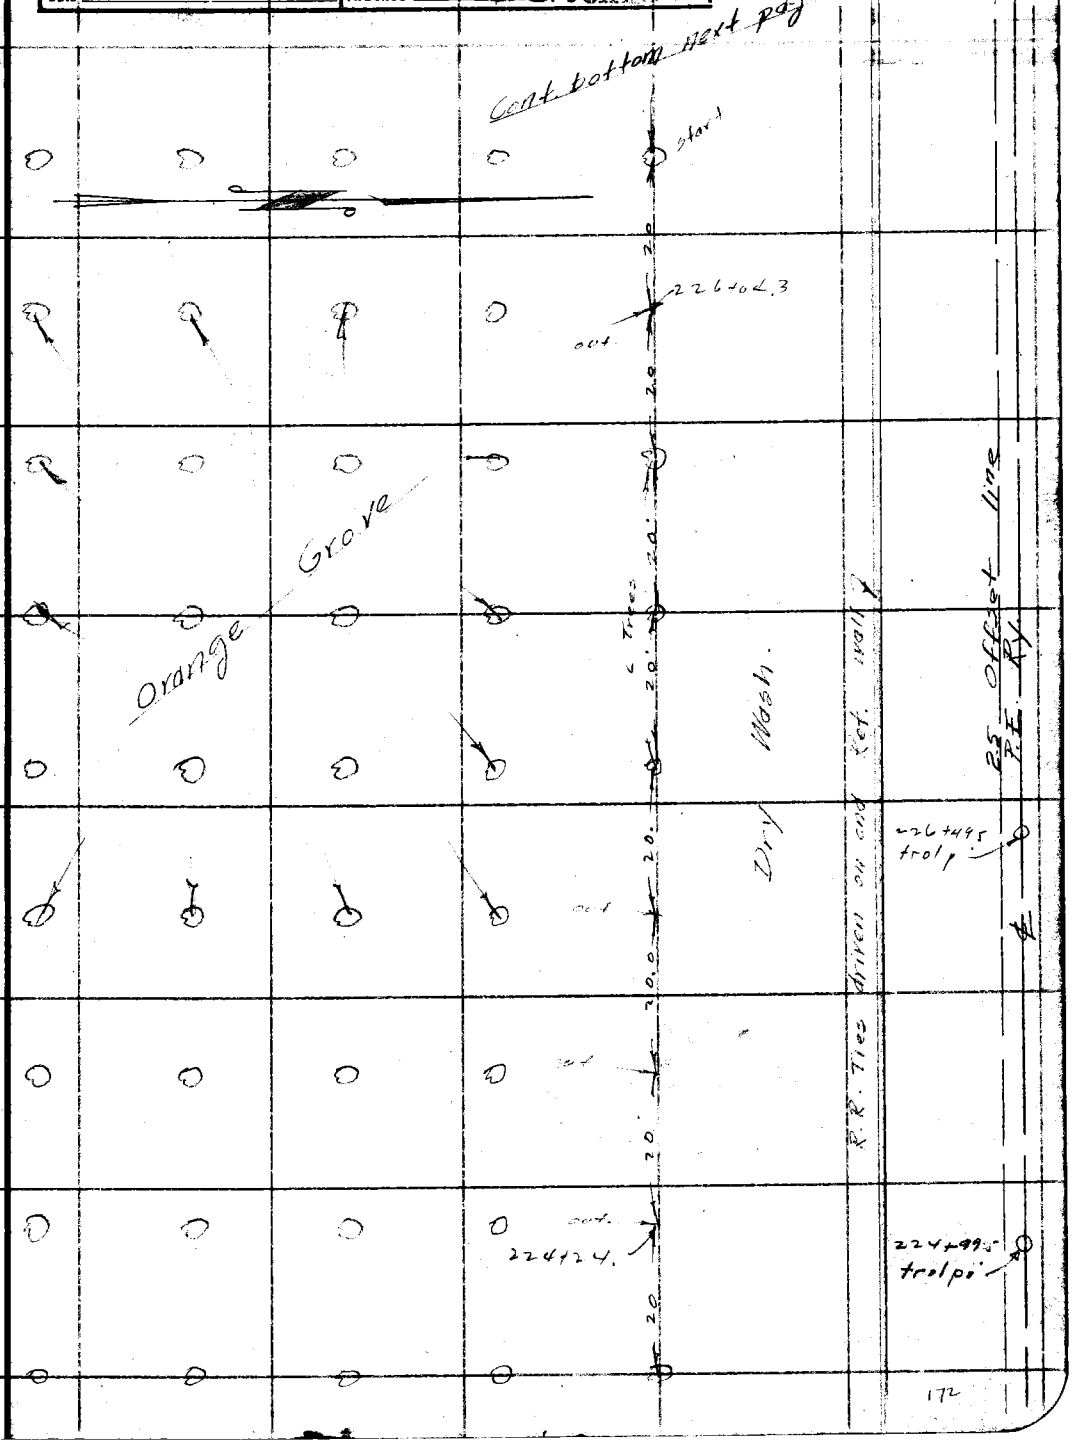

Note: ANY ADDITIONS OR CHANGES ON THIS SHEET MUST BE MADE OR CIRCLED IN Red Ink, WITH DATE AND NAME OF PERSON MAKING CHANGE.

Do not extend notes this side of this line

RETURN TO
LOS ANGELES COUNTY SURVEYOR
700 HALL OF RECORDS

FORM 247 10M 5-31

RETURN TO
LOS ANGELES COUNTY SURVEYOR
700 HALL OF RECORDS

Note: ANY ADDITIONS OR CHANGES ON THIS SHEET MUST BE MADE OR CIRCLED IN Red Ink. WITH DATE AND NAME OF PERSON MAKING CHANGE.

Do not extend notes this side of this line

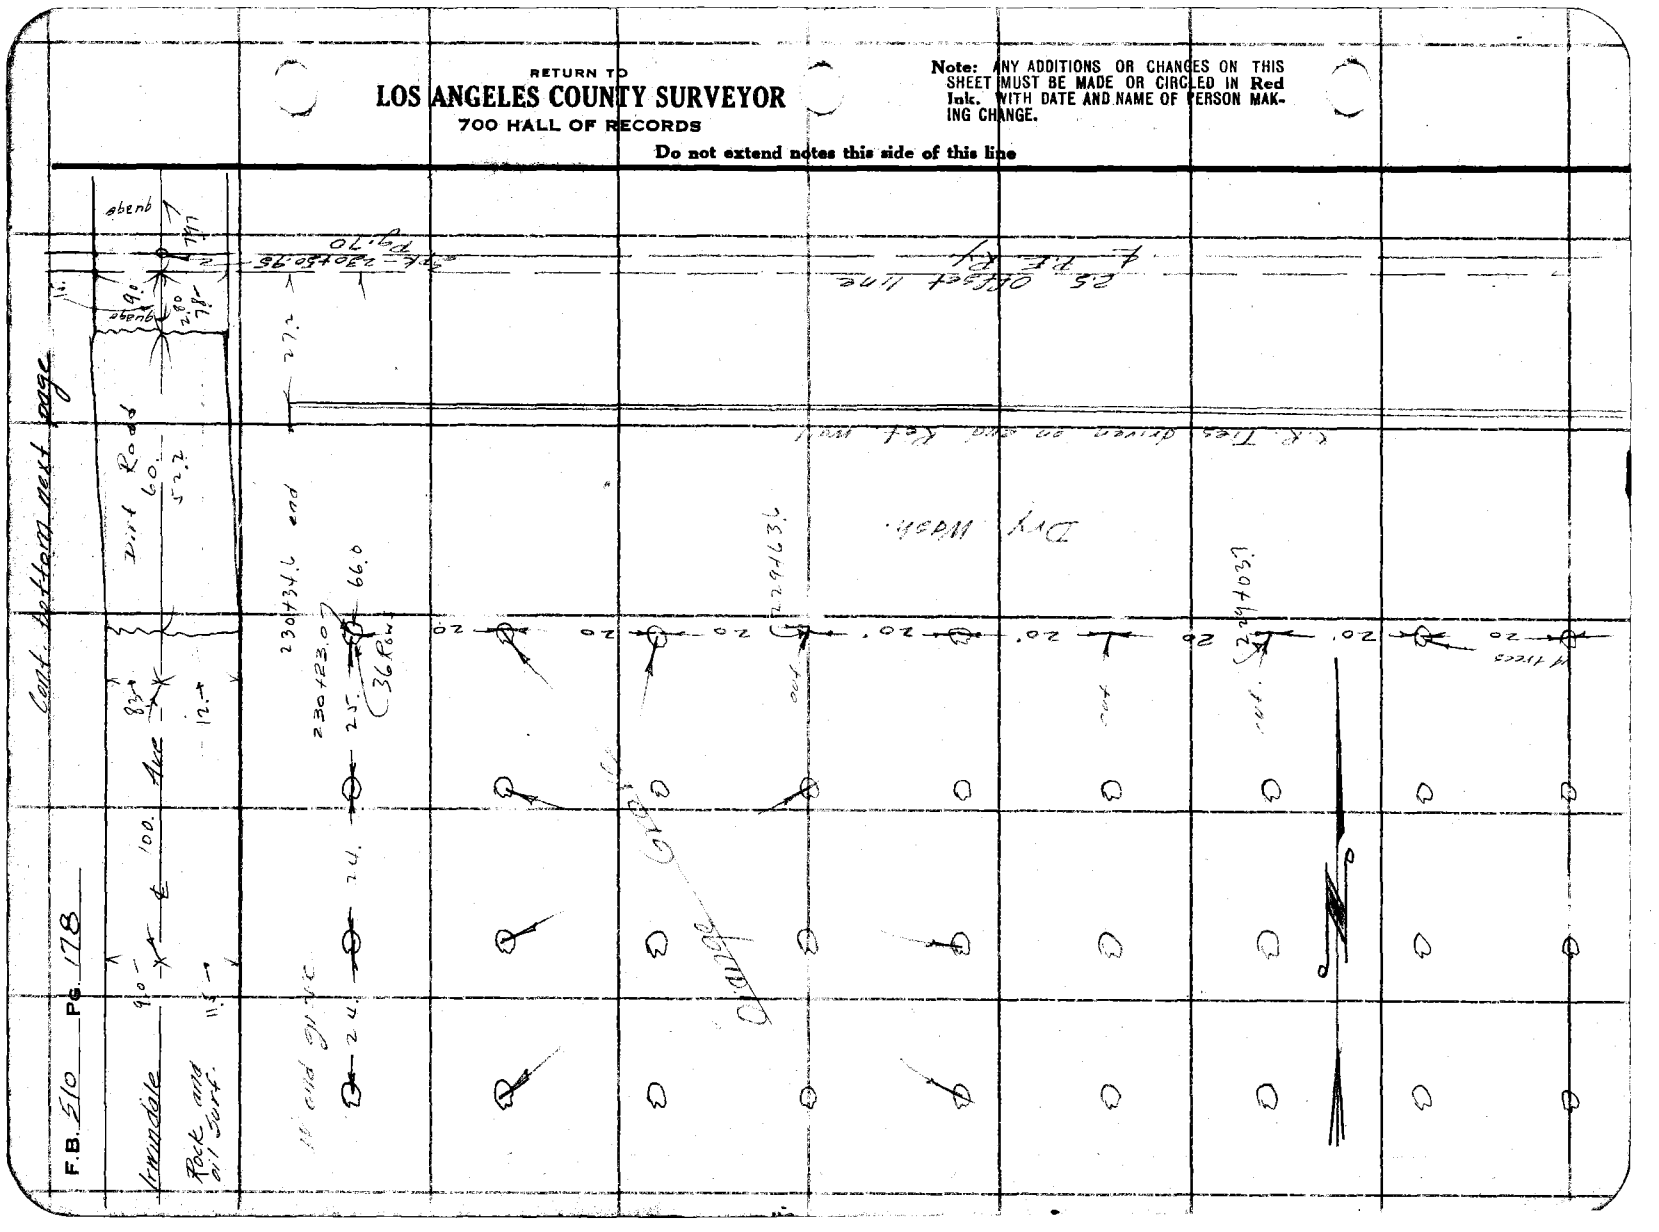

Notes Ck'd by	Survey of Badillo St.
Map No. B-754-4	W. O. 7103 Tape No. 071 St'd 84 °F.
Office Work H.N. Bradstreet	Surveyed by Rosecrans
Checked	Notes Date 7-10-33
Date	Indexed A. C. Johnson

F.B. 510 PG. 179

Cont. bottom next page

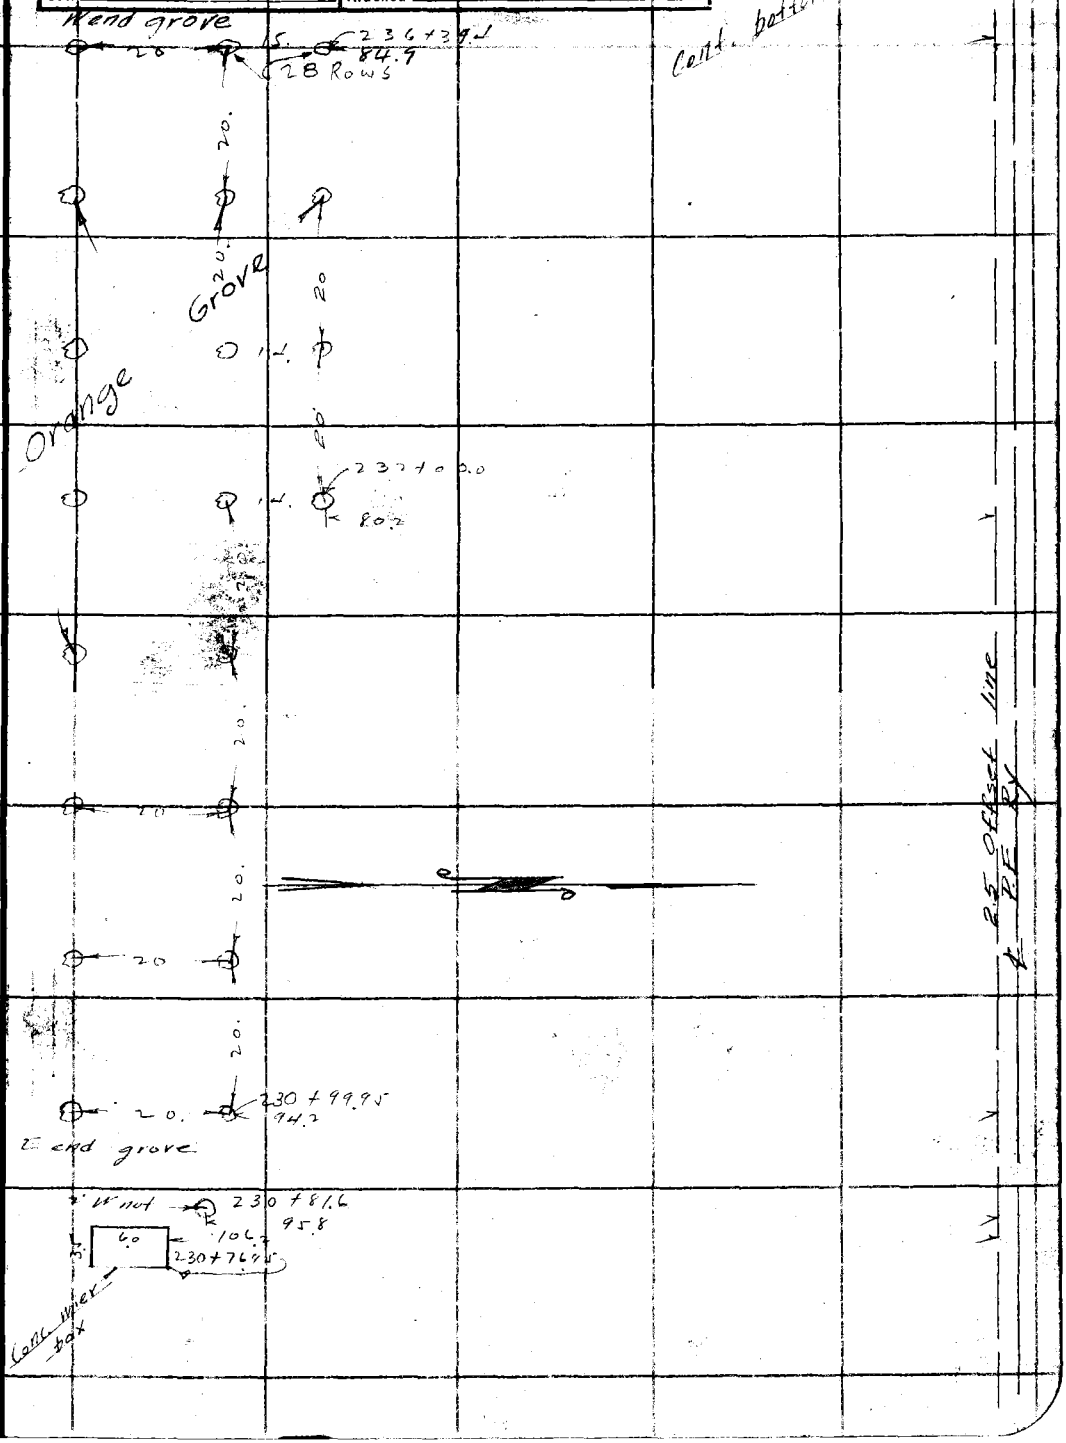

Note: ANY ADDITIONS OR CHANGES ON THIS SHEET MUST BE MADE OR CIRCLED IN Red Ink. WITH DATE AND NAME OF PERSON MAKING CHANGE.

Do not extend notes this side of this line

RETURN TO
LOS ANGELES COUNTY SURVEYOR
700 HALL OF RECORDS

FORM 247 10M 5-31

F.B. 510 Pg 180

Cont. bottom next page

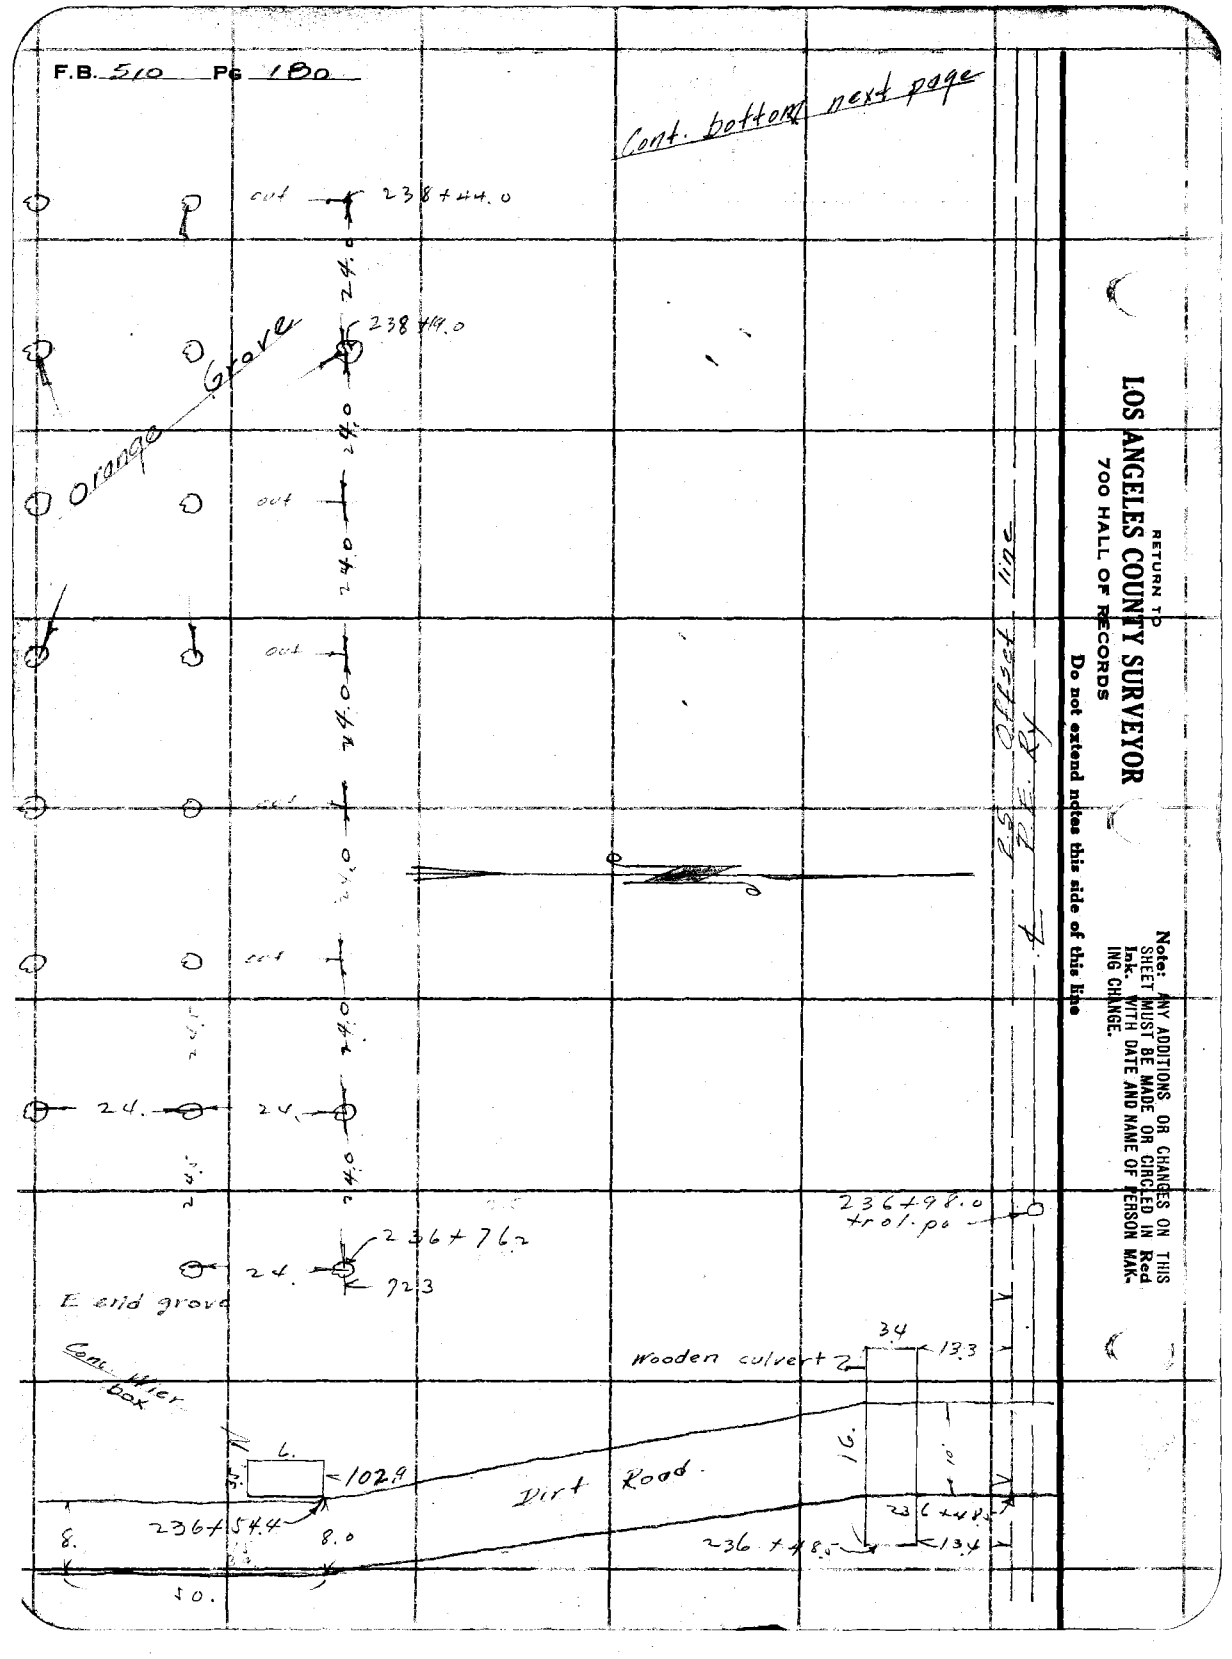

RETURN TO
LOS ANGELES COUNTY SURVEYOR
700 HALL OF RECORDS

Do not extend notes this side of this line

Note: ANY ADDITIONS OR CHANGES ON THIS SHEET MUST BE MADE OR CIRCLED IN Red Ink. WITH DATE AND NAME OF PERSON MAKING CHANGE.

Notes Ck'd by	Survey of Bidello St.
Map No. B-754-4	W. O. 7103 Tape No. 041 St'd 84 °F.
Office Work H.N. Bradstreet	Surveyed by Rosecrans
Checked	Notes Date 7-20-33
Date	Indexed A. C. Job[illegible]

F.B. 510 PG. 181

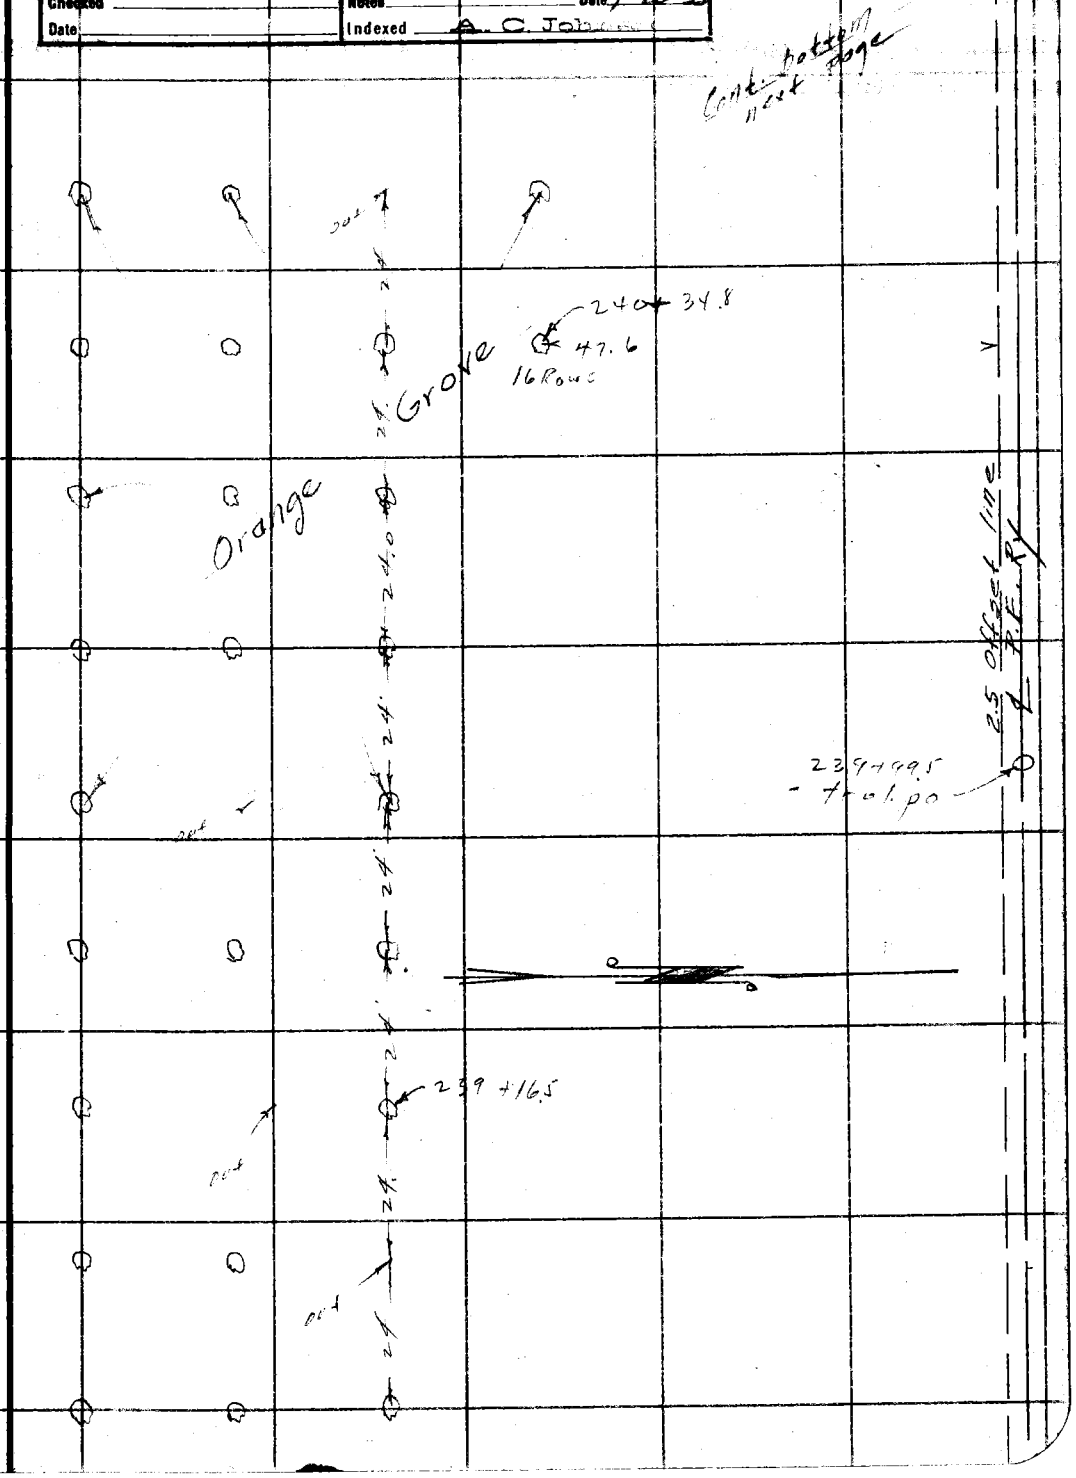

Note: ANY ADDITIONS OR CHANGES ON THIS SHEET MUST BE MADE OR CIRCLED IN Red Ink. WITH DATE AND NAME OF PERSON MAKING CHANGE.

Do not extend notes this side of this line

RETURN TO
LOS ANGELES COUNTY SURVEYOR
700 HALL OF RECORDS

FORM 247 10M 5-31

RETURN TO
LOS ANGELES COUNTY SURVEYOR
700 HALL OF RECORDS

Note: ANY ADDITIONS OR CHANGES ON THIS SHEET MUST BE MADE OR CIRCLED IN **Red Ink.** WITH DATE AND NAME OF PERSON MAKING CHANGE.

Do not extend notes this side of this line

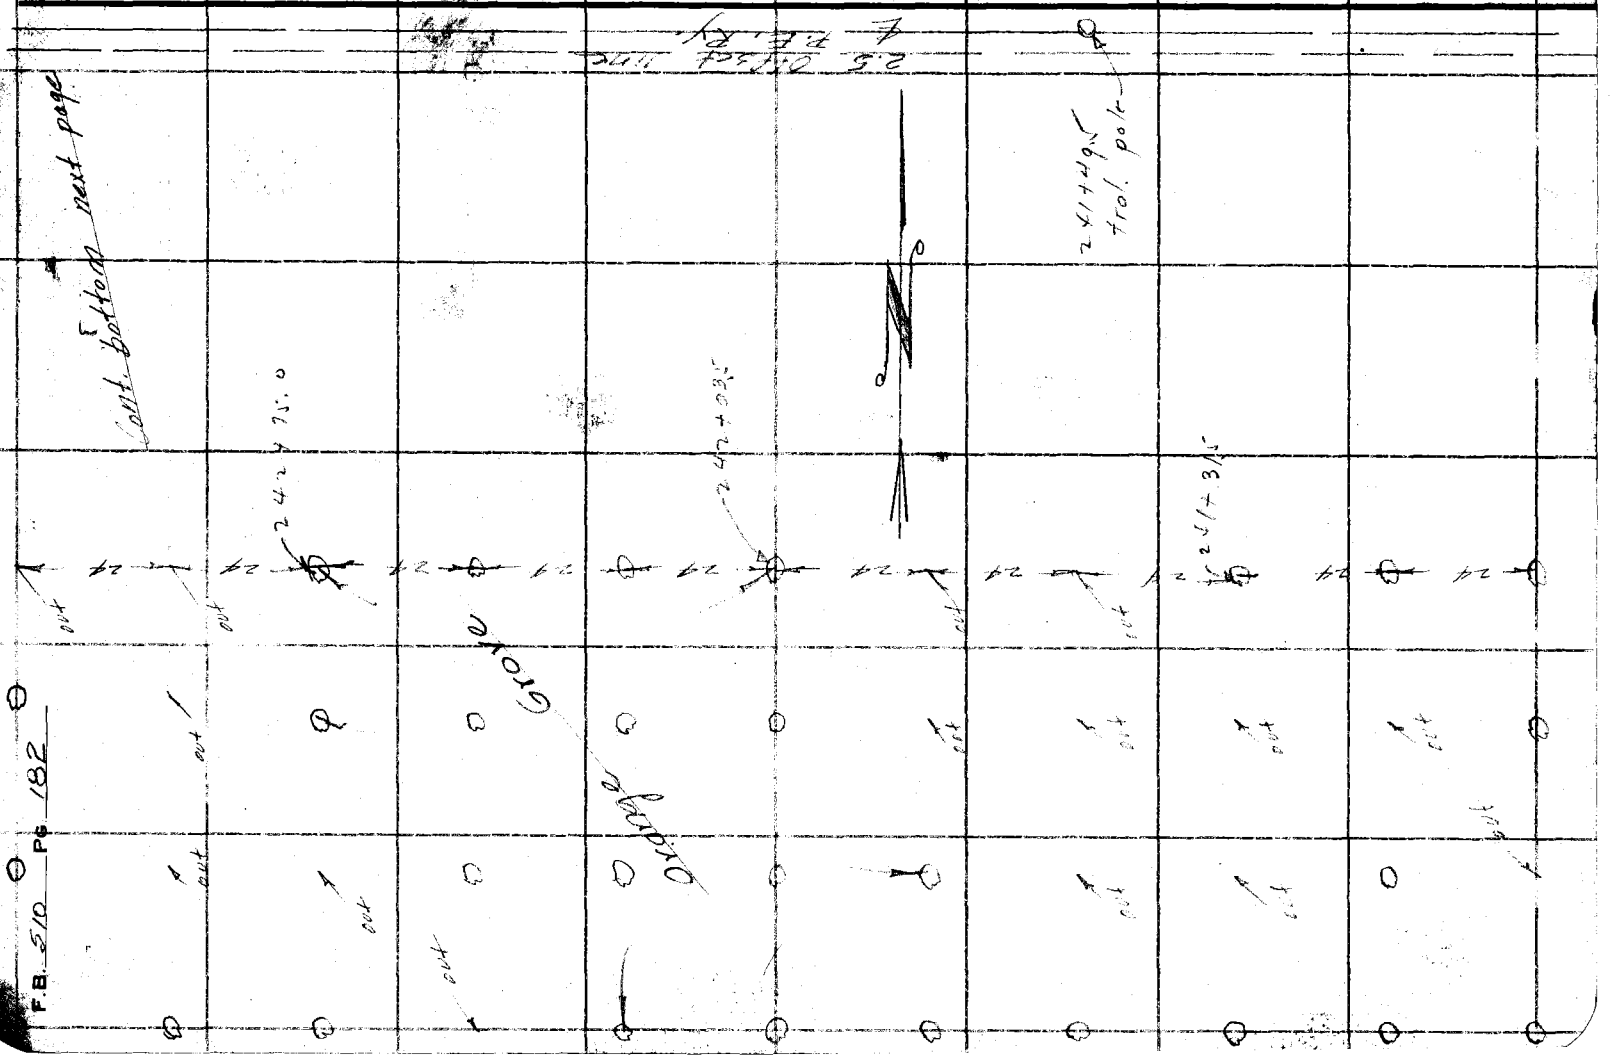

Notes Ck'd by	Survey of Badillo St
Map No. B-754-4	W. O. 7103 Tape No. 041 St'd 84 °F.
Office Work H.N. Bradstreet	Surveyed by Rosecrans
Checked	Notes Date 7-20-32
Date	Indexed A. C. Job

F.B. 510 PG. 183

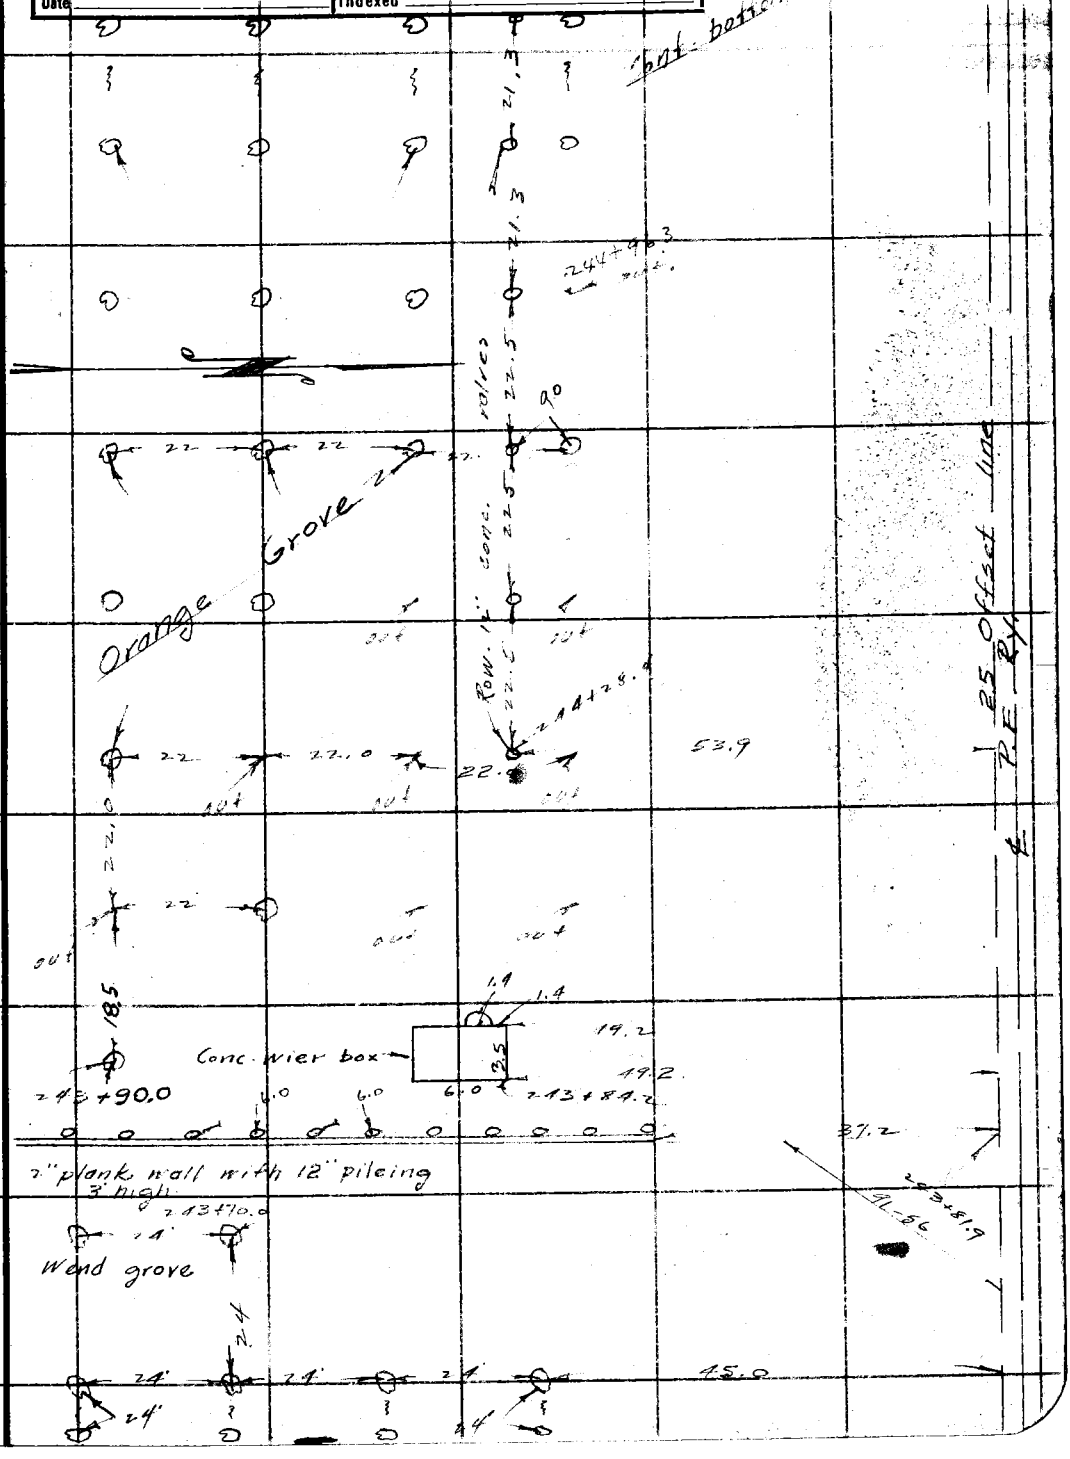

Note: ANY ADDITIONS OR CHANGES ON THIS SHEET MUST BE MADE OR CIRCLED IN Red Ink. WITH DATE AND NAME OF PERSON MAKING CHANGE.

Do not extend notes this side of this line

RETURN TO
LOS ANGELES COUNTY SURVEYOR
700 HALL OF RECORDS

FORM 247 10M 5-31

RETURN TO
LOS ANGELES COUNTY SURVEYOR
700 HALL OF RECORDS

Note: ANY ADDITIONS OR CHANGES ON THIS SHEET MUST BE MADE OR CIRCLED IN **Red Ink.** WITH DATE AND NAME OF PERSON MAKING CHANGE.

Do not extend notes this side of this line

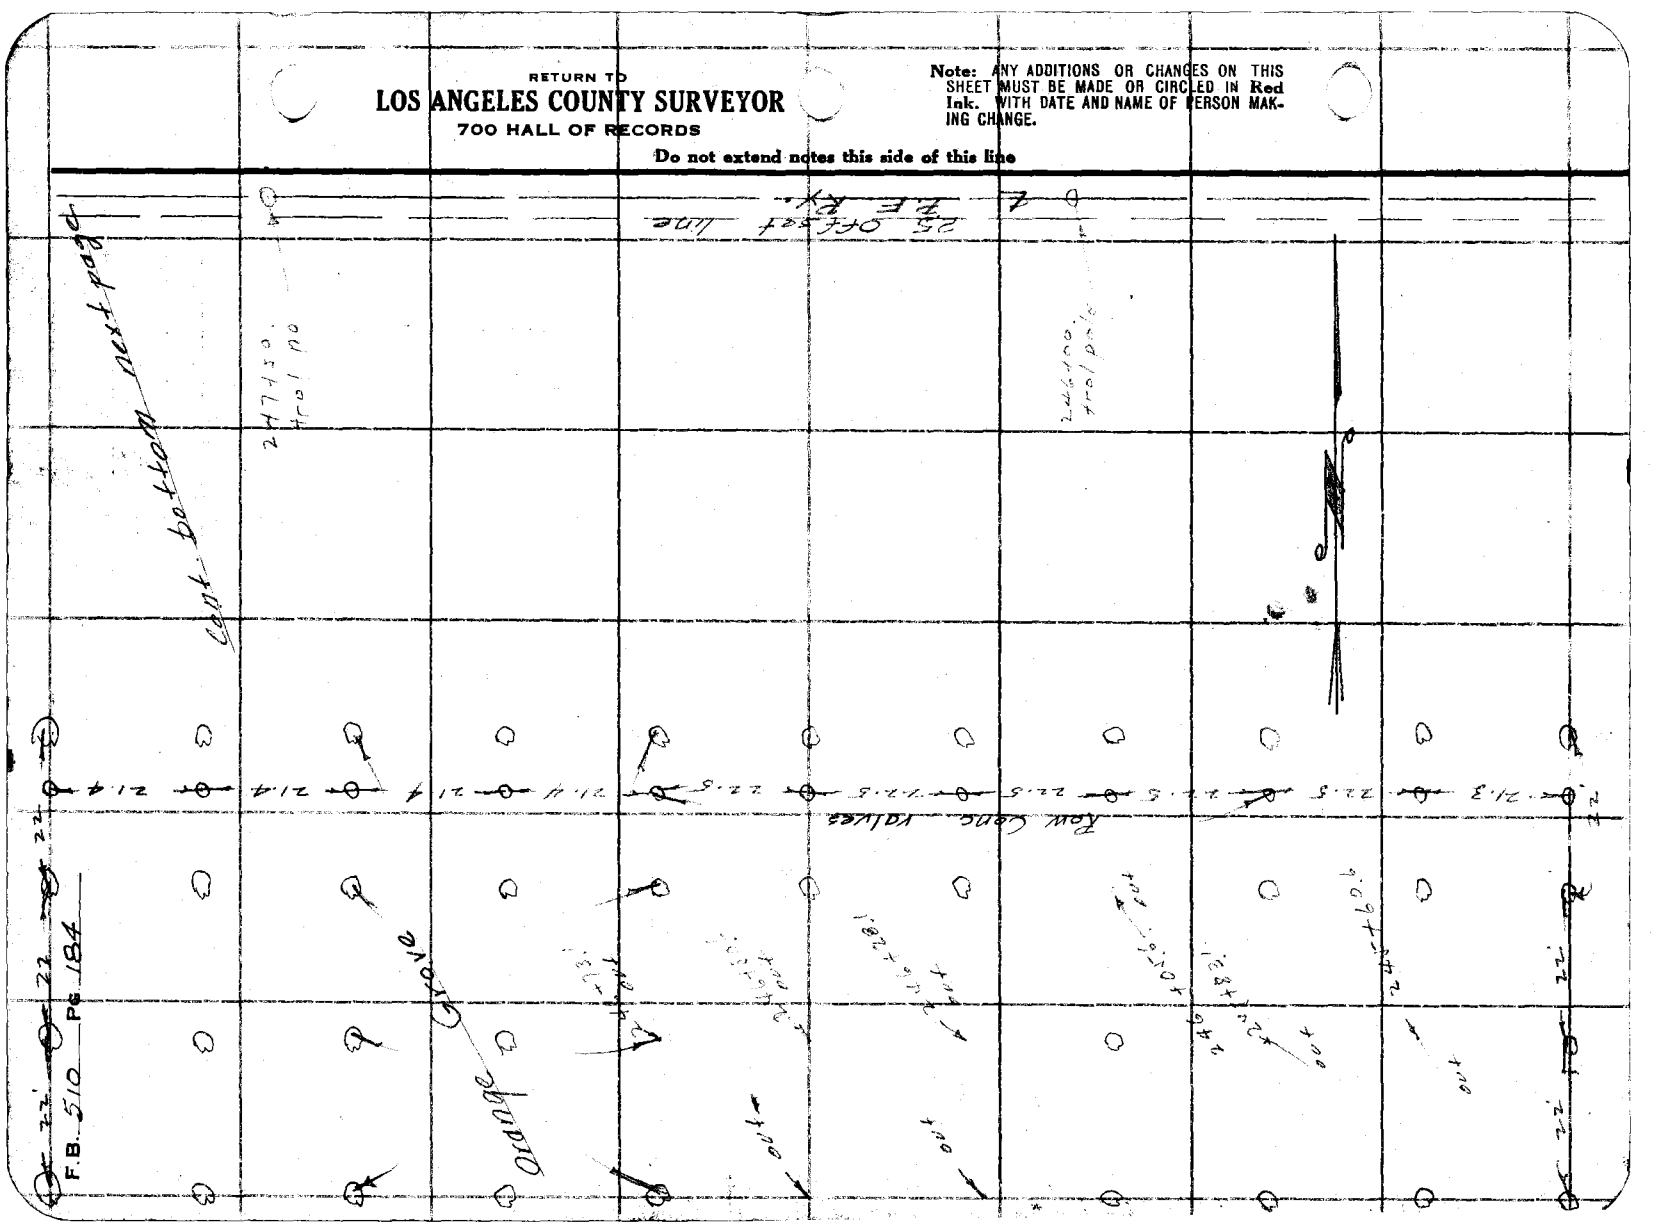

Notes Ck'd by	Survey of Badillo St.
Map No. B-754-4	W. O. 2103 Tape No. 091 St'd 84 °F.
Office Work H.N. Bradstreet	Surveyed by Rosecrans
Checked	Notes A. C. Johnson Date 7-20-32
Date	Indexed

F.B. 510 PG. 185

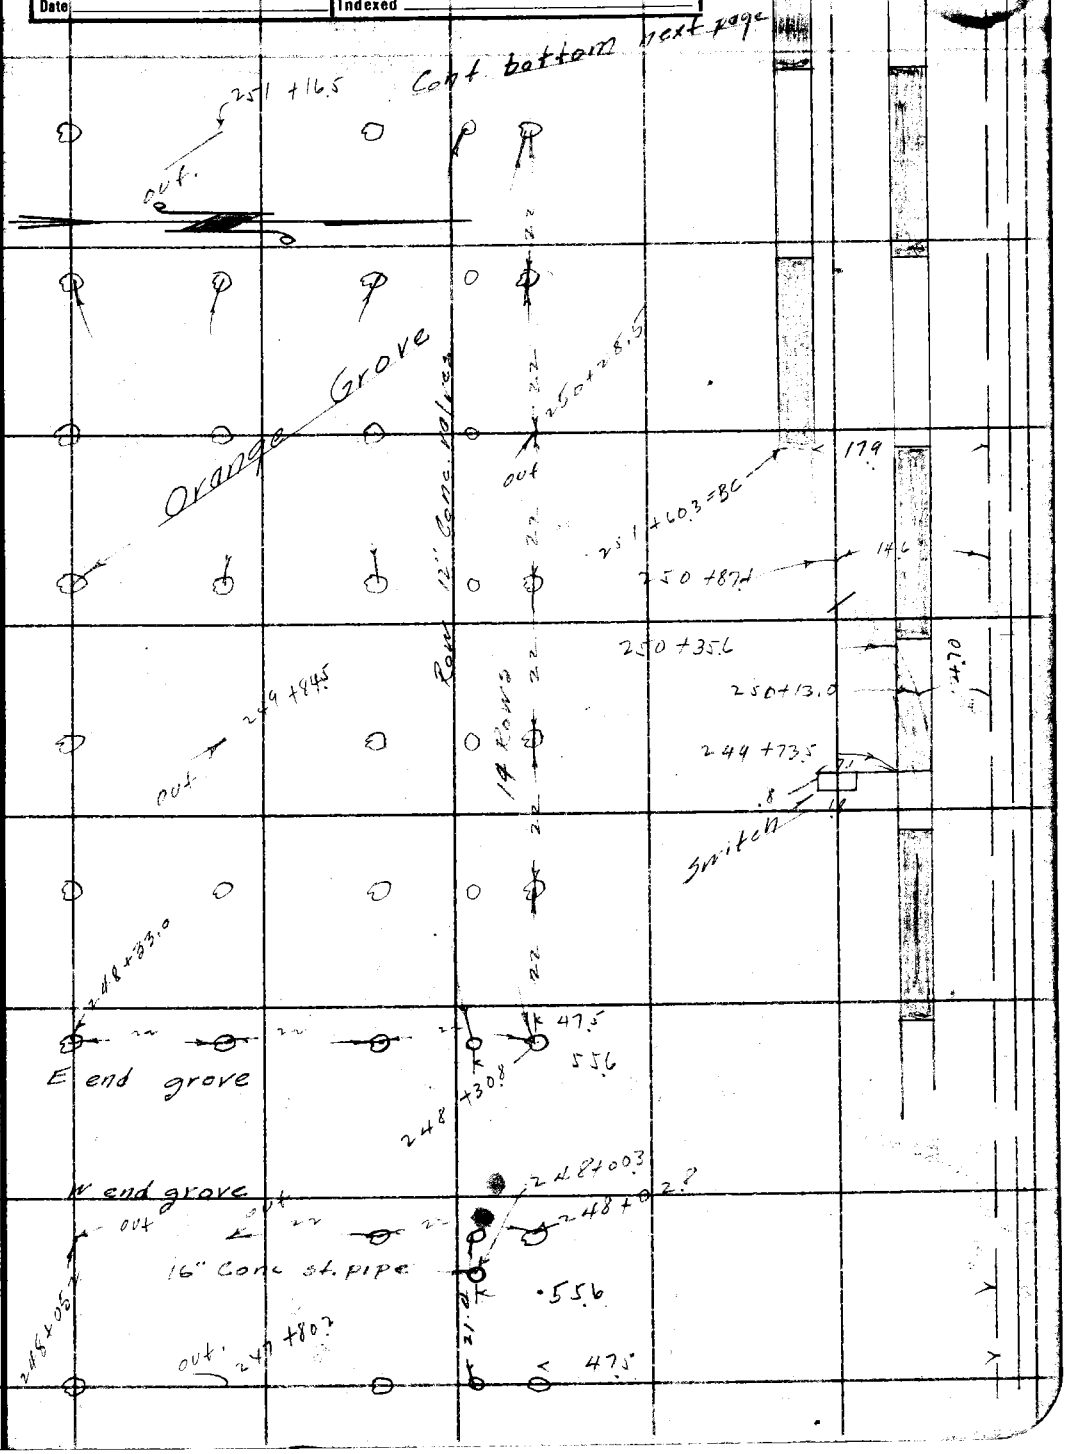

Note: ANY ADDITIONS OR CHANGES ON THIS SHEET MUST BE MADE OR CIRCLED IN Red Ink. WITH DATE AND NAME OF PERSON MAKING CHANGE.

Do not extend notes this side of this line

RETURN TO
LOS ANGELES COUNTY SURVEYOR
700 HALL OF RECORDS

FORM 247 10M 5-31

RETURN TO

LOS ANGELES COUNTY SURVEYOR

700 HALL OF RECORDS

Note: ANY ADDITIONS OR CHANGES ON THIS SHEET MUST BE MADE OR CIRCLED IN **Red Ink.** WITH DATE AND NAME OF PERSON MAKING CHANGE.

Do not extend notes this side of this line

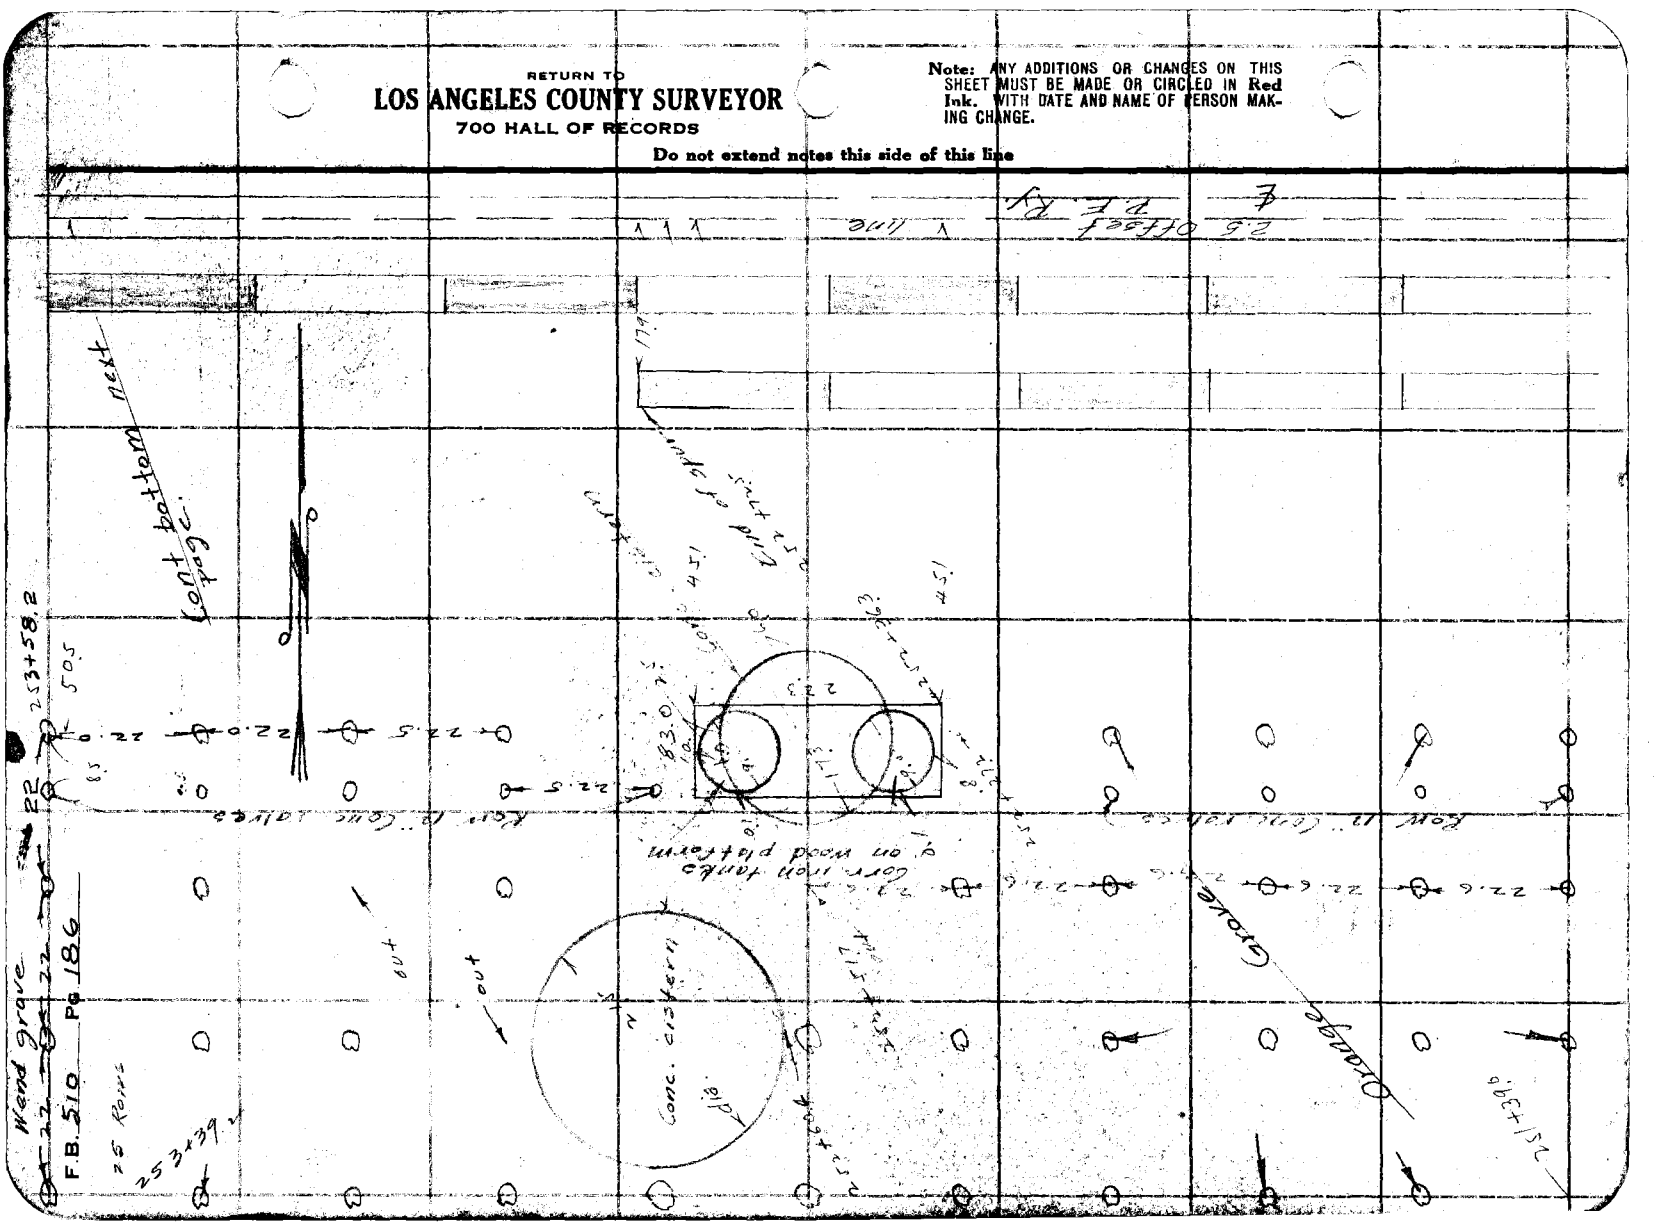

Notes Ck'd by	Survey of Padillo St.
Map No. B-754-5	W. O. 7103 Tape No. 011 St'd 64 °F.
Office Work H.N. Bradstreet	Surveyed by Rosecrans
Checked	Notes
Date	Indexed A. C. Johnson Date 7-20-33

F.B. 510 PG. 187

RETURN TO
LOS ANGELES COUNTY SURVEYOR
700 HALL OF RECORDS

Notes: ANY ADDITIONS OR CHANGES ON THIS SHEET MUST BE MADE OR CIRCLED IN Red Ink, WITH DATE AND NAME OF PERSON MAKING CHANGE.

Do not extend notes this side of this line

FORM 847 10M 8-31

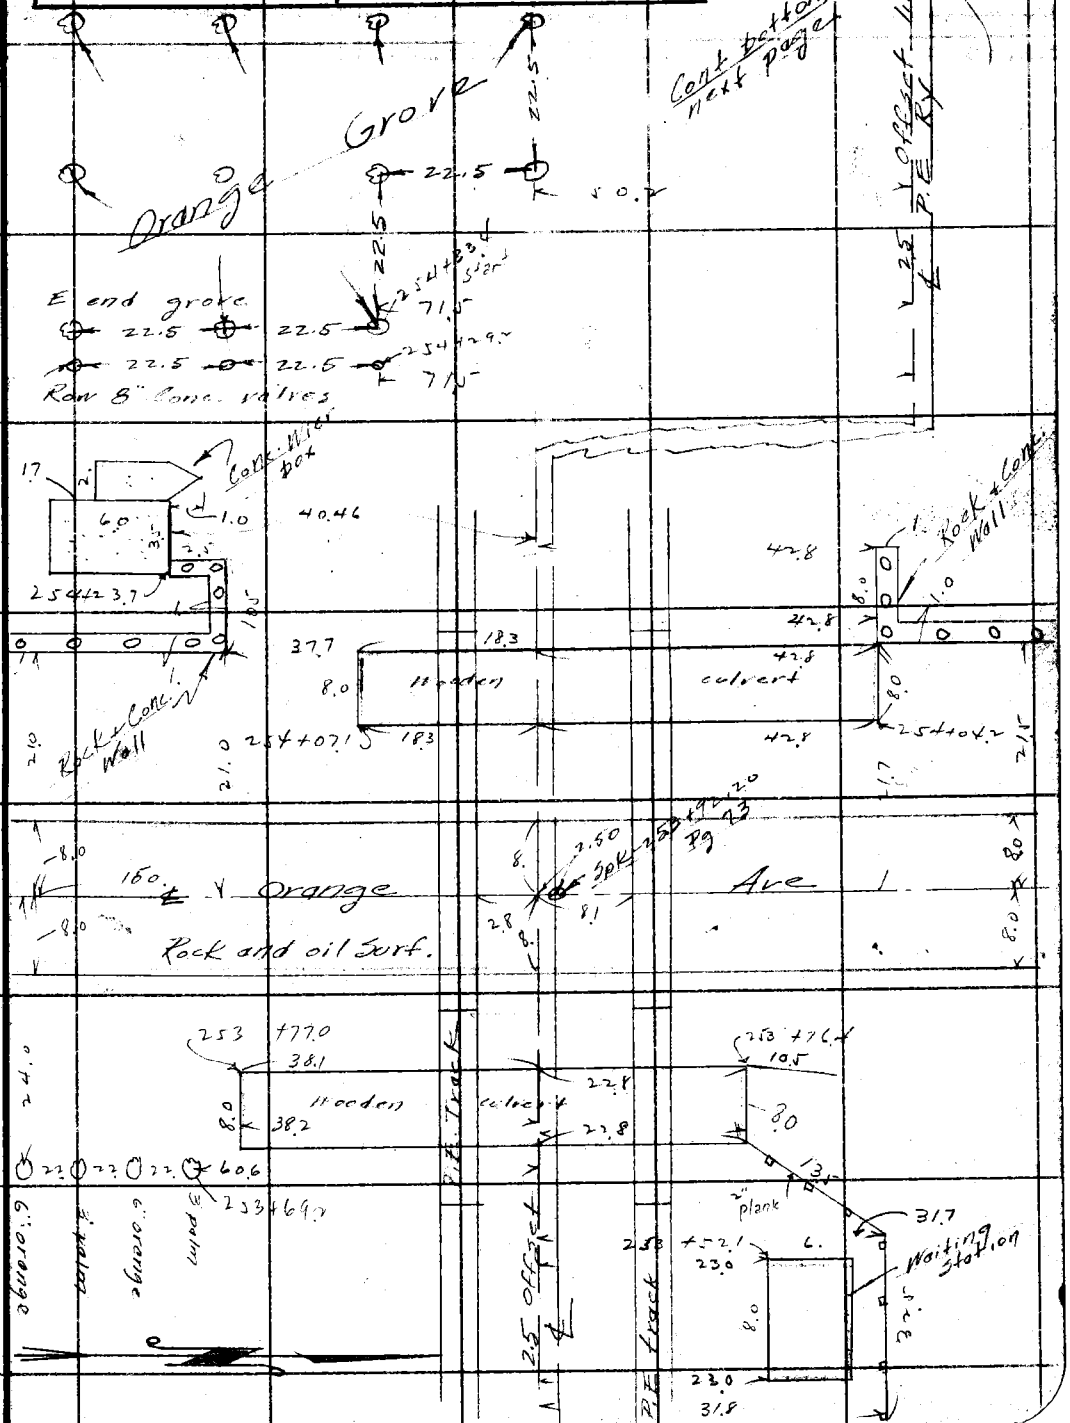

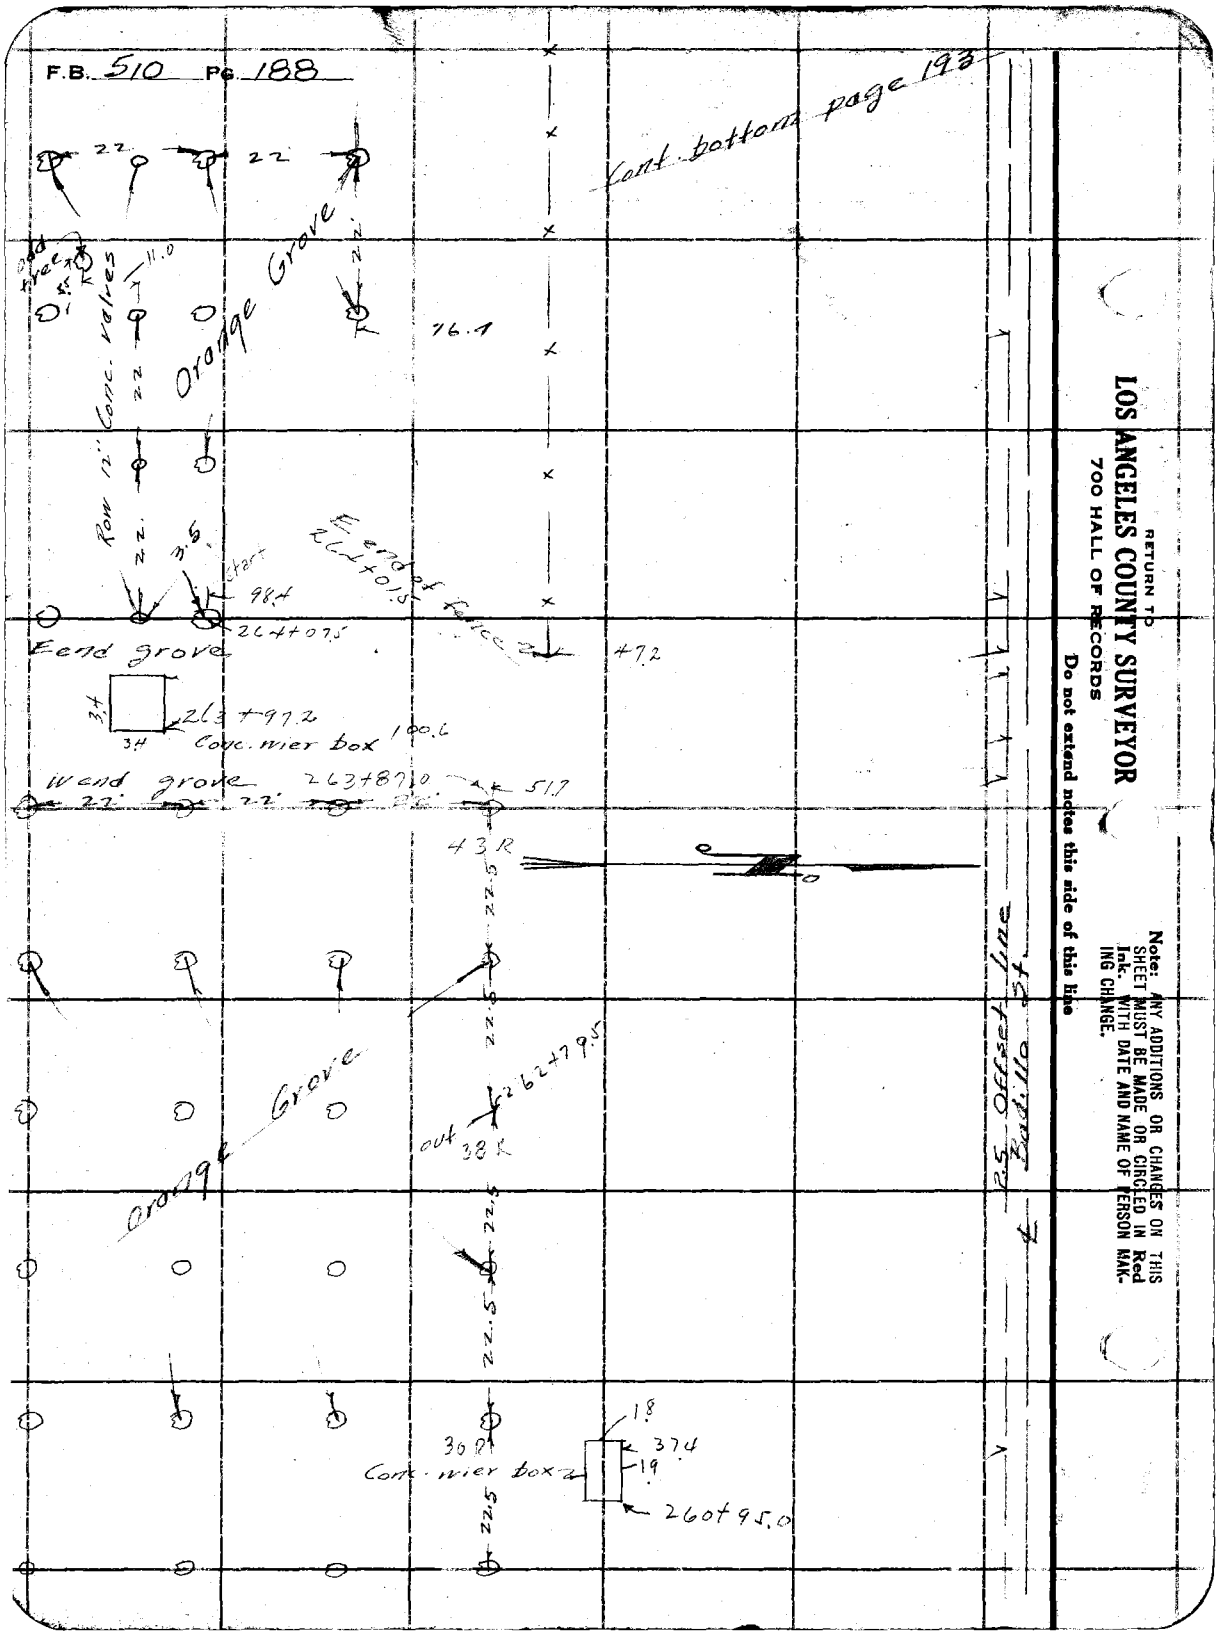
F.B. 510 PG. 188
Cont. bottom page 193
22
22
Orange Grove
Row 12" Conc. valves
11.0
76.1
22
22
3.5
start
98.4
264+07.5
End of fence
264+01.5
47.2
End grove
3.4
3.4
263+97.2
Conc. wier box
100.6
W end grove
263+87.0
51.7
22
22
43 R
22.5
22.5
262+79.5
out
38 R
Orange Grove
22.5
22.5
30 R
Conc. wier box
1.8
37.4
1.9
260+95.0
22.5
2.5 Offset line
Badillo St
RETURN TO
LOS ANGELES COUNTY SURVEYOR
700 HALL OF RECORDS
Do not extend notes this side of this line
Note: ANY ADDITIONS OR CHANGES ON THIS SHEET MUST BE MADE OR CIRCLED IN Red Ink. WITH DATE AND NAME OF PERSON MAKING CHANGE.

Notes Ck'd by	Survey of Badillo St
Map No. B-754-5	W. O. 7103 Tape No. 041 St'd 84 °F.
Office Work H.N. Bradstreet	Surveyed by Rosecrans
Checked	Notes Date 1-21-33
Date	Indexed A. C. Johnson

F.B. 510 PG. 189

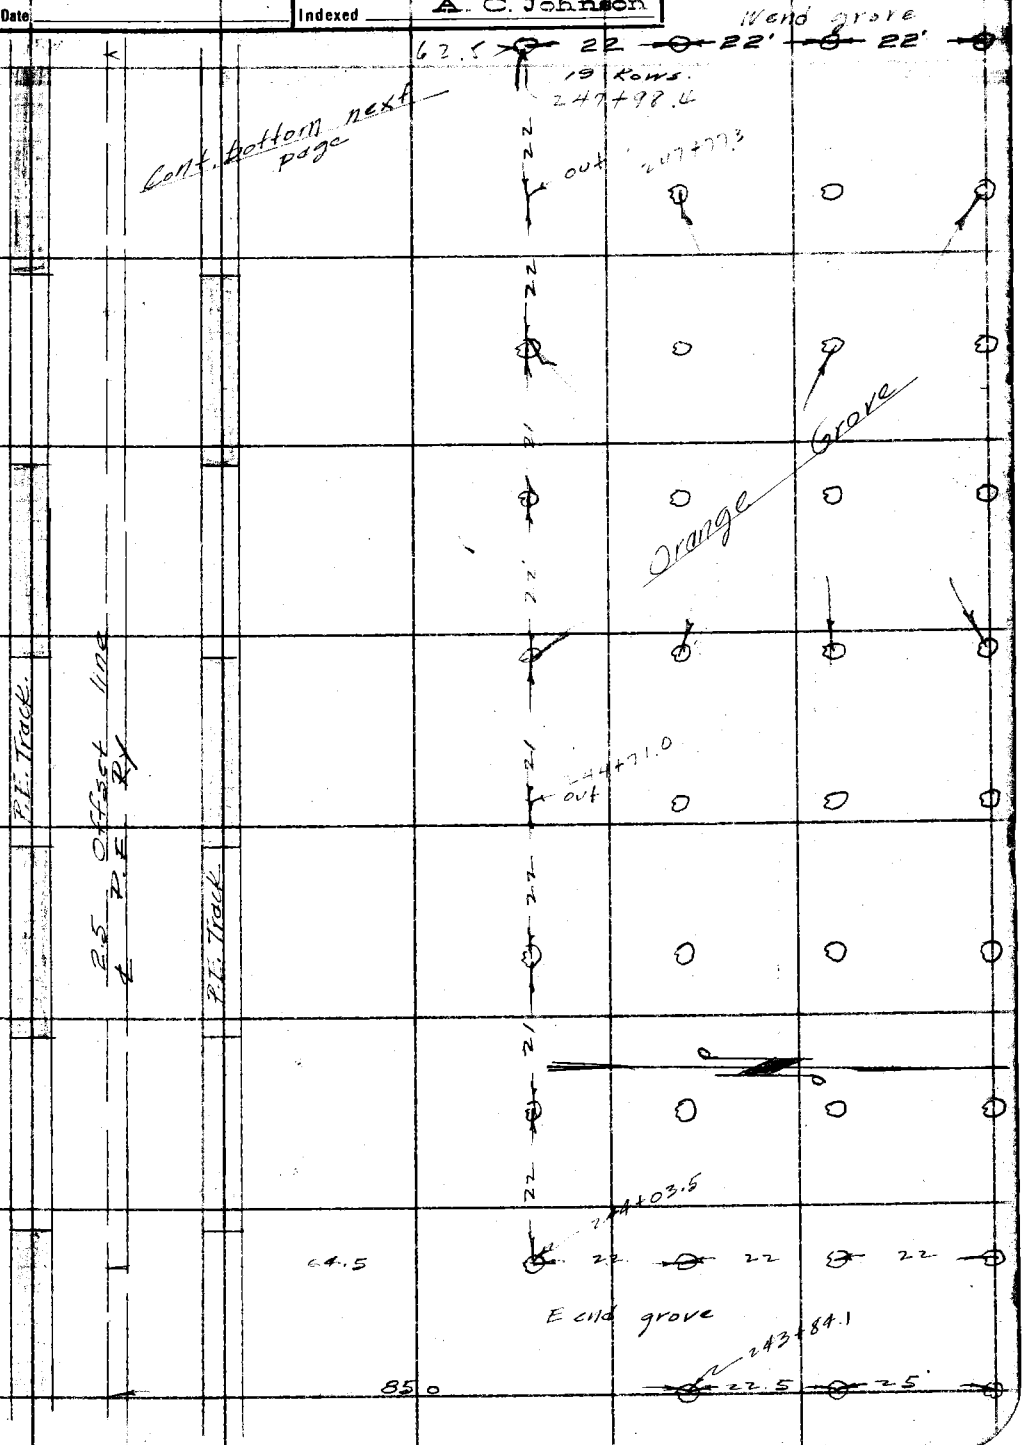

Note: ANY ADDITIONS OR CHANGES ON THIS SHEET MUST BE MADE OR CIRCLED IN Red Ink, WITH DATE AND NAME OF PERSON MAKING CHANGE.

Do not extend notes this side of this line

RETURN TO
LOS ANGELES COUNTY SURVEYOR
700 HALL OF RECORDS

FORM 247 10M 5-31

RETURN TO
LOS ANGELES COUNTY SURVEYOR
700 HALL OF RECORDS

Note: ANY ADDITIONS OR CHANGES ON THIS SHEET MUST BE MADE OR CIRCLED IN **Red Ink.** WITH DATE AND NAME OF PERSON MAKING CHANGE.

Do not extend notes this side of this line

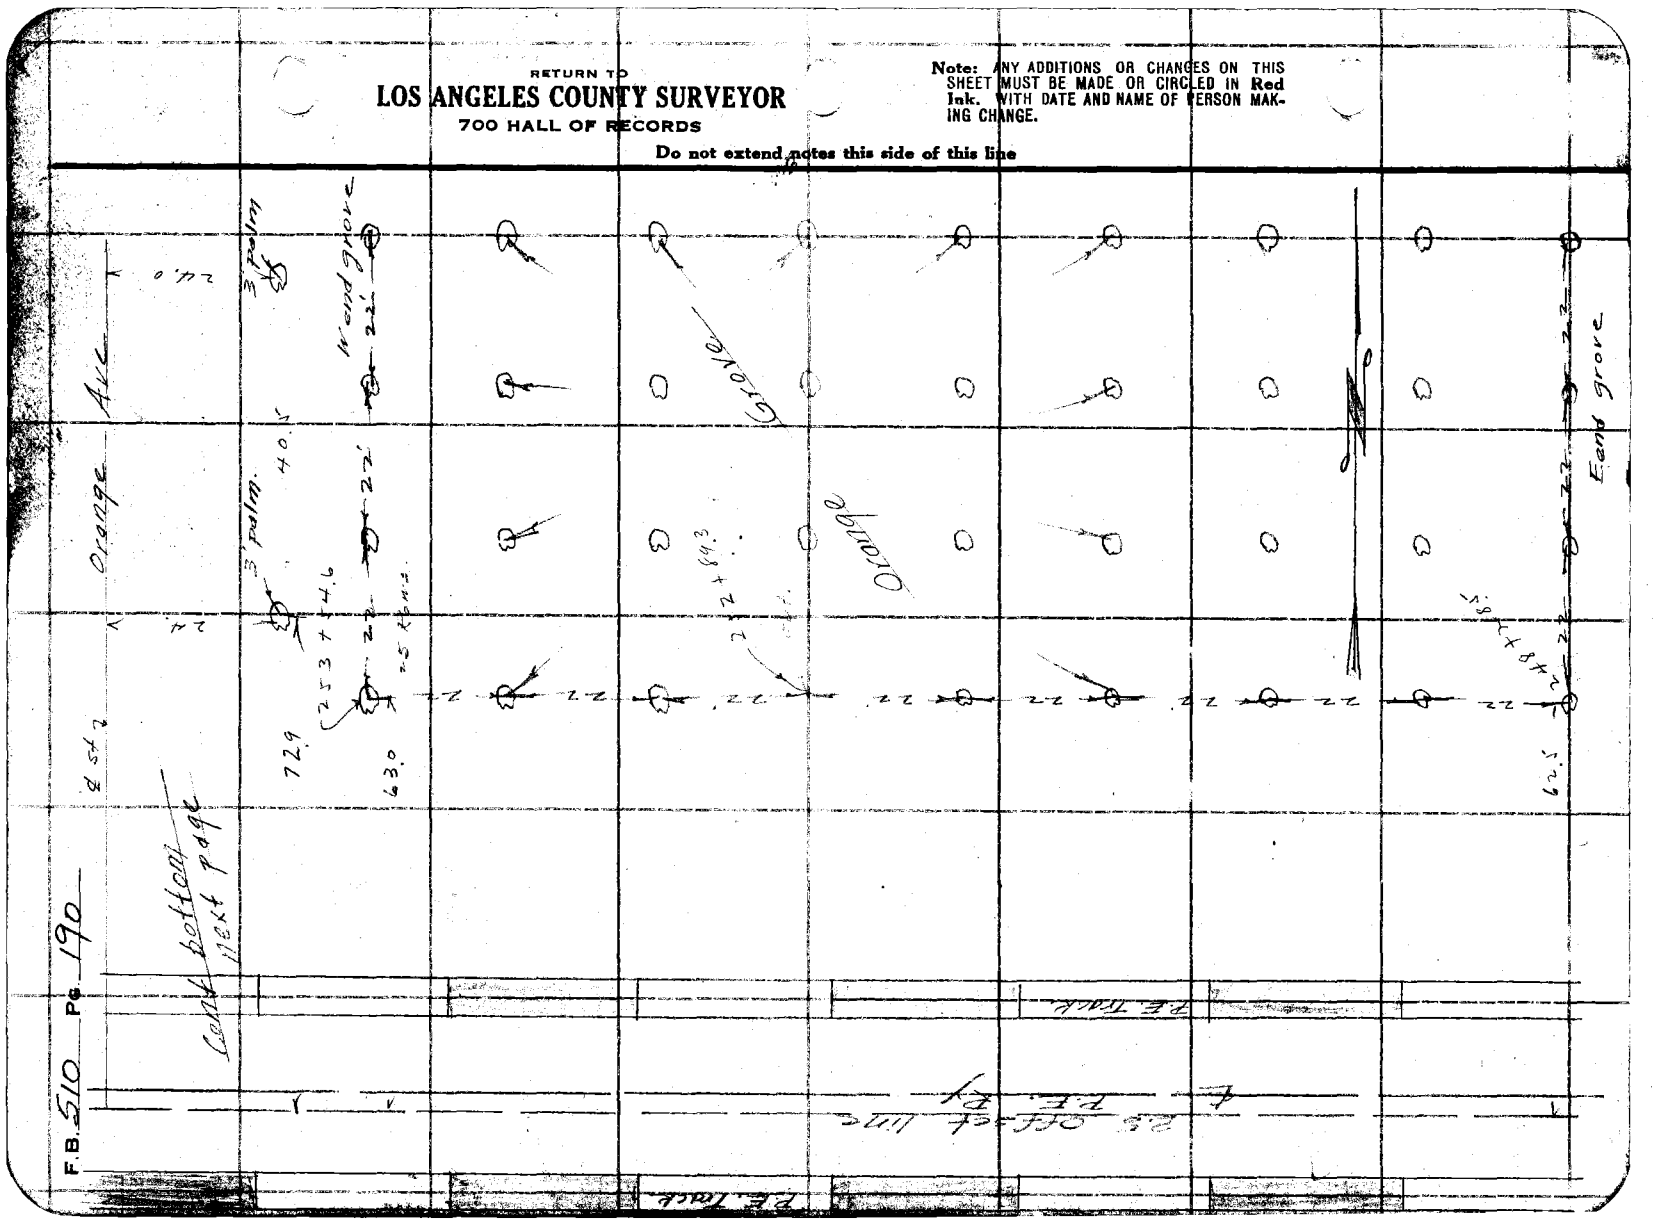

Notes Ck'd by	Survey of Badillo St
Map No. B-754-5	W. O. 7103 Tape No. 041 St'd 84 °F.
Office Work H.N. Bradstreet	Surveyed by Rosecrans
Checked	Notes Date 7-4-33
Date	Indexed A. C. Johnson

F.B. 510 PG. 191

Cont. bottom next page

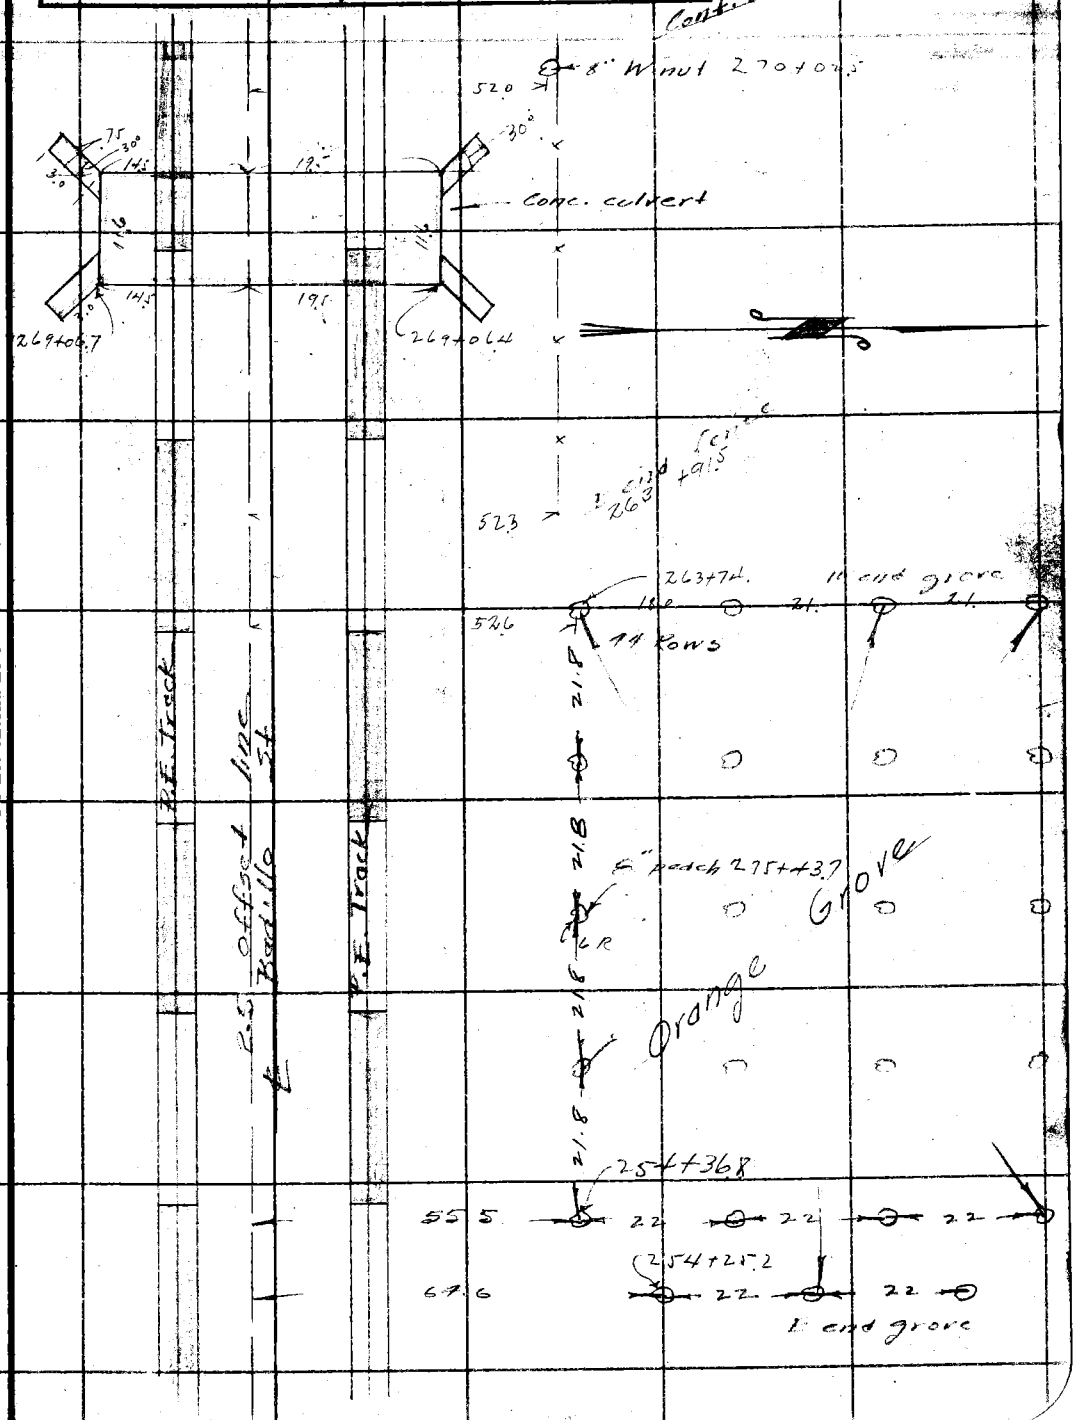

Note: ANY ADDITIONS OR CHANGES ON THIS SHEET MUST BE MADE OR CIRCLED IN Red Ink. WITH DATE AND NAME OF PERSON MAKING CHANGE.

Do not extend notes this side of this line

RETURN TO
LOS ANGELES COUNTY SURVEYOR
700 HALL OF RECORDS

FORM 247 10M 5-31

F.B. 510 Pg. 192

Cont. bottom Pg. 193.

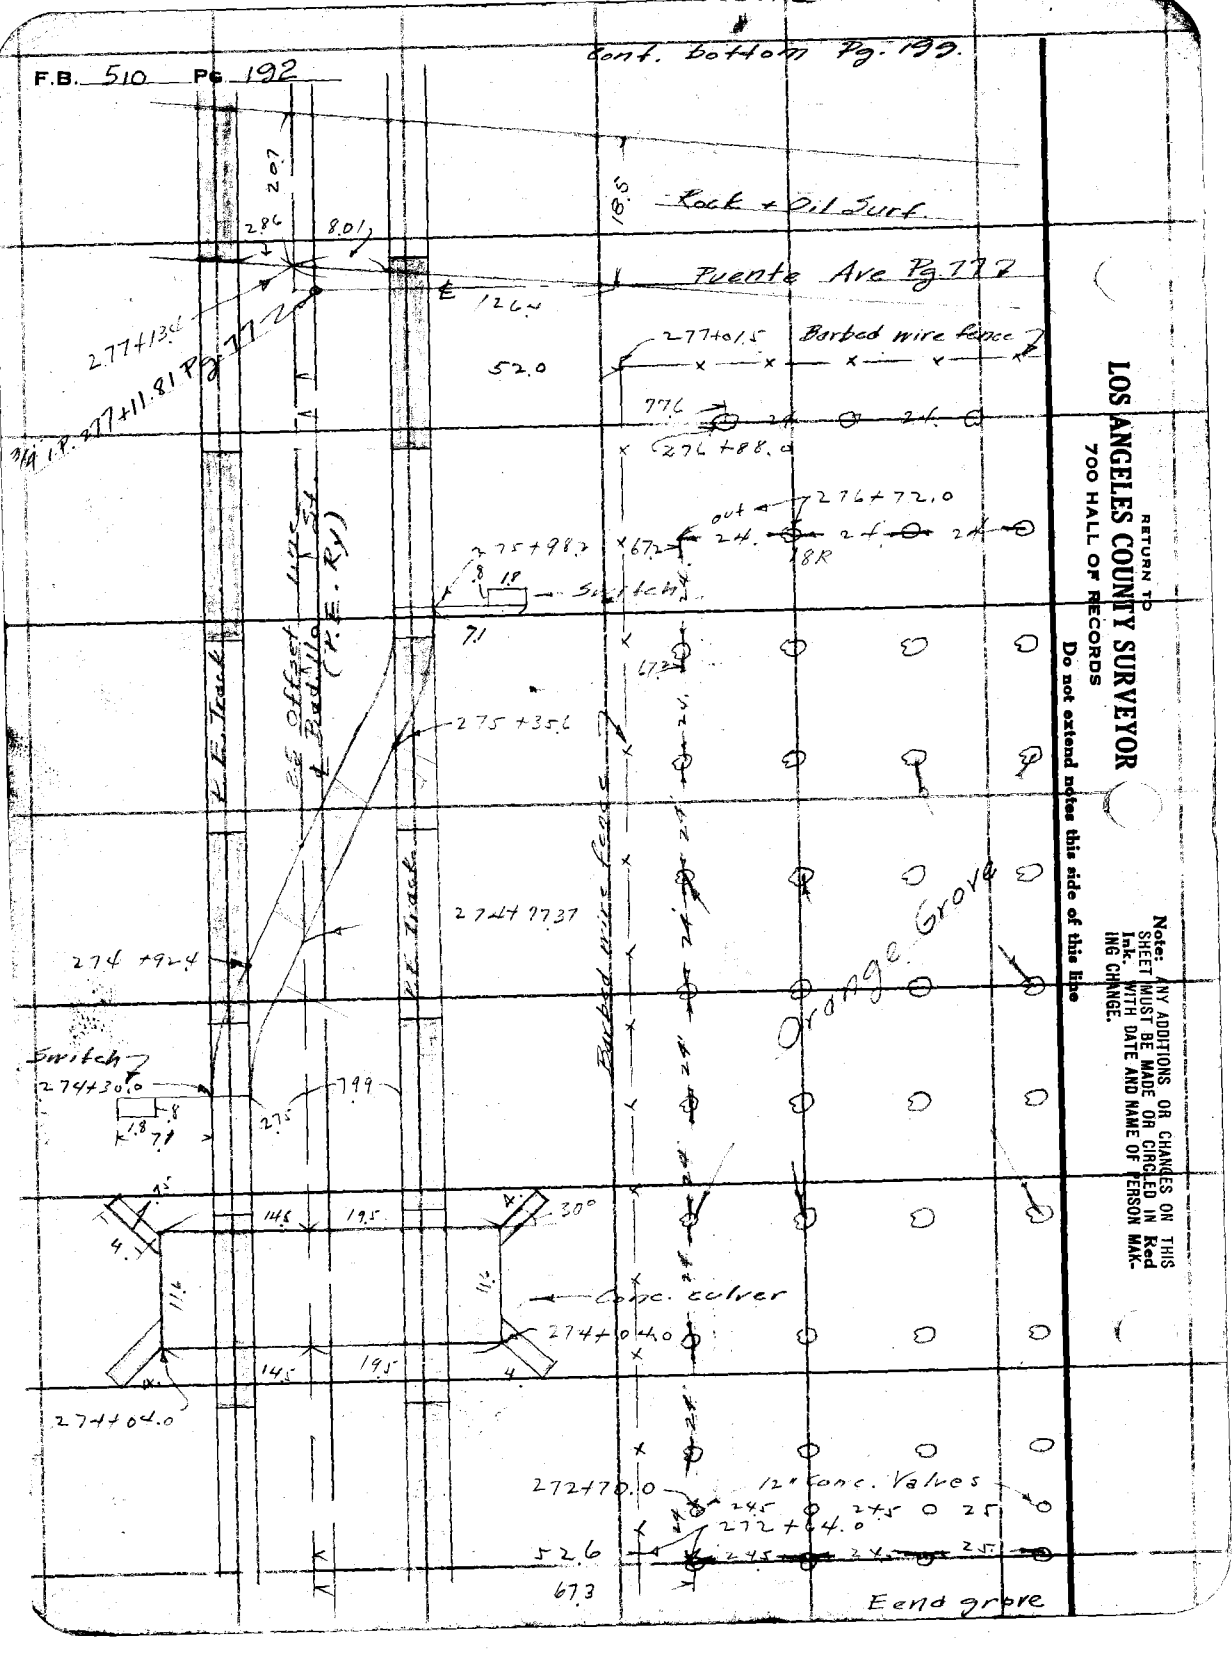

RETURN TO
LOS ANGELES COUNTY SURVEYOR
700 HALL OF RECORDS

Note: ANY ADDITIONS OR CHANGES ON THIS SHEET MUST BE MADE OR CIRCLED IN Red Ink. WITH DATE AND NAME OF PERSON MAKING CHANGE.

Do not extend notes this side of this line

Notes Ck'd by	Survey of Badillo St.
Map No. B-754-5	W. O. 7103 Tape No. 941 St'd 84 °F.
Office Work N.N. Broadstreet	Surveyed by Rosecrans
Checked	Notes Date 7-14-32
Date	Indexed A. C. Johnson

F.B. 510 PG. 193

cont. on bottom next page

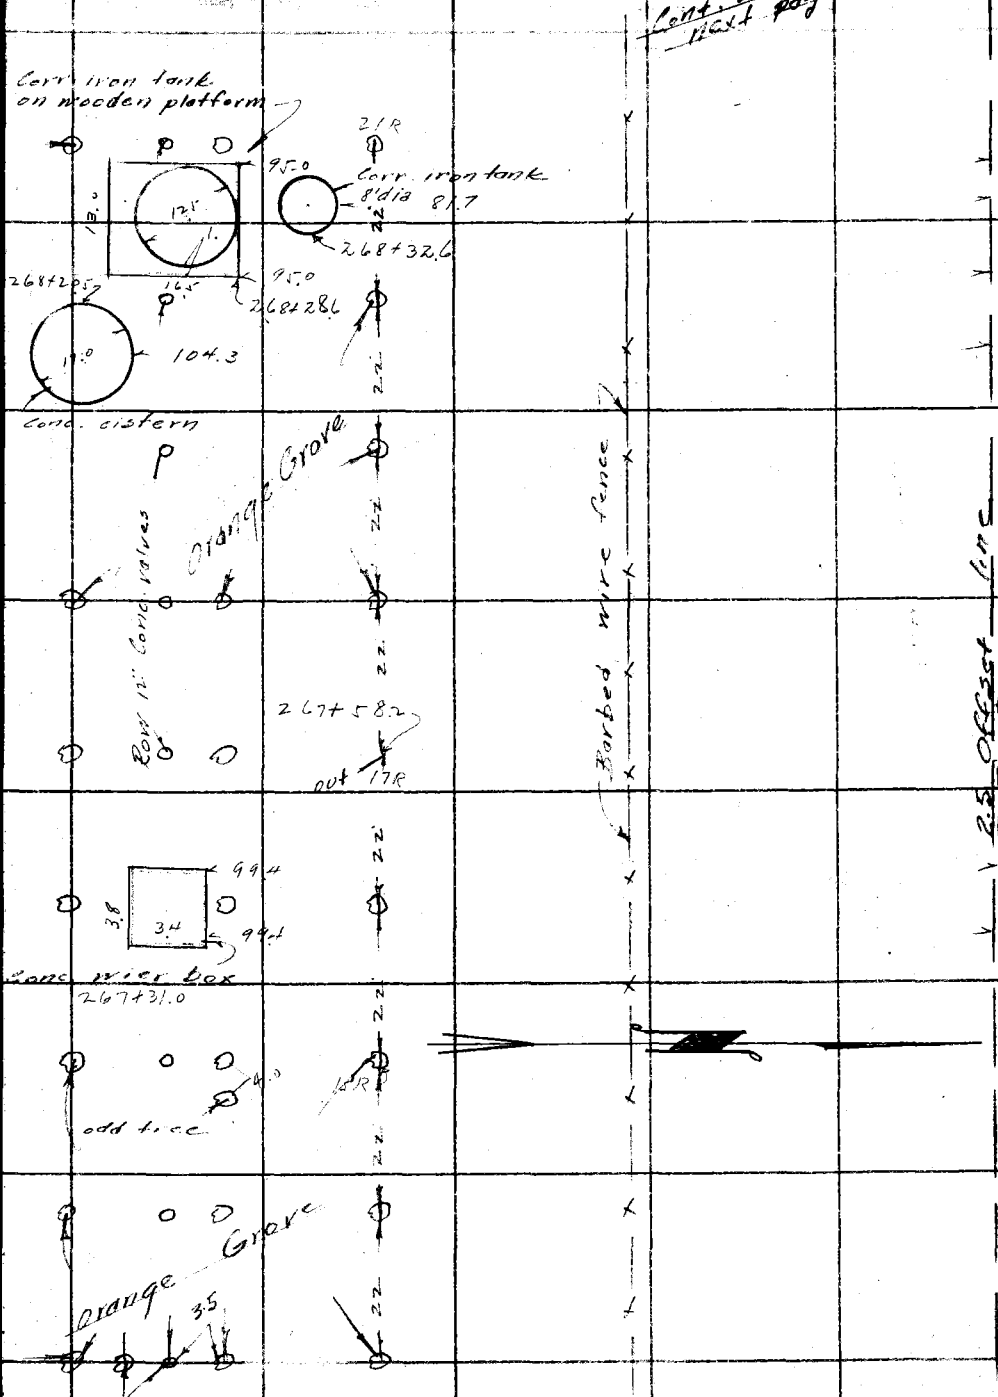

RETURN TO
LOS ANGELES COUNTY SURVEYOR
700 HALL OF RECORDS
Do not extend notes this side of this line
Note: ANY ADDITIONS OR CHANGES ON THIS SHEET MUST BE MADE OR CIRCLED IN Red Ink, WITH DATE AND NAME OF PERSON MAKING CHANGE.
FORM 247 10M 8-31

RETURN TO
LOS ANGELES COUNTY SURVEYOR
700 HALL OF RECORDS

Note: ANY ADDITIONS OR CHANGES ON THIS SHEET MUST BE MADE OR CIRCLED IN **Red Ink.** WITH DATE AND NAME OF PERSON MAKING CHANGE.

Do not extend notes this side of this line

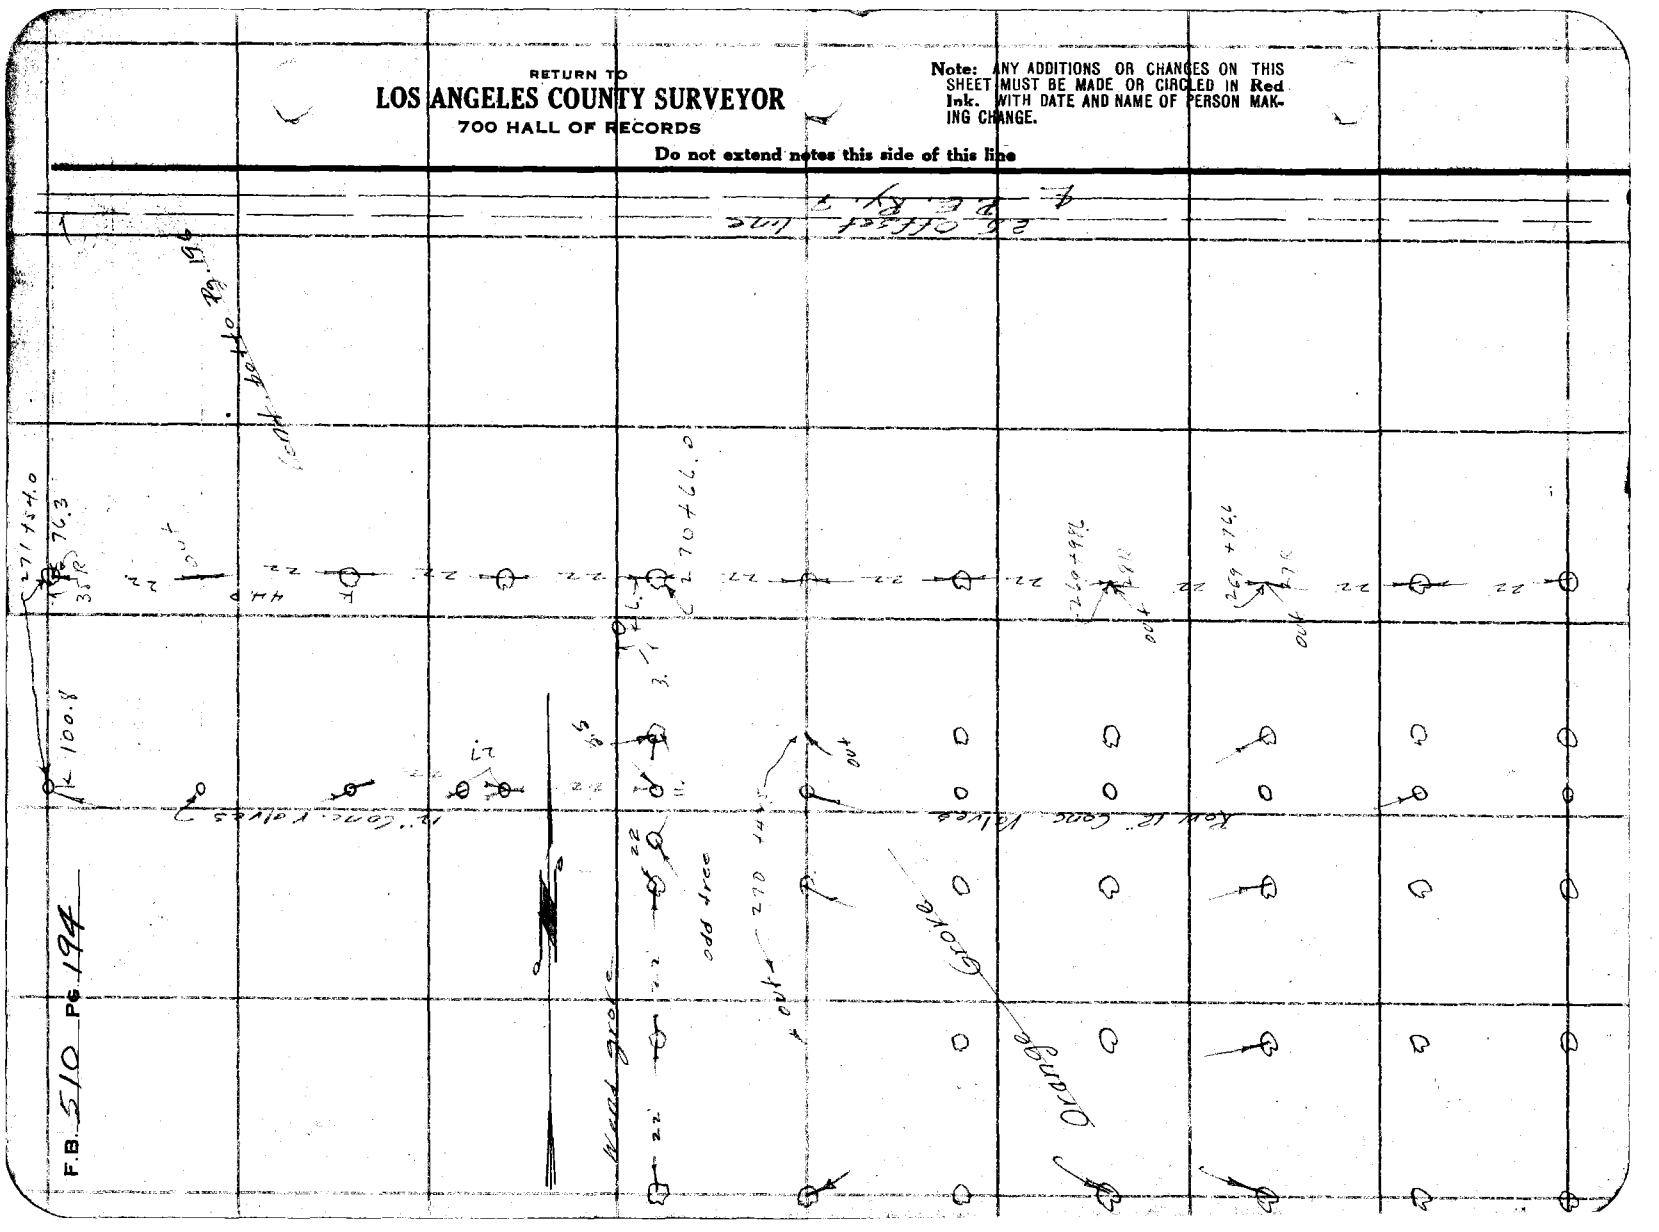

Notes Ck'd by	Survey of Bridlo St
Map No. B-754-5	W. O. 2103 Tape No. 041 St'd 84 OF.
Office Work H.N. Bradstreet	Surveyed by Rosecrans
Checked	Notes Date 1-28-33
Date	Indexed A. C. Johnson

F.B. 510 PG. 195

Note: ANY ADDITIONS OR CHANGES ON THIS SHEET MUST BE MADE OR CIRCLED IN Red Ink, WITH DATE AND NAME OF PERSON MAKING CHANGE.

Do not extend notes this side of this line

RETURN TO
LOS ANGELES COUNTY SURVEYOR
700 HALL OF RECORDS

FORM 247 10M 5-31

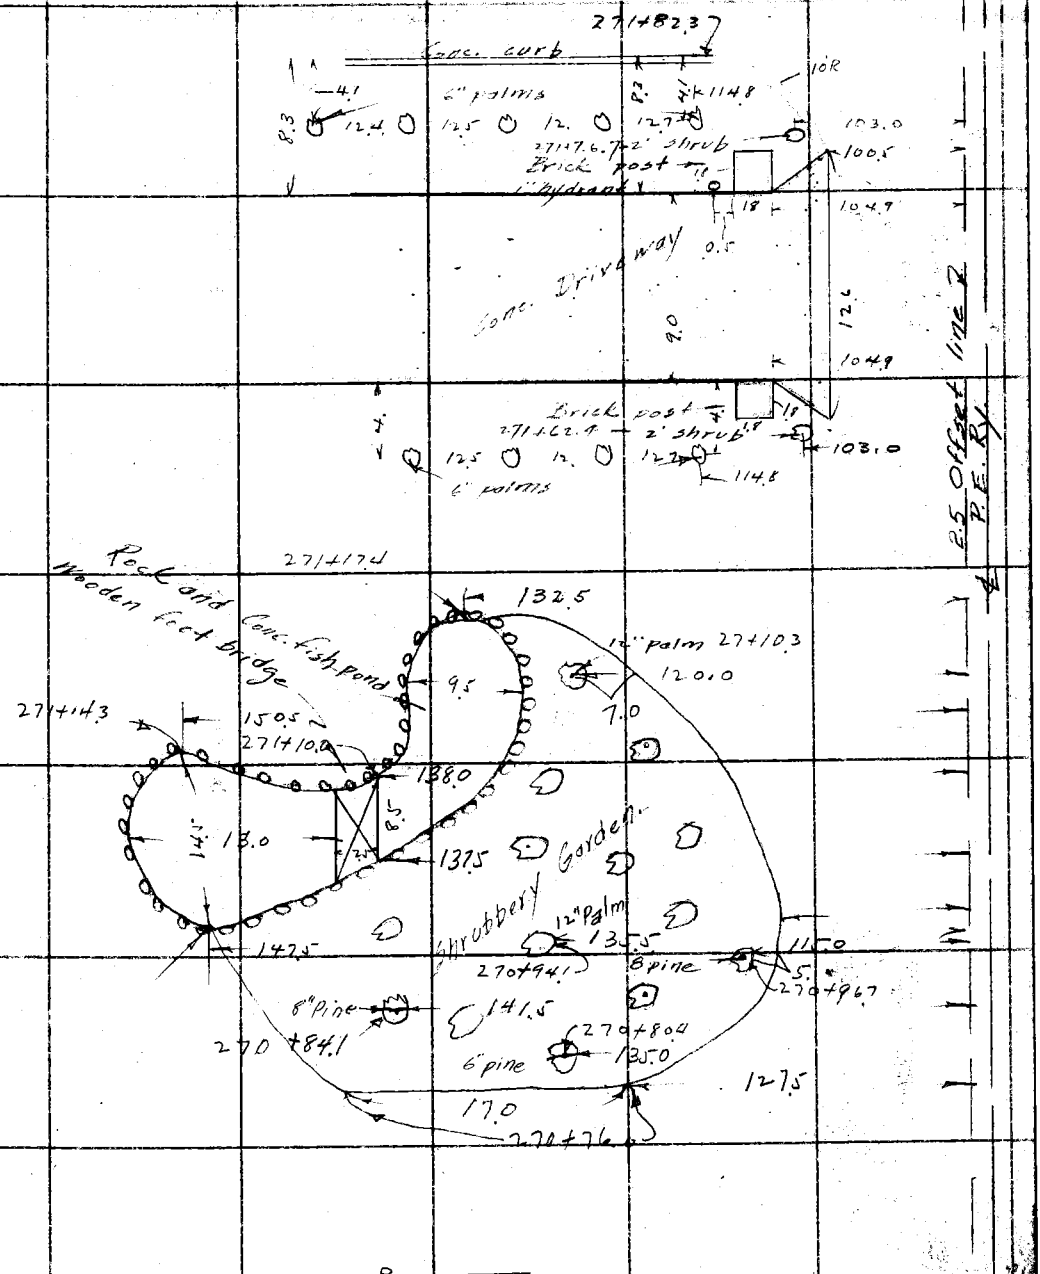

RETURN TO
LOS ANGELES COUNTY SURVEYOR
700 HALL OF RECORDS

Note: ANY ADDITIONS OR CHANGES ON THIS SHEET MUST BE MADE OR CIRCLED IN **Red Ink.** WITH DATE AND NAME OF PERSON MAKING CHANGE.

Do not extend notes this side of this line

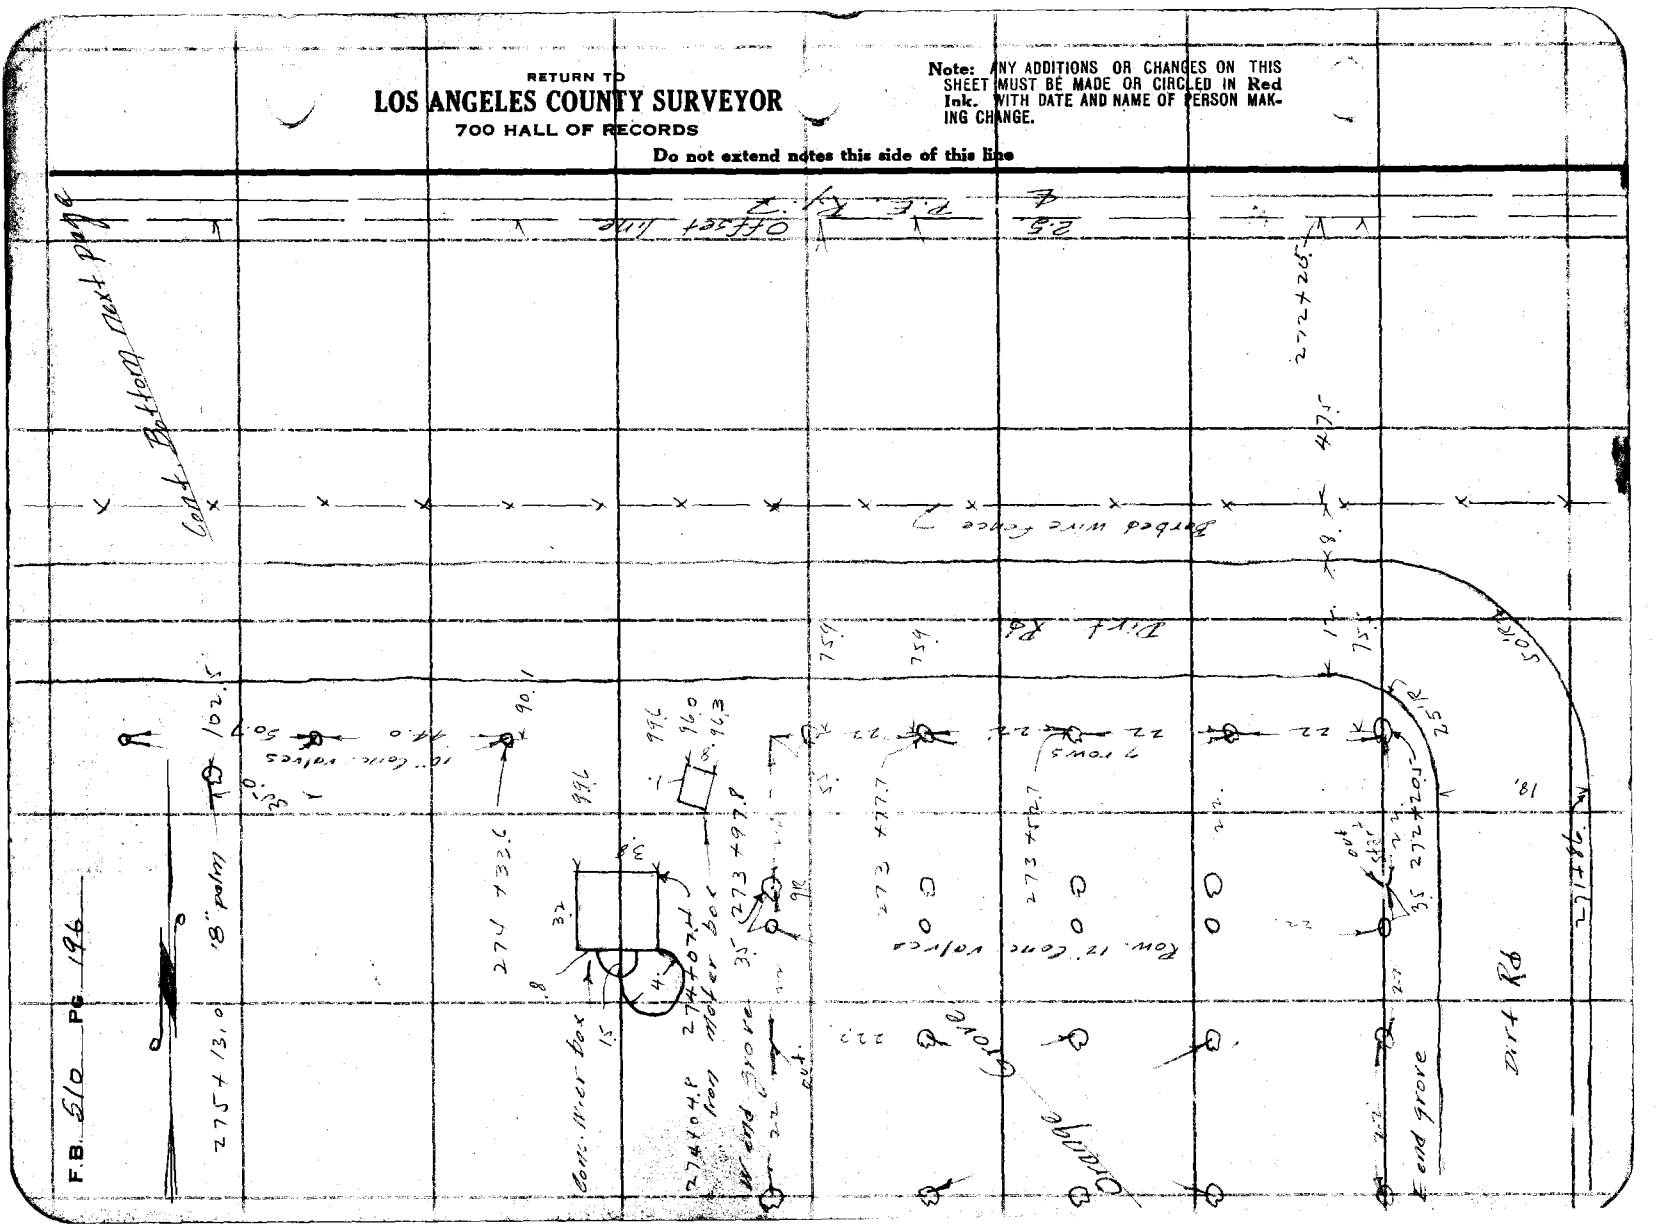

Notes Ck'd by	Survey of Badillo St.
Map No. B-764-5	W. O. 7103 Tape No. 041 St'd 84 °F.
Office Work H.H. Brodstreet	Surveyed by Rosecrans
Checked	Notes Date 7-24-33
Date	Indexed A. C. Johnson

F.B. 510 PG. 197

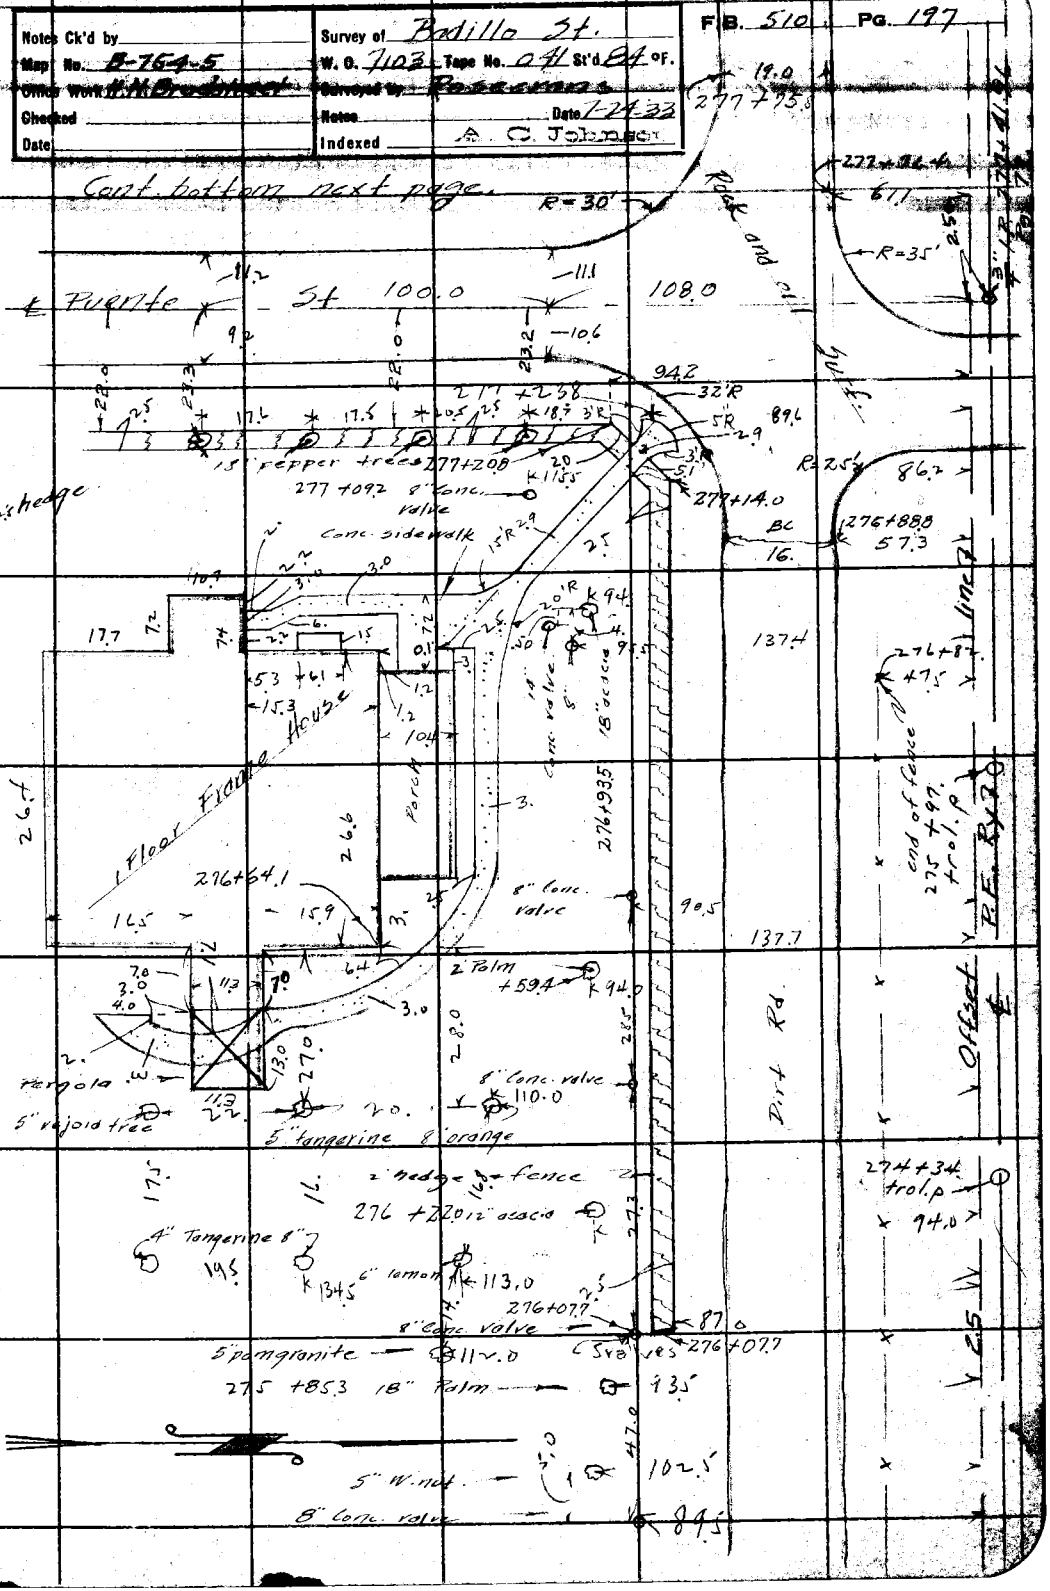

Note: ANY ADDITIONS OR CHANGES ON THIS SHEET MUST BE MADE OR CIRCLED IN Red Ink, WITH DATE AND NAME OF PERSON MAKING CHANGE.

Do not extend notes this side of this line

RETURN TO
LOS ANGELES COUNTY SURVEYOR
700 HALL OF RECORDS

FORM 247 10M 5-31

F.B. 510 PG. 198

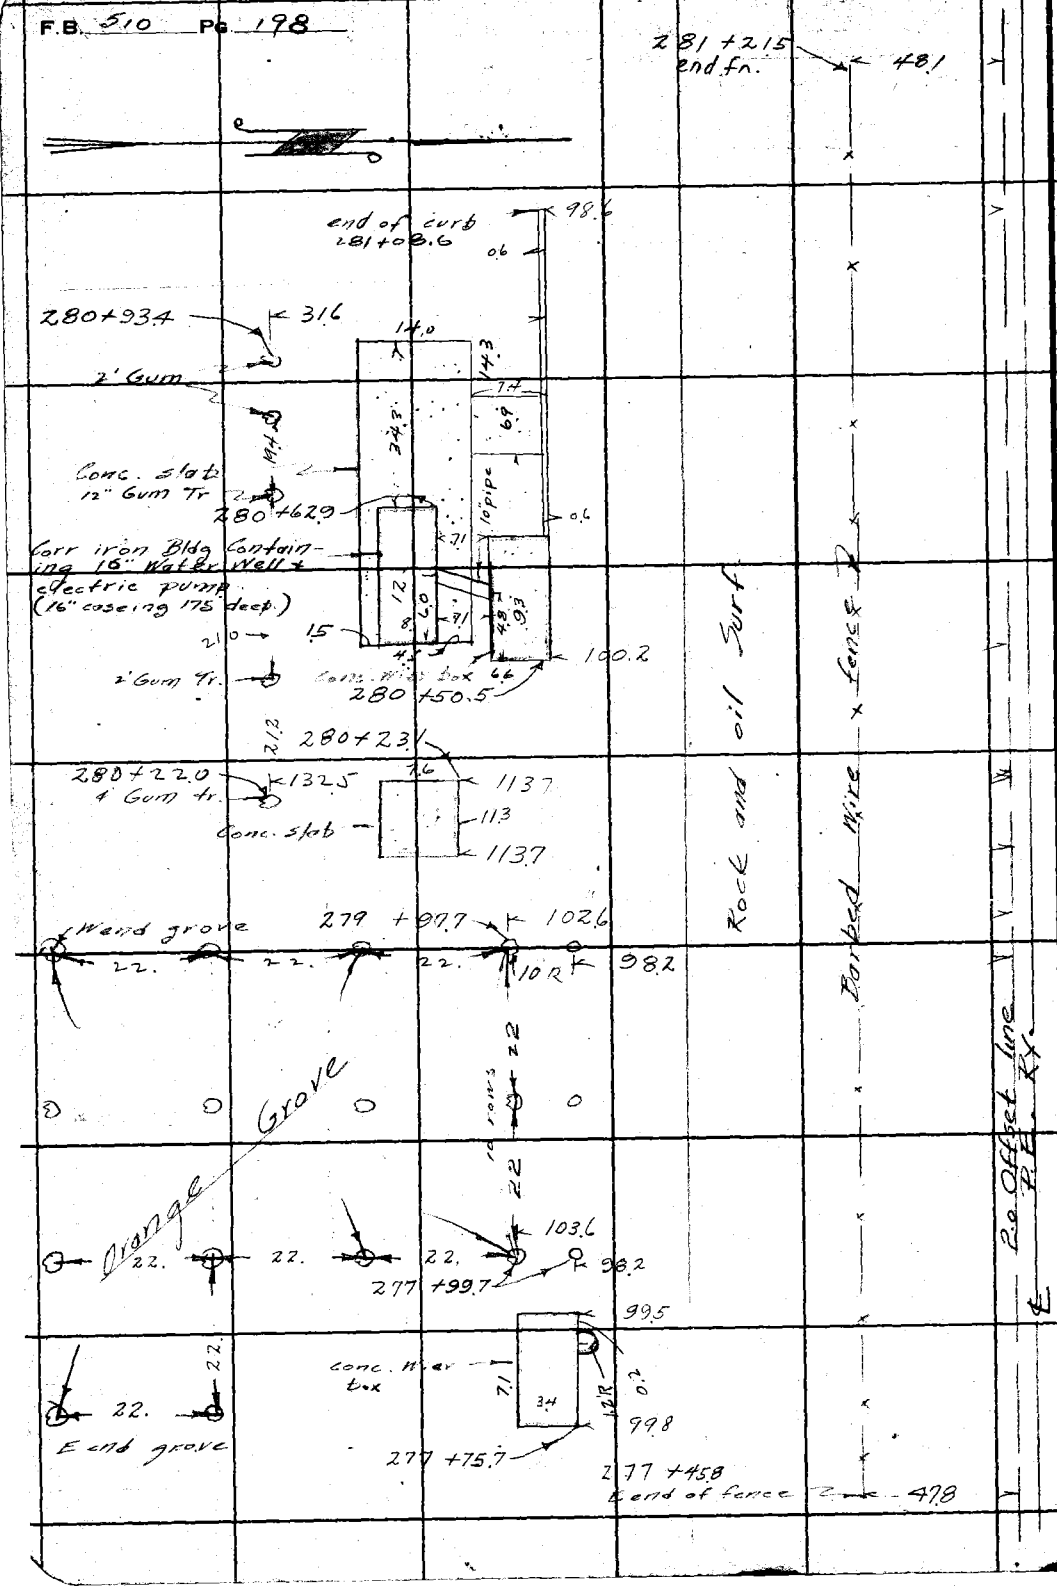

RETURN TO
LOS ANGELES COUNTY SURVEYOR
700 HALL OF RECORDS

Do not extend notes this side of this line

Note: ANY ADDITIONS OR CHANGES ON THIS SHEET MUST BE MADE OR CIRCLED IN Red Ink. WITH DATE AND NAME OF PERSON MAKING CHANGE.

Notes Ck'd by	Survey of Bed. 110 St.
Map No. B-754-5	W. O. 7103 Tape No. 041 St'd 84 °F.
Office Work H.N. Bradstreet	Surveyed by Rosecrans
Checked	Notes Date 7-27-33
Date	Indexed A. C. Johnson

F.B. 510 PG. 199

Cont. bottom next page

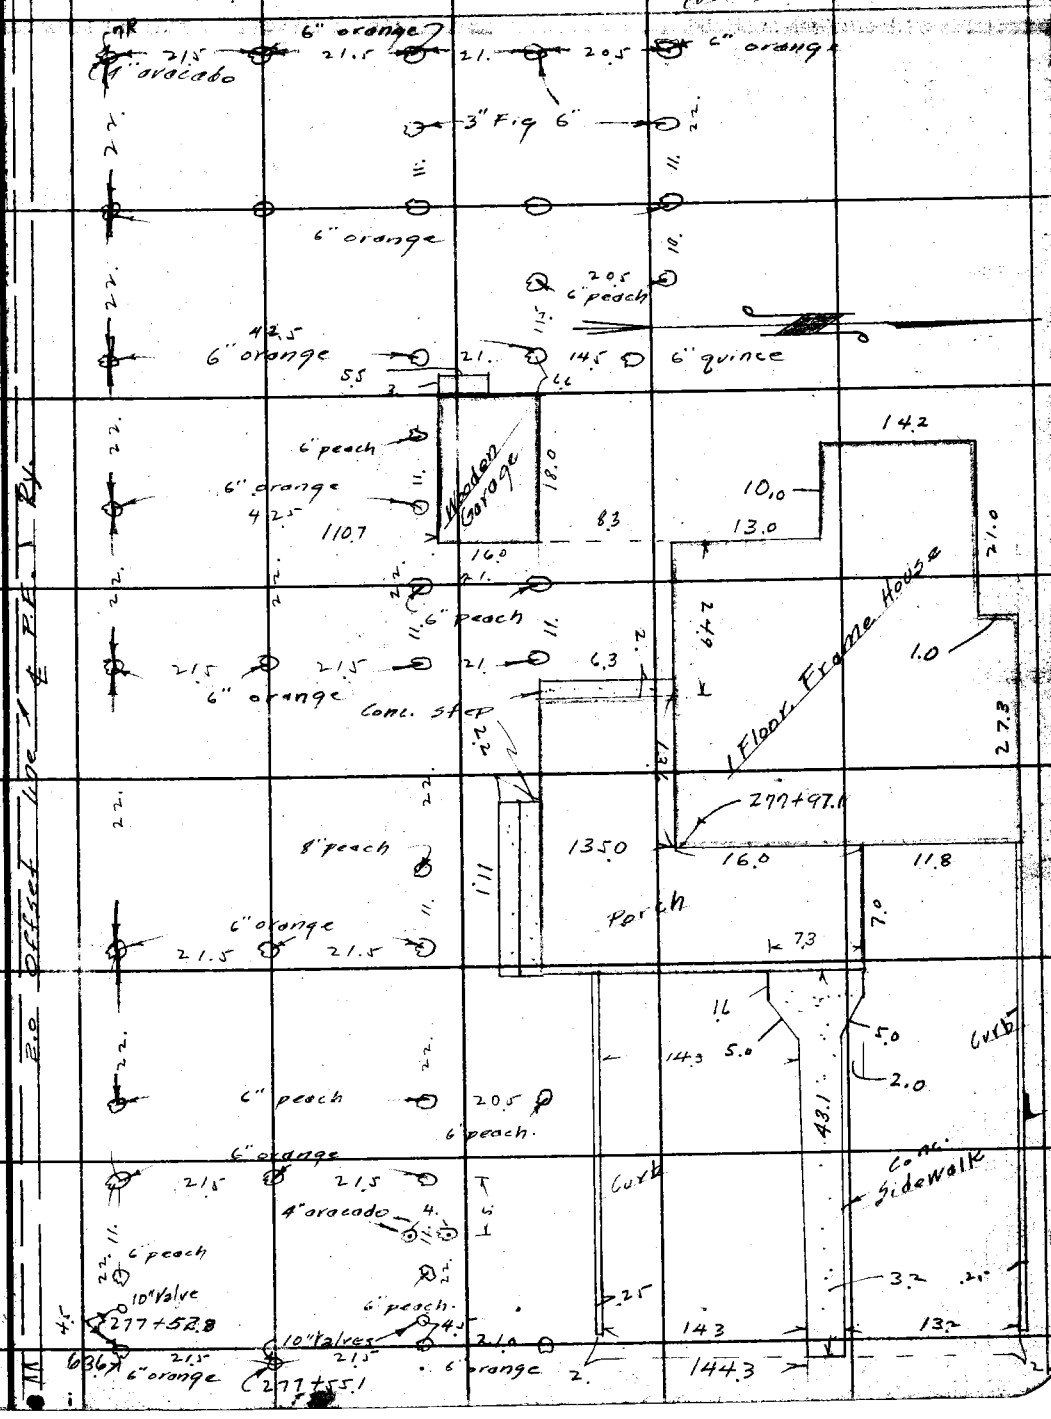

Note: ANY ADDITIONS OR CHANGES ON THIS SHEET MUST BE MADE OR CIRCLED IN Red Ink. WITH DATE AND NAME OF PERSON MAKING CHANGE.

Do not extend notes this side of this line

RETURN TO
LOS ANGELES COUNTY SURVEYOR
700 HALL OF RECORDS

FORM 247 10M 5-31

F.B. 510 Pg. 200

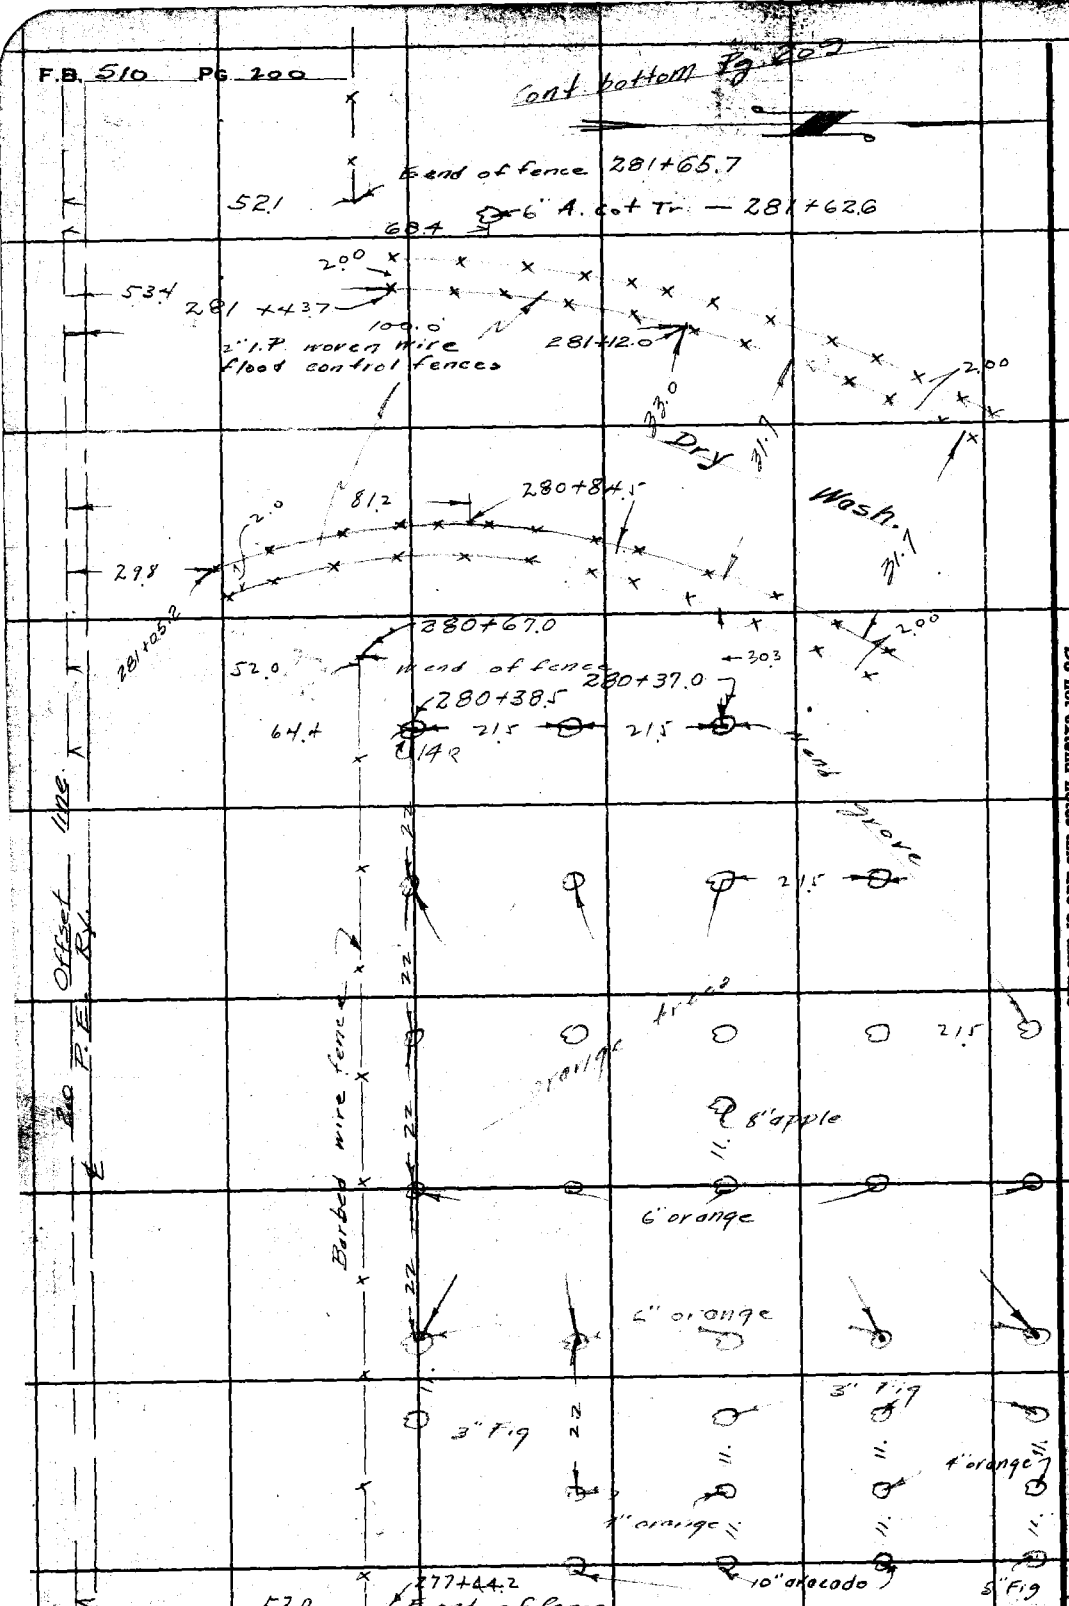

RETURN TO
LOS ANGELES COUNTY SURVEYOR
700 HALL OF RECORDS

Do not extend notes this side of this line

Note: ANY ADDITIONS OR CHANGES ON THIS SHEET MUST BE MADE OR CIRCLED IN Red Ink. WITH DATE AND NAME OF PERSON MAKING CHANGE.

Notes Ck'd by	Survey of Badillo St.
Map No. B-754-5	W. O. 7103 Tape No. all St'd 84 °F.
Office Work H.N.B.	Surveyed by Rosecrans
Checked	Notes
Date	Date 7-14-38
	Indexed A. C. Johnson

F.B. 510 PG. 201

Cont. bottom next page

RETURN TO
LOS ANGELES COUNTY SURVEYOR
700 HALL OF RECORDS

Do not extend notes this side of this line

Note: ANY ADDITIONS OR CHANGES ON THIS SHEET MUST BE MADE OR CIRCLED IN Red Ink, WITH DATE AND NAME OF PERSON MAKING CHANGE.

FORM 847 10M 5-31

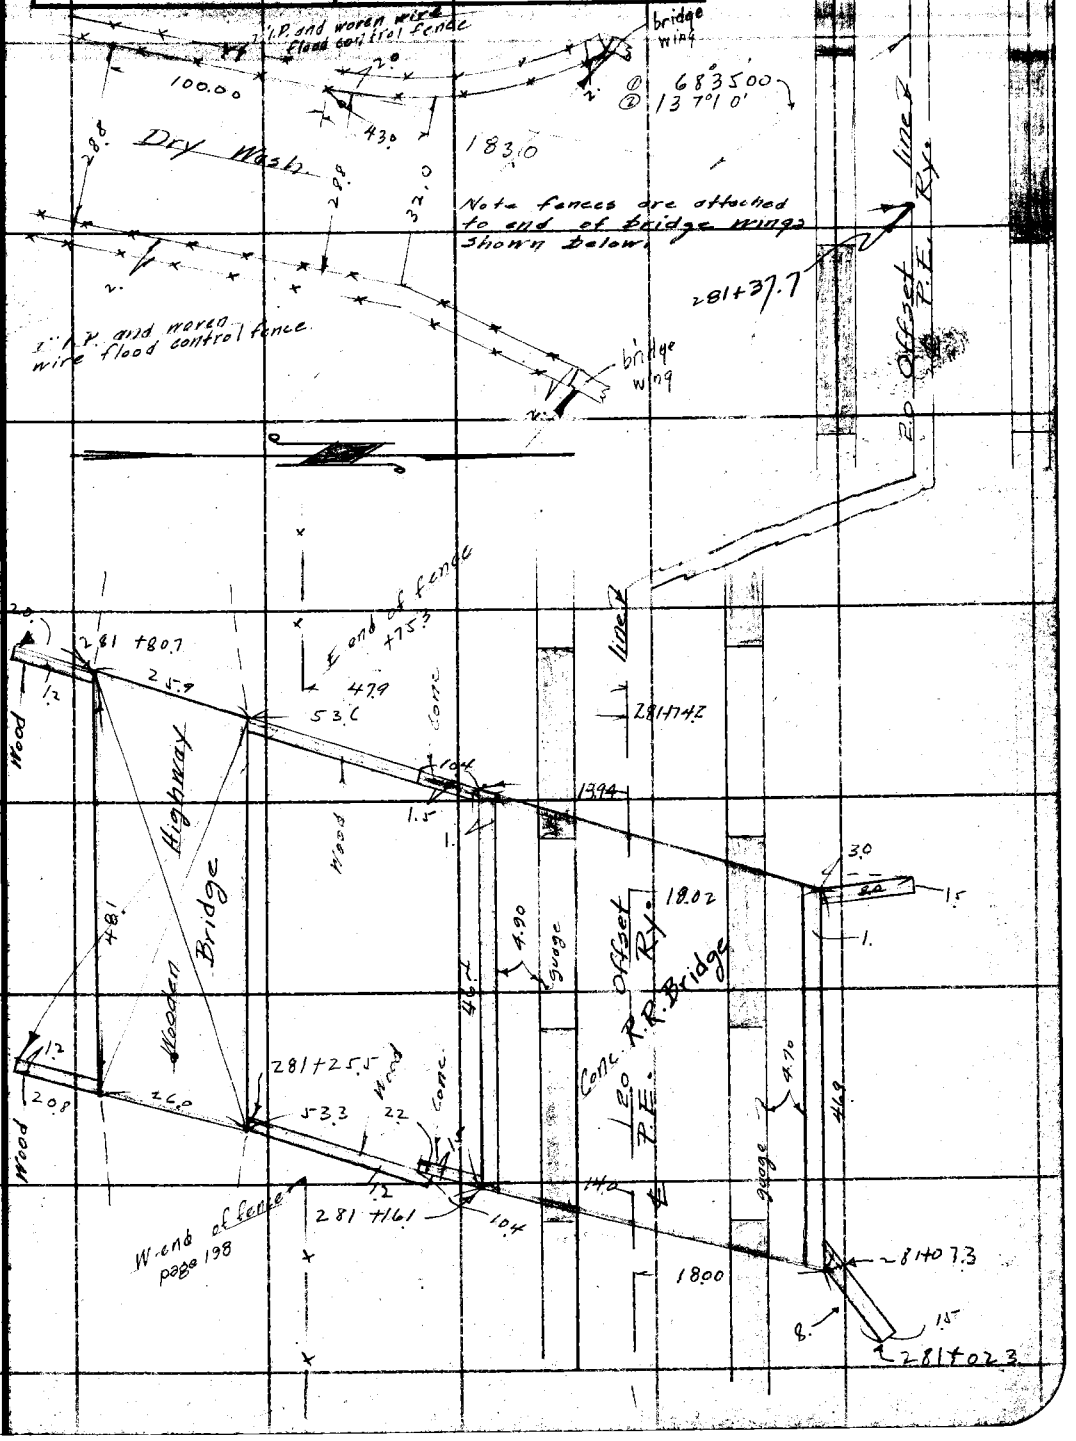

F.B. 510 Pg. 202

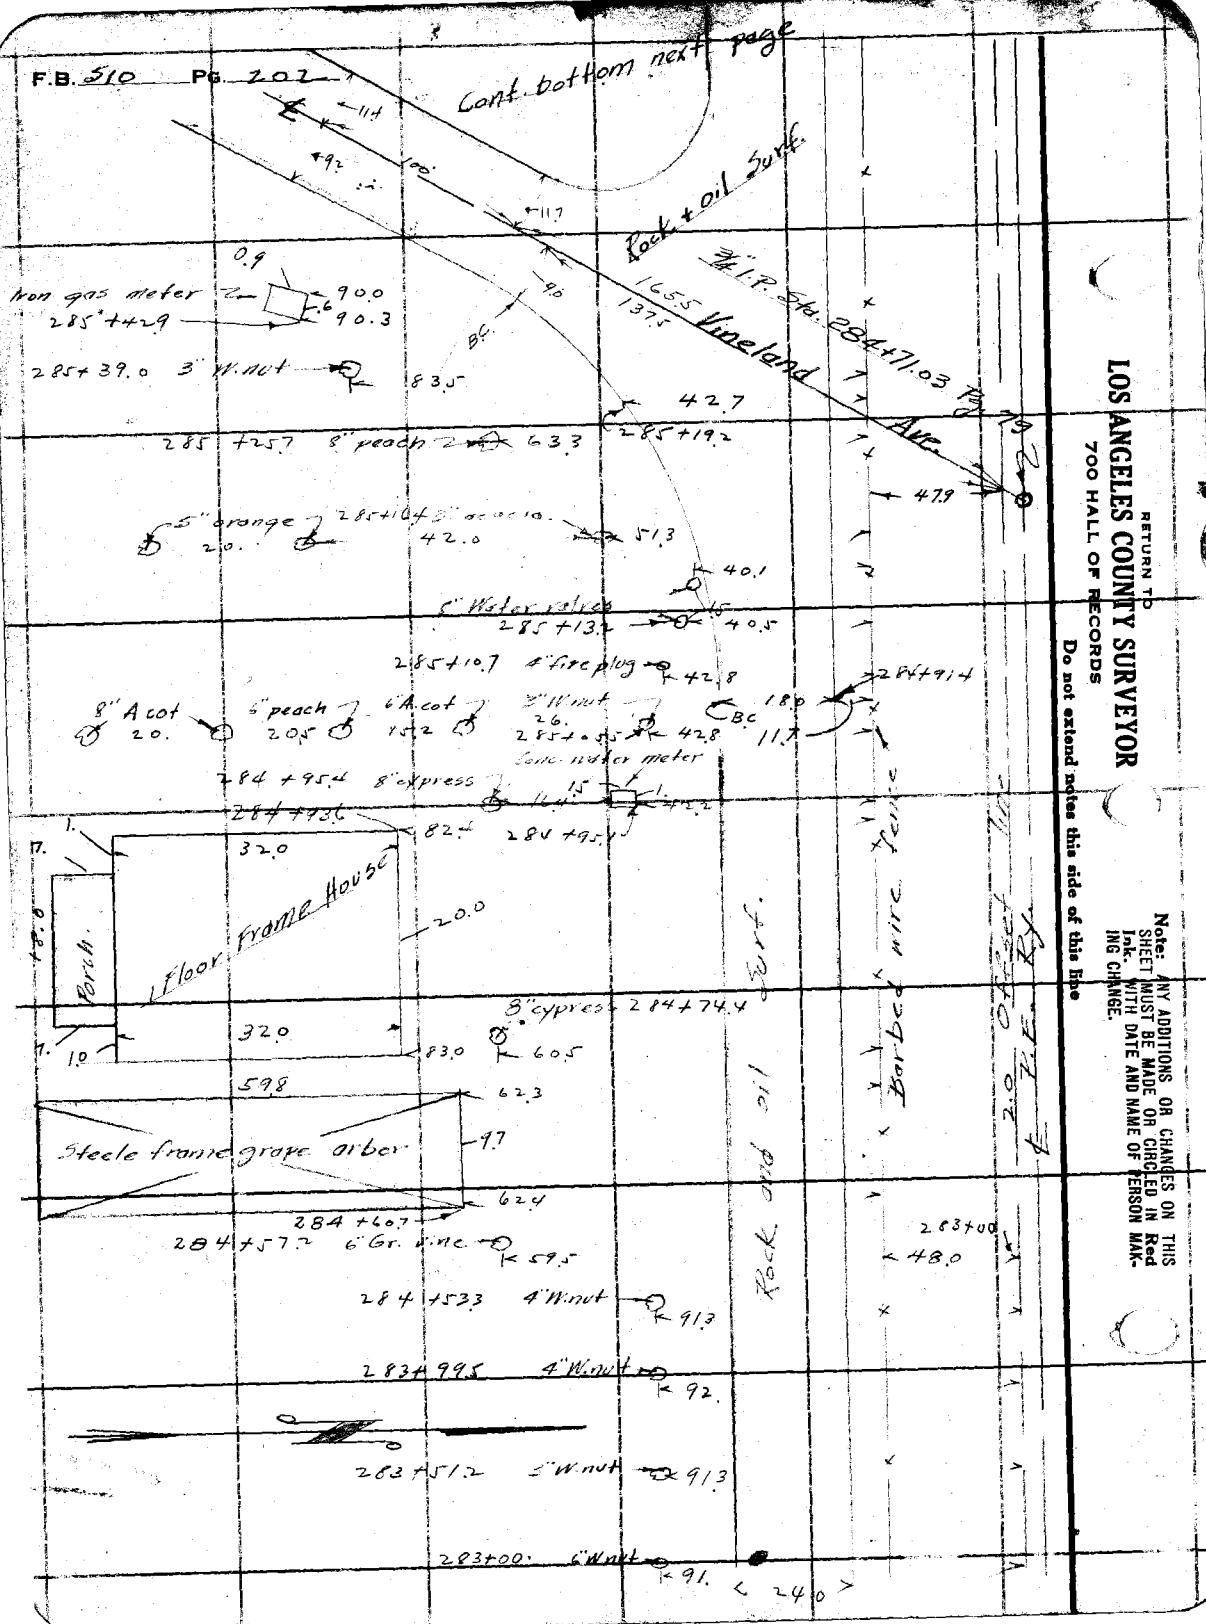

RETURN TO
LOS ANGELES COUNTY SURVEYOR
700 HALL OF RECORDS

Do not extend notes this side of this line

Note: ANY ADDITIONS OR CHANGES ON THIS SHEET MUST BE MADE OR CIRCLED IN Red Ink. WITH DATE AND NAME OF PERSON MAKING CHANGE.

Notes Ck'd by	Survey of Badillo St.
Map No. B-754-5	W. O. 7103 Tape No. 041 St'd 84 °F.
Office Work H.N. Broadstreet	Surveyed by Rosecrans
Checked	Notes Date 1-25-33
Date	Indexed A. C. Johnson

F.B. 510 PG. 203

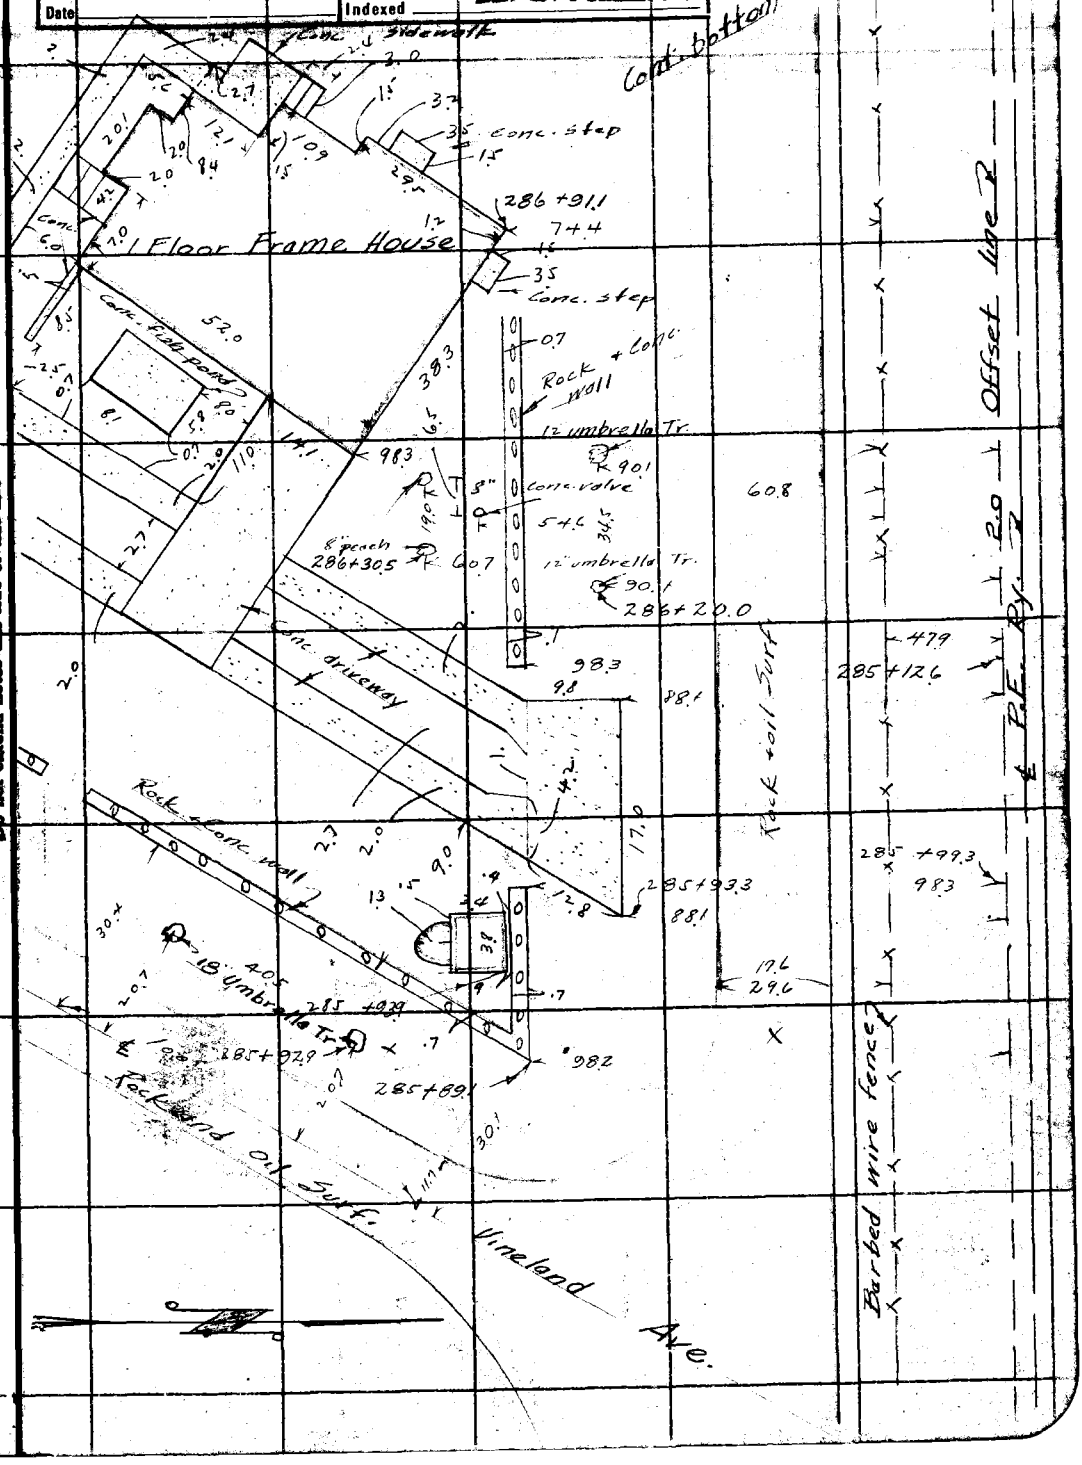

Note: ANY ADDITIONS OR CHANGES ON THIS SHEET MUST BE MADE OR CIRCLED IN Red Ink, WITH DATE AND NAME OF PERSON MAKING CHANGE.

Do not extend notes this side of this line

RETURN TO
LOS ANGELES COUNTY SURVEYOR
700 HALL OF RECORDS

FORM 247 10M 5-31

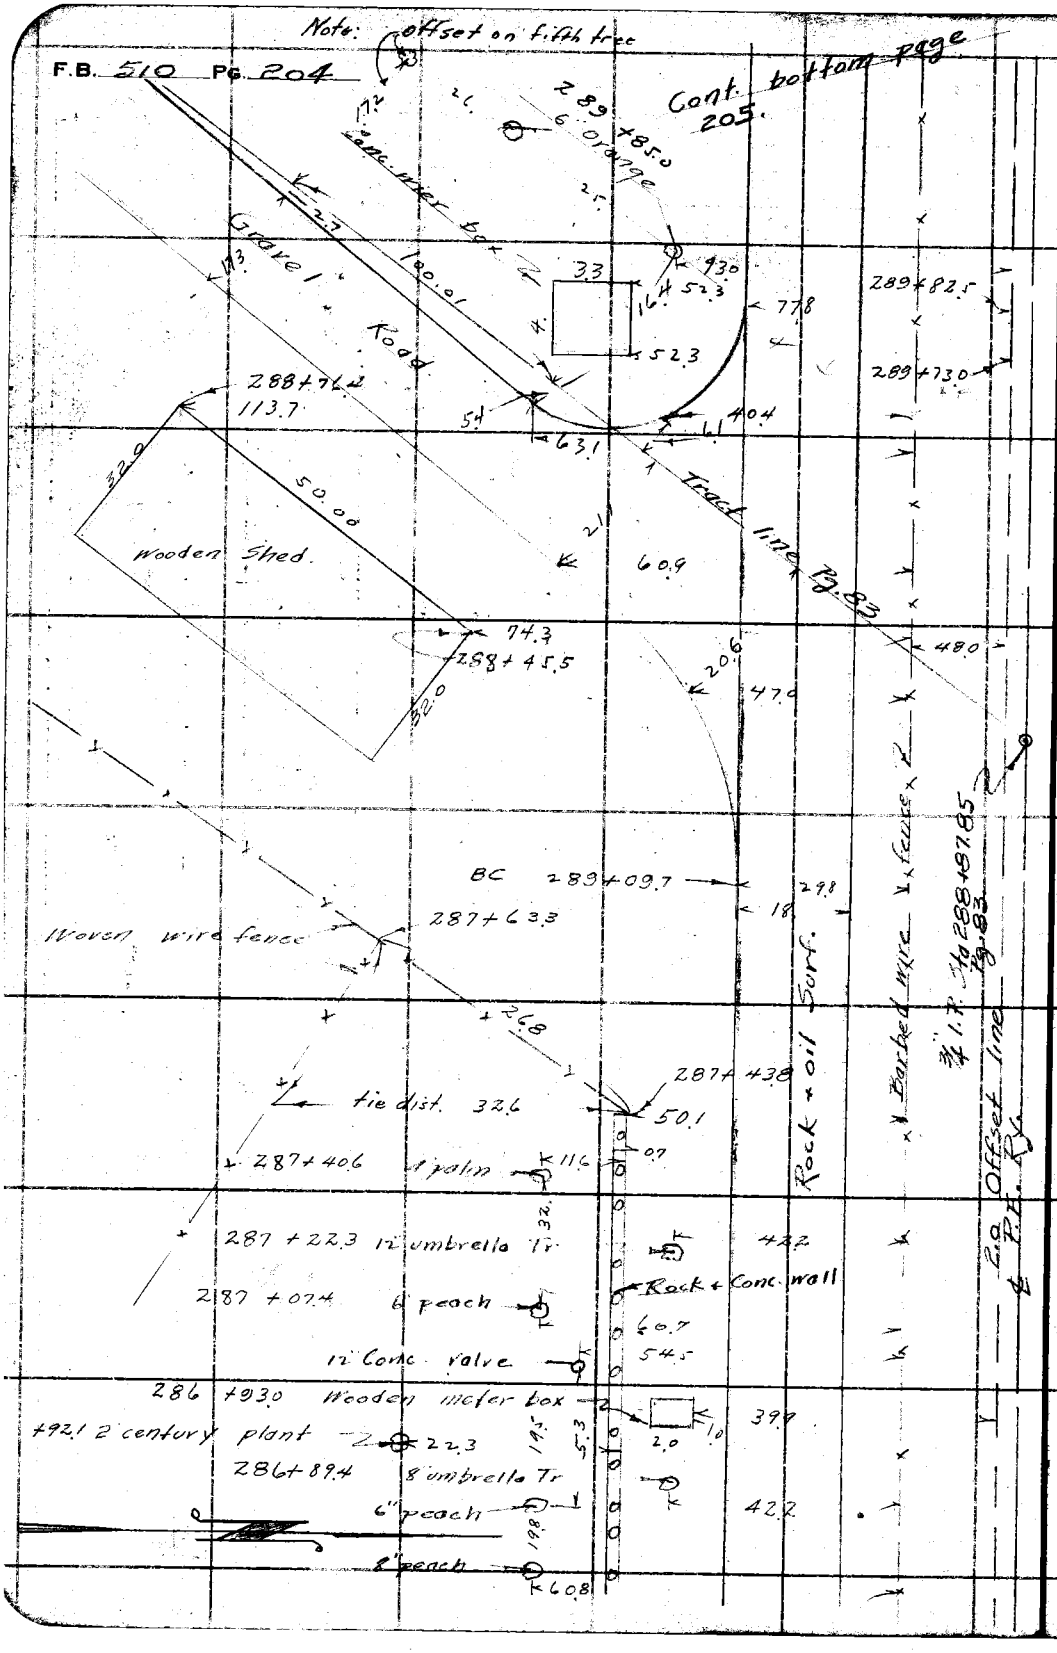

RETURN TO
LOS ANGELES COUNTY SURVEYOR
700 HALL OF RECORDS
Do not extend notes this side of this line

Note: ANY ADDITIONS OR CHANGES ON THIS SHEET MUST BE MADE OR CIRCLED IN Red Ink. WITH DATE AND NAME OF PERSON MAKING CHANGE.

Notes Ck'd by	Survey of Padillo St.
Map No. B-754-5	W. O. 7103 Tape No. 041 St'd 81 °F.
Office Work H.N. Bradstreet	Surveyed by Rosecrans
Checked	Notes Date 7-16-33
Date	Indexed A. C. Johnson

F.B. 510 PG. 205

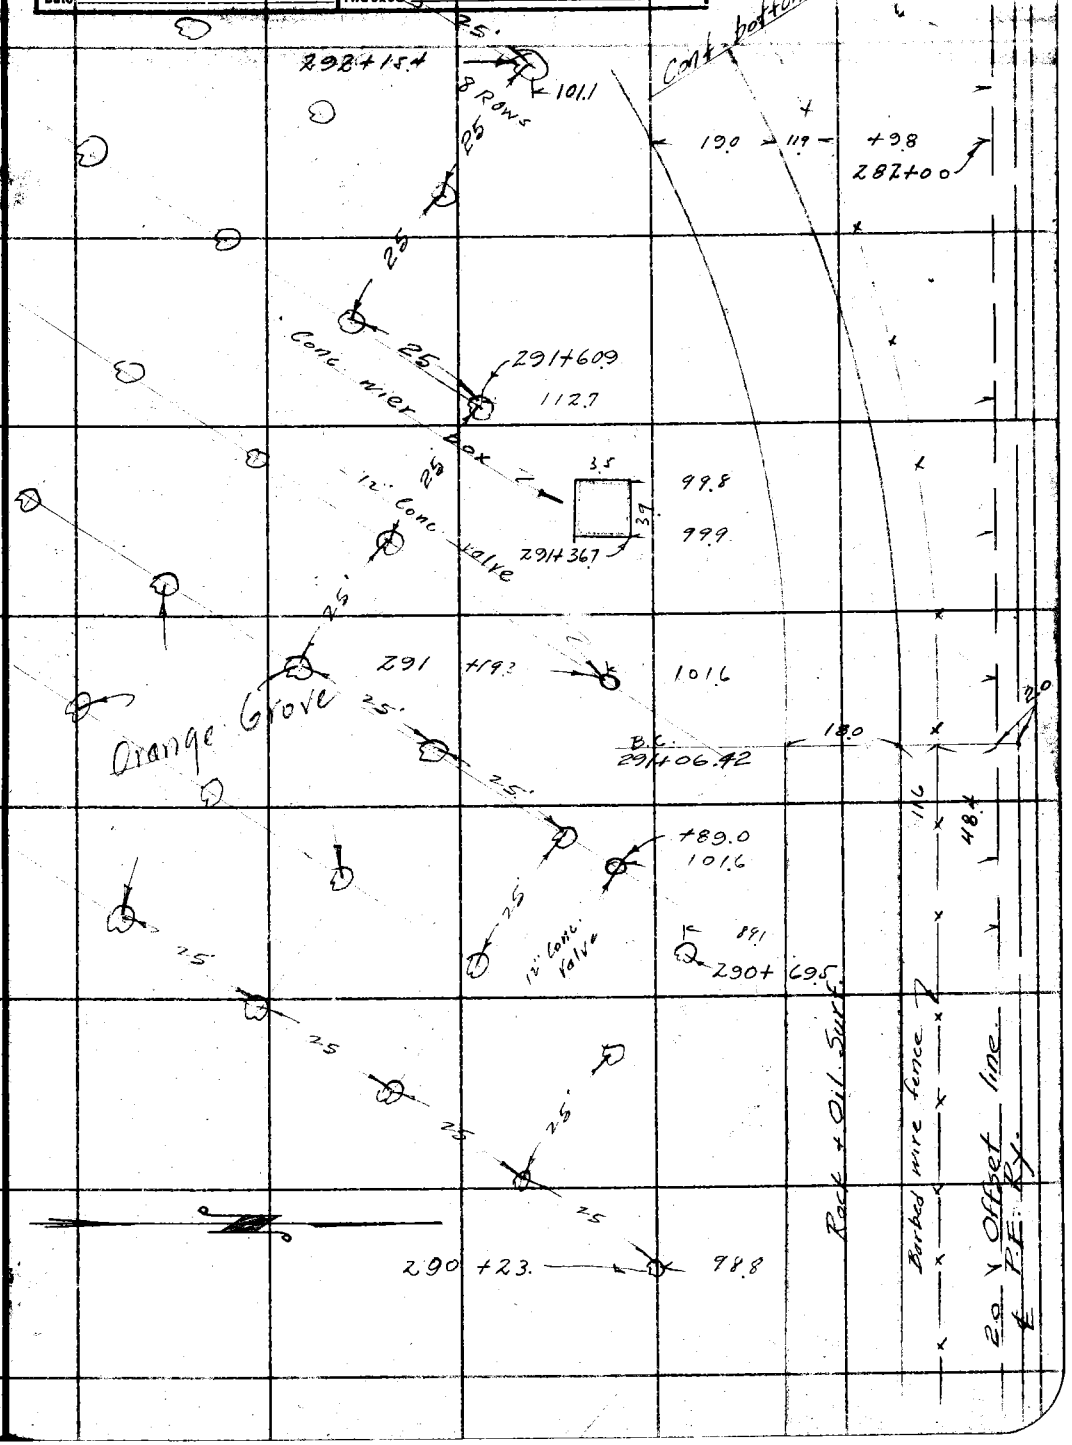

Note: ANY ADDITIONS OR CHANGES ON THIS SHEET MUST BE MADE OR CIRCLED IN Red Ink, WITH DATE AND NAME OF PERSON MAKING CHANGE.

Do not extend notes this side of this line

RETURN TO
LOS ANGELES COUNTY SURVEYOR
700 HALL OF RECORDS

FORM 247 10M 5-31

F.B. 510 Pg. 206

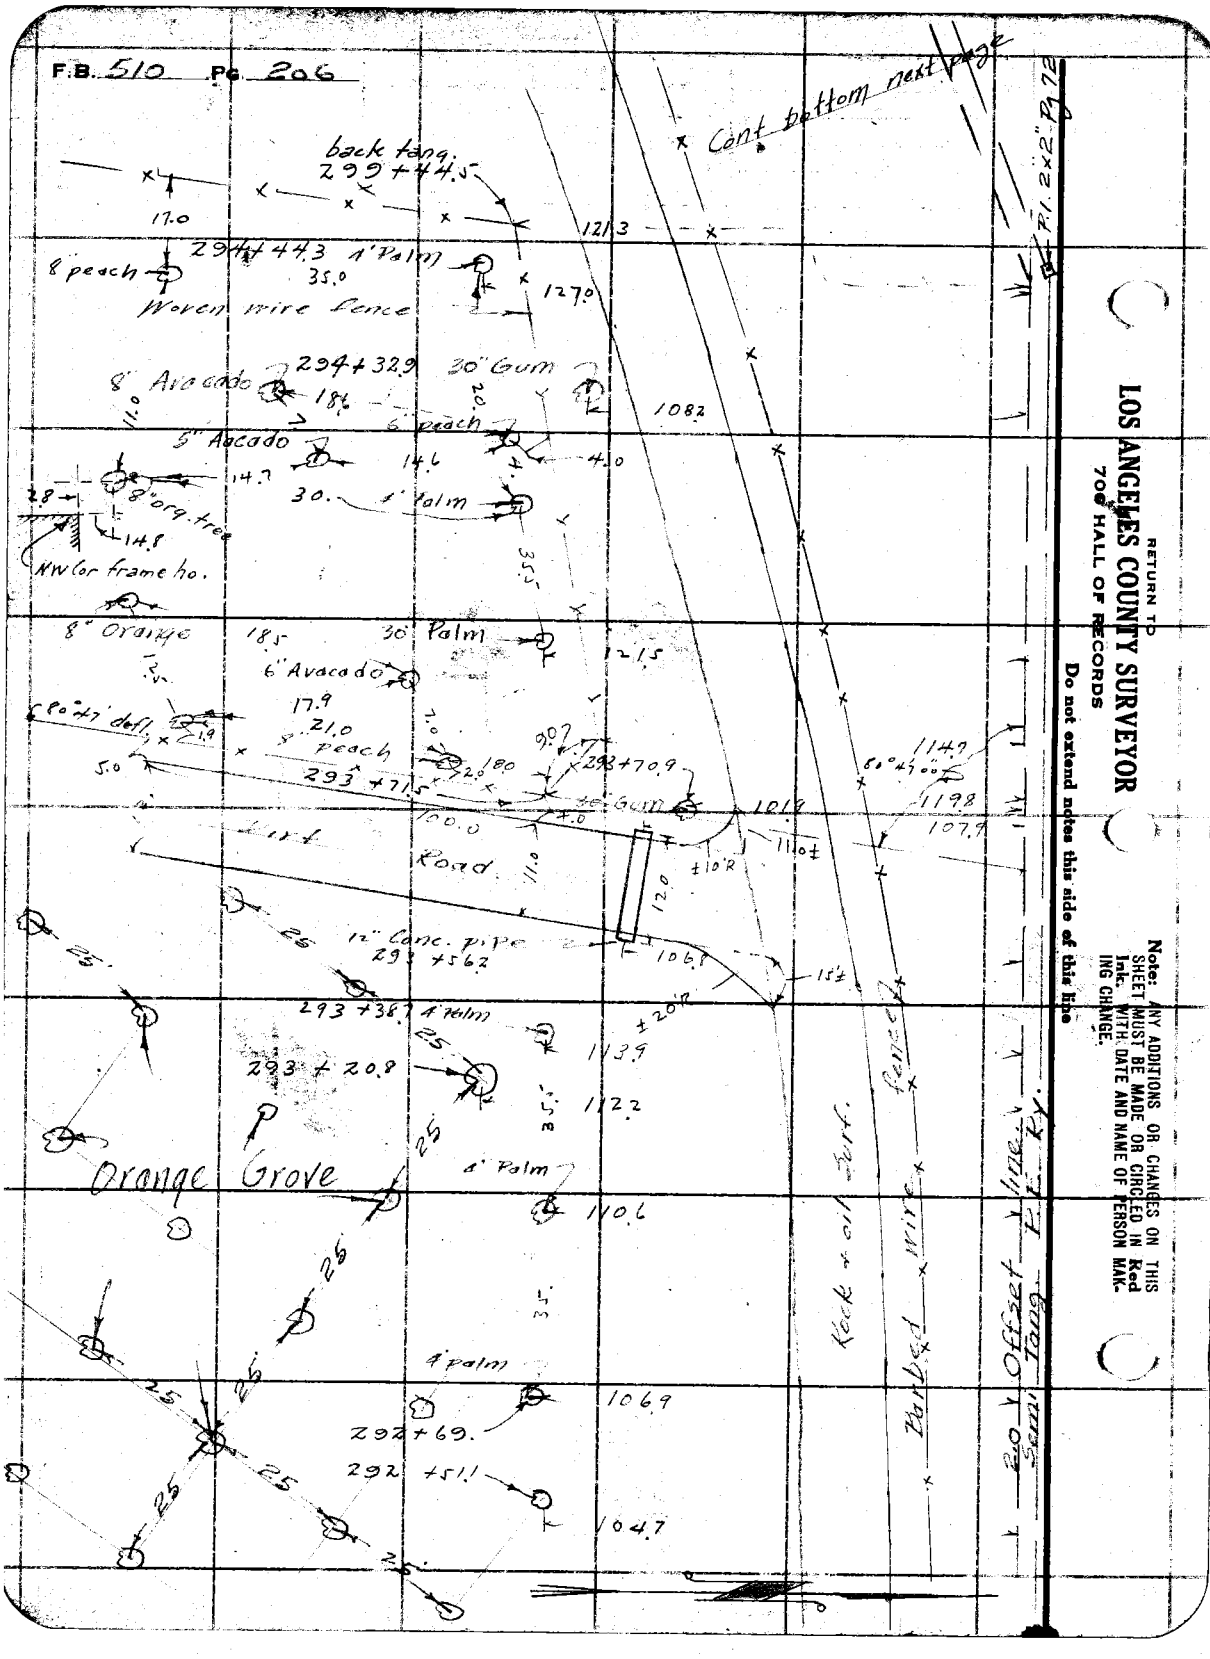

RETURN TO
LOS ANGELES COUNTY SURVEYOR
7007 HALL OF RECORDS

Do not extend notes this side of this line

Note: ANY ADDITIONS OR CHANGES ON THIS SHEET MUST BE MADE OR CIRCLED IN Red Ink. WITH DATE AND NAME OF PERSON MAKING CHANGE.

Notes Ck'd by	Survey of Badillo St.
Map No. B-754-5	W. O. 7103 Tape No. 041 St'd 84 °F.
Office Work H.N. Bradstreet	Surveyed by Roscerans
Checked	Notes Date Feb 33
Date	Indexed A. C. Johnson

F.B. 510 PG. 207

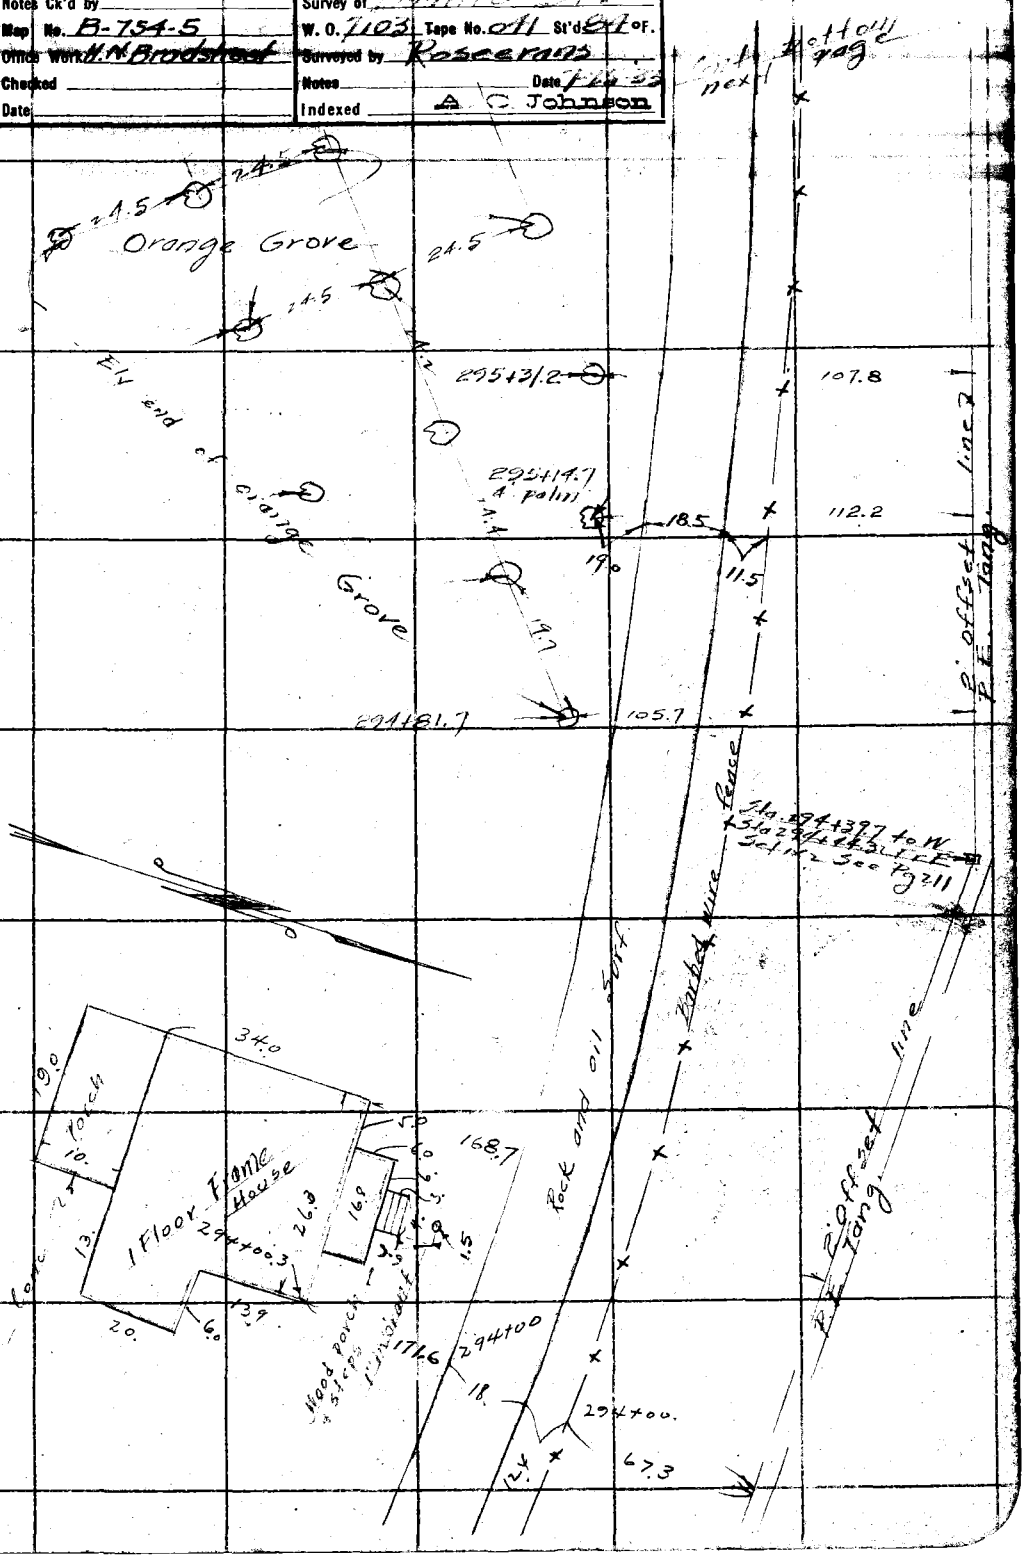

Note: ANY ADDITIONS OR CHANGES ON THIS SHEET MUST BE MADE OR CIRCLED IN Red Ink. WITH DATE AND NAME OF PERSON MAKING CHANGE.

Do not extend notes this side of this line

RETURN TO
LOS ANGELES COUNTY SURVEYOR
700 HALL OF RECORDS

FORM 247 10M 5-31

RETURN TO
LOS ANGELES COUNTY SURVEYOR
700 HALL OF RECORDS

Note: ANY ADDITIONS OR CHANGES ON THIS SHEET MUST BE MADE OR CIRCLED IN Red Ink. WITH DATE AND NAME OF PERSON MAKING CHANGE.

Do not extend notes this side of this line

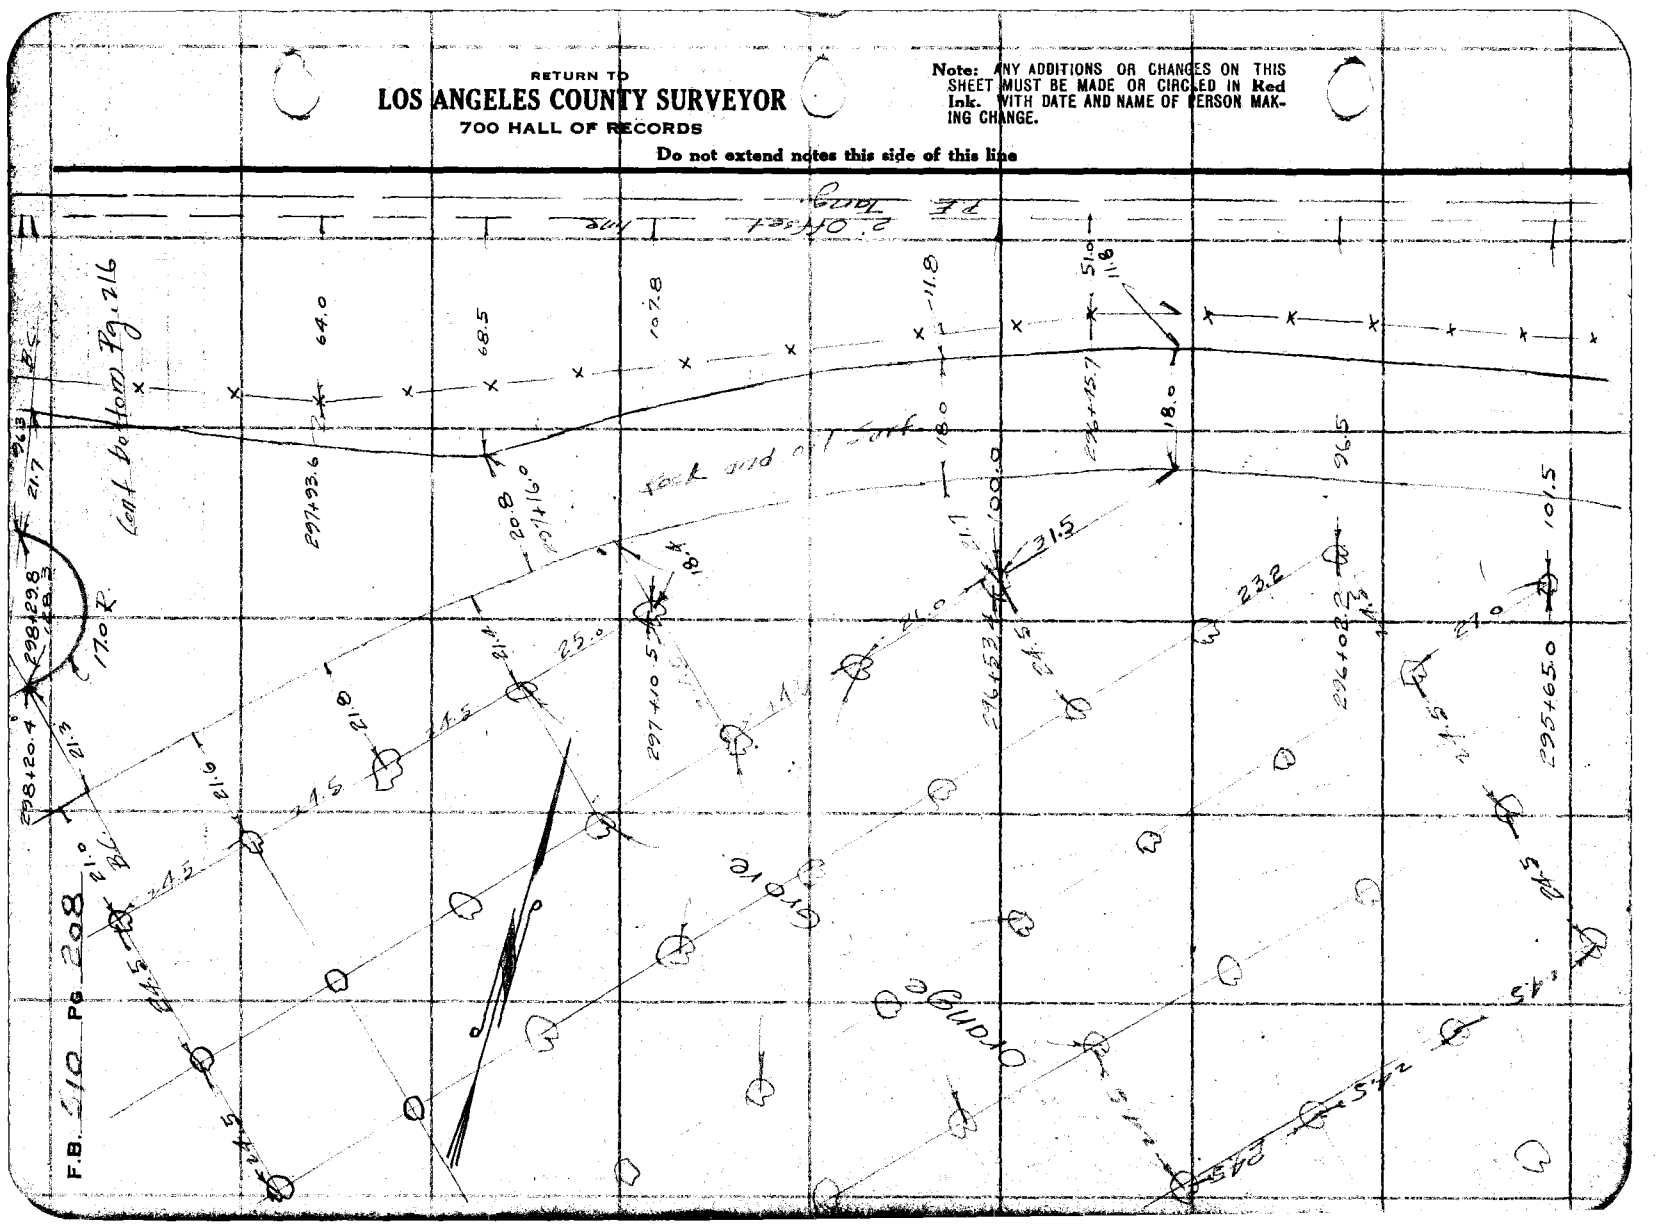

Notes Ck'd by
Map No. B-7545
Office Work
Checked
Date

Survey of Padilla St.
W. O. 1103 Tape No. 241 St'd 64 °F.
Surveyed by Rosecrans
Notes
Date 7-26-32
Indexed A. C. Johnson


Cont. bottom page next

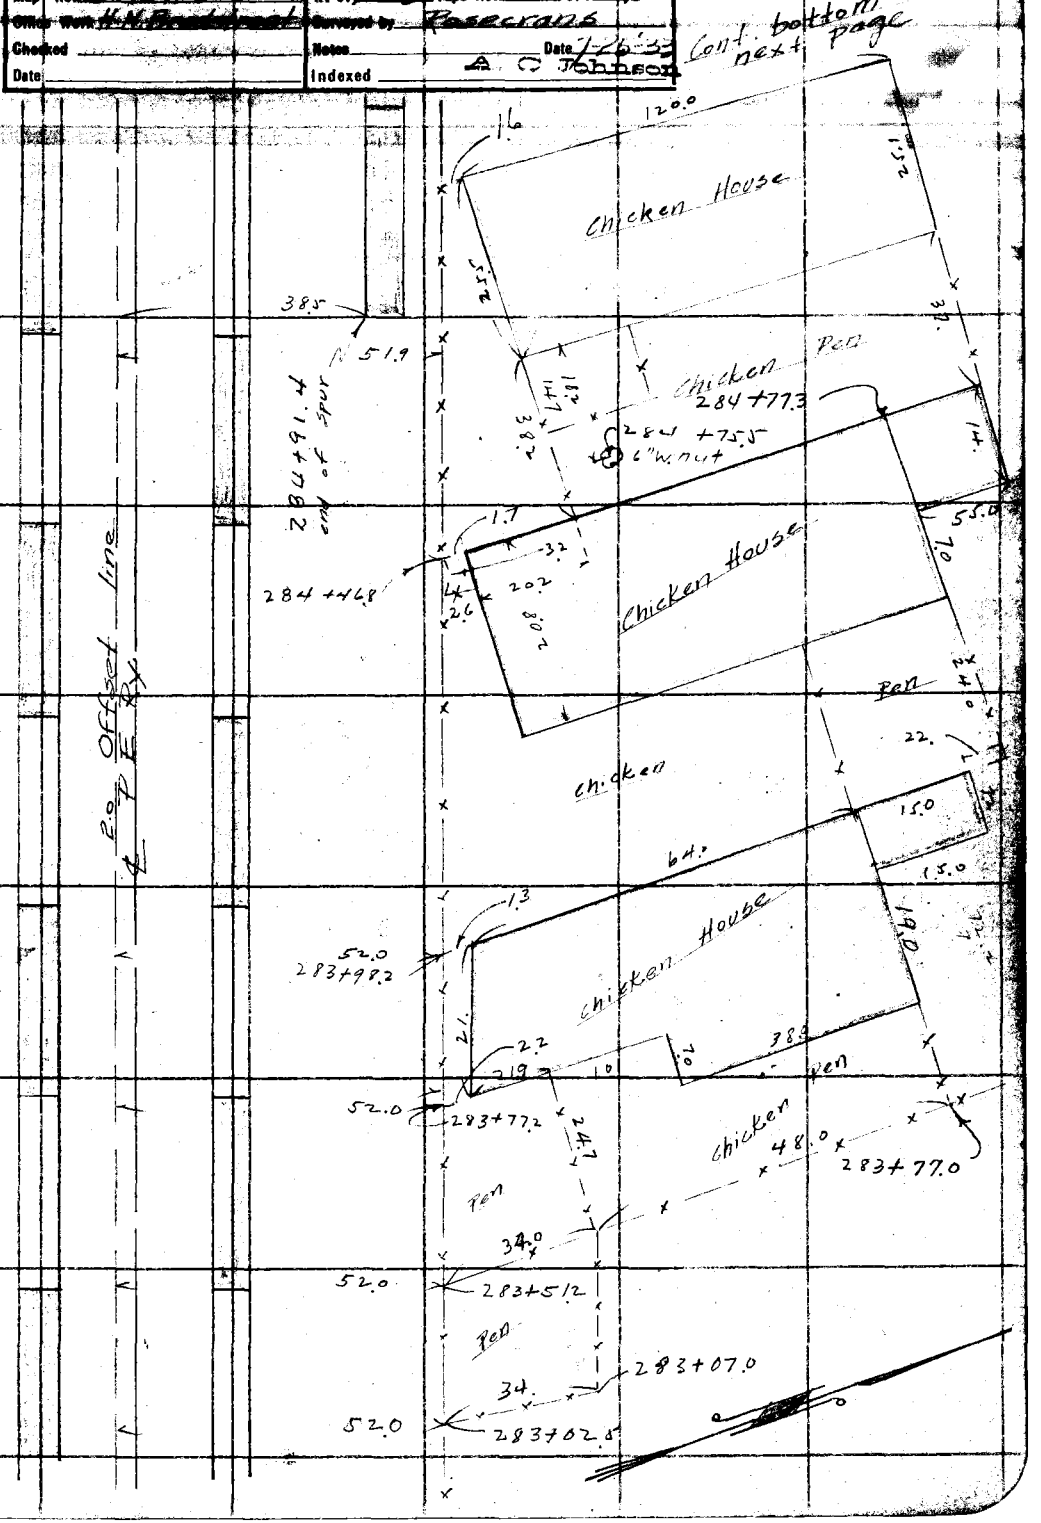

Note: ANY ADDITIONS OR CHANGES ON THIS SHEET MUST BE MADE OR CIRCLED IN Red Ink WITH DATE AND NAME OF PERSON MAKING CHANGE.

Do not extend notes this side of this line

RETURN TO
LOS ANGELES COUNTY SURVEYOR
700 HALL OF RECORDS

FORM 247 10M 8-31

RETURN TO
LOS ANGELES COUNTY SURVEYOR
700 HALL OF RECORDS

Note: ANY ADDITIONS OR CHANGES ON THIS SHEET MUST BE MADE OR CIRCLED IN **Red** Ink. WITH DATE AND NAME OF PERSON MAKING CHANGE.

Do not extend notes this side of this line

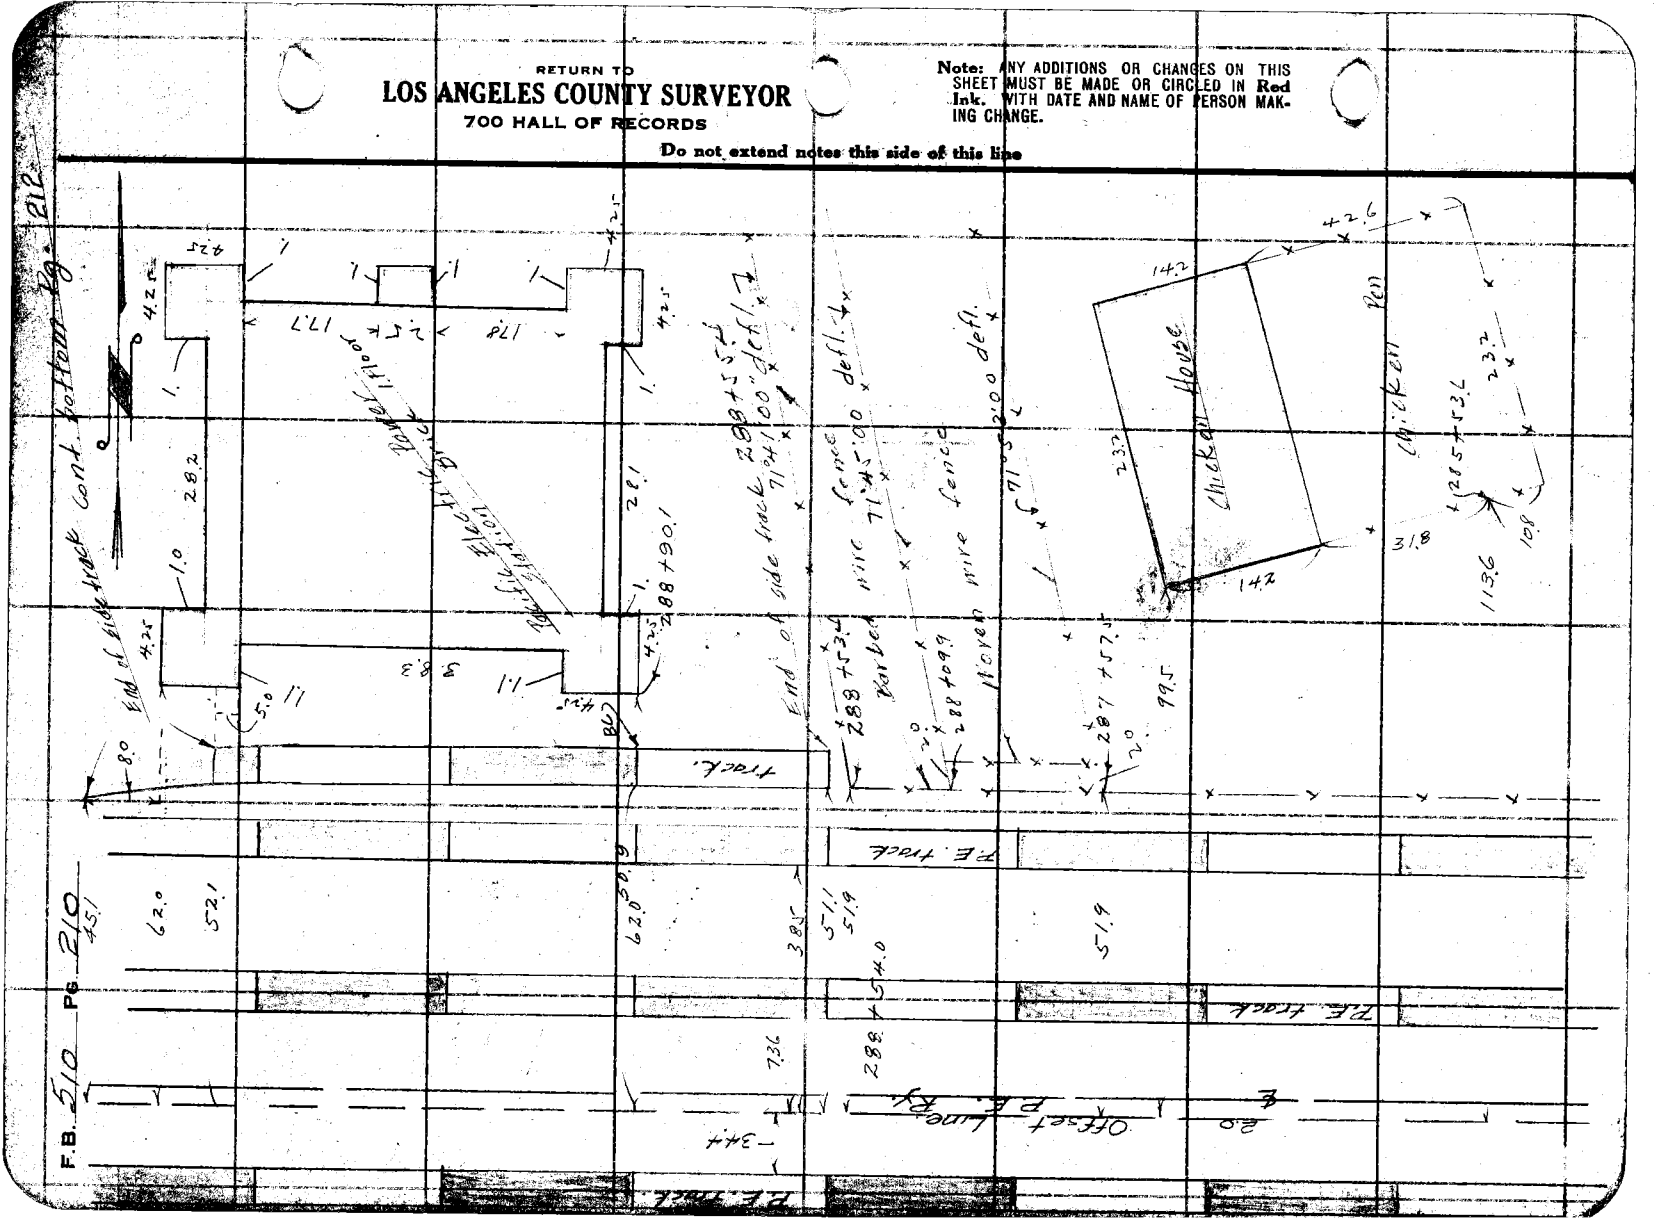

Notes Ck'd by	Survey of Padillo St.
Map No. B-754-5	W. O. 7103 Tape No. 041 St'd 84 °F.
Office Work H.N. Bradstreet	Surveyed by Rosecrans
Checked	Notes Date 7-31-33
Date	Indexed A. C. Johnson

F.B. 510 PG. 217

Cont bottom next page

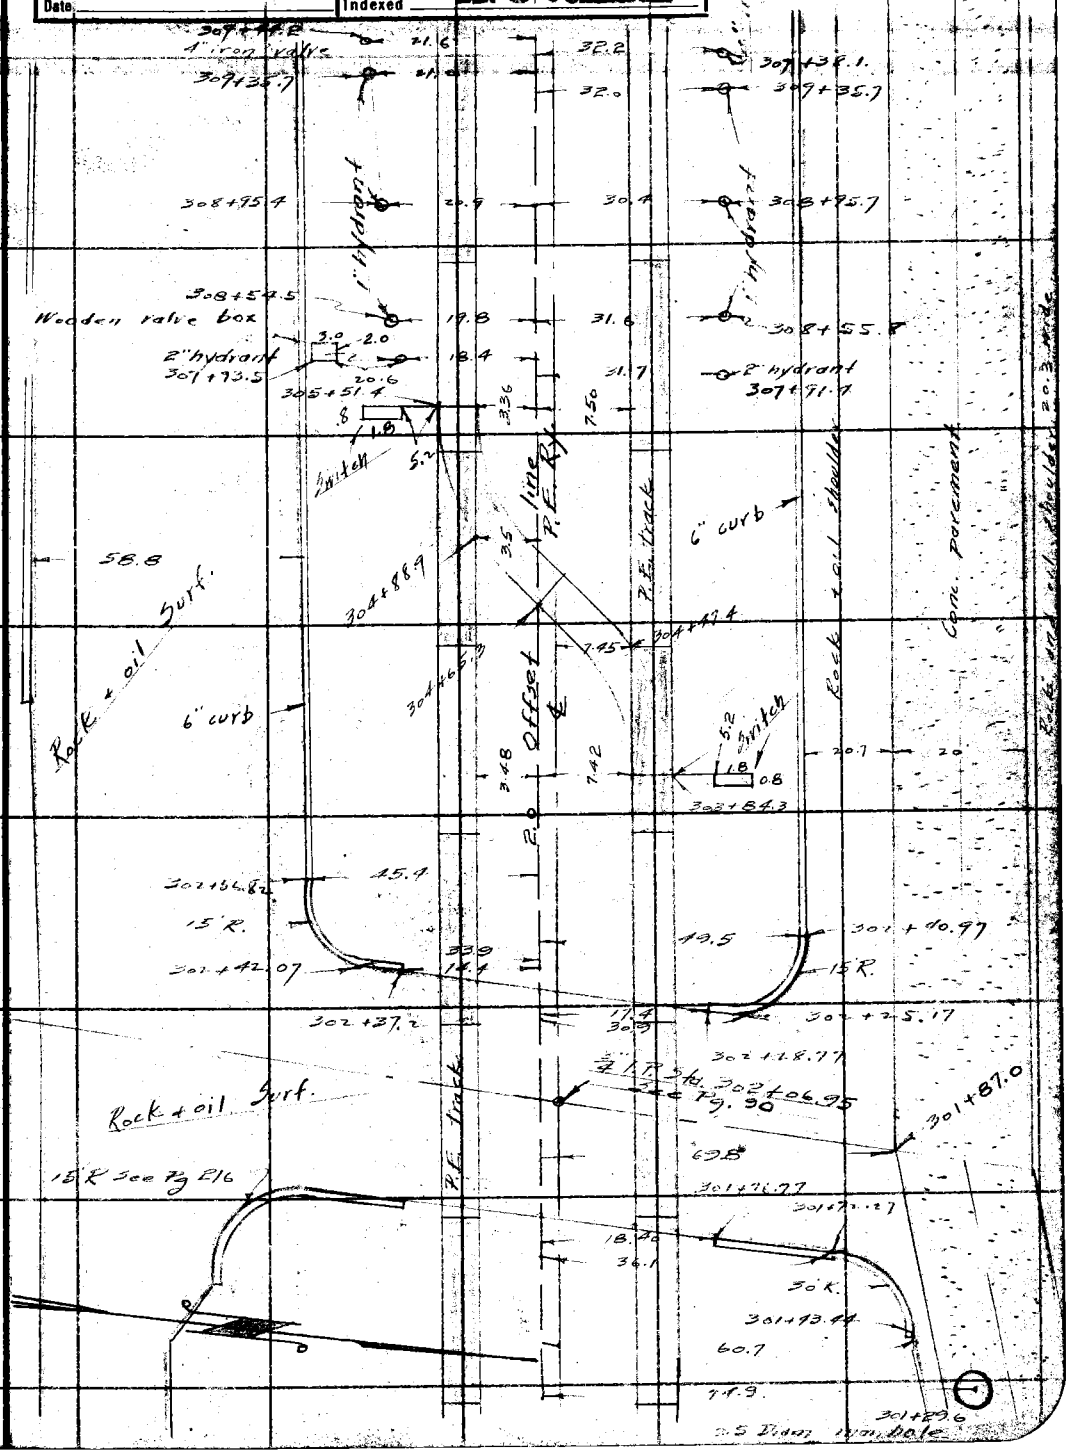

Note: ANY ADDITIONS OR CHANGES ON THIS SHEET MUST BE MADE OR CIRCLED IN Red Ink. WITH DATE AND NAME OF PERSON MAKING CHANGE.

Do not extend notes this side of this line

RETURN TO
LOS ANGELES COUNTY SURVEYOR
700 HALL OF RECORDS

FORM 247 10M 5-31

F.B. 510 Pg. 218

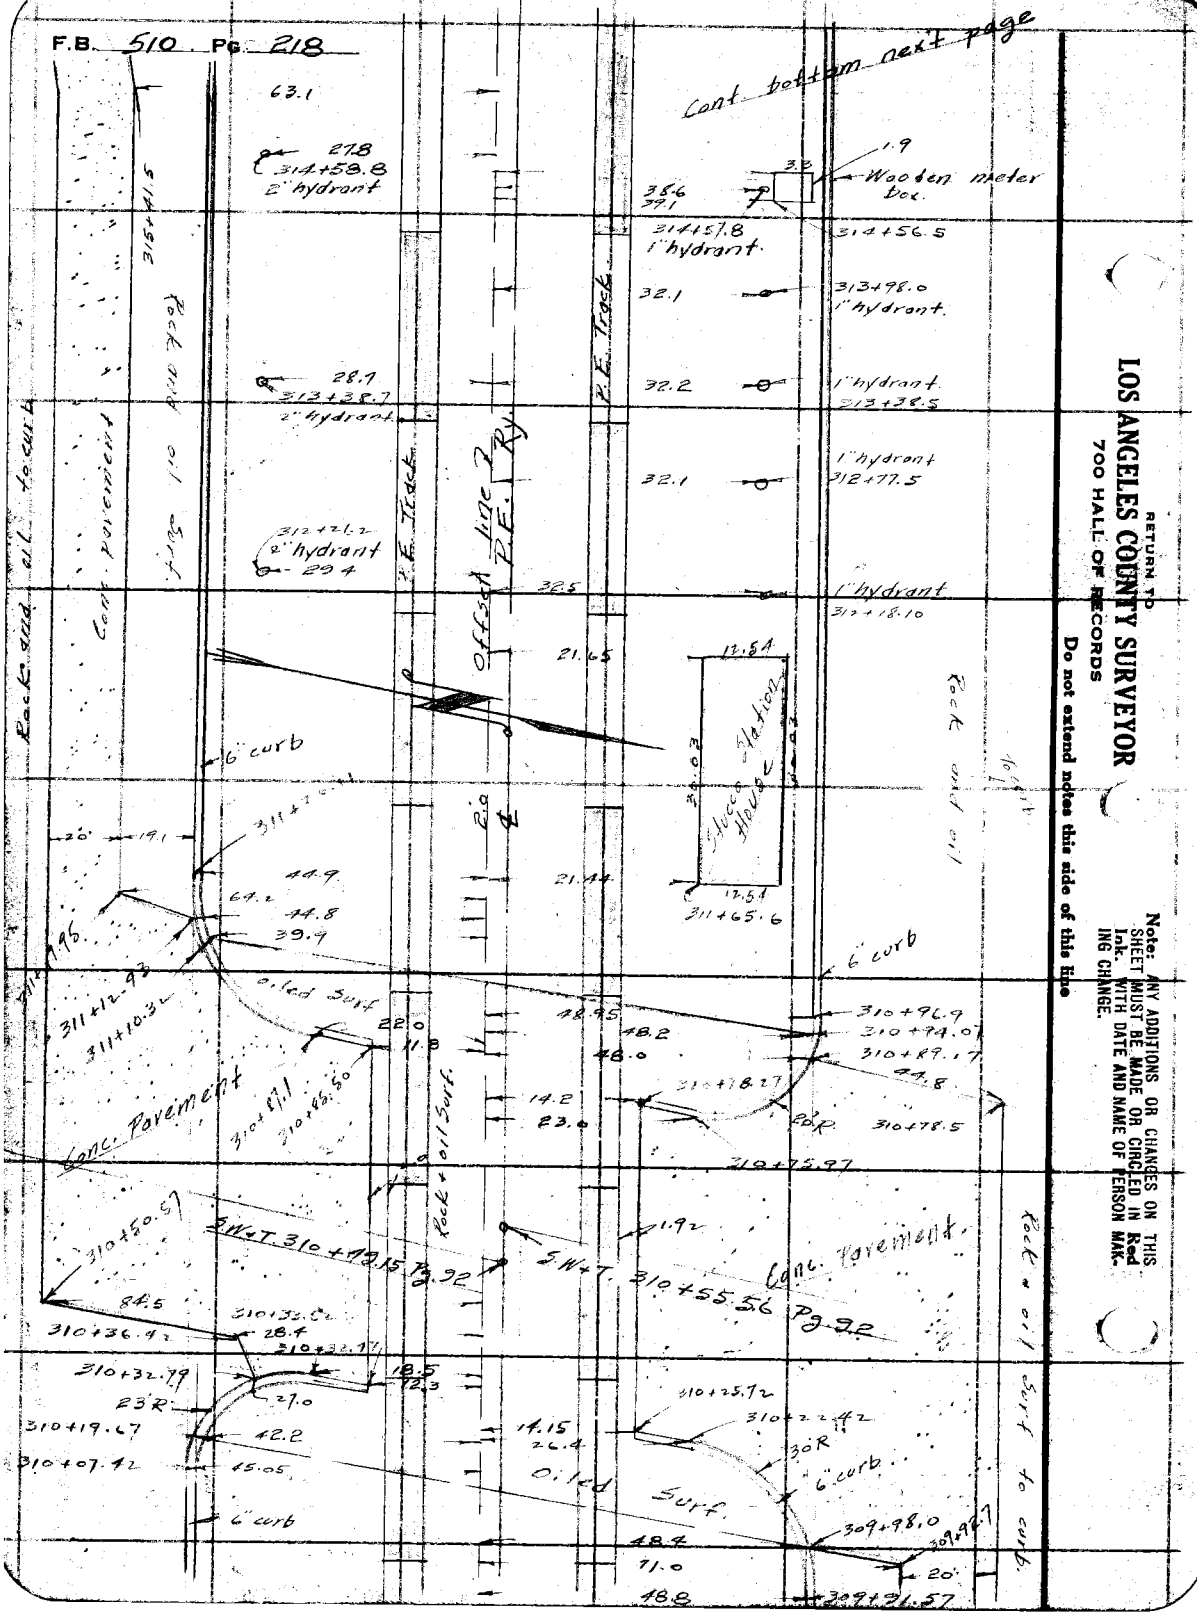

RETURN TO
LOS ANGELES COUNTY SURVEYOR
700 HALL OF RECORDS
Do not extend notes this side of this line

Note: ANY ADDITIONS OR CHANGES ON THIS SHEET MUST BE MADE OR CIRCLED IN Red Ink. WITH DATE AND NAME OF PERSON MAKING CHANGE.

Notes Ck'd by	Survey of Badillo St
Map No. B-754-5	W. O. 7103 Tape No. 041 St'd 84 °F.
Office Work H.N. Broadstreet	Surveyed by Rosecrans
Checked	Notes Date 7/3/53
Date	Indexed A. C. Johnson

F.B. 510 Pg. 211

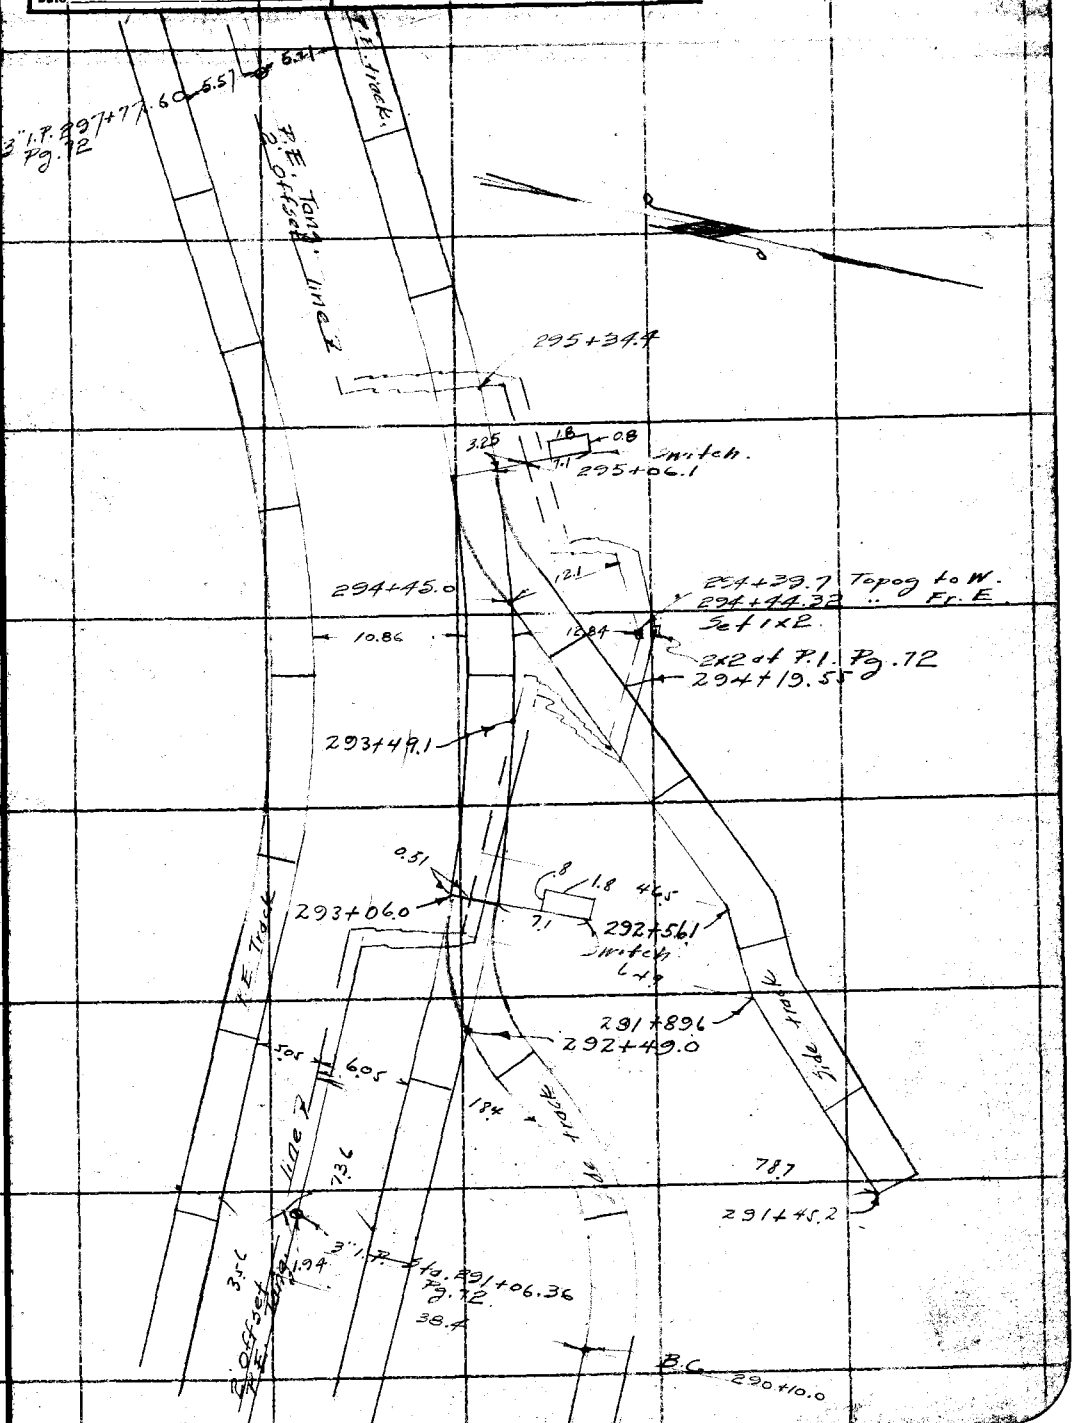

Note: ANY ADDITIONS OR CHANGES ON THIS SHEET MUST BE MADE OR CIRCLED IN Red Ink. WITH DATE AND NAME OF PERSON MAKING CHANGE.

RETURN TO
LOS ANGELES COUNTY SURVEYOR
700 HALL OF RECORDS

Do not extend notes this side of this line

FORM 247 10M 5-31

F.B. 510 PG. 212

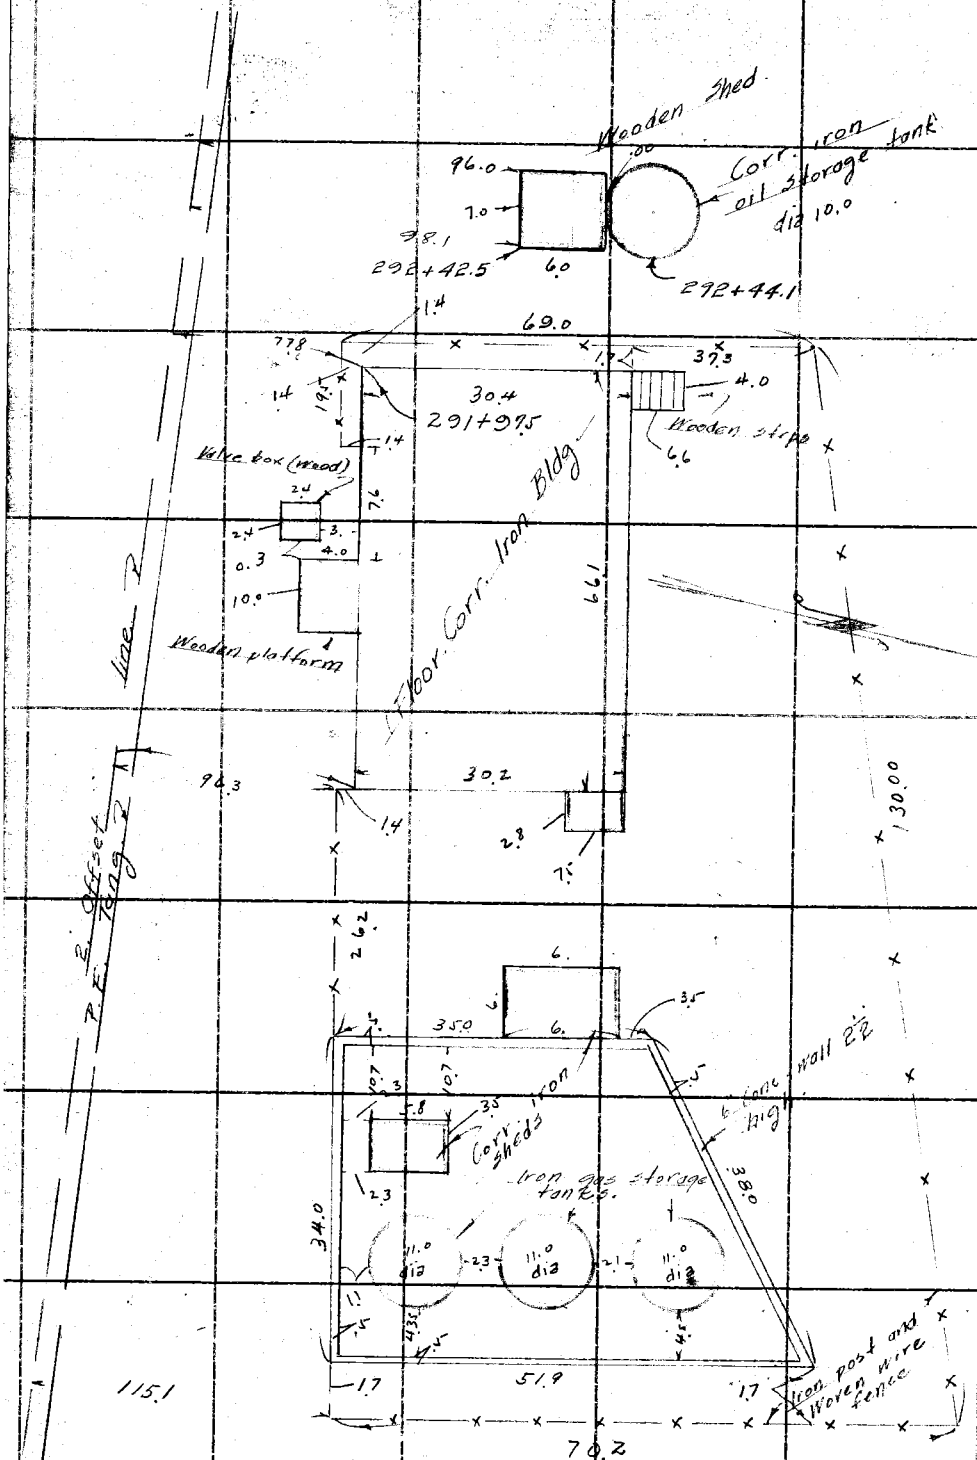

RETURN TO
LOS ANGELES COUNTY SURVEYOR
700 HALL OF RECORDS

Do not extend notes this side of this line

Note: ANY ADDITIONS OR CHANGES ON THIS SHEET MUST BE MADE OR CIRCLED IN Red Ink. WITH DATE AND NAME OF PERSON MAKING CHANGE.

Notes Ck'd by	Survey of Badillo St.
Map No. B-754-5	W. O. 7103 Tape No. 041 St'd 84 °F.
Office Work H.N. Broadbrook	Surveyed by Rosecrans
Checked	Notes Date 1/21/33
Date	Indexed A. C. Johnson

F.B. 510 PG. 213

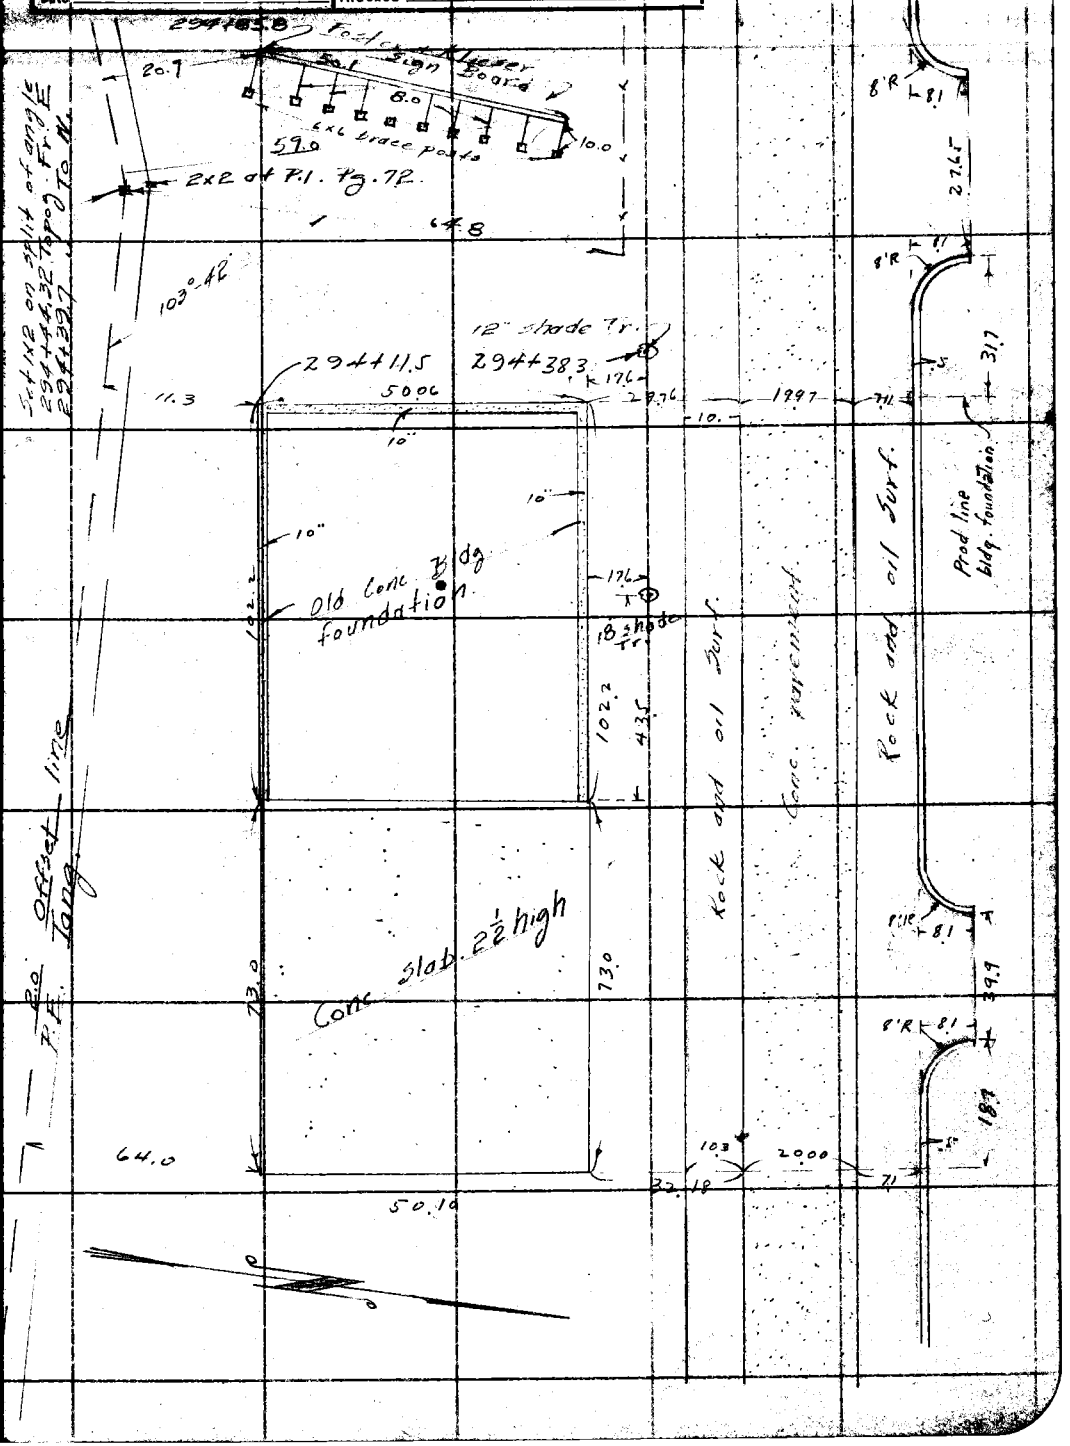

Note: ANY ADDITIONS OR CHANGES ON THIS SHEET MUST BE MADE OR CIRCLED IN Ink. WITH DATE AND NAME OF PERSON MAKING CHANGE.

Do not extend notes this side of this line

RETURN TO
LOS ANGELES COUNTY SURVEYOR
700 HALL OF RECORDS

FORM 247 10M 5-31

F.B. 510 PG. 214

LOS ANGELES COUNTY SURVEYOR
RETURN TO
700 HALL OF RECORDS

Do not extend notes this side of this line

Notes: ANY ADDITIONS OR CHANGES ON THIS SHEET MUST BE MADE OR CIRCLED IN Red Ink. WITH DATE AND NAME OF PERSON MAKING CHANGE.

Notes Ck'd by	Survey of Badillo St.
Map No. B-754-5	W. O. 7103 Tape No. 041 St'd 84 °F.
Office Work H.N. Bradstreet	Surveyed by Rosecrans
Checked	Notes Date 7-31-33
Date	Indexed A. C. Johnson

F.B. 510 PG. 215

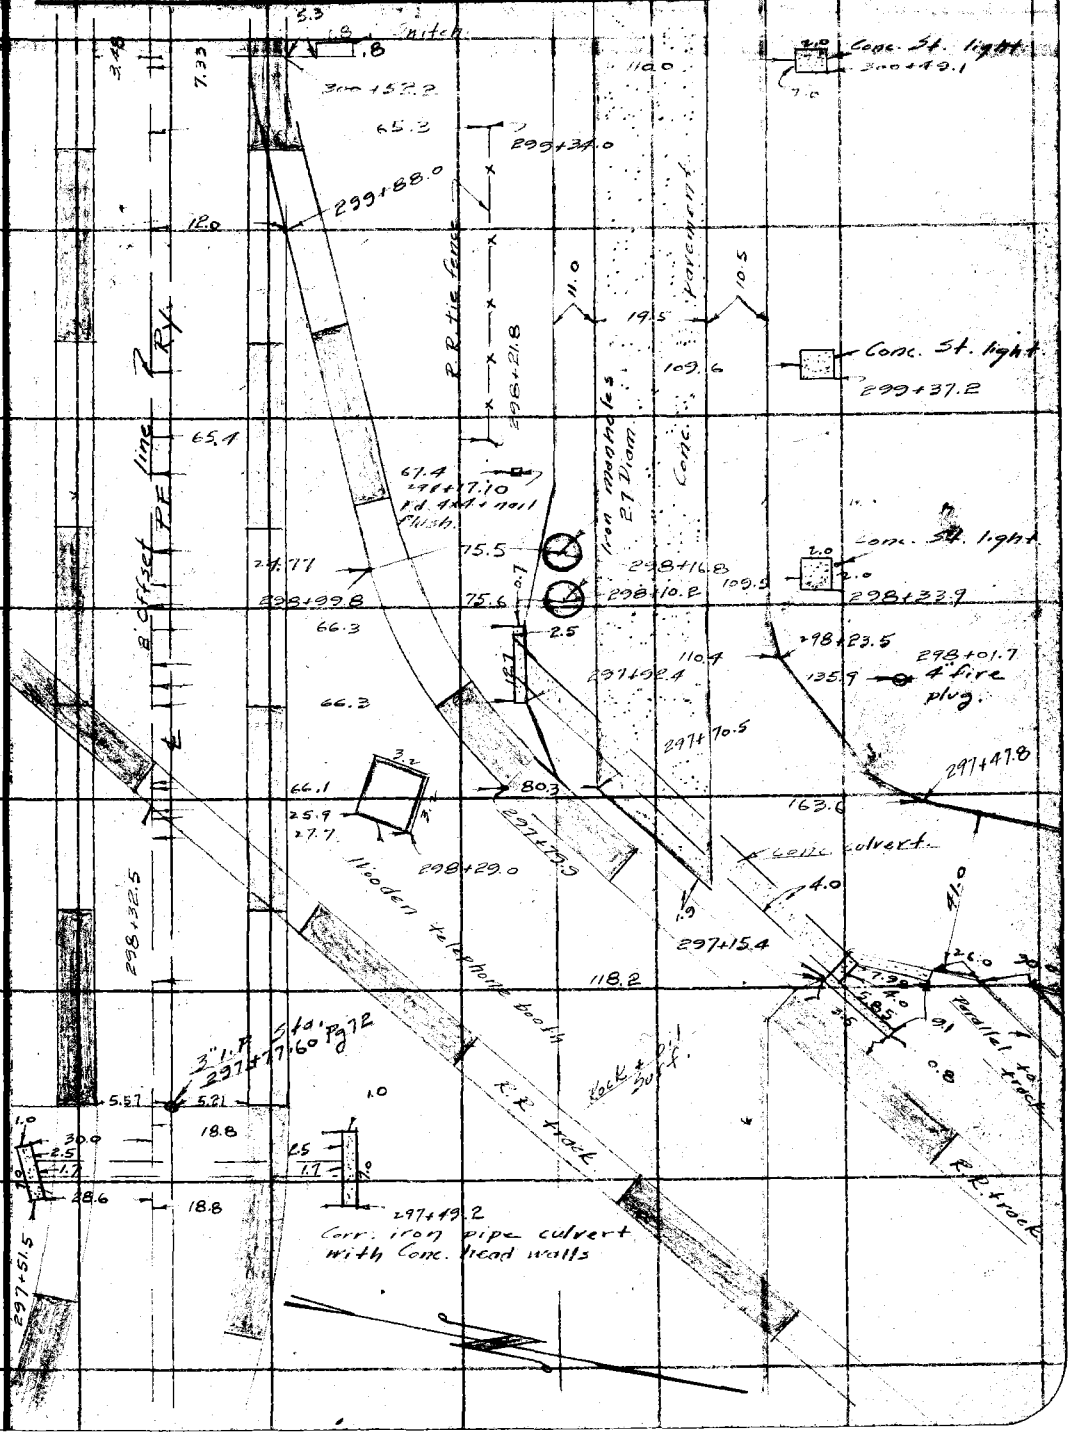

Notes: ANY ADDITIONS OR CHANGES ON THIS SHEET MUST BE MADE OR CIRCLED IN Red Ink, WITH DATE AND NAME OF PERSON MAKING CHANGE.

Do not extend notes this side of this line

RETURN TO
LOS ANGELES COUNTY SURVEYOR
700 HALL OF RECORDS

FORM 247 10M 8-31

F.B. 510 Pg 216

RETURN TO
LOS ANGELES COUNTY SURVEYOR
700 HALL OF RECORDS

Do not extend notes this side of this line

Note: ANY ADDITIONS OR CHANGES ON THIS SHEET MUST BE MADE OR CIRCLED IN Red Ink. WITH DATE AND NAME OF PERSON MAKING CHANGE.

Notes Ck'd by	Survey of Badillo St.
Map No. B-754-5	W. O. 7103 Tape No. 041 St'd 84 °F.
Office Work H.N. Bradstreet	Surveyed by Rosecrans
Checked	Notes Date 8-[illegible]
Date	Indexed A. C. Johnson

F.B. 510 PG. 219

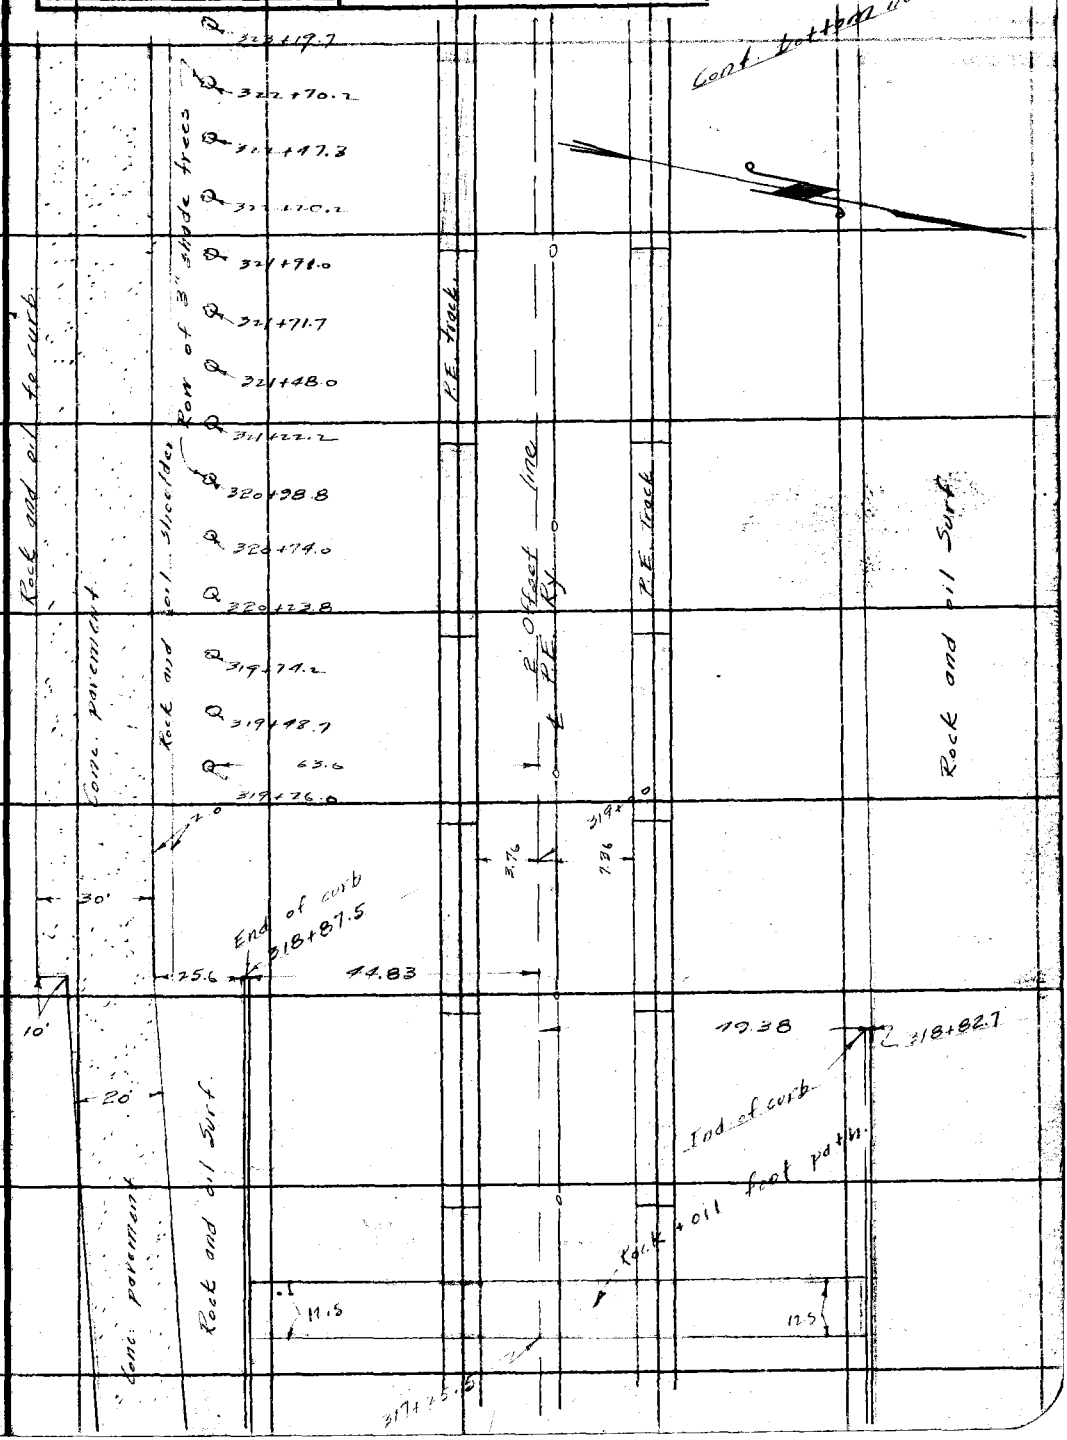

Note: ANY ADDITIONS OR CHANGES ON THIS SHEET MUST BE MADE OR CIRCLED IN Red Ink. WITH DATE AND NAME OF PERSON MAKING CHANGE.

Do not extend notes this side of this line

RETURN TO
LOS ANGELES COUNTY SURVEYOR
700 HALL OF RECORDS

FORM 247 10M 5-31

F.B. 510 PG 220

RETURN TO
LOS ANGELES COUNTY SURVEYOR
700 HALL OF RECORDS

Do not extend notes this side of this line

Note: ANY ADDITIONS OR CHANGES ON THIS SHEET MUST BE MADE OR CIRCLED IN Red Ink. WITH DATE AND NAME OF PERSON MAKING CHANGE.

Notes Ck'd by	Survey of Badillo St.
Map No. B-754-5	W. O. 2103 Tape No. 041 St'd 64 °F.
Office Work H. N. Bradstreet	Surveyed by Rasecrans
Checked	Notes Date 8-23-32
Date	Indexed A. C. Johnson

F.B. 510 Pg. 221

Note: ANY ADDITIONS OR CHANGES ON THIS SHEET MUST BE MADE OR CIRCLED IN Red Ink, WITH DATE AND NAME OF PERSON MAKING CHANGE.

RETURN TO
LOS ANGELES COUNTY SURVEYOR
720 HALL OF RECORDS

Do not extend notes this side of this line

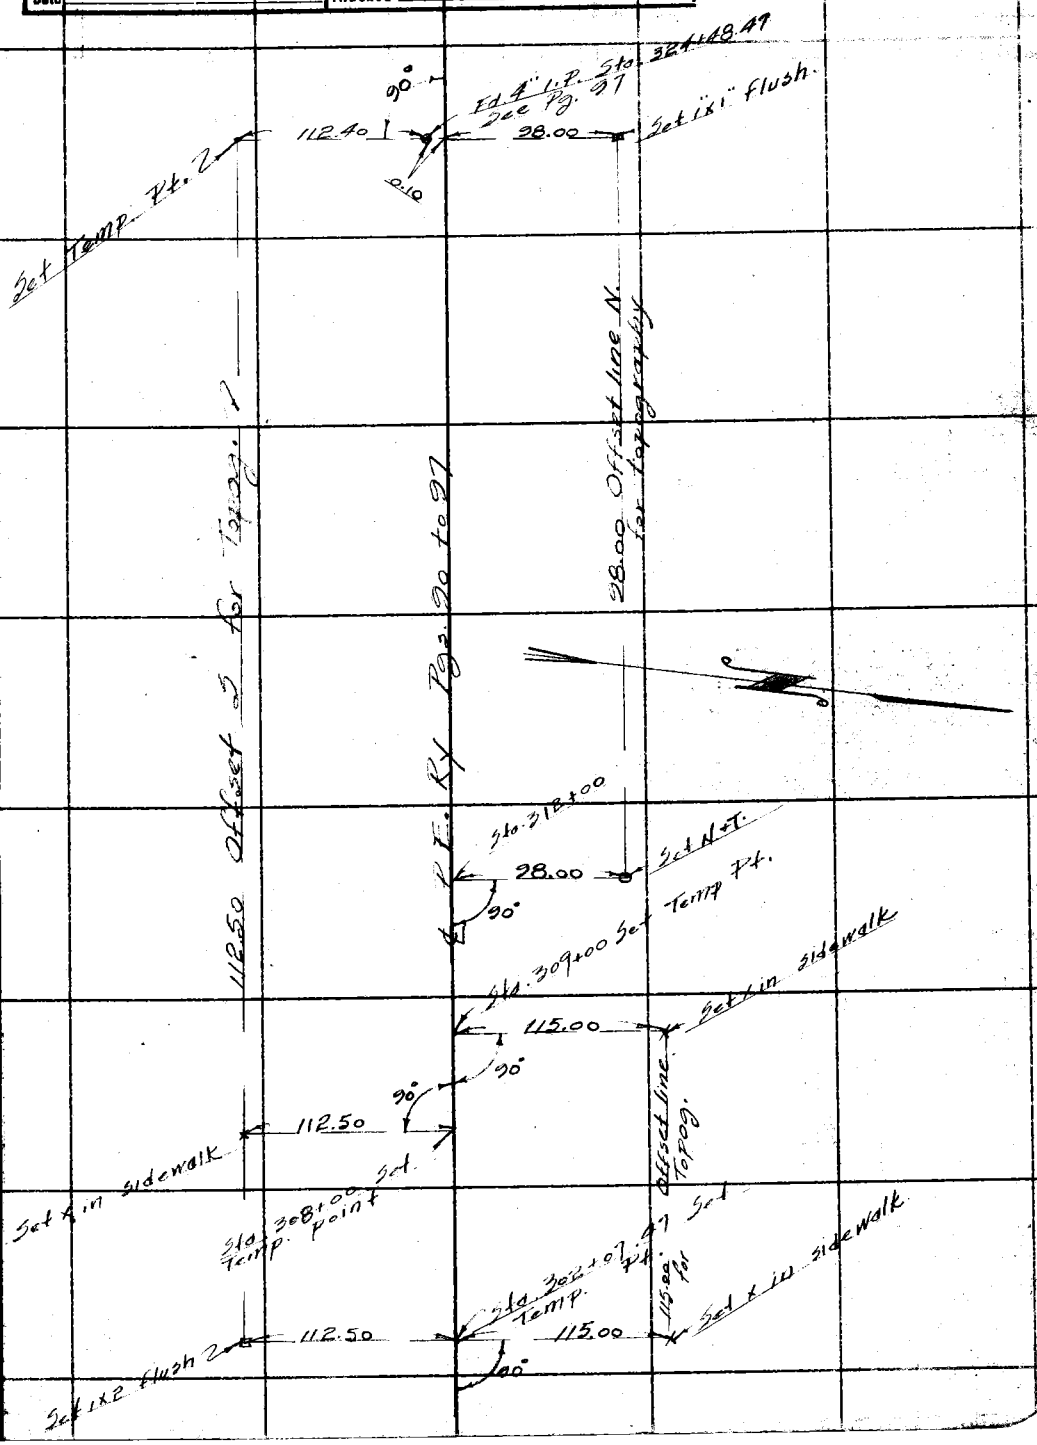

FORM 247 10M 8-31

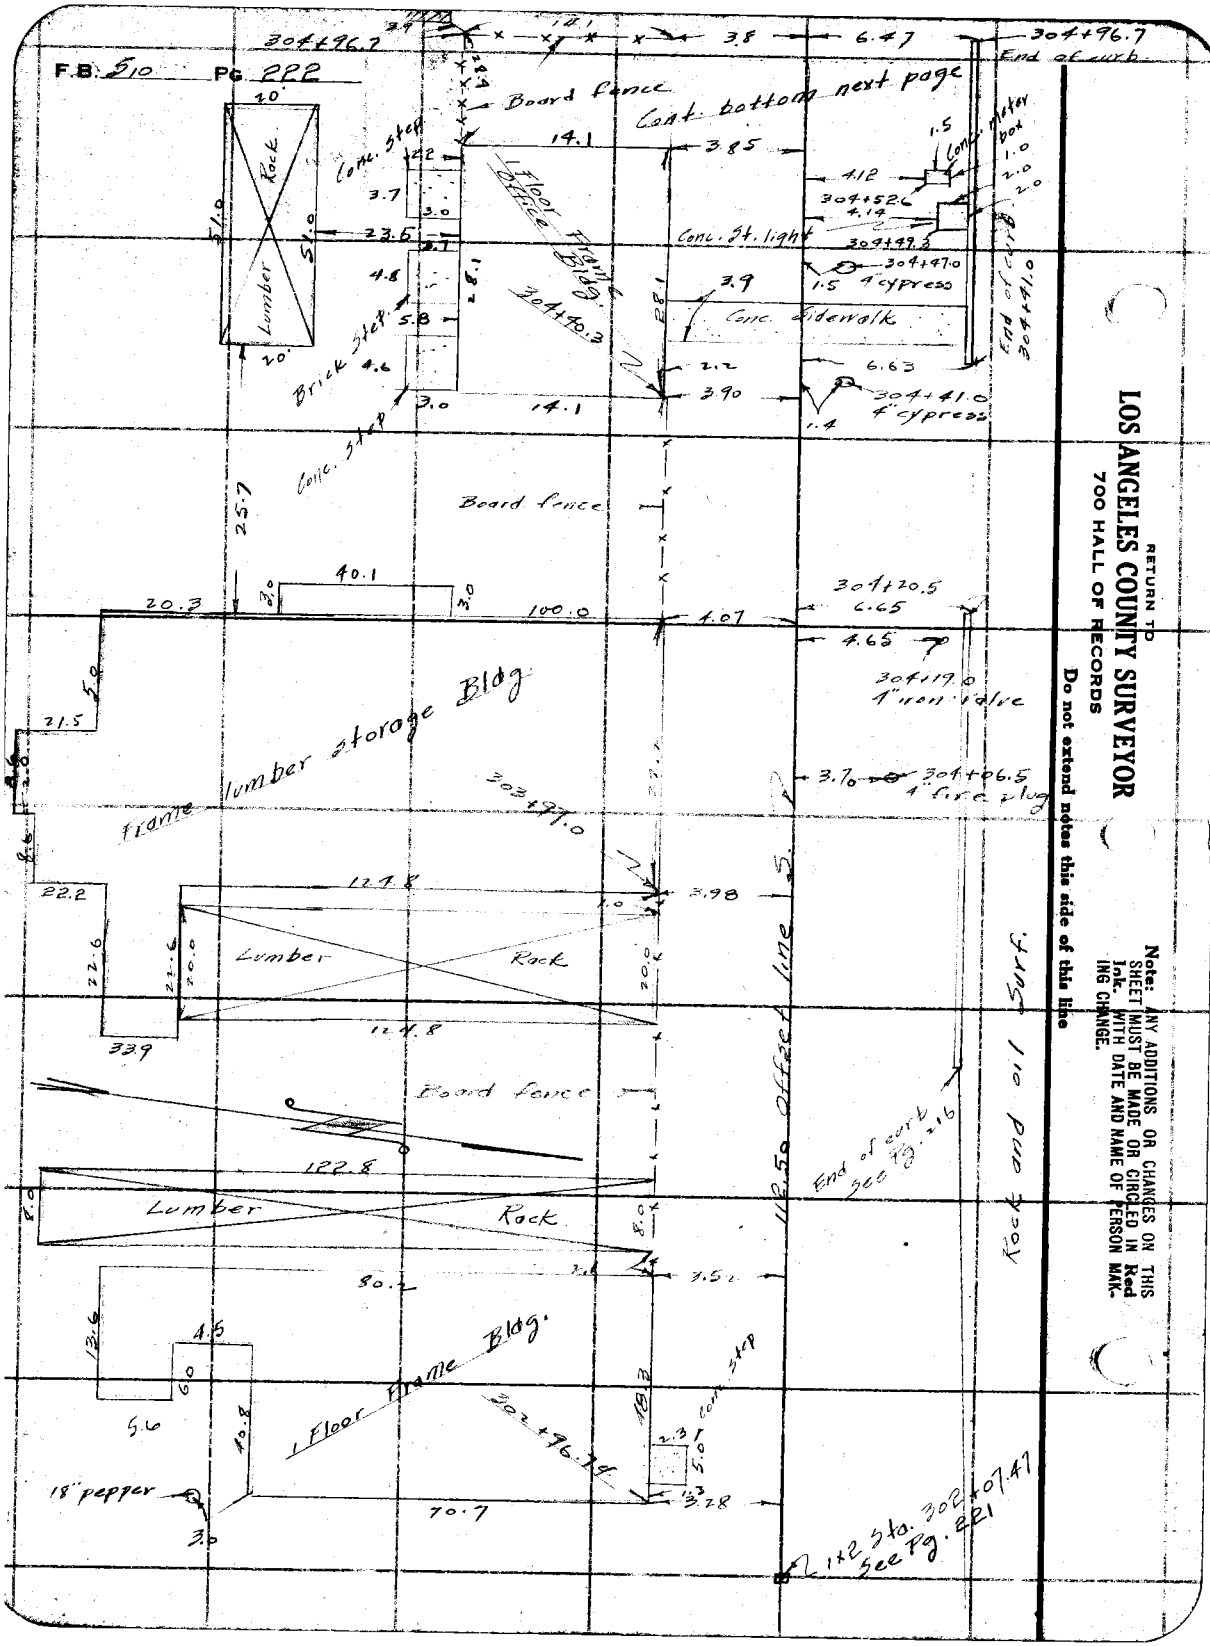

RETURN TO
LOS ANGELES COUNTY SURVEYOR
700 HALL OF RECORDS

Do not extend notes this side of this line

Note: ANY ADDITIONS OR CHANGES ON THIS SHEET MUST BE MADE OR CIRCLED IN Red Ink. WITH DATE AND NAME OF PERSON MAKING CHANGE.

Notes Ck'd by	Survey of Bad. 110 St
Map No. B-754-5	W. O. 7103 Tape No. 041 St'd 84 °F.
Office Work H.N. Bradstreet	Surveyed by Rosecrans
Checked	Notes Date 8-23-33
Date	Indexed A. C. Johnson

F.B. 510 PG. 223

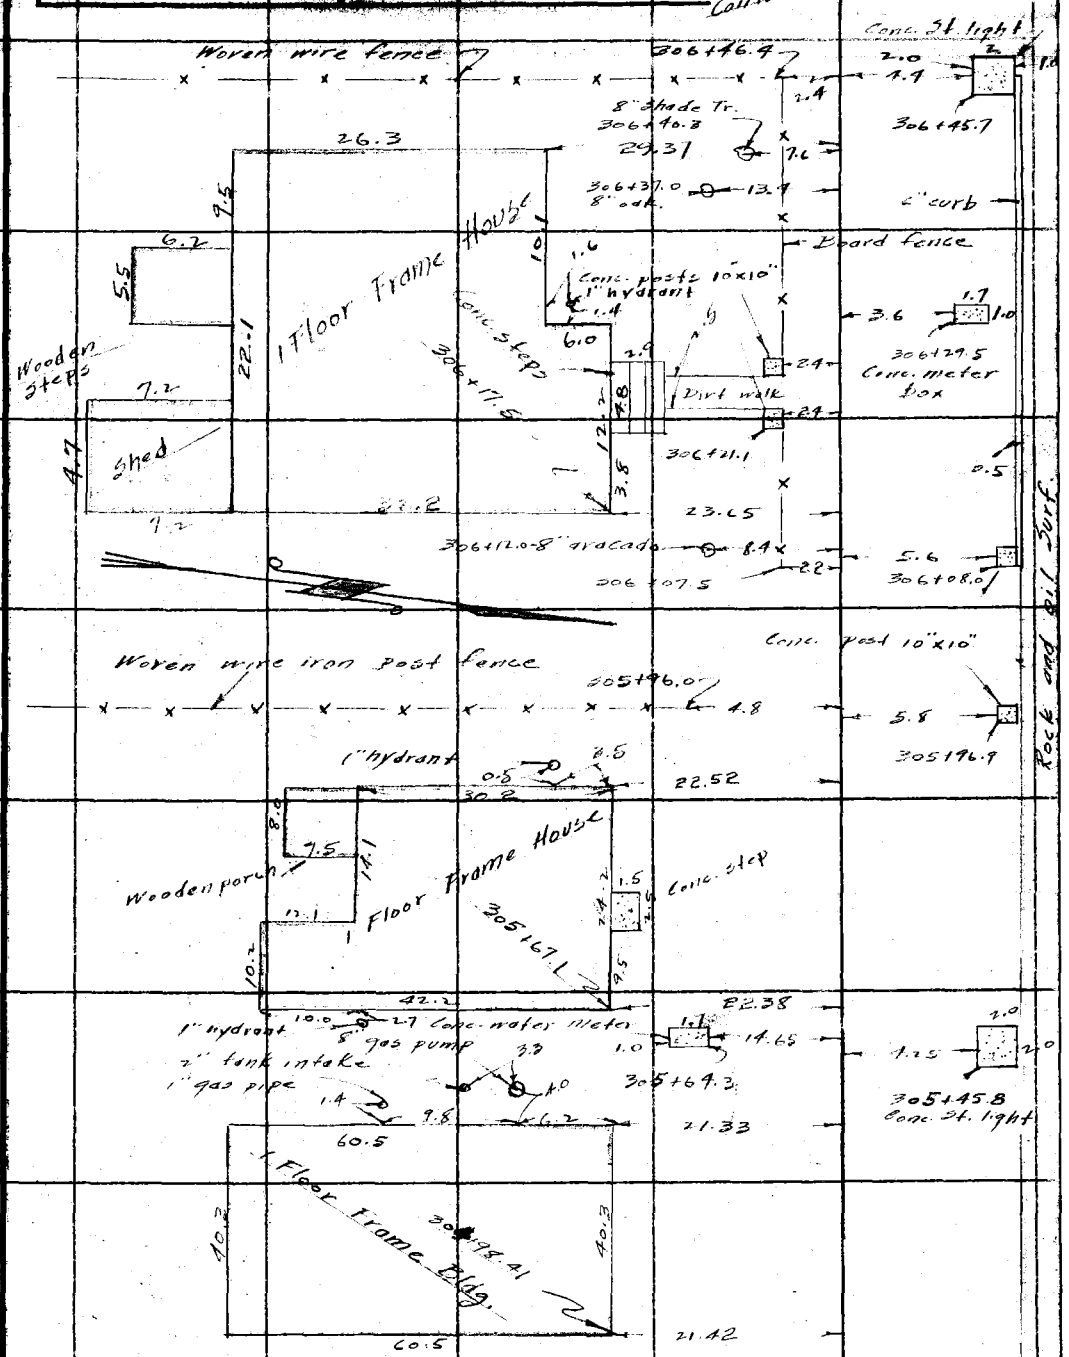

Note: ANY ADDITIONS OR CHANGES ON THIS SHEET MUST BE MADE OR CIRCLED IN Red Ink, WITH DATE AND NAME OF PERSON MAKING CHANGE.

RETURN TO
LOS ANGELES COUNTY SURVEYOR
700 HALL OF RECORDS

Do not extend notes this side of this line

FORM 247 10M 5-31

F.B. 510 Pg 224

RETURN TO
LOS ANGELES COUNTY SURVEYOR
700 HALL OF RECORDS

Do not extend notes this side of this line

Note: ANY ADDITIONS OR CHANGES ON THIS SHEET MUST BE MADE OR CIRCLED IN Red Ink. WITH DATE AND NAME OF PERSON MAKING CHANGE.

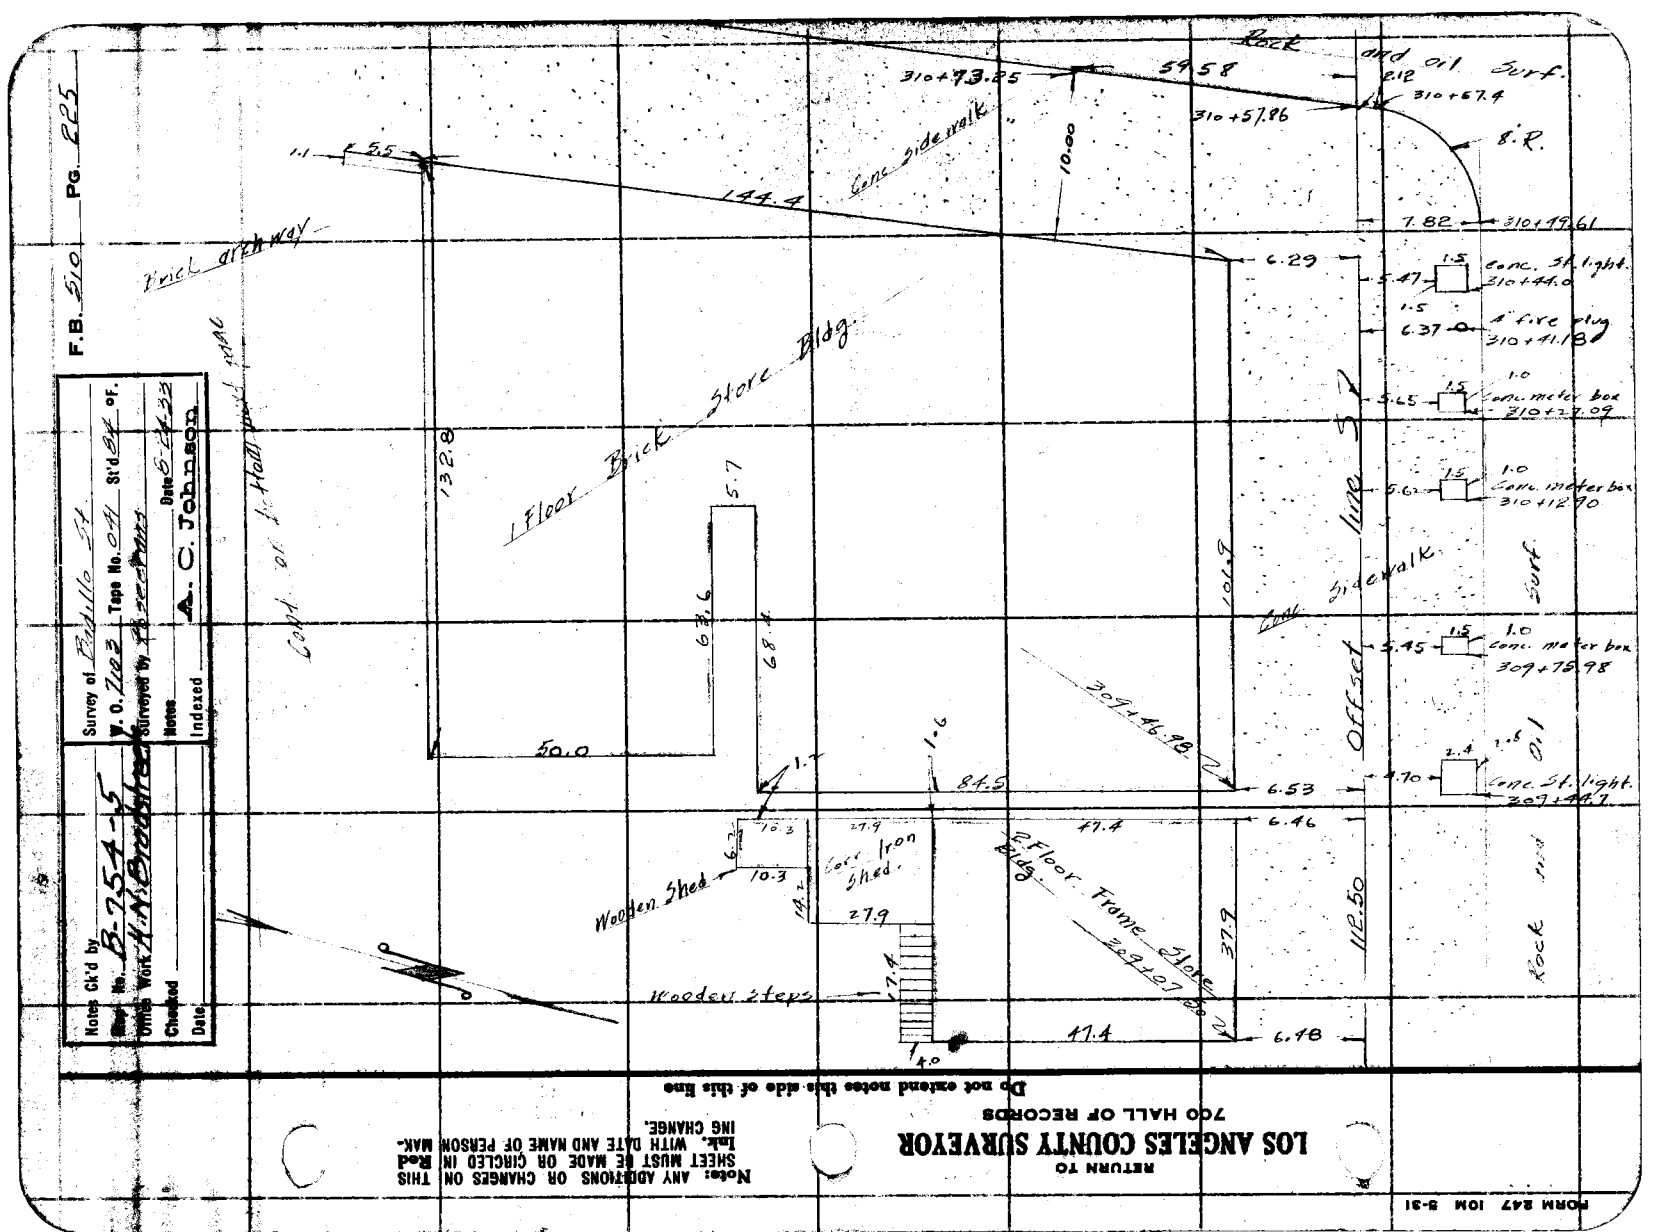

RETURN TO

LOS ANGELES COUNTY SURVEYOR

700 HALL OF RECORDS

Do not extend notes this side of this line

Note: ANY ADDITIONS OR CHANGES ON THIS SHEET MUST BE MADE OR CIRCLED IN Red Ink. WITH DATE AND NAME OF PERSON MAKING CHANGE.

FORM 847 10M 3-31

RETURN TO

LOS ANGELES COUNTY SURVEYOR

700 HALL OF RECORDS

Note: ANY ADDITIONS OR CHANGES ON THIS SHEET MUST BE MADE OR CIRCLED IN **Red Ink.** WITH DATE AND NAME OF PERSON MAKING CHANGE.

Do not extend notes this side of this line

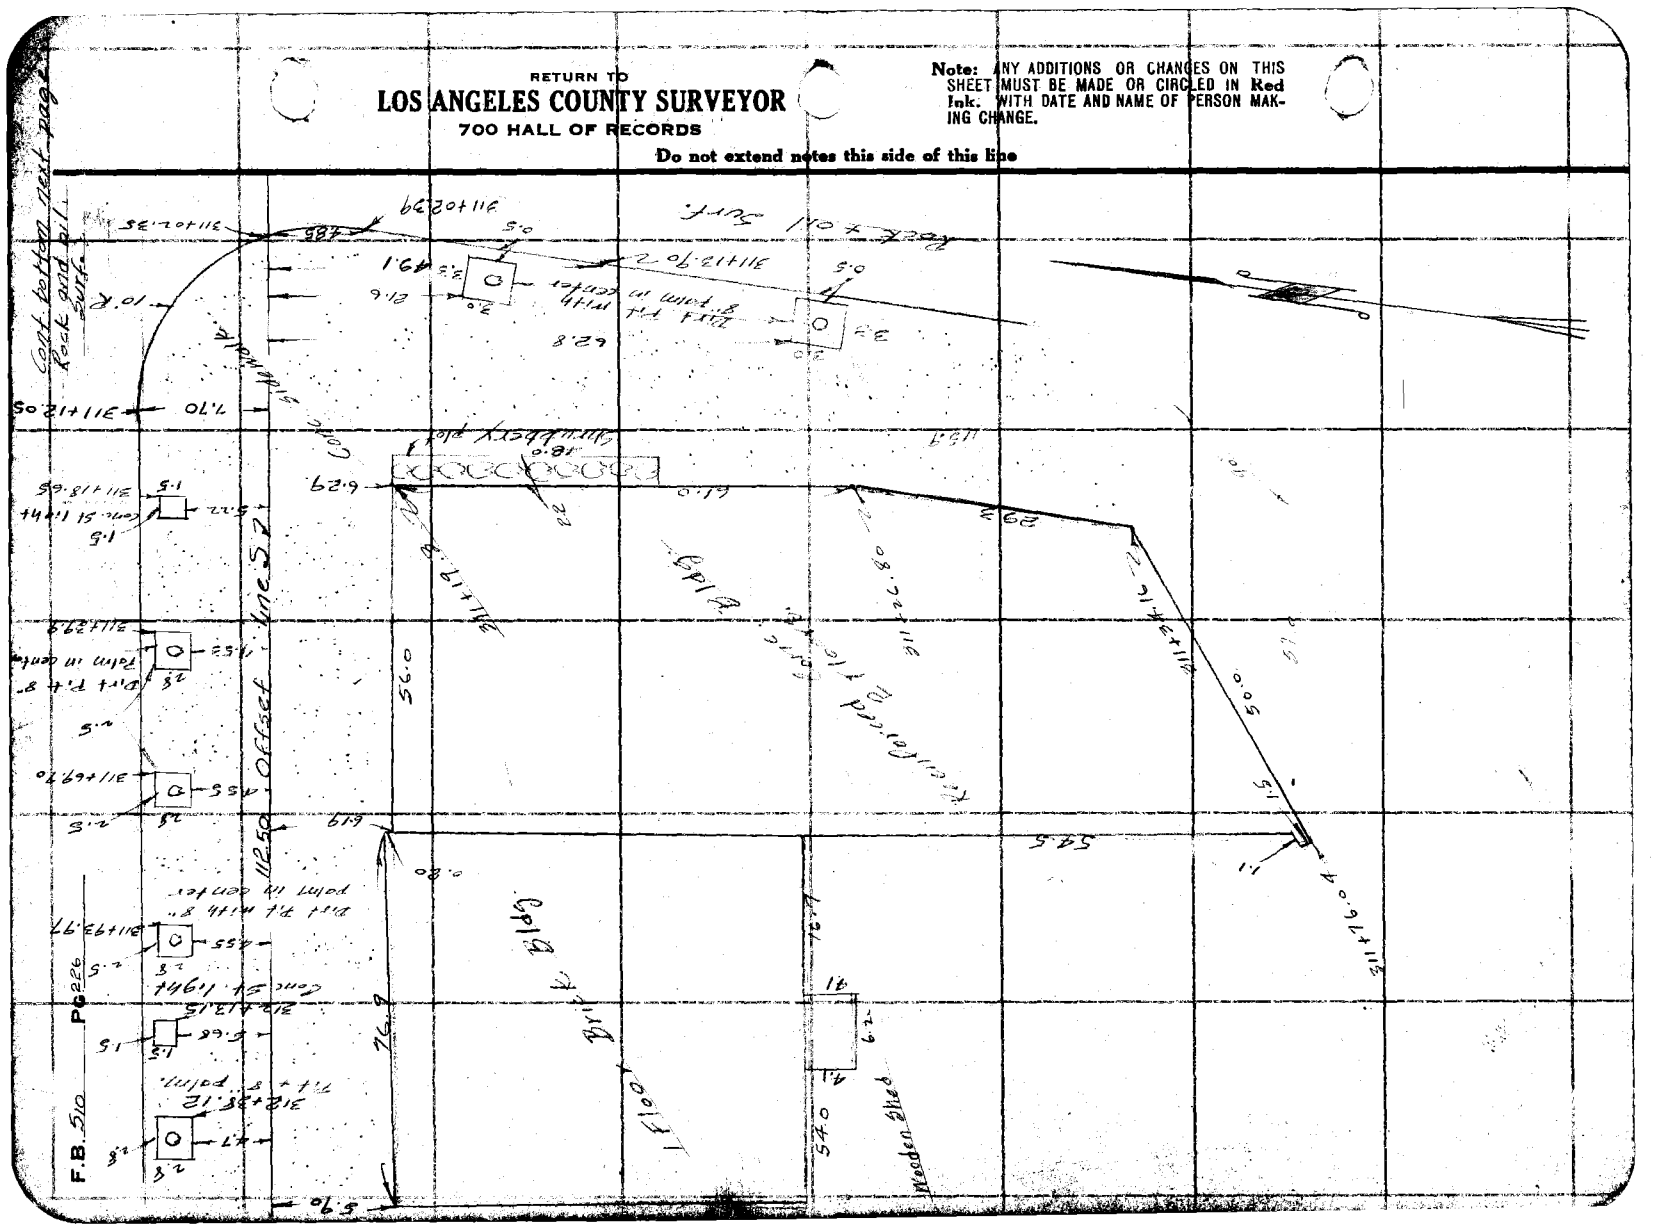

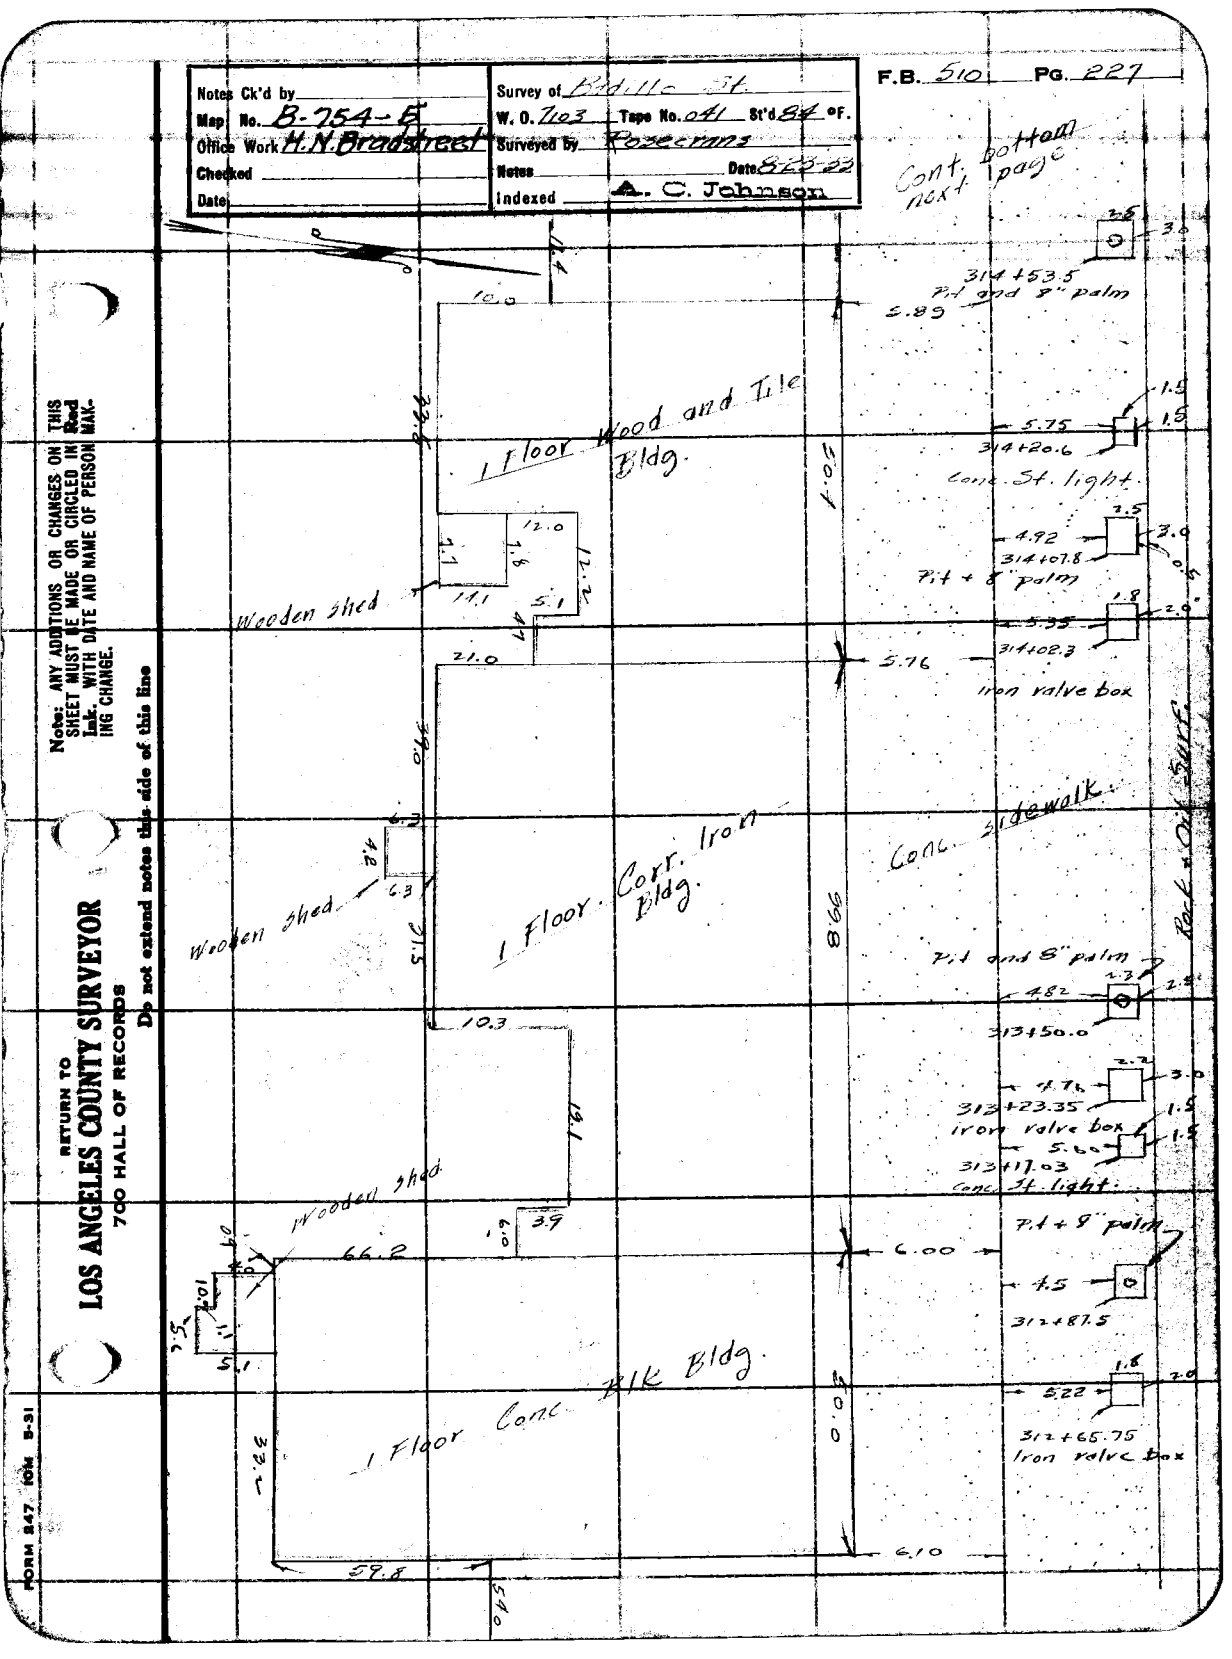
Notes Ck'd by
Map No. B-754-6
Office Work H.N. Bradstreet
Checked
Date
W. O. 7103 Tape No. 041 St'd 84 °F.
Surveyed by Rosemans
Indexed A. C. Johnson
F.B. 510 PG. 227
Cont. bottom next page
314+53.5
7-1 and 8" palm
5.89
1 Floor Wood and Tile Bldg.
314+20.6
Conc. St. light.
4.92
314+07.8
7-1 + 8" palm
5.35
314+02.3
5.76
iron valve box
Wooden shed
Wooden shed
1 Floor Corr. Iron Bldg.
Conc. Sidewalk
Rock + Oil Surf.
7-1 and 8" palm
4.82
313+50.0
4.76
313+23.35
iron valve box
5.60
313+17.03
Conc. St. light
7-1 + 8" palm
4.5
312+87.5
Wooden shed
1 Floor Conc Blk Bldg.
5.22
312+65.75
Iron valve box
6.10
59.8
RETURN TO
LOS ANGELES COUNTY SURVEYOR
700 HALL OF RECORDS
Do not extend notes this side of this line
Note: ANY ADDITIONS OR CHANGES ON THIS SHEET MUST BE MADE OR CIRCLED IN Red Ink, WITH DATE AND NAME OF PERSON MAKING CHANGE.
FORM 247 10M 8-31

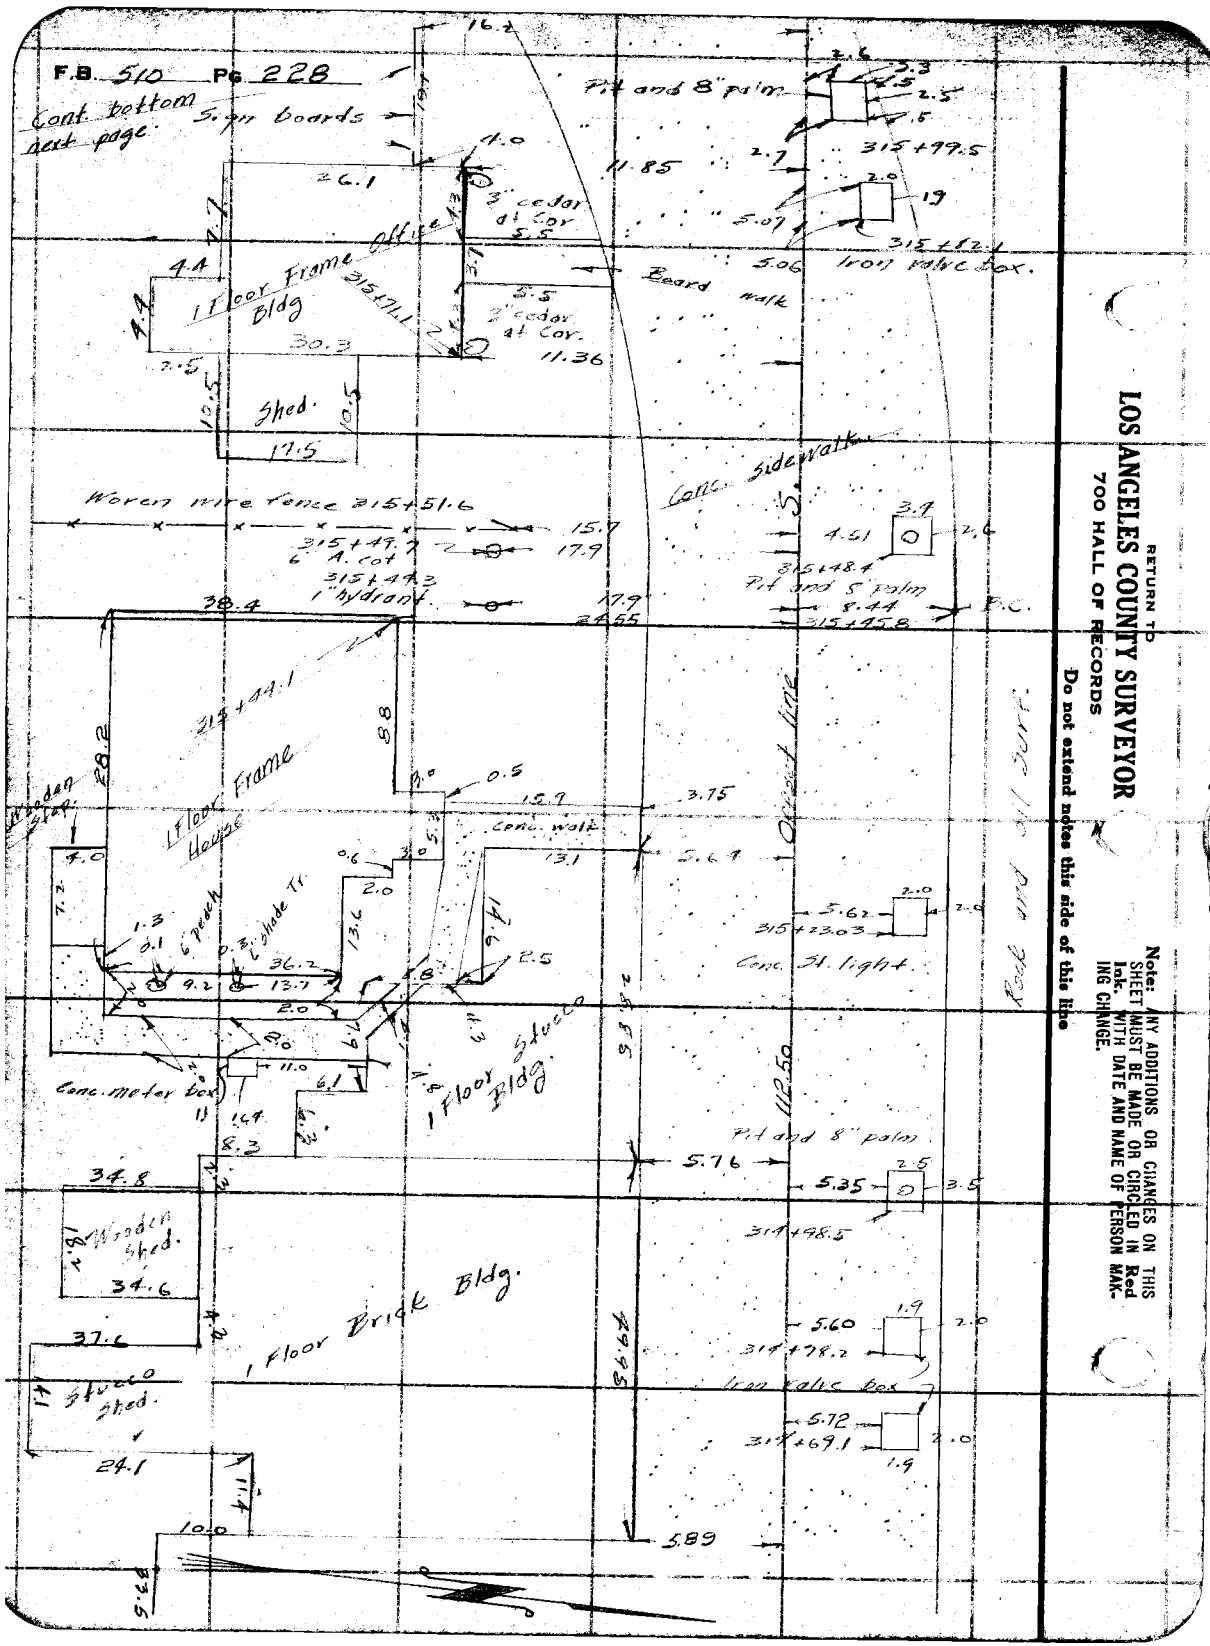

RETURN TO
LOS ANGELES COUNTY SURVEYOR
700 HALL OF RECORDS

Do not extend notes this side of this line

Note: ANY ADDITIONS OR CHANGES ON THIS SHEET MUST BE MADE OR CIRCLED IN Red Ink. WITH DATE AND NAME OF PERSON MAKING CHANGE.

Notes Ck'd by	Survey of Badillo St.
Map No. B-754-5	W. O. 7103 Tape No. 041 St'd 84 °F.
Office Work H.N. Bradsheet	Surveyed by Rosecrans
Checked	Notes Date 8-24-33
Date	Indexed A. C. Johnson

F.B. 510 PG. 229

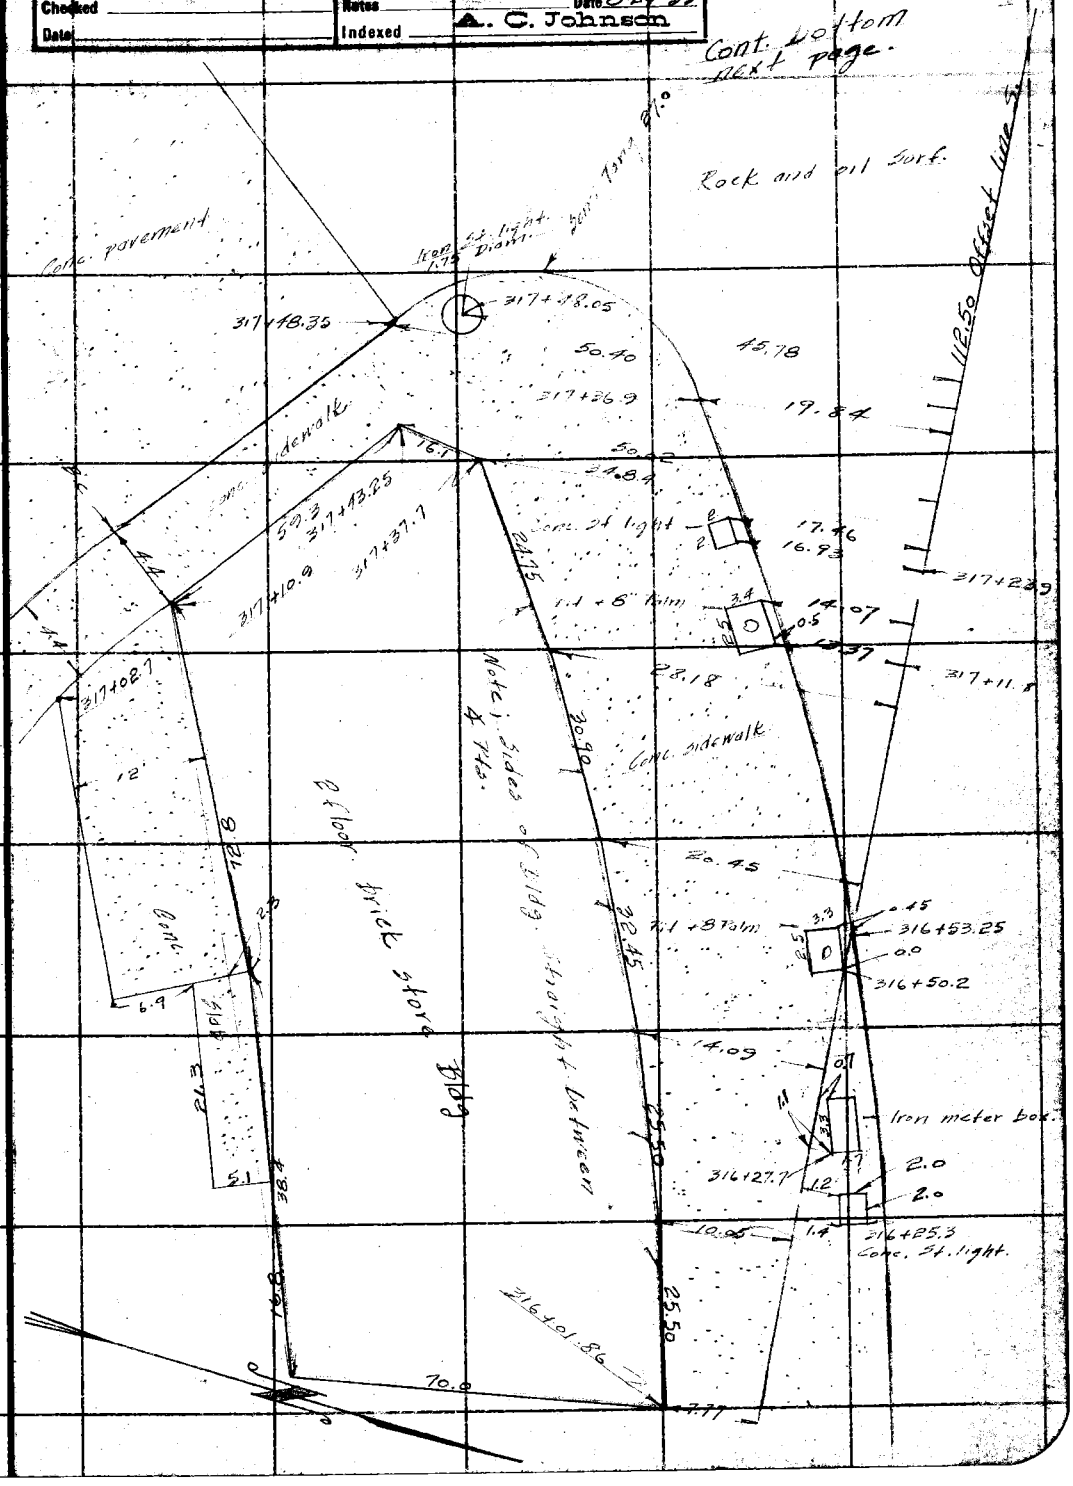

Note: ANY ADDITIONS OR CHANGES ON THIS SHEET MUST BE MADE OR CIRCLED IN Red Ink, WITH DATE AND NAME OF PERSON MAKING CHANGE.

RETURN TO
LOS ANGELES COUNTY SURVEYOR
700 HALL OF RECORDS

Do not extend notes this side of this line

FORM 247 10M 5-31

RETURN TO

LOS ANGELES COUNTY SURVEYOR

700 HALL OF RECORDS

Note: ANY ADDITIONS OR CHANGES ON THIS SHEET MUST BE MADE OR CIRCLED IN **Red Ink.** WITH DATE AND NAME OF PERSON MAKING CHANGE.

Do not extend notes this side of this line

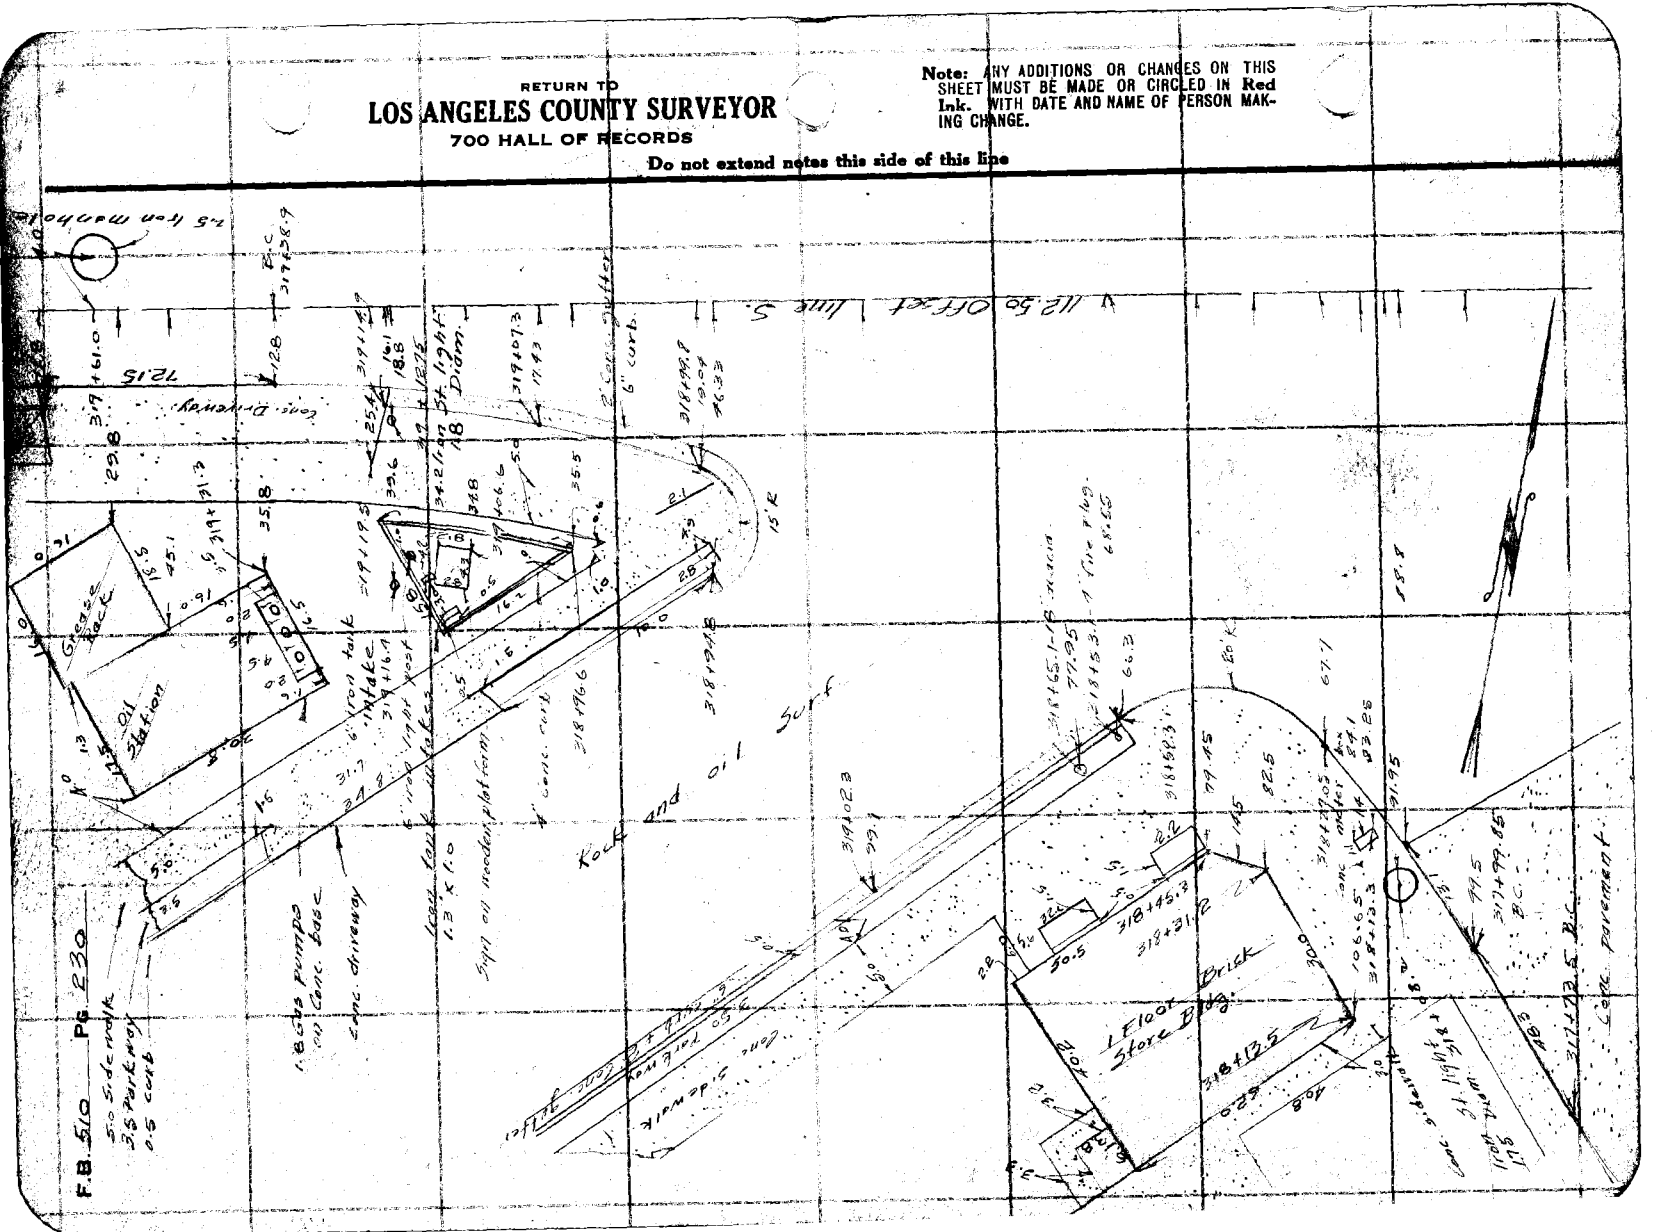

Notes Ck'd by	Survey of Cadillo St.
Map No. B-754-5	W. O. 7103 Tape No. 041 St'd 84 °F.
Office Work M.N. Broadsheet	Surveyed by Rosecrans
Checked	Notes Date 8-24-32
Date	Indexed A. C. Johnson

F.B. 310 PG. 231

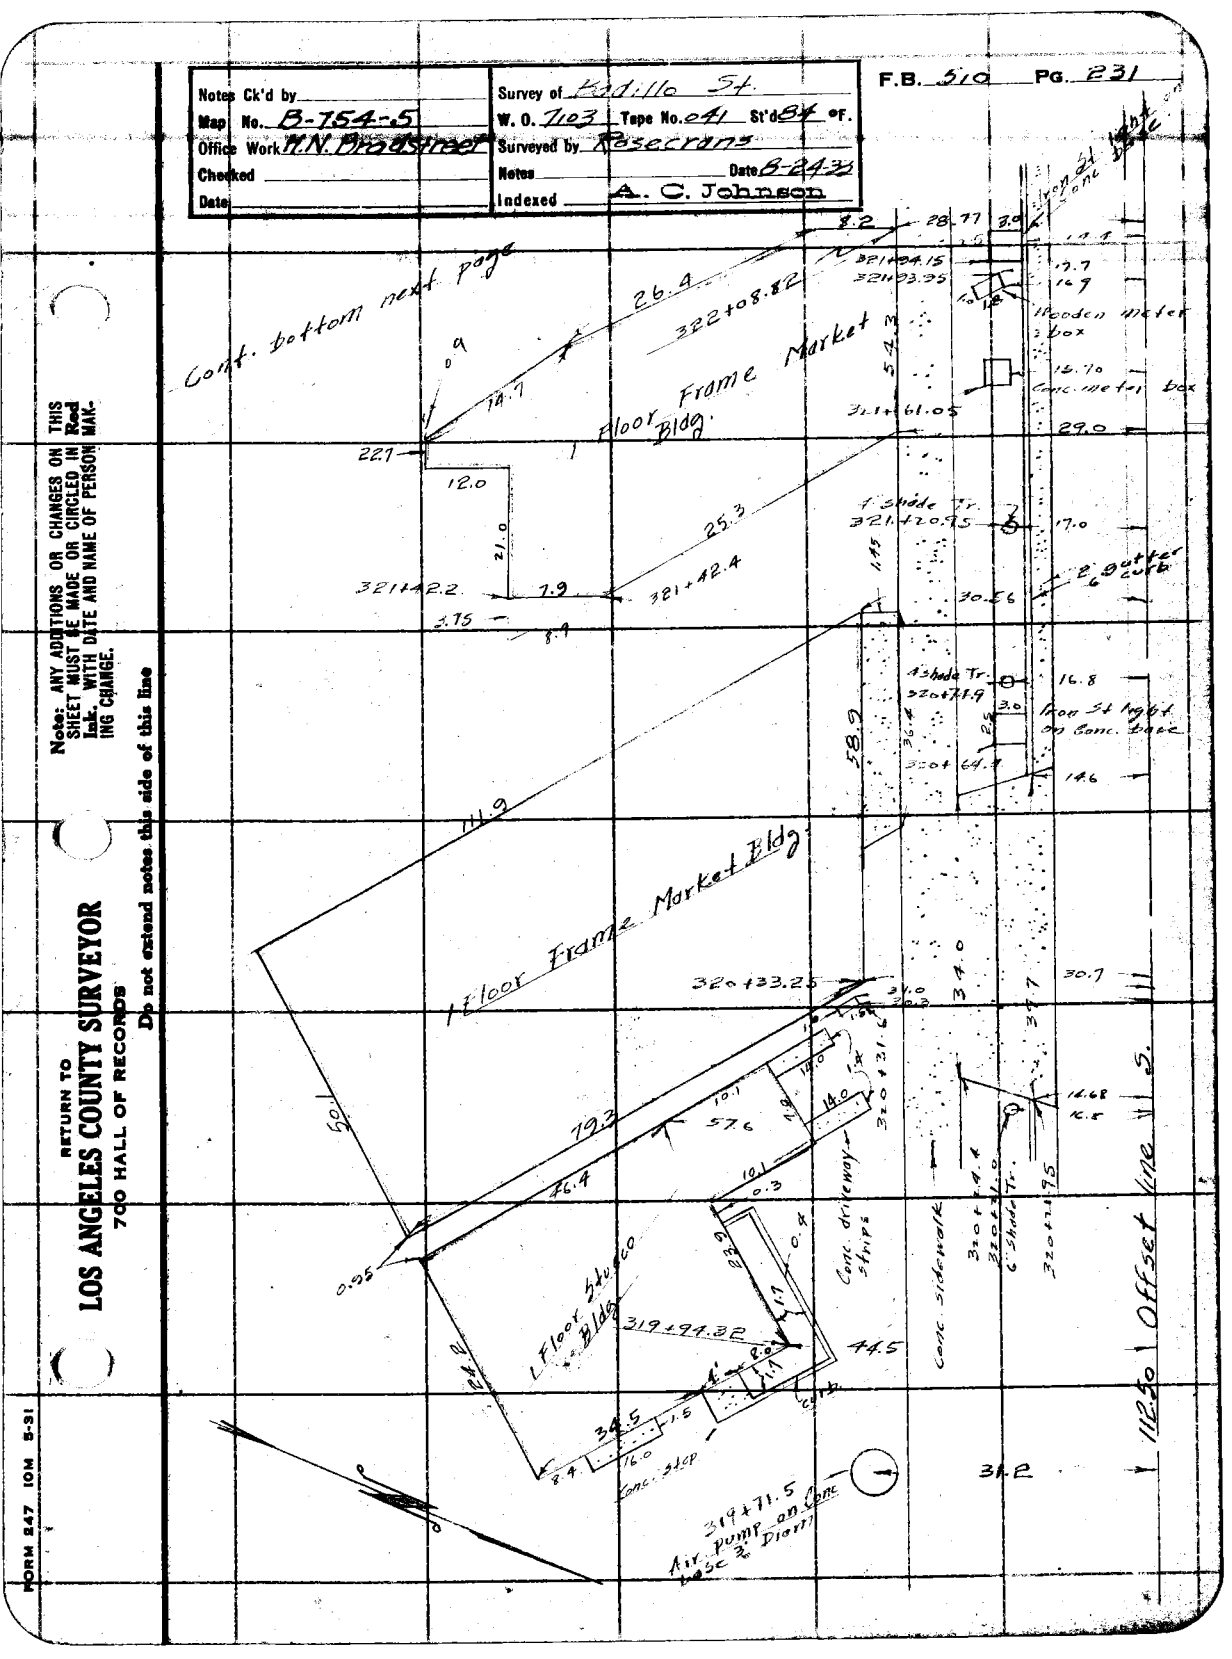

Notes: ANY ADDITIONS OR CHANGES ON THIS SHEET MUST BE MADE OR CIRCLED IN Red Ink, WITH DATE AND NAME OF PERSON MAKING CHANGE.

Do not extend notes this side of this line

RETURN TO
LOS ANGELES COUNTY SURVEYOR
700 HALL OF RECORDS

FORM 247 10M 5-31

F.B. 510 PG 232

RETURN TO
LOS ANGELES COUNTY SURVEYOR
700 HALL OF RECORDS
Do not extend notes this side of this line

Note: ANY ADDITIONS OR CHANGES ON THIS SHEET MUST BE MADE OR CIRCLED IN Red Ink. WITH DATE AND NAME OF PERSON MAKING CHANGE.

Notes Ck'd by	Survey of Badillo St.
Map No. B-754-5	W. O. 7103 Tape No. 041 St'd 84 °F.
Office Work H.N. Bradstreet	Surveyed by Rosecrans
Checked	Notes Date 9-11-33
Date	Indexed A. C. Johnson

F.B. 510 PG. 233

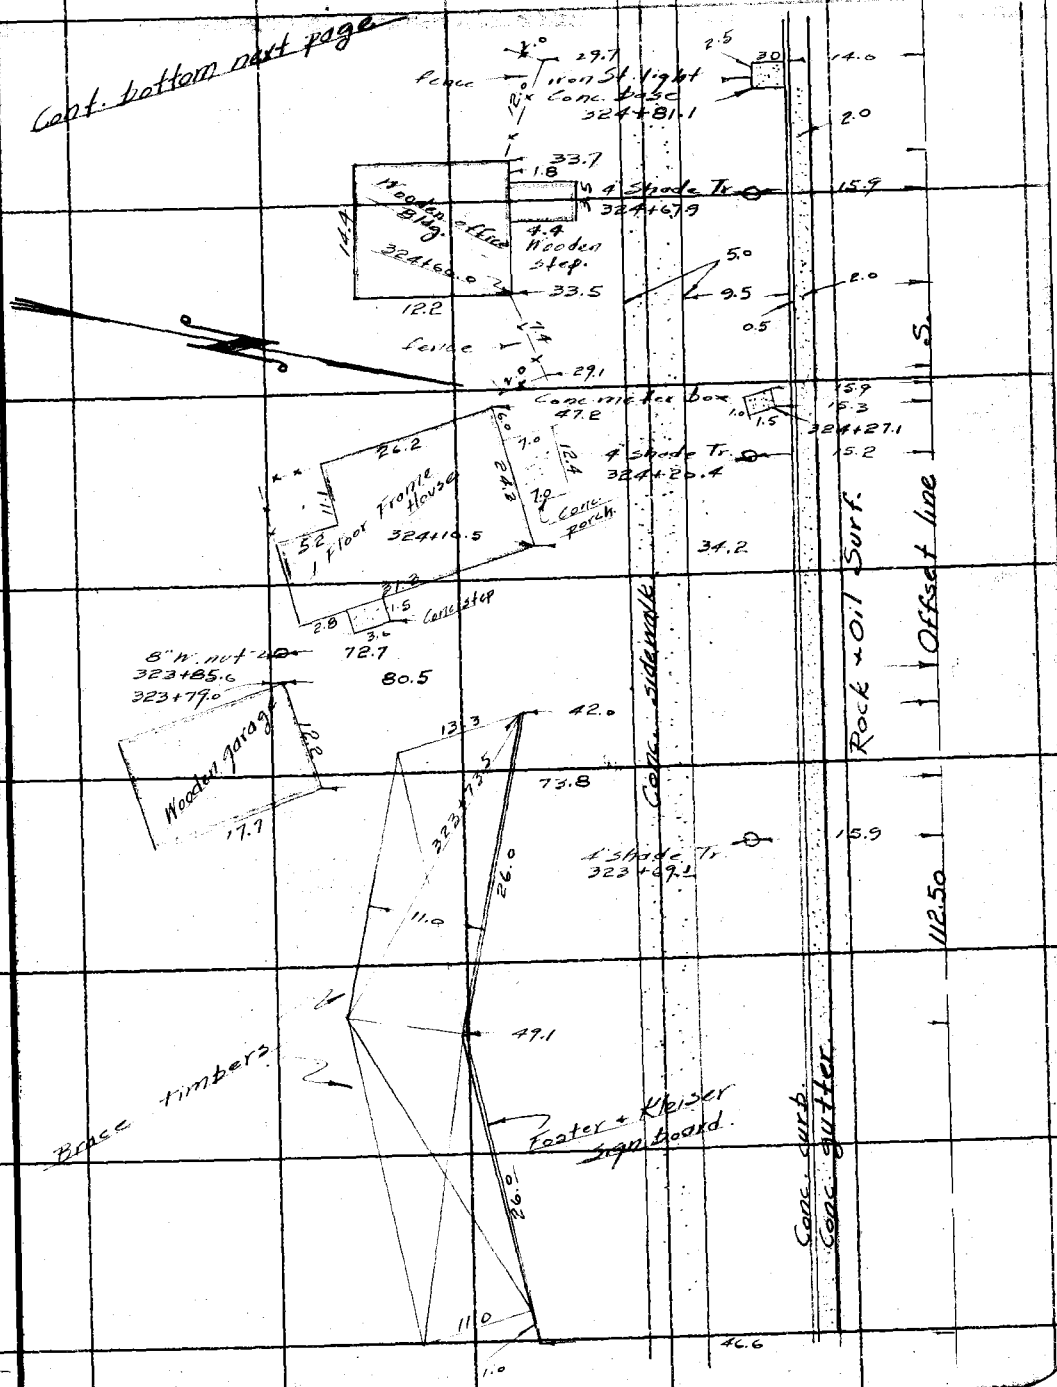

Note: ANY ADDITIONS OR CHANGES ON THIS SHEET MUST BE MADE OR CIRCLED IN Red Ink. WITH DATE AND NAME OF PERSON MAKING CHANGE.

Do not extend notes this side of this line

RETURN TO
LOS ANGELES COUNTY SURVEYOR
700 HALL OF RECORDS

FORM 247 10M 5-31

F.B. 510 Pg. 234

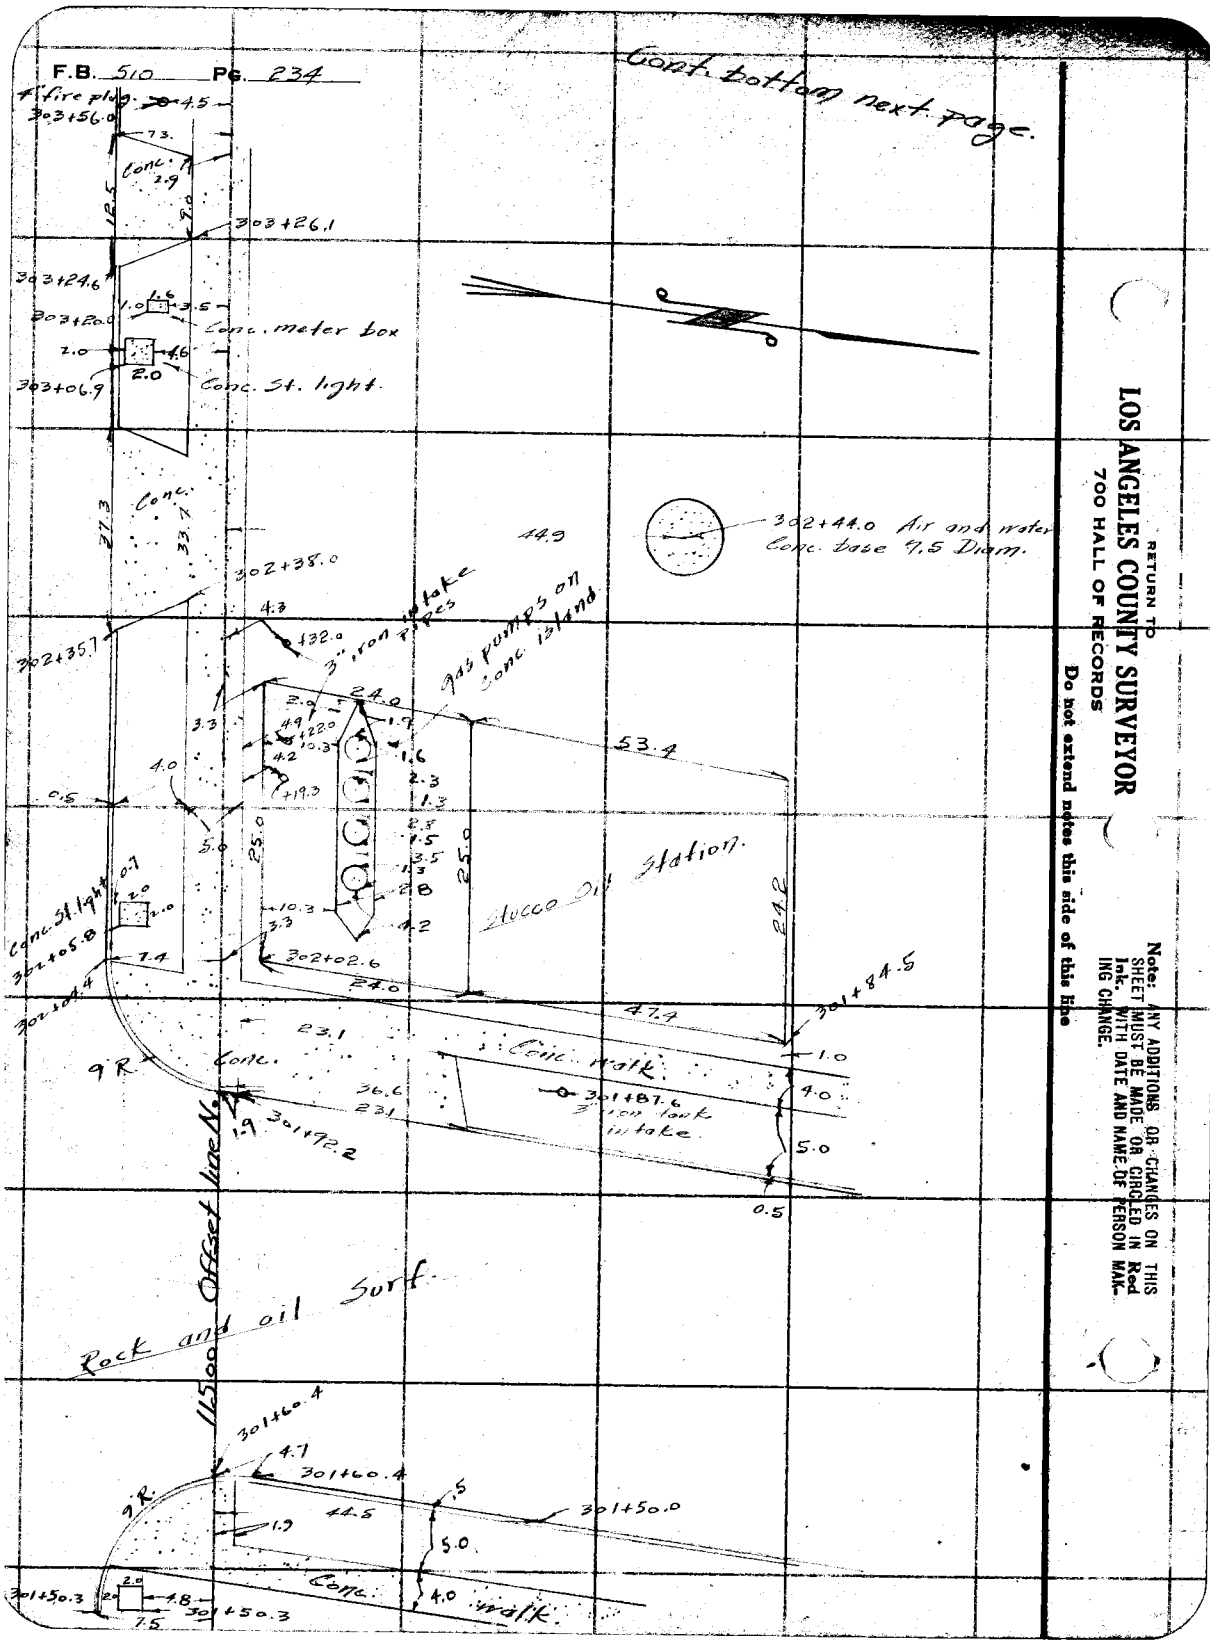

RETURN TO
LOS ANGELES COUNTY SURVEYOR
700 HALL OF RECORDS
Do not extend notes this side of this line

Note: ANY ADDITIONS OR CHANGES ON THIS SHEET MUST BE MADE OR CIRCLED IN Red Ink. WITH DATE AND NAME OF PERSON MAKING CHANGE.

Notes Ck'd by	Survey of Badillo St.
Map No. B-754-5	W. O. 7103 Tape No. 041 St'd 84°F.
Office Work H.N. Bradstreet	Surveyed by Rosecrans
Checked	Notes Date 7-11-33
Date	Indexed A. C. Johnson

F.B. 510 PG. 235

Cont. on bottom next page.

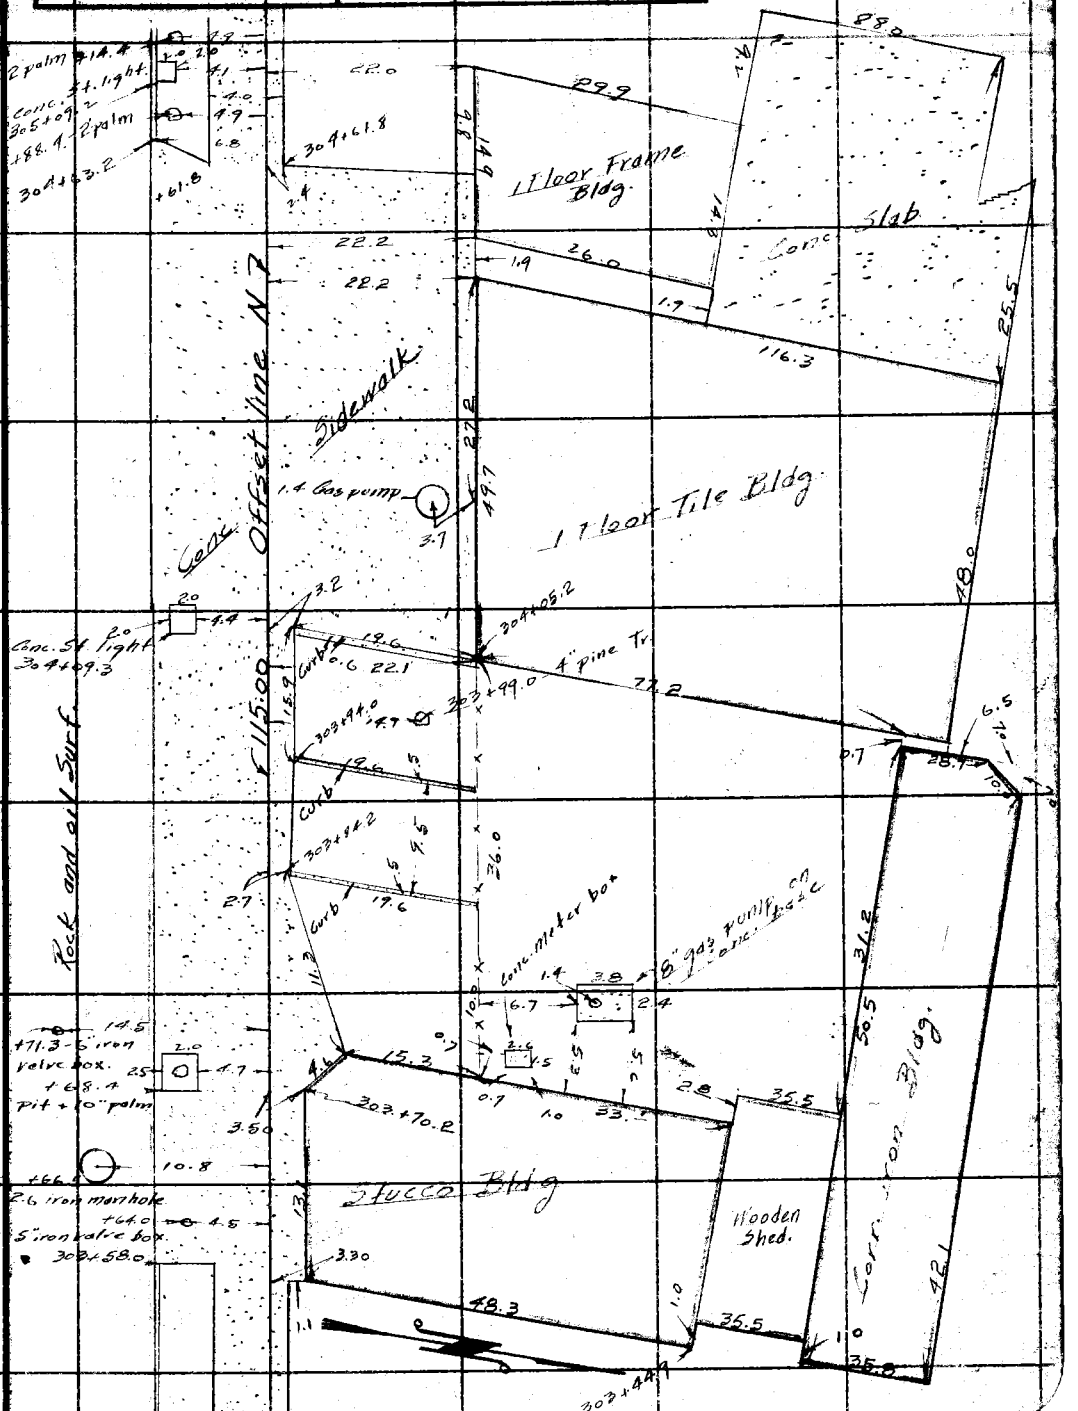

Note: ANY ADDITIONS OR CHANGES ON THIS SHEET MUST BE MADE OR CIRCLED IN Red Ink. WITH DATE AND NAME OF PERSON MAKING CHANGE.

Do not extend notes this side of this line

RETURN TO
LOS ANGELES COUNTY SURVEYOR
700 HALL OF RECORDS

FORM 247 10M 5-31

F.B. 510 Pg. 236

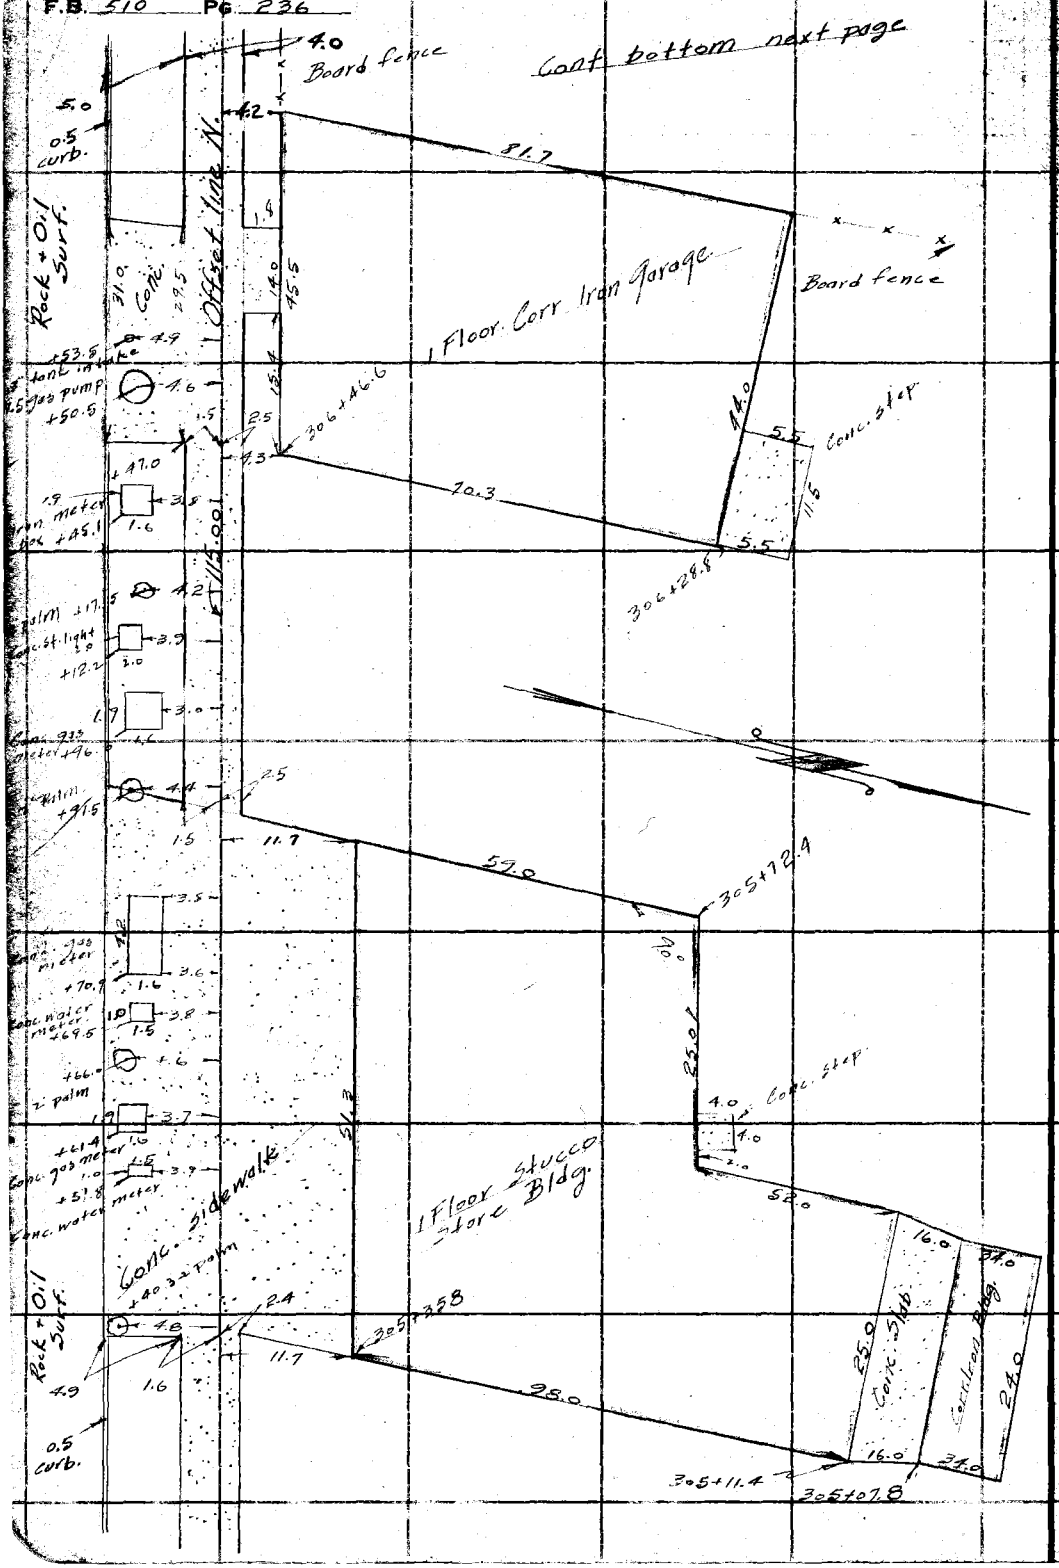

RETURN TO
LOS ANGELES COUNTY SURVEYOR
700 HALL OF RECORDS

Do not extend notes this side of this line

Note: ANY ADDITIONS OR CHANGES ON THIS SHEET MUST BE MADE OR CIRCLED IN **Red** Ink. WITH DATE AND NAME OF PERSON MAKING CHANGE.

Notes Ck'd by	Survey of Badillo St.
Map No. B-754-5	W. O. 7103 Tape No. 041 St'd 84 °F.
Office Work H.N. Bradstreet	Surveyed by Rosecrans
Checked	Notes Date 9-12-33
Date	Indexed A. C. Johnson

F.B. 510 PG. 237

Cont. on bottom next page.

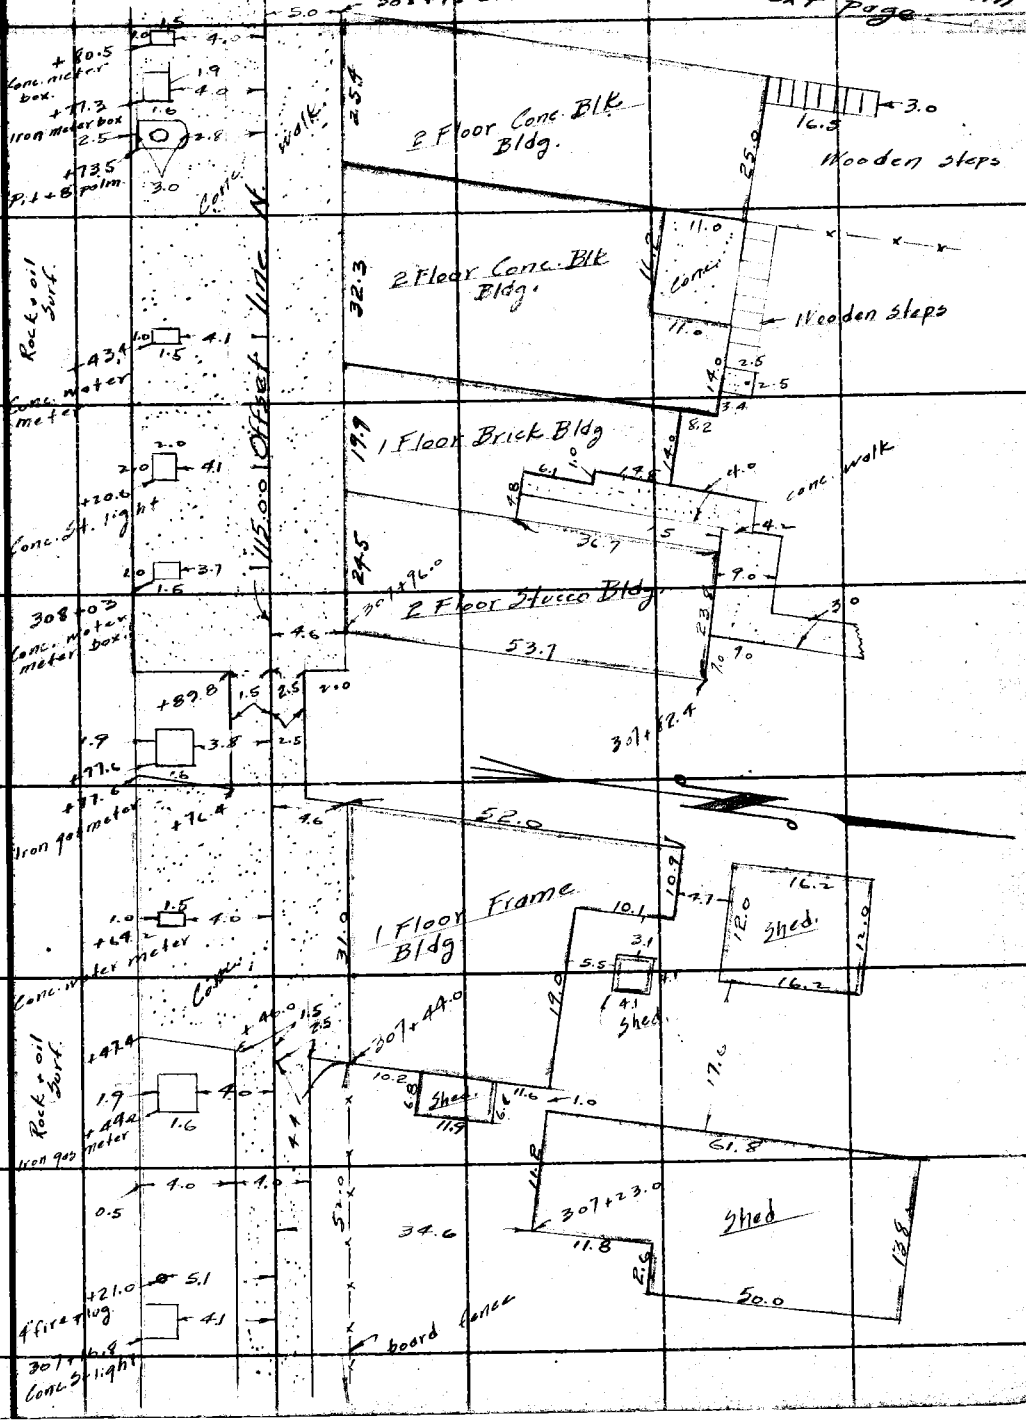

Note: ANY ADDITIONS OR CHANGES ON THIS SHEET MUST BE MADE OR CIRCLED IN Red Ink. WITH DATE AND NAME OF PERSON MAKING CHANGE.

Do not extend notes this side of this line

RETURN TO
LOS ANGELES COUNTY SURVEYOR
700 HALL OF RECORDS

FORM 247 10M 5-31

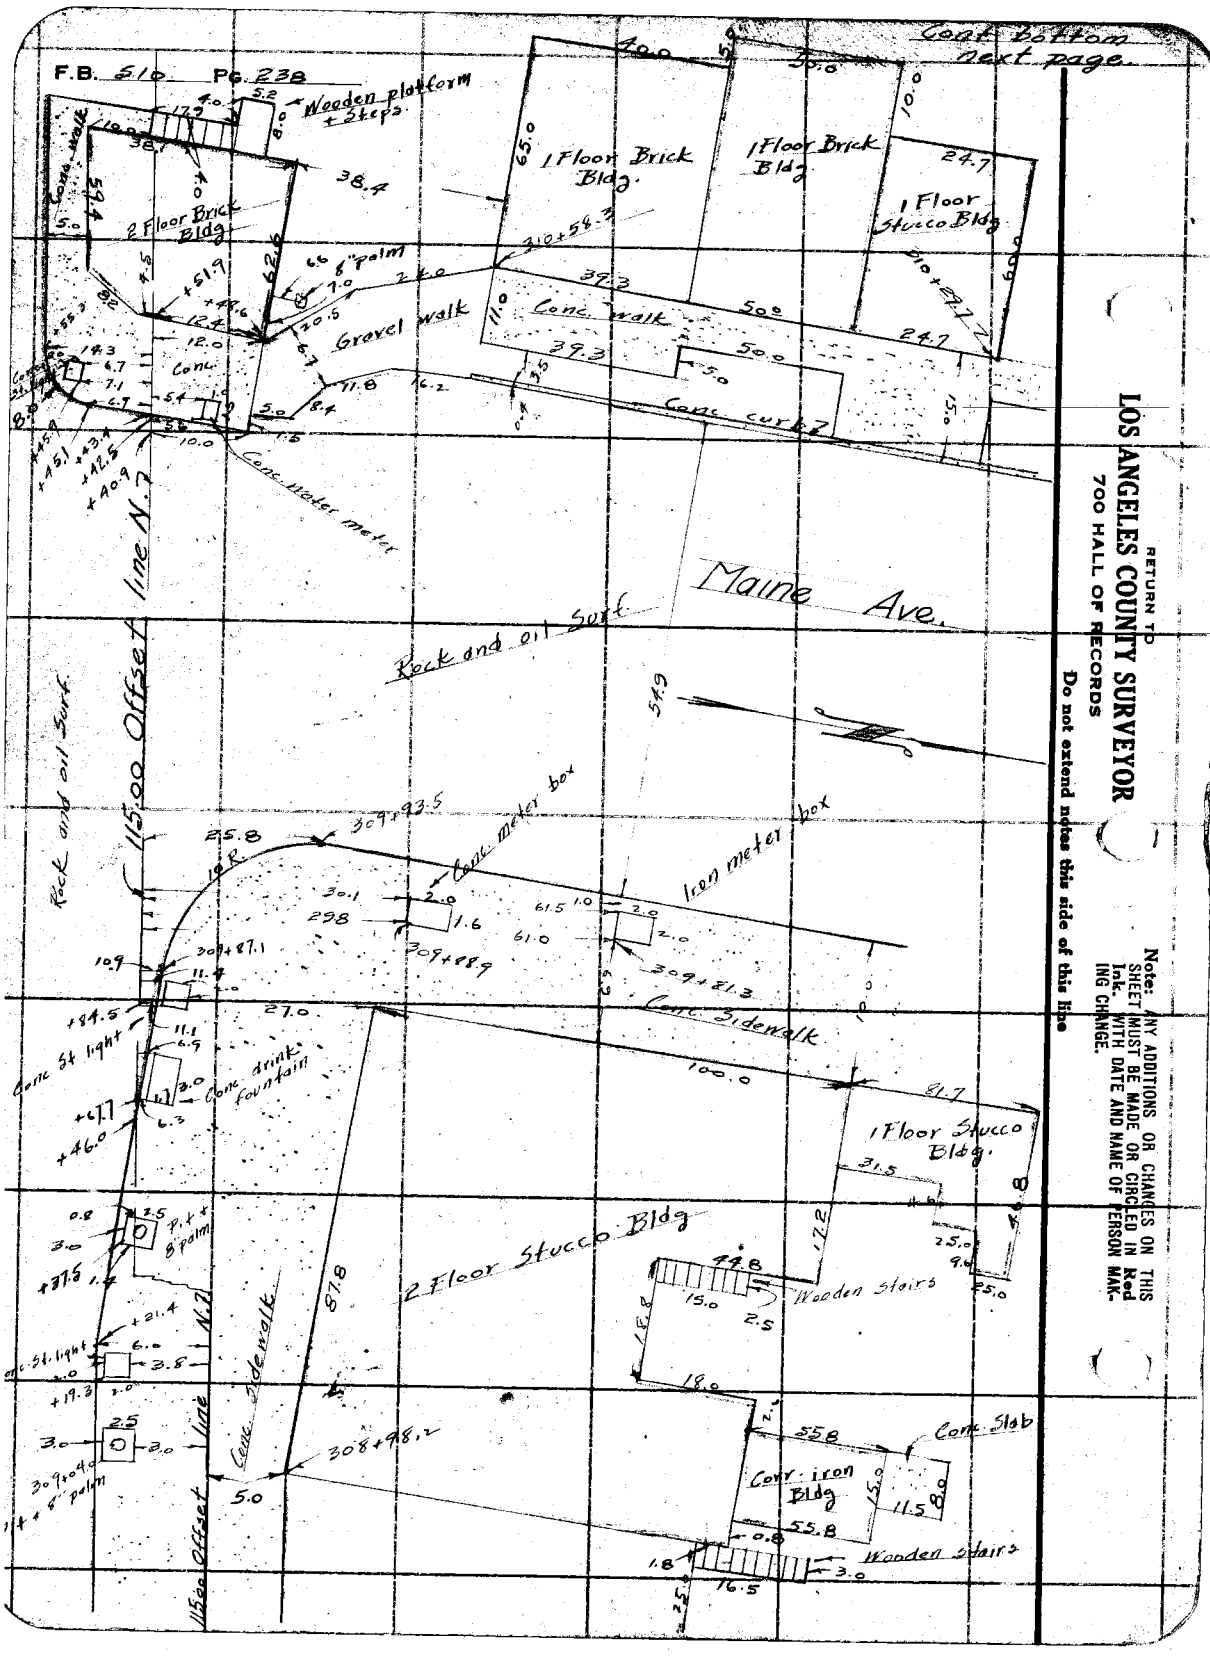

RETURN TO
LOS ANGELES COUNTY SURVEYOR
700 HALL OF RECORDS

Do not extend notes this side of this line

Note: ANY ADDITIONS OR CHANGES ON THIS SHEET MUST BE MADE OR CIRCLED IN Red Ink. WITH DATE AND NAME OF PERSON MAKING CHANGE.

Notes Ck'd by	Survey of Bastillo St.
Map No. B-754-5	W. O. 7103 Tape No. 041 St'd 84 °F.
Office Work H.H. Bradstreet	Surveyed by Rosecrans
Checked	Notes Date 7-12-33
Date	Indexed A. C. Johnson

F.B. 510 PG. 239

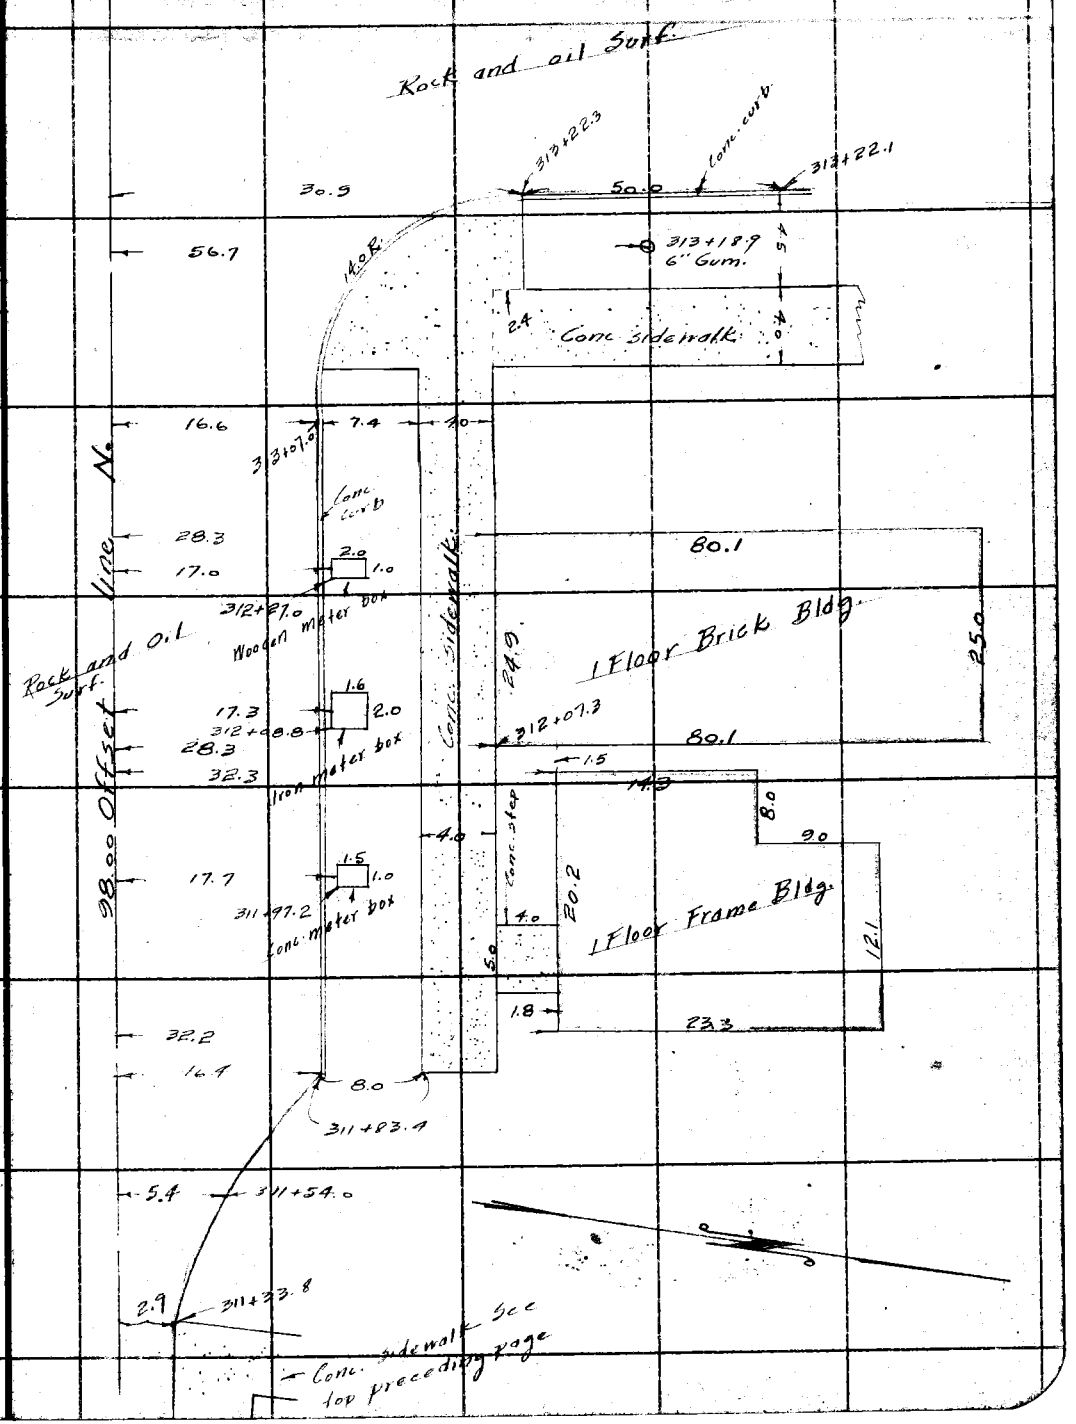

Note: ANY ADDITIONS OR CHANGES ON THIS SHEET MUST BE MADE OR CIRCLED IN Red Ink. WITH DATE AND NAME OF PERSON MAKING CHANGE.

Do not extend notes this side of this line

RETURN TO
LOS ANGELES COUNTY SURVEYOR
700 HALL OF RECORDS

FORM 247 10M 5-31

F.B. 510 PG. 240

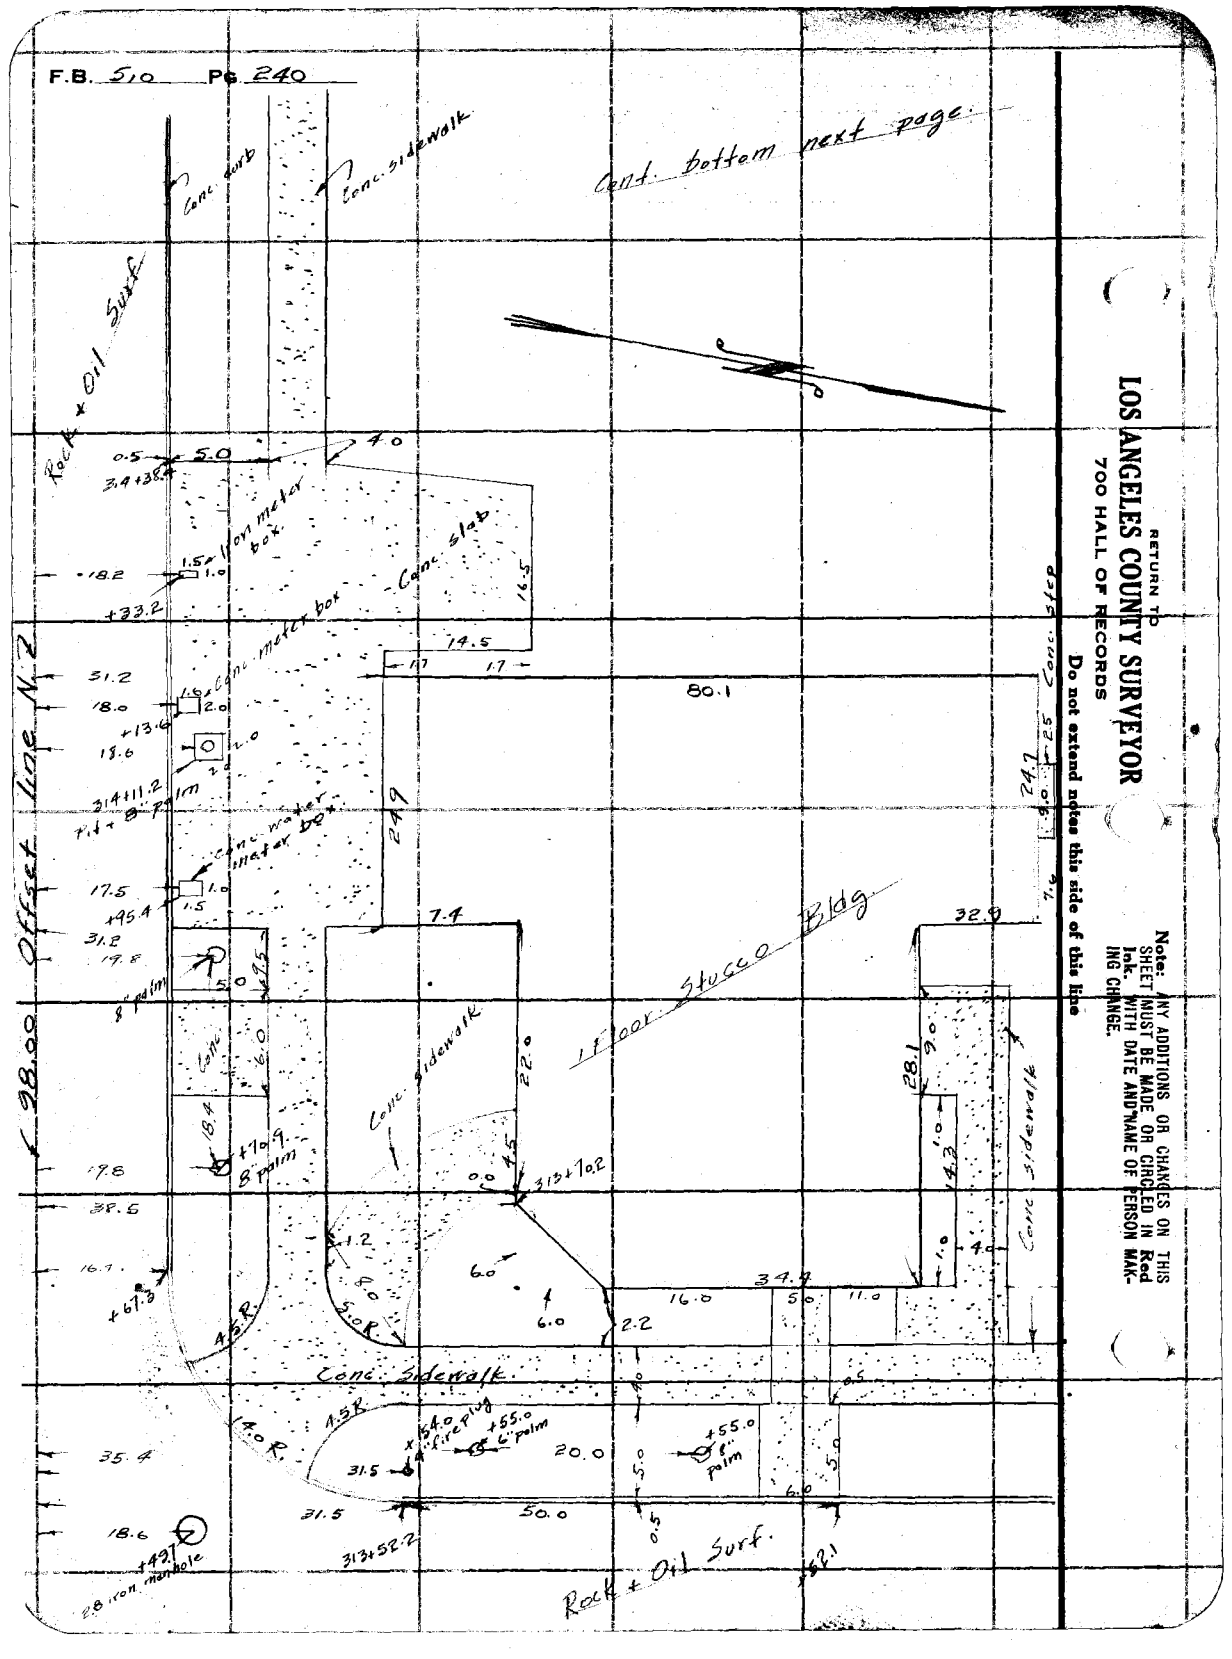

RETURN TO
LOS ANGELES COUNTY SURVEYOR
700 HALL OF RECORDS

Do not extend notes this side of this line

Note: ANY ADDITIONS OR CHANGES ON THIS SHEET MUST BE MADE OR CIRCLED IN Red Ink. WITH DATE AND NAME OF PERSON MAKING CHANGE.

Notes Ck'd by	Survey of Badillo St.
Map No. B754-5	W. O. 7103 Tape No. 041 St'd 84 °F.
Office Work N.N. Bradstreet	Surveyed by Rosecrans
Checked	Notes Date 9-13-33
Date	Indexed A. C. Johnson

F.B. 510 PG. 241

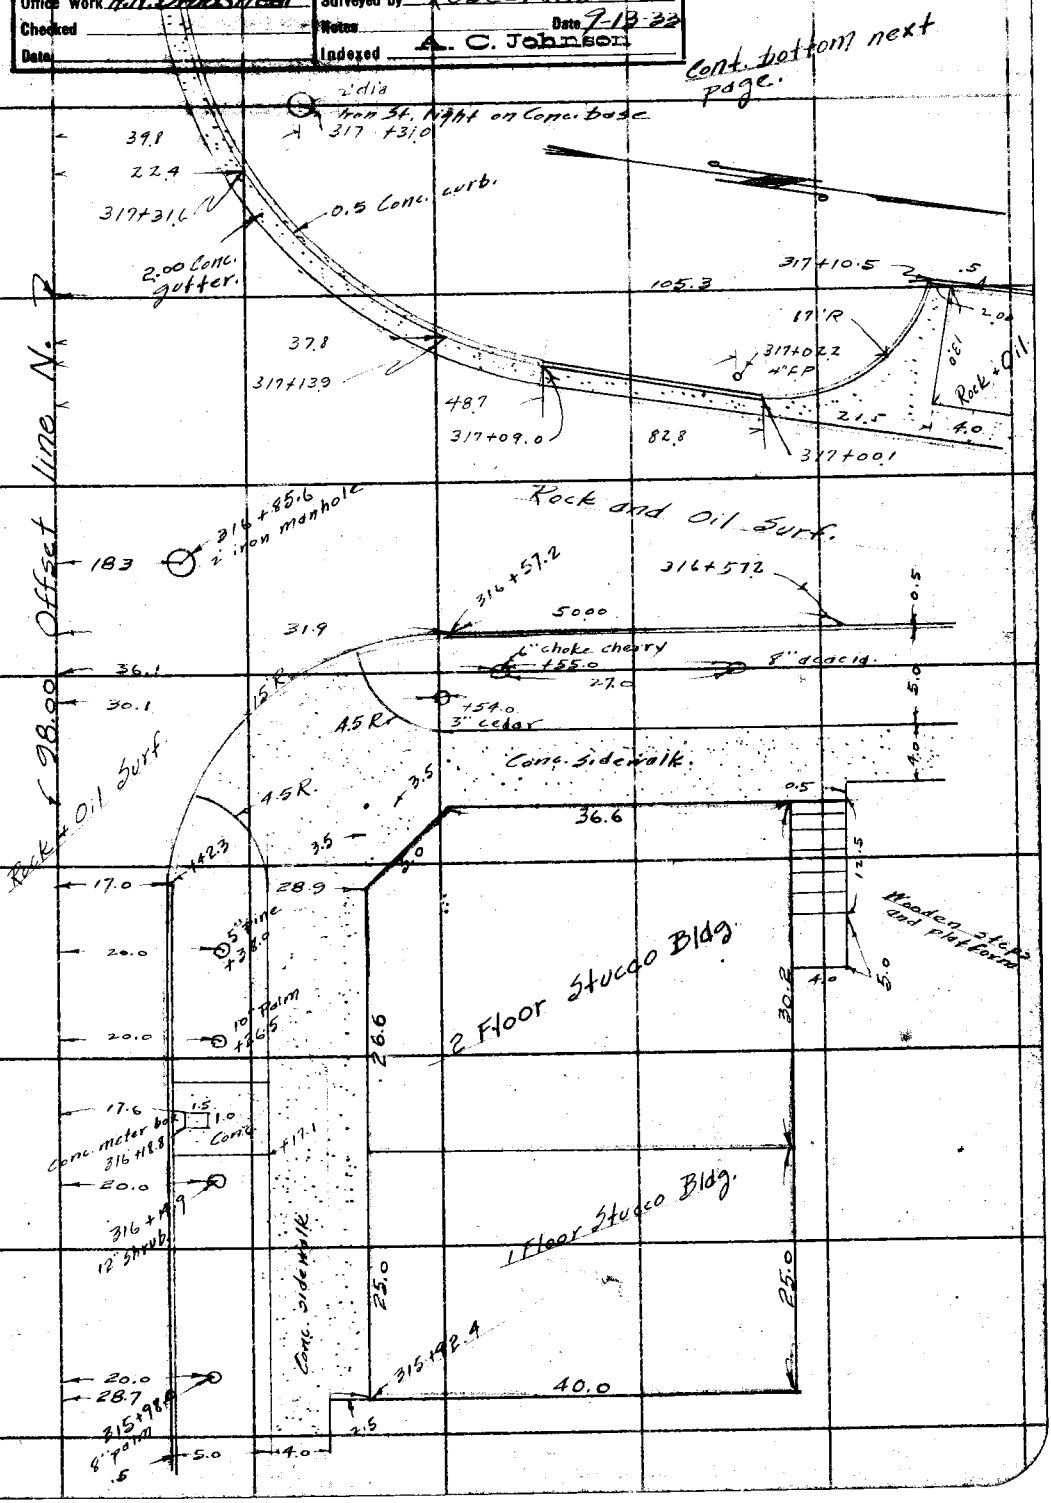

Note: ANY ADDITIONS OR CHANGES ON THIS SHEET MUST BE MADE OR CIRCLED IN Red Ink. WITH DATE AND NAME OF PERSON MAKING CHANGE.

Do not extend notes this side of this line

RETURN TO
LOS ANGELES COUNTY SURVEYOR
700 HALL OF RECORDS

FORM 247 10M 5-31

F.B. 510 PG 242

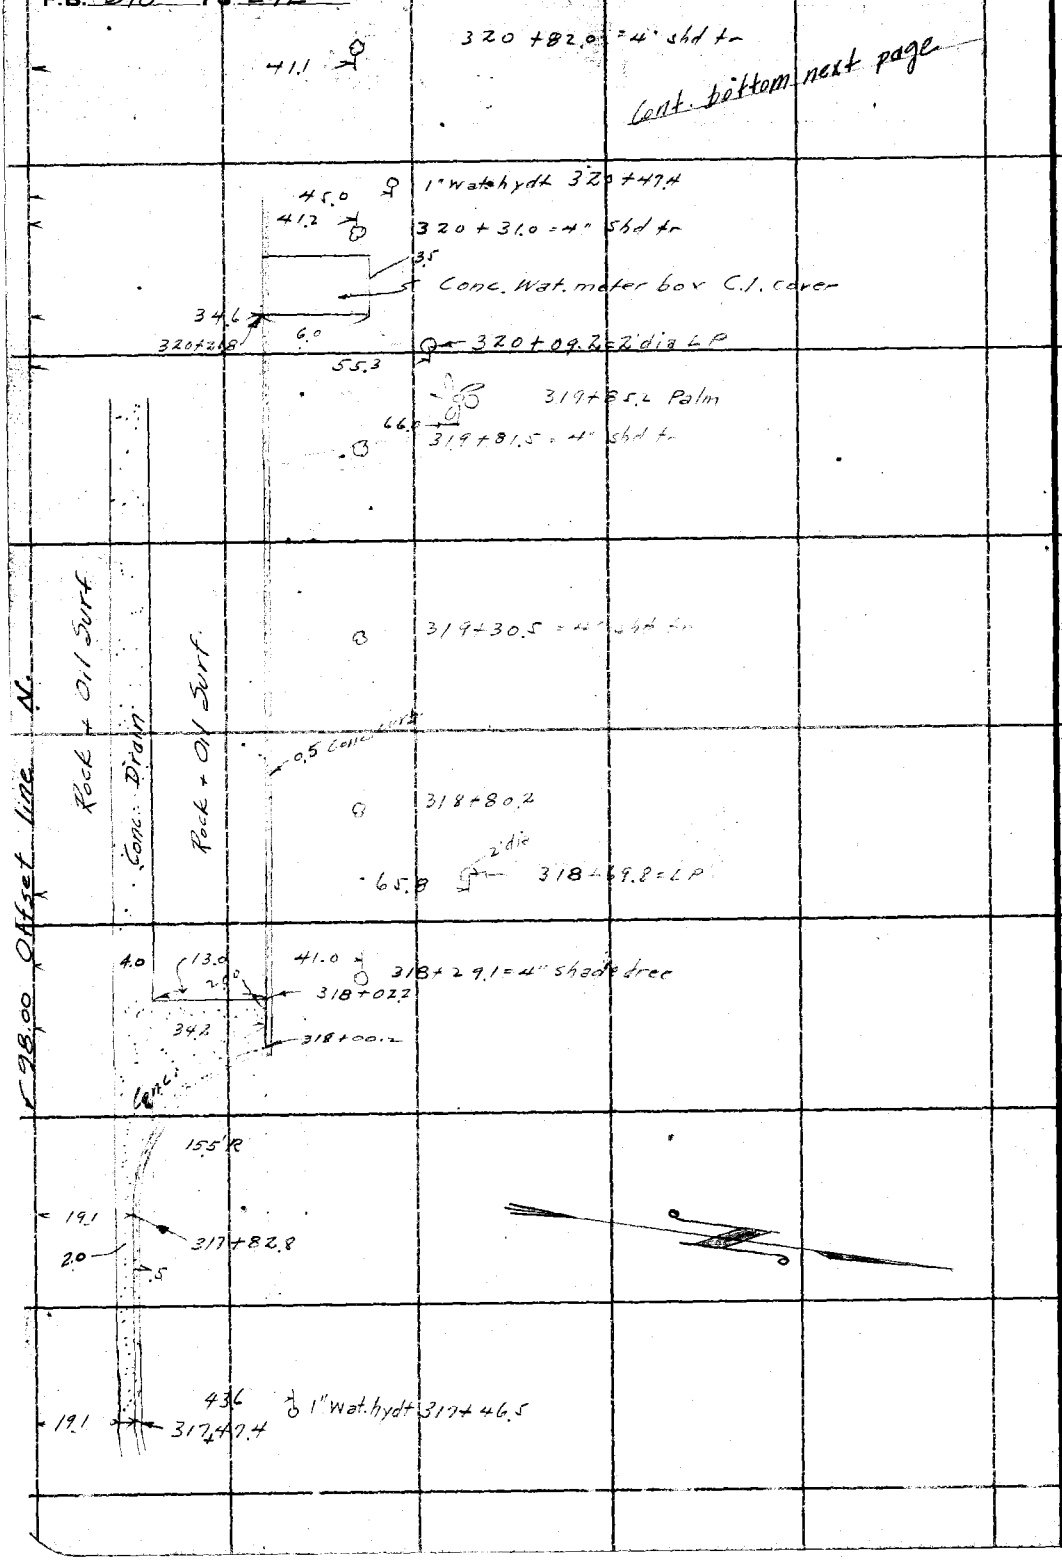

RETURN TO
LOS ANGELES COUNTY SURVEYOR
700 HALL OF RECORDS
Do not extend notes this side of this line

Note: ANY ADDITIONS OR CHANGES ON THIS SHEET MUST BE MADE OR CIRCLED IN Red Ink. WITH DATE AND NAME OF PERSON MAKING CHANGE.

Notes Ck'd by	Survey of Padillo St.
Map No. B-754-5	W. O. 7103 Tape No. 041 St'd 84 °F.
Office Work H.N. Bradstreet	Surveyed by Rosecrans
Checked	Notes Date 9-13-33
Date	Indexed A. C. Johnson

F.B. 510 PG. 243

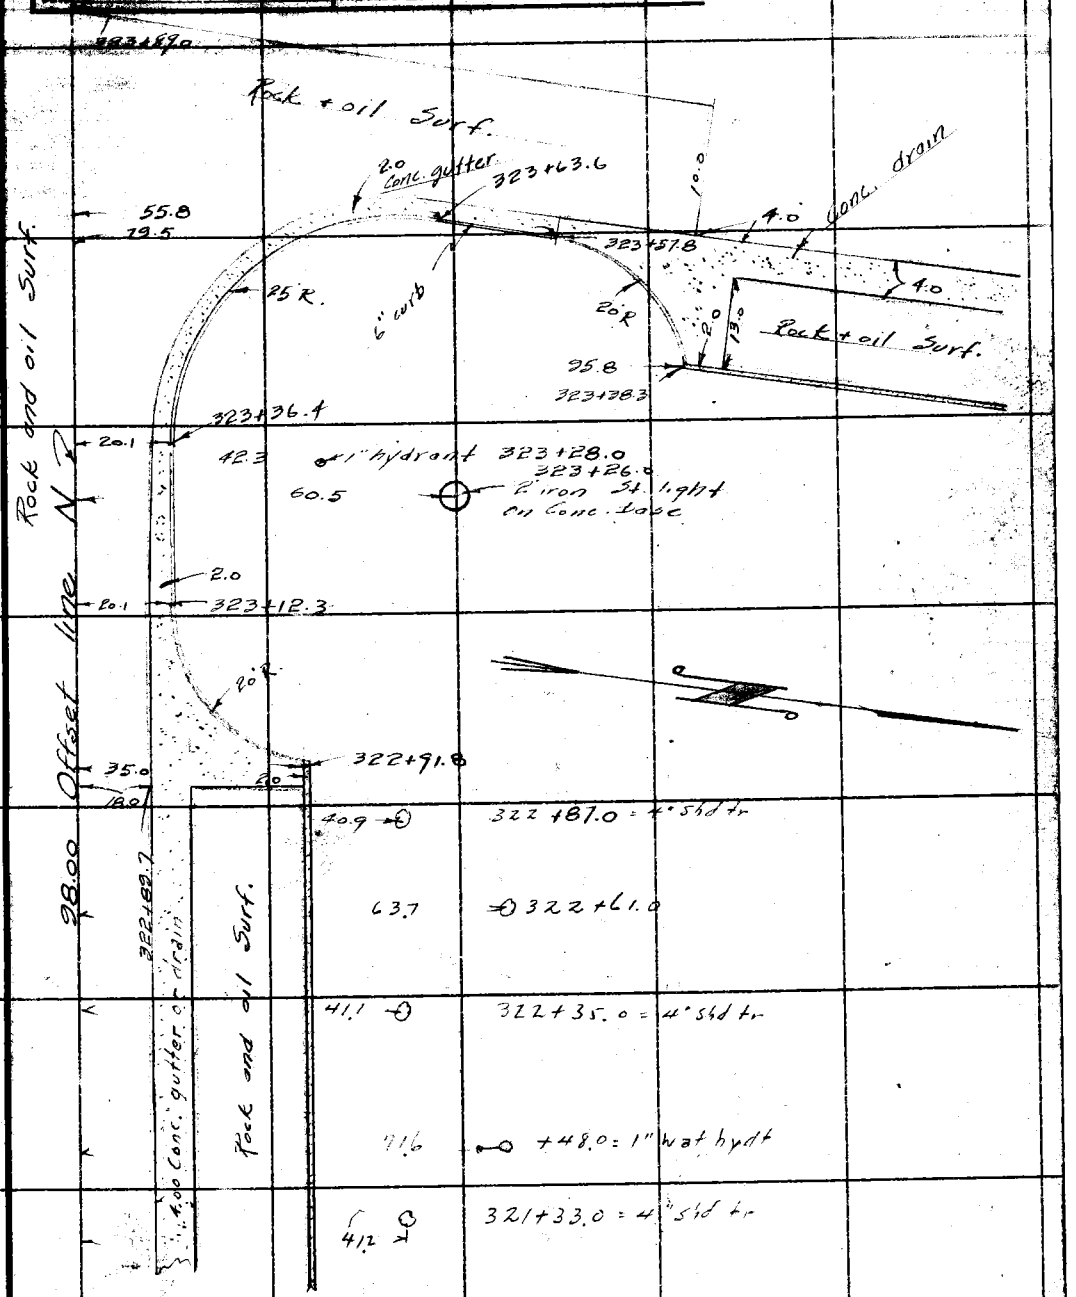

Note: ANY ADDITIONS OR CHANGES ON THIS SHEET MUST BE MADE OR CIRCLED IN Red Ink, WITH DATE AND NAME OF PERSON MAKING CHANGE.

RETURN TO
LOS ANGELES COUNTY SURVEYOR
700 HALL OF RECORDS

Do not extend notes this side of this line

FORM 247 10M 5-31

RETURN TO

LOS ANGELES COUNTY SURVEYOR

700 HALL OF RECORDS

Note: ANY ADDITIONS OR CHANGES ON THIS SHEET MUST BE MADE OR CIRCLED IN Red Ink. WITH DATE AND NAME OF PERSON MAKING CHANGE.

Do not extend notes this side of this line

F.B. 510 Pg. 244

Notes Ck'd by D. M. Finley	Survey of Badillo St.	F.B. 510 Pg. 245
Map No. B 10	W. O. 7103 Tape No 067 St'd 84 °F.	
Office Work	Surveyed by Evans	
Checked	Notes 12 Date 1/14/33	
Date	Indexed A. C. Johnson 1-17-35	

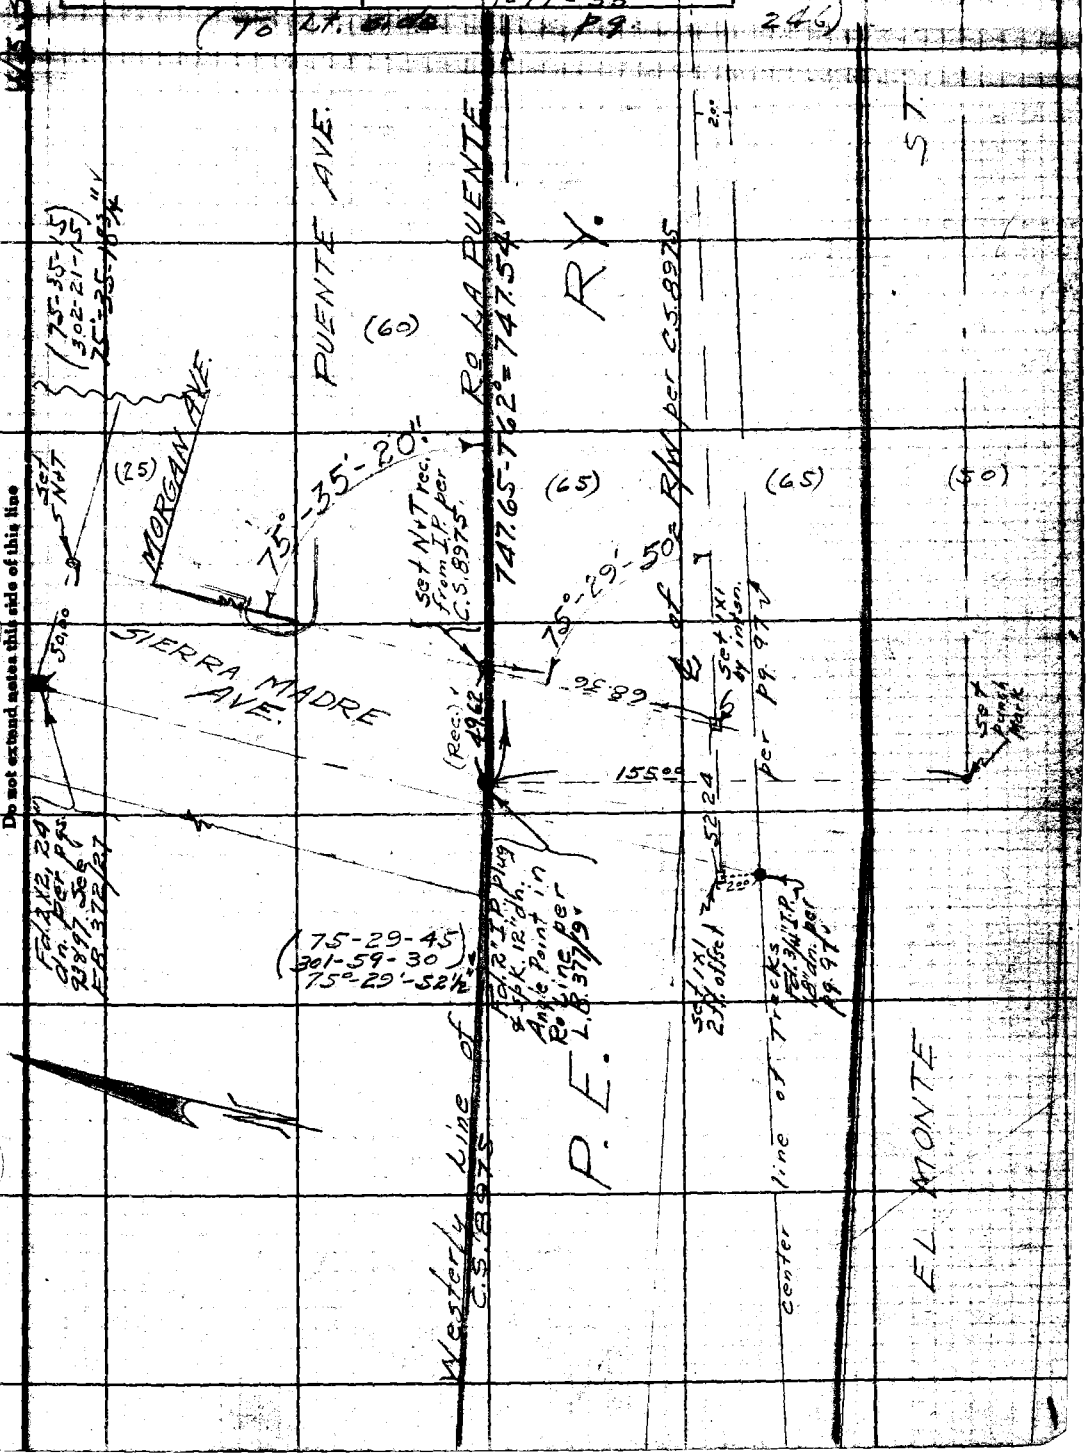

Note: ANY ADDITIONS OR CHANGES ON THIS SHEET MUST BE MADE OR CIRCLED IN Red Ink WITH DATE AND NAME OF PERSON MAKING CHANGE.

Do not extend notes this side of this line

RETURN TO
OS ANGELES COUNTY SURVEYOR
700 HALL OF RECORDS

FORM 247 5M 2-34

RETURN TO
LOS ANGELES COUNTY SURVEYOR
700 HALL OF RECORDS

Note: ANY ADDITIONS OR CHANGES ON THIS SHEET MUST BE MADE OR CIRCLED IN Red Ink WITH DATE AND NAME OF PERSON MAKING CHANGE.

W.S. 46D-4

Do not extend notes this side of this line

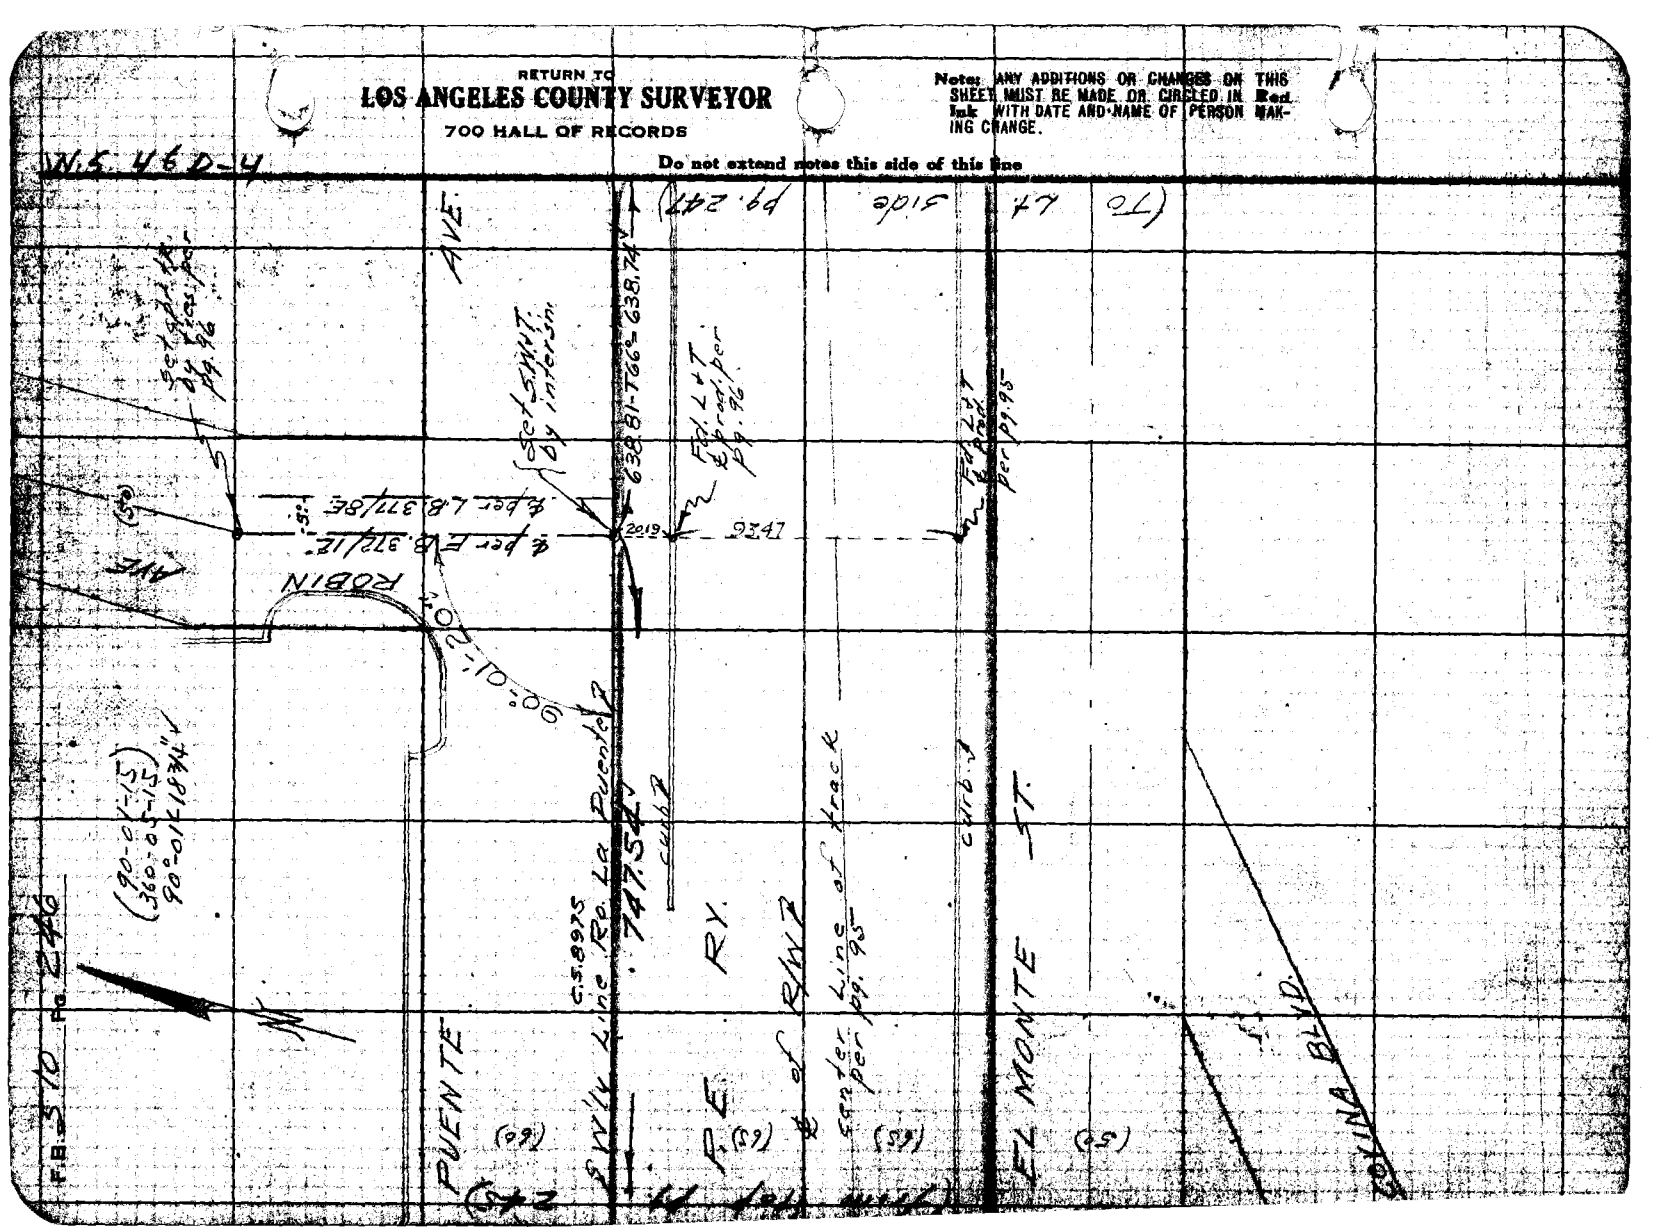

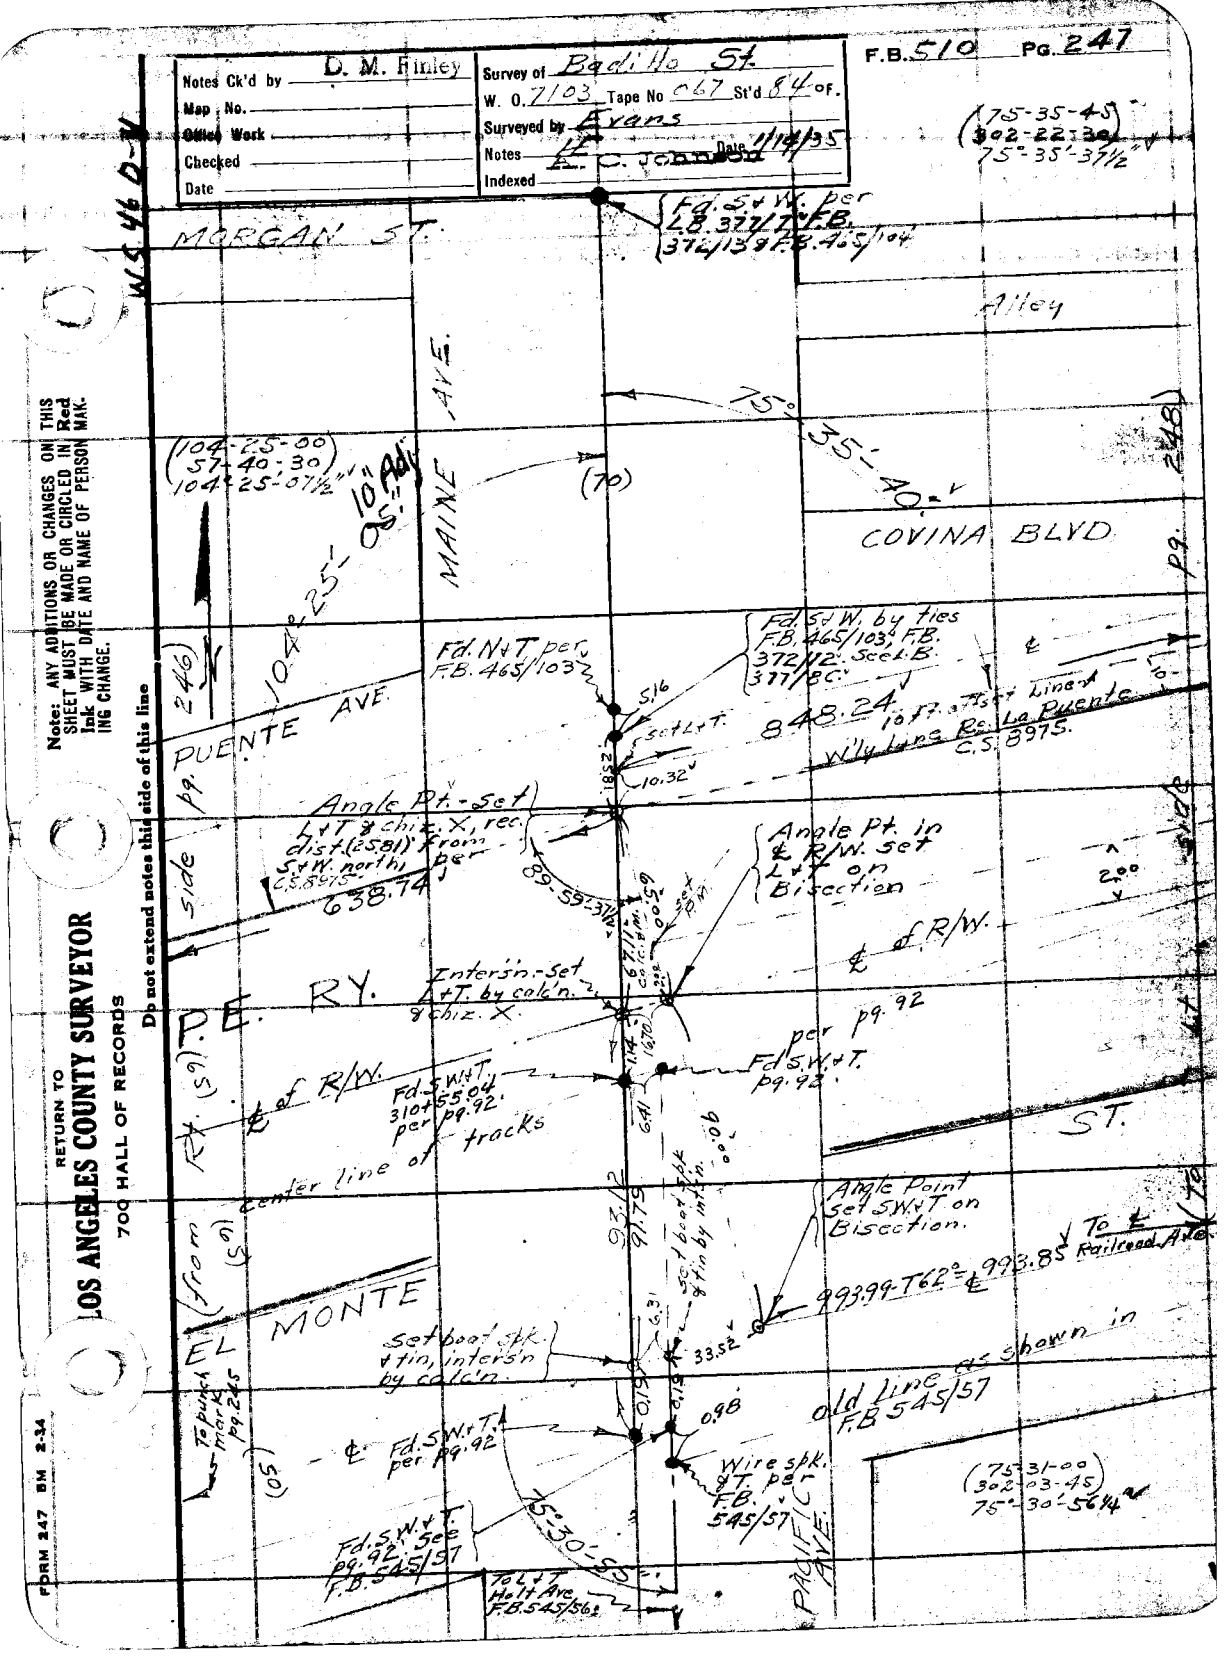
Notes Ck'd by D. M. Finley
Map No.
Office Work
Checked
Date
Survey of Padilla St.
W. O. 7103 Tape No C67 St'd 84 OF.
Surveyed by Evans
Notes E. C. Johnson Date 11/14/35
Indexed
F.B. 510 PG. 247
MORGAN ST.
W'LY 46.0'
Fd. S. & W. per L.B. 377/7 F.B. 374/139 F.B. 465/104
Alley
MAINE AVE.
(104°25'00" 57°40'30" 104°25'07½" 10 Adj 05')
(70)
35°40'
COVINA BLVD
Pg. 248
Fd. N. & T. per F.B. 465/103
Fd. S. & W. by ties F.B. 465/103, F.B. 372/12, Sect. B. 377/BC
PUENTE AVE.
Pg. 246
side
516
Set L. & T.
10.32
1822
848.24
1017.4 "A" Line
W'ly Line Rs. La Puente C.S. 8975.
Angle Pt. - Set L. & T. & chiz. X, rec. dist. (2581') from S. & W. northly per C.S. 8975.
638.74
89°59'31½"
Angle Pt. in ℄ R/W. set L. & T. on Bisection
℄ of R/W.
2.00
P.E. RY.
Inters'n. - Set L. & T. by calc'n. & chiz. X.
R/W. (S)
℄ of R/W.
Fd. S. & W. & T. 310/55.64 per pg. 92.
per pg. 92
Fd. S. W. & T. pg. 92.
ST.
Center line of tracks
(From (S)
EL MONTE
Angle Point Set S. W. & T. on Bisection.
999.99 T 62° ℄ 998.85 To ℄ Railroad Ave.
Set boot spk. & tin, inters'n by calc'n.
33.52
To Point of Beg. pg. 245
(05)
℄ Fd. S. W. & T. per pg. 92
0.98
Wire spk. & T. per F.B. 545/57
old line as shown in F.B. 545/57
(75°31'00" 30°03'45" 75°30'56½")
Fd. S. W. & T. See pg. 92 F.B. 545/57
15°30'52"
To L. & T. Holt Ave. F.B. 545/56
PACIFIC AVE.
RETURN TO
LOS ANGELES COUNTY SURVEYOR
700 HALL OF RECORDS
Do not extend notes this side of this line
Note: ANY ADDITIONS OR CHANGES ON THIS SHEET MUST BE MADE OR CIRCLED IN Red Ink WITH DATE AND NAME OF PERSON MAKING CHANGE.
FORM 247 BM 2-34

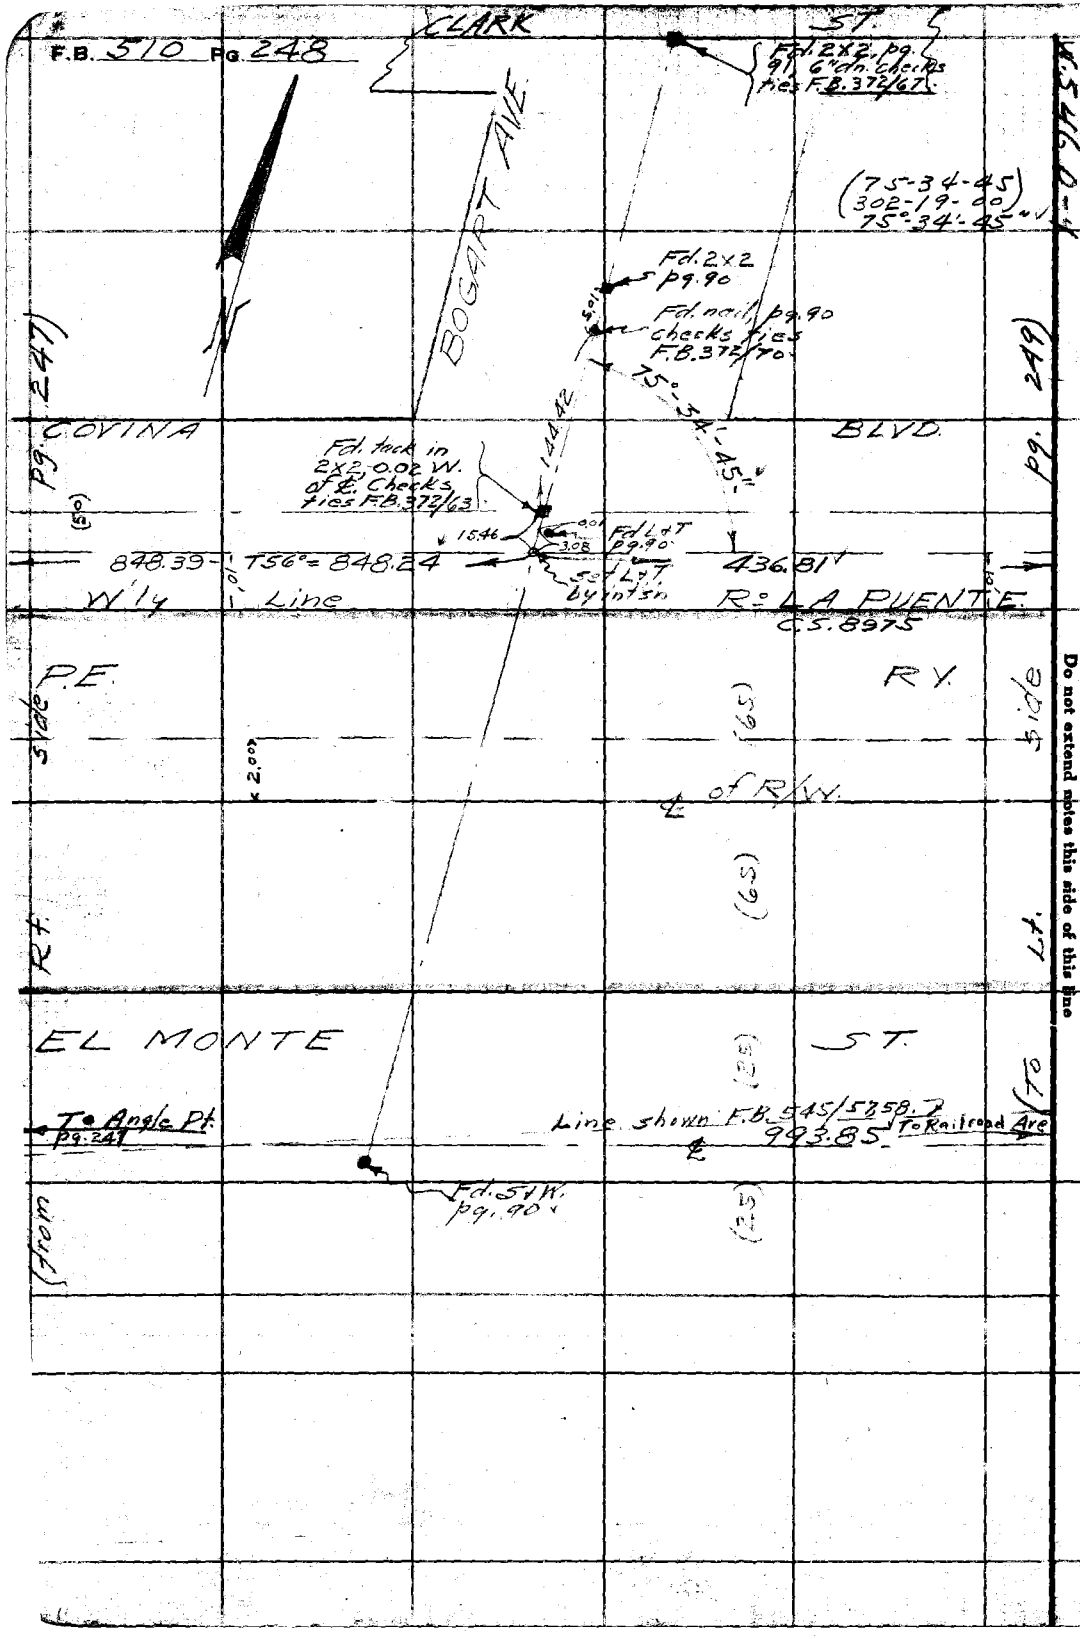

RETURN TO
LOS ANGELES COUNTY SURVEYOR
700 HALL OF RECORDS

Do not extend notes this side of this line

Note: ANY ADDITIONS OR CHANGES ON THIS SHEET MUST BE MADE OR CIRCLED IN Red Ink WITH DATE AND NAME OF PERSON MAKING CHANGE.

Notes Ck'd by D. M. Finley	Survey of Badillo St.
Map No.	W. O. 7103 Tape No 267 St'd 59 OF.
Office Work	Surveyed by Evans
Checked	Notes HE Date 1/15/35
Date	Indexed A. C. Johnson

F.B. 510 PG. 249

W.S. 416 D-4

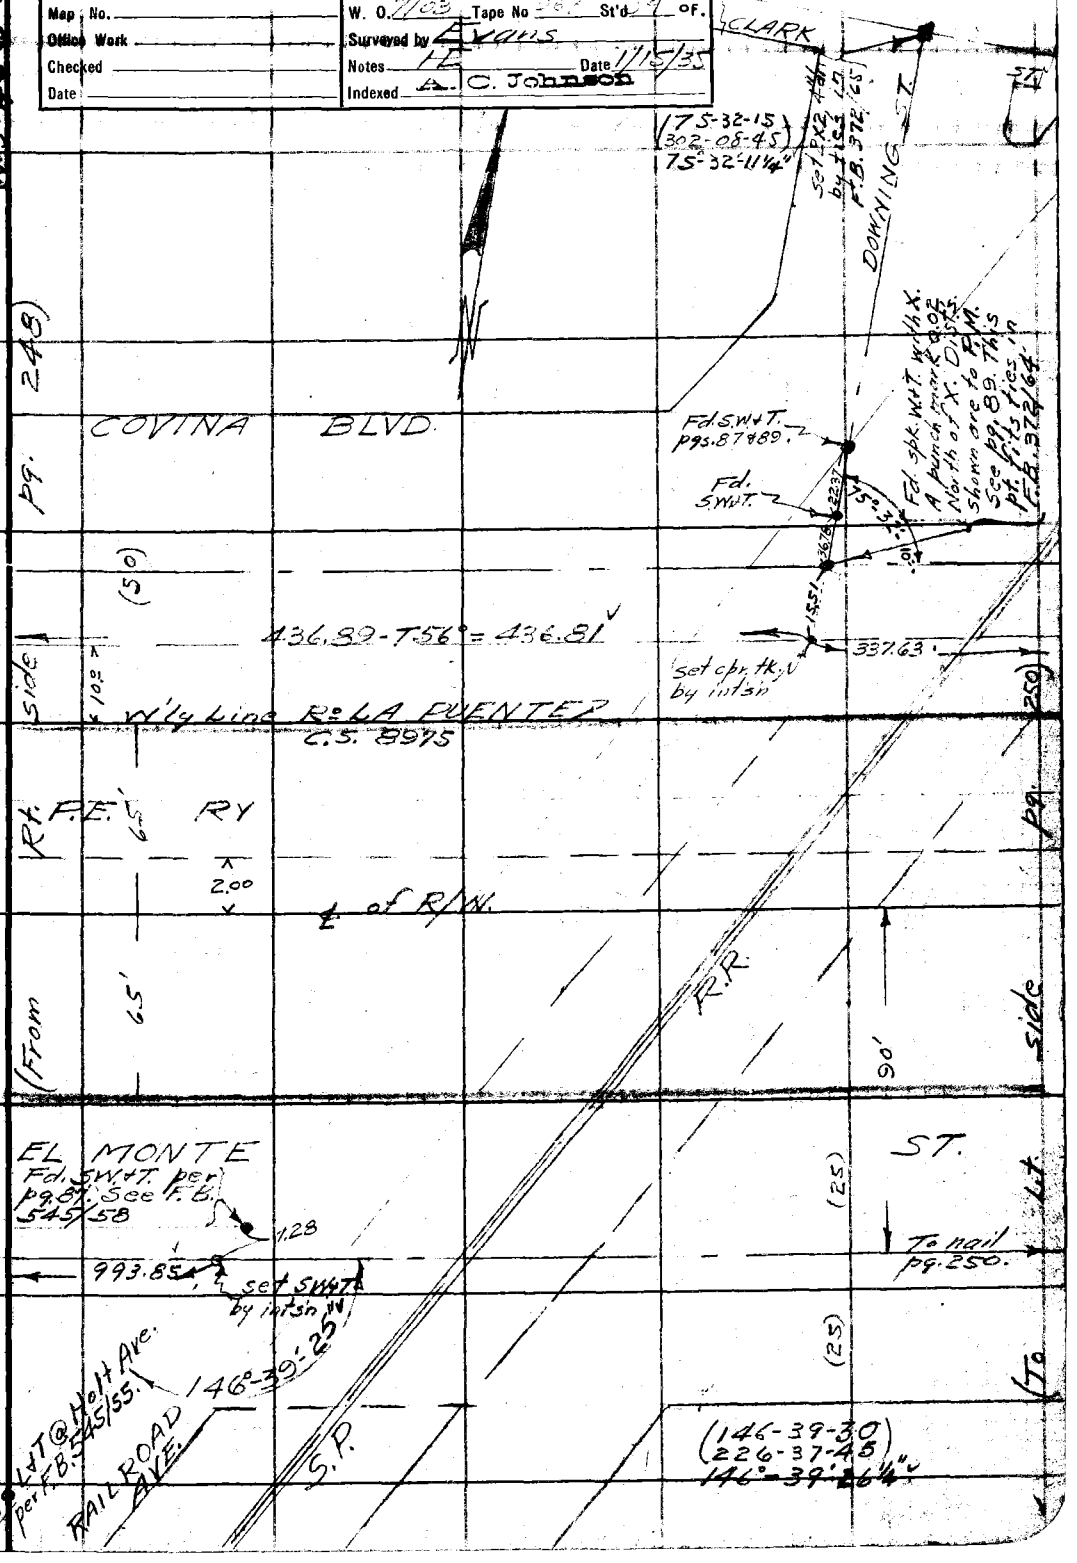

Note: ANY ADDITIONS OR CHANGES ON THIS SHEET MUST BE MADE OR CIRCLED IN Red Ink WITH DATE AND NAME OF PERSON MAKING CHANGE.

Do not extend notes this side of this line

RETURN TO
LOS ANGELES COUNTY SURVEYOR
700 HALL OF RECORDS

FORM 247 BM 2-34

F.B. 510 Pg. 250

RETURN TO
LOS ANGELES COUNTY SURVEYOR
700 HALL OF RECORDS

Do not extend notes this side of this line

Note: ANY ADDITIONS OR CHANGES ON THIS SHEET MUST BE MADE OR CIRCLED IN Red Ink WITH DATE AND NAME OF PERSON MAKING CHANGE.

Notes Ck'd by D. M. Finley	Survey of Badillo St.
Map No.	W. O. 1103 Tape No. 357 St'd 24 °F.
Office Work	Surveyed by Evans
Checked	Notes KE Date 1/15/35
Date	Indexed A. C. Johnson

F.B. 510 PG. 251

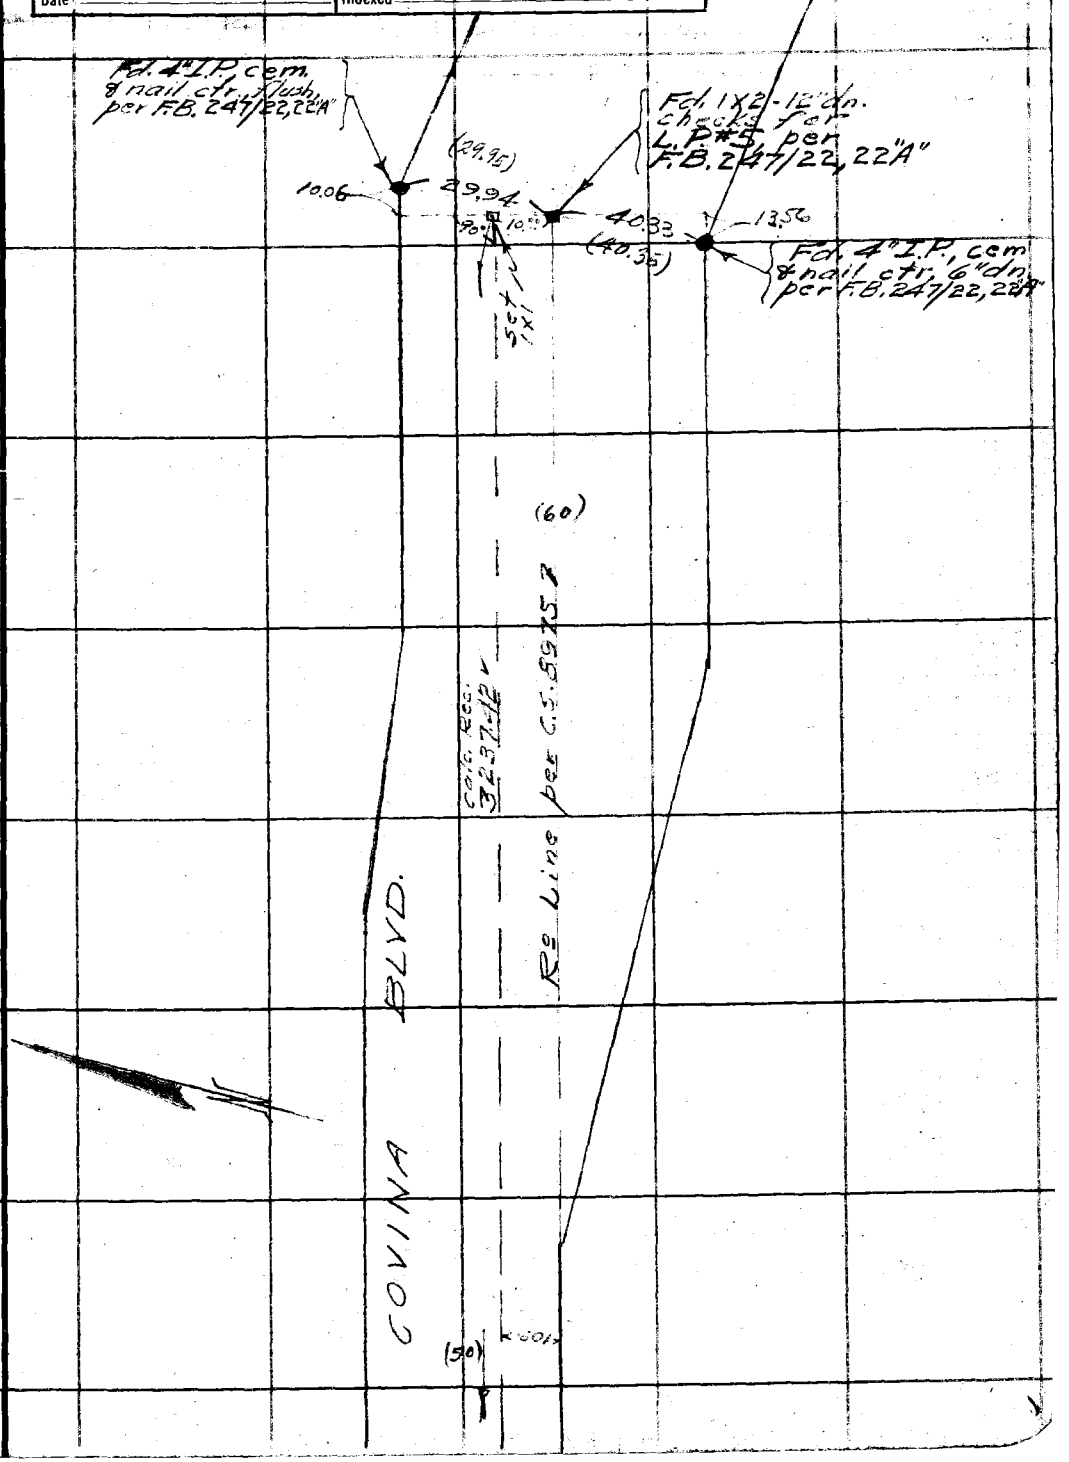

Note: ANY ADDITIONS OR CHANGES ON THIS SHEET MUST BE MADE OR CIRCLED IN Red Ink WITH DATE AND NAME OF PERSON MAKING CHANGE.

Do not extend notes this side of this line

RETURN TO
LOS ANGELES COUNTY SURVEYOR
700 HALL OF RECORDS

FORM 247 5M 2-34

RETURN TO
LOS ANGELES COUNTY SURVEYOR
700 HALL OF RECORDS

Note: ANY ADDITIONS OR CHANGES ON THIS SHEET MUST BE MADE OR CIRCLED IN Red Ink WITH DATE AND NAME OF PERSON MAKING CHANGE.

Do not extend notes this side of this line

W.S. 46 D-4

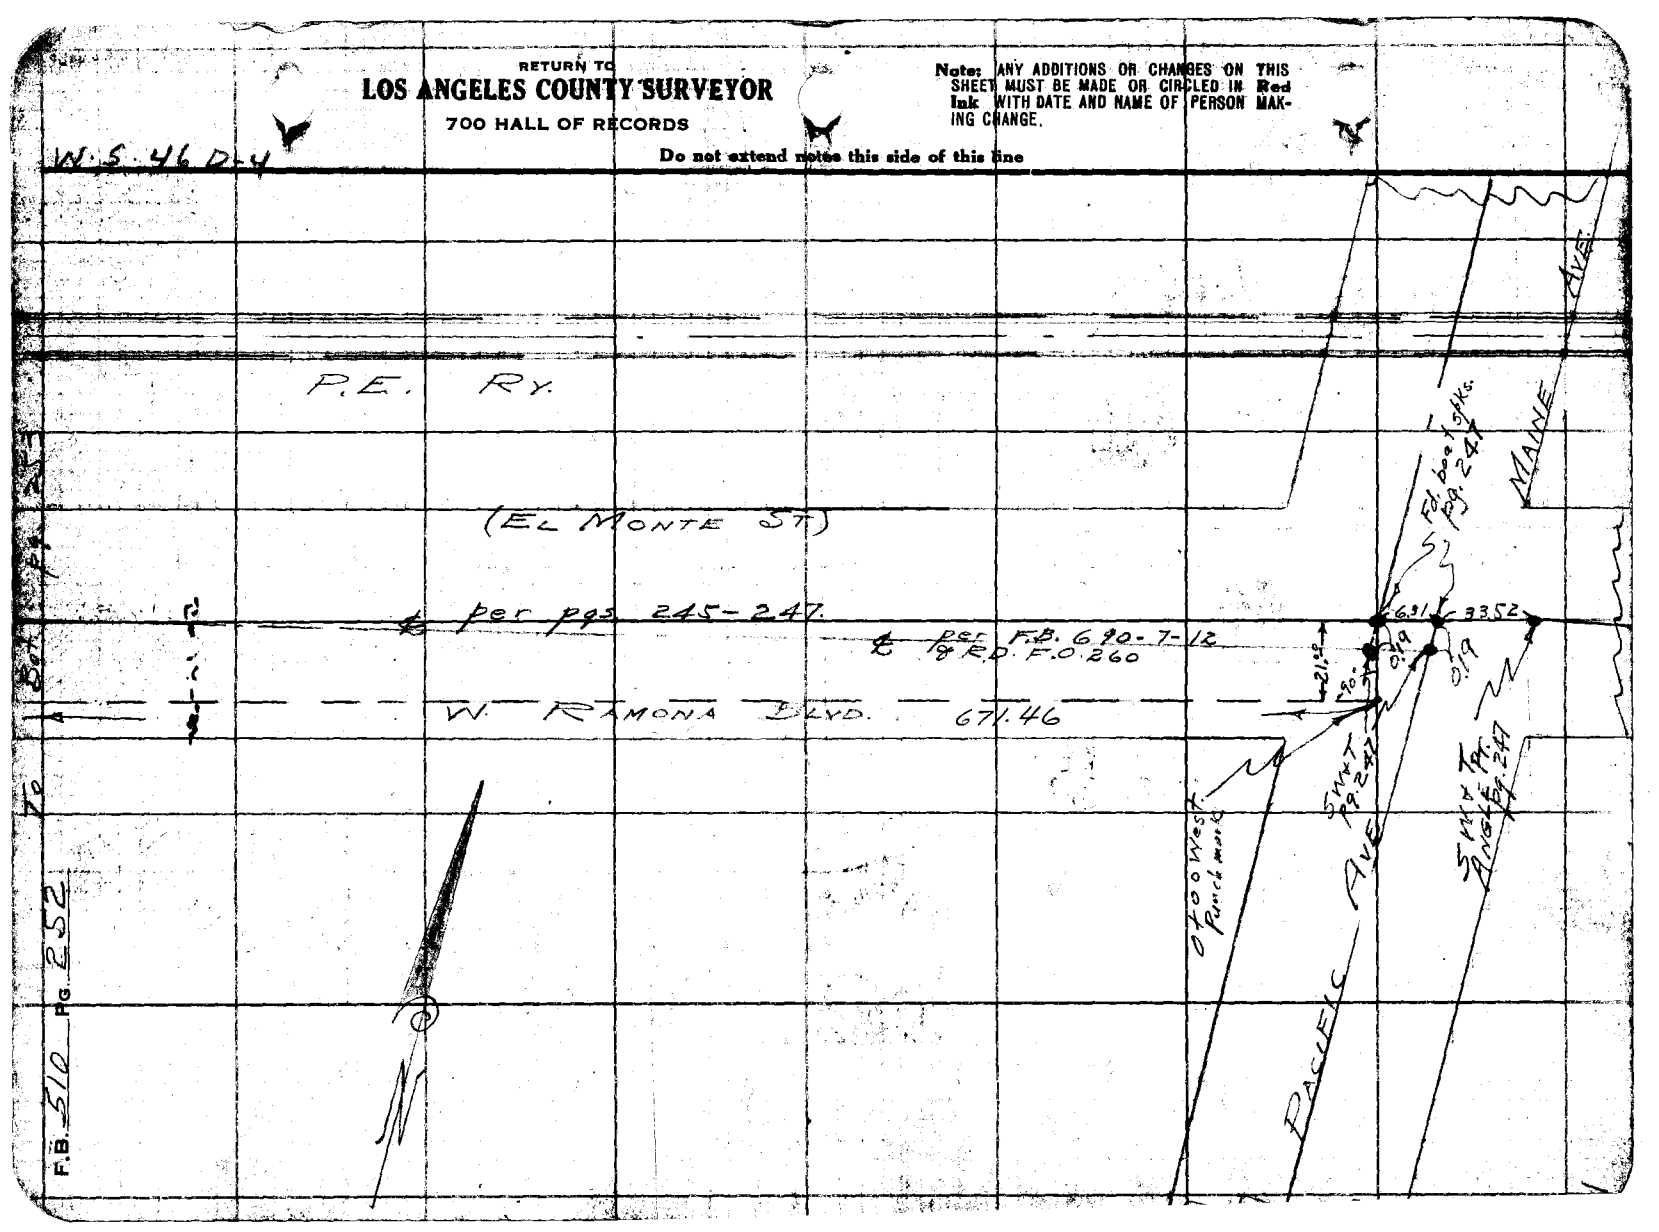

F.B. 510 PG. 254

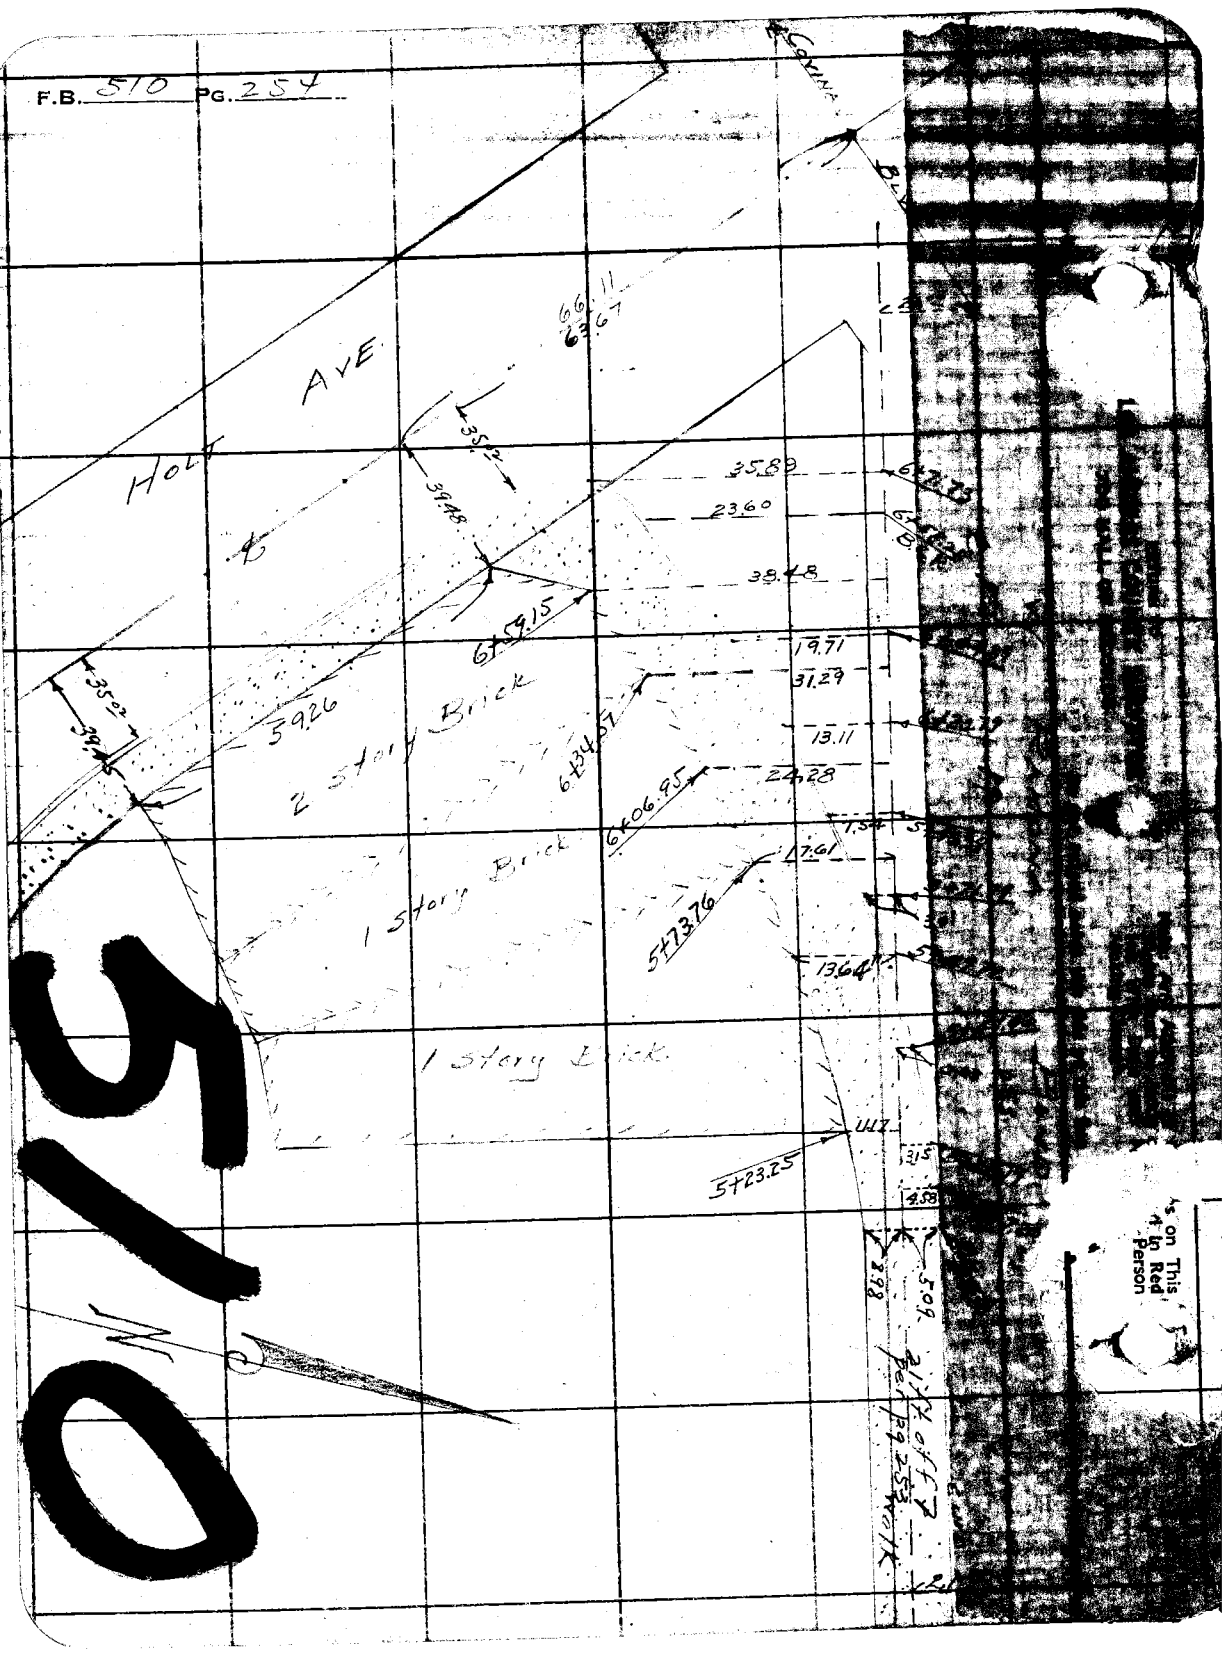

510

...s on This
...d in Red
Person

Notes Ck'd by	Survey of Badillo St.
Map No.	W. O. 7103 Tape No. St'd OF
Office Work	Surveyed by Evans
Checked	Notes PE Date 5-13-38
Date	Indexed 5-16-38

F.B. 510 PG. 253

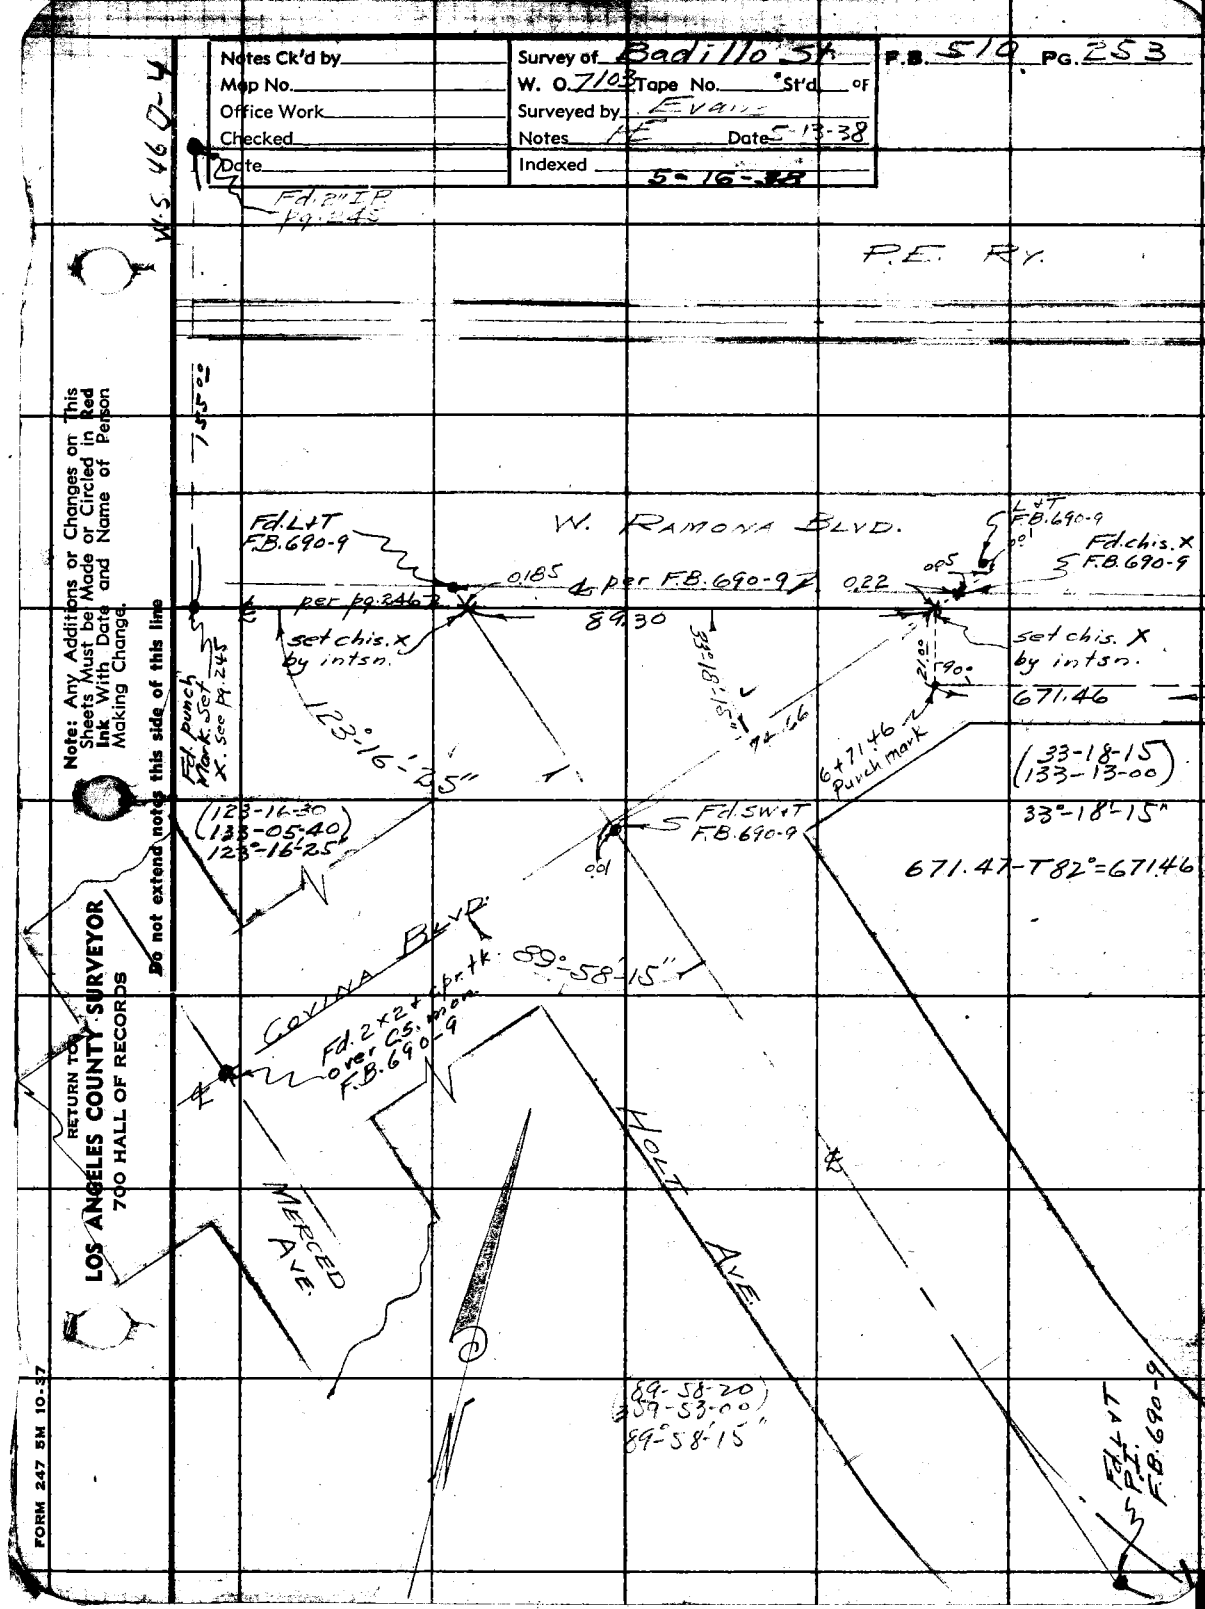

Note: Any Additions or Changes on This Sheets Must be Made or Circled in Red Ink With Date and Name of Person Making Change.

Do not extend notes this side of this line

RETURN TO
LOS ANGELES COUNTY SURVEYOR
700 HALL OF RECORDS

FORM 247 5M 10-37